Survey of
W. O. Tape No. St'd °F.
Surveyed by
Notes Date
Indexed

F.B. Pg.

252

F.B. 522 Pg. INDEX

F.B. 522

PAGES: Index, ,

9 to 11 incl., ,13 to 22 incl., ,

24 to 27 incl ., ,29 to 33 incl., ,

35 to 43 incl., ,45 to 48 incl.,

61 to 68 incl.,

91 to 101 incl., , 103 to 112

incl.,

TOPO 103-136

RETURN TO
LOS ANGELES COUNTY SURVEYOR
700 HALL OF RECORDS
Do not extend notes this side of this line

Note: ANY ADDITIONS OR CHANGES ON THIS SHEET MUST BE MADE OR CIRCLED IN Red Ink. WITH DATE AND NAME OF PERSON MAKING CHANGE.

Notes Ck'd by D. M. Finley
Map No. B-914-2
Office Work F. A. W.
Checked D. M. Finley
Date May 1933

Survey of Sepulveda Blvd.
W. O. 7185 Tape No. 051 St'd 84 °F.
Surveyed by Evans.
Notes H Date 5-1-33
Indexed A. C. Johnson 5-6-33

F.B. 522 Pg. 9

(To Bot. Pg. 10)

WS 23 D-4

Note: ANY ADDITIONS OR CHANGES ON THIS SHEET MUST BE MADE IN OR CIRCLED IN Red Ink, WITH DATE AND NAME OF PERSON MAKING CHANGE.

Do not extend notes this side of this line

RETURN TO
LOS ANGELES COUNTY SURVEYOR
700 HALL OF RECORDS

FORM 247 10M 8-31

M.R. 36-5.
SEC. 25
T. 1 S.
R. 15 W.

M.R. 36-5.
SEC. 30
T. 1 S.
R. 14 W

Proposed SEPULVEDA BLVD.
ARIZONA AVE
Proposed R/W Line.
Proposed R/W Line.
Zeswitt B.O.T.
2014.74-768=2014.53 ℄

50'
56'
(33)
(33)

(90°-30-45)
365°-23-00
90°-50'-45"

(89°-09)
356°-36)
89°-09'-00"

90°50'-45"
89°-09'-00"

curb
curb
curb
curb

MANCHESTER
AVE.
℄
℄

50'
50'

89°-54'-56"
90°-05'-04"

1703.41.23
Fd. L+T-FA.50-132
Tie's F.B. 289-247

(89°-55-00)
359°-39-45)
89°-54'-56¼"

(90°-05-30)
360°-21-45"
90°-05-26¼"

Fd. L+T-FA.50-134
1804.25 per F.B. 289-247

F.B. 289-247
1574.06 ℄

Proposed La Tijera Blvd.
F.B. 289-247

Fd. ¾" I.P. cem filled
Nail. Ties F.B. 289-247
88+08.19

Fd. L+T-FA.50-131
F.B. 289-247

F.B. 522 PG. 10

(5-2-33 Date. To Bot. pg. 11)

(To Sec. Cor.)

2127.89' T.

Set S.W. & T. 12" dn per ties F.B. 335 pg. 7. On line.

Fd. Sewer spk. & T. P.P.

14.38

Fd. N & T T.P.

138+87.20 P.O.T. Set 2x2-18" down.

2140.57' T. 2x2 Post.

(S)

(S)

M.R. 36-15

ARIZONA AVE.

S11°25-T72°=511.8'

710.10-T72°=710.0'

Fd. Nail & Tag

Set 2x2 in Conc.

E.C. 137+90.00

BLVD.

SEPULVEDA

Proposed

P.I. Fd 8" casing, cem. filled & cpr. nail @ 1/4 Sec. cor. per F.B. 335-7 & L.B. 213-22

S.9°-50'-E.

168°-20'-E.

Ties on Page 33

N

Δ = 11°-39'-50"
R = 6000
T = 612.84
L = 1221.44

(168°-20'-15")
(313°-21'-15")
168°-20'-18¾"

(11°-39'-45")
(46°-39'-15")
11°-39'-48¾"

(179°-59'-45")
(359°-59'-15")
179°-59'-48¾"

625.71+T68°=625.64

125+68.56 Set 2x2 B.C. 18" dn.

125+55.76
20+14.53 P.O.T.
Set S.W. & T. Flush.

20+14.53

SEC. 25.

(33)

(33)

SEC. 30.

(from 50' to 50' to 9)

W.R. 23 D-3

G-9 R.R.M.

RETURN TO
LOS ANGELES COUNTY SURVEYOR
700 HALL OF RECORDS
Do not extend notes this side of this line

Note: ANY ADDITIONS OR CHANGES ON THIS SHEET MUST BE MADE OR CIRCLED IN Red Ink. WITH DATE AND NAME OF PERSON MAKING CHANGE.

Notes Ck'd by D. M. Finley
Map No. B-914-2
Office Work F. A. W.
Checked D. M. Finley
Date May 1933

Survey of Sepulveda Blvd.
W. O. 7185 Tape No. 951 St'd 84 °F.
Surveyed by Evans
Notes Date 5-3-33
Indexed

F.B. 522 Pg. 11

Notes: ANY ADDITIONS OR CHANGES ON THIS SHEET MUST BE MADE IN OR CIRCLED IN Red Ink, WITH DATE AND NAME OF PERSON MAKING CHANGE.

Do not extend notes this side of this line

RETURN TO
LOS ANGELES COUNTY SURVEYOR
700 HALL OF RECORDS

FORM 247 10M 8-31

W 523, D 3

(To Bot. Pg. 13)

2.5' offset Line 2

1X2 set

2.50

SW.T. Free in Gu. Pg. B

(To Bot. Pg. 14)

(To Bot. Pg. 13)

Fd. old rotted 1x2. F.B. 396-17

(50)

795.22'

423.83

This ℄ shifted 0.04 S.W. - Pg. 19.

808.51' T.P.

808.45'

0.04

P.O.S.T. Set 1X2 12" dwn. (destroyed)

This pt. tied see Pg. 19

P.I. Set ¾" I.P. cone filled & cr. nail, 8" dn.

0.08

0.09 calc.

N 47°-15'-E

Newport Pg. 19

(154°47'15")
259°09'00"
154°47'15" W

714.69'

714.76-T68°= 714.69

P.O.S.T. Set 2X2 18" dn.

Proposed SEPULVEDA BLVD.

2140.76-T70°= 2140.57

(1/2)

N.W. cor. Sec. 30 Fd. 8" casing cem. Filled & pr. nail, 12" dn. Per ties F.B. 335-B. See L.B. 213-21

M.R.

36-B.

SEC. 30.

ARIZONA AVE.

1545.69-T66°= 1545.51' Per F.B. 396-17 (2599.5 per F.B. 396-17)

2128.08-T70°= 2127.89

(66)

From SW.T.

From top Pg. 10

RETURN TO
LOS ANGELES COUNTY SURVEYOR
700 HALL OF RECORDS

Note: ANY ADDITIONS OR CHANGES ON THIS SHEET MUST BE MADE OR CIRCLED IN **Red Ink.** WITH DATE AND NAME OF PERSON MAKING CHANGE.

Do not extend notes this side of this line

F.B. 522 PG. 12

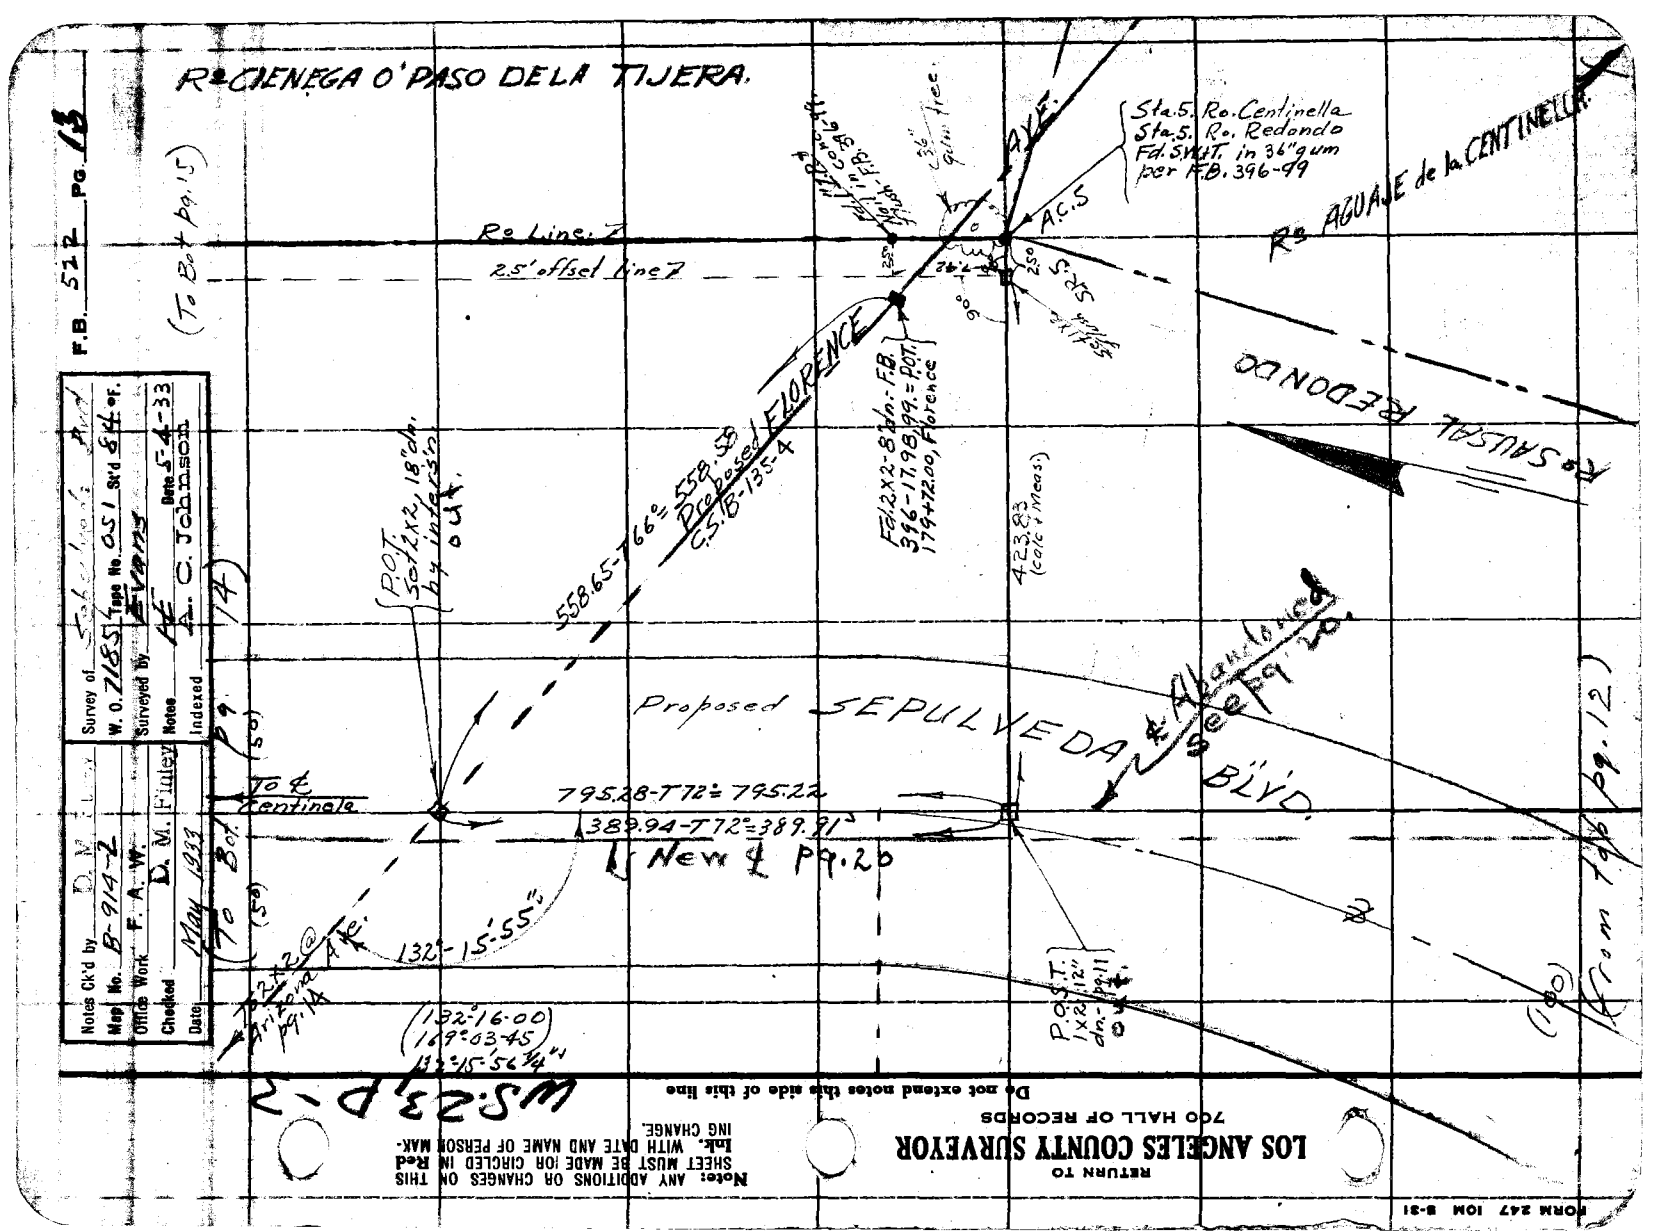
R.C. CIENEGA O' PASO DE LA TIJERA.
F.B. 512 PG. 18
(To Bot Pg. 15)
Survey of Sabichas Rancho
W.O. 7185 Tape No. as I Std & Ht of.
Surveyed by Evans
Notes
Indexed
Date 5-4-33
A. C. Johnson
Notes Ck'd by D. M. F.
Map No. B-914-2
Office Work F. A. W.
Checked D. M. Fluty
Date May 1933
Re Line: Z
2.5' offset Line Z
Re AGUAJE de la CENTINELLA
Sta. 5. Re. Centinella
Sta. 5. Re. Redondo
Fd. 5/16" I.T. in 36" gum
per F.B. 396-99
A.C.S
Re SAUSAL REDONDO
Proposed FLORENCE
558.65-T 66°= 558.39
C.S. 18-135-4
P.O.T. Set 1x2, 18" dn. by intersn.
Fd 1/2 x 2 - 8 dn. F.B. 396-17.98 = P.O.T. Florence 179+72.00
423.83 (Calc + Meas)
Proposed SEPULVEDA BLVD.
Alameda
See Fq. Pg.
To & Centinela
795.28-T 72°= 795.22
389.94-T 72°= 389.91
New & Pg. 26
132°-15'-55"
To Bot Pg. 14
(132°-16'-00")
169°-03'-45"
132°-15'-56 3/4"
P.O.S.T. 1x2, 12" dn. - Pg. 11
(To Bot Pg. 12)
WS 23 P-2
RETURN TO
LOS ANGELES COUNTY SURVEYOR
700 HALL OF RECORDS
Do not extend notes this side of this line
Note: ANY ADDITIONS OR CHANGES ON THIS SHEET MUST BE MADE IOR CIRCLED IN Red Ink. WITH DATE AND NAME OF PERSON MAKING CHANGE.
FORM 247 10M 8-31

RETURN TO
LOS ANGELES COUNTY SURVEYOR
700 HALL OF RECORDS

Note: ANY ADDITIONS OR CHANGES ON THIS SHEET MUST BE MADE OR CIRCLED IN Red Ink. WITH DATE AND NAME OF PERSON MAKING CHANGE.

Do not extend notes this side of this line

WS 29, D-3

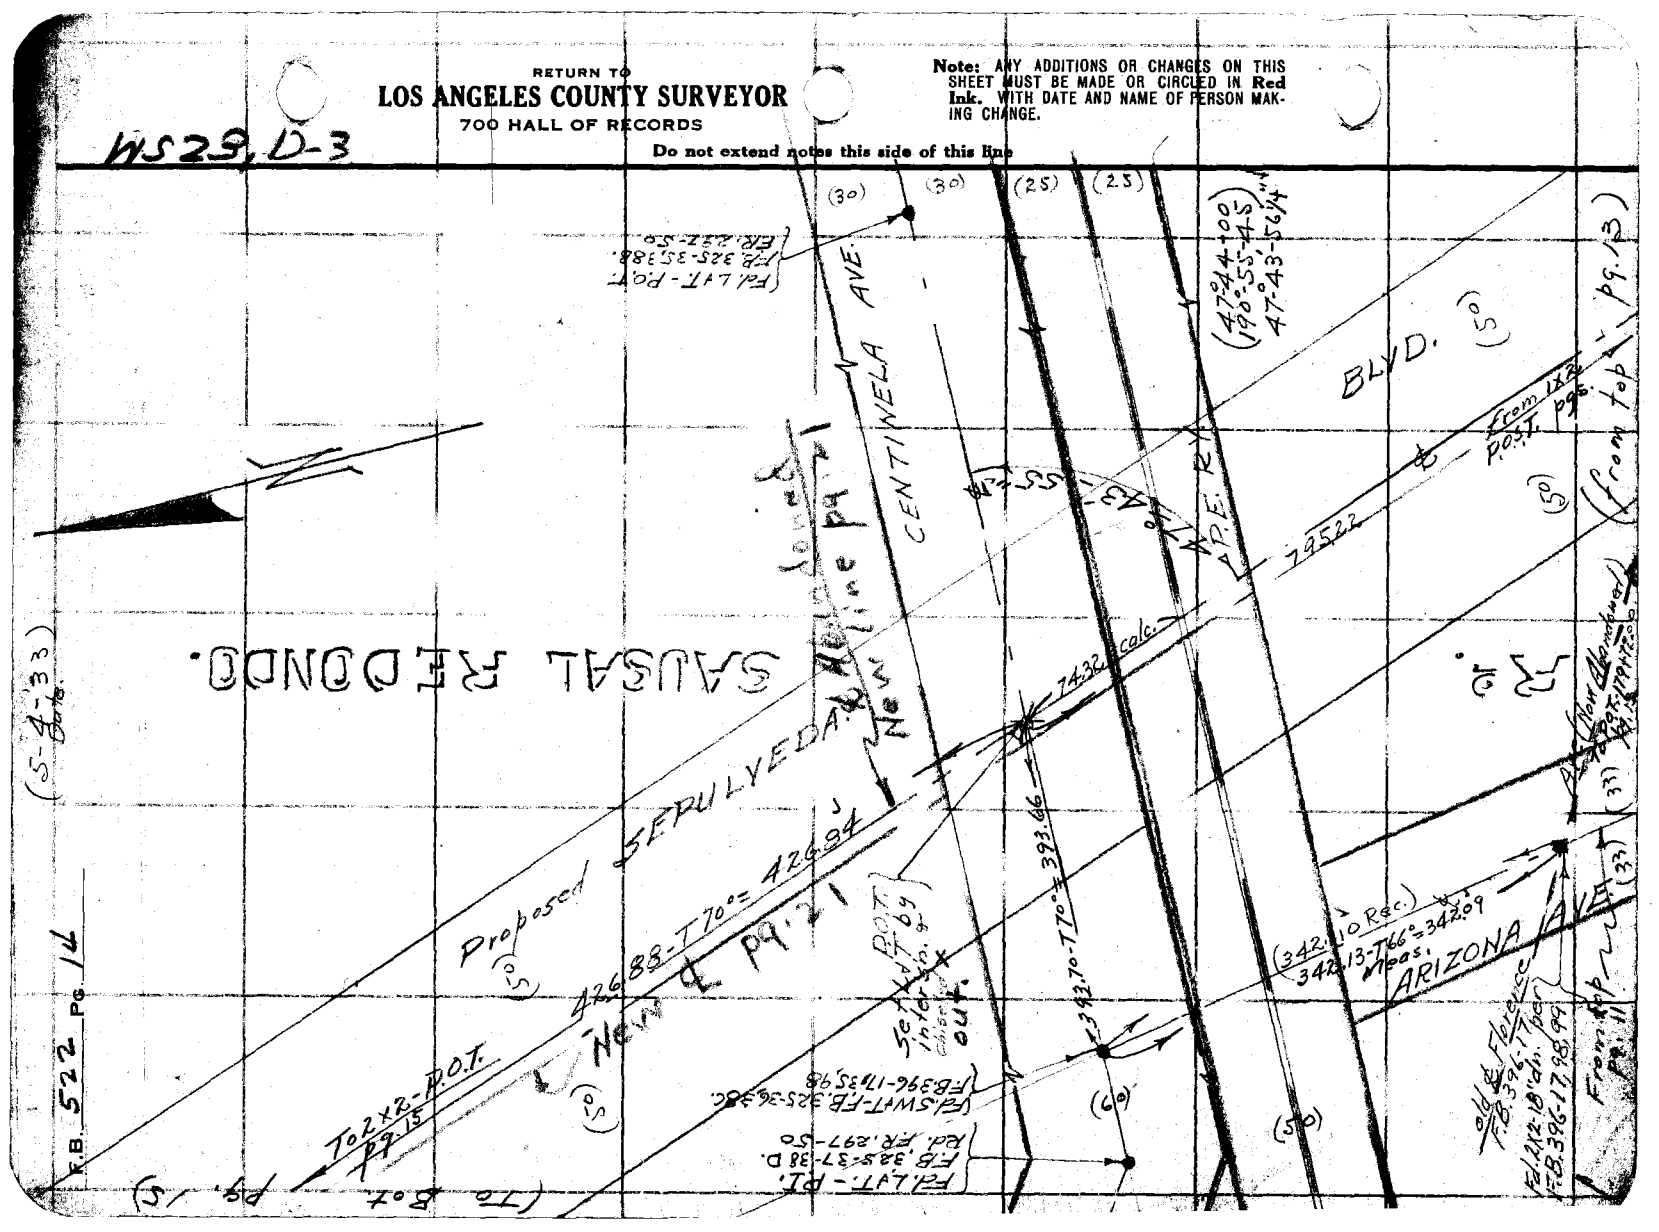
(30)
(30)
(25)
(25)
(47°44-100)
(190.55-4-5)
47°43-5 1/4"
CENTINELA AVE.
BLVD.
(50)
P.E. R/W
79522
(50)
(from 1x2 P.O.T. pg. 3)
(from top of pg. 3)
Proposed SEPULVEDA
New
74.32 calc.
426.88-T70°=426.94
(50)
New
(50)
(50)
(60)
(50)
(50)
(50

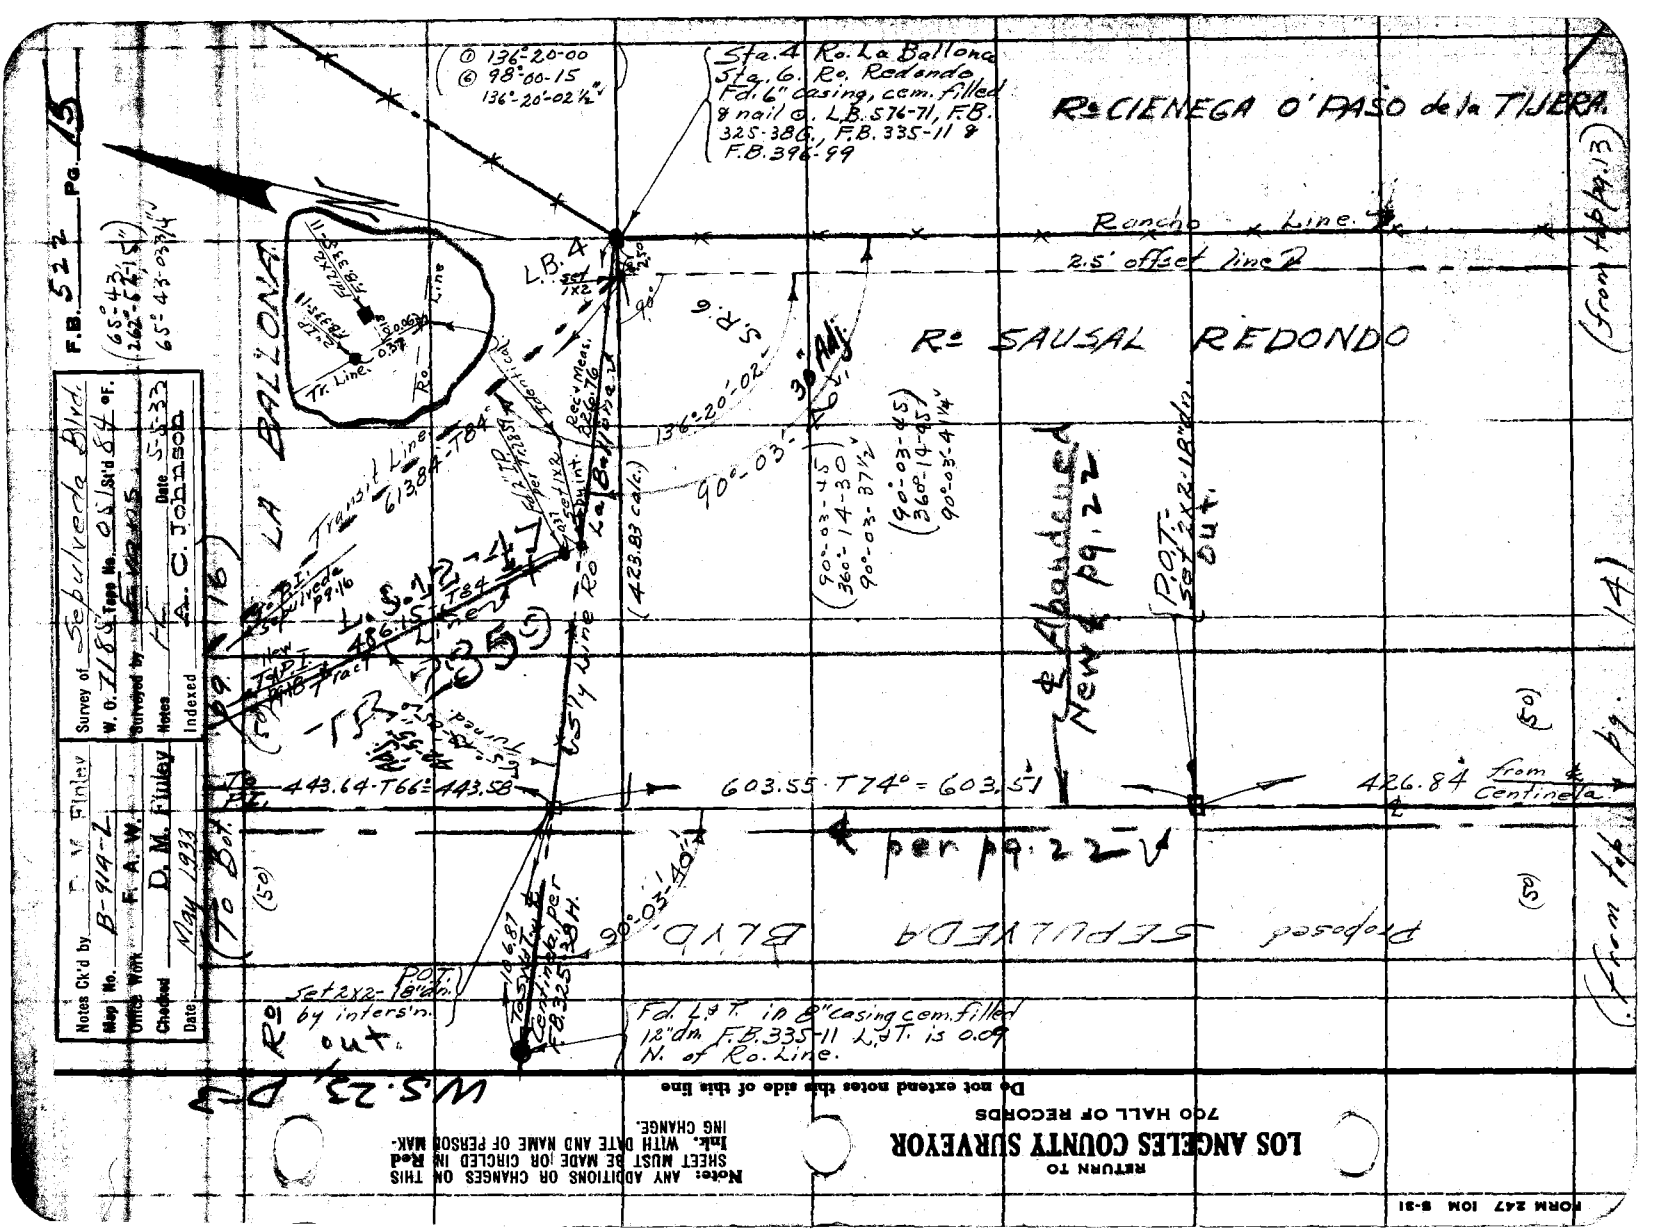
F.B. 522 Pg. 15
Sta. 4 Ro. La Ballona
Sta. 6 Ro. Redondo
Fd. 6" casing, cem. filled
& nail o. L.B. 576-71, F.B.
325-386, F.B. 335-11 &
F.B. 396-99
Rs CIENEGA O' PASO de la TIJERA
Rancho Line.
2.5' offset line
Rs SAUSAL REDONDO
L.B. 4
Ro
Tr. Line
Transit Line
Ro La Ballona
Ro Redondo
Ro Abandoned
New Ro
P.O.T. set 2x2 - 18" dp.
out.
Proposed SEPULVEDA BLVD.
Fd. 4" T. in 6" casing cem. filled
12" dm F.B. 335-11 L.4 T. is 0.09
N. of Ro. Line.
Set 2x2 - P.O.T. 18" dp.
by inters'n.
out.
W.S. 23, D.7
Notes Ck'd by F. V. Finley
Map No. B-914-2
Units Work F. A. W.
Checked D. M. Finley
Date May 1933
Survey of Sebulveda Blvd.
W. O. 7186 Topo No. 0.S.Sh'd 84 F.
Surveyed by [illegible] Date 5-1933
Notes A. C. Johnson
Indexed
Note: ANY ADDITIONS OR CHANGES ON THIS SHEET MUST BE MADE IOR CIRCLED IN Red Ink. WITH DATE AND NAME OF PERSON MAK-ING CHANGE.
LOS ANGELES COUNTY SURVEYOR
700 HALL OF RECORDS
RETURN TO
Do not extend notes this side of this line
FORM 247 10M 8-31

RETURN TO
LOS ANGELES COUNTY SURVEYOR
700 HALL OF RECORDS

Note: ANY ADDITIONS OR CHANGES ON THIS SHEET MUST BE MADE OR CIRCLED IN Red Ink. WITH DATE AND NAME OF PERSON MAKING CHANGE.

Do not extend notes this side of this line

WS 23, D-3

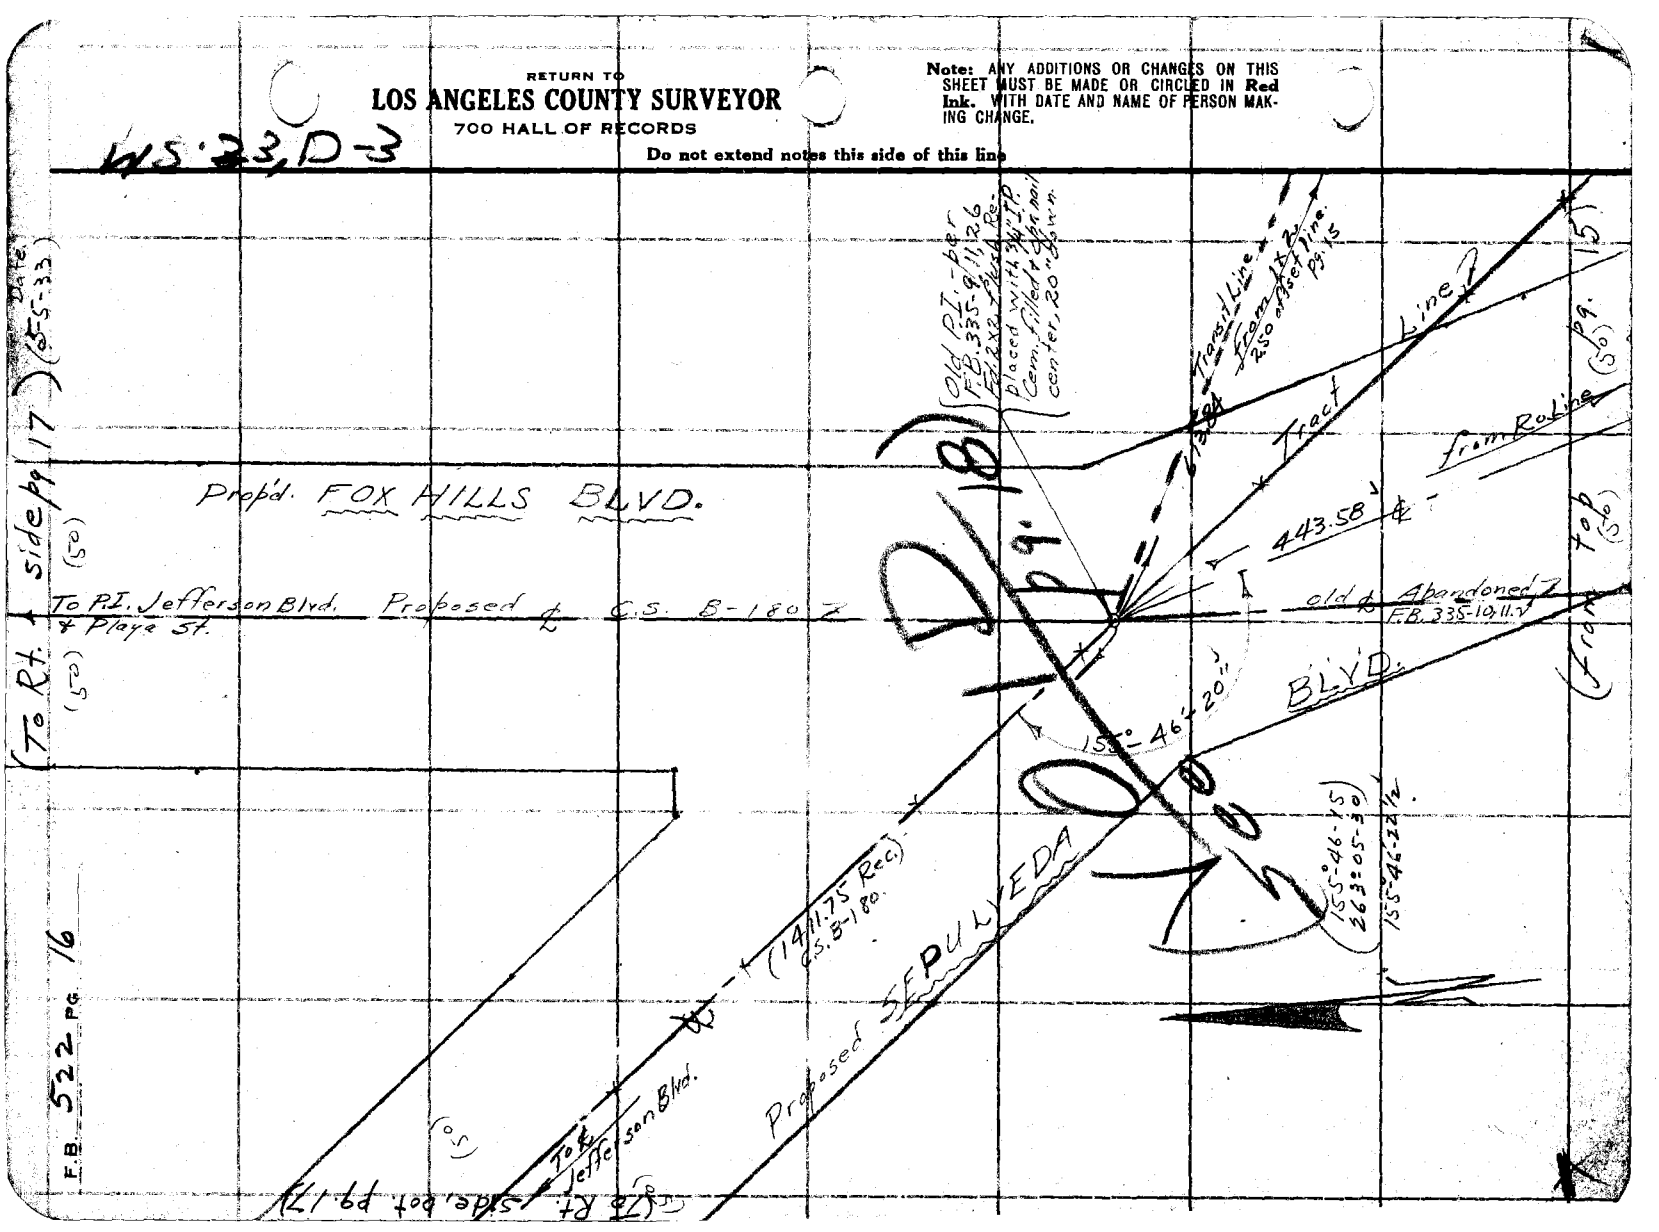

Notes Ck'd by D. M. Finley	Survey of Sepulveda Blvd.
Map No. 8-914-2	W. O. 7185 Tape No. 051 St'd 84 °F.
Office Work F. A. W.	Surveyed by Evans
Checked D. M. Finley	Notes HA Date 5-5-33
Date May 1933	Indexed A. C. Johnson

F.B. 522 Pg. 17

WS 23 D-2

Note: ANY ADDITIONS OR CHANGES ON THIS SHEET MUST BE MADE IN Red Ink. WITH DATE AND NAME OF PERSON MAKING CHANGE.

RETURN TO
LOS ANGELES COUNTY SURVEYOR
700 HALL OF RECORDS

Do not extend notes this side of this line

PLAYA ST.

JEFFERSON

Fd. SW+T, 2"dm.
F.B. 335-27
Rd. F.R. 300-75

Ties on Page 29

Prop'd FOX HILLS BL'V'D.

258.27 Meas.

BLVD.

Proposed & Per C.S. B-189

Fd. SW+T.
E.C. 1'Pe.r.
F.R. 300-75

(F.B. 335-26+27)

Fd. S.W.+T.
per F.B. 335
pg. 11+12

& C.S. B-180

(1411.75 Rec)

From P.I.

Proposed

SEPULVEDA BLVD.

From P.I.

(50)

(50)

(50)

FORM 247 10M 5-31

RETURN TO
LOS ANGELES COUNTY SURVEYOR
700 HALL OF RECORDS

Note: ANY ADDITIONS OR CHANGES ON THIS SHEET MUST BE MADE OR CIRCLED IN Red Ink. WITH DATE AND NAME OF PERSON MAKING CHANGE.

Do not extend notes this side of this line

WS 23 D-3

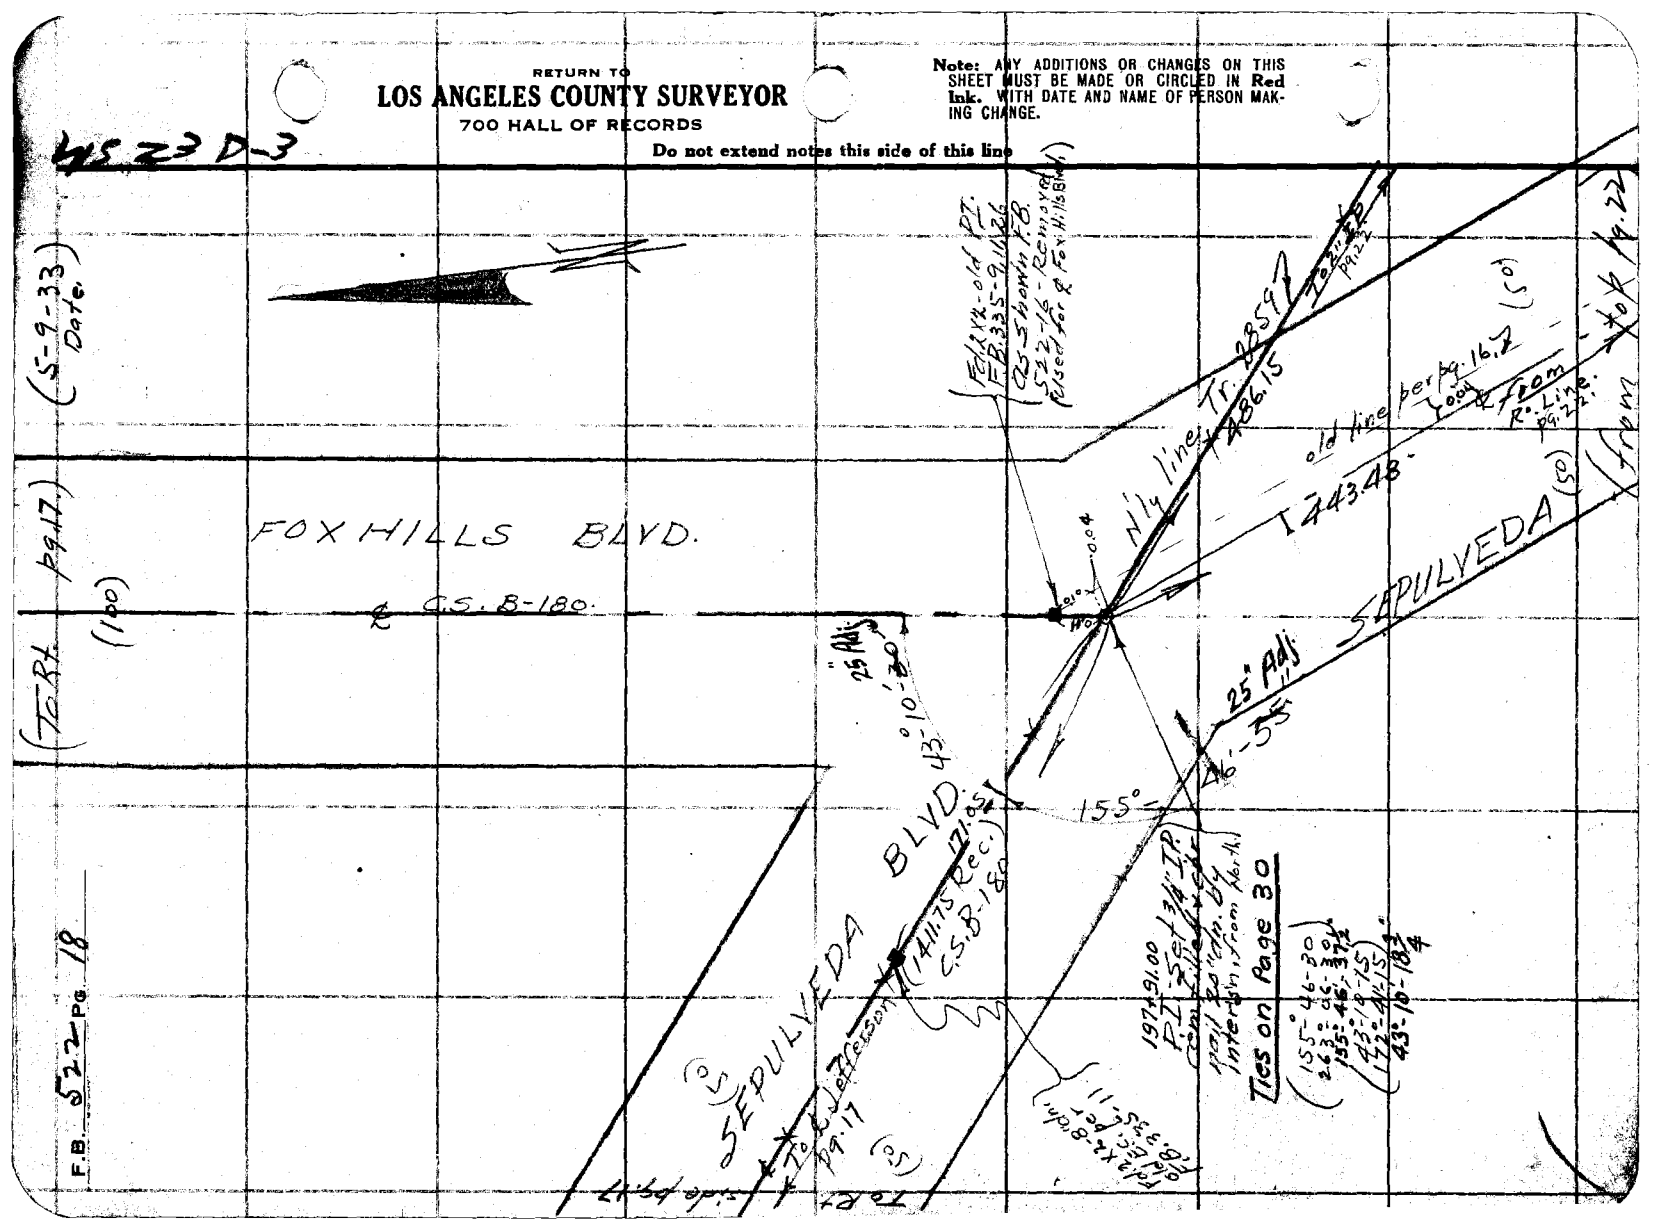

Notes Ck'd by D. M. Finley
Map No. B-914-2
Office Work F. A. W.
Checked D. M. Finley
Date May 1932

Survey of Sepulveda Blvd
W. O. 7185 Page No. 54 St'd 84 of F.
Surveyed by HE
Notes Date 5-10-33
Indexed C. C. Johnson

F.B. 527 Pg. 19

W.S. 23-2

(To Bot Pg. 20)

Florence Ave. Pg. 20

(50)

(50)

Ro. Line

2.5' to Ro. Line

S.M. 1.2' up

36" sum. Pg. 13

set 1x2 2.5

176+87.88 E.C.

385.94 S 64° 11' E

Line per R.M.

176+01.93 P.O.T. B.C. Set 2x2 18"dn 0.05

423.87

P.O.S.T. Set 1x2 12"dn

Bob Sq. Lead

0.09

Δ = 25° 12' 35"
R = 4000.00
T = 894.51
L = 1760.07
59.97

154° 47' 15" 25" Adj. 15"

P.I. Set 3/4" I.P. cem. Filled 3/8" copper nail 8"dn.

(154° 47' 15")
(259° 09' 00")
154° 47' 15"

714.60

SEPULVEDA BVD.

158+47.80 P.O.T. B.C. Set 2x2 18"dn

179.91

158+47.91 B.C.

0.05

P.O.S.T. Set 1x2 18"dn

Ties on Page 32

Proposed

℄ 2140.57

(50)

From P.O.T.

(From top of Pg. 10)

RETURN TO
LOS ANGELES COUNTY SURVEYOR
700 HALL OF RECORDS

Note: ANY ADDITIONS OR CHANGES ON THIS SHEET MUST BE MADE IN OR CIRCLED IN Red Ink. WITH DATE AND NAME OF PERSON MAKING CHANGE.

Do not extend notes this side of this line

FORM 247 10M 8-31

RETURN TO
LOS ANGELES COUNTY SURVEYOR
700 HALL OF RECORDS

Note: ANY ADDITIONS OR CHANGES ON THIS SHEET MUST BE MADE OR CIRCLED IN Red Ink. WITH DATE AND NAME OF PERSON MAKING CHANGE.

Do not extend notes this side of this line

WS 23, D-3

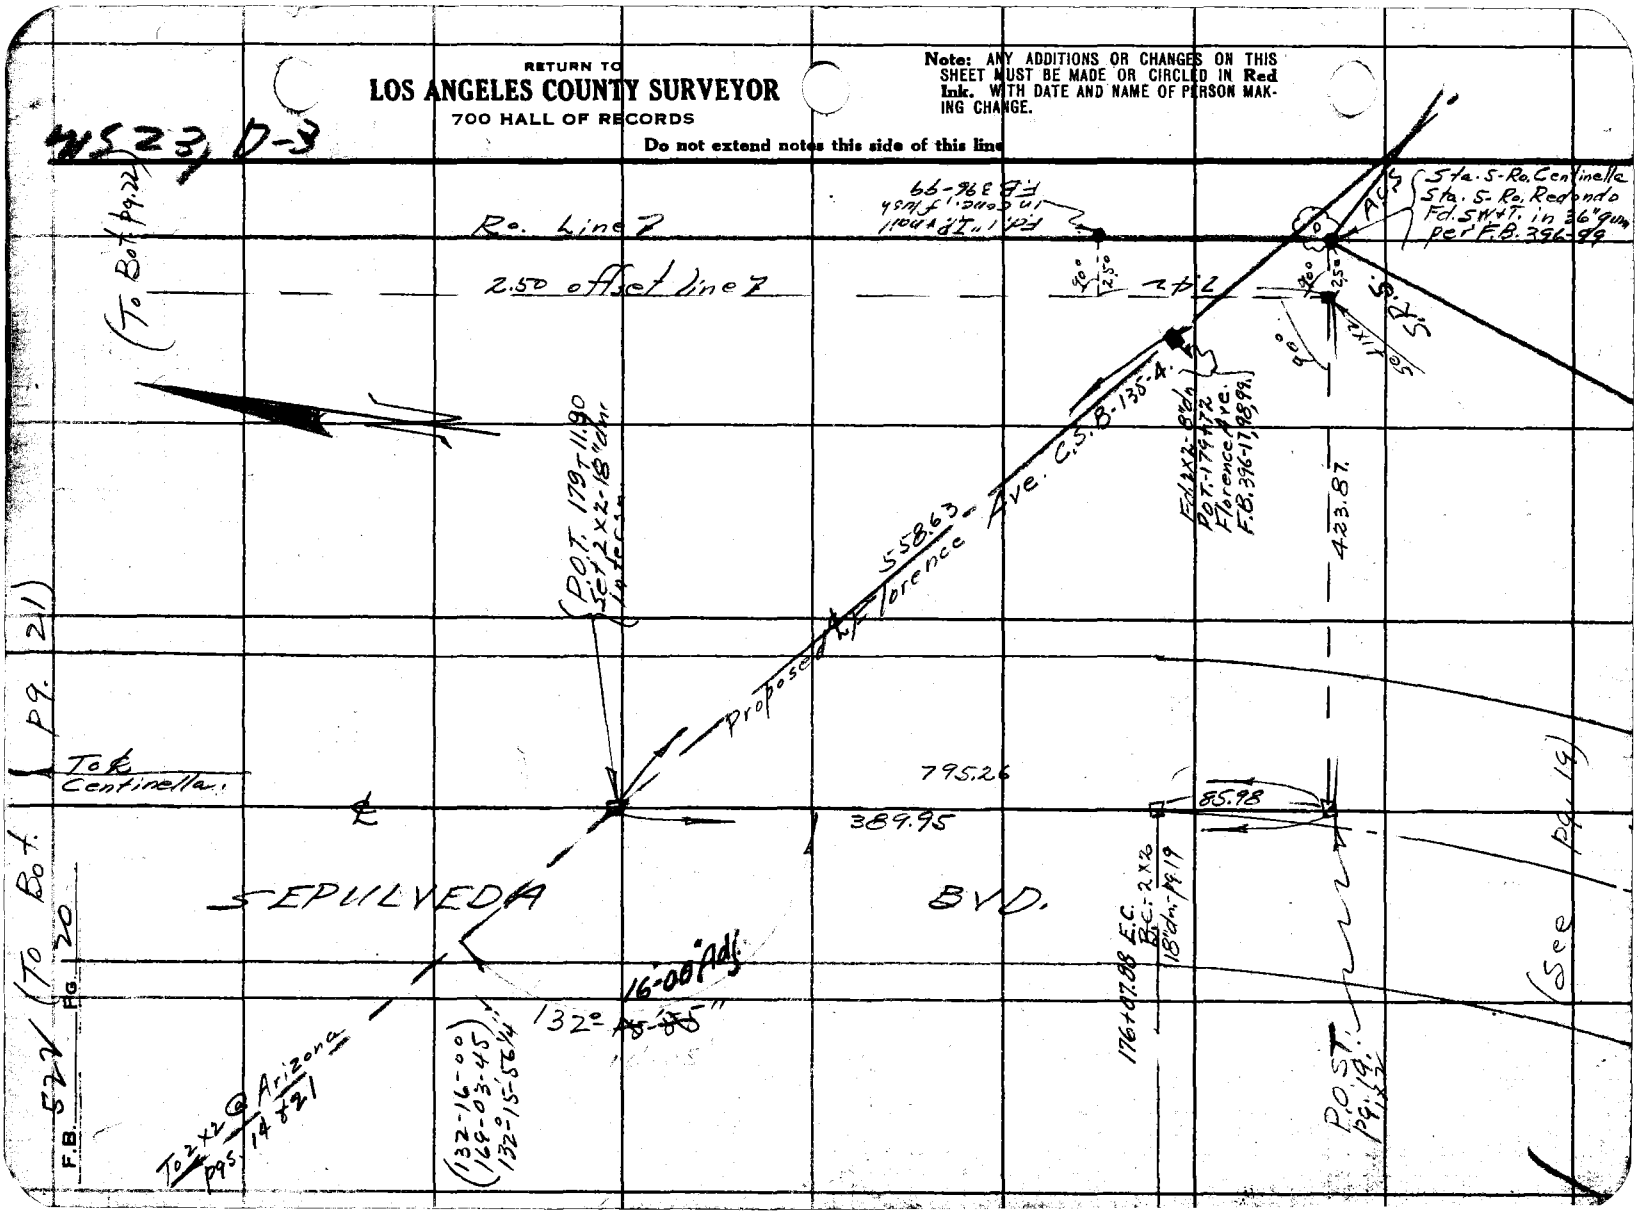

Notes Ck'd by	Survey of Sepulveda Blvd
Map No. B-914-2	W. O. 7188 Tape No 951 St'd 84 °F.
Office Work F. A. W.	Surveyed by Evans
Checked D. M. Hinley	Notes HE Date 5-1933
Date May 1933	Indexed

F.B. 522 Pg. 21

W.S. 23 D-3

Note: ANY ADDITIONS OR CHANGES OF THIS SHEET MUST BE MADE OR CIRCLED IN Red Ink. WITH DATE AND NAME OF PERSON MAKING CHANGE.

Do not extend notes this side of this line

RETURN TO
LOS ANGELES COUNTY SURVEYOR
700 HALL OF RECORDS

FORM 247 10M 5-31

Ties on Page 31

P.O.T. 183+17.21 Set L.T. Intersn.

Fd. L.T.-P.O.T. F.B. 325-35-38 & P.R. 297-SD

Sepulveda Blvd.

Centinela Ave.

P.E. Ry.

Florence Ave

Arizona Ave.

Fd. L.T.-P.O.T. F.B. 325-35-38 & P.R. 297-SD

Fd. 2x2-18"dg. F.B. 396-17, 98, 99. See F.B. 522-14

From top Pg. 41

(F.B. 396-17) To P.O.T. 179+72-19.20

Fd. 1x2 P.O.T. P.R. 297-SD

From top Pg. 20

A220.90

323.61

743.2 calc.

44.00 (Adj.) S85°-15'-E

47°

795.26

342.09 Meas. (342.10 Rec.)

S3°-32'-30"E

Fd. L.T.-P.L. F.B. 325-35-38 & P.R. 297-SD

(47°-44' 190.55.45 47-43-56)

(50) (30) (25) (33)

RETURN TO
LOS ANGELES COUNTY SURVEYOR
700 HALL OF RECORDS

Note: ANY ADDITIONS OR CHANGES ON THIS SHEET MUST BE MADE OR CIRCLED IN **Red Ink.** WITH DATE AND NAME OF PERSON MAKING CHANGE.

Do not extend notes this side of this line

45Z3D-3

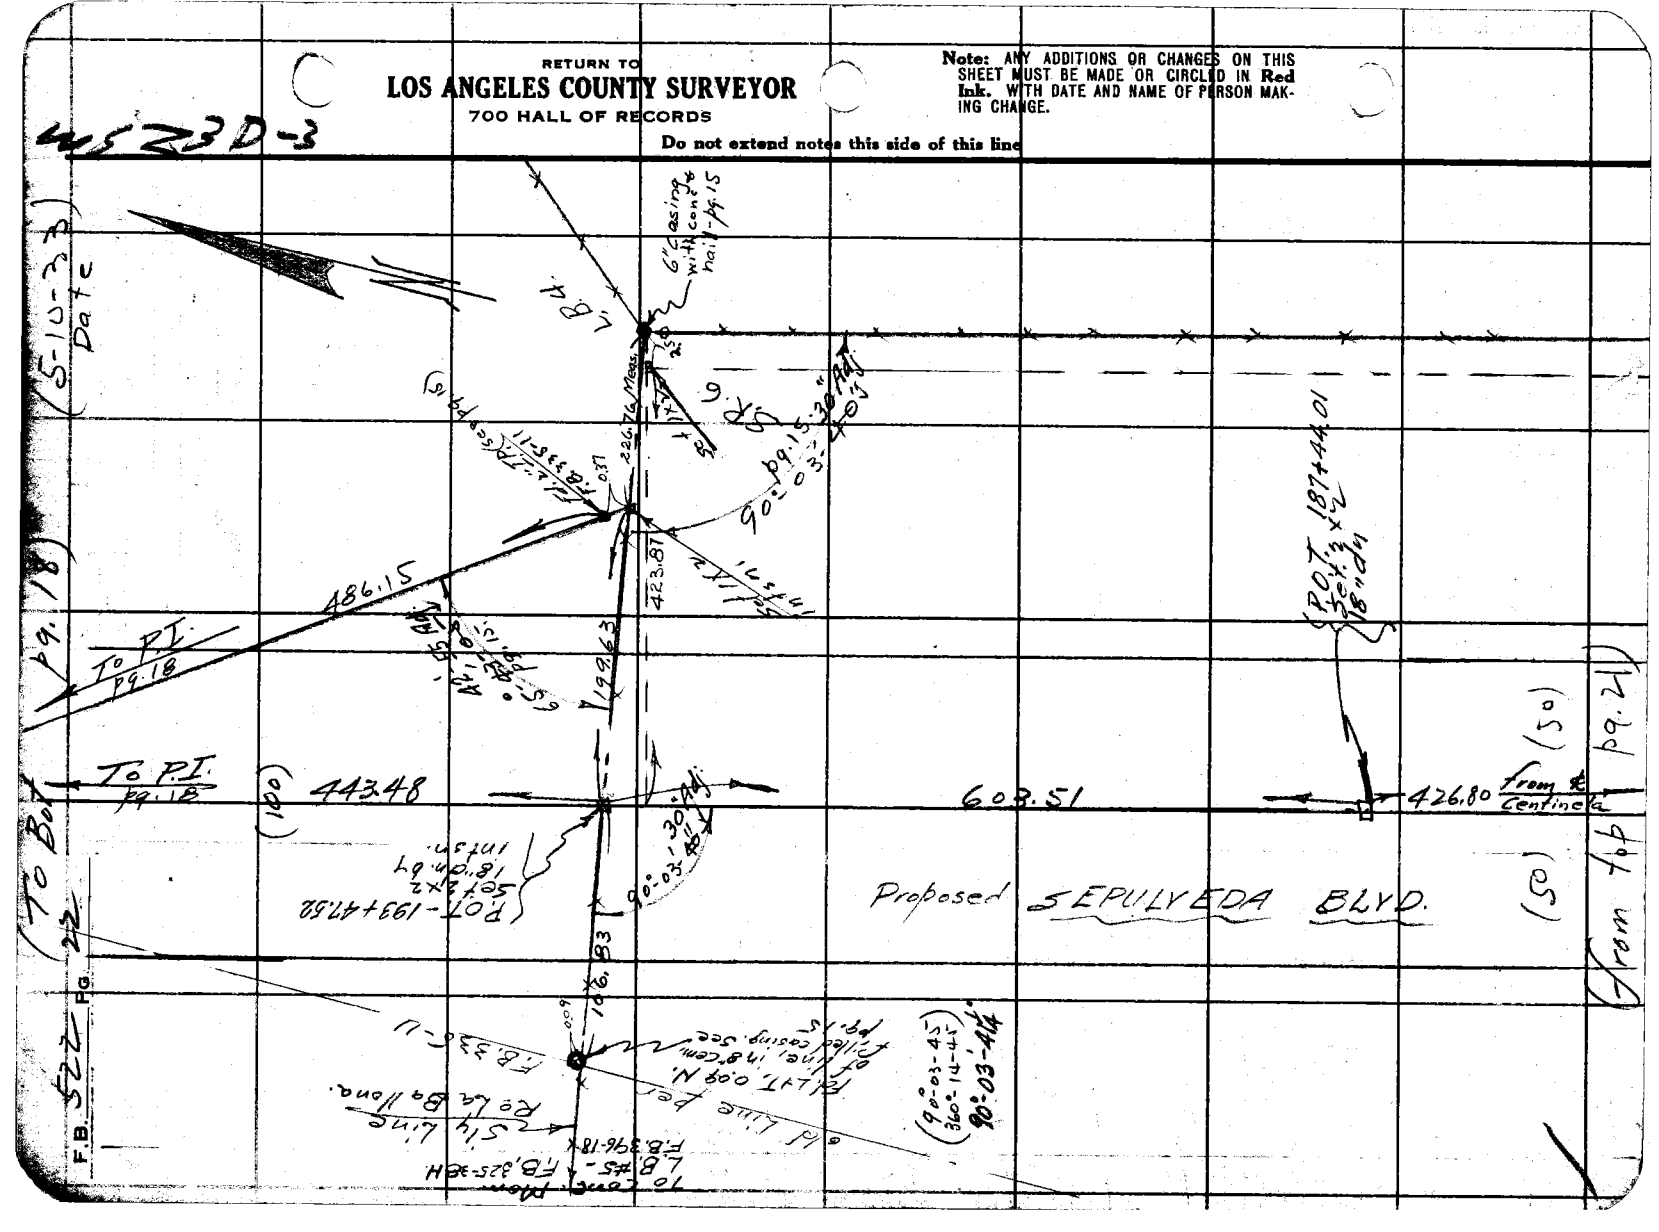

Notes Ck'd by	Survey of
Map No. B-914-1	W. O. ____ Tape No. ____ St'd ____ °F.
Office Work F. A. W.	Surveyed by
Checked D. M. Furey	Notes ____ Date ____
Date May 1933.	Indexed

F.B. 522 PG. 23

RETURN TO
LOS ANGELES COUNTY SURVEYOR
700 HALL OF RECORDS

Do not extend notes this side of this line

Note: ANY ADDITIONS OR CHANGES OF THIS SHEET MUST BE MADE OR CIRCLED IN Red Ink. WITH DATE AND NAME OF PERSON MAKING CHANGE.

FORM 847 10M 5-31

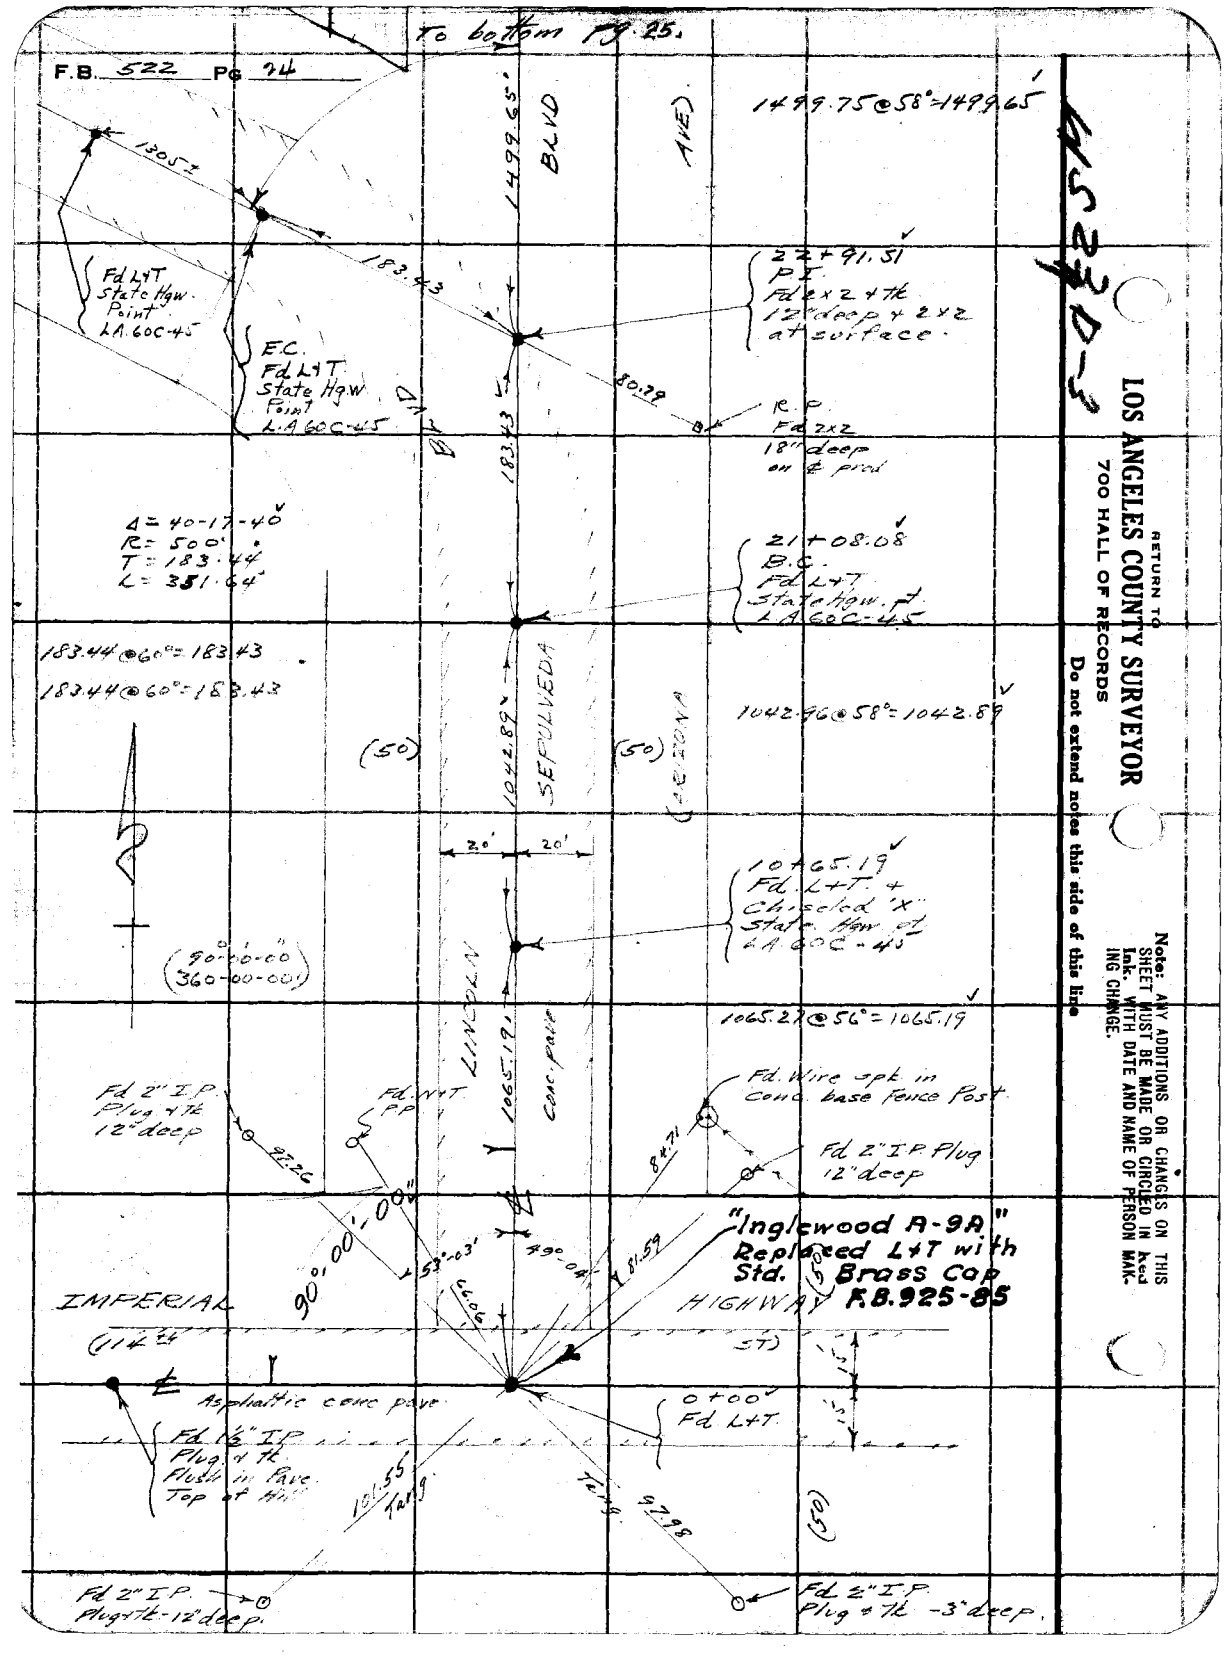

RETURN TO
LOS ANGELES COUNTY SURVEYOR
700 HALL OF RECORDS
Do not extend notes this side of this line

Note: ANY ADDITIONS OR CHANGES ON THIS SHEET MUST BE MADE OR CIRCLED IN Red Ink. WITH DATE AND NAME OF PERSON MAKING CHANGE.

Notes Ck'd by D W Finley	Survey of Sepulveda Blvd
Map No. B-914-1	W. O. 2185 Tape No. 019 St'd 68 °F.
Office Work F. A. W.	Surveyed by K. D. Moore
Checked U. M. Finley	Notes Moore Date 5-10-31
Date May 1933	Indexed A. C. Johnson

F.B. 527 Pg. 25

To be Here pg. 76

(33) 50' (33) 50'

SEC. 31
T2S - R14W

SEC. 36
T2S - R15W

52+81.54
Sec. Cor.
Fd L+T in 8"
Conc. Mon.
6" deep.
FB 251-72
FB 614-111
FB 289-247

FB 289-247
3710.63'

BLVD AVE)

(SAN ANTONIO

AVE)

CENTURY

2534.09'
FB 289-247

FB 289-247
90°03'15" V

BLVD

(50)

(89°57'50")
F.B. 614-111

2986

35.35

82.14

Fd N+T
PP

Fd N+T
PP

LINCOLN BLVD

Fd L+T
FB 289-247

1490.38-

Fd Wire Spk + T
Conc base Fence
Post

1490.46 @ 60° - 1490.38

(30) (50)

37+91.51
.16
POT
Set 2x2
18" deep.

80.49

51.90

Set "x" on
iron fence post

71.91

88.59

Fd N+T
PP

1499.65'

SEPULVEDA

(ARIZONA

SEC. 1
T 3S - R15W

SEC. 6
T 3S - R14W

From top pg.

Note: ANY ADDITIONS OR CHANGES ON THIS SHEET MUST BE MADE OR CIRCLED IN Red Ink. WITH DATE AND NAME OF PERSON MAKING CHANGE.

RETURN TO
LOS ANGELES COUNTY SURVEYOR
700 HALL OF RECORDS
Do not extend notes this side of this line

FORM 247 10M 8-31

F.B. 522 PG. 26

To bottom pg. 9

To L+T + ℄ Manchester

WS 23 D-4

SEC. 36
T2S - R15W

BLVD

(AVE)

F.B. 289-247
1549.06'

139+94.86
P.O.T.
Fd 2x2
18" deep
F.B. 289-247

89+92.17 - Sepulveda Blvd =
X 55+38.32 - La Tijera Blvd
Fd 3/4" I.P.
filled with
conc. + nail
18" deep
F.B. 289-247

Fd N+T
P.P.

BLVD

99.31'

153.51'

70.05'

797.61'

32.65'

Fd N+T
P.P.

Fd N+T
P.P.

48° 05' W
F.B. 289-241

136°

LATIGO

50'

163+35.98
P.O.T.
Fd 2x2
18" deep
F.B. 289-248

(33)

(33)

SEC. 31
T2S - R14W

Proposed ℄

50'

SEPULVEDA

F.B. 289-247
3210.63'

ARIZONA

50'

50'

From top pg

RETURN TO
LOS ANGELES COUNTY SURVEYOR
700 HALL OF RECORDS
Do not extend notes this side of this line

Note: ANY ADDITIONS OR CHANGES ON THIS SHEET MUST BE MADE OR CIRCLED IN Red Ink. WITH DATE AND NAME OF PERSON MAKING CHANGE.

Notes Ck'd by	D. M. Finley	Survey of	Sepulveda Blvd.
Map No.	B-914-2	W. O.	7185 Page No. 051 Bk'd 84 of F.
Office Work	F. A. W.	Surveyed by	
Checked	D. M. Finley	Notes	HE Date 5-12-33
Date	May 1933	Indexed	A. C. Johnson

F.B. 522 Pg. 27

RETURN TO
LOS ANGELES COUNTY SURVEYOR
700 HALL OF RECORDS
Do not extend notes this side of this line

Note: ANY ADDITIONS OR CHANGES OF THIS SHEET MUST BE MADE FOR CIRCLED IN Red Ink. WITH DATE AND NAME OF PERSON MAKING CHANGE.

W S 23

193+47.55 P.O.T. - Fd. 2 x 2 18" dn. pg. 22

Proposed SEPULVEDA BLVD. See pg

P.I. - 324+30 L.B. 576-75 Fd. 1 x 2 + chr. 4" deep.

187+44.04 P.O.T. - Fd. 2 x 2 18" dn. pg. 22

76.93

275.91

(105°-53-15) 63°-33-30 105°-53-22½"

105°-53-00 250 Adj.

689.09 - T 84°02

P.O.T. - 190+19.95 Sepulveda Blvd. Set 2 x 2 - 18" dn by interstn.

Conc. Rim Chamber See city Plat Grade

1.35'

9°-54'

100 ft Line

166°-154.08'

154.10 - T

Transit

CENTINELLA BVD.

Fd. X in pvmt. per F.B. 396-35

Tie to L.A. City No. Outfall Sewer

(179°-59-30) 359°-58-15 179°-59'-33¾"

Fd. L & T. - P.I. pg. 21

(Underground) North Outfall Sewer per F.B. 396-35

L.A. City

Fd. 2 x 2 - 308+72.03 L.B. 576-77. Sec F.B. 396-35 Top of ridge.

FORM 247 10M 8-31

RETURN TO

LOS ANGELES COUNTY SURVEYOR

700 HALL OF RECORDS

Note: ANY ADDITIONS OR CHANGES ON THIS SHEET MUST BE MADE OR CIRCLED IN **Red Ink.** WITH DATE AND NAME OF PERSON MAKING CHANGE.

Do not extend notes this side of this line

F.B. 322 PG. 28

FORM 247 10M 8-31

RETURN TO
LOS ANGELES COUNTY SURVEYOR
700 HALL OF RECORDS

Note: ANY ADDITIONS OR CHANGES ON THIS SHEET MUST BE MADE IOR CIRCLED IN **Red Ink.** WITH DATE AND NAME OF PERSON MAKING CHANGE.

Do not extend notes this side of this line

W. 5223 D-3

Notes Ck'd by
Map No. 8-714-2
Office Work F. A. W.
Checked D. W. [illegible]
Date May 1933.

Survey of Sepulveda Blvd.
W. O. 7785 Topo No. 651 3rd Sec.
Surveyed by [illegible]
Notes A. C. Johnson Date 5-12-33
Indexed

F.B. 522 Pg. 29

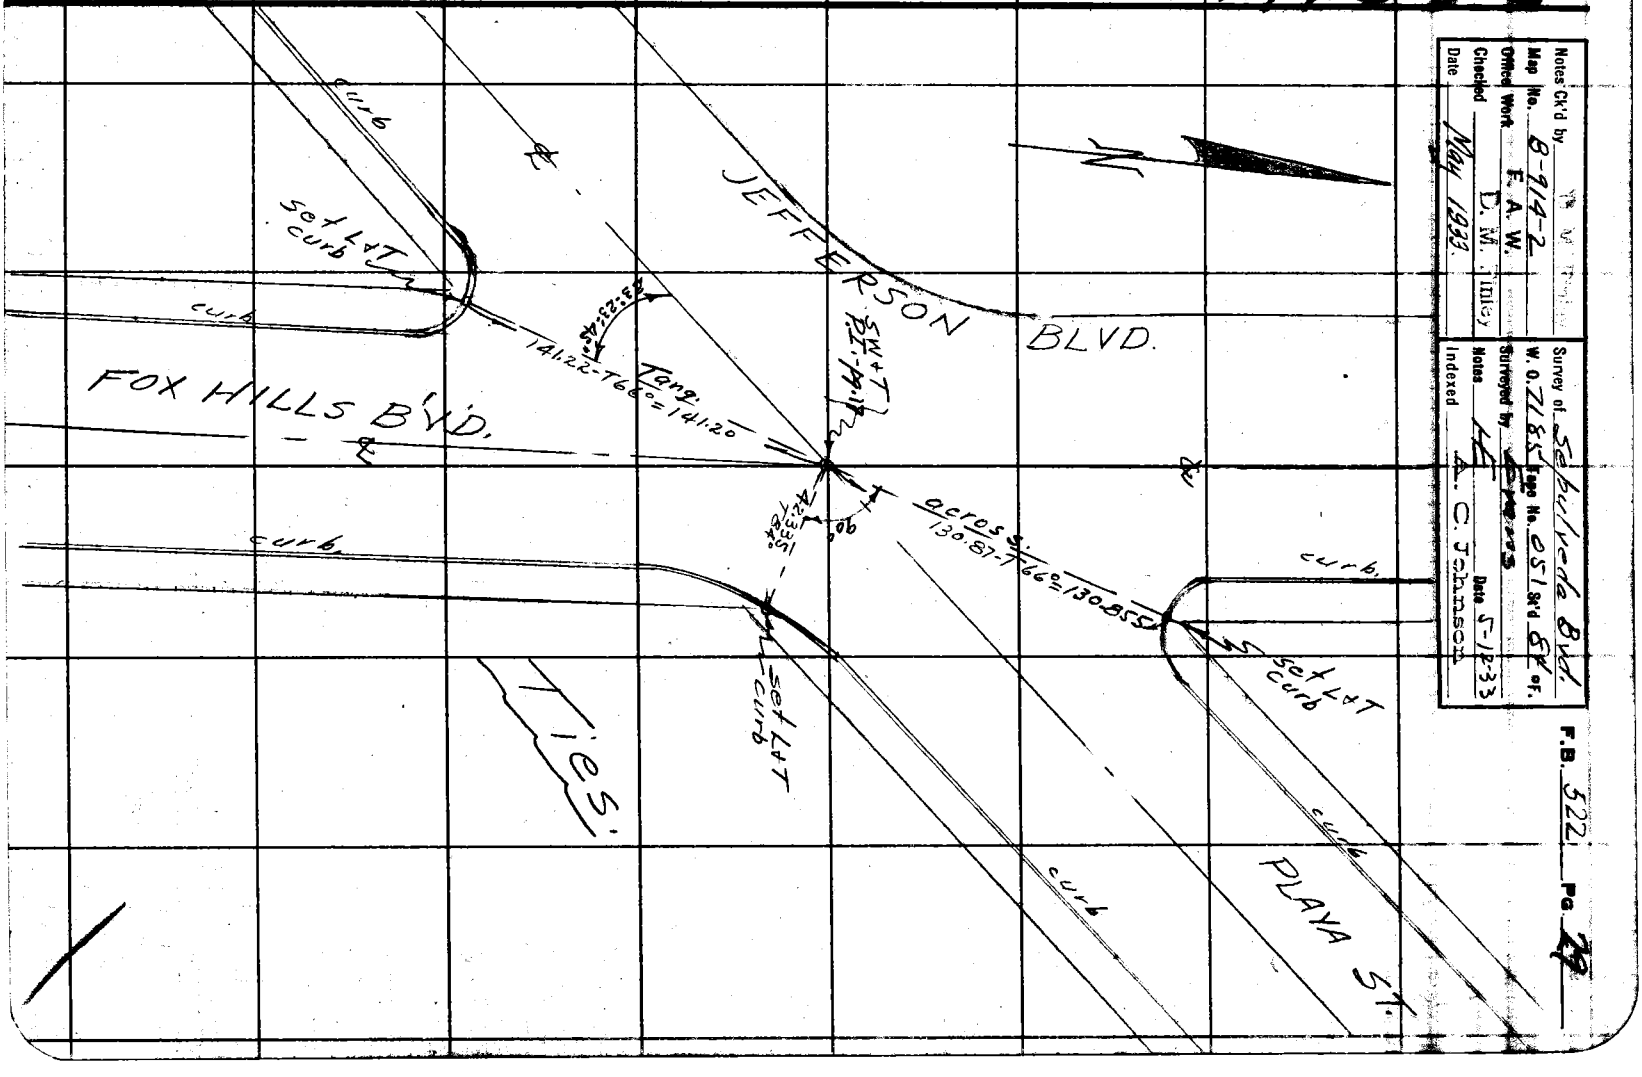

RETURN TO
LOS ANGELES COUNTY SURVEYOR
700 HALL OF RECORDS

Note: ANY ADDITIONS OR CHANGES ON THIS SHEET MUST BE MADE OR CIRCLED IN **Red Ink.** WITH DATE AND NAME OF PERSON MAKING CHANGE.

Do not extend notes this side of this line

Los 28, D-4

Date (5-15-53)

FOX HILLS BVD.

(50)

To Pl. Jefferson and Playa.

Set ¾" I.P. cem. filled w/ cor. nail 18" d/n. - R/W line.

Tract Line

5286 Calc't meas.

90°

P.I. - ¾" I.P. 25" d/n. - Pg. 18

5483 Calc'd meas.

SEPULVEDA BVD.

(50)

To Jefferson Blvd.

SEPULVEDA BVD.

Set ¾" I.P. cem. filled w/ cor. nail 18" d/n. R/W.

Point of Reference

F.B. 522 Pg. 30

FORM 247 10M 8-31

RETURN TO
LOS ANGELES COUNTY SURVEYOR
700 HALL OF RECORDS

Note: ANY ADDITIONS OR CHANGES ON THIS SHEET MUST BE MADE OR CIRCLED IN **Red Ink.** WITH DATE AND NAME OF PERSON MAKING CHANGE.

Do not extend notes this side of this line

W 5.23 D-3

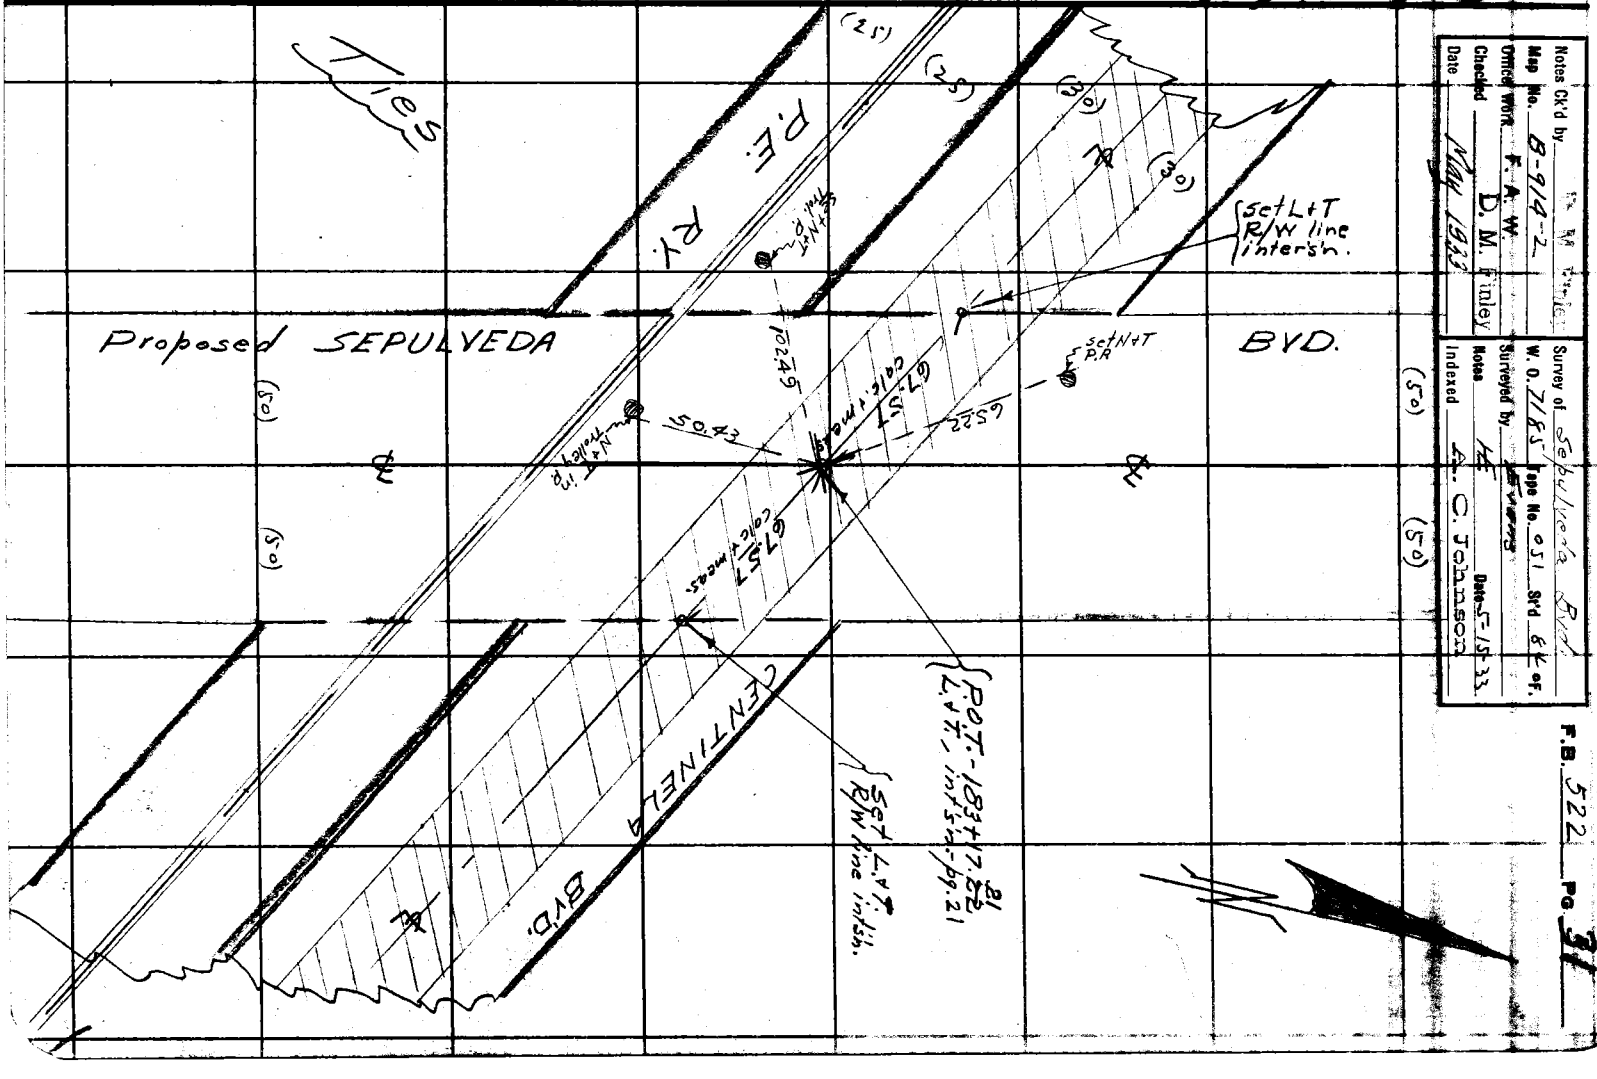

Notes Ck'd by [illegible]
Map No. B-914-2
Office Work F. A. W.
Checked D. M. Finley
Date May 1933

Survey of Sepulveda Blvd.
W. O. 7165 Type No. 051 Std 6 ft. of.
Surveyed by [illegible]
Notes Date 5-15-33.
Indexed A. C. Johnson

F.B. 522 Pg 31

RETURN TO
LOS ANGELES COUNTY SURVEYOR
700 HALL OF RECORDS

Note: ANY ADDITIONS OR CHANGES ON THIS SHEET MUST BE MADE OR CIRCLED IN **Red Ink.** WITH DATE AND NAME OF PERSON MAKING CHANGE.

Do not extend notes this side of this line

4523 D-3

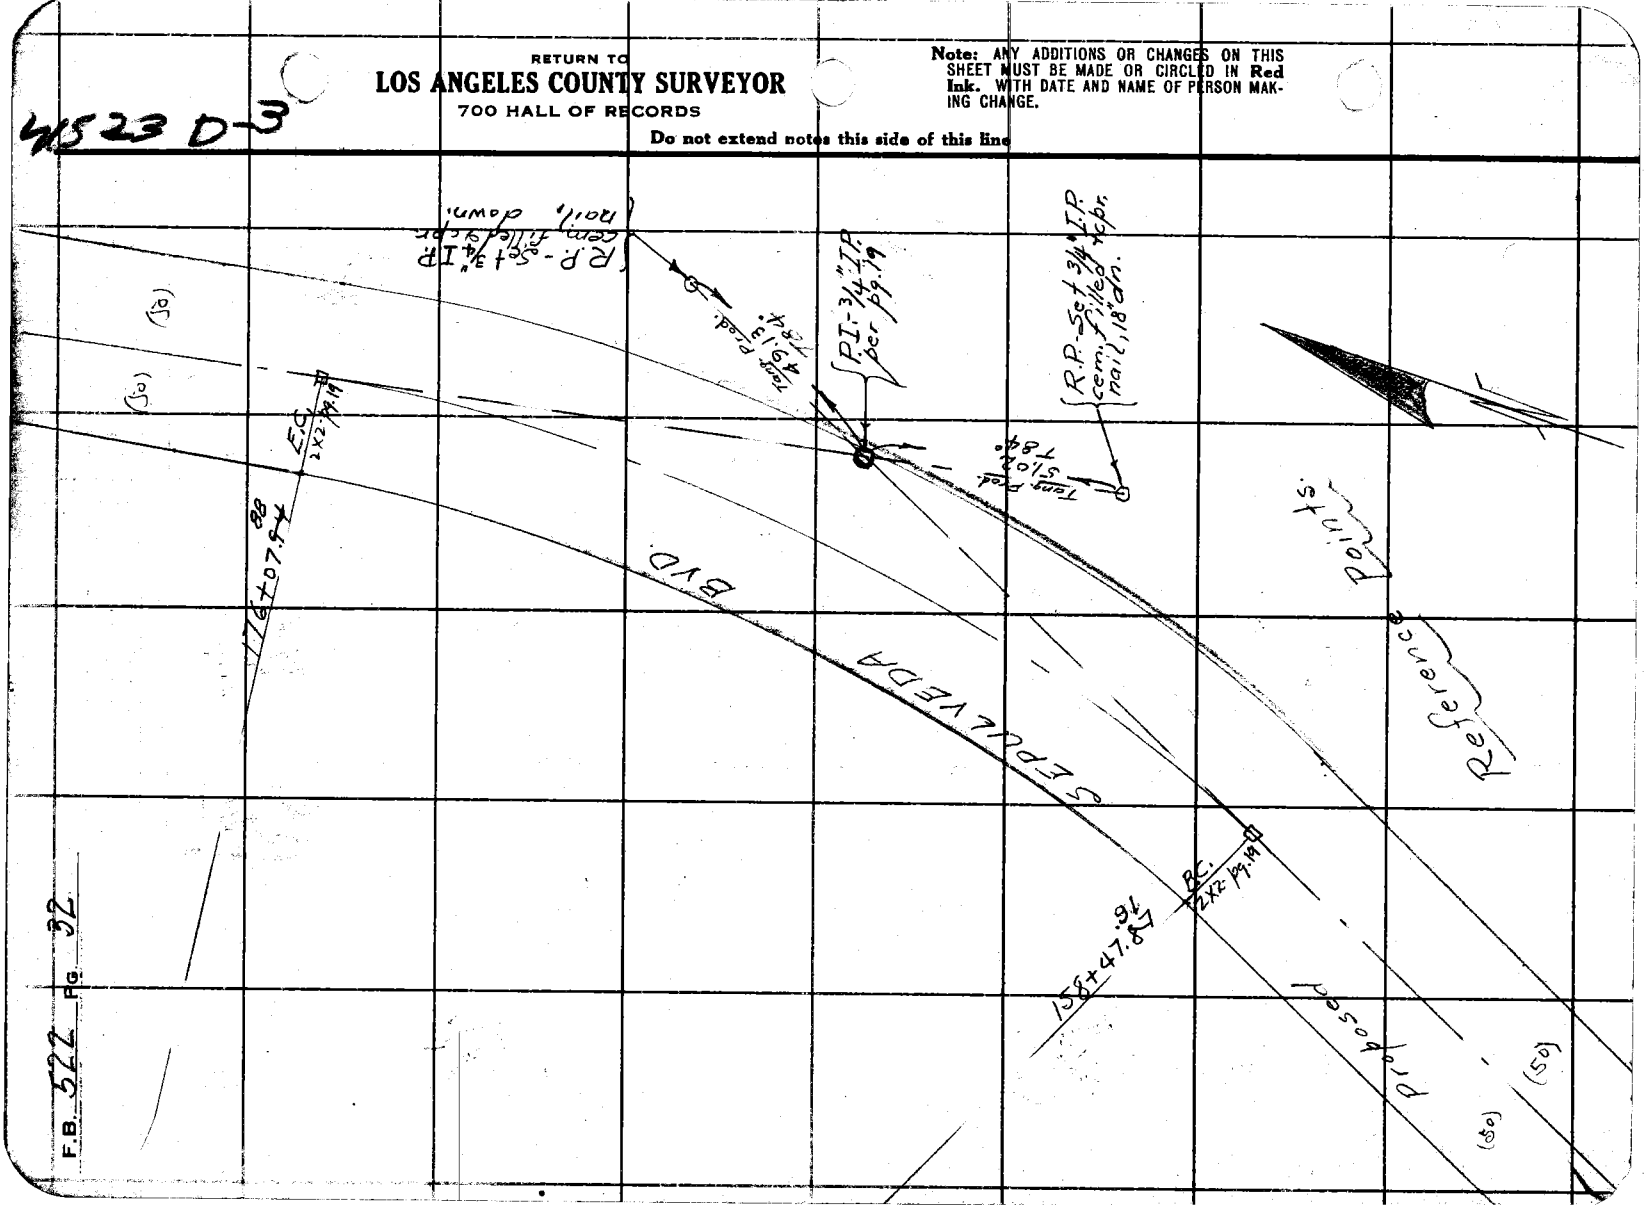

F.B. 522 PG. 32

Notes Ck'd by D. M. Finley	Survey of Sepulveda Blvd.
Map No. 8-914-2	W. O. 7185 Tape No. 051 St'd 84 °F.
Office Work F. A. W.	Surveyed by Evans
Checked D. M. Finley	Notes HE Date 5-15-33
Date May 1933	Indexed E. C. Johnson

F.B. 522 Pg. 33

(50)

(50)

Note: ANY ADDITIONS OR CHANGES OF THIS SHEET MUST BE MADE IN OR CIRCLED IN Red Ink. WITH DATE AND NAME OF PERSON MAKING CHANGE.

Do not extend notes this side of this line

RETURN TO
LOS ANGELES COUNTY SURVEYOR
700 HALL OF RECORDS

FORM 247 10M 5-31

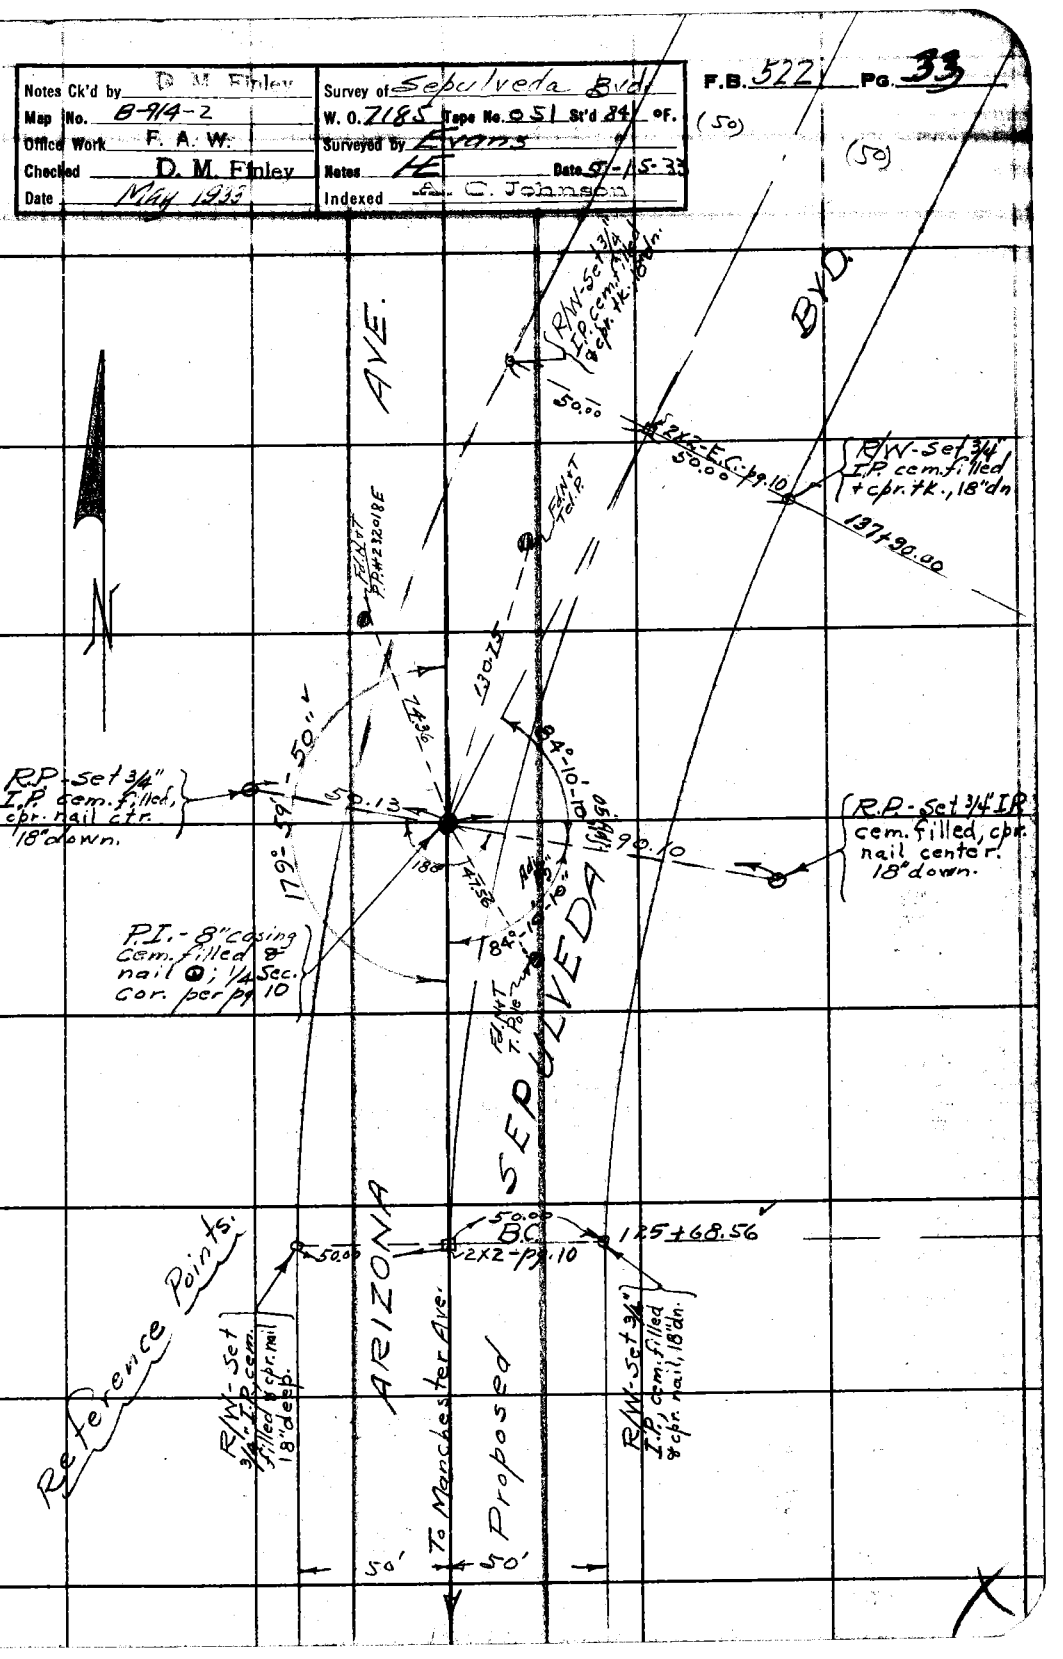

RETURN TO
LOS ANGELES COUNTY SURVEYOR
700 HALL OF RECORDS

Note: ANY ADDITIONS OR CHANGES ON THIS SHEET MUST BE MADE OR CIRCLED IN **Red Ink.** WITH DATE AND NAME OF PERSON MAKING CHANGE.

Do not extend notes this side of this line

B. 522 Pg. 34

Notes Ck'd by	Survey of Sepulveda Blvd
Map No. B-914-1	W. O. 7185 Tape No. St'd °F.
Office Work F. A. W.	Surveyed by L. D. Moore
Checked D. M. Finley	Notes Vanfleet Date 5-11-33
Date May 1933	Indexed C. Johnson 5-25-33

F.B. 522 Pg. 31

Note: ANY ADDITIONS OR CHANGES ON THIS SHEET MUST BE MADE OR CIRCLED IN Red Ink, WITH DATE AND NAME OF PERSON MAKING CHANGE.

Do not extend notes this side of this line

RETURN TO
LOS ANGELES COUNTY SURVEYOR
700 HALL OF RECORDS

FORM 247 10M 5-31

TOPOGRAPHY
on
SEPULVEDA BLVD
from
IMPERIAL HIGHWAY
to
~~MANCHESTER~~ AVE. Jefferson Blvd.
W.O. # 7185

May 11, 1933

For ℄ Notes see F.B. 522-

F.B. 522 PG 36

To bottom pg 37

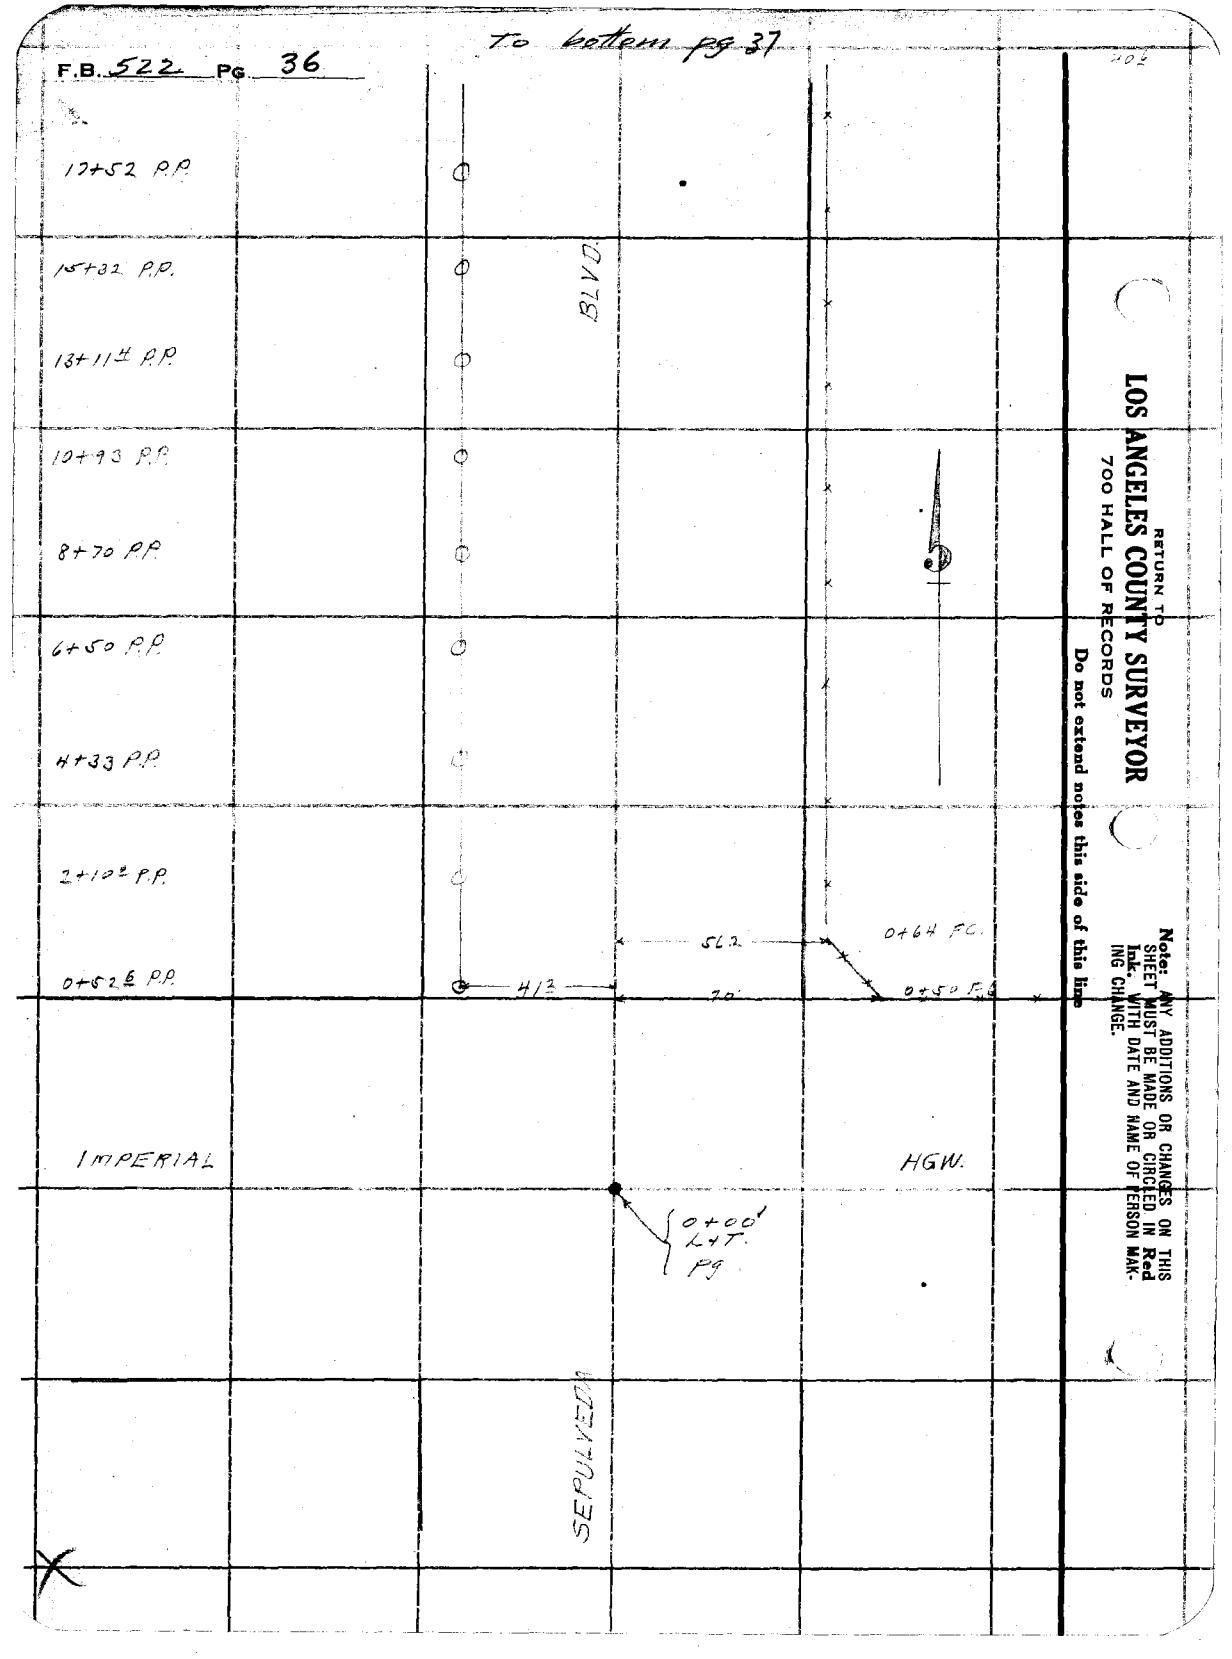

RETURN TO
LOS ANGELES COUNTY SURVEYOR
700 HALL OF RECORDS

Do not extend notes this side of this line

Note: ANY ADDITIONS OR CHANGES ON THIS SHEET MUST BE MADE OR CIRCLED IN Red Ink. WITH DATE AND NAME OF PERSON MAKING CHANGE.

Notes Ck'd by	Survey of Sepulveda Blvd
Map No. B-914-1	W. O. 7185 Tape No. St'd °F.
Office Work F. A. W.	Surveyed by L. O. Moore
Checked D. M. Finley	Notes A.W. Van Fleet Date 5-19-33
Date May 1933	Indexed

F.B. 522 Pg. 37

To bottom pg 38

23+73 P.P.

LINCOLN BLVD.

3-16° 37.2

28+73 Guy Pole

BLVD

22+91.5' P.I. 2x2 Pg. 24

22+50? Edge of Conc. Pavement

Steel Post & Wire Fence

SEPULVEDA

48.9 36.3

Concrete Culvert 10.3

41.5 37.3

21+60.3

21+09 P.P.

40.9 58.6 21+09

19+72 P.P.

From top pg 36

Note: ANY ADDITIONS OR CHANGES ON THIS SHEET MUST BE MADE OR CIRCLED IN Red Ink, WITH DATE AND NAME OF PERSON MAKING CHANGE.

Do not extend notes this side of this line

RETURN TO
LOS ANGELES COUNTY SURVEYOR
700 HALL OF RECORDS

FORM 247 10M 8-31

To bottom pg 39

F.B. 522 Pg. 38

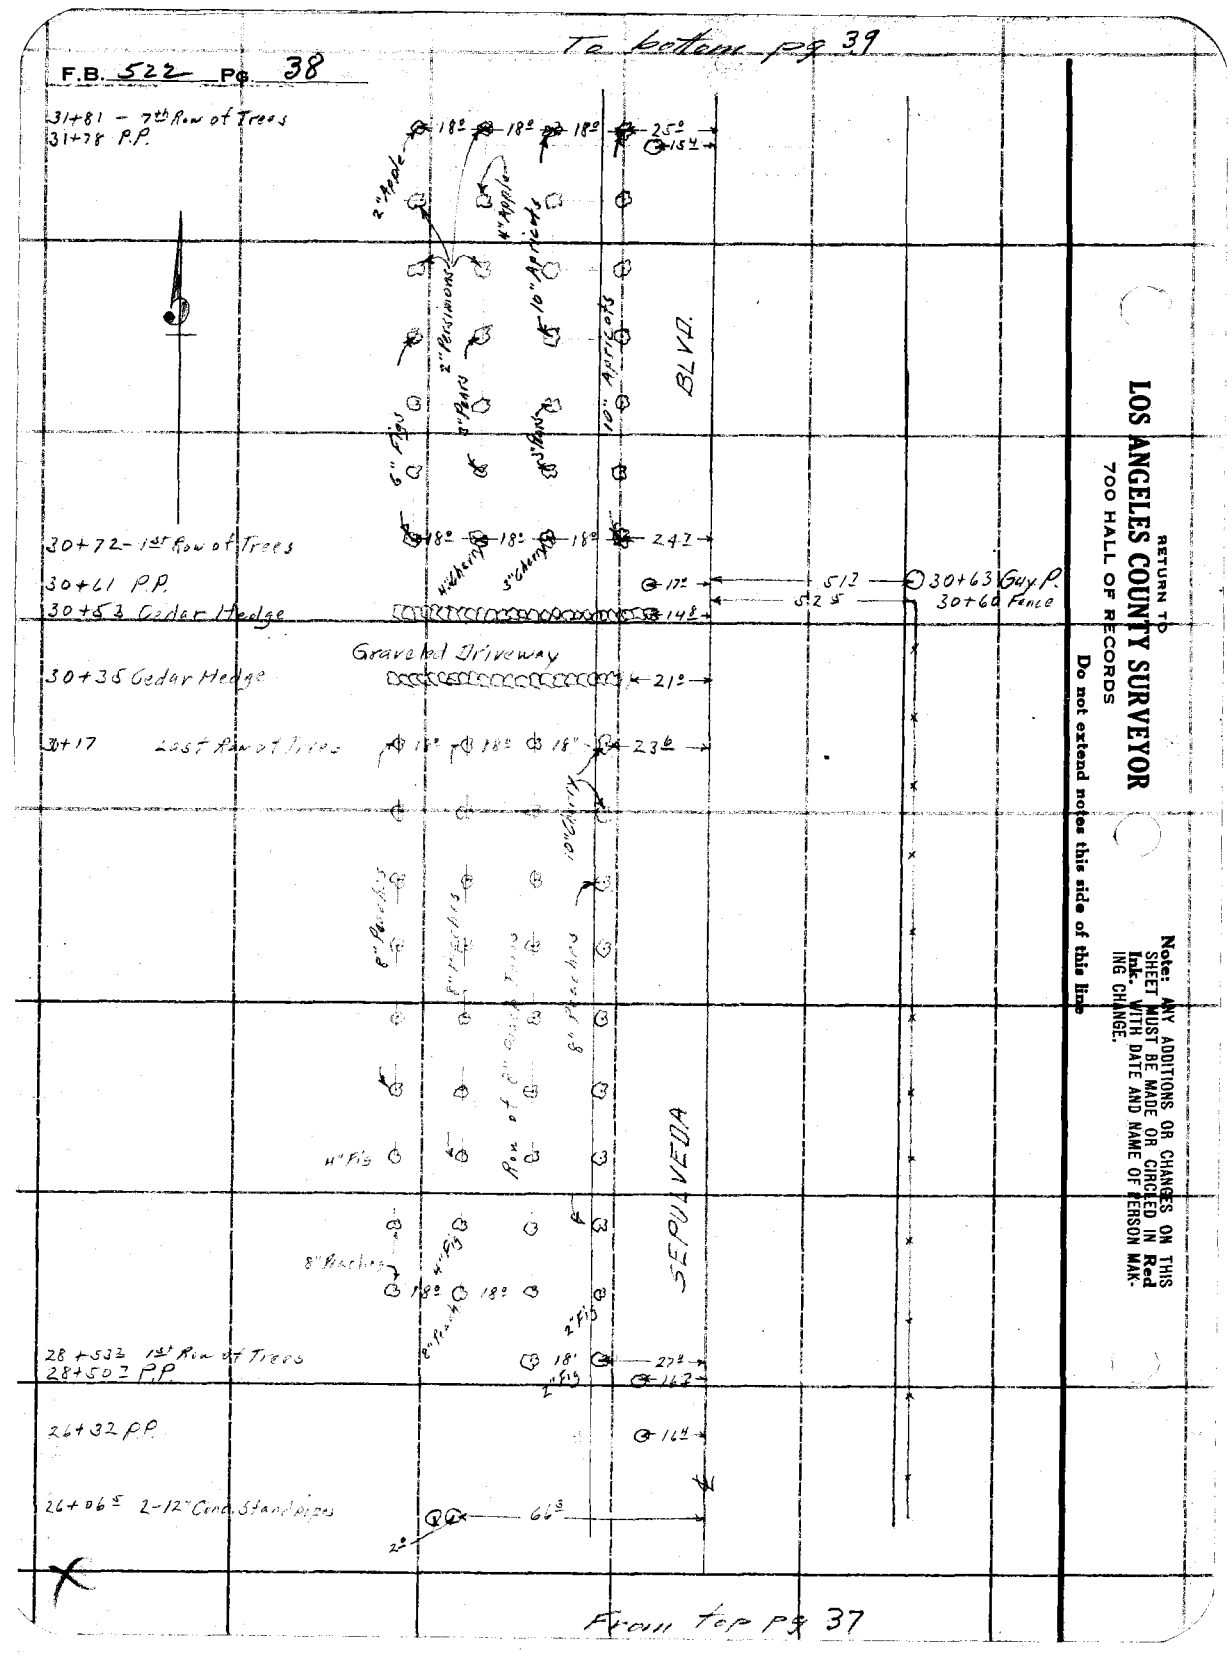

From Top pg 37

RETURN TO
LOS ANGELES COUNTY SURVEYOR
700 HALL OF RECORDS

Do not extend notes this side of this line

Note: ANY ADDITIONS OR CHANGES ON THIS SHEET MUST BE MADE OR CIRCLED IN Red Ink WITH DATE AND NAME OF PERSON MAKING CHANGE.

Notes Ck'd by
Map No. B-914-1
Office Work F. A. W.
Checked D. M. Finley
Date May 1933

Survey of Sepulveda Blvd.
W. O. 7185 Tape No. St'd °F.
Surveyed by L. D. Moore
Notes A. W. Van Fleet Date 5-11-33
Indexed A. C. Johnson

F.B. 522 Pg. 39

To bottom pg 40

37+21 P.P. — 16⁸ →

35+04 P.P. — 17⁴ →

BLVD

34+09 - 11th Olive — 24⁴ →

6" Olives

33+03 - 5th Olive

32+61 P.P. — 17² →

SEPULVEDA

Olives

32+49 Fruit Trees — 17' — 19' — 24⁴ →
5" Apricots
4" Quince

32+31 - Fruit Trees — 17 — 19 — 24⁴ →

32+2 Cedar Hedge — 14² →

Said Driveway

31+88 Cedar Hedge — 2⁵ — 4¹⁰ — 11⁰ — 15³ →
4" Poplars

From top pg. 38

Note: ANY ADDITIONS OR CHANGES ON THIS SHEET MUST BE MADE OR CIRCLED IN Red Ink, WITH DATE AND NAME OF PERSON MAKING CHANGE.

Do not extend notes this side of this line

RETURN TO
LOS ANGELES COUNTY SURVEYOR
700 HALL OF RECORDS

FORM 247 10M 8-31

F.B. 522 Pg. 40

To bottom pg 41

63+26 P.P.

61+07 P.P.

58+78 P.P.

56+67 P.P.

54+49 P.P.

62+07 P.P.

60+44 P.P.

58+87 P.P.

57+26 P.P.

Barbed Wire Fence

55+61 P.P.

53+95 P.P.

202

274

284

53+18 F.Cor.

H.S.

54

53+08 F.Cor.

CENTURY

52+81.78

Lt. to Concrete Mon

BLVD.

52+59 P.P.

198

269

52+58 P.P.

653

52+31.34 F.Cor.

509

52+18 F.Cor.

50+41 P.P.

48+20 P.P.

46+00 P.P.

43+79 P.P.

41+63 P.P.

39+40 P.P.

SEPULVEDA

Steel Post & Wire Fence

From top pg 39

RETURN TO
LOS ANGELES COUNTY SURVEYOR
700 HALL OF RECORDS

Do not extend notes this side of this line

Note: ANY ADDITIONS OR CHANGES ON THIS SHEET MUST BE MADE OR CIRCLED IN Red Ink. WITH DATE AND NAME OF PERSON MAKING CHANGE.

Notes Ck'd by D. M. F.	Survey of Sepulveda Blvd.
Map No. B-914-1	W. O. 7185 Tape No. St'd °F.
Office Work F. A. W.	Surveyed by L. O. Moore
Checked D. M. Finley	Notes A.W. Vanlier Date 5-11-33
Date May 1933	Indexed A. C. Johnson

F.B. 528 PG. 41

To bottom pg 42

87+43 P.P.

87+63 P.P.

85+86 P.P.

85+24 P.P.

Barbed Wire Fence

84+05 P.P.

84+38 P.P.

82+76 P.P.

80+85 P.P.

81+18 P.P.

78+66 P.P.

79+63 P.P.

78+05 P.P.

76+45 P.P.

76+42 P.P.

74+85 P.P.

74+27 P.P.

73+24 P.P.

72+97 P.P.

71+54 P.P.

70+02 P.P.

69+86 P.P.

68+43 P.P.

67+66 P.P.

66+84 P.P.

65+46 P.P.

65+23 P.P.

63+64 P.P.

BLVD

SEPULVEDA

From top pg 40

Note: ANY ADDITIONS OR CHANGES ON THIS SHEET MUST BE MADE OR CIRCLED IN Red Ink, WITH DATE AND NAME OF PERSON MAKING CHANGE.

Do not extend notes this side of this line

RETURN TO
LOS ANGELES COUNTY SURVEYOR
700 HALL OF RECORDS

FORM 247 10M 8-31

To bottom pg 43

F.B. 522 PG 42

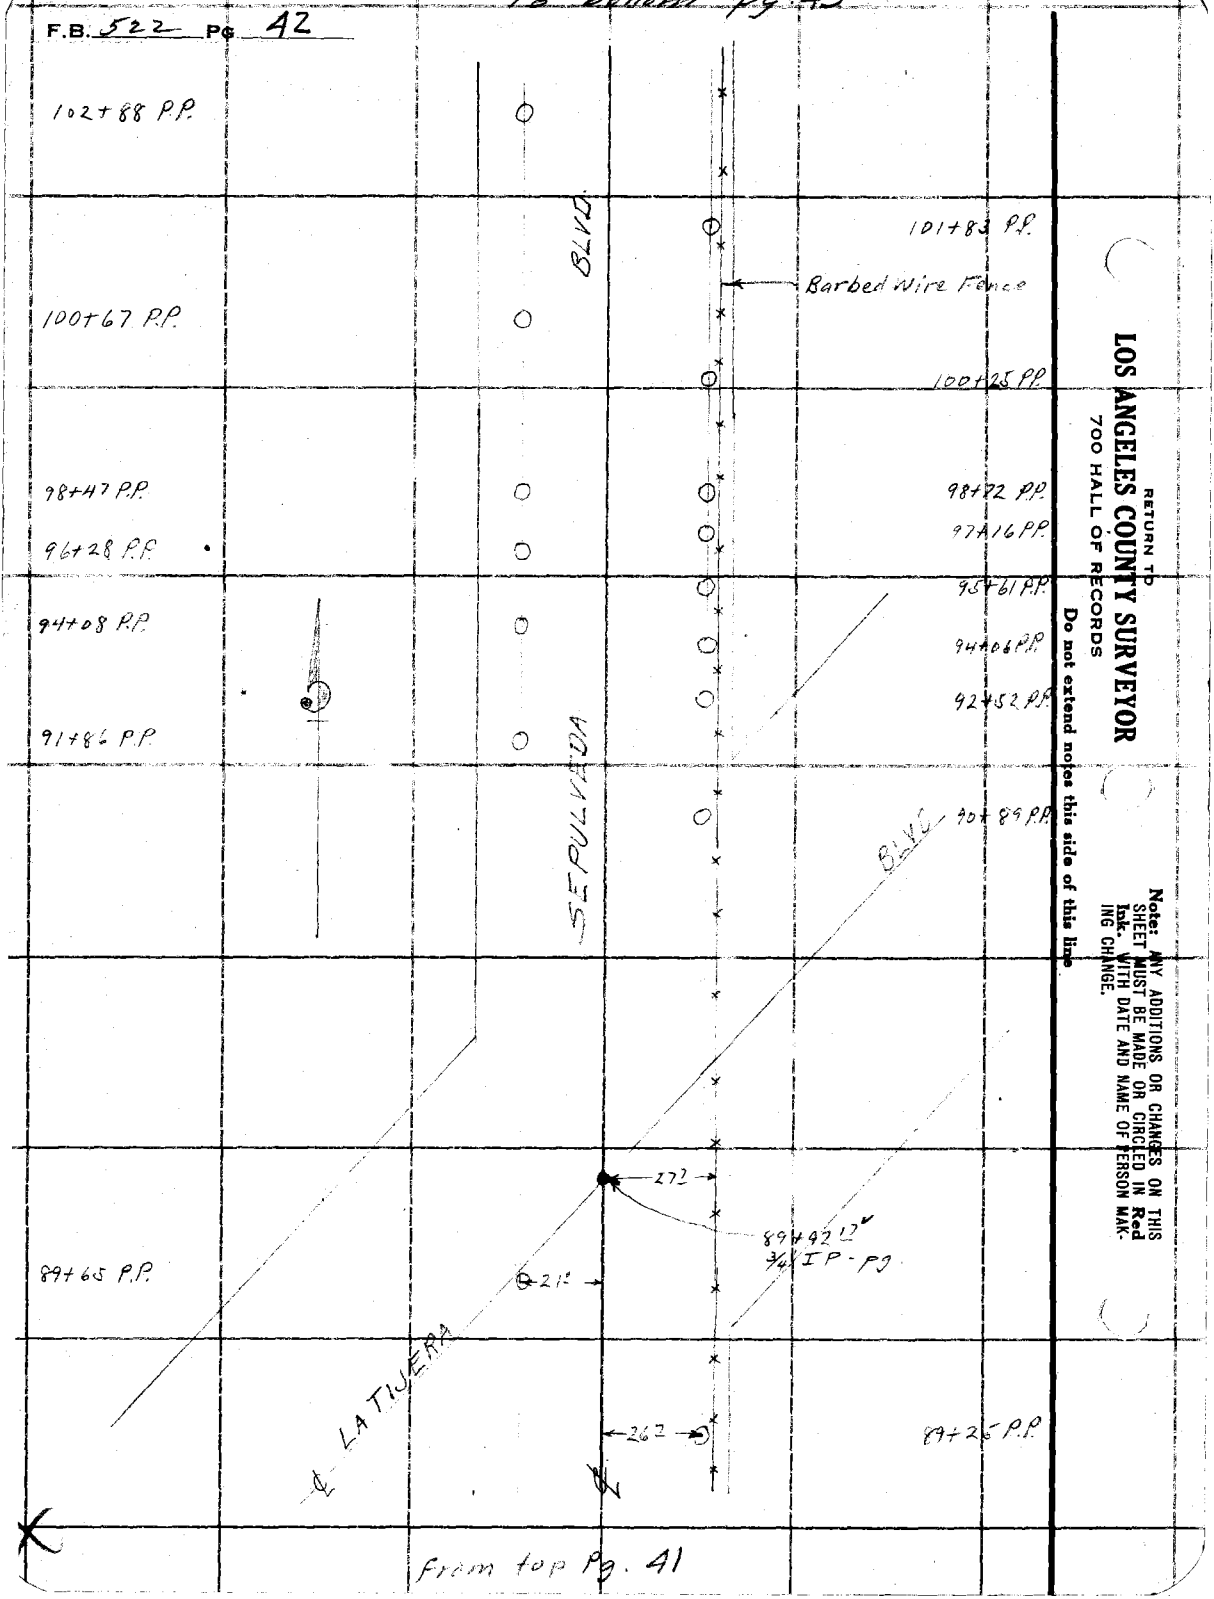

From top Pg. 41

RETURN TO
LOS ANGELES COUNTY SURVEYOR
700 HALL OF RECORDS

Do not extend notes this side of this line

Note: ANY ADDITIONS OR CHANGES ON THIS SHEET MUST BE MADE OR CIRCLED IN Red Ink. WITH DATE AND NAME OF PERSON MAKING CHANGE.

Map No. B-914-1 F. A. W.	W. O. 7185 Tape No. St'd °F.
Office Work	Surveyed by L. D. Moore
Checked D. M. Finley	Notes Van Fleet Date 5-11-33
Date May 1933.	Indexed A. C. Johnson

F.B. 522 Pg. 43

(To Bot pg. 45)

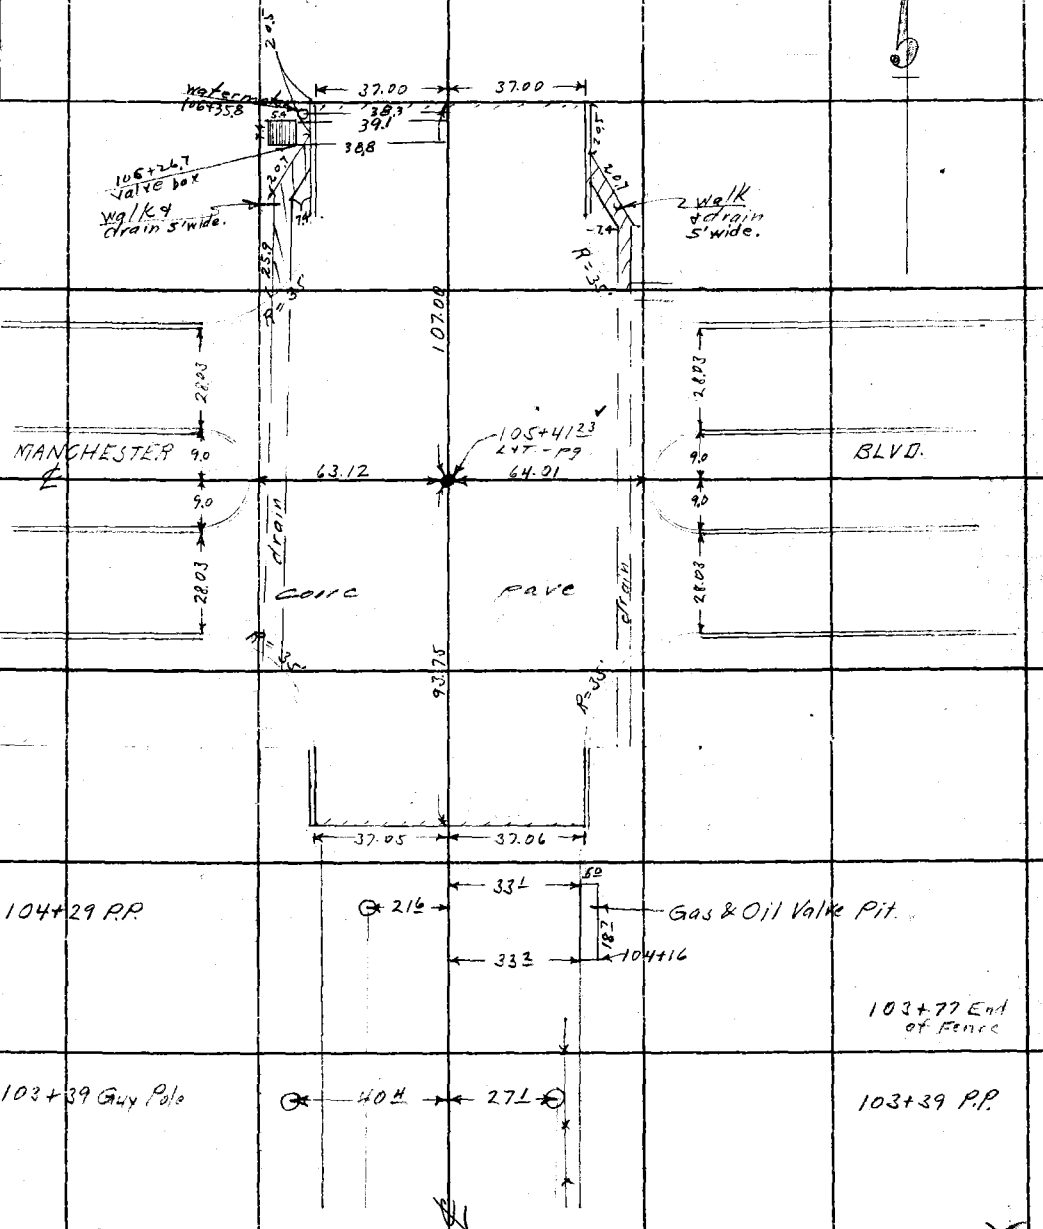

From Top pg. 42

Note: ANY ADDITIONS OR CHANGES ON THIS SHEET MUST BE MADE IN Red Ink, WITH DATE AND NAME OF PERSON MAKING CHANGE.

Do not extend notes this side of this line

RETURN TO
LOS ANGELES COUNTY SURVEYOR
700 HALL OF RECORDS

FORM 247 10M 8-31

RETURN TO

LOS ANGELES COUNTY SURVEYOR

700 HALL OF RECORDS

Note: ANY ADDITIONS OR CHANGES ON THIS SHEET MUST BE MADE OR CIRCLED IN **Red Ink.** WITH DATE AND NAME OF PERSON MAKING CHANGE.

Do not extend notes this side of this line

F.B. 522 P. 44

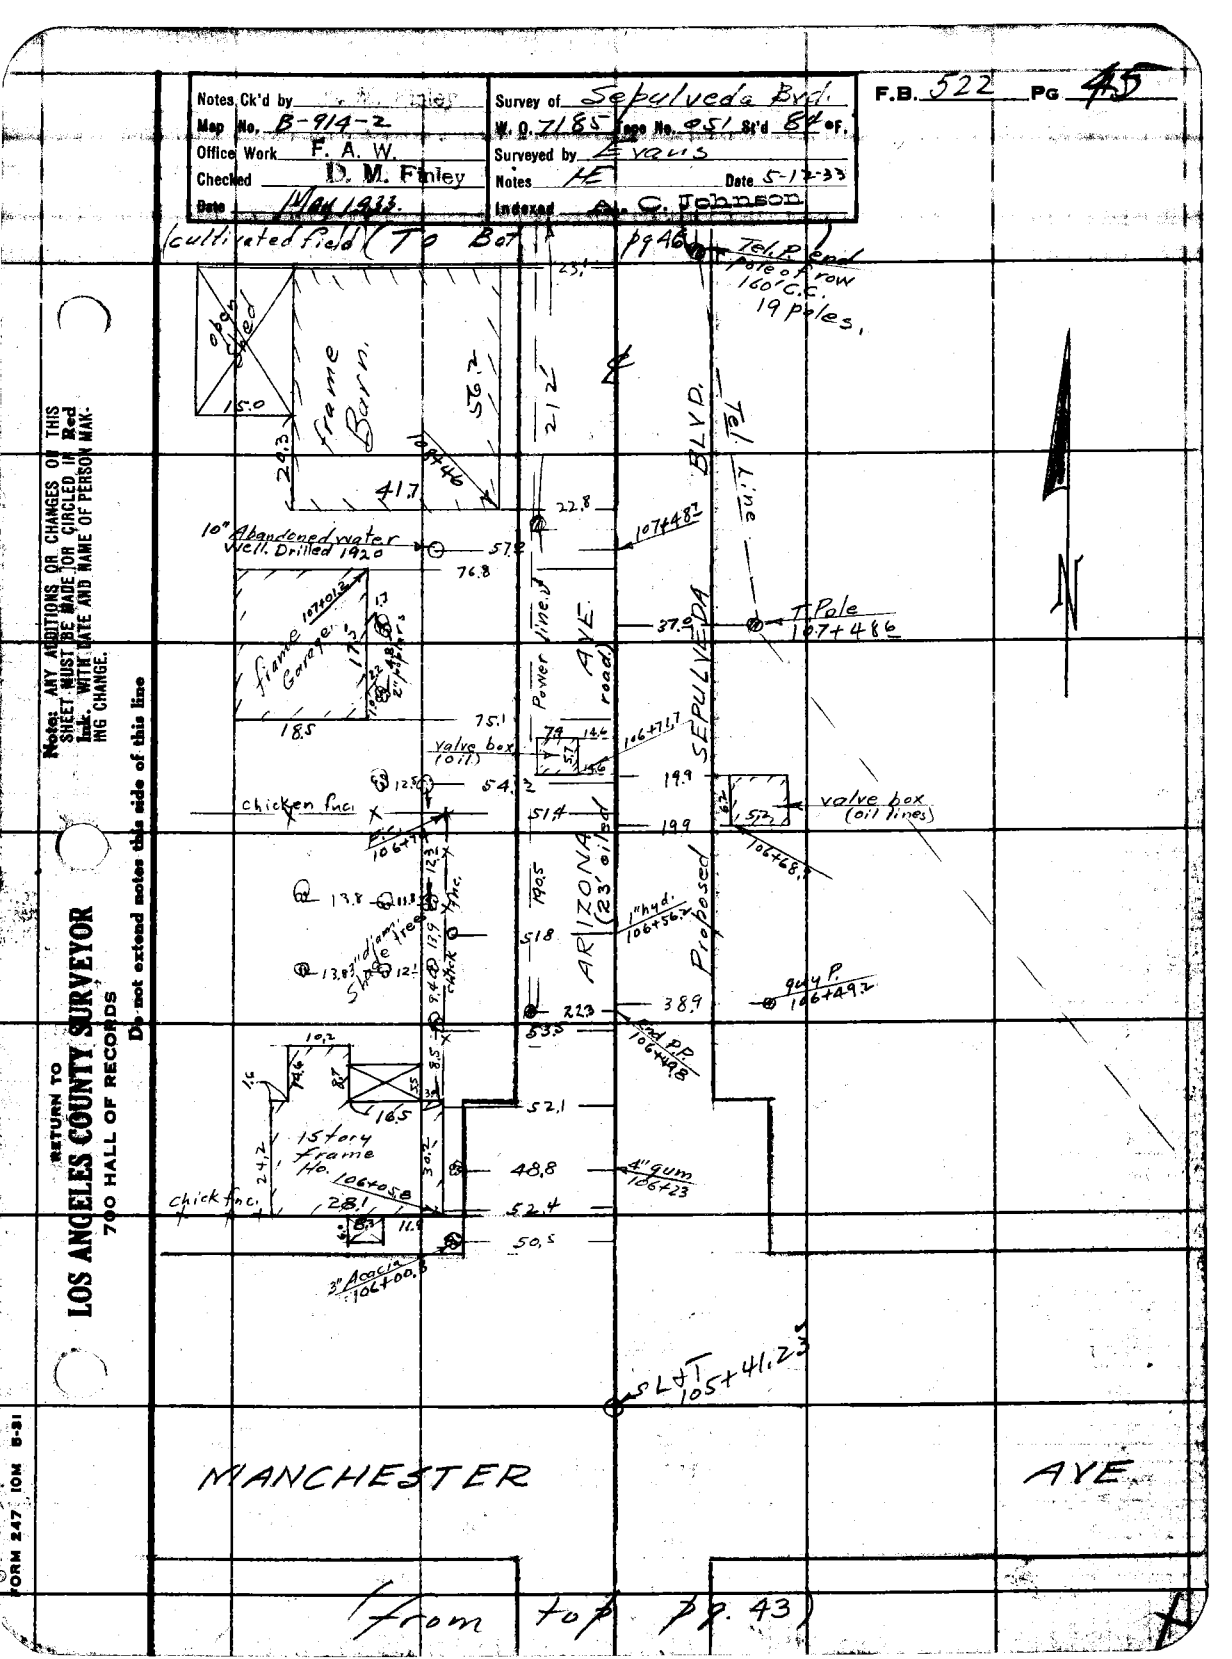
Notes Ck'd by
Map No. B-914-2
Office Work F. A. W.
Checked D. M. Finley
Date May 1933.
Survey of Sepulveda Blvd.
W. O. 7185 Page No. 951 Sht'd 84 of
Notes HE
Date 5-12-33
Indexed A. C. Johnson
F.B. 522 PG 45
cultivated field (To Bot. pg 46)
Tel. P. and pole of row 160' C.C. 19 Poles.
abdn. shed
frame Barn
St.
Sepulveda BLVD.
Tel.
10" Abandoned water well. Drilled 1920
frame Garage
Power line
road
AVE.
T. Pole 107+486
valve box (oil)
chicken fnc.
valve box (oil lines)
ARIZONA (23' oiled)
Proposed
1" hyd. 106+56.7
Sta. 106+00
Sta. 107+00
Sta.

F.B. 522 PG 46

(5-12-33)
date

RETURN TO
LOS ANGELES COUNTY SURVEYOR
700 HALL OF RECORDS

Do not extend notes this side of this line

Note: ANY ADDITIONS OR CHANGES ON THIS SHEET MUST BE MADE OR CIRCLED IN Red Ink. WITH DATE AND NAME OF PERSON MAKING CHANGE.

Fld. pg. 47

Bot pg. 47

Culti vated

Culti vated

N

94.0
347
20.8
S.M.T.
P.
S11°91
P.I. - 1/4 Sec. Cor
P.
220
12.5+93
123+143
121+68.8
119+33.5
117+14.2
114+93.3
Line.
Pond
ARIZONA AVE.
(23' oiled Road)
Proposed SEPULVEDA BVD.
Tel. Lines on 19 poles @ 16 c.c. in row.
B.C. .56
125+68.42

(from top pg. 45)

Notes Ck'd by	Survey of Sepulveda Blvd.
Map No. B-914-2	W. O. 7161 Tape No. 251 St'd 64 °F.
Office Work F. A. W.	Surveyed by Evans
Checked O. M. Fiske	Notes K. C. Johnson Date 5-12-33
Date May 1933	Indexed

F.B. 522 Pg. 47

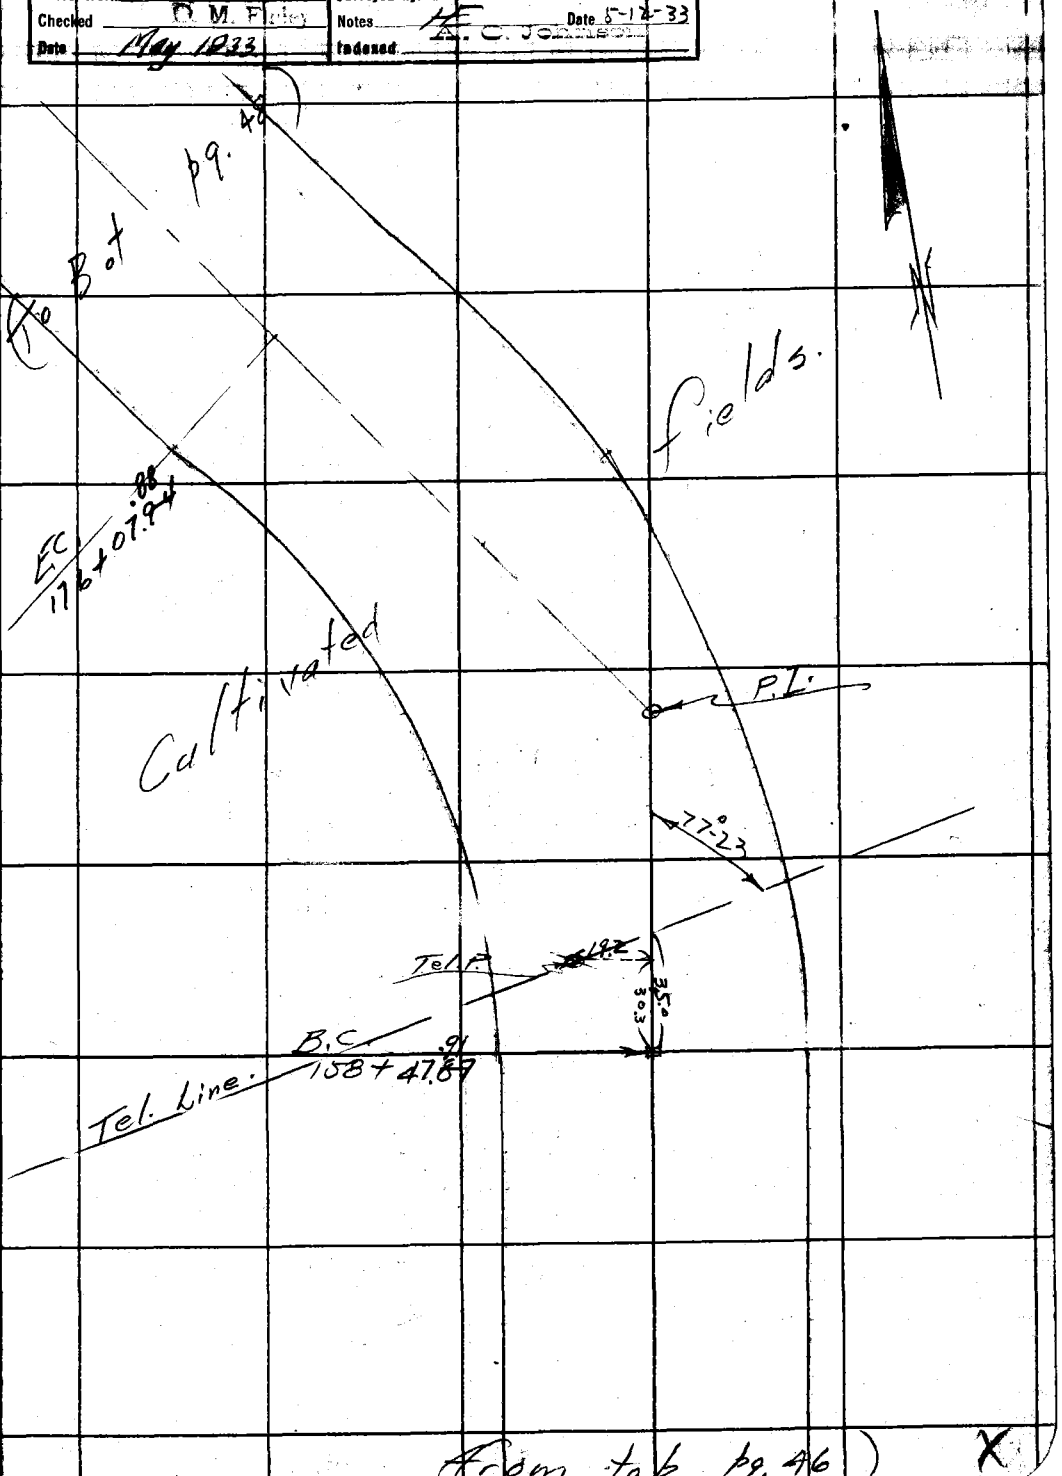

Note: ANY ADDITIONS OR CHANGES OF THIS SHEET MUST BE MADE IN OR CIRCLED IN Red Ink, WITH DATE AND NAME OF PERSON MAKING CHANGE.

Do not extend notes this side of this line

RETURN TO
LOS ANGELES COUNTY SURVEYOR
700 HALL OF RECORDS

FORM 247 10M 8-51

F.B. 522 PG. 48

(5 top)

5-12-33
Date

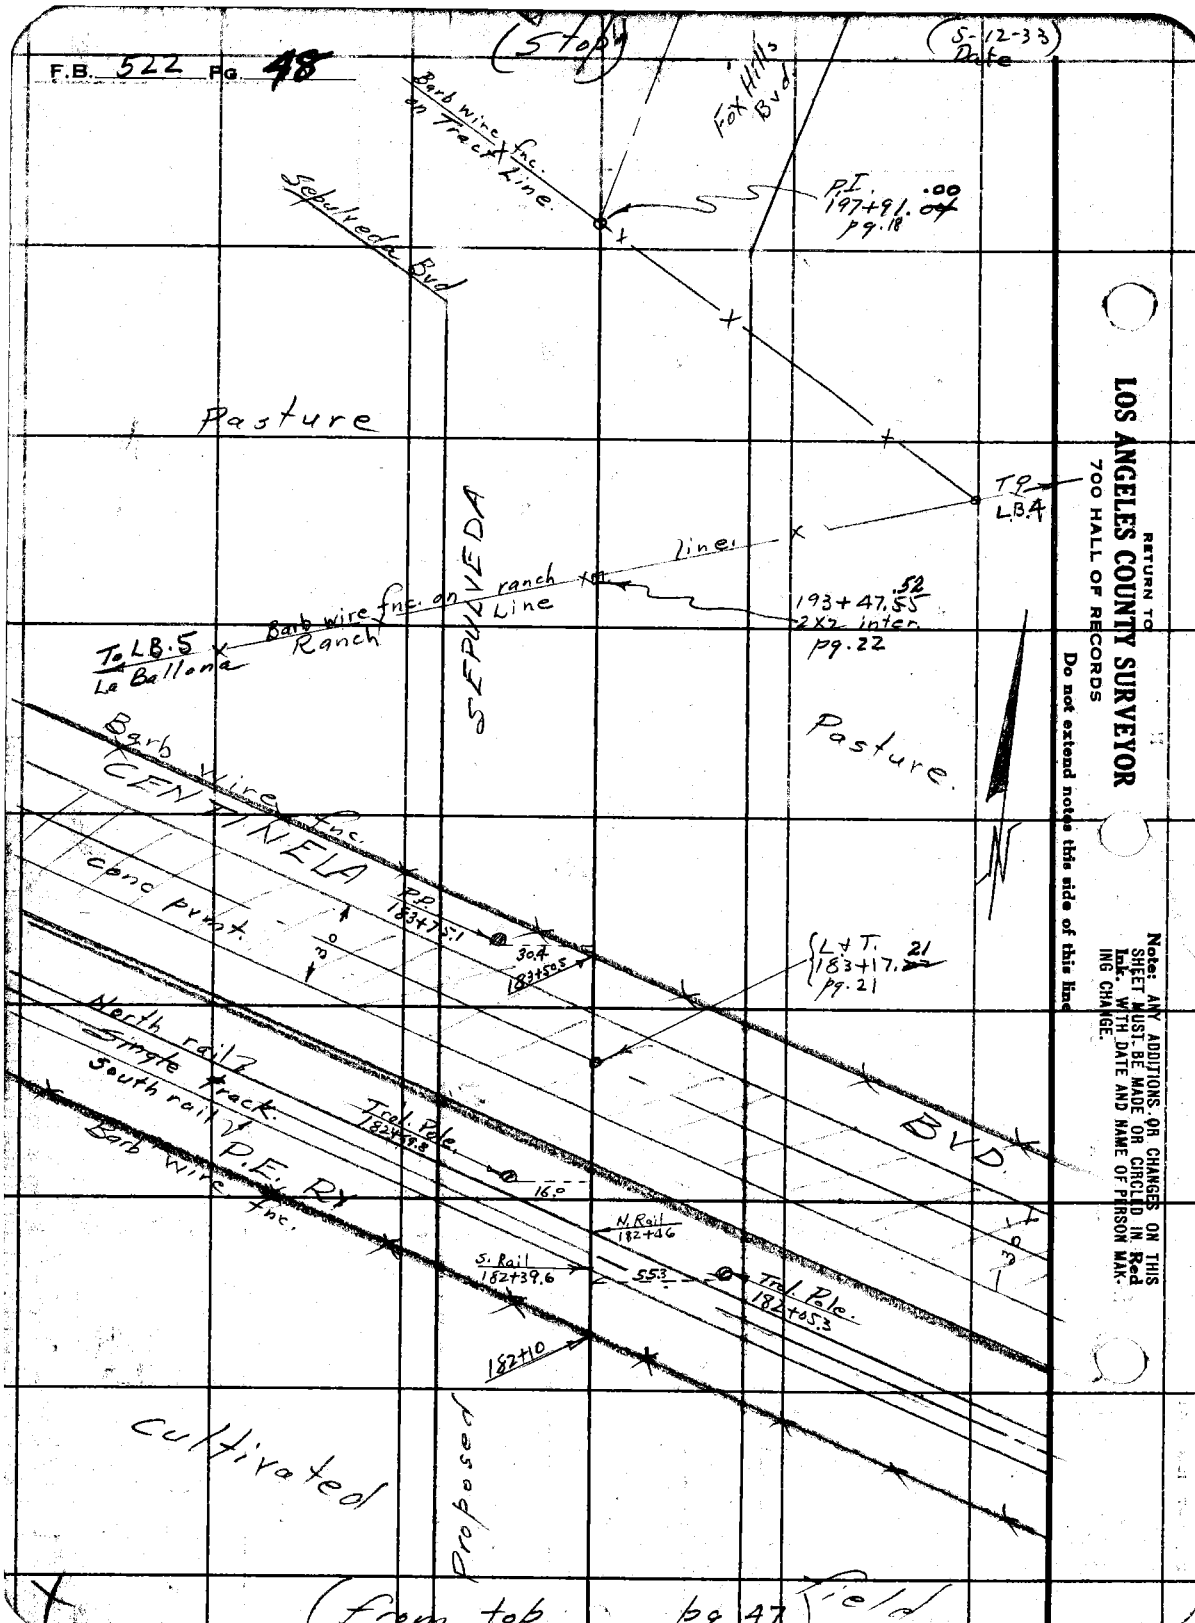

RETURN TO
LOS ANGELES COUNTY SURVEYOR
700 HALL OF RECORDS

Do not extend notes this side of this line

Notes: ANY ADDITIONS OR CHANGES ON THIS SHEET MUST BE MADE OR CIRCLED IN Red Ink. WITH DATE AND NAME OF PERSON MAKING CHANGE.

Notes Ck'd by	Survey of Centinela Blvd
Map No.	W. O. 7777 Tape No. St'd 66 ef.
Office Work	Surveyed by L D Moore
Checked	Notes Moore Date 5-14-34
Date	Indexed A. C. Johnson 5-21-34

F.B. 522 PG. 61

Note: ANY ADDITIONS OR CHANGES ON THIS SHEET MUST BE MADE OR CIRCLED IN Red Ink. WITH DATE AND NAME OF PERSON MAKING CHANGE.

SURVEY
OF
CENTINELA BLVD.
From
FLORENCE AVE
to
MANCHESTER AVE.
Job # 7777

May 14-15, 1934

A Moore
Atkins
Fenner
Lawson

For "X" Sections see L.B

RETURN TO
LOS ANGELES COUNTY SURVEYOR
700 HALL OF RECORDS
Do not extend notes this side of this line

FORM 247 10M 5-31

X

RETURN TO

LOS ANGELES COUNTY SURVEYOR

700 HALL OF RECORDS

Note: ANY ADDITIONS OR CHANGES ON THIS SHEET MUST BE MADE OR CIRCLED IN **Red Ink.** WITH DATE AND NAME OF PERSON MAKING CHANGE.

Do not extend notes this side of this line

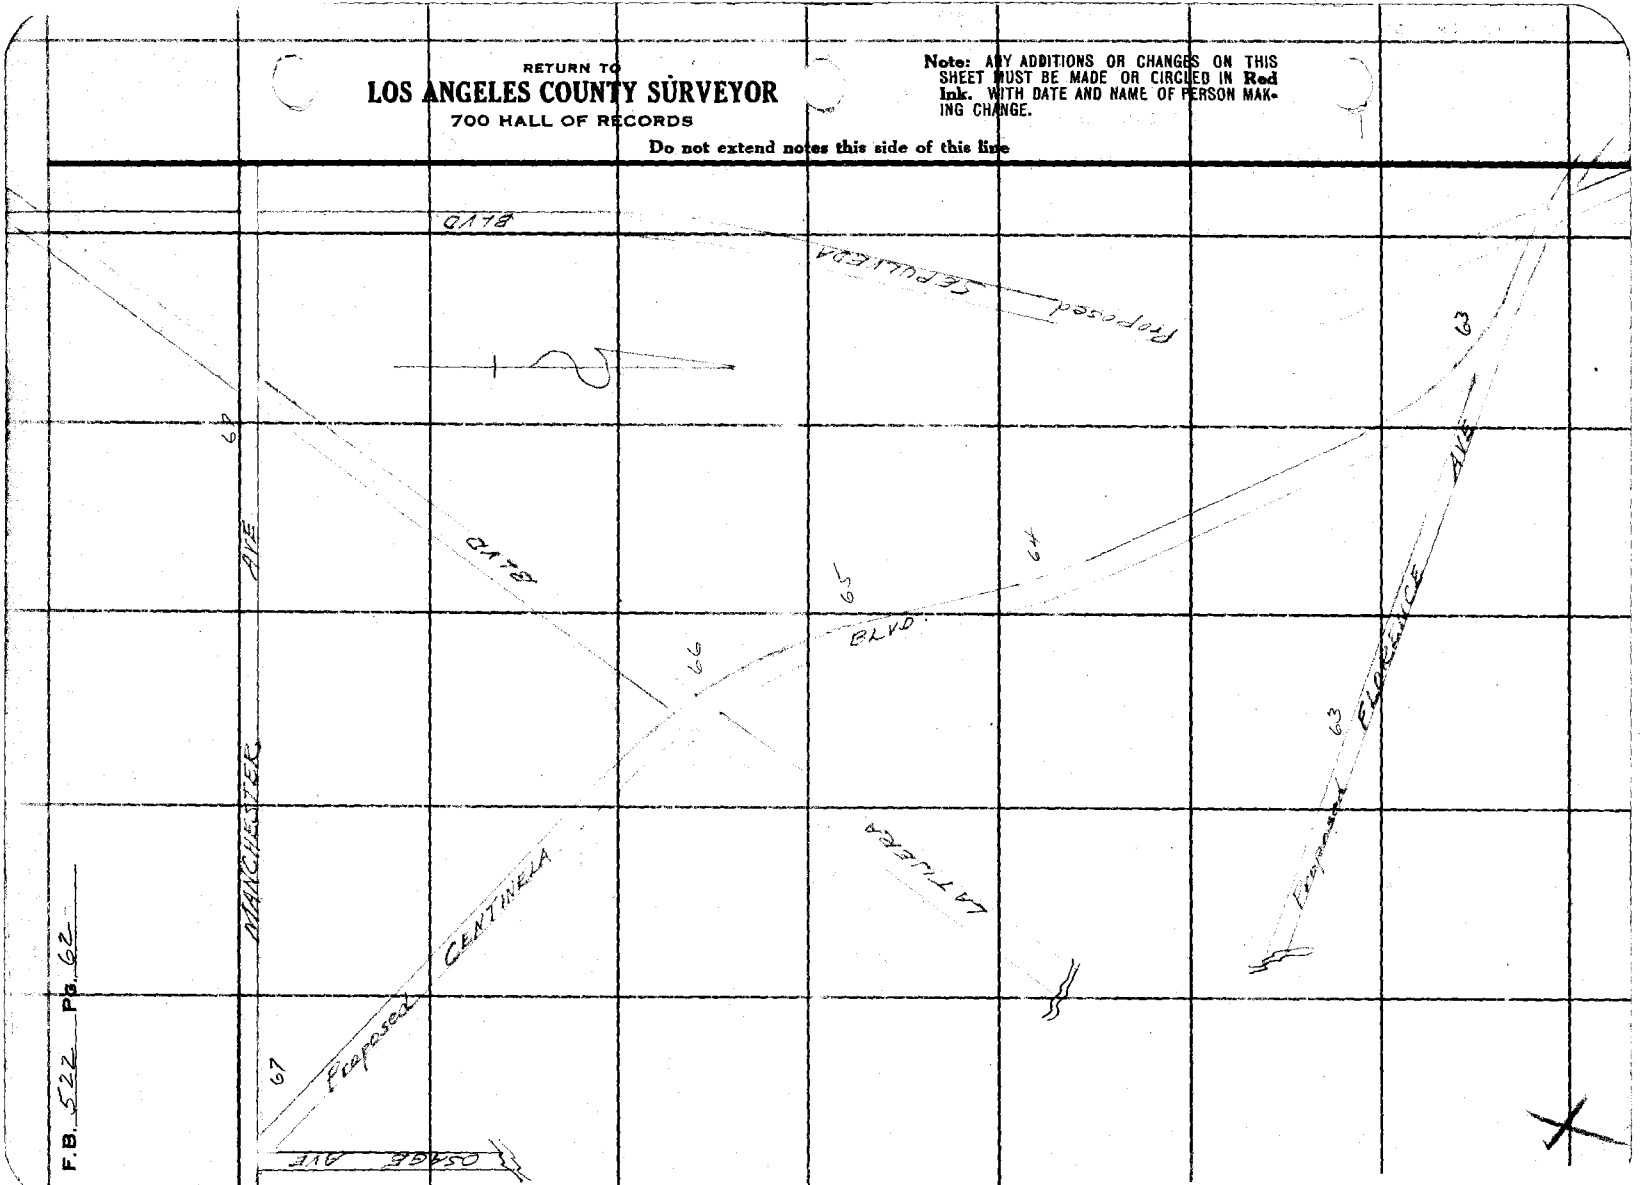

F.B. 522 Pg. 62

Notes Ck'd by Blackmer	Survey of Centinela Blvd.	F.B. 522 Pg. 63
Map No. B-1009	W. O. 7771 Tape No. St'd 68° °F.	
Office Work H.N. Bradstreet	Surveyed by L.D. Moore	
Checked Blackmer	Notes Metric Date 5-14-34	
Date June 1934	Indexed A. C. Johnson	

Notes: ANY ADDITIONS OR CHANGES ON THIS SHEET MUST BE MADE OR CIRCLED IN Red Ink, WITH DATE AND NAME OF PERSON MAKING CHANGE.

Hwy 3, D-3

RETURN TO
LOS ANGELES COUNTY SURVEYOR
700 HALL OF RECORDS

Do not extend notes this side of this line

FORM 247 10M 5-31

To Eastern Pg. 64

CENTINELA BLVD

N 42° 03' E

P.O.T
Fd 2x2
F.B. 522-20
F.B. 396-17

AVE

95.27

40

5+46.87 E.C.
Set 2x2
18" deep

280.46'

P.I.
Set 2x2
18" deep

148° 40' 00"

Δ = 31°-20'-00"
R = 1000'
T = 280.46'
L = 546.87'

FLORENCE

280.46

Proposed

(148° - 40' - 00"
234° - 40' - 00")

O+00 - P.C.
Fd 2x2 4"
18" deep

BLVD.

P.I.
Fd 2x2
18" deep

180.63

SEPULVEDA

Fd 2x2
18" deep

2.27

P.O.T - 179+11.90
Fd 2x2 4"
F.B. 522-20

.51

Proposed

Proposed

RETURN TO
LOS ANGELES COUNTY SURVEYOR
700 HALL OF RECORDS

Note: ANY ADDITIONS OR CHANGES ON THIS SHEET MUST BE MADE OR CIRCLED IN **Red Ink.** WITH DATE AND NAME OF PERSON MAKING CHANGE.

Do not extend notes this side of this line

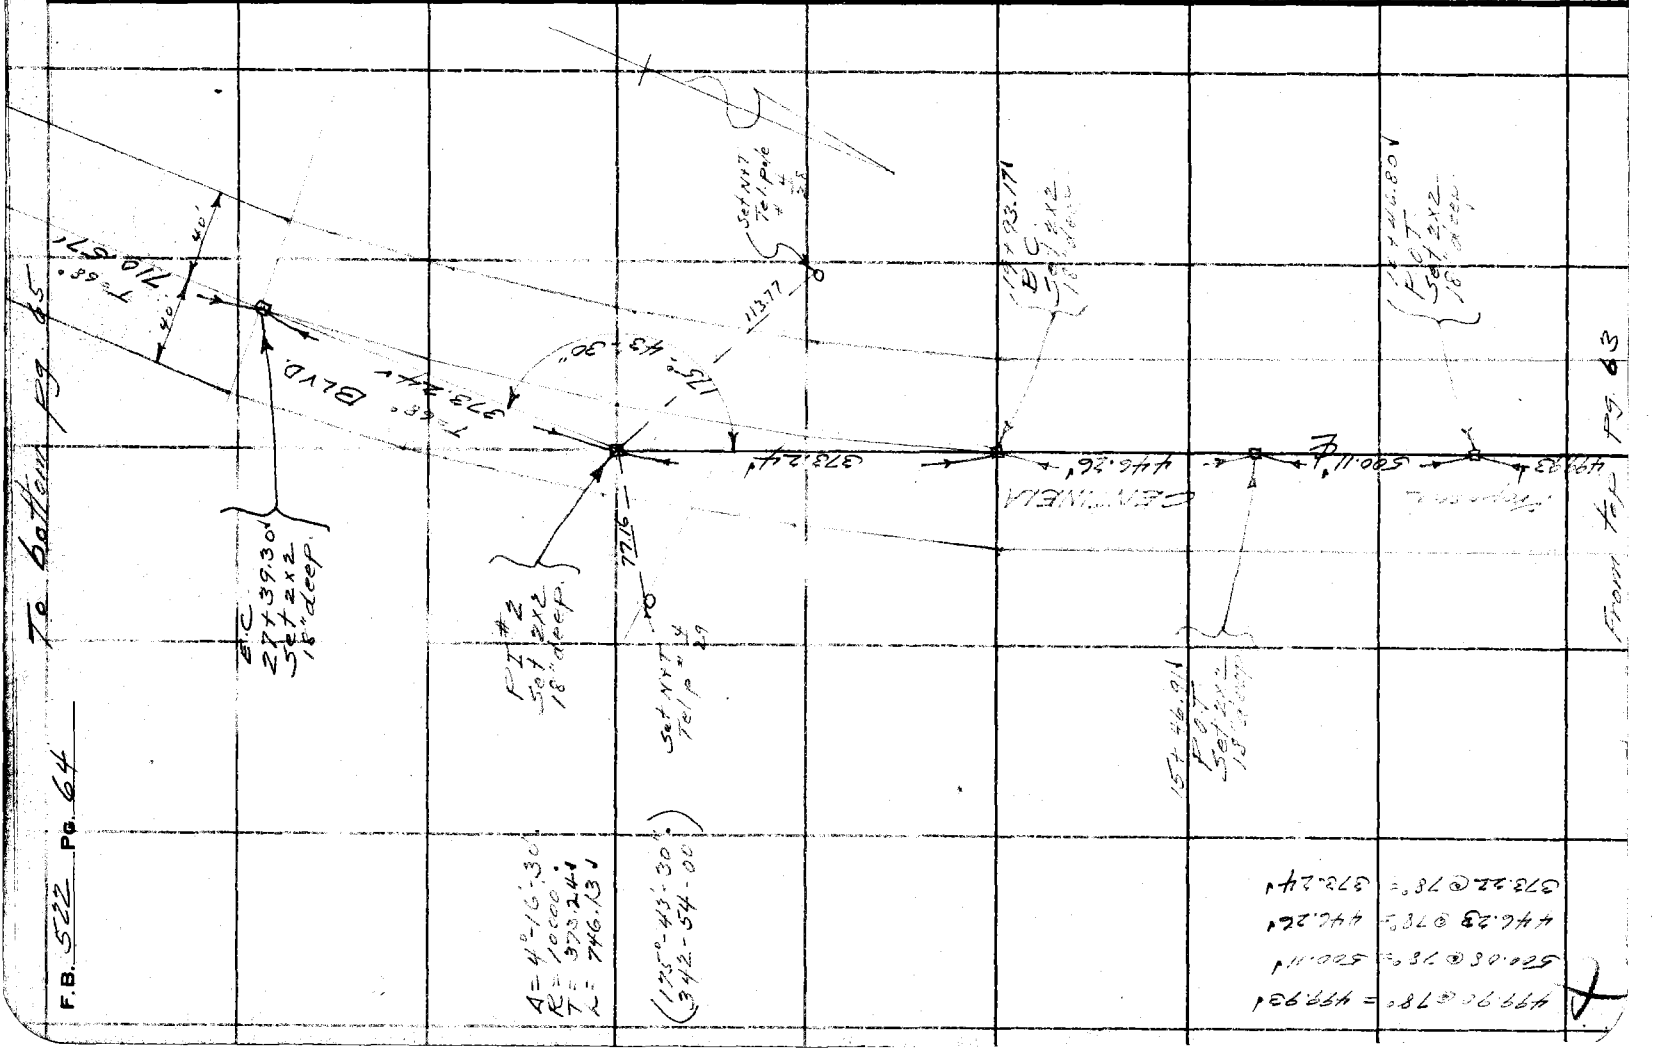
To Bottom Pg 65
From Top Pg 63
F.B. 5222 Pg. 64
BLVD.
CENTINELA
Set N.I.P. Tel. Pole
Set 2x2 18" deep
Set Nail & Tag
Set Nail & Tag
Set Nail & Tag

Notes Ck'd by Blackmer	Survey of Centinela Blvd.
Map No. B-1009	W. O. 2111 Tape No. St'd 66 °F.
Office Work H.N. Bradstreet	Surveyed by L. D. Moore
Checked Blackmer	Notes Date 5-15-34
Date June 1934	Indexed A. C. Johnson

F.B. 524 Pg. 65

To bottom Pg. 66.

199.71'
T=68°

P.O.S.T. #A
Set 2x2
18" deep

333.10'
T=68°

49+35.64
B.C.
Set 2x2
18" deep

BL. NO.

785.69'

40' 40'

41+49.95
P.O.T.
Set 2x2
18" deep

T=68°
700.08'
CENTINELA

34+49.87
P.O.T.
Set 2x2
18" deep

T=68°
710.57'
Proposed

From top Pg. 64

Note: ANY ADDITIONS OR CHANGES ON THIS SHEET MUST BE MADE OR CIRCLED IN Red Ink. WITH DATE AND NAME OF PERSON MAKING CHANGE.

Do not extend notes this side of this line

RETURN TO
LOS ANGELES COUNTY SURVEYOR
700 HALL OF RECORDS

FORM 247 10M 8-31

F.B. 522 Pg. 66

To bottom pg. 67

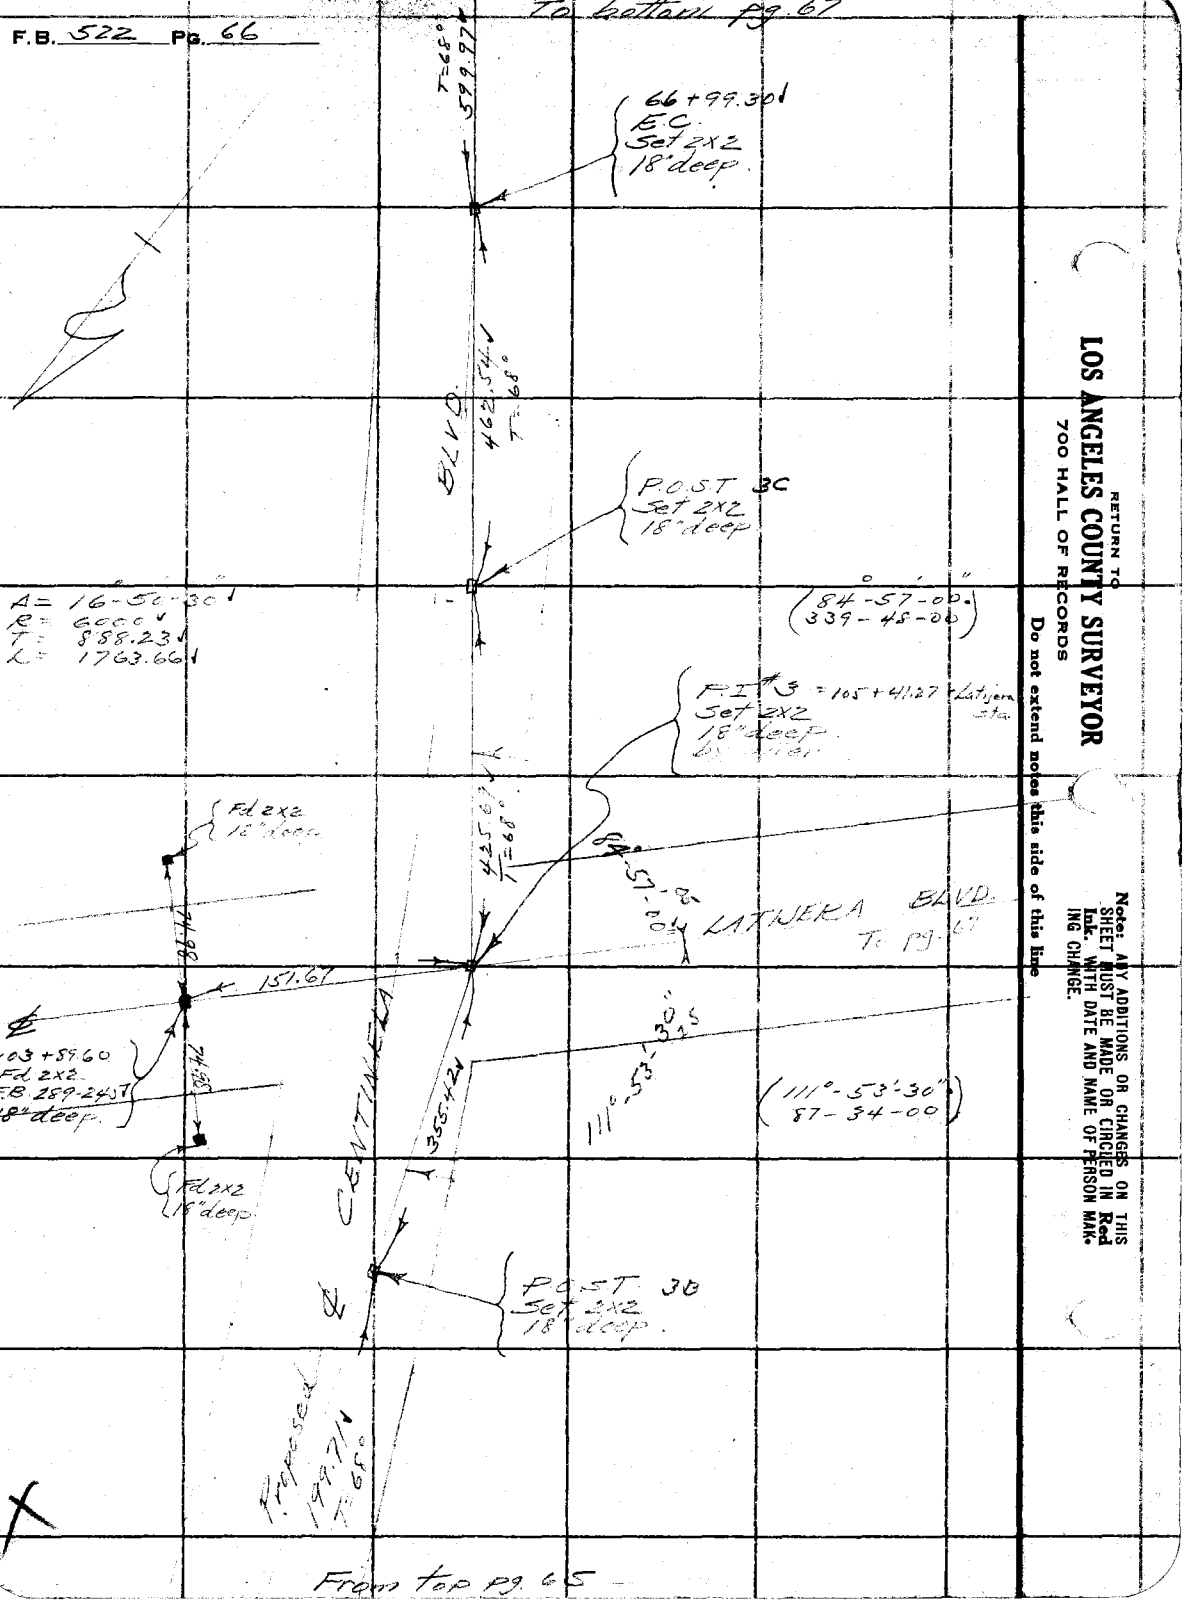

From top pg. 65

RETURN TO
LOS ANGELES COUNTY SURVEYOR
700 HALL OF RECORDS

Do not extend notes this side of this line

Note: ANY ADDITIONS OR CHANGES ON THIS SHEET MUST BE MADE OR CIRCLED IN Red Ink. WITH DATE AND NAME OF PERSON MAKING CHANGE.

Notes Ck'd by Blackmer	Survey of Centinela Blvd.
Map No. B-1009	W. O. 2777 Tape No. St'd 64 °F.
Office Work H.K. Bradstreet	Surveyed by L.D. Moore
Checked Blackmer	Notes None Date 5-15-34
Date June 1934	Indexed A. C. Johnson

F.B. 522 Pg. 67

Notes: ANY ADDITIONS OR CHANGES ON THIS SHEET MUST BE MADE OR CIRCLED IN Red Ink, WITH DATE AND NAME OF PERSON MAKING CHANGE.

Do not extend notes this side of this line

RETURN TO
LOS ANGELES COUNTY SURVEYOR
700 HALL OF RECORDS

FORM 247 10M 8-31

Per F.B. 523, D-9, M.M. S. 24, A-4

Per F.B. 251-701

BLVD.

Conc. Pave

10' 20' 20' 10'

Fd L+T — S Fd L+T

85.50 58.8 64.00

86+06.35
Fd L+T
F.B. 289-246
F.B. 251-131, 70

OSAGE AVE.
per F.B. 251-131, 701

T=68° 10'15"

69.64 69.64 190

(48°-20'-15")
193-21-00

BLVD.

Fd L+T 21.0 9.0 19.0 21.0 S Fd L+T

28.0 28.0

48°-20'-15"

CENTINELA

78+99.20
P.O.T.
Set 2x2
18" deep

599.93
T=68°

72+99.27
P.O.T.
Set 2x2
18" deep

Prop. Conc. Pave

599.93

Conc. Pave

Conc. Pave

LATIMER AVE.

Fd L+T

Fd 2x2
F.B. 289-246

Fd L+T

From Fol. 99/66

F.B. 522 Pg. 68

Location of Improvements

22+70	–	55' - R	– Tel p
23+40	–	80' - L	– Tel p
57+45	–	82' - L	– PP
67+70	–	46.4 - R	– PP
68+17	–	2.8 - R	– Tel p
68+75	–	65.2 L	– PP
85+47	–	3.4 - R	– PP
85+52	–	0.8 - R	– Tel p

RETURN TO
LOS ANGELES COUNTY SURVEYOR
700 HALL OF RECORDS

Do not extend notes this side of this line

Note: ANY ADDITIONS OR CHANGES ON THIS SHEET MUST BE MADE OR CIRCLED IN Red Ink. WITH DATE AND NAME OF PERSON MAKING CHANGE.

Notes Ck'd by McPherson	Survey of Century Blvd.	F.B. S22	Pg. 91
Map No. B-1045	W. O. 8080 Tape No 27 St'd 24		
Office Work J. D. Price	Surveyed by Pasadena		
Checked Drew	Notes	Date 7-12-35	
Date June 1935	Indexed A. C. Johnson 4-3-1895		

Normandie Ave

Cont. bottom next page.

(95)

CENTURY BOULEVARD SURVEY

From Vermont Ave to Western Ave.

Index to Notes

Blvd

Bud long

From Vermont Ave to Vermont Ave pages 103-112

(94)

To Budlong Ave

J.N. 8080

Ave

E. A. Rosecrans
H. S. Johnson
J. A. Witless
C. R. Lawson
W. F. Harris

party

Century

C.S.B-1045

C-3-35

Vermont Ave.

(93)

RETURN TO
LOS ANGELES COUNTY SURVEYOR
700 HALL OF RECORDS

Note: ANY ADDITIONS OR CHANGES ON THIS SHEET MUST BE MADE OR CIRCLED IN Red Ink WITH DATE AND NAME OF PERSON MAKING CHANGE.

Do not extend notes this side of this line

FORM 247 BM 2-44

F.B. 522 PG. 92

Index to notes

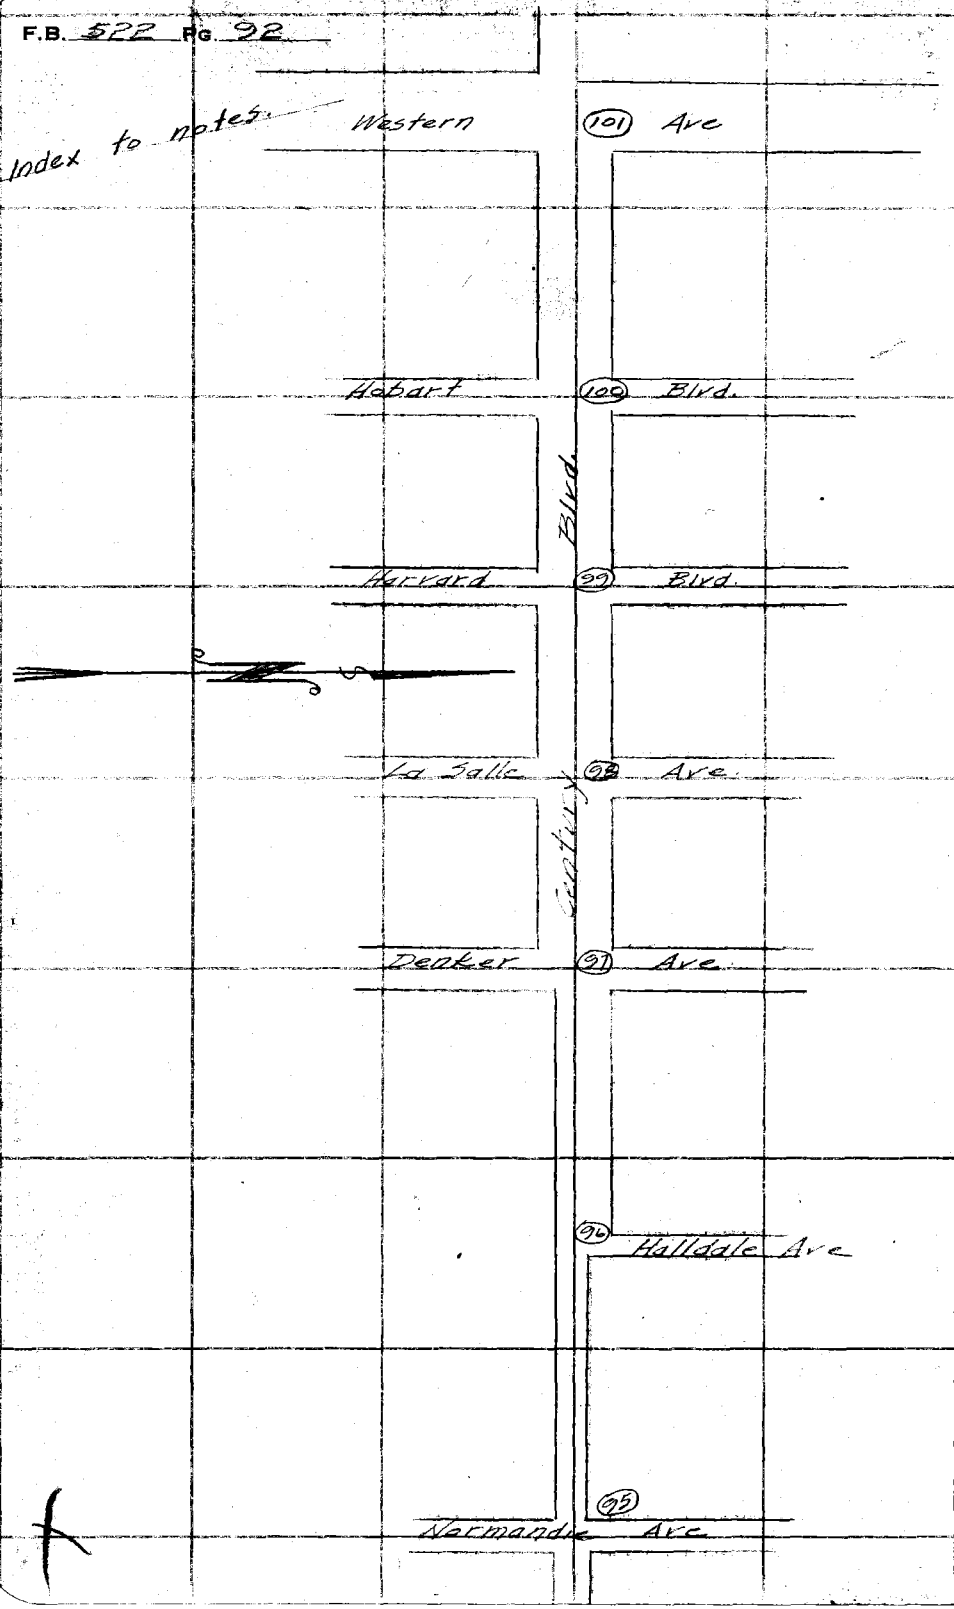

RETURN TO
LOS ANGELES COUNTY SURVEYOR
700 HALL OF RECORDS

Do not extend notes this side of this line

Note: ANY ADDITIONS OR CHANGES ON THIS SHEET MUST BE MADE OR CIRCLED IN Red Ink WITH DATE AND NAME OF PERSON MAKING CHANGE.

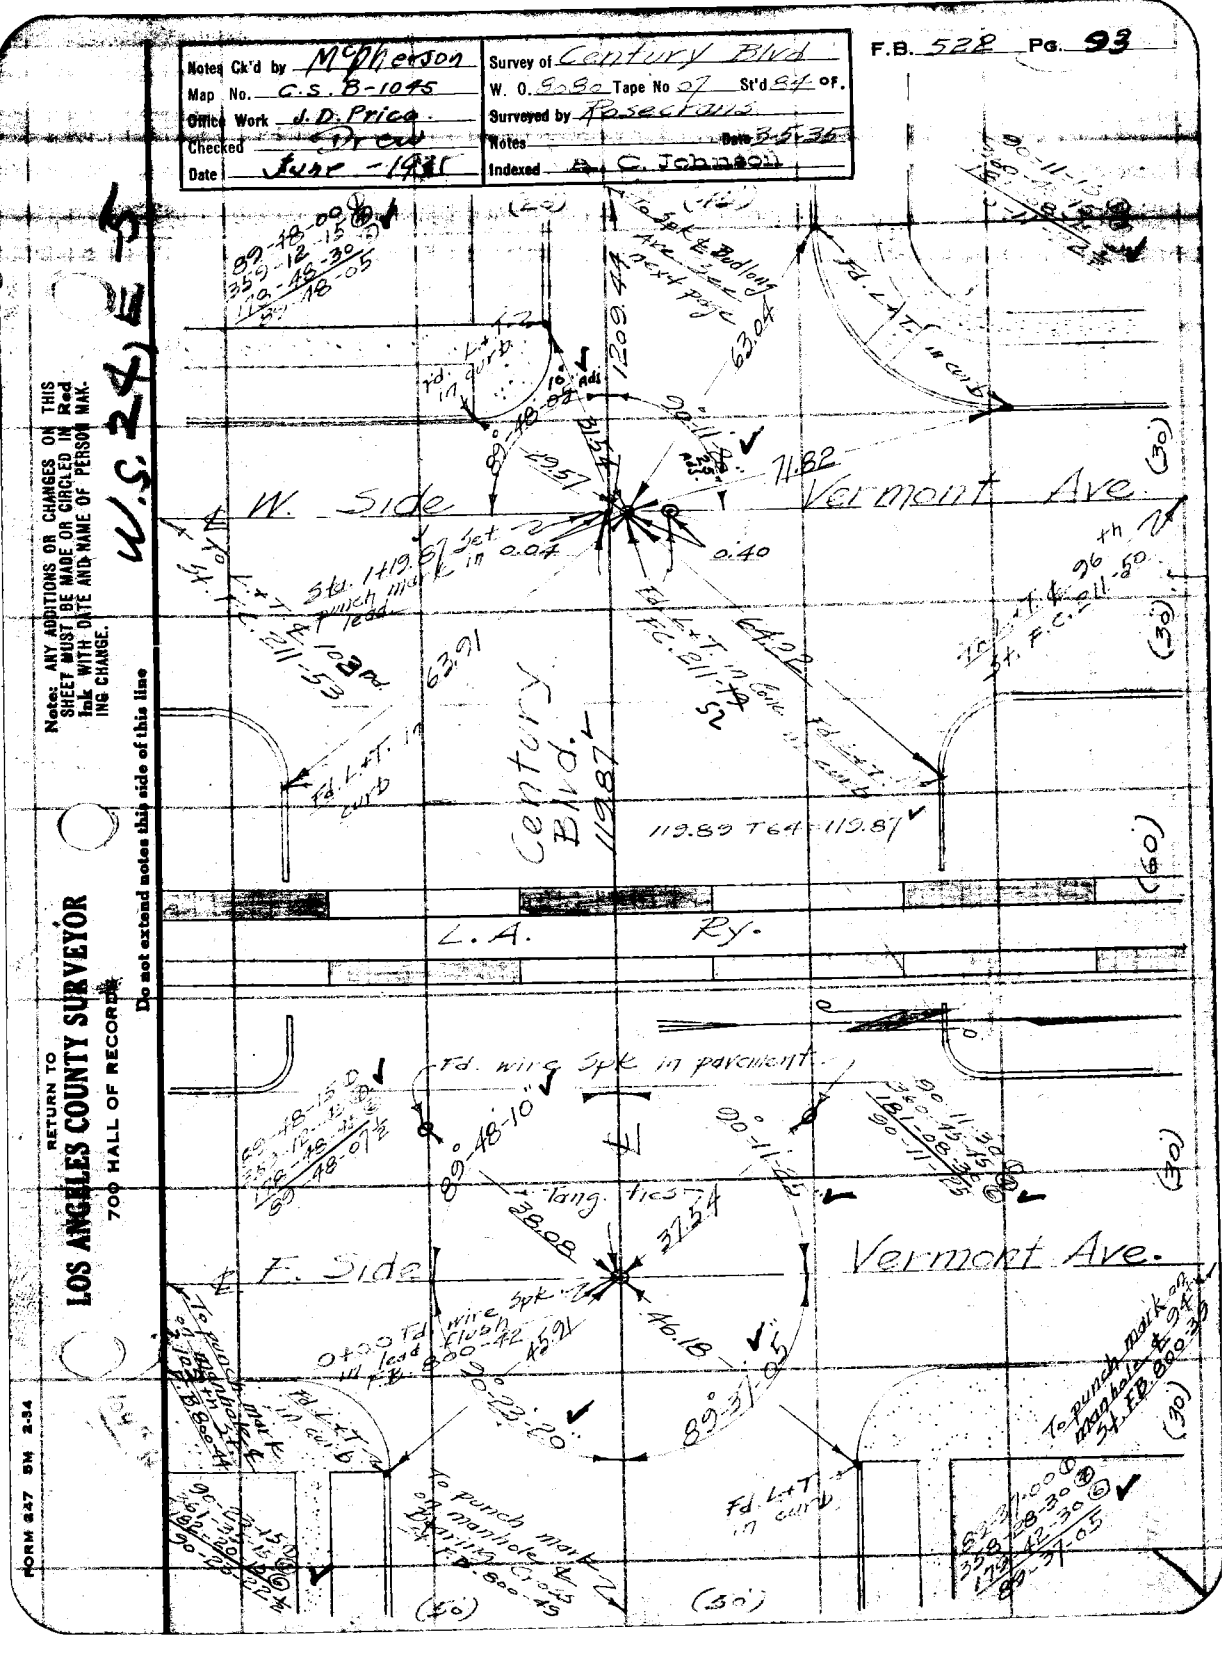
Notes Ck'd by McPherson
Map No. C.S. B-1045
Office Work J.D. Price
Checked
Date June - 1931
Survey of Century Blvd
W. O. 9.9c Tape No 07 St'd 64 of.
Surveyed by Rosecrans
Notes Date 8-5-36
Indexed A. C. Johnson
F.B. 522 Pg. 93
U.S. 24
W. Side
Vermont Ave.
E. Side
Vermont Ave.
Century Blvd.
119.87
L.A. Ry.
Set 2 in o.04
o.40
Sta. 1419.87 punch mark in lead
Fd. L+T. in curb
Fd. L+T. in Conc. curb
Fd. wire Spk in pavement
Fd. wire Spk flush
Fd. L+T. in curb
To punch mark on manhole
Fd. L+T. in curb
To punch mark on manhole
Fd. L+T. in curb
To Spk & Budlong Ave. next page
Fd. L+T. in curb
Fd. L+T. in curb
St. F.C.
St. F.C.
89-48-00
355-12-30
110-46-05
89°-48-10"
90°-11-45"
89°-31-00"
90°-11-30"
20°-22-20
63.04
63.91
71.82
46.18
38.08
31.54
(60)
(30)
(40)
(50)
RETURN TO
LOS ANGELES COUNTY SURVEYOR
700 HALL OF RECORDS
Do not extend notes this side of this line
Notes: ANY ADDITIONS OR CHANGES ON THIS SHEET MUST BE MADE OR CIRCLED IN Red Ink WITH DATE AND NAME OF PERSON MAKING CHANGE.
FORM 627 5M 2-34

RETURN TO
LOS ANGELES COUNTY SURVEYOR
700 HALL OF RECORDS

Note: ANY ADDITIONS OR CHANGES ON THIS SHEET MUST BE MADE OR CIRCLED IN Red Ink WITH DATE AND NAME OF PERSON MAKING CHANGE.

W.S. 24, D-5, WS 26, A-1

Do not extend notes this side of this line.

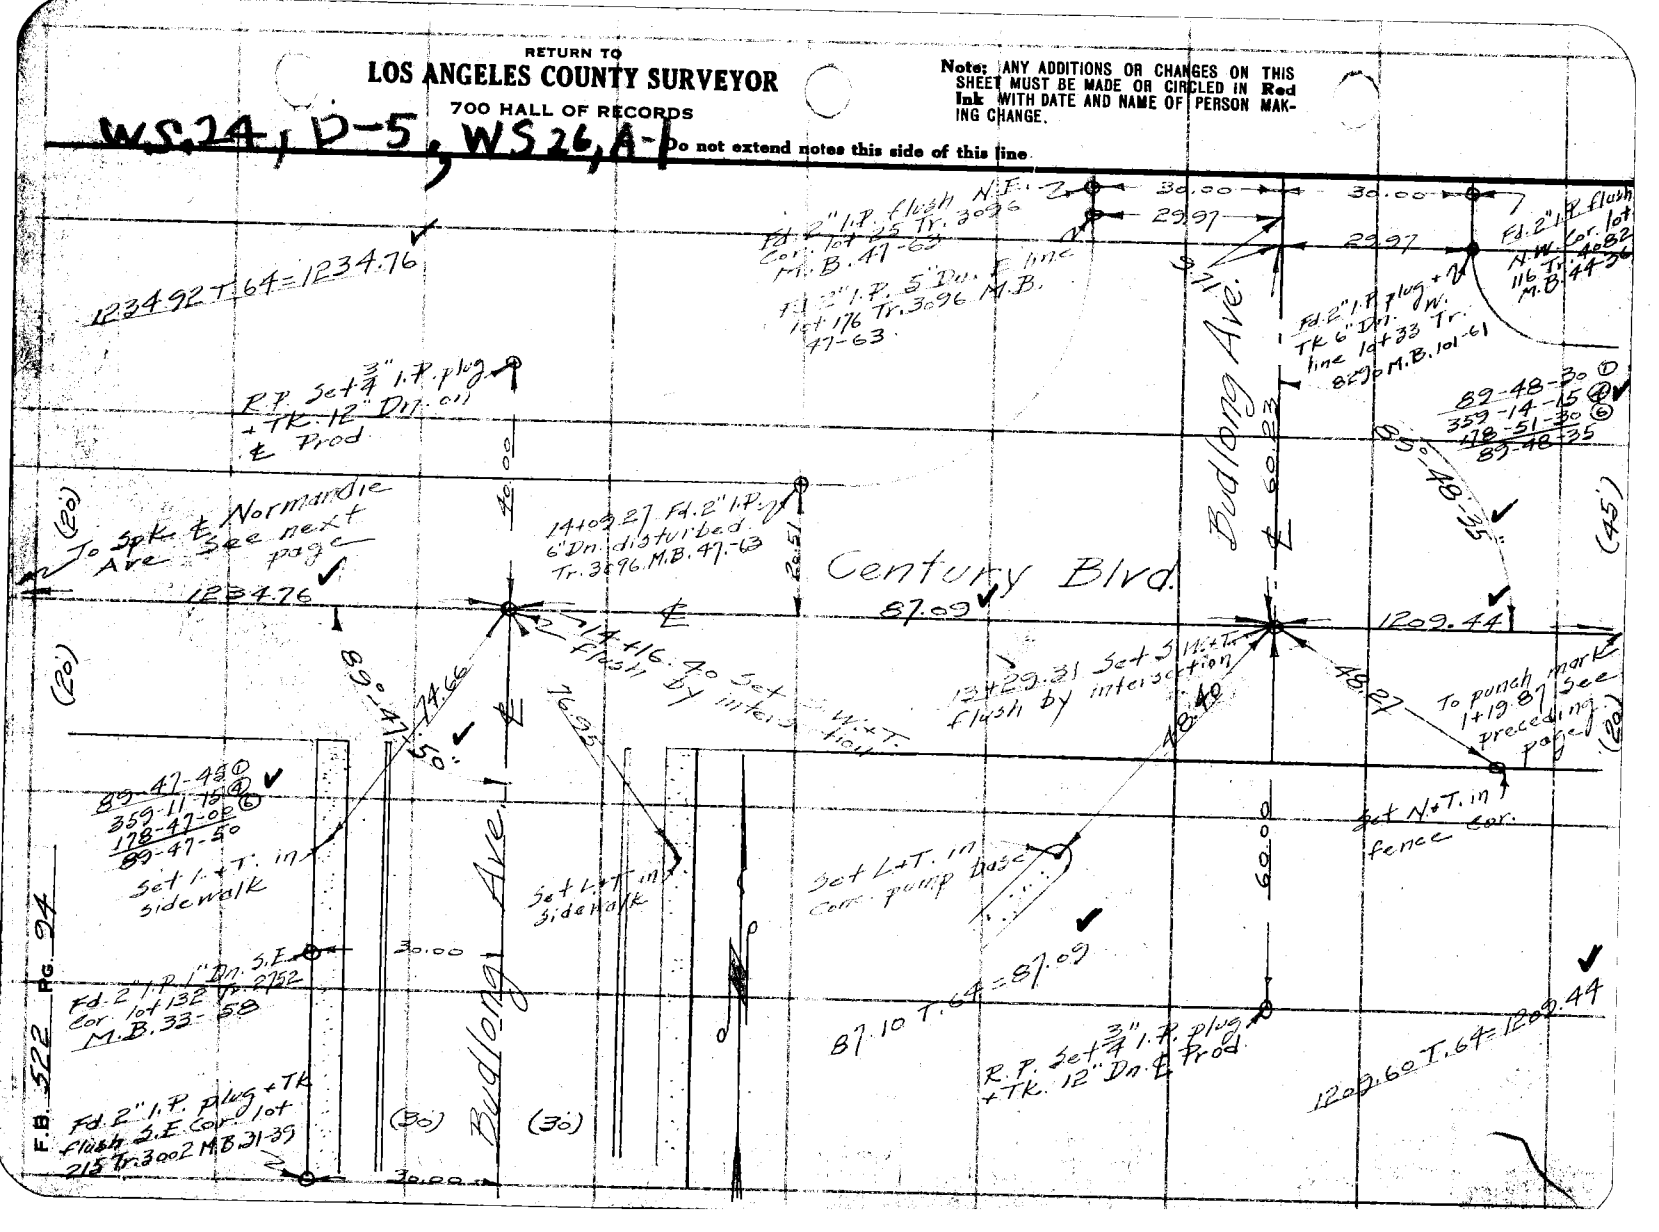

Notes Ck'd by	McPherson	Survey of	Century Blvd.
Map No.	C.S.B.-1045.	W. O.	2650 Tape No 07 St'd 24°
Office Work	J.D. Price.	Surveyed by	Rosecrans
Checked	Drew.	Notes	Date 3-6-35
Date	June 1935	Indexed	C. Johnson

F.B. 522 Pg. 95

Note: ANY ADDITIONS OR CHANGES ON THIS SHEET MUST BE MADE OR CIRCLED IN Red Ink WITH DATE AND NAME OF PERSON MAKING CHANGE.

Do not extend notes this side of this line

RETURN TO
LOS ANGELES COUNTY SURVEYOR
700 HALL OF RECORDS

FORM 247 5M 2-34

Set punch mark on manhole by ties ± 97th St. F.B. 131-28

Ave.

Century Blvd.

Normandie

Set L.+T. in walk

Set punch mark on manhole by ties ± 102nd St. F.B. 131-52

F.B. 522 Pg. 96

RETURN TO
LOS ANGELES COUNTY SURVEYOR
700 HALL OF RECORDS

Do not extend notes this side of this line

Notes: ANY ADDITIONS OR CHANGES ON THIS SHEET MUST BE MADE OR CIRCLED IN Red Ink WITH DATE AND NAME OF PERSON MAKING CHANGE.

WS 24, 045, WS 24 AH

Fd 2" I.P. plug + nail
S. Dm. N.W. Cor. Lot 45
Tr. 4882 M.B. 52-54

Halldale Ave.

(30)

33+48.29 Fd 2" I.P. plug + TK. Tr. 4882 M.B. 101-57

33+50.21 Set L+T. in walk

Set L+T on line of Concrete platform

89°-45'-10"

(45) To 22nd & Denker Ave. See next page

50.00

50.00

Fd 2" I.P. flush S.W. Cor. Lot 44 Tr. 4882 M.B. 52-54

21.97

661.86

10.03

662.37

(20) Century

(10) Blvd.

33+13.53 Set S.W. + T. in intersection by

Spk. & Normandie Ave. TP See preceding page

661.96 T.60 = 661.86

662.41 T.60 = 662.31

50.00

K.P. Set ¾" I.P. plug + TK. 12 Dr. E Prod.

Notes Ck'd by	McPherson	Survey of	Century Blvd.
Map No.	C. S. B-1045	W. O.	8000 Tape No 07 St'd E.I. OF.
Office Work	J. D. Price	Surveyed by	Rosecrans
Checked	Stroud	Notes	Date 3-13-35
Date	June - 1935	Indexed	A. C. Johnson

F.B. 522 PG. 97

Note: ANY ADDITIONS OR CHANGES OF THIS SHEET MUST BE MADE OR CIRCLED IN Red Ink WITH DATE AND NAME OF PERSON MAKING CHANGE.

M.S. 24, P-5, W.S. 25, A-1

Do not extend notes this side

RETURN TO
LOS ANGELES COUNTY SURVEYOR
700 HALL OF RECORDS

FORM 247 SM 2-34

Ed. 2x2-6" Dm. & 99.12 and & Denker Ave F.B. 800-14

Ave.

(30) (30)

89-55-15 ①
359-41-00 ④
179-31-45 ⑥
89-55-15 ✓

Ed. L.T. in sidewalk

122.46

89°55'20"

Ed. L.T. in curb

(45)

To punch mark on manhole & La Salle Ave See next page

54.63

Ed. L.T. in curb 2x2-6" Dm. & 80.26 F.B. 800-14

Century

4.87

5.26

661.86

Blvd.

(45)

(20)

Ed. L.T. in curb

54.01

Ed. L.T. in curb

To Spk 33 & 13.53 at ✓ Halldale Ave. See preceding page

90°19'45"

(45)

(30) (30)

Denker

90-19-45 ①
361-19-00 ④ ✓
181-58-30 ⑥
90-19-45

Set 10" mail & 193rd and & Denker by ties F.B. 800-26

F.B. 522 PG. 38

W.S. 24 D-5

RETURN TO
LOS ANGELES COUNTY SURVEYOR
700 HALL OF RECORDS

Do not extend notes this side of this line

Note: ANY ADDITIONS OR CHANGES ON THIS SHEET MUST BE MADE OR CIRCLED IN Red Ink WITH DATE AND NAME OF PERSON MAKING CHANGE.

Fd punch mark on manhole ℄ La Salle Ave. and ℄ 98th St. F.B. 800-13

Fd 2x2"-6' Dir. ℄ La Salle Ave and ℄ Alley F.B. 800-13 0.02 W. of line

155.04 T.68 = 155.02

155.02

La Salle Ave.

(30') (30')

69-48-15
360-12-00
110-48-15½

89°-48-15"

To punch mark on manhole ℄ Harvard See next page

Fd L+T. in curb

Int. set punch mark 23+95.22

54.50

Set 4 punch marks on rim of manhole

54.12

(45') Fd. Spk. in lead in curb

℄ Century Blvd.

325.06

325.36

54.36

0.02

54.53

Fd. Pk. on man hole per F.B. 800-31

90°-19-40

To 2x2-3948.26 ℄ Denker See preceding page

(45')

Fd L+T. in curb

Fd L+T. in curb

325.40 T.64 = 325.36

90-19-45 ①
90-19-40 ④
361-58-00 ②
181-38-00
90-19-40

Fd punch mark on manhole ℄ La Salle Ave and 4.10 3rd St. F.B. 800-33

Notes Ck'd by	McPherson	Survey of	Century Blvd.
Map No.	C.S. B-1045	W. O.	C.S.	Tape No.	1	St'd	E 1	OF.
Office Work	J.D. Price.	Surveyed by	Rosecrans
Checked	Drew	Notes		Date	3-13-36
Date	June 1931	Indexed	A. C. Johnson

F.B. 522 Pg. 99

W.S. 24, D-5

Note: ANY ADDITIONS OR CHANGES ON THIS SHEET MUST BE MADE OR CIRCLED IN Red INK WITH DATE AND NAME OF PERSON MAKING CHANGE.

RETURN TO
LOS ANGELES COUNTY SURVEYOR
700 HALL OF RECORDS

Do not extend notes this side of this line

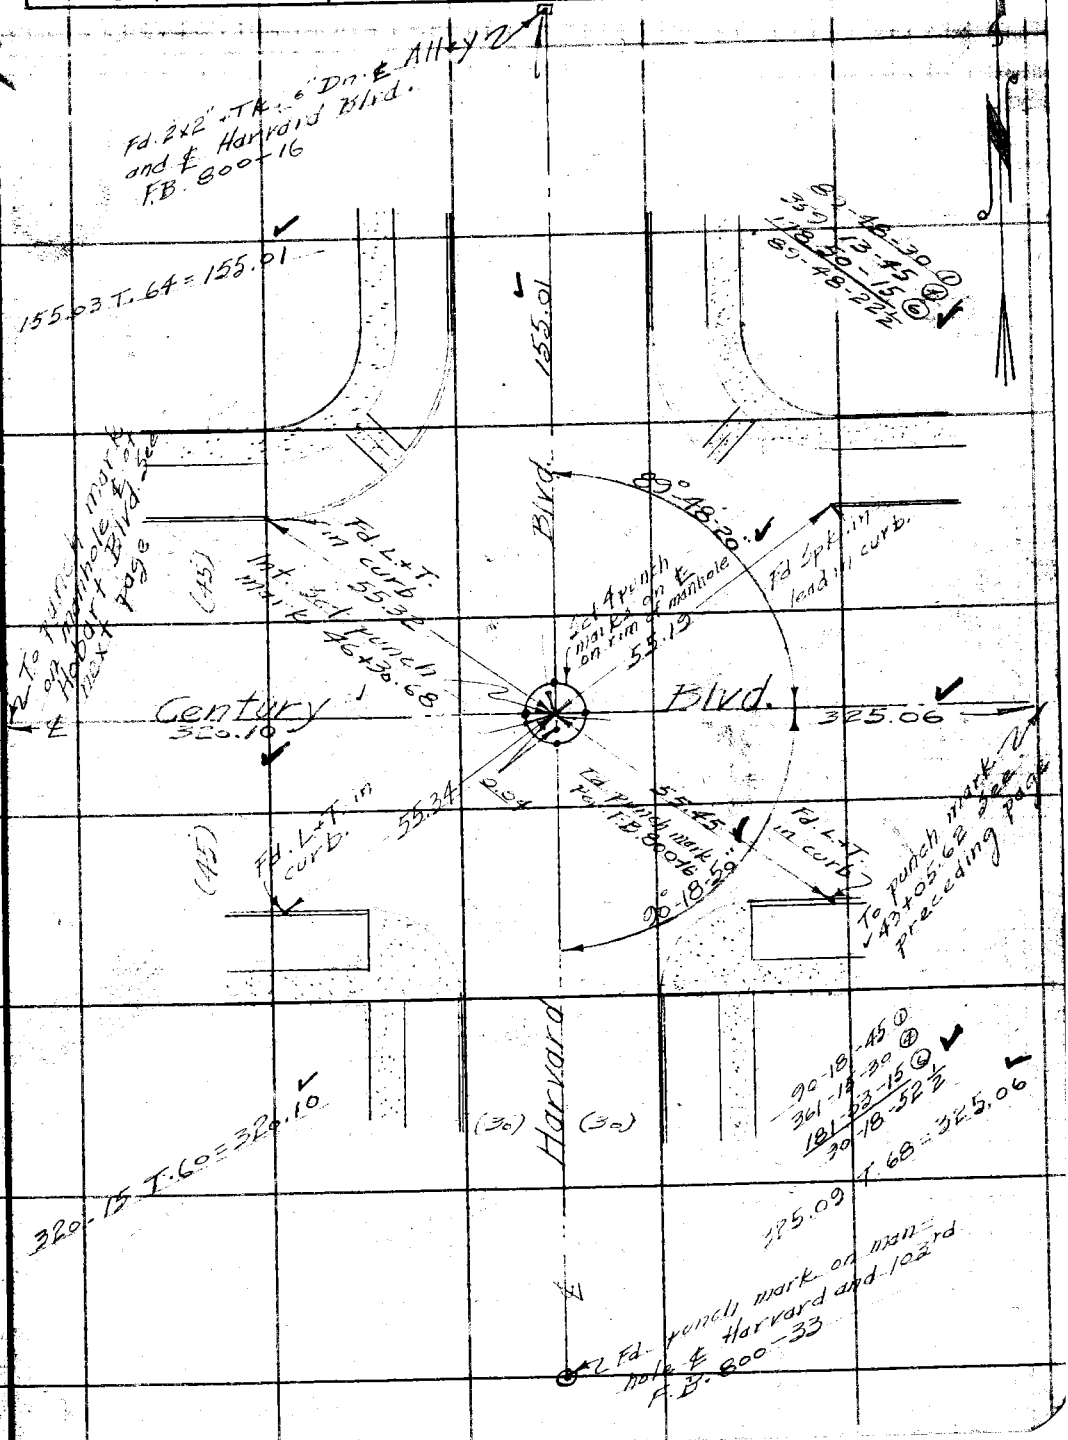

F.B. 522 Pg. 100

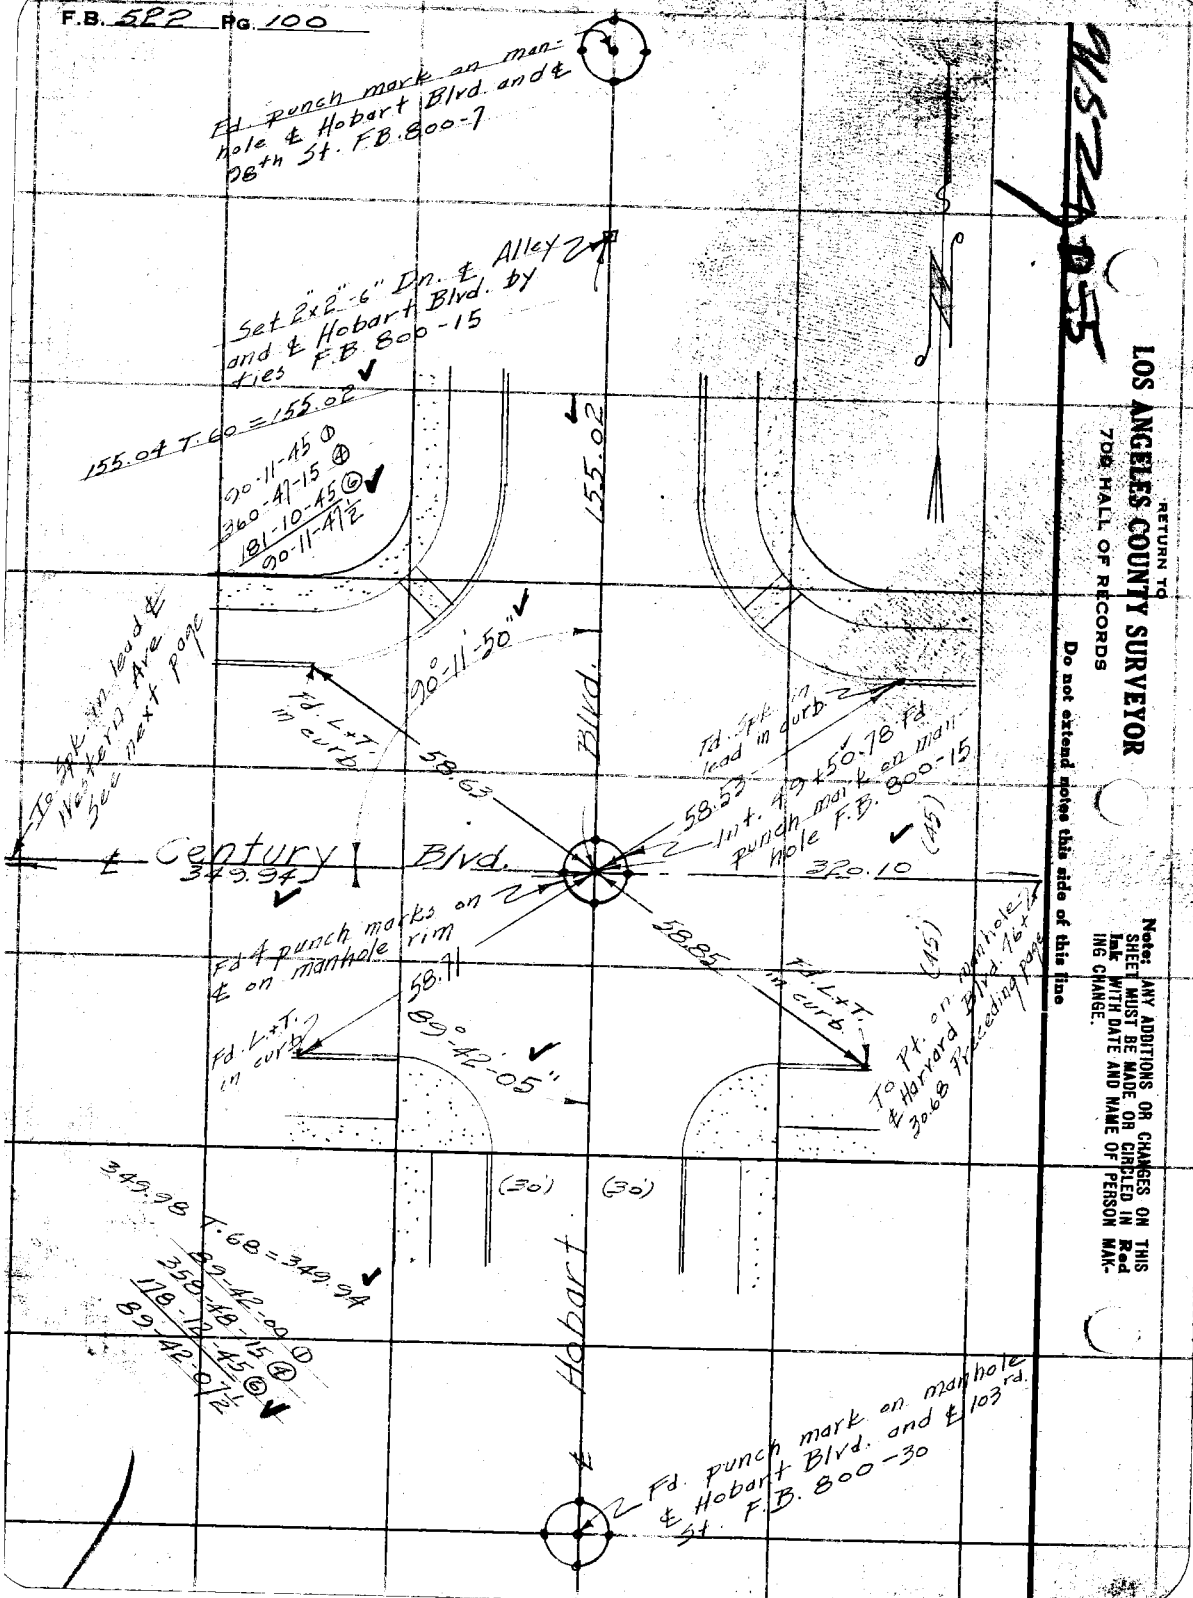

RETURN TO
LOS ANGELES COUNTY SURVEYOR
7DB HALL OF RECORDS

Do not extend notes this side of this line

Note: ANY ADDITIONS OR CHANGES ON THIS SHEET MUST BE MADE OR CIRCLED IN Red Ink WITH DATE AND NAME OF PERSON MAKING CHANGE.

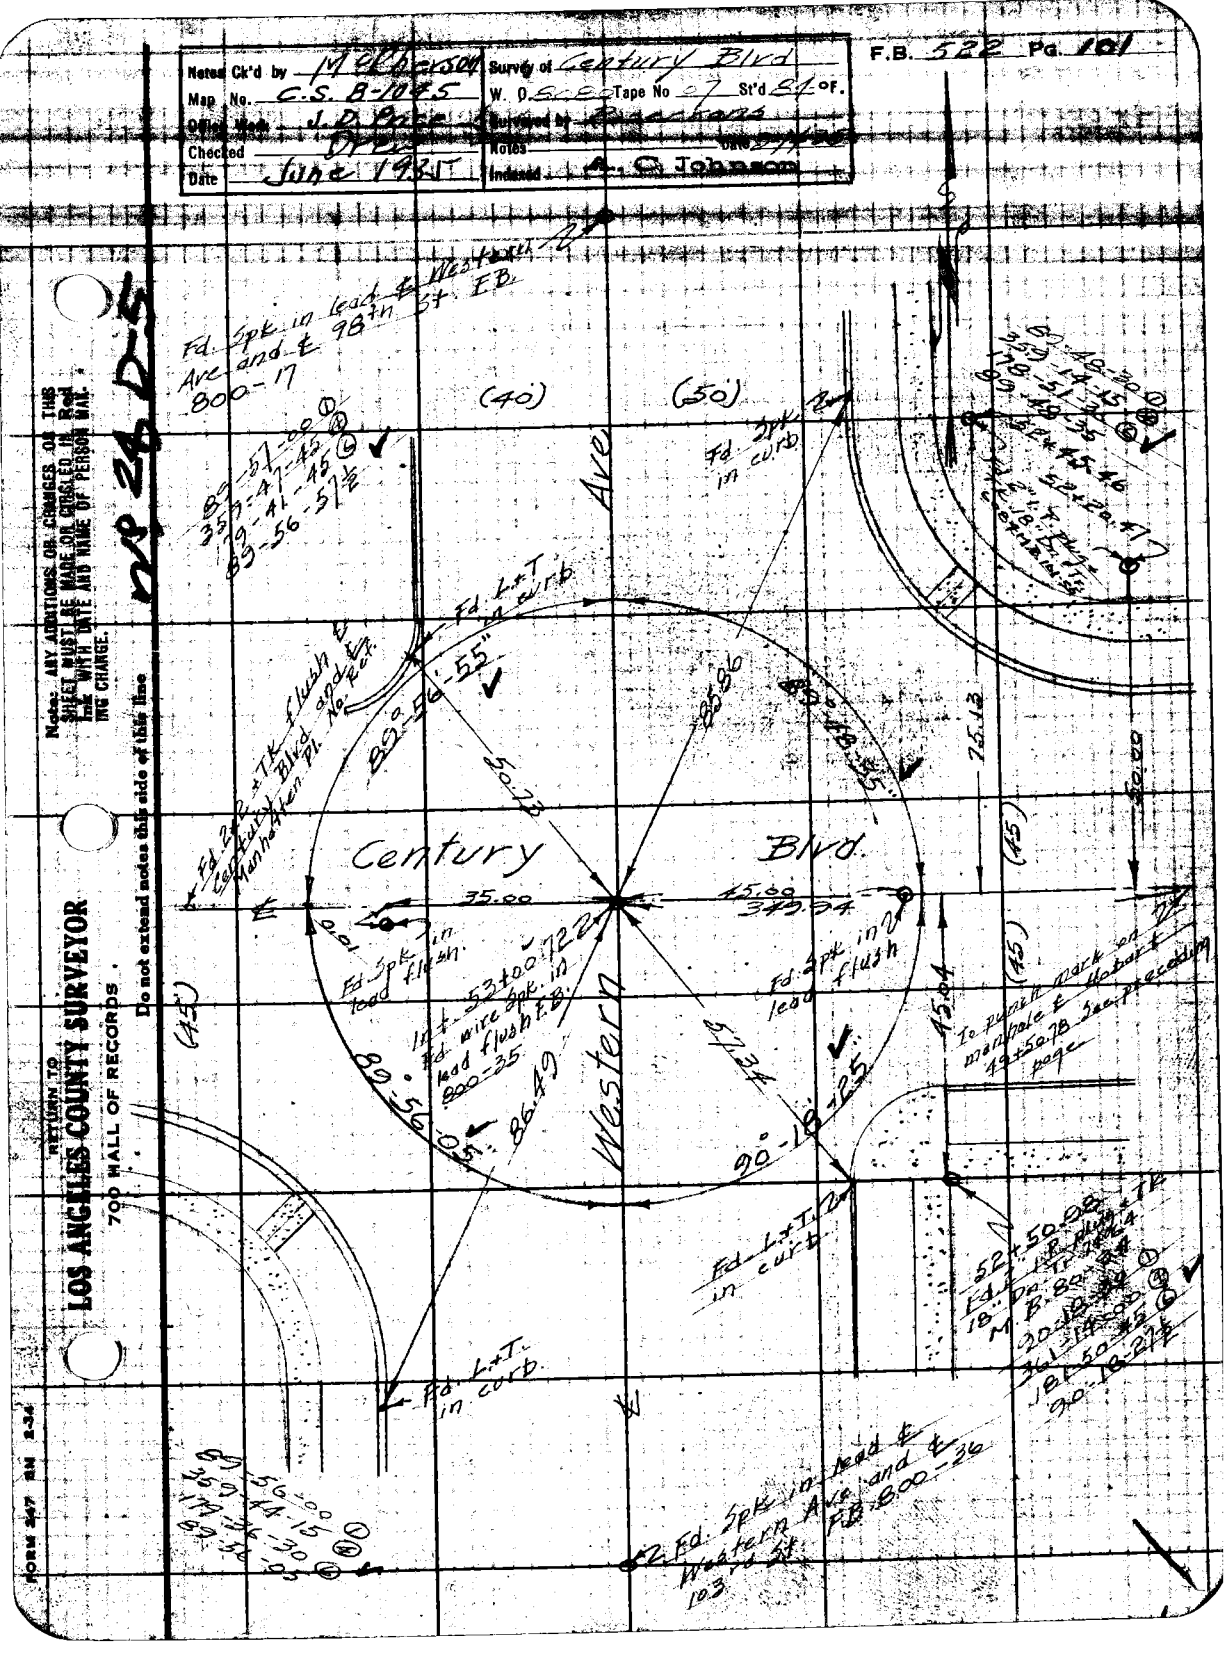
Noted Ck'd by McPherson
Map No. C.S. B-1045
Office Work J.D. Bates
Checked
Survey of Century Blvd
W. O. See Tape No 27 St'd 54 OF.
Surveyed by Meadows
Notes
Indexed A. G. Johnson
F.B. 522 Pg. 101
Note: ANY ADDITIONS OR CHANGES OF THIS SHEET MUST BE MADE OR CODED IN RED INK WITH DATE AND NAME OF PERSON MAK-ING CHANGE.
Do not extend notes this side of this line
RETURN TO
LOS ANGELES COUNTY SURVEYOR
700 HALL OF RECORDS
FORM 247 RM 2-54
Fd. Spk. in lead & West 98th St. EB.
Ave. and &
800-17
(40)
(50')
Fd. Spk. in curb
Ave
Fd. L & T. in curb
Century Blvd.
Western
35.00
45.00
345.94
50.73
75.13
(45)
Fd. Spk. in lead flush
Fd. wire spk. in lead flush E.B.
800-35
Fd. L & T. in curb
Fd. L & T. in curb
Fd. Spk. in lead & Western Ave. and & 103rd St. FB 800-36

RETURN TO

LOS ANGELES COUNTY SURVEYOR

700 HALL OF RECORDS

Note: ANY ADDITIONS OR CHANGES ON THIS SHEET MUST BE MADE OR CIRCLED IN **Red Ink** WITH DATE AND NAME OF PERSON MAKING CHANGE.

Do not extend notes this side of this line

F.B. 522 Pg. 102

Notes Ck'd by	McPherson	Survey of	Century Blvd
Map No.	C.S.B-1045	W. O.	3080 Tape No 07 St'd 84 of.
Office Work	D. Price	Surveyed by	Rose Evans
Checked	Drew	Notes	Date 3-8-35
Date	June 1935	Indexed	G. Co. Johnson

F.B. 522 Pg. 103

Note: ANY ADDITIONS OR CHANGES ON THIS SHEET MUST BE MADE OR CIRCLED IN Red Ink WITH DATE AND NAME OF PERSON MAKING CHANGE.

Do not extend notes this side of this line

RETURN TO
LOS ANGELES COUNTY SURVEYOR
700 HALL OF RECORDS

FORM 247 BM 2-34

Conc. catch basin
Conc. bottom 1+26.4
11 ex. page
P. pole 1+69.6
Conc. catch basin
Conc. walk
6" curb
1+35.0
Punch mark 1+19.87
See Fg. 93
Conc. pavement
Century Blvd
W. Roadway
Vermont Ave.
0+94.9 edge of Conc.
0+90.2
60.25
6" curb
0+79.5
50.15
0+67.0
50.00
L. A. Ry track
gauge 0+60.72
0+49.88 gauge
L. A. Ry. track
0+95.7 gauge
Conc. walk
0+42.25
0+38.3
50.0
6" curb
0+35.0
53.3
E. Roadway
Vermont Ave
Rock + Oil Surf.
Century
Spk in lead 0+00
See Fg. 93
100
8" iron valve
0-09.8
28.6
0-14.7
12.25
0-11.8-22
manhole
35.10
0-29.9
Conc. walk
9.5
5.0
0.5
curb Conc.
35.00
W. edge of Conc.
35.05
0-30.45
pavement
curb
35.00
1+93.3
5.0
4.0
Conc. catch basin
1+75.4
Conc. Walk
1+55.51
45.8
1+30.27
38.9
2.43
1+19.8-8" iron valve
6.0
9.0
0.5
1+34.8
1+26.8
2.2 manhole
100
58.4
0+89.8
6" curb
4.0
Conc. walk
59.00
0+79.55
47.90
17.80
0+64.22 guage 0+66.15
48.4
0+43.15
0+37.7
6" curb
48.35
51.55
0+34.8
36.1
2.4 manhole
0+23.3
2.2 manhole
0+00
100
15.1
96
0-11.2
6 iron valve
5a.38
0-15.25
15.5
35.0

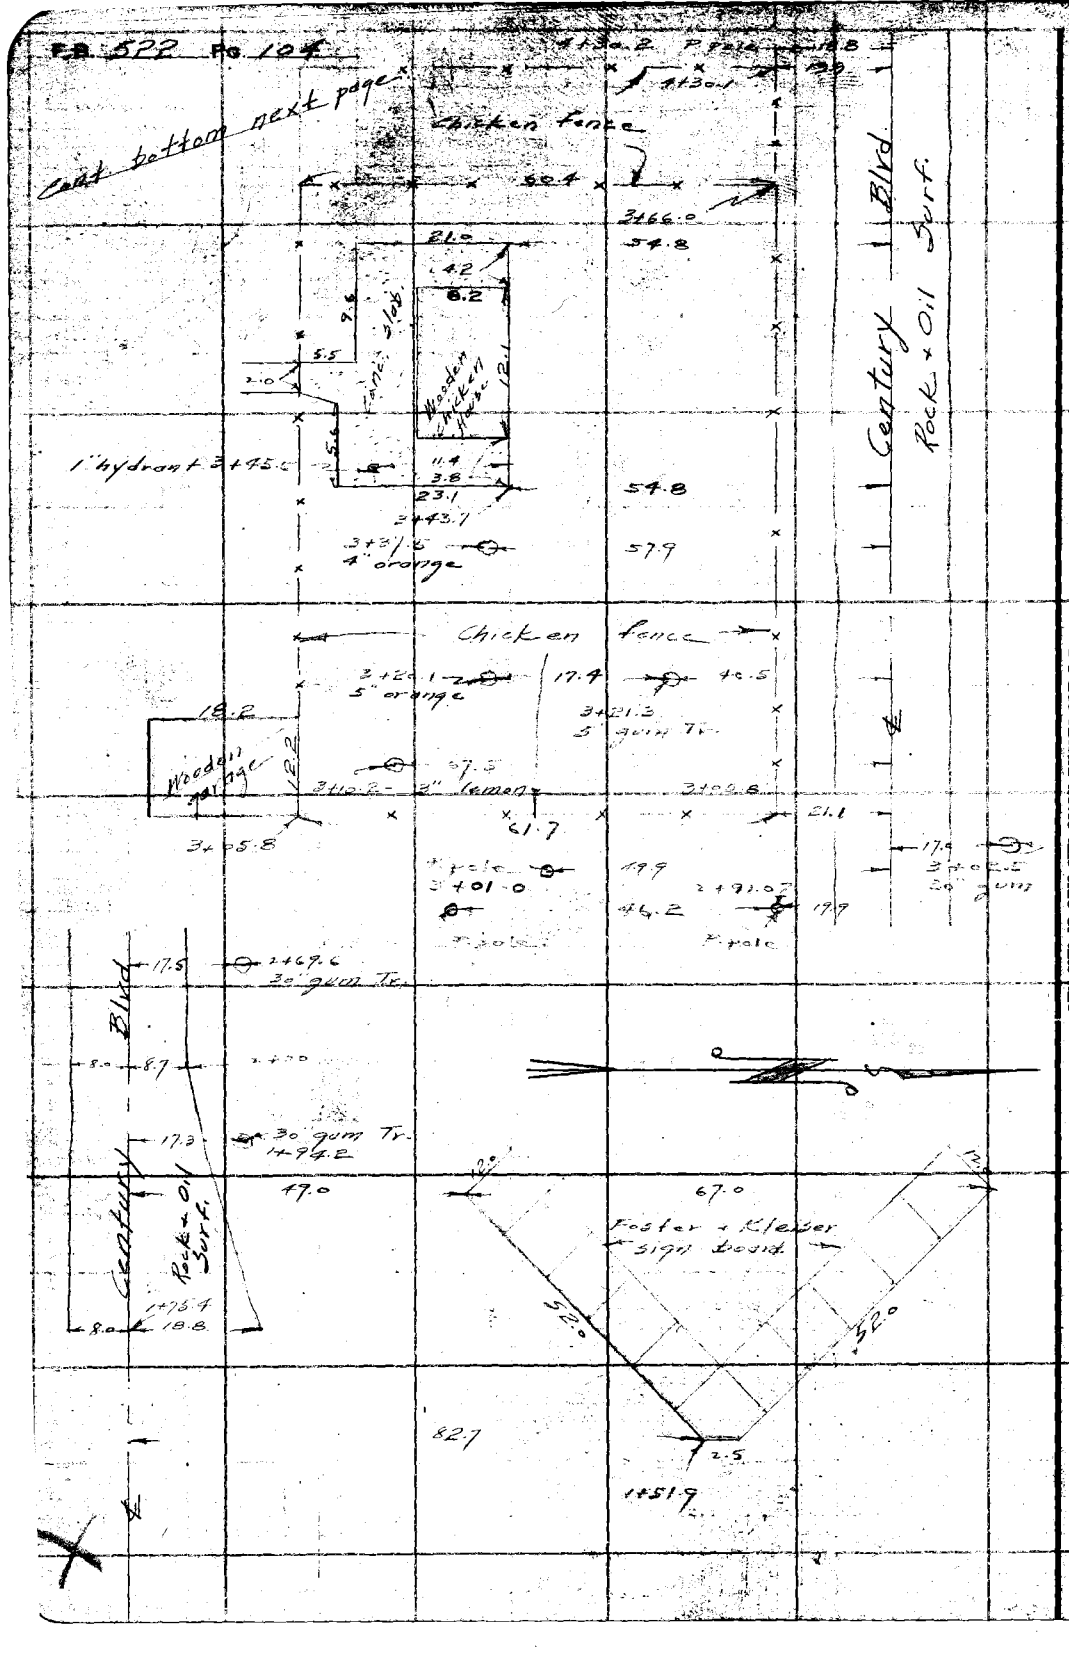
cont. bottom next page
Chicken fence
Century Blvd
Rock + Oil Surf.
1" hydrant 3+95.5
Wooden Chicken House
4" orange
Chicken fence
5" orange
Wood 4" tree
2" lemon
3" gum Tr.
Foster + Kleiser Sign board
RETURN TO
LOS ANGELES COUNTY SURVEYOR
700 HALL OF RECORDS
Do not extend notes this side of this line
Note: ANY ADDITIONS OR CHANGES ON THIS SHEET MUST BE MADE OR CIRCLED IN Red Ink WITH DATE AND NAME OF PERSON MAKING CHANGE.

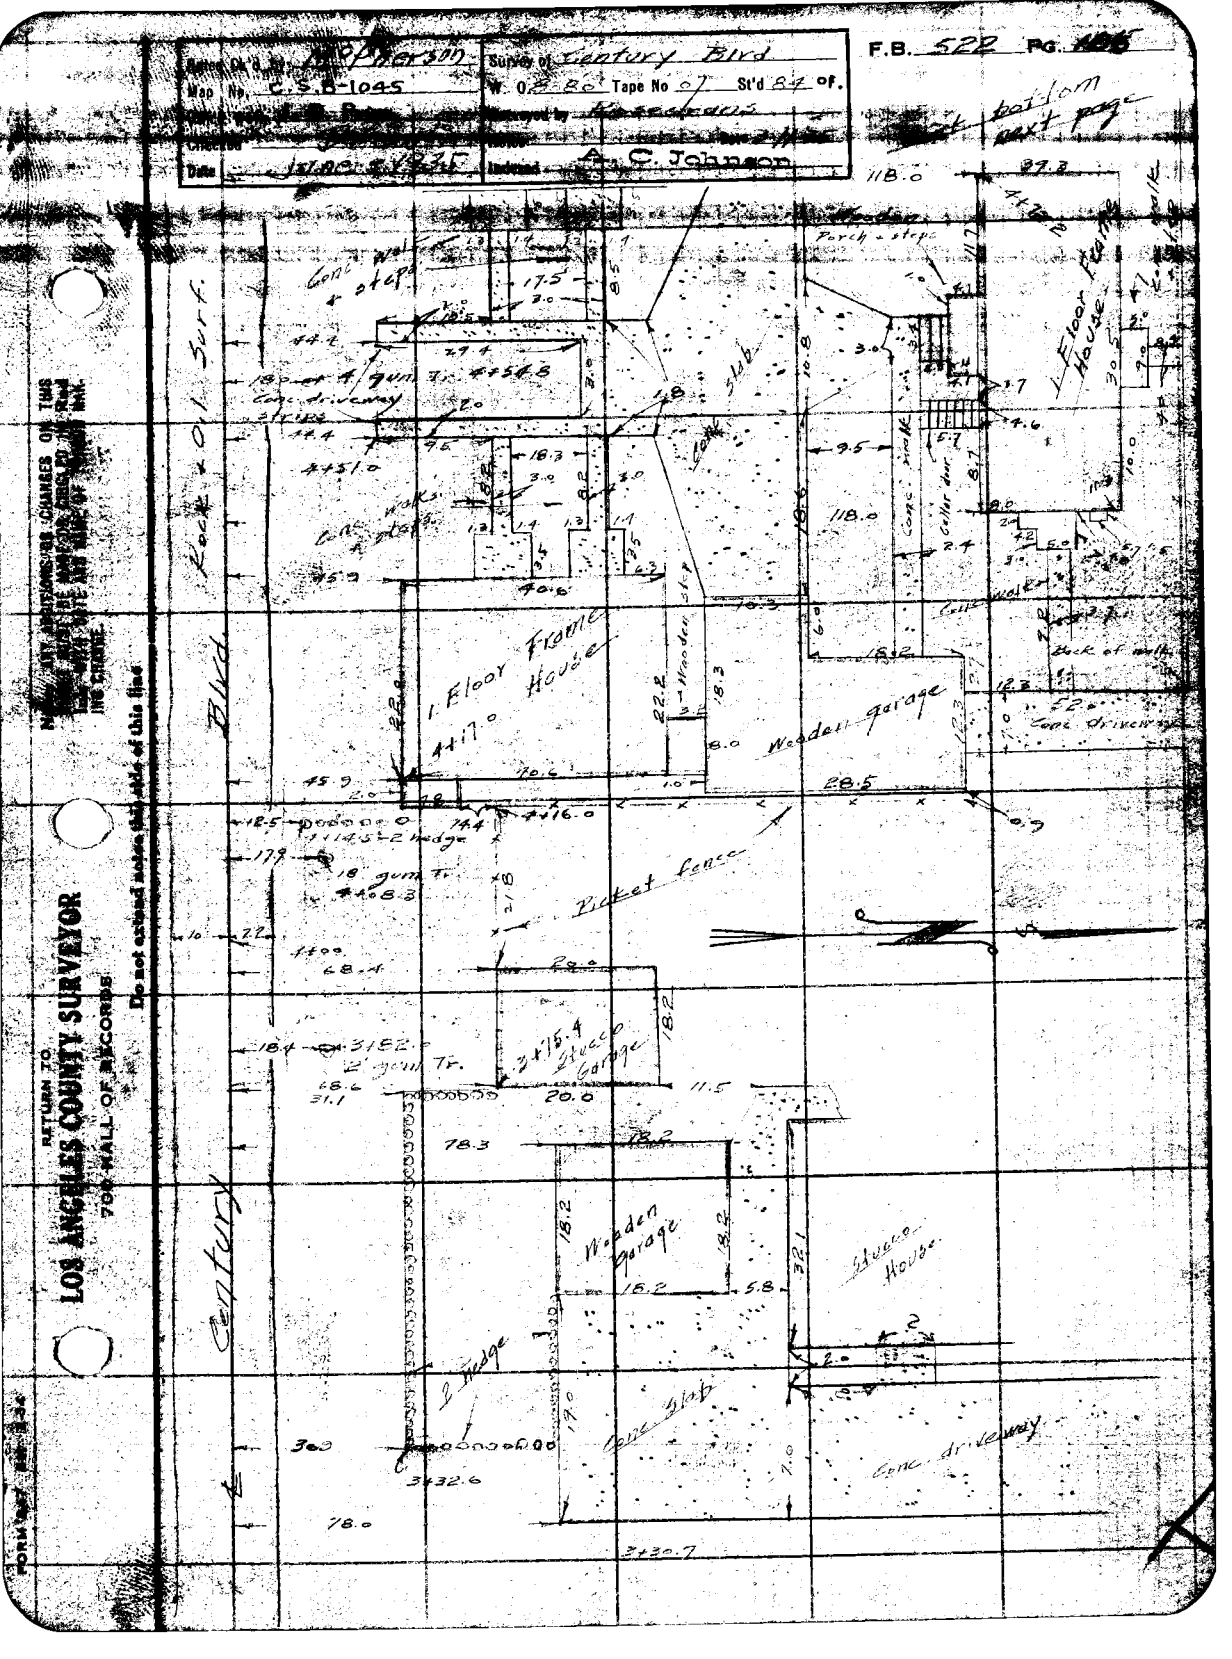
Survey of Century Blvd
Map No. C.S.B-1045
Tape No 07
Entered A. C. Johnson
F.B. 522 PG.
Century Blvd
Rock & Oil Surf.
1 Floor Frame House
Wooden garage
Picket fence
Stucco Garage
Stucco House
Wooden garage
Conc. driveway
Conc. walk
Conc. slab
Conc. steps
Porch & steps
Back of walk
Bldg
Hedge
Gum Tr.
RETURN TO
LOS ANGELES COUNTY SURVEYOR
720 HALL OF RECORDS
Do not extend notes this side of this line

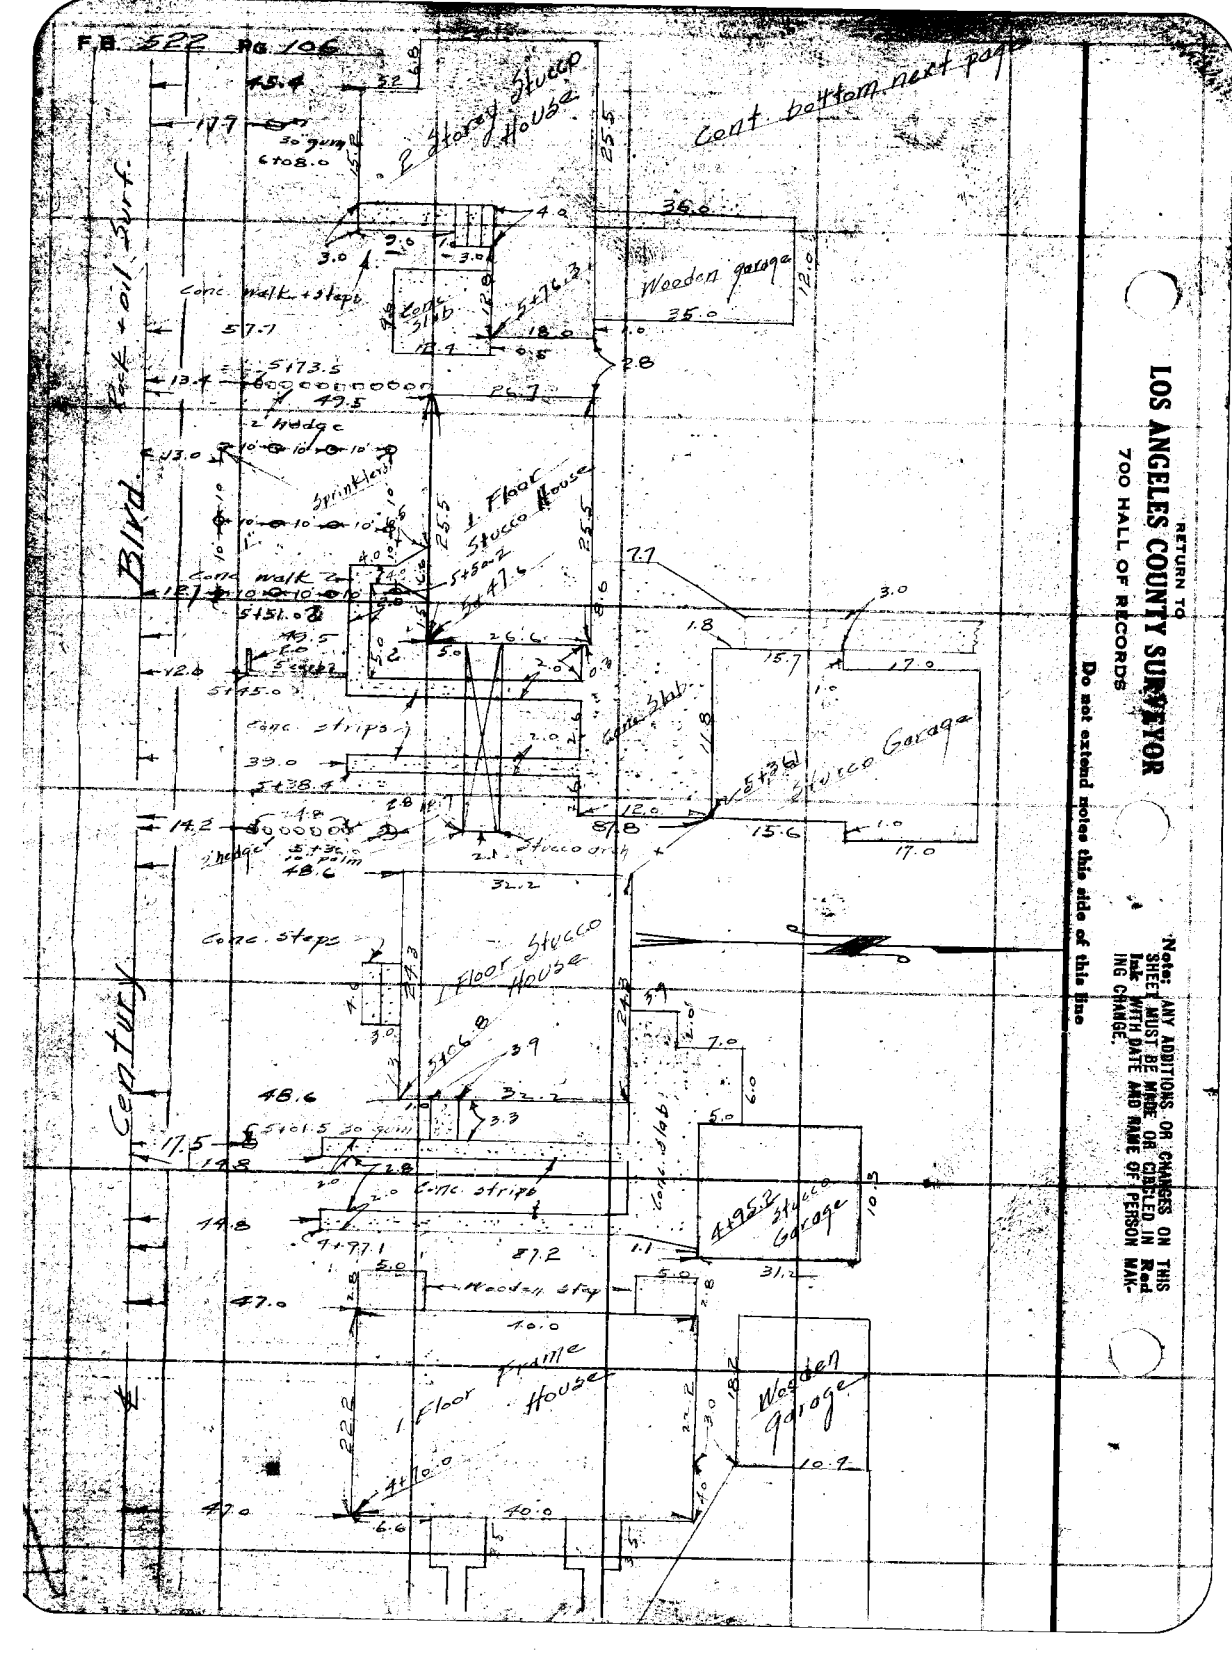
F.B. 522 PG. 106
RETURN TO
LOS ANGELES COUNTY SURVEYOR
700 HALL OF RECORDS
Do not extend notes this side of this line
Note: ANY ADDITIONS OR CHANGES ON THIS SHEET MUST BE MADE OR CODED IN Red Ink WITH DATE AND NAME OF PERSON MAKING CHANGE.
Cont. bottom next page
2 Story House
Stucco
Conc walk + steps
Conc Slab
Wooden garage
Sprinklers
1 Floor Stucco House
Conc walk
Conc stripe
Stucco Garage
Hedge
Stucco arch
Conc steps
1 Floor Stucco House
Conc Slab
Stucco Garage
Wood + Stone
1 Floor Frame House
Wooden garage
Century
Blvd.
Park + oil Surf.

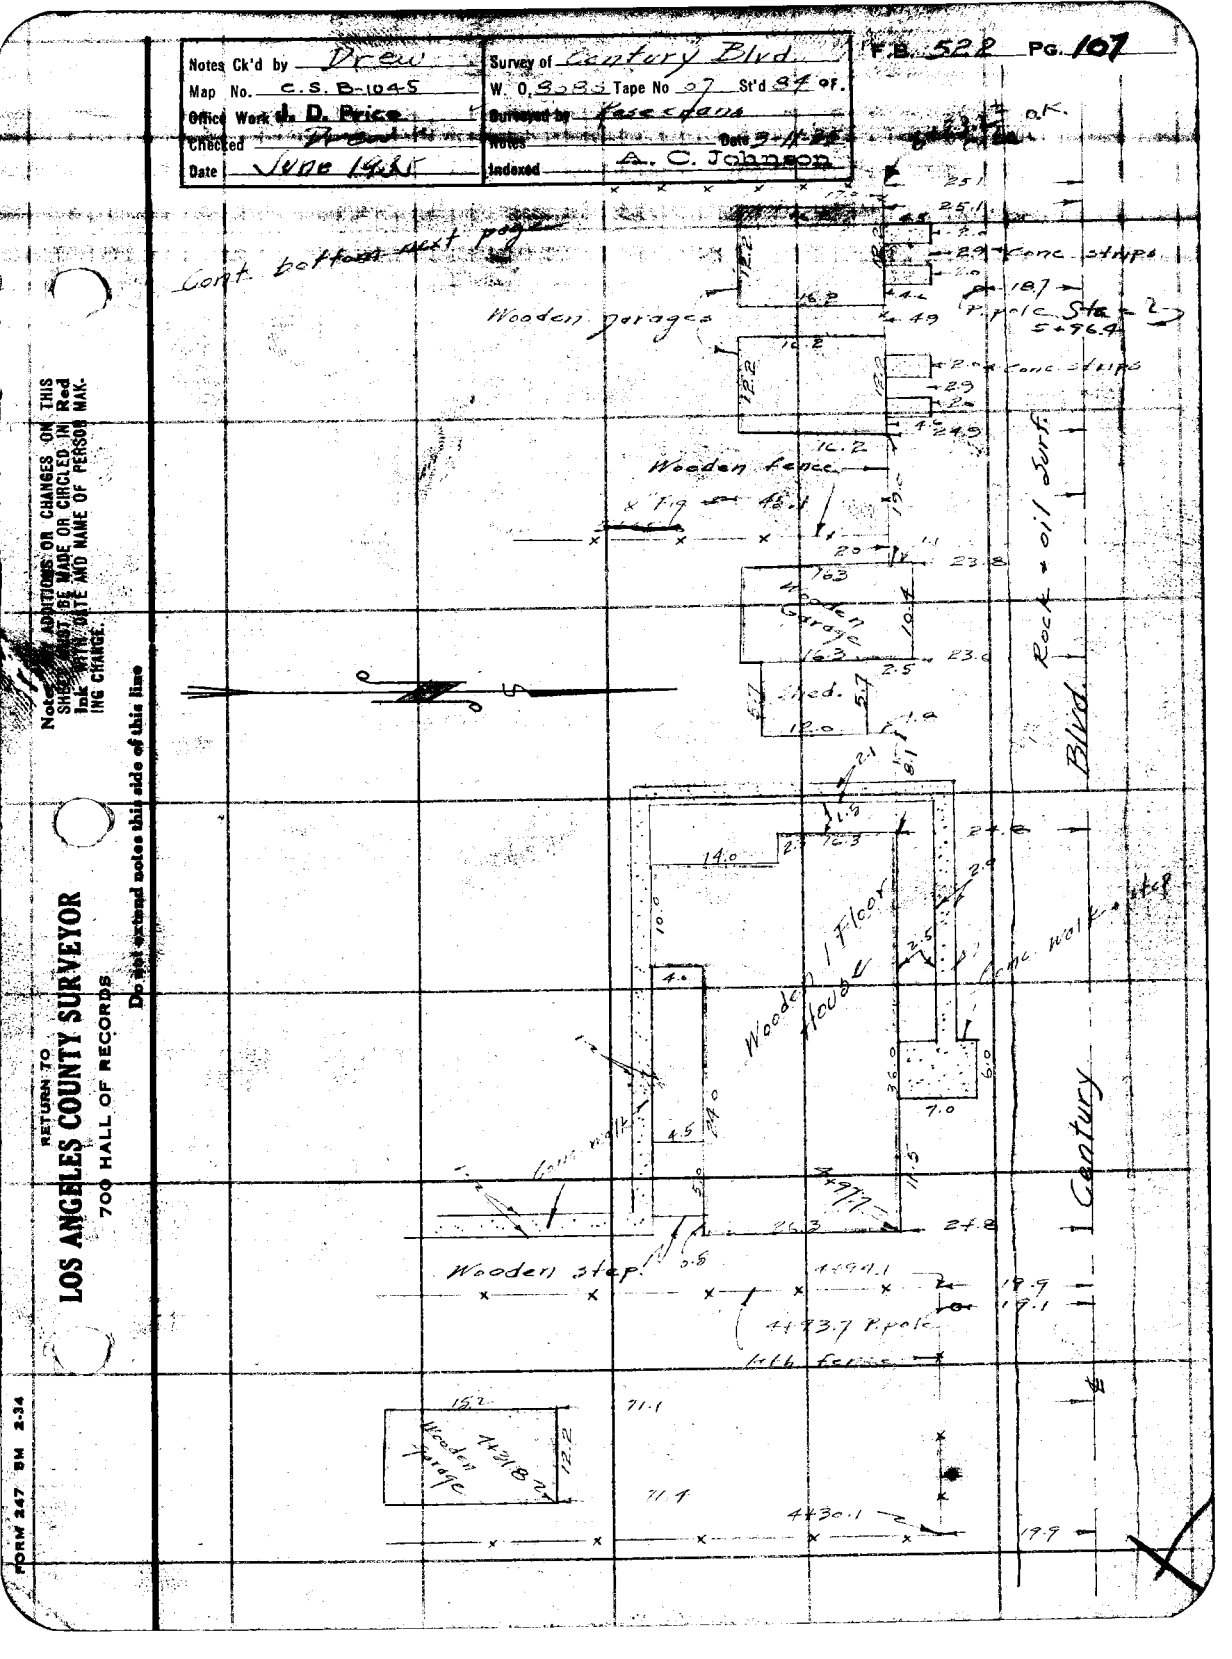
Notes Ck'd by Drew
Map No. C.S. B-1045
Office Work by D. Price
Checked
Indexed A. C. Johnson
F.B. 522 PG. 107
O.K.
Cont. bottom next page
Wooden garages
Conc. steps
Wooden fence
Wooden Garage
Shed.
Rock - oil surf.
Blvd.
Century
1 Floor
Wood
Conc. wall
Wooden step
Wooden Garage
Conc. Sta = 2
5+96.4
Conc. Sta = 2
4+93.7 P pole
Fence
Fig
Tree
Pole
Do not extend notes this side of this line
Notes, additions or changes on this sheet must be made or circled in red ink with date and name of person making change.
RETURN TO
LOS ANGELES COUNTY SURVEYOR
700 HALL OF RECORDS
FORM 247 SM 2-34

F.B. 522 PG. 108

Cont. bottom next page

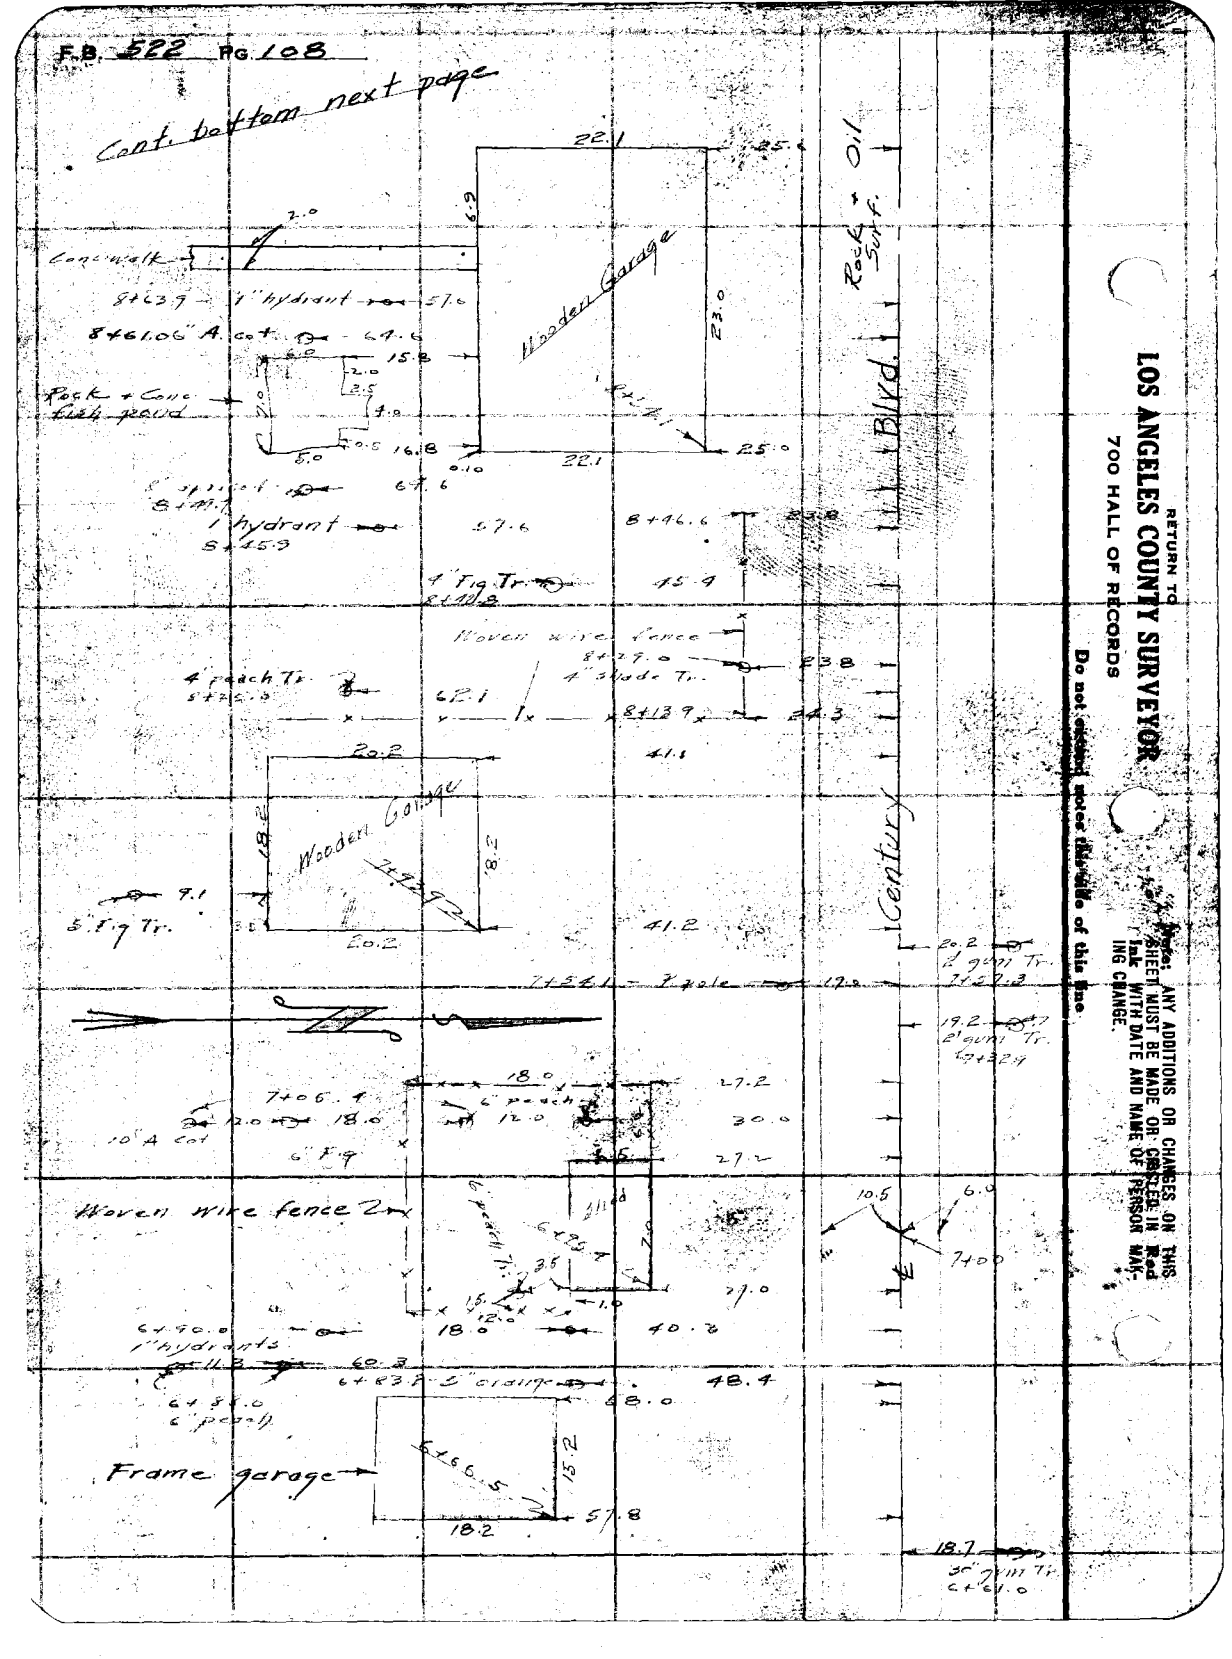

RETURN TO
LOS ANGELES COUNTY SURVEYOR
700 HALL OF RECORDS

Note: ANY ADDITIONS OR CHANGES ON THIS SHEET MUST BE MADE OR CENTERED IN Red Ink WITH DATE AND NAME OF PERSON MAKING CHANGE.

Do not disturb notes this side of this line

Notes Ck'd by Drew	Survey of Century Blvd
Map No. C.S.D-1046	W. O. 8080 Tape No 27 St'd 84 OF.
Office Work J. D. Price	Surveyed by Rasschaert
Checked Drew	Notes Date 5-12-35
Date June 1985	Indexed C. Johnson

F.B. 522 Pg. 109

Cont. bottom next page

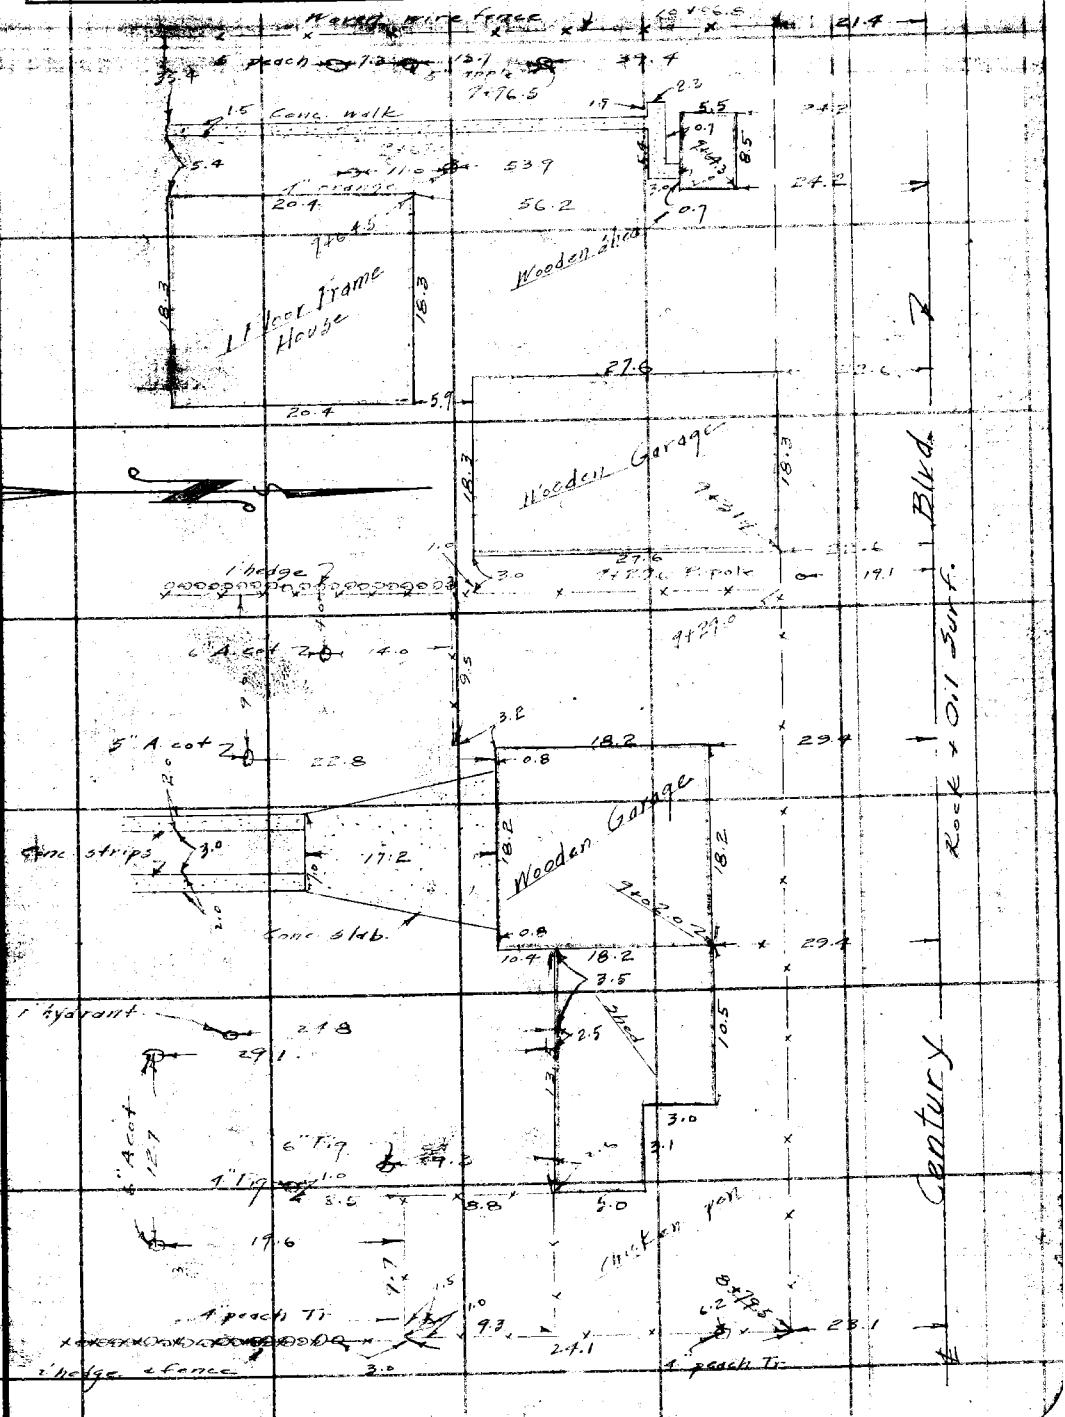

Note: ANY ADDITIONS OR CHANGES ON THIS SHEET MUST BE MADE OR CIRCLED IN Red Ink WITH DATE AND NAME OF PERSON MAKING CHANGE.

Do not extend notes this side of this line

RETURN TO
LOS ANGELES COUNTY SURVEYOR
700 HALL OF RECORDS

COM 247 BM 2.34

RETURN TO
LOS ANGELES COUNTY SURVEYOR
700 HALL OF RECORDS

Note: ANY ADDITIONS OR CHANGES ON THIS SHEET MUST BE MADE OR CIRCLED IN **Red Ink** WITH DATE AND NAME OF PERSON MAKING CHANGE.

Do not extend notes this side of this line

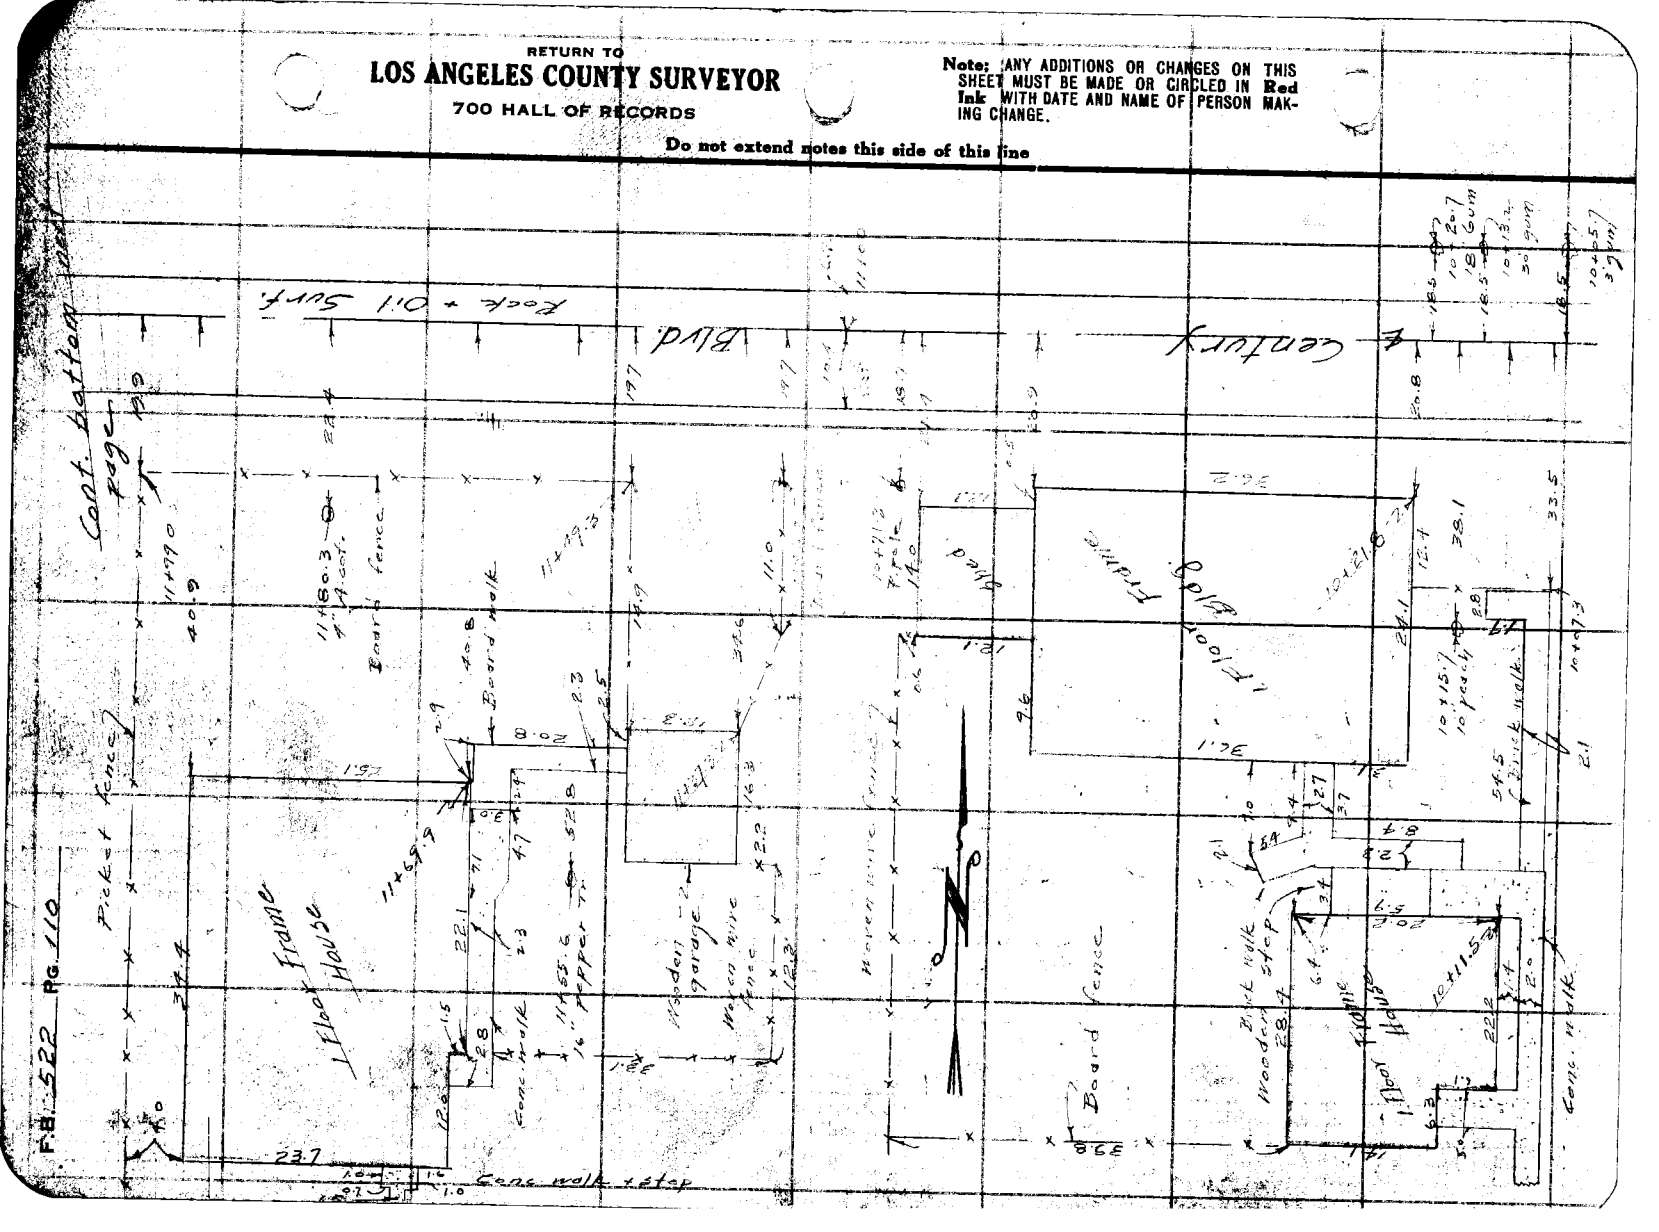

Notes Ck'd by Drew	Survey of Century Blvd
Map No. C.S.B-1045	W. O. 805 Tape No 57 St'd 94 or.
Office Work J. D. Price.	Surveyed by Peterkins
Checked DPC	Notes Date 6-11-35
Date June - 1935	Indexed A. C. Johnson

F.B. 522 - Pg. 111

- 11th bottom next page

2" gas pumps on Conc. Base

2" tank intake

Frame garage station 12

light post conc. base

4-2" gas tank intakes

4" Pipe

13+03.4 - 5" Fig

4" Fig 12+92.2

12+94.0 6" Fig

10th fence

Rock + Oil Surf

Blvd.

Century

8" Board fence

Wooden Garage

Shed

Picket fence

Wooden shed

1" hydrant

Wooden Garage

12+29.8

P. pole 12+28.9

12+27.4 Sycamore Tr.

12+25.1 6" Fig

12+12.2 Magnolia

Note: ANY ADDITIONS OR CHANGES ON THIS SHEET MUST BE MADE OR CIRCLED IN Red Ink WITH DATE AND NAME OF PERSON MAKING CHANGE.

Do not extend notes this side of this line

RETURN TO LOS ANGELES COUNTY SURVEYOR 700 HALL OF RECORDS

FORM 247 BM 2-34

F.B. 522 Pg. 112

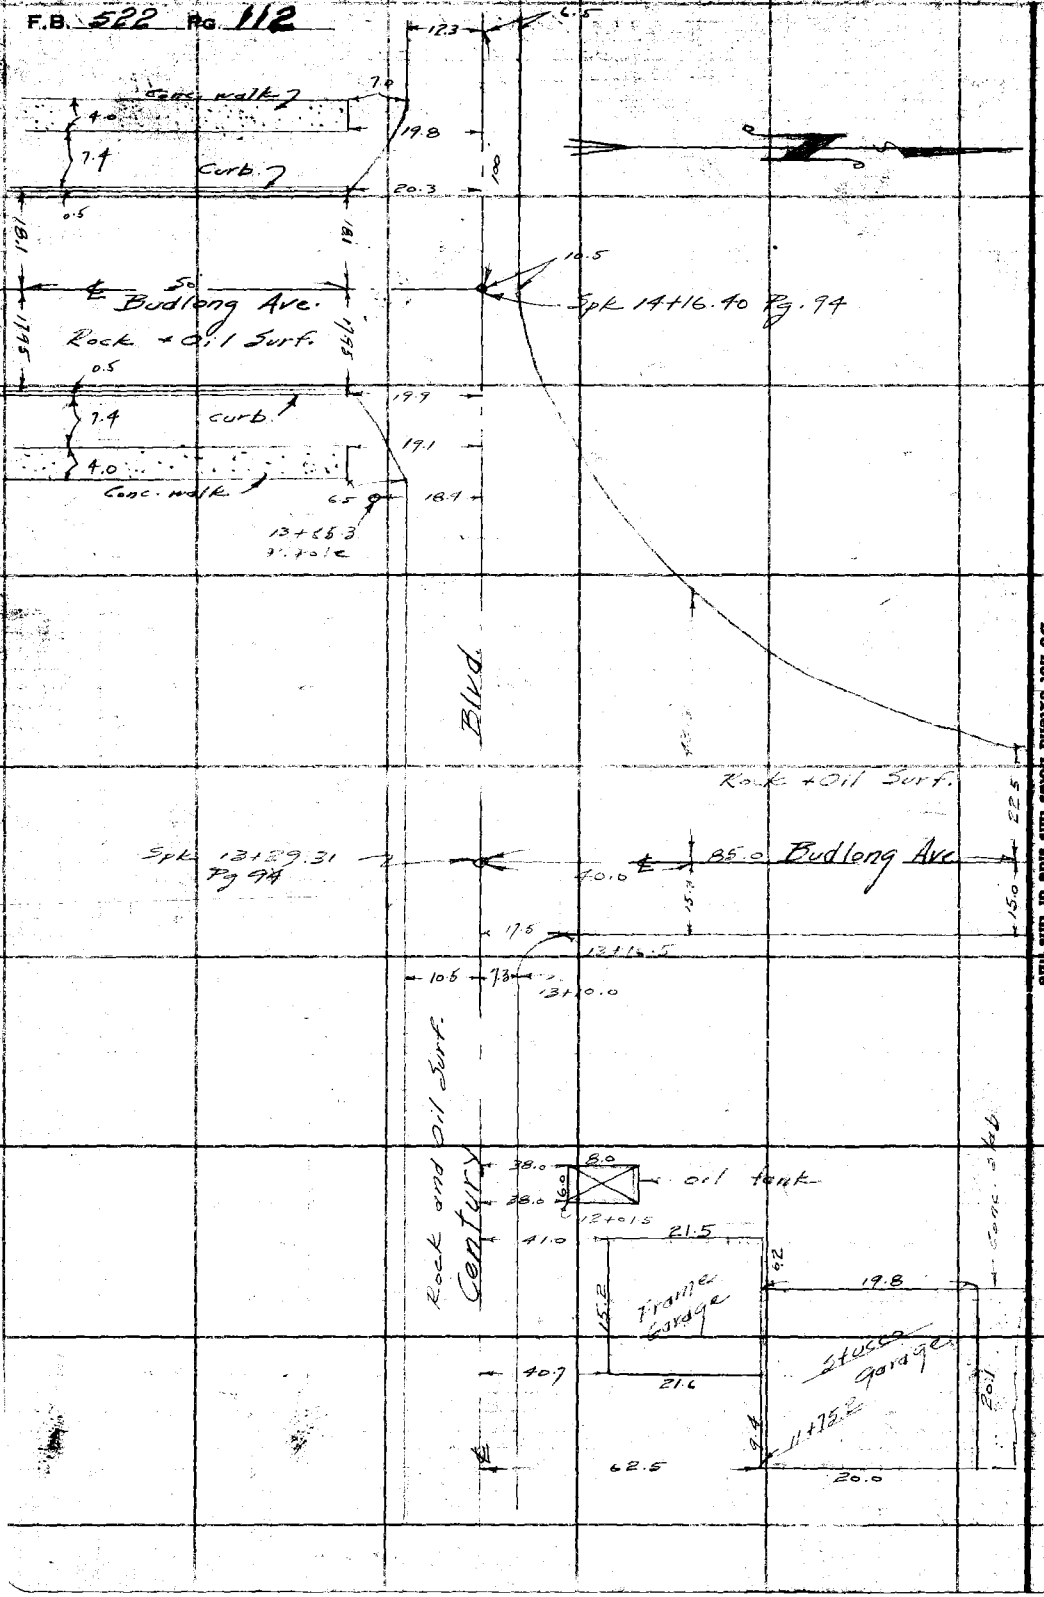

RETURN TO
LOS ANGELES COUNTY SURVEYOR
700 HALL OF RECORDS

Do not extend notes this side of this line

Note: ANY ADDITIONS OR CHANGES ON THIS SHEET MUST BE MADE OR CIRCLED IN Red Ink WITH DATE AND NAME OF PERSON MAKING CHANGE.

Notes Ck'd by _____ Survey of Century Blvd F.B. 522 Pg. 113
Map No. _____ W. O. 4396 Case No. 619 Std. 68 °F
Checked _____ Notes _____ Date 1-22-43
Date _____ Indexed _____

TOPOGRAPHY

ON

CENTURY BLVD

FROM:- BUDLONG AVE

TO:- DENKER AVE

W. N. 4396

Jan. 20, 1943.

C. A. Benson - Chief-of-Party.

G. H. Nichols & Jack Gregory - Rmen.

D. G. Waltermire - Hd. Ch.

A. G. DeLong - R. Ch.

Note: Any Additions or Changes on this Sheet Must Be Made or Called to the Attn. With Date and Name of Person Making Change.

Do not extend notes this side of this line.

RETURN TO LOS ANGELES COUNTY SURVEYOR 700 HALL OF RECORDS

RETURN TO
LOS ANGELES COUNTY SURVEYOR
700 HALL OF RECORDS

Note: Any Additions or Changes on this Sheet Must be Made or Circled in Red Ink With Date and Name of Person Making Change.

Do not extend notes this side of this line.

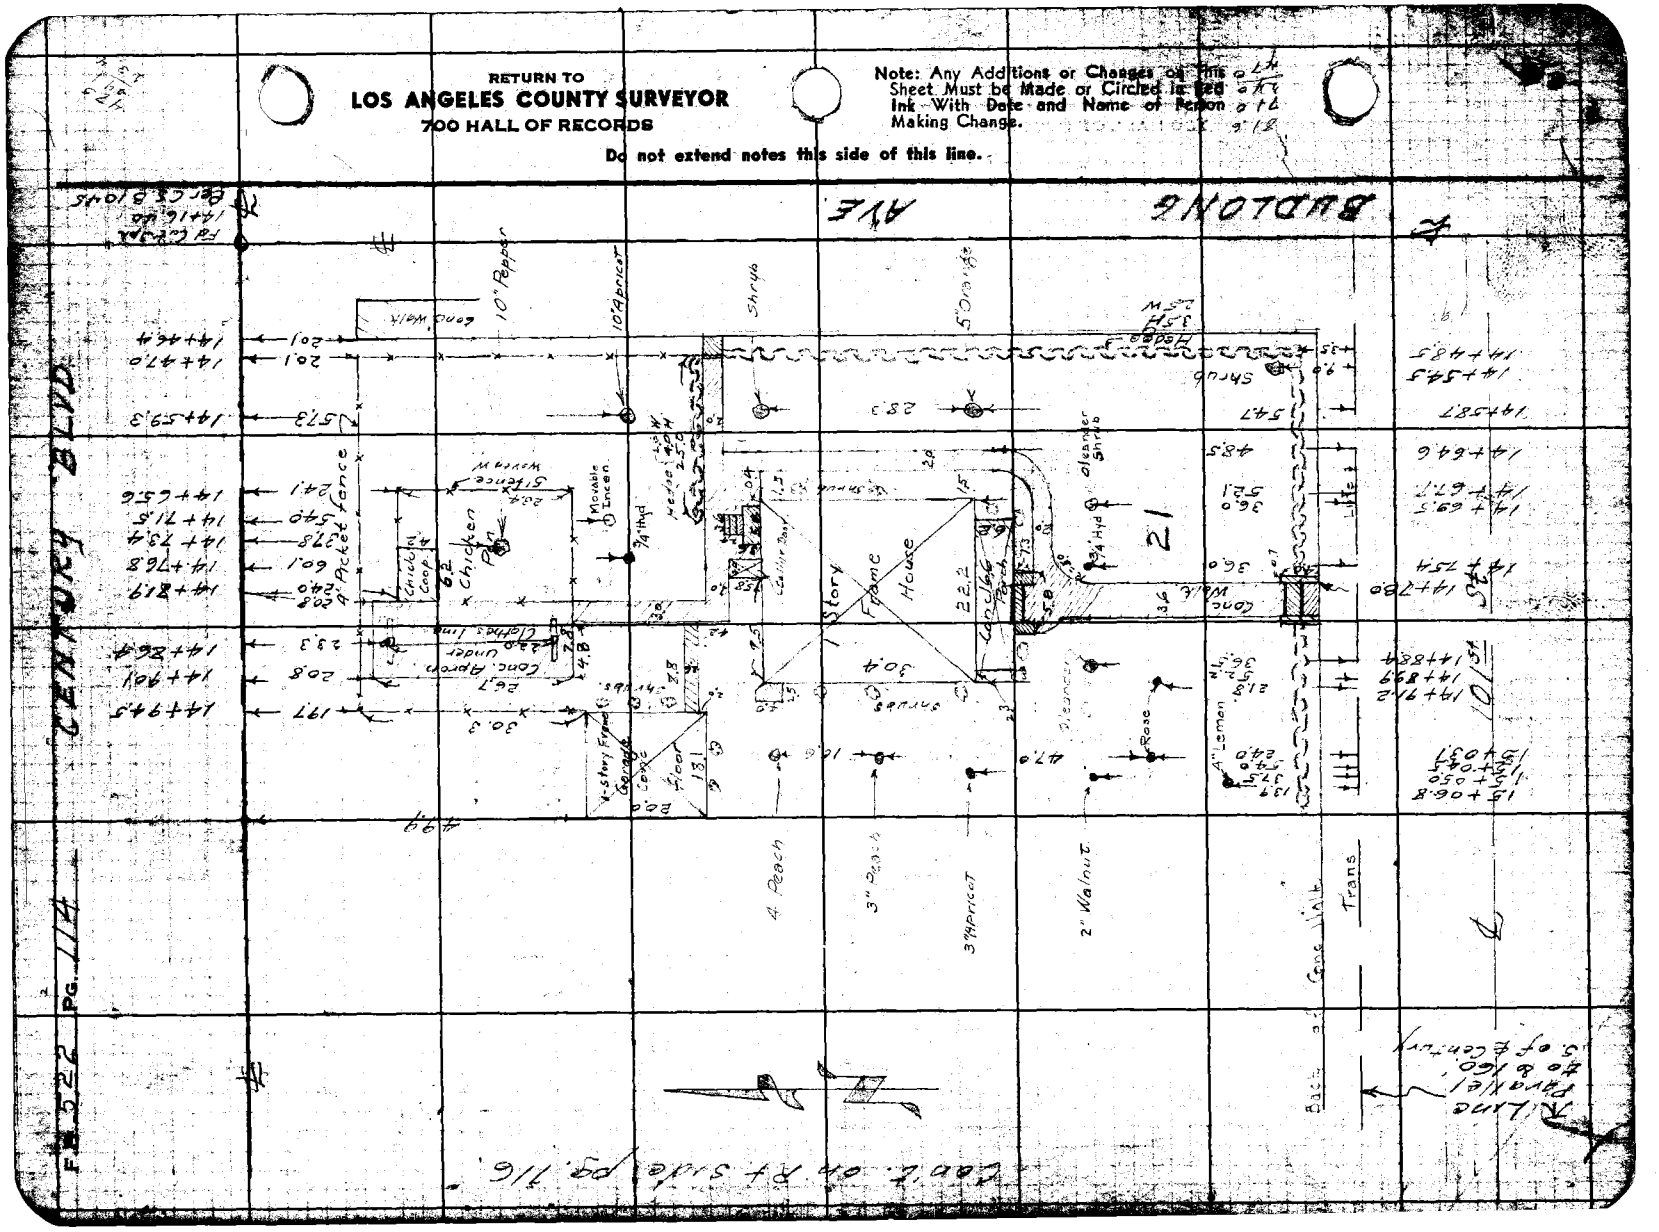
ALE
BUDLONG
FB 522 PG. 114
10" Pepper
10" Apricot
Shrub
Concrete Walk
Asphalt
Movable Chicken Pen
Chicken Coop
6' Picket Fence
Wire Fence
1 Story Frame House
Concrete Porch
Concrete Walk
Lattice
Rose
Garage
Concrete Apron under Clothes Line
Concrete Curb
Gas Line
Trans
4" Peach
3" Peach
3" Apricot
2" Walnut

RETURN TO
LOS ANGELES COUNTY SURVEYOR
700 HALL OF RECORDS

Note: Any Additions or Changes on This Sheet Must be Made or Circled in Red Ink With Date and Name of Person Making Change.

Do not extend notes this side of this line.

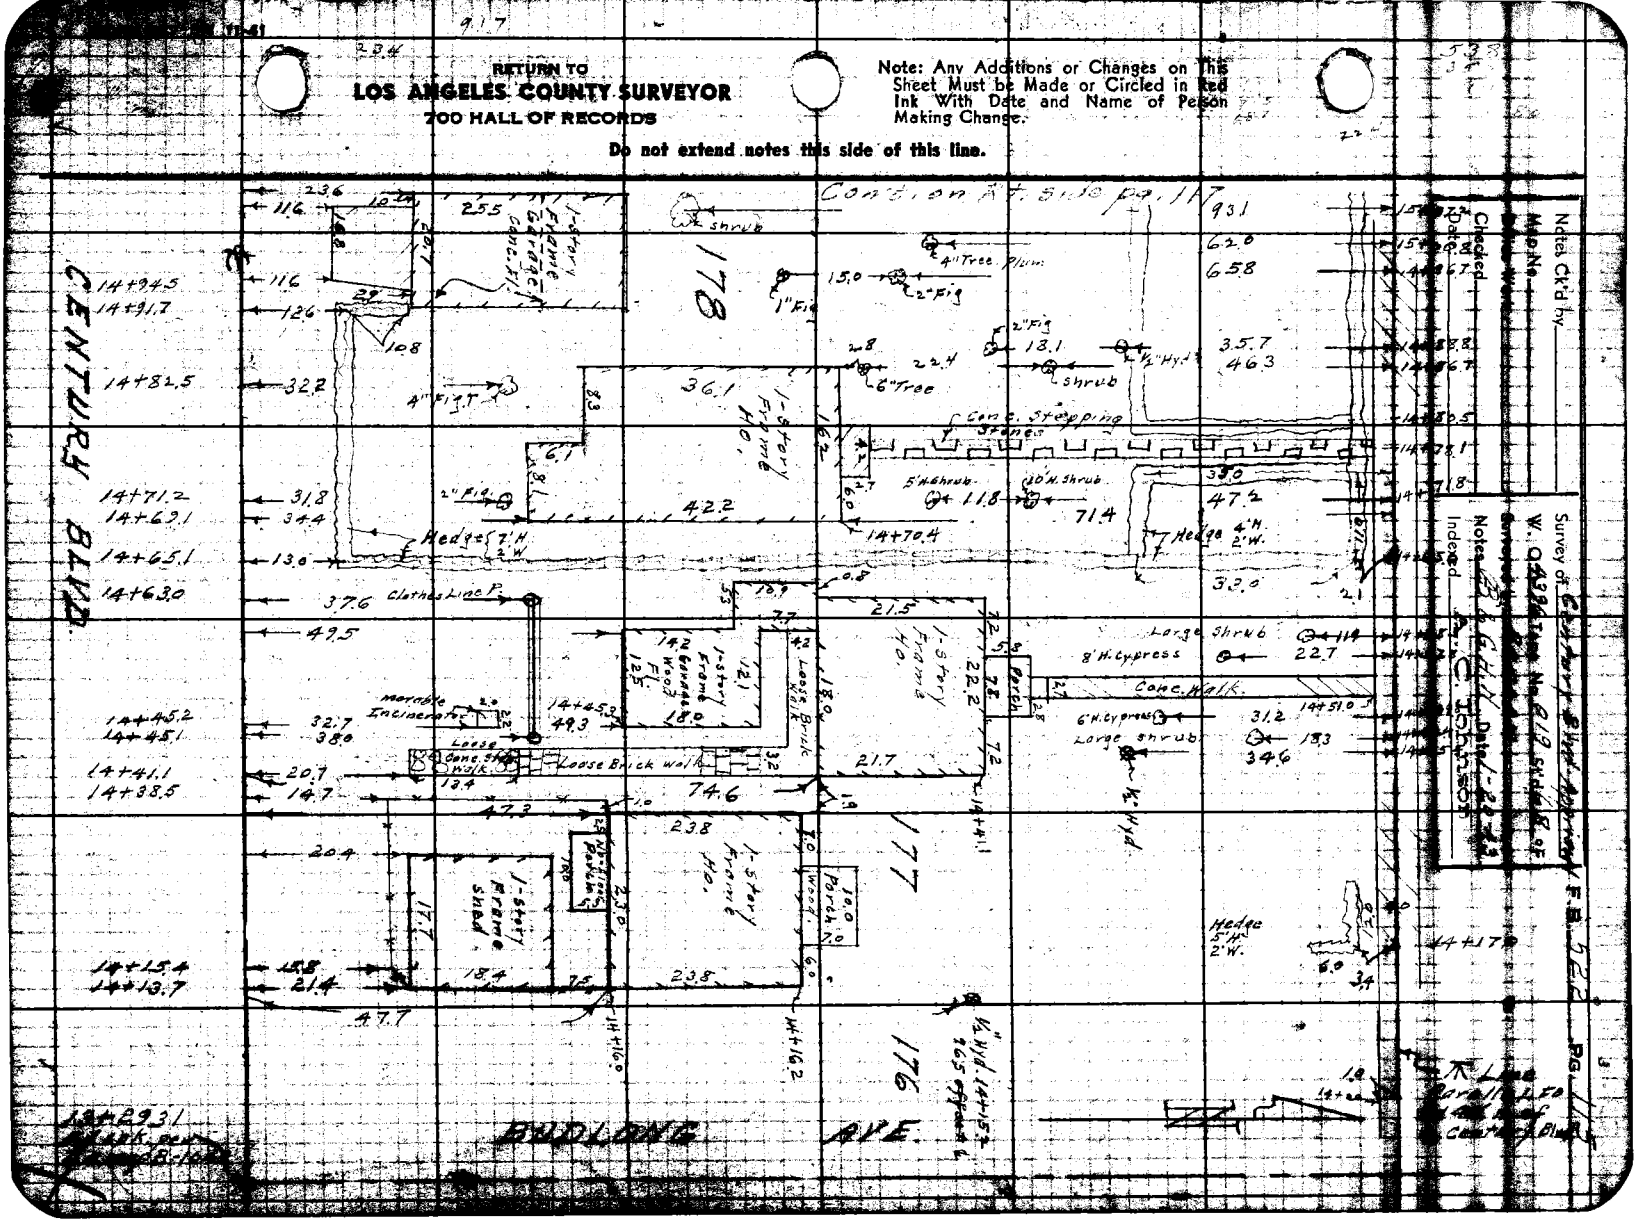

RETURN TO
LOS ANGELES COUNTY SURVEYOR
700 HALL OF RECORDS

Note: Any Additions or Changes on This Sheet Must be Made or Circled in Red Ink With Date and Name of Person Making Change.

Do not extend notes this side of this line.

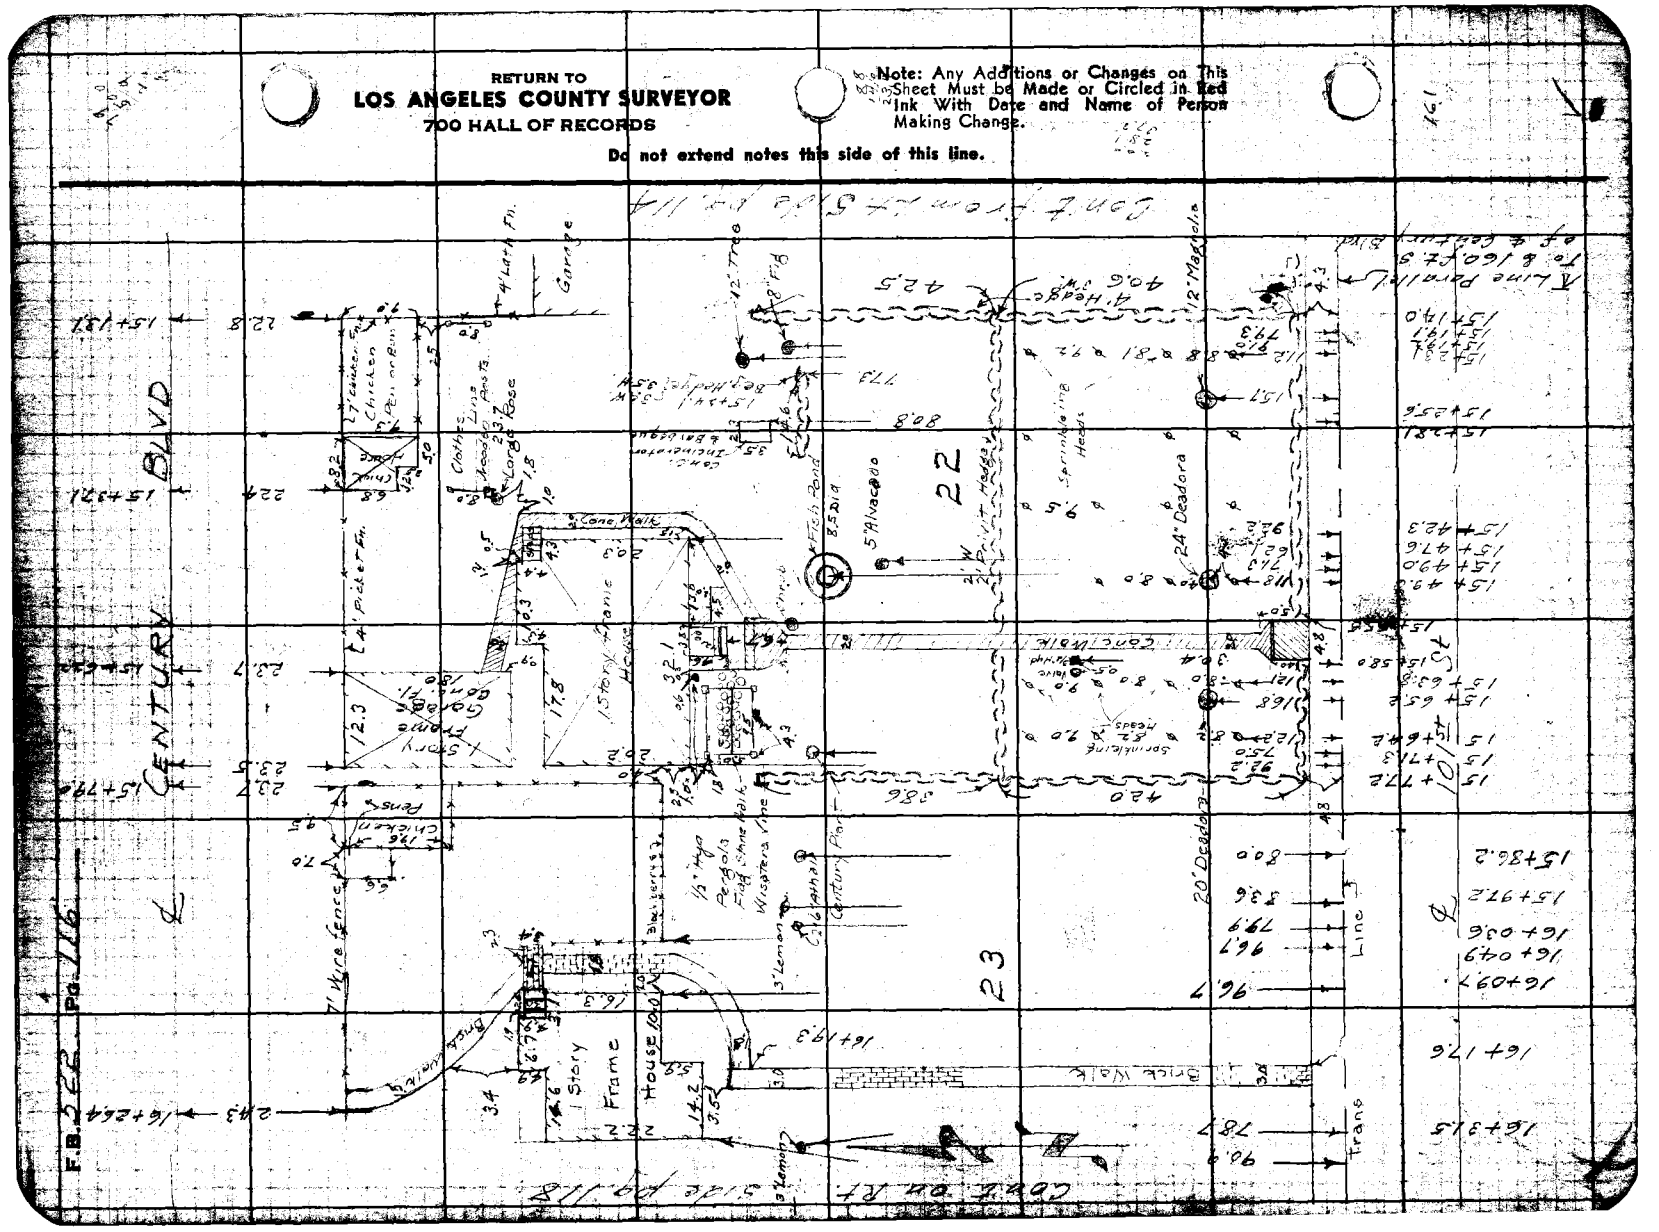

FORM 247 SM 11-41

RETURN TO
LOS ANGELES COUNTY SURVEYOR
700 HALL OF RECORDS

Note: Any Additions or Changes on This Sheet Must be Made or Circled in Red Ink With Date and Name of Person Making Change.

Do not extend notes this side of this line.

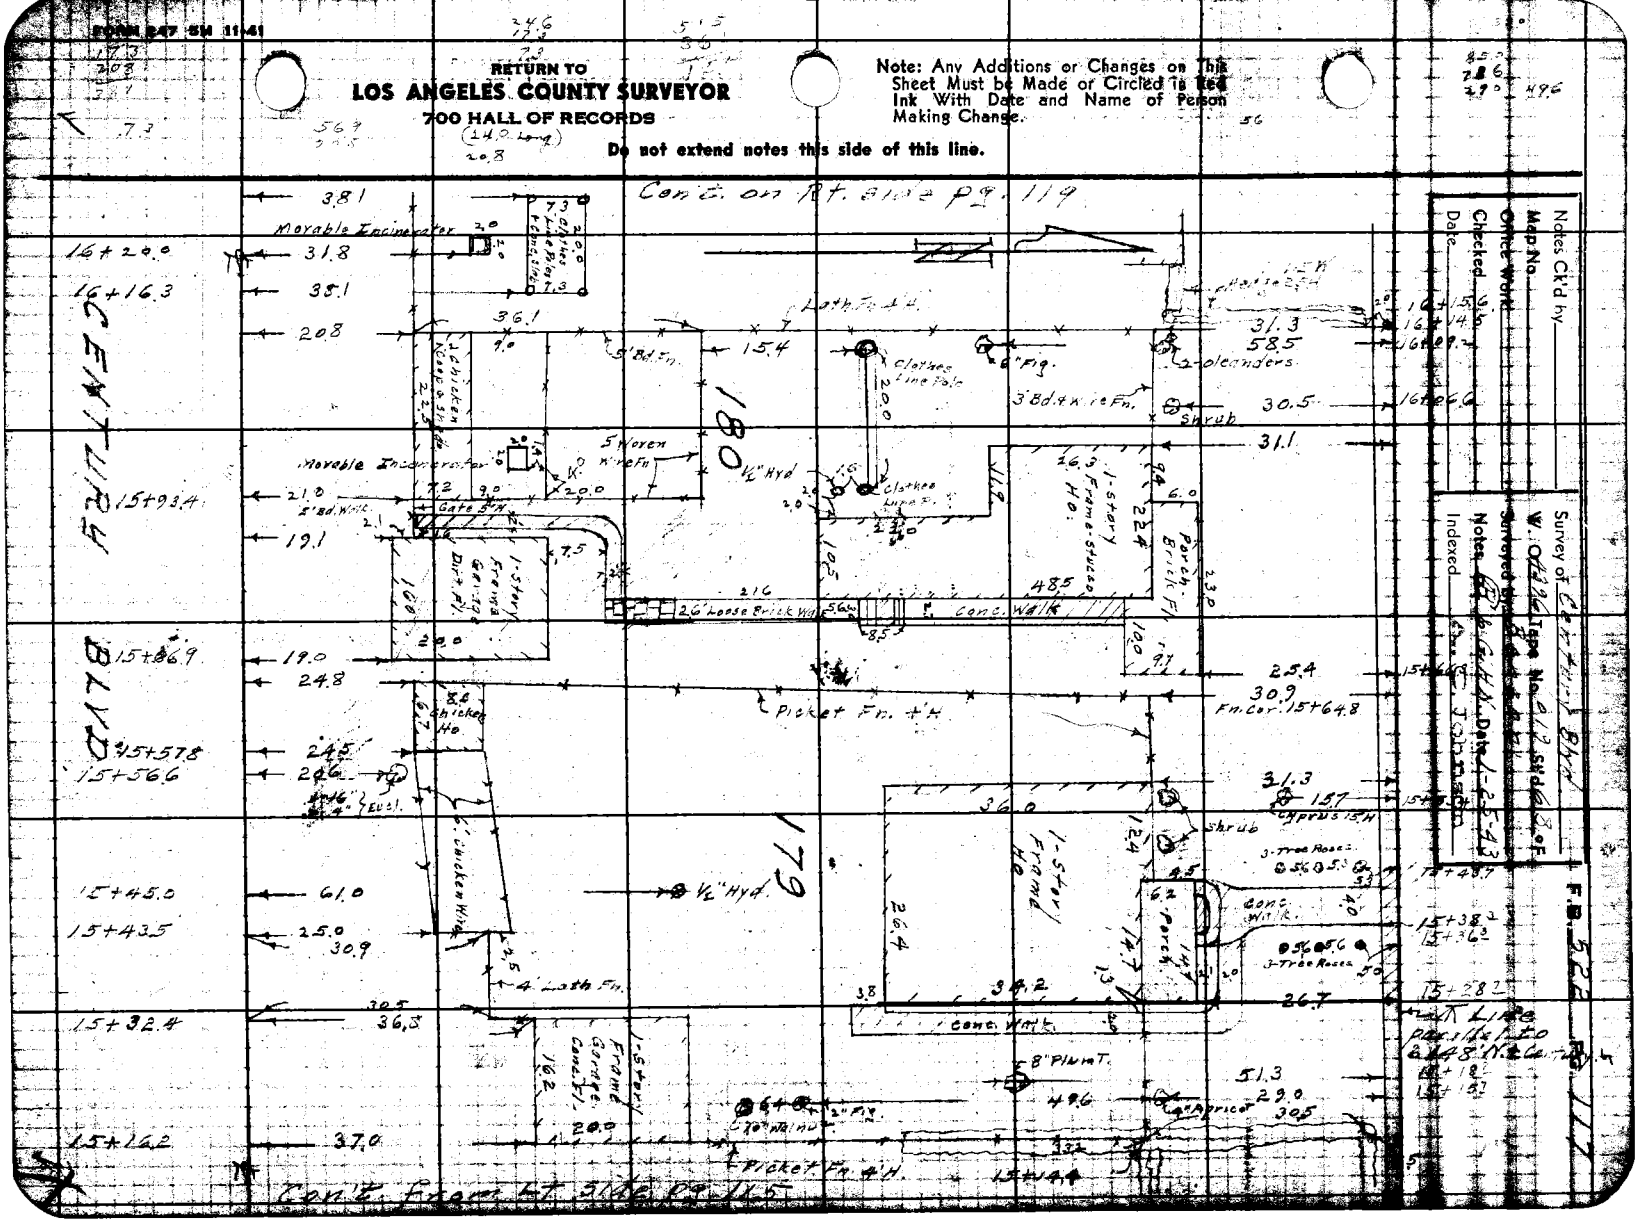

RETURN TO
LOS ANGELES COUNTY SURVEYOR
700 HALL OF RECORDS

Note: Any Additions or Changes on This Sheet Must be Made or Circled in Red Ink With Date and Name of Person Making Change.

Do not extend notes this side of this line.

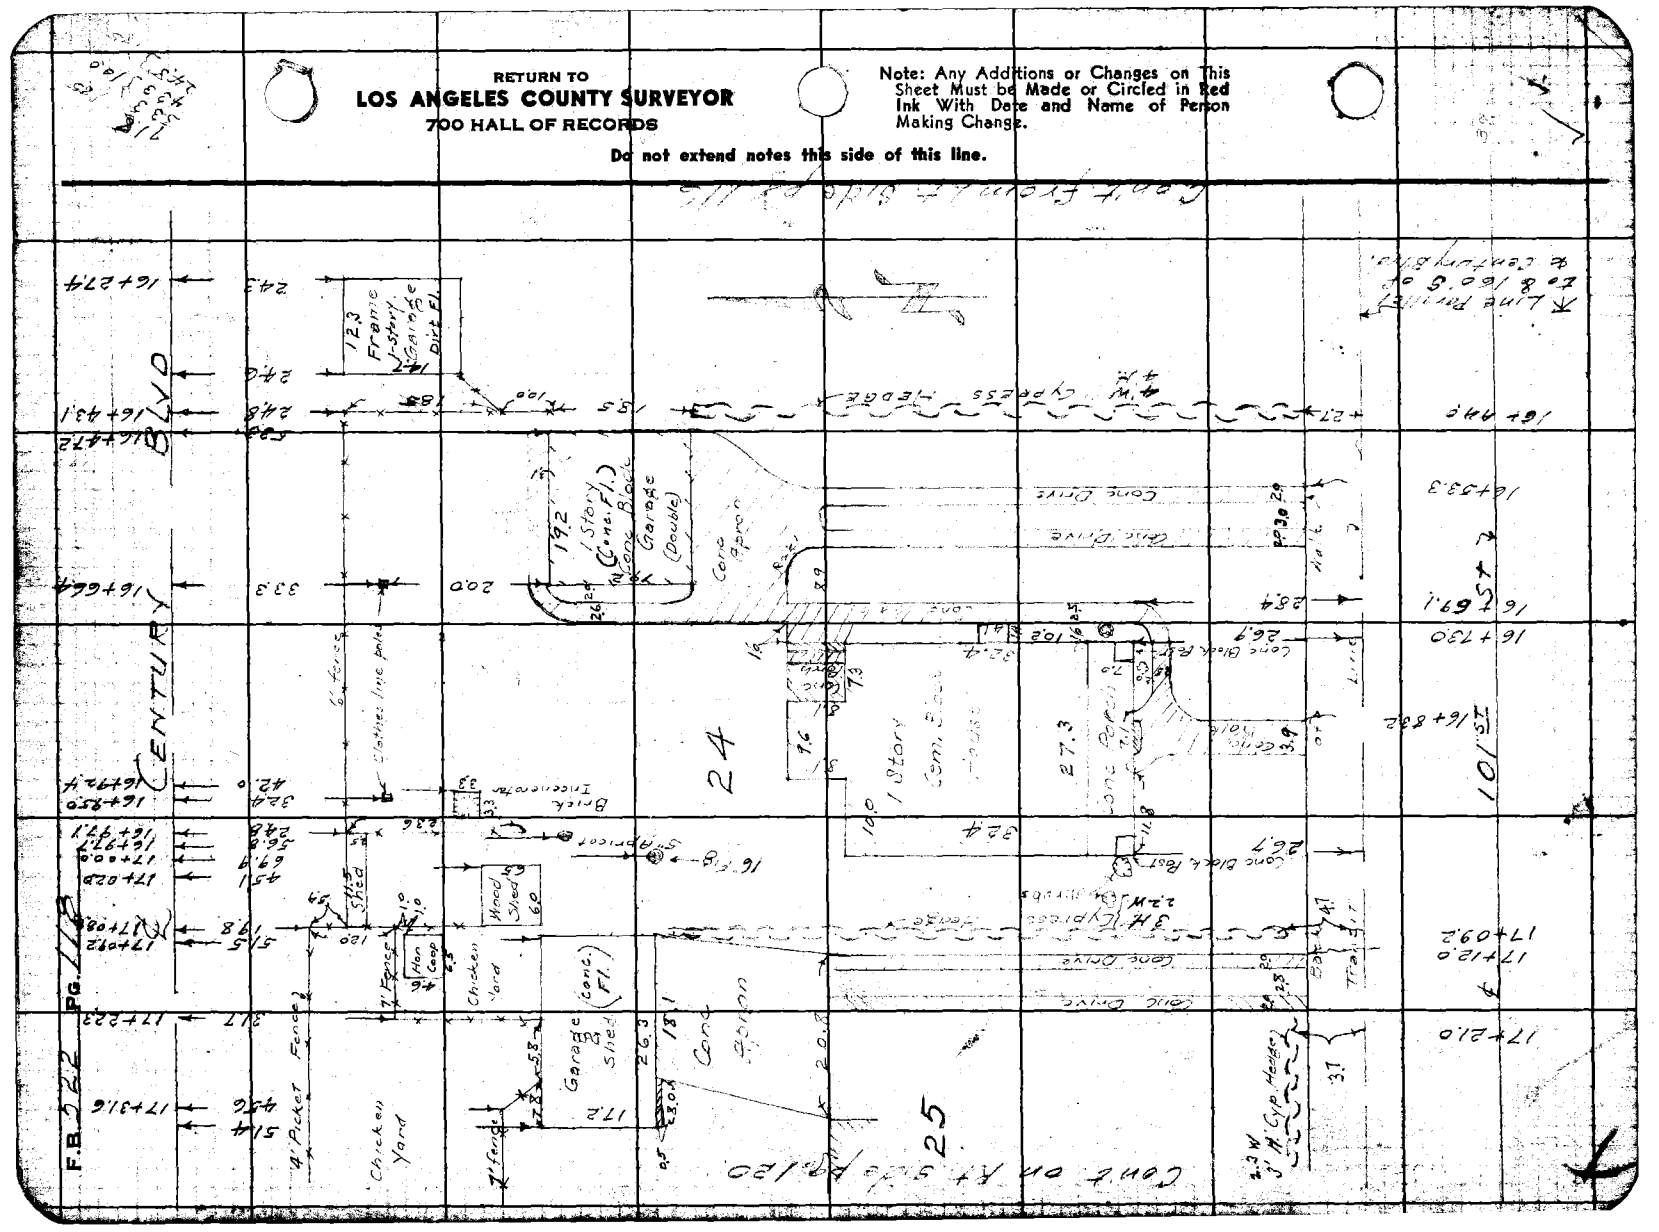

RETURN TO
LOS ANGELES COUNTY SURVEYOR
700 HALL OF RECORDS

Note: Any Additions or Changes on This Sheet Must be Made or Circled in Red Ink With Date and Name of Person Making Change.

Do not extend notes this side of this line.

Notes Ck'd by
Map No.
Office Work
Checked
Date

Survey of
W. O. No. Base No. Std.
Surveyed by
Notes
Indexed


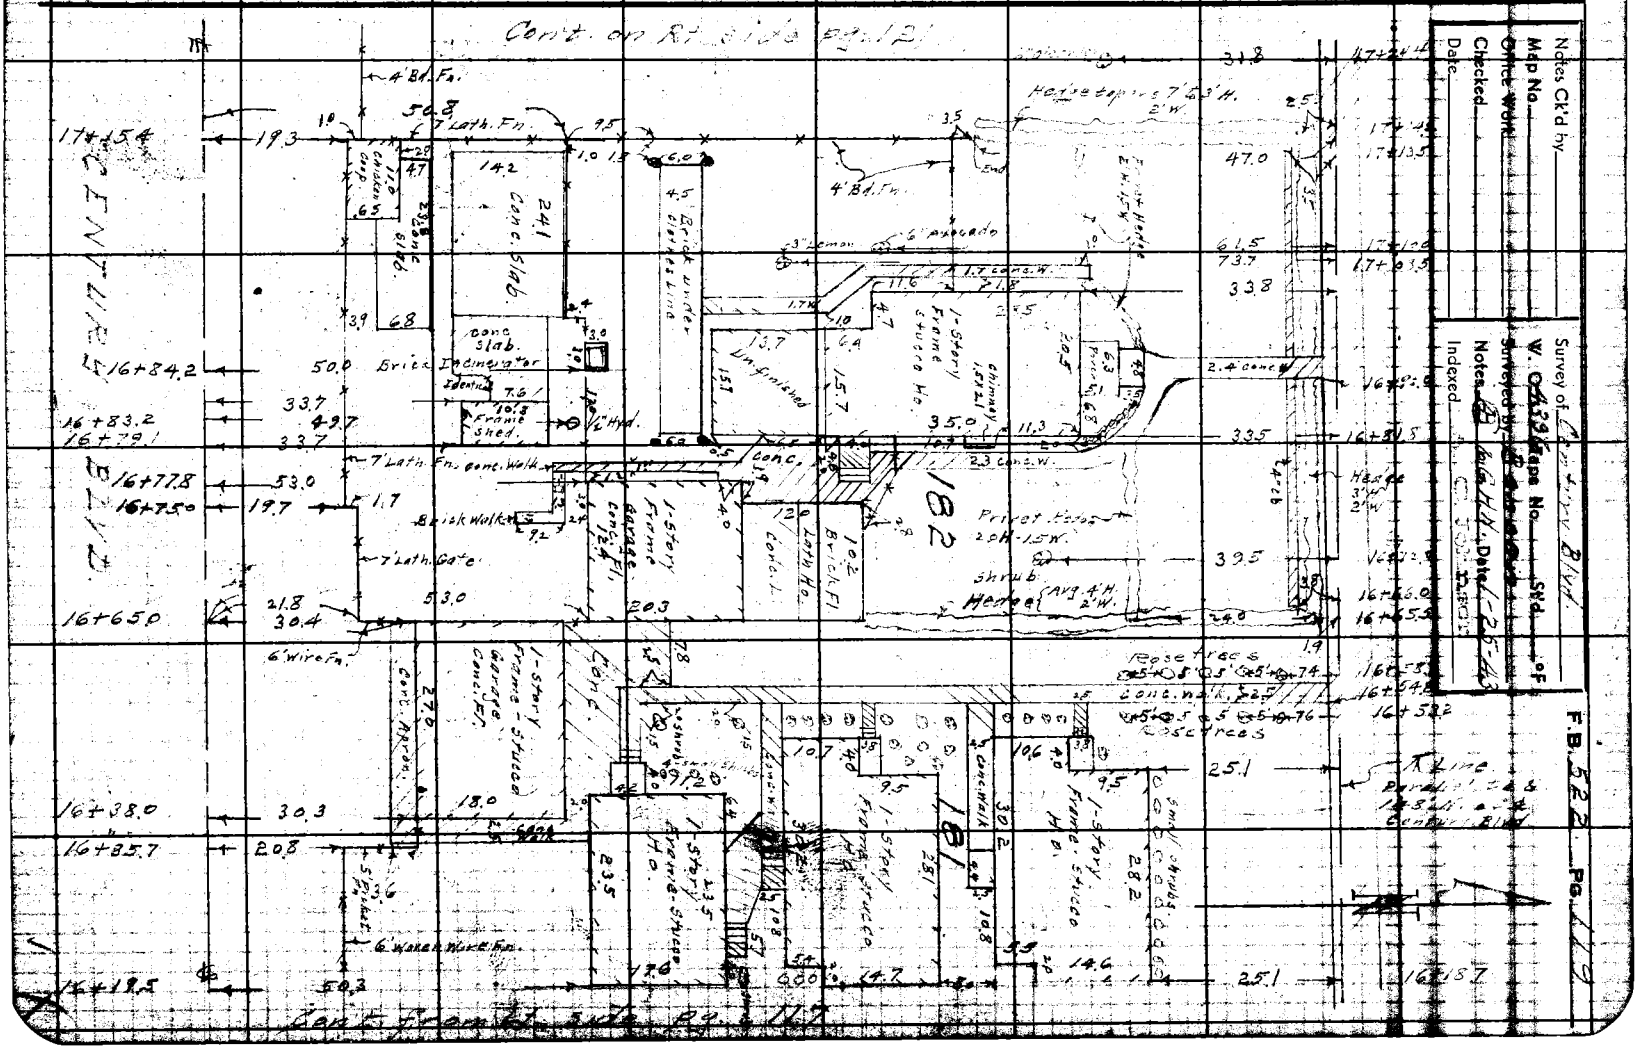

RETURN TO
LOS ANGELES COUNTY SURVEYOR
700 HALL OF RECORDS

Note: Any Additions or Changes on This Sheet Must be Made or Circled in Red Ink With Date and Name of Person Making Change.

Do not extend notes this side of this line.

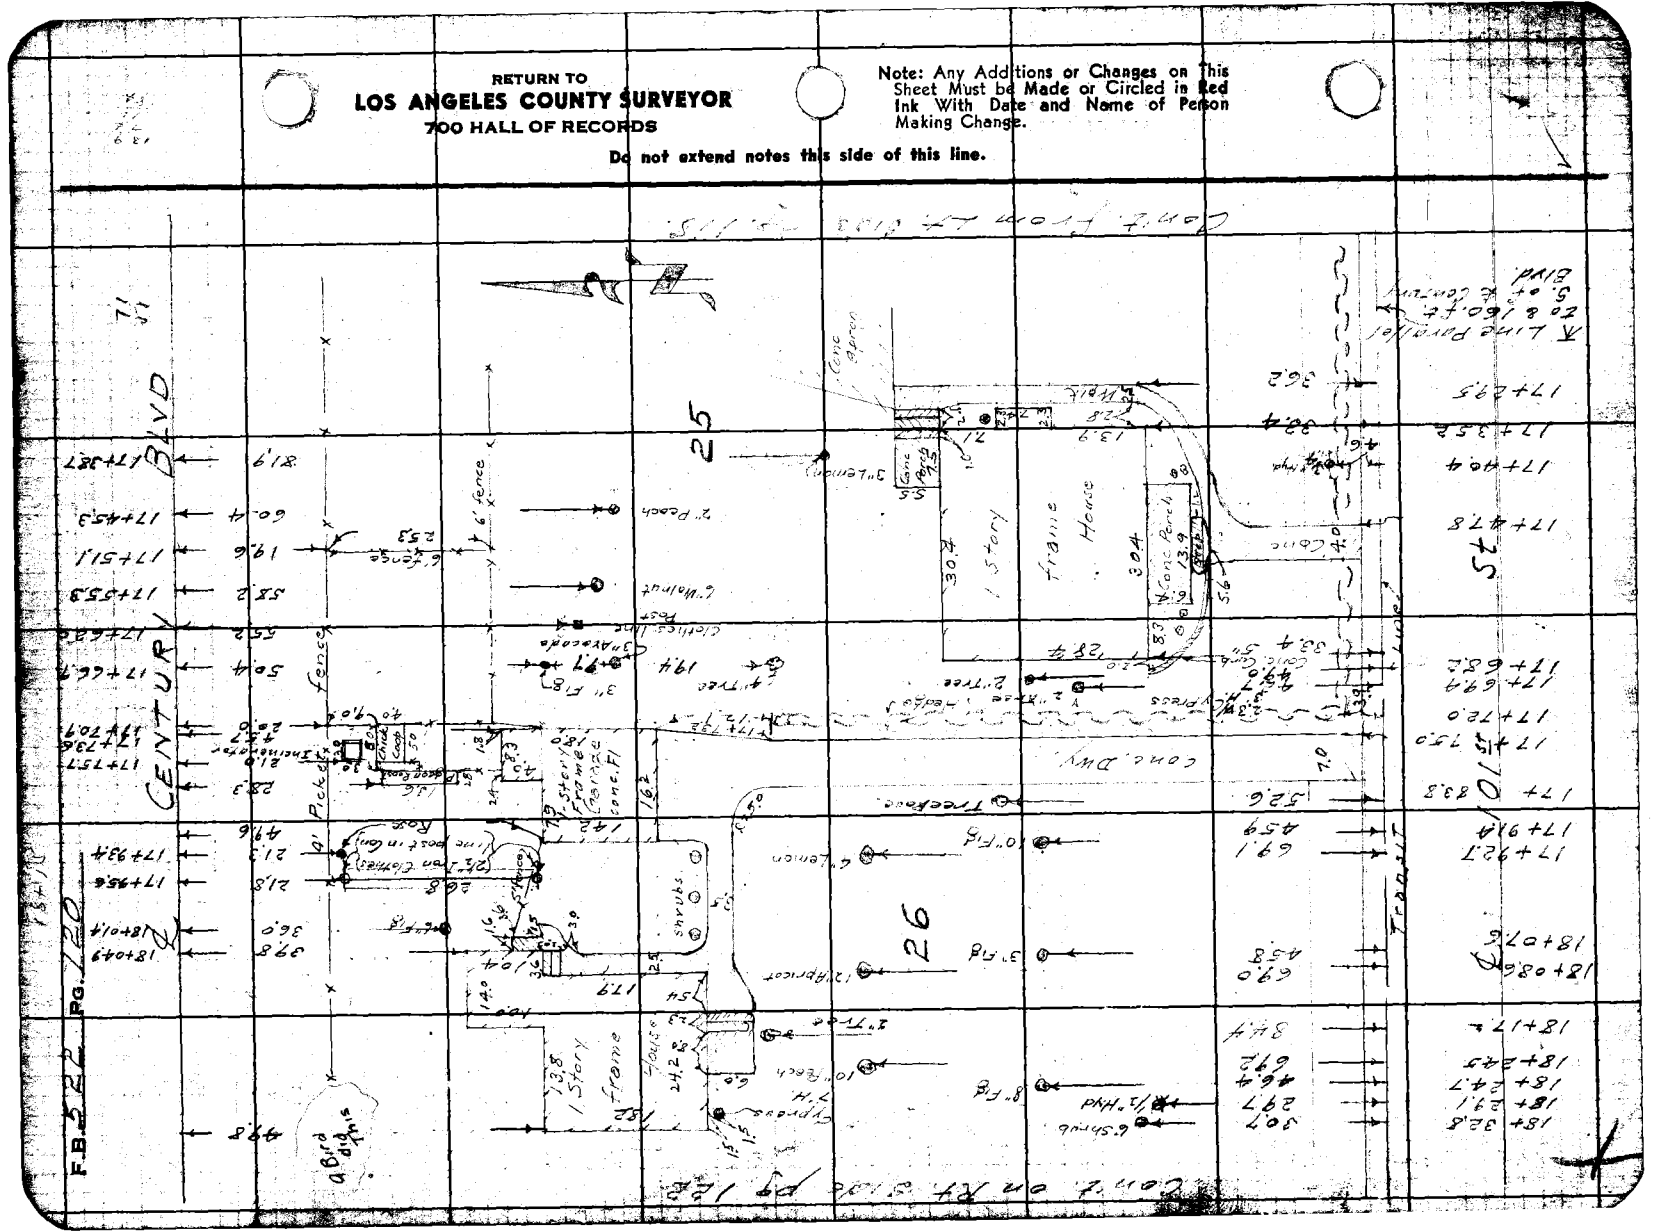
CENTURY BLVD
F.B. 522 PG. 120
25
26
27
Frame House
1 Story
Conc. Drive
Conc. Porch
Conc. Apron
Tree Fence
Pickett fence
6' fence
Shrubs
Conc. Curb
Conc. Walk
Line Post in Conc.


RETURN TO
LOS ANGELES COUNTY SURVEYOR
700 HALL OF RECORDS

Note: Any Additions or Changes on This Sheet Must be Made or Circled in Red Ink With Date and Name of Person Making Change.

Do not extend notes this side of this line.

Notes Ck'd by
Map No.
Office Work
Checked
Date

Survey of
W. O. Map No. Surveyed by
Notes
Indexed


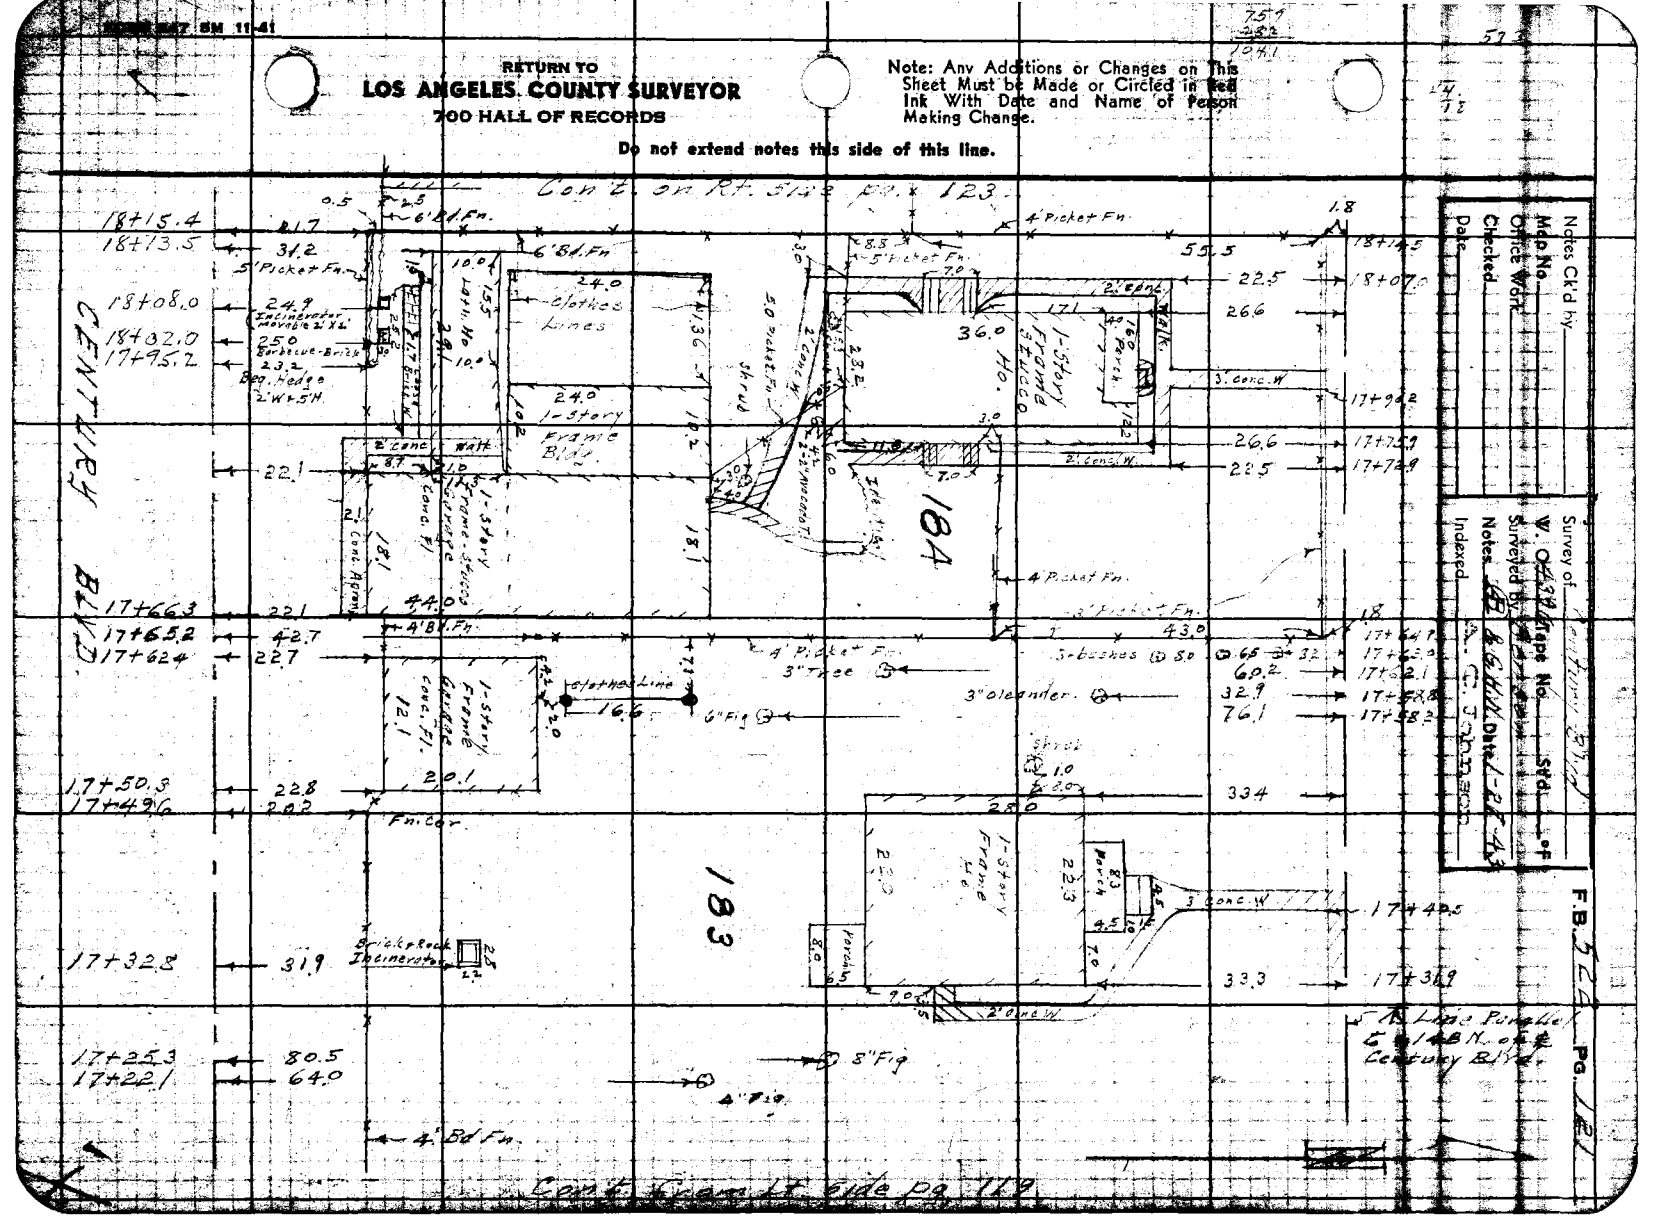

RETURN TO
LOS ANGELES COUNTY SURVEYOR
700 HALL OF RECORDS

Note: Any Additions or Changes on This Sheet Must be Made or Circled in Red Ink With Date and Name of Person Making Change.

Do not extend notes this side of this line.

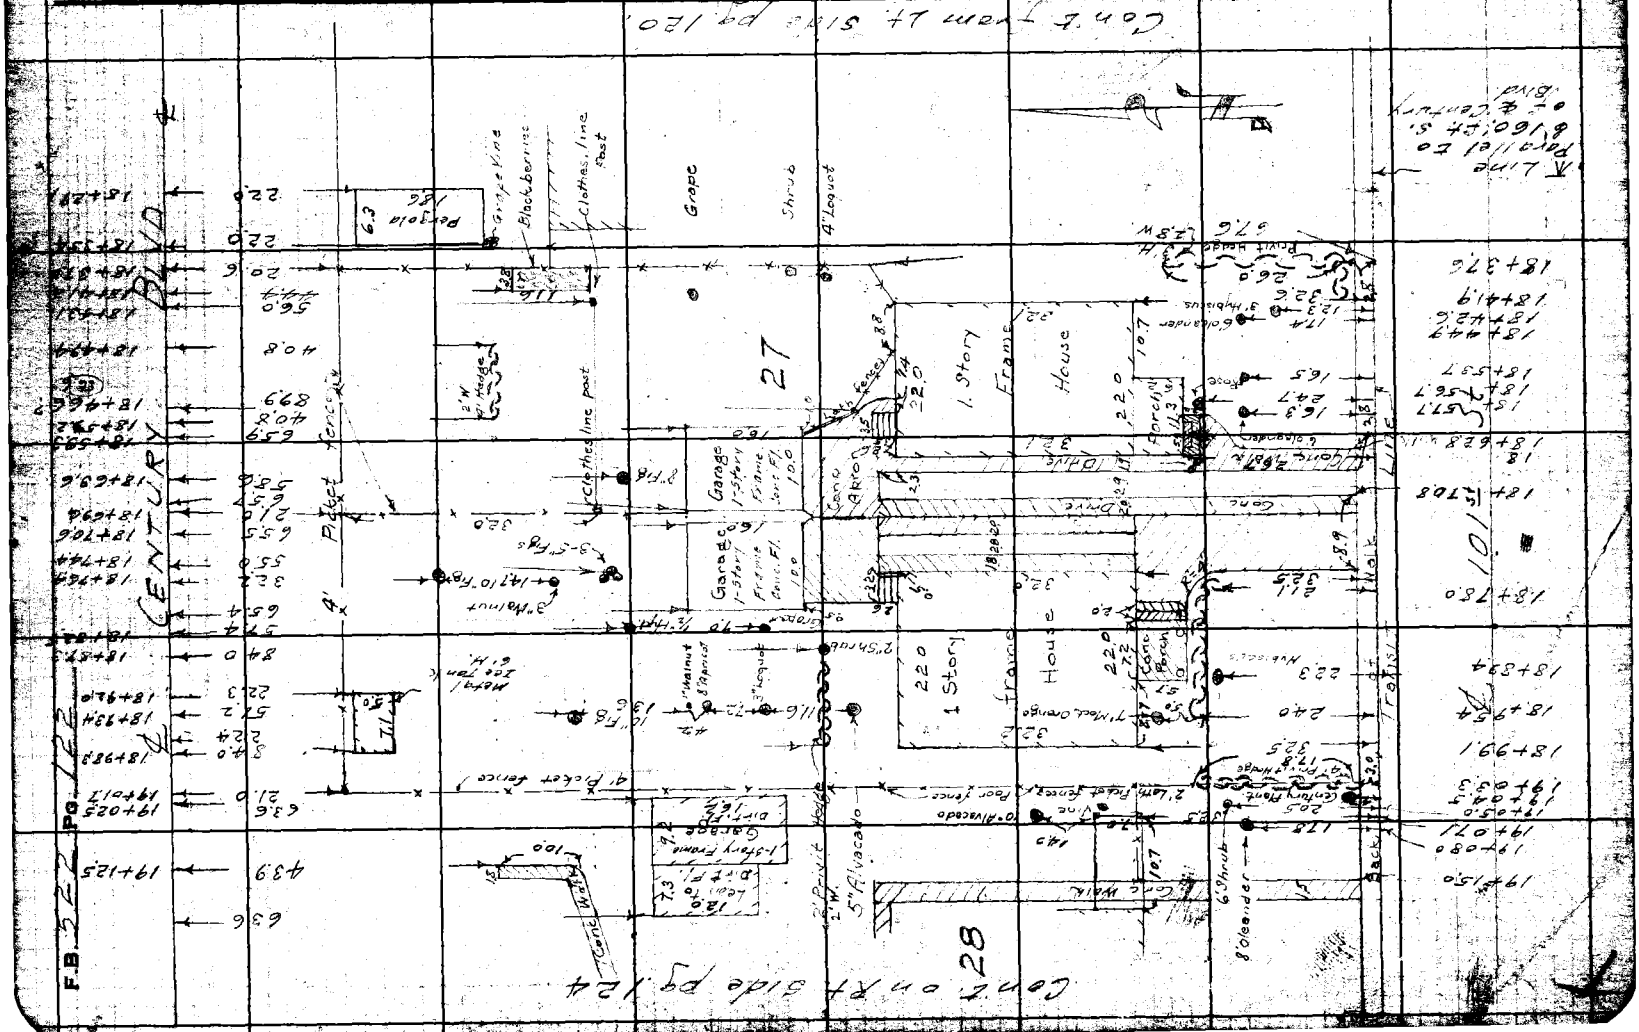
Cont. from 14 side pg. 120
Line
& Century Blvd
Grape
Shrub
4' Laquat
Grape Vine
Blackberries
Clothes line post
Pergola
Picket fence
27
1 Story Frame House

FORM 827-LR 11-41

RETURN TO
LOS ANGELES COUNTY SURVEYOR
700 HALL OF RECORDS

Note: Any Additions or Changes on This Sheet Must be Made or Circled in Red Ink With Date and Name of Person Making Change.

Do not extend notes this side of this line.

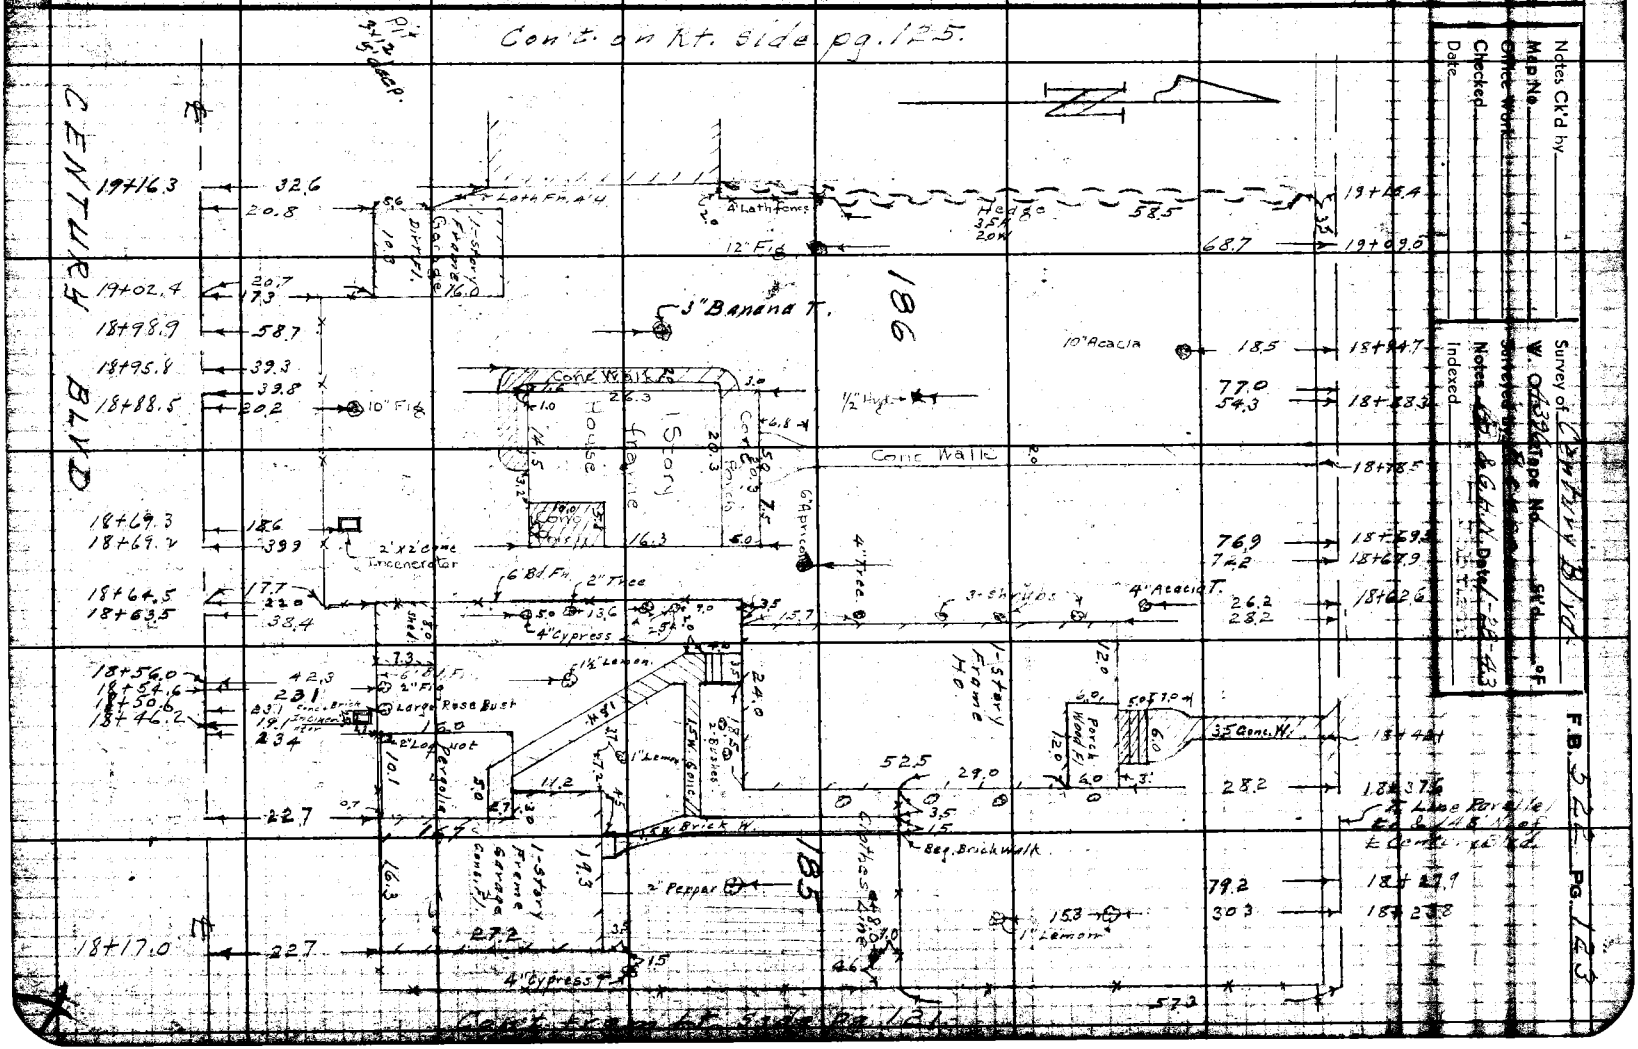

RETURN TO
LOS ANGELES COUNTY SURVEYOR
700 HALL OF RECORDS

Note: Any Additions or Changes on This Sheet Must be Made or Circled in Red Ink With Date and Name of Person Making Change.

Do not extend notes this side of this line.

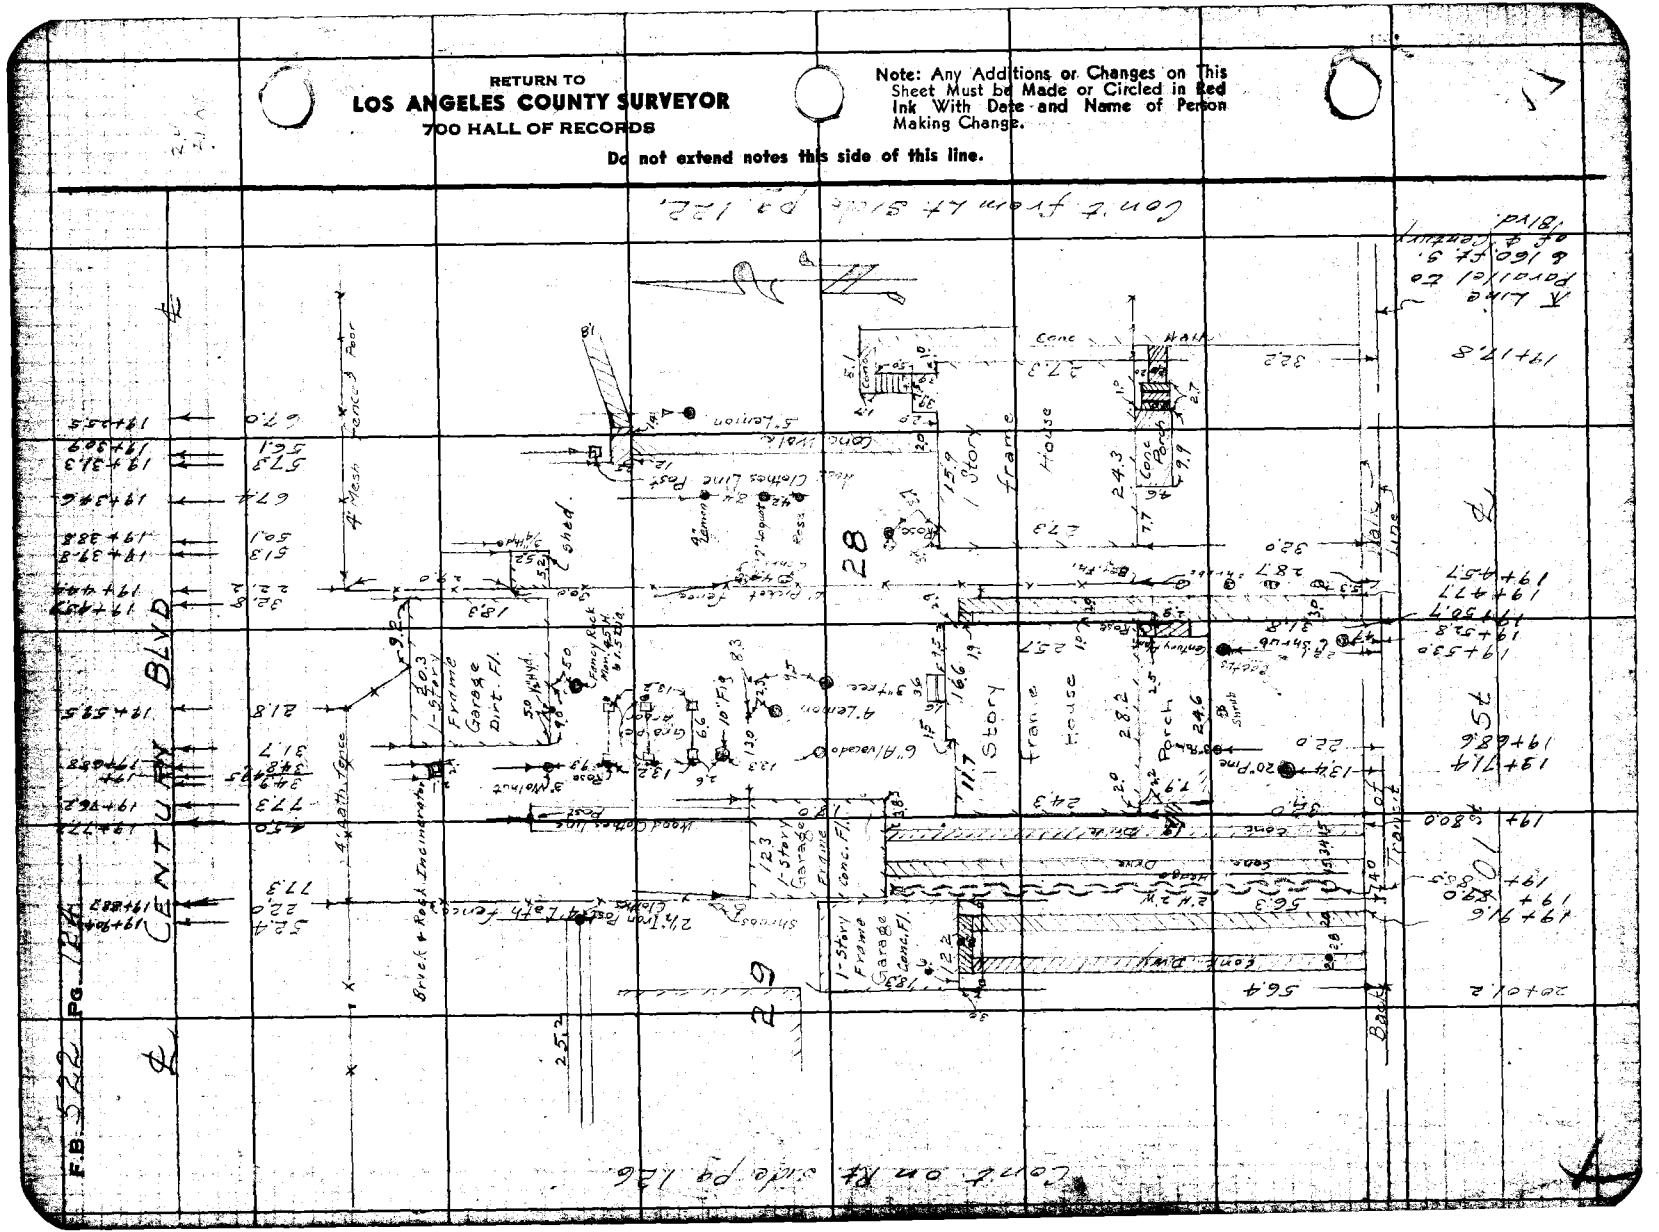

FORM 247 SM 11-41

RETURN TO
LOS ANGELES COUNTY SURVEYOR
700 HALL OF RECORDS

Note: Any Additions or Changes on This Sheet Must be Made or Circled in Red Ink With Date and Name of Person Making Change.

Do not extend notes this side of this line.

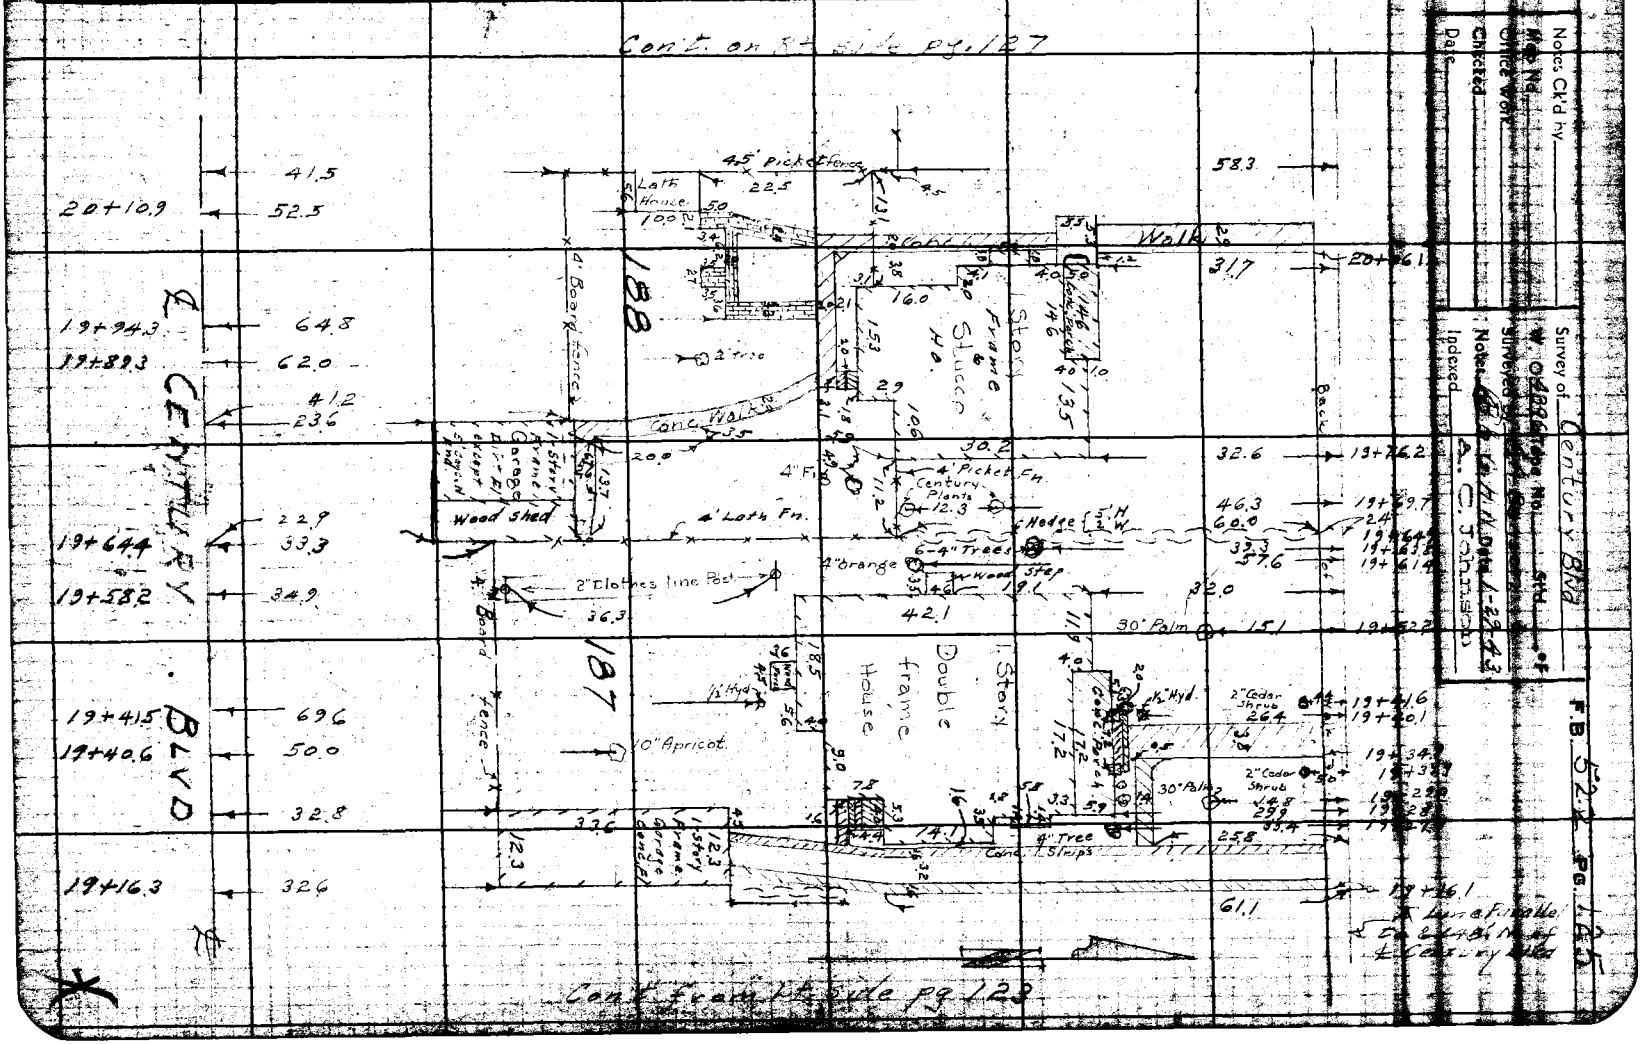

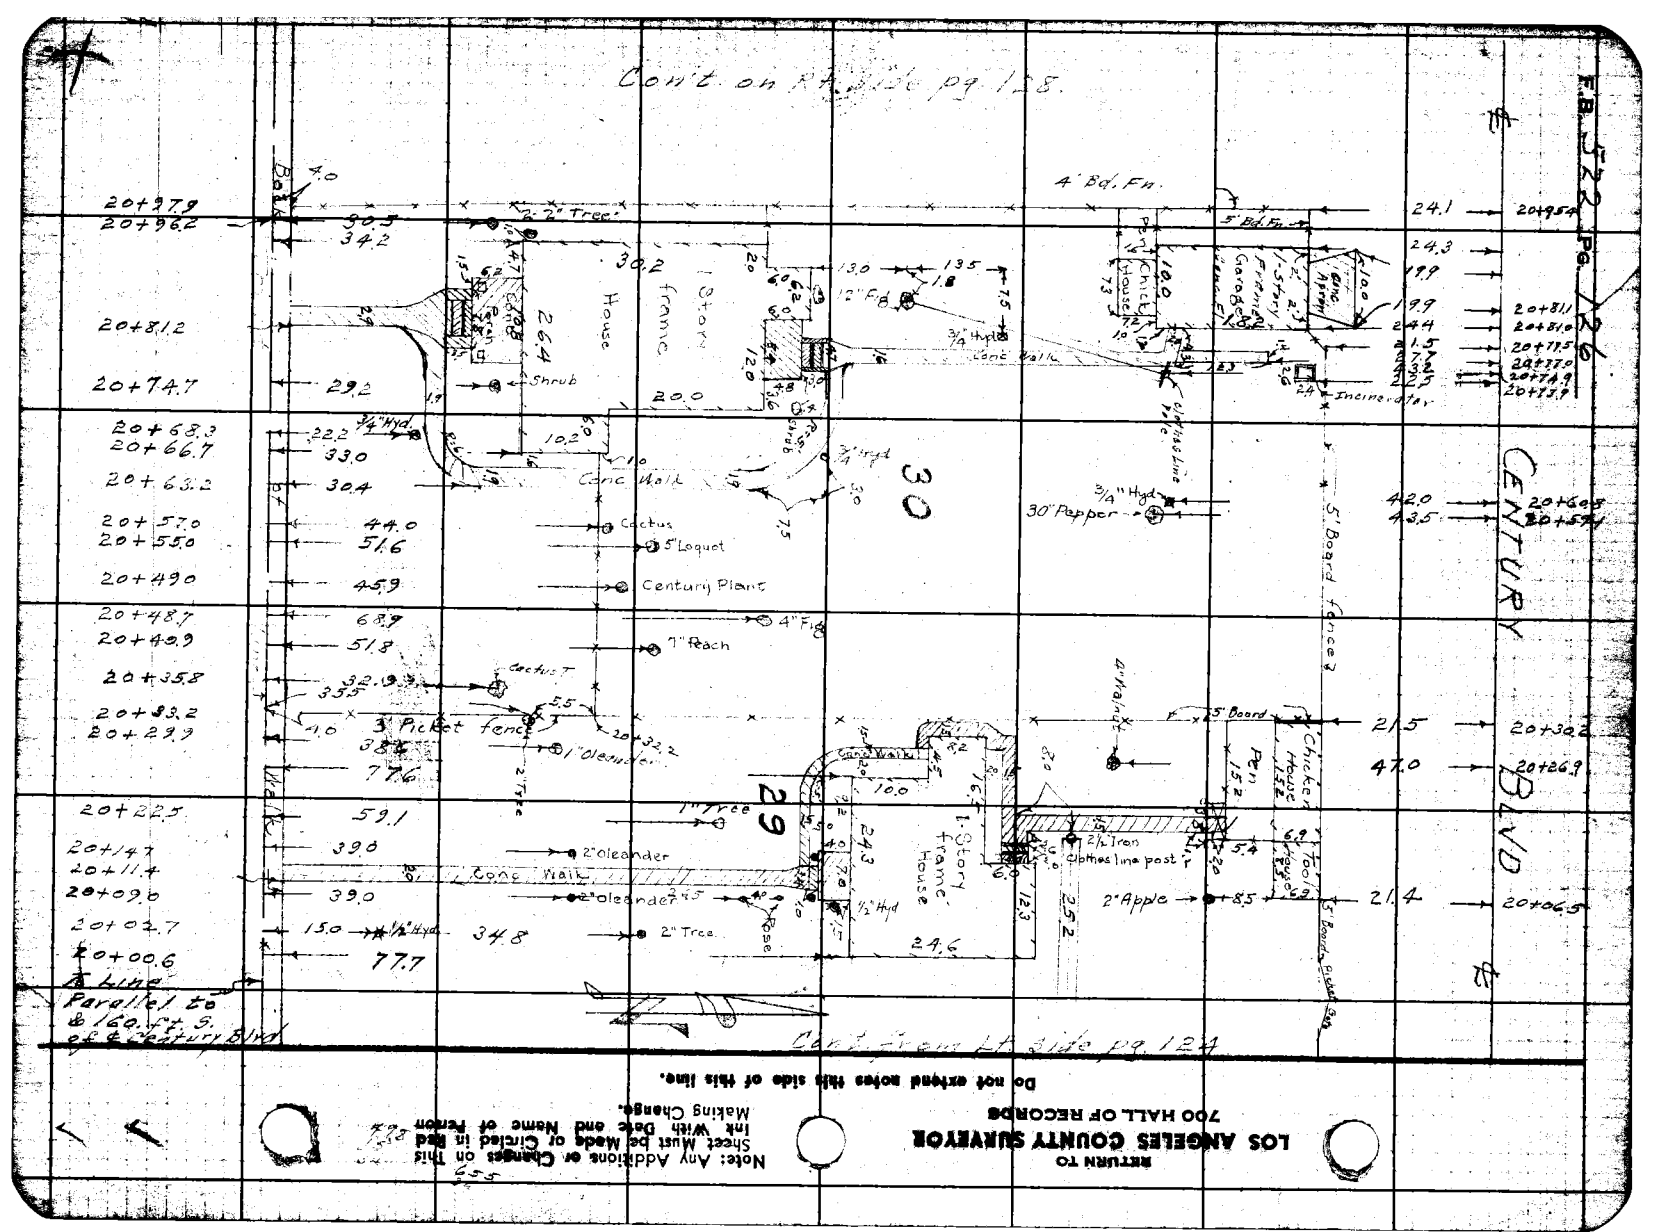
Cont. on R.S. 126 pg 128.
F.B. 522 Pg. 126
CENTURY BLVD
20+97.9
20+96.2
20+81.2
20+74.7
20+68.3
20+66.7
20+63.2
20+57.0
20+55.0
20+49.0
20+48.7
20+40.9
20+35.8
20+33.2
20+29.3
20+22.5
20+14.7
20+11.4
20+09.6
20+02.7
20+00.6
Bk. of Walk
4.0
30.5
34.2
2-2" Trees
30.2
1 Story frame House
26.4
Porch
Entry
Shrub
29.2
22.2
3/4" Hyd.
33.0
10.2
Conc. Walk
30.4
44.0
Cactus
51.6
5" Loquet
45.9
Century Plant
68.9
4" Fig
51.8
7" Peach
Cactus
32.1
35.5
5.5
3' Picket fence
1" Oleander
38.4
77.6
59.1
1" Tree
39.0
2" Oleander
Conc. Walk
39.0
2" Oleander
15.0
1/2" Hyd.
34.8
2" Tree
77.7
Line Parallel to & 160 Ft. S. of Century Blvd
4' Bd. Fn.
5' Bd. Fn.
24.1
20+95.4
Pen
Chicken Houses
10.0
13.3
1.0
1-Story Frame Garage
Conc. Apron
24.3
19.9
19.9
24.4
21.5
22.7
23.3
22.5
20+81.1
20+81.0
20+77.5
20+77.0
20+74.9
20+73.9
Incinerator
13.0
13.5
1.8
12" Fig
7.5
3/4" Hyd
Conc. Walk
20.0
6.0
6.2
4.8
5.0
1.6
2.4
3/4" Hyd
3.0
7.5
3/4" Hyd
30" Pepper
42.0
43.5
20+66.8
20+59.7
5' Board fence
Chicken House
Pen
15.2
15.2
2.6
2.4
Incinerator
30
29
4" Walnut
5' Board
21.5
47.0
20+32.2
20+26.9
10.0
16' 1-Story frame house
24.3
24.6
12.3
25.2
2" Iron Clothes line post
2" Apple
8.5
21.4
20+06.5
5' Board fence
Cont. from Lt. side pg 124
RETURN TO
LOS ANGELES COUNTY SURVEYOR
700 HALL OF RECORDS
Note: Any Additions or Changes on This Sheet Must be Made and Name of Person Making Change.
Ink With Date and Name of Circled in Red
Do not extend notes this side of this line.

FORM 247 SM 11-41

RETURN TO
LOS ANGELES COUNTY SURVEYOR
700 HALL OF RECORDS

Note: Any Additions or Changes on This Sheet Must be Made or Circled in Red Ink With Date and Name of Person Making Change.

Do not extend notes this side of this line.

Cont on Rt side pg. 123

Notes Ck'd by
Map No.
Office Work
Checked
Date

Survey of Century Blvd
Surveyed by
Noted
Date 2-1-43

F.B. 322 PG. 127

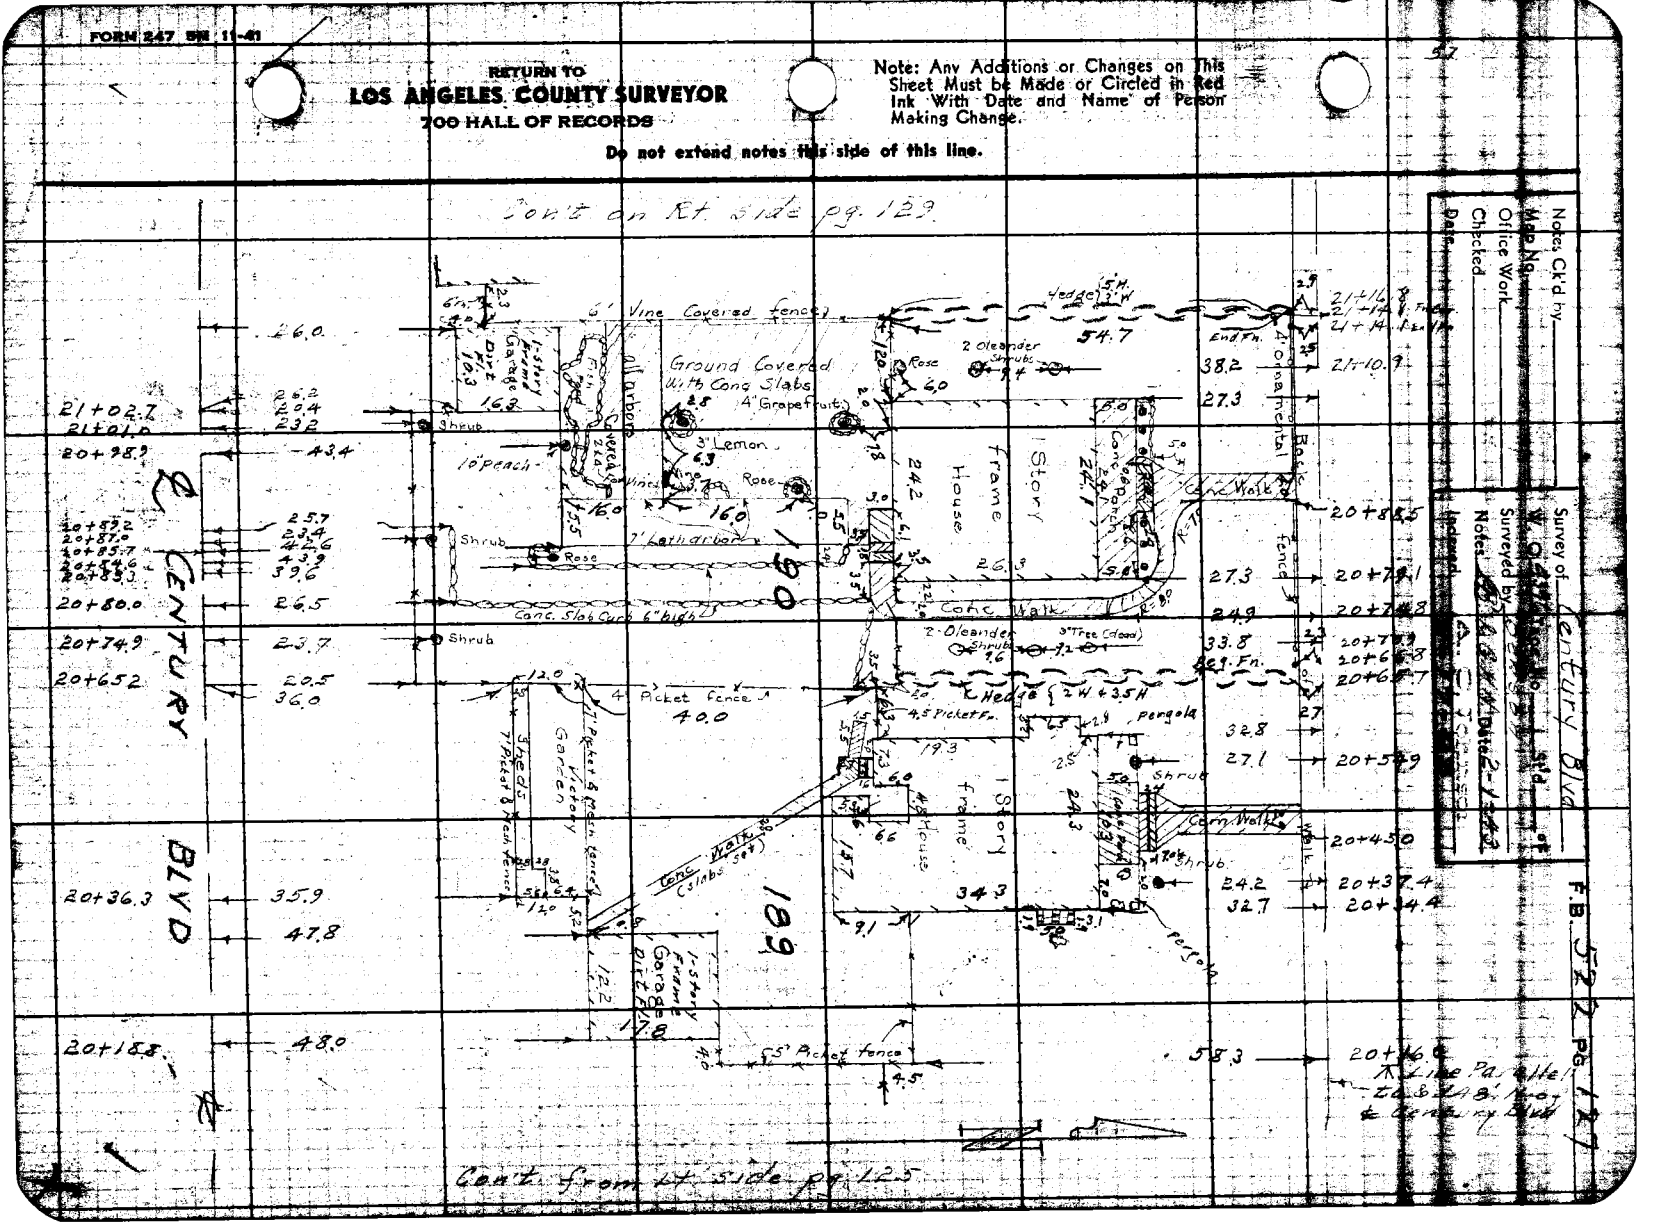

Cont. from Rt side pg. 125

RETURN TO
LOS ANGELES COUNTY SURVEYOR
700 HALL OF RECORDS

Note: Any Additions or Changes on This Sheet Must be Made of Circled in Red Ink With Date and Name of Person Making Change.

Do not extend notes this side of this line.

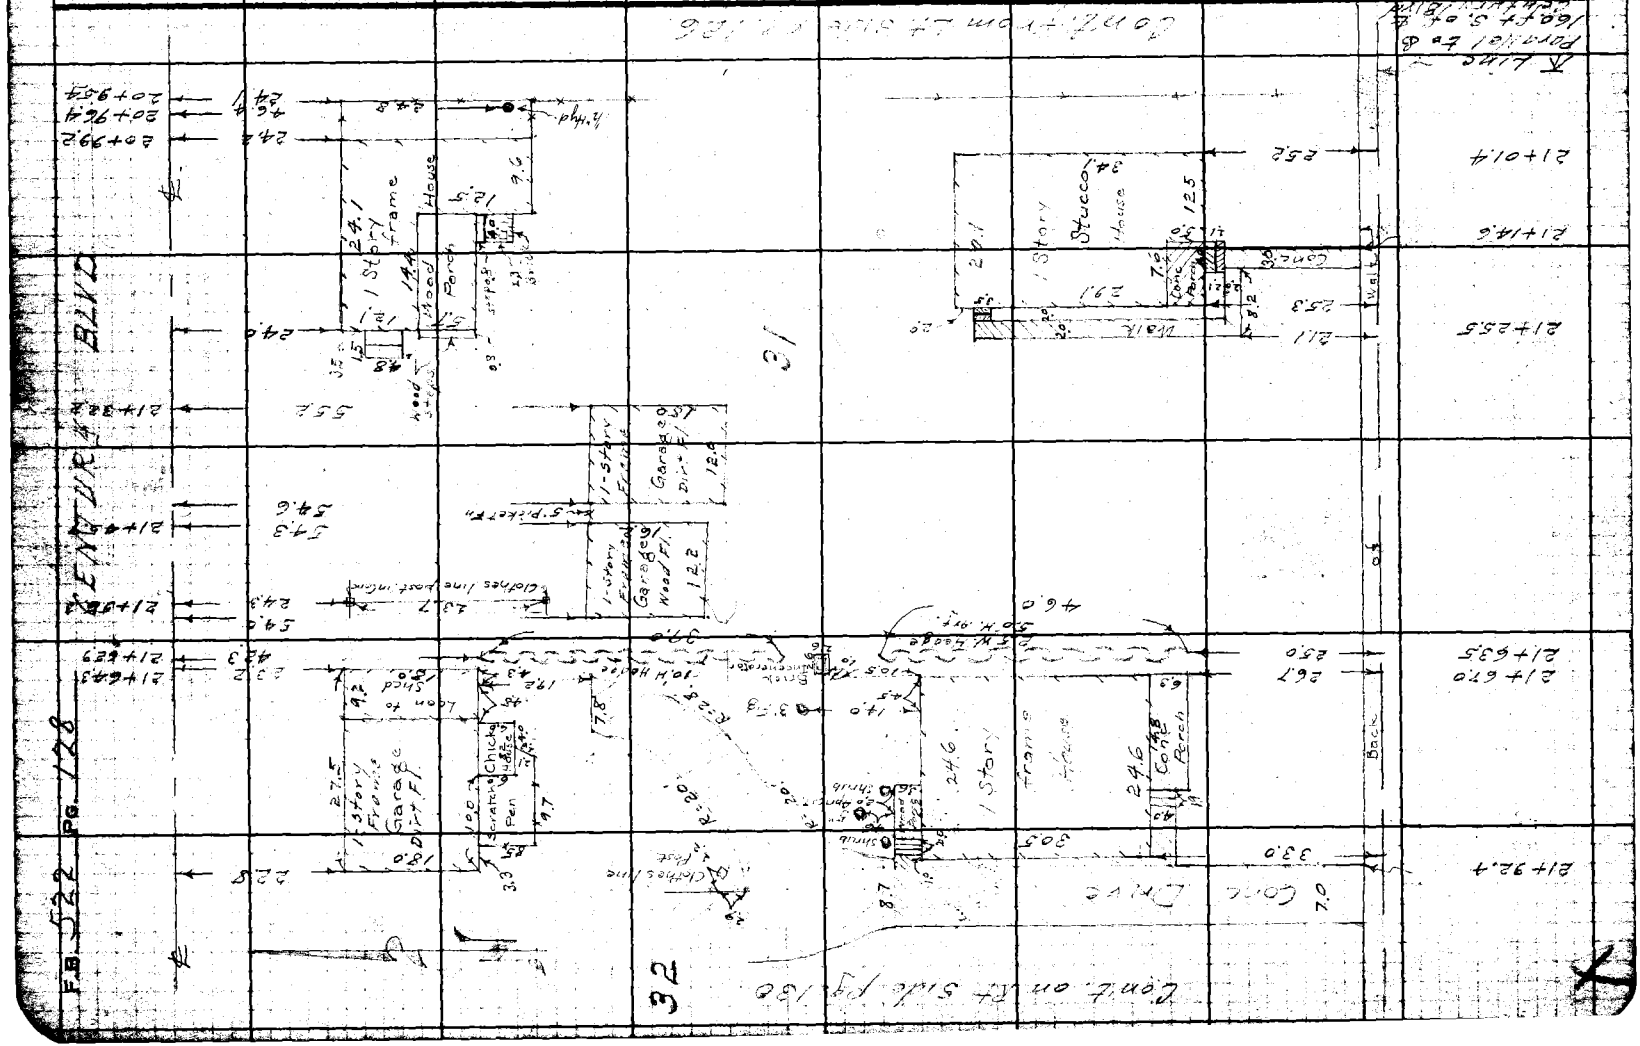

Notes Ck'd by
Map No.
Office Work
Checked
Date

Survey of CENTURY BLVD
W. O. 4396 Tape No. St'd °F
Surveyed by C.A. Benson
Notes GHN Date 6-2-43
Indexed

F.B. 322 PG. 129

Note: Any Additions or Changes on This Sheet Must be Made or Circled in Red Ink With Date and Name of Person Making Change.

Do not extend notes this side of this line.

RETURN TO
LOS ANGELES COUNTY SURVEYOR
7DO HALL OF RECORDS

FORM 247 5M 10-39

Back
5' Board fence
344
263
1 Story frame
House
Porch
Single
4x4 Clothes Line Post
192
191
203
222
1 Story Frame Garage Dirt F.
Vine Covered
5.4' Board fence
8' Board
& CENTURY BLVD

RETURN TO
LOS ANGELES COUNTY SURVEYOR
700 HALL OF RECORDS

Note: Any Additions or Changes on This Sheet Must be Made or Circled In Red Ink With Date and Name of Person Making Change.

Do not extend notes this side of this line.

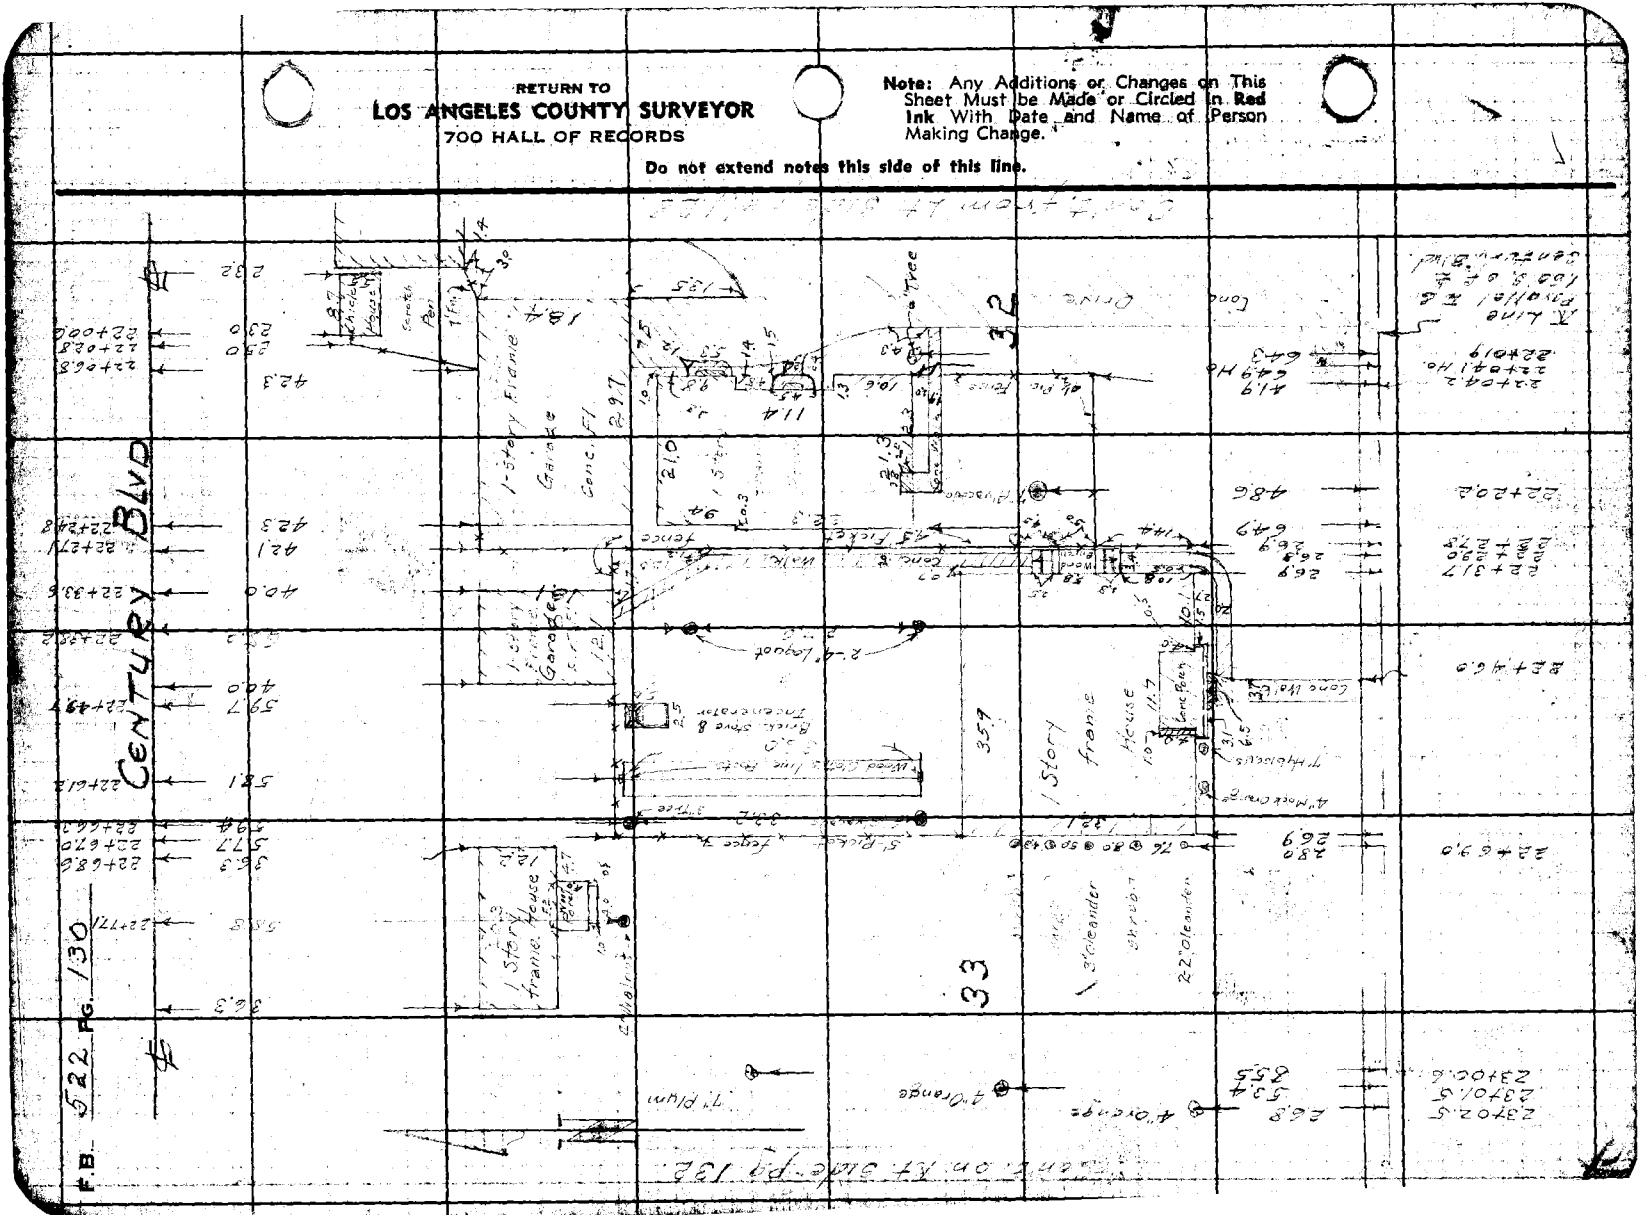

FORM 247 SM 10-39

RETURN TO
LOS ANGELES COUNTY SURVEYOR
700 HALL OF RECORDS

Note: Any Additions or Changes on This Sheet Must be Made or Circled in Red Ink With Date and Name of Person Making Change.

Do not extend notes this side of this line.

Cont'd on Rt. Side pg. 133

Notes Ck'd by
Map No.
Office Work Checked
Page

Survey of CENTURY BLVD
W. of Normandie Ave. St. 5
Surveyed by C.H.S. Date 2-2-43
Noted
Indexed

F.B. 322 PG. 131

123+14.6 — 20.5 — 6' Woven wire fence Iron posts — 12" Apricot — Rose — 12" Cedar — 12" Cedar — 12" Cedar

CENTURY BLVD

194

25.1 Stucco 1 Story 16.0 House — 12.1 — 3.0 Conc Porch — 17.5 — 39 Conc Ent — 5.0 — 12.1 — 5.2

64.6 — 64.7 — 20.4 — 50.9 — 22+66.3 — 22+65.5 — Gate — 6' Wire fence — W.F. — 1 Story Stucco Garage Floor El. — 17.5 — Conc — Conc — Drive — Drive — Conc — Drive — Conc — Drive — 23.8 — 34.7 — 34.5

22+45.7 — 50.9 — 22+39.1 — 61.4 — 22+38.0 — 52.5 — 22+34.7 — 20.3 — 5' Chicken fence — 1 Story Garage Floor El. — 18.0 — Conc Apron — 5' H'board fence — Clothes line Poles — 2" Avocado — 193 — 22.0 — 1 Story Frame House 23.1 — Conc Walk — 5' 34 ft. — 34.6 — 32.4

22+21.4 — 51.9 — 22+19.1 — 61.2 — 22+15.1 — 20.3 — 16.0 — 2" Avocado — 5' Board fence — 30.2

Cont from Lt. side pg 129

RETURN TO
LOS ANGELES COUNTY SURVEYOR
700 HALL OF RECORDS

Note: Any Additions or Changes on This Sheet Must be Made or Circled in **Red Ink** With Date and Name of Person Making Change.

Do not extend notes this side of this line.

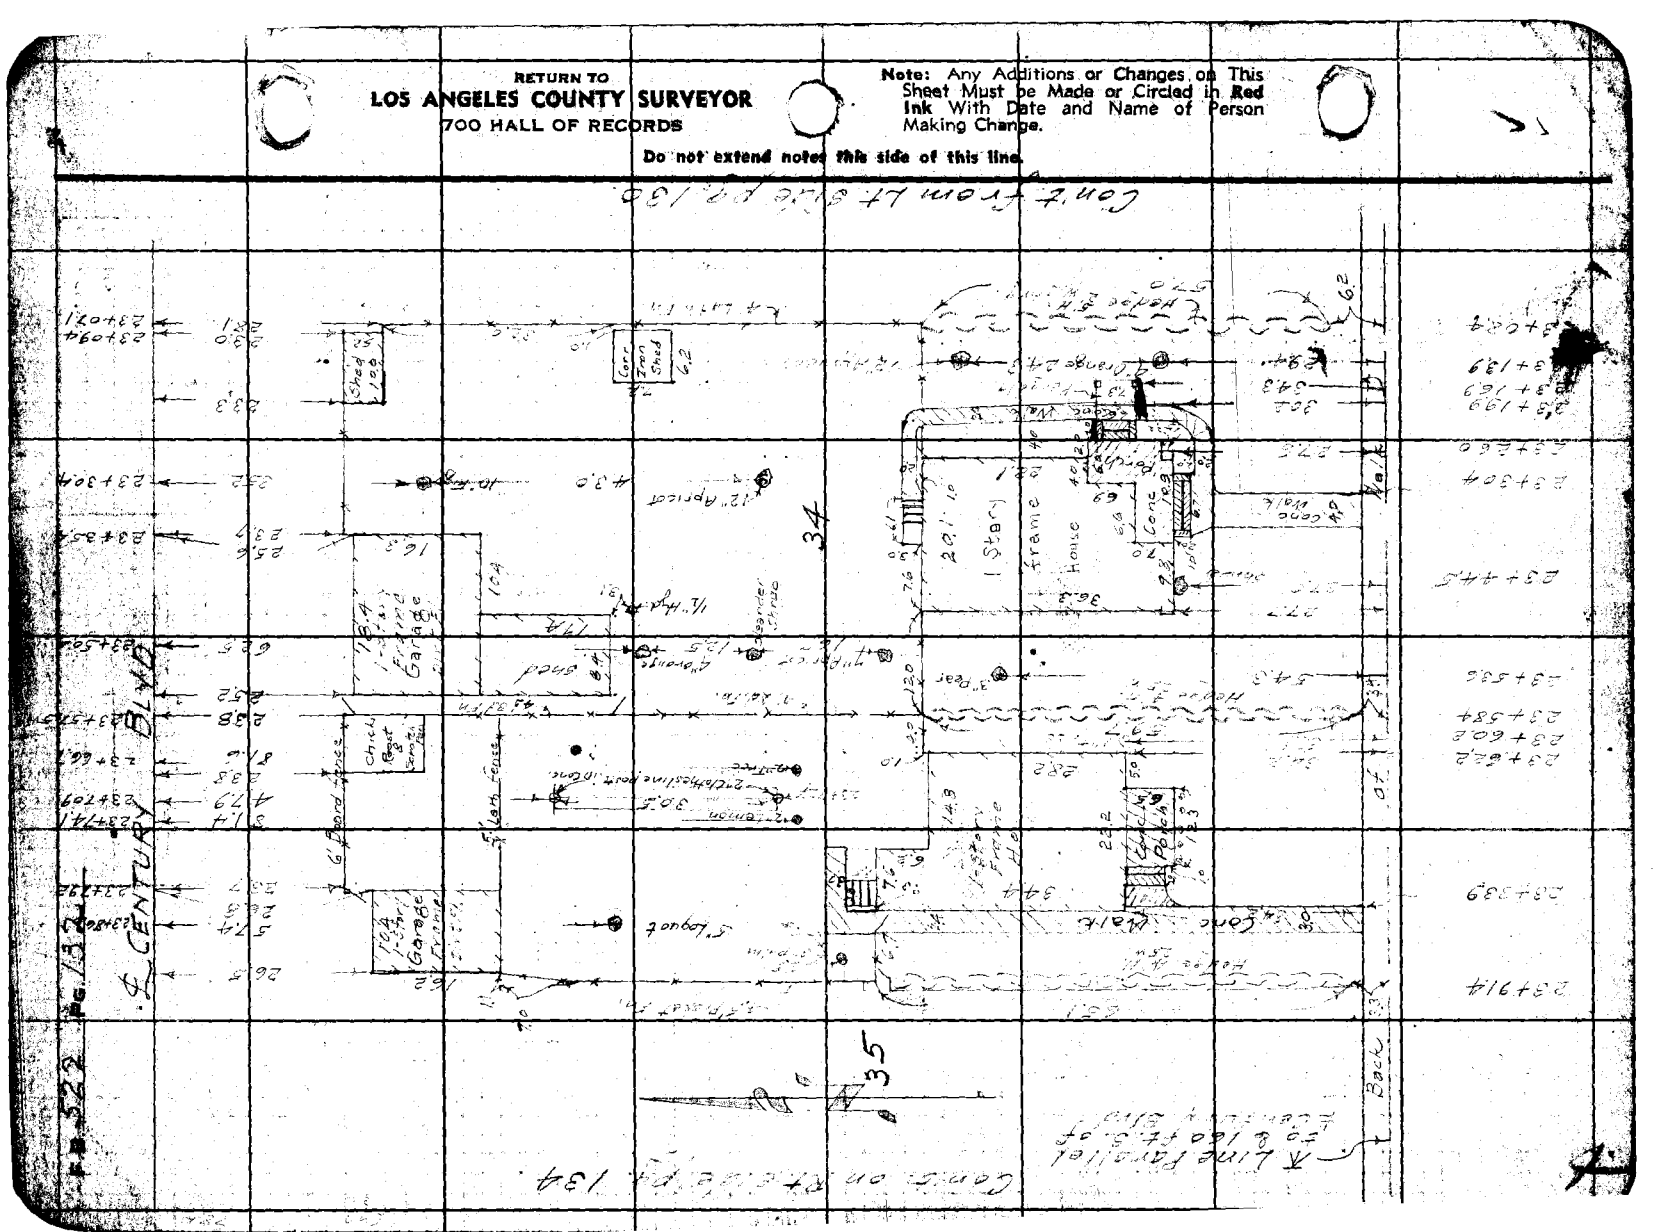

FORM 247 5M (11-41)

RETURN TO
LOS ANGELES COUNTY SURVEYOR
700 HALL OF RECORDS

Note: Any Additions or Changes on This Sheet Must be Made or Circled in Red Ink With Date and Name of Person Making Change.

Do not extend notes this side of this line.

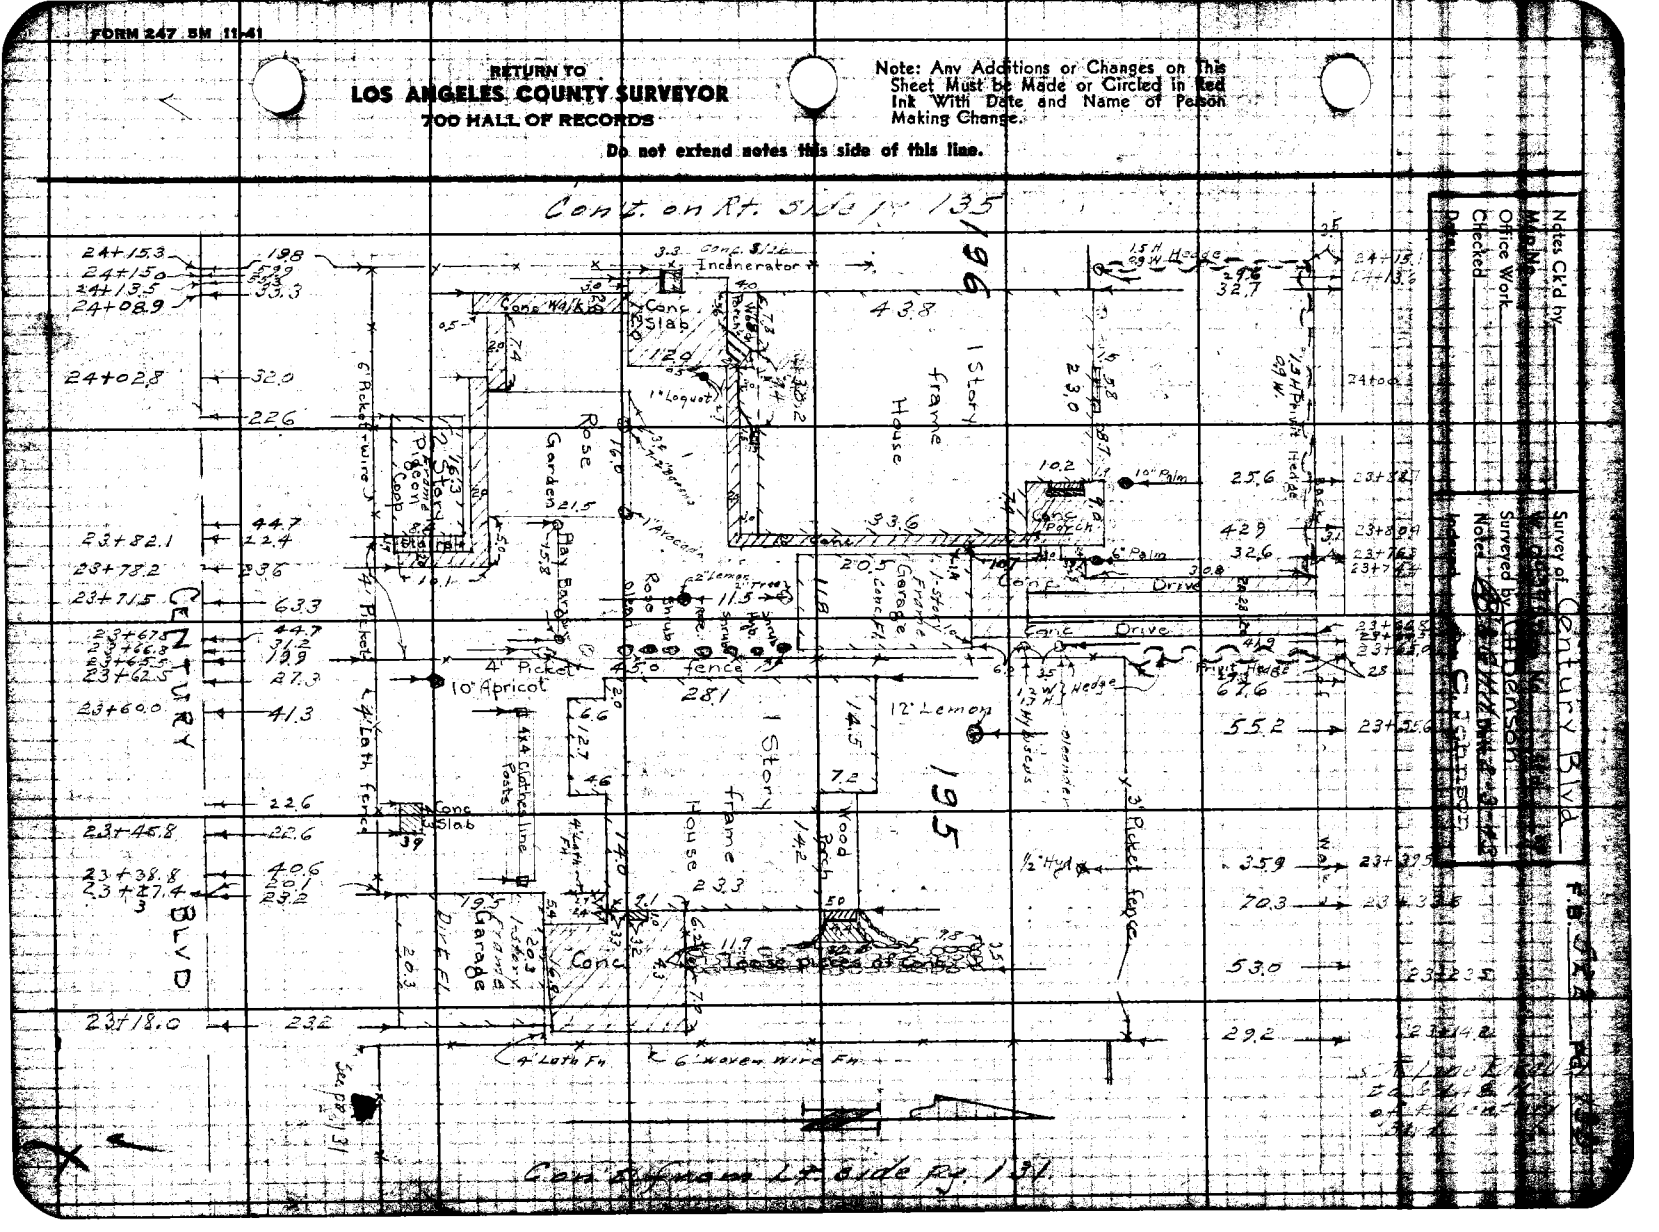

RETURN TO
LOS ANGELES COUNTY SURVEYOR
700 HALL OF RECORDS

Note: Any Additions or Changes on This Sheet Must be Made or Circled in Red Ink With Date and Name of Person Making Change.

Do not extend notes this side of this line.

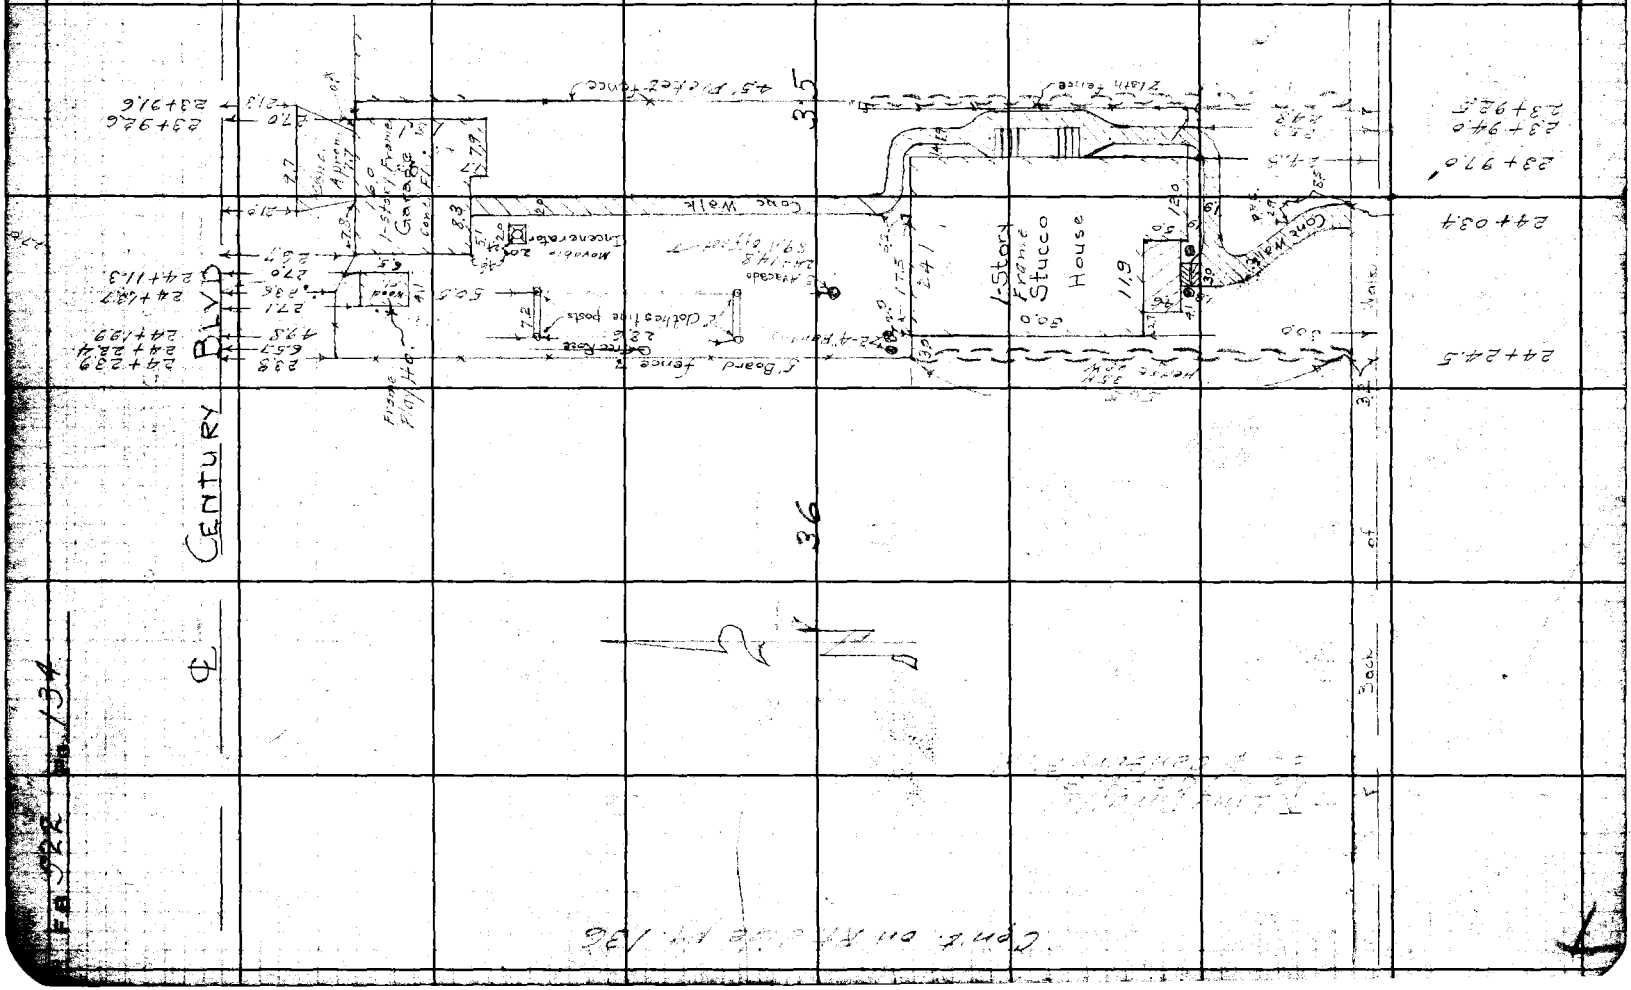

FORM 247 SM 11-41

RETURN TO
LOS ANGELES COUNTY SURVEYOR
700 HALL OF RECORDS

Note: Any Additions or Changes on This Sheet Must be Made or Circled in Red Ink With Date and Name of Person Making Change.

Do not extend notes this side of this line.

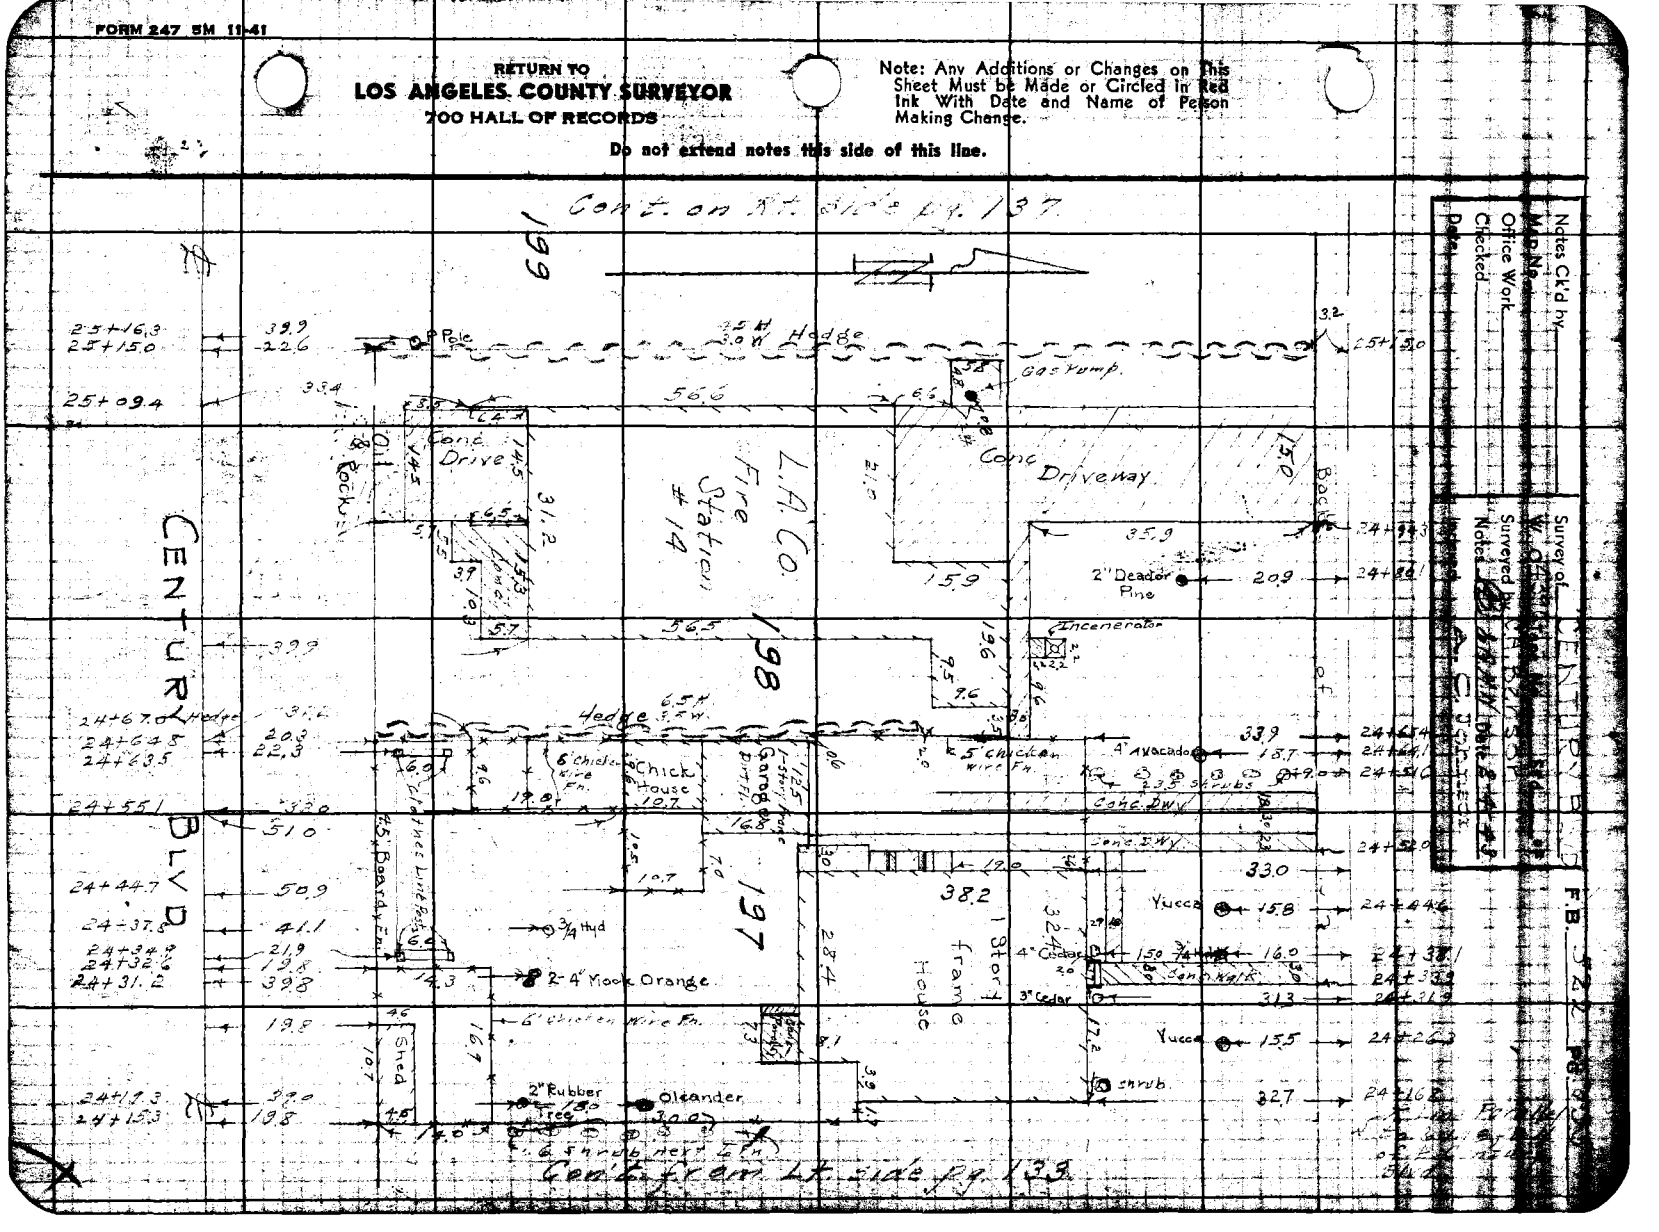

RETURN TO
LOS ANGELES COUNTY SURVEYOR
700 HALL OF RECORDS

Note: Any Additions or Changes on This Sheet Must be Made or Circled in Red Ink With Date and Name of Person Making Change.

Do not extend notes this side of this line.

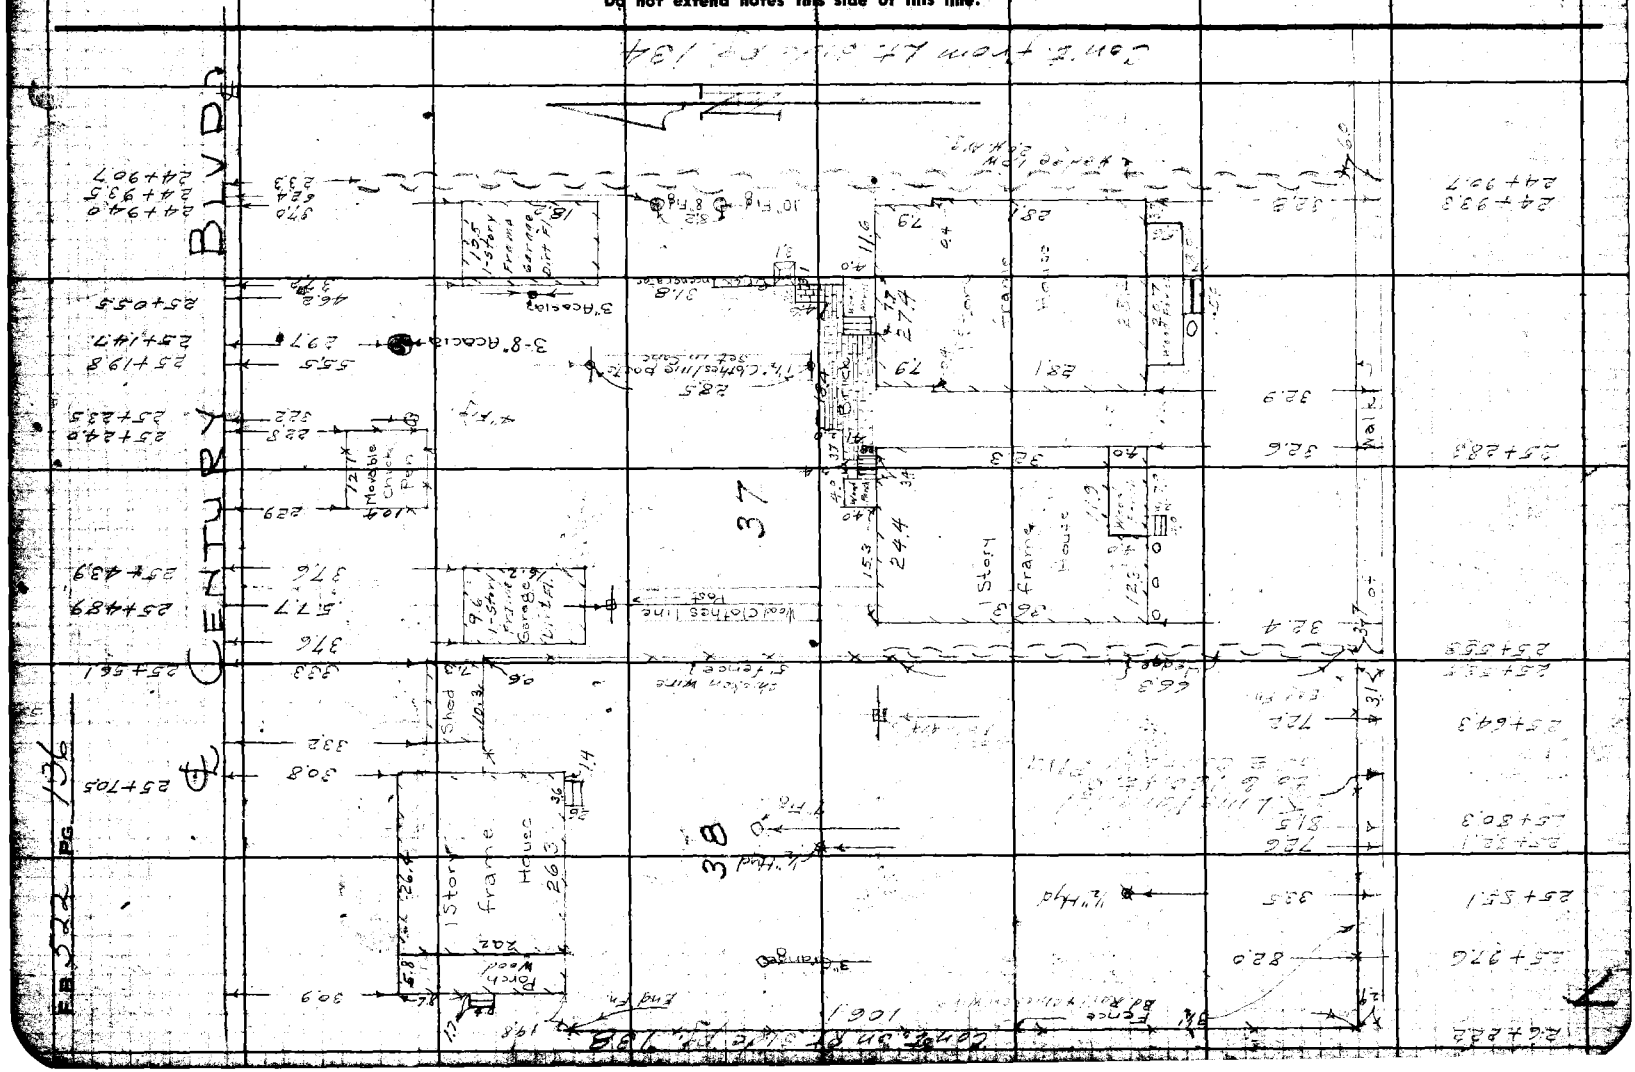

Notes Ck'd by
Map No.
Office Work
Checked
Date

Survey of CENTURY BLVD
W. O. 4296 Tape No. St'd °F
Surveyed by GA Benson
Notes GAB Date 2-5-43
Indexed A C Johnson

F.B. 522 PG. 137

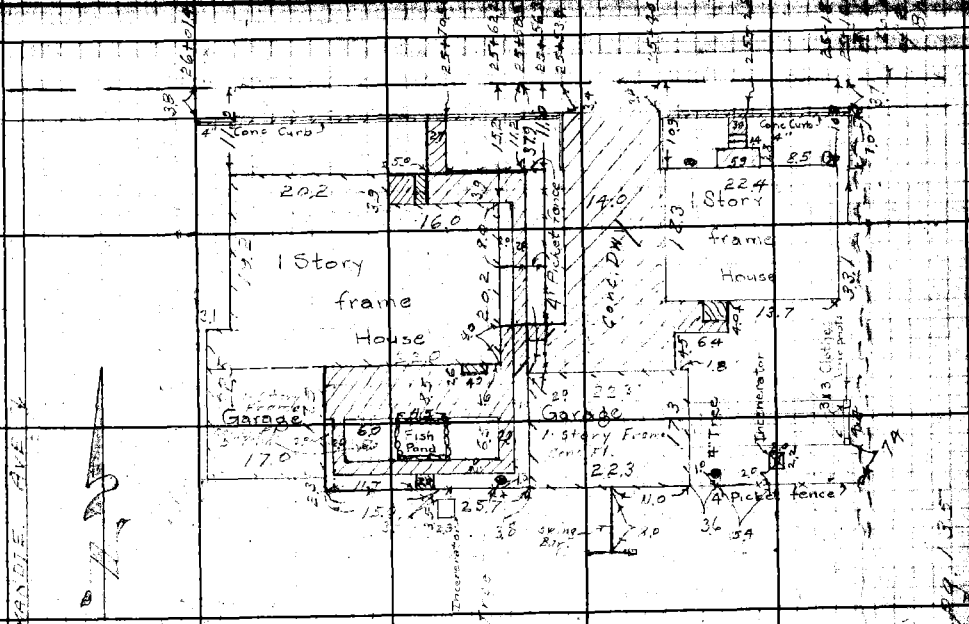

200

199

℄ NORMANDIE AVE.

℄ CENTURY BLVD

Fd Spk. Angle Point
Per C.S.B. 1045
26+51.26

Note: Any Additions or Changes on this Sheet Must be Made or Circled in Red Ink With Date and Name of Person Making Change.

Do not extend notes this side of this line.

RETURN TO
LOS ANGELES COUNTY SURVEYOR
700 HALL OF RECORDS

FORM 247 BM 11-41

RETURN TO
LOS ANGELES COUNTY SURVEYOR
700 HALL OF RECORDS

Note: Any Additions or Changes on This Sheet Must be Made or Circled in Red Ink With Date and Name of Person Making Change.

Do not extend notes this side of this line.

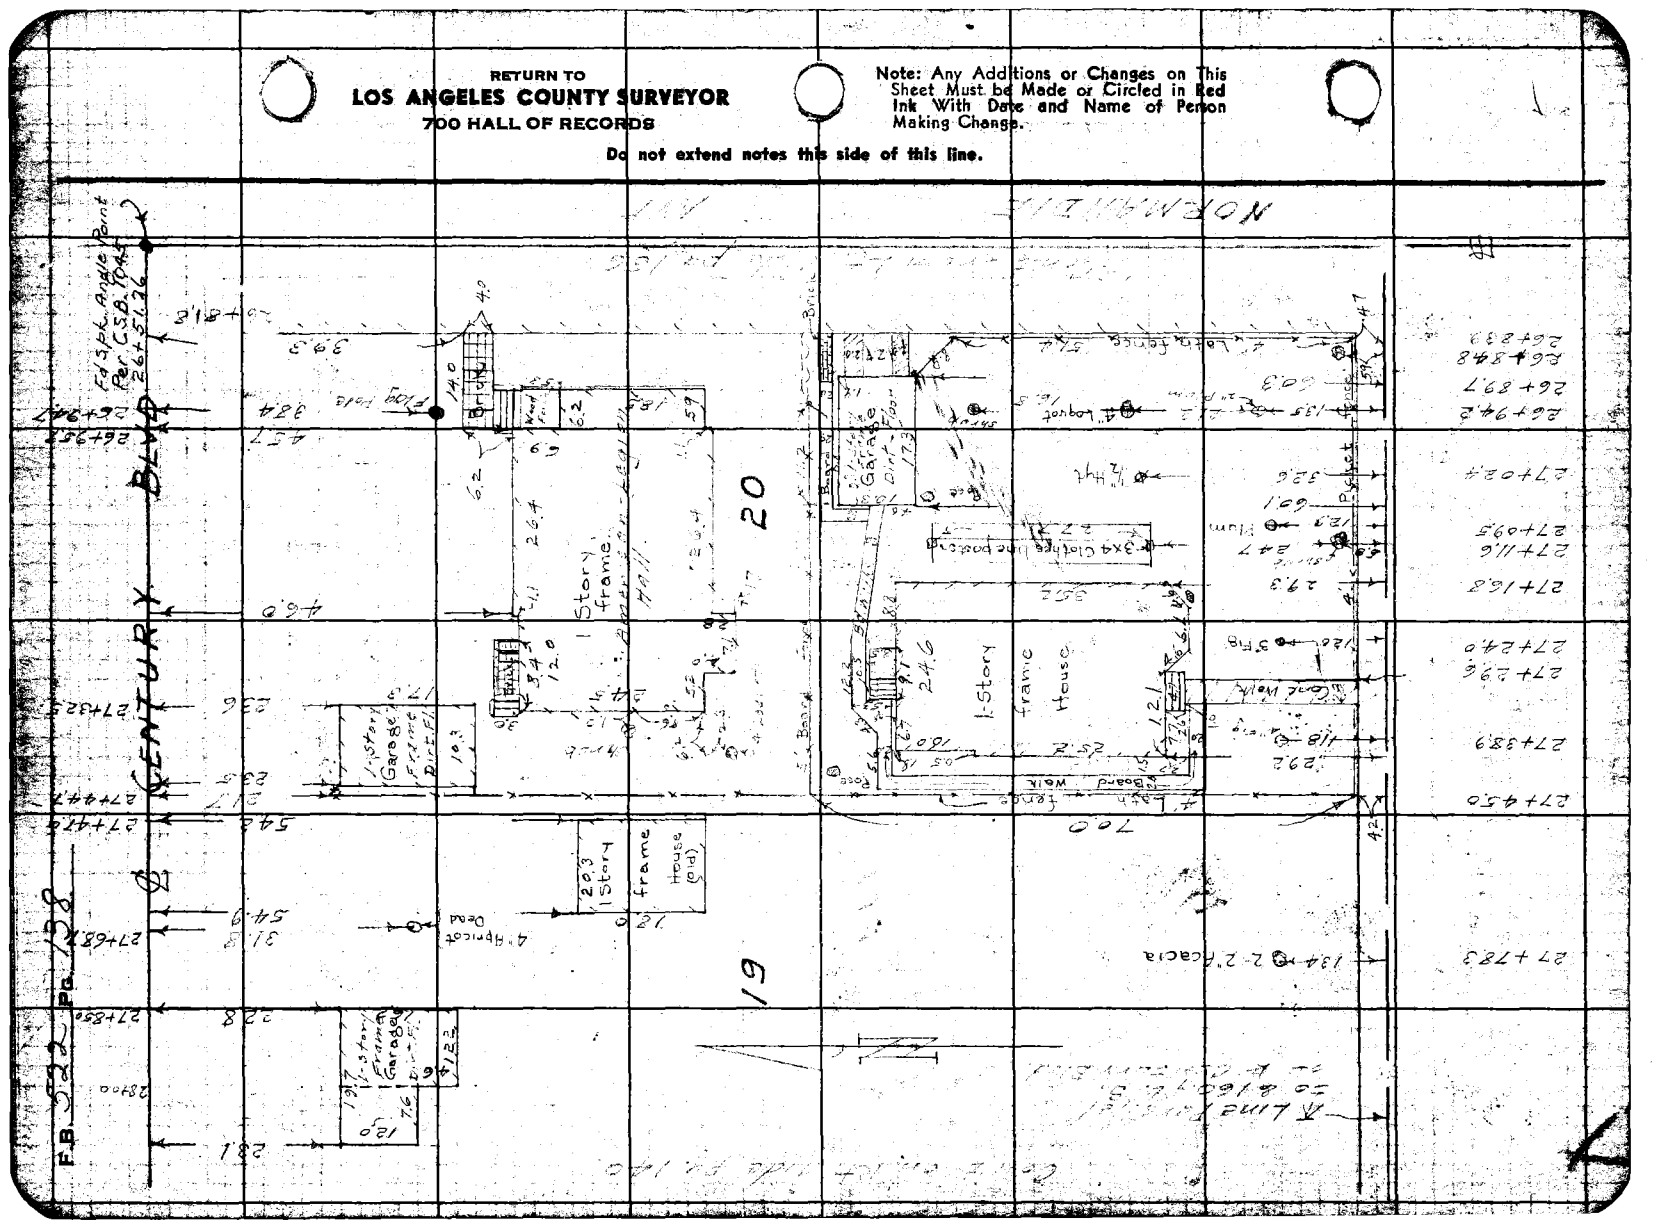

Notes Ck'd by		Survey of Century Blvd	F.B. 522 Pg. 139
Map No.		W. O. 4396 Tape No.	St'd. °F
Office Work		Surveyed by C.A. Berard	
Checked		Notes	Date
Date		Indexed 2-25-43	

Note: Any Additions or Changes on This Sheet Must be Made or Circled in Red Ink With Date and Name of Person Making Change.

Do not extend notes this side of this line.

RETURN TO
LOS ANGELES COUNTY SURVEYOR
700 HALL OF RECORDS

FORM 247 RM 11-41
























RETURN TO
LOS ANGELES COUNTY SURVEYOR
700 HALL OF RECORDS

Note: Any Additions or Changes on This Sheet Must be Made or Circled in Red Ink With Date and Name of Person Making Change.

Do not extend notes this side of this line.

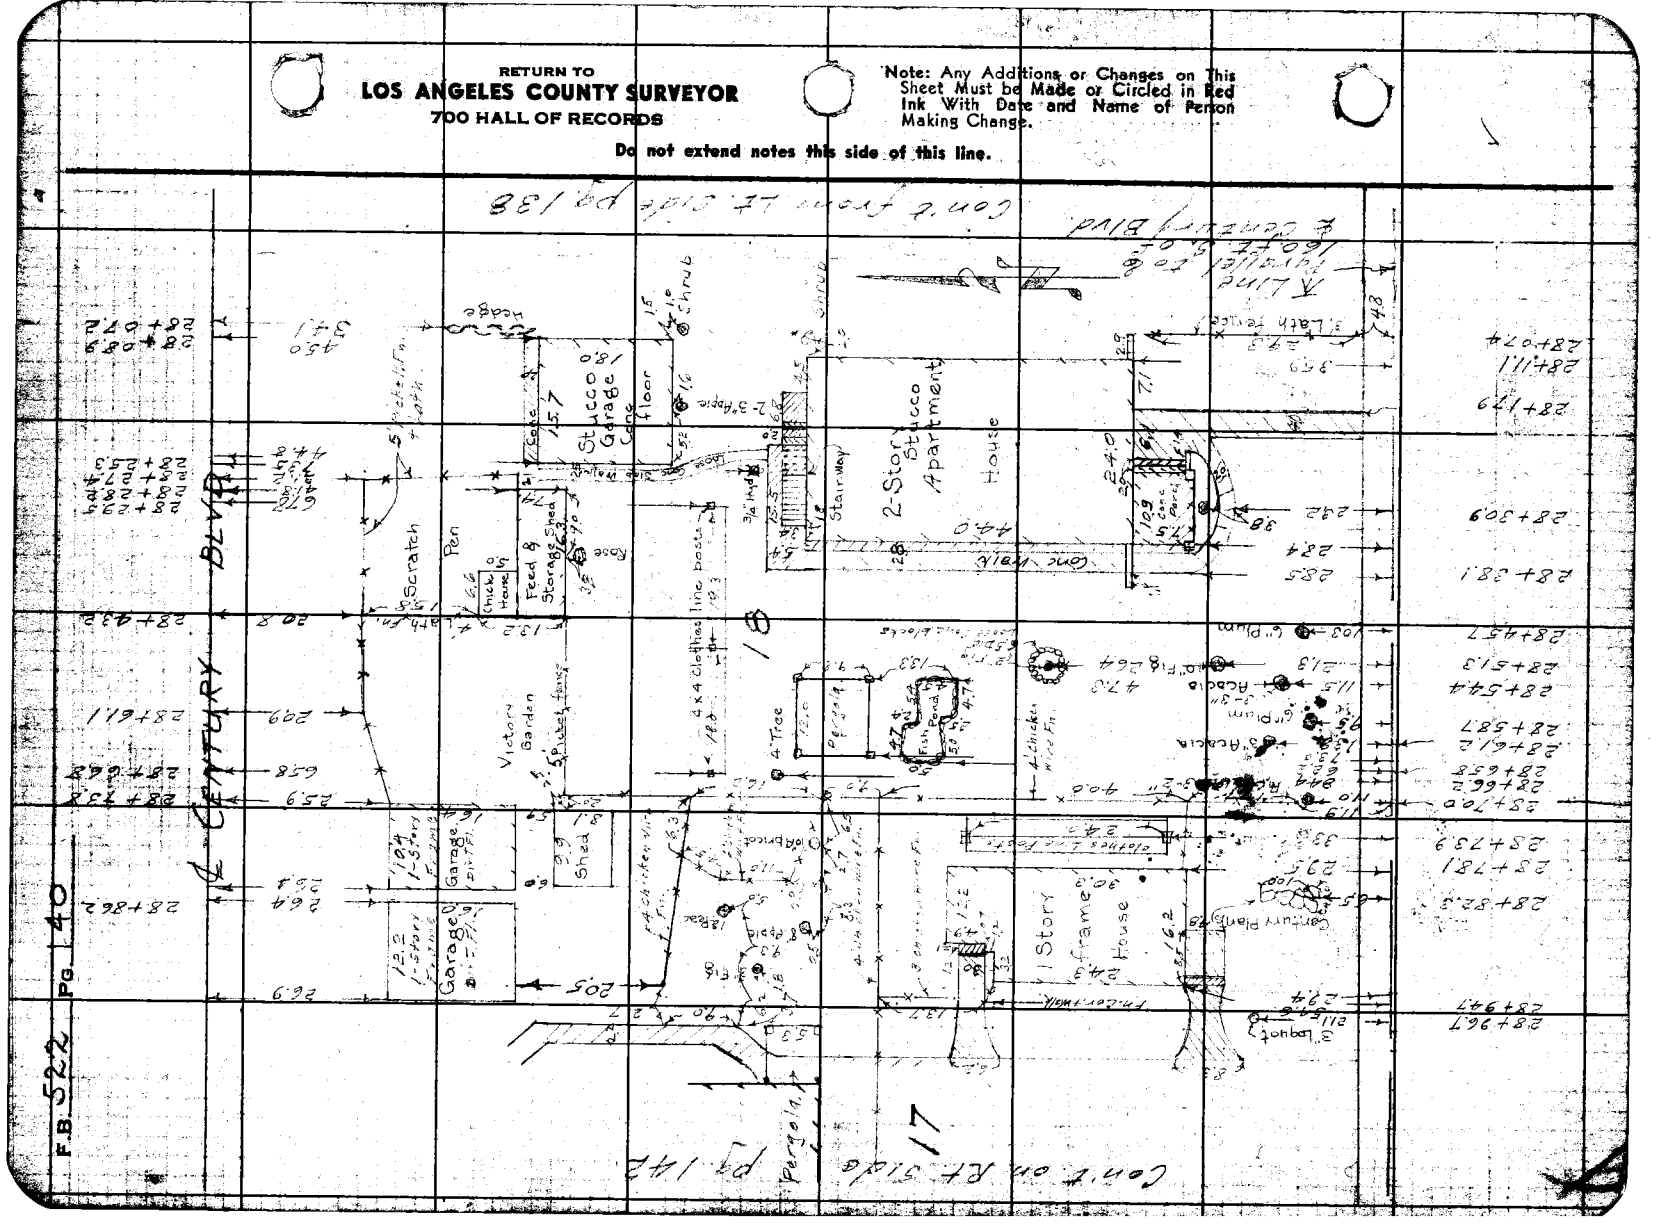
Cont'd from Lt side pg 138
Century Blvd
Century Blvd
Cont'd on Rt side pg 142
Century Blvd
Scratch
Pen
Chicken House
Feed & Storage Shed
Victory Garden
Stucco Garage
Cons. Floor
2-Story Stucco Apartment House
Stairway
Garage
Garage
Shed
1 Story Frame House
Fish Pond
Pergola
Clothes Line Posts
4 Tree

Notes Ck'd by
Map No.
Office Work
Checked
Date

Survey of CENTURY BLVD
W. O. 2396 Tape No. Sht'd °F.
Surveyed by A. Bernard
Notes C. Kelly Date 2-8-43
Indexed C. Johnson

F.B. 522 PG. 141

Note: Any Additions or Changes on this Sheet Must be Made or Circled in Red Ink With Date and Name of Person Making Change.

Do not extend notes this side of this line.

RETURN TO
LOS ANGELES COUNTY SURVEYOR
700 HALL OF RECORDS

FORM 247 5M 11-41

CENTURY BLVD

1 Story frame House

1-Story Frame Garage

Clothes line posts

Hedge 6.0 H 3.0 W.

Wire fence

Ornamental Fence

Concrete Curb

Sidewalk

Apricot

4 Woven Wire Fence

Lot 29

Lot 30

Lot 28

F.B. 522 PG. 142

RETURN TO
LOS ANGELES COUNTY SURVEYOR
720 HALL OF RECORDS

Do not extend notes this side of this line.

Note: Any Additions or Changes on This Sheet Must be Made or Circled in Red Ink With Date and Name of Person Making Change.

℄ of CENTURY BLVD

29+96.6
29+85.7
29+82.5
29+80.1
29+79.6
29+63.1
29+61.9
29+57.8
29+51.4
29+49.0
29+46.0
29+43.9
29+41.5
29+33.7
29+28.3
29+05.3
29+04.1
29+95.1

5' Chicken Wire Fn.
Shed
Bird Pole
5" Persimmon
Grape Arbor
4.5 Chicken Wire Fn.
Blackberries
Loquats
Oleanders
Pole
Century
Gnt
Ole
Ave.
Avocado
Banana
Hedge
Fence
Story
frame House
16
242
Brick Incinerator
Conc. Porch
178
264
274
Conc. Walks
25' Picket Fn.
8" F.H.
Bronze
Oleanders
Shrub
Lath
Trees
Shrubs
Ivy
Cent.
Ole
Century

Century Blvd
Survey Mon. Set & 160 Ft. S. of ℄ Century Blvd

FORM 247 SM 11-41

RETURN TO
LOS ANGELES COUNTY SURVEYOR
700 HALL OF RECORDS

Note: Any Additions or Changes on This Sheet Must be Made or Circled in Red Ink With Date and Name of Person Making Change.

Do not extend notes this side of this line.

Notes Ck'd by _____
Map No. _____
Office Work _____
Checked _____
Date _____

Survey of CENTURY BLVD
W.O. 4231 Tract No. _____ of
Surveyed by C.A.R. Date 2-8-43
Notes _____
Indexed _____ Date _____


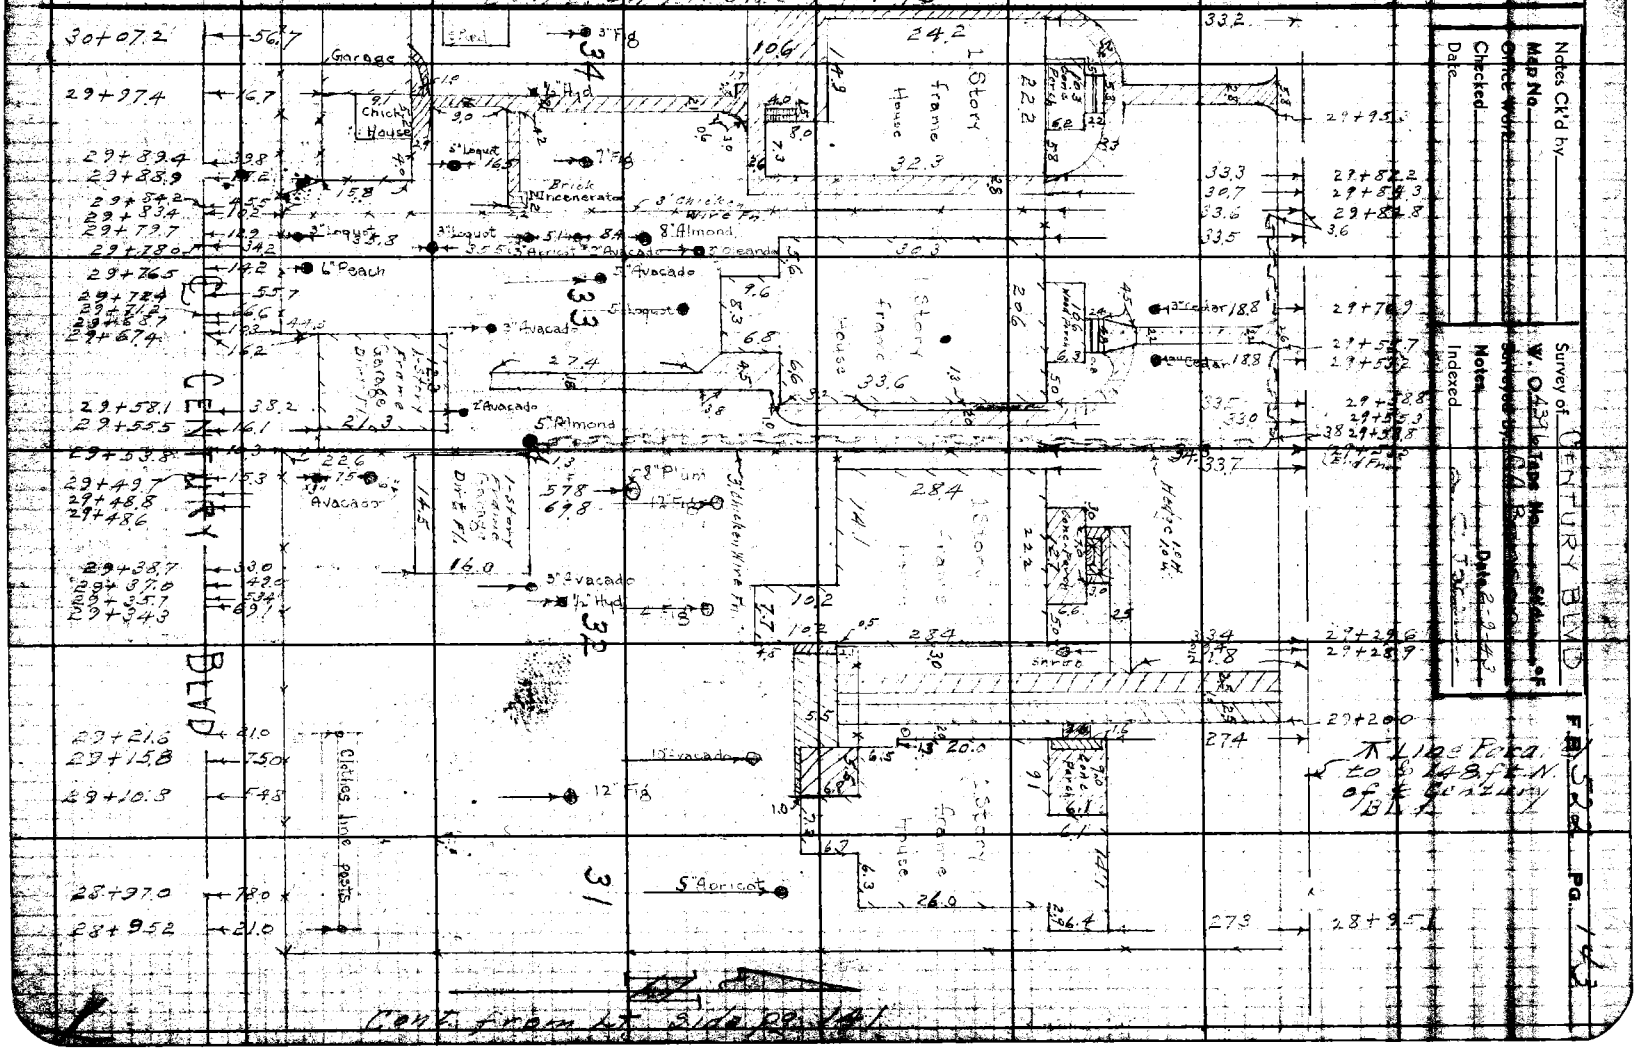

RETURN TO
LOS ANGELES COUNTY SURVEYOR
700 HALL OF RECORDS

Note: Any Additions or Changes on This Sheet Must be Made or Circled in Red Ink With Date and Name of Person Making Change.

Do not extend notes this side of this line.

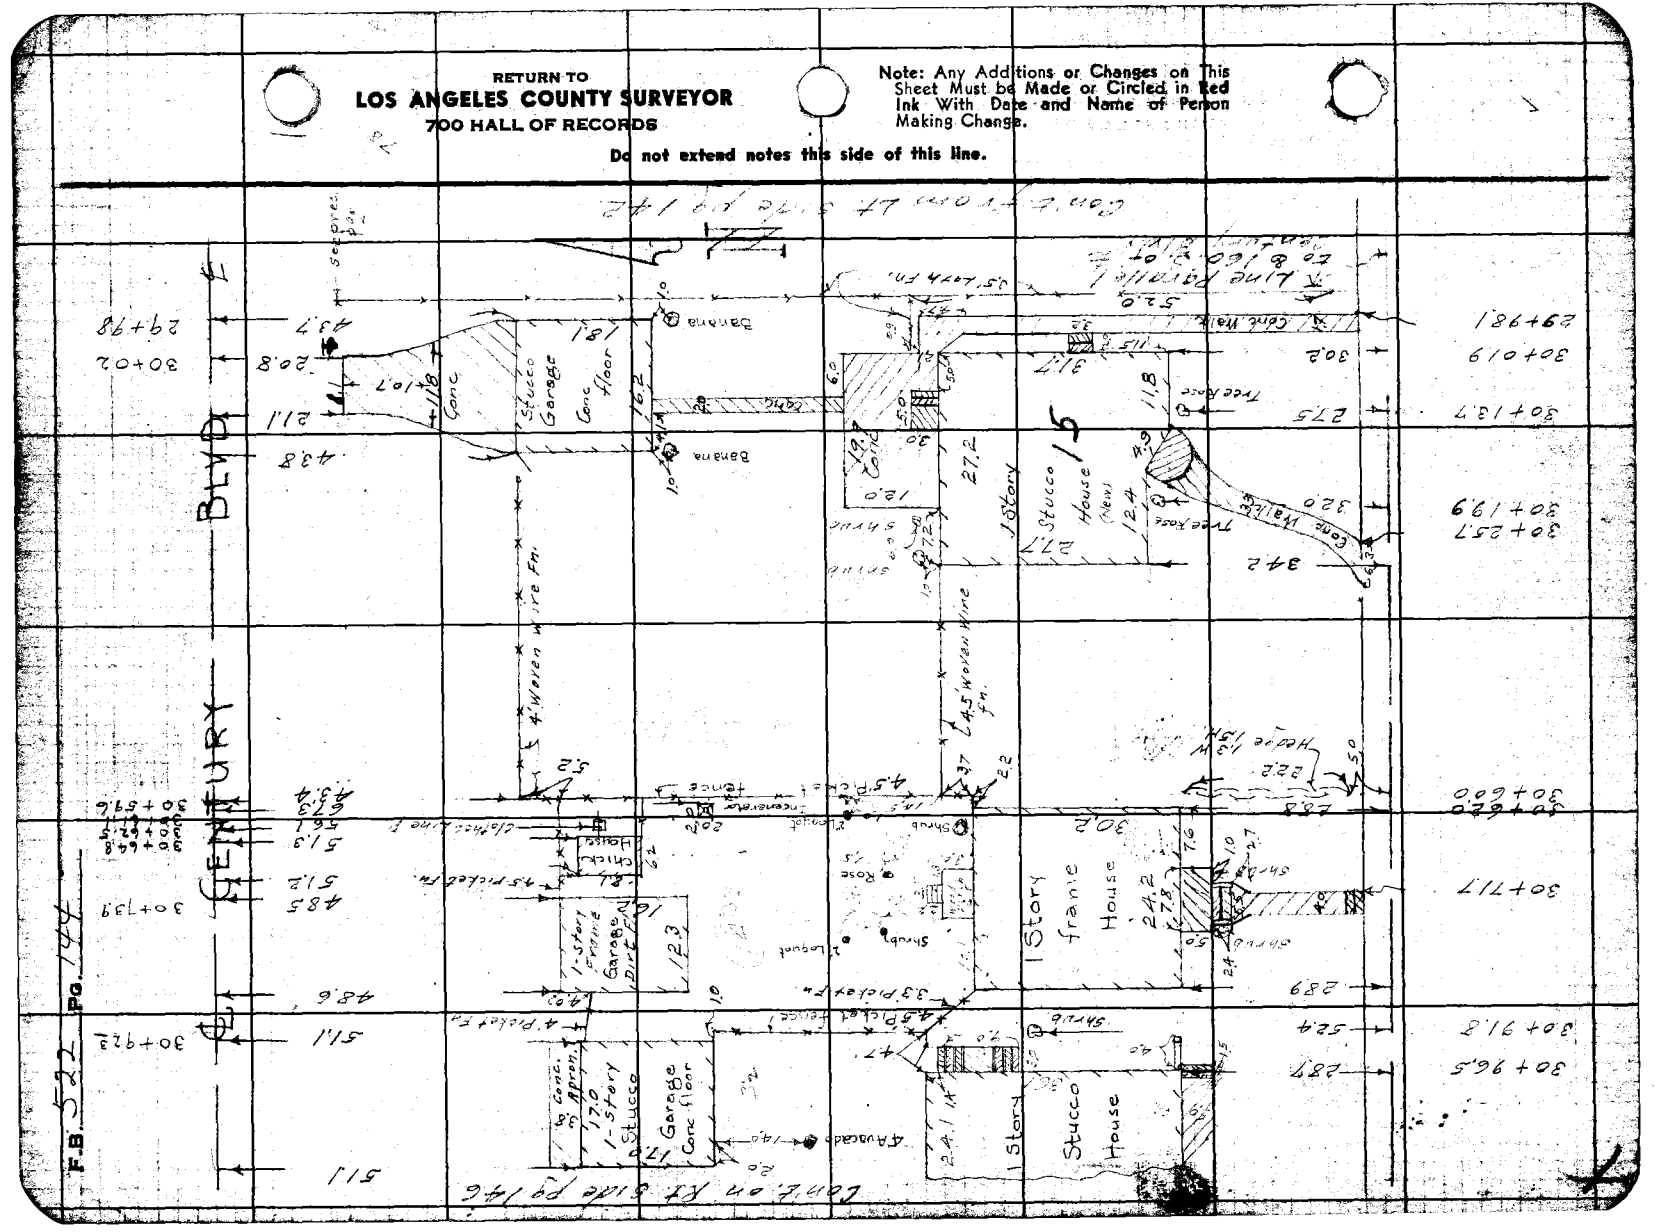
CENTURY BLVD
F.B. 532 PG. 144
1 Story Stucco House
1 Story frame House
1-Story Stucco Garage Conc floor
1-story frame Garage Dirt floor
Conc Apron
Conc Walk
Trees
Shrubs
Lawn
Planter
Fence
4 Wires w/ire Fn.
4.5 Wires w/ire Fn.
3 Picket Fn.
4 Picket Fn.
4.5 Picket Fence
Continued on Side Pg 146
Continued from Side Pg 142
Line Retained
Co. 8 160.07
Co. 8 160.07

FORM 247 BM 11-41

RETURN TO
LOS ANGELES COUNTY SURVEYOR
700 HALL OF RECORDS

Note: Any Additions or Changes on This Sheet Must be Made or Circled in Red Ink With Date and Name of Person Making Change.

Do not extend notes this side of this line.

Cont. on Rt. Side Pg. 147

Notes Ck'd by
Map No
Checked
Date

Survey of CENTURY BLVD
W. Of Jas No. Std. °E
Notes
Indexed
Date 2-19-43

F.B. 322 Pg. 7

30+93.3 44.7 51.1 — Mock 2" orange — 37 — 18.3 — 8.0 — 6.0 — 1 Story frame House — 3" Shrub — 1.6 — 2.0 Rose — 2" Loquat. — 4x4 Posts — 69.4 31+06.5 — 55.0 31+00.0 Rose 30+98.5 — 32.8 30+91.7 — 60.6 30+39.1

30+87.5 38.8 — 8" Apricot — 18.5 — 16.7 — 1 Story frame House — 26.2 — 24.5 30+86.4

30+51.8 44.9 — 3" Tree — 8" Fig

30+78.8 38.8 — 8" Fig

30+75.1 51.1 — 4' Wire Fn.

30+74.1 10.2 — 25.6 — Conc Walk — 24 — 30.4 — 1 Story Stucco House — 4' Lath fence ½" Hvd. — 35.4 30+71.2

2" Lemon — 22.3 30+49.

30+62.0 25.0 — 36 — 53.8 30+61.

30+60.4 10.4 — 10.2 — 9.5 — 2.6 — 1 Story Garage Frame — 3.4 — 7.1 — 12.3 — Conc S — Walk — 27.2 — 4' Picket Fn.

30+54.5 10.2 — Conc Walk — 3.4 — 10.6 — 18.4 — 6.3 — 2" Orange — 21.7 30+47.

30+48.7 17.1 — Incinerator — 3.2 — 8.0 — 12.2 — 4' Picket fence

30+46.2 12.4 — 30+46.0 10.3 — 30+42.8 2.7 — Incinerator — 2.8 — 2.0 — Conc Walk — 32.4 30+42.

30+39.8 4.7 — 3.0 — 1.6 — 2.7 — 2.8 — 1.2 — 6.5 — 4.0 — 164 — 1 Story Stucco House — 33.6 — 336

30+30.7 End Fn — 10' Fig — 162 — 35 — 4.3 — 24.4 — 15.8 — 25.0 — 18.2 — 6.0 — 30+26.3

30+26.8 3.9 — 30+24.7 4.3 — 30+23.7 4.8 — Board — 6' Picket + Lath Fn. Two Fences — 8' Avocado — Conc S — 33.7 30+14.2

30+15.9 6.4 — 30+14.8 12.5 — 17.0 — 4' chicken Wire Fn. — Fire place — 4' chicken Wire Fn. — 33.2 30+13.0

Garage Frame 1 Story — 14.3 — 13.5 — 30+11.2 — 7.9 — 18 — 33 — Conc 10.6 — 8.6 — frame House — 1 Story

30+97.4 4.7 — 13.5 — Cont. on Rt. Side Pg. 143

T. Line
Bear N 14° 30' E
143.3 Ft. to
Pt.

F.B. 222 PG. 146

RETURN TO
LOS ANGELES COUNTY SURVEYOR
700 HALL OF RECORDS

Do not extend notes this side of this line.

Note: Any Additions or Changes on This Sheet Must be Made or Circled in Red Ink With Date and Name of Person Making Change.

1-Story Stucco House (Lot 13)

1-Story Frame & Stucco (Floor-?) 38.2

Feed & Tool Shed

30.3 1-story Frame Shed conc. fl.

1-Story Shed Frame Dirt fl.

1-Story Stucco Garage conc. fl.

Brick

Conc. Porch Fl.

Conc. Wall

Chicken Wire

Picket Fence

Frame-bamboo Pickets

Brick Enclosure

Lime Tree

Orange

Banana

Shrubs

Lot 14

Lot 15

FORM 247 SM 11-41

RETURN TO
LOS ANGELES COUNTY SURVEYOR
700 HALL OF RECORDS

Note: Any Additions or Changes on This Sheet Must be Made or Circled in Red Ink With Date and Name of Person Making Change.

Do not extend notes this side of this line.

Notes Ck'd by
Map No.
Correct work
Checked
Date

Survey of CENTURY BLVD
W. C. & S. Tract No.
Surveyed by
Notes in Book
Indexed

F.B. 522 PG. 41

Cont. on Mt. Sht. pg. 49.

CENTURY BLVD

Hedge 3.0H 2.0W

3" Avacado

3/4 Hyd.

10" Apricot

3" Loquat

8" Avacado

Wood Fence

6" Fig

5" Avacado

12" Peach

8" Fig

2" Loquat

35' Picket Fence

35' Lath fence

Hedge 4.5H 3.0W

Rose

Shrub

Cone Walk

Cone Porch

Cone Slab

Cone Apron

Concrete Garage

Brick Incenerator

2-2" Gas

Concrete Line Post

Picket fence

Garage

Shrub

Rose

Cone

Clothes line

Post in Cone

Incenerator

Lath fence

Hedge 4.5H 2.5W

8" Plum

Rose

2" Orange

1-Story frame House

1-Story frame Garage

39

40

41

38

32+03.6
31+94.0
31+93.7
31+89.0
31+86.0
31+80.7
31+79.6
31+76.8
31+71.1
31+68.3
31+63.2
31+62.5
31+42.5
31+40.7
31+38.6
31+36.5
31+33.4
31+30.3
31+19.3
31+12.7
31+37.9
31+36.1
31+33.0
31+32.0
31+23.7
31+04.5
31+02.4

Cont. from Lt. Sht. pg. 145

N. Line of Tr. 6116 to S 1/4 Cor. of Sec. 11, T.2S., R.13W.

RETURN TO
LOS ANGELES COUNTY SURVEYOR
700 HALL OF RECORDS

Note: Any Additions or Changes on This Sheet Must be Made or Circled in Red Ink With Date and Name of Person Making Change.

Do not extend notes this side of this line.

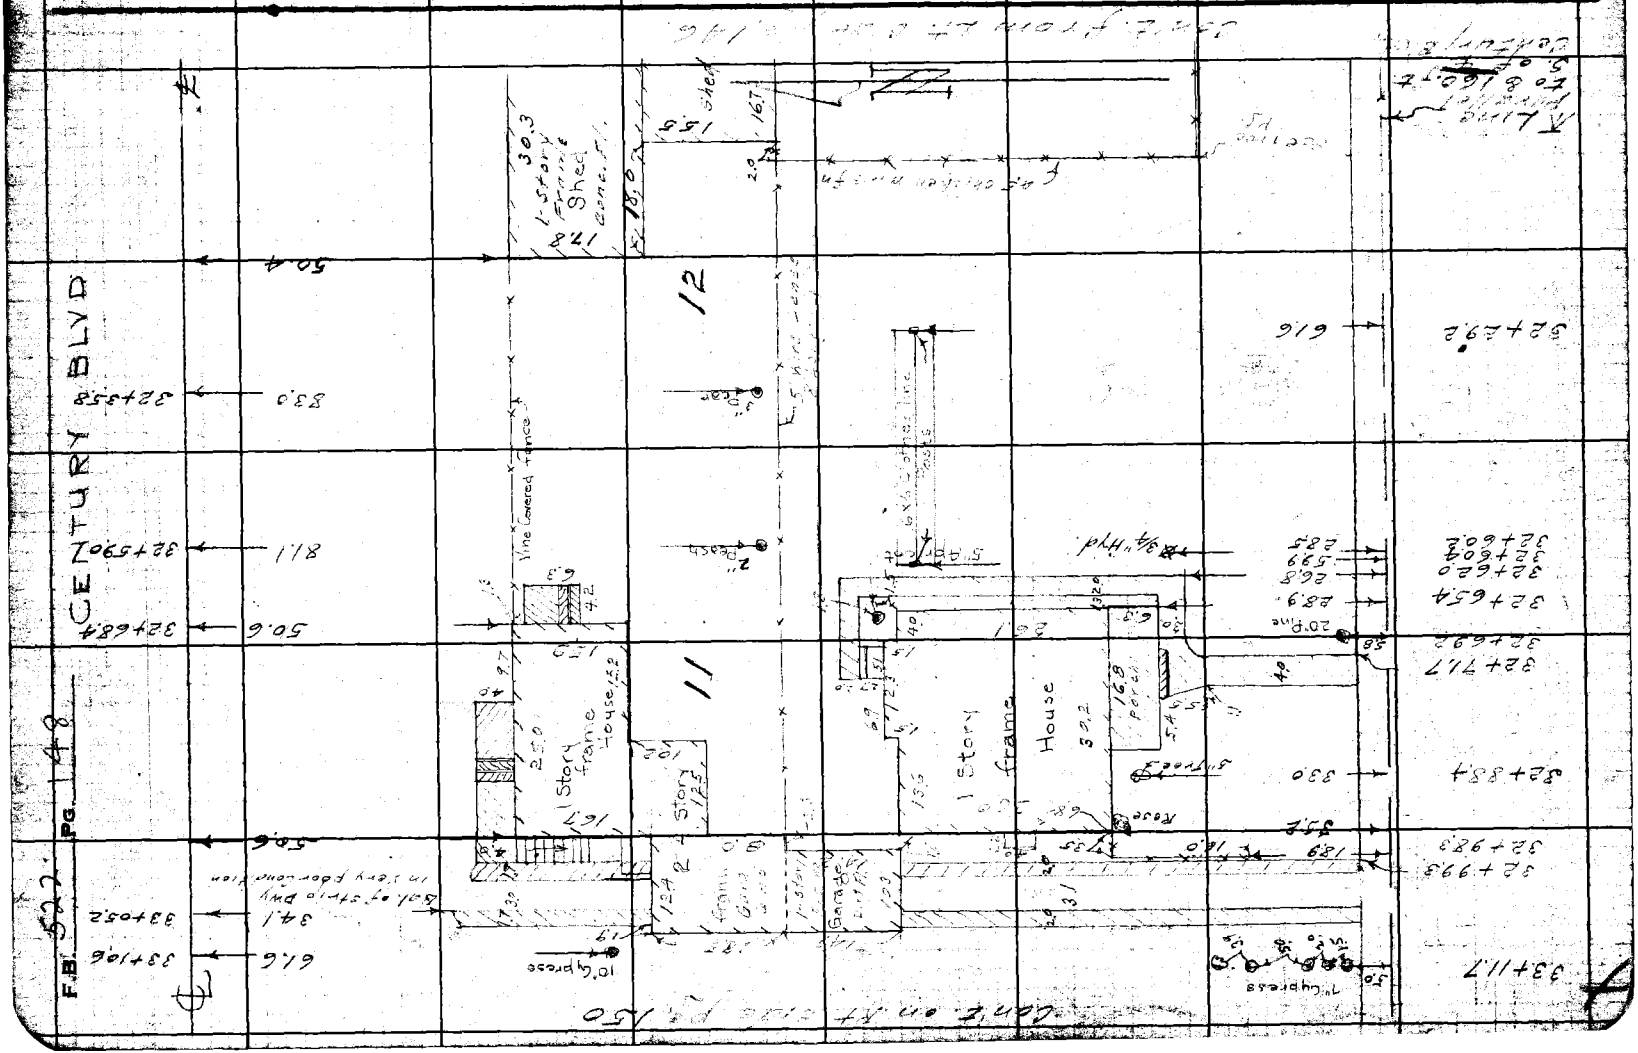

FORM 847 RM 11-48

RETURN TO
LOS ANGELES COUNTY SURVEYOR
267
700 HALL OF RECORDS

Note: Any Additions or Changes on this Sheet Must be Made or Circled in Red Ink With Date and Name of Person Making Change.

Do not extend notes this side of this line.

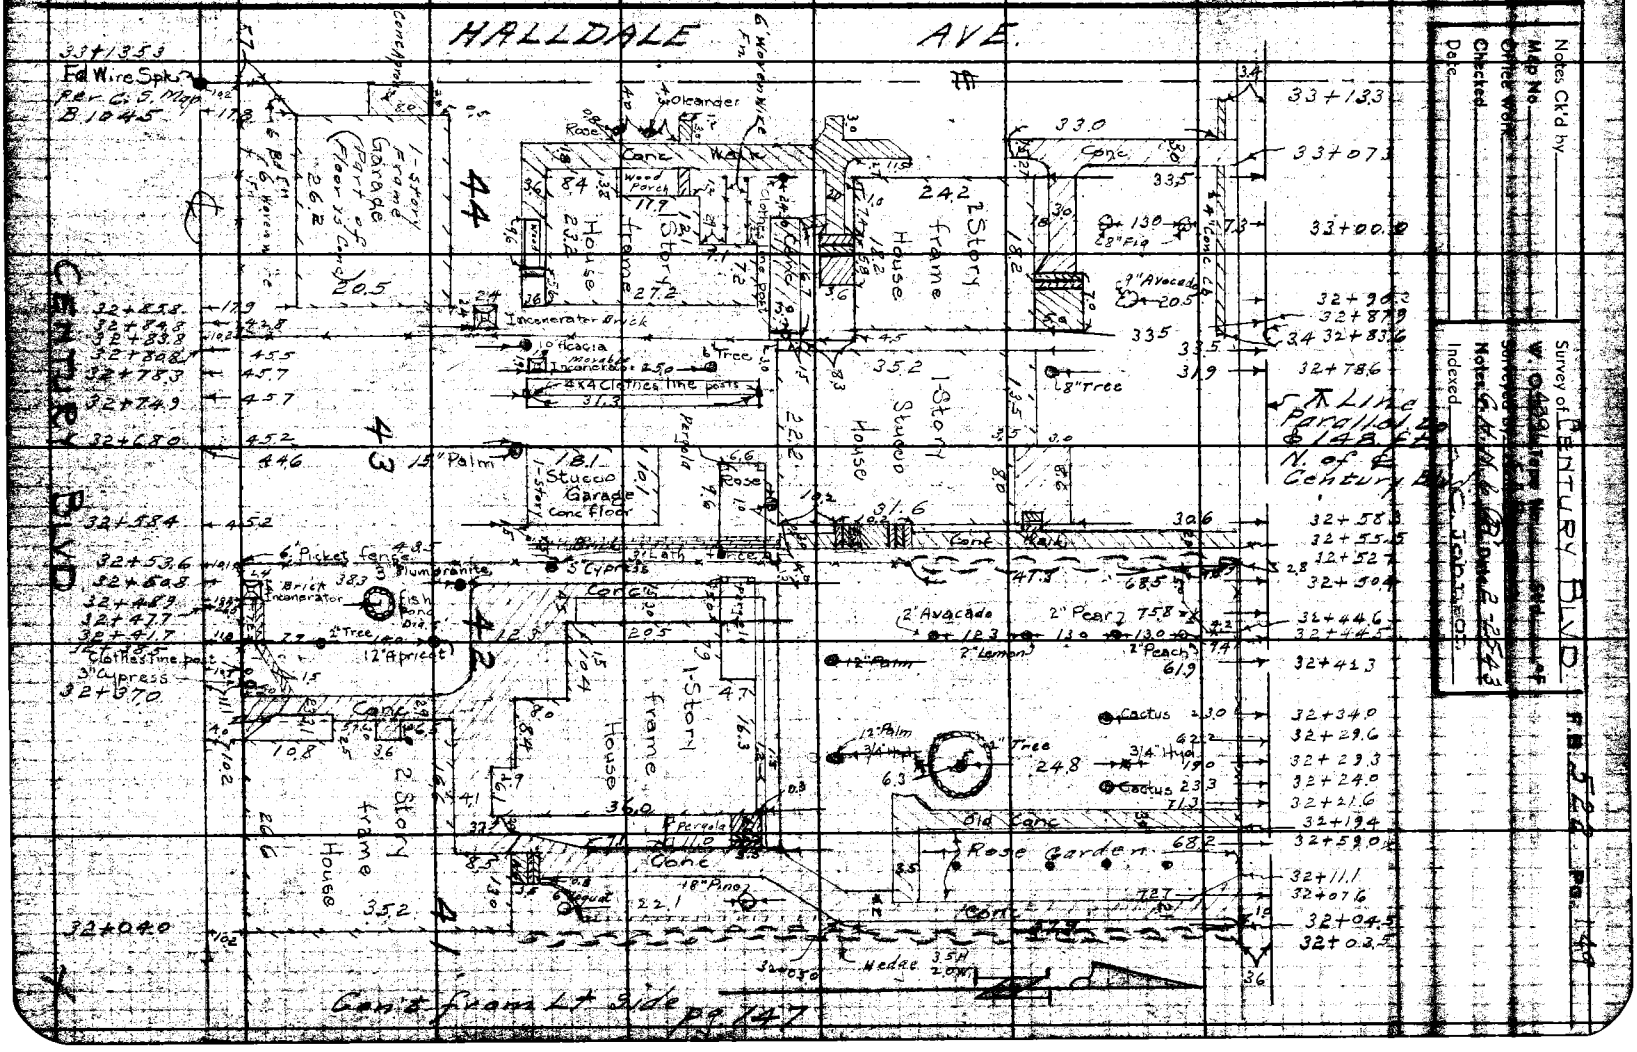


RETURN TO
LOS ANGELES COUNTY SURVEYOR
700 HALL OF RECORDS

Note: Any Additions or Changes on This Sheet Must be Made or Circled in Red Ink With Date and Name of Person Making Change.

Do not extend notes this side of this line.

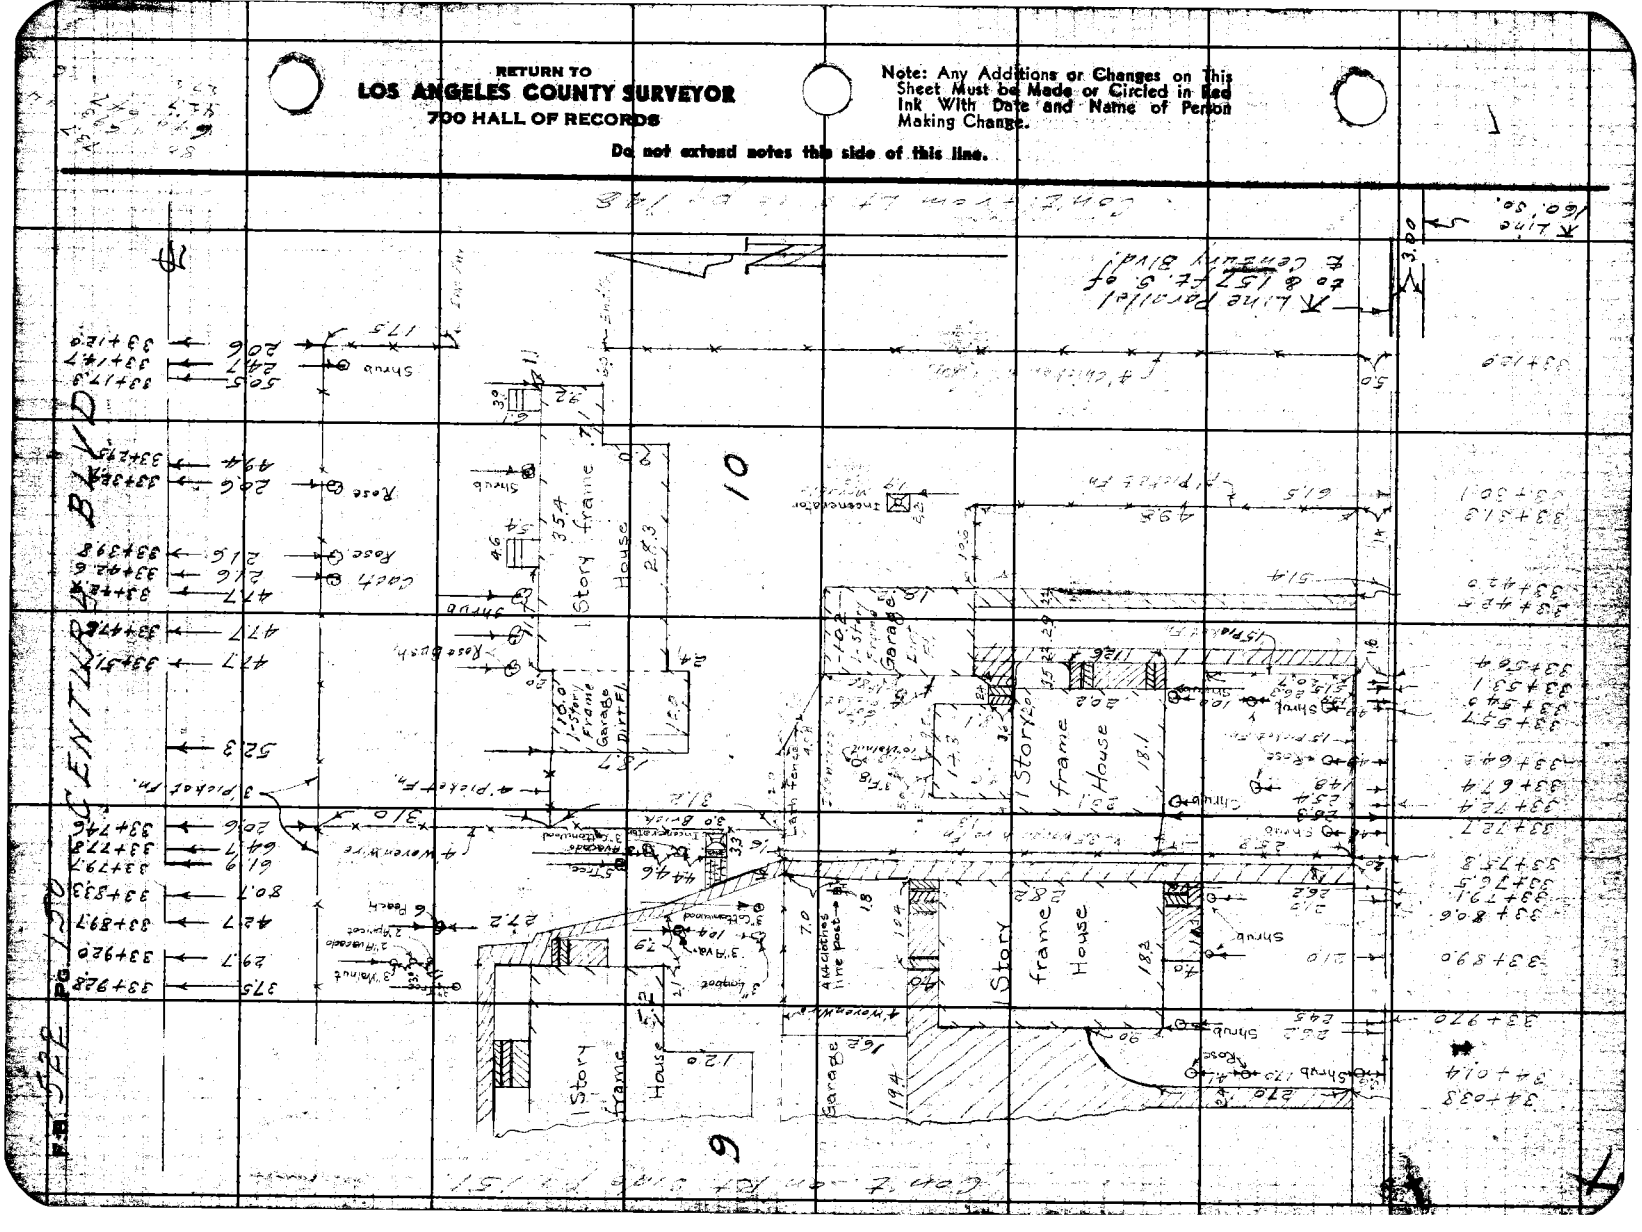

FORM 247 SM 11-41

RETURN TO
LOS ANGELES COUNTY SURVEYOR
700 HALL OF RECORDS

Note: Any Additions or Changes on this Sheet Must be Made or Circled in Red Ink With Date and Name of Person Making Change.

Do not extend notes this side of this line.

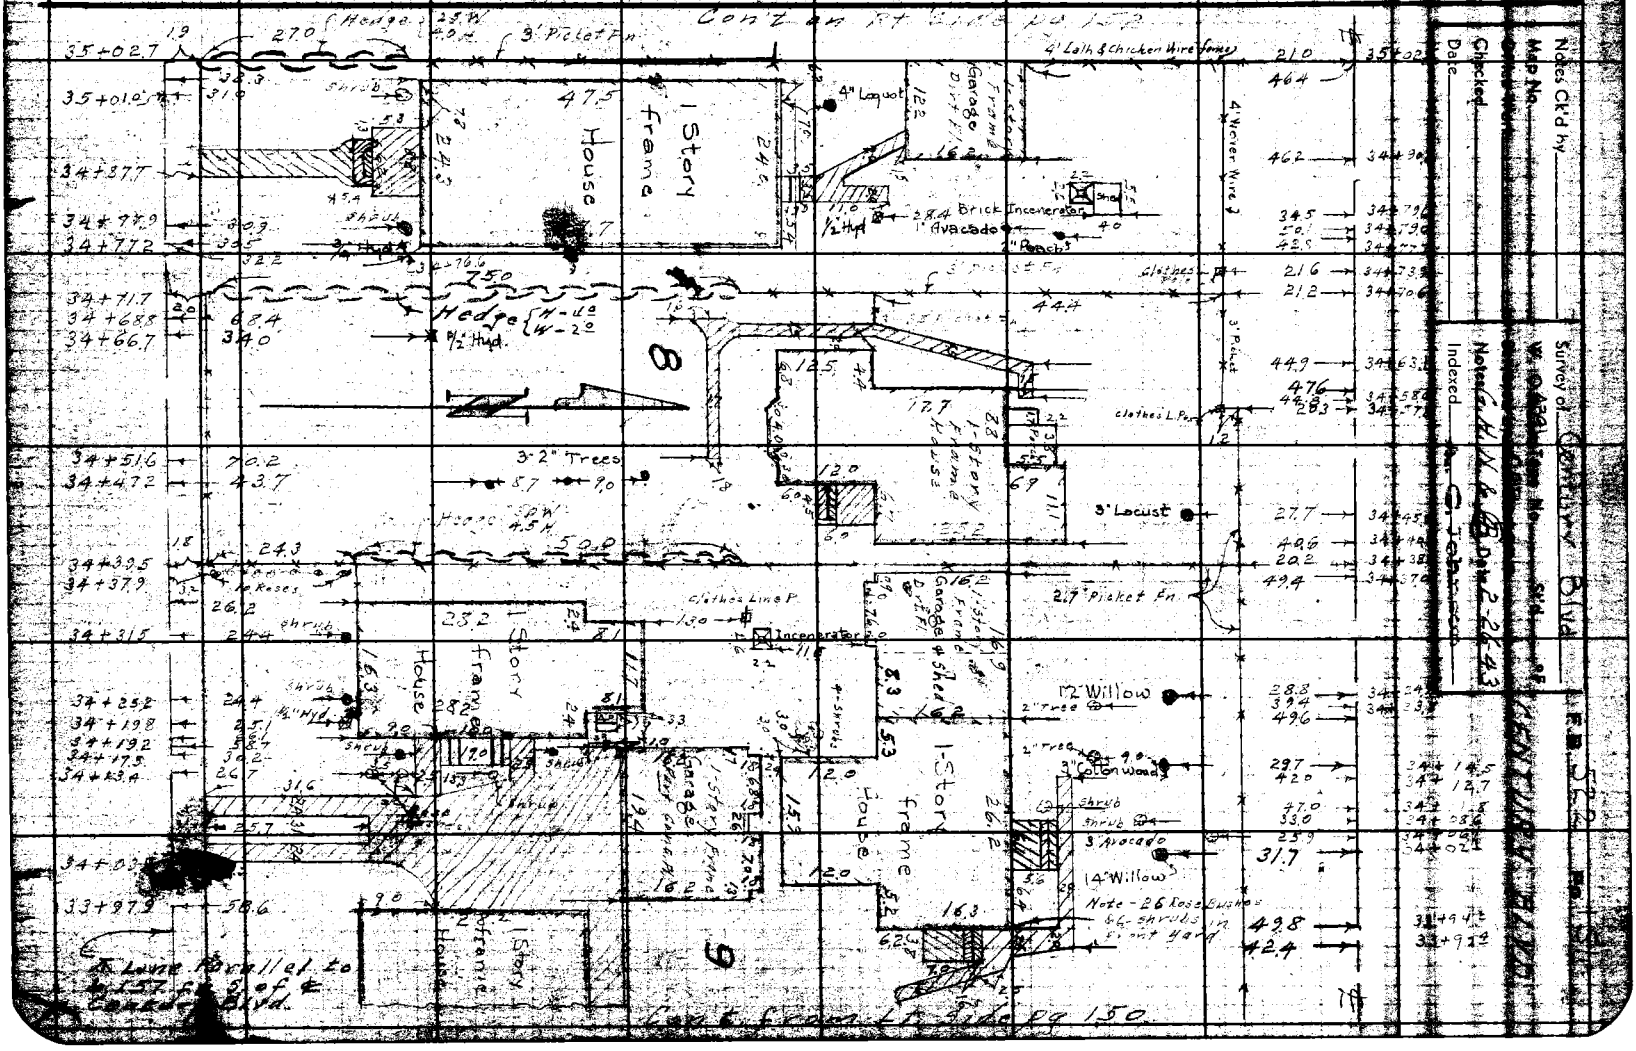

RETURN TO
LOS ANGELES COUNTY SURVEYOR
700 HALL OF RECORDS

Note: Any Additions or Changes on This Sheet Must be Made or Circled in Red Ink With Date and Name of Person Making Change.

Do not extend notes this side of this line.

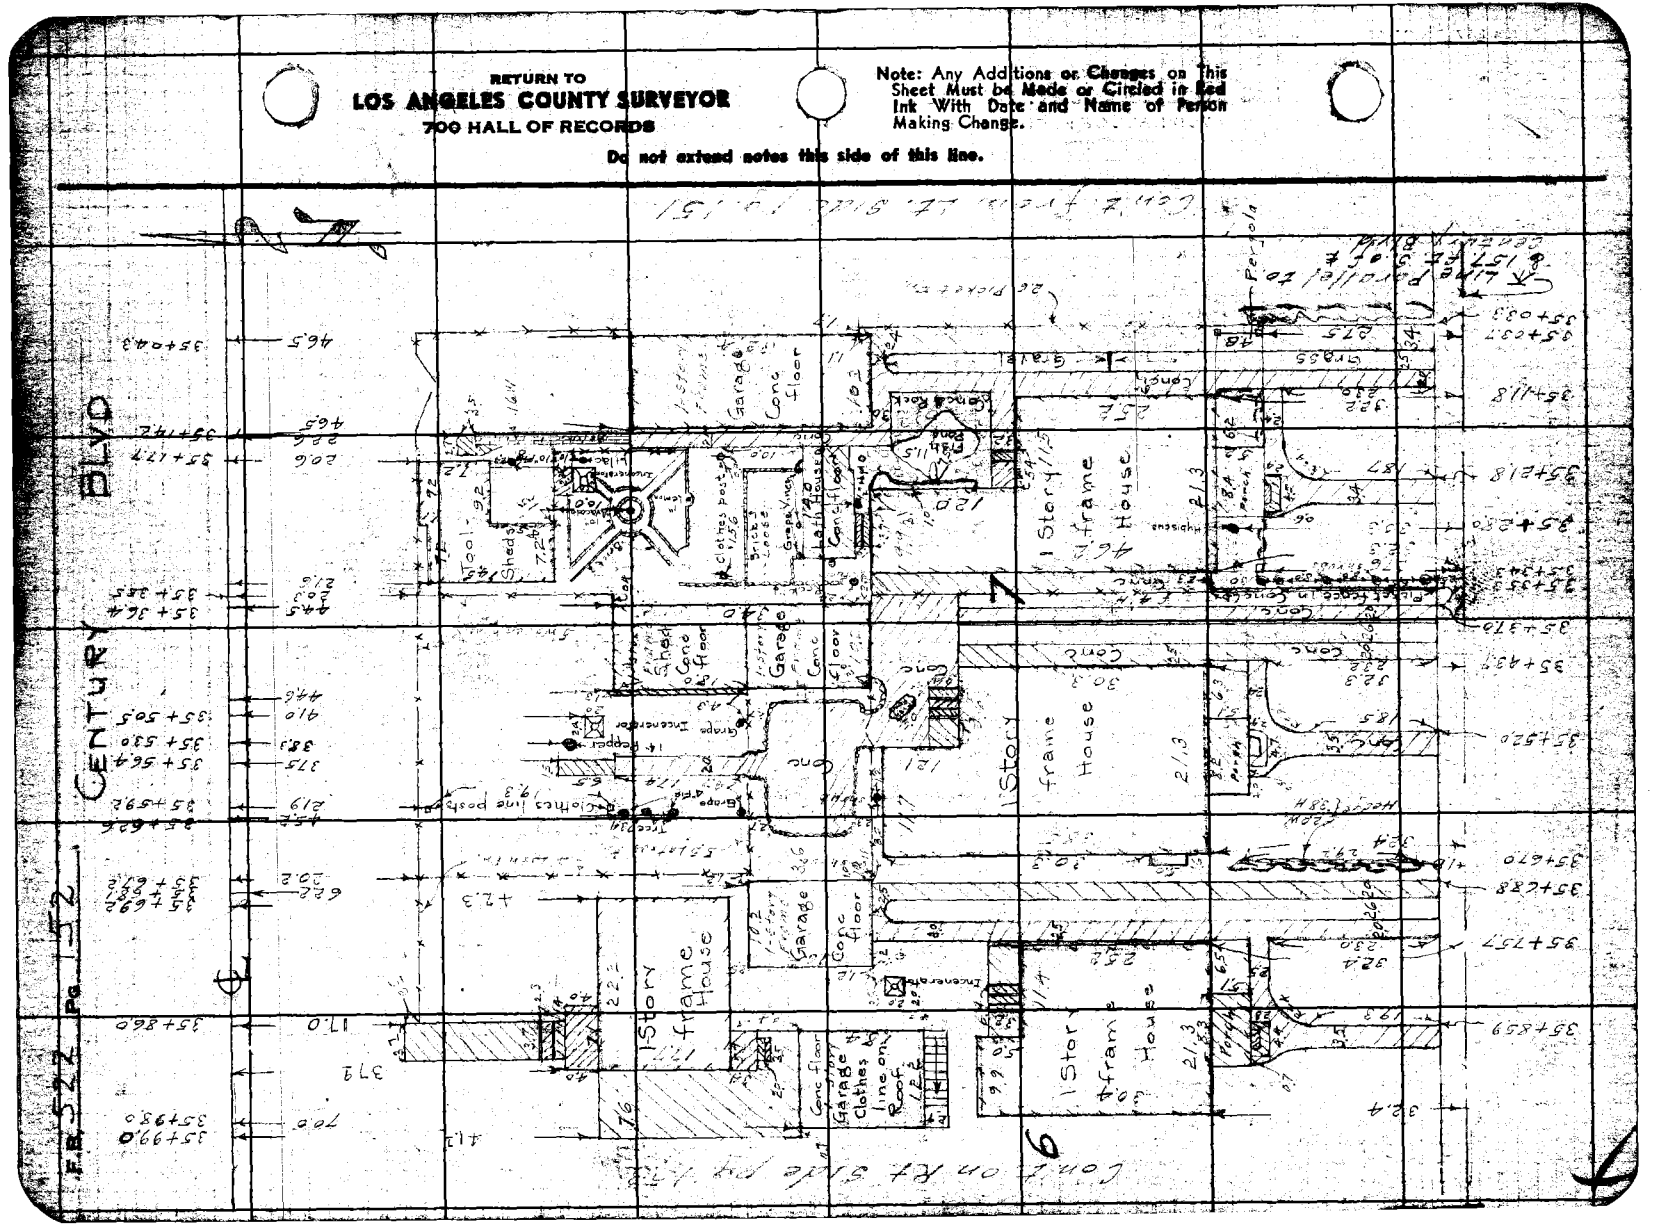
F.B. 522 Pg. 152
CENTURY BLVD.
Cont'd on Rt. Side Pg. 151
Cont'd from Lt. Side Pg. 151
Garage
Conc floor
1 Story frame House
Shed
Tool
Clothes post
Fish pond
Lath House
Greenhouse
Garage Conc floor
Garage Conc floor
Garage Conc floor

FORM 247, SM 11-41

RETURN TO
LOS ANGELES COUNTY SURVEYOR
700 HALL OF RECORDS

Note: Any Additions or Changes on This Sheet Must be Made or Circled in Red Ink With Date and Name of Person Making Change.

Do not extend notes this side of this line.

Cont. on Rt. Sht. 154.

Notes Ck'd by _____
Map No. _____ Sht. _____ of _____
Office Work _____
Checked _____
Date _____

Survey of CENTURY BLVD
W.O. 4324 Maps No. _____ Sht. _____ of _____
Surveyed by _____ Date 2-26-43
Notes _____ Date _____
Indexed _____

F.B. 522 Pg. 118
CENTURY 8446

37+41.7 — 62.2
37+09.5 — 49.6 — 54.0
36+79.6 — 19.2
36+87.9 — 25.8
36+83.0 — 34.0
36+80.2 — 30.5
36+79.1 — 27.7

8' Avacado Str.
24.4
1 Story frame house
20.2
60
6" Tree
10" Fig
48+ Clothes line posts
1 Story frame house
3.8
20' Fig
Incinerator

40.7 — 37+16.5
45.7 — 37+10.9
44.2
44.3 — 36+87.6
48.8 — 36+77.
22.1 — 36+66.5

A line parallel to & 157 ft. S. of ℄ Century Blvd

45' Fig
2" Tree
2" Tree
1" Tree
18.1
Double Garage
1-story frame
Pergola
8.6 Hedge 5'W
Hedge 2'W
8" Apricot
4' Picket fence
Rose
2 Willows
10" 8"
14"
32.5
27.6
2 1/2 Story frame house
2 1/3
Bor Cone
Broken Cone
Garage Cone floor
1-story frame
Shed
30.3
32.5
27.8
48
4' Picket Fn.
4' Lath fence
42.0

47.4 — 36+21.5
47.4 — 36+31.8
45. — 36+30.
65.3 — 36+27.
67.8 — 36+20.
47.8 — 36+12.9
62.4 — 36+
57.5 — 36+00.0
19.7 — 35+9

Cont. from Lt. Side Pg. 152

154

RETURN TO
LOS ANGELES COUNTY SURVEYOR
700 HALL OF RECORDS

Note: Any Additions or Changes on This Sheet Must be Made or Circled in Red Ink With Date and Name of Person Making Change.

Do not extend notes this side of this line.

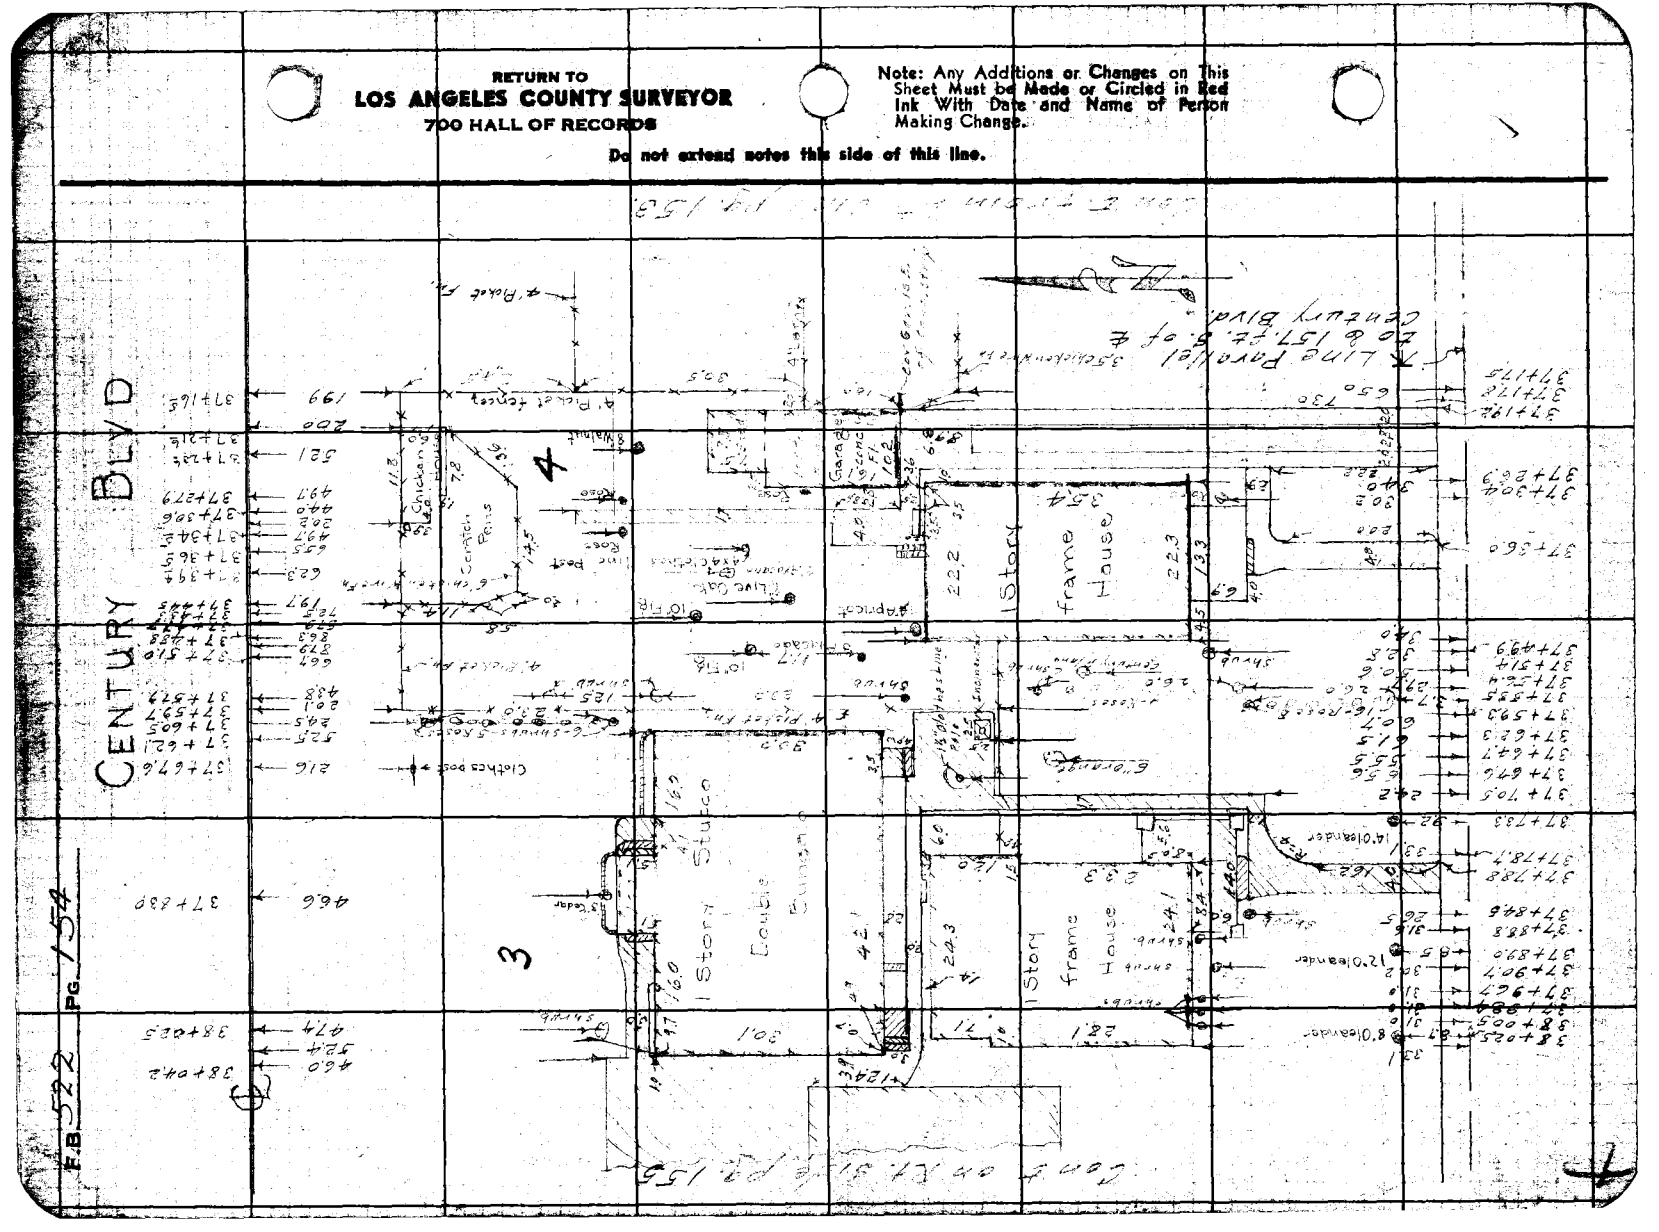

F.B. 5222 PG. 154

FORM 247 SM 11-41

RETURN TO
LOS ANGELES COUNTY SURVEYOR
700 HALL OF RECORDS

Note: Any Additions or Changes on this Sheet Must be Made or Circled in Red Ink With Date and Name of Person Making Change.

Do not extend notes this side of this line.

Notes Ck'd by
Map No.
Office Work
Checked
Date

Survey of [illegible]
Surveyed by [illegible]
Noted [illegible]
Indexed [illegible]

F.B. [illegible] Pg. [illegible]

Cont. on Rt. side p. 156

For this Lot See page 156

38+70.1
38+68.9
38+66.6
38+58.9
38+44.8
38+33.1
38+24.9
38+24.1
38+22.9
38+12.1
38+0.8

6.5.0
6.5.4
34.6
61.3
30.8
27.2
27.1
51.2
19.9
51.7
24.7
51.9

220
Clothes line post
2-Loquat
10" Fig
1.0 A 3"
Lath House 8.2
20.3
5.1
17.9
2-3" Figs
2" Loquat
4x4 Clothes posts
23.0
9.0
14.0 4" Fig
4" Fig
5" Fig
3" Fig
Incinerator
16.0
24.3
1-Story frame House
1-Story frame House & Garage (Dirt Fl. Garage)
2.3.4
4.1
3.2
Loquat
Cypress Hedge
H 40' W
Garage
Concr. Fl.
1-Story frame
Garage
Stucco
32.2
Garage
1-Story
Concr. Fl.
Stucco
Picket fence
2
3

69.0
53.7
61.3
50.9
61.7
32.5
71.6
79.7
83.7
50.8
50.8
46.2
73.1
73.1

38+77.7
38+69.5
38+56.6
38+53.8
38+49.6
38+24.0
38+21.1
38+08.1

Cont. from Lt. side pg. 154

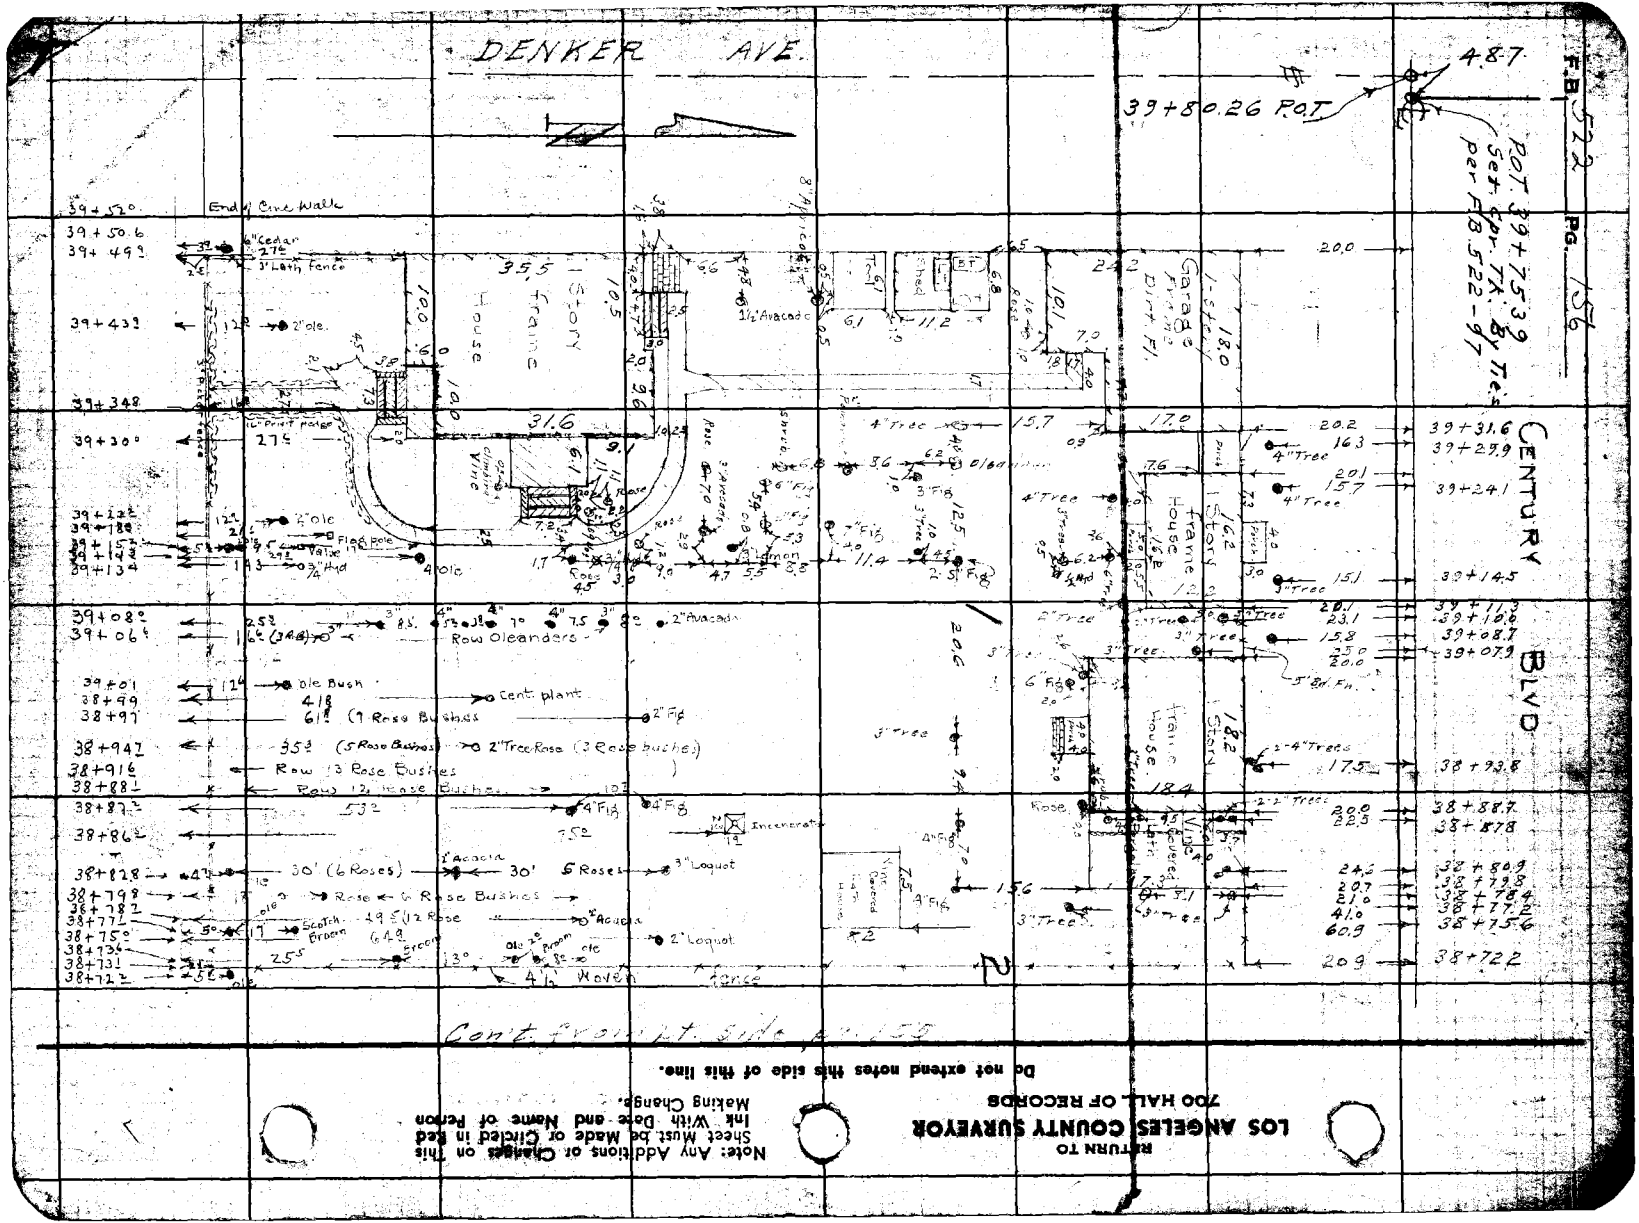
DENKER AVE.
39+80.26 P.O.T.
4.87
P.O.T. 39+75.39 Set. per TR. By T.S. per F.B. 522-97
F.B. 522 PG. 156
39+52.0
End Curb Walk
39+50.6
39+49.9
6" Cedar 27¢
3' Lath Fence
39+43.9
2" ole.
39+34.8
39+30.0
