Survey of

W. O. Tape No. St'd °F.

Surveyed by

Notes Date

Indexed A. C. Johnson 7-30-74

F.B. 541 Pg. 1

541

RETURN TO

LOS ANGELES COUNTY SURVEYOR

700 HALL OF RECORDS

Note: ANY ADDITIONS OR CHANGES ON THIS SHEET MUST BE MADE OR CIRCLED IN **Red Ink.** WITH DATE AND NAME OF PERSON MAKING CHANGE.

Do not extend notes this side of this line

F.B. 54 Pg. 2

Notes Ck'd by	Survey of
Map No.	W. O. Tape No. St'd °F.
Office Work	Surveyed by
Checked	Notes Date
Date	Indexed E. C. Johnson

F.B. 541 PG. 3

INDEX.

El Monte Bridle Trail (Div. 1.) 5 Pgs. to

Note: ANY ADDITIONS OR CHANGES ON THIS SHEET MUST BE MADE OR CIRCLED IN Red Ink. WITH DATE AND NAME OF PERSON MAKING CHANGE.

Do not extend notes this side of this line

RETURN TO
LOS ANGELES COUNTY SURVEYOR
700 HALL OF RECORDS

FORM 247 10M 5-31

RETURN TO
LOS ANGELES COUNTY SURVEYOR
700 HALL OF RECORDS

Note: ANY ADDITIONS OR CHANGES ON THIS SHEET MUST BE MADE OR CIRCLED IN Red Ink, WITH DATE AND NAME OF PERSON MAKING CHANGE.

Do not extend notes this side of this line

F.B. 541 Pg. 4

Div #1

Notes Ck'd by	Survey of [illegible]
Map No. B-1005	W. O. 8012 Tape No. St'd °F.
Office Work	Surveyed by [illegible]
Checked	Notes A Moore Date
Date	Indexed A. C. Johnson

F.B. 541 Pg. 5

SURVEY
of
EL MONTE BRIDLE TRAIL
DIV. #1
from
SIPHON ROAD
NORTH ALONG EAST BANK
of the
RIO HONDO RIVER
to
PECK ROAD
Job # 8012

Party

Hugh F. Evans	Dep.	100' Tape # 067-Nor. @ 84° F.
Geo. F. Brock	↑	
D.S. Sedig	H.C.	
G.D. Kenniston	R.C.	

Note: ANY ADDITIONS OR CHANGES ON THIS SHEET MUST BE MADE OR CIRCLED IN Red Ink. WITH DATE AND NAME OF PERSON MAKING CHANGE.

Do not extend notes this side of this line

RETURN TO
LOS ANGELES COUNTY SURVEYOR
700 HALL OF RECORDS

FORM 247 10M 5-31

RETURN TO
LOS ANGELES COUNTY SURVEYOR
700 HALL OF RECORDS

Note: ANY ADDITIONS OR CHANGES ON THIS SHEET MUST BE MADE OR CIRCLED IN **Red Ink.** WITH DATE AND NAME OF PERSON MAKING CHANGE.

Do not extend notes this side of this line

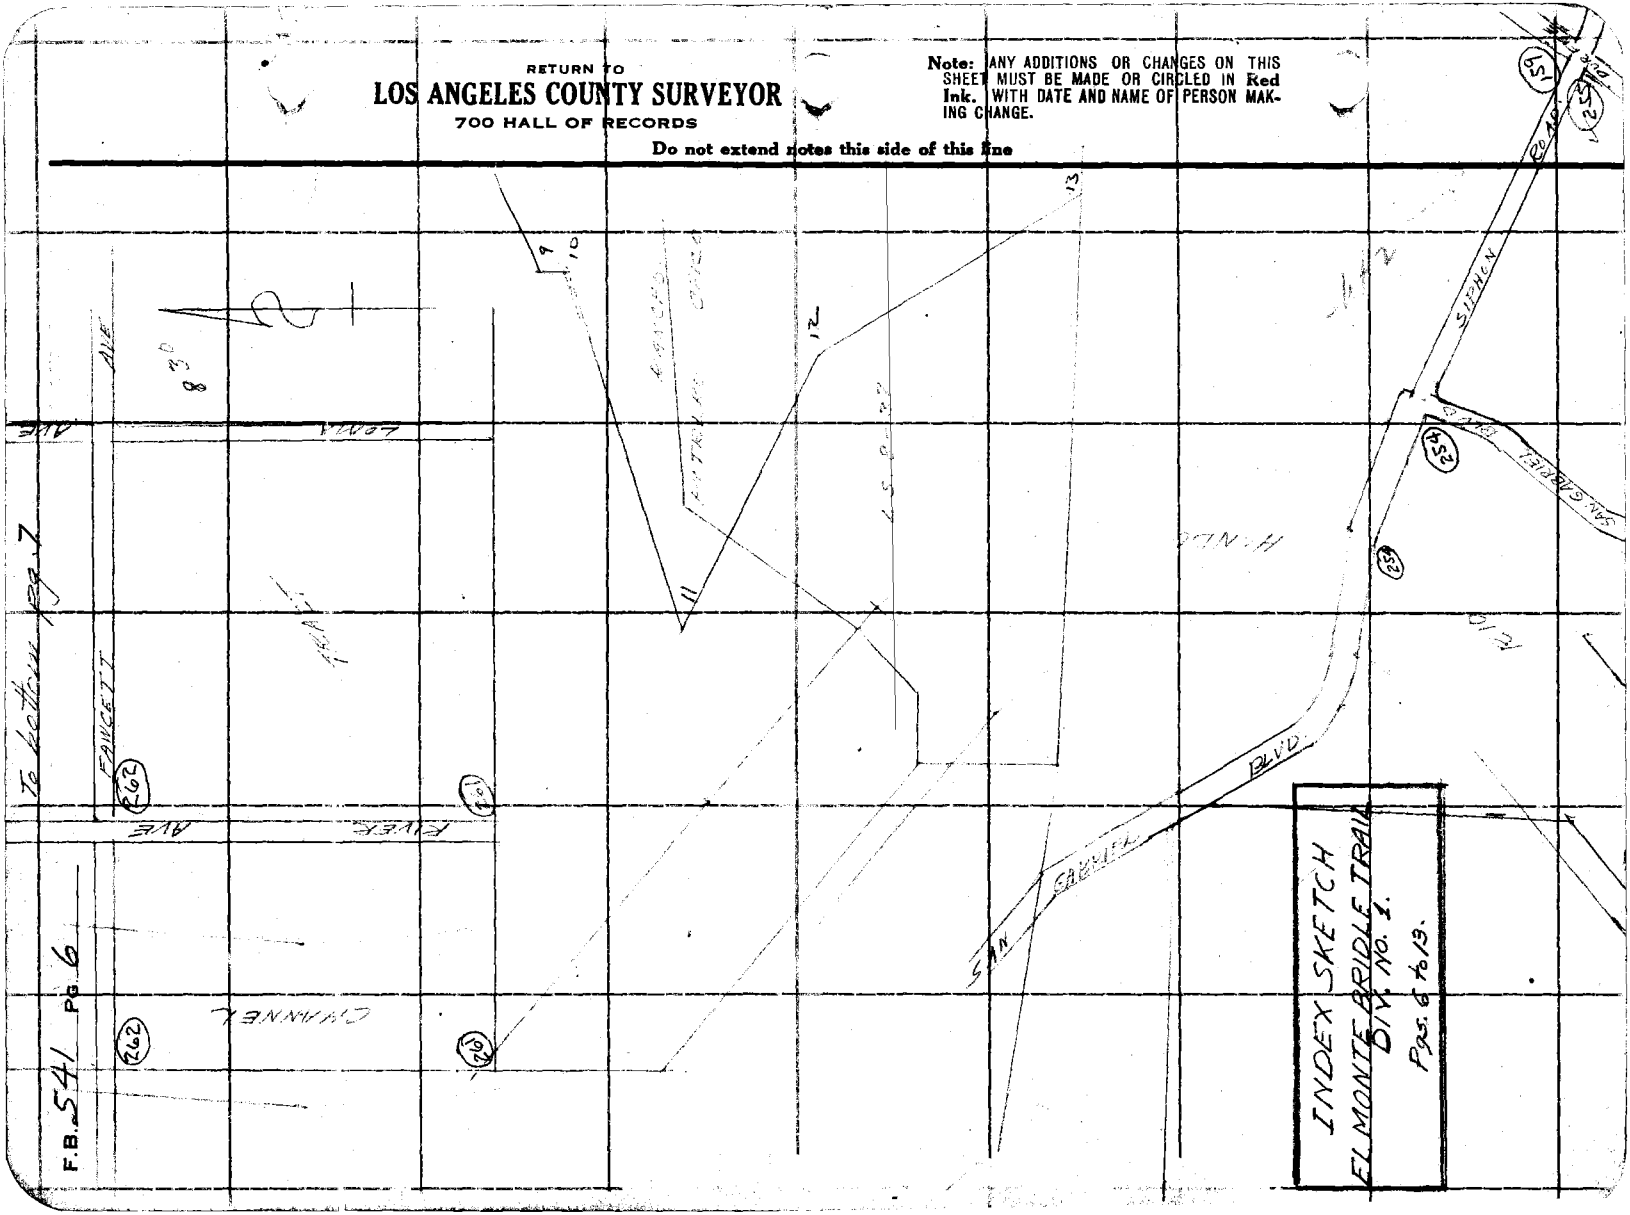

To bottom pg 8

Notes Ck'd by	Survey of El Monte Bridle Trail
Map No. B-1005-2,3	W. O. 8[illegible] Tape No. St'd °F.
Office Work	Surveyed by L. D. Moore
Checked	Notes Moore Date
Date	Indexed A. C. Johnson

F.B. 541 PG. 7

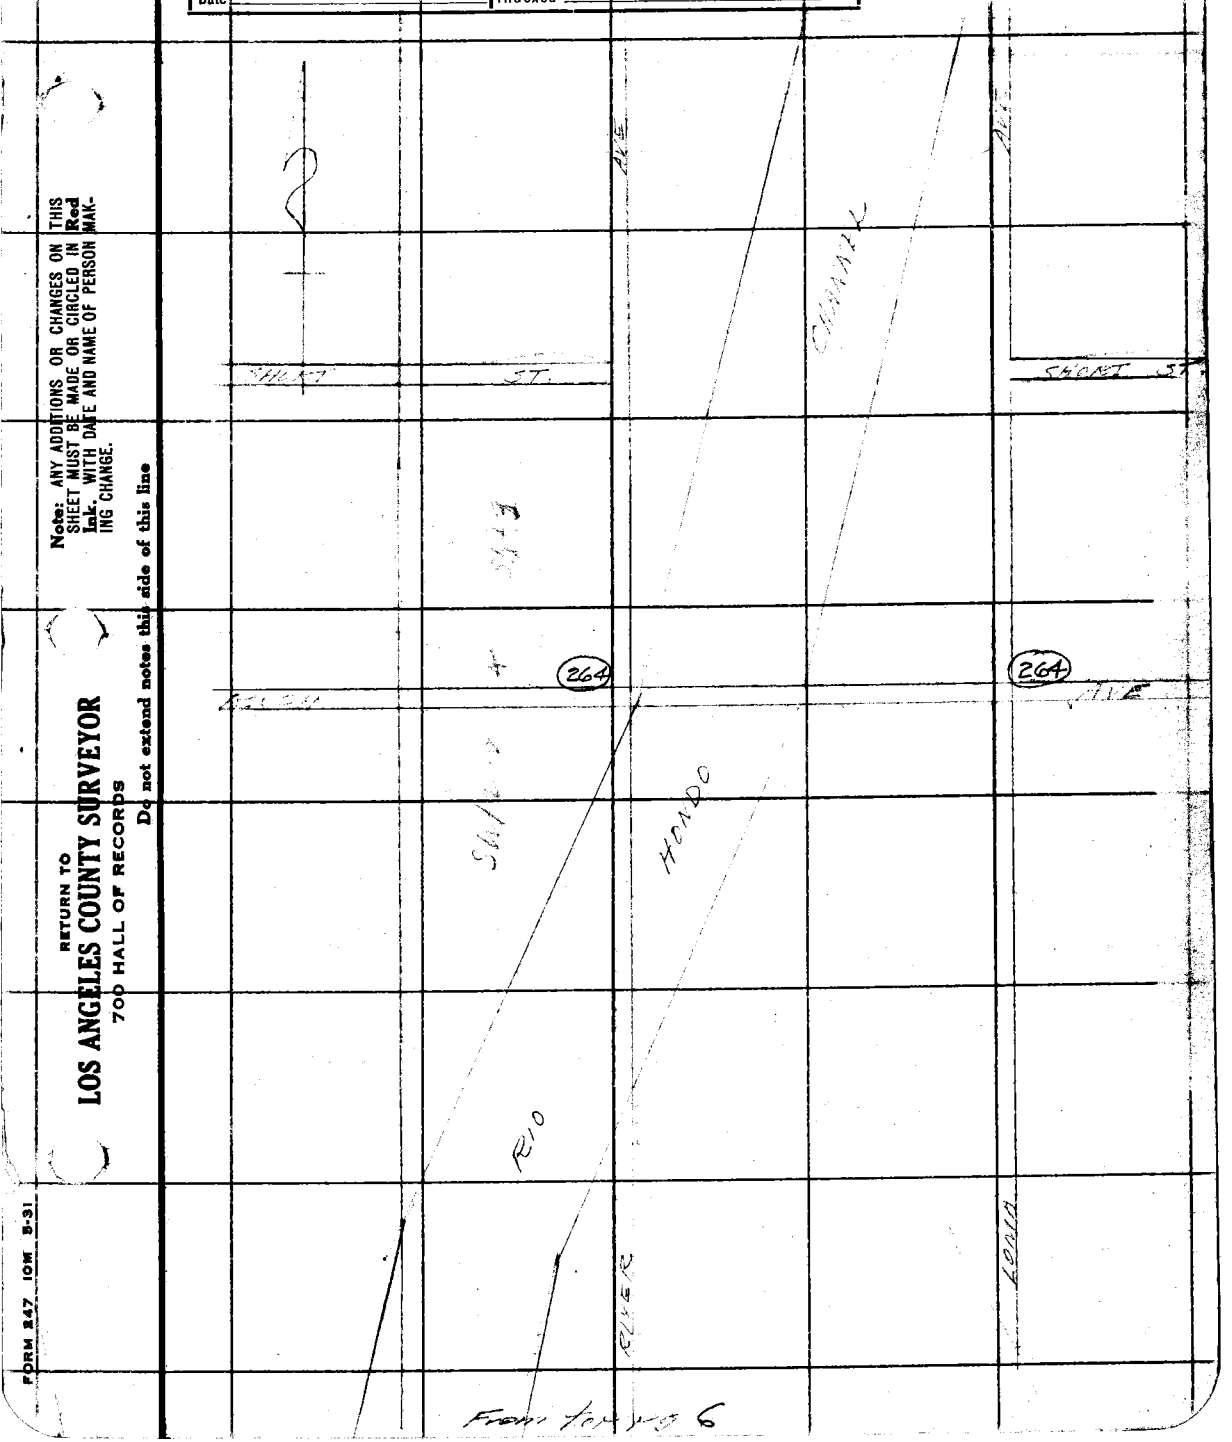

Note: ANY ADDITIONS OR CHANGES ON THIS SHEET MUST BE MADE OR CIRCLED IN Red Ink, WITH DATE AND NAME OF PERSON MAKING CHANGE.

Do not extend notes this side of this line

RETURN TO
LOS ANGELES COUNTY SURVEYOR
700 HALL OF RECORDS

FORM 247 10M 5-31

From top pg 6

RETURN TO
LOS ANGELES COUNTY SURVEYOR
700 HALL OF RECORDS

Note: ANY ADDITIONS OR CHANGES ON THIS SHEET MUST BE MADE OR CIRCLED IN **Red Ink.** WITH DATE AND NAME OF PERSON MAKING CHANGE.

Do not extend notes this side of this line

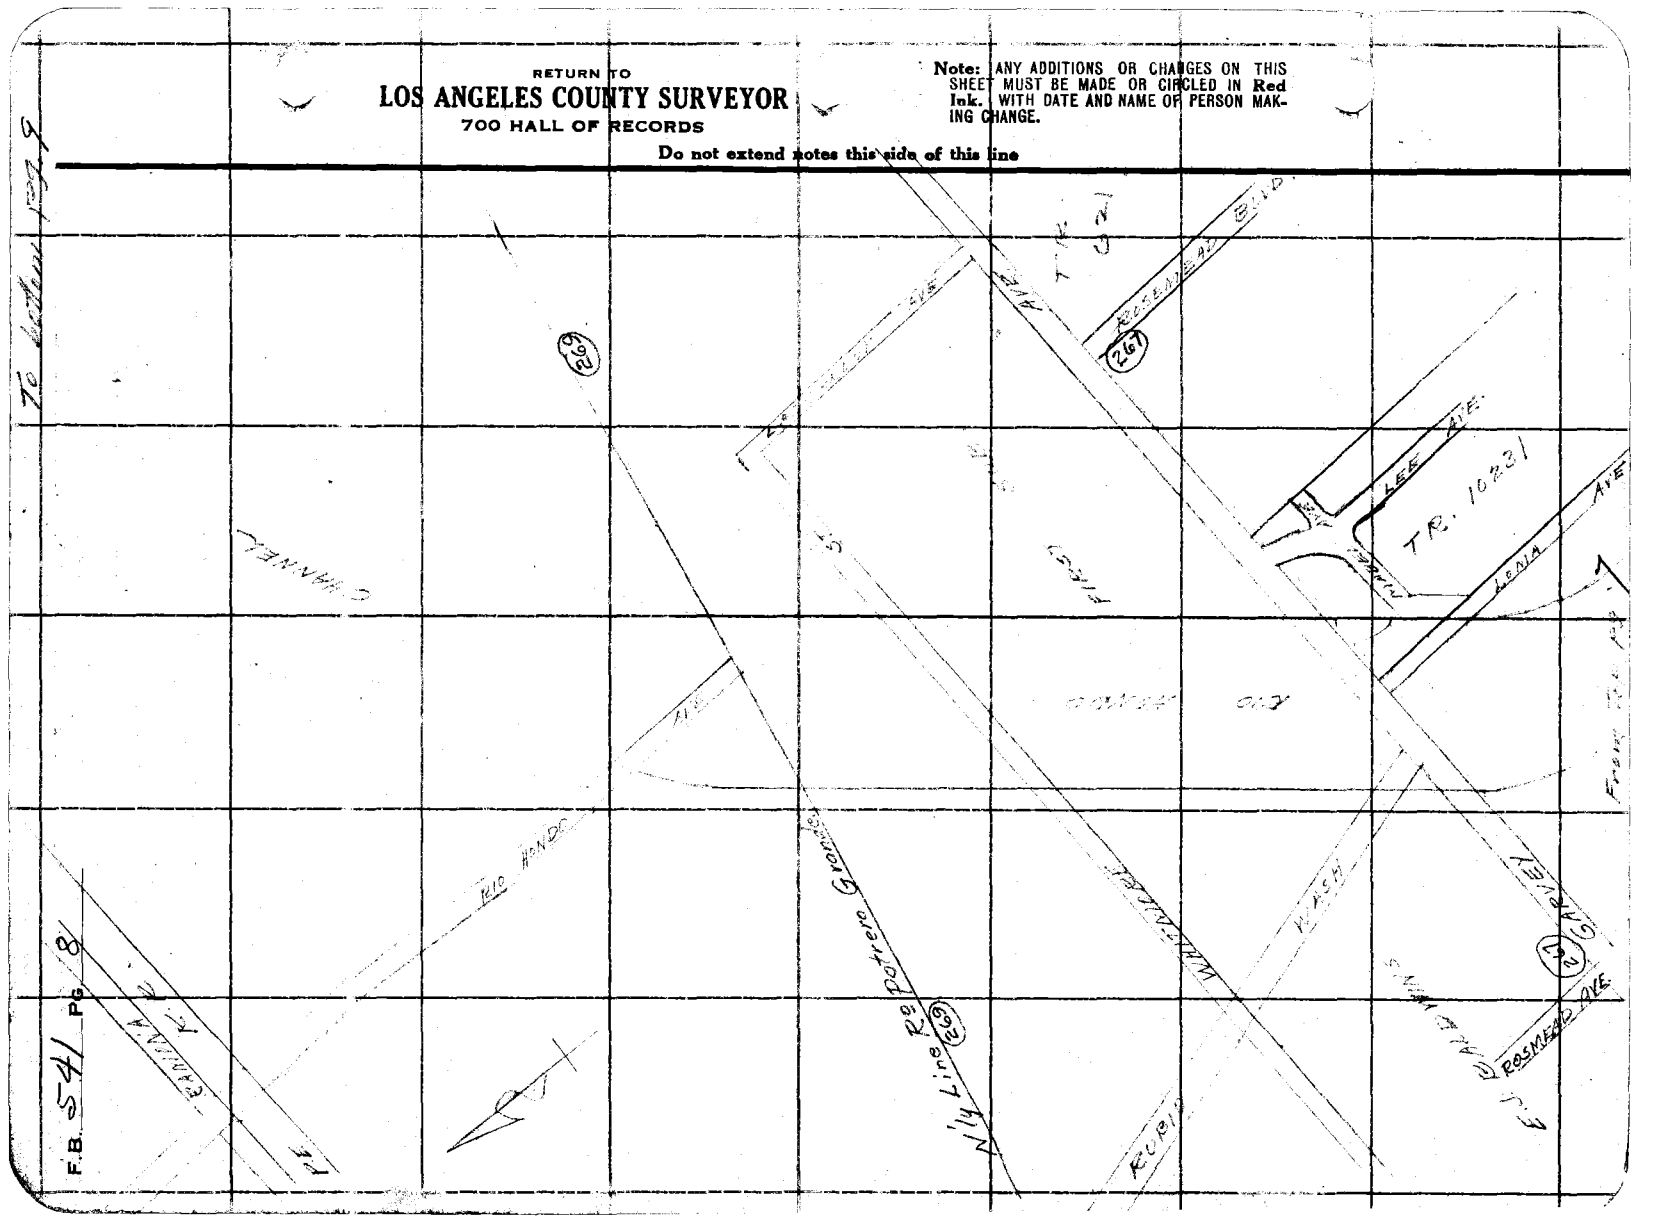

FORM 247 10M 5-31

RETURN TO
LOS ANGELES COUNTY SURVEYOR
700 HALL OF RECORDS

Note: ANY ADDITIONS OR CHANGES ON THIS SHEET MUST BE MADE OR CIRCLED IN **Red Ink.** WITH DATE AND NAME OF PERSON MAKING CHANGE.

Do not extend notes this side of this line

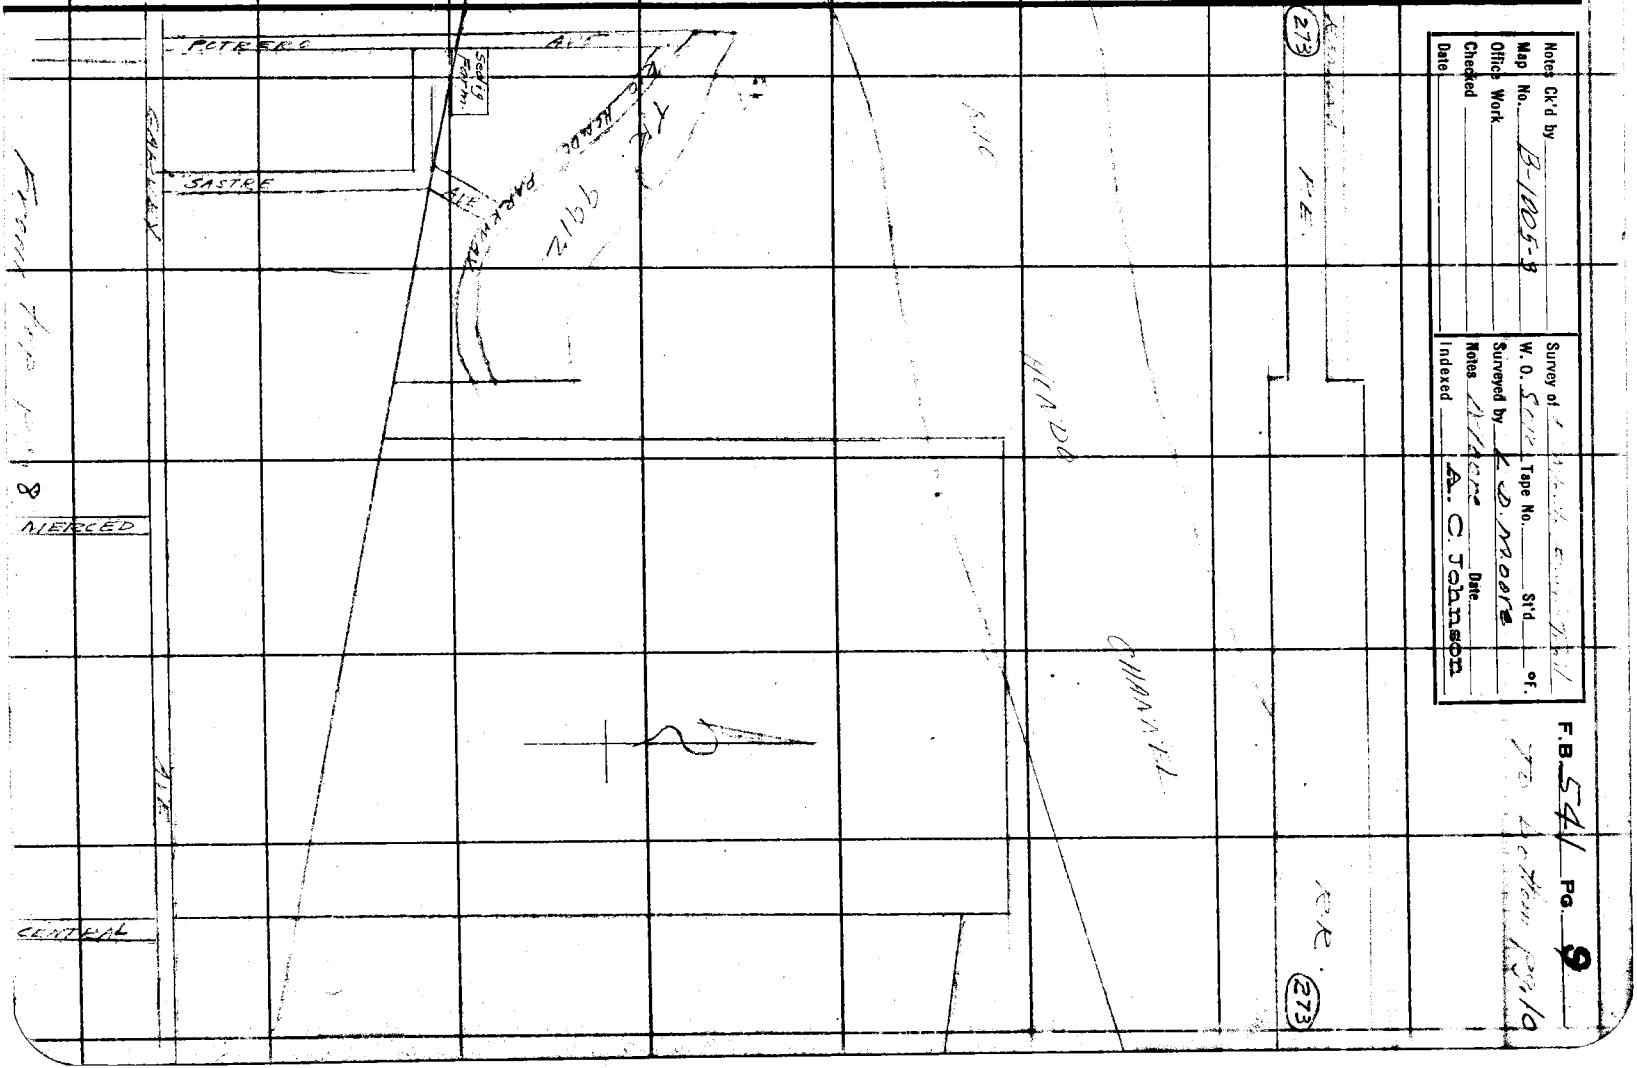

Notes Ck'd by
Map No. B-1105-8
Office Work
Checked
Date

Survey of
W. O. [illegible] Tape No. [illegible] Sl'd [illegible] of.
Surveyed by K. D. Moore
Notes [illegible] Date
Indexed A. C. Johnson

F.B. 54 Pg. 9

RETURN TO

LOS ANGELES COUNTY SURVEYOR

700 HALL OF RECORDS

Note: ANY ADDITIONS OR CHANGES ON THIS SHEET MUST BE MADE OR CIRCLED IN **Red Ink.** WITH DATE AND NAME OF PERSON MAKING CHANGE.

Do not extend notes this side of this line

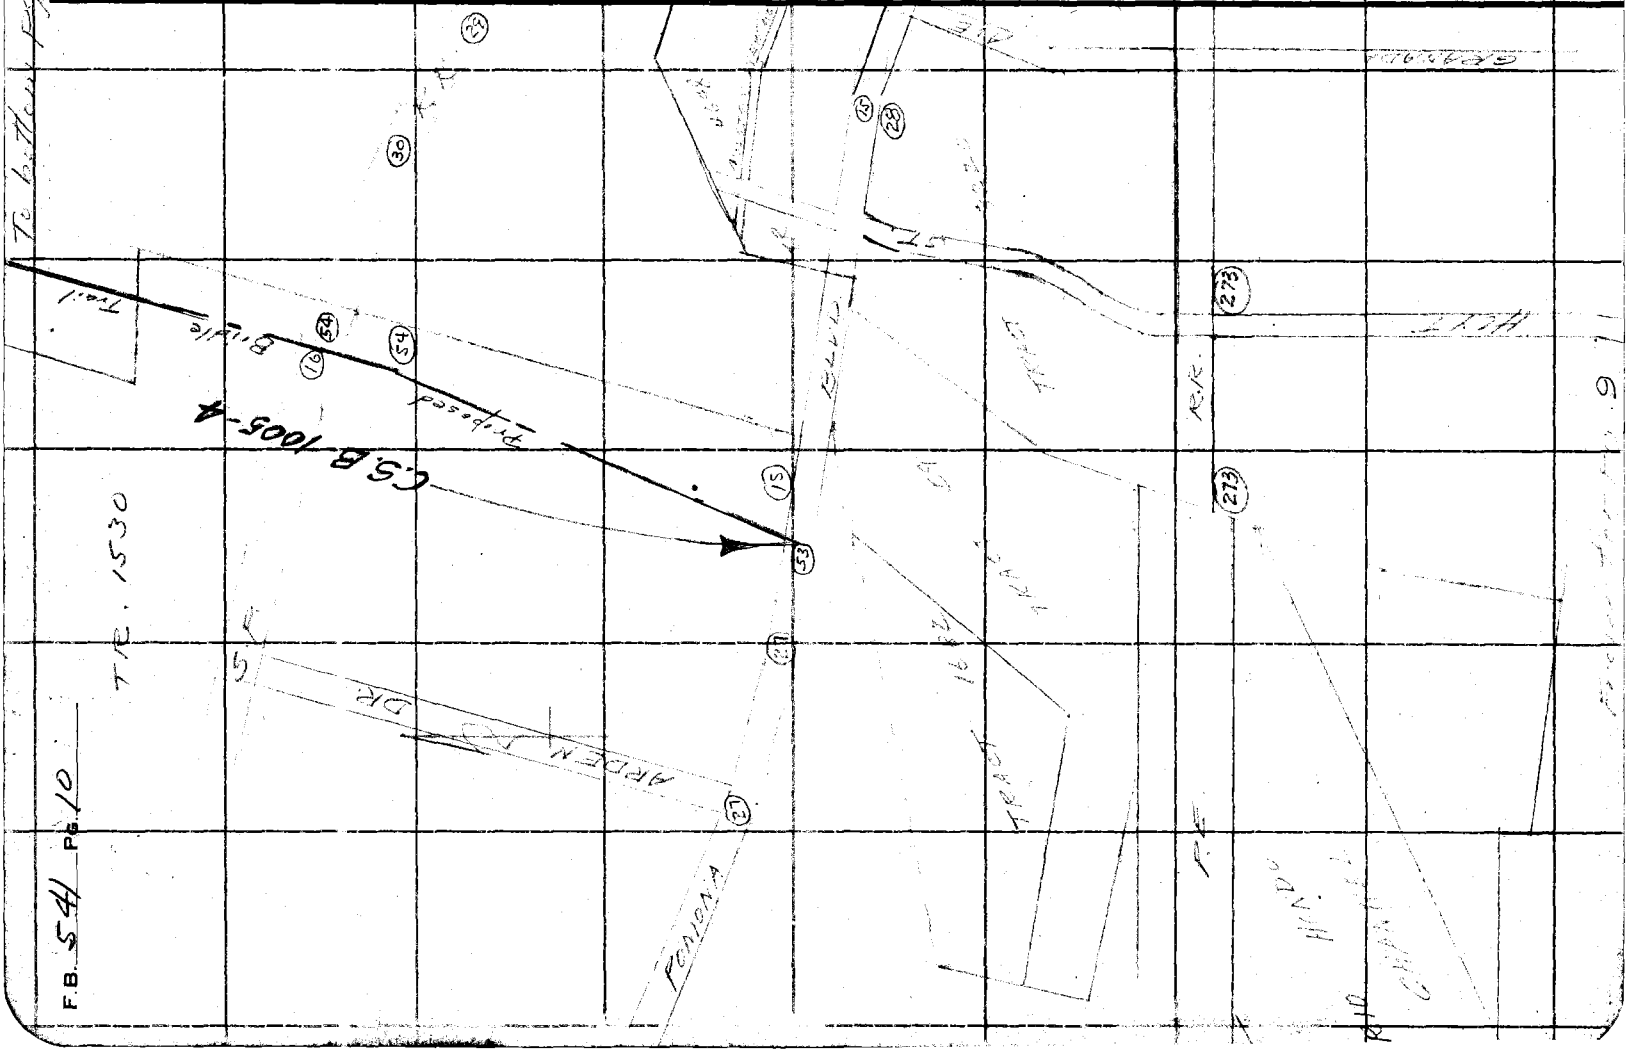

Notes Ck'd by D. M. Finley	Survey of [illegible]
Map No. B-1005-4	W. O. [illegible] Tape No. ____ St'd ____ °F.
Office Work C. W. Cox	Surveyed by [illegible] Moore
Checked	Notes Moore Date
Date	Indexed A. C. Johnson

F.B. 541 PG. 11

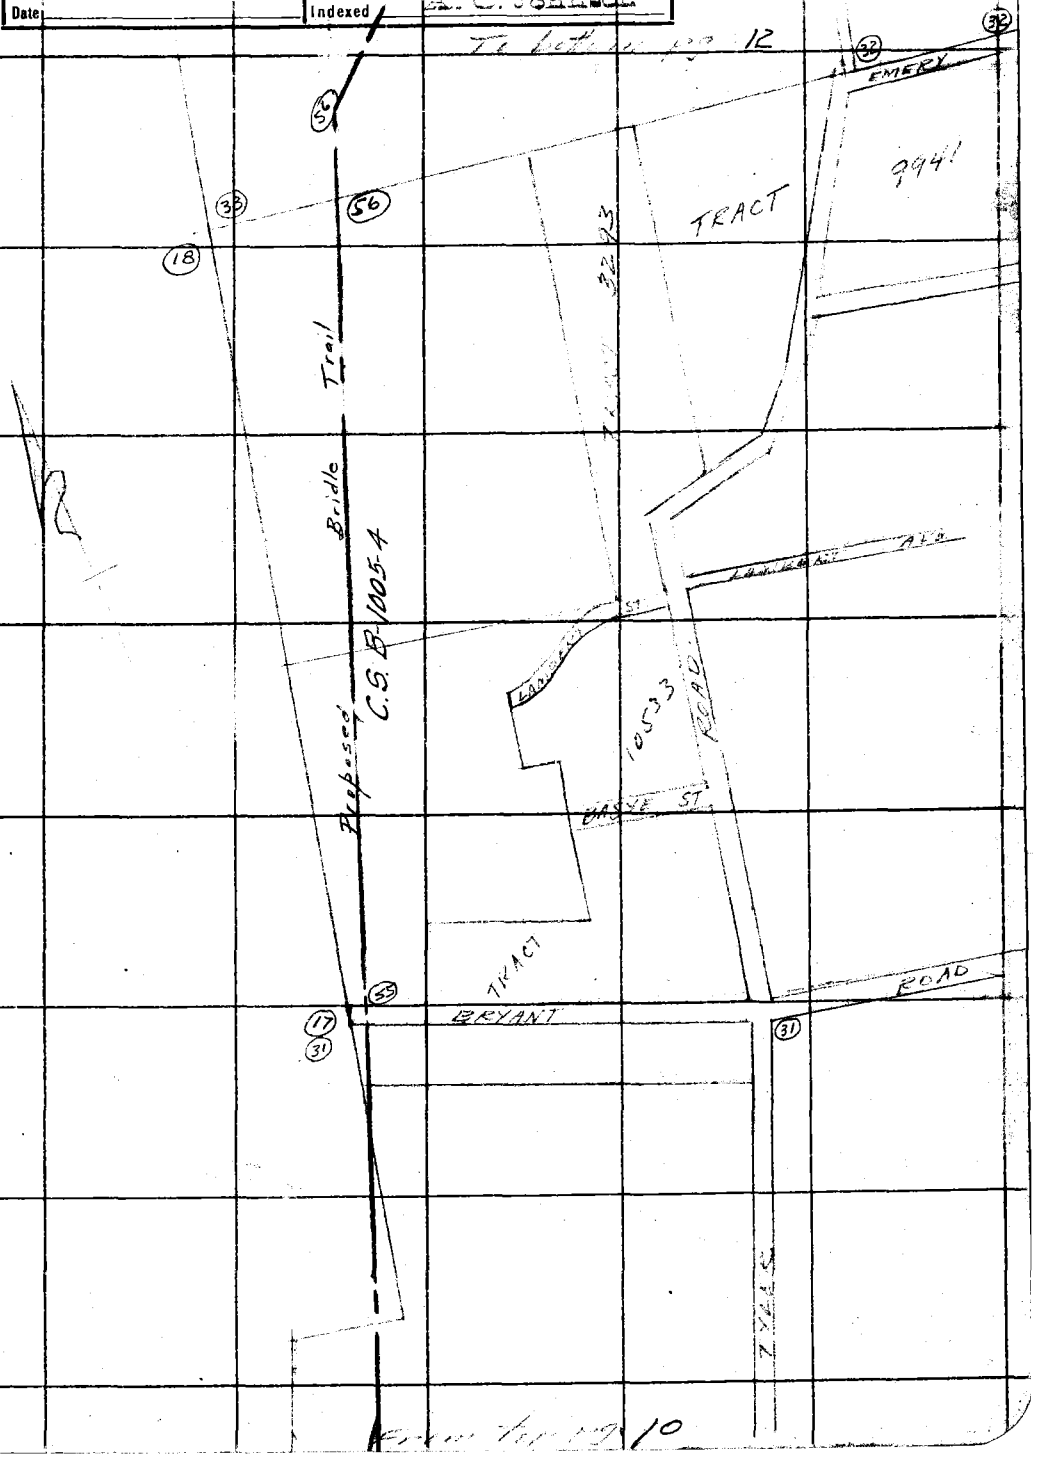

Note: ANY ADDITIONS OR CHANGES ON THIS SHEET MUST BE MADE OR CIRCLED IN Red Ink. WITH DATE AND NAME OF PERSON MAKING CHANGE.

RETURN TO
LOS ANGELES COUNTY SURVEYOR
700 HALL OF RECORDS

Do not extend notes this side of this line

FORM 247 10M 5-31

RETURN TO
LOS ANGELES COUNTY SURVEYOR
700 HALL OF RECORDS

Note: ANY ADDITIONS OR CHANGES ON THIS SHEET MUST BE MADE OR CIRCLED IN Red Ink. WITH DATE AND NAME OF PERSON MAKING CHANGE.

Do not extend notes this side of this line

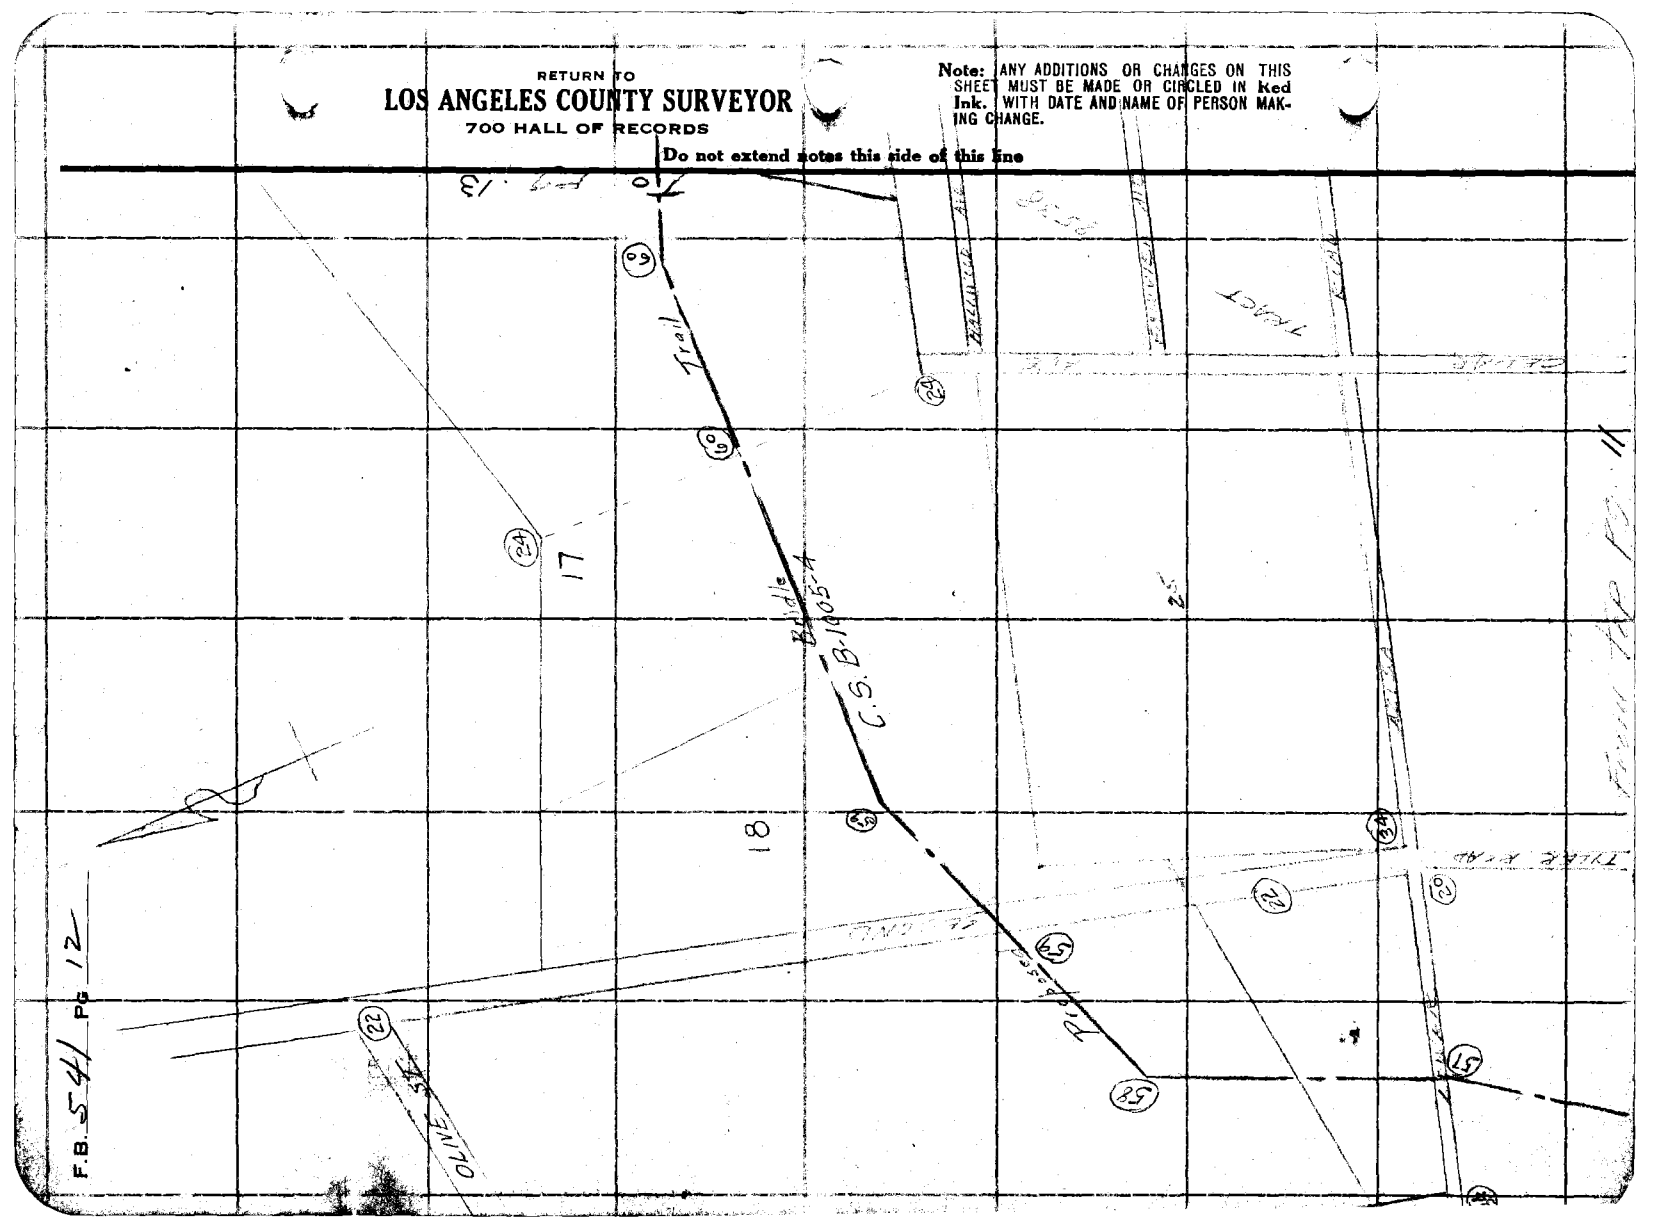

Div #1

Notes Ck'd by D. M. Finley	Survey of
Map No. B-1005-4	W. O. 8[illegible] Tape No. St'd °F.
Office Work C. W. Cox	Surveyed by L. D. Moore
Checked	Notes Moore Date
Date	Indexed A. C. Johnson

F.B. 541 Pg. 13

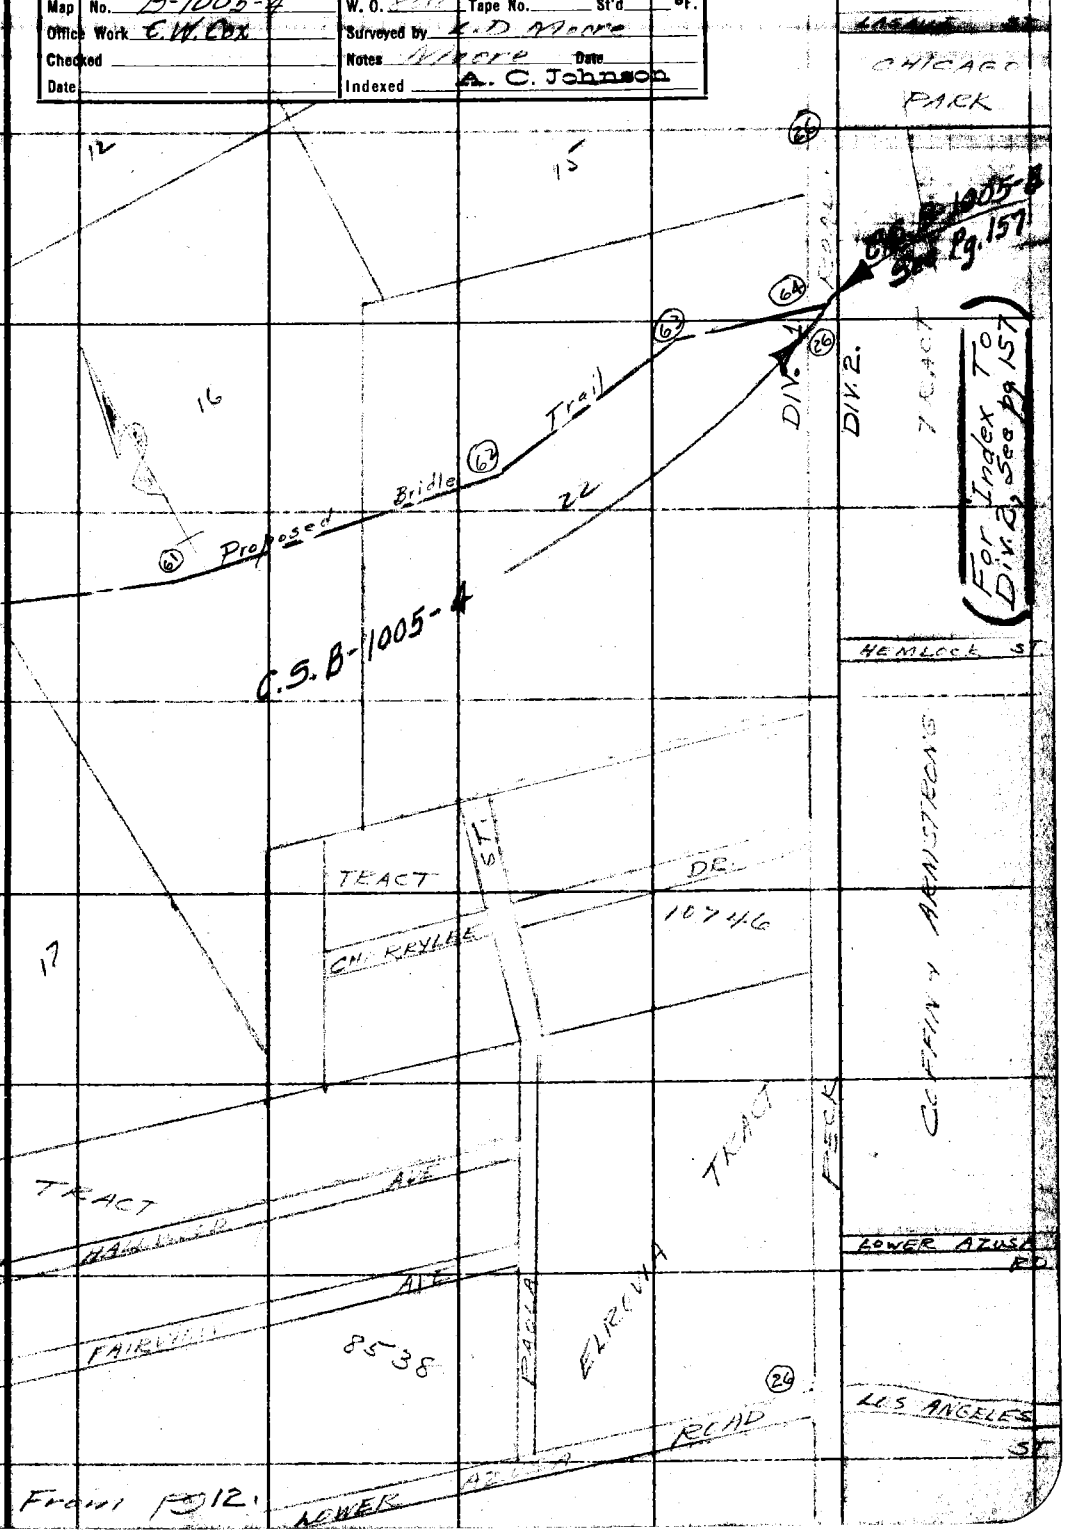

Note: ANY ADDITIONS OR CHANGES ON THIS SHEET MUST BE MADE OR CIRCLED IN Red Ink. WITH DATE AND NAME OF PERSON MAKING CHANGE.

RETURN TO
LOS ANGELES COUNTY SURVEYOR
700 HALL OF RECORDS

Do not extend notes this side of this line

FORM 247 10M 5-91

RETURN TO

LOS ANGELES COUNTY SURVEYOR

700 HALL OF RECORDS

Note: ANY ADDITIONS OR CHANGES ON THIS SHEET MUST BE MADE OR CIRCLED IN Red Ink. WITH DATE AND NAME OF PERSON MAKING CHANGE.

Do not extend notes this side of this line.

F.B. 5241 Pg 14

Notes Ck'd by McPherson	Survey of El Monte Bridle Trail
Map No. B-1005-4	W. O. 8012 Tape No. 067 St'd 84 °F.
Office Work C.W. Gaz	Surveyed by Evans
Checked	Notes HE Date 3/7/34
Date	Indexed A. C. Johnson

F.B. 541 Pg. 15

46, A-4

(To Bot. pg. 16)

Preliminary Survey of El Monte Bridle Trail from Valley Blvd. to Pock Rd. (pgs. 15 to 52.

(For FINAL LOCATION See pgs. 53 to 64)

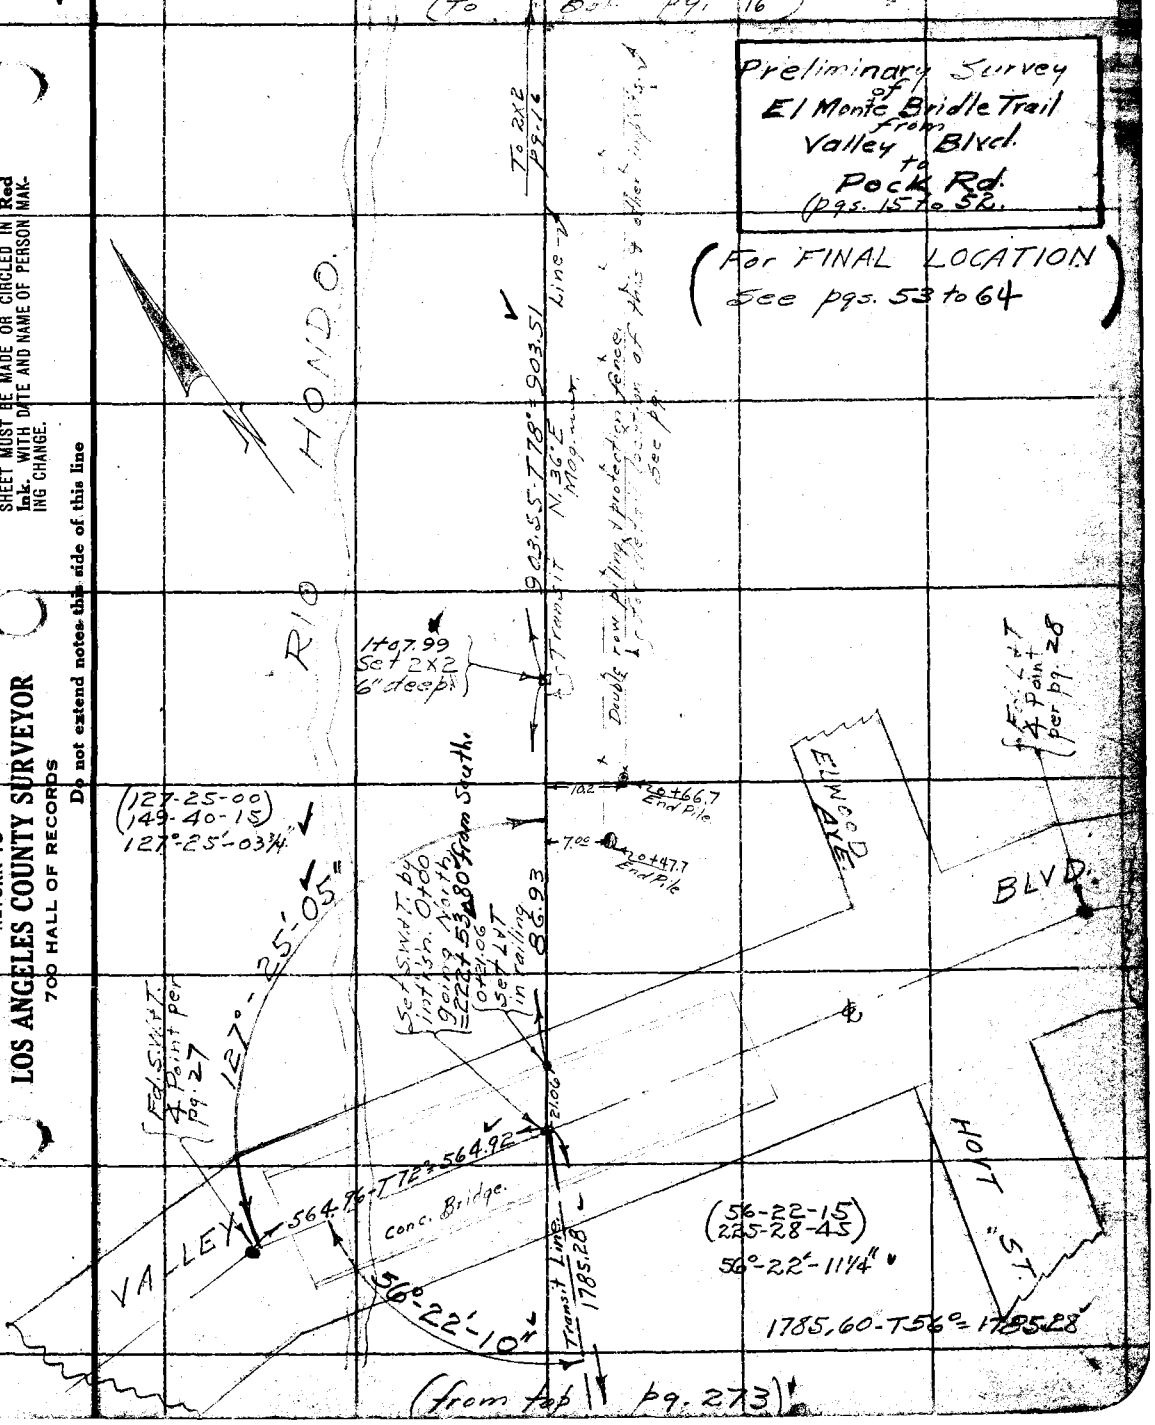

Note: ANY ADDITIONS OR CHANGES ON THIS SHEET MUST BE MADE OR CIRCLED IN Red Ink. WITH DATE AND NAME OF PERSON MAKING CHANGE.

RETURN TO
LOS ANGELES COUNTY SURVEYOR
700 HALL OF RECORDS

Do not extend notes this side of this line

FORM 247 10M 5-31

RETURN TO
LOS ANGELES COUNTY SURVEYOR
700 HALL OF RECORDS

Note: ANY ADDITIONS OR CHANGES ON THIS SHEET MUST BE MADE OR CIRCLED IN Red Ink. WITH DATE AND NAME OF PERSON MAKING CHANGE.

46, A-4

Do not extend notes this side of this line

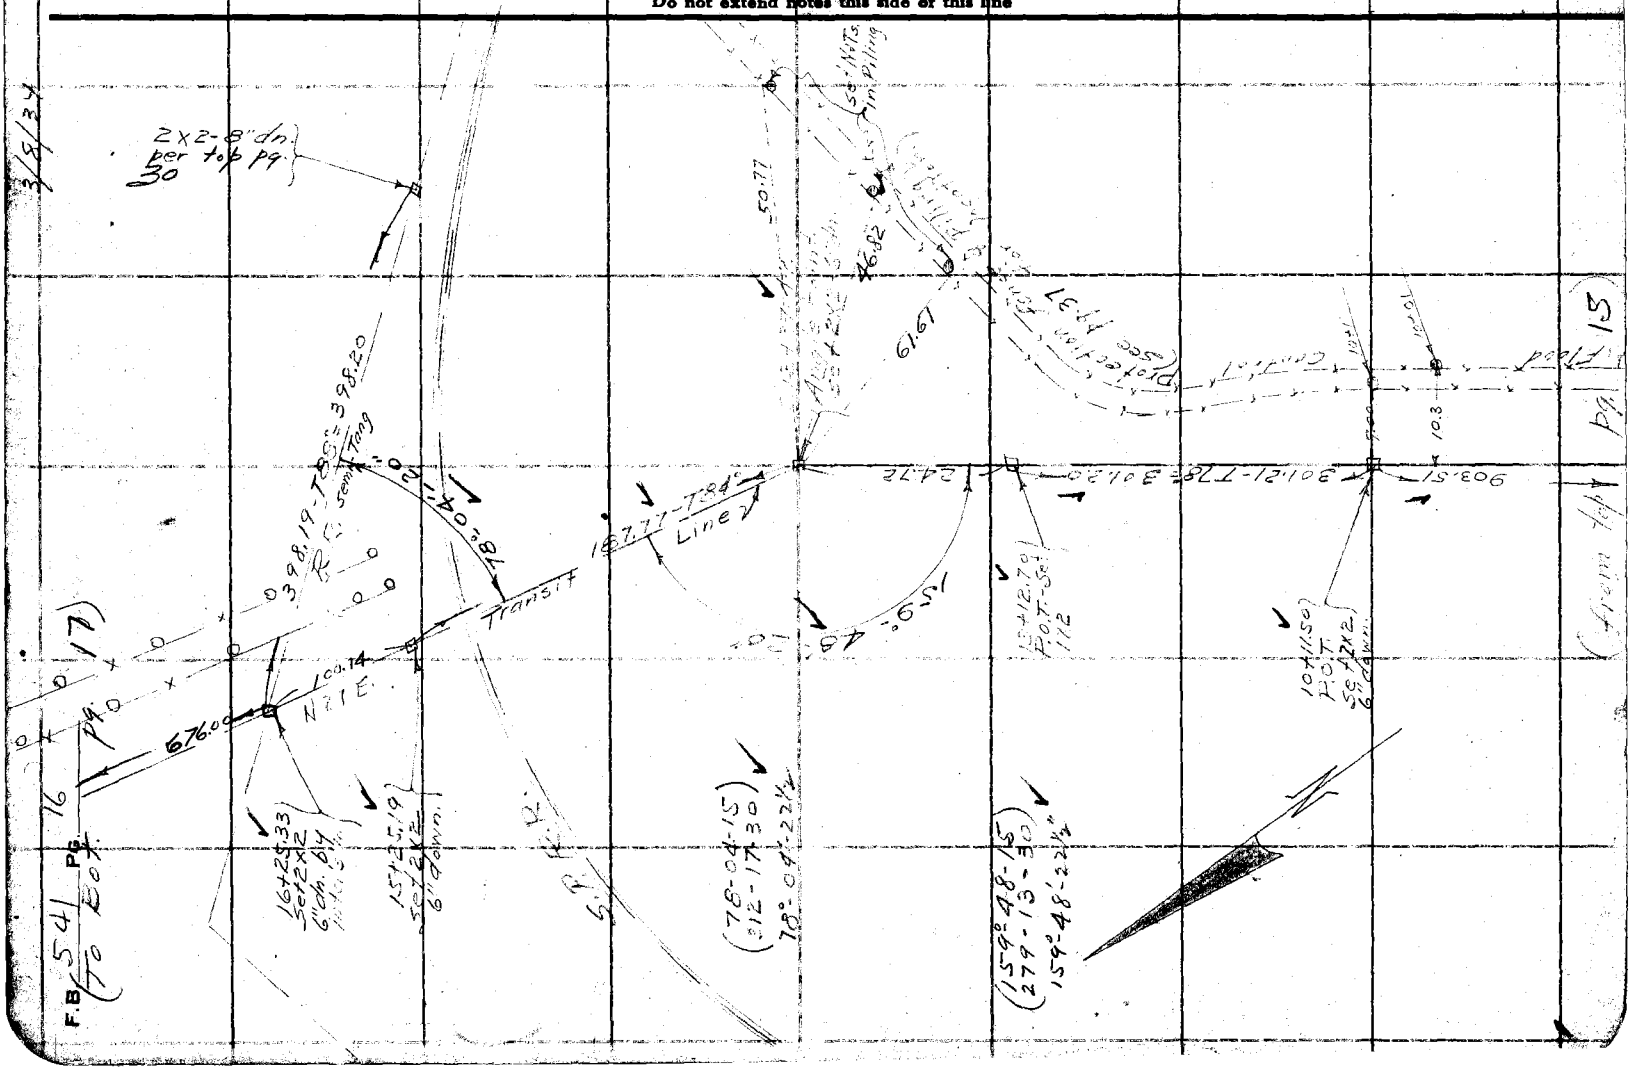

Notes Ck'd by McPherson	Survey of El Monte Biddle Trail
Map No. B-1005-4	W. O. 8012 Tape No. 067 St'd 84 °F.
Office Work C.W. Cox	Surveyed by Evans
Checked	Notes HE Date 3/8/34
Date	Indexed A. C. Johnson

F.B. 541 PG. 17

46, A-4

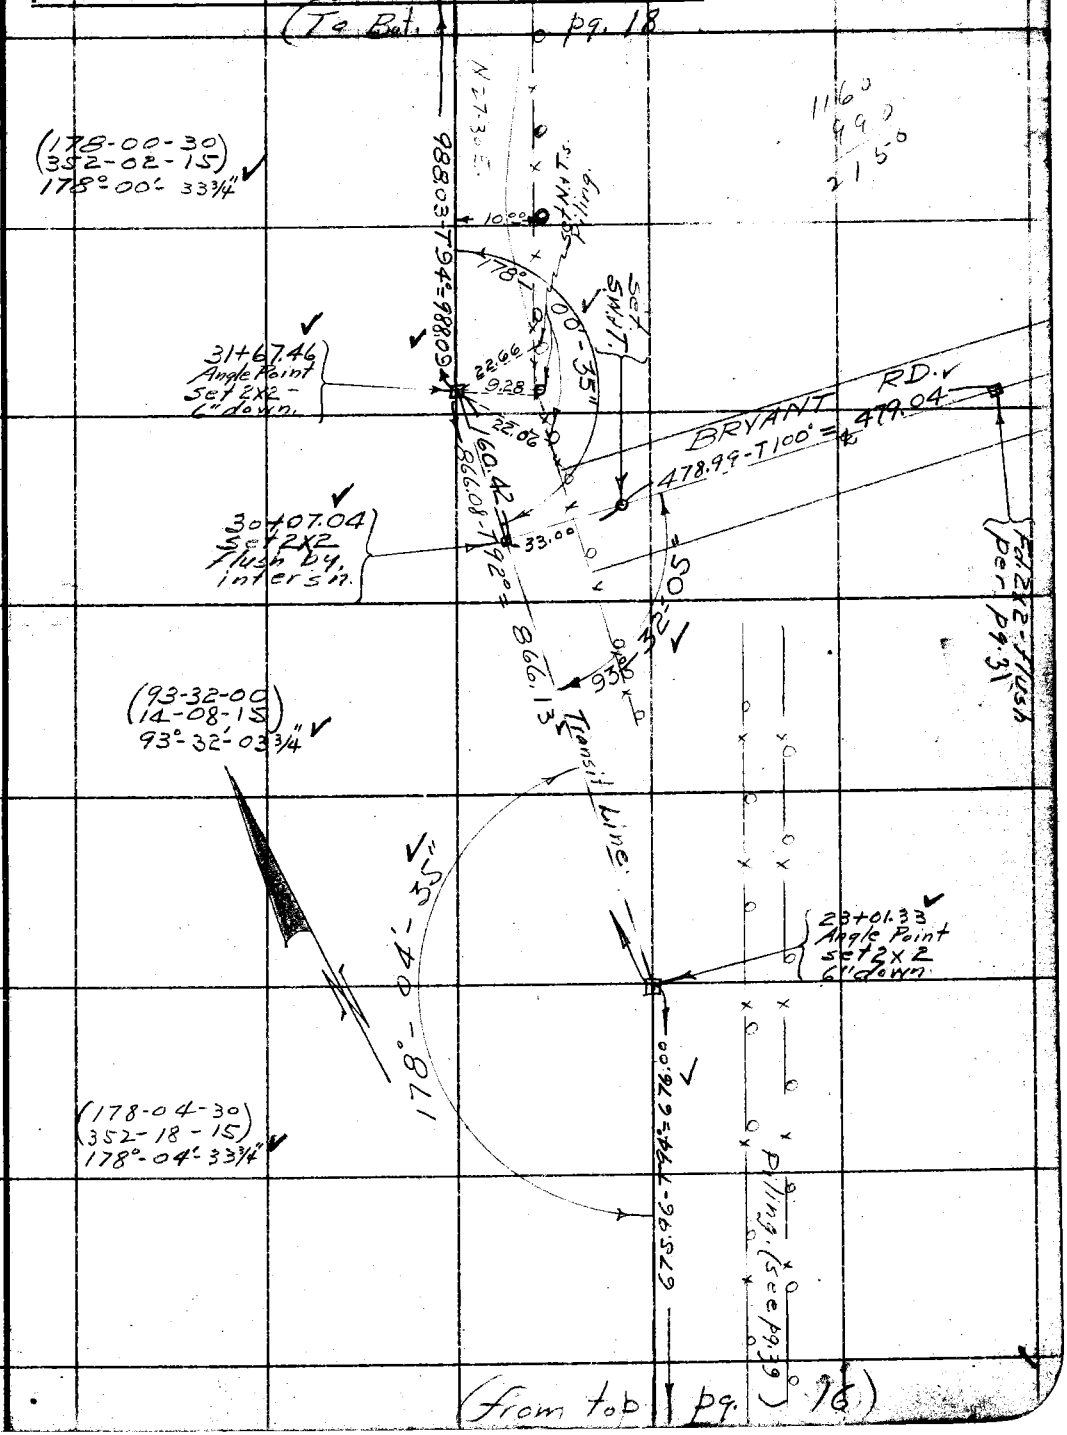

Note: ANY ADDITIONS OR CHANGES ON THIS SHEET MUST BE MADE OR CIRCLED IN Red Ink, WITH DATE AND NAME OF PERSON MAKING CHANGE.

Do not extend notes this side of this line

RETURN TO
LOS ANGELES COUNTY SURVEYOR
700 HALL OF RECORDS

FORM 247 10M 5-31

RETURN TO
LOS ANGELES COUNTY SURVEYOR
700 HALL OF RECORDS

46, 44

Note: ANY ADDITIONS OR CHANGES ON THIS SHEET MUST BE MADE OR CIRCLED IN Red Ink. WITH DATE AND NAME OF PERSON MAKING CHANGE.

Do not extend notes this side of this line

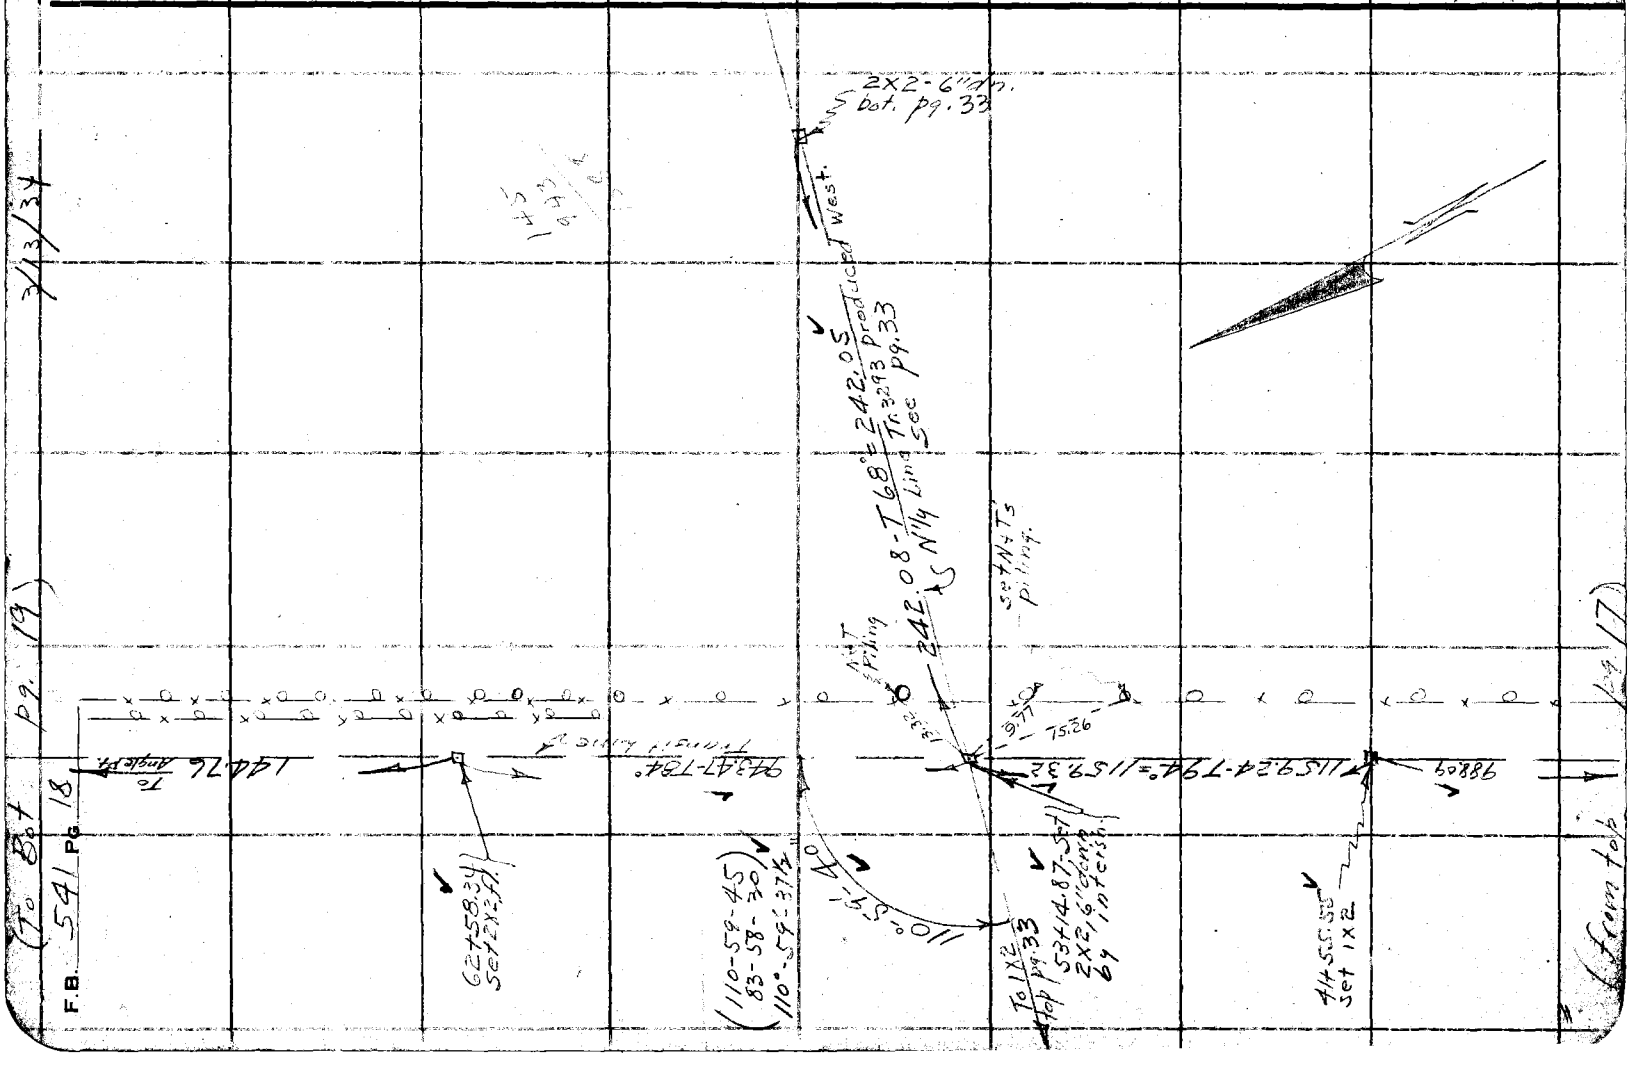

Notes Ck'd by McPherson	Survey of El Monte Bridle Trail
Map No. B-1005-4	W. O. 8012 Tape No. 067 St'd 84 °F.
Office Work C. W. Cox	Surveyed by Evans
Checked	Notes 14 Date 3/13/34
Date	Indexed A. C. Johnson

F.B. 541 PG. 19

46, A-4

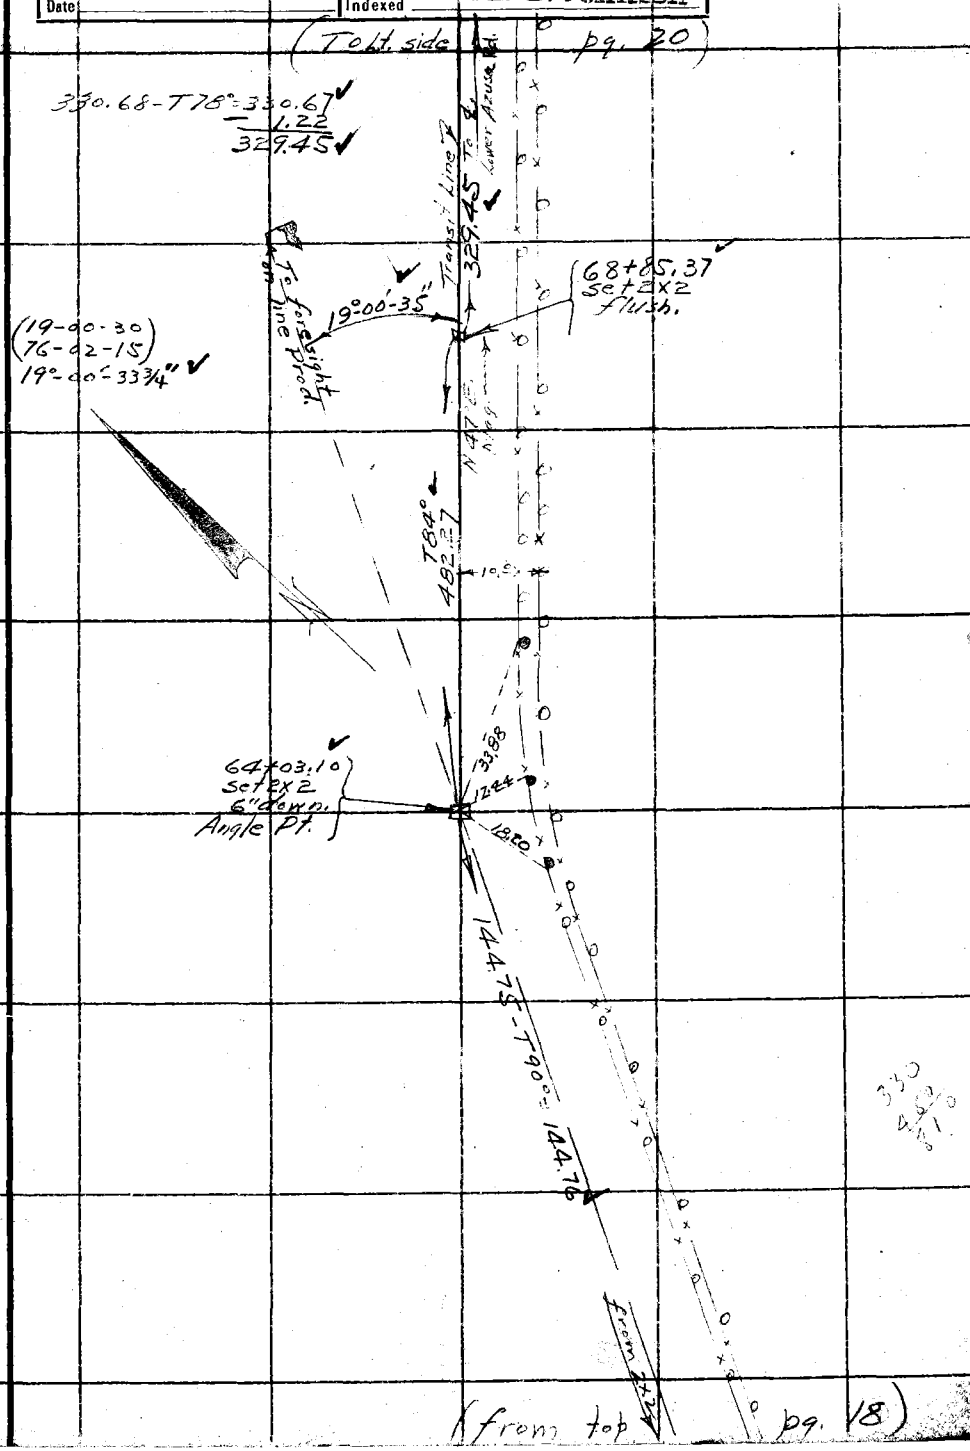

Note: ANY ADDITIONS OR CHANGES ON THIS SHEET MUST BE MADE OR CIRCLED IN Red Ink. WITH DATE AND NAME OF PERSON MAKING CHANGE.

Do not extend notes this side of this line

RETURN TO
LOS ANGELES COUNTY SURVEYOR
700 HALL OF RECORDS

FORM 247 10M 5-31

RETURN TO
LOS ANGELES COUNTY SURVEYOR
700 HALL OF RECORDS

Note: ANY ADDITIONS OR CHANGES ON THIS SHEET MUST BE MADE OR CIRCLED IN Red Ink. WITH DATE AND NAME OF PERSON MAKING CHANGE.

Do not extend notes this side of this line

46, A-4

46, A-4

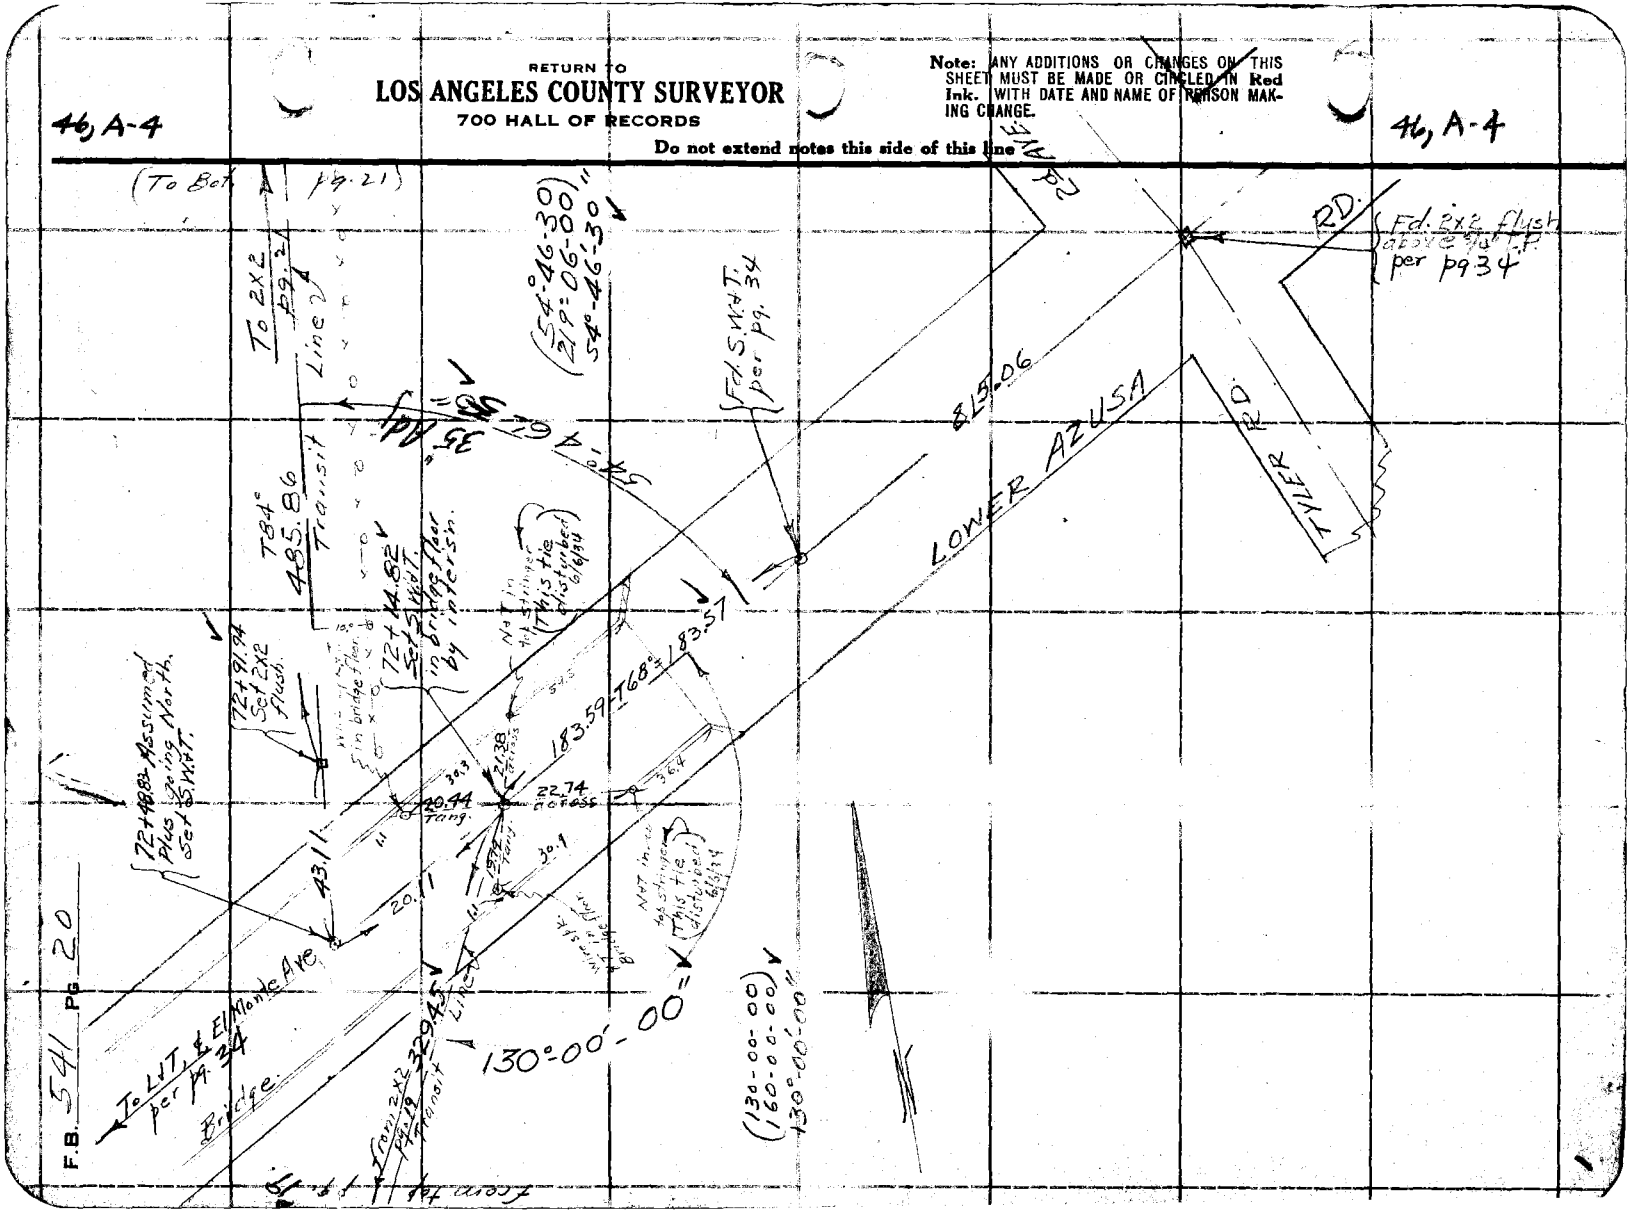

Notes Ck'd by McPherson	Survey of El Monte Bridle Trail
Map No. B-1005-4	W. O. 8012 Tape No. 067 St'd 84 °F.
Office Work C.W. Cox	Surveyed by Evans
Checked	Notes HT Date 3/19/34
Date	Indexed A. C. Jones

F.B. 541 PG. 21

46 A-3

(To Lt. side p 9-27)

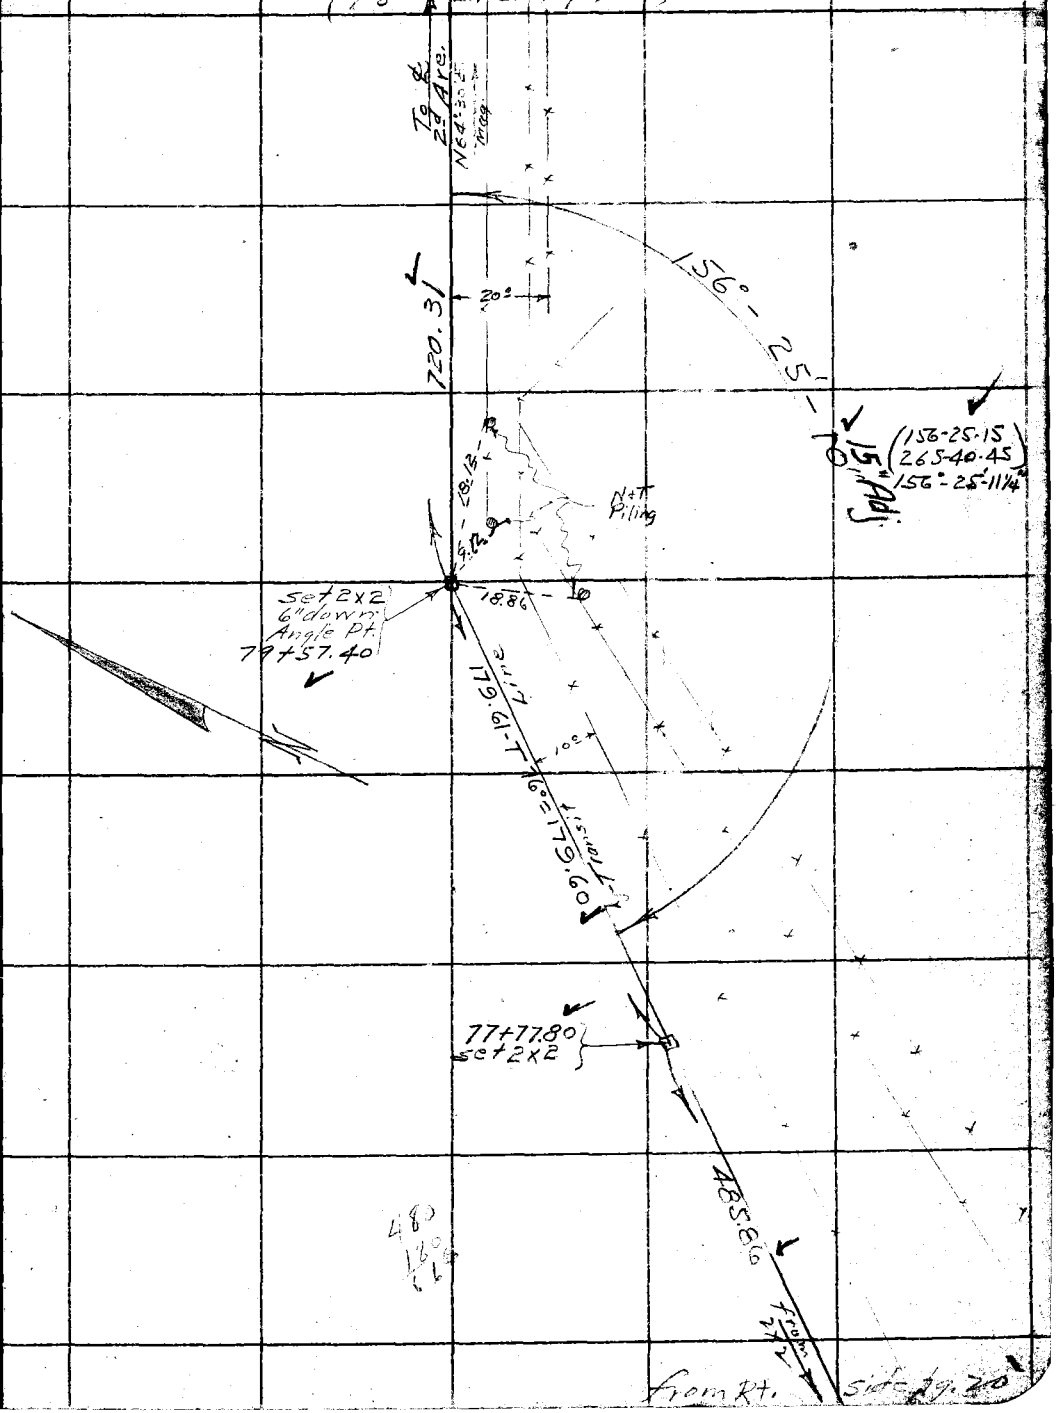

Note: ANY ADDITIONS OR CHANGES ON THIS SHEET MUST BE MADE OR CIRCLED IN Red Ink. WITH DATE AND NAME OF PERSON MAKING CHANGE.

Do not extend notes this side of this line

RETURN TO
LOS ANGELES COUNTY SURVEYOR
700 HALL OF RECORDS

FORM 247 10M 5-31

RETURN TO
LOS ANGELES COUNTY SURVEYOR
700 HALL OF RECORDS

Note: ANY ADDITIONS OR CHANGES ON THIS SHEET MUST BE MADE OR CIRCLED IN Red Ink. WITH DATE AND NAME OF PERSON MAKING CHANGE.

46/A-3

Do not extend notes this side of this line

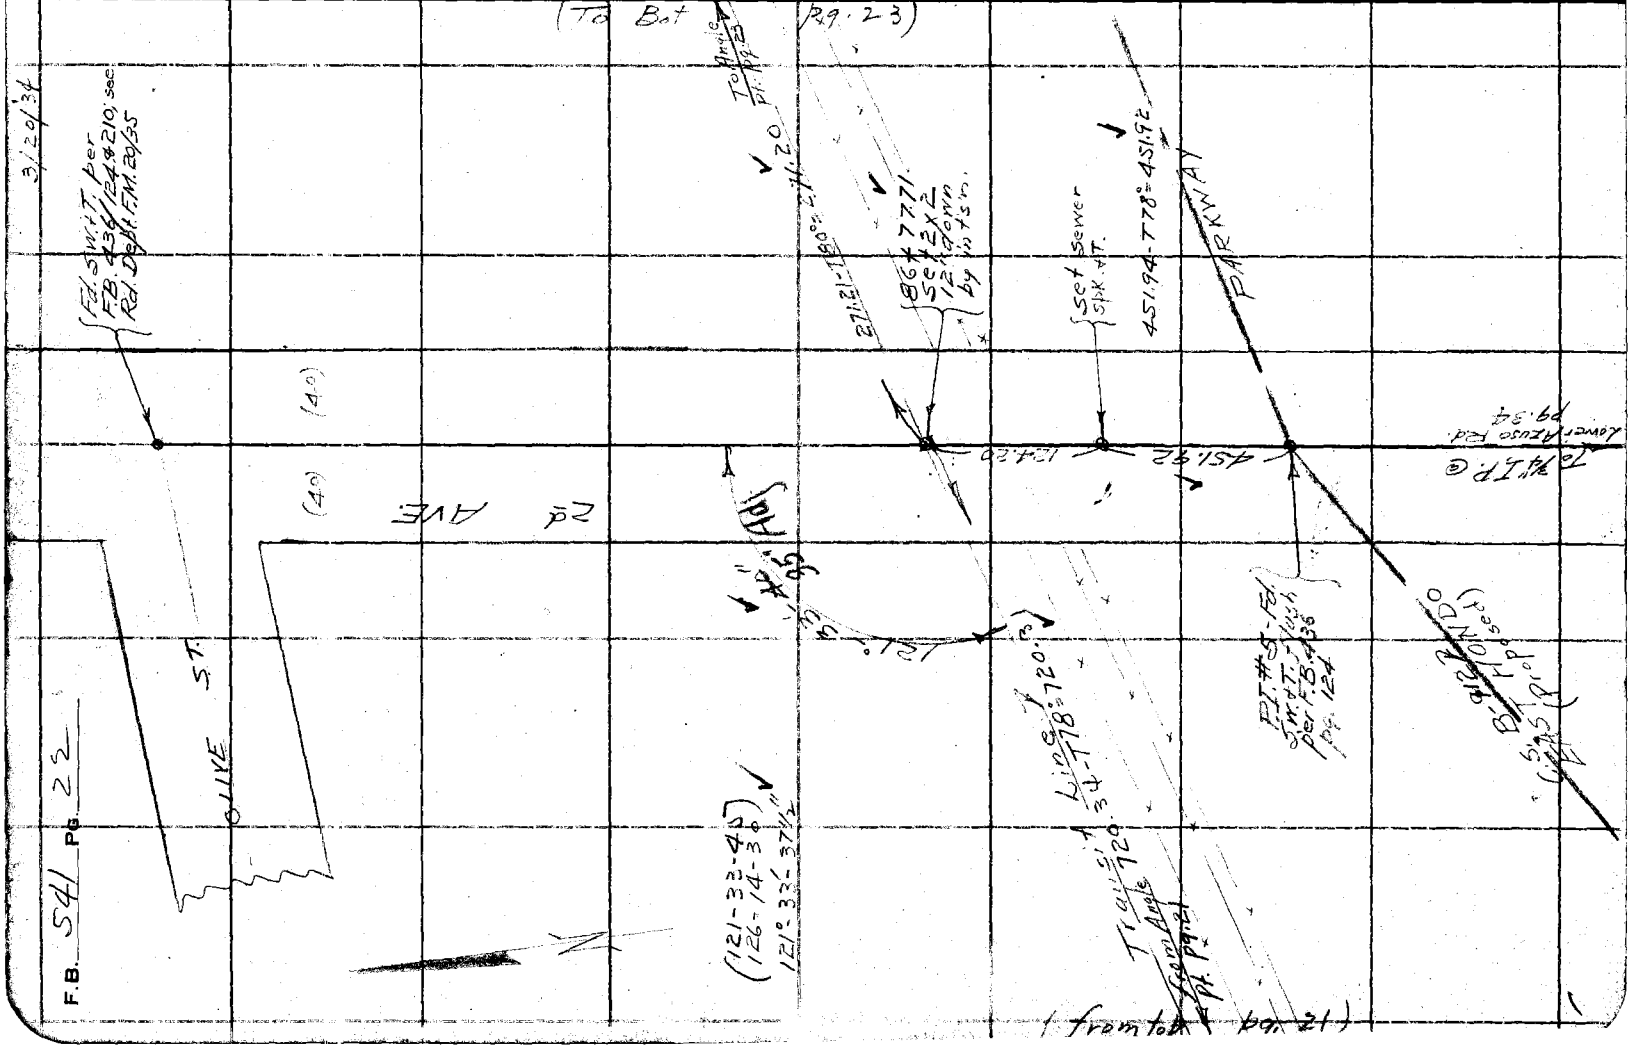

(To Bdt. pg. 24)

F.B. 541 PG. 23

Notes Ck'd by McPherson	Survey of El Monte Bridle Trail
Map No. B-1005-4	W. O. 8012 Tape No. 067 St'd 84 °F.
Office Work C. W. Cox	Surveyed by Evans
Checked	Notes HE Date 3/20/34
Date	Indexed A. C. Johnson

46, A-3

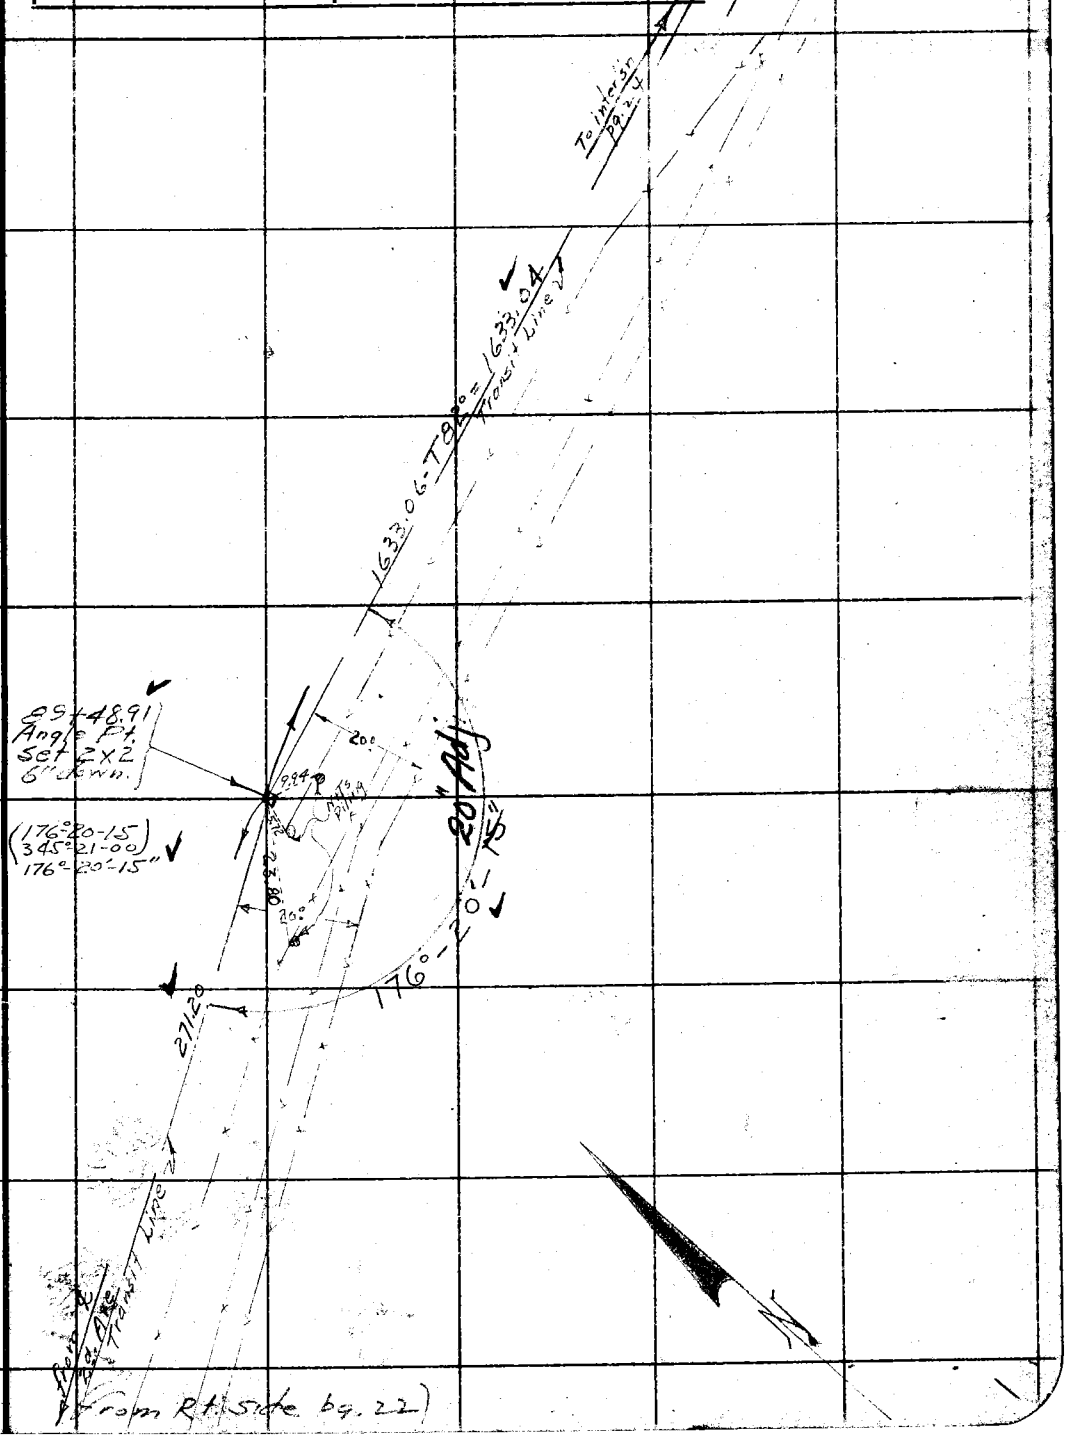

Note: ANY ADDITIONS OR CHANGES ON THIS SHEET MUST BE MADE OR CIRCLED IN Red Ink. WITH DATE AND NAME OF PERSON MAKING CHANGE.

Do not extend notes this side of this line

RETURN TO
LOS ANGELES COUNTY SURVEYOR
700 HALL OF RECORDS

FORM 247 10M 5-31

RETURN TO
LOS ANGELES COUNTY SURVEYOR
700 HALL OF RECORDS

46, B-3

Note: ANY ADDITIONS OR CHANGES ON THIS SHEET MUST BE MADE OR CIRCLED IN Red Ink. WITH DATE AND NAME OF PERSON MAKING CHANGE.

Do not extend notes this side of this line

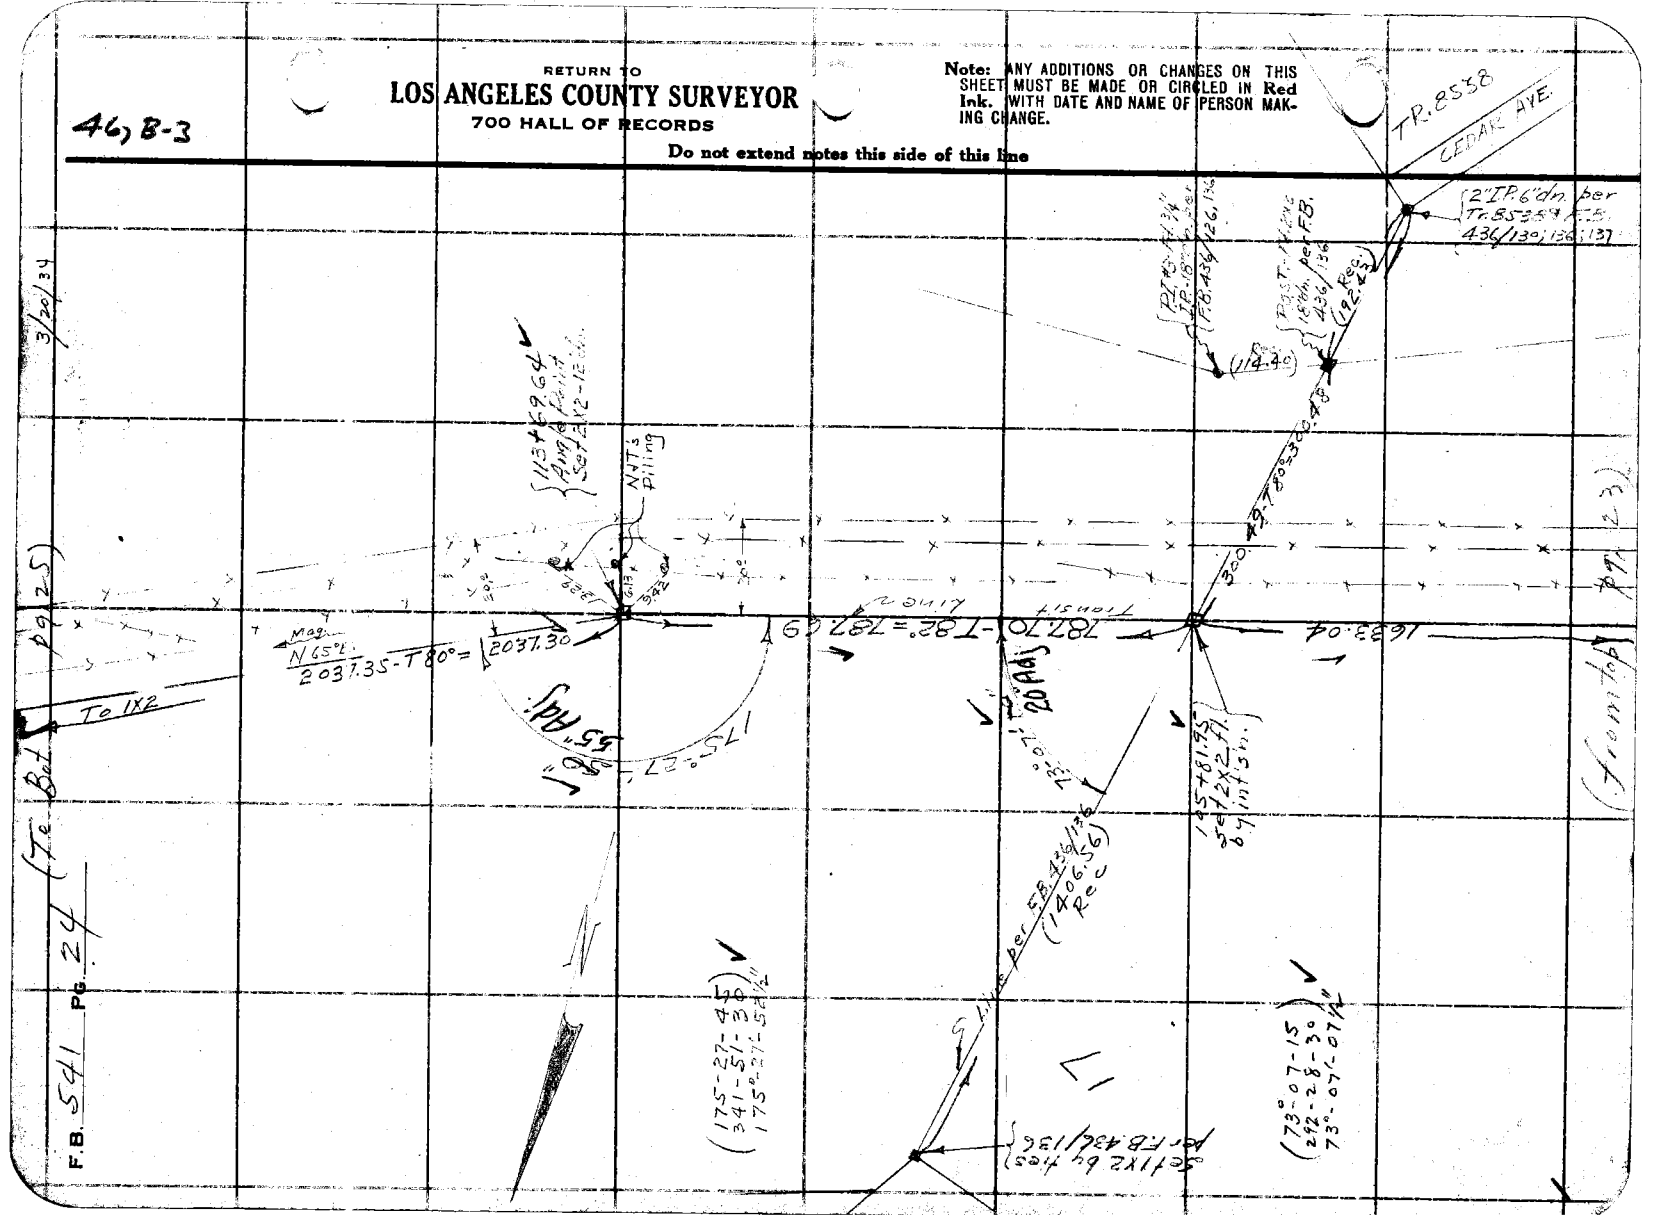

Notes Ck'd by McPherson	Survey of El Monte Bridle Trail-Dist. F.B. 541 PG. 26
Map No. B-1005-4	W. O. 8012 Tape No. 067 St'd 84 °F.
Office Work C. W. Cox	Surveyed by Evans
Checked	Notes HE Date 3/21/34
Date	Indexed A. C. Johnson

4 & B-3

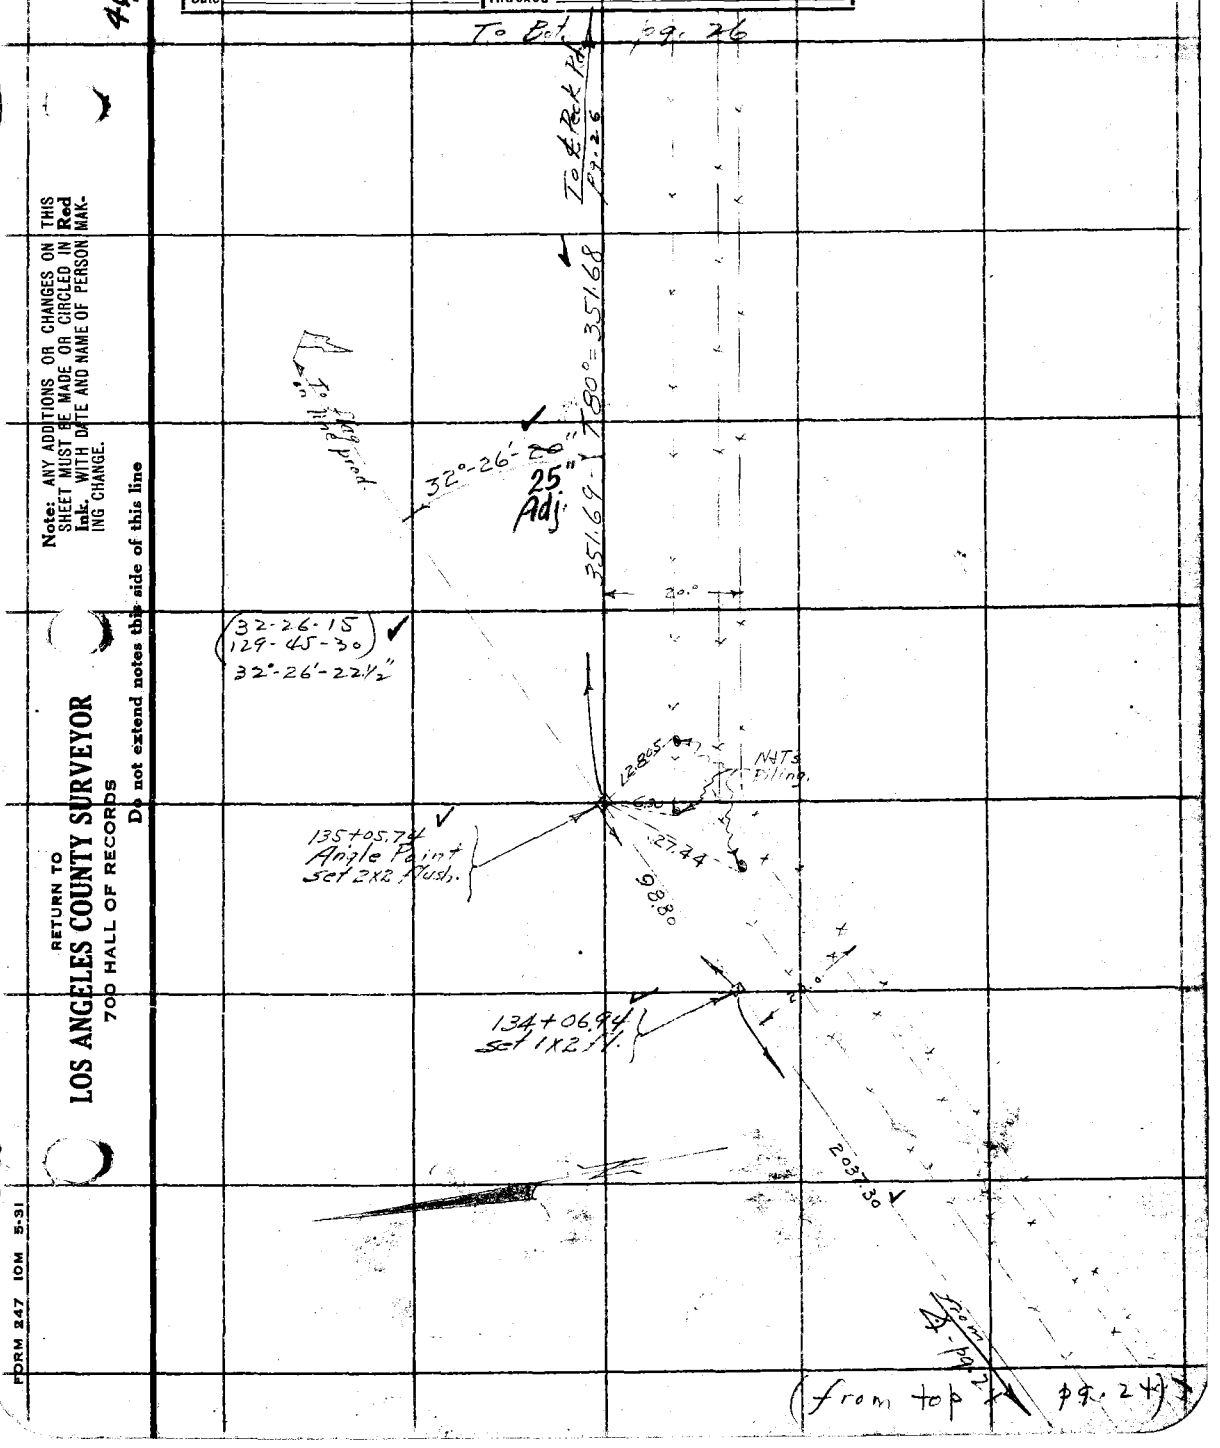

Note: ANY ADDITIONS OR CHANGES ON THIS SHEET MUST BE MADE OR CIRCLED IN Red Ink. WITH DATE AND NAME OF PERSON MAKING CHANGE.

RETURN TO
LOS ANGELES COUNTY SURVEYOR
700 HALL OF RECORDS

Do not extend notes this side of this line

FORM 247 10M 5-31

RETURN TO
LOS ANGELES COUNTY SURVEYOR
700 HALL OF RECORDS

Note: ANY ADDITIONS OR CHANGES ON THIS SHEET MUST BE MADE OR CIRCLED IN Red Ink. WITH DATE AND NAME OF PERSON MAKING CHANGE.

Do not extend notes this side of this line

46 B-3

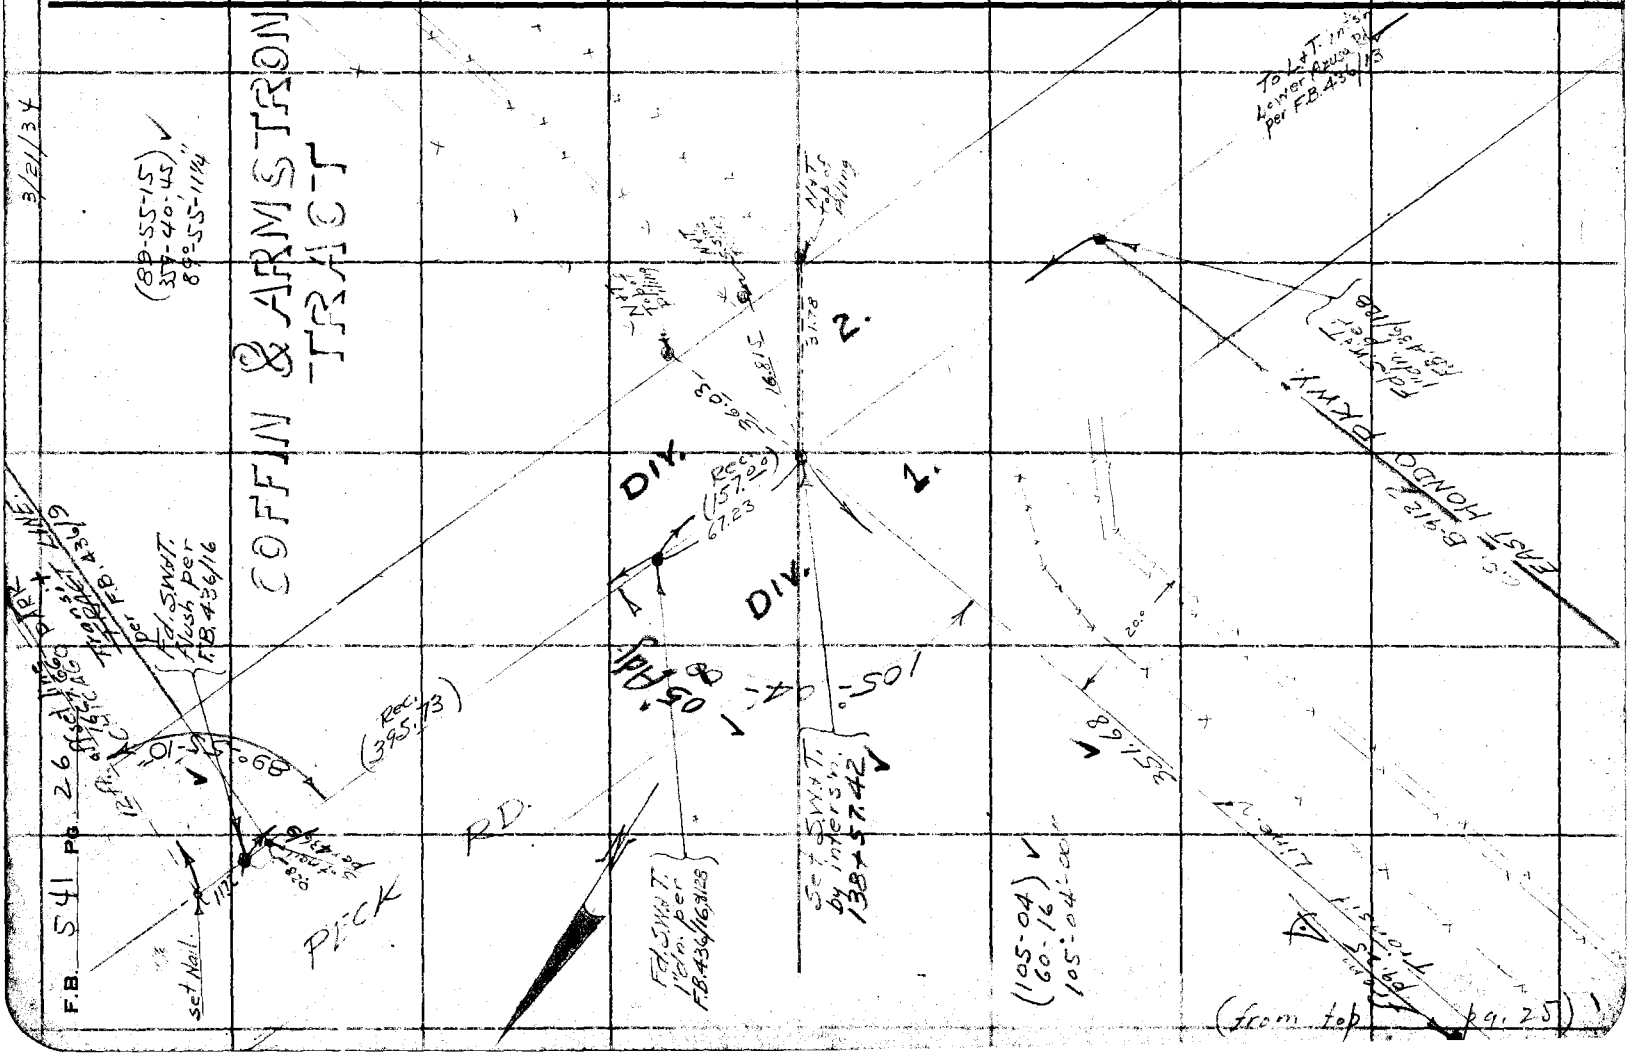

Notes Ck'd by McPherson	Survey of EL MONTE BRIDLE TRAIL
Map No. B-1005-4	W. O. 8012 Tape No. 067 St'd 84 °F.
Office Work C. W. Cox	Surveyed by Evans
Checked	Notes HE Date 2/28/34
Date	Indexed

F.B. 541 PG. 27

44, D-6

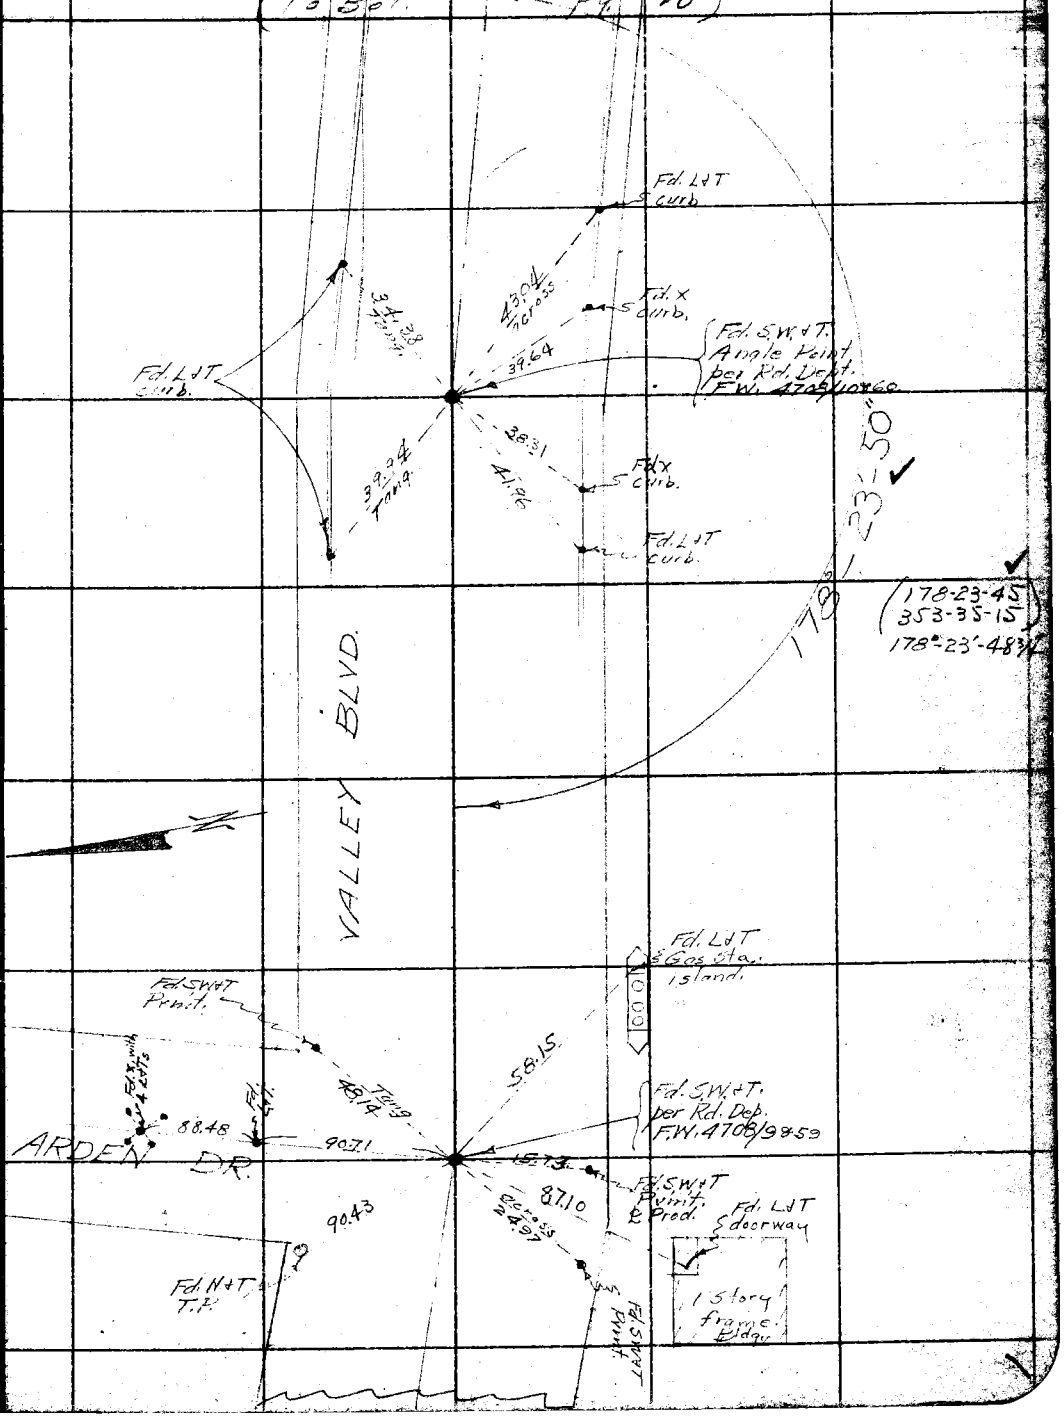

Note: ANY ADDITIONS OR CHANGES ON THIS SHEET MUST BE MADE OR CIRCLED IN Red Ink. WITH DATE AND NAME OF PERSON MAKING CHANGE.

RETURN TO
LOS ANGELES COUNTY SURVEYOR
700 HALL OF RECORDS

Do not extend notes this side of this line

FORM 247 10M 5-31

F.B. 541 Pg. 28

2/28/34

46, A-4

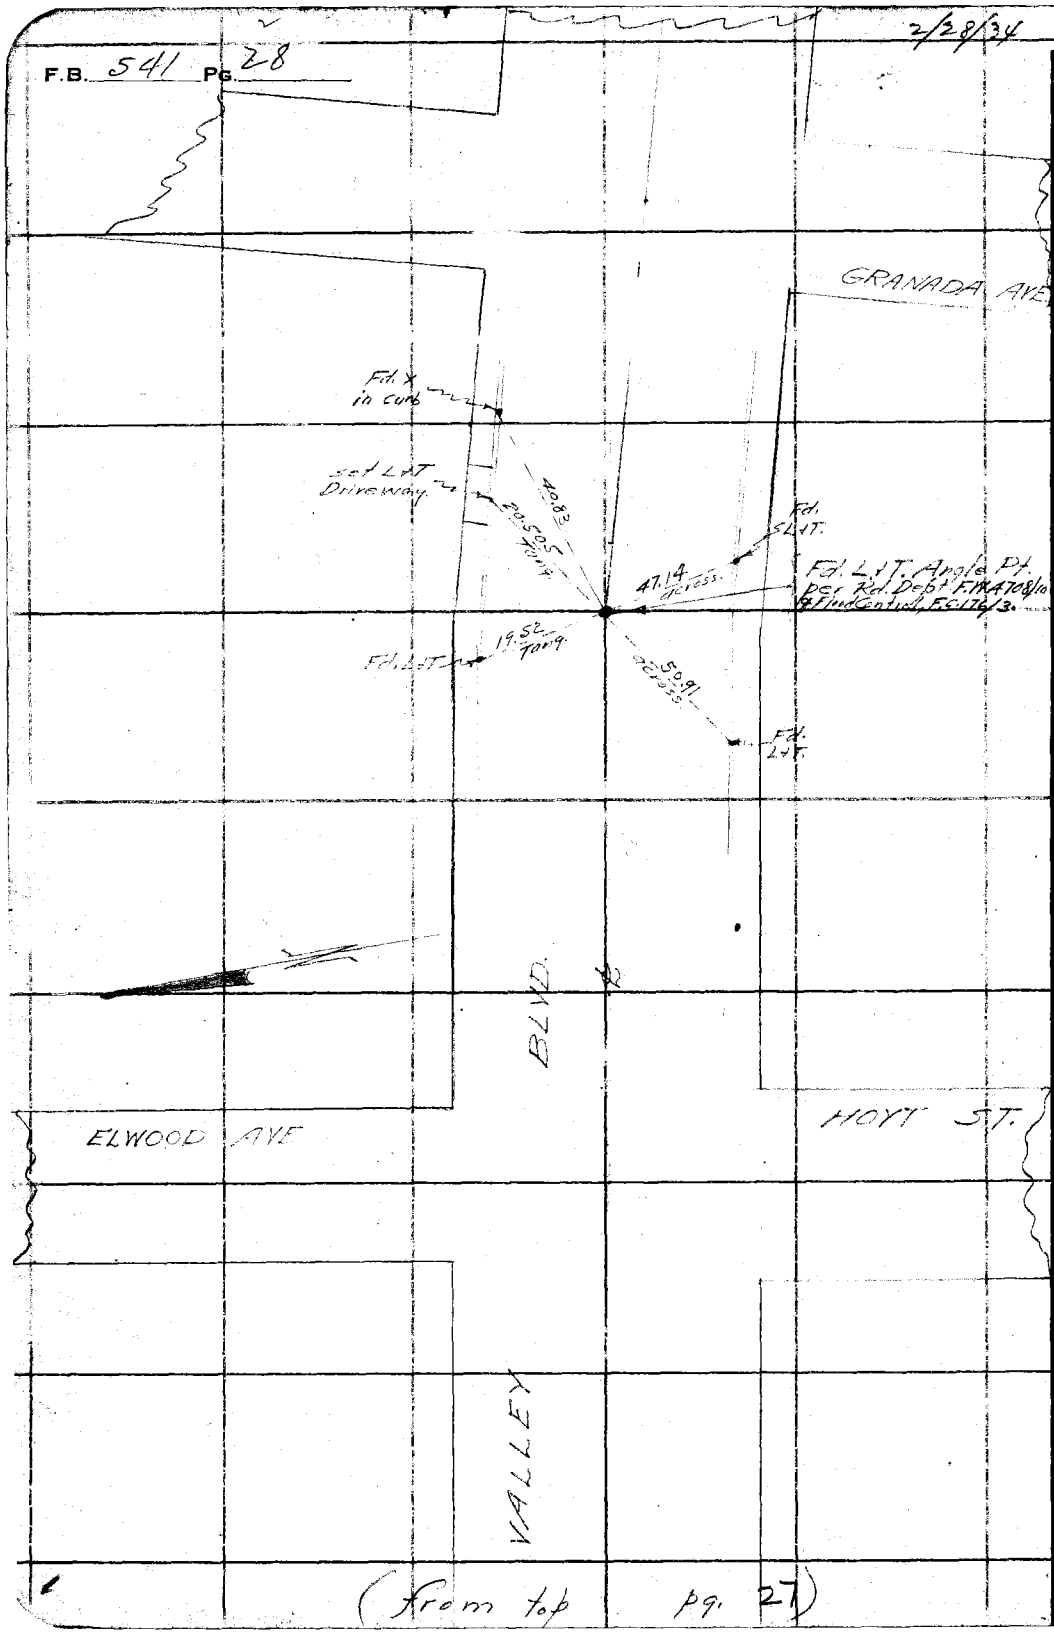

RETURN TO
LOS ANGELES COUNTY SURVEYOR
700 HALL OF RECORDS

Do not extend notes this side of this line

Note: ANY ADDITIONS OR CHANGES ON THIS SHEET MUST BE MADE OR CIRCLED IN Red Ink. WITH DATE AND NAME OF PERSON MAKING CHANGE.

(from top pg. 27)

3

Notes Ck'd by McPherson	Survey of El Monte Bridle Trail
Map No. B-1005-4	W. O. 8017 Tape No. 067 St'd 84 °F.
Office Work C.W. Cox	Surveyed by Evans
Checked	Notes HE Date 2/27/34
Date	Indexed A. C. Johnson

F.B. 541 PG. 29

W5.46-B-5

(To Bot. Pg. 3c)

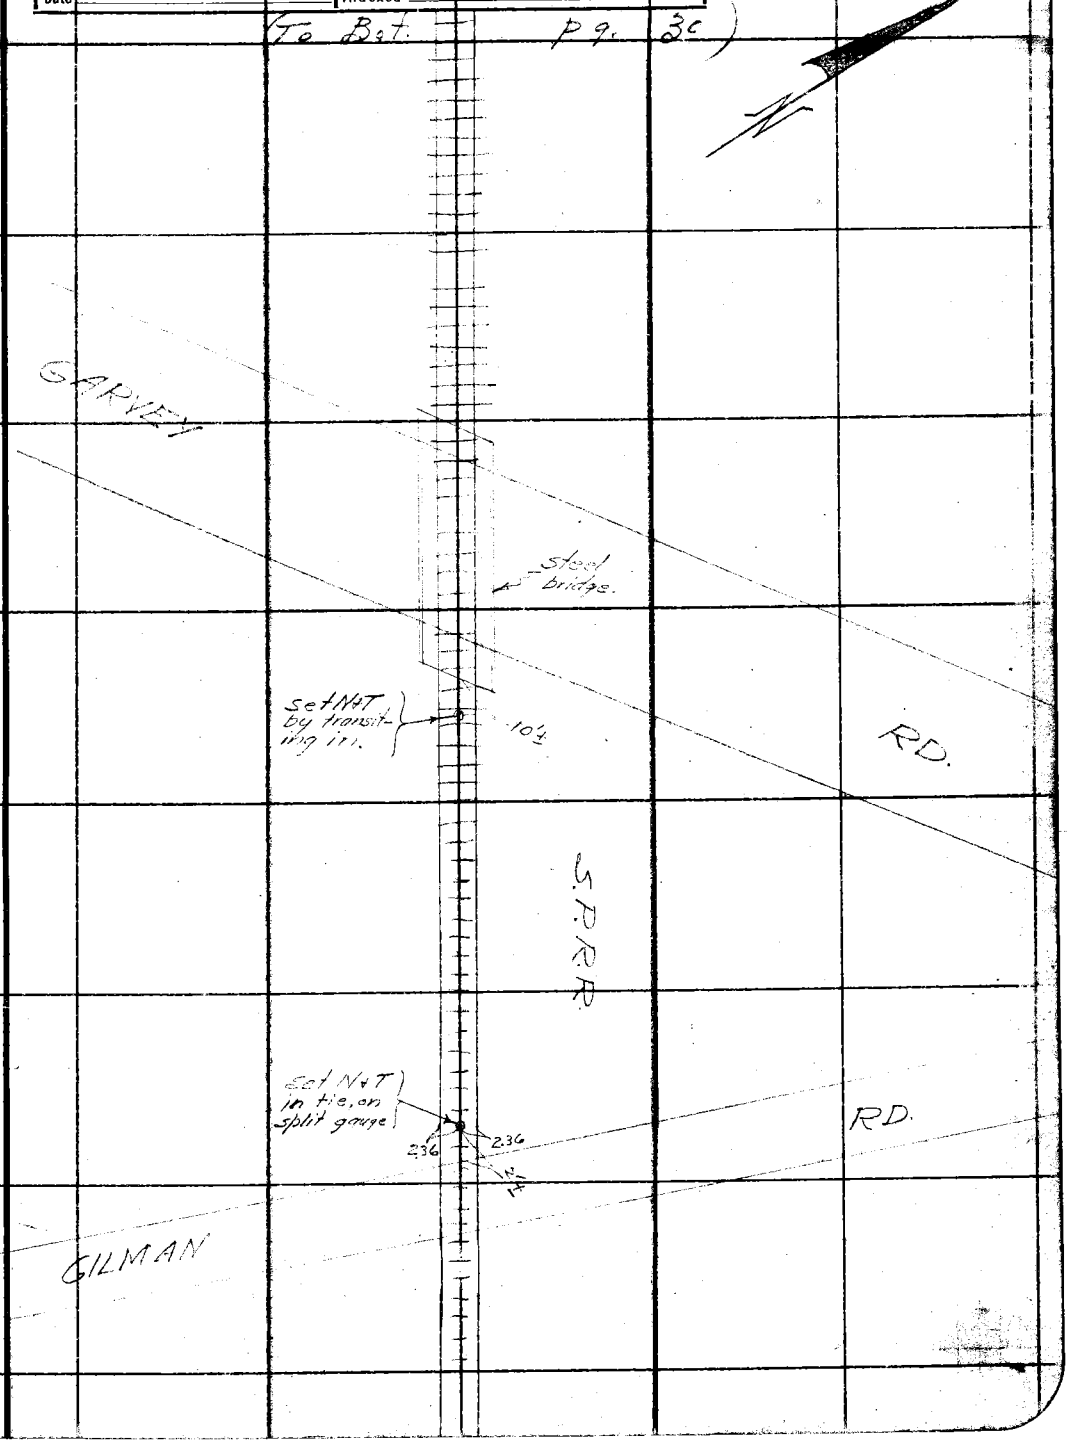

Note: ANY ADDITIONS OR CHANGES ON THIS SHEET MUST BE MADE OR CIRCLED IN Red Ink. WITH DATE AND NAME OF PERSON MAKING CHANGE.

Do not extend notes this side of this line

RETURN TO
LOS ANGELES COUNTY SURVEYOR
700 HALL OF RECORDS

FORM 247 10M 5-31

RETURN TO
LOS ANGELES COUNTY SURVEYOR
700 HALL OF RECORDS

Note: ANY ADDITIONS OR CHANGES ON THIS SHEET MUST BE MADE OR CIRCLED IN Red Ink. WITH DATE AND NAME OF PERSON MAKING CHANGE.

Do not extend notes this side of this line

46, A-4

2/27/34

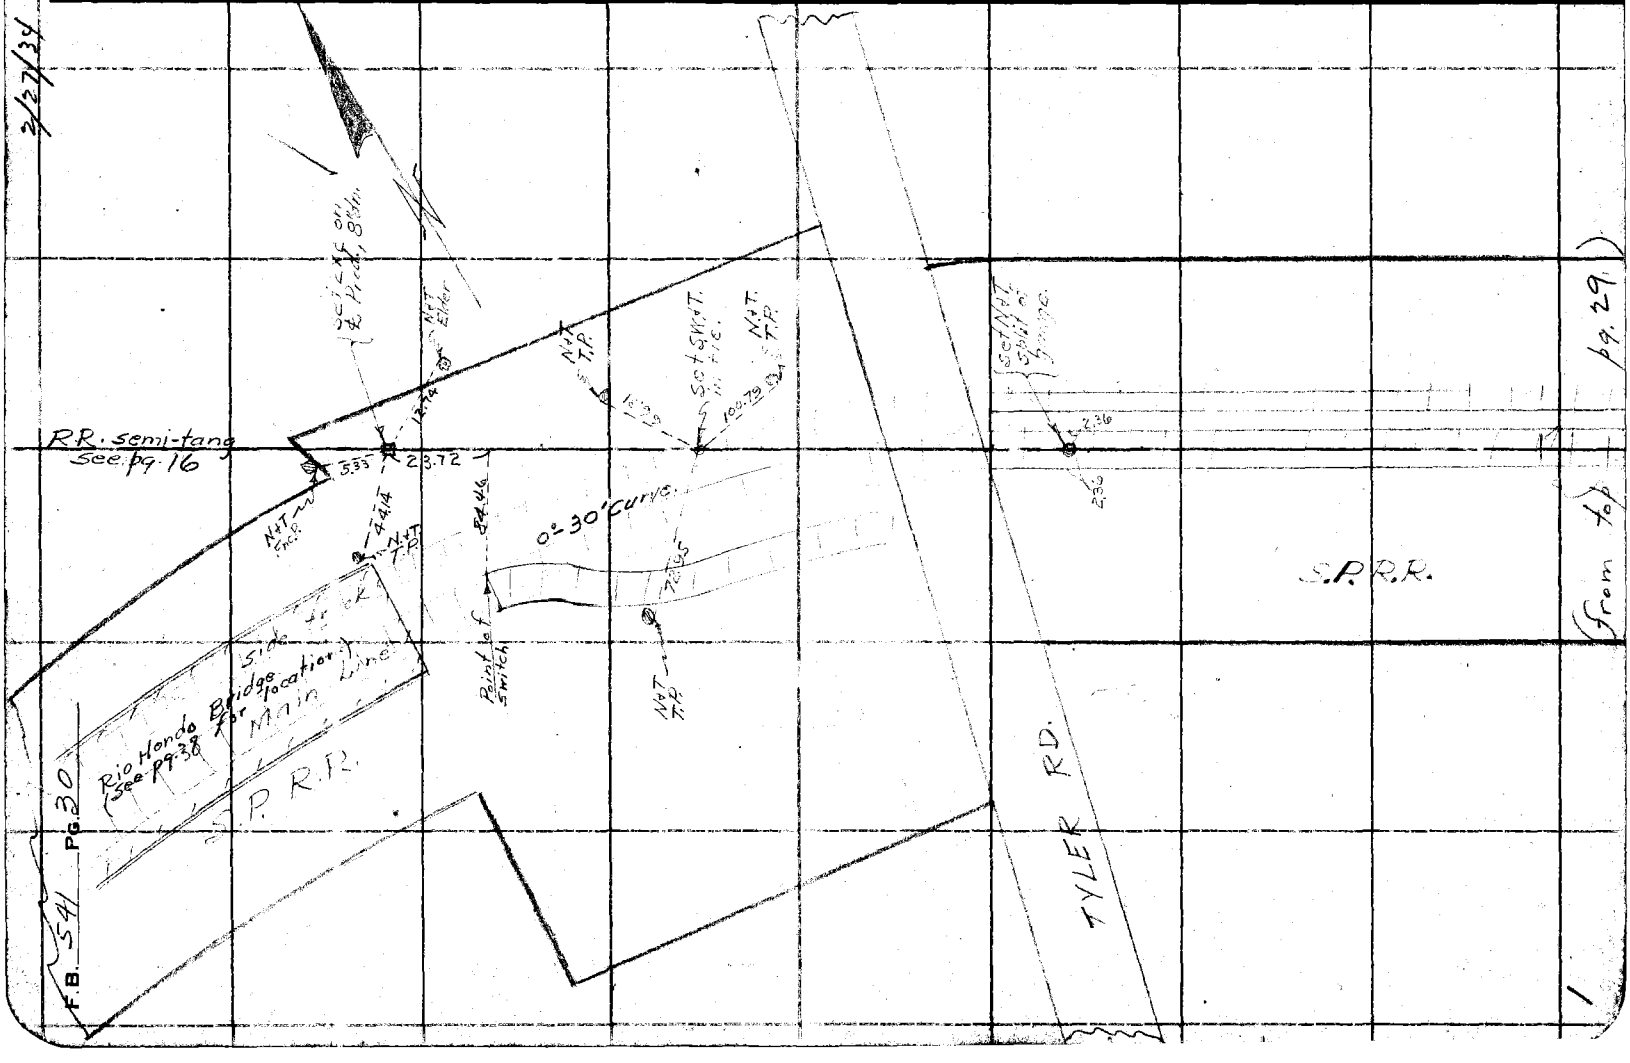

Notes Ck'd by McPherson	Survey of El Monte Bridle Trail (Div. 1) F.B. 541 PG. 31
Map No. B-1005-4	W. O. 8012 Tape No. 067 St'd 84 °F.
Office Work C.W. Cox	Surveyed by Evans
Checked	Notes HE Date 2/28/34
Date	Indexed E. C. Johnson

46, A-4

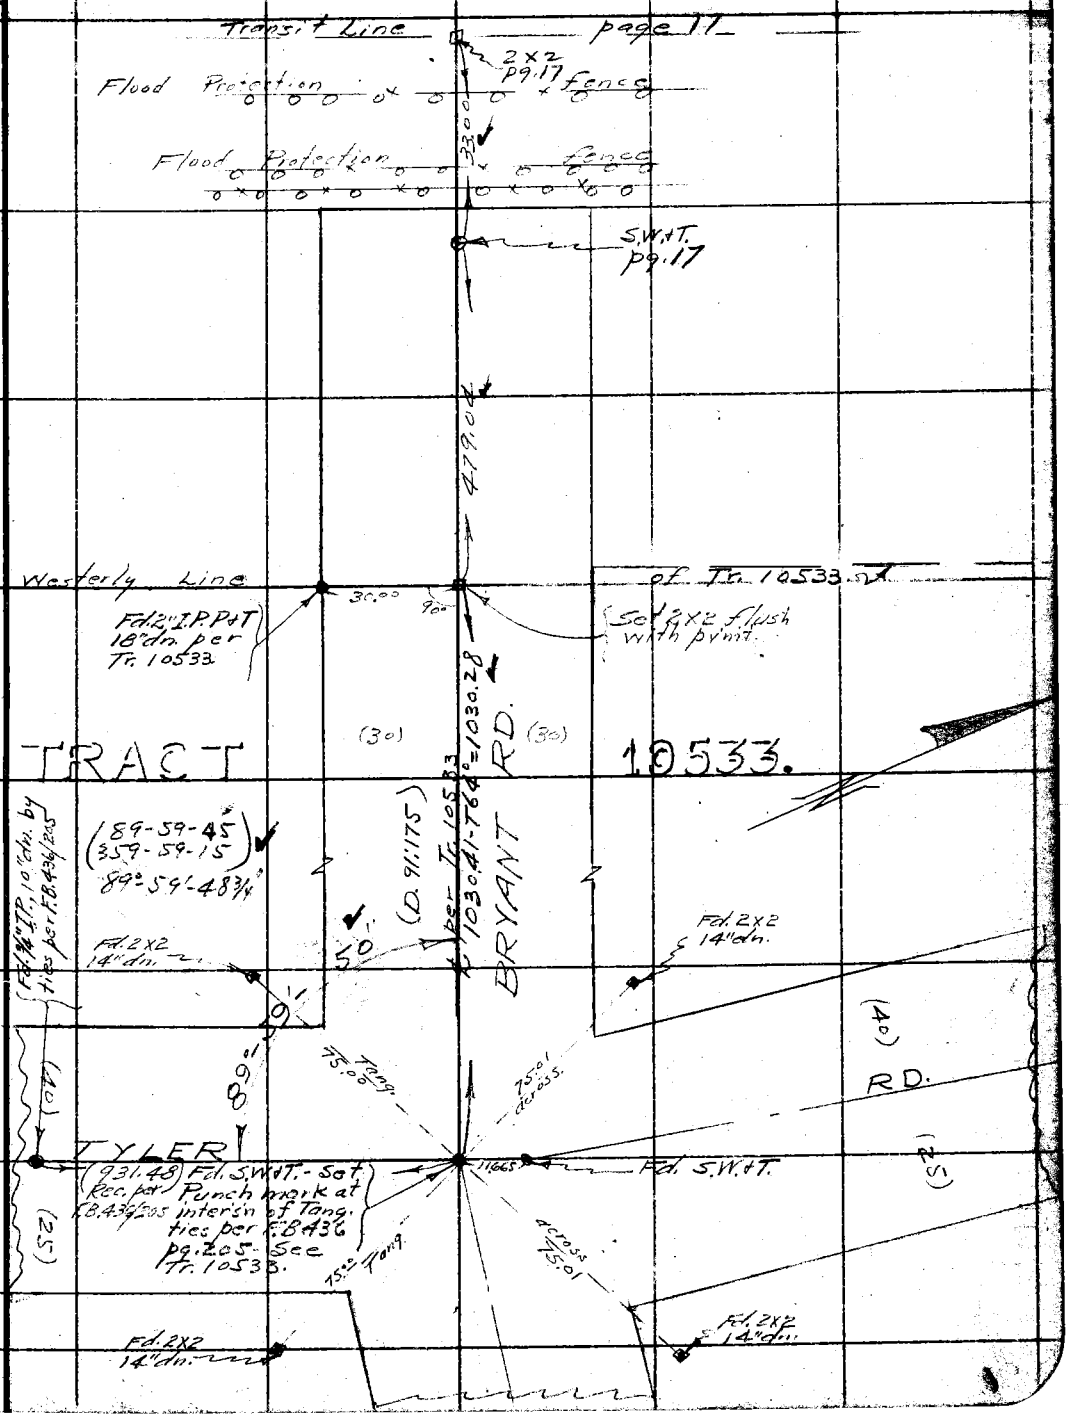

Note: ANY ADDITIONS OR CHANGES ON THIS SHEET MUST BE MADE OR CIRCLED IN Red Ink. WITH DATE AND NAME OF PERSON MAKING CHANGE.

Do not extend notes this side of this line

RETURN TO
LOS ANGELES COUNTY SURVEYOR
700 HALL OF RECORDS

FORM 247 10M 5-31

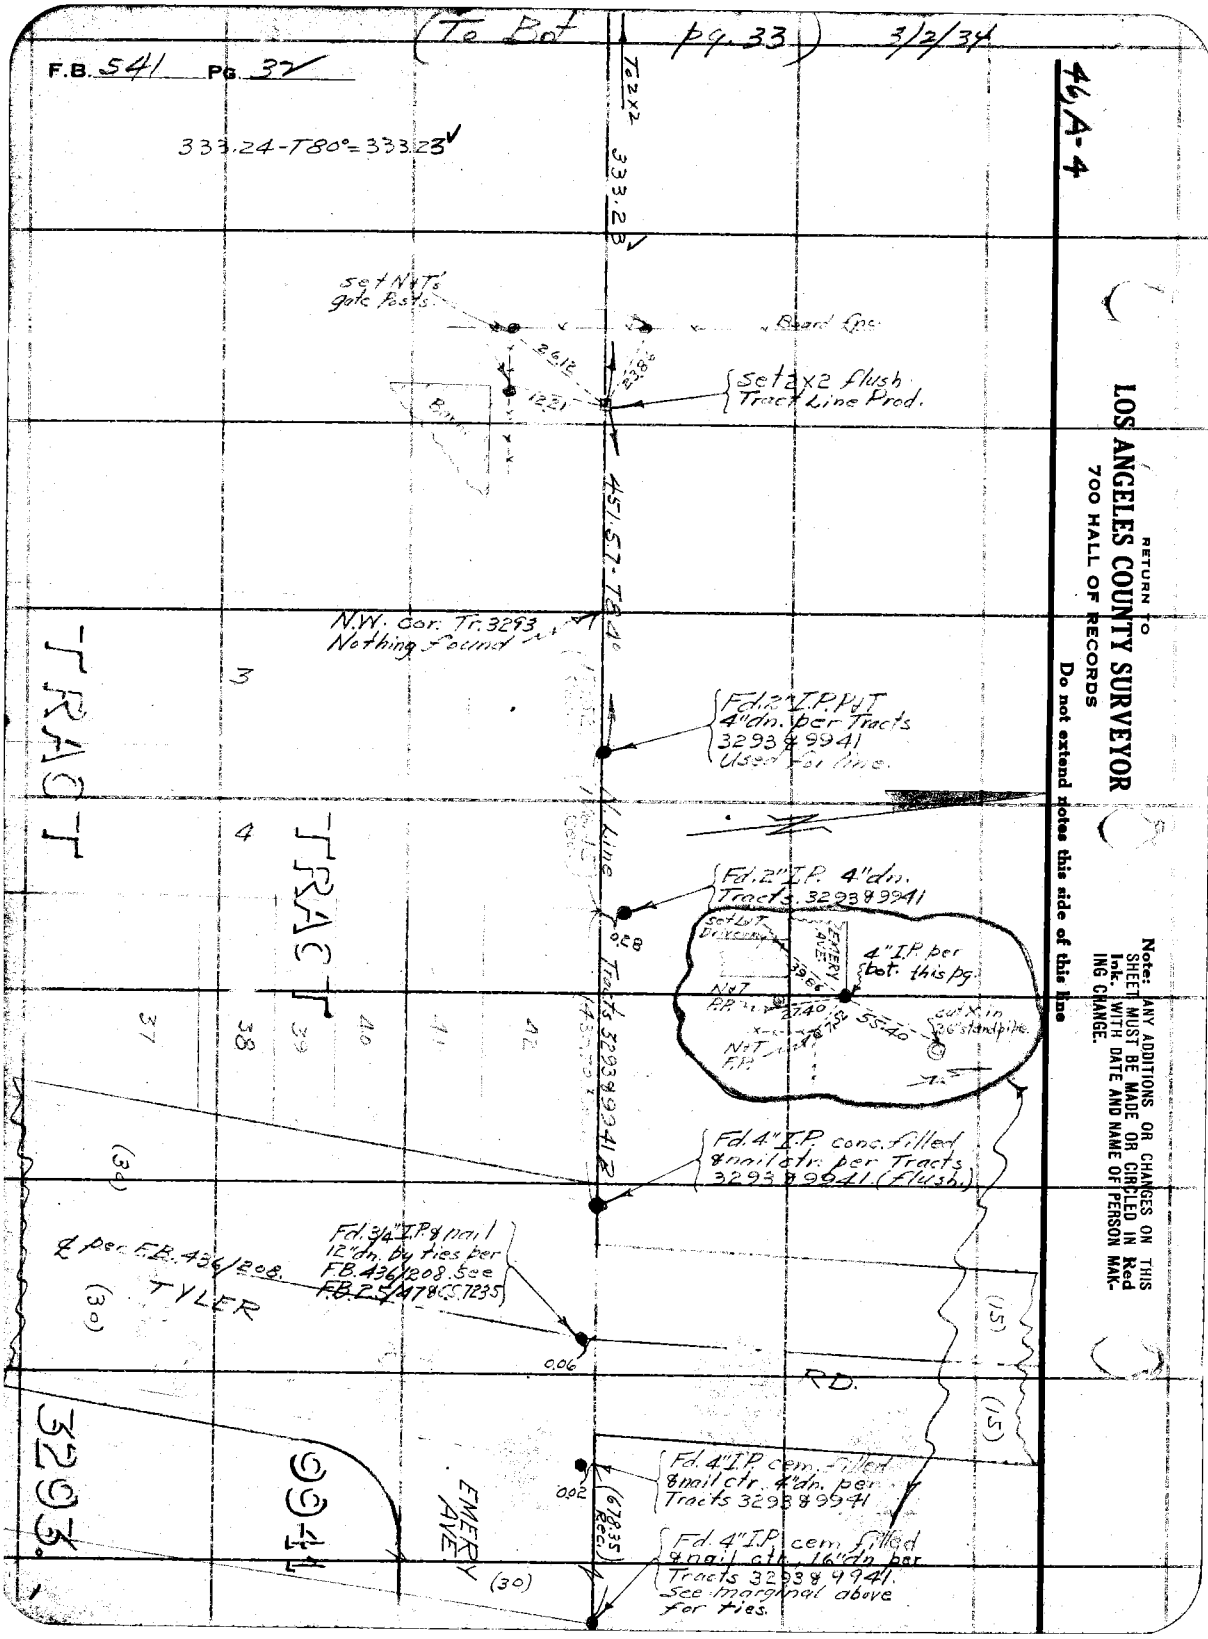
(To Bot pg. 33) 3/2/34
F.B. 541 Pg. 32
46, A-4
333.24-T80°=333.23
To 2x2
333.23
set N&T's gate Posts
Board fnc.
26.12
23.86
12.21
Set 2x2 flush Tract Line Prod.
451.57-T84°
N.W. Cor. Tr. 3293 Nothing found
3
4
TRACT
TRACT
Fd. 2" I.P. P&T 4" dn. per Tracts 3293 & 9941 Used for line.
N Line
Fd. 2" I.P. 4" dn. Tracts 3293 & 9941
0.28
Set L&T Driveway
EMERY AVE.
4" I.P. per bot. this pg.
39.66
N&T P.P.
27.40
55.40
cut X in 26" standpipe
N&T F.P.
Tracts 3293 & 9941
37
38
39
40
41
42
Fd. 4" I.P. conc. filled & nail ctr. per Tracts 3293 & 9941 (flush)
(30)
Fd. 3/4" I.P. & nail 12" dn. by ties per F.B. 436/208. See F.B. 25/47 & C.S. 7235
℄ per F.B. 436/208.
TYLER
(30)
0.06
RD.
(15)
(15)
3293.
9941
EMERY AVE
0.02
(678.35 Rec.)
Fd. 4" I.P. cem. filled & nail ctr. 4" dn. per Tracts 3293 & 9941
Fd. 4" I.P. cem. filled & nail ctr. 16" dn. per Tracts 3293 & 9941. See marginal above for ties.
(30)
RETURN TO
LOS ANGELES COUNTY SURVEYOR
700 HALL OF RECORDS
Do not extend notes this side of this line
Note: ANY ADDITIONS OR CHANGES ON THIS SHEET MUST BE MADE OR CIRCLED IN Red Ink. WITH DATE AND NAME OF PERSON MAKING CHANGE.

(Div 1)

Notes Ck'd by McPherson	Survey of El Monte Bridle Trail
Map No. B-1005-A	W. O. 8012 Tape No. 067 St'd 84 °F.
Office Work C.W. Cox	Surveyed by Evans
Checked	Notes HE Date 3/2/34
Date	Indexed A. C. Johnson

F.B. 541 PG. 33

46, A-4

(End)

Fd. 2x2 + T flush - see Flood Control F.F.B. 111/99

0.43

27.03

set 1x2 flush

15.70

Fd. 2" I.P. P+T. Flush. Flood Control F.C. 176/20821

0.38

Proposed West R/W Line.

N. Line Tr. 3293 Prod. W'ly. 7

797.79 - T 78° = 797.76

Transit Line per pg. 18

152.31 - T 68° = 152.29

N+T Pile.

N+T in top Pile

Piling

Fd. 2" I.P. P+T. Flush - Proposed East R/W Line. Flood F.C. 176/20821. same for ties.

Fd. 2" I.P. P+T 6" high - No Rec.

0.25

32.22

13.38

7.68

N+T Pile.

0.54

21.45

set 2x2 6" dn.

333.23 from 3x2

from top pg. 32

Note: ANY ADDITIONS OR CHANGES ON THIS SHEET MUST BE MADE OR CIRCLED IN Red Ink. WITH DATE AND NAME OF PERSON MAKING CHANGE.

Do not extend notes this side of this line

RETURN TO
LOS ANGELES COUNTY SURVEYOR
700 HALL OF RECORDS

FORM 247 10M 5-31

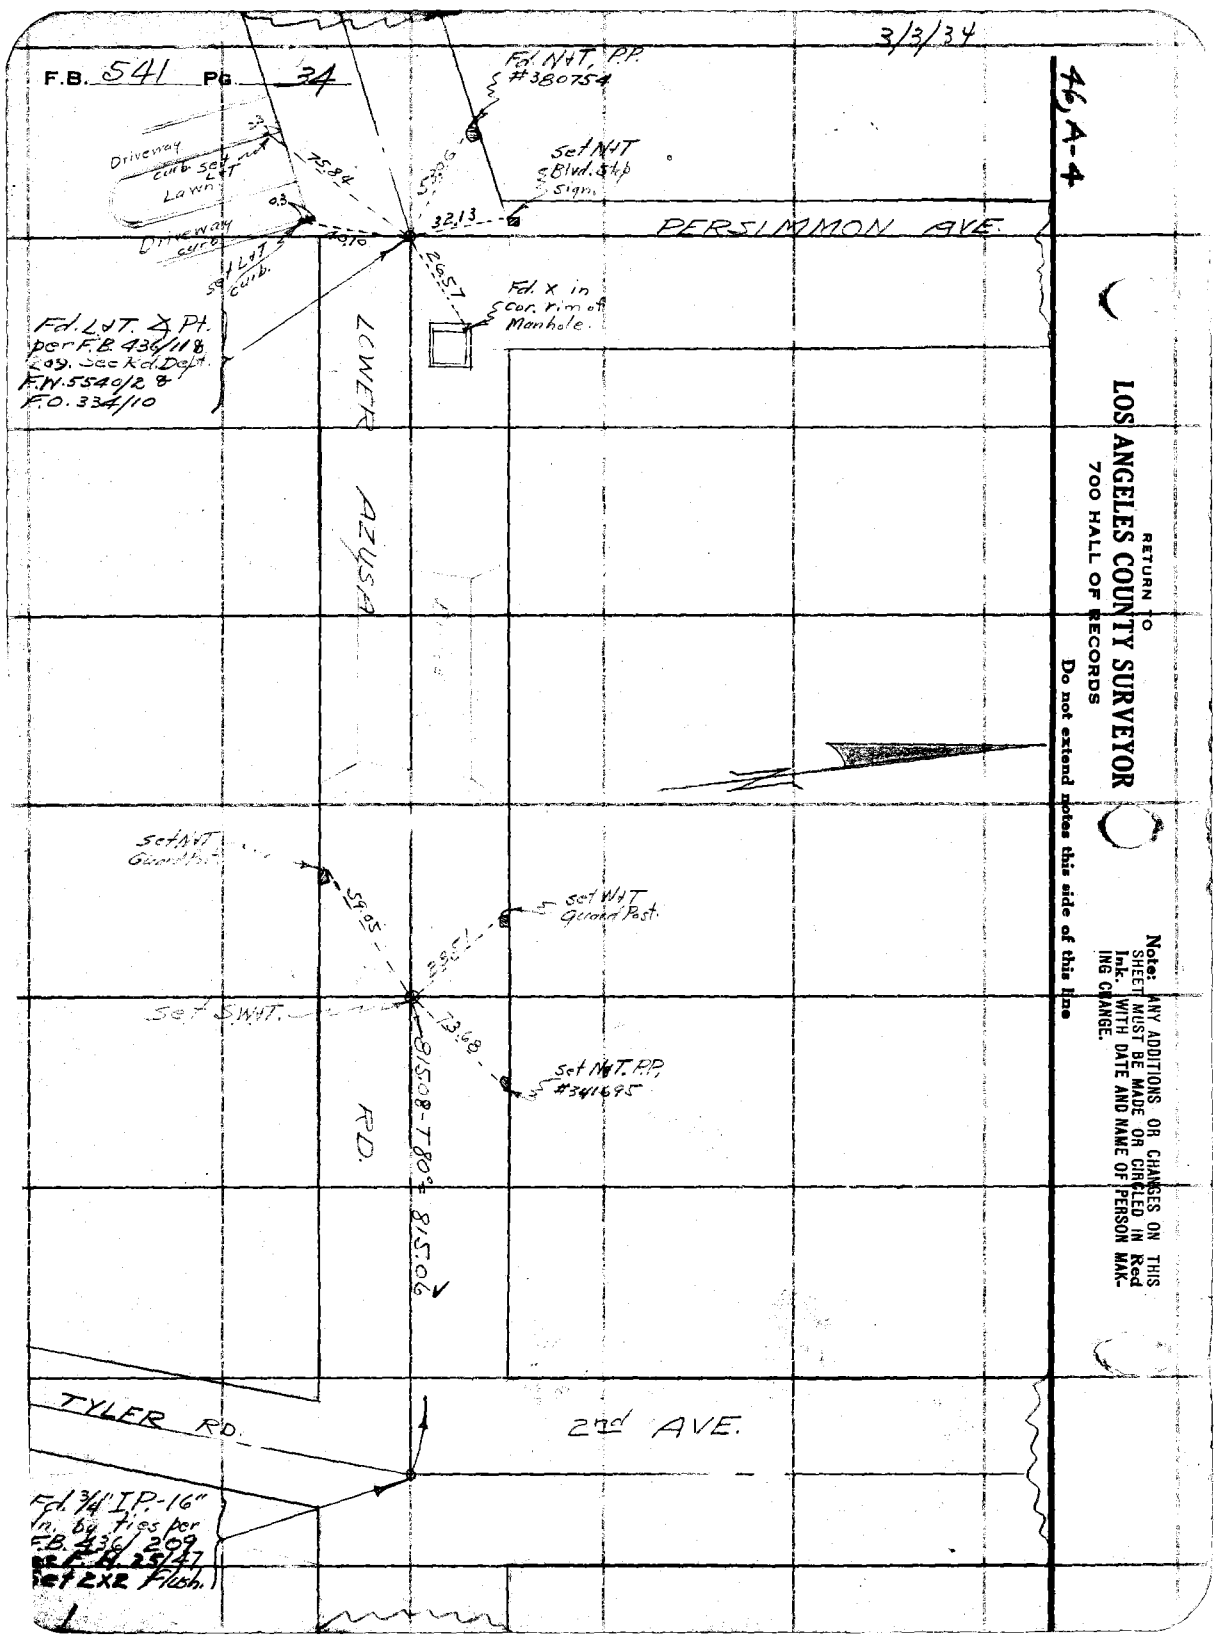
F.B. 541 PG. 34
3/3/34
46, A-4
Fd. N&T, P.P. #380754
Set N&T Blvd. Stop Sign.
Driveway curb
Set L&T Lawn
Driveway curb
Set L&T curb
75.84
32.13
40.10
26.57
PERSIMMON AVE.
Fd. X in Cor. rim of Manhole.
Fd. L&T. ∡ Pt. per F.B. 436/118 Log. See Rd. Dept. F.W. 5540/2 & F.O. 334/10
LOWER AZUSA RD.
Set N&T Guard Post
59.05
Set W&T Guard Post.
Set S.W.T.
73.68
Set N&T. P.P. #341695
815.08-T80° = 815.06
TYLER RD.
2nd AVE.
Fd. 3/4" I.P.-16" In. by ties per F.B. 436/209 & F.H. 25/47 Set 2X2 Flush.
RETURN TO
LOS ANGELES COUNTY SURVEYOR
700 HALL OF RECORDS
Do not extend notes this side of this line
Note: ANY ADDITIONS OR CHANGES ON THIS SHEET MUST BE MADE OR CIRCLED IN Red Ink. WITH DATE AND NAME OF PERSON MAKING CHANGE.

Notes Ck'd by McPherson	Survey of El Monte "Bridal" Trail
Map No. B-1005-A	W. O. 8012 Tape No. 067 St'd 84 °F.
Office Work C.W. Cox	Surveyed by Evans
Checked	Notes Brock Date 3/15/34
Date	Indexed A. C. Johnson

F.B. 541 PG. 85

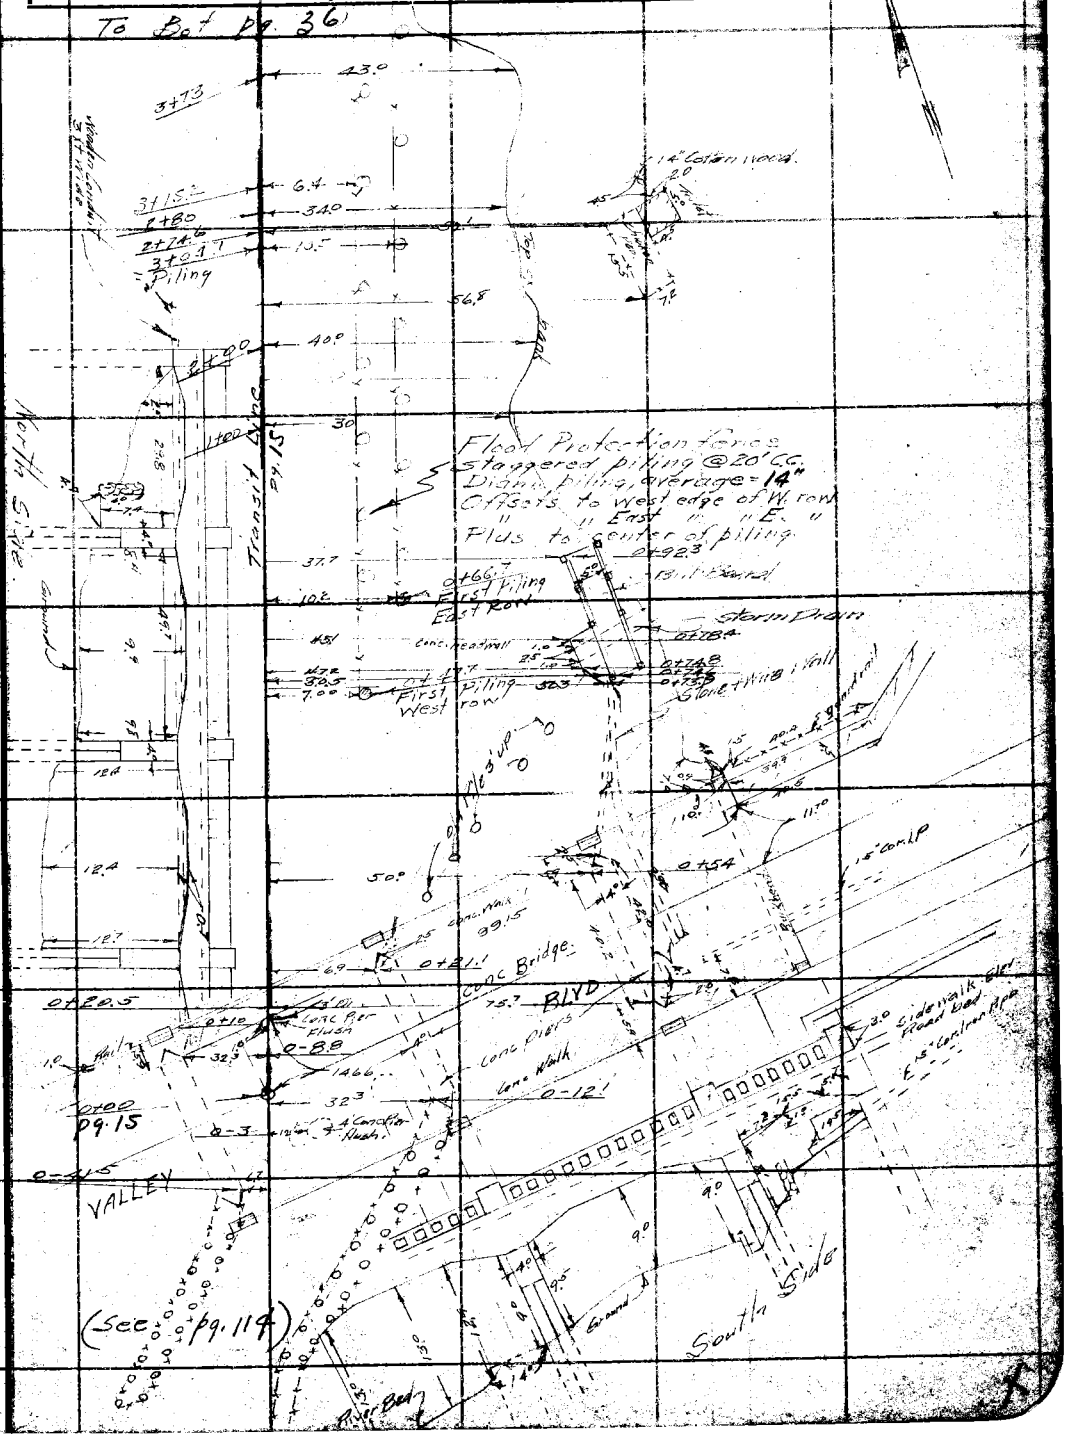

Note: ANY ADDITIONS OR CHANGES ON THIS SHEET MUST BE MADE OR CIRCLED IN Red Ink, WITH DATE AND NAME OF PERSON MAKING CHANGE.

Do not extend notes this side of this line

RETURN TO
LOS ANGELES COUNTY SURVEYOR
700 HALL OF RECORDS

FORM 247 10M 5-31

To Bot. Pg 37 Lot 11 - Tract 3228
Lot 6 - King Tr.

F.B. 541 PG. 36

from top pg 35

RETURN TO
LOS ANGELES COUNTY SURVEYOR
700 HALL OF RECORDS
Do not extend notes this side of this line

Note: ANY ADDITIONS OR CHANGES ON THIS SHEET MUST BE MADE OR CIRCLED IN Red Ink. WITH DATE AND NAME OF PERSON MAKING CHANGE.

Notes Ck'd by D. M. Finley	Survey of [illegible]
Map No. B-1005-4	W. O. 8012 Tape No. C67 St'd 84°F.
Office Work C.W. Cox	Surveyed by Evans
Checked	Notes Brock Date 3/15/34
Date	Indexed A. C. Johnson

F.B. 541 PG. 37

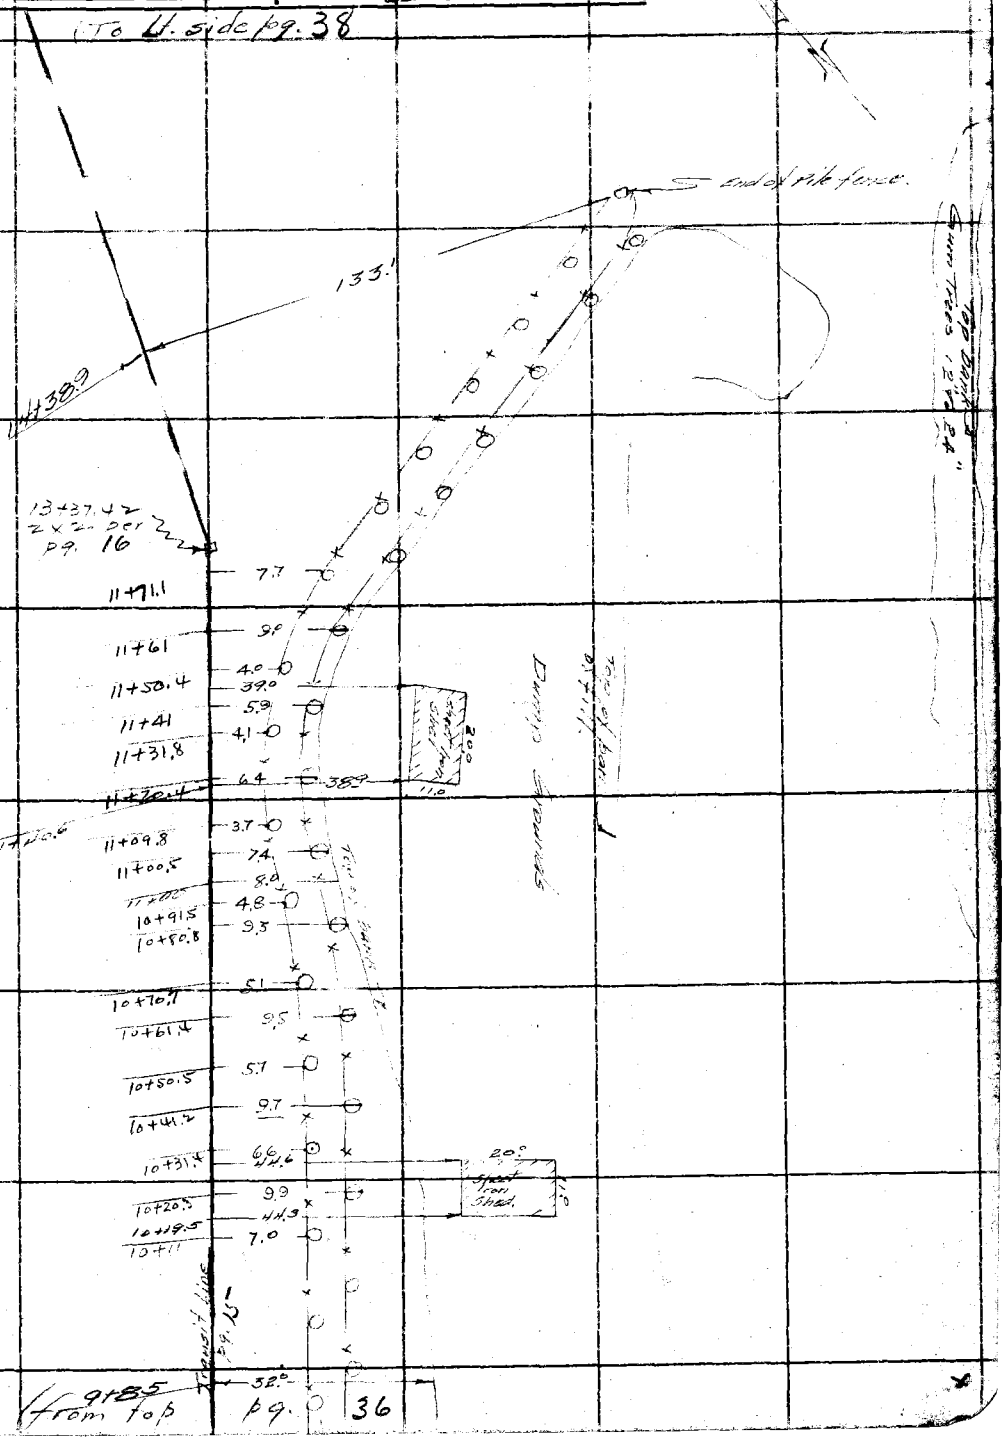

Note: ANY ADDITIONS OR CHANGES ON THIS SHEET MUST BE MADE OR CIRCLED IN Red Ink. WITH DATE AND NAME OF PERSON MAKING CHANGE.

RETURN TO
LOS ANGELES COUNTY SURVEYOR
700 HALL OF RECORDS

Do not extend notes this side of this line

FORM 247 10M 5-31

RETURN TO
LOS ANGELES COUNTY SURVEYOR
700 HALL OF RECORDS

Note: ANY ADDITIONS OR CHANGES ON THIS SHEET MUST BE MADE OR CIRCLED IN Red Ink, WITH DATE AND NAME OF PERSON MAKING CHANGE.

Do not extend notes this side of this line

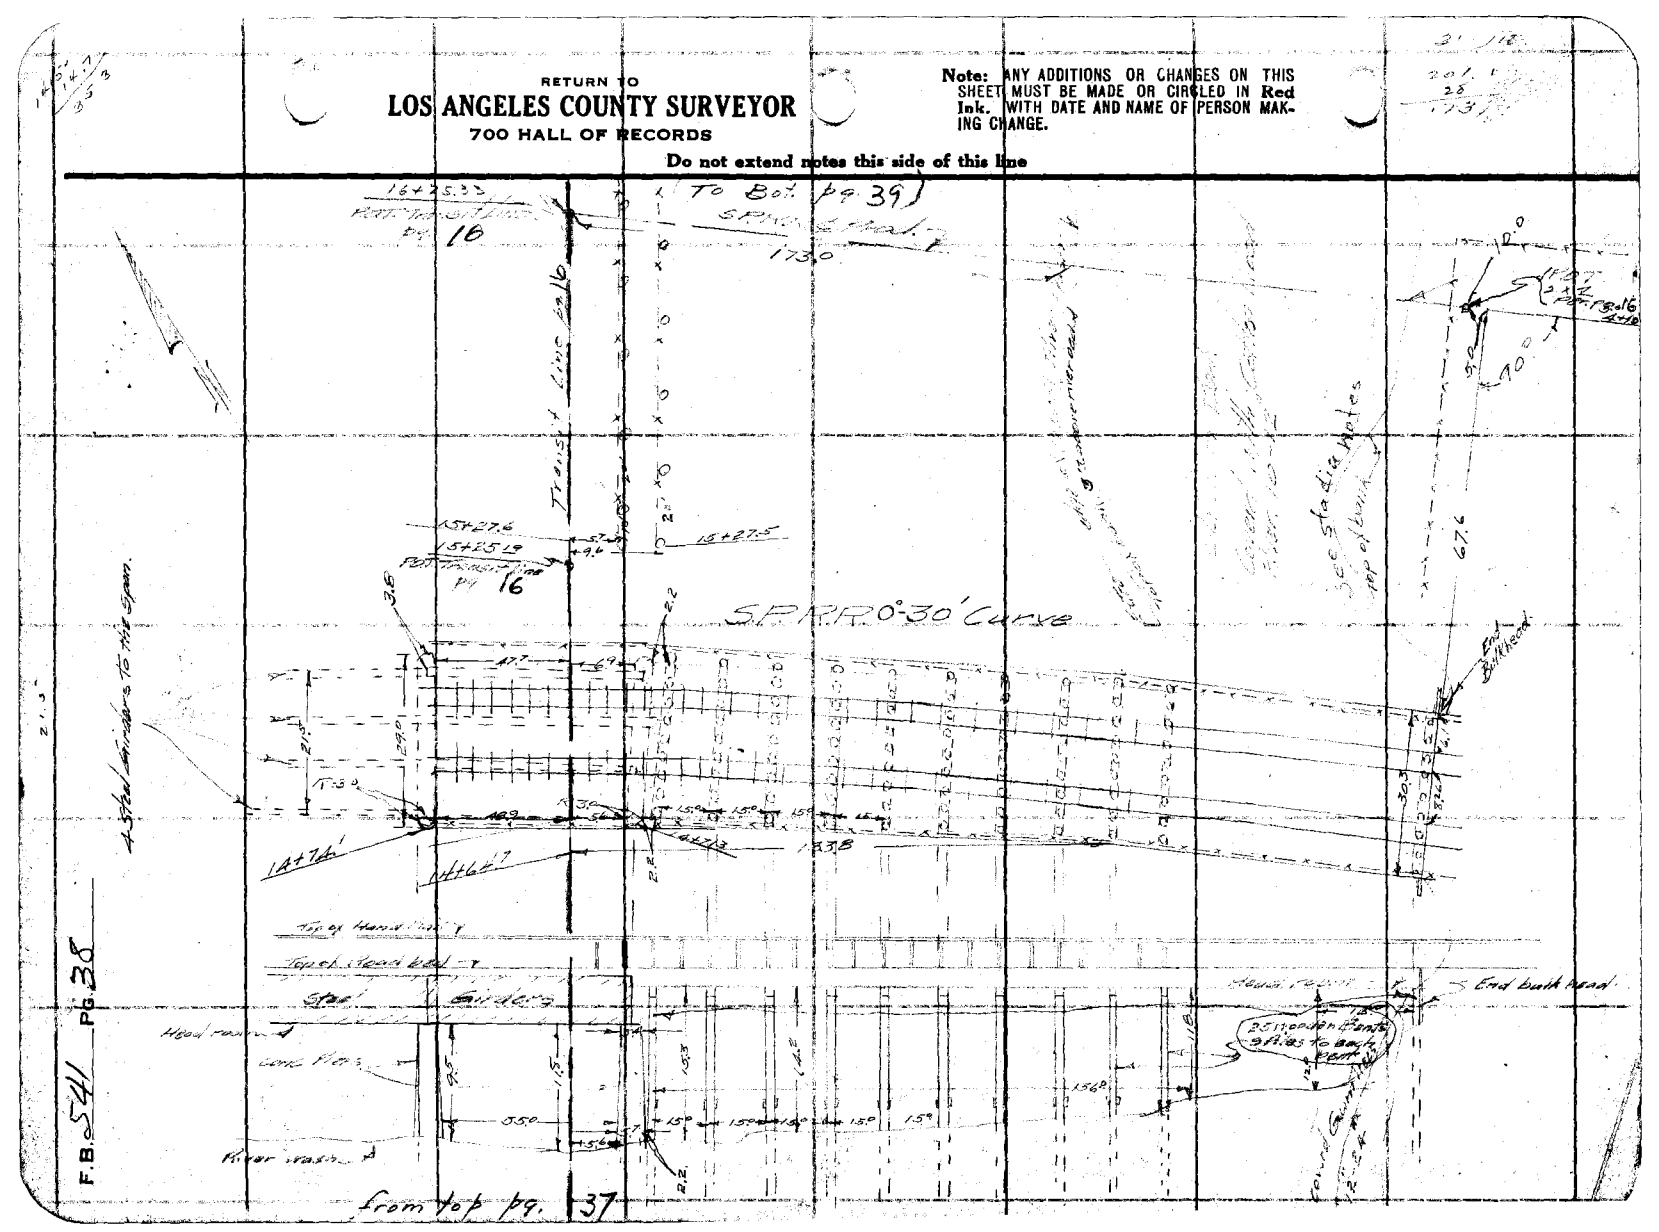

Notes Ck'd by D. M. Finley	Survey of El Monte Bridle Trail
Map No. B-1005-4	W. O. 8012 Tape No. 067 St'd 04 °F.
Office Work C.W. Cox	Surveyed by Evans
Checked	Notes Brock Date 3/15/34
Date	Indexed A. C. Johnson

F.B. 541 Pg. 39

(To Bal. pg. 40)

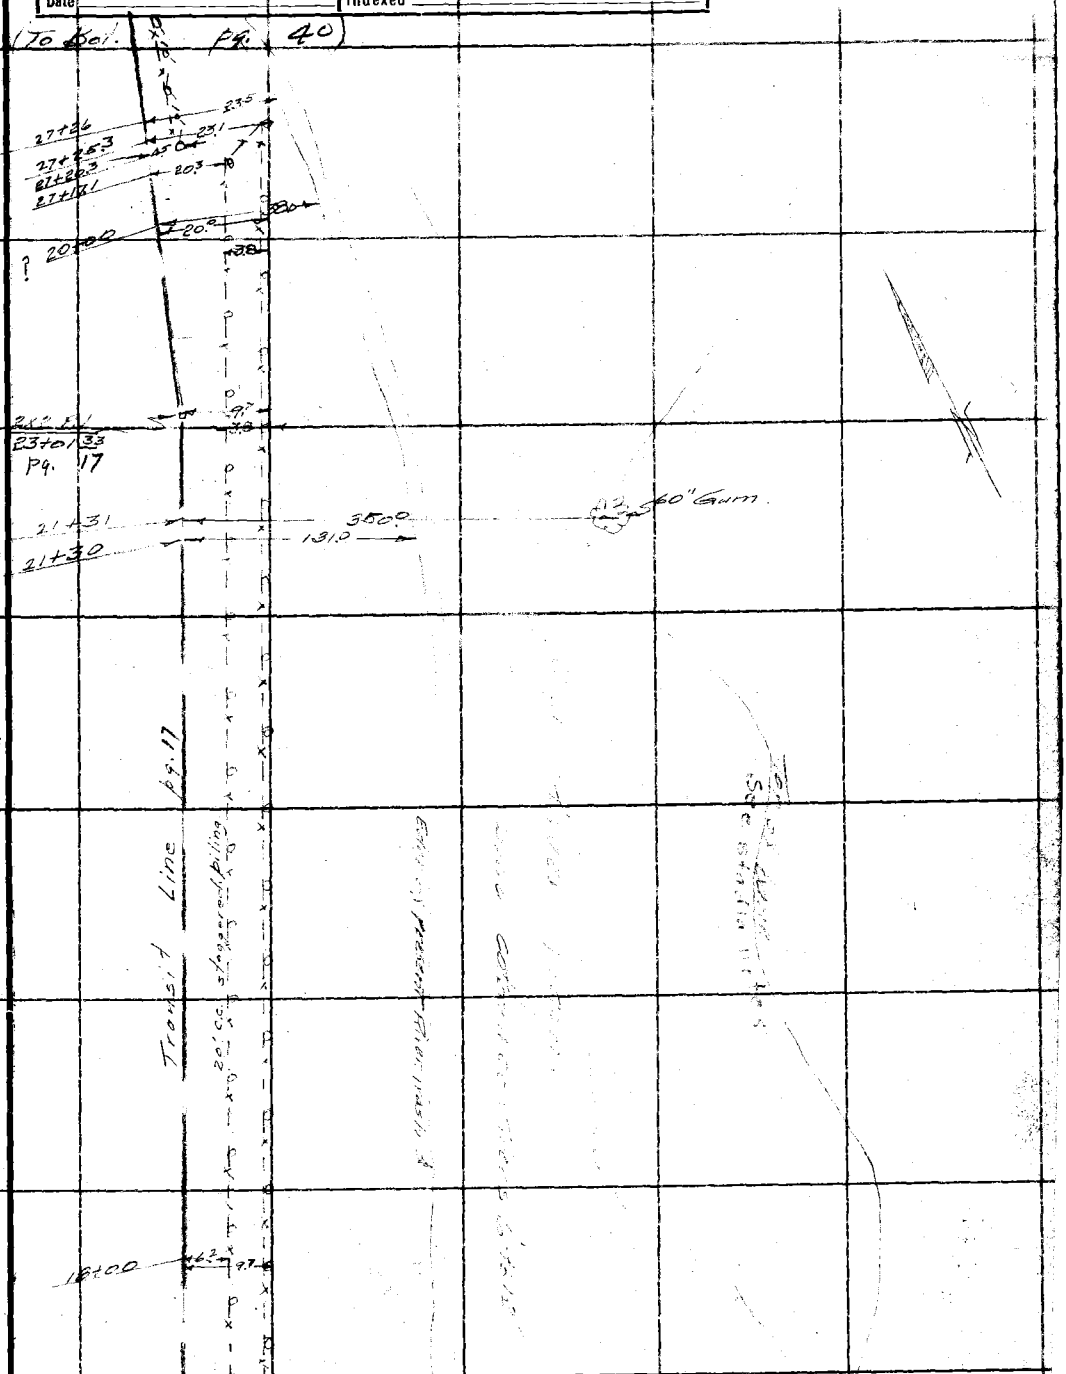

(from Rt. side pg. 38

Note: ANY ADDITIONS OR CHANGES ON THIS SHEET MUST BE MADE OR CIRCLED IN Red Ink. WITH DATE AND NAME OF PERSON MAKING CHANGE.

Do not extend notes this side of this line

RETURN TO
LOS ANGELES COUNTY SURVEYOR
700 HALL OF RECORDS

FORM 247 10M 5-31

F.B. 541 Pg. 40

(To Bk. Pg. 41)

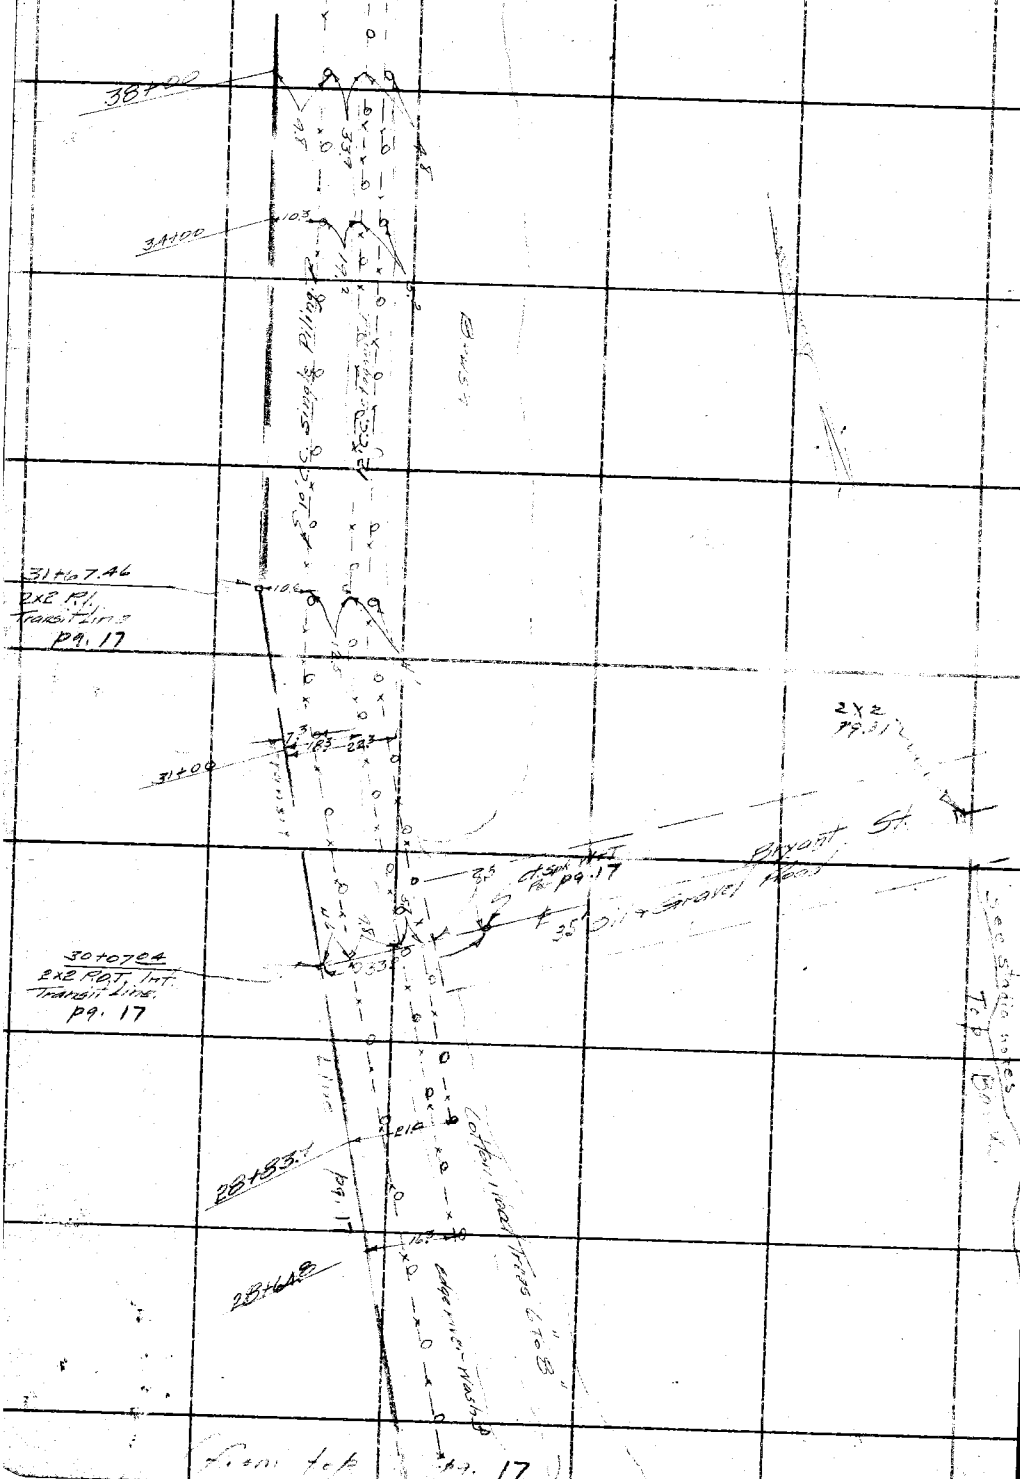

RETURN TO
LOS ANGELES COUNTY SURVEYOR
700 HALL OF RECORDS
Do not extend notes this side of this line

Note: ANY ADDITIONS OR CHANGES ON THIS SHEET MUST BE MADE OR CIRCLED IN Red Ink. WITH DATE AND NAME OF PERSON MAKING CHANGE.

Notes Ck'd by D. M. Finley	Survey of [illegible]
Map No. B-1005-4	W. O. 8012 Tape No. ____ St'd ____ °F.
Office Work C.W. Cox	Surveyed by Evans
Checked	Notes Brock Date 3-16-34
Date	Indexed A. C. Johnson

F.B. 541 PG. 41

Note: ANY ADDITIONS OR CHANGES ON THIS SHEET MUST BE MADE OR CIRCLED IN Red Ink. WITH DATE AND NAME OF PERSON MAKING CHANGE.

Do not extend notes this side of this line

RETURN TO
LOS ANGELES COUNTY SURVEYOR
700 HALL OF RECORDS

FORM 247 10M 5-31

F.B. 541 PG. 42

RETURN TO
LOS ANGELES COUNTY SURVEYOR
700 HALL OF RECORDS

Do not extend notes this side of this line

Note: ANY ADDITIONS OR CHANGES ON THIS SHEET MUST BE MADE OR CIRCLED IN Red Ink. WITH DATE AND NAME OF PERSON MAKING CHANGE.

Notes Ck'd by D. M. Finley	Survey of El Monte Bridle Trail
Map No. B-1005-4	W. O. 8012 Tape No. 067 St'd 84 °F.
Office Work C.W. Cox	Surveyed by Evans
Checked	Notes Brock Date 3/16/34
Date	Indexed A. C. Johnson

F.B. 541 PG 43

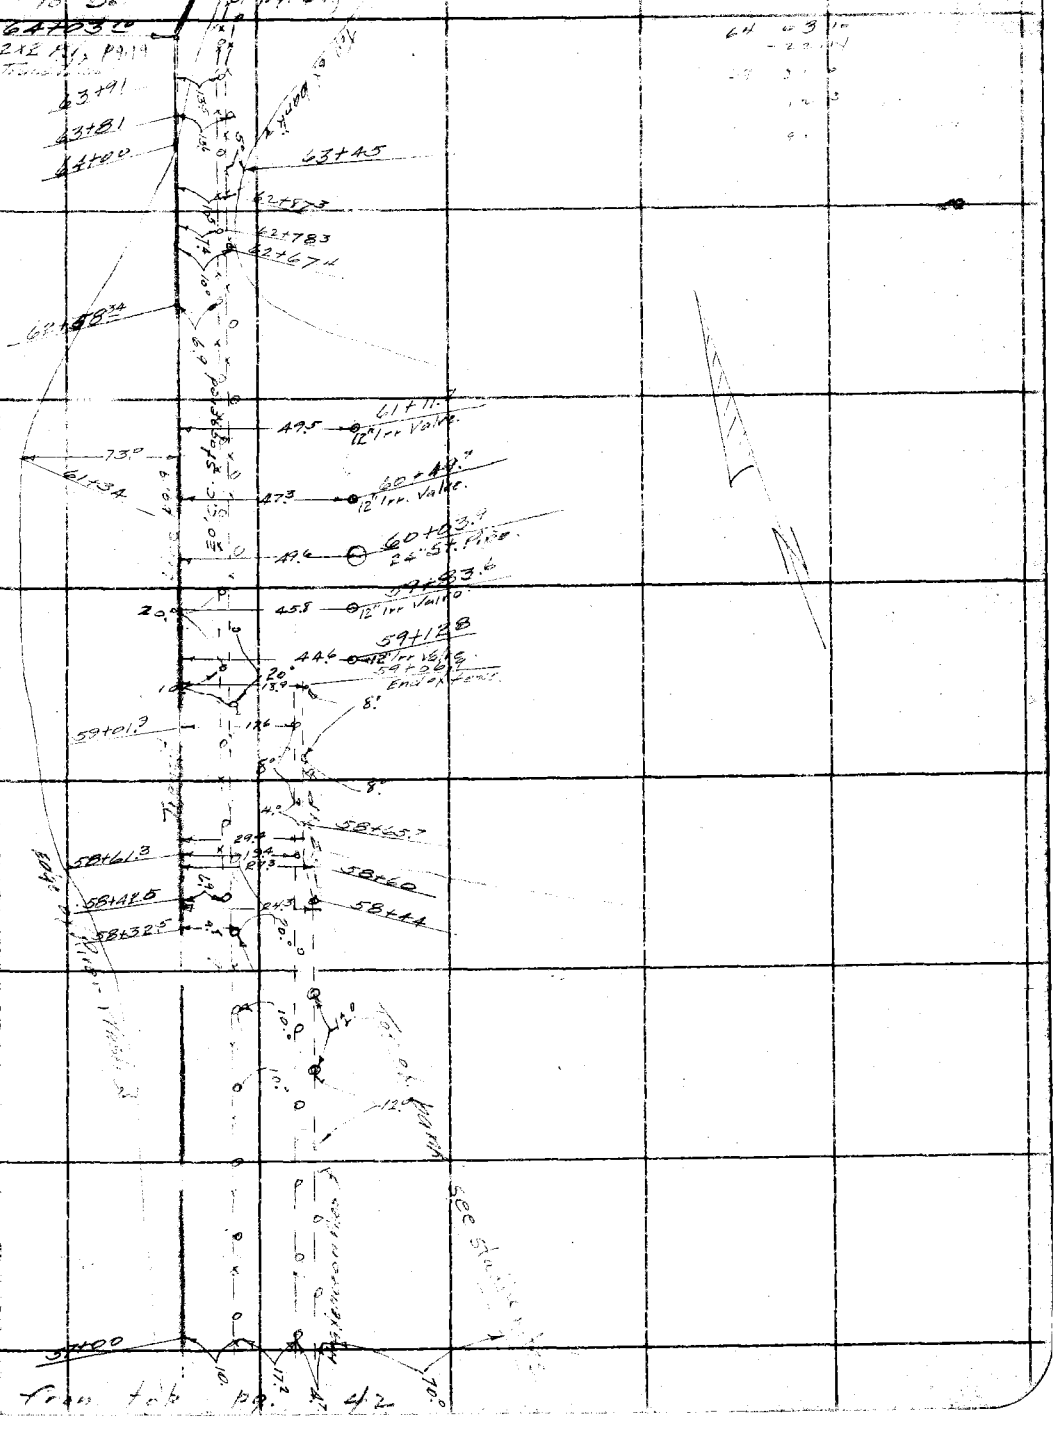

Note: ANY ADDITIONS OR CHANGES ON THIS SHEET MUST BE MADE OR CIRCLED IN Red Ink. WITH DATE AND NAME OF PERSON MAKING CHANGE.

Do not extend notes this side of this line

RETURN TO
LOS ANGELES COUNTY SURVEYOR
700 HALL OF RECORDS

FORM 247 10M 5-31

RETURN TO

LOS ANGELES COUNTY SURVEYOR

700 HALL OF RECORDS

Note: ANY ADDITIONS OR CHANGES ON THIS SHEET MUST BE MADE OR CIRCLED IN Red Ink. WITH DATE AND NAME OF PERSON MAKING CHANGE.

Do not extend notes this side of this line

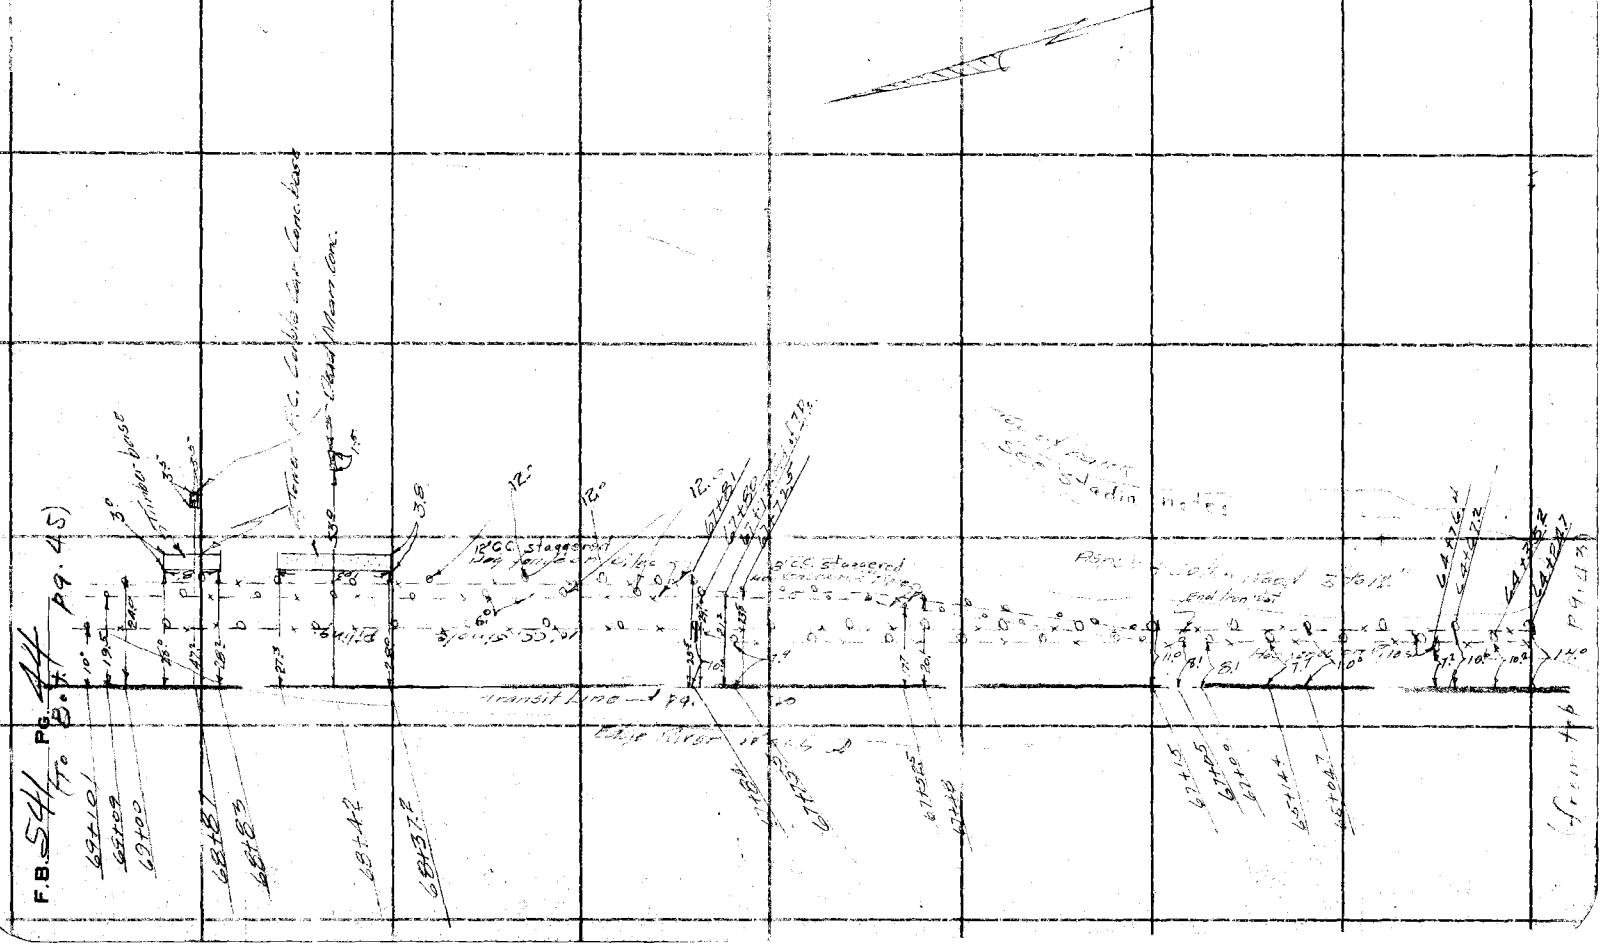

Notes Ck'd by	D. M. Finley	Survey of	El Monte Bridle Trail
Map No.	B-1005-4	W. O.	8012 Tape No. 061 St'd 84 OF.
Office Work	C.W. Cox	Surveyed by	Evans
Checked		Notes	Brock Date 3/16/34
Date		Indexed	A. C. Johnson

F.B. 541 PG. 45

To Bk. pg. 96

Note: ANY ADDITIONS OR CHANGES ON THIS SHEET MUST BE MADE OR CIRCLED IN Red Ink, WITH DATE AND NAME OF PERSON MAKING CHANGE.

Do not extend notes this side of this line

RETURN TO
LOS ANGELES COUNTY SURVEYOR
700 HALL OF RECORDS

(from top pg. 44)

FORM 247 10M 8-31

F.B. 541 PG. 46

(To Bot. pg. 47)

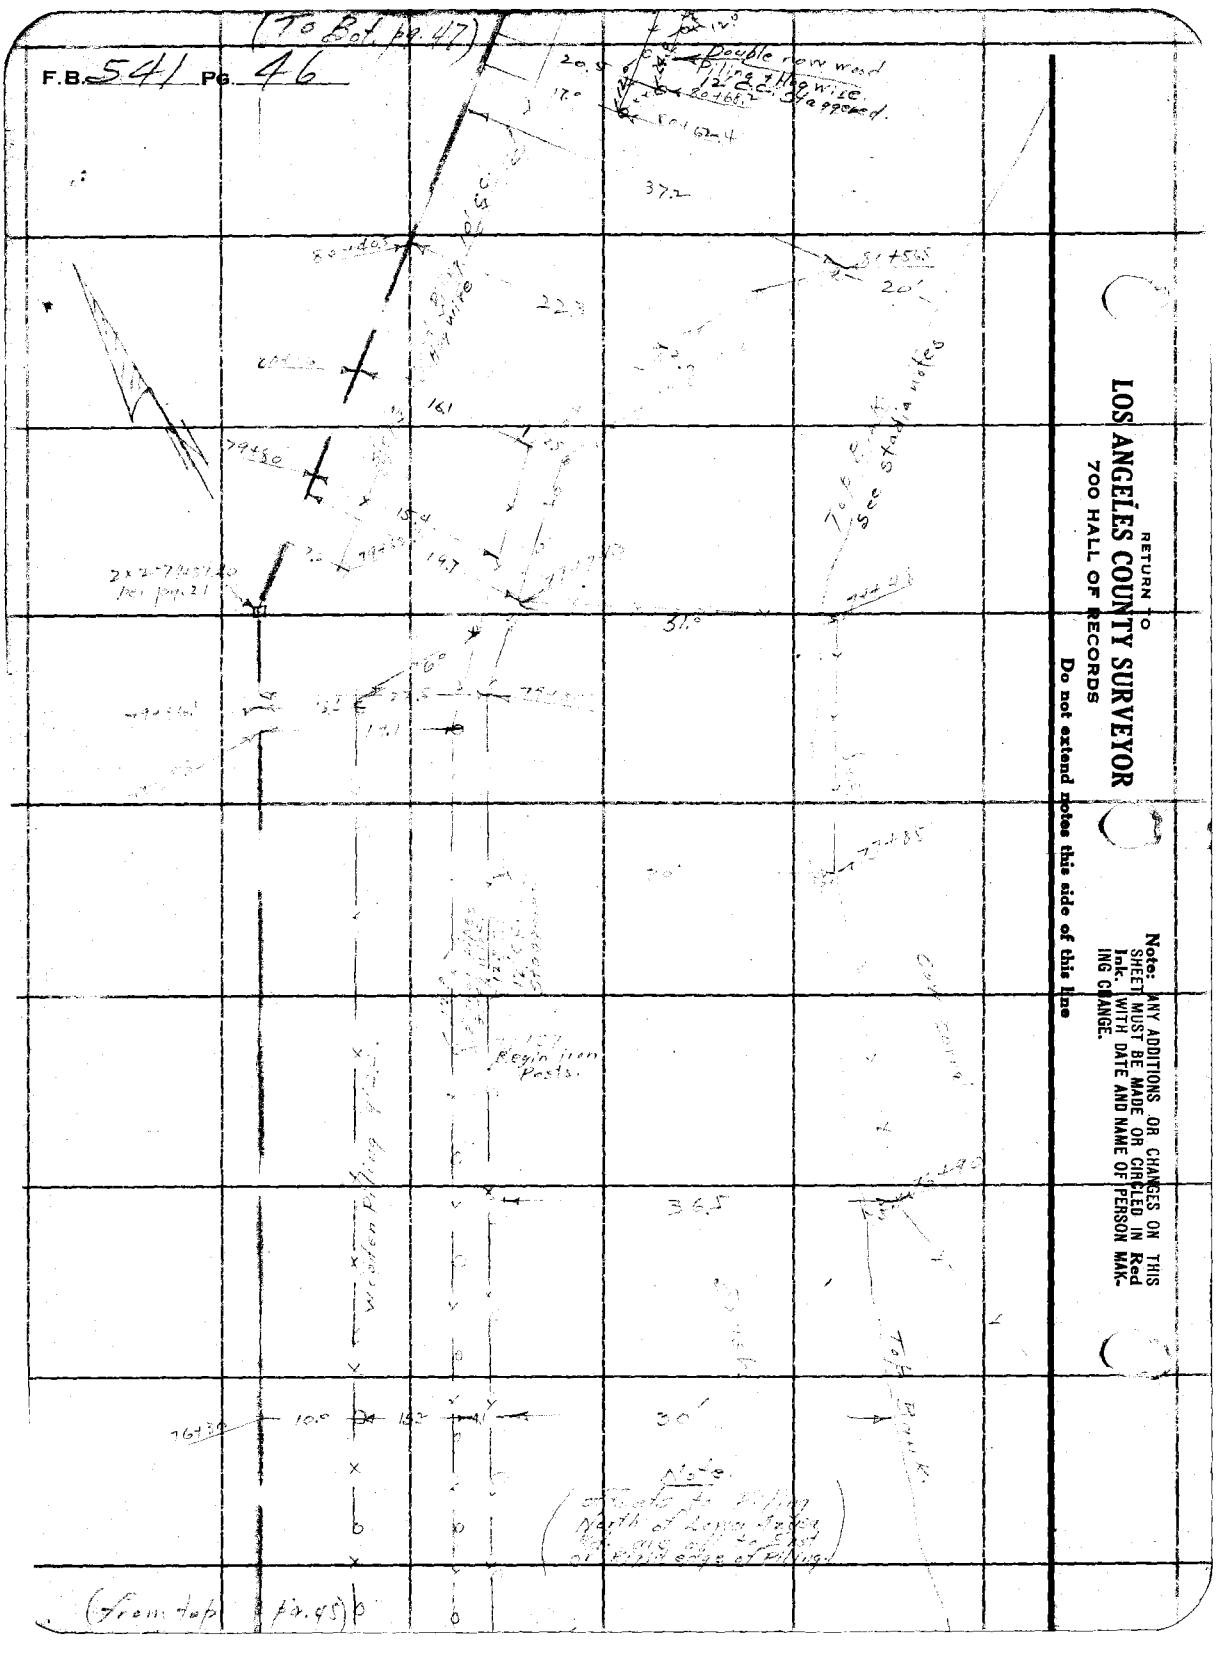

RETURN TO
LOS ANGELES COUNTY SURVEYOR
700 HALL OF RECORDS

Do not extend notes this side of this line

Note: ANY ADDITIONS OR CHANGES ON THIS SHEET MUST BE MADE OR CIRCLED IN Red Ink, WITH DATE AND NAME OF PERSON MAKING CHANGE.

Notes Ck'd by D. M. Finley	Survey of El Monte Bridle Trail	F.B. 541	Pg. 47
Map No. B-1005-4	W. O. 8012 Tape No. 067 St'd 84 °F.		
Office Work C.W. Cox	Surveyed by Evans		
Checked	Notes HE Date 3/22/34		
Date	Indexed A. C. Johnson		

(To Bot. pg. 48)

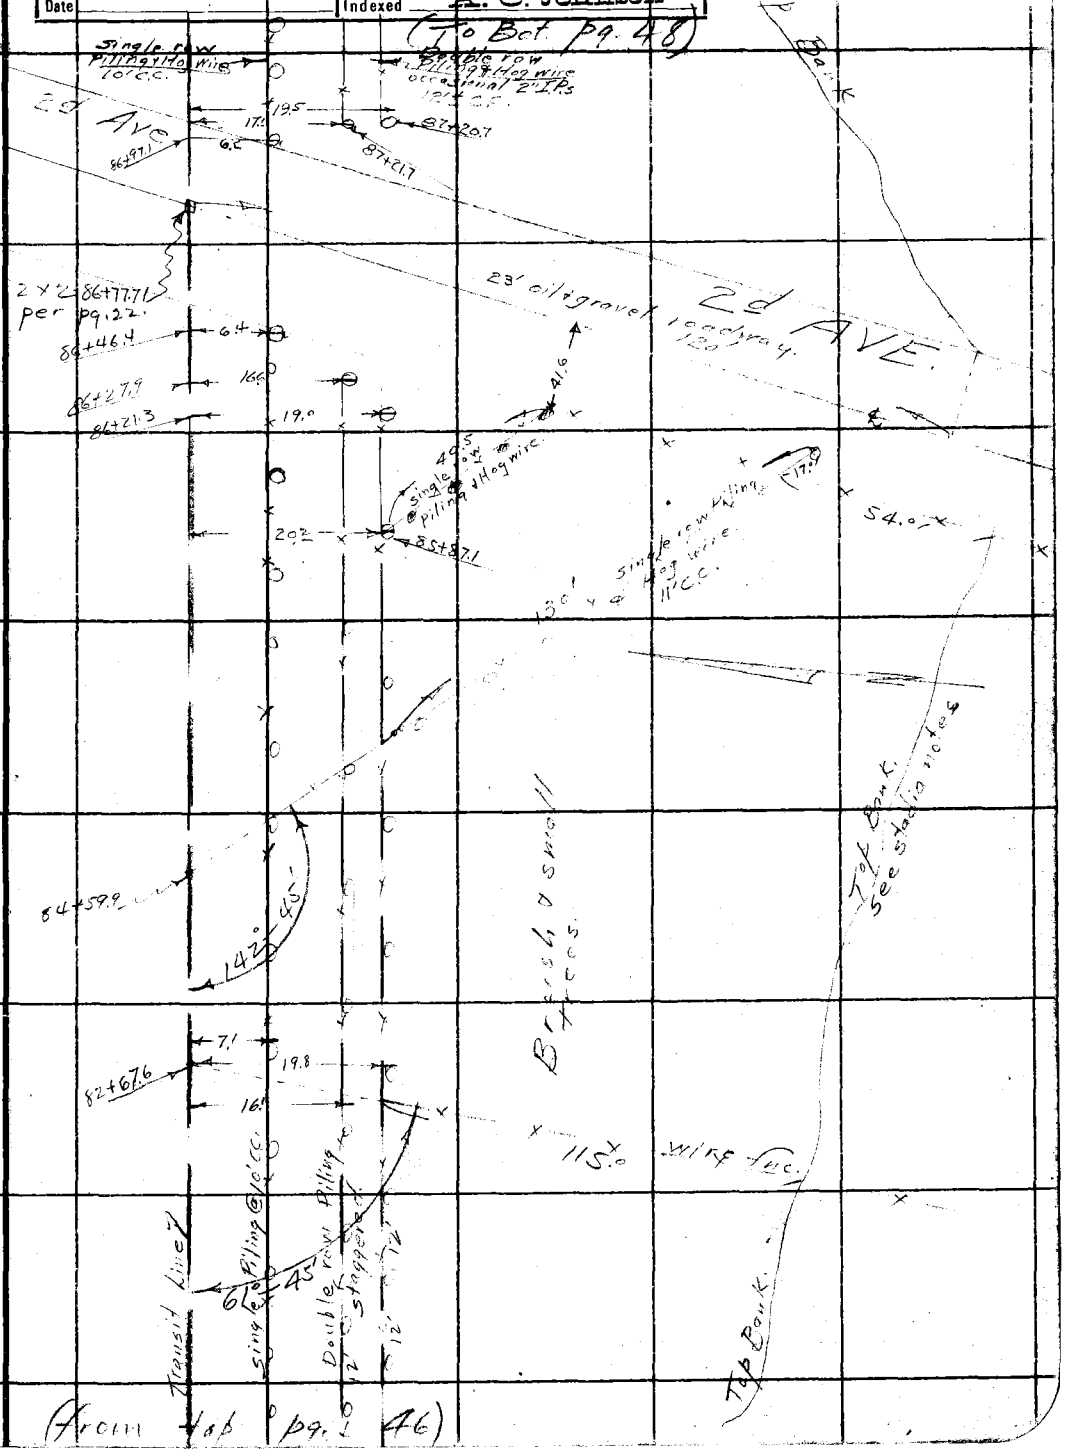

(From top pg. 46)

Note: ANY ADDITIONS OR CHANGES ON THIS SHEET MUST BE MADE OR CIRCLED IN Red Ink. WITH DATE AND NAME OF PERSON MAKING CHANGE.

RETURN TO
LOS ANGELES COUNTY SURVEYOR
700 HALL OF RECORDS
Do not extend notes this side of this line

FORM 247 10M 5-31

F.B. 541 PG. 48

RETURN TO
LOS ANGELES COUNTY SURVEYOR
700 HALL OF RECORDS
Do not extend notes this side of this line

Note: ANY ADDITIONS OR CHANGES ON THIS SHEET MUST BE MADE OR CIRCLED IN Red Ink. WITH DATE AND NAME OF PERSON MAKING CHANGE.

Notes Ck'd by D. M. Finley
Map No. B-1005-4
Office Work C.W. Cox.
Checked
Date

Survey of El Monte - Whittier
W. O. 2012 Tape No. 66 St'd 81 °F.
Surveyed by Evans
Notes H- Date 3/14/34
Indexed A. C. Johnson

F.B. 541 PG. 49

(To Bet. Pgs. 50)

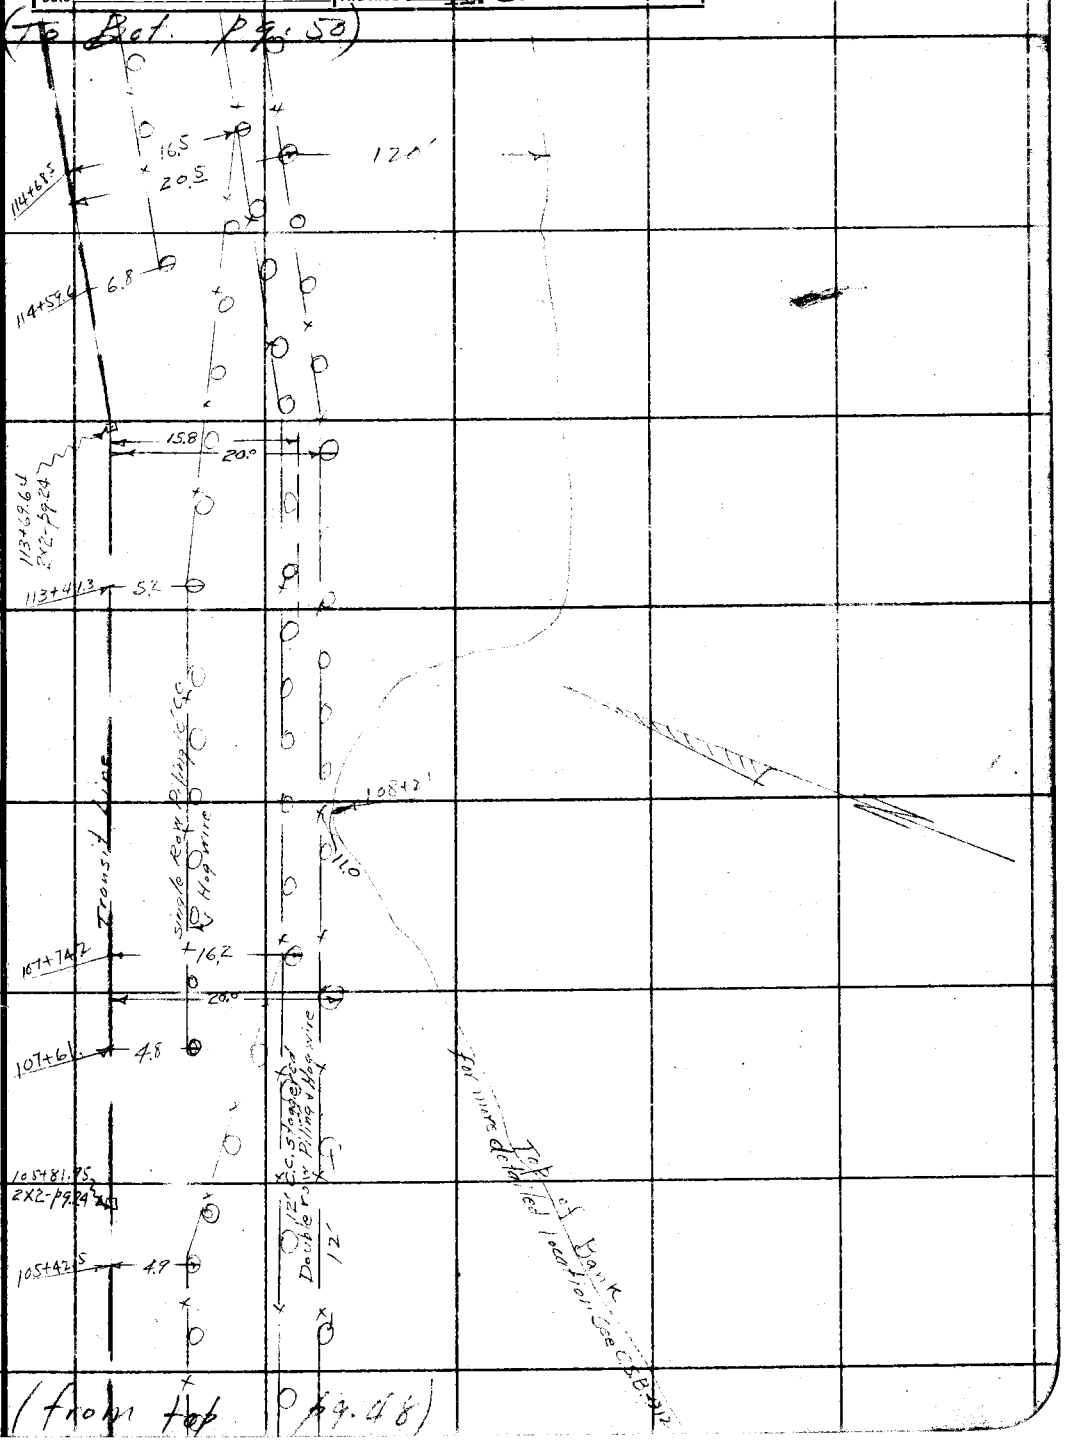

Note: ANY ADDITIONS OR CHANGES ON THIS SHEET MUST BE MADE OR CIRCLED IN Red Ink. WITH DATE AND NAME OF PERSON MAKING CHANGE.

Do not extend notes this side of this line

RETURN TO
LOS ANGELES COUNTY SURVEYOR
700 HALL OF RECORDS

FORM 247 10M 5-31

RETURN TO
LOS ANGELES COUNTY SURVEYOR
700 HALL OF RECORDS

Note: ANY ADDITIONS OR CHANGES ON THIS SHEET MUST BE MADE OR CIRCLED IN **Red Ink.** WITH DATE AND NAME OF PERSON MAKING CHANGE.

Do not extend notes this side of this line

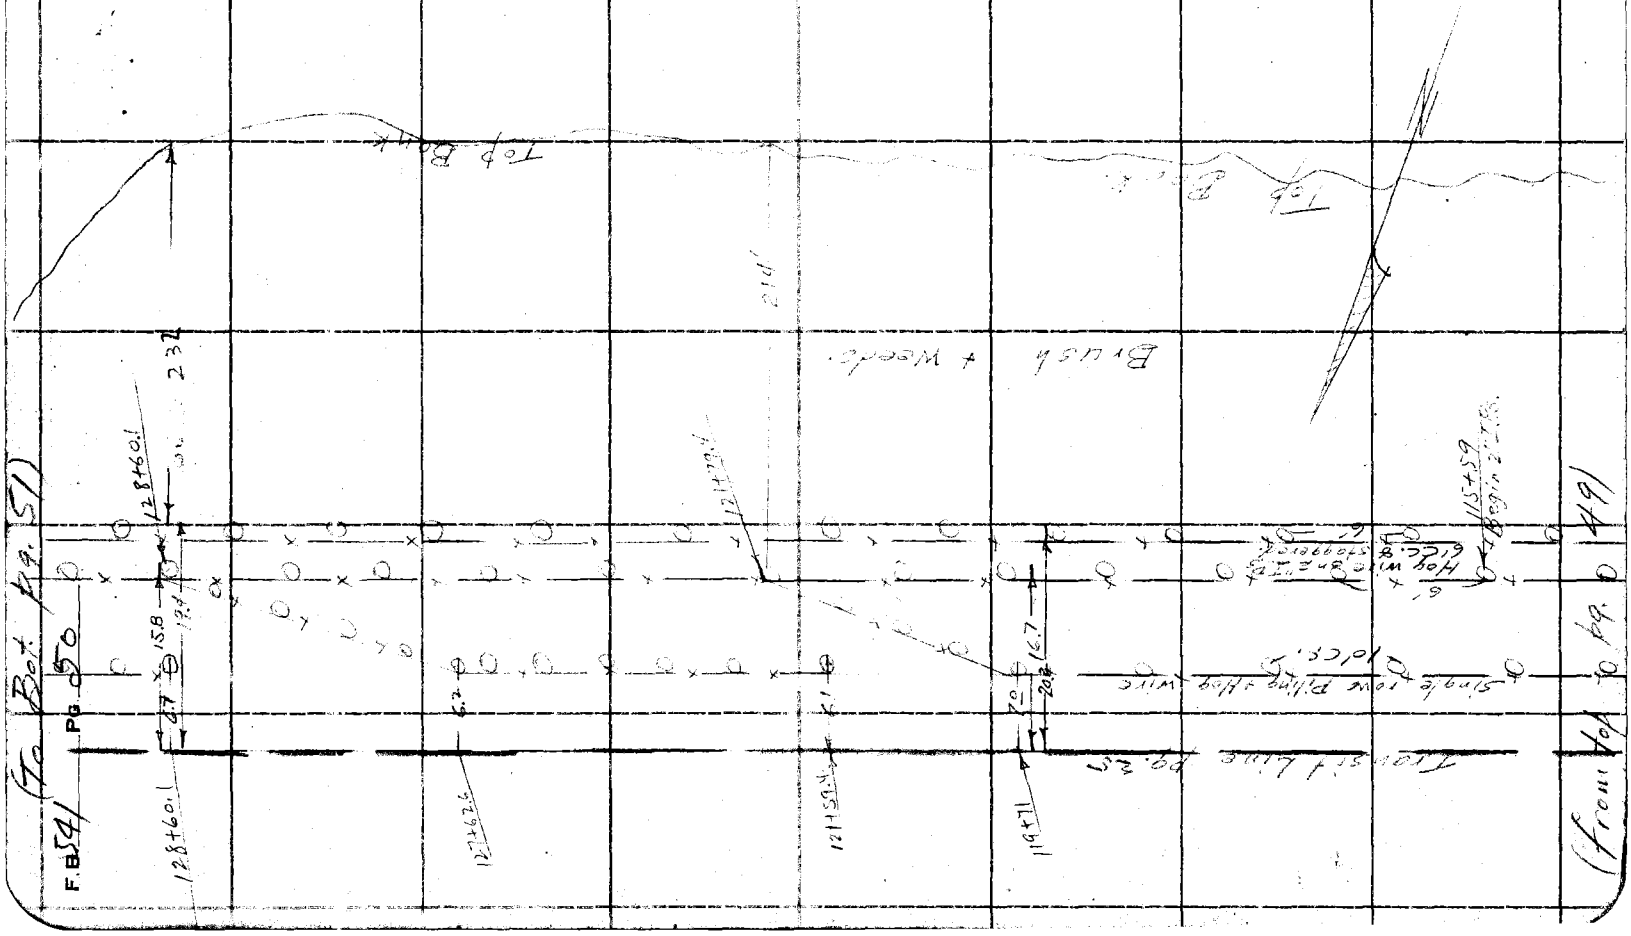

Notes Ck'd by	D. M. Finley	Survey of	El Monte Bridle Trail
Map No.	B-1005-4	W. O.	8612 Tape No. 067 St'd 64 °F.
Office Work	C.W. Cox	Surveyed by	Evans
Checked		Notes	HE Date 3/23/34
Date		Indexed	A. C. Johnson

F.B. 591 PG. 51

(To Bot pg. 051)

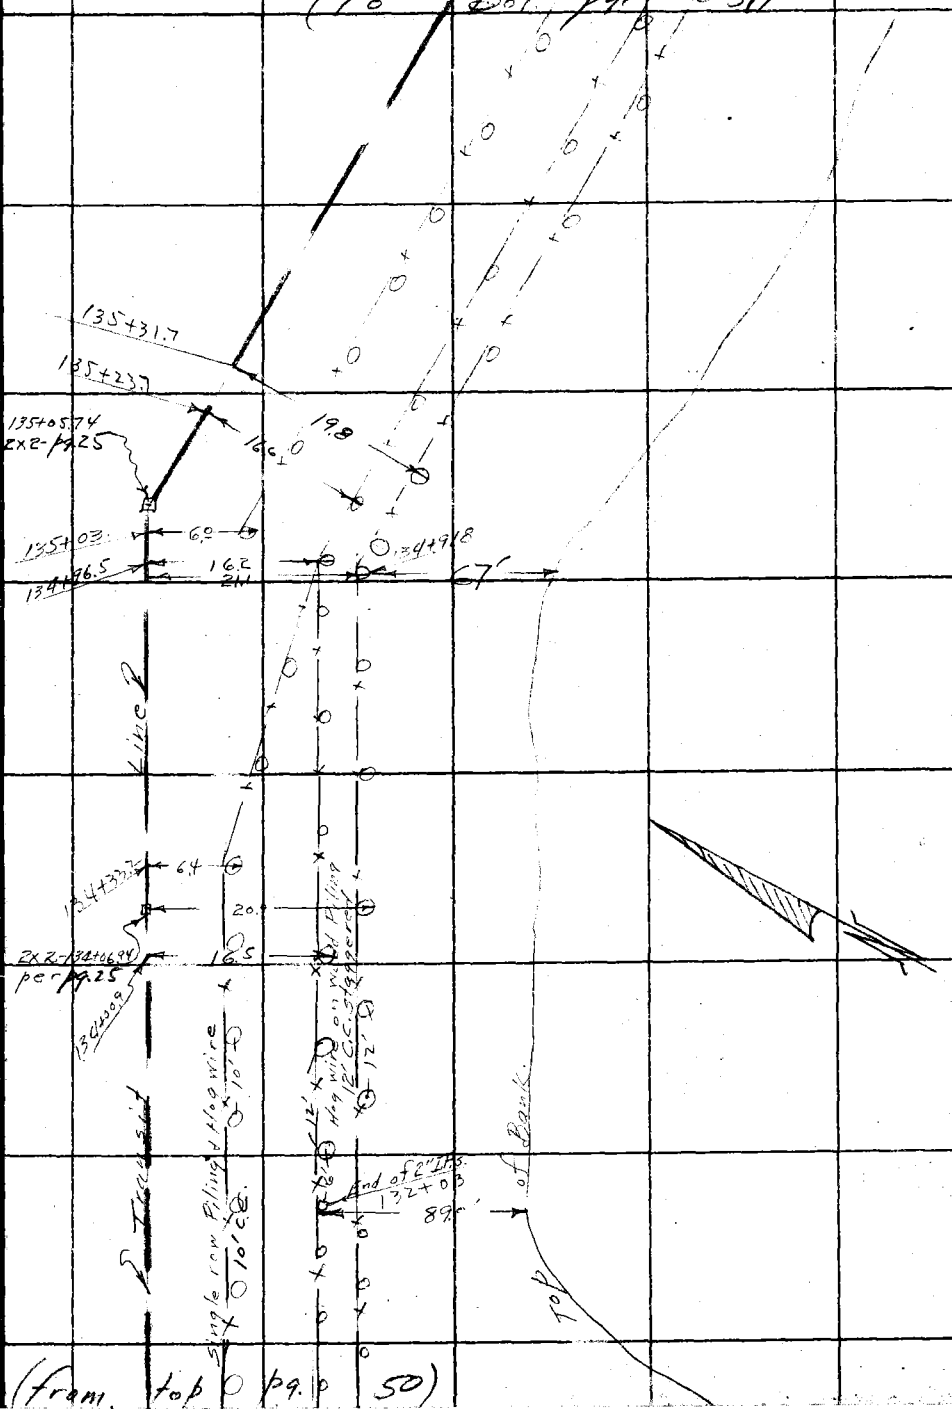

(from top pg. 50)

Note: ANY ADDITIONS OR CHANGES ON THIS SHEET MUST BE MADE OR CIRCLED IN Red Ink. WITH DATE AND NAME OF PERSON MAKING CHANGE.

Do not extend notes this side of this line

RETURN TO
LOS ANGELES COUNTY SURVEYOR
700 HALL OF RECORDS

FORM 247 10M 5-31

RETURN TO
LOS ANGELES COUNTY SURVEYOR
700 HALL OF RECORDS

Note: ANY ADDITIONS OR CHANGES ON THIS SHEET MUST BE MADE OR CIRCLED IN **Red Ink.** WITH DATE AND NAME OF PERSON MAKING CHANGE.

Do not extend notes this side of this line

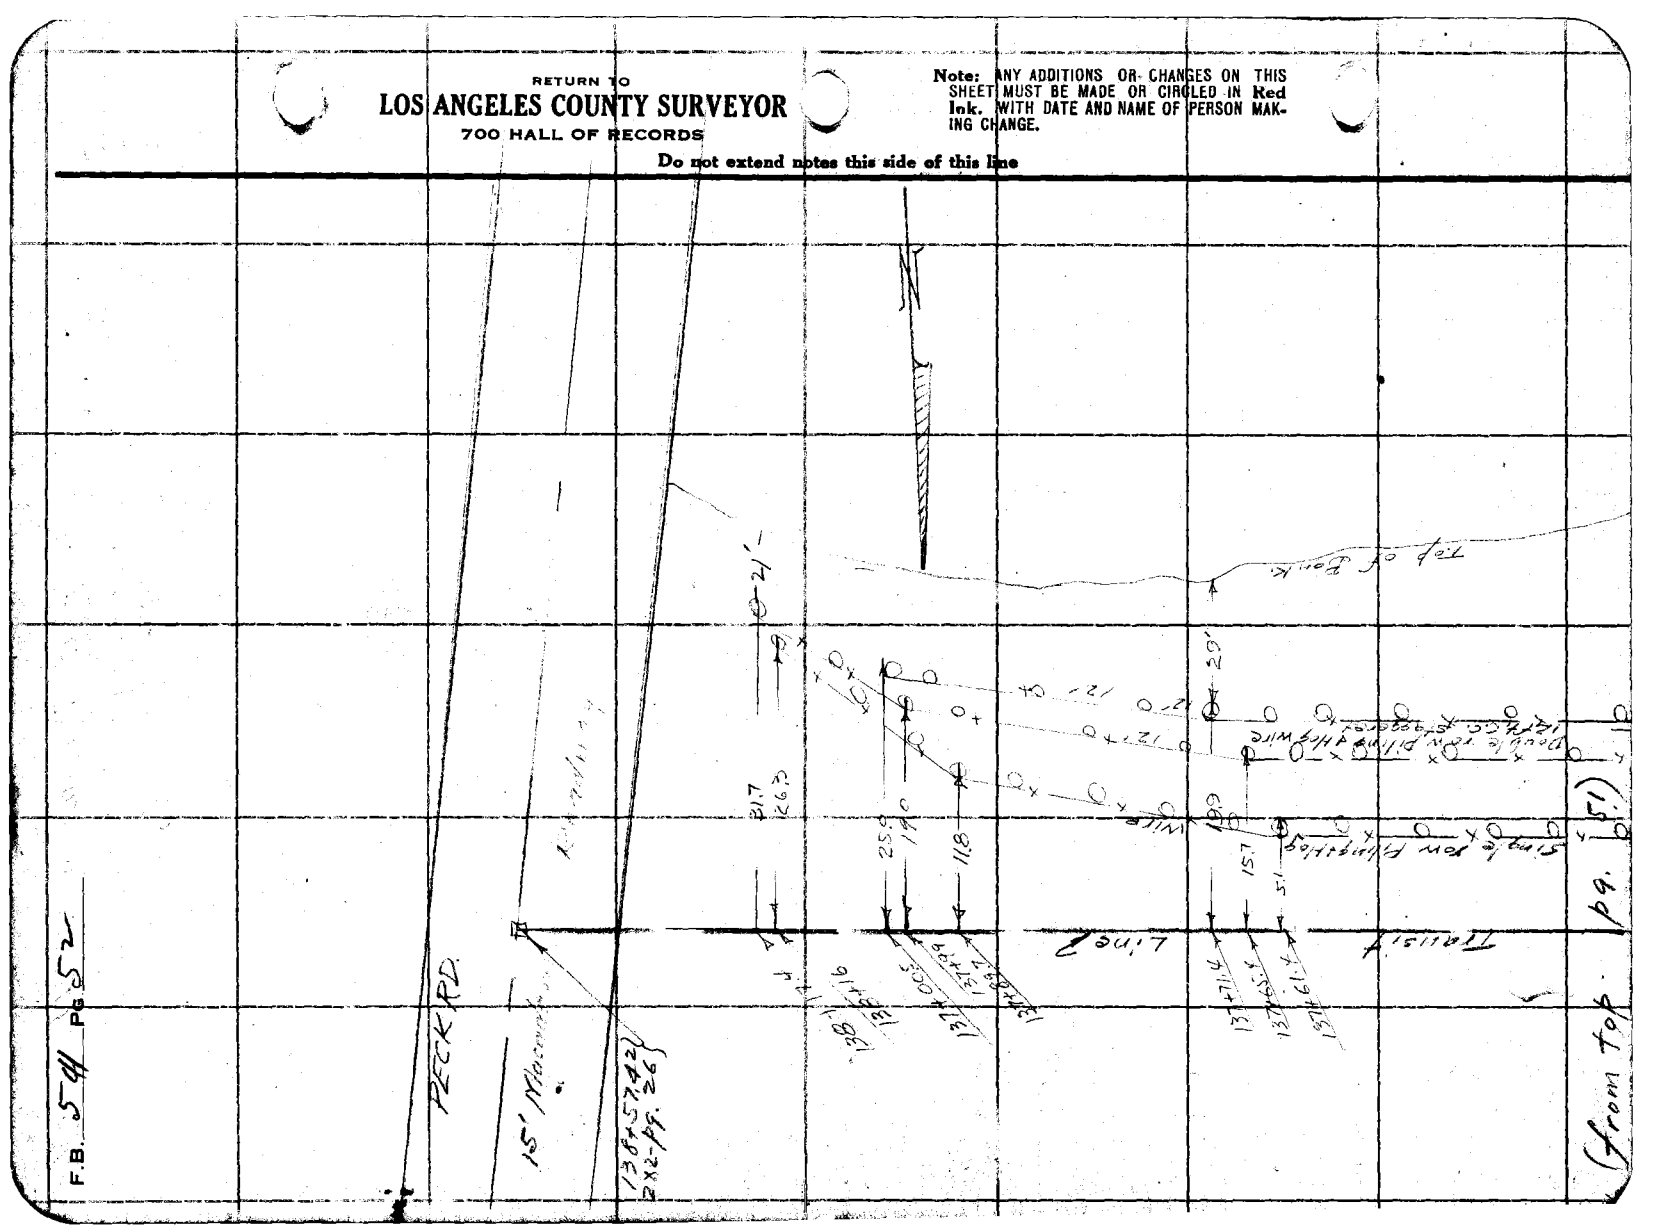

DIV. 1

Notes Ck'd by D. M. Finley	Survey of El Monte Bridle Trail	F.B. 541	Pg. 53
Map No. B-1005-4	W. O. 8012 Tape No 067 St'd 84 of.		
Office Work C. W. Cox	Surveyed by Evans.		
Checked	Notes 1E Date 6/1/34		
Date	Indexed A. C. Johnson		

4, A-4

(To Bot. pg. 54)

Proposed ℄ of EL MONTE BRIDLE TRL. from VALLEY BLVD. to PECK RD. (Pgs. 53 to 64)

Transit Line per pg. 15

Proposed EL MONTE BRIDLE TRAIL.

℄

1127.01 calc.

(20) (20)

VALLEY BLVD.

℄ per pgs. 15-27 & 28

calc. 25-05"

127°

80.00'

0+00 - Set SW. & T.

calc. & Meas. 100.73

Fd. SW. & T. per pg. 15

Note: ANY ADDITIONS OR CHANGES ON THIS SHEET MUST BE MADE OR CIRCLED IN Red Ink WITH DATE AND NAME OF PERSON MAKING CHANGE.

Do not extend notes this side of this line

RETURN TO
LOS ANGELES COUNTY SURVEYOR
700 HALL OF RECORDS

FORM 247 5M 2-34

F.B. 541 PG. 54

(To Bef. pg. 55) 6/1/34

46 A-4

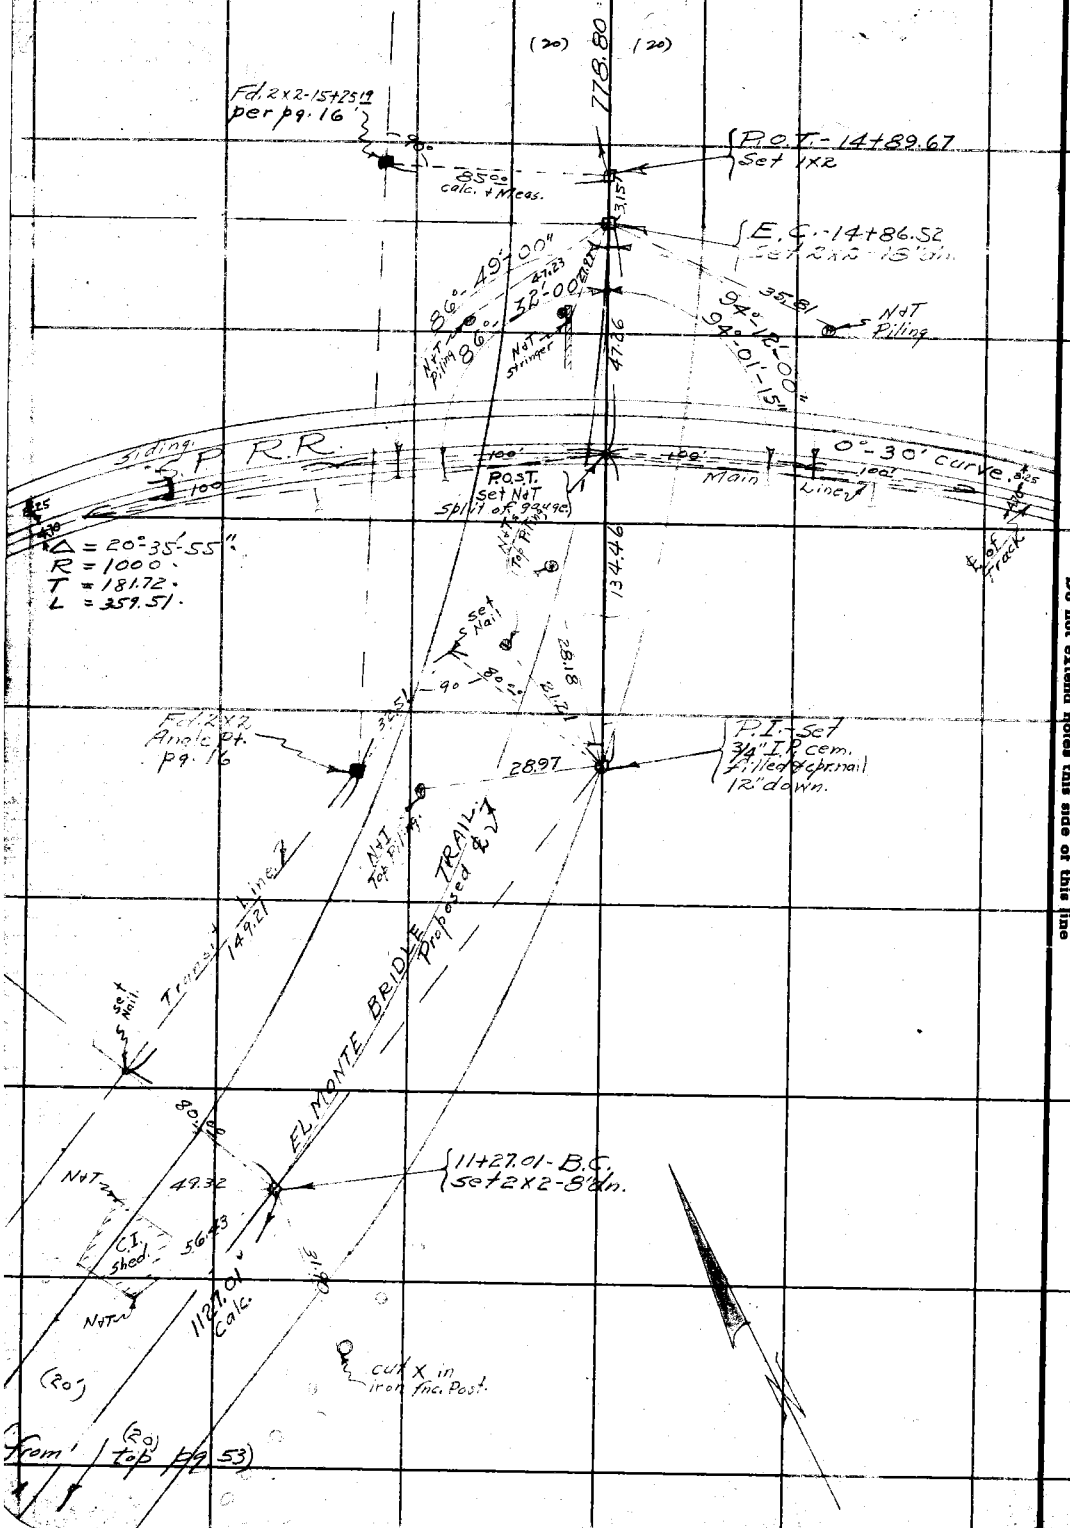

RETURN TO
LOS ANGELES COUNTY SURVEYOR
700 HALL OF RECORDS

Do not extend notes this side of this line

Note: ANY ADDITIONS OR CHANGES ON THIS SHEET MUST BE MADE OR CIRCLED IN Red Ink WITH DATE AND NAME OF PERSON MAKING CHANGE.

DIV. 1.

Notes Ck'd by D. M. Finley	Survey of El Monte Bridle Trl.
Map No. B-1005-4	W. O. 8012 Tape No 067 St'd 84 °F.
Office Work C.W. Cox	Surveyed by Evans
Checked	Notes HE Date 6/4/34
Date	Indexed A. C. Johnson

F.B. 541 Pg. 55

46, A-4

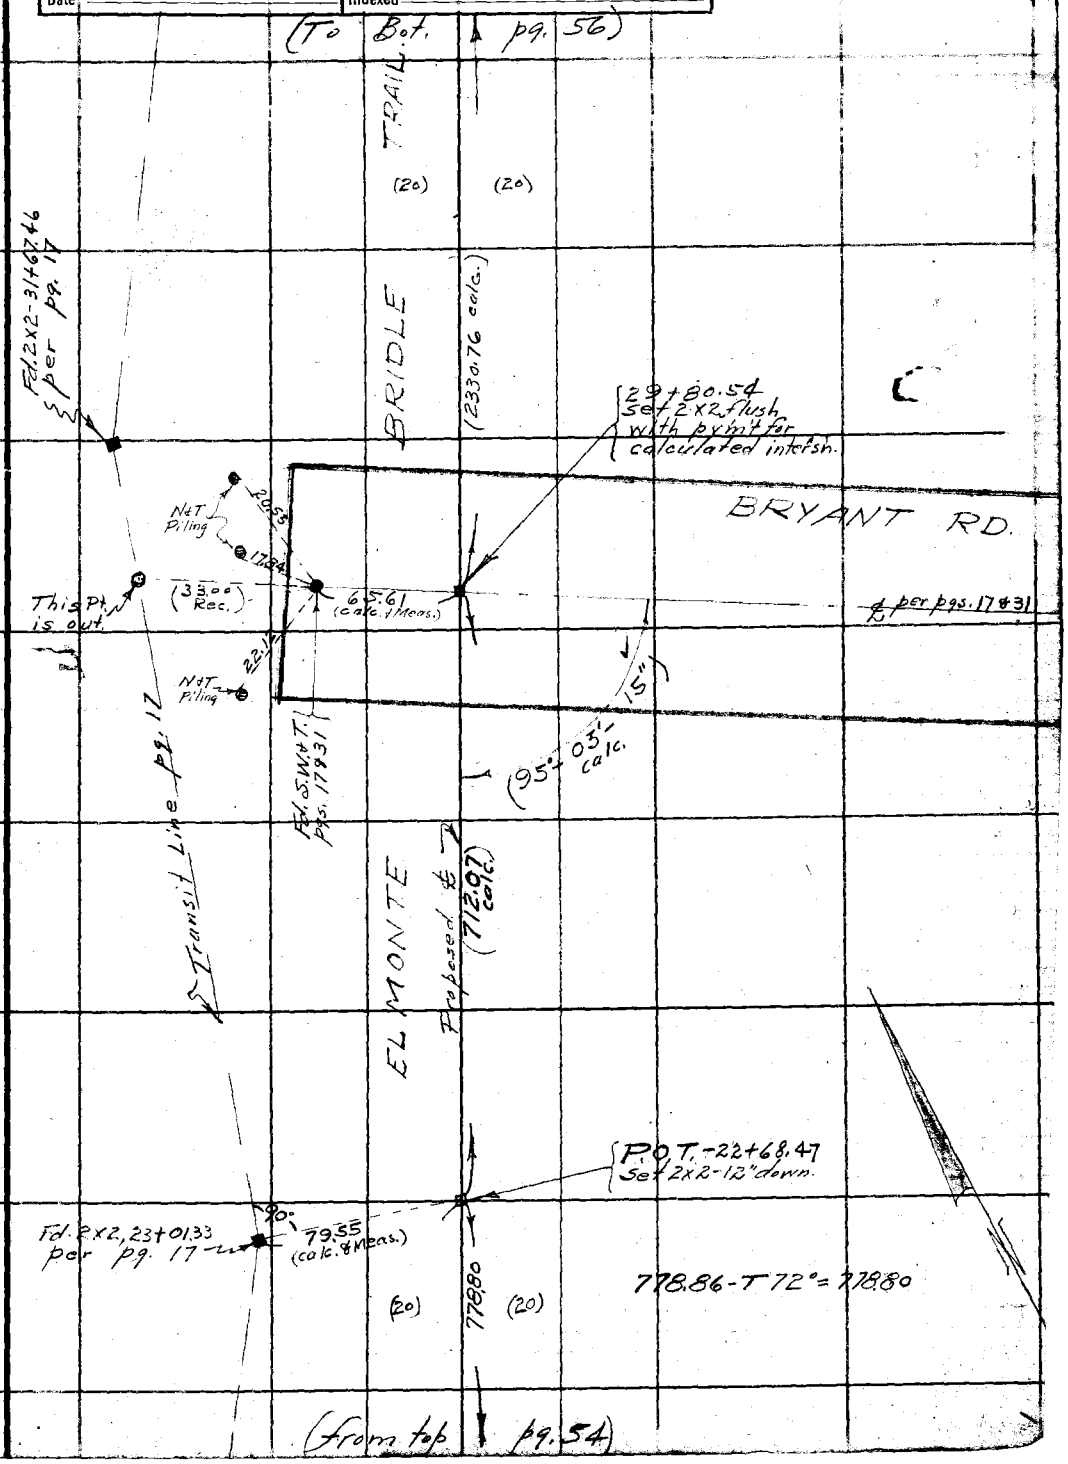

Note: ANY ADDITIONS OR CHANGES ON THIS SHEET MUST BE MADE OR CIRCLED IN Red Ink WITH DATE AND NAME OF PERSON MAKING CHANGE.

Do not extend notes this side of this line

RETURN TO
LOS ANGELES COUNTY SURVEYOR
700 HALL OF RECORDS

FORM 247 5M 2-34

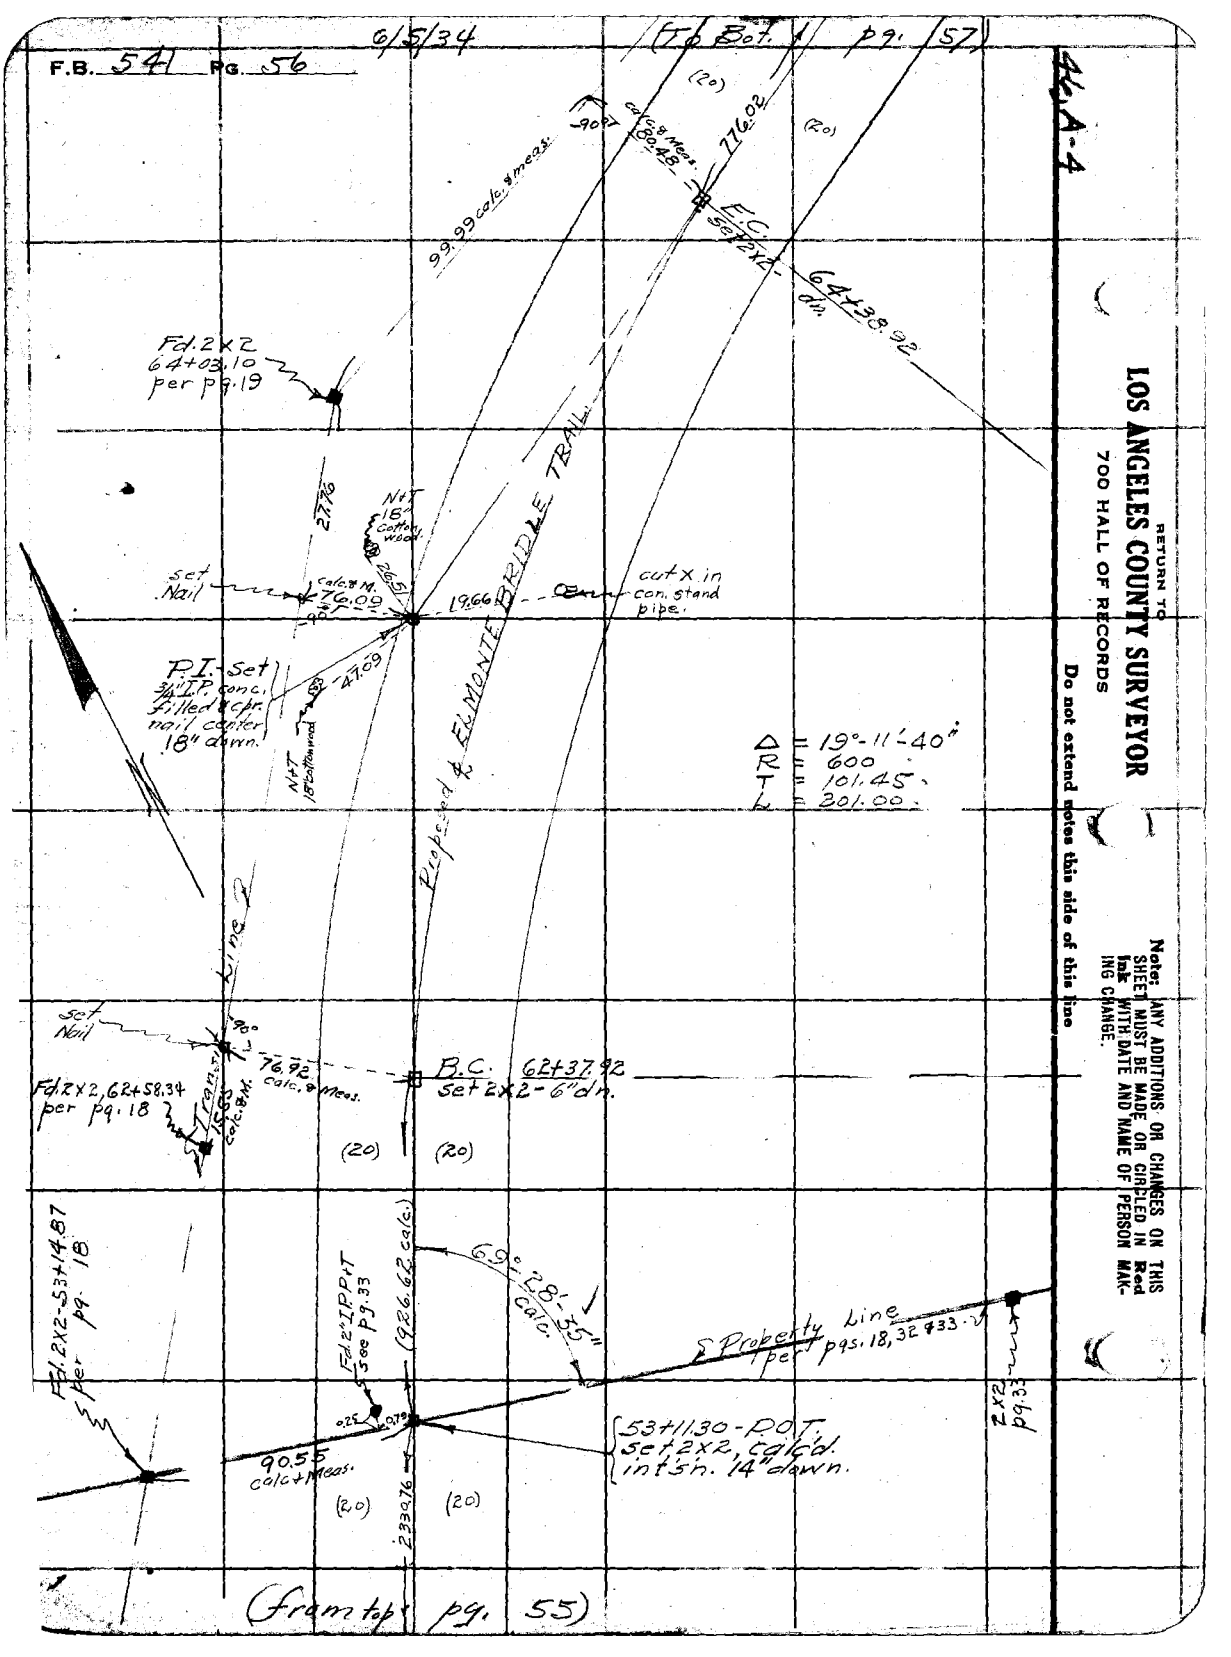

RETURN TO
LOS ANGELES COUNTY SURVEYOR
700 HALL OF RECORDS
Do not extend notes this side of this line
Note: ANY ADDITIONS OR CHANGES ON THIS SHEET MUST BE MADE OR CIRCLED IN Red Ink WITH DATE AND NAME OF PERSON MAKING CHANGE.

Div 1

Notes Ck'd by D.M. Finley	Survey of El Monte Bridle Trail	F.B. 541	Pg. 57
Map No. B-1005-4	W. O. 8012 Tape No 067 St'd 84 of.		
Office Work C.W. Cox	Surveyed by Evans		
Checked	Notes AE Date 6/5/34		
Date	Indexed A. C. Johnson		

46 A-4

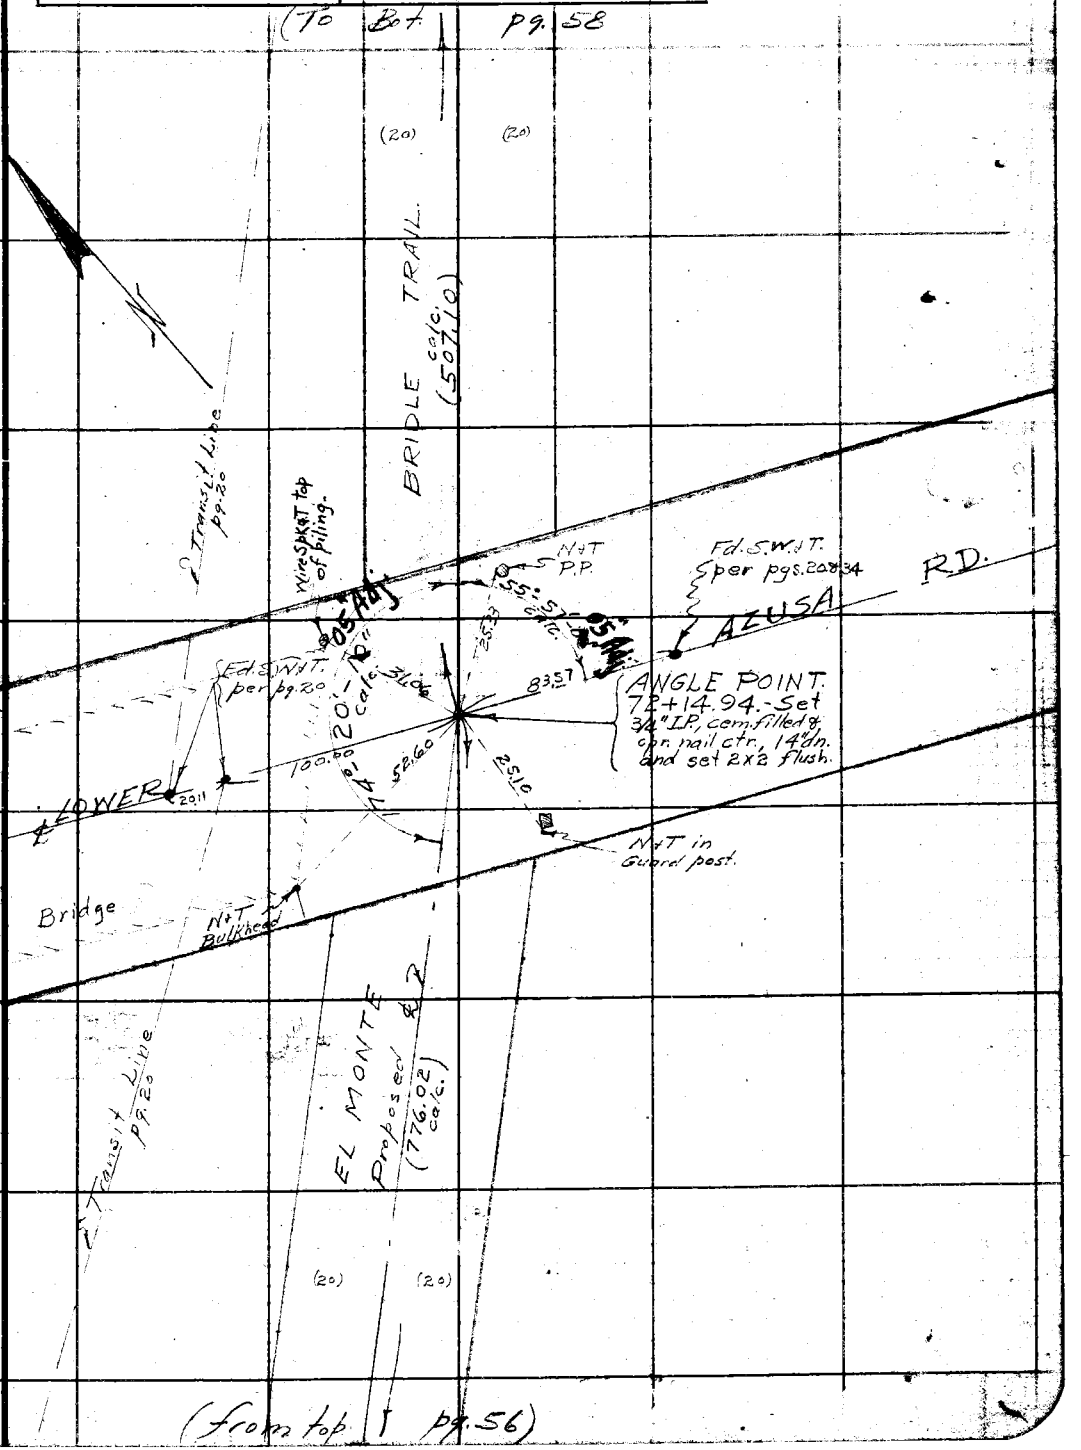

Note: ANY ADDITIONS OR CHANGES ON THIS SHEET MUST BE MADE OR CIRCLED IN Red Ink WITH DATE AND NAME OF PERSON MAKING CHANGE.

Do not extend notes this side of this line

RETURN TO
LOS ANGELES COUNTY SURVEYOR
700 HALL OF RECORDS

FORM 247 BM 2-34

RETURN TO
LOS ANGELES COUNTY SURVEYOR
700 HALL OF RECORDS

46, A-3

Note: ANY ADDITIONS OR CHANGES ON THIS SHEET MUST BE MADE OR CIRCLED IN **Red Ink** WITH DATE AND NAME OF PERSON MAKING CHANGE.

Do not extend notes this side of this line

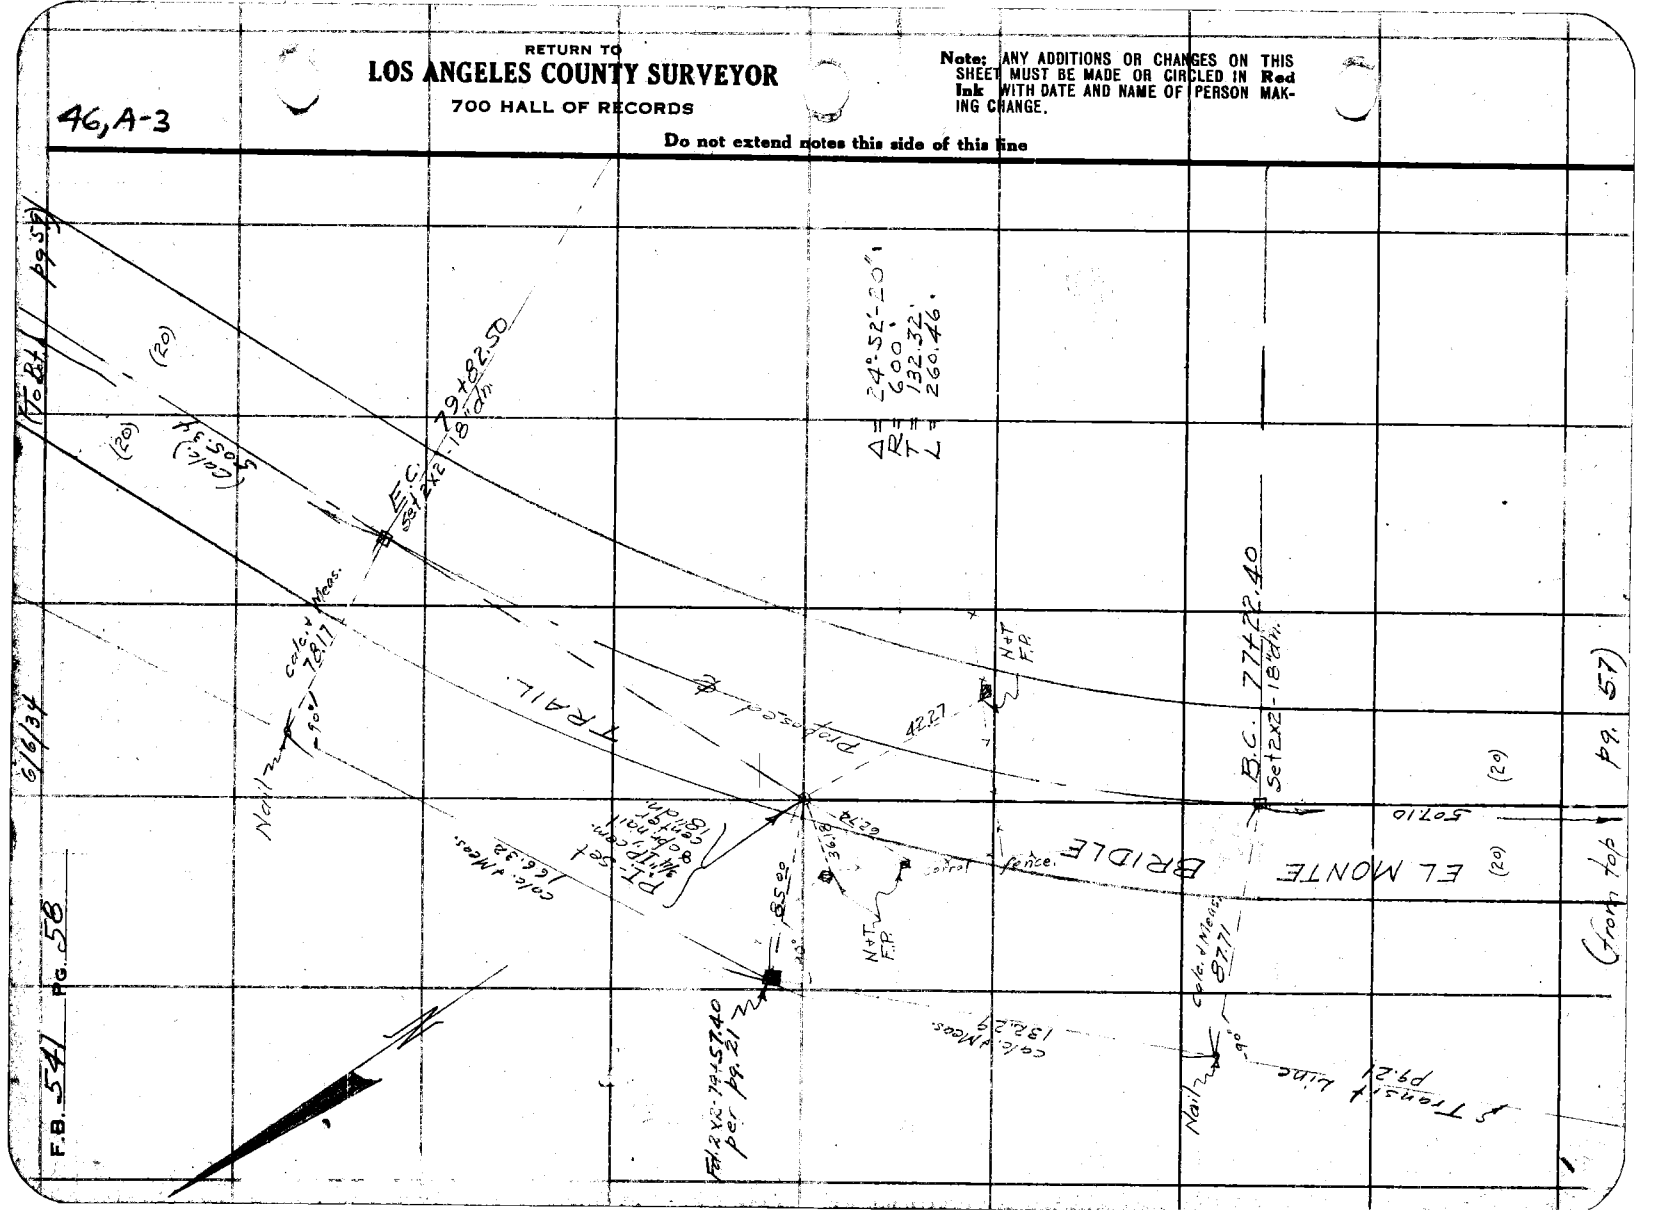

Div 1

Notes Ck'd by D. M. Finley	Survey of El Monte Bridle Trail
Map No. B-1005-4	W. O. 8012 Tape No 067 St'd 84 °F.
Office Work C. W. Cox	Surveyed by Evans
Checked	Notes HE Date 6/6/34
Date	Indexed L. C. Johnson

F.B. 541 PG. 59

46, A-3

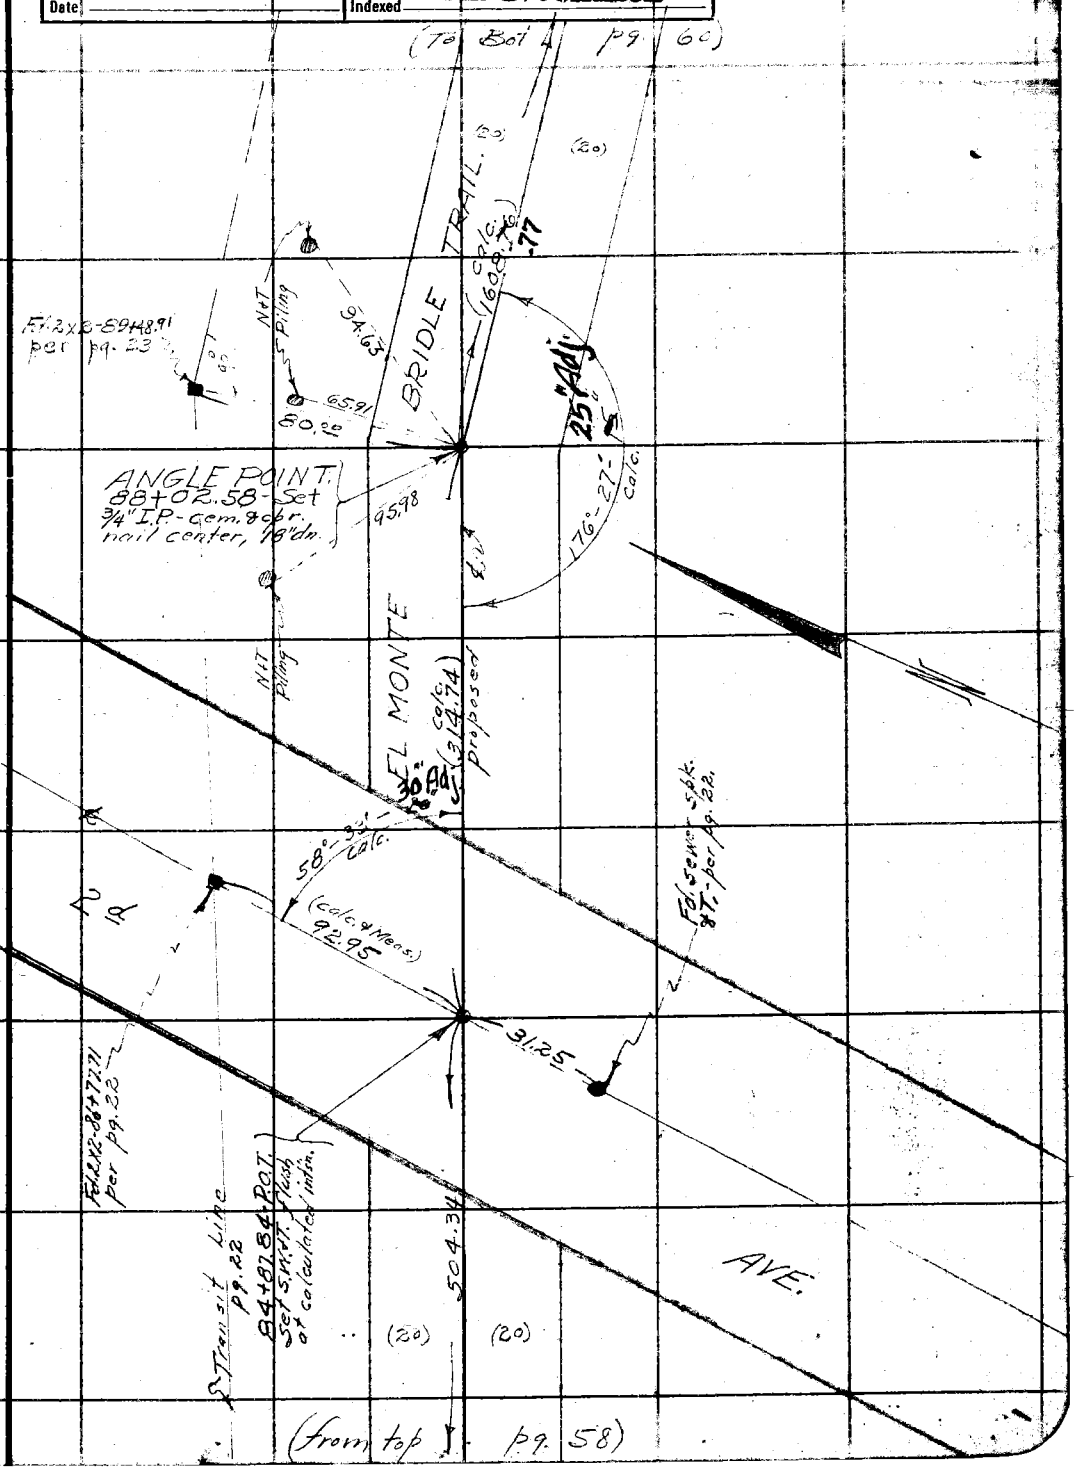

Note: ANY ADDITIONS OR CHANGES ON THIS SHEET MUST BE MADE OR CIRCLED IN Red Ink WITH DATE AND NAME OF PERSON MAKING CHANGE.

Do not extend notes this side of this line

RETURN TO
LOS ANGELES COUNTY SURVEYOR
700 HALL OF RECORDS

FORM 247 5M 2-34

F.B. 541 Pg. 60

6/6/34

46 B-3

RETURN TO

LOS ANGELES COUNTY SURVEYOR

700 HALL OF RECORDS

Do not extend notes this side of this line

Note: ANY ADDITIONS OR CHANGES ON THIS SHEET MUST BE MADE OR CIRCLED IN Red Ink WITH DATE AND NAME OF PERSON MAKING CHANGE.

DIV 1

Notes Ck'd by D.M. Finley	Survey of El Monte Bridle Trl.	F.B. 541	Pg. 61
Map No. B-1005-4	W. O. 8012 Tape No 067 St'd 84 of.		
Office Work C.W. Cox.	Surveyed by Evans.		
Checked	Notes AE Date 6/11/34		
Date	Indexed C. Johnson		

46, B-3

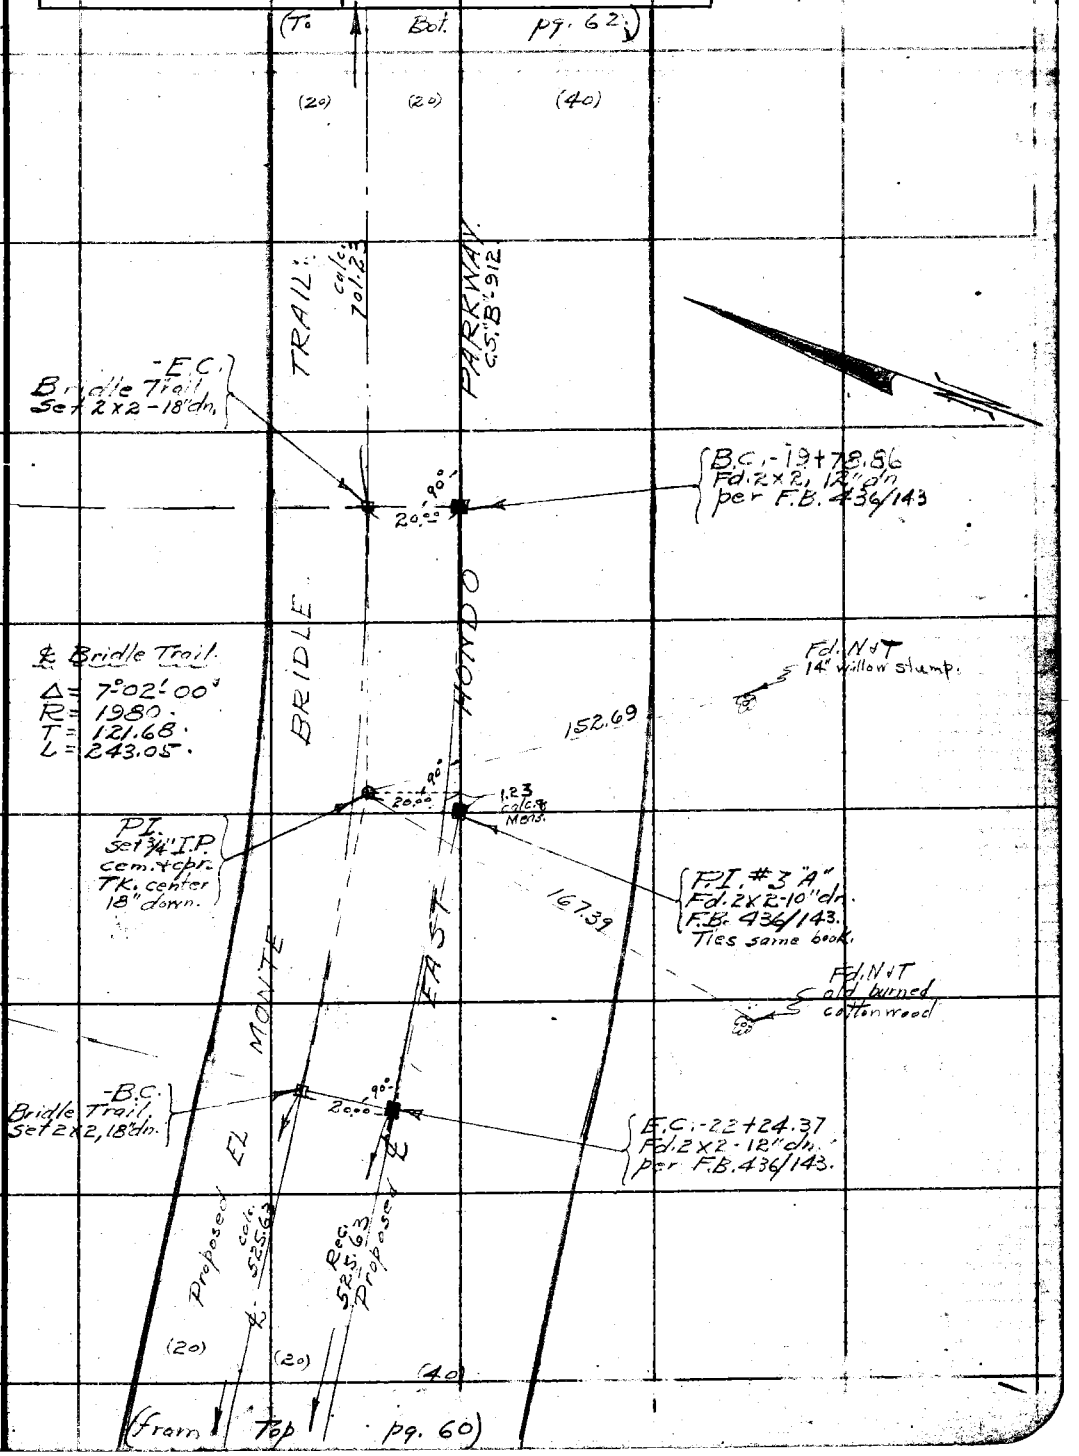

Note: ANY ADDITIONS OR CHANGES ON THIS SHEET MUST BE MADE OR CIRCLED IN Red Ink WITH DATE AND NAME OF PERSON MAKING CHANGE.

Do not extend notes this side of this line

RETURN TO
LOS ANGELES COUNTY SURVEYOR
700 HALL OF RECORDS

FORM 247 5M 2-34

F.B. 541 Pg. 62

(To Bet pg. 63. 6/11/34

45, B-3

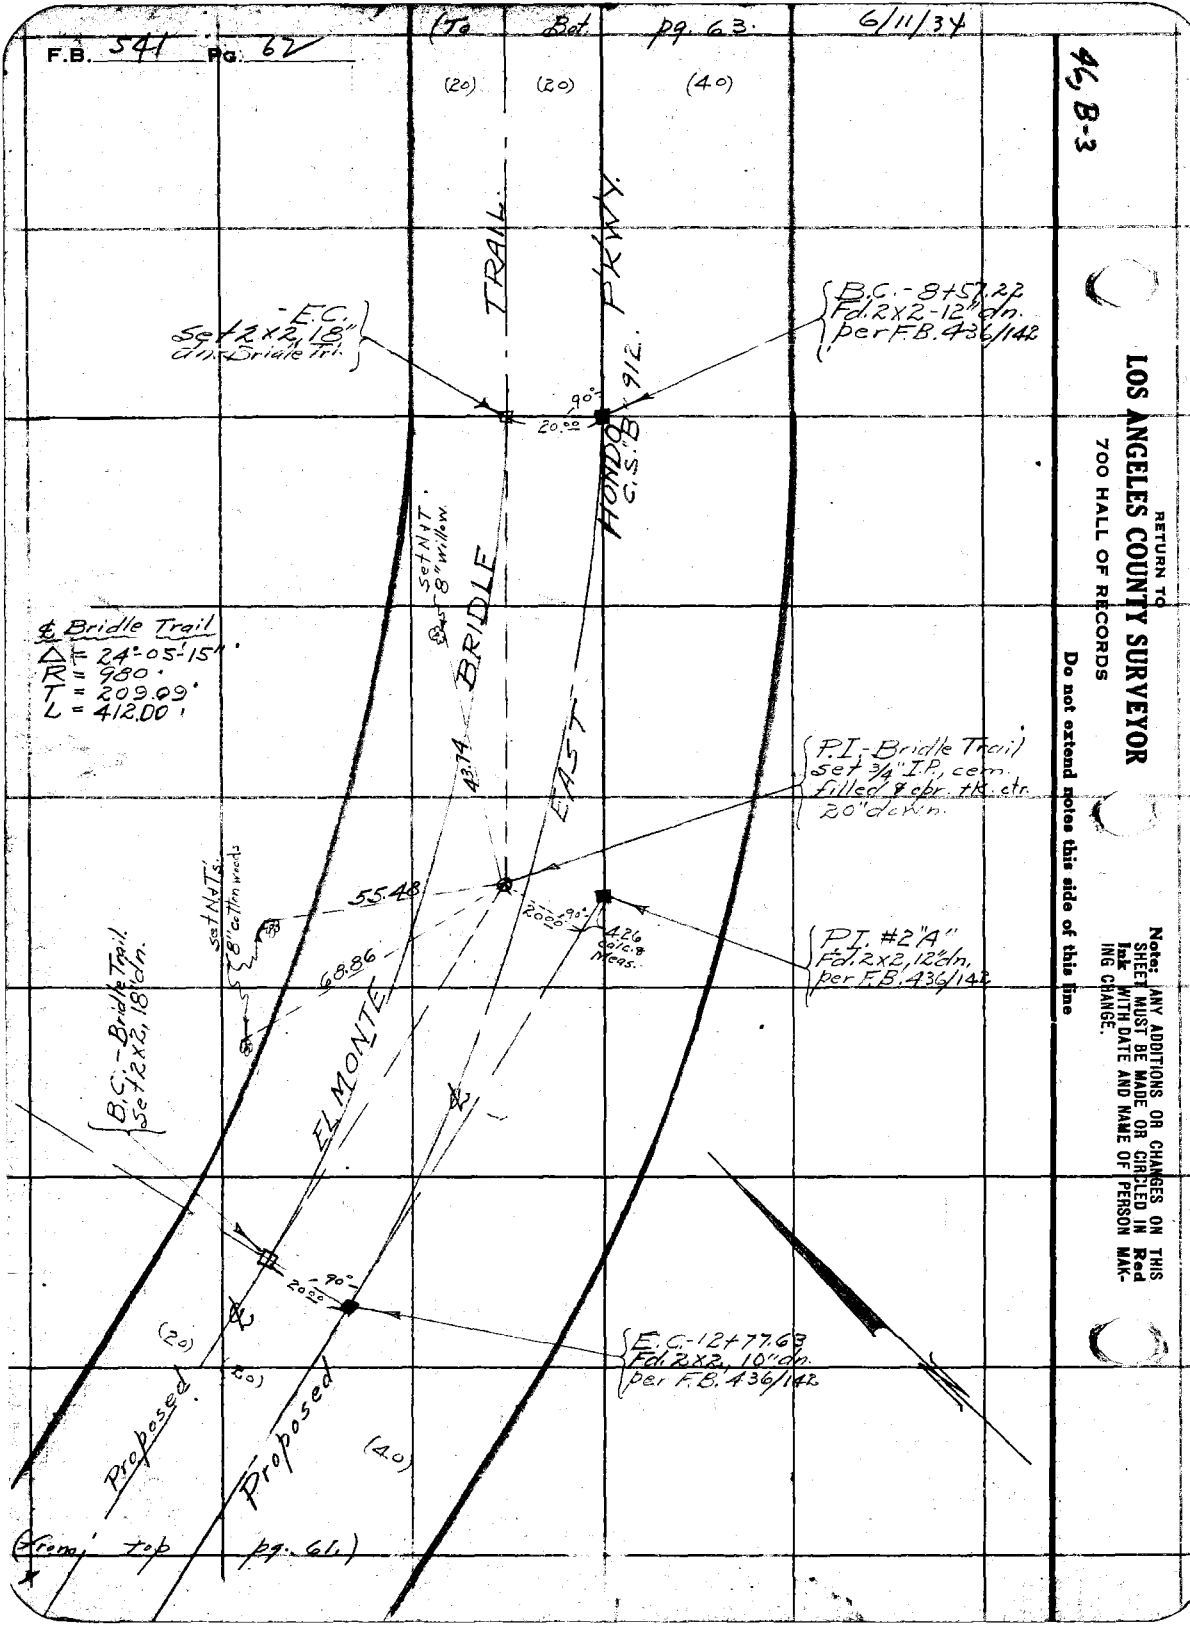

(From top pg. 61)

RETURN TO
LOS ANGELES COUNTY SURVEYOR
700 HALL OF RECORDS

Do not extend notes this side of this line

Notes: ANY ADDITIONS OR CHANGES ON THIS SHEET MUST BE MADE OR CIRCLED IN Red Ink WITH DATE AND NAME OF PERSON MAKING CHANGE.

DIV I

Notes Ck'd by D.M. Finley	Survey of EL MONTE BRIDLE TRL. F.B. 541 Pg. 63
Map No. B-1005-4	W. O. 8012 Tape No 067 St'd 84 of.
Office Work C.W. Cox	Surveyed by Evans
Checked	Notes AE Date 6/14/34
Date	Indexed A. C. Johnson

46, B-3

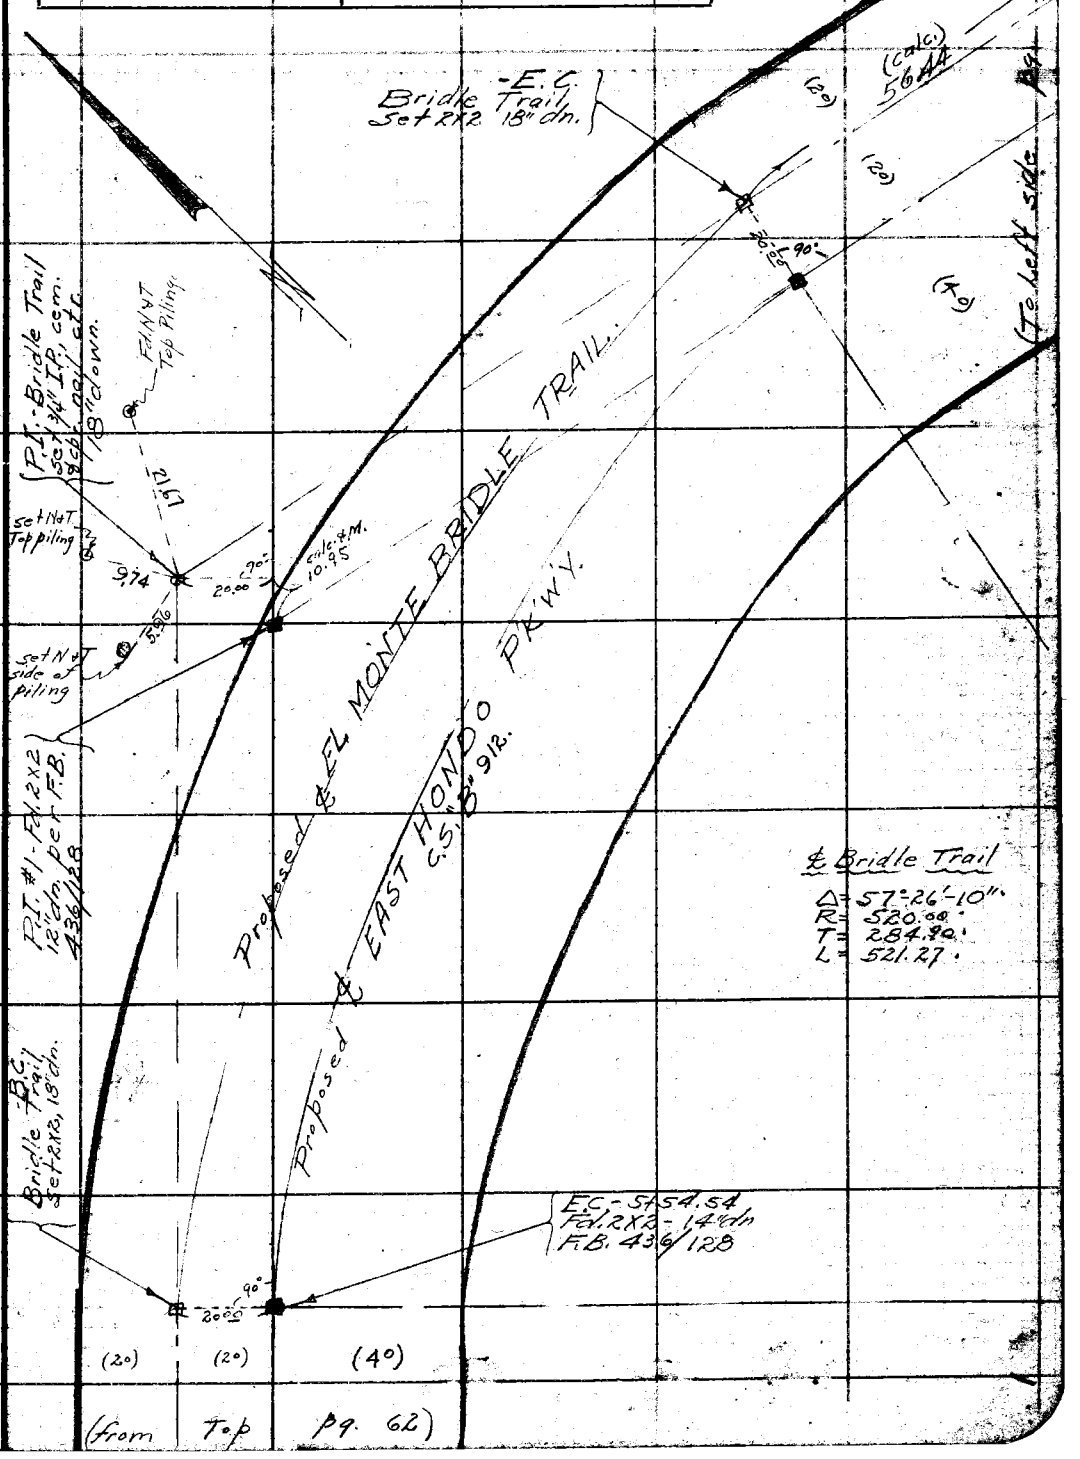

Note: ANY ADDITIONS OR CHANGES ON THIS SHEET MUST BE MADE OR CIRCLED IN Red Ink WITH DATE AND NAME OF PERSON MAKING CHANGE.

Do not extend notes this side of this line

RETURN TO
LOS ANGELES COUNTY SURVEYOR
700 HALL OF RECORDS

FORM 247 5M 2-34

RETURN TO
LOS ANGELES COUNTY SURVEYOR
700 HALL OF RECORDS

Note: ANY ADDITIONS OR CHANGES ON THIS SHEET MUST BE MADE OR CIRCLED IN **Red Ink** WITH DATE AND NAME OF PERSON MAKING CHANGE.

46, B-3

Do not extend notes this side of this line

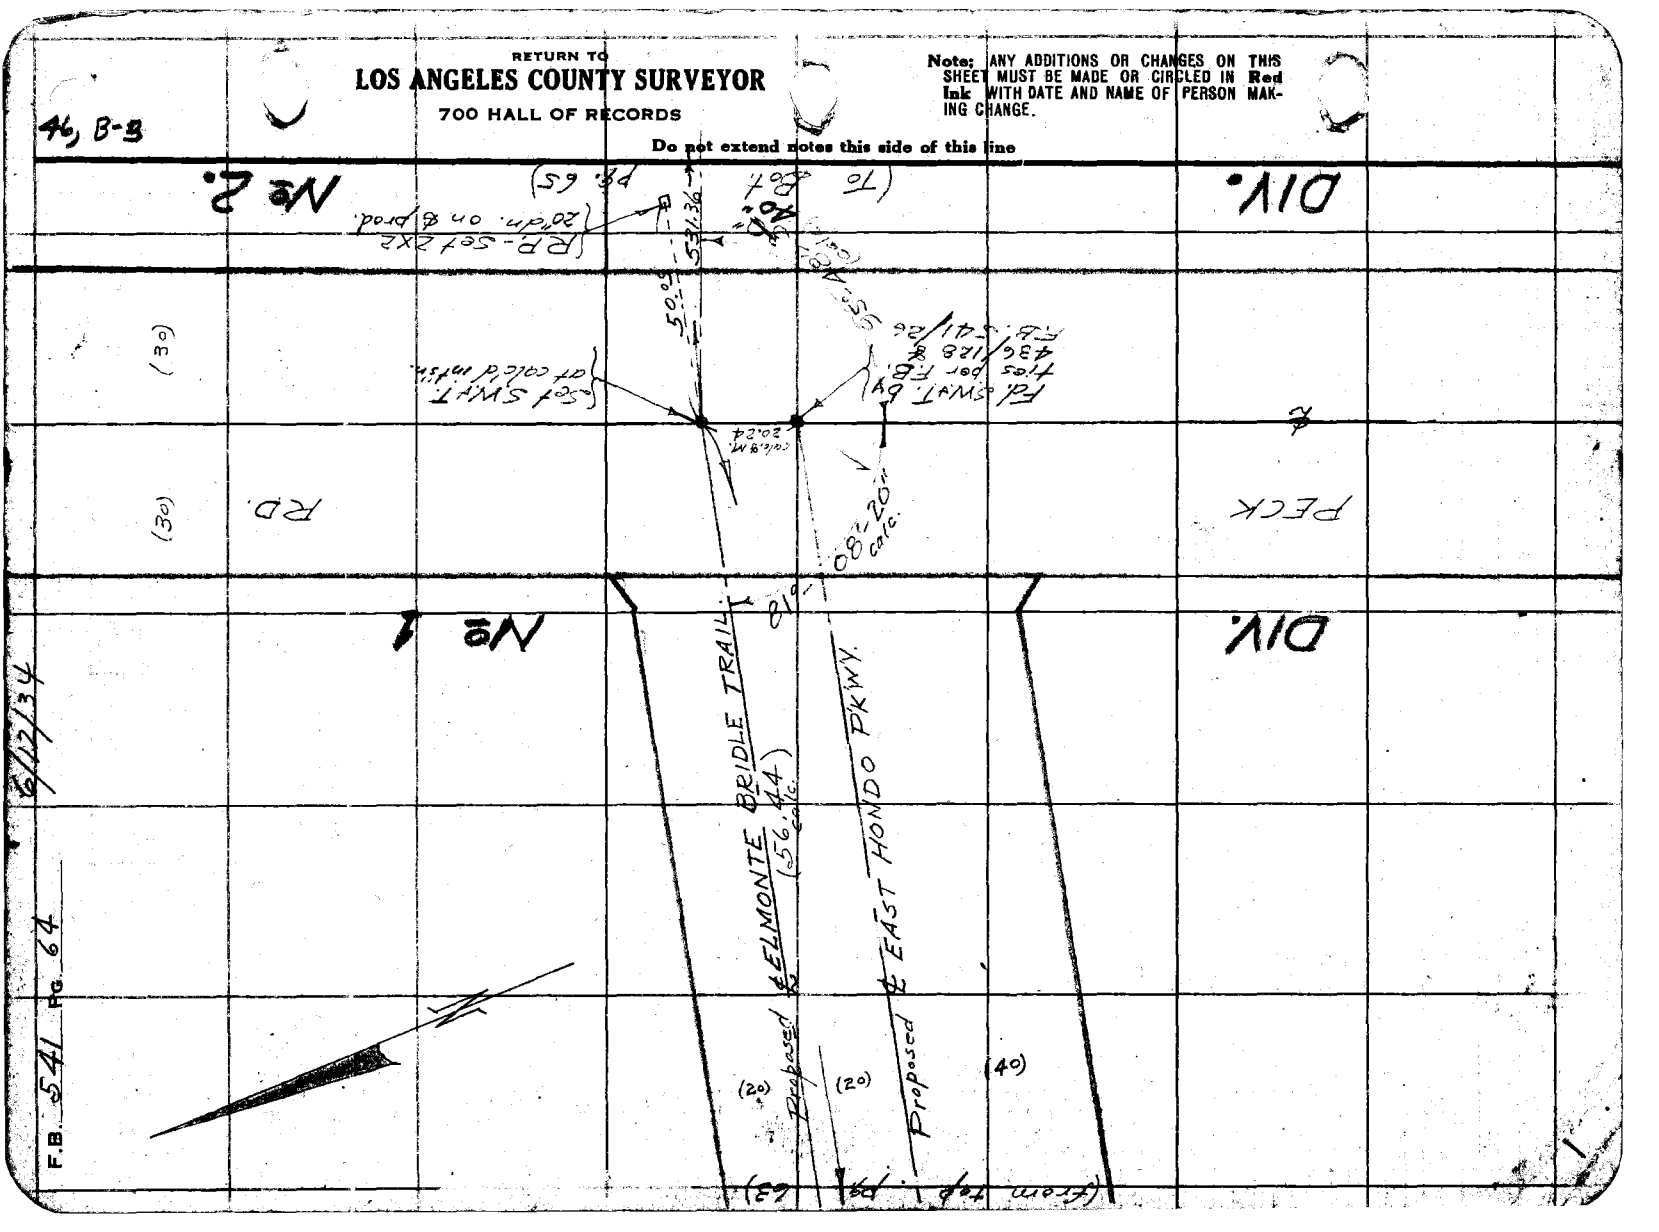

Div. 2

Notes Ck'd by D. M. Finley	Survey of El Monte Bridle Trl. F.B. 541 Pg. 65
Map No. B-1005-5	W. O. 8012 Tape No 067 St'd 84 °F.
Office Work C. W. Cox	Surveyed by Evans
Checked	Notes Date 8/6/34
Date	Indexed A. C. Johnson 8-14-34

46, B-3

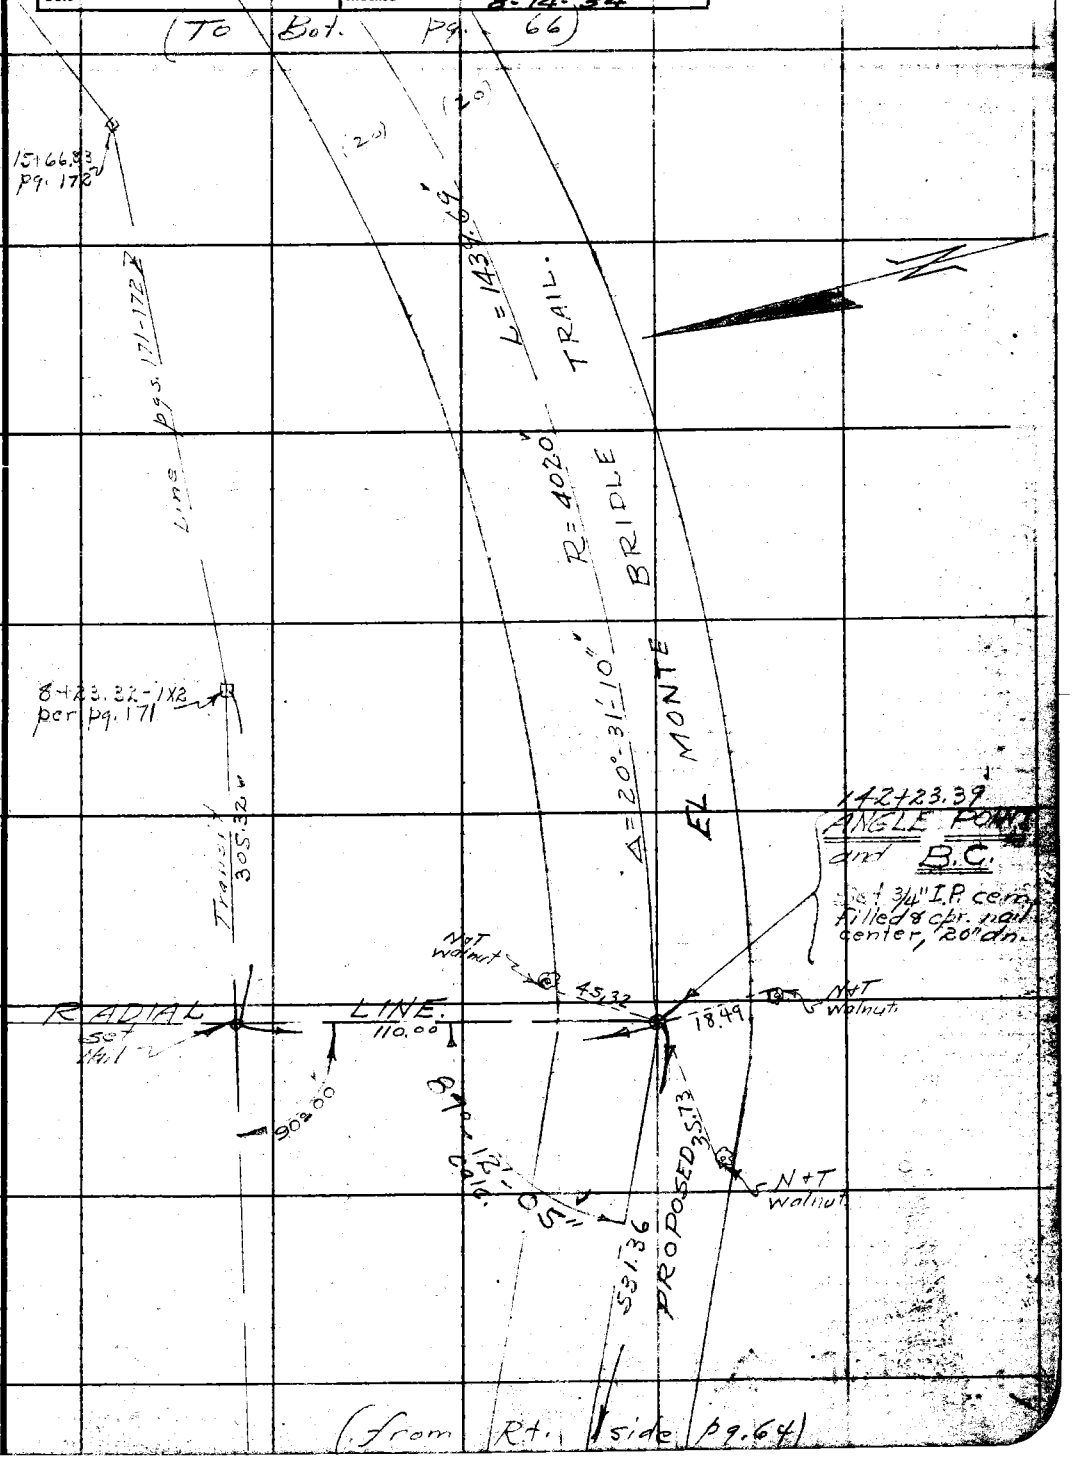

Note: ANY ADDITIONS OR CHANGES ON THIS SHEET MUST BE MADE OR CIRCLED IN Red Ink WITH DATE AND NAME OF PERSON MAKING CHANGE.

Do not extend notes this side of this line

RETURN TO
LOS ANGELES COUNTY SURVEYOR
700 HALL OF RECORDS

FORM 247 5M 2-34

RETURN TO
LOS ANGELES COUNTY SURVEYOR
700 HALL OF RECORDS

Note: ANY ADDITIONS OR CHANGES ON THIS SHEET MUST BE MADE OR CIRCLED IN **Red Ink** WITH DATE AND NAME OF PERSON MAKING CHANGE.

46 B-3

Do not extend notes this side of this line

Notes Ck'd by D. M. Finley	Survey of El Monte Bridle Trl.	F.B. 541	Pg. 67
Map No. B-1005-5	W. O. 5017 Tape No 67 St'd 54 of.		
Office Work C. W. Cox	Surveyed by [illegible]		
Checked	Notes AE Date 8/7/34		
Date	Indexed A. C. Johnson		

46, C-3

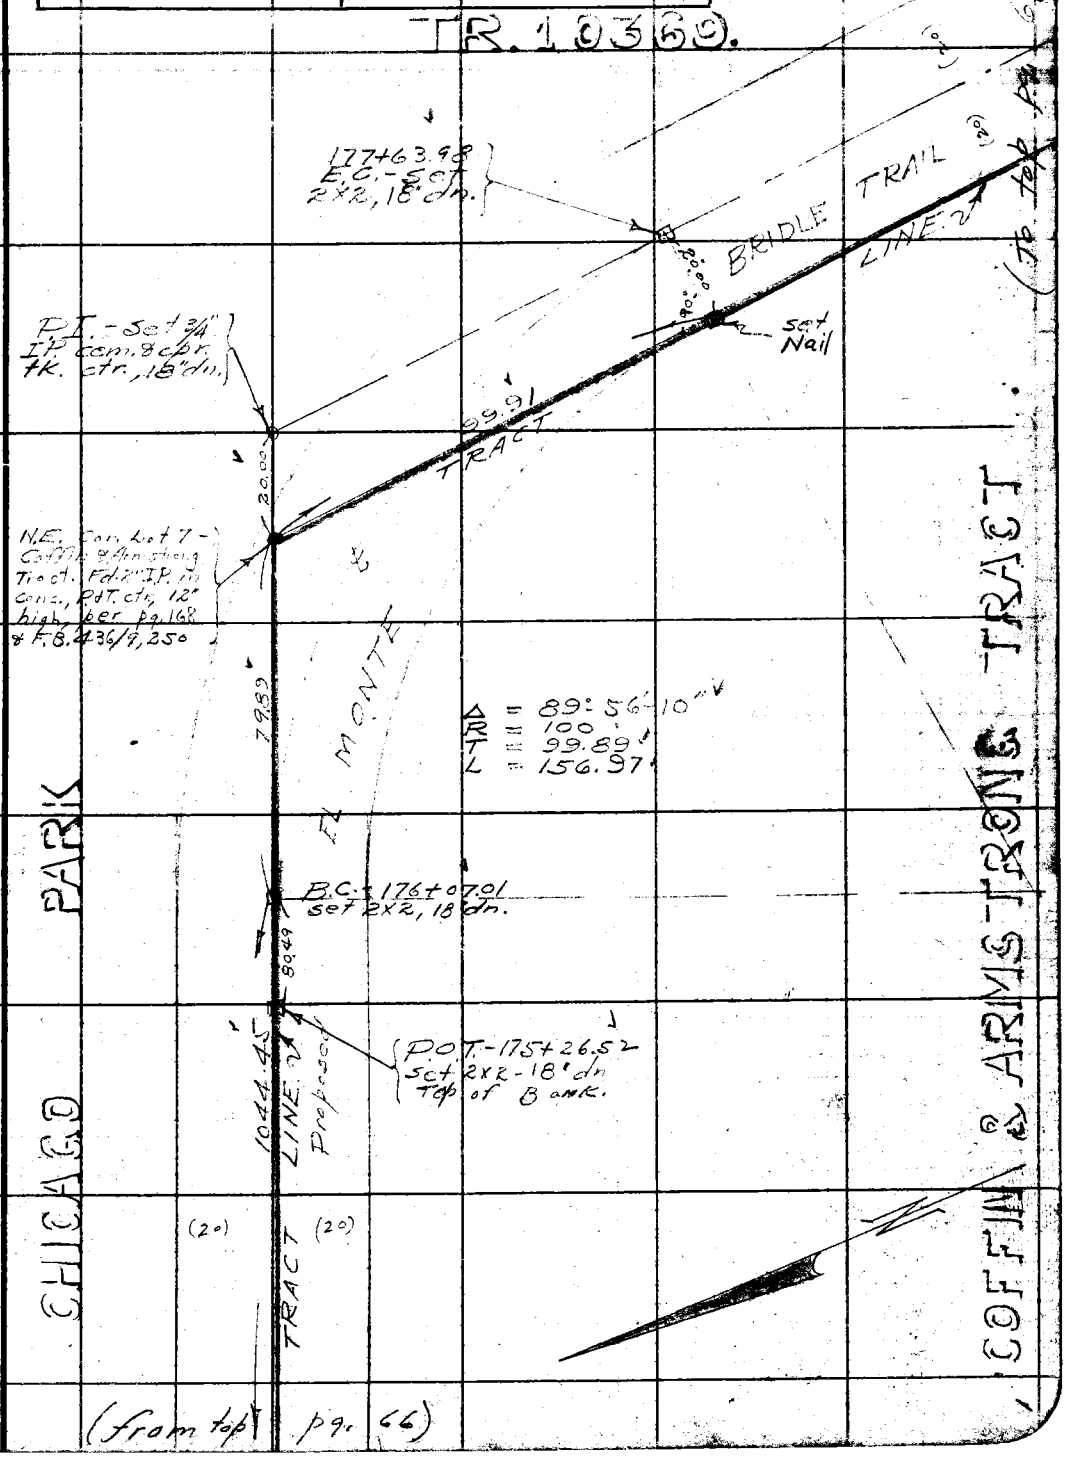

Note: ANY ADDITIONS OR CHANGES ON THIS SHEET MUST BE MADE OR CIRCLED IN Red Ink WITH DATE AND NAME OF PERSON MAKING CHANGE.

Do not extend notes this side of this line

RETURN TO
LOS ANGELES COUNTY SURVEYOR
700 HALL OF RECORDS

FORM 247 5M 2-34

RETURN TO
LOS ANGELES COUNTY SURVEYOR
700 HALL OF RECORDS

46, B-4

Note: ANY ADDITIONS OR CHANGES ON THIS SHEET MUST BE MADE OR CIRCLED IN **Red Ink** WITH DATE AND NAME OF PERSON MAKING CHANGE.

Do not extend notes this side of this line

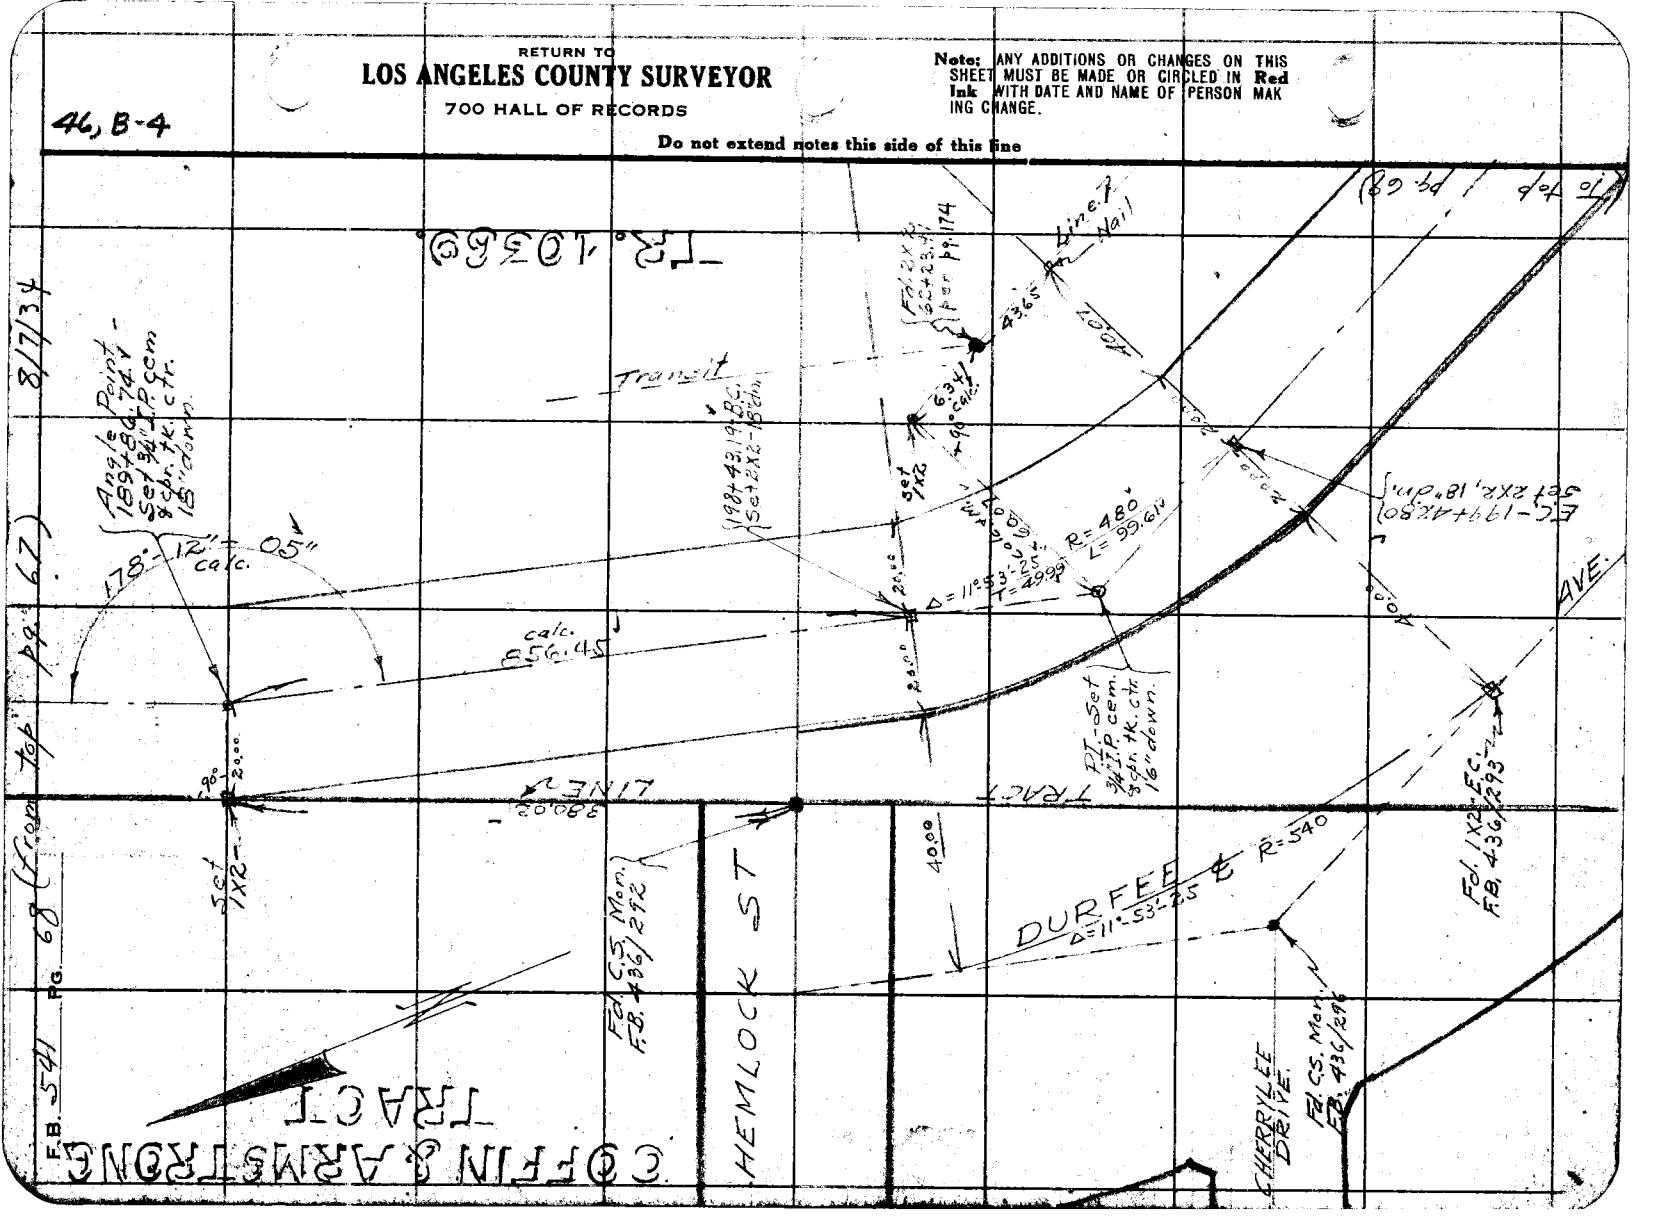

Notes Ck'd by D. M. Finley	Survey of El Monte Bridle Trail	F.B. 541	Pg. 69
Map No. B-1005-5	W. O. 8012 Tape No [illegible] St'd 84 of.		
Office Work C. W. Cox	Surveyed by Evans		
Checked	Notes [illegible] Date 8/8/34		
Date	Indexed A. C. Johnson		

46, B-4

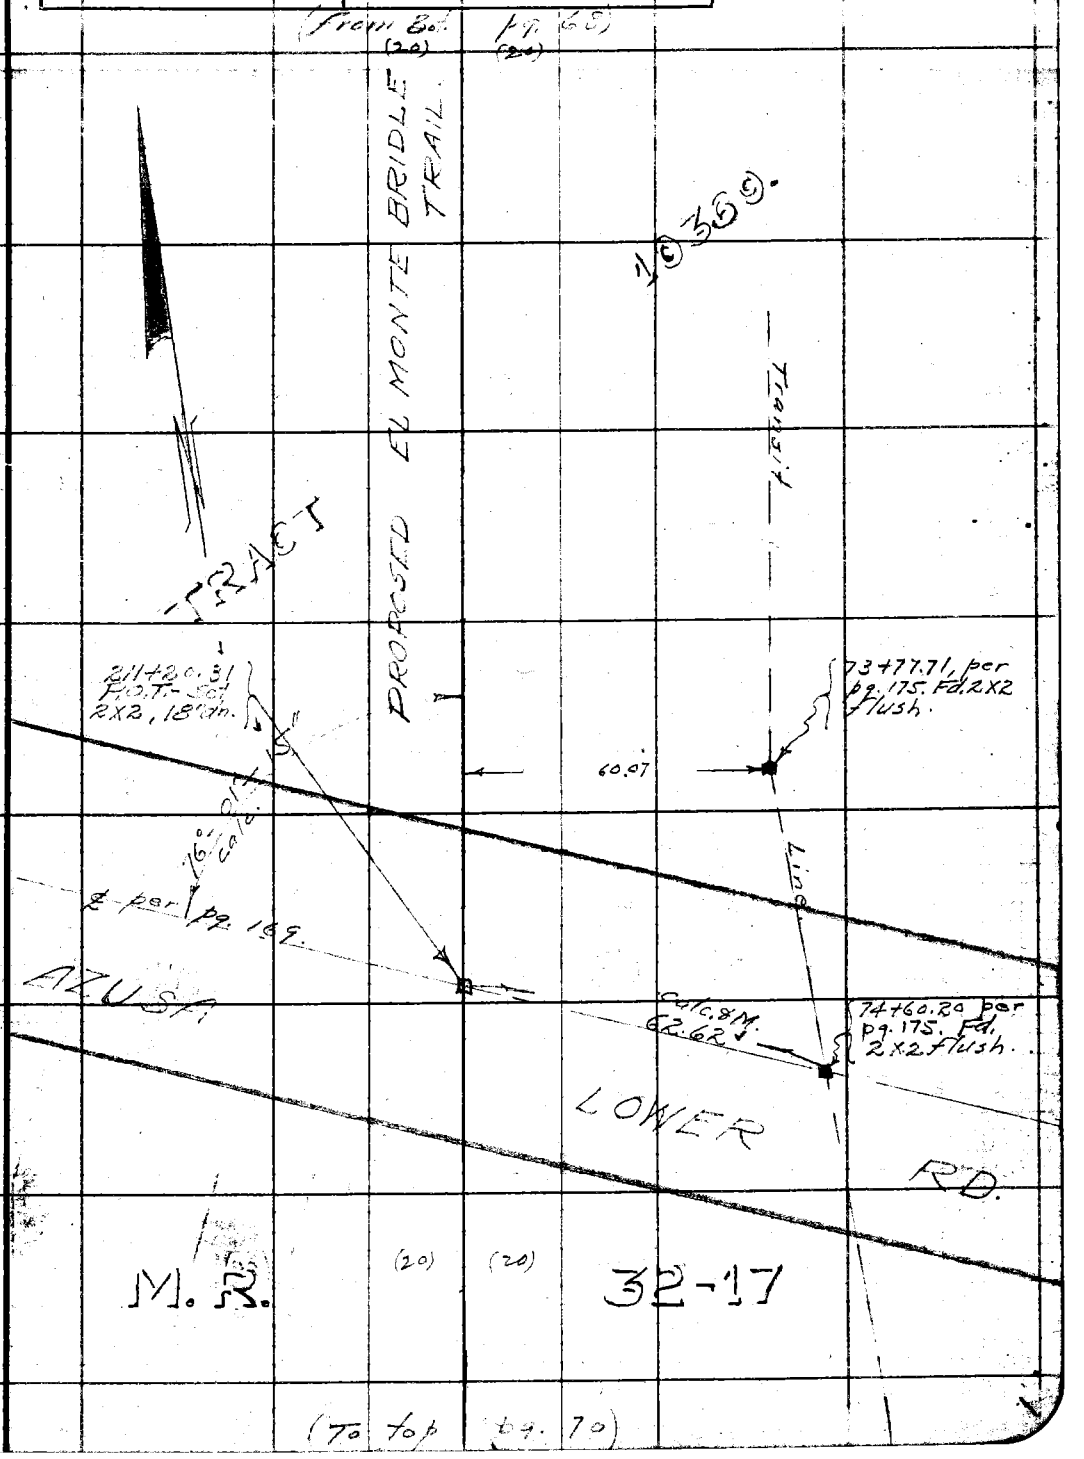

Note: ANY ADDITIONS OR CHANGES ON THIS SHEET MUST BE MADE OR CIRCLED IN Red Ink WITH DATE AND NAME OF PERSON MAKING CHANGE.

Do not extend notes this side of this line

RETURN TO
LOS ANGELES COUNTY SURVEYOR
700 HALL OF RECORDS

FORM 247 5M 2-34

F.B. 541 Pg. 70

(From Bot. pg. 69) 8/8/34

46, C-4

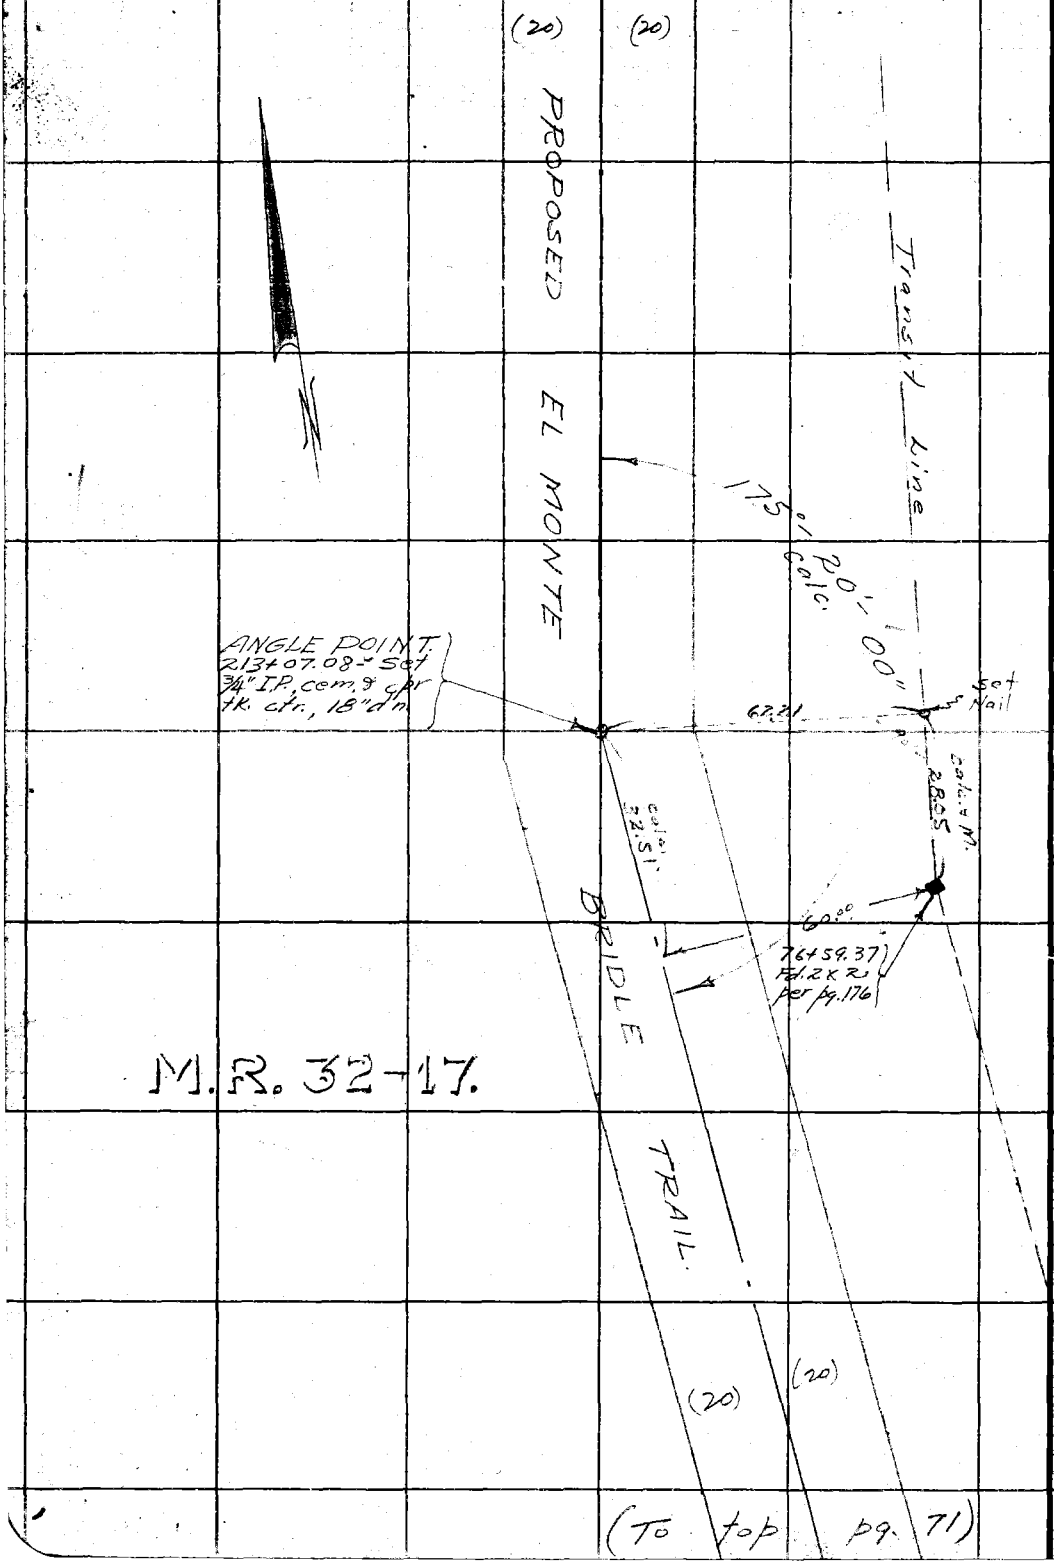

(To top pg. 71)

RETURN TO
LOS ANGELES COUNTY SURVEYOR
700 HALL OF RECORDS

Do not extend notes this side of this line

Note: ANY ADDITIONS OR CHANGES ON THIS SHEET MUST BE MADE OR CIRCLED IN **Red Ink** WITH DATE AND NAME OF PERSON MAKING CHANGE.

Notes Ck'd by D. M. Finley	Survey of El Monte Bridle Trail	F.B. 541	Pg. 71
Map No. B-1005-5	W. O. [illegible] Tape No [illegible] St'd [illegible] OF.		
Office Work C.W. Cox	Surveyed by Evans		
Checked	Notes [illegible] Date 8/8/34		
Date	Indexed A. C. Johnson		

46, C4

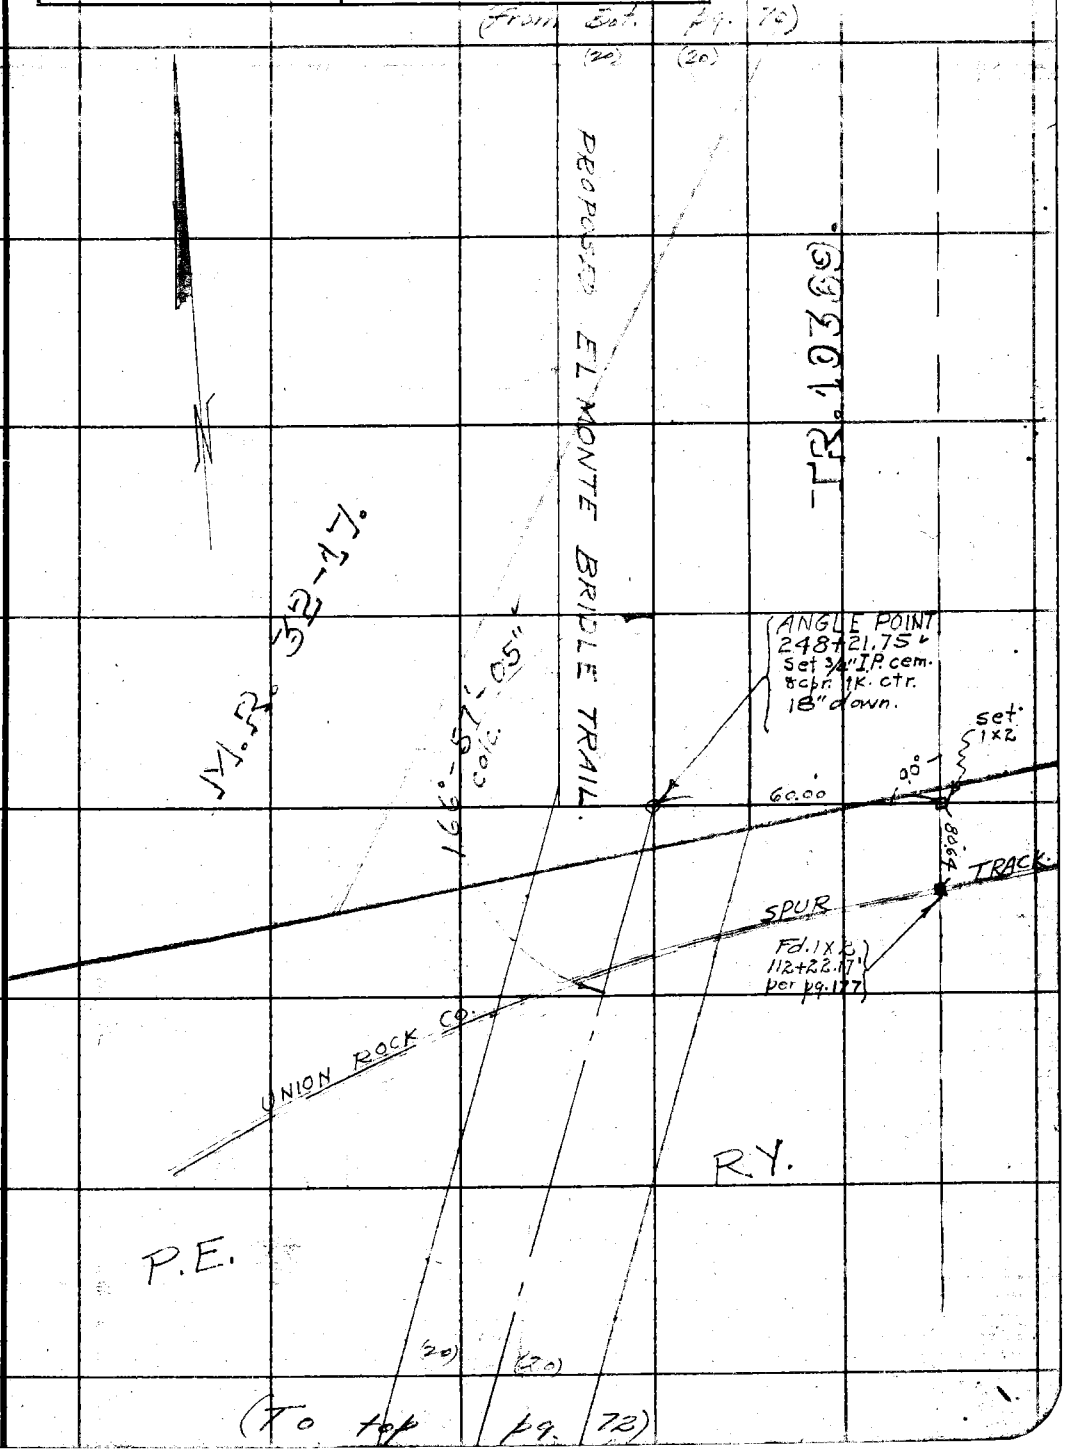

Note: ANY ADDITIONS OR CHANGES ON THIS SHEET MUST BE MADE OR CIRCLED IN Red Ink WITH DATE AND NAME OF PERSON MAKING CHANGE.

Do not extend notes this side of this line

RETURN TO
LOS ANGELES COUNTY SURVEYOR
700 HALL OF RECORDS

FORM 247 5M 2-34

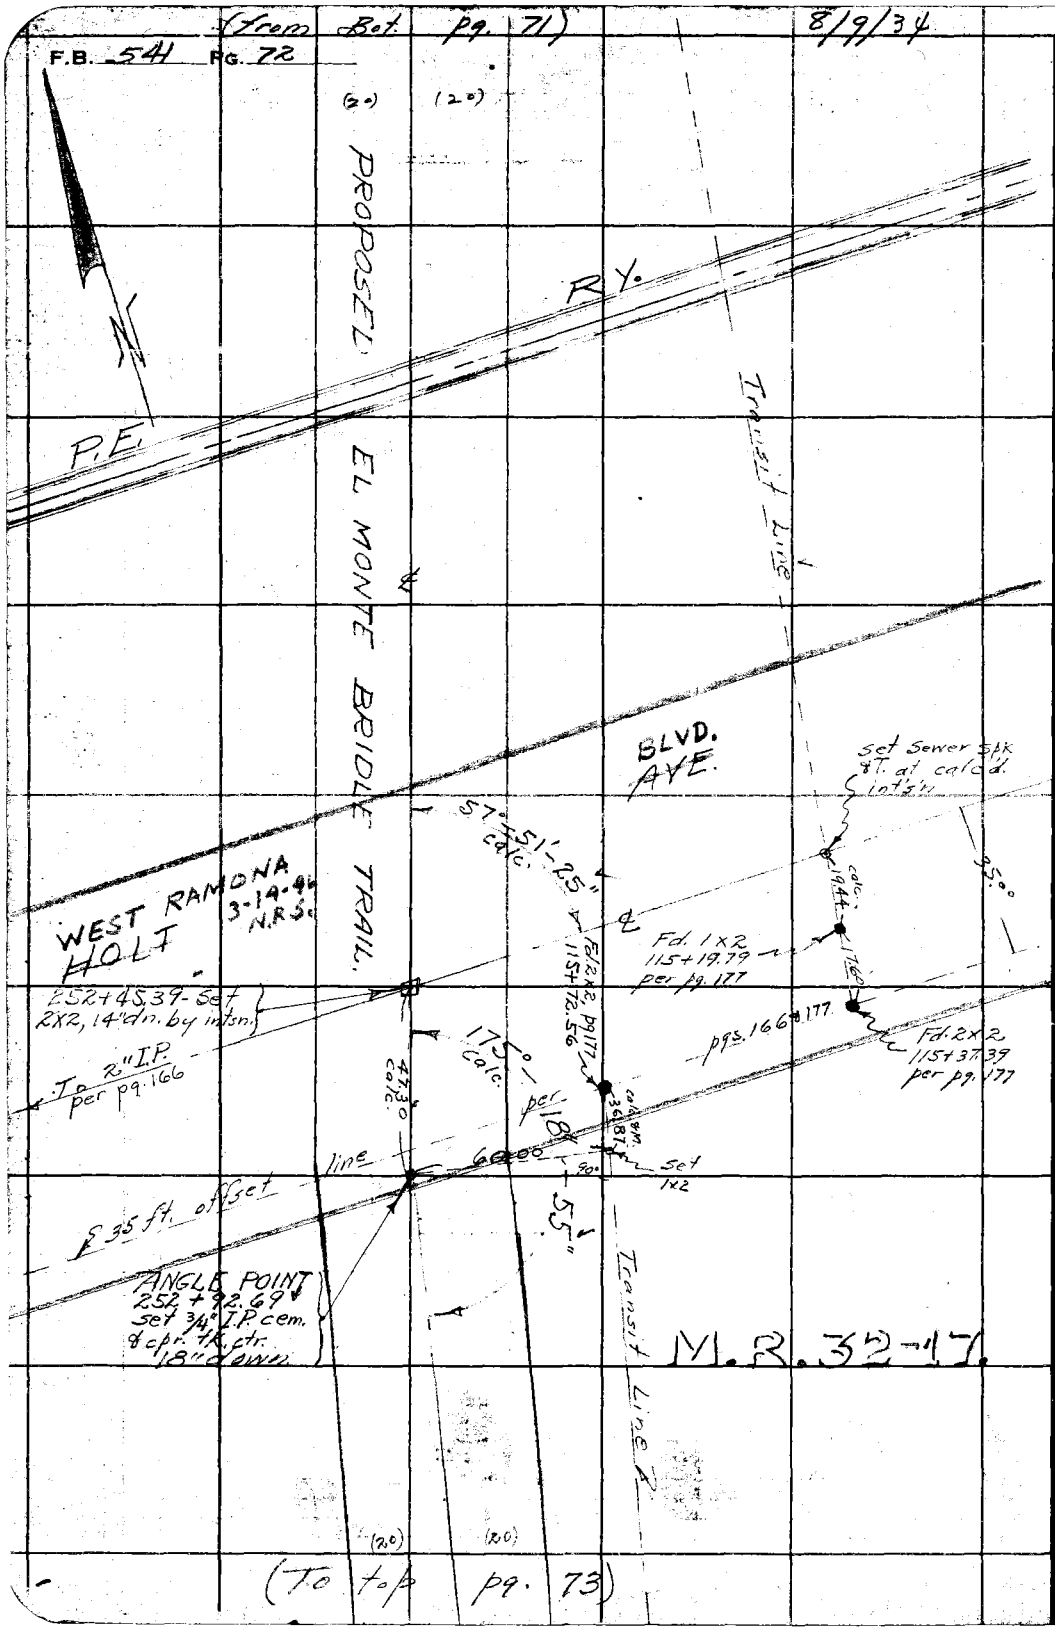

RETURN TO
LOS ANGELES COUNTY SURVEYOR
700 HALL OF RECORDS
Do not extend notes this side of this line

Note: ANY ADDITIONS OR CHANGES ON THIS SHEET MUST BE MADE OR CIRCLED IN **Red Ink** WITH DATE AND NAME OF PERSON MAKING CHANGE.

Notes Ck'd by D. M. Finley	Survey of El Monte Bridle Trail	F.B. 541	Pg. 75
Map No. B-1005-6	W. O. 8017 Tape No 067 St'd 84 of.		
Office Work C. W. Cox	Surveyed by Evans		
Checked	Notes	Date 8/9/34	
Date	Indexed A. C. Johnson		

WS.46-B-5

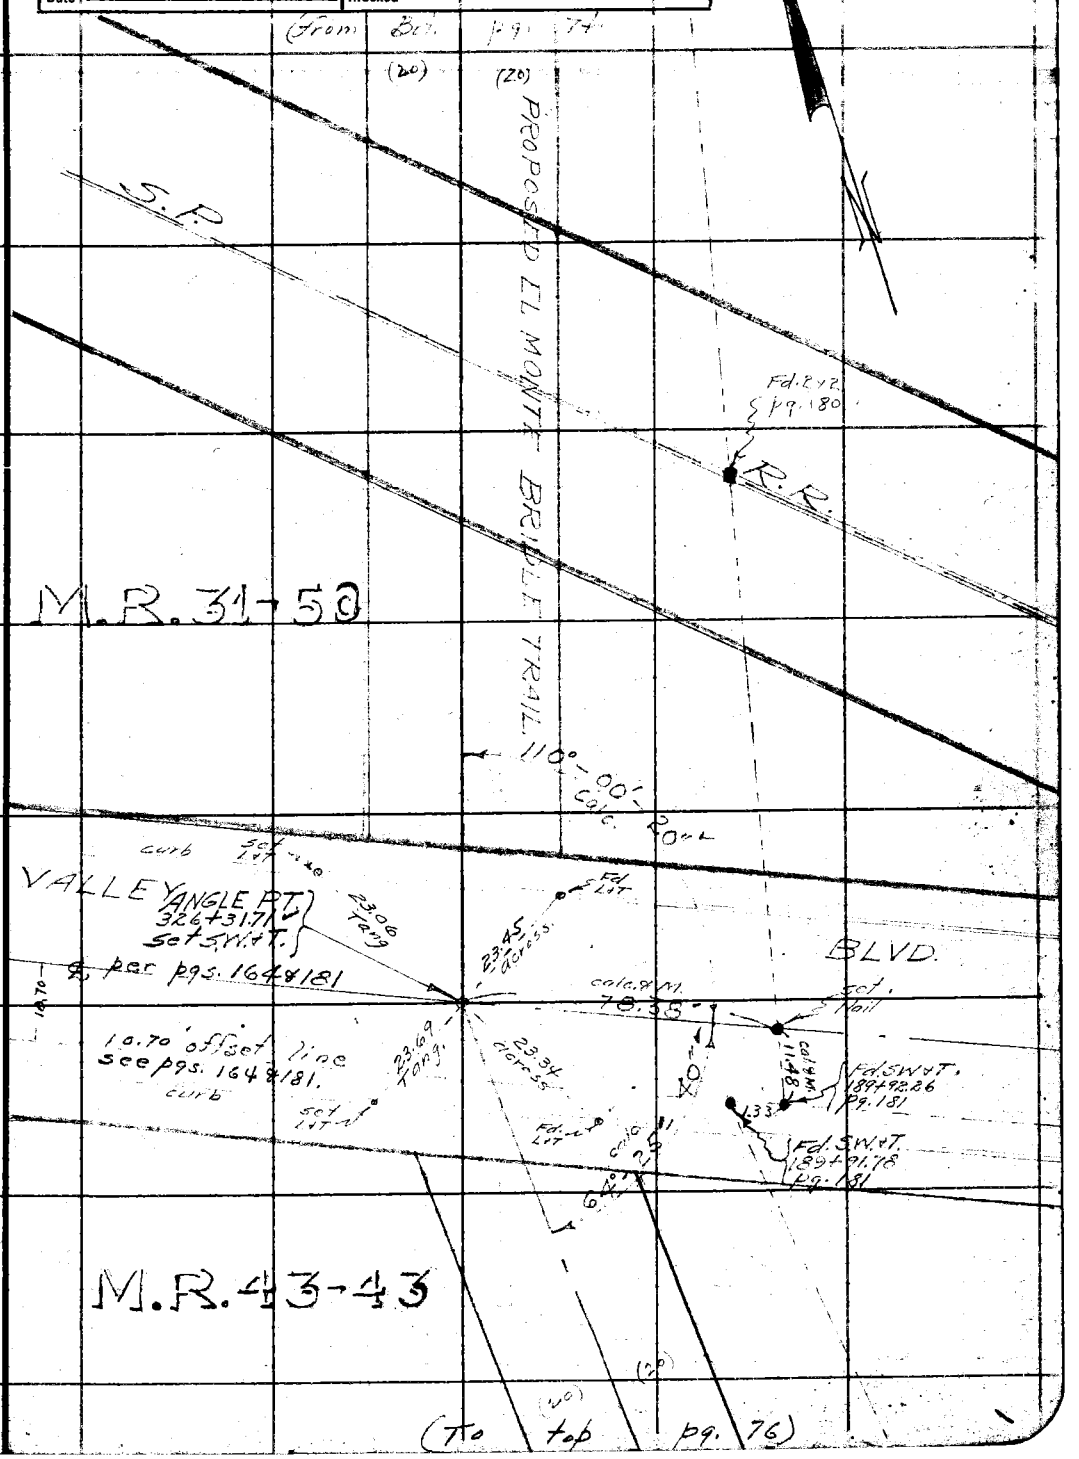

Note: ANY ADDITIONS OR CHANGES ON THIS SHEET MUST BE MADE OR CIRCLED IN Red Ink WITH DATE AND NAME OF PERSON MAKING CHANGE.

Do not extend notes this side of this line

RETURN TO
LOS ANGELES COUNTY SURVEYOR
700 HALL OF RECORDS

FORM 247 BM 2-34

RETURN TO
LOS ANGELES COUNTY SURVEYOR
700 HALL OF RECORDS

Note: ANY ADDITIONS OR CHANGES ON THIS SHEET MUST BE MADE OR CIRCLED IN **Red Ink** WITH DATE AND NAME OF PERSON MAKING CHANGE.

WS 37-D-1

Do not extend notes this side of this line

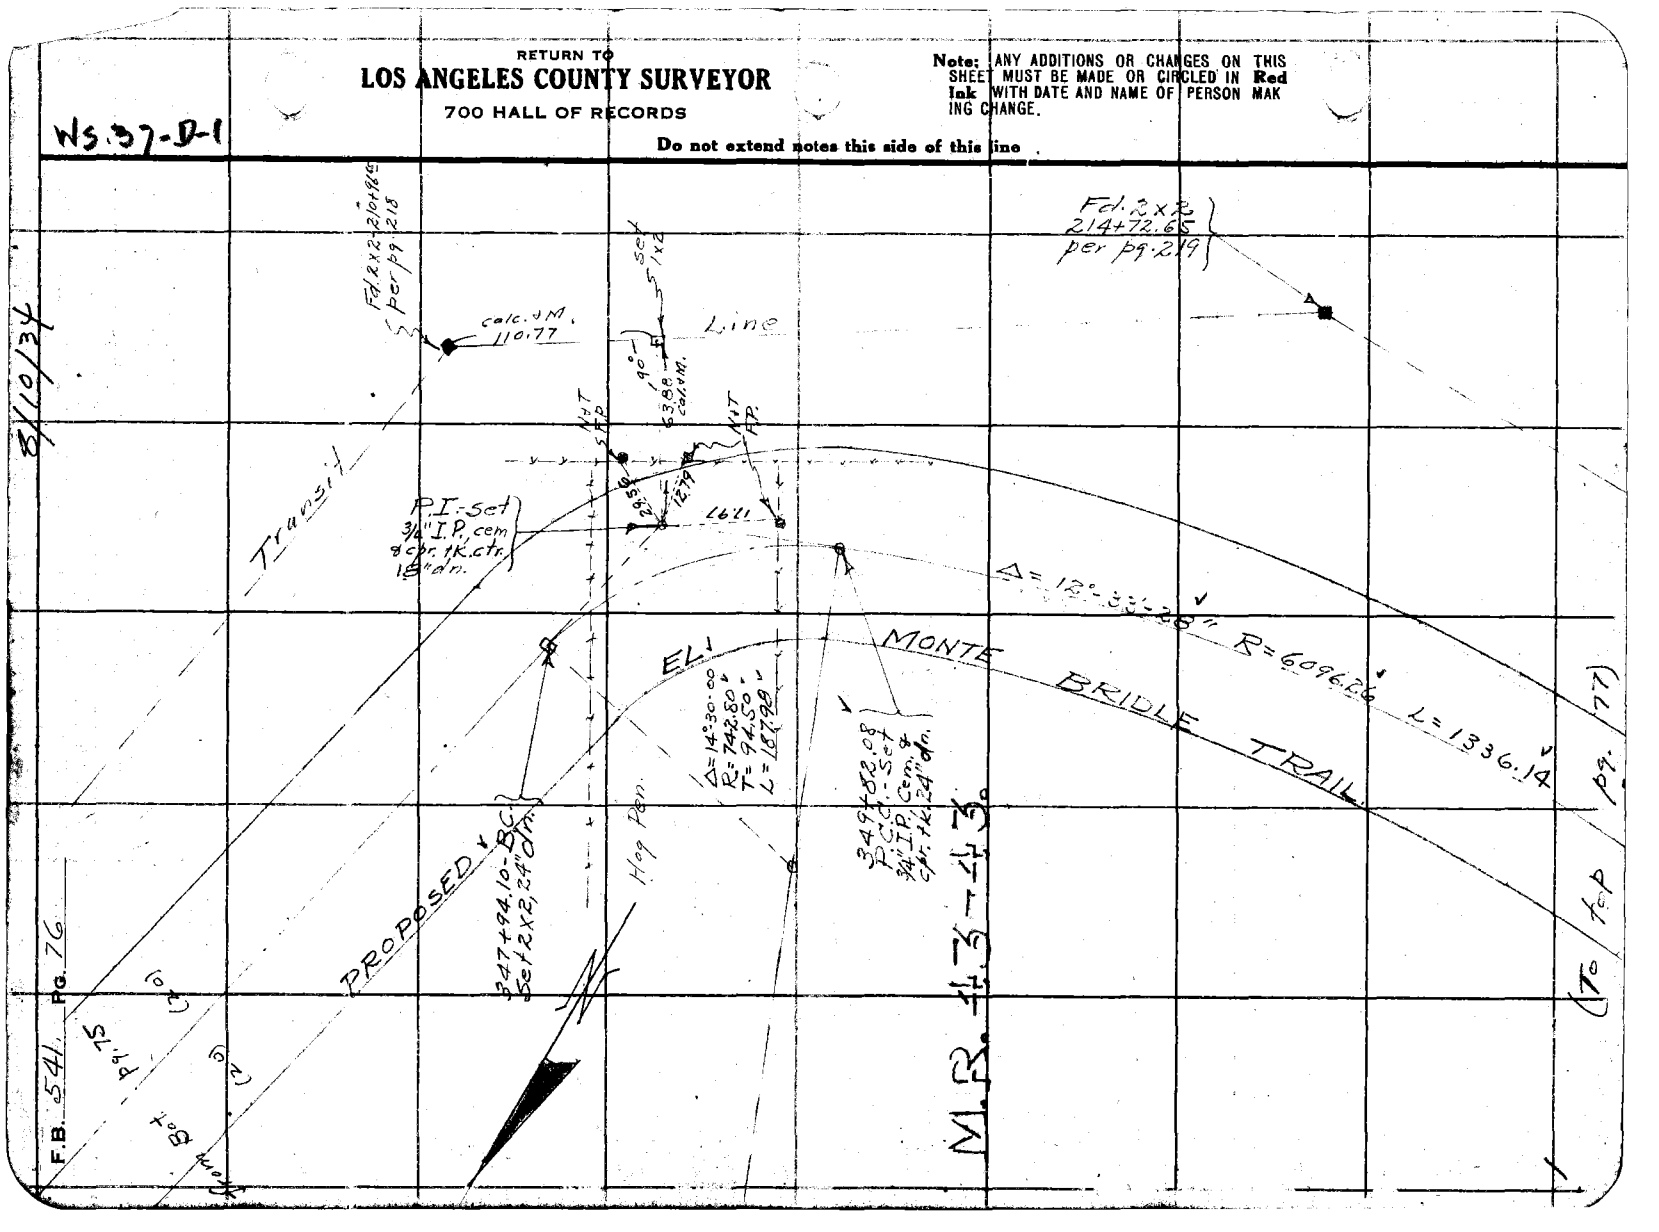

Notes Ck'd by D. M. Finley	Survey of El Monte Bridle Trail	F.B. 241 Pg. 77
Map No. B-1005-6	W. O. 80[illegible] Tape No [illegible] St'd [illegible] of.	
Office Work C.W. Cox	Surveyed by Evans	
Checked	Notes	Date 8/10/54
Date	Indexed	A. C. Johnson

W5.37.C-2

(From Dct. (20) Pg. 76)

Note: ANY ADDITIONS OR CHANGES ON THIS SHEET MUST BE MADE OR CIRCLED IN Red Ink WITH DATE AND NAME OF PERSON MAKING CHANGE.

Do not extend notes this side of this line

RETURN TO
LOS ANGELES COUNTY SURVEYOR
700 HALL OF RECORDS

FORM 247 BM 2-34

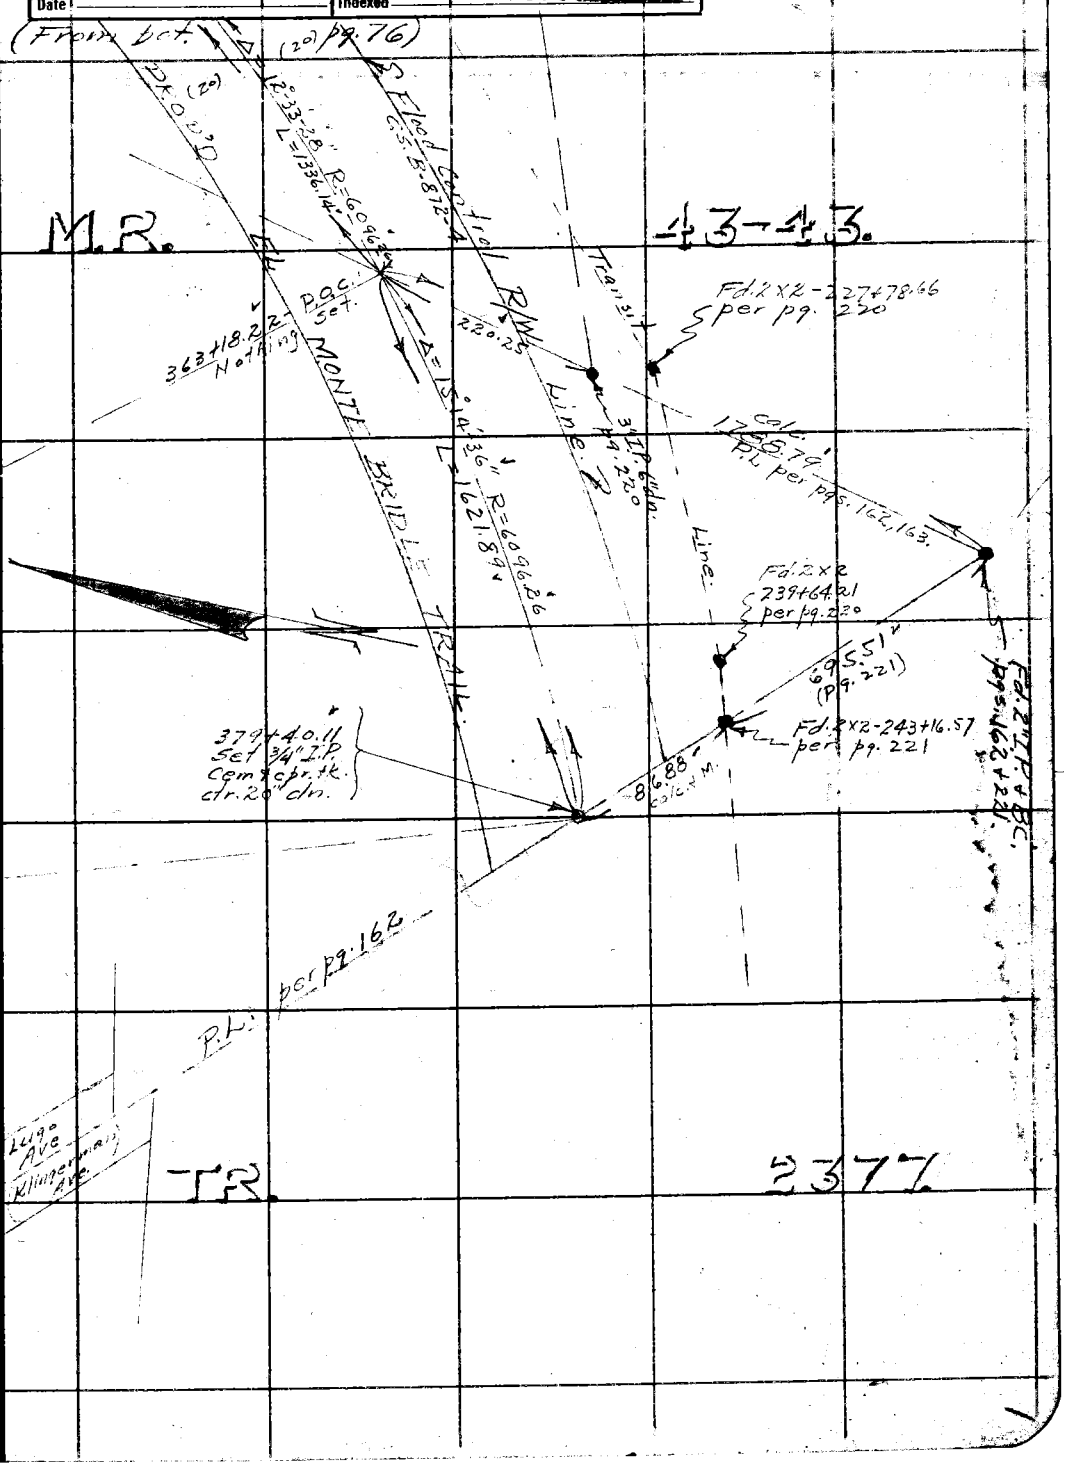

RETURN TO

LOS ANGELES COUNTY SURVEYOR

700 HALL OF RECORDS

Note: ANY ADDITIONS OR CHANGES ON THIS SHEET MUST BE MADE OR CIRCLED IN **Red Ink** WITH DATE AND NAME OF PERSON MAKING CHANGE.

Do not extend notes this side of this line

F.B. 54 PG. 78

Notes Ck'd by D. M. Finley	Survey of	F.B. 541 Pg. 79	
Map No. B-1005-2	W. O. Tape No St'd of.	IMPVTS. ON DIV. 1-SIPHON RD. to VALLEY BLVD.	
Office Work C. W. Cox	Surveyed by		
Checked	Notes Date 11-16-34		
Date	Indexed A. C. Johnson 2-1-35		

Cont at bot. pg 80

Note: ANY ADDITIONS OR CHANGES ON THIS SHEET MUST BE MADE OR CIRCLED IN Red Ink WITH DATE AND NAME OF PERSON MAKING CHANGE.

Do not extend notes this side of this line

RETURN TO
LOS ANGELES COUNTY SURVEYOR
700 HALL OF RECORDS

FORM 247 5M 2-34

RETURN TO
LOS ANGELES COUNTY SURVEYOR
700 HALL OF RECORDS

Note: ANY ADDITIONS OR CHANGES ON THIS SHEET MUST BE MADE OR CIRCLED IN **Red Ink** WITH DATE AND NAME OF PERSON MAKING CHANGE.

Do not extend notes this side of this line

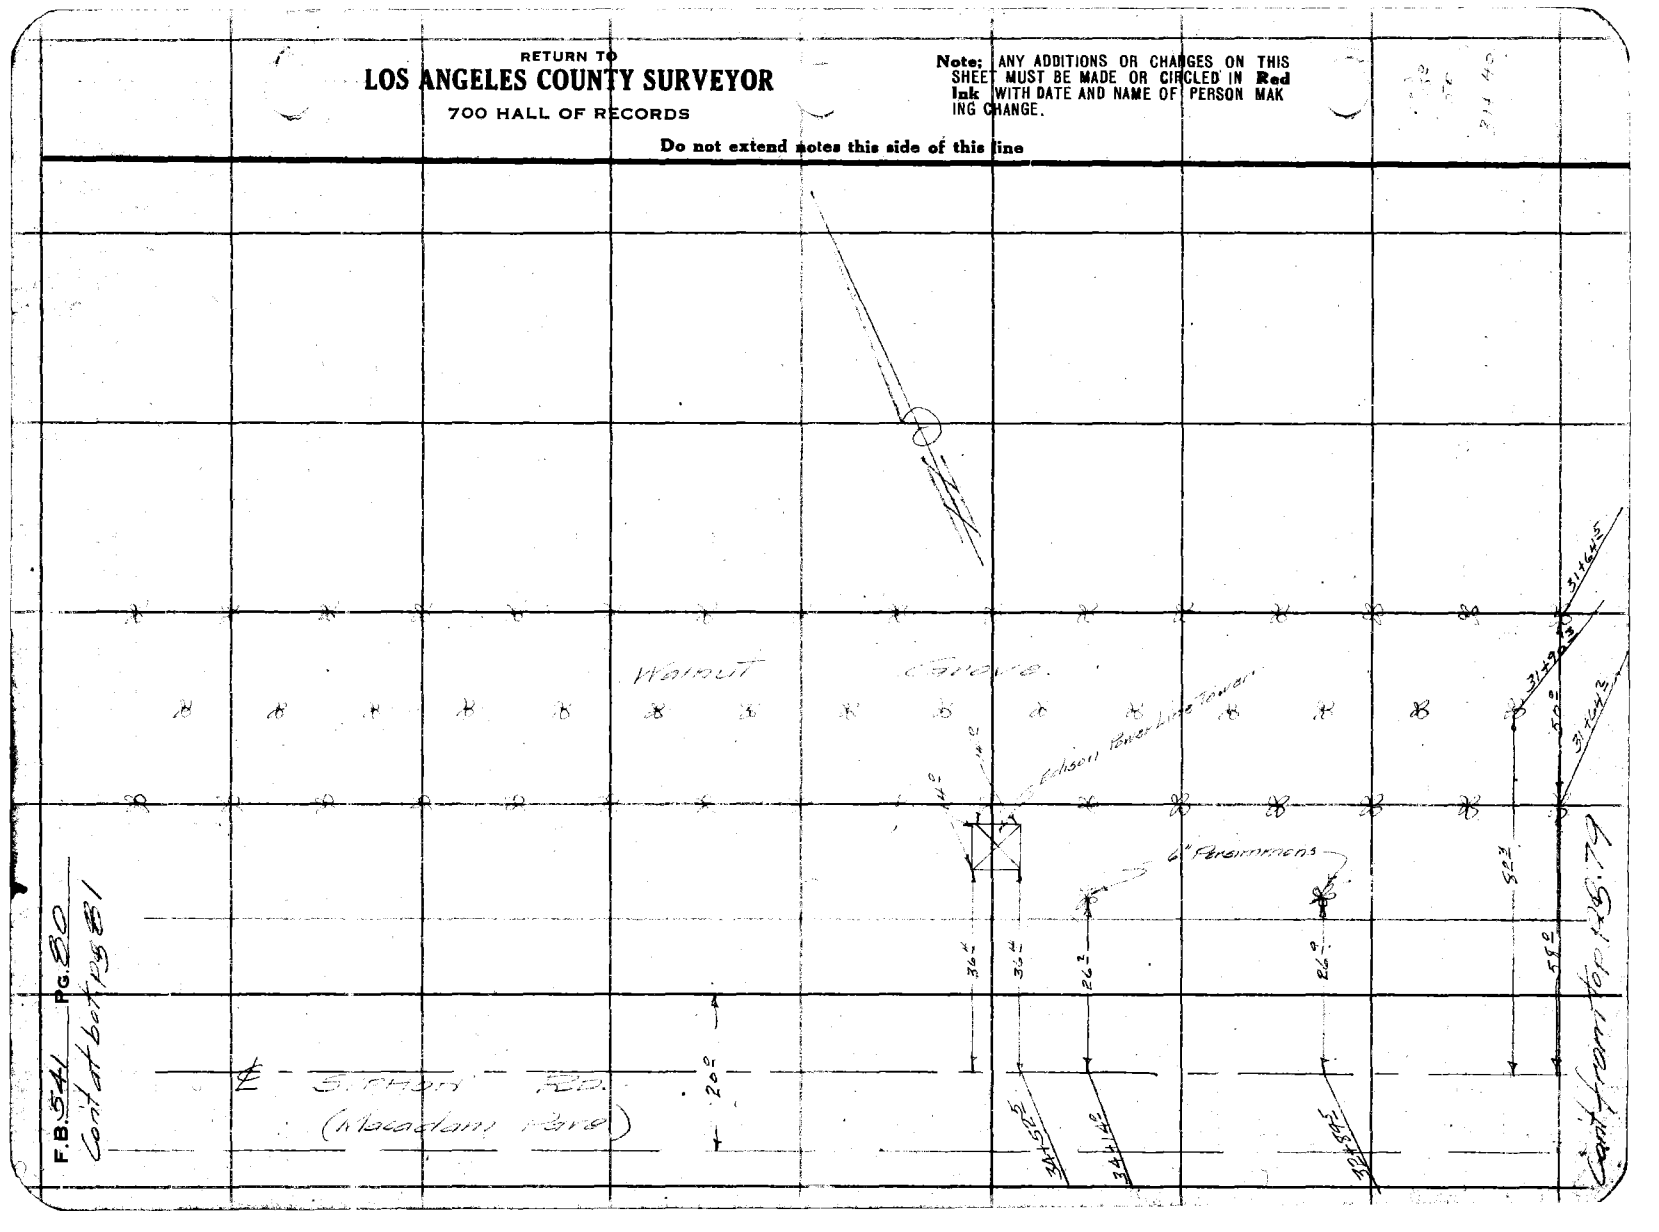

Notes Ck'd by D. M. Finley	Survey of [illegible]
Map No. B-1005-2	W. O. [illegible] Tape No ____ St'd ____ OF.
Office Work C. W. Cox	Surveyed by Evans
Checked	Notes Brock Date 11-16-34
Date	Indexed A. C. Johnson

F.B. 541 Pg. 81

Cont. of bot. pg 82

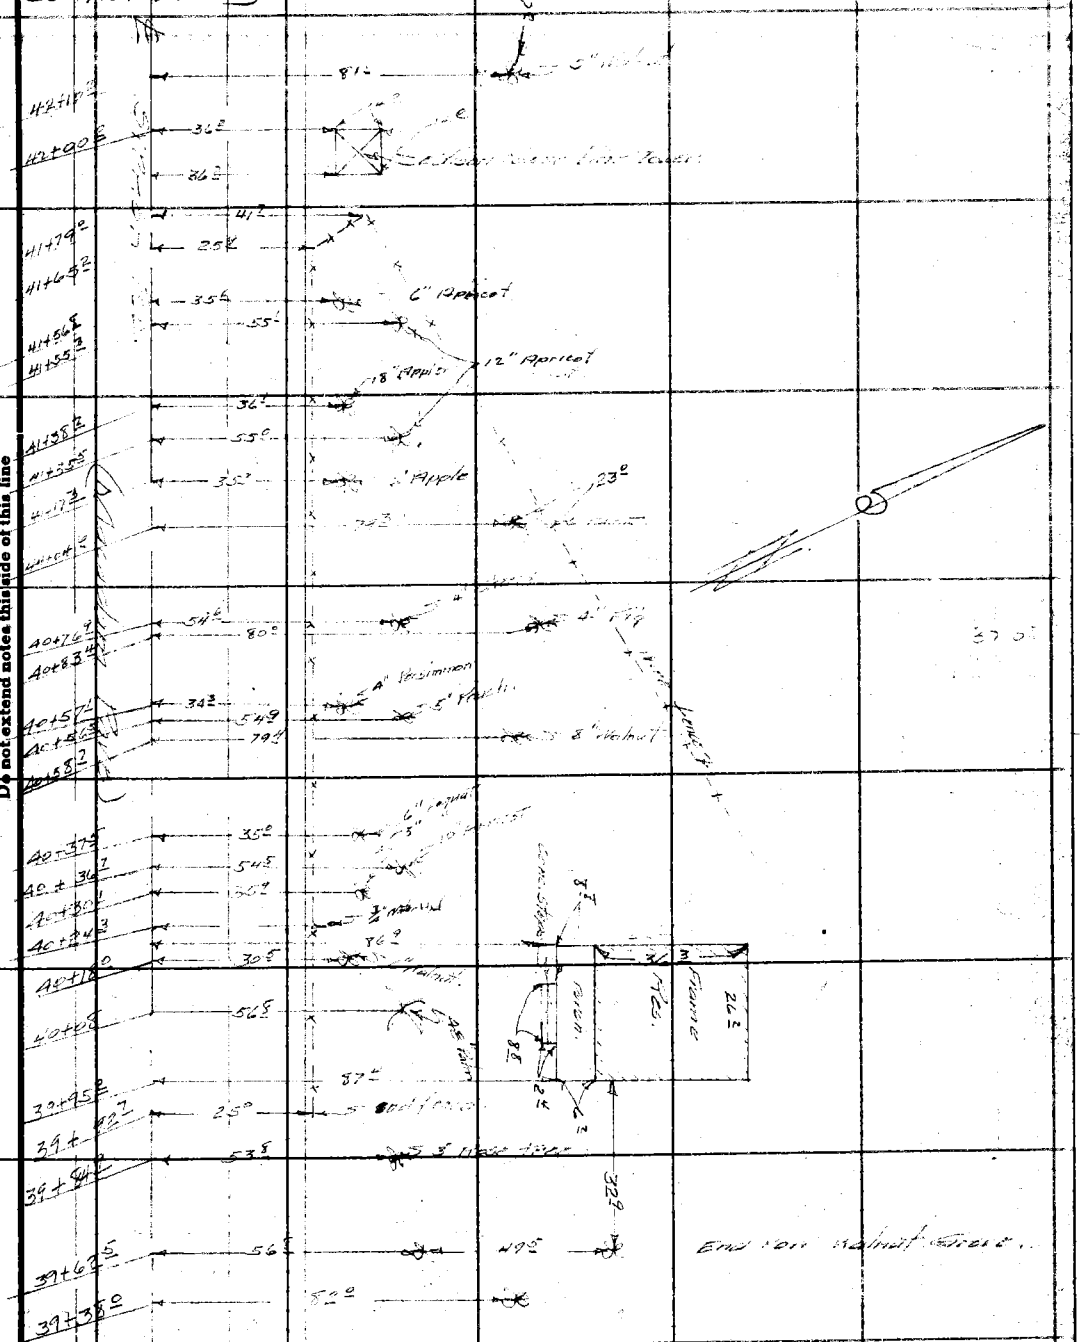

Cont from top pg 80

Note: ANY ADDITIONS OR CHANGES ON THIS SHEET MUST BE MADE OR CIRCLED IN Red Ink WITH DATE AND NAME OF PERSON MAKING CHANGE.

Do not extend notes this side of this line

RETURN TO
LOS ANGELES COUNTY SURVEYOR
700 HALL OF RECORDS

FORM 247 5M 2-34

RETURN TO
LOS ANGELES COUNTY SURVEYOR
700 HALL OF RECORDS

Note: ANY ADDITIONS OR CHANGES ON THIS SHEET MUST BE MADE OR CIRCLED IN **Red Ink** WITH DATE AND NAME OF PERSON MAKING CHANGE.

Do not extend notes this side of this line

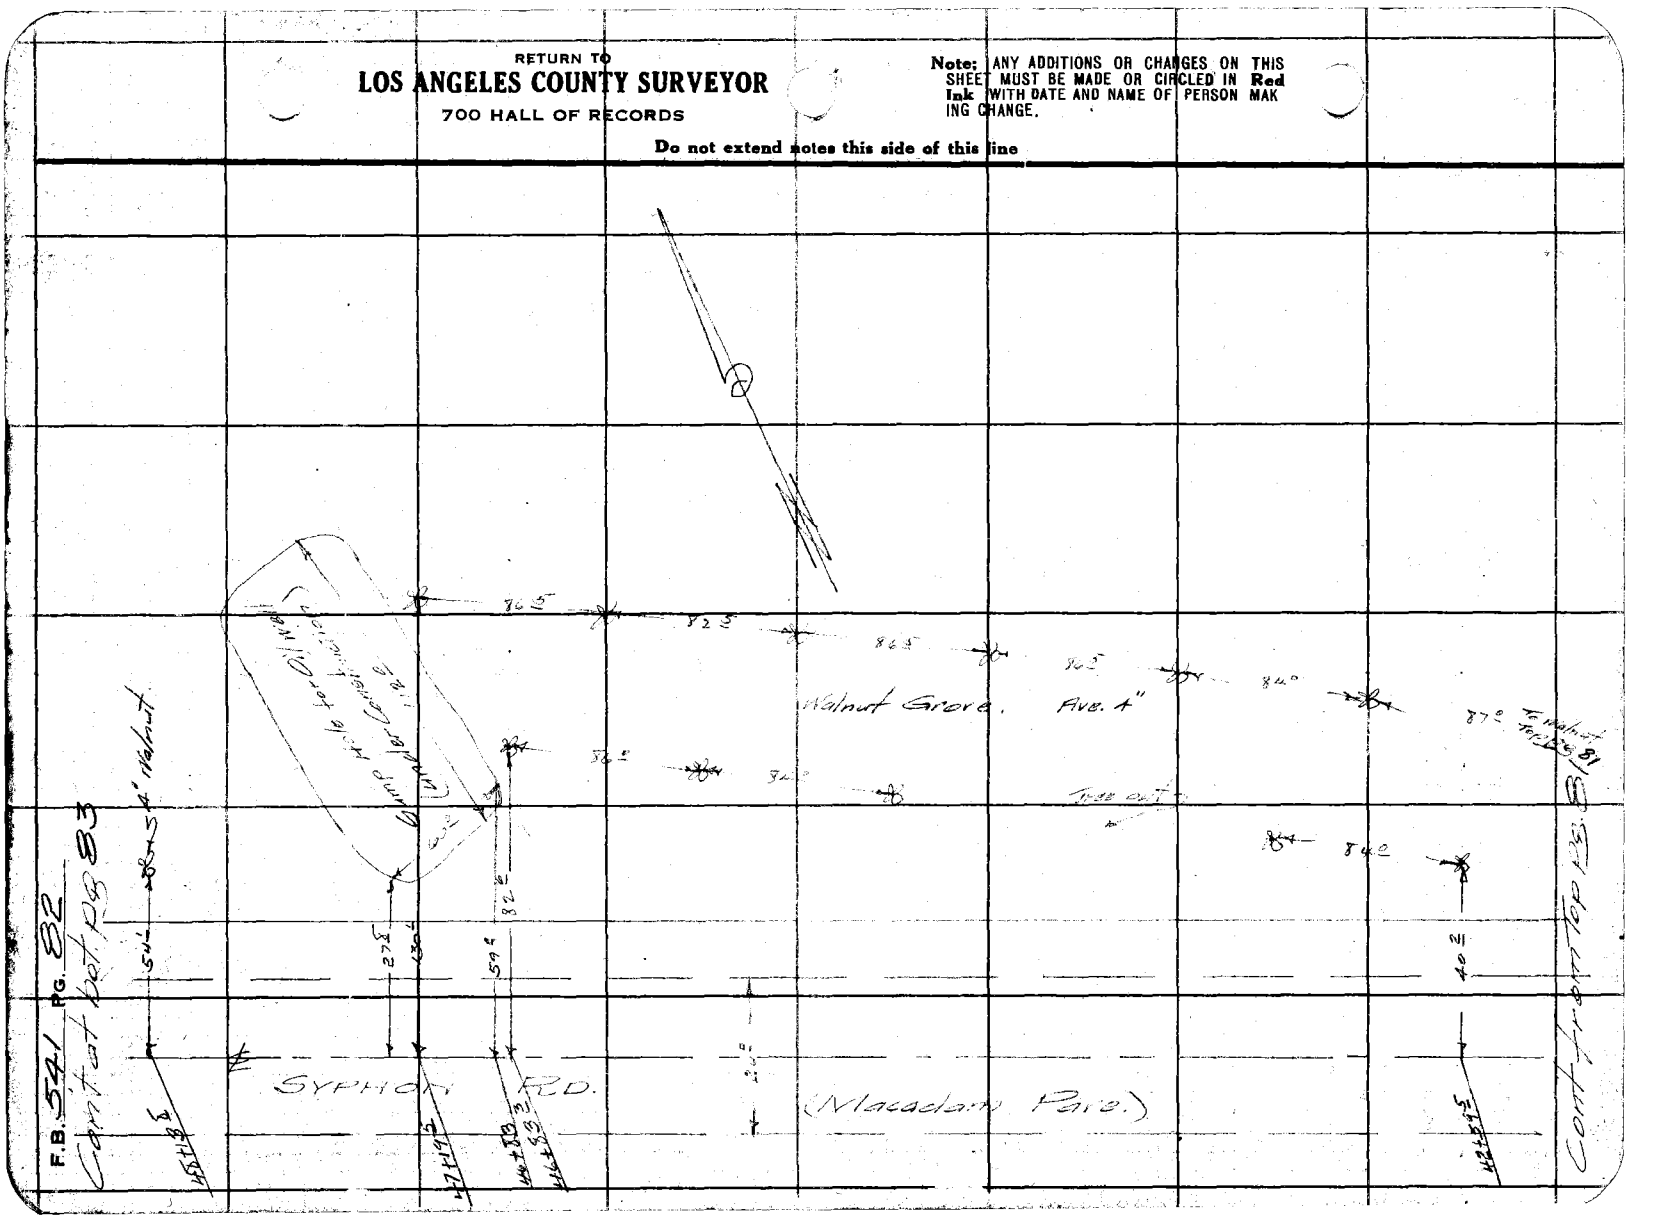

Notes Ck'd by D. M. Finley	Survey of [illegible]	F.B. 541	Pg. 83
Map No. B-1005-2	W. O. ____ Tape No ____ St'd ____ °F.		
Office Work C.W. Cox	Surveyed by [illegible]		
Checked	Notes [illegible] Date 11-16-34		
Date	Indexed A. C. Johnson		

Cont. at bot. pg 84

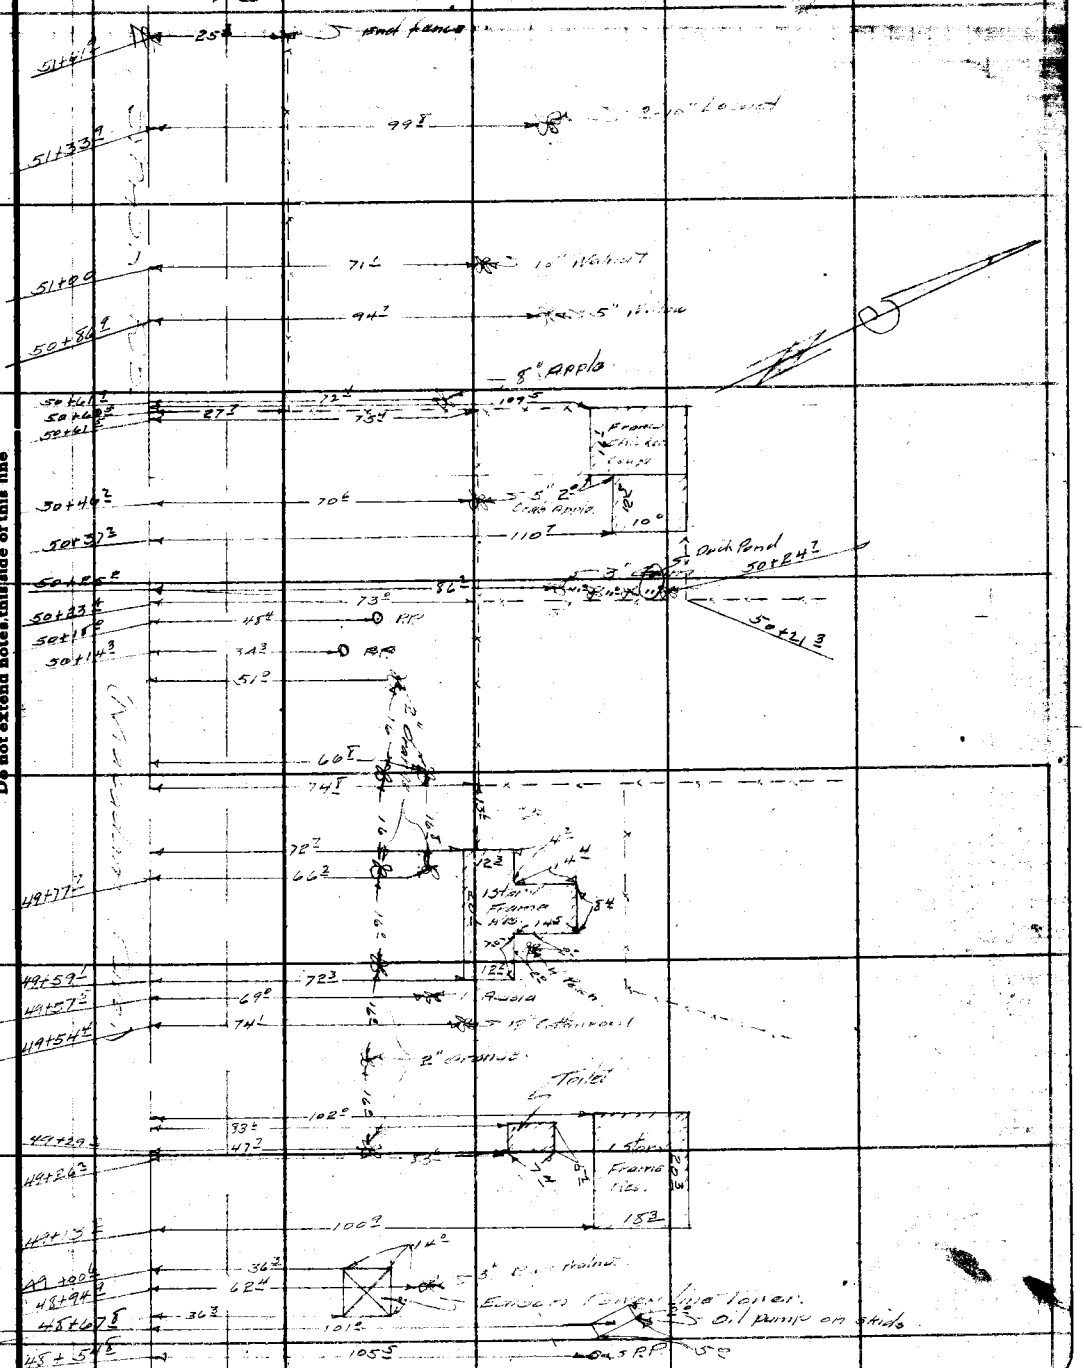

Cont. from Top Pg 82

Note: ANY ADDITIONS OR CHANGES ON THIS SHEET MUST BE MADE OR CIRCLED IN Red Ink WITH DATE AND NAME OF PERSON MAKING CHANGE.

Do not extend notes this side of this line

RETURN TO
LOS ANGELES COUNTY SURVEYOR
700 HALL OF RECORDS

FORM 247 5M 2-34

F.B. 541 PG. 84

Cont of bot. PG 85

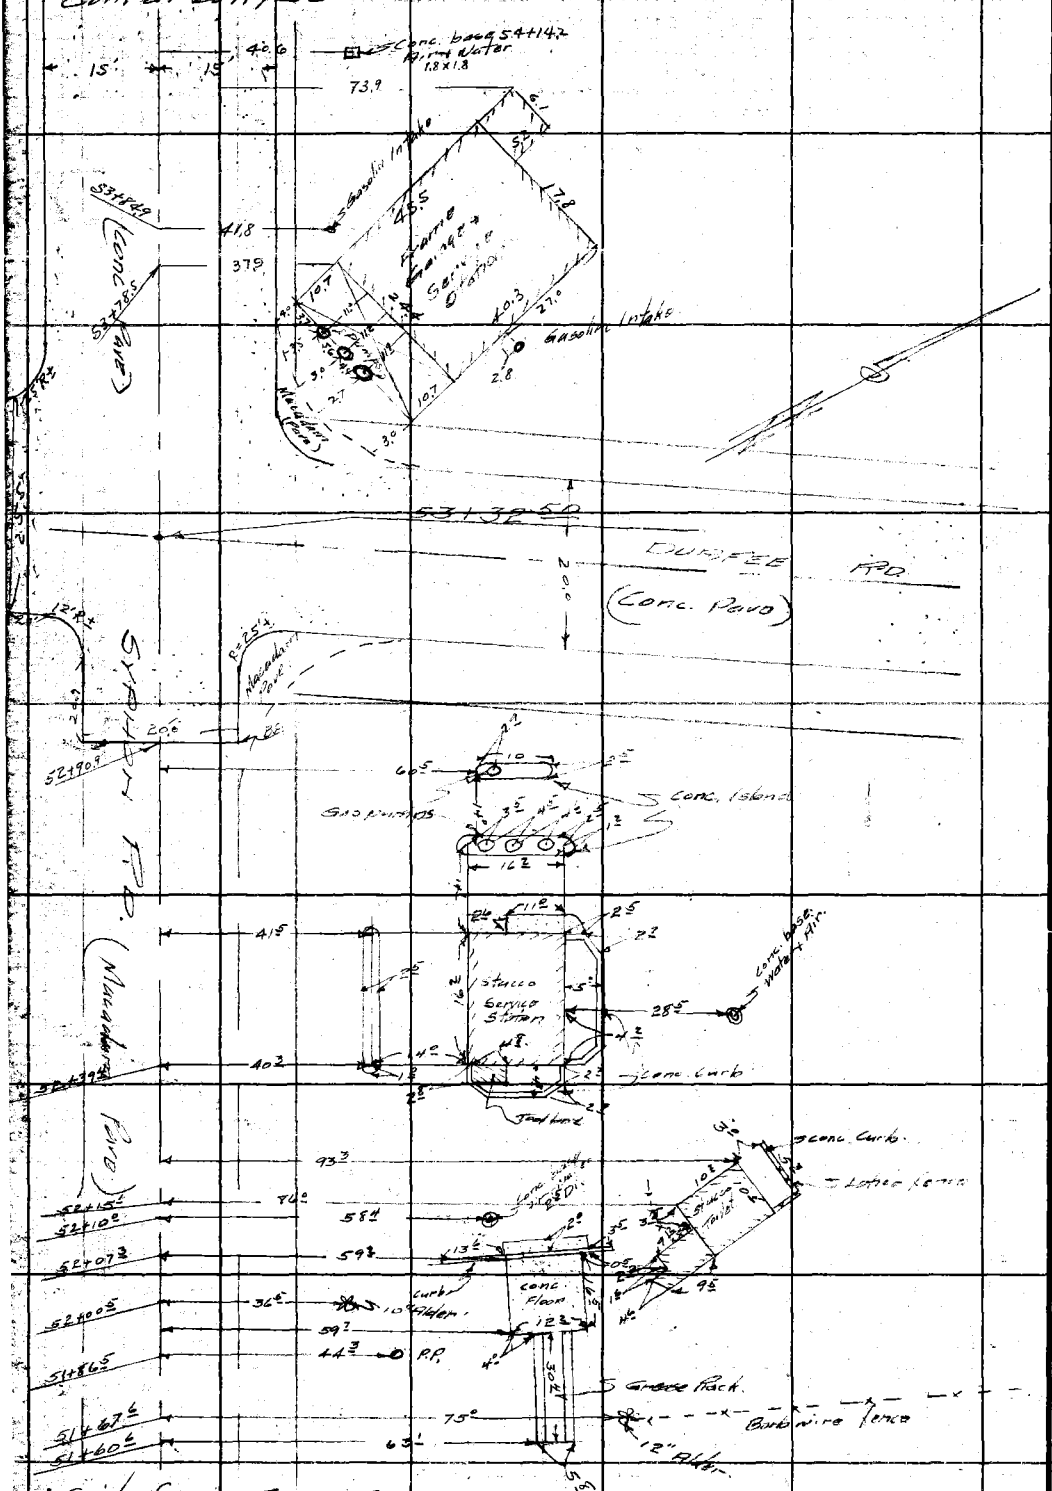

RETURN TO
LOS ANGELES COUNTY SURVEYOR
700 HALL OF RECORDS

Note: ANY ADDITIONS OR CHANGES ON THIS SHEET MUST BE MADE OR CIRCLED IN Red Ink WITH DATE AND NAME OF PERSON MAKING CHANGE.

Do not extend notes this side of this line

Notes	Ck'd by D. M. Finley	Survey of Elysian Park	F.B. 541 Pg. 85
Map	No. B-1005-2	W. O.	Tape No St'd °F.
Office Work	C. W. Cox.	Surveyed by	
Checked		Notes	Date 12-7-34
Date		Indexed A. C. Johnson	

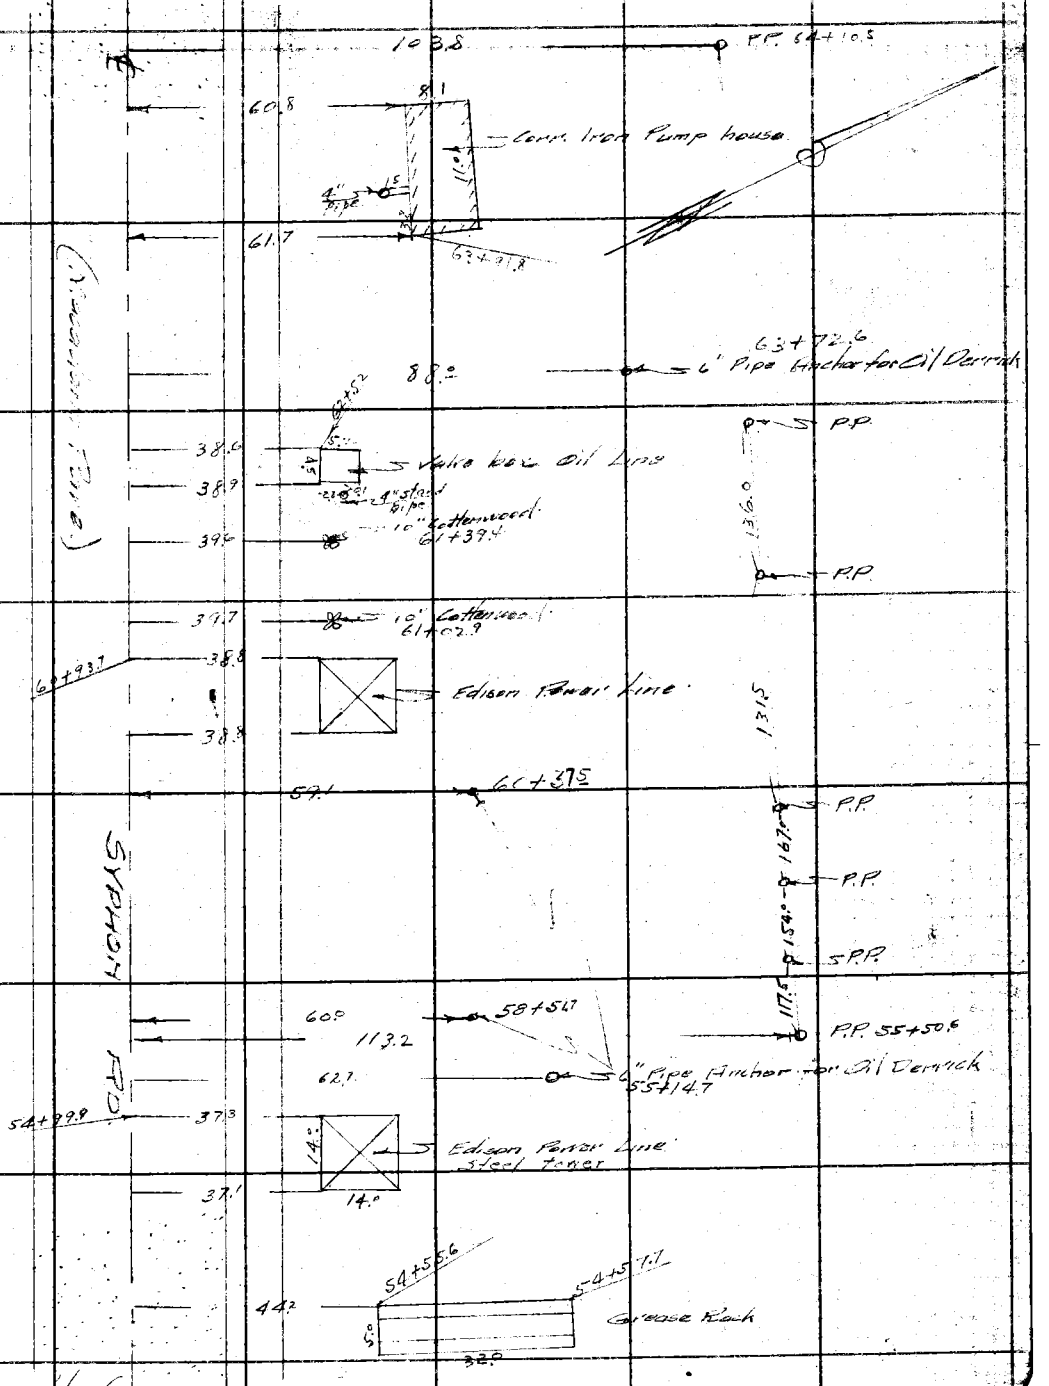

Note: ANY ADDITIONS OR CHANGES ON THIS SHEET MUST BE MADE OR CIRCLED IN Red Ink WITH DATE AND NAME OF PERSON MAKING CHANGE.

Do not extend notes this side of this line

RETURN TO
LOS ANGELES COUNTY SURVEYOR
700 HALL OF RECORDS

FORM 247 BM 2-34

RETURN TO
LOS ANGELES COUNTY SURVEYOR
700 HALL OF RECORDS

Note: ANY ADDITIONS OR CHANGES ON THIS SHEET MUST BE MADE OR CIRCLED IN **Red Ink** WITH DATE AND NAME OF PERSON MAKING CHANGE.

Do not extend notes this side of this line

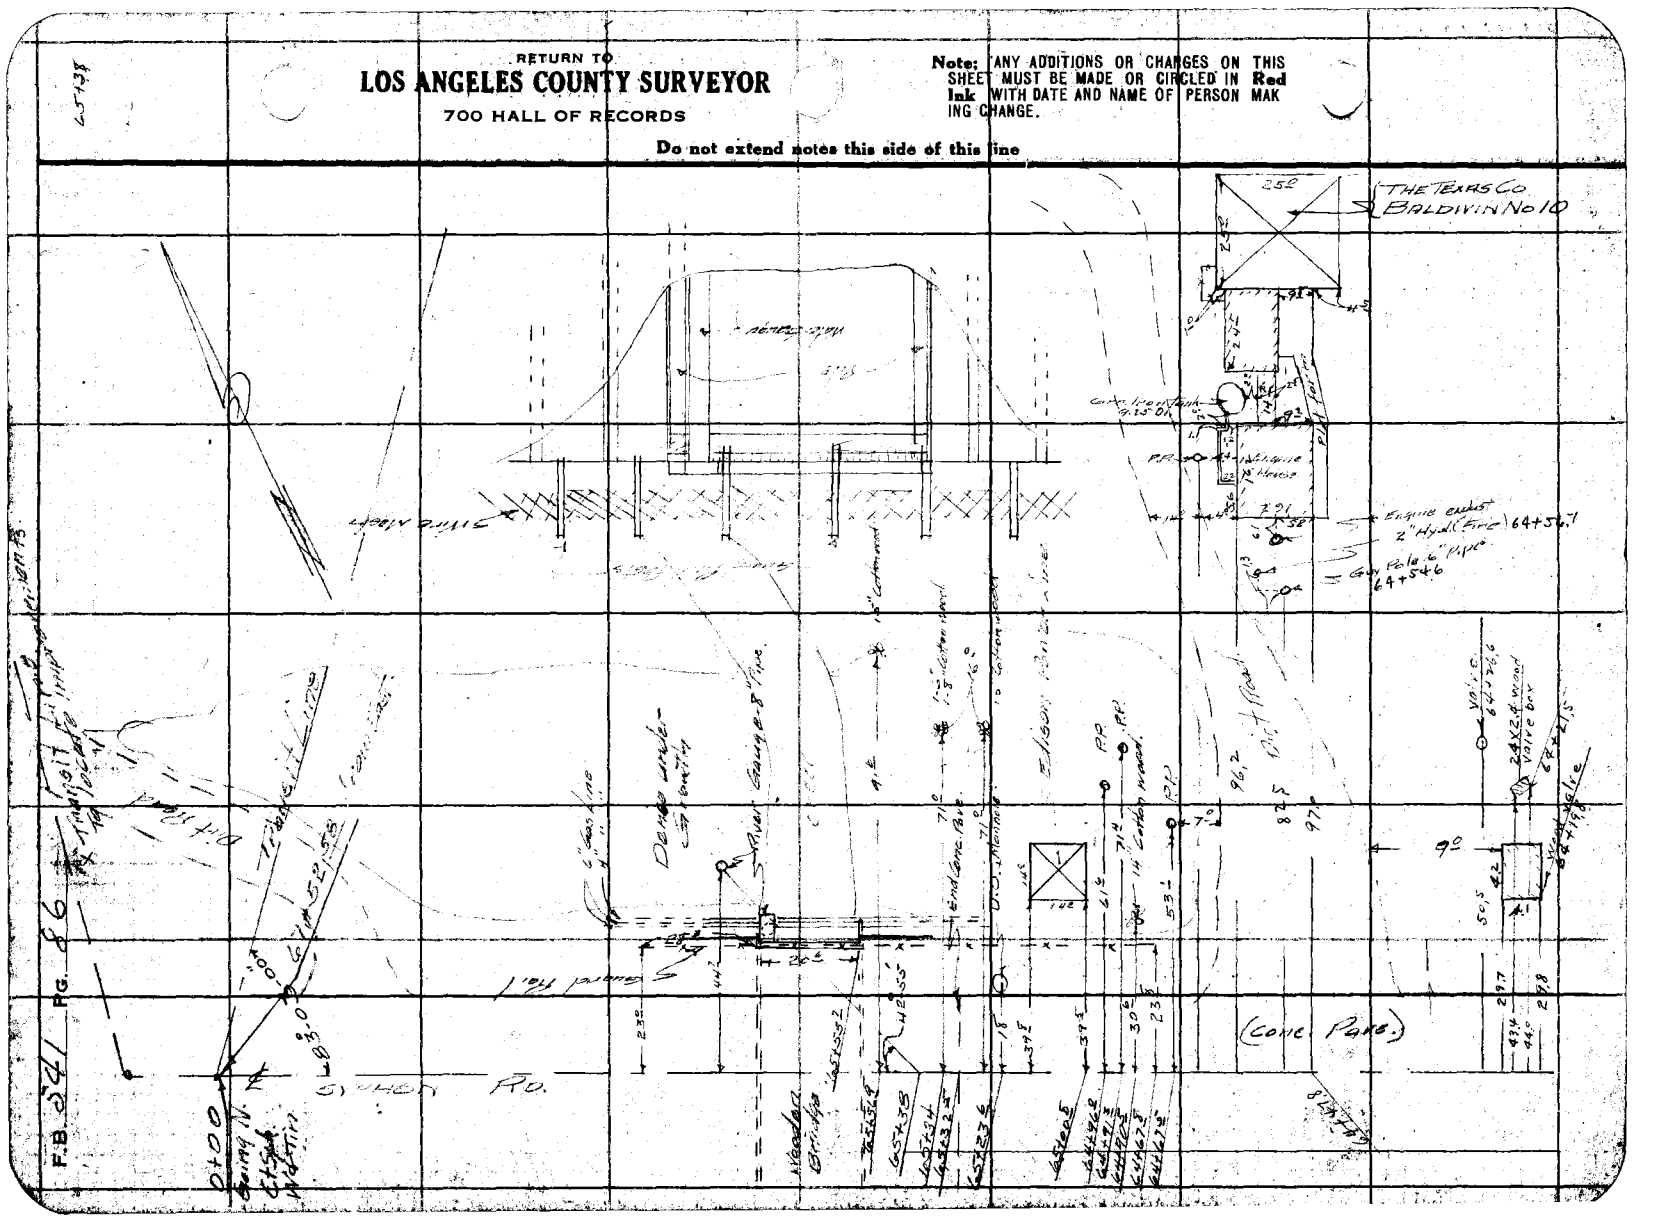

Notes Ck'd by D. M. Finley	Survey of El Monte Brazilia Trail	F.B. 541	Pg. 67
Map No. B-1005-2	W. O. 8012 Tape No ____ St'd ____ of.		
Office Work C. W. Cox	Surveyed by Evans		
Checked	Notes Brook Date 2-1-34		
Date	Indexed A. C. Johnson		

50.8 - 2-1-34
85.2 - 13-23

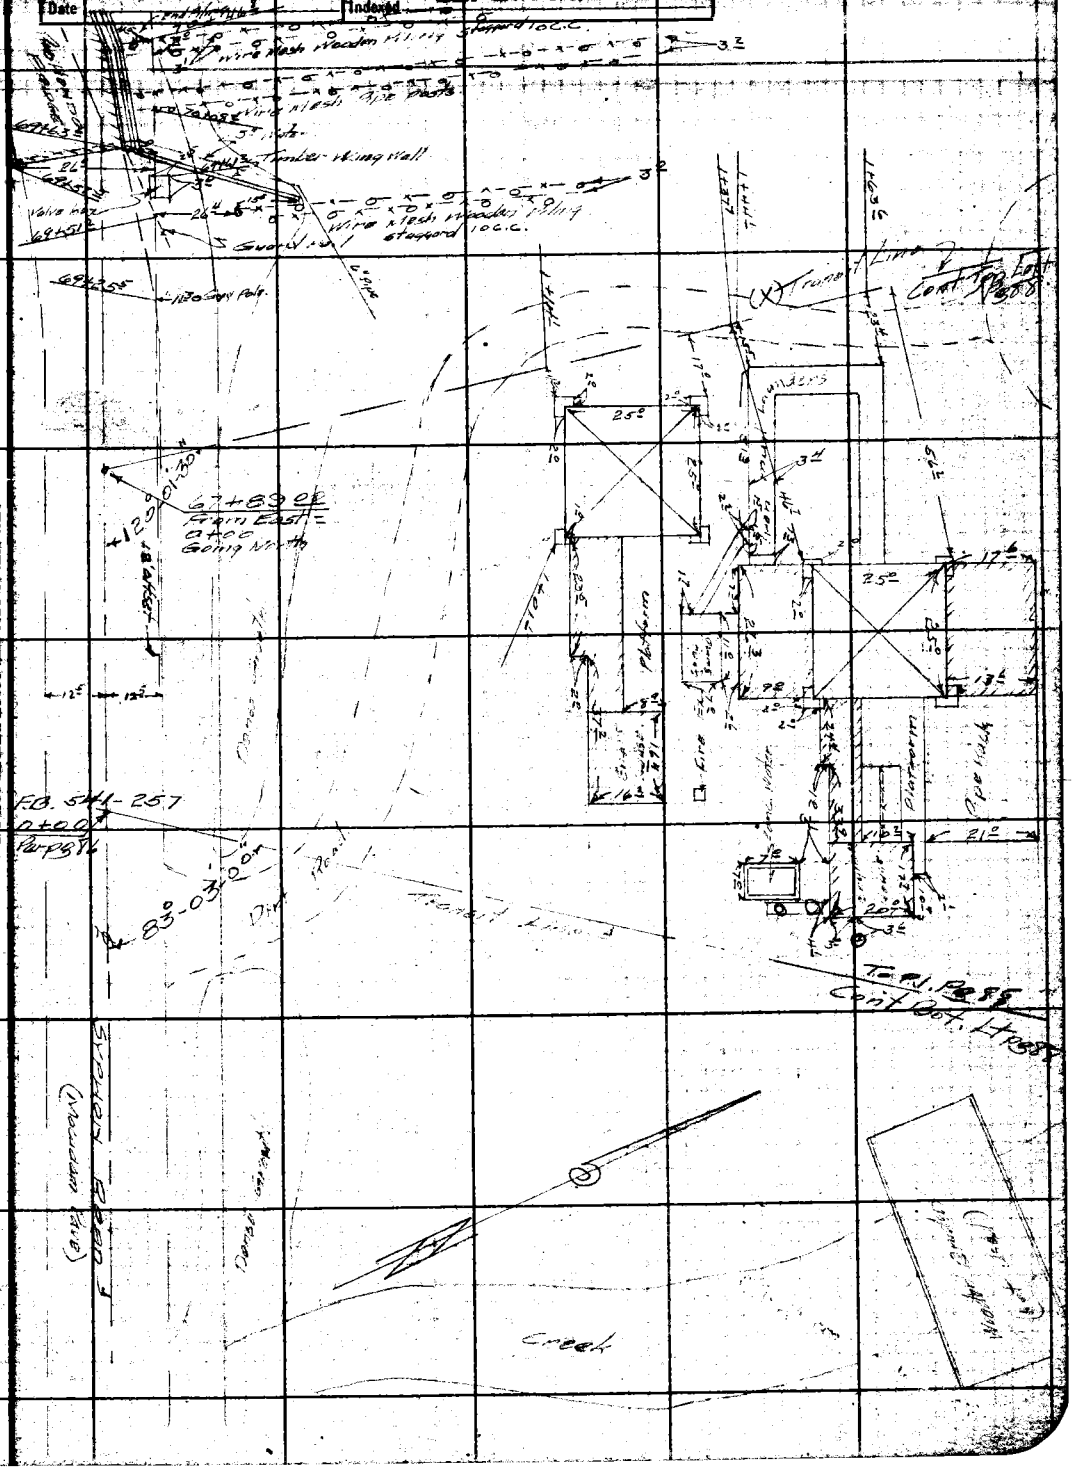

Note: ANY ADDITIONS OR CHANGES ON THIS SHEET MUST BE MADE OR CIRCLED IN Red Ink WITH DATE AND NAME OF PERSON MAKING CHANGE.

Do not extend notes this side of this line

RETURN TO
LOS ANGELES COUNTY SURVEYOR
700 HALL OF RECORDS

FORM 247 5M 2-34

RETURN TO
LOS ANGELES COUNTY SURVEYOR
700 HALL OF RECORDS

Note: ANY ADDITIONS OR CHANGES ON THIS SHEET MUST BE MADE OR CIRCLED IN Red Ink WITH DATE AND NAME OF PERSON MAKING CHANGE.

Do not extend notes this side of this line

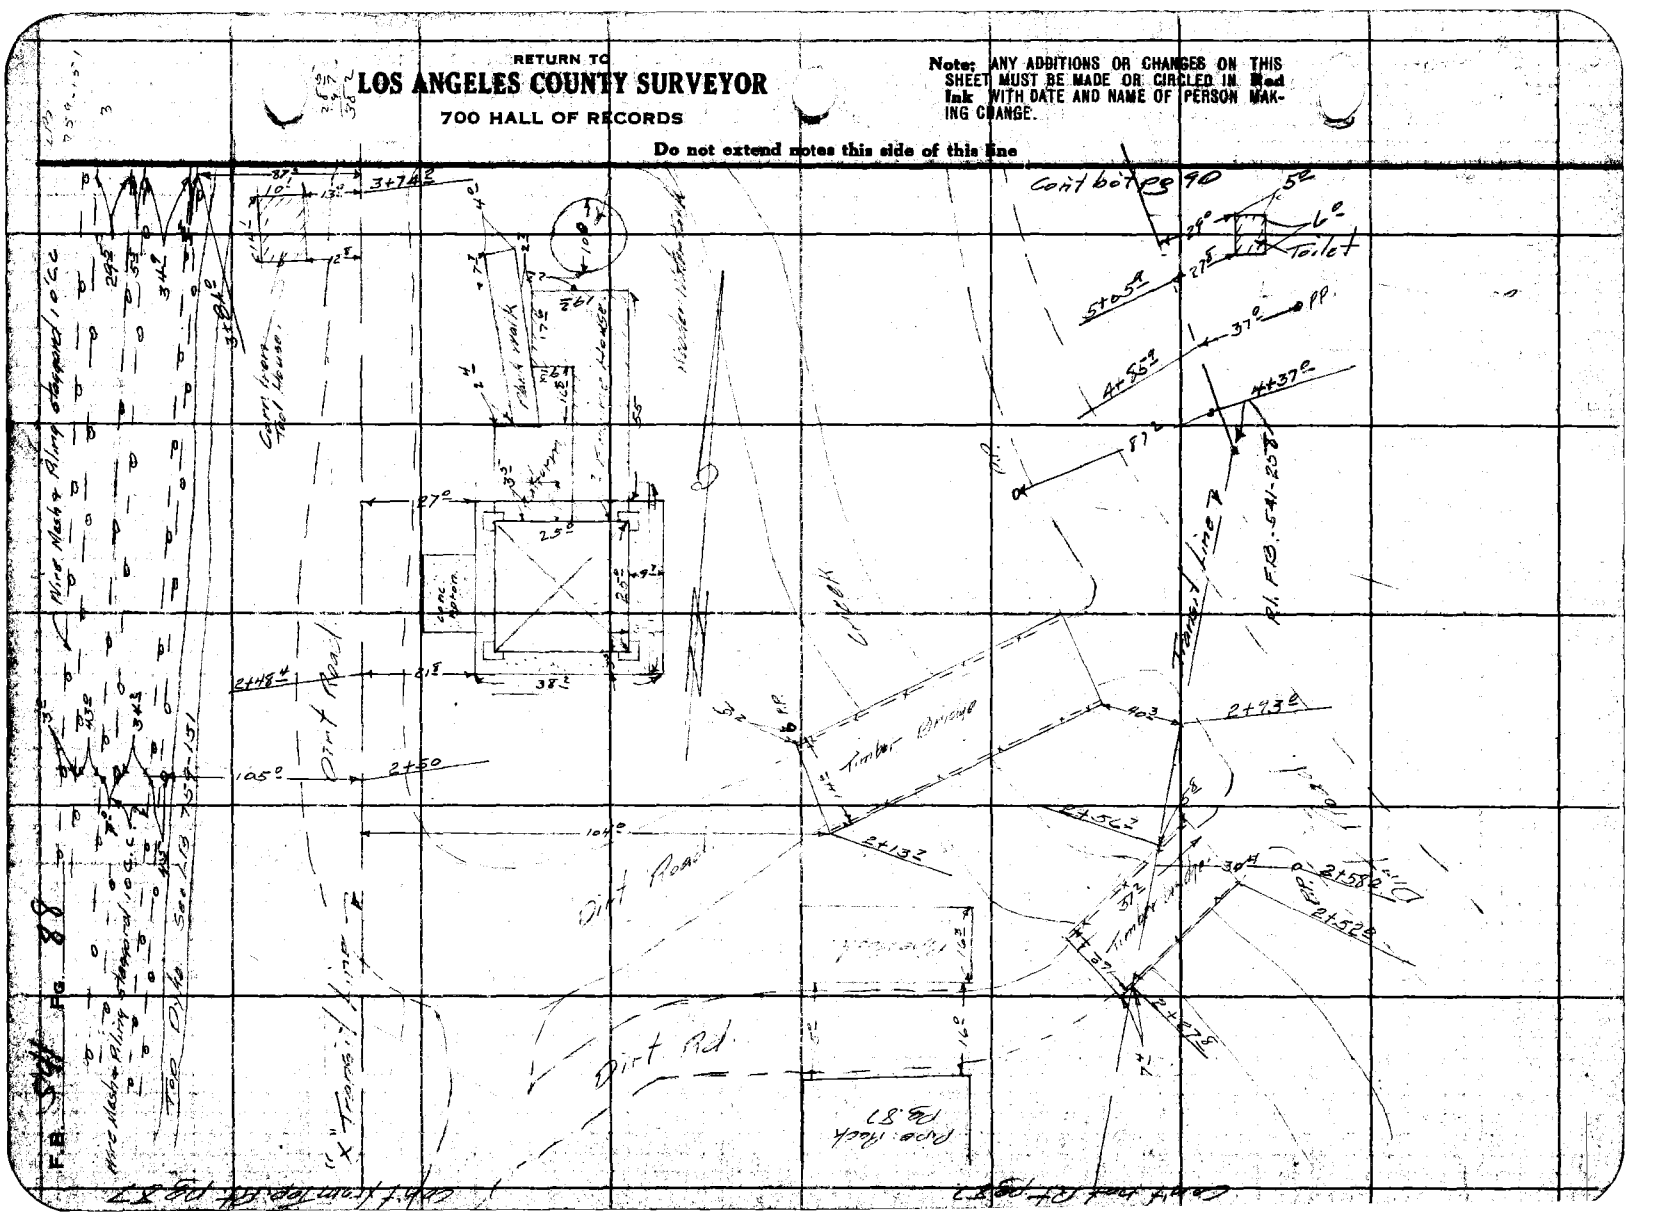

Notes Ck'd by D. M. Finley	Survey of El Monte Bridle Trail
Map No. B-1005-2	W. O. 3012 Tape No ____ St'd ____ °F.
Office Work C.W. Cox	Surveyed by Evans
Checked	Notes ____ Date 12-1-34
Date	Indexed A. C. Johnson

F.B. 541 Pg. 89

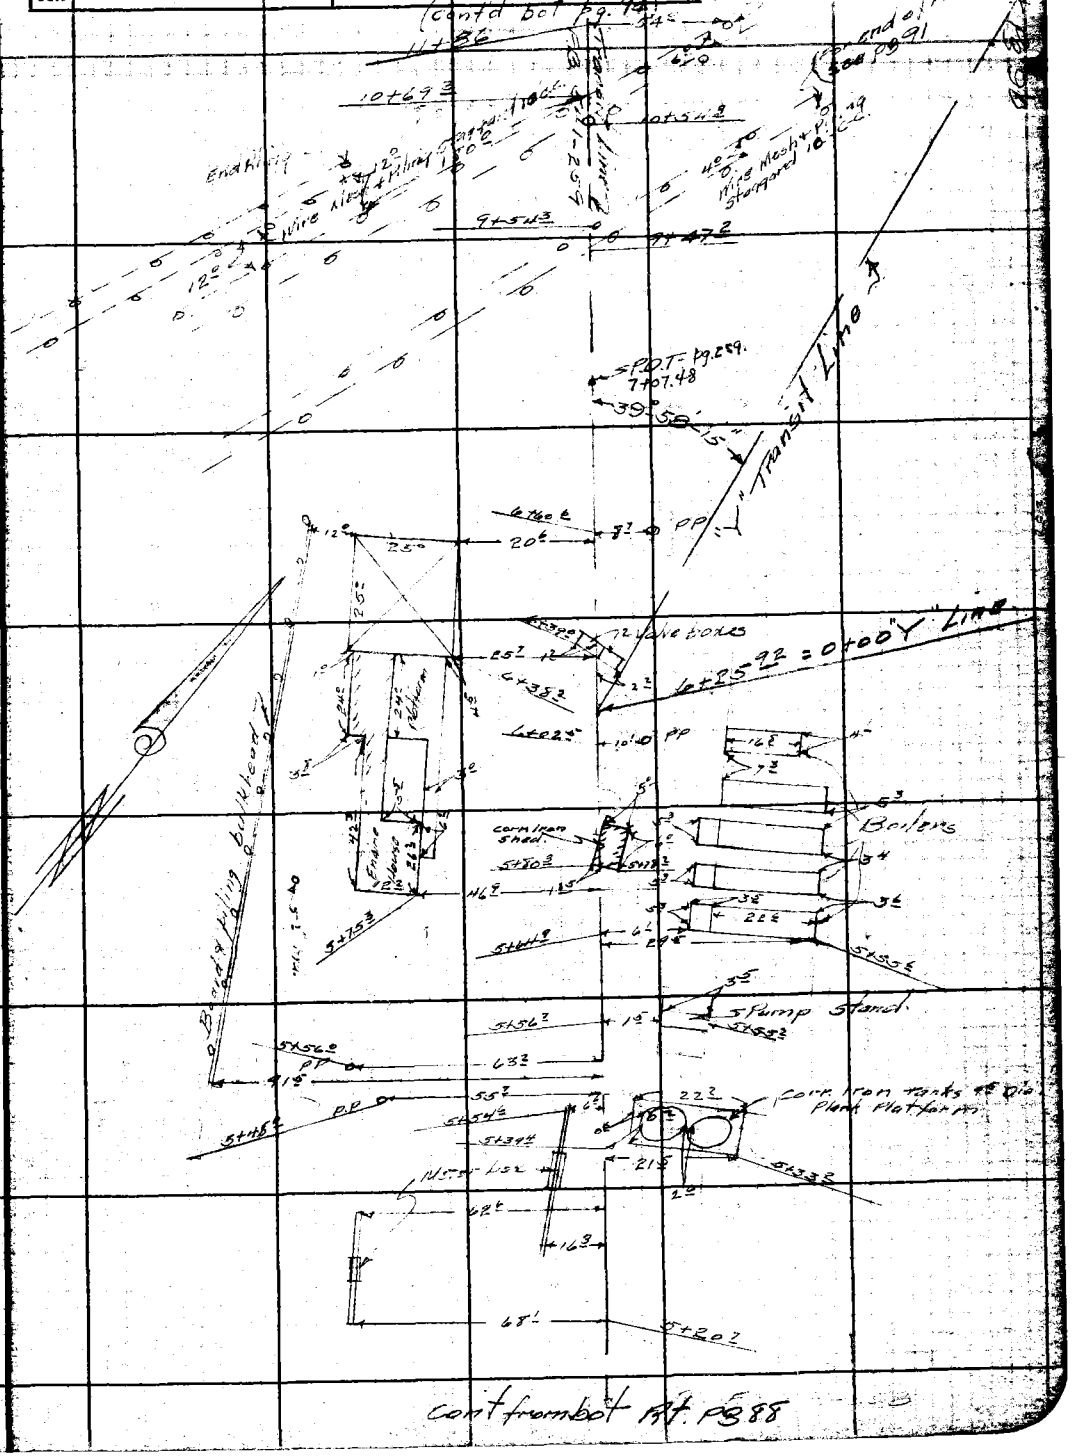

Notes: ANY ADDITIONS OR CHANGES ON THIS SHEET MUST BE MADE OR CIRCLED IN Red Ink WITH DATE AND NAME OF PERSON MAKING CHANGE.

Do not extend notes this side of this line

RETURN TO
LOS ANGELES COUNTY SURVEYOR
700 HALL OF RECORDS.

FORM 247 5M 2-34

F.B. 541 PG. 90

Cont bot pg 91.

Cont from Top Rt pg 89.

RETURN TO
LOS ANGELES COUNTY SURVEYOR
700 HALL OF RECORDS

Do not extend notes this side of this line

Note: ANY ADDITIONS OR CHANGES ON THIS SHEET MUST BE MADE OR CIRCLED IN Red Ink WITH DATE AND NAME OF PERSON MAKING CHANGE.

Notes Ck'd by D. M. Finley
Map No. B-1065-2
Office Work C.W. Cox
Checked
Date

Survey of E. Monte Bradley Trail
W. O. 5012 Tape No St'd °F.
Surveyed by Evans
Notes Book Date 12-1-34
Indexed A. C. Johnson

F.B. 541 Pg. 91

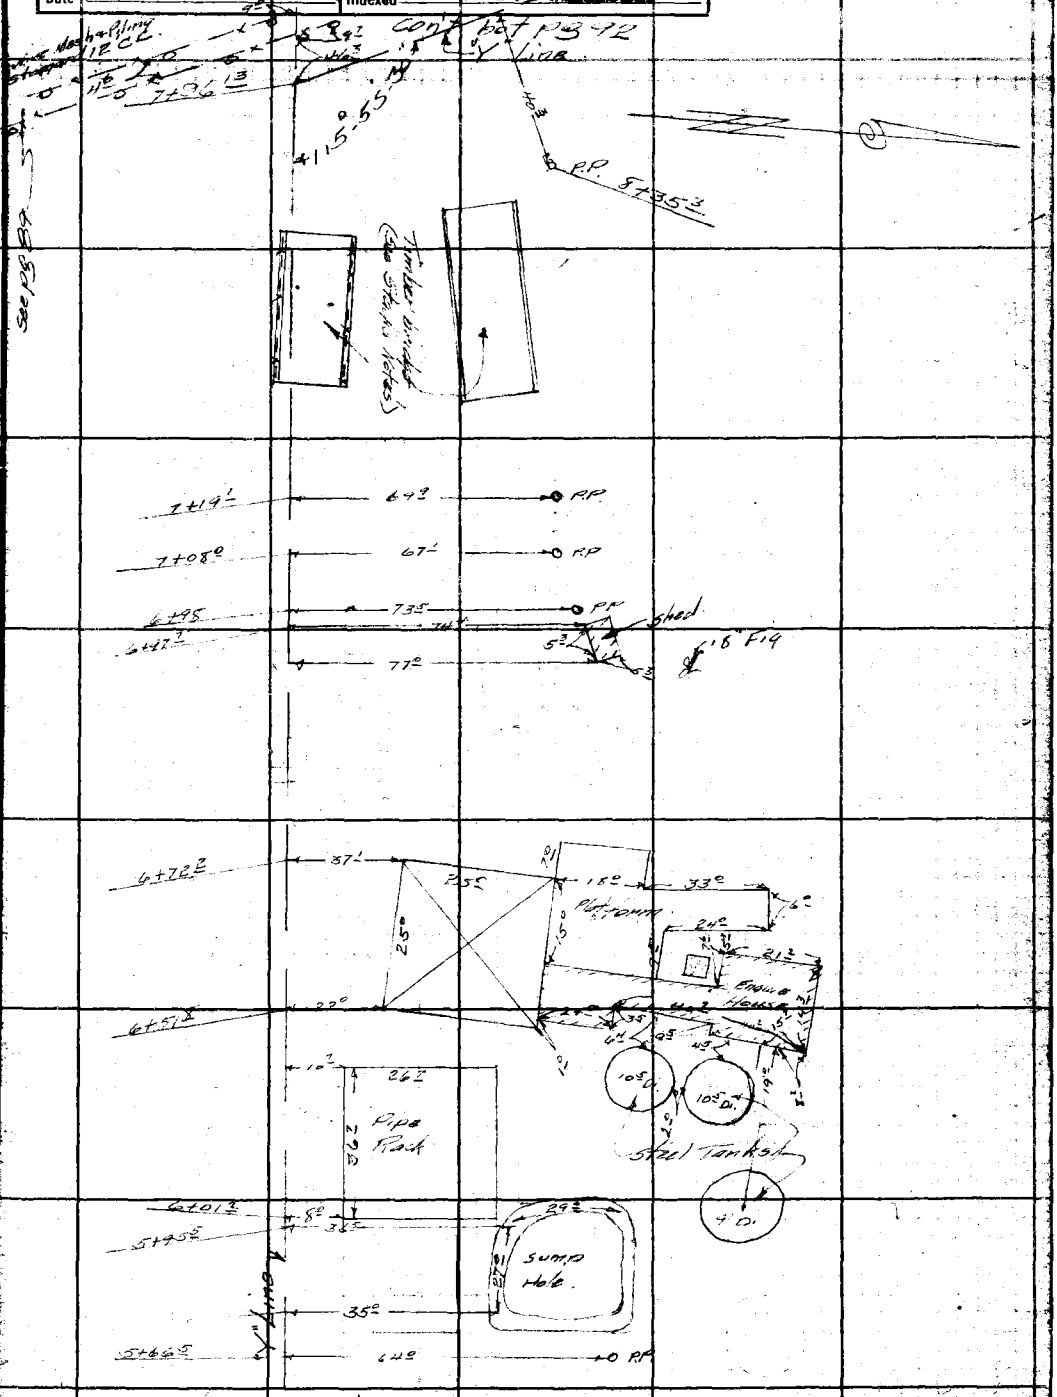

Note: ANY ADDITIONS OR CHANGES ON THIS SHEET MUST BE MADE OR CIRCLED IN Red Ink WITH DATE AND NAME OF PERSON MAK-ING CHANGE.

Do not extend notes this side of this line

RETURN TO
LOS ANGELES COUNTY SURVEYOR
700 HALL OF RECORDS

FORM 247 BM 2-34

RETURN TO

LOS ANGELES COUNTY SURVEYOR

700 HALL OF RECORDS

Note: ANY ADDITIONS OR CHANGES ON THIS SHEET MUST BE MADE OR CIRCLED IN Red Ink WITH DATE AND NAME OF PERSON MAKING CHANGE.

Do not extend notes this side of this line

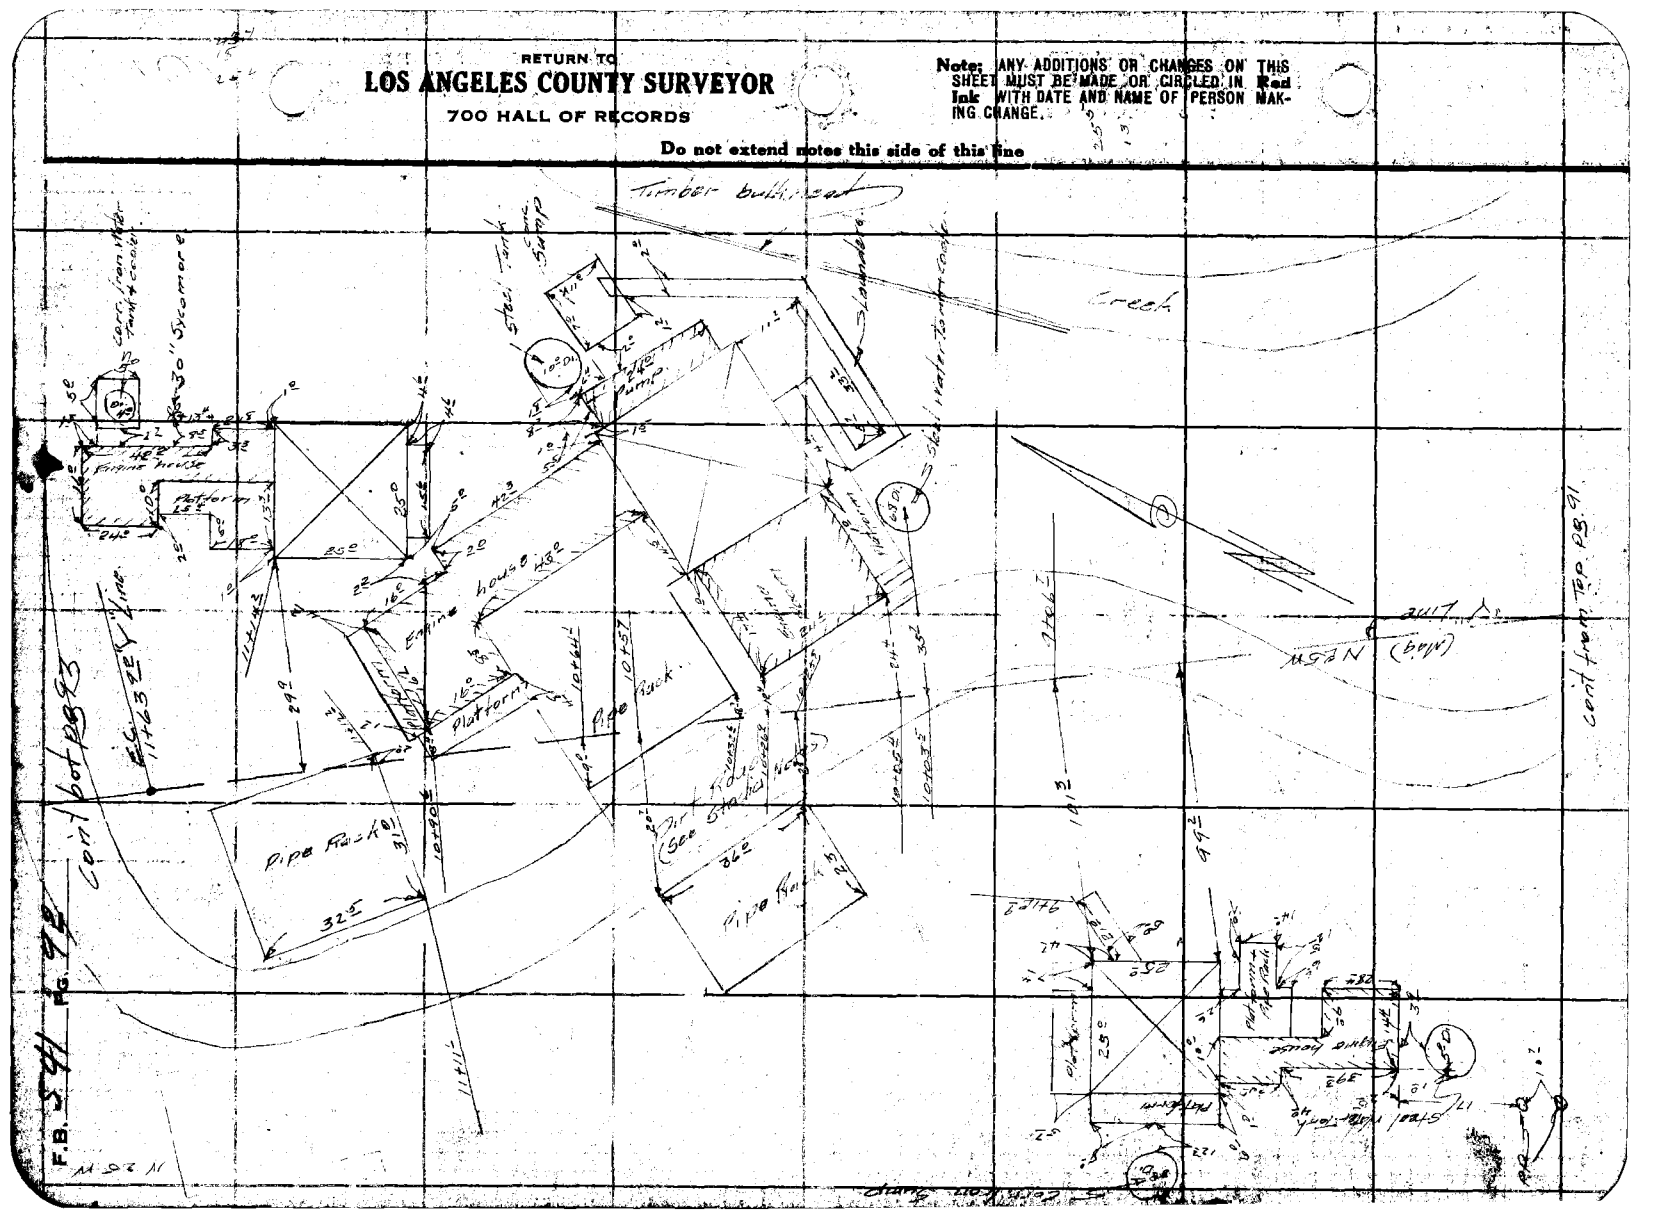

Notes Ck'd by D. M. Finley	Survey of	F.B. 541	Pg. 93
Map No. B-1005-2	W. O.	Tape No	St'd °F.
Office Work C.W. Cox	Surveyed by		
Checked	Notes	Date 12-17-34	
Date	Indexed A. C. Johnson		

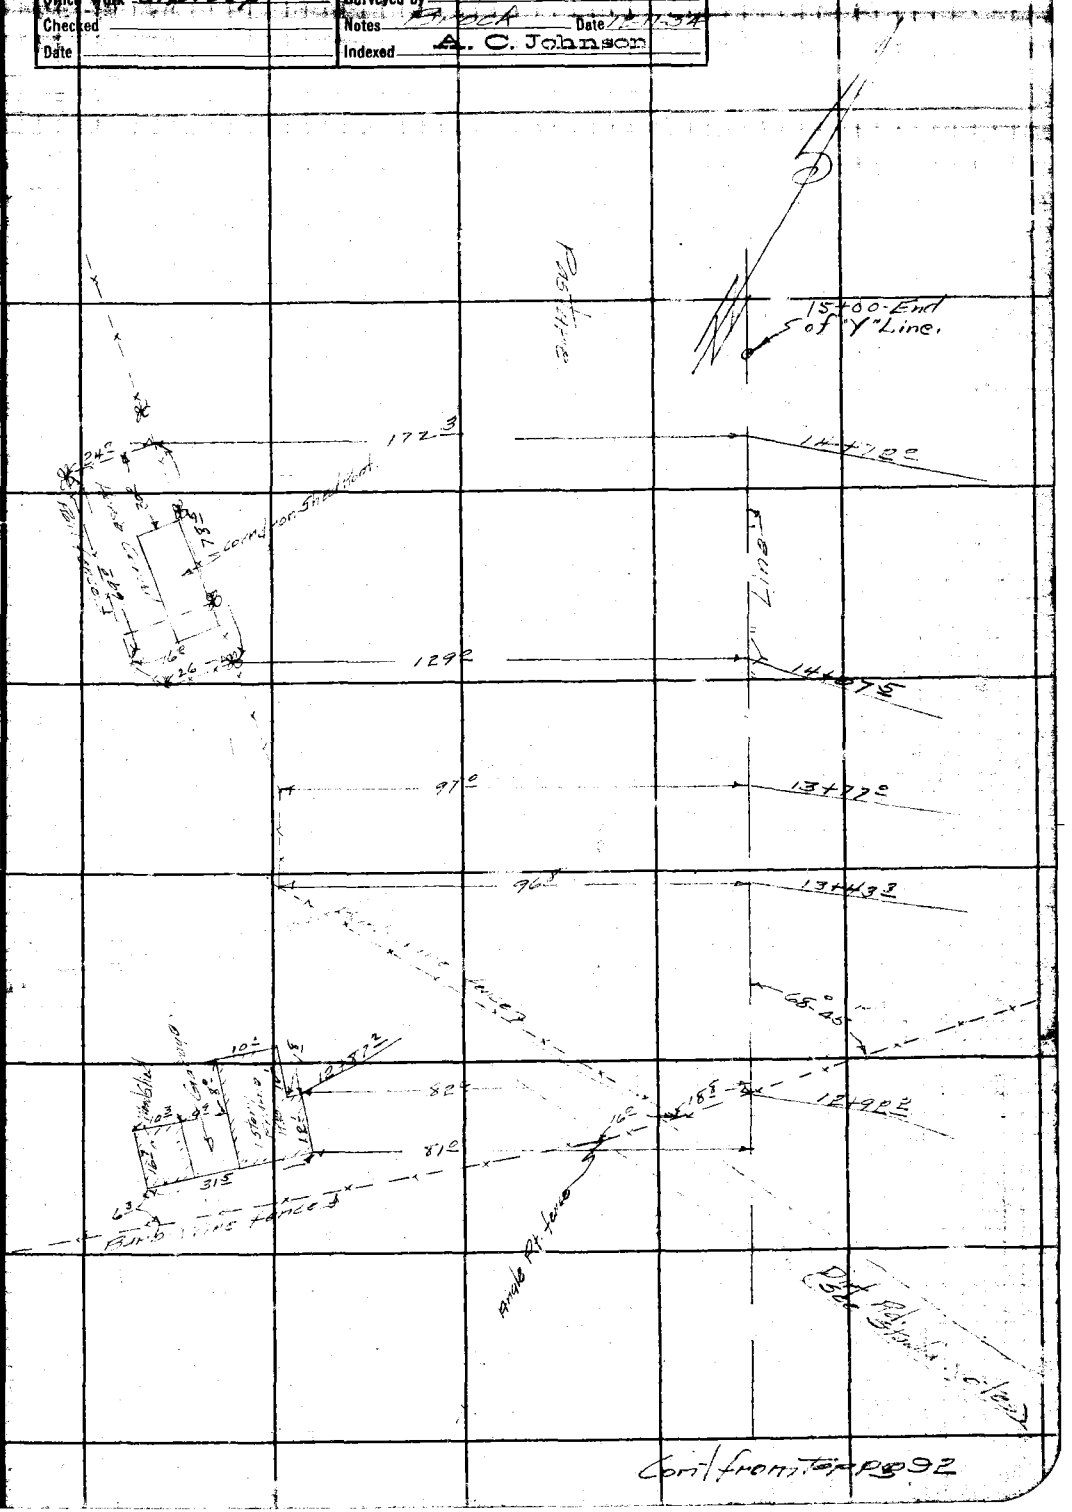

Note: ANY ADDITIONS OR CHANGES ON THIS SHEET MUST BE MADE OR CIRCLED IN Red Ink WITH "DATE AND NAME OF PERSON MAKING CHANGE.

Do not extend notes this side of this line

RETURN TO
LOS ANGELES COUNTY SURVEYOR
700 HALL OF RECORDS.

FORM 247 BM 2-34

F.B. 541 PG. 94

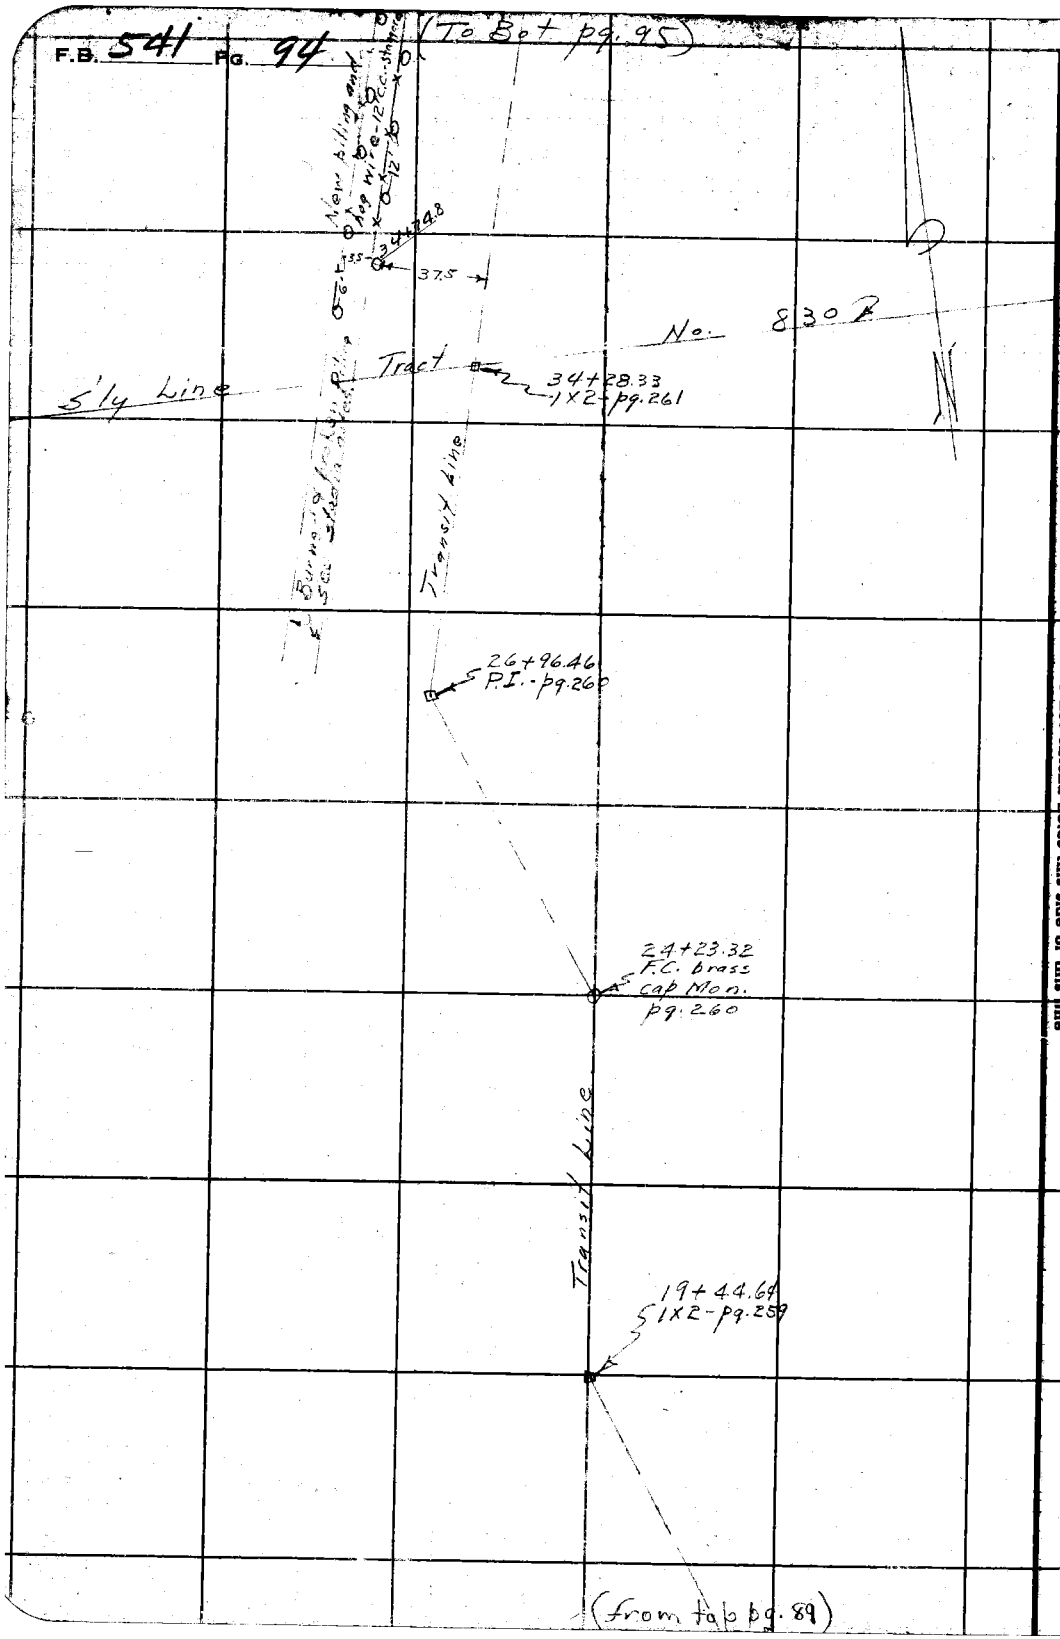

RETURN TO
LOS ANGELES COUNTY SURVEYOR
700 HALL OF RECORDS

Note: ANY ADDITIONS OR CHANGES ON THIS SHEET MUST BE MADE OR CIRCLED IN Red Ink WITH DATE AND NAME OF PERSON MAKING CHANGE.

Do not extend notes this side of this line

Notes Ck'd by D. M. Finley	Survey of El Monte Bridle Trail
Map No. B-1005-2	W. O. 8617 Tape No ____ St'd ____ °F.
Office Work C. W. Cox	Surveyed by Evans
Checked	Notes 14 Date 12/19/34
Date	Indexed A. C. Johnson

F.B. 541 Pg. 95

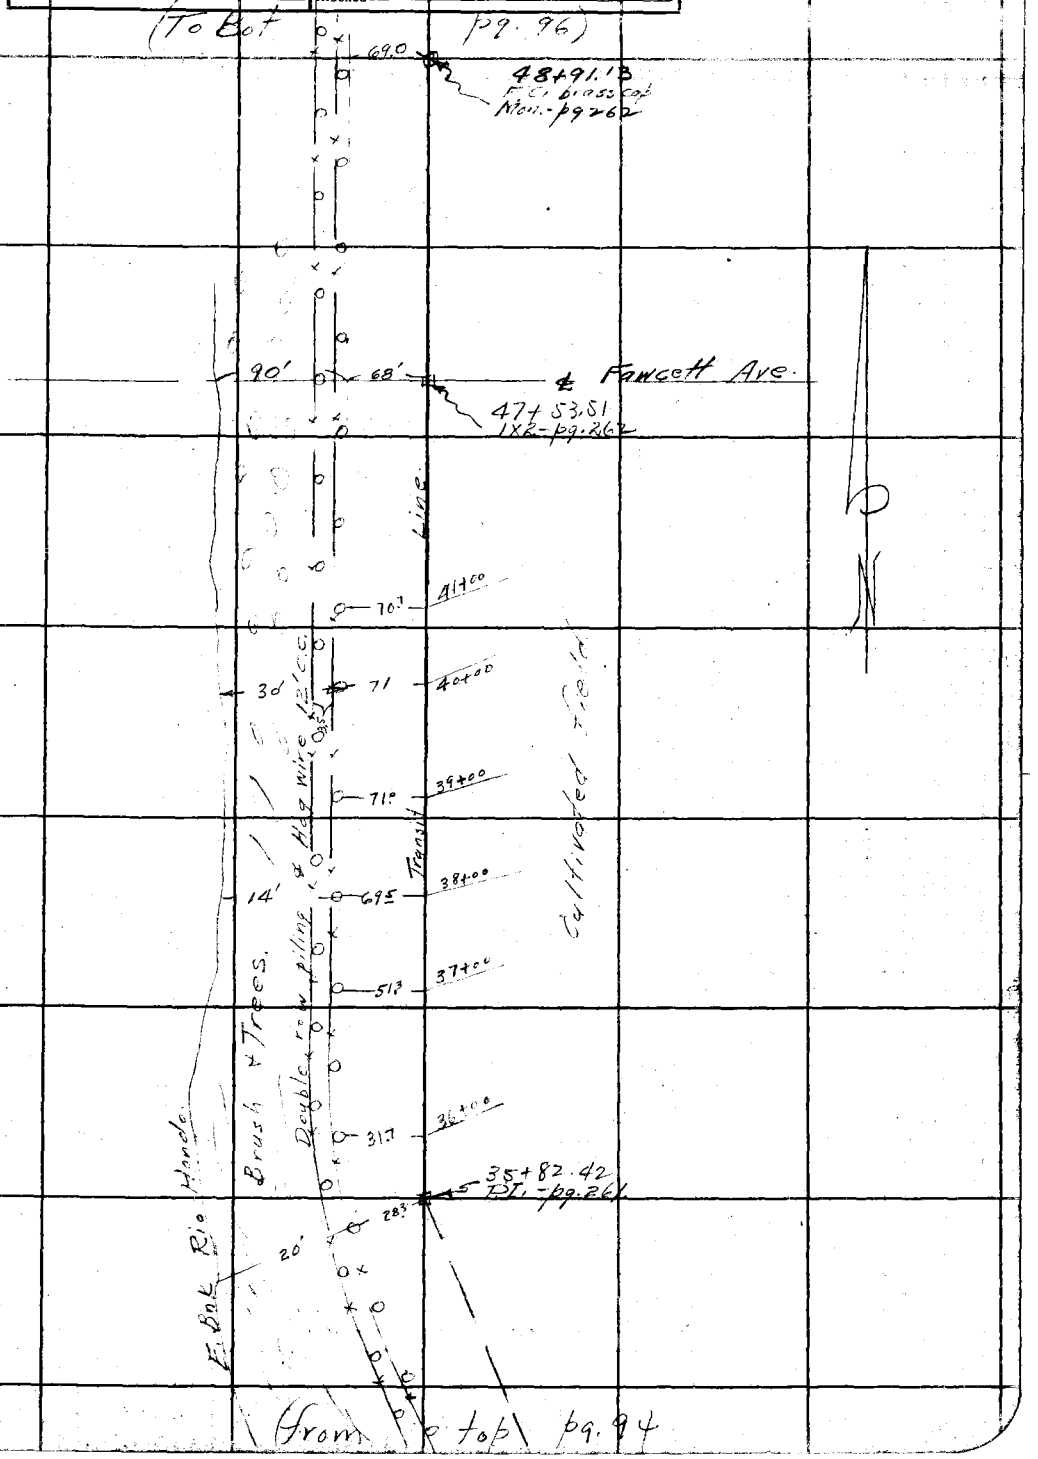

Note: ANY ADDITIONS OR CHANGES ON THIS SHEET MUST BE MADE OR CIRCLED IN Red Ink WITH DATE AND NAME OF PERSON MAKING CHANGE.

Do not extend notes this side of this line

RETURN TO
LOS ANGELES COUNTY SURVEYOR
700 HALL OF RECORDS

FORM 247 5M 2-34

F.B. 541 Pg. 96

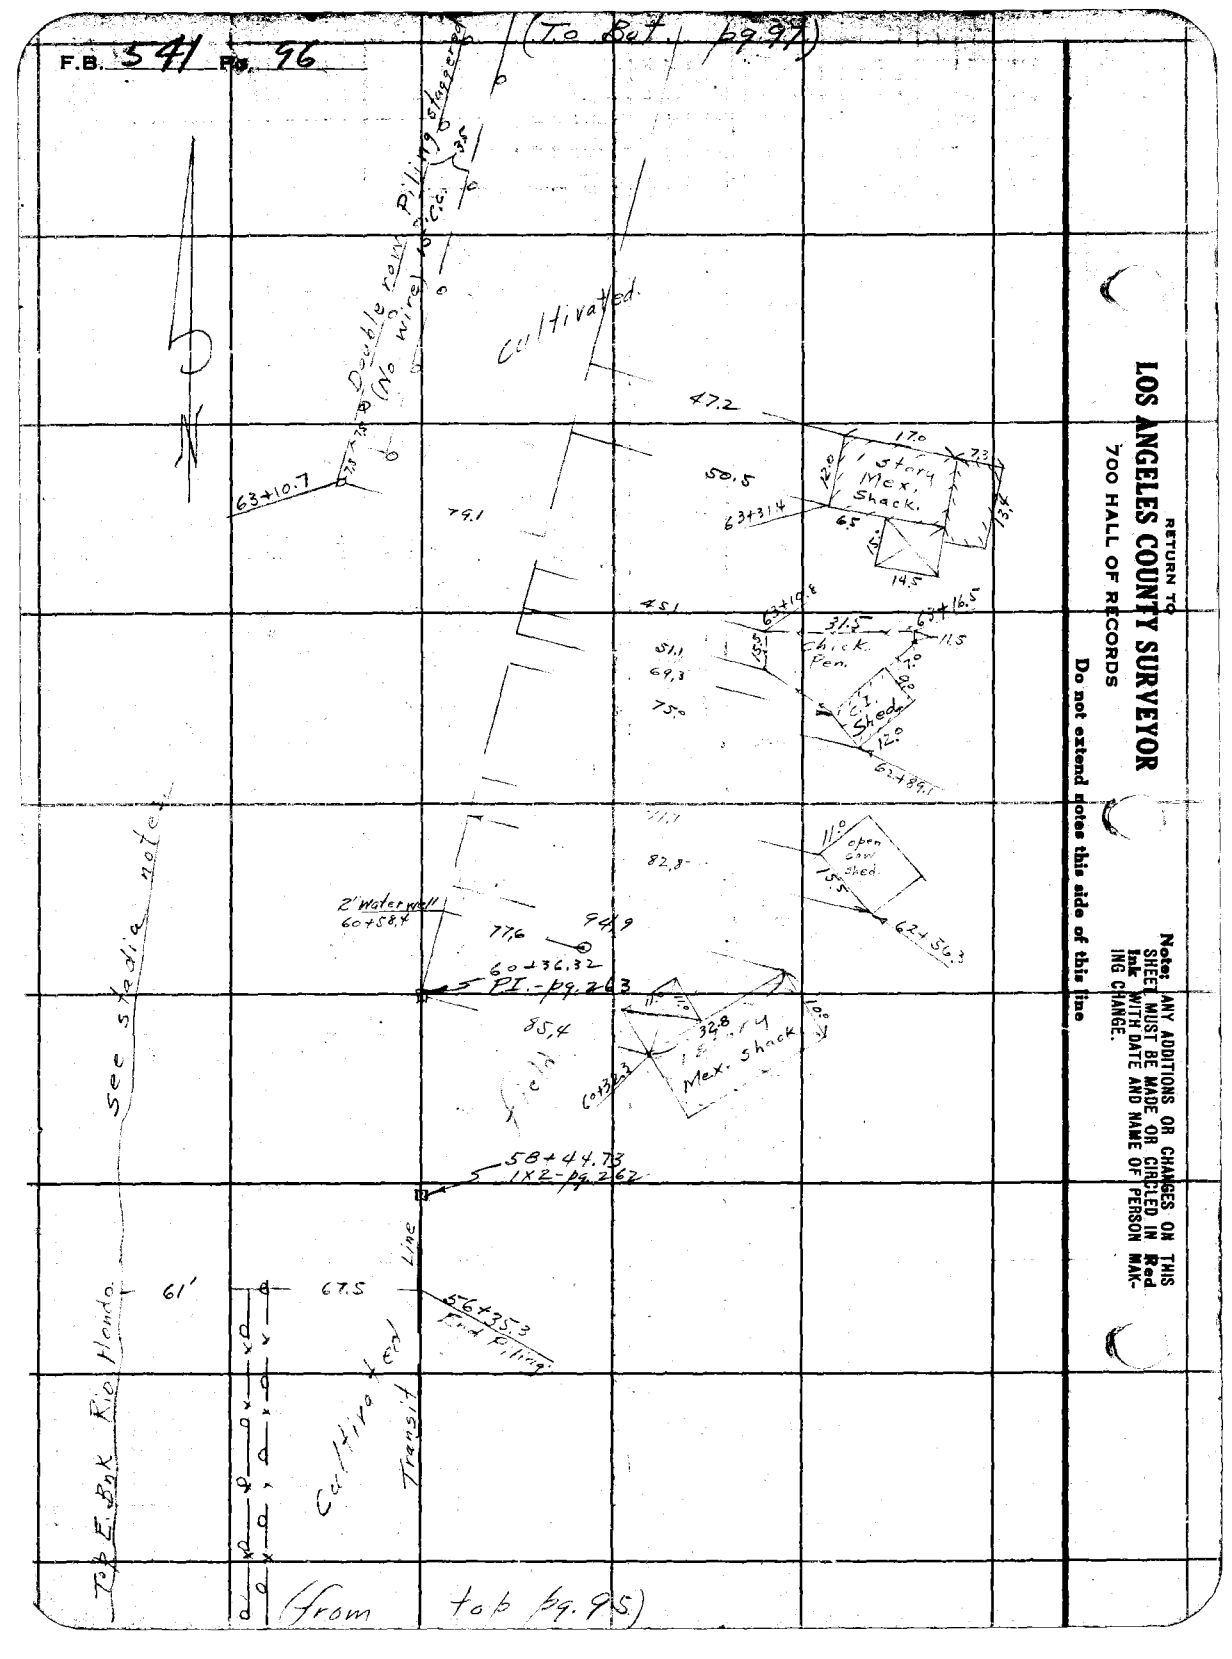

RETURN TO
LOS ANGELES COUNTY SURVEYOR
700 HALL OF RECORDS

Do not extend notes this side of this line

Note: ANY ADDITIONS OR CHANGES ON THIS SHEET MUST BE MADE OR CIRCLED IN Red Ink WITH DATE AND NAME OF PERSON MAKING CHANGE.

Notes Ck'd by D. M. Finley	Survey of El Monte Bridle Trl.		F.B. 541 Pg. 97
Map No. B-1005-2	W. O. 8012	Tape No ____ St'd ____ of.	
Office Work C. W. Cox	Surveyed by Evans		
Checked	Notes	Date 12/19/34	
Date	Indexed A. C. Johnson		

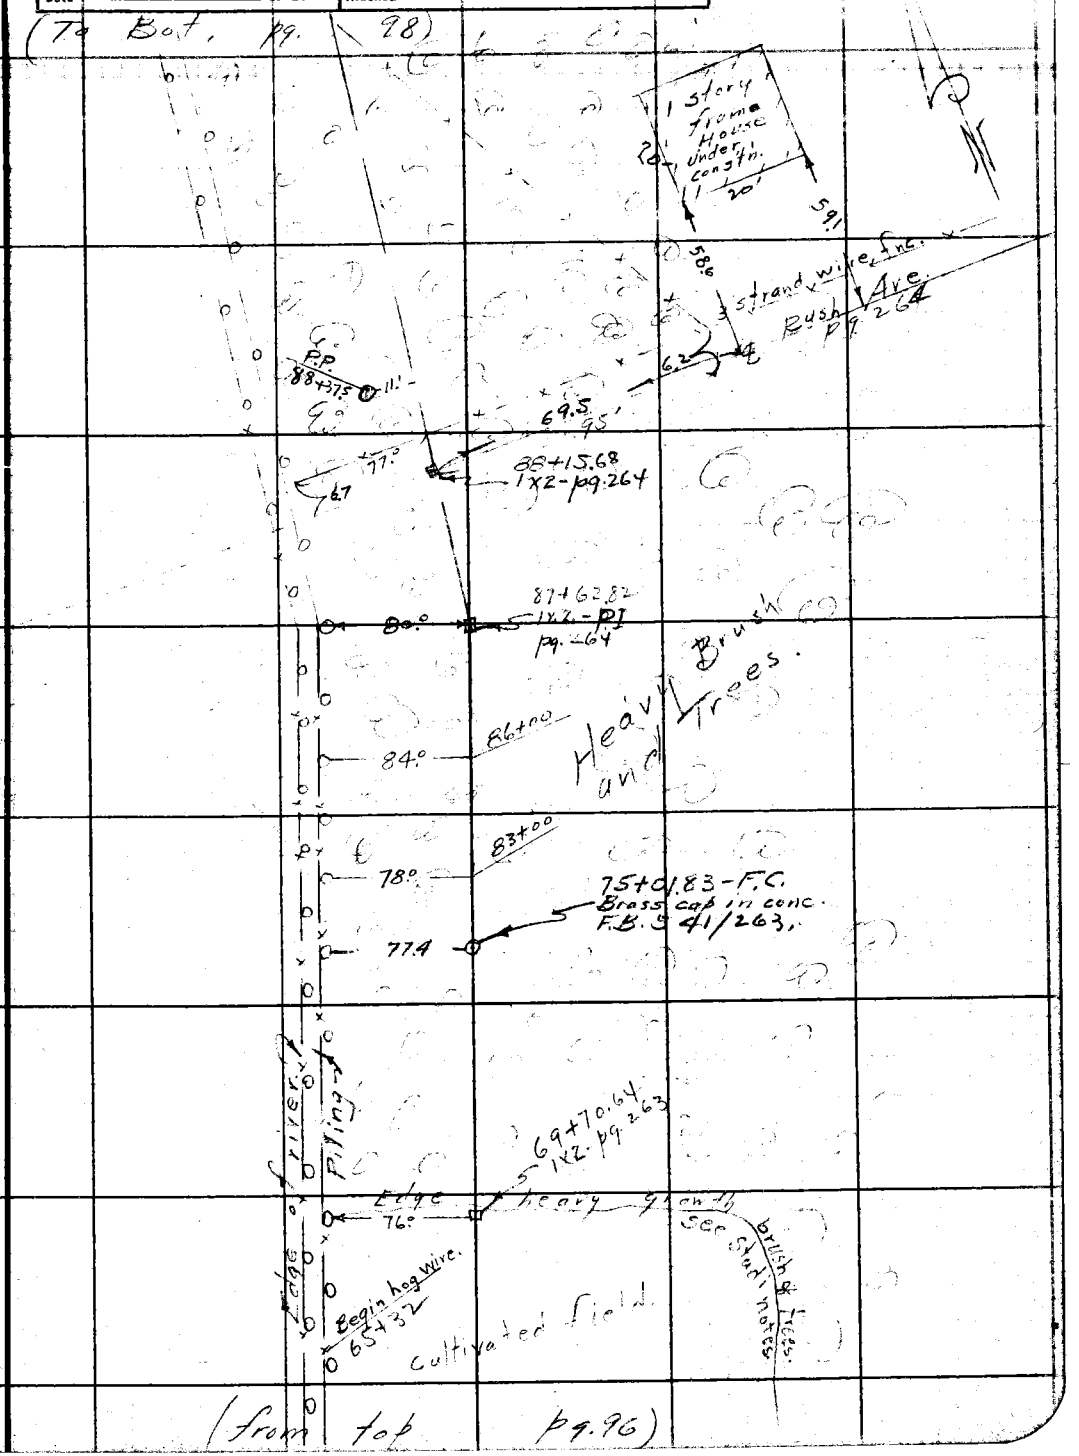

Note: ANY ADDITIONS OR CHANGES ON THIS SHEET MUST BE MADE OR CIRCLED IN Red Ink WITH DATE AND NAME OF PERSON MAKING CHANGE.

Do not extend notes this side of this line

RETURN TO
LOS ANGELES COUNTY SURVEYOR
700 HALL OF RECORDS

FORM 247 5M 2-34

F.B. 541 Pg. 98 (To Bot pg. 99)

(from top pg. 97)

RETURN TO
LOS ANGELES COUNTY SURVEYOR
700 HALL OF RECORDS
Do not extend notes this side of this line
Note: ANY ADDITIONS OR CHANGES ON THIS SHEET MUST BE MADE OR CIRCLED IN Red Ink WITH DATE AND NAME OF PERSON MAKING CHANGE.

Notes Ck'd by D. M. Finley	Survey of El Monte Bridle Trail	F.B. 541	Pg. 98
Map No. B-1005-3	W. O. 8017 Tape No ____ St'd ____ of.		
Office Work C. W. Cox	Surveyed by Evans		
Checked	Notes	Date 12/21/34	
Date	Indexed A. C. Johnson		

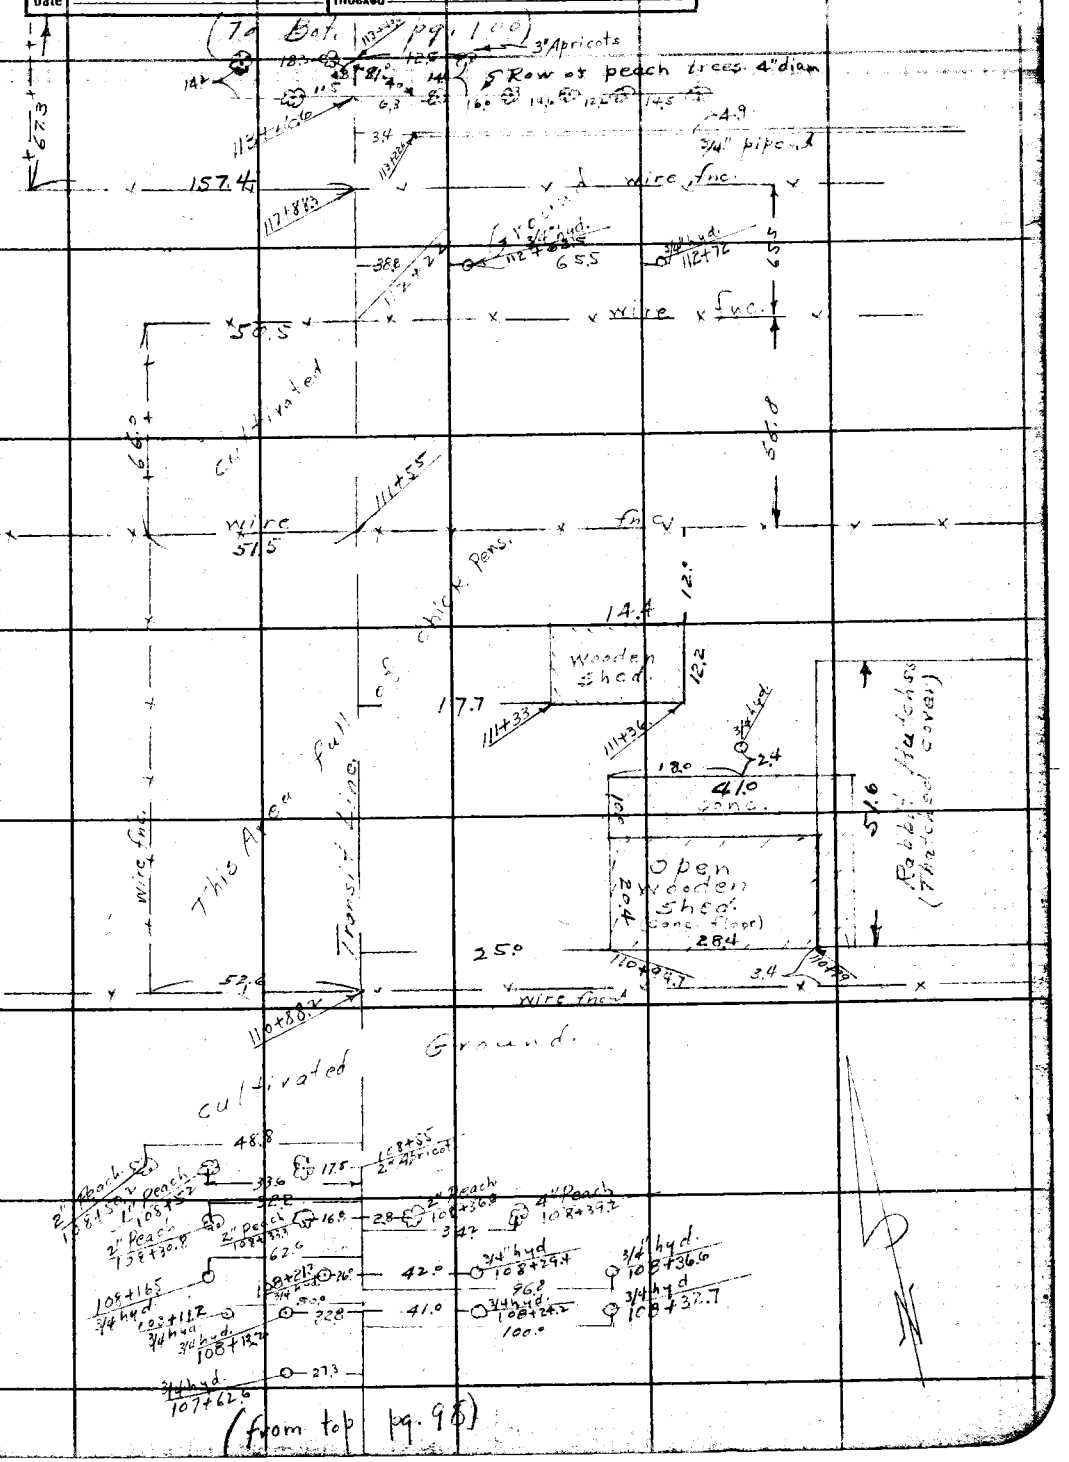

Note: ANY ADDITIONS OR CHANGES ON THIS SHEET MUST BE MADE OR CIRCLED IN Red Ink WITH DATE AND NAME OF PERSON MAKING CHANGE.

Do not extend notes this side of this line

RETURN TO
LOS ANGELES COUNTY SURVEYOR
700 HALL OF RECORDS

FORM 247 5M 2-34

F.B. 541 Pg. 100 (To Bot. Pg. 101)

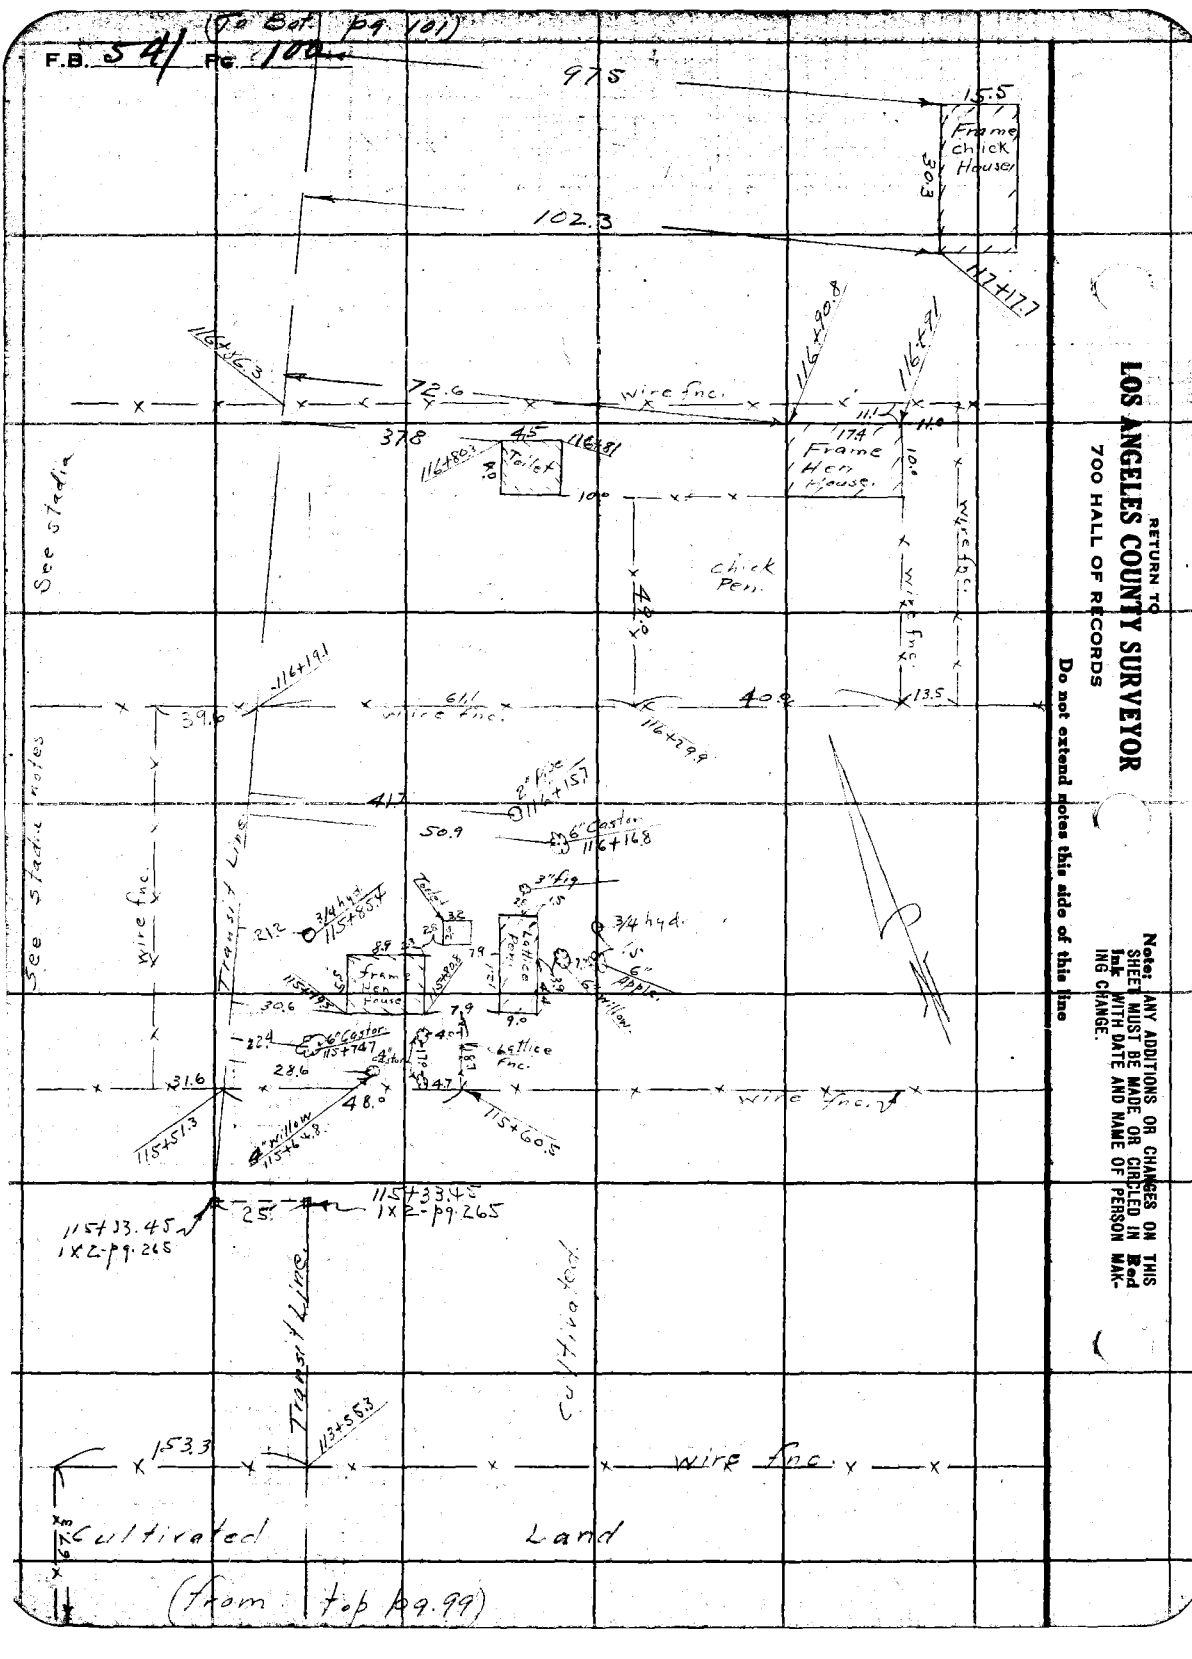

RETURN TO
LOS ANGELES COUNTY SURVEYOR
700 HALL OF RECORDS

Do not extend notes this side of this line

Note: ANY ADDITIONS OR CHANGES ON THIS SHEET MUST BE MADE OR CIRCLED IN Red Ink WITH DATE AND NAME OF PERSON MAKING CHANGE.

Notes Ck'd by D. M. Finley	Survey of El Monte Bridle Trail		F.B. 541 Pg. 101
Map No. B-1005-3	W. O. 8012	Tape No ____ St'd ____ OF.	
Office Work C.W. Cox	Surveyed by Evans		
Checked	Notes	Date 12/21/34	
Date	Indexed A. C. Johnson		

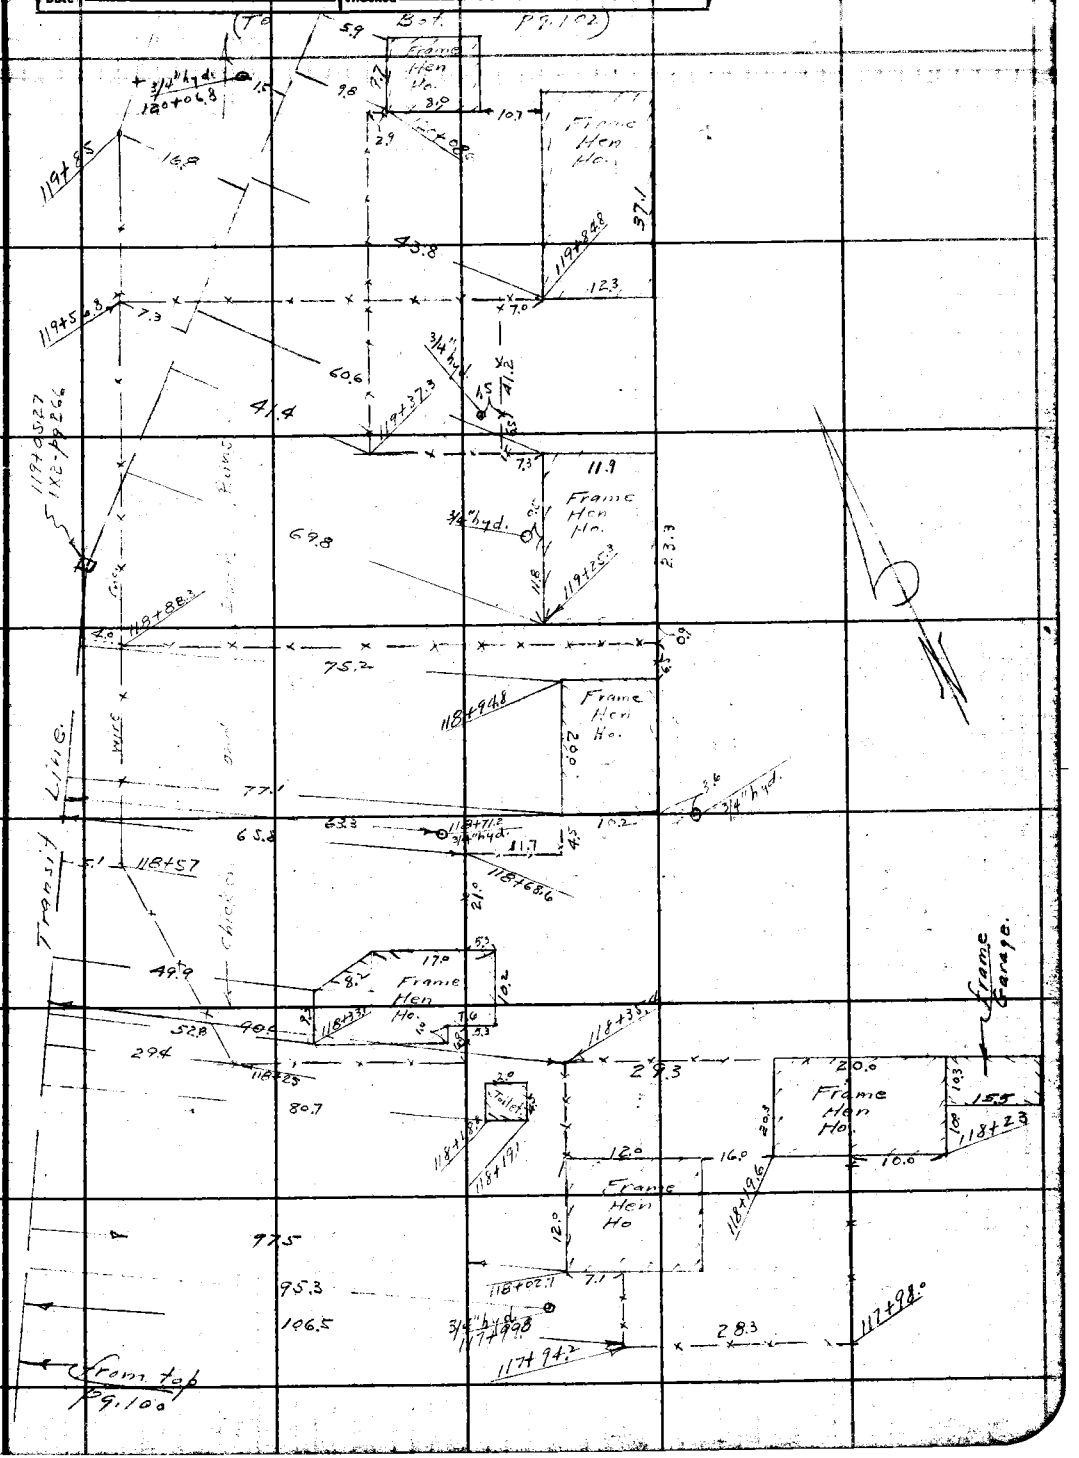

Note: ANY ADDITIONS OR CHANGES ON THIS SHEET MUST BE MADE OR CIRCLED IN Red Ink WITH DATE AND NAME OF PERSON MAKING CHANGE.

Do not extend notes this side of this line

RETURN TO
LOS ANGELES COUNTY SURVEYOR
700 HALL OF RECORDS

FORM 247 5M 2-34

F.B. 541 Pg. 102

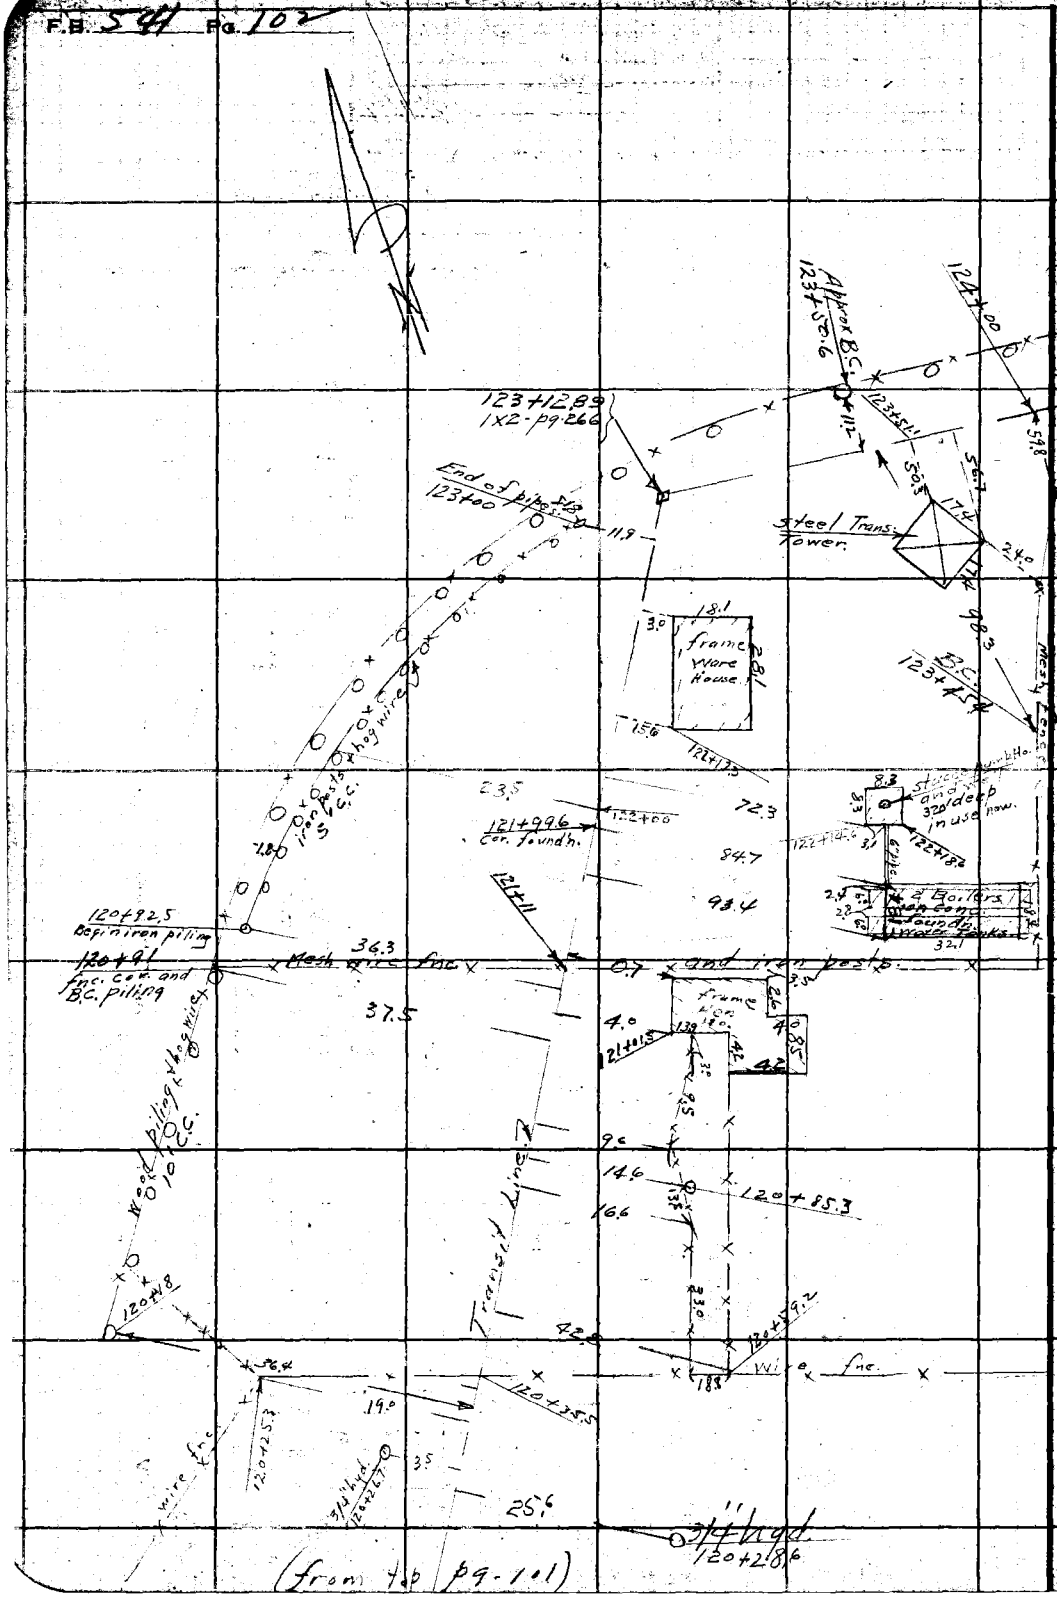

RETURN TO

LOS ANGELES COUNTY SURVEYOR

700 HALL OF RECORDS

Do not extend notes this side of this line

Note: ANY ADDITIONS OR CHANGES ON THIS SHEET MUST BE MADE OR CIRCLED IN Red Ink WITH DATE AND NAME OF PERSON MAKING CHANGE.

Notes Ck'd by D. M. Finley	Survey of El Monte Bridle Trail	F.B. 541	Pg. 103
Map No. B-1005-3	W. O. 8012 Tape No 067 St'd 84 of.		
Office Work C. W. Cox	Surveyed by Evans		
Checked	Notes	Date 1/7/55	
Date	Indexed A. C. Johnson		

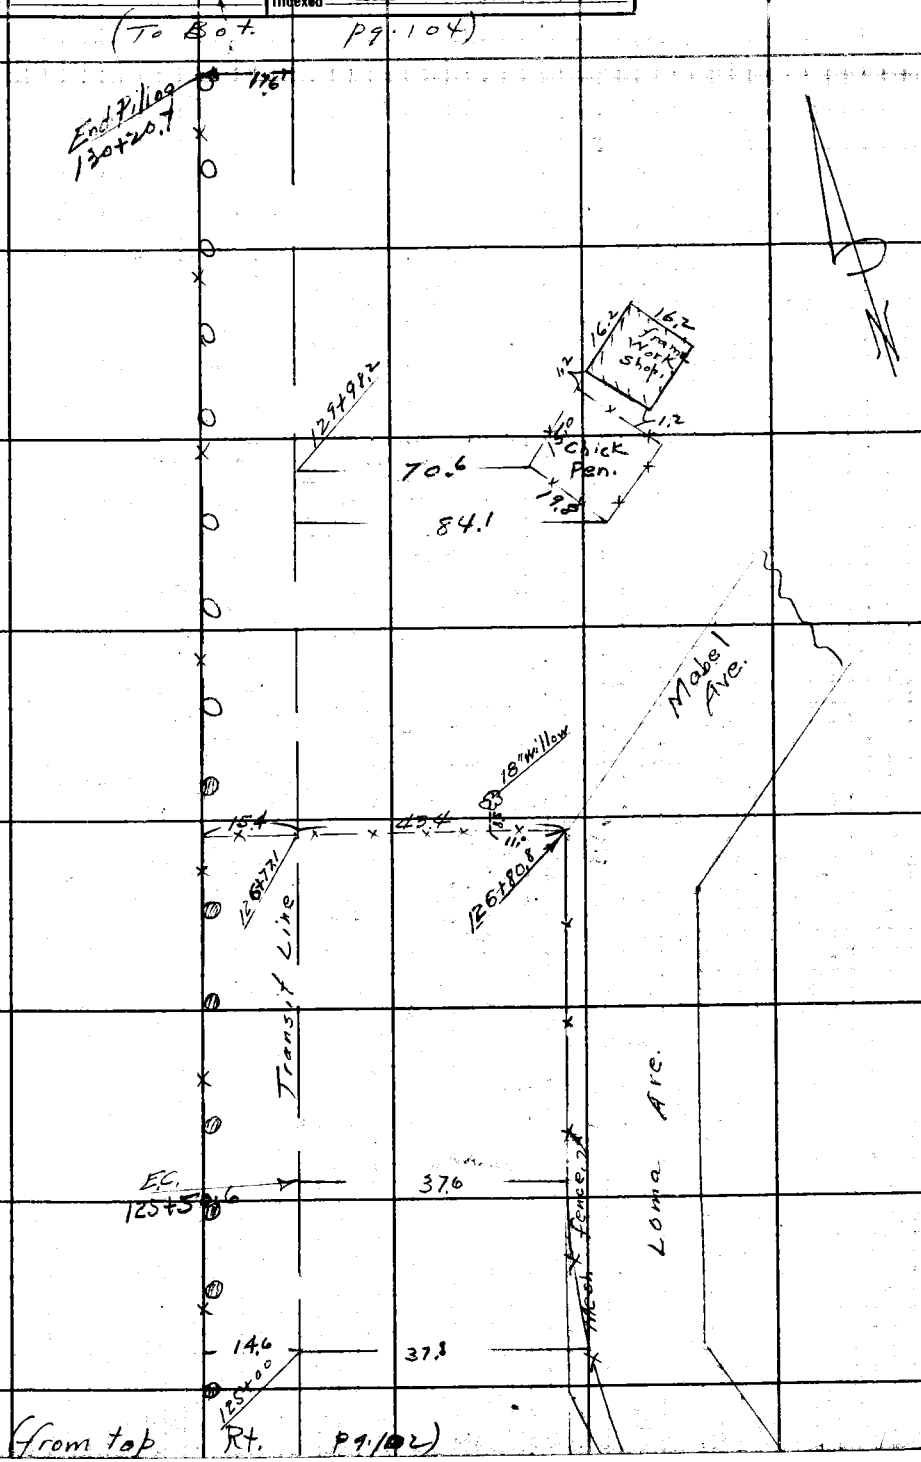

Note: ANY ADDITIONS OR CHANGES ON THIS SHEET MUST BE MADE OR CIRCLED IN Red Ink WITH DATE AND NAME OF PERSON MAKING CHANGE.

Do not extend notes this side of this line

RETURN TO
LOS ANGELES COUNTY SURVEYOR
700 HALL OF RECORDS

FORM 247 5M 2-34

Cont at Bot pg 105

Cont from Top pg 103

RETURN TO
LOS ANGELES COUNTY SURVEYOR
700 HALL OF RECORDS
Do not extend notes this side of this line
Note: ANY ADDITIONS OR CHANGES ON THIS SHEET MUST BE MADE OR CIRCLED IN Red Ink WITH DATE AND NAME OF PERSON MAKING CHANGE.

Notes Ck'd by	D. M. Finley	Survey of	
Map No.	B-1005-3	W. O.	Tape No	St'd	OF.
Office Work	C.W. Cox	Surveyed by	
Checked		Notes	Date
Date		Indexed	A. C. Johnson

F.B. 541 PG. 105

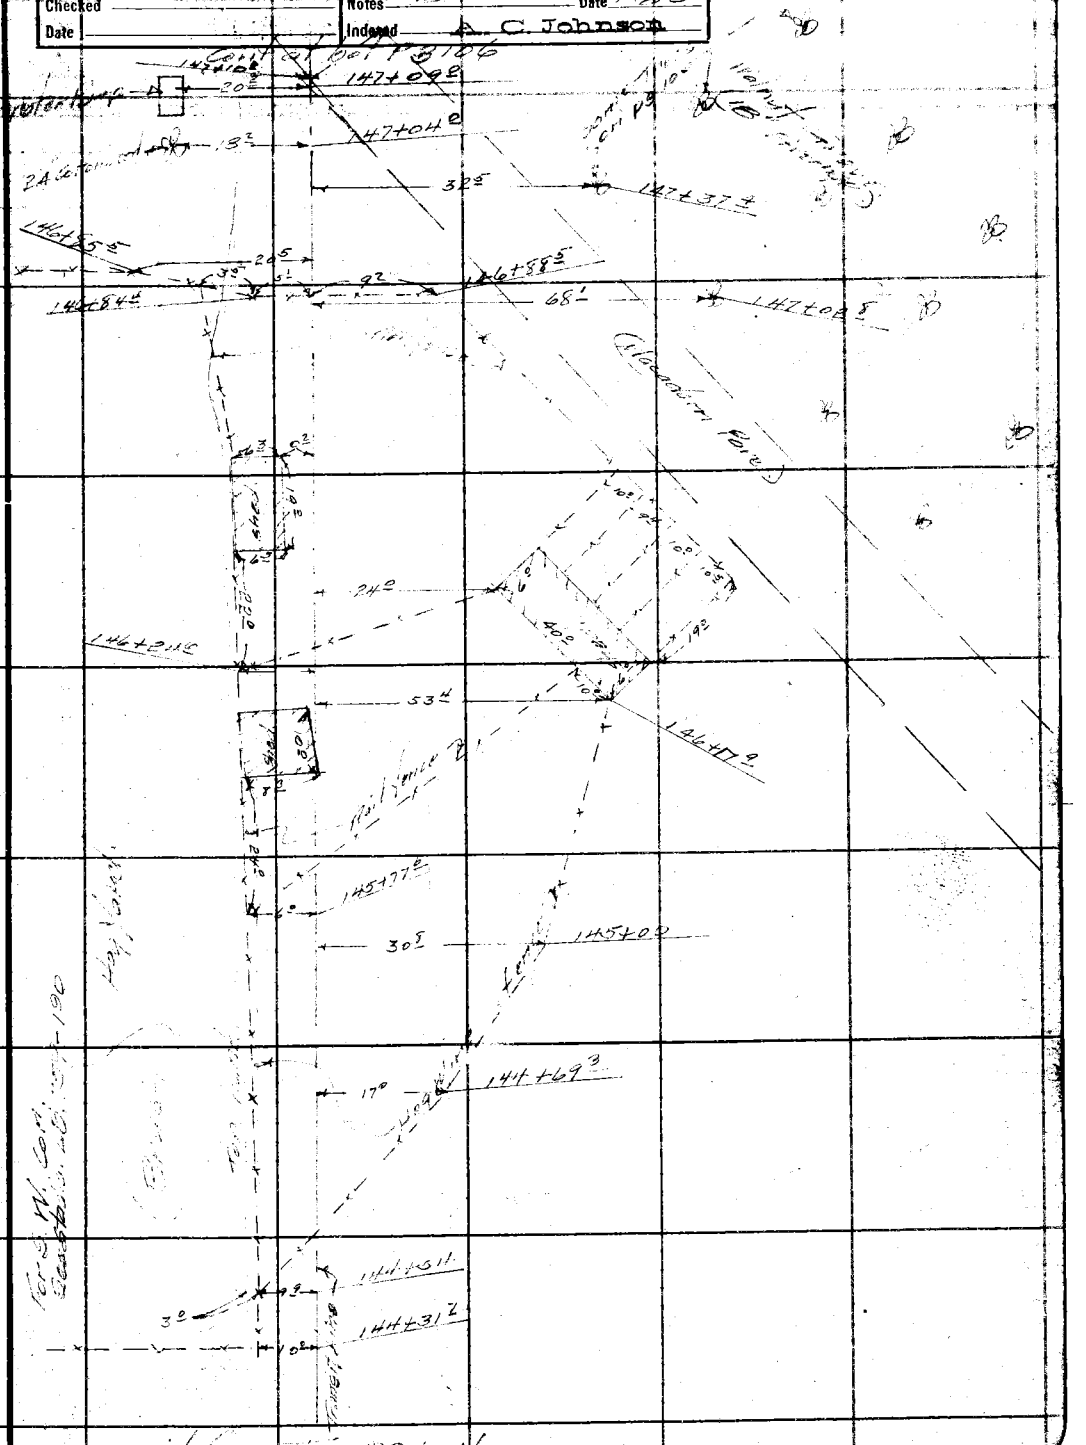

Note: ANY ADDITIONS OR CHANGES ON THIS SHEET MUST BE MADE OR CIRCLED IN Red Ink WITH DATE AND NAME OF PERSON MAKING CHANGE.

Do not extend notes this side of this line

RETURN TO
LOS ANGELES COUNTY SURVEYOR
700 HALL OF RECORDS

FORM 247 SM 2-34

F.B. 541 PG. 106

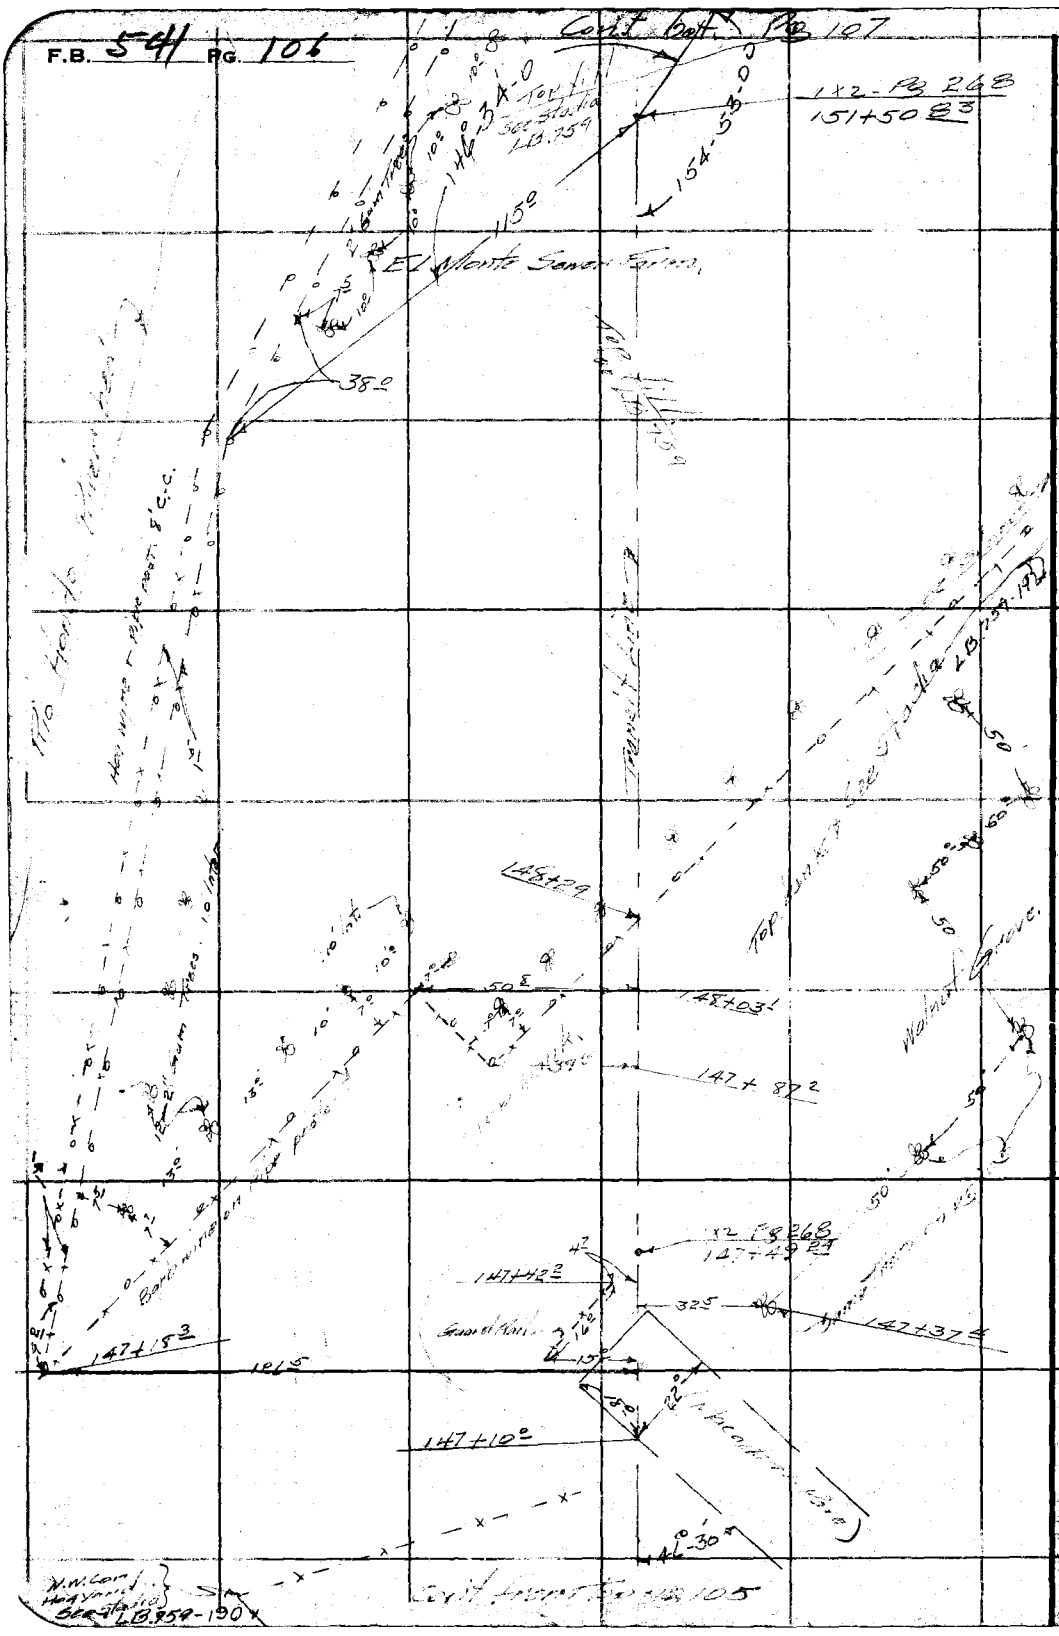

RETURN TO

LOS ANGELES COUNTY SURVEYOR

700 HALL OF RECORDS

Do not extend notes this side of this line

Note: ANY ADDITIONS OR CHANGES ON THIS SHEET MUST BE MADE OR CIRCLED IN Red Ink WITH DATE AND NAME OF PERSON MAKING CHANGE.

(To Bot. Pg 108)

Notes Ck'd by	D. M. Finley	Survey of	[illegible]
Map No.	B-1005-3	W. O.	[illegible] Tape No ____ St'd ____ OF.
Office Work	C. W. Cox	Surveyed by	Evans
Checked		Notes	Brush Date [illegible]
Date		Indexed	[illegible]

F.B. 541 Pg. 107

cult. field.

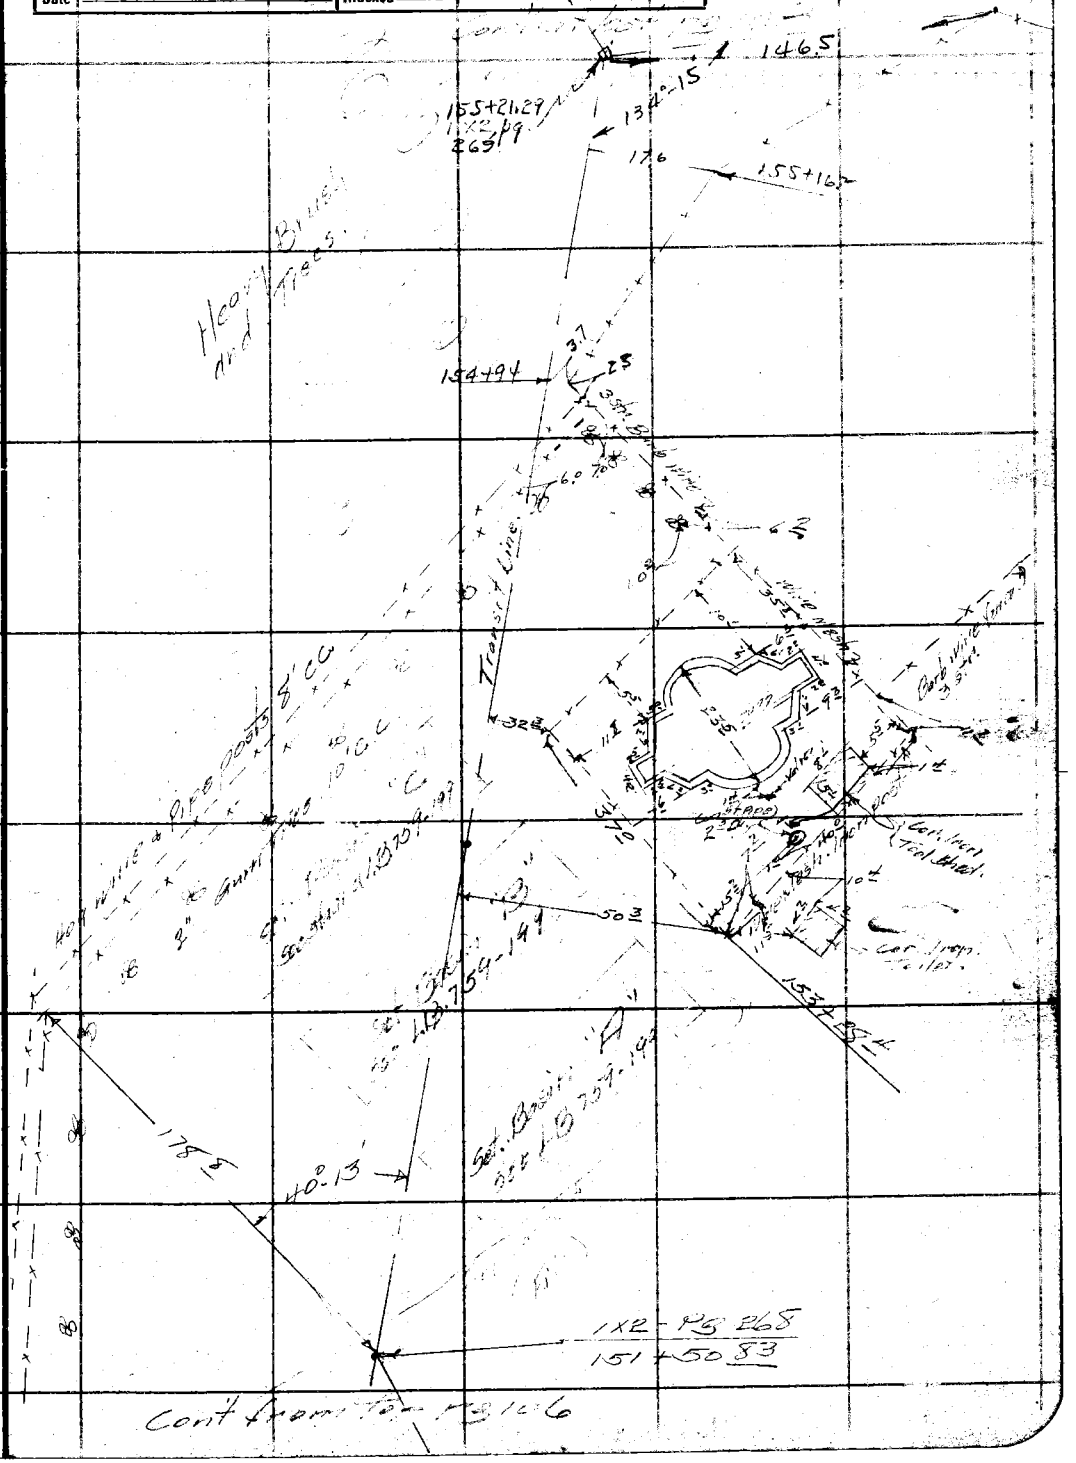

Note: ANY ADDITIONS OR CHANGES ON THIS SHEET MUST BE MADE OR CIRCLED IN Red Ink WITH DATE AND NAME OF PERSON MAKING CHANGE.

Do not extend notes this side of this line

RETURN TO
LOS ANGELES COUNTY SURVEYOR
700 HALL OF RECORDS

FORM 247 5M 2-34

F.B. 541 PG. 108

(To Bot. pg. 109.)

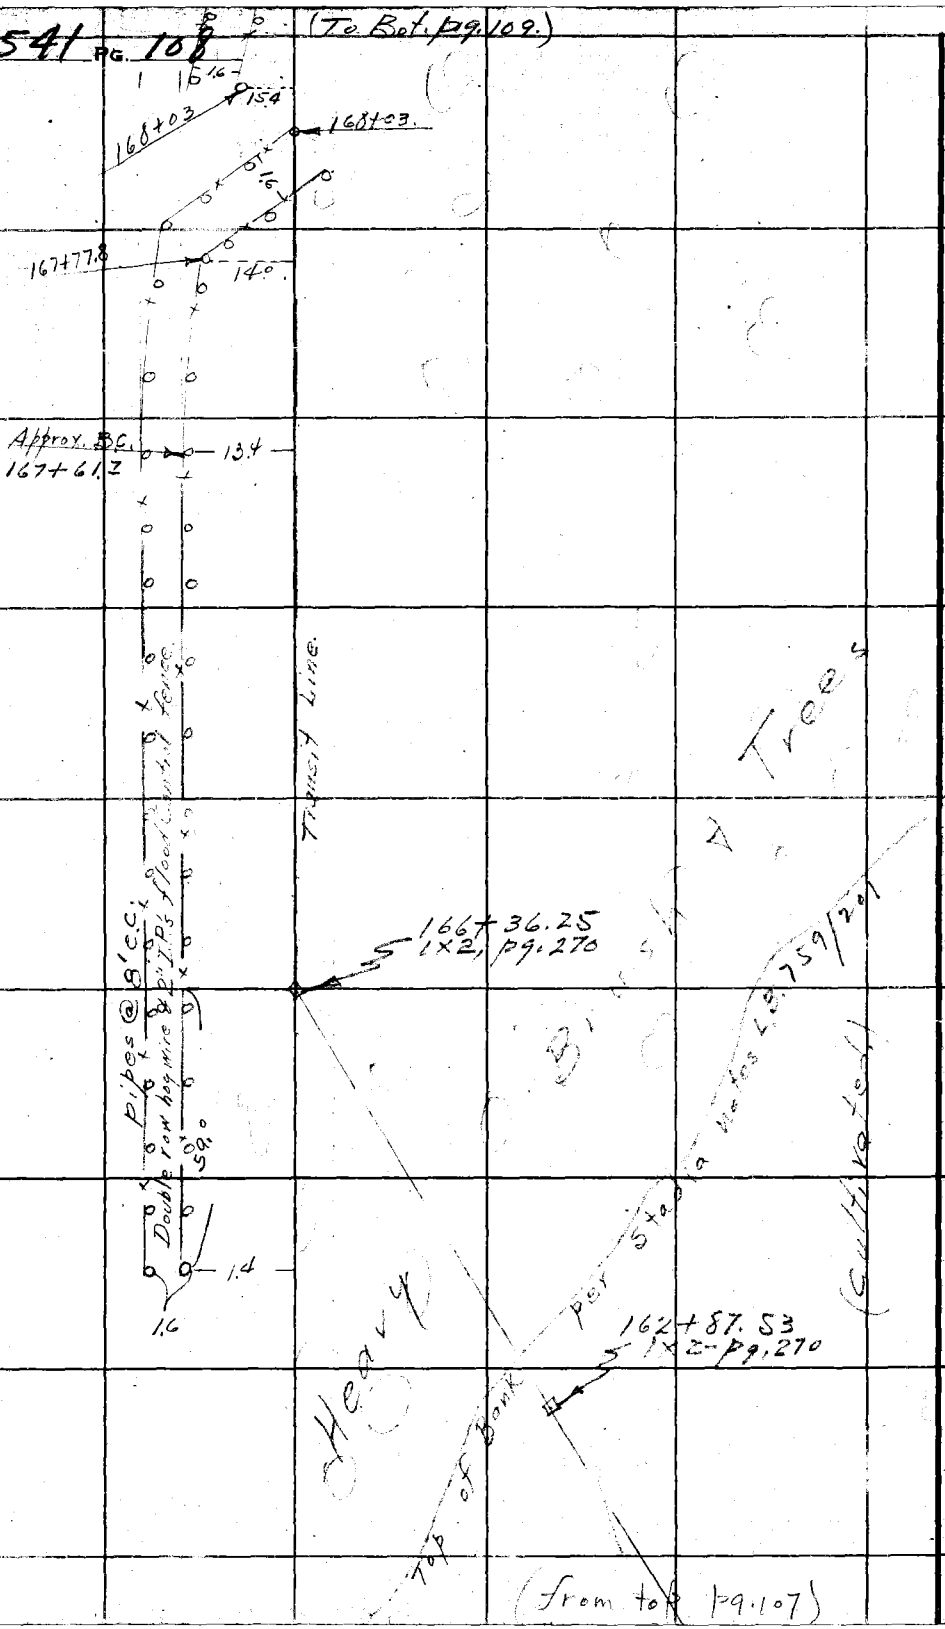

RETURN TO
LOS ANGELES COUNTY SURVEYOR
700 HALL OF RECORDS

Do not extend notes this side of this line

Note: ANY ADDITIONS OR CHANGES ON THIS SHEET MUST BE MADE OR CIRCLED IN **Red Ink** WITH DATE AND NAME OF PERSON MAKING CHANGE.

Notes Ck'd by D. M. Finley	Survey of El Monte Bridge [illegible]
Map No. B-1005-3	W. O. [illegible] Tape No [illegible] St'd [illegible] OF.
Office Work C.W. Cox	Surveyed by Evans
Checked	Notes [illegible] Date 1/28/35
Date	Indexed A. C. Johnson

F.B. 541 Pg. 109

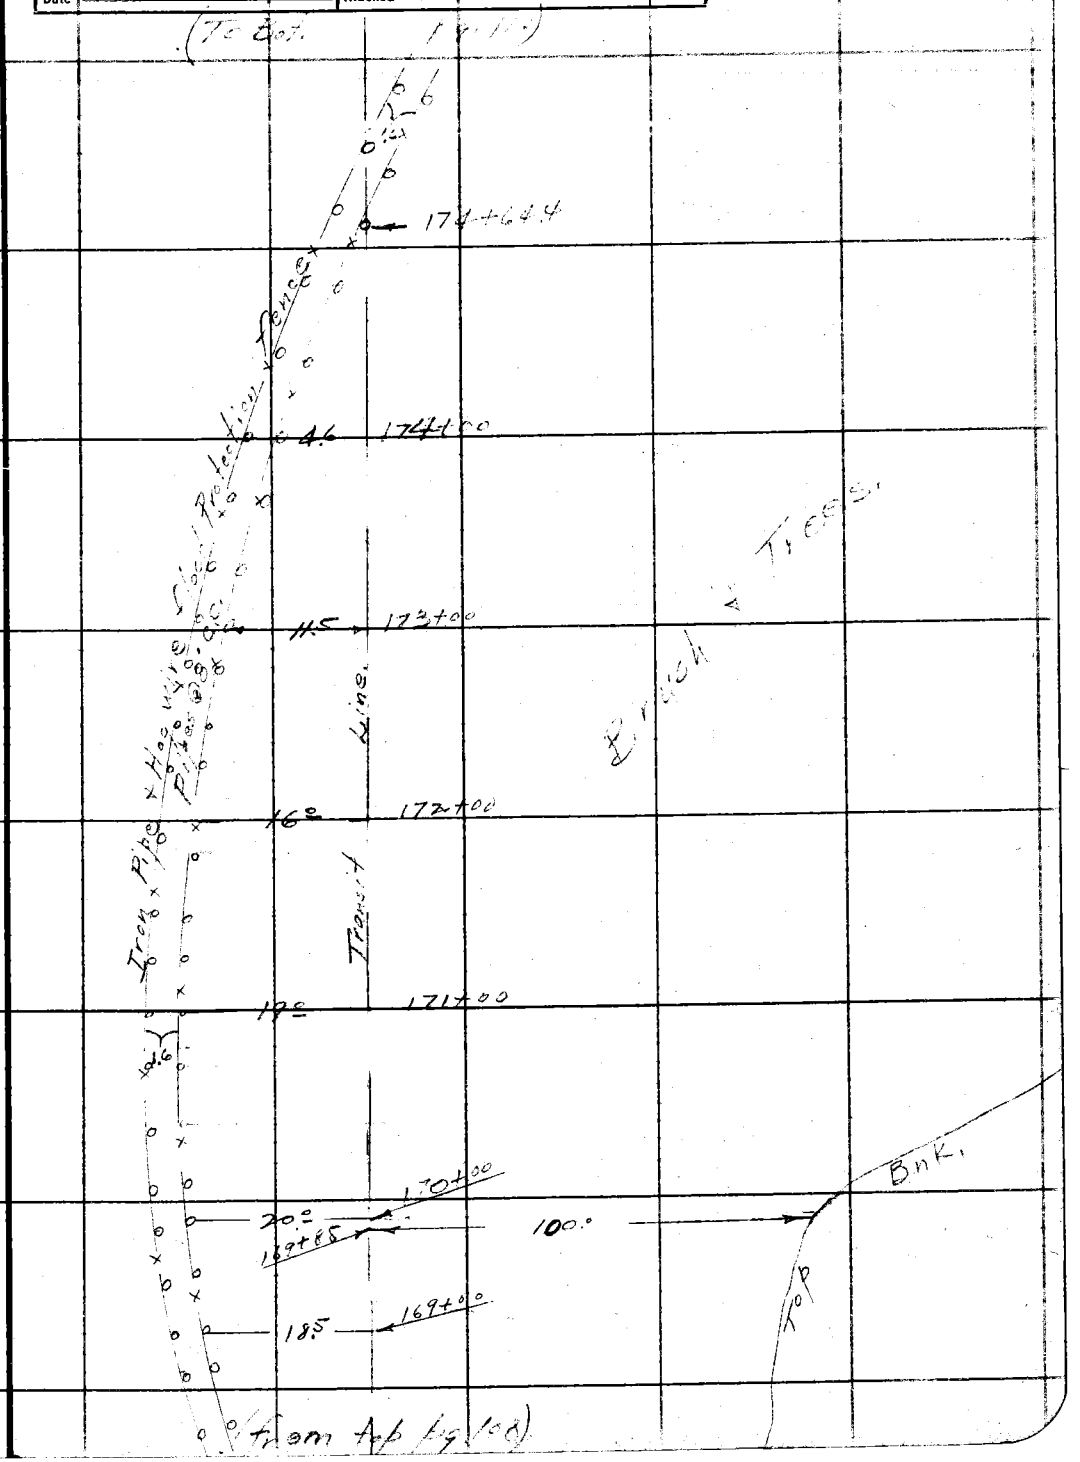

Note: ANY ADDITIONS OR CHANGES ON THIS SHEET MUST BE MADE OR CIRCLED IN Red Ink WITH DATE AND NAME OF PERSON MAKING CHANGE.

Do not extend notes this side of this line

RETURN TO
LOS ANGELES COUNTY SURVEYOR
700 HALL OF RECORDS

FORM 247 5M 2-34

F.B. 541 PG. 110

(To Bot. pg. 111)

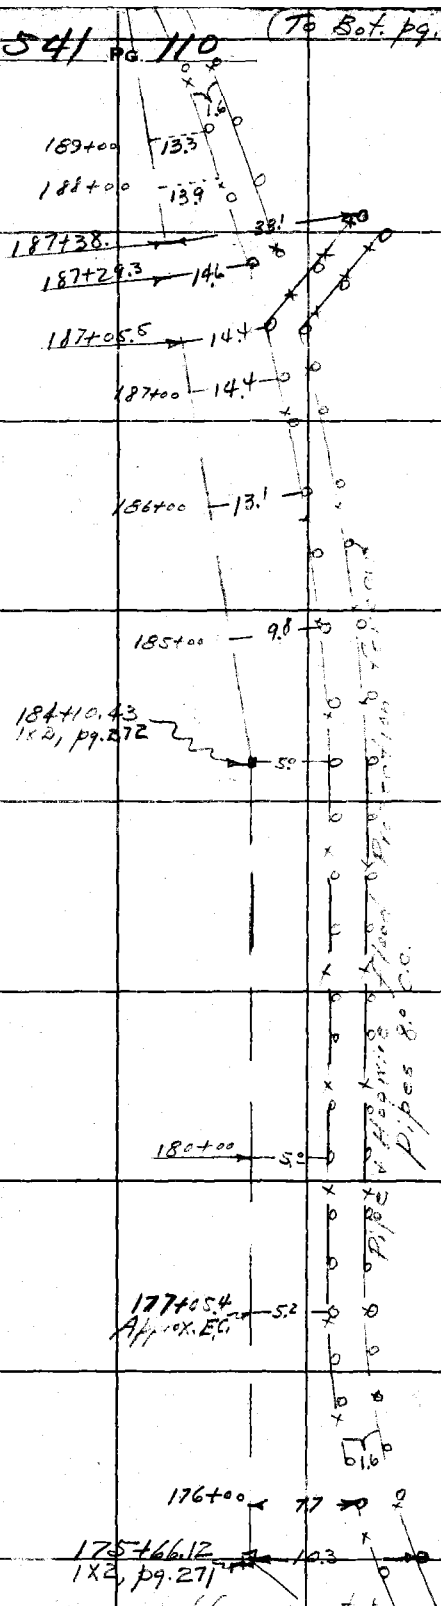

(from Bot. pg. 109)

RETURN TO
LOS ANGELES COUNTY SURVEYOR
700 HALL OF RECORDS

Note: ANY ADDITIONS OR CHANGES ON THIS SHEET MUST BE MADE OR CIRCLED IN **Red Ink** WITH DATE AND NAME OF PERSON MAKING CHANGE.

Do not extend notes this side of this line

Notes Ck'd by	D. M. Finley	Survey of	
Map No.	B-1005-3	W. O.	Tape No	St'd	OF.
Office Work	C. W. Cox	Surveyed by	
Checked		Notes	Date 11-28-34
Date		Indexed	H. C. JOHNSON

F.B. 541 PG. 111

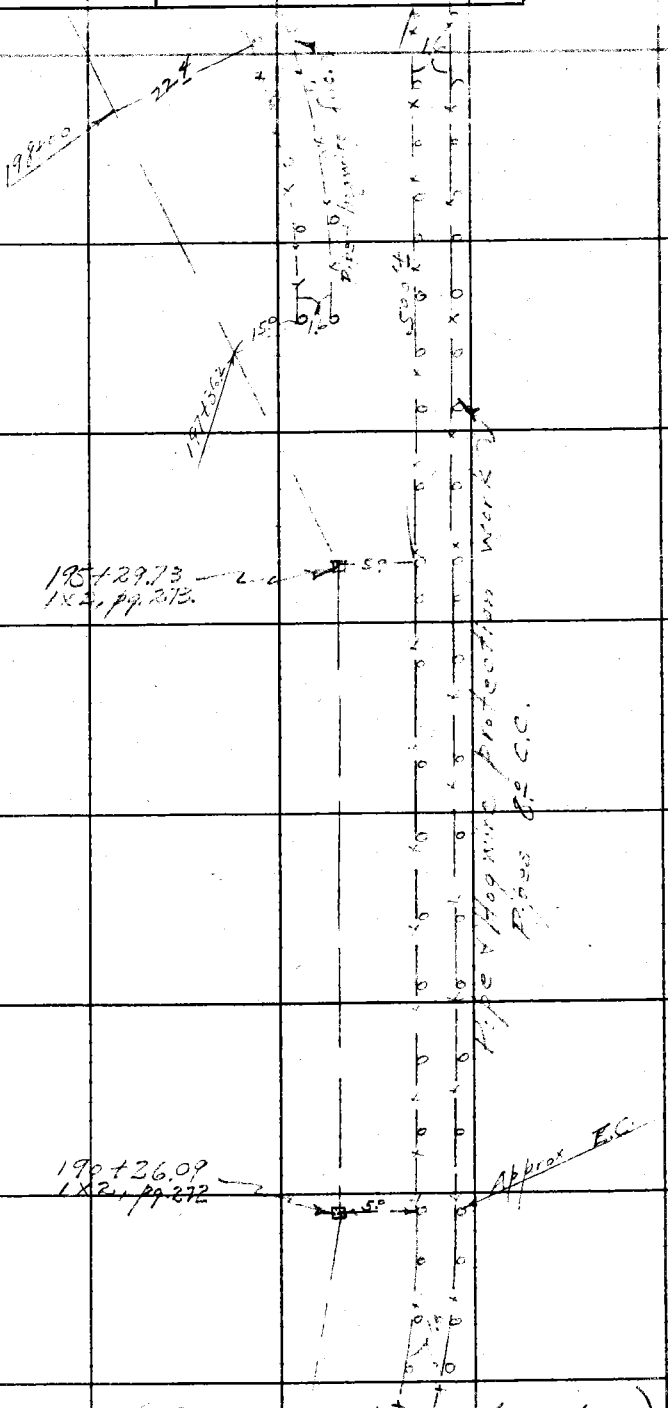

Note: ANY ADDITIONS OR CHANGES ON THIS SHEET MUST BE MADE OR CIRCLED IN Red Ink WITH DATE AND NAME OF PERSON MAKING CHANGE.

Do not extend notes this side of this line

RETURN TO
LOS ANGELES COUNTY SURVEYOR
700 HALL OF RECORDS

FORM 247 BM 2-34

F.B. 541 PG. 112

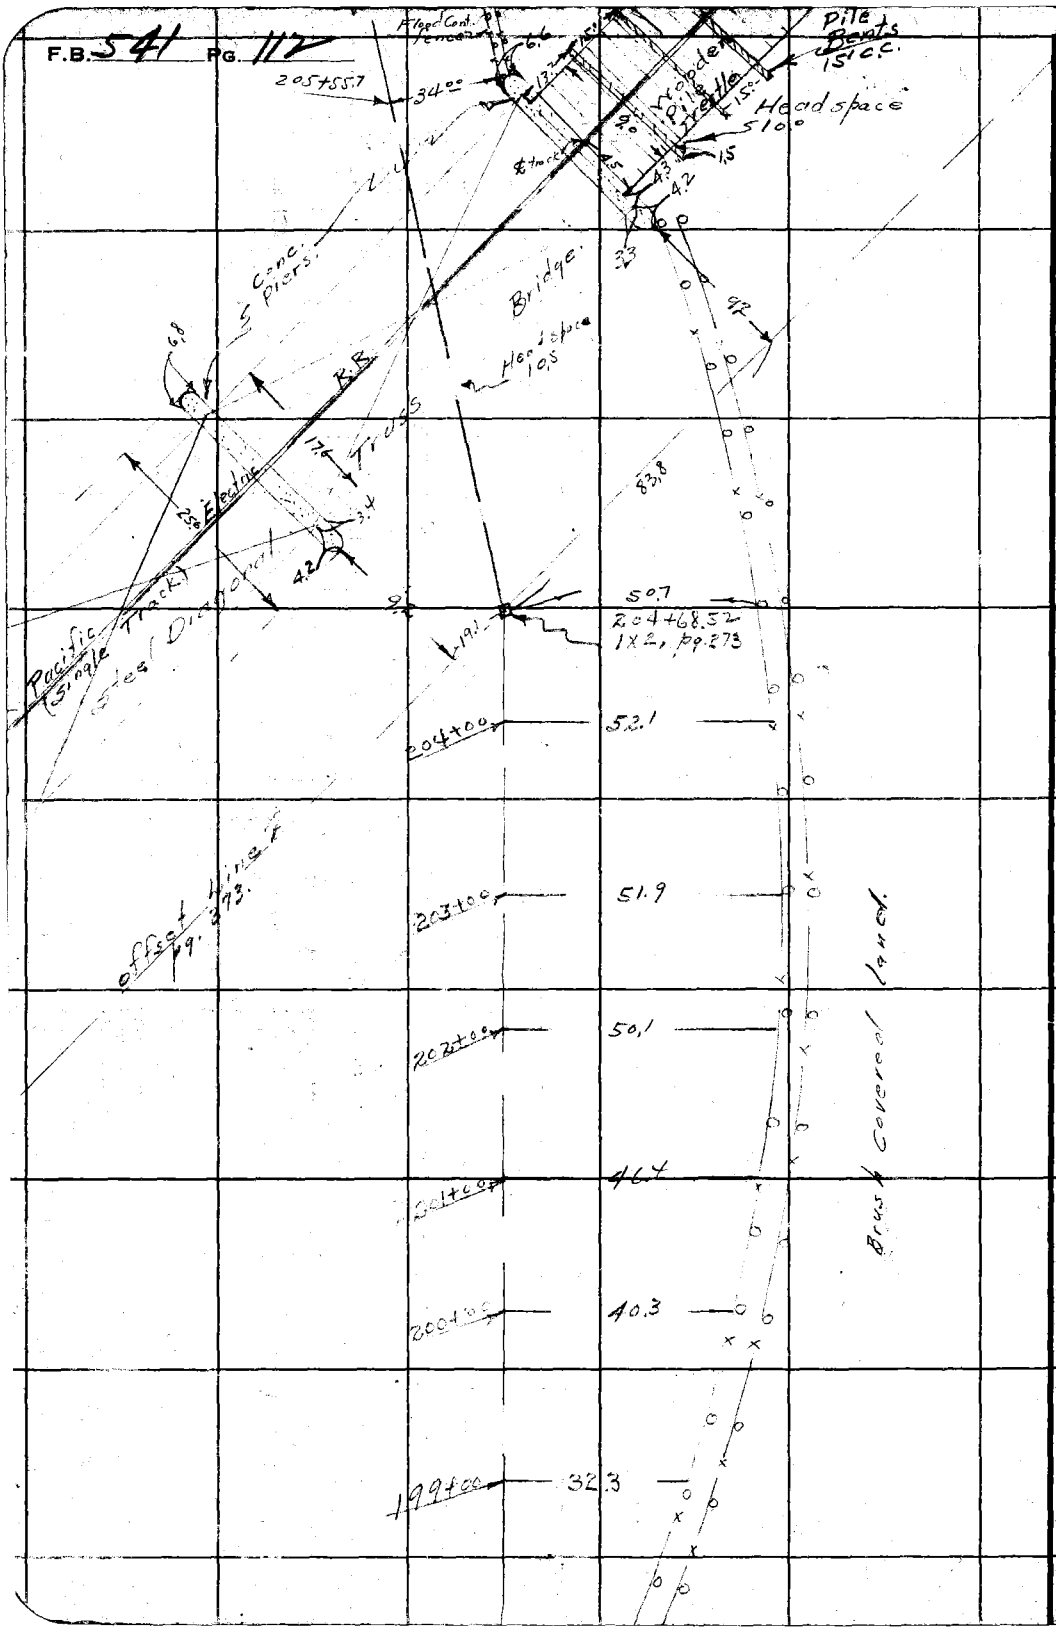

RETURN TO
LOS ANGELES COUNTY SURVEYOR
700 HALL OF RECORDS

Do not extend notes this side of this line

Note: ANY ADDITIONS OR CHANGES ON THIS SHEET MUST BE MADE OR CIRCLED IN **Red Ink** WITH DATE AND NAME OF PERSON MAKING CHANGE.

Notes Ck'd by	D. M. Finley	Survey of	[illegible]
Map No.	B-1005-3	W. O.	[illegible] Tape No ____ St'd ____ °F.
Office Work	C. W. Cox.	Surveyed by	[illegible]
Checked		Notes	[illegible] Date [illegible]
Date		Indexed	A. C. Johnson

F.B. 541 Pg. 113

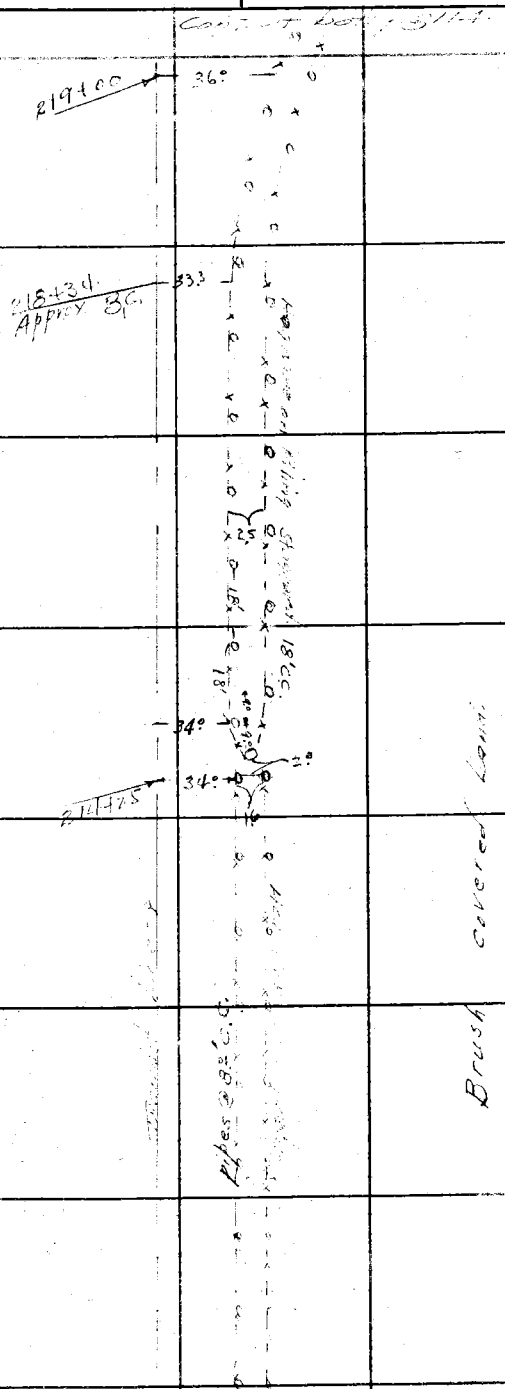

Cont. from pg 112

Note: ANY ADDITIONS OR CHANGES ON THIS SHEET MUST BE MADE OR CIRCLED IN Red Ink WITH DATE AND NAME OF PERSON MAKING CHANGE.

Do not extend notes this side of this line

RETURN TO
LOS ANGELES COUNTY SURVEYOR
700 HALL OF RECORDS

FORM 247 5M 2-34

F.B. 541 PG. 114

RETURN TO
LOS ANGELES COUNTY SURVEYOR
700 HALL OF RECORDS

Do not extend notes this side of this line

Note: ANY ADDITIONS OR CHANGES ON THIS SHEET MUST BE MADE OR CIRCLED IN **Red Ink** WITH DATE AND NAME OF PERSON MAKING CHANGE.

FORM 247 5M 2-34

RETURN TO

LOS ANGELES COUNTY SURVEYOR

700 HALL OF RECORDS

Note: ANY ADDITIONS OR CHANGES ON THIS SHEET MUST BE MADE OR CIRCLED IN **Red Ink** WITH DATE AND NAME OF PERSON MAKING CHANGE.

Do not extend notes this side of this line

Notes, Ck'd by _____

Map No. _____

Office Work _____

Checked _____

Date _____

Survey of _____

W. O. _____ Tape No _____ St'd _____ OF.

Surveyed by _____

Notes _____

Indexed _____ Date _____

F.B. 324 PG. 115

F.B. 541 PG. 116

RETURN TO
LOS ANGELES COUNTY SURVEYOR
700 HALL OF RECORDS

Note: ANY ADDITIONS OR CHANGES ON THIS SHEET MUST BE MADE OR CIRCLED IN **Red Ink** WITH DATE AND NAME OF PERSON MAKING CHANGE.

Do not extend notes this side of this line

FORM 247 5M 2-34

RETURN TO

LOS ANGELES COUNTY SURVEYOR

700 HALL OF RECORDS

Note: ANY ADDITIONS OR CHANGES ON THIS SHEET MUST BE MADE OR CIRCLED IN **Red Ink** WITH DATE AND NAME OF PERSON MAKING CHANGE.

Do not extend notes this side of this line

Notes Ck'd by _____

Map No. _____

Office Work

Checked _____

Date _____

Survey of _____

W. O. _____ Tape No _____ St'd _____ Of

Surveyed by _____

Notes _____

Indexed _____ Date _____

F.B. 544 PG. 117

RETURN TO

LOS ANGELES COUNTY SURVEYOR

700 HALL OF RECORDS

Note: ANY ADDITIONS OR CHANGES ON THIS SHEET MUST BE MADE OR CIRCLED IN **Red Ink** WITH DATE AND NAME OF PERSON MAKING CHANGE.

Do not extend notes this side of this line

F.B. 544 PG. 118

FORM 247 5M 2-34

RETURN TO

LOS ANGELES COUNTY SURVEYOR

700 HALL OF RECORDS

Note: ANY ADDITIONS OR CHANGES ON THIS SHEET MUST BE MADE OR CIRCLED IN **Red Ink** WITH DATE AND NAME OF PERSON MAKING CHANGE.

Do not extend notes this side of this line

Notes Ck'd by _____

Map No. _____

Office Work

Checked _____

Date _____

Survey of _____

W. O. _____ Tape No _____ St'd _____ or.

Surveyed by _____

Notes _____

Indexed _____ Date _____

F.B. 541 Pg. 119

RETURN TO

LOS ANGELES COUNTY SURVEYOR

700 HALL OF RECORDS

Note: ANY ADDITIONS OR CHANGES ON THIS SHEET MUST BE MADE OR CIRCLED IN **Red Ink** WITH DATE AND NAME OF PERSON MAKING CHANGE.

Do not extend notes this side of this line

F.B. 541 PG. 120

FORM 247 5M 2-34

RETURN TO

LOS ANGELES COUNTY SURVEYOR

700 HALL OF RECORDS

Note: ANY ADDITIONS OR CHANGES ON THIS SHEET MUST BE MADE OR CIRCLED IN **Red Ink** WITH DATE AND NAME OF PERSON MAKING CHANGE.

Do not extend notes this side of this line

Notes Ck'd by _____

Map No. _____

Office Work _____

Checked _____

Date _____

Survey of _____

W. O. _____ Tape No _____ St'd _____ OF.

Surveyed by _____

Notes _____

Indexed _____ Date _____

F.B. S41 PG. 121

RETURN TO

LOS ANGELES COUNTY SURVEYOR

700 HALL OF RECORDS

Note: ANY ADDITIONS OR CHANGES ON THIS SHEET MUST BE MADE OR CIRCLED IN Red Ink WITH DATE AND NAME OF PERSON MAKING CHANGE.

Do not extend notes this side of this line

F.B. 544 PG. 122

FORM 247 5M 2-34

RETURN TO

LOS ANGELES COUNTY SURVEYOR

700 HALL OF RECORDS

Note: ANY ADDITIONS OR CHANGES ON THIS SHEET MUST BE MADE OR CIRCLED IN **Red Ink** WITH DATE AND NAME OF PERSON MAKING CHANGE.

Do not extend notes this side of this line

Notes Ck'd by _____

Map No. _____

Office Work _____

Checked _____

Date _____

Survey of _____

W. O. _____ Tape No _____ St'd _____ of.

Surveyed by _____

Notes _____

Indexed _____ Date _____

F.B. 594 PG. 173

RETURN TO

LOS ANGELES COUNTY SURVEYOR

700 HALL OF RECORDS

Note: ANY ADDITIONS OR CHANGES ON THIS SHEET MUST BE MADE OR CIRCLED IN **Red Ink** WITH DATE AND NAME OF PERSON MAKING CHANGE.

Do not extend notes this side of this line

F.B. 549 PG. 12-4

FORM 247 BM 2-34

RETURN TO

LOS ANGELES COUNTY SURVEYOR

700 HALL OF RECORDS

Note: ANY ADDITIONS OR CHANGES ON THIS SHEET MUST BE MADE OR CIRCLED IN **Red Ink** WITH DATE AND NAME OF PERSON MAKING CHANGE.

Do not extend notes this side of this line

Notes Ck'd by

Map No.

Office Work

Checked

Date

Survey of

W. O. Tape No St'd of.

Surveyed by

Notes

Indexed Date

F.B. 544 Pg. 125

RETURN TO

LOS ANGELES COUNTY SURVEYOR

700 HALL OF RECORDS

Note: ANY ADDITIONS OR CHANGES ON THIS SHEET MUST BE MADE OR CIRCLED IN **Red Ink** WITH DATE AND NAME OF PERSON MAKING CHANGE.

Do not extend notes this side of this line

F.B. 841 PG. 126

FORM 247 5M 2-34

RETURN TO

LOS ANGELES COUNTY SURVEYOR

700 HALL OF RECORDS

Note: ANY ADDITIONS OR CHANGES ON THIS SHEET MUST BE MADE OR CIRCLED IN **Red Ink** WITH DATE AND NAME OF PERSON MAKING CHANGE.

Do not extend notes this side of this line

Notes Ck'd by

Map No.

Office Work

Checked

Date

Survey of

W. O. Tape No St'd

Surveyed by

Notes

Indexed Date

F.B. 541 PG. 127

RETURN TO

LOS ANGELES COUNTY SURVEYOR

700 HALL OF RECORDS

Note; ANY ADDITIONS OR CHANGES ON THIS SHEET MUST BE MADE OR CIRCLED IN **Red Ink** WITH DATE AND NAME OF PERSON MAKING CHANGE.

Do not extend notes this side of this line

F.B. 541 PG. 128

FORM 247 5M 2-34

RETURN TO

LOS ANGELES COUNTY SURVEYOR

700 HALL OF RECORDS

Note: ANY ADDITIONS OR CHANGES ON THIS SHEET MUST BE MADE OR CIRCLED IN **Red Ink** WITH DATE AND NAME OF PERSON MAKING CHANGE.

Do not extend notes this side of this line

Notes Ck'd by

Map No.

Office Work

Checked

Date

Survey of

W. O. Tape No St'd of

Surveyed by

Notes

Date

Indexed

F. B. 541 Pg. 129

RETURN TO

LOS ANGELES COUNTY SURVEYOR

700 HALL OF RECORDS

Note: ANY ADDITIONS OR CHANGES ON THIS SHEET MUST BE MADE OR CIRCLED IN **Red Ink** WITH DATE AND NAME OF PERSON MAKING CHANGE.

Do not extend notes this side of this line

F.B. 541 PG. 130

FORM 247 5M 2-34

RETURN TO

LOS ANGELES COUNTY SURVEYOR

700 HALL OF RECORDS

Note: ANY ADDITIONS OR CHANGES ON THIS SHEET MUST BE MADE OR CIRCLED IN **Red Ink** WITH DATE AND NAME OF PERSON MAKING CHANGE.

Do not extend notes this side of this line

Notes Ck'd by _____

Map No. _____

Office Work

Checked _____

Date _____

Survey of _____

W. O. _____ Tape No _____ Sr'd _____ OF.

Surveyed by _____

Notes _____ Date _____

Indexed _____

F.B. 541 Pg. 121

RETURN TO

LOS ANGELES COUNTY SURVEYOR

700 HALL OF RECORDS

Note: ANY ADDITIONS OR CHANGES ON THIS SHEET MUST BE MADE OR CIRCLED IN **Red Ink** WITH DATE AND NAME OF PERSON MAKING CHANGE.

Do not extend notes this side of this line

F.B. 544 PG. 132

FORM 247 5M 2-34

RETURN TO

LOS ANGELES COUNTY SURVEYOR

700 HALL OF RECORDS

Note: ANY ADDITIONS OR CHANGES ON THIS SHEET MUST BE MADE OR CIRCLED IN **Red Ink** WITH DATE AND NAME OF PERSON MAKING CHANGE.

Do not extend notes this side of this line

Notes Ck'd by _____

Map No. _____

Office Work

Checked _____

Date _____

Survey of _____

W. O. _____ Tape No _____ St'd _____ Of.

Surveyed by _____

Notes _____

Indexed _____ Date _____

F.B. 544 Pg. 133

RETURN TO

LOS ANGELES COUNTY SURVEYOR

700 HALL OF RECORDS

Note; ANY ADDITIONS OR CHANGES ON THIS SHEET MUST BE MADE OR CIRCLED IN Red Ink WITH DATE AND NAME OF PERSON MAKING CHANGE.

Do not extend notes this side of this line

F.B. 541 PG. 134

FORM 247 5M 2-34

RETURN TO

LOS ANGELES COUNTY SURVEYOR

700 HALL OF RECORDS

Note: ANY ADDITIONS OR CHANGES ON THIS SHEET MUST BE MADE OR CIRCLED IN **Red Ink** WITH DATE AND NAME OF PERSON MAKING CHANGE.

Do not extend notes this side of this line

Notes Ck'd by _____

Map No. _____

Office Work _____

Checked _____

Date _____

Survey of _____

W. O. _____ Tape No _____ St'd _____ OF.

Surveyed by _____

Notes _____

Date _____

Indexed _____

F.B. 544 PG. 735

RETURN TO

LOS ANGELES COUNTY SURVEYOR

700 HALL OF RECORDS

Note: ANY ADDITIONS OR CHANGES ON THIS SHEET MUST BE MADE OR CIRCLED IN **Red Ink** WITH DATE AND NAME OF PERSON MAKING CHANGE.

Do not extend notes this side of this line

F.B. 541 PG. 136

FORM 247 5M 2-34

RETURN TO

LOS ANGELES COUNTY SURVEYOR

700 HALL OF RECORDS

Note: ANY ADDITIONS OR CHANGES ON THIS SHEET MUST BE MADE OR CIRCLED IN **Red Ink** WITH DATE AND NAME OF PERSON MAKING CHANGE.

Do not extend notes this side of this line

Notes Ck'd by

Map No.

Office Work

Checked

Date

Survey of

W. O. Tape No Sht'd of

Surveyed by

Notes

Indexed Date

F.B. 544 PG. 137

RETURN TO

LOS ANGELES COUNTY SURVEYOR

700 HALL OF RECORDS

Note: ANY ADDITIONS OR CHANGES ON THIS SHEET MUST BE MADE OR CIRCLED IN **Red Ink** WITH DATE AND NAME OF PERSON MAKING CHANGE.

Do not extend notes this side of this line

F.B. 541 PG. 138

FORM 247 5M 2-34

RETURN TO

LOS ANGELES COUNTY SURVEYOR

700 HALL OF RECORDS

Note: ANY ADDITIONS OR CHANGES ON THIS SHEET MUST BE MADE OR CIRCLED IN **Red Ink** WITH DATE AND NAME OF PERSON MAKING CHANGE.

Do not extend notes this side of this line

Notes Ck'd by _____

Map No. _____

Office Work _____

Checked _____

Date _____

Survey of _____

W. O. _____ Tape No. _____ St'd _____ of _____

Surveyed by _____

Notes _____ Date _____

Indexed _____

F.B. 354 PG. 139

RETURN TO

LOS ANGELES COUNTY SURVEYOR

700 HALL OF RECORDS

Note: ANY ADDITIONS OR CHANGES ON THIS SHEET MUST BE MADE OR CIRCLED IN **Red Ink** WITH DATE AND NAME OF PERSON MAKING CHANGE.

Do not extend notes this side of this line

F.B. 541 PG. 140

FORM 247 5M 2-34

RETURN TO

LOS ANGELES COUNTY SURVEYOR

700 HALL OF RECORDS

Note: ANY ADDITIONS OR CHANGES ON THIS SHEET MUST BE MADE OR CIRCLED IN **Red Ink** WITH DATE AND NAME OF PERSON MAKING CHANGE.

Do not extend notes this side of this line

Notes Ck'd by

Map No.

Office Work Checked

Date

Survey of

W. O. Tape No St'd Of.

Surveyed by

Notes

Indexed Date

F.B. 524 Pg. 141

RETURN TO

LOS ANGELES COUNTY SURVEYOR

700 HALL OF RECORDS

Note: ANY ADDITIONS OR CHANGES ON THIS SHEET MUST BE MADE OR CIRCLED IN **Red Ink** WITH DATE AND NAME OF PERSON MAKING CHANGE.

Do not extend notes this side of this line

F.B. 541 PG. 142

FORM 247 5M 2-34

RETURN TO

LOS ANGELES COUNTY SURVEYOR

700 HALL OF RECORDS

Note: ANY ADDITIONS OR CHANGES ON THIS SHEET MUST BE MADE OR CIRCLED IN **Red Ink** WITH DATE AND NAME OF PERSON MAKING CHANGE.

Do not extend notes this side of this line

Notes Ck'd by _____

Map No. _____

Offic'l Work _____

Checked _____

Date _____

Survey of _____

W. O. _____ Tape No _____ St'd _____ OF.

Surveyed by _____

Notes _____ Date _____

Indexed _____

F.B. 341 PG. 143

RETURN TO

LOS ANGELES COUNTY SURVEYOR

700 HALL OF RECORDS

Note; ANY ADDITIONS OR CHANGES ON THIS SHEET MUST BE MADE OR CIRCLED IN **Red Ink** WITH DATE AND NAME OF PERSON MAKING CHANGE.

Do not extend notes this side of this line

F.B. 541 Pg. 144

FORM 247 5M 2-34

RETURN TO

LOS ANGELES COUNTY SURVEYOR

700 HALL OF RECORDS

Note: ANY ADDITIONS OR CHANGES ON THIS SHEET MUST BE MADE OR CIRCLED IN **Red Ink** WITH DATE AND NAME OF PERSON MAKING CHANGE.

Do not extend notes this side of this line

Notes Ck'd by _____

Map No. _____

Office Work _____

Checked _____

Date _____

Survey of _____

W. O. _____ Tape No _____ Sr'd _____ of _____

Surveyed by _____

Notes _____ Date _____

Indexed _____

F.B. 541 Pg. 145

RETURN TO

LOS ANGELES COUNTY SURVEYOR

700 HALL OF RECORDS

Note: ANY ADDITIONS OR CHANGES ON THIS SHEET MUST BE MADE OR CIRCLED IN **Red Ink** WITH DATE AND NAME OF PERSON MAKING CHANGE.

Do not extend notes this side of this line

F.B. 541 PG. 146

FORM 247 5M 2-34

RETURN TO

LOS ANGELES COUNTY SURVEYOR

700 HALL OF RECORDS

Note: ANY ADDITIONS OR CHANGES ON THIS SHEET MUST BE MADE OR CIRCLED IN **Red Ink** WITH DATE AND NAME OF PERSON MAKING CHANGE.

Do not extend notes this side of this line

Notes Ck'd by _____

Map No. _____

Office Work

Checked _____

Date _____

Survey of _____

W. O. _____ Tape No _____ St'd _____ OF.

Surveyed by _____

Notes _____ Date _____

Indexed _____

F.B. 541 PG. 147

RETURN TO

LOS ANGELES COUNTY SURVEYOR

700 HALL OF RECORDS

Note: ANY ADDITIONS OR CHANGES ON THIS SHEET MUST BE MADE OR CIRCLED IN **Red Ink** WITH DATE AND NAME OF PERSON MAKING CHANGE.

Do not extend notes this side of this line

F.B. 541 Pg. 148

FORM 247 5M 2-34

RETURN TO

LOS ANGELES COUNTY SURVEYOR

700 HALL OF RECORDS

Note: ANY ADDITIONS OR CHANGES ON THIS SHEET MUST BE MADE OR CIRCLED IN **Red Ink** WITH DATE AND NAME OF PERSON MAKING CHANGE.

Do not extend notes this side of this line

Notes Ck'd by _____

Map No. _____

Office Work

Checked _____

Date _____

Survey of _____

W. O. _____ Tape No _____ St'd _____ OF.

Surveyed by _____

Notes _____ Date _____

Indexed _____

F.B. 541 PG. 129

RETURN TO

LOS ANGELES COUNTY SURVEYOR

700 HALL OF RECORDS

Note: ANY ADDITIONS OR CHANGES ON THIS SHEET MUST BE MADE OR CIRCLED IN **Red Ink** WITH DATE AND NAME OF PERSON MAKING CHANGE.

Do not extend notes this side of this line

F.B. 541 Pg. 150

Div 2

Notes Ck'd by D. M. Finley	Survey of El Monte Bridle Trail
Map No. B-1006	W. O. [illegible] Tape No. ____ St'd ____ °F.
[illegible] C.H. [illegible]	[illegible]
Checked	Notes Moore Date
Date	Indexed A. C. Johnson 5-21-34

F.B. 541 Pg. 151

SURVEY
of
EL MONTE BRIDLE TRAIL
DIV #2
from
SIPHON ROAD
to
PECK ROAD
ALONG WEST BANK
of the
SAN GABRIEL RIVER
Job # 8012

Tape #067
Normal @ 84°F

Party	
H.F. Evans	Dep.
A.W. Van Fleet	T
G.F. Brock	H.C.
D.S. Sedig	R.C.
H.L. Martin	T

Note: ANY ADDITIONS OR CHANGES ON THIS SHEET MUST BE MADE OR CIRCULATED IN [illegible] WITH DATE AND NAME OF PERSON [illegible] ING CHANGE.

RETURN TO
LOS ANGELES COUNTY SURVEYOR
700 HALL OF RECORDS
Do not expand notes this side of this line

FORM 247 10M 5-31

RETURN TO
LOS ANGELES COUNTY SURVEYOR
700 HALL OF RECORDS

Note: ANY ADDITIONS OR CHANGES ON THIS SHEET MUST BE MADE OR CIRCLED IN **Red Ink.** WITH DATE AND NAME OF PERSON MAKING CHANGE.

Do not extend notes this side of this line

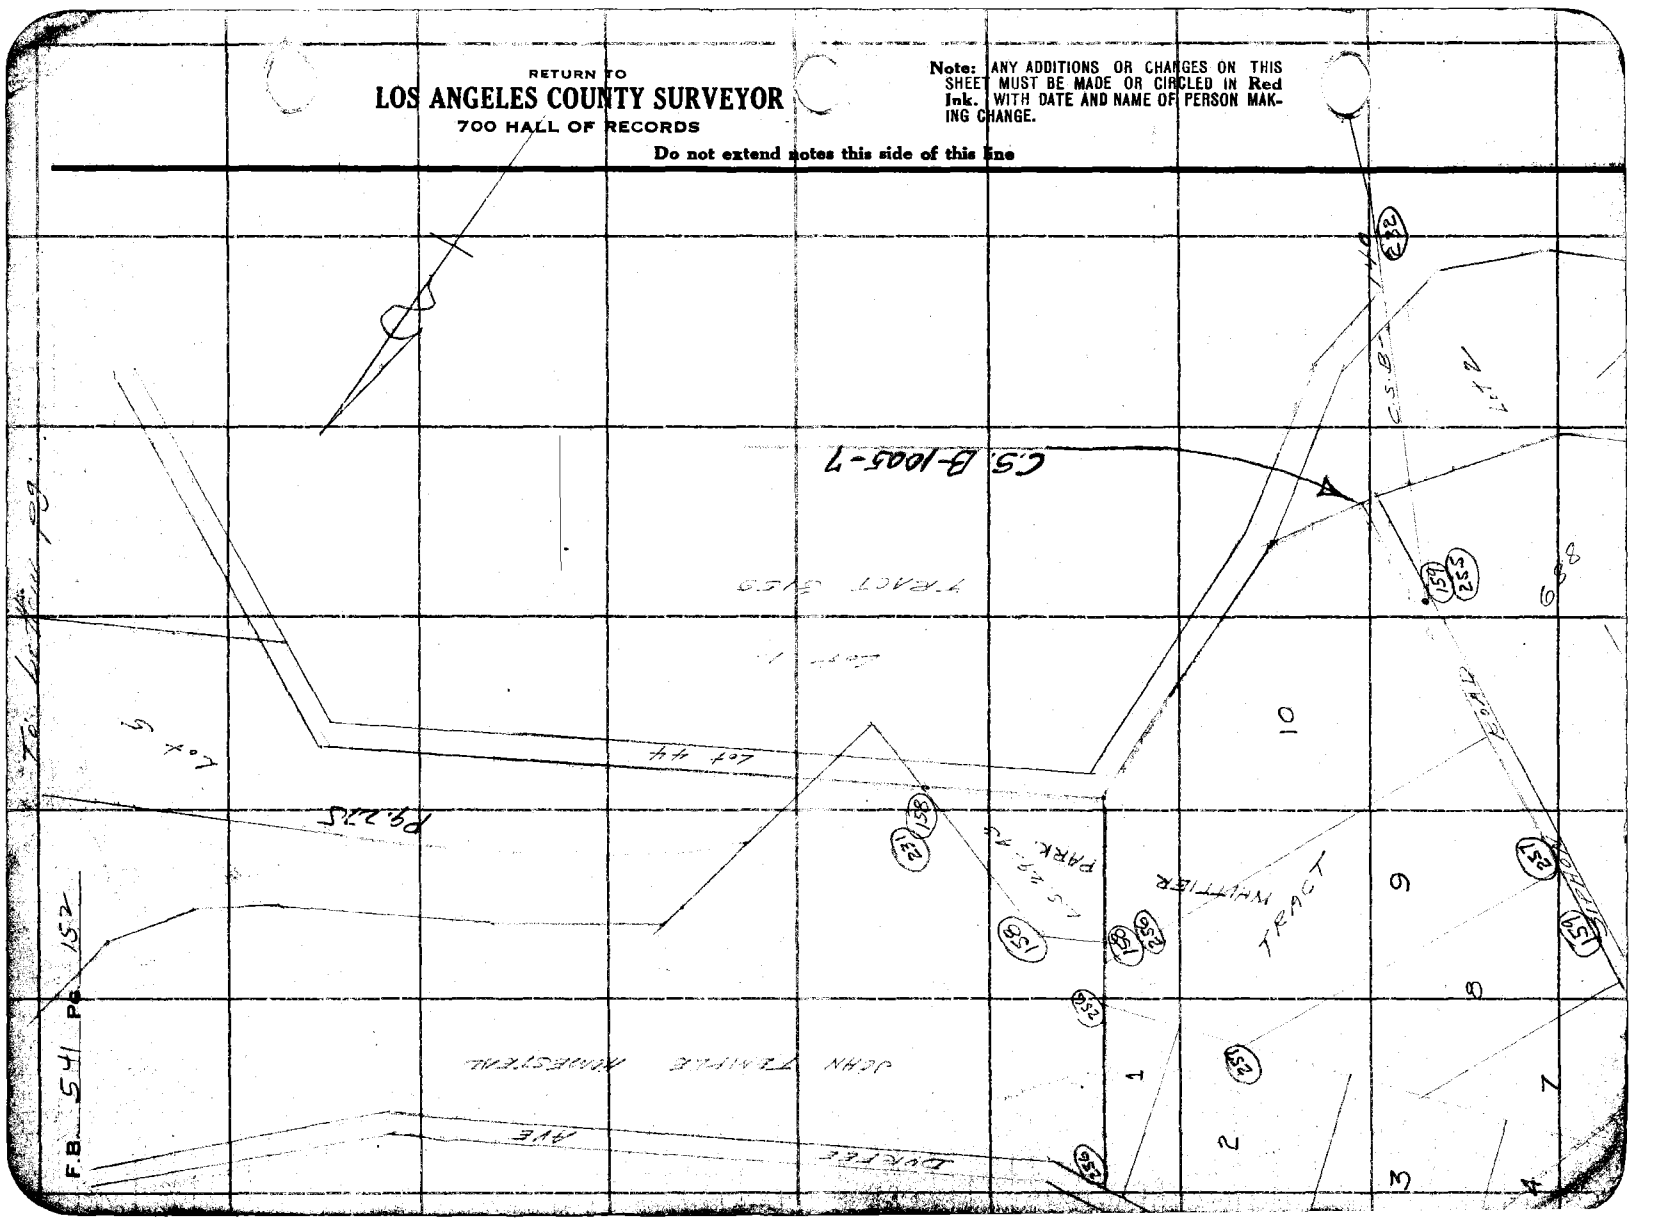

Notes Ck'd by D.M. Finley	Survey of [illegible]
Map No. B-1005-7	W. O. [illegible] Tape No. ____ St'd ____ °F.
Office Work C.W. Cox	Surveyed by L.D. Moore
Checked	Notes Moore Date
Date	Indexed A. C. Johnson

F.B. 541 PG. 153

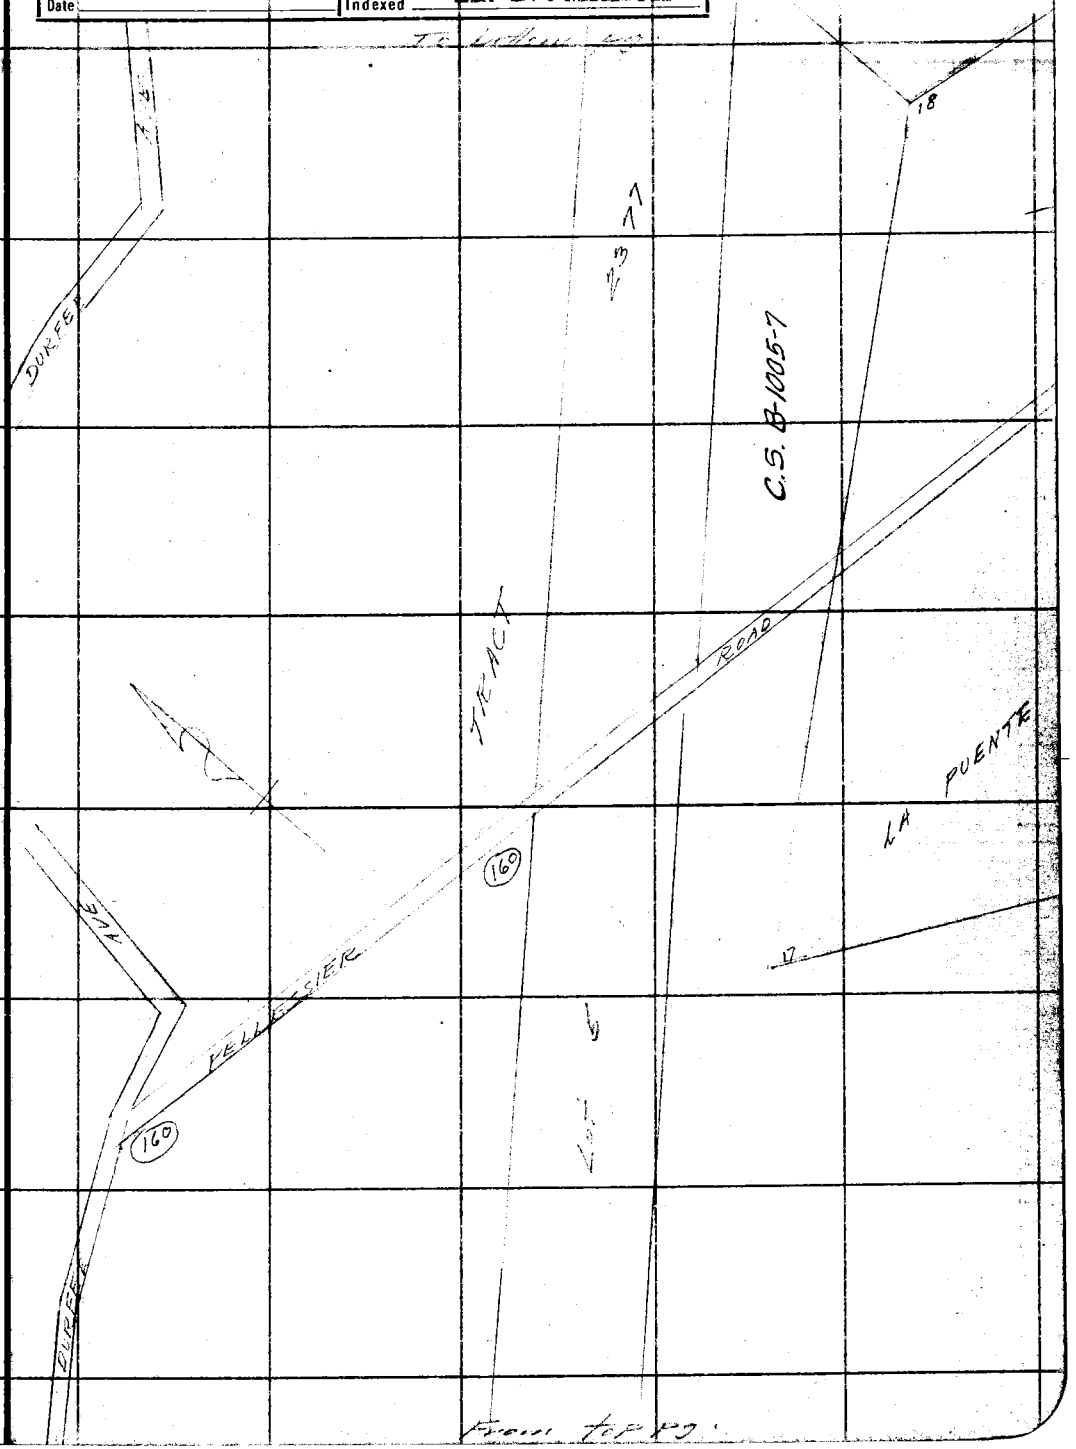

Note: ANY ADDITIONS OR CHANGES ON THIS SHEET MUST BE MADE OR CIRCLED IN Red Ink. WITH DATE AND NAME OF PERSON MAKING CHANGE.

RETURN TO
LOS ANGELES COUNTY SURVEYOR
700 HALL OF RECORDS

Do not extend notes this side of this line

FORM 247 10M. 5-31

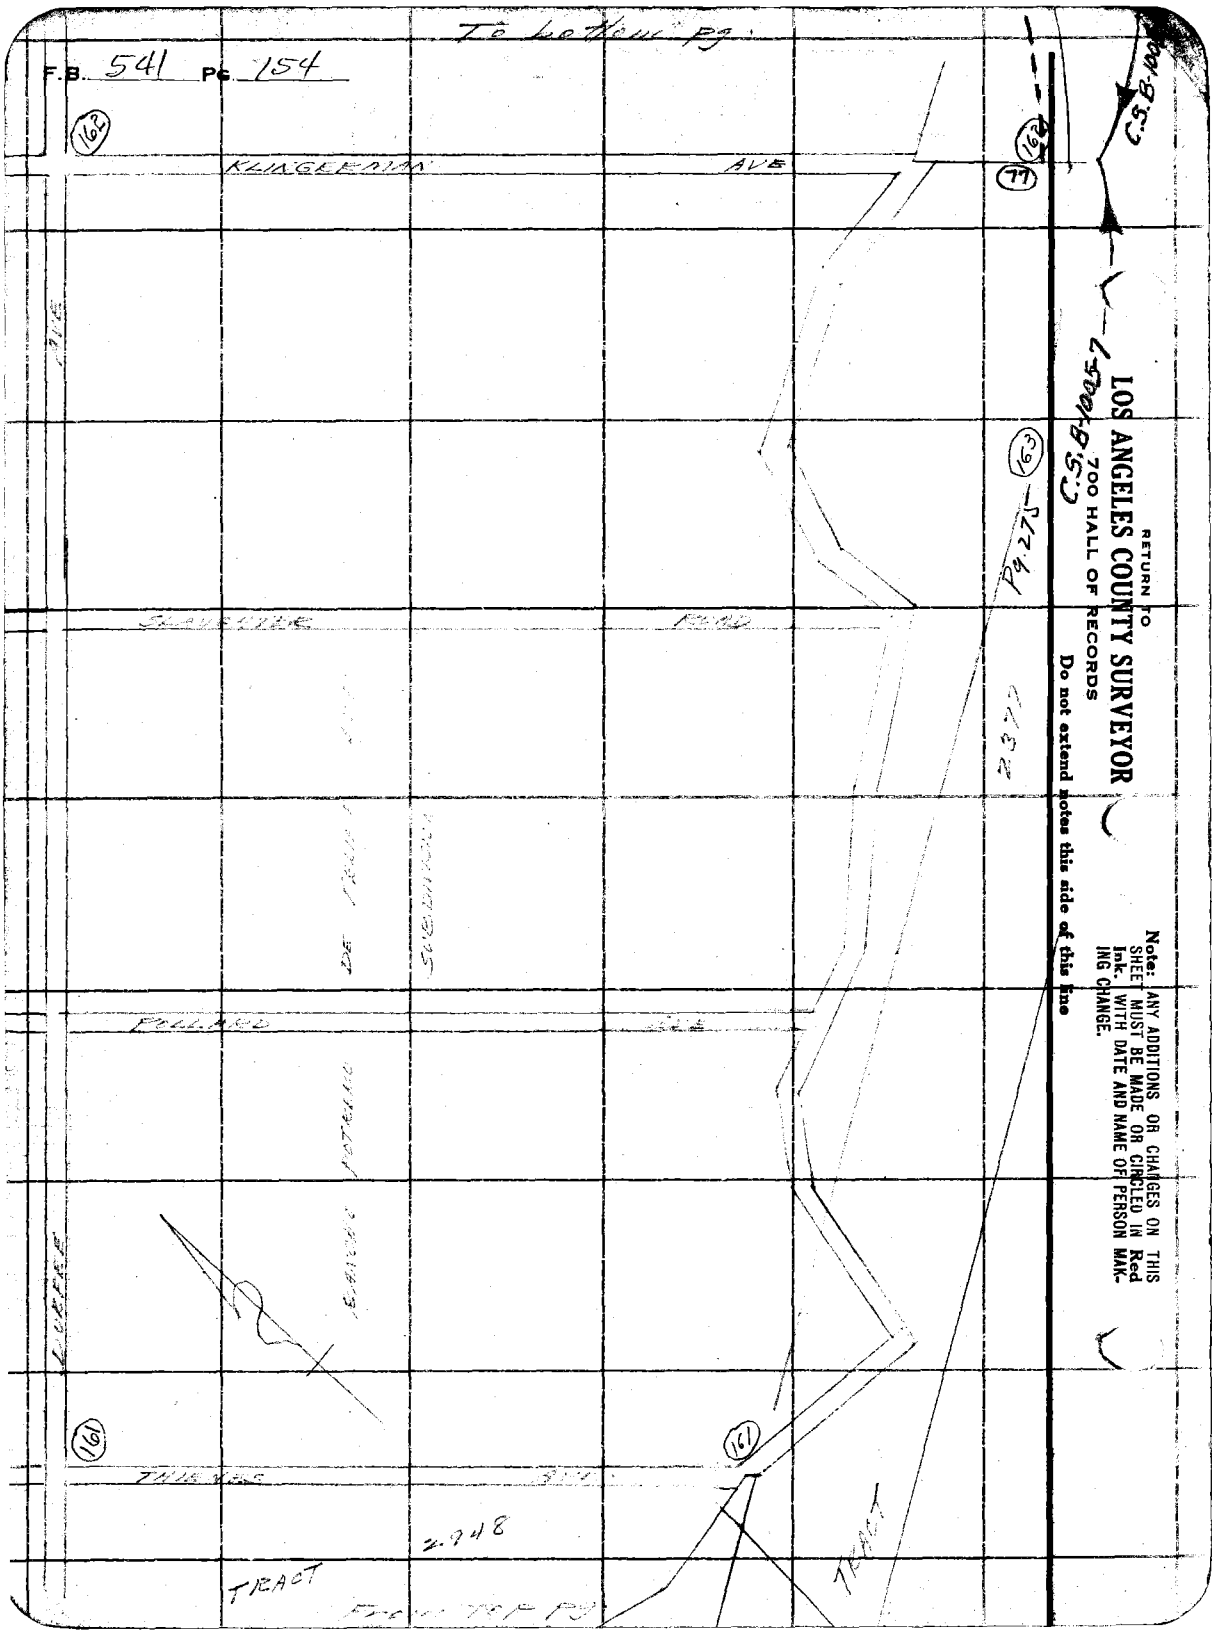
To bottom pg.
F.B. 541 Pg. 154
162
KLINGERMAN AVE
162
77
C.S.B-100
C.S.B-1005-7
163
Pg. 275
SLAVERTER ROAD
2377
POLLARD AVE
161
161
THIENES AVE
2948
TRACT
TRACT
From top pg.
RETURN TO
LOS ANGELES COUNTY SURVEYOR
700 HALL OF RECORDS
Do not extend notes this side of this line
Note: ANY ADDITIONS OR CHANGES ON THIS SHEET MUST BE MADE OR CIRCLED IN Red Ink. WITH DATE AND NAME OF PERSON MAKING CHANGE.

Div #2.

Notes Ck'd by D.M. Finley	Survey of El Monte Bridle Trail
Map No. B-1005-6	W. O. 8012 Tape No. ____ St'd ____ °F.
Office Work C. W. Cox	Surveyed by L. D. Moore
Checked	Notes Moore Date
Date	Indexed A. C. Johnson

F.B. 541 PG. 155

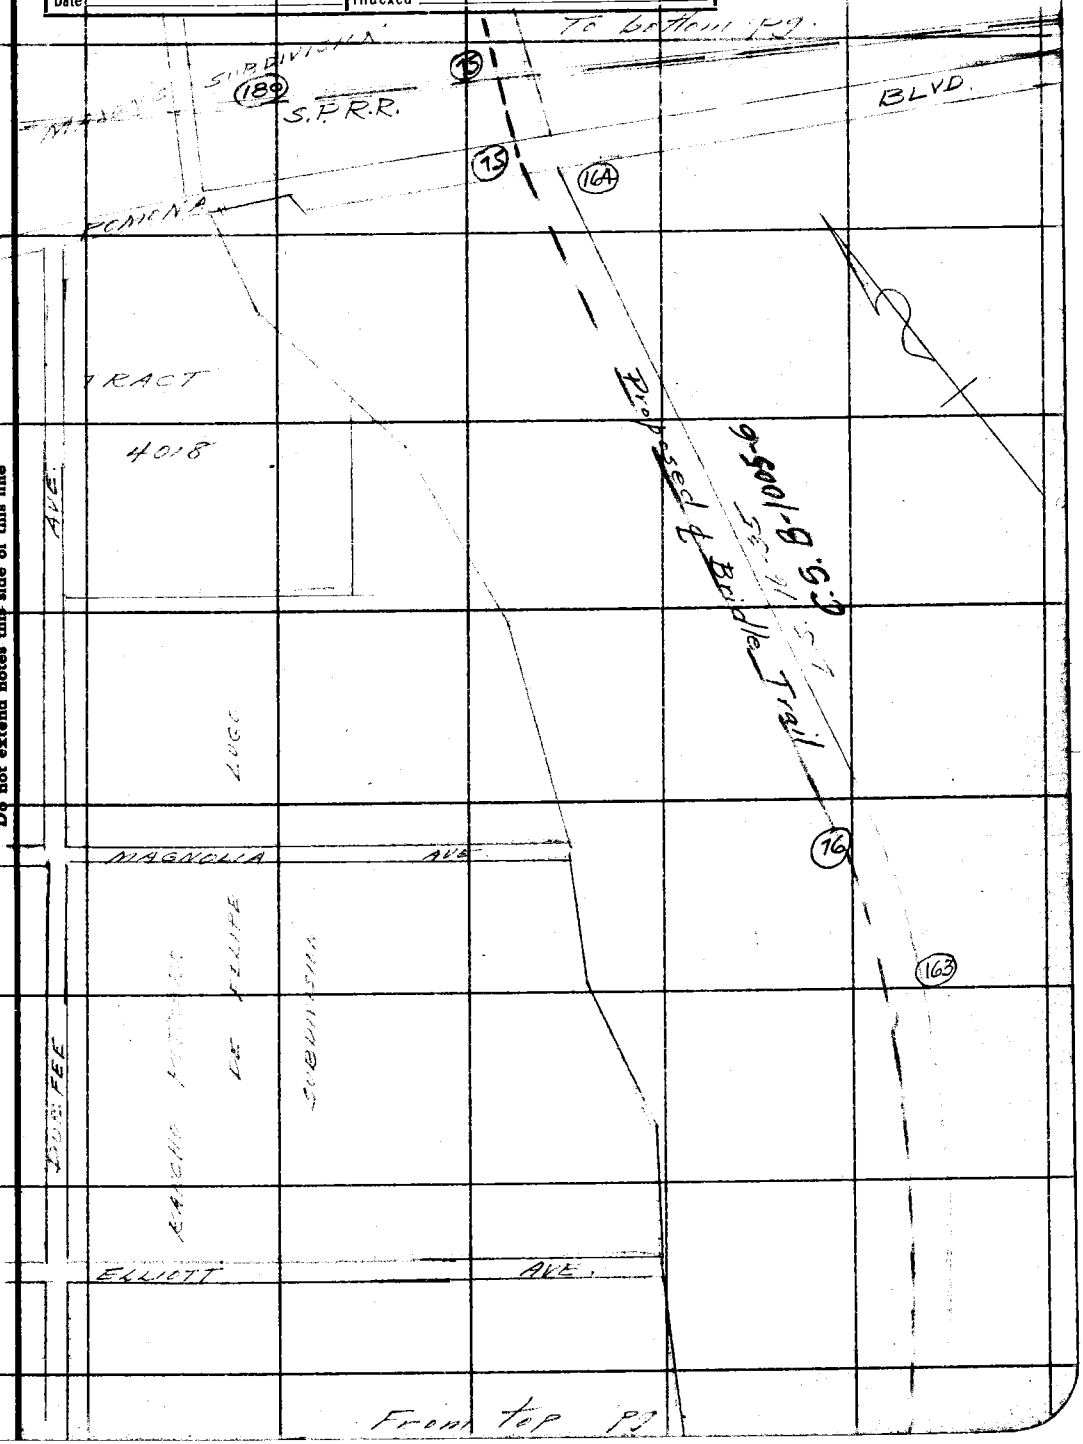

Note: ANY ADDITIONS OR CHANGES ON THIS SHEET MUST BE MADE OR CIRCLED IN Red Ink. WITH DATE AND NAME OF PERSON MAKING CHANGE.

Do not extend notes this side of this line

RETURN TO
LOS ANGELES COUNTY SURVEYOR
700 HALL OF RECORDS

FORM 247 10M 5-31

RETURN TO
LOS ANGELES COUNTY SURVEYOR
700 HALL OF RECORDS

Note: ANY ADDITIONS OR CHANGES ON THIS SHEET MUST BE MADE OR CIRCLED IN **Red Ink.** WITH DATE AND NAME OF PERSON MAKING CHANGE.

Do not extend notes this side of this line

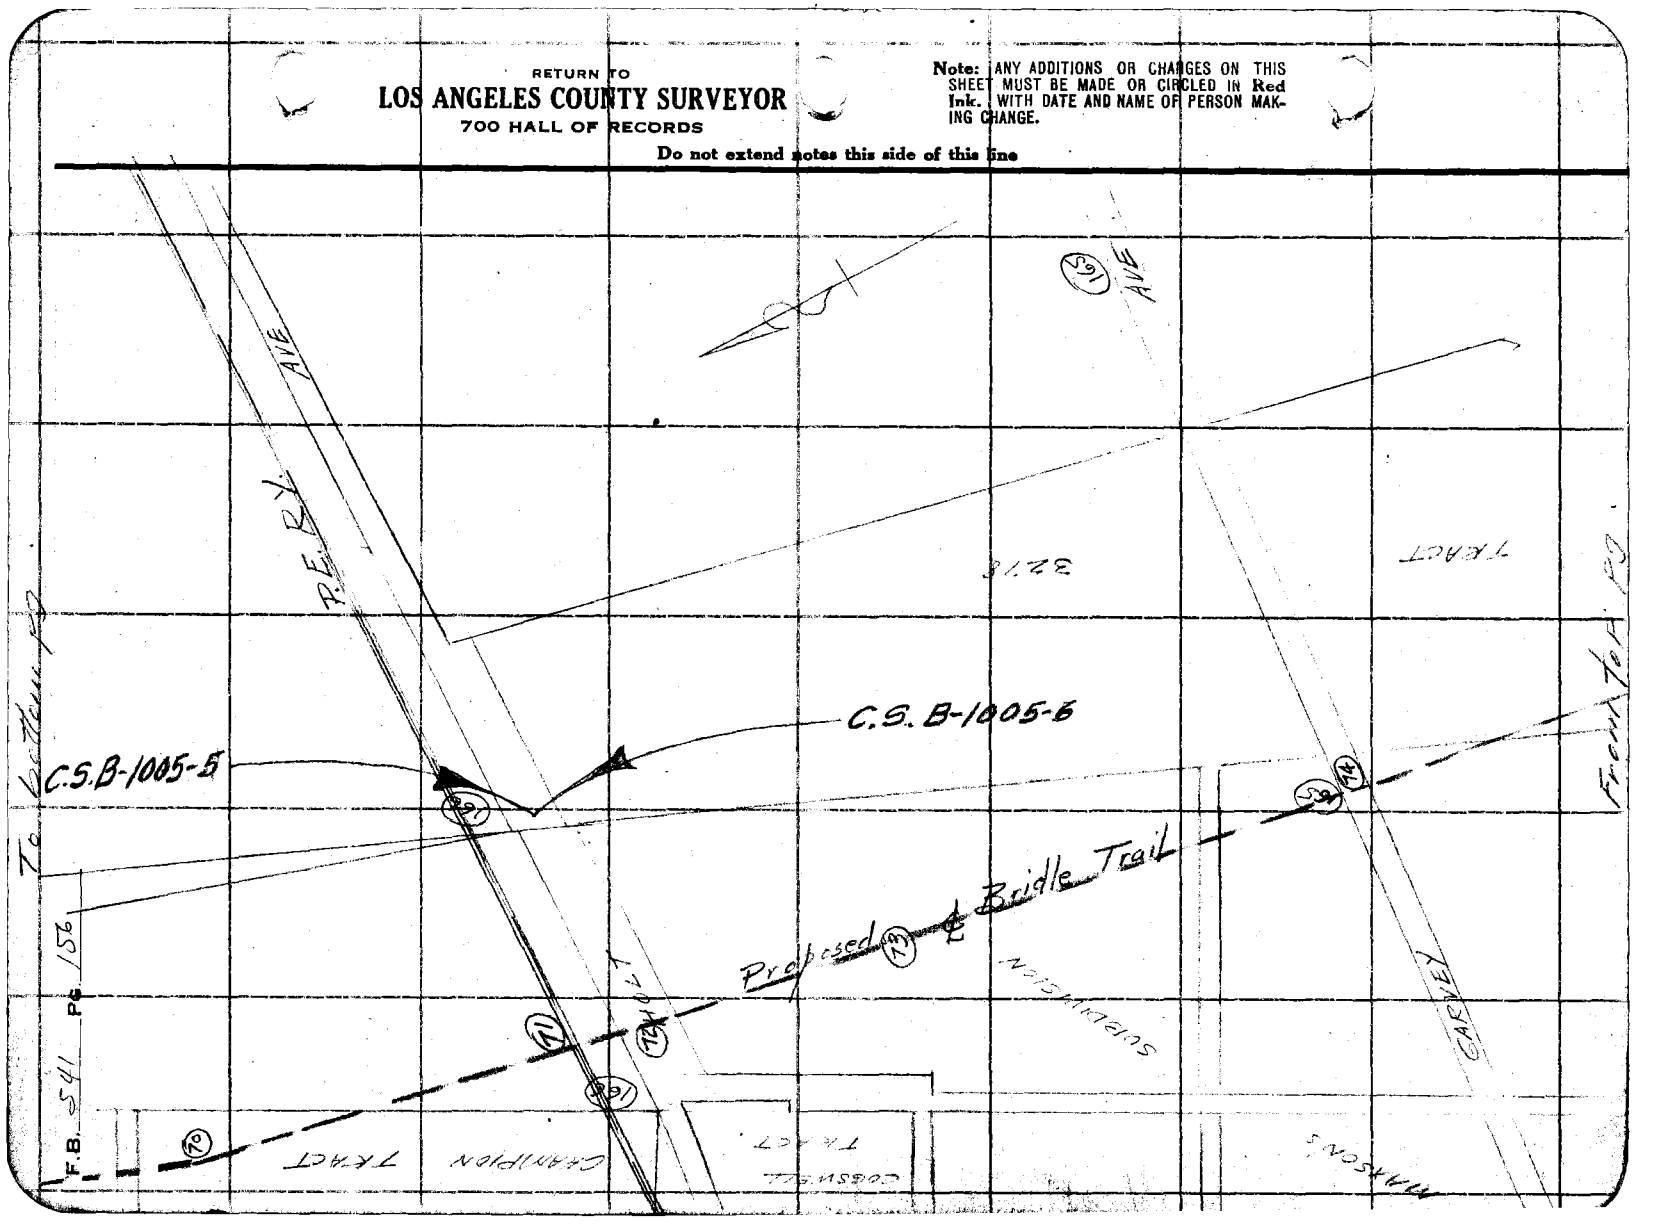

Notes Ck'd by D. M. Finley
Map No. B-1005-5
Office Work C. W. Cox
Checked
Date

Survey of El Monte Bridle Trail
W. O.
Tape No. St'd °F.
Surveyed by L. D. Moore
Notes Moore Date
Indexed A. C. Johnson

F.B. 541 PG. 157

Note: ANY ADDITIONS OR CHANGES ON THIS SHEET MUST BE MADE OR CIRCLED IN Red Ink. WITH DATE AND NAME OF PERSON MAKING CHANGE.

Do not extend notes this side of this line

RETURN TO
LOS ANGELES COUNTY SURVEYOR
700 HALL OF RECORDS

FORM 247 10M 5-31

E-8/15/34

F.B. 541 Pg. 158

84° Tape #067

37,B-3

RETURN TO
LOS ANGELES COUNTY SURVEYOR
700 HALL OF RECORDS

Do not extend notes this side of this line

Note: ANY ADDITIONS OR CHANGES ON THIS SHEET MUST BE MADE OR CIRCLED IN Red Ink. WITH DATE AND NAME OF PERSON MAKING CHANGE.

Notes Ck'd by D. M. Finley	Survey of El Monte Bridge Trail
Map No. B-1A05-7	W. O. [illegible] Tape No. [illegible] St'd [illegible] °F.
Office Work C.W. Cox	Surveyed by L. D. Moore
Checked	Notes Moore Date 12-4-33
Date	Indexed A. C. Johnson

F.B. 547 Pg. 159

32 A-3
B-3

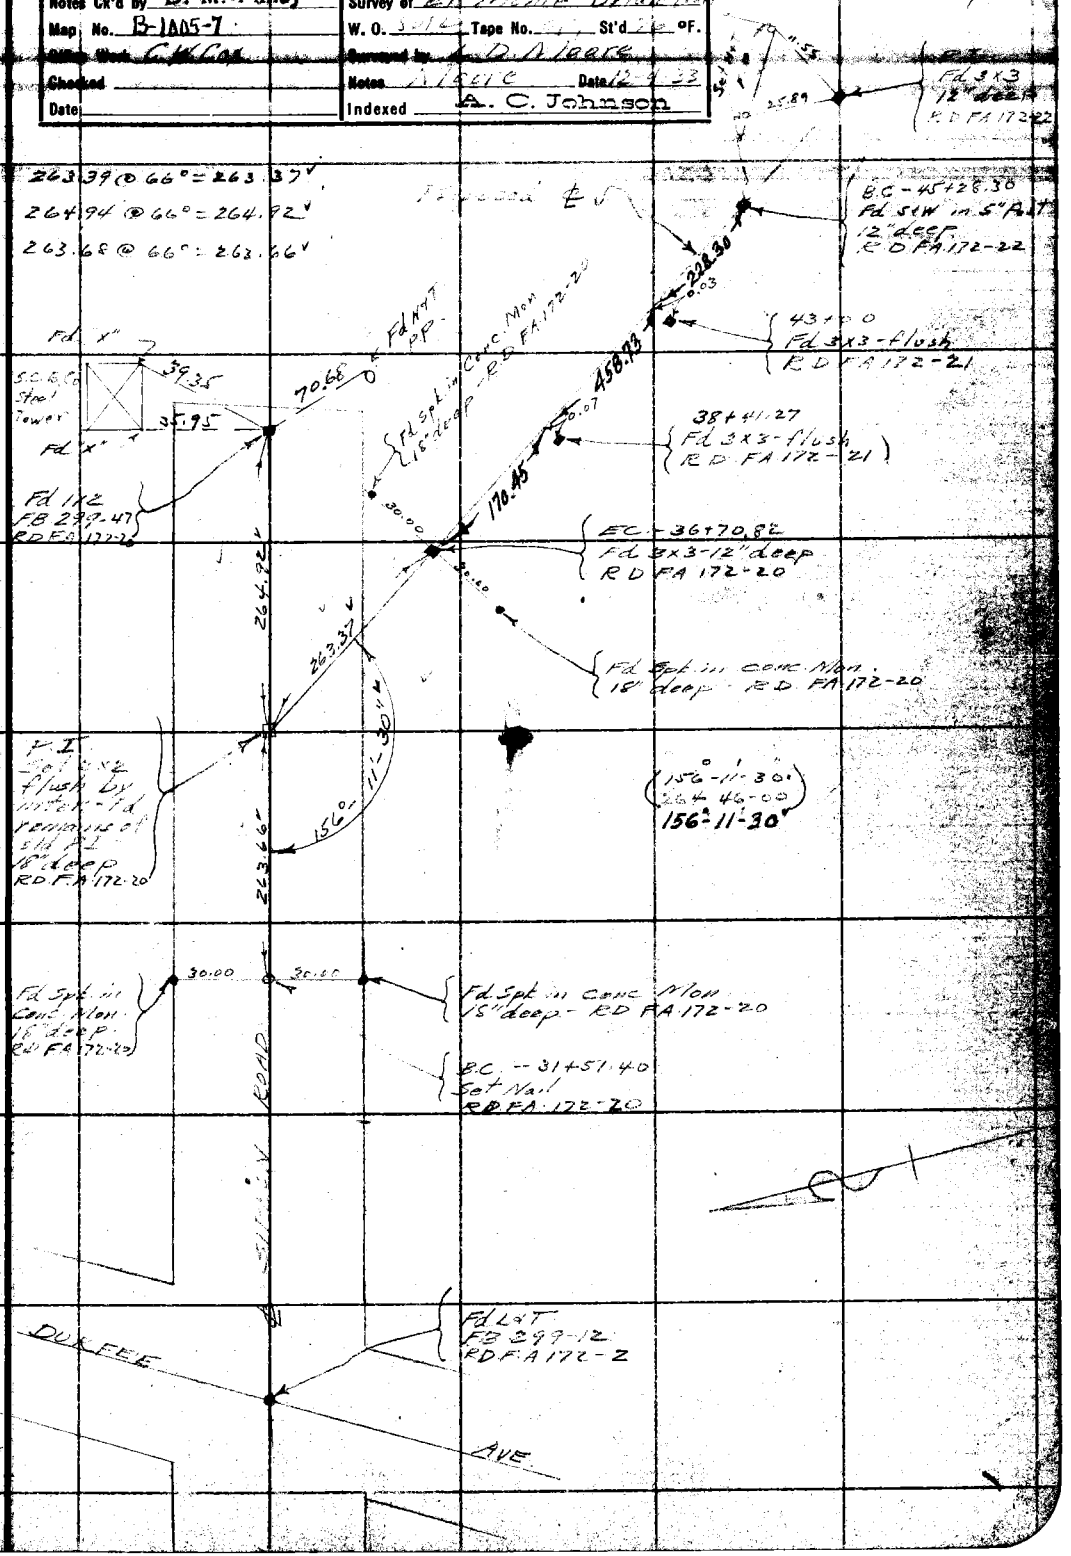

Note: ANY ADDITIONS OR CHANGES ON THIS SHEET MUST BE MADE OR CIRCLED IN Red Ink. WITH DATE AND NAME OF PERSON MAKING CHANGE.

Do not extend notes this side of this line

RETURN TO
LOS ANGELES COUNTY SURVEYOR
700 HALL OF RECORDS

FORM 247 10M 5-31

B-7
37, C-2

RETURN TO
LOS ANGELES COUNTY SURVEYOR
700 HALL OF RECORDS

Note: ANY ADDITIONS OR CHANGES ON THIS SHEET MUST BE MADE OR CIRCLED IN **Red Ink.** WITH DATE AND NAME OF PERSON MAKING CHANGE.

Do not extend notes this side of this line

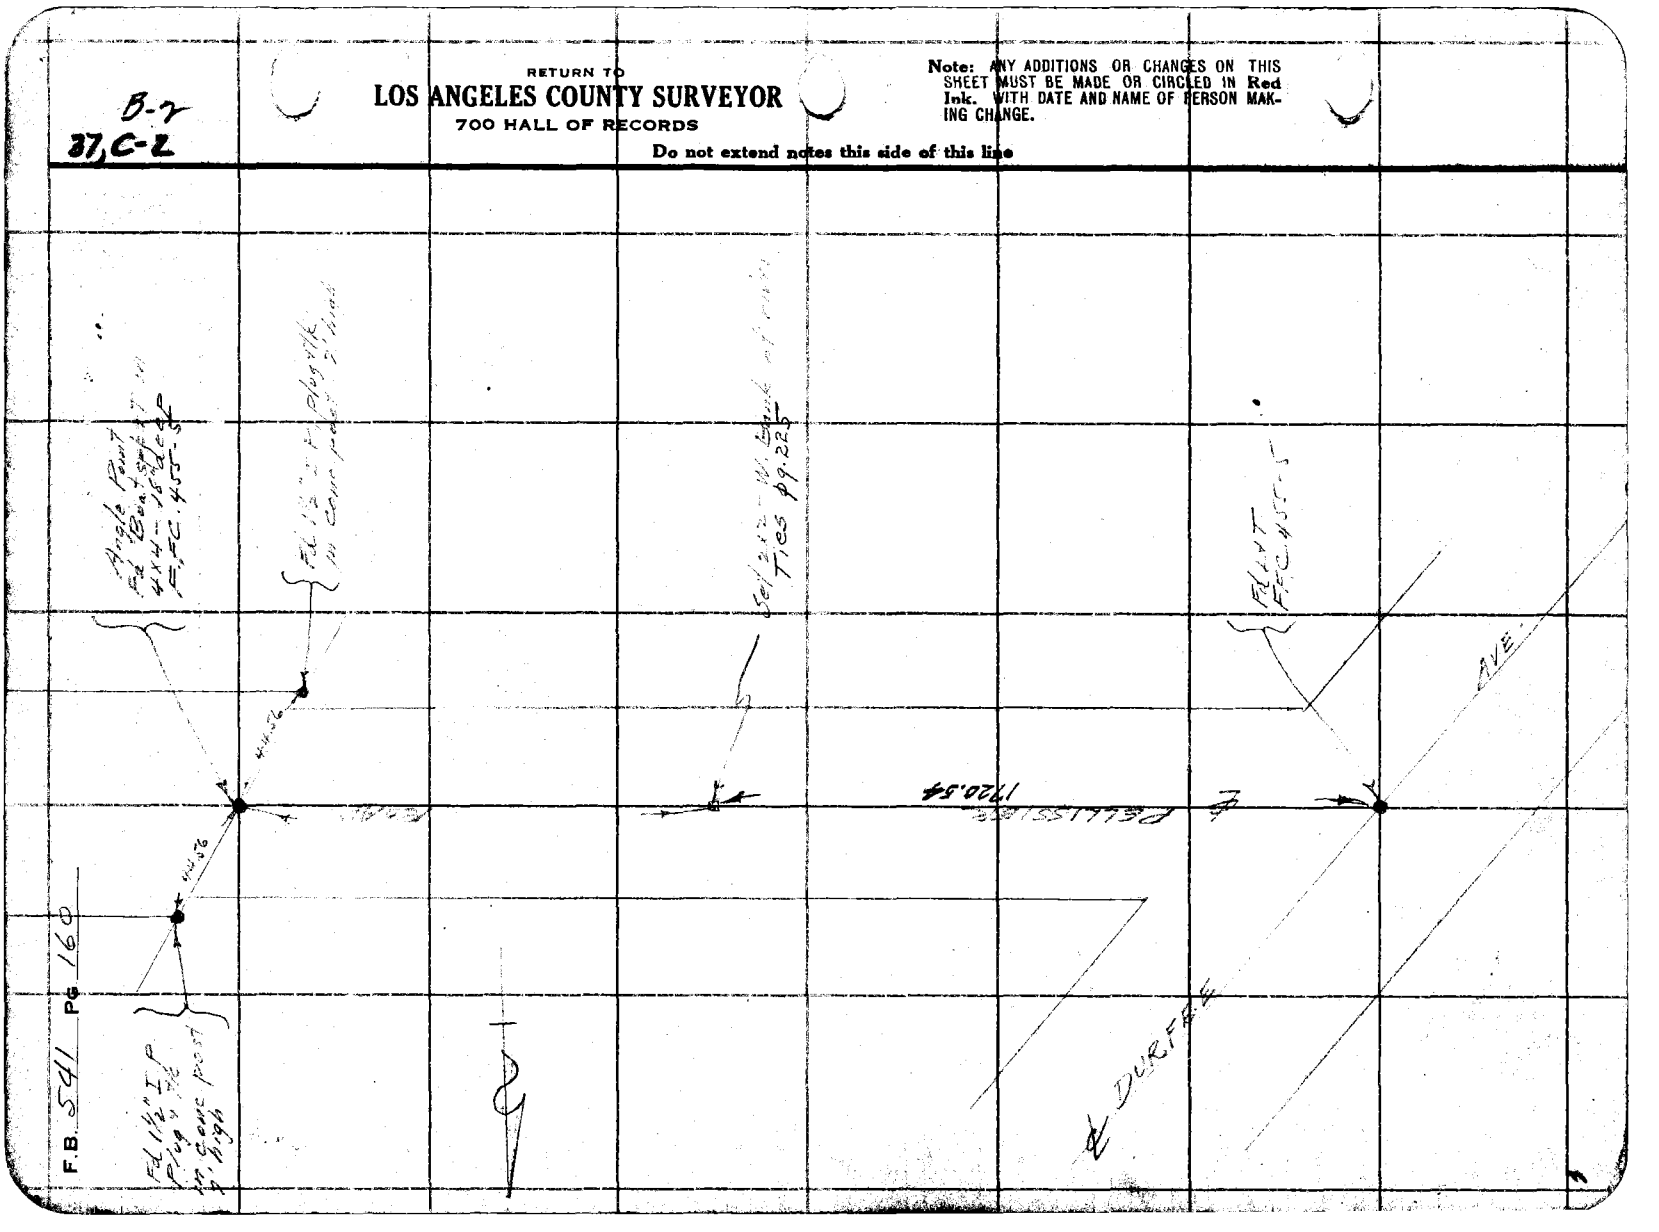

F.B. 5411 Pg 160

Notes Ck'd by D. M. Finley	Survey of El Monte Bridle Trail
Map No. B-1005-7	W. O. 8012 Tape No. 06 St'd 76 °F.
Office Work C.W. Cox	Surveyed by L. D. Moore
Checked	Notes Moore Date 12-6-33
Date	Indexed A. C. Johnson

F.B. 591 PG. 161

37 C-2

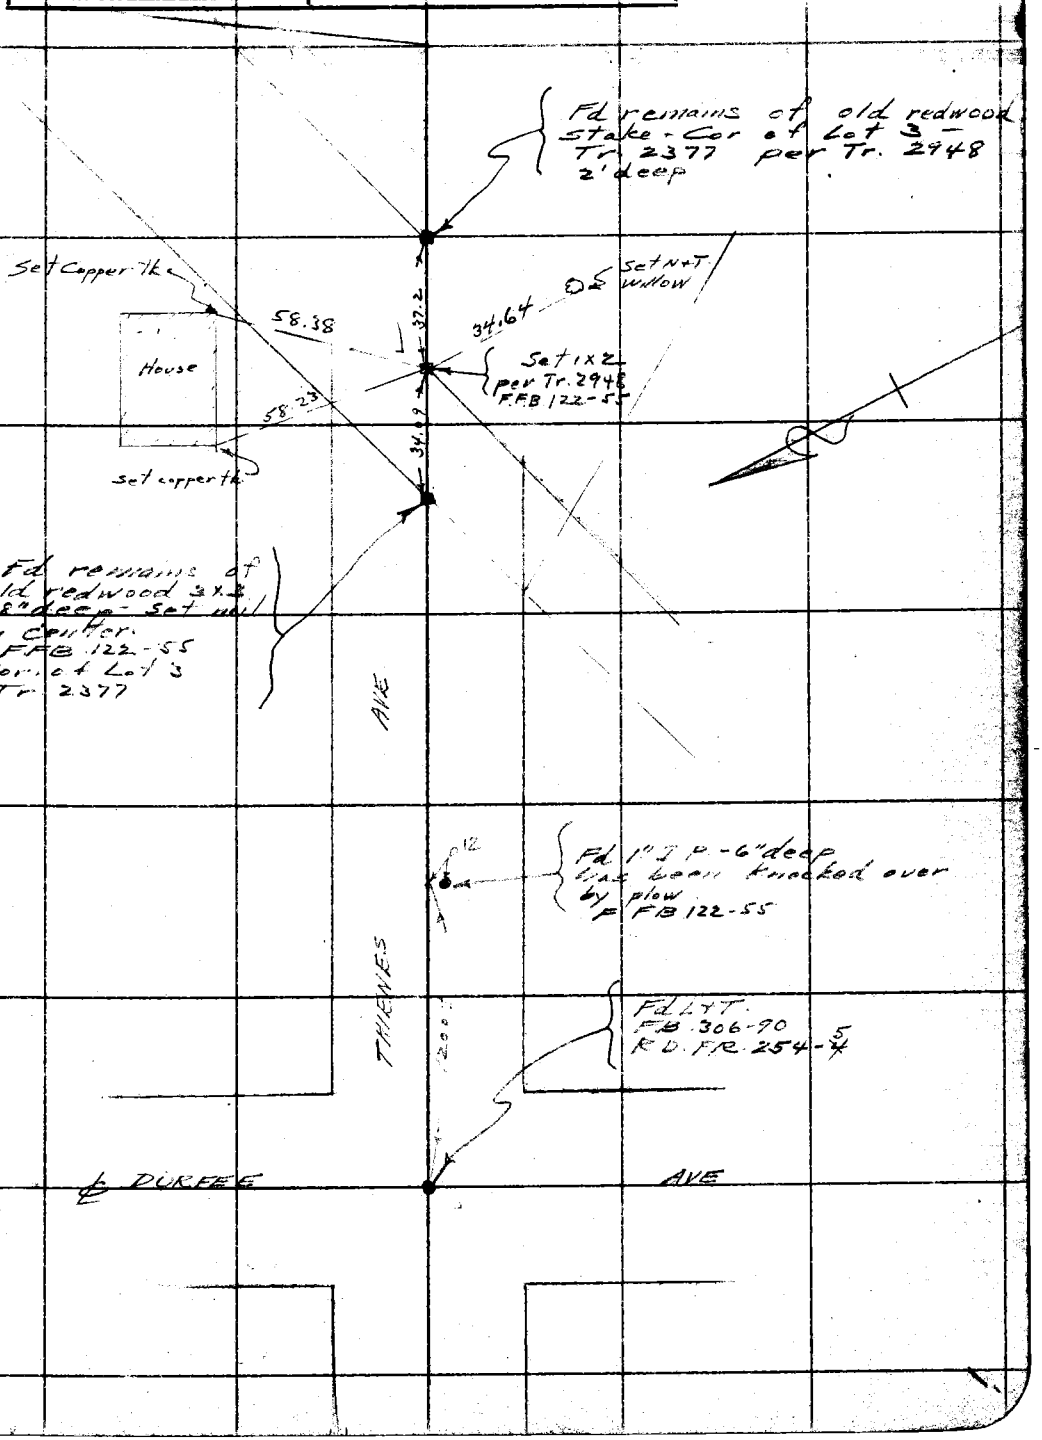

Note: ANY ADDITIONS OR CHANGES ON THIS SHEET MUST BE MADE OR CIRCLED IN Red Ink. WITH DATE AND NAME OF PERSON MAKING CHANGE.

Do not extend notes this side of this line

RETURN TO
LOS ANGELES COUNTY SURVEYOR
700 HALL OF RECORDS

FORM 247 10M 5-31

RETURN TO
LOS ANGELES COUNTY SURVEYOR
700 HALL OF RECORDS

Note: ANY ADDITIONS OR CHANGES ON THIS SHEET MUST BE MADE OR CIRCLED IN Red Ink. WITH DATE AND NAME OF PERSON MAKING CHANGE.

37 C-2

Do not extend notes this side of this line

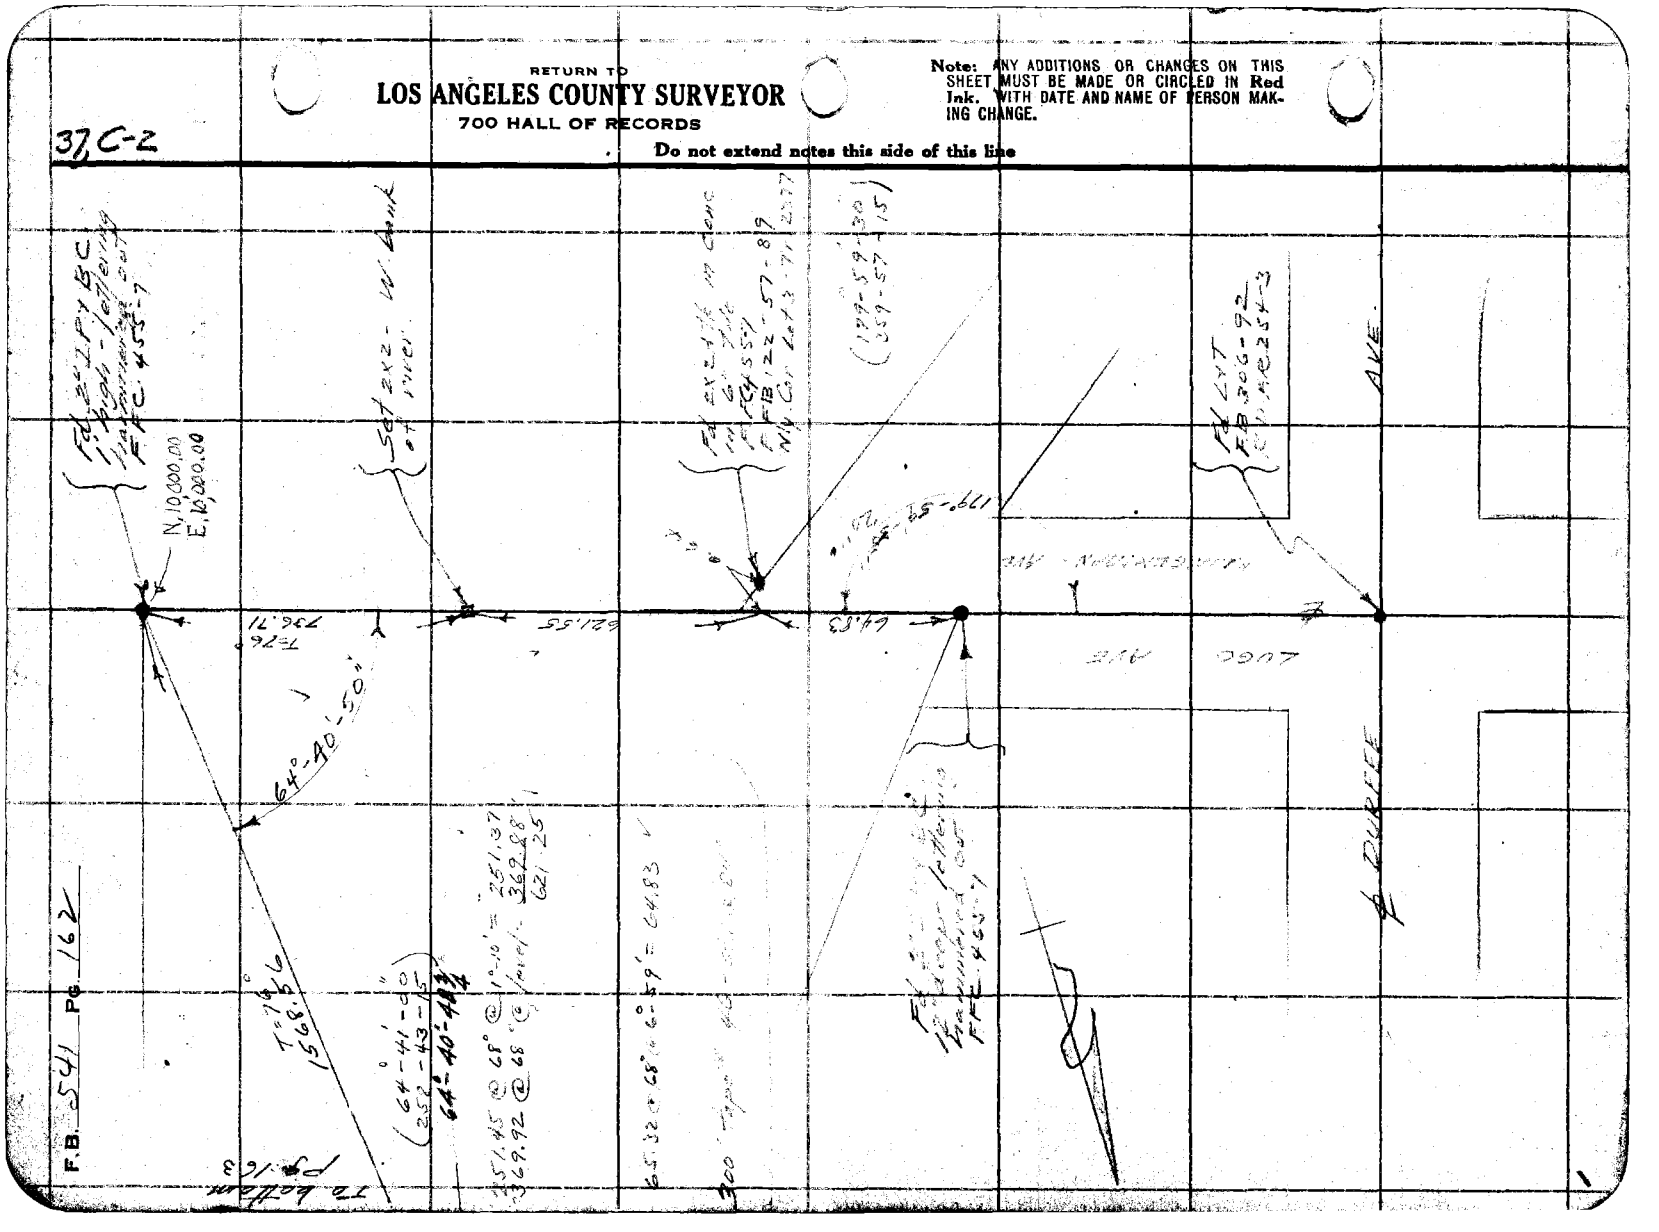

Notes Ck'd by D. M. Finley	Survey of El Monte Bridle Trail
Map No. B-1005-6	W. O. 8012 Tape No. 061 St'd 76 °F.
Office Work C. W. Cox	Surveyed by L. D. Moore
Checked	Notes Moore Date 12-11-33
Date	Indexed A. C. Johnson

F.B. 541 Pg. 163

37, C-2, D-2

To bottom pg 164

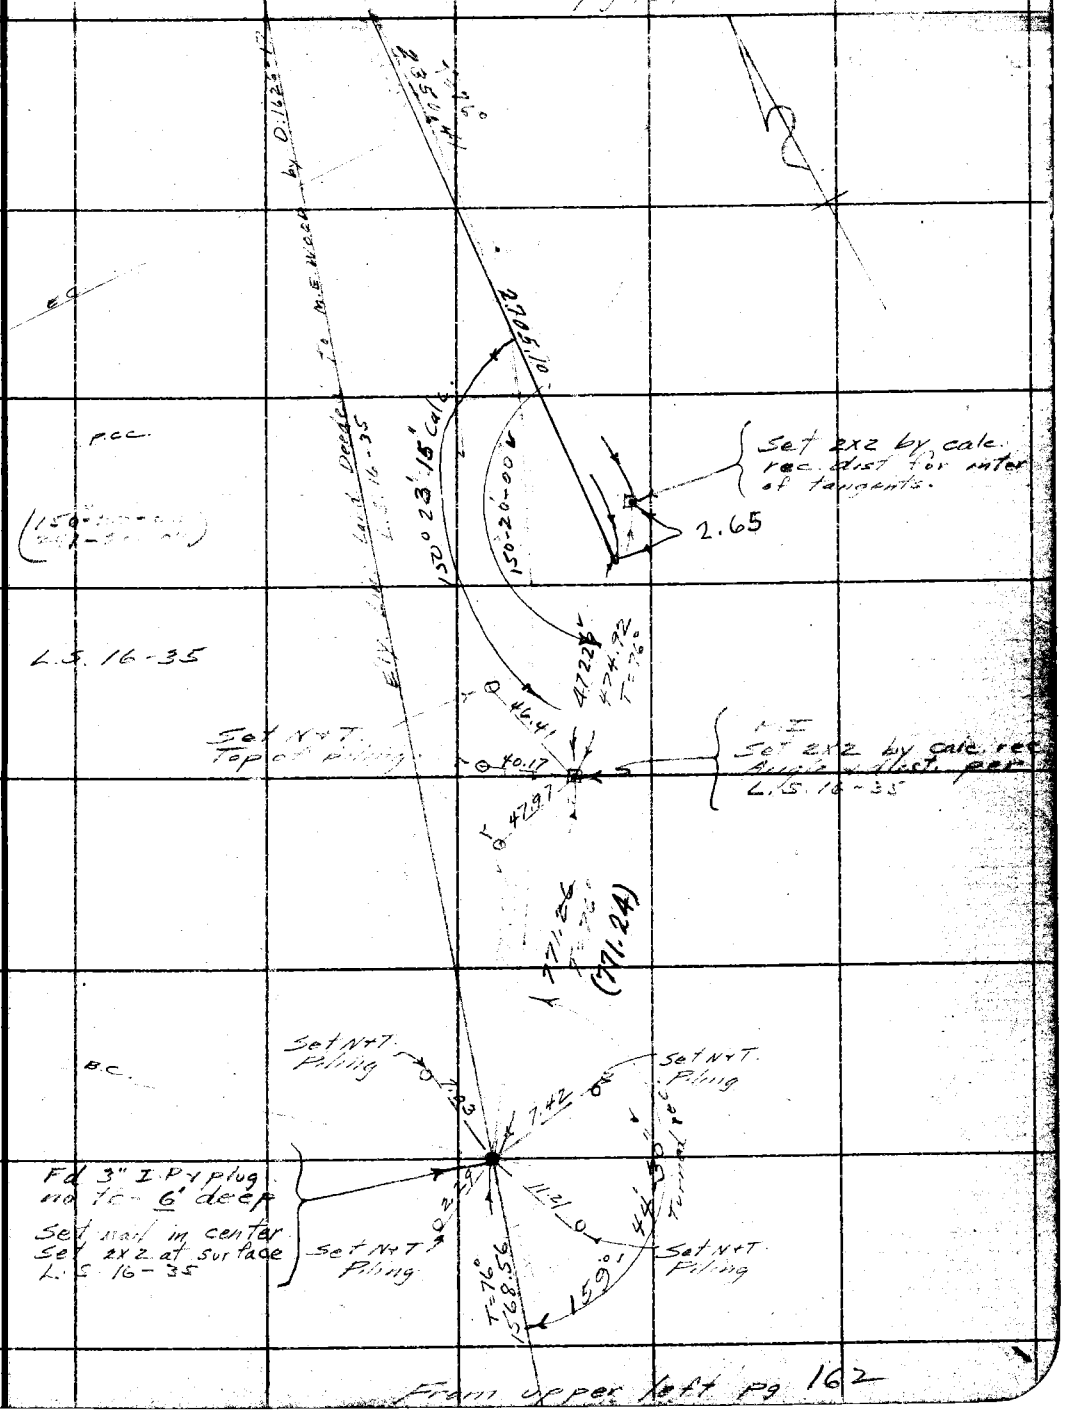

From upper left pg 162

Note: ANY ADDITIONS OR CHANGES ON THIS SHEET MUST BE MADE OR CIRCLED IN Red Ink. WITH DATE AND NAME OF PERSON MAKING CHANGE.

Do not extend notes this side of this line

RETURN TO
LOS ANGELES COUNTY SURVEYOR
700 HALL OF RECORDS

FORM 247 10M 5-31

F.B. 541 Pg. 164

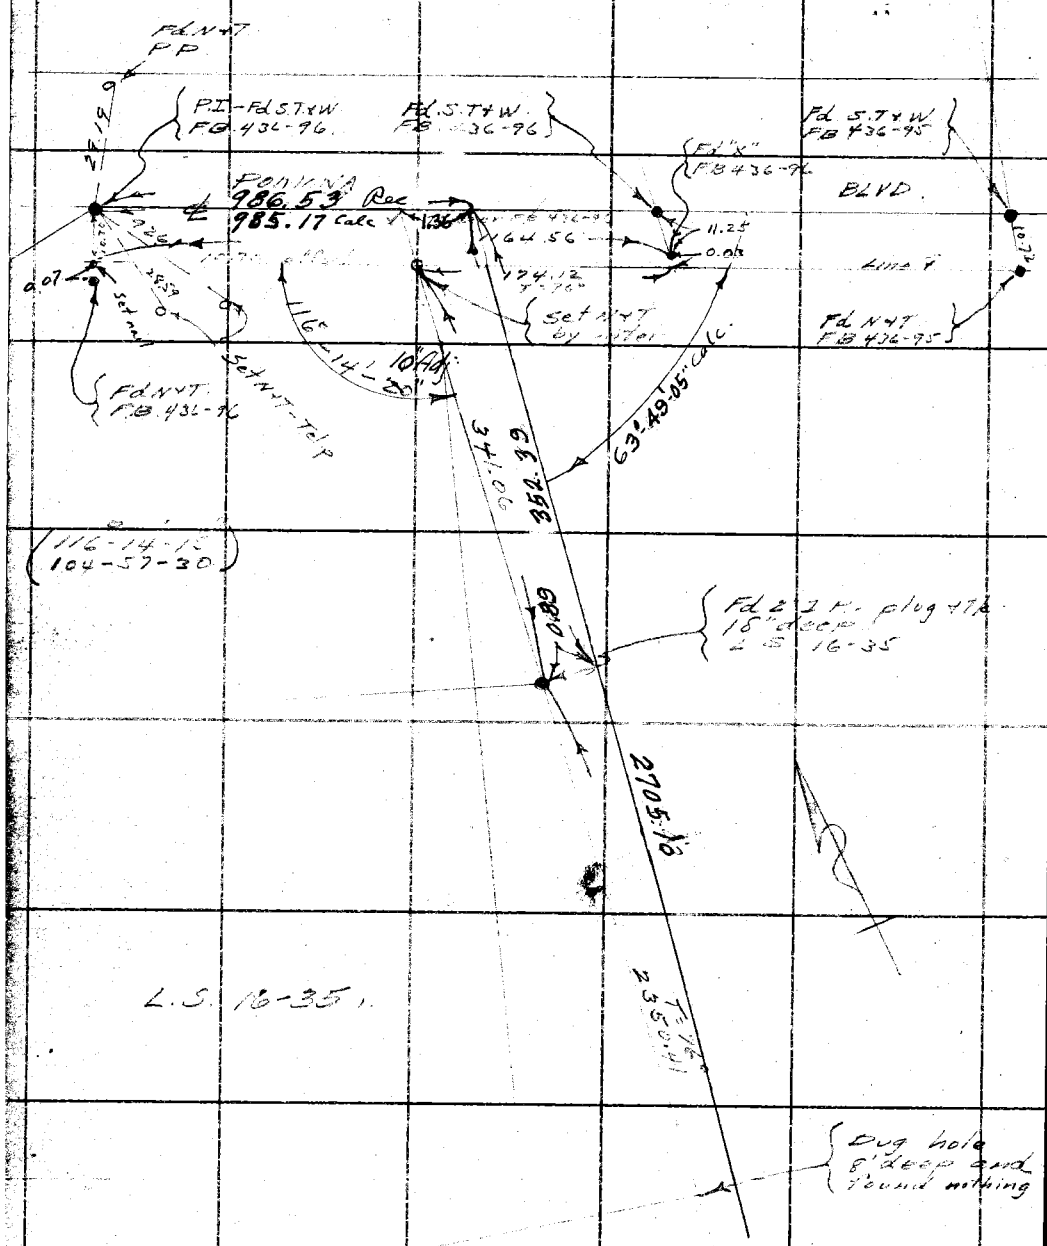

From Top Pg. 163

4-B-5

RETURN TO
LOS ANGELES COUNTY SURVEYOR
700 HALL OF RECORDS

Do not extend notes this side of this line

Note: ANY ADDITIONS OR CHANGES ON THIS SHEET MUST BE MADE OR CIRCLED IN Red Ink. WITH DATE AND NAME OF PERSON MAKING CHANGE.

46-B-5

Notes Ck'd by D. M. Finley	Survey of El Monte Bridle Trail
Map No. B-1005-6	W. O. 8012 Tape No. 061 St'd 76 °F.
Office Work C.W. Cox	Surveyed by L. D. Moore
Checked	Notes Moore Date 12-12-33
Date	Indexed A. C. Johnson

F.B. 541 PG. 105

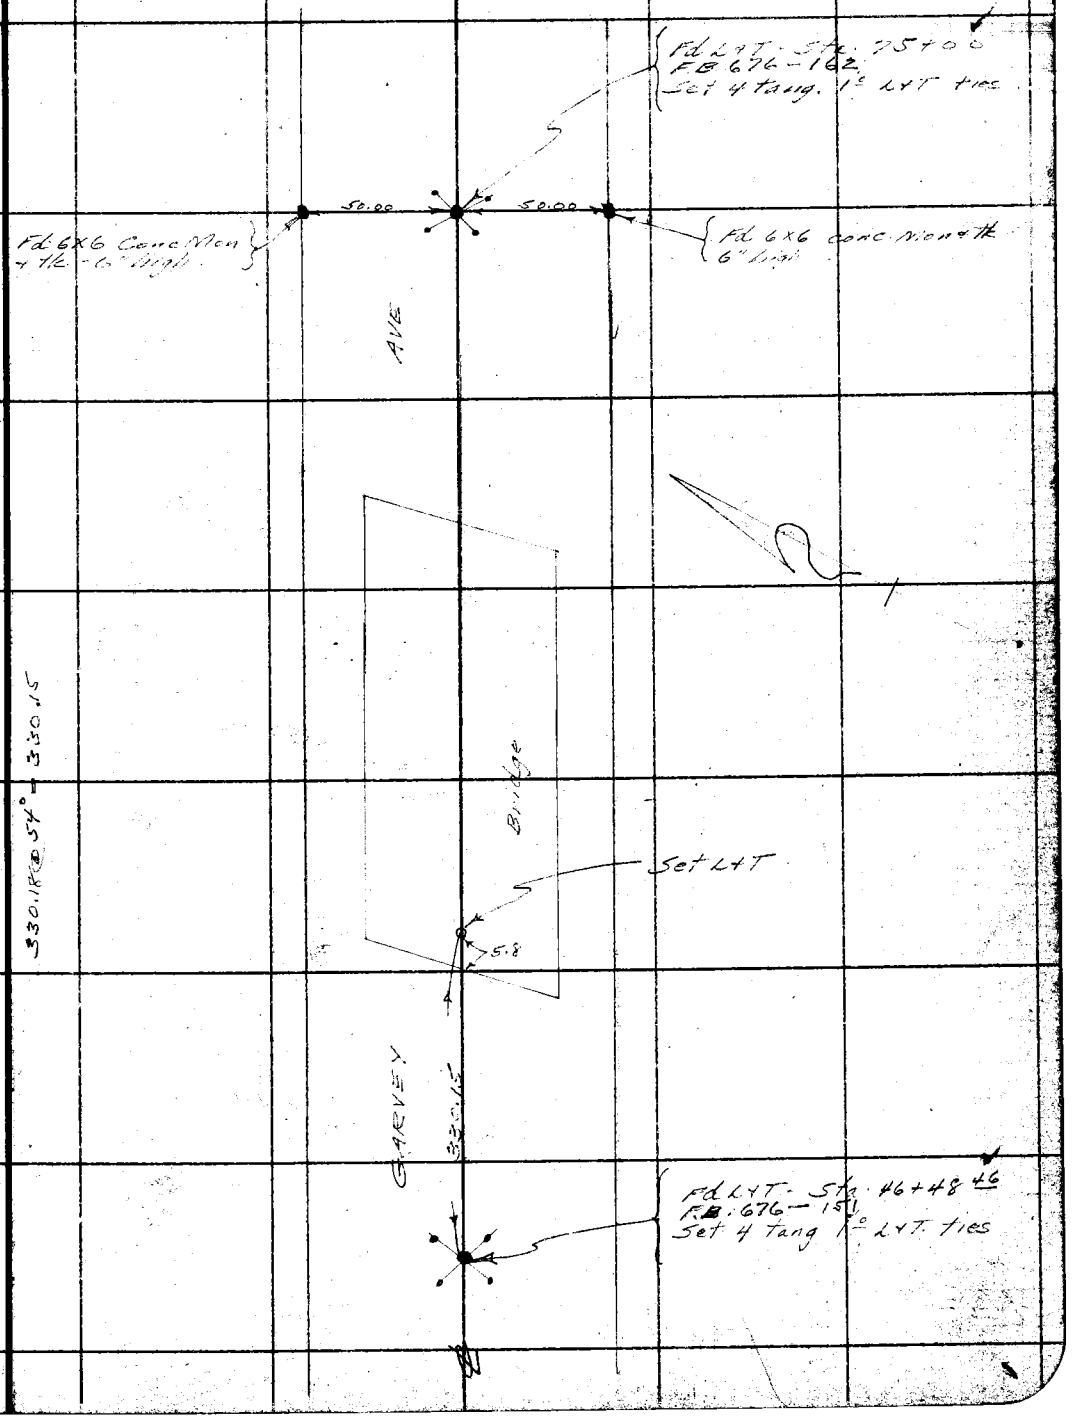

Note: ANY ADDITIONS OR CHANGES ON THIS SHEET MUST BE MADE OR CIRCLED IN Red Ink, WITH DATE AND NAME OF PERSON MAKING CHANGE.

Do not extend notes this side of this line

RETURN TO
LOS ANGELES COUNTY SURVEYOR
700 HALL OF RECORDS

FORM 247 10M 5-31

F.B. 541 PG 166

96 B-4

RETURN TO
LOS ANGELES COUNTY SURVEYOR
700 HALL OF RECORDS
Do not extend notes this side of this line

Note: ANY ADDITIONS OR CHANGES ON THIS SHEET MUST BE MADE OR CIRCLED IN Red Ink. WITH DATE AND NAME OF PERSON MAKING CHANGE.

(Div. 2)

Notes Ck'd by D. M. Finley	Survey of El Monte Bridle Trail
Map No. B-1005-E	W. O. 8012 Tape No. 067 St'd 84 °F.
Office Work C.W. Cox	Surveyed by Evans
Checked	Notes HE Date 3/29/34
Date	Indexed A. C. Johnson

F.B. 541 Pg. 167

WS.46-B-3

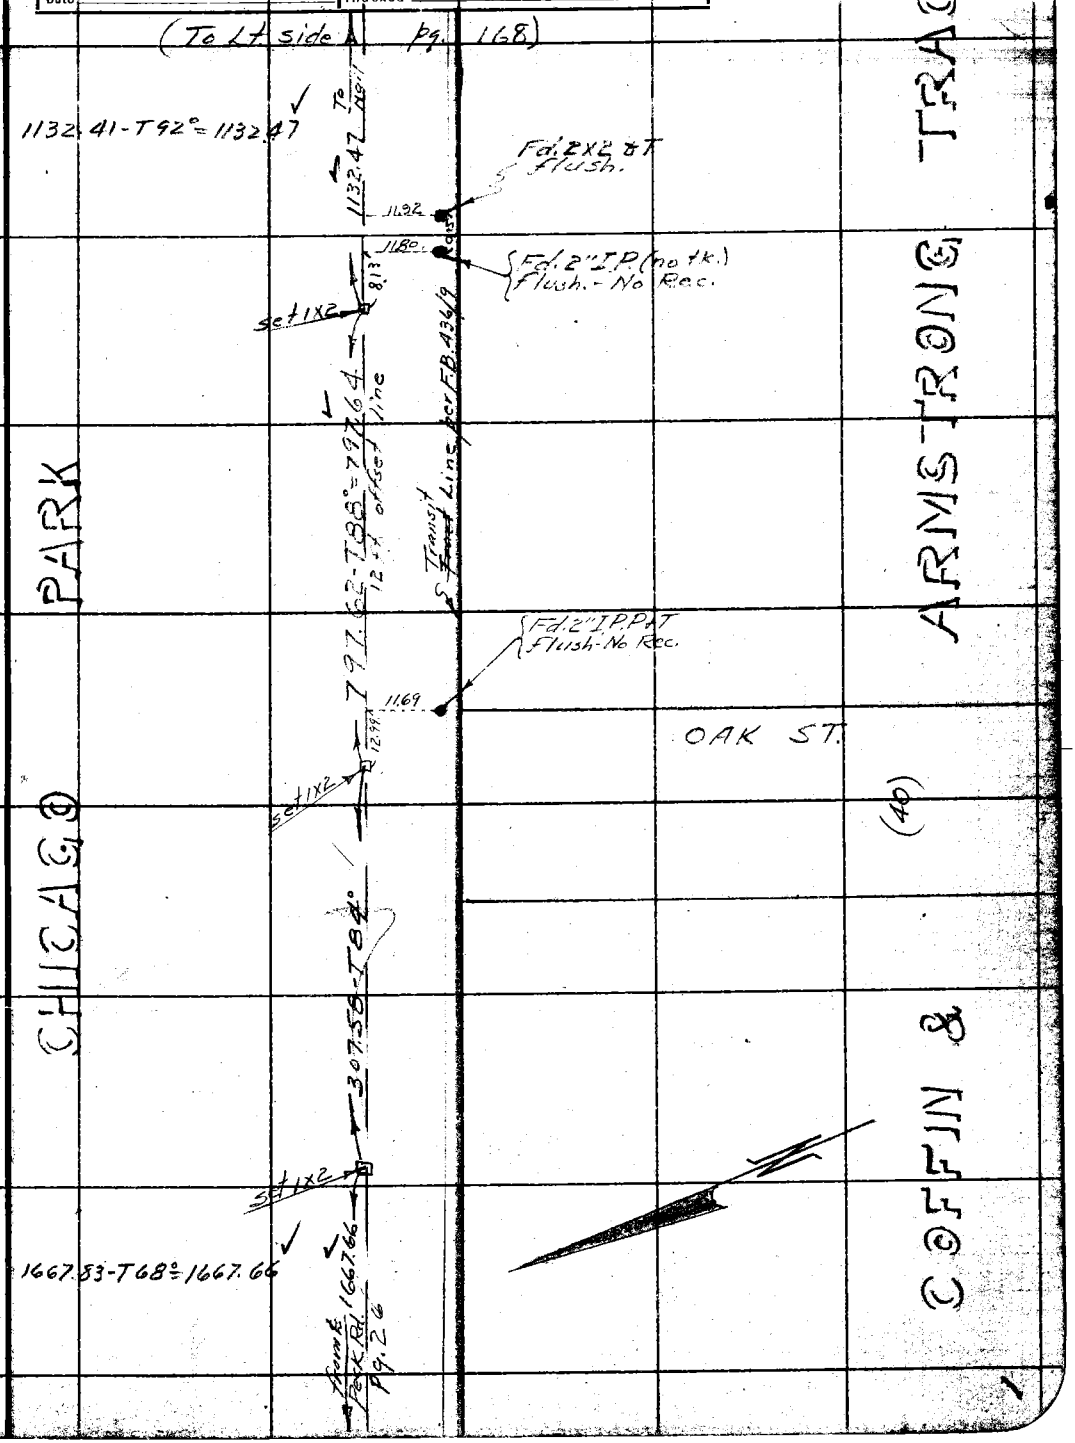

Note: ANY ADDITIONS OR CHANGES ON THIS SHEET MUST BE MADE OR CIRCLED IN Red Ink. WITH DATE AND NAME OF PERSON MAKING CHANGE.

Do not extend notes this side of this line

RETURN TO
LOS ANGELES COUNTY SURVEYOR
700 HALL OF RECORDS

FORM 247 10M 5-31

RETURN TO
LOS ANGELES COUNTY SURVEYOR
700 HALL OF RECORDS

Note: ANY ADDITIONS OR CHANGES ON THIS SHEET MUST BE MADE OR CIRCLED IN Red Ink. WITH DATE AND NAME OF PERSON MAKING CHANGE.

Do not extend notes this side of this line

46, C-3
B-4

TRACT 10569.

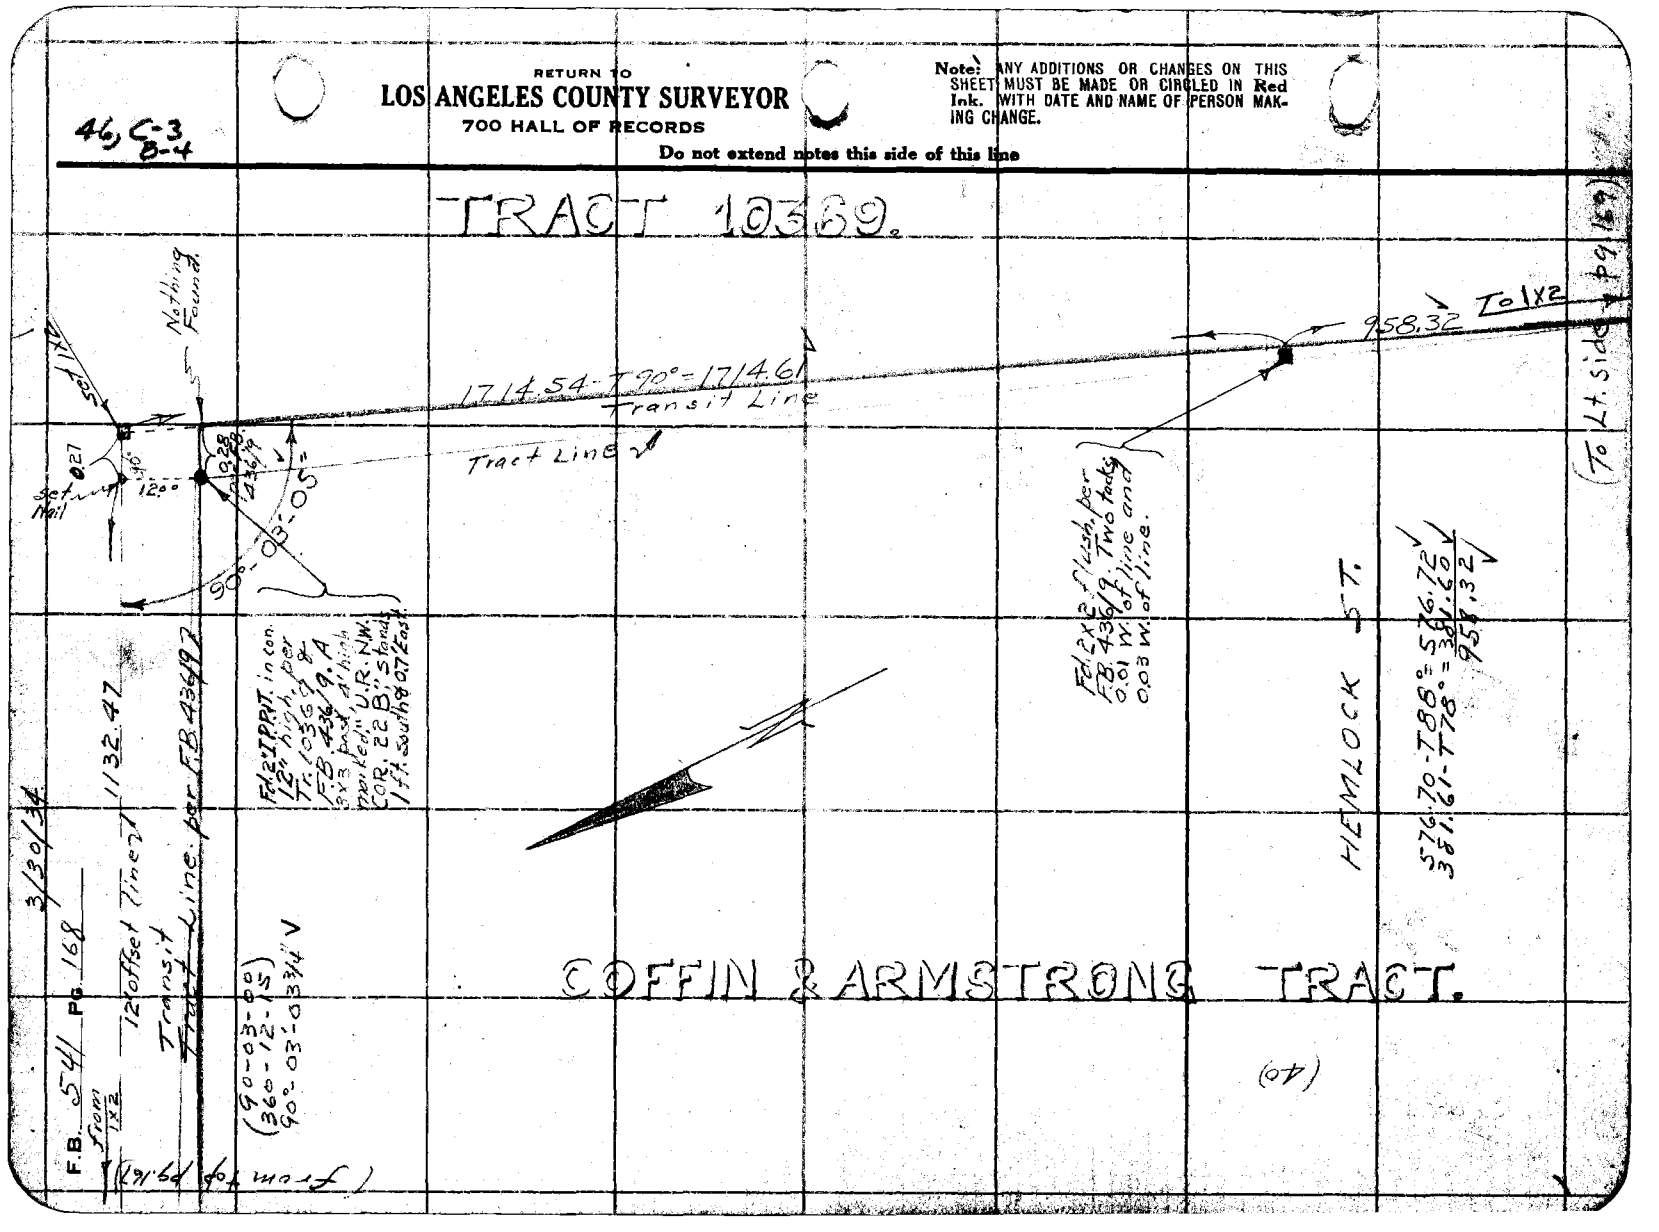

COFFIN & ARMSTRONG TRACT.

(40)

Div. II

Notes Ck'd by D. M. Finley	Survey of El Monte Bridle Trail	F.B. 541	Pg. 169
Map No. B-1005-5	W. O. 8012 Tape No. 067 St'd 84°F.		
Office Work C.W. Cox	Surveyed by Evans		
Checked	Notes HE Date 4/2/34		
Date	Indexed A. C. Johnson		

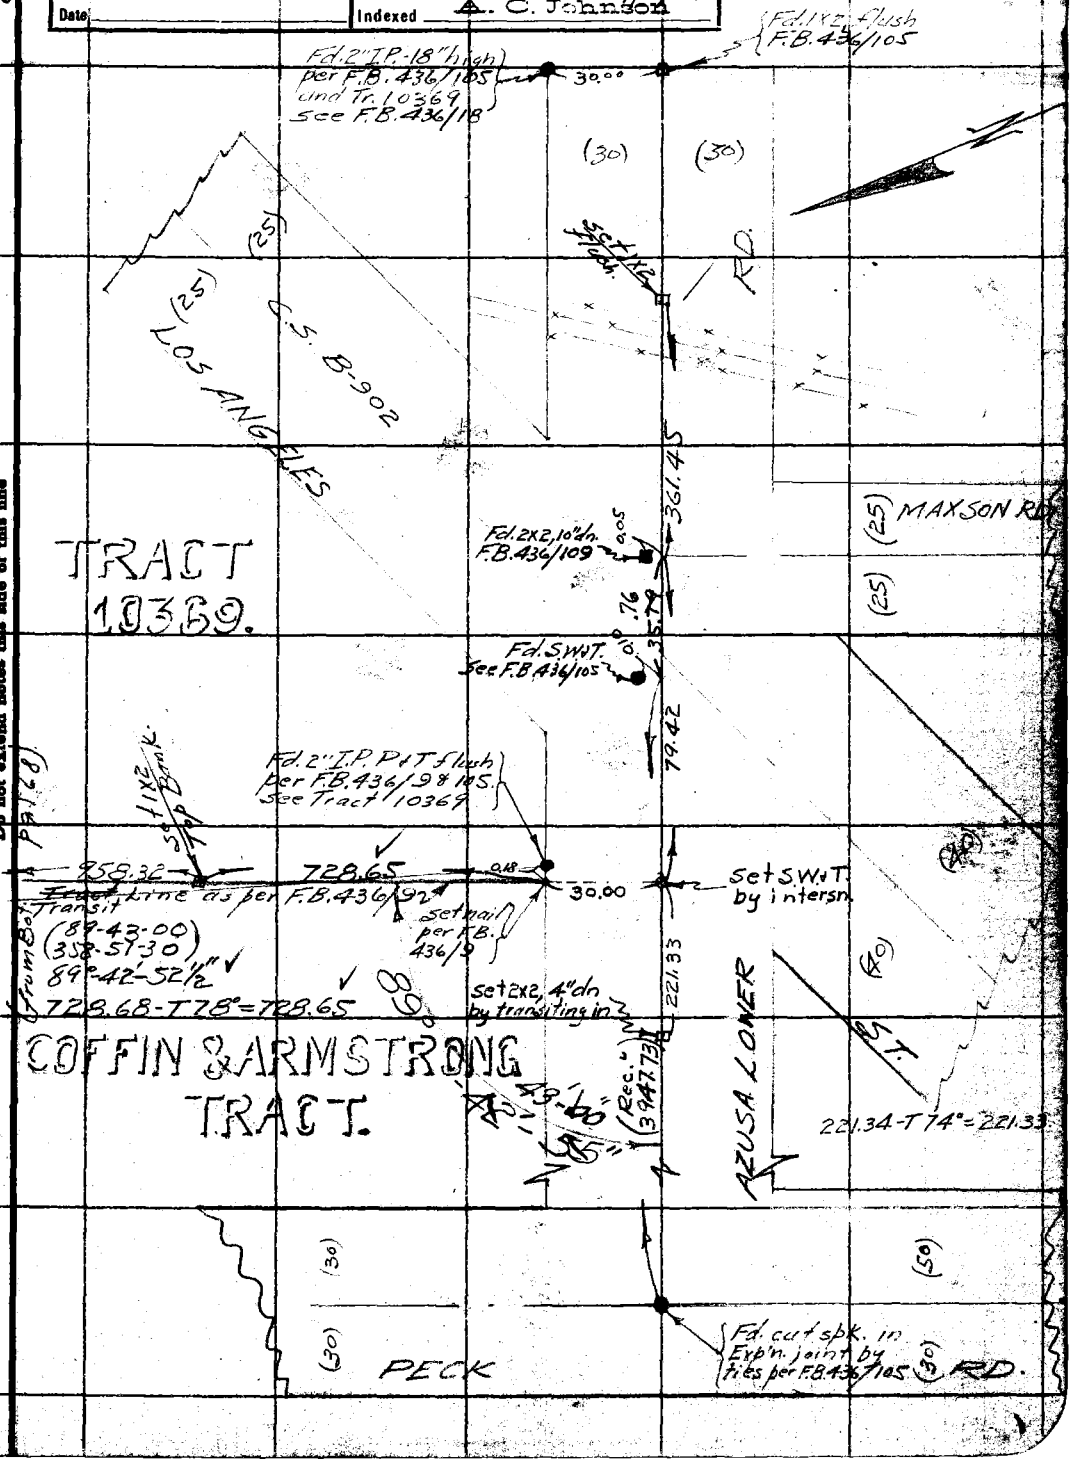

46, B-4 C-4

46, B-4

Note: ANY ADDITIONS OR CHANGES ON THIS SHEET MUST BE MADE OR CIRCLED IN Red Ink. WITH DATE AND NAME OF PERSON MAKING CHANGE.

Do not extend notes this side of this line

RETURN TO
LOS ANGELES COUNTY SURVEYOR
700 HALL OF RECORDS

FORM 247 10M 5-31

RETURN TO

LOS ANGELES COUNTY SURVEYOR

700 HALL OF RECORDS

Note: ANY ADDITIONS OR CHANGES ON THIS SHEET MUST BE MADE OR CIRCLED IN **Red** Ink. WITH DATE AND NAME OF PERSON MAKING CHANGE.

Do not extend notes this side of this line

F.B. 541 Pg. 170

Div II

Notes Ck'd by D. M. Finley	Survey of El Monte Bridle Trail
Map No. B-1005-5	W.O. 8012 Tape No. 067 St'd 84 °F.
Office Work C.W. Cox	Surveyed by Evans
Checked	Notes HE Date 4/3/34
Date	Indexed A. C. Johnson

F.B. 541 Pg. 171

46, B-3

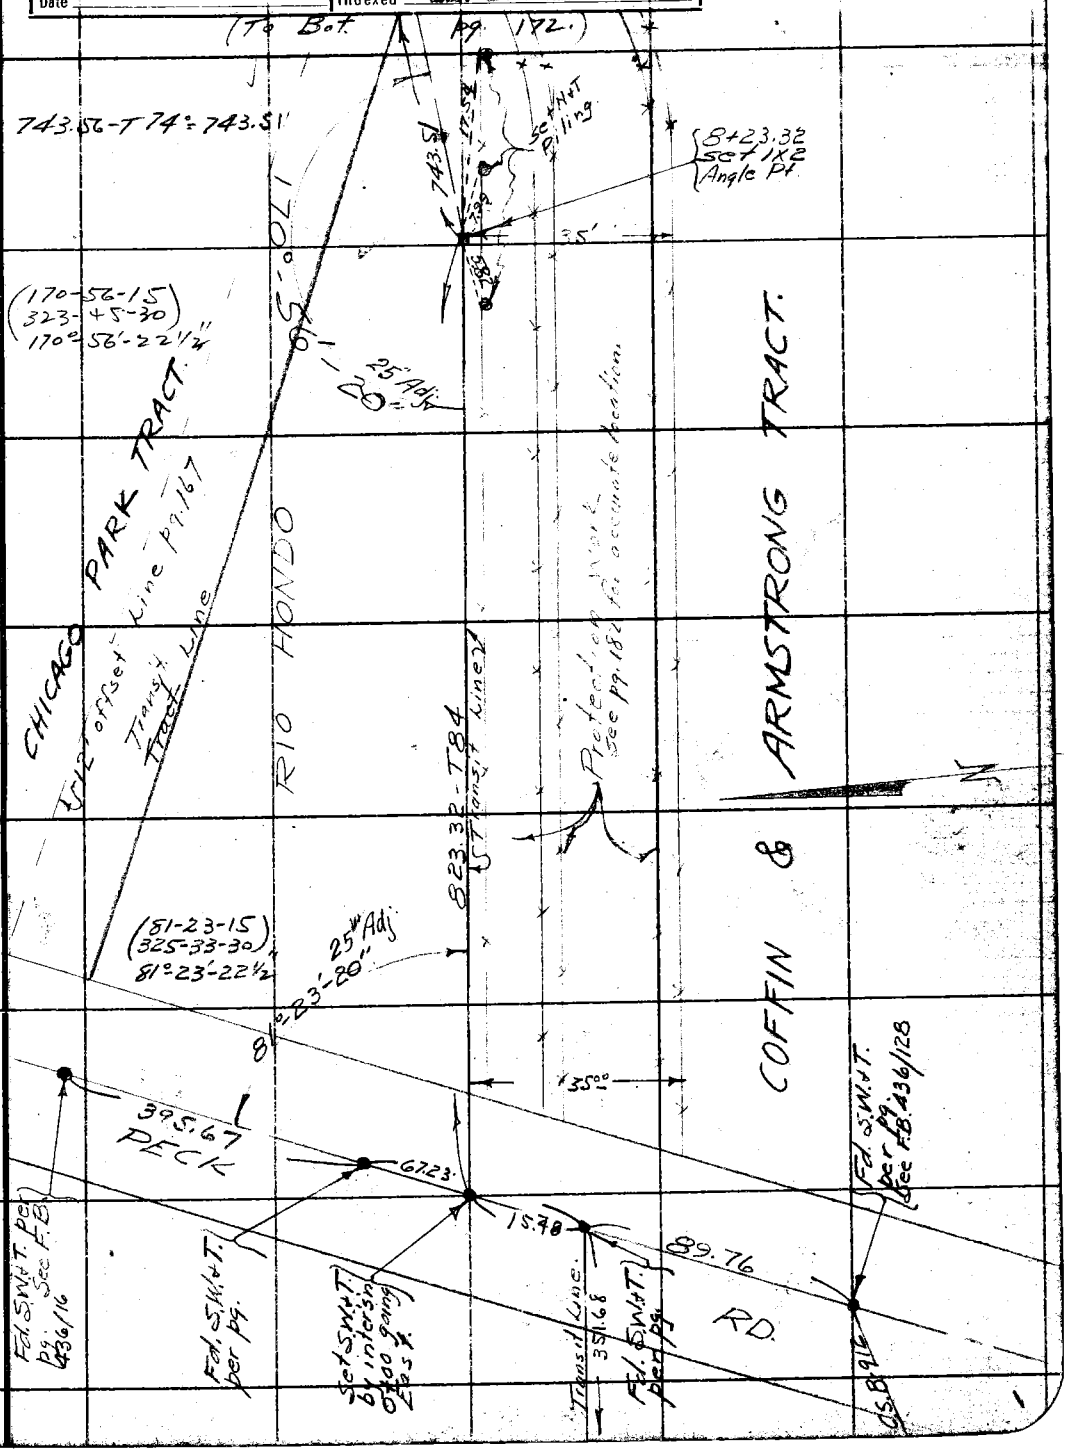

Note: ANY ADDITIONS OR CHANGES ON THIS SHEET MUST BE MADE OR CIRCLED IN Red Ink. WITH DATE AND NAME OF PERSON MAKING CHANGE.

RETURN TO
LOS ANGELES COUNTY SURVEYOR
700 HALL OF RECORDS

Do not extend notes this side of this line

FORM 247 10M 5-31

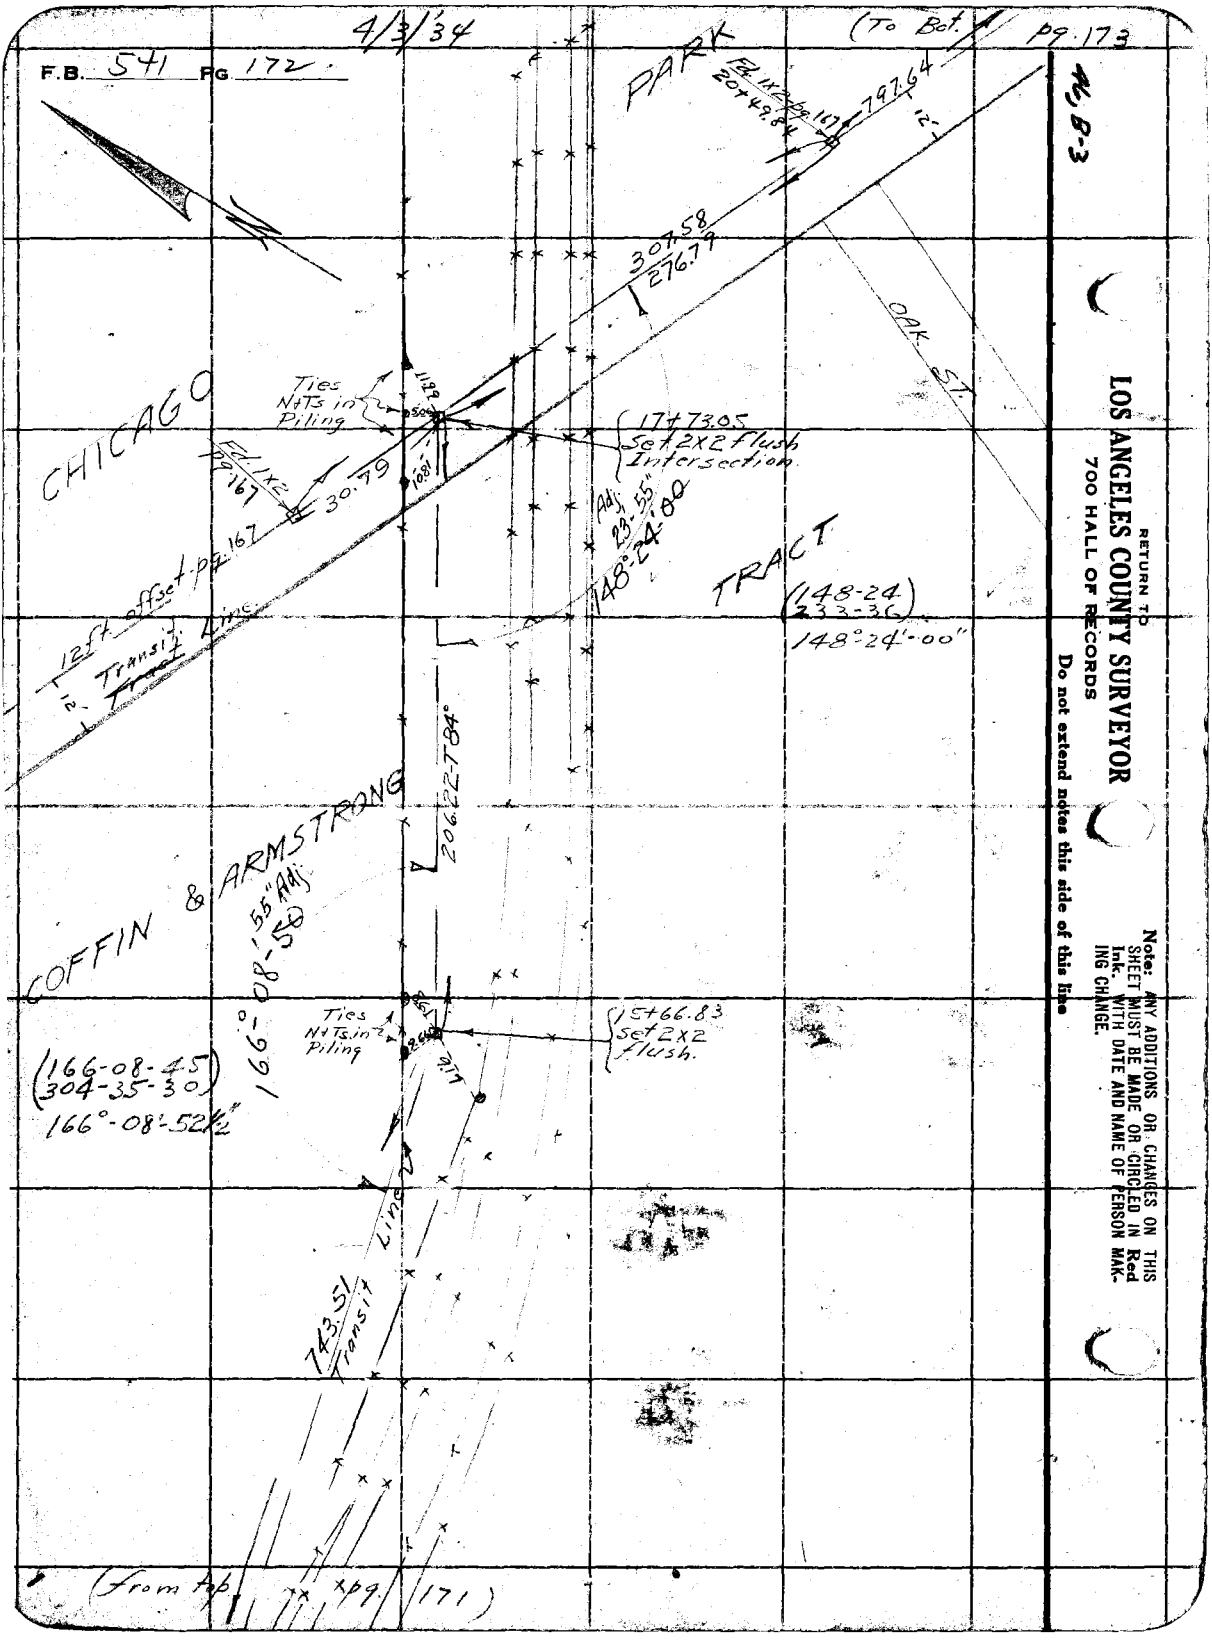
4/3/34
(To Bot. pg. 173
F.B. 541 PG. 172
PARK
Fd. 1x2 pg. 167
20+49.84
797.64
12'
307.58
276.79
OAK ST.
CHICAGO
Ties
N+Ts in
Piling
11.99
5.06
17+73.05
Set 2x2 flush
Intersection
Fd. 1x2
pg. 167
30.79
10.81
Adj.
23'-55"
148°-24'-00
TRACT
(148-24
233-36)
148°-24'-00"
12 ft. offset pg. 167
Transit Line
12'
206.22-T84°
COFFIN & ARMSTRONG
166°-08'-50
55" Adj.
Ties
N+Ts in
Piling
15+66.83
Set 2x2
flush.
(166-08-45
304-35-30)
166°-08'-52½"
Line
743.51
Transit
(from top pg. 171)
RETURN TO
LOS ANGELES COUNTY SURVEYOR
700 HALL OF RECORDS
Do not extend notes this side of this line
Note: ANY ADDITIONS OR CHANGES ON THIS SHEET MUST BE MADE OR CIRCLED IN Red Ink. WITH DATE AND NAME OF PERSON MAKING CHANGE.

DIV II

Notes Ck'd by D. M. Finley	Survey of El Monte Bridle Trail		F.B. 541 Pg. 173
Map No. B-1005-5	W. O. 8012	Tape No. 067	St'd 84 °F.
Office Work C.W. Cox	Surveyed by Evans		
Checked	Notes 1E	Date 4/4/84	
Date	Indexed A. C. Johnson		

46 C-3

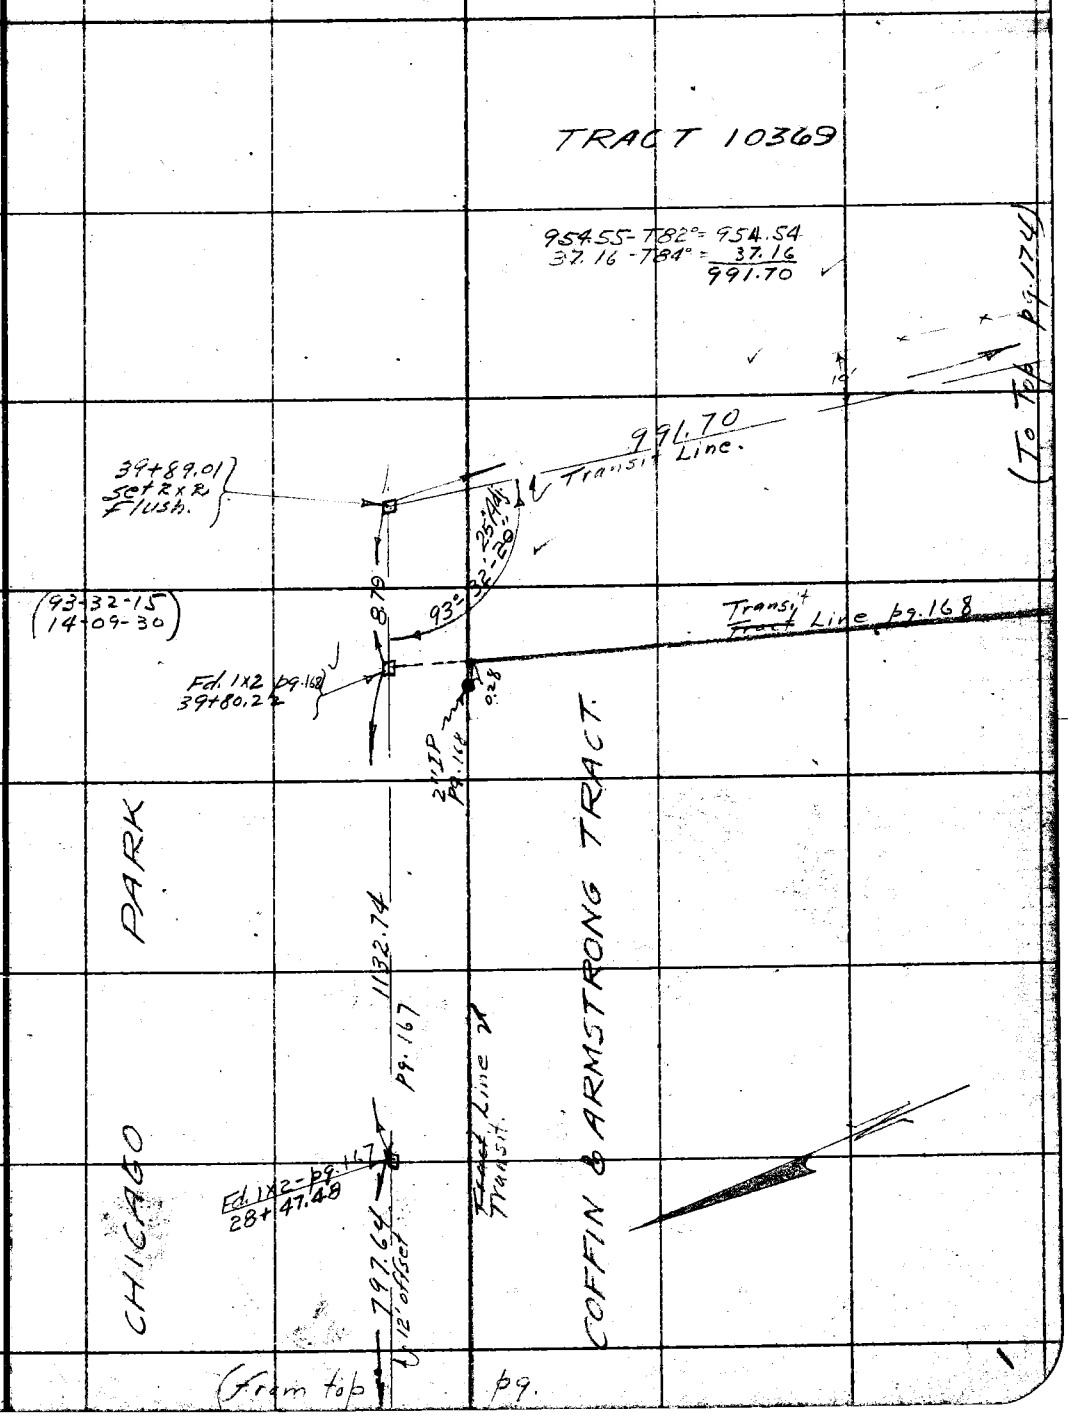

Note: ANY ADDITIONS OR CHANGES ON THIS SHEET MUST BE MADE OR CIRCLED IN Red Ink, WITH DATE AND NAME OF PERSON MAKING CHANGE.

Do not extend notes this side of this line

RETURN TO
LOS ANGELES COUNTY SURVEYOR
700 HALL OF RECORDS

FORM 247 10M 5-31

46, B-4, C-4

RETURN TO
LOS ANGELES COUNTY SURVEYOR
700 HALL OF RECORDS

Note: ANY ADDITIONS OR CHANGES ON THIS SHEET MUST BE MADE OR CIRCLED IN Red Ink WITH DATE AND NAME OF PERSON MAKING CHANGE.

Do not extend notes this side of this line

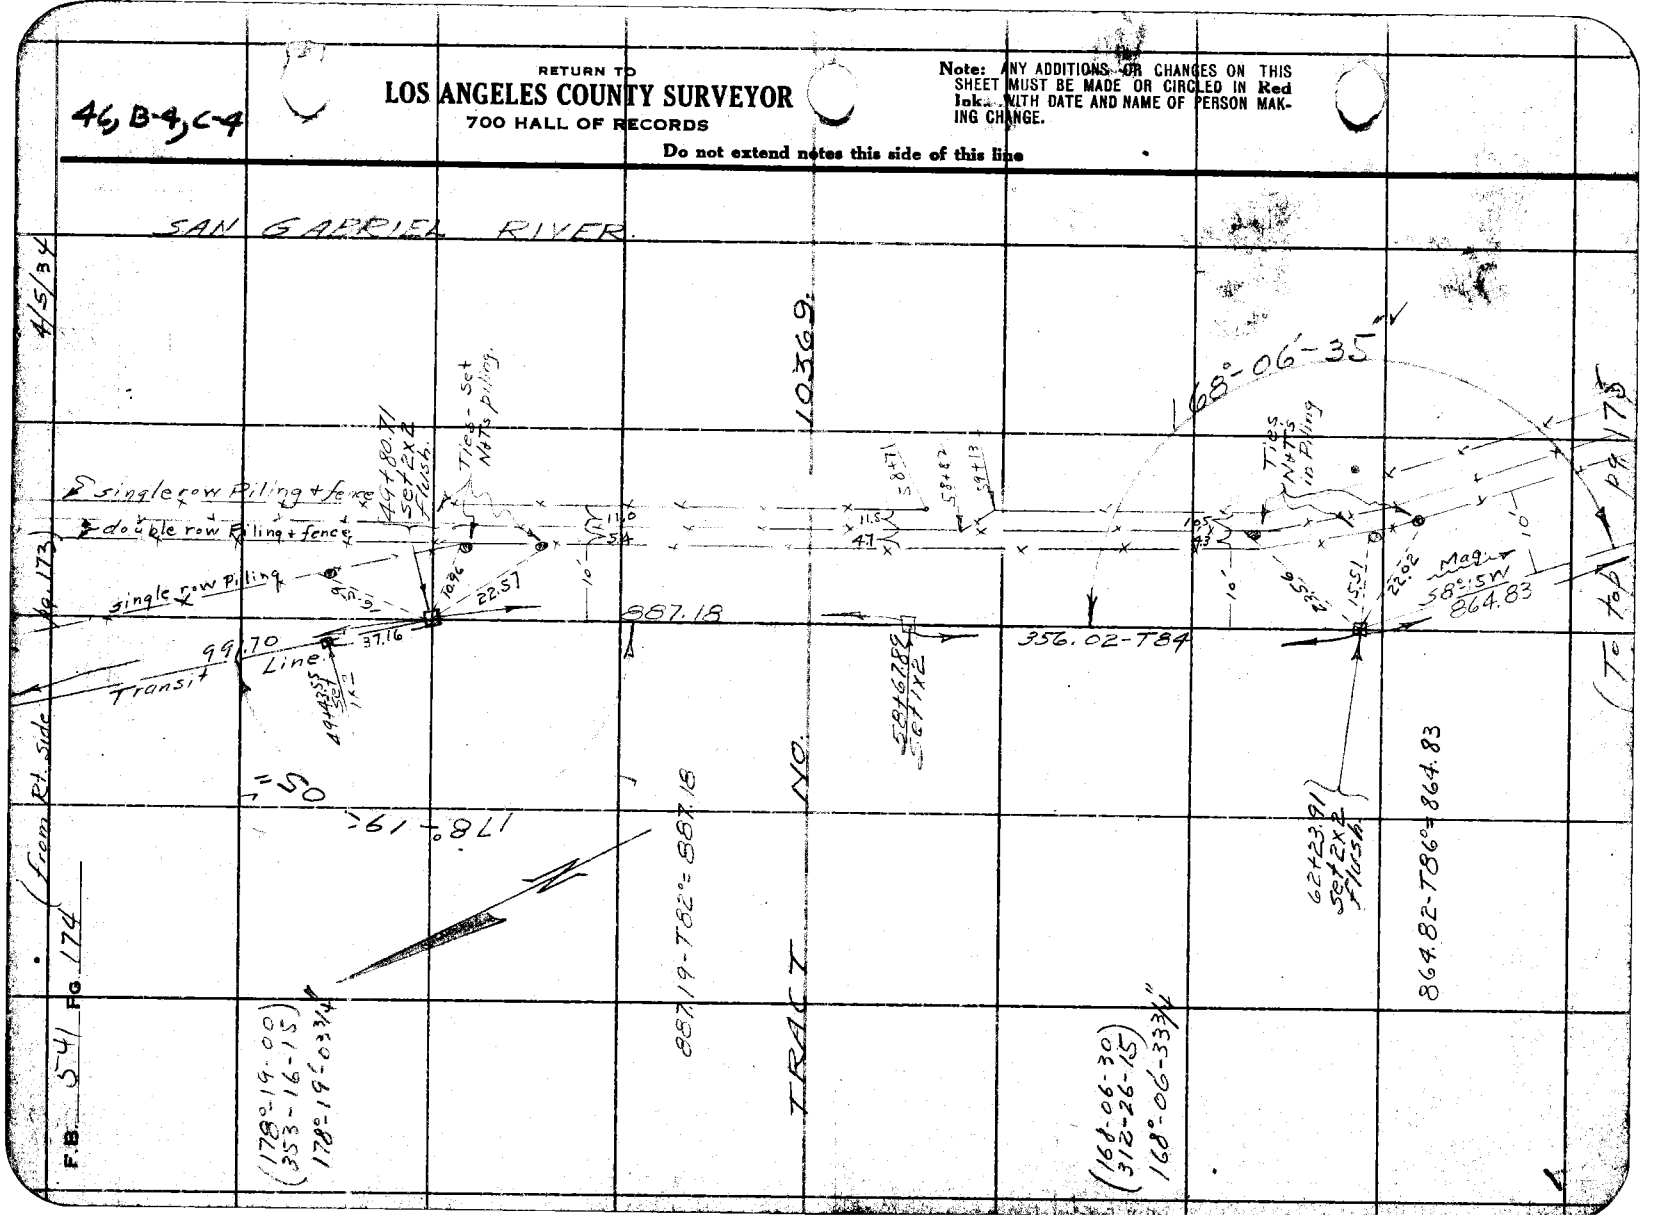

DIV II

Notes Ck'd by D. M. Finley	Survey of El Monte Bridle Trl.
Map No. B-1005-5	W. O. 8012 Tape No. 067 St'd 84° F.
Office Work C. W. Cox	Surveyed by Evans
Checked	Notes HE Date 4/5/34
Date	Indexed C. Johnson

F.B. 541 Pg. 175

C-4
96, B-4

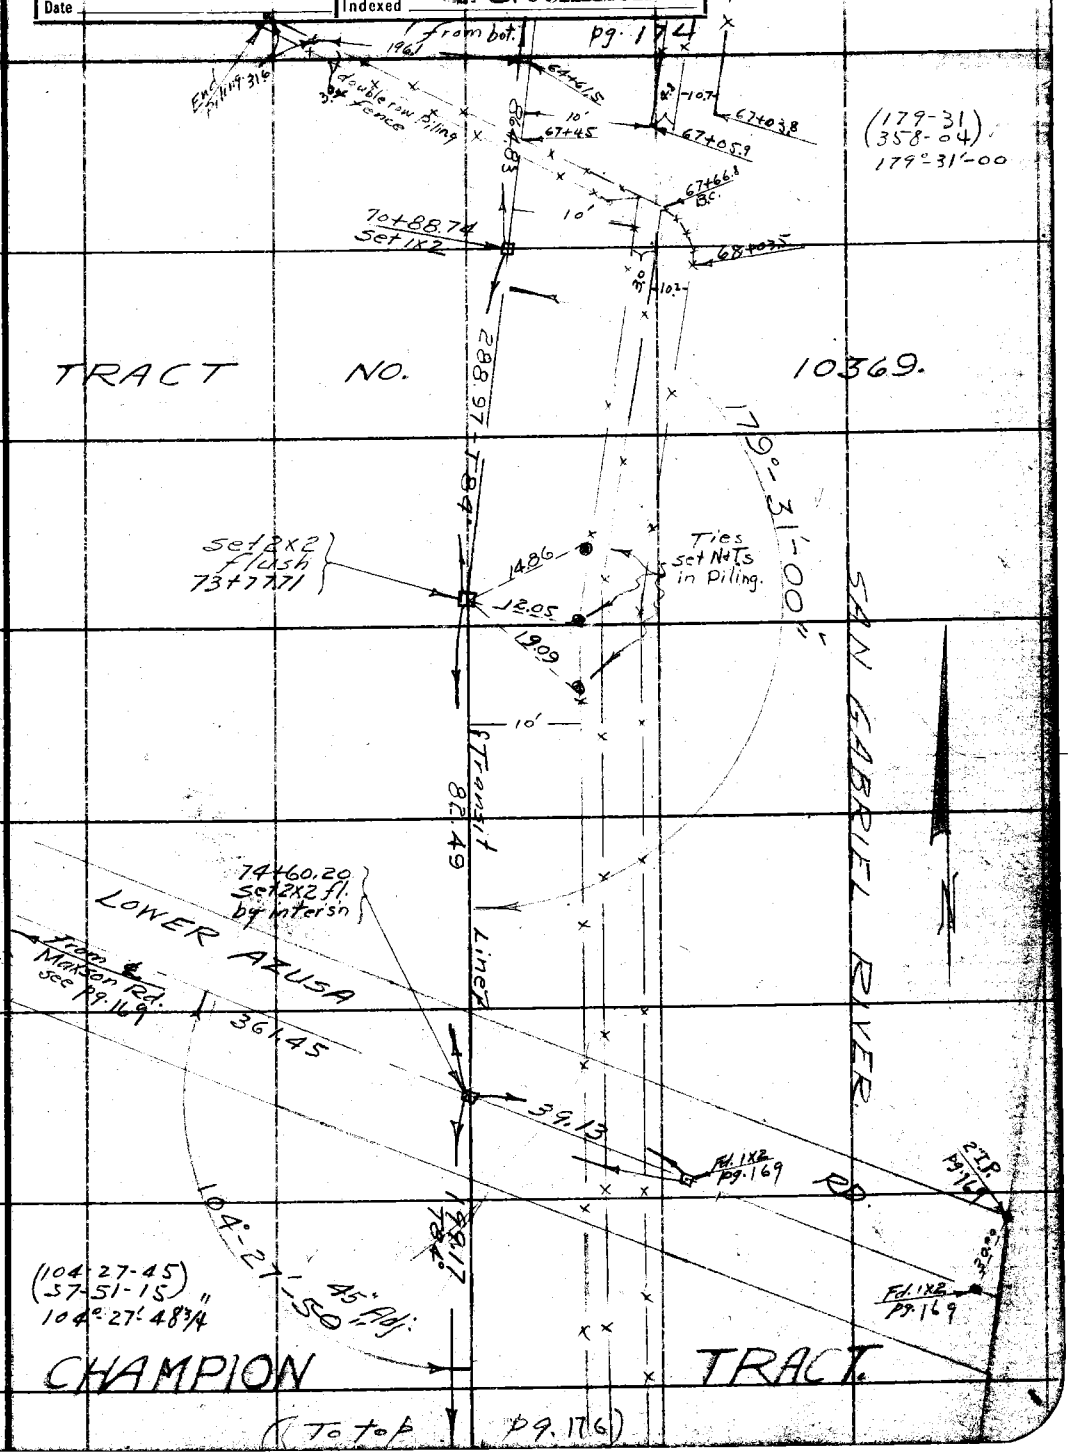

Note: ANY ADDITIONS OR CHANGES ON THIS SHEET MUST BE MADE OR CIRCLED IN Red Ink. WITH DATE AND NAME OF PERSON MAKING CHANGE.

Do not extend notes this side of this line

RETURN TO
LOS ANGELES COUNTY SURVEYOR
700 HALL OF RECORDS

FORM 247 10M 5-31

(from Bot. pg. 175) 4/6/34

F.B. 541 PG 176

46, B-4

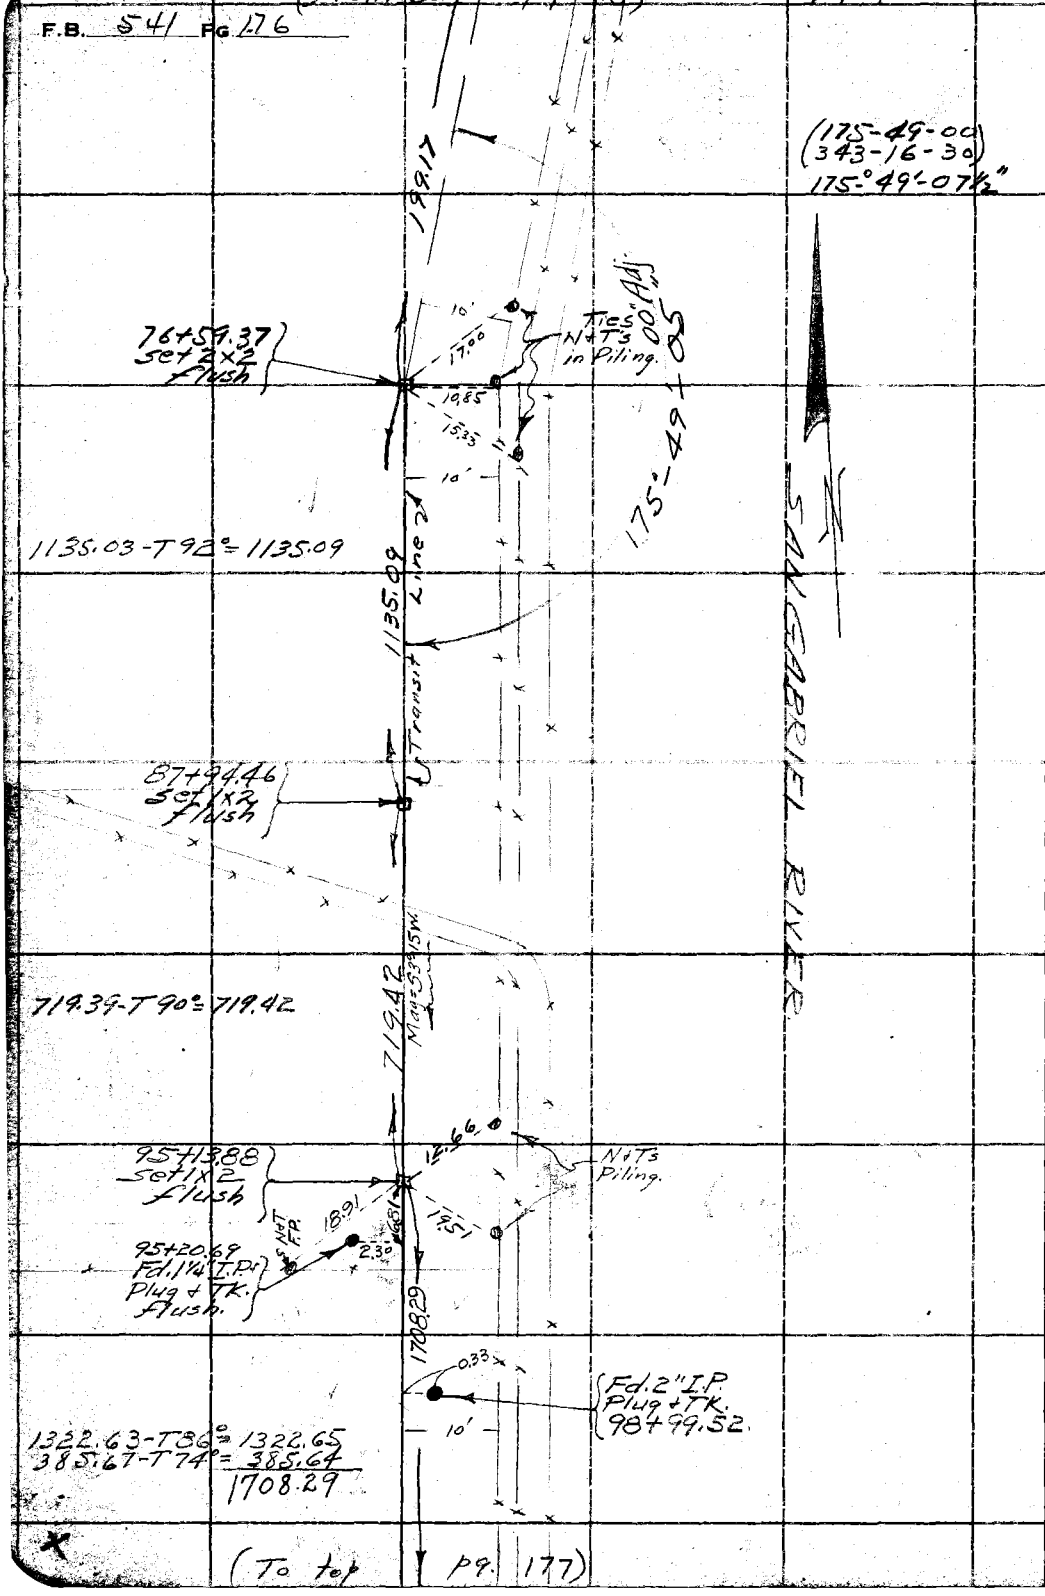

(To top pg. 177)

RETURN TO
LOS ANGELES COUNTY SURVEYOR
700 HALL OF RECORDS
Do not extend notes this side of this line

Note: ANY ADDITIONS OR CHANGES ON THIS SHEET MUST BE MADE OR CIRCLED IN Red Ink. WITH DATE AND NAME OF PERSON MAKING CHANGE.

Div II.

Notes Ck'd by D. M. Finley	Survey of El Monte Bridle Trail	F.B. 541	Pg. 177
Map No. B-1005-5	W. O. 8012 Tape No. 067 St'd 84 °F.		
Office Work G.W. Cox	Surveyed by Evans		
Checked	Notes HE Date 4/9/34		
Date	Indexed A. C. Johnson		

46, B-4

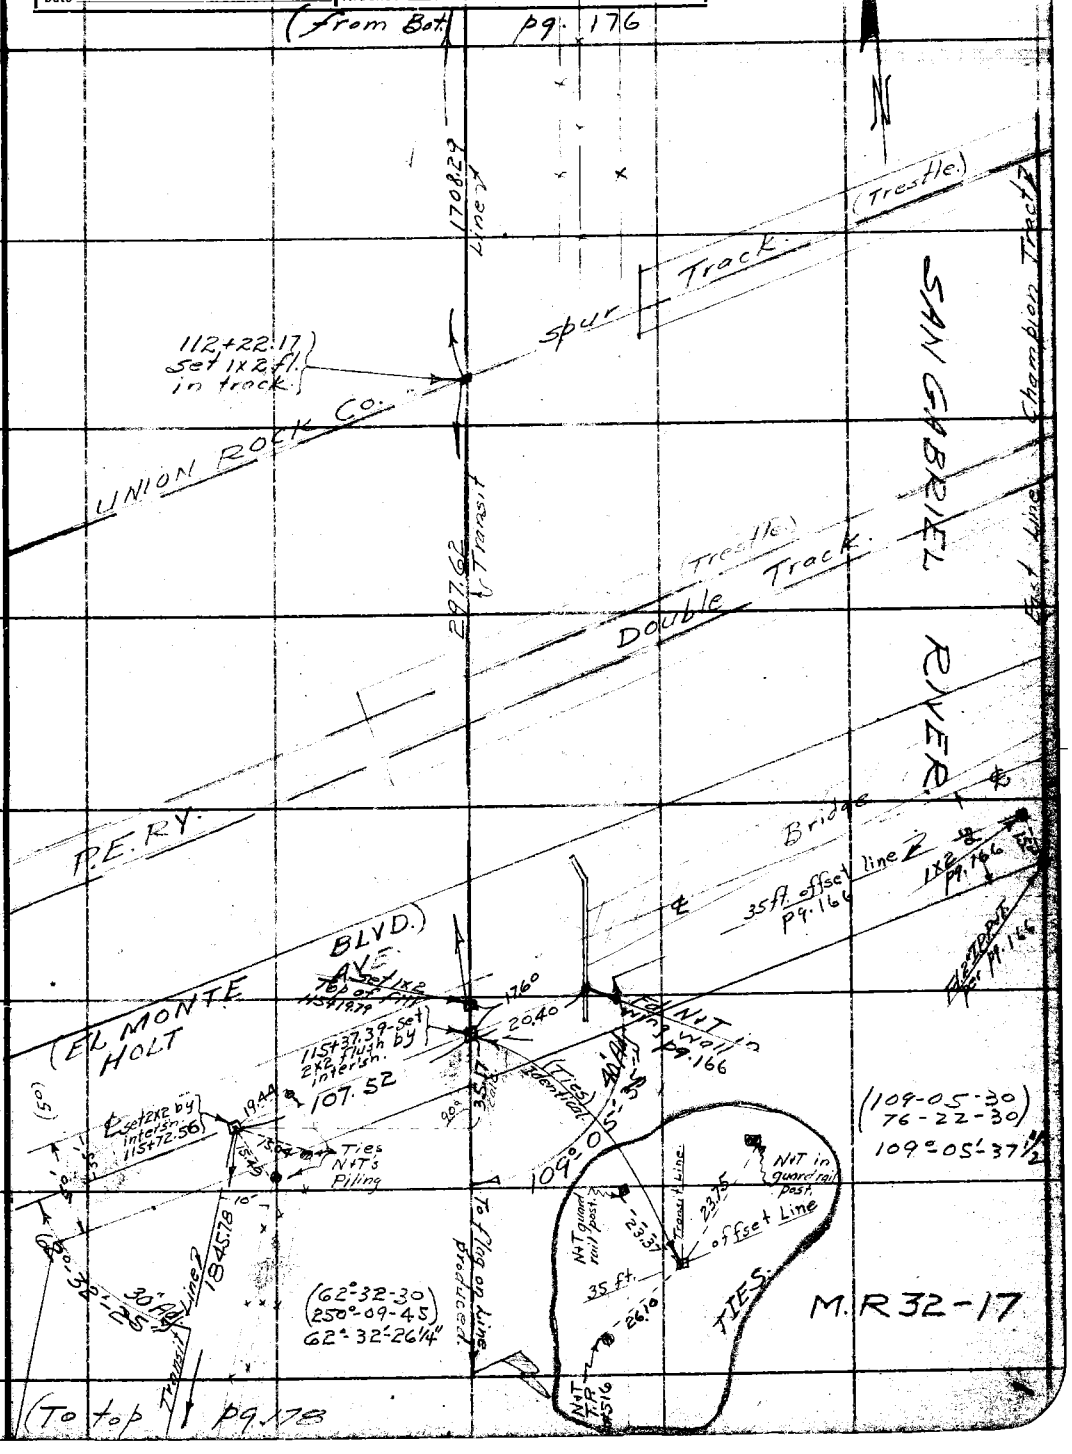

Note: ANY ADDITIONS OR CHANGES ON THIS SHEET MUST BE MADE OR CIRCLED IN Red Ink. WITH DATE AND NAME OF PERSON MAKING CHANGE.

Do not extend notes this side of this line

RETURN TO
LOS ANGELES COUNTY SURVEYOR
700 HALL OF RECORDS

FORM 247 10M 5-31

RETURN TO
LOS ANGELES COUNTY SURVEYOR
700 HALL OF RECORDS

Note: ANY ADDITIONS OR CHANGES ON THIS SHEET MUST BE MADE OR CIRCLED IN **Red Ink.** WITH DATE AND NAME OF PERSON MAKING CHANGE.

Do not extend notes this side of this line

46, B-5

4/10/34

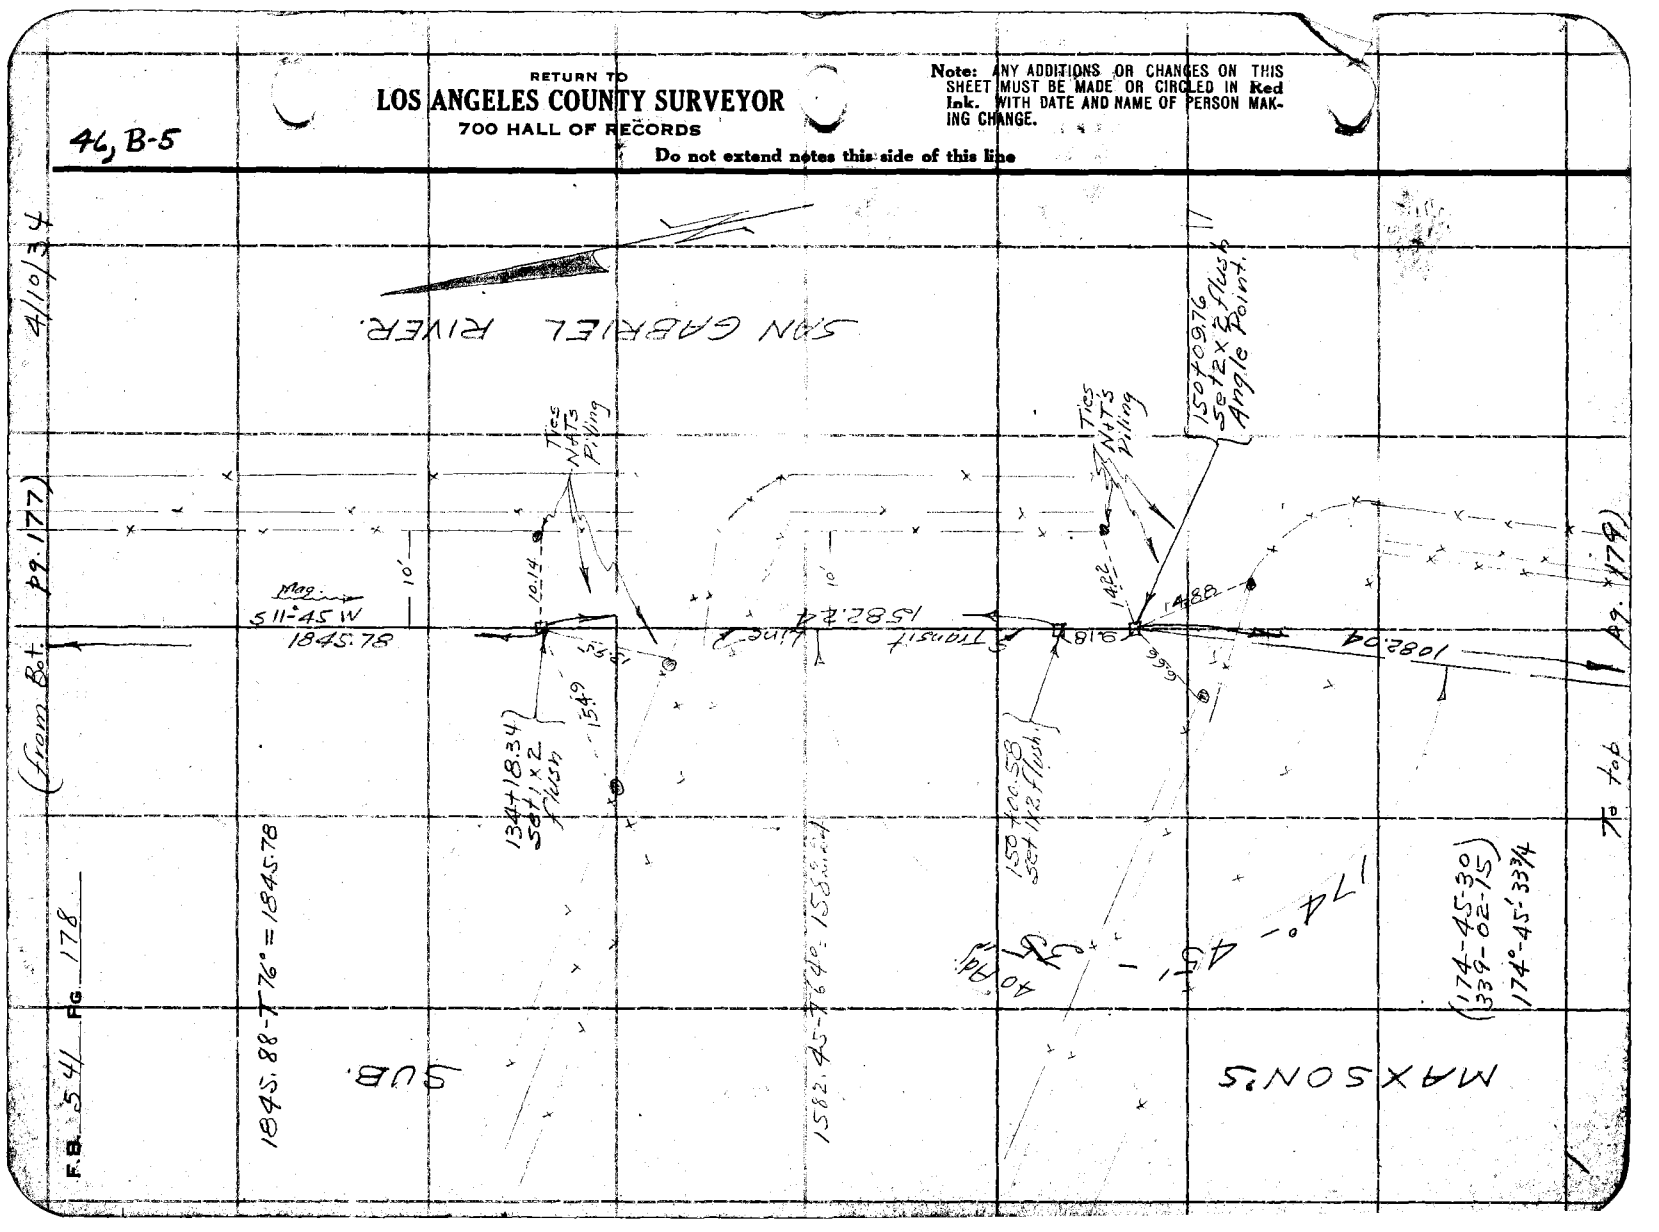

F.B. 541 Pg. 178

Div. II.

Notes Ck'd by D. M. Finley	Survey of El Monte Bridle Trail
Map No. B-1005-6	W. O. 8012 Tape No. 067 St'd 84 °F.
Office Work C.W. Cox	Surveyed by Evans.
Checked	Notes HE Date 4/11/34
Date	Indexed A. C. Johnson

F.B. 541 Pg. 179

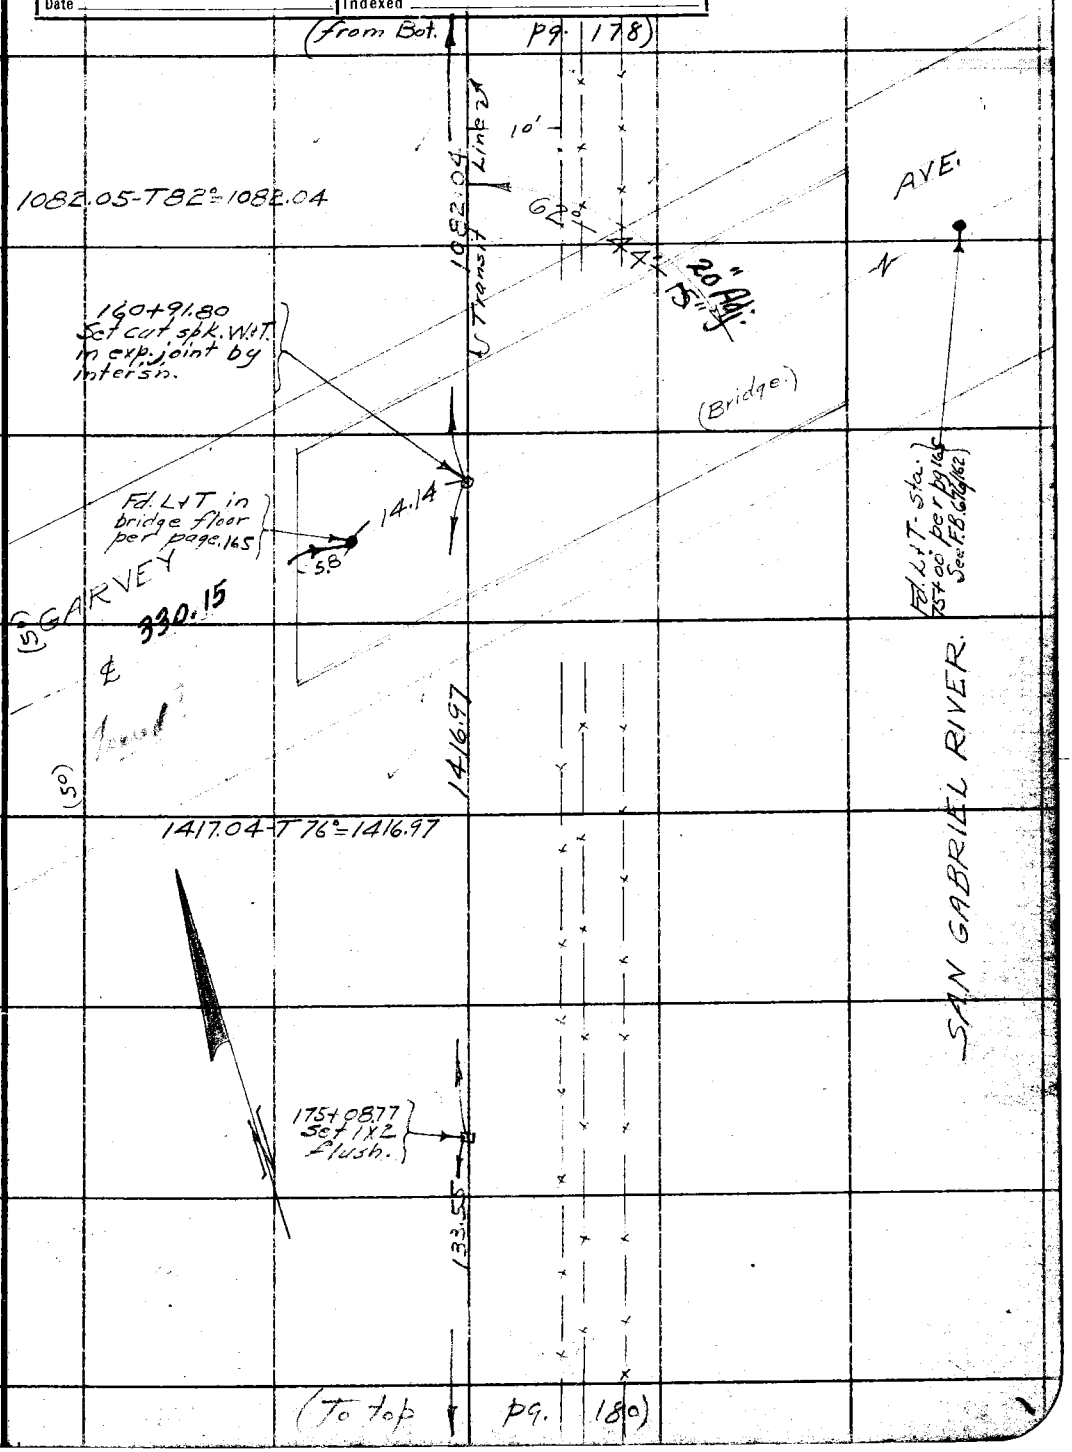

Note: ANY ADDITIONS OR CHANGES ON THIS SHEET MUST BE MADE OR CIRCLED IN Red Ink. WITH DATE AND NAME OF PERSON MAKING CHANGE.

Do not extend notes this side of this line

RETURN TO
LOS ANGELES COUNTY SURVEYOR
700 HALL OF RECORDS

FORM 247 10M 5-31

RETURN TO
LOS ANGELES COUNTY SURVEYOR
700 HALL OF RECORDS

Note: ANY ADDITIONS OR CHANGES ON THIS SHEET MUST BE MADE OR CIRCLED IN Red Ink. WITH DATE AND NAME OF PERSON MAKING CHANGE.

Do not extend notes this side of this line

46 B-5

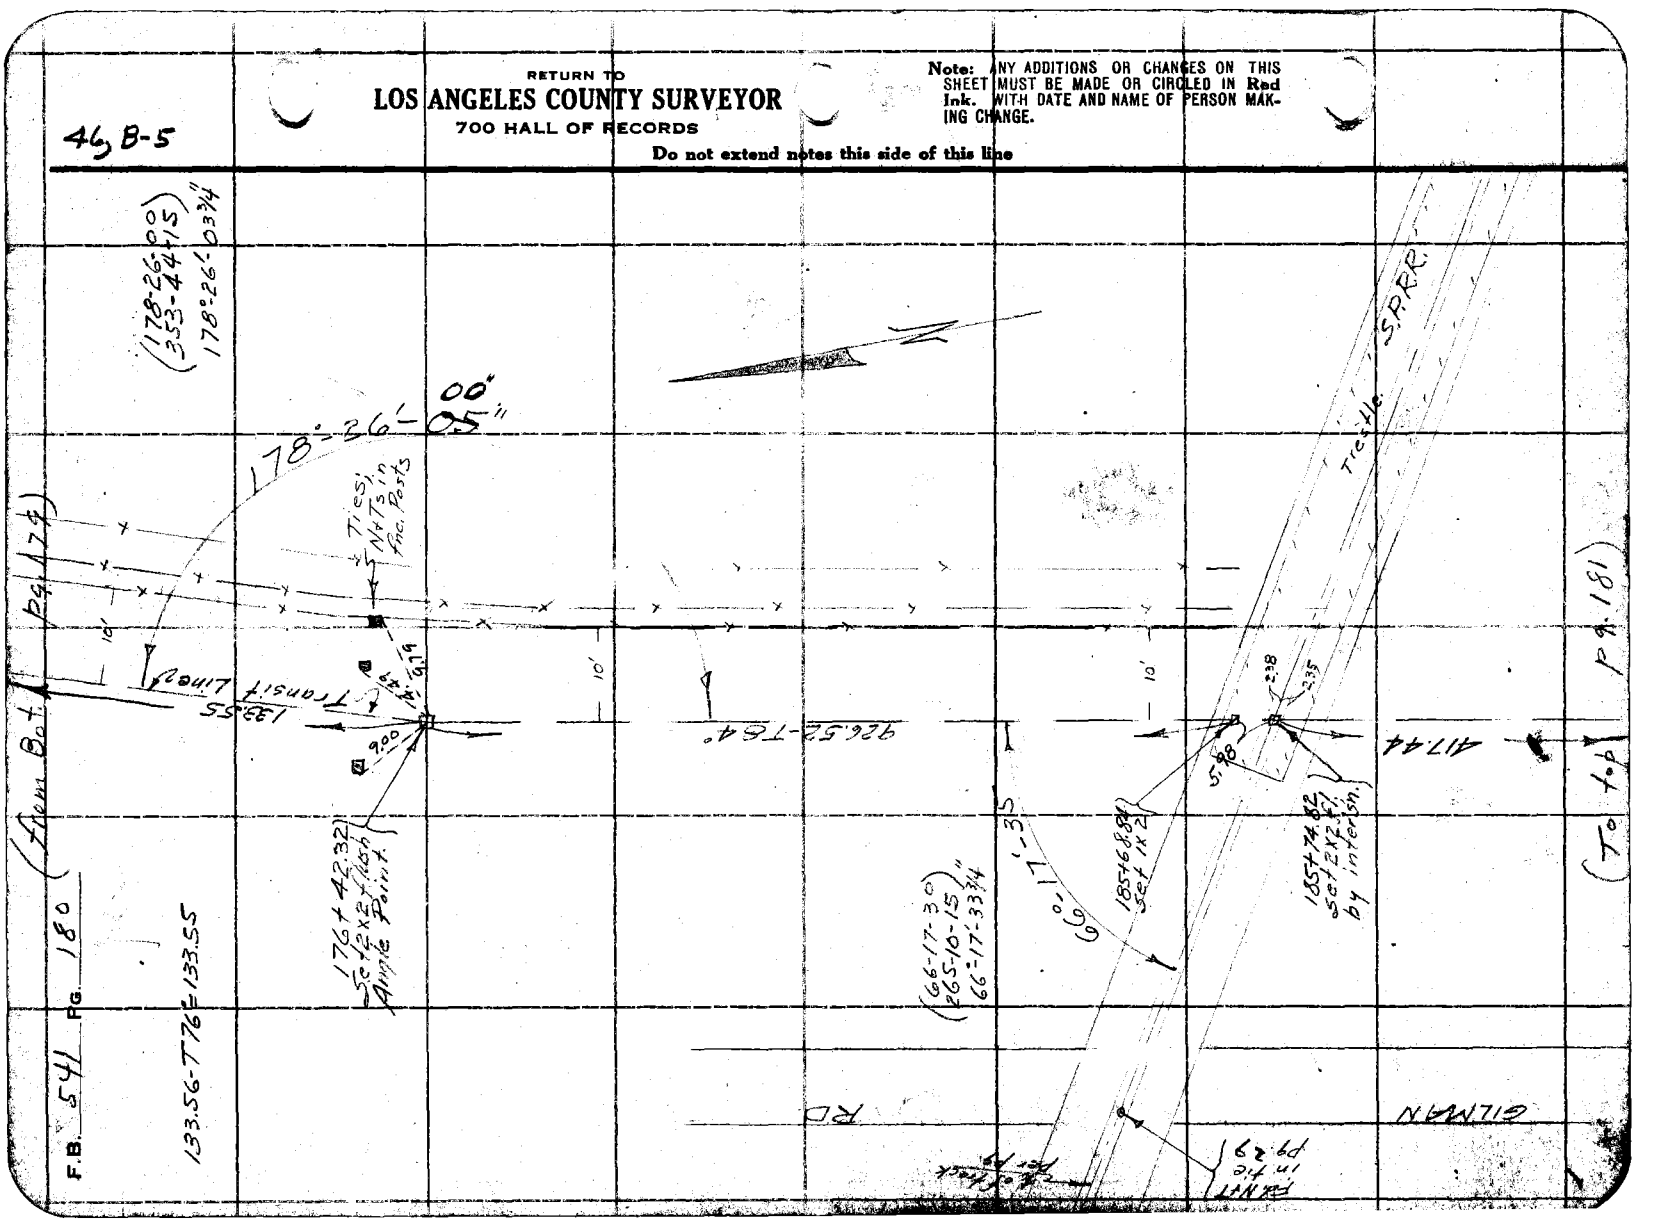

Notes Ck'd by D. M. Finley	Survey of El Monte Bridle Trl.
Map No. B-1005-6	W. O. 8012 Tape No. 067 St'd 84 °F.
Office Work C. W. Cox	Surveyed by Evans
Checked	Notes HE Date 4/25/34
Date	Indexed A. C. Johnson

F.B. 541 Pg. 181

46, B-6

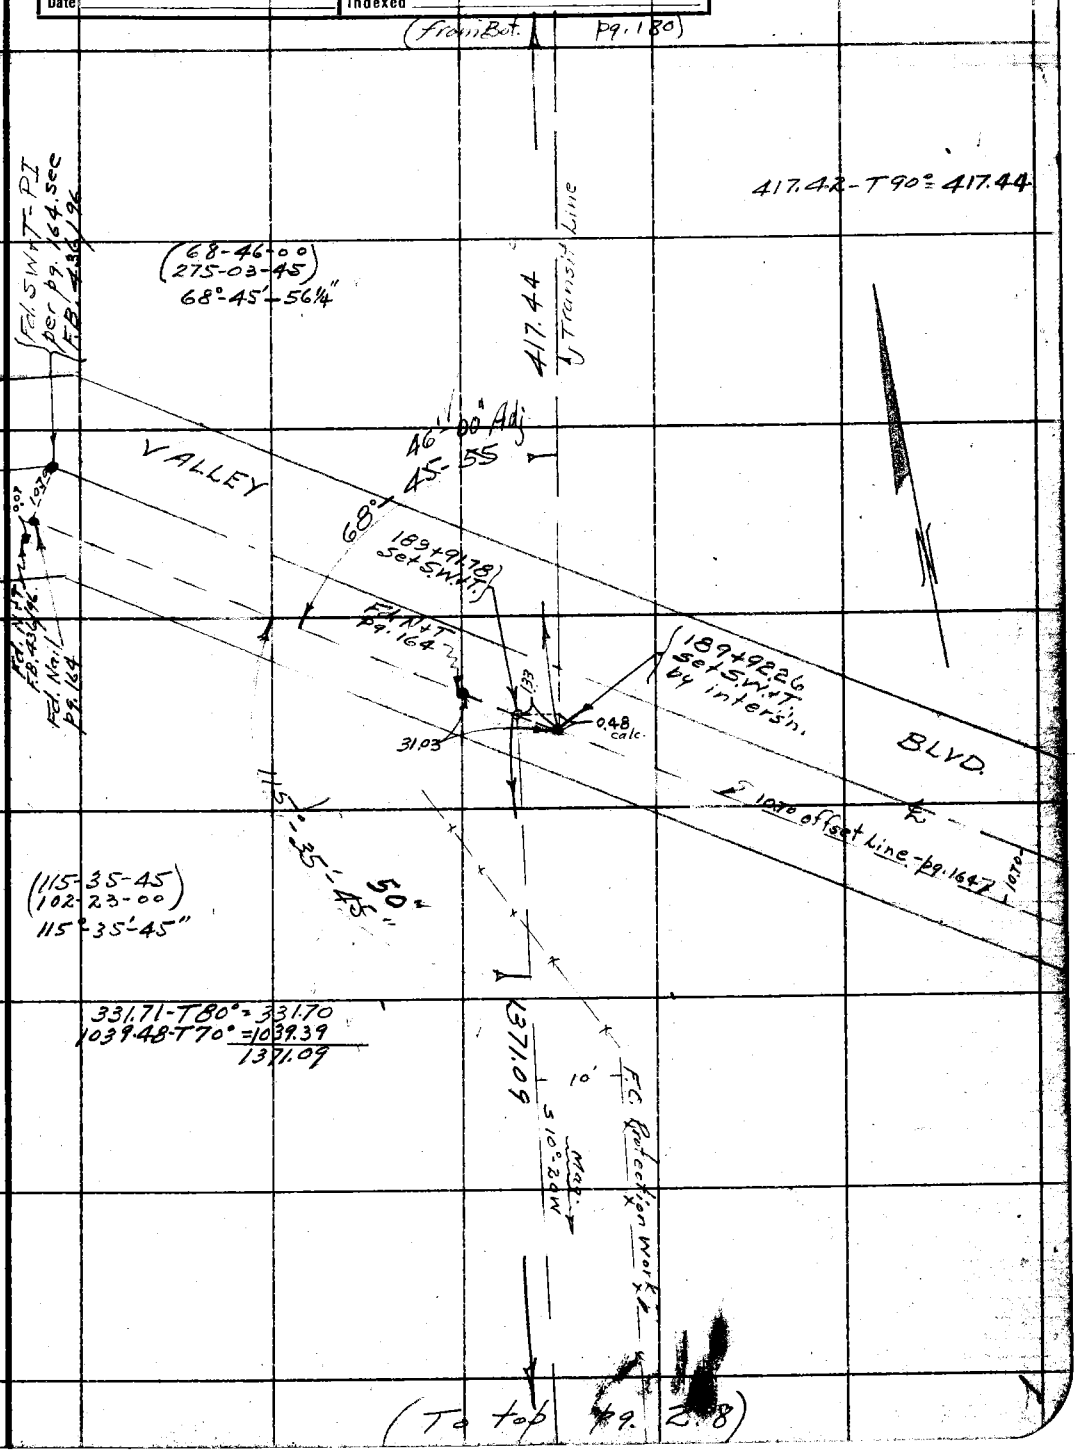

Note: ANY ADDITIONS OR CHANGES ON THIS SHEET MUST BE MADE OR CIRCLED IN Red Ink. WITH DATE AND NAME OF PERSON MAKING CHANGE.

Do not extend notes this side of this line

RETURN TO
LOS ANGELES COUNTY SURVEYOR
700 HALL OF RECORDS

FORM 247 10M 5-31

Cont at bot. Pg 183

F.B. 541 Pg. 182

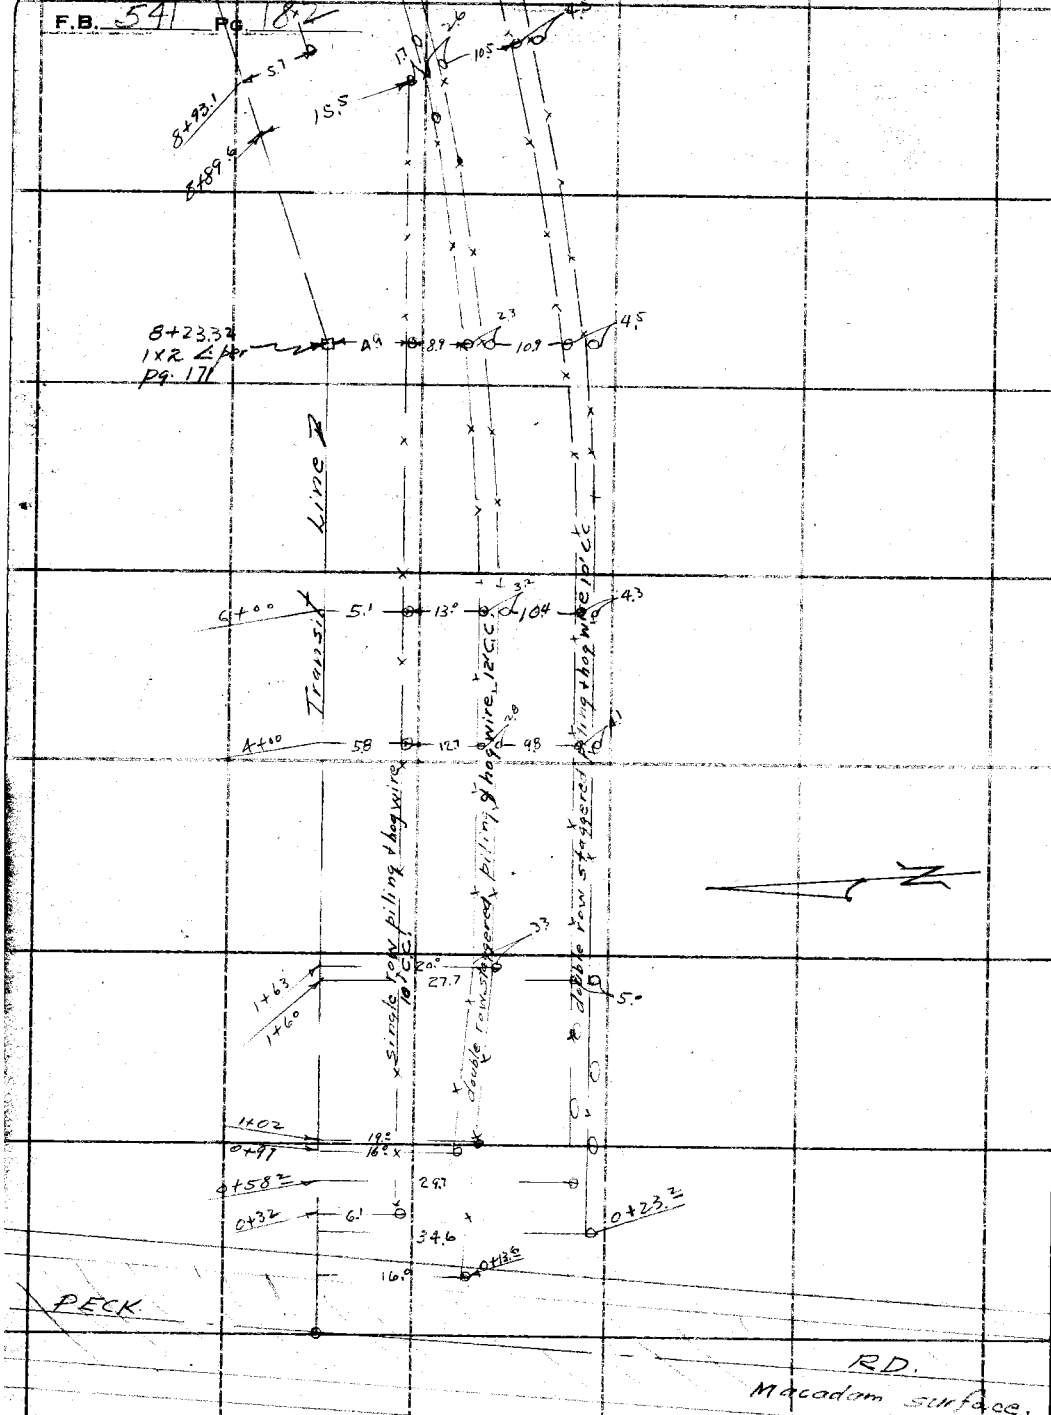

Location Imp'vts from Peck Rd to Valley Blvd. (pgs. 183-217)

RETURN TO
LOS ANGELES COUNTY SURVEYOR
700 HALL OF RECORDS
Do not extend notes this side of this line

Note: ANY ADDITIONS OR CHANGES ON THIS SHEET MUST BE MADE OR CIRCLED IN Red Ink. WITH DATE AND NAME OF PERSON MAKING CHANGE.

Notes Ck'd by D. M. Finley	Survey of El Monte Bridle Trl.
Map No. B-1005-5	W. O. 8012 Tape No. .067 St'd 84 °F.
Office Work C. W. Cox	Surveyed by Evans
Checked	Notes HE Date 4-25-34
Date	Indexed A. C. Johnson

F.B. 541 Pg. 183

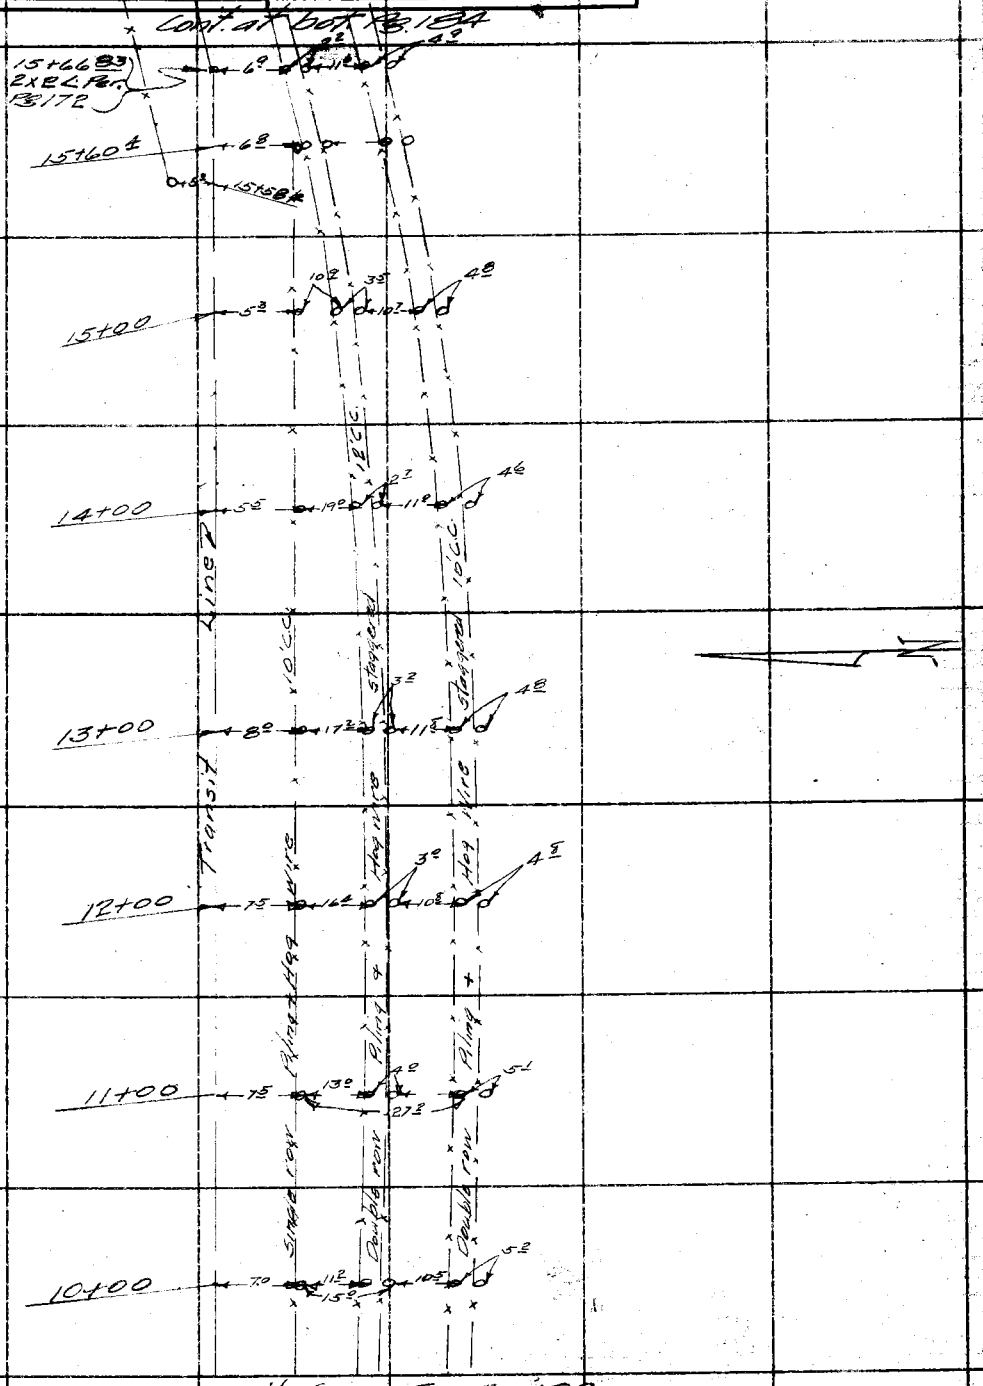

Note: ANY ADDITIONS OR CHANGES ON THIS SHEET MUST BE MADE OR CIRCLED IN Red Ink. WITH DATE AND NAME OF PERSON MAKING CHANGE.

RETURN TO
LOS ANGELES COUNTY SURVEYOR
700 HALL OF RECORDS

Do not extend notes this side of this line

FORM 247 10M 8-31

RETURN TO
LOS ANGELES COUNTY SURVEYOR
700 HALL OF RECORDS

Note: ANY ADDITIONS OR CHANGES ON THIS SHEET MUST BE MADE OR CIRCLED IN **Red Ink.** WITH DATE AND NAME OF PERSON MAKING CHANGE.

Do not extend notes this side of this line

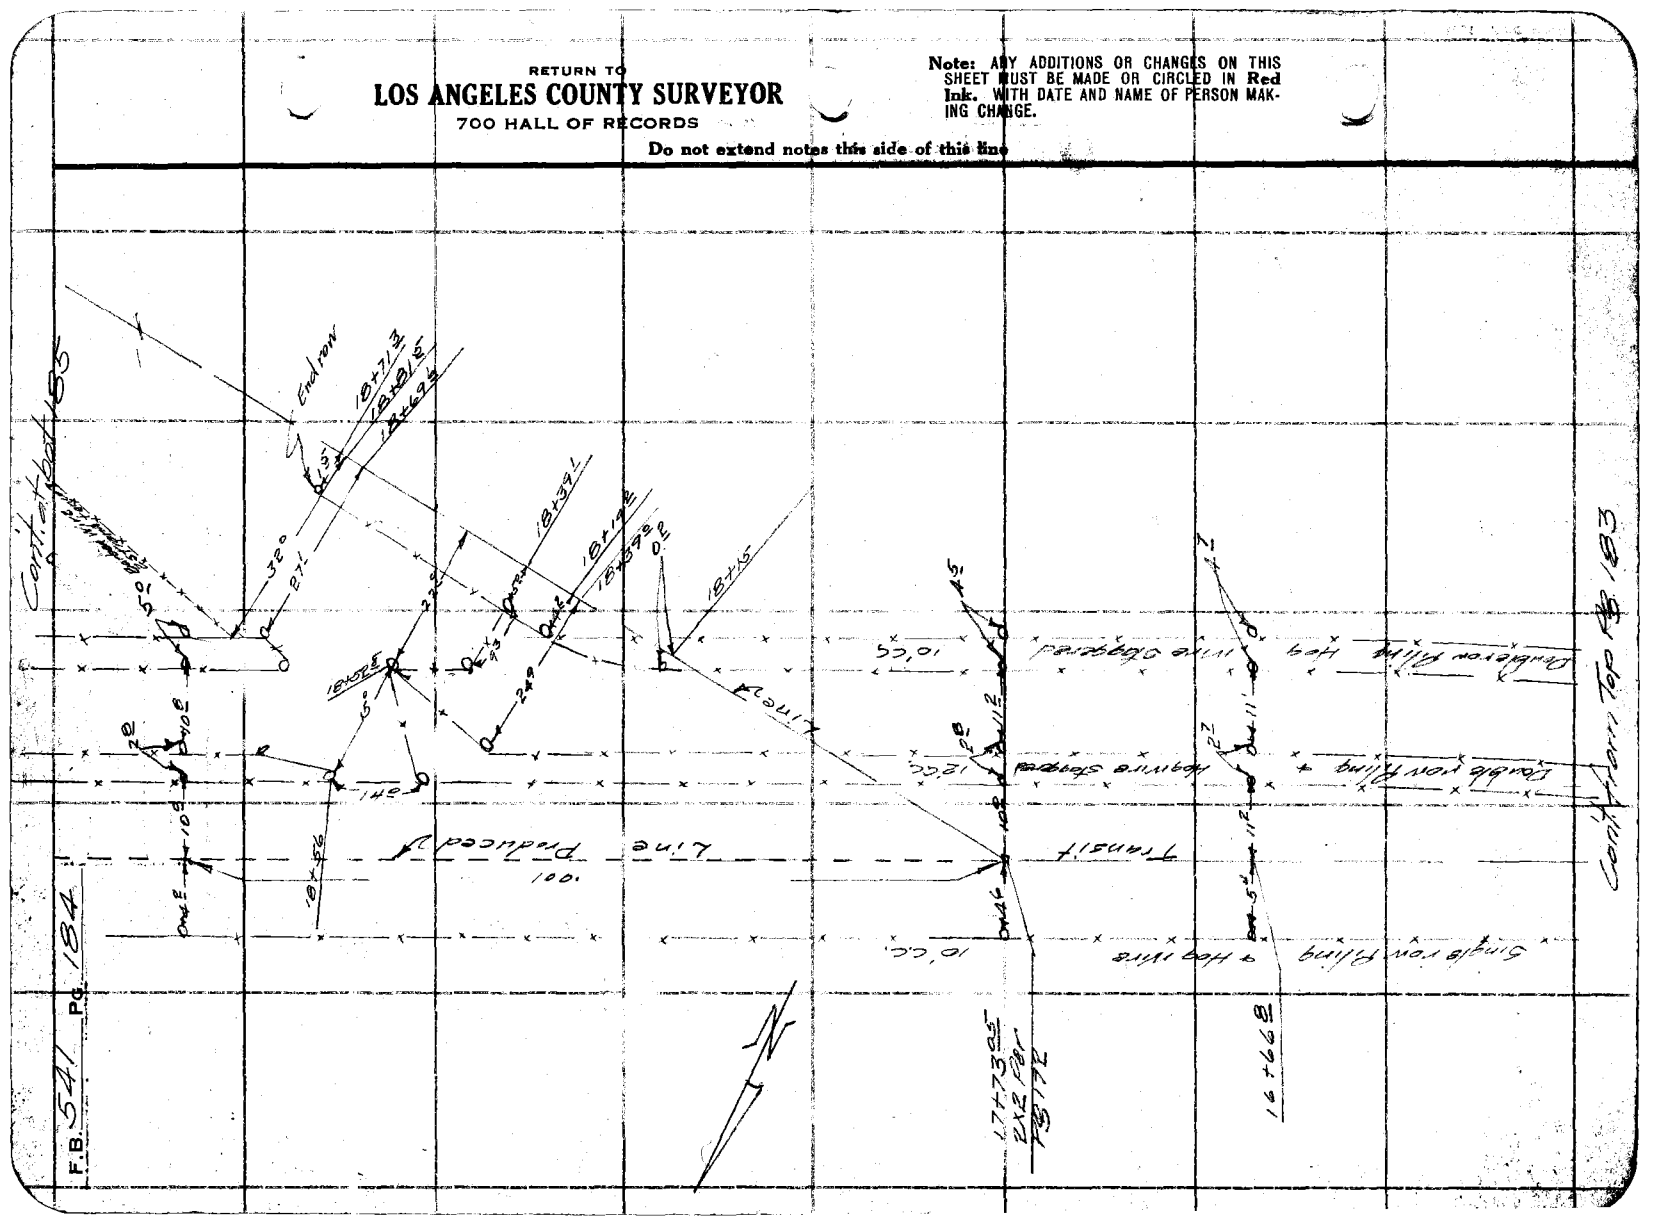

Notes Ck'd by D. M. Finley	Survey of El Monte Bridleta F.B. 541 Pg. 185
Map No. B-1005-5	W. O. 8012 Tape No. .067 St'd 84 °F.
Office Work C. W. Cox	Surveyed by Evans
Checked	Notes HE Date 4-26-34
Date	Indexed A. C. Johnson

Cont. at bot. Pg 186

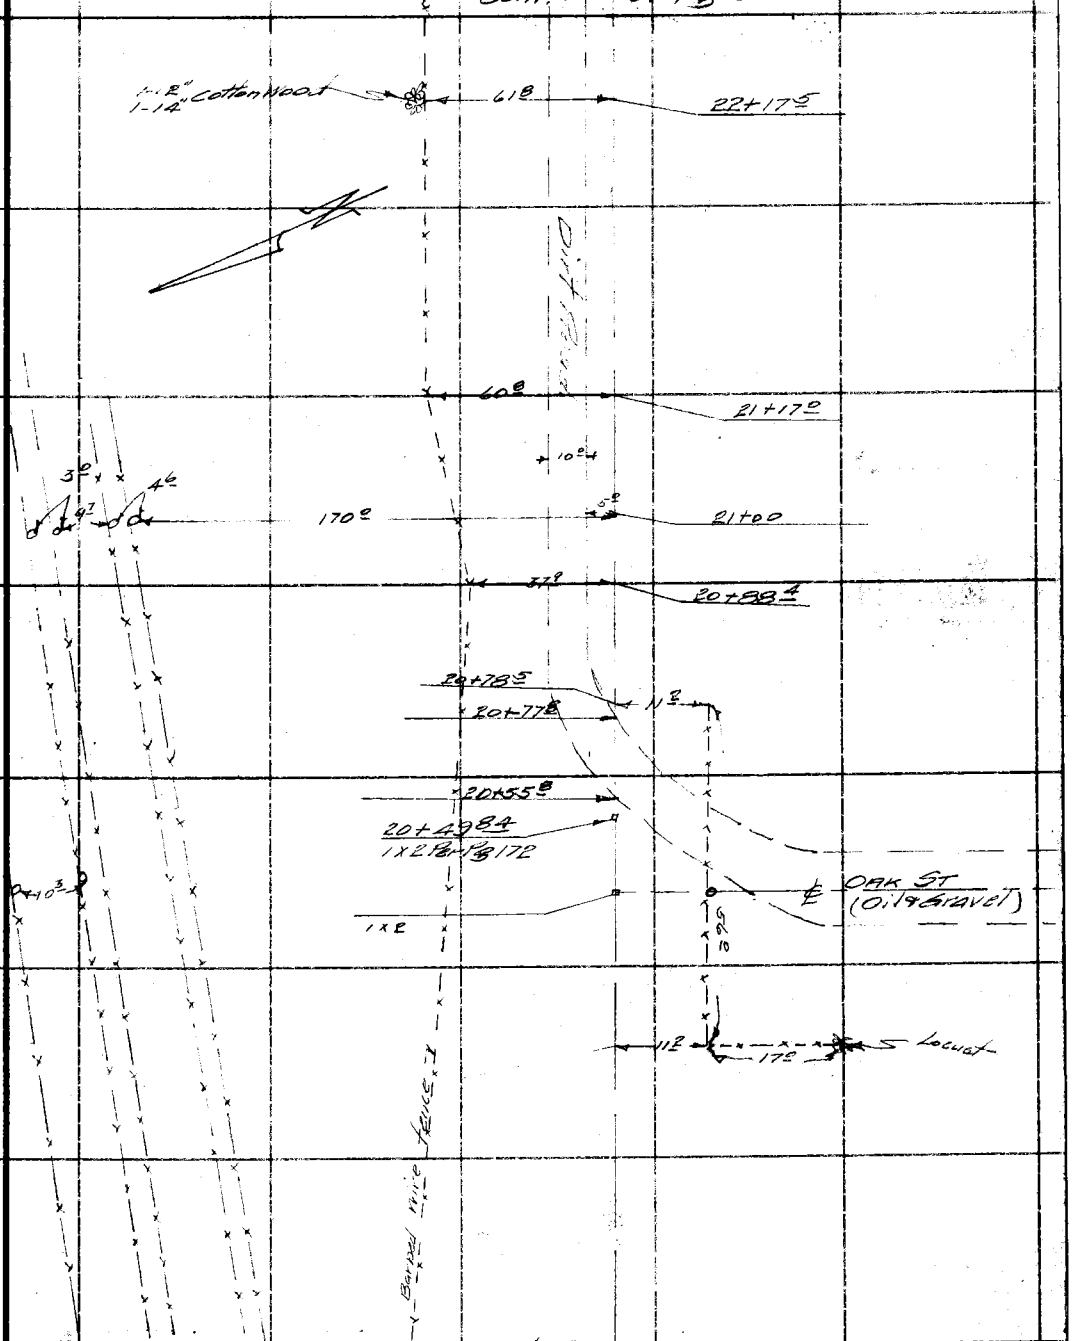

Cont from Top Pg 184

Note: ANY ADDITIONS OR CHANGES ON THIS SHEET MUST BE MADE OR CIRCLED IN Red Ink. WITH DATE AND NAME OF PERSON MAKING CHANGE.

RETURN TO
LOS ANGELES COUNTY SURVEYOR
700 HALL OF RECORDS
Do not extend notes this side of this line

FORM 247 10M 8-31

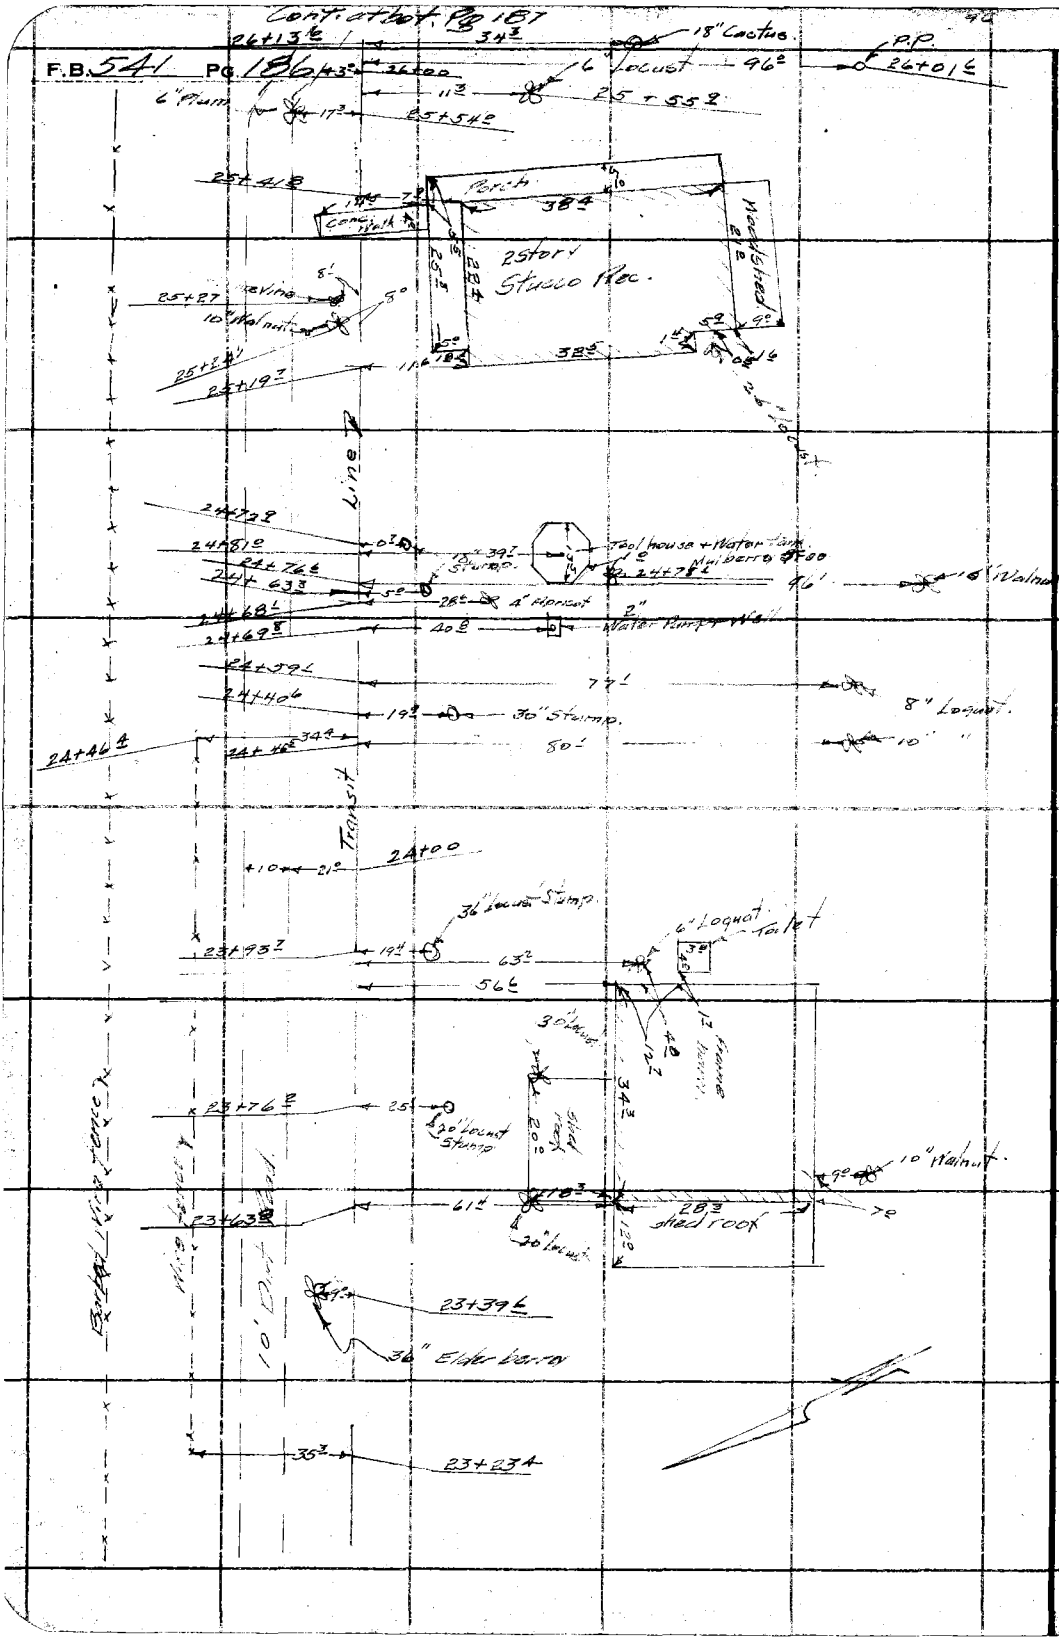

RETURN TO
LOS ANGELES COUNTY SURVEYOR
700 HALL OF RECORDS

Do not extend notes this side of this line

Note: ANY ADDITIONS OR CHANGES ON THIS SHEET MUST BE MADE OR CIRCLED IN **Red Ink**. WITH DATE AND NAME OF PERSON MAKING CHANGE.

Notes Ck'd by D. M. Finley	Survey of El Monte Bridle Trail
Map No. B-1005-5	W. O. 8012 Tape No. 067 St'd 84 °F.
Office Work C. W. Cox	Surveyed by Evans
Checked	Notes Brock Date 4/28/34
Date	Indexed A. C. Johnson

F.B. 541 Pg 187

Cont at bot. pg 188

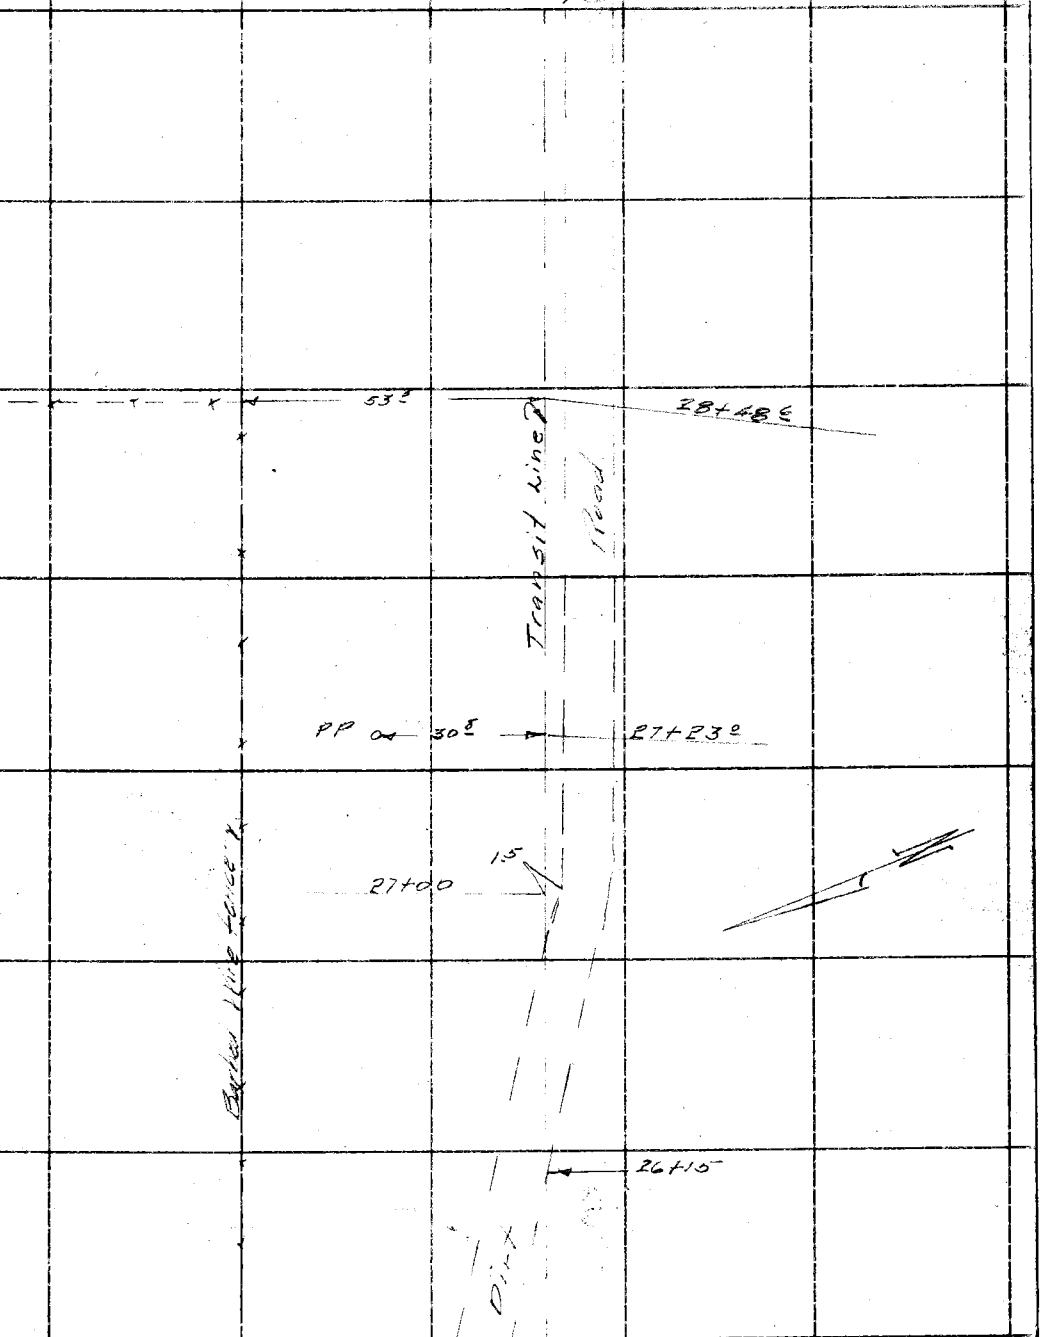

Cont. From top pg 186

Note: ANY ADDITIONS OR CHANGES ON THIS SHEET MUST BE MADE OR CIRCLED IN Red Ink. WITH DATE AND NAME OF PERSON MAKING CHANGE.

RETURN TO
LOS ANGELES COUNTY SURVEYOR
700 HALL OF RECORDS

Do not extend notes this side of this line

FORM 247 10M 5-31

F.B. 541 Pg. 188

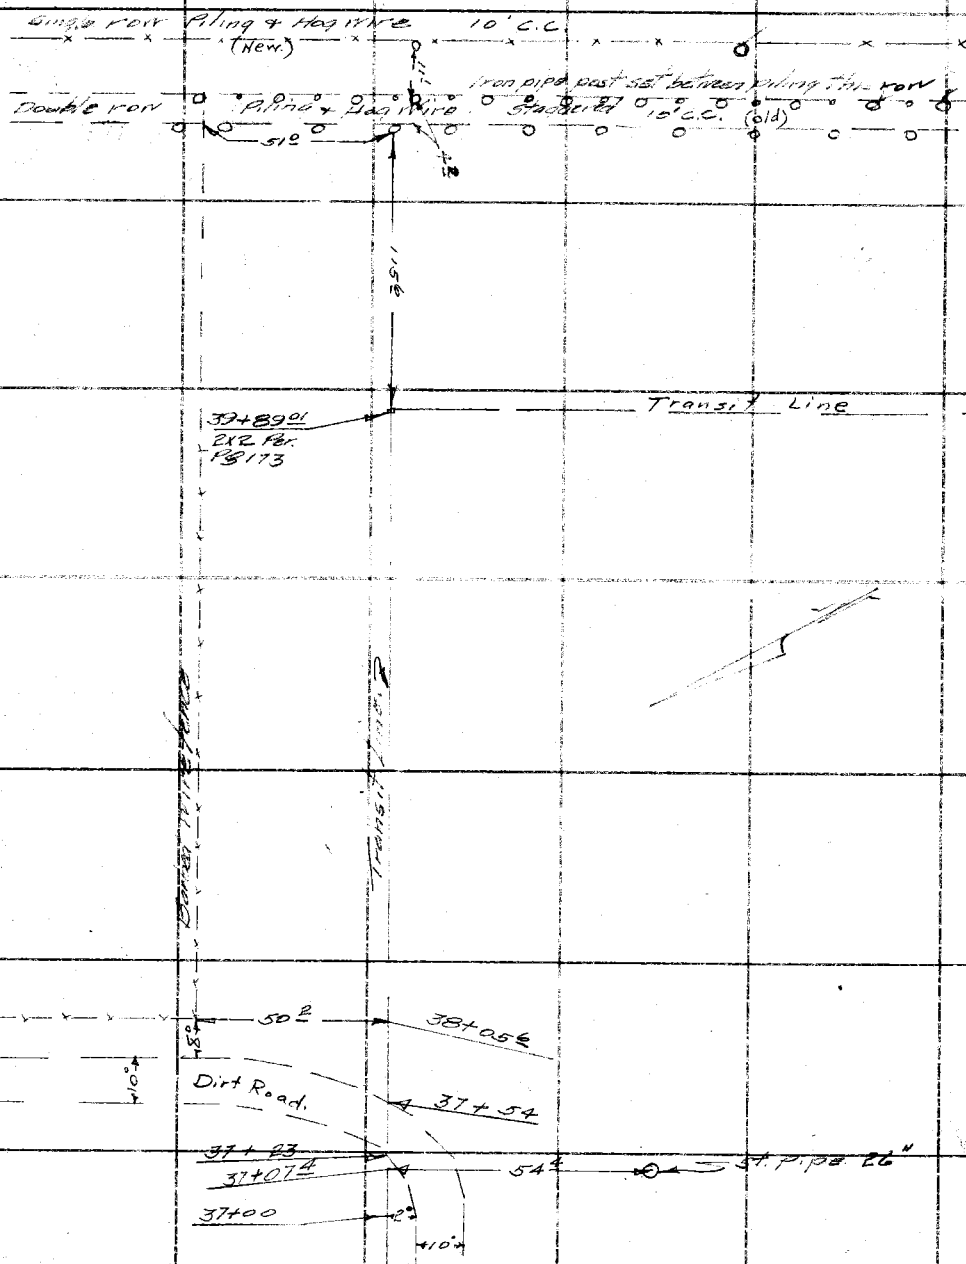

(From T.P Pg. 187)

RETURN TO
LOS ANGELES COUNTY SURVEYOR
700 HALL OF RECORDS

Do not extend notes this side of this line

Note: ANY ADDITIONS OR CHANGES ON THIS SHEET MUST BE MADE OR CIRCLED IN Red Ink. WITH DATE AND NAME OF PERSON MAKING CHANGE.

Notes Ck'd by D. M. Finley	Survey of El Monte Bridle Trl.
Map No. B-1005-5	W. O. 8012 Tape No. 067 St'd 64 °F.
Office Work C. W. Cox	Surveyed by Evans
Checked	Notes Brock Date 4/28/34
Date	Indexed A. C. Johnson

F.B. 54 Pg. 189

Cont'd at bot. Pg 190

Note: ANY ADDITIONS OR CHANGES ON THIS SHEET MUST BE MADE OR CIRCLED IN Red Ink WITH DATE AND NAME OF PERSON MAKING CHANGE.

RETURN TO
LOS ANGELES COUNTY SURVEYOR
700 HALL OF RECORDS
Do not extend notes this side of this line

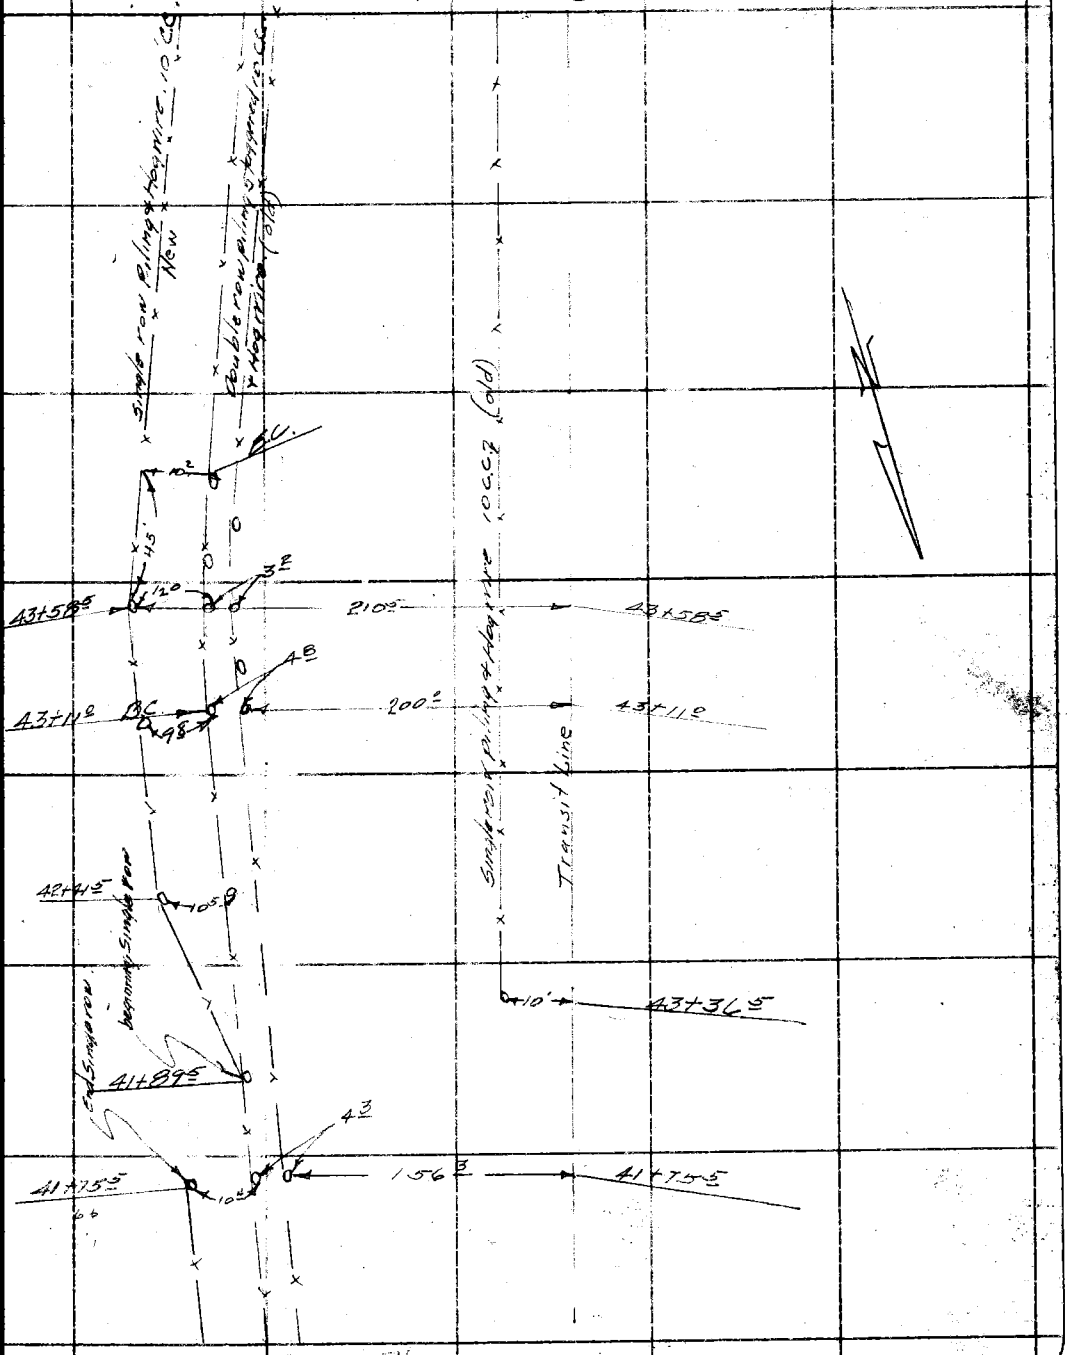

From RT. Top Pg 188

FORM 247 10M 8-31

RETURN TO
LOS ANGELES COUNTY SURVEYOR
700 HALL OF RECORDS

Note: ANY ADDITIONS OR CHANGES ON THIS SHEET MUST BE MADE OR CIRCLED IN **Red Ink.** WITH DATE AND NAME OF PERSON MAKING CHANGE.

Do not extend notes this side of this line

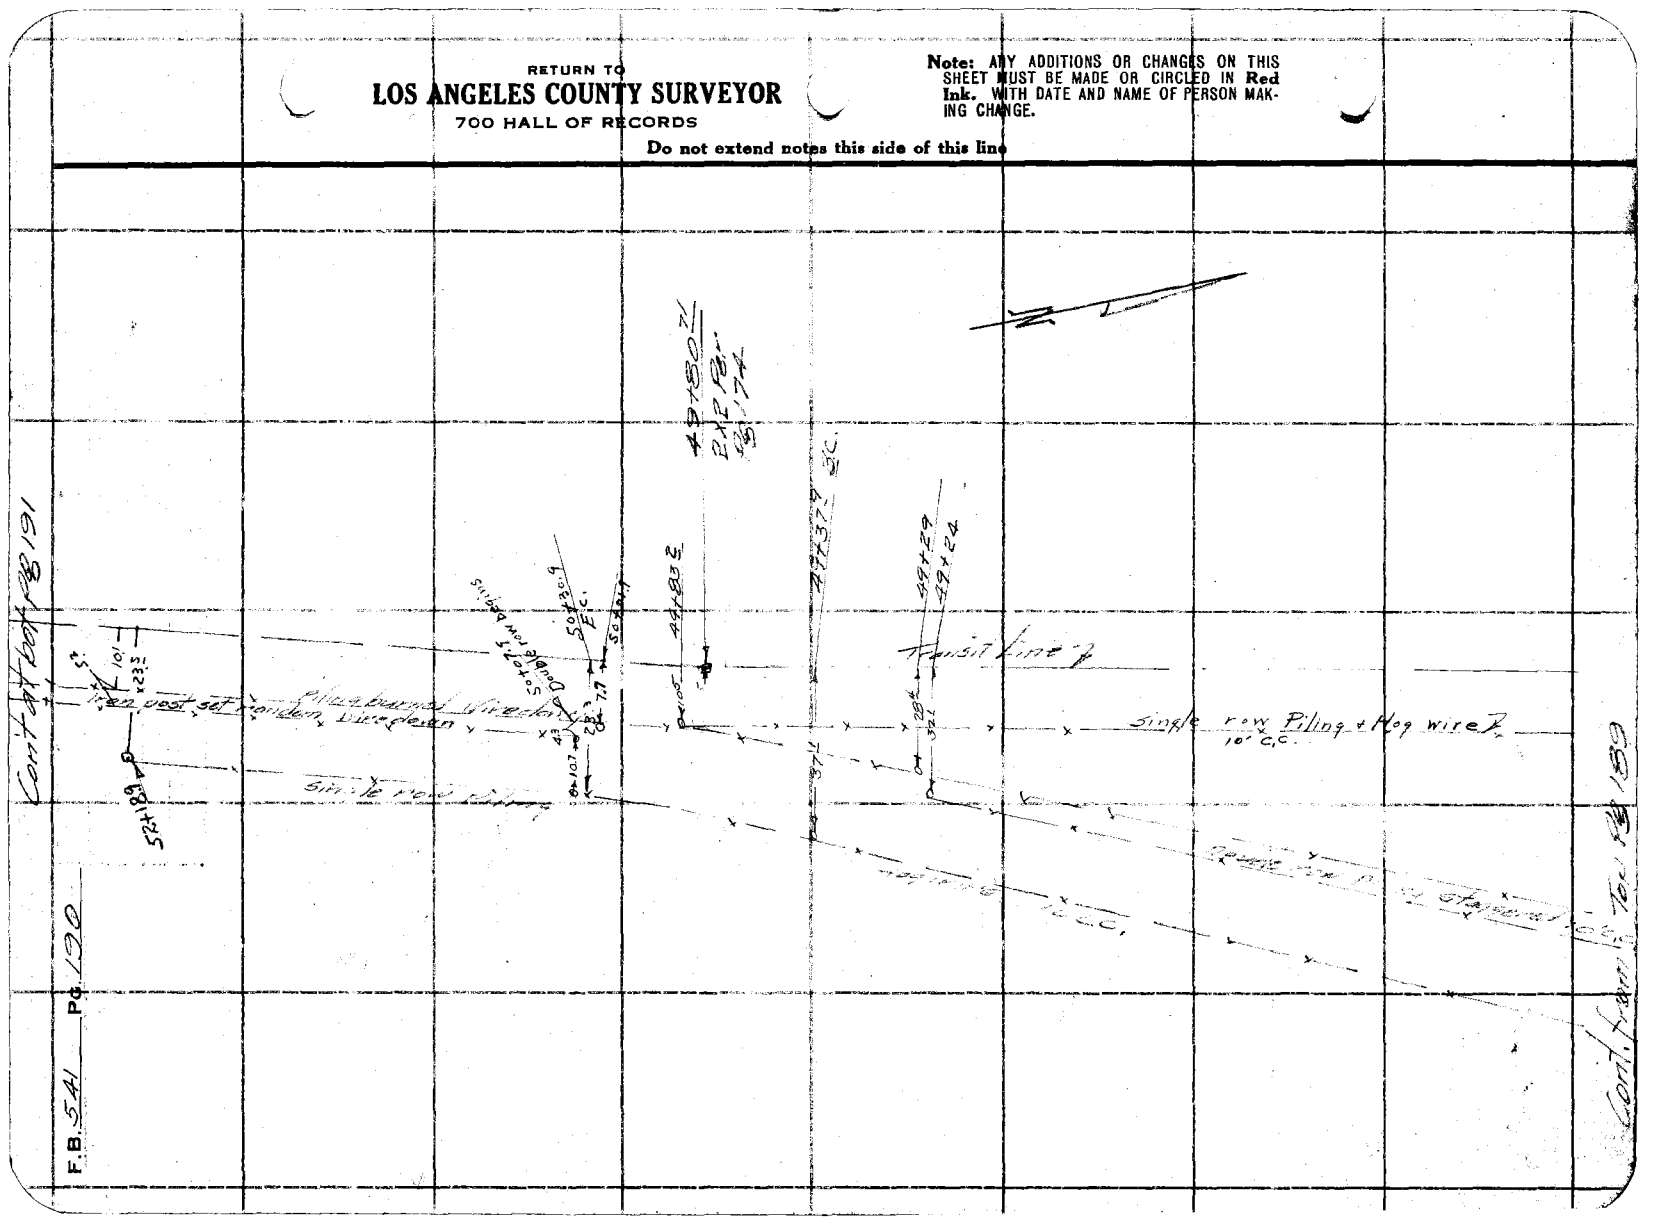

Notes Ck'd by D. M. Finley	Survey of El Monte Bridle Trl.
Map No. B-1005-5	W. 08012 Tape No. 067 St. 84 °F.
Office Work C. W. Cox	Surveyed by Evans
Checked	Notes HE Date 4/30/34
Date	Indexed A. C. Johnson

F.B. 541 Pg. 191

Cont. at bot. Pg 192

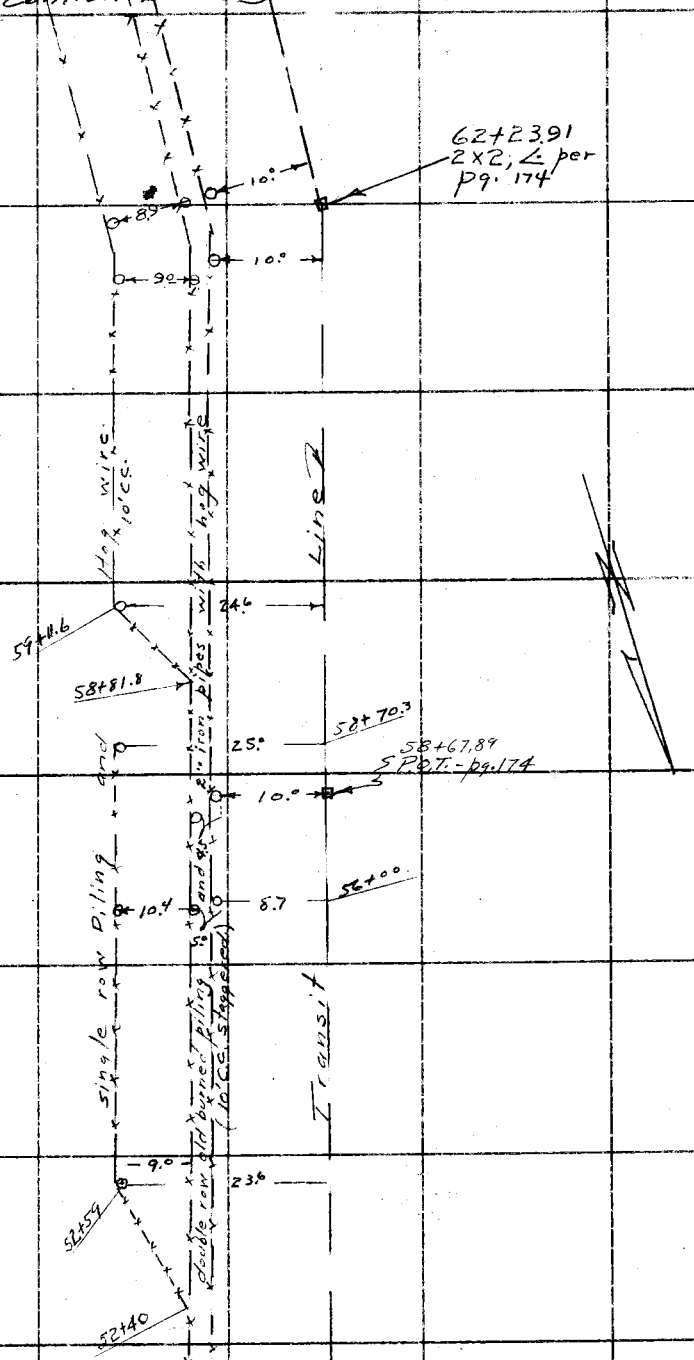

Cont from Top Pg 190

Note: ANY ADDITIONS OR CHANGES ON THIS SHEET MUST BE MADE OR CIRCLED IN Red Ink. WITH DATE AND NAME OF PERSON MAKING CHANGE.

RETURN TO
LOS ANGELES COUNTY SURVEYOR
700 HALL OF RECORDS

Do not extend notes this side of this line

FORM 247 10M 5-31

RETURN TO

LOS ANGELES COUNTY SURVEYOR

700 HALL OF RECORDS

Note: ANY ADDITIONS OR CHANGES ON THIS SHEET MUST BE MADE OR CIRCLED IN **Red Ink.** WITH DATE AND NAME OF PERSON MAKING CHANGE.

Do not extend notes this side of this line

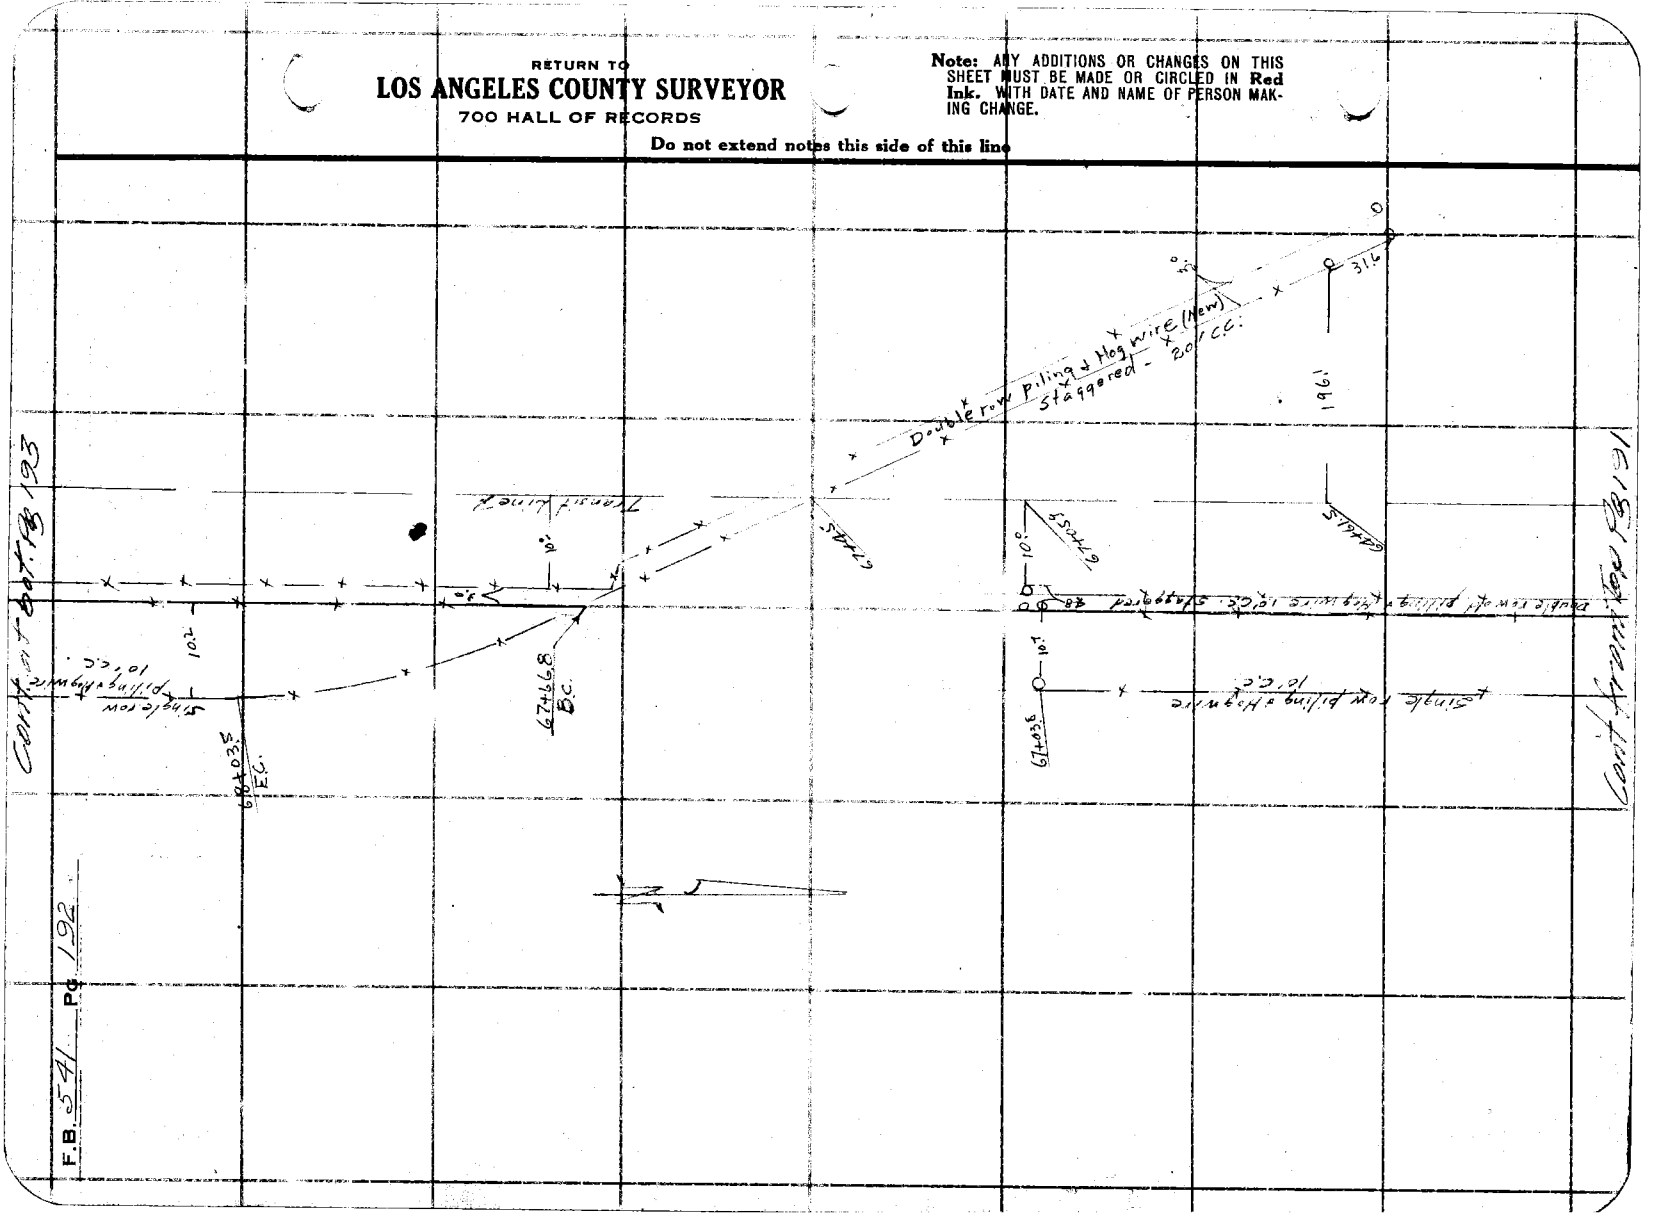

Notes Ck'd by	D. M. Pinley	Survey of	El Monte Bridle Trail
Map No.	B-1005-5	W. O.	8042 Tape No: 067 St'd 84 °F.
Office Work	C. M. Cox	Surveyed by	Evans
Checked		Notes	HE Date 5-1-34
Date		Indexed	A. C. Johnson

F.B. 541 Pg. 193

Cont. at bot Pg 194

RETURN TO
LOS ANGELES COUNTY SURVEYOR
700 HALL OF RECORDS
Do not extend notes this side of this line

Note: ANY ADDITIONS OR CHANGES ON THIS SHEET MUST BE MADE OR CIRCLED IN Red Ink, WITH DATE AND NAME OF PERSON MAKING CHANGE.

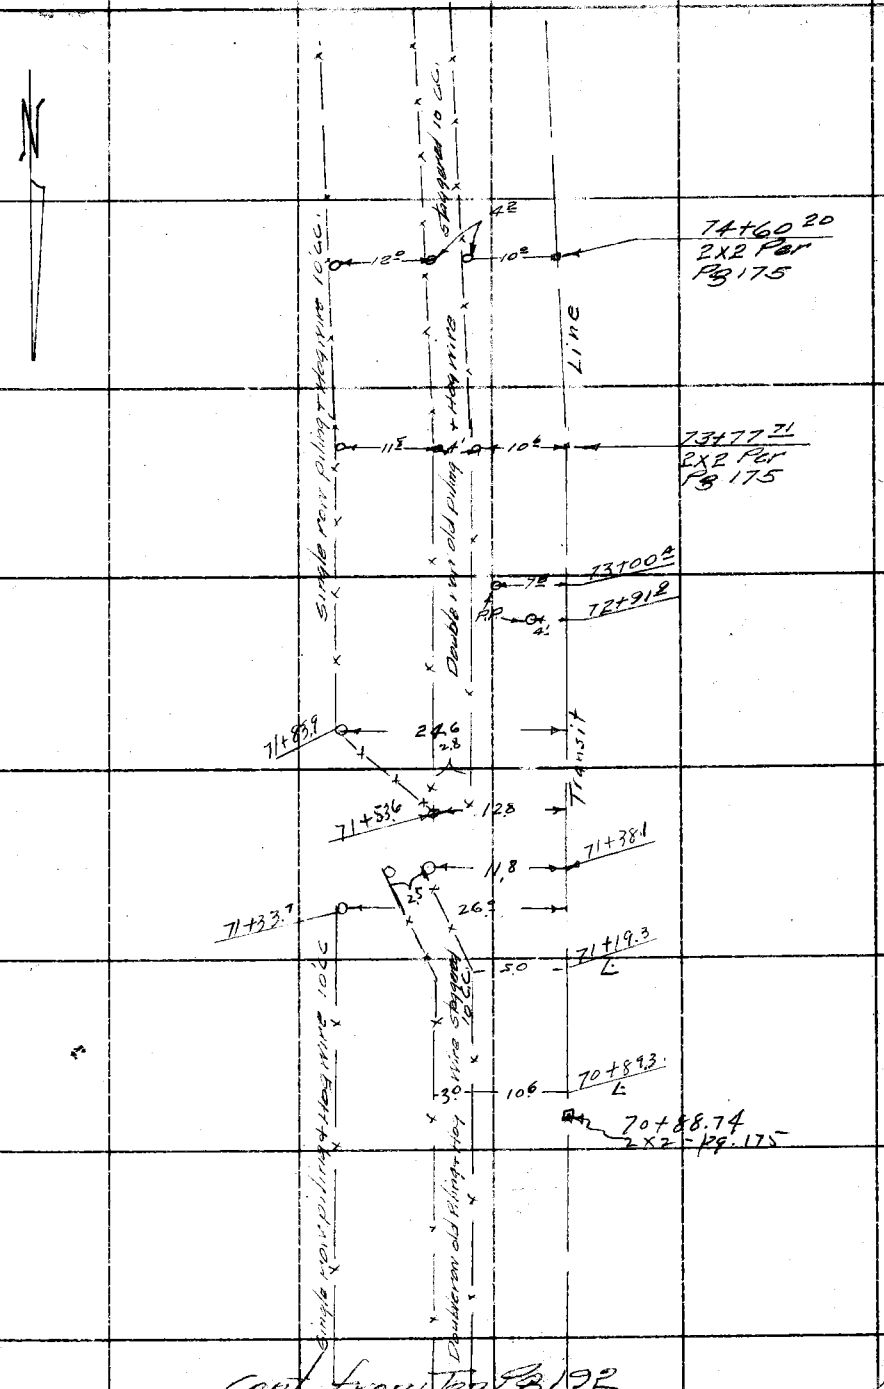

Cont from Pg 192

FORM 247 10M 8-31

RETURN TO

LOS ANGELES COUNTY SURVEYOR

700 HALL OF RECORDS

Note: ANY ADDITIONS OR CHANGES ON THIS SHEET MUST BE MADE OR CIRCLED IN **Red Ink.** WITH DATE AND NAME OF PERSON MAKING CHANGE.

Do not extend notes this side of this line

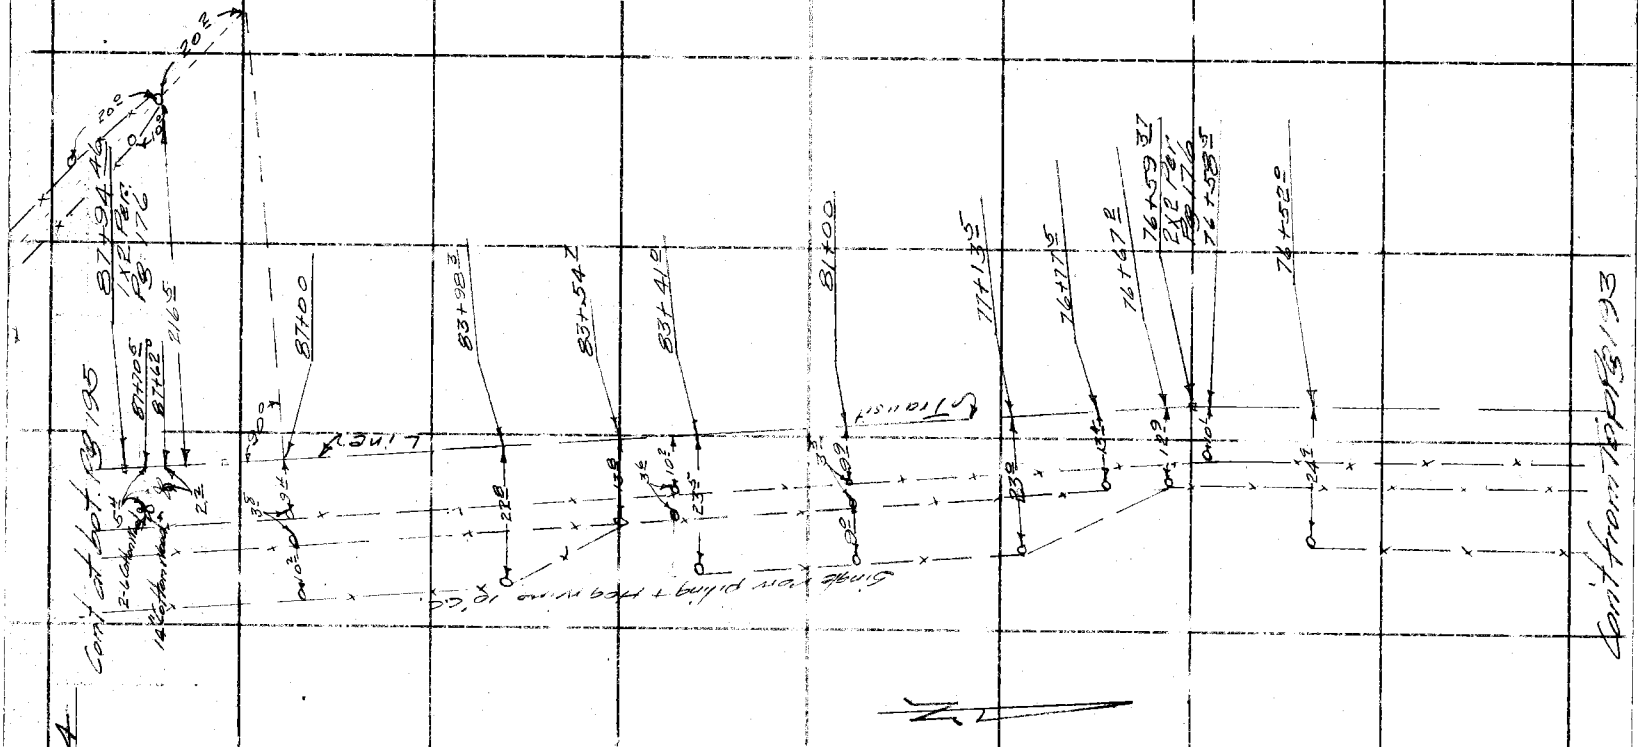

Notes Ck'd by D. M. Finley	Survey of El Monte Bridle Trail
Map No. B-1005-5	W. O. 8012 Tape No. 1067 St'd 84 °F.
Office Work C.W. Cox	Surveyed by Evans
Checked	Notes Brock Date 5-1-34
Date	Indexed A. C. Johnson

F.B. 541 Pg. 195

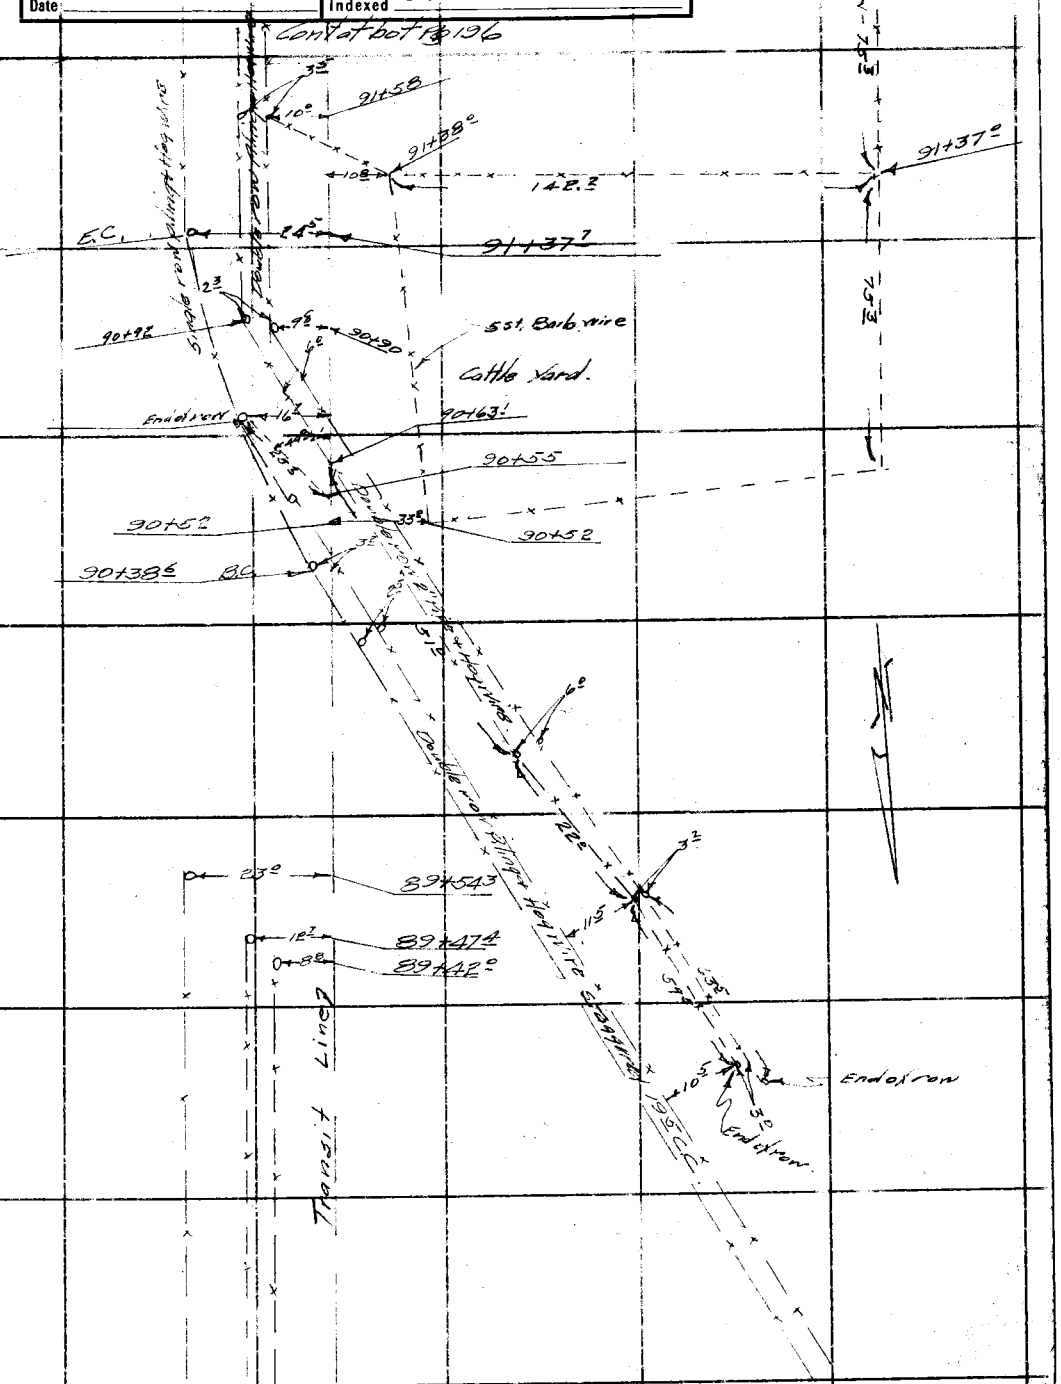

Cont from Top Pg 194

Note: ANY ADDITIONS OR CHANGES ON THIS SHEET MUST BE MADE OR CIRCLED IN Red Ink, WITH DATE AND NAME OF PERSON MAKING CHANGE.

RETURN TO
LOS ANGELES COUNTY SURVEYOR
700 HALL OF RECORDS

Do not extend notes this side of this line

FORM 247 10M 8-31

RETURN TO
LOS ANGELES COUNTY SURVEYOR
700 HALL OF RECORDS

Note: ANY ADDITIONS OR CHANGES ON THIS SHEET MUST BE MADE OR CIRCLED IN **Red Ink.** WITH DATE AND NAME OF PERSON MAKING CHANGE.

Do not extend notes this side of this line

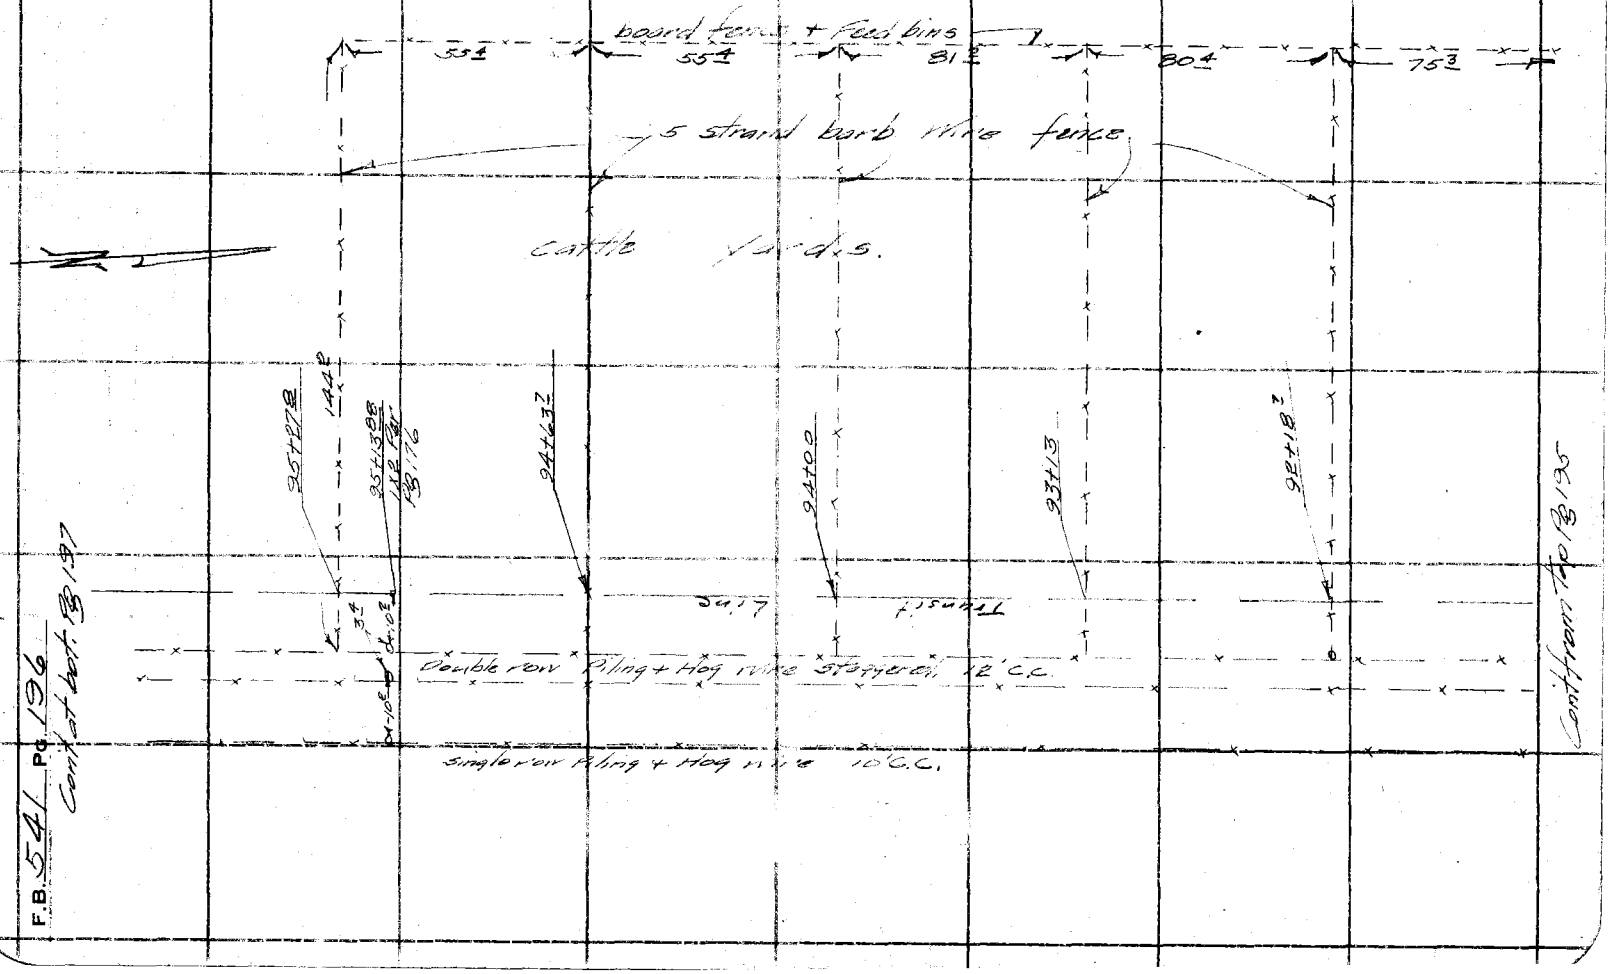

F.B. 541 Pg. 196

Notes Ck'd by D. M. Finley	Survey of El Monte Bridle Trail
Map No. B-1005-5	W. O. 8012 Tape No. 061 St'd 84 °F.
Office Work C. W. Cox	Surveyed by Evans
Checked	Notes Brock Date 5-1-34
Date	Indexed A. C. Johnson

F.B. 541 Pg. 197

Cont. at bot. pg 198

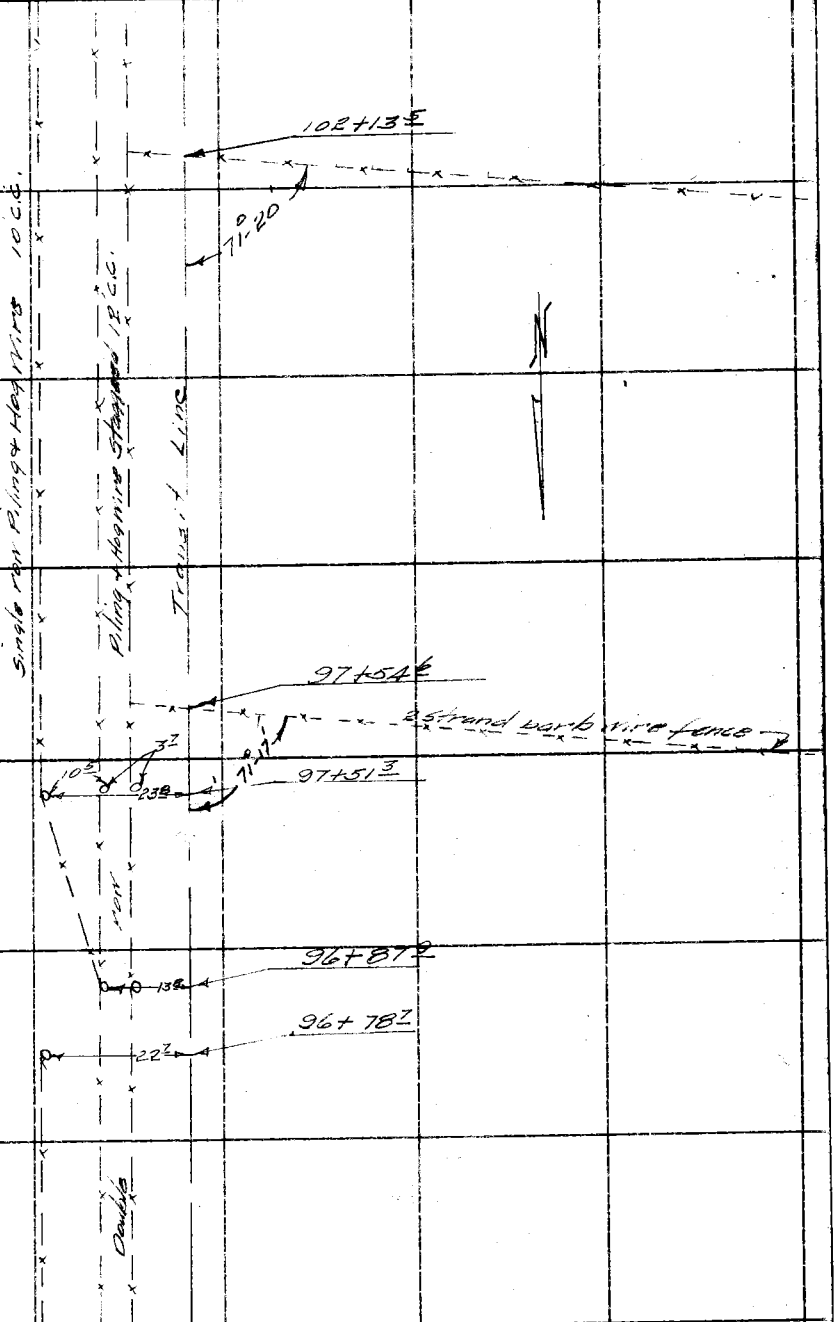

Cont from Top pg. 196

Note: ANY ADDITIONS OR CHANGES ON THIS SHEET MUST BE MADE OR CIRCLED IN Red Ink. WITH DATE AND NAME OF PERSON MAKING CHANGE.

RETURN TO
LOS ANGELES COUNTY SURVEYOR
700 HALL OF RECORDS
Do not extend notes this side of this line

FORM 247 10M 8-31

RETURN TO
LOS ANGELES COUNTY SURVEYOR
700 HALL OF RECORDS

Note: ANY ADDITIONS OR CHANGES ON THIS SHEET MUST BE MADE OR CIRCLED IN **Red Ink.** WITH DATE AND NAME OF PERSON MAKING CHANGE.

Do not extend notes this side of this line

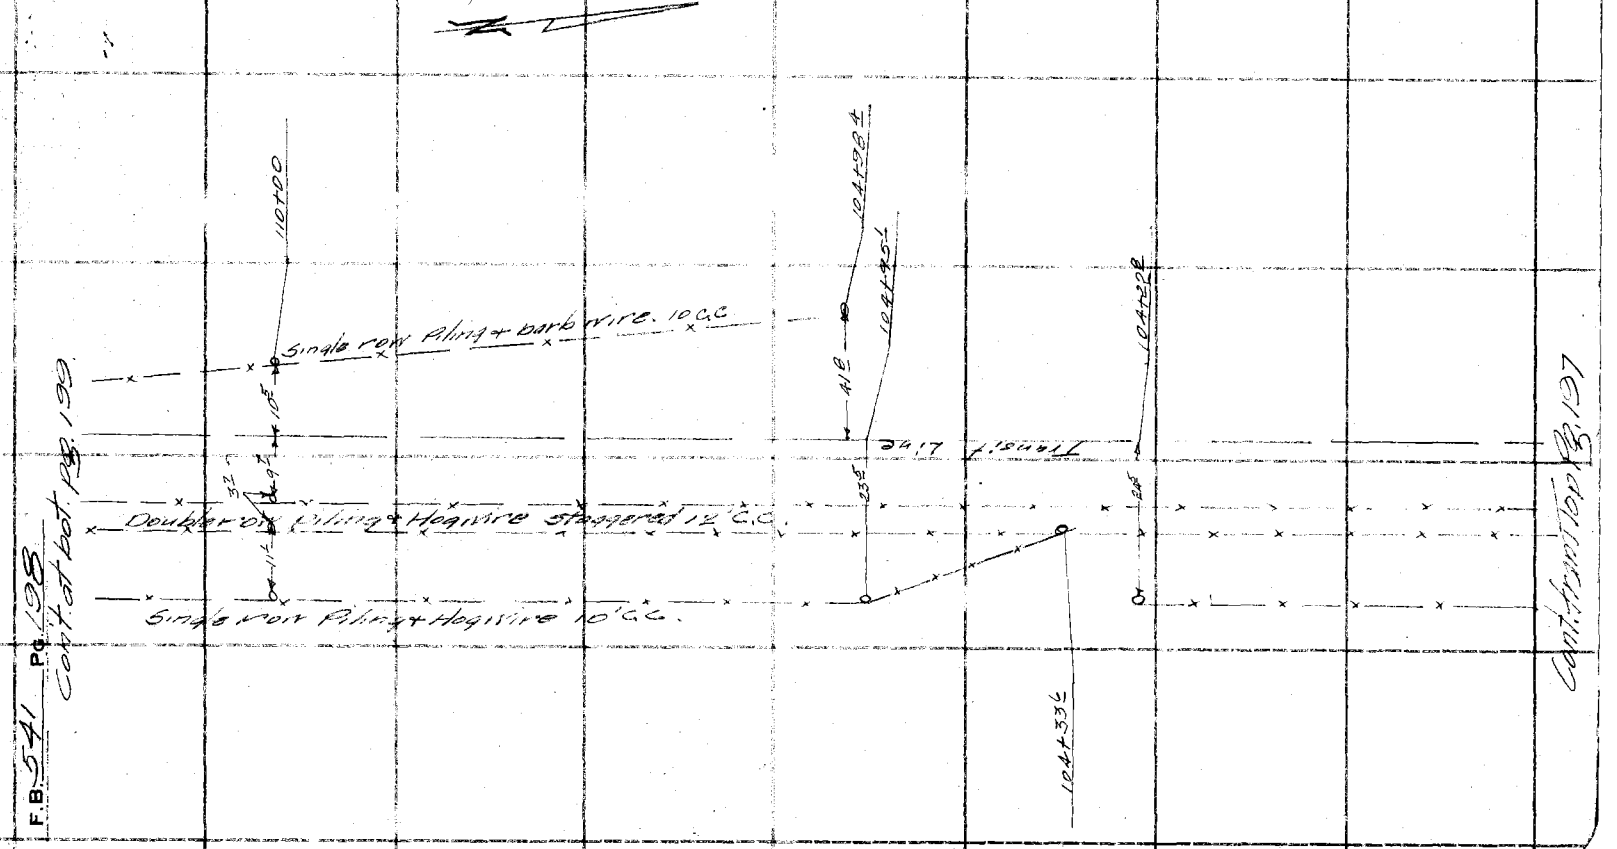

Notes Ck'd by D. M. Finley	Survey of El Monte Bridle Trail
Map No. B-1005-5	W. O. 8016 Tape No. 067 St'd 84 °F.
Office Work C. W. Cox	Surveyed by Evans
Checked	Notes Brock Date 5-2-34
Date	Indexed A. C. Johnson

F.B. 541 Pg. 199

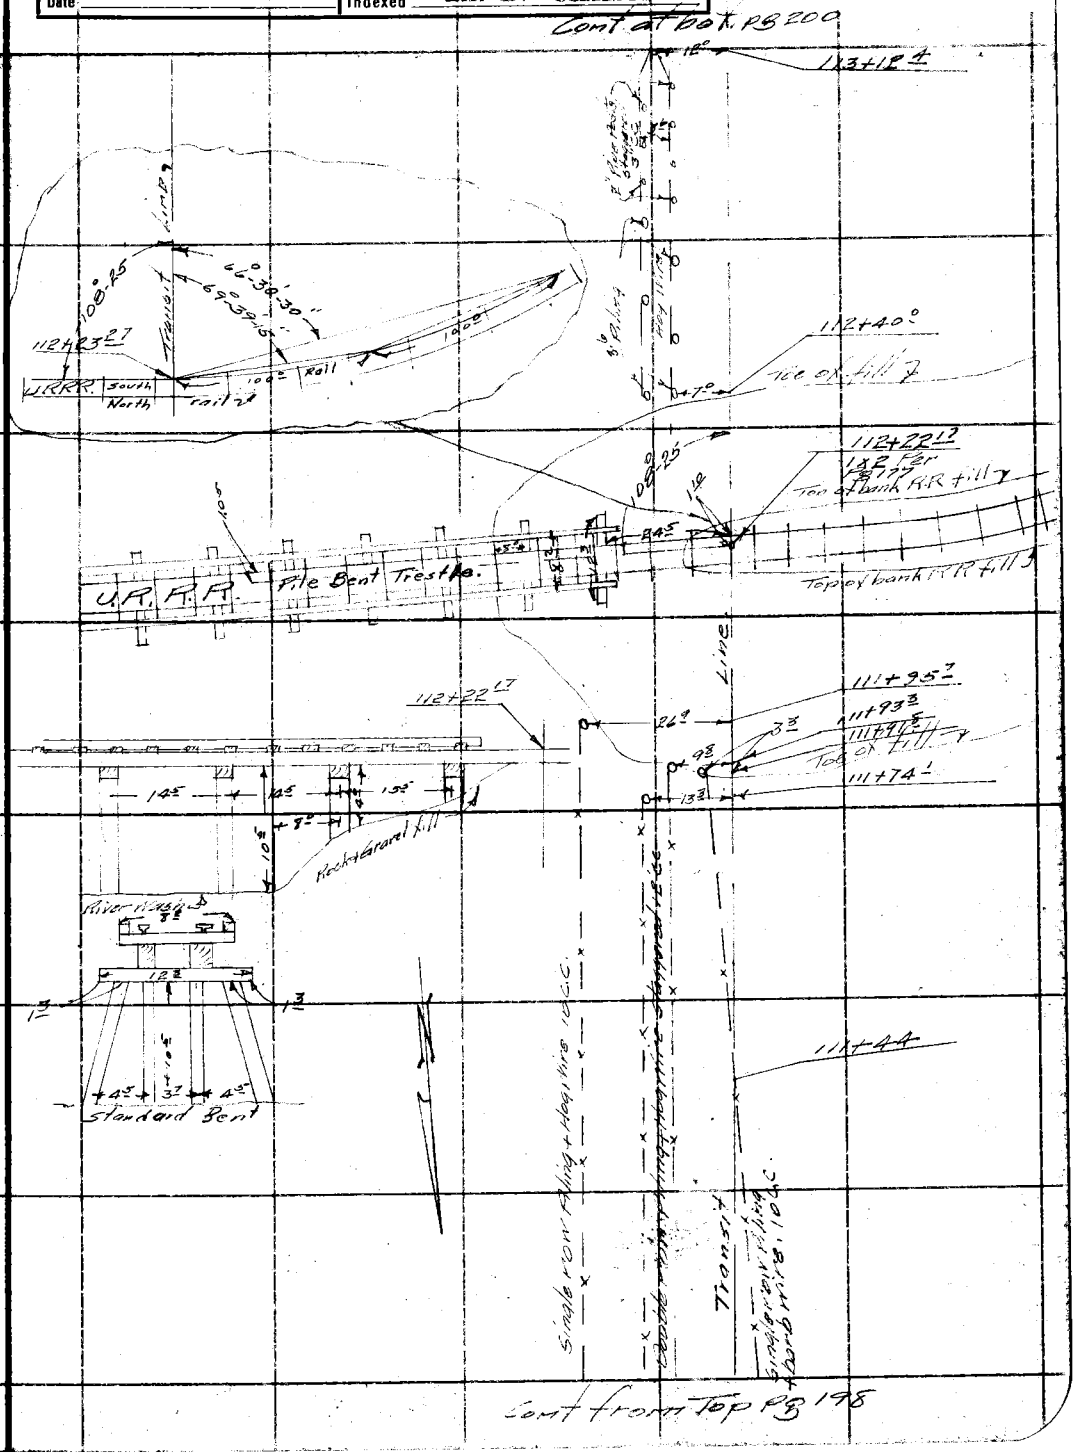

Note: ANY ADDITIONS OR CHANGES ON THIS SHEET MUST BE MADE OR CIRCLED IN Red Ink. WITH DATE AND NAME OF PERSON MAKING CHANGE.

RETURN TO
LOS ANGELES COUNTY SURVEYOR
700 HALL OF RECORDS

Do not extend notes this side of this line

FORM 247 10M 5-31

F.B. 541 PG. 200

Cont. at bot. PG 201

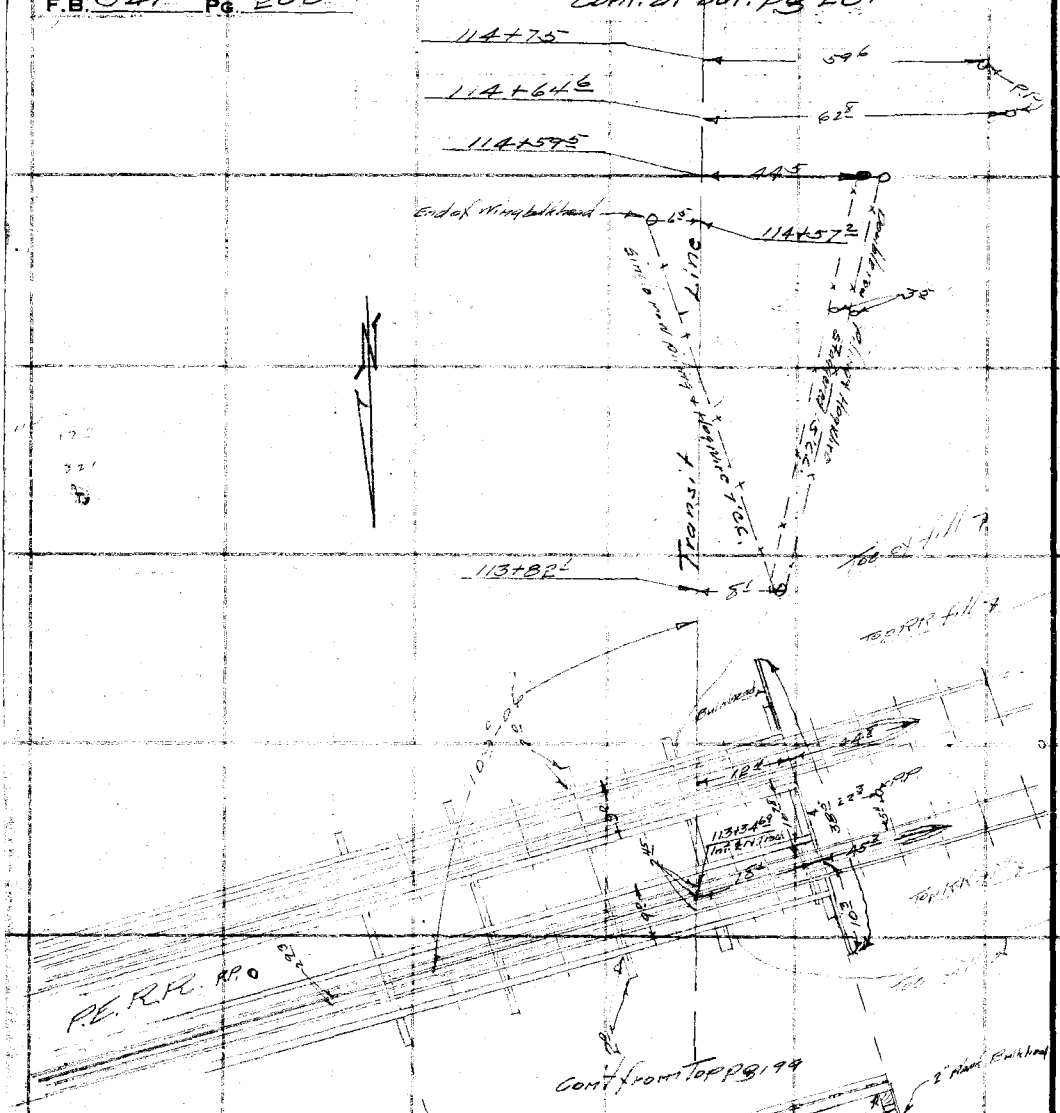

RETURN TO
LOS ANGELES COUNTY SURVEYOR
700 HALL OF RECORDS

Note: ANY ADDITIONS OR CHANGES ON THIS SHEET MUST BE MADE OR CIRCLED IN Red Ink, WITH DATE AND NAME OF PERSON MAKING CHANGE.

Do not extend notes this side of this line

Notes Ck'd by D. M. Finley	Survey of El Monte Bridge Trail
Map No. B-1005-5	W. O. 8012 Tape No. .067 St'd 84 °F.
Office Work C. W. Cox	Surveyed by Evans
Checked	Notes Brock Date 5-2-34
Date	Indexed A. C. Johnson

F.B. 541 Pg. 201

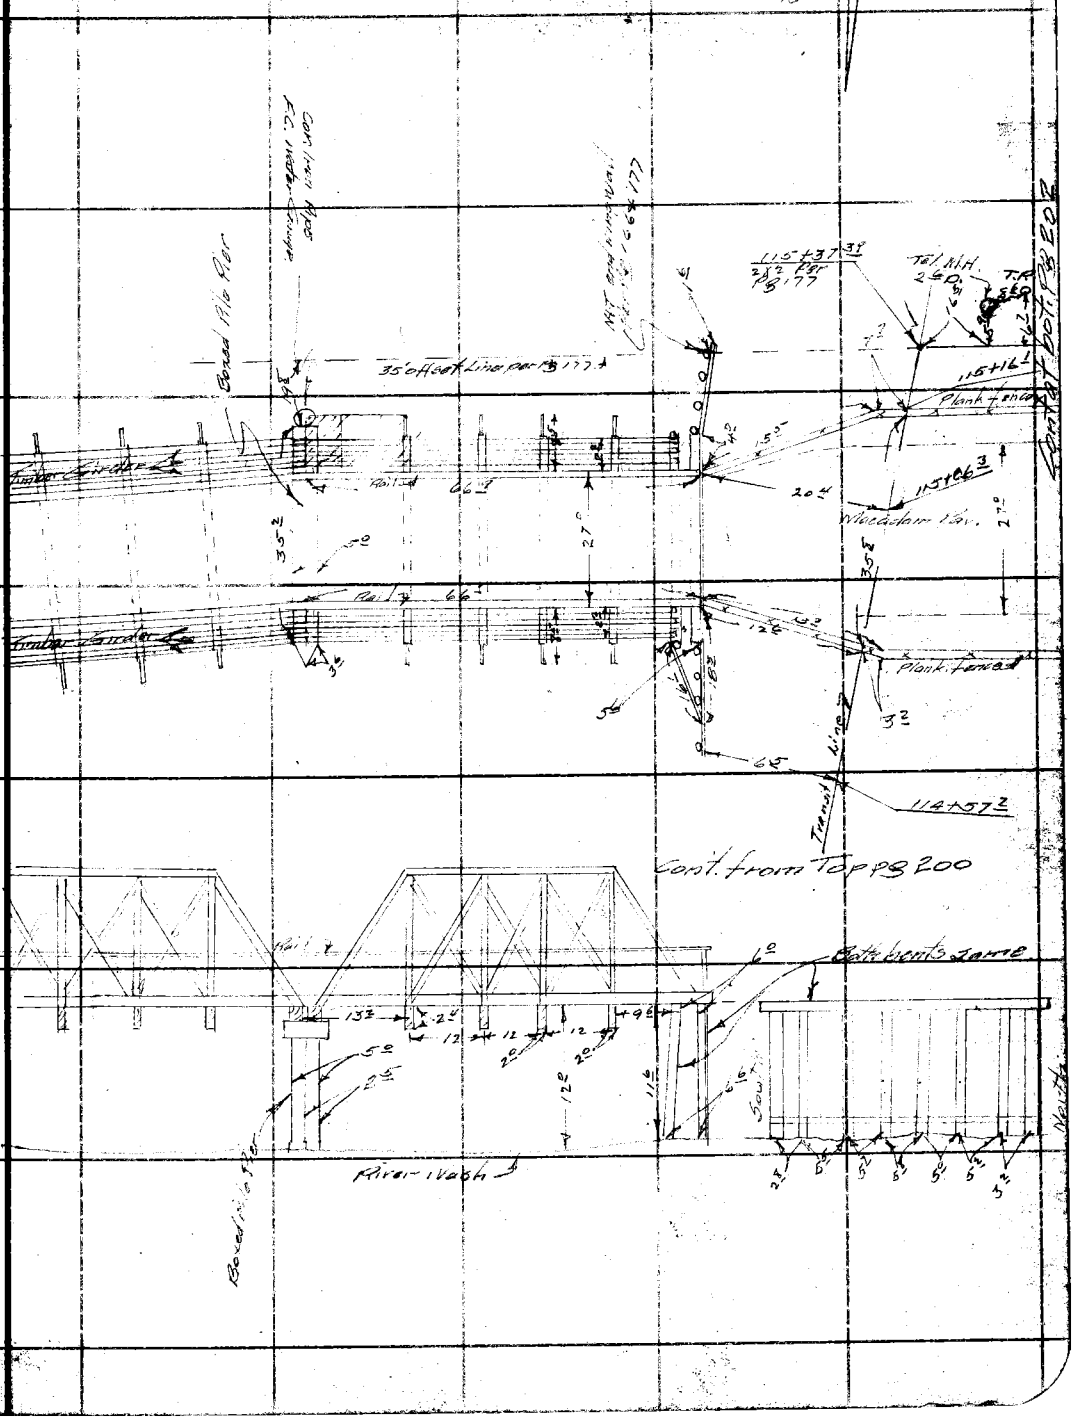

Note: ANY ADDITIONS OR CHANGES ON THIS SHEET MUST BE MADE OR CIRCLED IN Red Ink. WITH DATE AND NAME OF PERSON MAKING CHANGE.

RETURN TO
LOS ANGELES COUNTY SURVEYOR
700 HALL OF RECORDS

Do not extend notes this side of this line

FORM 247 10M 8-31

RETURN TO
LOS ANGELES COUNTY SURVEYOR
700 HALL OF RECORDS

Note: ANY ADDITIONS OR CHANGES ON THIS SHEET MUST BE MADE OR CIRCLED IN **Red Ink.** WITH DATE AND NAME OF PERSON MAKING CHANGE.

Do not extend notes this side of this line

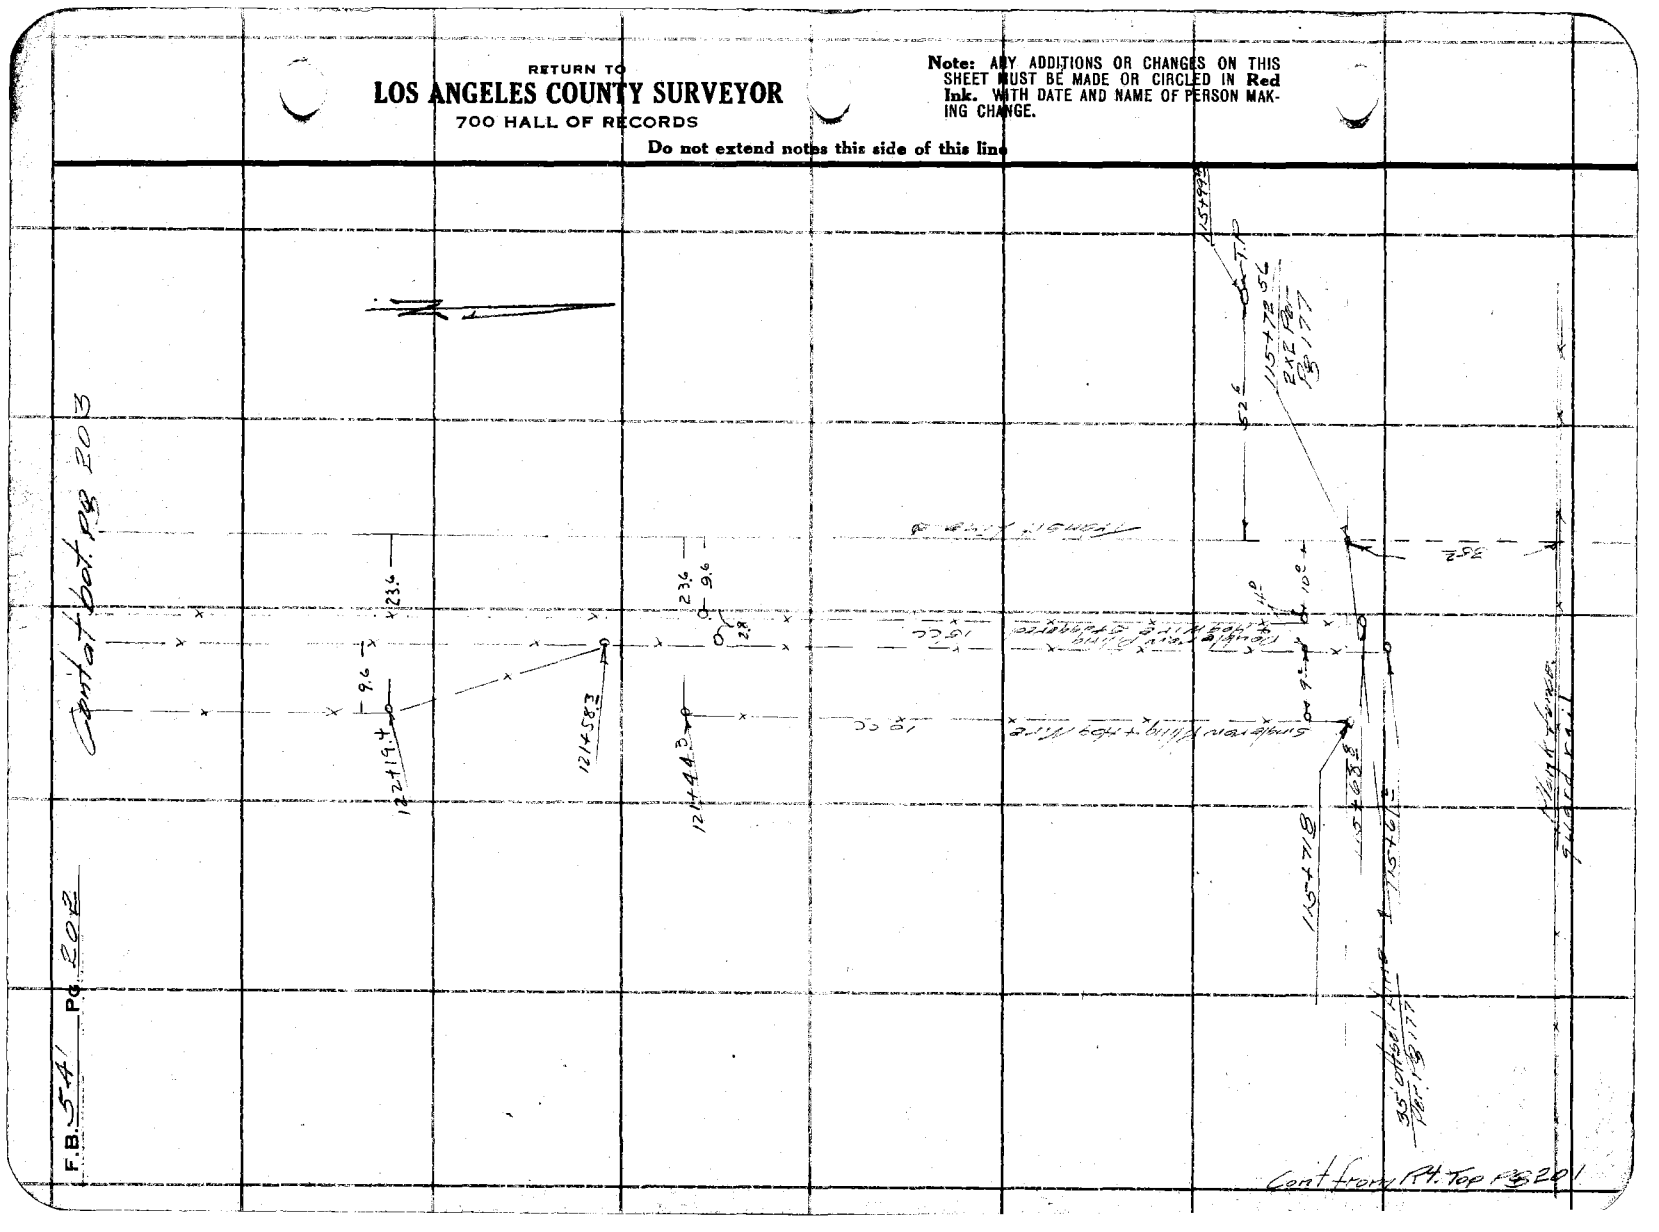

Notes Ck'd by D. M. Finley	Survey of El Monte Bridge Trail
Map No. B-1005-6	W. O. 8012 Tape No. .067 St'd 84 °F.
Office Work C.W. Cox	Surveyed by Evans
Checked	Notes Brock Date 5-8-34
Date	Indexed A. C. Johnson

F.B. 541 Pg. 203

Cont. at bot. pg 204

Cont. from top pg 202

Note: ANY ADDITIONS OR CHANGES ON THIS SHEET MUST BE MADE OR CIRCLED IN Red Ink. WITH DATE AND NAME OF PERSON MAKING CHANGE.

Do not extend notes this side of this line

RETURN TO
LOS ANGELES COUNTY SURVEYOR
700 HALL OF RECORDS

FORM 247 10M 5-31

RETURN TO

LOS ANGELES COUNTY SURVEYOR

700 HALL OF RECORDS

Note: ANY ADDITIONS OR CHANGES ON THIS SHEET MUST BE MADE OR CIRCLED IN **Red Ink.** WITH DATE AND NAME OF PERSON MAKING CHANGE.

Do not extend notes this side of this line

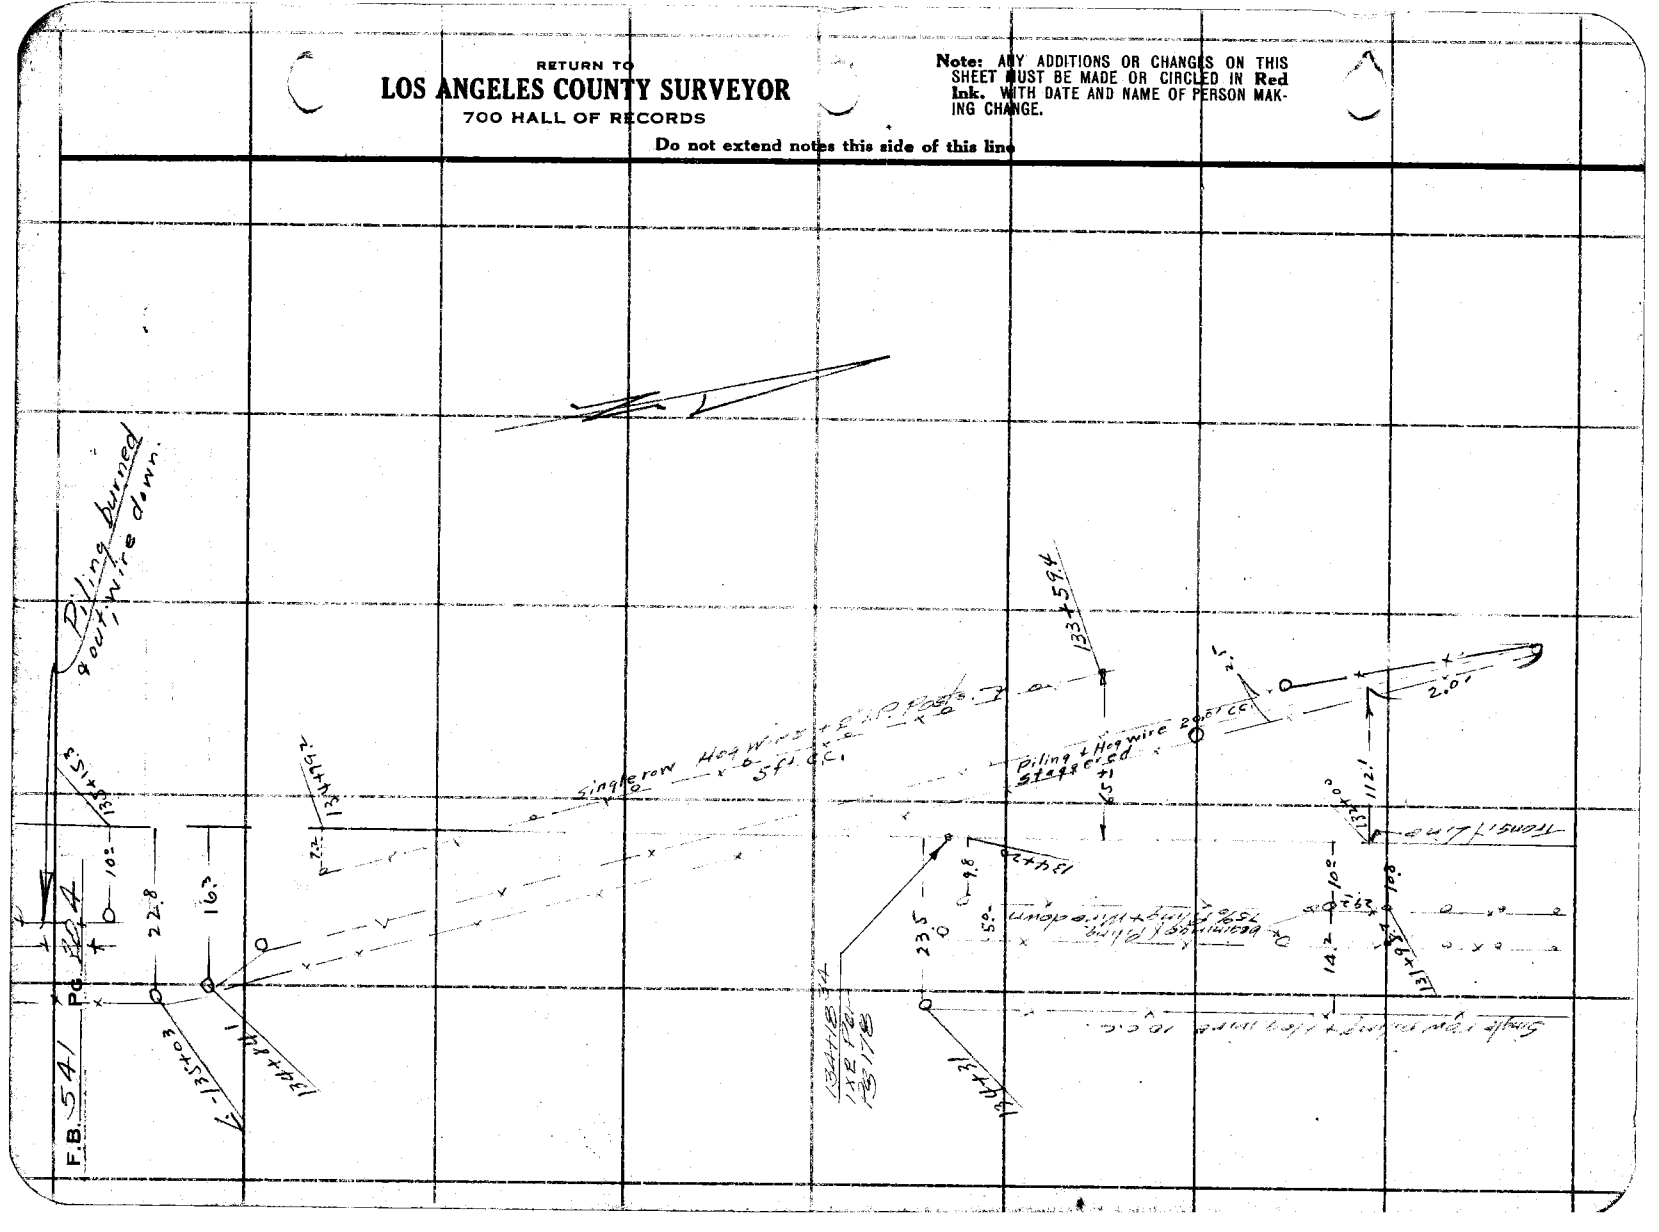

Notes Ck'd by D. M. Finley	Survey of El Monte Bridle Trail
Map No. B-1005-6	W. O. 8012 Tape No. 061 St'd 84 °F.
Office Work C. W. Cox	Surveyed by E. Evans
Checked	Notes Brock Date 5-3-34
Date	Indexed A. C. Johnson

F.B. 541 Pg. 205

146

Cont. at bot. pg 206

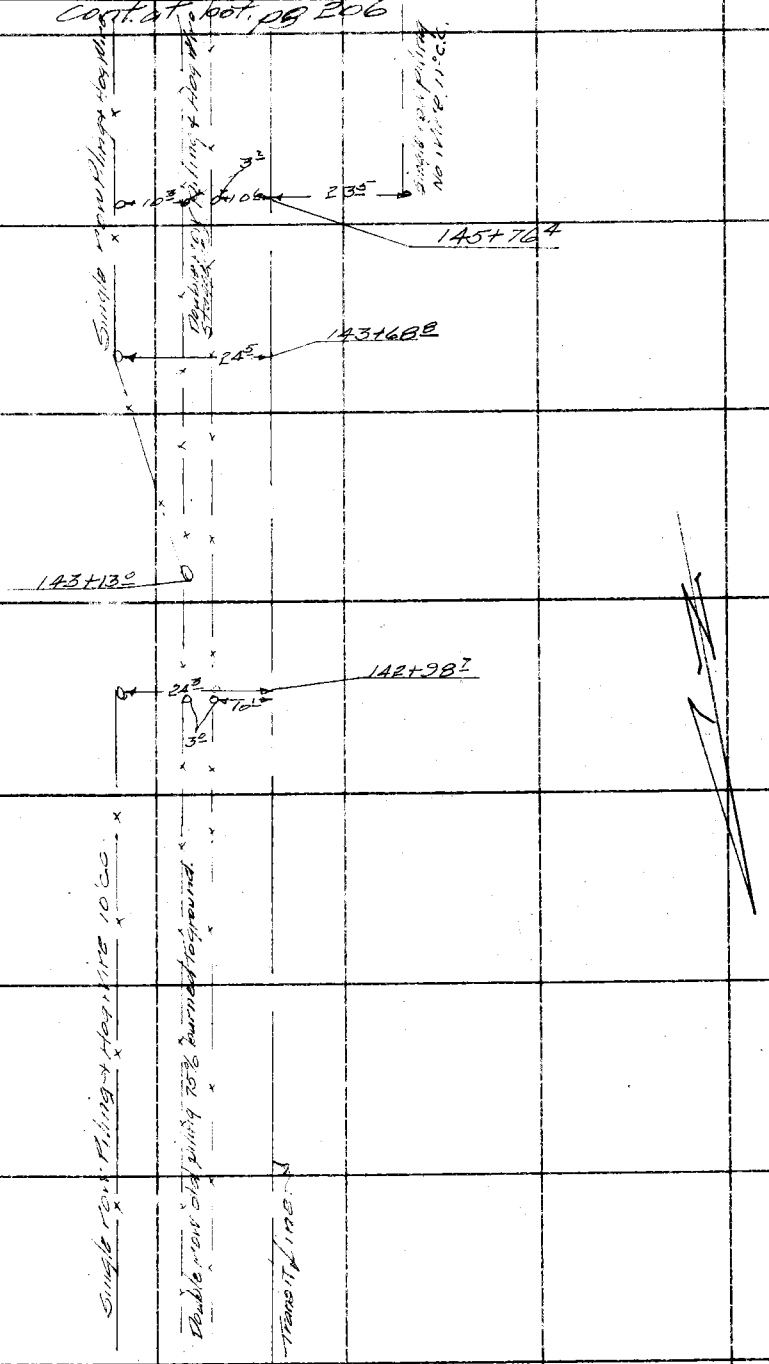

Cont from Top pg 204

Note: ANY ADDITIONS OR CHANGES ON THIS SHEET MUST BE MADE OR CIRCLED IN Red Ink. WITH DATE AND NAME OF PERSON MAKING CHANGE.

RETURN TO
LOS ANGELES COUNTY SURVEYOR
700 HALL OF RECORDS

Do not extend notes this side of this line

FORM 247 10M 5-31

F.B. 541 PG. 206

Cont at bot Pg 207

Cont. from Top Pg 205

RETURN TO
LOS ANGELES COUNTY SURVEYOR
700 HALL OF RECORDS
Do not extend notes this side of this line

Note: ANY ADDITIONS OR CHANGES ON THIS SHEET MUST BE MADE OR CIRCLED IN Red Ink. WITH DATE AND NAME OF PERSON MAKING CHANGE.

Notes Ck'd by D. M. Finley	Survey of El Monte Bridle Trail
Map No. B-1005-6	W. O. 8012 Tape No. 067 St'd 84 °F.
Office Work C. W. Cox	Surveyed by Evans
Checked	Notes Brock Date 5-3-34
Date	Indexed A. C. Johnson

F.B. 541 PG. 207

Cont. at Lt. Center Pg 208

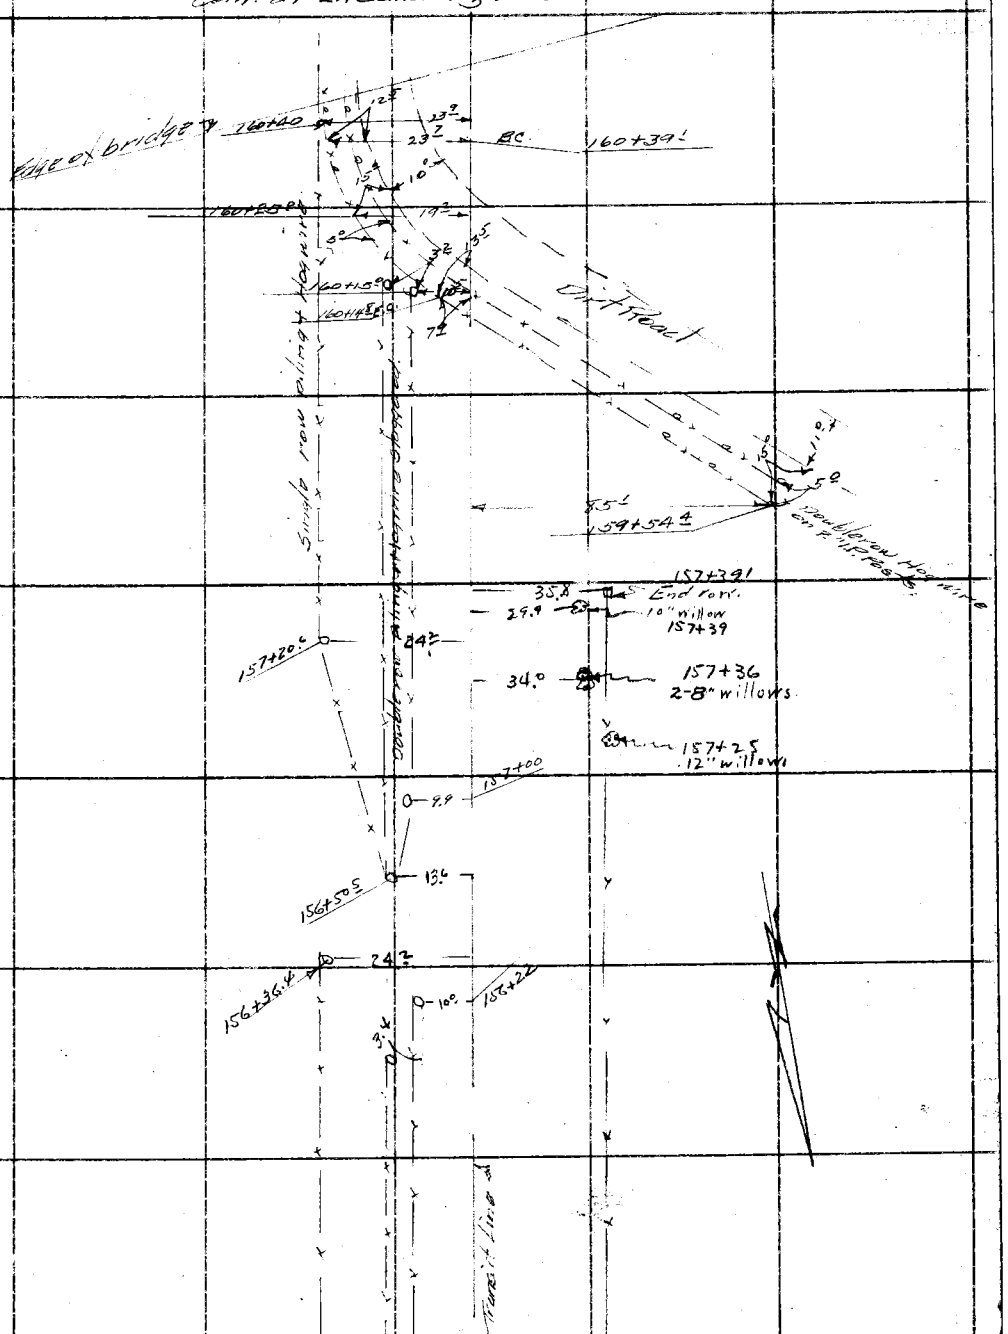

Cont. from Top Pg 206

Note: ANY ADDITIONS OR CHANGES ON THIS SHEET MUST BE MADE OR CIRCLED IN Red Ink, WITH DATE AND NAME OF PERSON MAKING CHANGE.

RETURN TO
LOS ANGELES COUNTY SURVEYOR
700 HALL OF RECORDS
Do not extend notes this side of this line

FORM 247 10M 8-31

RETURN TO
LOS ANGELES COUNTY SURVEYOR
700 HALL OF RECORDS

Note: ANY ADDITIONS OR CHANGES ON THIS SHEET MUST BE MADE OR CIRCLED IN **Red Ink.** WITH DATE AND NAME OF PERSON MAKING CHANGE.

Do not extend notes this side of this line

F.B. 541 PG. 208

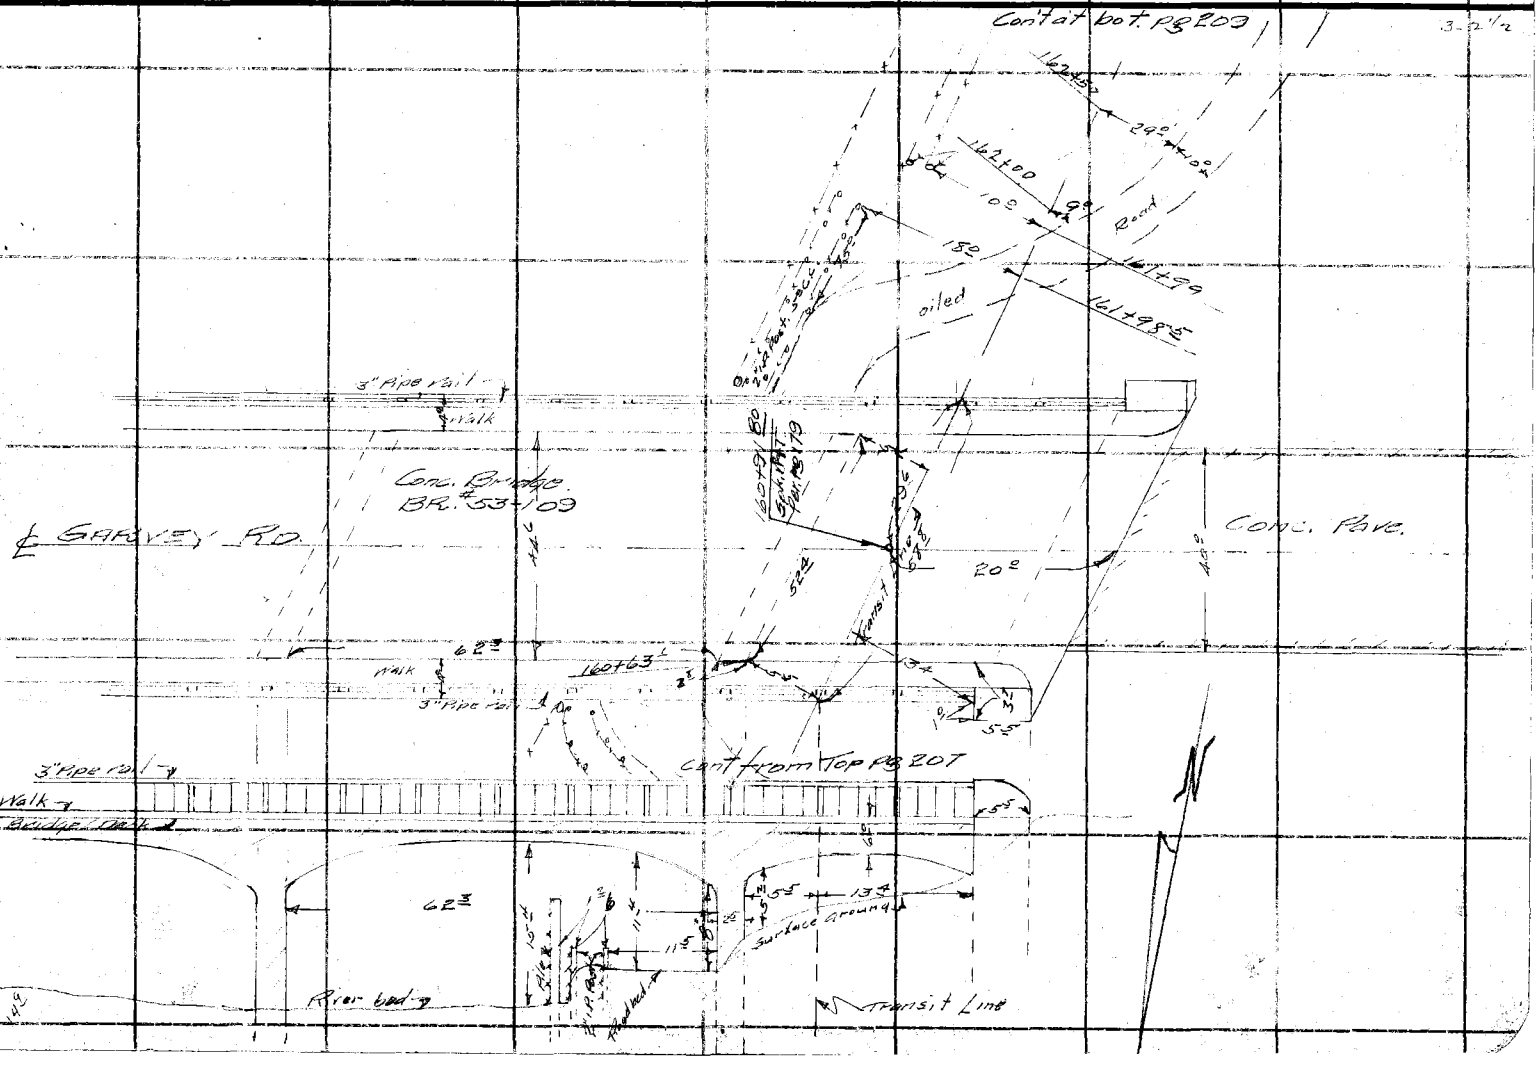

Notes Ck'd by D. M. Finley	Survey of El Monte Bridle Trail
Map No. B-1005-6	W. O. 8012 Tape No. 067 St'd 84 °F.
Office Work C. W. Cox	Surveyed by Evans
Checked	Notes Brock Date 5-4-34
Date	Indexed A. C. Johnson

F.B. 541 Pg 209

Cont. at bot. pg 210

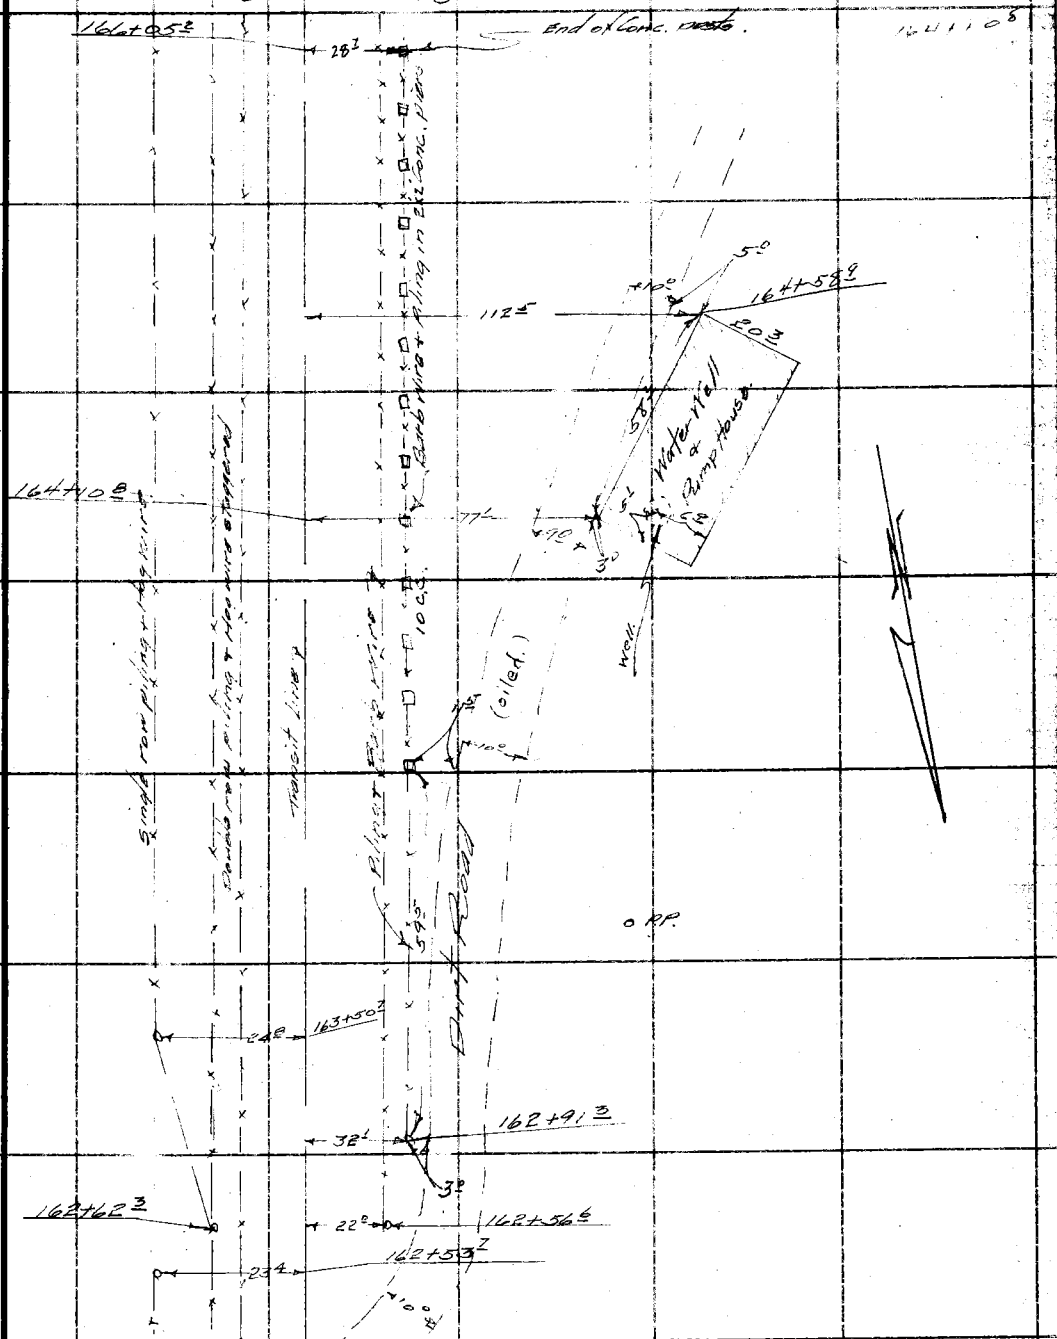

Cont from bot. Rt. Pg 208

Note: ANY ADDITIONS OR CHANGES ON THIS SHEET MUST BE MADE OR CIRCLED IN Red Ink. WITH DATE AND NAME OF PERSON MAKING CHANGE.

RETURN TO
LOS ANGELES COUNTY SURVEYOR
700 HALL OF RECORDS
Do not extend notes this side of this line

FORM 247 10M 8-31

F.B. 541 PG. 210

Con't. at bot pg 211

Con't from top pg 209.

RETURN TO
LOS ANGELES COUNTY SURVEYOR
700 HALL OF RECORDS
Do not extend notes this side of this line
Note: ANY ADDITIONS OR CHANGES ON THIS SHEET MUST BE MADE OR CIRCLED IN Red Ink. WITH DATE AND NAME OF PERSON MAKING CHANGE.

Notes Ck'd by D. M. Finley	Survey of Ft Monte Brille Trail
Map No. B-1005-6	W. O. 8012 Tape No. .067 St'd 84 °F.
Office Work C. W. Cox	Surveyed by Evans
Checked	Notes Brock Date 5-4-34
Date	Indexed A. C. Johnson

F.B. 541 Pg. 211

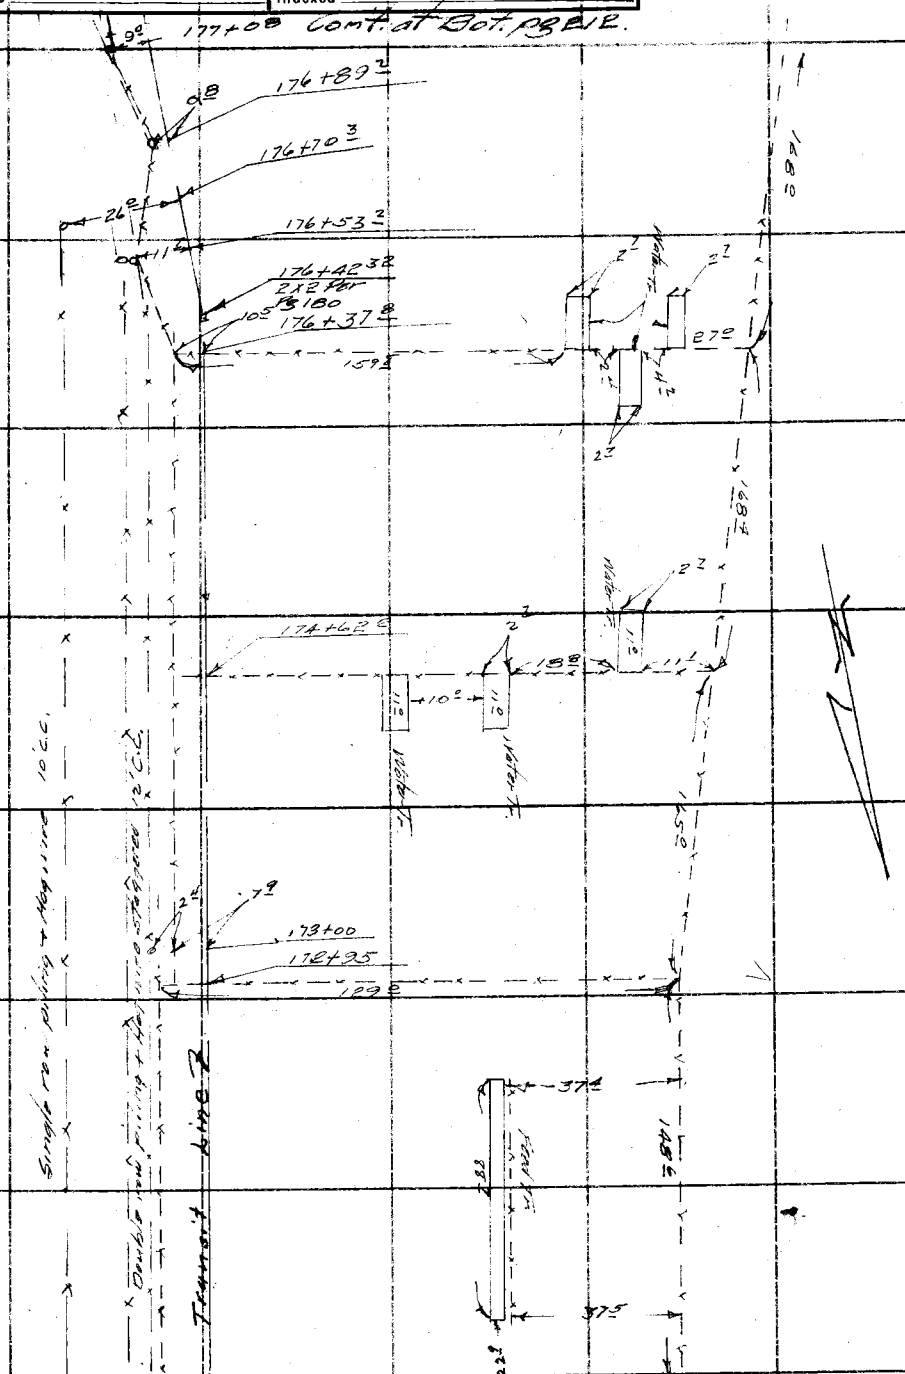

cont from Top pg 210

Note: ANY ADDITIONS OR CHANGES ON THIS SHEET MUST BE MADE OR CIRCLED IN Red Ink, WITH DATE AND NAME OF PERSON MAKING CHANGE.

RETURN TO
LOS ANGELES COUNTY SURVEYOR
700 HALL OF RECORDS

Do not extend notes this side of this line

FORM 247 10M 8-31

F.B. 541 PG 212

Cont at Bot PG 213

Cont from Top PG 211

RETURN TO
LOS ANGELES COUNTY SURVEYOR
700 HALL OF RECORDS
Do not extend notes this side of this line
Note: ANY ADDITIONS OR CHANGES ON THIS SHEET MUST BE MADE OR CIRCLED IN Red Ink. WITH DATE AND NAME OF PERSON MAKING CHANGE.

Notes Ck'd by D. M. Finley	Survey of El Monte Bridle Trail
Map No. B-1005-6	W. O. 8012 Tape No. 067 St'd 84 °F.
Office Work C. W. Cox	Surveyed by Evans
Checked	Notes Brook Date 5-4-34
Date	Indexed A. C. Johnson

F.B. 541 Pg. 213

Cont at bot pg 214

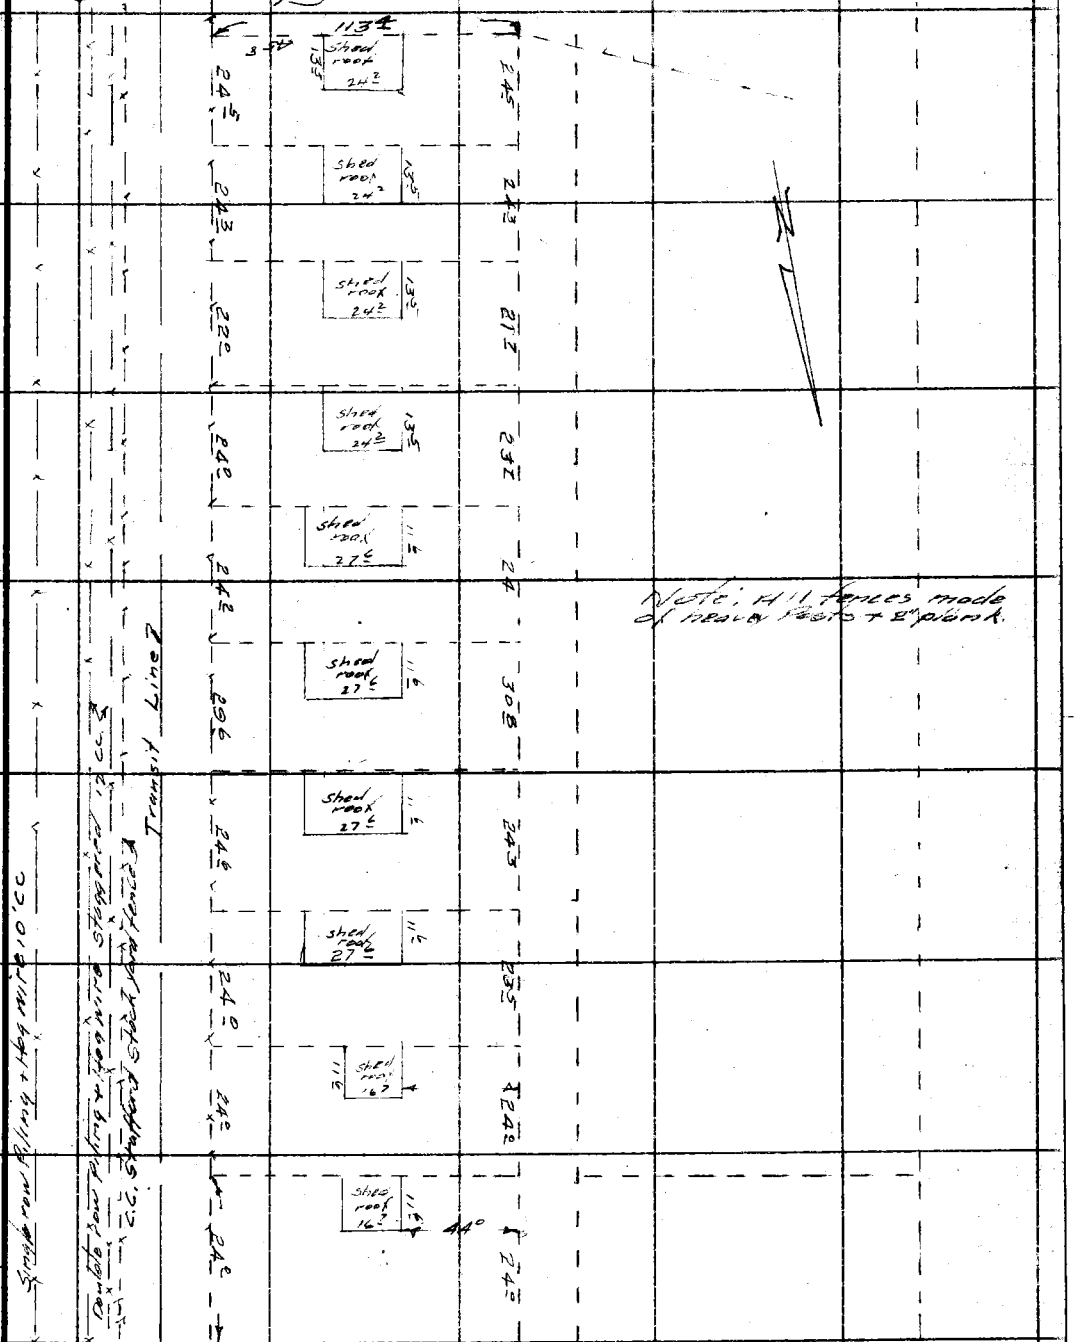

Note: All fences made of heavy Posts + 2" plank.

Cont from Top pg 212

Note: ANY ADDITIONS OR CHANGES ON THIS SHEET MUST BE MADE OR CIRCLED IN Red Ink. WITH DATE AND NAME OF PERSON MAKING CHANGE.

RETURN TO
LOS ANGELES COUNTY SURVEYOR
700 HALL OF RECORDS
Do not extend notes this side of this line

FORM 247 10M 8-31

RETURN TO
LOS ANGELES COUNTY SURVEYOR
700 HALL OF RECORDS

Note: ANY ADDITIONS OR CHANGES ON THIS SHEET MUST BE MADE OR CIRCLED IN **Red Ink.** WITH DATE AND NAME OF PERSON MAKING CHANGE.

Do not extend notes this side of this line

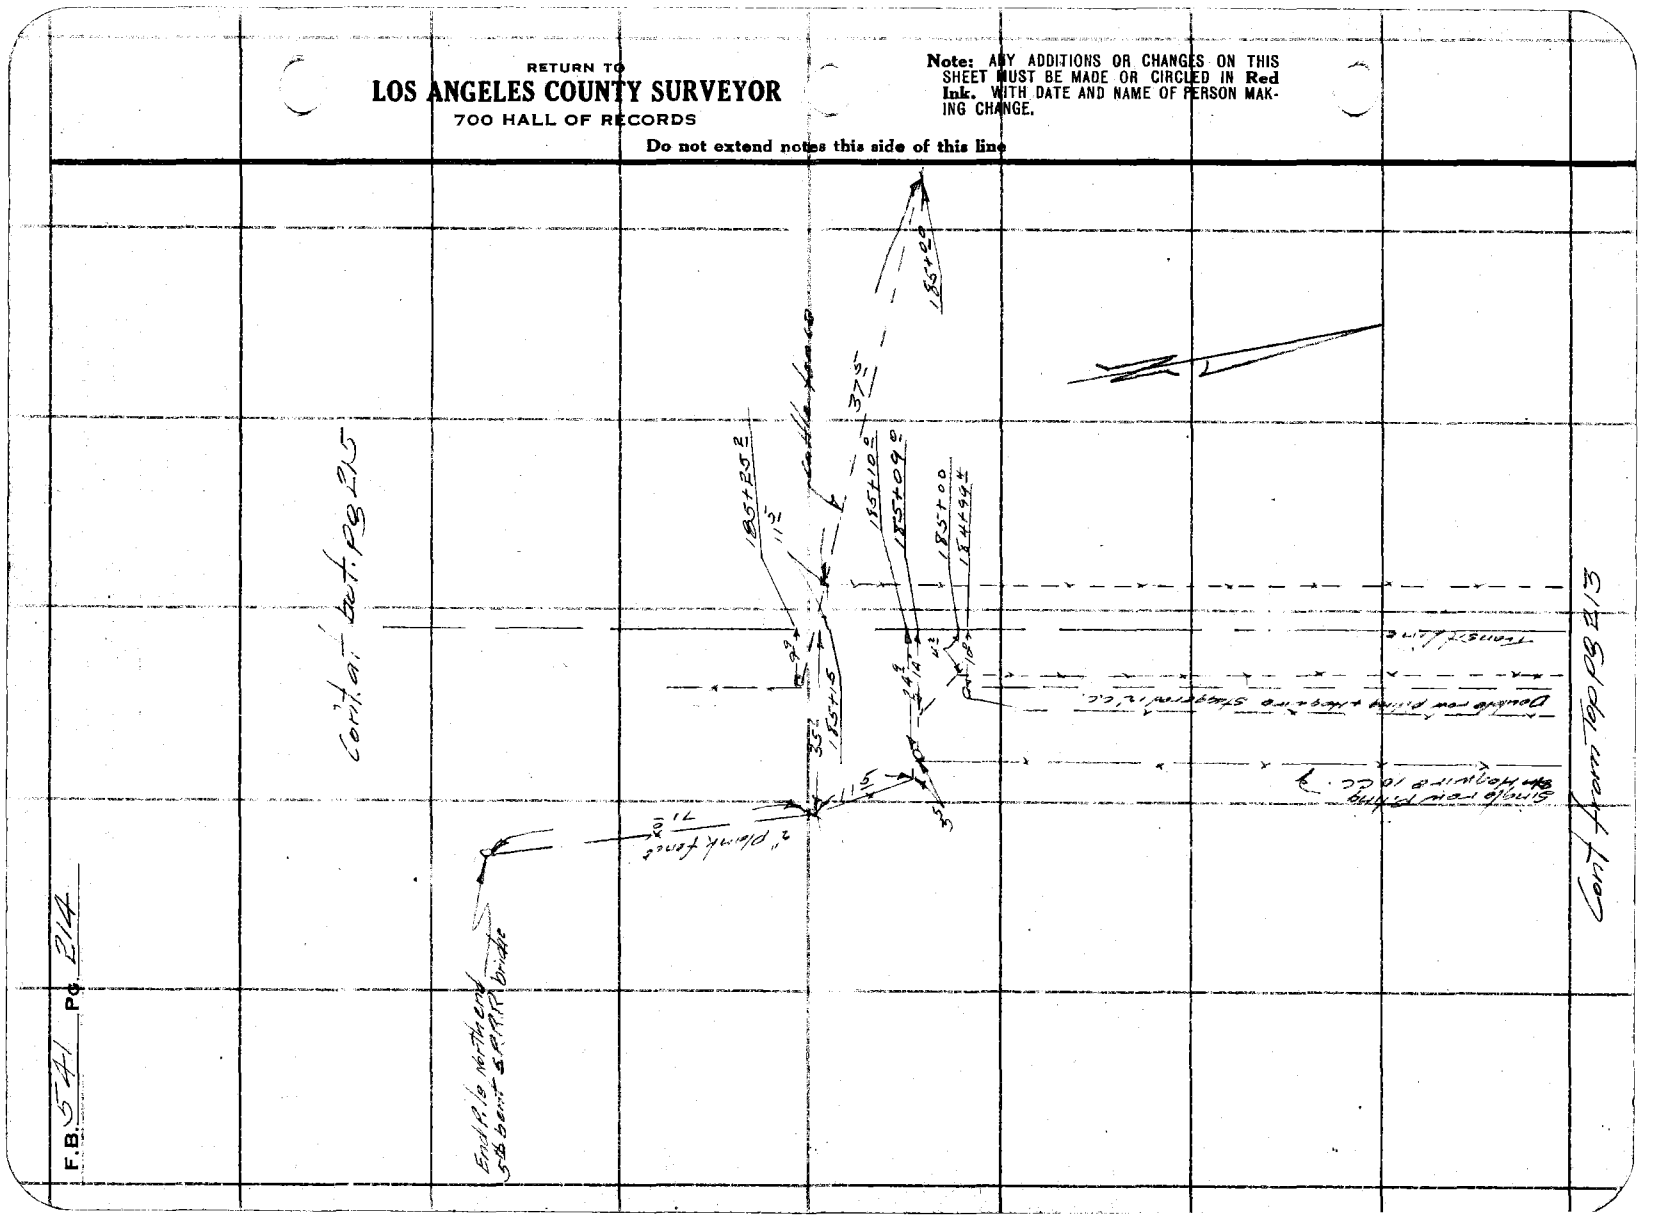

Notes Ck'd by D. M. Finley	Survey of El Monte Bridle Tr.
Map No. B-1005-6	W. O. 8012 Tape No. 067 St'd 84 °F.
Office Work C. W. Cox	Surveyed by Evans
Checked	Notes Brock Date 5-7-34
Date	Indexed A. C. Johnson

F.B. 541 Pg. 215

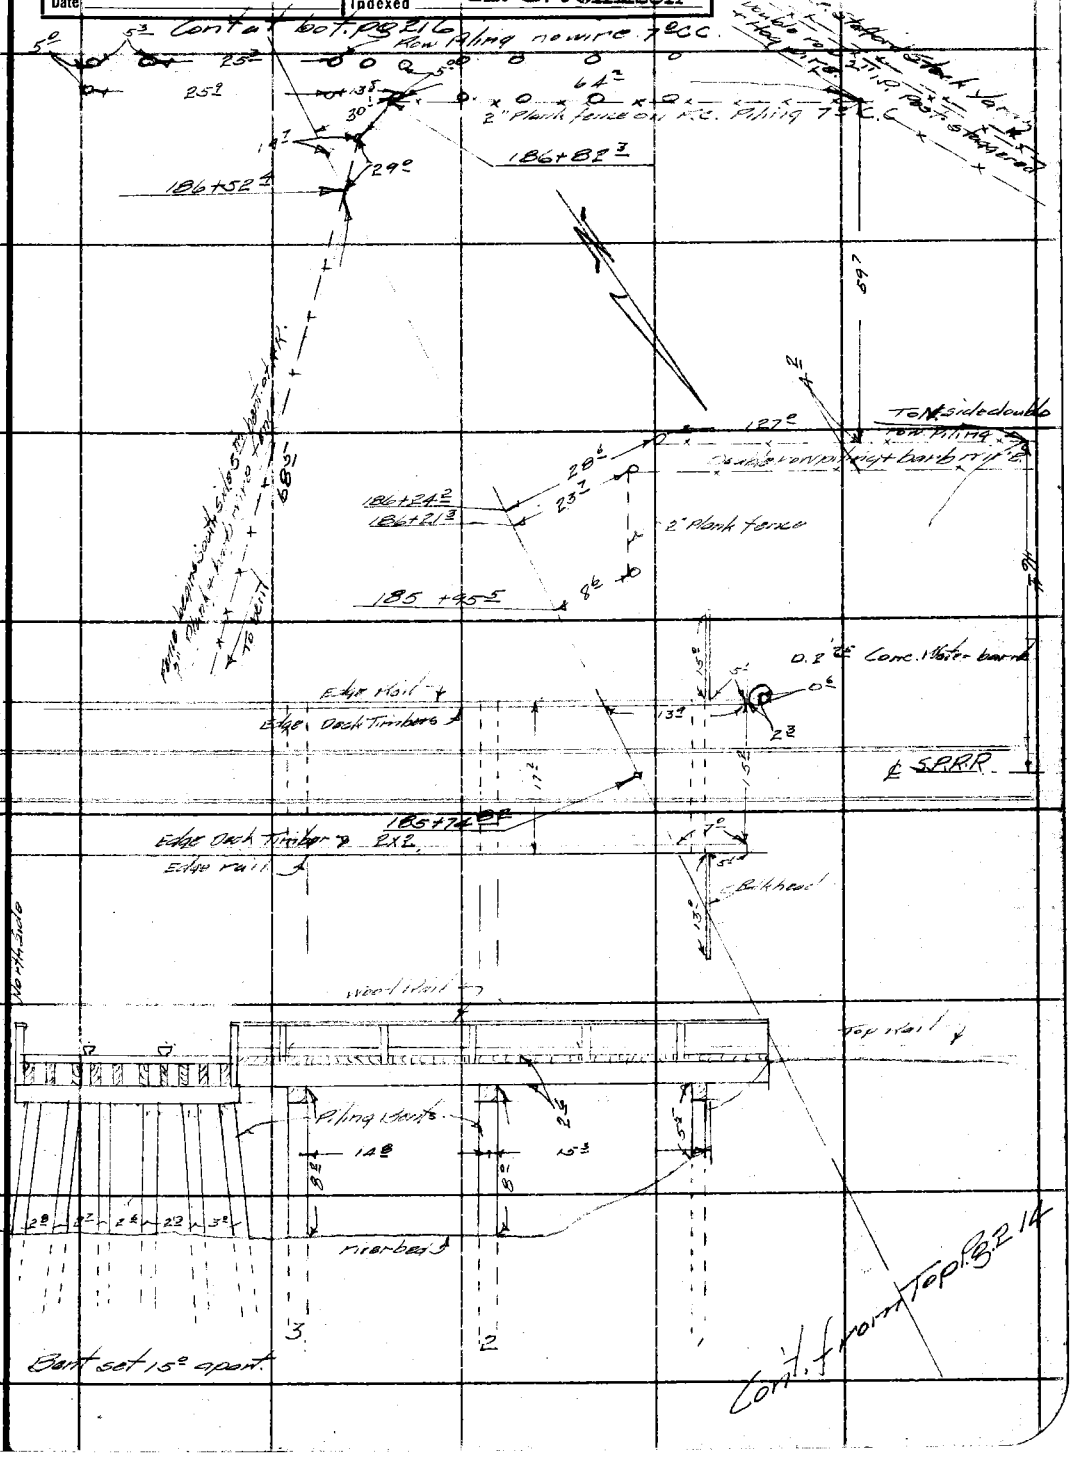

Note: ANY ADDITIONS OR CHANGES ON THIS SHEET MUST BE MADE OR CIRCLED IN Red Ink. WITH DATE AND NAME OF PERSON MAKING CHANGE.

Do not extend notes this side of this line

RETURN TO
LOS ANGELES COUNTY SURVEYOR
700 HALL OF RECORDS

FORM 247 10M 8-31

F.B. 541 PG. 216

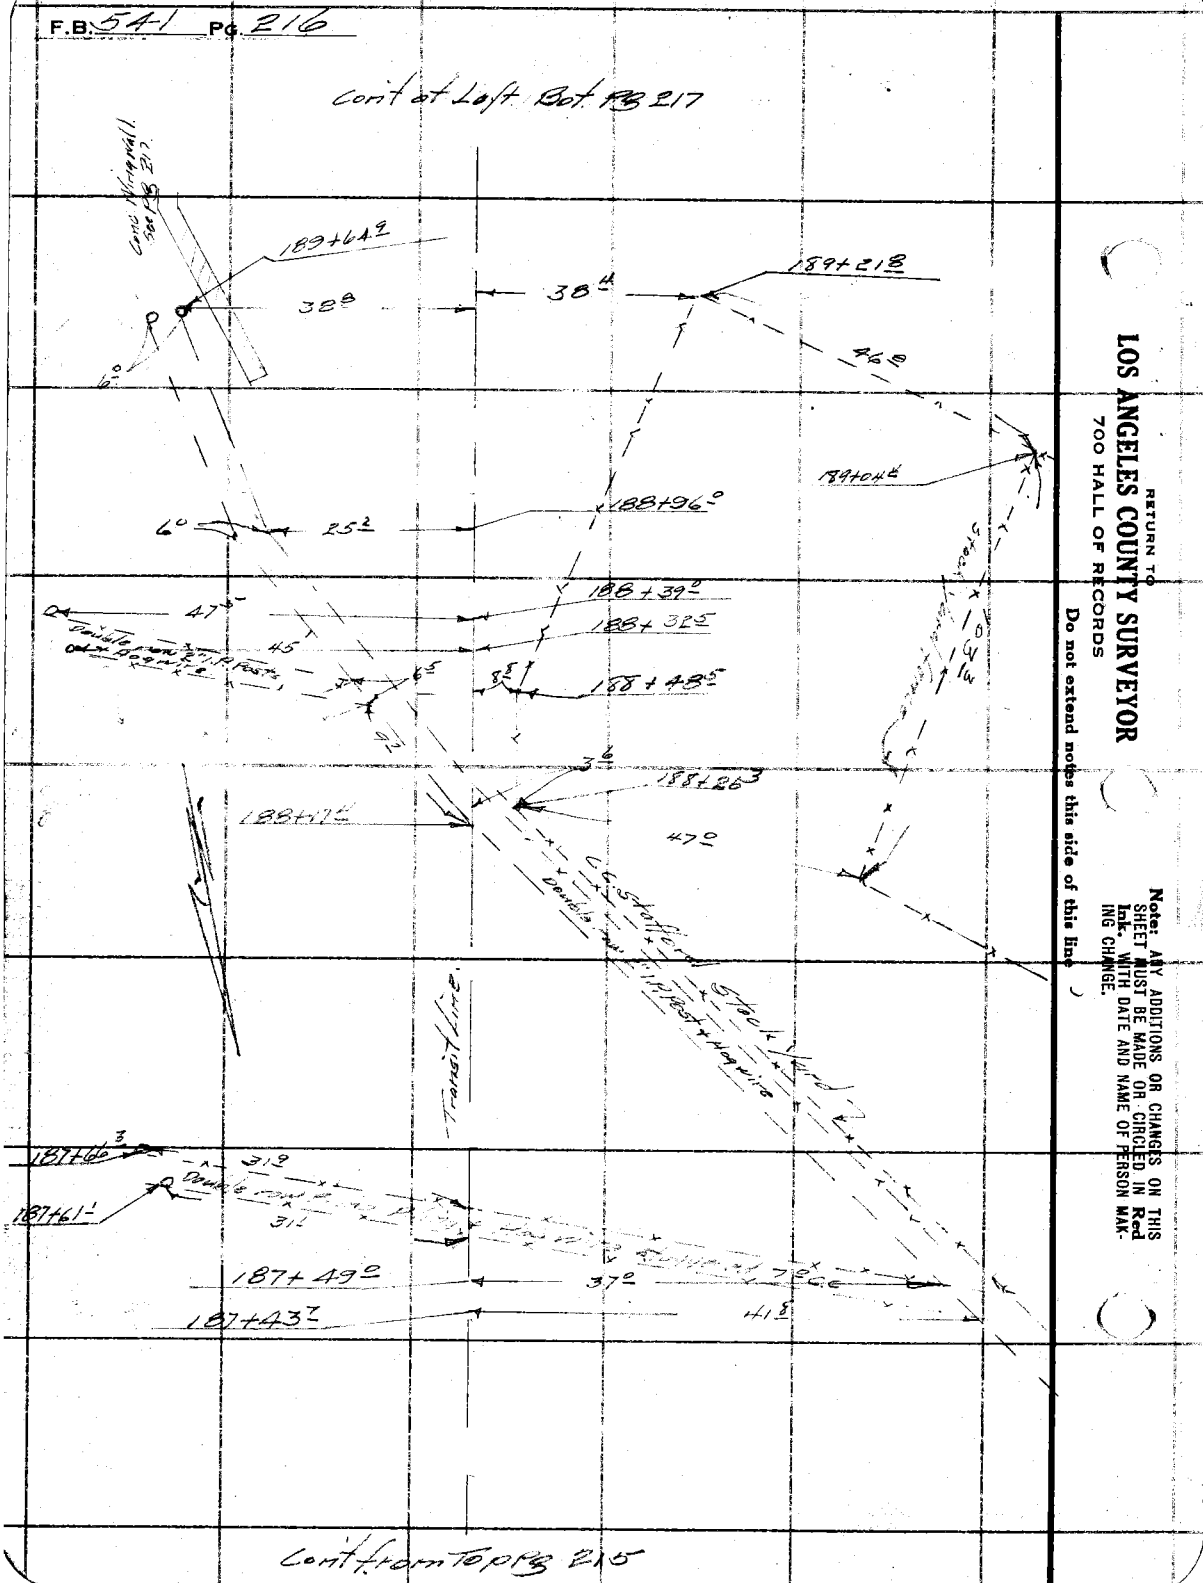

RETURN TO
LOS ANGELES COUNTY SURVEYOR
700 HALL OF RECORDS

Do not extend notes this side of this line

Note: ANY ADDITIONS OR CHANGES ON THIS SHEET MUST BE MADE OR CIRCLED IN Red Ink. WITH DATE AND NAME OF PERSON MAKING CHANGE.

Notes Ck'd by D. M. Finley	Survey of El Monte Bridle Trail
Map No. B-1005-6	W. O. 8012 Tape No. 1061 St'd 84 °F.
Office Work C. W. Cox	Surveyed by Evans
Checked	Notes Brock Date 5-7-34
Date	Indexed A. C. Johnson

F.B. 541 Pg. 217

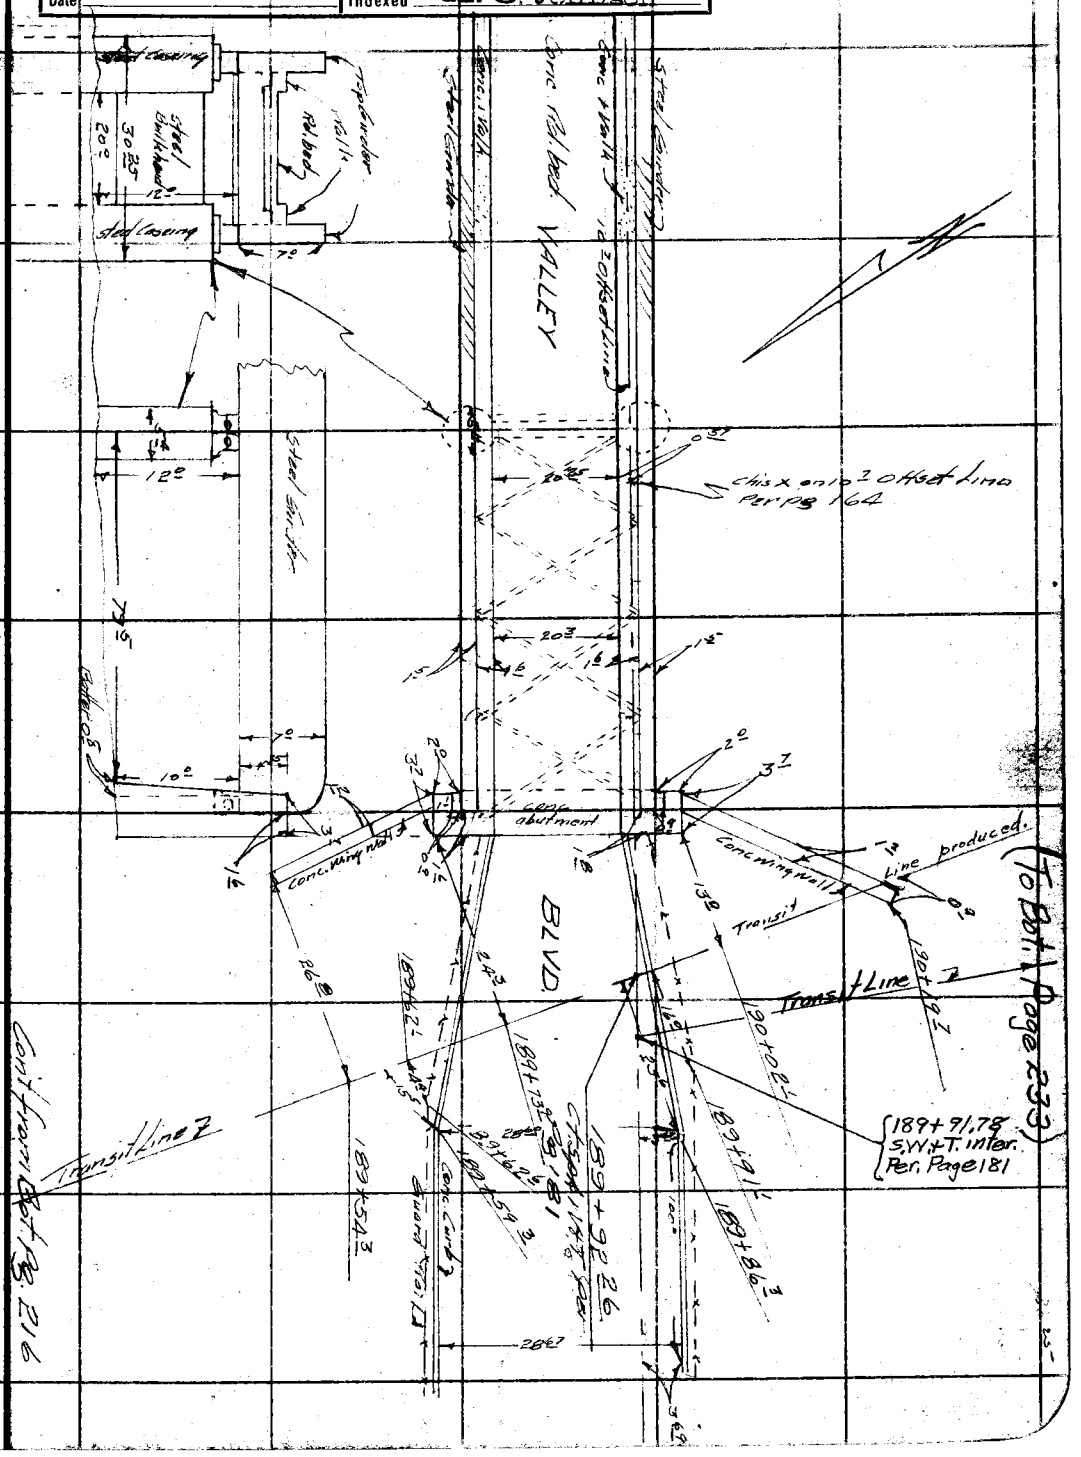

Note: ANY ADDITIONS OR CHANGES ON THIS SHEET MUST BE MADE OR CIRCLED IN Red Ink. WITH DATE AND NAME OF PERSON MAKING CHANGE.

RETURN TO
LOS ANGELES COUNTY SURVEYOR
700 HALL OF RECORDS

Do not extend notes this side of this line

FORM 247 10M 5-31

RETURN TO
LOS ANGELES COUNTY SURVEYOR
700 HALL OF RECORDS

Note: ANY ADDITIONS OR CHANGES ON THIS SHEET MUST BE MADE OR CIRCLED IN **Red Ink.** WITH DATE AND NAME OF PERSON MAKING CHANGE.

Do not extend notes this side of this line

37, D-1,

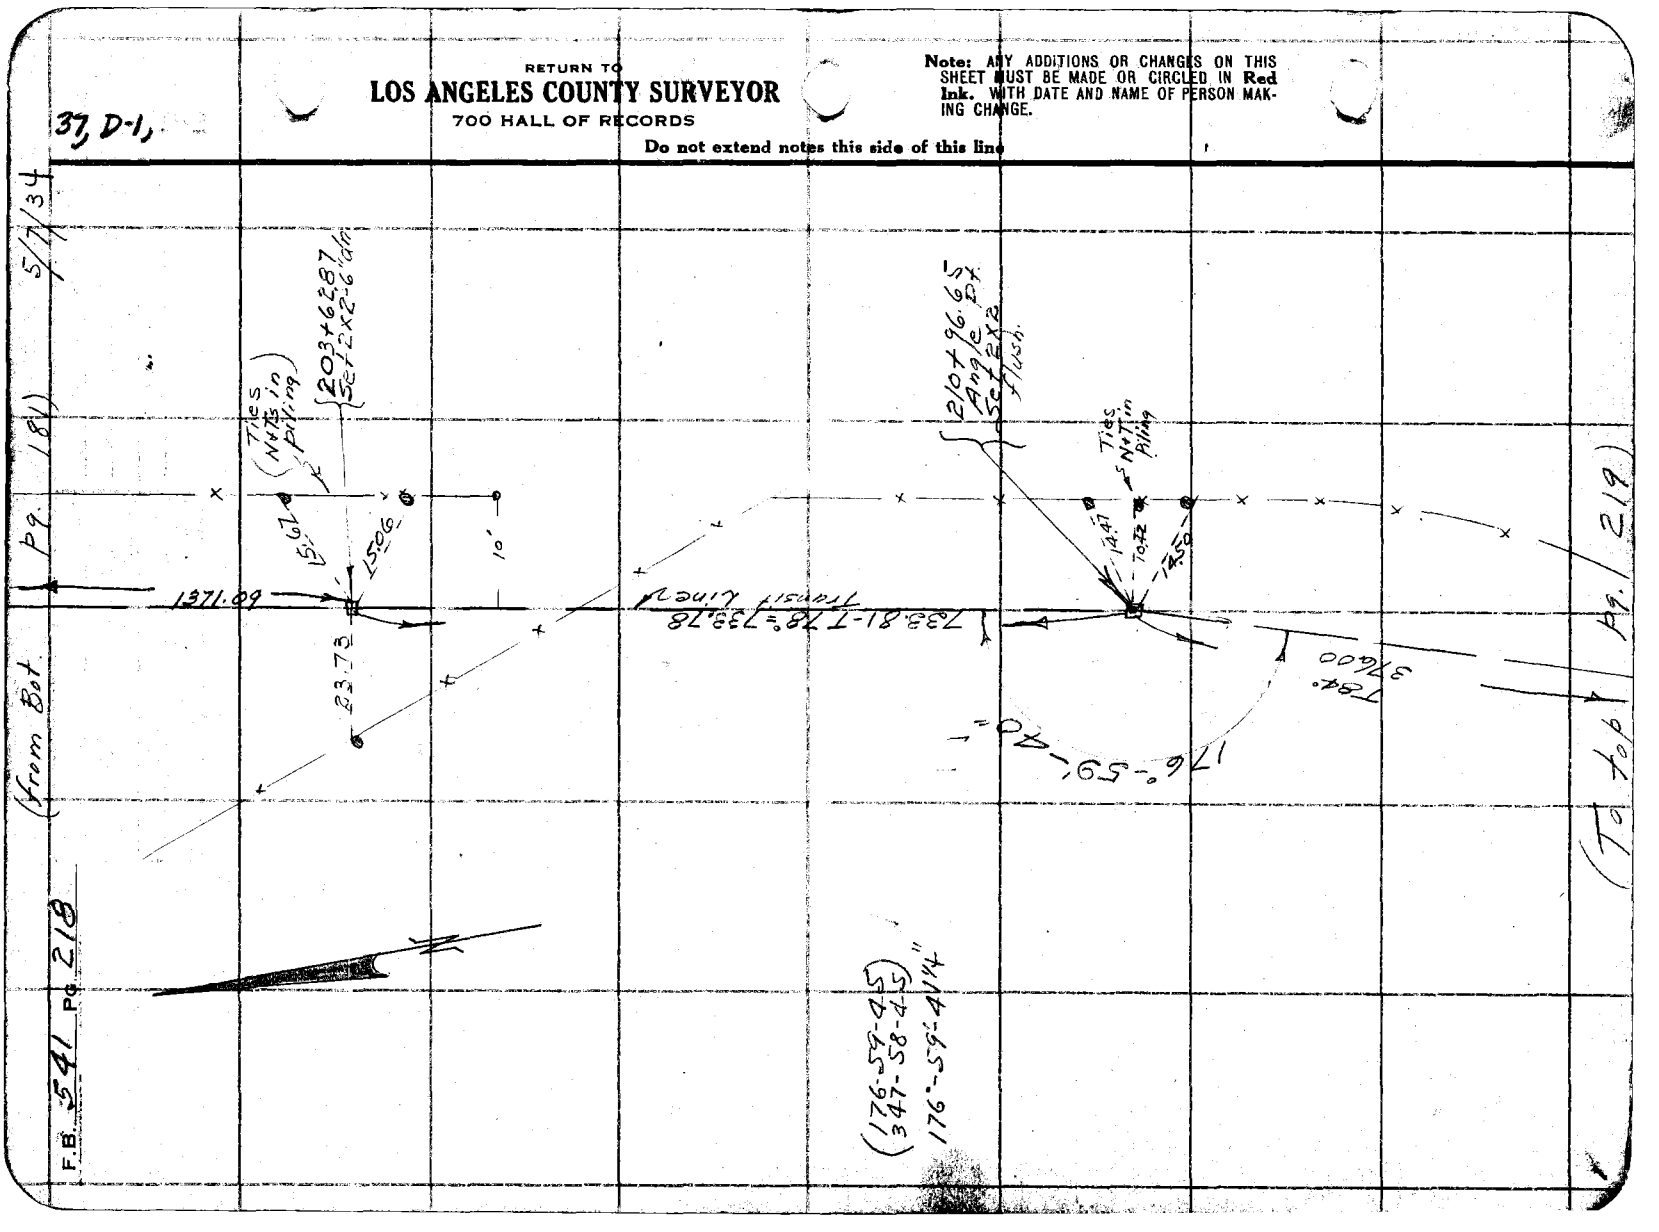

Notes Ck'd by D.M. Finley	Survey of El Monte Bridle Trail
Map No. B-1005-6	W. O. 8012 Page No. 067 St'd 84 °F.
Office Work C.W. Cox	Surveyed by [illegible]
Checked	Notes [illegible] Date 5/8/34
Date	Indexed A. C. Johnson

F.B. 541 PG. 219

37 D-2

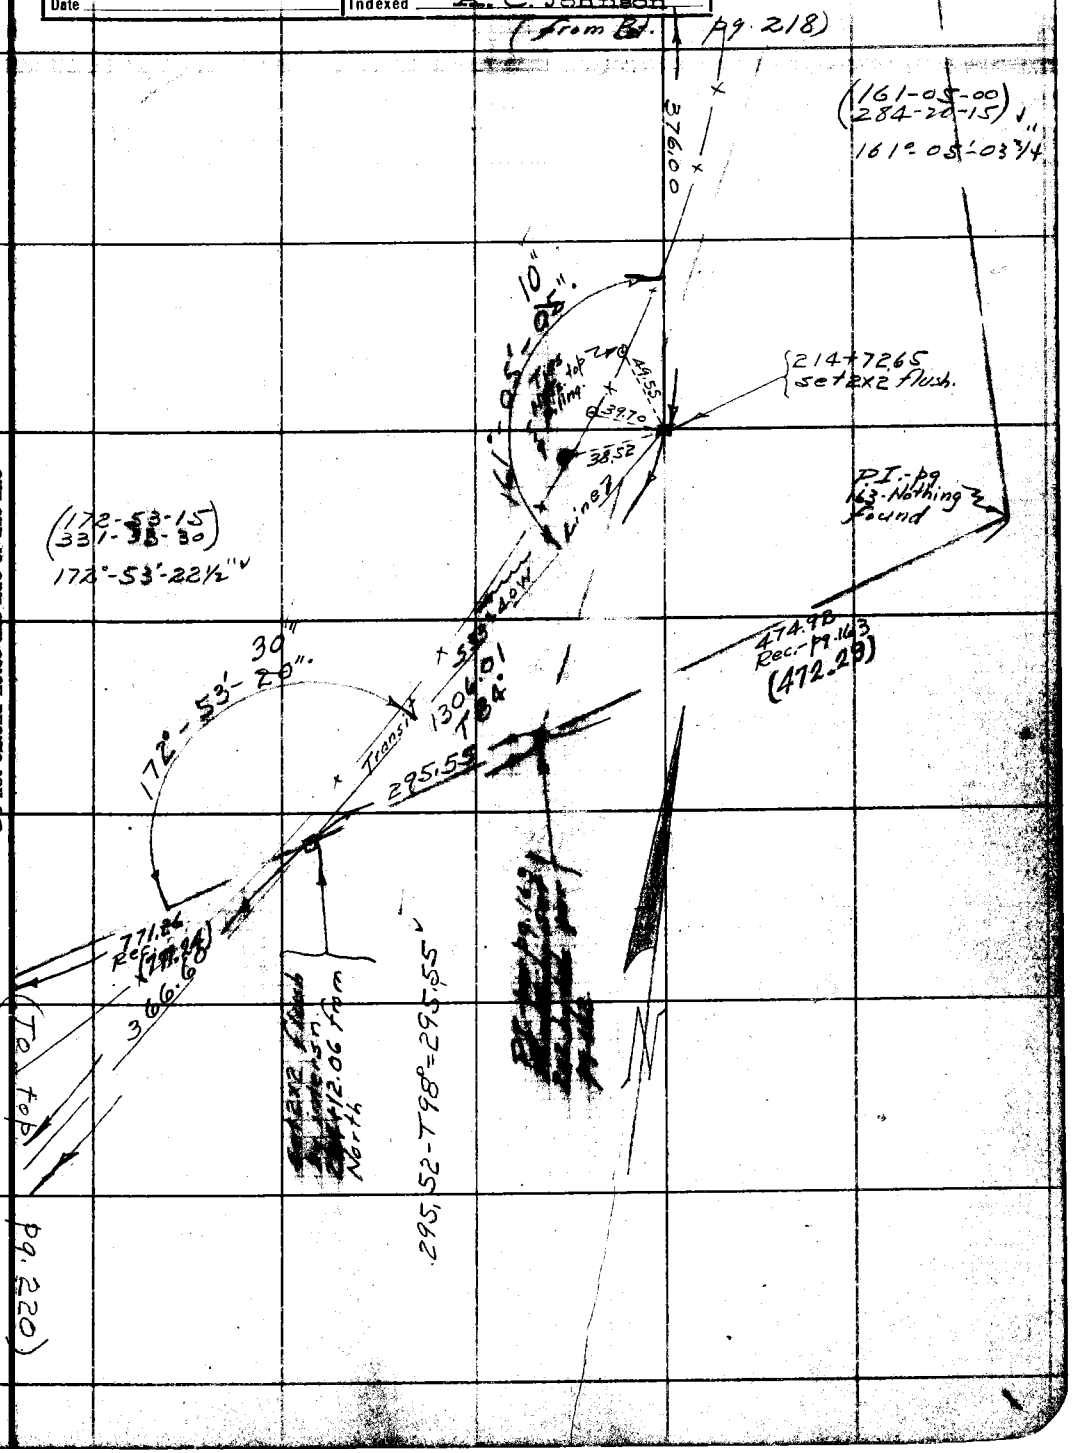

Note: ANY ADDITIONS OR CHANGES ON THIS SHEET MUST BE MADE OR CIRCLED IN Red Ink. WITH DATE AND NAME OF PERSON MAKING CHANGE.

Do not extend notes this side of this line

RETURN TO
LOS ANGELES COUNTY SURVEYOR
700 HALL OF RECORDS

FORM 247 10M 8-31

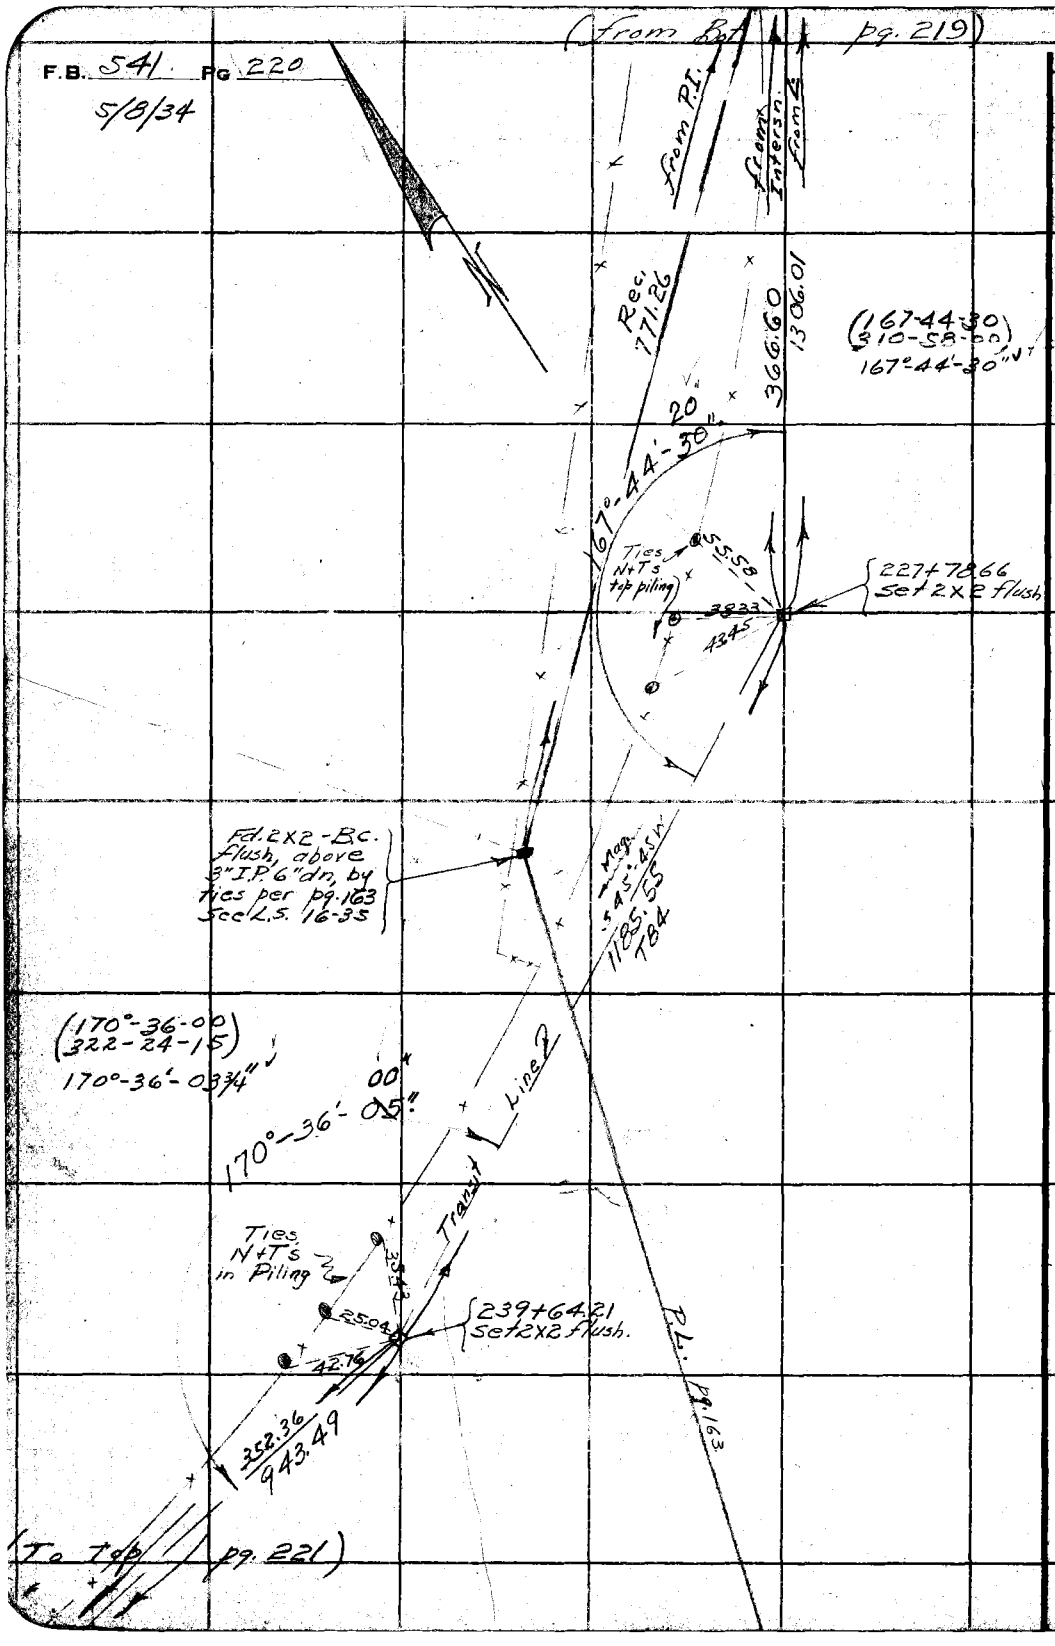

37, C-2

RETURN TO
LOS ANGELES COUNTY SURVEYOR
700 HALL OF RECORDS
Do not extend notes this side of this line

Note: ANY ADDITIONS OR CHANGES ON THIS SHEET MUST BE MADE OR CIRCLED IN Red Ink. WITH DATE AND NAME OF PERSON MAKING CHANGE.

Notes Ck'd by D. M. Finley	Survey of El Monte Bridle Trl.
Map No. B-1005-7	W. O. 8012 Tape No. 067 St'd 84 °F.
Office Work C. W. Cox	Surveyed by [illegible]
Checked	Notes LE Date 5/9/34
Date	Indexed A. C. Johnson

F.B. 541 PG. 221

37, C-2

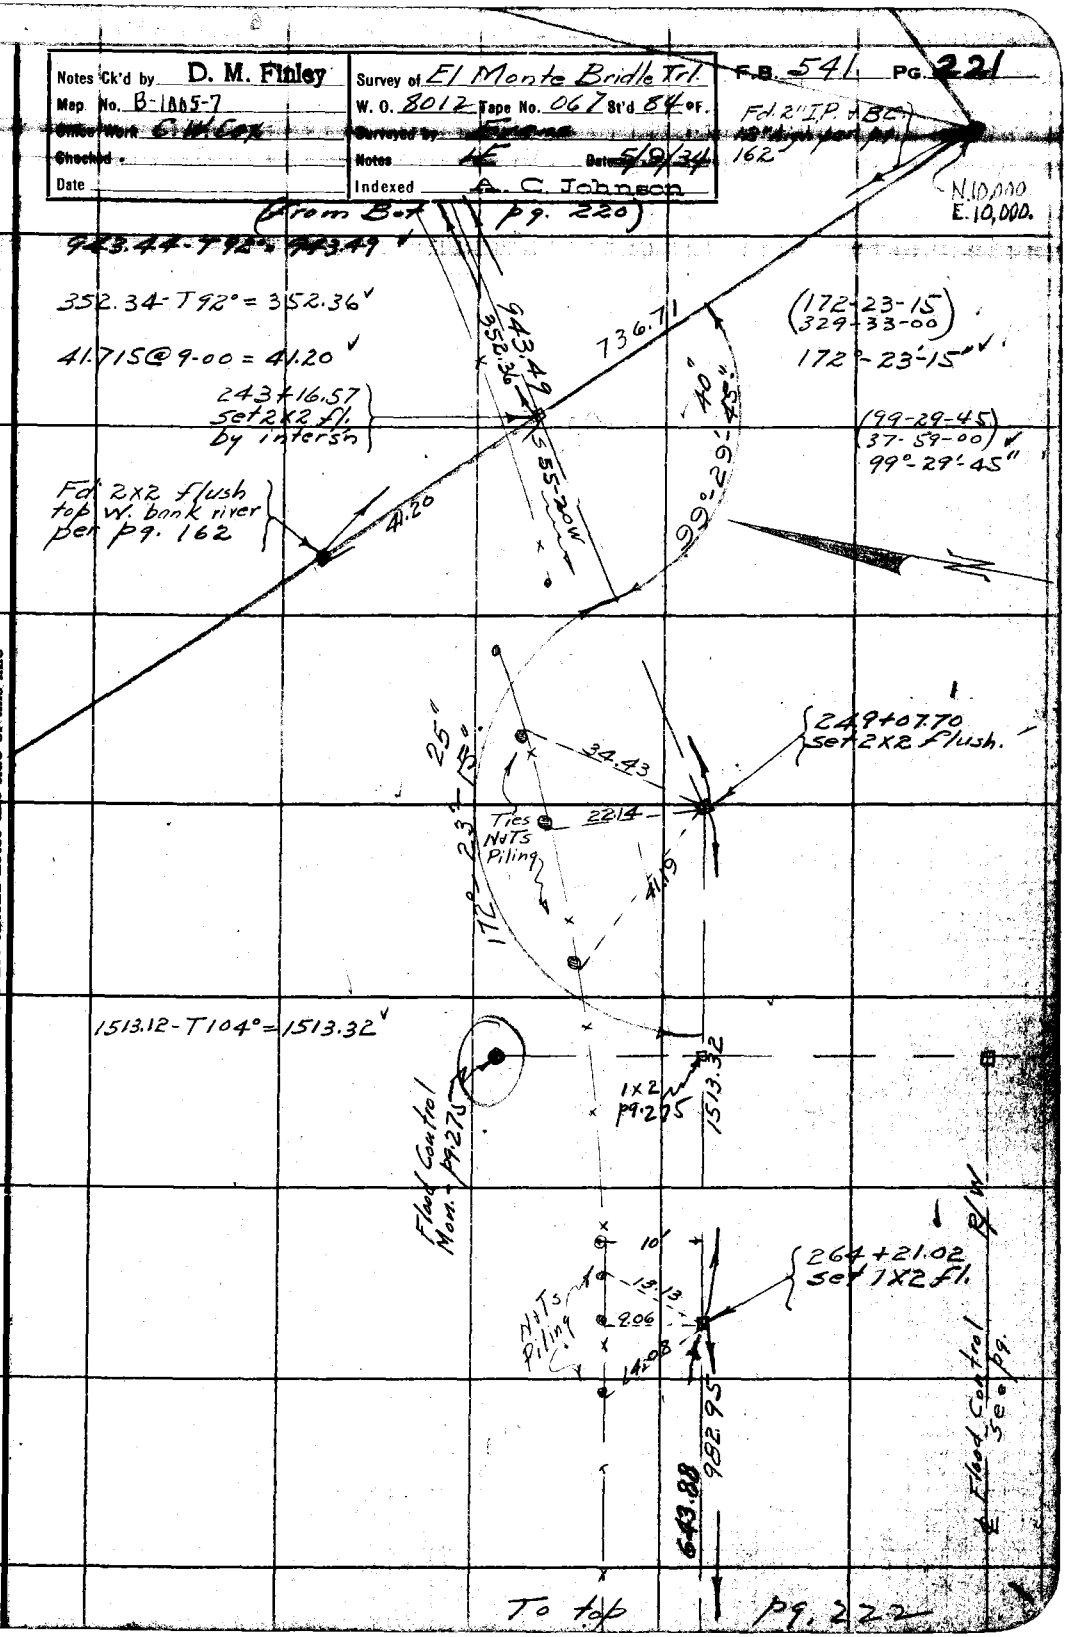

Note: ANY ADDITIONS OR CHANGES ON THIS SHEET MUST BE MADE OR CIRCLED IN Red Ink. WITH DATE AND NAME OF PERSON MAKING CHANGE.

Do not extend notes this side of this line

RETURN TO
LOS ANGELES COUNTY SURVEYOR
700 HALL OF RECORDS

FORM 247 10M 5-31

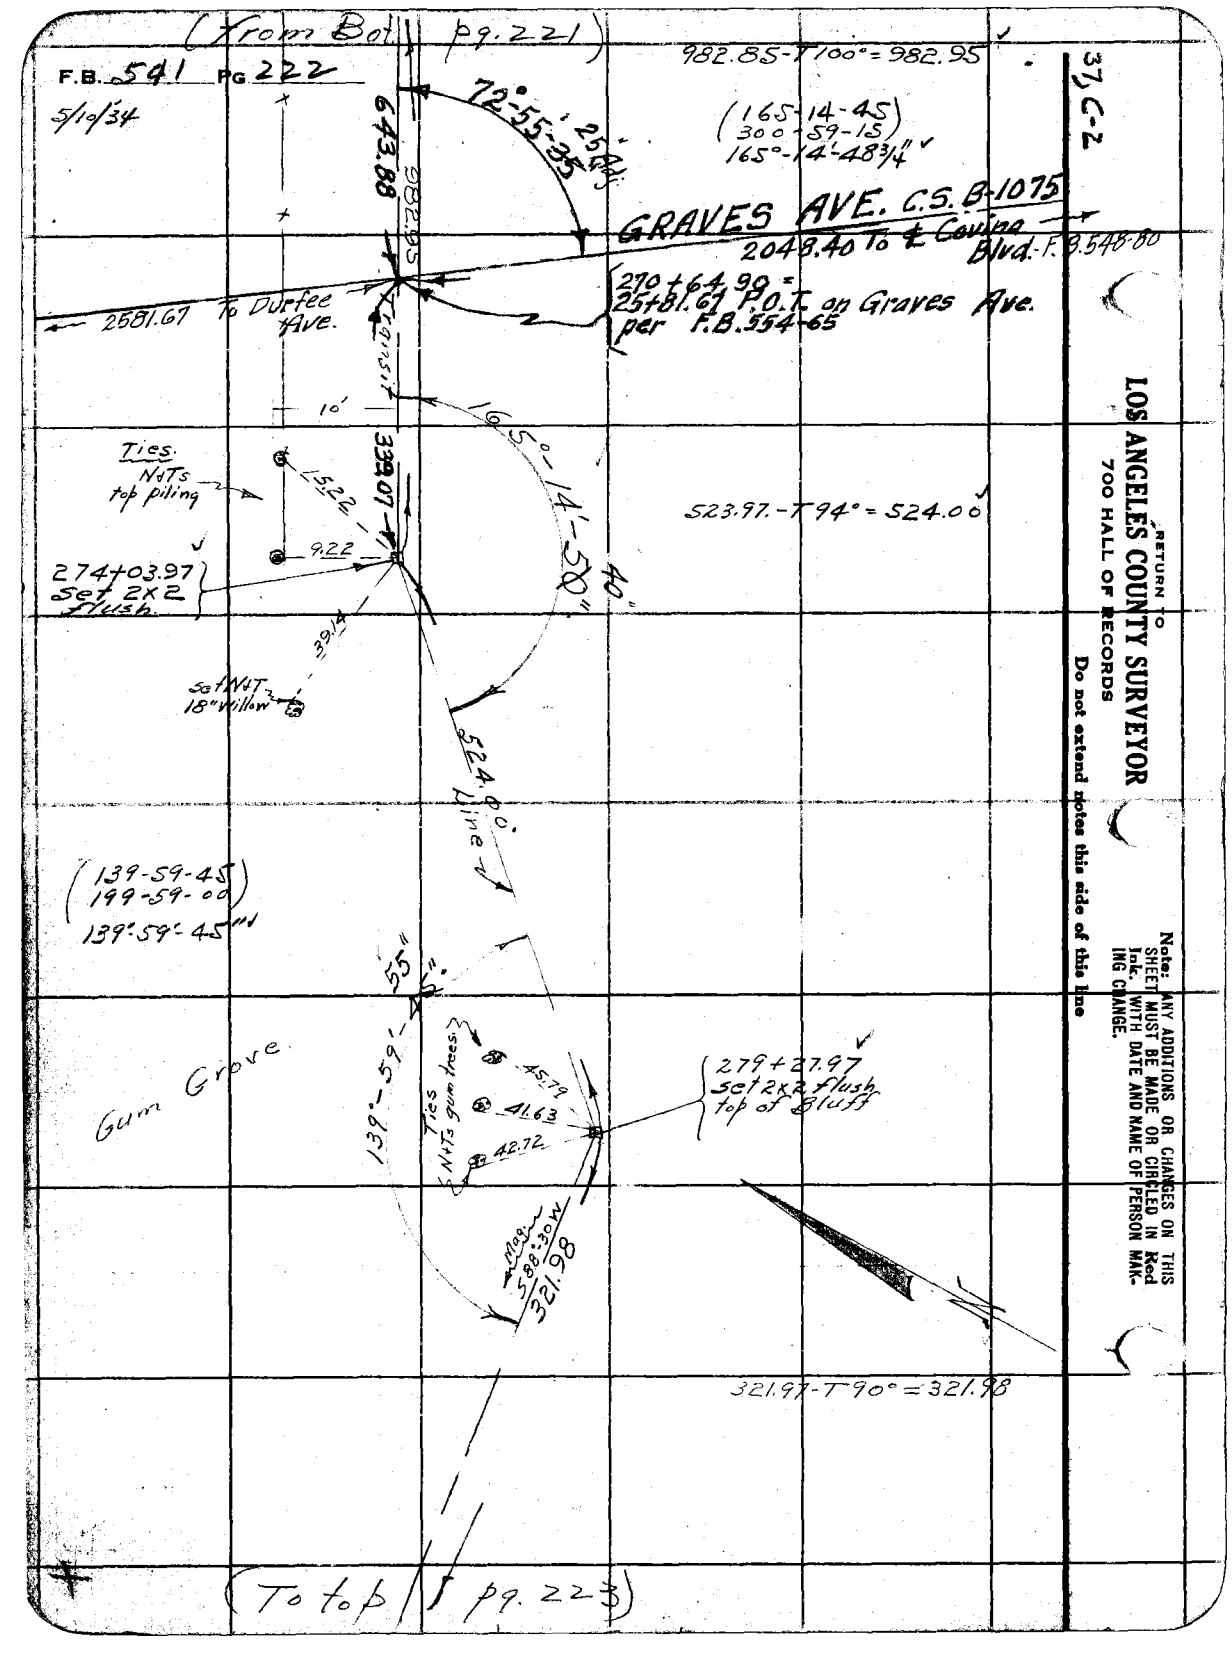

RETURN TO
LOS ANGELES COUNTY SURVEYOR
700 HALL OF RECORDS
Do not extend notes this side of this line
Note: ANY ADDITIONS OR CHANGES ON THIS SHEET MUST BE MADE OR CIRCLED IN Red Ink, WITH DATE AND NAME OF PERSON MAKING CHANGE.

Notes Ck'd by D. M. Finley	Survey of El Monte Bridle Trl.
Map No. B-1005-7	W. O. 8012 Tape No. 067 St'd 84 °F.
Office Work C.W. Cox	Surveyed by Evans
Checked	Notes HE Date 5/11/34
Date	Indexed A. C. Johnson

F.B. 541 Pg. 223

37, C-2

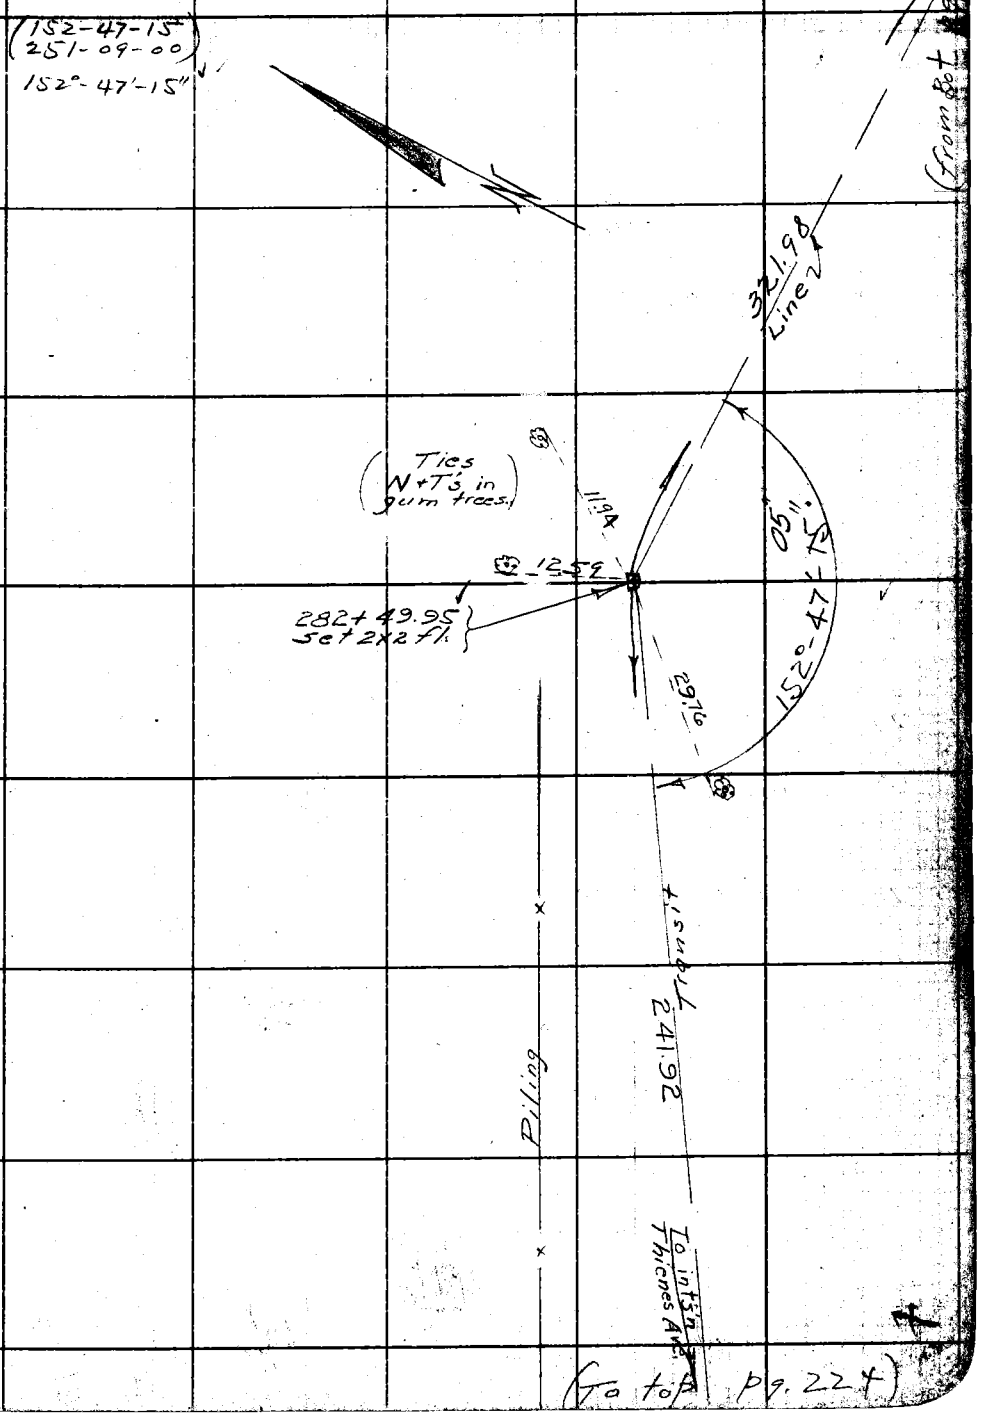

Note: ANY ADDITIONS OR CHANGES ON THIS SHEET MUST BE MADE OR CIRCLED IN Red Ink. WITH DATE AND NAME OF PERSON MAKING CHANGE.

Do not extend notes this side of this line

RETURN TO
LOS ANGELES COUNTY SURVEYOR
700 HALL OF RECORDS

FORM 247 10M 5-31

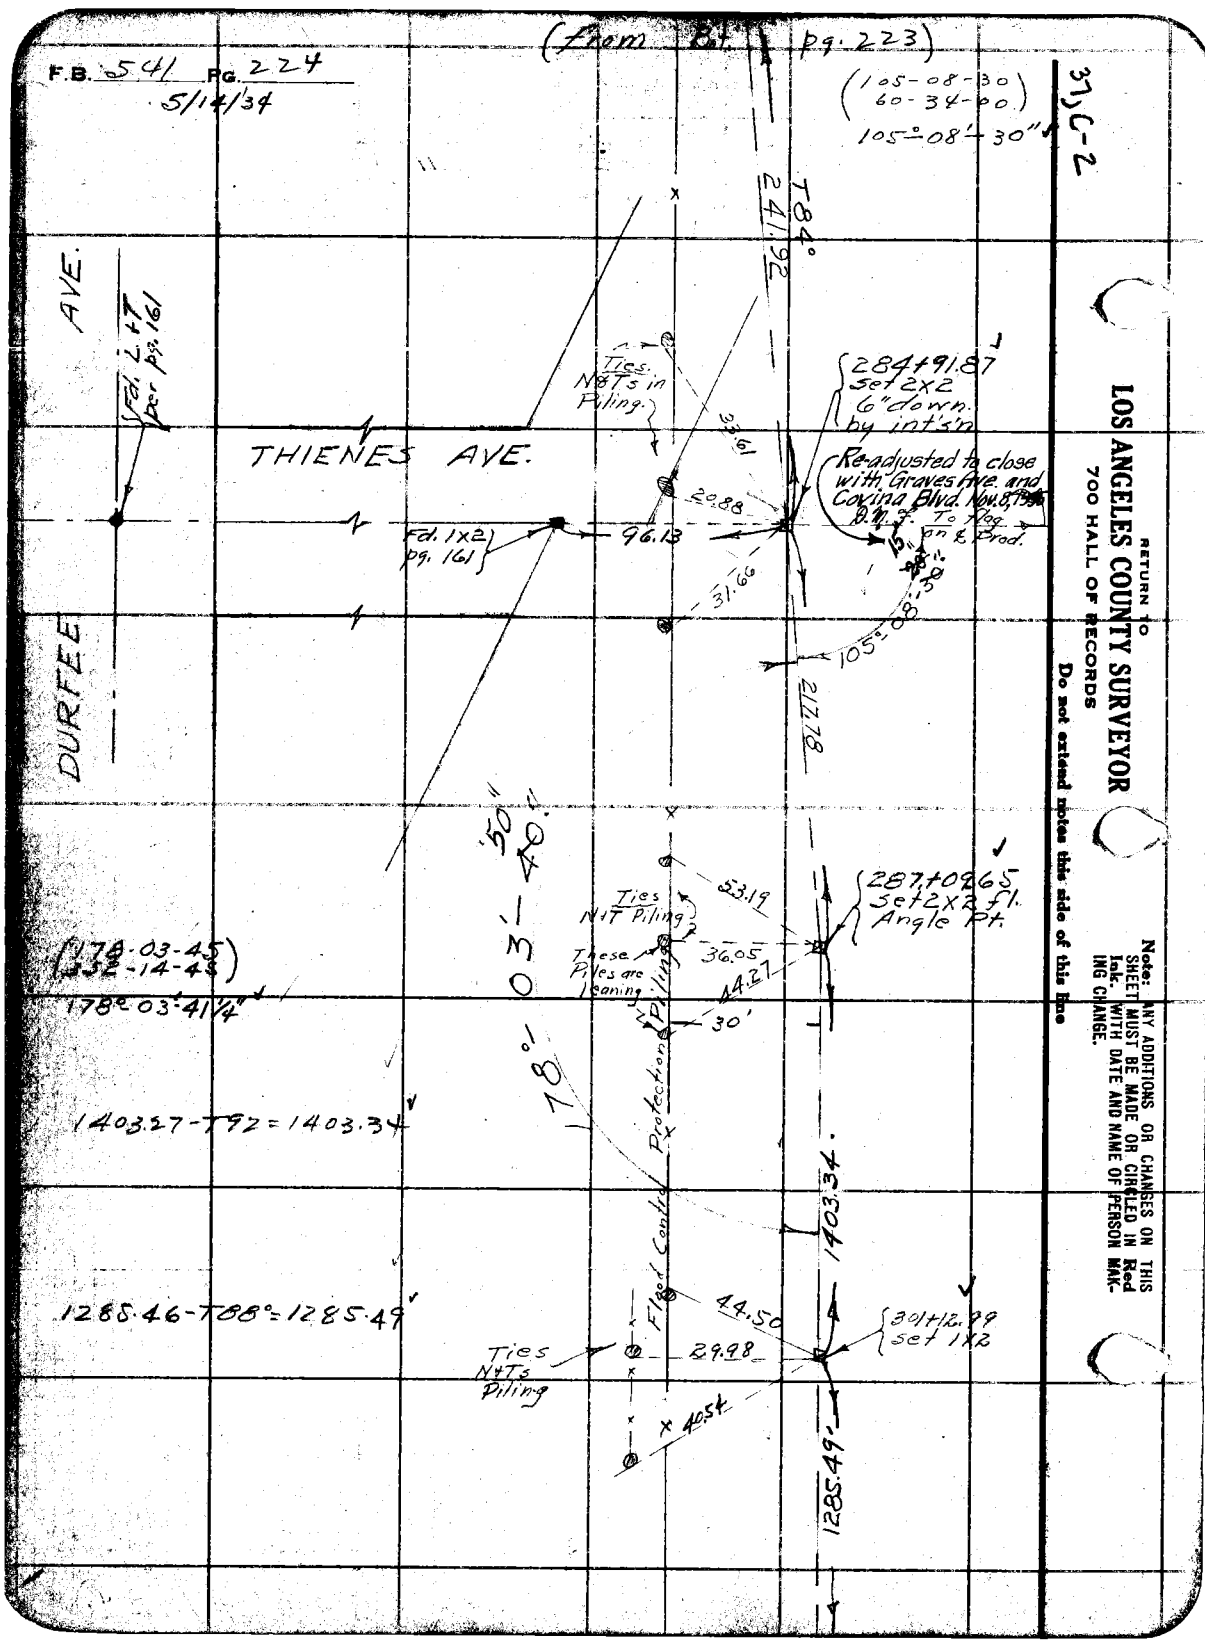

RETURN TO
LOS ANGELES COUNTY SURVEYOR
700 HALL OF RECORDS
Do not extend notes this side of this line

Note: ANY ADDITIONS OR CHANGES ON THIS SHEET MUST BE MADE OR CIRCLED IN Red Ink. WITH DATE AND NAME OF PERSON MAKING CHANGE.

Notes Ck'd by D. M. Finley	Survey of El Monte Bridle Trail
Map No. B-1005-7	W. O. 8012 Tape No. 067 St'd 84 °F.
Office Work C.W.Cox	Reviewed by Evans
Checked	Notes 1E Date 6/15/34
Date	Indexed A. C. Johnson

F.B. 541 Pg. 225

37, B-2

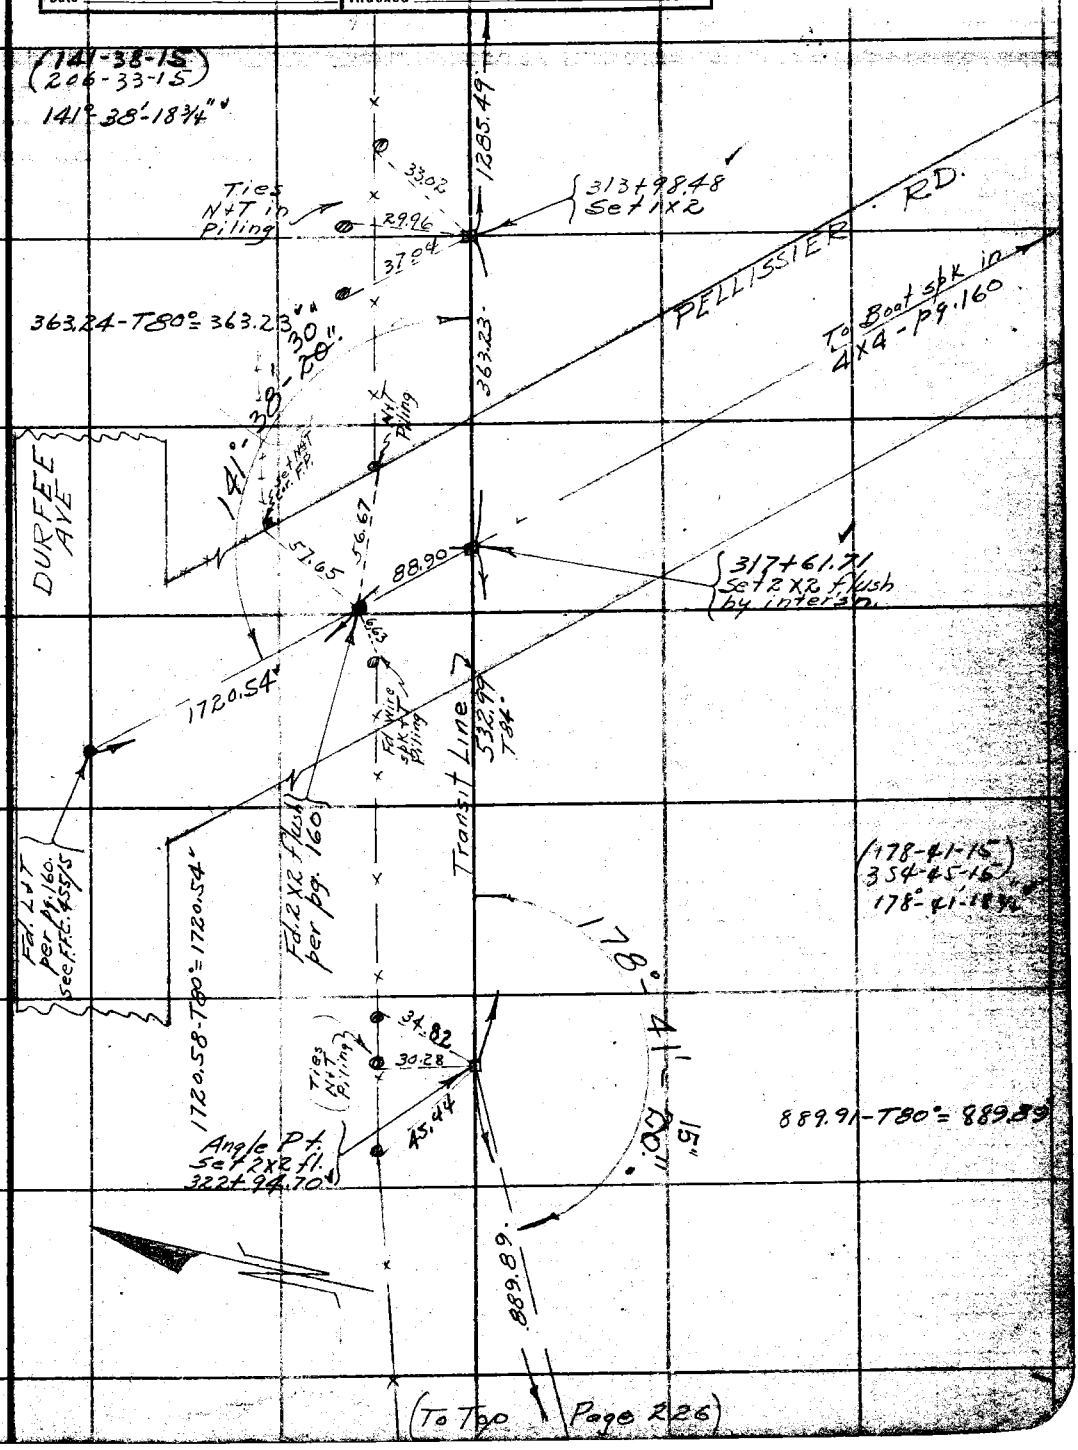

(To Top Page 226)

Note: ANY ADDITIONS OR CHANGES ON THIS SHEET MUST BE MADE OR CIRCLED IN Red Ink. WITH DATE AND NAME OF PERSON MAKING CHANGE.

RETURN TO
LOS ANGELES COUNTY SURVEYOR
700 HALL OF RECORDS
Do not extend notes this side of this line

FORM 247 10M 8-31

RETURN TO
LOS ANGELES COUNTY SURVEYOR
700 HALL OF RECORDS

Note: ANY ADDITIONS OR CHANGES ON THIS SHEET MUST BE MADE OR CIRCLED IN **Red Ink.** WITH DATE AND NAME OF PERSON MAKING CHANGE.

Do not extend notes this side of this line

37 B-2

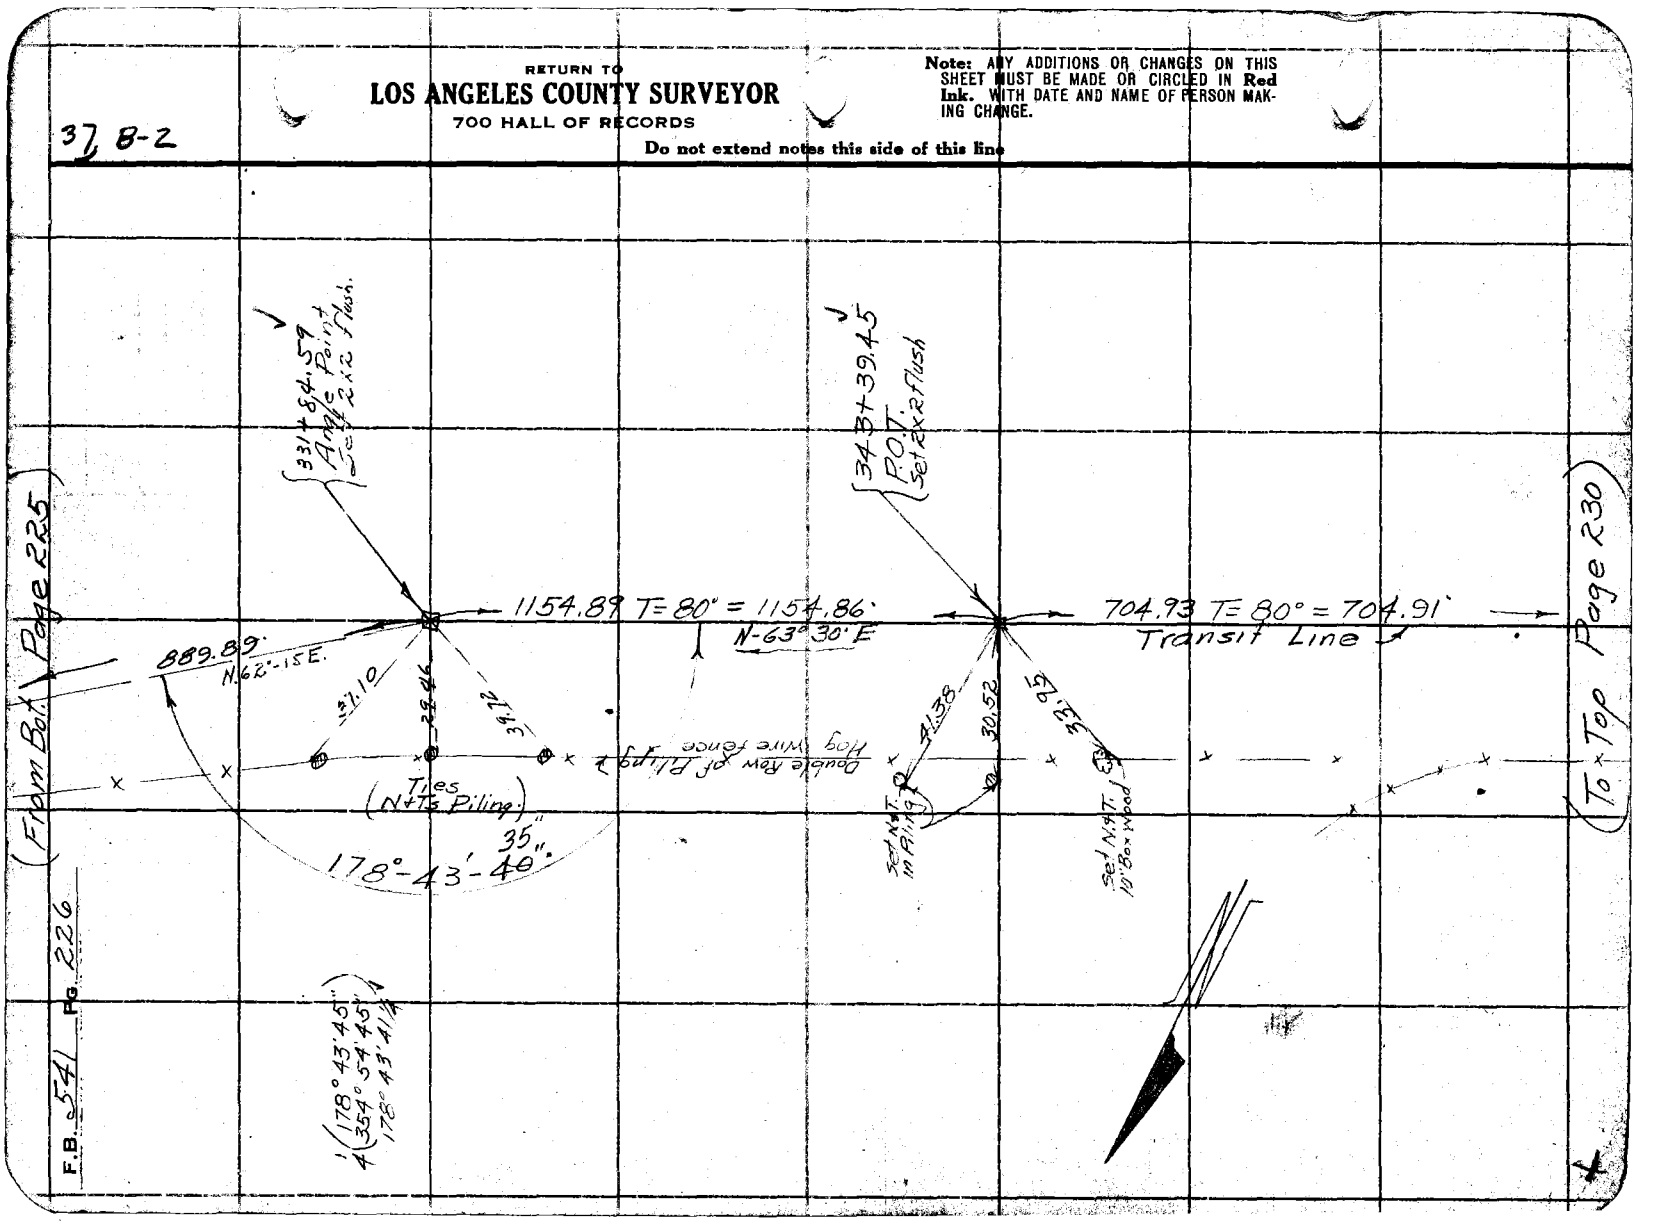

Notes Ck'd by D. M. Finley	Survey of El Monte Bridle Trl.
Map No. B-1005-7	W. O. 8012 Tape No 067 St'd 84 °F.
Office Work C. W. Cox	Surveyed by Evans
Checked	Notes PE Date 6/7/34
Date	Indexed A. C. Johnson 6-8-34

F.B. 541 Pg. 227

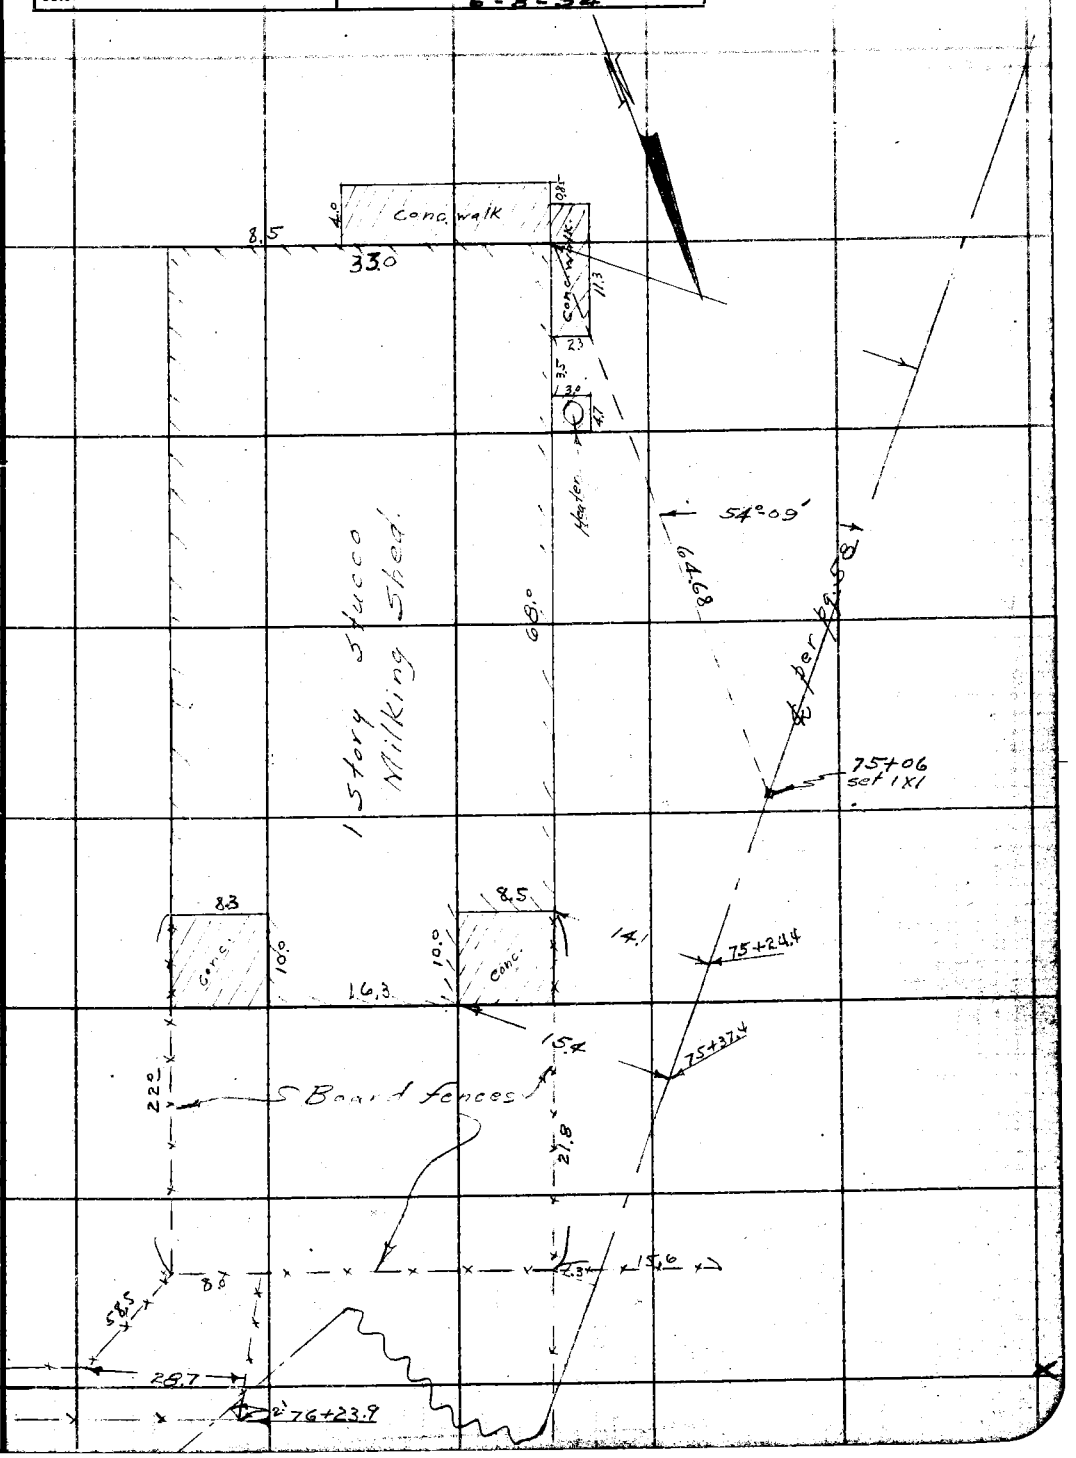

Note: ANY ADDITIONS OR CHANGES ON THIS SHEET MUST BE MADE OR CIRCLED IN Red Ink WITH DATE AND NAME OF PERSON MAKING CHANGE.

Do not extend notes this side of this line

RETURN TO
LOS ANGELES COUNTY SURVEYOR
700 HALL OF RECORDS

FORM 247 5M 2-34

RETURN TO

LOS ANGELES COUNTY SURVEYOR

700 HALL OF RECORDS

Note: ANY ADDITIONS OR CHANGES ON THIS SHEET MUST BE MADE OR CIRCLED IN **Red Ink** WITH DATE AND NAME OF PERSON MAKING CHANGE.

Do not extend notes this side of this line

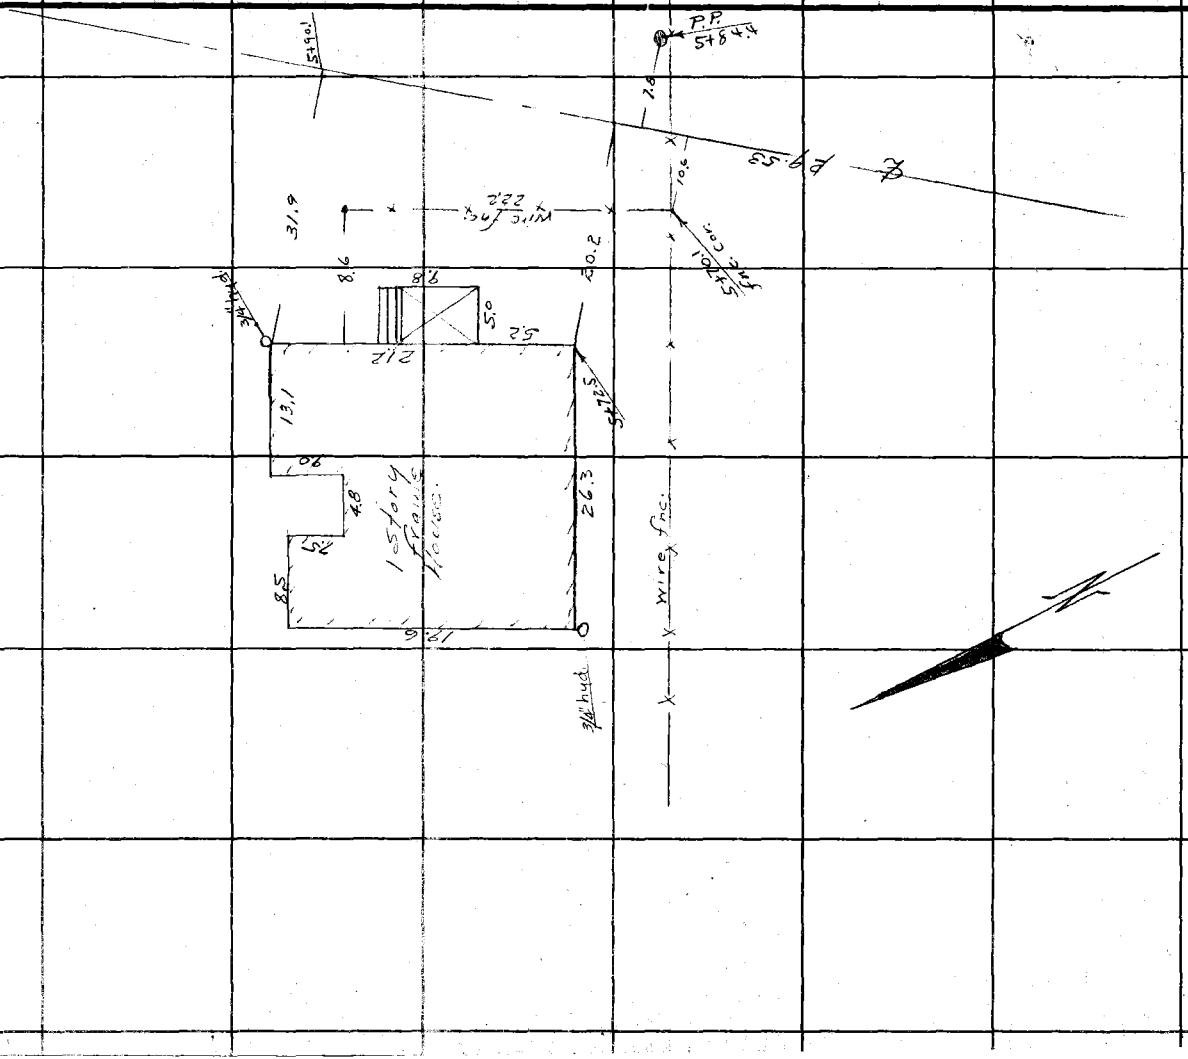

F.B. 541 PG. 228

Notes Ck'd by D. M. Finley	Survey of El Monte Bridle Trail
Map No. B-1005-7	W. O. 8012 Tape No 067 St'd 64 °F.
Office Work C.W. Cox	Surveyed by Evans
Checked	Notes Date 6/7/34
Date	Indexed A. C. Johnson

F.B. 541 Pg. 229

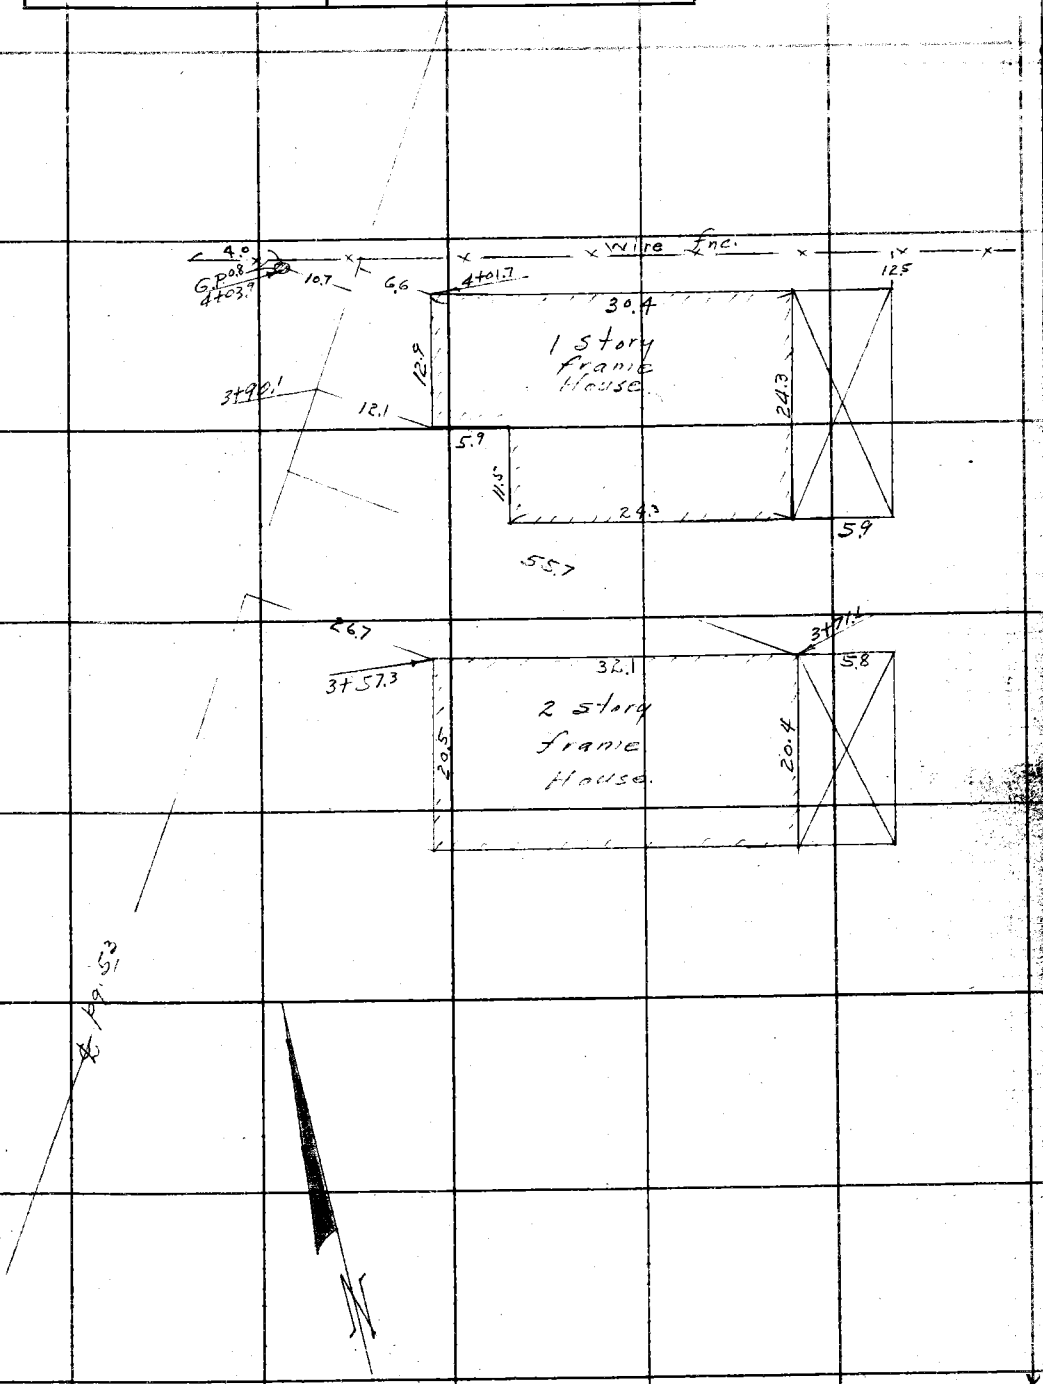

Note: ANY ADDITIONS OR CHANGES ON THIS SHEET MUST BE MADE OR CIRCLED IN Red Ink WITH DATE AND NAME OF PERSON MAKING CHANGE.

Do not extend notes this side of this line

RETURN TO
LOS ANGELES COUNTY SURVEYOR
700 HALL OF RECORDS

FORM 247 5M 2-34

F.B. 541 Pg. 230

(From Bot. Page 226)

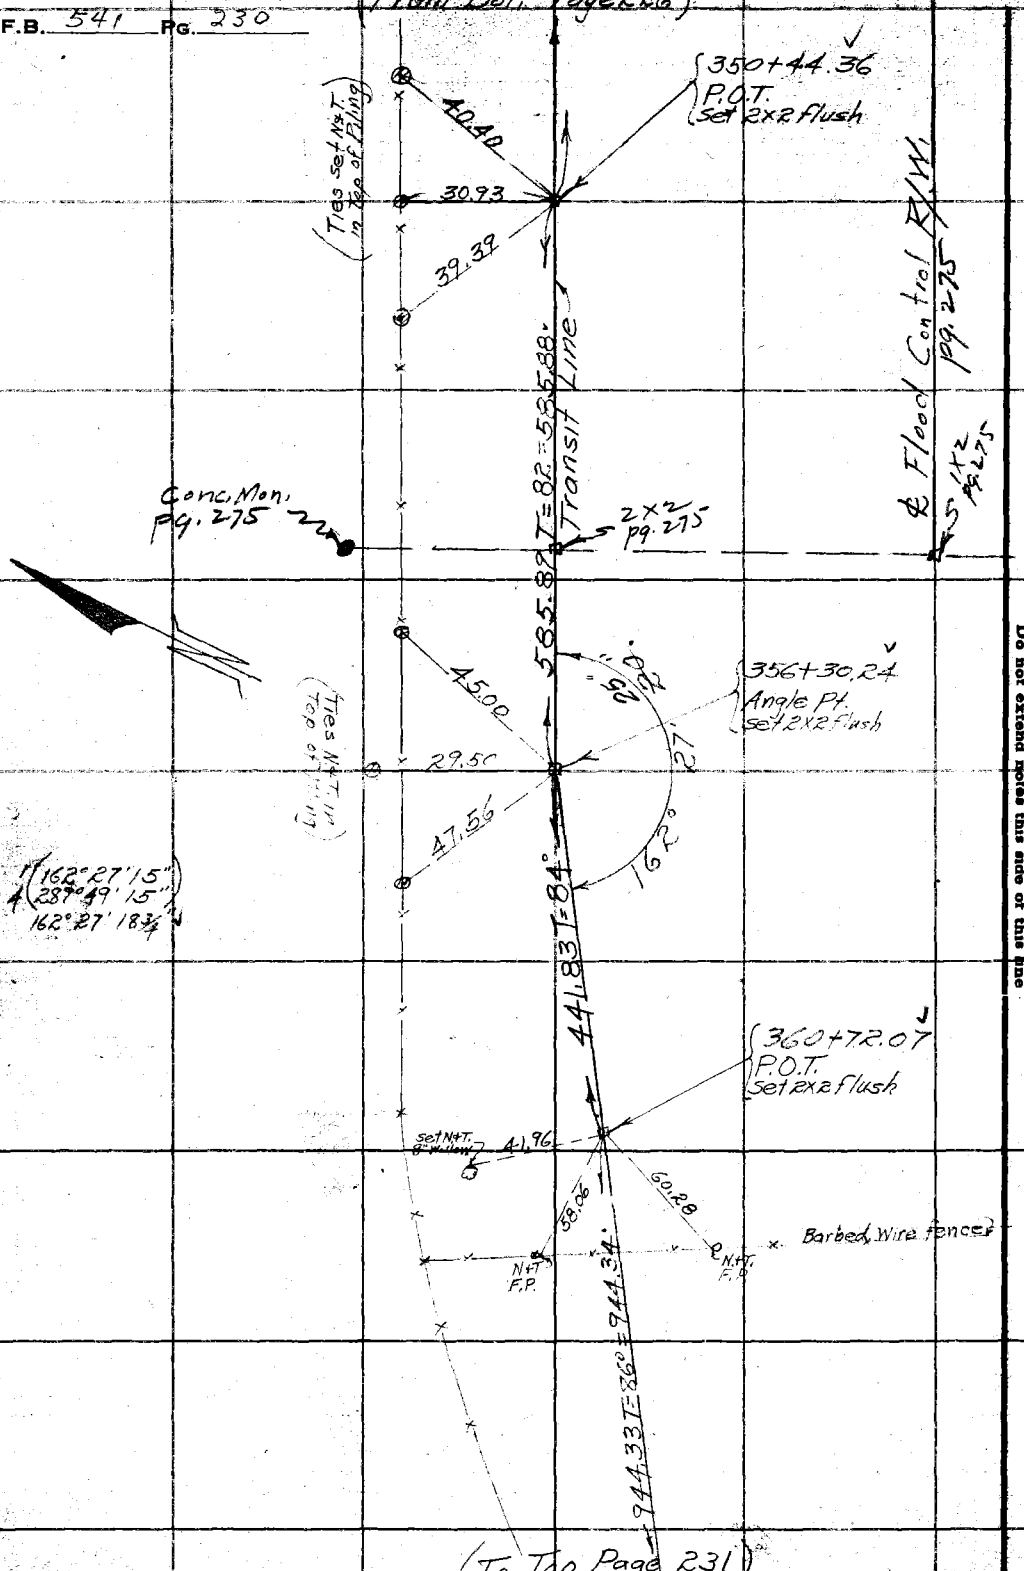

(To Top Page 231)

RETURN TO
LOS ANGELES COUNTY SURVEYOR
700 HALL OF RECORDS

Do not extend notes this side of this line

Notes: ANY ADDITIONS OR CHANGES ON THIS SHEET MUST BE MADE OR CANCELLED IN Red Ink WITH DATE AND NAME OF PERSON MAKING CHANGE.

SJ B-2, B-3

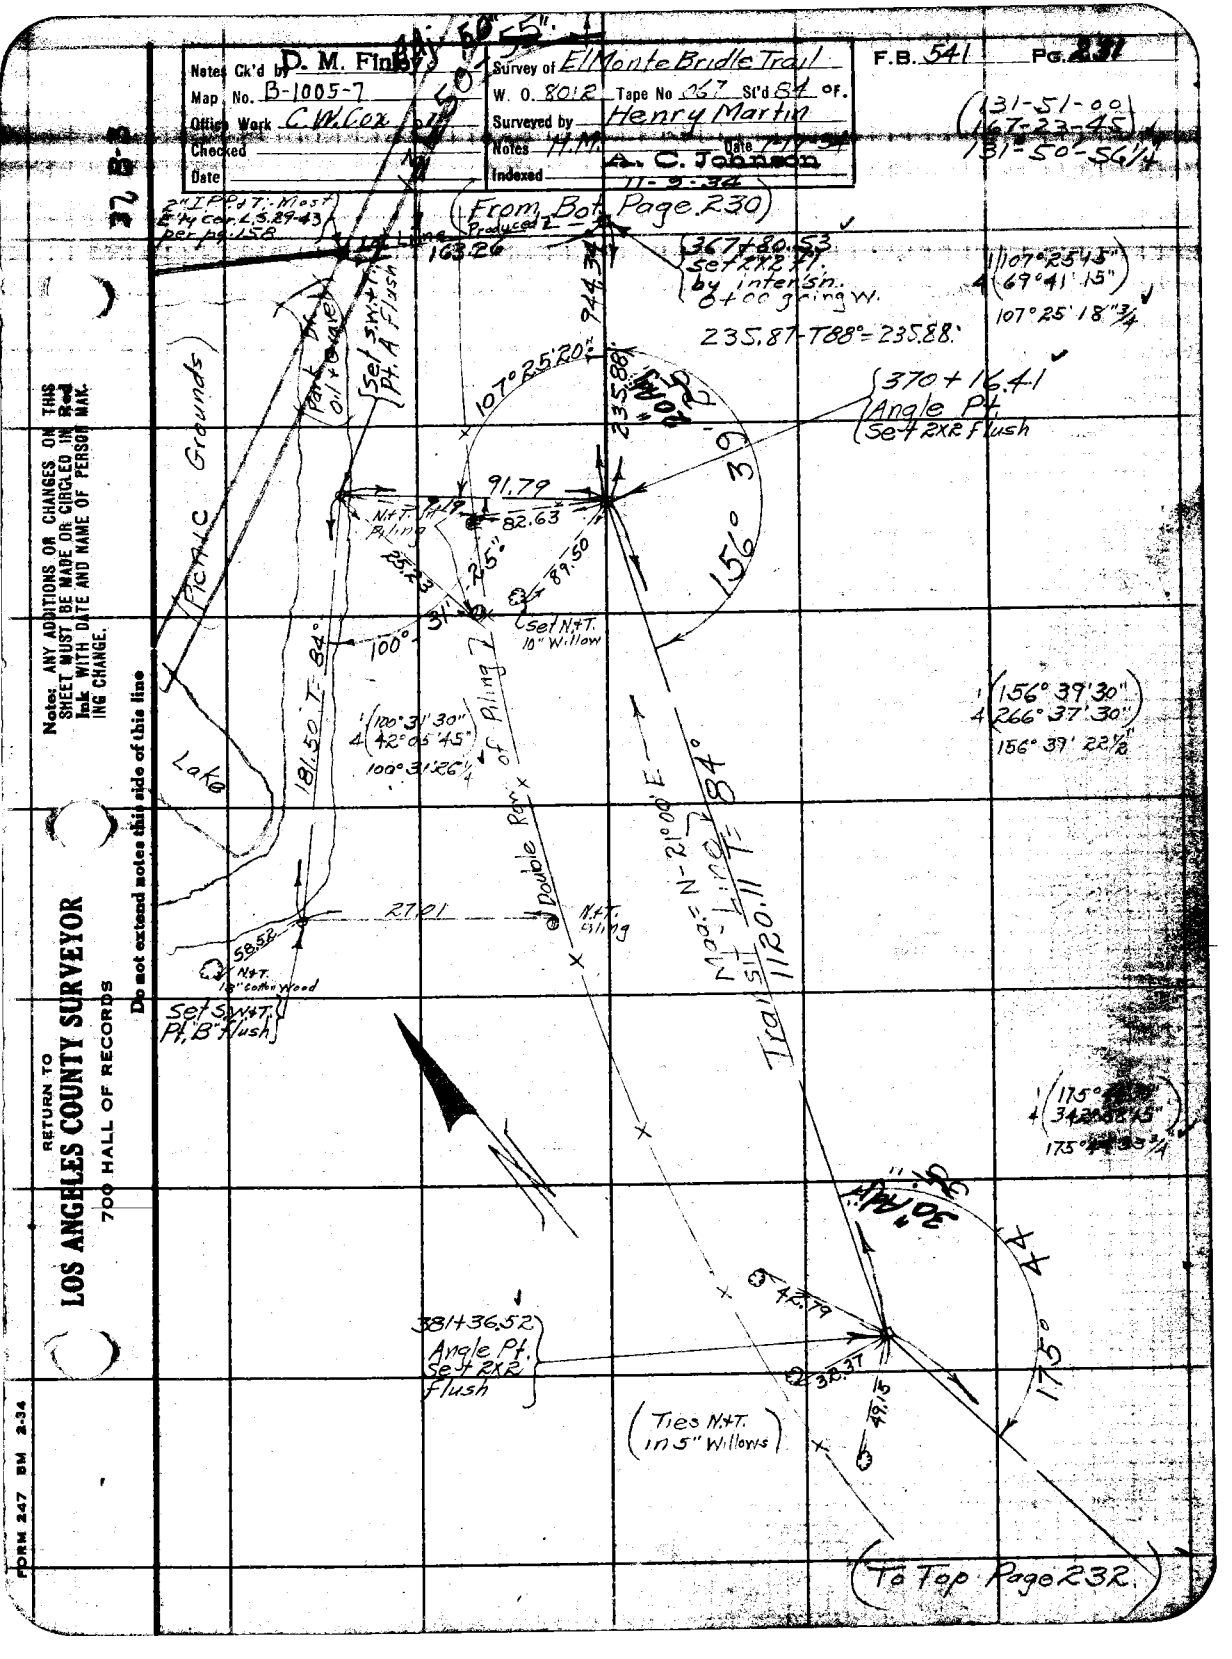

RETURN TO
LOS ANGELES COUNTY SURVEYOR
700 HALL OF RECORDS

Do not extend notes this side of this line

Notes: ANY ADDITIONS OR CHANGES ON THIS SHEET MUST BE MADE OR CIRCLED IN Red Ink WITH DATE AND NAME OF PERSON MAKING CHANGE.

FORM 247 BM 2-34

RETURN TO
LOS ANGELES COUNTY SURVEYOR
700 HALL OF RECORDS

Note; ANY ADDITIONS OR CHANGES ON THIS SHEET MUST BE MADE OR CIRCLED IN Red Ink WITH DATE AND NAME OF PERSON MAKING CHANGE.

37, B-3

Do not extend notes this side of this line

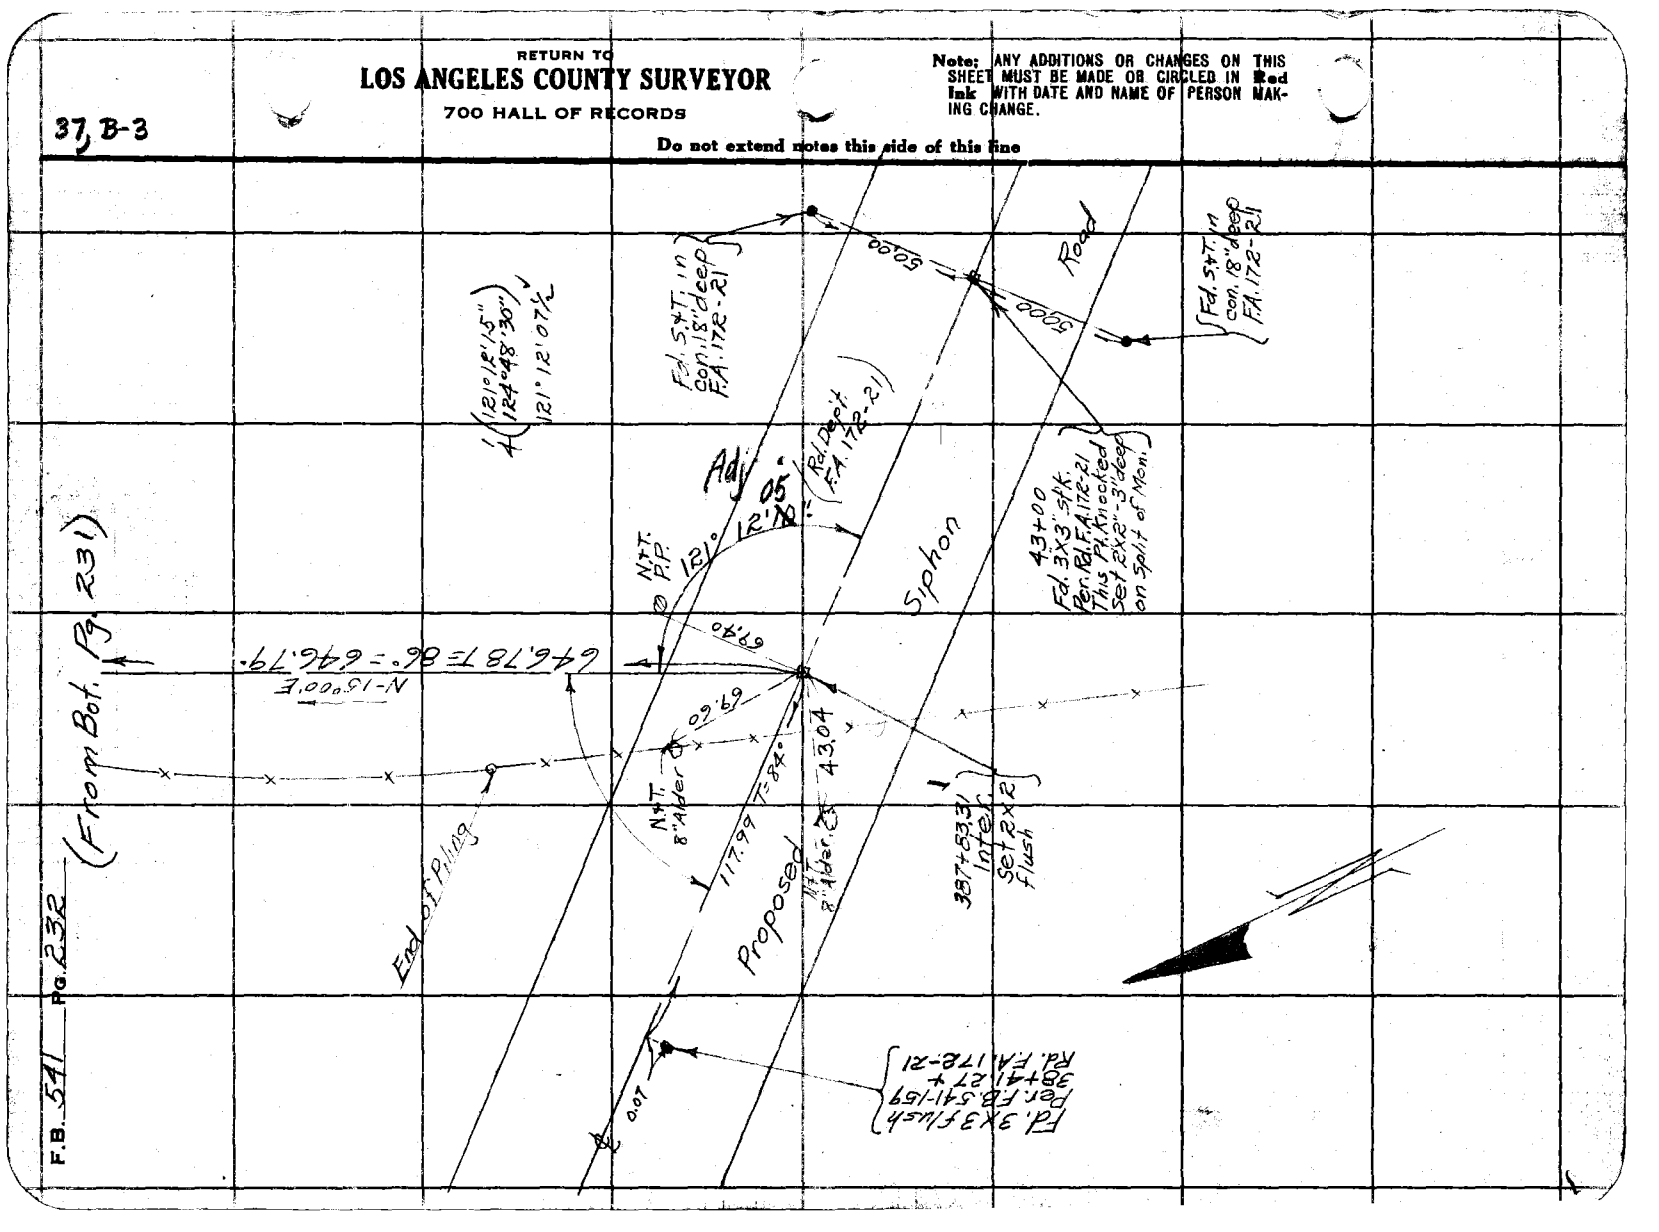

Notes Ck'd by D. M. Finley	Survey of El Monte Bridle Trail
Map No. B-1005-6	W. O. 8012 Tape No ____ St'd ____ OF.
Office Work C.W. Cox	Surveyed by Martin
Checked	Notes Brock Date 7-19-32
Date	Indexed A. C. Johnson

F.B. 541 Pg. 233

(To Bot. Page 234)

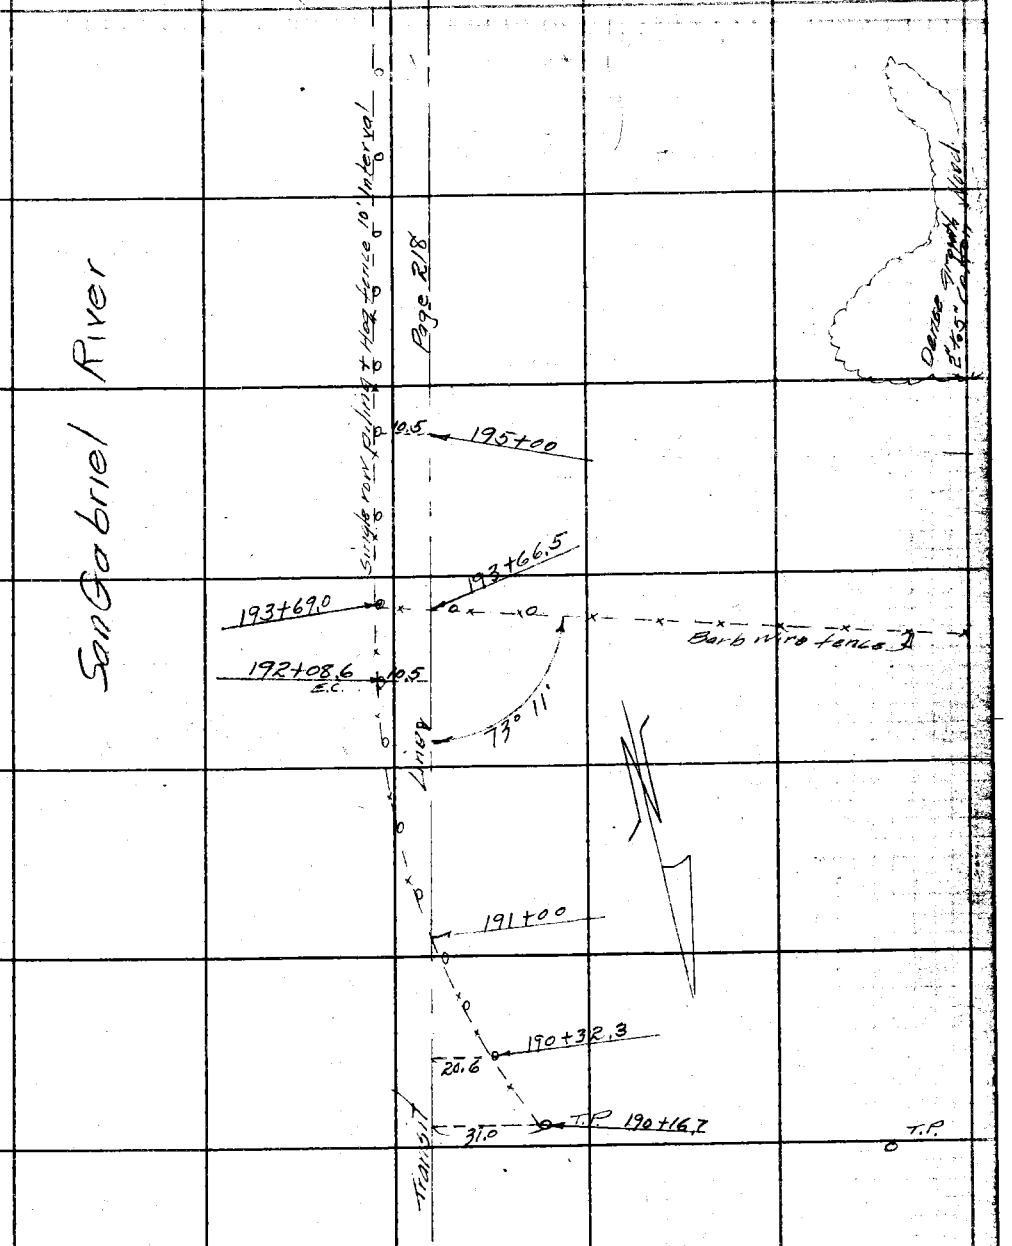

(From Lower Rt. Pg. 217)

Note: ANY ADDITIONS OR CHANGES ON THIS SHEET MUST BE MADE OR CIRCLED IN Red Ink WITH DATE AND NAME OF PERSON MAKING CHANGE.

RETURN TO
LOS ANGELES COUNTY SURVEYOR
700 HALL OF RECORDS

Do not extend notes this side of this line

FORM 247 BM 2-34

RETURN TO
LOS ANGELES COUNTY SURVEYOR
700 HALL OF RECORDS

Note: ANY ADDITIONS OR CHANGES ON THIS SHEET MUST BE MADE OR CIRCLED IN **Red Ink** WITH DATE AND NAME OF PERSON MAKING CHANGE.

Do not extend notes this side of this line

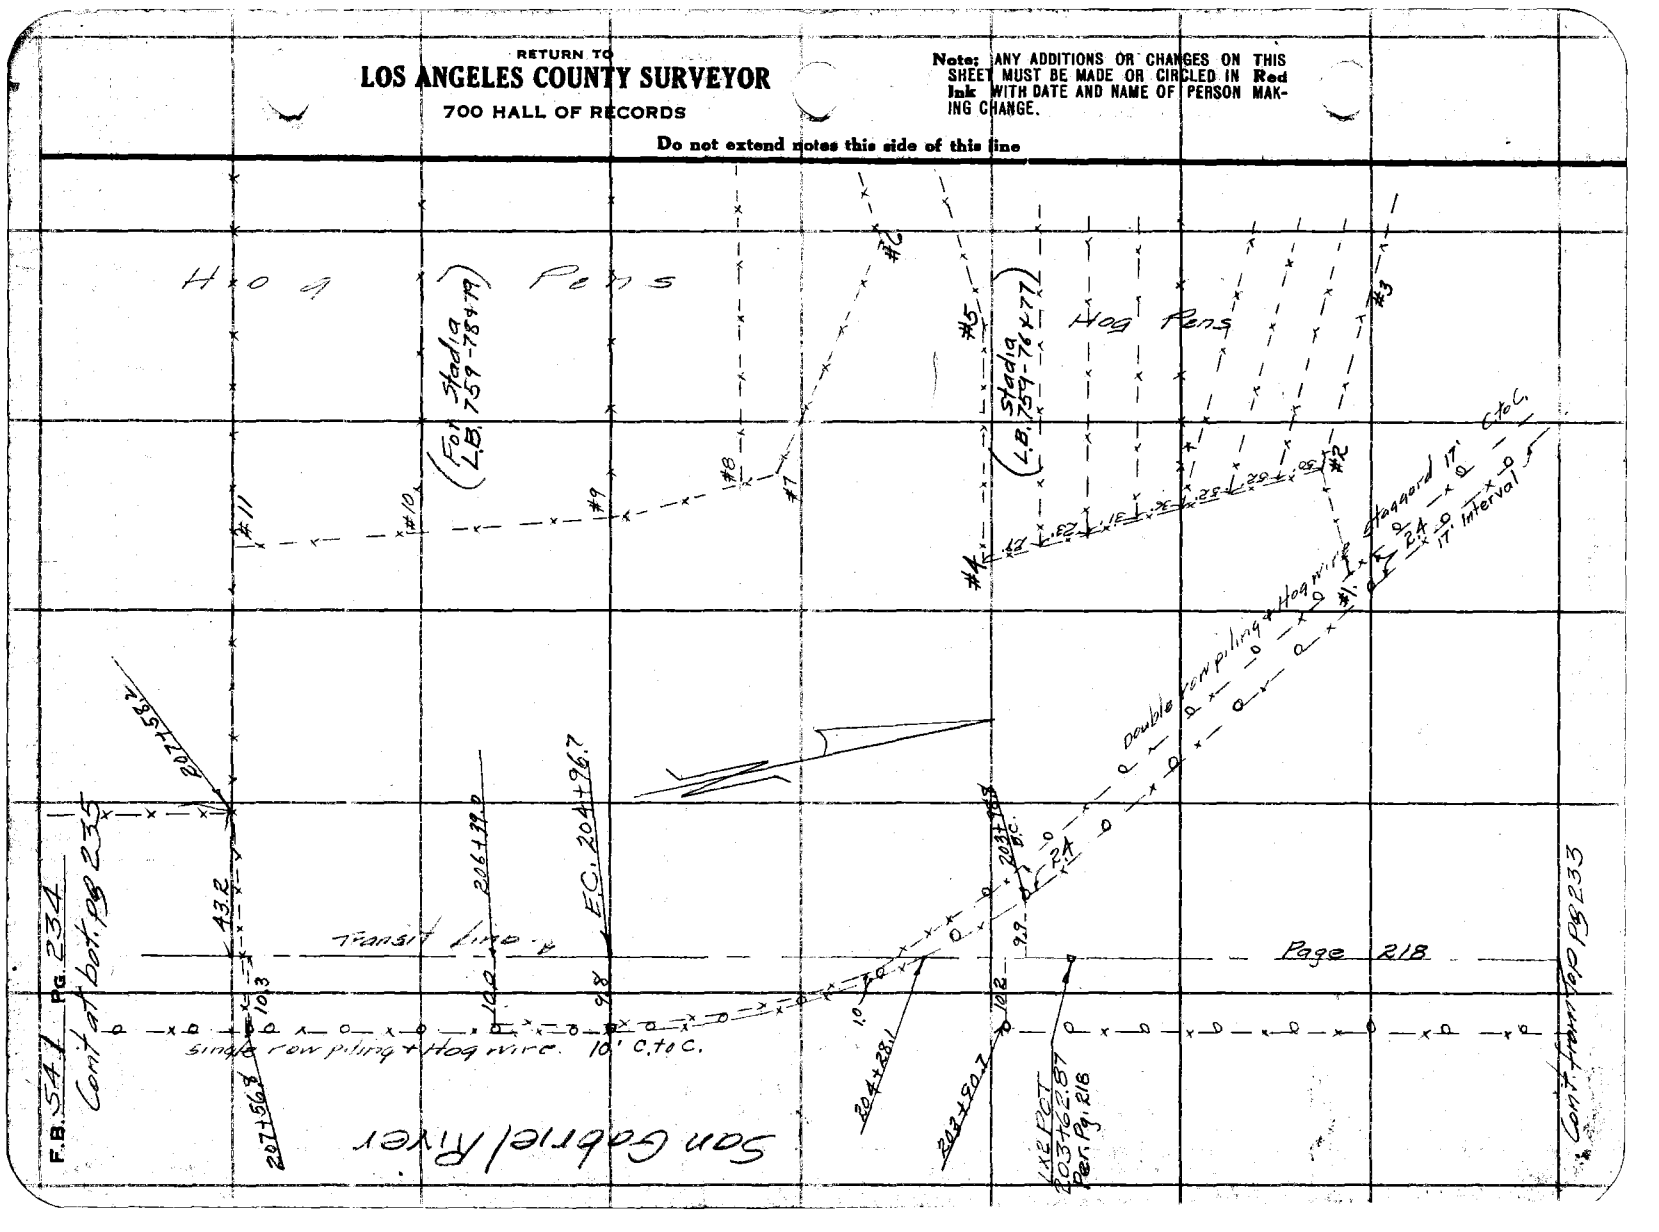

Notes Ck'd by D. M. Finley	Survey of El Monte Bridle Trail	F.B. 541	Pg. 235
Map No. B-1005-6	W. O. [illegible] Tape No ____ St'd ____ of.		
Office Work C.W. Cox	Surveyed by Martin		
Checked	Notes Brock Date 1-19-34		
Date	Indexed A. C. Johnson		

Con't at bot. pg 236

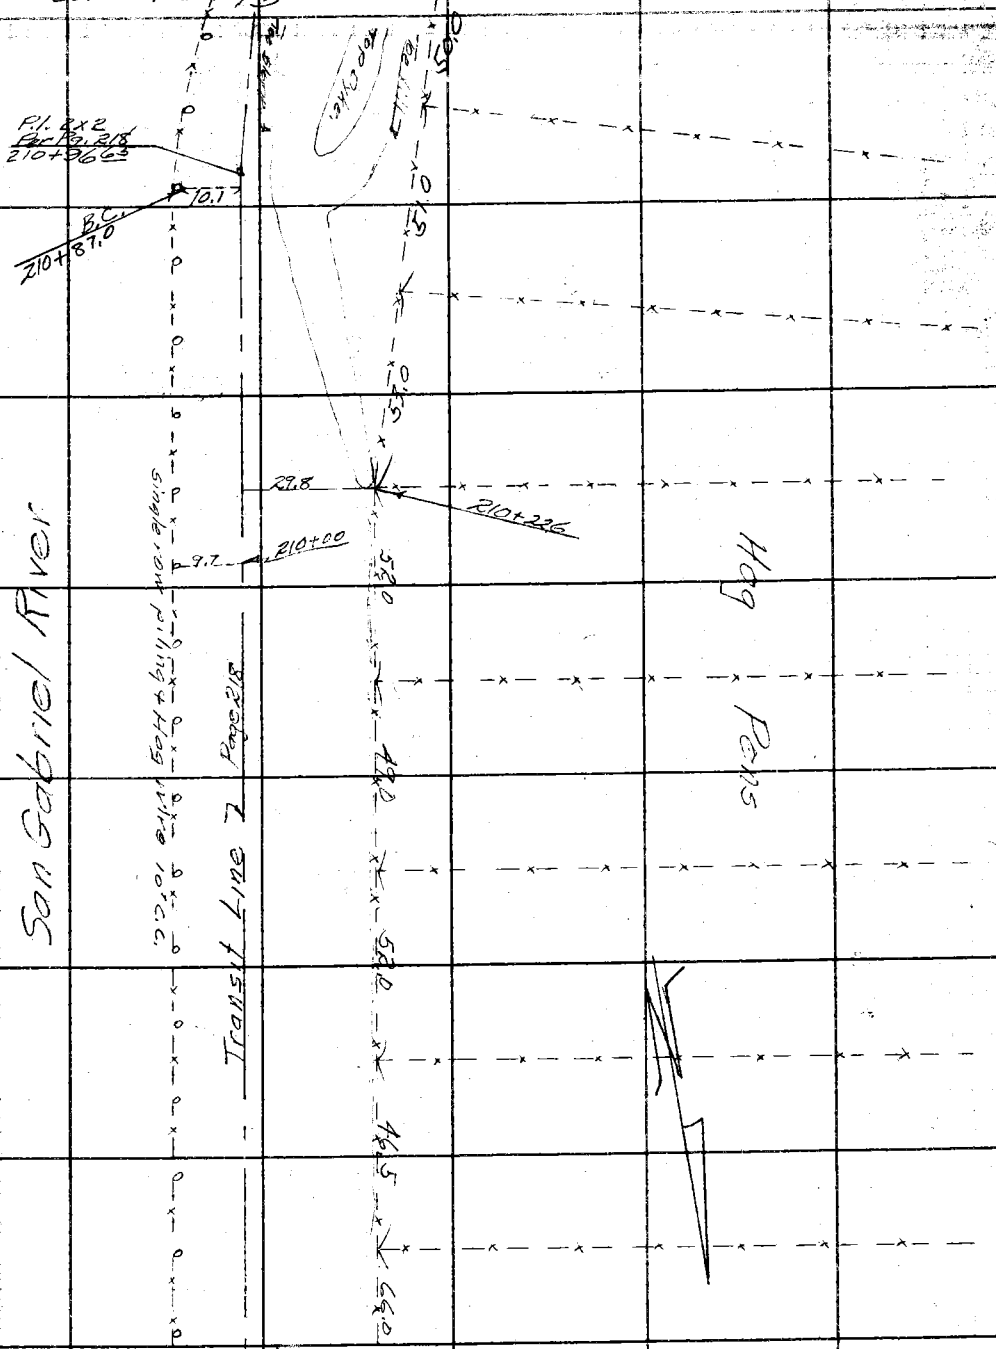

Con't from Top pg 234

Note: ANY ADDITIONS OR CHANGES ON THIS SHEET MUST BE MADE OR CIRCLED IN Red Ink WITH DATE AND NAME OF PERSON MAKING CHANGE.

Do not extend notes this side of this line

RETURN TO
LOS ANGELES COUNTY SURVEYOR
700 HALL OF RECORDS

FORM 247 5M 2-34

RETURN TO
LOS ANGELES COUNTY SURVEYOR
700 HALL OF RECORDS

Note: ANY ADDITIONS OR CHANGES ON THIS SHEET MUST BE MADE OR CIRCLED IN Red Ink WITH DATE AND NAME OF PERSON MAKING CHANGE.

Do not extend notes this side of this line

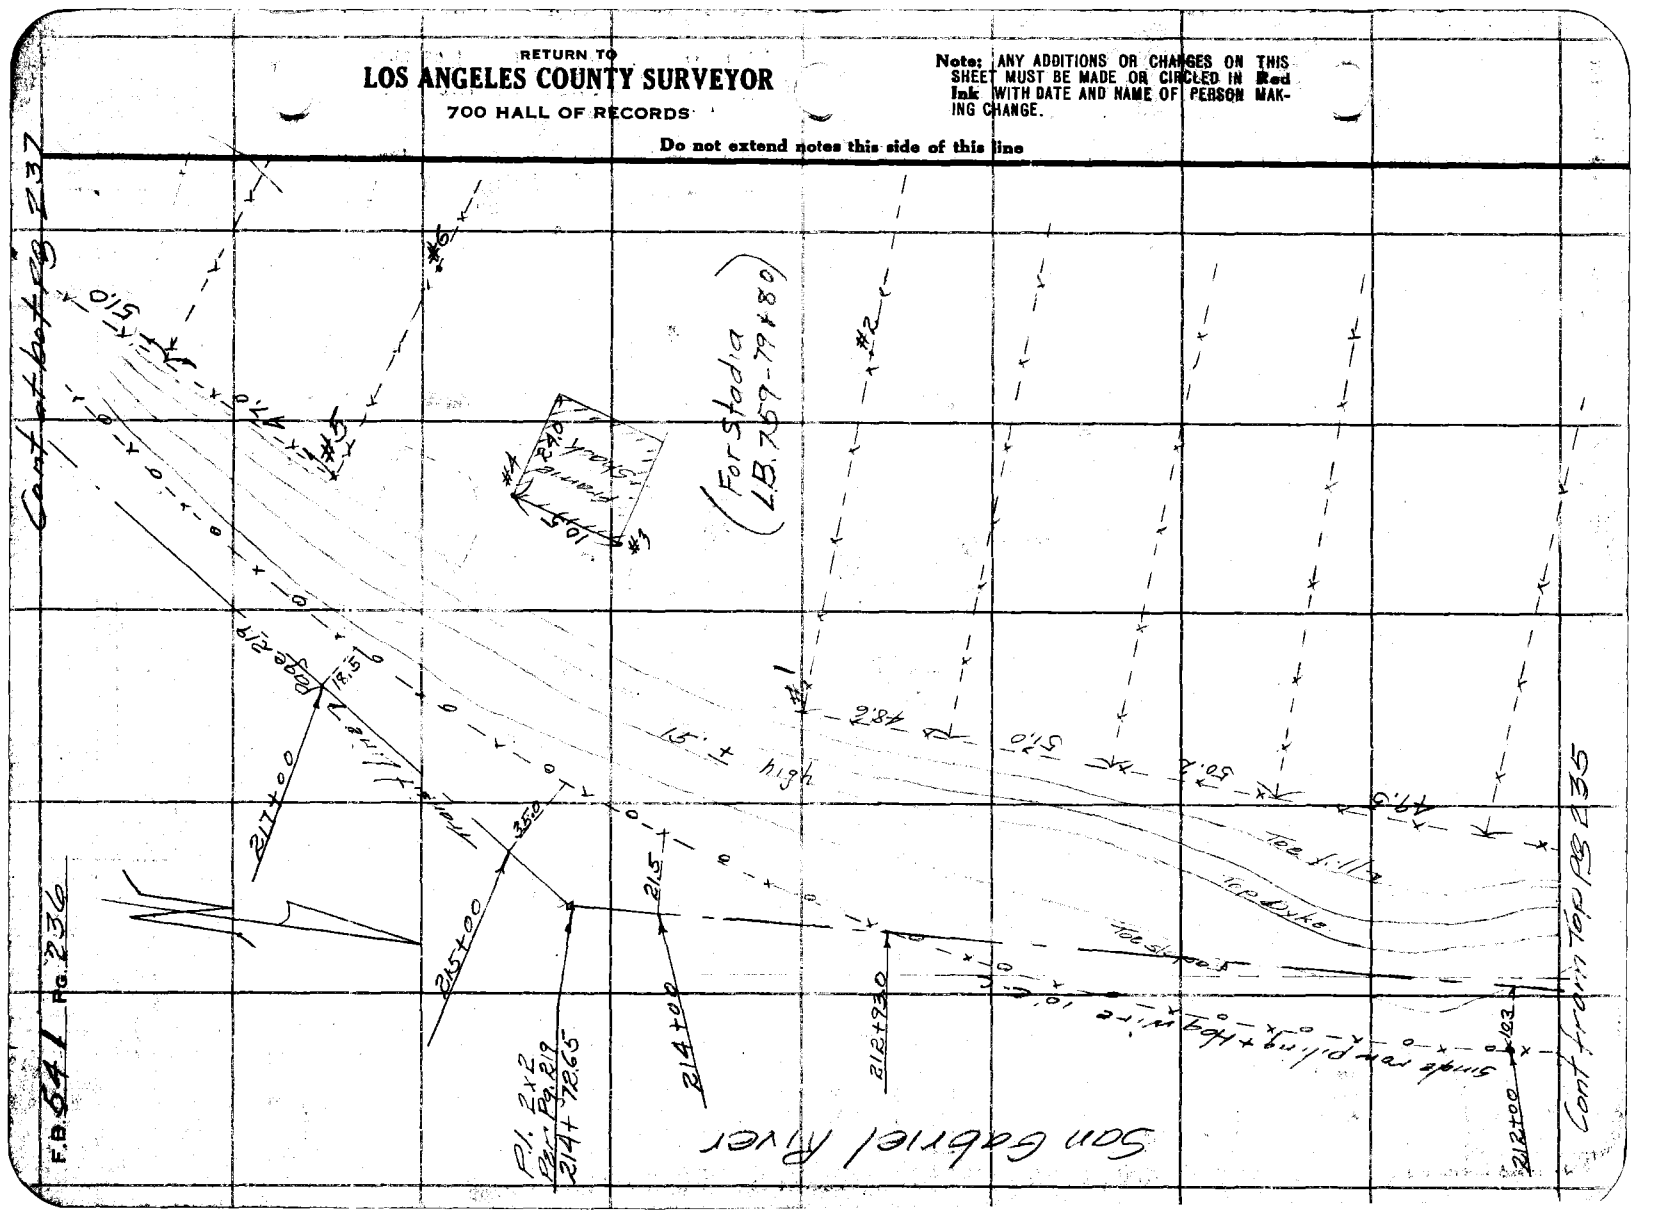

Notes Ck'd by D. M. Finley	Survey of El Monte Bridle Trail
Map No. B-1005-6	W. 08012 Tape No ____ St'd ____ of.
Office Work C.W. Cox	Surveyed by Martin
Checked	Notes Brock Date 9-2032
Date	Indexed A. C. Johnson

F.B. 541 Pg. 237

P.I. 227+78.06 / 224+12.06

Cont at bot pg 238

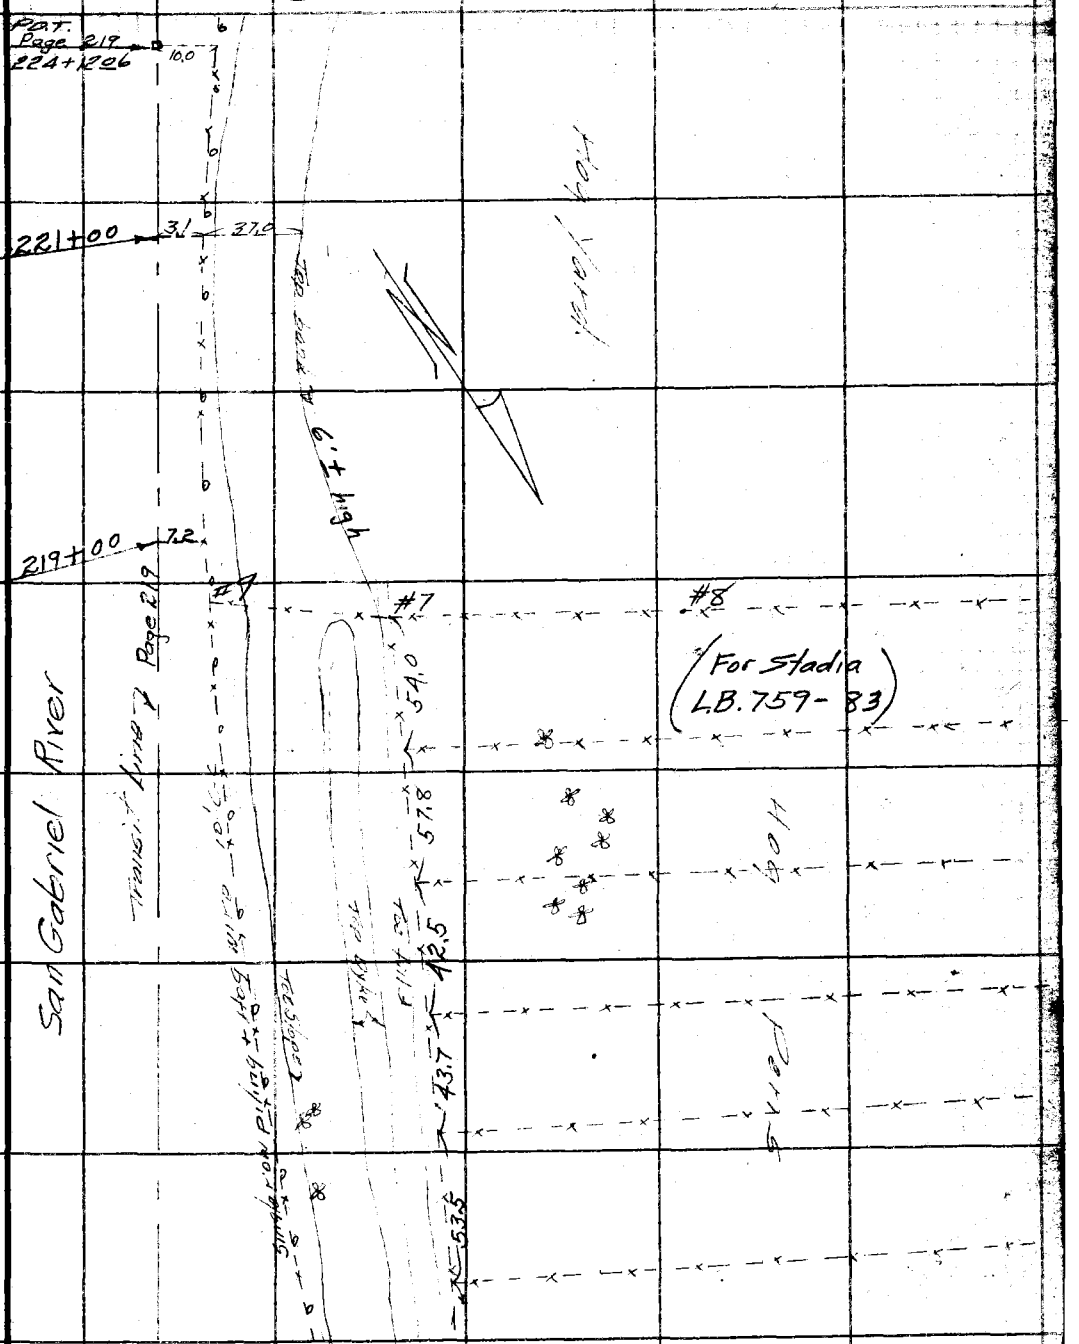

Cont from Top pg 236

Note: ANY ADDITIONS OR CHANGES ON THIS SHEET MUST BE MADE OR CIRCLED IN Red Ink WITH DATE AND NAME OF PERSON MAKING CHANGE.

Do not extend notes this side of this line

RETURN TO
LOS ANGELES COUNTY SURVEYOR
700 HALL OF RECORDS

FORM 247 5M 2-34

F.B. 541 Pg. 238

Cont at bot Pg 239

Cont from Top Pg 237

RETURN TO
LOS ANGELES COUNTY SURVEYOR
700 HALL OF RECORDS

Do not extend notes this side of this line

Note: ANY ADDITIONS OR CHANGES ON THIS SHEET MUST BE MADE OR CIRCLED IN Red Ink WITH DATE AND NAME OF PERSON MAKING CHANGE.

Notes Ck'd by D. M. Finley	Survey of [illegible]
Map No. B-1005-6	W. O. [illegible] Tape No ____ St'd ____ °F.
Office Work C.W. Cox	Surveyed by Martin
Checked	Notes [illegible] C. Johnson Date [illegible]
Date	Indexed

F.B. 541 Pg. 239

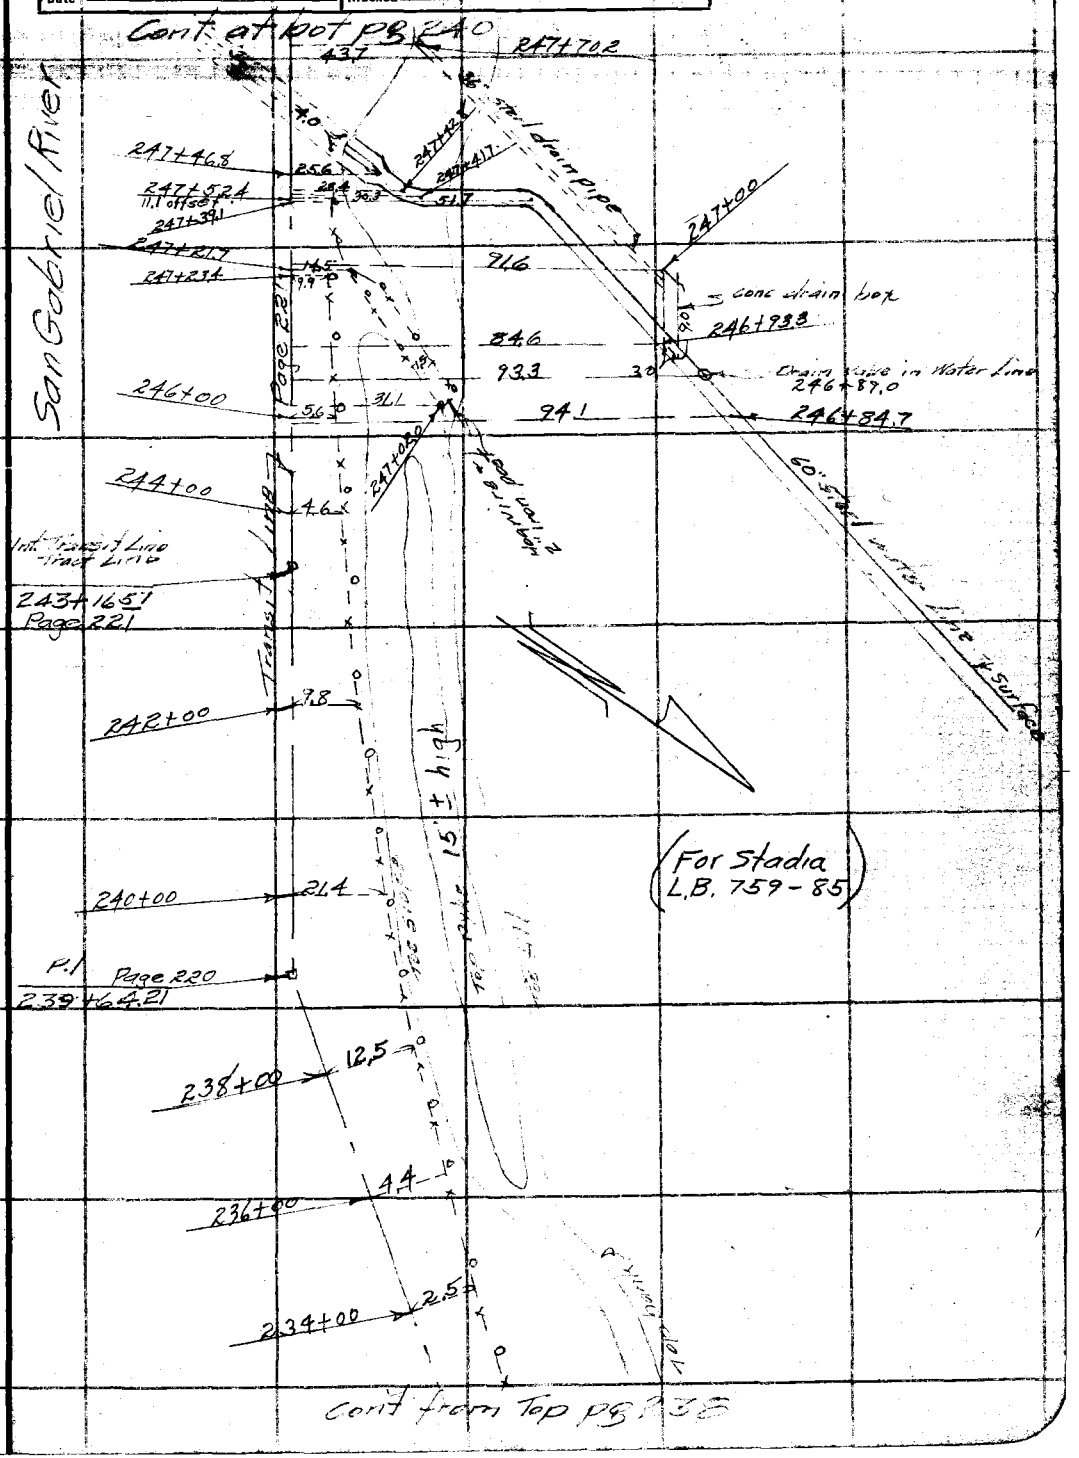

Note: ANY ADDITIONS OR CHANGES ON THIS SHEET MUST BE MADE OR CIRCLED IN Red Ink WITH DATE AND NAME OF PERSON MAKING CHANGE.

Do not extend notes this side of this line

RETURN TO
LOS ANGELES COUNTY SURVEYOR
700 HALL OF RECORDS

FORM 247 5M 8-24

F.B. 541 PG. 240

Con't at bot pg 241

RETURN TO
LOS ANGELES COUNTY SURVEYOR
700 HALL OF RECORDS

Do not extend notes this side of this line

Note: ANY ADDITIONS OR CHANGES ON THIS SHEET MUST BE MADE OR CIRCLED IN **Red Ink** WITH DATE AND NAME OF PERSON MAKING CHANGE.

Notes Ck'd by D. M. Finley	Survey of El Monte Bridle Tr.	F.B. 541	Pg. 241
Map No. B-1005-7	W. O. 8612 Tape No ___ St'd ___ °F.		
Office Work C.W. Cox	Surveyed by Martin		
Checked	Notes Brock Date 1-23-34		
Date	Indexed A. C. Johnson		

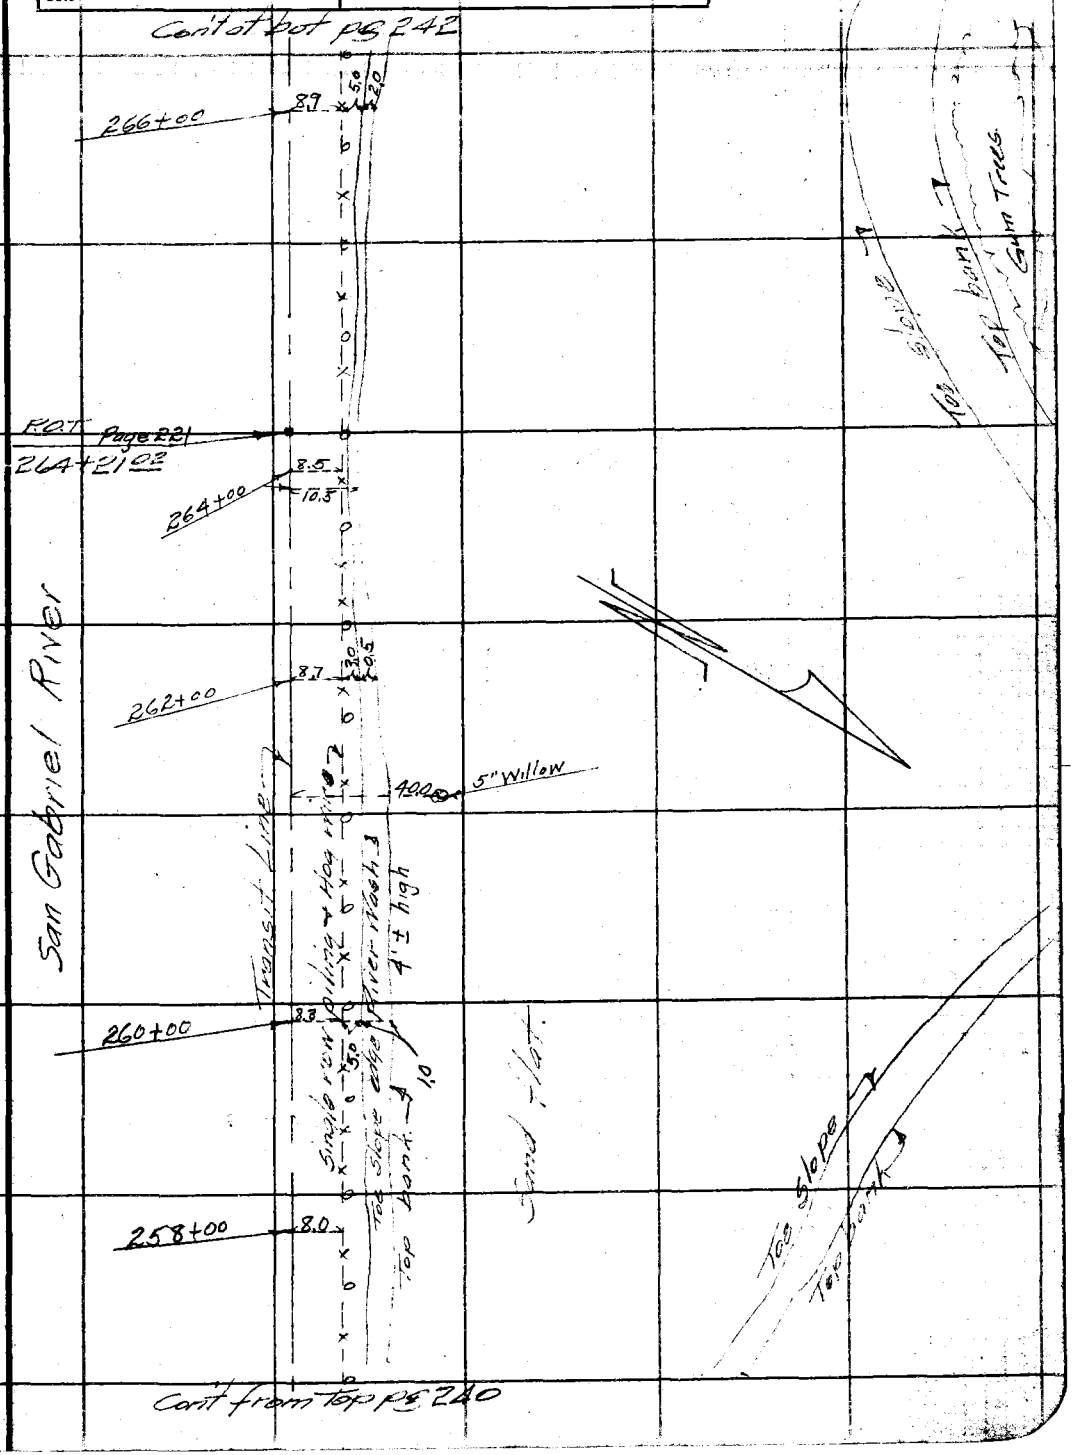

Note: ANY ADDITIONS OR CHANGES ON THIS SHEET MUST BE MADE OR CIRCLED IN Red Ink WITH DATE AND NAME OF PERSON MAKING CHANGE.

Do not extend notes this side of this line

RETURN TO
LOS ANGELES COUNTY SURVEYOR
700 HALL OF RECORDS

FORM 247 5M 2-34

F.B. 541 PG. 242

Con't at bot pg 243

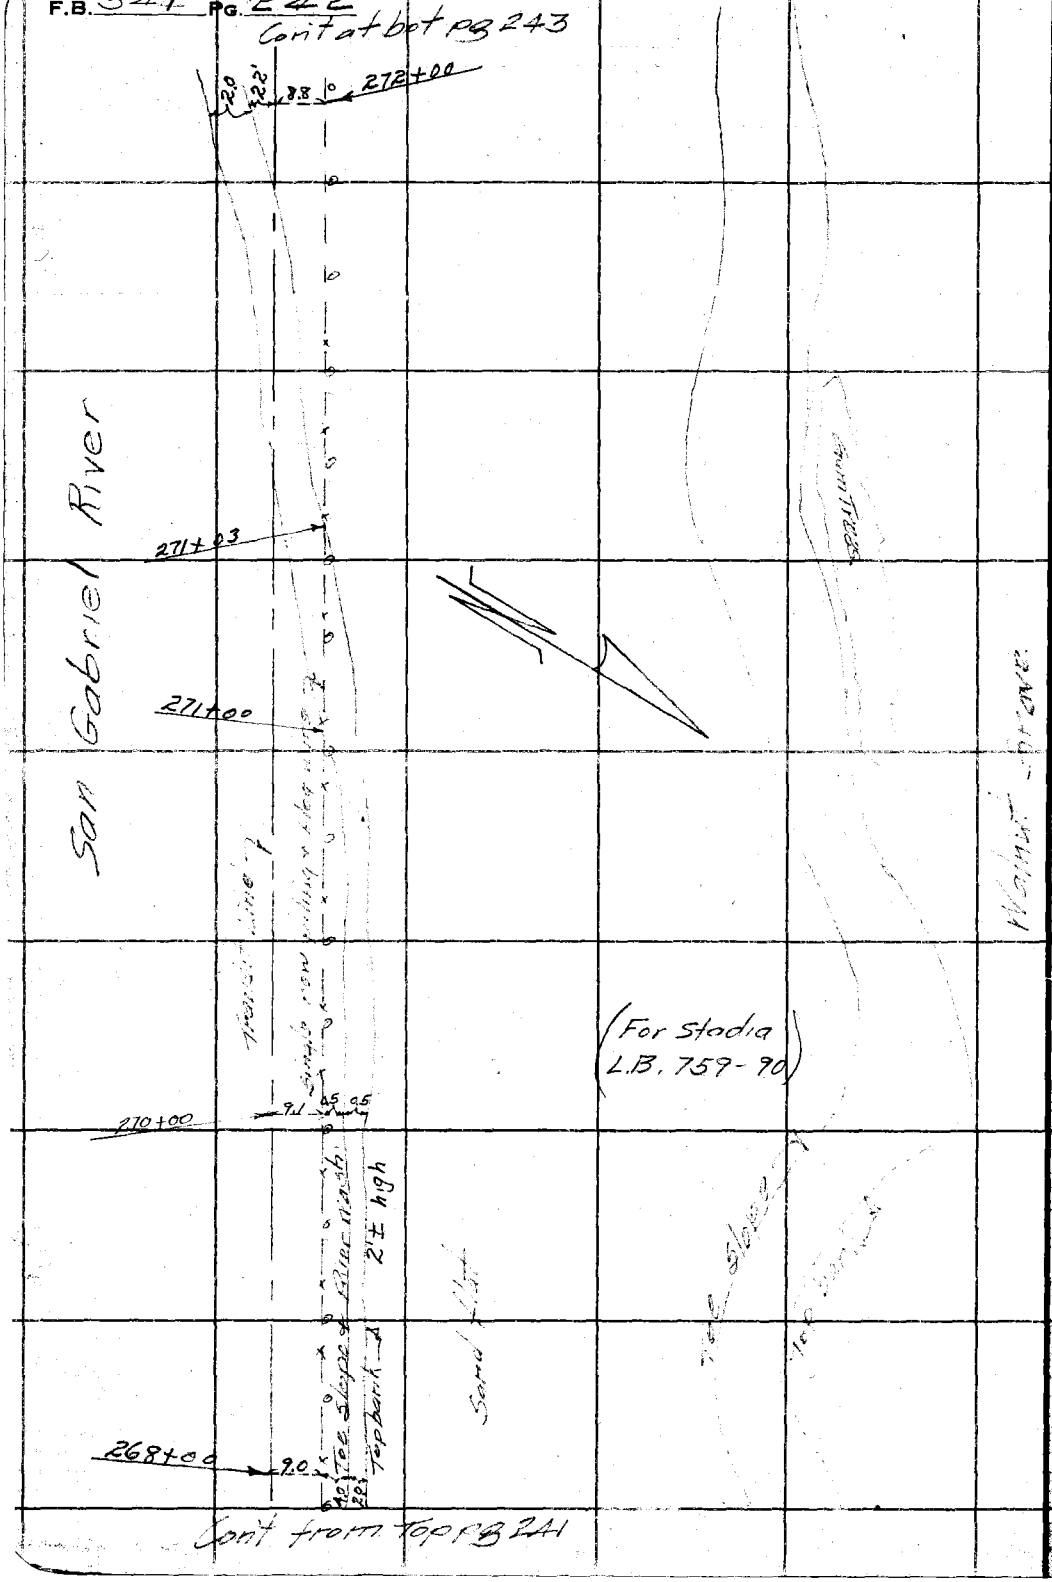

Con't from Top pg 241

RETURN TO
LOS ANGELES COUNTY SURVEYOR
700 HALL OF RECORDS
Do not extend notes this side of this line
Note: ANY ADDITIONS OR CHANGES ON THIS SHEET MUST BE MADE OR CIRCLED IN Red Ink WITH DATE AND NAME OF PERSON MAKING CHANGE.

Notes Ck'd by D. M. Finley	Survey of El Monte Bridle Trail	F.B. 541	Pg. 243
Map No. B-1085-7	W. O. 8012 Tape No ____ St'd ____ °F.		
Office Work C.W. Cox	Surveyed by Martin		
Checked	Notes Brock Date 7-24-34		
Date	Indexed A. C. Johnson		

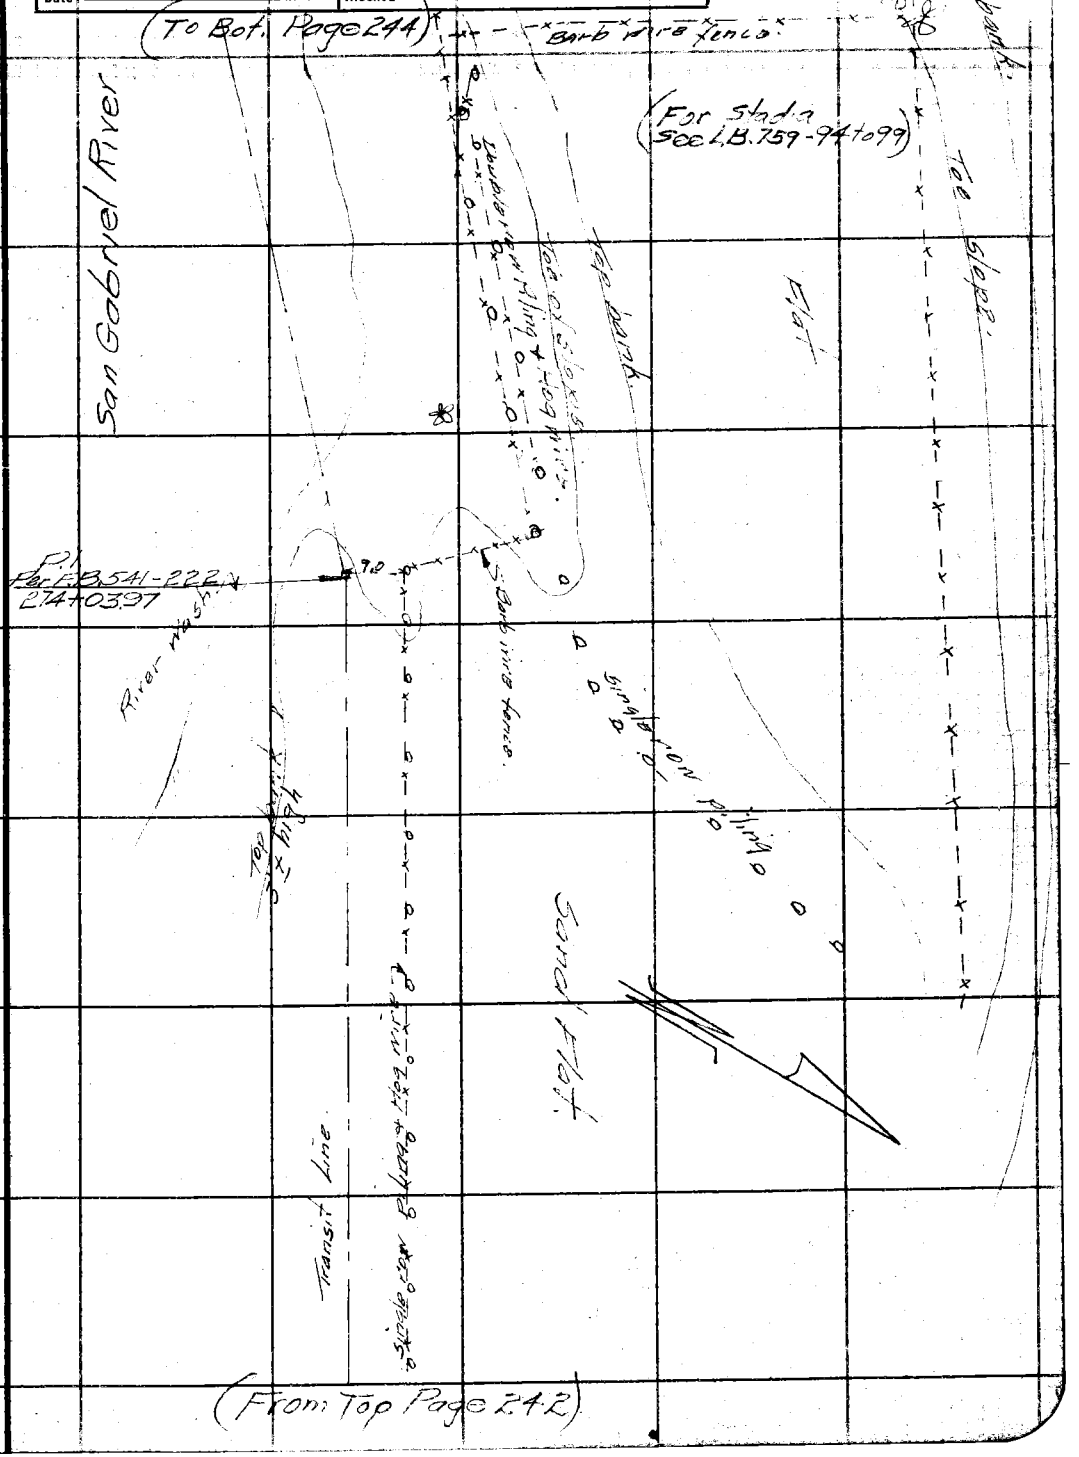

Note: ANY ADDITIONS OR CHANGES ON THIS SHEET MUST BE MADE OR CIRCLED IN Red Ink WITH DATE AND NAME OF PERSON MAKING CHANGE.

Do not extend notes this side of this line

RETURN TO
LOS ANGELES COUNTY SURVEYOR
700 HALL OF RECORDS

FORM 247 5M 2-34

RETURN TO
LOS ANGELES COUNTY SURVEYOR
700 HALL OF RECORDS

Note: ANY ADDITIONS OR CHANGES ON THIS SHEET MUST BE MADE OR CIRCLED IN **Red Ink** WITH DATE AND NAME OF PERSON MAKING CHANGE.

Do not extend notes this side of this line

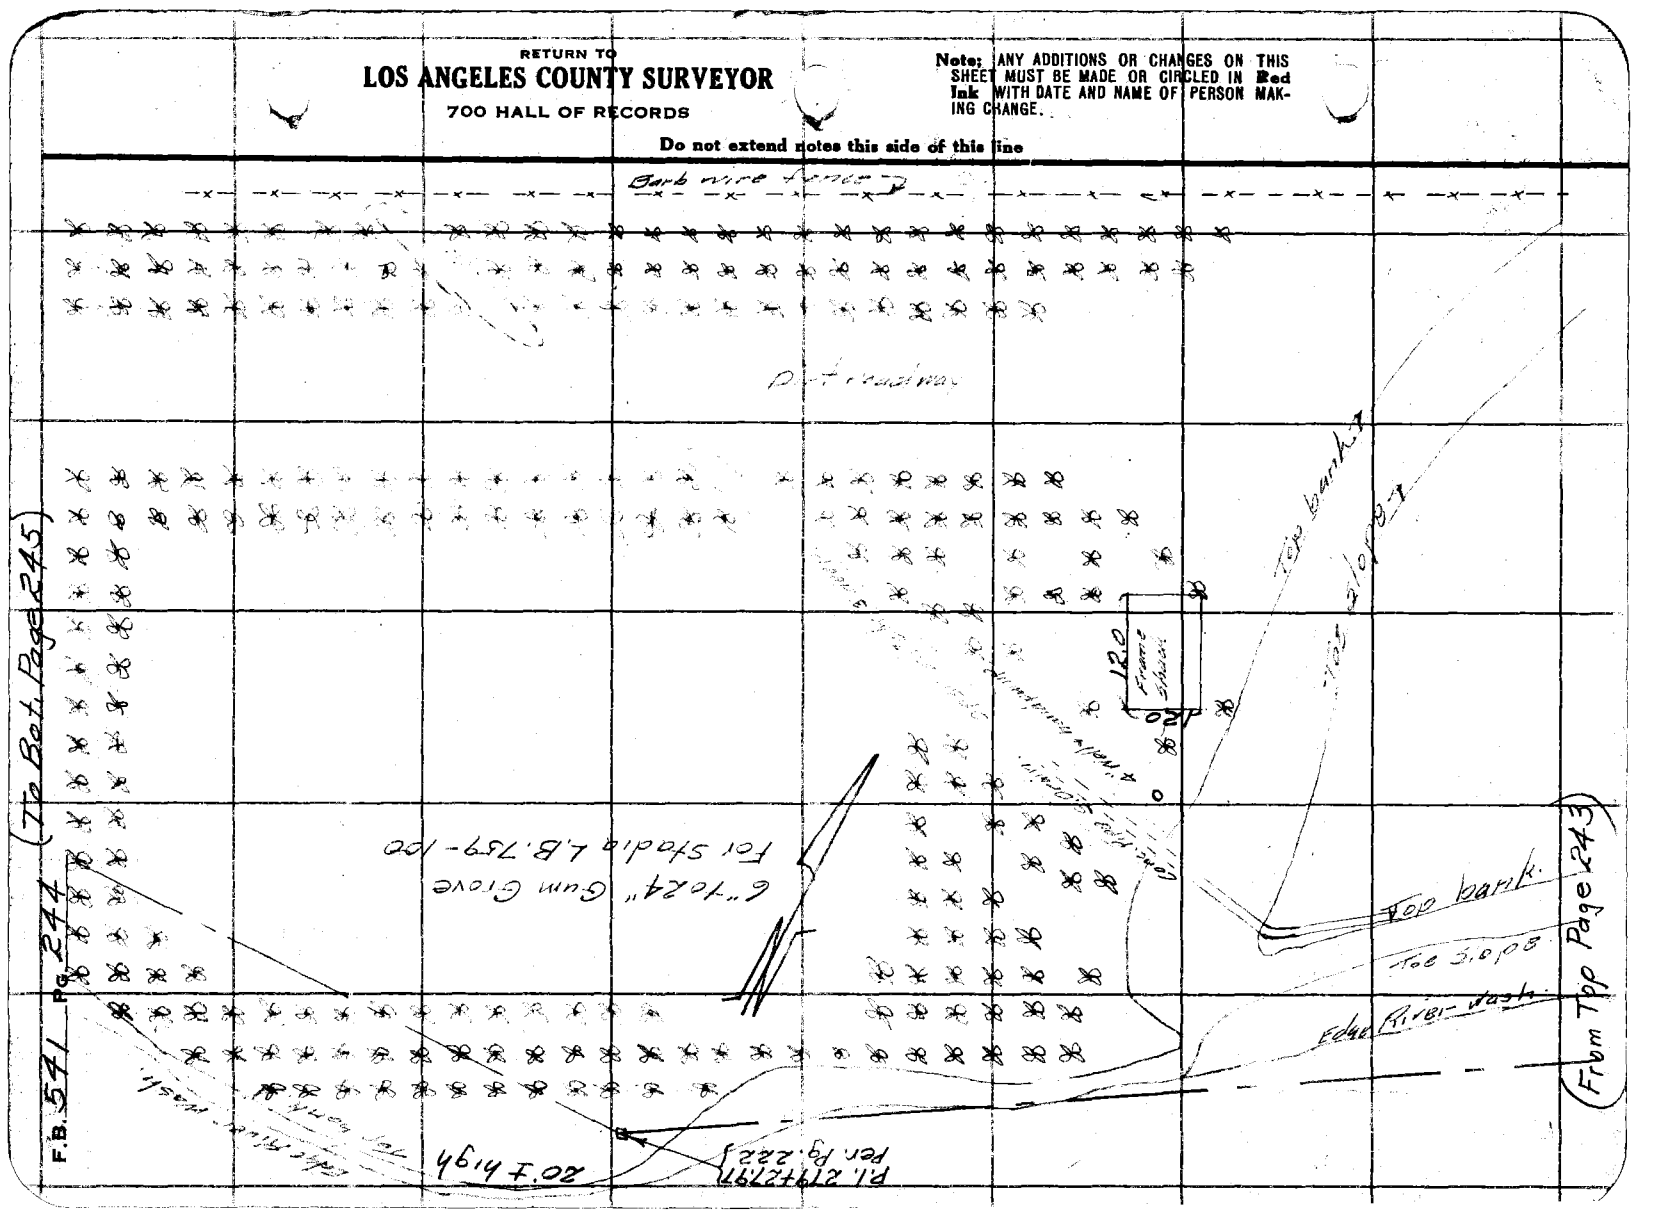

Notes Ck'd by D. M. Finley	Survey of El Monte Bridle Trail	F.B. 541	Pg. 245
Map No. B-1005-7	W. O. 8012 Tape No ____ St'd ____ of.		
Office Work C.W. Cox	Surveyed by Martin		
Checked	Notes Brock Date 7-24-34		
Date	Indexed E. C. Johnson		

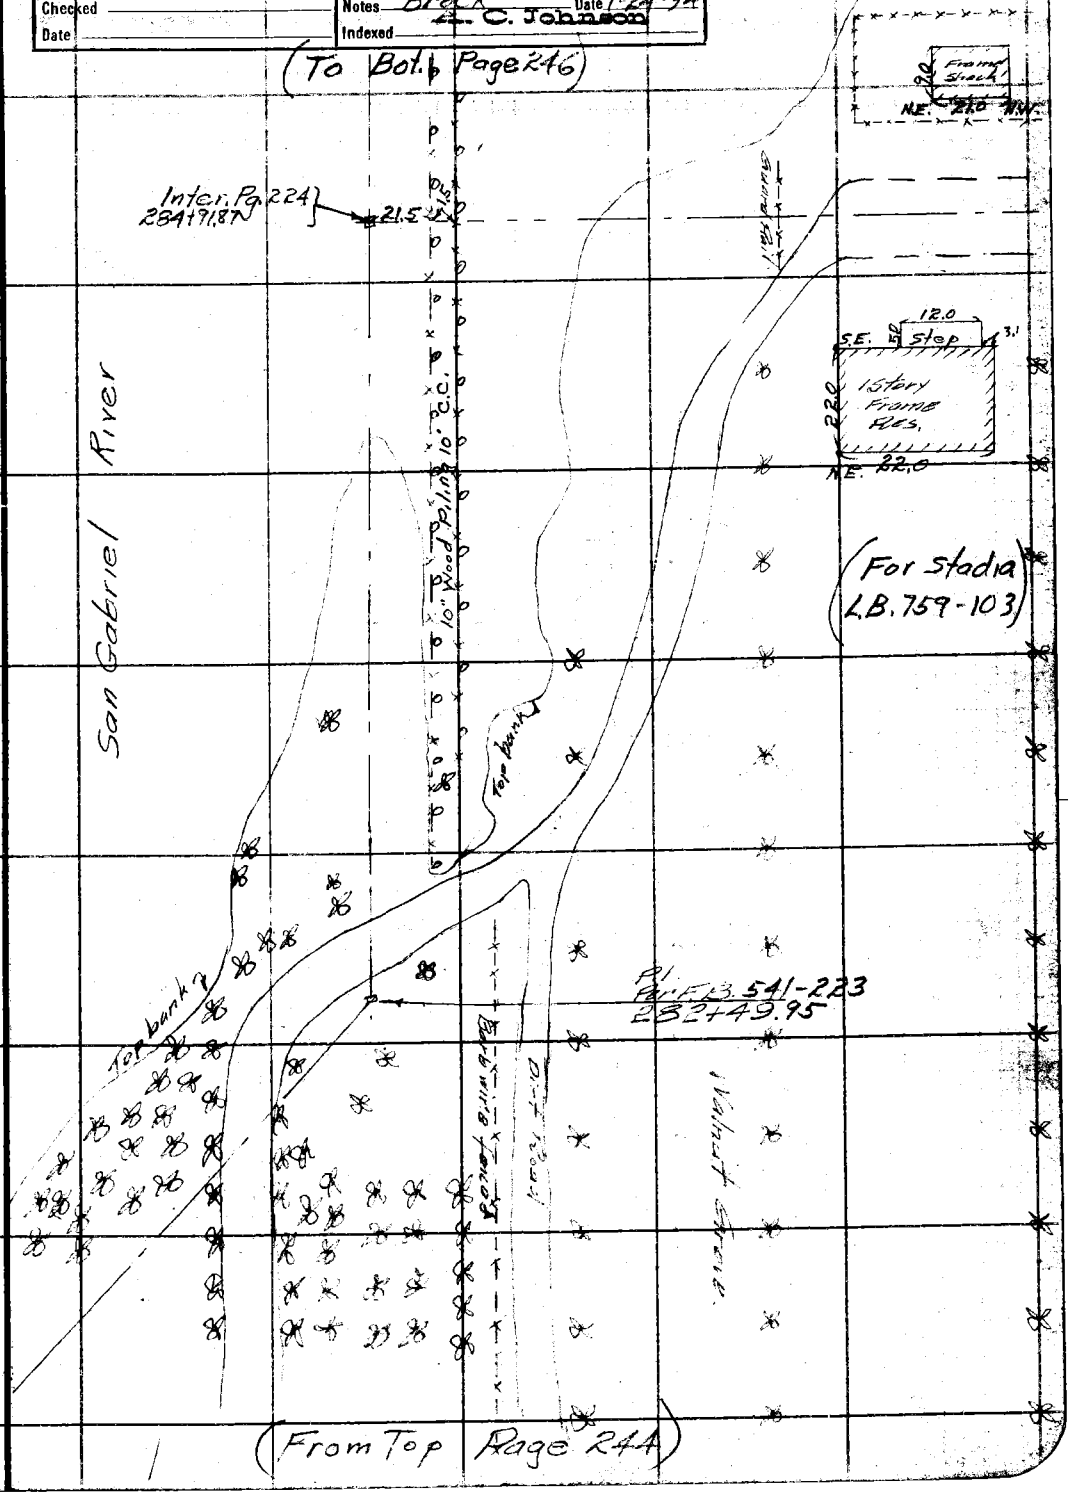

Note: ANY ADDITIONS OR CHANGES ON THIS SHEET MUST BE MADE OR CIRCLED IN Red Ink WITH DATE AND NAME OF PERSON MAKING CHANGE.

Do not extend notes this side of this line

RETURN TO
LOS ANGELES COUNTY SURVEYOR
700 HALL OF RECORDS

FORM 247 5M 2:34

RETURN TO
LOS ANGELES COUNTY SURVEYOR
700 HALL OF RECORDS

Note: ANY ADDITIONS OR CHANGES ON THIS SHEET MUST BE MADE OR CIRCLED IN **Red Ink** WITH DATE AND NAME OF PERSON MAKING CHANGE.

Do not extend notes this side of this line

F.B. 541 PG. 246

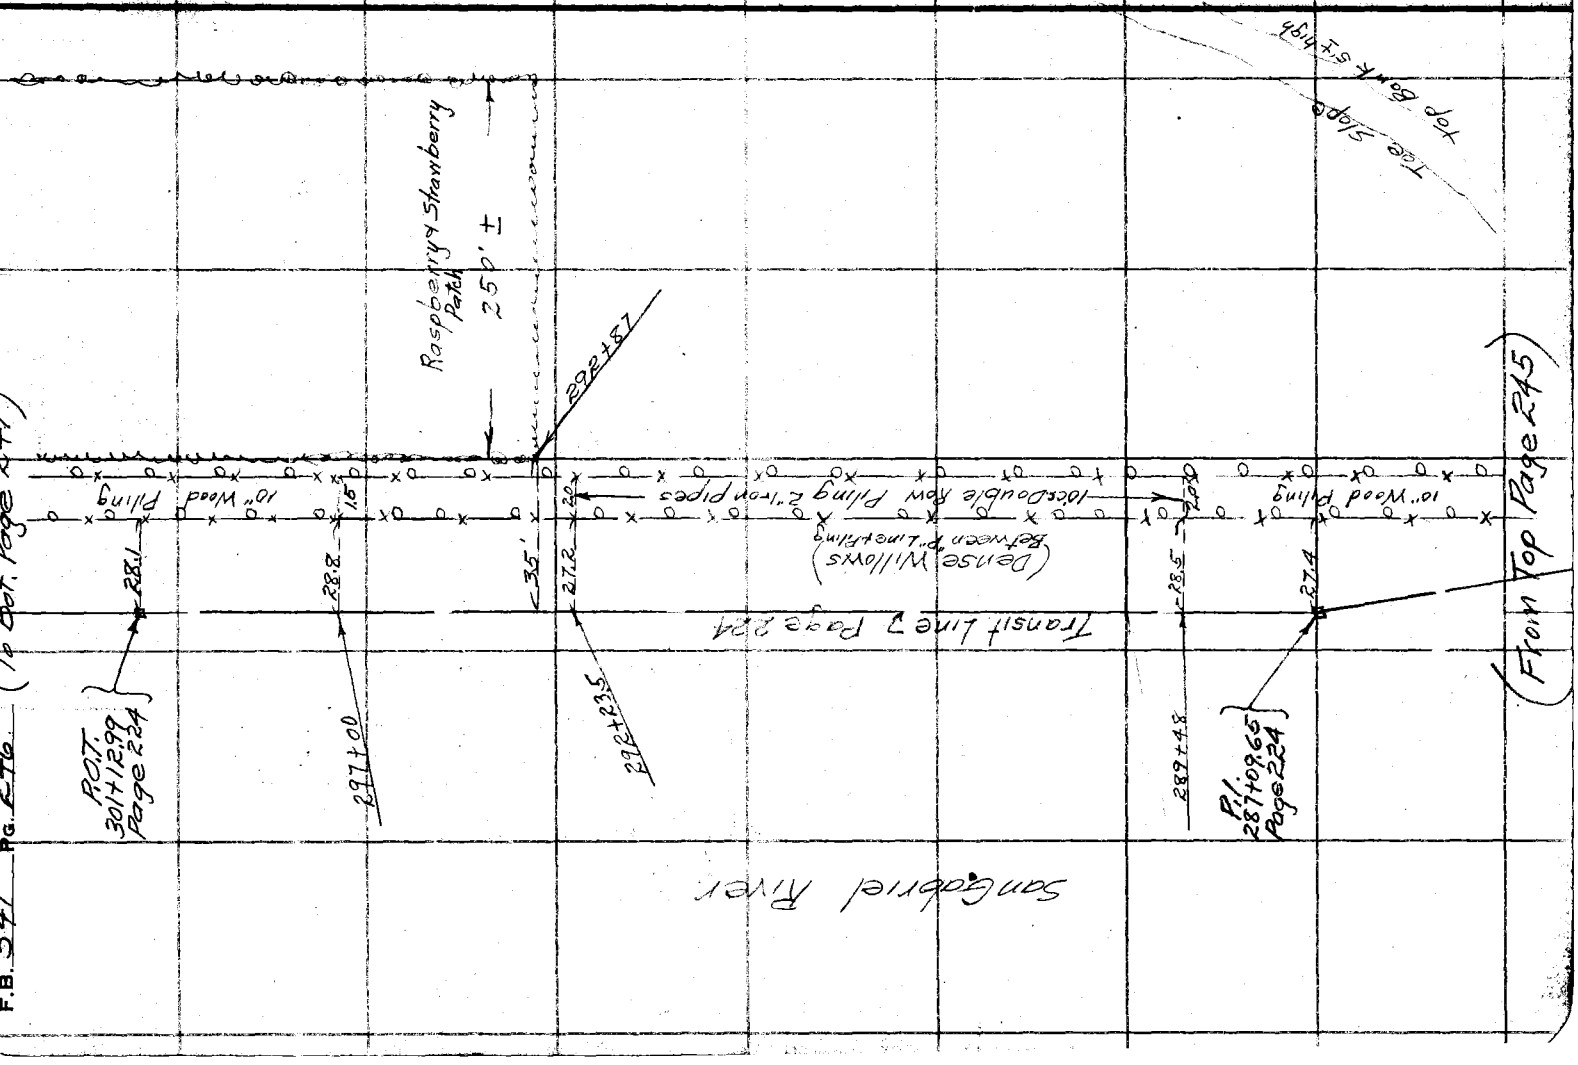

Notes Ck'd by D. M. Finley	Survey of El Monte Bridle Trail	F.B. 541	Pg. 247
Map No. B-1005-7	W. O. 2012 Tape No ____ St'd ____ °F.		
Office Work C.W. Cox	Surveyed by Henry Martin		
Checked	Notes Brock Date 7-26-34		
Date	Indexed A. C. Johnson		

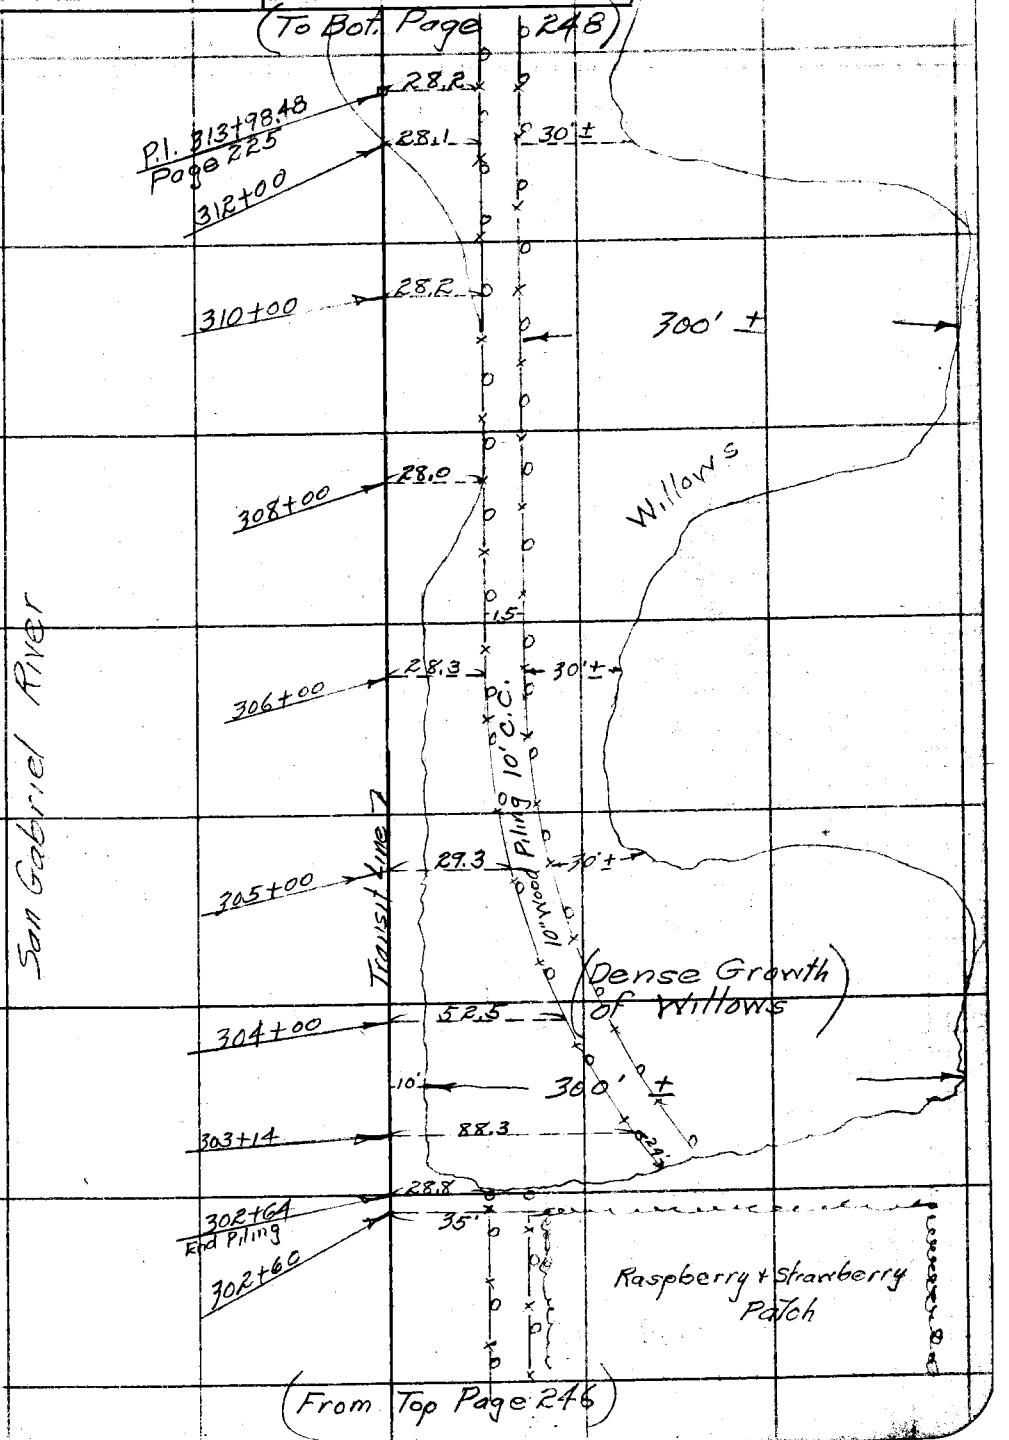

Note: ANY ADDITIONS OR CHANGES ON THIS SHEET MUST BE MADE OR CIRCLED IN Red Ink WITH DATE AND NAME OF PERSON MAKING CHANGE.

Do not extend notes this side of this line

RETURN TO
LOS ANGELES COUNTY SURVEYOR
700 HALL OF RECORDS

FORM 247 5M 2-34

F.B. 541 Pg. 248

(To Bot. Page 249)

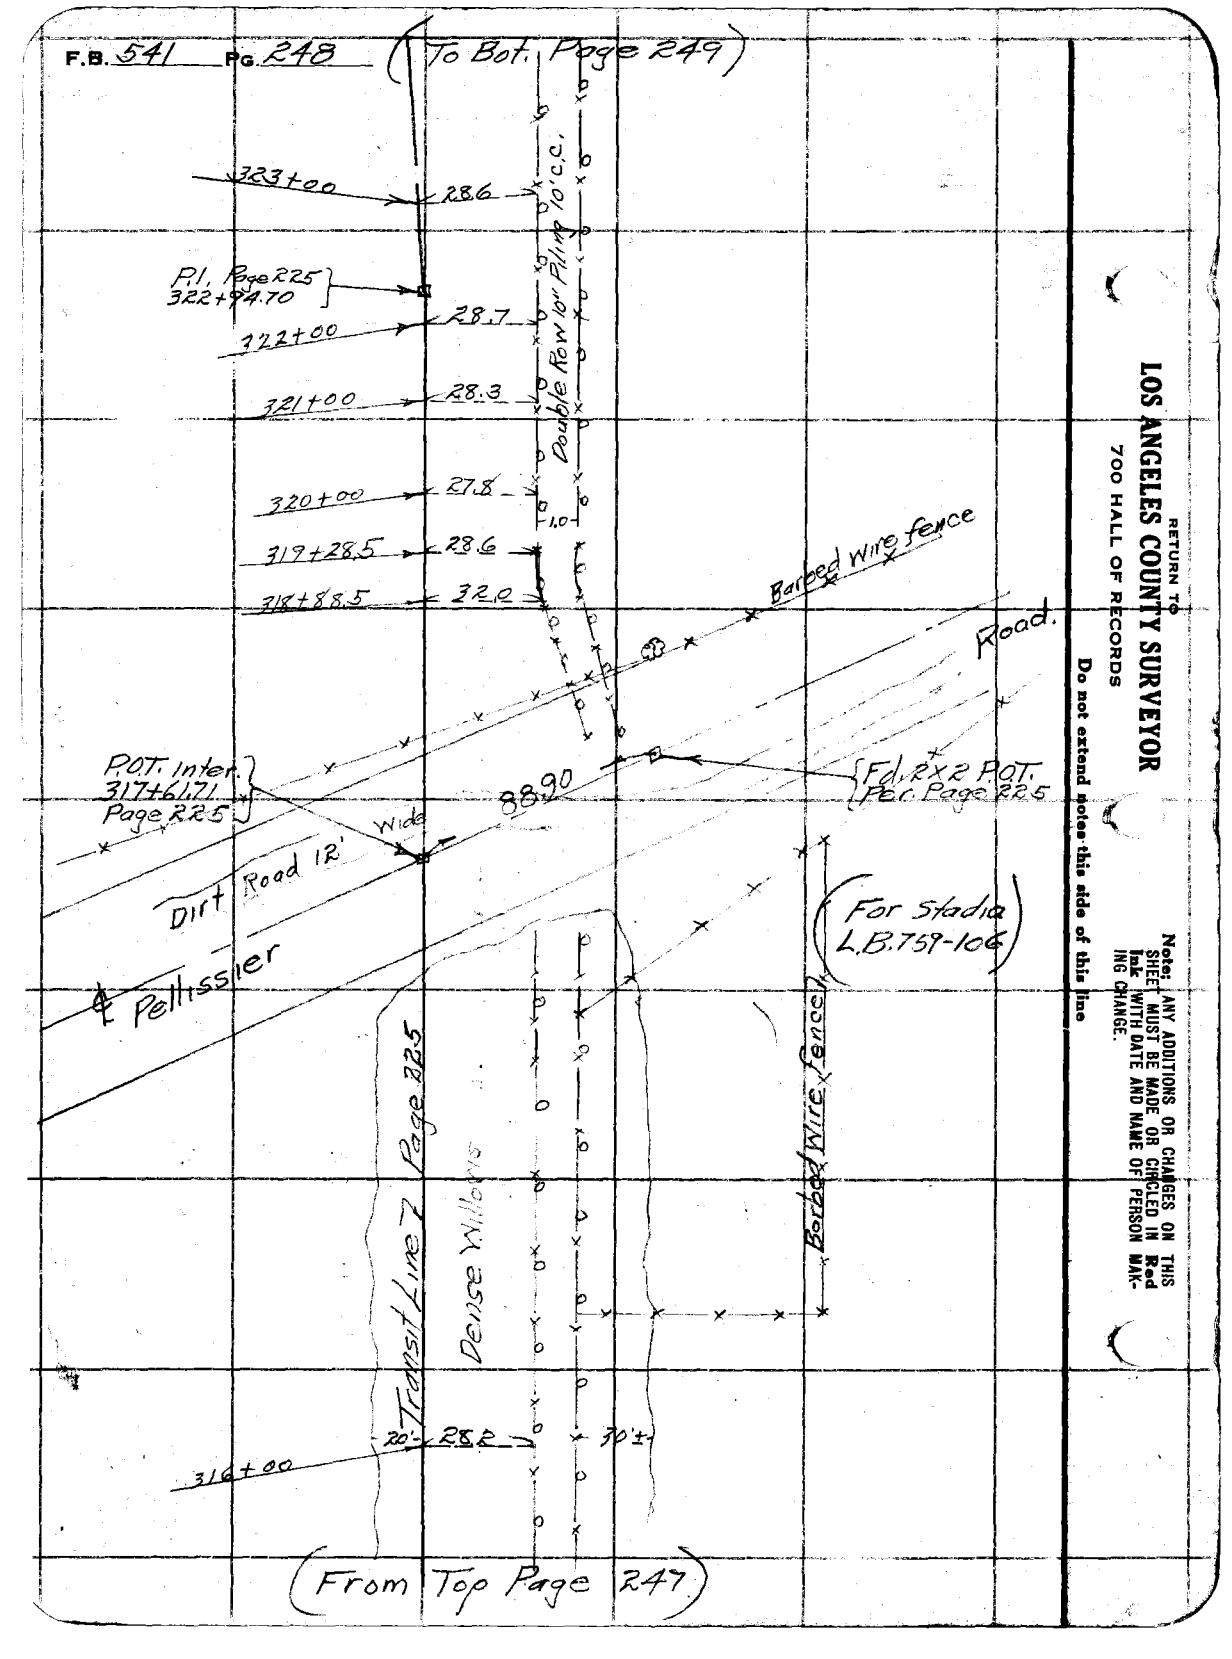

(From Top Page 247)

RETURN TO
LOS ANGELES COUNTY SURVEYOR
700 HALL OF RECORDS
Do not extend notes this side of this line
Note: ANY ADDITIONS OR CHANGES ON THIS SHEET MUST BE MADE OR CIRCLED IN Red Ink WITH DATE AND NAME OF PERSON MAKING CHANGE.

Notes Ck'd by D. M. Finley	Survey of El Monte Bridle Trail		F.B. 541 Pg 249
Map No. B-1005-7	W. O. 8012 Tape No ____ Sr'd ____ of.		
Office Work C.W. Cox	Surveyed by Henry Martin		
Checked	Notes H.M.	Date 7-27-34	
Date	Indexed C. Johnson		

(For Stadia LB.759-109)

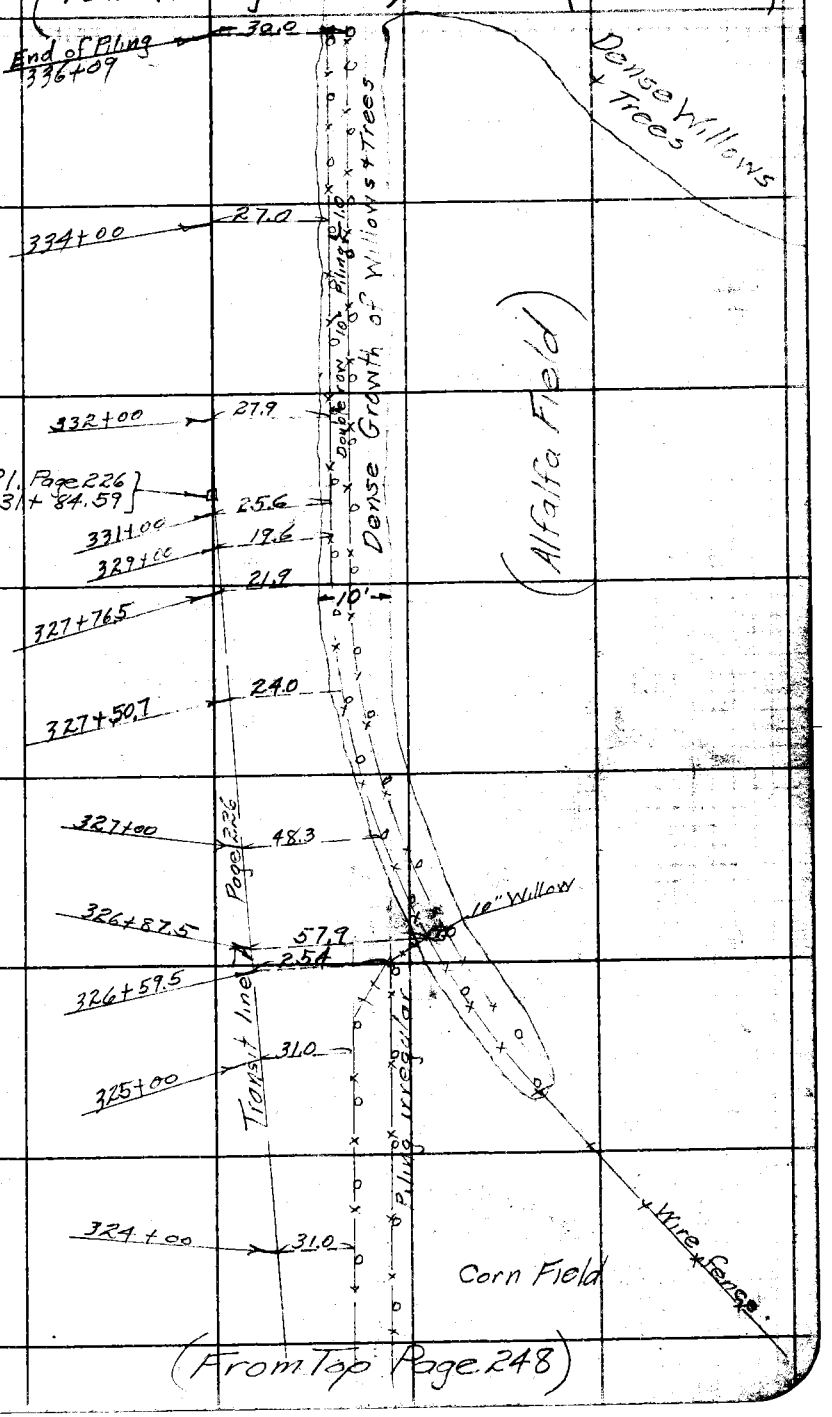

Note: ANY ADDITIONS OR CHANGES ON THIS SHEET MUST BE MADE OR CIRCLED IN Red Ink WITH DATE AND NAME OF PERSON MAKING CHANGE.

Do not extend notes this side of this line

RETURN TO
LOS ANGELES COUNTY SURVEYOR
700 HALL OF RECORDS

FORM 247 BM 2-34

F.B. 541 Pg 250 (To Bot. Page 251)

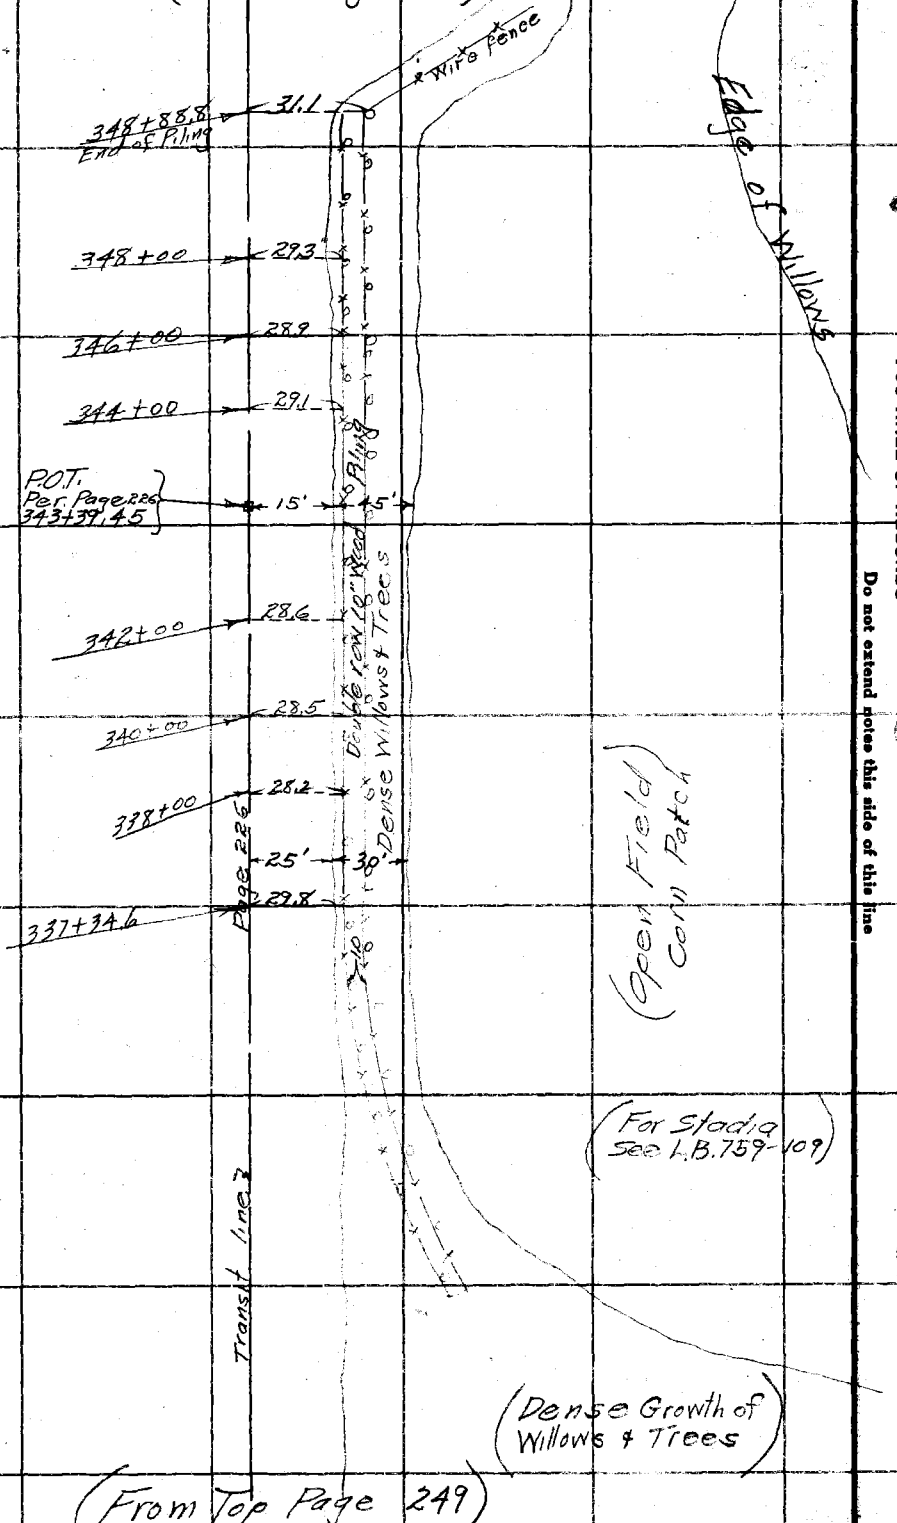

RETURN TO
LOS ANGELES COUNTY SURVEYOR
700 HALL OF RECORDS

Do not extend notes this side of this line

Note: ANY ADDITIONS OR CHANGES ON THIS SHEET MUST BE MADE OR CIRCLED IN Red Ink WITH DATE AND NAME OF PERSON MAKING CHANGE.

Notes Ck'd by D. M. Finley	Survey of El Monte Bridle Trail	F.B. 541	Pg. 251
Map No. B-1005-7	W. O. 8012 Tape No ____ St'd ____ °F.		
Office Work C.W. Cox	Surveyed by Henry Martin		
Checked	Notes Martin Date 7-27-34		
Date	Indexed A. C. Johnson		

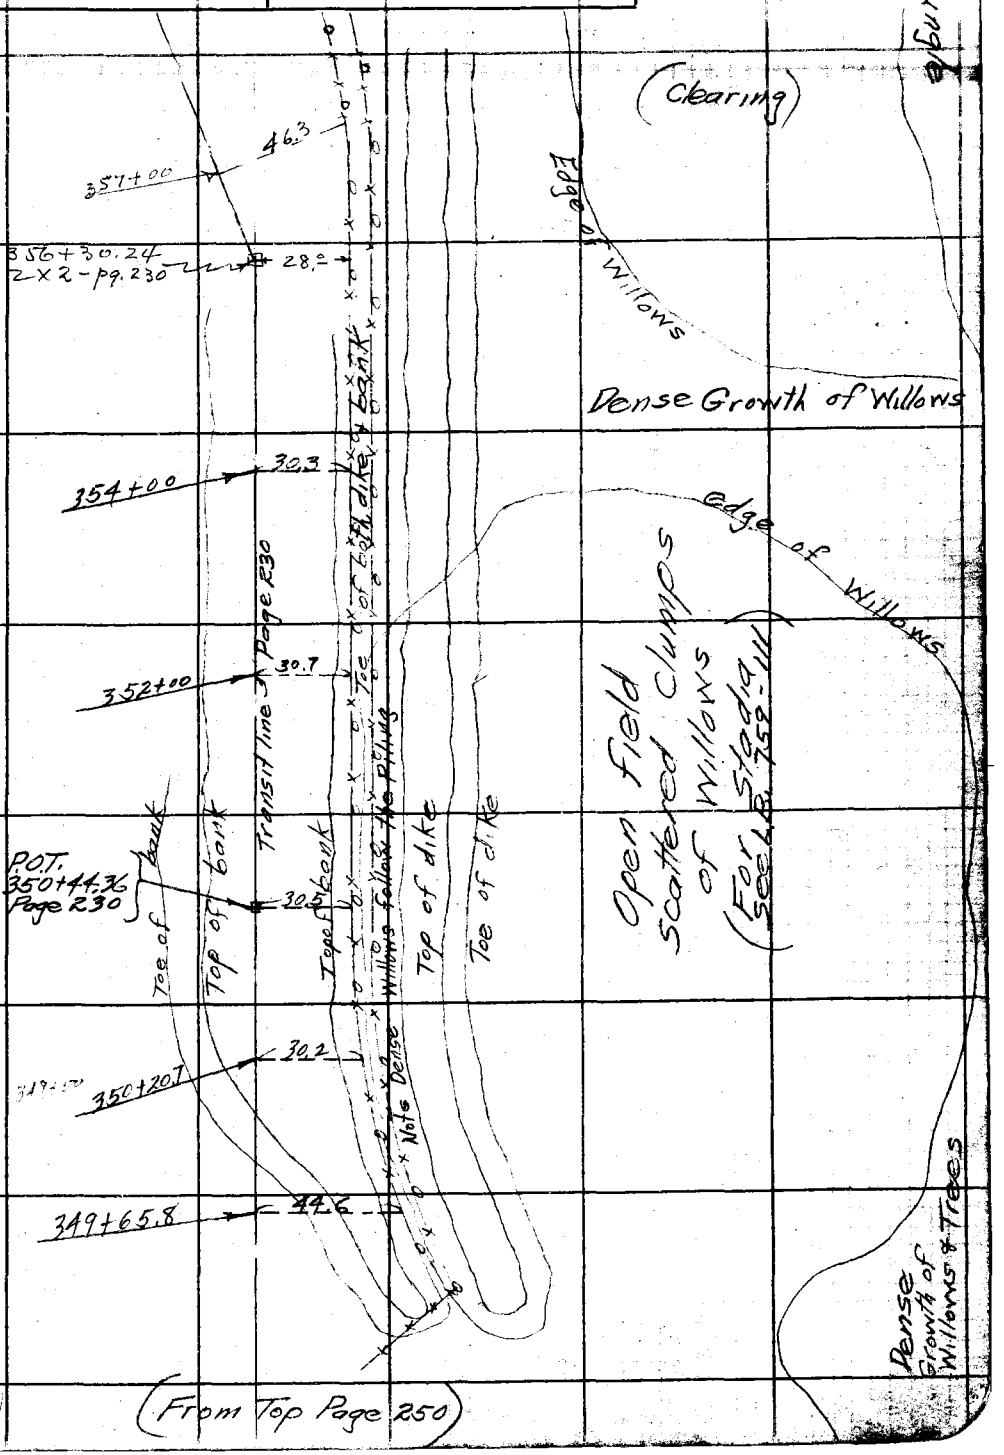

Note: ANY ADDITIONS OR CHANGES ON THIS SHEET MUST BE MADE OR CIRCLED IN Red Ink WITH DATE AND NAME OF PERSON MAKING CHANGE.

Do not extend notes this side of this line

RETURN TO
LOS ANGELES COUNTY SURVEYOR
700 HALL OF RECORDS

FORM 247 5M 2-34

F.B. 541 PG. 252

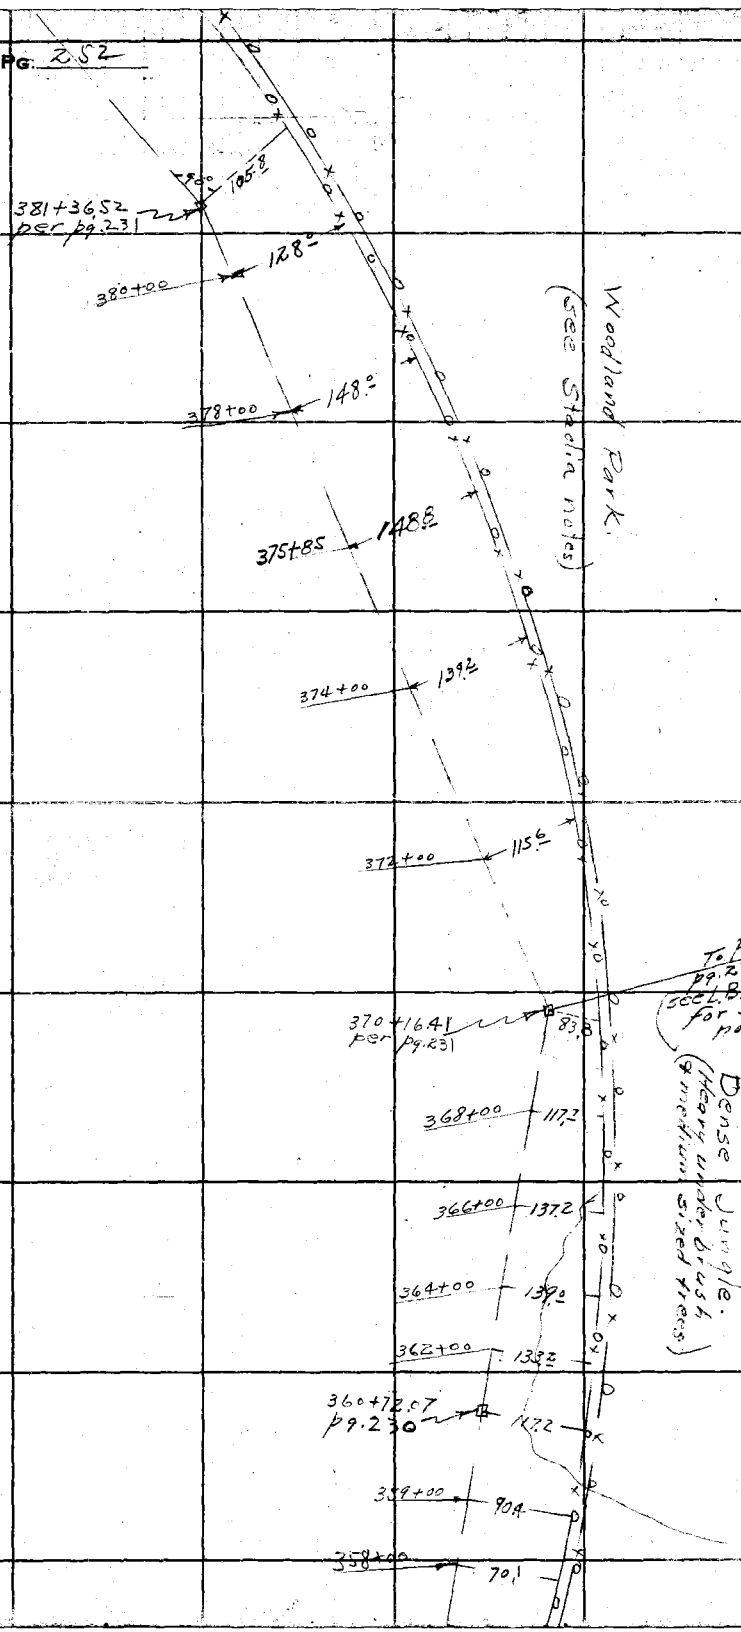

RETURN TO
LOS ANGELES COUNTY SURVEYOR
700 HALL OF RECORDS

Do not extend notes this side of this line

Note: ANY ADDITIONS OR CHANGES ON THIS SHEET MUST BE MADE OR CIRCLED IN Red Ink WITH DATE AND NAME OF PERSON MAKING CHANGE.

Notes Ck'd by D. M. Finley	Survey of El Monte Bridle Trail	F.B. 541	Pg. 253
Map No. B-1005-7	W. O. 8217 Tape No [illegible] St'd 84 OF.		
Office Work C.W. Cox	Surveyed by Evans		
Checked	Notes [illegible] Date 8/13/34		
Date	Indexed H. C. Johnson		

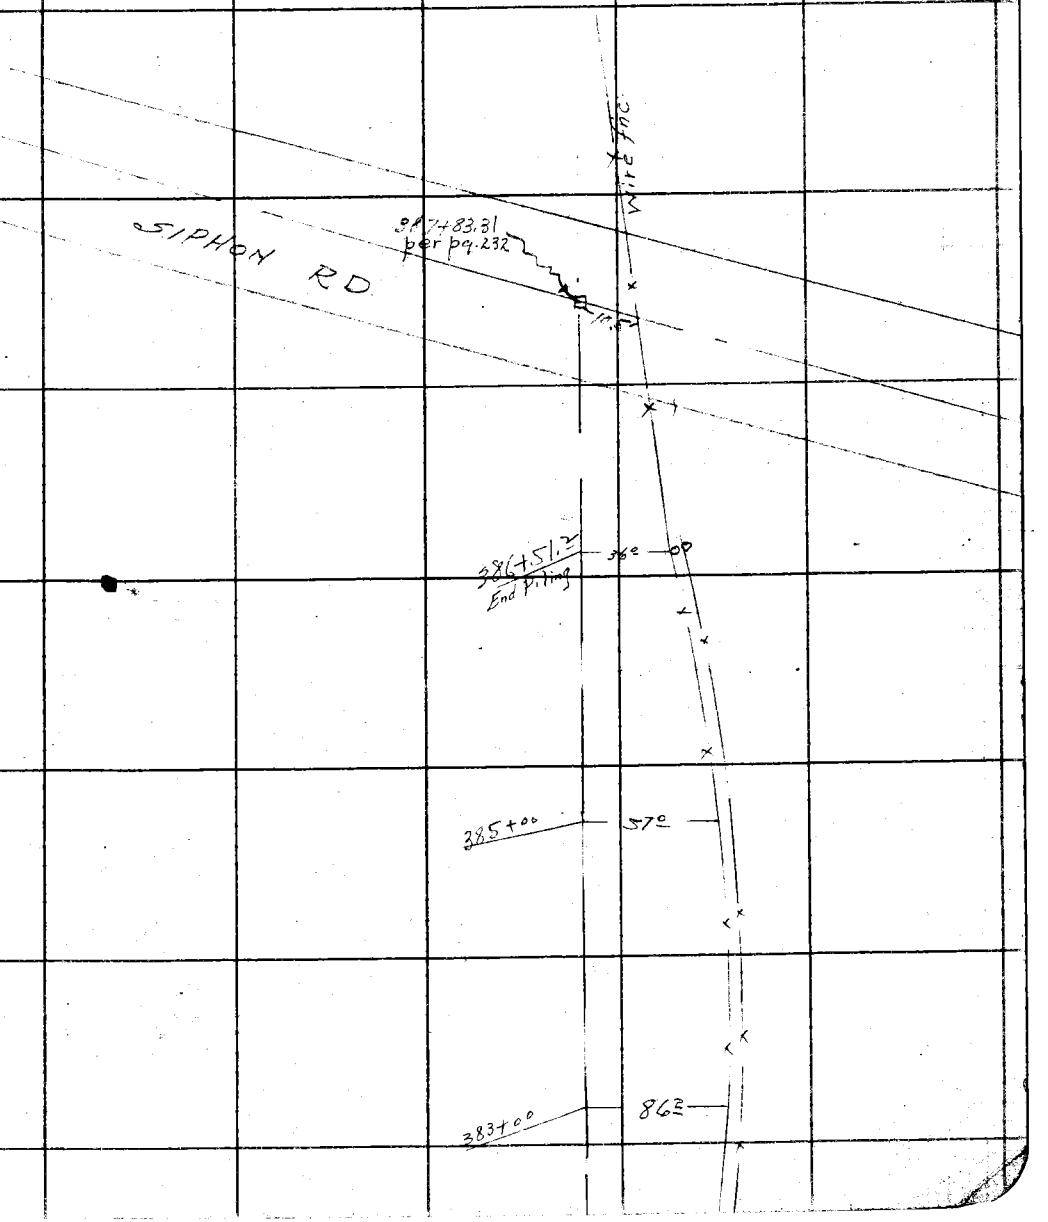

Note: ANY ADDITIONS OR CHANGES ON THIS SHEET MUST BE MADE OR CIRCLED IN Red Ink WITH DATE AND NAME OF PERSON MAKING CHANGE.

Do not extend notes this side of this line

RETURN TO
LOS ANGELES COUNTY SURVEYOR
700 HALL OF RECORDS

FORM 247 BM 2-34

RETURN TO
LOS ANGELES COUNTY SURVEYOR
700 HALL OF RECORDS

Note: ANY ADDITIONS OR CHANGES ON THIS SHEET MUST BE MADE OR CIRCLED IN Red Ink WITH DATE AND NAME OF PERSON MAKING CHANGE.

37 A-3

Do not extend notes this side of this line

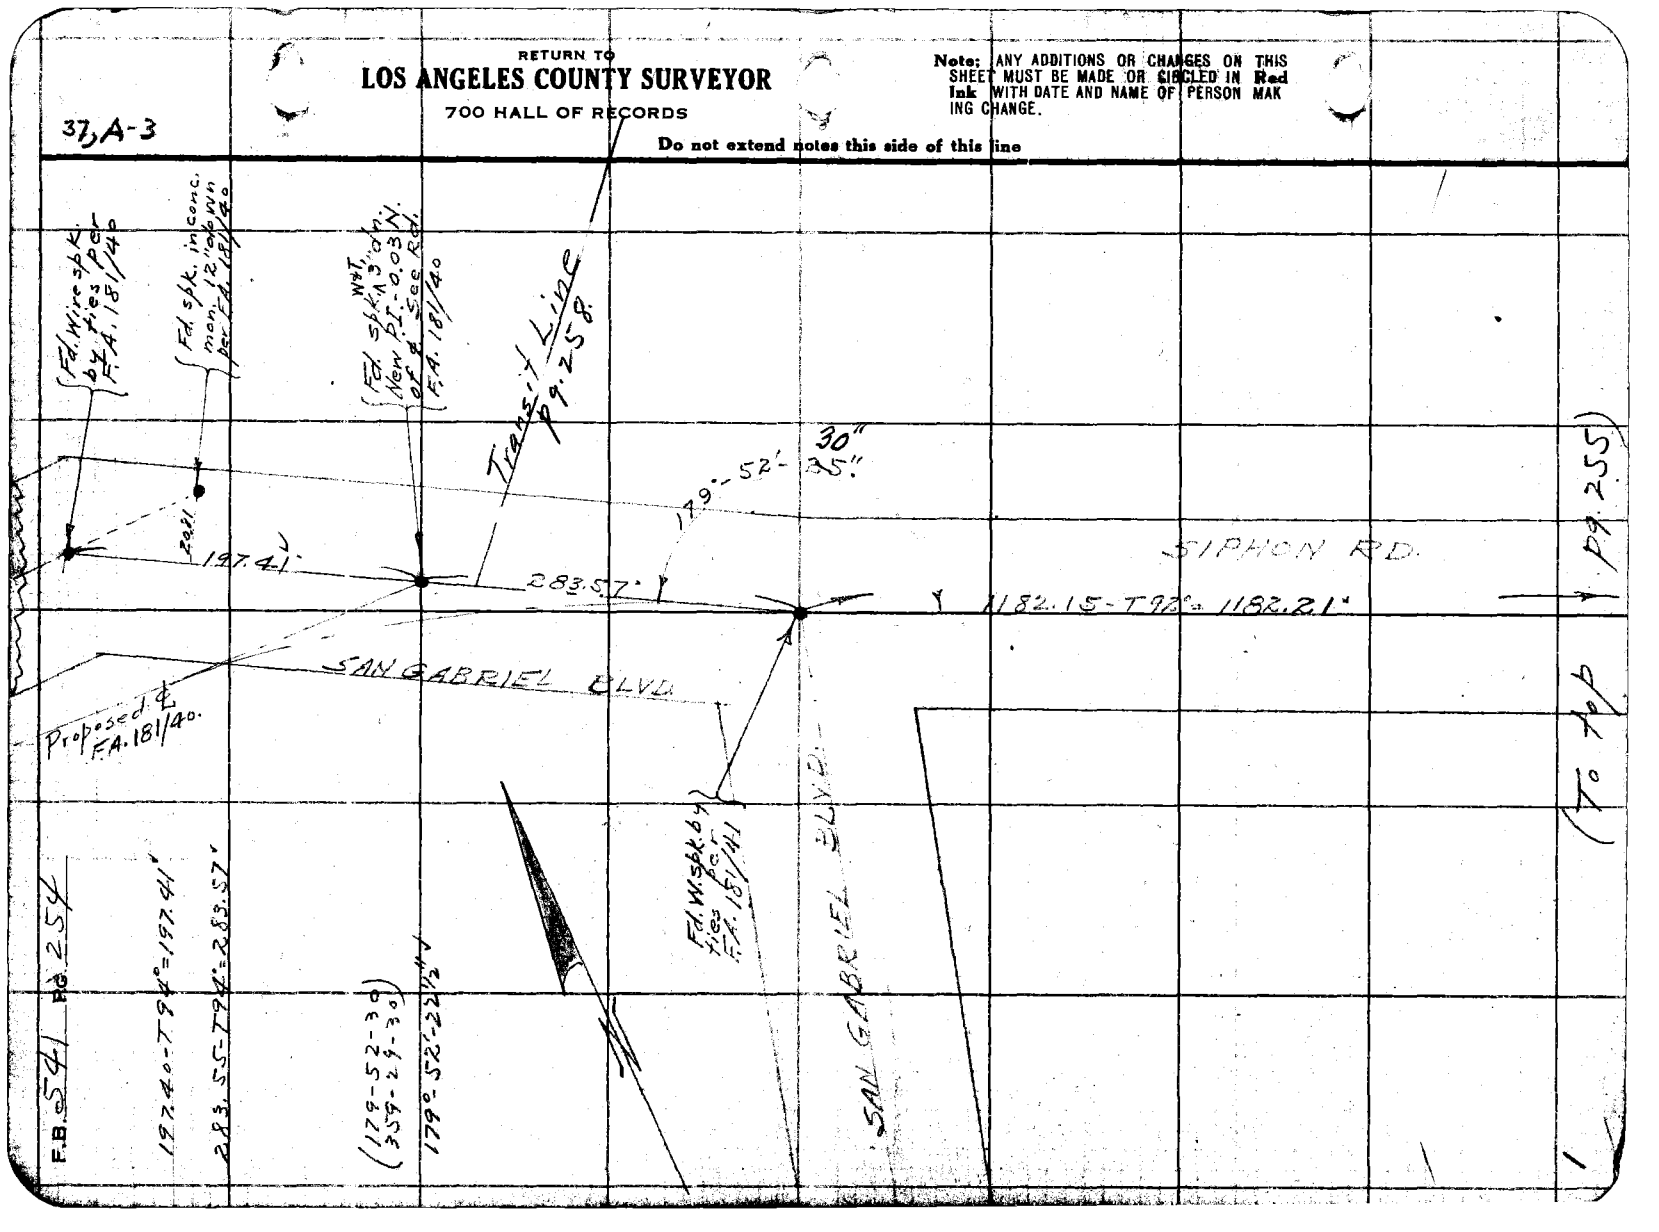

Notes Ck'd by D. M. Finley	Survey of El Monte Bridle Trail		F.B. 541 Pg. 255
Map No. B-1005-7	W. O. 8012 Tape No 067 St'd 84 of.		
Office Work C. W. Cox	Surveyed by Evans		
Checked	Notes	Date 8/16/34	
Date	Indexed A. C. Johnson 11-3-34		

37, A-3

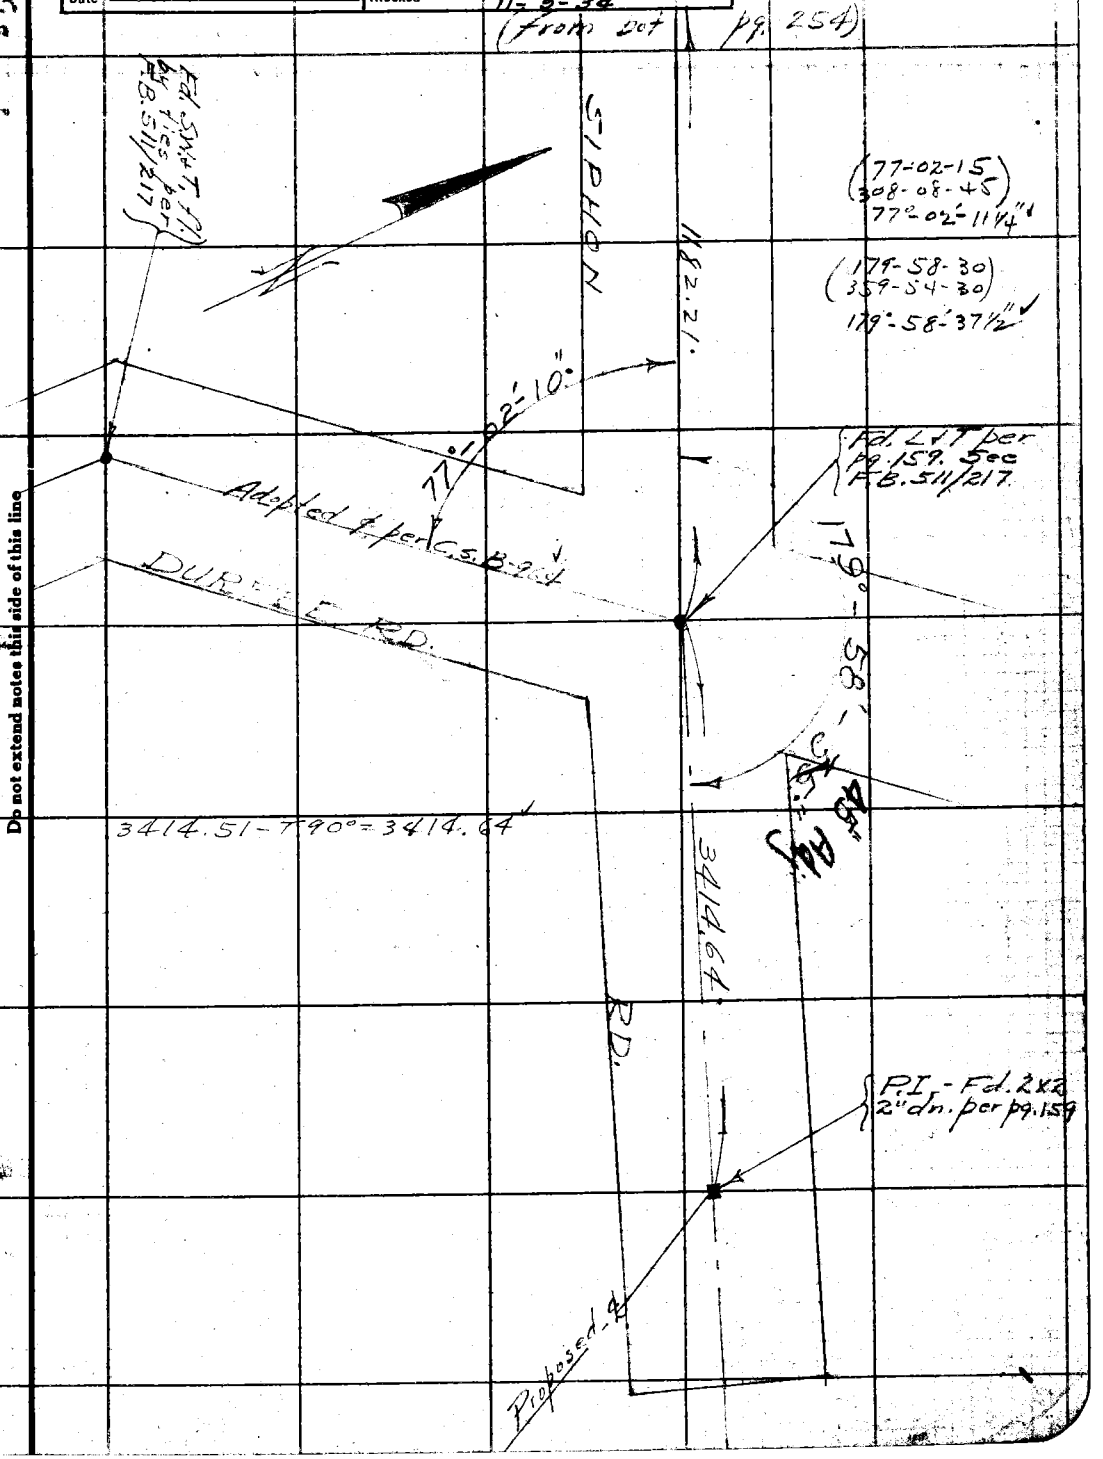

Note: ANY ADDITIONS OR CHANGES ON THIS SHEET MUST BE MADE OR CIRCLED IN Red Ink WITH DATE AND NAME OF PERSON MAKING CHANGE.

Do not extend notes this side of this line

RETURN TO
LOS ANGELES COUNTY SURVEYOR
700 HALL OF RECORDS

FORM 247 5M 2-34

37, B-3

RETURN TO
LOS ANGELES COUNTY SURVEYOR
700 HALL OF RECORDS

Note; ANY ADDITIONS OR CHANGES ON THIS SHEET MUST BE MADE OR CIRCLED IN Red Ink WITH DATE AND NAME OF PERSON MAKING CHANGE.

Do not extend notes this side of this line

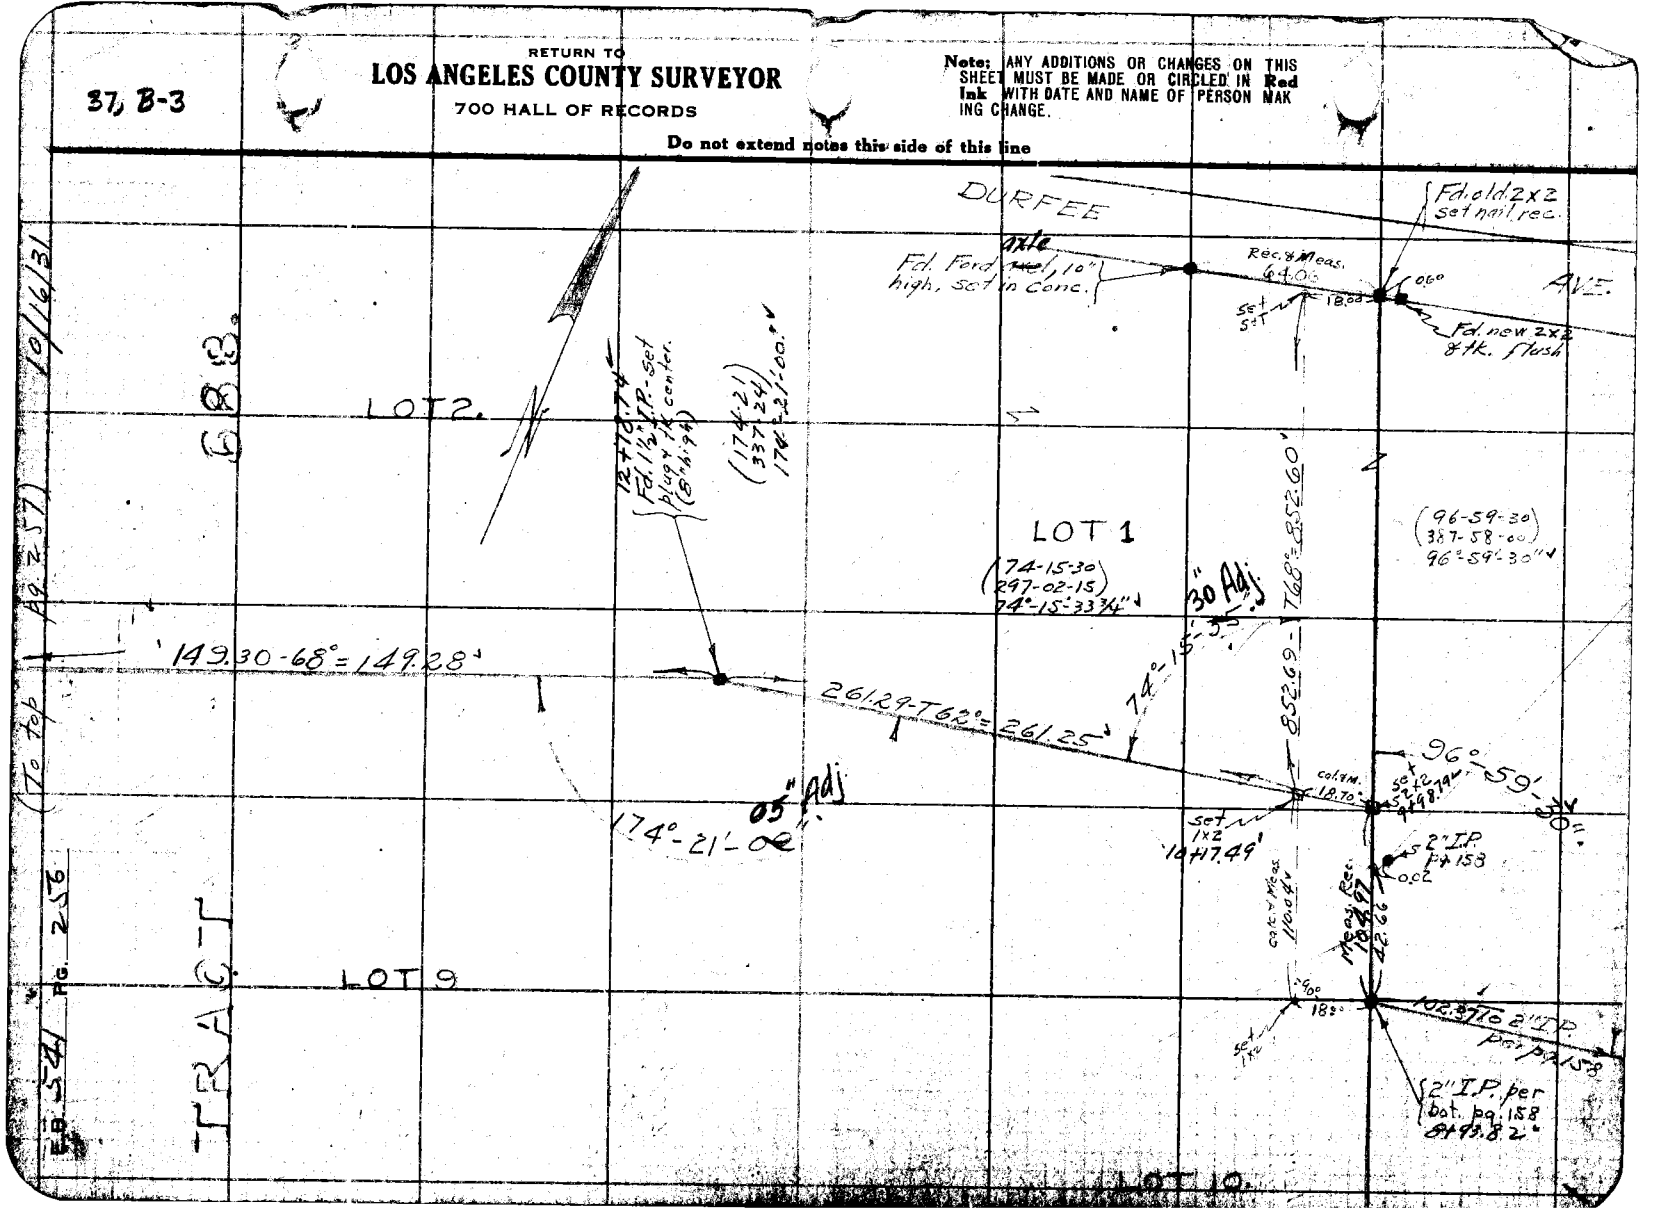

Notes Ck'd by D. M. Finley	Survey of [illegible]	F.B. 541	Pg. 267
Map No. B-1005-7	W. O. [illegible] Tape No [illegible] St'd [illegible] OF.		
Office Work C.W. Cox	Surveyed by Evans		
Checked	Notes [illegible] Date 10/18/34		
Date	Indexed [illegible]		

37, B-3

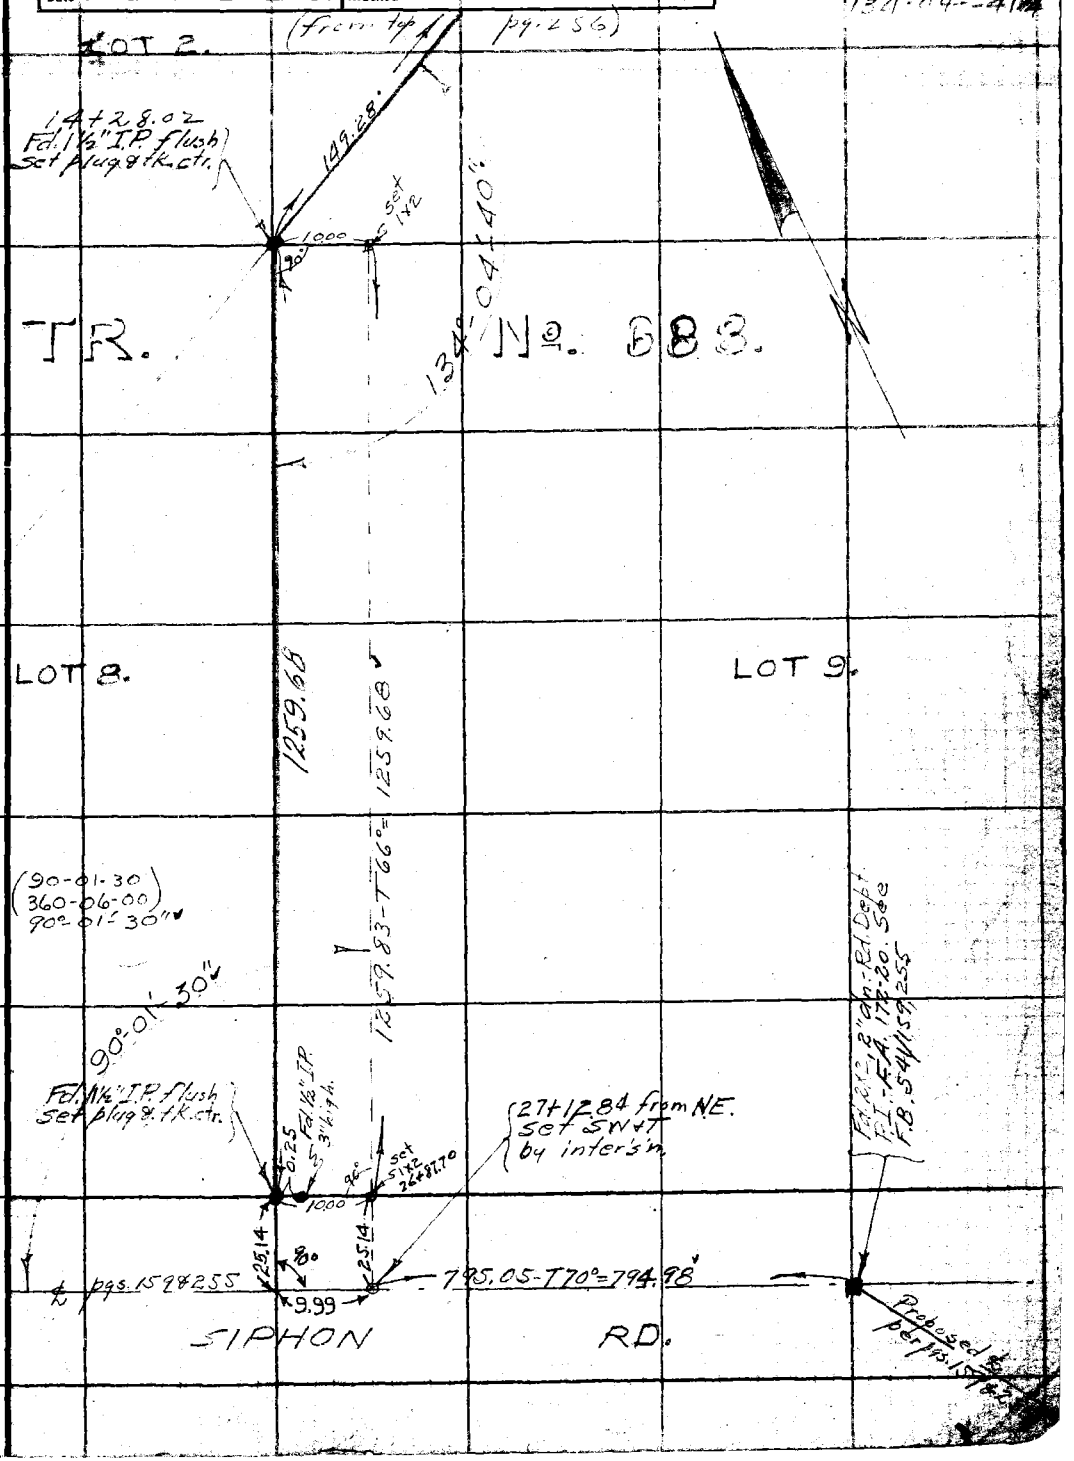

Note: ANY ADDITIONS OR CHANGES ON THIS SHEET MUST BE MADE OR CIRCLED IN Red Ink WITH DATE AND NAME OF PERSON MAKING CHANGE.

Do not extend notes this side of this line

RETURN TO
LOS ANGELES COUNTY SURVEYOR
700 HALL OF RECORDS

FORM 247 5M 2-34

F.B. 541 PG. 258

RETURN TO
LOS ANGELES COUNTY SURVEYOR
700 HALL OF RECORDS
Do not extend notes this side of this line

Note: ANY ADDITIONS OR CHANGES ON THIS SHEET MUST BE MADE OR CIRCLED IN Red Ink WITH DATE AND NAME OF PERSON MAKING CHANGE.

(To Bot. / [illegible] 260)

Notes Ck'd by D. M. Finley	Survey of El Monte Bridle Trail
Map No. B-1005-2	W. O. 8012 Tape No 063 St'd 84 °F.
Office Work C. W. Cox	Surveyed by Evans.
Checked	Notes HE Date 10/26/34
Date	Indexed A. C. Johnson

F.B. 541 Pg. 259

37, A-2

Note: ANY ADDITIONS OR CHANGES ON THIS SHEET MUST BE MADE OR CIRCLED IN Red Ink WITH DATE AND NAME OF PERSON MAKING CHANGE.

Do not extend notes this side of this line

RETURN TO
LOS ANGELES COUNTY SURVEYOR
700 HALL OF RECORDS

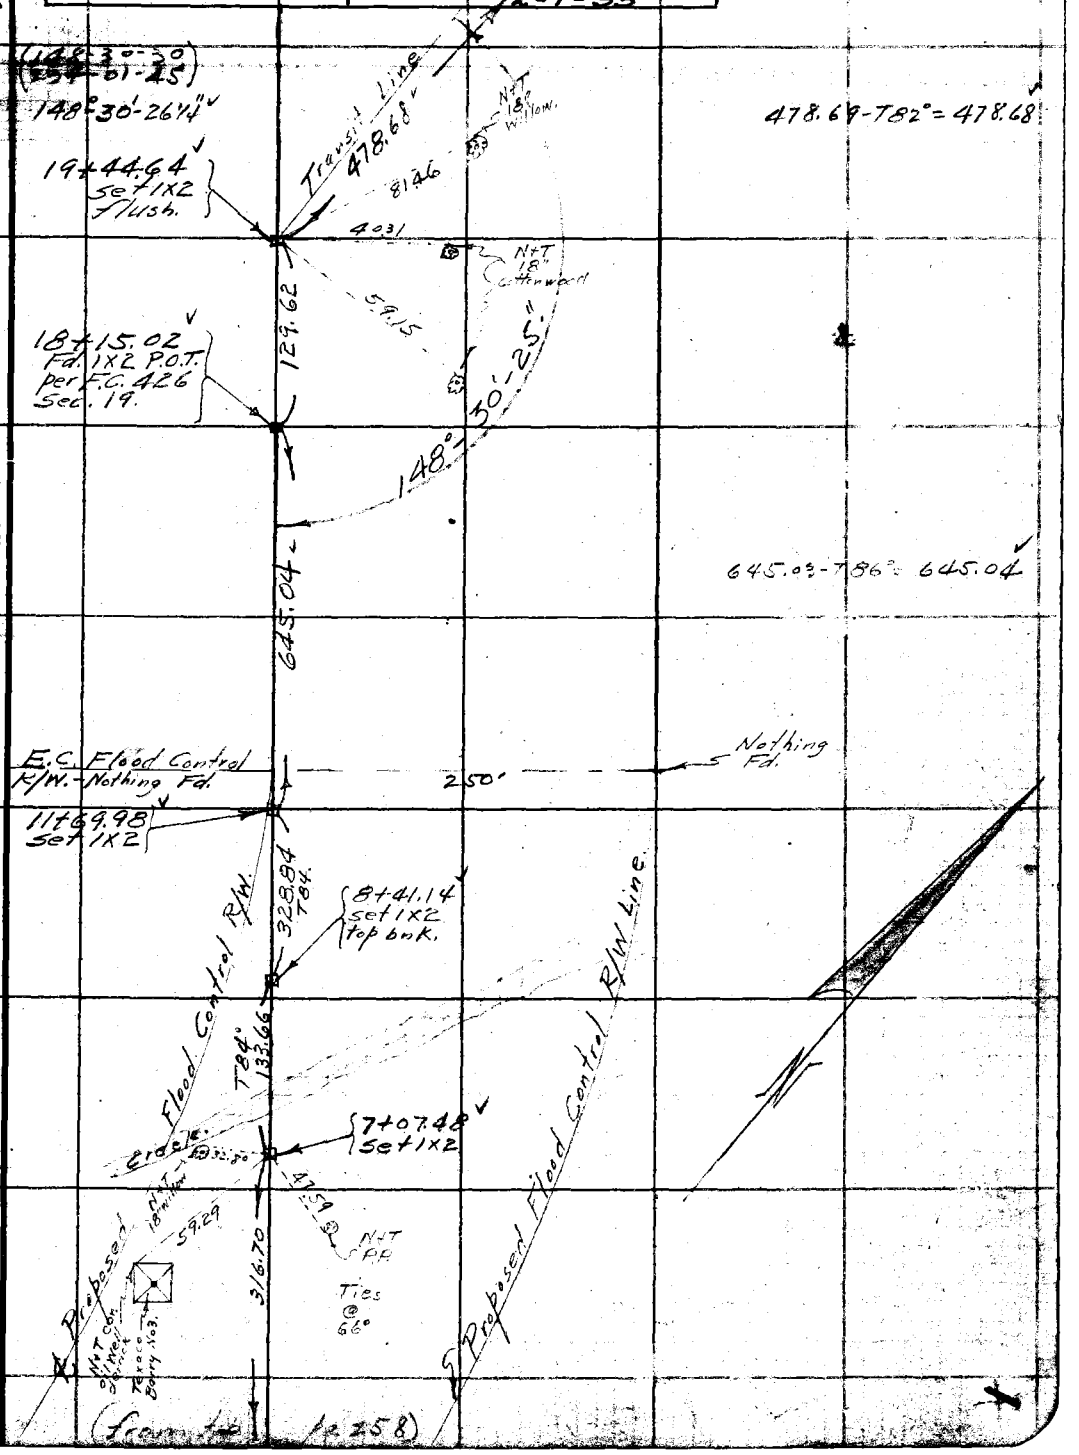

FORM 247 5M 2-34

10/29/34

(To Bot. of pg. 261)

37, A-2

(from top of pg. 259)

RETURN TO
LOS ANGELES COUNTY SURVEYOR
700 HALL OF RECORDS
Do not extend notes this side of this line
Note: ANY ADDITIONS OR CHANGES ON THIS SHEET MUST BE MADE OR CIRCLED IN Red Ink WITH DATE AND NAME OF PERSON MAKING CHANGE.

(To Bot pg. 262)

Notes Ck'd. by D. M. Finley	Survey of El Monte Bridle Trail	F.B. 541	Pg. 261
Map No. B-1005-2	W. O. 8012 Tape No 063 St'd 24 of.		
Office Work C. W. Cox	Surveyed by Evans		
Checked	Notes	Date 10/29/54	
Date	Indexed A. C. Johnson		

37, A-2

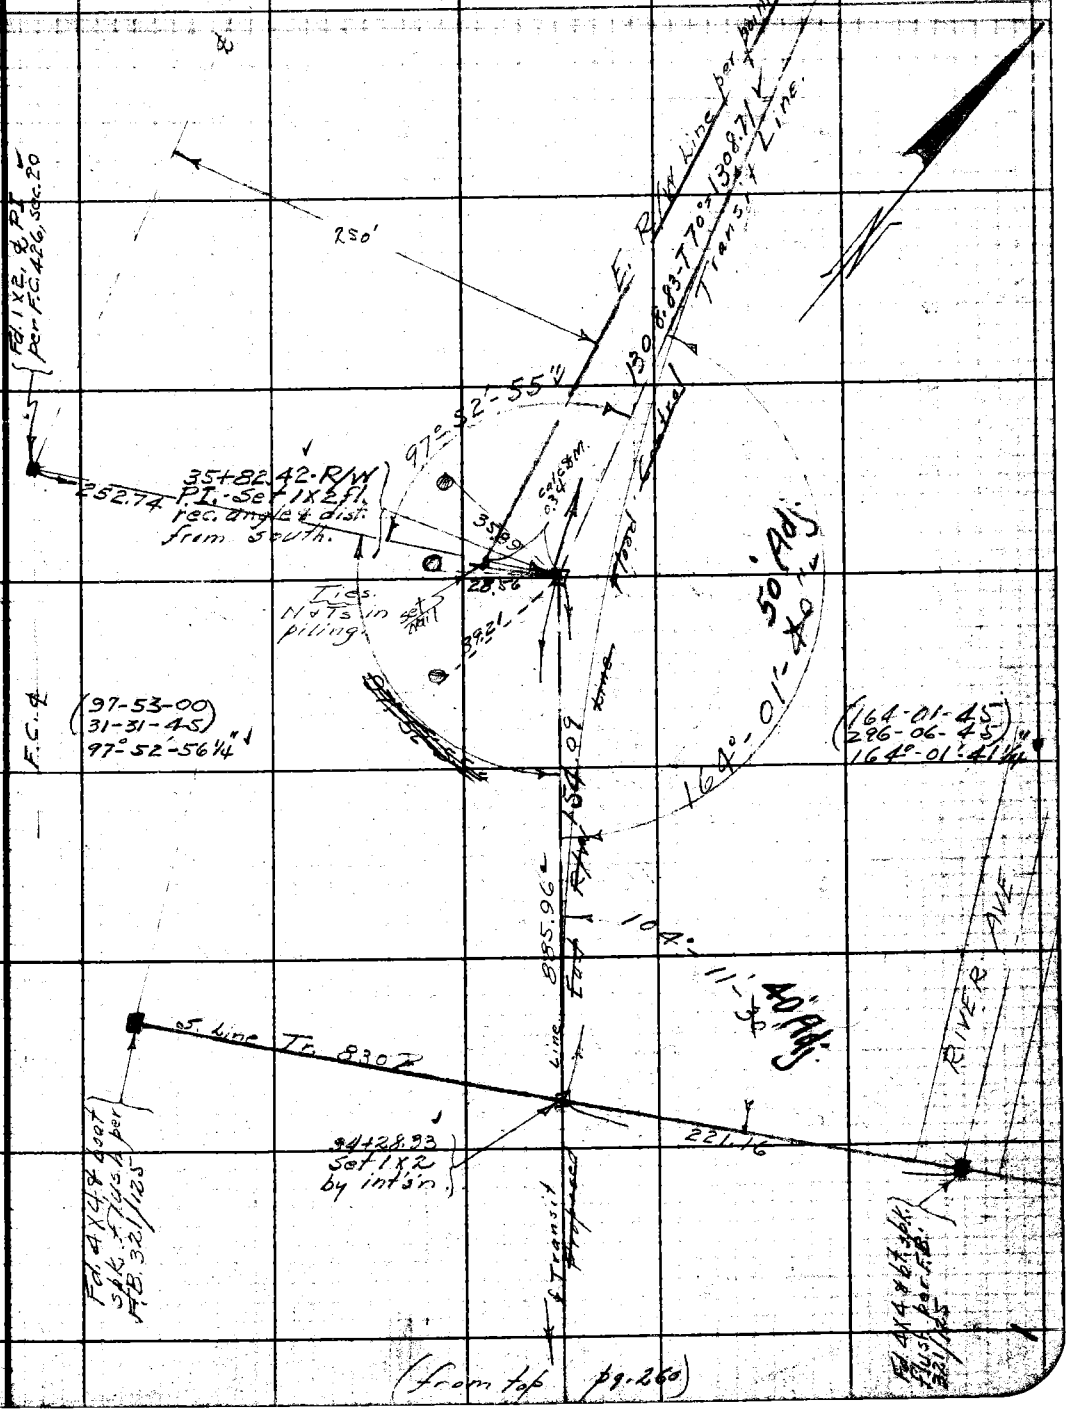

Note: ANY ADDITIONS OR CHANGES ON THIS SHEET MUST BE MADE OR CIRCLED IN Red Ink WITH DATE AND NAME OF PERSON MAKING CHANGE.

Do not extend notes this side of this line

RETURN TO
LOS ANGELES COUNTY SURVEYOR
700 HALL OF RECORDS

FORM 247 5M 2-34

RETURN TO
LOS ANGELES COUNTY SURVEYOR
700 HALL OF RECORDS

Note; ANY ADDITIONS OR CHANGES ON THIS SHEET MUST BE MADE OR CIRCLED IN Red Ink WITH DATE AND NAME OF PERSON MAKING CHANGE.

37 A-2

Do not extend notes this side of this line

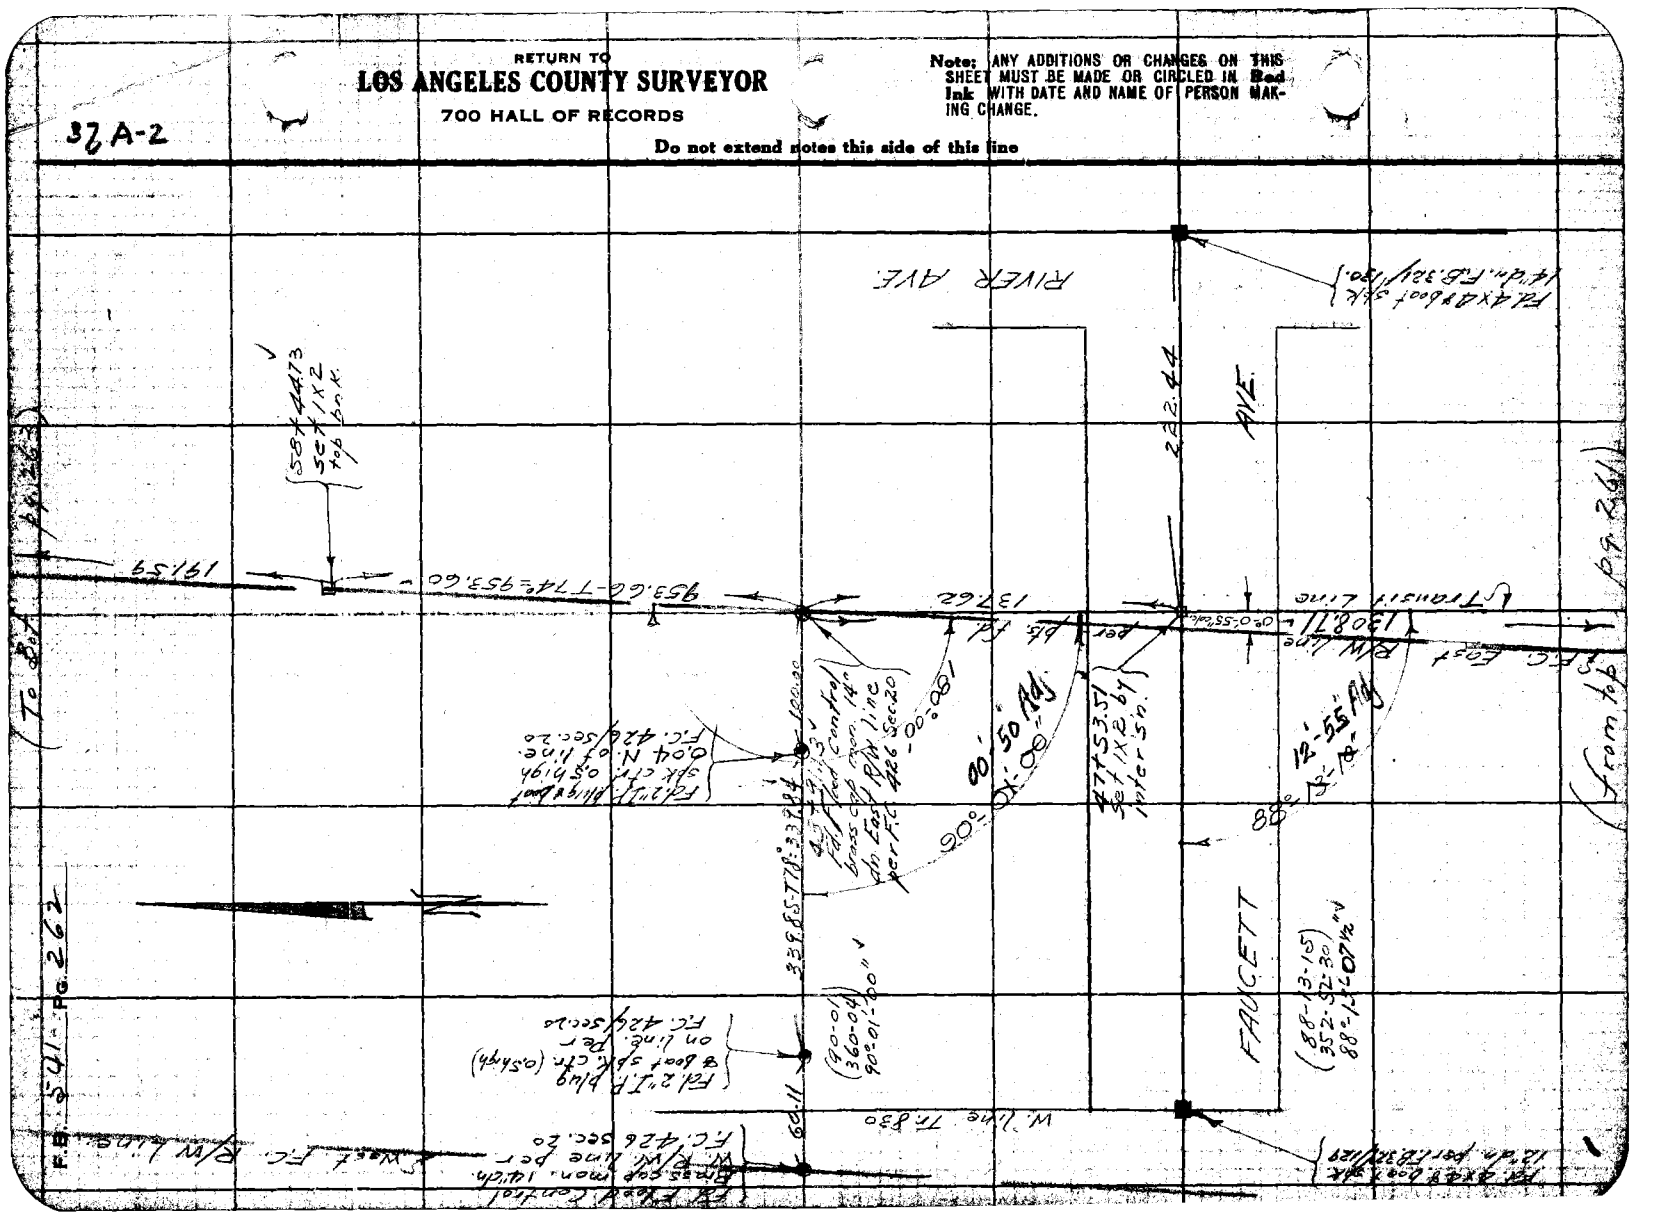

Notes Ck'd by D. M. Finley	Survey of El Monte Bridle Trail	F.B. 541	Pg. 263
Map No. B-1005-2	W. O. 8012 Tape No 062 St'd 84 °F.		
Office Work C.W. Cox	Surveyed by Evans		
Checked	Notes	Date 10/31/34	
Date	Indexed A. C. Johnson		

37, A-2

(179-59-00)
(359-55-45)
179°58'56¼"

(To Bot. pg. 264)

Fd. F.C. brass cap mon. 6" high W. R/W line F.C. 426 Sec. 21

Fd. 2" I.P. & bent spk. 6" high, 0.04 South of line. F.C. 426 Sec. 21

90°-00'-00" 89°-59'-55"

Fd. 2" I.P. & bent spk. 10" high, 0.02 S. of line per F.C. 426 Sec. 21

Rec. (25.00)

(500' Rec.)

M. 25.00

126 0.99

(75+01.83 - Fd. F.C. brass cap mon. 6" high F.C. 426 Sec. 21

179°-58'

531.24 - T 70° = 531.19 Line

(69+70.64 Set 1x2 edge of Woods.

934.38 - T 74° = 934.32 Transit

N+T 12" Cottonwood

71.42

Tres @ 72°F.

N+T F.P.

59.89

(60+36.32 P.I. - Set 1x2 rec. dist. from F.C. mon. South.

(1145.19)

166°-04'-45"

(166-04-45)
(304-19-00)
166°-04'-45"

99.21

N+T. 18" cottonwood

191.59

(from top pg. 262)

Note: ANY ADDITIONS OR CHANGES ON THIS SHEET MUST BE MADE OR CIRCLED IN Red Ink WITH DATE AND NAME OF PERSON MAKING CHANGE.

Do not extend notes this side of this line

RETURN TO
LOS ANGELES COUNTY SURVEYOR
700 HALL OF RECORDS

FORM 247-5M 2-34

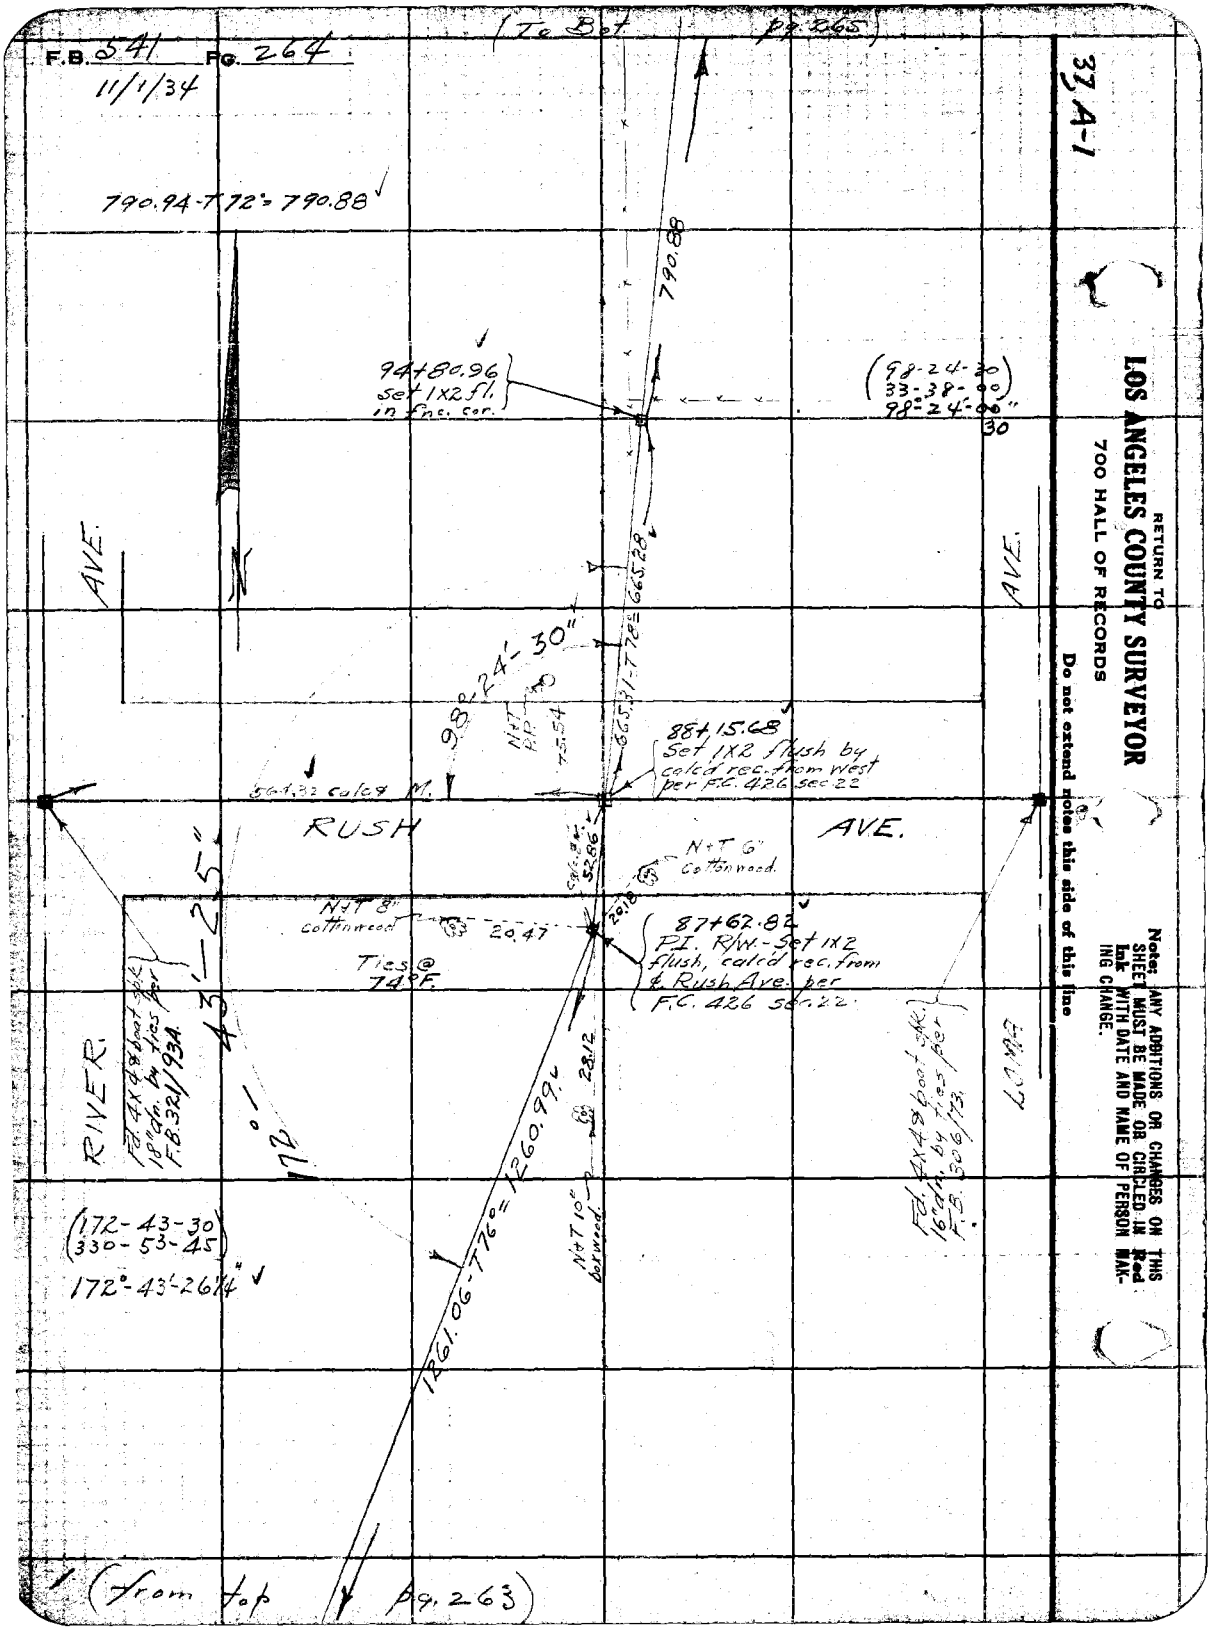
F.B. 541 Pg. 264
11/1/34
(To Bot pg. 265)
37, A-1
790.94-T 72° = 790.88
790.88
94+80.96
set 1X2 fl.
in fnc. cor.
(98-24-30)
33-38-00
98°-24'-00"
30
AVE.
AVE.
665.31-T 78° = 665.28
98°-24'-30"
N+T
P.P.
75.54
88+15.68
Set 1X2 flush by
calc'd rec. from west
per F.C. 426 sec. 22
564.32 calc'd M.
RUSH
AVE.
N+T 6"
Cottonwood.
N+T 8"
cottonwood
20.47
87+62.82
P.I. R/W.-Set 1X2
flush, calc'd rec. from
& Rush Ave. per
F.C. 426 sec. 22
Ties @
74°F.
43'-25"
RIVER.
Fd. 4X4 & boat spk.
18" dn. by ties per
F.B. 321/93A
172°
28.12
1261.06-T 76° = 1260.99
N+T 10"
boxwood.
Fd. 4X4 & boat spk.
16" dn. by ties per
F.B. 306/73.
LAMB
(172-43-30)
(330-53-45)
172°-43'-26¼"
(from top pg. 263)
RETURN TO
LOS ANGELES COUNTY SURVEYOR
700 HALL OF RECORDS
Do not extend notes this side of this line
Note: ANY ADDITIONS OR CHANGES ON THIS SHEET MUST BE MADE OR CIRCLED IN Red Ink WITH DATE AND NAME OF PERSON MAKING CHANGE.

Notes Ck'd by D. M. Finley	Survey of El Monte Bridle Trail		F.B. 541 Pg. 265
Map No. B-1005-2, 3	W. O. 2012	Tape No 063 St'd 84 of.	
Office Work C.W. Cox	Surveyed by Evans.		
Checked	Notes HE	Date 11/2/34	
Date	Indexed A. C. Johnson		

37, A-1

(To bot. pg. 266.)

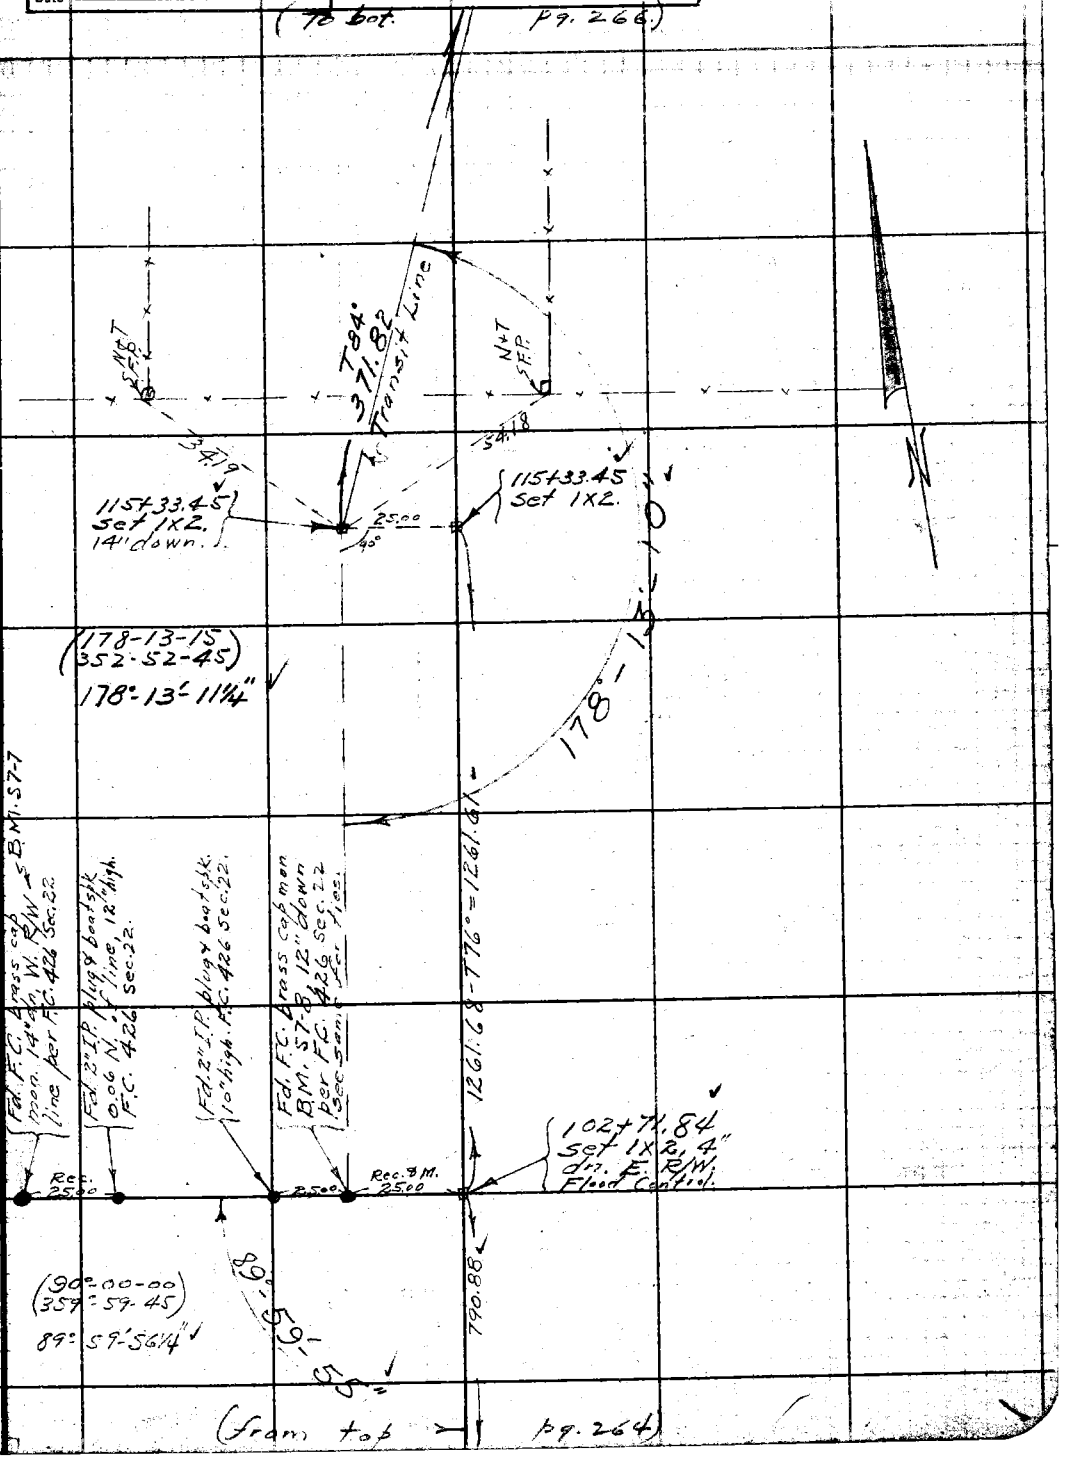

Note: ANY ADDITIONS OR CHANGES ON THIS SHEET MUST BE MADE OR CIRCLED IN Red Ink WITH DATE AND NAME OF PERSON MAKING CHANGE.

Do not extend notes this side of this line

RETURN TO
LOS ANGELES COUNTY SURVEYOR
700 HALL OF RECORDS

FORM 247 BM 2-34

F.B. 541 PG. 266
(To Bot. pg. 267)
37 A-1
(163-29-45)
(293-58-45)
163°-29'-41 1/4"
11-5-34
782.50-T88°-782.52
Piling & Wire
Flood Protection
123+12.89
Set 1X2
13.61
9.93
14.27
77.80
N+T's top piling
163°-29'-40"
66.43
124+16.06
Fd. 2" I.P. P+T
8" dn. per Tr. 10231. See Flood P.C. 174/123 & Rd. Z. 314/132
Fd. N+T
G.P. #3749998E.
92.75
92.5
50.77
x in top foundation bolt
Fd. N+T
P.P. #3749995
LOMA AVE.
407.60-T92°-407.62
Line
Transit
45.82
Ties
N+T's in trees.
119+05.27
Set 1X2.
4.58
12.56
371.82
161°-21'-40"
(161-21-45)
(285-26-30)
161°-21'-37 1/2"
RETURN TO
LOS ANGELES COUNTY SURVEYOR
700 HALL OF RECORDS
Do not extend notes this side of this line
Note: ANY ADDITIONS OR CHANGES ON THIS SHEET MUST BE MADE OR CIRCLED IN Red Ink WITH DATE AND NAME OF PERSON MAKING CHANGE.

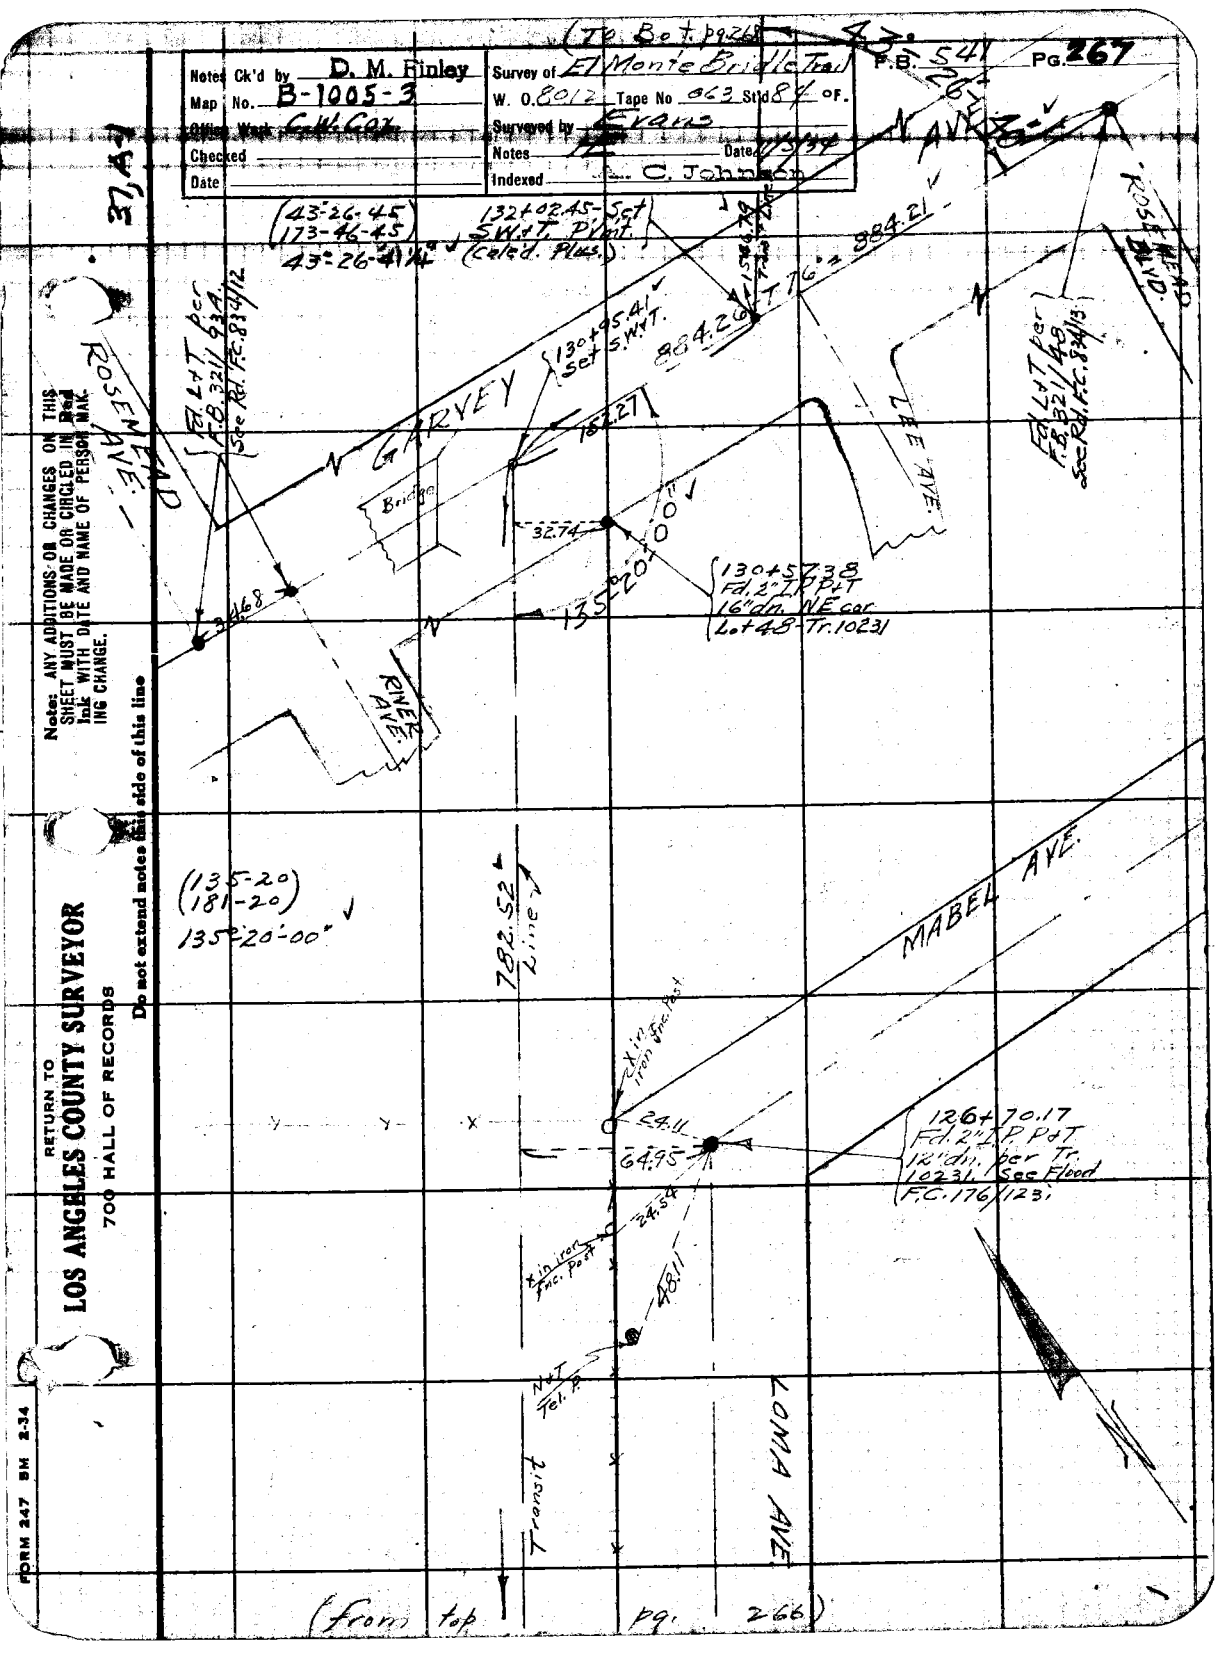

(To Bot. pg.268)
43°-26'-45"
F.B. 541
Pg. 267
Notes Ck'd by D. M. Finley
Map No. B-1005-3
Office Work C.W. Cox
Checked
Date
Survey of El Monte Bridle Trail
W. O. 8012 Tape No 063 Std 84 OF.
Surveyed by Evans
Notes
Date 11/5/34
Indexed C. Johnson
37, A-1
(43°-26-45)
(173-46-45)
43°-26-41¼"
132+02.45-Set S.W.&T. P'vmt. (Calc'd. Plus.)
884.26
T 76° = 884.21
ROSEMEAD BLVD.
Fd. L&T per F.B. 321/48 See Rd. F.C. 834/13
Fd. L&T per F.B. 321/93A. See Rd. F.C. 834/12
ROSEMEAD AVE.
GARVEY
130+95.41 Set S.W.&T.
152.27
Bridge
32.74
135°-20'-00"
130+57.38 Fd. 2" I.P. P&T 16" dn. NE cor. Lot 48-Tr. 10231
LEE AVE.
34.68
RIVER AVE.
(135-20)
(181-20)
135°-20'-00"
782.52 Line
MABEL AVE.
x in iron fnc. post
24.11
64.95
126+70.17 Fd. 2" I.P. P&T 12" dn. per Tr. 10231. See Flood F.C. 176/123.
24.54
x in iron fnc. post
48.11
N&T Tel. P.
Transit
LOMA AVE
(from top pg. 266)
Note: ANY ADDITIONS OR CHANGES ON THIS SHEET MUST BE MADE OR CIRCLED IN Red Ink WITH DATE AND NAME OF PERSON MAKING CHANGE.
Do not extend notes this side of this line
RETURN TO
LOS ANGELES COUNTY SURVEYOR
700 HALL OF RECORDS
FORM 247 BM 2-34

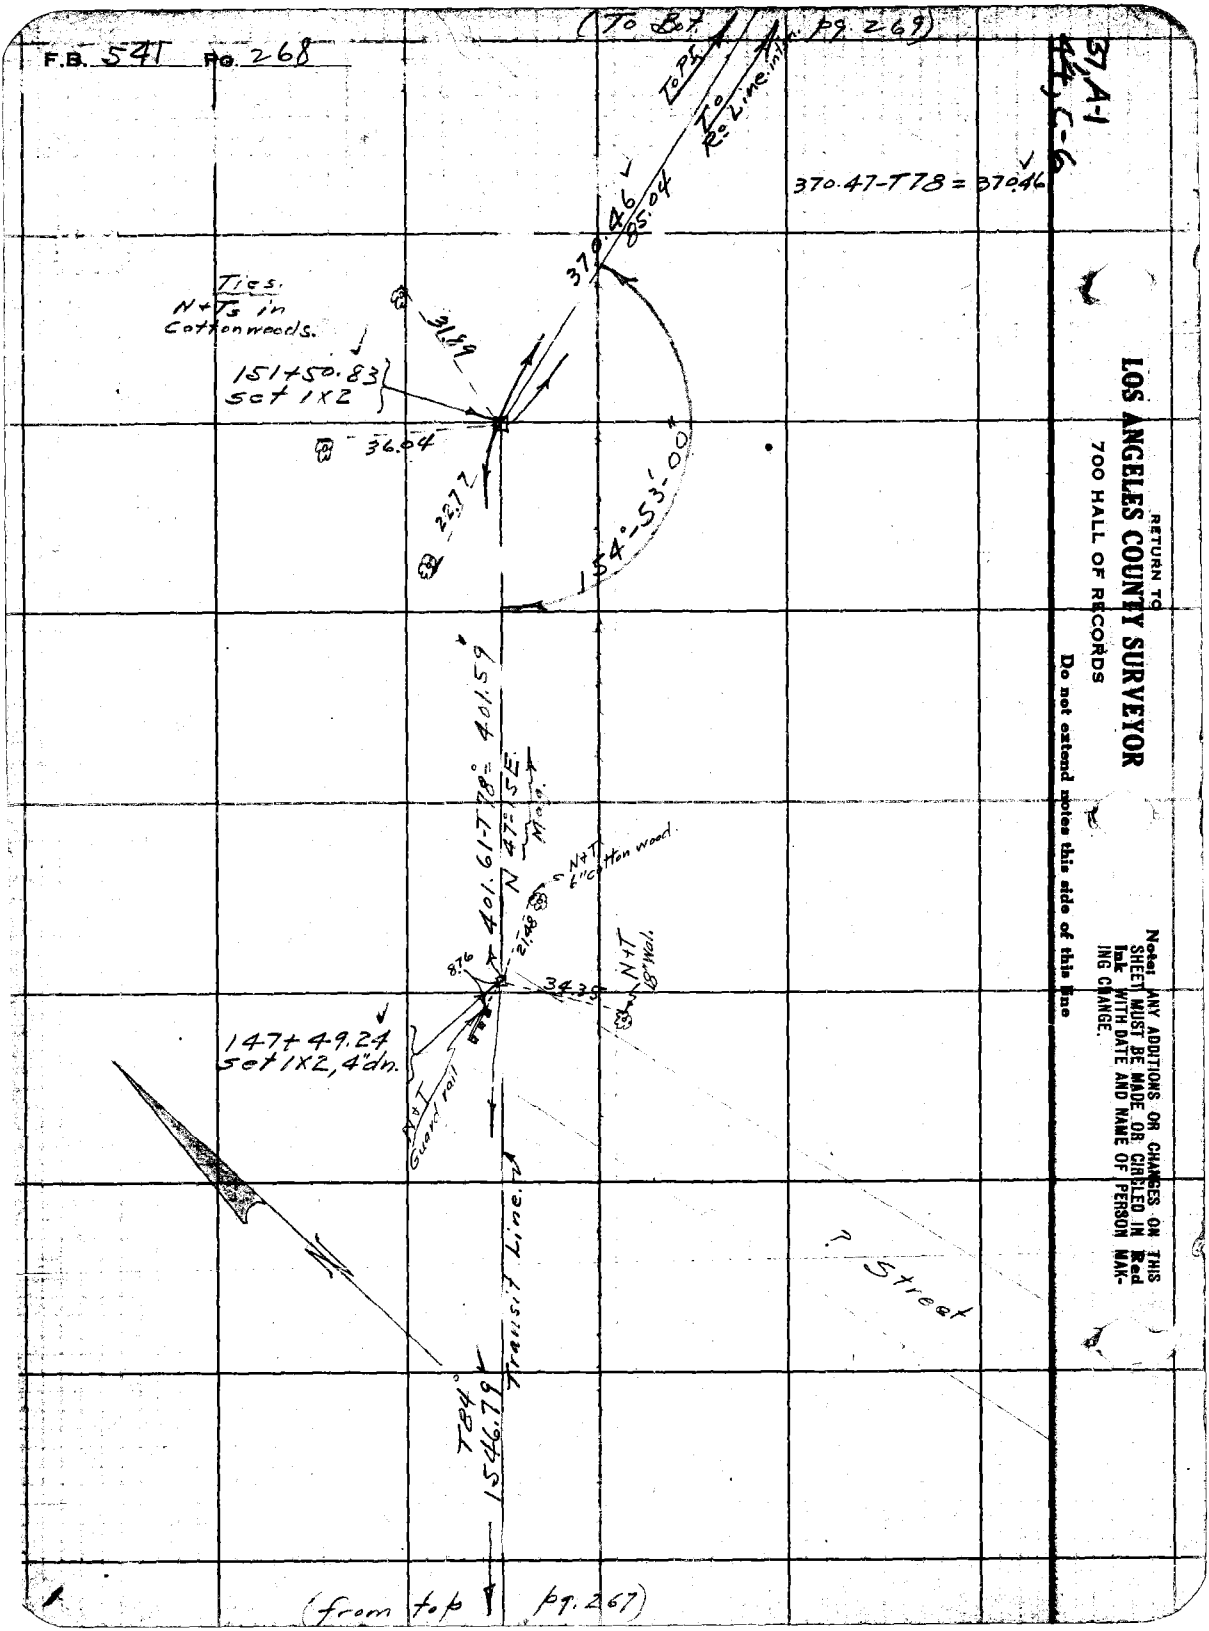
F.B. 541 Pg. 268
(To Bot. pg. 269)
To PI
To Ro Line int.
370.47-T78 = 370.46
370.46
85.04
Ties.
N+Ts in
Cottonwoods.
31.89
151+50.83
set 1X2
36.04
22.77
154°-53'-00"
401.61-T78° = 401.59
N 47° 5E
Mag.
N+T
6" cotton wood.
21.48
8.76
34.35
N+T
18" Wal.
147+49.24
set 1X2, 4" dn.
N+T
Guard rail
Transit Line
? Street
T84°
1546.79
(from top pg. 267)
37, A-1
44, C-6
RETURN TO
LOS ANGELES COUNTY SURVEYOR
700 HALL OF RECORDS
Do not extend notes this side of this line
Note: ANY ADDITIONS OR CHANGES ON THIS SHEET MUST BE MADE OR CIRCLED IN Red Ink WITH DATE AND NAME OF PERSON MAKING CHANGE.

Notes Ck'd by D. M. Finley	Survey of El Monte Bridle Trail	F.B. 541	Pg. 269
Map No. B-1005-3	W. O. 8012 Tape No 063 St'd 84 OF		
Office Work G.W. Gaz.	Surveyed by Evans		
Checked	Notes 12 Date 11/8/84		
Date	Indexed A. C. Johnson 6.18		

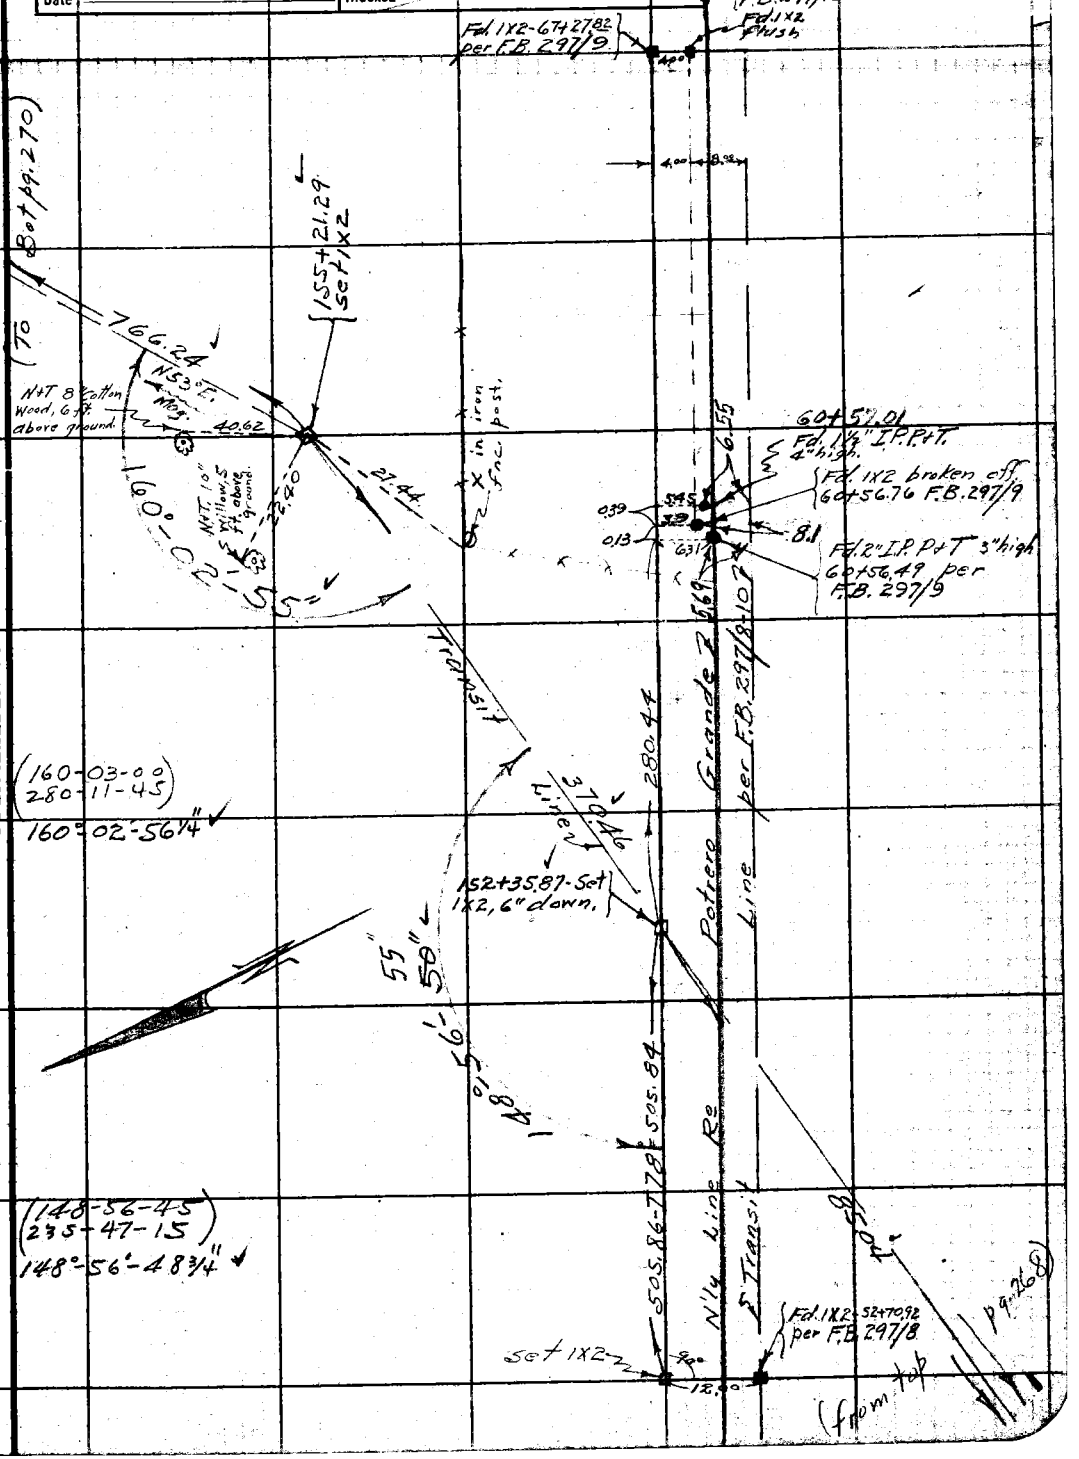

Note: ANY ADDITIONS OR CHANGES ON THIS SHEET MUST BE MADE OR CIRCLED IN Red Ink WITH DATE AND NAME OF PERSON MAKING CHANGE.

Do not extend notes this side of this line.

RETURN TO
LOS ANGELES COUNTY SURVEYOR
700 HALL OF RECORDS

FORM 247 BM 2-34

RETURN TO
LOS ANGELES COUNTY SURVEYOR
700 HALL OF RECORDS

Note: ANY ADDITIONS OR CHANGES ON THIS SHEET MUST BE MADE OR CIRCLED IN **Red Ink** WITH DATE AND NAME OF PERSON MAKING CHANGE.

Do not extend notes this side of this line

44, D-6

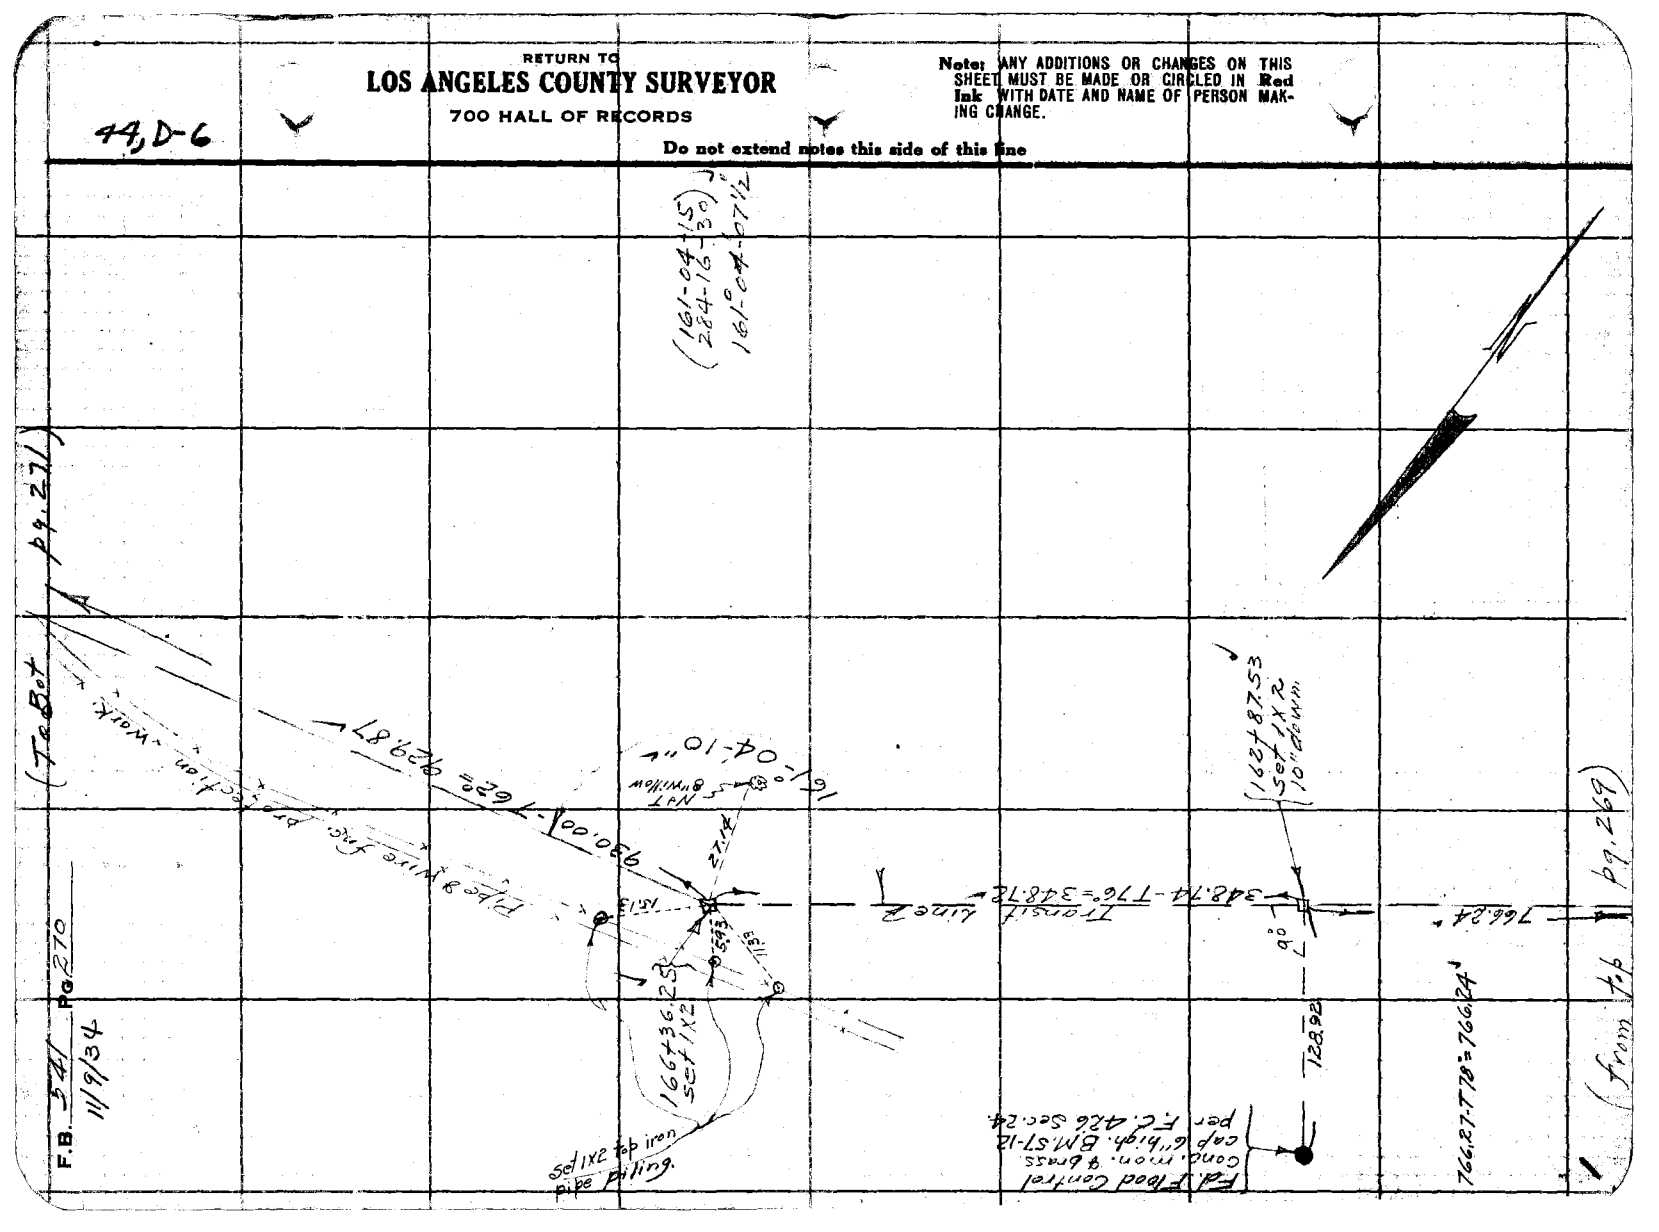

F.B. 541 PG 270
11/9/34

Notes Ck'd by D. M. Finley	Survey of El Monte Brittle Trail
Map No. B-1005-3	W. O. 8012 Tape No 063 St'd 24 °F.
Office Work C. W. Cox	Surveyed by Evans
Checked	Notes H Date 11/13/34
Date	Indexed A. C. Johnson

F.B. 541 Pg. 271

44, D-6

(To Bot. pg. 272)

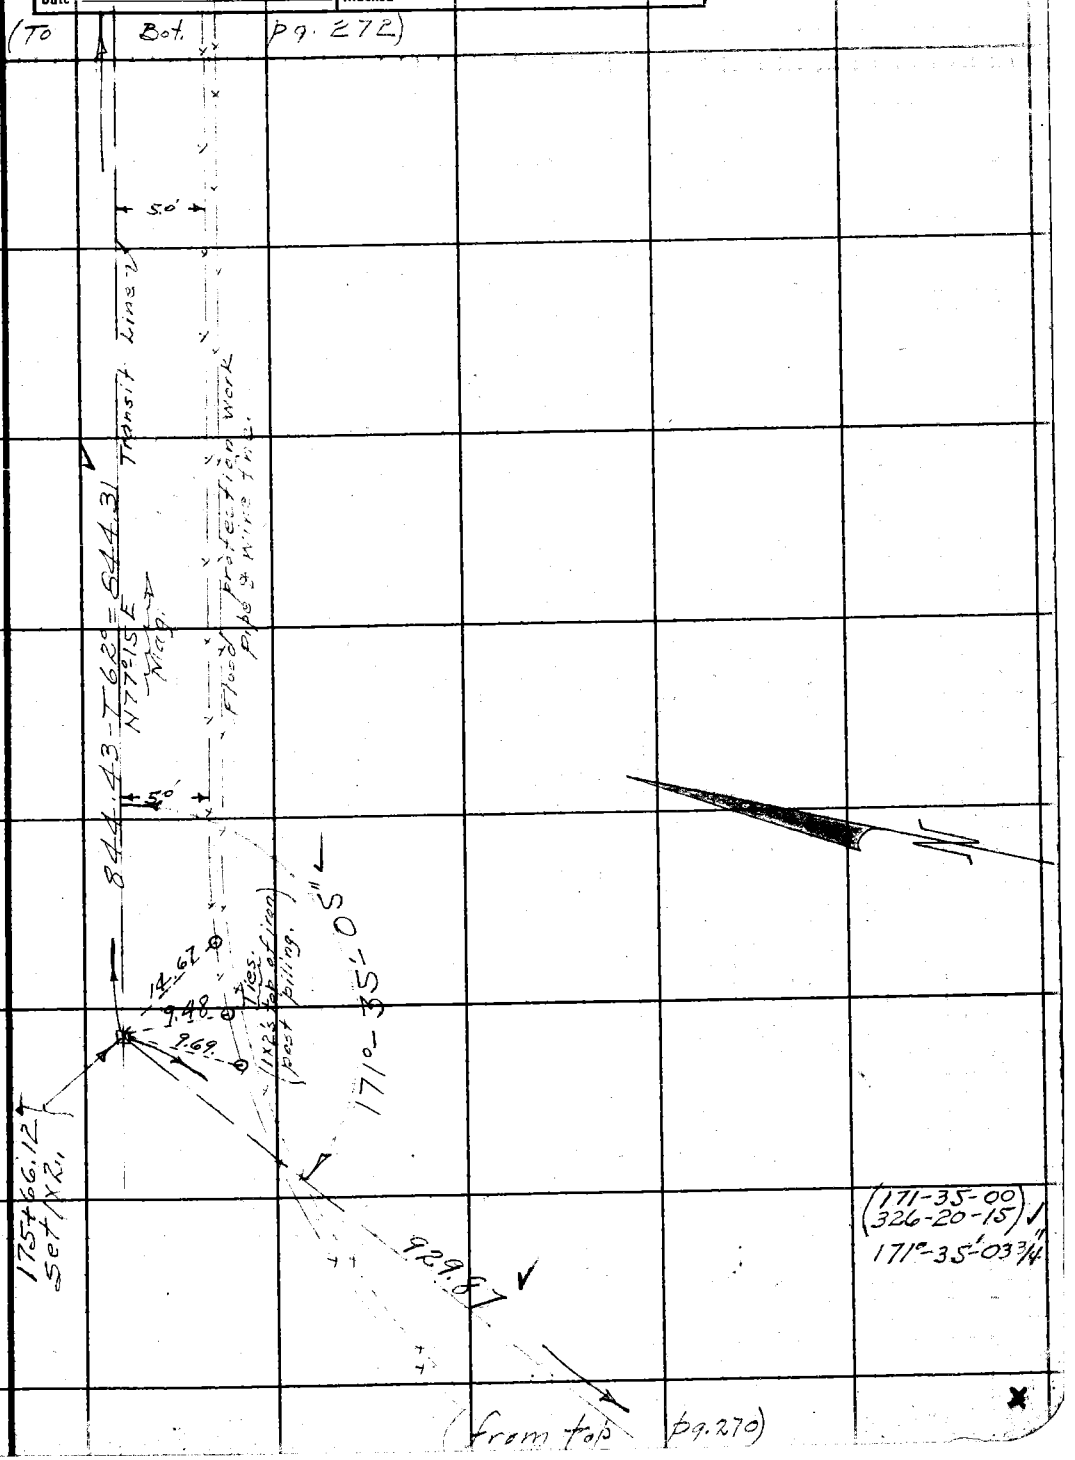

(from top pg. 270)

Note: ANY ADDITIONS OR CHANGES ON THIS SHEET MUST BE MADE OR CIRCLED IN Red Ink WITH DATE AND NAME OF PERSON MAKING CHANGE.

Do not extend notes this side of this line

RETURN TO
LOS ANGELES COUNTY SURVEYOR
700 HALL OF RECORDS

FORM 247 5M 2-34

RETURN TO
LOS ANGELES COUNTY SURVEYOR
700 HALL OF RECORDS

44, D-6

Note: ANY ADDITIONS OR CHANGES ON THIS SHEET MUST BE MADE OR CIRCLED IN Red Ink WITH DATE AND NAME OF PERSON MAKING CHANGE.

Do not extend notes this side of this line

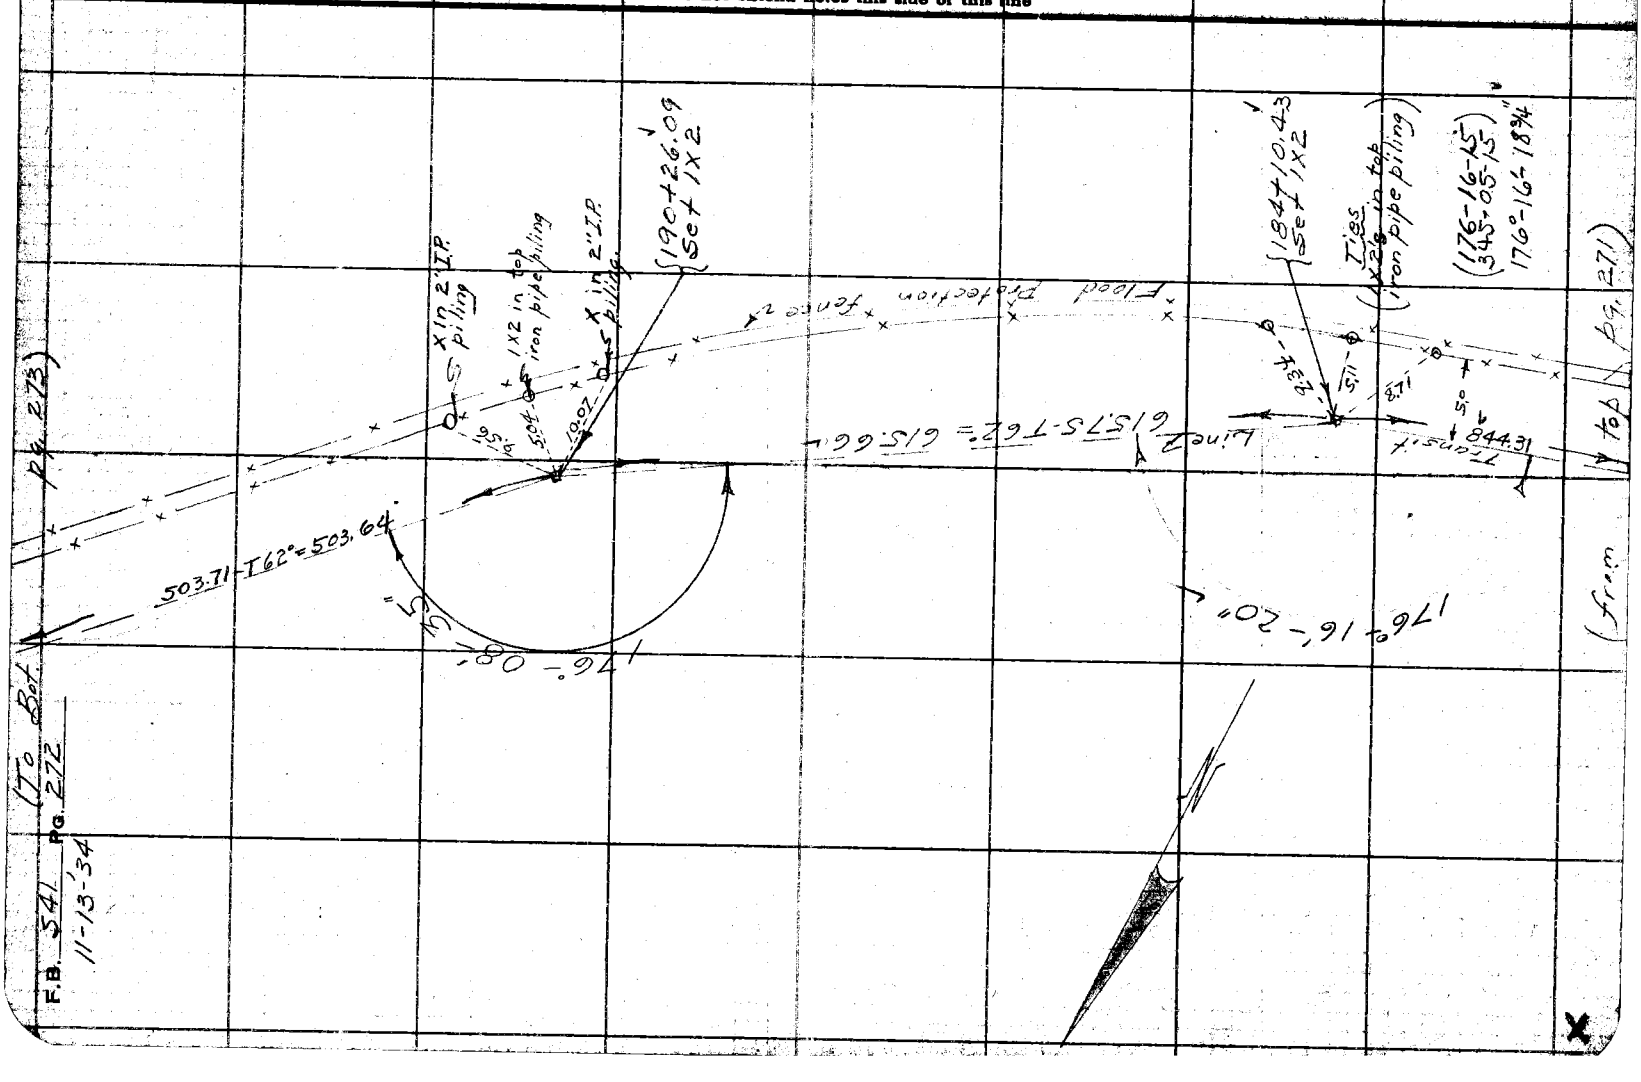

Notes Ck'd by D. M. Finley	Survey of El Monte Bridle Trail	F.B. 541	Pg. 273
Map No. B-1005-3	W. O. 2012 Tape No ___ St'd ___ of ___		
Office Work C.W. Cox	Surveyed by Evans		
Checked	Notes A. C. Johnson Date		
Date	Indexed		

46-A-5
44 D-6

Note: ANY ADDITIONS OR CHANGES ON THIS SHEET MUST BE MADE OR CIRCLED IN Red Ink WITH DATE AND NAME OF PERSON MAKING CHANGE.

Do not extend notes this side of this line

RETURN TO
LOS ANGELES COUNTY SURVEYOR
700 HALL OF RECORDS

FORM 247 5M 2-34

RETURN TO

LOS ANGELES COUNTY SURVEYOR

700 HALL OF RECORDS

Note: ANY ADDITIONS OR CHANGES ON THIS SHEET MUST BE MADE OR CIRCLED IN **Red Ink** WITH DATE AND NAME OF PERSON MAKING CHANGE.

Do not extend notes this side of this line

F.B. 541 Pg. 274

Notes Ck'd by D. M. Finley	Survey of El Monte Bridge Trl	F.B. 541	Pg 275
Map No. B-1005-7	W. O. 8012 Tape No 067 St'd 84 °F.		
Office Work C.W. Cox	Surveyed by Evans		
Checked	Notes	Date 4/3/35	
Date	Indexed A. C. Johnson 4-8-35		

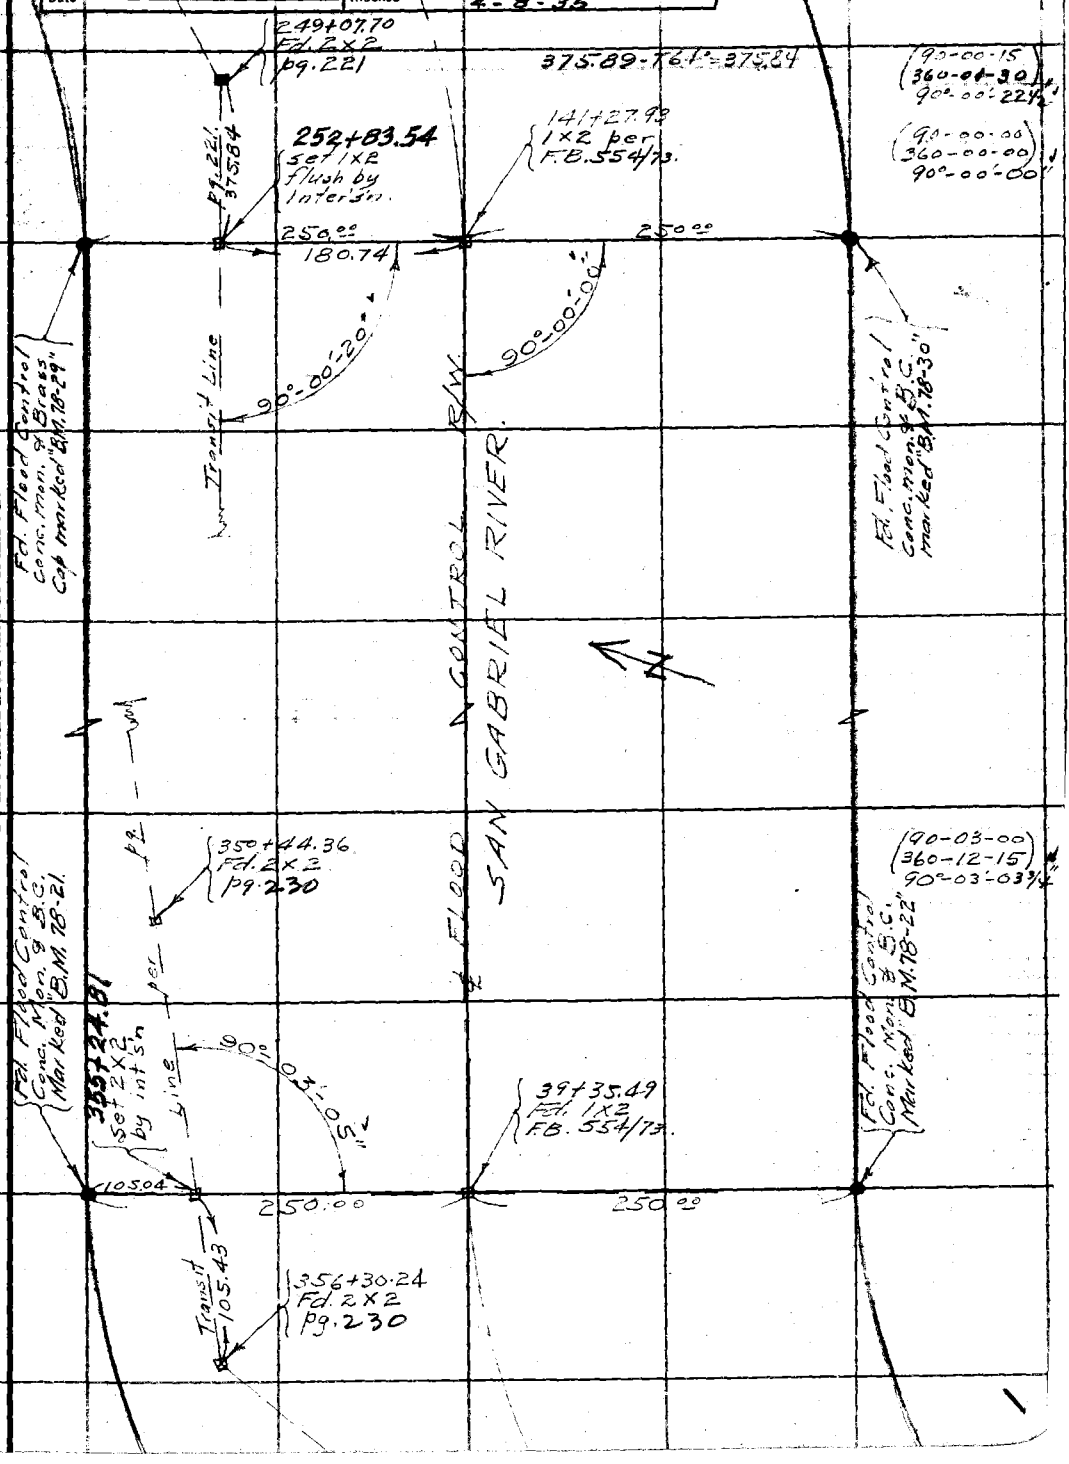

Note: ANY ADDITIONS OR CHANGES ON THIS SHEET MUST BE MADE OR CIRCLED IN Red Ink WITH DATE AND NAME OF PERSON MAKING CHANGE.

Do not extend notes this side of this line

RETURN TO
LOS ANGELES COUNTY SURVEYOR
700 HALL OF RECORDS

FORM 247 5M 2-34
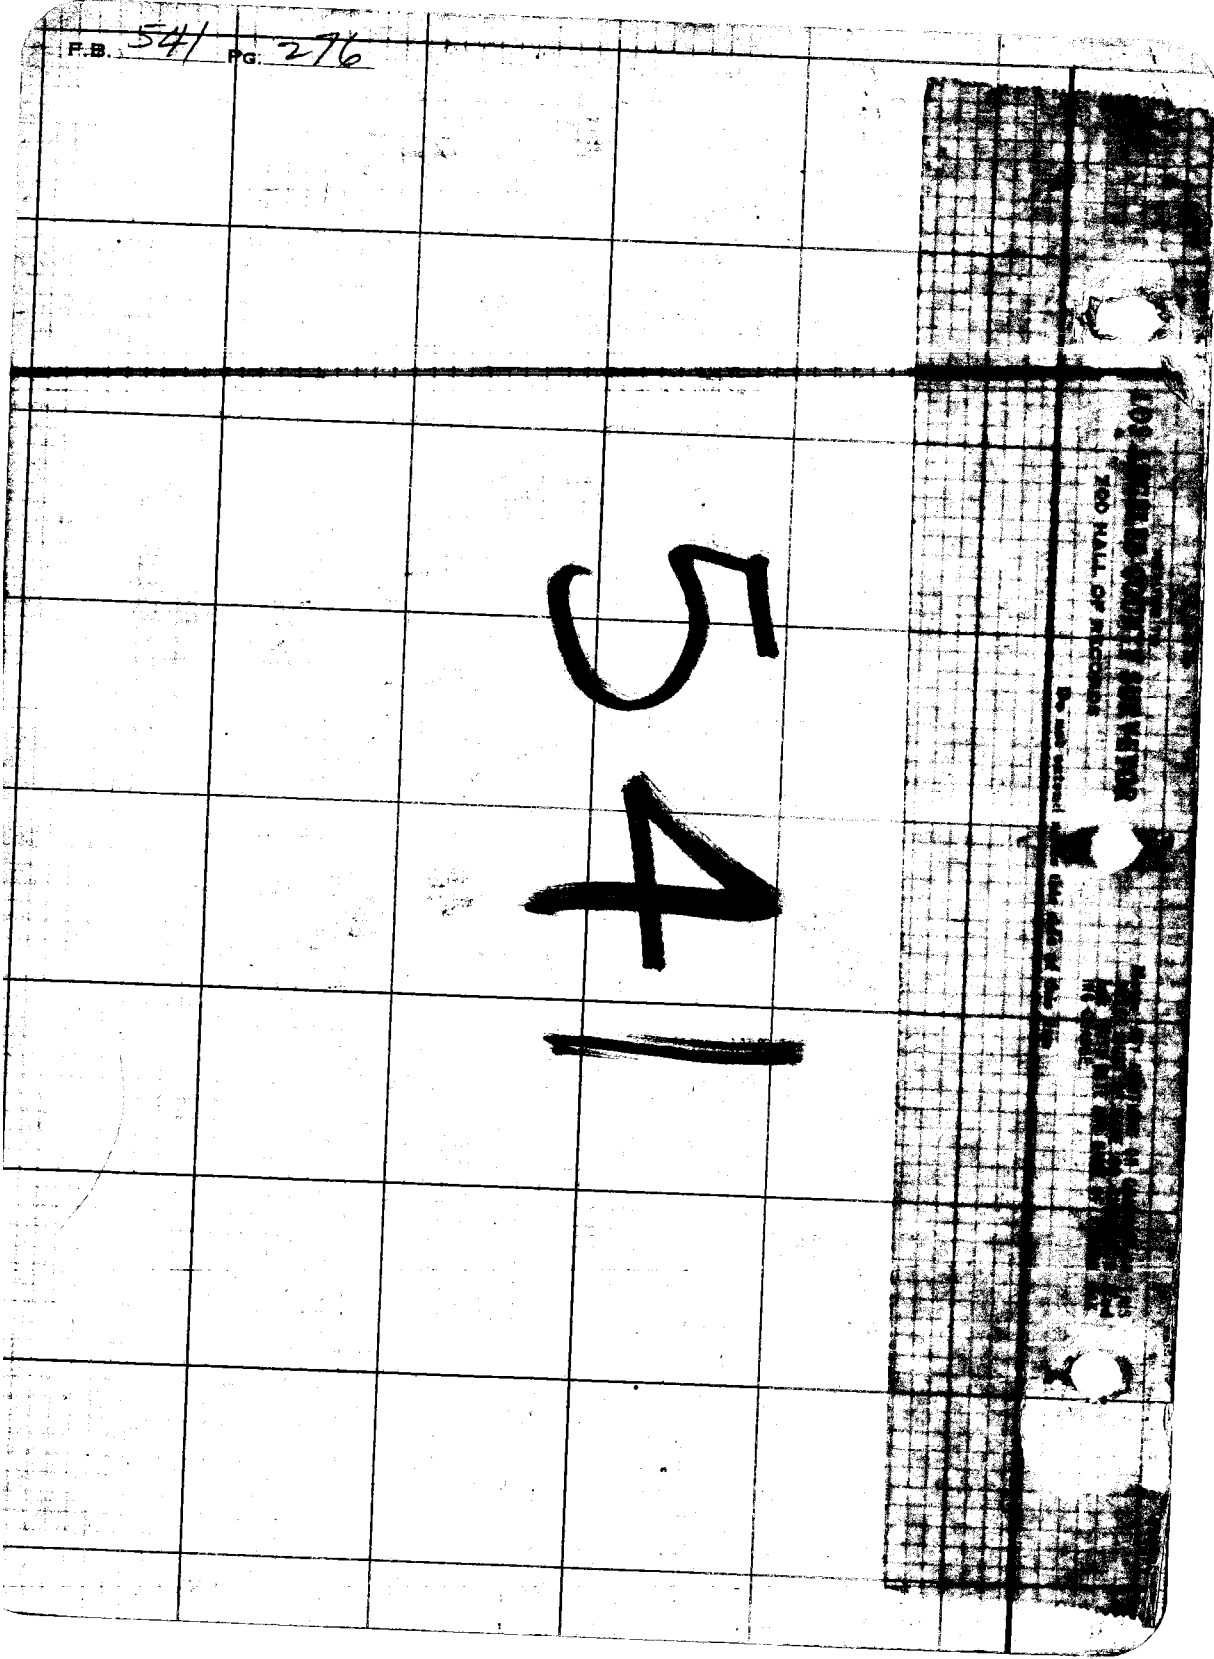
P.B. 541 PG. 276