Notes Ck'd by	Survey of	F.B. PG.
Map No.	W. O. Tape No. St'd of	
Office Work	Surveyed by	
Checked	Notes Date	
Date	Indexed	

Note: Any Additions or Changes on This Sheets Must be Made or Circled in Red Ink With Date and Name of Person Making Change.

Do not extend notes this side of this line

RETURN TO
LOS ANGELES COUNTY SURVEYOR
700 HALL OF RECORDS

FORM 247 5M 10-57

F.B. 623 PG. Index

F.B. 623

PAGES: Index, 1to 41 incl., 42 51 52 to 127 incl., 128 to 145 incl., 146 to 179 incl., , 181 to 203 incl., , 205 to 213 incl., , 215 to 251 incl.,

RETURN TO:
LOS ANGELES COUNTY SURVEYOR
700 HALL OF RECORDS

Do not extend notes this side of this line

Note: Any Additions or Changes on This Sheets Must be Made or Circled in Red Ink With Date and Name of Person Making Change.

Alhambra Ave.

1302

C.S.B. - [redacted]

F.B. 623 Pg. 1

SURVEY OF ALHAMBRA AVE. FROM HELLMAN AVE. TO MISSION ROAD.

H.F. EVANS - Dep.
H.L. MARTIN - R.C.
D.S. SEDIG - R.C.
J.W. HARRIS - R.C.
W.D. WILLEFORD - R.C.

RETURN TO
LOS ANGELES COUNTY SURVEYOR
700 HALL OF RECORDS

Do not extend notes this side of this line

Note: ANY ADDITIONS OR CHANGES ON THIS SHEET MUST BE MADE OR ENTERED IN Red Ink WITH DATE AND NAME OF PERSON MAKING CHANGE.

RETURN TO
LOS ANGELES COUNTY SURVEYOR
700 HALL OF RECORDS

Notice: ANY ADDITIONS OR CHANGES ON THIS SHEET MUST BE MADE OR CIRCLED IN Red Ink WITH DATE AND NAME OF PERSON MAKING CHANGE.

Do not extend notes this side of this line

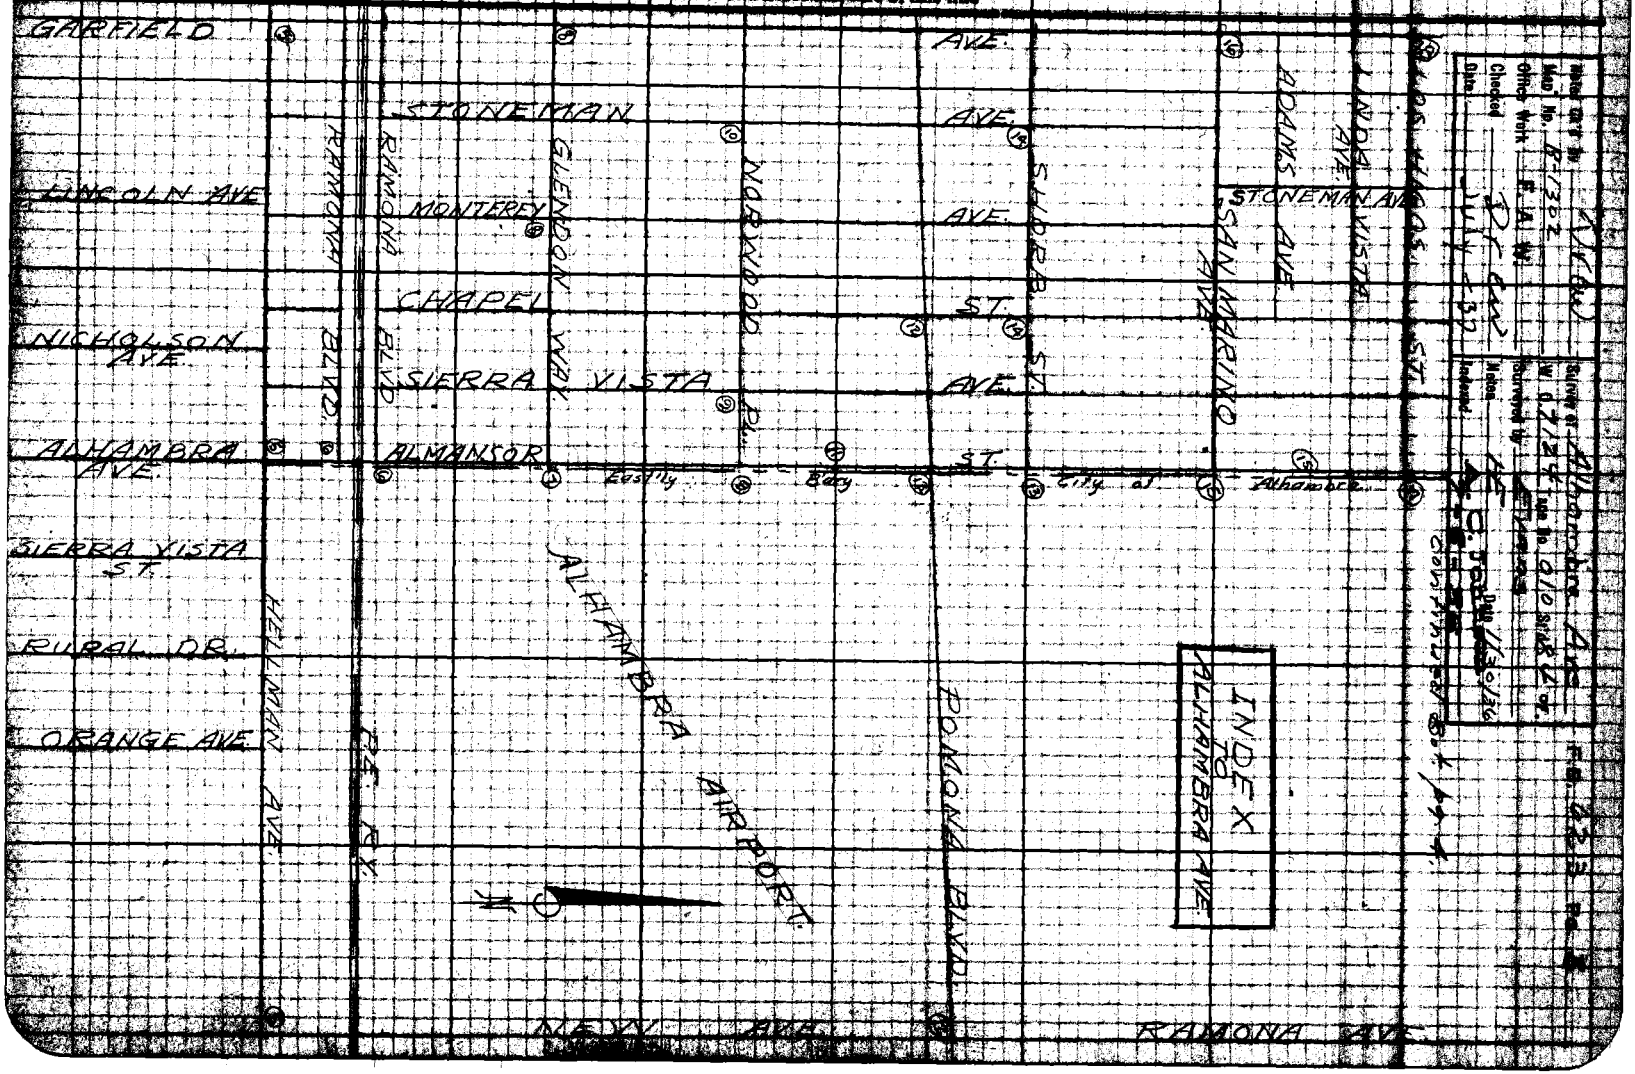

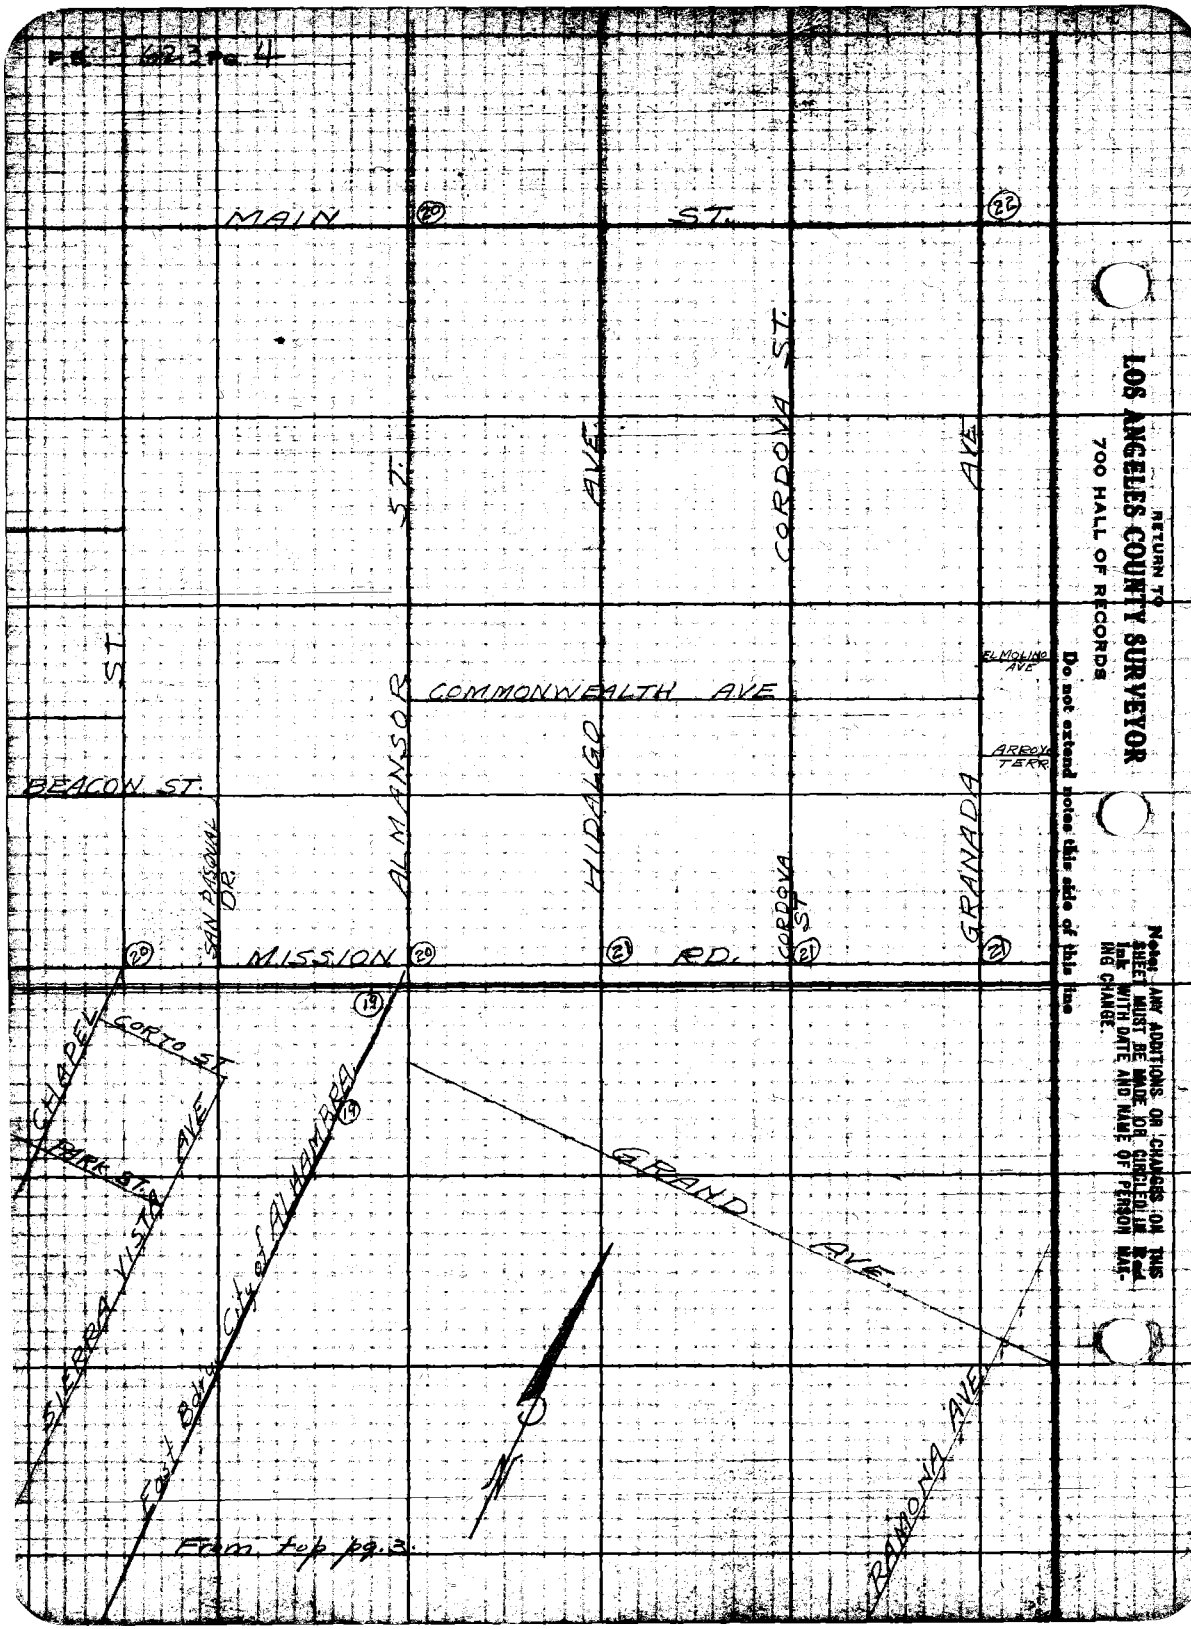

F.B. 623 Pg. 4
MAIN ST.
20
22
ST.
ALMANSOR ST.
HIDALGO AVE.
CORDOVA ST.
GRANADA AVE.
COMMONWEALTH AVE
EL MOLINO AVE
ARROYO TERR
BEACON ST.
SAN PASQUAL DR.
MISSION RD.
CORDOVA ST
21
19
CHAPEL
CORTO ST.
PARK ST.
SIERRA VISTA AVE
East Bdry City of ALHAMBRA
GRAND AVE.
RAMONA AVE.
From top pg. 3
RETURN TO
LOS ANGELES COUNTY SURVEYOR
700 HALL OF RECORDS
Do not extend notes this side of this line
Note: ANY ADDITIONS OR CHANGES ON THIS SHEET MUST BE MADE OR CIRCLED IN Red Ink WITH DATE AND NAME OF PERSON MAKING CHANGE.

RETURN TO
LOS ANGELES COUNTY SURVEYOR
700 HALL OF RECORDS

Notice: ANY ADDITIONS OR CHANGES ON THIS SHEET MUST BE MADE OR CIRCLED IN RED INK WITH DATE AND NAME OF PERSON MAKING CHANGE.

Do not extend notes on this side of this line

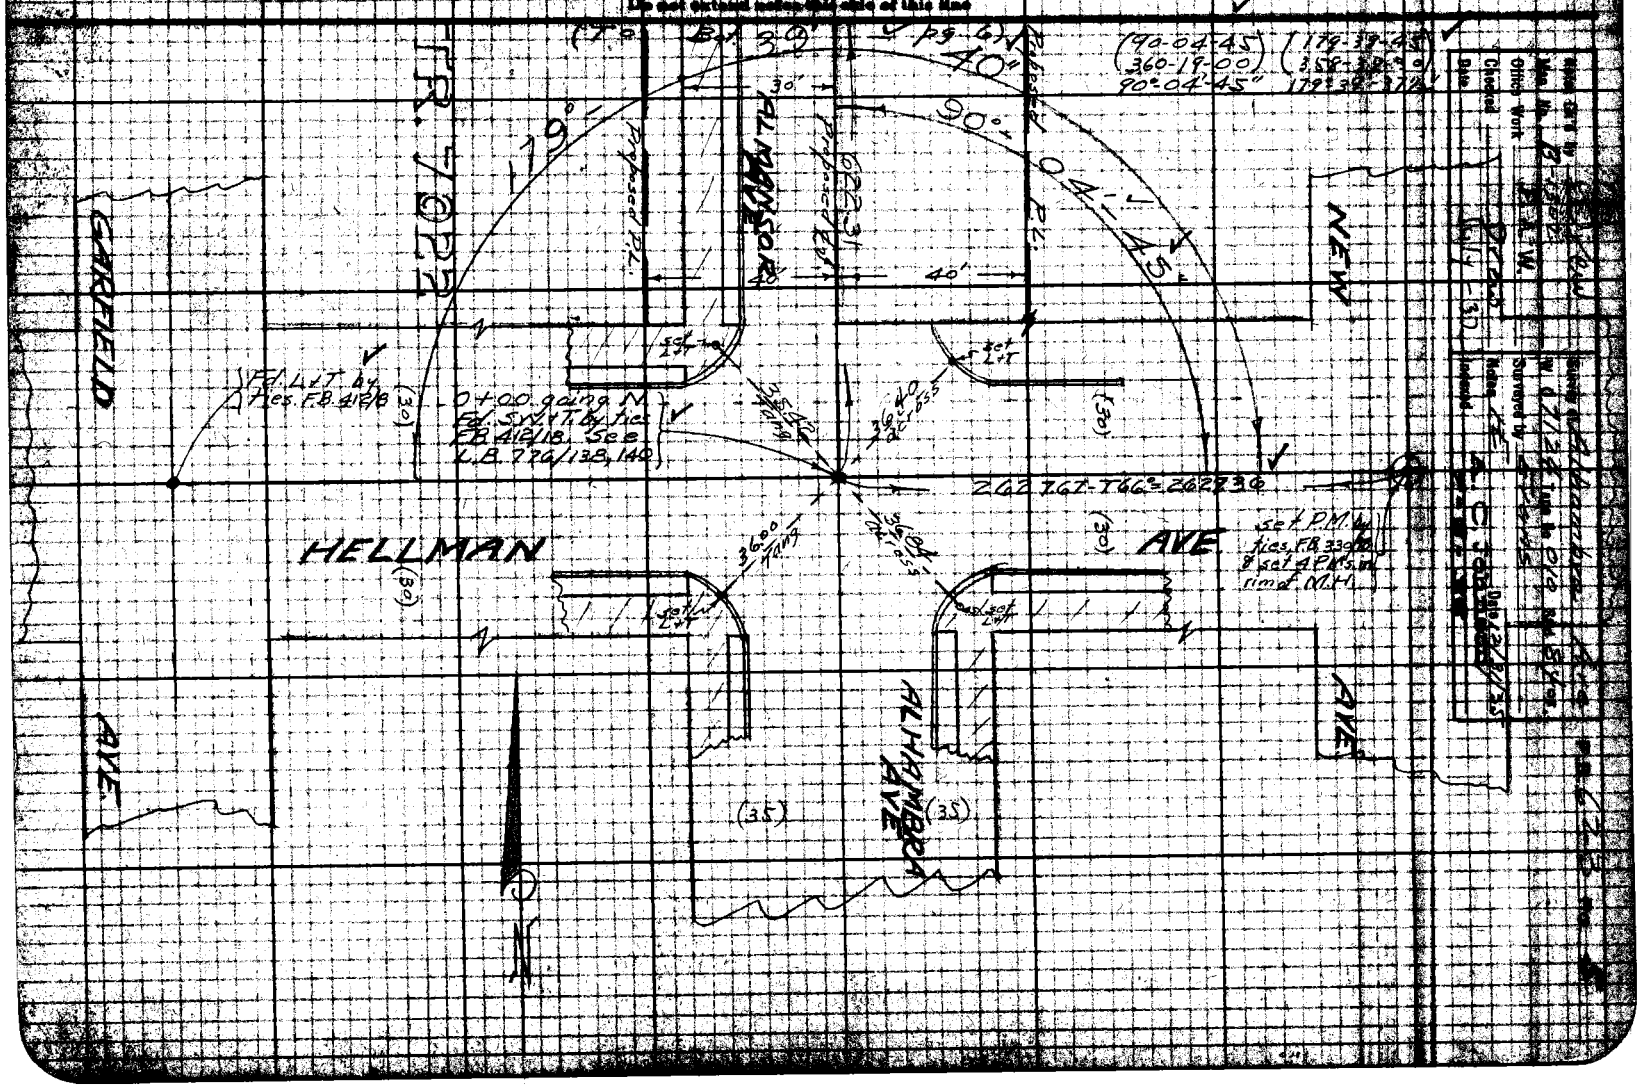

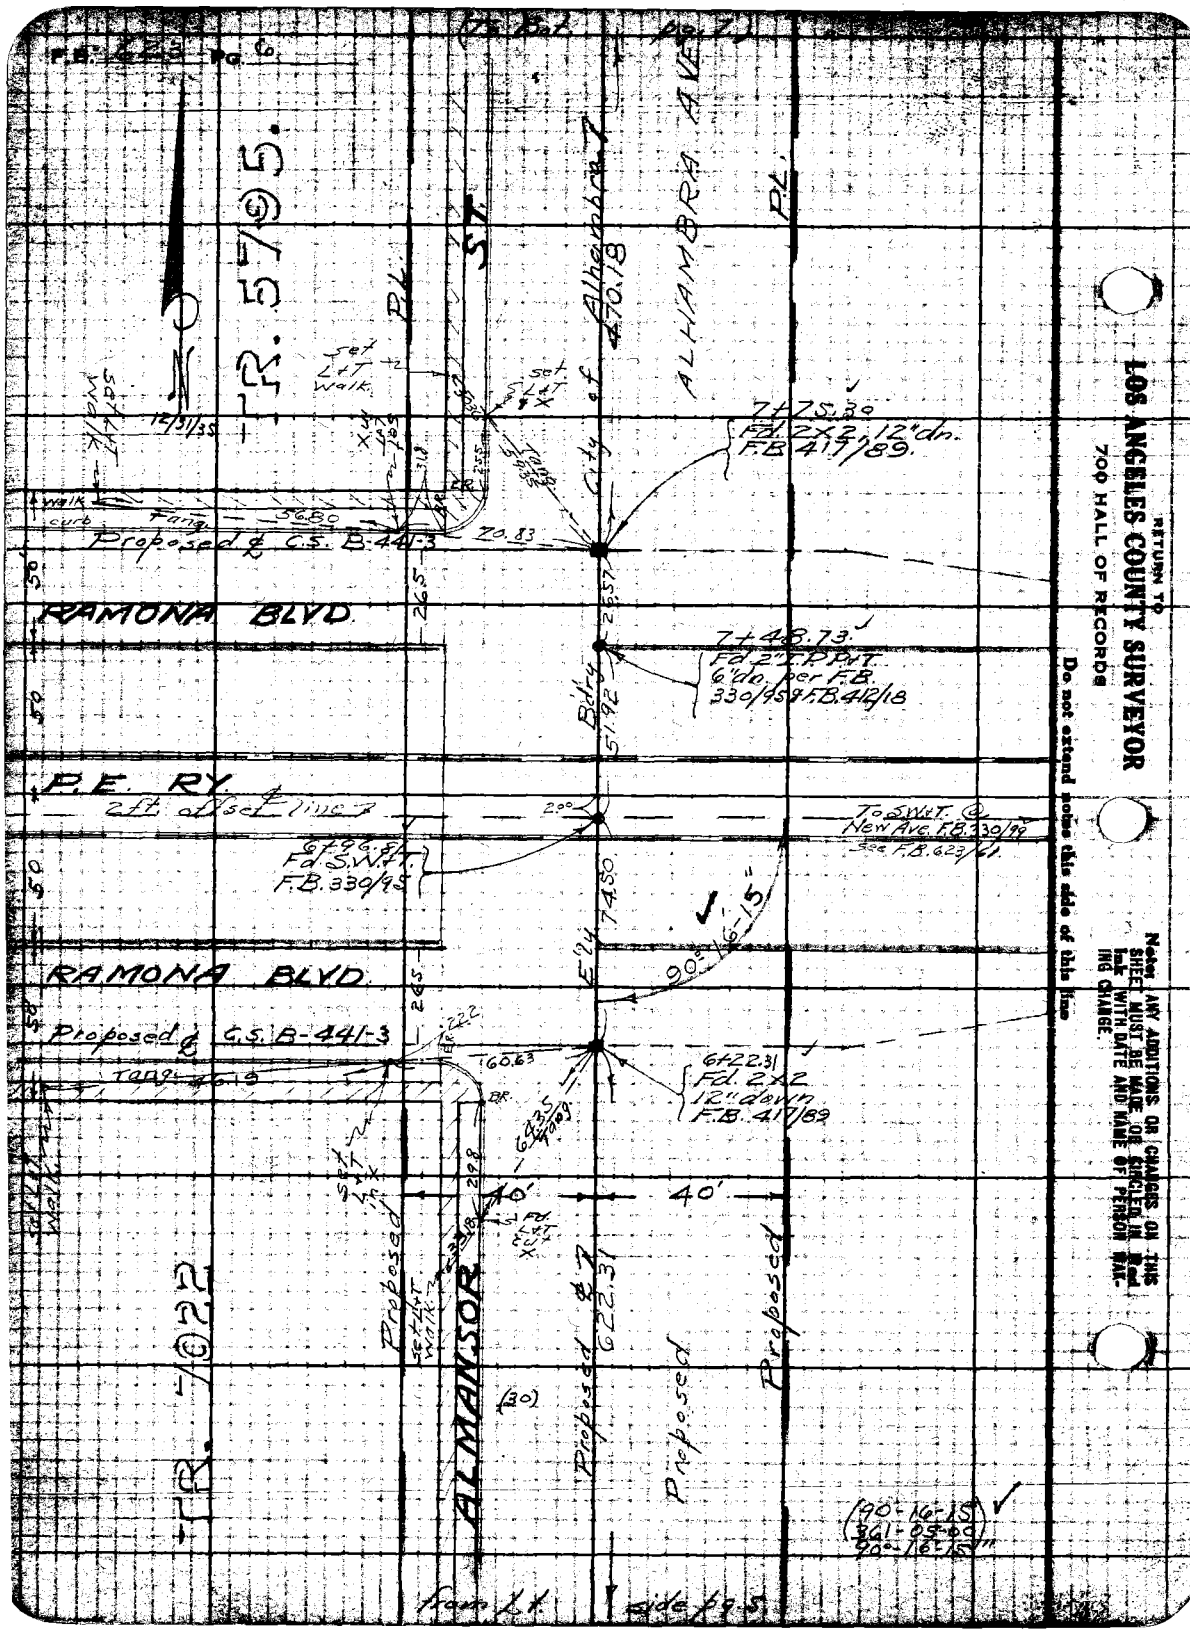

RETURN TO
LOS ANGELES COUNTY SURVEYOR
700 HALL OF RECORDS

Do not extend notes this side of this line

Note: ANY ADDITIONS OR CHANGES ON THIS SHEET MUST BE MADE OR CIRCLED IN Red Ink WITH DATE AND NAME OF PERSON MAKING CHANGE.

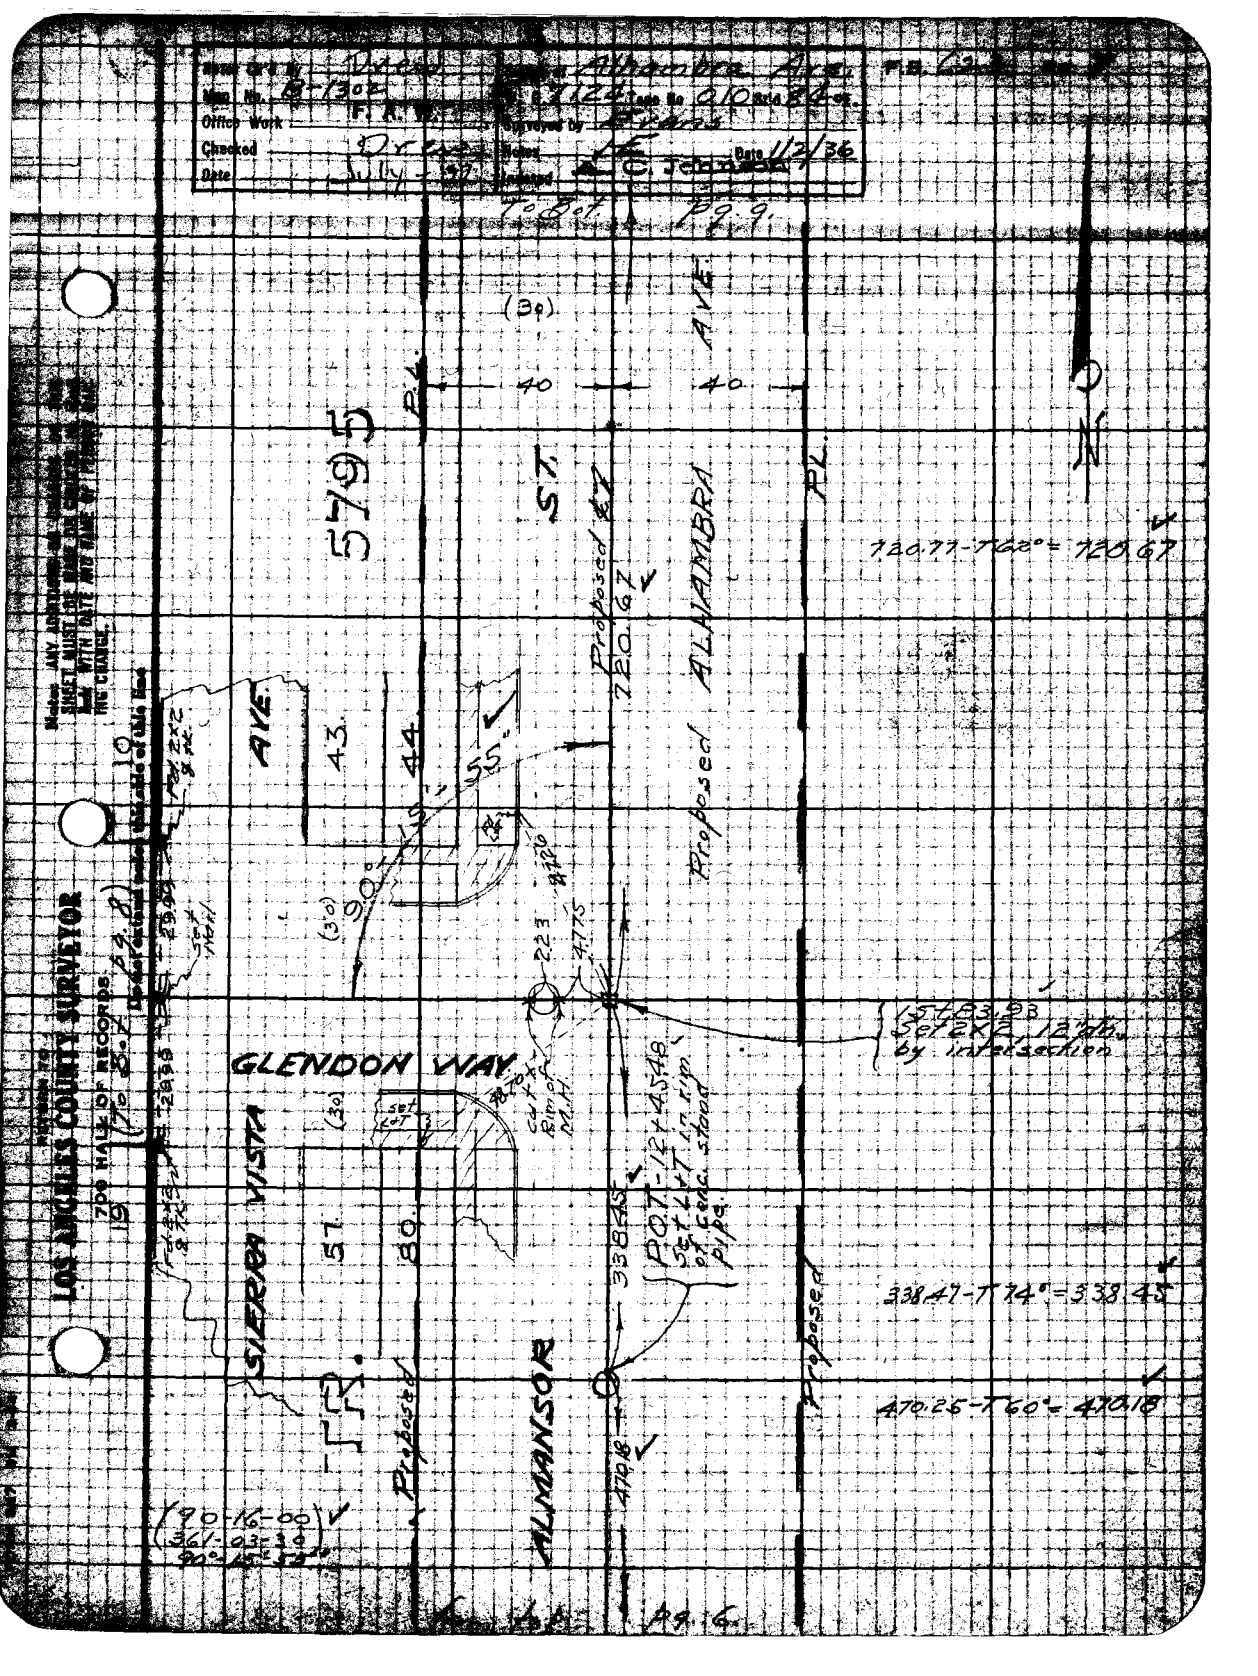

Drew
Alhambra Ave.
Map No. B-1302
Office Work F. A. W.
Surveyed by Evans
Checked Drew
Date July - 37
Date 1/2/36
C. Johnson
To Bot. Pg. 9.
(30)
40
40
P.L.
P.L.
5795
ST.
AVE.
Proposed ALHAMBRA
Proposed ℄
720.67
720.77-T62° = 720.67
AVE.
43
44
55
90°
(30)
223
4775
15+83.93
Set 2X2, 12" dn.
by intersection
GLENDON WAY
(30)
Set L+T
Cut Rim of M.H.
P.O.T.-12+45.48
Set L+T in rim of conc. stand pipe.
SIERRA VISTA
57
80
338.45
338.47-T74° = 338.45
470.25-T60° = 470.18
ALMANSOR
Proposed
Proposed
470.18
(90-16-00)
(361-03-30)
90°-15'-55"
Pg. 6.
LOS ANGELES COUNTY SURVEYOR
700 HALL OF RECORDS
Notes ANY ADDITIONS OR CHANGES IN THIS SHEET MUST BE MADE ON COUNTY SURVEYOR WITH DATE AND NAME OF PERSON MAKING CHANGE.

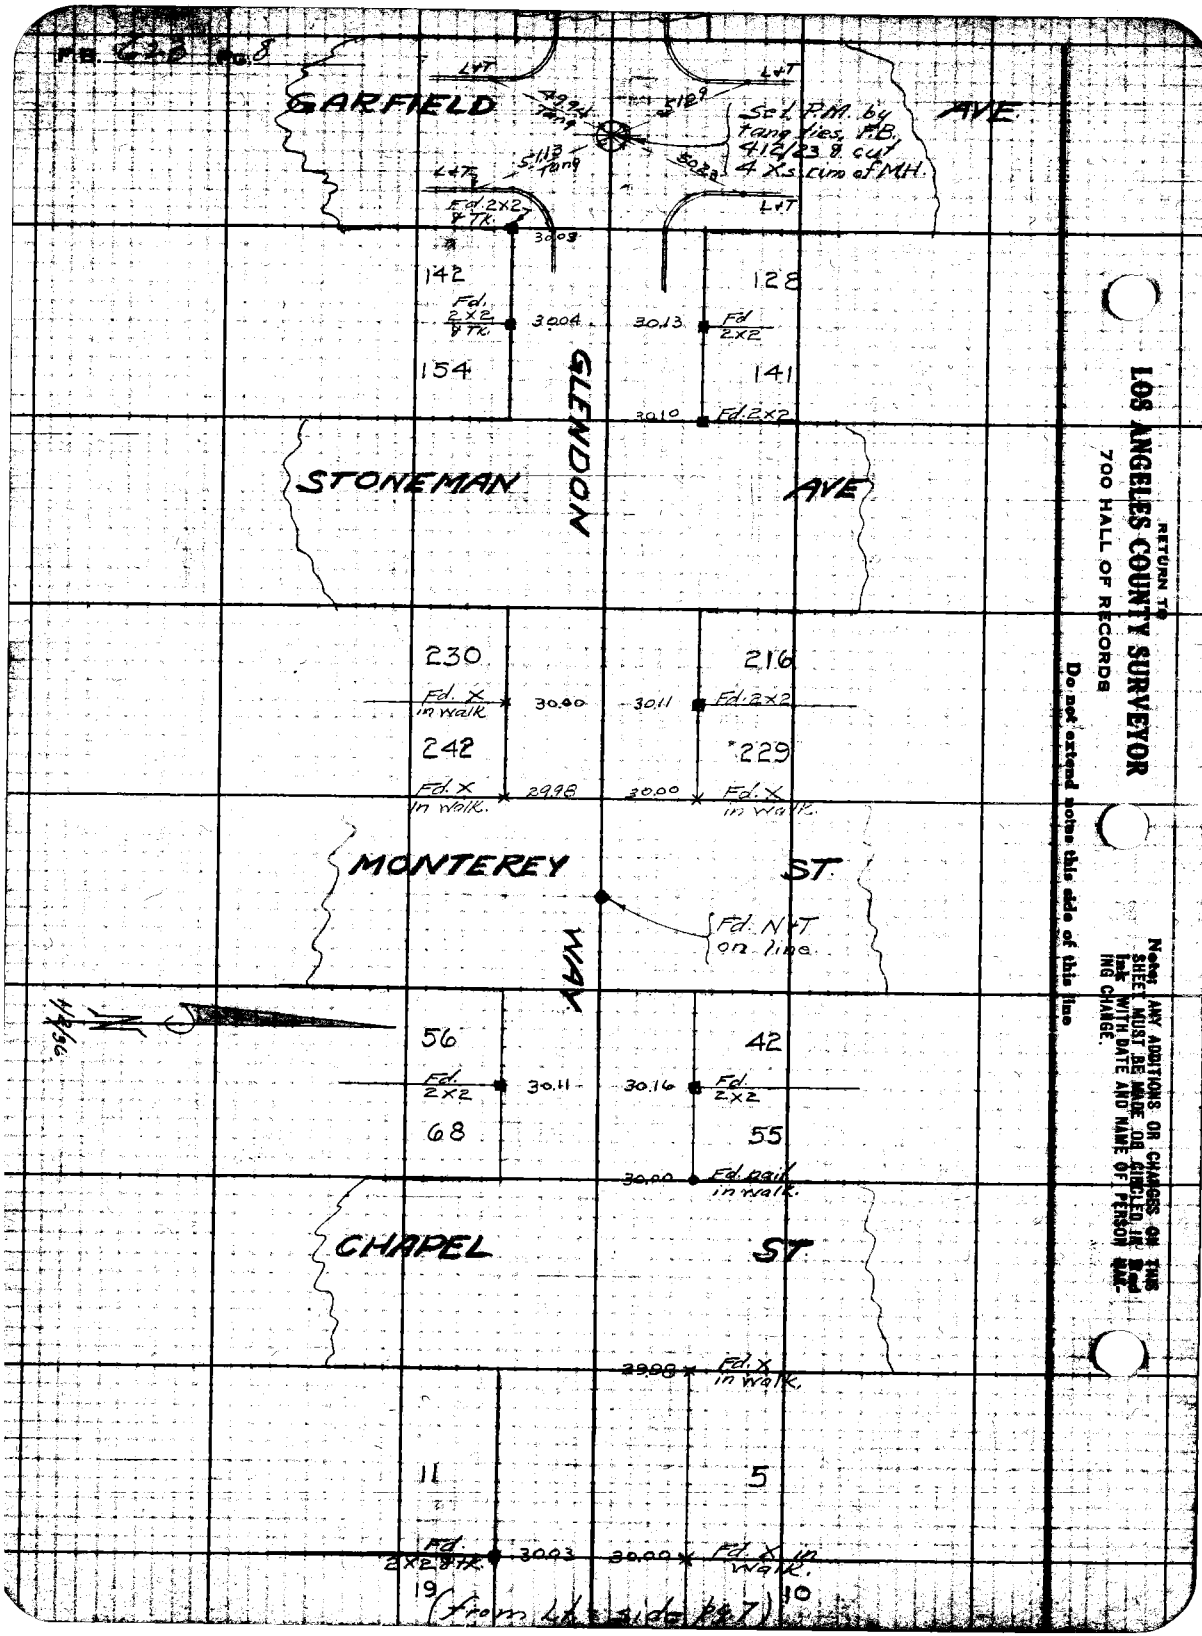

RETURN TO
LOS ANGELES COUNTY SURVEYOR
700 HALL OF RECORDS

Do not extend notes this side of this line

Note: ANY ADDITIONS OR CHANGES ON THIS SHEET MUST BE MADE OR CIRCLED IN Red Ink WITH DATE AND NAME OF PERSON MAKING CHANGE.

Notes Ck'd by Drew	Survey of Alhambra Ave
Map No. B-1302	W. O. 7124 Tape No. 010 Std 84 oz.
Office Work F. A. W.	Surveyed by Evans
Checked Drew	Notes HE Date 1/2/36
Date July -37	Indexed C. Johnson

F.B. 623 Page

(To Bot pg. 11.)

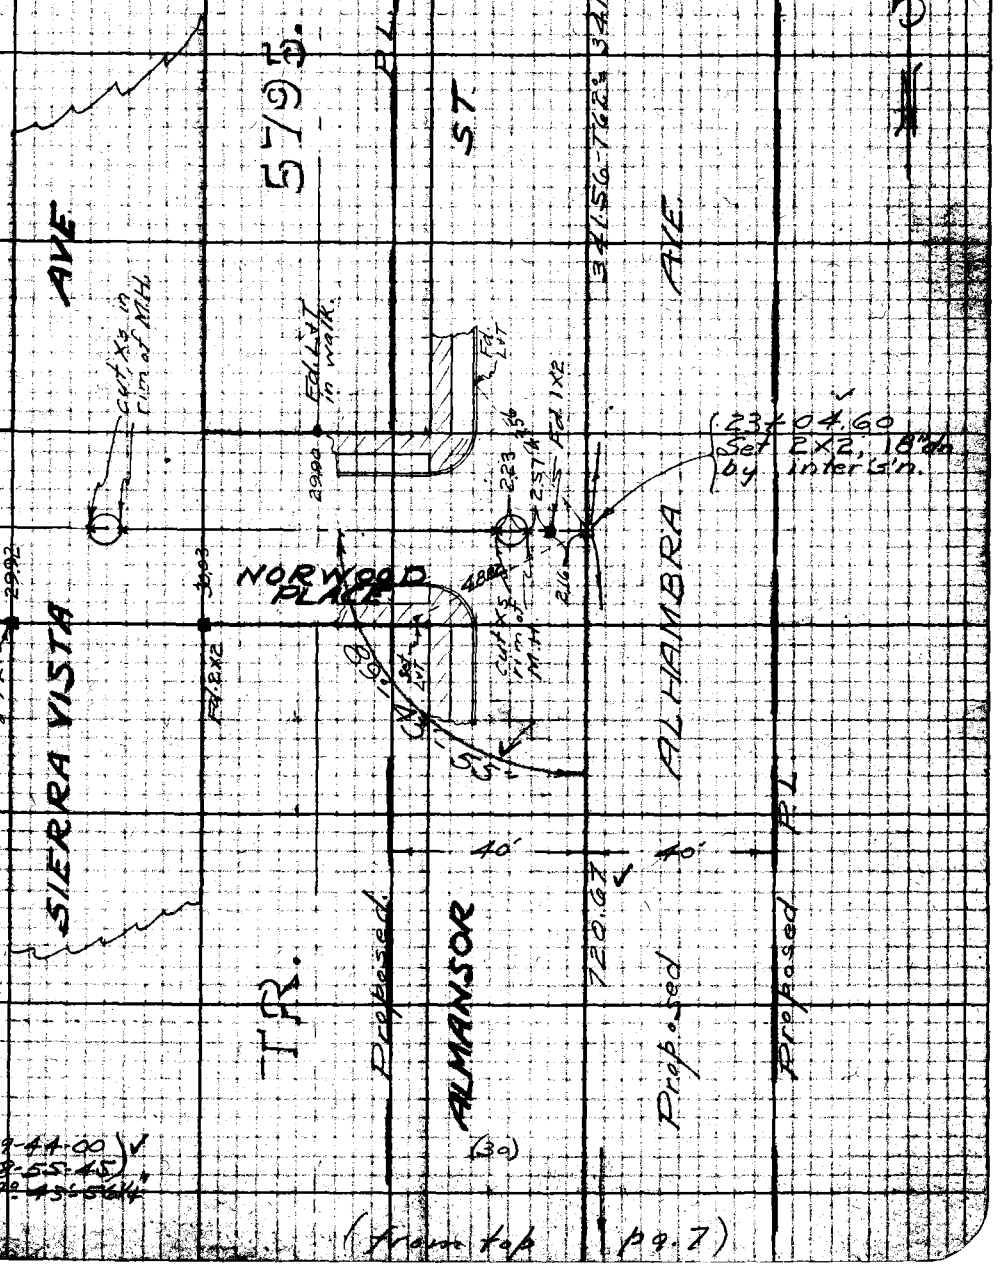

(from top pg. 7)

RETURN TO
LOS ANGELES COUNTY SURVEYOR
700 HALL OF RECORDS
Do not extend notes this side of this line
Notes: ANY ADDITIONS OR CHANGES ON THIS SHEET MUST BE MADE OR CIRCLED IN RED INK WITH DATE AND NAME OF PERSON MAKING CHANGE.
FORM 247 BM 2-34

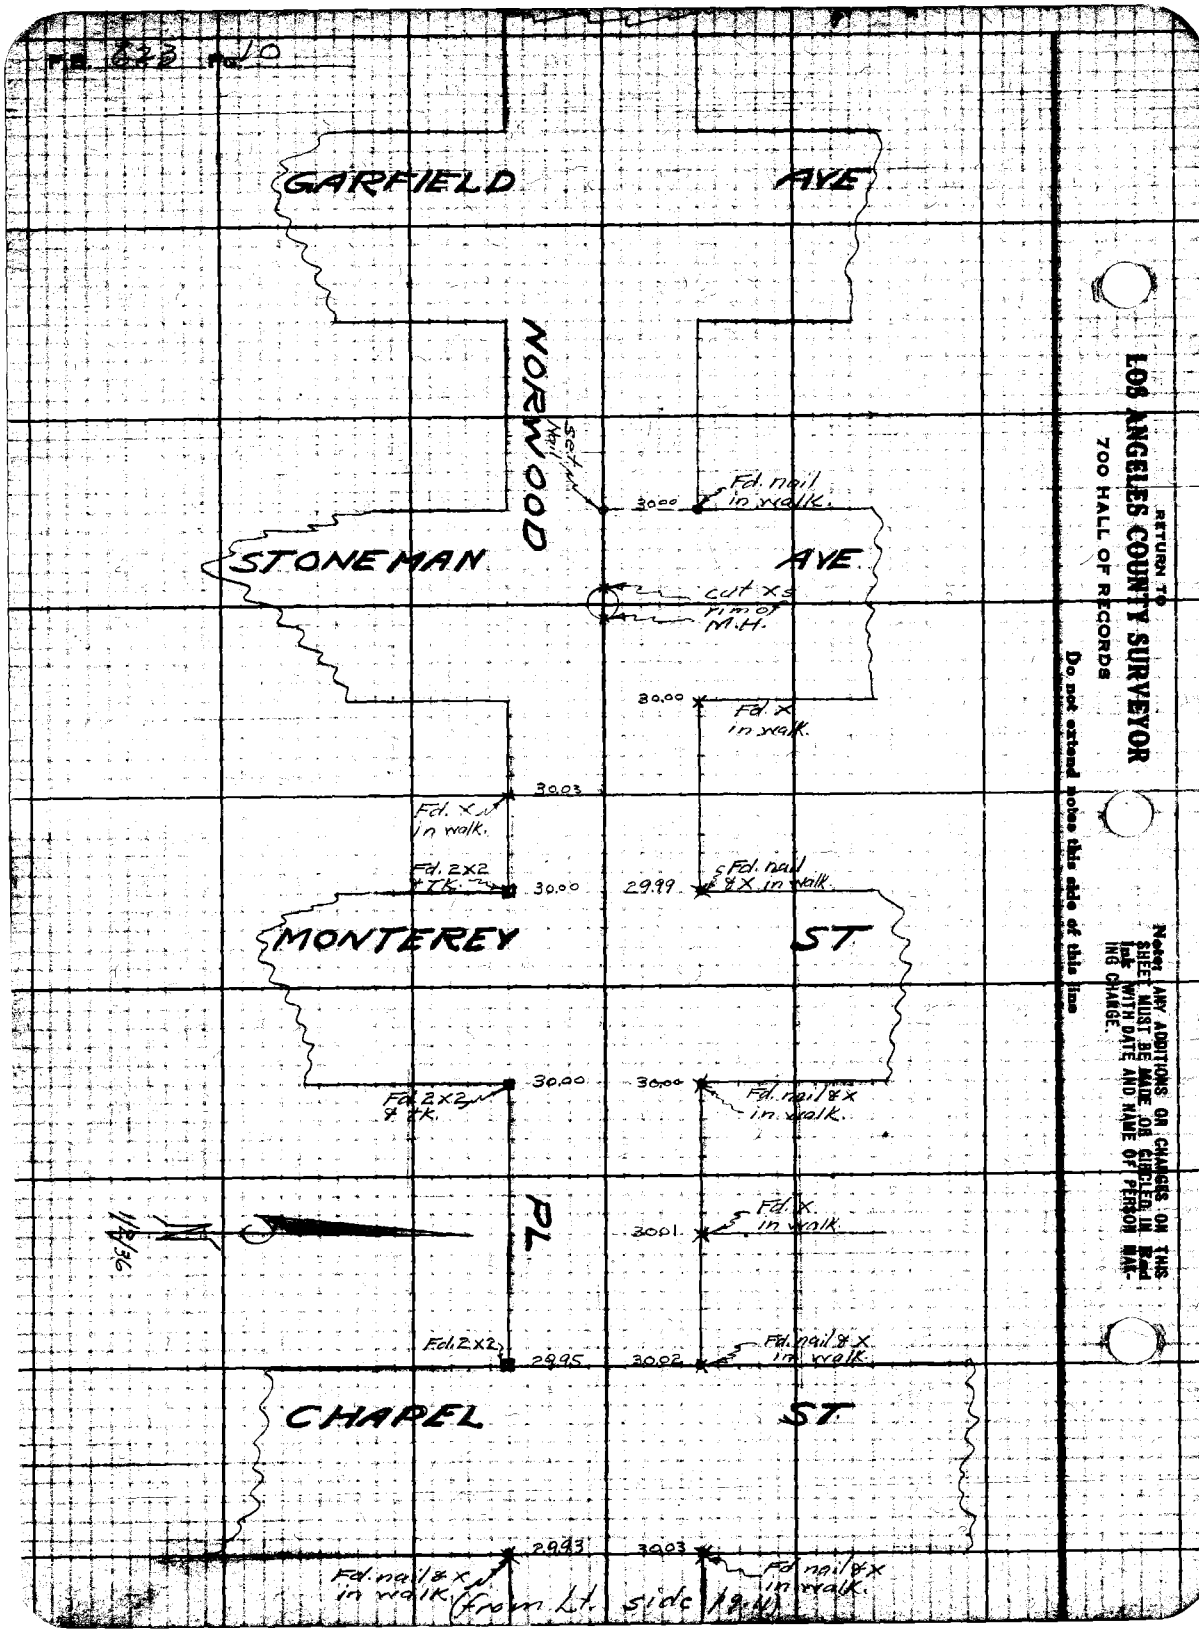

RETURN TO
LOS ANGELES COUNTY SURVEYOR
700 HALL OF RECORDS

Do not extend notes this side of this line

Note: ANY ADDITIONS OR CHANGES ON THIS SHEET MUST BE MADE OR CIRCLED IN Red Ink WITH DATE AND NAME OF PERSON MAKING CHANGE.

Map Ck'd by	Drew	Survey of	Alhambra Ave
Map No.	B-1302	W. O. 7124 Map No 010	St'd 84 or
Office Work	F. A. W.	Surveyed by	Evans
Checked	Drew	Notes HE	Date 1/6/36
Date	July 37	Indexed	C. Johnson

F.B. 623 Pg. 11

RETURN TO
LOS ANGELES COUNTY SURVEYOR
700 HALL OF RECORDS

Notes: ANY ADDITIONS OR CHANGES ON THIS SHEET MUST BE MADE OR CIRCLED IN Red Ink WITH DATE AND NAME OF PERSON MAKING THE CHANGE.

Do not extend notes this side of this line

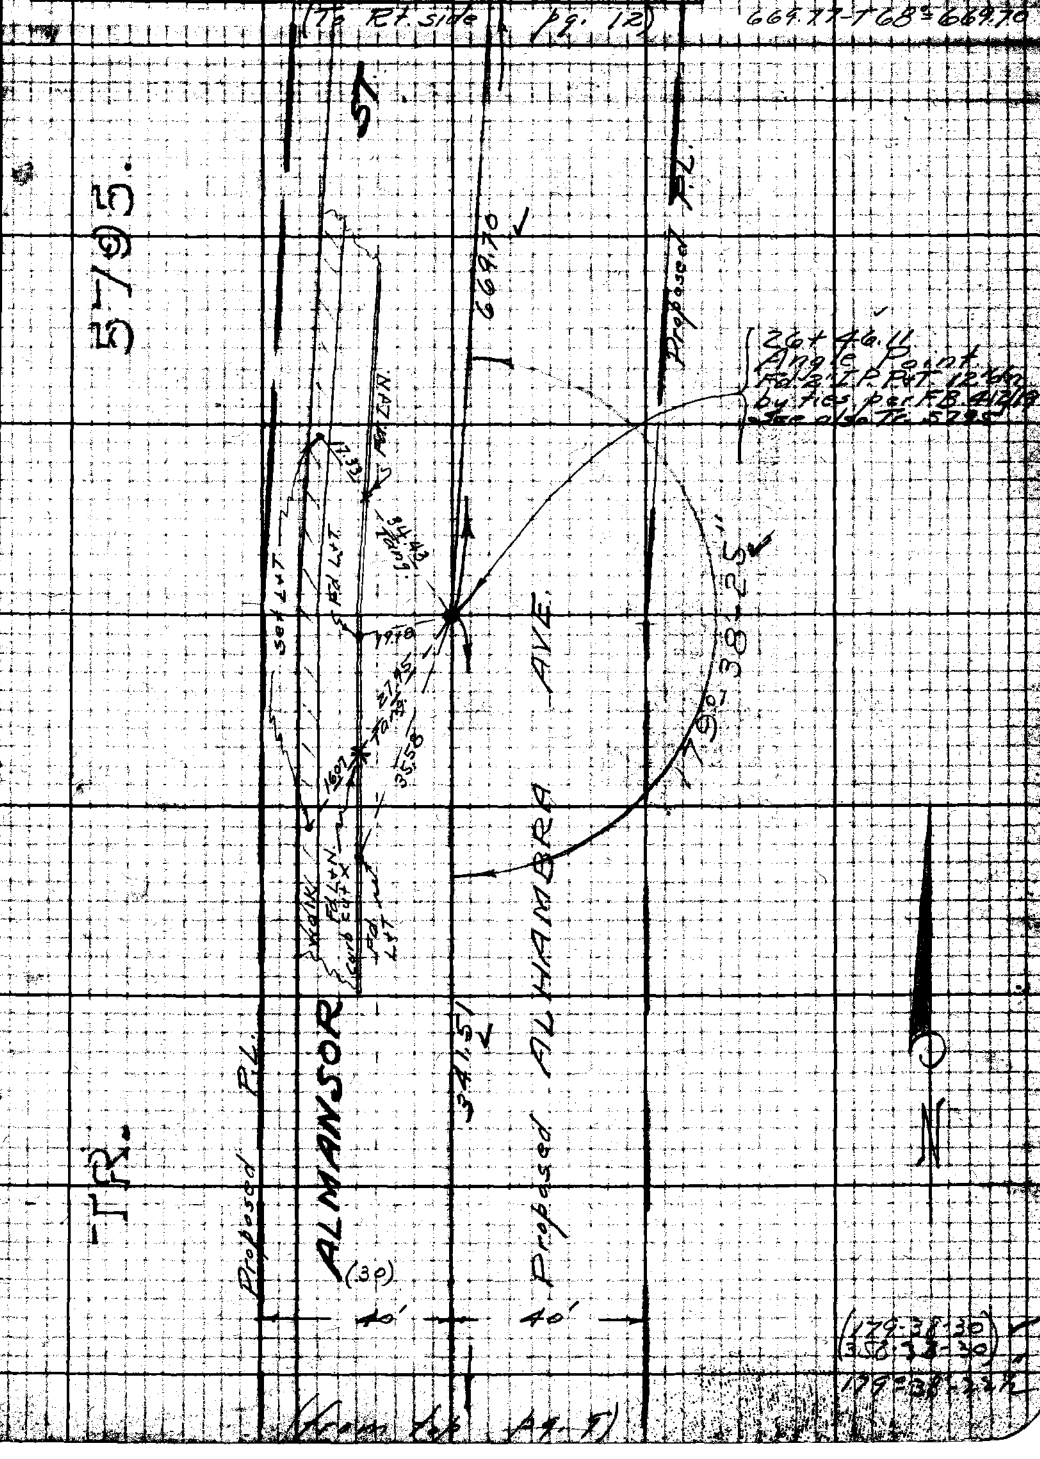

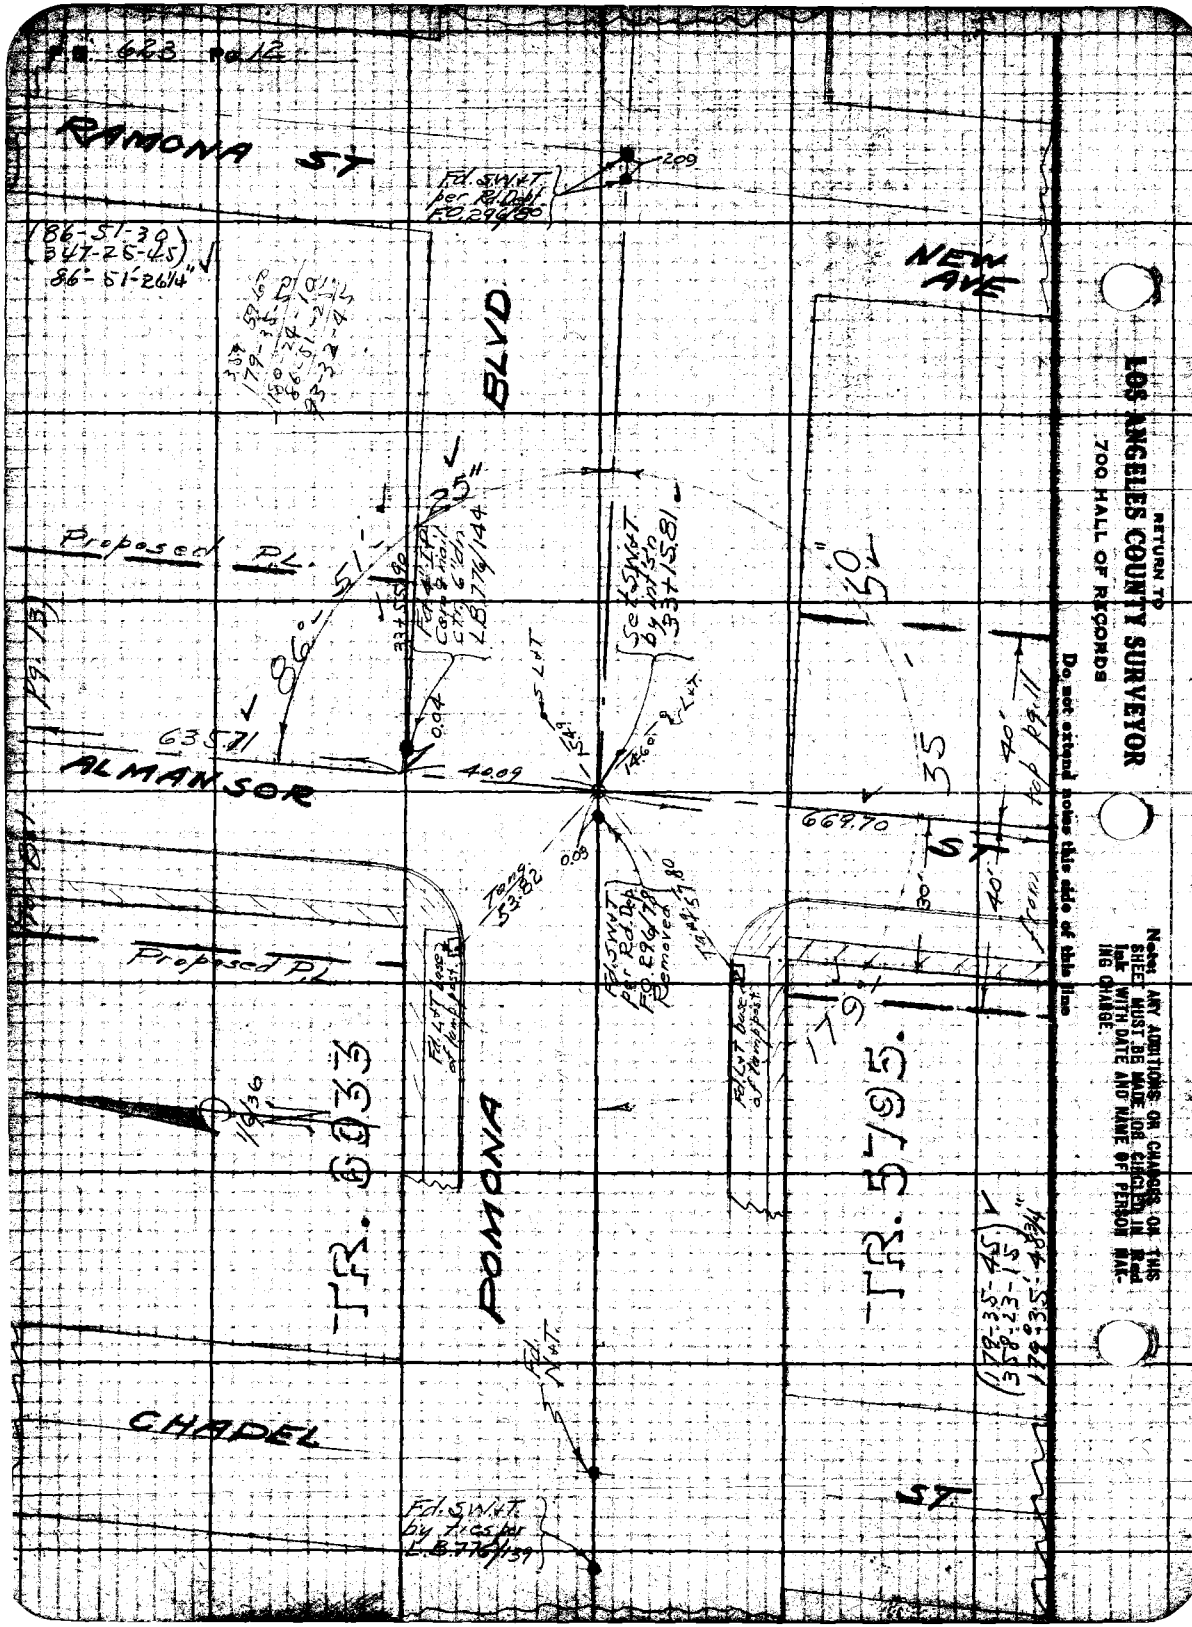

RETURN TO
LOS ANGELES COUNTY SURVEYOR
700 HALL OF RECORDS

Do not extend notes this side of this line

Note: ANY ADDITIONS OR CHANGES ON THIS SHEET MUST BE MADE OR CIRCLED IN Red Ink WITH DATE AND NAME OF PERSON MAKING CHANGE.

FORM 247 BM 2-34

RETURN TO
LOS ANGELES COUNTY SURVEYOR
700 HALL OF RECORDS

Note: ANY ADDITIONS OR CHANGES ON THIS SHEET MUST BE MADE OR CHECKED IN WITH Ink WITH DATE AND NAME OF PERSON MAKING CHANGE.

Do not extend notes this side of this line

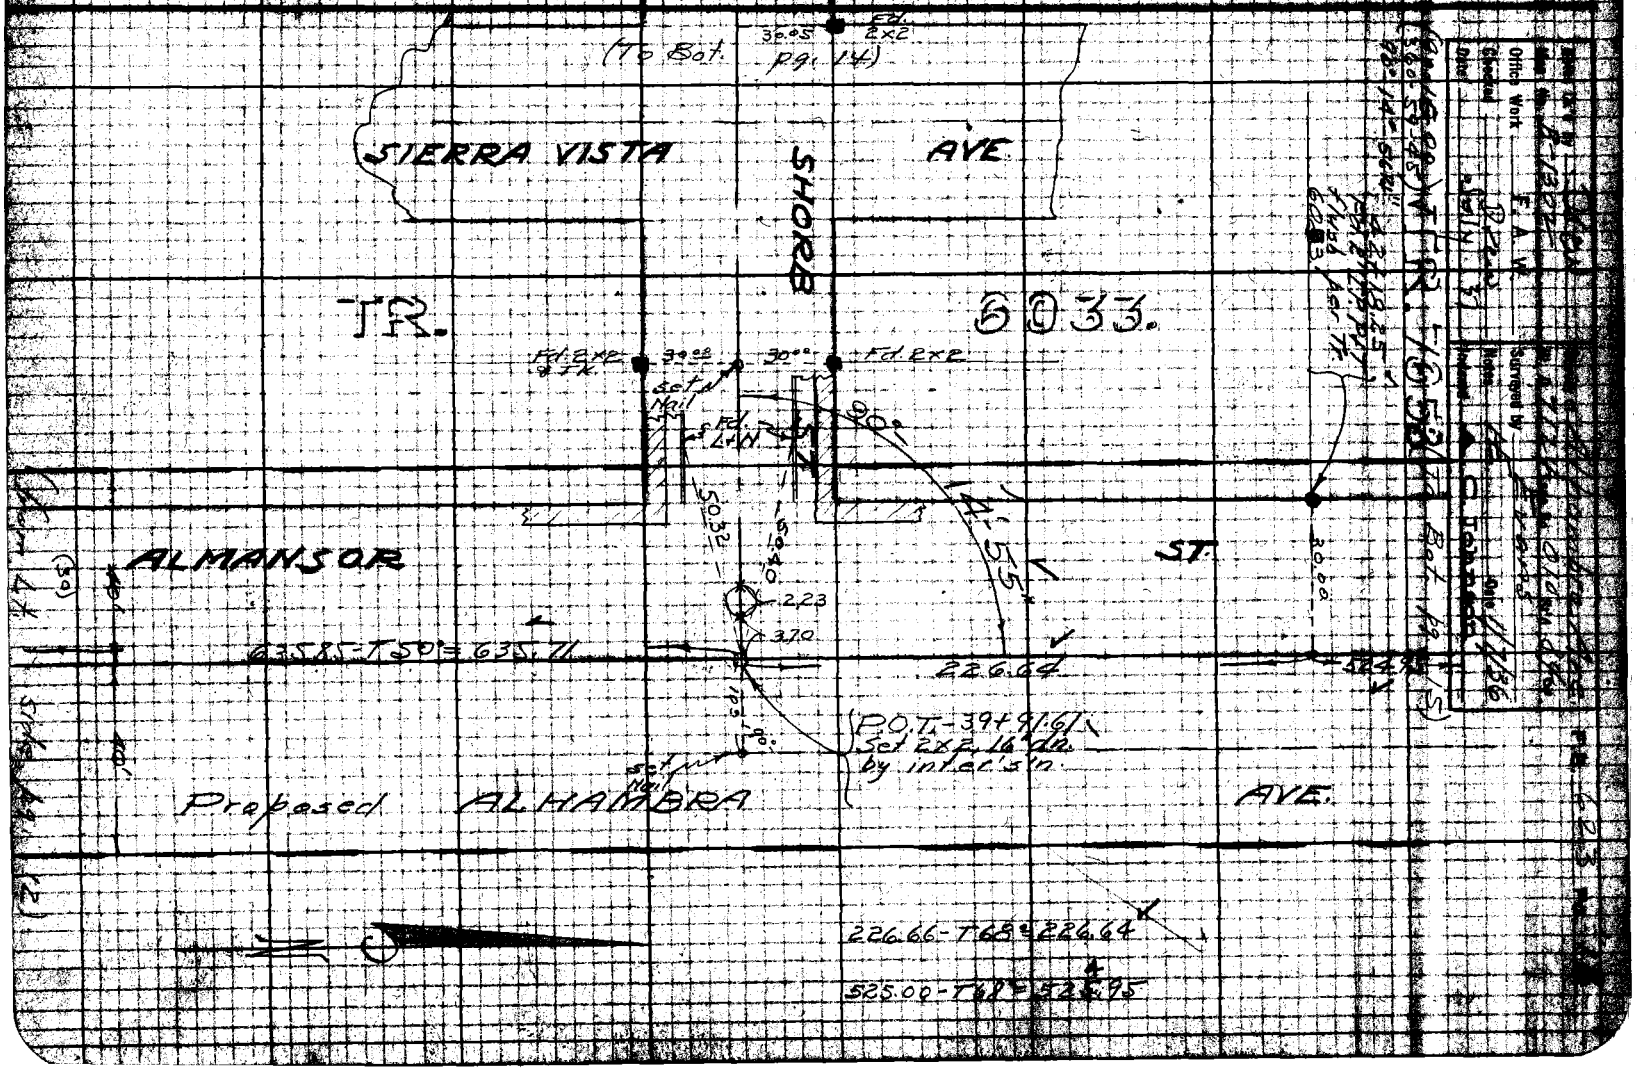

Office Work F. A. W.
Checked
Date
Surveyed by
Notes
Date 11/7/36

F.B. 623 Pg. 14

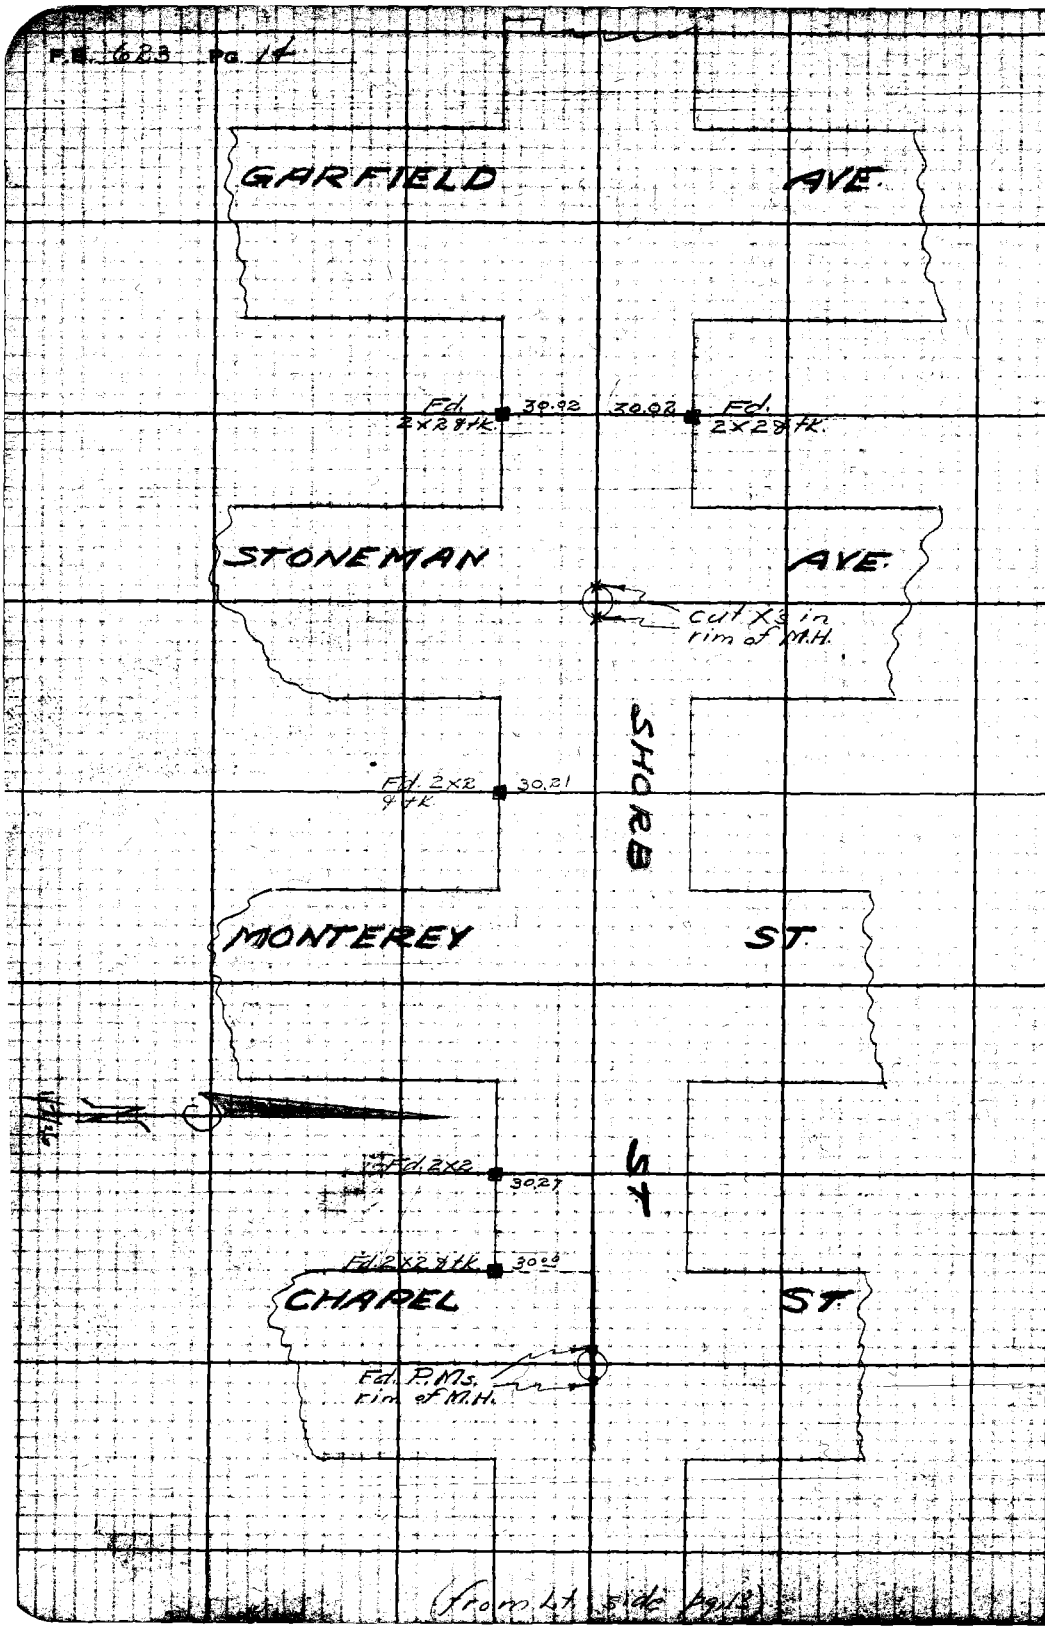

(from Lt. side pg. 13)

RETURN TO
LOS ANGELES COUNTY SURVEYOR
700 HALL OF RECORDS

Do not extend notes this side of this line

Note: ANY ADDITIONS OR CHANGES ON THIS SHEET MUST BE MADE OR CIRCLED IN Red Ink WITH DATE AND NAME OF PERSON MAKING CHANGE.

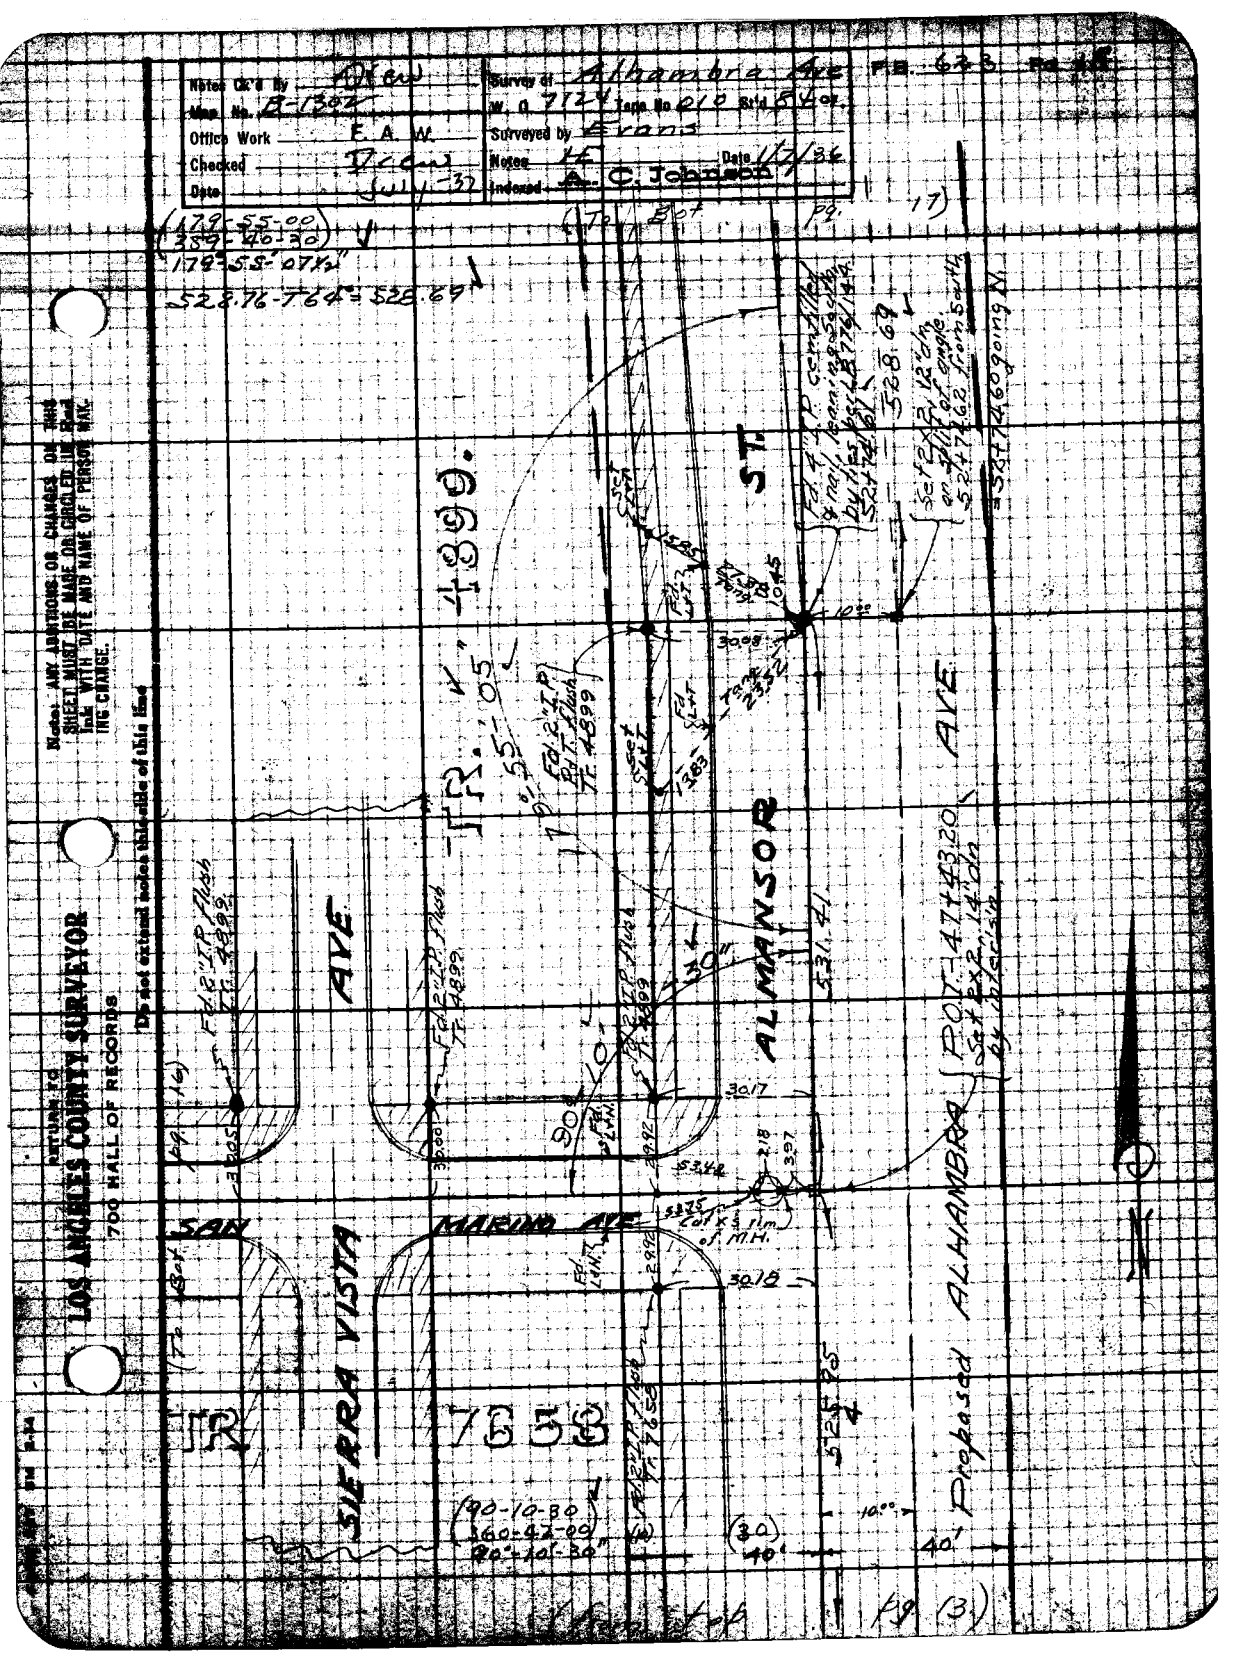

Notes Ck'd by Drew
Map No. B-1302
Office Work F. A. W.
Checked Drew
Date July-32
Survey of Alhambra Ave
W. O. 7724 Tape No 010 Std 84 oz.
Surveyed by Evans
Notes HE Date 1/7/36
Indexed A. C. Johnson
(179-55-00)
(359-40-30)
179°-55'-07½"
528.76-T64° = 528.69
(To Bot pg. 17)
TR. 4899.
179°-55'-05"
ALMANSOR ST.
AVE
SAN MARINO AVE
SIERRA VISTA
TR 7658
Proposed ALHAMBRA AVE
POT-47+43.20
Set 2x2, 14" dn by interstn
Fd. 2" I.P. flush Tr. 4899
Fd. 2" I.P. flush Tr. 7658
Fd. 4" I.P. cem filled & nail, leaning south by ties per LB 776/144
528.69
Set 2x2, 12" dn on split of angle 52+74.62 from south
= 52+74.60 going N.
Set 2x2, 14" dn
Cut x 3 tim of M.H.
(90-10-30)
(360-42-00)
90°-10'-30"
(30)
40'
10.00
(To Bot pg. 16)
(To Bot pg. 3)
Note: ANY ADDITIONS OR CHANGES ON THIS SHEET MUST BE MADE OR CIRCLED IN Red Ink WITH DATE AND NAME OF PERSON MAKING CHANGE.
Do not extend notes this side of this line
RETURN TO
LOS ANGELES COUNTY SURVEYOR
700 HALL OF RECORDS

F.B. 623 PG. 16

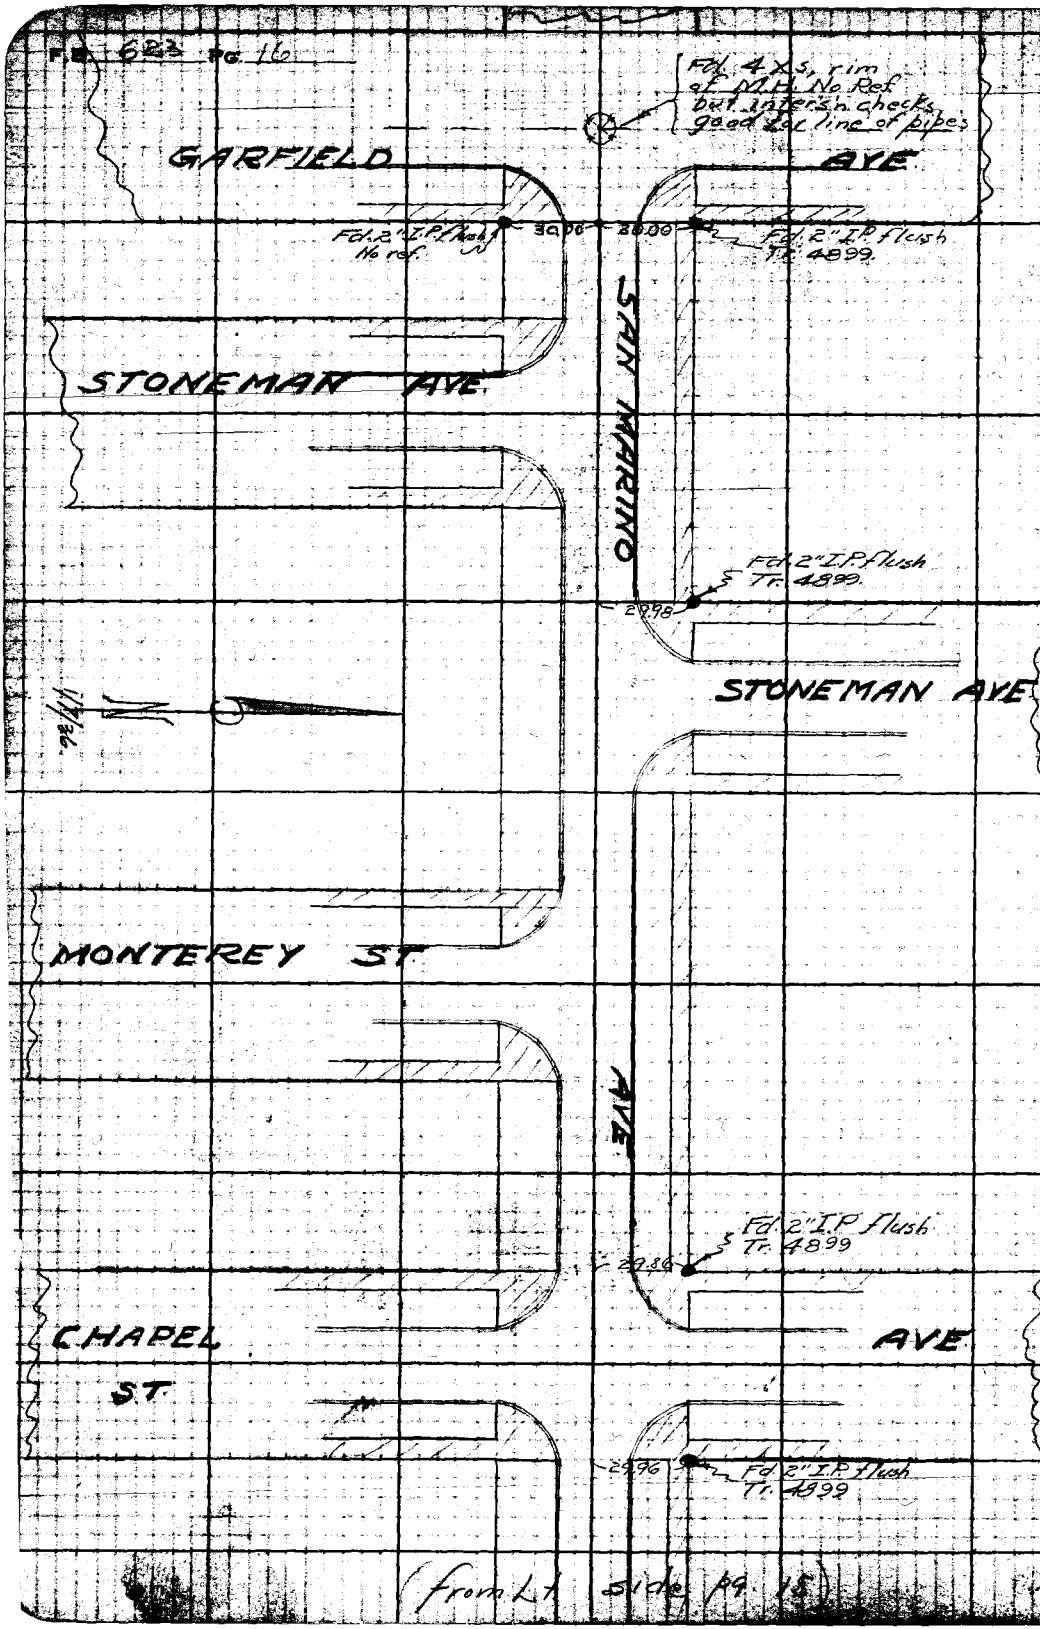

RETURN TO
LOS ANGELES COUNTY SURVEYOR
700 HALL OF RECORDS
Do not extend notes this side of this line
Note: ANY ADDITIONS OR CHANGES ON THIS SHEET MUST BE MADE OR CIRCLED IN Red Ink WITH DATE AND NAME OF PERSON MAKING CHANGE.

(from Lt side pg. 15)

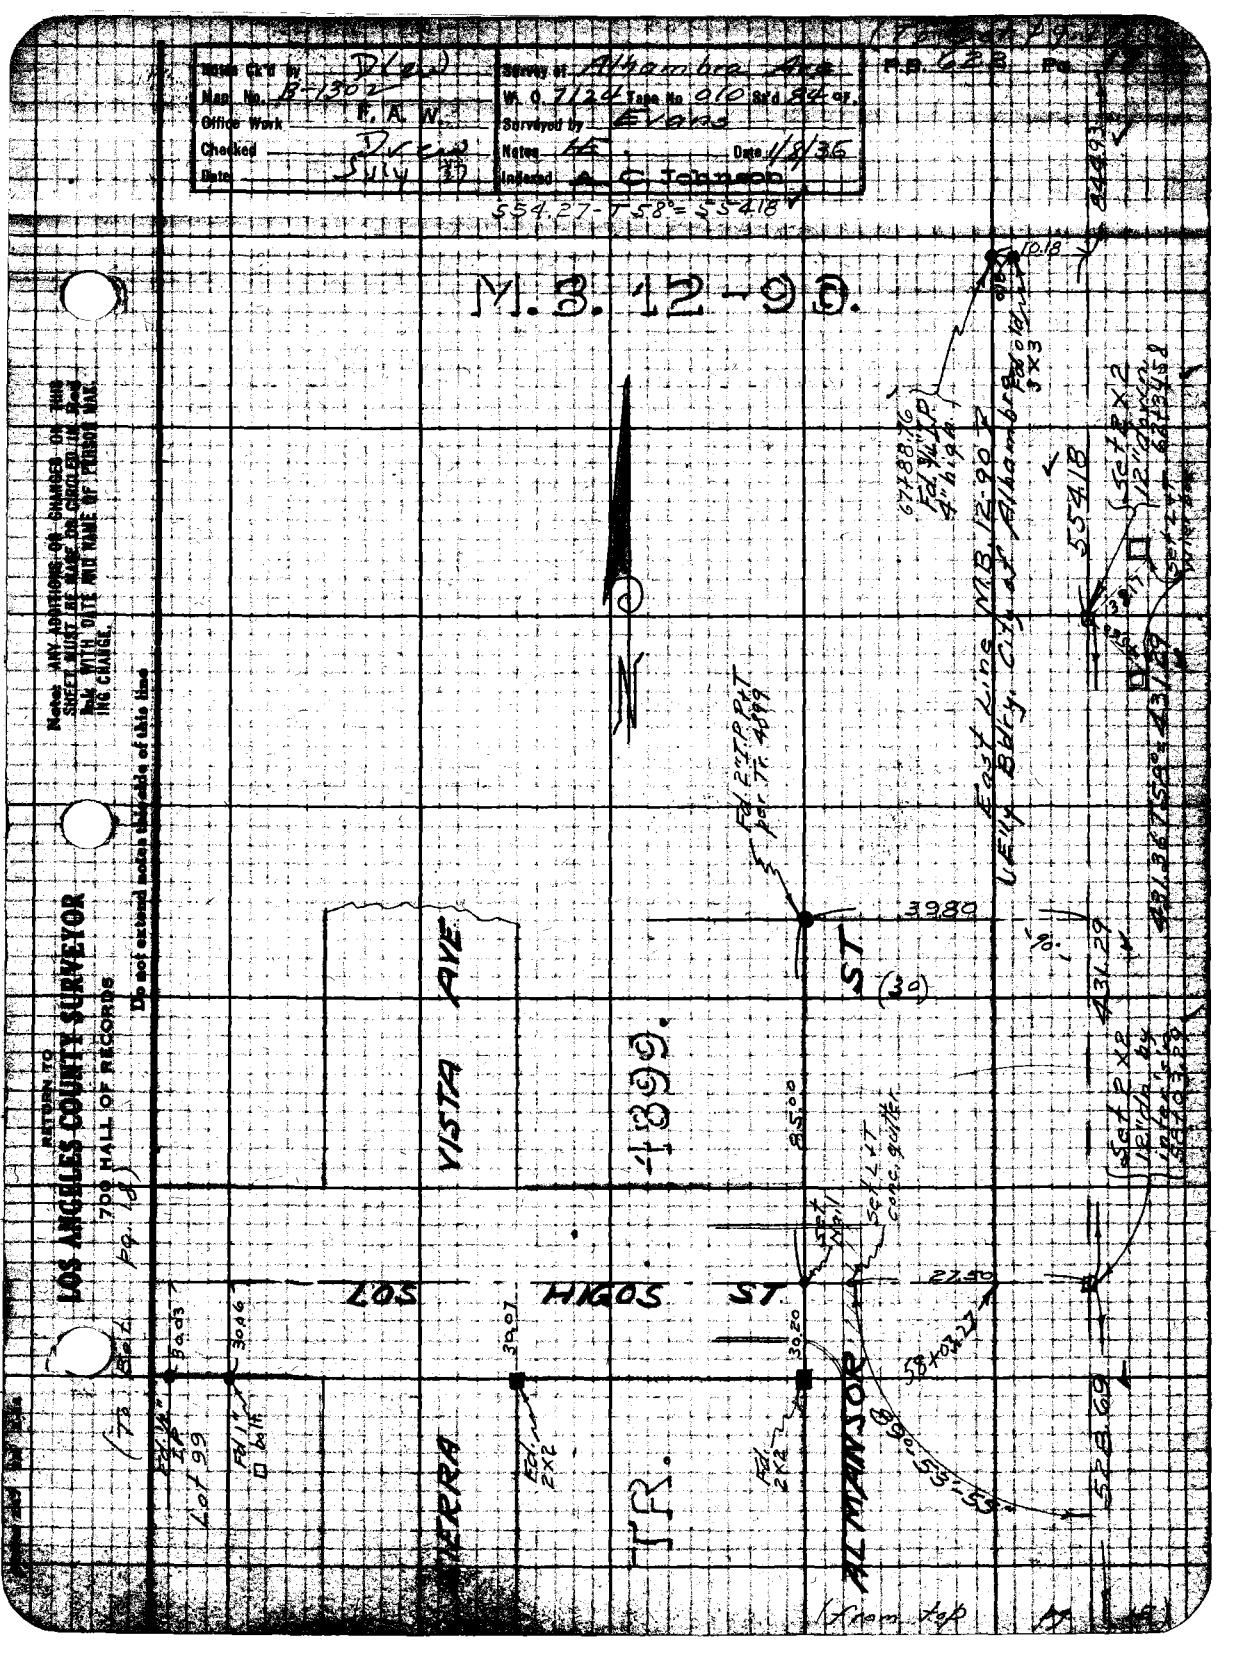

Notes Ck'd by D(...)
Map No. B-1302
Office Work F. A. W.
Checked Drew
Date July 37
Survey of Alhambra Ave
W. O. 7124 Tape No 010 Std 84 of.
Surveyed by Evans
Notes HE Date 1/8/36
Indexed A. C. Johnson
P.B. 623 Pg.
554.27-T58°=554.18
M.B. 12-90.
East Line M.B. 12-90
Ely Bdry. City of Alhambra
VISTA AVE
4899.
LOS HIGOS ST
SIERRA
TR.
ALMANSOR
ST
(30)
3980
85.00
27.50
30.20
30.07
30.06
30.03
Lot 99
Fd 2"T.P.P.T. per Tr. 4899
Set L+T conc. gutter
Set Nail
Fd 2x2
Fd 1" □ bolt
Fd 1/2" I.P.
Fd 2x2
Set 2x2 12" dn by inter'sn
Set 2x2 12" dn by inter'sn
Fd 3x3
Fd 3/4" I.P. 4" high
10.18
554.18
431.29
528.69
(from top)
Note: ANY ADDITIONS OR CHANGES ON THIS SHEET MUST BE MADE OR CIRCLED IN RED INK WITH DATE AND NAME OF PERSON MAKING CHANGE.
Do not extend notes this side of this line
RETURN TO
LOS ANGELES COUNTY SURVEYOR
700 HALL OF RECORDS

F.B. 623 Pg. 18

(90-27-15)
(361-48-45) ✓
98-27-11¼"

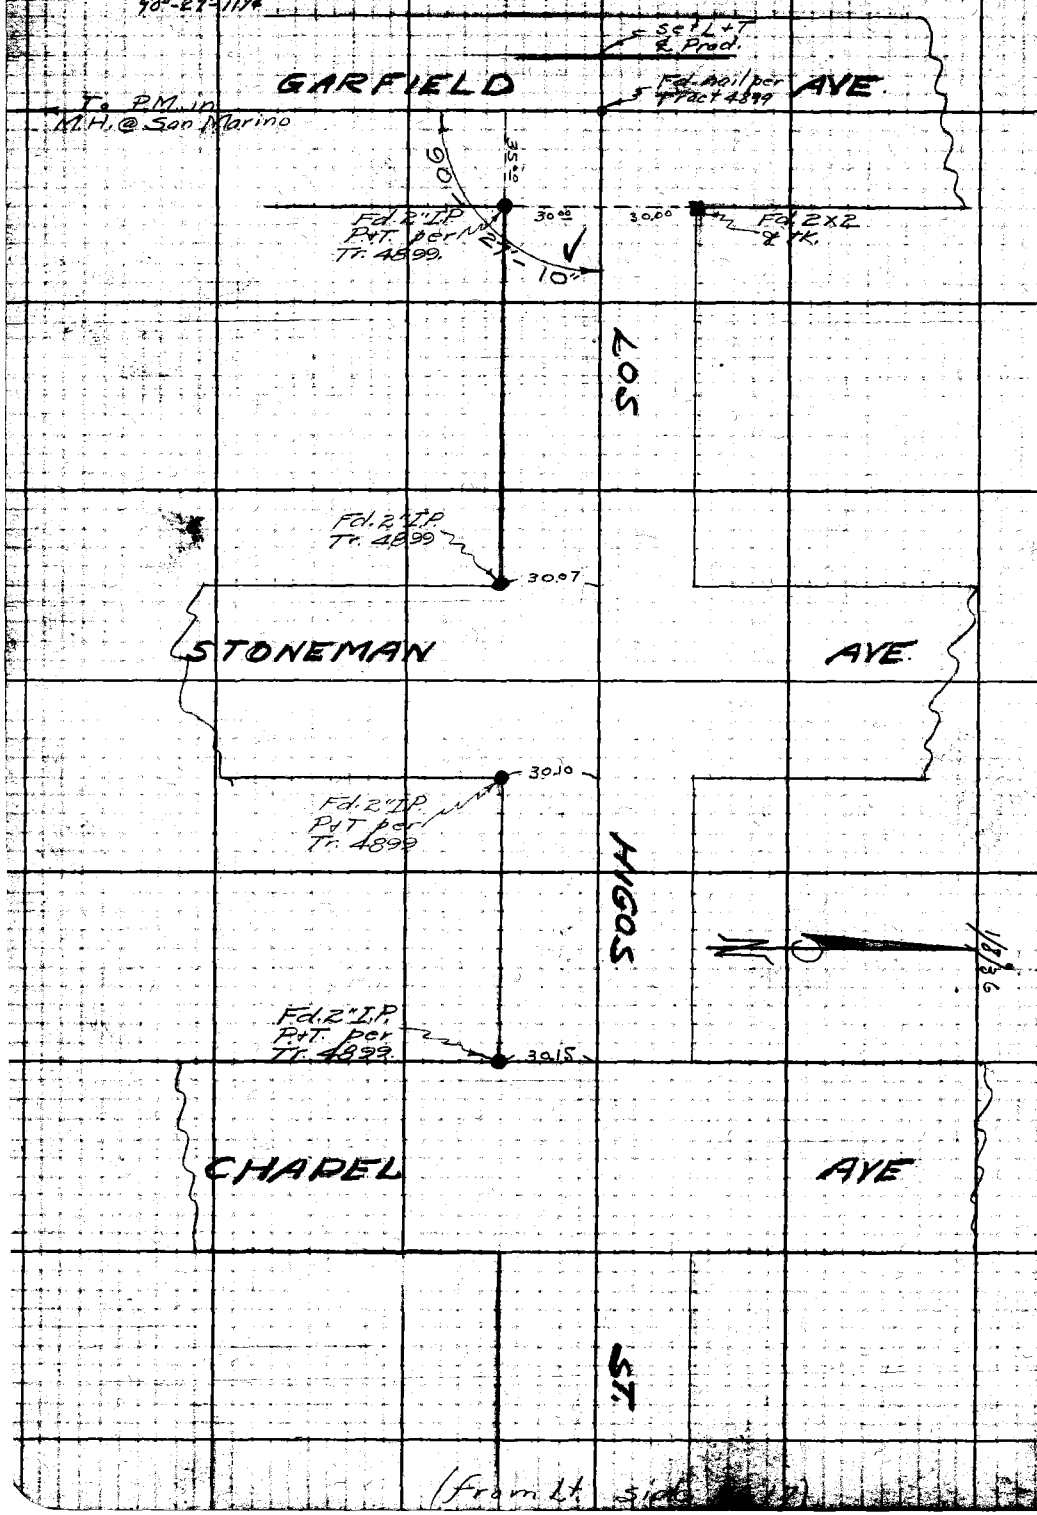

(From Lt. side [illegible])

RETURN TO
LOS ANGELES COUNTY SURVEYOR
700 HALL OF RECORDS

Do not extend notes this side of this line

Note: ANY ADDITIONS OR CHANGES ON THIS SHEET MUST BE MADE OR CIRCLED IN Red Ink WITH DATE AND NAME OF PERSON MAKING CHANGE.

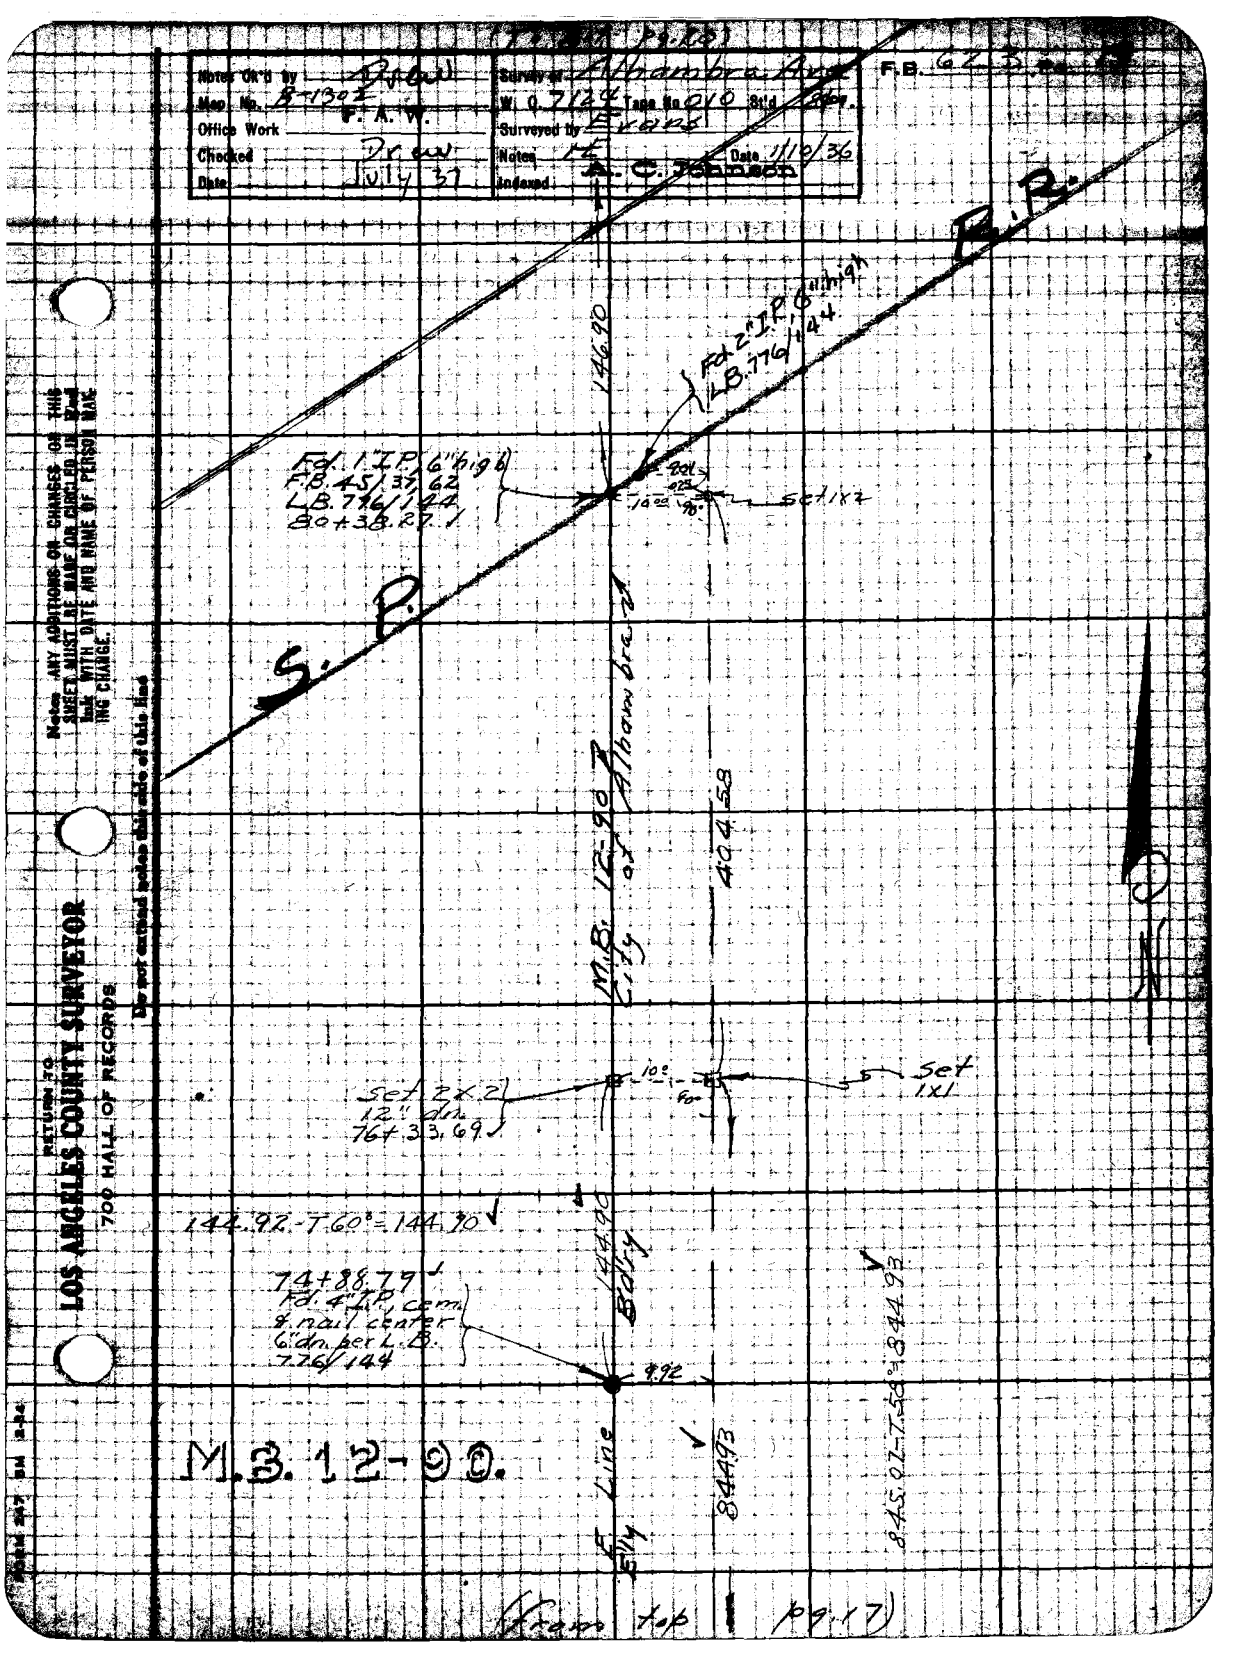

Notes Ck'd by
Map No. B-1302
Office Work F. A. W.
Checked Drew
Date July 37
Survey of Alhambra Ave.
W. O. 7124 Tape No. 010 Std. Edge
Surveyed by Evans
Notes
Date 1/10/36
Indexed A. C. Johnson
F.B. 623
R.R.
S.P.
146.90
Fd. 2" I.P. 6" high
LB. 776/144
Fd. 1" I.P. 6" high
F.B. 45/37, 62
LB. 776/144
80+38.27
Set 1x2
M.B. 12-90
City of Alhambra
404.58
Set 2x2
12" dn.
76+33.69
Set 1x1
144.92-T60°=144.90
144.90
Bdry
74+88.79
Fd. 4" I.P. cem.
& nail center
6" dn. per L.B.
776/144
9.92
845.07-T58°=844.93
844.93
E. Line
Ely
M.B. 12-90.
(from top pg. 17)
Notes ANY ADDITIONS OR CHANGES OF THIS SHEET MUST BE MADE OR CIRCLED IN Red Ink WITH DATE AND NAME OF PERSON MAKING CHANGE.
Do not extend notes this side of this line
RETURN TO
LOS ANGELES COUNTY SURVEYOR
700 HALL OF RECORDS

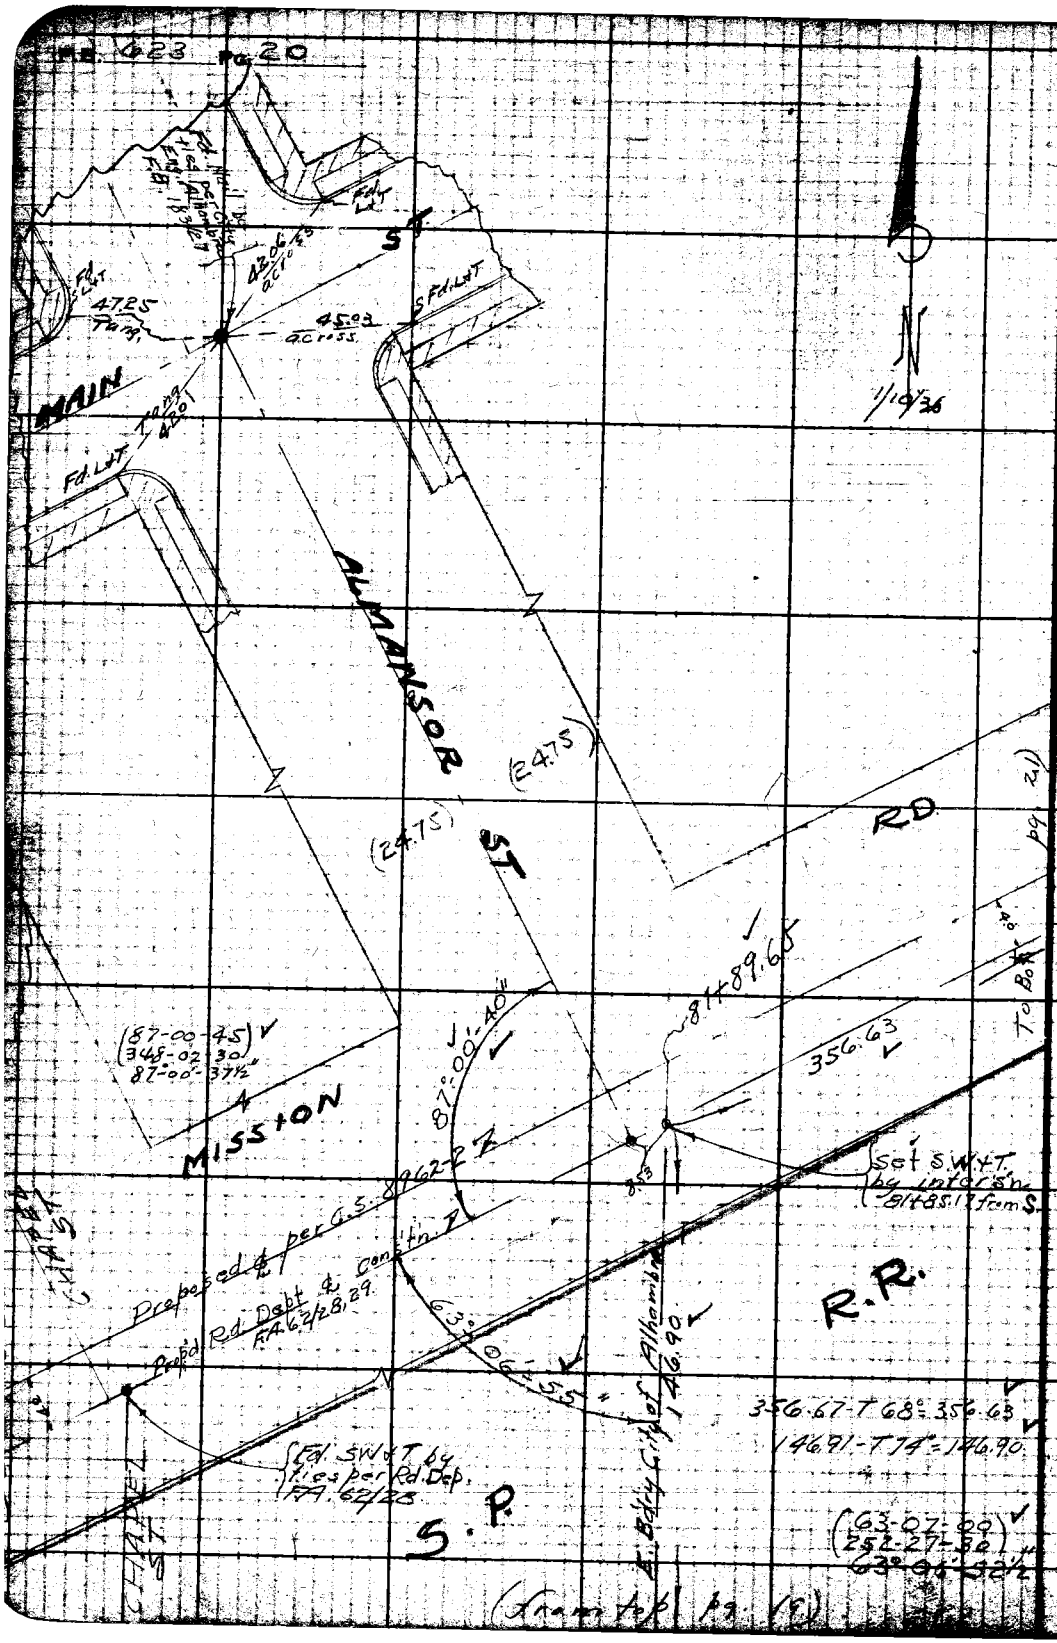

RETURN TO
LOS ANGELES COUNTY SURVEYOR
700 HALL OF RECORDS
Do not extend notes this side of this line
Note: ANY ADDITIONS OR CHANGES ON THIS SHEET MUST BE MADE OR CIRCLED IN RED Ink WITH DATE AND NAME OF PERSON MAKING CHANGE.

(from top pg. 19)

Notes Ck'd by Drew
Map No. B-1302
Office Work F. A. W.
Checked Drew
Date July-37

Survey of Alhambra Ave
W. O. 7124 Tape No. 010 Mtd 84 oz.
Surveyed by Evans
Notes H.
Indexed A. G. Johnson
Date 1/13/36

F.B. 623

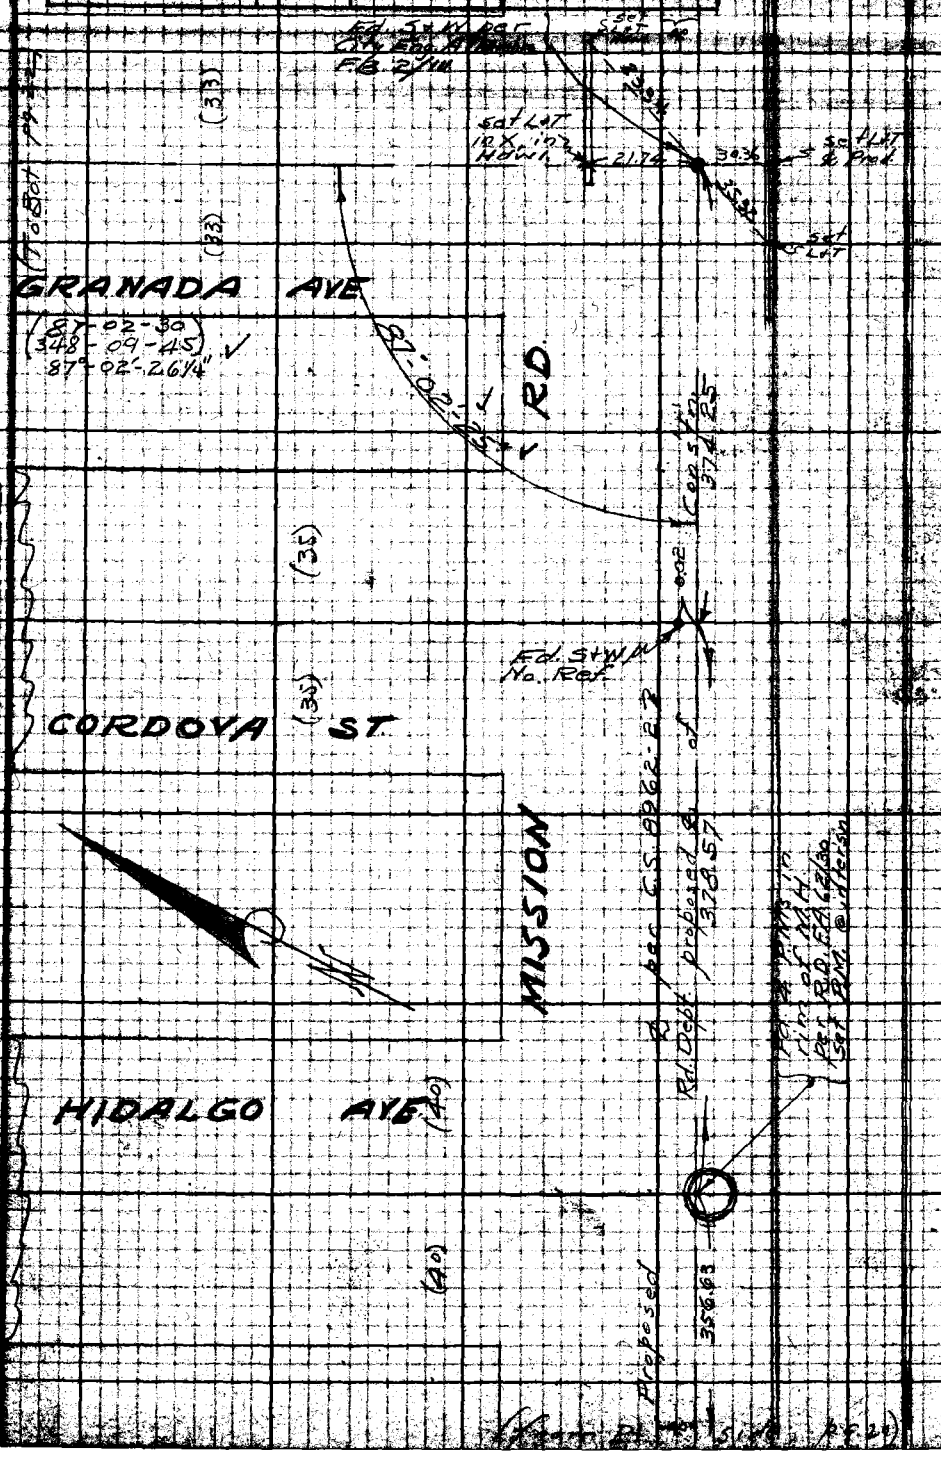

Notes: ANY ADDITIONS OR CHANGES ON THIS SHEET MUST BE MADE OR CIRCLED IN RED INK WITH DATE AND NAME OF PERSON MAKING CHANGE.

Do not extend notes this side of this line

RETURN TO
LOS ANGELES COUNTY SURVEYOR
700 HALL OF RECORDS

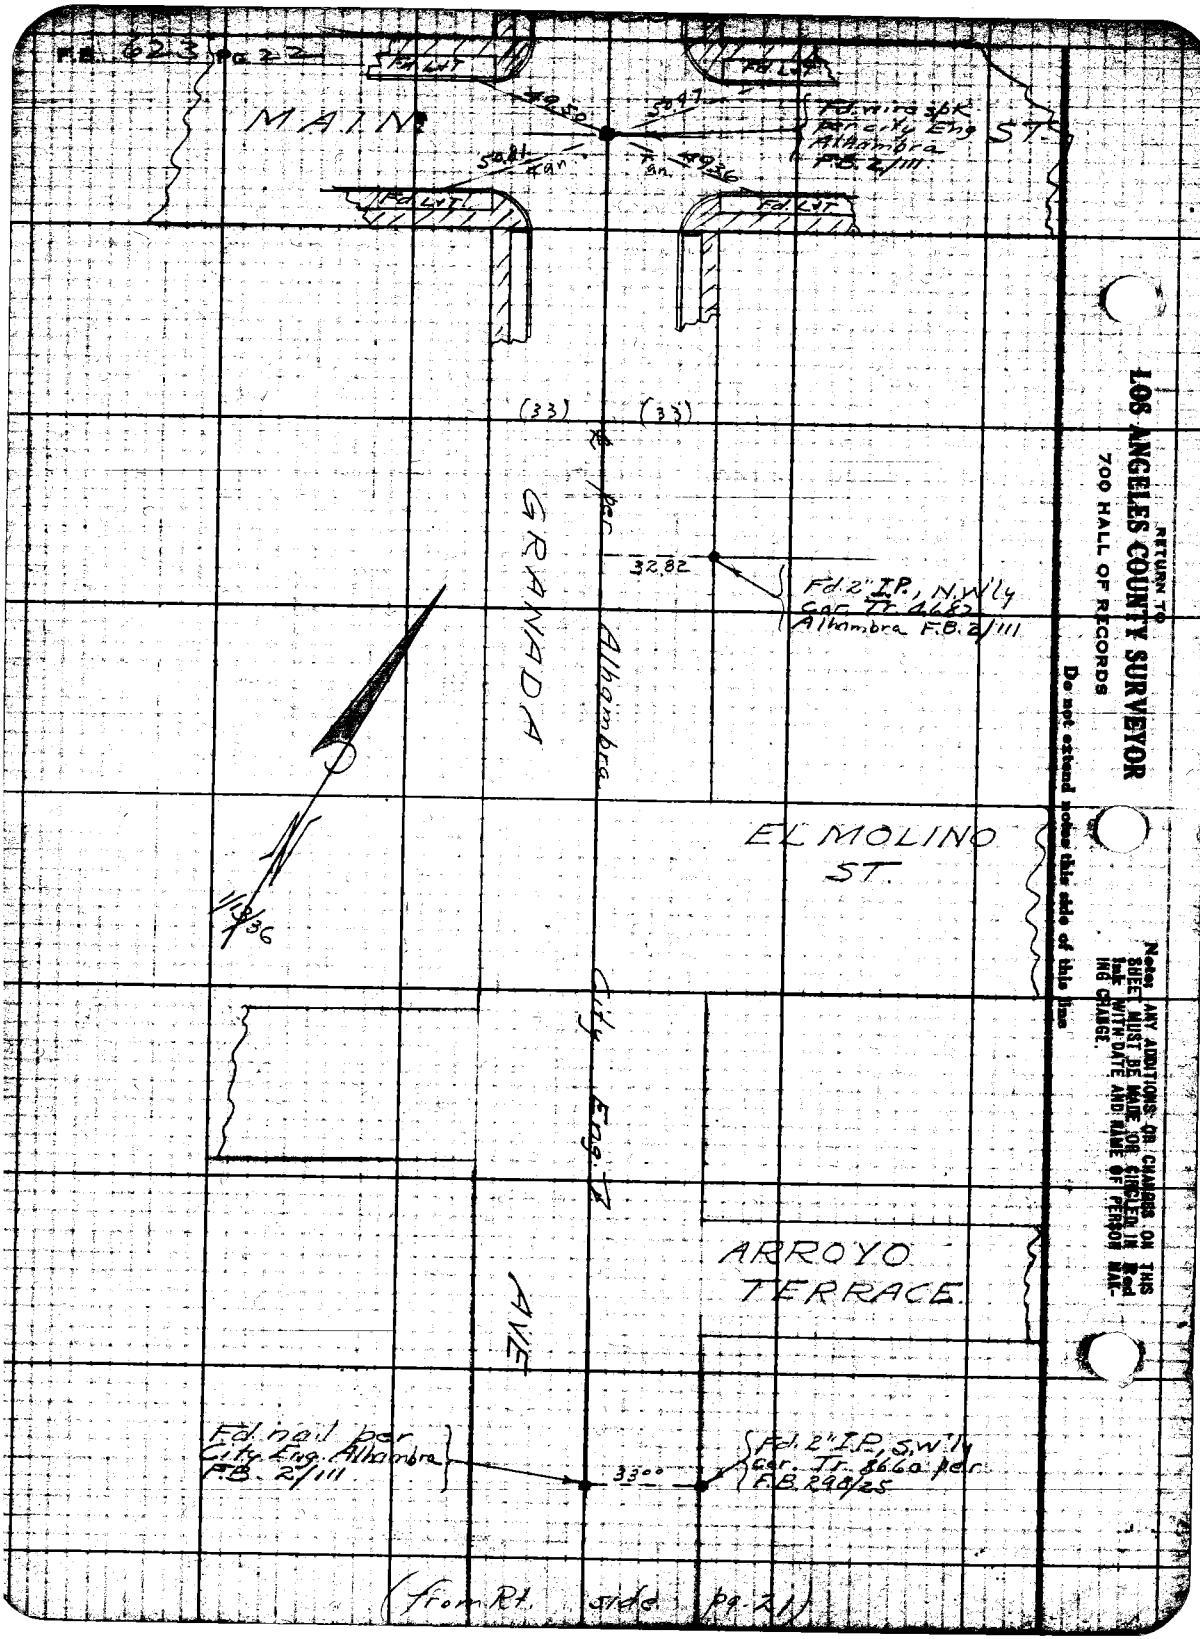
F.B. 623 pg. 22
MAIN
ST.
Fd. LvT
Fd. wire spk per City Eng Alhambra F.B. 2/111
49.50
50.47
50.81
49.36
(33)
(33)
GRANADA
Alhambra
32.82
Fd. 2" I.P., N.W'ly Cor. Tr. 4682 Alhambra F.B. 2/111
EL MOLINO ST.
1/13/36
City Eng. ℄
ARROYO TERRACE
AVE
Fd. nail per City Eng. Alhambra F.B. 2/111
33.00
Fd. 2" I.P., S.W'ly Cor. Tr. 8660 per F.B. 298/25
(from Rt. side pg. 21)
RETURN TO
LOS ANGELES COUNTY SURVEYOR
700 HALL OF RECORDS
Do not extend notes this side of this line
Note: ANY ADDITIONS OR CHANGES ON THIS SHEET MUST BE MADE OR CIRCLED IN Red Ink WITH DATE AND NAME OF PERSON MAKING CHANGE.

Map No.	B-1022		
Other Work	F. A. W.		
Checked	D.C.	Notes	Martin Date 1-13-36
Date	1-15-37		A. C. Johnson

Alhambra Ave

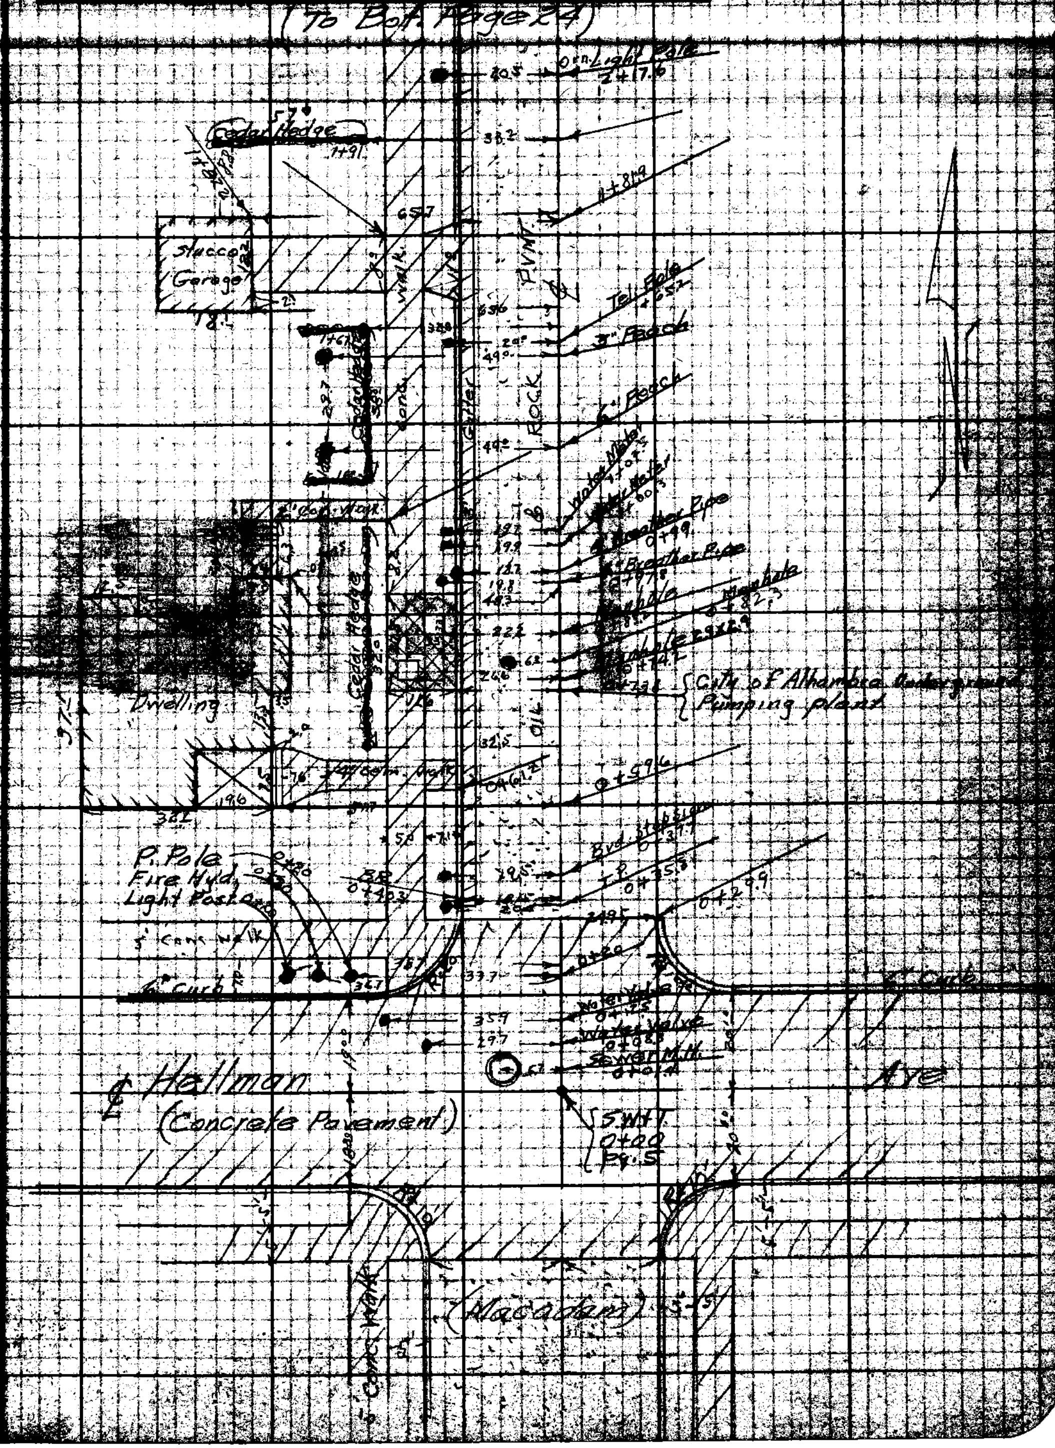

LOS ANGELES COUNTY SURVEYOR
700 HALL OF RECORDS
Notice: ANY ADDITIONS OR CHANGES ON THIS SHEET MUST BE MADE OR CIRCLED IN RED WITH DATE AND NAME OF PERSON MAKING CHANGE.

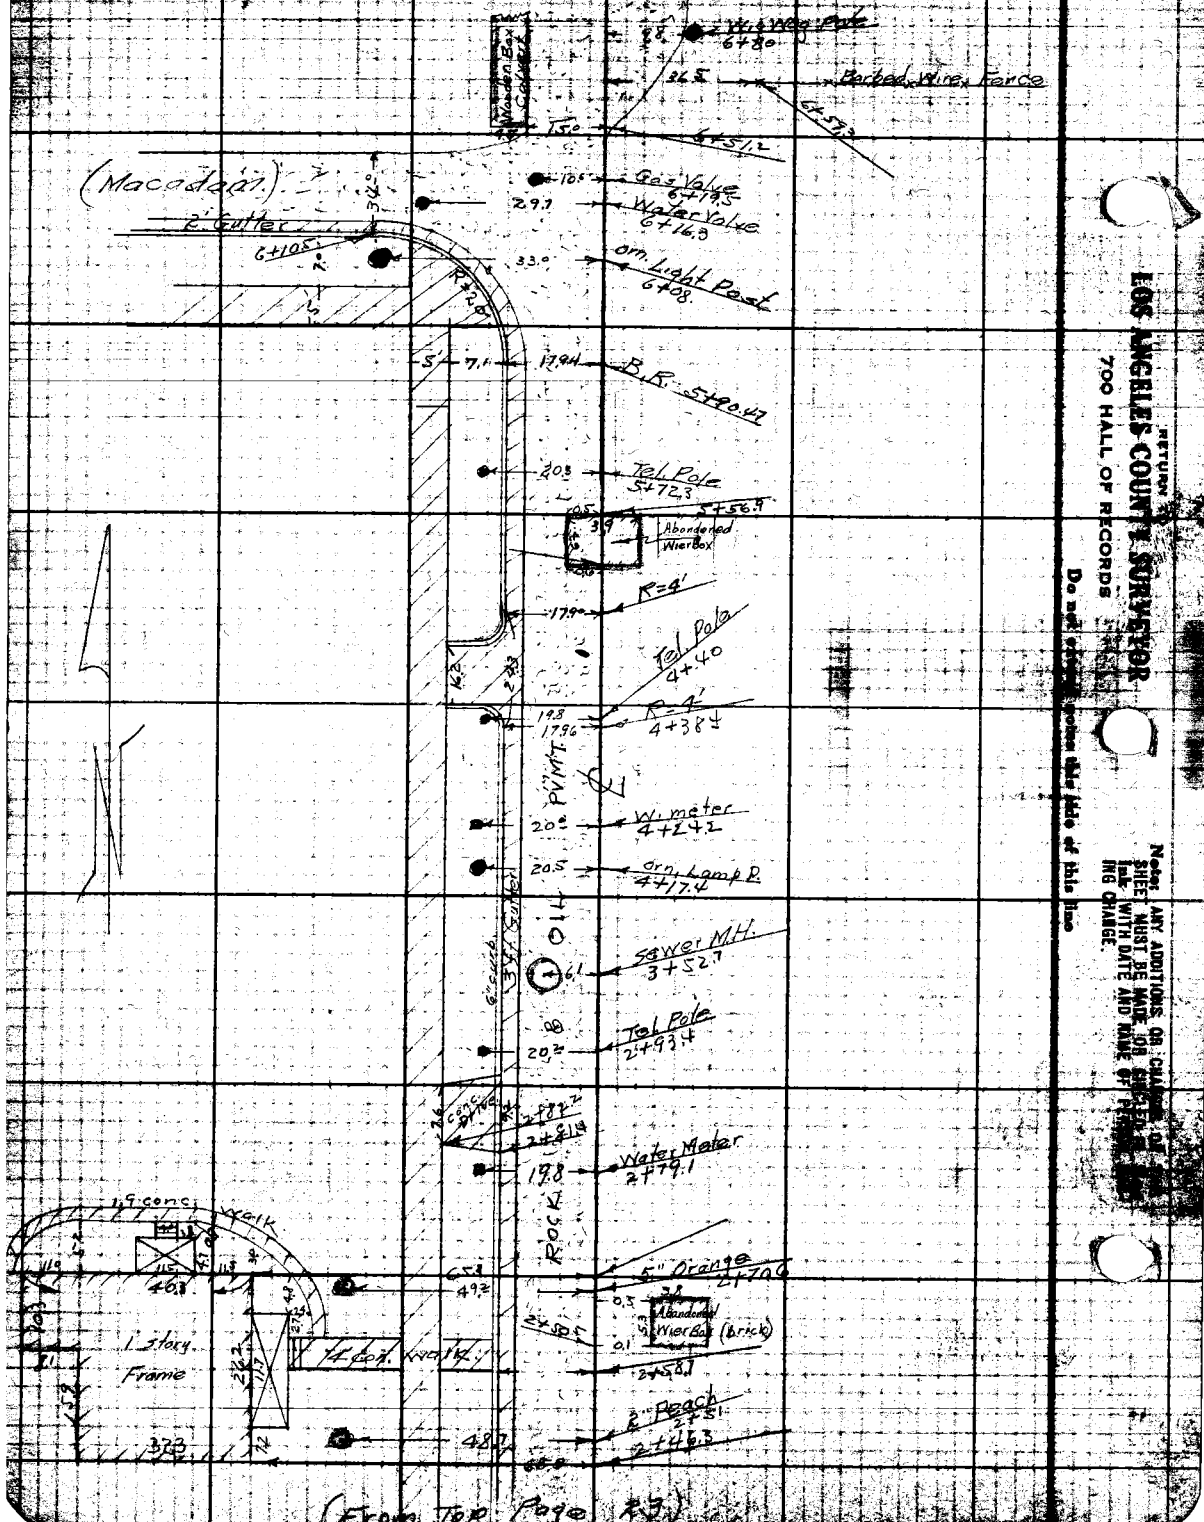

RETURN TO
LOS ANGELES COUNTY SURVEYOR
700 HALL OF RECORDS
Do not write below this line of this line
NOTE: ANY ADDITIONS OR CHANGES ON THIS SHEET MUST BE MADE ON SHEET WITH DATE AND NAME OF PERSON MAKING CHANGE.

Notes Ck'd by	Drew	Survey of	Alhambra Ave
Map No.	B-1302	W. O.	7124
Office Work	T. A. W.	Surveyed by	Evans
Checked	Drew	Notes	Martin
Date	July -37	Indexed	A. C. Johnson

F.B. 623 Pg. 25

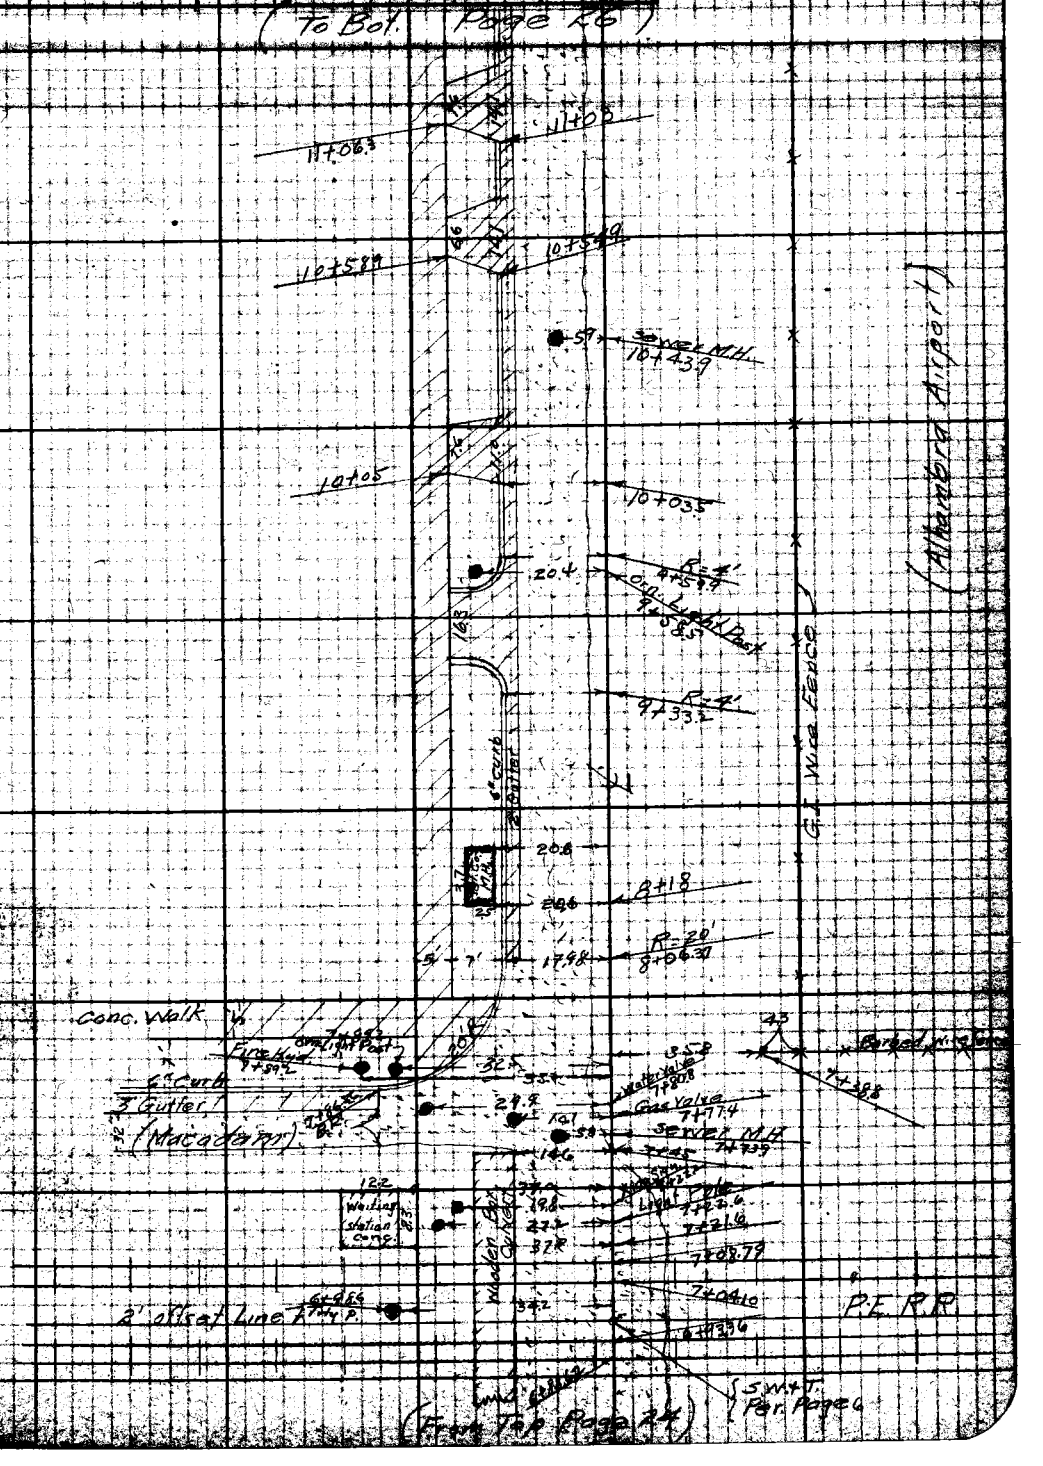

Notes ANY ADDITIONS OR CHANGES ON THIS SHEET MUST BE MADE AND SHOWN ON THE SHEET WITH DATE AND NAME OF PERSON MAKING CHANGE.

Do not extend notes this side of this line

COUNTY SURVEYOR

RECORDS

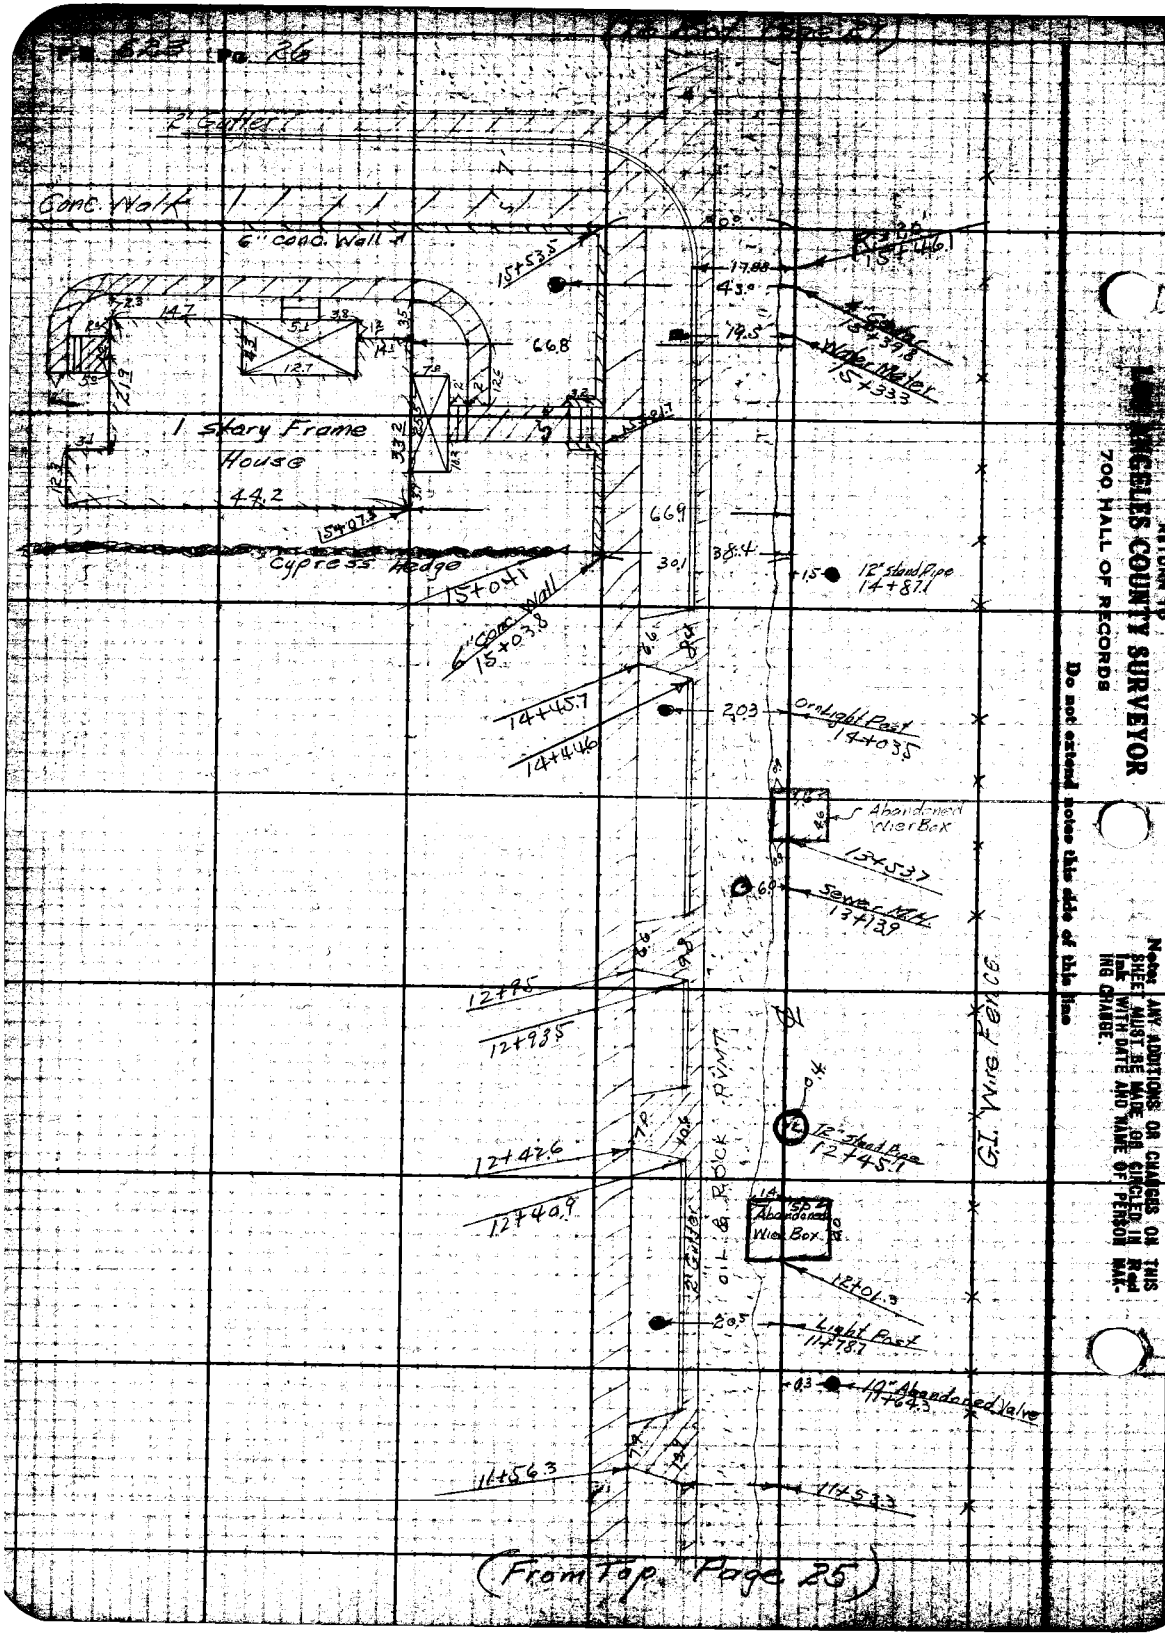

RETURN TO
LOS ANGELES COUNTY SURVEYOR
700 HALL OF RECORDS
Do not extend notes this side of this line
NOTE: ANY ADDITIONS OR CHANGES ON THIS SHEET MUST BE MADE ON CIRCLED LINE WITH DATE AND NAME OF PERSON MAKING CHANGE.

Notes Co. [illegible] | Survey of Alhambra Ave | F.B. [illegible] Pg. [illegible]
Map No. [illegible] | W.O. 7124 Tape No. Std. Pt.
Office Work F.A.W. | Surveyed by Evans
Checked [illegible] | Notes Martin Date 1-14-36
Date July [illegible] | Indexed A. C. Johnson

(To Bot. Page 28)

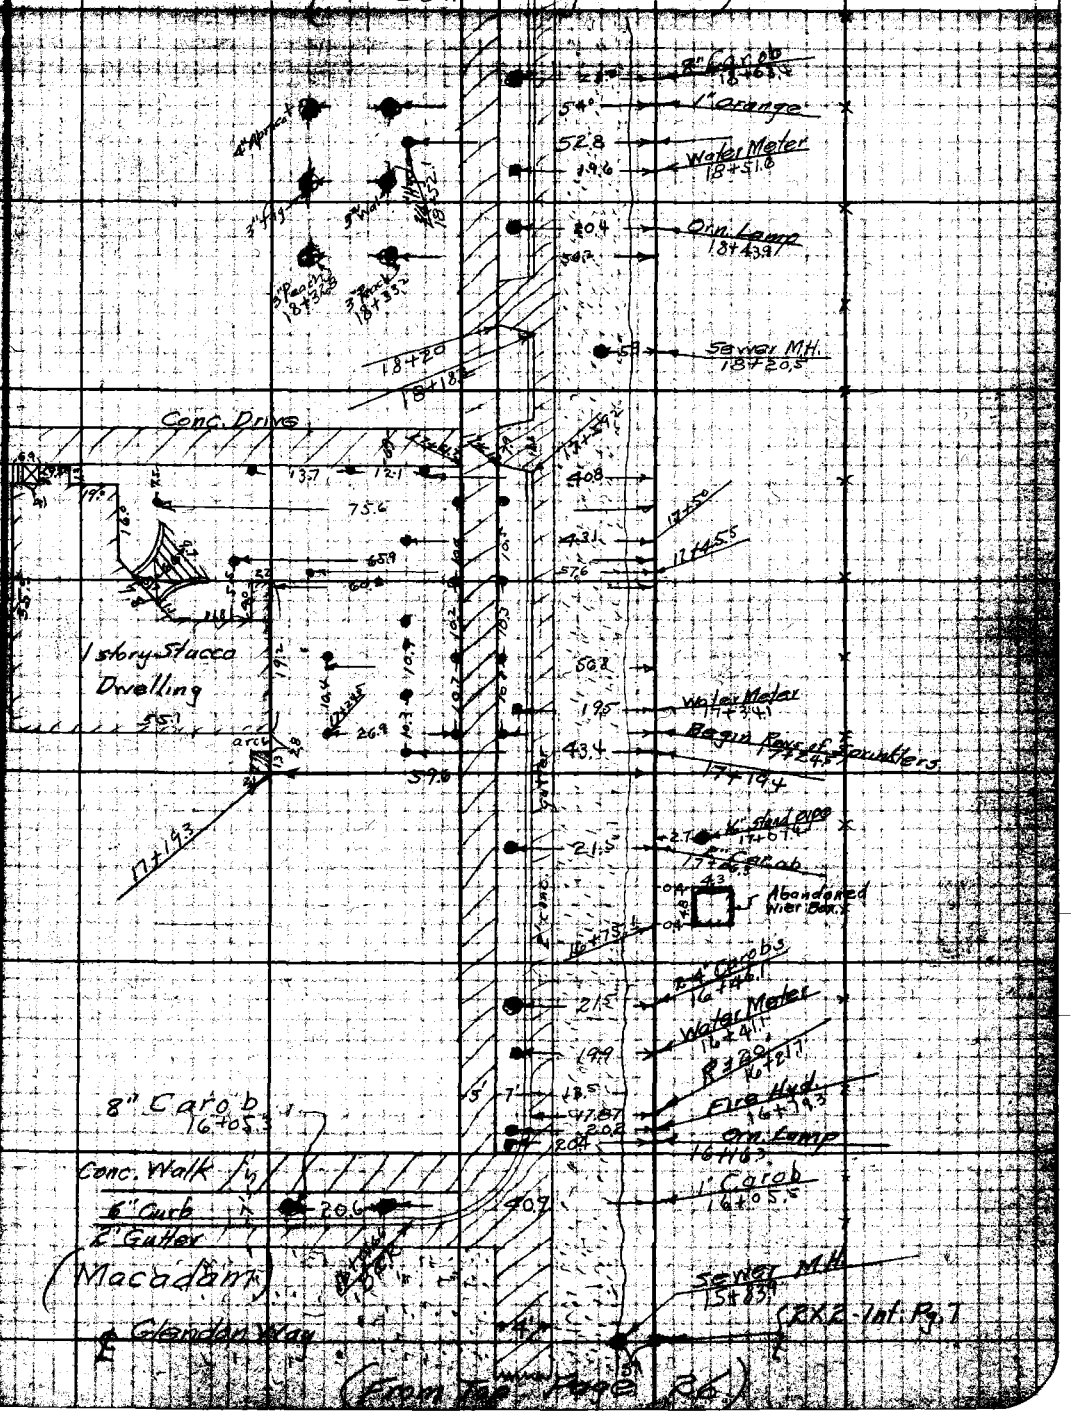

(From Top Page 26)

LOS ANGELES COUNTY SURVEYOR
700 HALL OF RECORDS
Do not extend notes this side of this line.

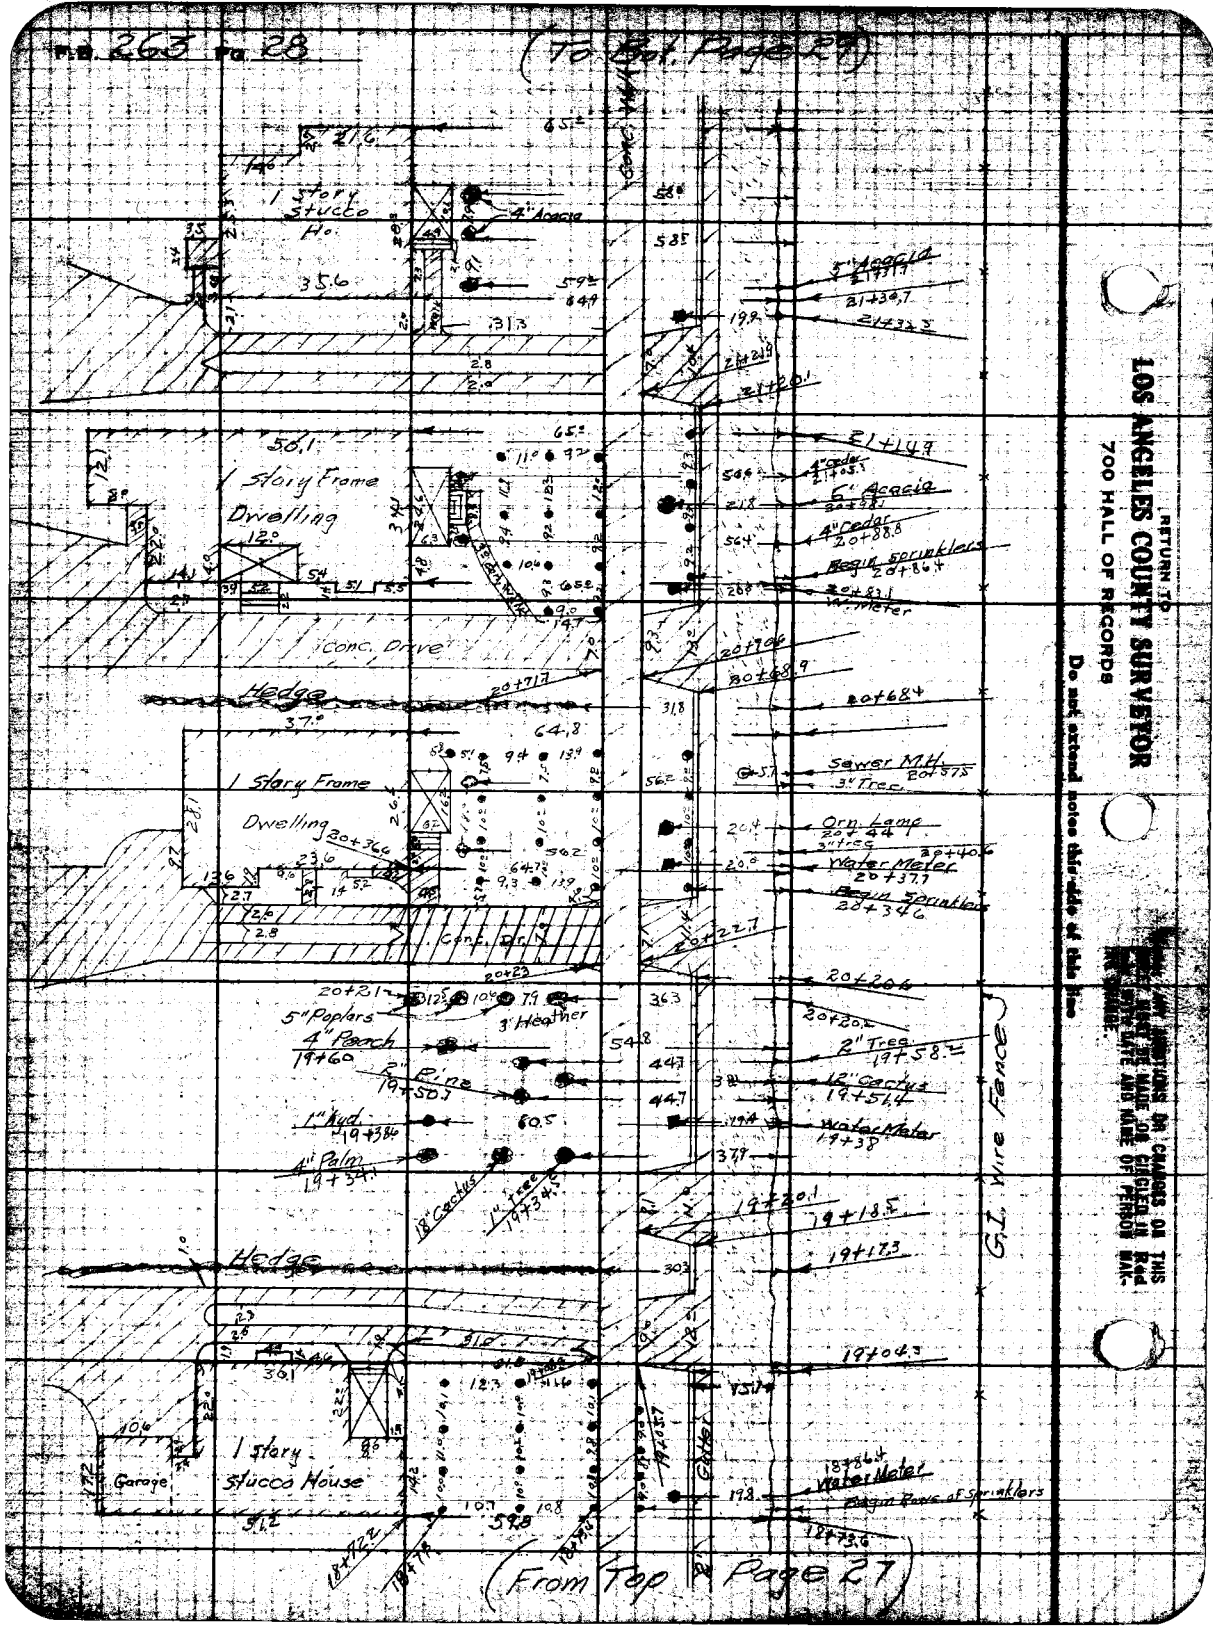

RETURN TO
LOS ANGELES COUNTY SURVEYOR
700 HALL OF RECORDS
Do not extend notes this side of this line

Notes Ck'd by Drew | Survey of Alhambra Ave | F.B. [illegible] Pg. [illegible]
Map No. B-1302 | W. [illegible] | Page No. | Ck'd | of
Office Work F.A.W. | Surveyed by [illegible]
Checked Drew | Notes McNin | Date 1-15-36
Date July-37 | Inspector A. C. Johnson

(To Bot. Page 30)

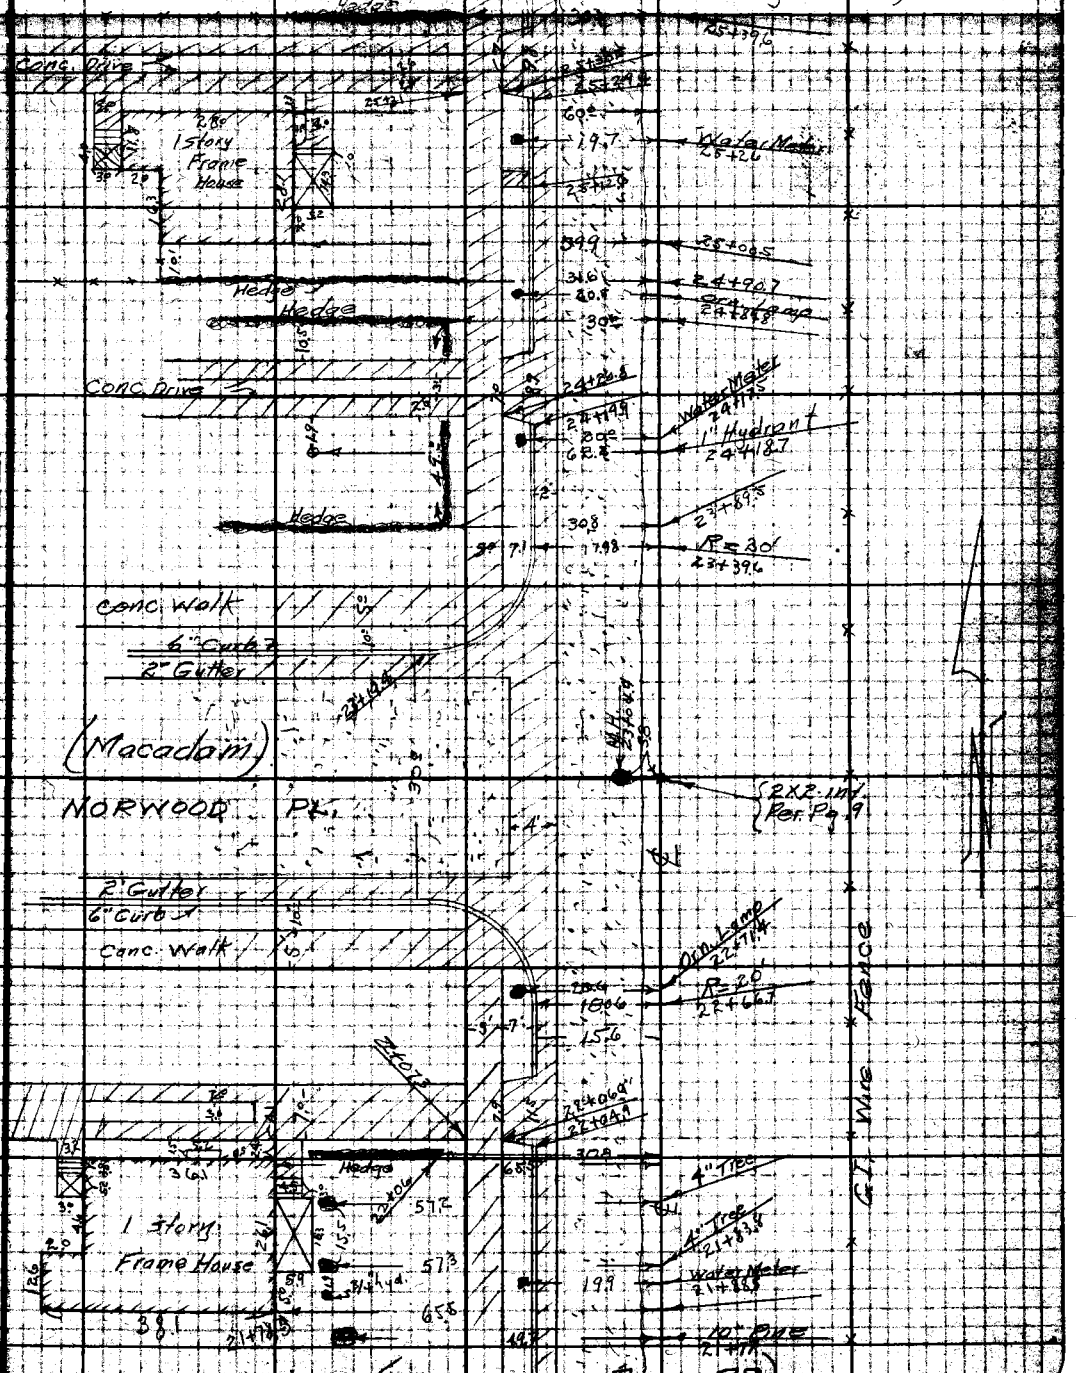

(From Top Page R8)

Note: ANY ADDITIONS OR CHANGES ON THIS SHEET MUST BE MADE OR CIRCLED IN RED INK WITH DATE AND NAME OF PERSON MAKING CHANGE.
Do not extend notes this side of this line
RETURN TO LOS ANGELES COUNTY SURVEYOR 700 HALL OF RECORDS

(To Bot Page 31)

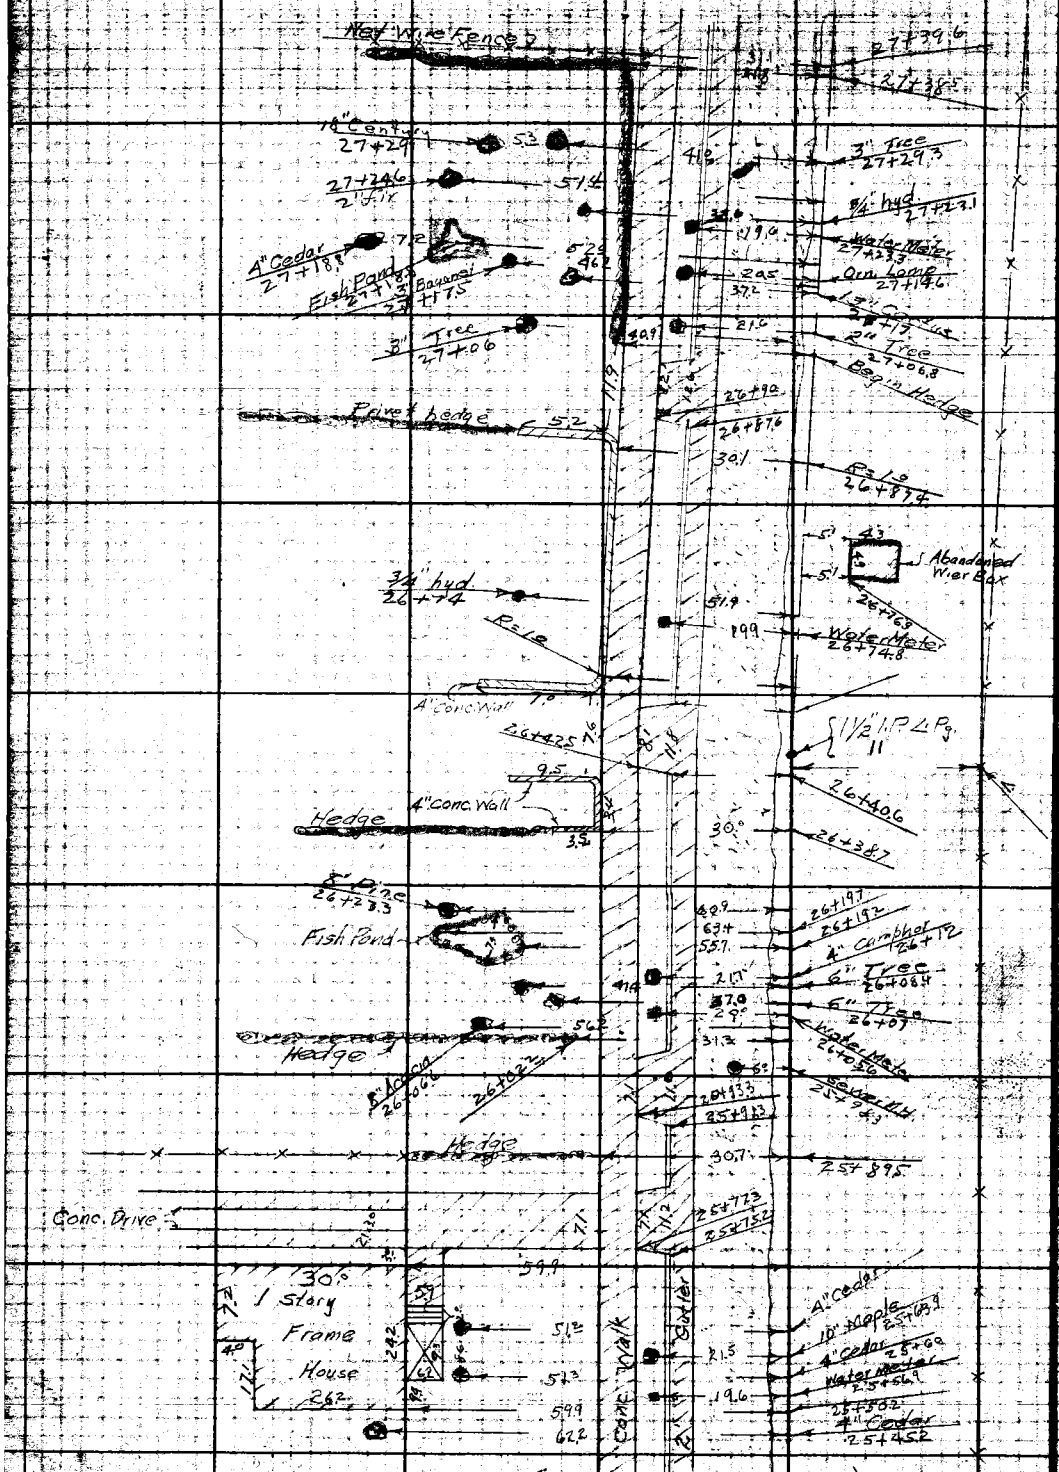

(From Top Page 29)

RETURN TO
LOS ANGELES COUNTY SURVEYOR
700 HALL OF RECORDS
Do not extend notes this side of this line
Note: ANY ADDITIONS OR CHANGES ON THIS SHEET MUST BE MADE OR CIRCLED IN Red Ink WITH DATE AND NAME OF PERSON MAKING CHANGE.

Notes Ck'd by Drew	Survey of Alhambra Ave		F.B. 343 Pg. 31
Map No. B-1302	W.O. 7124	Topo No.	Sh'd
Office Work F.A.W.	Surveyed by Evans		
Checked Drew	Notes Martin	Date 1-15-36	
Date July-37	Indexed A. C. Johnson		

(To Bottom Page 32)

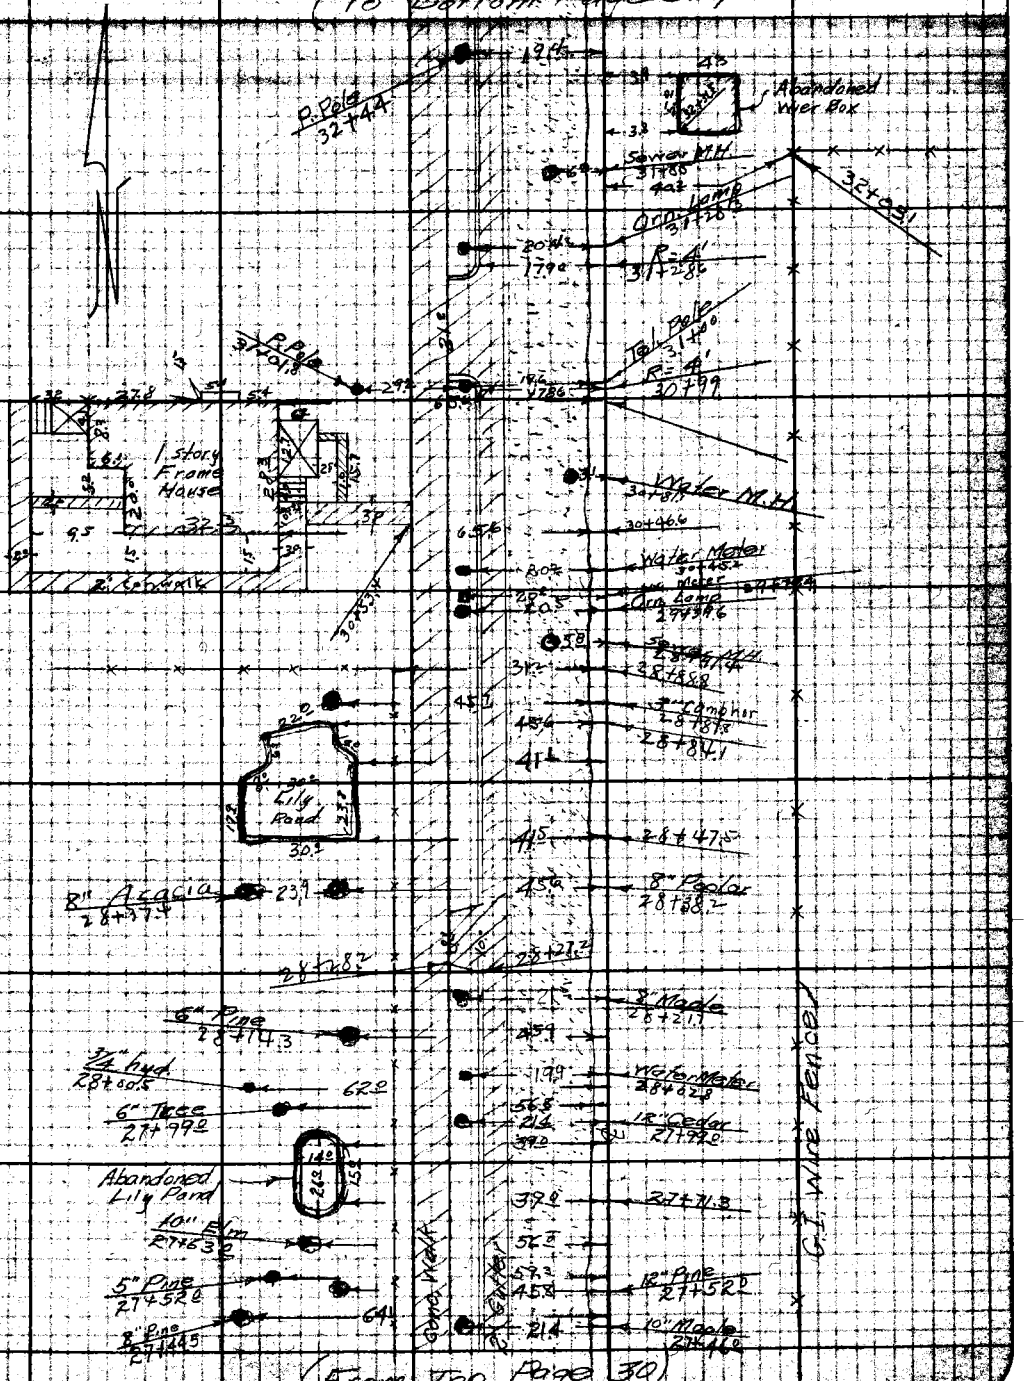

(From Top Page 30)

Notes: ANY ADDITIONS OR CHANGES ON THIS SHEET MUST BE MADE OR CHECKED IN WITH DATE AND NAME OF PERSON MAKING CHANGE.
RETURN TO LOS ANGELES COUNTY SURVEYOR 700 HALL OF RECORDS
Do not extend notes outside of this line!

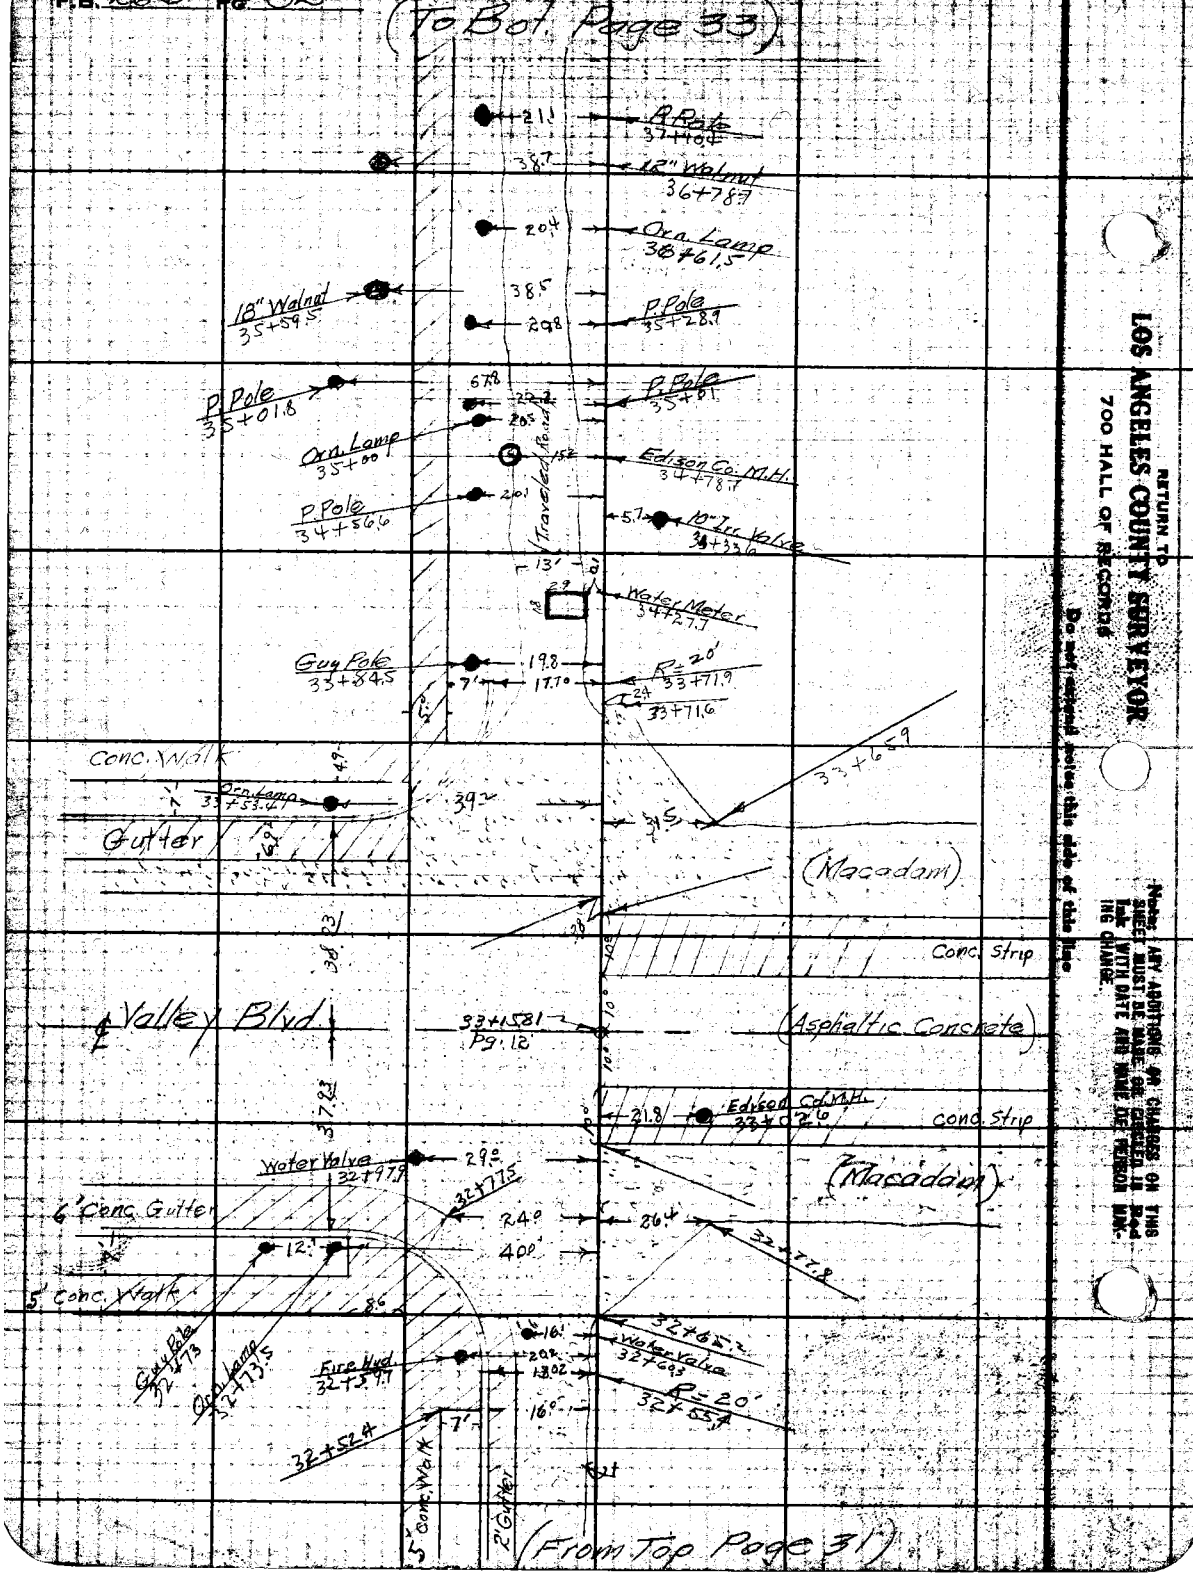

RETURN TO
LOS ANGELES COUNTY SURVEYOR
700 HALL OF RECORDS
Do not extend notes this side of this line
Note: ANY ADDITIONS OR CHANGES ON THIS SHEET MUST BE MADE OR CHECKED IN RED Ink WITH DATE AND NAME OF PERSON MAKING CHANGE.

Notes Ch'd by	[illegible]	Survey of	Alhambra Ave
Map No.	B-1302	W. O.	7124
Office Work	[illegible]	Surveyed by	Evans
Checked	[illegible]	Notes	Martin
Date	[illegible]	Date	1-16-36
		Reviewed	A. C. Johnson

F.B. [illegible] Pg. 33

(From Page 34)

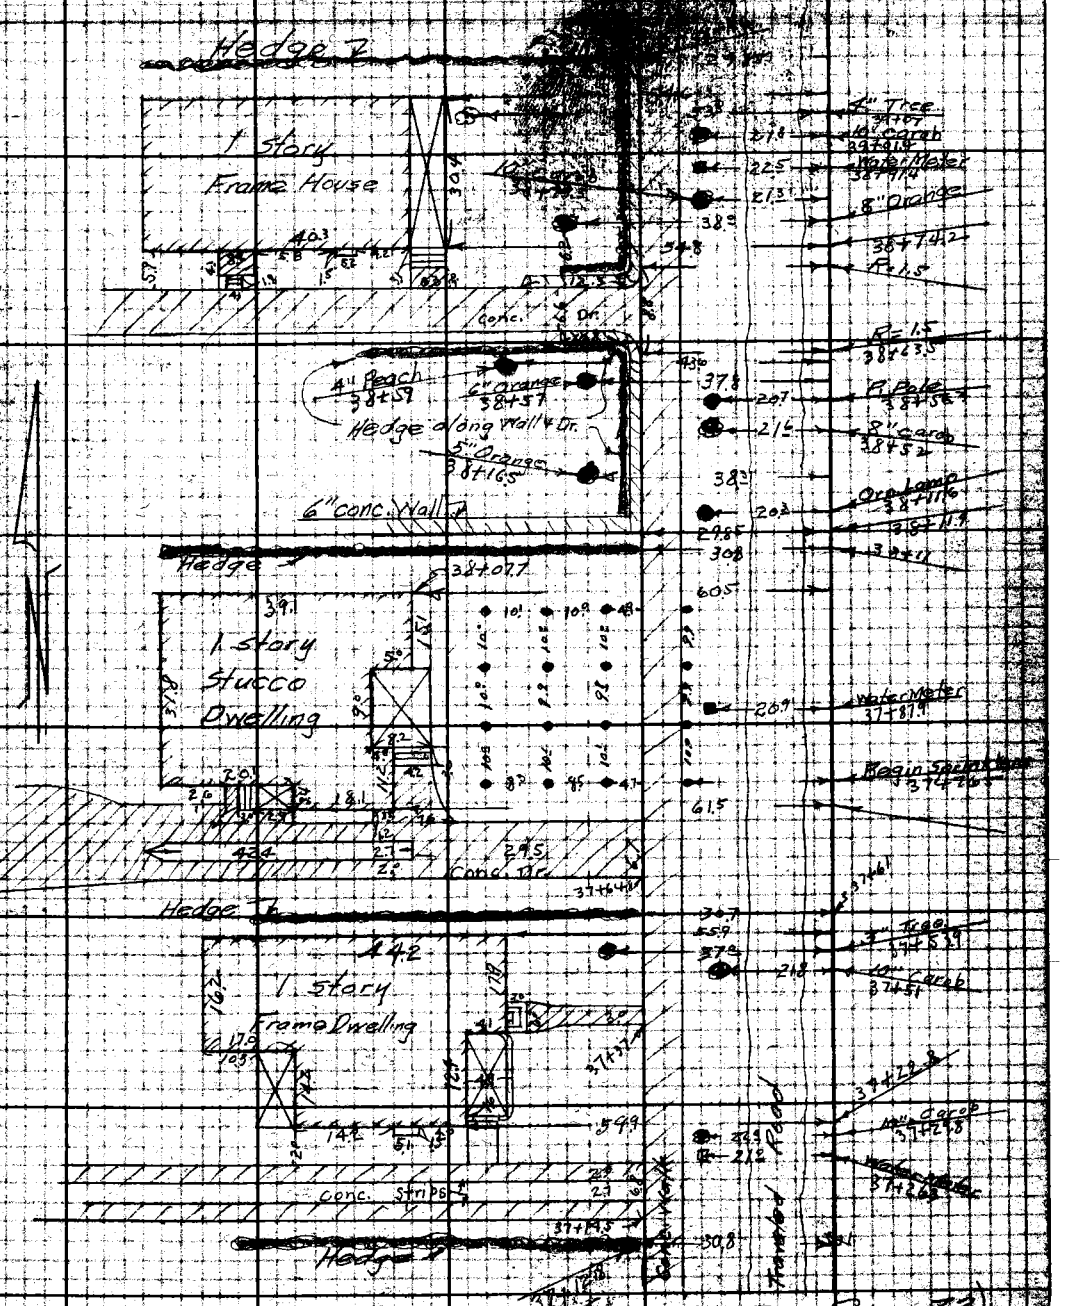

(From Top Page 32)

RETURN TO
LOS ANGELES COUNTY SURVEYOR
700 HALL OF RECORDS
Do not extend [illegible]
FORM 547 SM. 5-34

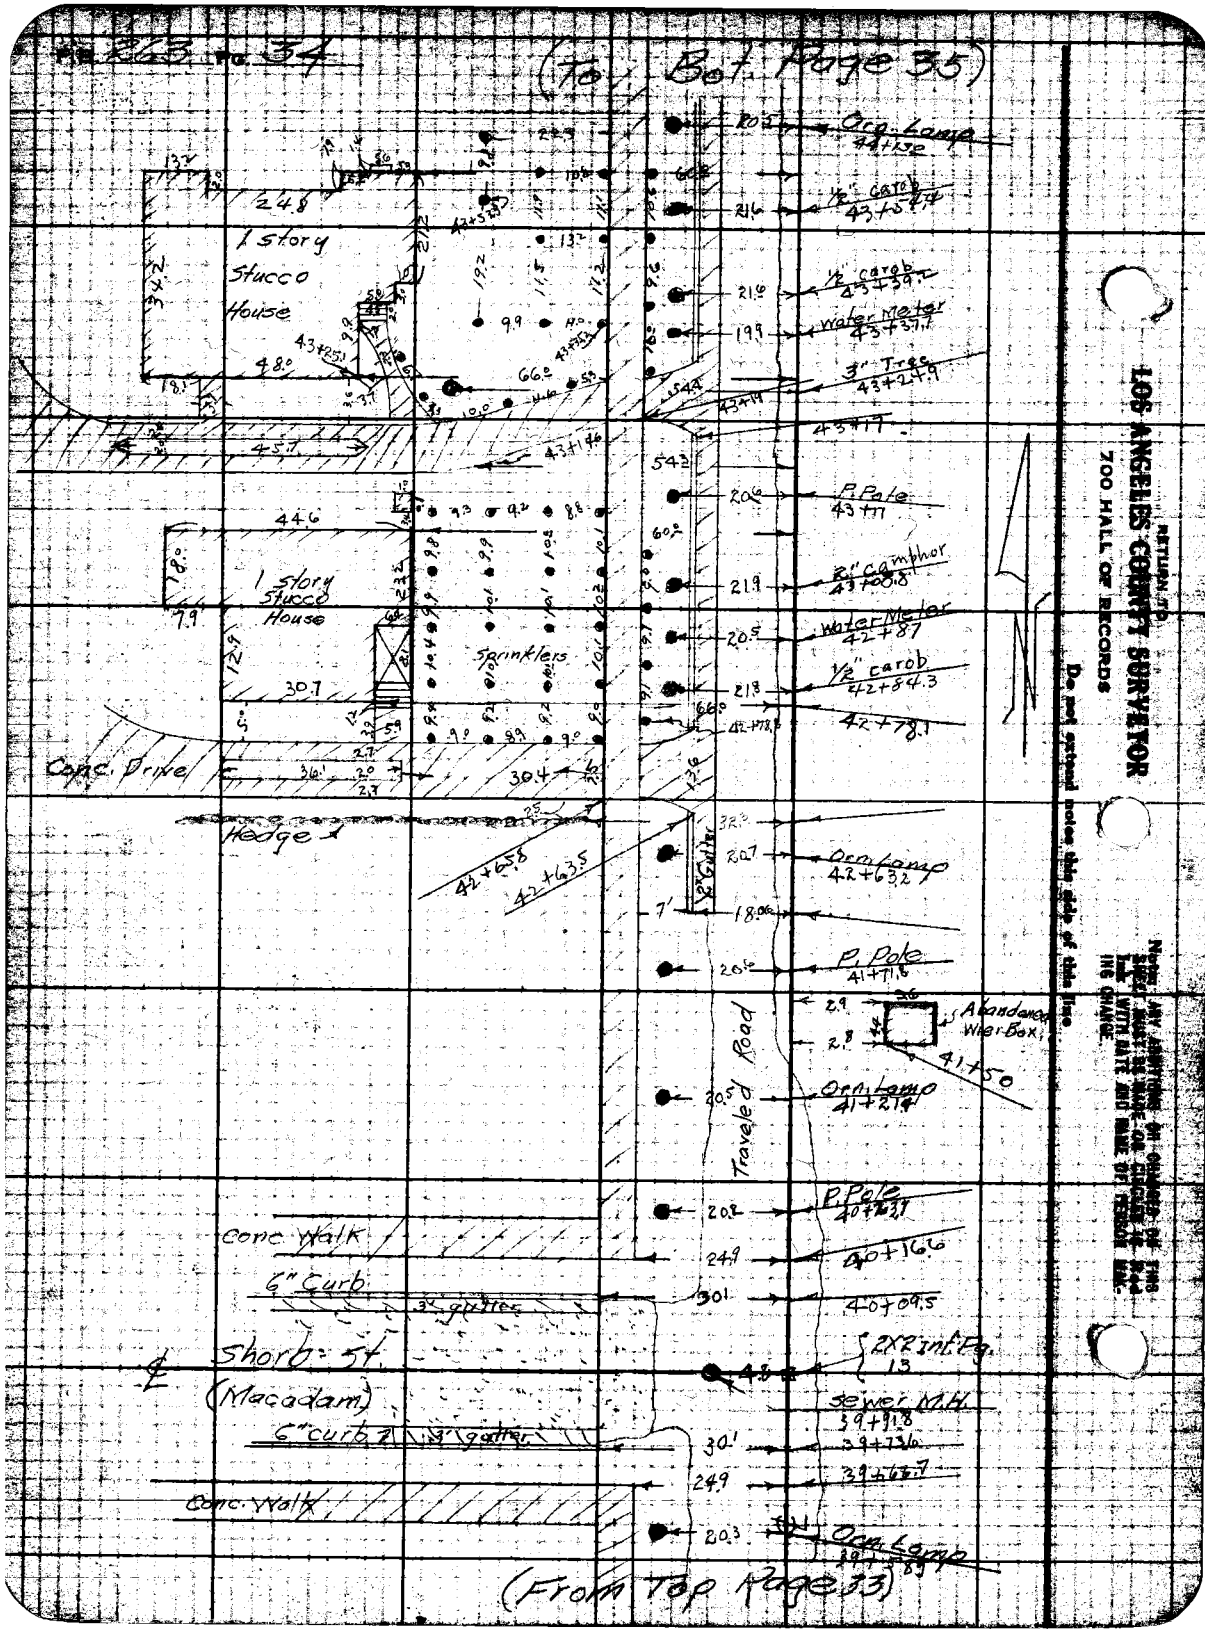

Fig. 263 Pg. 34
(To Bot. Page 35)
Orn. Lamp 44+13.2
1/2" carob 43+54.4
1/2" carob 43+39.2
Water Meter 43+37.7
3" Tree 43+24.9
43+17
1 story Stucco House
P. Pole 43+11
2" Camphor 43+00.8
Water Meter 42+87
1/2" carob 42+84.3
42+78.1
Sprinklers
Conc. Drive
Hedge
42+65.8
42+63.5
Orn. Lamp 42+63.2
P. Pole 41+71.8
Abandoned Wier Box
41+50
Orn. Lamp 41+21.4
Traveled Road
P. Pole 40+63.7
40+16.6
40+09.5
Conc. Walk
6" Curb
3" gutter
Shorb. St.
(Macadam)
2X2 Inf. Pg. 13
Sewer M.H. 39+91.8
39+73.6
39+66.7
Conc. Walk
Orn. Lamp 39+58.9
(From Top Page 33)
RETURN TO
LOS ANGELES COUNTY SURVEYOR
700 HALL OF RECORDS
Do not extend notes this side of this line

Notes Ck'd by Drew	Survey of Alhambra Ave	F.B. [illegible]	Pg. [illegible]
Map No. B-1302	W. O. 7124 Tape No.	Sht.	of
Office Work F. A. W.	Surveyed by Evans		
Checked Drew	Notes Martin	Date 1-16-36	
Date July -37	Indexed A. C. Johnson		

(To Bot. Page 36)

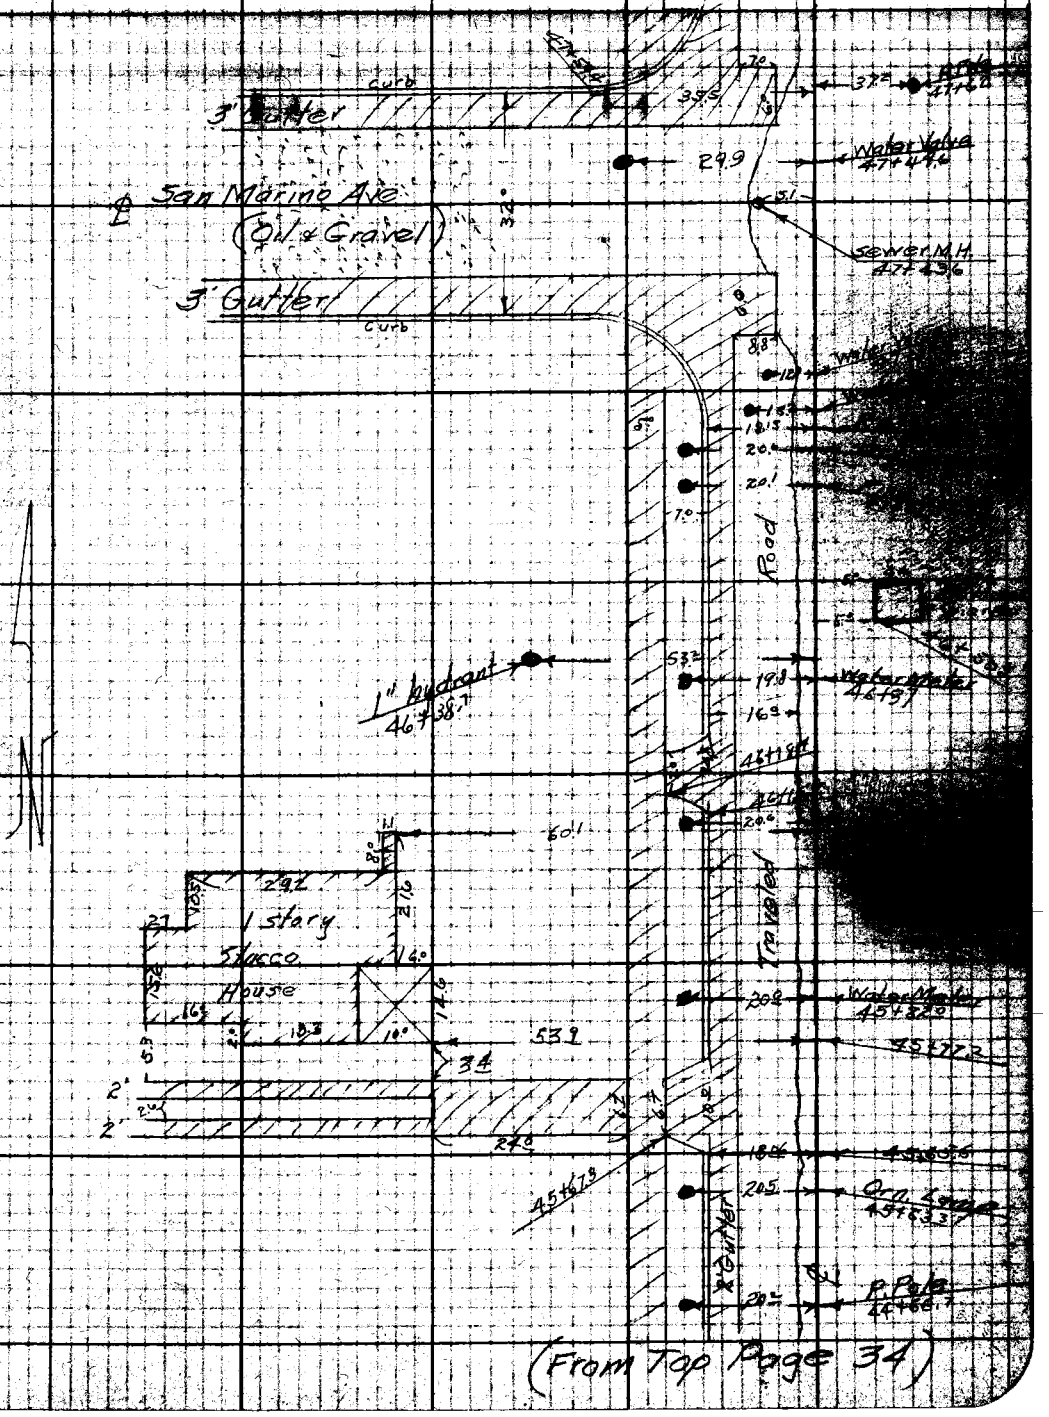

(From Top Page 34)

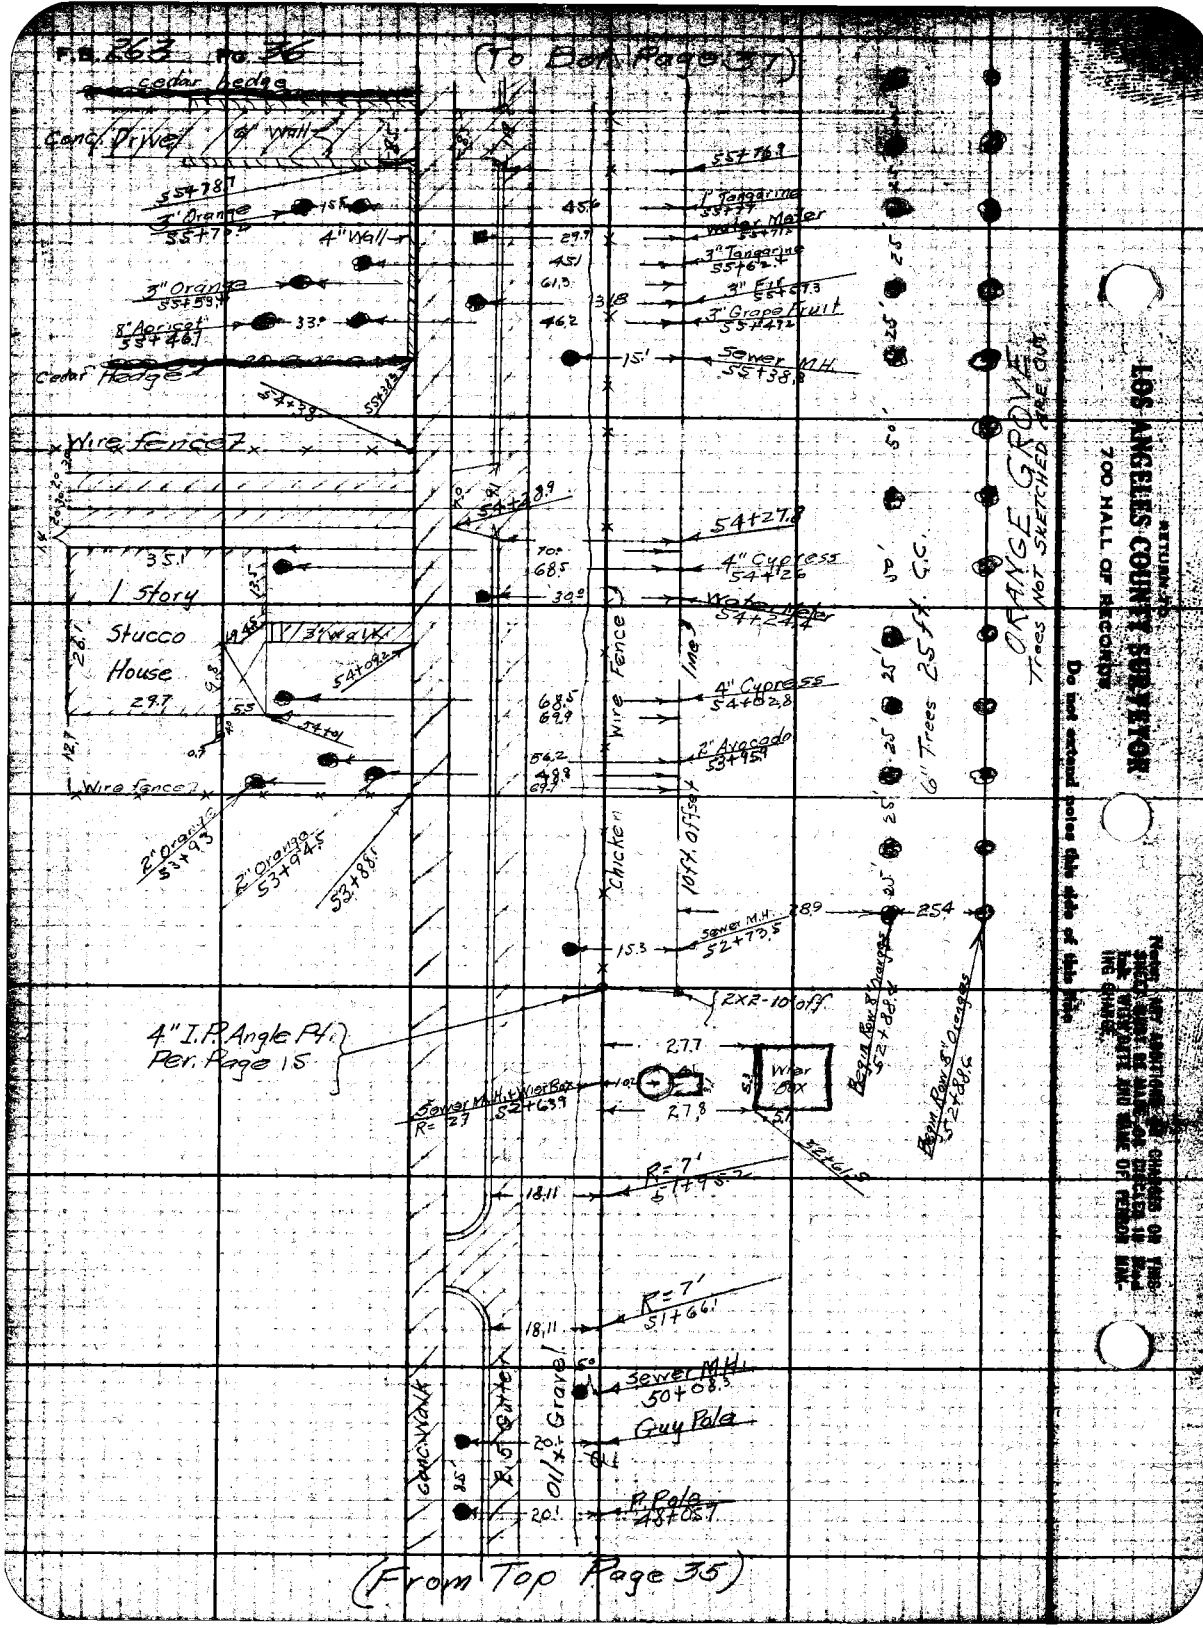
F.B. 263 Pg. 36
(To Bot. Page 37)
cedar hedge
Conc. Drive
6" Wall
55+78.7
3" Orange
55+75.0
4" Wall
3" Orange
55+59.4
8" Apricot
55+46.7
Cedar Hedge
Wire fence
1 Story
Stucco
House
3" Walk
Wire fence
2" Orange
53+93
2" Orange
53+94.5
53+88.1
55+76.9
1" Tangarine
Water Meter
3" Tangarine
3" Fir
3" Grape Fruit
Sewer M.H.
55+38.8
54+28.9
54+27.8
4" Cypress
54+26
Water Meter
54+24.4
4" Cypress
54+02.8
2" Avocado
53+95.9
Chicken Wire Fence
10 ft. offset line
Sewer M.H.
52+73.5
2X2-10' off
4" I.P. Angle Pt.
Per. Page 15
Sewer M.H. + Wier Box
R=27
52+63.9
Wier Box
Begin Row 8" Oranges
52+88.4
Begin Row 5" Oranges
52+88.6
R=7'
51+95.2
R=7'
51+66.1
Sewer M.H.
50+08.3
Guy Pole
P. Pole
48+05.7
Conc. Walk
R.S. Gutter
Oil + Gravel
6" Trees 25 ft. C.C.
ORANGE GROVE
Trees NOT SKETCHED ARE OUT
(From Top Page 35)
RETURN TO
LOS ANGELES COUNTY SURVEYOR
700 HALL OF RECORDS
Do not extend notes this side of this line

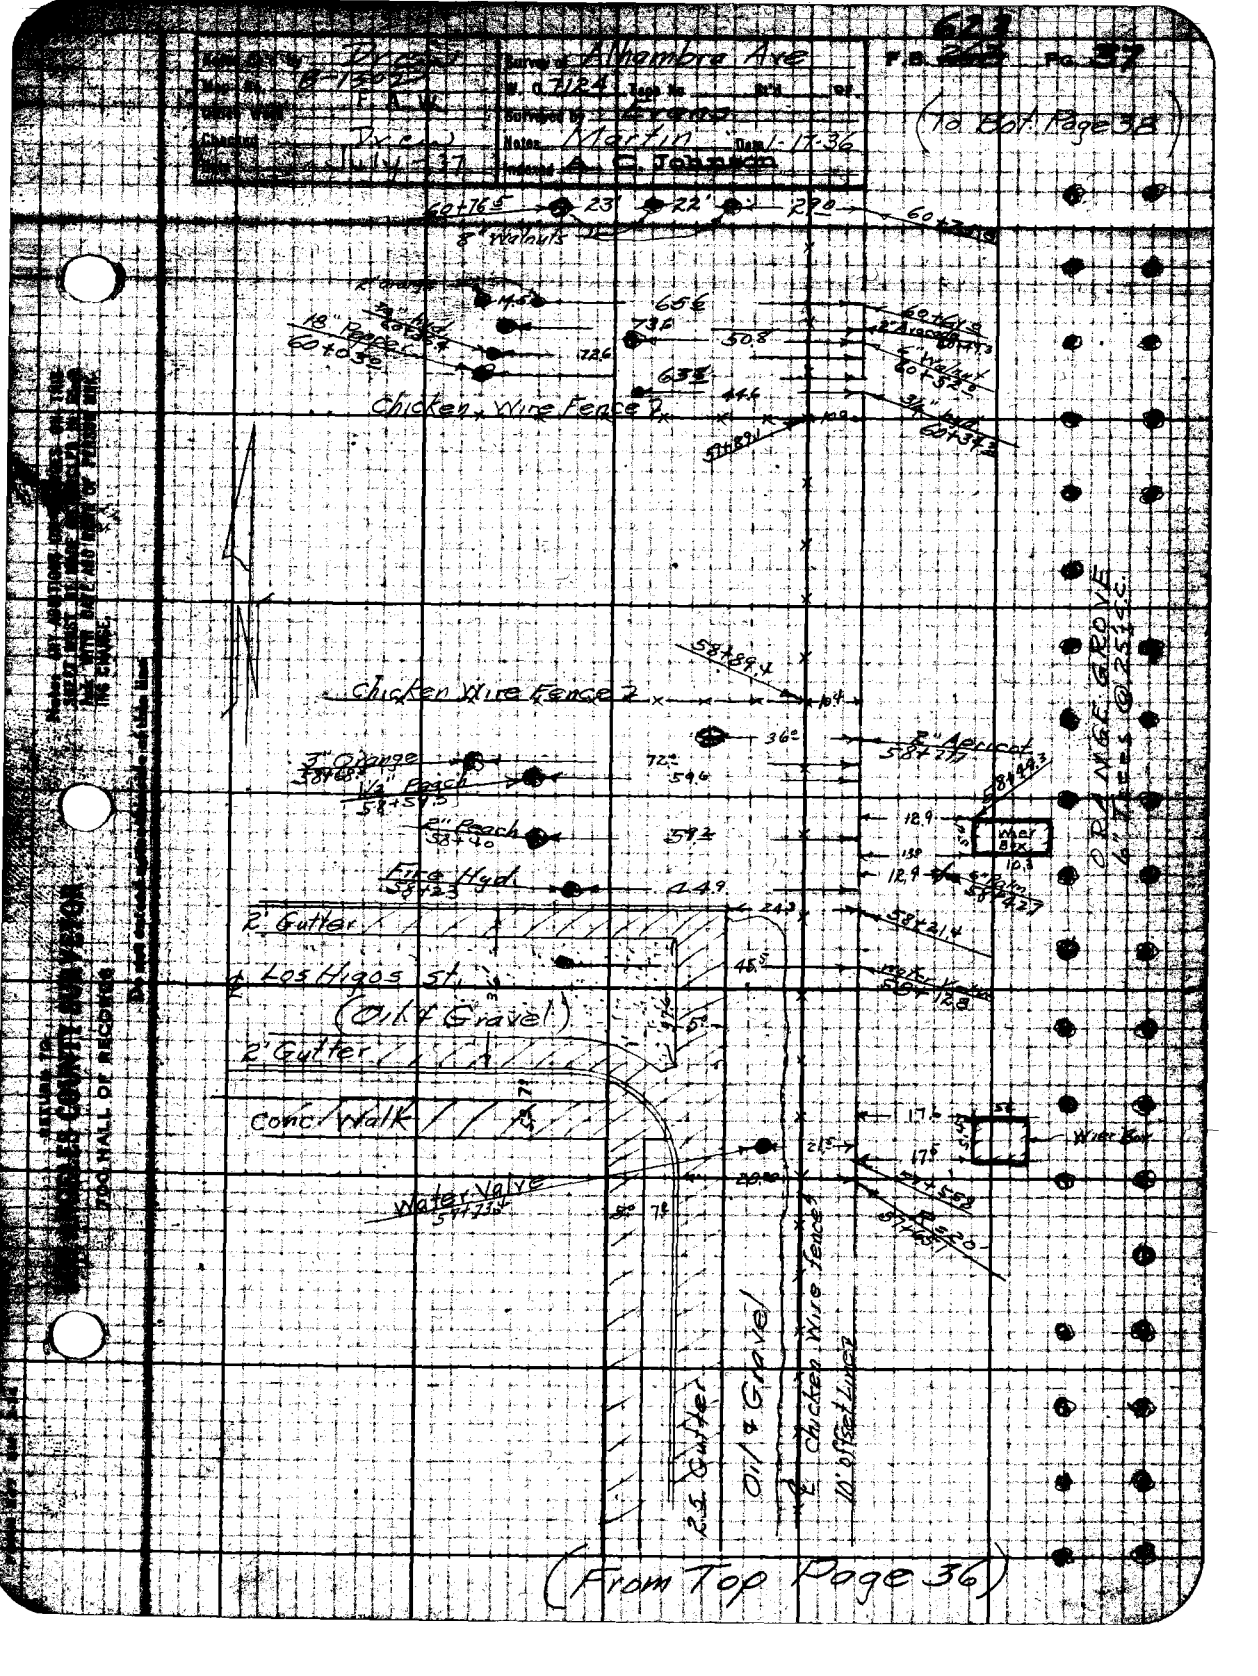

623
F.B. 263 Pg. 37
Alhambra Ave
W. O. 7124
Martin
Date 1-17-36
A. C. Johnson
(To Bot. Page 38)
60+76.5
23'
22'
29.0
8" Walnuts
2" Orange
18" Pepper
60+03.0
65.6
73.6
50.8
72.6
63.8
44.6
Chicken Wire Fence
58+89.4
Chicken Wire Fence
36.0
2" Apricot
58+77.7
3" Orange
58+68.3
1½" Peach
58+59.5
72.0
59.6
2" Peach
58+40
59.2
Fire Hyd.
58+23
44.9
12.9
Water Box
10.3
12.9
58+21.4
2' Gutter
Los Higos St.
(Oil & Gravel)
45.5
Water Valve
58+12.8
2' Gutter
Conc. Walk
17.6
17.5
Water Box
Water Valve
59+73.4
20.0
R=20'
Chicken Wire Fence
10' Offset Line
Oil & Gravel
2.5' Gutter
ORANGE GROVE
6" Trees @ 25' c.c.
(From Top Page 36)

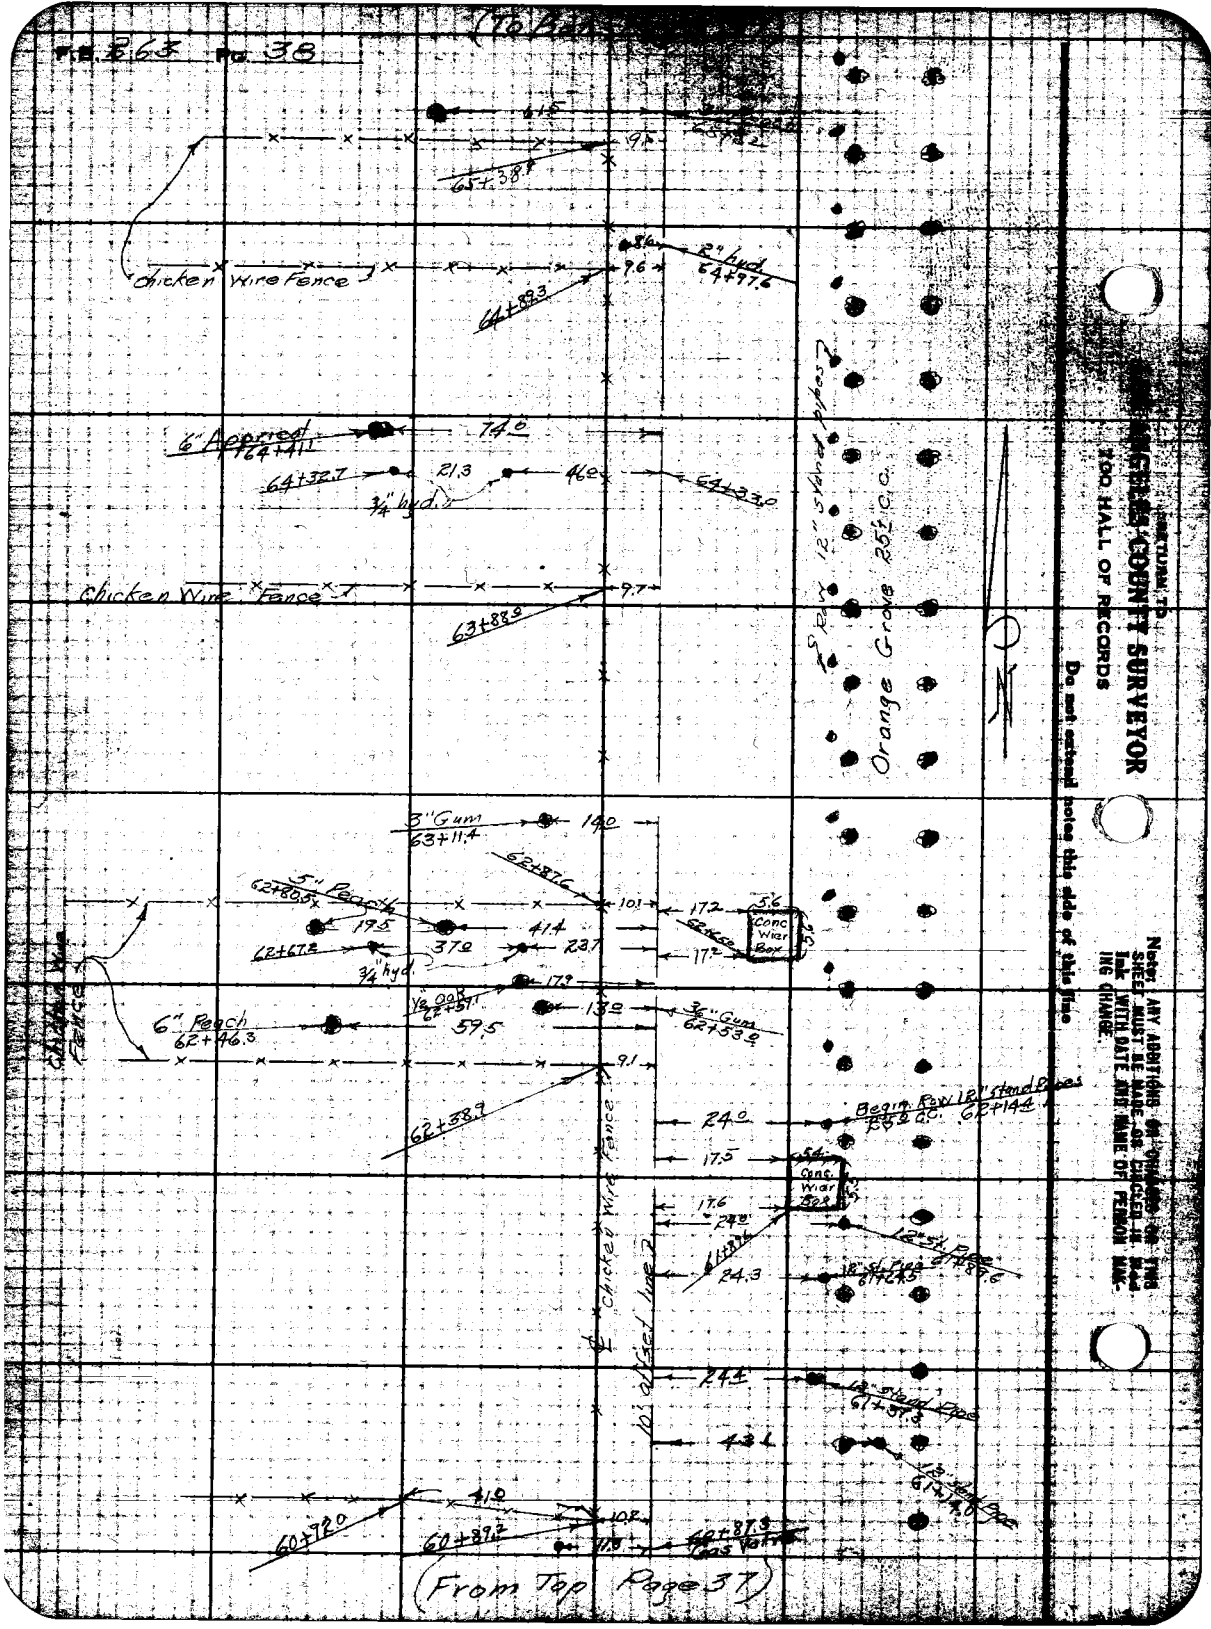

RETURN TO
LOS ANGELES COUNTY SURVEYOR
TOO HALL OF RECORDS
Do not extend notes this side of this line

Note: ANY ADDITIONS OR CHANGES ON THIS SHEET MUST BE MADE OR CHECKED IN Red Ink WITH DATE AND NAME OF PERSON MAKING CHANGE.

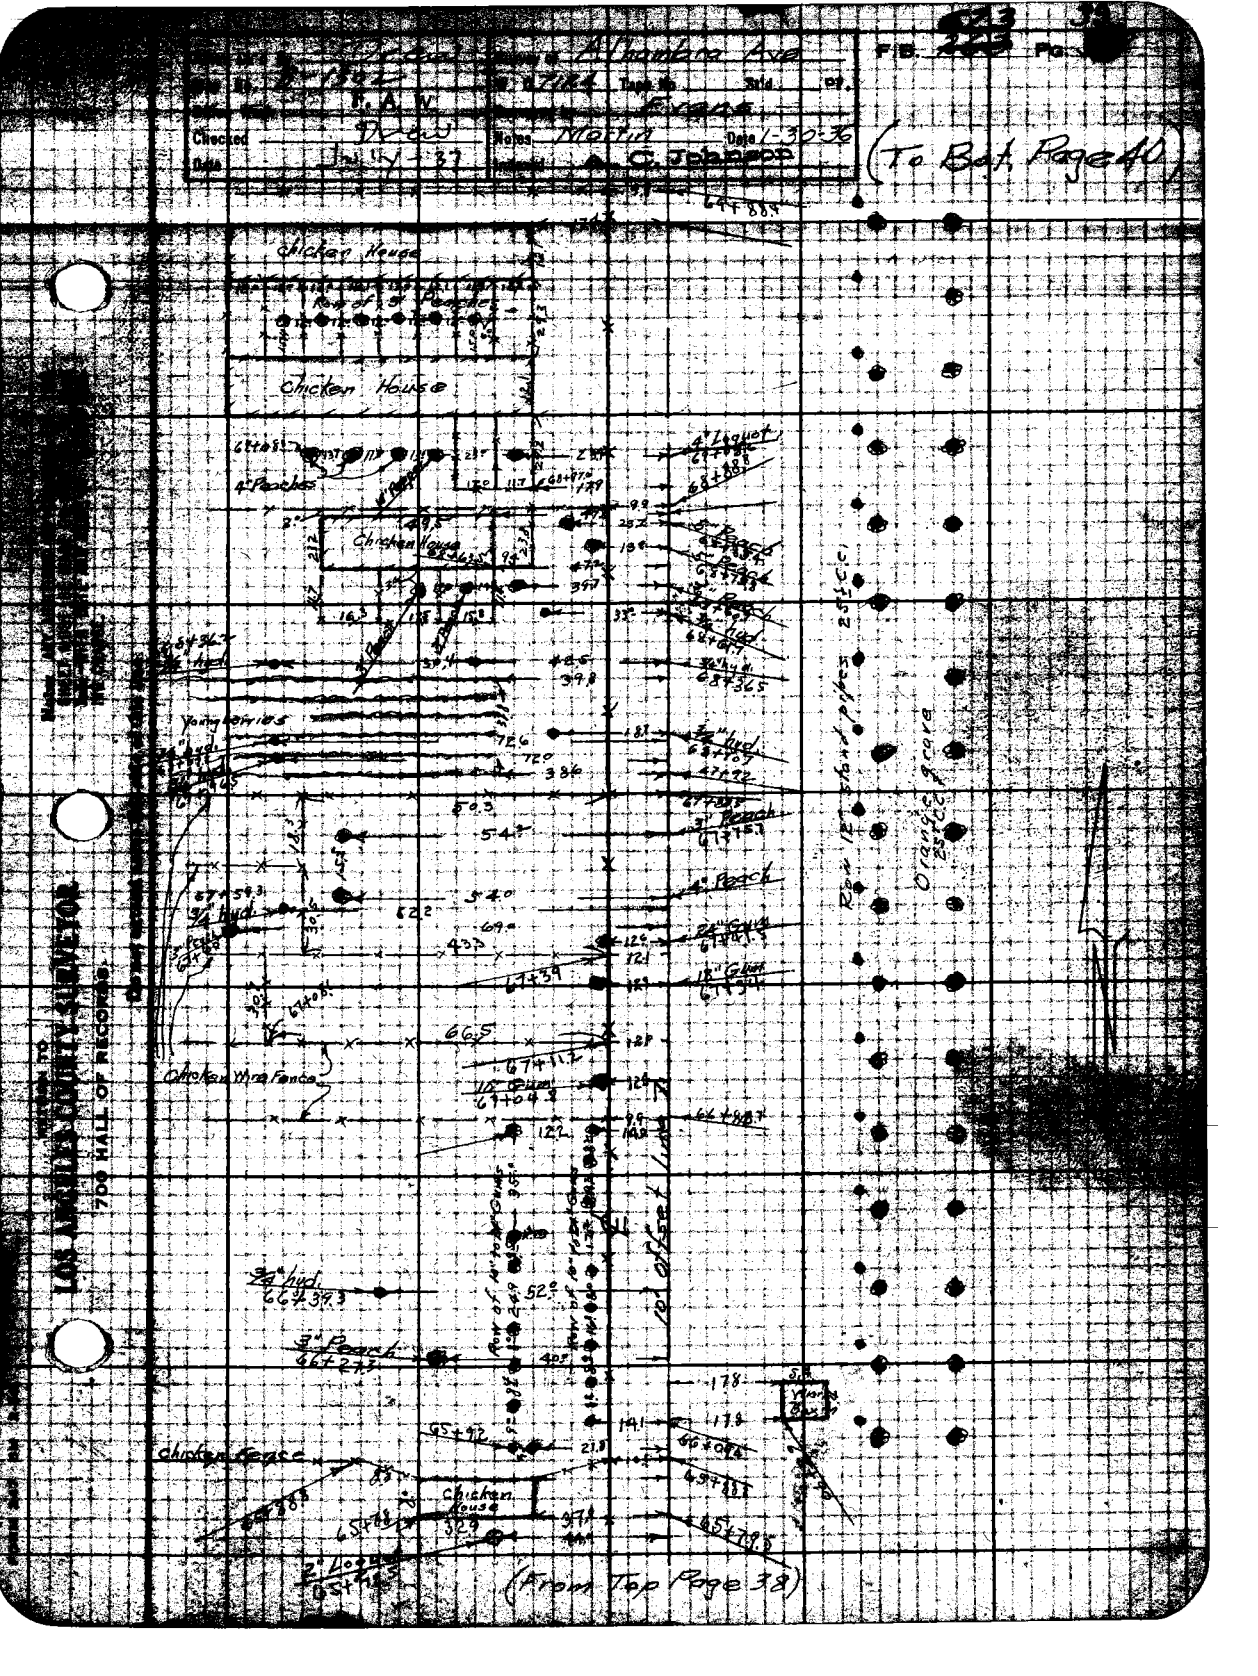

700 HALL OF RECORDS


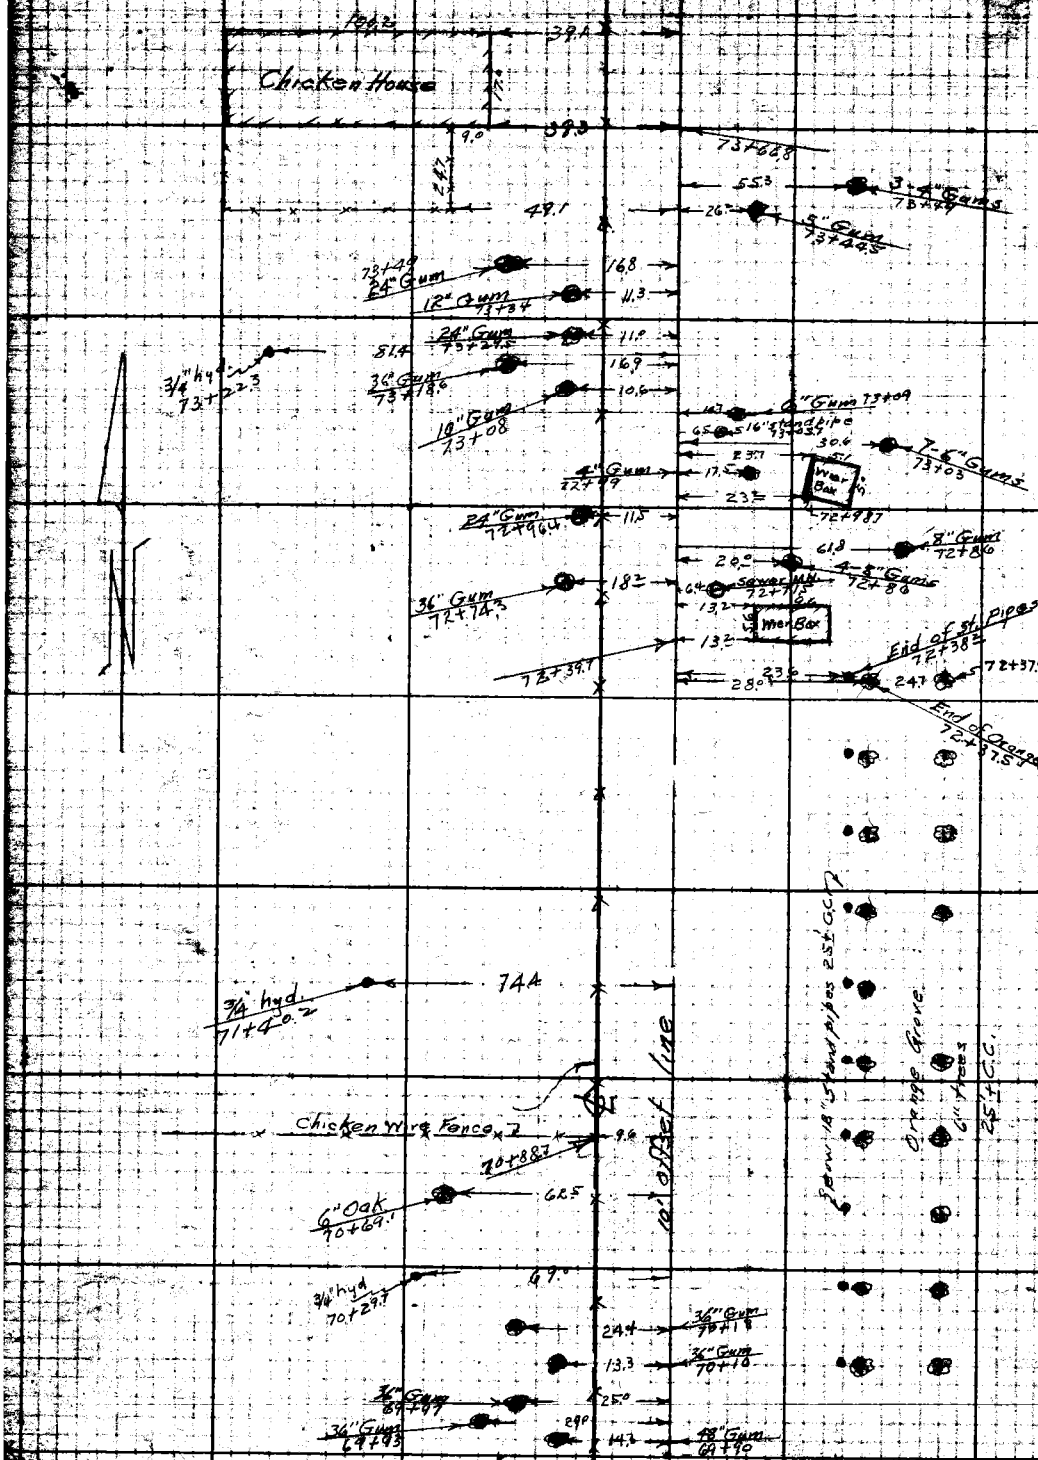

(From Top Page 39)

RETURN TO
LOS ANGELES COUNTY SURVEYOR
700 HALL OF RECORDS
Do not extend notes this side of this line
Note: ANY ADDITIONS OR CHANGES ON THIS SHEET MUST BE MADE OR CHECKED IN RED Ink WITHOUT AND NAME OF PERSON MAKING CHANGE.

Notes Ck'd by Drew	Survey of Alhambra Ave	F.B. 623	Pg. 41
Map No. B-1302	W. O. 7124 Tape No. Std. °F.		
Office Work F. A. W.	Surveyed by Evans		
Checked Drew	Notes Martin Date 1-30-36		
Date July - 37	Indexed A. C. Johnson		

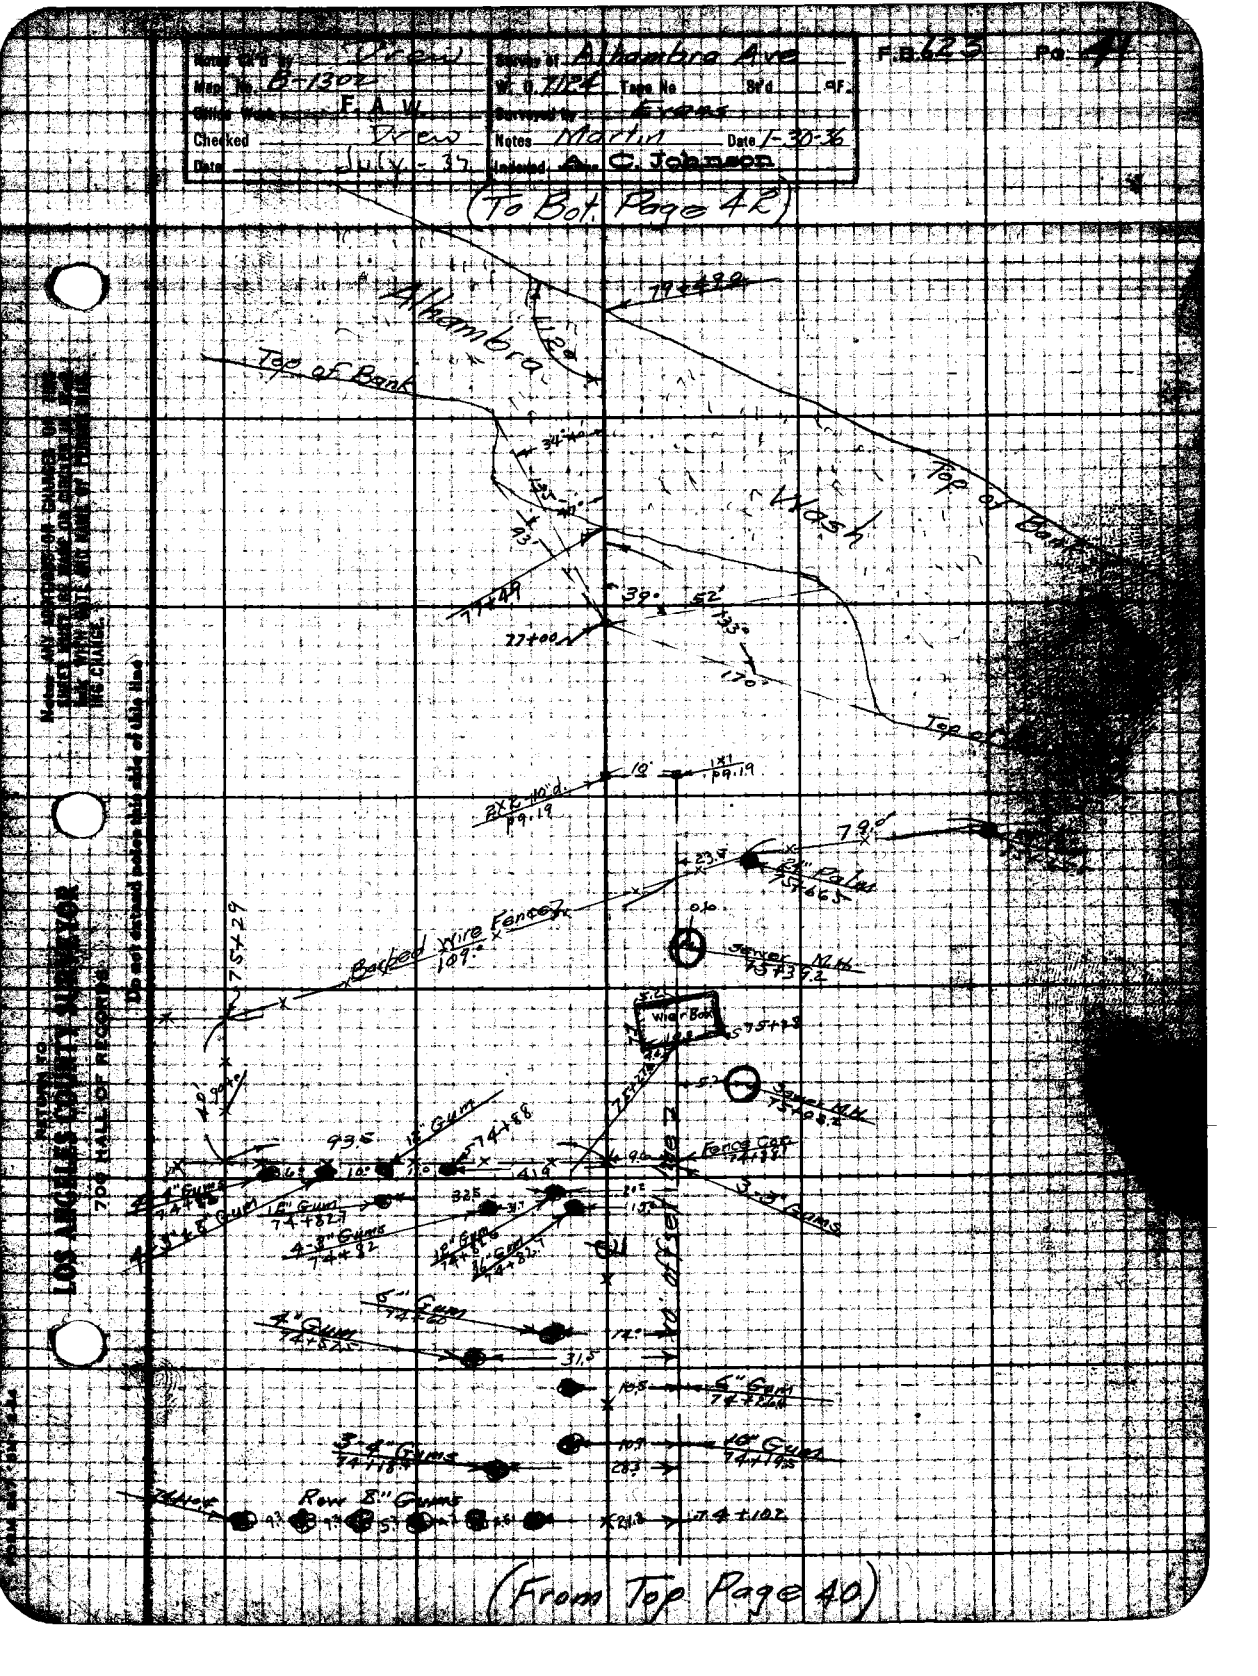

Notes: ANY ADDITIONS OR CHANGES OF THIS SHEET MUST BE MADE ON CIRCLES IN THIS BOX WITH DATE AND NAME OF PERSON MAKING CHANGE.
Do not extend notes this side of this line
RETURN TO LOS ANGELES COUNTY SURVEYOR 700 HALL OF RECORDS

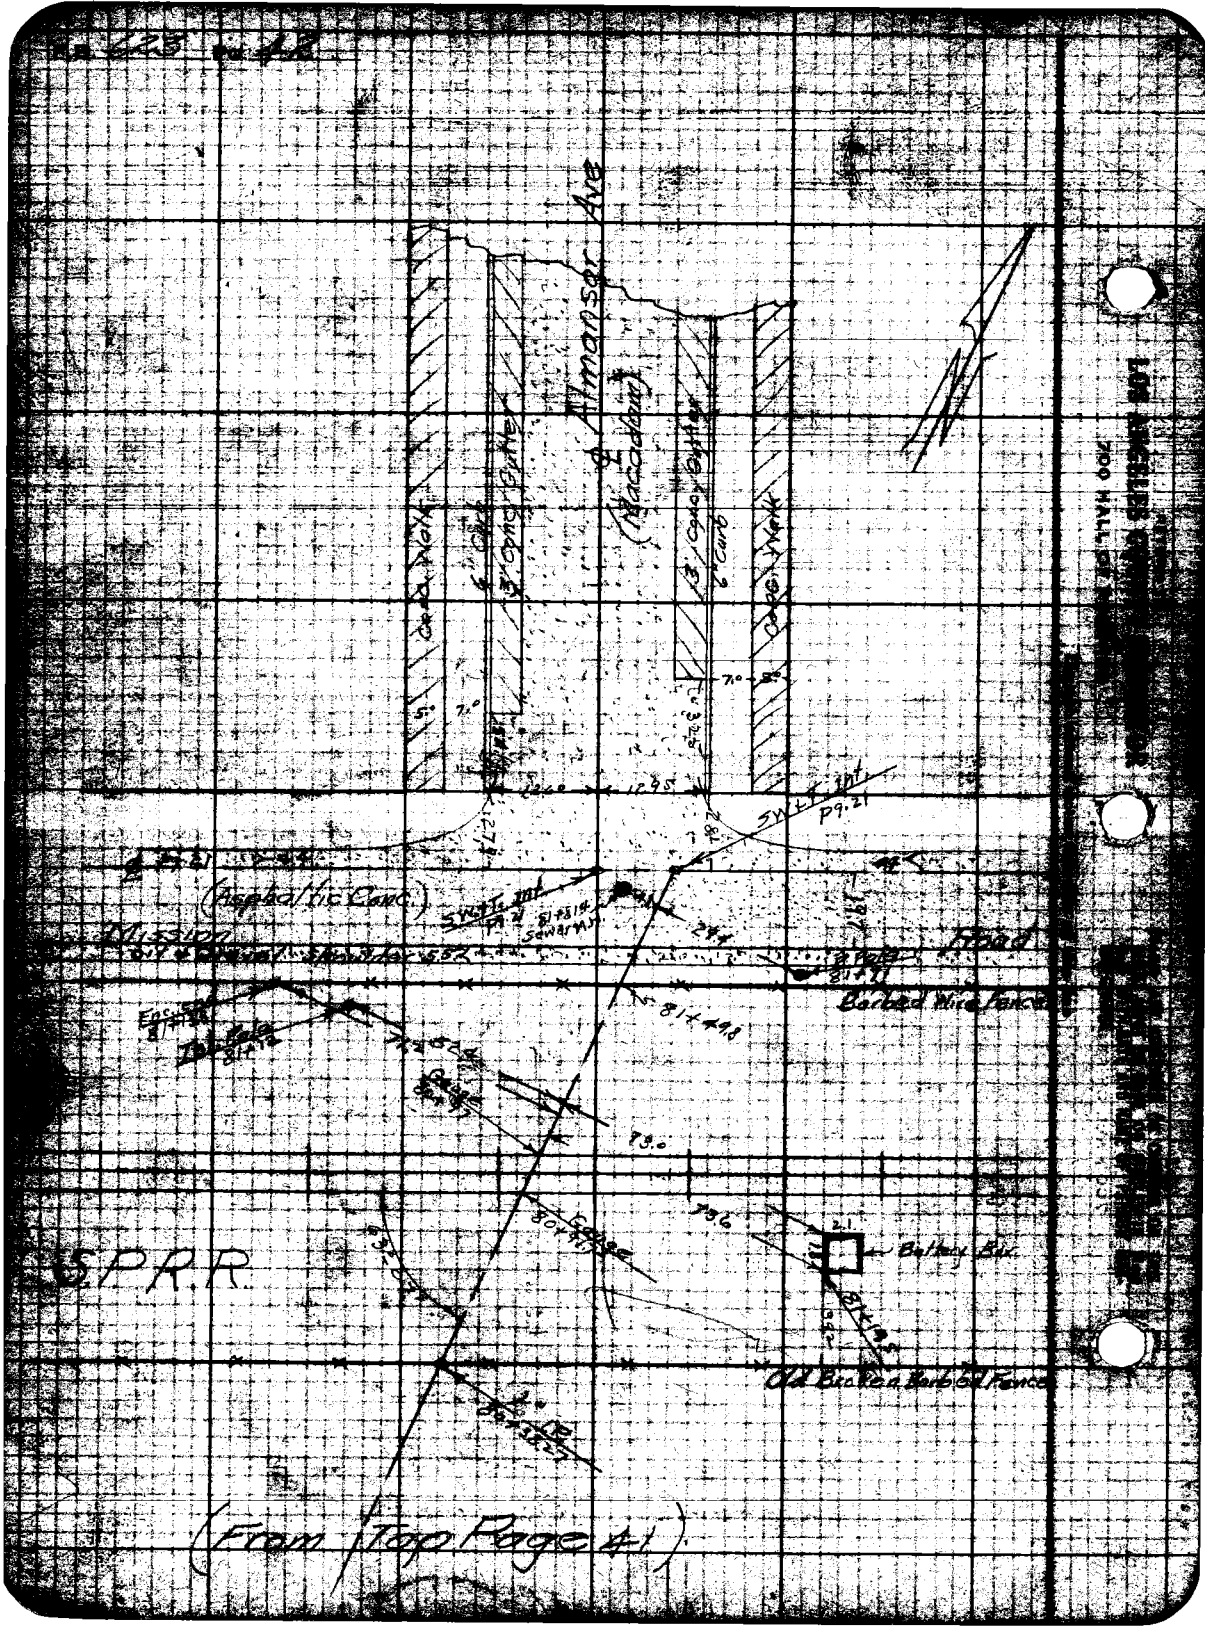

Almansor Ave
(Macadam)
Conc. Walk
6" Curb
3' Conc. Gutter
3' Conc. Gutter
6" Curb
Conc. Walk
(Asphaltic Conc.)
Mission
Road
Barbed Wire Fence
Gauge
Battery Box
Old Broken Barbed Fence
S.P.R.R.
(From Top Page 41)

SURVEY OF LAKE AVE. FROM GARVEY AVE. NORTH TO MISSION DRIVE.

Hugh F. Evans - Dep.
Henry L. Martin - T.
Delbert S. Sedig - H.C.
J.W. Harris - R.C.
W.D. Wallerford - R.C.
H.R. Smith - R.C.
A.R. Landtiser - R.C.

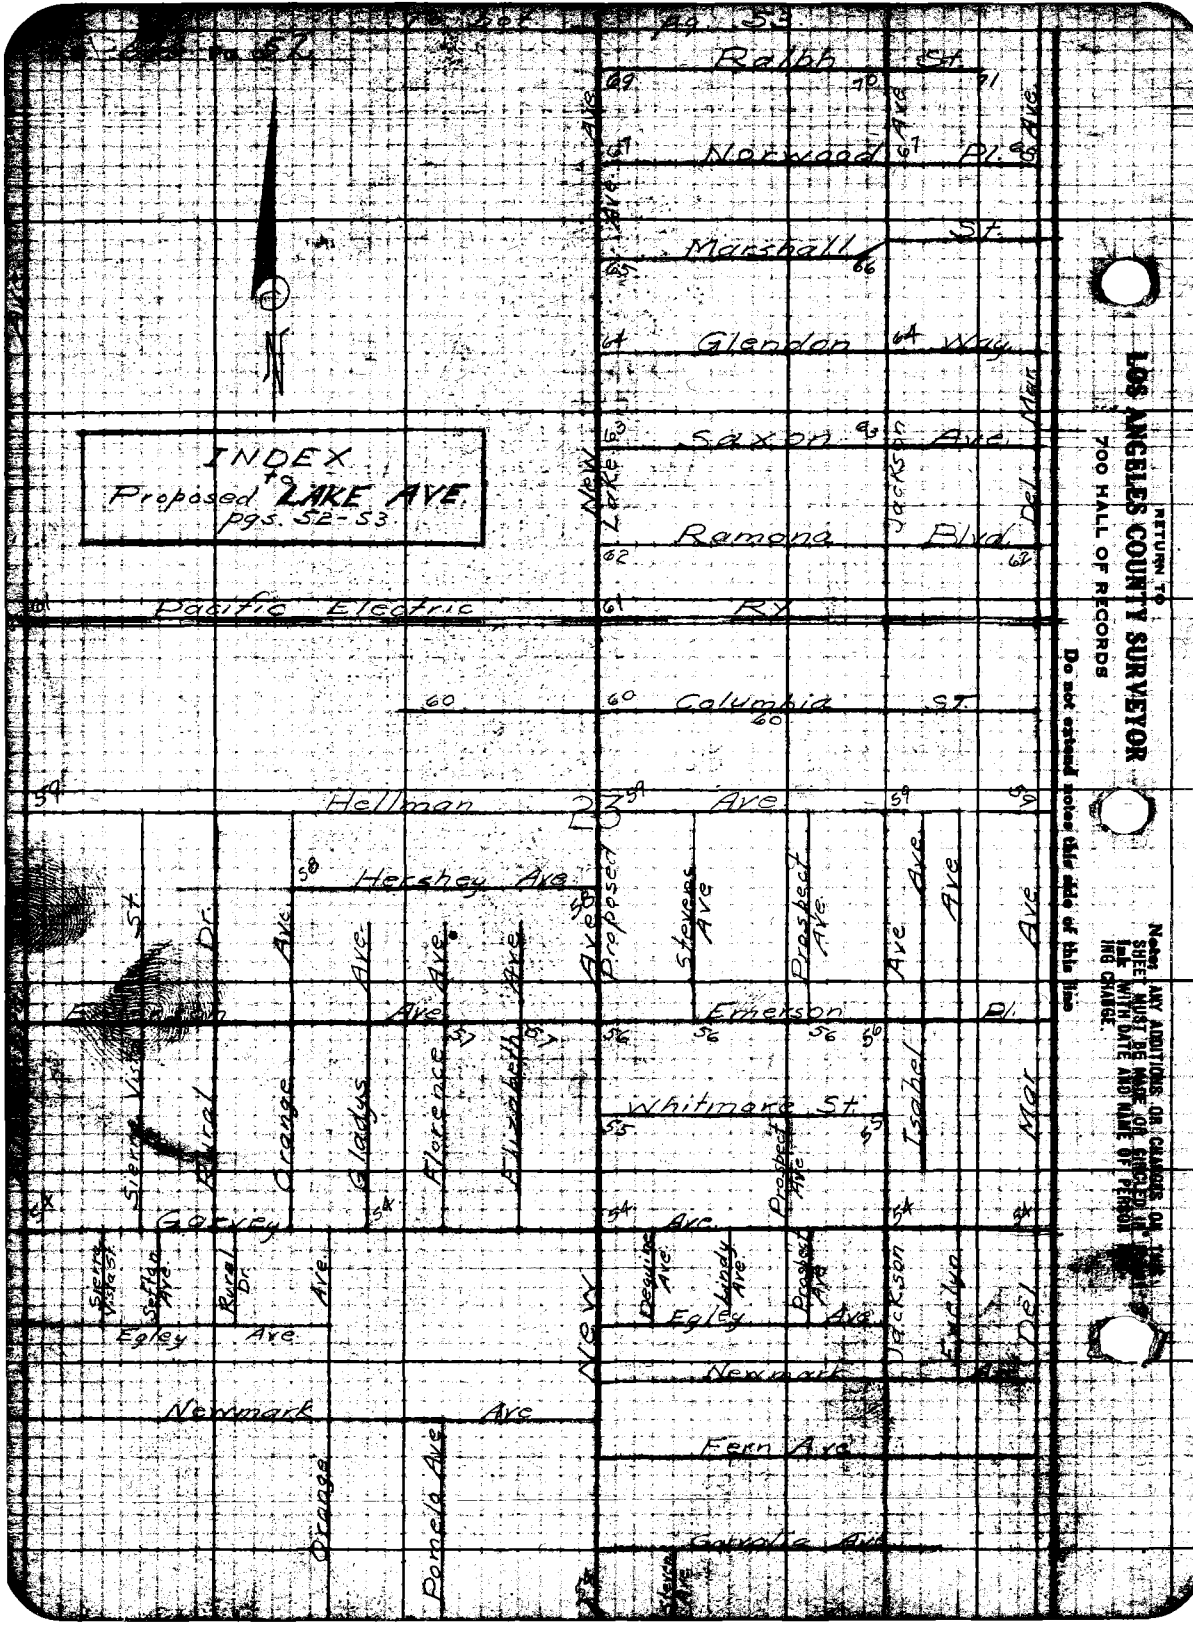

RETURN TO
LOS ANGELES COUNTY SURVEYOR
700 HALL OF RECORDS
Do not extend notes this side of this line
Note: ANY ADDITIONS OR CHANGES ON THIS SHEET MUST BE MADE OR CIRCLED IN PENCIL WITH DATE AND NAME OF PERSON MAKING CHANGE.

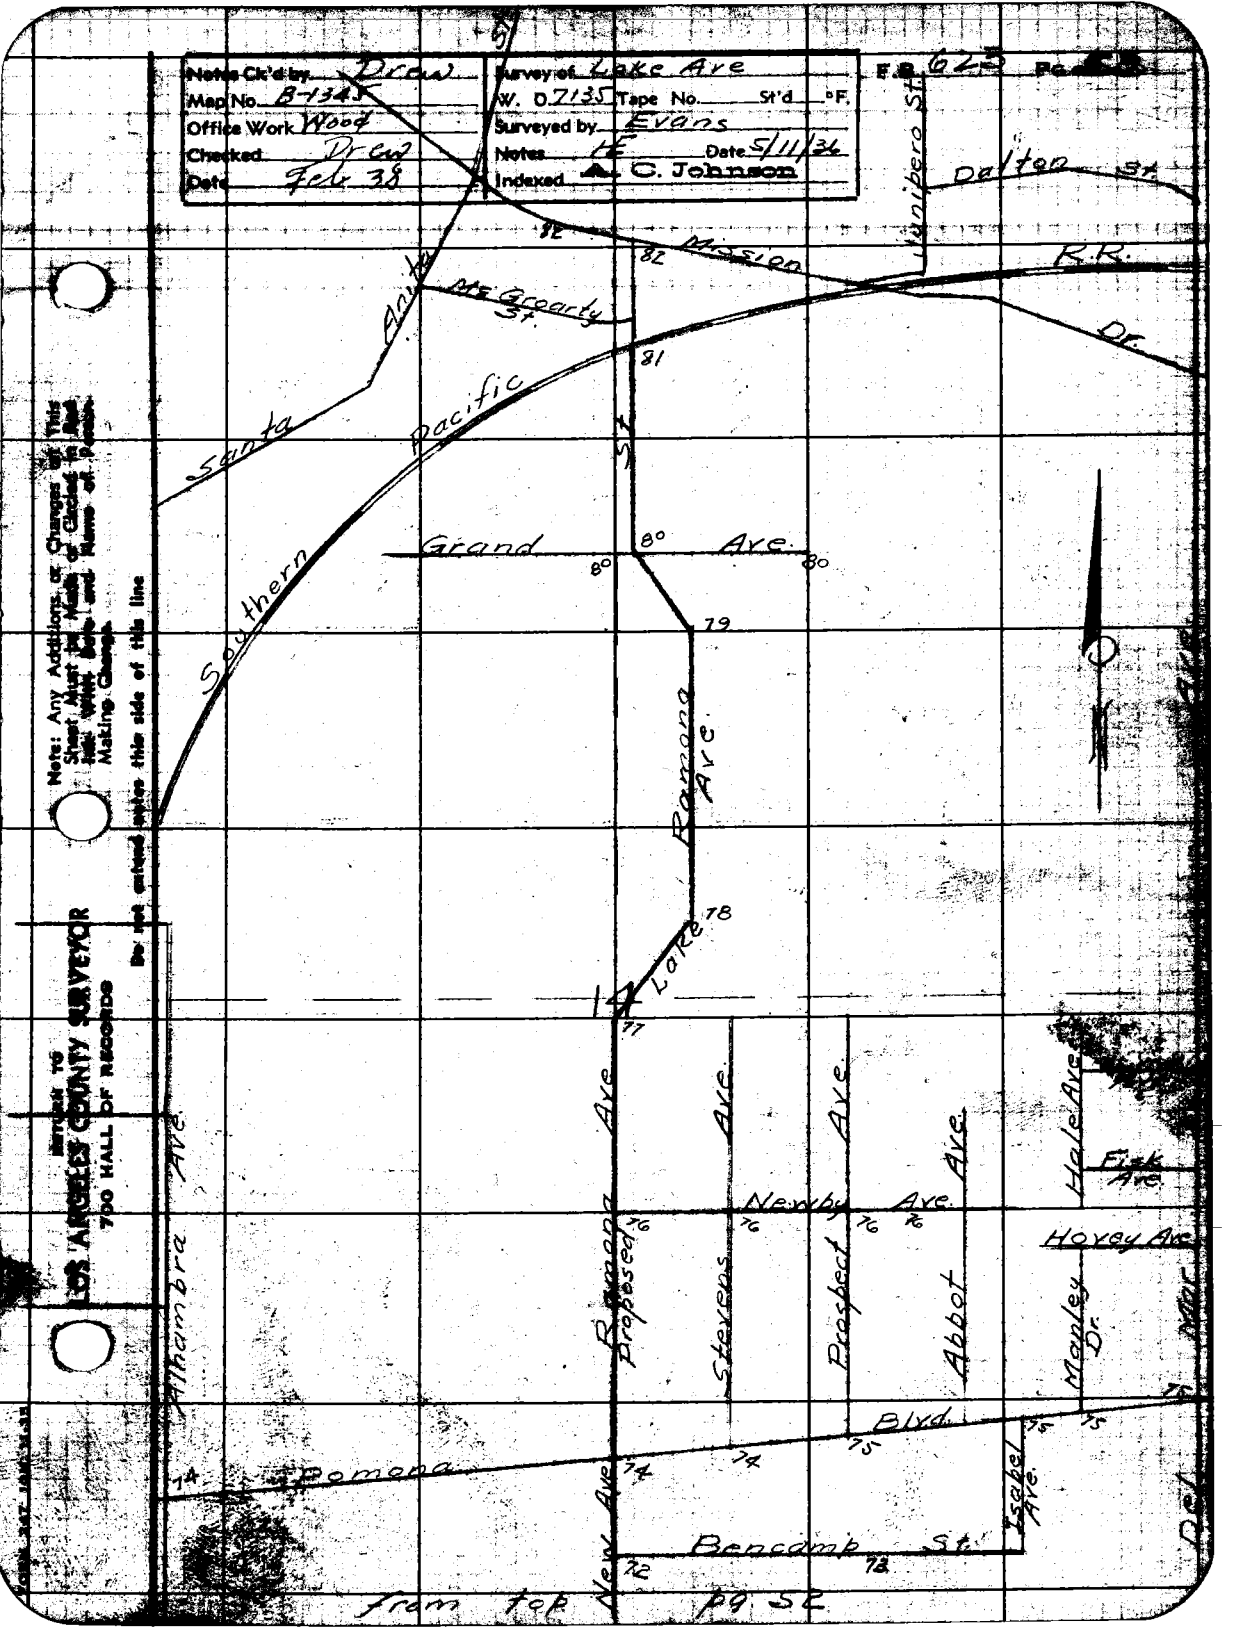
Notes Ck'd by Drew
Map No. B-1345
Office Work Wood
Checked Drew
Date Feb 38
Survey of Lake Ave
W. O. 7135 Tape No. St'd °F.
Surveyed by Evans
Notes HE Date 5/11/36
Indexed A. C. Johnson
F.B. 623 Pg.
Dalton St.
Junipero St.
Mission
R.R.
Dr.
Mc Groarty St.
Santa Anita
Southern Pacific
Grand Ave.
Ramona Ave.
Lake
Alhambra Ave.
Ramona Ave Proposed
Stevens Ave.
Prospect Ave.
Abbot Ave.
Hale Ave.
Fisk Ave.
Newby Ave.
Hovey Ave.
Manley Dr.
Mar
Pomona Blvd.
New Ave.
Isabel Ave.
Bencamp St.
Del
from top pg. 52
Note: Any Additions or Changes of This Sheet Must be Made or Circled in Red Ink With Date and Name of Person Making Change.
Do not extend notes this side of this line
RETURN TO
LOS ANGELES COUNTY SURVEYOR
700 HALL OF RECORDS

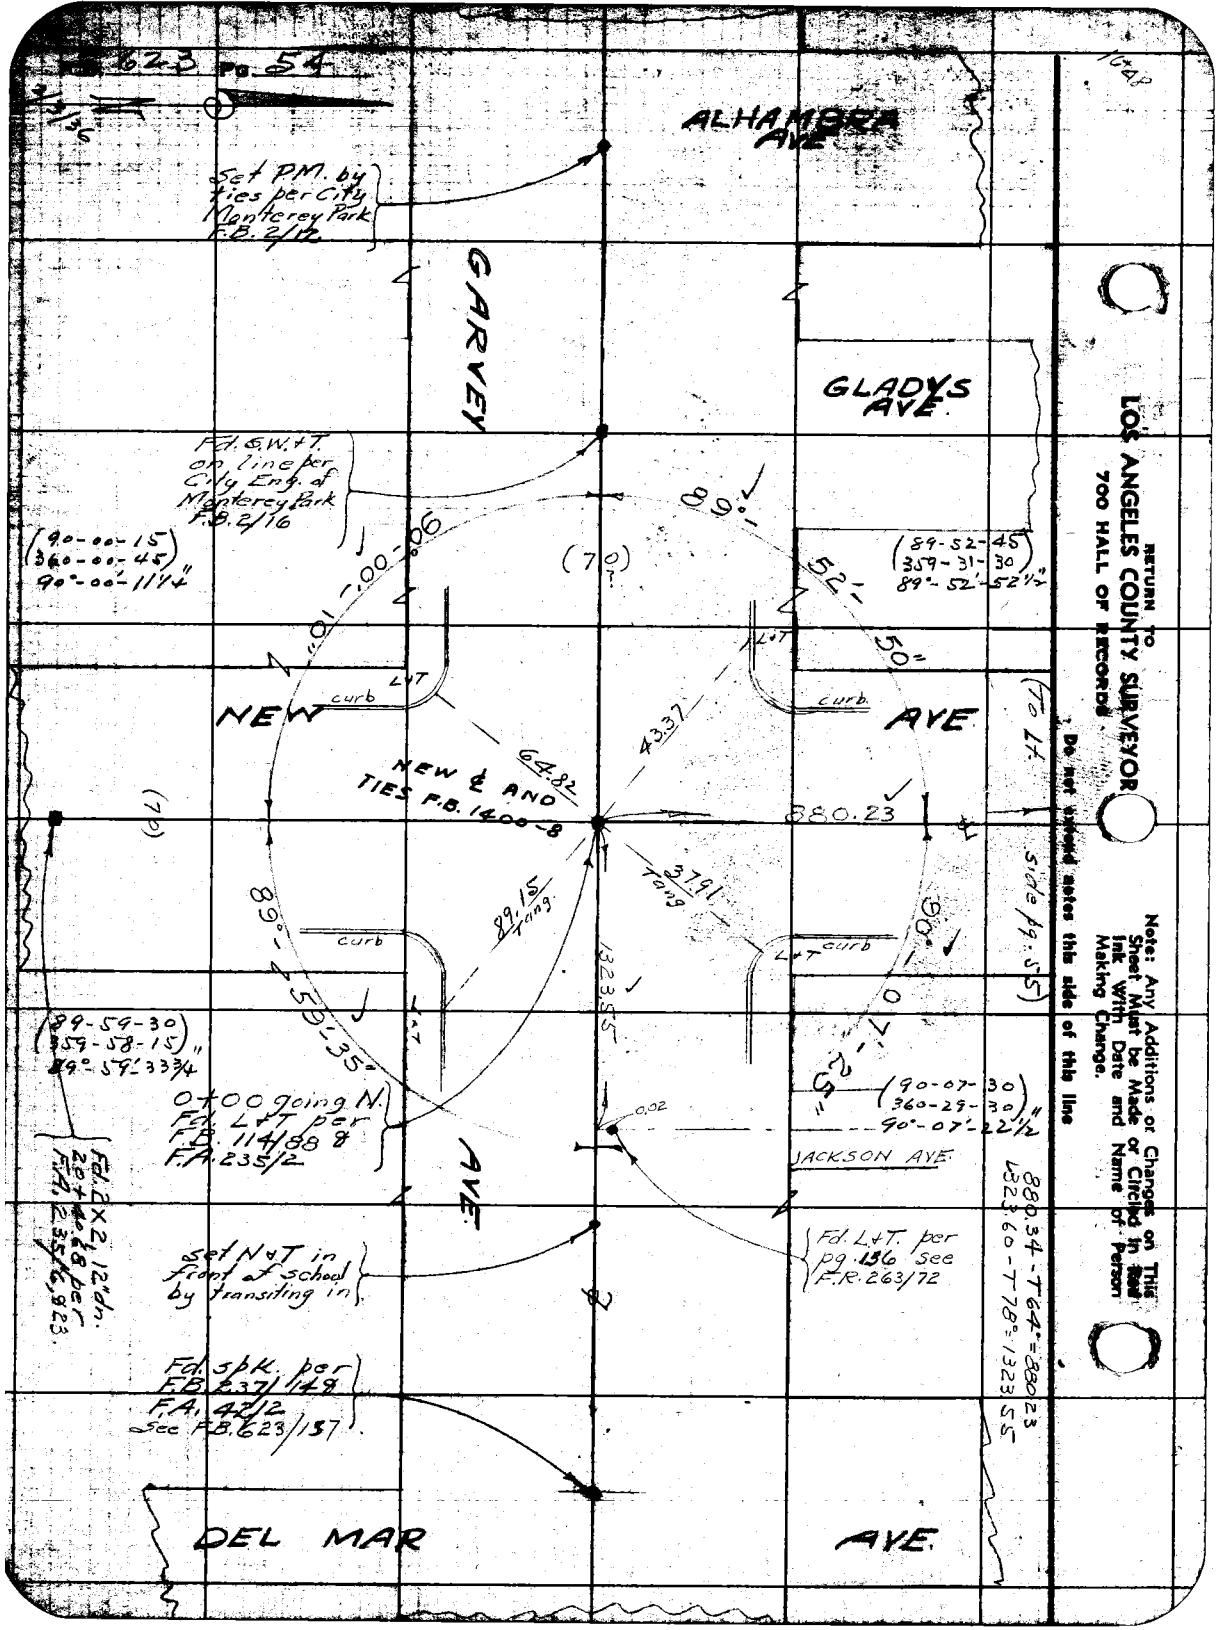

623 Pg. 54
ALHAMBRA AVE
Set P.M. by ties per City Monterey Park F.B. 2/12
GARVEY
GLADYS AVE.
Fd. S.W.+T. on line per City Eng. of Monterey Park F.B. 2/16
(90-00-15)
(360-00-45)
90°-00'-11¼"
(89-52-45)
(359-31-30)
89°-52'-52½"
(70)
89°-52'-50"
90°-00'-10"
L+T
curb
NEW
AVE
NEW ℄ AND TIES F.B. 1400-8
64.82
43.37
880.23
(To Lt. side pg. 55)
(70)
89°-59'-35"
89.15 Tang.
37.91 Tang
1323.55
90°-07'-25"
(89-59-30)
(359-58-15)
89°-59'-33¾"
0+00 going N. Fd. L+T per F.B. 114/88 & F.A. 235/2
0.02
(90-07-30)
(360-29-30)
90°-07'-22½"
JACKSON AVE.
AVE.
Fd. 2X2, 12" dn. 20+40.68 per F.A. 235/6, 923.
Set N+T in front of school by transiting in
Fd. L+T. per pg. 136 see F.R. 263/72
880.34 - T64° = 880.23
1323.60 - T78° = 1323.55
Fd. spk. per F.B. 237/148 F.A. 42/2 See F.B. 623/137
DEL MAR
AVE.
RETURN TO
LOS ANGELES COUNTY SURVEYOR
700 HALL OF RECORDS
Do not extend notes this side of this line
Note: Any Additions or Changes on This Sheet Must be Made or Circled in Red Ink With Date and Name of Person Making Change.

Notes Ck'd by	Survey of Lake Ave.
Map No. 8-[illegible]	W. O. 7135 Tape No. 010 St'd 84° F.
Office Work Wood	Surveyed by Evans.
Checked Drew	Notes HE Date 2/3/36
Date Feb 38	Indexed A. C. Johnson

F.B. 623 Pg. [illegible]

(90-06-38)
(360-2[illegible]-45)
90°-06'-26¼"

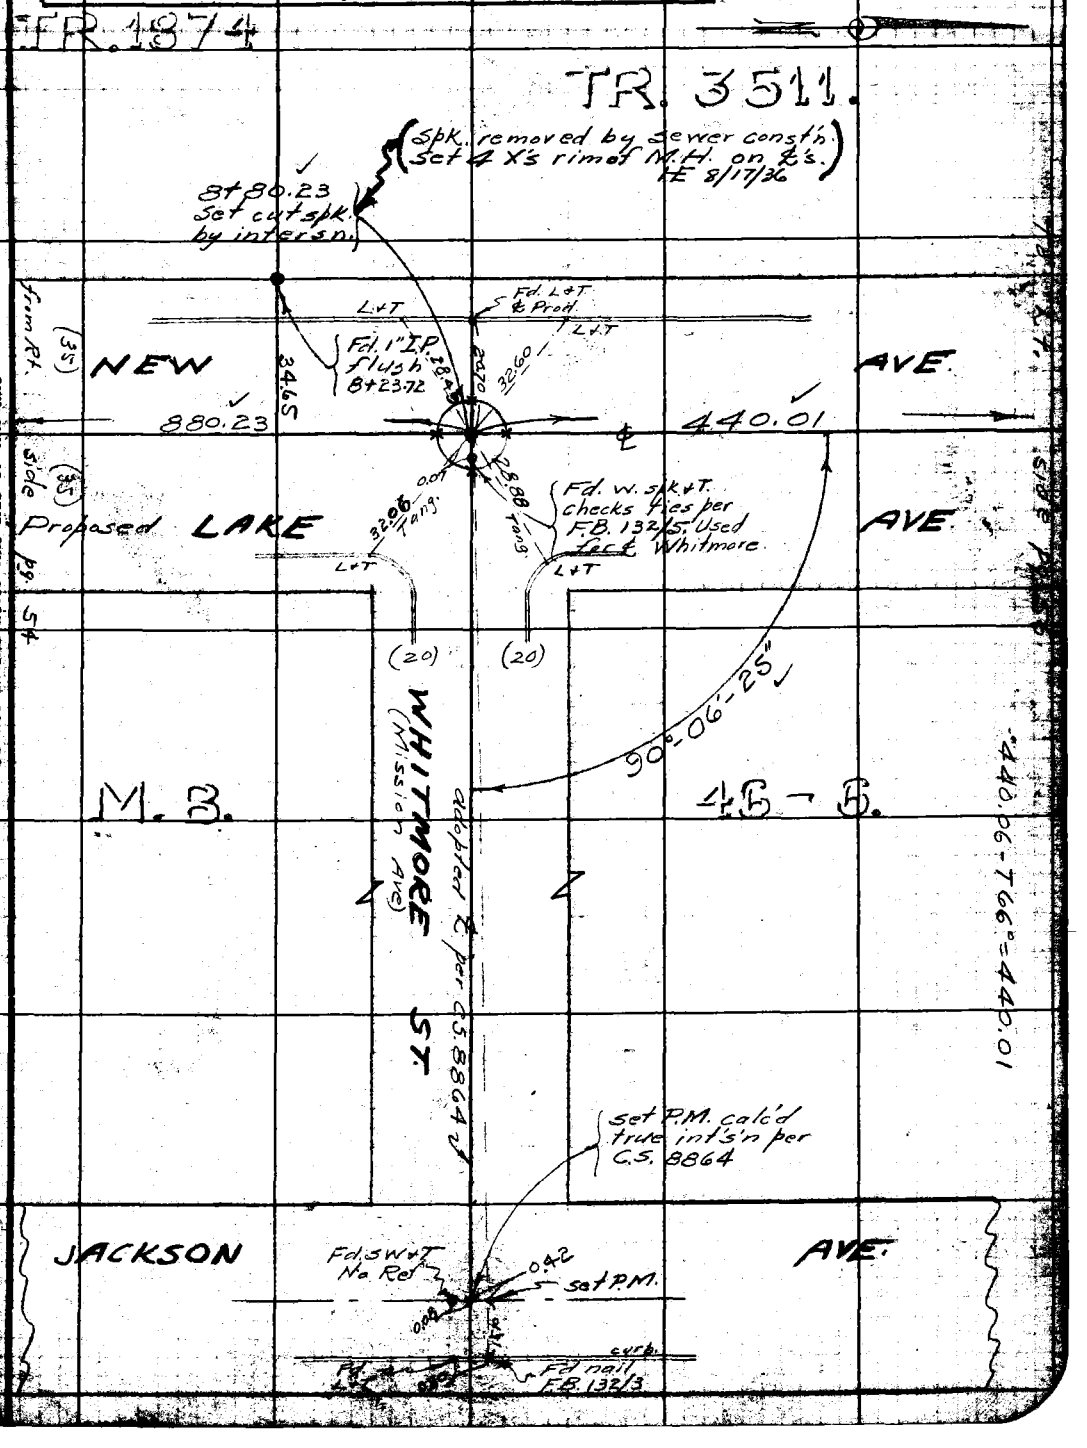

Note: Any Additions or Changes on This Sheet Must be Made or Circled in Red Ink With Date and Name of Person Making Change.

Do not extend notes this side of this line

RETURN TO
LOS ANGELES COUNTY SURVEYOR
700 HALL OF RECORDS

FORM 247 1016 11-35

RETURN TO
LOS ANGELES COUNTY SURVEYOR
700 HALL OF RECORDS

Note: Any Additions or Changes on This Sheet Must be Made or Circled in Red Ink With Date and Name of Person Making Change.

Do not extend notes this side of this line

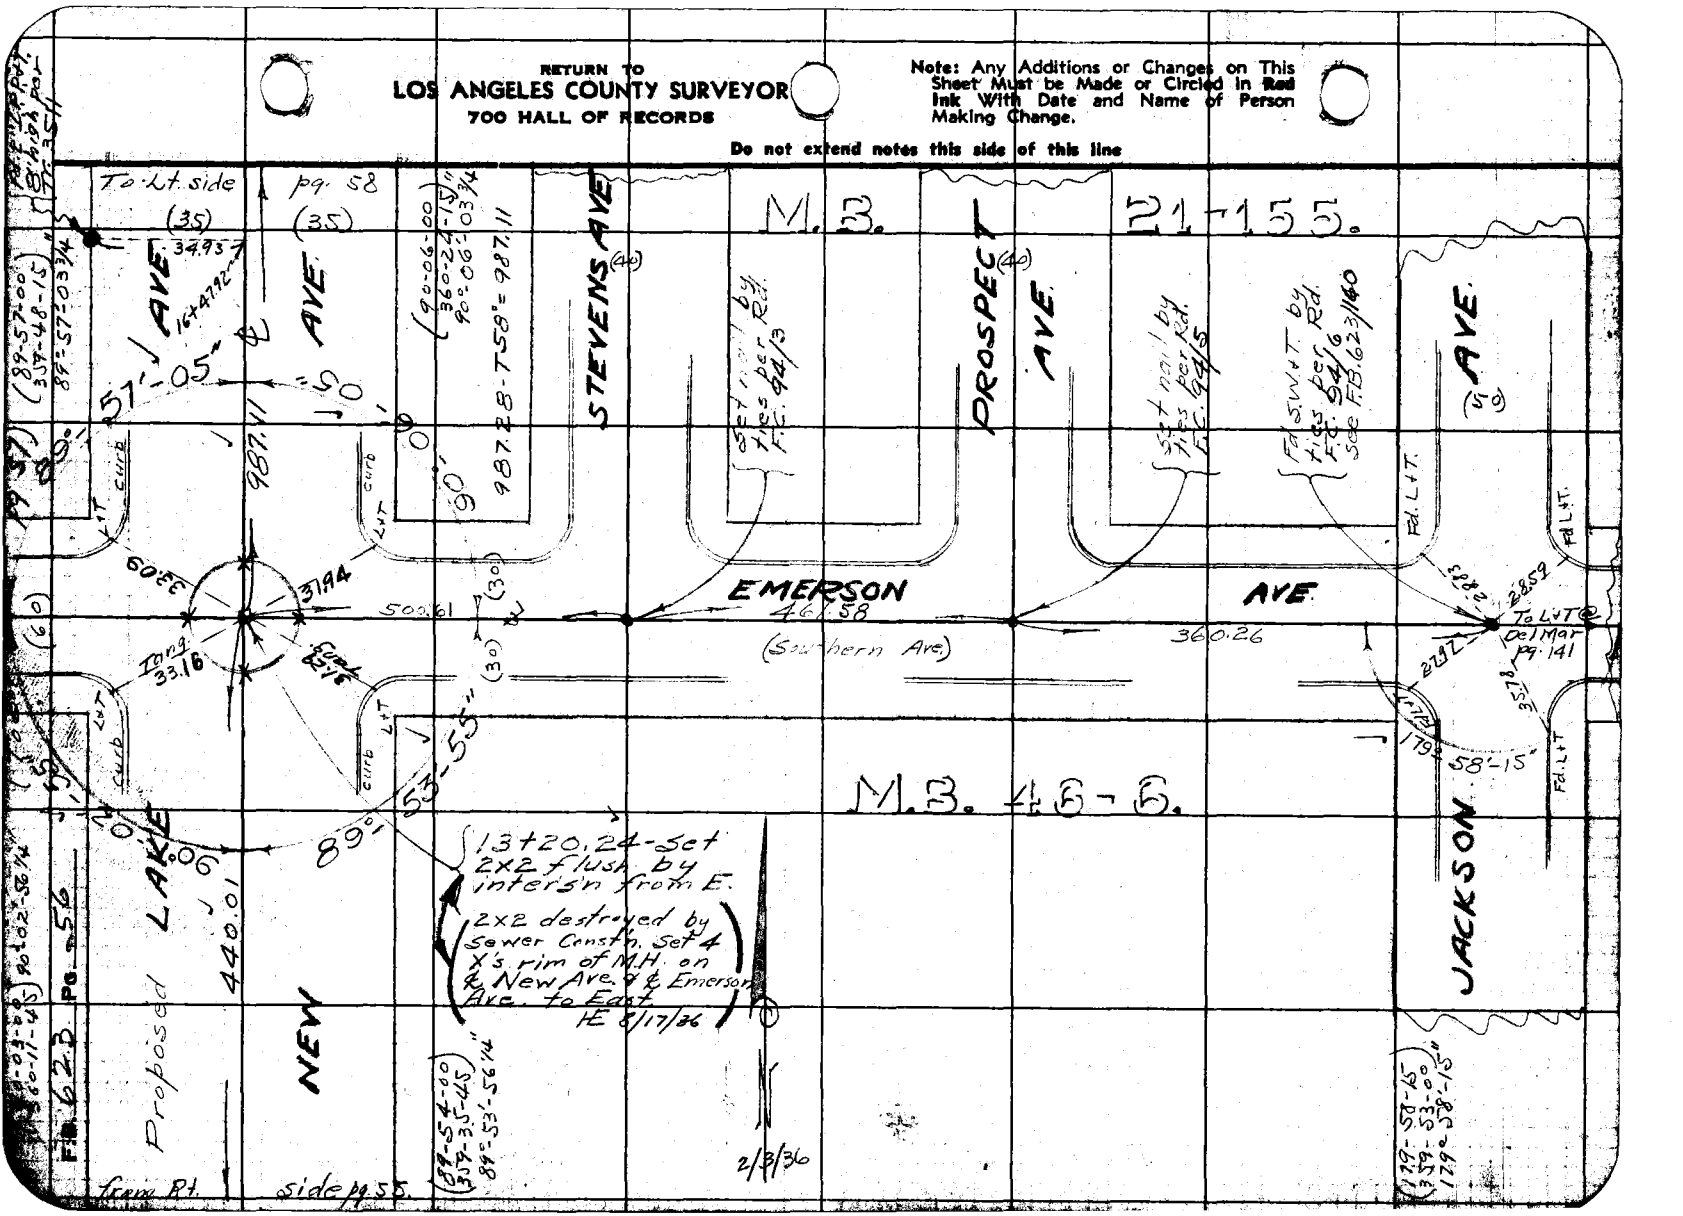

Notes Ck'd by Drew	Survey of Lake Ave.
Map No. B-1345	W. 0.7135 Tape No. 010 St'd °F.
Office Work Wood	Surveyed by Evans
Checked Drew	Notes HF Date 2/4/36
Date Feb 38	Indexed A. C. Johnson

F.B. 623 Pg. 57

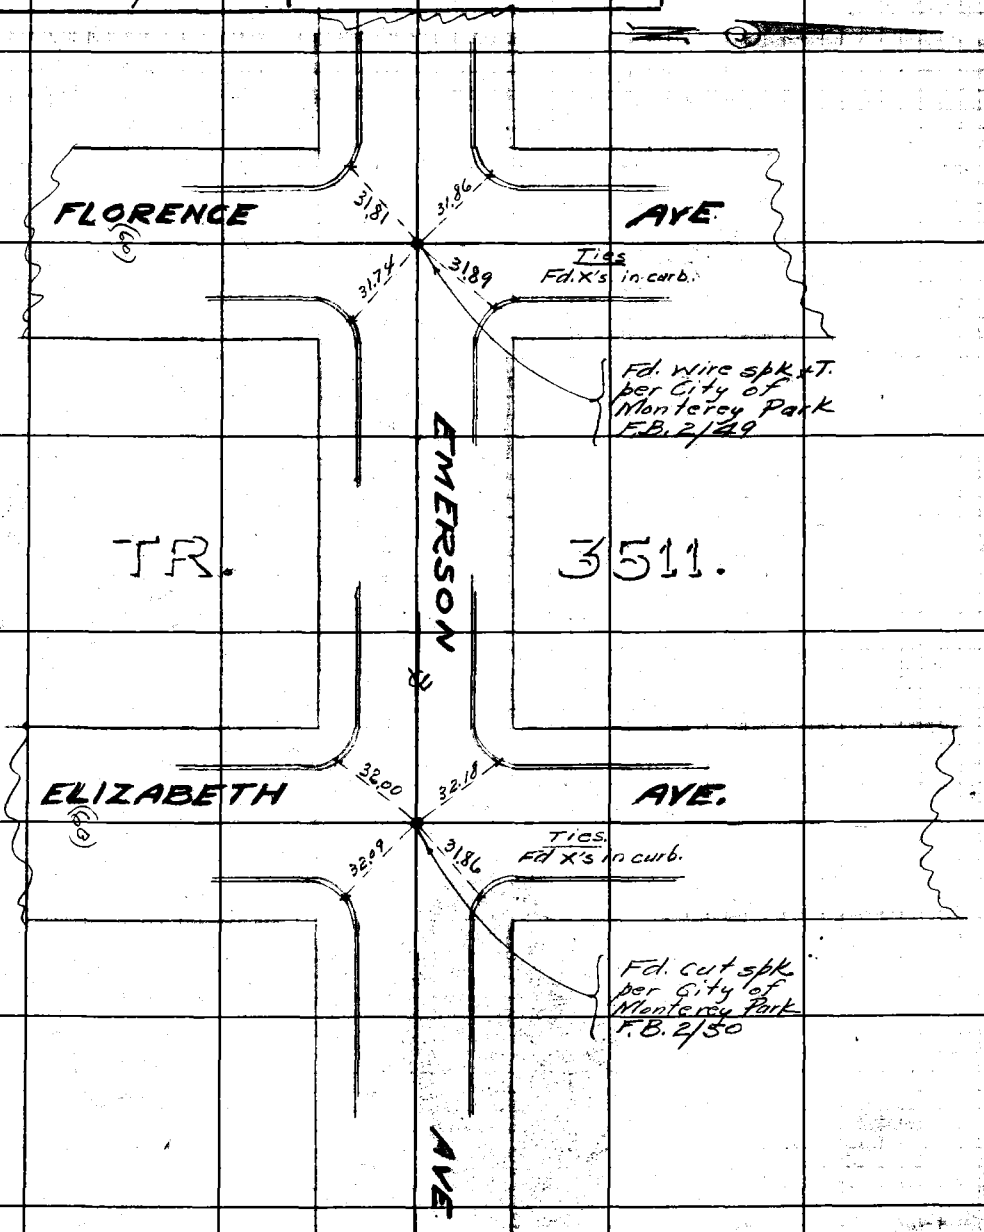

Note: Any Additions or Changes on This Sheet Must be Made or Circled in Red Ink With Both and Name of Person Making Change.
Do not extend notes this side of this line
RETURN TO
LOS ANGELES COUNTY SURVEYOR
700 HALL OF RECORDS

from top pg. 56

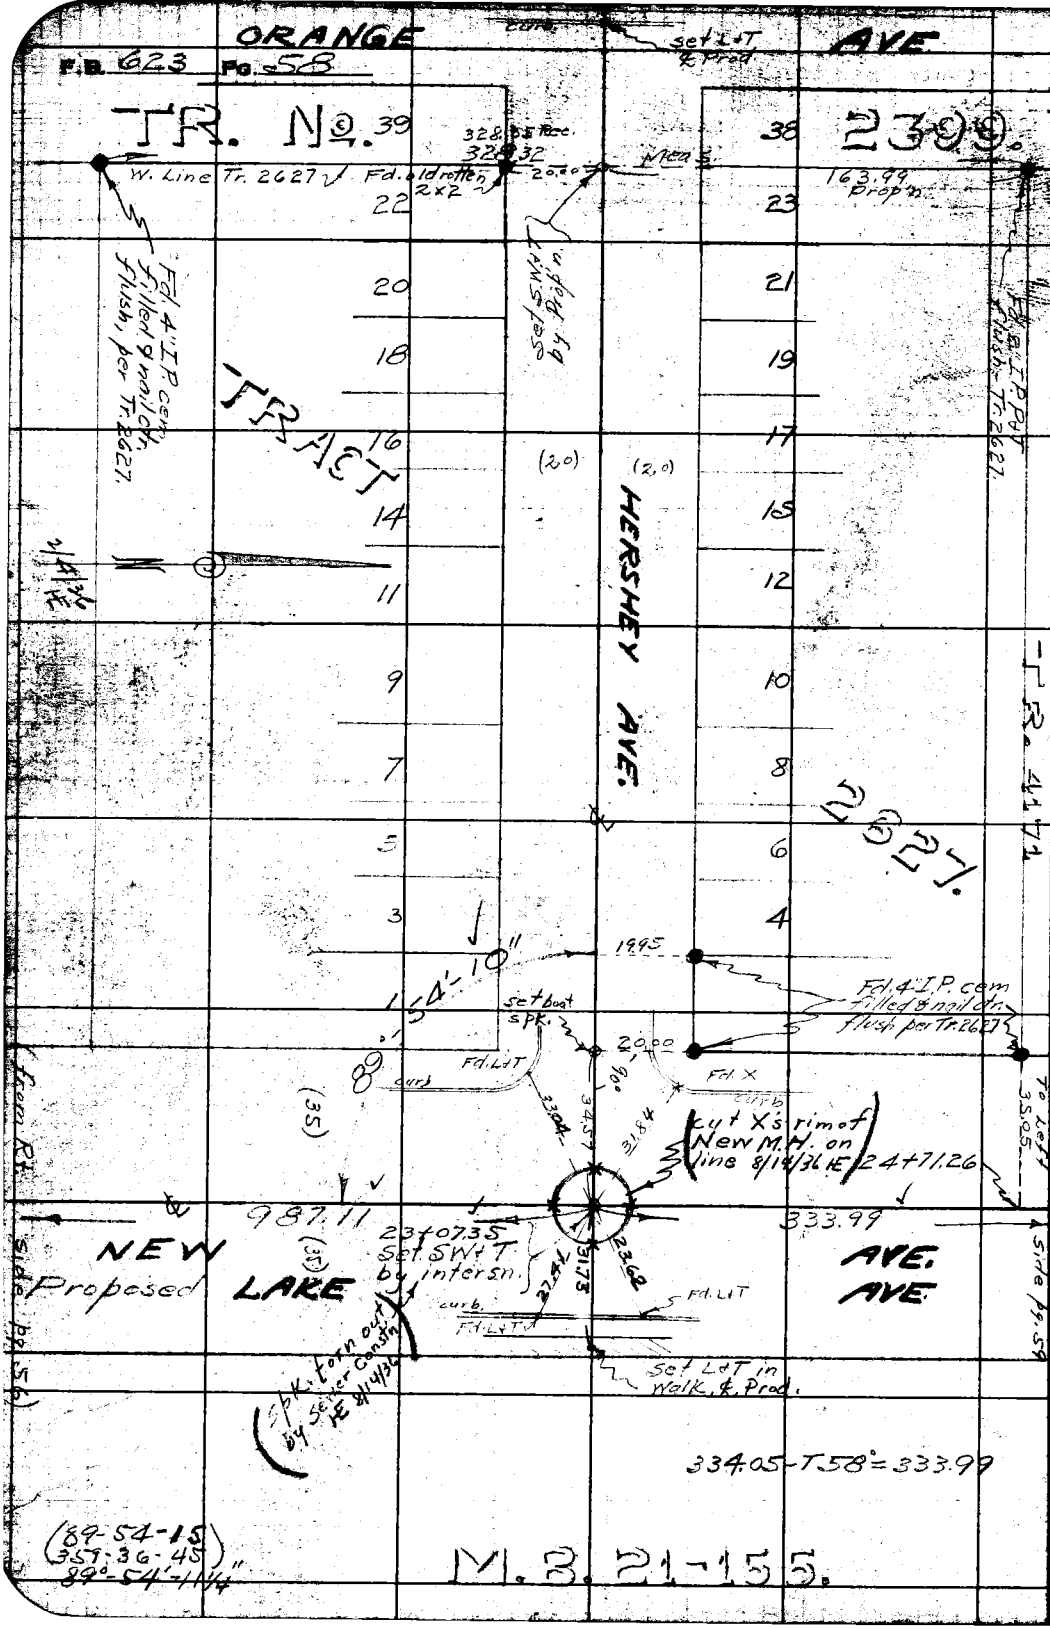

RETURN TO
LOS ANGELES COUNTY SURVEYOR
700 HALL OF RECORDS

Do not extend notes this side of this line

Note: Any Additions or Changes on This Sheet Must be Made or Circled in Red Ink With Date and Name of Person Making Change.

Notes Ck'd by Drew	Survey of Lake Ave.
Map No. B-1345	W. O. 7135 Tape No. 010 St'd 84°F.
Office Work Wood	Surveyed by Evans
Checked Drew	Notes HE Date 2/5/36
Date Feb 38	Indexed A. C. Johnson

F.B. 623 Pg. 58

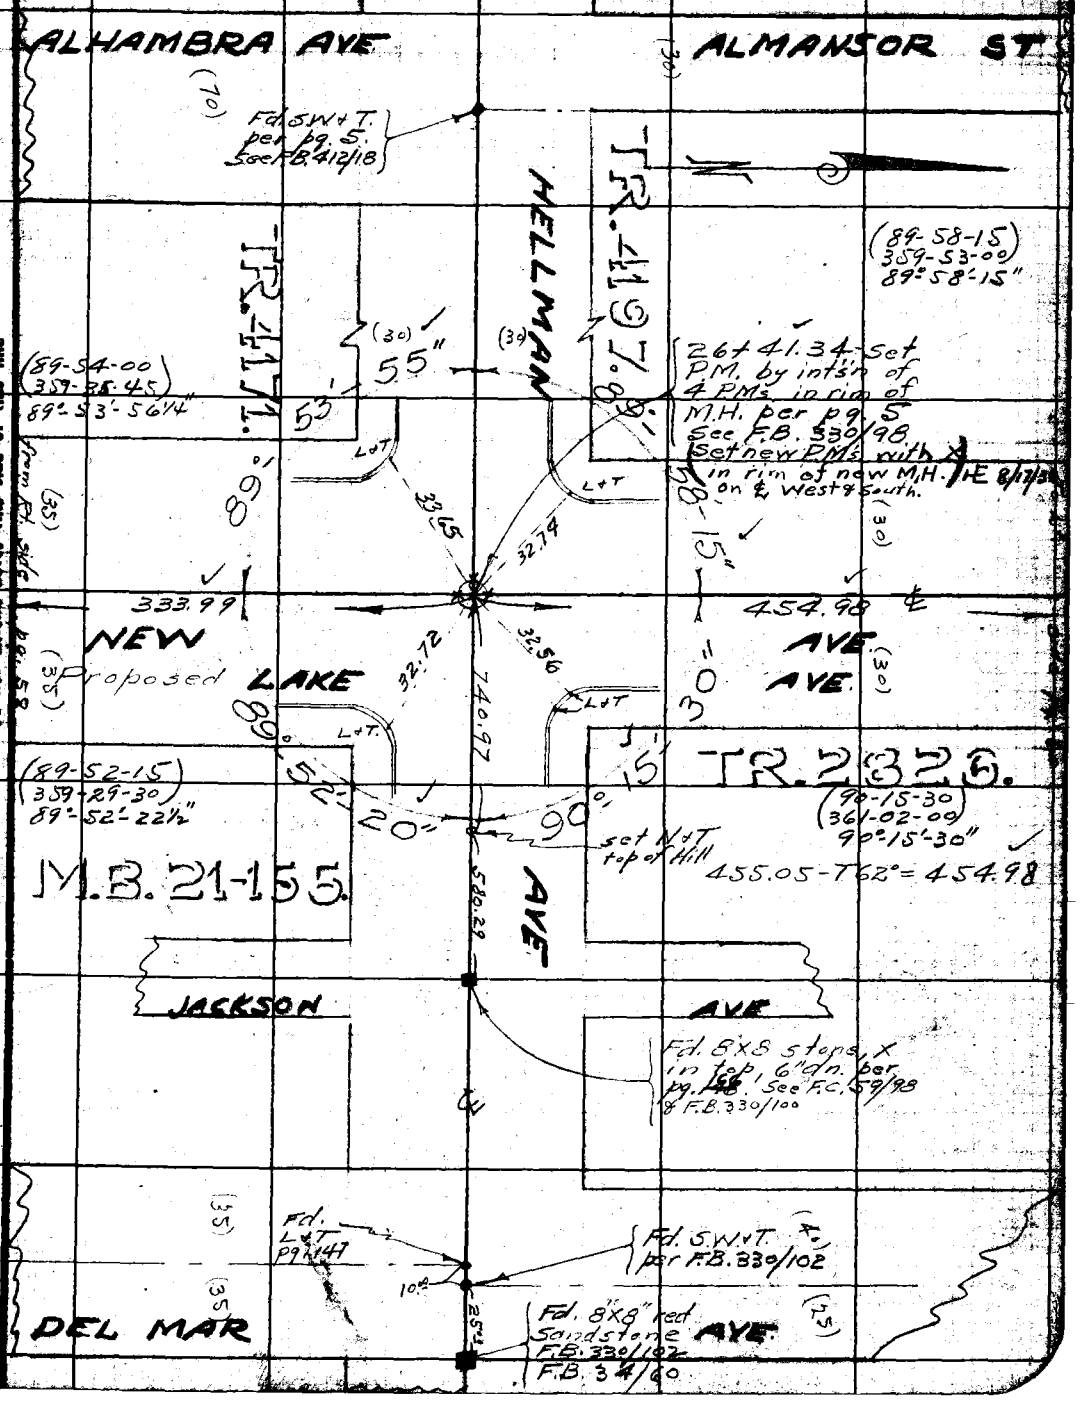

Note: Any Additions or Changes on This Sheet Must be Made or Circled in Red Ink. With Date and Name of Person Making Change.

Do not extend notes this side of this line

RETURN TO LOS ANGELES COUNTY SURVEYOR 700 HALL OF RECORDS

FORM 847 10M 11-35

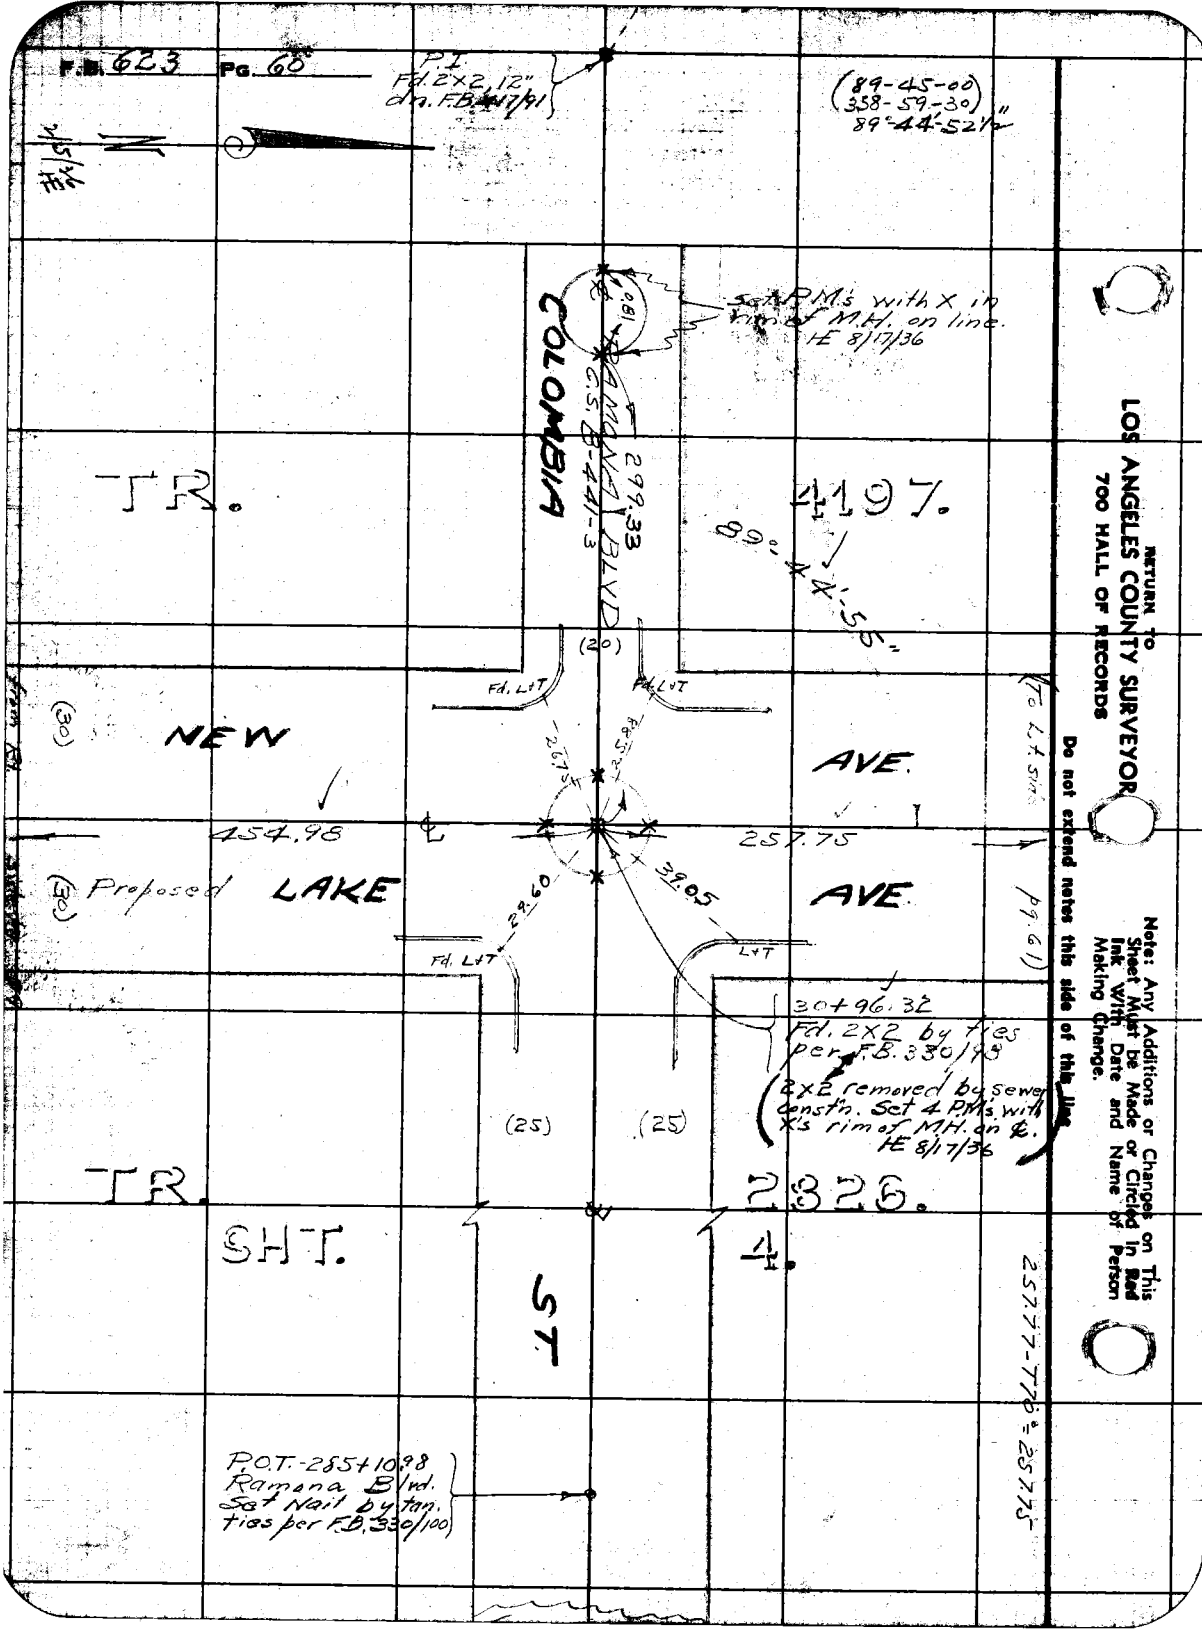
F.B. 623 PG. 60
P.I.
Fd. 2X2, 12"
dn. F.B. 417/91
(89-45-00)
(358-59-30)
89°-44'-52½"
N
Set P.M.'s with X in rim of M.H. on line. HE 8/17/36
COLOMBIA
RAMONA BLVD
C.S. B-441-3
299.33
TR.
4197.
89°-44'-55"
(20)
Fd. L+T
Fd. L+T
(30)
NEW
AVE.
454.98
257.75
(30) Proposed
LAKE
AVE.
29.60
39.05
Fd. L+T
L+T
30+96.32
Fd. 2X2 by ties per F.B. 330/98
2X2 removed by sewer constn. Set 4 P.M.'s with X's rim of M.H. on ℄. HE 8/17/36
(25)
(25)
TR.
2326.
SHT.
4.
ST.
P.O.T.-285+10.98
Ramona Blvd.
Set Nail by tan. ties per F.B. 330/100
(To L.t. sine pg. 61)
257.77-T70°=257.75
RETURN TO
LOS ANGELES COUNTY SURVEYOR
700 HALL OF RECORDS
Do not extend notes this side of this line
Note: Any Additions or Changes on This Sheet Must be Made or Circled in Red Ink With Date and Name of Person Making Change.

Notes Ck'd by Drew	Survey of Lake Ave	F.B. 623	Pg. 61
Map No. B-1345	W. 07135 Tape No. 0 [illegible] 84 F		
Office Work Wood	Surveyed by Evans		
Checked Drew	Notes HE Date 4/13/36		
Date Feb 38	Indexed A. C. Johnson		

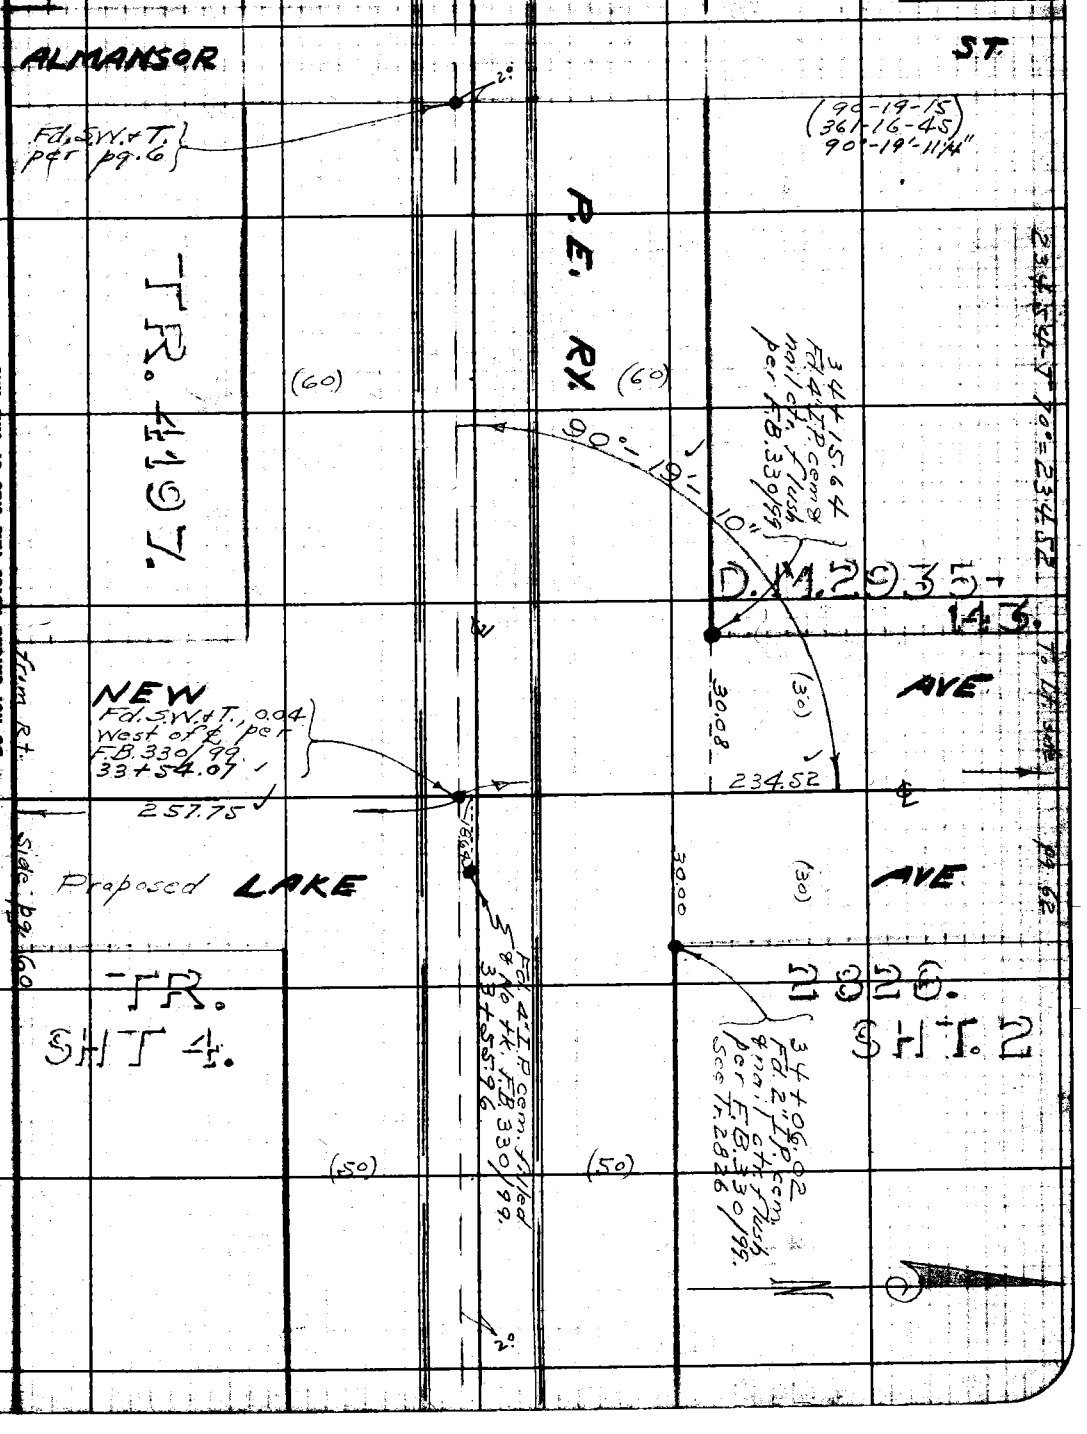

Note: Any Additions or Changes on This Sheet Must be Made or Circled in Red Ink With Date and Name of Person Making Change.

Do not extend notes this side of this line

RETURN TO
LOS ANGELES COUNTY SURVEYOR
700 HALL OF RECORDS

FORM 247 10M 11-35

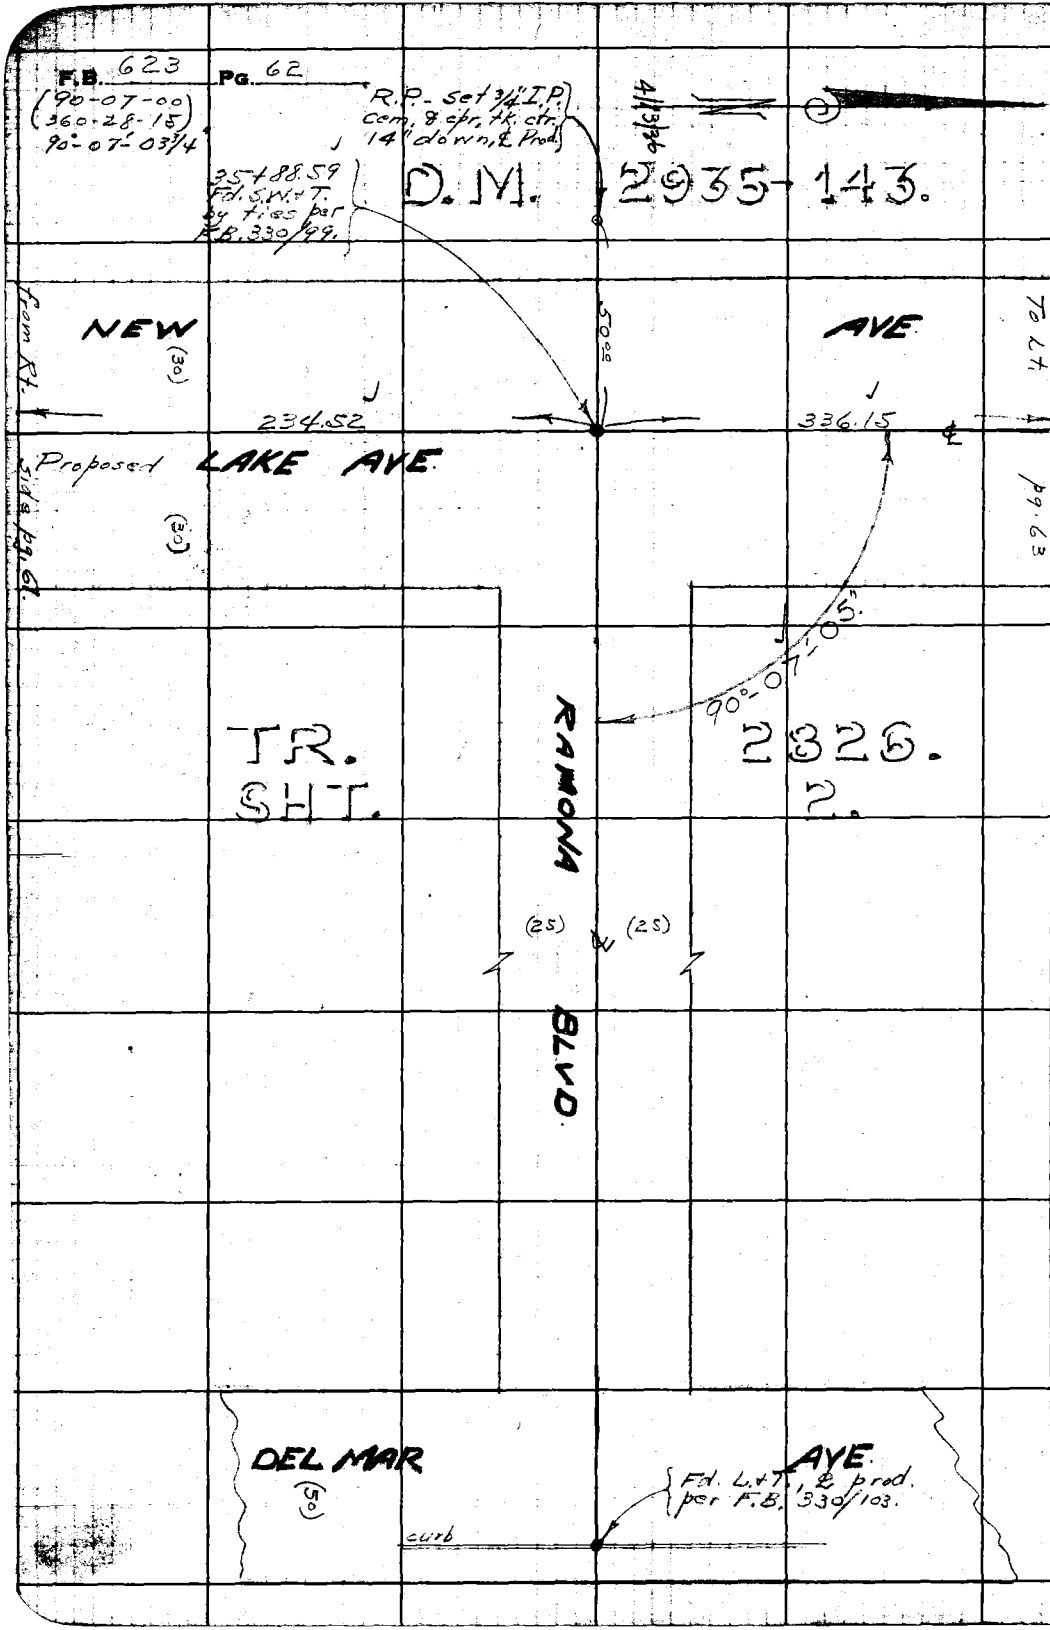

RETURN TO
LOS ANGELES COUNTY SURVEYOR
700 HALL OF RECORDS

Note: Any Additions or Changes on This Sheet Must be Made or Circled in Red Ink With Date and Name of Person Making Change.

Do not extend notes this side of this line

Notes Ck'd by Drew	Survey of Lake Ave	F.B. 623 Pg. 63
Map No. B-1345	W. O. 7135 Tape No. 072 St'd 84°F.	336.21-T62° = 336.16
Office Work Wood	Surveyed by Evans	
Checked Drew	Notes HE Date 4/15/36	
Date Feb 38	Indexed A. C. Johnson	

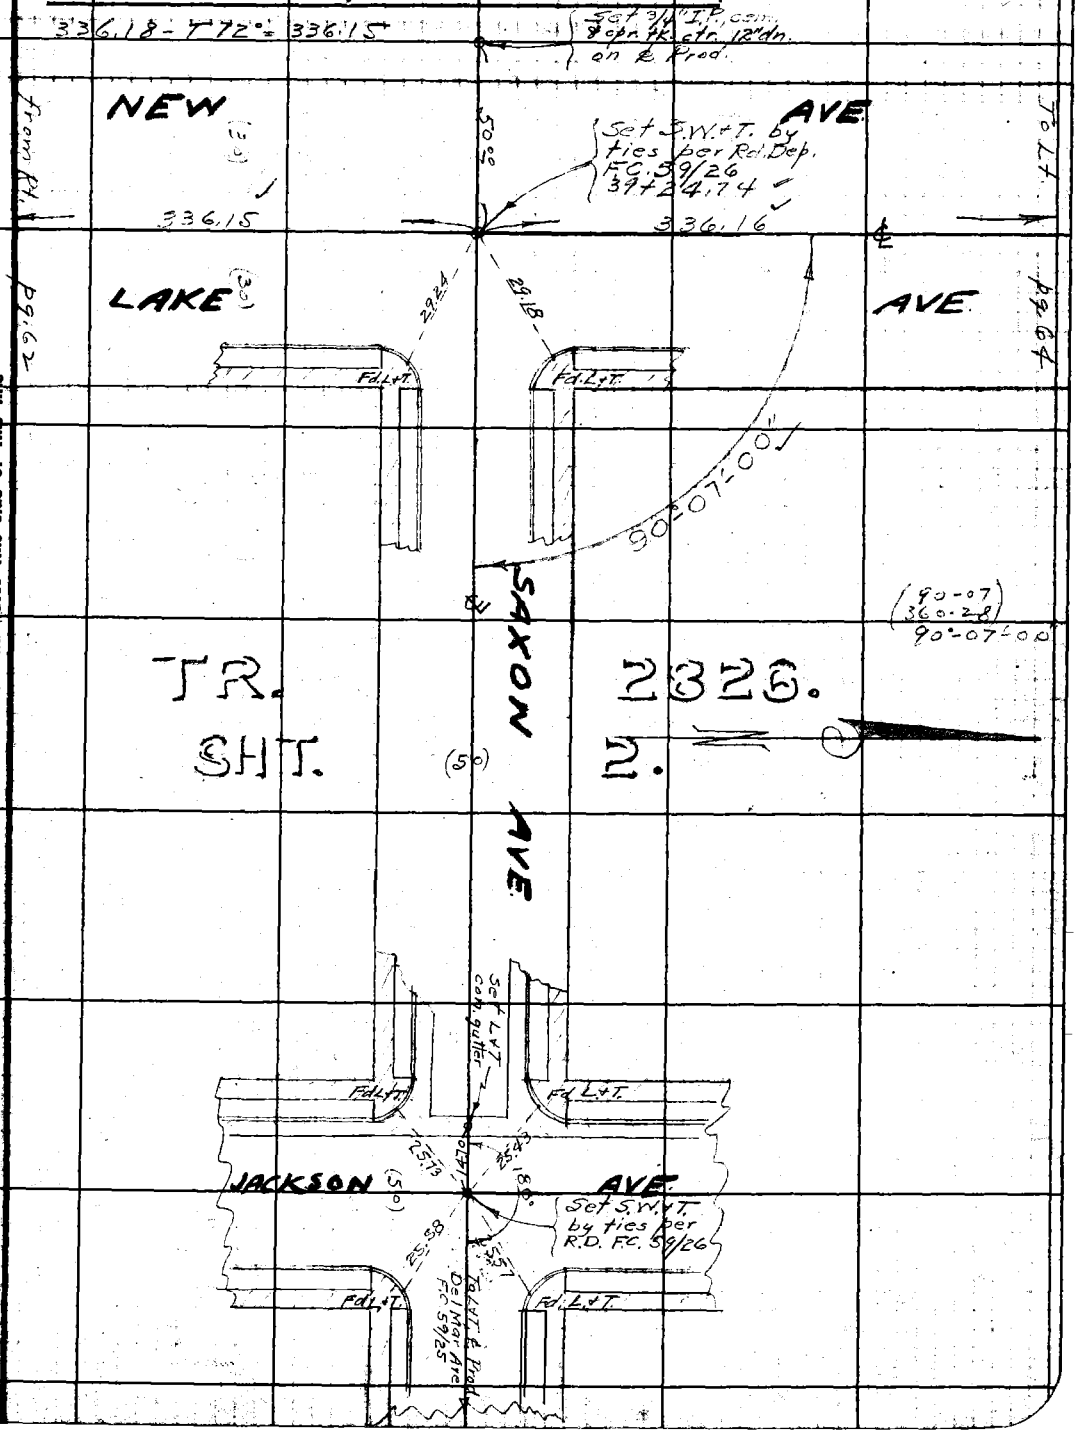

Note: Any Additions or Changes on This Sheet Must be Made or Circled in Red Ink With Date and Name of Person Making Change.

Do not extend notes this side of this line

RETURN TO
LOS ANGELES COUNTY SURVEYOR
700 HALL OF RECORDS

FORM 247 10M 11-35

F.B. 623 Pg. 64

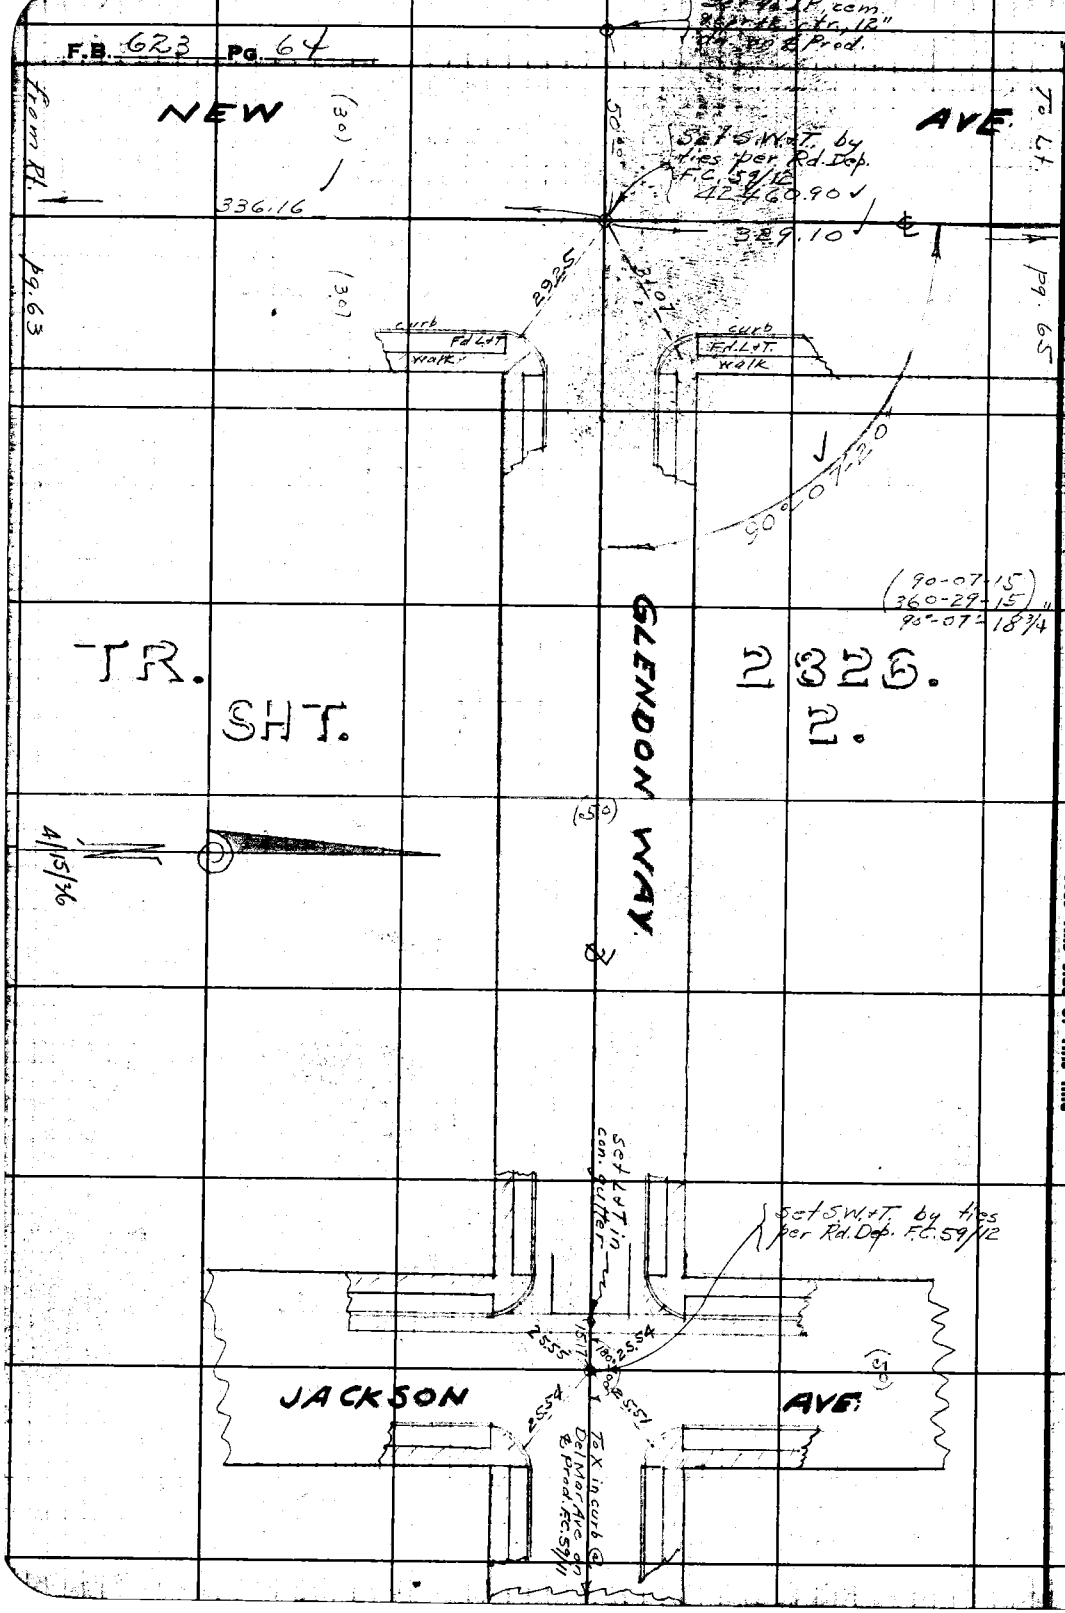

RETURN TO
LOS ANGELES COUNTY SURVEYOR
700 HALL OF RECORDS

Note: Any Additions or Changes on This Sheet Must be Made or Circled in Red Ink With Date and Name of Person Making Change.

Do not extend notes this side of this line

Notes Ck'd by Drew	Survey of Lake Ave.	F.B. 623 Pg. 65
Map No. B-1345	W. O. 7135 Tape No. 072 St'd 84°F.	(90-07-00)
Office Work Wood	Surveyed by Evans.	(360-28-15)
Checked Drew	Notes HE Date 4/13/36	90°-07'-03¾"
Date Feb 38	Indexed A. C. Johnson	438.60-T64°=438.54

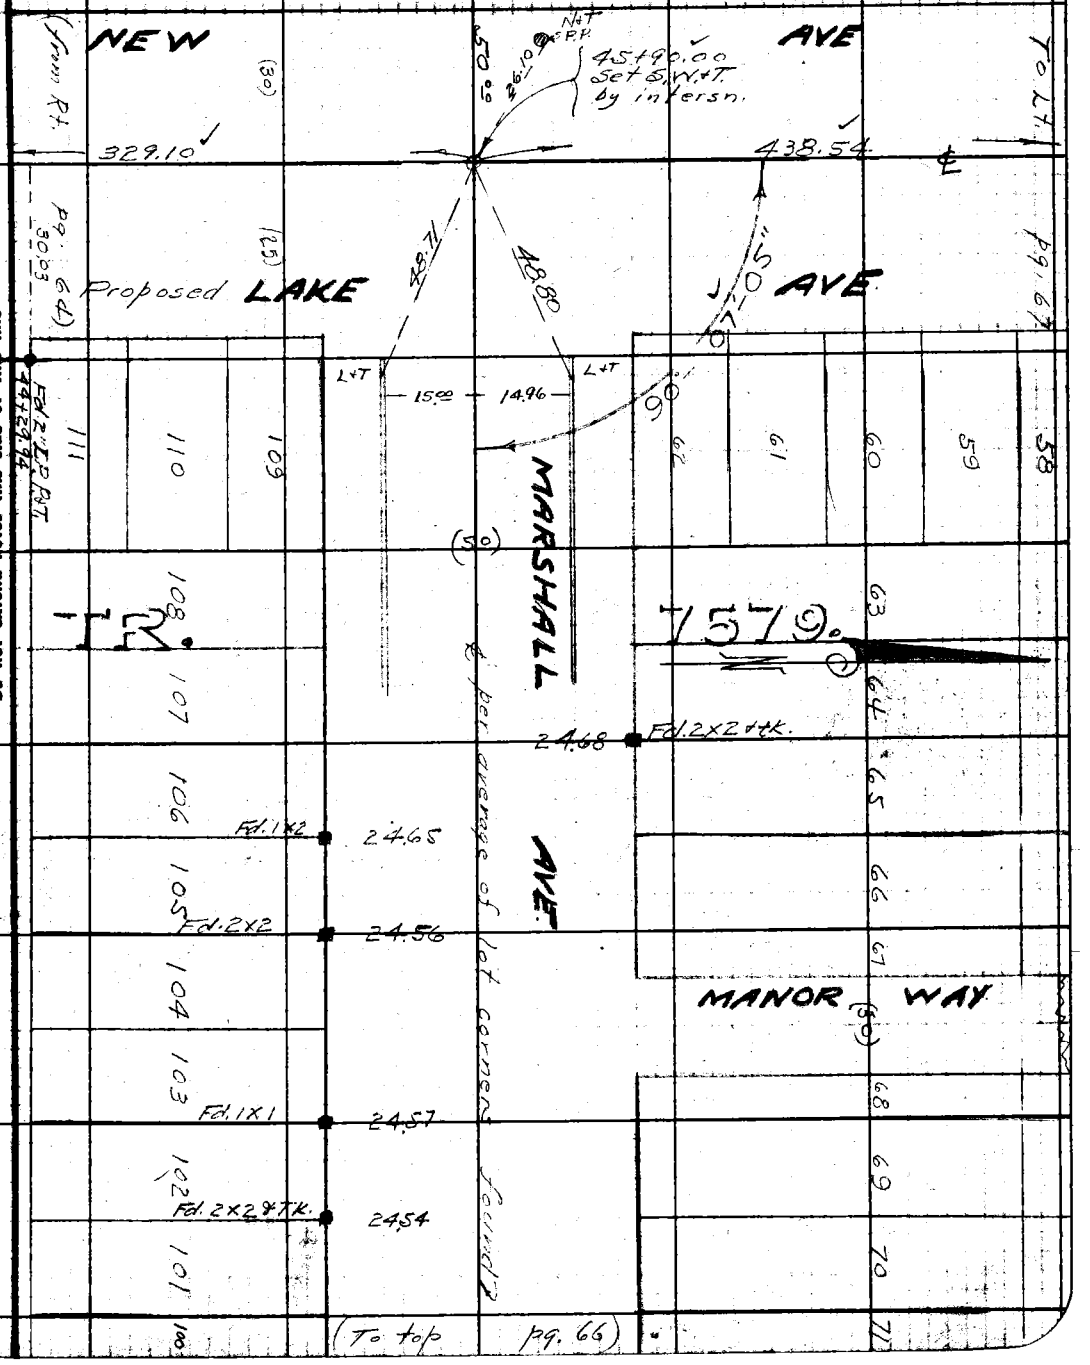

Note: Any Additions or Changes on This Sheet Must be Made or Circled in Red Ink With Date and Name of Person Making Change.

Do not extend notes this side of this line

RETURN TO
LOS ANGELES COUNTY SURVEYOR
700 HALL OF RECORDS

FORM 247 10M 11-35

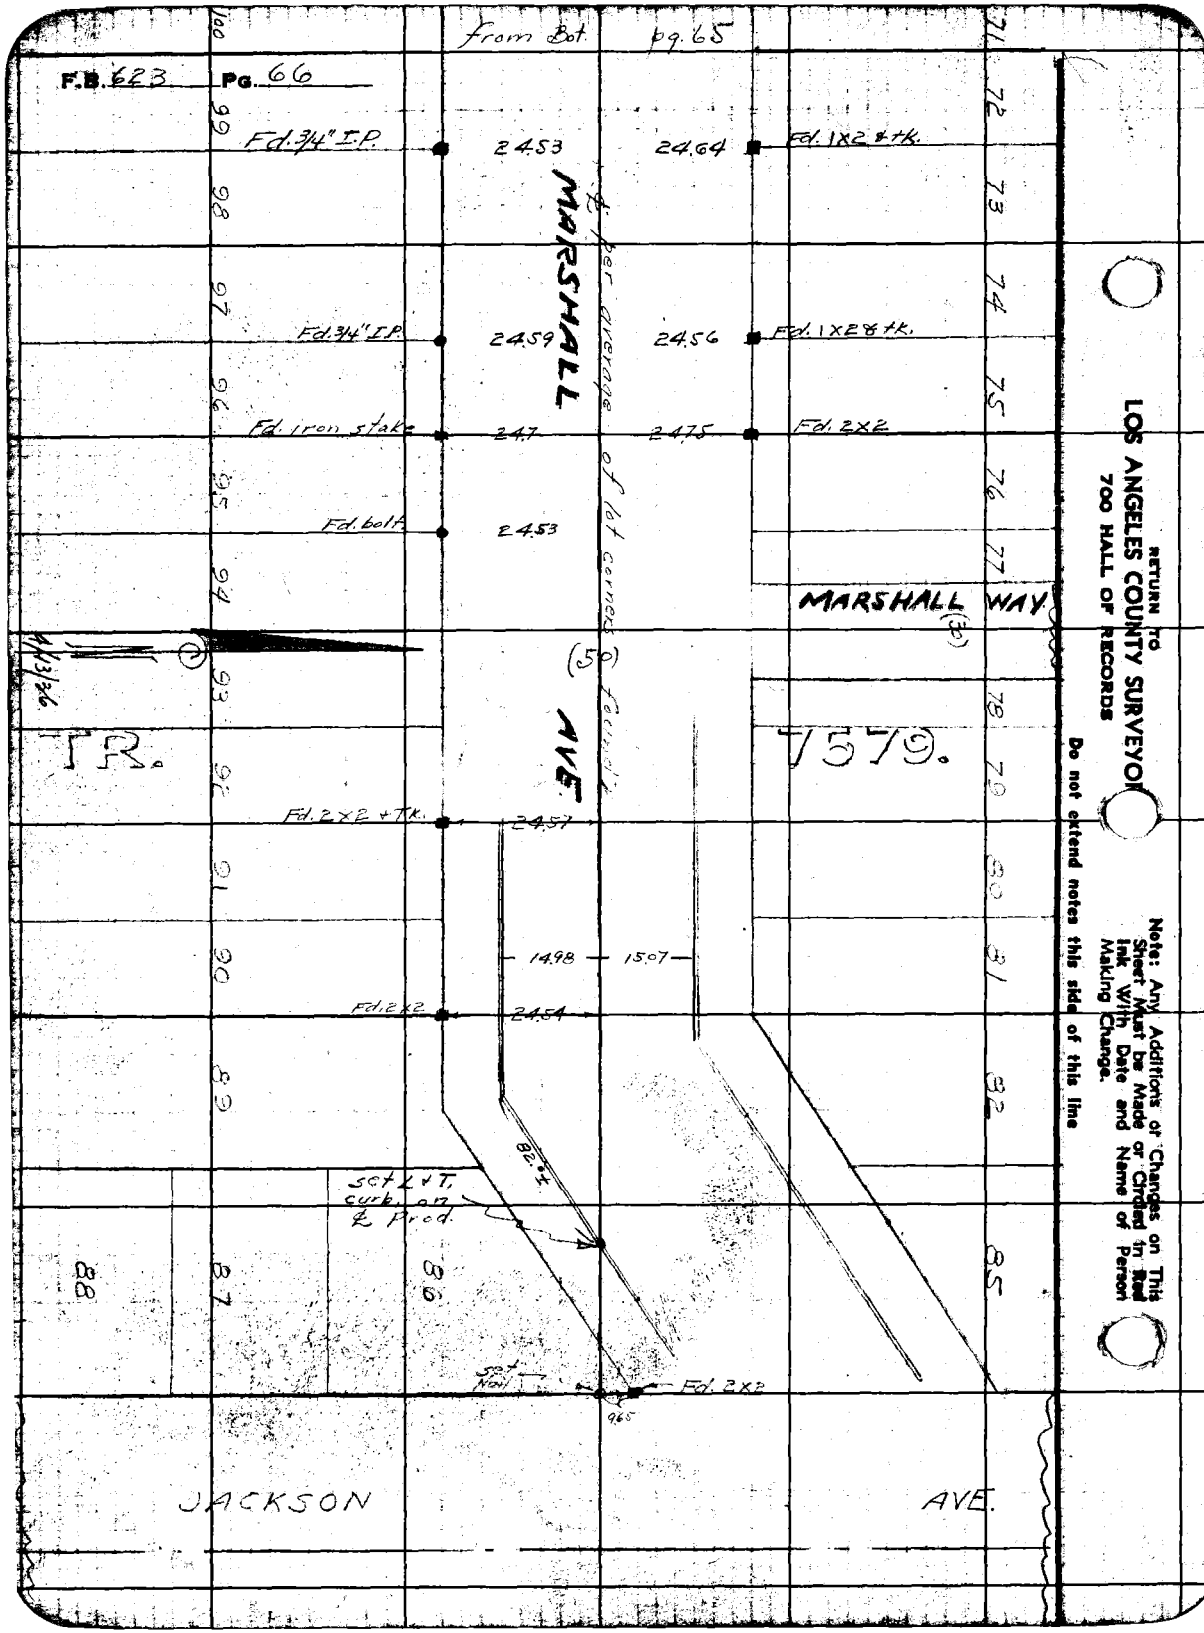

F.B. 623 Pg. 66
from Bot. pg. 65
Fd. 3/4" I.P.
24.53
24.64
Fd. 1x2 & tk.
MARSHALL
℄ per average of lot corners found
Fd. 3/4" I.P.
24.59
24.56
Fd. 1x2 & tk.
Fd. iron stake
24.7
24.75
Fd. 2x2
Fd. bolt
24.53
MARSHALL WAY
(30)
(50)
AVE.
TR.
7579.
Fd. 2x2 + Tk.
24.57
14.98
15.07
Fd. 2x2
24.54
82.0±
set L + T, curb on ℄ Prod.
Set Nail
Fd. 2x2
9.65
JACKSON
AVE.
RETURN TO
LOS ANGELES COUNTY SURVEYOR
700 HALL OF RECORDS
Note: Any Additions or Changes on This Sheet Must be Made or Circled in Red Ink With Date and Name of Person Making Change.
Do not extend notes this side of this line

Notes Ck'd by Drew	Survey of Lake Ave	F.B. 623 Pg. 67
Map No. B-1345	W. O. 7135 Tape No. 072 St'd 84° F.	(90-01-00) (360-03-45) 90°-00'-56¼"
Office Work Wood	Surveyed by Evans.	
Checked Drew	Notes HE Date 4/16/36	
Date Feb 38	Indexed A. C. Johnson	

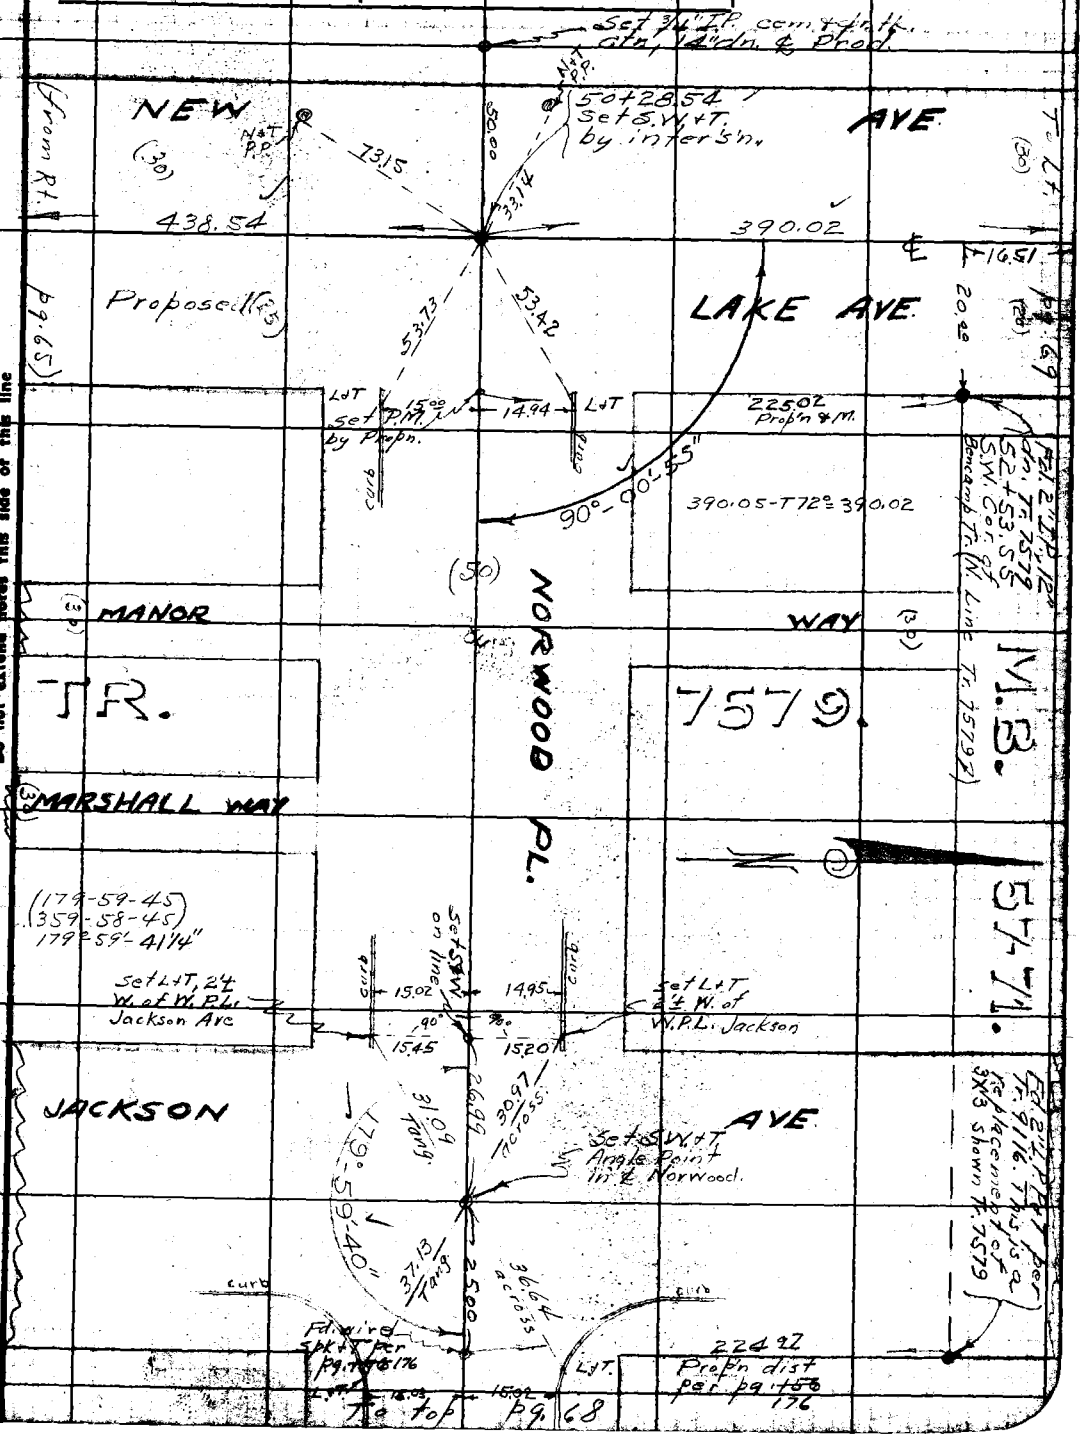

Note: Any Additions or Changes on This Sheet Must be Made or Circled in Red Ink With Date and Name of Person Making Change.

Do not extend notes this side of this line

RETURN TO LOS ANGELES COUNTY SURVEYOR 700 HALL OF RECORDS

FORM 247 10M 11-35

RETURN TO
LOS ANGELES COUNTY SURVEYOR
700 HALL OF RECORDS

Note: Any Additions or Changes on This Sheet Must be Made or Circled in Red Ink With Date and Name of Person Making Change.

Do not extend notes this side of this line

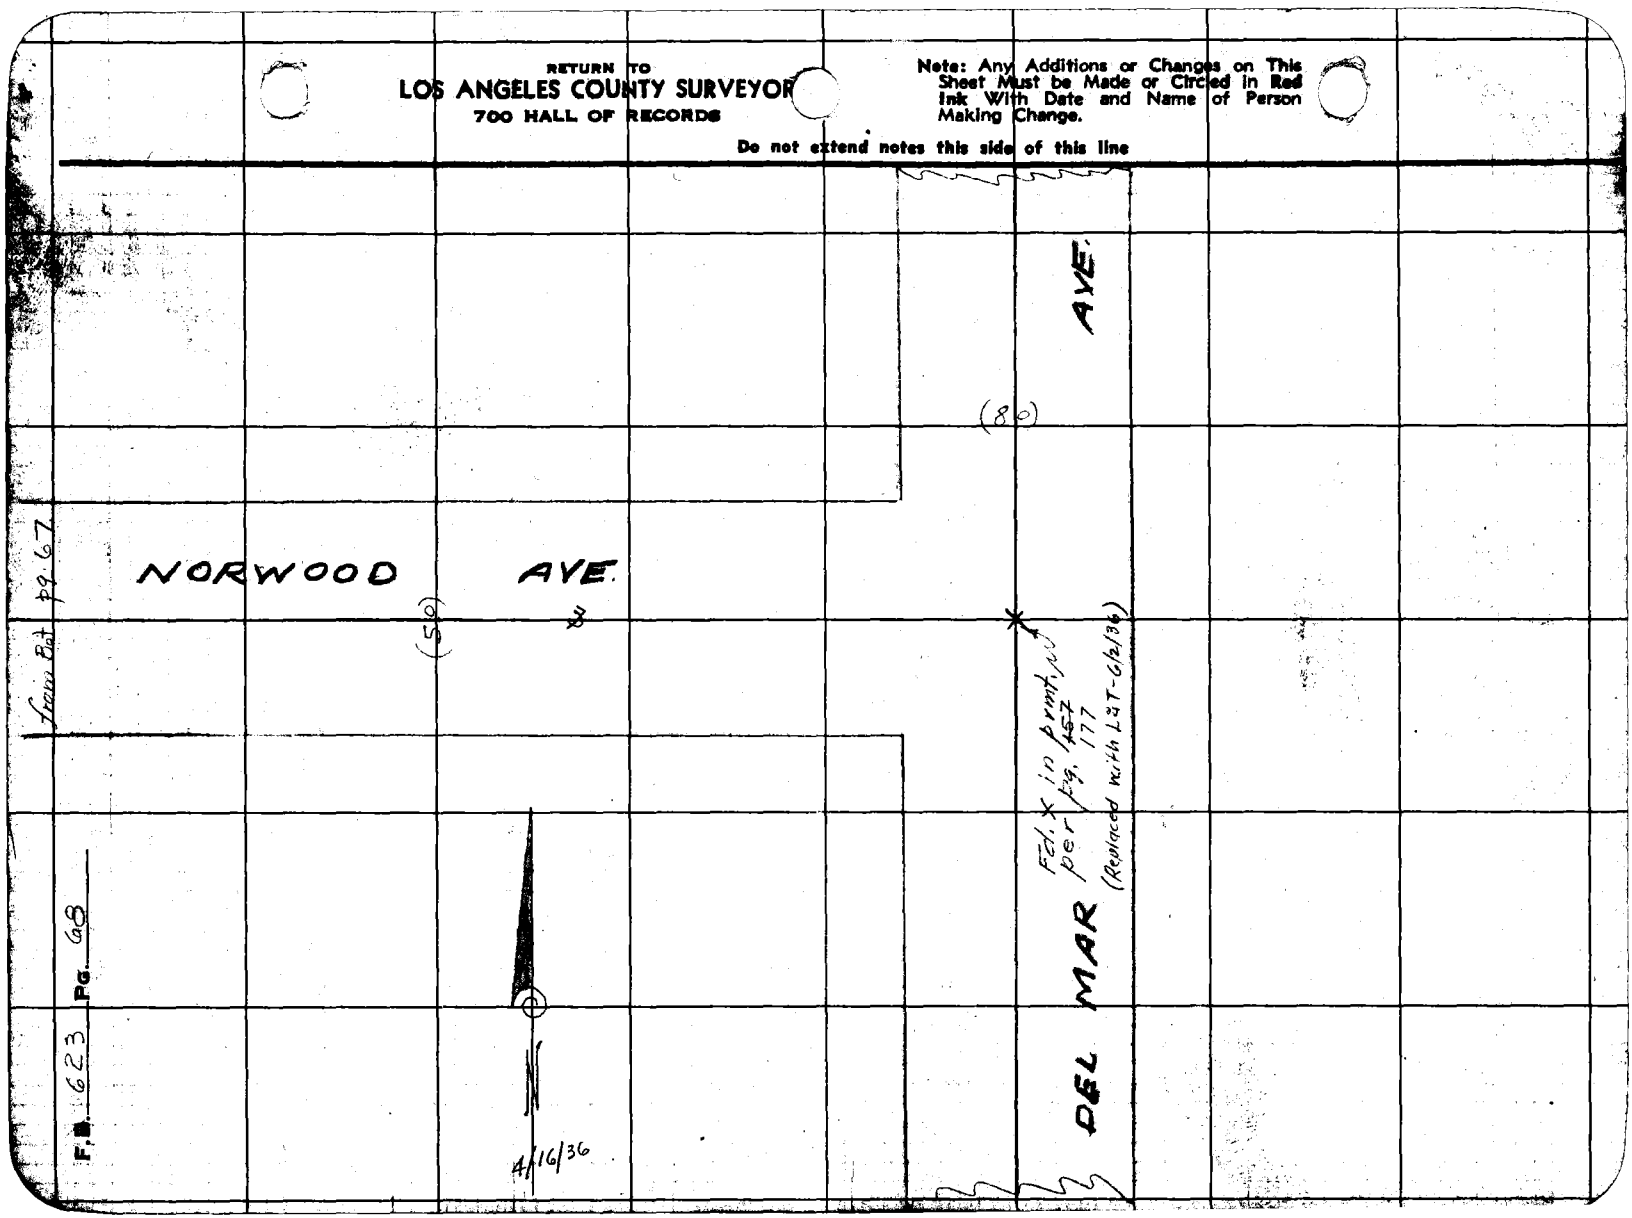

Notes Ck'd by Drew	Survey of Lake Ave.	F.B. 623 Pg. 69
Map No. B-1345	W. 07135 Tape No 072 St'd 24 F.	(90-01-00) (360-04-15)
Office Work Wood	Surveyed by Evans	90°-01-03¾"
Checked Drew	Notes HE Date 4/16/36	
Date Feb 38	Indexed A. C. Johnson	

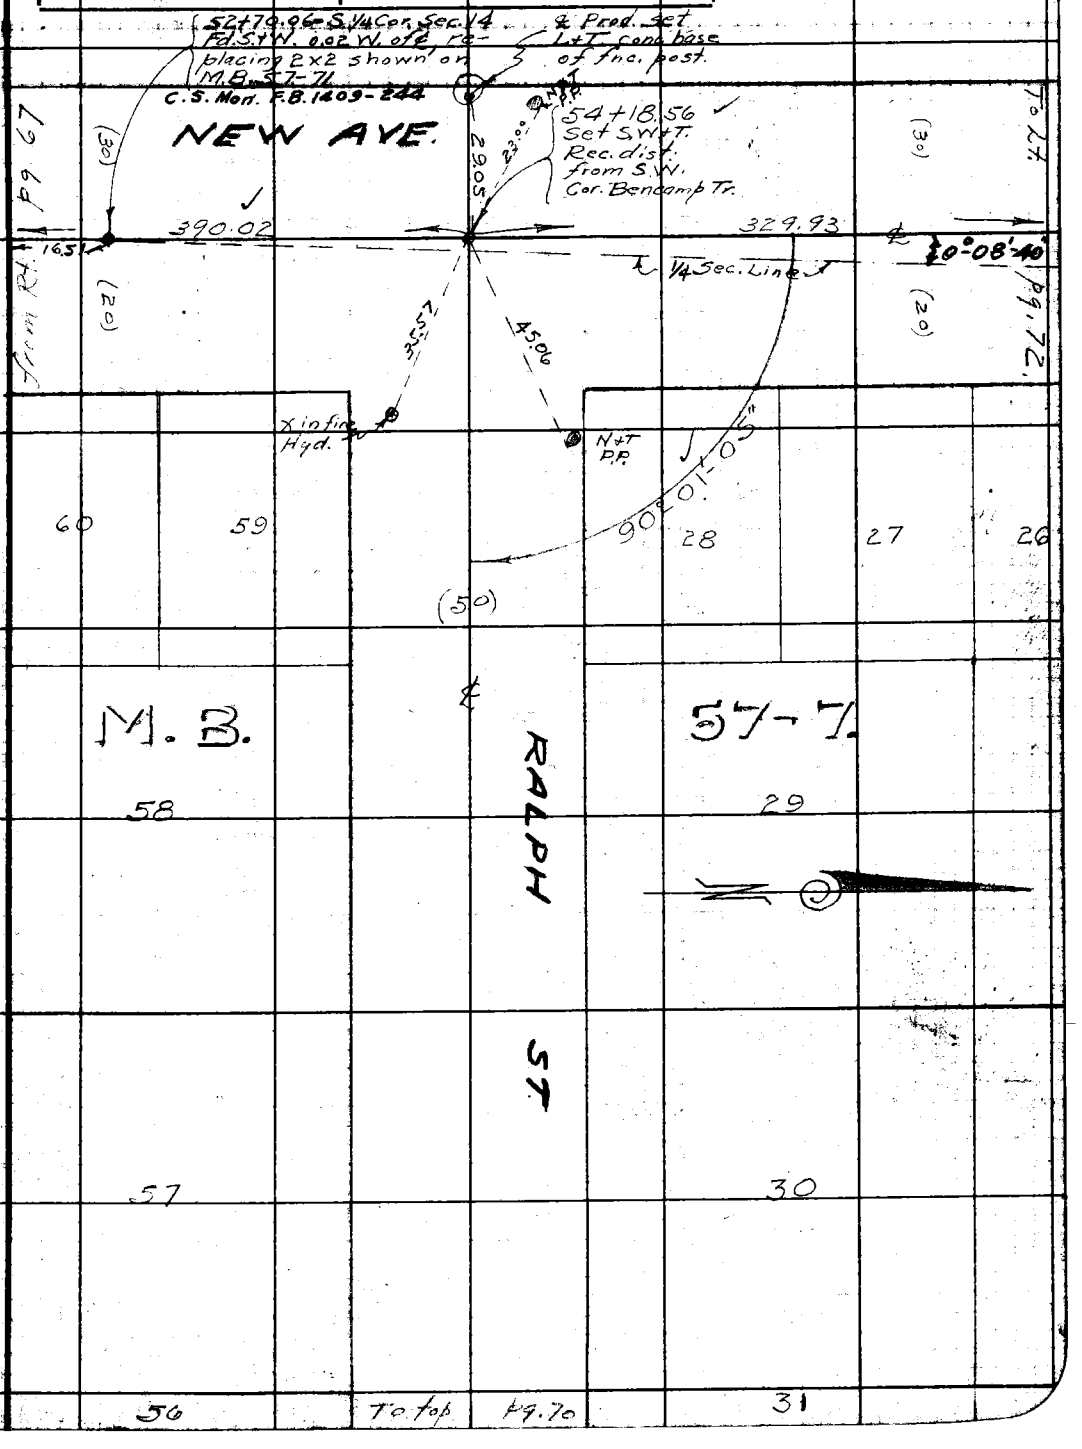

Note: Any Additions or Changes on This Sheet Must be Made or Circled in Red Ink With Date and Name of Person Making Change.

Do not extend notes this side of this line

RETURN TO
LOS ANGELES COUNTY SURVEYOR
700 HALL OF RECORDS

FORM 247 10M 11-35

F.B. 623 Pg. 70

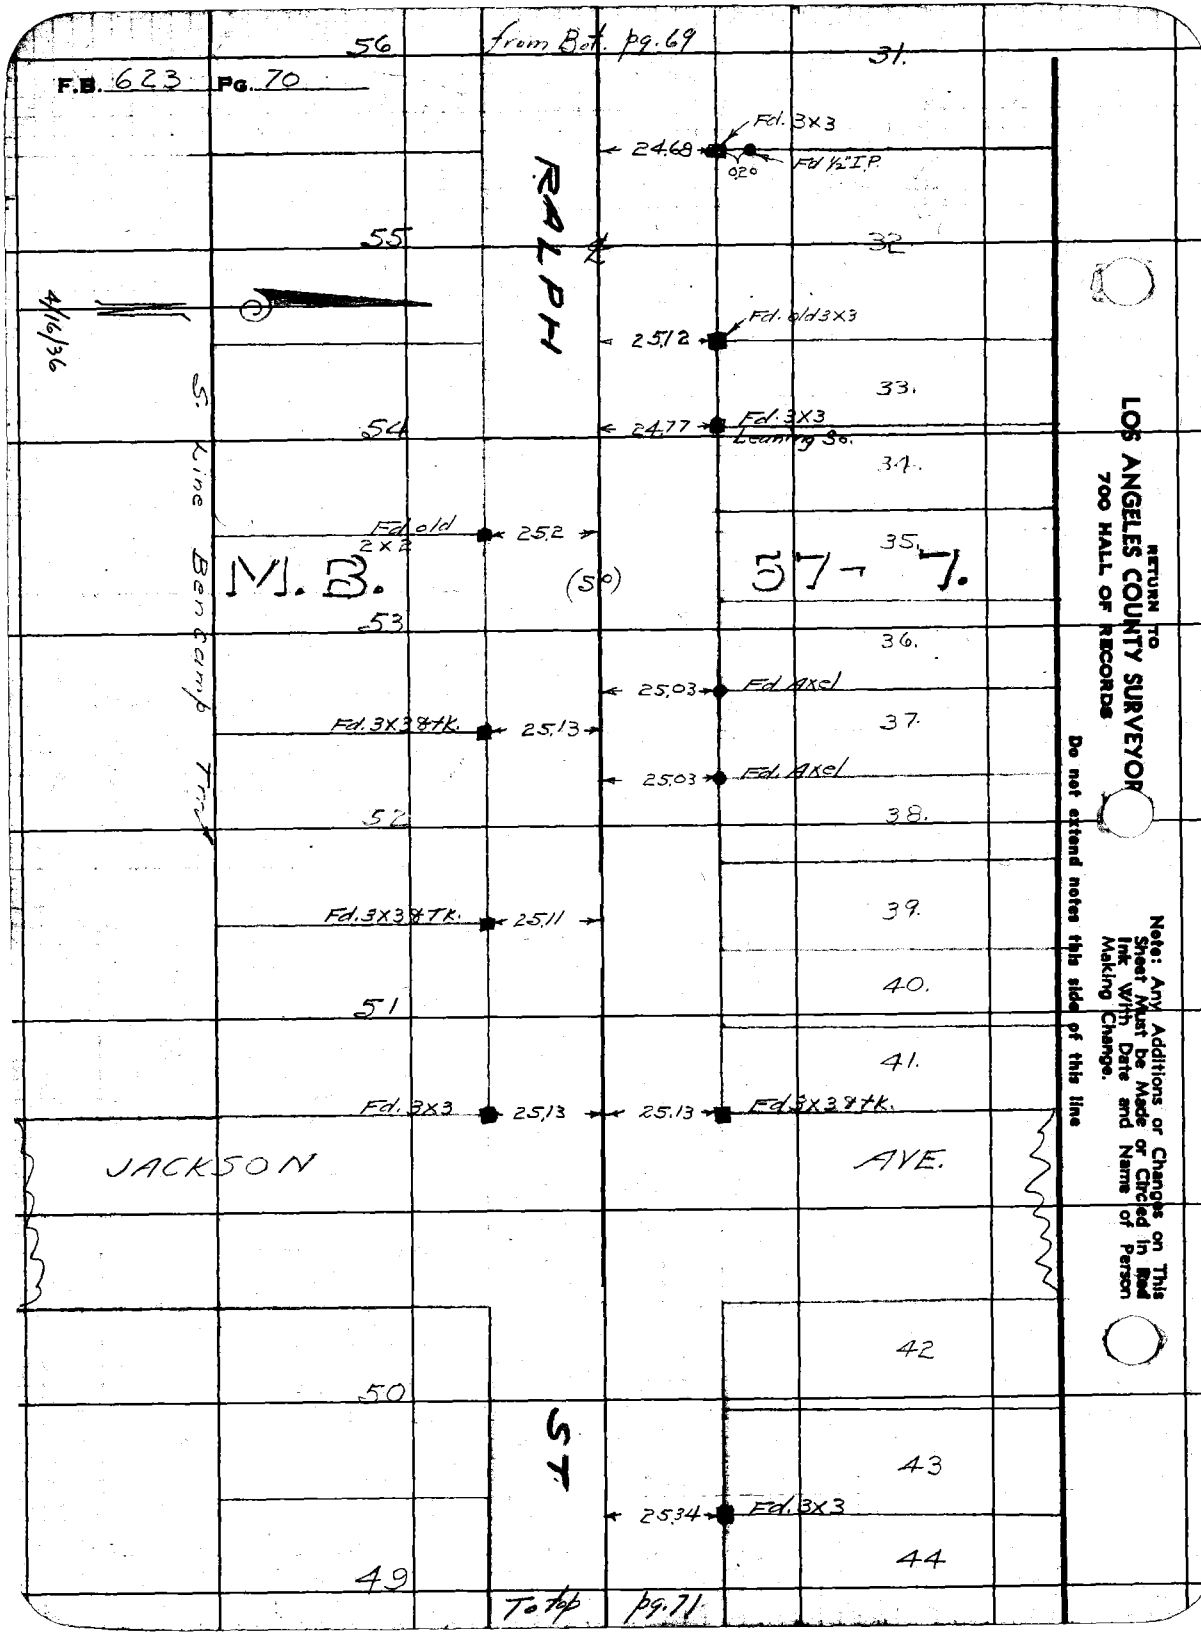

RETURN TO
LOS ANGELES COUNTY SURVEYOR
700 HALL OF RECORDS

Do not extend notes this side of this line

Note: Any Additions or Changes on This Sheet Must be Made or Circled in Red Ink With Date and Name of Person Making Change.

Notes Ck'd by Drew	Survey of Lake Ave.
Map No. B-1345	W. O. 7135 Tape No. 072 St'd 84°F.
Office Work Wood	Surveyed by Evans
Checked Drew	Notes HE Date 4/16/36
Date Feb 38	Indexed A. C. Johnson

F.B. 623 Pg. 71

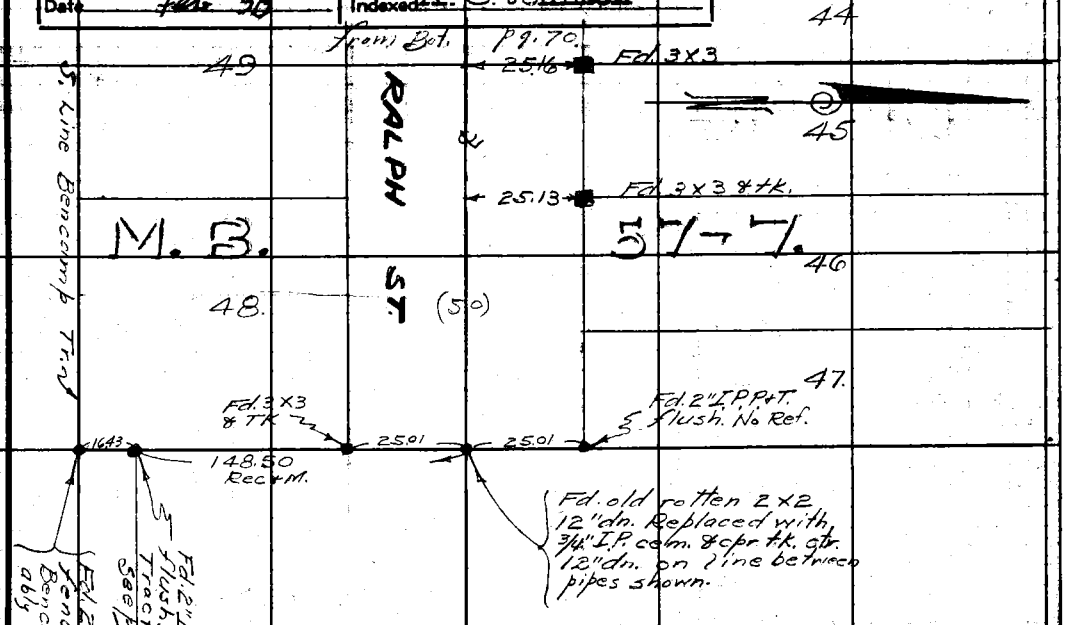

Note: Any Additions or Changes on This Sheet Must be Made or Circled in Red Ink With Date and Name of Person Making Change.

Do not extend notes this side of this line

RETURN TO
LOS ANGELES COUNTY SURVEYOR
700 HALL OF RECORDS

FORM 247 10M 11-38

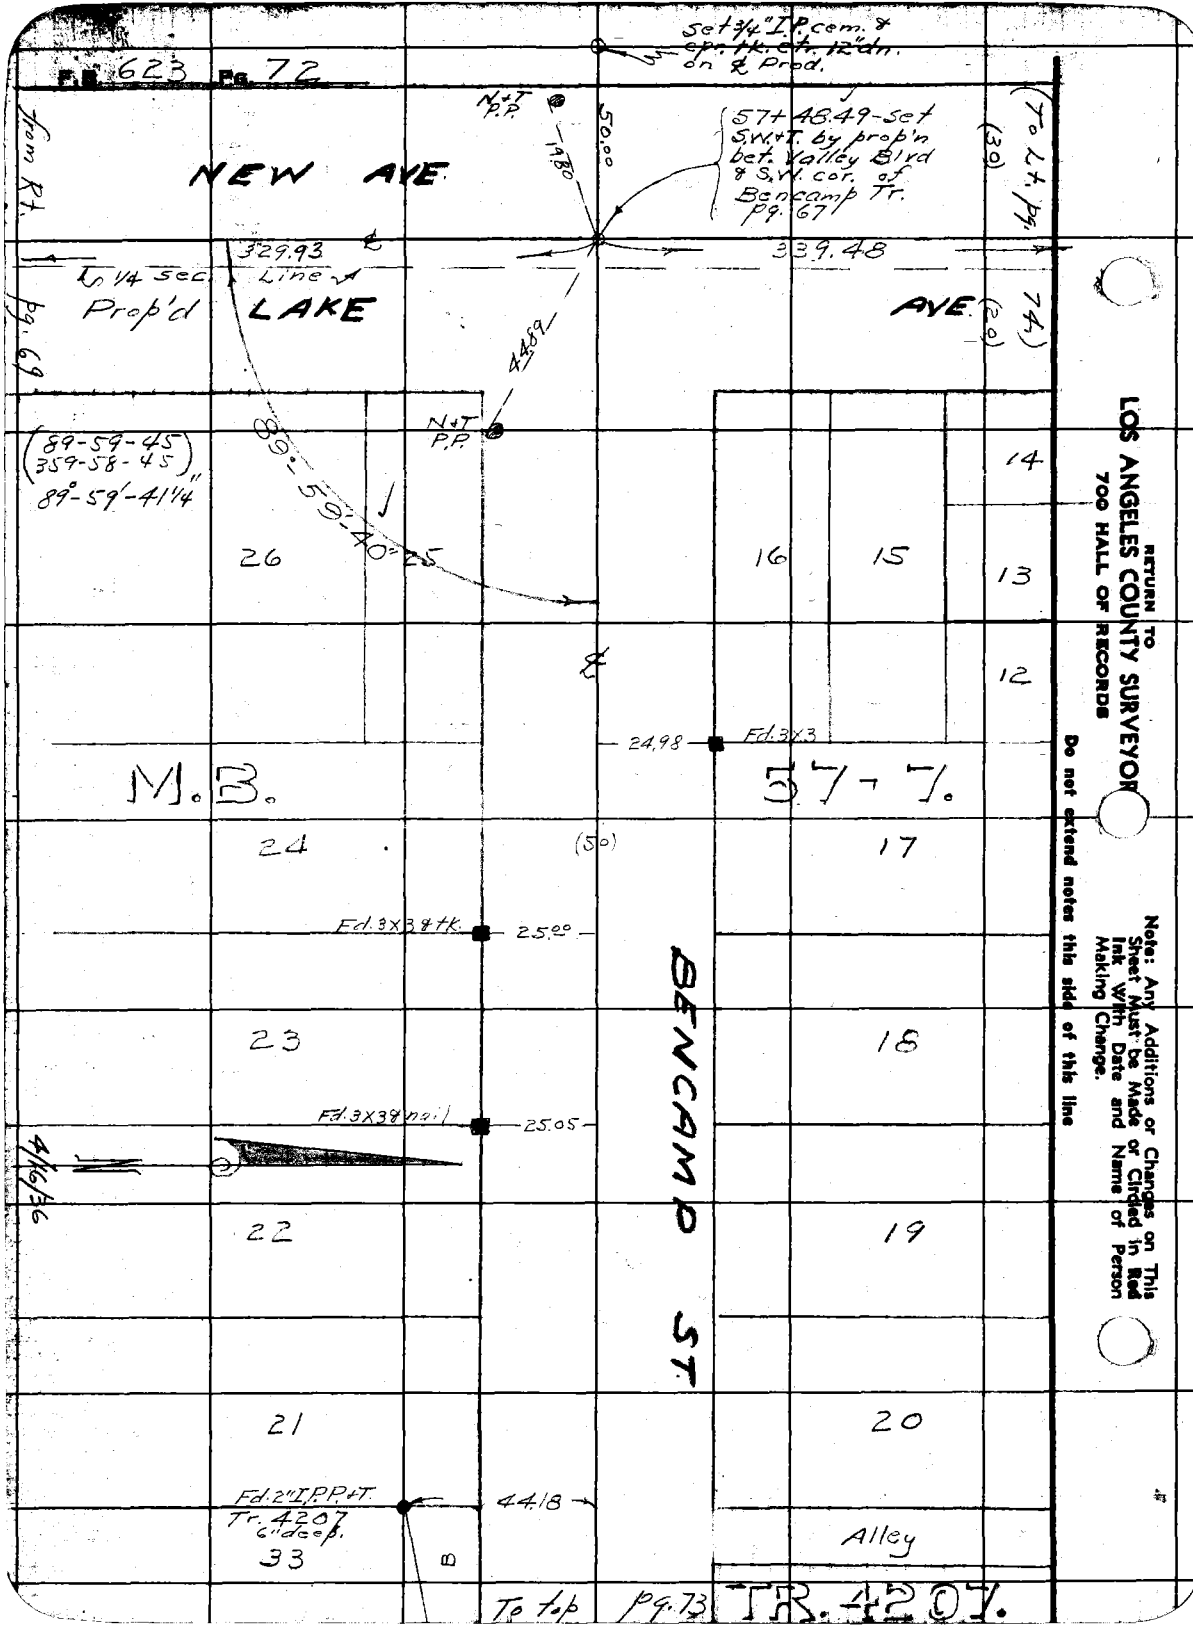

RETURN TO
LOS ANGELES COUNTY SURVEYOR
700 HALL OF RECORDS

Note: Any Additions or Changes on This Sheet Must be Made or Circled in Red Ink With Date and Name of Person Making Change.

Do not extend notes this side of this line

Notes Ck'd by Drew	Survey of Lake Ave.
Map No. B-1345	W. 07/35 Tape No. 072 [illegible] F.
Office Work Wood	Surveyed by Evans
Checked Drew	Notes HE Date 4/17/36
Date Feb 38	Indexed A. C. Johnson

F.B. 623 Pg. 78

from Bot. pg. 72

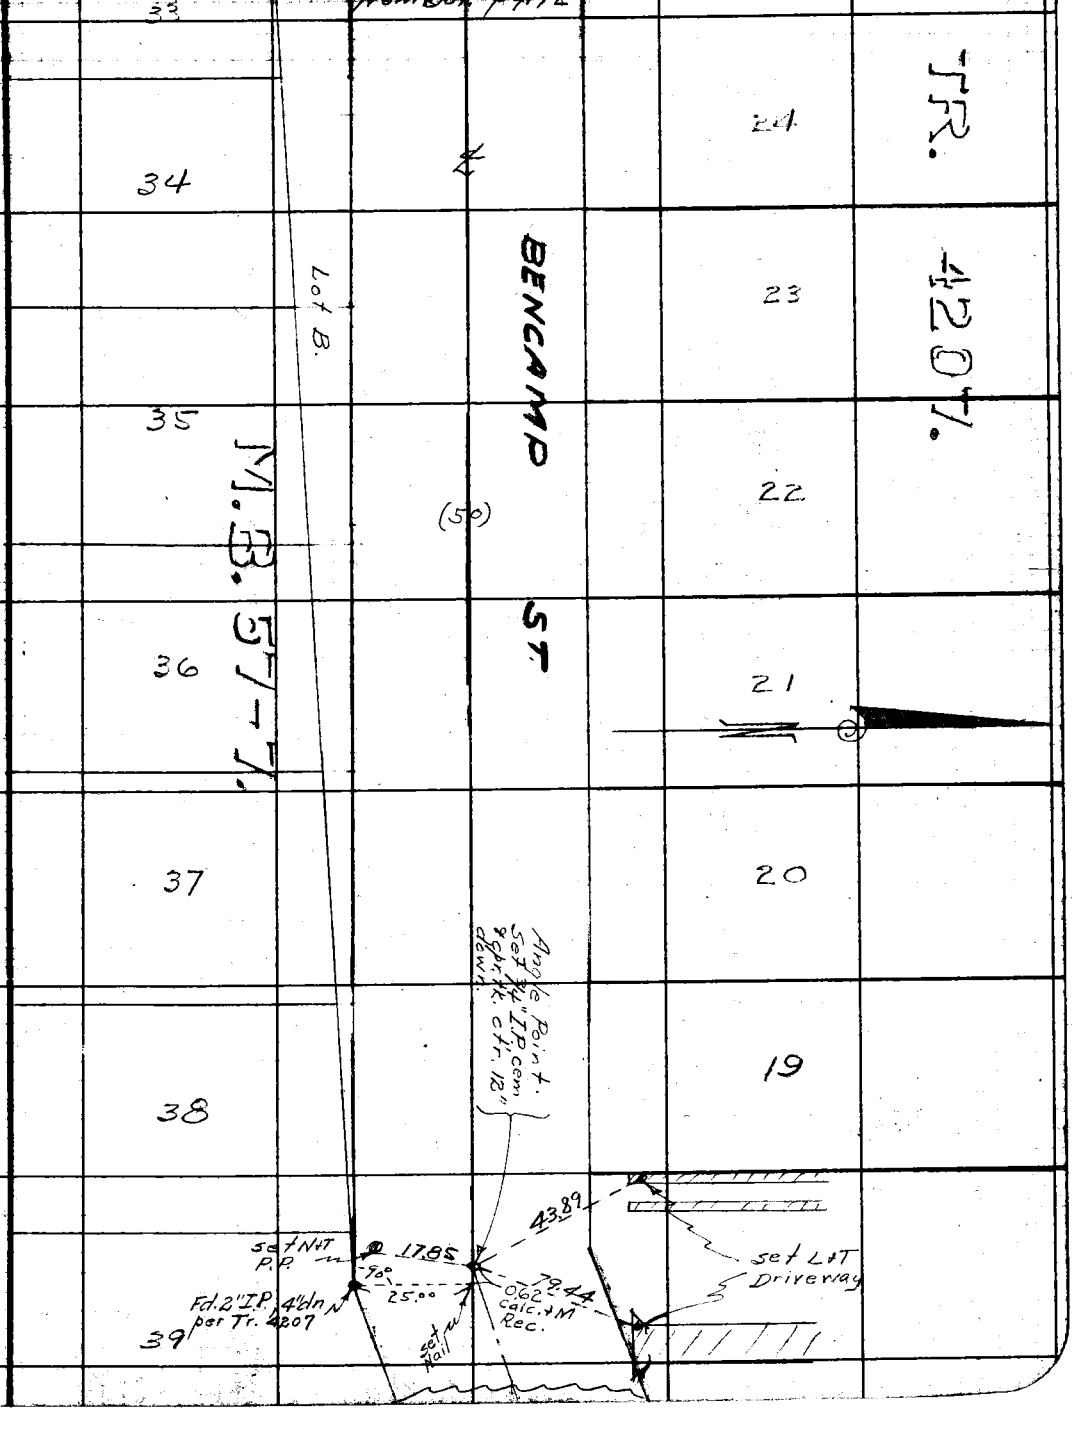

Note: Any Additions or Changes on This Sheet Must be Made or Circled in Red Ink With Date and Name of Person Making Change

Do not extend notes this side of this line

RETURN TO
LOS ANGELES COUNTY SURVEYOR
700 HALL OF RECORDS

FORM 247 10M 11-35

RETURN TO
LOS ANGELES COUNTY SURVEYOR
700 HALL OF RECORDS

Note: Any Additions or Changes on This Sheet Must be Made or Circled in Red Ink With Date and Name of Person Making Change.

Do not extend notes this side of this line

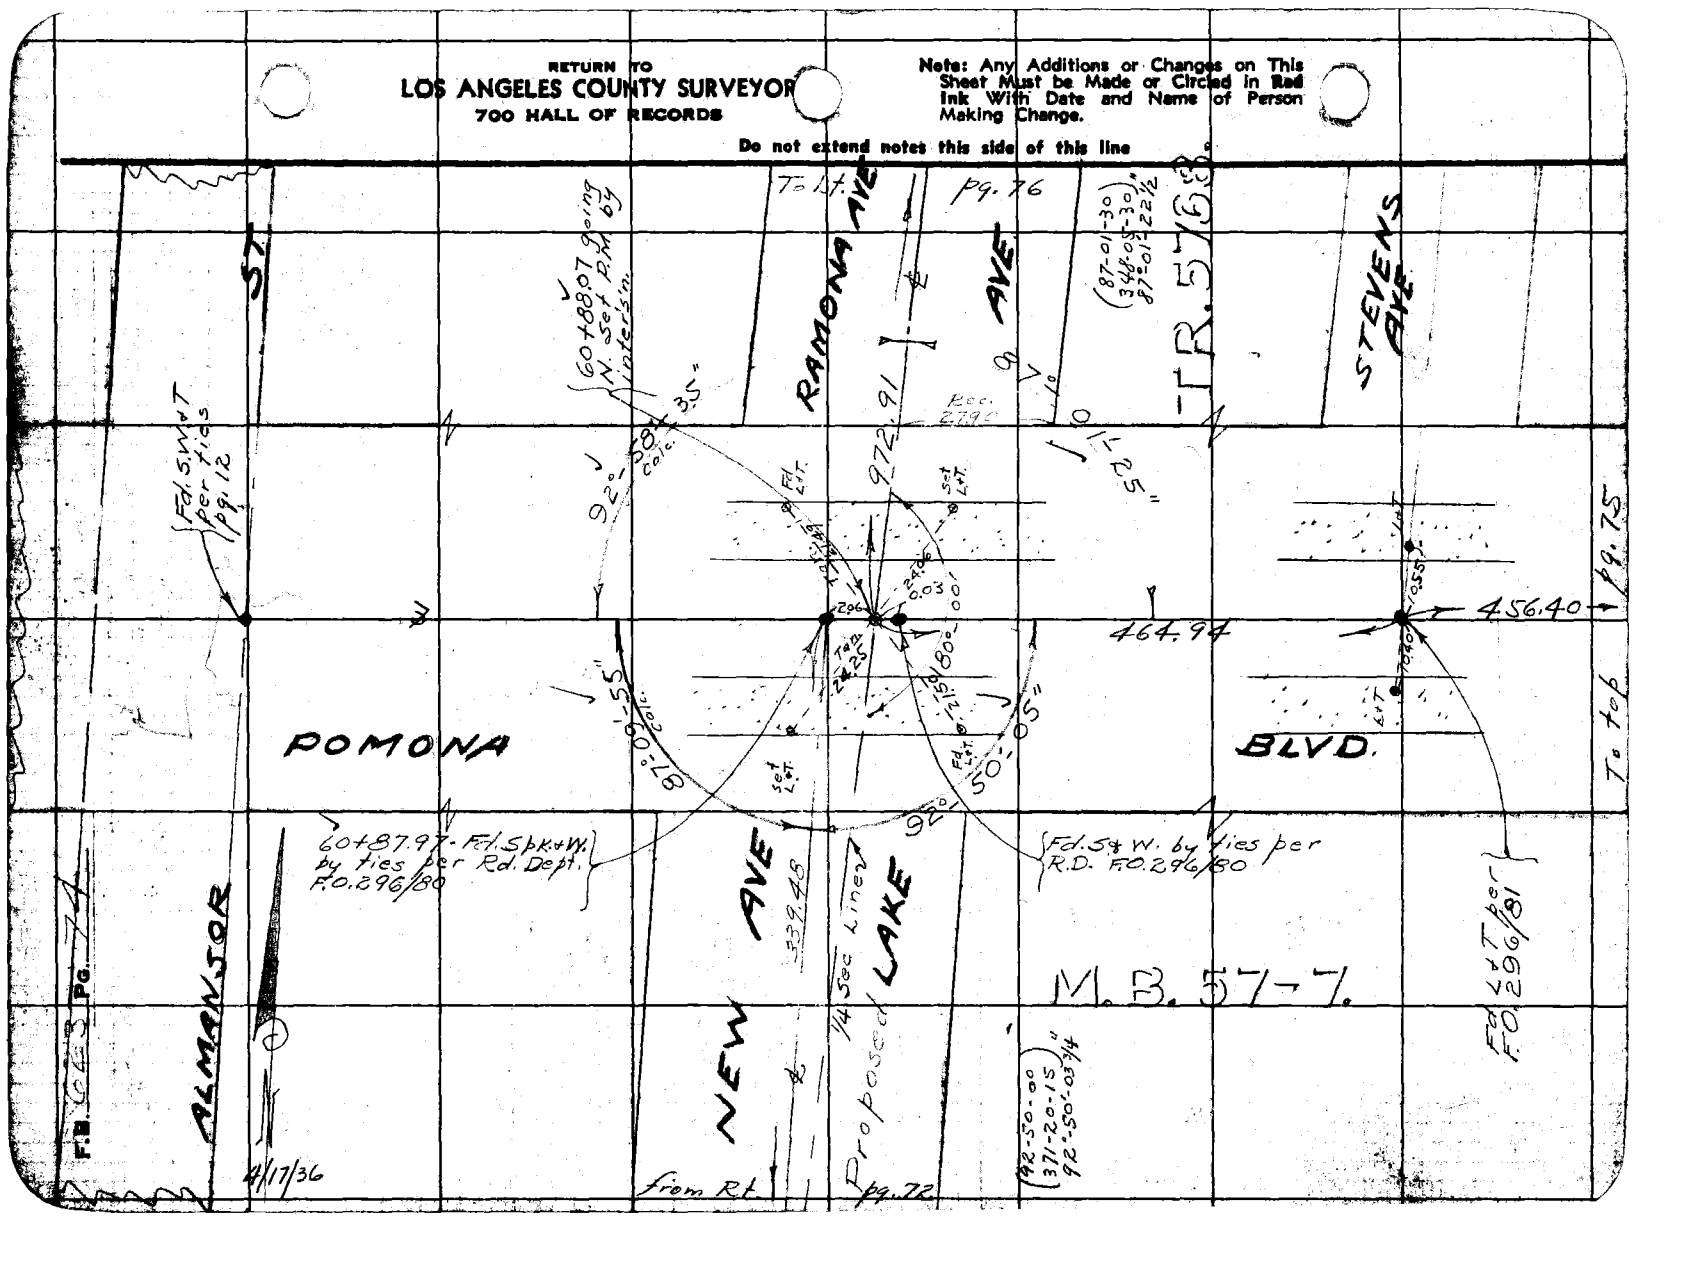

Notes Ck'd by Drew	Survey of Lake Ave.
Map No. B-1345	W. O. 7793 Tape No. 072 St'd 84 F.
Office Work Wood	Surveyed by Evans
Checked Drew	Notes HE Date 4/21/36
Date Feb 38	Indexed A. C. Johnson

F.B. 623 Pg. 75

from Bot. ↑ pg. 74

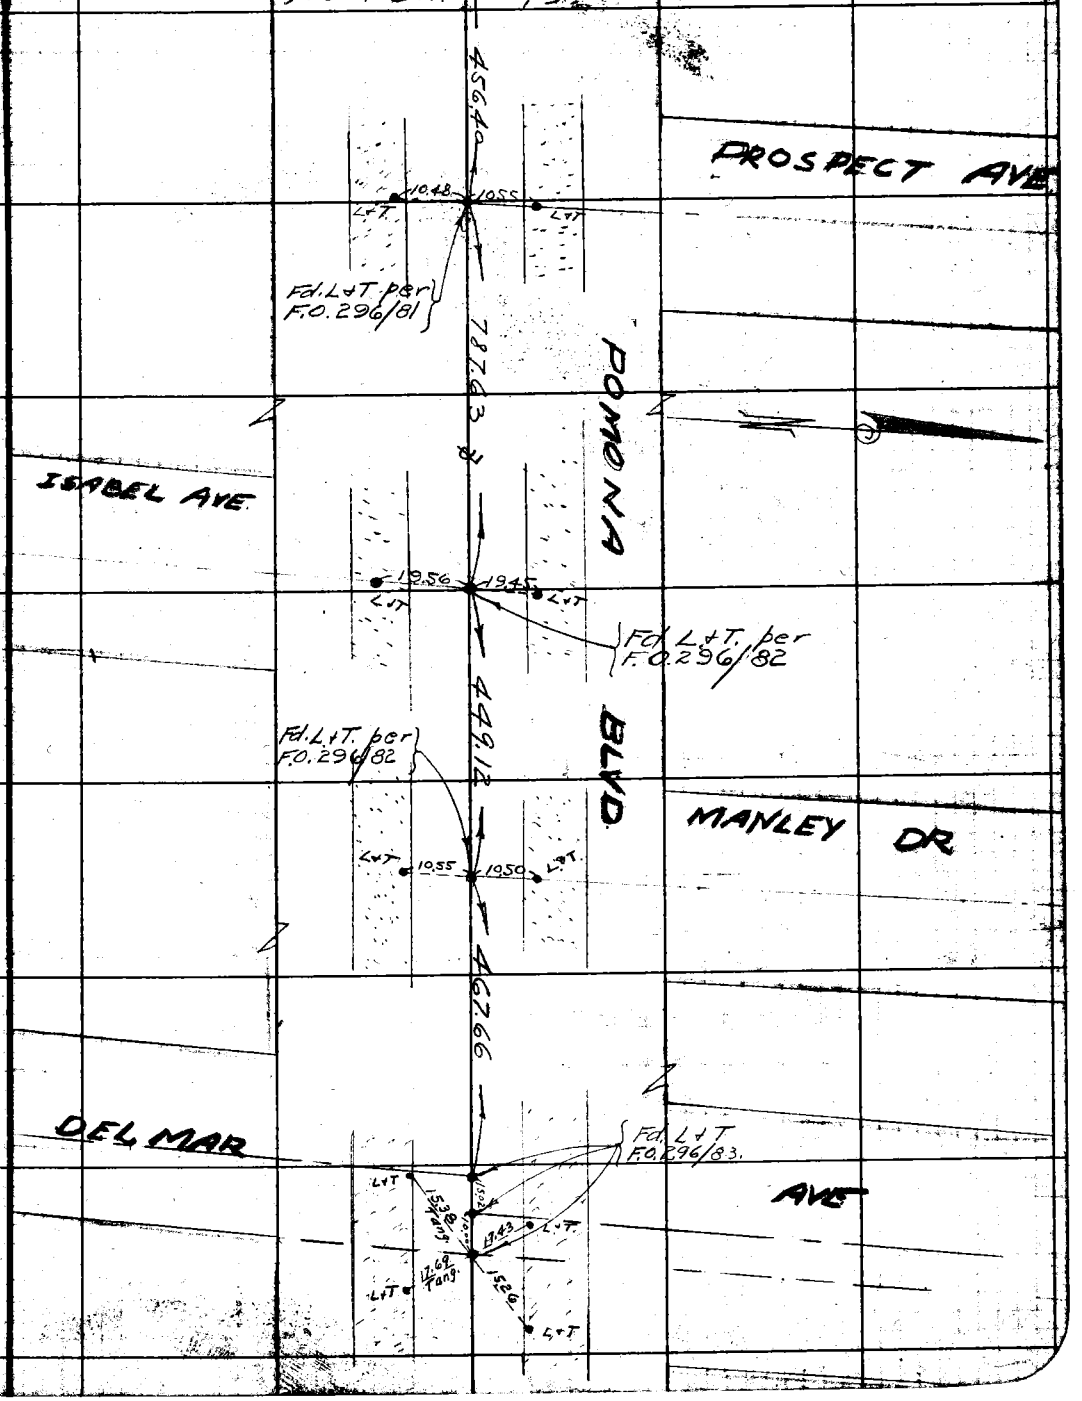

Note: Any Additions or Changes on This Sheet Must be Made or Circled in Red Ink With Date and Name of Person Making Change

Do not extend notes this side of this line

RETURN TO
LOS ANGELES COUNTY SURVEYOR
700 HALL OF RECORDS

FORM 247 10M 11-38

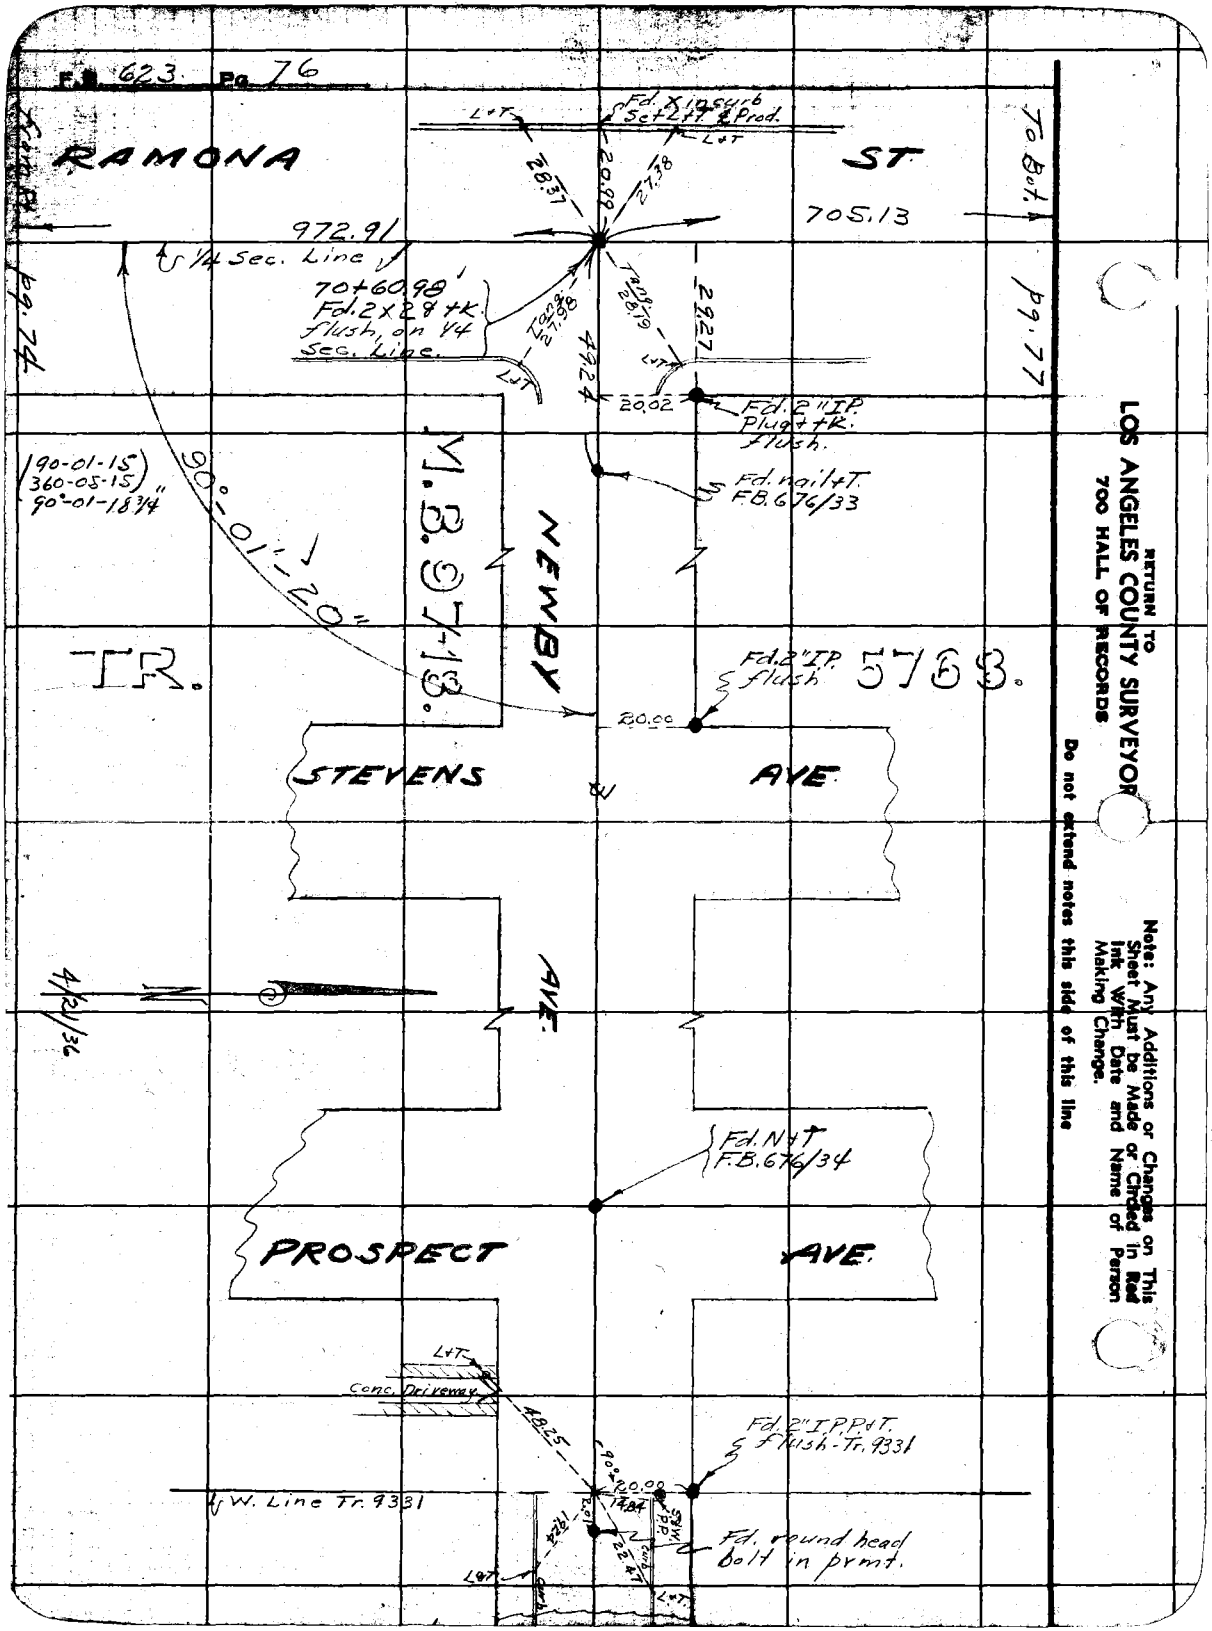
F.B. 623 Pg. 76
RAMONA ST
To Bot.
Fd. X in curb Set L+T & Prod.
L+T
28.37
20.99
27.38
972.91
705.13
1/4 Sec. Line
70+60.98
Fd. 2 x 2 8 +K. flush, on 1/4 Sec. Line.
Tang. 27.98
Tang. 28.19
29.27
49.24
20.02
Fd. 2" I.P. Plug + tk. flush.
Fd. nail + T. F.B. 676/33
pg. 74
pg. 77
(90-01-15)
(360-05-15)
90°-01-18 3/4"
90°-01'-20"
M.B. 97-18.
NEWBY
TR. 5763.
Fd. 2" I.P. flush
20.00
STEVENS AVE.
AVE.
4/21/36
Fd. N+T F.B. 676/34
PROSPECT AVE.
L+T
Conc. Driveway
48.25
Fd. 2" I.P. P+T. flush - Tr. 9331
90°
20.00
14.84
W. Line Tr. 9331
Fd. round head bolt in pvmt.
L+T
L+T
RETURN TO
LOS ANGELES COUNTY SURVEYOR
700 HALL OF RECORDS
Note: Any Additions or Changes on This Sheet Must be Made or Circled in Red Ink With Date and Name of Person Making Change.
Do not extend notes this side of this line

Notes Ck'd by Drew	Survey of Lake Ave.
Map No. B-1345	W. O. 713 Tape No. 072 St'd 84 F.
Office Work Wood	Surveyed by Evans.
Checked Drew	Notes HE Date 4/21/36
Date Feb 38	Indexed A. C. Johnson

F.B. 623 Pg. 77

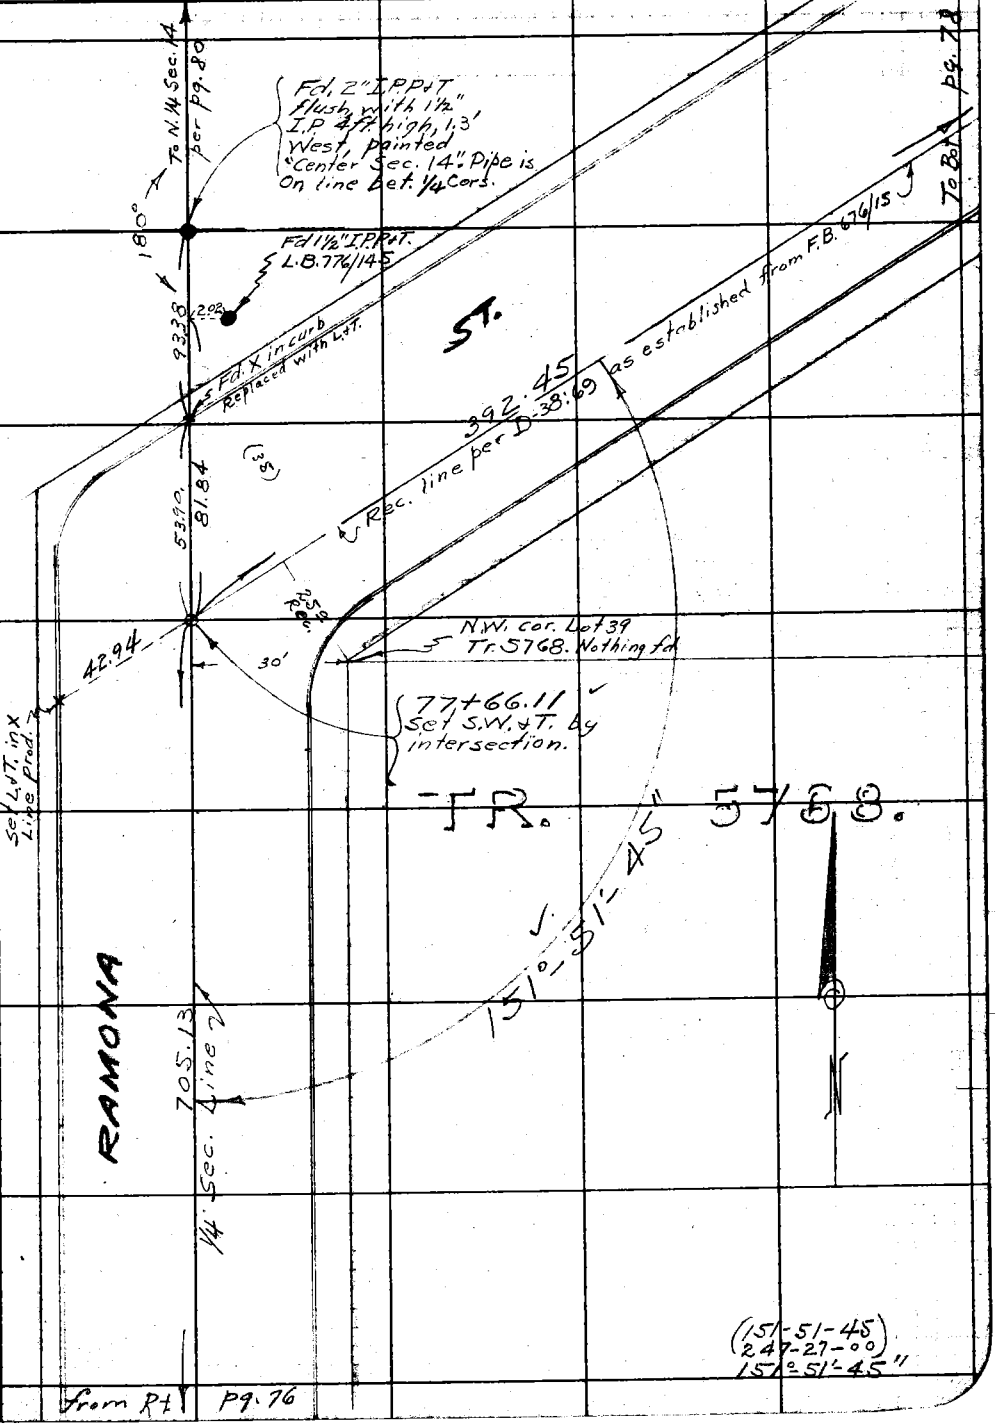

Note: Any Additions or Changes on This Sheet Must be Made or Circled in Red Ink With Date and Name of Person Making Change.

Do not extend notes this side of this line

RETURN TO
LOS ANGELES COUNTY SURVEYOR
700 HALL OF RECORDS

FORM 347 10M 11-38

F.B. 623 PG. 78

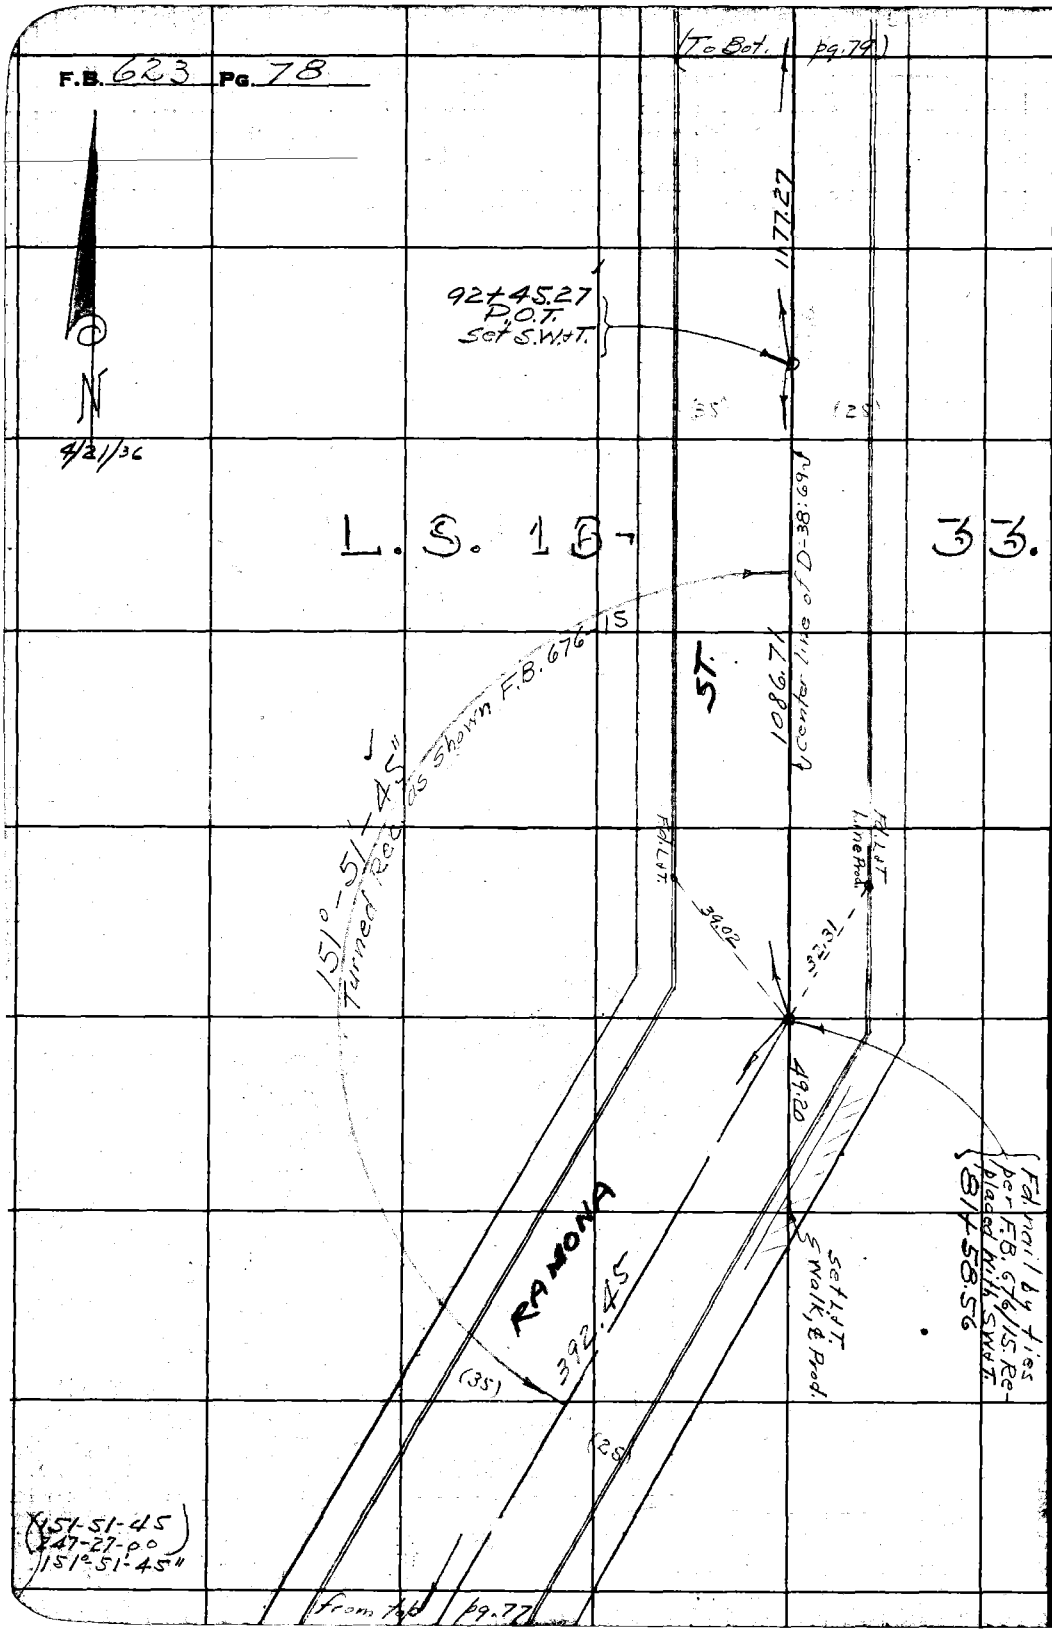

RETURN TO
LOS ANGELES COUNTY SURVEYOR
700 HALL OF RECORDS

Note: Any Additions or Changes on This Sheet Must be Made or Circled in Red Ink With Date and Name of Person Making Change.

Do not extend notes this side of this line

Notes Ck'd by Drew	Survey of Lake Ave
Map No. B-1345	W. O. 7135 Tape No. 072 St'd 64 °F.
Office Work Wood	Surveyed by Evans
Checked Drew	Notes HE Date 4/21/36
Date Feb 38	Indexed A. C. Johnson

F.B. 623 Pg. 79
(158-41)
(274-44)
158°-41'-00"

To Bot. pg. 80

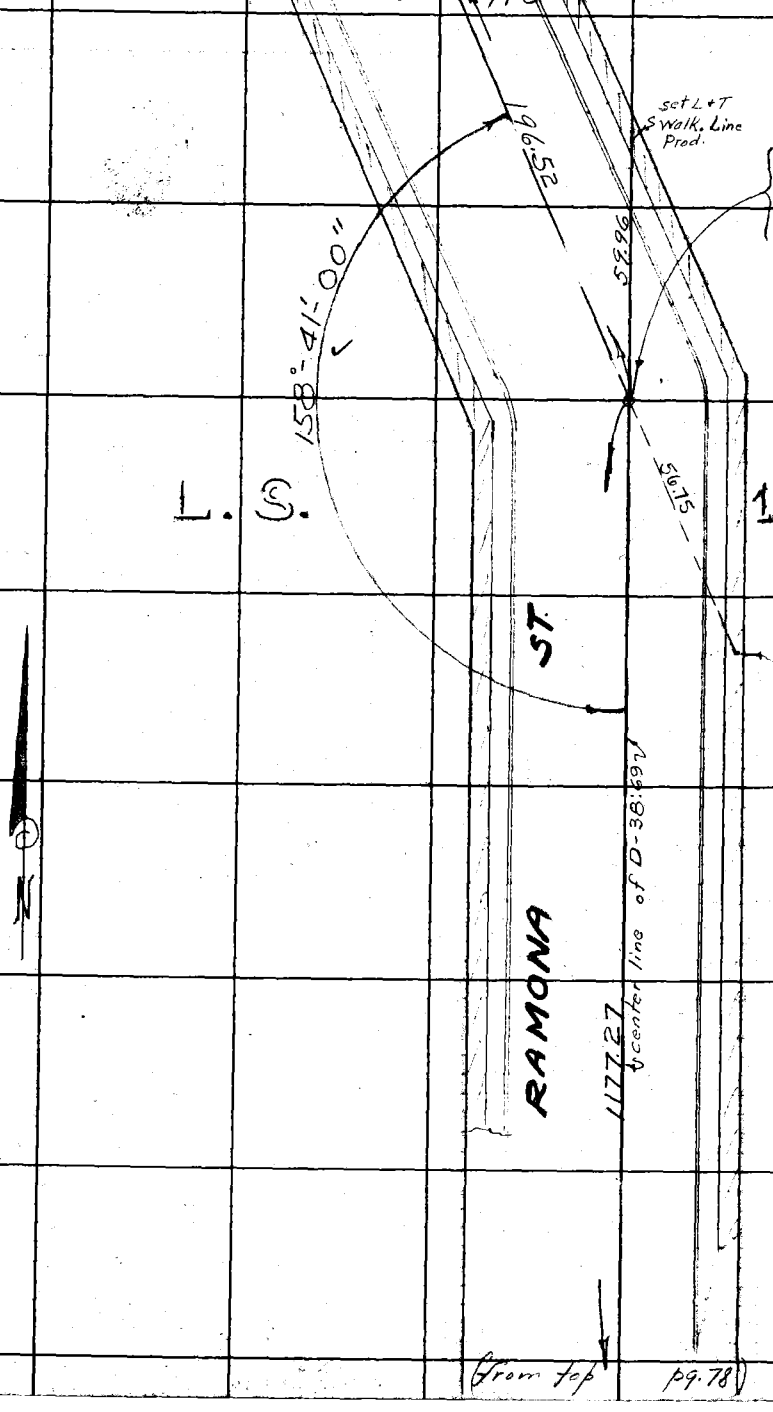

(From top pg. 78)

Note: Any Additions or Changes on This Sheet Must Be Made in Red Ink With Date and Name of Person Making Change

Do not extend notes this side of this line

RETURN TO
LOS ANGELES COUNTY SURVEYOR
700 HALL OF RECORDS

FORM 247 10M 11-38

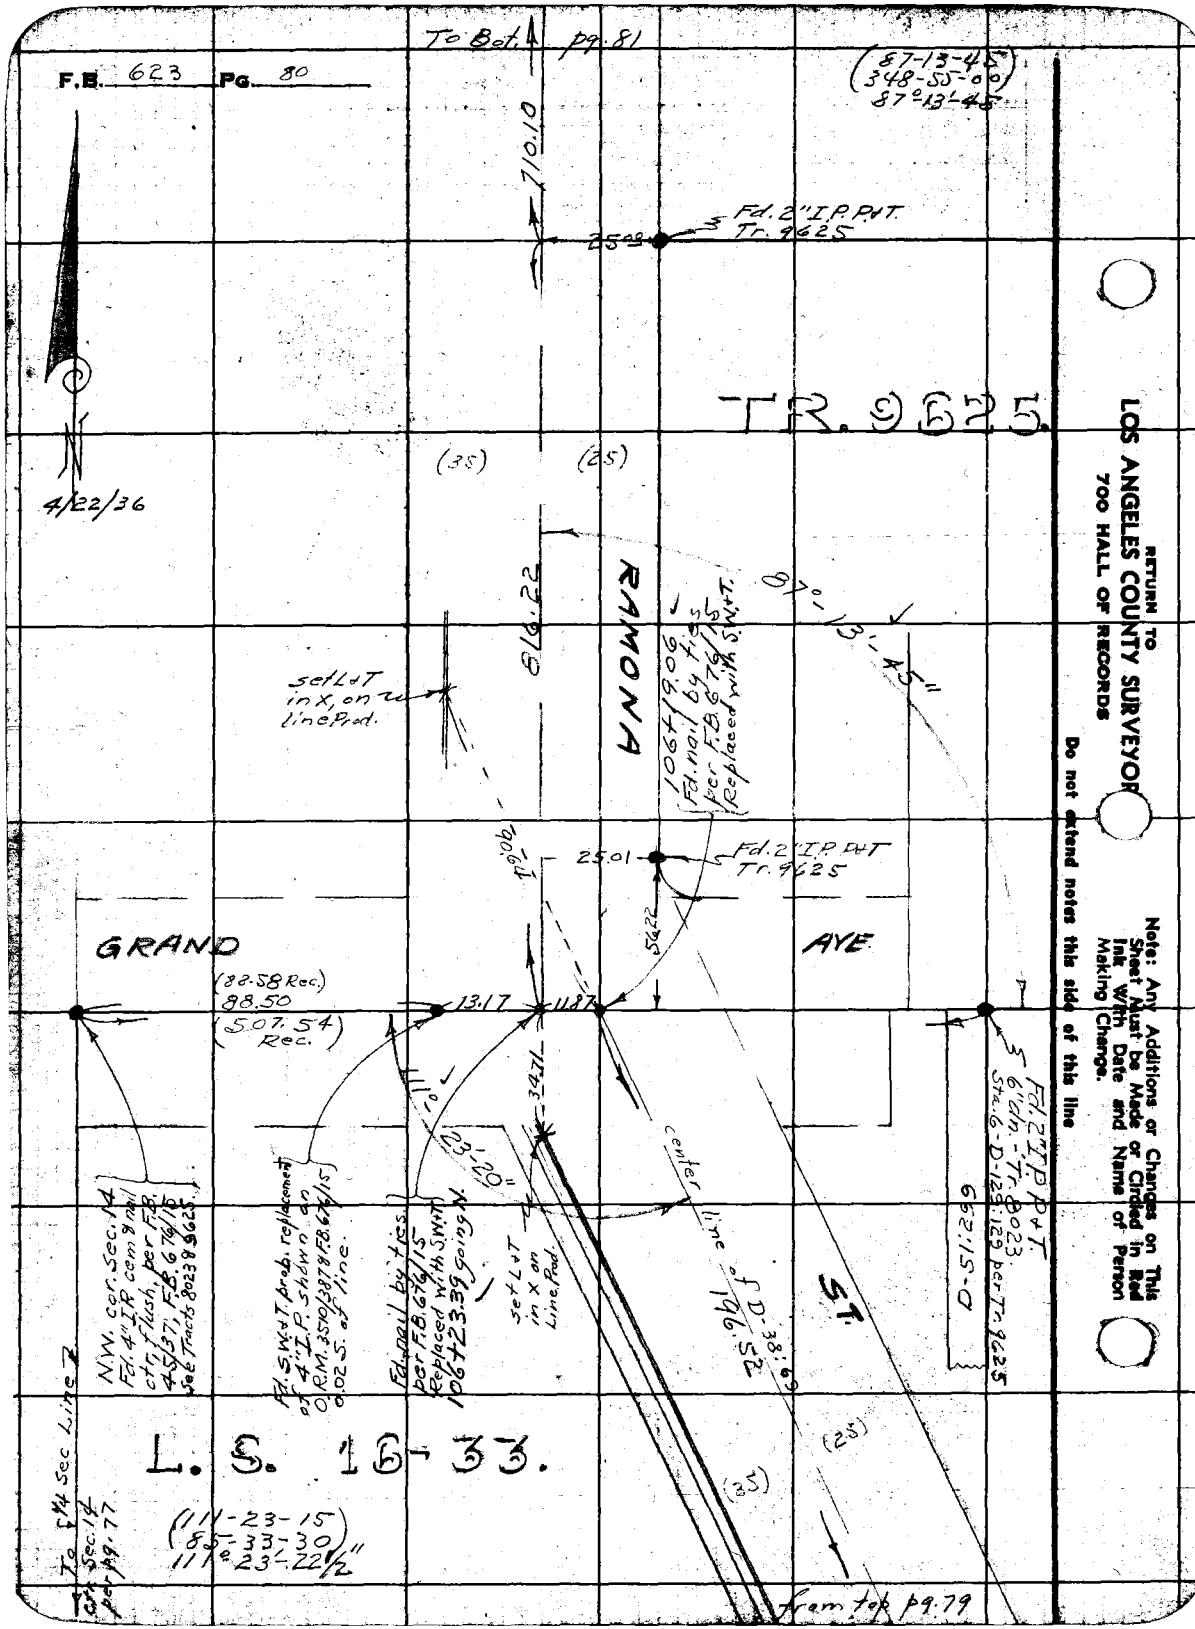
F.B. 623 Pg. 80
To Bot. pg. 81
(87-13-45)
(348-55-00)
87°13'-45
710.10
Fd. 2" I.P. P&T.
Tr. 9625
25.03
TR. 9625.
(35)
(25)
4/22/36
816.22
RAMONA
87°-13'-45"
set L&T in X, on line Prod.
106+19.06
Fd. nail by ties per F.B. 676/15
Replaced with S.W.&T.
25.01
Fd. 2" I.P. P&T
Tr. 9625
56.22
GRAND
AVE
(88.58 Rec.)
88.50
(507.54 Rec.)
13.17
11.87
34.71
111°-23'-20"
center line of D-38.69
196.52
ST.
Fd. 2" I.P. P&T.
6" dn. - Tr. 8023
Sta. 6-D-129.129 per Tr. 9625
662.15-0
N.W. cor. Sec. 14
Fd. 4" I.P. cem & nail ctr. flush, per F.B. 45/37, F.B. 676/15
See Tracts 8023 & 9625.
Fd. S.W.&T. prob. replacement of 4" I.P. shown on O.R.M. 3510/387 & F.B. 676/15
0.02 S. of line.
Fd. nail by ties per F.B. 676/15
Replaced with S.W.&T.
106+23.39 going N.
set L&T in X on Line Prod.
L. S. 16-33.
(111-23-15)
(85-33-30)
111°23'-22½"
To 5¼ Sec Line
Ctr. Sec. 14 per pg. 77
(35)
(25)
from top pg. 79
RETURN TO
LOS ANGELES COUNTY SURVEYOR
700 HALL OF RECORDS
Do not extend notes this side of this line
Note: Any Additions or Changes on This Sheet Must be Made or Circled in Red Ink With Date and Name of Person Making Change.

(To Bot pg. 82)

Notes Ck'd by Drew	Survey of Lake Ave
Map No. B-1345	W. O. 7135 Tape No. 072 St'd 84 E.
Office Work Wood	Surveyed by Evans
Checked Drew	Notes HE Date 4/23/36
Date Feb 38	Indexed A. C. Johnson

F.B. 623 Pg. 81

(179-43-15)
(358-52-45)
179°43'-11¼"

M. B. 14-1.

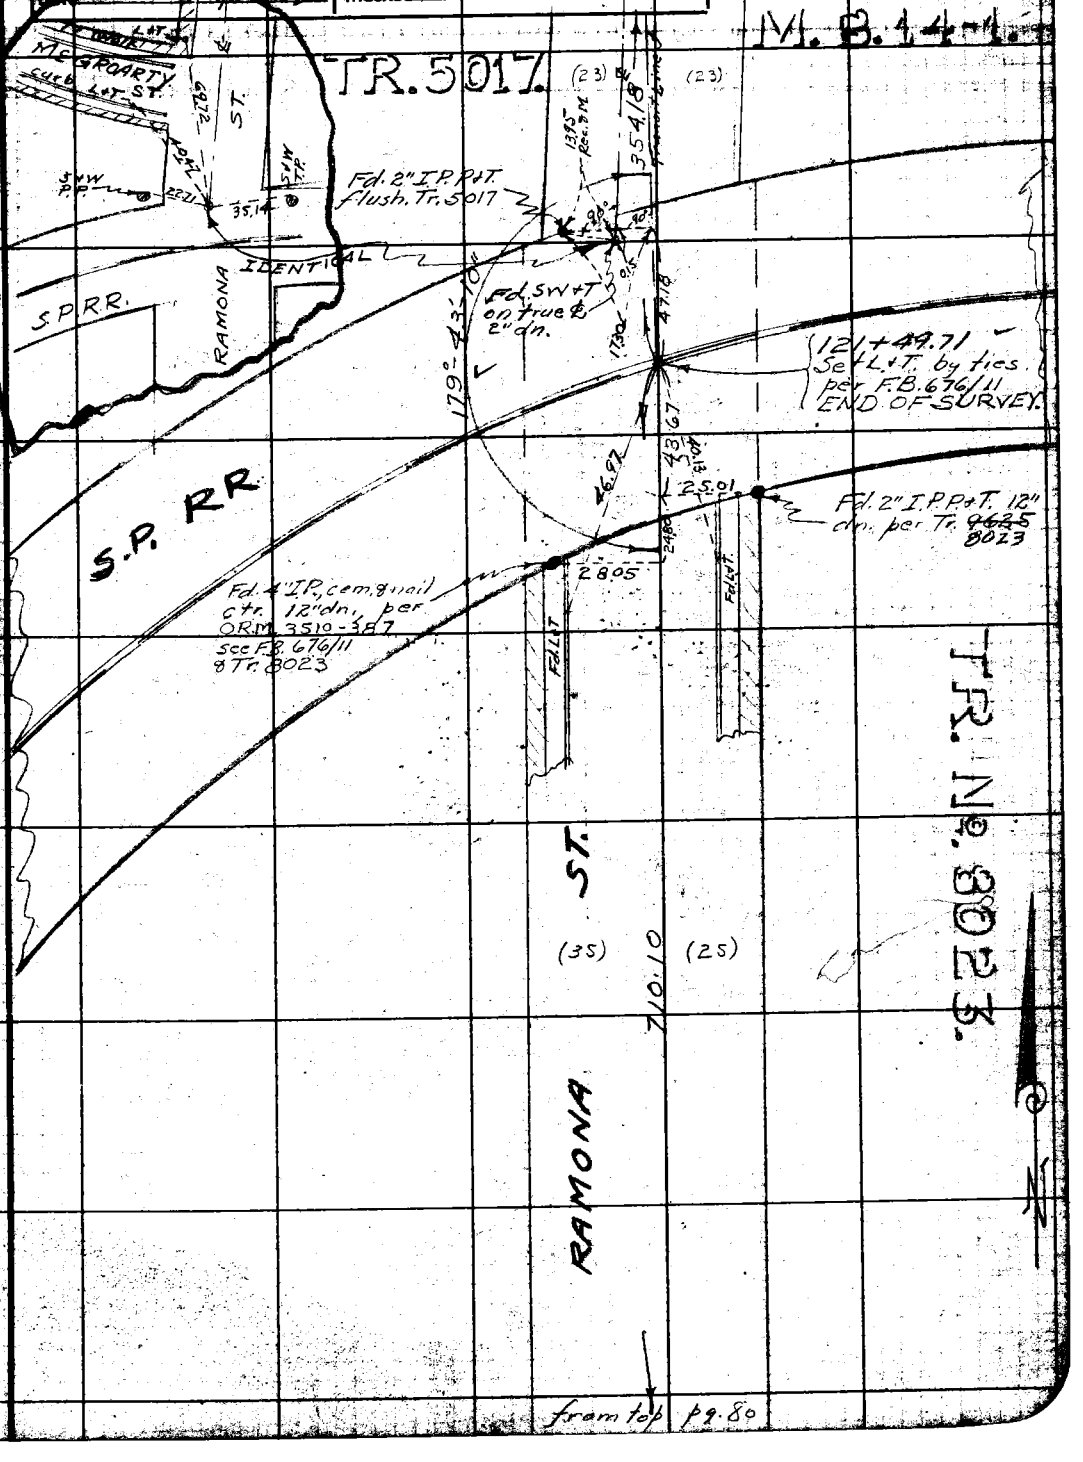

from top pg. 80

Note: Any Additions or Changes on This Sheet Must be Made or Circled in Red Ink With Date and Name of Person Making Change.

Do not extend notes this side of this line

RETURN TO
LOS ANGELES COUNTY SURVEYOR
700 HALL OF RECORDS

FORM 247 10M 11-35

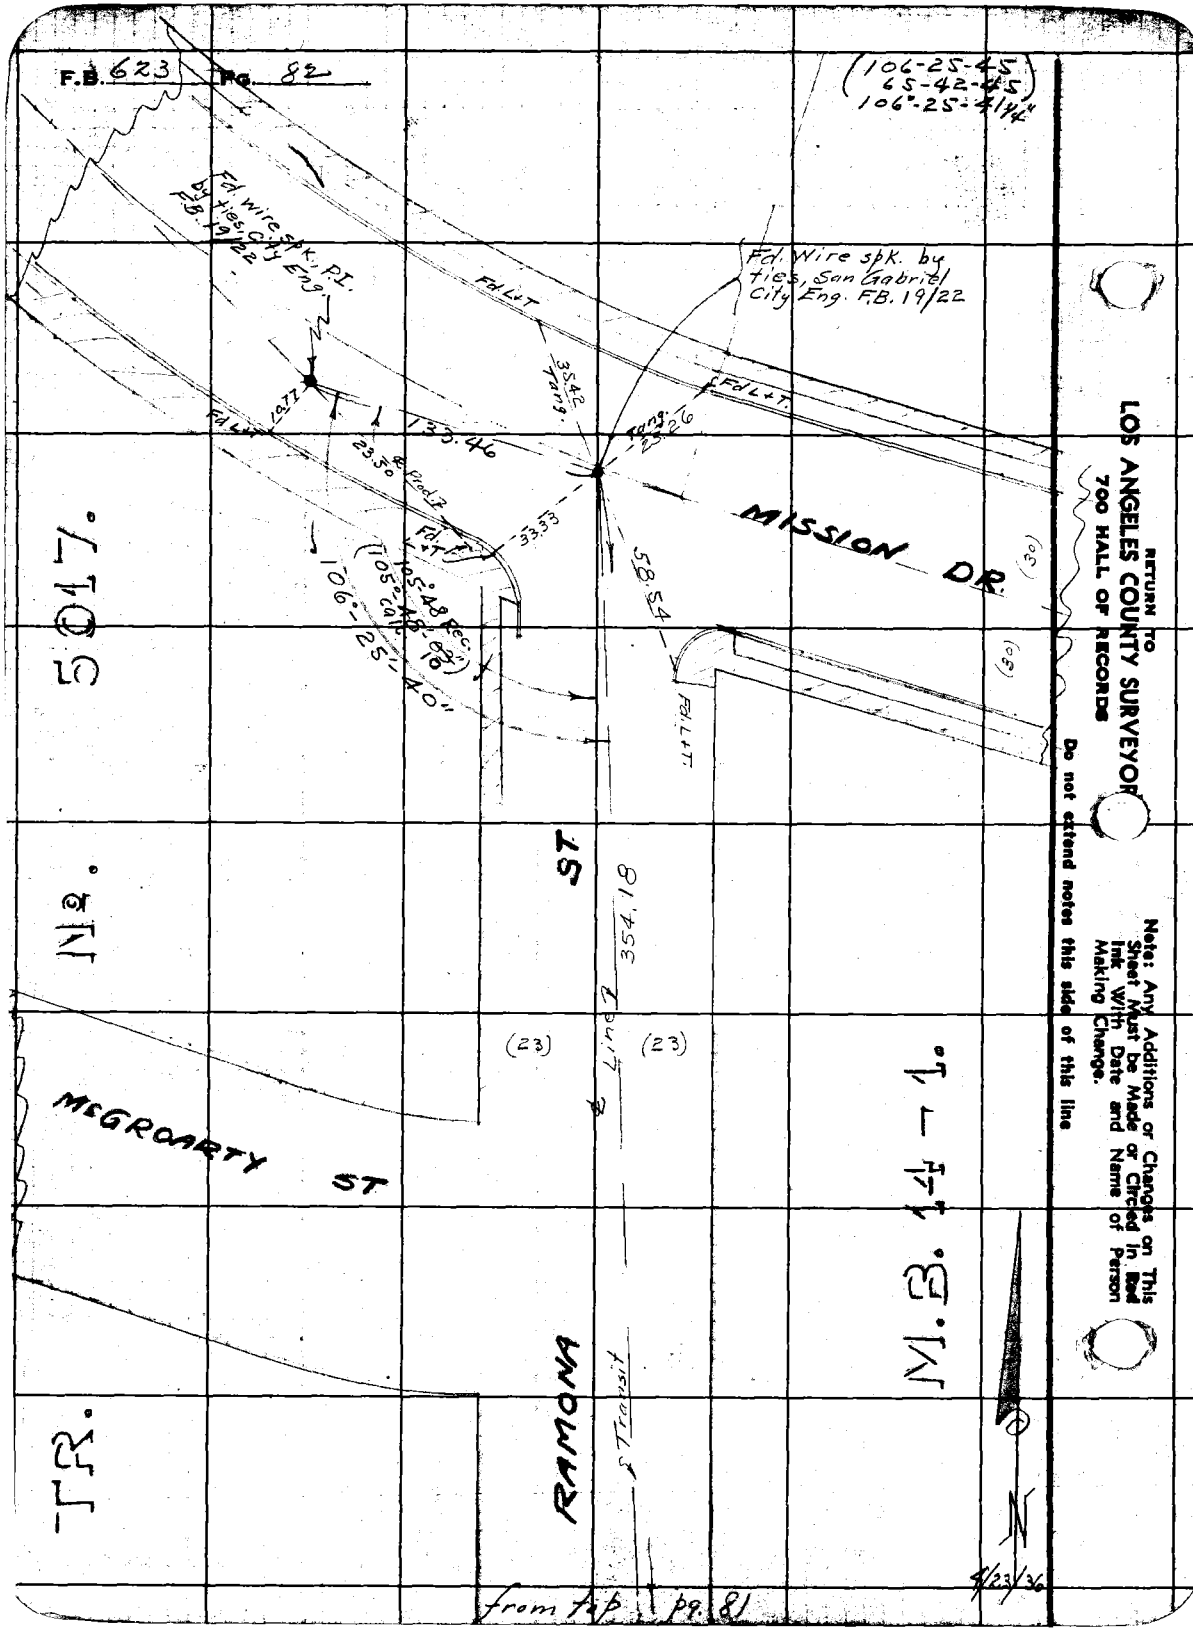
F.B. 623 Pg. 82
(106-25-45
65-42-45)
106°-25'-41¼"
Fd. wire spk. P.I. by ties, City Eng. F.B. 19/22
Fd. Wire spk. by ties, San Gabriel City Eng. F.B. 19/22
Fd. L+T
35.42 Tang.
Tang. 23.26
133.46
23.50
Prod. ℄
Fd. L+T
33.33
58.54
105°-48 Rec.
(105°-48'-03")
Calc. 10
106°-25'-40"
MISSION DR.
(30)
(30)
Fd. L+T
ST
354.18
℄ Line ℄
(23)
(23)
McGROARTY ST
RAMONA
℄ Transit
M.B. 14-1.
N
4/23/36
5017.
No.
TR.
from top pg. 81
RETURN TO
LOS ANGELES COUNTY SURVEYOR
700 HALL OF RECORDS
Do not extend notes this side of this line
Note: Any Additions or Changes on This Sheet Must be Made or Circled in Red Ink With Date and Name of Person Making Change.

(To Bot Page 84)

Notes Ck'd by Drew	Survey of Lake Ave	F.B. 623 Pg 83
Map No. B-1345	W. O. 7135 Tape No. 072 St'd 84 °F.	
Office Work Wood	Surveyed by Evans	
Checked Drew	Notes 1-E Date 4/28/36	
Date Feb 38	Indexed A. C. Johnson 8-19-36	

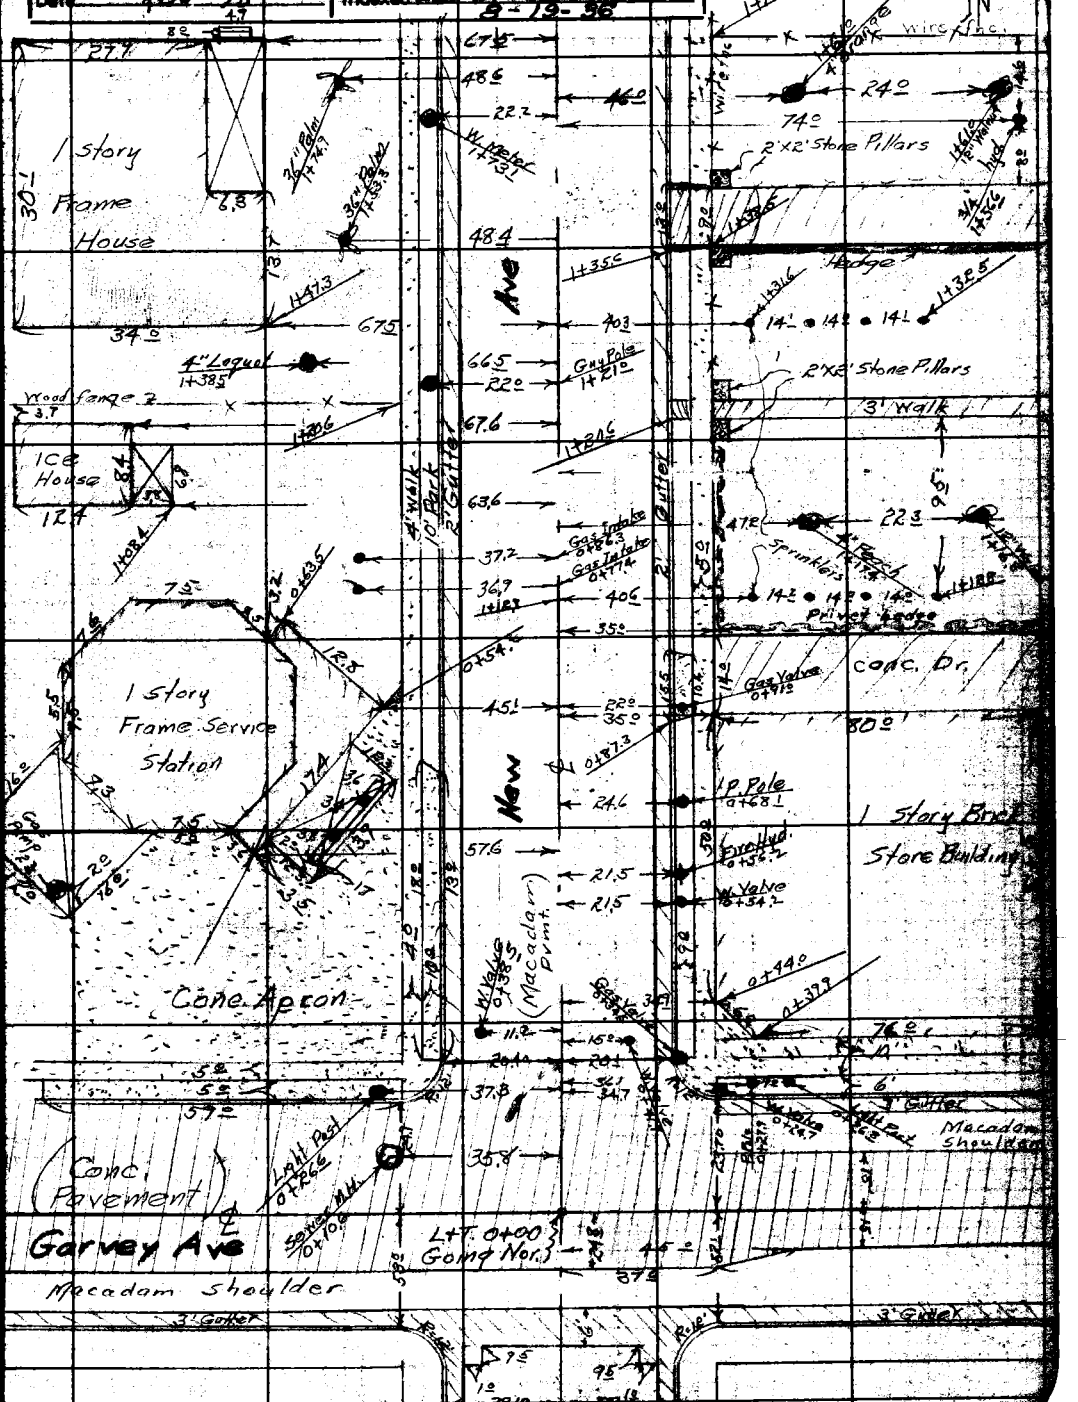

Note: Any Additions or Changes on This Sheet Must be Made or Circled in Red Ink With Date and Name of Person Making Change.

Do not extend notes this side of this line.

LOS ANGELES ... 700 HALL OF RECORDS

FORM 347

(To Bot. Page 85)

F.B. 623 Pg. 84

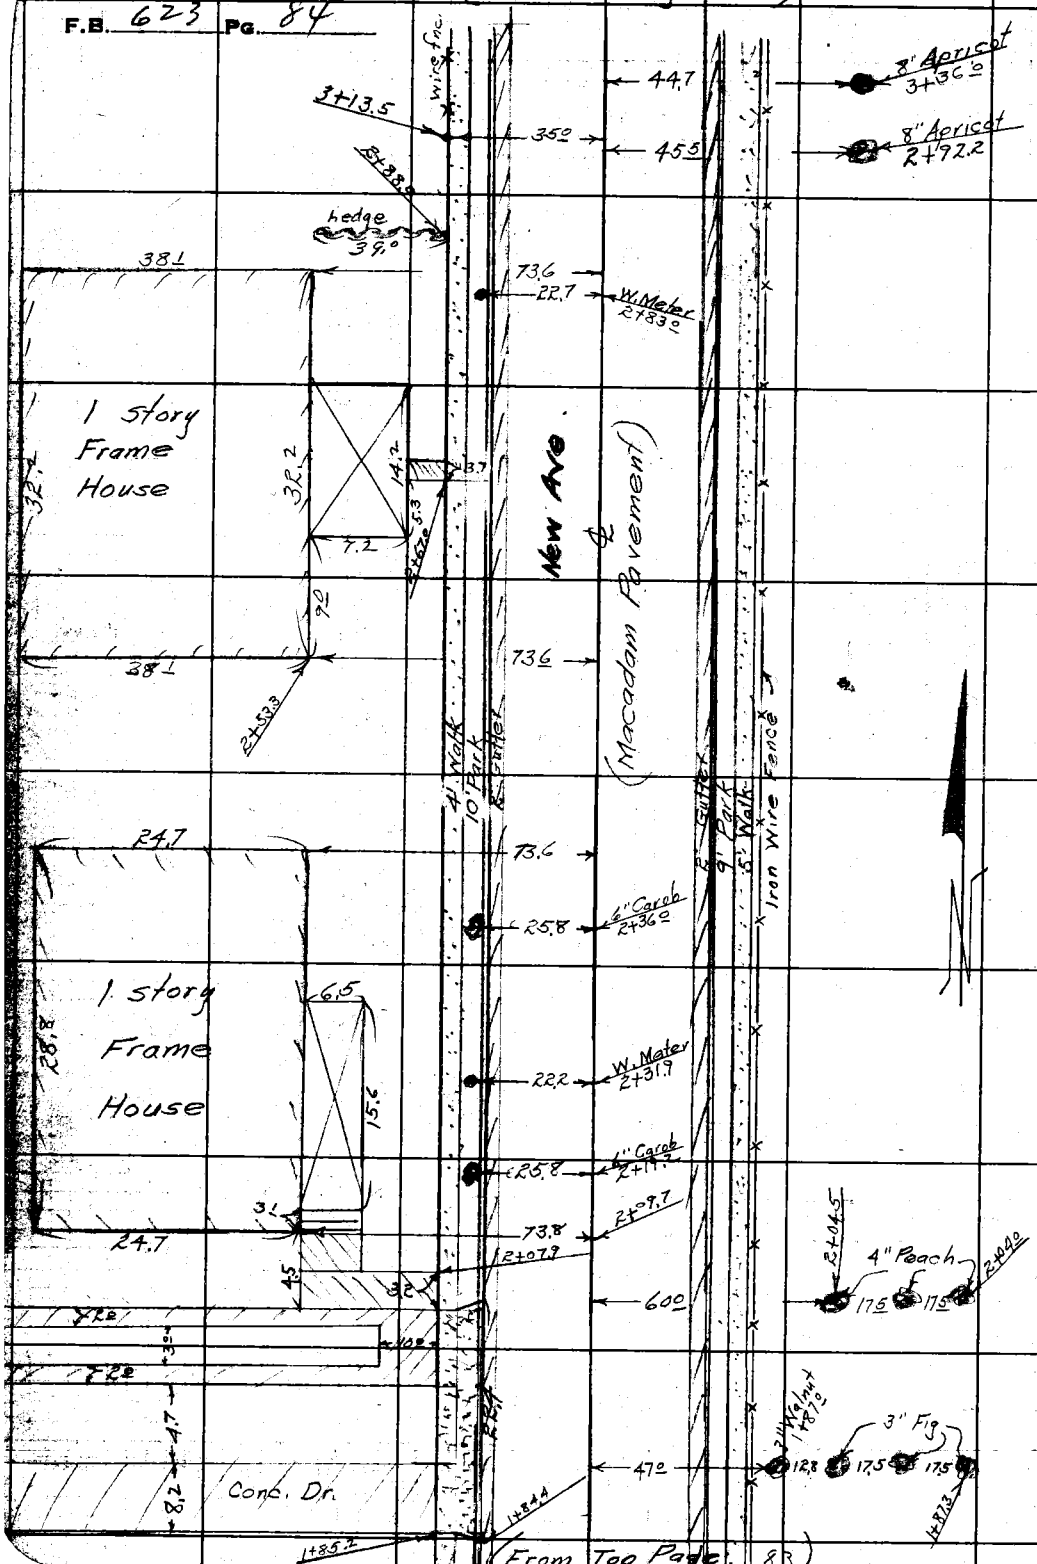

(From Top Page 83)

RETURN TO
LOS ANGELES COUNTY SURVEYOR
700 HALL OF RECORDS

Do not extend notes this side of this line

Note: Any Additions or Changes on This Sheet Must be Made or Circled in Red Ink With Date and Name of Person Making Change.

Notes Ck'd by Drew
Map No. B-1345
Office Work Wood
Checked Drew
Date Feb 38

Survey of Lake Ave.
W. O. 7135 Tape No. 972 St'd 24° F.
Surveyed by Evans
Notes HF Date 4/29/38
Indexed A. C. Johnson

F.B. 623 Pg. 85

(To Bot. Page 86)

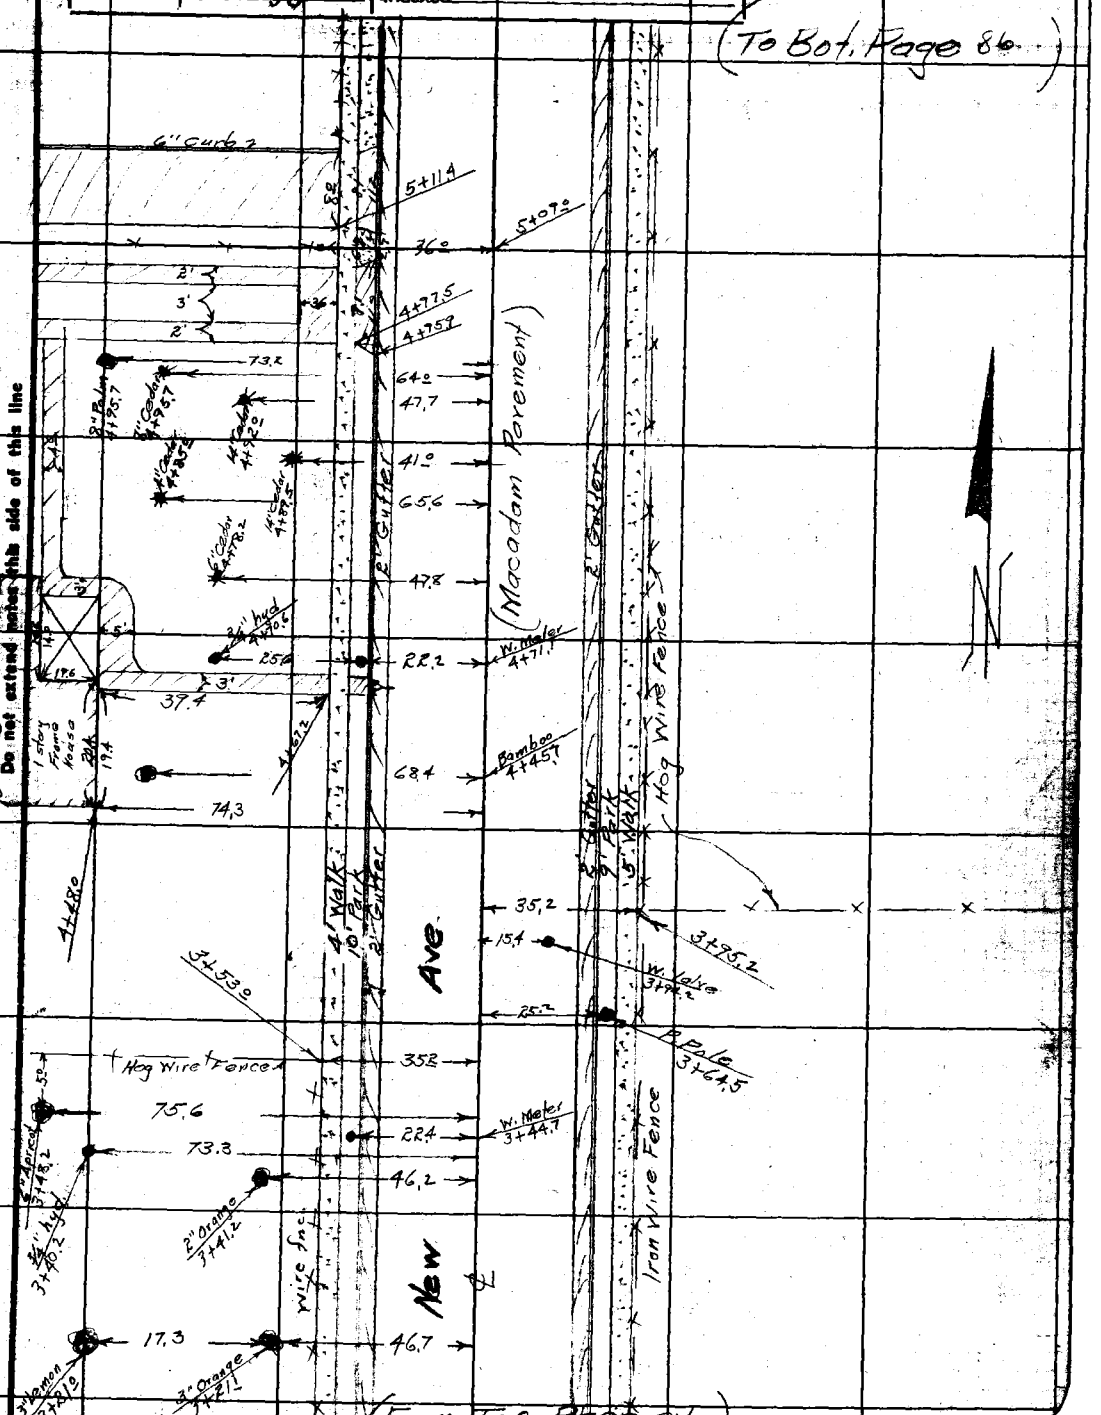

(From Top Page 84)

Note: Any Additions or Changes on This Sheet Must be Made or Circled in Red Ink With Date and Name of Person Making Change.

Do not extend notes this side of this line

RETURN TO
LOS ANGELES COUNTY SURVEYOR
700 HALL OF RECORDS

FORM 247 10M 11-38

(To Bk Page 87)

F.B. 623 PG. 86

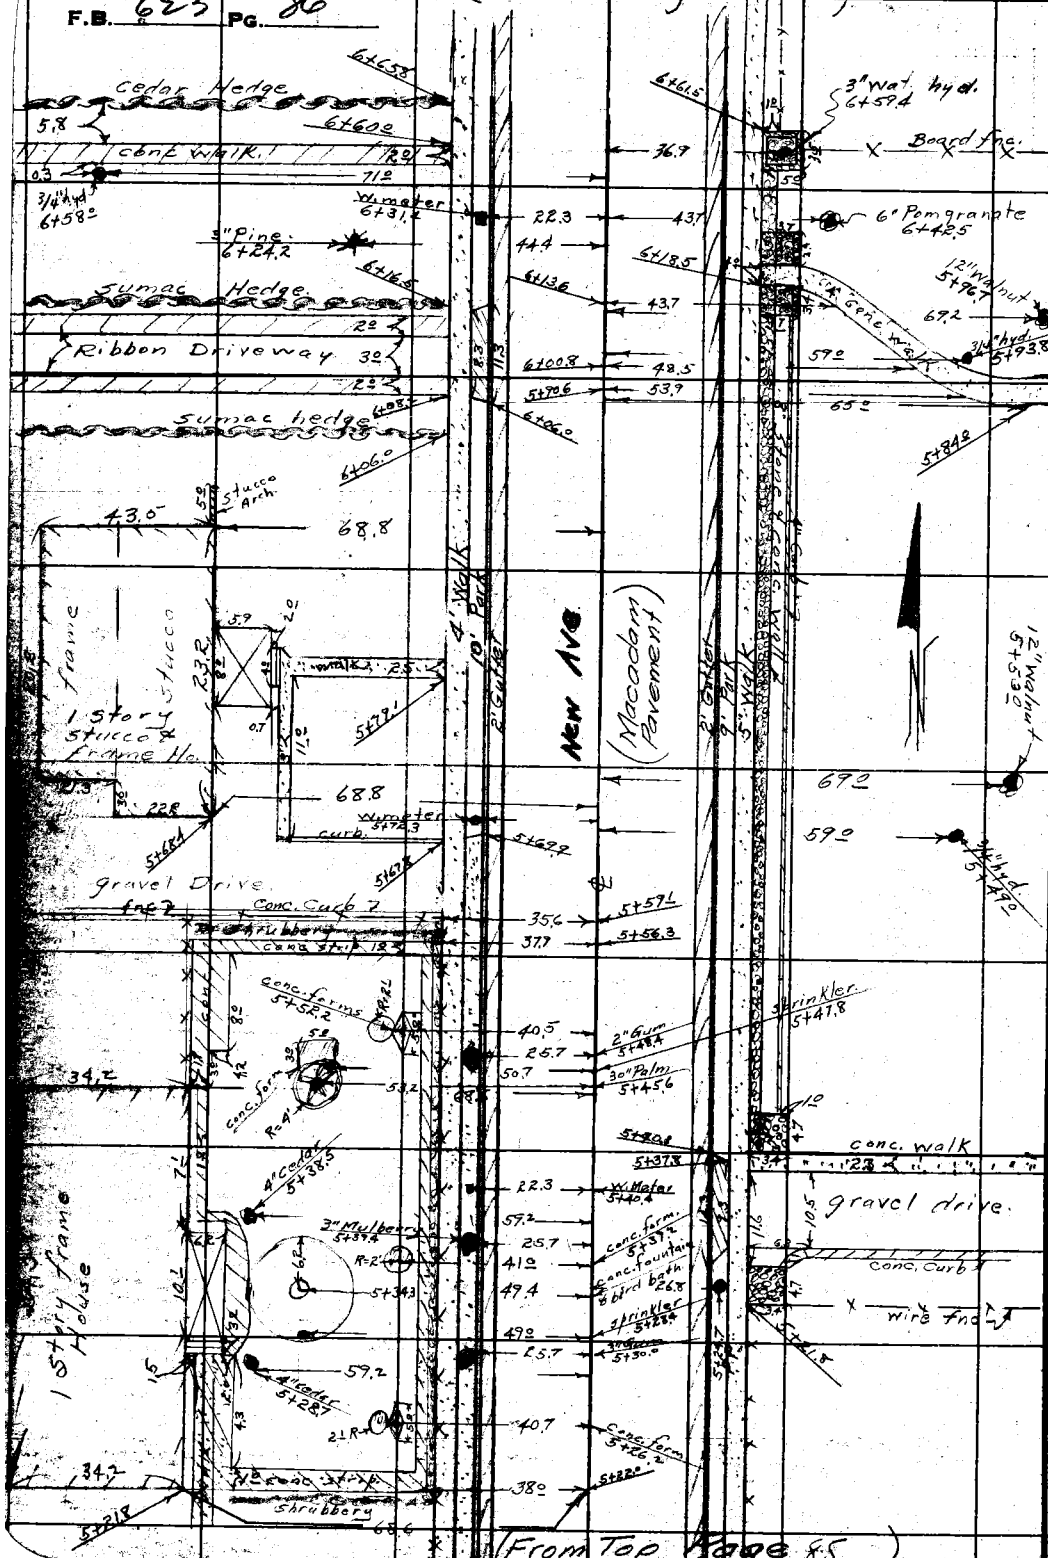

(From Top Page 85)

RETURN TO
LOS ANGELES COUNTY SURVEYOR
700 HALL OF RECORDS

Do not extend notes this side of this line

Note: Any Additions or Changes on This Sheet Must Be Made or Checked in Red Ink With Date and Name of Person Making Change.

(To Bot. Page 88)

Notes Ck'd by Drew	Survey of Lake Ave.
Map No. B-1345	W. O. 713 S Tape No. 072 St'd 24 F.
Office Work Wood	Surveyed by Evans
Checked Drew	Notes HE Date 4/30/36
Date Feb 38	Indexed A. C. Johnson

F.B. 623 PG. 87

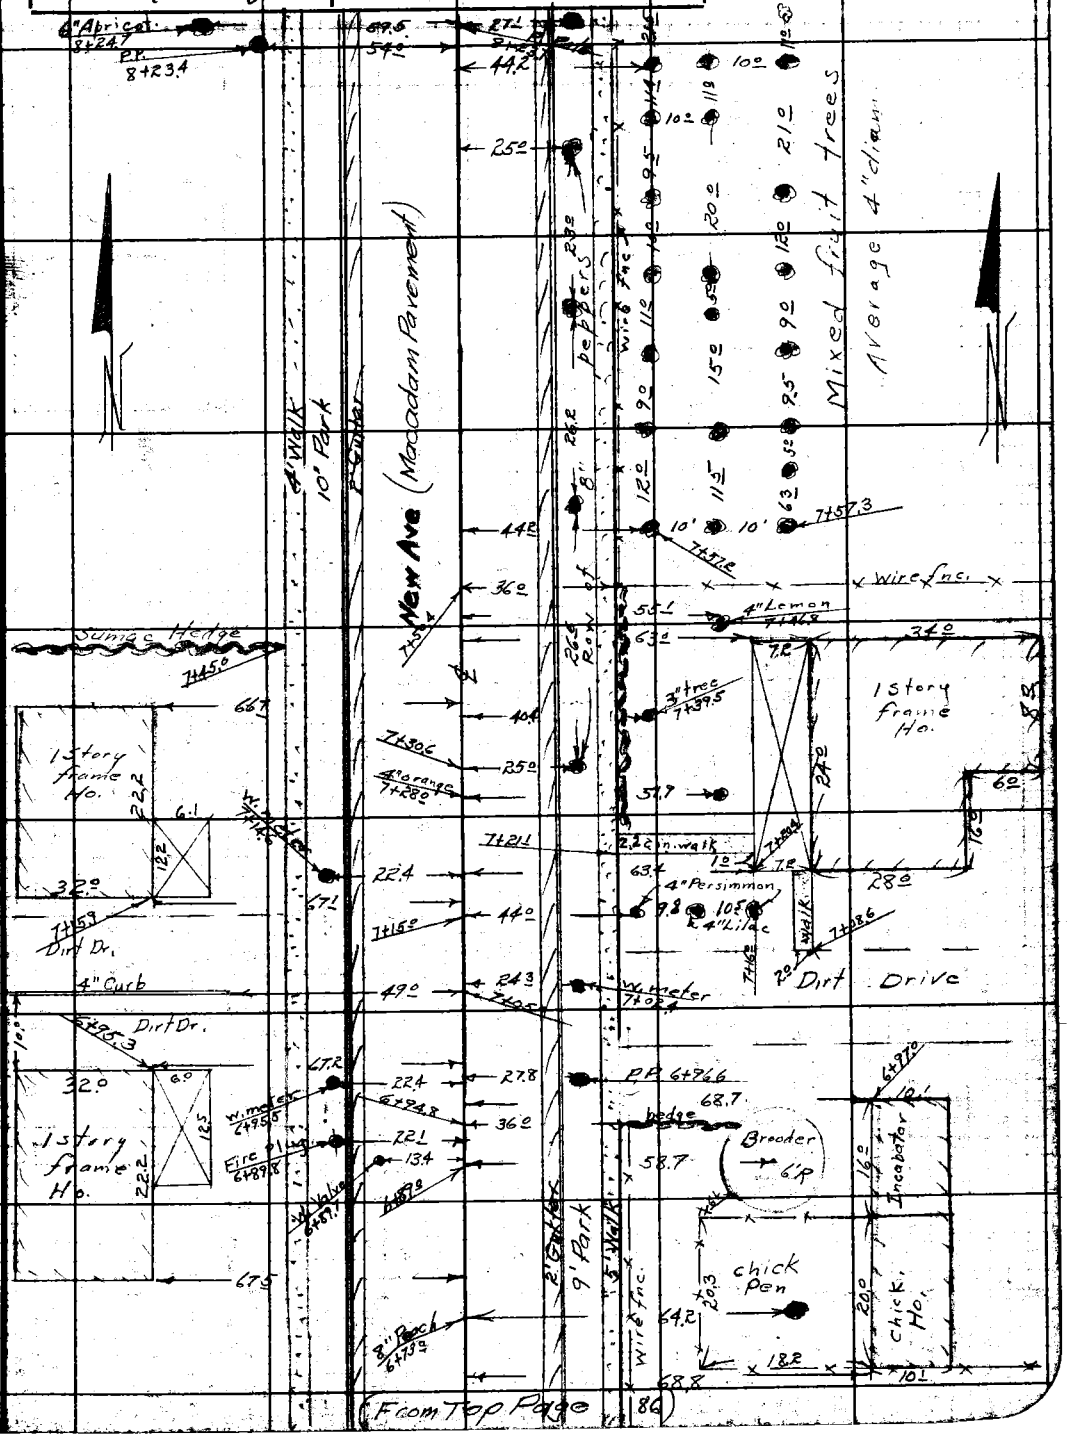

Note: Any Additions or Changes on This Sheet Must be Made or Circled in Red Ink With Date and Name of Person Making Change.

Do not extend notes this side of this line

LOS ANGELES COUNTY SURVEYOR
700 HALL OF RECORDS

FORM 247

F.B. 623 PG. 88

(To Bot. Page 87)

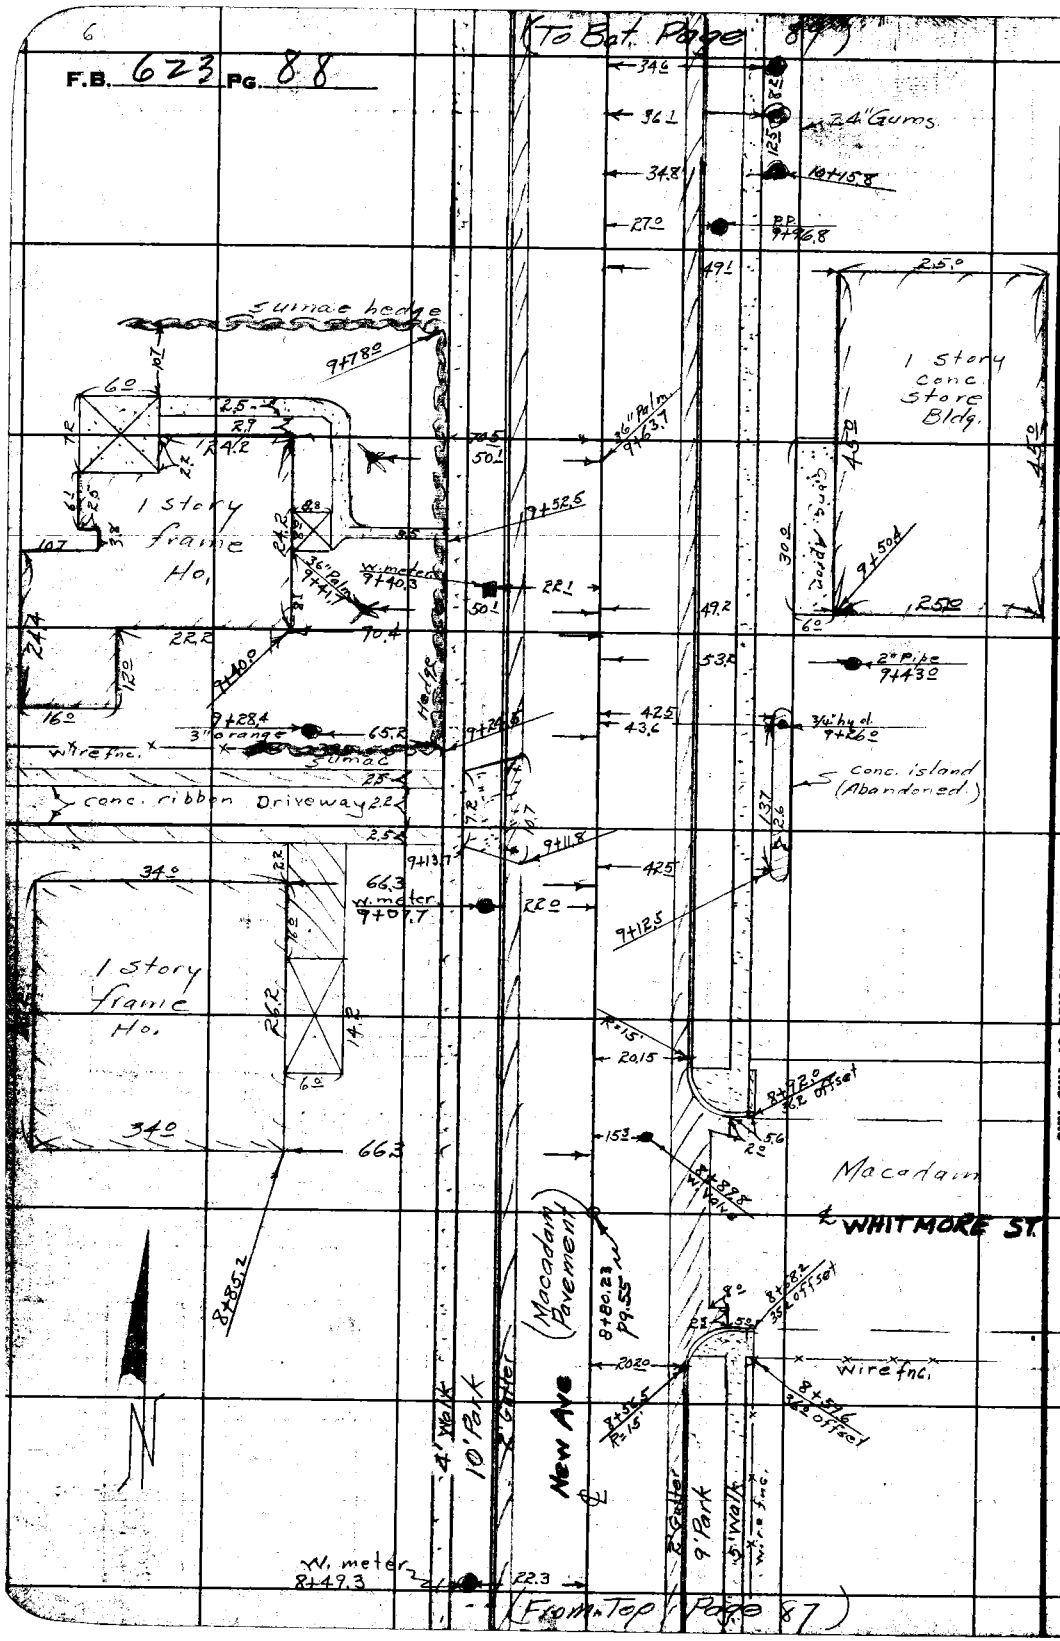

(From Top Page 87)

RETURN TO
LOS ANGELES COUNTY SURVEYOR
700 HALL OF RECORDS

Do not extend notes this side of this line

Note: Any Additions or Changes on This Sheet Must be Made or Circled in Red Ink With Date and Name of Person Making Change.

(To Bot. pg. 90)

Notes Ck'd by Drew	Survey of Lake Ave	F.B. 623 Pg 89
Map No. B-1345	W. O. 7135 Tape No. 072 St'd 84°F.	
Office Work Wood	Surveyed by Evans	
Checked Drew	Notes HE Date 5/1/36	
Date Feb 38	Indexed A. C. Johnson	

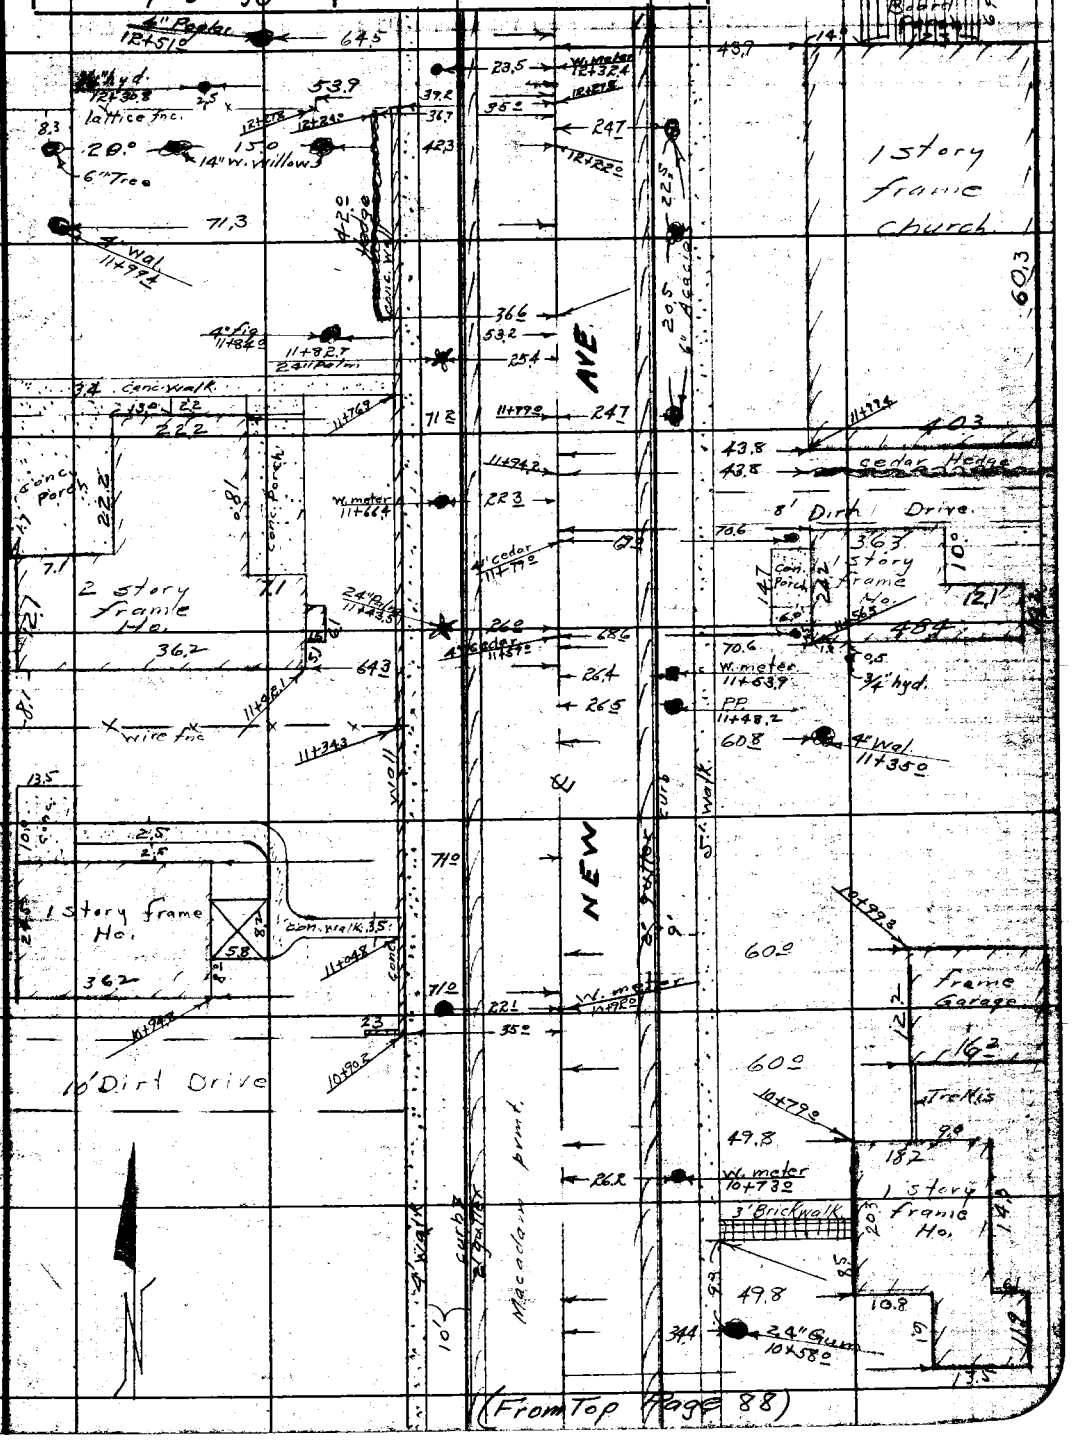

(From Top Page 88)

Note: Any Additions or Changes on This Sheet Must be Made or Circled in Red Ink With Date and Name of Person Making Change.
De not extend notes this side of this line
LOS ANGELES COUNTY SURVEYOR
700 HALL OF RECORDS

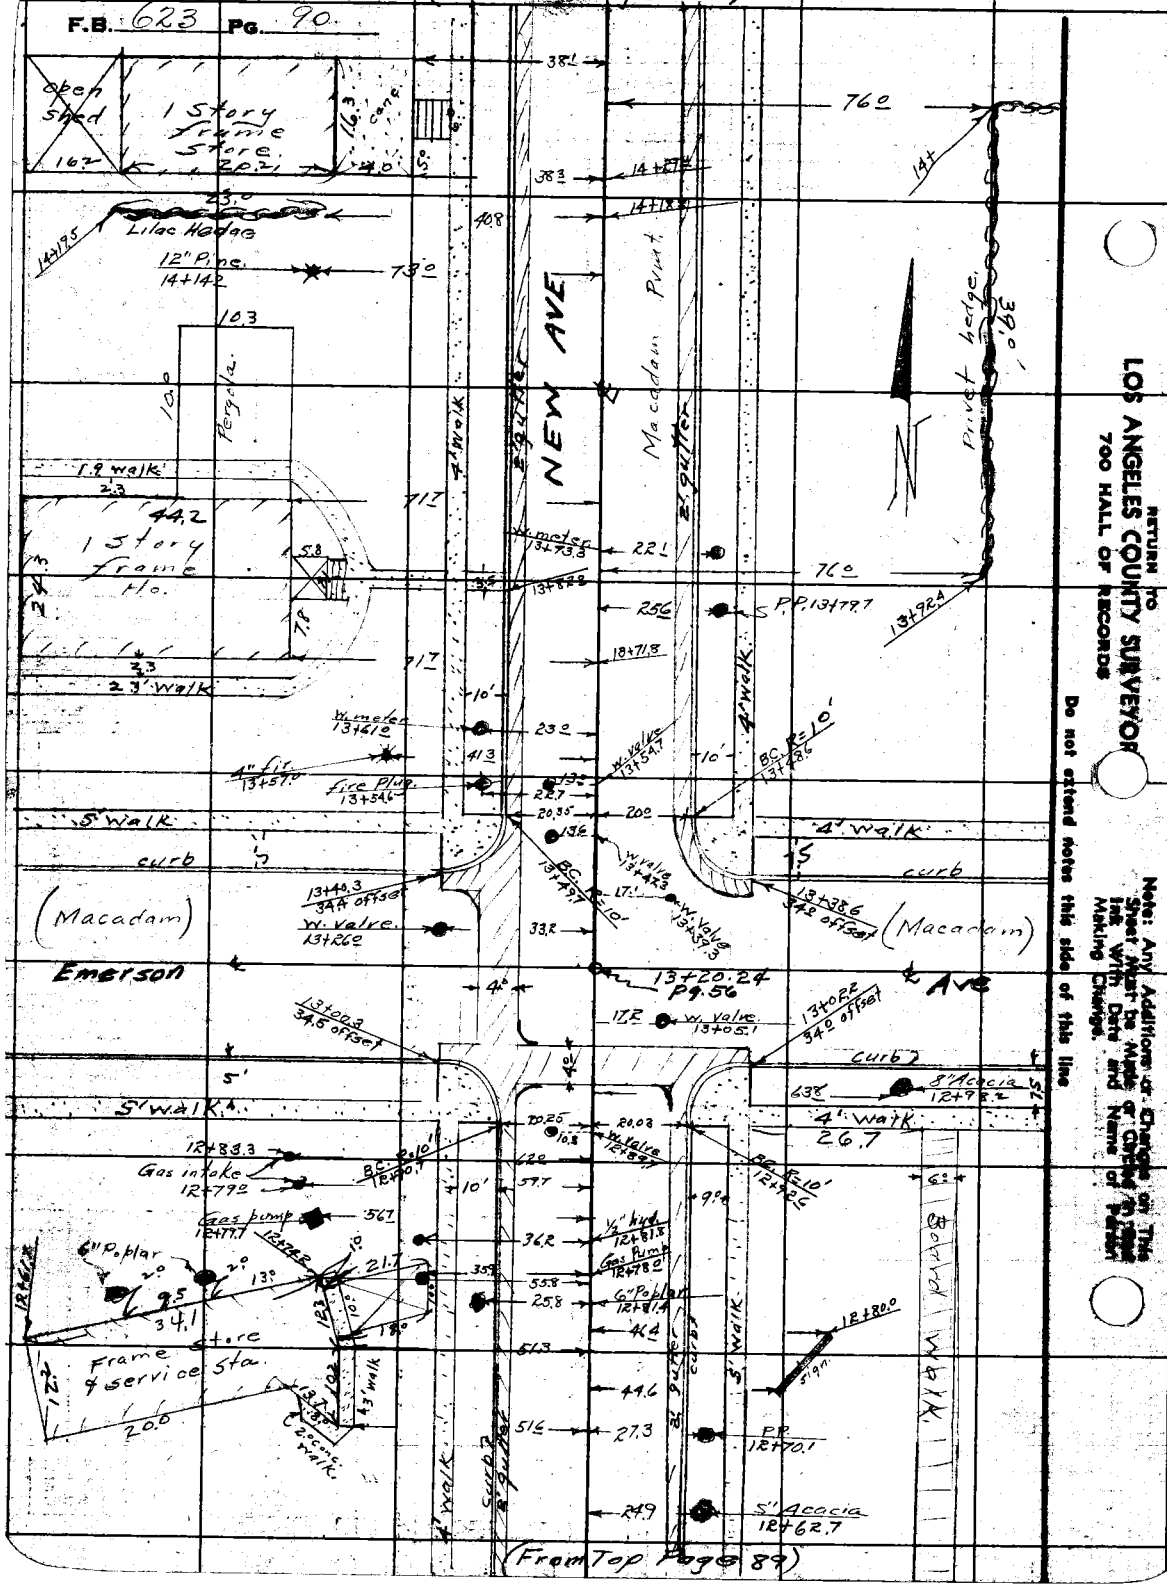
8
(To Bot. Page 91)
F.B. 623 Pg. 90
open shed
1 Story frame store
Lilac Hedge
12" Pine
Pergola
1 Story frame Ho.
2.3' walk
NEW AVE
Macadam Pvmt.
Privet hedge
4' walk
2' gutter
W. meter 13+73.3
P.P. 13+79.7
W. meter 13+61.0
4" fir 13+57.0
fire Plug 13+54.6
W. valve 13+54.7
BC. R=10' 13+48.6
5' walk
4' walk
curb
(Macadam)
13+40.3 34.4 offset
W. valve 13+26.0
BC. R=10' 13+49.7
W. valve 13+47.3
W. valve 13+39.3
13+38.6 34.2 offset
Emerson
Ave
13+20.24 Pg. 56
13+00.3 34.5 offset
W. valve 13+05.1
13+02.2 34.0 offset
8" Acacia 12+98.2
4' walk 26.7
12+83.3
Gas intake 12+79.0
BC. R=10' 12+90.7
W. valve 12+89.7
BC. R=10' 12+92.6
Gas pump 12+77.7
6" Poplar
1/2" hyd. 12+81.8
Gas Pump 12+78.0
6" Poplar 12+81.4
Frame store & service sta.
2.0 conc. walk
4' walk
curb
8' gutter
5' walk
12+80.0
Bond walk
P.P. 12+70.1
5" Acacia 12+62.7
(From Top Page 89)
RETURN TO
LOS ANGELES COUNTY SURVEYOR
700 HALL OF RECORDS
Do not extend notes this side of this line
Note: Any Additions or Changes on This Sheet Must be Made or Circled in Red Ink With Date and Name of Person Making Change.

Notes Ck'd by Drew	Survey of Lake Ave
Map No. B-1345	W. O. 7135 Tape No. 07R St'd 24°F.
Office Work Wood	Surveyed by Evans
Checked Drew	Notes Martin Date 5-1-36
Date Feb 38	Indexed C. Johnson

F.B. 623 Pg. 91

(To Bot. Page 92)

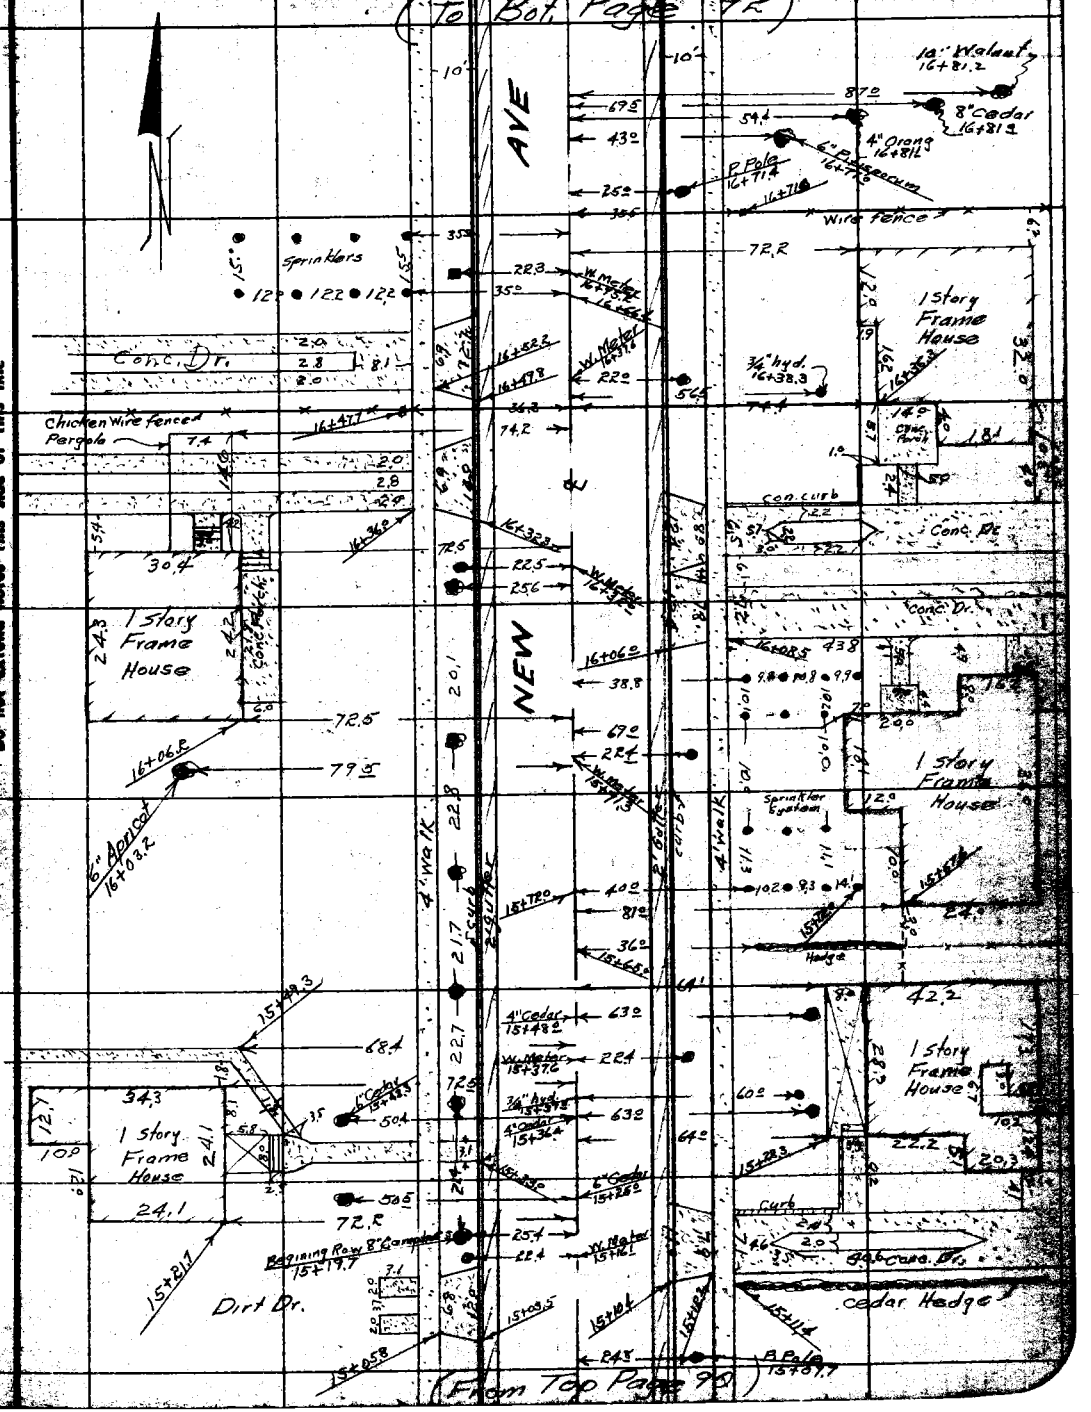

Note: Any Additions or Changes on This Sheet Must be Made or Circled in Red Ink With Date and Name of Person Making Change.

Do not extend notes this side of this line

LOS ANGELES COUNTY SURVEYOR
700 HALL OF RECORDS

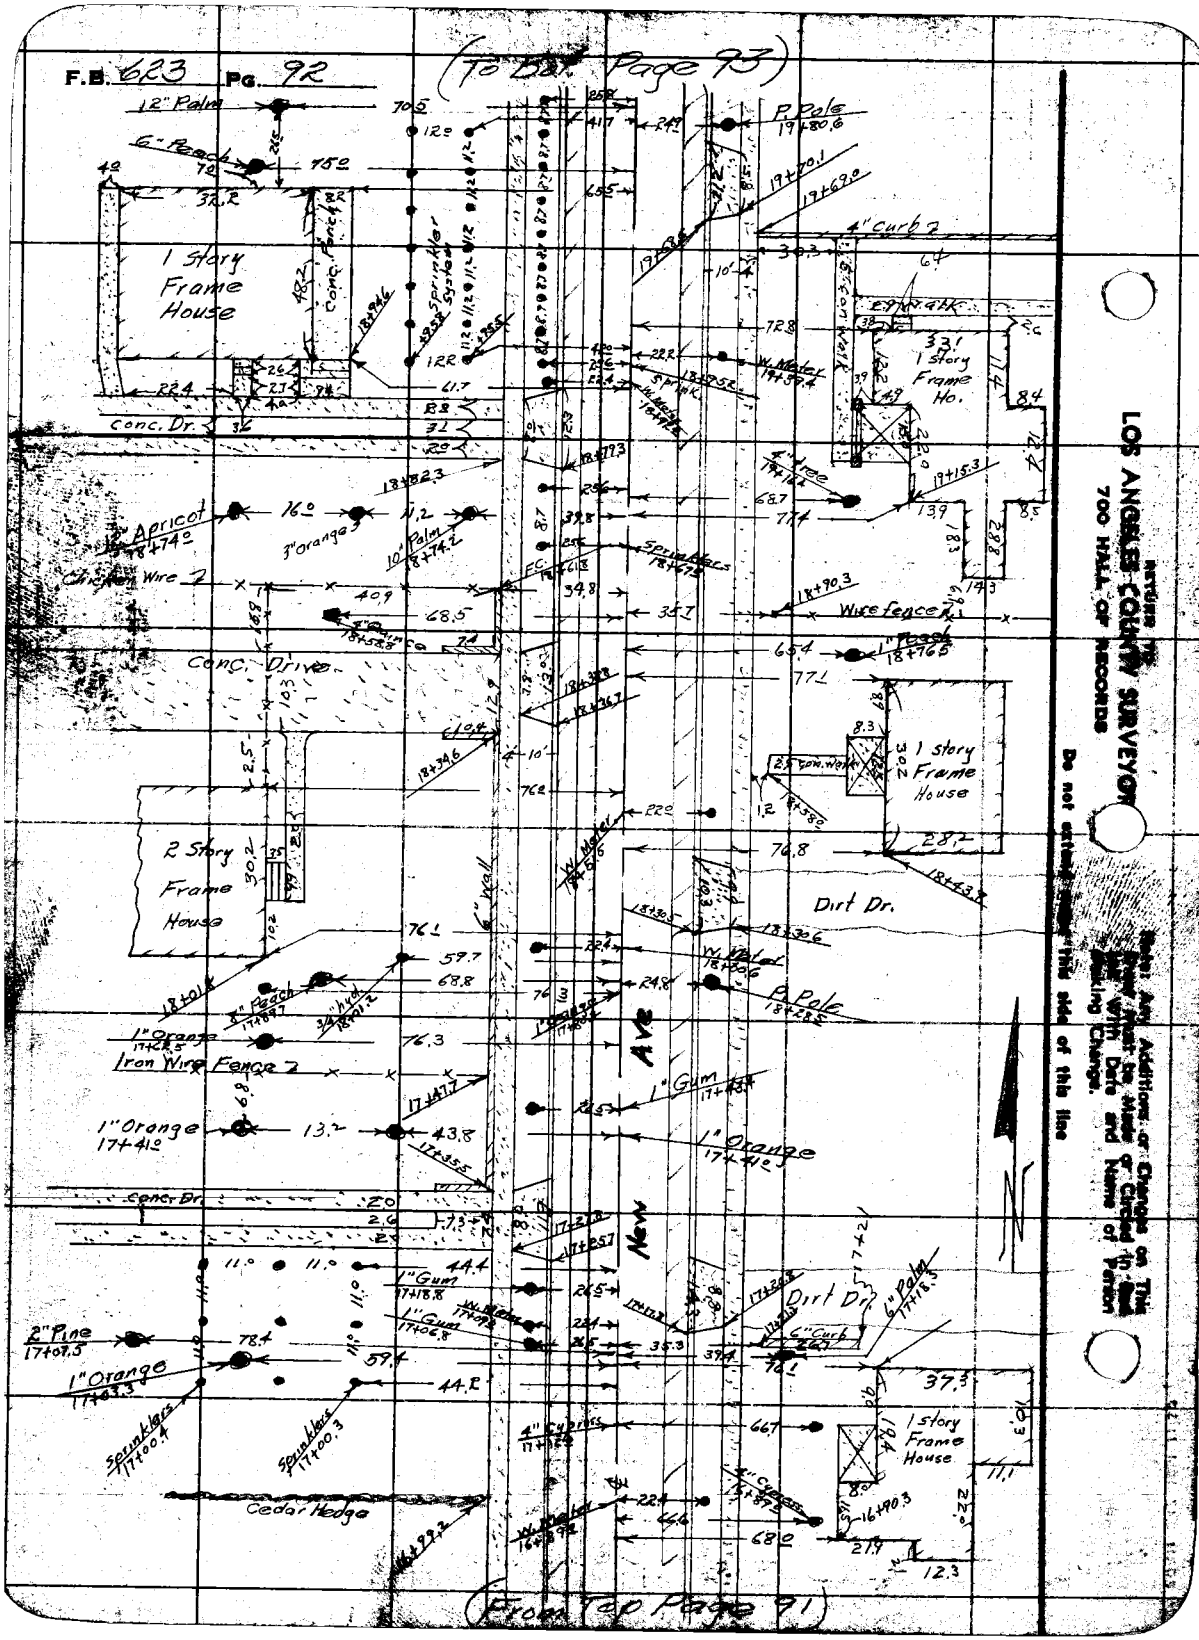
F.B. 623 Pg. 92
(To Bot. Page 93)
12" Palm
6" Peach
1 Story Frame House
Conc. Fence
Sprinkler System
P. Pole 19+80.6
4" Curb
1 Story Frame Ho.
Conc. Dr.
4" Tree
3" Orange
10" Palm
Chicken Wire
Sprinklers
Wire fence
Conc. Drive
1" Peach
1 Story Frame House
2 Story Frame House
Dirt Dr.
6" Wall
W. Meter
P. Pole
1" Orange
Iron Wire Fence
1" Gum
New Ave
Conc. Dr.
1" Gum
1" Gum
2" Pine
1" Orange
Sprinklers
Sprinklers
Dirt Dr.
6" Palm
6" Curb
1 Story Frame House
4" Cypress
Cedar Hedge
W. Meter
(From Top Page 91)
RETURN TO
LOS ANGELES COUNTY SURVEYOR
700 HALL OF RECORDS
Do not extend [illegible] this side of this line
Note: Any Additions or Changes on This Sheet Must be Made or Circled in Red Ink With Date and Name of Person Making Change.

Notes Ck'd by Drew	Survey of Lake Ave
Map No. B-1345	W. O. 7135 Tape No. 072 St'd 34 °F.
Office Work Lynwood	Surveyed by Evans
Checked Drew	Notes Martin Date 5-4-36
Date Feb 38	Indexed A. C. Johnson

F.B. 623 PG. 93

(To Bot. Page 94)

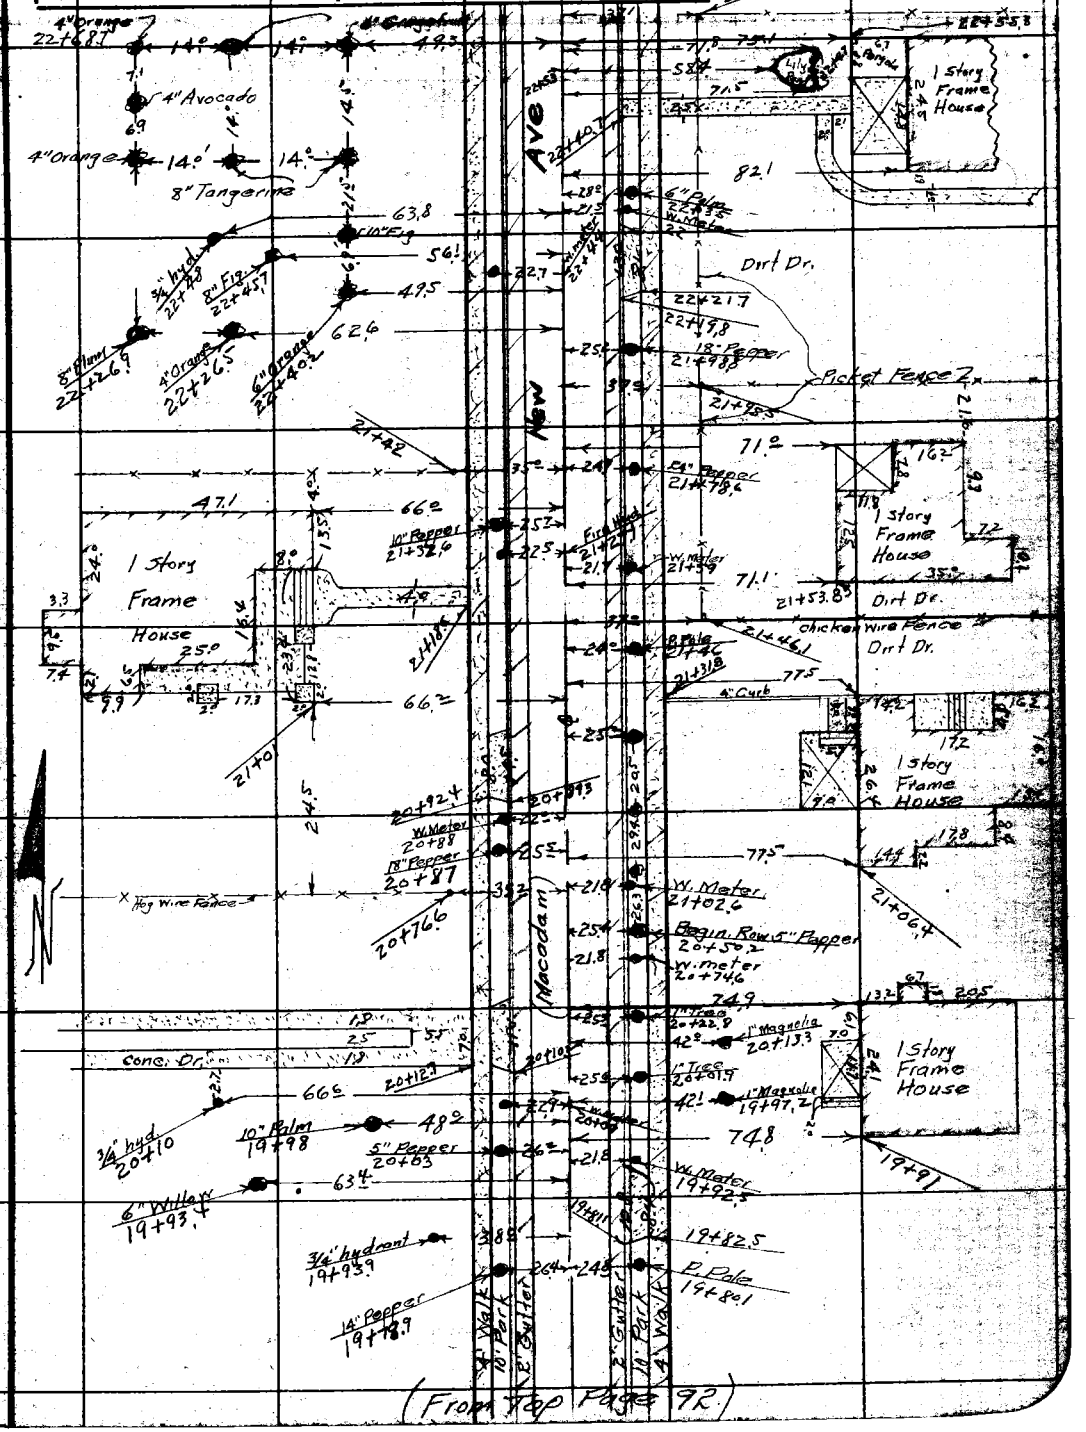

(From Top Page 92)

Note: Any Additions or Changes on This Sheet Must Be Made or Circled In Red Ink With Date and Name of Person Making Change.

Do not extend notes this side of this line

LOS ANGELES COUNTY SURVEYOR
700 HALL OF RECORDS

FORM 647 10M 11-38

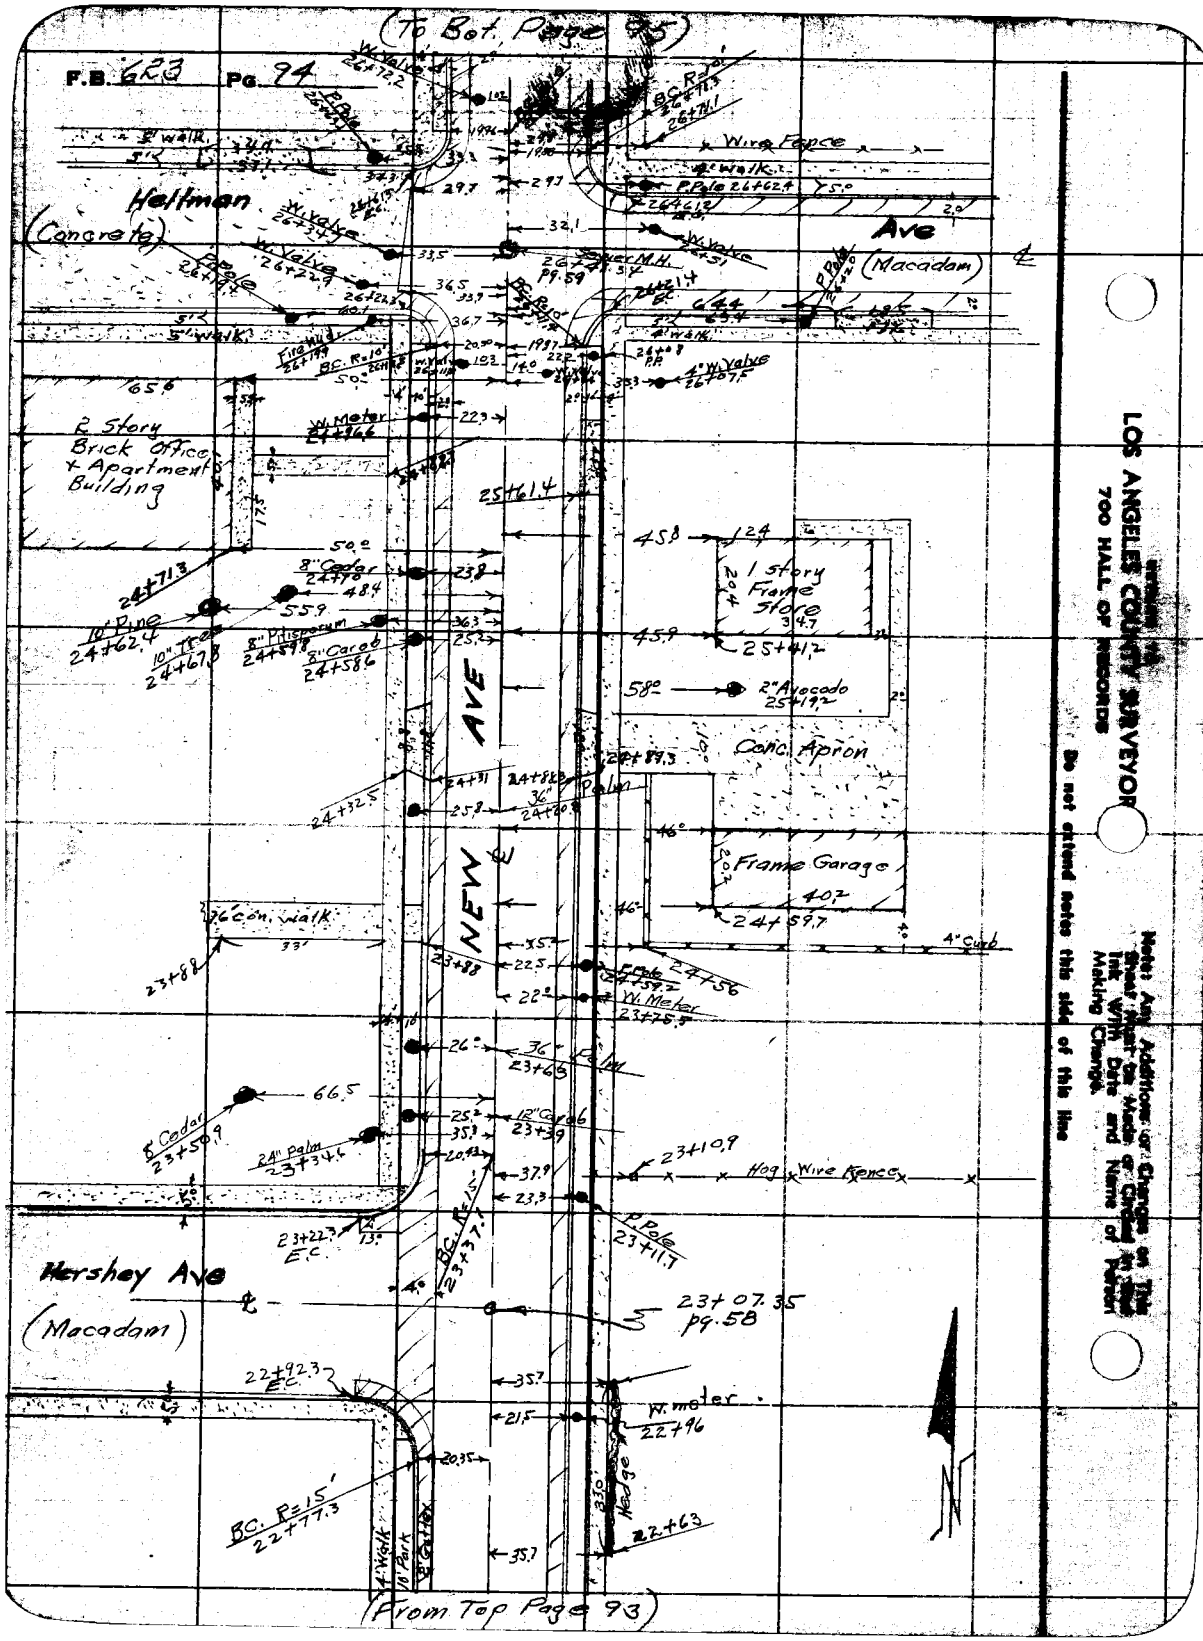
F.B. 623 Pg. 94
Hellman Ave
(Concrete)
(Macadam)
2 Story Brick Office + Apartment Building
1 Story Frame Store
Conc. Apron
Frame Garage
NEW AVE
Hershey Ave
(Macadam)
Wire Fence
Hog Wire Fence
Hedge
(From Top Page 93)
LOS ANGELES COUNTY SURVEYOR
700 HALL OF RECORDS
Do not extend notes this side of this line

Notes Ck'd by Drew	Survey of Lake Ave
Map No. 6-1345	W. O. 7135 Tape No. 012 St'd 74 °F.
Office Work Linood	Surveyed by Evans
Checked Drew	Notes Martin Date 5-4-36
Date Feb 38	Indexed A. C. Johnson

F.B. 623 Pg. 95

(To Bot. Page 96)

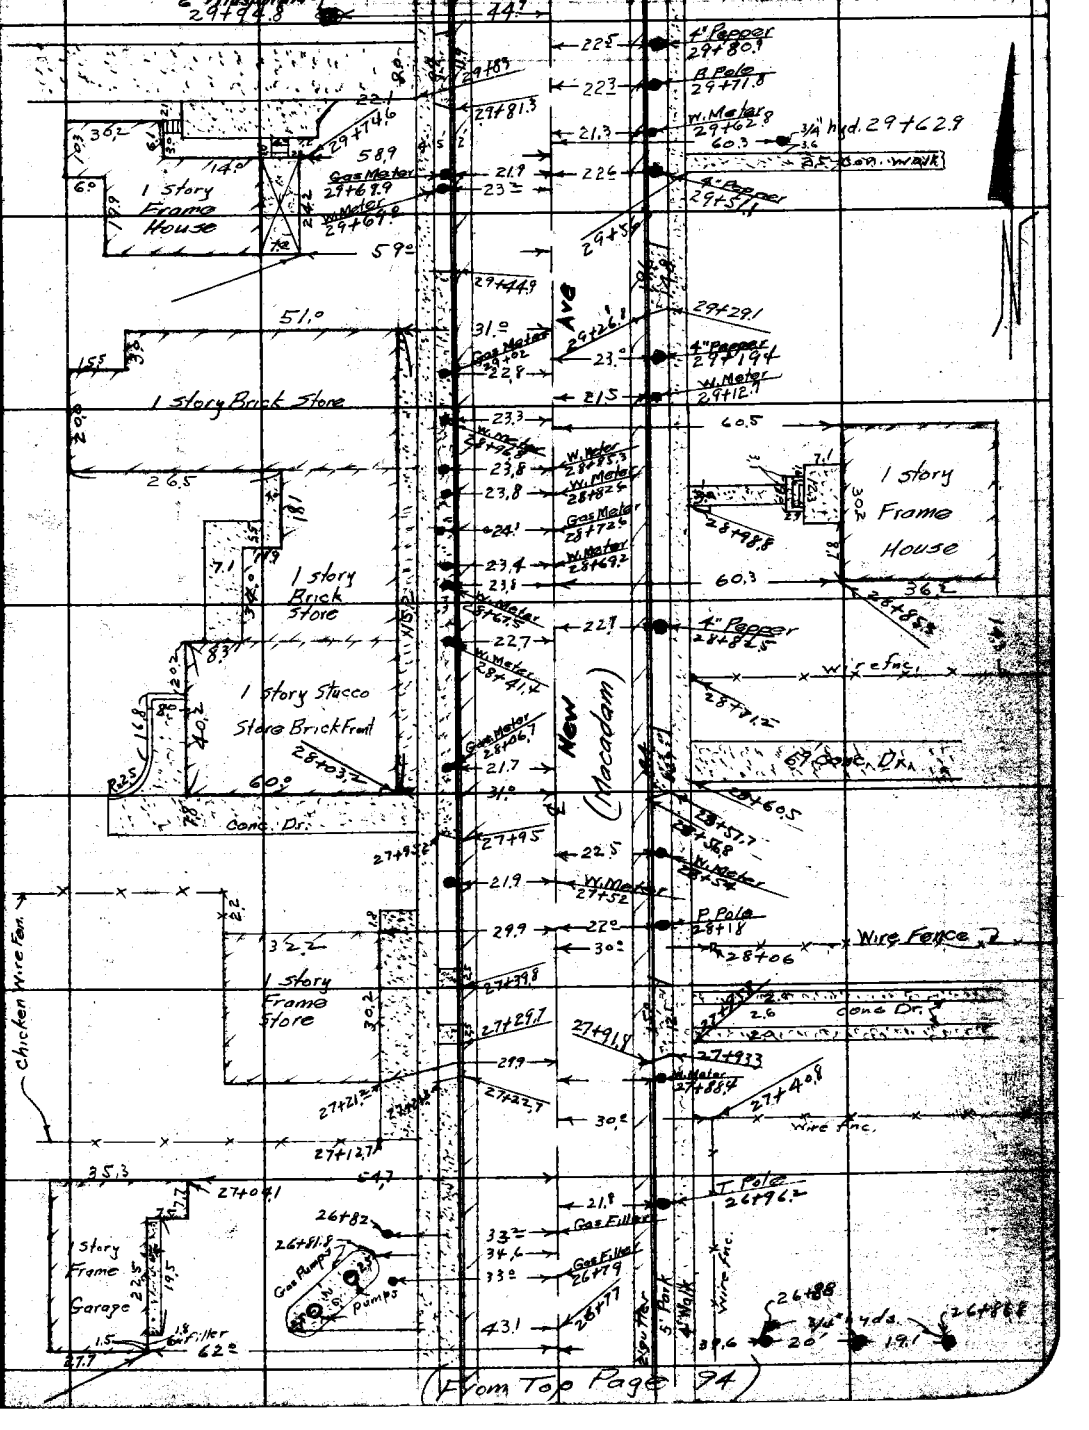

(From Top Page 94)

Note: Any Additions or Changes on This Sheet Must Be Made or Checked in Red Ink With Date and Name of Person Making Change.

Do not extend notes this side of this line

LOS ANGELES COUNTY SURVEYOR
700 HALL OF RECORDS

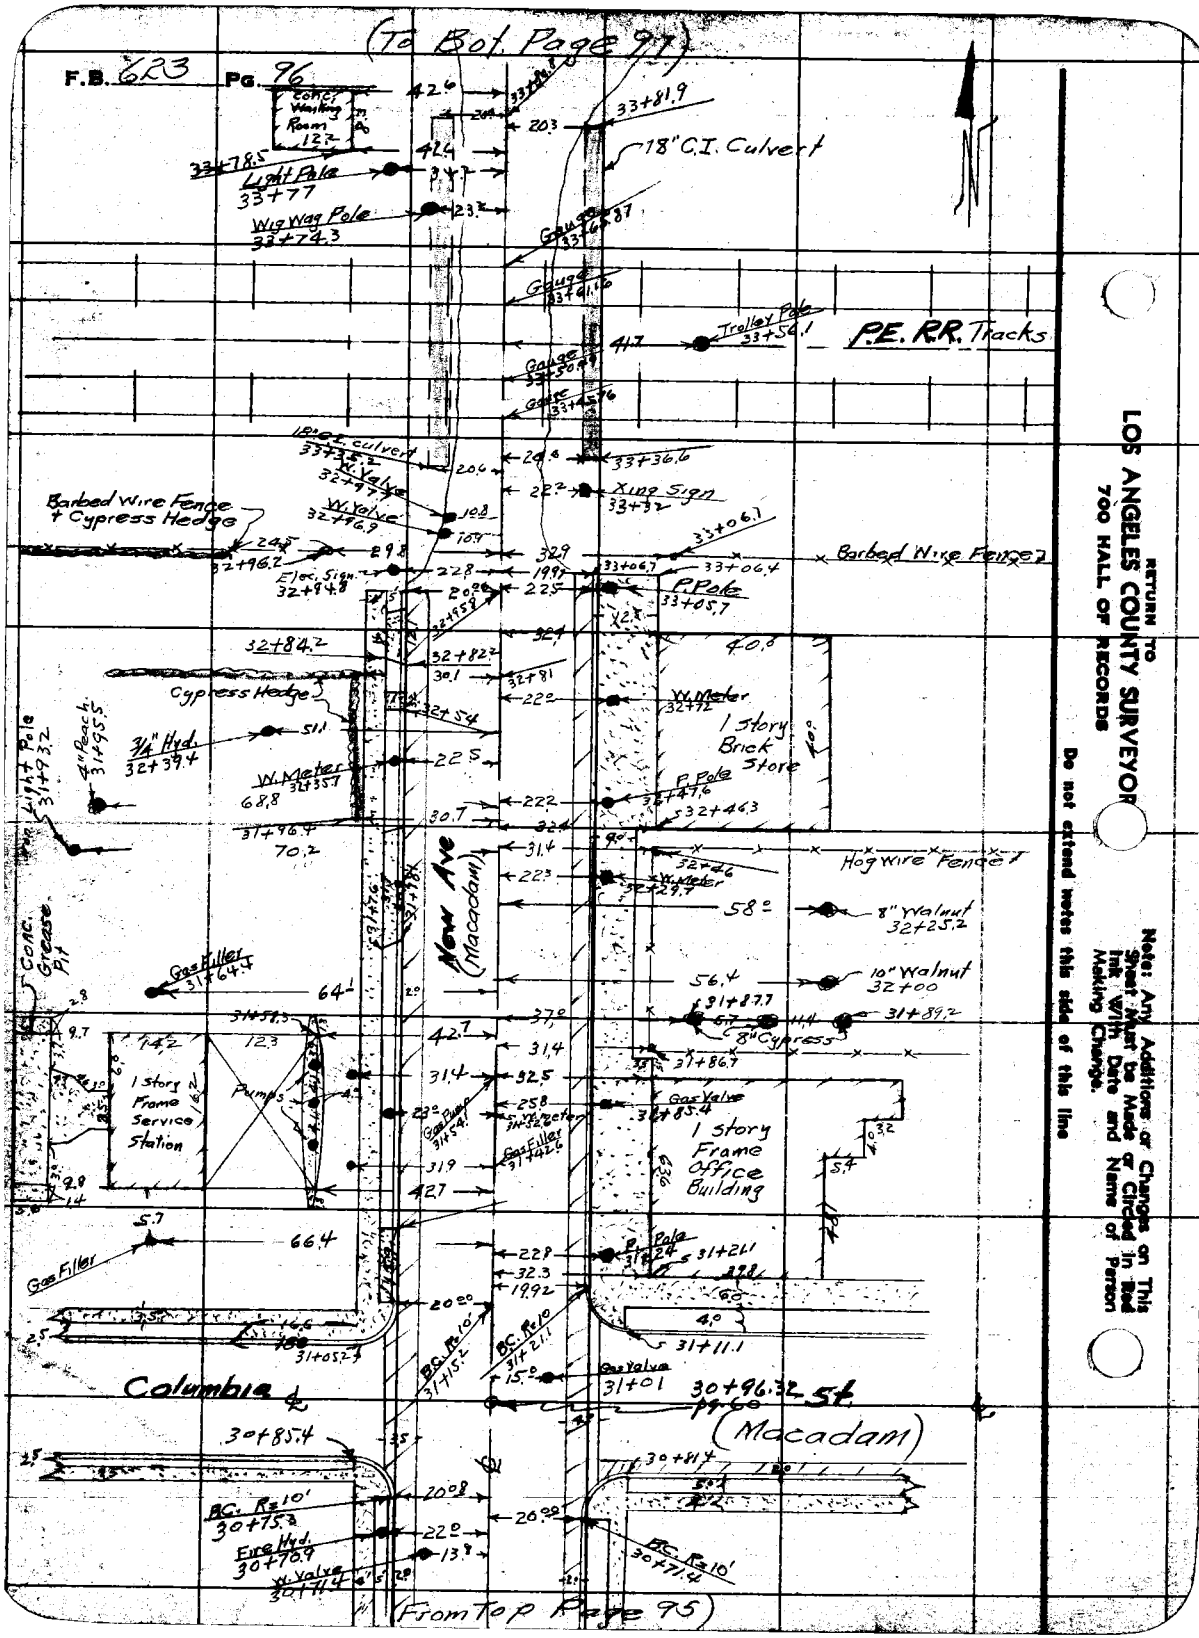
(To Bot. Page 97)
F.B. 623 Pg. 96
Conc. Waiting Room 12.2
18" C.I. Culvert
Light Pole 33+77
Wig Wag Pole 33+74.3
Gauge 33+65.87
Gauge 33+61.16
Trolley Pole 33+56.1
P.E. R.R. Tracks
Gauge 33+50.9
Gauge 33+45.76
18" C.I. culvert 33+35.2
W. Valve 32+97.7
W. Valve 32+96.9
Xing Sign 33+32
Barbed Wire Fence + Cypress Hedge
Barbed Wire Fence
Elec. Sign 32+94.8
P. Pole 33+05.7
Cypress Hedge
W. Meter 32+72
1 Story Brick Store
3/4" Hyd. 32+39.4
4" Peach 31+95.5
W. Meter 32+35.7
P. Pole 32+47.6
Light Pole 31+93.2
Hog wire Fence
W. Meter 32+29.7
New Ave (Macadam)
8" Walnut 32+25.2
Conc. Grease Pit
Gas Filler 31+64.4
10" Walnut 32+00
8" Cypress
1 Story Frame Service Station
Pumps
Gas Pump 31+54.1
W. Meter 31+52.6
Gas Filler 31+42.6
Gas Valve 31+85.4
1 Story Frame Office Building
Gas Filler
P. Pole 31+24
31+21.1
B.C. R=10' 31+15.2
B.C. R=10' 31+21.1
31+11.1
Gas Valve 31+01
Columbia
30+96.32 St.
(Macadam)
30+85.4
B.C. R=10' 30+75.3
Fire Hyd. 30+70.9
W. Valve 30+71.4
B.C. R=10' 30+71.4
(From Top Page 95)
RETURN TO
LOS ANGELES COUNTY SURVEYOR
700 HALL OF RECORDS
Note: Any Additions or Changes on This Sheet Must be Made or Circled in Red Ink With Date and Name of Person Making Change.
Do not extend notes this side of this line

Notes Ck'd by Drew	Survey of Lake Ave	F.B. 623	Pg. 97
Map No. B-1345	W. O. 7135 Tape No. 072 St'd 84 °F.		
Office Work Wood	Surveyed by Evans		
Checked Drew	Notes Martin Date 5-6-36		
Date Feb 38	Indexed A. C. Johnson		

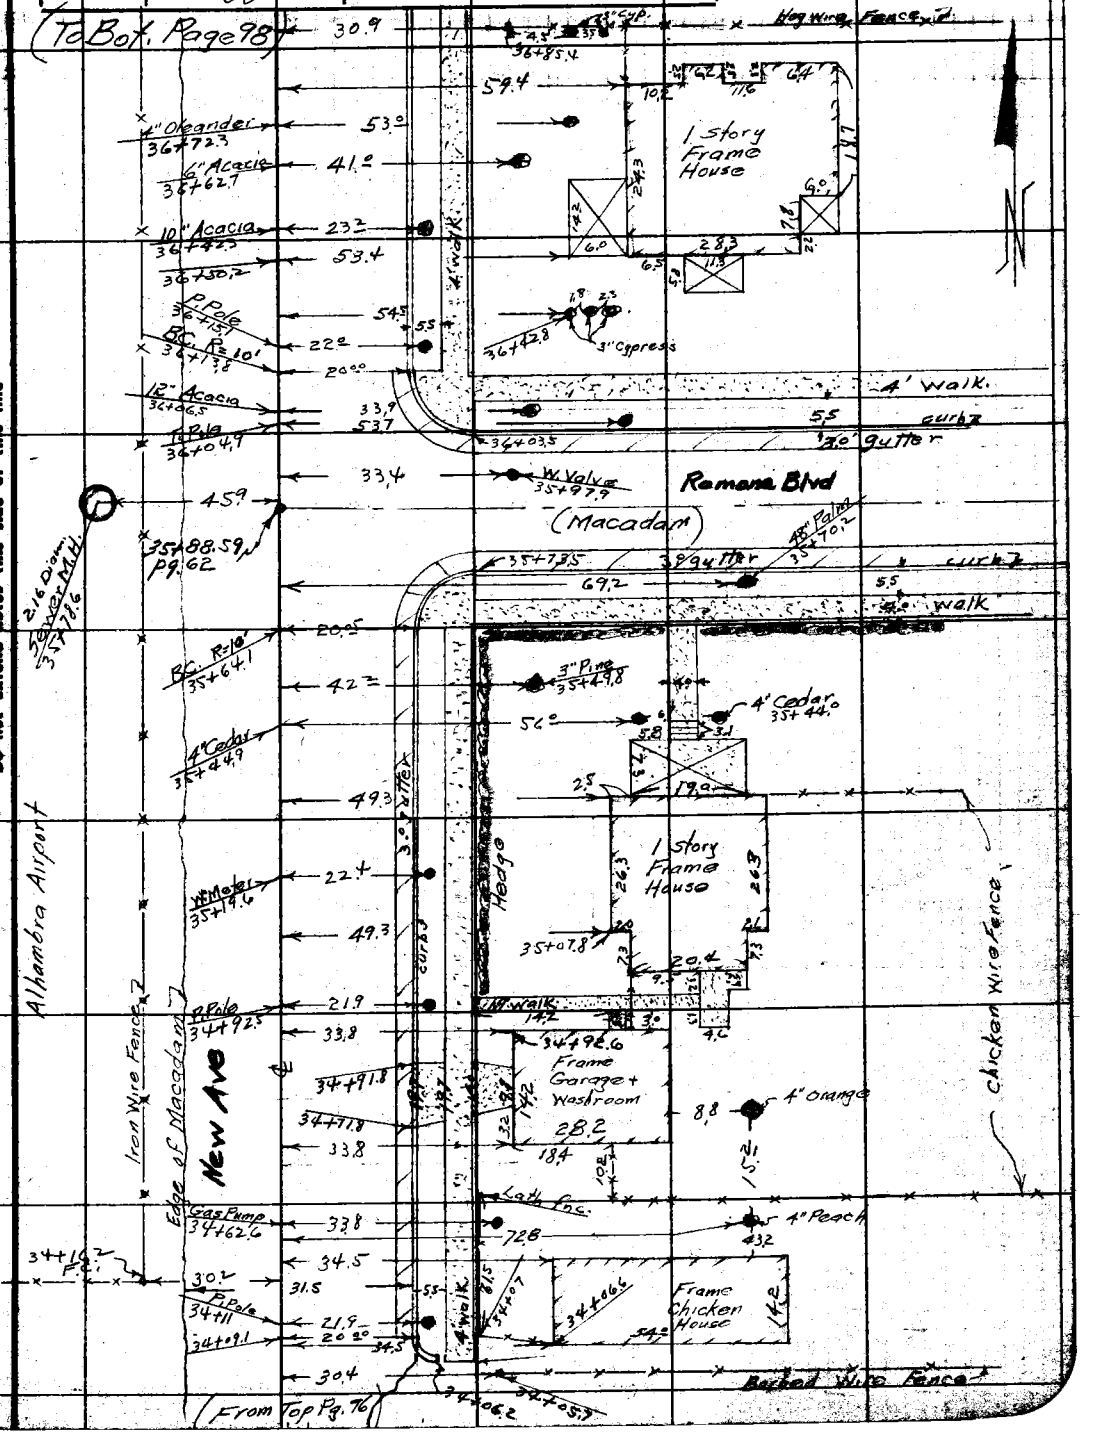

Note: Any Additions or Changes on This Sheet Must be Made or Circled in Red Ink With Date and Name of Person Making Change.

Do not extend notes this side of this line

RETURN TO
LOS ANGELES COUNTY SURVEYOR
700 HALL OF RECORDS

FORM 247 10M 11-38

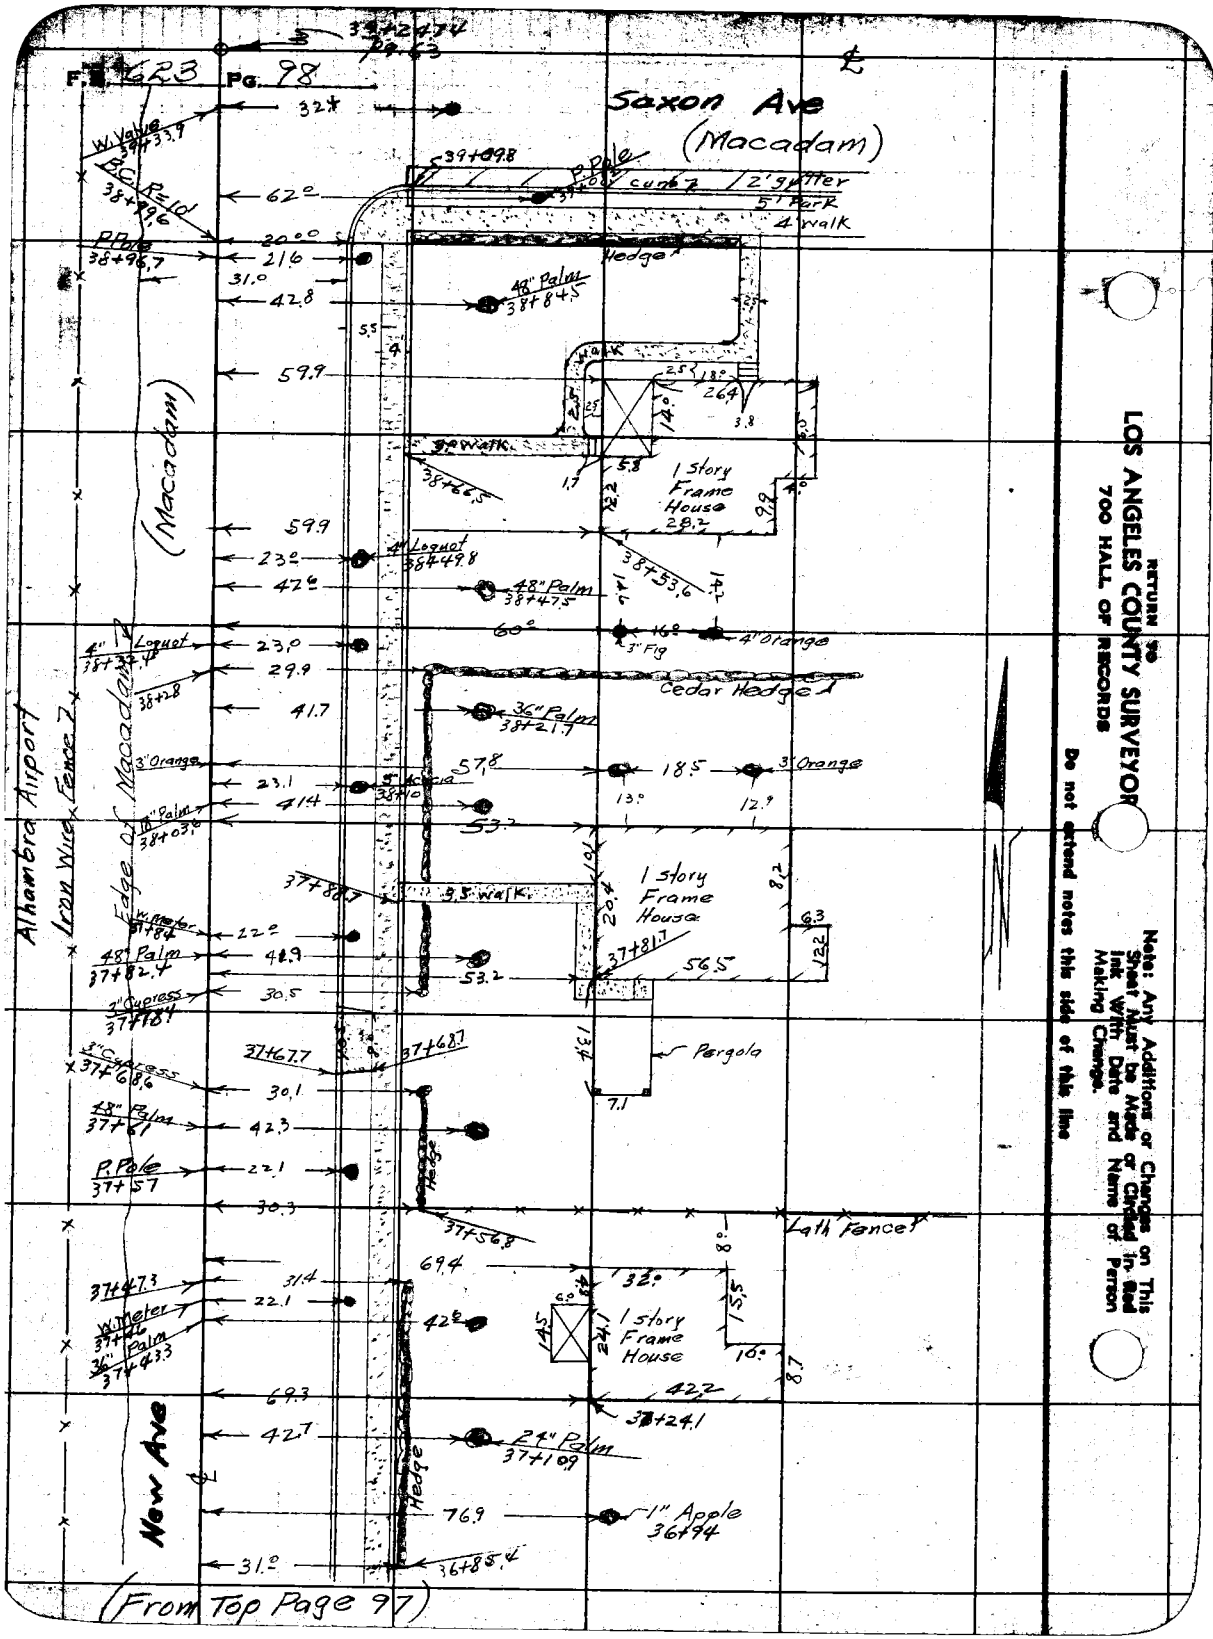

RETURN TO
LOS ANGELES COUNTY SURVEYOR
700 HALL OF RECORDS

Do not extend notes this side of this line

Note: Any Additions or Changes on This Sheet Must be Made or Circled in Red Ink With Date and Name of Person Making Change.

Notes Ck'd by Drew	Survey of Lake Ave
Map No. B-1345	W. O. 7135 Tape No. 078 St'd 34 °F.
Office Work Wood	Surveyed by Evans
Checked Drew	Notes Martin Date 5-6-36
Date Feb 38	Indexed A. C. Johnson

F.B. 623 Pg. 99

(To Bot. Page 100)

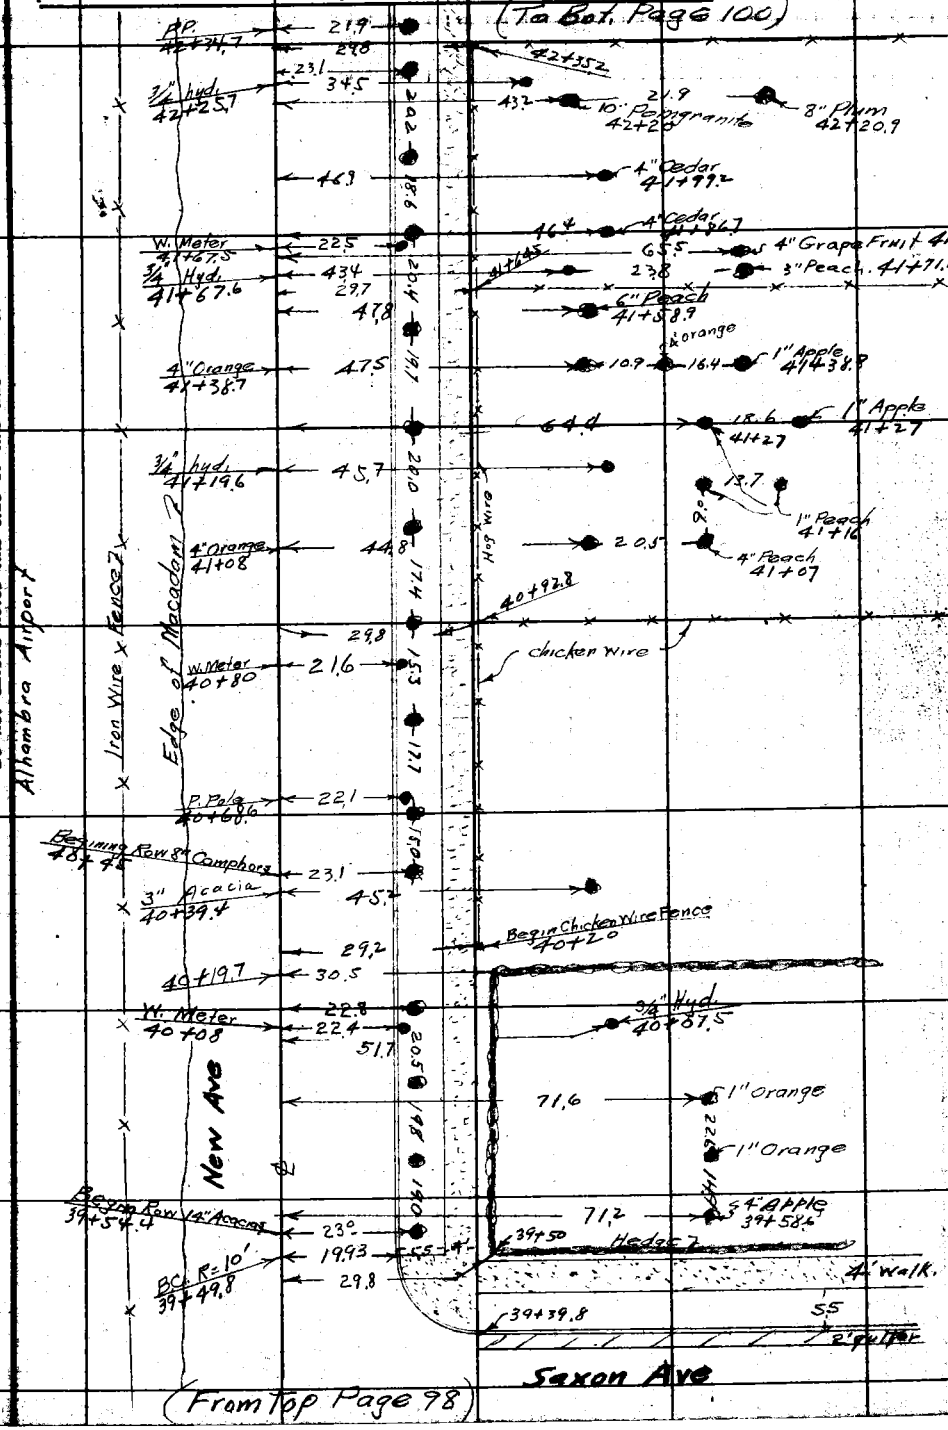

(From Top Page 98)

Note: Any Additions or Changes on This Sheet Must be Made or Circled in Red Ink With Date and Name of Person Making Change.

Do not extend notes this side of this line

RETURN TO LOS ANGELES COUNTY SURVEYOR 700 HALL OF RECORDS

FORM 247 10M 11-38

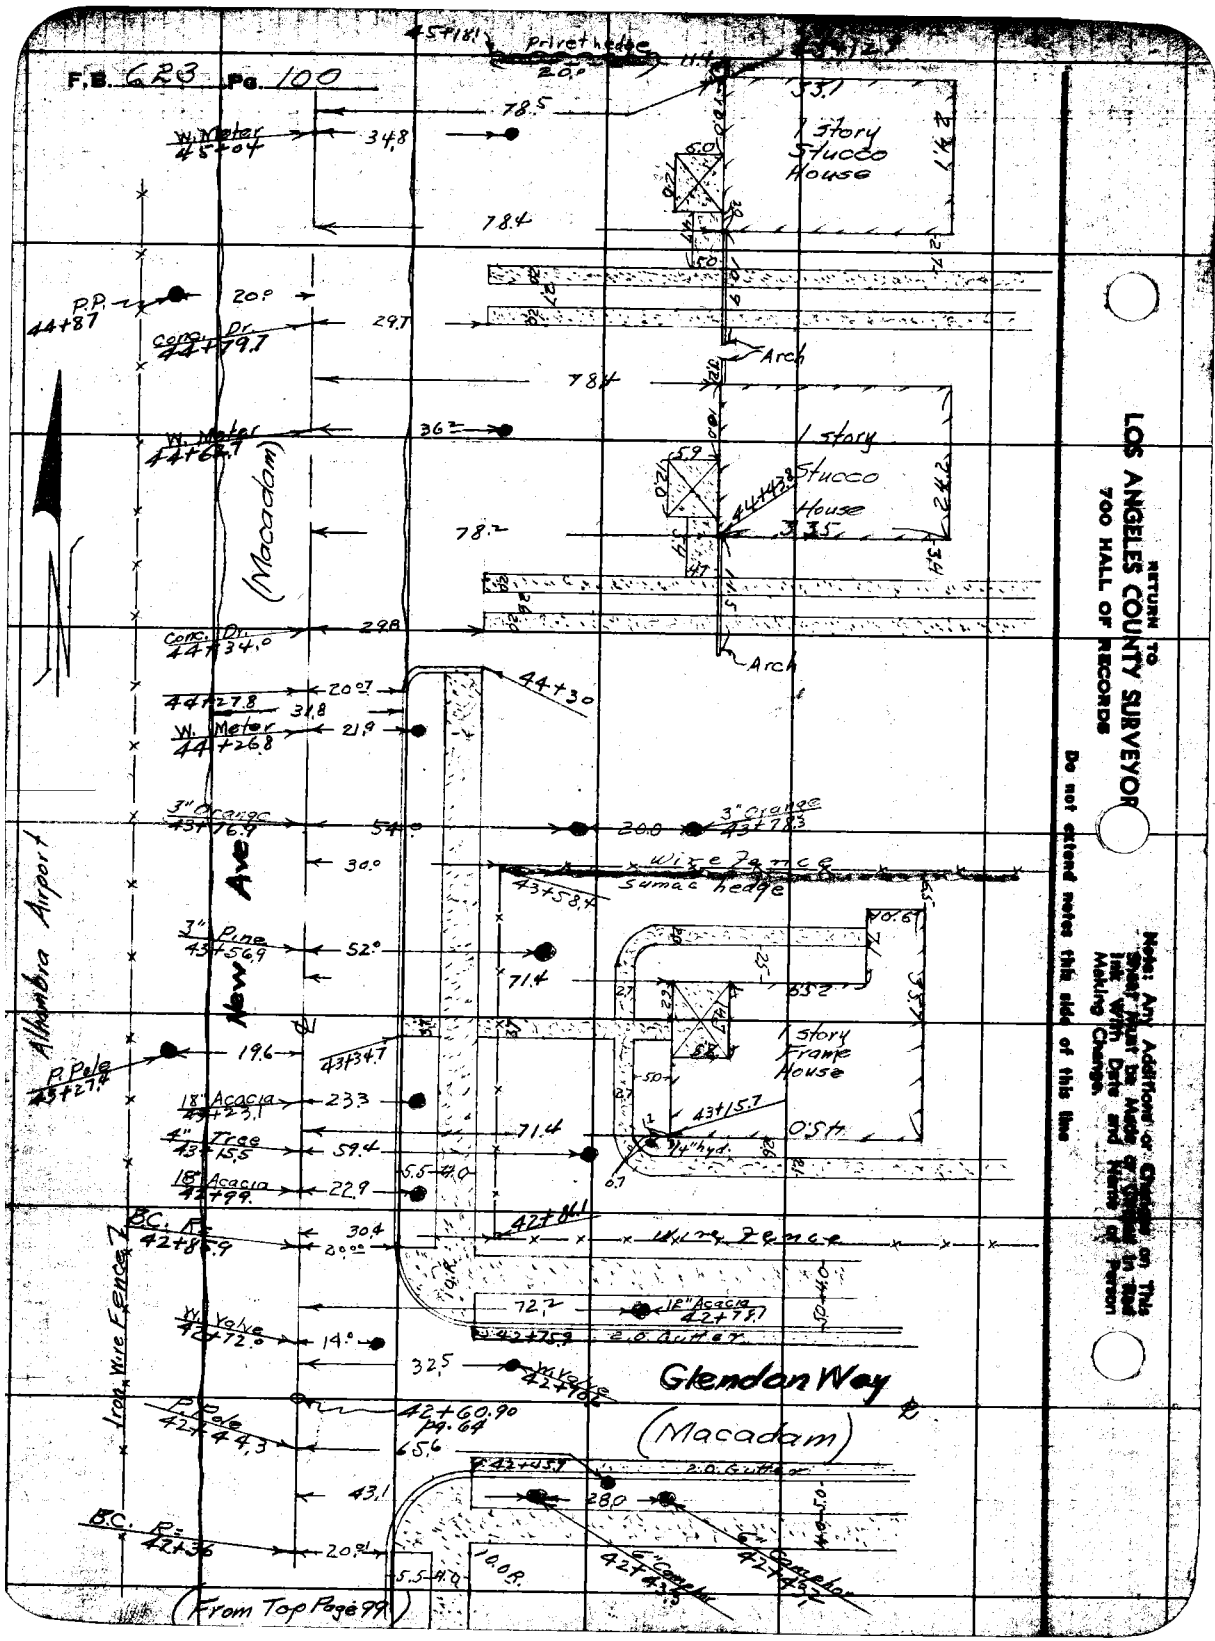

RETURN TO
LOS ANGELES COUNTY SURVEYOR
700 HALL OF RECORDS
Do not extend notes this side of this line
Note: Any Additions or Changes on This Sheet Must Be Made Only in Red Ink With Date and Name of Person Making Change

Notes Ck'd by Drew	Survey of Lake Ave	F.B. 623 Pg. 101
Map No. B-1345	W. O. 7135 Tape No. 872 St'd 84°F.	
Office Work Wood	Surveyed by Evans	
Checked Drew	Notes Martin Date 5-7-36	
Date Feb 38	Indexed A. C. Johnson	

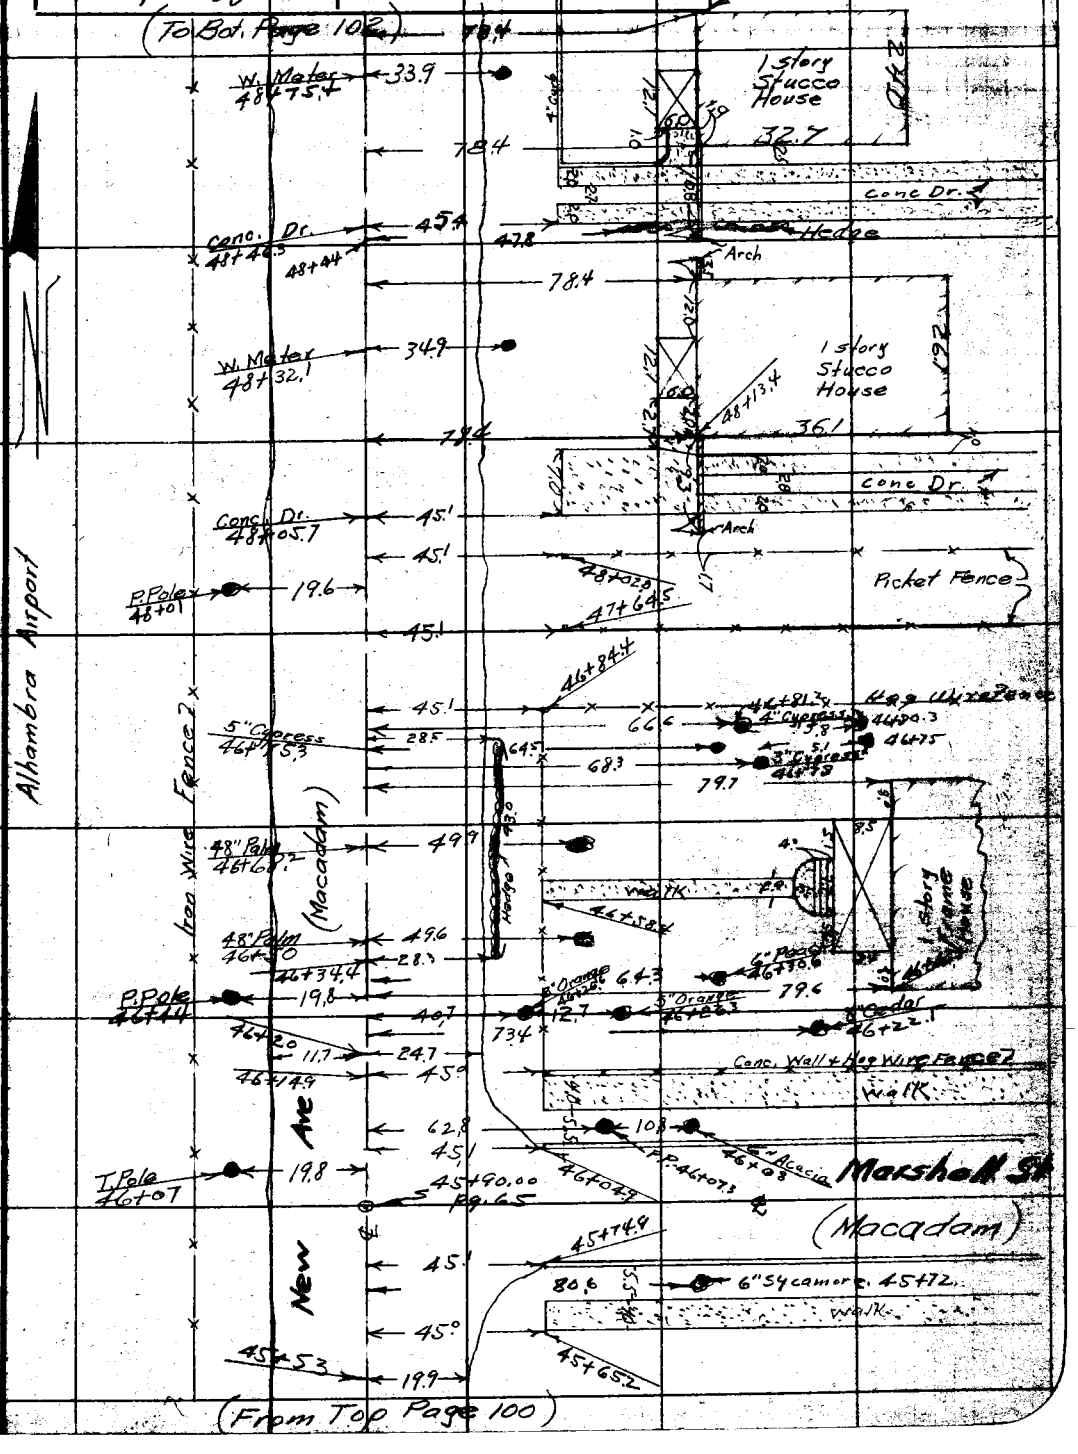

Note: Any Additions or Changes on This Sheet Must be Made or Circled in Red Ink With Date and Name of Person Making Change.

Do not extend notes this side of this line

RETURN TO
LOS ANGELES COUNTY SURVEYOR
700 HALL OF RECORDS

FORM 247 10M 11-35

(To Bot. Page 103)

F.B. 623 Pg. 102

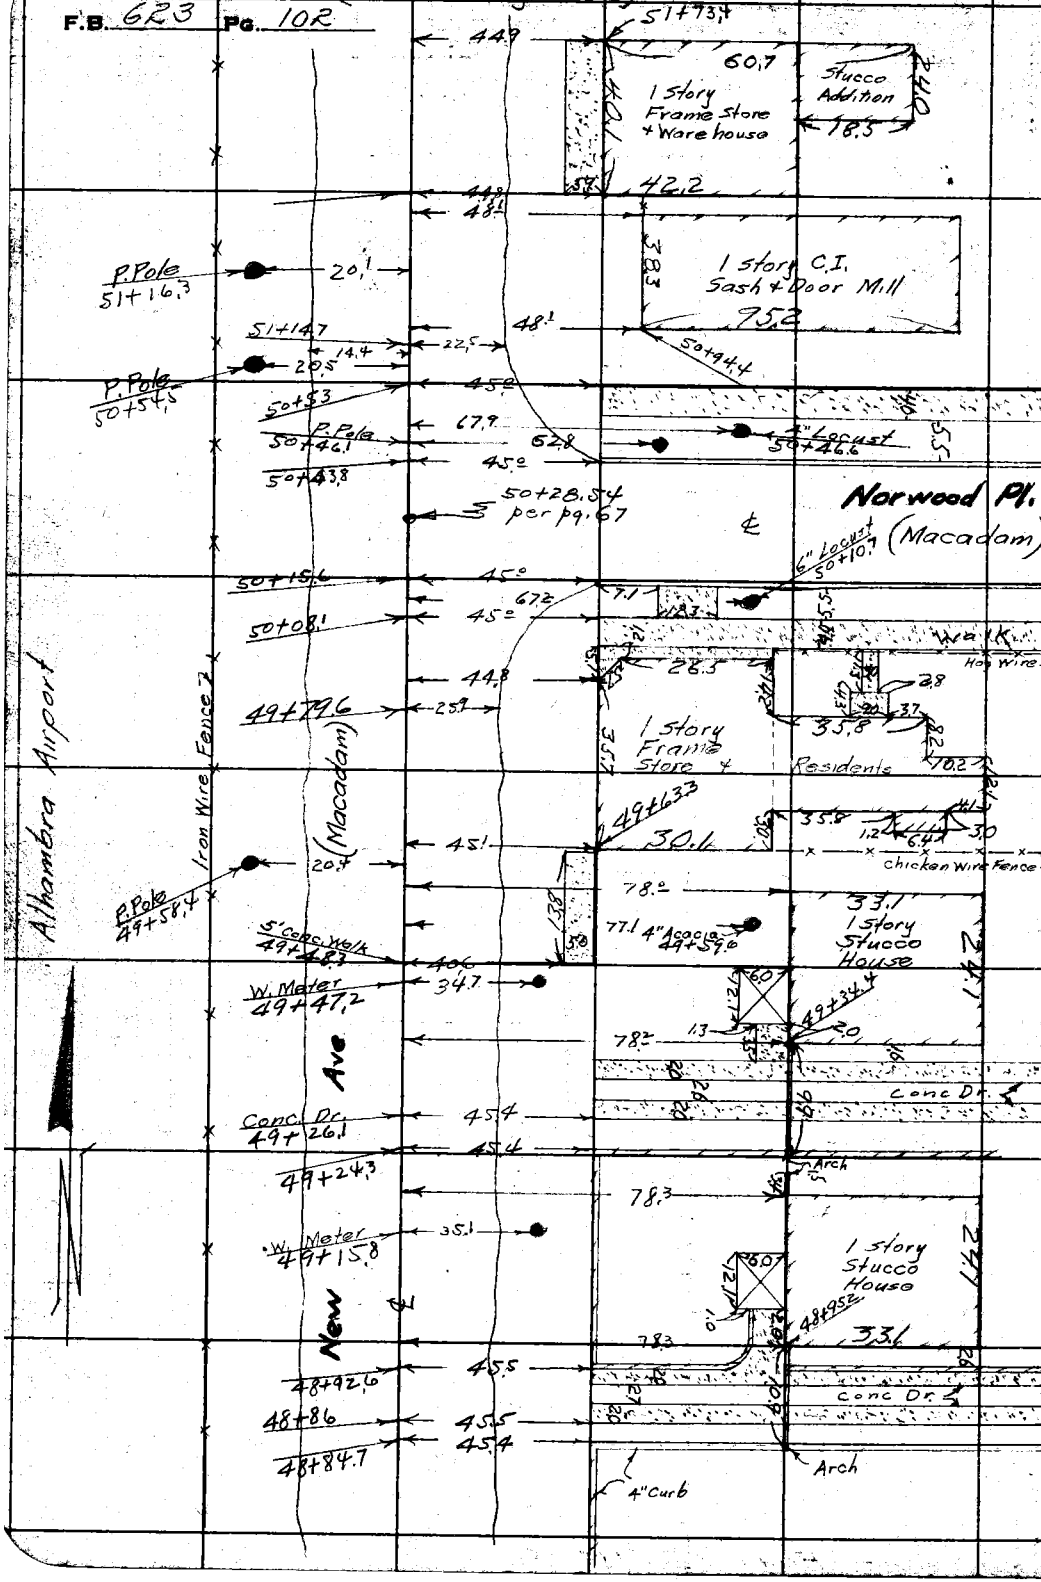

RETURN TO
LOS ANGELES COUNTY SURVEYOR
700 HALL OF RECORDS

Do not attend notes this side of this line

Note: Any Additions or Changes on This Sheet Must be Made or Circled in Red Ink With Date and Name of Person Making Change.

Notes Ck'd by Drew	Survey of Lake Ave	F.B. 623	PG. 103
Map No. B-1345	W. O. 7135 Tape No. 072 St'd 84°F.		
Office Work Wood	Surveyed by Evans		
Checked Drew	Notes Martin Date 5-7-36		
Date Feb 39	Indexed A. C. Johnson		

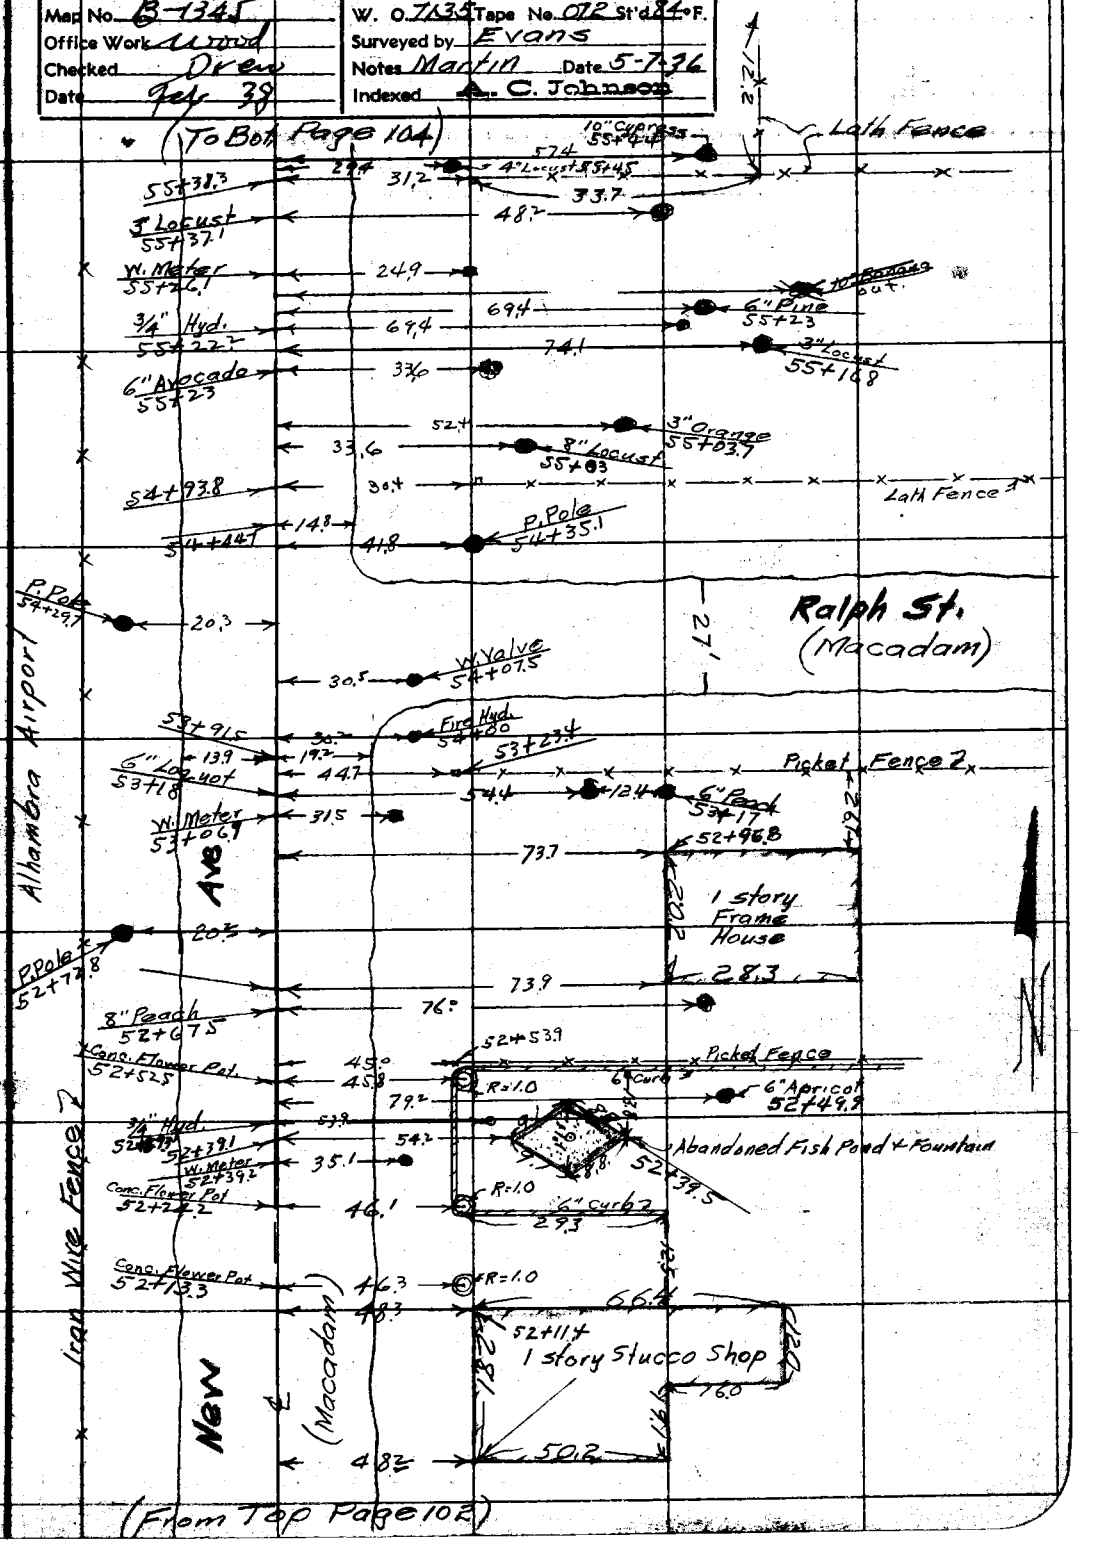

Note: Any Additions or Changes on This Sheet Must be Made or Circled in Red Ink With Date and Name of Person Making Change.

Do not extend notes this side of this line

RETURN TO LOS ANGELES COUNTY SURVEYOR 700 HALL OF RECORDS

FORM 247 10M 11-35

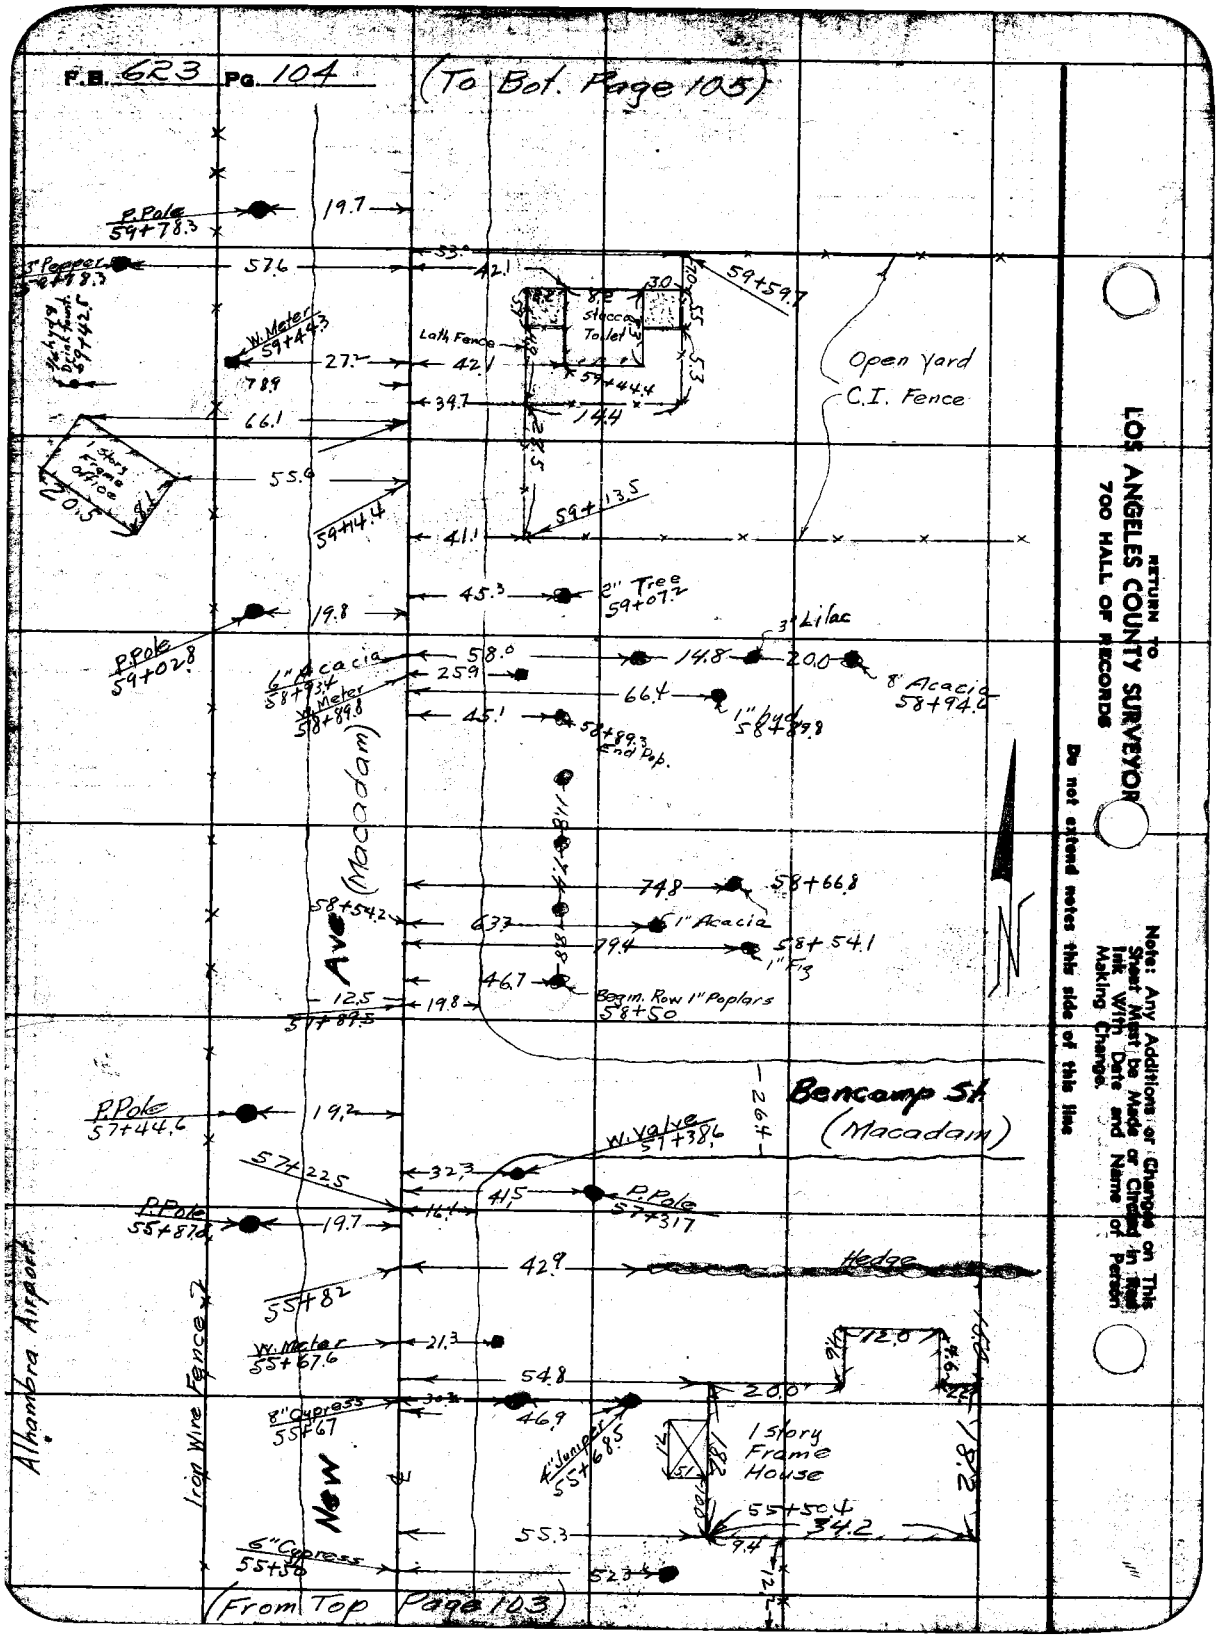
F.B. 623 Pg. 104
(To Bot. Page 105)
P. Pole 59+78.3
19.7
3" Pepper 59+78.3
57.6
53.0
42.1
59+59.7
Stucco Toilet
Lath Fence
W. Meter 59+44.3
27.2
42.1
78.9
39.7
59+44.4
14.4
66.1
Open Yard
C.I. Fence
1 Story Frame Office
55.6
59+14.4
59+13.5
41.1
45.3
2" Tree 59+07.2
19.8
P. Pole 59+02.8
3" Lilac
6" Acacia 58+93.4
58.0
14.8
20.0
8" Acacia 58+94.6
W. Meter 58+89.8
25.9
66.4
1" hyd 58+89.8
45.1
58+89.3 End Pop.
Ave (Macadam)
74.8
58+66.8
58+54.2
63.3
1" Acacia
79.4
58+54.1
1" Fig
46.7
Begin. Row 1" Poplars 58+50
12.5
19.8
57+89.5
Bencamp St. (Macadam)
26.4
P. Pole 57+44.6
19.2
W. Valve 57+38.6
57+22.5
32.3
41.5
P. Pole 57+31.7
P. Pole 55+87.0
19.7
16.1
42.9
Hedge
55+82
W. Meter 55+67.6
21.3
12.0
54.8
20.0
8" Cypress 55+67
30.3
46.9
4" Juniper 55+68.5
1 Story Frame House
55+50.4
34.2
55.3
9.4
6" Cypress 55+50
52.3
Alhambra Airport
Iron Wire Fence
New
(From Top Page 103)
RETURN TO
LOS ANGELES COUNTY SURVEYOR
700 HALL OF RECORDS
Note: Any Additions or Changes on This Sheet Must be Made or Circled in Red Ink With Date and Name of Person Making Change.
Do not extend notes this side of this line

Notes Ck'd by Drew	Survey of Lake Ave	F.B. 623 Pg. 105
Map No. B-1345	W. O. 7135 Tape No. 072 St'd 84°F.	
Office Work Wood	Surveyed by Evans	
Checked Drew	Notes Martin Date 5-8-36	
Date Feb 38	Indexed A. C. Johnson	

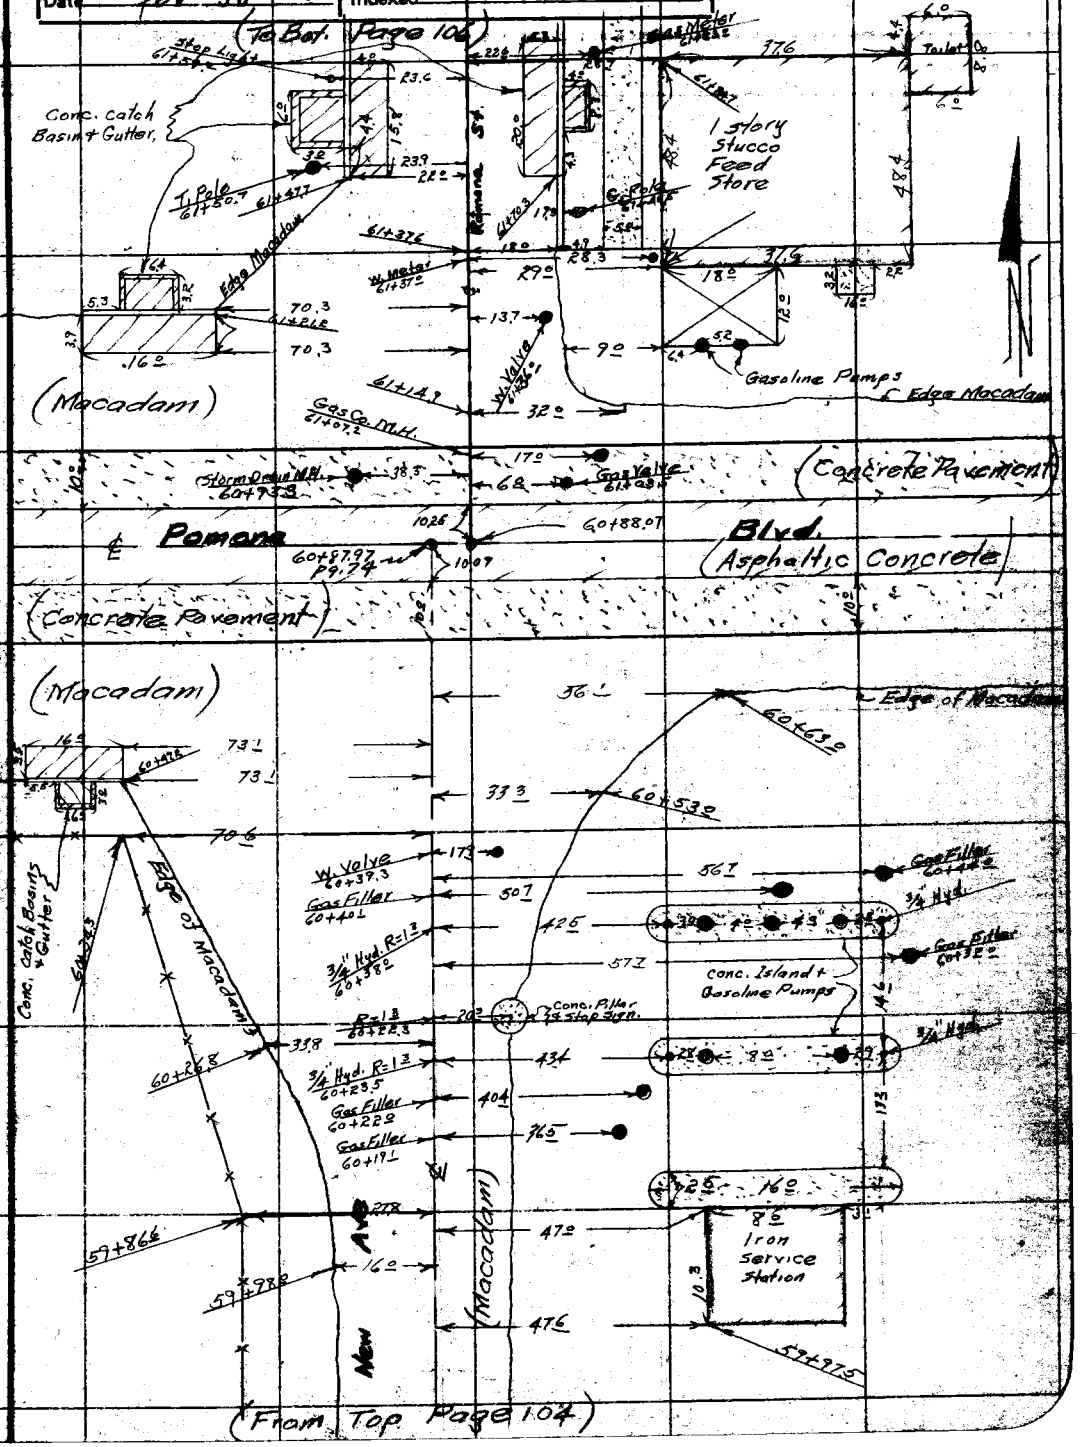

Note: Any Additions or Changes on This Sheet Must be Made or Circled in Red Ink With Date and Name of Person Making Change.

Do not extend notes this side of this line

RETURN TO
LOS ANGELES COUNTY SURVEYOR
700 HALL OF RECORDS

FORM 347 10M 11-35

(To Bot. Page 107)

F.B. 623 Pg. 106

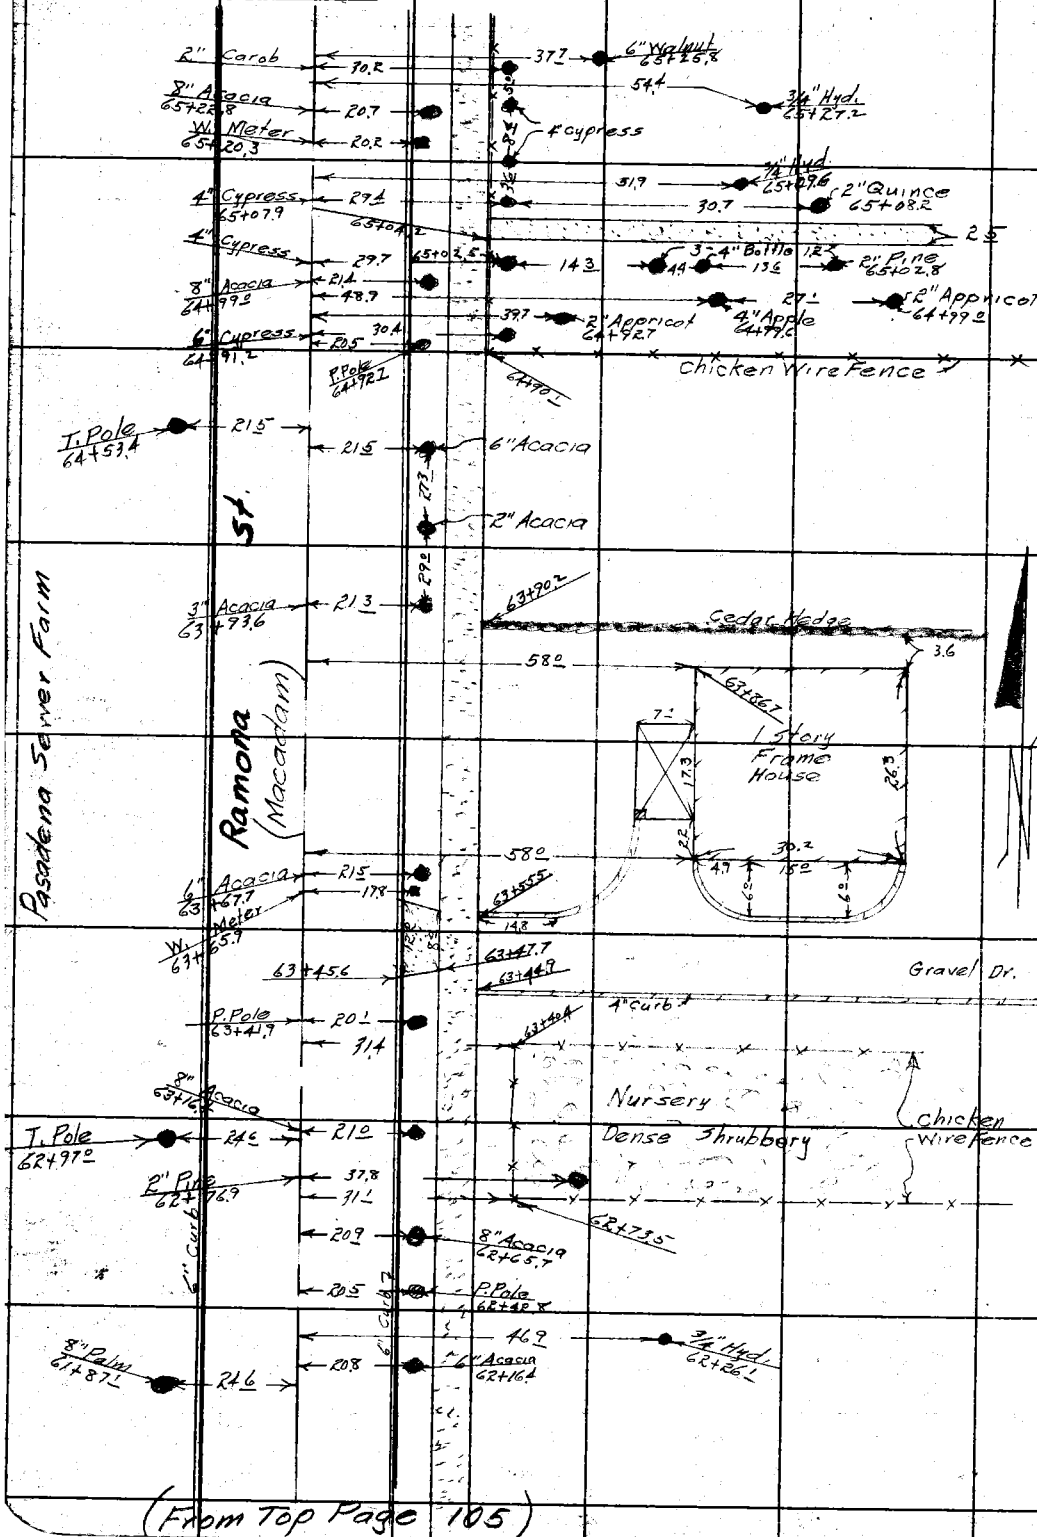

(From Top Page 105)

RETURN TO
LOS ANGELES COUNTY SURVEYOR
700 HALL OF RECORDS

Do not extend notes this side of this line

Note: Any Additions or Changes on This Sheet Must be Made or Checked in Red Ink, With Date and Name of Person Making Change.

Notes Ck'd by Drew	Survey of Lake Ave
Map No. B-1345	W. O. 7135 Tape No. 072 St'd 24°F.
Office Work Wood	Surveyed by Evans
Checked Drew	Notes Martin Date 5-11-36
Date Feb 38	Indexed A. C. Johnson

F.B. 683 PG. 107

(To Bot. Page 108)

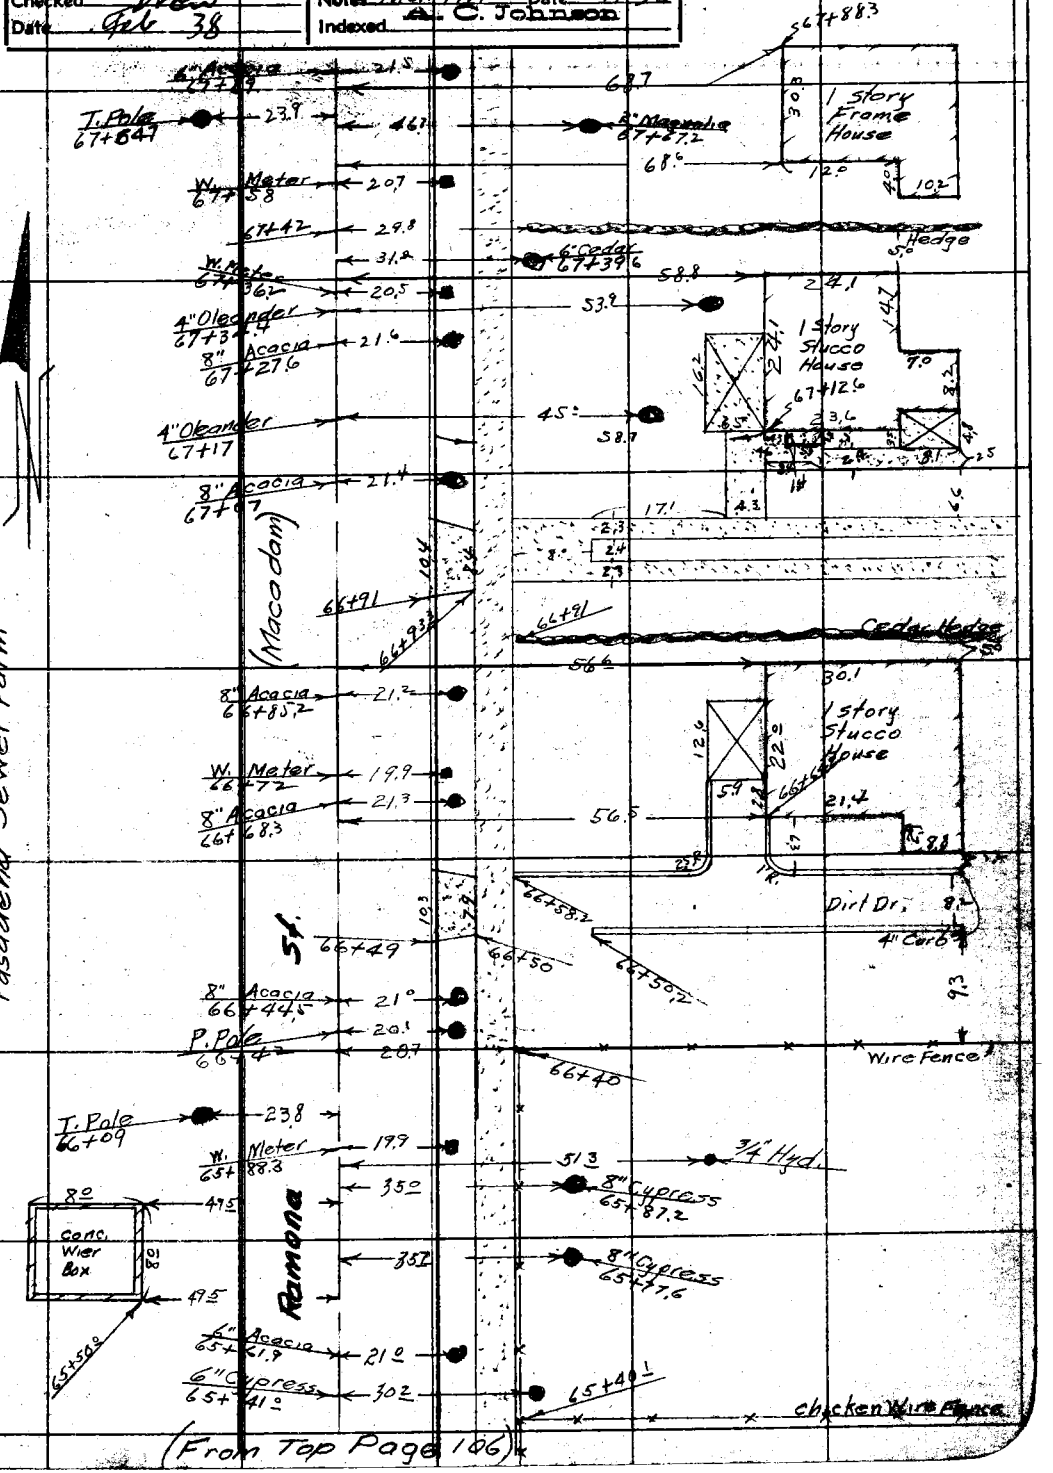

(From Top Page 106)

Note: Any Additions or Changes on This Sheet Must be Made or Circled in Red Ink With Date and Name of Person Making Change.

Do not extend notes this side of this line

LOS ANGELES COUNTY SURVEYOR
700 HALL OF RECORDS

FORM 247 10M 11-38

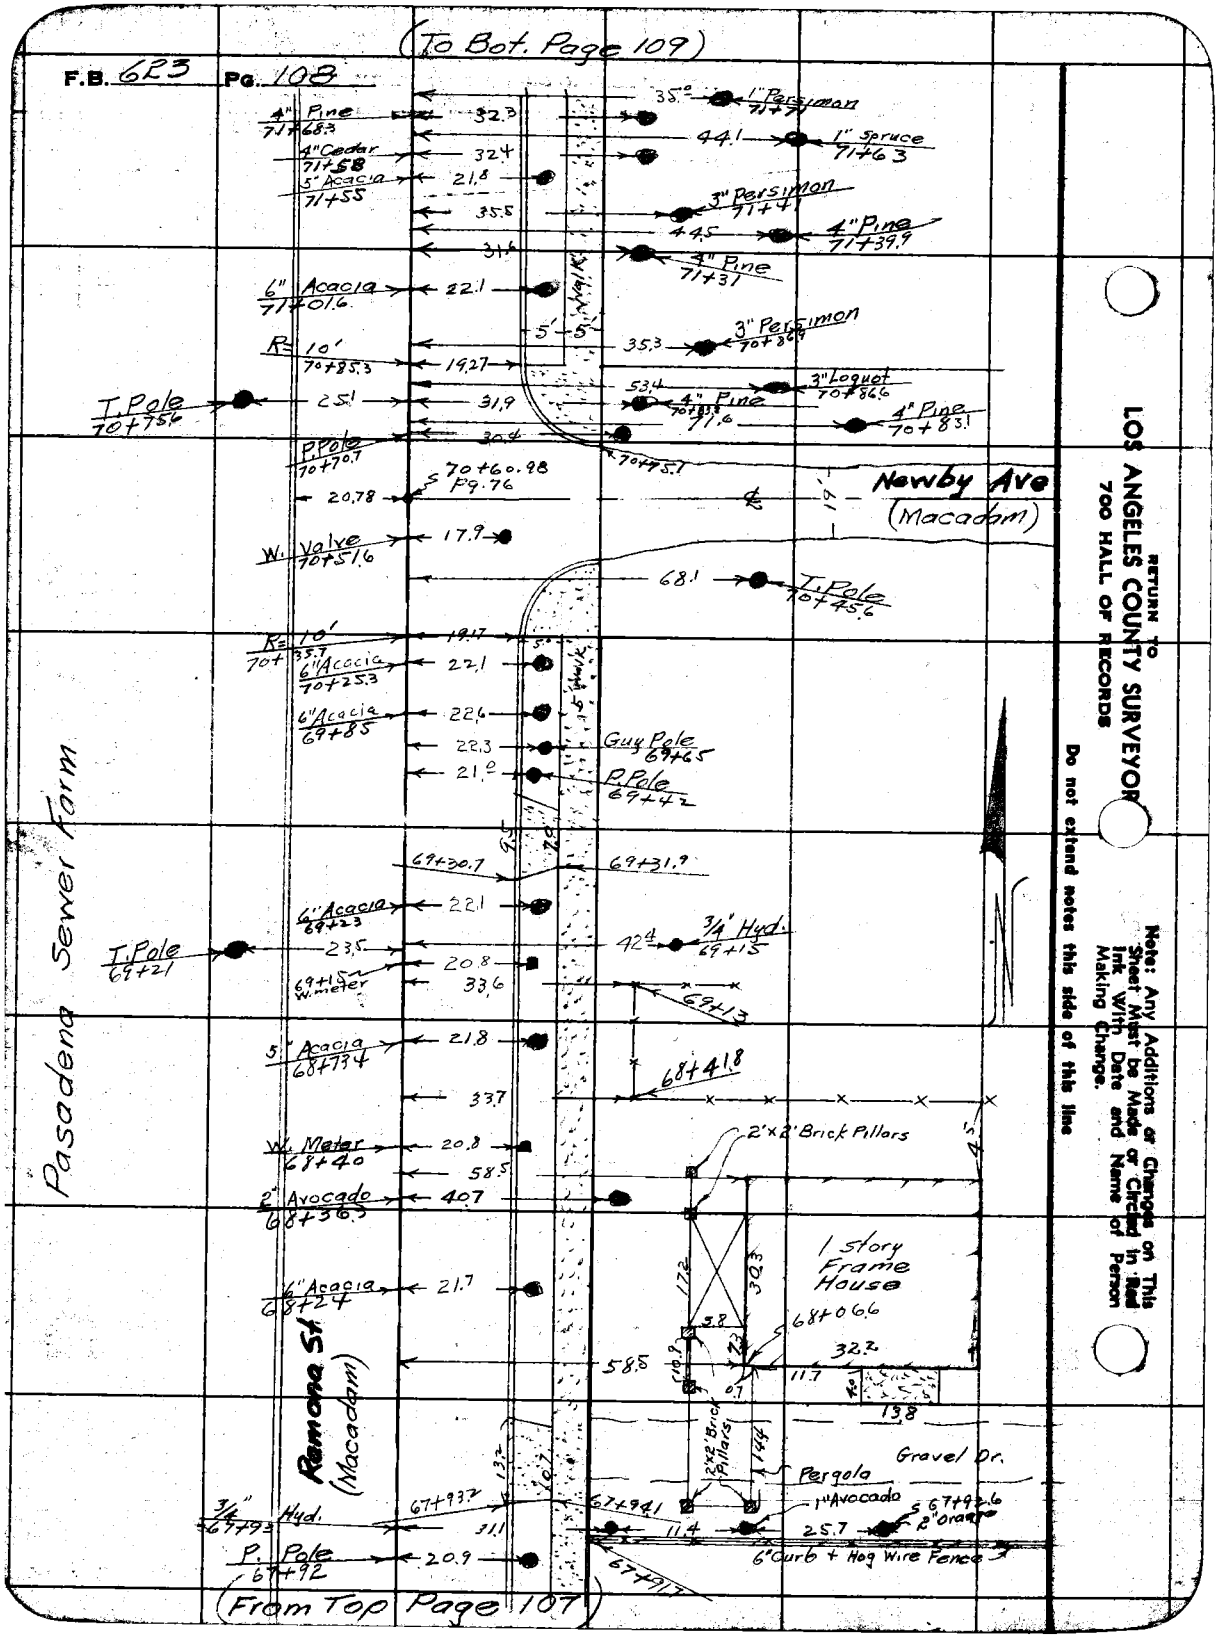
(To Bot. Page 109)
F.B. 623 Pg. 108
4" Pine 71+68.3
4" Cedar 71+58
5" Acacia 71+55
1" Persimon 71+71
1" Spruce 71+63
3" Persimon 71+41
4" Pine 71+39.9
4" Pine 71+31
6" Acacia 71+01.6
R= 10' 70+85.3
3" Persimon 70+86.9
3" Loquot 70+86.6
T. Pole 70+75.6
4" Pine 70+83.8
4" Pine 70+83.1
P. Pole 70+70.7
70+60.98 Pg. 76
Newby Ave (Macadam)
W. Valve 70+51.6
T. Pole 70+45.6
R= 10' 70+35.7
6" Acacia 70+25.3
6" Acacia 69+85
Guy Pole 69+65
P. Pole 69+42
69+30.7
69+31.9
6" Acacia 69+23
T. Pole 69+21
3/4" Hyd. 69+15
69+15 W. meter
69+13
5" Acacia 68+73.4
68+41.8
W. Meter 68+40
2" Avocado 68+36.3
2'x2' Brick Pillars
1 Story Frame House
6" Acacia 68+24
68+06.6
Ramona St (Macadam)
Gravel Dr.
Pergola
1" Avocado
67+92.6 2" orange
3/4" Hyd. 67+93
P. Pole 67+92
6" Curb + Hog Wire Fence
Pasadena Sewer Farm
(From Top Page 107)
RETURN TO
LOS ANGELES COUNTY SURVEYOR
700 HALL OF RECORDS
Do not extend notes this side of this line
Note: Any Additions or Changes on This Sheet Must be Made or Circled in Red Ink With Date and Name of Person Making Change.

Notes Ck'd by Drew	Survey of Lake Ave
Map No. B-13.45	W. O. 7635 Tape No. 072 St'd 84°F.
Office Work Wood	Surveyed by Evans
Checked Drew	Notes Martin Date 5/11/36
Date Feb 38	Indexed A. C. Johnson

F.B. 623 PG. 1[redacted]

(To Bot. Page 110)

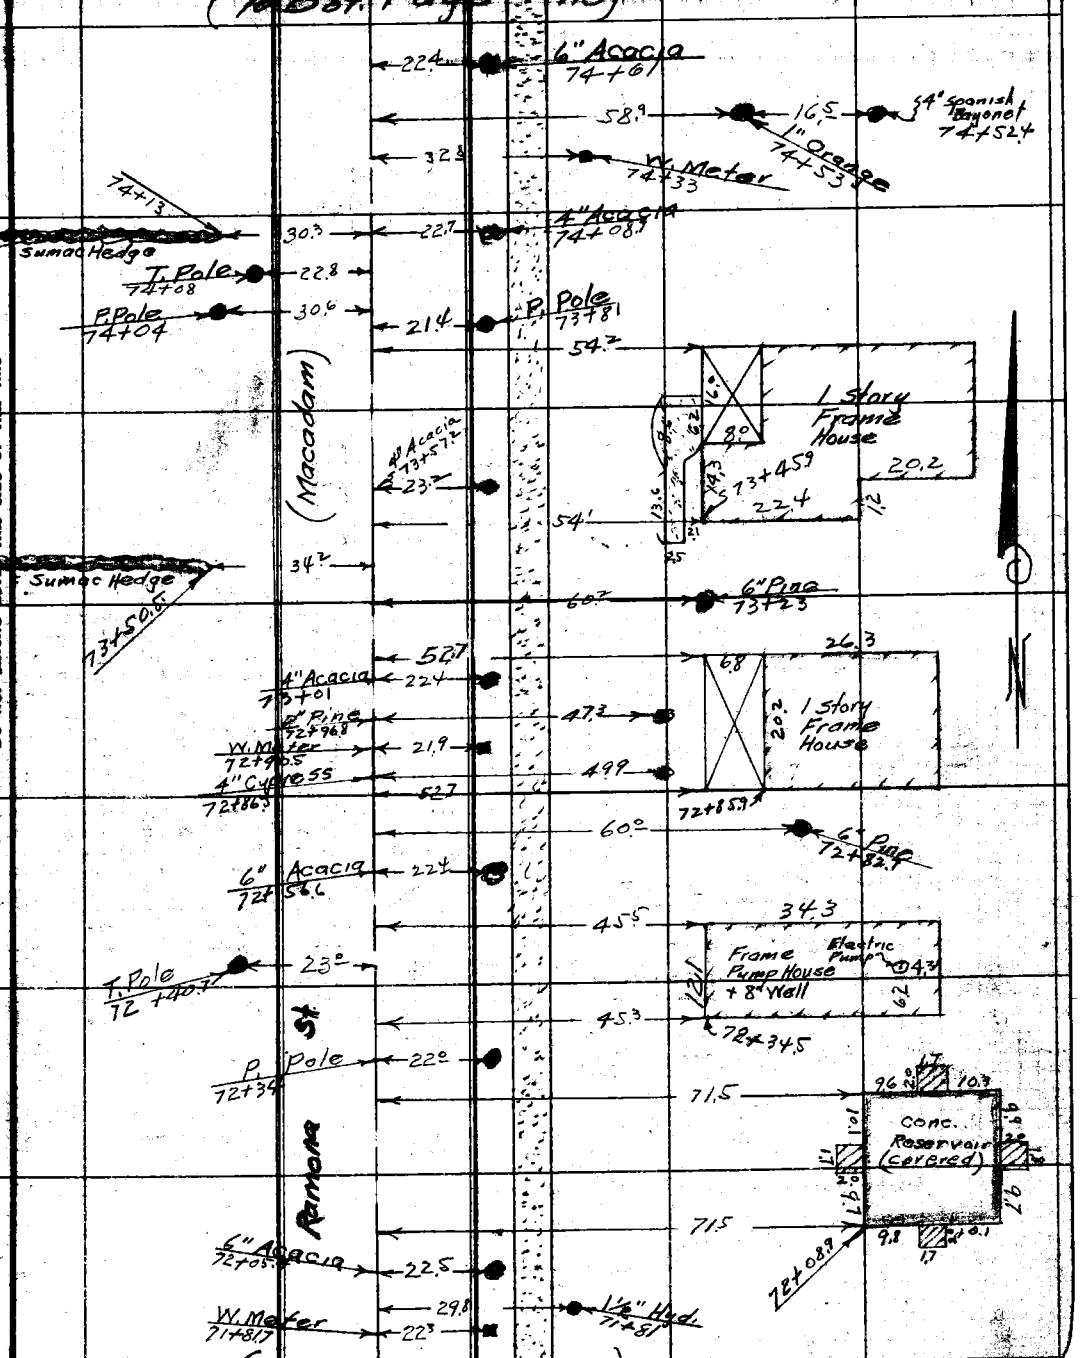

(From Top Page 108)

Note: Any Additions or Changes on This Sheet Must be Made or Circled in Red Ink With Date and Name of Person Making Change.

Do not extend notes this side of this line

RETURN TO
LOS ANGELES COUNTY SURVEYOR
700 HALL OF RECORDS

FORM 247 10M 11-35

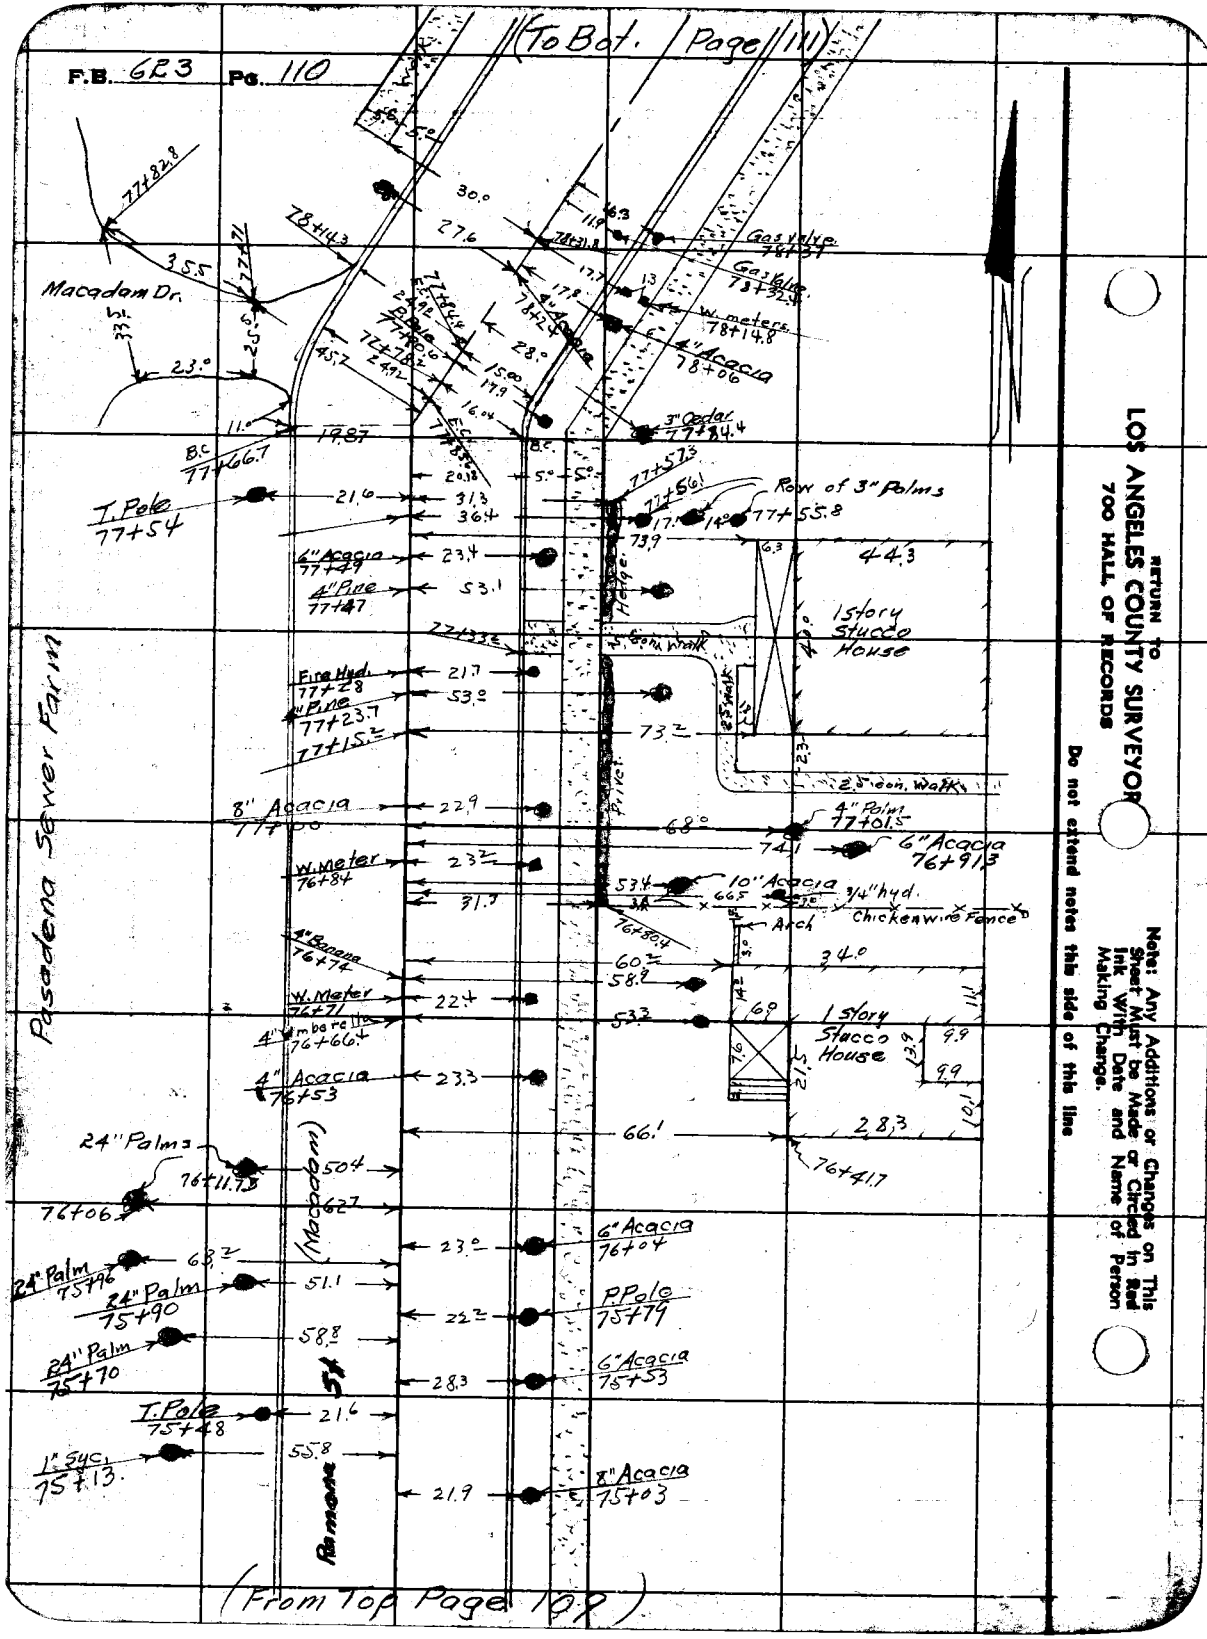
F.B. 623 Pg. 110
(To Bot. Page 111)
Macadam Dr.
Pasadena Sewer Farm
Ramona St.
(Macadam)
Gas valve 78+37
Gas valve 78+32.4
W. meters 78+14.8
4" Acacia 78+06
3" Cedar 77+84.4
Row of 3" Palms 77+55.8
T. Pole 77+54
6" Acacia 77+49
4" Pine 77+47
Fire Hyd. 77+28
4" Pine 77+23.7
77+15.2
8" Acacia
W. Meter 76+84
4" Banana 76+74
W. Meter 76+71
4" Umbrella 76+66.4
4" Acacia 76+53
24" Palms 76+11.7
76+06
24" Palm 75+96
24" Palm 75+90
24" Palm 75+70
T. Pole 75+48
1" Syc. 75+13
1 story Stucco House
2.5' con. walk
4" Palm 77+01.5
6" Acacia 76+91.3
10" Acacia
3/4" hyd.
Chickenwire Fence
Arch
76+80.4
76+41.7
6" Acacia 76+04
P. Pole 75+79
6" Acacia 75+53
8" Acacia 75+03
(From Top Page 109)
RETURN TO
LOS ANGELES COUNTY SURVEYOR
700 HALL OF RECORDS
Do not extend notes this side of this line
Note: Any Additions or Changes on This Sheet Must be Made or Circled in Red Ink With Date and Name of Person Making Change.

Notes Ck'd by Drew	Survey of Lake Ave
Map No. B-1345	W. O. 7135 Tape No. 072 St'd 84°F.
Office Work Lynwood	Surveyed by Evans
Checked Drew	Notes Martin Date 7/2/46
Date Feb 38	Indexed A. C. Johnson

F.B. 623 PG. 111

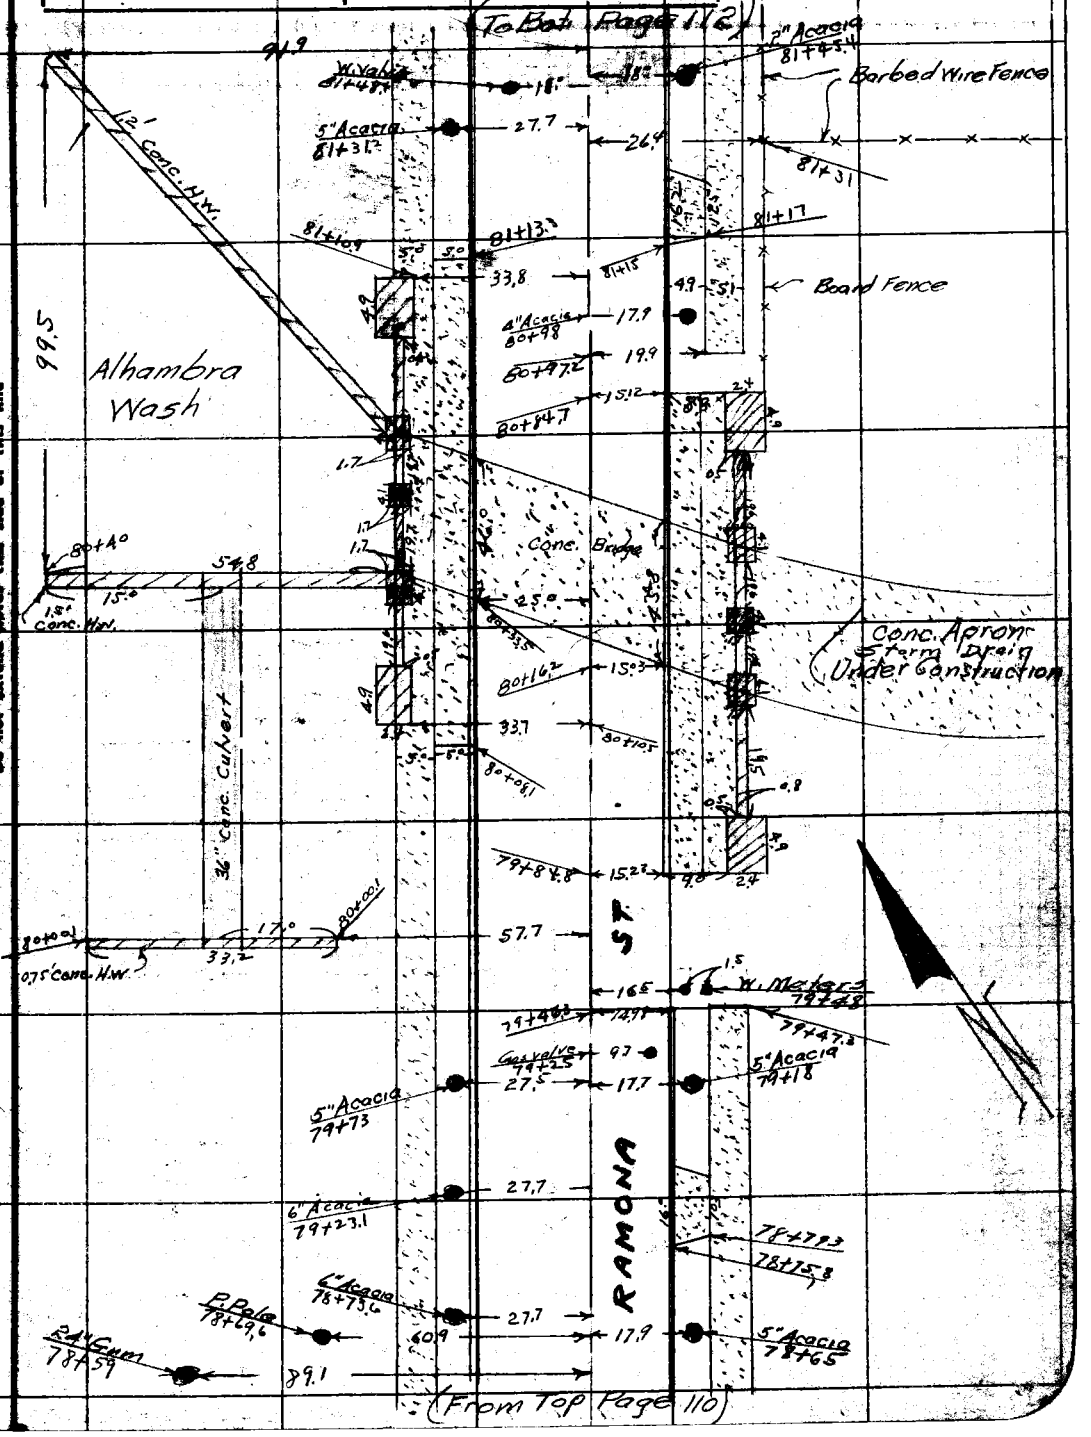

Note: Any Additions or Changes on This Sheet Must be Made or Circled in Red Ink With Date and Name of Person Making Change.

Do not extend notes this side of this line

RETURN TO
LOS ANGELES COUNTY SURVEYOR
700 HALL OF RECORDS

FORM 247 10M 11-38

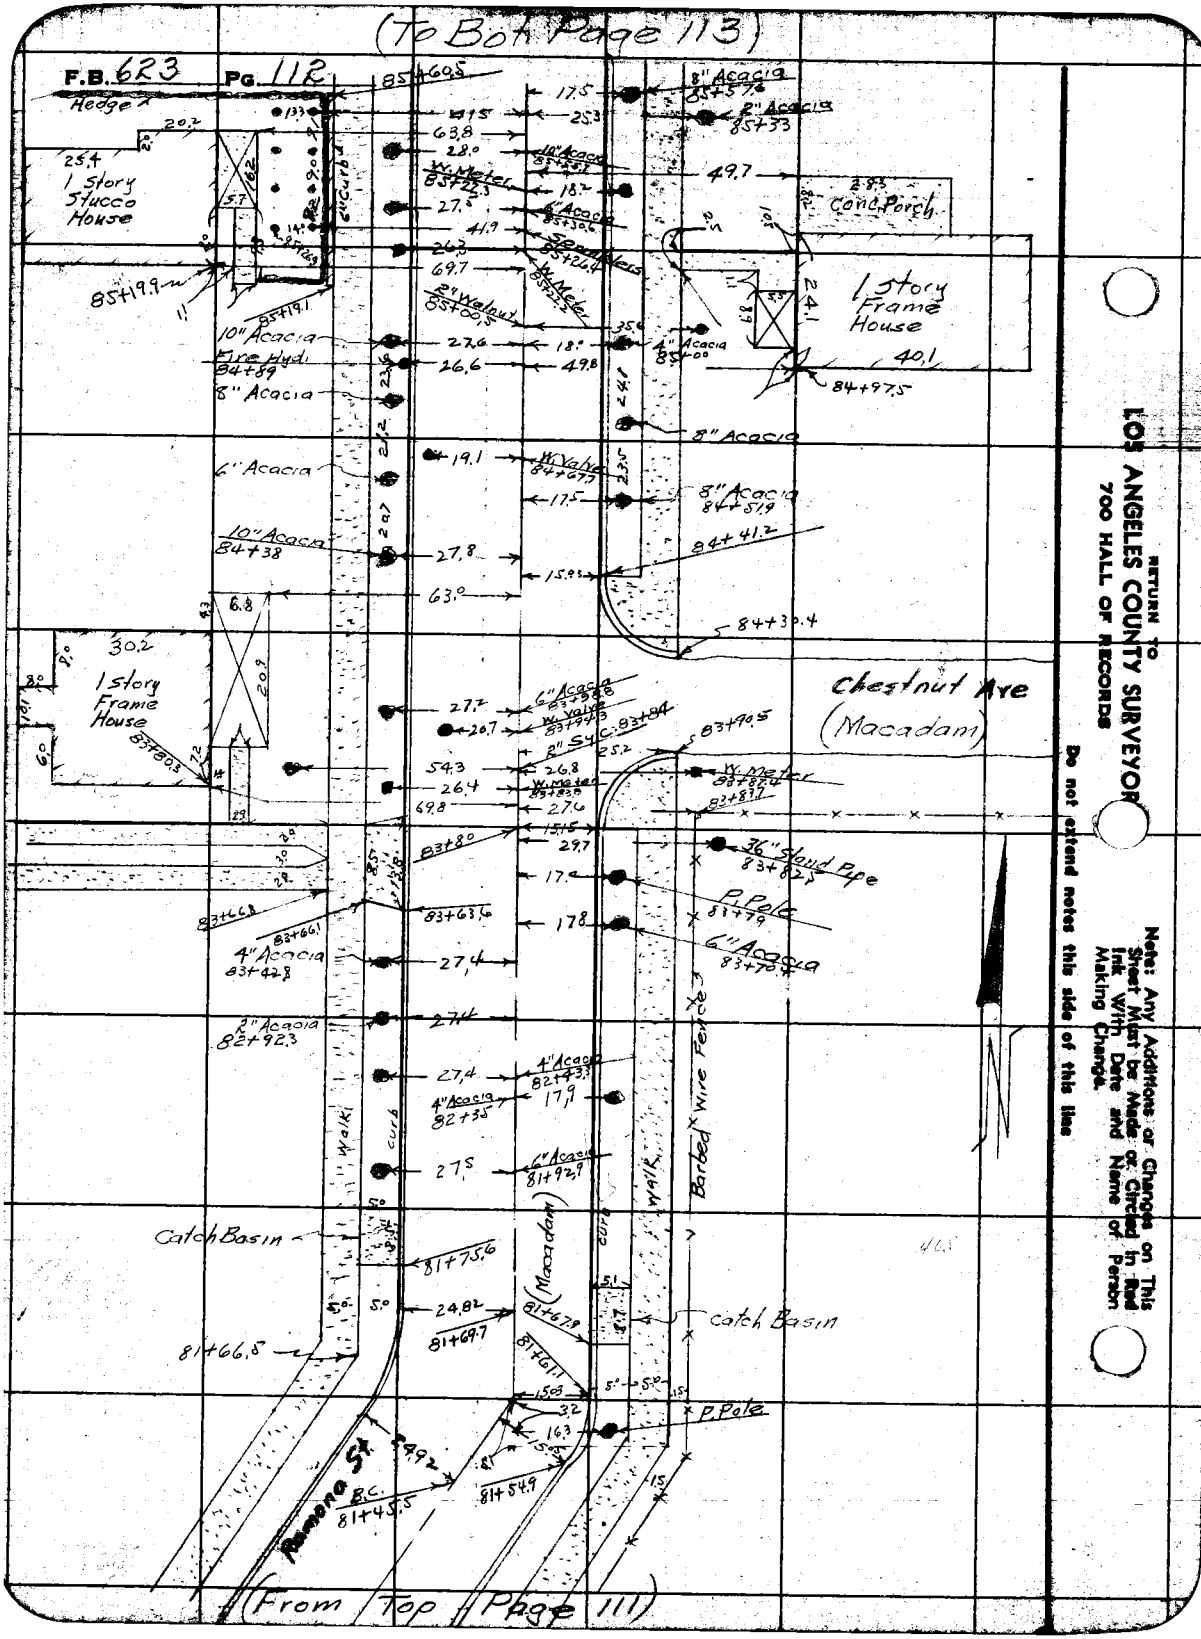
(To Bot Page 113)
F.B. 623 Pg. 112
Hedge
1 Story Stucco House
85+60.5
8" Acacia 85+57.6
2" Acacia 85+33
W. Meter 85+22.3
10" Acacia 85+25.7
6" Acacia 85+30.6
Sprinklers 85+26.4
W. Meter 85+22.2
2" Walnut 85+00.5
Conc. Porch
1 Story Frame House
4" Acacia 85+00
84+97.5
85+19.9
85+19.1
10" Acacia
Fire Hyd. 84+89
8" Acacia
6" Acacia
W. Valve 84+67.7
8" Acacia 84+51.9
10" Acacia 84+38
84+41.2
84+30.4
1 Story Frame House
83+80.3
Chestnut Ave (Macadam)
6" Acacia 83+98.8
W. Valve 83+94.3
2" Sy. C. 83+84
83+90.5
W. Meter 83+87.4
83+83.7
36" Stand Pipe 83+82.5
P. Pole 83+79
6" Acacia 83+70.4
83+80
83+66.8
83+66.1
83+63.6
4" Acacia 83+42.8
2" Acacia 82+92.3
4" Acacia 82+43.3
4" Acacia 82+35
6" Acacia 81+92.9
Walk
curb
Barbed Wire Fence
Catch Basin
81+75.6
(Macadam)
81+67.9
81+69.7
81+61.1
81+66.5
catch Basin
P. Pole
Ramona St.
B.C. 81+45.5
81+54.9
(From Top Page 111)
RETURN TO
LOS ANGELES COUNTY SURVEYOR
700 HALL OF RECORDS
Do not extend notes this side of this line
Note: Any Additions or Changes on This Sheet Must be Made or Circled in Red Ink With Date and Name of Person Making Change.

Notes Ck'd by Dr[illegible]	Survey of Lake Ave	F.B. 623 Pg. 113
Map No. B-[illegible]	W. O. 7135 Tape No. 072 St'd 84 °F.	(To Bot. Page 114)
Office Work Wood	Surveyed by Evans	
Checked Dr[illegible]	Notes Martin Date	
Date Feb 38	Indexed A. C. Johnson	

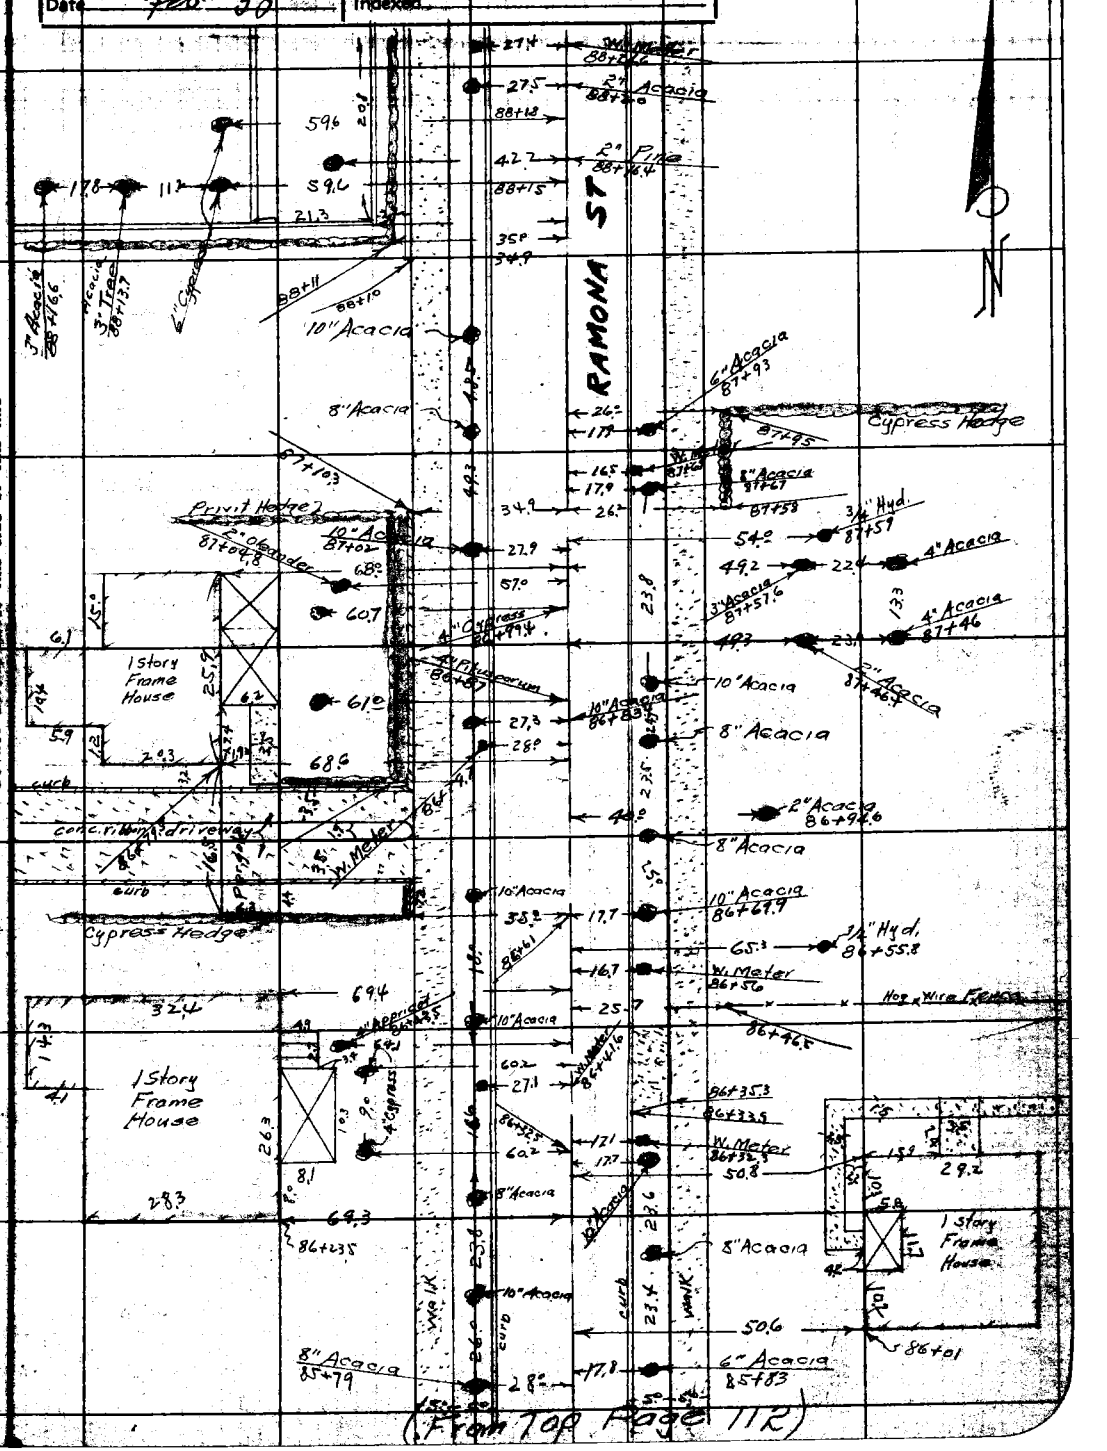

(From Top Page 112)

Note: Any Additions or Changes on This Sheet Must be Made or Circled in Red Ink With Date and Name of Person Making Change.

Do not extend notes this side of this line

RETURN TO
LOS ANGELES COUNTY SURVEYOR
700 HALL OF RECORDS

FORM 247 10M 11-38

F.B. 623 PG. 114 (To Bot. Page 115)

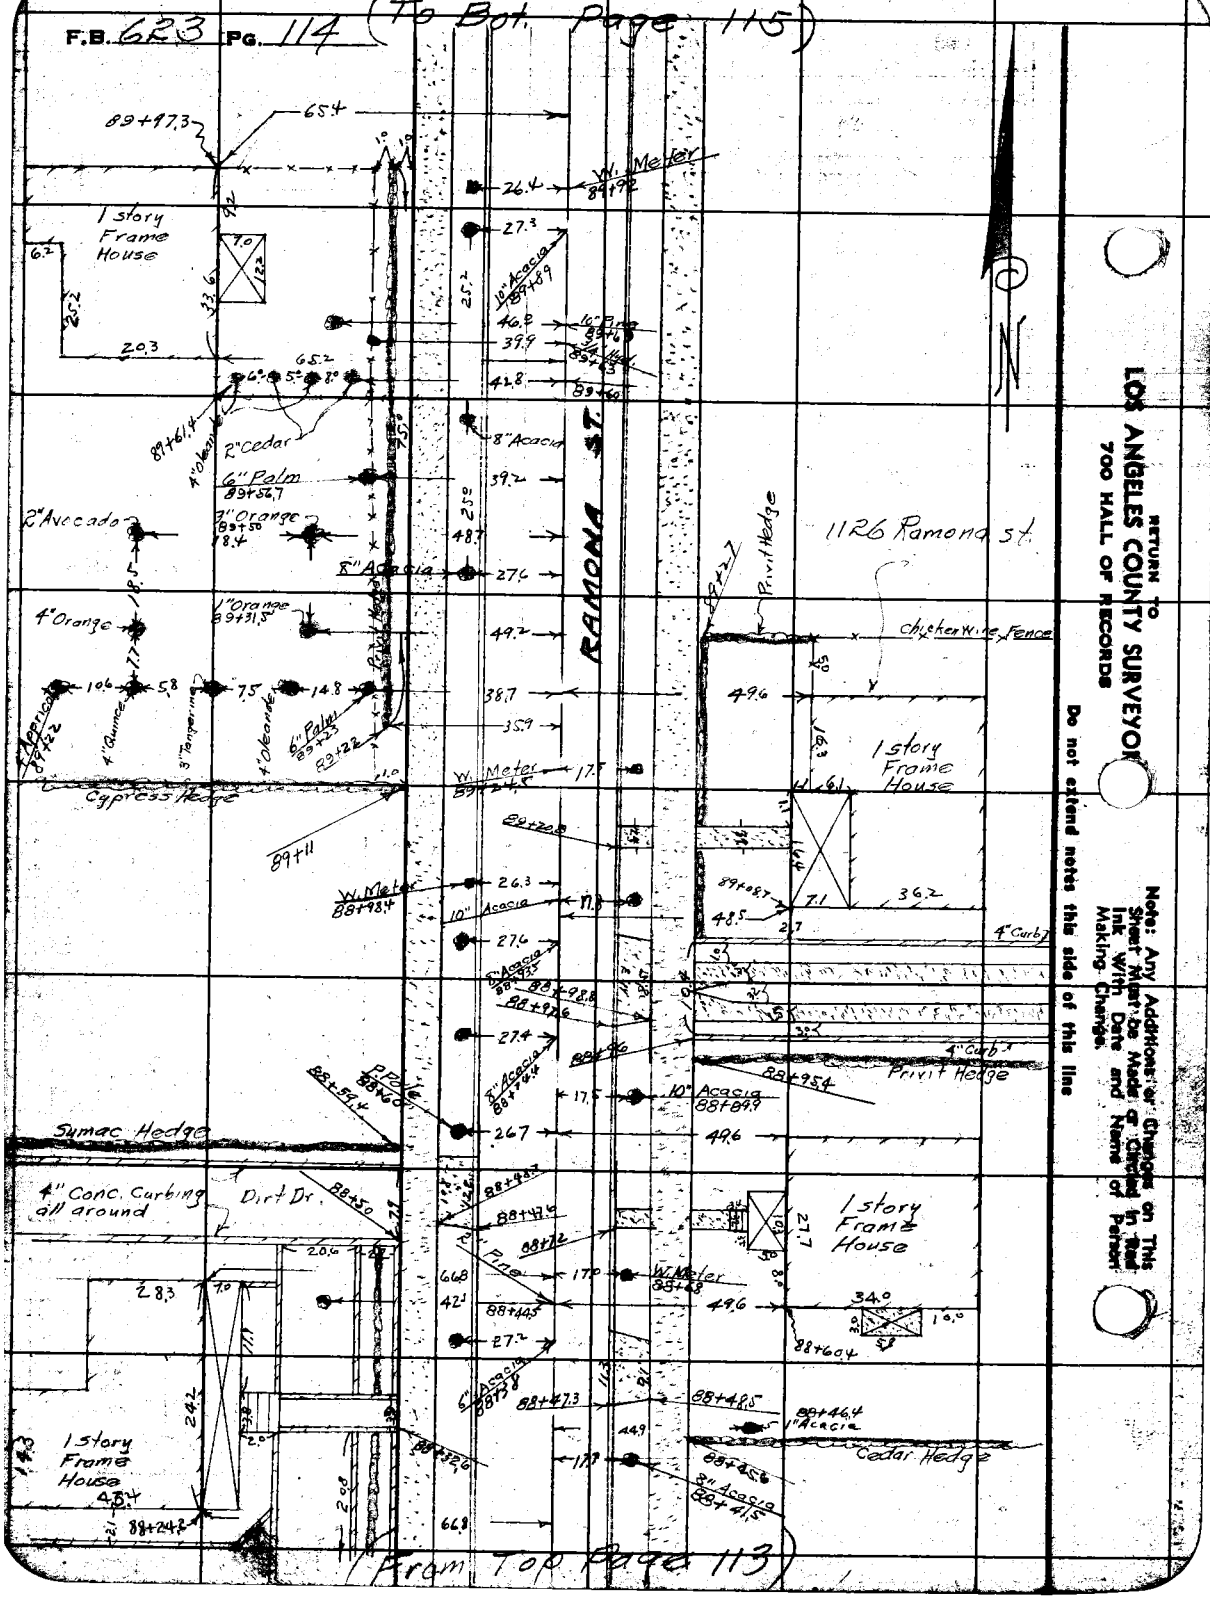

RETURN TO
LOS ANGELES COUNTY SURVEYOR
700 HALL OF RECORDS

Do not extend notes this side of this line

Note: Any Additions or Changes on This Sheet Must be Made or Checked in Red Ink with Date and Name of Person Making Change.

Notes Ck'd by Drew	Survey of Lake Ave
Map No. B-1345	W. 0.71.36 Tape No. 07P St'd 84 °F.
Office Work Wood	Surveyed by Evans
Checked Drew	Notes Martin Date
Date Feb 38	Indexed A. C. Johnson

F.B. 623 PG. 115

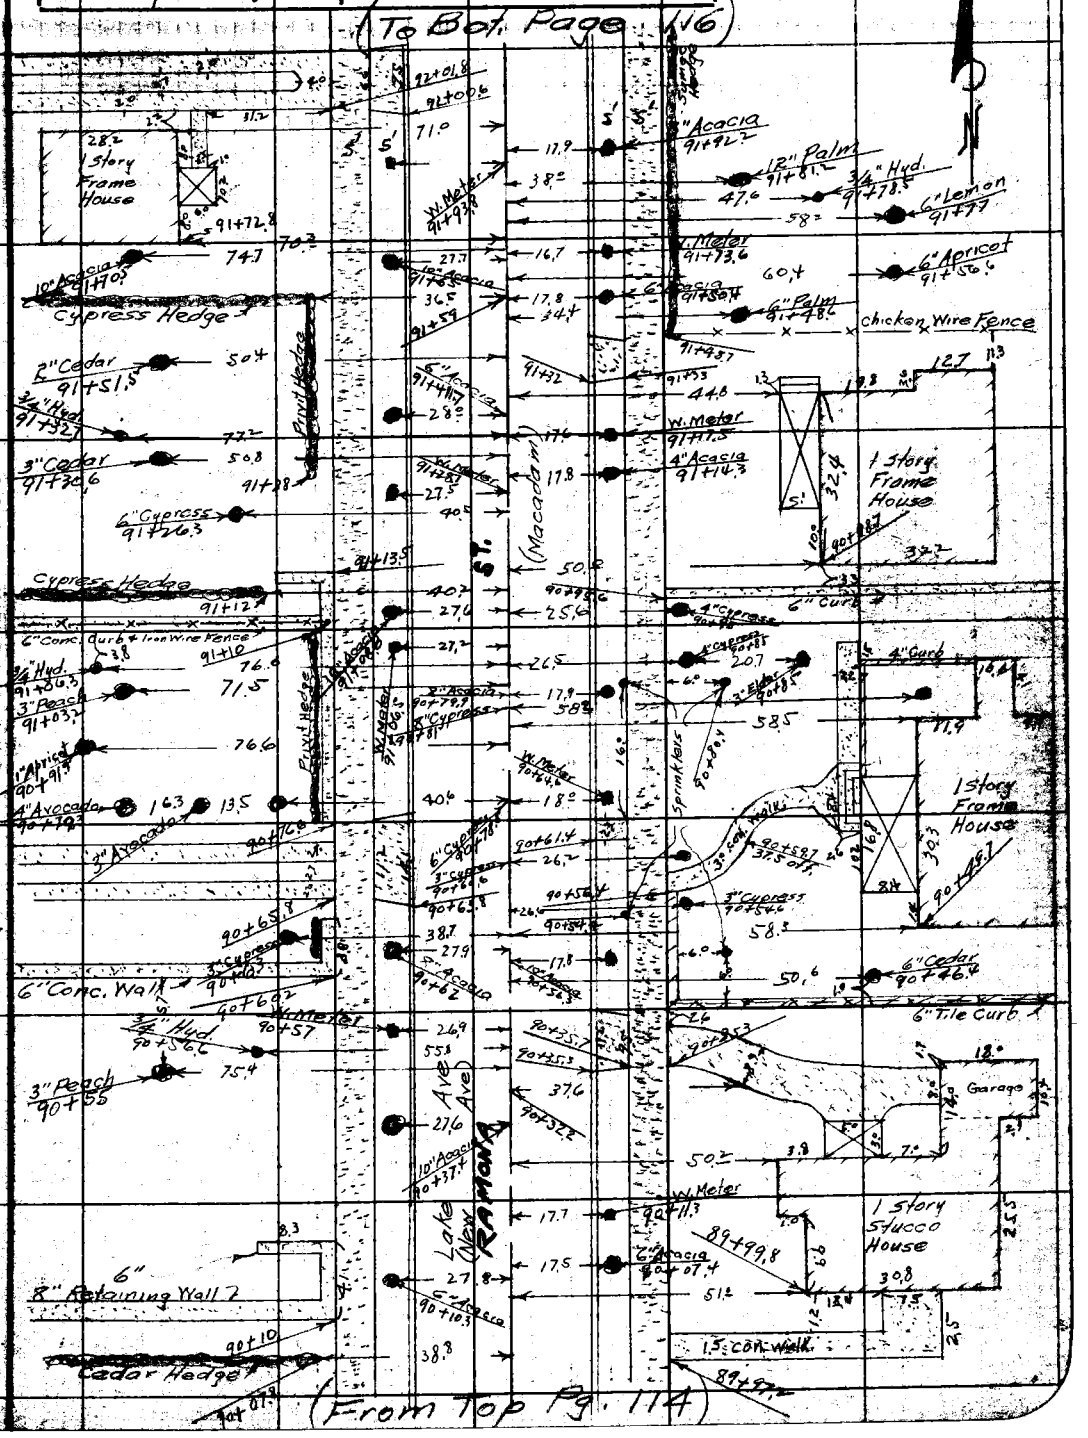

Note: Any Additions or Changes on This Sheet Must Be Made or Circled in Ink With Date and Name of Person Making Change.

Do not extend notes this side of this line

RETURN TO
LOS ANGELES COUNTY SURVEYOR
700 HALL OF RECORDS

FORM 247 10M 11-48

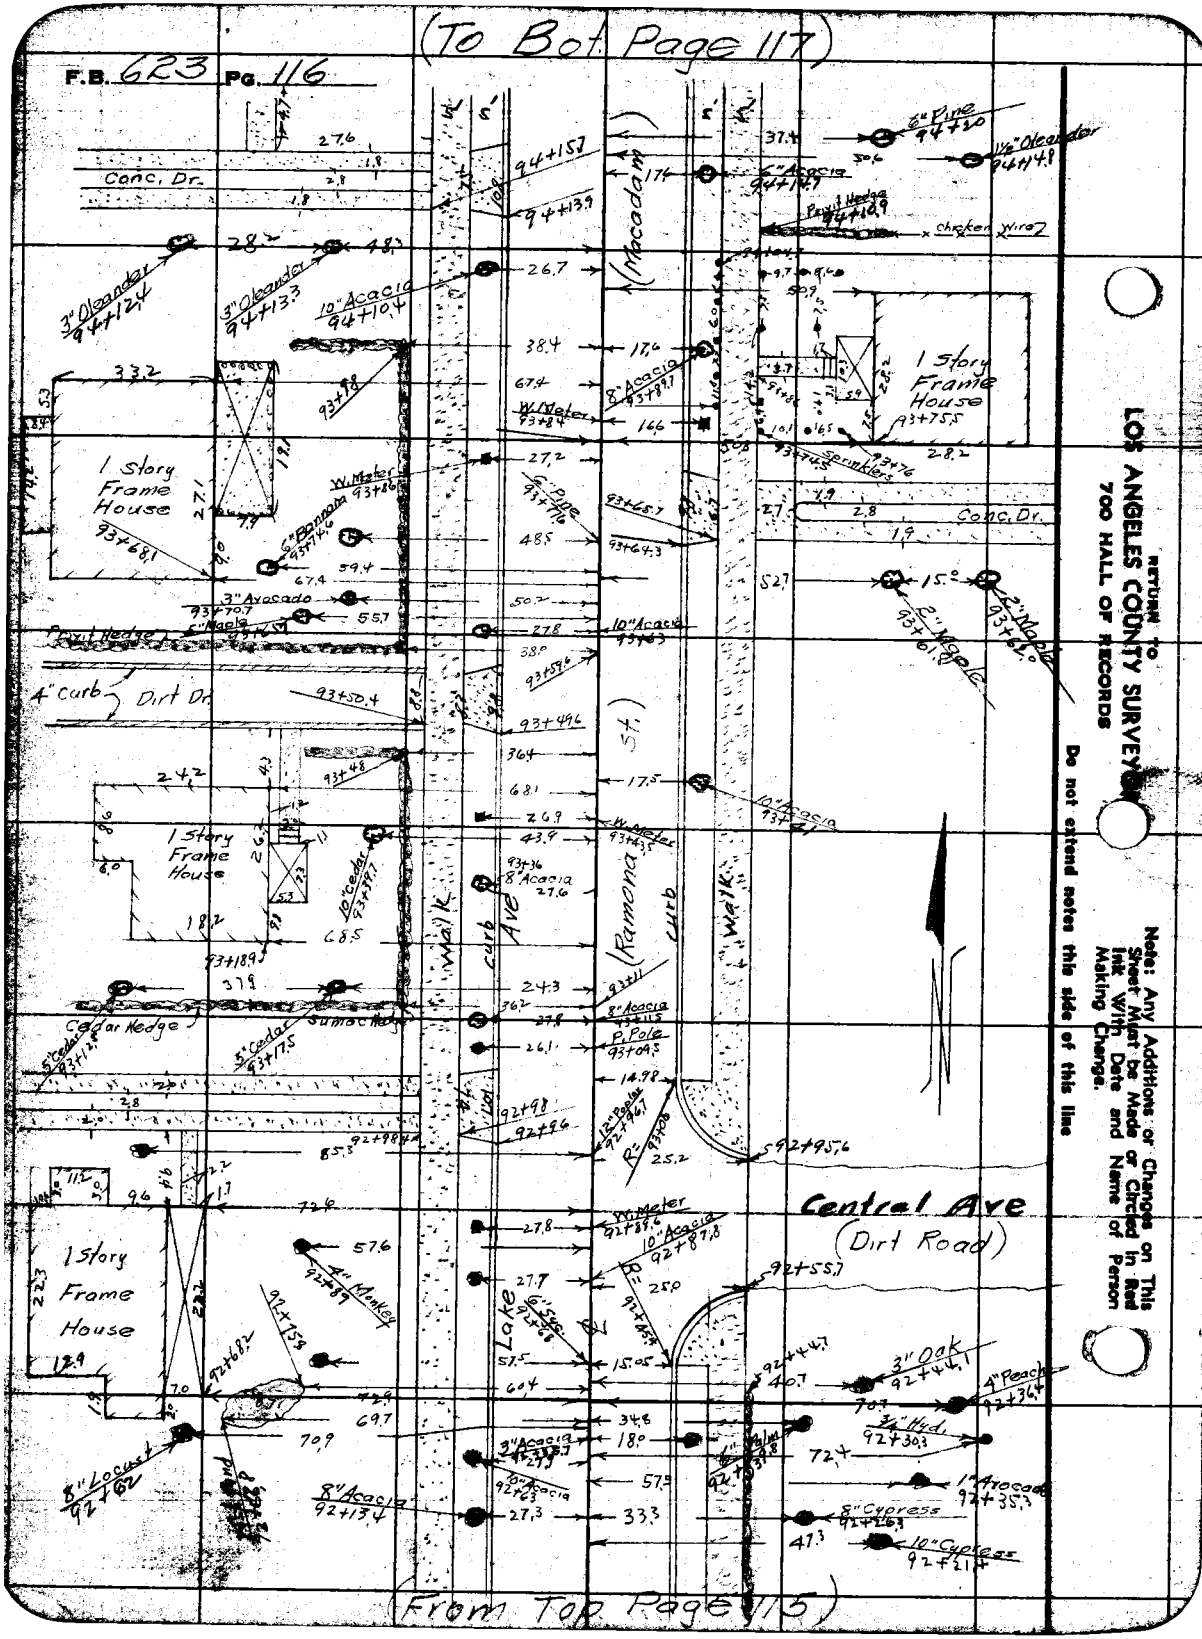
(To Bot. Page 117)
F.B. 623 Pg. 116
Conc. Dr.
(Macadam)
1 Story Frame House
Dirt Dr.
4" curb
Ramona St.
Walk
Curb
Ave
Lake
Central Ave
(Dirt Road)
Cedar Hedge
Sumac Hedge
Privit Hedge
Chicken Wire
Sprinklers
Conc. Dr.
(From Top Page 115)
RETURN TO
LOS ANGELES COUNTY SURVEYOR
700 HALL OF RECORDS
Do not extend notes this side of this line
Note: Any Additions or Changes on This Sheet Must be Made or Circled in Red Ink With Date and Name of Person Making Change.

Notes Ck'd by Drew	Survey of Lake Ave
Map No. B-1345	W. O. 7135 Tape No. 072 St'd 84°F.
Office Work Wood	Surveyed by Evans
Checked Drew	Notes HM Date 8-12-36
Date Feb 38	Indexed A. C. Johnson

F.B. 623 PG. 117

(To Bot. Page 118)

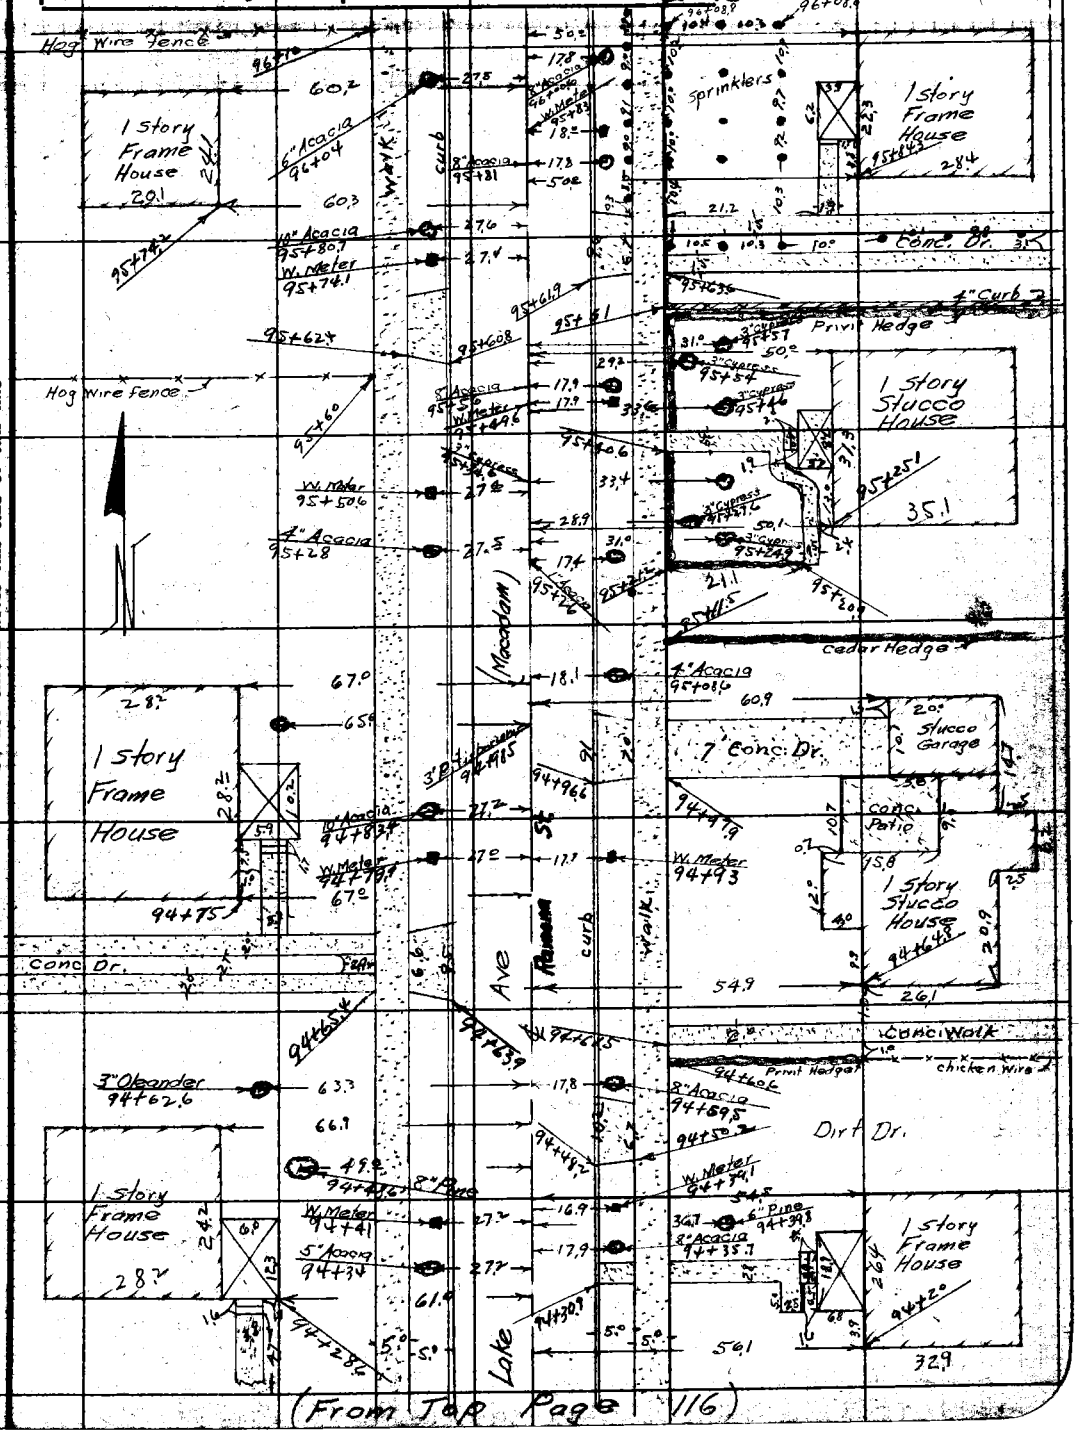

LOS ANGELES COUNTY SURVEYOR
700 HALL OF RECORDS
Do not extend notes this side of this line
Note: Any Additions or Changes on This Sheet Must be Made in Ink With Date and Name of Person Making Change.

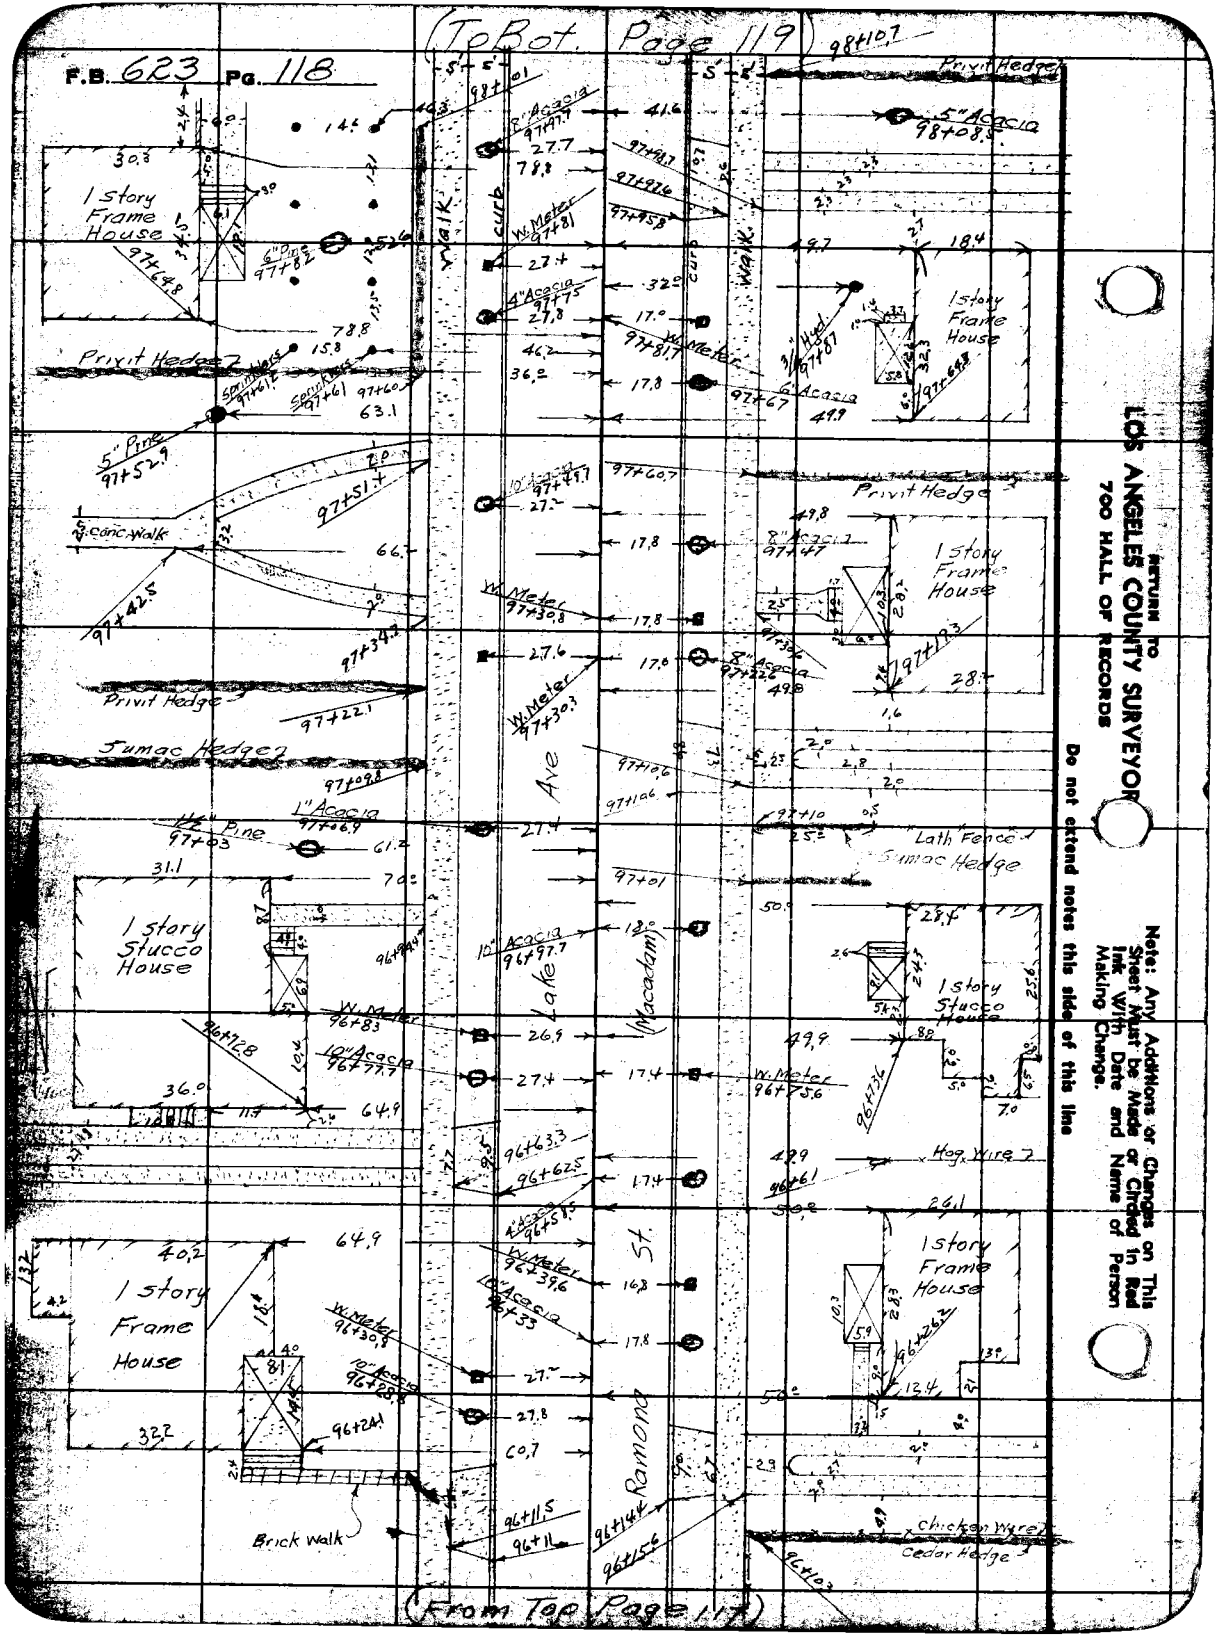

RETURN TO
LOS ANGELES COUNTY SURVEYOR
700 HALL OF RECORDS

Do not extend notes this side of this line

Note: Any Additions or Changes on This Sheet Must be Made or Circled in Red Ink With Date and Name of Person Making Change.

Notes Ck'd by Drew	Survey of Lake Ave
Map No. B-1345	W. O. 7135 Tape No. 072 St'd 84 °F.
Office Work Wood	Surveyed by Evans
Checked Drew	Notes HM Date 8-12-36
Date Feb 38	Indexed A. C. Johnson

F.B. 623 PG. 119

(To Bot. Page 120)

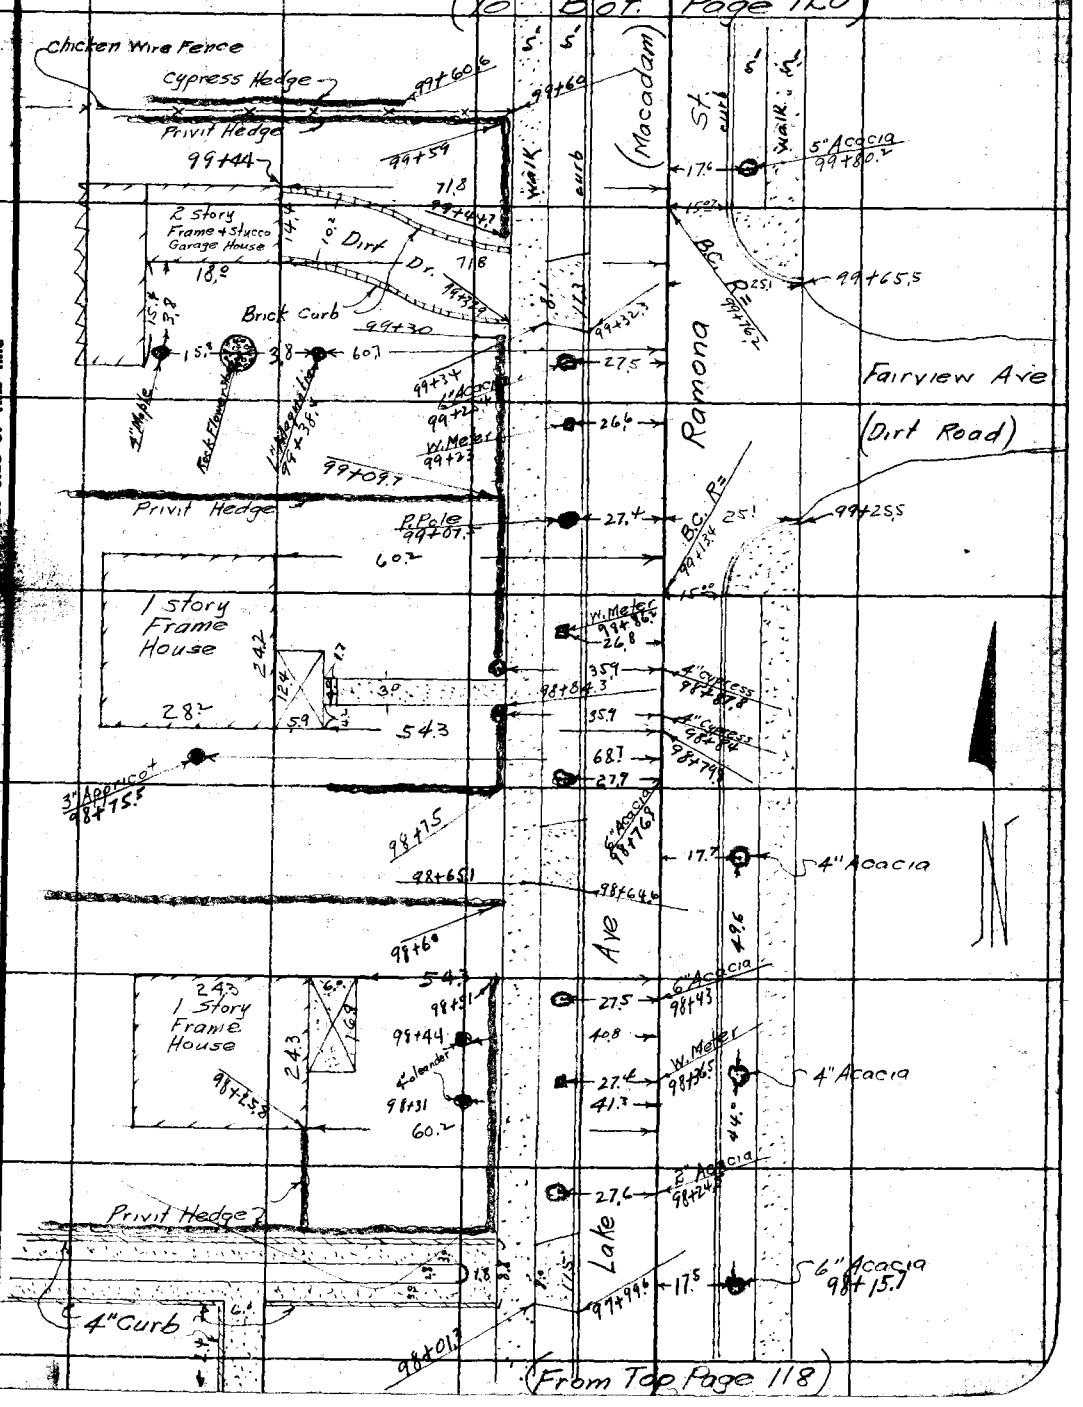

Note: Any Additions or Changes on This Sheet Must be Made or Circled in Red Ink With Date and Name of Person Making Change.

Do not extend this side of this line

RETURN TO
LOS ANGELES COUNTY SURVEYOR
700 HALL OF RECORDS

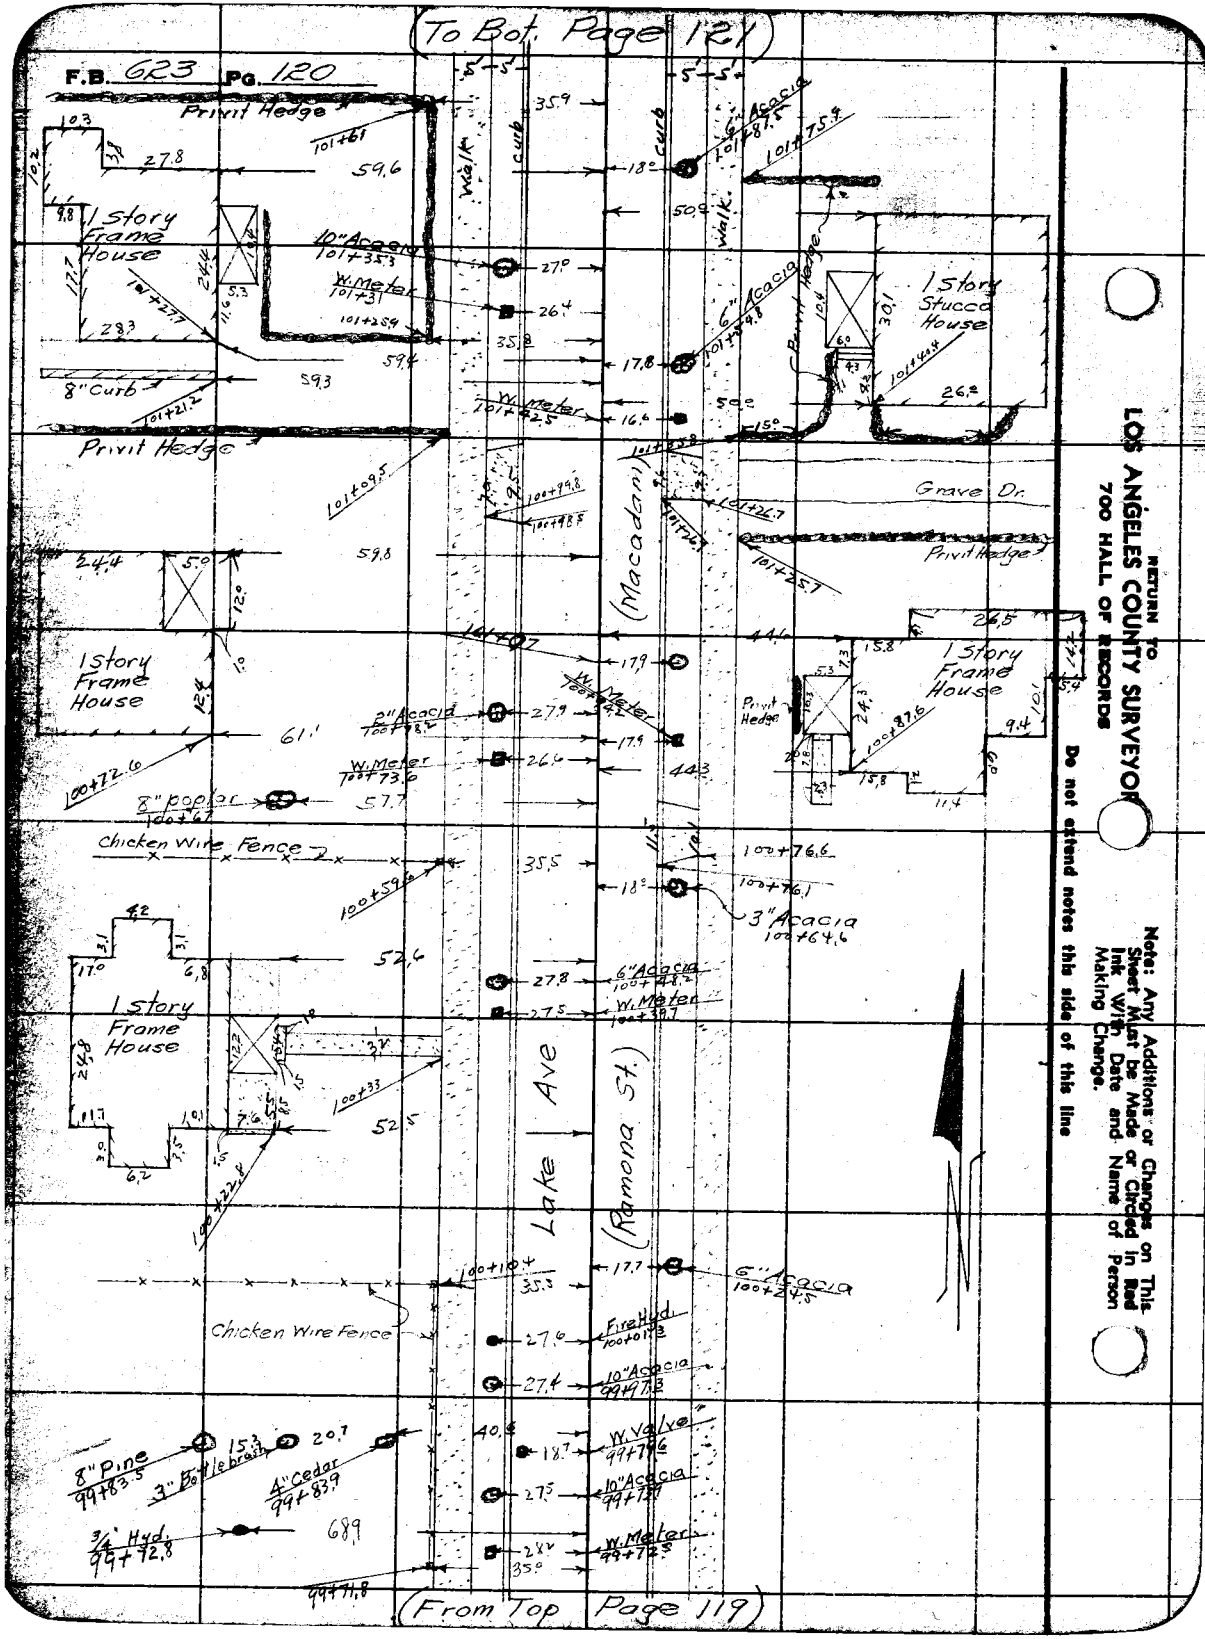

RETURN TO
LOS ANGELES COUNTY SURVEYOR
700 HALL OF RECORDS

Do not extend notes this side of this line

Note: Any Additions or Changes on This Sheet Must be Made or Circled in Red Ink With Date and Name of Person Making Change.

Notes Ck'd by Drew	Survey of Lake Ave
Map No. B-1345	W. O. 7138 Tape No. 072 St'd 24°F.
Office Work Wood	Surveyed by Evans
Checked Drew	Notes HM Date 8-13-36
Date Feb 38	Indexed A. C. Johnson

F.B. 623 Pg. 121

(To Bot. Page 122)

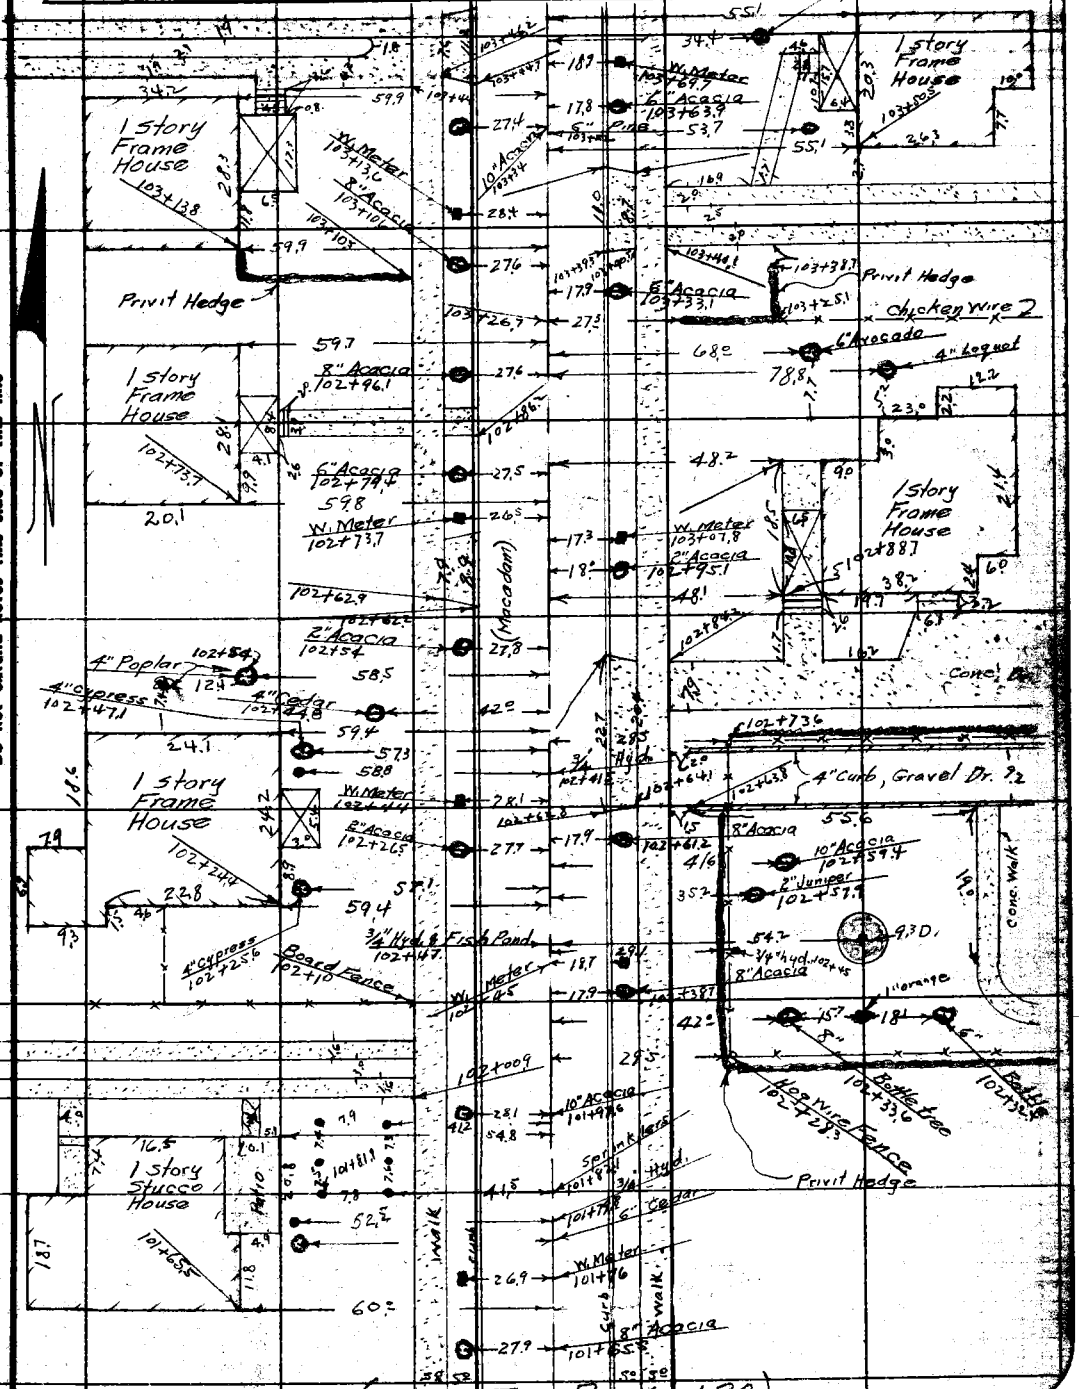

Notice Any Additions or Changes on This Sheet Must Be Made or Circled in Red Ink With Date and Name of Person Making Change.

Do not extend notes this side of this line

RETURN TO
LOS ANGELES COUNTY SURVEYOR
700 HALL OF RECORDS

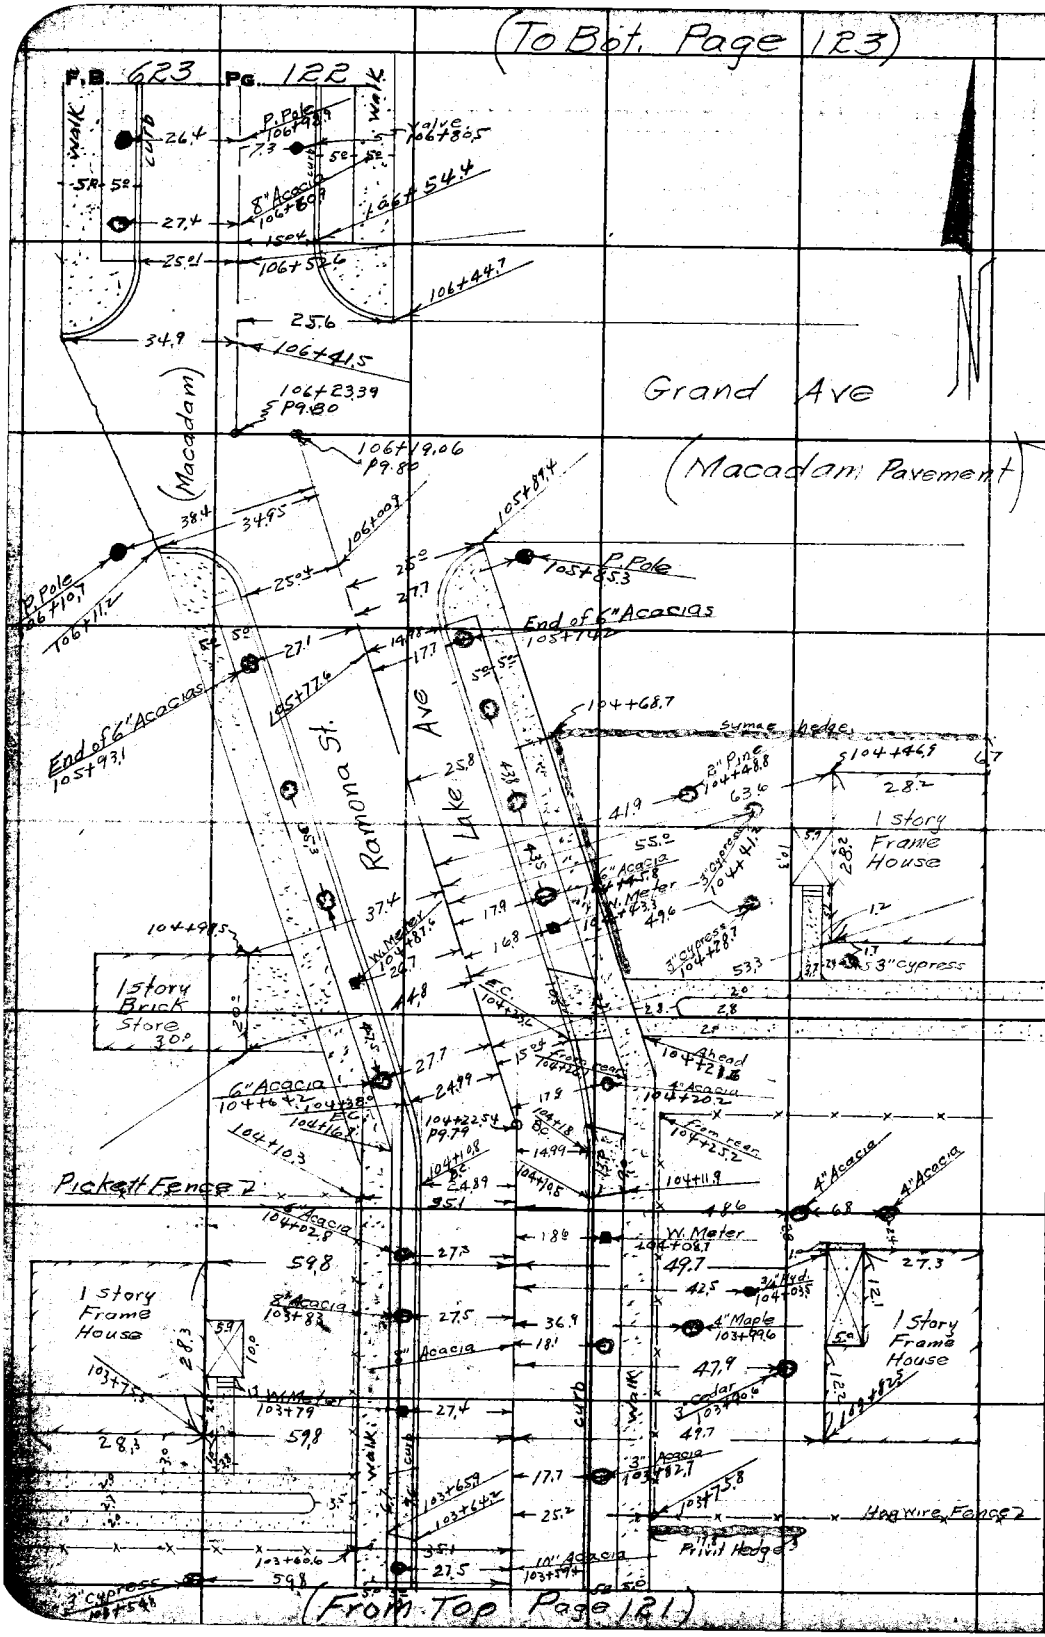

RETURN TO
LOS ANGELES COUNTY SURVEYOR
700 HALL OF RECORDS

Do not extend notes this side of this line

Note: Any Additions or Changes on This Sheet Must be Made or Circled in Red Ink With Date and Name of Person Making Change.

Notes Ck'd by Drew	Survey of Lake Ave	F.B. 623	Pg. 123
Map No. B-1345	W. O. 7136 Tape No. 072 St'd 84°F.		
Office Work Wood	Surveyed by Evans		
Checked Drew	Notes HM Date 8-13-36		
Date Feb 38	Indexed A. C. Johnson		

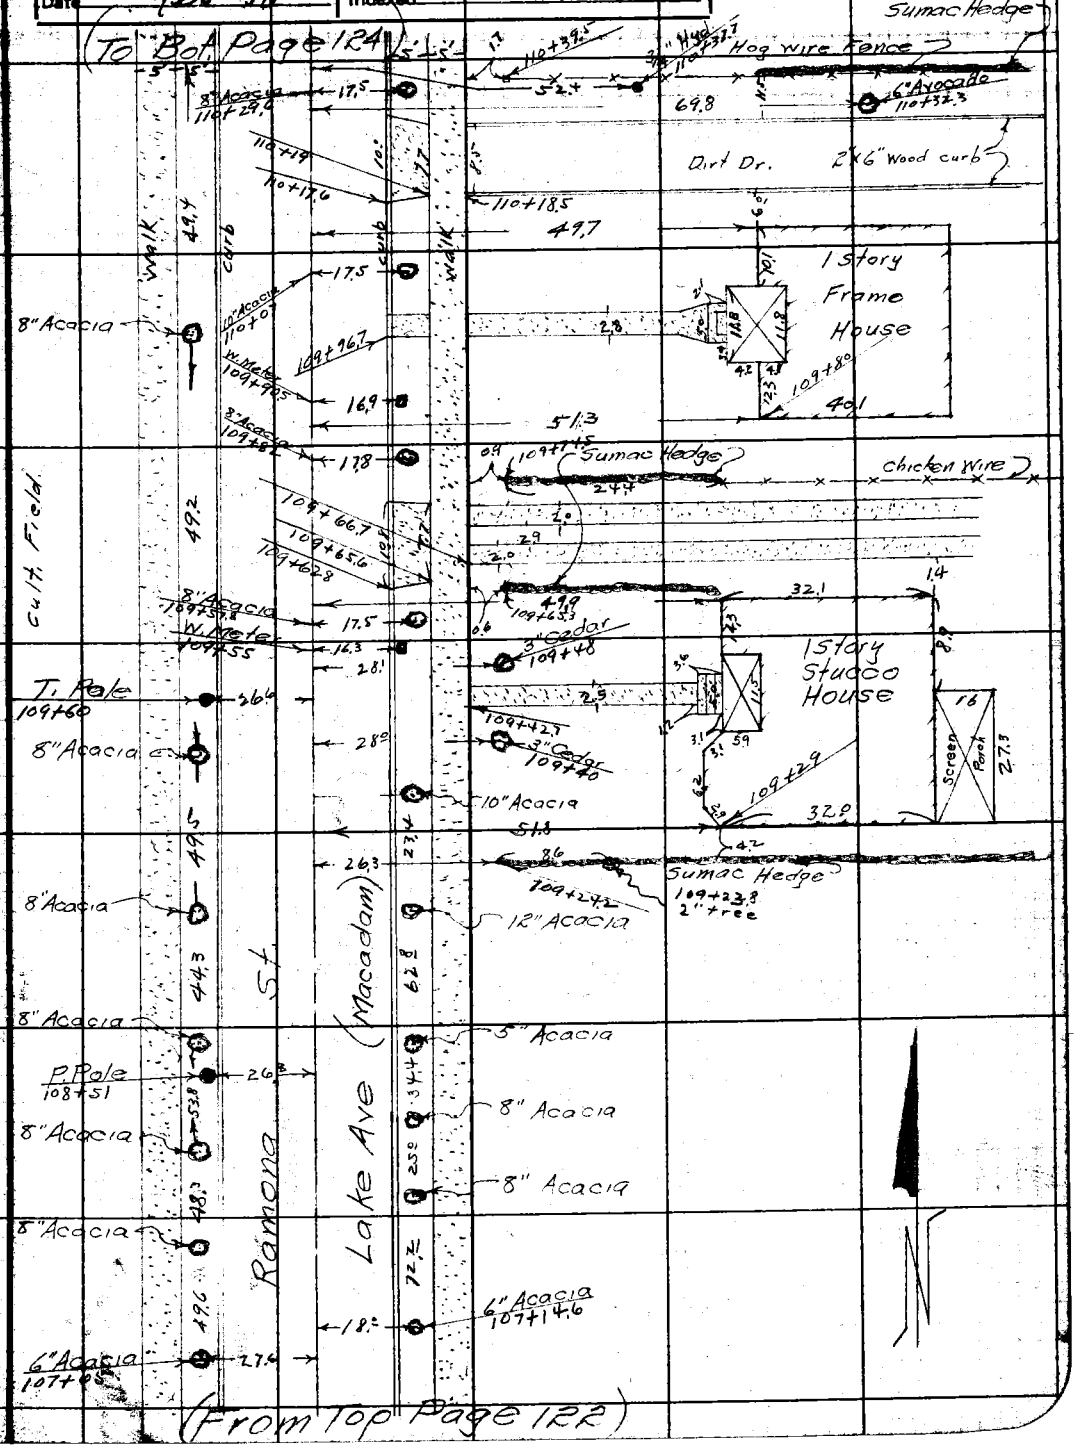

Note: Any Additions or Changes on This Sheet Must be Made or Circled in Red Ink With Date and Name of Person Making Change.

Do not extend notes this side of this line

RETURN TO
LOS ANGELES COUNTY SURVEYOR
700 HALL OF RECORDS

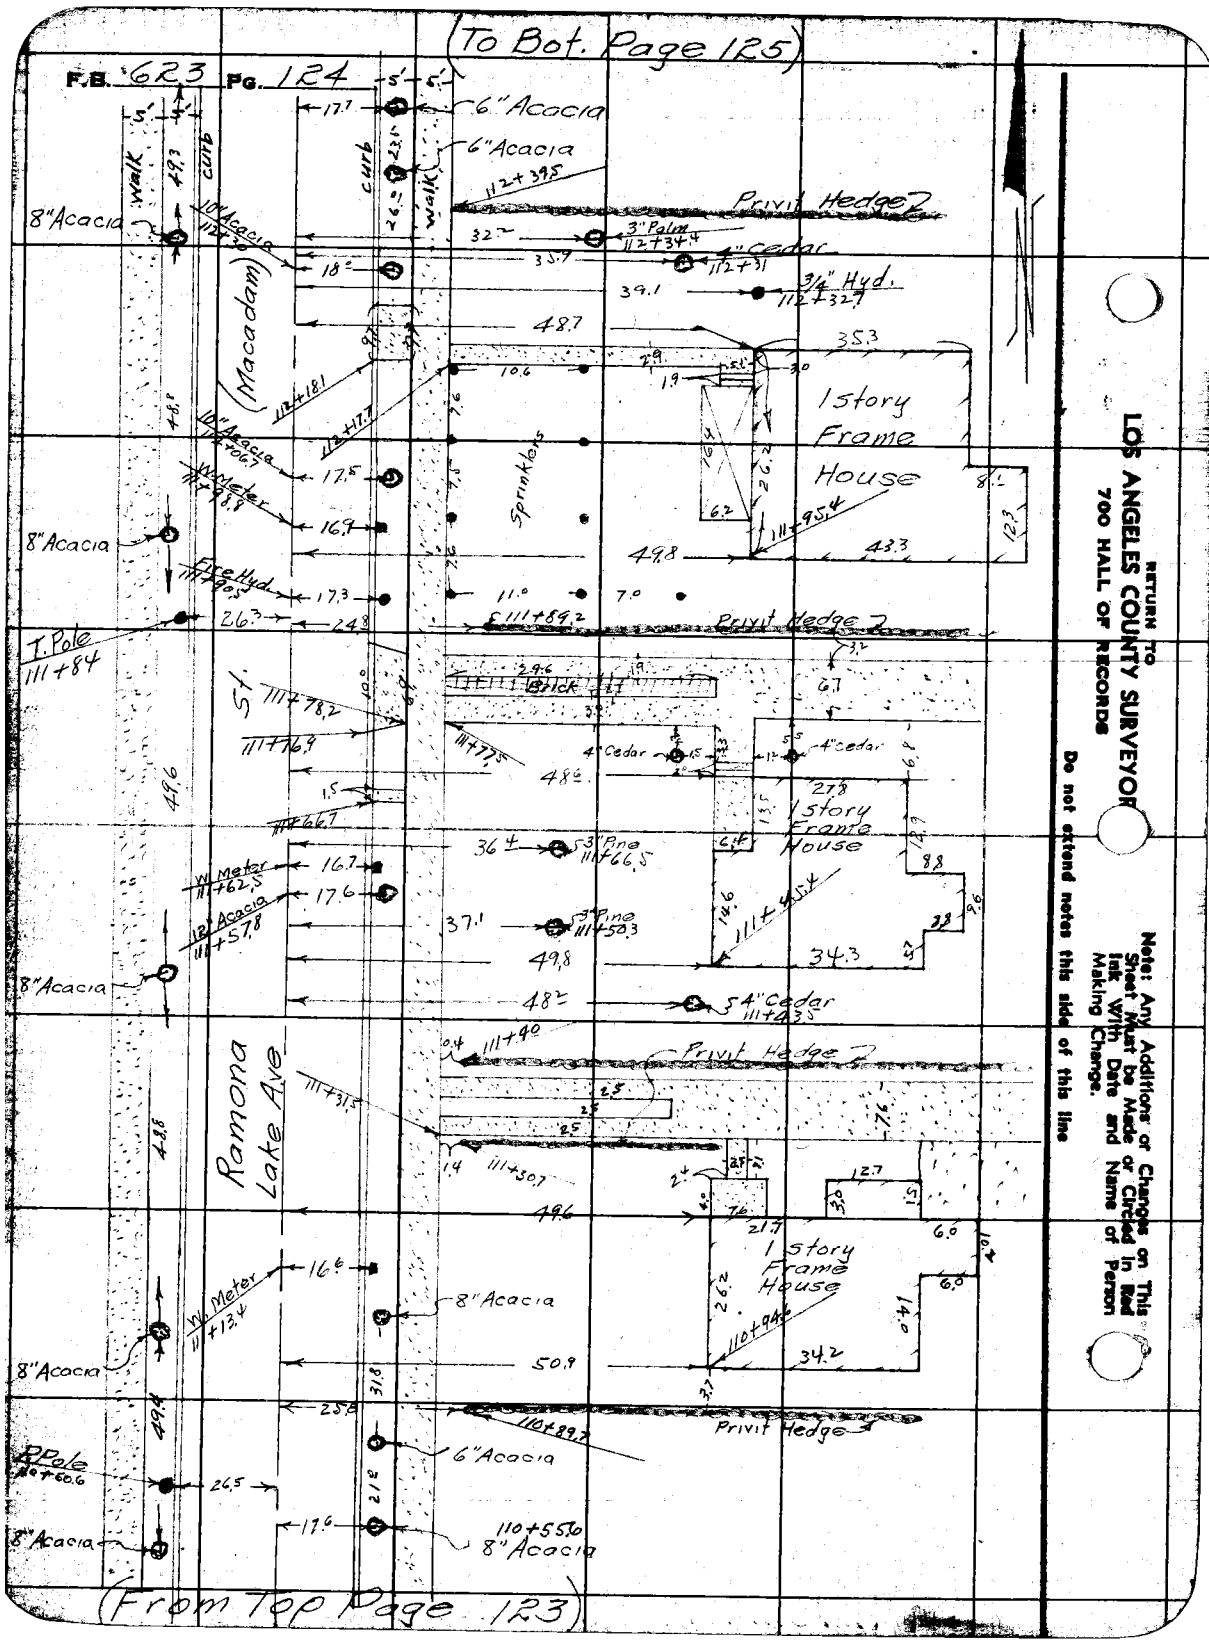
(To Bot. Page 125)
F.B. 623 Pg. 124
6" Acacia
6" Acacia
Privit Hedge
3" Palm
4" Cedar
3/4" Hyd.
(Macadam)
1 Story Frame House
Sprinklers
8" Acacia
Fire Hyd.
T. Pole
St.
Brick
4" Cedar
1 Story Frame House
3" Pine
Ramona Lake Ave
Privit Hedge
1 Story Frame House
8" Acacia
Privit Hedge
6" Acacia
PPole
8" Acacia
(From Top Page 123)
RETURN TO
LOS ANGELES COUNTY SURVEYOR
700 HALL OF RECORDS
Do not extend notes this side of this line
Note: Any Additions or Changes on This Sheet Must be Made or Circled in Red Ink With Date and Name of Person Making Change.

Notes Ck'd by Drew	Survey of Lake Ave	F.B. 623 Pg. 125
Map No. B-1345	W. 07135 Tape No. 072 St'd 84 °F.	
Office Work Wood	Surveyed by Evans	
Checked Drew	Notes HM Date 8-14-36	
Date Feb 38	Indexed A. C. Johnson	

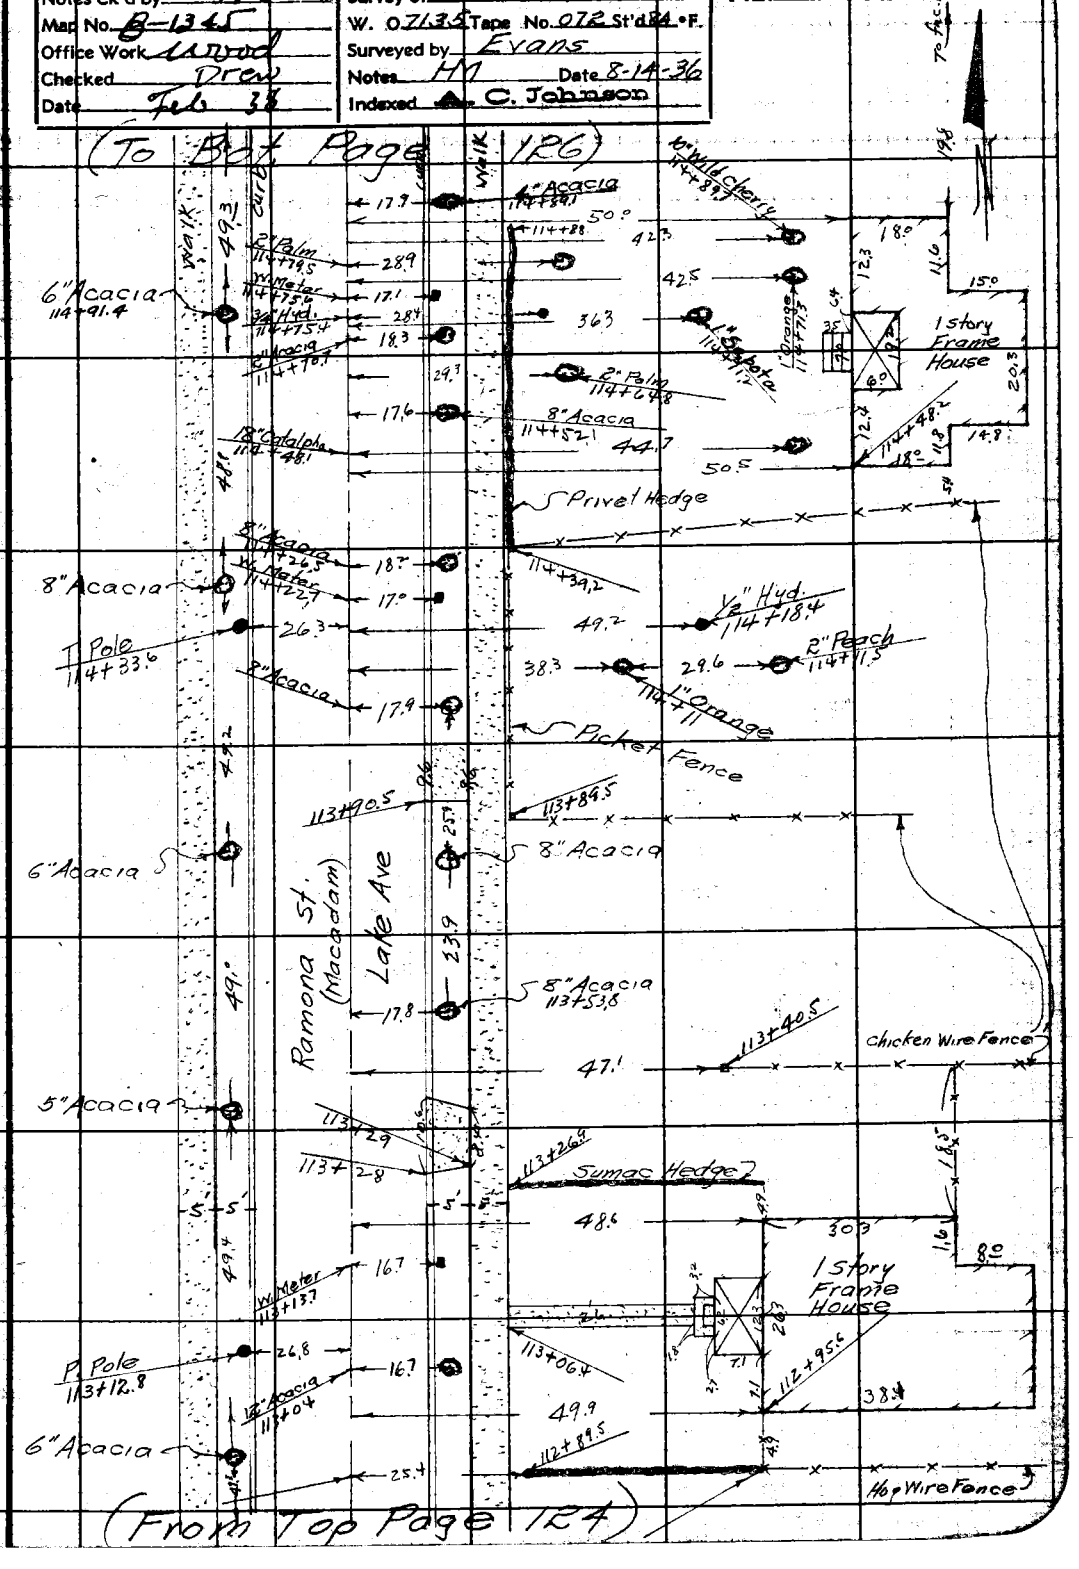

Note: Any Additions or Changes on This Sheet Must be Made or Circled in Red Ink With Date and Name of Person Making Change.

Do not extend notes this side of this line

RETURN TO
LOS ANGELES COUNTY SURVEYOR
700 HALL OF RECORDS

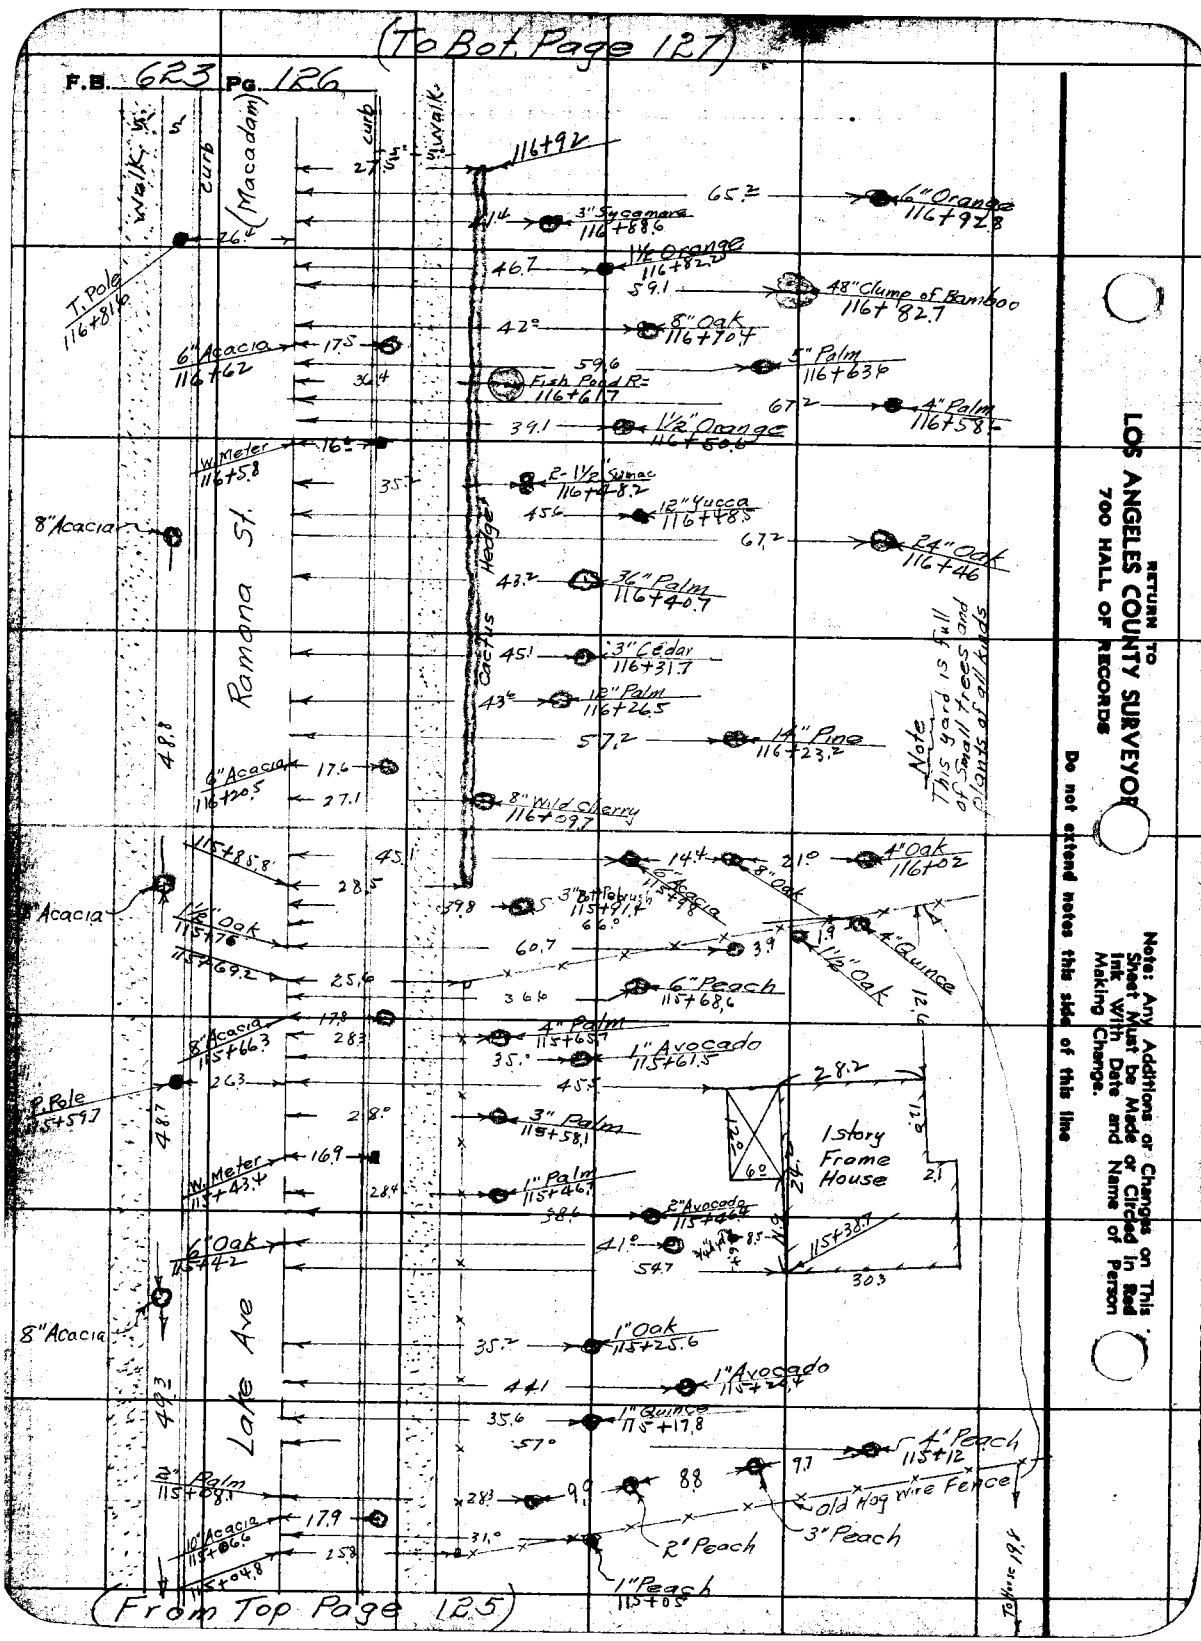
(To Bot. Page 127)
F.B. 623 Pg. 126
Walk
curb
(Macadam)
curb
Walk
116+92
65.2
6" Orange
116+92.8
3" Sycamore
116+88.6
26.4
T. Pole
116+81.6
46.7
1½ Orange
116+82.2
59.1
48" Clump of Bamboo
116+82.7
42°
8" Oak
116+70.4
6" Acacia
116+62
17.5
36.4
59.6
5" Palm
116+63.6
Fish Pond R=
116+61.7
67.2
4" Palm
116+58.6
39.1
1½" Orange
116+50.6
W. Meter
116+5.8
16°
35.2
2-1½" Sumac
116+48.2
8" Acacia
45.6
12" Yucca
116+48.5
67.2
24" Oak
116+46
Ramona St.
Cactus Hedge
43.2
36" Palm
116+40.7
45.1
3" Cedar
116+31.7
43.6
12" Palm
116+26.5
57.2
14" Pine
116+23.2
48.8
6" Acacia
116+20.5
17.6
27.1
8" Wild Cherry
116+09.7
Note
This yard is full of small trees and plants of all kinds
115+85.8
45.1
28.5
14.4
21°
4" Oak
116+02
8" Acacia
39.8
3" Bot. Pebrush
115+91.4
66°
6" Acacia
115+98
8" Oak
1½" Oak
115+76
115+69.2
60.7
3.9
1.9
4" Quince
1½" Oak
25.6
36.6
6" Peach
115+68.6
12.6
17.8
28.3
8" Acacia
115+66.3
4" Palm
115+65.7
35.°
1" Avocado
115+61.5
26.3
45.5
28.2
P. Pole
115+59.7
48.7
28.°
3" Palm
115+58.1
1 story
Frame
House
12.0
6.0
24.
2.1
W. Meter
115+43.4
16.9
28.4
1" Palm
115+46.7
38.6
2" Avocado
115+46.4
6" Oak
115+4.2
41°
54.7
115+38.7
30.3
8" Acacia
Lake Ave
35.2
1" Oak
115+25.6
44.1
1" Avocado
115+20.4
49.3
35.6
1" Quince
115+17.8
57°
4" Peach
115+12
2" Palm
115+08.1
28.3
9.9
8.8
9.7
Old Hog Wire Fence
10" Acacia
115+06.6
17.9
31.°
2" Peach
3" Peach
115+04.8
25.8
1" Peach
115+05
To House 19.4
(From Top Page 125)
RETURN TO
LOS ANGELES COUNTY SURVEYOR
700 HALL OF RECORDS
Do not extend notes this side of this line
Note: Any Additions or Changes on This Sheet Must be Made or Circled in Red Ink With Date and Name of Person Making Change.

Notes Ck'd by Drew	Survey of Lake Ave
Map No. B-1345	W. O. 7136 Tape No. 072 St'd 84°F.
Office Work Wood	Surveyed by Evans
Checked Drew	Notes HM Date 8-14-36
Date Feb 38	Indexed A. C. Johnson

F.B. 623 PG. 127

(To Bot. Page 128)

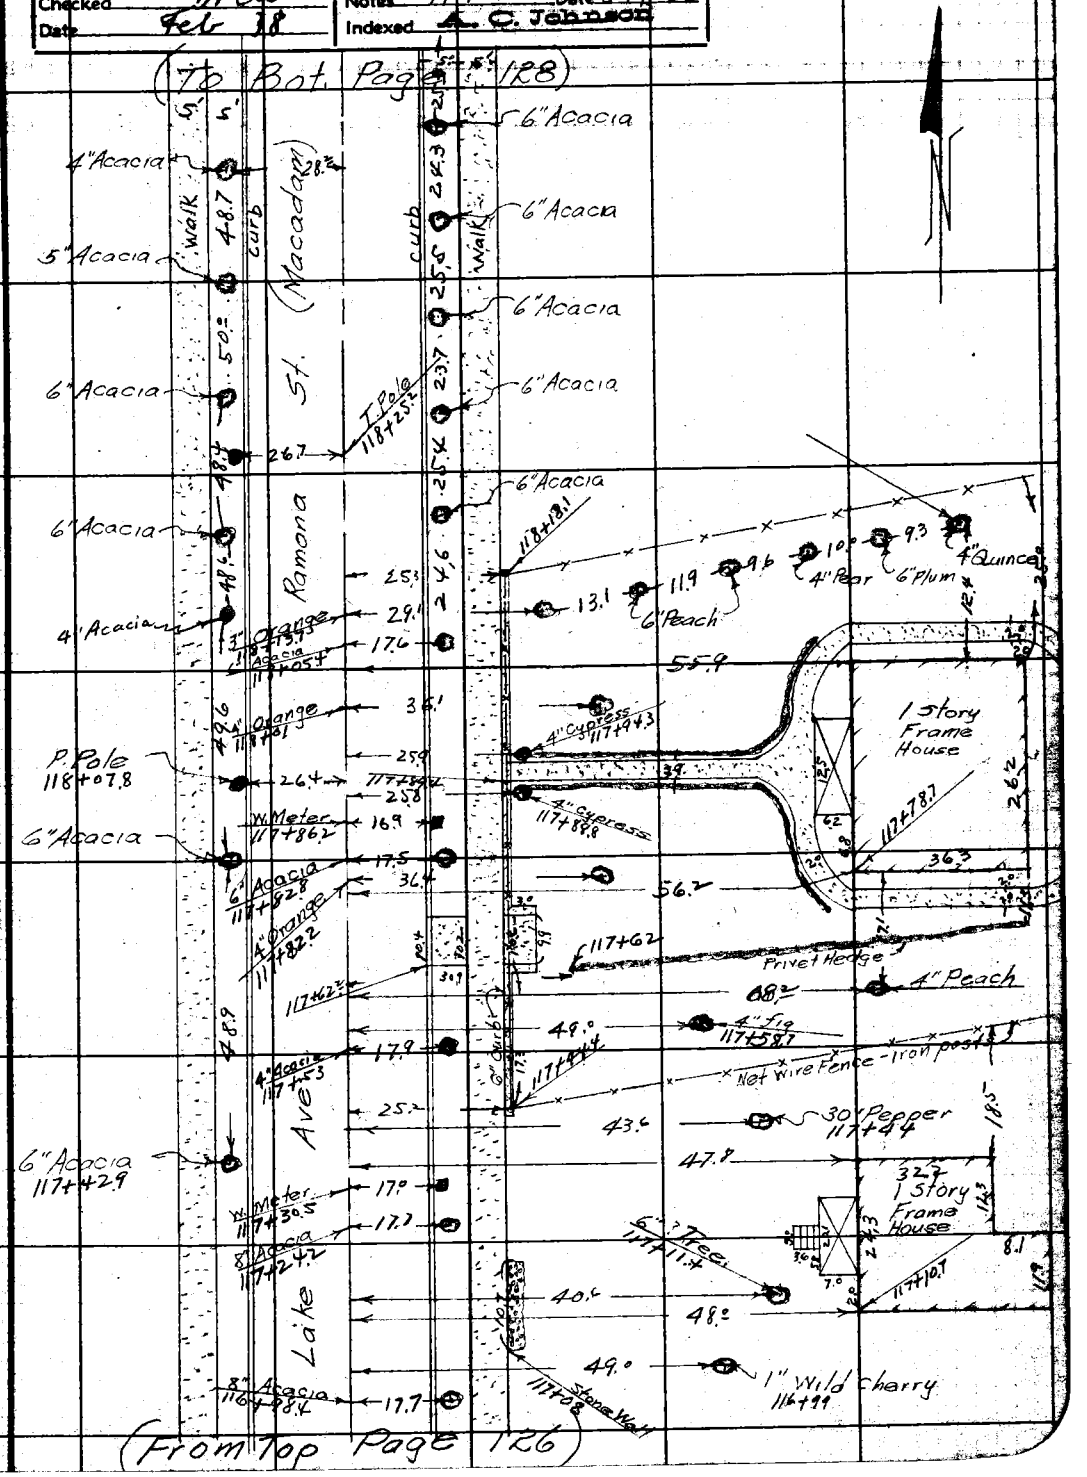

Note: Any Additions or Changes on This Sheet Must be Made or Circled in Red Ink With Date and Name of Person Making Change.

Do not extend notes this side of this line

RETURN TO
LOS ANGELES COUNTY SURVEYOR
700 HALL OF RECORDS

FORM 247 10M 11-38

Stop
End of Survey

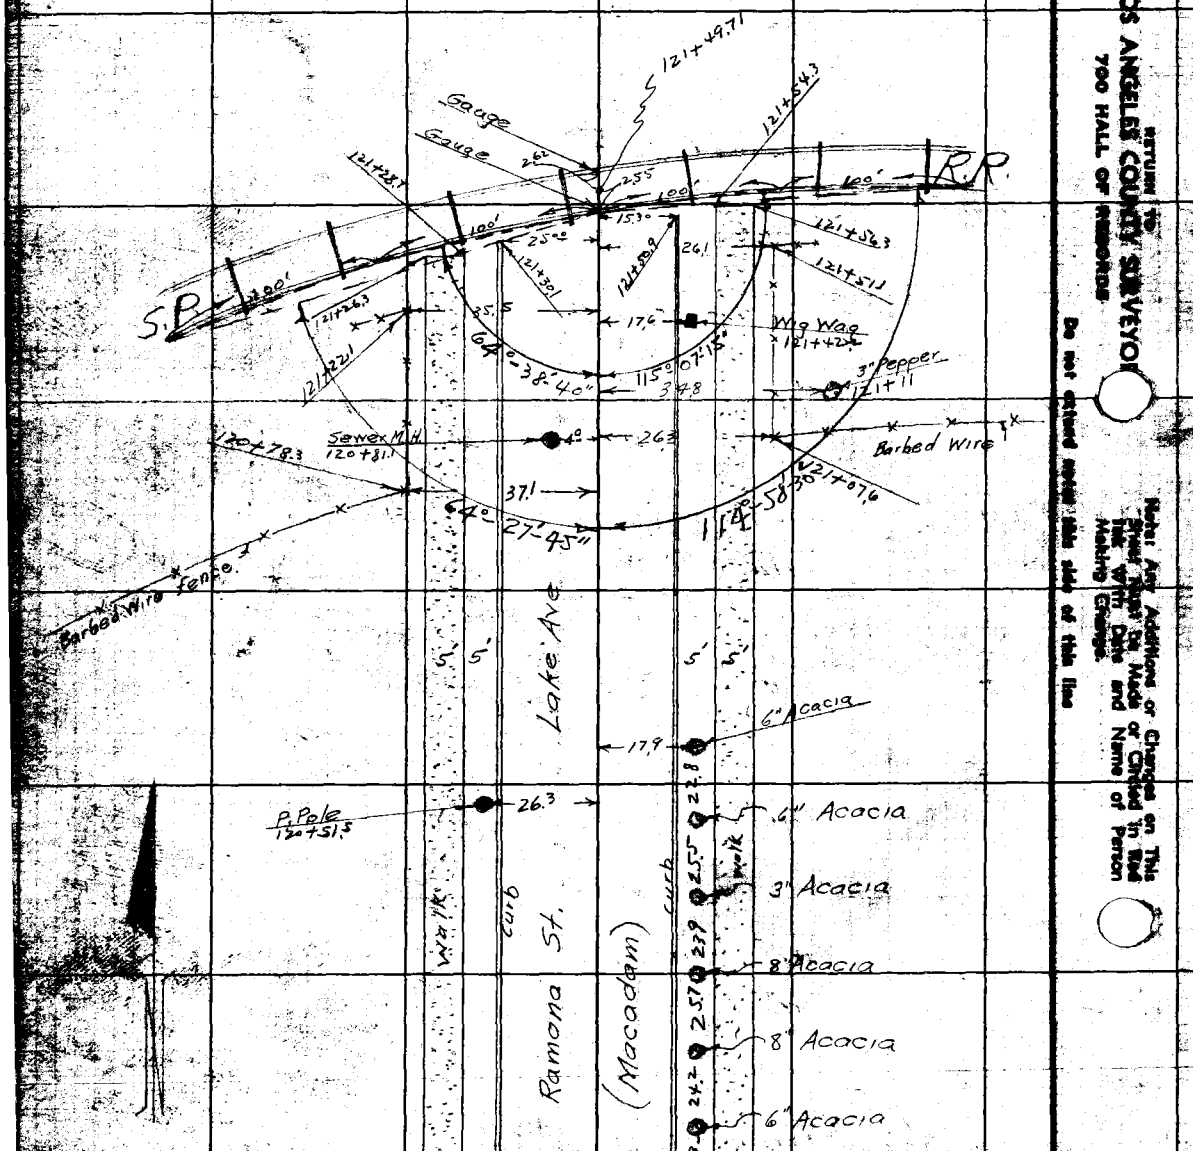

(From Top Page 127)

RETURN TO
LOS ANGELES COUNTY SURVEYOR
700 HALL OF RECORDS
Do not extend notes this side of this line
Note: Any Additions or Changes on This Sheet Must be Made or Circled in Red Ink With Date and Name of Person Making Change.

SURVEY OF SANTA ANITA AVE

FROM

[illegible]

IN 7145

Dec 31 1935 to June 2 1936

[illegible]

TOPOGRAPHY [illegible]

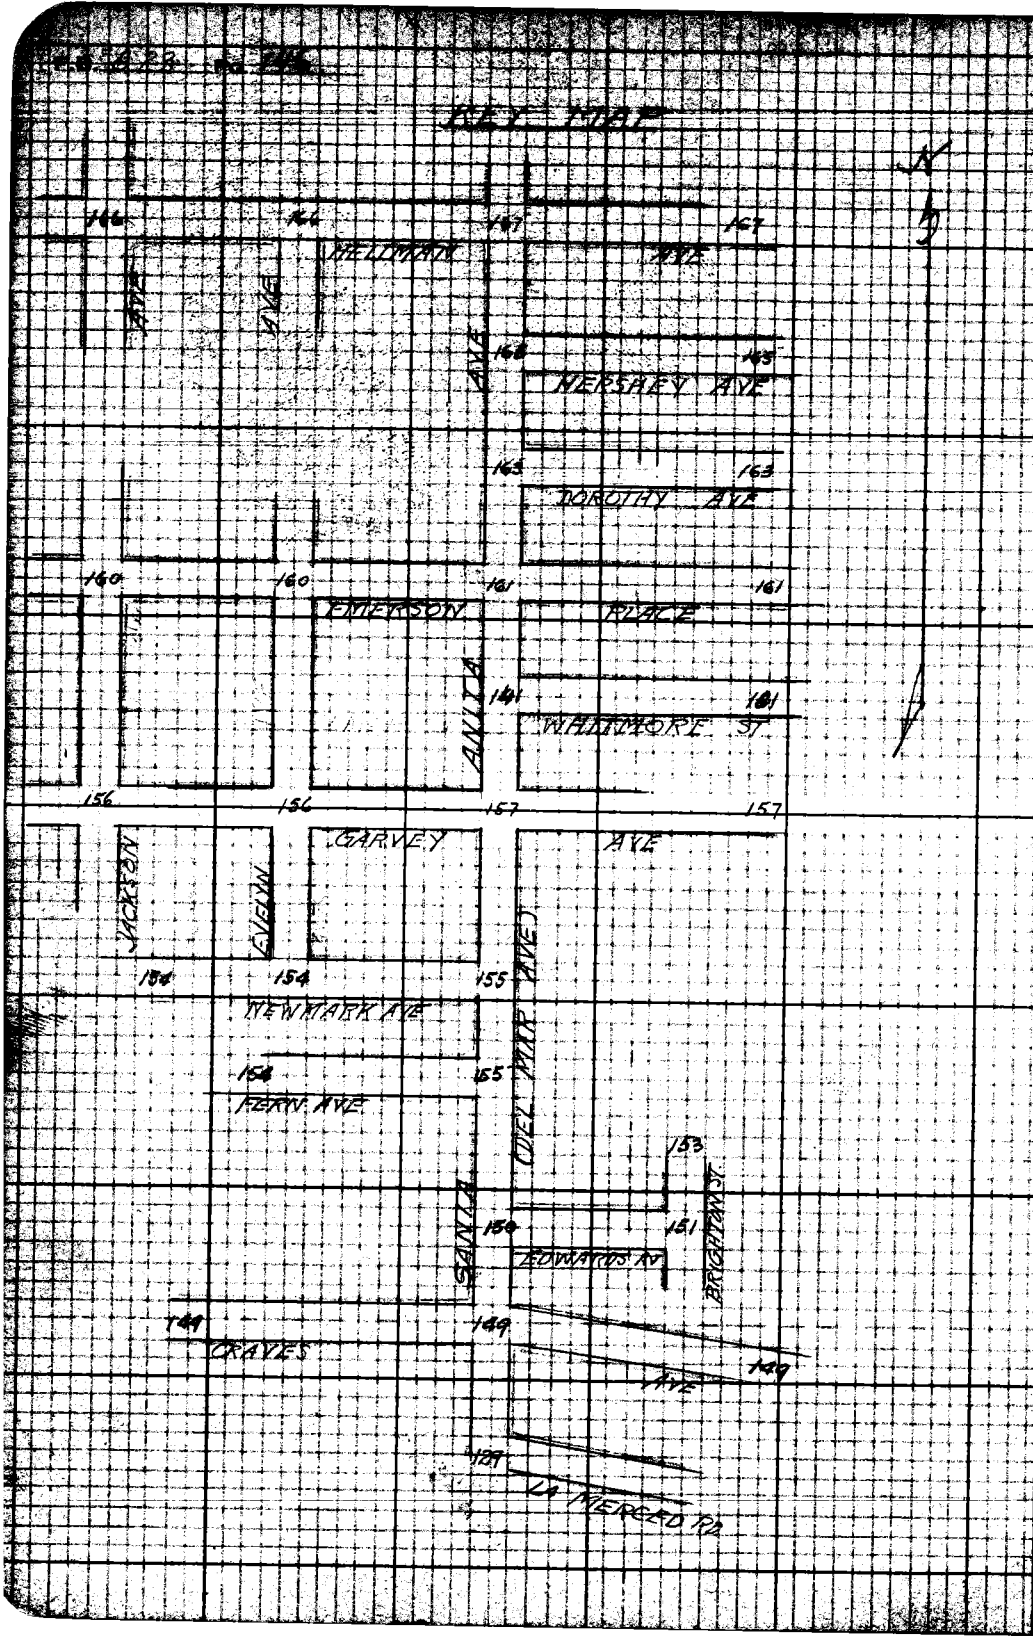

RETURN TO
LOS ANGELES COUNTY SURVEYOR
700 HALL OF RECORDS

Do not extend notes this side of this line

Note: ANY ADDITIONS OR CHANGES ON THIS SHEET MUST BE MADE OR CIRCLED IN Red Ink WITH DATE AND NAME OF PERSON MAKING CHANGE.

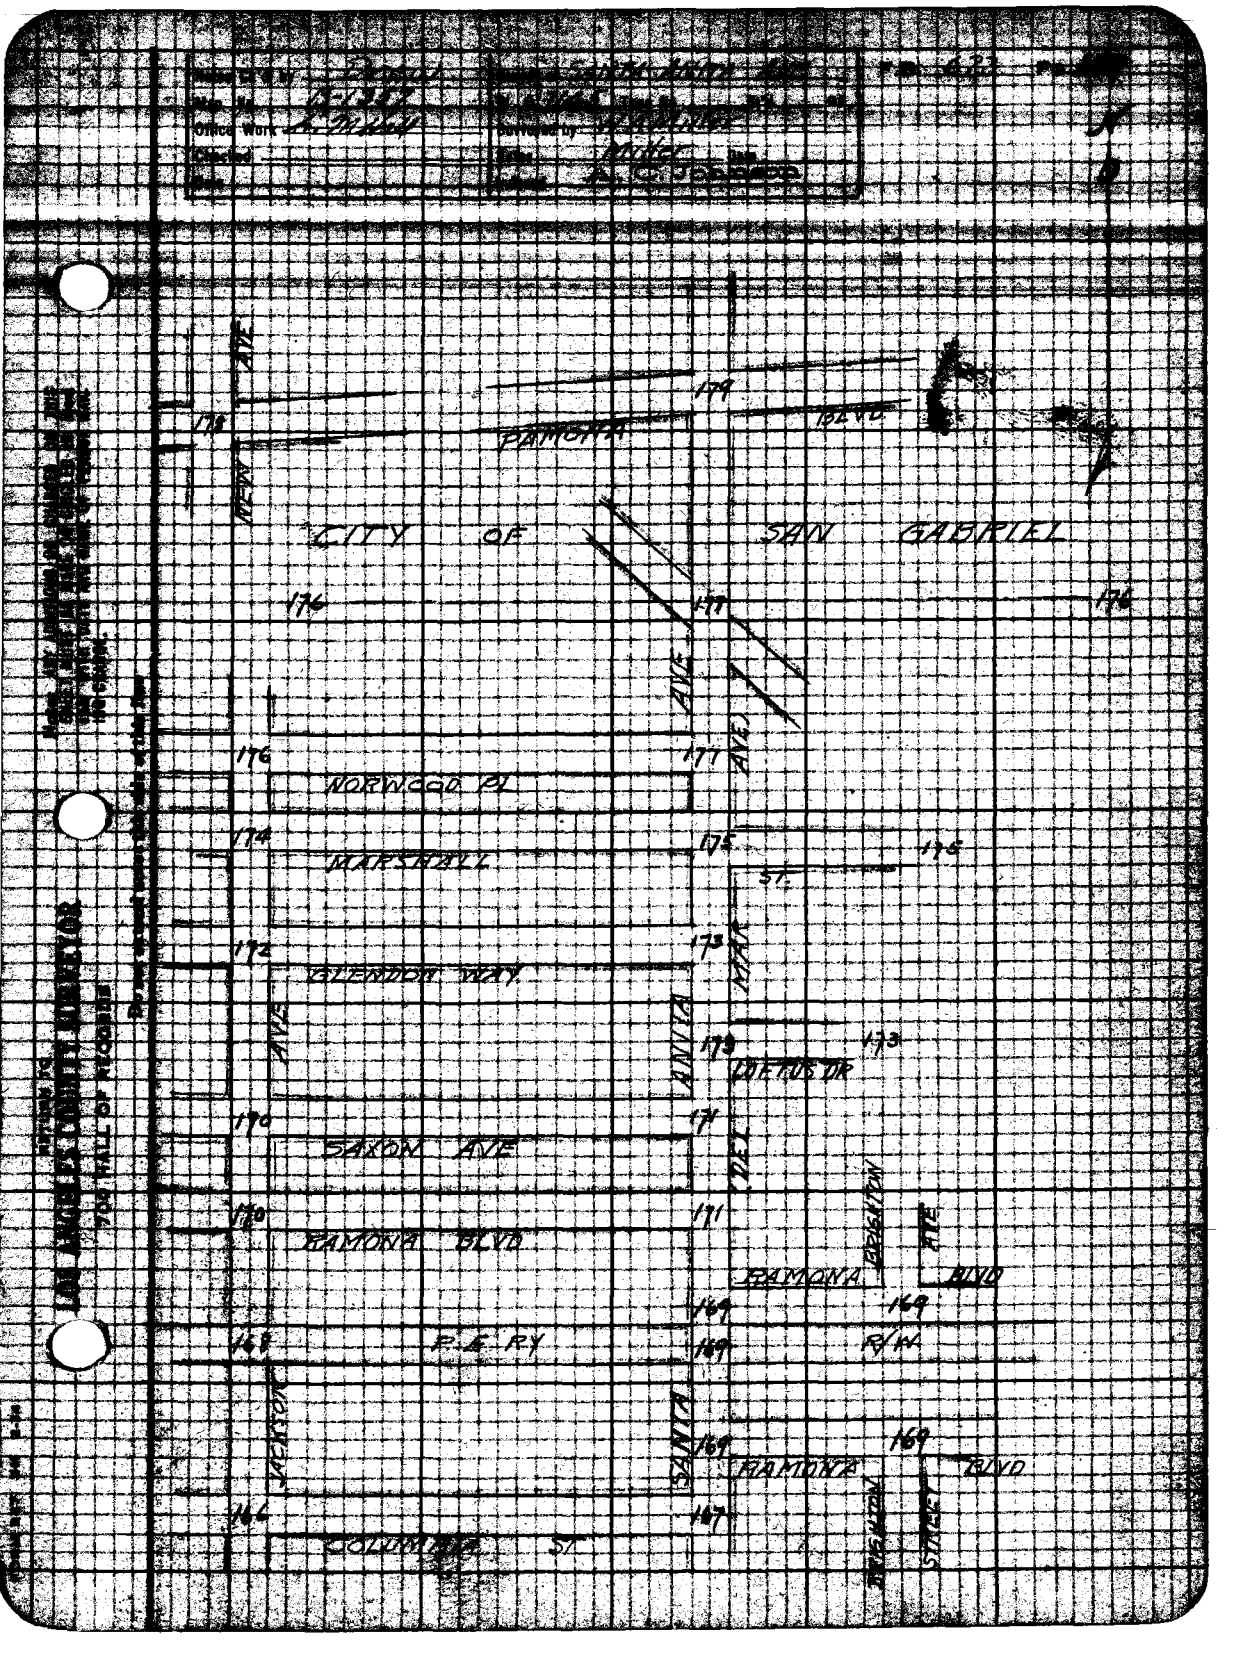

Office Work
Surveyed by
Miller
A. C. Johnson
CITY OF SAN GABRIEL
NEW AVE
PAMONA BLVD
NORWOOD PL
MARSHALL ST
GLENDON WAY
LOFTUS DR
SAXON AVE
RAMONA BLVD
P.E. RY
R/W
COLUMBIA ST
JACKSON AVE
SANTA ANITA AVE
DEL MAR AVE
BRIGHTON AVE
STREET
178
179
176
177
174
175
172
173
170
171
169
168
167
LOS ANGELES COUNTY SURVEYOR
700 HALL OF RECORDS

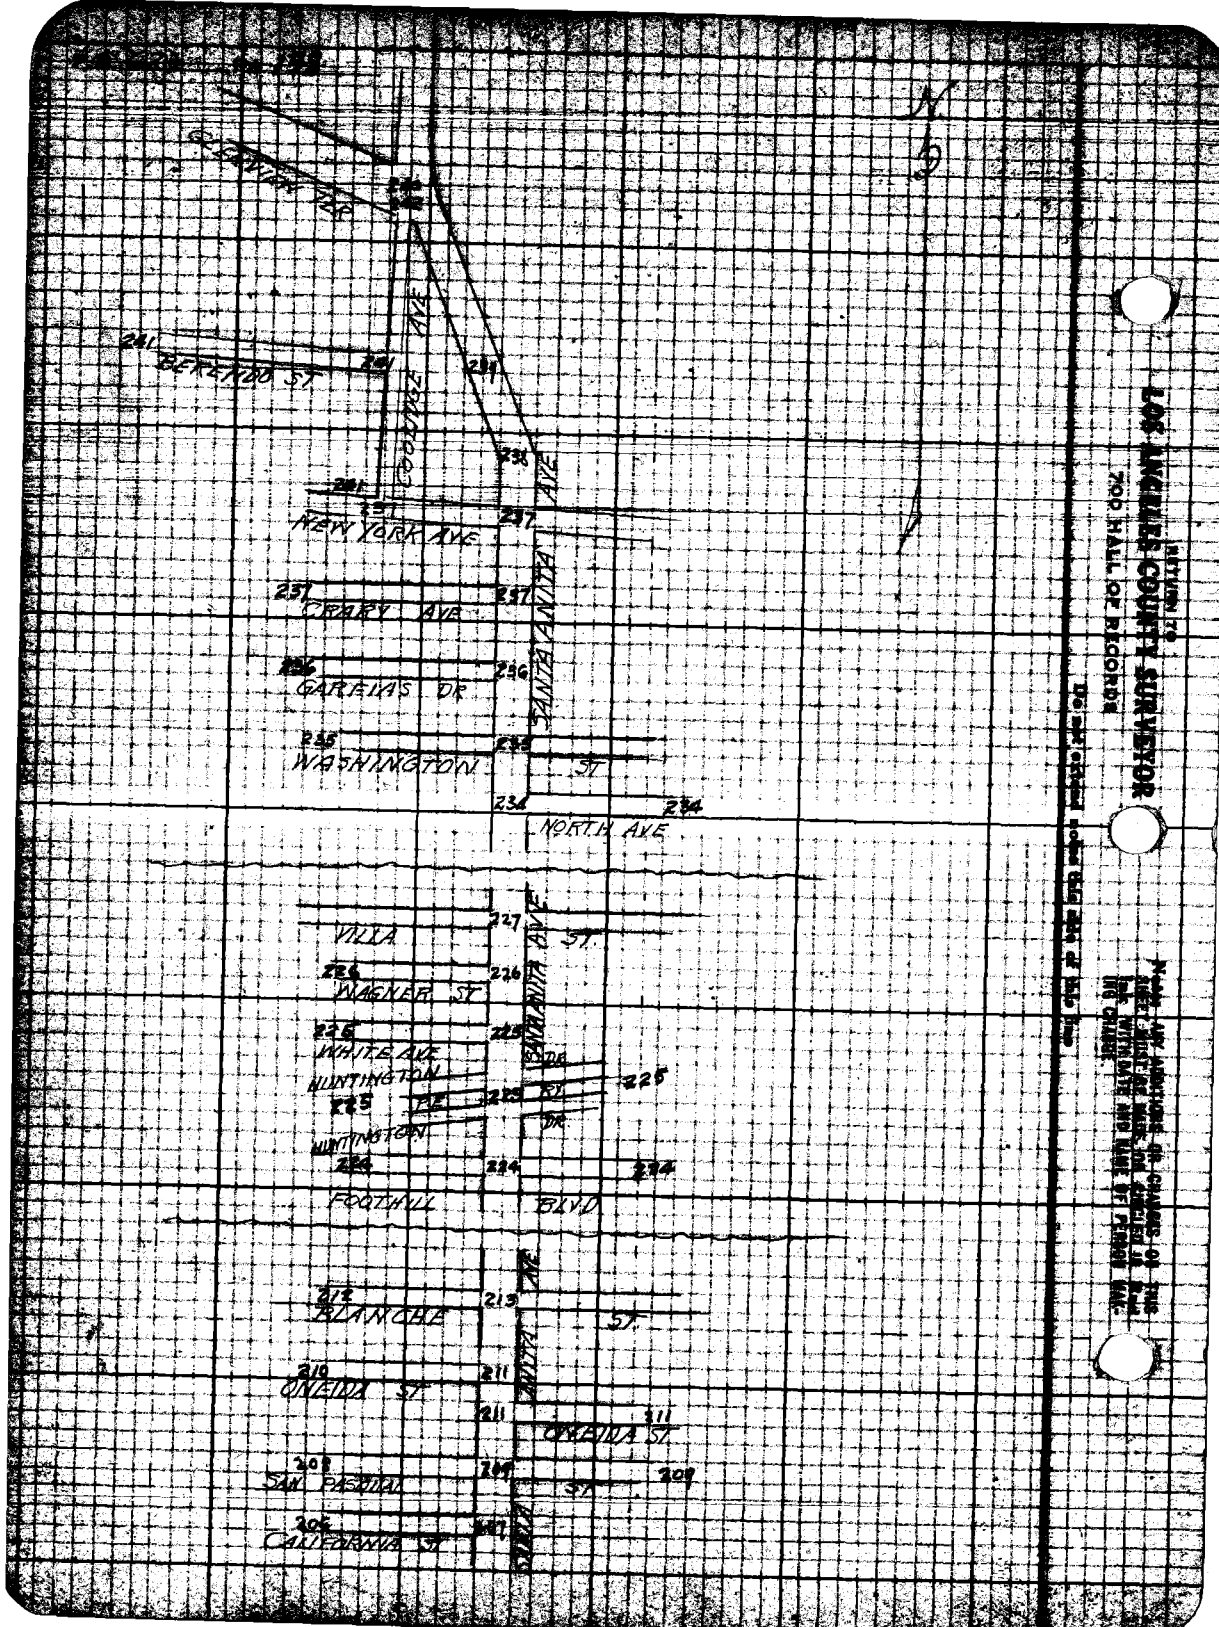

RETURN TO
LOS ANGELES COUNTY SURVEYOR
700 HALL OF RECORDS

Note: ANY ADDITIONS OR CHANGES ON THIS SHEET MUST BE MADE ON SHEET 1A. Mark Tak WITH DATE AND NAME OF PERSON MAKING CHANGE.

Do not extend notes this side of this line

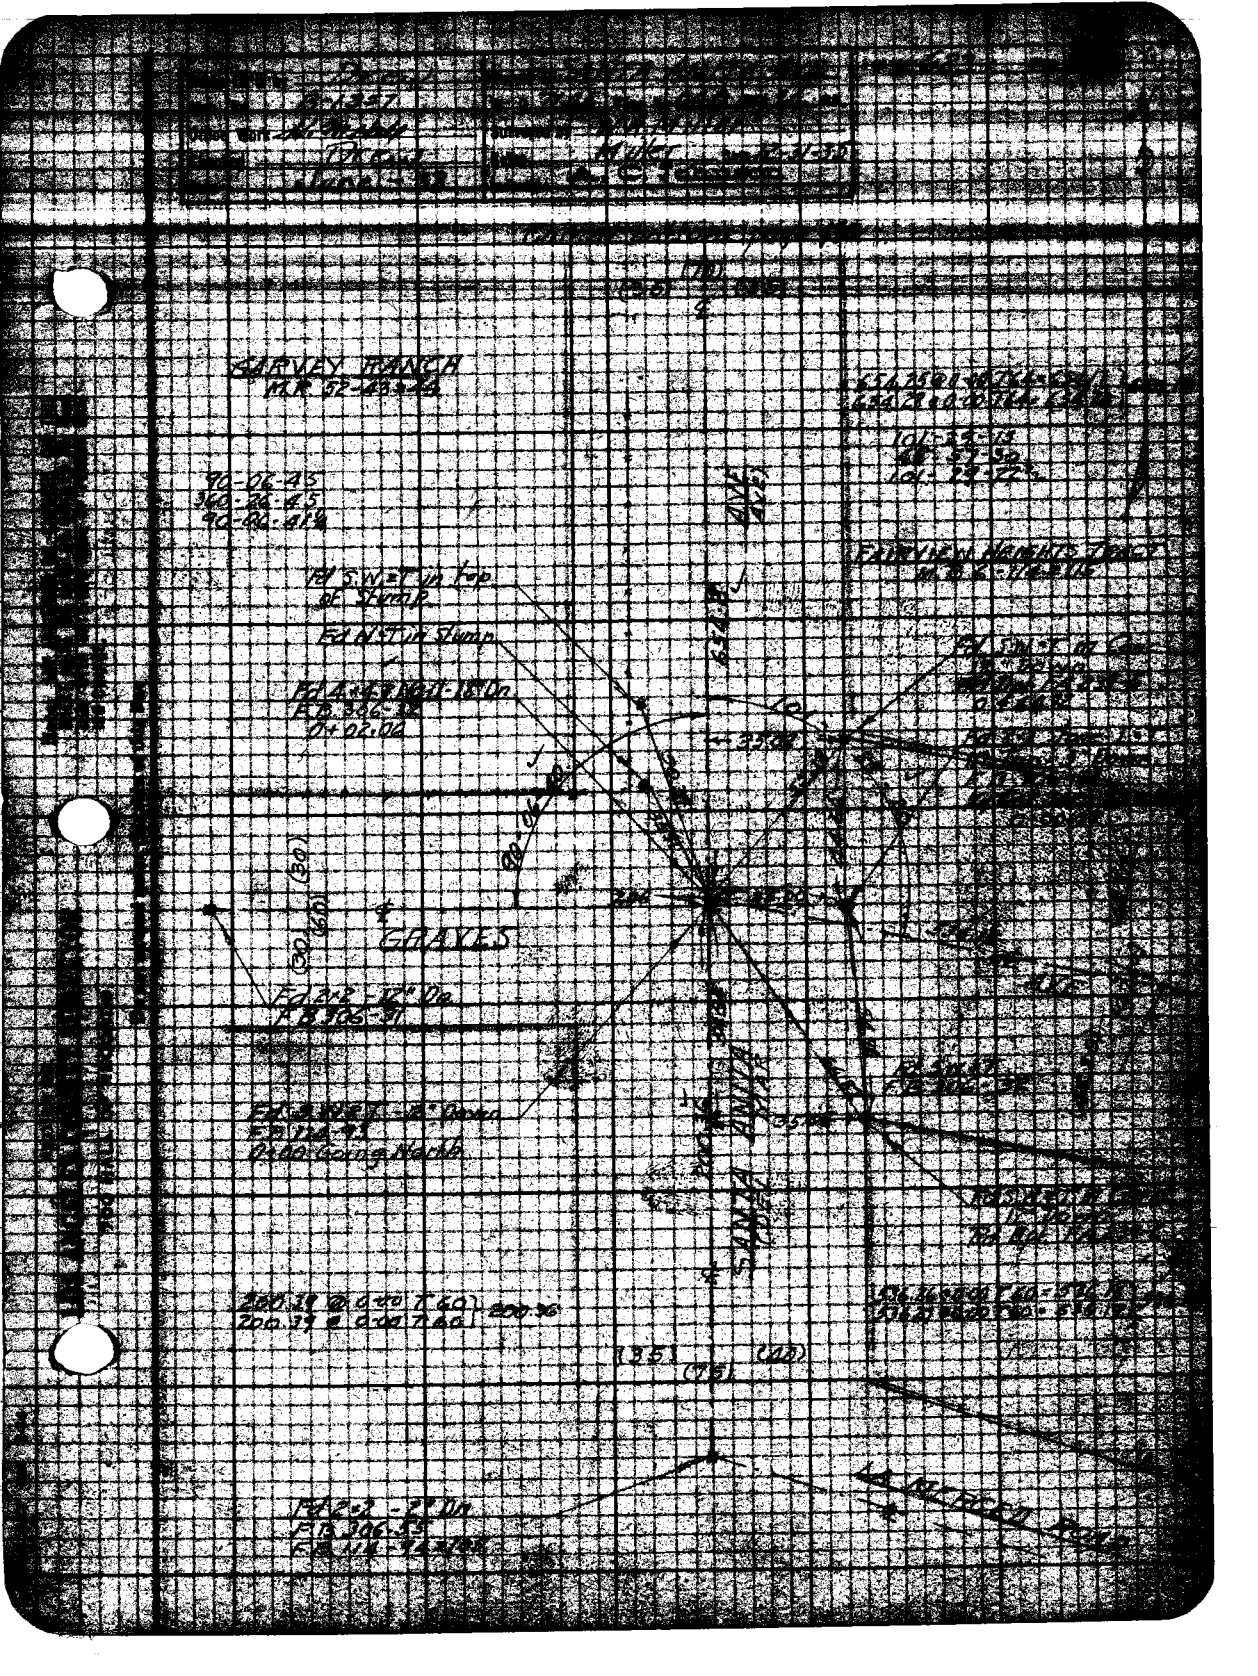
GARVEY RANCH
M.R. 52-43
90-06-45
360-26-45
90-06-41½
Fd S.W.T in top of Stump
Fd N.T in Stump
Fd 4+47 No.11-18" Dn
F.B. 306-32
0+02.00
GRAVES
Fd 2+2 - 12" Dn
F.B. 306-31
0+00 Going North
200.39 @ 0+00 T 60
200.39 @ 0+00 T 60
200.36
Fd 2+2 - 2" Dn
F.B. 306-55
FAIRVIEW HEIGHTS TRACT
SANTA ANITA
LA MERCED ROAD

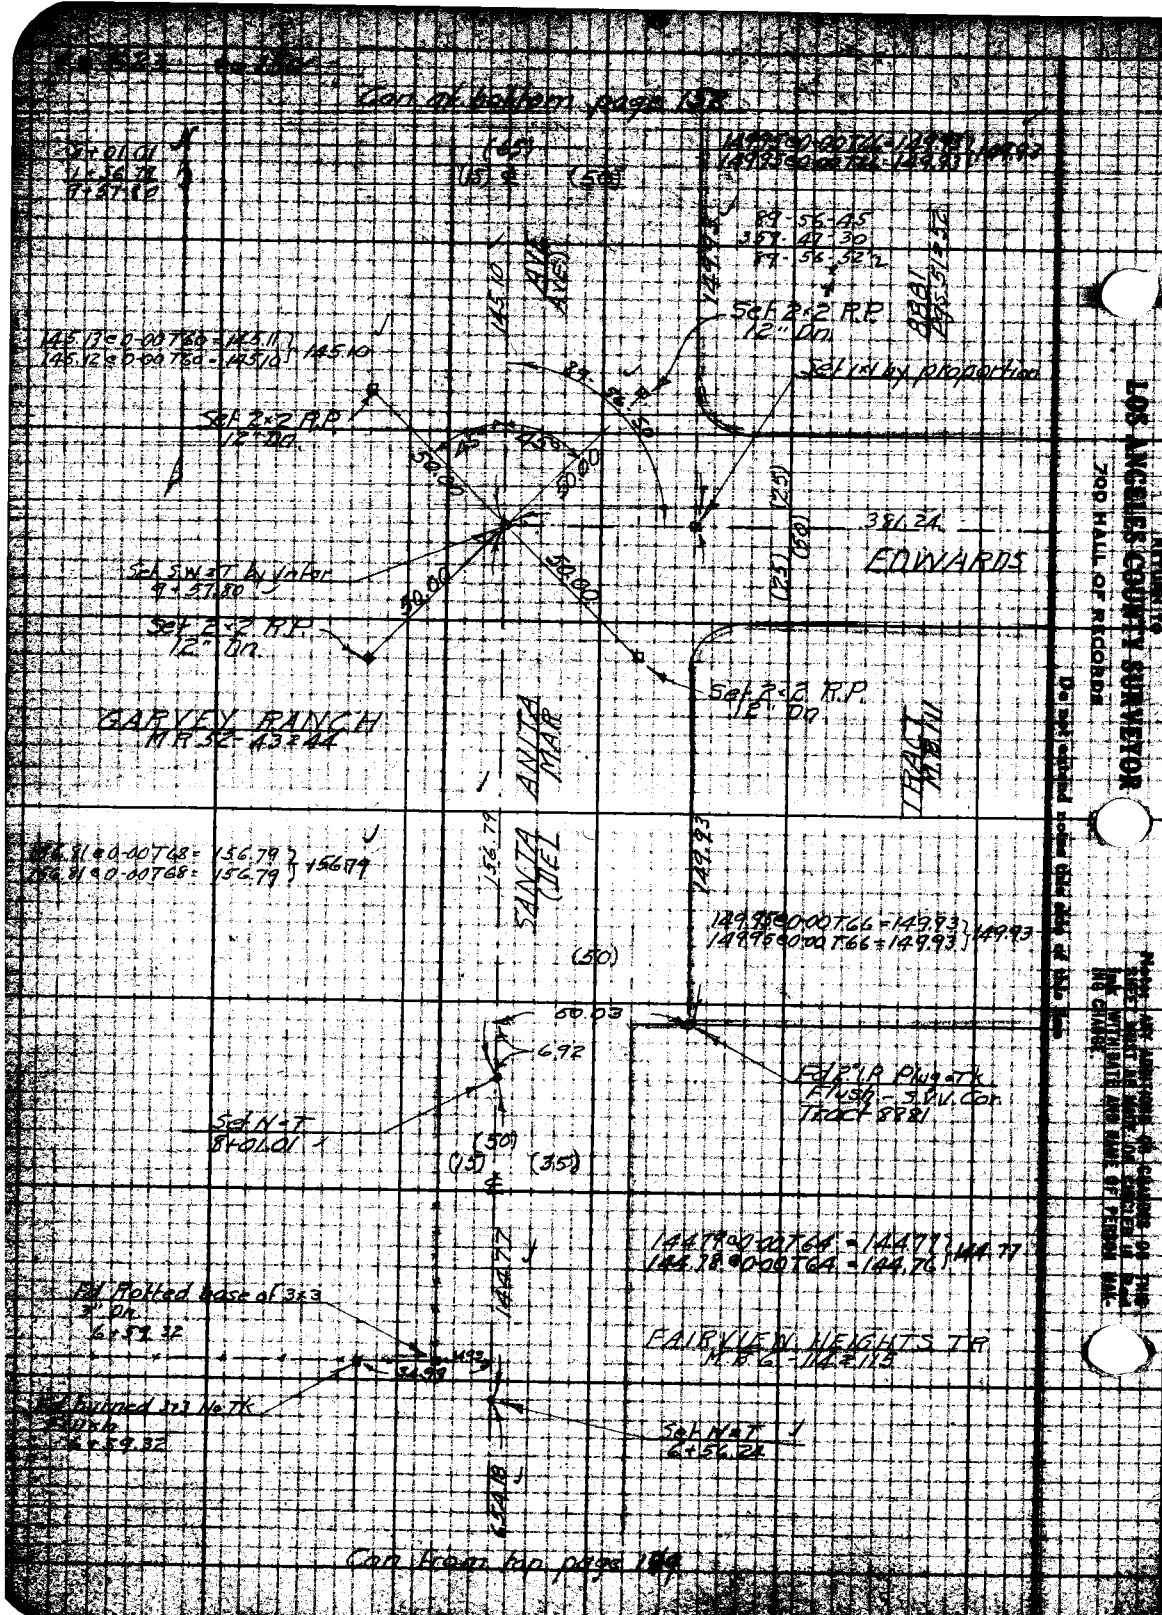

RETURN TO
LOS ANGELES COUNTY SURVEYOR
700 HALL OF RECORDS
Do not extend notes this side of this line
Please ANY ADDITIONS OR CHANGES ON THIS SHEET MUST BE MADE OR CHECKED IN RED INK WITH DATE AND NAME OF PERSON MAKING CHANGE.

Notes Ck'd by	Drew	Survey of	SANTA ANITA AVE
Map No.	[illegible]	W.O.	7645
Office Work	[illegible]	Surveyed by	W.A. Miller
Checked	Drew	Notes	Miller Date 1-2-36
Date	June - 38	Indexed	A. C. Johnson

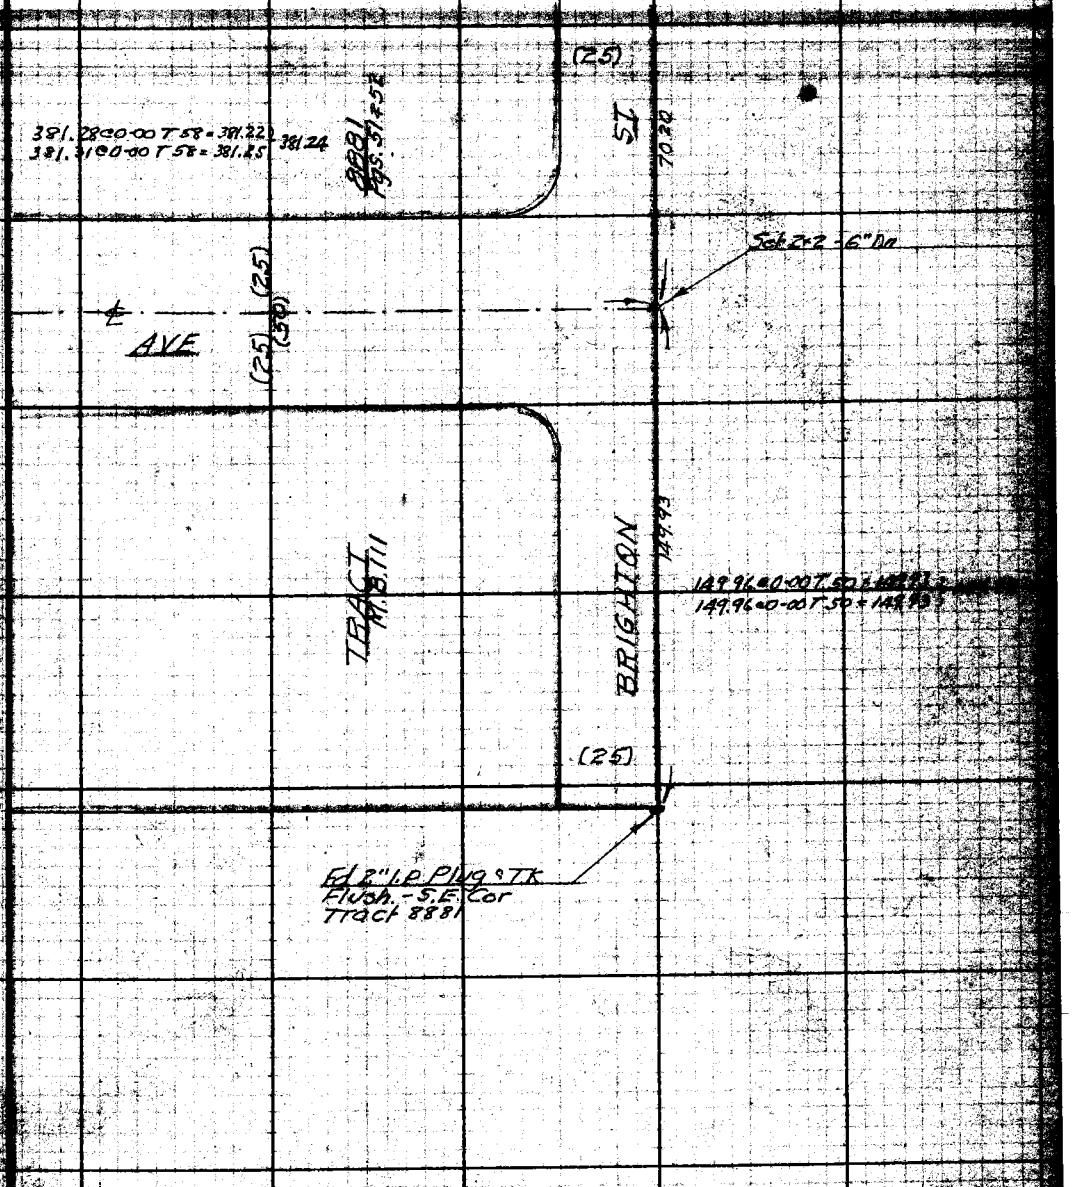

Notes: ANY ADDITIONS OR CHANGES ON THIS SHEET MUST BE MADE OR CIRCLED IN Red Ink WITH DATE AND NAME OF PERSON MAKING CHANGE.

Do not extend notes this side of this line

RETURN TO
LOS ANGELES COUNTY SURVEYOR
700 HALL OF RECORDS

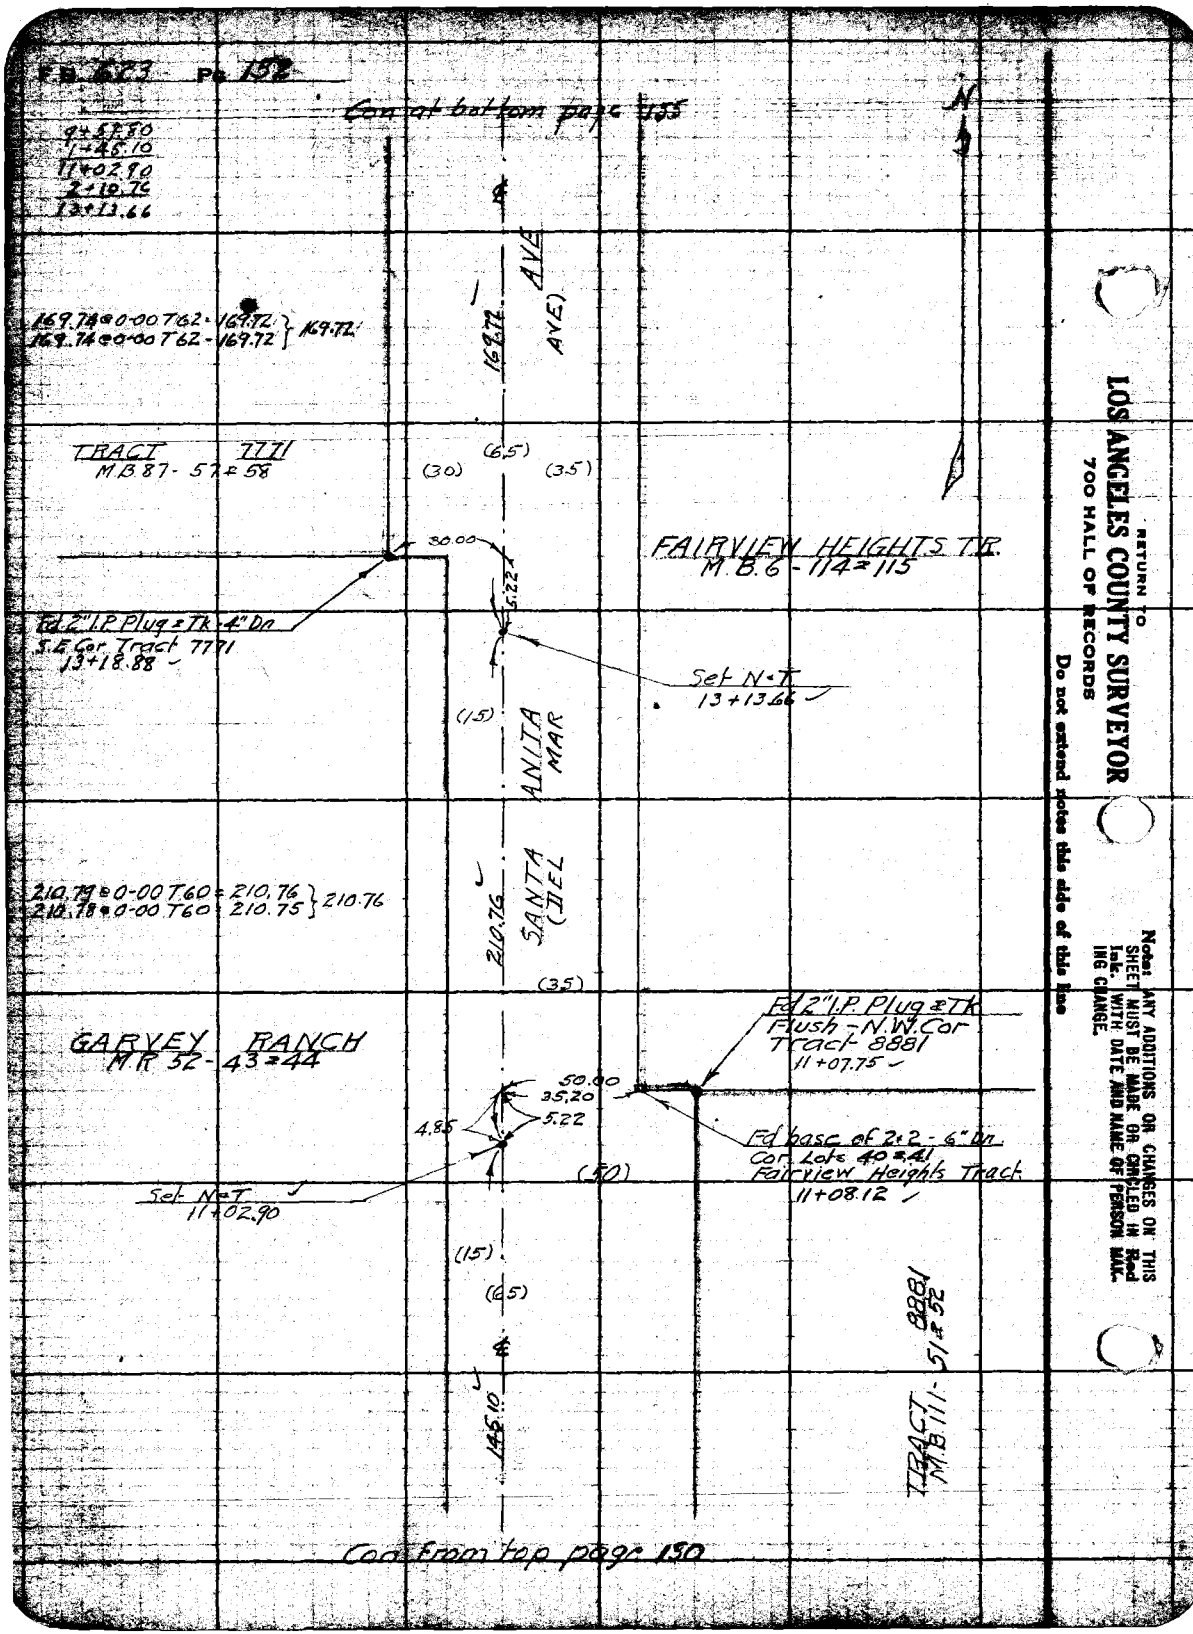

RETURN TO
LOS ANGELES COUNTY SURVEYOR
700 HALL OF RECORDS
Do not extend notes this side of this line

Note: ANY ADDITIONS OR CHANGES ON THIS SHEET MUST BE MADE OR CIRCLED IN Red Ink. WITH DATE AND NAME OF PERSON MAKING CHANGE.

Notes Ch'd by Drew	Survey of SANTA ANITA AVE
Map No. B-1307	W.O. 7145 Type No. 040 Sh'd 84 Ft.
Office Work H. M. Hall	Surveyed by W.A. Miller
Checked Drew	Notes Miller Date 1-3-36
Date June - 38	Indexed [illegible]

F.B. [illegible]

Note: ANY ADDITIONS OR CHANGES ON THIS SHEET MUST BE MADE OR CIRCLED IN Red Ink WITH DATE AND NAME OF PERSON MAKING CHANGE.

RETURN TO
LOS ANGELES COUNTY SURVEYOR
700 HALL OF RECORDS

Do not extend notes this side of this line

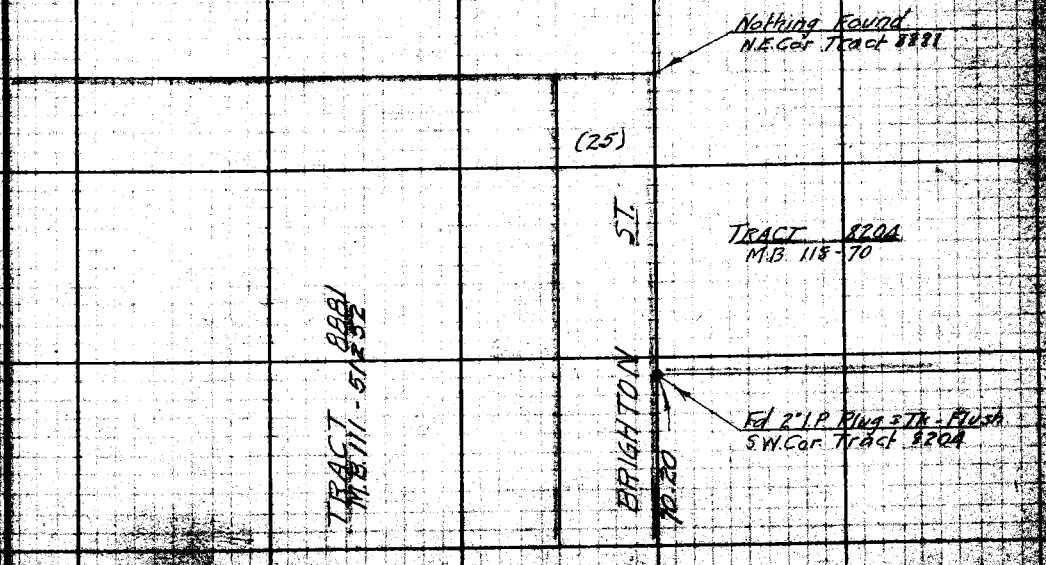

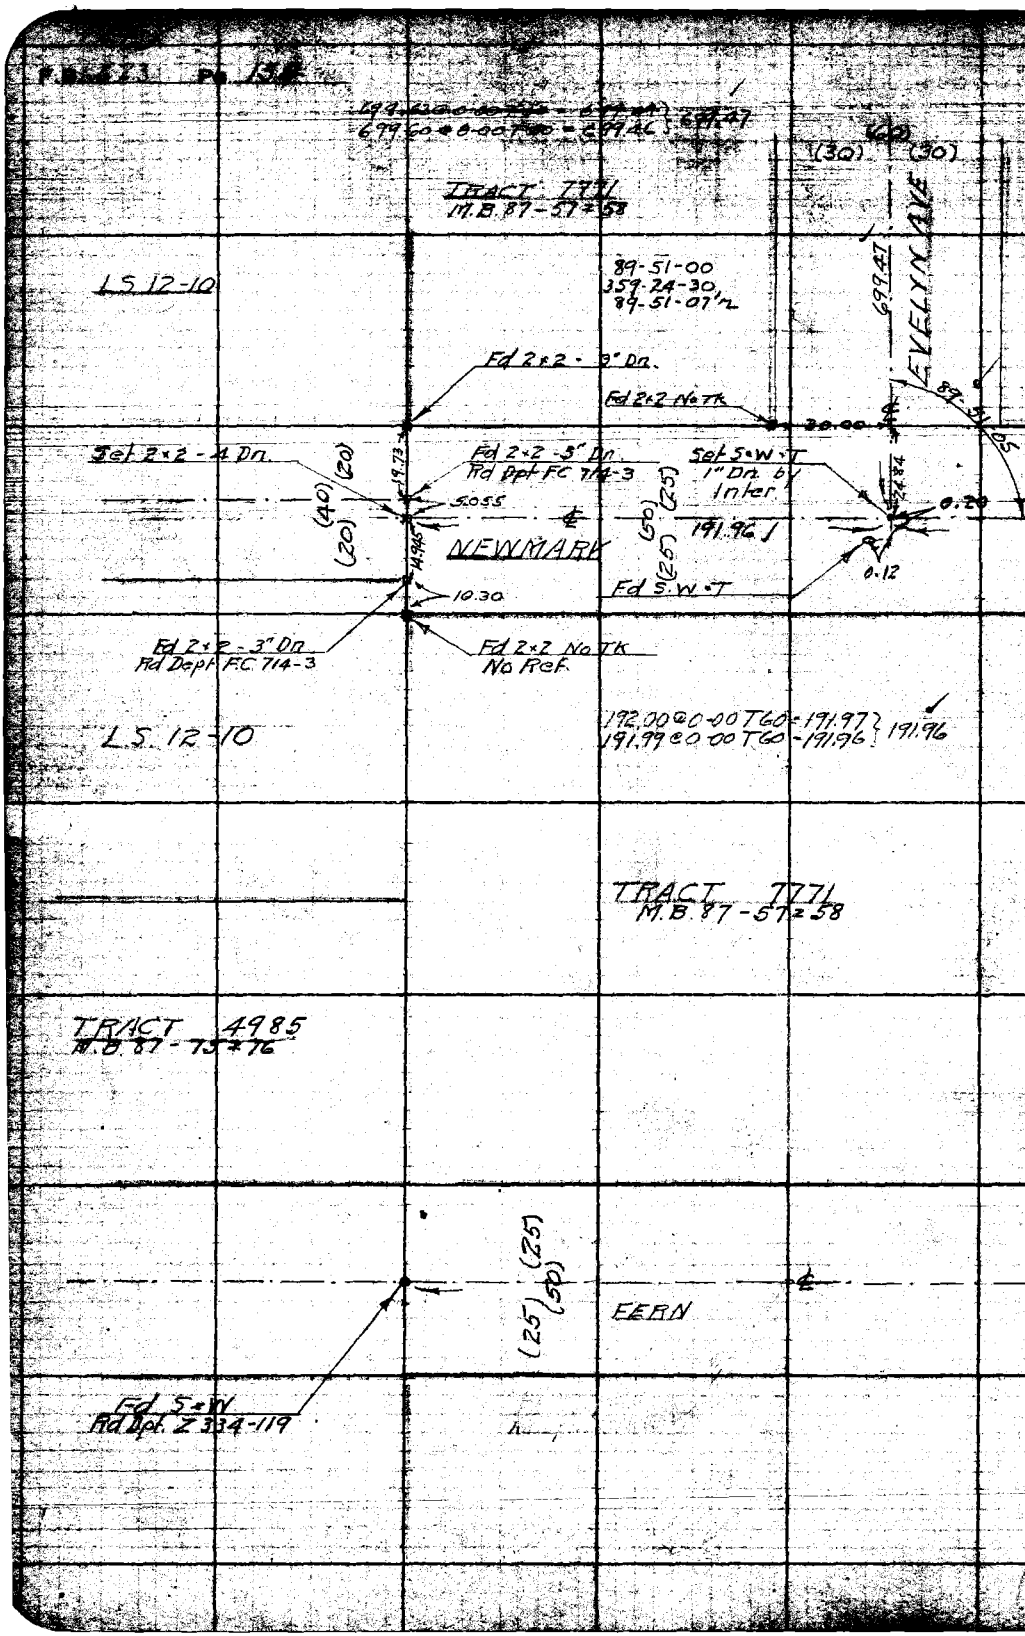

RETURN TO
LOS ANGELES COUNTY SURVEYOR
700 HALL OF RECORDS
Do not extend notes this side of this line
Note: ANY ADDITIONS OR CHANGES ON THIS SHEET MUST BE MADE OR CIRCLED IN Red Ink, WITH DATE AND NAME OF PERSON MAKING CHANGE.

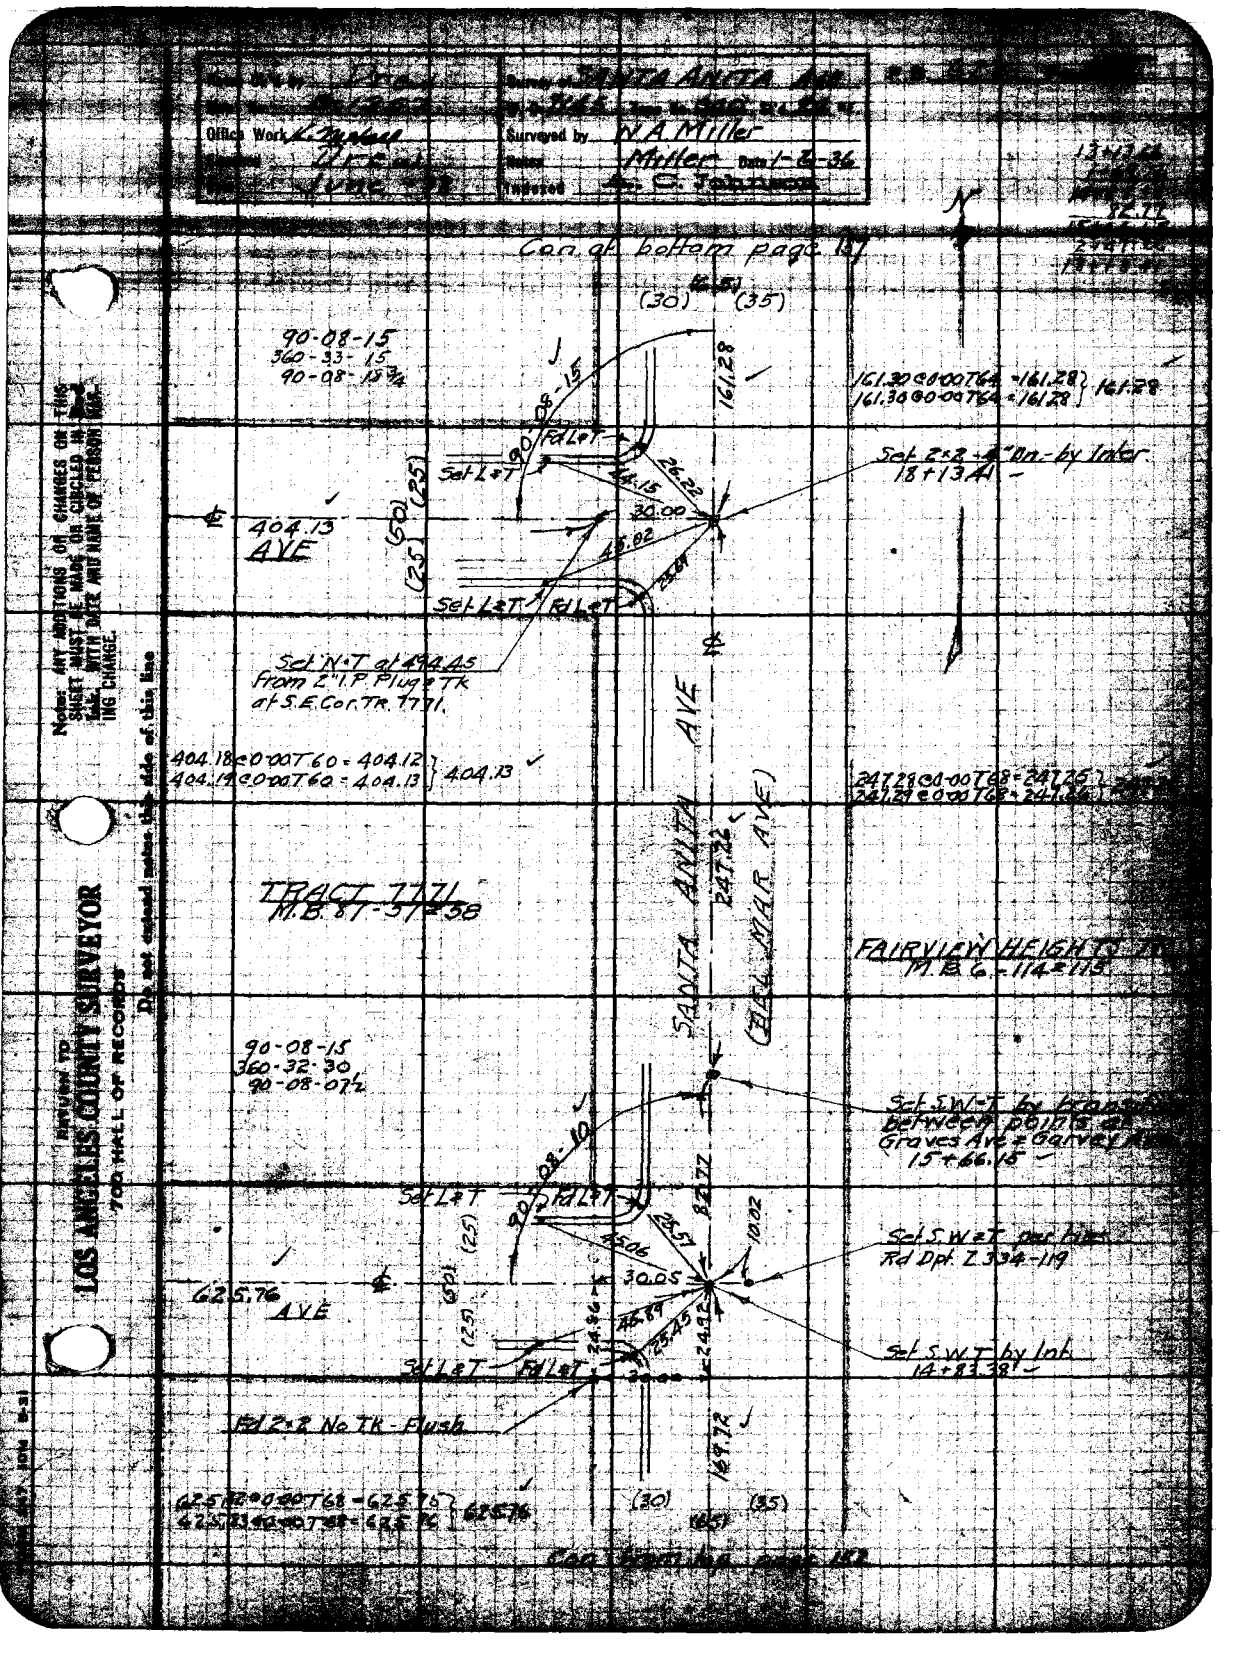

Office Work
Surveyed by N.A. Miller
Notes Miller Date 1-2-36
Indexed A. C. Johnson
Con. at bottom page 157
(30) (35)
90-08-15
360-33-15
90-08-15 3/4
161.28
161.30 @ 0-00 T64 = 161.28
161.30 @ 0-00 T64 = 161.28
161.28
Fd L&T
Set L&T
26.22
44.15
30.00
45.02
Set 2x2 - 4" Dn. - by Inter.
18+13.41
404.13
AVE
(50)
(25)
Set L&T
Fd L&T
Set N&T at 494.45
from 2" I.P. Plug & Tk
at S.E. Cor. Tr. 7771.
404.18 @ 0-00 T60 = 404.12
404.19 @ 0-00 T60 = 404.13
404.13
247.28 @ 0-00 T68 = 247.26
247.29 @ 0-00 T68 = 247.26
SANTA ANITA AVE
247.26
(BEL MAR AVE)
TRACT 7771
M.B. 87-37-38
FAIRVIEW HEIGHTS
M.B. 6-114-115
90-08-15
360-32-30
90-08-07 1/2
Set S.W.T. by transit
between points at
Graves Ave & Garvey Ave
15+66.15
90-08-10
Set L&T
Fd L&T
82.77
10.02
25.57
45.06
30.05
Set S.W.T. per Tiles
Rd Dpt. Z 334-119
625.76
AVE
(50)
(25)
46.89
25.45
24.92
24.86
Set S.W.T. by Int.
14+83.38
Set L&T
Fd L&T
Fd 2x2 No Tk - Flush
169.72
625.82 @ 0-00 T68 = 625.76
625.83 @ 0-00 T68 = 625.76
625.76
(30)
(35)
(65)
Con. from top page 152
Note: ANY ADDITIONS OR CHANGES ON THIS SHEET MUST BE MADE OR CIRCLED IN RED INK, WITH DATE AND NAME OF PERSON MAKING CHANGE.
Do not extend notes this side of this line
RETURN TO
LOS ANGELES COUNTY SURVEYOR
700 HALL OF RECORDS

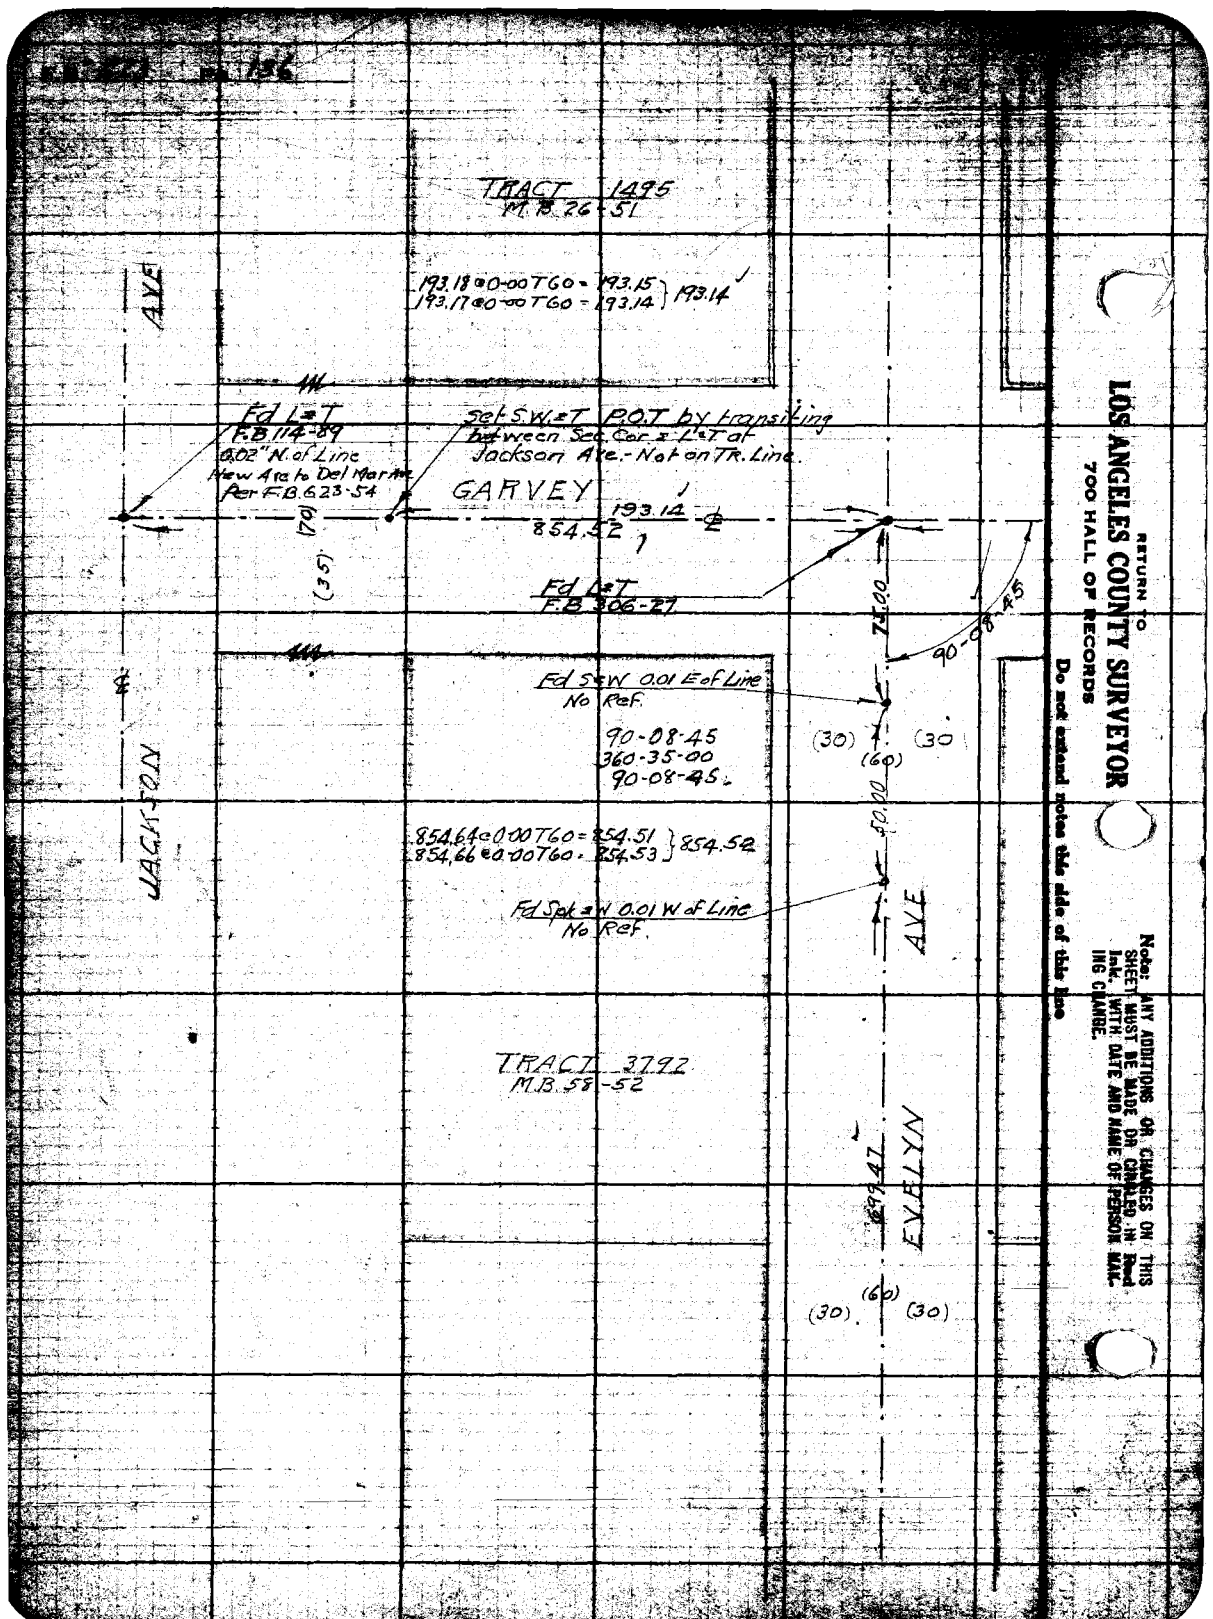

RETURN TO
LOS ANGELES COUNTY SURVEYOR
700 HALL OF RECORDS
Do not extend notes this side of this line

Note: ANY ADDITIONS OR CHANGES ON THIS SHEET MUST BE MADE OR CHECKED IN Red Ink, WITH DATE AND NAME OF PERSON MAKING CHANGE.

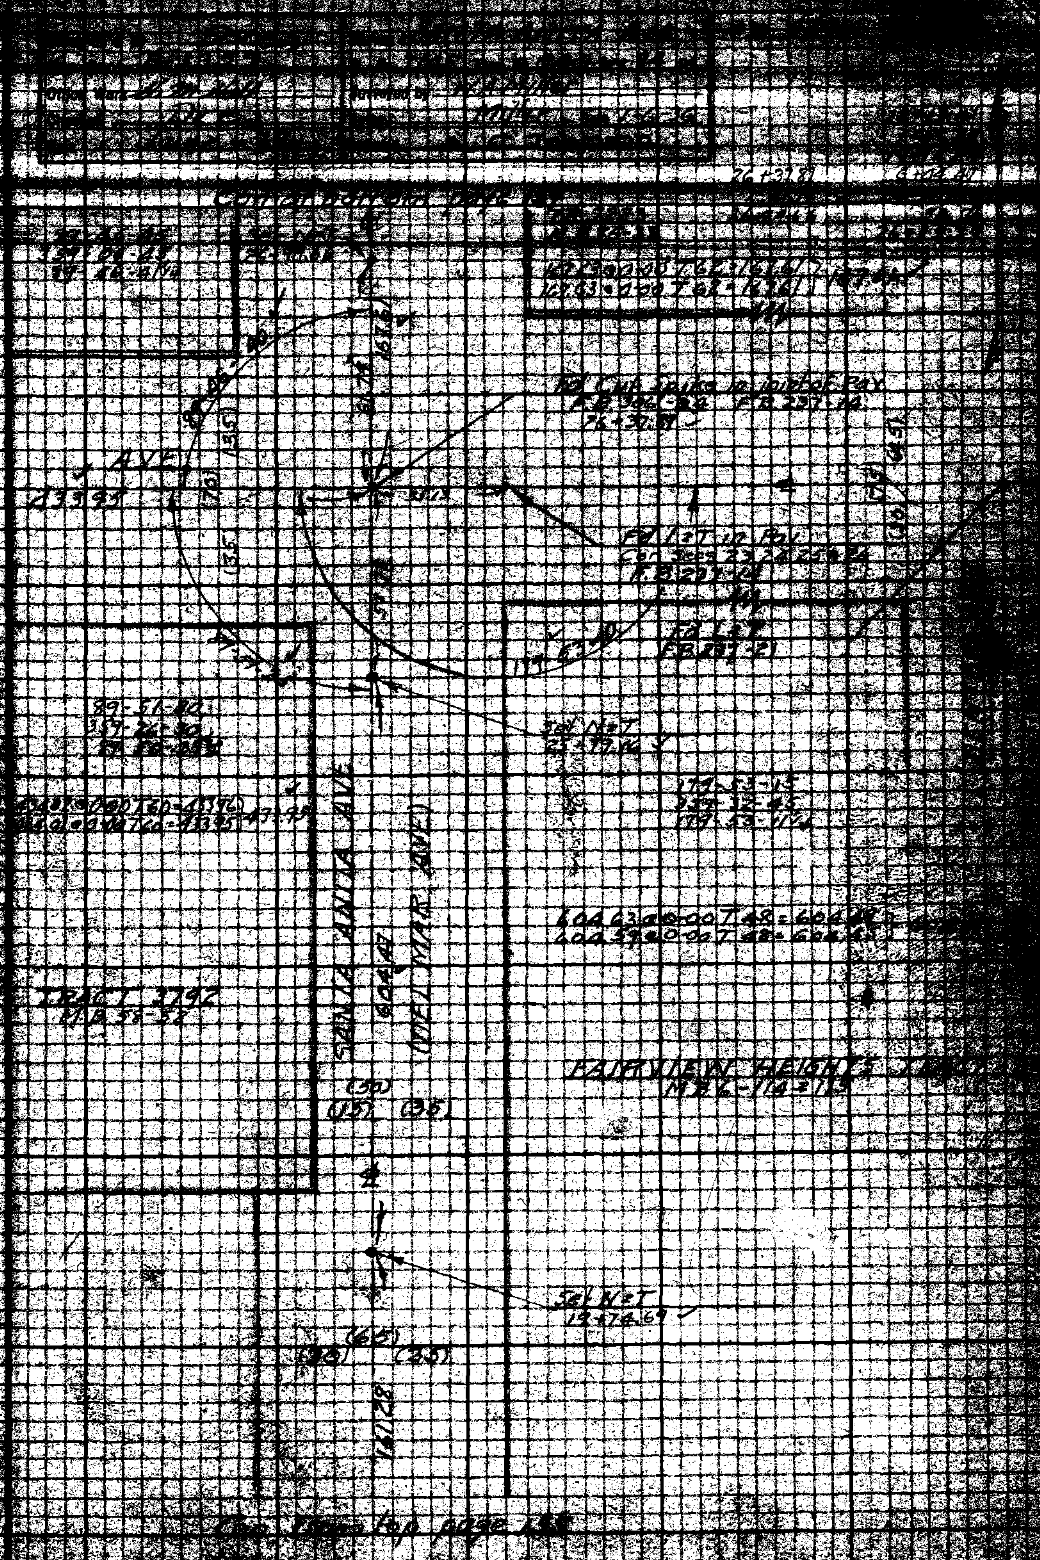

SANTA ANITA AVE
TRACT 3792
Set N&T
13+76.69

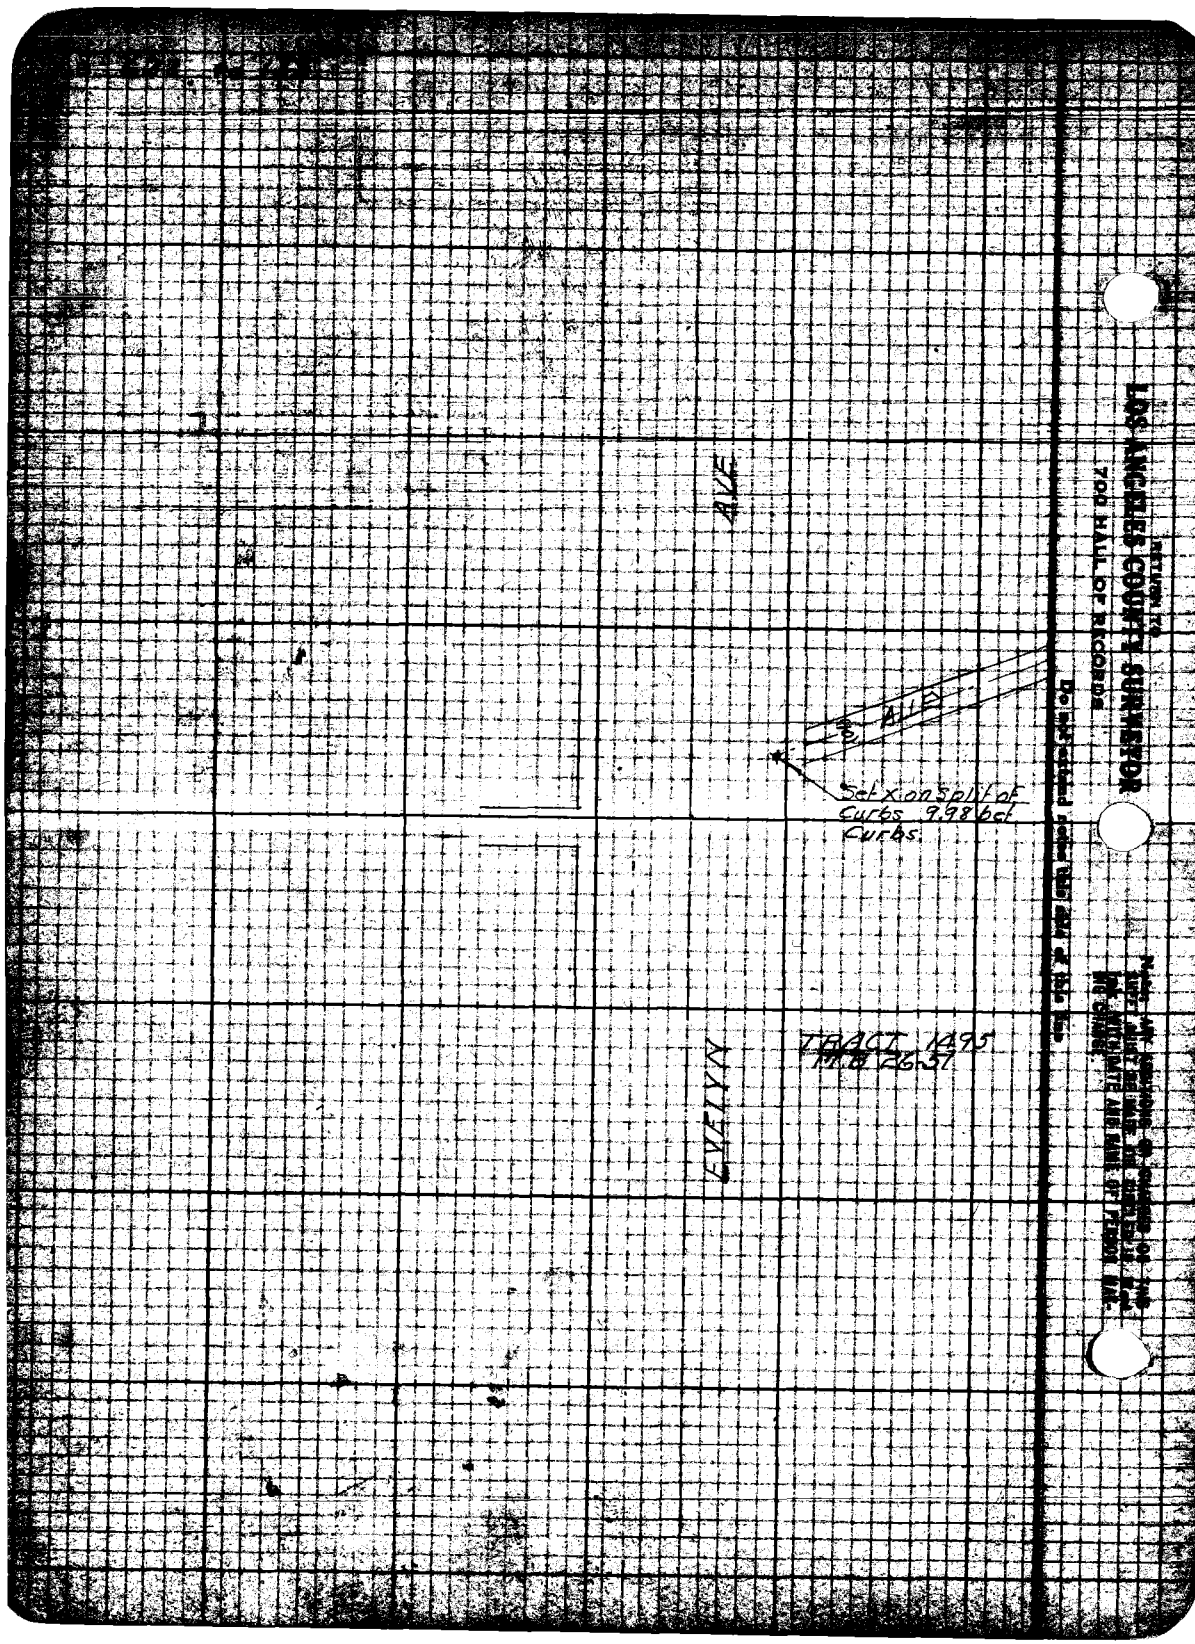

RETURN TO
LOS ANGELES COUNTY SURVEYOR
700 HALL OF RECORDS
Do not extend notes this date of this line
AVE
EVELYN
Set X on Split of Curbs 9.98 bet Curbs.
TRACT 1495
M.B. 26-57

Notes Ck'd by Drew	Survey of SANTA ANITA AVE F.B. 623
Map No. B-2357	W. O. 7145 Tape No. 040 Std 84 of
Office Work [illegible]	Surveyed by [illegible]
Checked Drew	Notes Miller Date 1-8-36
Date June - 38	Indexed C. Johnson

26+37.[illegible]
1+[illegible]
28+05.50
32.41
28+37.[illegible]
2+72.37
31+10.28
1+85.11
32+95.39

Con at bottom page 161

109-39-45
78-39-00
109-39-45

(70)
(35) (35)

202.02 @ 0-00 T 60 = 201.99
202.02 @ 0-00 T 60 = 201.99 } 201.99

MISSION COURT
M.B. 12-133

109-39-45

201.99

Set x on Split of Curbs - 9.96 bet. Curbs.

Set N-T by Inter. 32+95.39

27.61

ALLE

SANTA ANITA AVE

185.11

(DEL MAR AVE)

185.14 @ 0-00 T 62 = 185.11
185.14 @ 0-00 T 62 = 185.11 } 185.11

SAN GABRIEL IMPROVEMENT CO
M.R. 54 page 72

TRACT 1495
M.B. 26-51

Fd 2" I.P. No Plug nor Tk
30" Dn. Used Ctr. Pipe

(70)
(35) (35)

35.00
5.46

Set N&T
31+10.28

(35) (75) (40)

TRACT 7223
M.B. 85-38

272.41 @ 0-00 T 62 = 272.38
272.40 @ 0-00 T 62 = 272.37 } 272.37

89-56-15
359-46-15
89-56-33¾

272.37

Fd S.W.-T No Ref.
0.01 E. of Line
28+37.91

89-56-33

32.41

NEW TIES
F.B. 1435-39

Set N&T on Split of Cbs.
19.80 bet. Curbs.

(10) (10)
(20)

ALLEY

Set N-T by Inter
28+05.50

Set N&T on Split of Curbs
20' bet. Curbs

167.61

(35) (40)
(75)

BRIGHTON

Con from [illegible] page 157

Note: ANY ADDITIONS OR CHANGES ON THIS SHEET MUST BE MADE OR CIRCLED IN RED INK WITH DATE AND NAME OF PERSON MAKING CHANGE.

Do not extend notes through the line

RETURN TO
LOS ANGELES COUNTY SURVEYOR
700 HALL OF RECORDS

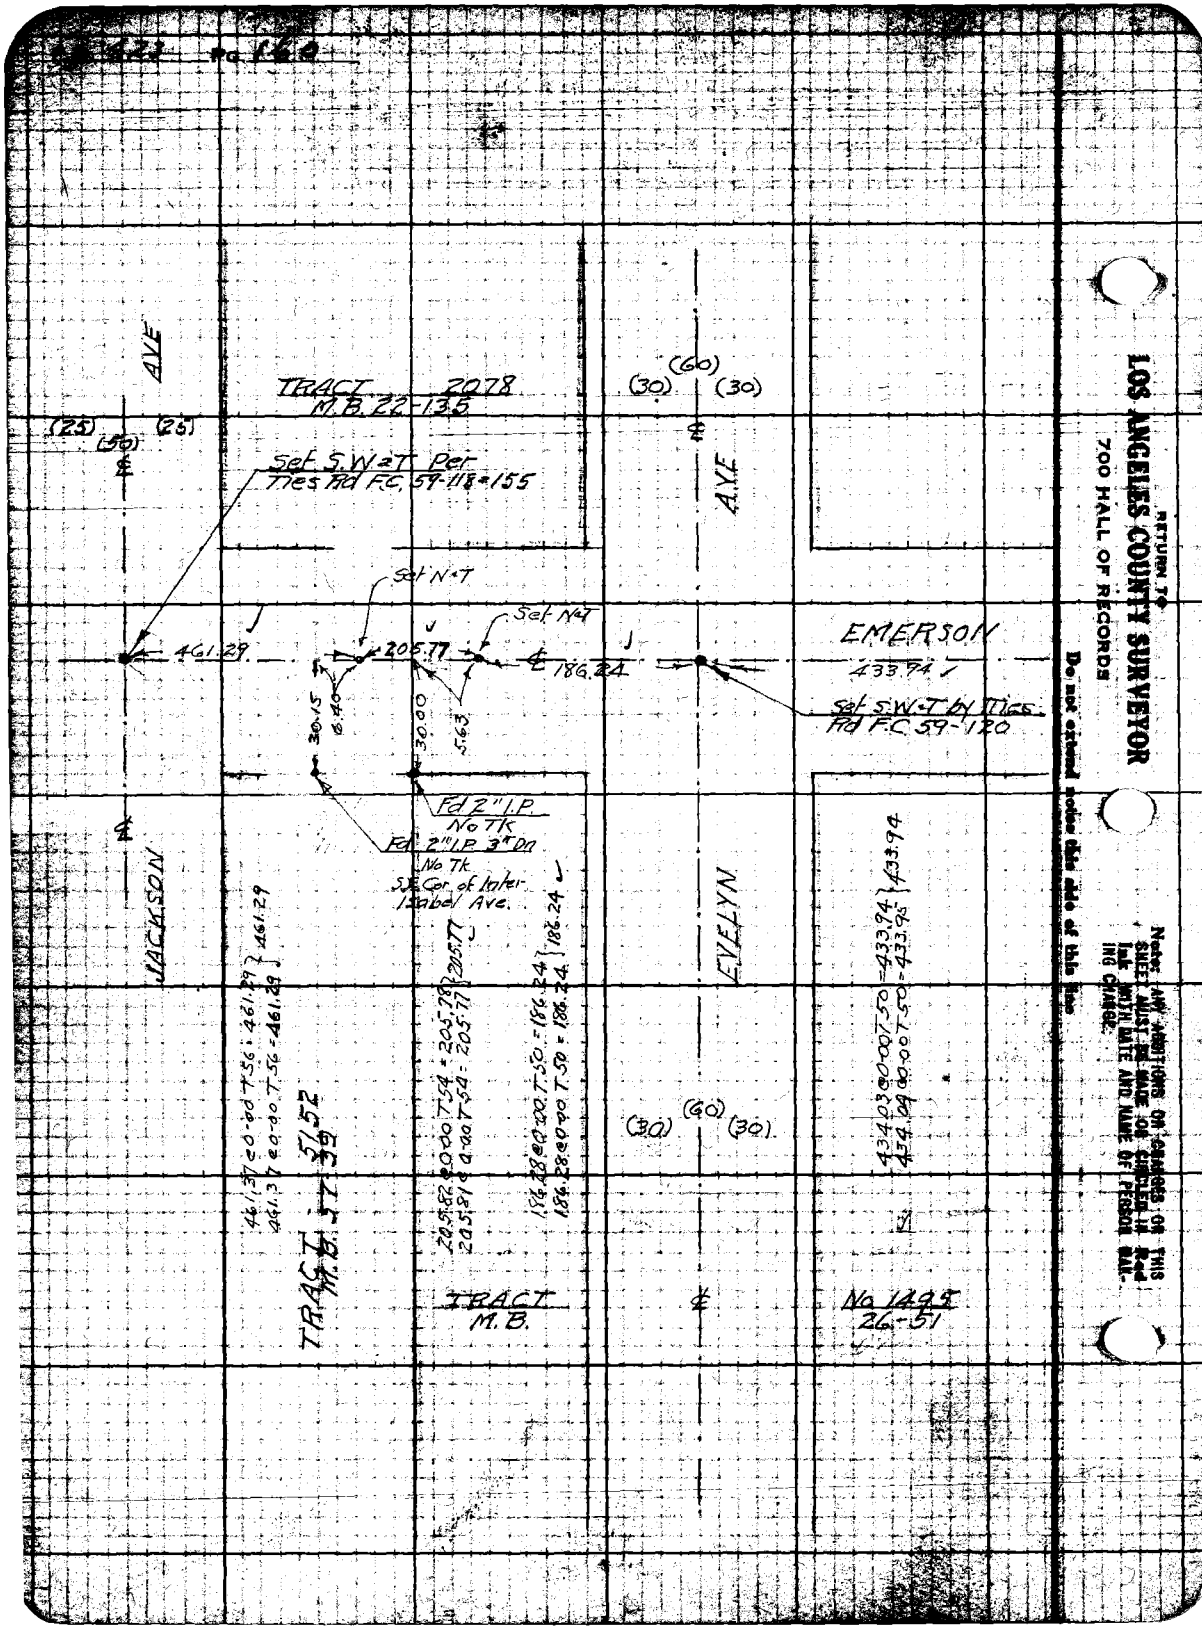

RETURN TO
LOS ANGELES COUNTY SURVEYOR
700 HALL OF RECORDS

Do not extend notes this side of this line

Note: ANY ADDITIONS OR CHANGES ON THIS SHEET MUST BE MADE OR CIRCLED IN Red Ink WITH DATE AND NAME OF PERSON MAKING CHANGE.

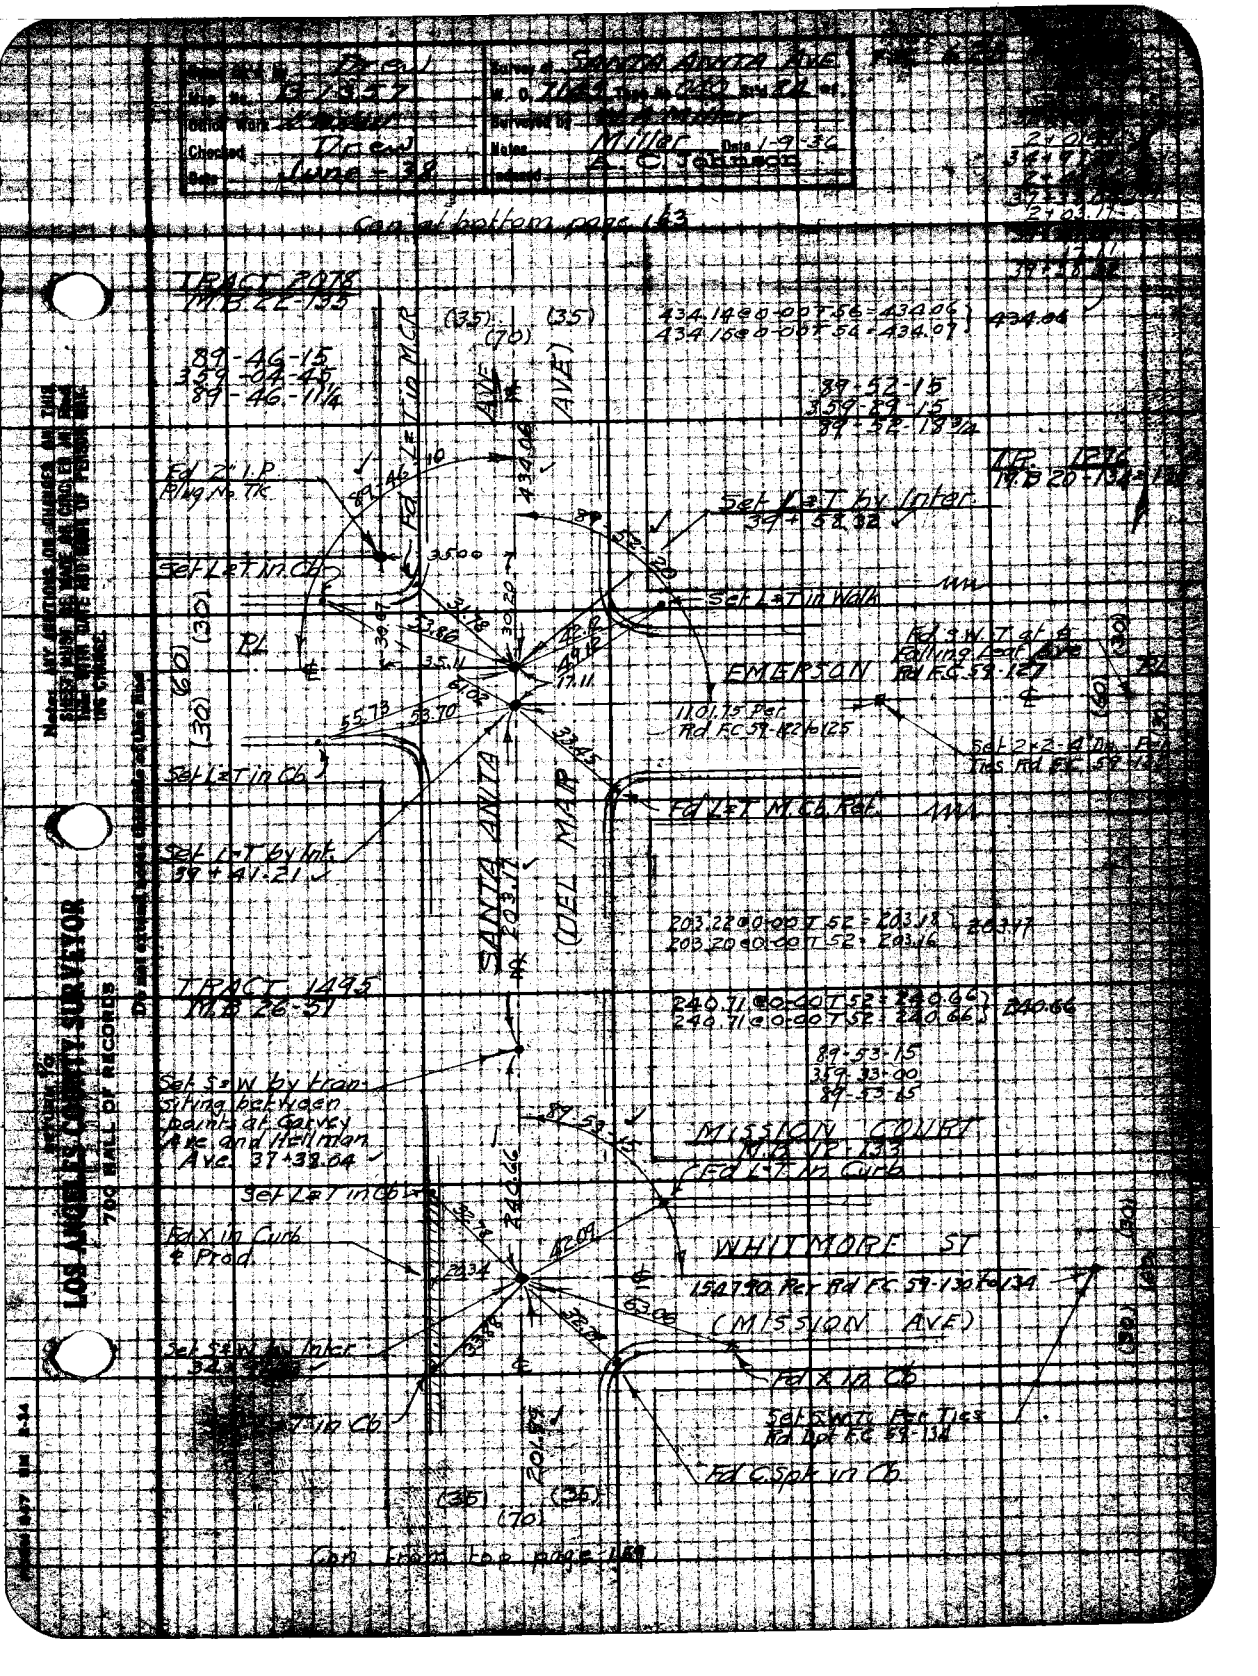

Drew
Map No. 13-1357
Office Work
Checked Drew
Date June - 38
Survey of SANTA ANITA AVE
W. O. 7149
Surveyed by
Notes Miller Date 1-9-36
Indexed A. C. Johnson
Con at bottom page 163
TRACT 2078
M.B. 22-135
89-46-15
359-04-45
89-46-11¼
434.14@0-00T56=434.06
434.15@0-00T56=434.07
434.06
89-52-15
359-29-15
89-52-18¾
TR. 1276
M.B. 20-134
Fd 2" I.P. Plug No. Tk
Set L&T in Cb
Set L&T by Inter. 39+58.32
Set L&T in Walk
Fd S.W.T. at ℄ Falling Leaf Ave Rd F.C. 59-127
EMERSON
1101.75 Per Rd F.C. 59-122 to 125
Set 2x2-4' Dn. Per Ties Rd F.C. 59-
Set L&T in Cb
Fd L&T M.Cb. Ret.
Set L&T by Int. 39+41.21
SANTA ANITA
(DEL MAR)
203.22@0-00T52=203.18
203.20@0-00T52=203.16
203.17
TRACT 1495
M.B. 26-51
240.71@0-00T52=240.66
240.71@0-00T52=240.66
240.66
89-53-15
359-33-00
89-53-15
Set S&W by transiting between points at Garvey Ave. and Hellman Ave. 37+38.04
MISSION COURT
M.B. 12-133
Fd L&T in Curb
Set L&T in Cb
Fd X in Curb & Prod.
WHITMORE ST
1547.90 Per Rd F.C. 59-130 to 134
(MISSION AVE)
Set S&W by Inter
Fd X in Cb
Set S.W.T. Per Ties Rd Dpt F.C. 59-134
Fd C.Spk in Cb
Con from top page 169
LOS ANGELES COUNTY SURVEYOR
700 HALL OF RECORDS

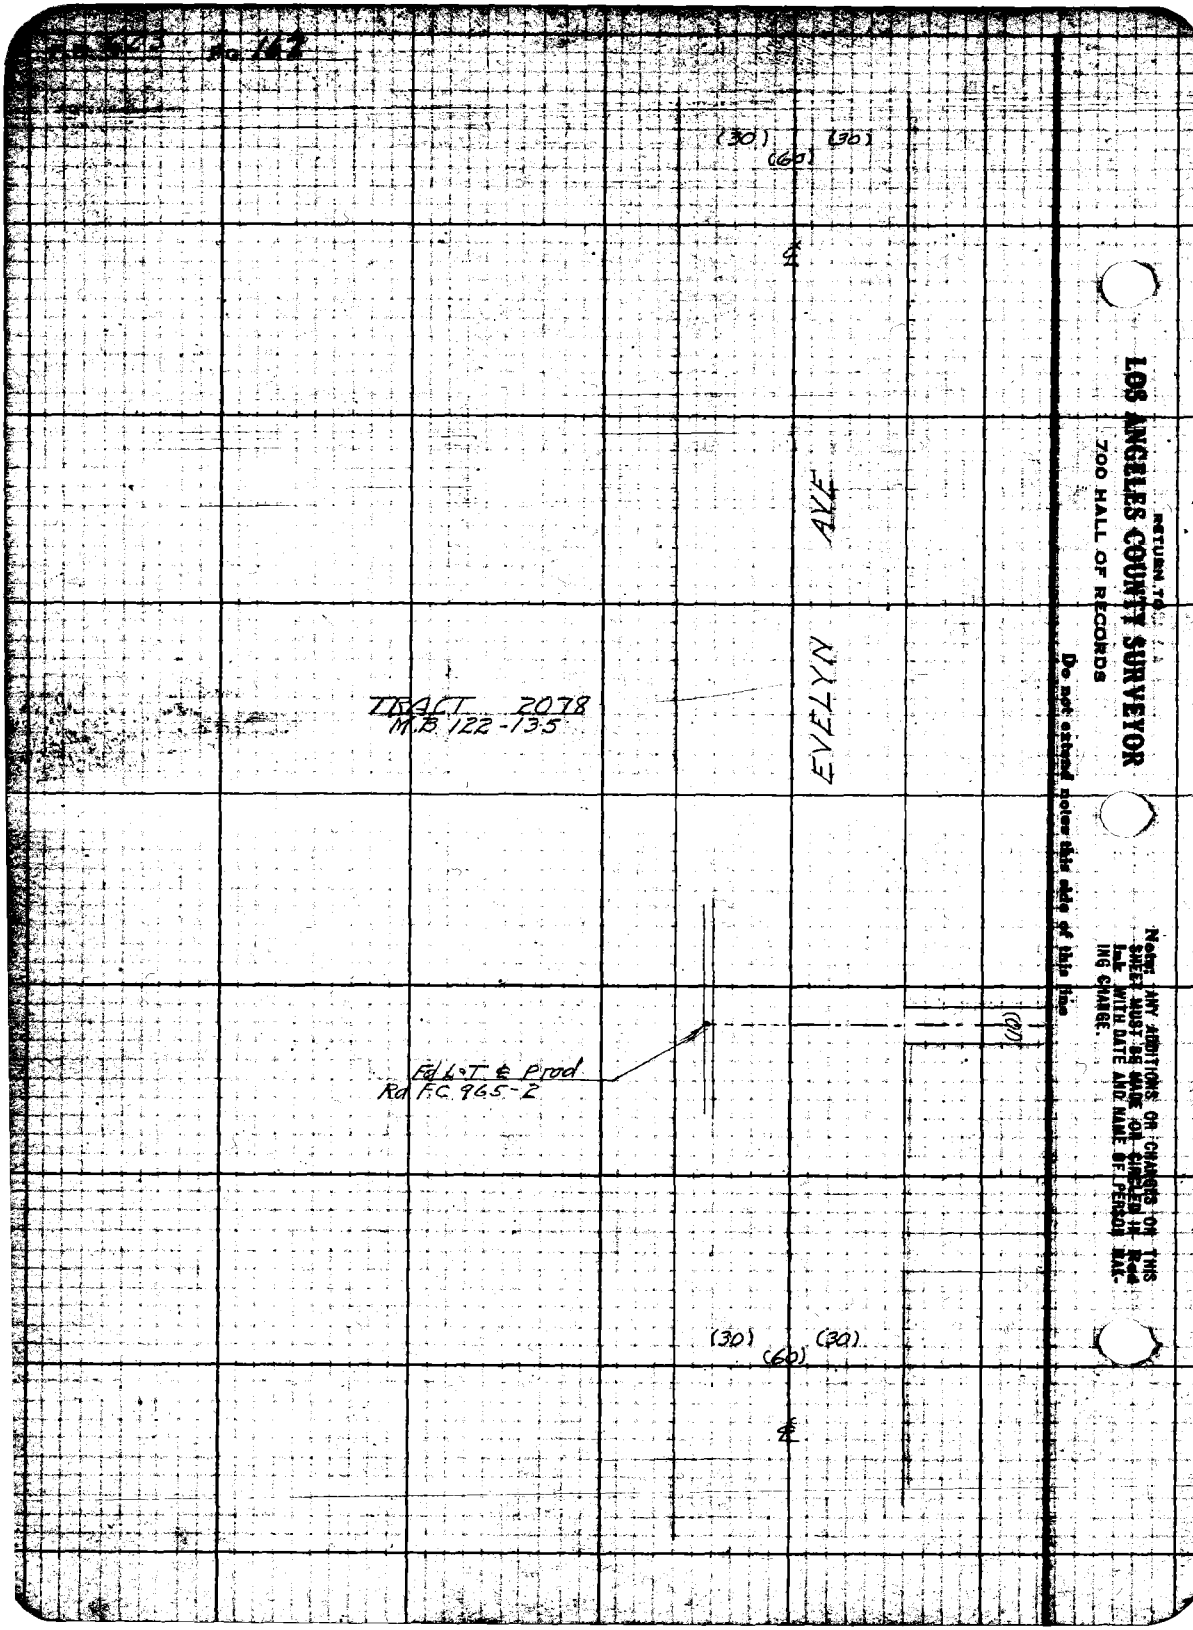

(30) (30)
(60)
℄
EVELYN AVE
TRACT 2078
M.B. 122-13-5
Fd L.T. ℄ Prod
Rd F.C. 965-2
(30) (30)
(60)
℄
RETURN TO
LOS ANGELES COUNTY SURVEYOR
700 HALL OF RECORDS
Do not extend notes this side of this line
Note: ANY ADDITIONS OR CHANGES ON THIS SHEET MUST BE MADE OR CIRCLED IN Red Ink WITH DATE AND NAME OF PERSON MAKING CHANGE.

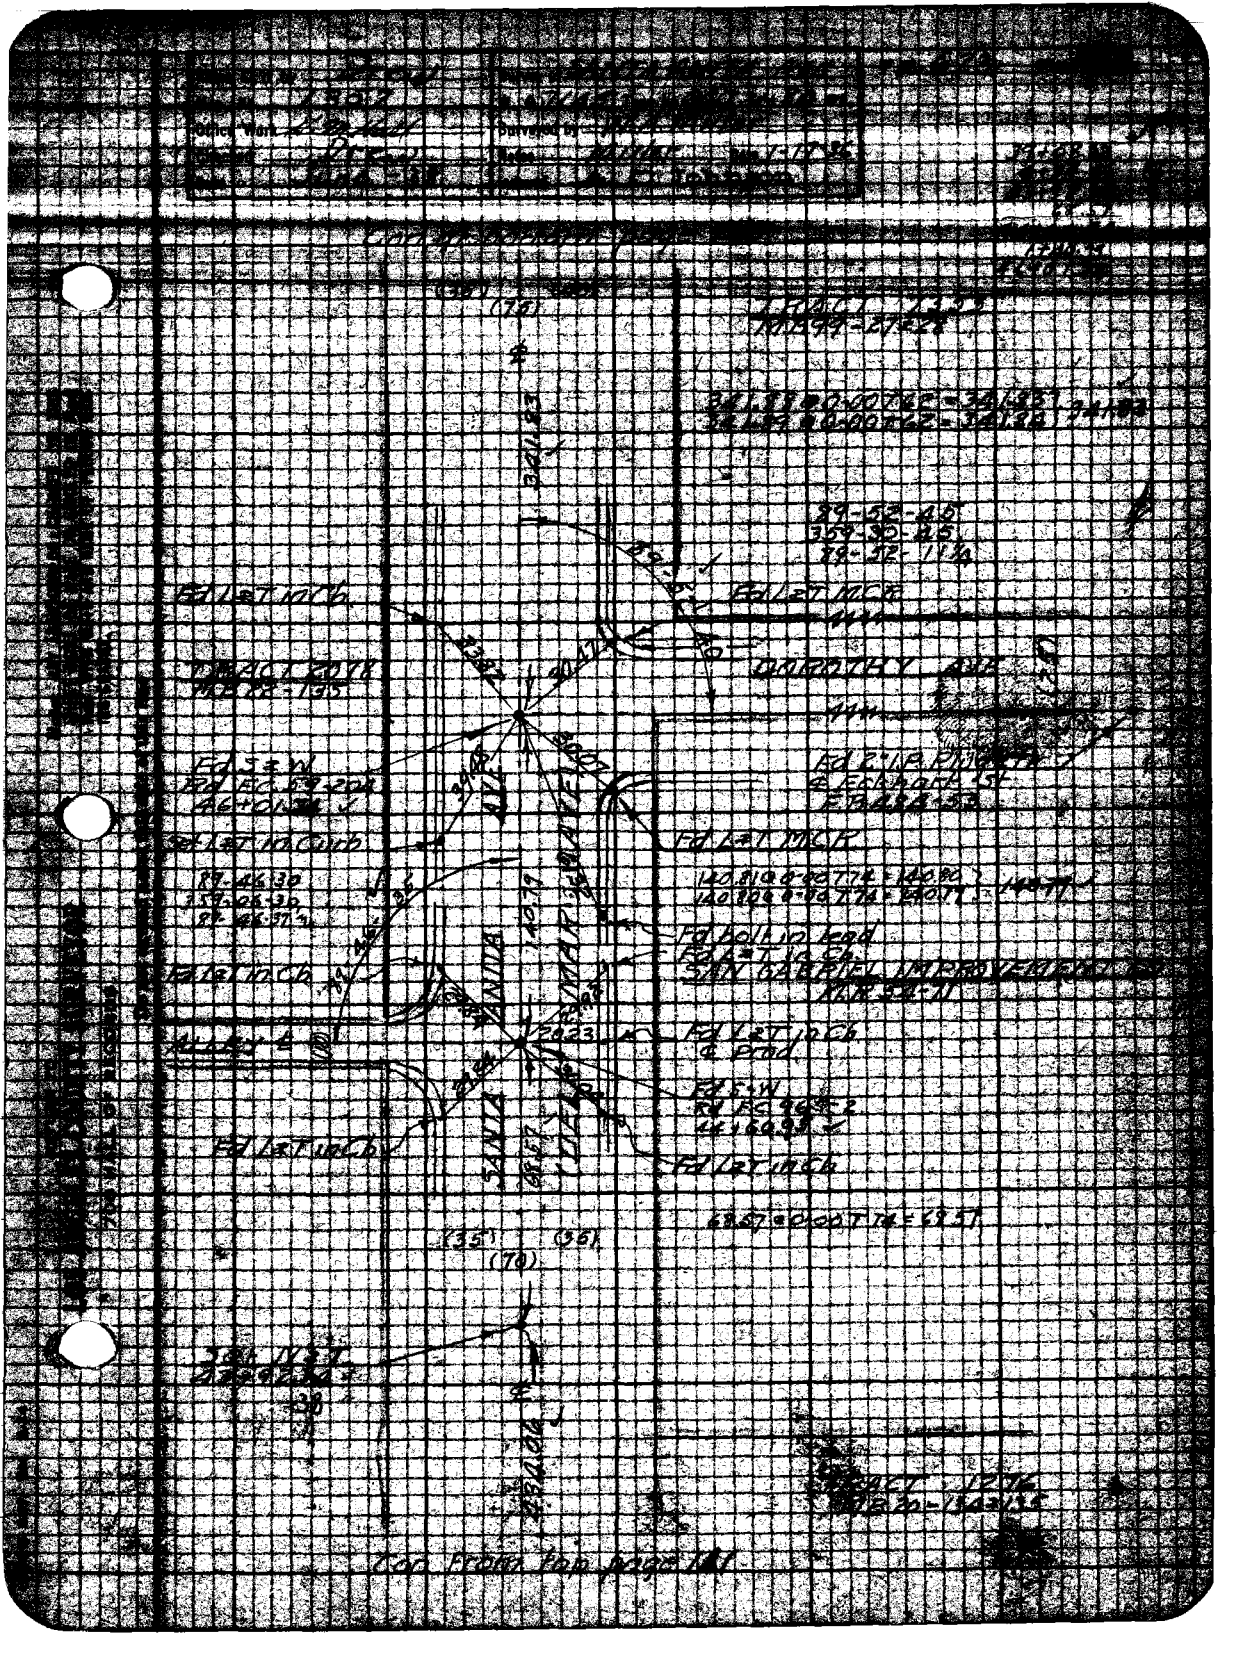

Office Work
Surveyed by
Fd L&T in Ch
Fd L&T MCR
DOROTHY AVE
Fd S&W
Fd L&T in Curb
Fd L&T MCR
Fd bolt in lead
SAN GABRIEL IMPROVEMENT
Fd L&T in Ch
Fd L&T in Ch
Fd L&T in Ch
Fd L&T in Ch
SANTA ANITA AVE
MARSHALL AVE
(35)
(70)
Con from top page 181

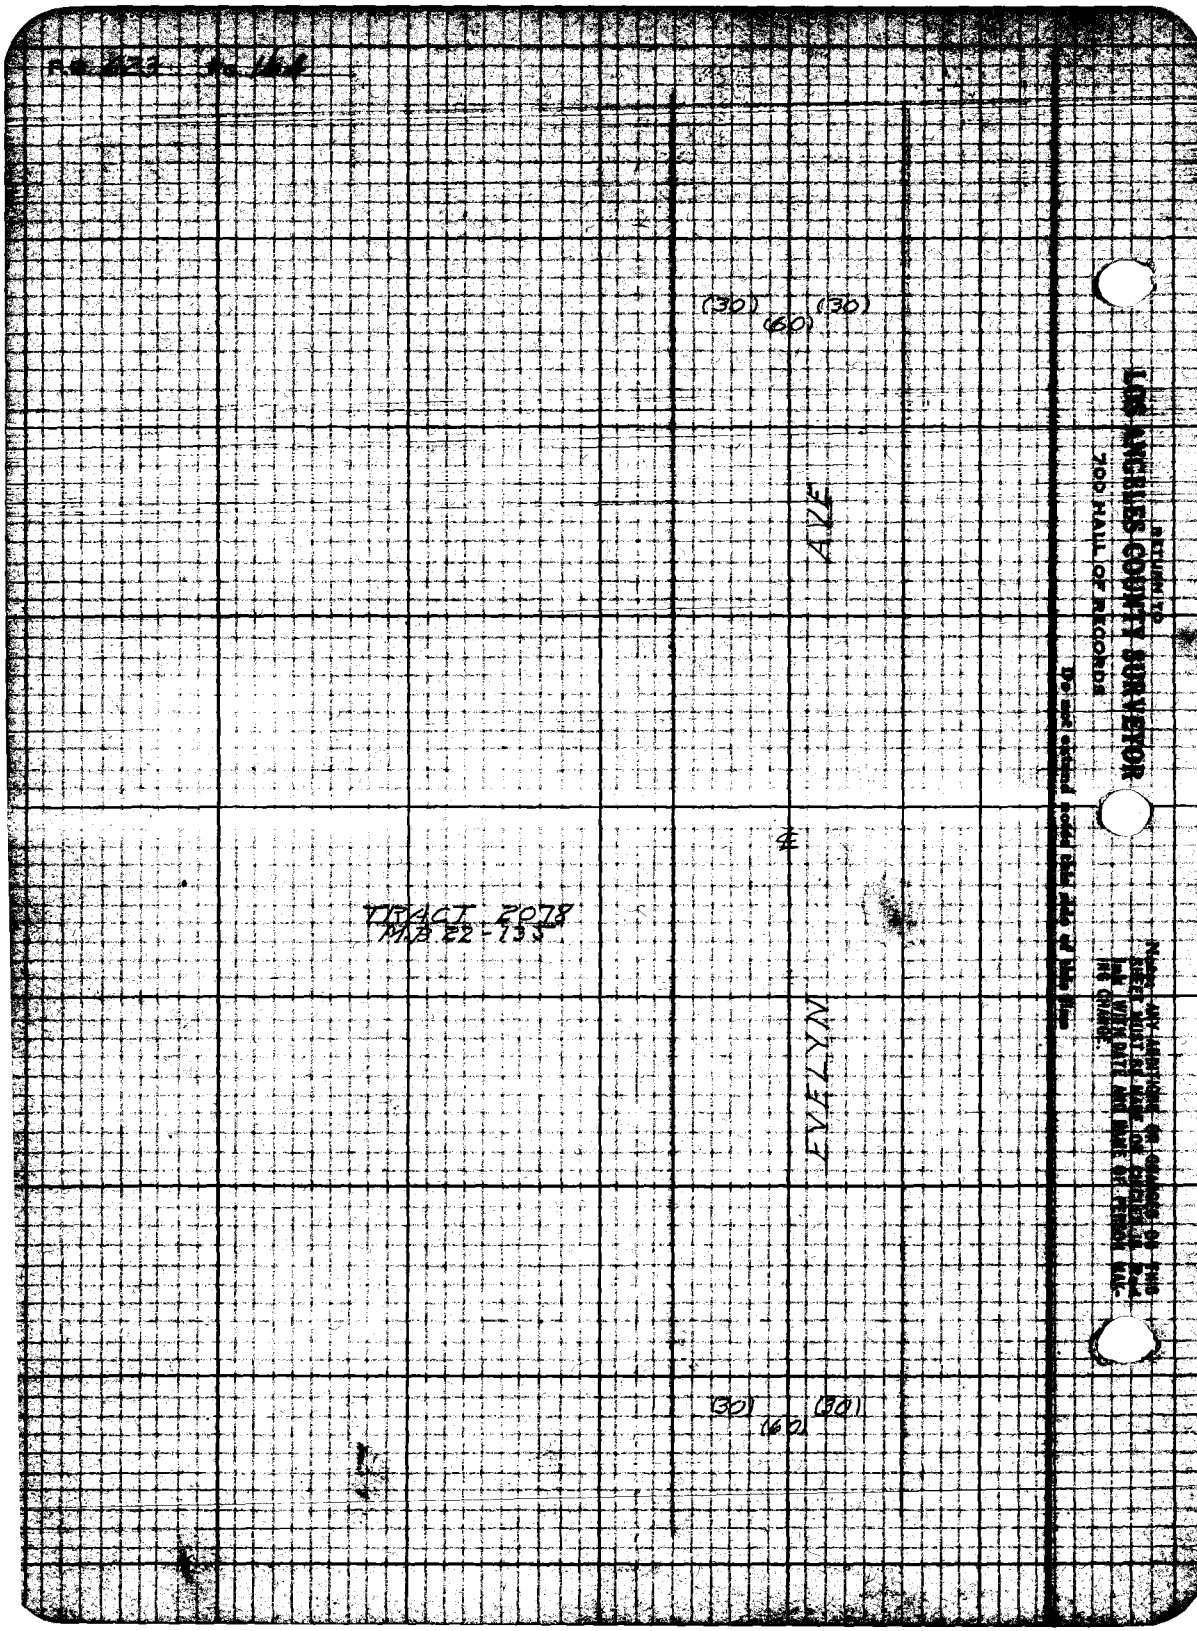

(30) (60) (30)
AVE
℄
TRACT 2078
M.B. 22-135
EVELYN
(30) (60) (30)
RETURN TO
LOS ANGELES COUNTY SURVEYOR
700 HALL OF RECORDS
Do not extend notes this side of this line

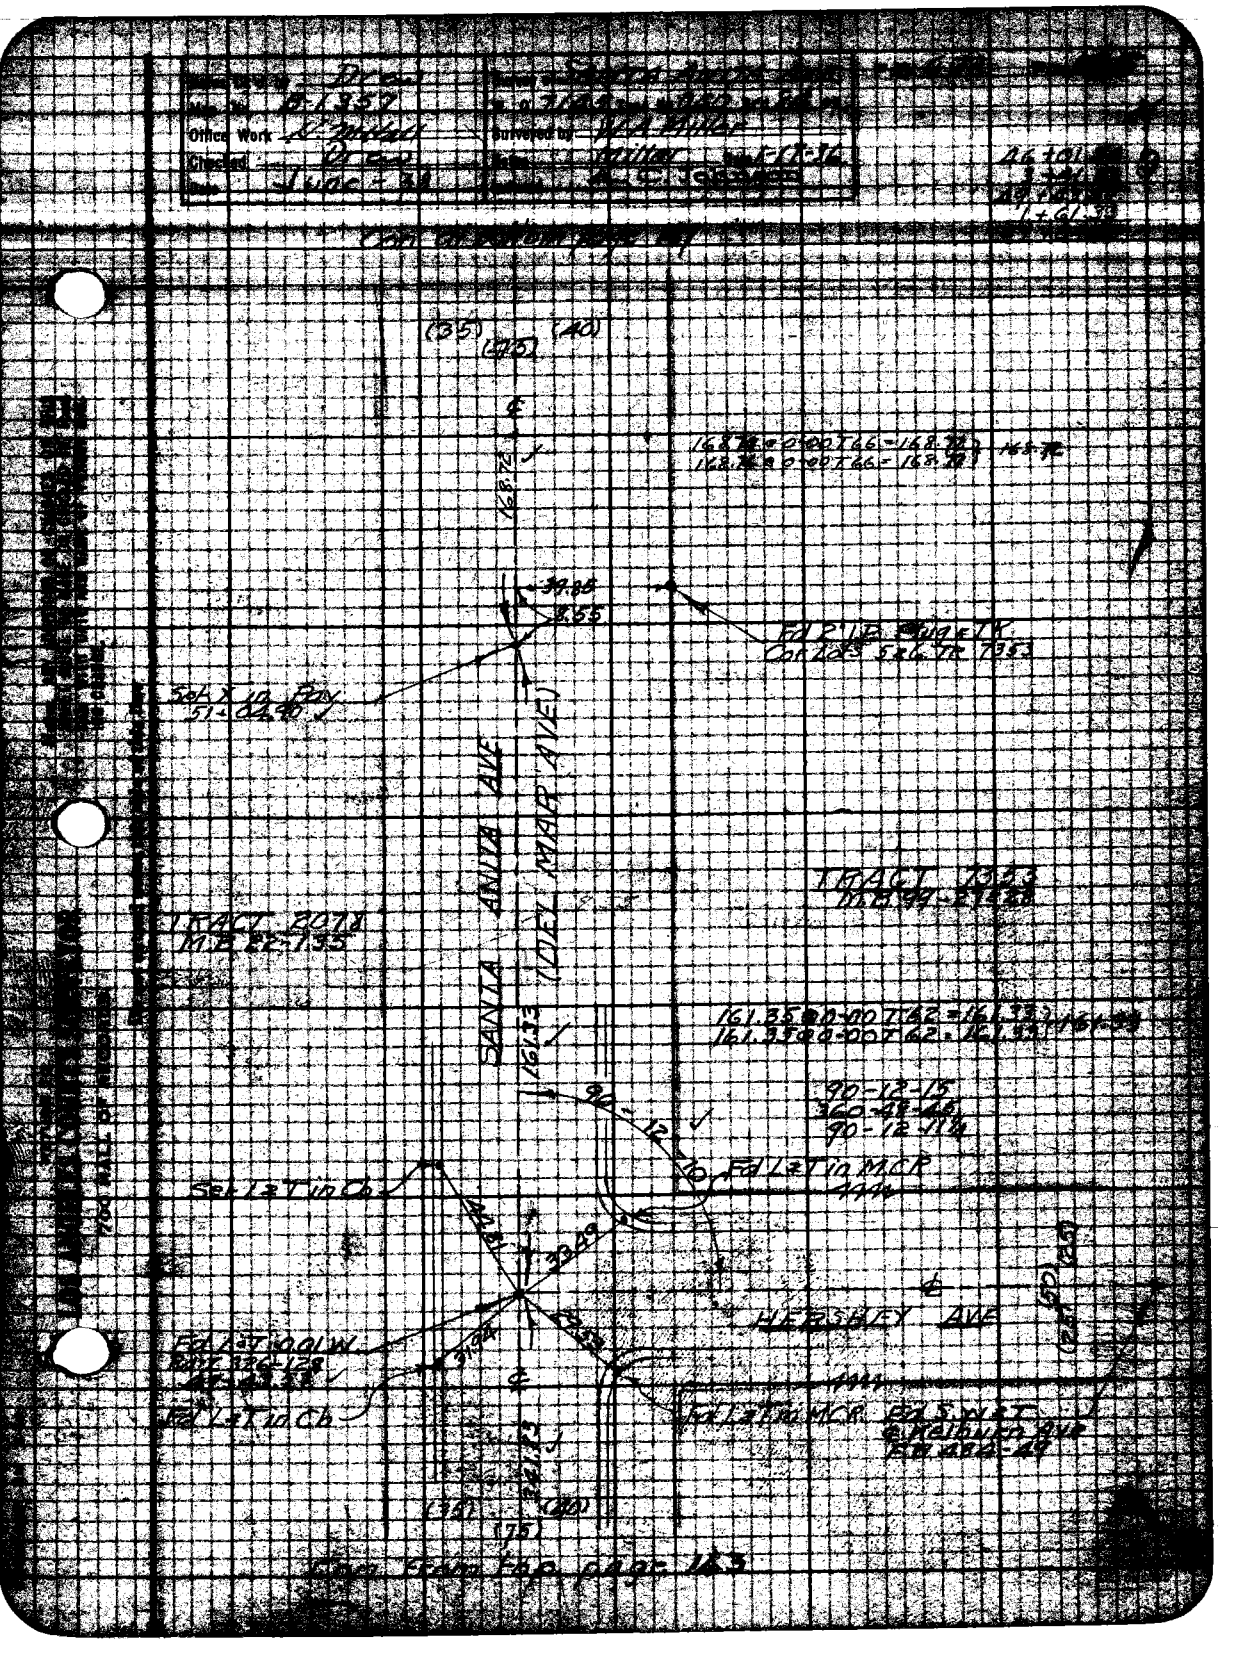

Drew
Office Work
Checked
Date
Surveyed by
Miller
(35)
(40)
(75)
168.72
39.85
8.55
Set X in Bay
51+04.90
SANTA ANITA AVE
(DEL MAR AVE)
TRACT 2078
M.B. 22-135
TRACT 7353
161.33
90-12-15
Set L&T in Cb
Fd L&T in MCR
HERSHEY AVE
Fd L&T in Cb
Fd L&T in MCR
(35)
(40)
(75)

LOS ANGELES COUNTY SURVEYOR
700 HALL OF RECORDS
LOS ANGELES, CALIFORNIA

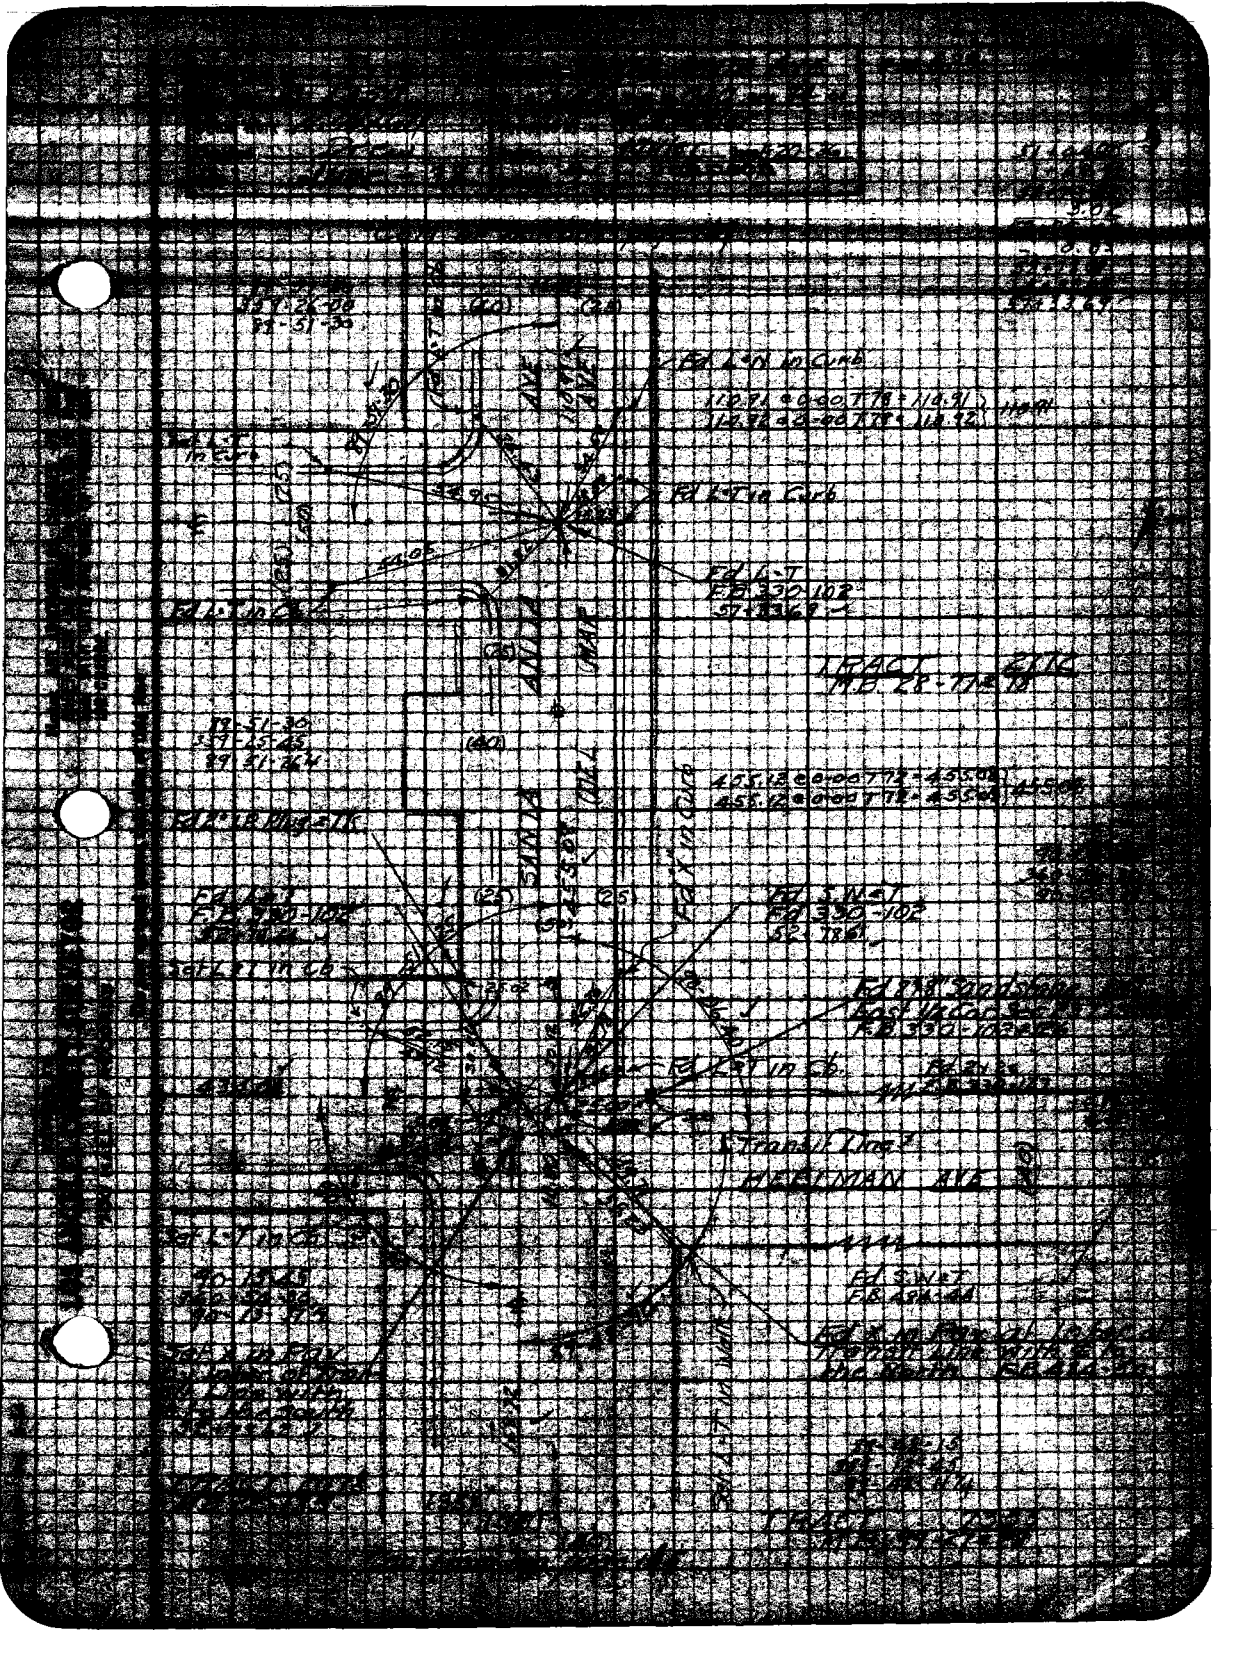
TRACT
M.B. 28 : 77 & 78
Transit Line
HARTMAN AVE
Fd 1-7 in Ch.
Fd 1-8 in Ch.
RETURN TO
LOS ANGELES COUNTY SURVEYOR
700 HALL OF RECORDS

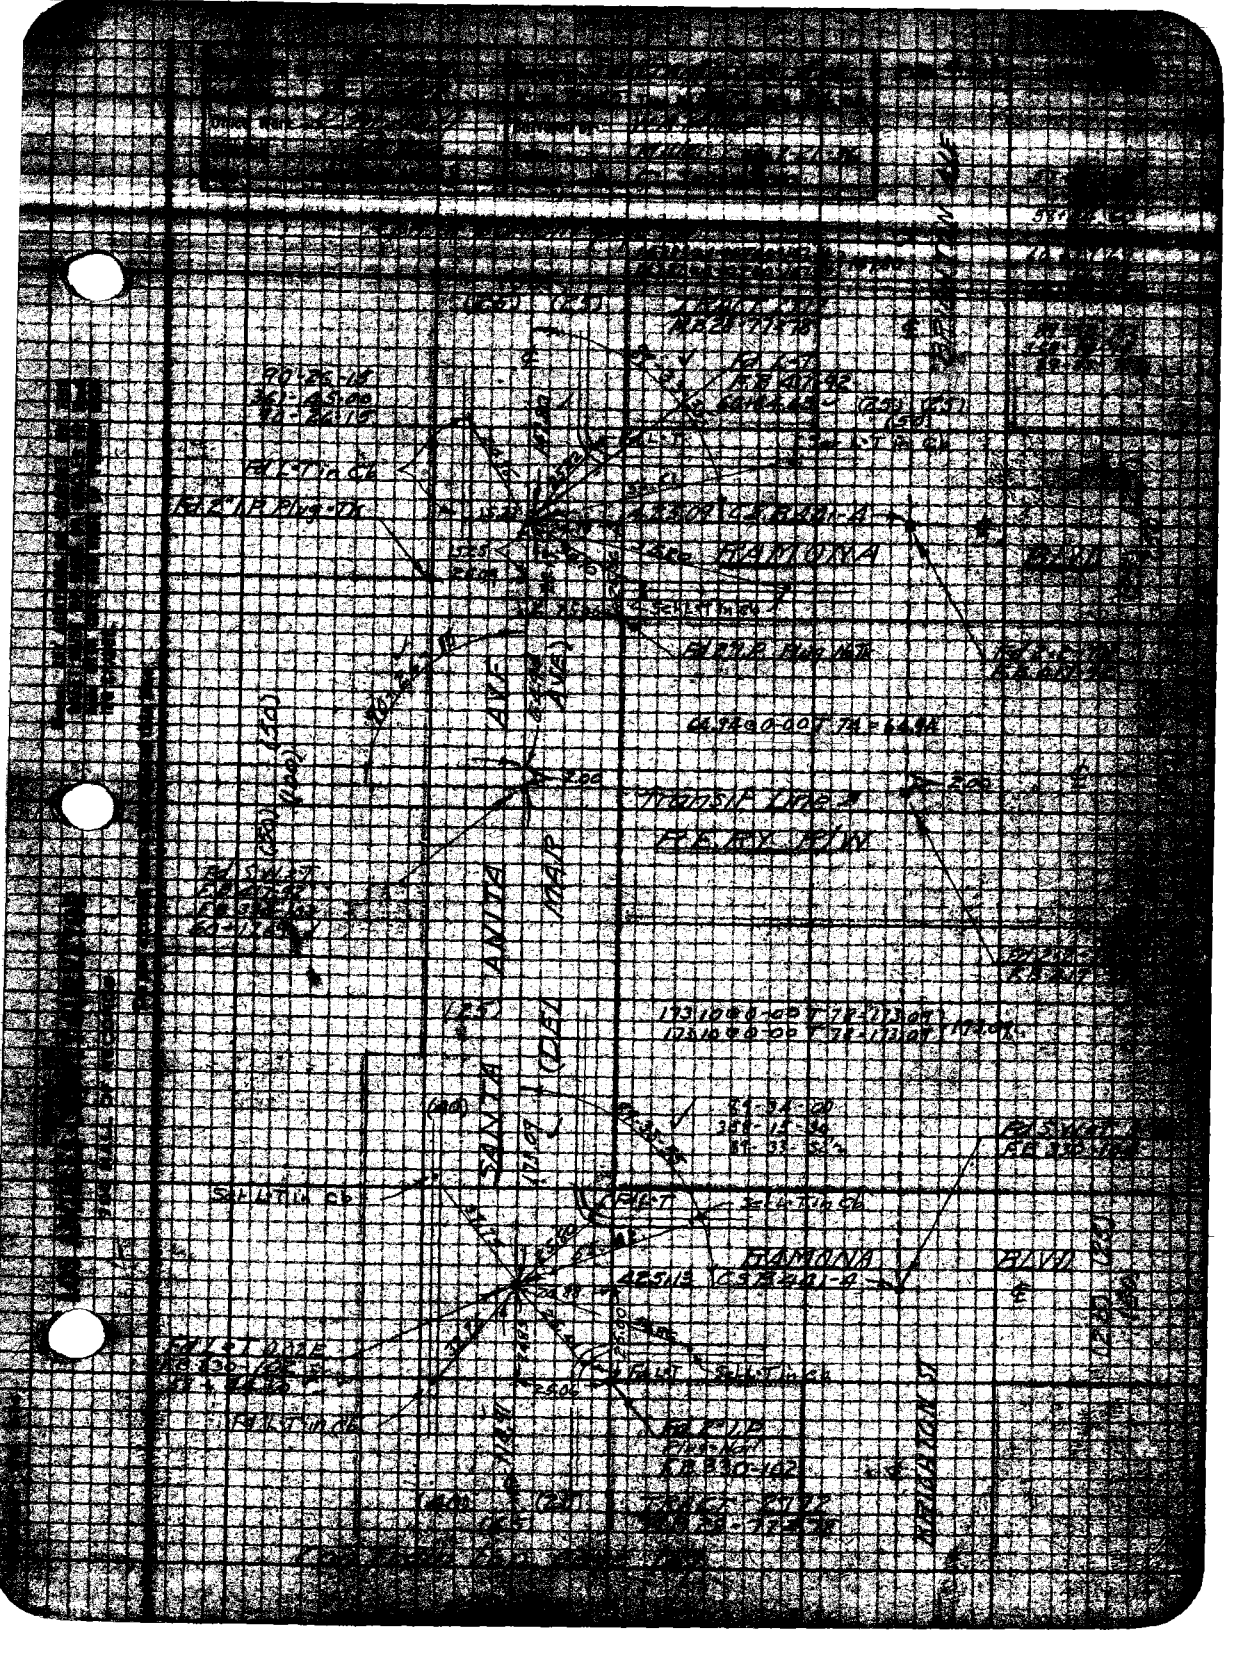

RAMONA
SANTA ANITA AVE
(DEL MAR AVE)
Transit Line
RAMONA BLVD

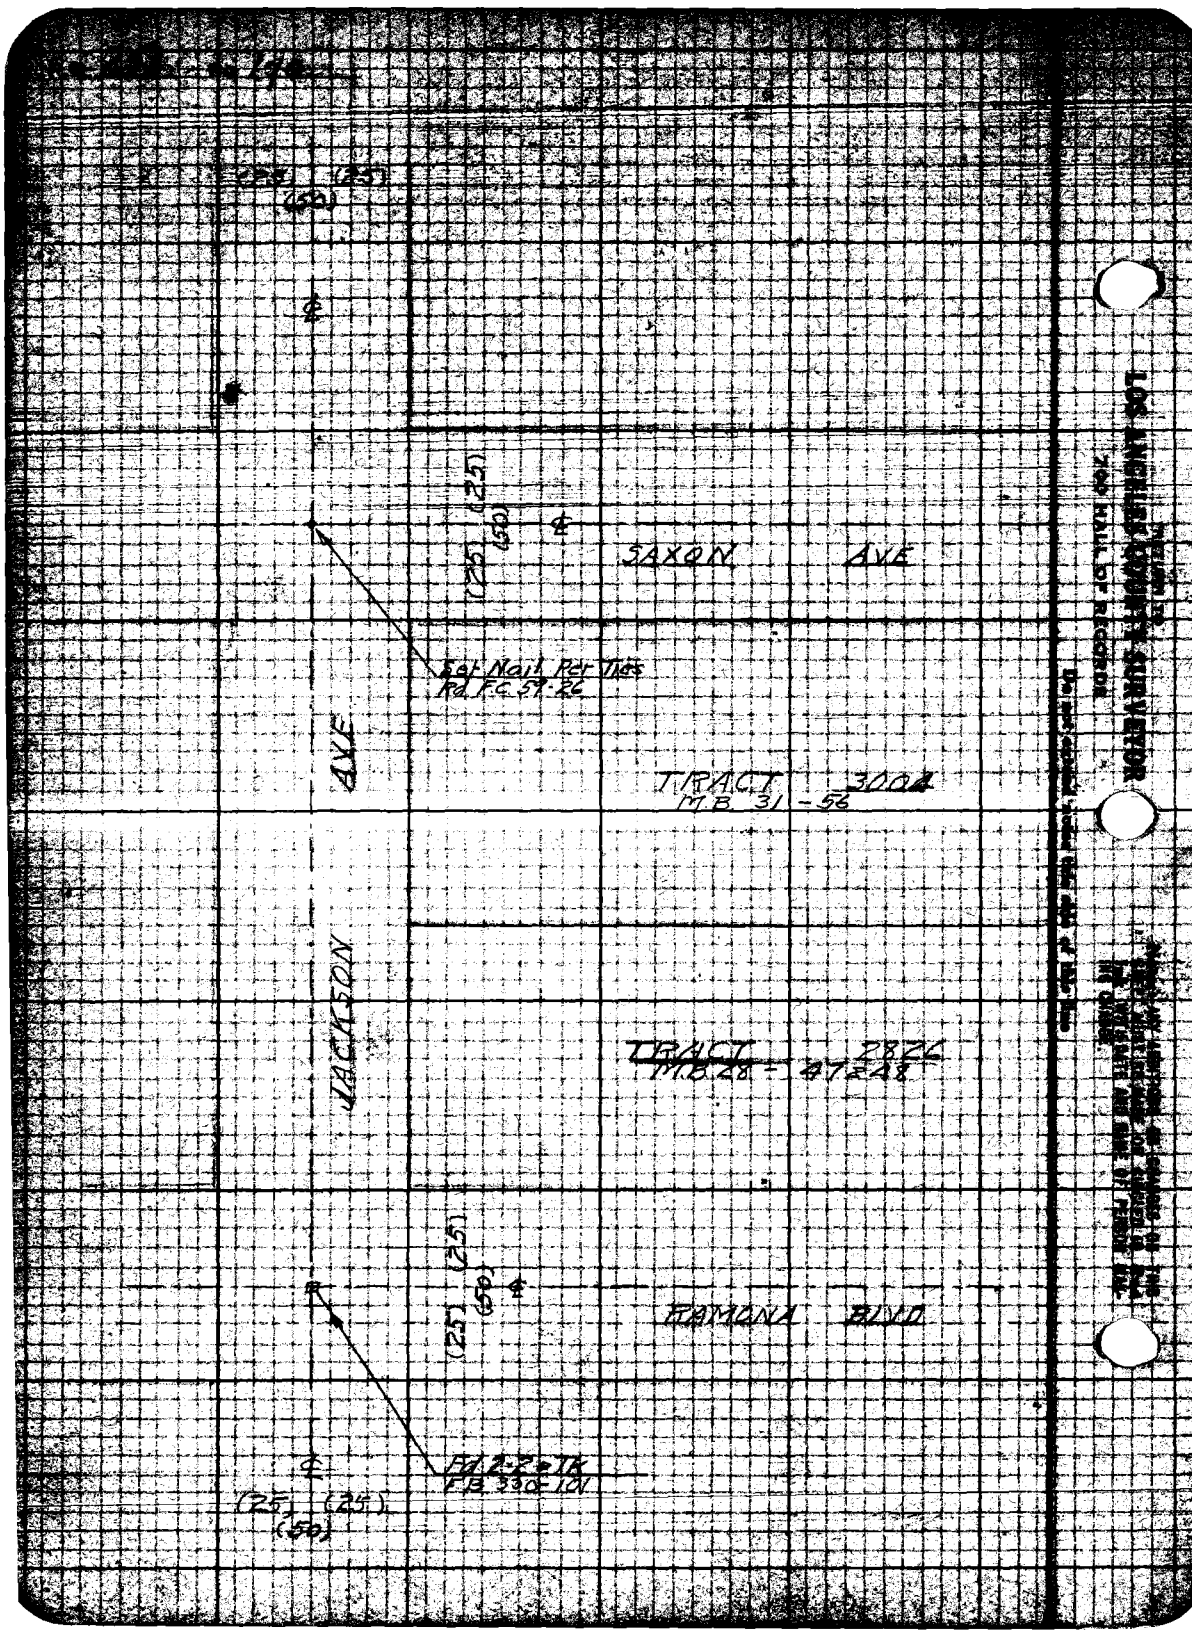
(25) (25)
(50)
℄
(25) (25)
(50)
℄
SAXON AVE
Set Nail Per Ties
Rd F.C. 59-26
AVE
TRACT 3004
M.B. 31-56
JACKSON
TRACT 2826
M.B. 28-47 & 48
(25) (25)
(50)
℄
RAMONA BLVD
℄
Rd 2-2 & 1K
F.B. 330-101
(25) (25)
(50)
LOS ANGELES COUNTY SURVEYOR
700 HALL OF RECORDS

Notes Ck'd by: Dixon	Survey of: SANTA ANITA AVE	F.B. 623	Pg.
Map No. B-1357	W. O. 7145 Tape No. 040 St'd 84°F.		
Office Work: L. Mitchell	Surveyed by: W.A. Miller		
Checked: Dixon	Notes: Miller Date: 1-21-36		
Date: Nov-38	Indexed: A. G. Johnson		

60+84.63
1+47.80
62+32.43
1+58.56
63+90.99
1+77.57
65+68.56

Con at bottom page 173

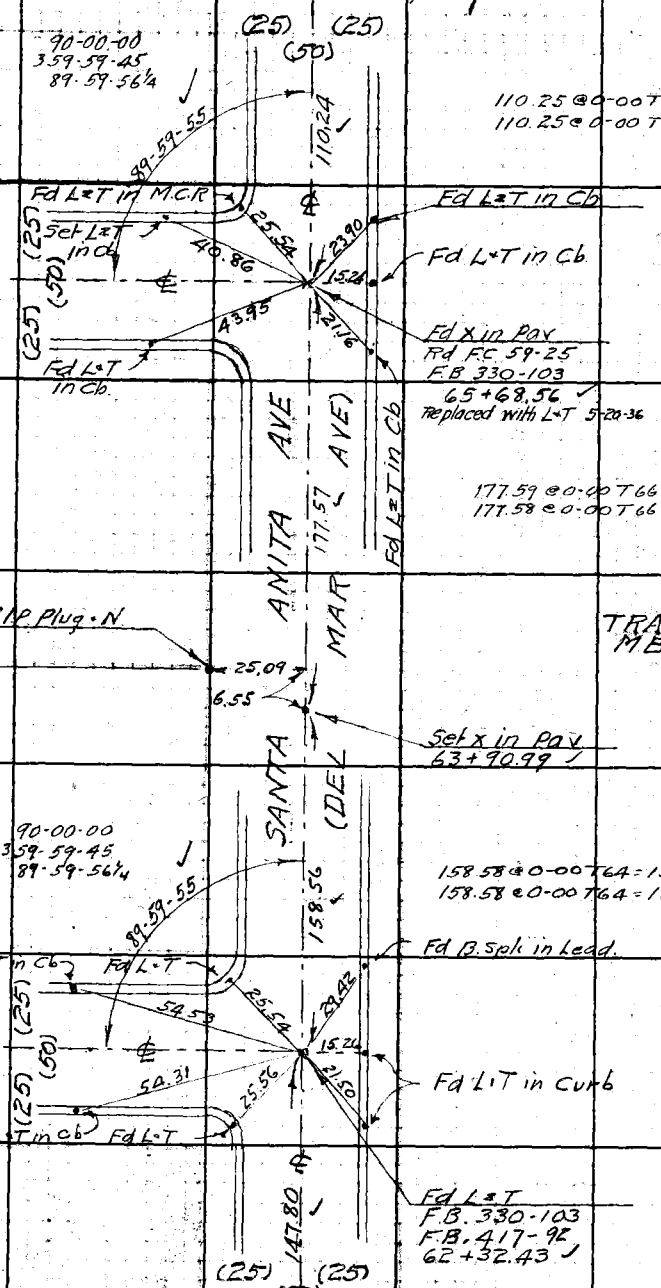

Con from top page 169

Note: Any Additions or Changes on This Sheet Must Be Made of Circled in Red Ink With Date and Name of Person Making Change.

Do not extend notes this side of this line

REVIEW TO
LOS ANGELES COUNTY SURVEYOR
700 HALL OF RECORDS

FORM 247 10M 11-35

F.B. 623 Pg. 192

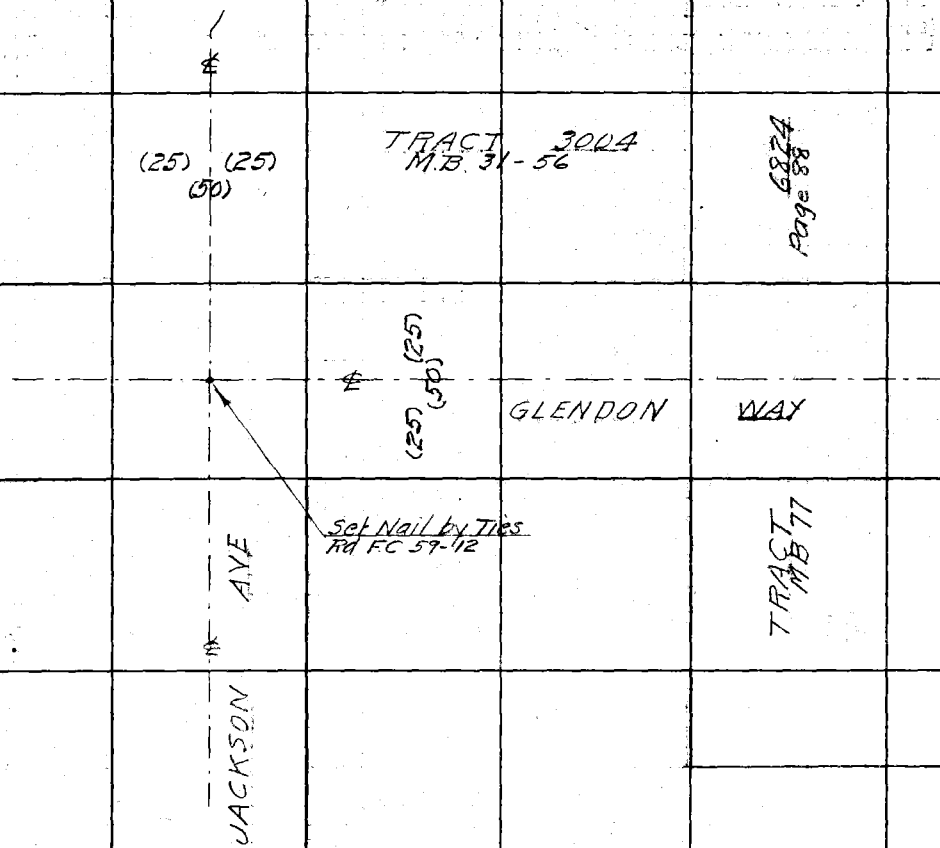

RETURN TO
LOS ANGELES COUNTY SURVEYOR
700 HALL OF RECORDS

Do not extend notes this side of this line

Note! Any Additions or Changes on This Sheet Must be Made or Circled in Red Ink With Date and Name of Person Making Change.

Notes Ck'd by Drew	Survey of SANTA ANITA AVE	F.B. 623	Pg. 173
Map No. B-1357	W. O. 7145 Tape No. 040 St'd 84°F.		
Office Work L. McHall	Surveyed by W.A. Miller		
Checked Drew	Notes Miller Date 1-22-36		
Date June - 38	Indexed C. Johnson		

65+68.56
1+10.24
66+78.80
42.62
67+21.42
1+83.23
69+04.65

Con at bottom page 175

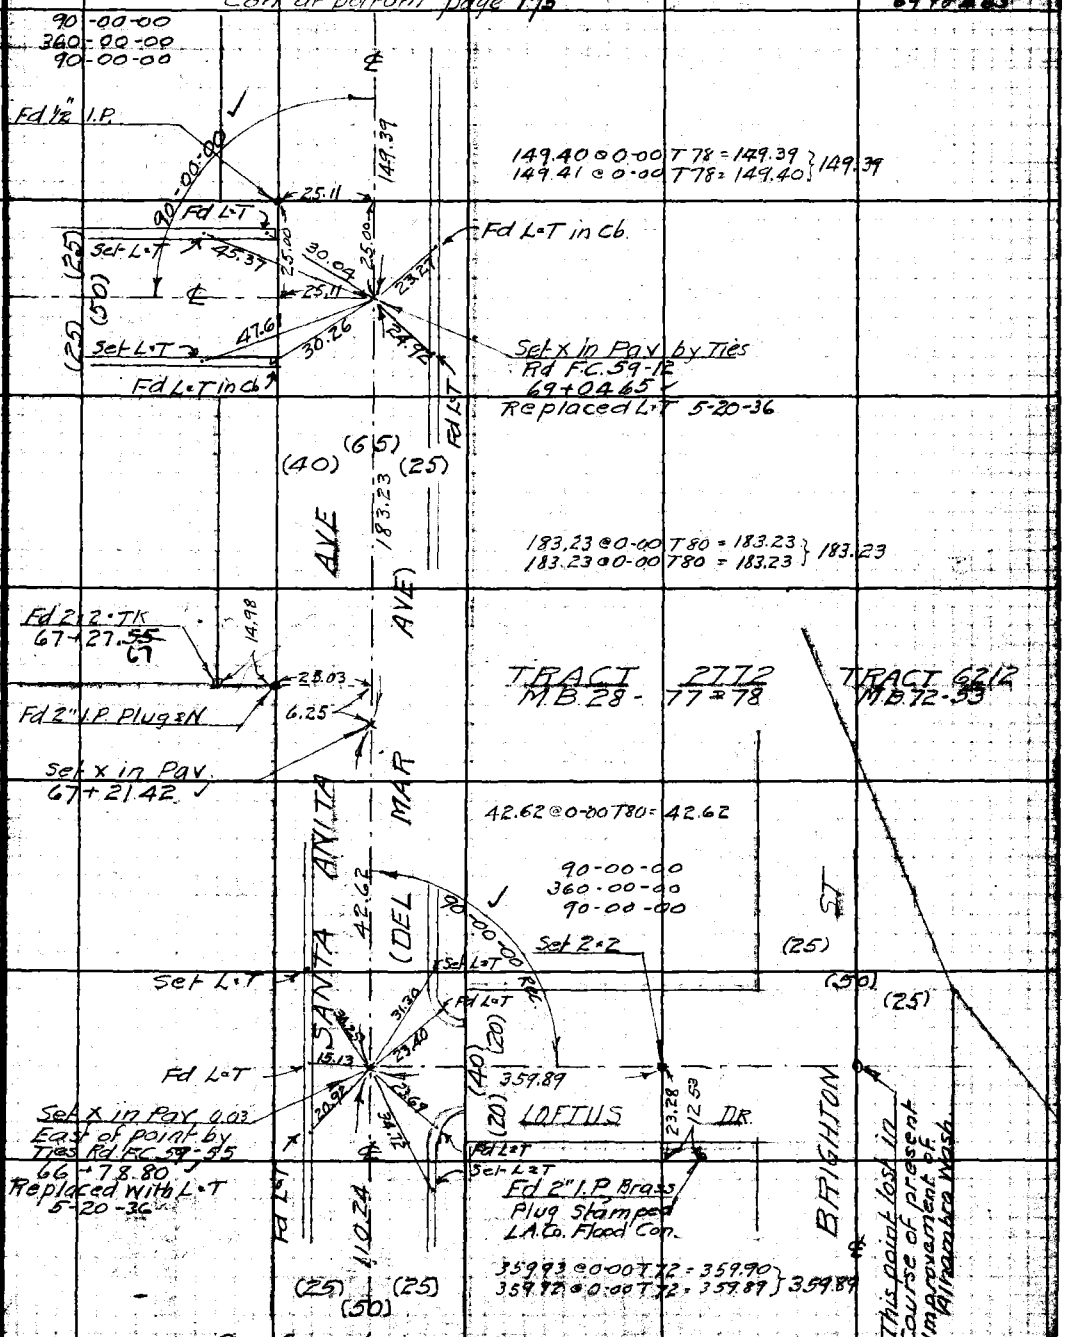

Con from top page 171

RETURN TO
LOS ANGELES COUNTY SURVEYOR
700 HALL OF RECORDS
Note: Any Additions or Changes on This Sheet Must be Made or Circled in Red Ink With Date and Name of Person Making Change.
Do not extend notes this side of this line
FORM 247 10M 11-35

F. 623 Pg. 174

402.40 @ 0-00 T76 = 412.38
402.41 @ 0-00 T76 = 412.39 } 412.38

187.41
412.38

TRACT 9116
M.B. 124-78

Fd 2" I.P.
No Plug
S.W. Cor Tr 9116

(25) (25)
(50)

TRACT 3926
M.B. 46-4

(20)
(40)
(20)

MARSHALL ST

Fd Spk - 4" Dia
Rd RC 59-36

JACKSON AVE

TRACT 3926
M.B. 46-4

(25) (25)
(50)

TRACT 3004
M.B. 31-56

TRACT 6824
M.B. 77-88

RETURN TO
LOS ANGELES COUNTY SURVEYOR
700 HALL OF RECORDS

Do not extend notes this side of this line

Note: Any Additions or Changes on This Sheet Must be Made or Circled in Red Ink With Date and Name of Person Making Change.

Notes Ck'd by Drew	Survey of SANTA ANITA AVE
Map No. B-1357	W. O. 7145 Tape No. 040 St'd 84 °F.
Office Work K. M. Hall	Surveyed by W. A. Miller
Checked Drew	Notes Miller Date 1-22-36
Date June - 38	Indexed A. C. Johnson

F.B. 623 Pg. 175

69+04.65
1+49.39
70+54.04
2+04.77
72+58.81
14.82
72+73.63
2+01.49
74+75.12

Con at bottom page 177

(80)
(40) (40)
Fd 2" I.P. Plug & TK S.E. Cor Tr 9116
38.16
14.13
Set X in Pav 74+75.12
AVE 201.81 AVE)
201.83 @ 0-00 T 72 = 201.81
201.83 @ 0-00 T 72 = 201.81 } 201.81
(65)
(25) (40)
201.51 @ 0-00 T 70 = 201.49
201.51 @ 0-00 T 70 = 201.49 } 201.49
TRACT 8214
M.B. 102 - 74 & 75
89-59-30
359-58-15
89-59-33 3/4
ANITA 201.49 MAR
90-01-45
360-07-00
90-01-45
(50)
(25) (25)
KELBURN AVE
89-59-35
90-01-45
Set L&T in Cb
Set L&T in Cb
44.97
49.12
55.55
57.28
52.09
14.82
49.82
(20) (20) (40)
Set L&T in Cb
30.46
MARSHALL ST
(30) (55) (25)
Replaced with L&T 5-20-36
Set X in Pav by Ties
Rd F.C. 59-178
72+73.63
Fd L&T M.C.R.
Fd 2" I.P. & N. 6" Dn.
Rd Z 326-71
Fd L&T
Rd Z 326-70
72+58.81
(50)
(25) (25)
204.77
SANTA (DEL
204.78 @ 0-00 T 80 = 204.77
204.78 @ 0-00 T 80 = 204.77 } 204.77
TRACT 6212
M.B. 72 - 53
TRACT 2772
M.B. 28 - 77 & 78
Fd 1½" I.P. Plug & N
24.87
3.67
Set X in Pav 70+54.04
149.39
(40) (65) (25)

Con From top page 173

Note: Any Additions or Changes on This Sheet Must be Made or Circled in Red Ink With Date and Name of Person Making Change.

Do not extend notes this side of this line

RETURN TO
LOS ANGELES COUNTY SURVEYOR
700 HALL OF RECORDS

FORM 247 10M 11-35

F.B. 623 Pg. 146

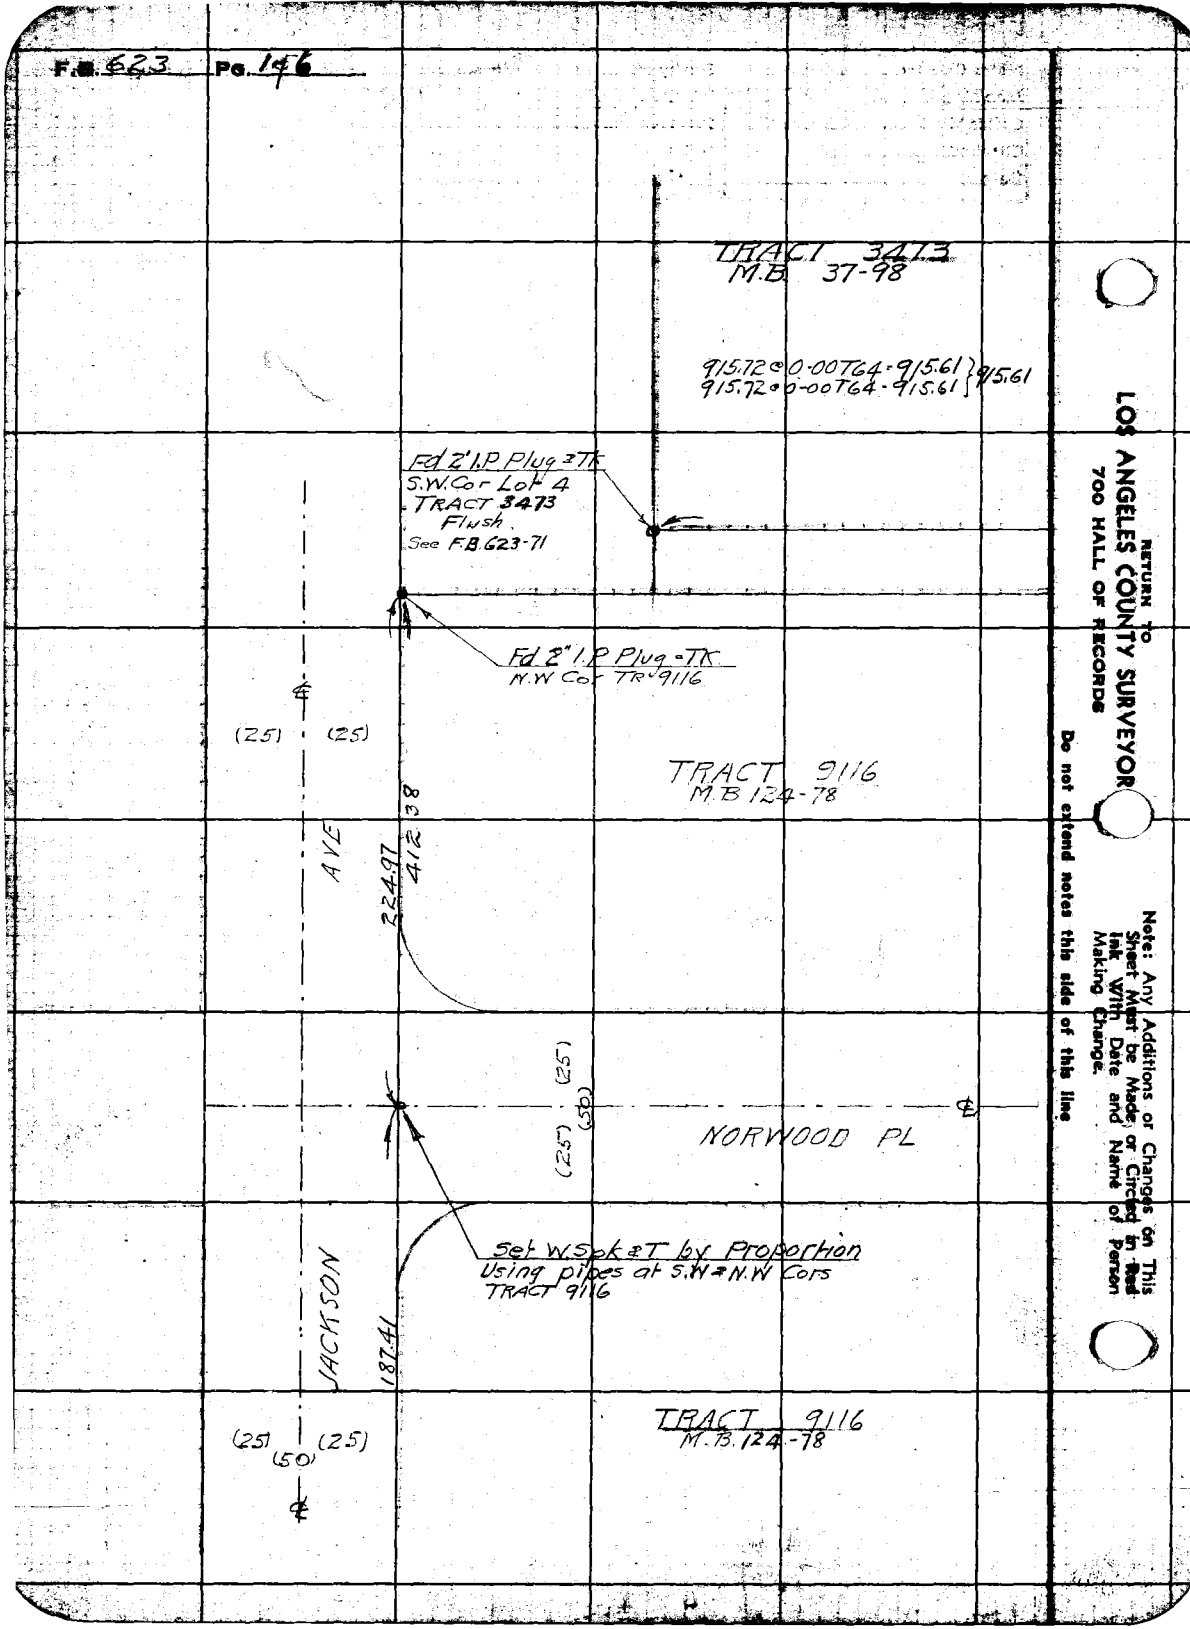

RETURN TO
LOS ANGELES COUNTY SURVEYOR
700 HALL OF RECORDS

Do not extend notes this side of this line

Note: Any Additions or Changes on This Sheet Must be Made or Circled in Red Ink With Date and Name of Person Making Change.

Notes Checked by: DK Grant
Map No. 13-1357
Office Work: [illegible]
Checked: Drew
Date: June -38

Survey of: SANTA ANITA AVE.
W. 0.145 Tape No. 040 st'd 84°F.
Surveyed by: W.A. Miller
Notes: Miller Date: 3-20-36
Indexed: A. C. Johnson

F.B. 623 Pg. 177

74+75.12
2+01.81
76+76.93
2+42.34
79+19.27

Con at bottom page 179

79+19.27
21.61
79+50.88
20.96
79+71.84

(31.5) (25) (40)

Fd L.W. & Tk. stamped L.A.Co. Flood Con. Dist. 79+71.84 ✓

Fd L.W. & Tk. Stamped L.A.Co. Flood Con. Dist. 79+50.88 ✓

Fd L.W. & Tk. Stamped L.A.Co. Flood Con. Dist. 79+19.27 ✓

145.20@0-00T70=145.19
145.20@0-00T70=145.19 } 145.19

128.64@0-00T62=128.62
128.62@0-00T62=128.60 } 128.61

Fd 2" I.P. 0.80 N No Plug S.W. Cor TR 5048

Fd 2" I.P. Top bent over S.E. Cor. TR 5048

℄ Proposed Parkway

915.61 — 128.61 — 349.29 — 468.79 — 179.59

Fd 2x2 & TK. F.B. 317-5, 7, 9

Fd 2" I.P. & Brass Plug Stamped L.A.Co. Flood Control Dist.

39.93

Fd 3/4" I.P. No Plug N.E. Cor TR 9116

89-51-10 ✓ 89-57-10 ✓

89-51-15
359-24-30
89-51-07½

89-59-15
359-56-45
89-59-11½

349.35@0-00T62=349.30
349.33@0-00T62=349.28 } 349.29

468.87@0-00T62=468.80
468.86@0-00T62=468.79 } 468.79

179.62@0-00T62=179.59
179.62@0-00T62=179.59 } 179.59

242.36@0-00T72=202.34
242.36@0-00T72=202.34 } 242.34

(40) (40) (75)

Set L.T in Curb

58.32

Set L.T

Set N.T. Ph Pole

72.87

22.49

(25) (50) (25)

Curb

68.98

24.88

Set L.T

Replaced with L.T 6-2-36

Set X in Pav. by Proportion. Using pipes at S.E. & N.E. Cors Tract 9116 76+76.93 ✓

Fd. 2x2 & Tk. Flush

39.98

89-54-05 ✓

85.29

89-54-00
359-36-15
89-54-03¾

Set N.T. Ph Pole

TRACT 8214
M.B. 102-74 & 75

SANTA ANITA AVE (DEL MAR AVE)

242.34

201.81

(40) (40) (80)

Con from top page 175

Note: Any Additions or Changes on This Sheet Must Be Made or Circled in Red Ink, With Date and Name of Person Making Change.

Do not unfold below this side of this line

RETURN TO LOS ANGELES COUNTY SURVEYOR 700 HALL OF RECORDS

FORM 247 1005 11-38

F.B. 623 Pg. 178

RETURN TO
LOS ANGELES COUNTY SURVEYOR
700 HALL OF RECORDS

Do not extend notes this side of this line

Note: Any Additions or Changes on This Sheet Must be Made or Circled in Red Ink With Date and Name of Person Making Change.

Notes Ck'd by Drew	Survey of SANTA ANITA AVE
Map No. B-1357	W. O. 7145 Tape No. 040 St'd 84 °F.
Office Work N. M. Kelp	Surveyed by W.A. Miller
Checked Drew	Notes Miller Date 3-23-36
Date June-38	Indexed A. C. Johnson

F.B. 623 Pg. 177

79 + 71.84
1 + 45.19
81 + 17.03
54.06
81 + 71.09
45.95
82 + 17.04
6 + 49.95
88 + 66.99

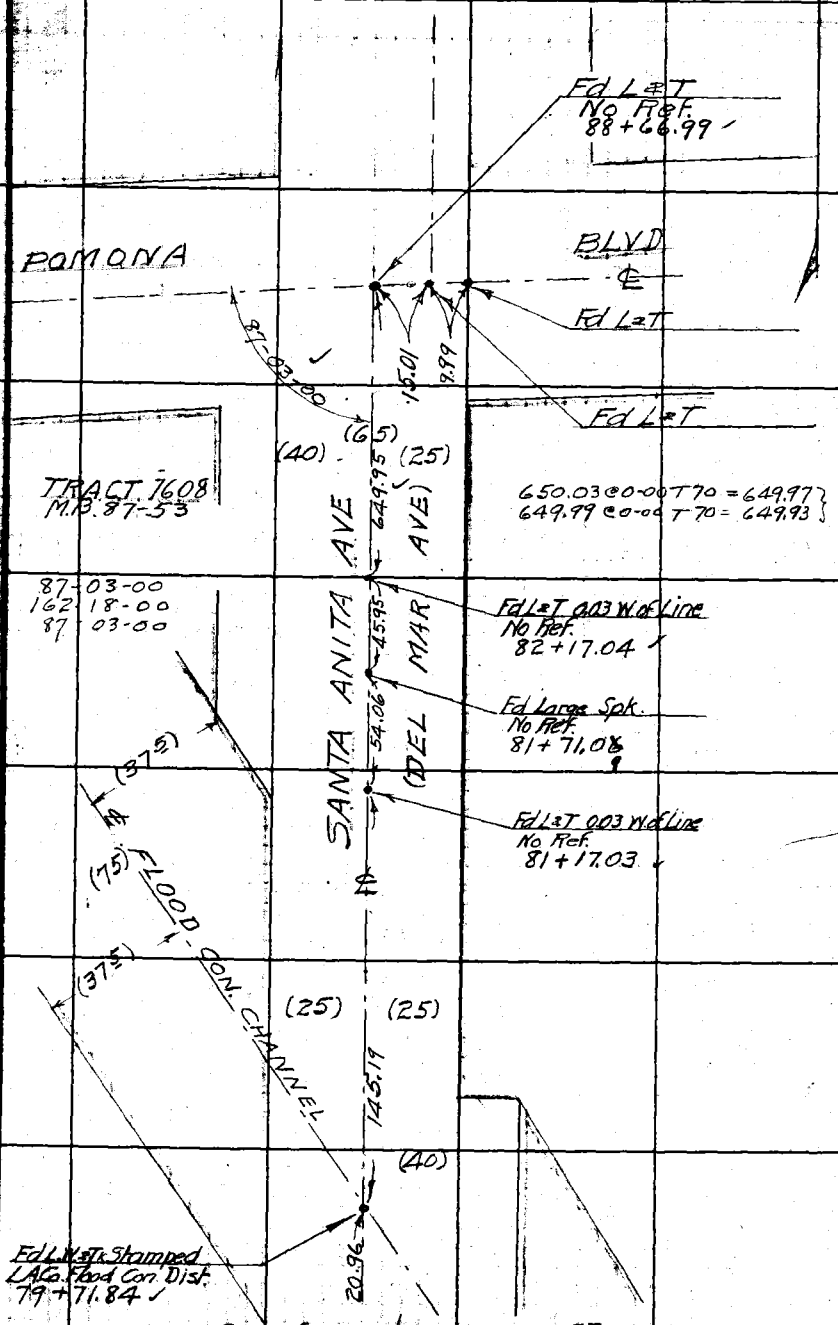

Con from top page 177

Note: Any Additions or Changes on This Sheet Must Be Made or Circled in Red Ink With Date and Name of Person Making Change.

Do not extend notes this side of this line

RETURN TO
LOS ANGELES COUNTY SURVEYOR
700 HALL OF RECORDS

FORM 847 10M 11-35

F.B. 623 Pg. 189

RETURN TO
LOS ANGELES COUNTY SURVEYOR
700 HALL OF RECORDS

Note: Any Additions or Changes on This Sheet Must be Made or Circled in Red Ink With Date and Name of Person Making Change.

Do not extend notes this side of this line

Notes Ck'd by	Survey of SANTA ANITA AVE
Map No. B-1257	W. O. 7145 Tape No. Sl'd °F.
Office Work L. McGall	Surveyed by W. A. Miller
Checked	Notes Miller & Braden Date 3-26-36
Date	Indexed A. C. Johnson 3-27-36

F.B. 623 Pg.

Note: Any Additions or Changes on This Sheet Must be Made or Circled in Red Ink With Date and Name of Person Making Change.

Do not extend notes this side of this line

RETURN TO
LOS ANGELES COUNTY SURVEYOR
700 HALL OF RECORDS

TOPOGRAPHY. SANTA ANITA AVE
FROM.
GRAVES AVE. TO SAN GABRIEL CITY LIMITS
J.N. 7145
Mar 26 1936 to June 1 1936

Miller
Braden
Stewart
Adams
Clinite

CENTER LINE - PAGES 145-179

FORM 347 10M 11-33

F.B. 623 Pg. 182

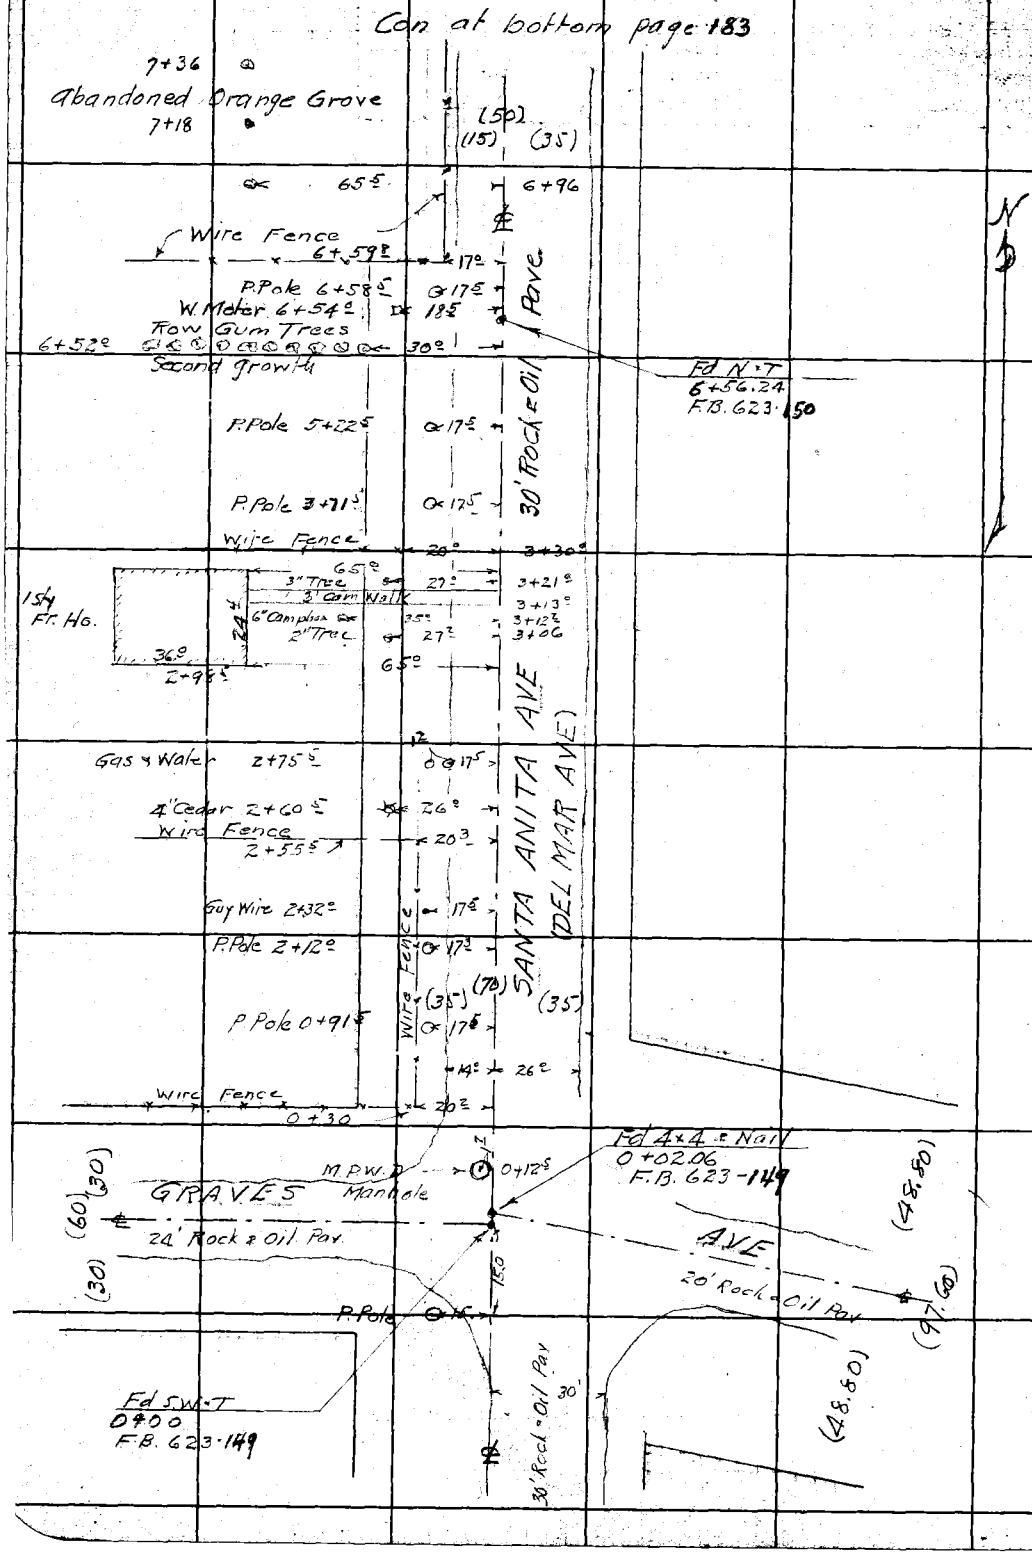

RETURN TO
LOS ANGELES COUNTY SURVEYOR
700 HALL OF RECORDS

Note: Any Additions or Changes on This Sheet Must be Made or Circled in Red Ink With Date and Name of Person Making Change.

Do not extend notes this side of this line

Notes Ck'd by Drew	Survey of SANTA ANITA AVE	F.B. 623	Pg. [illegible]
Map No. B-1357	W. D. 7145 Tape No. St'd °F.		
Office Work H. McHall	Surveyed by W.A. Miller		
Checked Drew	Notes Miller & Braden Date 3-27-36		
Date June - 38	Indexed A. C. Johnson		

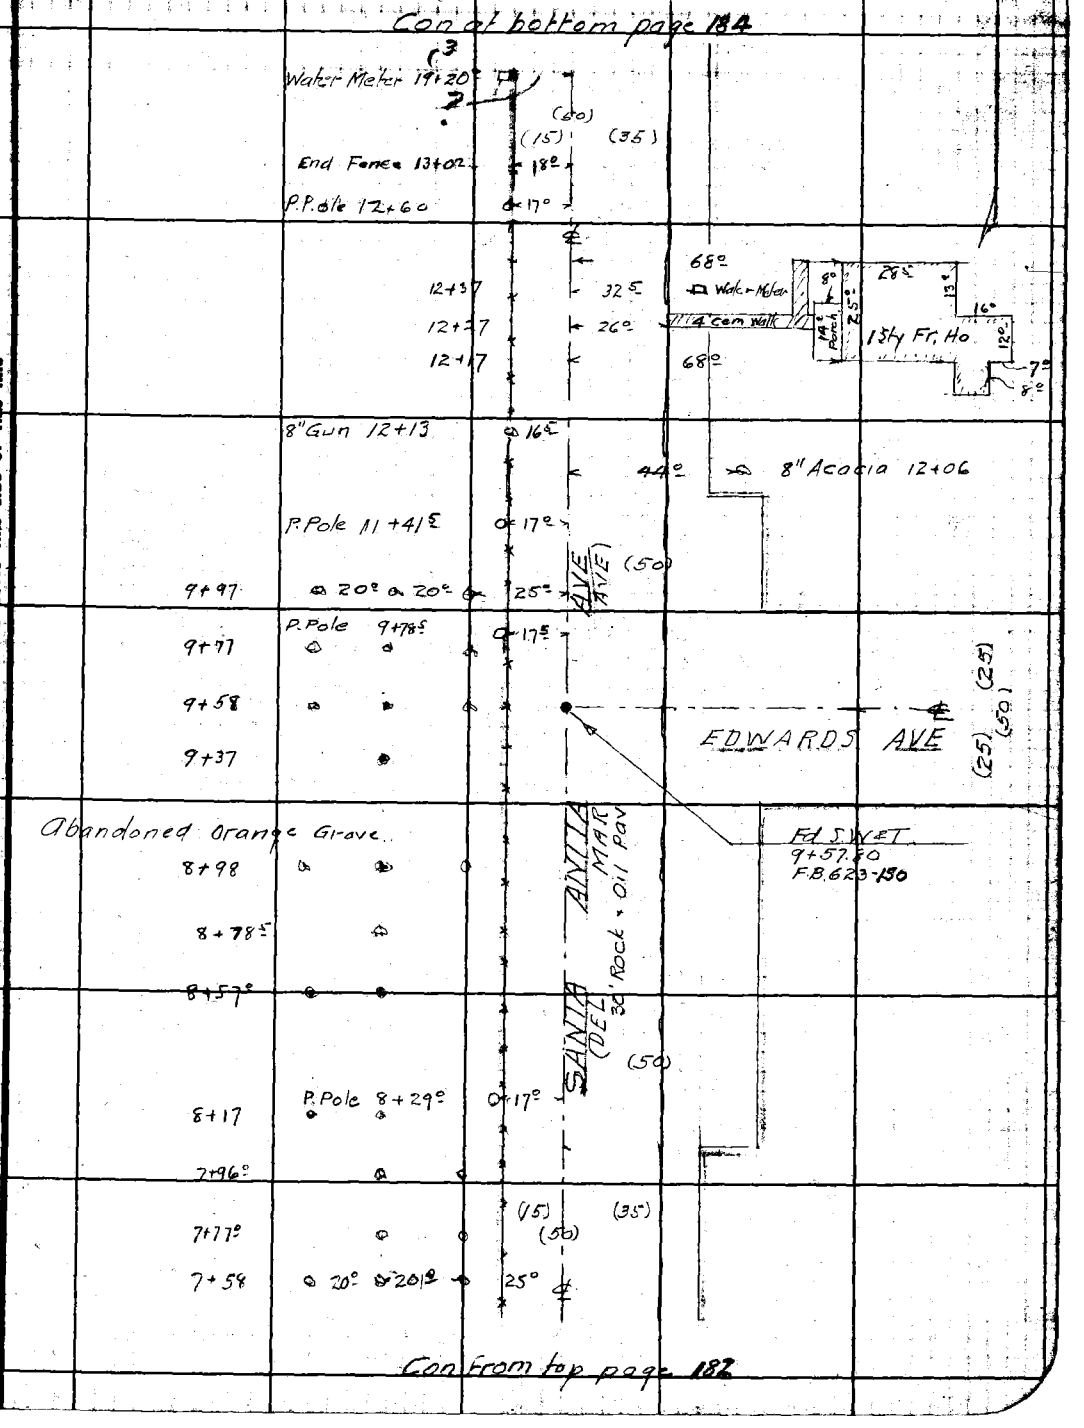

Note: Any Additions or Changes on This Sheet Must be Made or Circled in Red Ink With Date and Name of Person Making Change.

Do not extend notes this side of this line

RETURN TO
LOS ANGELES COUNTY SURVEYOR
700 HALL OF RECORDS

FORM 247 10M 11-35

F.B. 623 Pg. 184

Con at bottom page 185

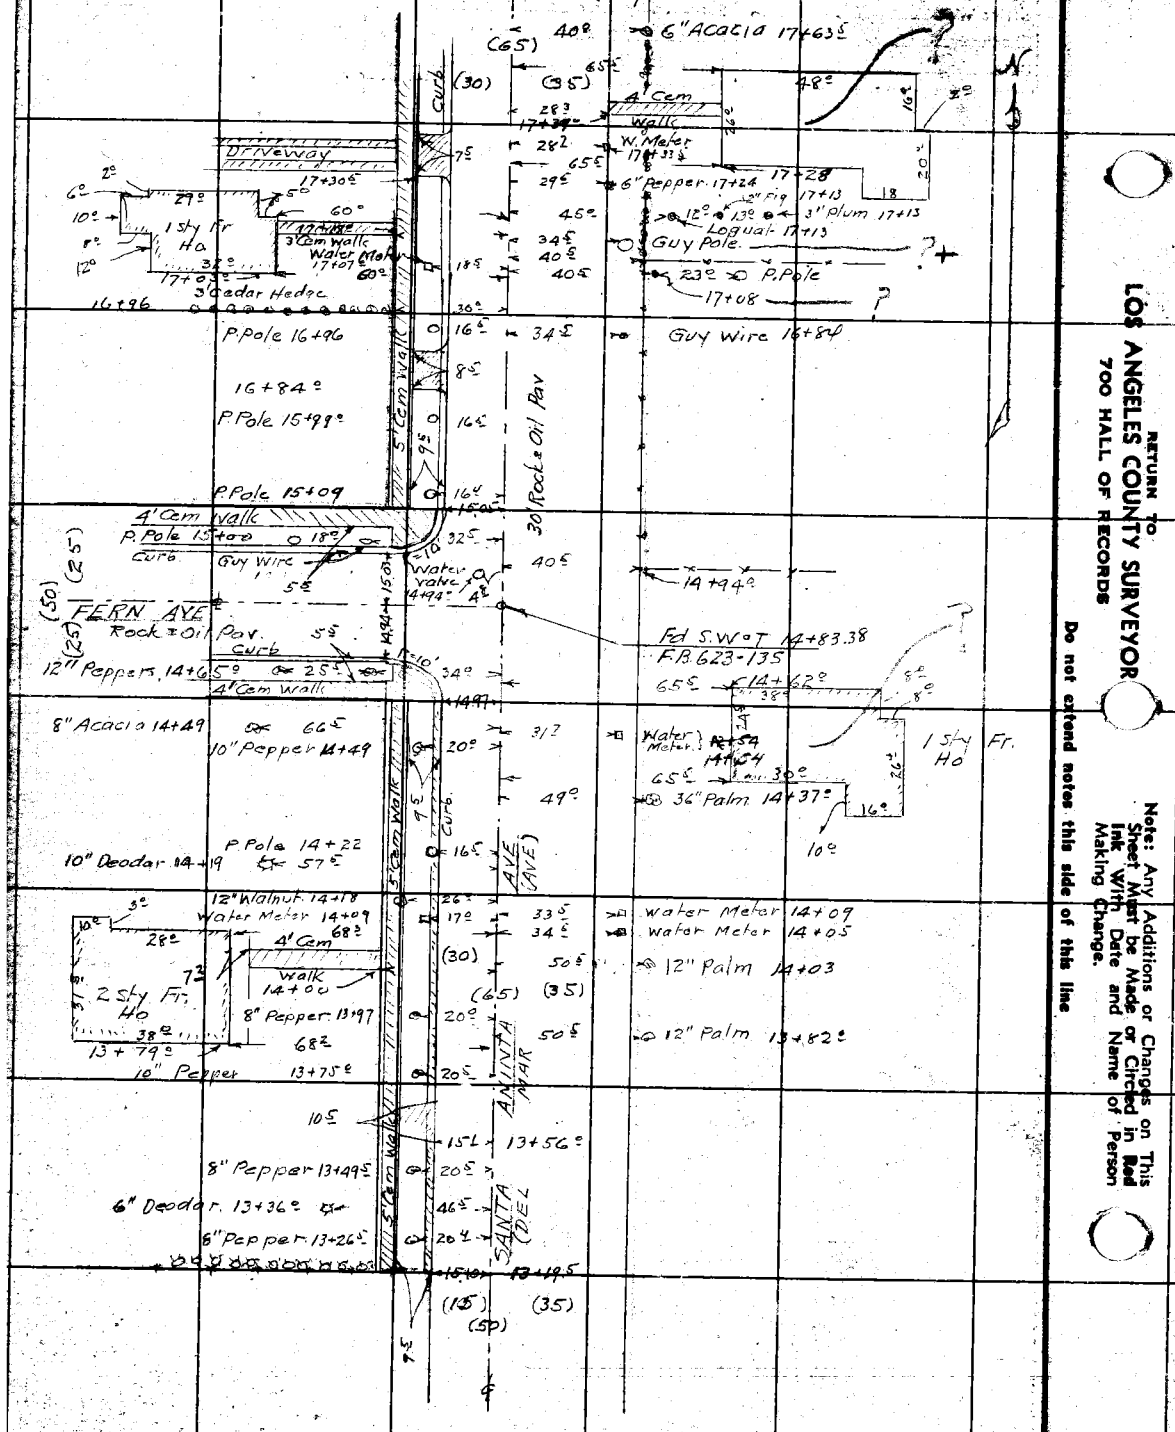

Con from top page 183

RETURN TO
LOS ANGELES COUNTY SURVEYOR
700 HALL OF RECORDS

Note: Any Additions or Changes on This Sheet Must be Made or Circled in Red Ink With Date and Name of Person Making Change.

Do not extend notes this side of this line

Notes Ck'd by Drew	Survey of SANTA ANITA AVE
Map No. B-1357	W. O. 7145 Tape No. St'd °F.
Office Work A. M. Hall	Surveyed by W.A.Miller
Checked Drew	Notes Miller & Black Date 3-27-36
Date June - 38	Indexed A. C. Johnson

F.B. 623 PG. 185

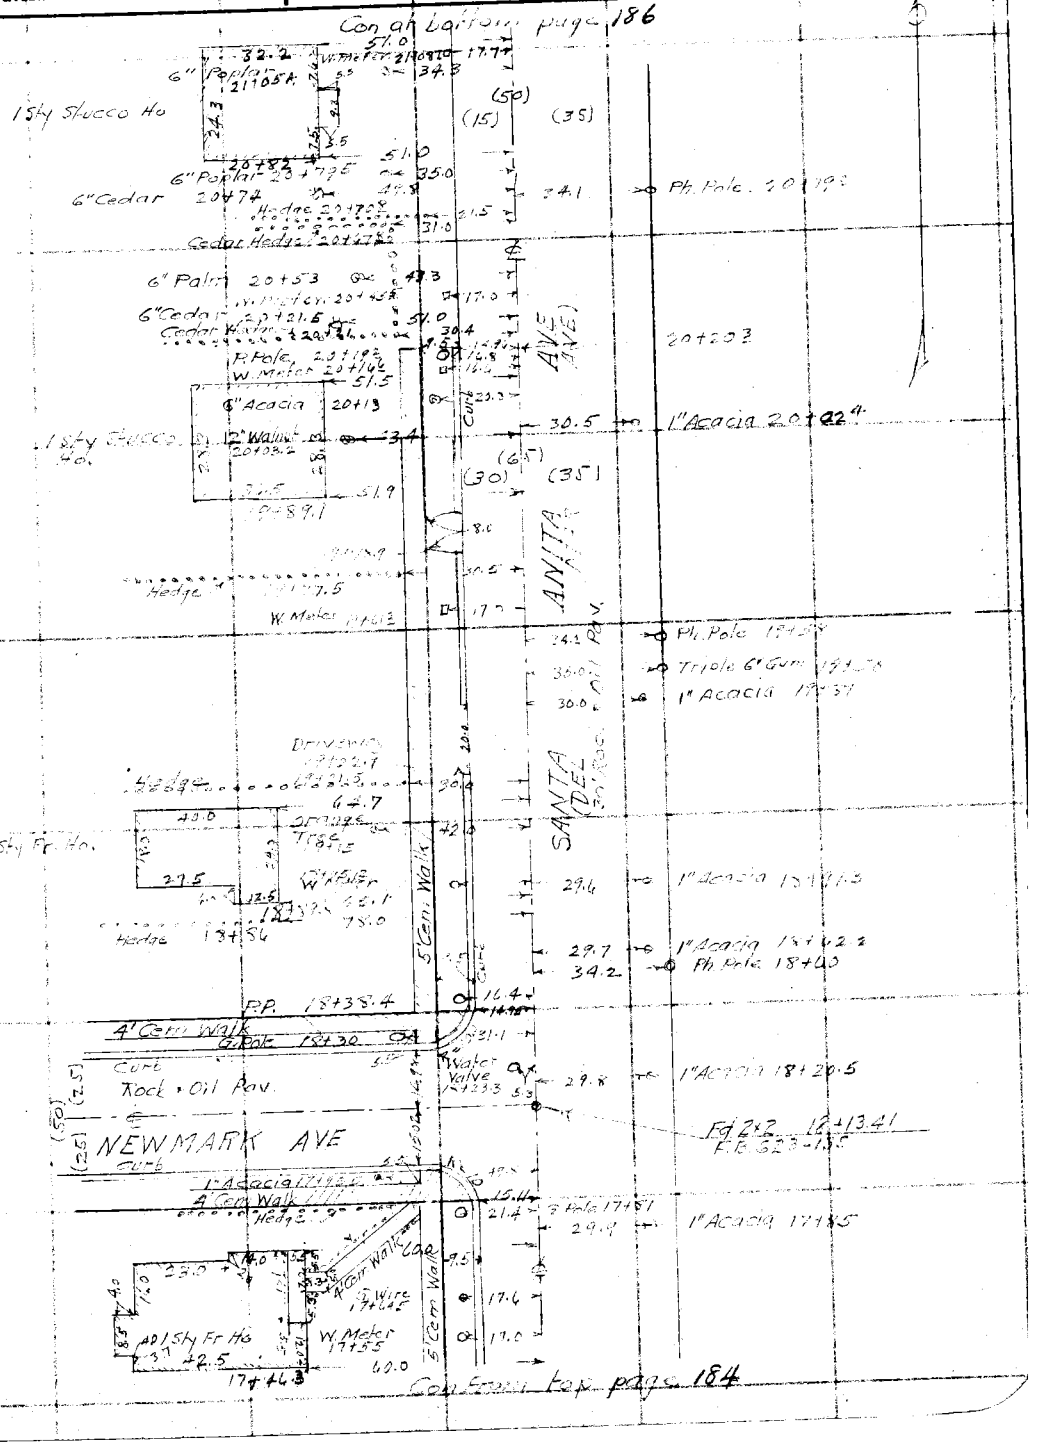

Note: Any Additions or Changes on This Sheet Must be Made or Circled in Red Ink With Date and Name of Person Making Change.

Do not extend notes this side of this line

RETURN TO
LOS ANGELES COUNTY SURVEYOR
700 HALL OF RECORDS

FORM 247 10M 11-35

F.B. 623 PG. 186

Con at bottom page 187

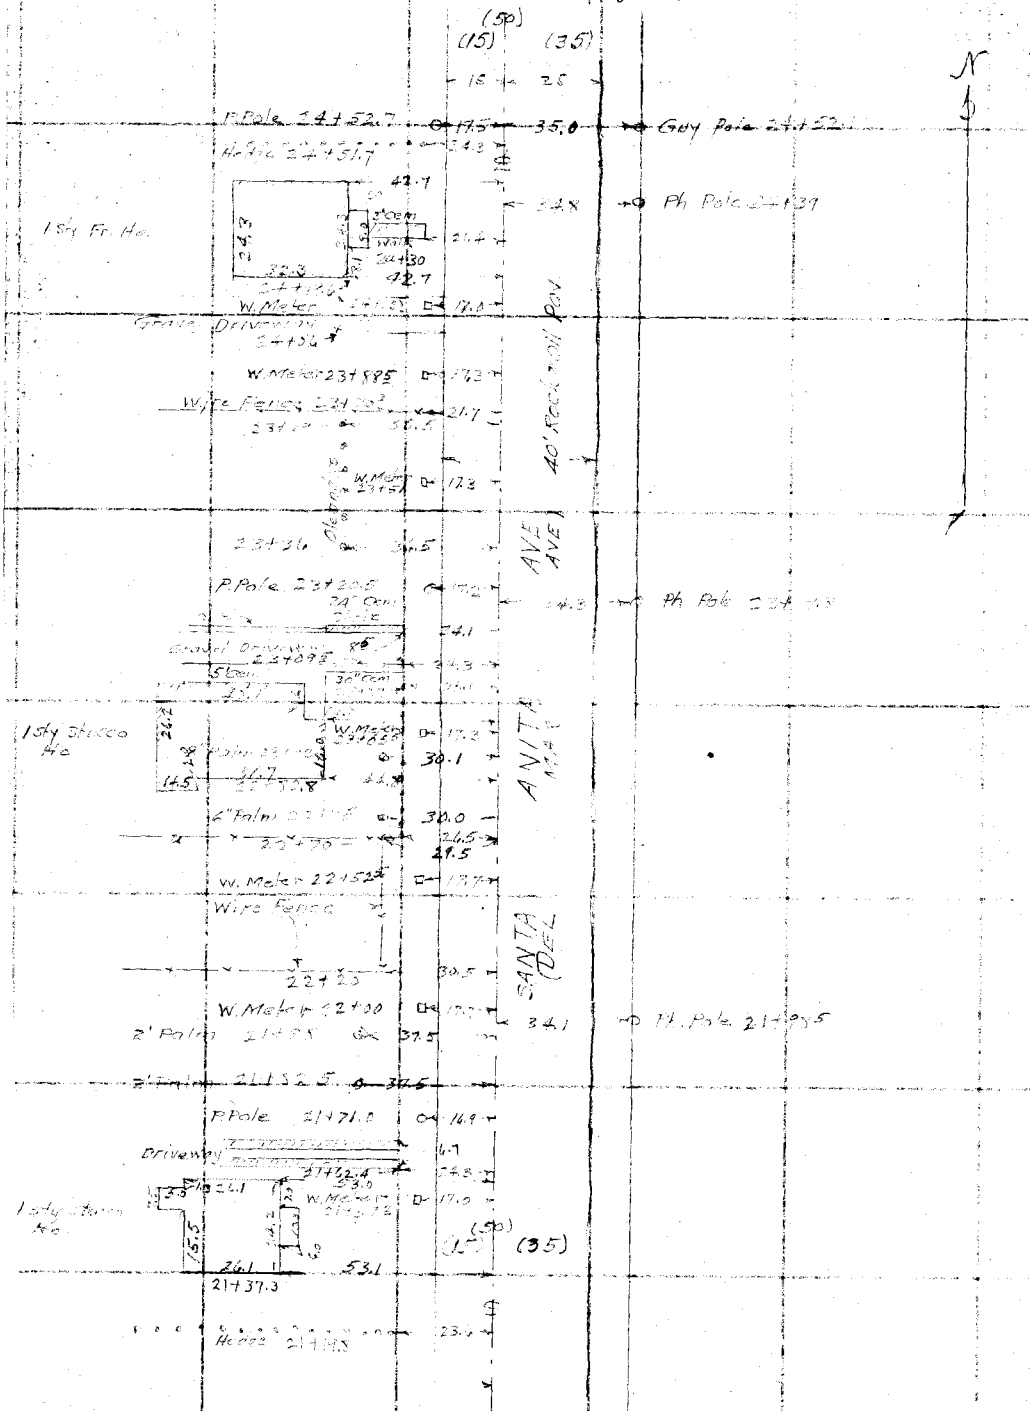

Con from top page 185

RETURN TO
LOS ANGELES COUNTY SURVEYOR
700 HALL OF RECORDS

Do not extend notes this side of this line

Note: Any Additions or Changes on This Sheet Must be Made or Circled in Red Ink With Date and Name of Person Making Change.

Notes Ck'd by Drew	Survey of SANTA ANITA AVE
Map No. B-1357	W. O. 7145 Tape No. St'd °F.
Office Work L. M. Hall	Surveyed by W. A. Miller
Checked Drew	Notes Millers Braden Date 3-31-38
Date June - 38	Indexed A. C. Johnson

F.B. 623 PG. 187

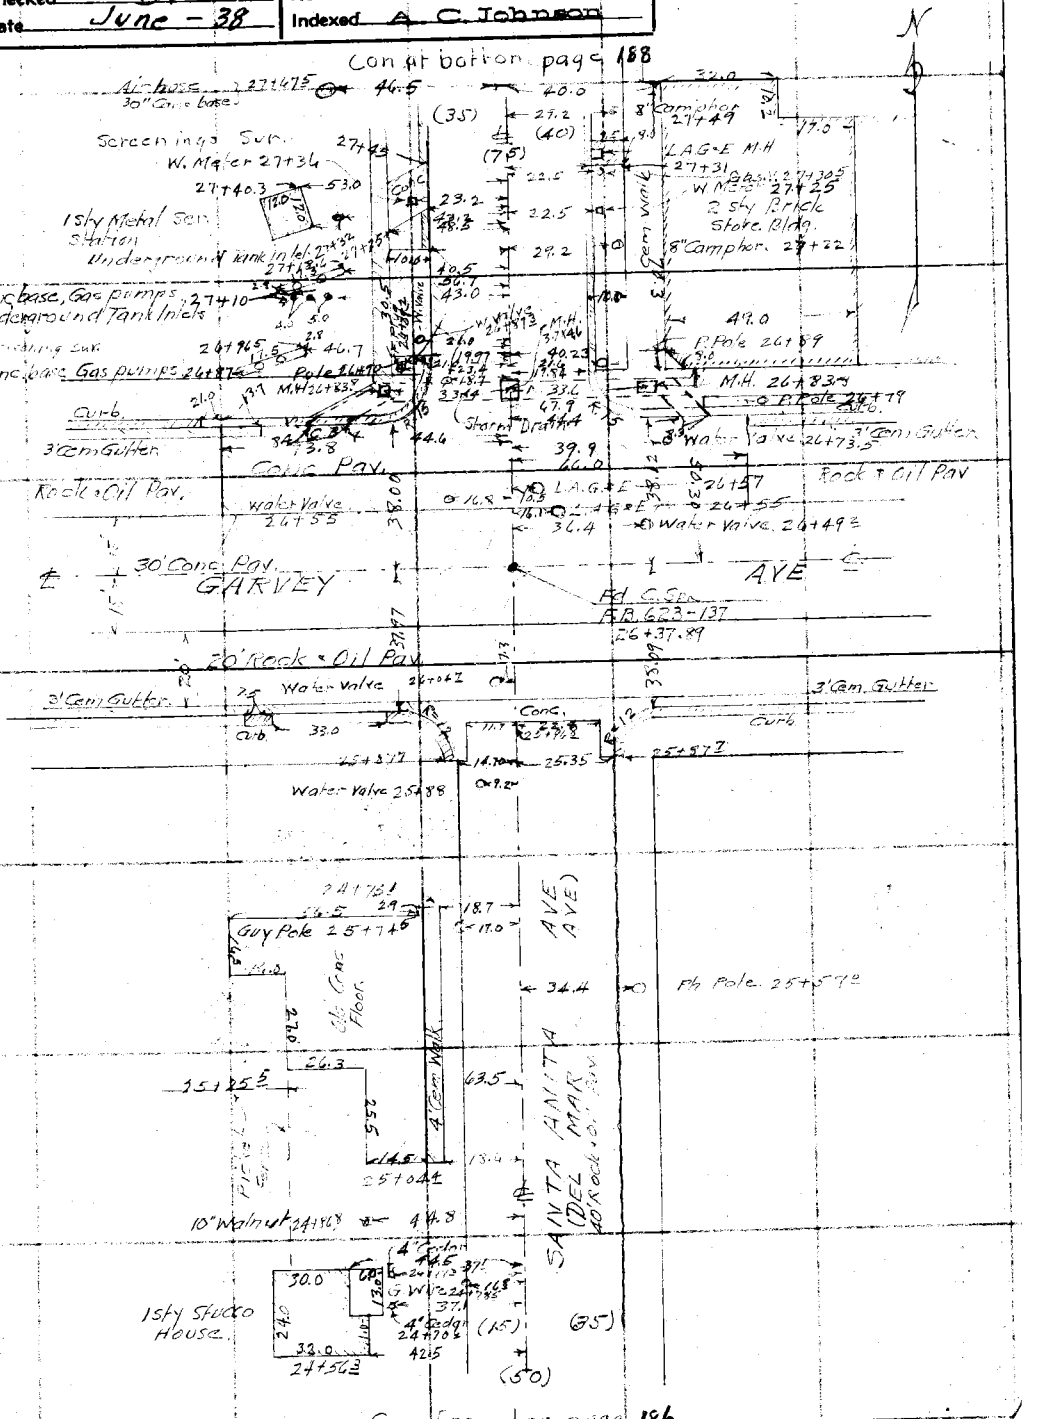

Note: Any Additions or Changes on This Sheet Must Be Made or Circled in Red Ink With Date and Name of Person Making Change.

Do not extend notes this side of this line

RETURN TO
LOS ANGELES COUNTY SURVEYOR
700 HALL OF RECORDS

FORM 247 10M 11-35

F.B. 623 PG. 188

Con. at bottom page 187

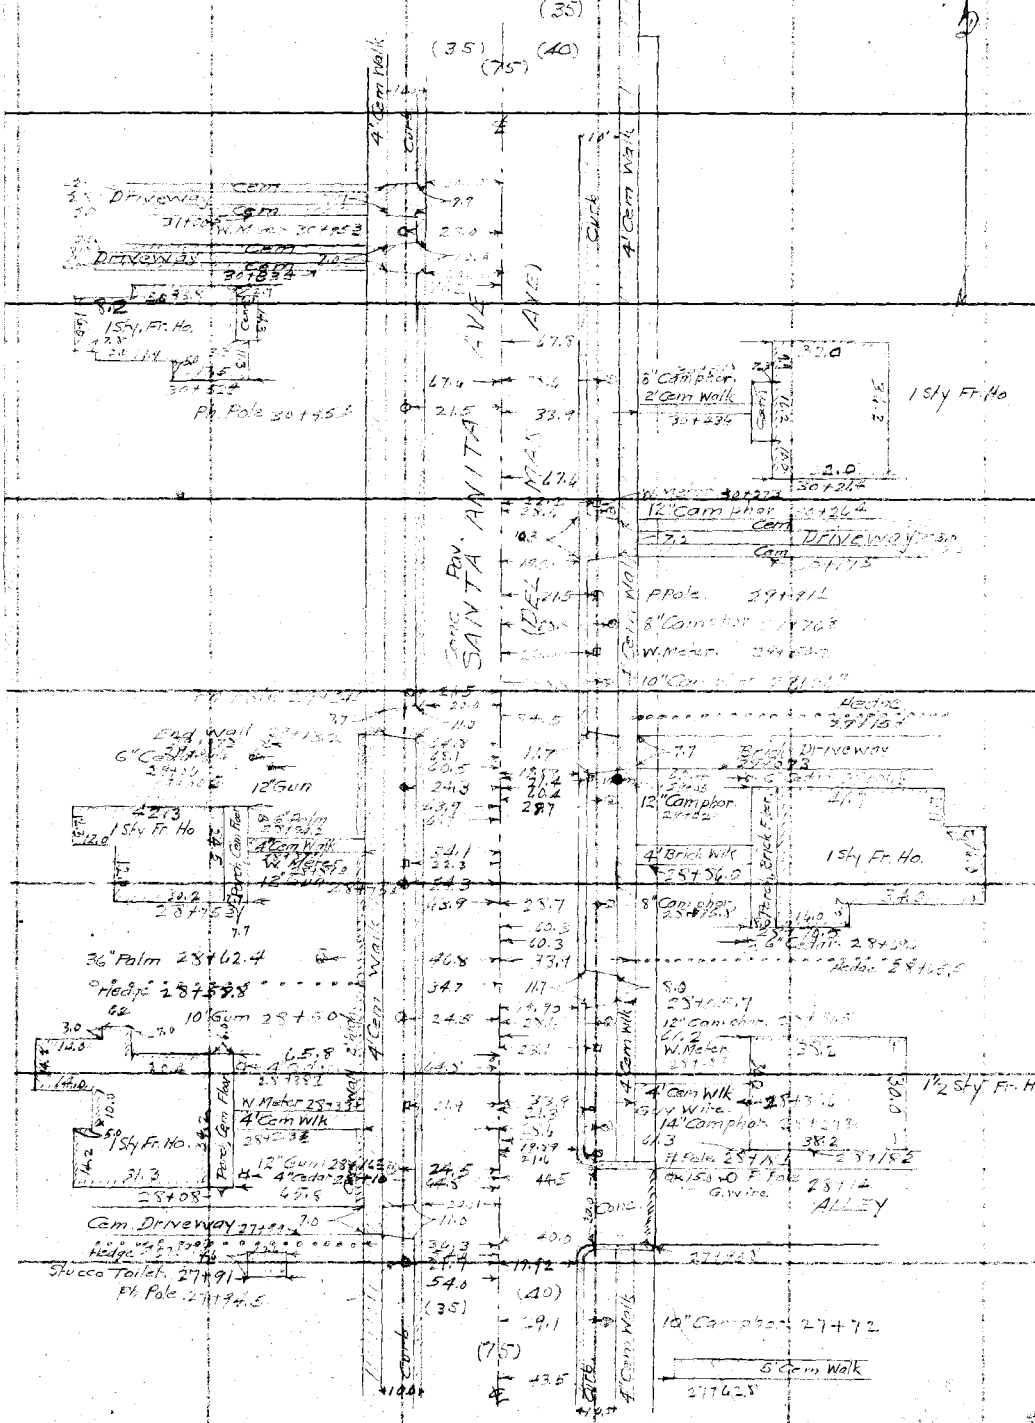

RETURN TO
LOS ANGELES COUNTY SURVEYOR
700 HALL OF RECORDS

Do not extend notes this side of this line

Note: Any Additions or Changes on This Sheet Must be Made or Circled in Red Ink With Date and Name of Person Making Change.

Notes Ck'd by Jr ew	Survey of SANTA ANITA AVE
Map No. B-1357	W. O. 7145 Tape No. ___ St'd ___ °F.
Office Work H. M. Hall	Surveyed by W A Miller
Checked Drew	Notes Miller & Braden Date 4-1-36
Date June - 38	Indexed A. C. Johnson

F.B. 623 PG. 189

Con. at bottom page 190

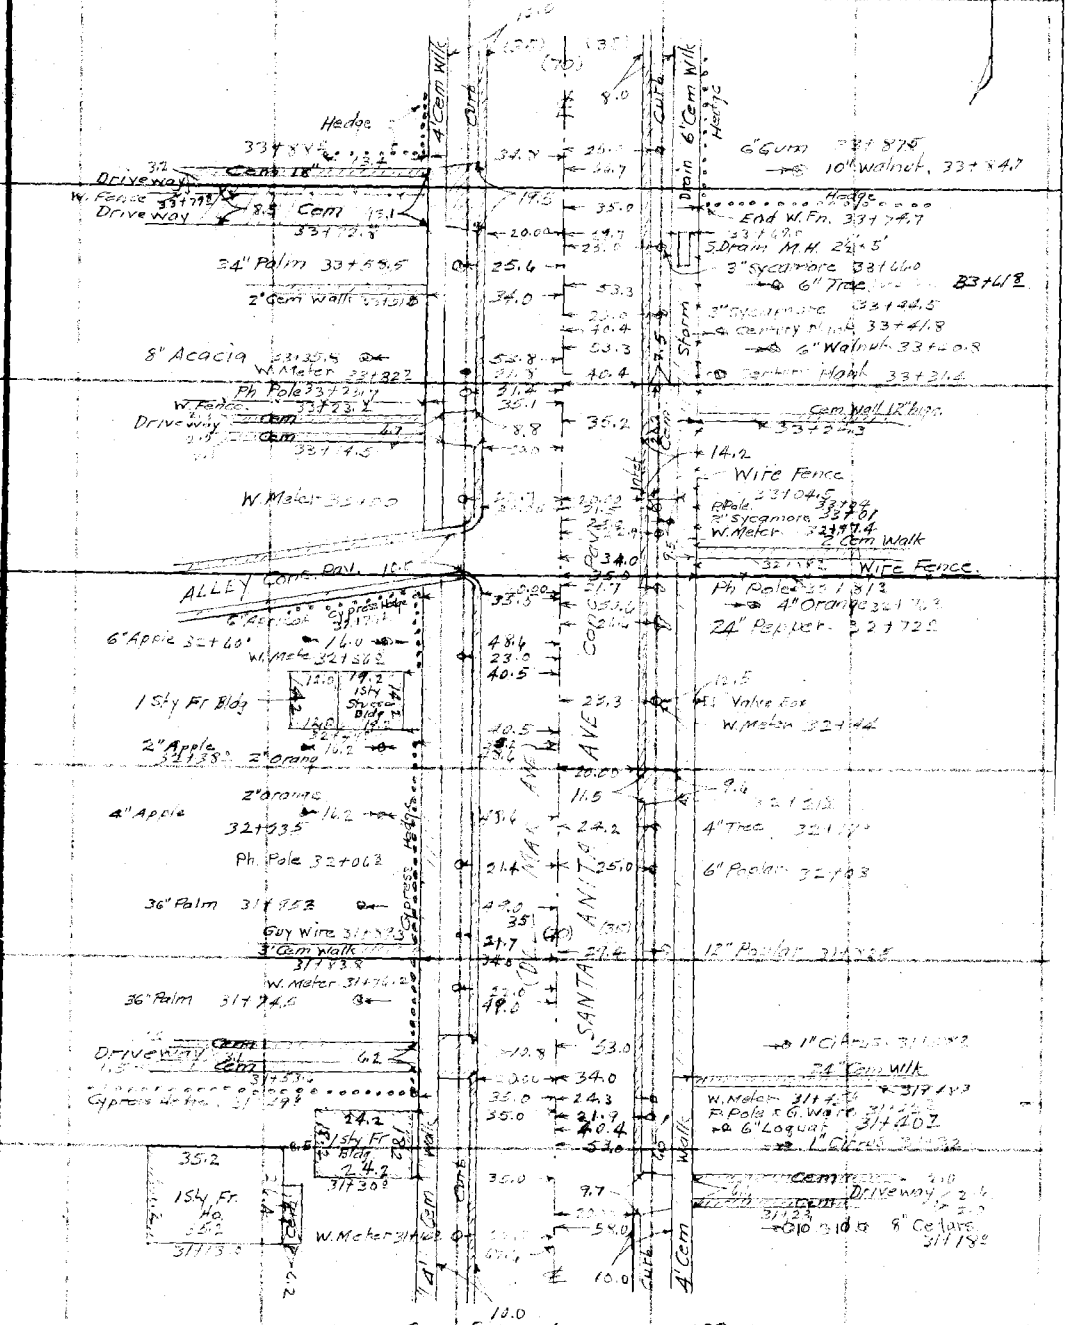

Con. From top page 188

Note: Any Additions or Changes on This Sheet Must be Made or Circled in Red Ink With Date and Name of Person Making Change.

Do not extend notes this side of this line

RETURN TO
LOS ANGELES COUNTY SURVEYOR
700 HALL OF RECORDS

FORM 247 10M 11-35

F.B. 623 PG. 190

Con at bottom page 191

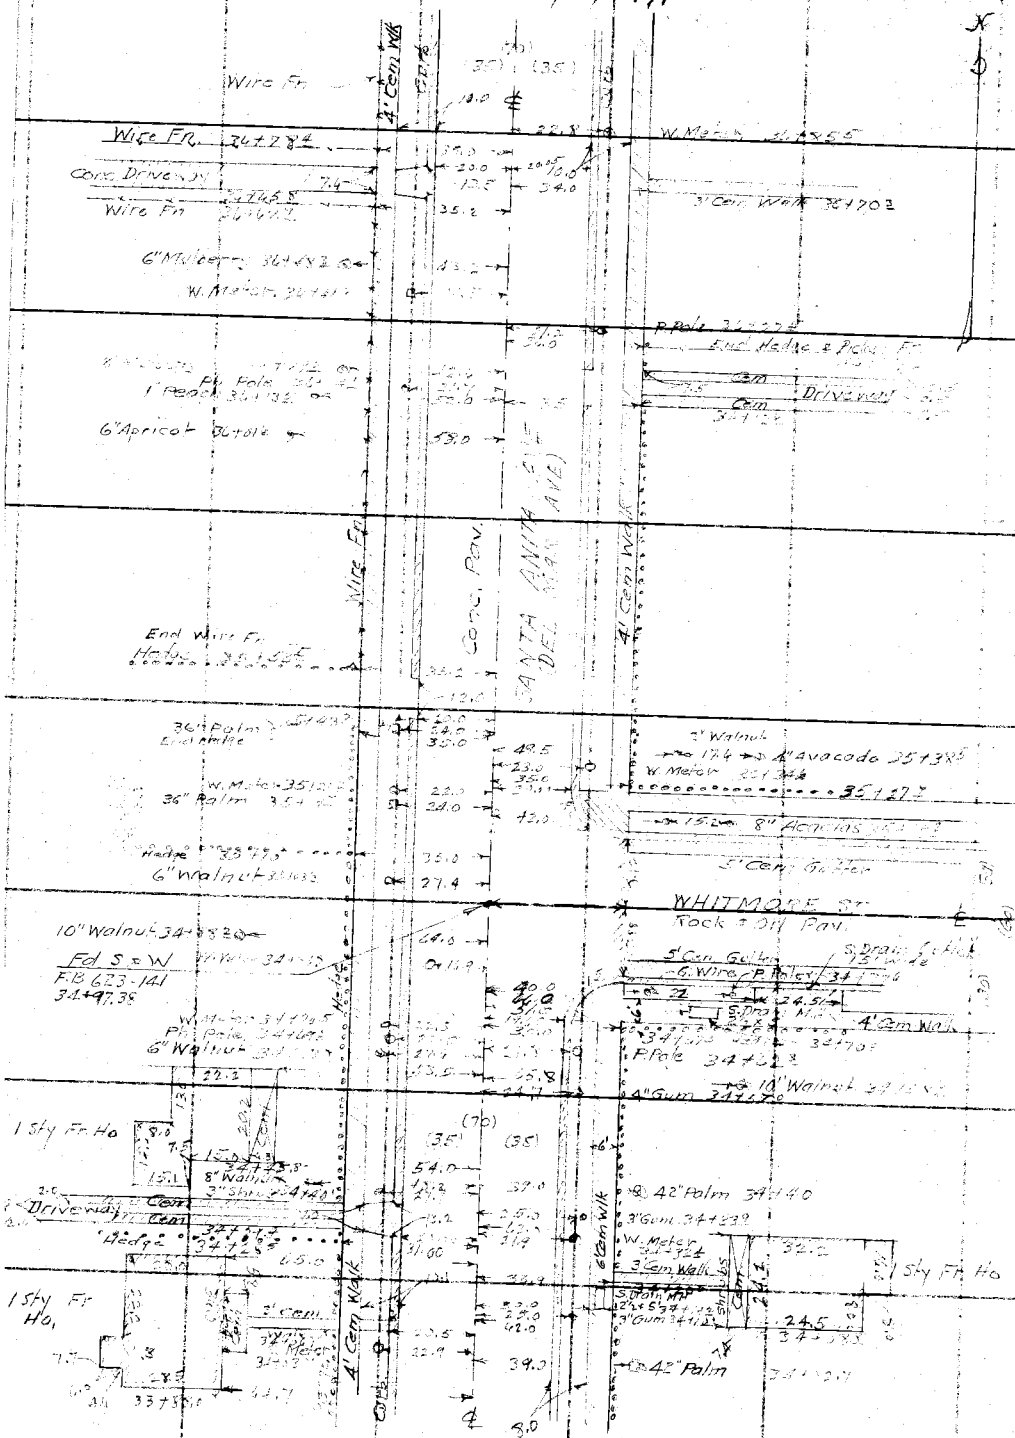

Con from top page 189

RETURN TO
LOS ANGELES COUNTY SURVEYOR
700 HALL OF RECORDS

Do not extend notes this side of this line

Note: Any Additions or Changes on This Sheet Must be Made or Circled in Red Ink With Date and Name of Person Making Change.

Notes Ck'd by Drew	Survey of SANTA ANITA AVE
Map No. B-1357	W. O. 7445 Tape No. St'd °F.
Office Work A. M. Hall	Surveyed by W. A. Miller
Checked Drew	Notes Miller-Braden Date 4-15-36
Date June - 38	Indexed A. C. Johnson

F.B. 623 PG. 191

Con at bottom page 192

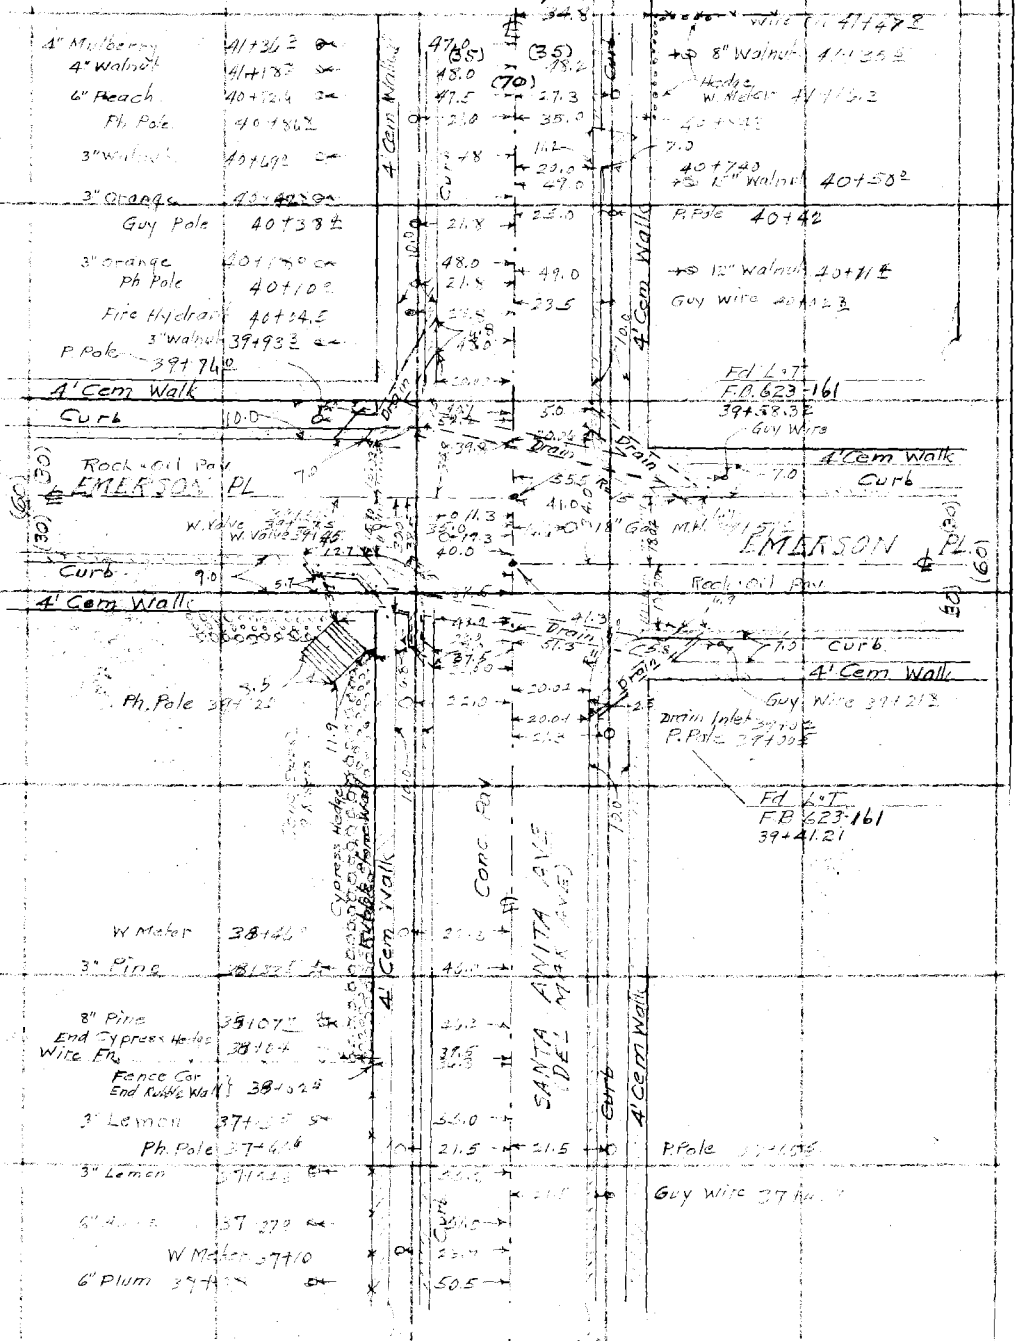

Con from top page 190

Note: Any Additions or Changes on This Sheet Must Be Made or Circled in Red Ink With Date and Name of Person Making Change.

Do not extend notes this side of this line

RETURN TO
LOS ANGELES COUNTY SURVEYOR
700 HALL OF RECORDS

FORM 247 10M 11-35

F.B. 623 Pg. 192

Con at bottom page 193

N

(70) (35) (35)

4' Cem Walk — Curb — 4' Cem Walk

18" Acacia 45+45.0 — 22.0

W. Meter 43+31.2 — 23.0

6" Camphor 45+14.2 — 24.0 — 25.2 — P. Pole 45+14.2

Board Fn 45+16 — 22.2

Ph. Pole 45+39 — 21.0

Wire Fn

6" Camphor 45+43.2 — 24.4

5' Cem Walk 44+35.0 — 17.2

18" Acacia 44+34.2 — 24.7

W. Meter 44+70.5 — 22.8

Board Fn 44+72.5 — 35.2

ANITA AVE (ALLEY) — Cons. Pow.

— ℄ ALLEY —

Curb — 19.21 — 30.31

35.2

Fd 5x W Pg 143
44+60.95

1 sty Fr. Stone & House.

22.5 — 22.2

W. Meter 43+78.5 — 33.3

Wire Fn 43+86.3 — 22.0

Ph Pole 43+42 — 21.5

W. Meter 43+72.2 — 22.0

15" Pepper 43+67.0

4" Pepper 43+66.8

SANTA (DEL)

4" Melaleuca 43+07.4 — 12.0 — 18.3

15" Pepper 43+42.1 — 22.0

P. Pole

End Wall 43+25.2

3" Lemon 43+05.7 — 33.4

6" Cedar 43+14.2 — 20.0 — 42.7

W. Meter

48" Palm 43+21.4

Grave Driveway 43+07.2

6" Cedar 43+25.

Wire Fn 43+22

Ph Pole 43+02 — 24.5

15" Olive 42+94.5 — 24.4 — 48.7

48" Palm 43+03.3

12" Olive 42+93.2 — 21.0

8" Apricot 42+44.2 — 23.3

Rubble wall 18" high 42+41.8

6" Peach

8" Plum 42+48 — 22.2

Wire Fn

4' Cem Walk — Curb — Curb — 4' Cem Walk

6" Olive 42+02.8

8" Cherimoya 42+04.4 — 22.0

End wall 42+34.4

Ph Pole 42+35.5 — 25.3 — P. Pole 42+35.5

3" Guava 42+39.7

10" Cedar 41+98.2 — 27.4 — W. Meter 41+98.3

Concrete wall 18" high

2" Gum 41+62.0 — 24.0

Fish Pool 41+41.2

Curb

Cons. Driveway 41+45.5 — 11.3 — 12

Curb

Wire Fn 41+45.2 — 19.90 — 20.0

32.9

(35) (70) (35)

Con from top page 191

RETURN TO
LOS ANGELES COUNTY SURVEYOR
700 HALL OF RECORDS

Do not extend notes this side of this line

Note: Any Additions or Changes on This Sheet Must be Made or Circled in Red Ink With Date and Name of Person Making Change.

Notes Ck'd by Drew	Survey of SANTA ANITA AVE
Map No. B-1357	W. O. 7145 Tape No. St'd °F.
Office Work H. M. Hall	Surveyed by W. A. Miller
Checked Drew	Notes Miller - Bender Date 1-21-36
Date June - 38	Indexed A. C. Johnson

F.B. 623 Pg. 193

Con. at bottom page 194

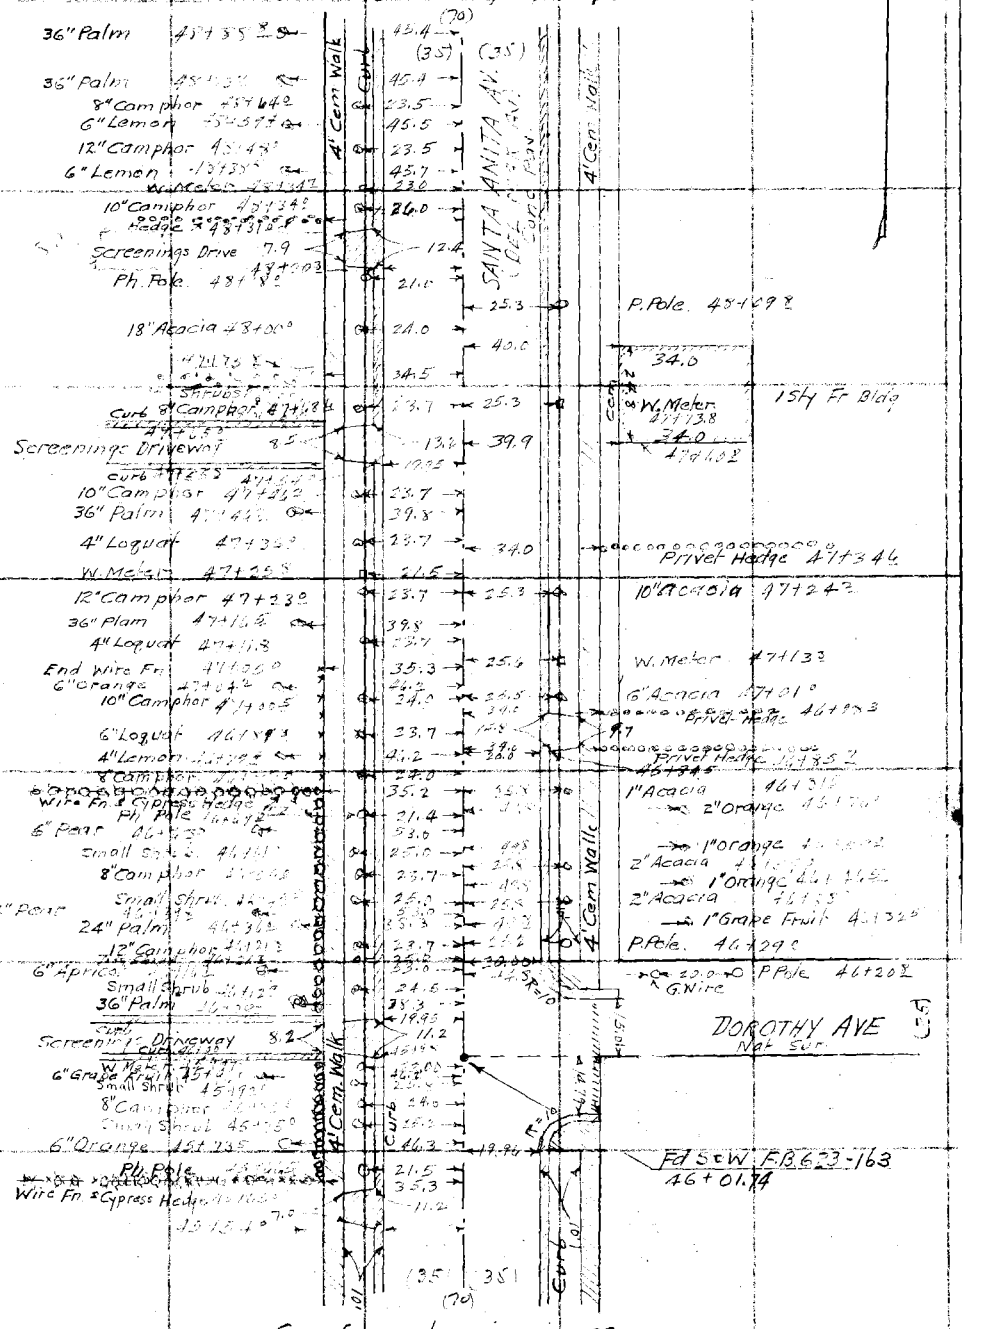

Con. from top page 192

Note: Any Additions or Changes on This Sheet Must be Made or Circled in Red Ink With Date and Name of Person Making Change.

Do not extend notes this side of this line

RETURN TO
LOS ANGELES COUNTY SURVEYOR
700 HALL OF RECORDS

FORM 247 10M 11-35

F.B. 623 PG. 194

Con at bottom page 195

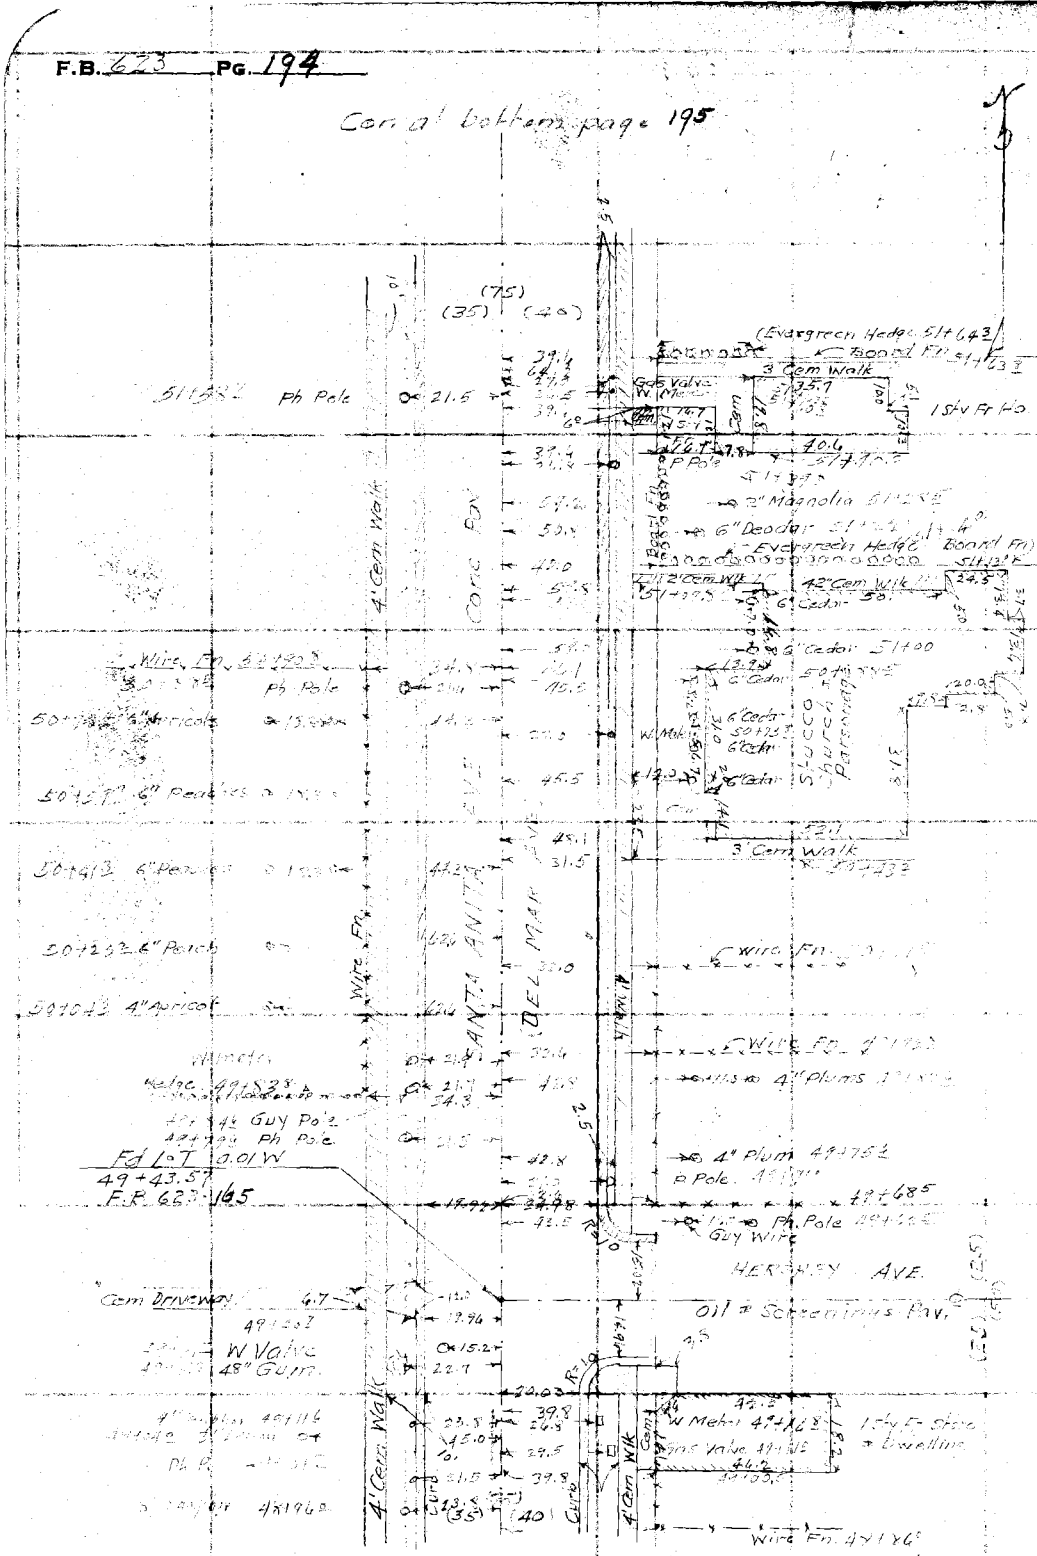

Con from top page 193

RETURN TO
LOS ANGELES COUNTY SURVEYOR
700 HALL OF RECORDS

Do not extend notes this side of this line

Note: Any Additions or Changes on This Sheet Must be Made or Circled in Red Ink With Date and Name of Person Making Change.

Notes Ck'd by Trew	Survey of SANTA ANITA AVE
Map No. B-1357	W. O. 7145 Tape No. St'd °F.
Office Work W. M. Hall	Surveyed by W A Miller
Checked Drew	Notes Miller & Bradan Date 5-18-36
Date June - 38	Indexed A. C. Johnson

F.B. 623 Pg. 195

Con at bot-tom page 196

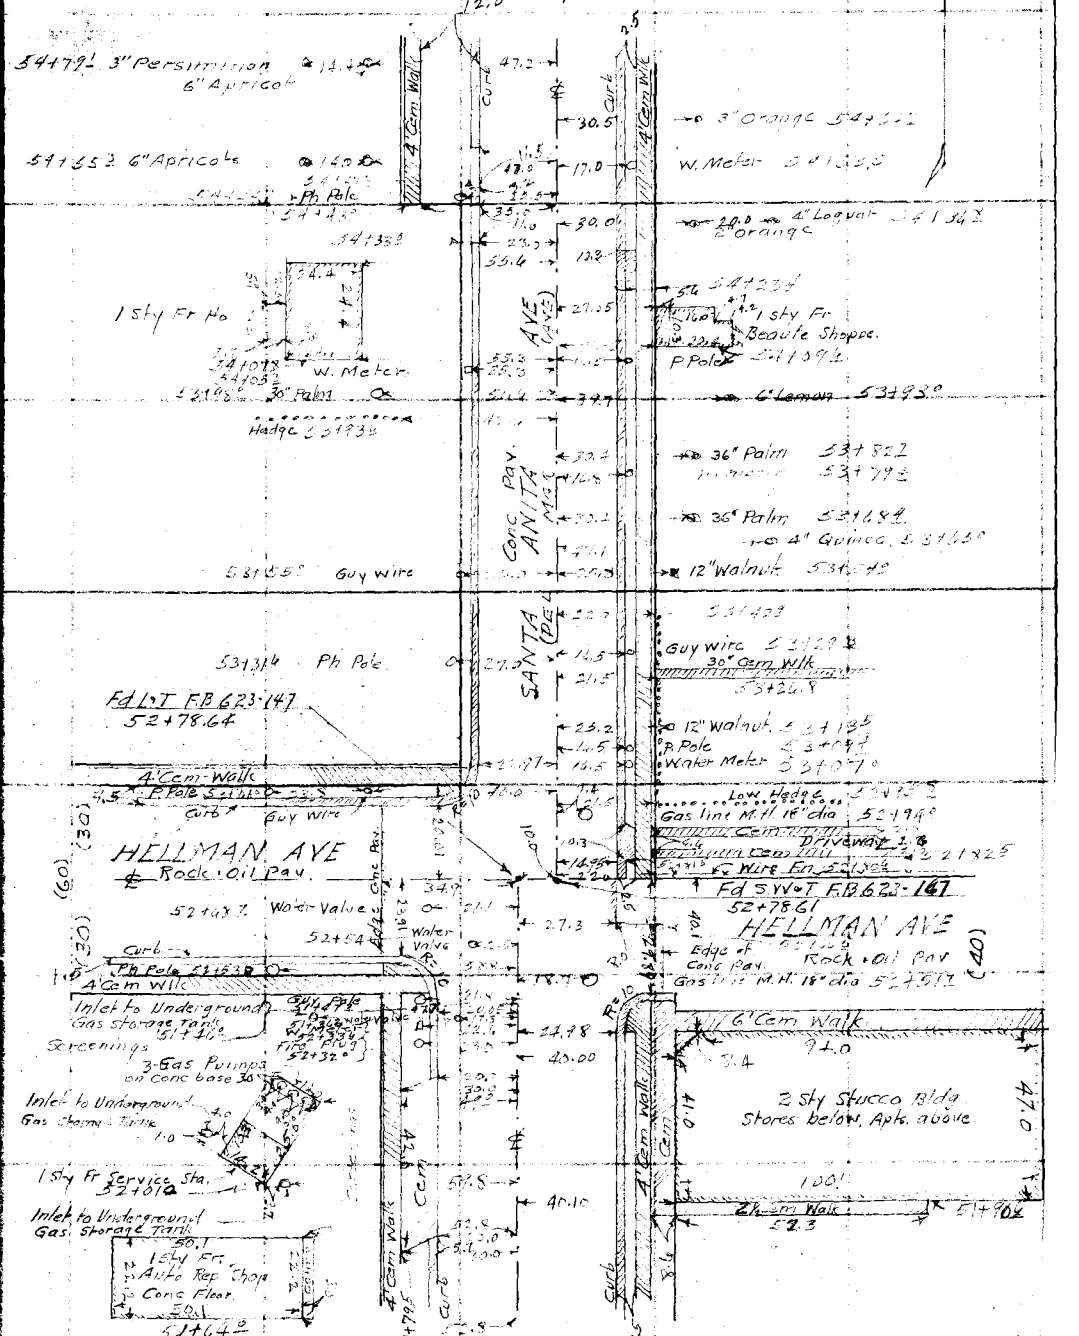

Con from top page 194

Note: Any Additions or Changes on This Sheet Must Be Made or Circled in Red Ink With Date and Name of Person Making Change.

Do not extend notes this side of this line

RETURN TO
LOS ANGELES COUNTY SURVEYOR
700 HALL OF RECORDS

FORM 247 10M 11-35

F.B. 623 PG. 196

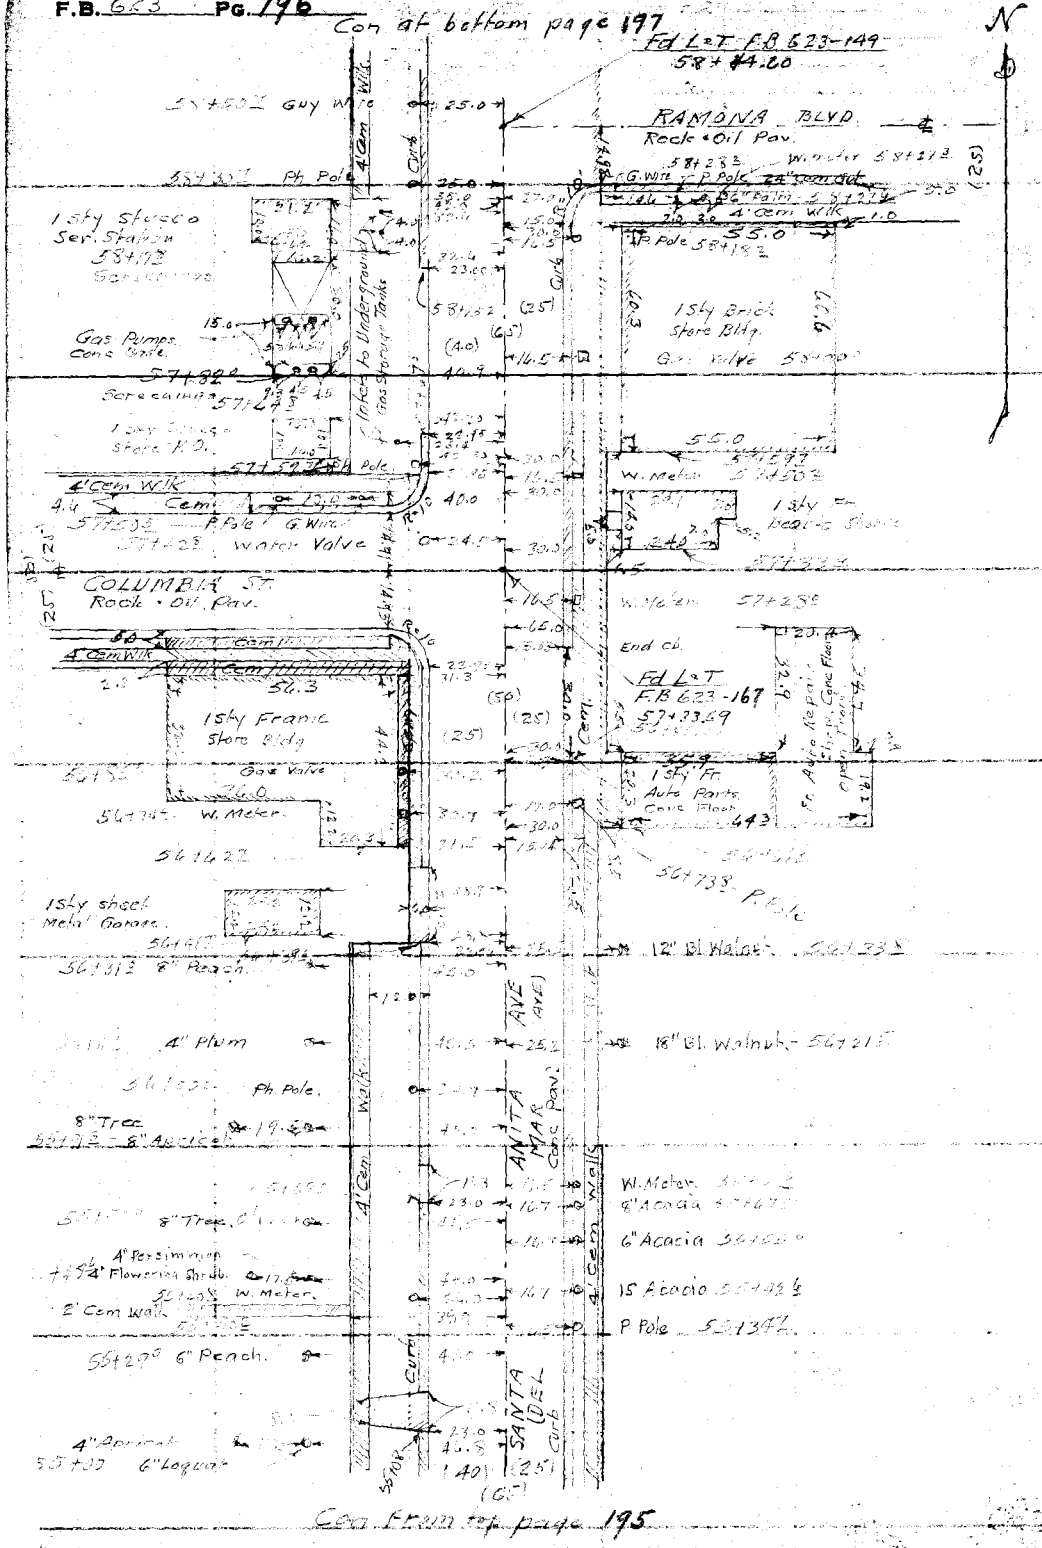

RETURN TO
LOS ANGELES COUNTY SURVEYOR
700 HALL OF RECORDS

Do not extend notes this side of this line

Note: Any Additions or Changes on This Sheet Must be Made or Circled in Red Ink With Date and Name of Person Making Change.

Notes Ck'd by Drew	Survey of SANTA ANITA AVE
Map No. B-1357	W. 0.7145 Tape No. St'd °F.
Office Work A. M. Hall	Surveyed by W. A. Miller
Checked Drew	Notes Miller & Braden Date 5-20-36
Date June - 38	Indexed A. C. Johnson

F.B. 623 PG. 197

Con at bottom page 198

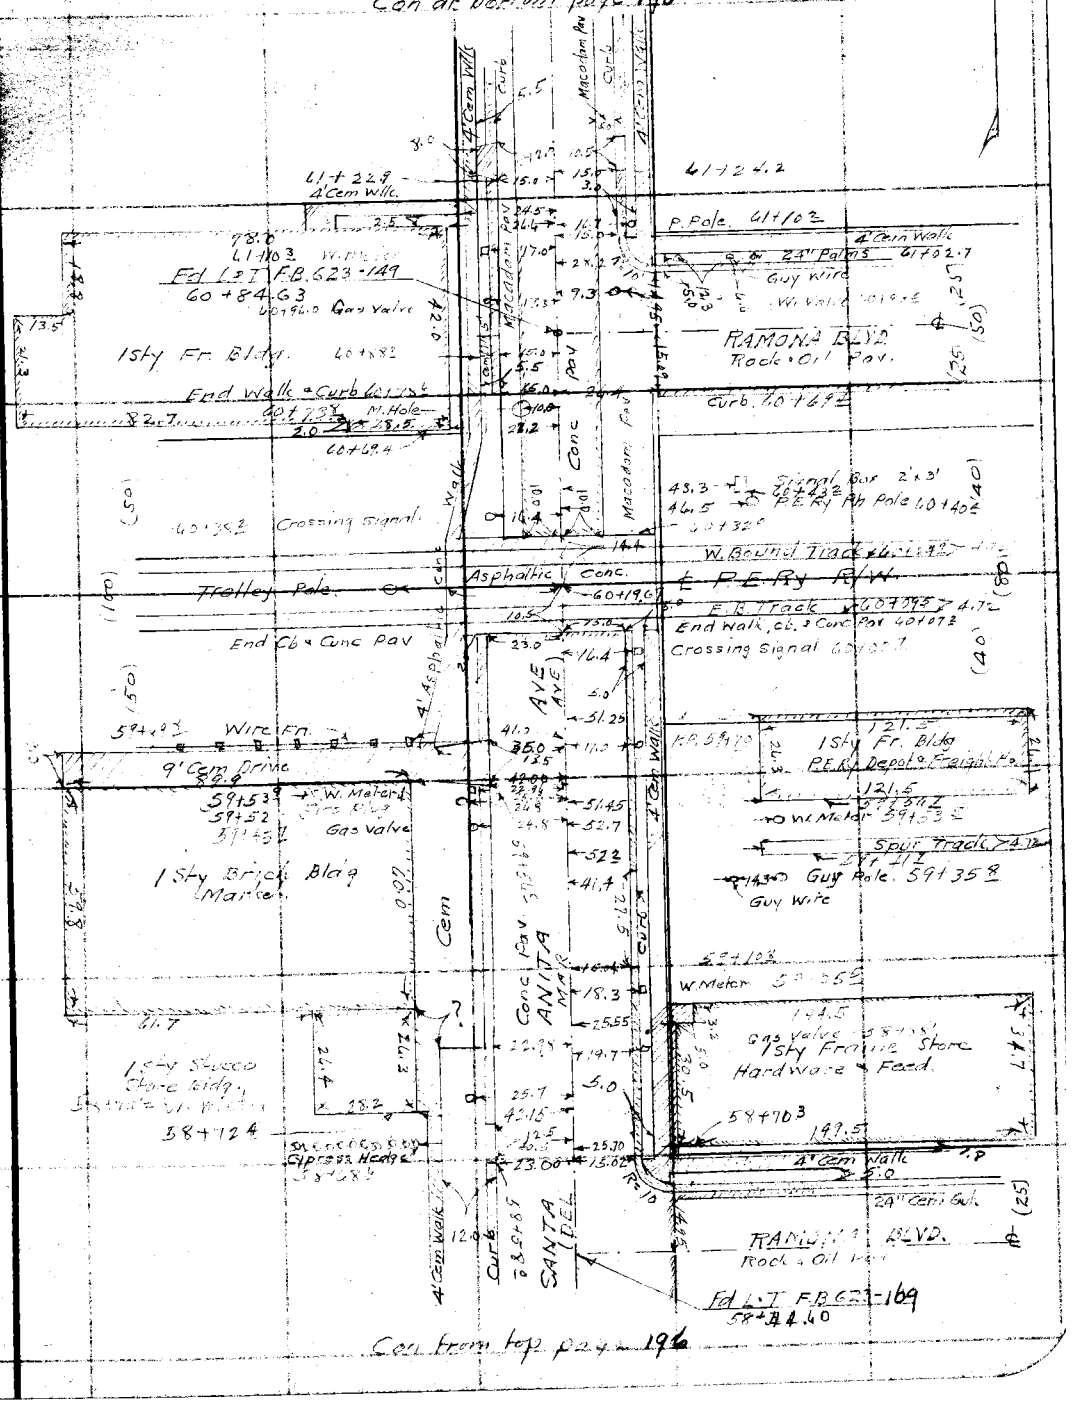

Con from top page 196

Note: Any Additions or Changes on This Sheet Must be Made or Circled in Red Ink With Date and Name of Person Making Change.

Do not extend notes this side of this line

RETURN TO
LOS ANGELES COUNTY SURVEYOR
700 HALL OF RECORDS

FORM 247 10M 11-35

F.B. 623 PG. 198

Con at bottom page 199

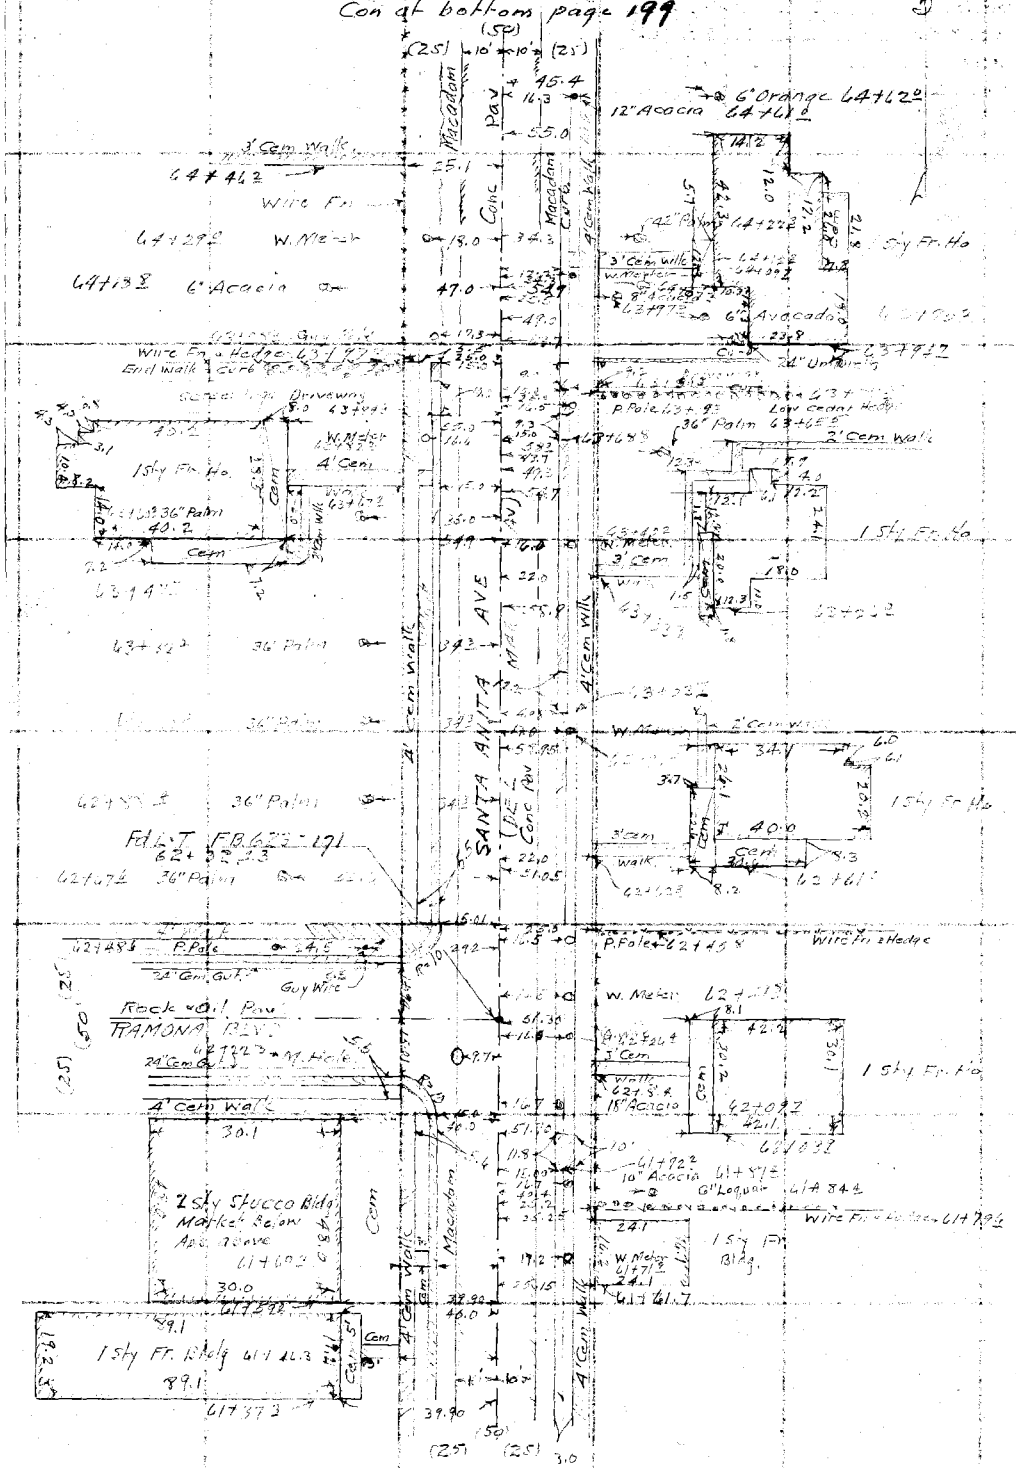

RETURN TO
LOS ANGELES COUNTY SURVEYOR
700 HALL OF RECORDS

Note: Any Additions or Changes on This Sheet Must be Made or Circled in Red Ink With Date and Name of Person Making Change.

Do not extend notes this side of this line

Notes Ck'd by Drew	Survey of SANTA ANITA AVE
Map No. B-1357	W. O. 7145 Tape No. St'd °F.
Office Work L. M. Hall	Surveyed by W.A. Miller
Checked Drew	Notes Miller + Braden Date 5-22-86
Date June - 88	Indexed C. Johnson

F.B. 623 PG. 199

N

Note: Any Additions or Changes on This Sheet Must be Made or Circled in Ink With Date and Name of Person Making Change.

Do not extend notes this side of this line

RETURN TO
LOS ANGELES COUNTY SURVEYOR
7dO HALL OF RECORDS

FORM 247 10M 11-35

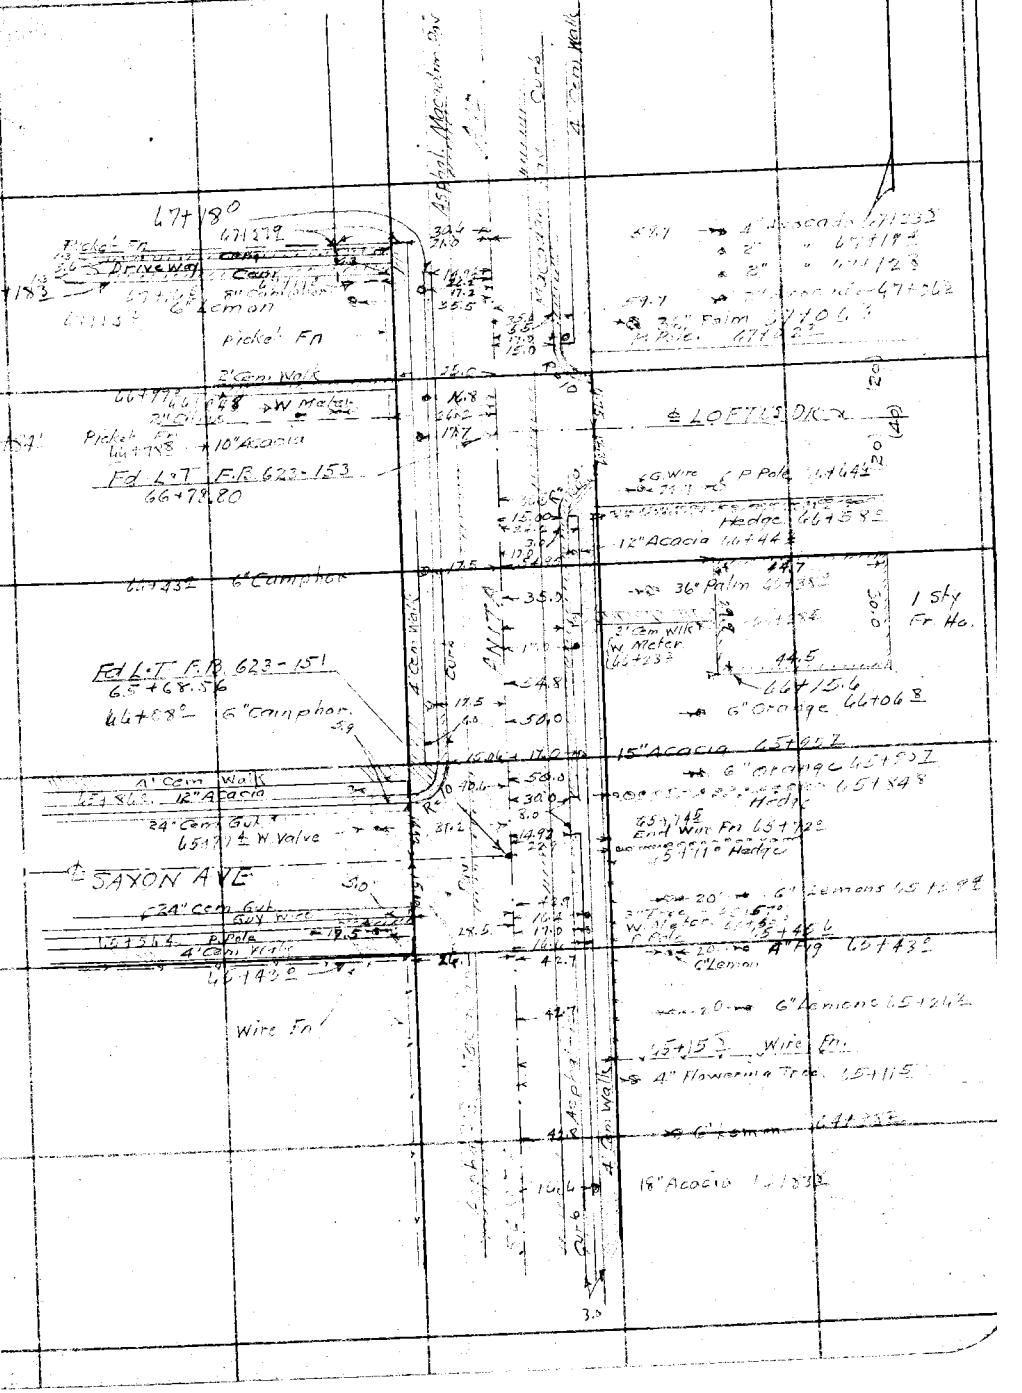

F.B. 623 PG. 200

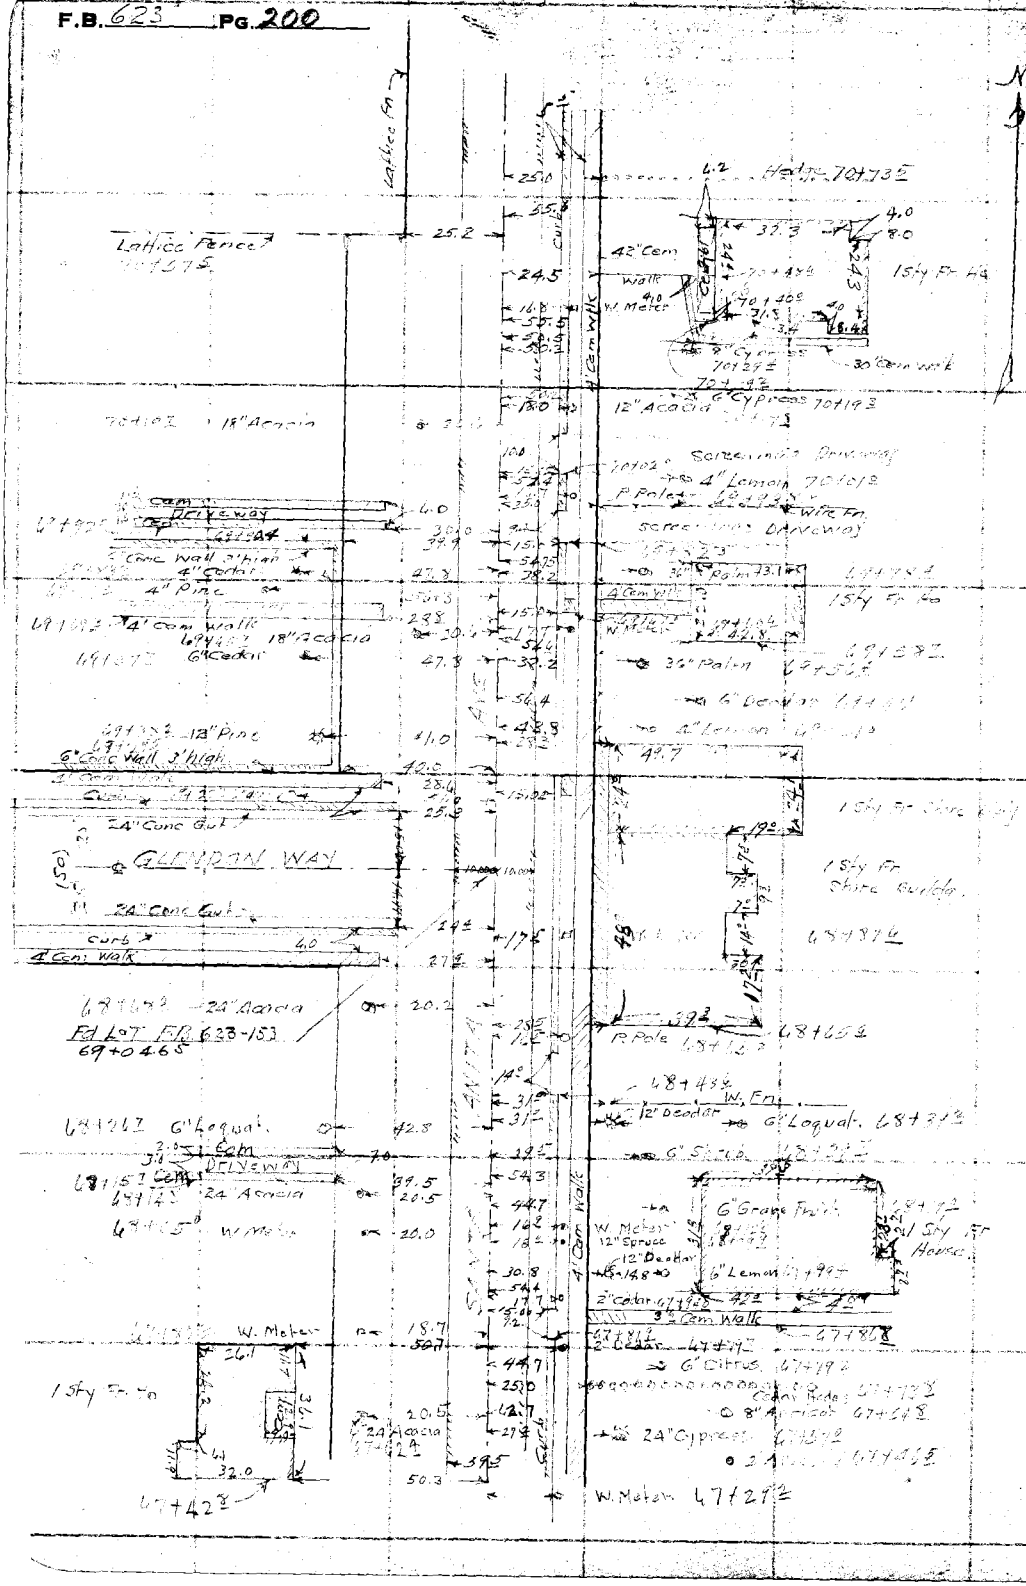

RETURN TO
LOS ANGELES COUNTY SURVEYOR
700 HALL OF RECORDS

Do not extend notes this side of this line

Note: Any Additions or Changes on This Sheet Must be Made or Circled in Red Ink With Date and Name of Person Making Change.

Notes Ck'd by: Dr cw	Survey of: SANTA ANITA AVE
Map No. B-1357	W. O. 7145 Tape No. St'd °F.
Office Work: S. M. Hall	Surveyed by: W A Miller
Checked: Dr cw	Notes: Miller & Braden Date: 5-28 & 36
Date: June - 38	Indexed: A. C. Johnson

F.B. 623 PG 201

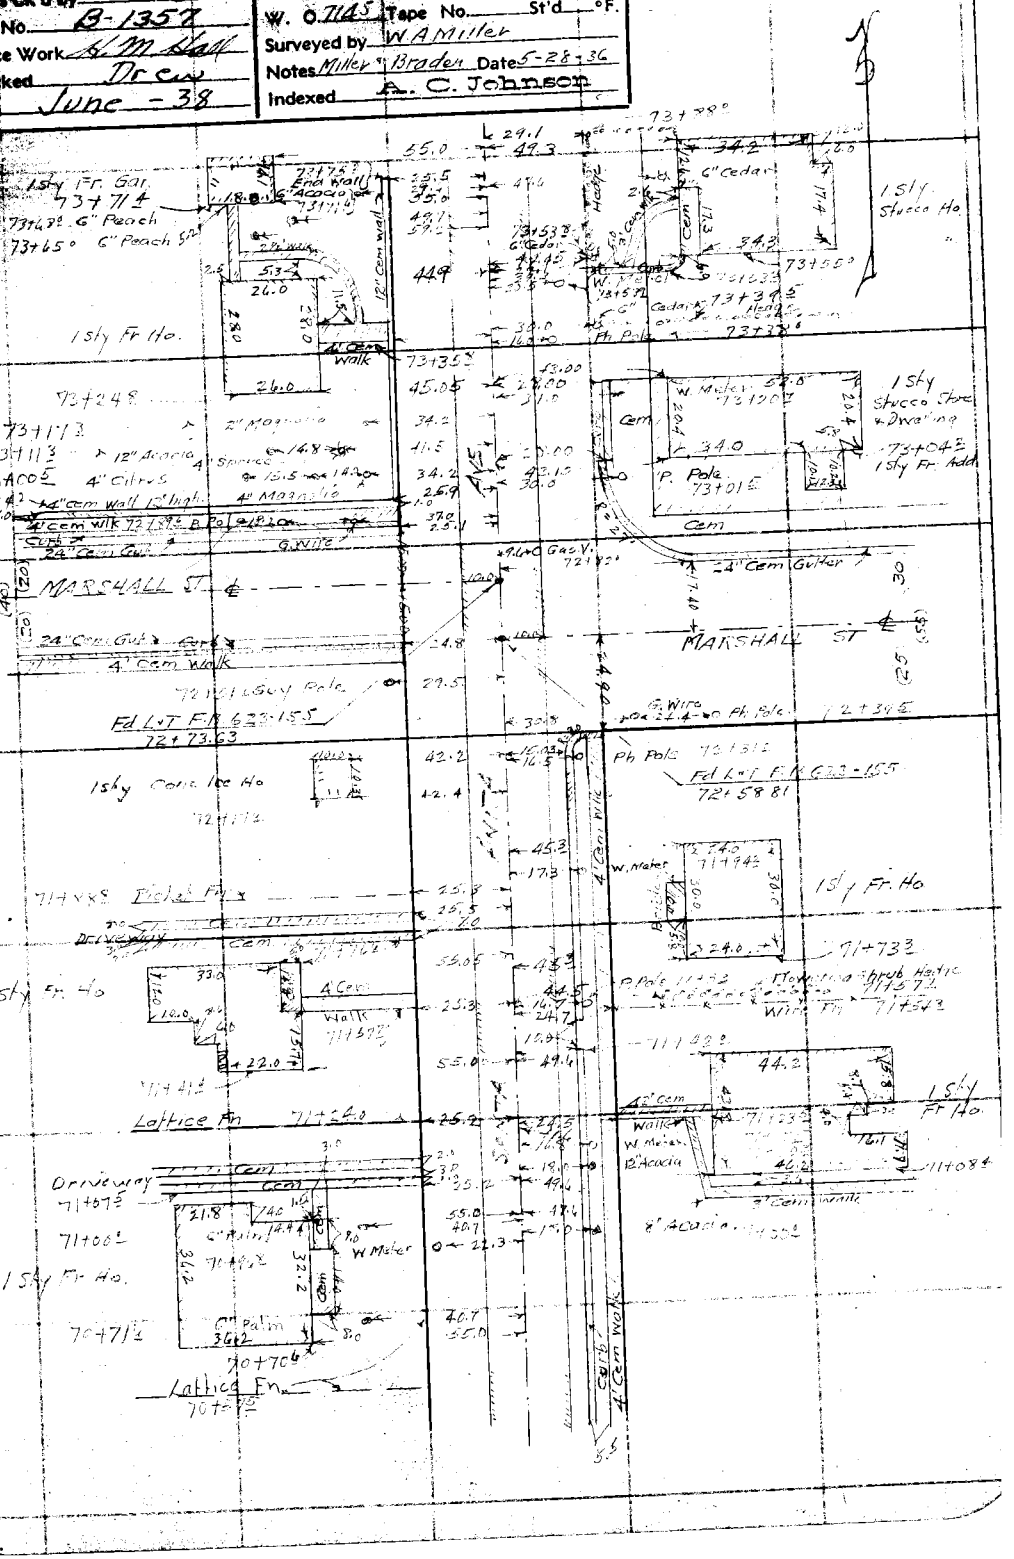

Note: Any Additions or Changes on This Sheet Must be Made or Circled in Red Ink With Date and Name of Person Making Change.

Do not extend notes this side of this line

RETURN TO
LOS ANGELES COUNTY SURVEYOR
700 HALL OF RECORDS

FORM 247 10M 11-35

F.B. 623 PG. 202

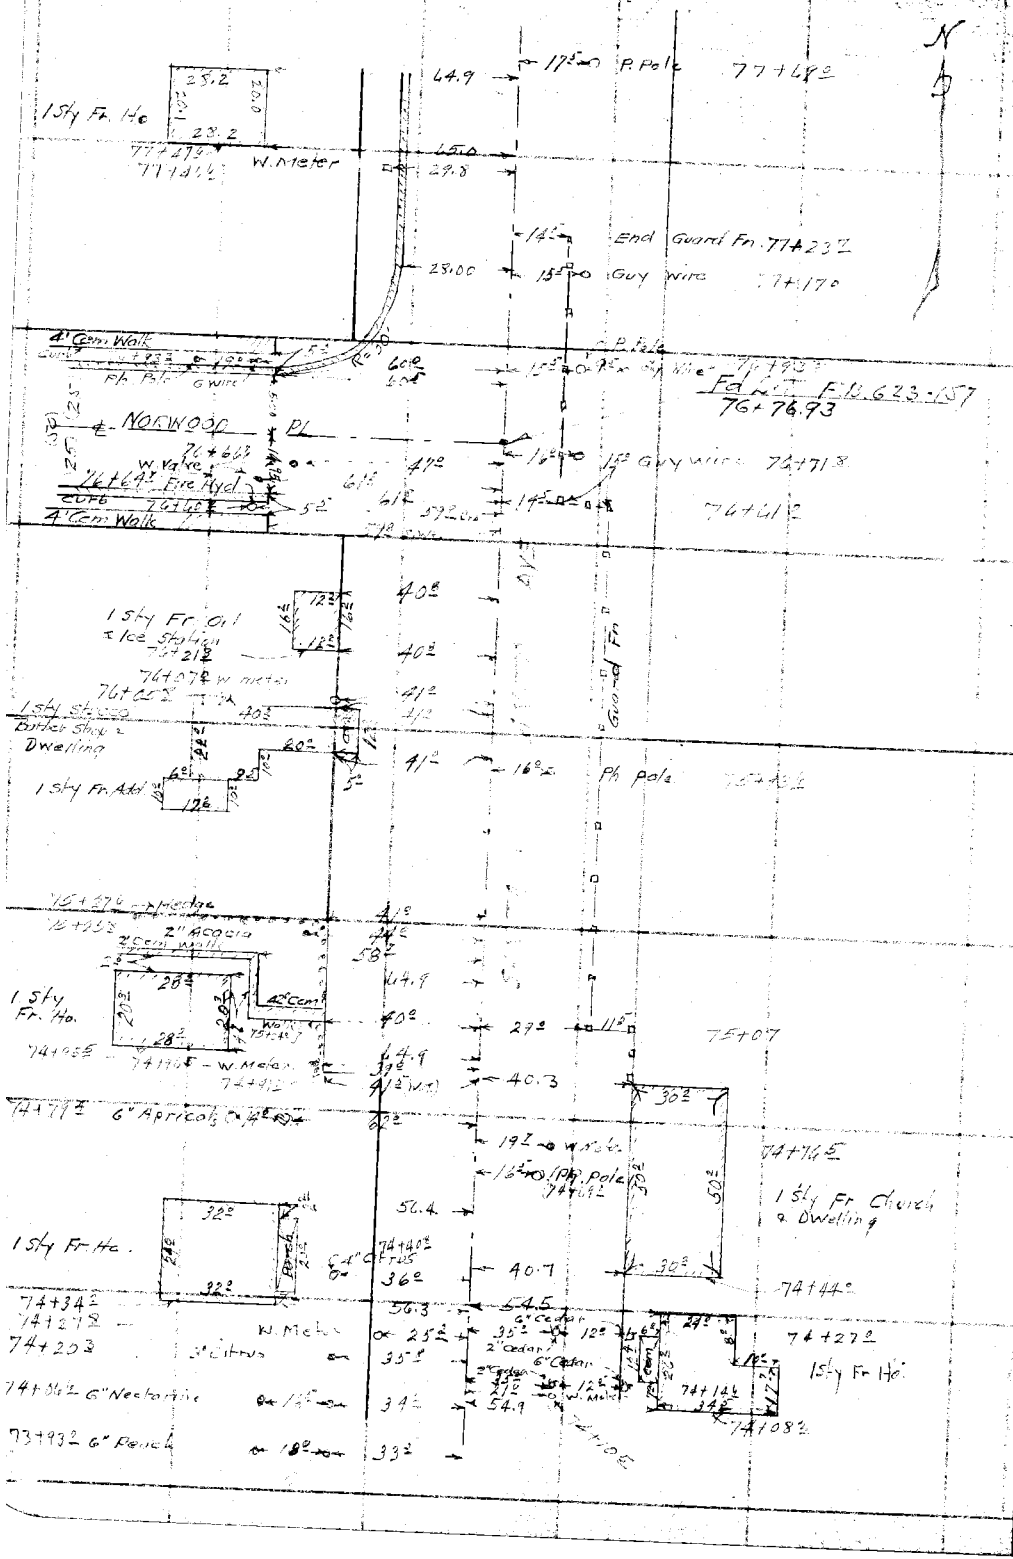

RETURN TO
LOS ANGELES COUNTY SURVEYOR
700 HALL OF RECORDS

Do not extend notes this side of this line

Note: Any Additions or Changes on This Sheet Must be Made in Ink With Date and Name of Person Making Change. Or Circled in Red

Notes Ck'd by Drew	Survey of SANTA ANITA AVE
Map No. B-1357	W. O. 7145 Tape No. St'd °F.
Office Work H. M. Hall	Surveyed by W.A. Miller
Checked Drew	Notes Miller + Braden Date 6-1-36
Date June - 38	Indexed A. C. Johnson

F.B. 623 PG. 203

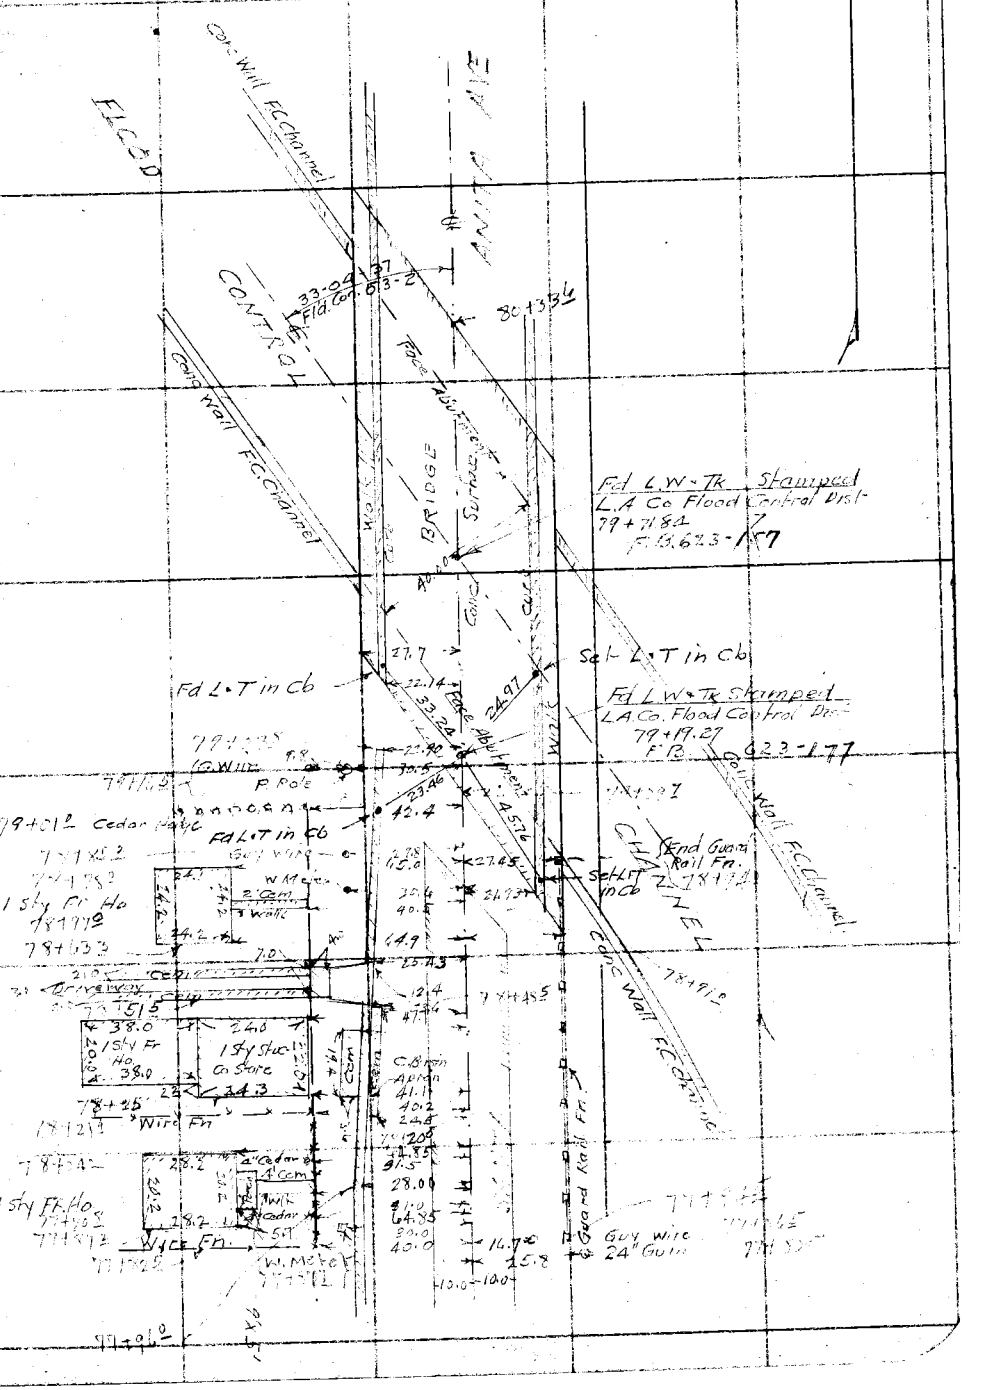

Note: Any Additions or Changes on This Sheet Must be Made or Circled in Red Ink With Date and Name of Person Making Change.

Do not extend notes this side of this line

RETURN TO
LOS ANGELES COUNTY SURVEYOR
700 HALL OF RECORDS

FORM 247 10M 11-35

F.B. 623 PG. 204

RETURN TO
LOS ANGELES COUNTY SURVEYOR
700 HALL OF RECORDS

Note: Any Additions or Changes on This Sheet Must be Made or Circled in **Red Ink** With Date and Name of Person Making Change.

Do not extend notes this side of this line

Notes Ck'd by	Survey of SANTA ANITA AVE	F.B. 623	PG 205
Map No.	W. O. 7145 Tape No. 058 St'd 84° F.		
Office Work	Surveyed by W.A. Miller		
Checked	Notes Miller Date		
Date	Indexed A. C. Johnson 9-21-36		

Note: Any Additions or Changes on This Sheet Must be Made or Circled in Red Ink With Date and Name of Person Making Change.

Do not extend notes this side of this line

SURVEY OF SANTA ANITA AVE
FROM
CALIFORNIA ST TO BLANCHE ST
J.N 7145
JUNE 3 1936 TO JUNE 8 1936

Miller
Brown
Stewart
Haas
Climie

TOPOGRAPHY PAGES 205-221

RETURN TO
LOS ANGELES COUNTY SURVEYOR
700 HALL OF RECORDS

FORM 247 10M 11-35

F.B. 623 PG. 206

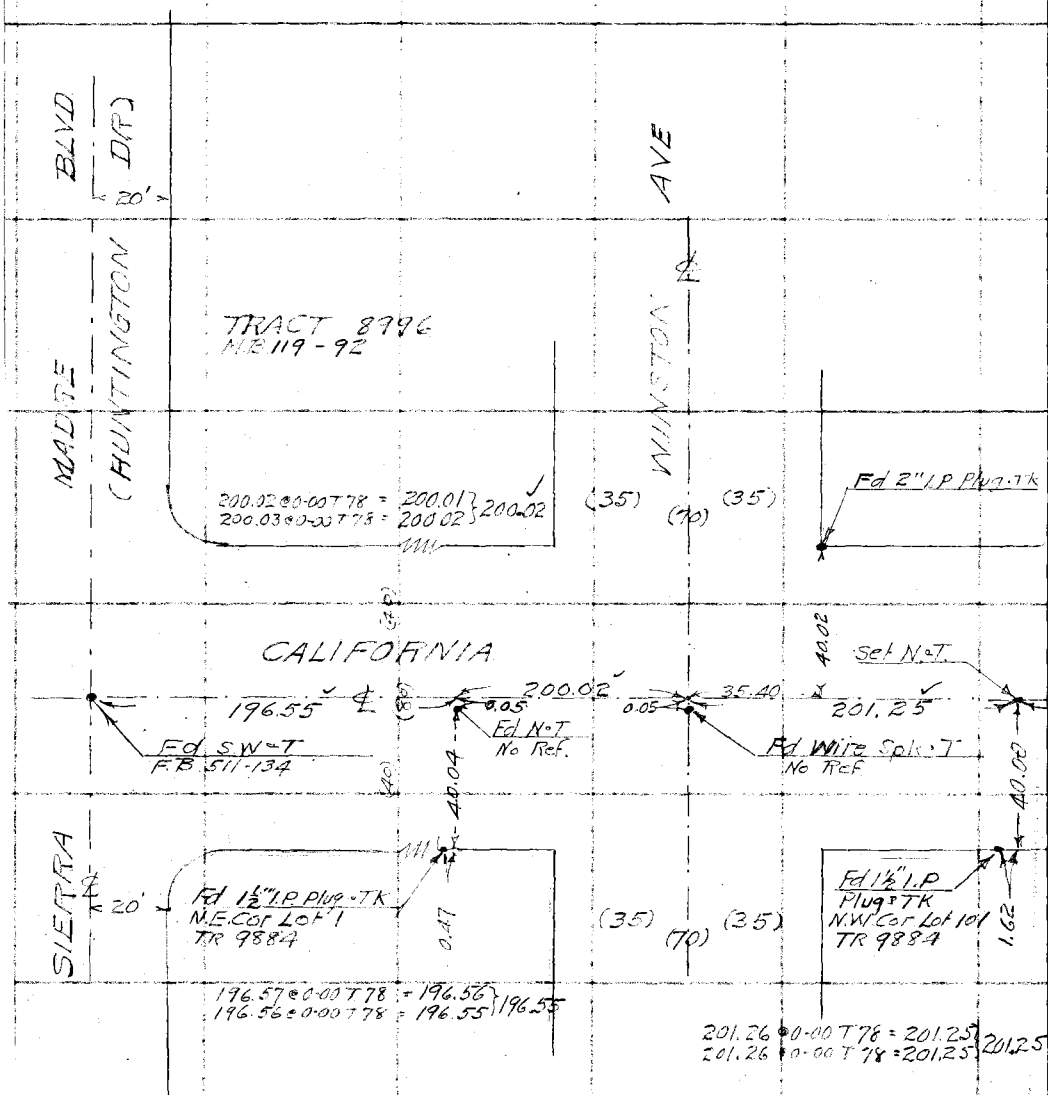

RETURN TO
LOS ANGELES COUNTY SURVEYOR
700 HALL OF RECORDS

Do not extend notes this side of this line

Note: Any Additions or Changes on This Sheet Must be Made or Circled in Red Ink With Date and Name of Person Making Change.

Notes Ck'd by Drew	Survey of SANTA ANITA AVE
Map No. B-1357	W. O. 7145 Tape No. 058 St'd 84 °F.
Office Work H. M. Hall	Surveyed by W.A. Miller
Checked Drew	Notes Miller Date 6-4-36
Date June - 38	Indexed A. C. Johnson

F.B. 623 Pg. 207

3+64.07
7.70
3+71.77

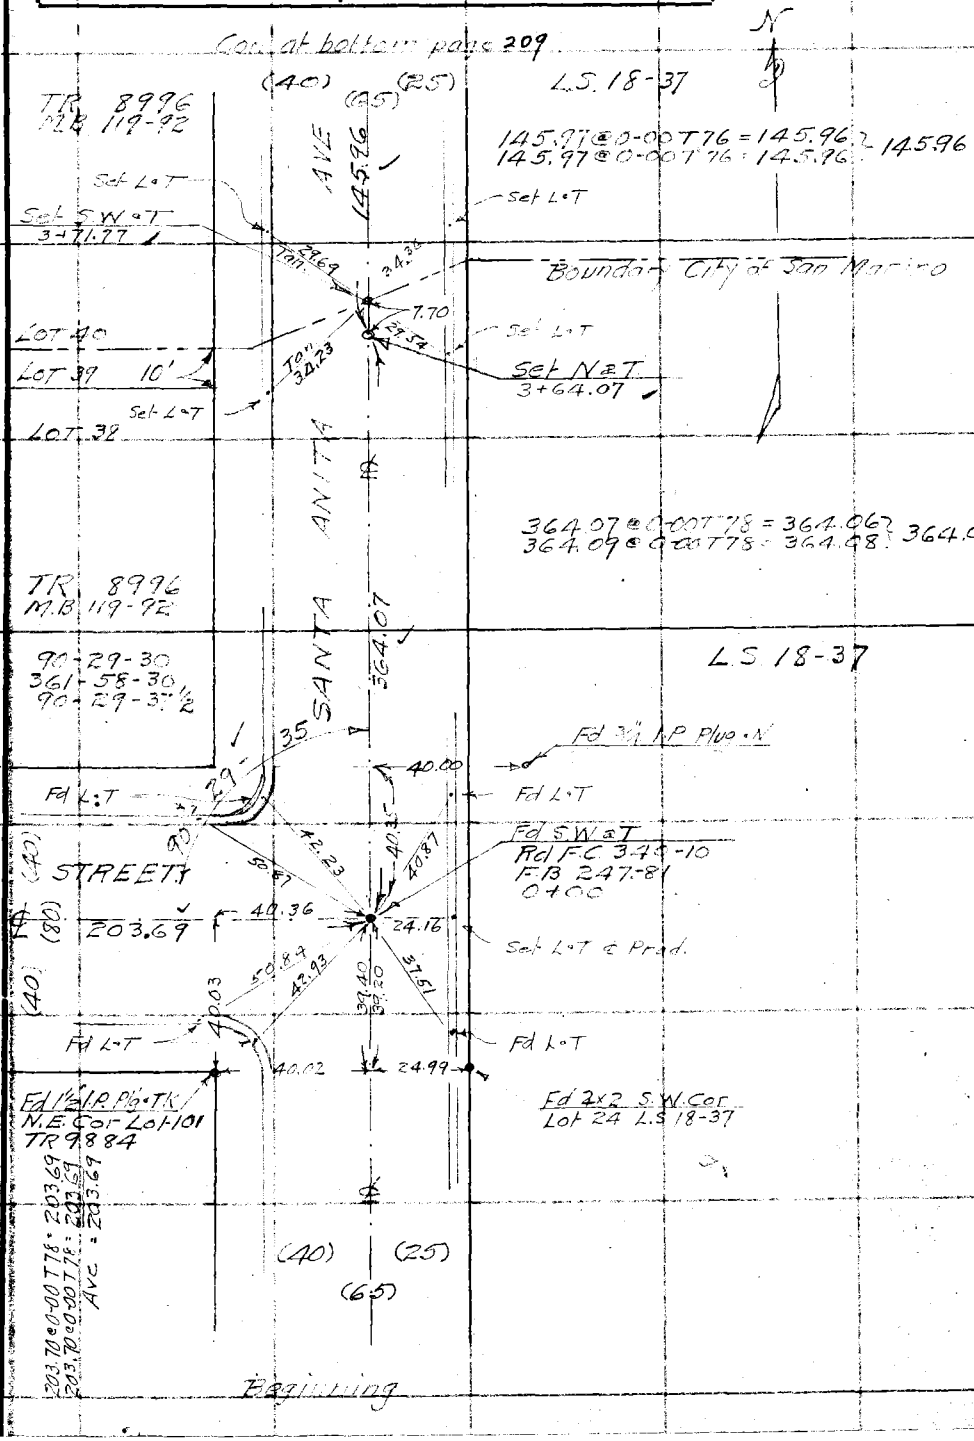

Note: Any Additions or Changes on This Sheet Must be Made or Circled in Red Ink With Date and Name of Person Making Change.

Do not extend notes this side of this line

RETURN TO
LOS ANGELES COUNTY SURVEYOR
700 HALL OF RECORDS

FORM 247 10M 11-35

RETURN TO
LOS ANGELES COUNTY SURVEYOR
700 HALL OF RECORDS

Note: Any Additions or Changes on This Sheet Must be Made or Circled in **Red Ink** With Date and Name of Person Making Change.

Do not extend notes this side of this line

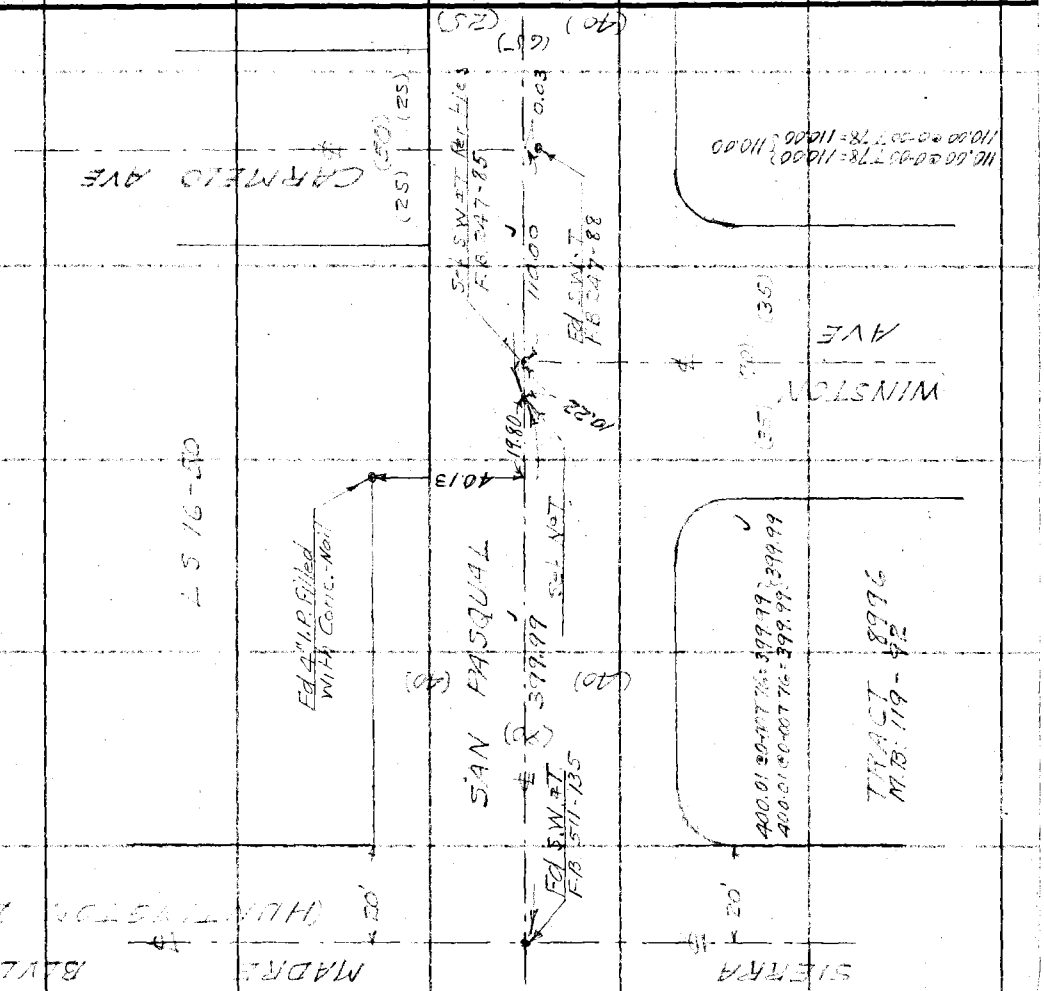

F.B. 623 PG. 208

Notes Ck'd by Drew	Survey of SANTA ANITA AVE
Map No. B-1357	W. O. 7145 Tape No. 058 St'd 84 °F.
Office Work H. M. Hall	Surveyed by W A Miller
Checked Drew	Notes Miller Date 6-4-36
Date June - 38	Indexed A. C. Johnson

F.B. 623 Pg 209

3+64.07
1+45.96
5+10.03
1+96.07
7+06.10
4.85
7+10.95
7+81.85
14+92.80

Con at bottom page 211

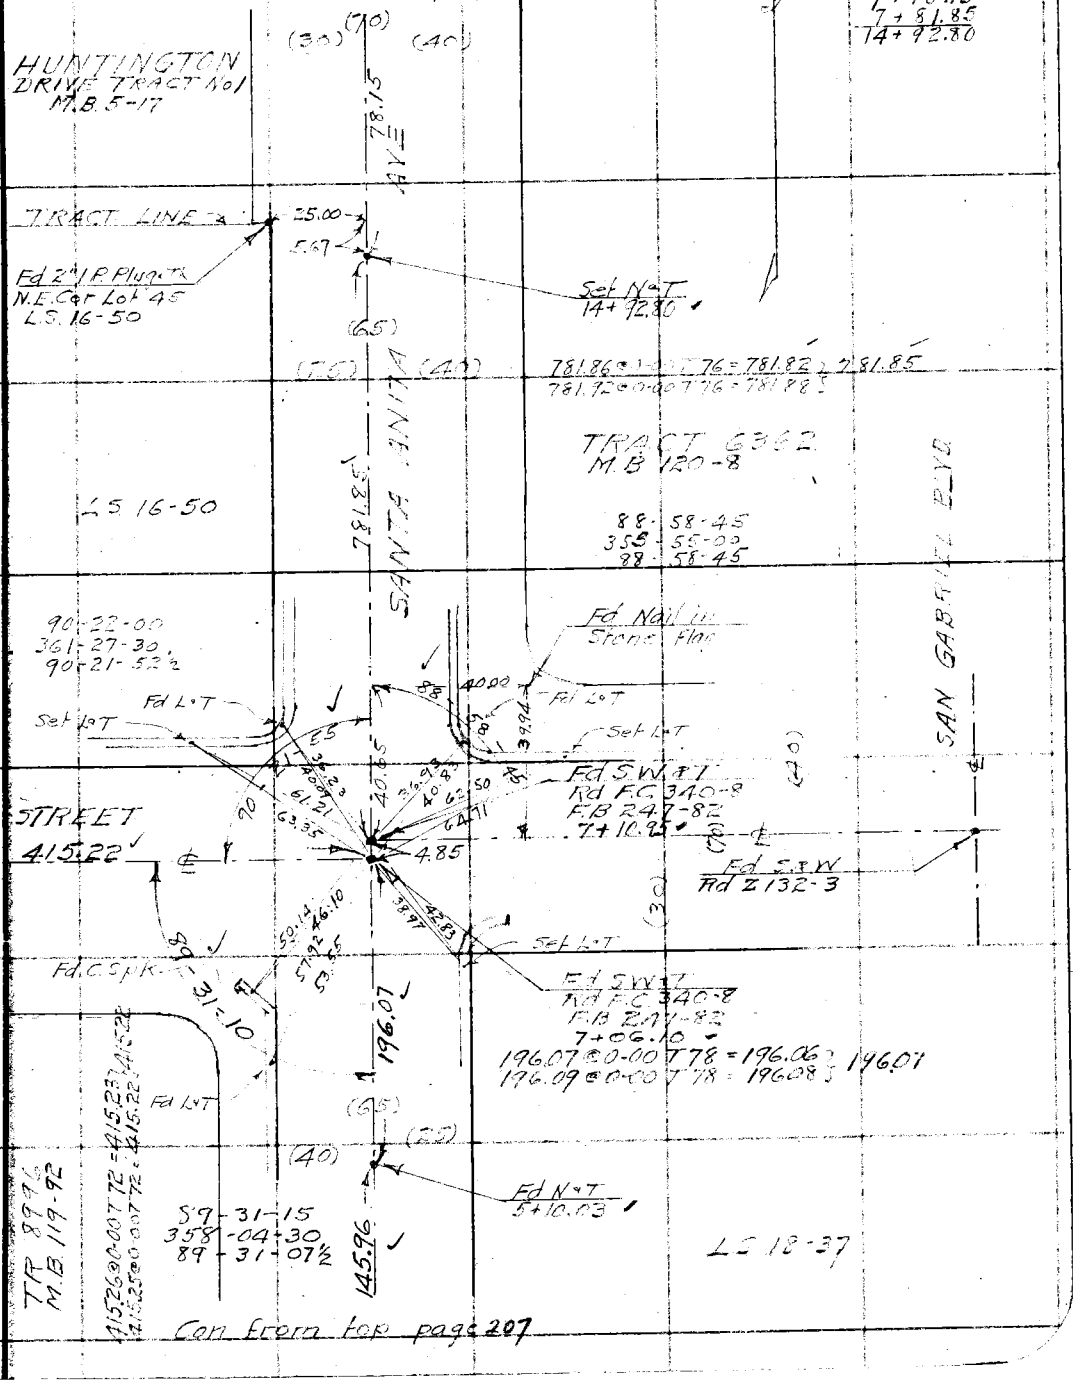

Con from top page 207

Note: Any Additions or Changes on This Sheet Must be Made or Circled in Red Ink With Date and Name of Person Making Change.

Do not extend notes this side of this line

RETURN TO
LOS ANGELES COUNTY SURVEYOR
700 HALL OF RECORDS

FORM 247 10M 11-35

F.B. 623 PG. 210

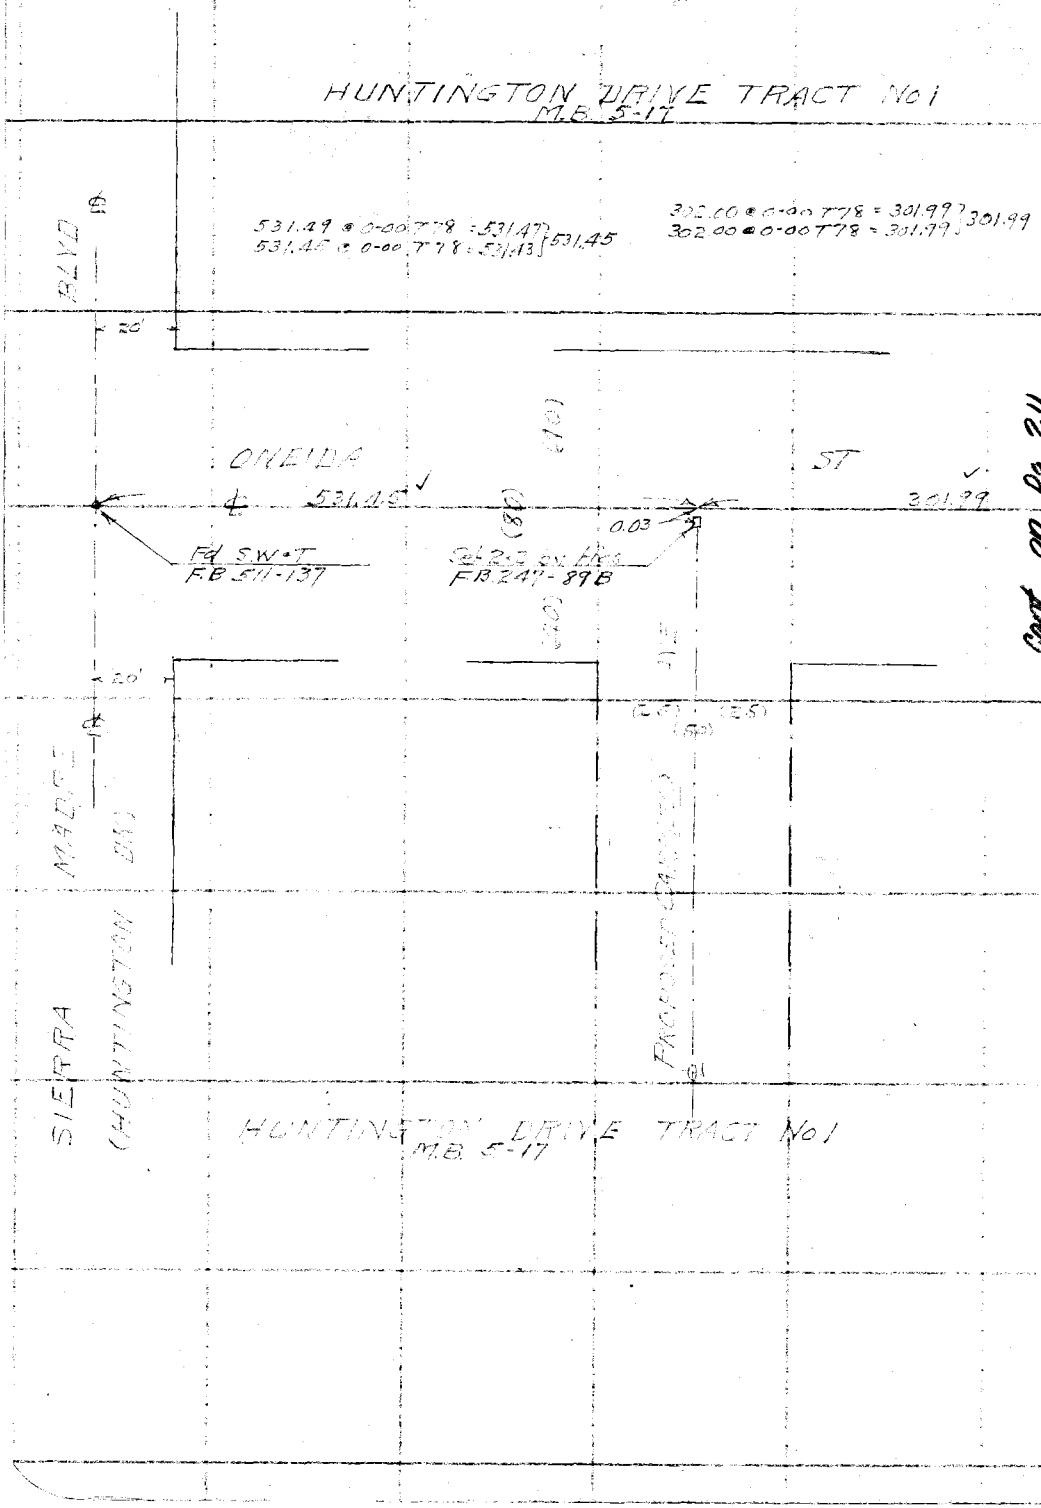

Cont. on Pg. 211

RETURN TO
LOS ANGELES COUNTY SURVEYOR
700 HALL OF RECORDS

Do not extend notes this side of this line

Note: Any Additions or Changes on This Sheet Must be Made or Circled in Red Ink With Date and Name of Person Making Change.

Notes Ck'd by Drew	Survey of SANTA ANITA AVE
Map No. B-1357	W. O. 7145 Tape No. 058 St'd 84 °F.
Office Work L. M. Hall	Surveyed by W A Miller
Checked Drew	Notes Miller Date 6-5-36
Date June-38	Indexed A. C. Johnson

F.B. 623 Pg 211

14+92.80
78.15
15+70.95
184.84
17+55.79

Con at bottom page 213

N

(60)
(30) (30)

90-57-45
363-50-30
90-57-37.2

335.09@0-00T78 = 335.08
335.09@0-00T78 = 335.08 } 335.08

Fd 4" I.P. Filled With Cons-Nail

335.08

40

29.88

Set L&T

Fd L&T

90-57

58.95

37.97

40.08

39.58

TRACT 5574
M.B. 74-38

Fd L&T in wall

(80)

(40)

39.62

36.42

37.98

Set L&T

40.50

38.97

41.38

Fd 1x1 x T/S
F.B. 511-137
F.B. 247-82
Rd F.C. 340-
17+55.79

Fd L&T in wall

30.01

Fd 4" I.P. Filled With Cons-Nail.

184.85@0-00T78 = 184.84
184.86@0-00T78 = 184.85 } 184.84

(30) (30)
(60)

184.84

SANTA ANITA AVE

88-59-30
355-58-15
88-59-33¾

Fd 2" I.P. No Plug no-T

88-59

30.00

Fd L&T

30.00

(30)

35.12

57.88

35.86

58.13

Set L&T

Fd L&T

ONEIDA ST

Fd S.W.-T
Rd Z 322-142

Fd S.W.-T
Rd F.C. 340-6
Rd Z 322-144
F.B. 247-82
15+70.95

Fd L&T

78.15

(30)

(40)

(70)

TR 6362
M.B. 120-8

HUNTINGTON DRIVE TR. No 1
M.B. 21-17

SAN GABRIEL BLVD

Con from top page 209

Cont. on pg. 210

Note: Any Additions or Changes on This Sheet Must be Made or Circled in Red Ink With Date and Name of Person Making Change.

Do not extend notes this side of this line

RETURN TO
LOS ANGELES COUNTY SURVEYOR
700 HALL OF RECORDS

FORM 247 10M 11-35

F.B. 623 Pg. 2/2

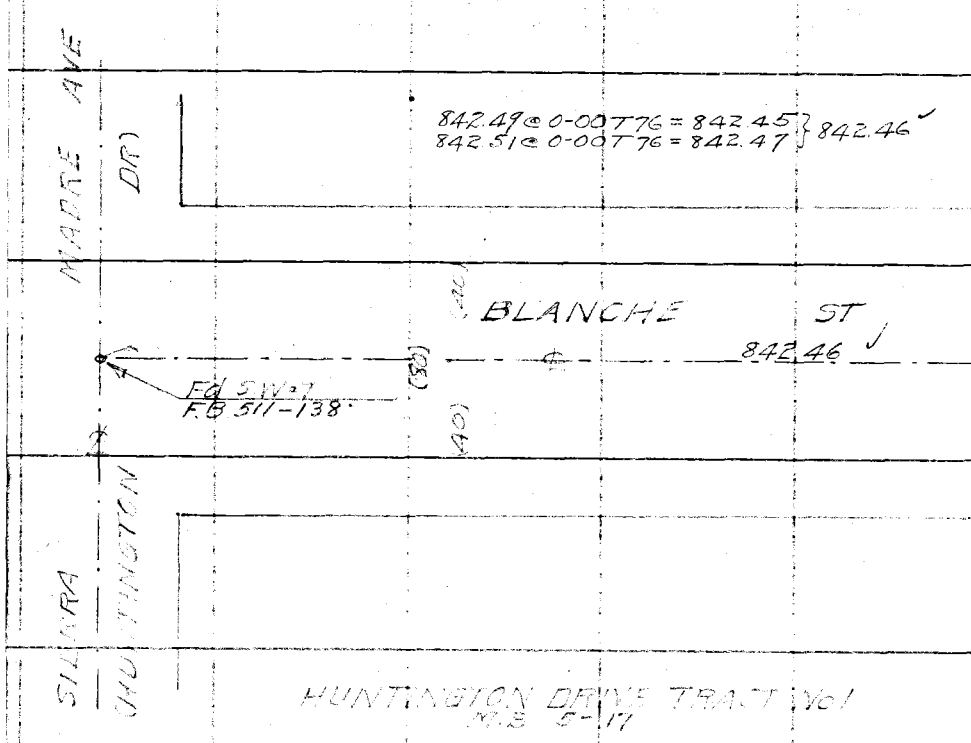

RETURN TO
LOS ANGELES COUNTY SURVEYOR
700 HALL OF RECORDS

Do not extend notes this side of this line

Note: Any Additions or Changes on This Sheet Must be Made or Circled in Red Ink With Date and Name of Person Making Change.

Notes Ck'd by Drew	Survey of SANTA ANITA AVE	F.B. 623	Pg 213
Map No. B-1357	W. O. 7145 Tape No. 058 St'd 84 °F.		
Office Work H. M. Hall	Surveyed by W.A. Miller		
Checked Drew	Notes Miller Date 6-5-36		
Date June - 38	Indexed A. C. Johnson		

17 + 55.79
3 + 35.08
20 + 90.87
1 + 84.98
22 + 75.85

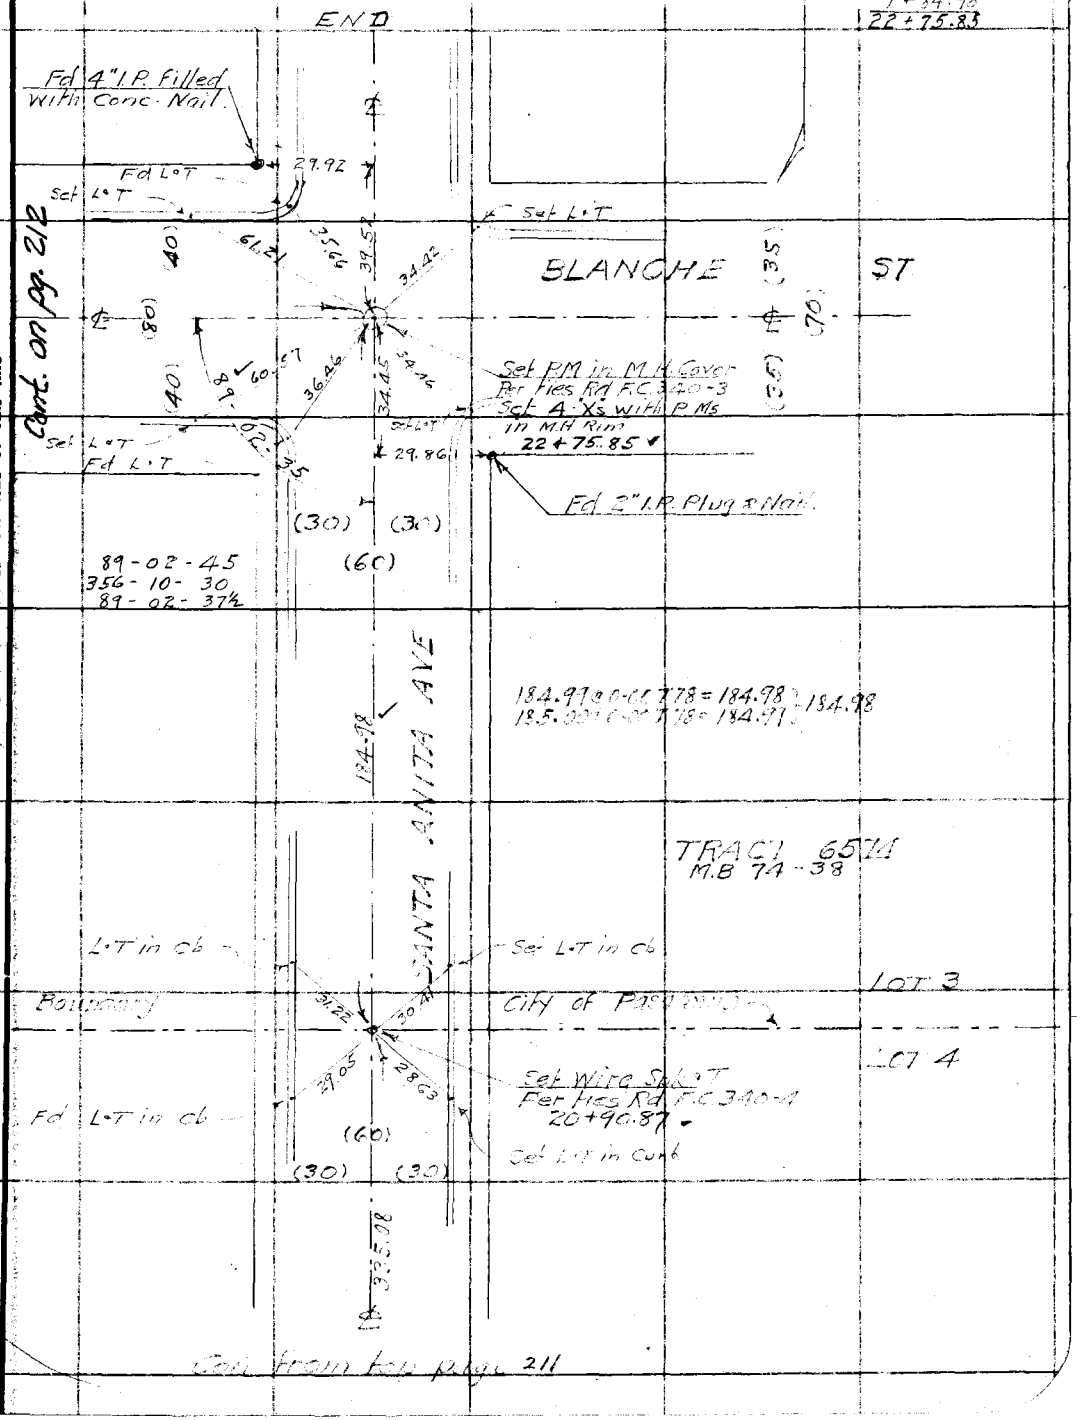

Note: Any Additions or Changes on This Sheet Must be Made or Circled in Red Ink With Date and Name of Person Making Change.

Do not extend notes this side of this line

RETURN TO
LOS ANGELES COUNTY SURVEYOR
700 HALL OF RECORDS

FORM 247 10M 11-35

F.B. 623 PG. 214

RETURN TO
LOS ANGELES COUNTY SURVEYOR
700 HALL OF RECORDS

Do not extend notes this side of this line

Note: Any Additions or Changes on This Sheet Must be Made or Circled in Red Ink With Date and Name of Person Making Change.

Notes Ck'd by	Survey of SANTA ANITA AVE
Map No.	W. O. 7145 Tape No. St'd °F.
Office Work H. M. Hall	Surveyed by W. A. Miller
Checked	Notes Date June 1936
Date	Indexed A. C. Johnson 9-21-36

F.B. 623 Pg. 215

TOPOGRAPHY SANTA ANITA AVE
FROM
CALIFORNIA ST TO BLANCHE ST.
JN 7145
June 9 1936 to June 1936

Miller
Bradley
Stewart
Clinton

CENTER LINE - PAGE 205 213

Note: Any Additions or Changes on This Sheet Must be Made or Circled in Red Ink With Date and Name of Person Making Change.

Do not extend notes this side of this line

RETURN TO
LOS ANGELES COUNTY SURVEYOR
700 HALL OF RECORDS

FORM 247 10M 11-35

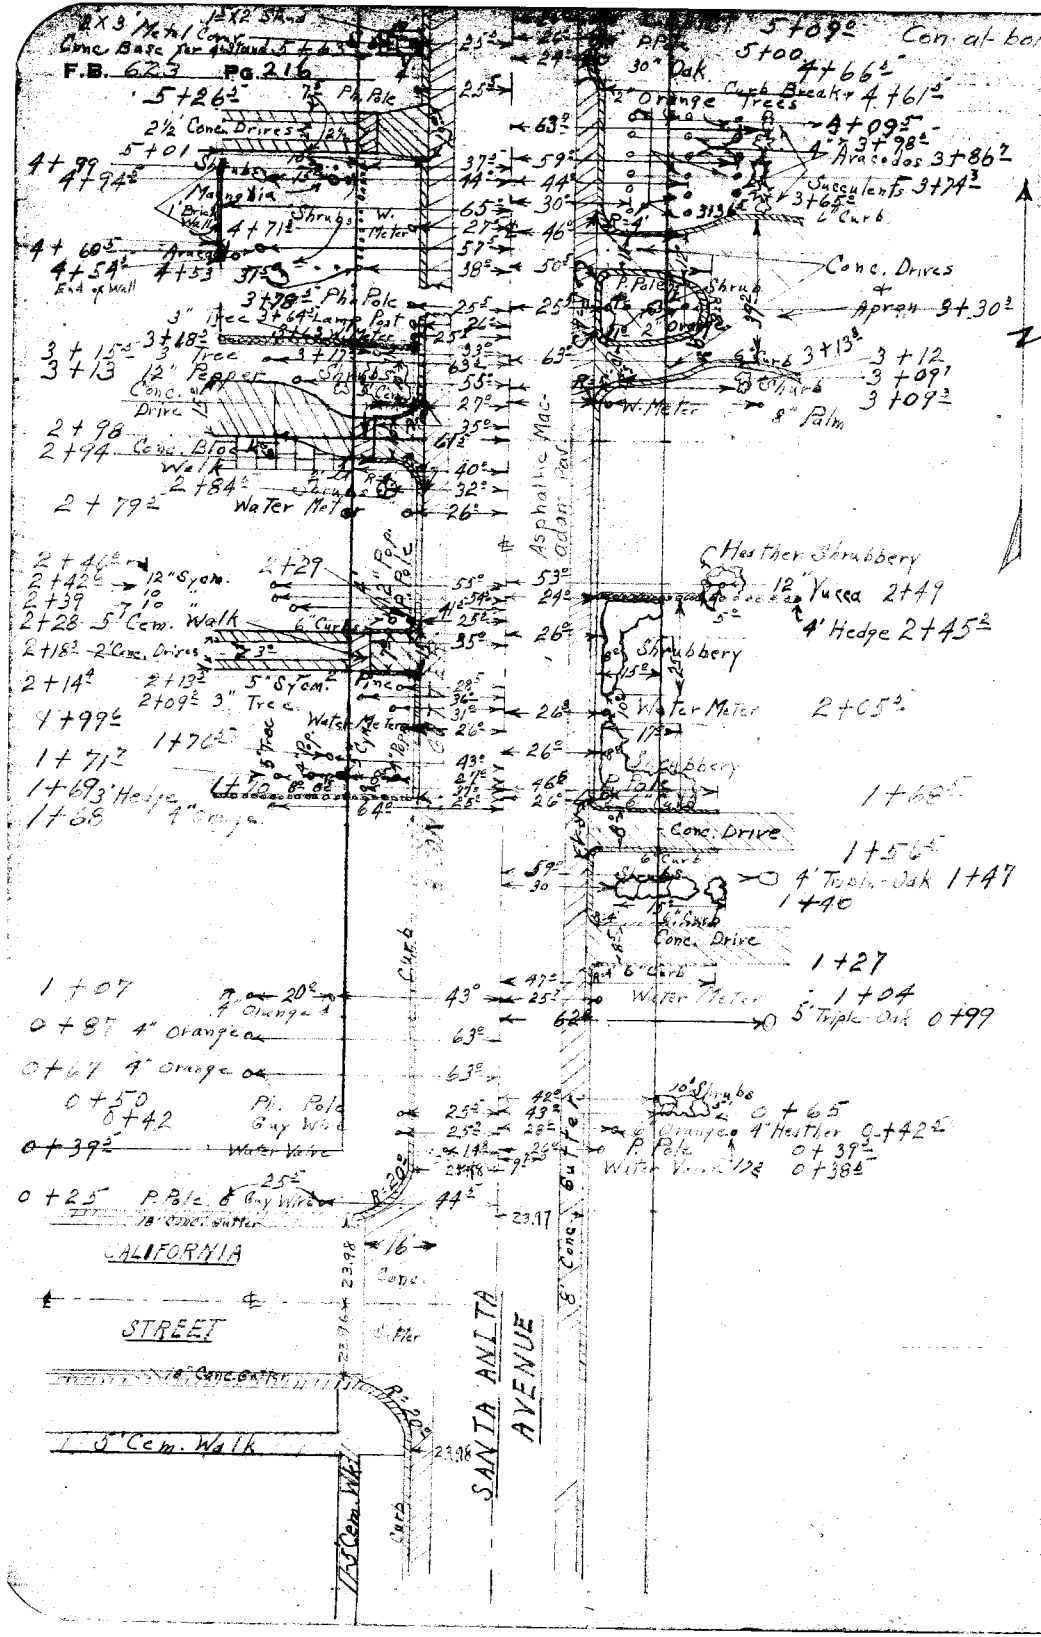

RETURN TO
LOS ANGELES COUNTY SURVEYOR
700 HALL OF RECORDS

Do not extend notes this side of this line

Note: Any Additions or Changes on This Sheet Must be Made or Circled in Red Ink With Date and Name of Person Making Change.

Notes Ck'd by Drew	Survey of SANTA ANITA AVE
Map No. B-1357	W. O. 1145 Tape No. ____ St'd ____ °F.
Office Work H. M. Hall	Surveyed by W.A. Miller
Checked Drew	Notes W.E. Braden Date 6/9-36
Date June-38	Indexed A. C. Johnson

F.B. 623 PG 217

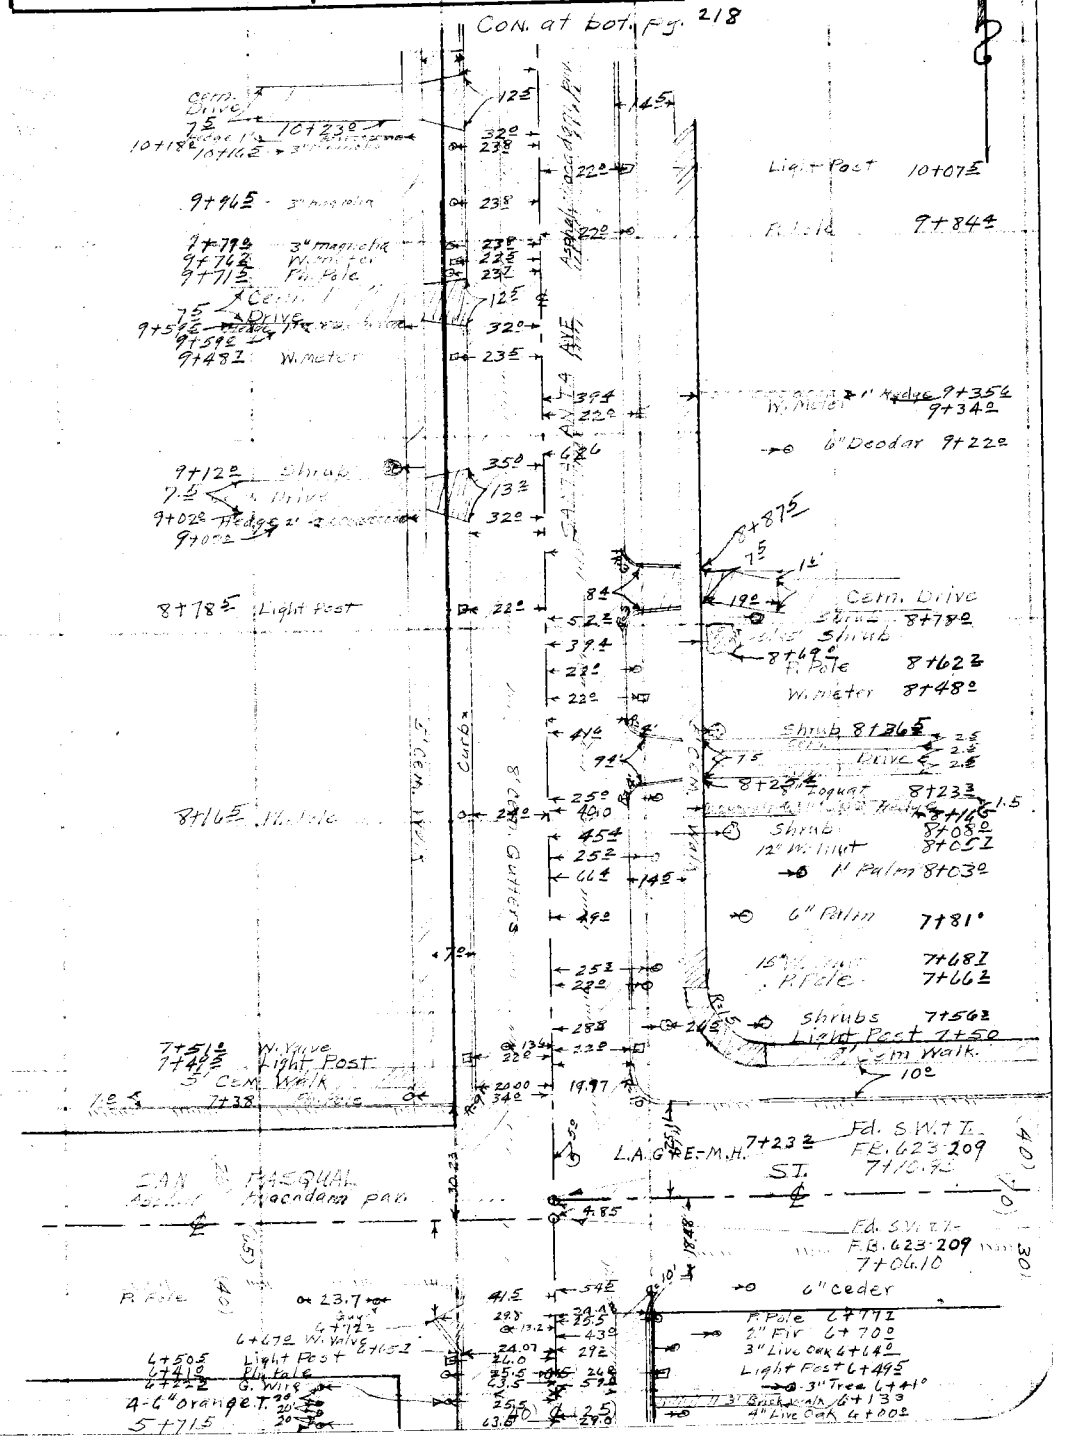

Note: Any Additions or Changes on This Sheet Must be Made or Circled in Red Ink With Date and Name of Person Making Change.

Do not extend notes this side of this line

RETURN TO
LOS ANGELES COUNTY SURVEYOR
700 HALL OF RECORDS

FORM 247 10M 11-35

F.B. 623 PG. 218

Con. at bot. page 219

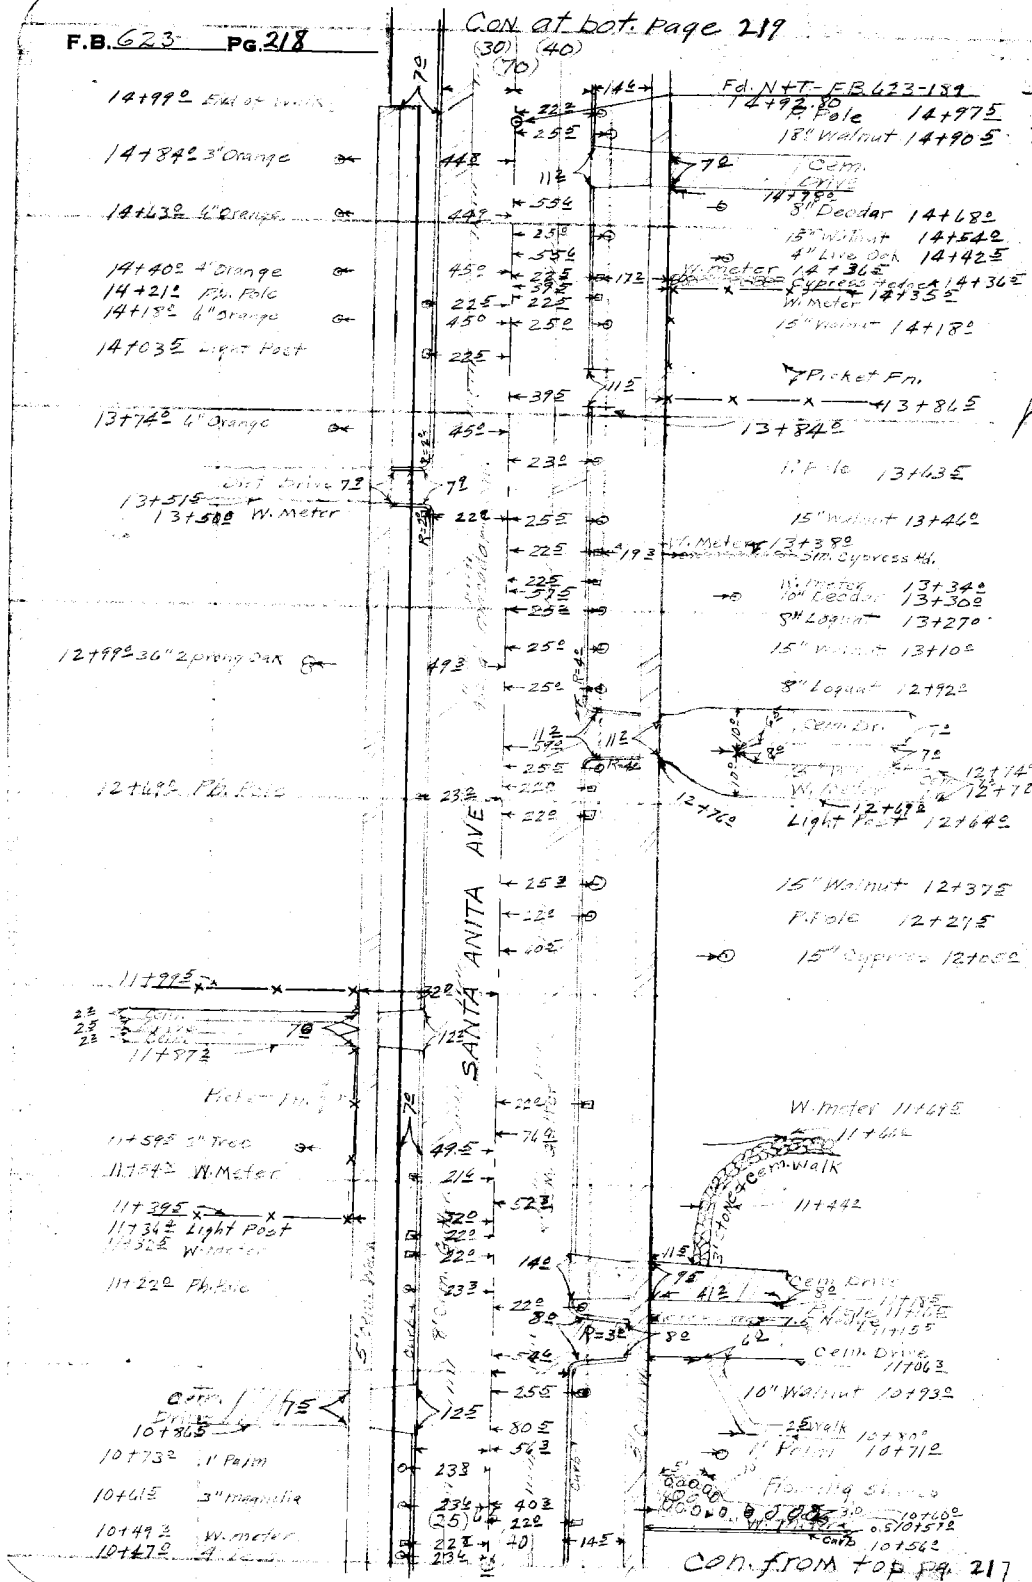

RETURN TO
LOS ANGELES COUNTY SURVEYOR
700 HALL OF RECORDS

Do not extend notes this side of this line

Note: Any Additions or Changes on This Sheet Must be Made or Circled in Red Ink With Date and Name of Person Making Change.

Notes Ck'd by: Drew	Survey of: SANTA ANITA AVE
Map No. B-1357	W. O. 7145 Tape No. ____ St'd ____ °F.
Office Work: A. M. Hall	Surveyed by: W A Miller
Checked: Drew	Notes: ____ Date: ____
Date: June - 1938	Indexed: A. C. Johnson

F.B. 623 Pg 219

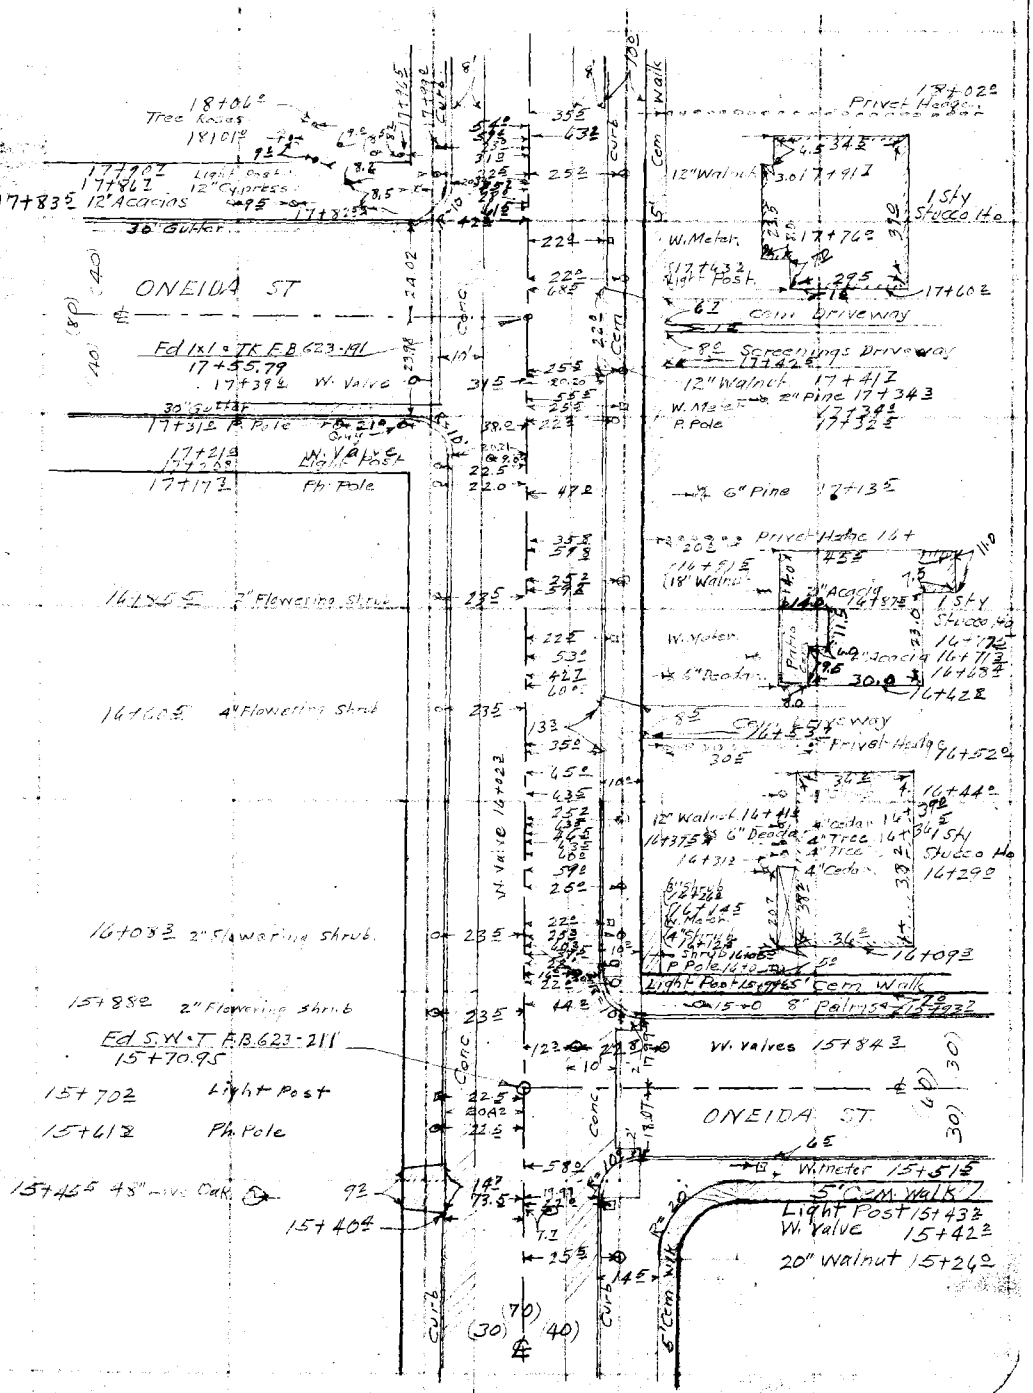

Note: Any Additions or Changes on This Sheet Must be Made or Circled in Red Ink With Date and Name of Person Making Change.

Do not extend notes this side of this line

RETURN TO
LOS ANGELES COUNTY SURVEYOR
700 HALL OF RECORDS

FORM 247 10M 11-35

F.B. 623 PG. 220

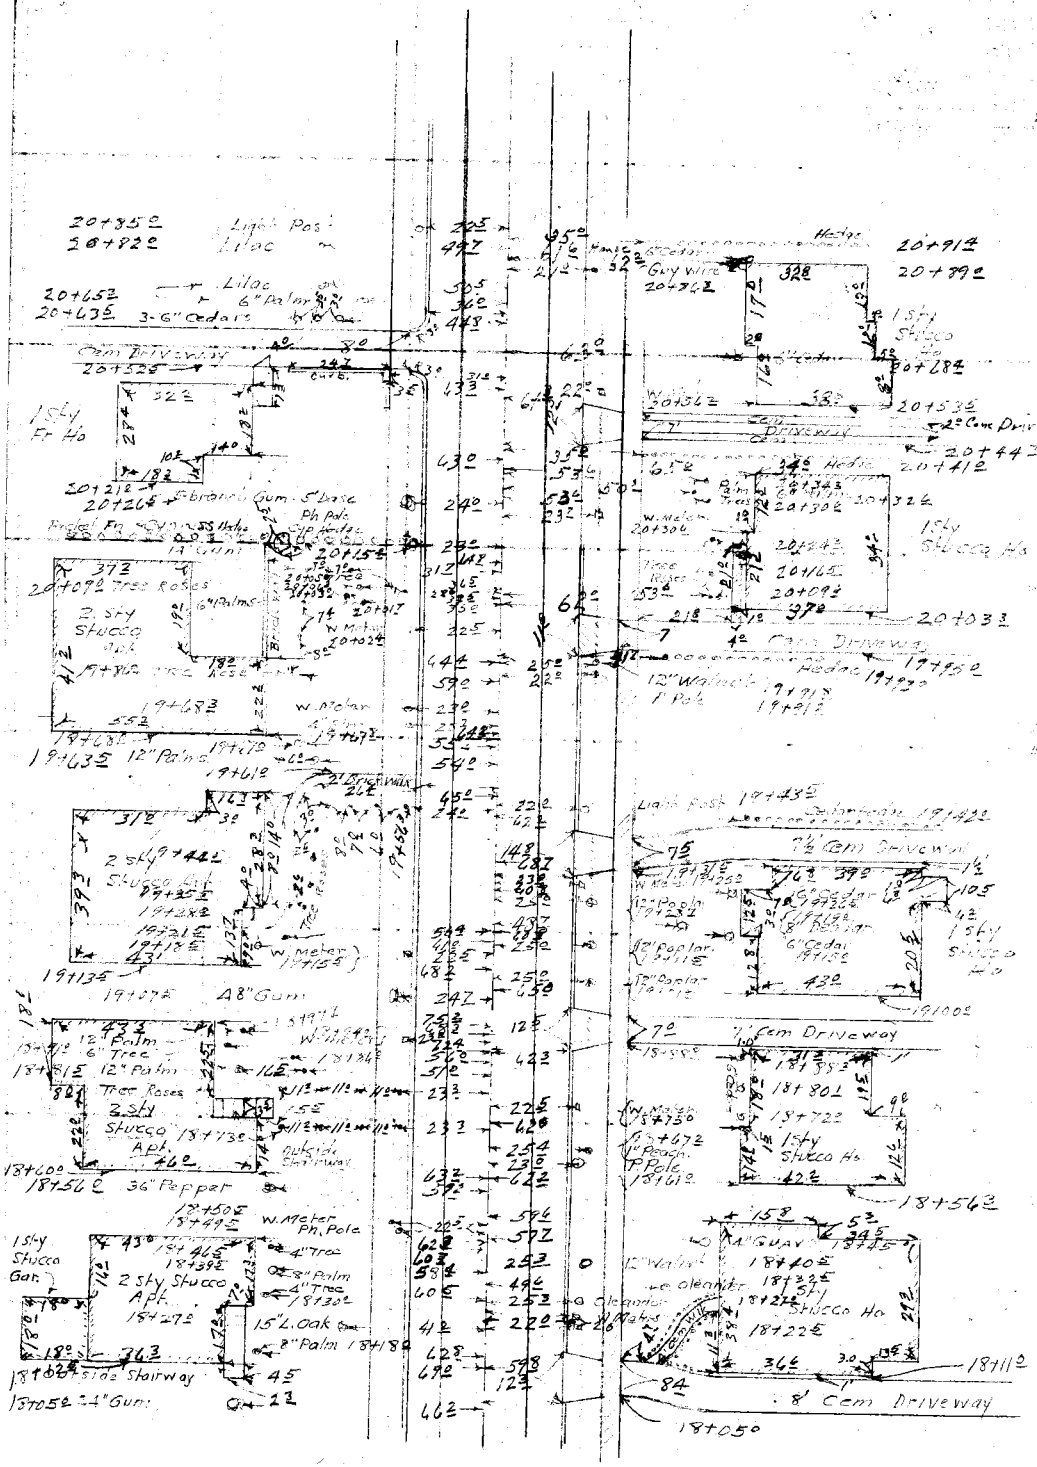

RETURN TO
LOS ANGELES COUNTY SURVEYOR
700 HALL OF RECORDS

Do not extend notes this side of this line

Note: Any Additions or Changes on This Sheet Must be Made or Circled in Red Ink With Date and Name of Person Making Change.

Notes Ck'd by Drew	Survey of SANTA ANITA AVE.
Map No. B-1357	W. O. 7145 Tape No. ____ St'd ____ °F.
Office Work K. M. Hall	Surveyed by W.A. Miller
Checked Drew	Notes Miller Date ____
Date June 1938	Indexed A. C. Johnson

F.B. 623 PG. 221

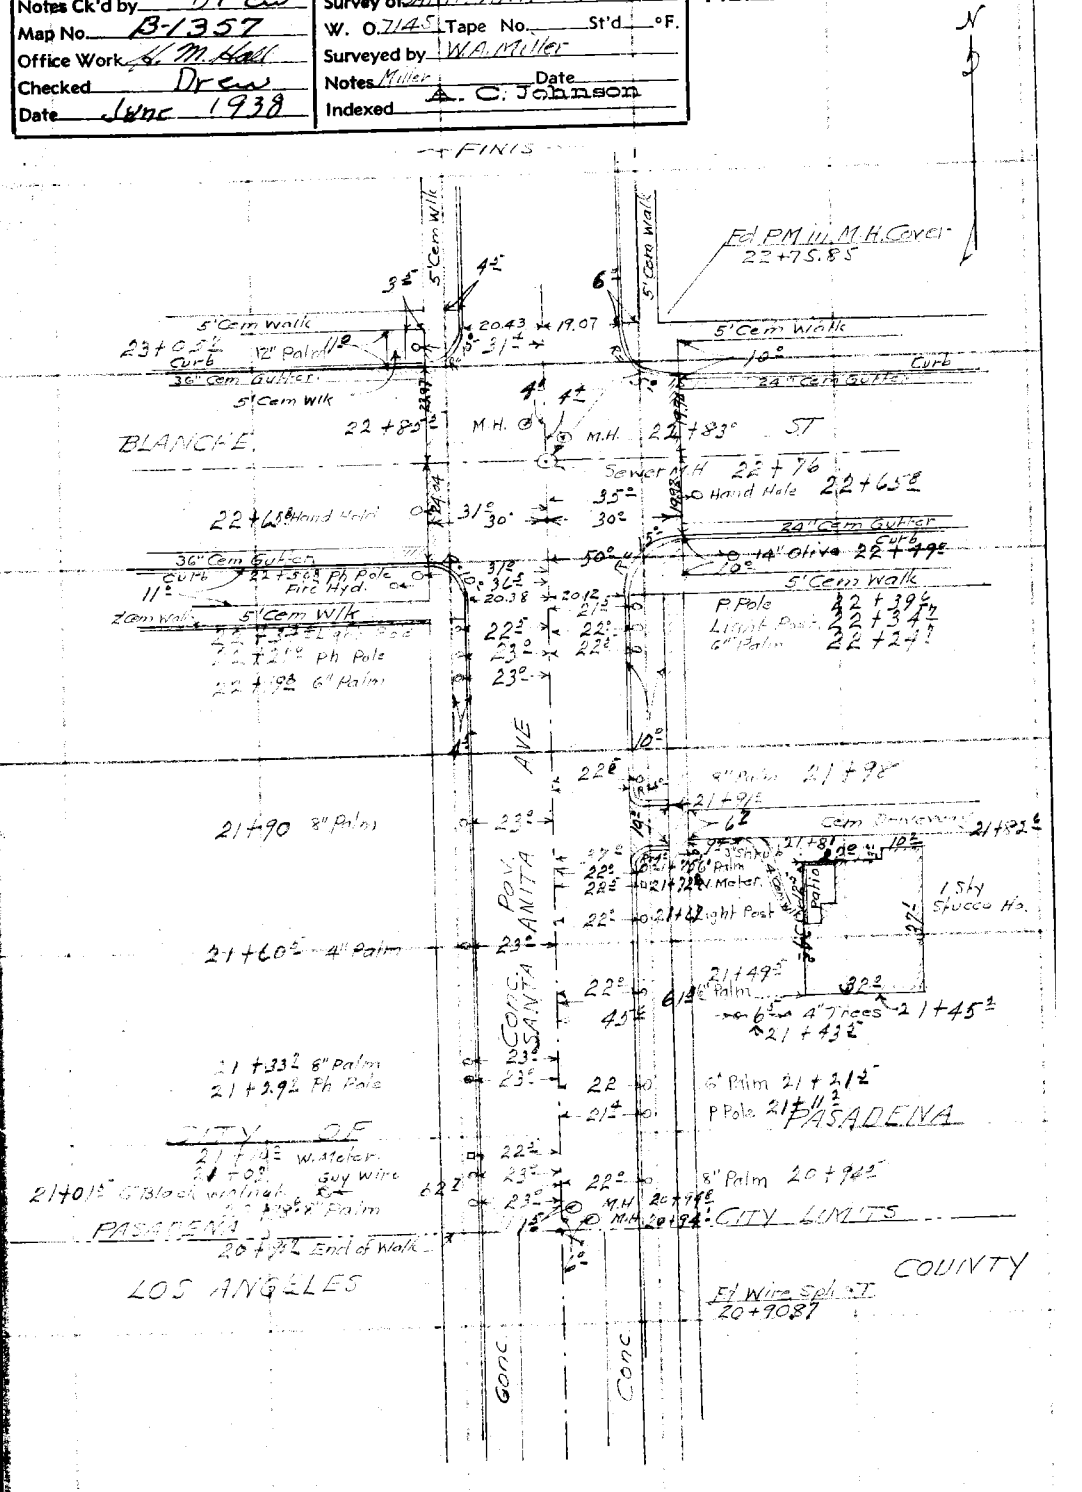

Con. from top page 220

RETURN TO
LOS ANGELES COUNTY SURVEYOR
700 HALL OF RECORDS

Note: Any Additions or Changes on This Sheet Must Be Made or Circled in Red Ink With Date and Name of Person Making Change.

Do not extend notes this side of this line

FORM 247 10M 11-35

F.B. 623 PG. 222

RETURN TO
LOS ANGELES COUNTY SURVEYOR
700 HALL OF RECORDS

Note: Any Additions or Changes on This Sheet Must be Made or Circled in **Red Ink** With Date and Name of Person Making Change.

Do not extend notes this side of this line

Notes Ck'd by	Survey of SANTA ANITA AVE
Map No.	W. O. 7145 Tape No. St'd °F.
Office Work H. M. Hall	Surveyed by W.A. Miller
Checked	Notes Date
Date	Indexed A. C. Johnson 9-21-36

F.B. 623 PG 223

SURVEY OF SANTA ANITA AVE
FROM
FOOTHILL BLVD TO VILLA ST.
J.N. 7145

Miller
brass
[illegible]
Clinton

TOPOGRAPHY PAGES 229-232

Note: Any Additions or Changes on This Sheet Must be Made or Circled in Red Ink With Date and Name of Person Making Change.

Do not extend notes this side of this line

RETURN TO
LOS ANGELES COUNTY SURVEYOR
700 HALL OF RECORDS

FORM 247 10M 11-35

F.B. 623 PG. 224

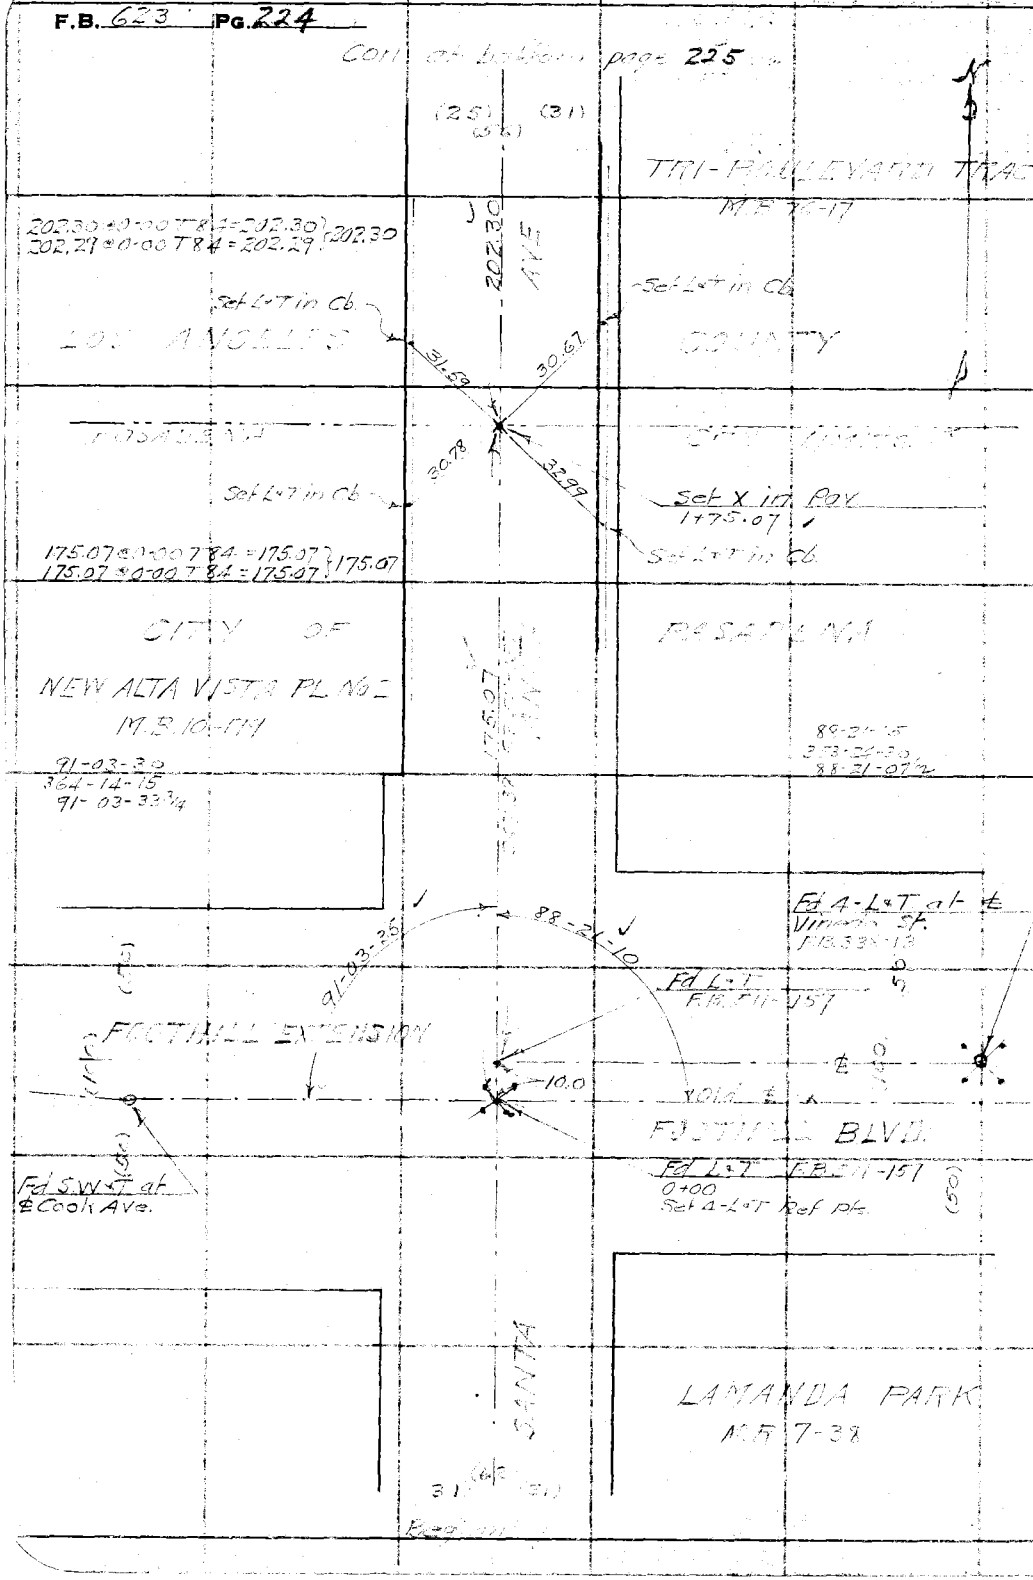

RETURN TO
LOS ANGELES COUNTY SURVEYOR
700 HALL OF RECORDS

Do not extend notes this side of this line

Note: Any Additions or Changes on This Sheet Must be Made or Circled in Red Ink With Date and Name of Person Making Change.

Notes Ck'd by Drew	Survey of SANTA ANITA AVE	F.B. 623 Pg 225
Map No. B-1357	W. O. 1145 Tape No. St'd °F.	
Office Work H. M. Hall	Surveyed by W.A. Miller	
Checked Drew	Notes Miller Date	
Date June 1938	Indexed A. C. Johnson	

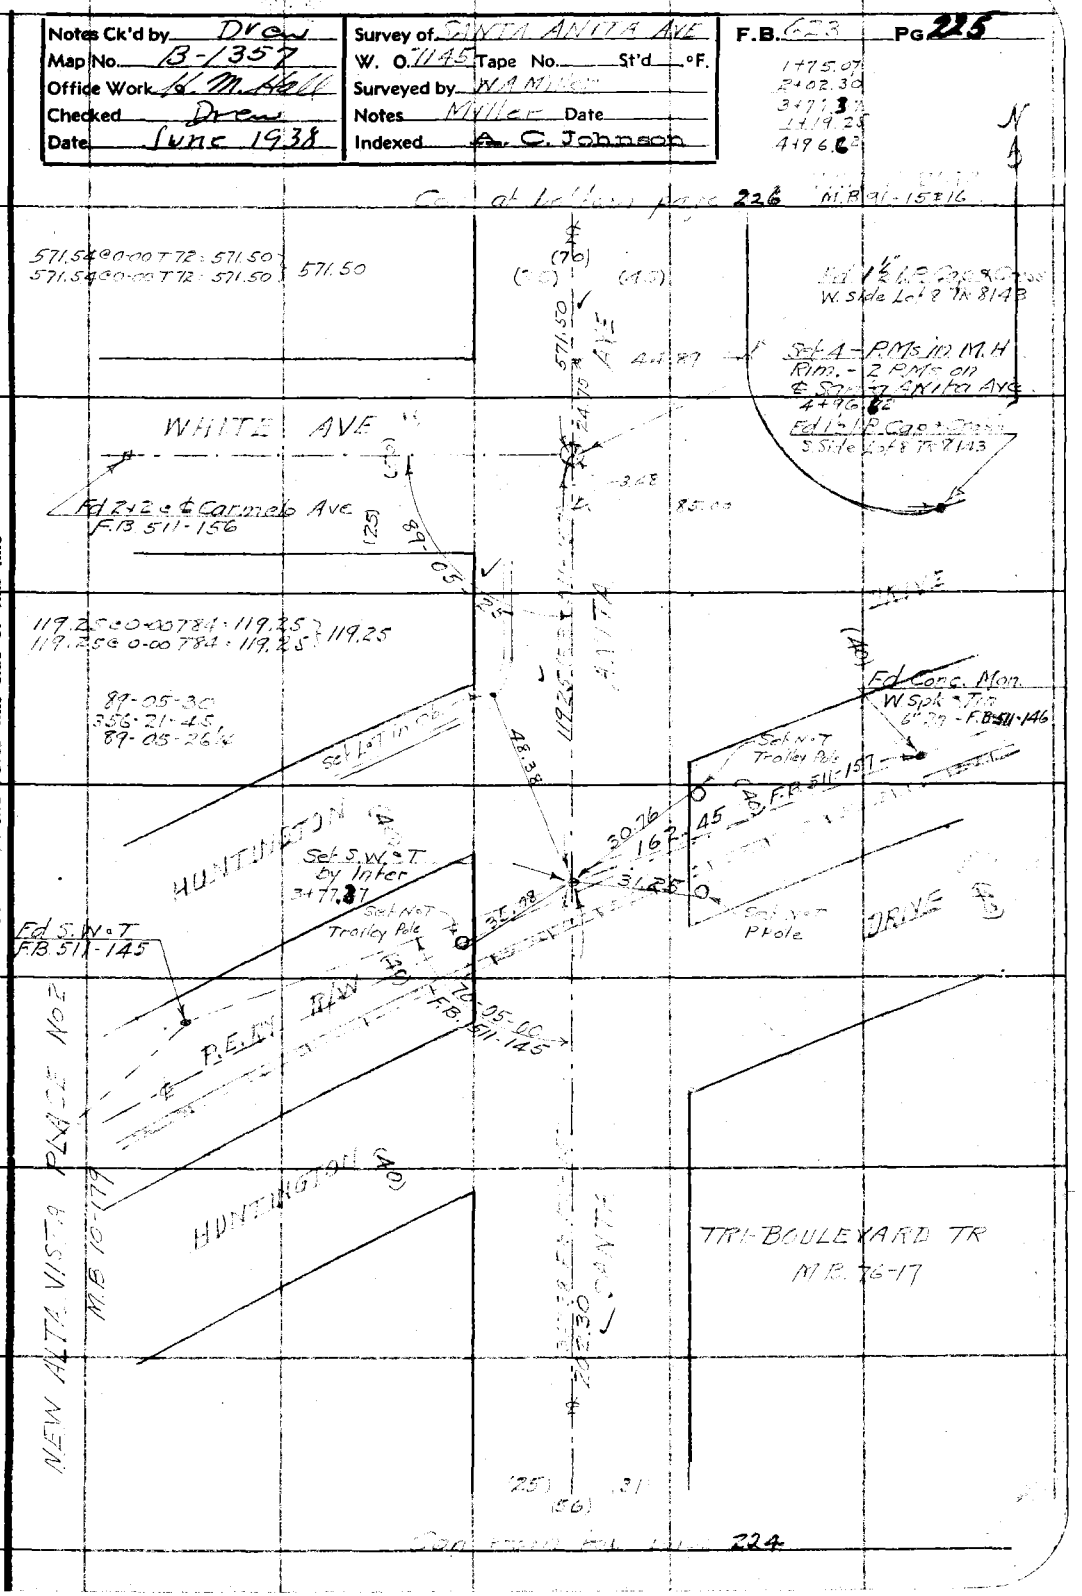

Note: Any Additions or Changes on This Sheet Must be Made or Circled in Red Ink With Date and Name of Person Making Change.

Do not extend notes this side of this line

RETURN TO
LOS ANGELES COUNTY SURVEYOR
700 HALL OF RECORDS

FORM 247 10M 11-35

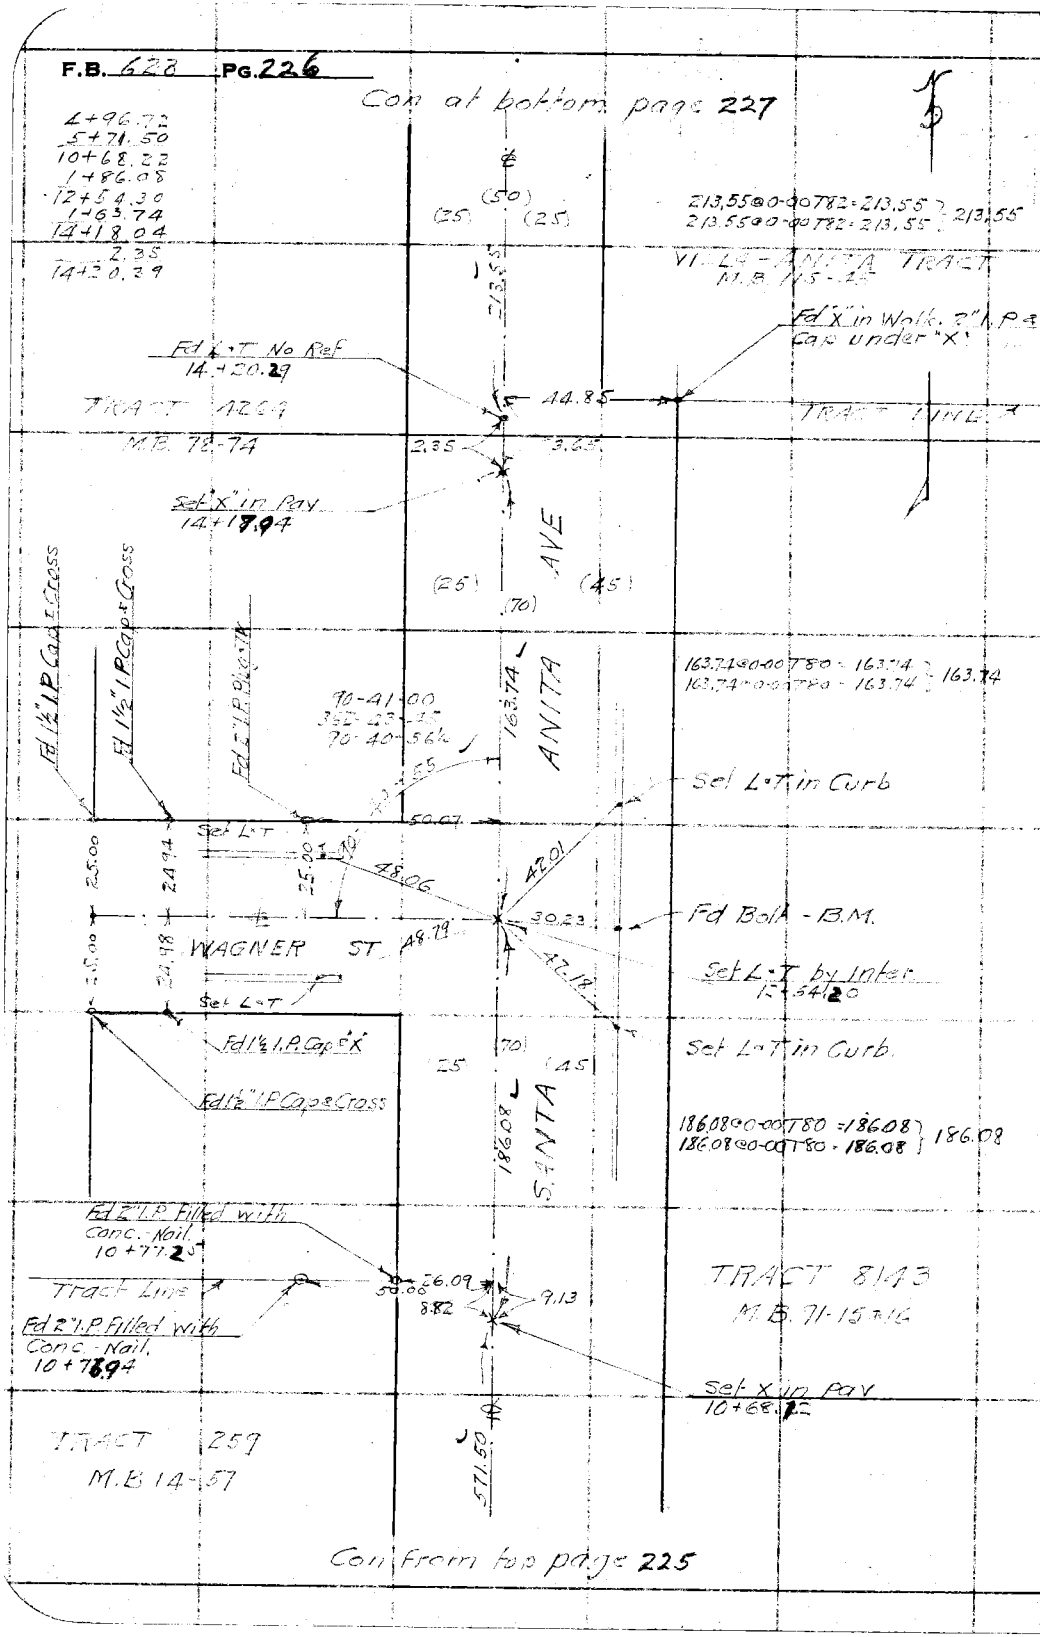

RETURN TO
LOS ANGELES COUNTY SURVEYOR
700 HALL OF RECORDS

Do not extend notes this side of this line

Note: Any Additions or Changes on This Sheet Must be Made or Circled in Red Ink With Date and Name of Person Making Change.

Notes Ck'd by Drew	Survey of SANTA ANITA AVE
Map No. B-1357	W. O. [illegible] Tape No. [illegible] St'd °F.
Office Work H. M. Hall	Surveyed by [illegible]
Checked Drew	Notes [illegible] Date
Date June 1938	Indexed A. C. Johnson

F.B. 623 Pg. 227

14+20.39
2+13.55
16+33.94

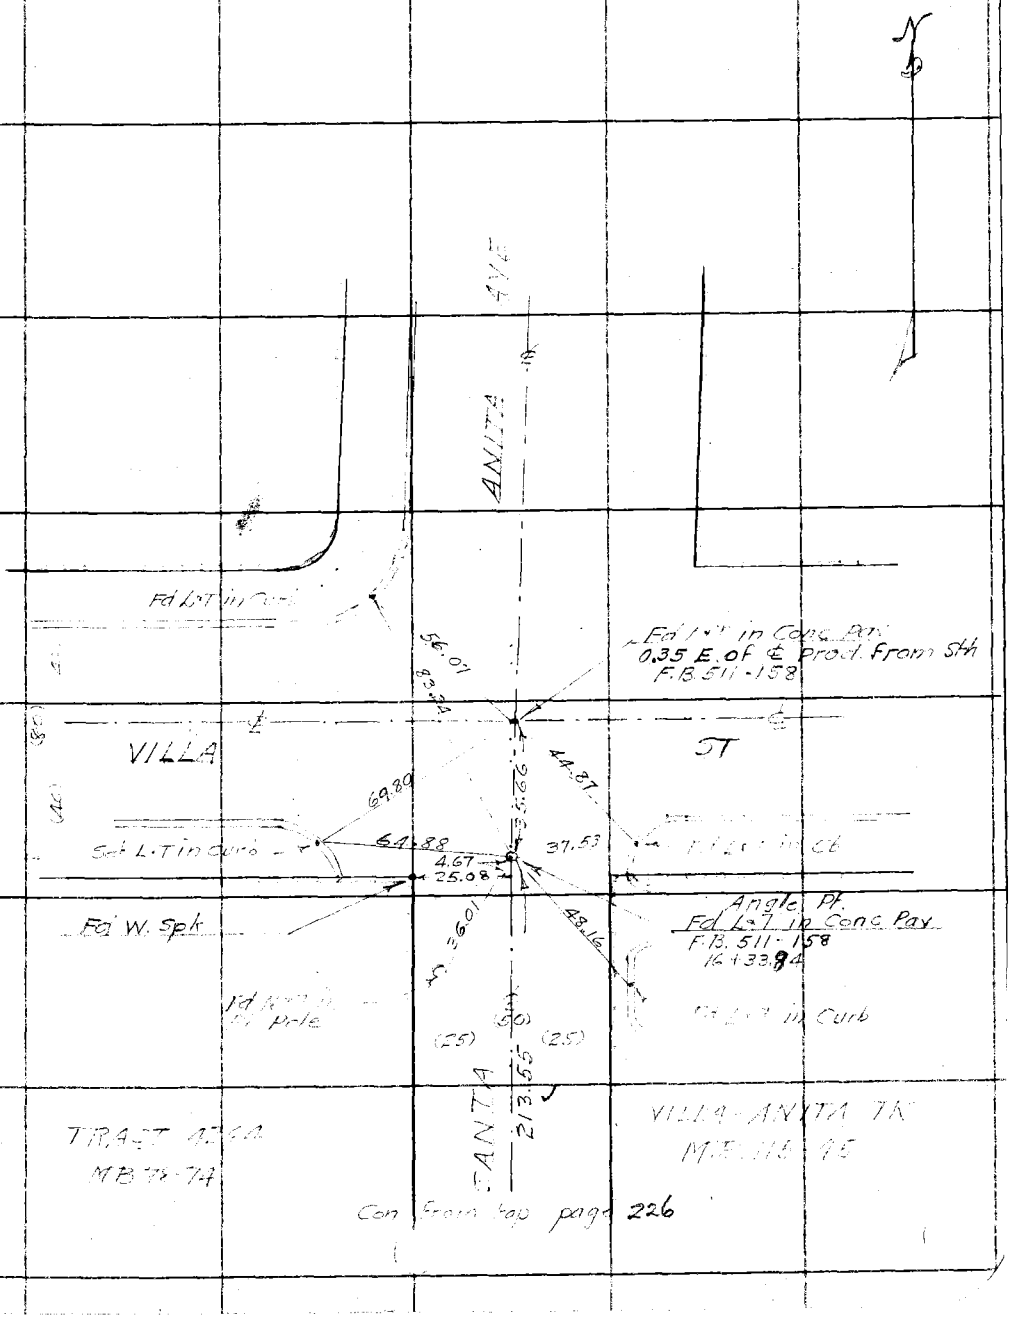

Note: Any Additions or Changes on This Sheet Must be Made or Circled in Red Ink With Date and Name of Person Making Change.

Do not extend notes this side of this line

RETURN TO
LOS ANGELES COUNTY SURVEYOR
700 HALL OF RECORDS

FORM 247 10M 11-35

F.B. 623 Pg. 228

RETURN TO
LOS ANGELES COUNTY SURVEYOR
700 HALL OF RECORDS

Do not extend notes this side of this line

Note: Any Additions or Changes on This Sheet Must be Made or Circled in **Red Ink** With Date and Name of Person Making Change.

Notes Ck'd by	Survey of SANTA ANITA AVE.
Map No.	W. O. 7145 Tape No. St'd °F.
Office Work	Surveyed by W.A. Miller
Checked	Notes [illegible] Date July [illegible]
Date	Indexed A. C. Johnson 9-21-36

F.B. [illegible] PG 229

TOPOGRAPHY SANTA ANITA AVE
FROM
FOOTHILL BLVD to VILLA ST
J.N. 7145

Miller
Brown
Stewart
Chase

CENTER LINE - PAGES 223-228

Note: Any Additions or Changes on This Sheet Must be Made or Circled in Red Ink With Date and Name of Person Making Change.

Do not extend notes this side of this line

RETURN TO
LOS ANGELES COUNTY SURVEYOR
700 HALL OF RECORDS

FORM 247 10M 11-35

F.B. 625 PG. 230

Con. at bottom page 231

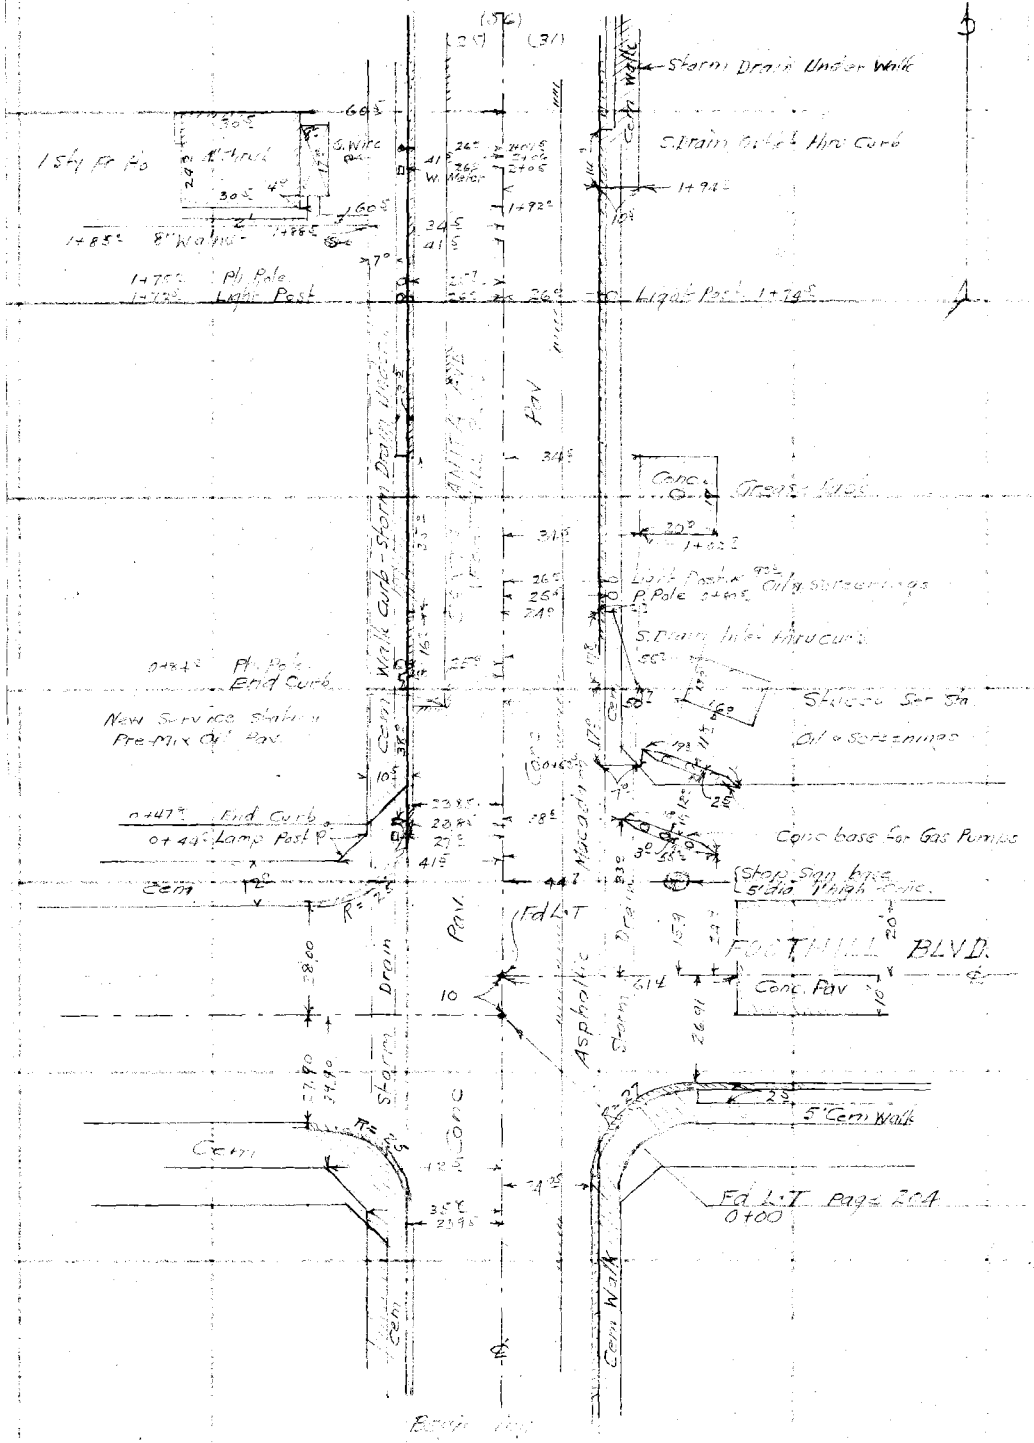

RETURN TO
LOS ANGELES COUNTY SURVEYOR
700 HALL OF RECORDS

Note: Any Additions or Changes on This Sheet Must be Made or Circled in Red Ink With Date and Name of Person Making Change.

Do not extend notes this side of this line

Notes Ck'd by Drew	Survey of SANTA ANITA AVE
Map No. B-1357	W. O. 7145 Tape No. St'd °F.
Office Work L M Hall	Surveyed by W A Miller
Checked Drew	Notes Miller Date
Date June - 38	Indexed A. C. Johnson

F.B. 623 PG. 231

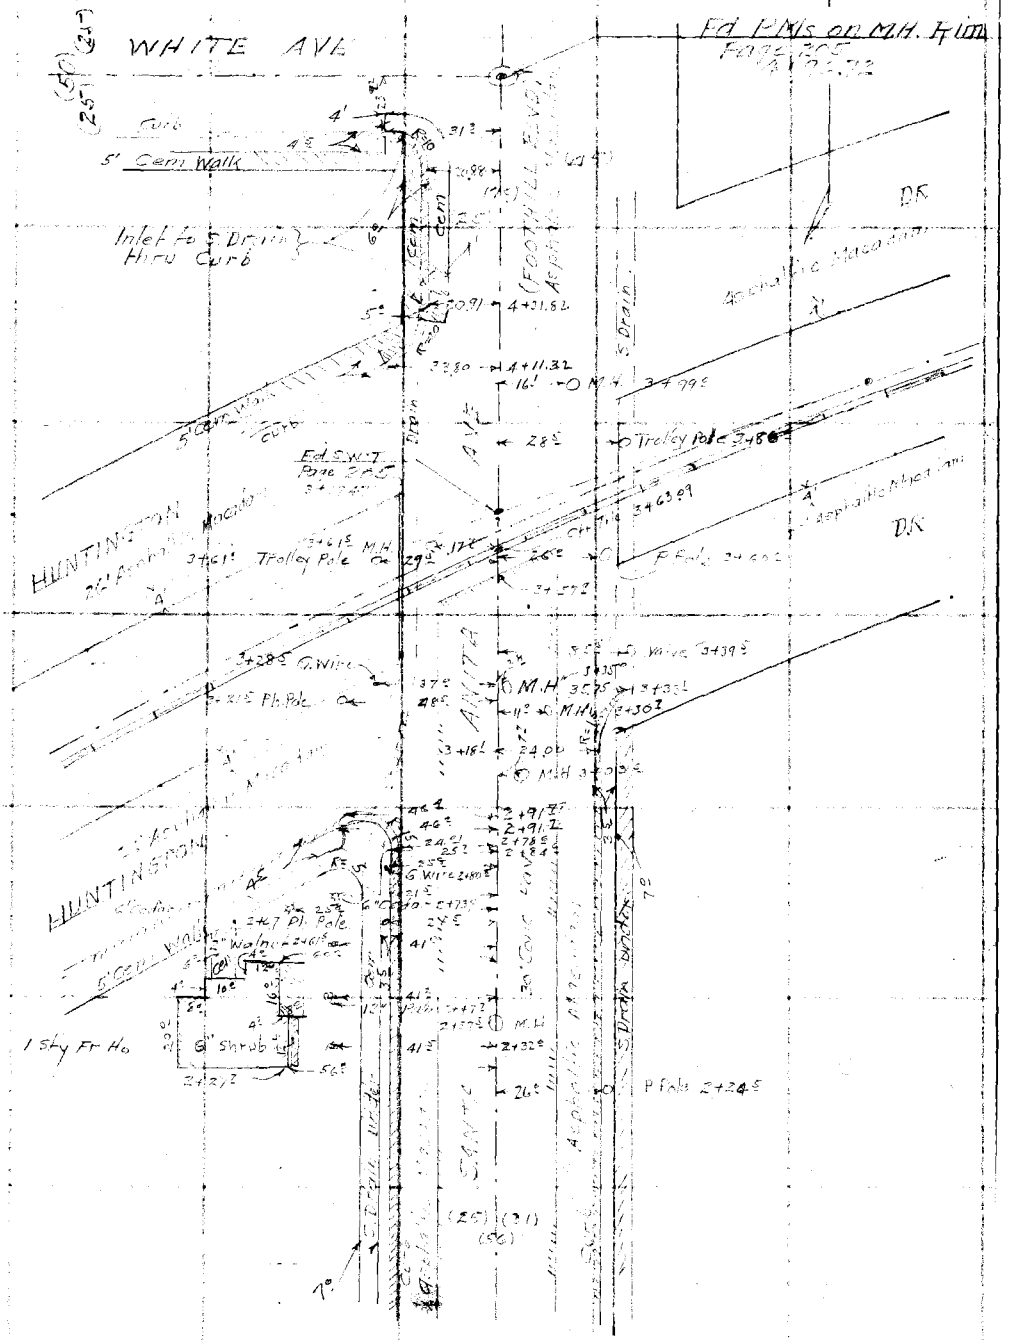

Note: Any Additions or Changes on This Sheet Must be Made or Circled in Red Ink With Date and Name of Person Making Change.

Do not extend notes this side of this line

RETURN TO
LOS ANGELES COUNTY SURVEYOR
700 HALL OF RECORDS

FORM 247 10M 11-35

F.B. 623 PG. 232

RETURN TO
LOS ANGELES COUNTY SURVEYOR
700 HALL OF RECORDS

Do not extend notes this side of this line

Note: Any Additions or Changes on This Sheet Must be Made or Circled in Red Ink With Date and Name of Person Making Change.

Notes Ck'd by Dr cw	Survey of SANTA ANITA AVE
Map No.	W. O. 7145 Tape No. 652 St'd 84 °F.
Office Work H. M. Hall	Surveyed by W.A. Miller
Checked Dr cw	Notes Miller Date 7-13-36
Date June - 38	Indexed A. C. Johnson 9-21-36

F.B. 623 PG. 233

SURVEY OF SANTA ANITA AVE
FROM
NORTH AVE TO BERENDO ST.
J.N 7145

Miller
Willess
Braden
Stewart
Shore

[illegible] PAGES 243-252

Note: Any Additions or Changes on This Sheet Must be Made or Circled in Red Ink With Date and Name of Person Making Change.

Do not extend notes this side of this line

RETURN TO
LOS ANGELES COUNTY SURVEYOR
700 HALL OF RECORDS

FORM 247 10M 11-35

F.B. 623 PG. 234

Con at bottom page 235

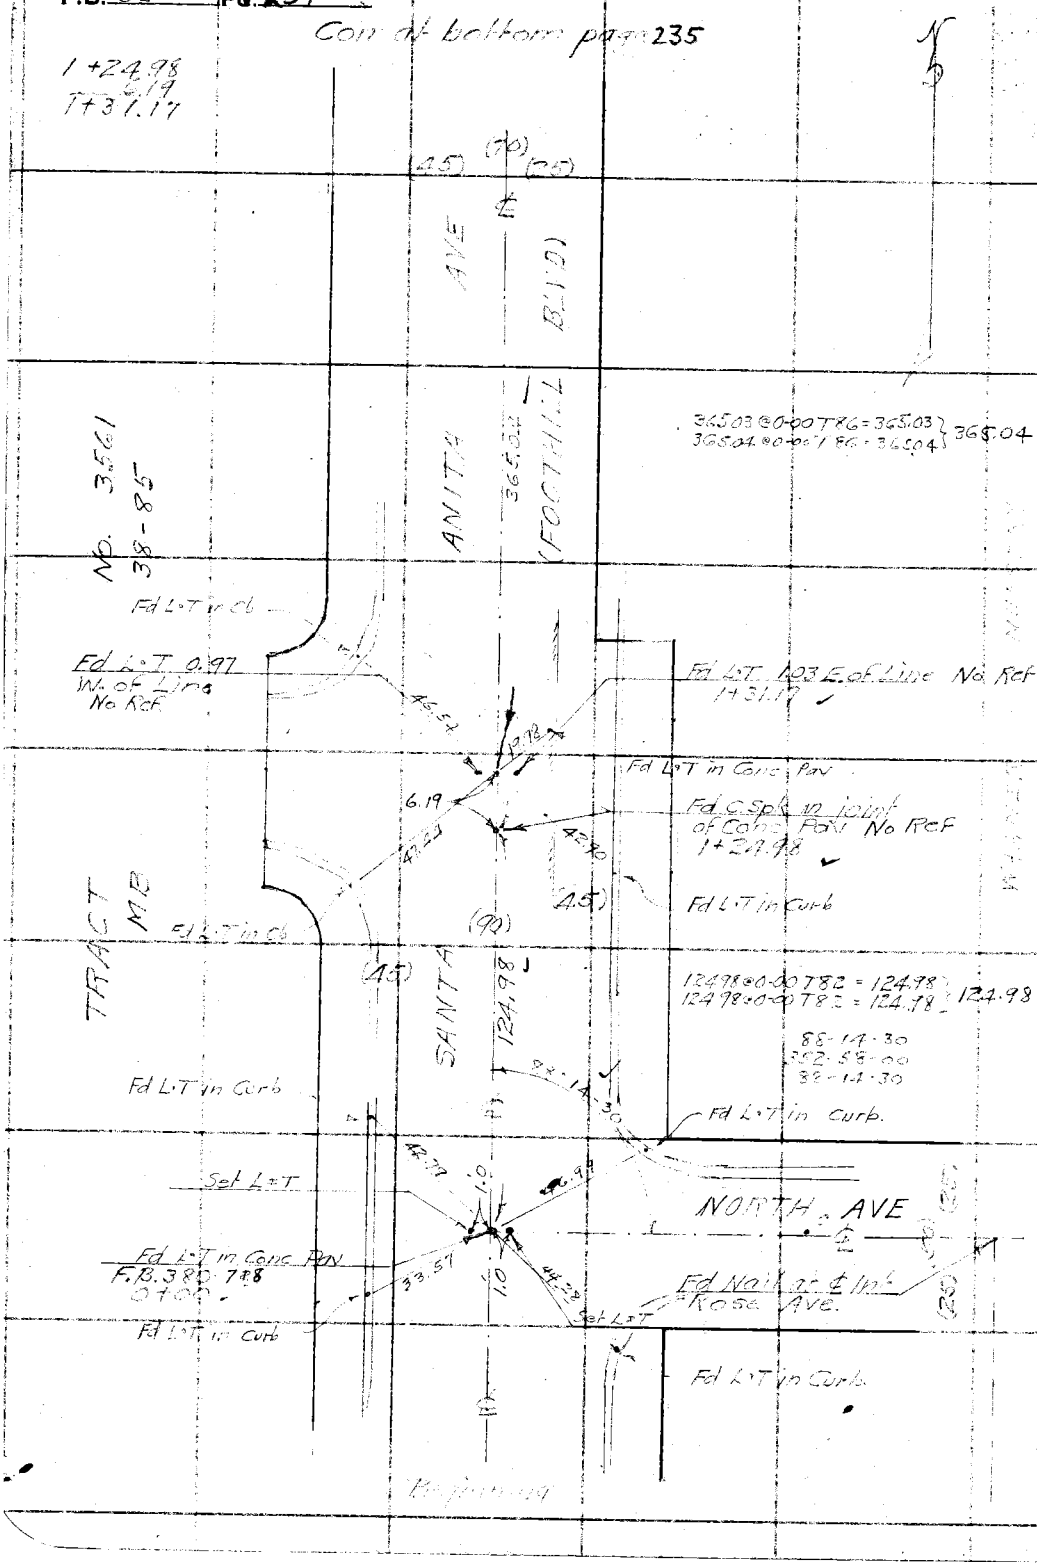

RETURN TO
LOS ANGELES COUNTY SURVEYOR
700 HALL OF RECORDS

Note: Any Additions or Changes on This Sheet Must be Made or Circled in Red Ink With Date and Name of Person Making Change.

Do not extend notes this side of this line

Notes Ck'd by Drew	Survey of SANTA ANITA AVE
Map No. B-1357	W. O. 7145 Tape No. 258 St'd 84 °F.
Office Work H. M. Hall	Surveyed by W.A. Miller
Checked Drew	Notes Miller Date 7-13-36
Date June 1938	Indexed A. C. Johnson

F.B. 623 Pg. 235

1+31.17 N
3+65.09
4+96.21
3+88.06
8+84.27

TRACT 6433
M.B. 104-20

Con at bottom page 236

90-40-30
362-41-30
90-40-22

466.24@0-00T94=466.27
466.23@0-00T94=466.26 } 466.26

Fd L+T in Curb

Fd L+T in Conc Pav

Fd S.W.&T at ℄ Int
Grand Oaks Ave.
F.B 380-7

WASHINGTON ST

Fd L+T
0.98 W. of ℄
F.B 380-7

Fd L+T 1.02 E. of ℄
F.B 380-7
8+84.27

Fd L+T in Conc Pav

Fd L+T in Curb

388.04@0-00T86=388.05
388.07@0-00T86=388.08 } 388.06

SANTA ANITA AVE (FOOTHILL BLVD)

No. 3561
38-85

Fd L+T in Curb

Fd L+T in Conc Pav

Fd L+T 1.0 W. of Line
No Ref.

Fd L+T 1.0 E. of Line
4+96.21 No Ref

Fd L+T in Conc Pav

TRACT
M.B.

Fd L+T in Cb

Con from top page 234

Note: Any Additions or Changes on This Sheet Must be Made or Circled in Red Ink With Date and Name of Person Making Change.

Do not extend notes this side of this line

RETURN TO
LOS ANGELES COUNTY SURVEYOR
700 HALL OF RECORDS

FORM 247 10M 11-35

F.B. 623 Pg. 236

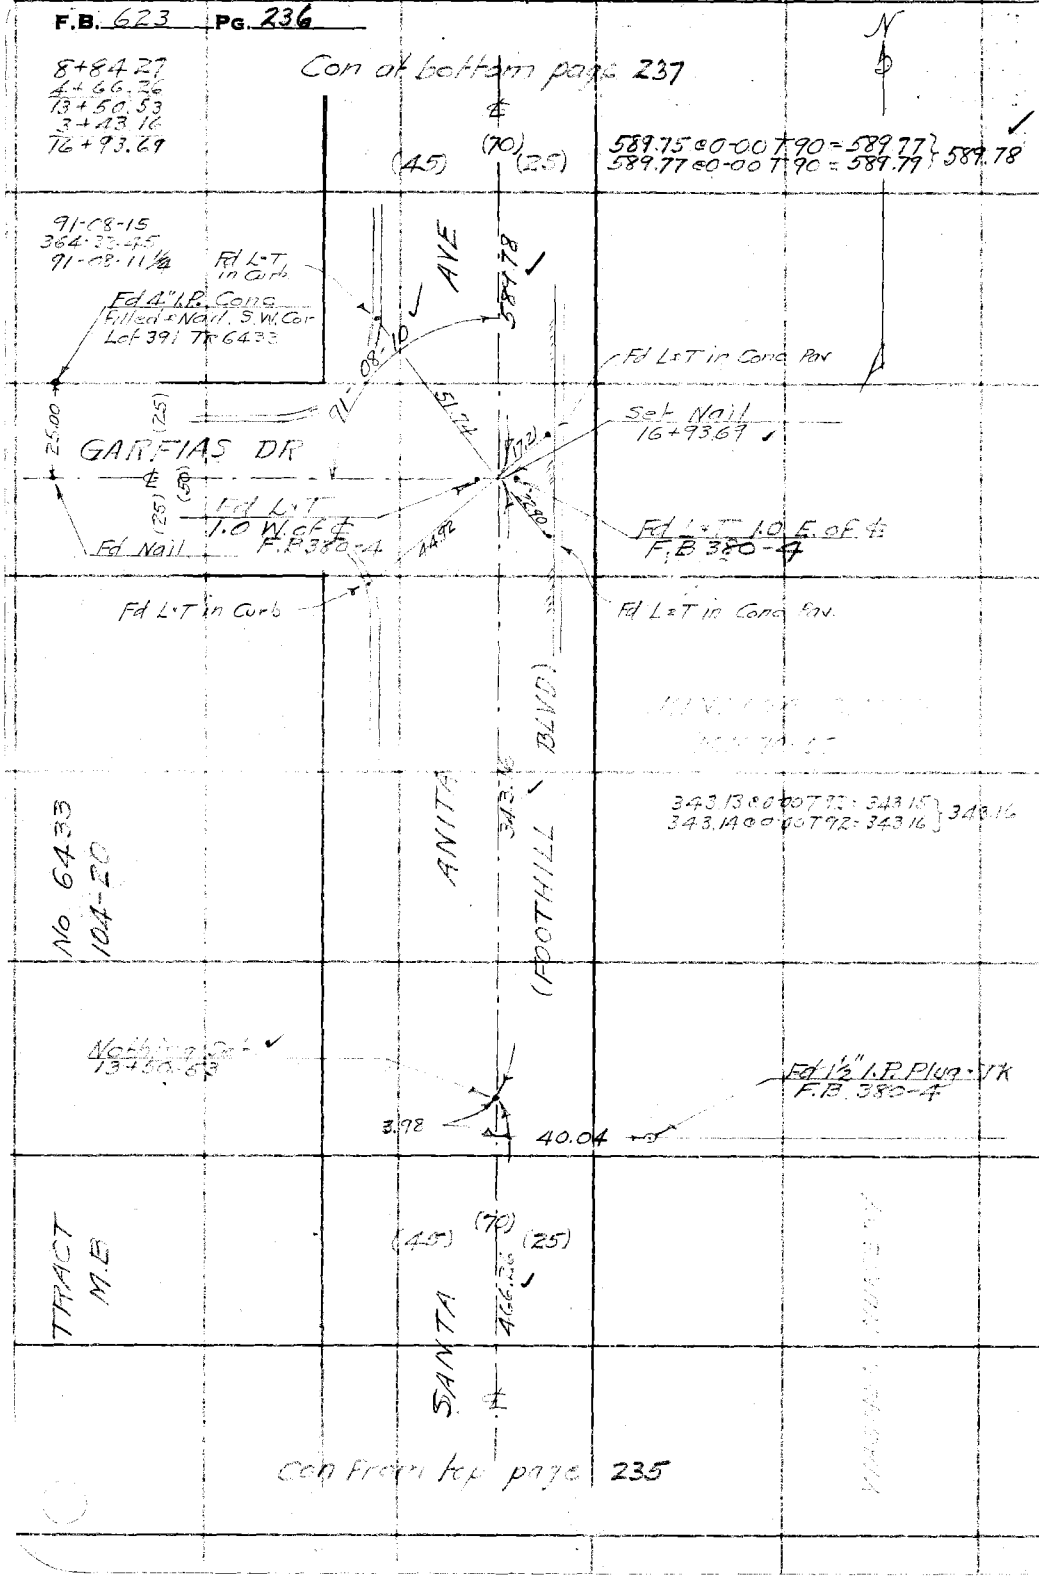

RETURN TO
LOS ANGELES COUNTY SURVEYOR
700 HALL OF RECORDS

Note: Any Additions or Changes on This Sheet Must be Made or Circled in Red Ink With Date and Name of Person Making Change.

Do not extend notes this side of this line

Notes Ck'd by Drew	Survey of SANTA ANITA AVE	F.B. 623 PG. 237
Map No. B-1357	W. O. 7145 Tape No. 058 St'd 84 °F.	
Office Work H. M. Hall	Surveyed by W A Miller	
Checked Drew	Notes Miller Date 7-14-36	
Date June 1938	Indexed A. C. Johnson	

16+93.69
5+87.78
22+83.47
5+86.42
28+69.89

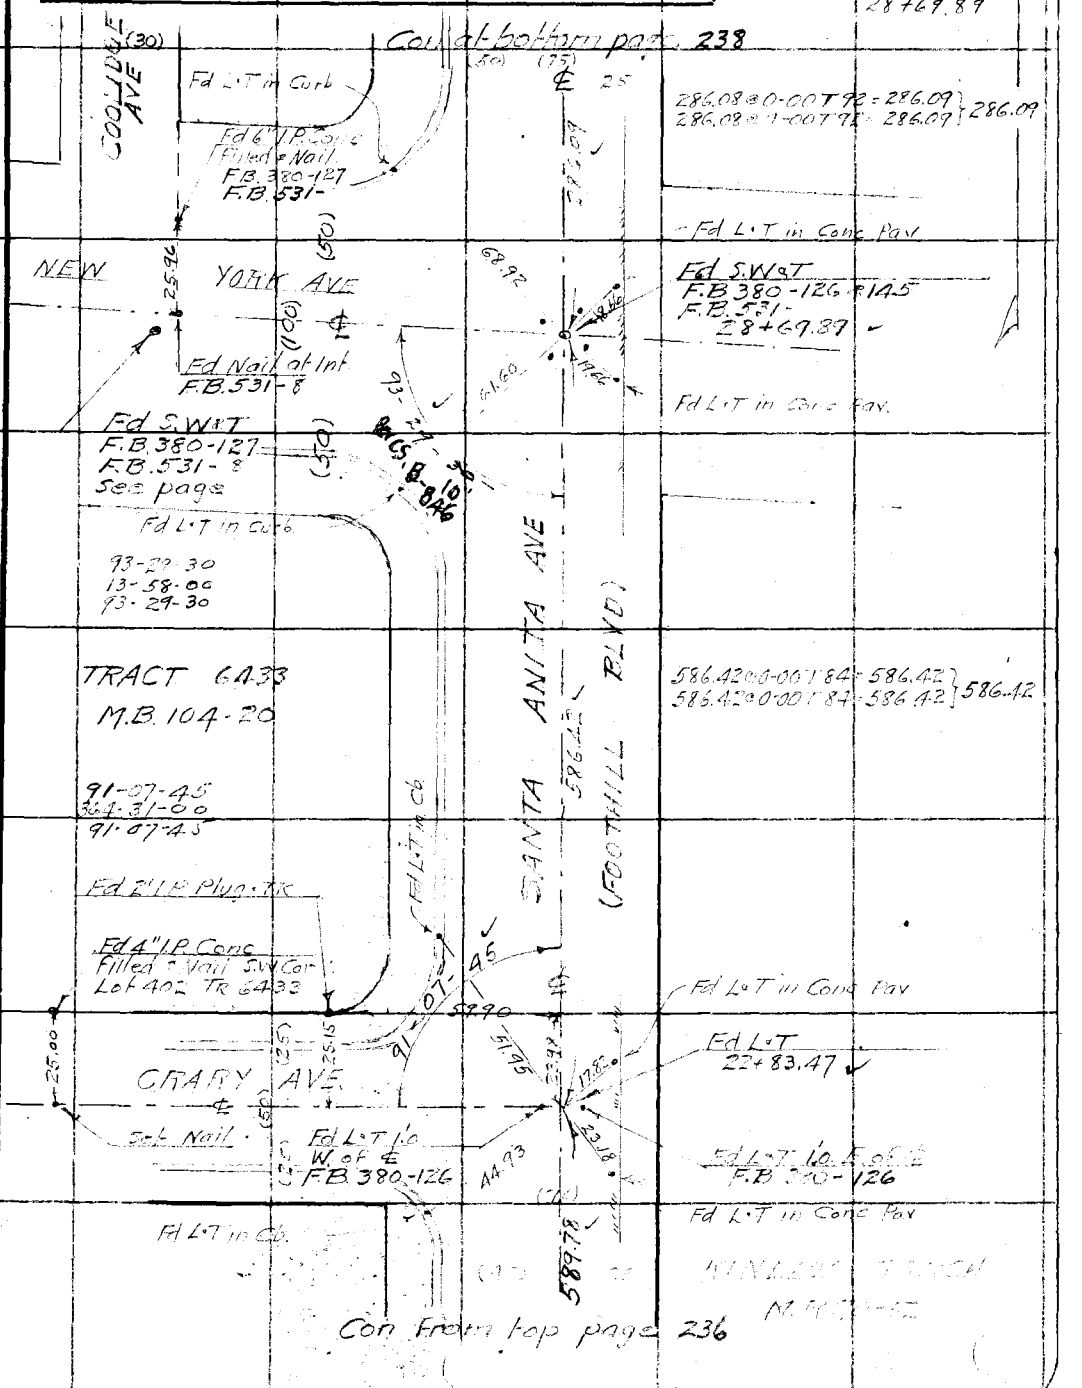

Note: Any Additions or Changes on This Sheet Must be Made or Circled in Red Ink With Date and Name of Person Making Change.

Do not extend notes this side of this line

RETURN TO
LOS ANGELES COUNTY SURVEYOR
700 HALL OF RECORDS

FORM 247 10M 11-35

F.B. 623 Pg. 238

Con at bottom page 239

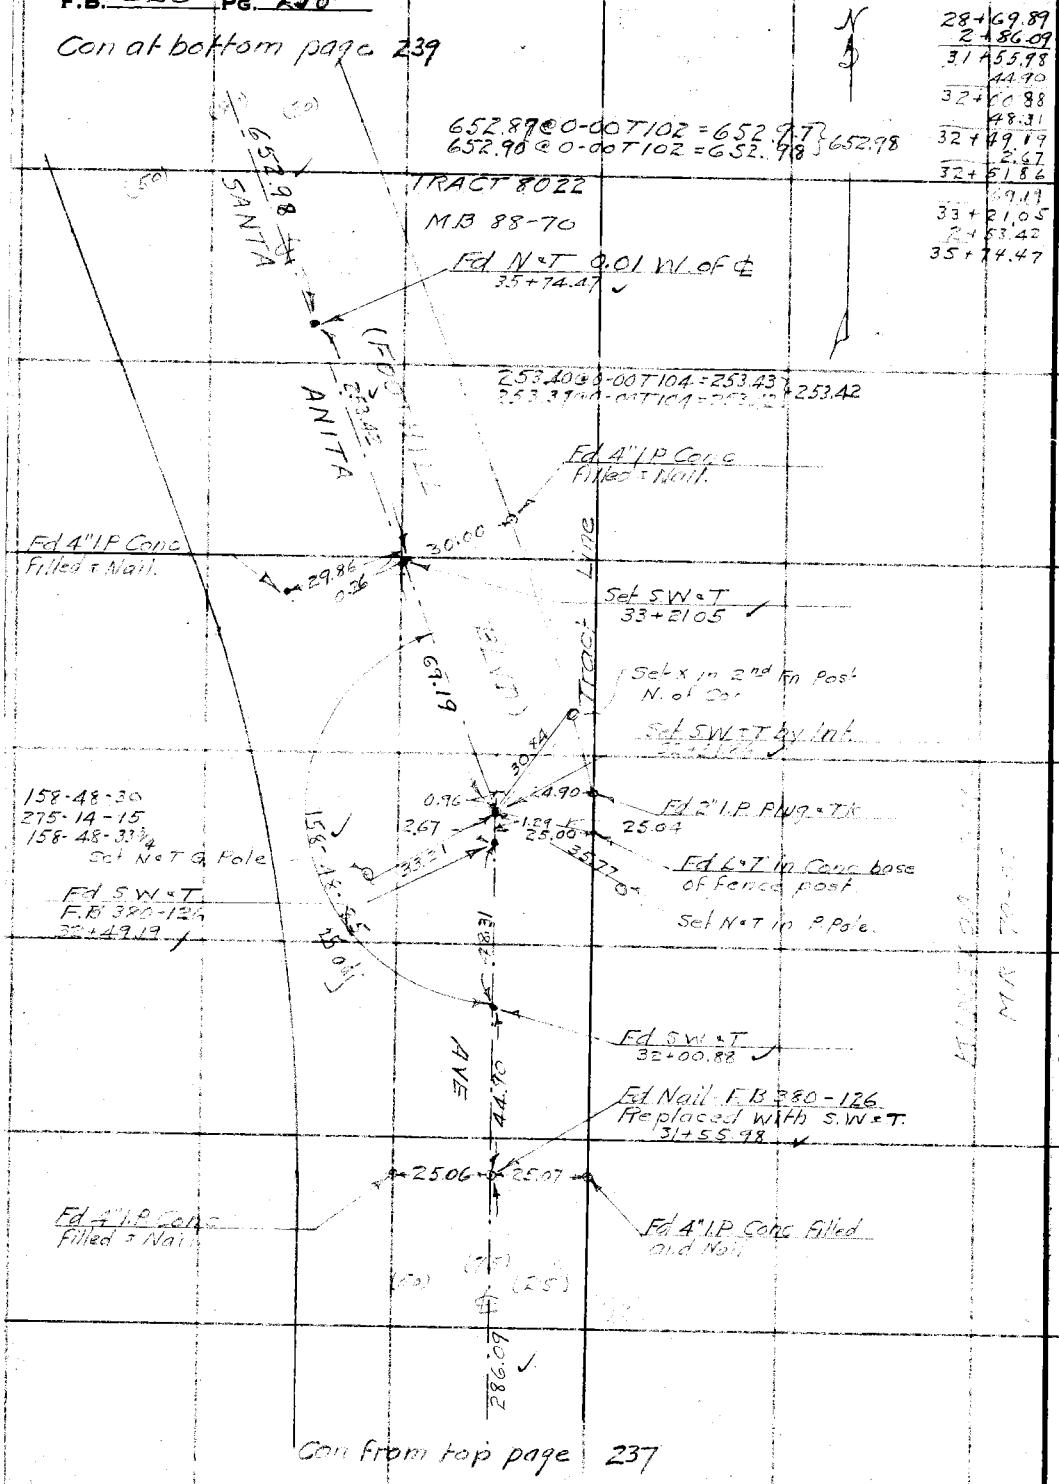

Con from top page 237

RETURN TO
LOS ANGELES COUNTY SURVEYOR
700 HALL OF RECORDS

Do not extend notes this side of this line

Note: Any Additions or Changes on This Sheet Must be Made or Circled in Red Ink With Date and Name of Person Making Change.

Notes Ck'd by Drew	Survey of SANTA ANITA AVE
Map No. B-1357	W. O. 7145 Tape No. 058 St'd 84 °F.
Office Work H. M. Hall	Surveyed by W. A. Miller
Checked Drew	Notes Miller Date July '36
Date June 1938	Indexed A. C. Johnson

F.B. 623 PG. 239

35+74.47
-6+52.96
42+27.45
-1+66.29
43+93.74

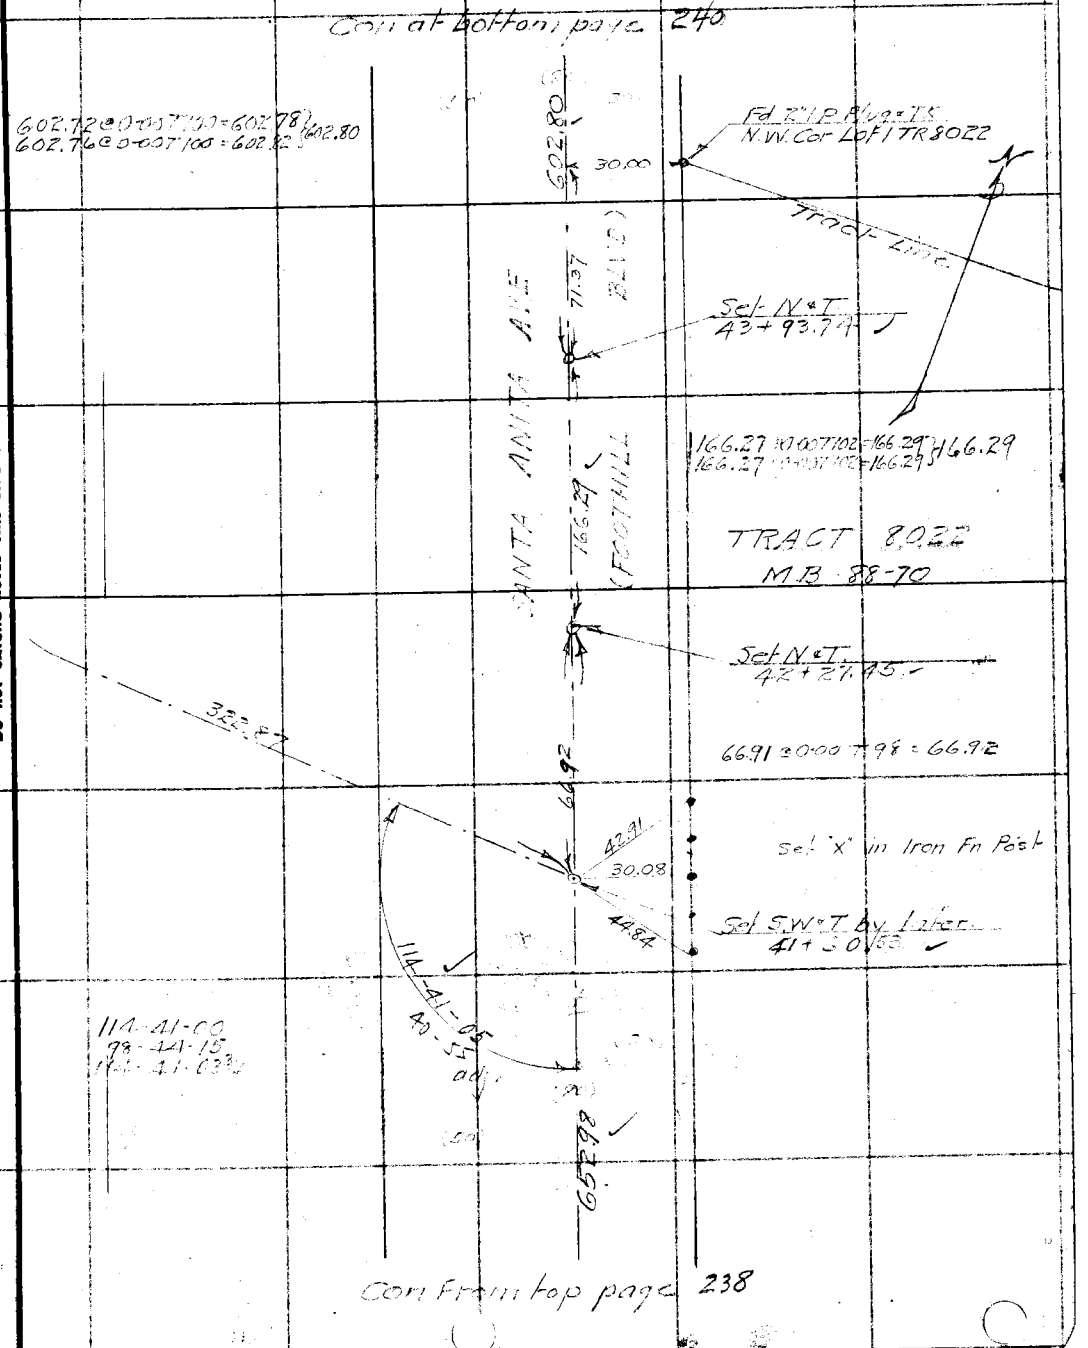

Note: Any Additions or Changes on This Sheet Must be Made or Circled in Red Ink With Date and Name of Person Making Change.

Do not extend notes this side of this line

RETURN TO
LOS ANGELES COUNTY SURVEYOR
700 HALL OF RECORDS

FORM 247 10M 11-35

F.B. 623 PG. 240

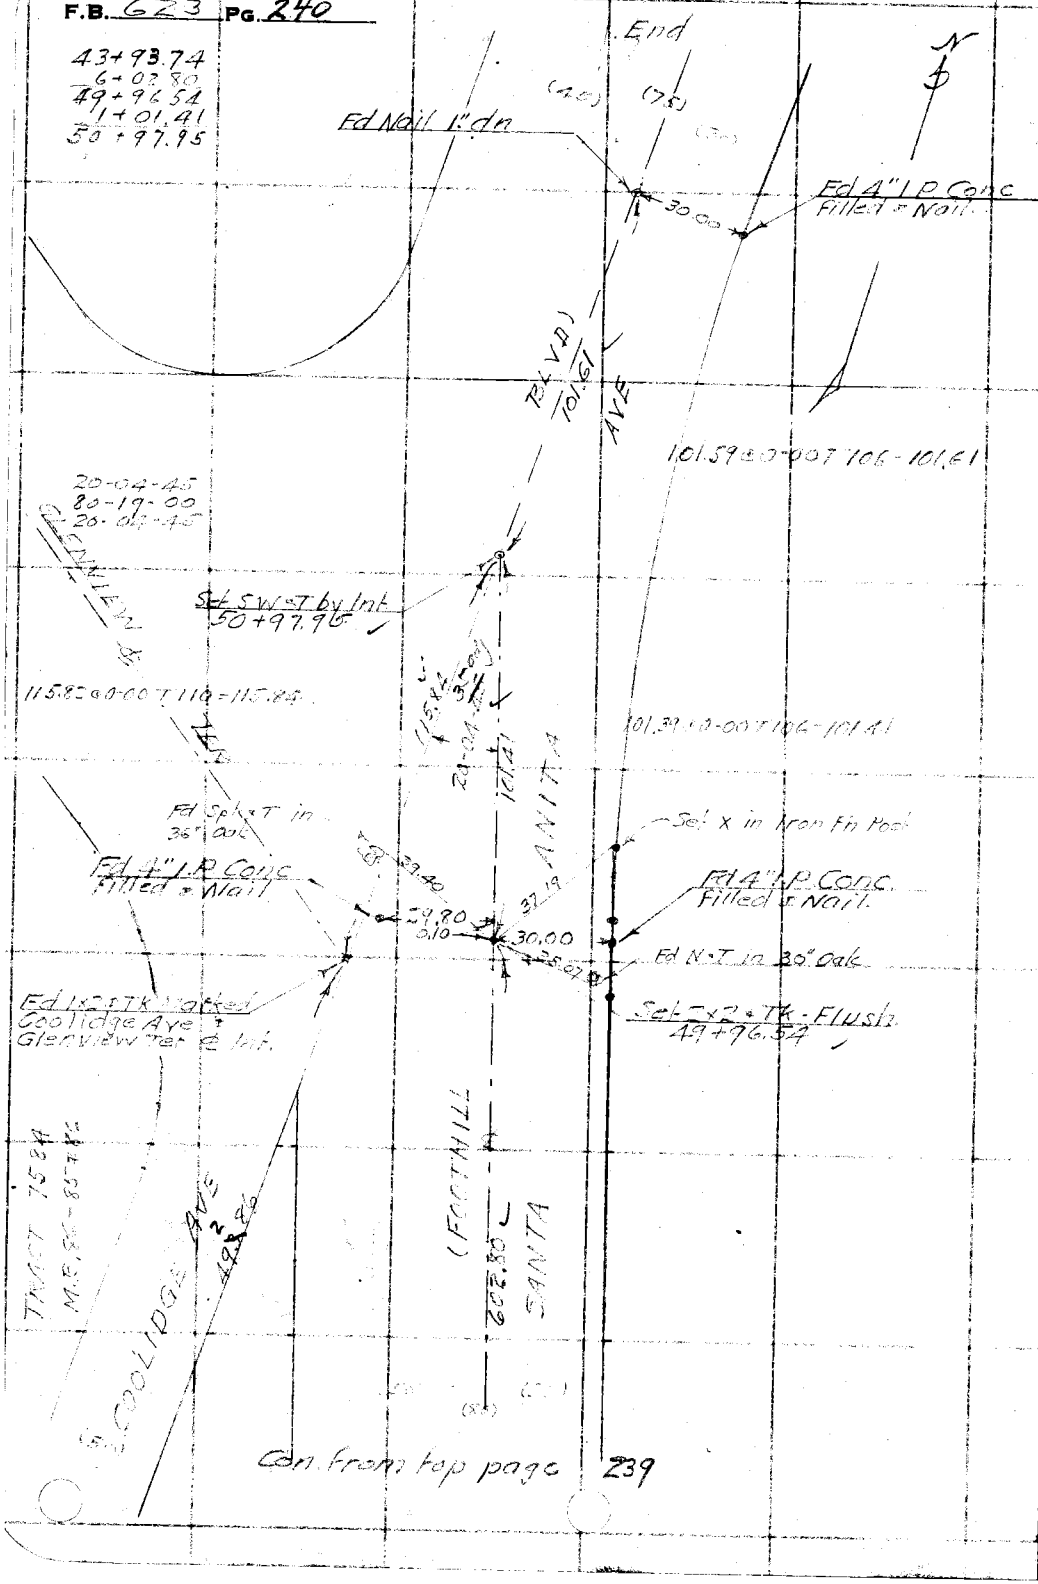

Con. from top page 239

RETURN TO
LOS ANGELES COUNTY SURVEYOR
700 HALL OF RECORDS

Do not extend notes this side of this line

Note: Any Additions or Changes on This Sheet Must be Made or Circled in Red Ink With Date and Name of Person Making Change.

Notes Ck'd by Drew	Survey of SANTA ANITA AVE	F.B. 623 PG. 241
Map No. B-1357	W. O. 7145 Tape No. 058 St'd °F.	
Office Work H. M. Hall	Surveyed by W A Miller	
Checked Drew	Notes Miller Date 7-17-36	
Date June 1938	Indexed A. C. Johnson	

Con at bottom page 242

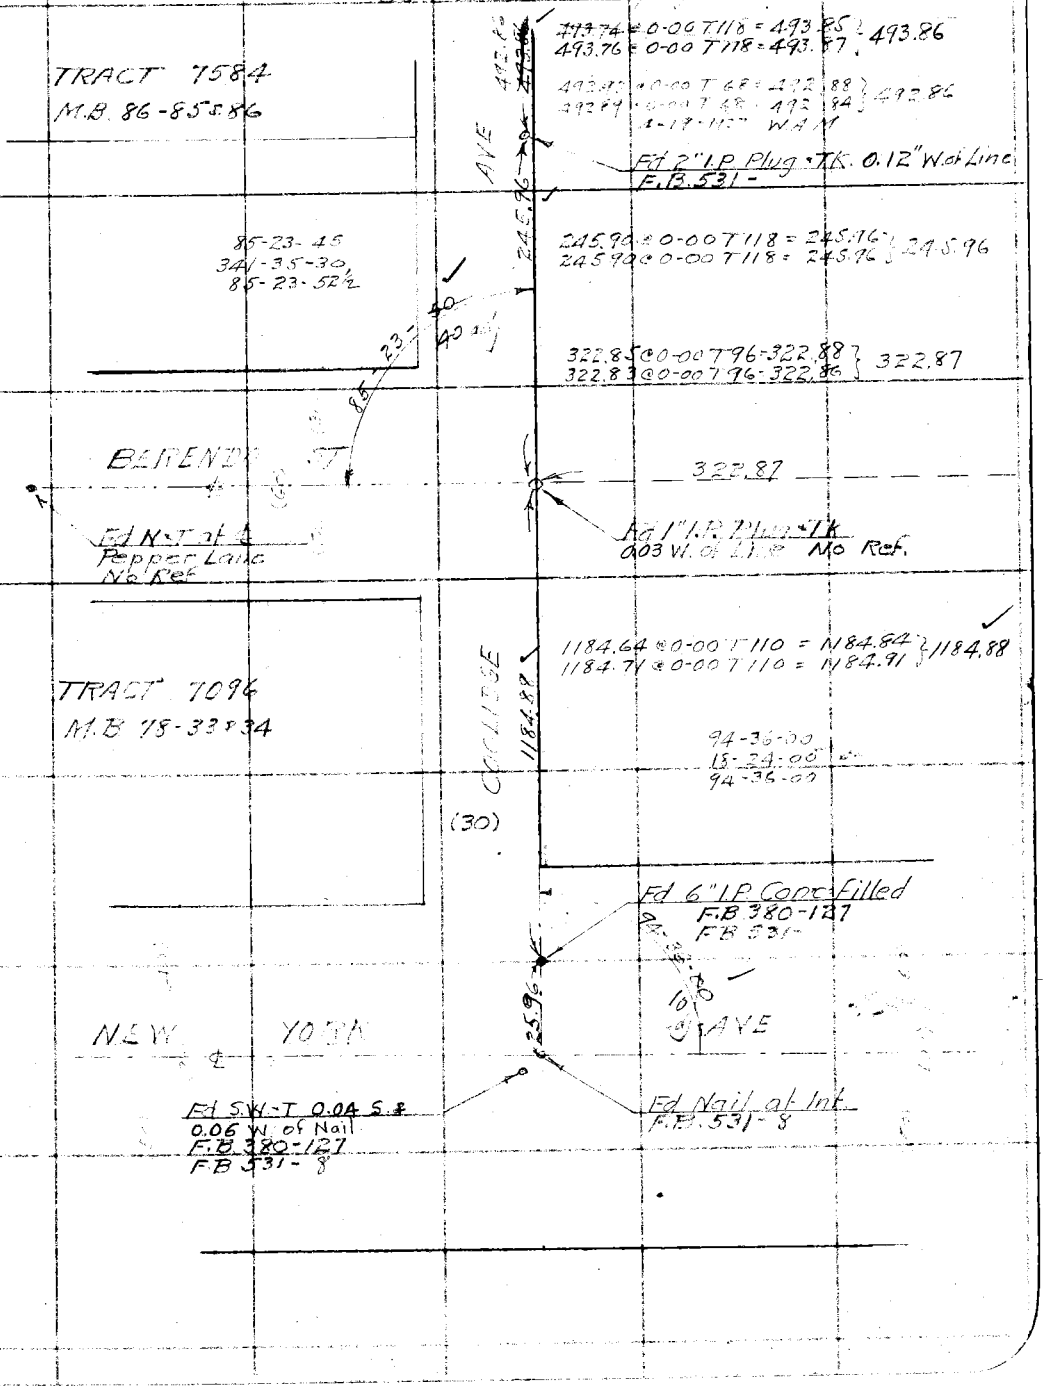

Note: Any Additions or Changes on This Sheet Must be Made or Circled in Red Ink With Date and Name of Person Making Change.

Do not extend notes this side of this line

RETURN TO
LOS ANGELES COUNTY SURVEYOR
700 HALL OF RECORDS

FORM 247 10M 11-38

F.B. 623 PG. 242

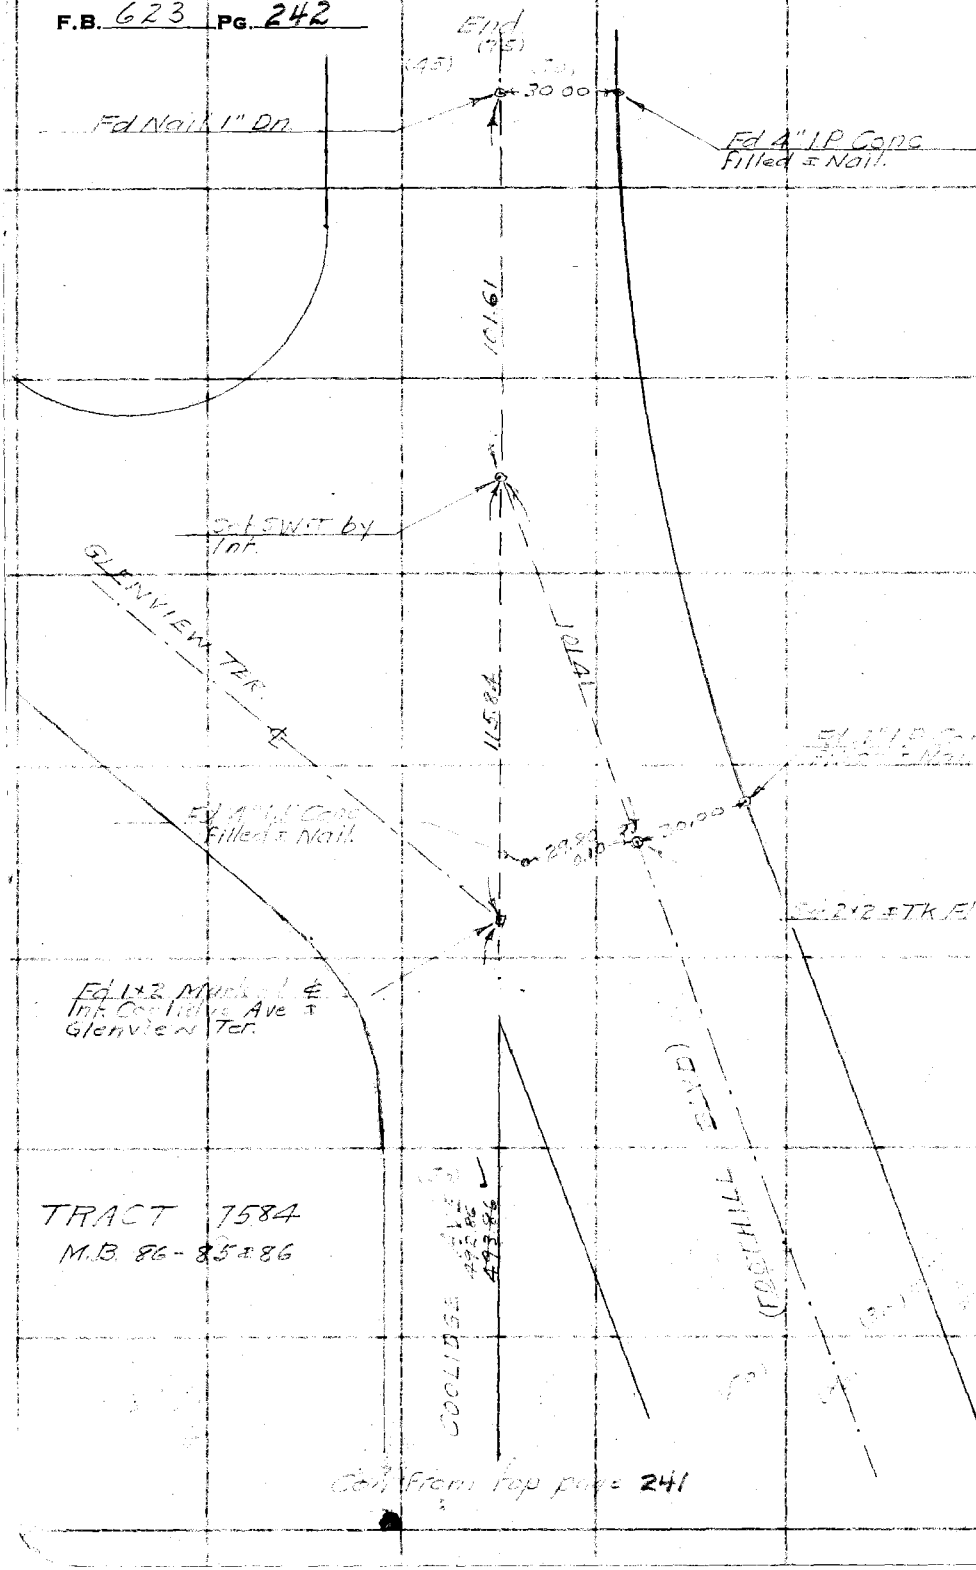

RETURN to
LOS ANGELES COUNTY SURVEYOR
700 HALL OF RECORDS

Do not extend notes this side of this line

Note: Any Additions or Changes on This Sheet Must be Made or Circled in Red Ink With Date and Name of Person Making Change.

Notes Ck'd by Drew	Survey of SANTA ANITA AVE
Map No. B-1357	W. O. 7145 Tape No. St'd °F.
Office Work H. M. Hall	Surveyed by W A Miller
Checked Drew	Notes Miller Date July 1936
Date June 1938	Indexed A. C. Johnson 9-27-36

F.B. 623 PG. 243

TOPOGRAPHY SANTA ANITA AVE
FROM
NORTH AVE TO BERENDO ST.
J.N. 7145

Miller
Willess
Braden
Stewart
Clinton

[illegible] PAGES 233-242

Note: Any Additions or Changes on This Sheet Must be Made or Circled in Red Ink With Date and Name of Person Making Change.

Do not extend notes this side of this line

RETURN TO
LOS ANGELES COUNTY SURVEYOR
700 HALL OF RECORDS

FORM 247 10M 11-38

F.B. 623 PG. 244

Con at bottom page 245

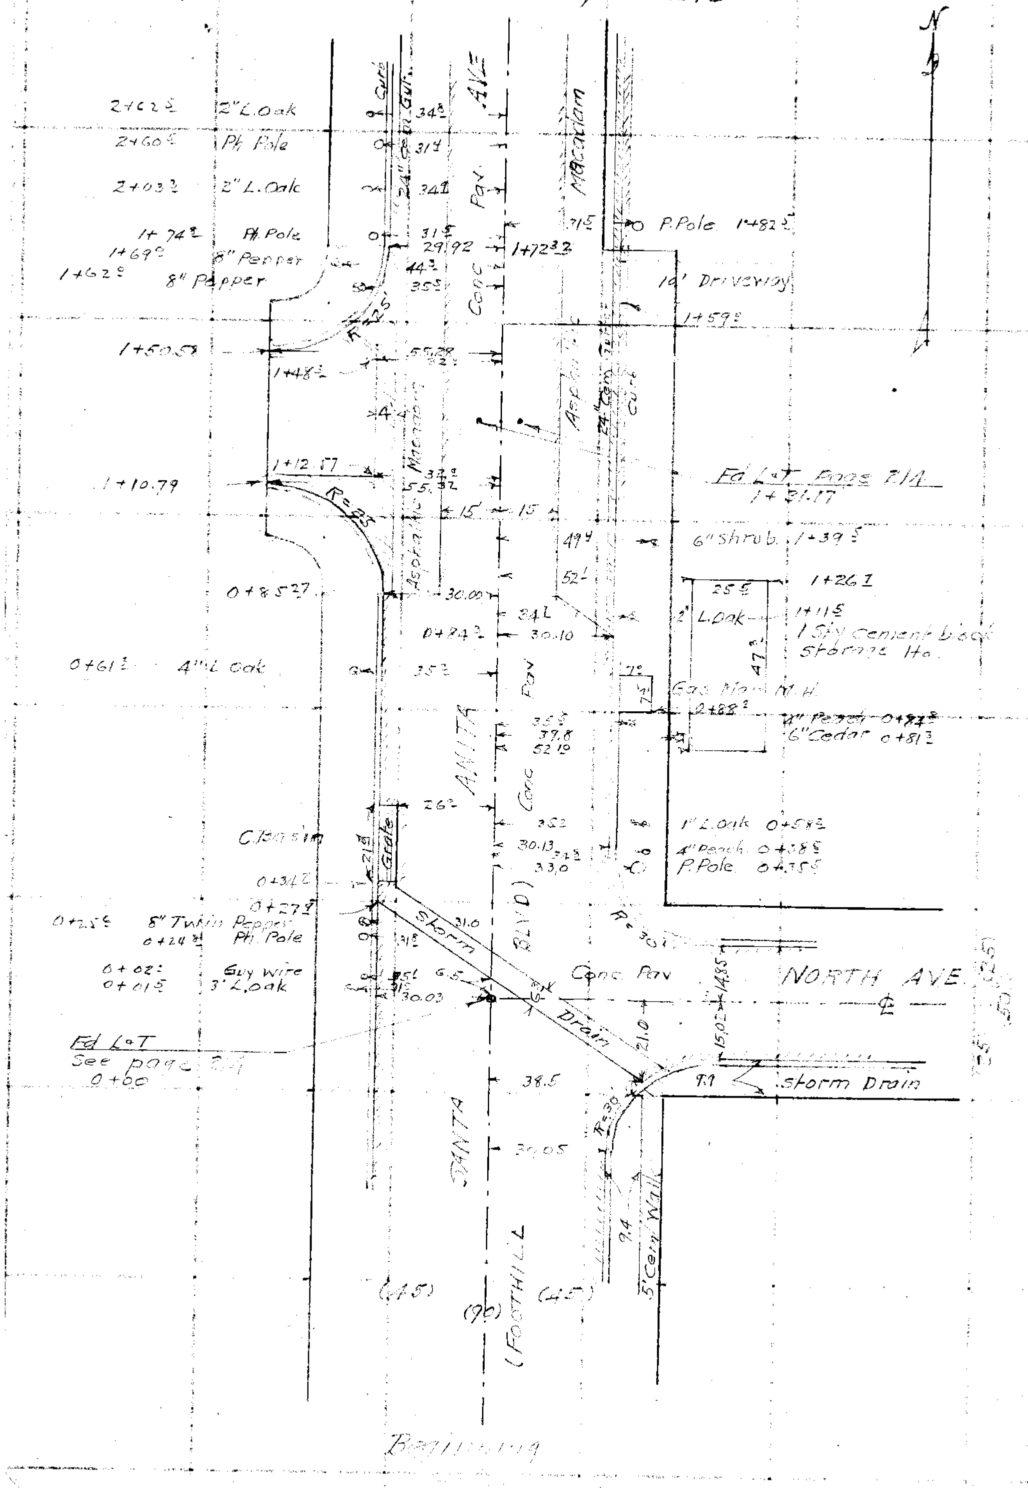

RETURN TO
LOS ANGELES COUNTY SURVEYOR
700 HALL OF RECORDS

Note: Any Additions or Changes on This Sheet Must be Made or Circled in Red Ink With Date and Name of Person Making Change.

Do not extend notes this side of this line

Notes Ck'd by Drew	Survey of SANTA ANITA AVE
Map No. B-1357	W. O. 7145 Tape No. St'd °F.
Office Work H. M. Hall	Surveyed by W A Miller
Checked Drew	Notes Miller Date 7-36
Date 1938	Indexed A. C. Johnson

F.B. 623 PG 245

Continued from page 244

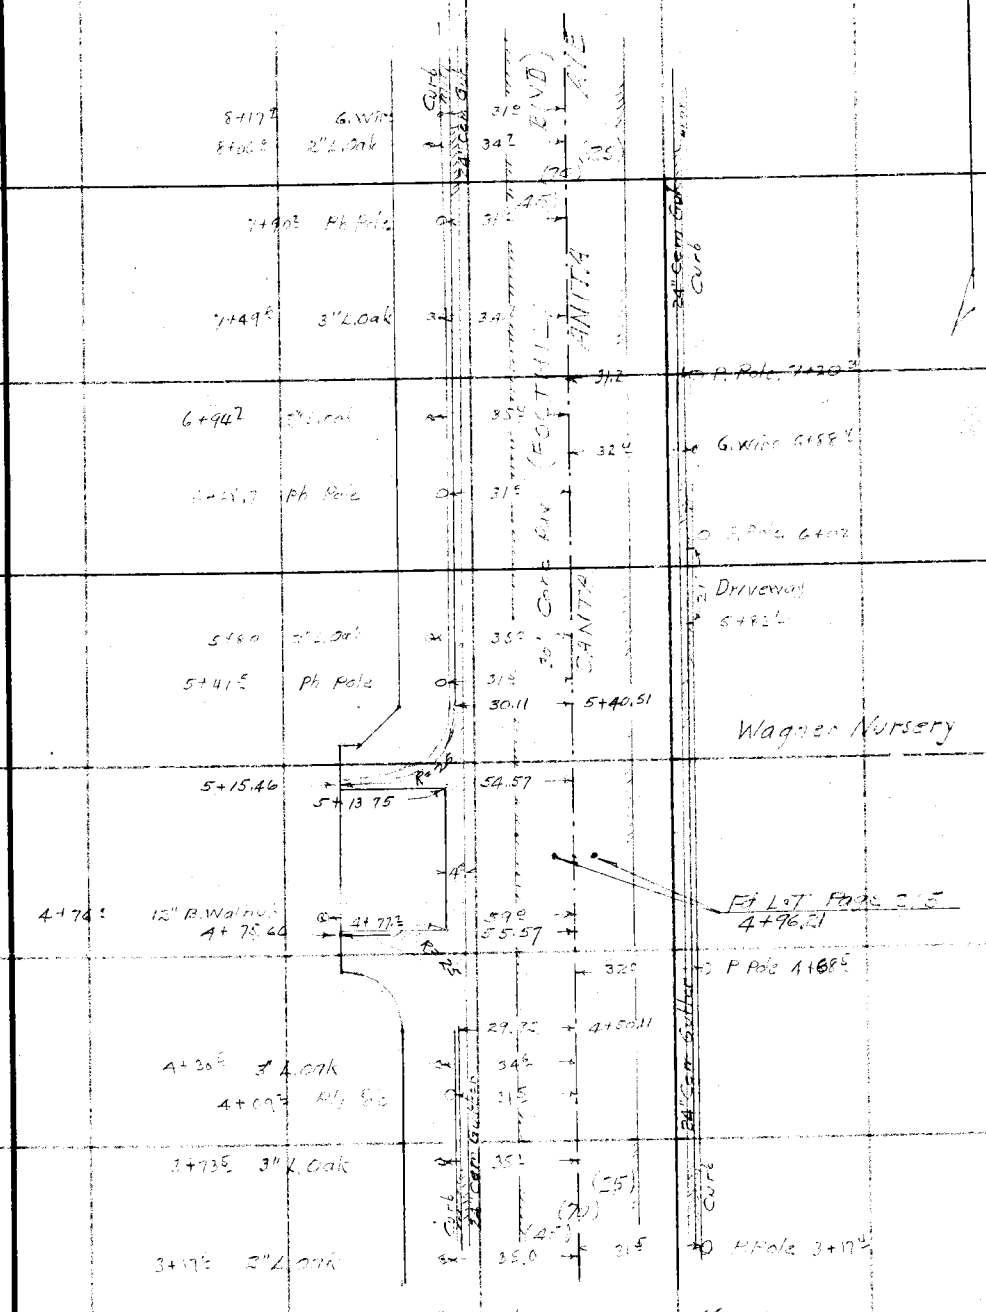

Continued top page 246

Note: Any Additions or Changes on This Sheet Must be Made or Circled in Red Ink With Date and Name of Person Making Change.

Do not extend notes this side of this line

RETURN TO
LOS ANGELES COUNTY SURVEYOR
700 HALL OF RECORDS

FORM 247 10M 11-35

F.B. 623 PG. 246

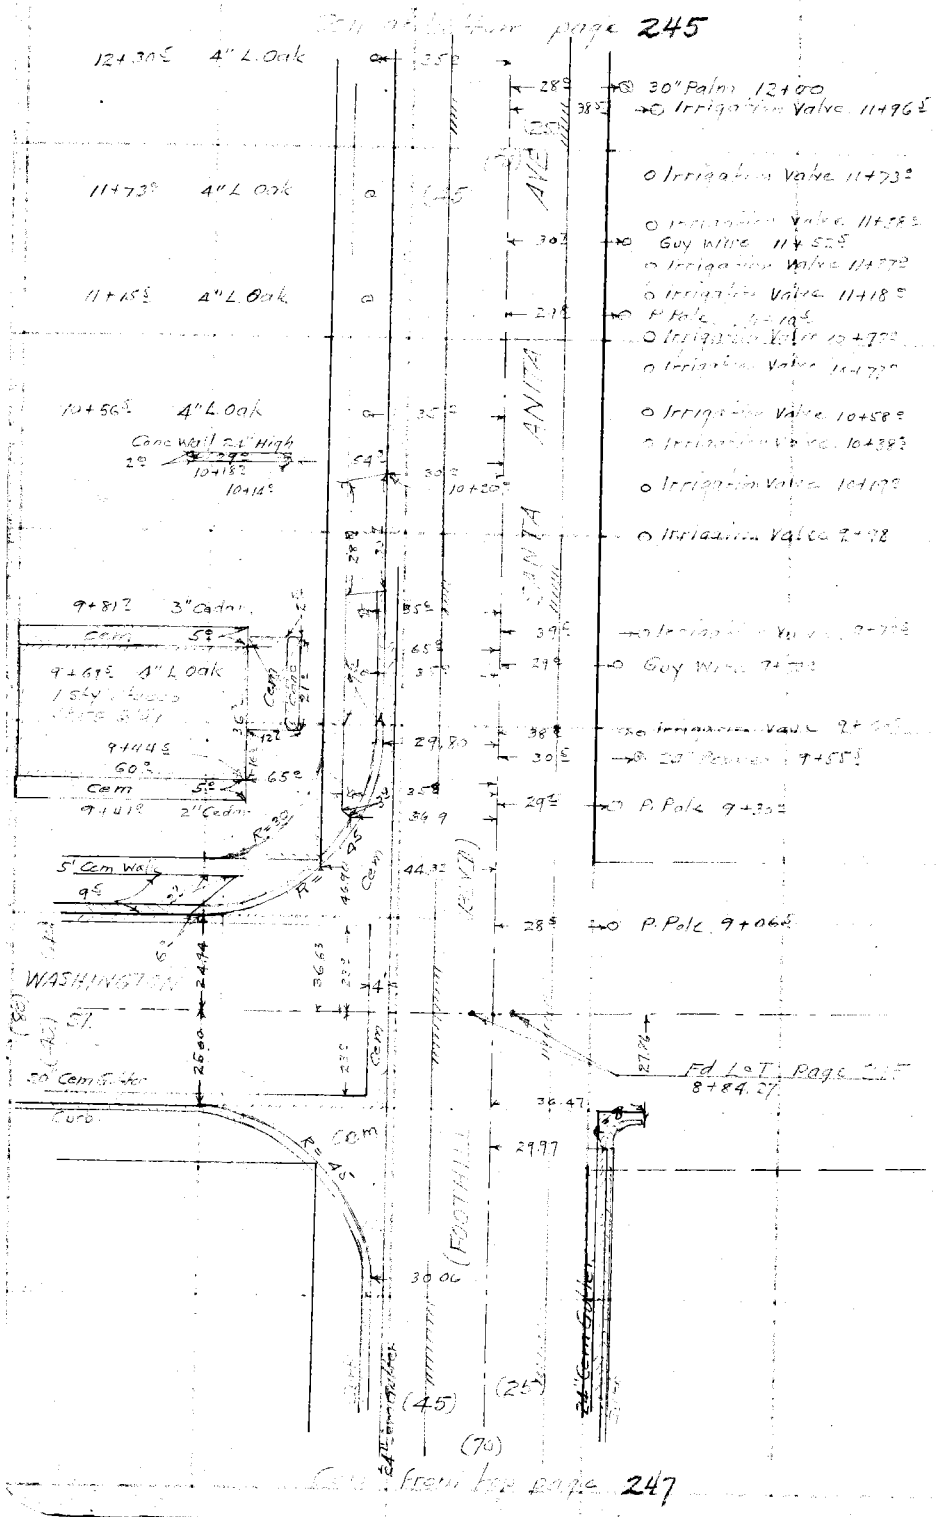

RETURN TO
LOS ANGELES COUNTY SURVEYOR
700 HALL OF RECORDS

Do not extend notes this side of this line

Note: Any Additions or Changes on This Sheet Must be Made or Circled in Red Ink With Date and Name of Person Making Change.

Notes Ck'd by Drew	Survey of SANTA ANITA AVE	F.B.	Pg. 247
Map No. B-1357	W. O. 7145 Tape No. St'd °F.		
Office Work H. M. Hall	Surveyed by W. A. Miller		
Checked Drew	Notes Miller Date 7-27-36		
Date June 1938	Indexed A. C. Johnson		

Con at bottom Page 248

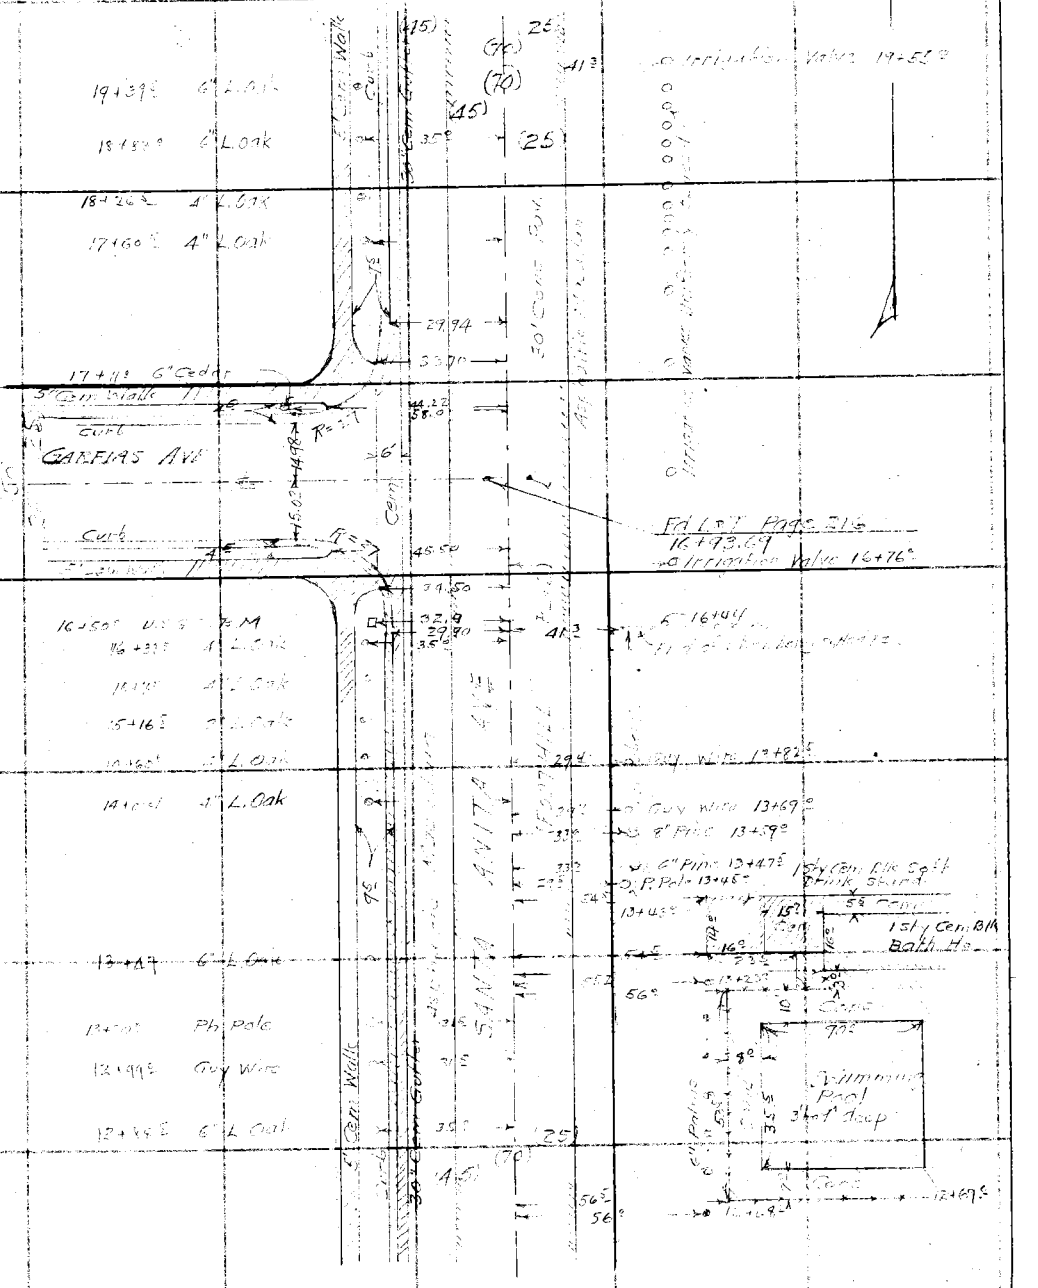

Con From top page 248

Note: Any Additions or Changes on This Sheet Must be Made or Circled in Red Ink With Date and Name of Person Making Change.

Do not extend notes this side of this line

RETURN TO
LOS ANGELES COUNTY SURVEYOR
700 HALL OF RECORDS

FORM 247 10M 11-35

F.B. 623 PG. 248

247

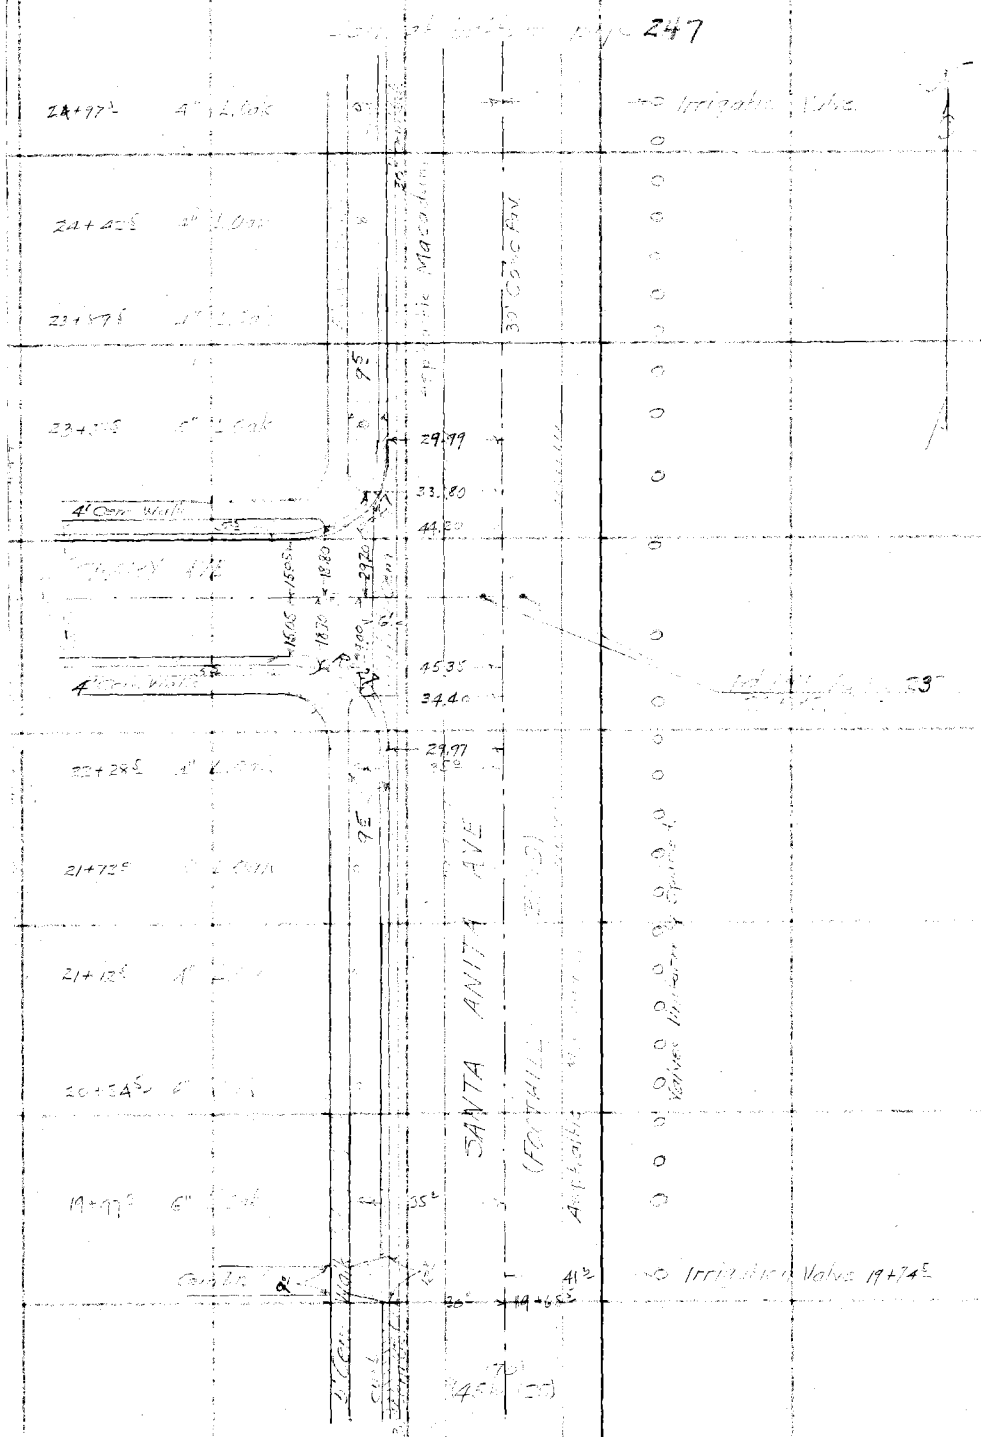

Con from the page 249

RETURN TO
LOS ANGELES COUNTY SURVEYOR
700 HALL OF RECORDS

Note: Any Additions or Changes on This Sheet Must be Made or Circled in Red Ink With Date and Name of Person Making Change.

Do not extend notes this side of this line

Notes Ck'd by Drew	Survey of SANTA ANITA AVE
Map No. B-1357	W. O. 7145 Tape No. St'd °F.
Office Work H. M. Hall	Surveyed by W. A. [illegible]
Checked Drew	Notes [illegible] Date [illegible]
Date June 38	Indexed A. C. Johnson

F.B. 623 PG. 249

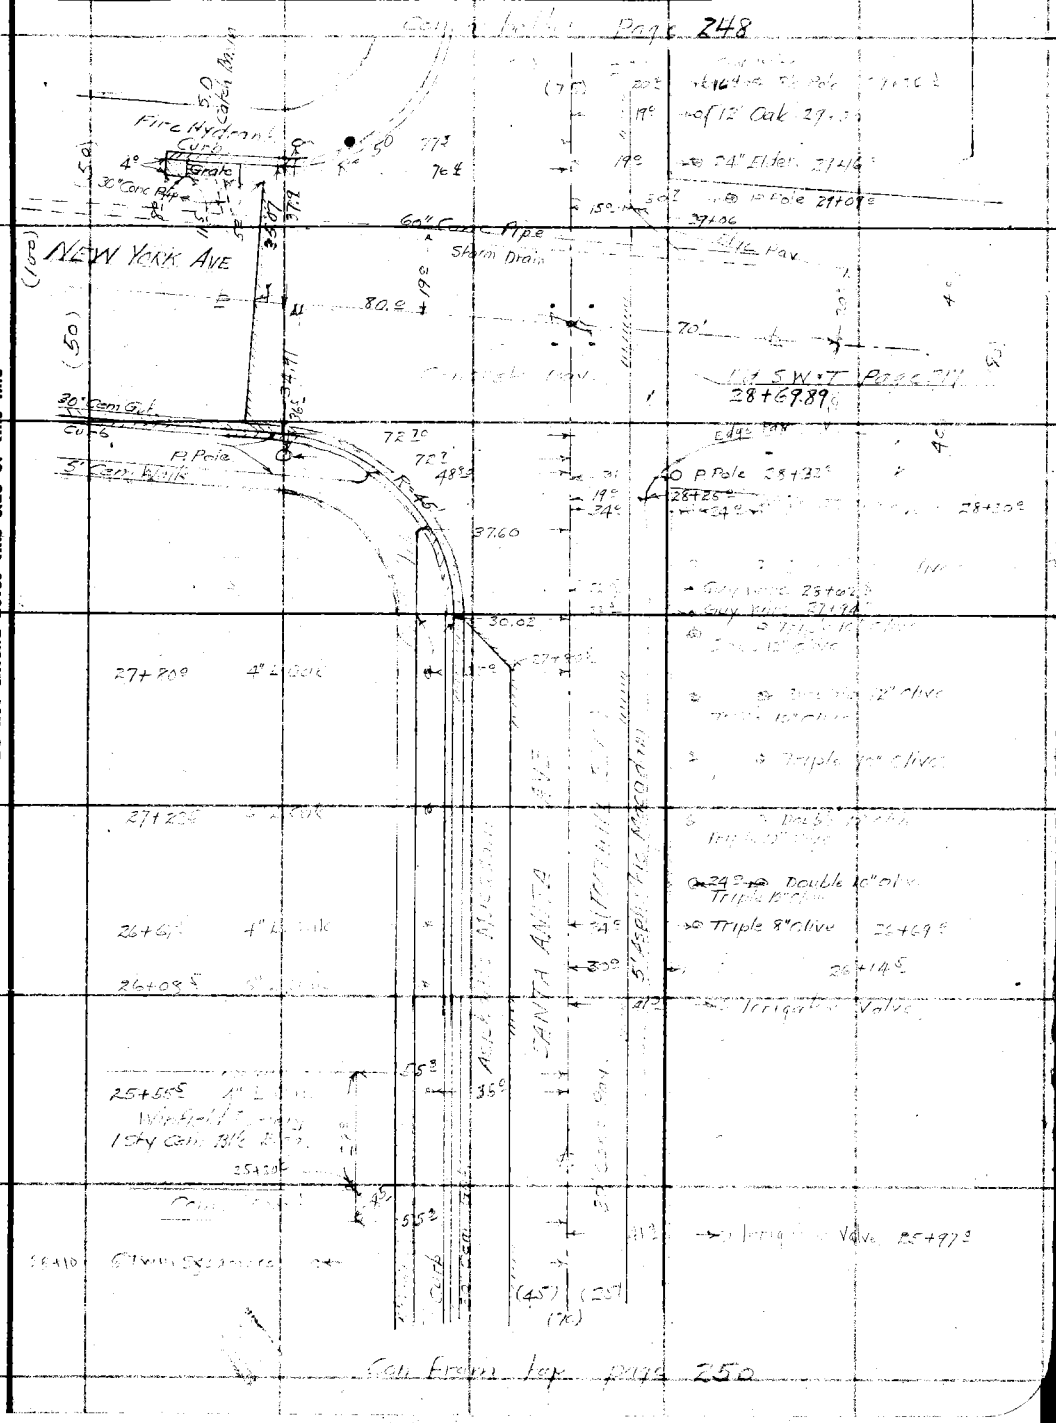

Note: Any Additions or Changes on This Sheet Must be Made or Circled in Red Ink With Date and Name of Person Making Change.

Do not extend notes this side of this line

RETURN TO
LOS ANGELES COUNTY SURVEYOR
700 HALL OF RECORDS

FORM 247 10M 11-38

F.B. 623 PG. 250

Con at bottom page 251

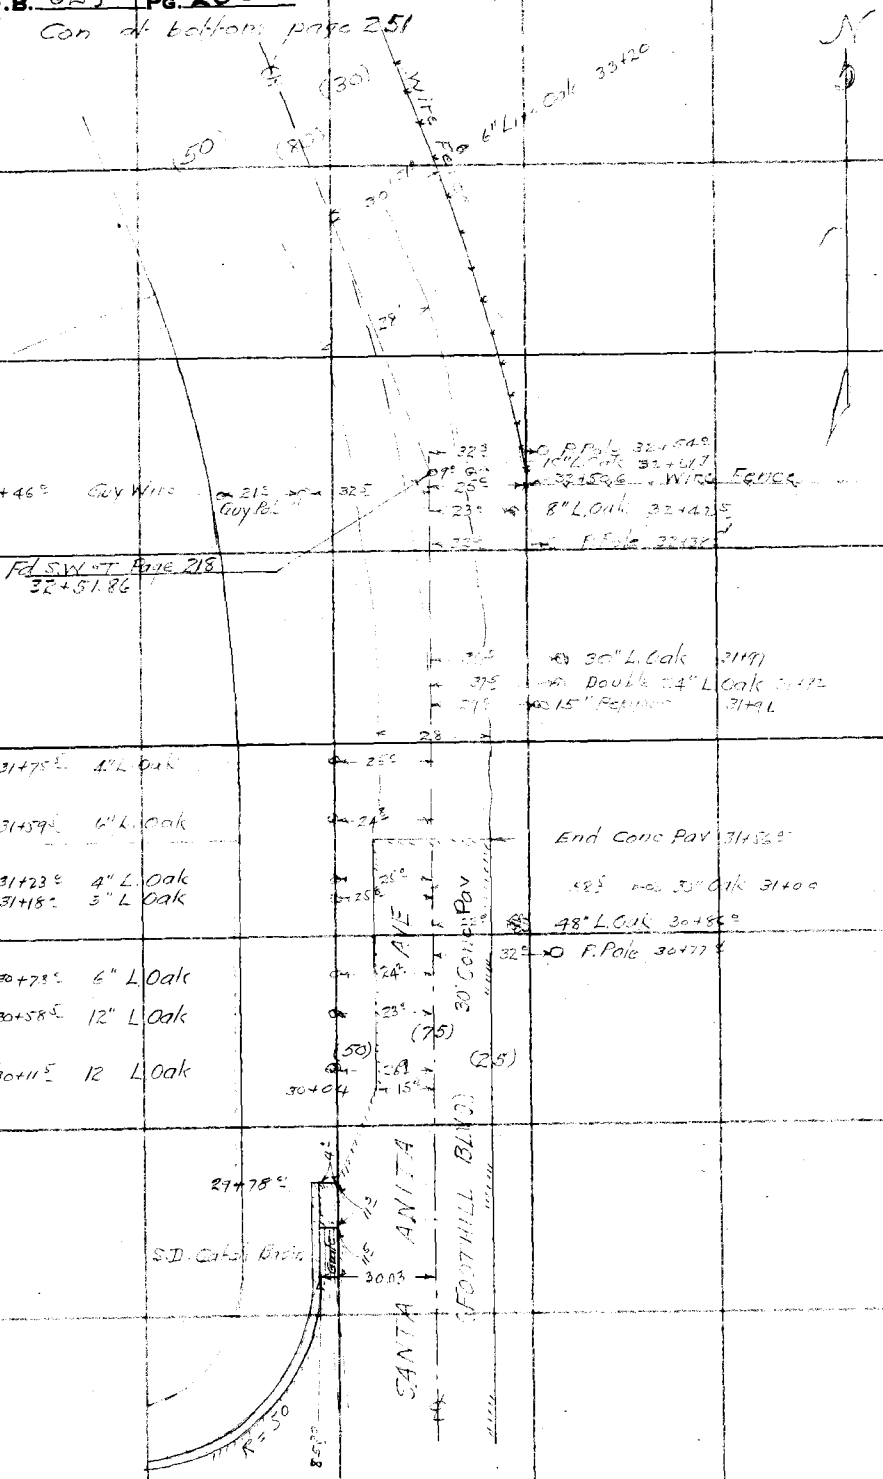

Con From top page 249

RETURN TO
LOS ANGELES COUNTY SURVEYOR
700 HALL OF RECORDS

Note: Any Additions or Changes on This Sheet Must be Made or Circled in Red Ink With Date and Name of Person Making Change.

Do not extend notes this side of this line

Notes Ck'd by Drew	Survey of SANTA ANITA AVE	F.B. 623 Pg. 251
Map No. 13-1357	W. O. 7145 Tape No. St'd °F.	
Office Work H. M. Hall	Surveyed by W.A. Miller	
Checked Drew	Notes Miller Date 7-28-36	
Date June - 38	Indexed A. C. Johnson	

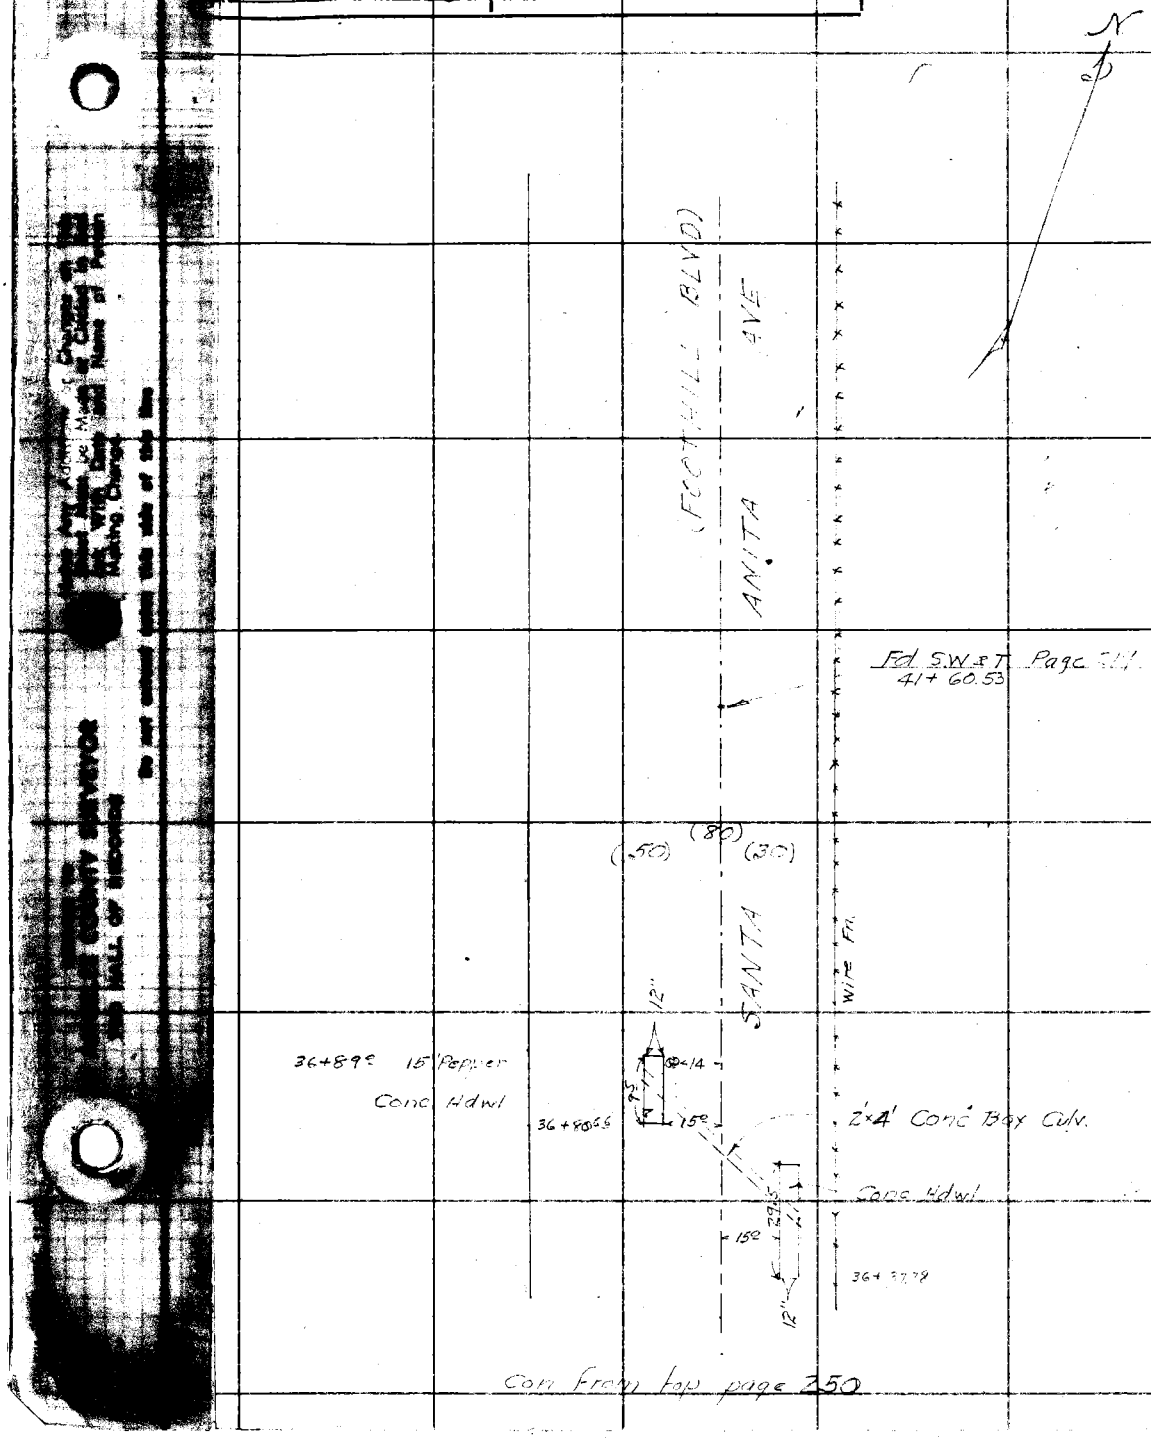

Con from top page 250

F.B. 623 PG. 252

623