Survey of
W. O. Tape No. St'd °F.
Surveyed by
Notes Date
Indexed

F.B. 645 Pg. 1

F.B. 645

INDEX Pg. 2 to 96

645

LOS ANGELES
700

F.B. 645 PG. 2

SURVEY OF GAGE AVE. FROM ALAMEDA ST. TO CENTRAL AVE.

Sept. - Oct. 1936

100' Band Tape #972
100.000 @ 84°

Hugh F. Evans - Dep.
Henry L. Martin - R
D.S. Sedig - H.C.
N.R. Smith - R.C.
A B. Landtiser - Flag.

(See pgs. 35-94 for location imp'v't's.)

C.S.B-1245

Bearings based on C.S.B-479.

RETURN TO
LOS ANGELES COUNTY SURVEYOR
700 HALL OF RECORDS

Do not extend notes this side of this line

Note: Any Additions or Changes on This Sheet Must be Made or Circled in Red Ink With Date and Name of Person Making Change.

INDEX SKETCH

Notes Ck'd by	Survey of GAGE AVE
Map No. B-1245	W. O. 8157 Tape No. 072 St'd 84°F.
Office Work Cox	Surveyed by Evans
Checked Aaen	Notes HE Date 9/21/36
Date Mar-39	Indexed C. Johnson 10-31-36

F.B. 645 Pg. 3

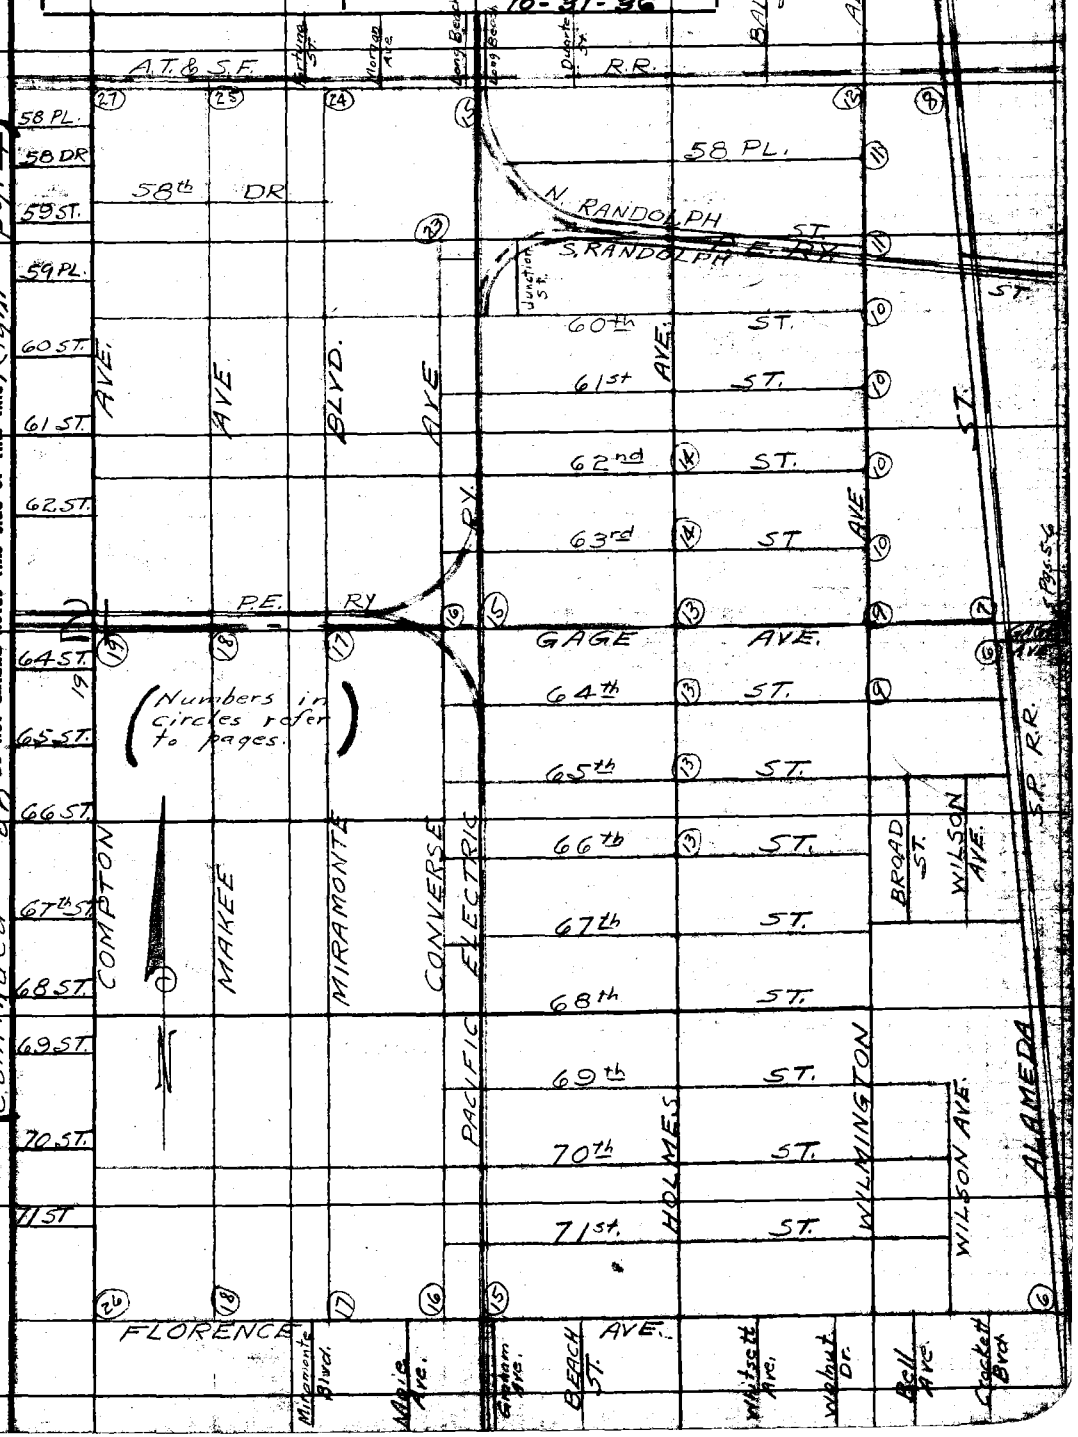

Note: Any Additions or Changes on This Sheet Must be Made or Circled in Red Ink With Date and Name of Person Making Change.

Do not extend notes this side of this line

(Continued on Right pg. 4)

RETURN TO
LOS ANGELES COUNTY SURVEYOR
700 HALL OF RECORDS

FORM 247 10M 11-35

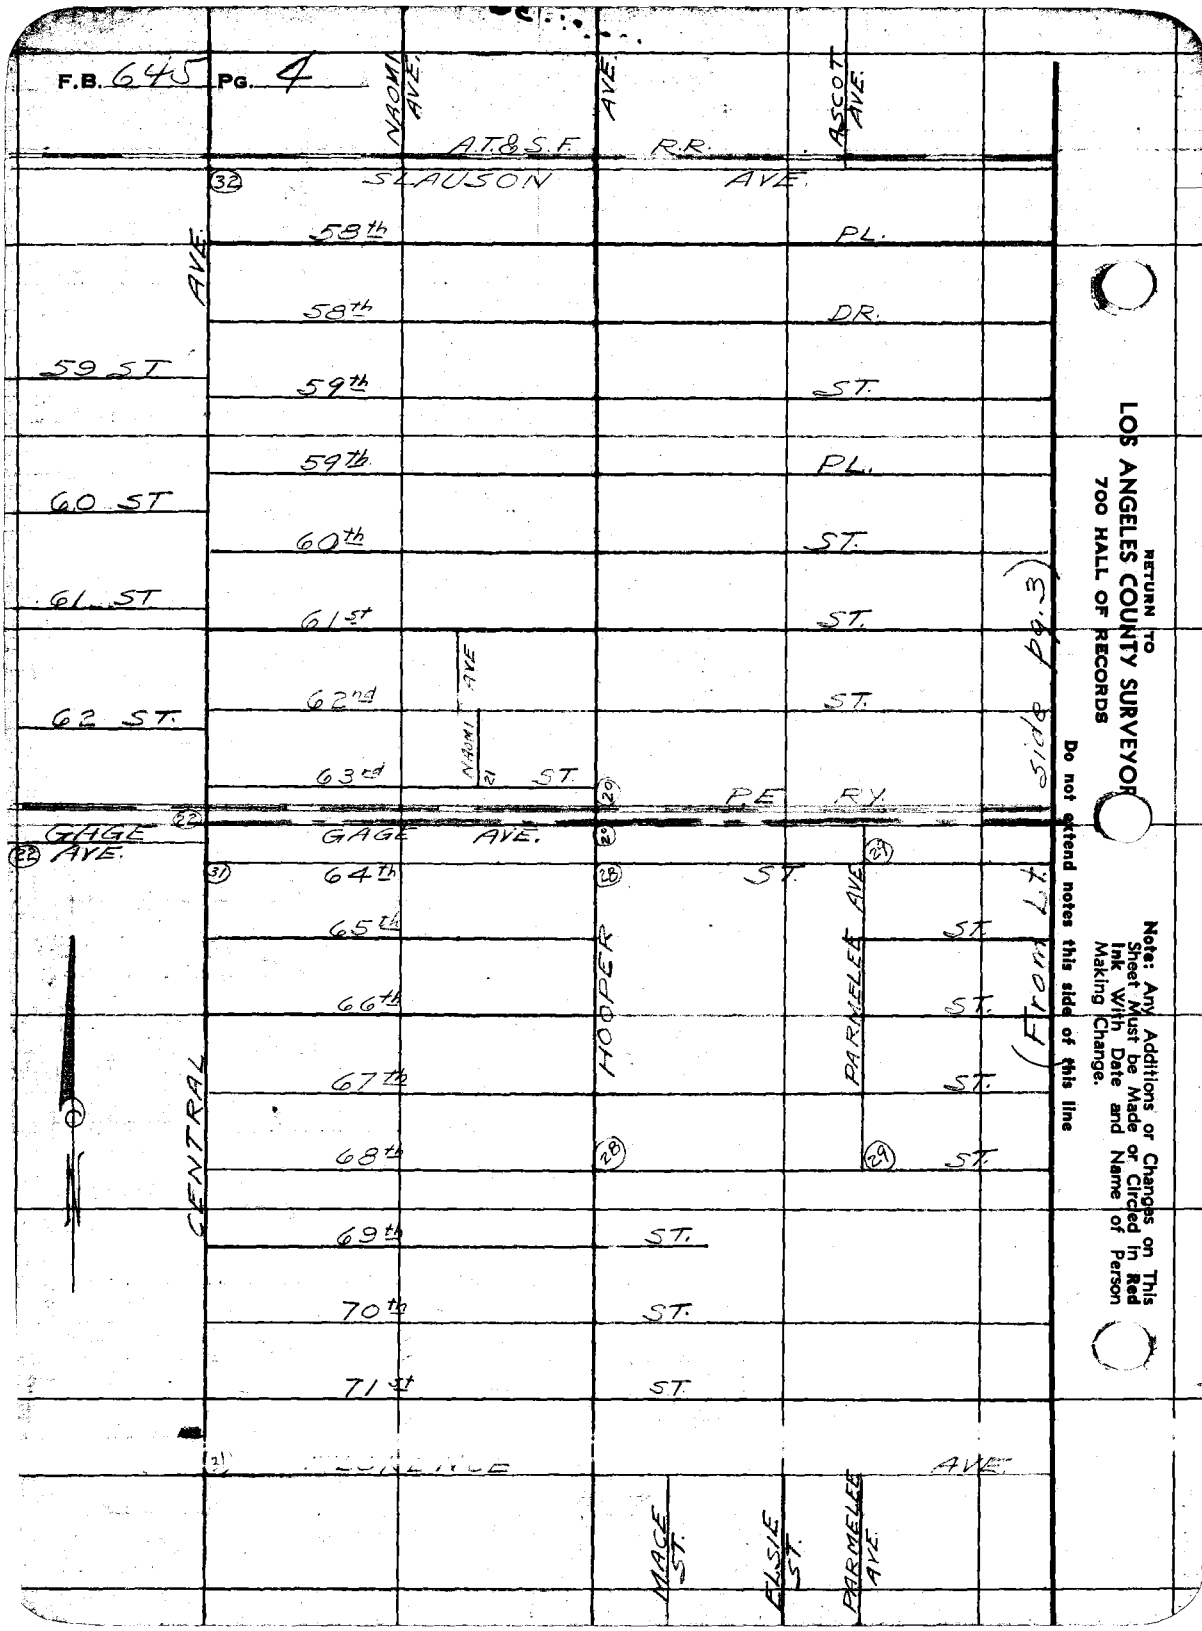
F.B. 645 PG. 4
NAOMI AVE.
AVE.
ASCOT AVE.
A.T.&S.F. R.R.
SLAUSON AVE.
58th PL.
58th DR.
59 ST
59th ST.
59th PL.
60 ST
60th ST.
61 ST
61st ST.
62 ST.
62nd ST.
NAOMI AVE
63rd ST.
P.E. RY.
GAGE AVE.
GAGE AVE.
64th ST.
65th ST.
66th ST.
67th ST.
68th ST.
69th ST.
70th ST.
71st ST.
CENTRAL AVE.
HOOPER
PARMELEE AVE
MACE ST.
ELSIE ST.
PARMELEE AVE.
(From Lt. side pg. 3)
RETURN TO
LOS ANGELES COUNTY SURVEYOR
700 HALL OF RECORDS
Do not extend notes this side of this line
Note: Any Additions or Changes on This Sheet Must be Made or Circled in Red Ink With Date and Name of Person Making Change.

Notes Ck'd by A. A. R.	Survey of Gage Ave
Map No. B-1245	W. 0815 Tape No. 072 St'd 84° F.
Office Work COX	Surveyed by Evans
Checked AAR	Notes 14 Date 9/1/36
Date Mar. 37	Indexed A. C. Johnson 10-31-36

F.B. 645 Pg. 5

To Bot. pg. 6

W.S. 7 C-4

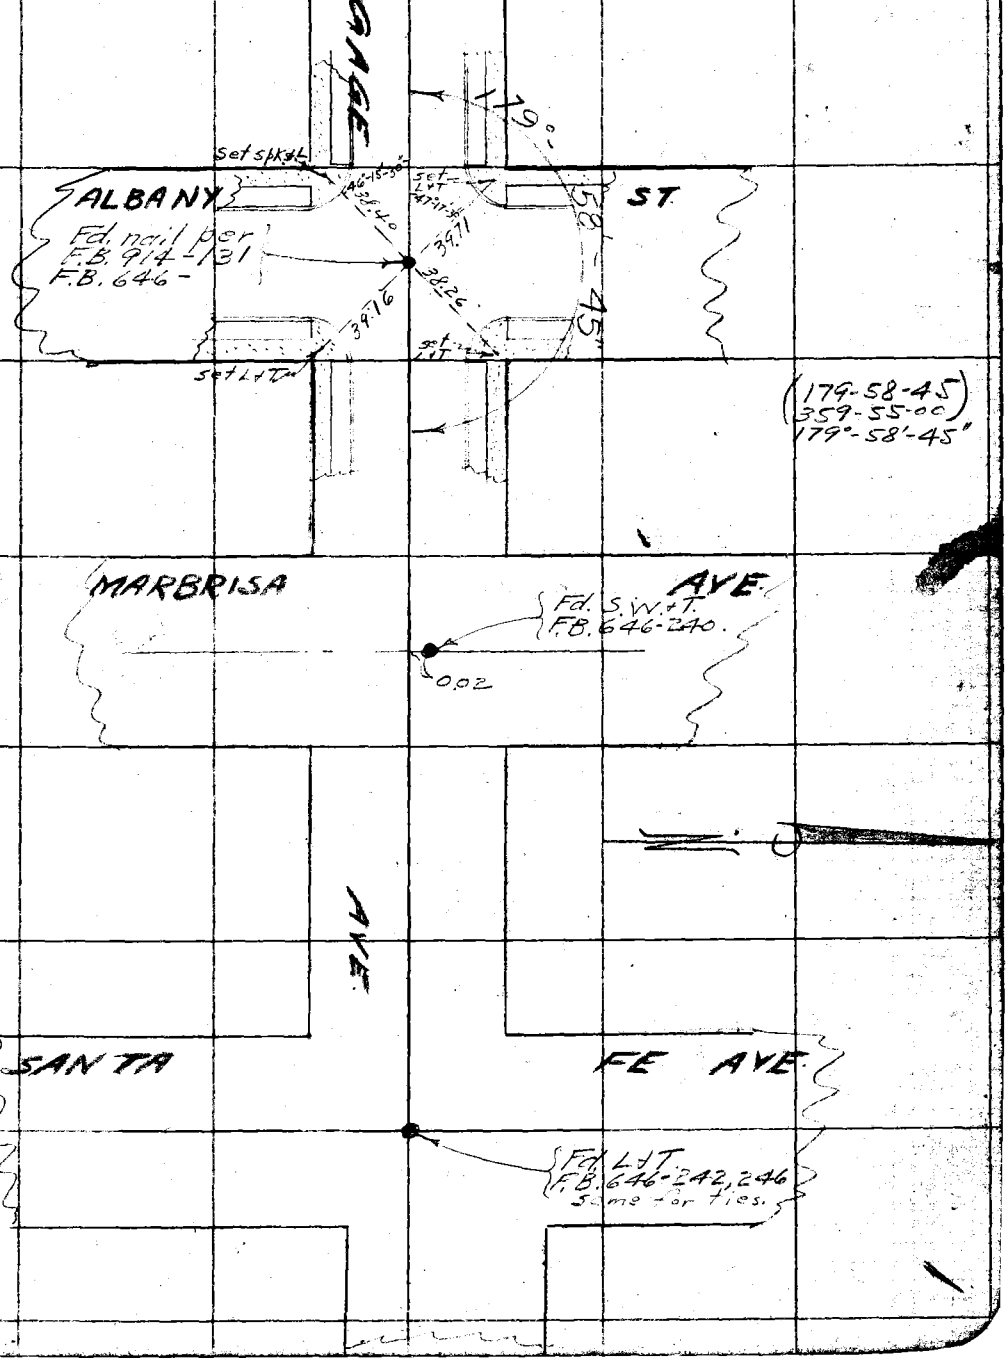

Note: Any Additions or Changes on This Sheet Must be Made or Circled in Red Ink With Date and Name of Person Making Change.

Do not extend notes this side of this line

RETURN TO
LOS ANGELES COUNTY SURVEYOR
700 HALL OF RECORDS

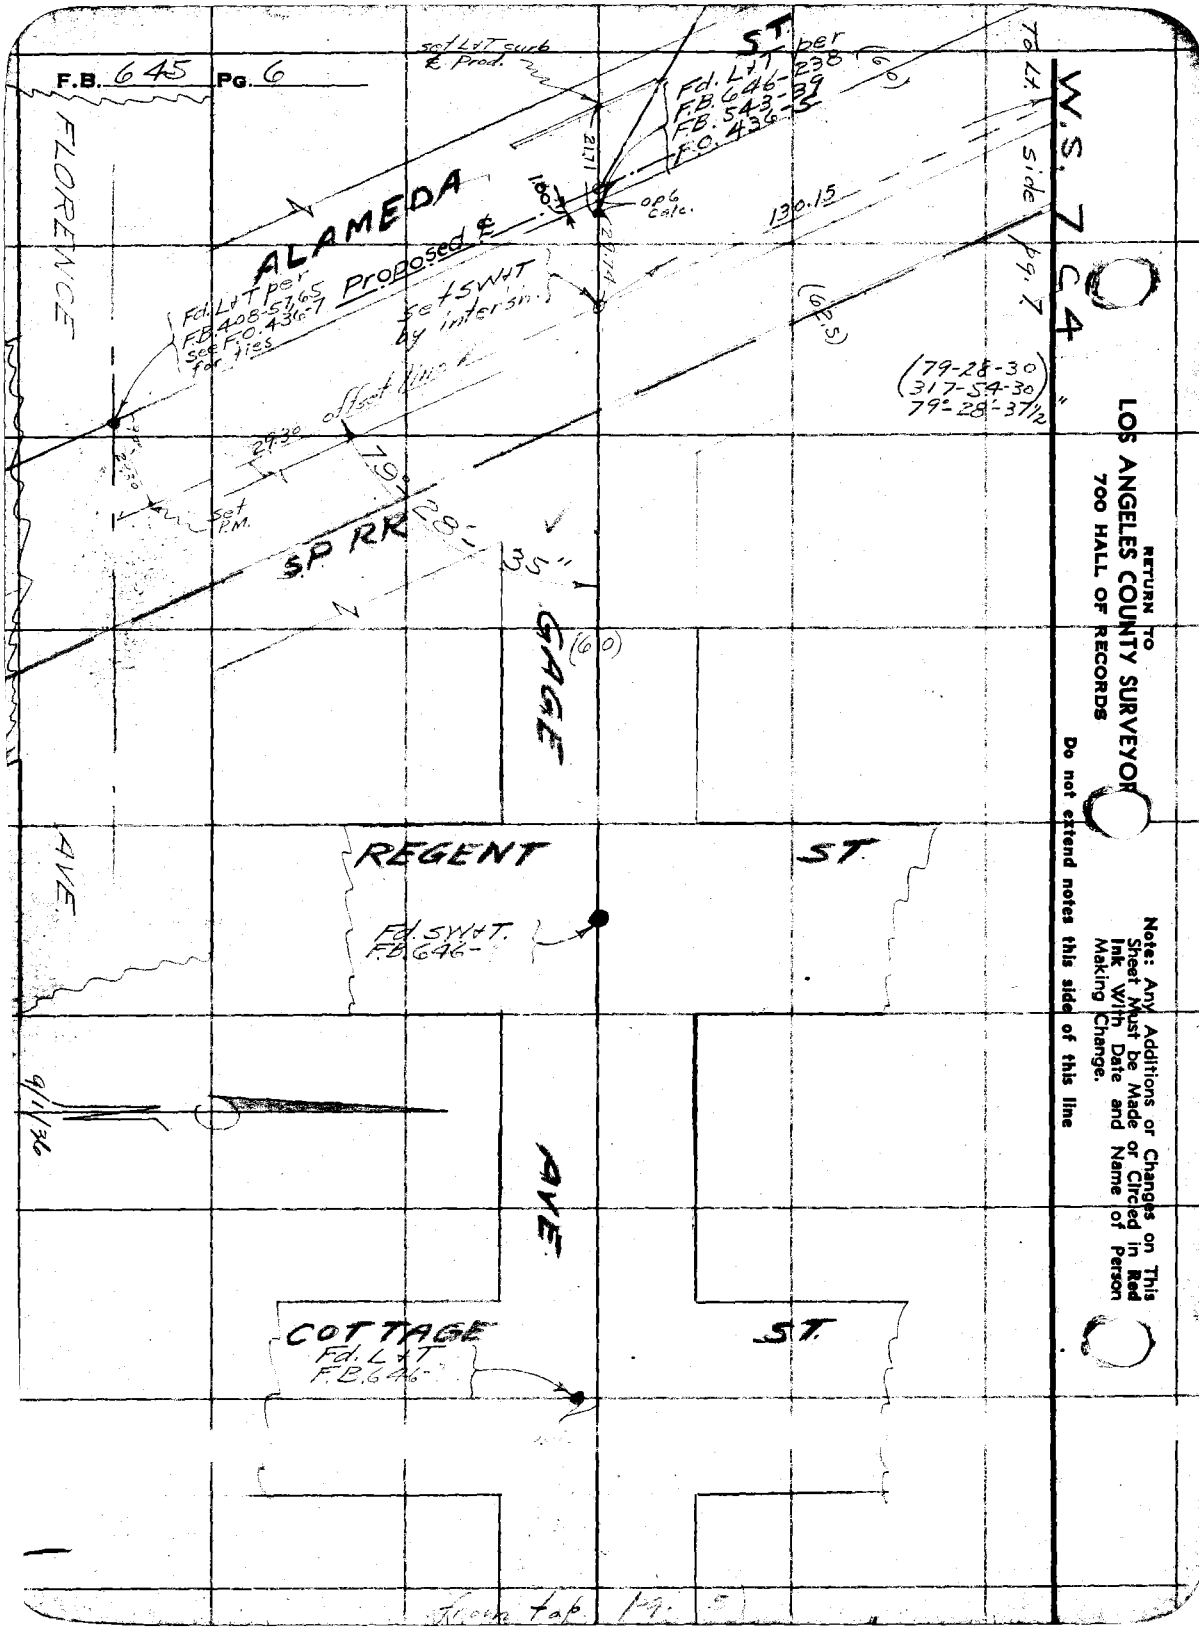

RETURN TO
LOS ANGELES COUNTY SURVEYOR
700 HALL OF RECORDS

Note: Any Additions or Changes on This Sheet Must be Made or Circled in Red Ink With Date and Name of Person Making Change.

Do not extend notes this side of this line

Notes Ck'd by A. A. R.	Survey of Gage Ave
Map No. B-1245	W. O. 8157 Tape No. 072 St'd 24° F.
Office Work Cox	Surveyed by Evans
Checked AAR	Notes 14" Date 9/1/36
Date Mar. 37	Indexed ~~A. C. Johnson~~

F.B. 645 PG. 7

816.59 } 816.60
816.62 }

To Rt. side pg 9.

W.S. 7 C 4

Note: Any Additions or Changes on This Sheet Must be Made or Circled in Red Ink With Date and Name of Person Making Change.

Do not extend notes this side of this line

RETURN TO
LOS ANGELES COUNTY SURVEYOR
700 HALL OF RECORDS

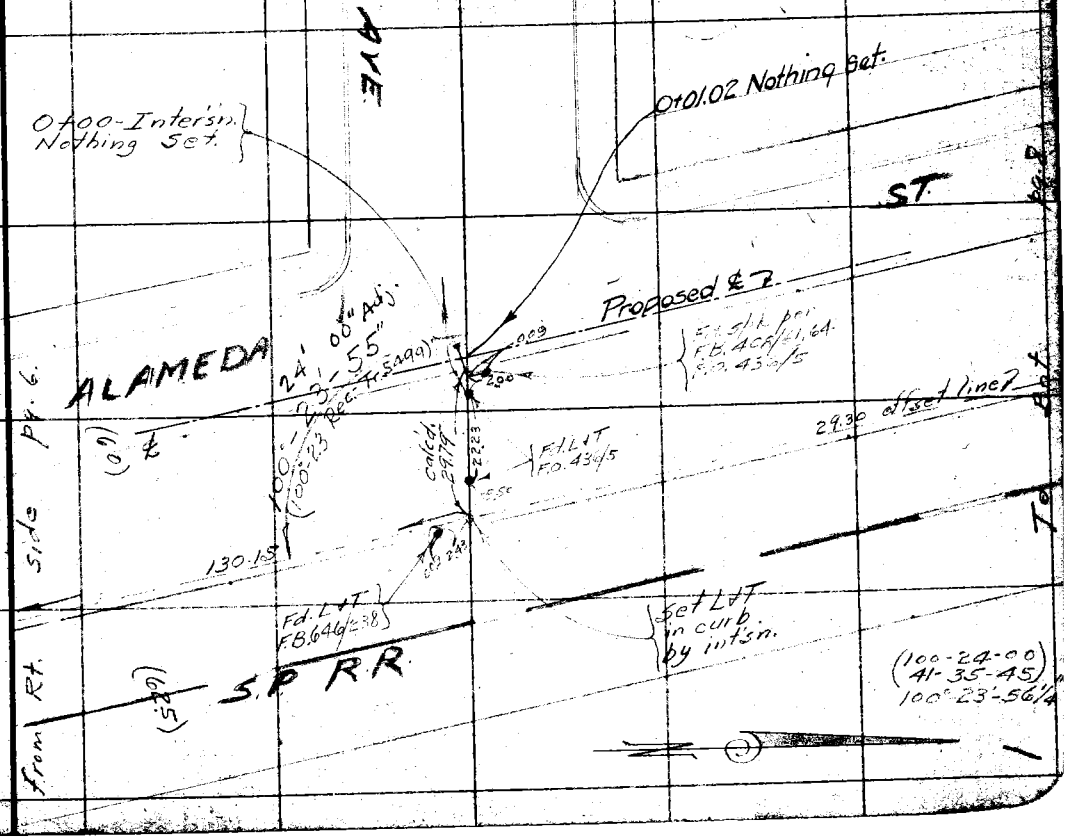

FORM 247 10M 11-35

F.B. 645 Pg. 8

From Rt. side Pg. 7

WS 7 B 4

RETURN TO
LOS ANGELES COUNTY SURVEYOR
700 HALL OF RECORDS

Do not extend notes this side of this line

Note: Any Additions or Changes on This Sheet Must be Made or Circled in Red Ink With Date and Name of Person Making Change.

Notes Ck'd by A. A. R.	Survey of Gage Ave	F.B. 645	PG. 9
Map No. B-1245	W. O. 8157 Tape No. 072 St'd 84 °F.		
Office Work Cox	Surveyed by Evans		
Checked aar	Notes HE Date 9/2/36		
Date Mar. 37	Indexed		

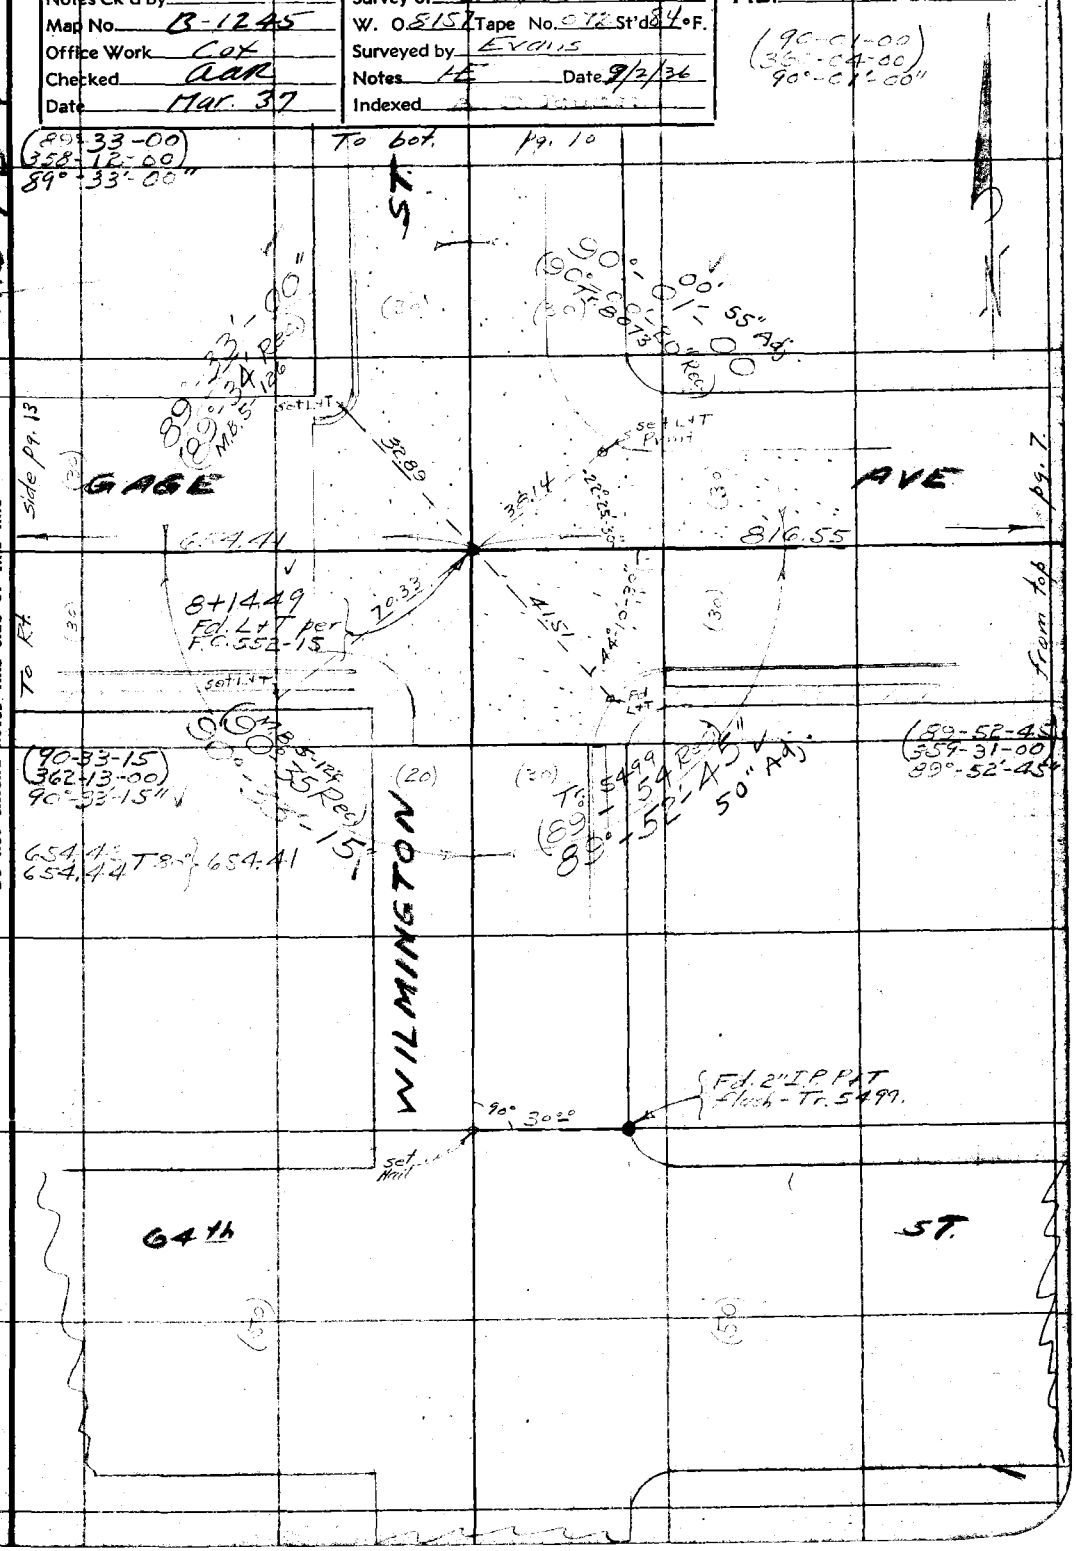

Note: Any Additions or Changes on This Sheet Must be Made or Circled in Red Ink With Date and Name of Person Making Change.

Do not extend notes this side of this line

RETURN TO
LOS ANGELES COUNTY SURVEYOR
700 HALL OF RECORDS

FORM 247 10M 11-35

F.B. 645 PG. 10

To bot. pg. 11

N

9/7/76

60th ST

0.02

Set P.M. by 4 tang L+T's per F.C. 552-7

ST.

61st ST

0.04

Set P.M. by 4 tang L+T's per F.C. 552-9

WILMINGTON

62d ST.

0.04

Set P.M. by 4 tang L+T's per F.C. 552-11

63rd ST.

0.04

Set P.M. by 4 tang L+T's per F.C. 552-13

from top pg. 9

W.S. 7 B-4

RETURN TO
LOS ANGELES COUNTY SURVEYOR
700 HALL OF RECORDS

Note: Any Additions or Changes on This Sheet Must be Made or Circled in Red Ink With Date and Name of Person Making Change.

Do not extend notes this side of this line

Notes Ck'd by A. A. R.	Survey of GAGE AVE.
Map No. B-1245	W. O. 8157 Tape No. 072 St'd 84°F.
Office Work Cox	Surveyed by Evans
Checked aak	Notes HE Date 9/2/36
Date Mar. 37	Indexed A. C. Johnson

F.B. 645 PG. 11

W.S. 7 B-4

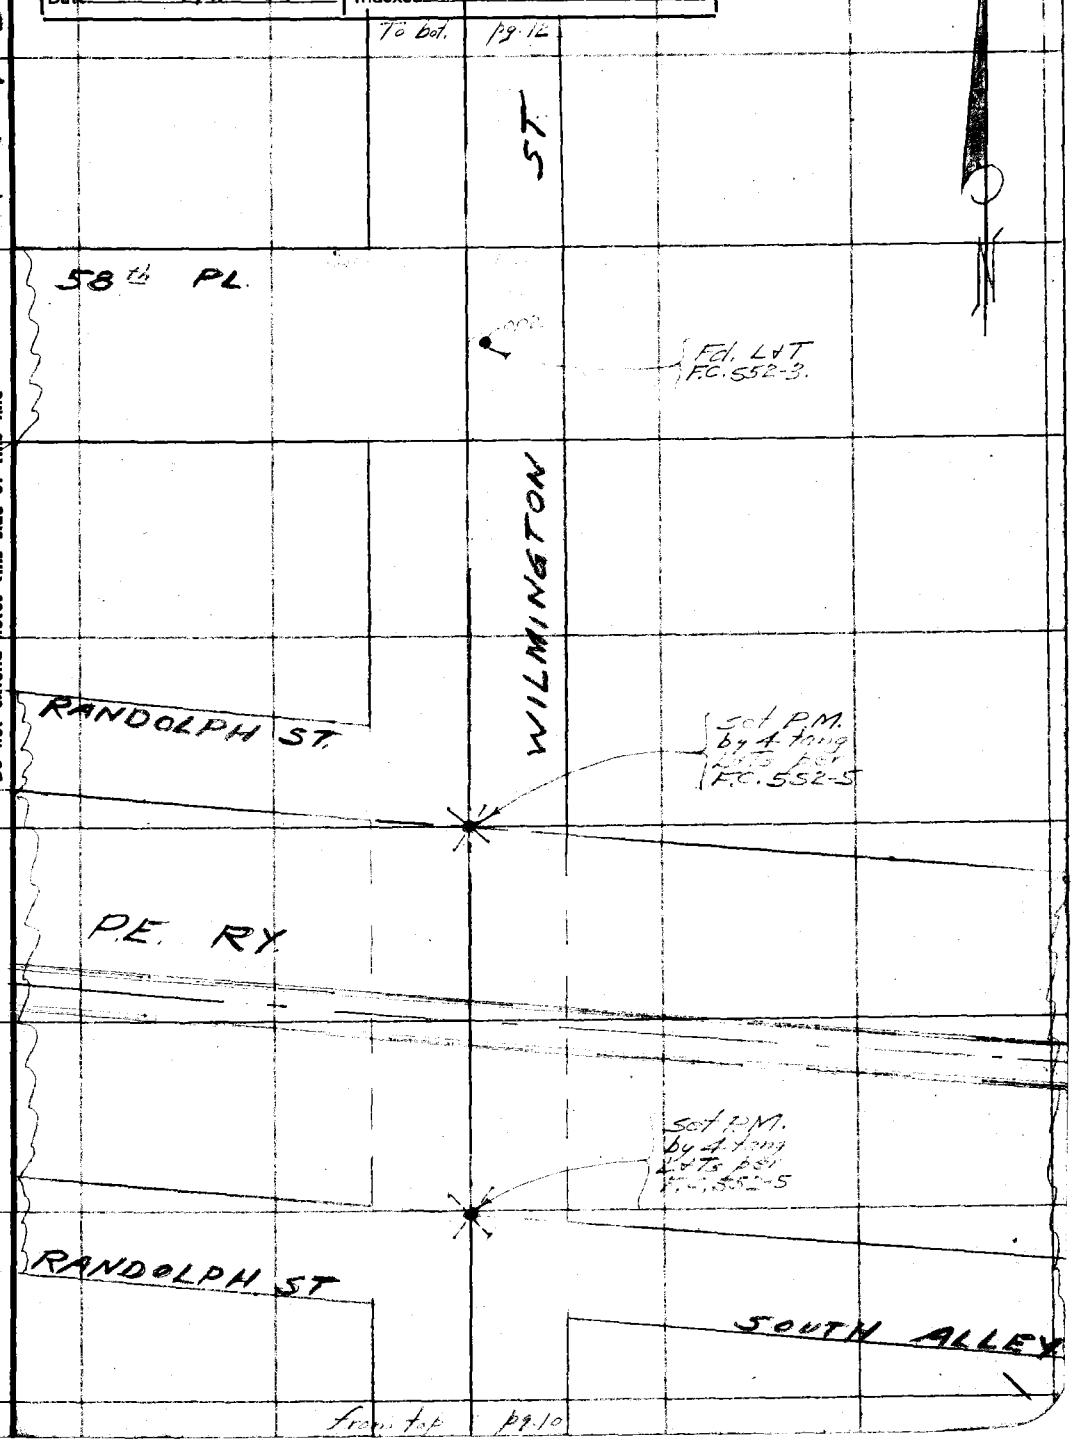

Note: Any Additions or Changes on This Sheet Must be Made or Circled in Red Ink With Date and Name of Person Making Change.

Do not extend notes this side of this line

RETURN TO
LOS ANGELES COUNTY SURVEYOR
700 HALL OF RECORDS

FORM 247 10M 11-35

F.B. 645 PG. 12

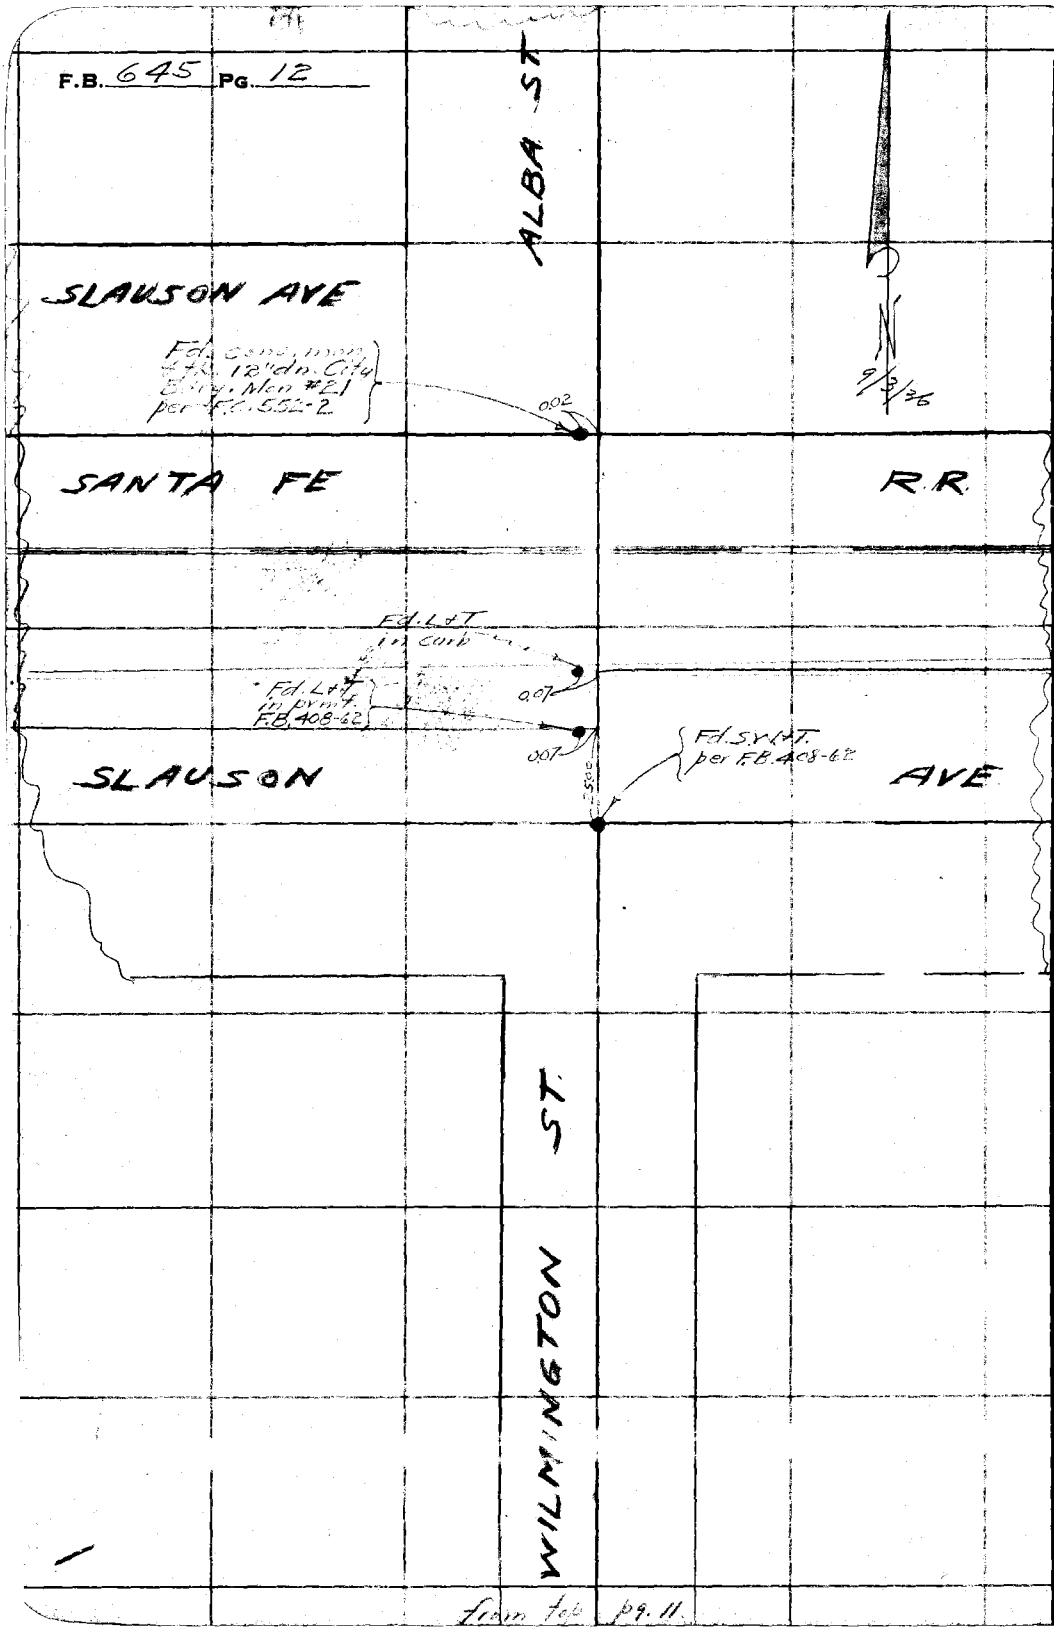

W.S. 7 B-4

RETURN TO
LOS ANGELES COUNTY SURVEYOR
700 HALL OF RECORDS

Note: Any Additions or Changes on This Sheet Must be Made or Circled in Red Ink With Date and Name of Person Making Change.

Do not extend notes this side of this line

from top pg. 11.

To Bot. pg. 14

Notes Ck'd by A. A. R.	Survey of Gage Ave	F.B. 645	Pg. 13
Map No. B-1245	W. O. 8157 Tape No. 072 St'd 84°F.		
Office Work Cox	Surveyed by Evans		
Checked aar	Notes H Date 9/4/36		
Date Mar. 37	Indexed A. C. Johnson		

W.S. 7 B-45

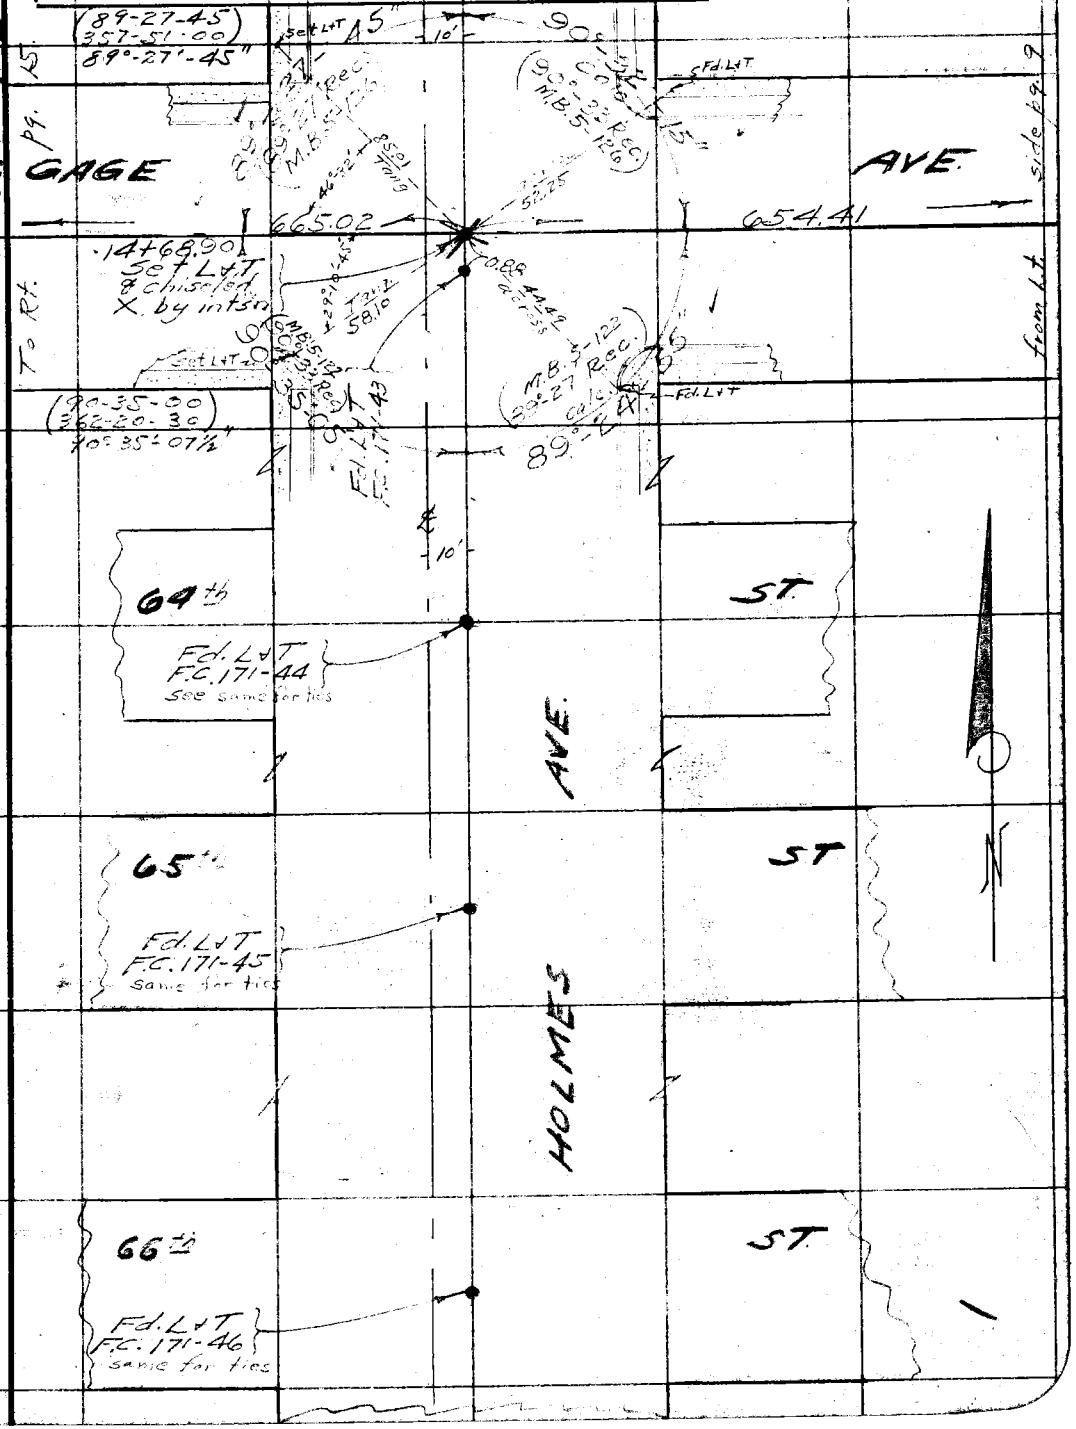

Note: Any Additions or Changes on This Sheet Must be Made or Circled in Red Ink With Date and Name of Person Making Change.

Do not extend notes this side of this line

RETURN TO
LOS ANGELES COUNTY SURVEYOR
700 HALL OF RECORDS

FORM 247 10M 11-35

F.B. 645 PG. 14

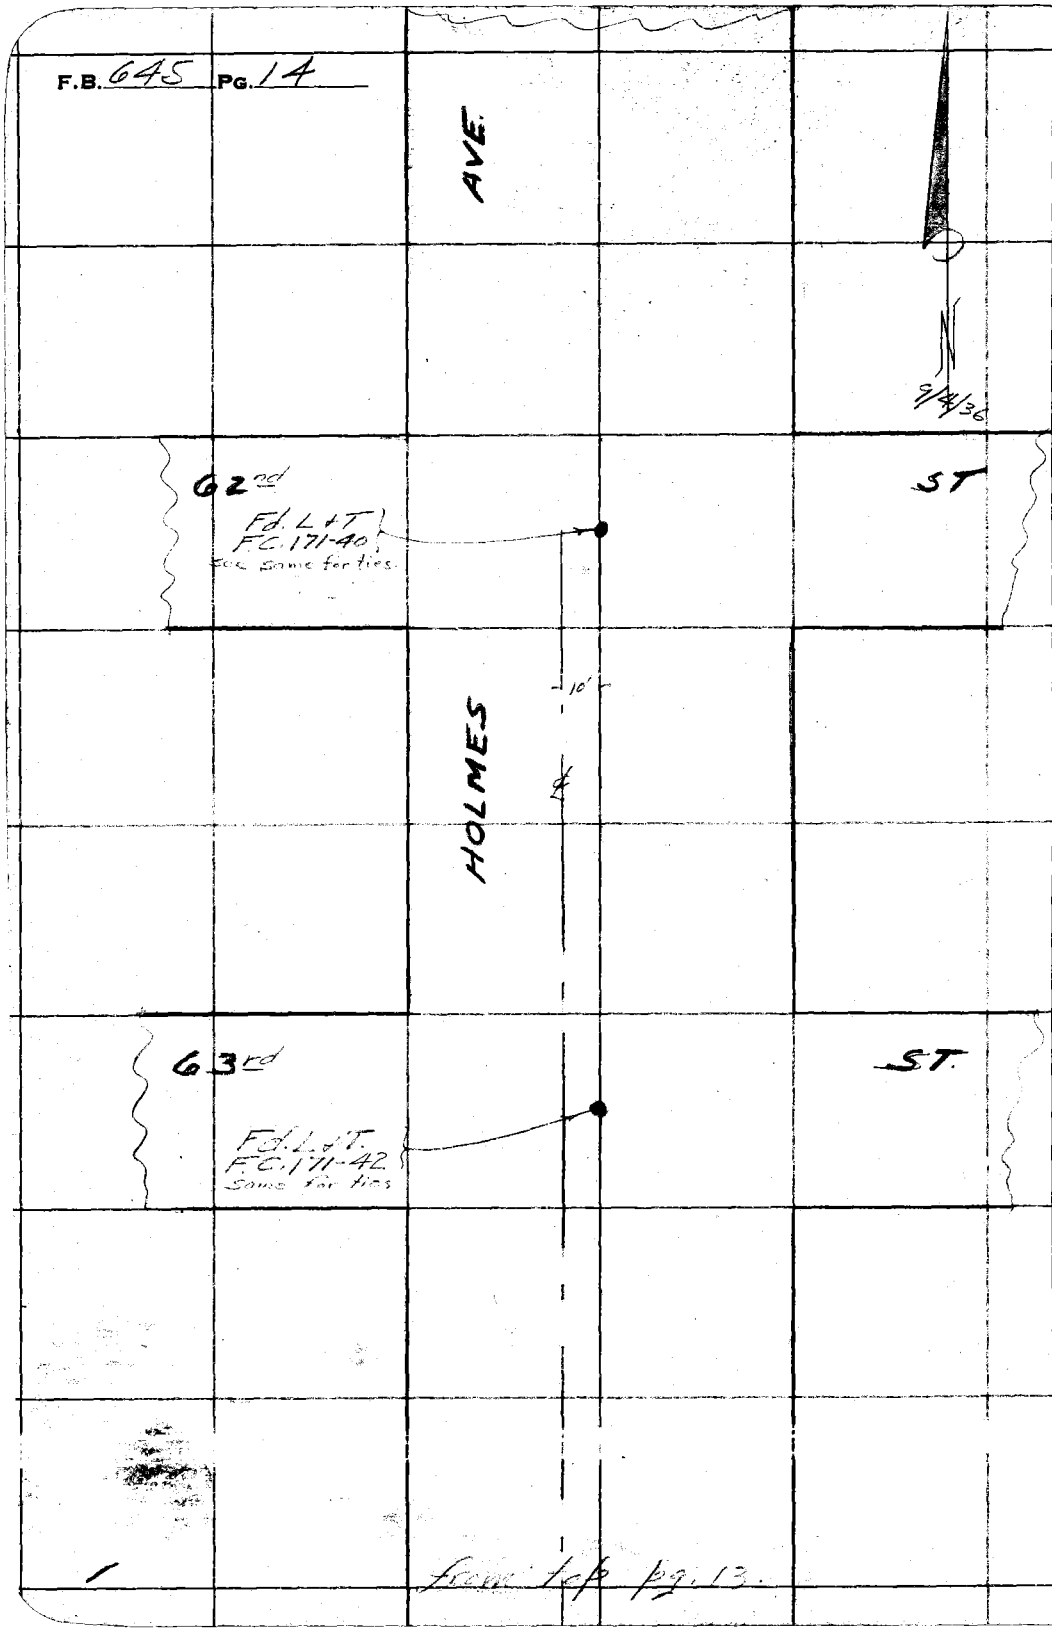

W.S. 7 B-4

RETURN TO
LOS ANGELES COUNTY SURVEYOR
700 HALL OF RECORDS

Note: Any Additions or Changes on This Sheet Must be Made or Circled in Red Ink With Date and Name of Person Making Change.

Do not extend notes this side of this line

from top pg. 13.

Notes Ck'd by A. A. R.	Survey of Gage Ave	F.B. [illegible]	Pg. 15
Map No. B-1245	W. O. 8157 Tape No. 072 St'd 84°F.		
Office Work Cox	Surveyed by Evans.		
Checked AAR	Notes HE Date 9/4/36		
Date Mar. 37	Indexed A. C. Johnson		

W.S. 7 B-4.5

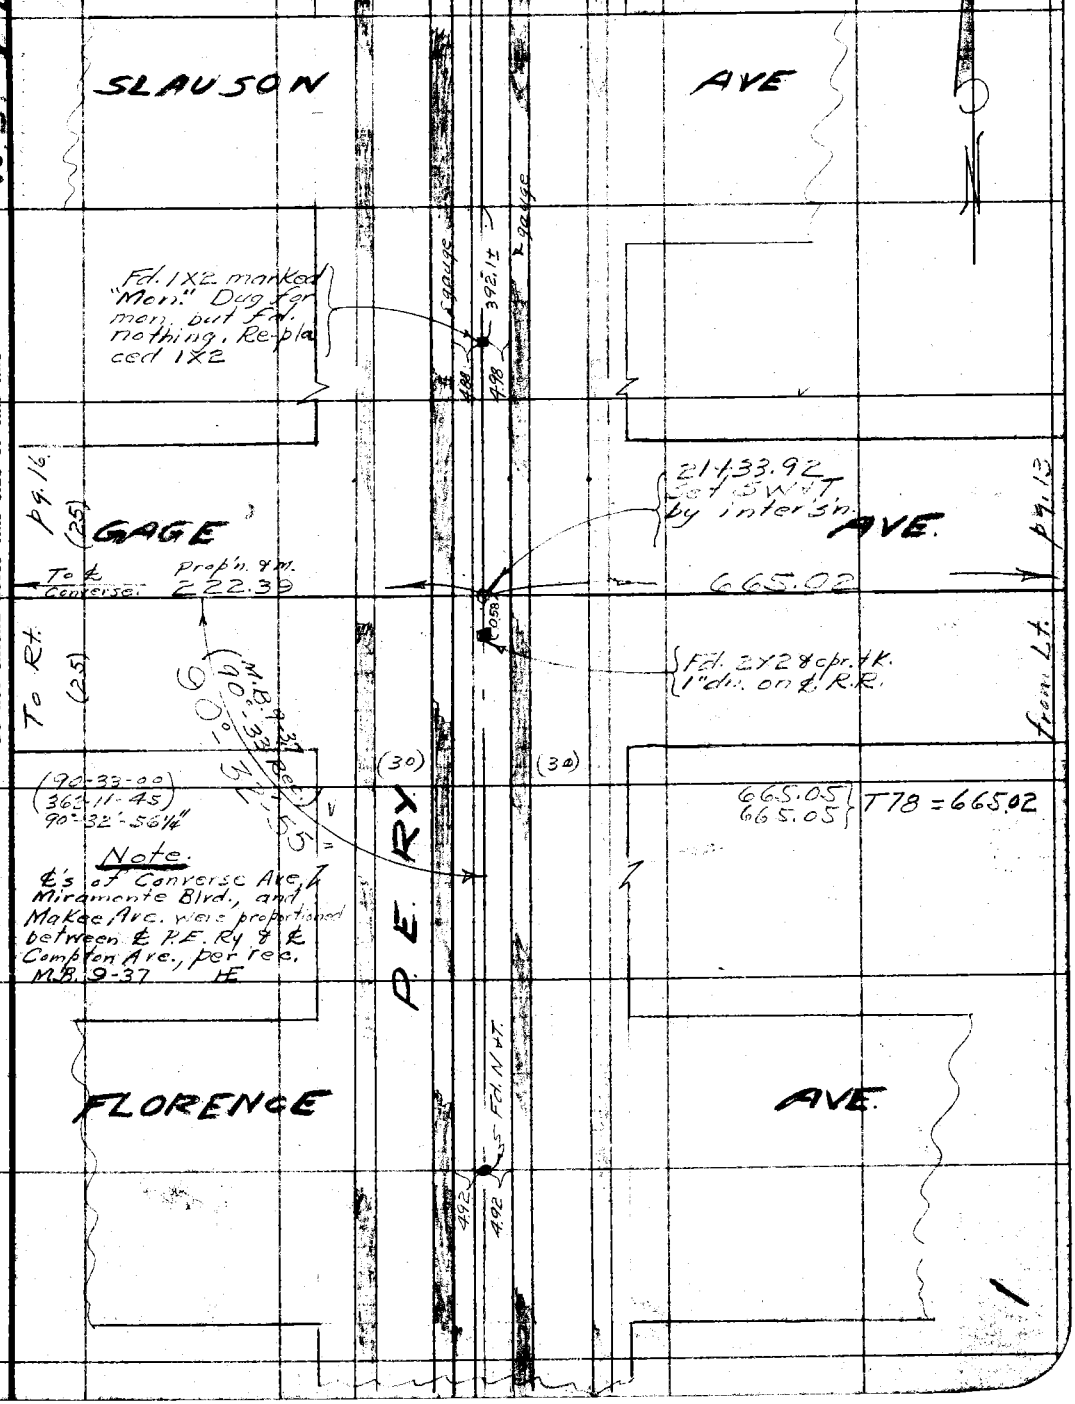

Note: Any Additions or Changes on This Sheet Must be Made or Circled in Red Ink With Date and Name of Person Making Change.

Do not extend notes this side of this line

RETURN TO
LOS ANGELES COUNTY SURVEYOR
700 HALL OF RECORDS

FORM 247 10M 11-35

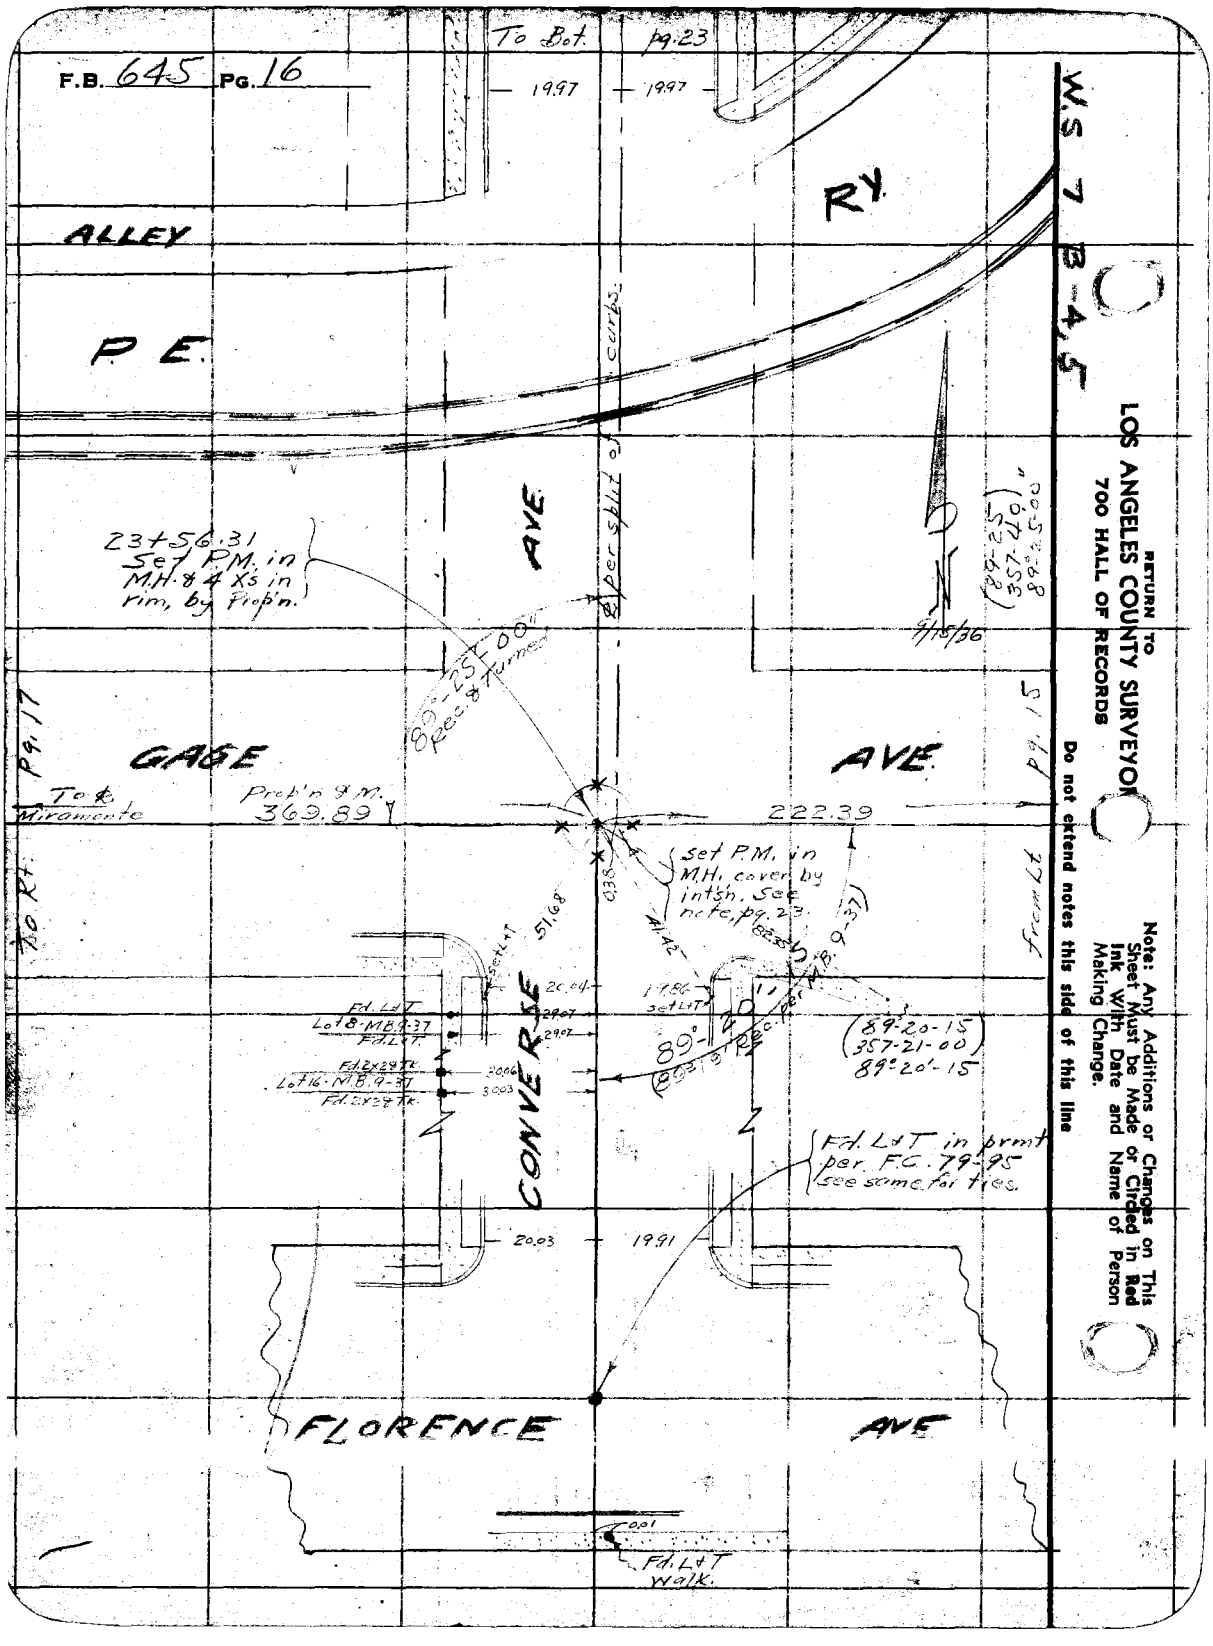

RETURN TO
LOS ANGELES COUNTY SURVEYOR
700 HALL OF RECORDS

Do not extend notes this side of this line

Note: Any Additions or Changes on This Sheet Must be Made or Circled in Red Ink With Date and Name of Person Making Change.

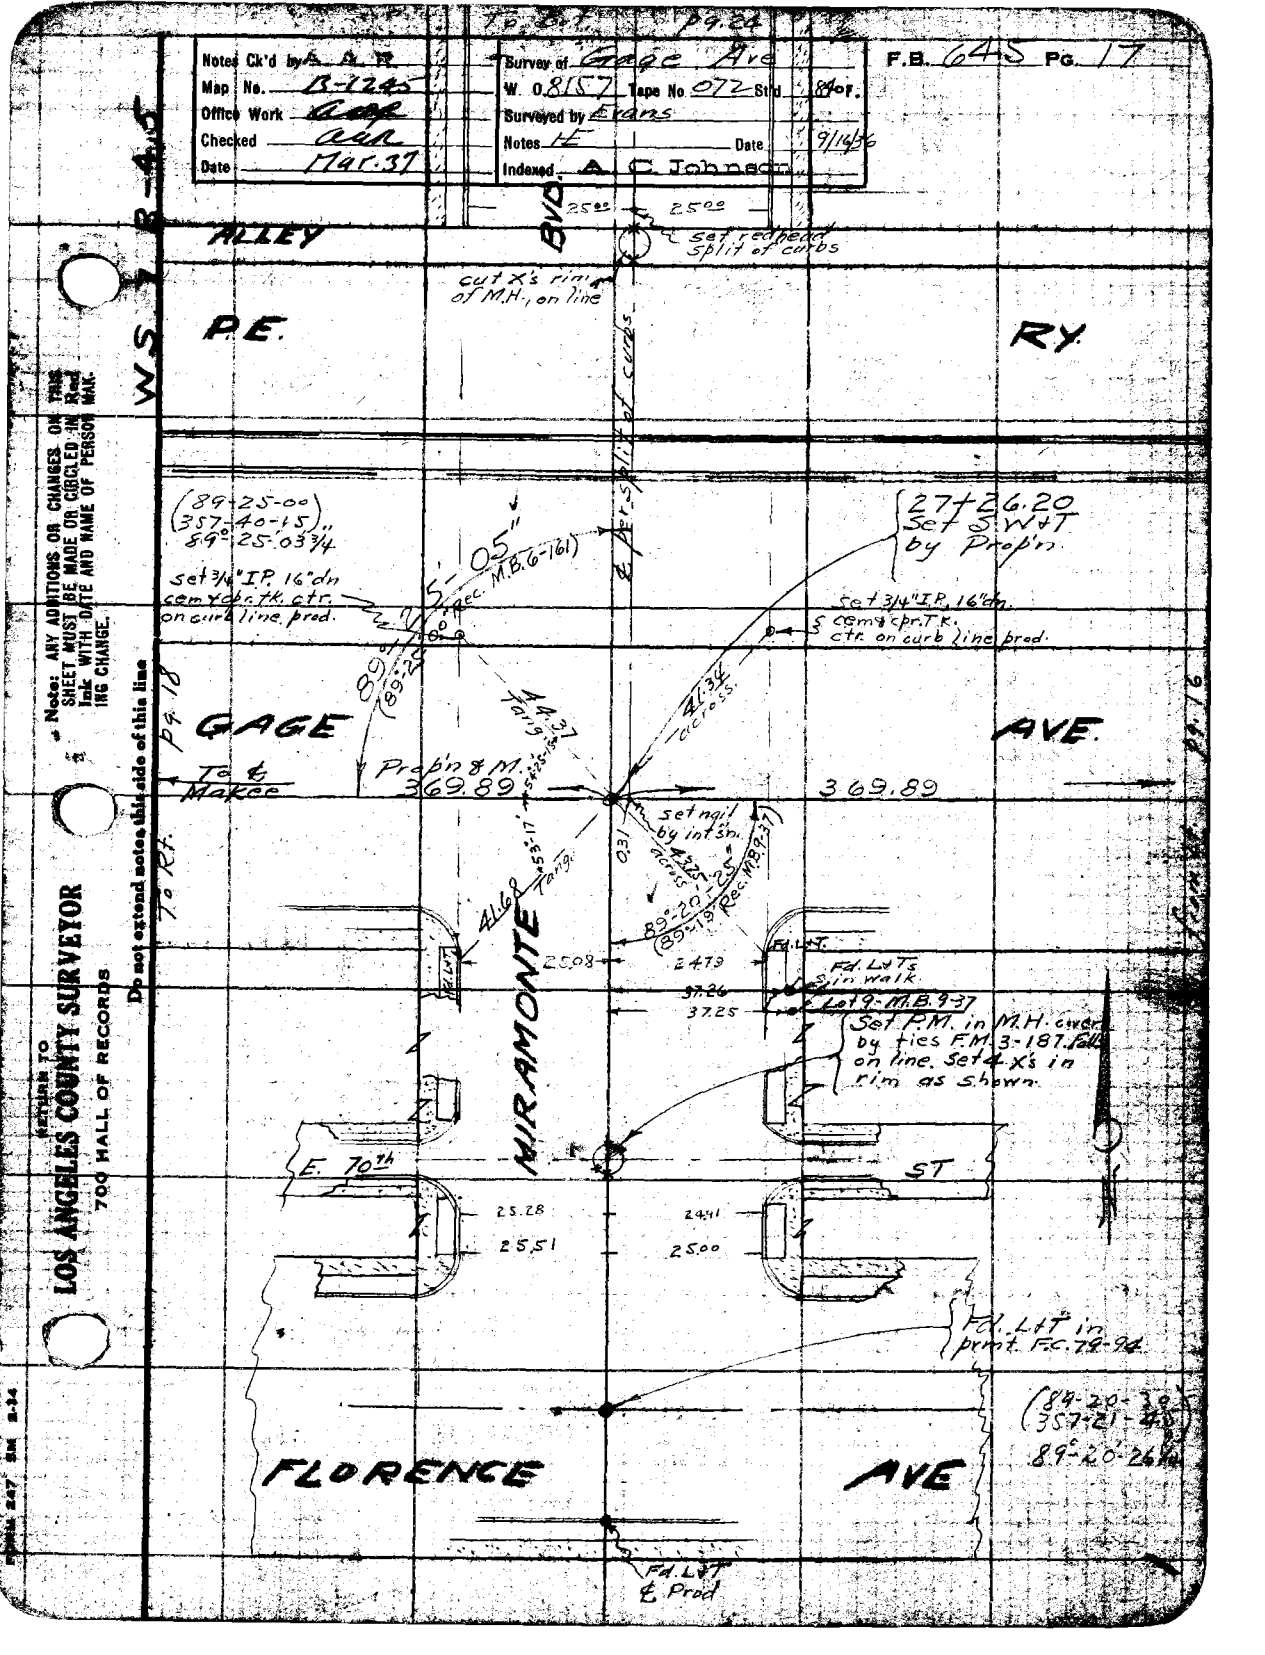

Notes Ck'd by A. A. R.
Map No. B-1245
Office Work
Checked
Date Mar. 37
Survey of Gage Ave
W. O. 8157 Tape No. 072 Std. 84 of.
Surveyed by Evans
Notes HE Date 9/16/36
Indexed A. C. Johnson
F.B. 645 Pg. 17
To Bt. pg. 24
WS 7 B-4.5
ALLEY
BVD.
25.00
25.00
set redhead split of curbs
cut X's rim of M.H., on line
P.E.
RY.
℄ per split of curbs
(89-25-00)
(357-40-15)
89°-25'-03 3/4"
set 3/4" I.P. 16" dn cem & cpr. tk. ctr. on curb line prod.
27+26.20 Set S.W.&T. by Prop'n.
set 3/4" I.P. 16" dn. cem & cpr. T.K. ctr. on curb line prod.
GAGE
AVE.
To ℄ Makee
Prop'n & M. 369.89
369.89
44.37 Tang.
41.34 across
set nail by int'sn.
41.68 Tang.
0.31
43.25 across
89°-20'-25" (89°-19' Rec. M.B. 9-37)
To Rt. pg. 18
pg. 16
MIRAMONTE
25.08
24.79
Fd. L&T.
Fd. L&T's in walk
37.26
37.25
Lot 9 - M.B. 9-37
Set P.M. in M.H. cover by ties F.M. 3-187. Falls on line. Set 4 X's in rim as shown.
E. 70th
ST
25.28
25.51
24.41
25.00
Fd. L&T in prmt. F.C. 79-94
(89-20-30)
(357-21-45)
89°-20'-26 1/4"
FLORENCE
AVE
Fd. L&T ℄ Prod
Note: ANY ADDITIONS OR CHANGES ON THIS SHEET MUST BE MADE OR CIRCLED IN Red Ink WITH DATE AND NAME OF PERSON MAKING CHANGE.
Do not extend notes this side of this line
RETURN TO
LOS ANGELES COUNTY SURVEYOR
700 HALL OF RECORDS
FORM 247 SM 2-34

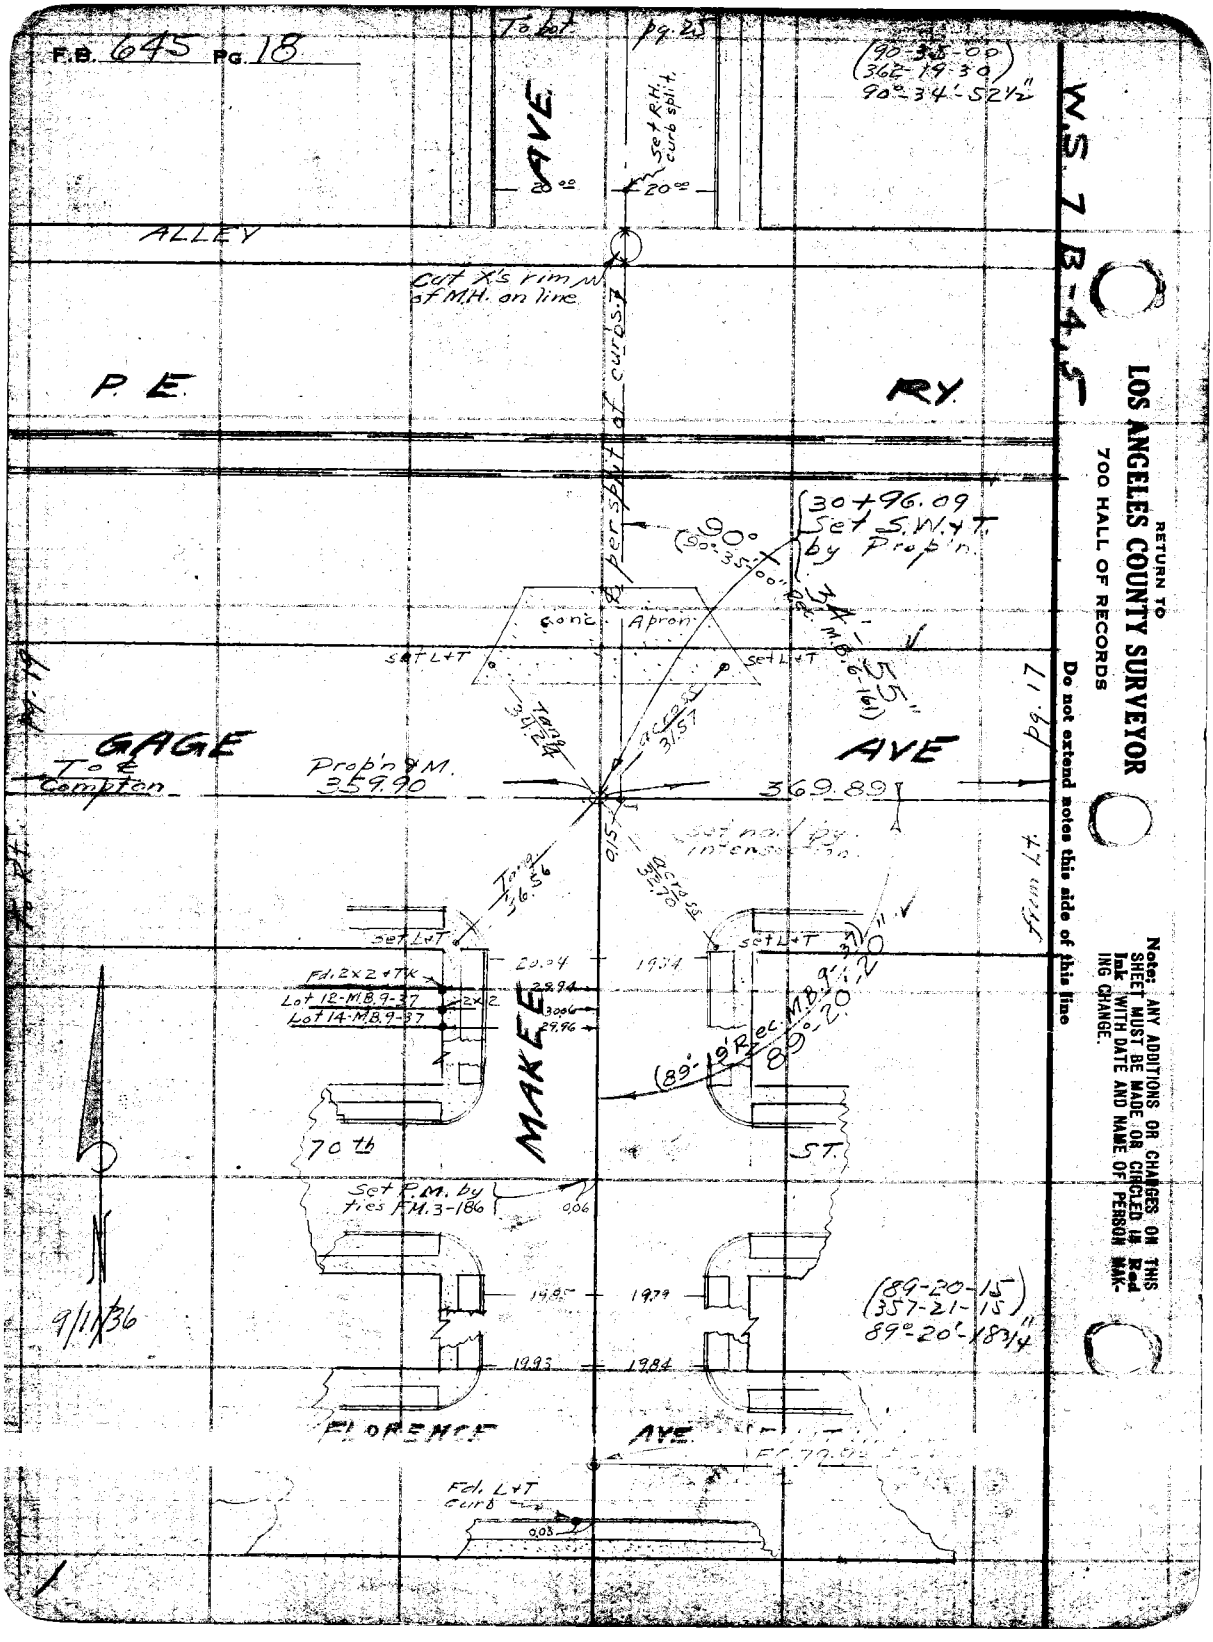
F.B. 645 PG. 18
To lot pg. 25
(90-35-00)
(362-19-30)
90°-34'-52½"
AVE
Set R.H. curb split
20.00
20.00
ALLEY
Cut X's rim of M.H. on line
P. E.
RY.
℄ per split of curbs
(30+96.09
Set S.W.+T. by Prop'n.
90°
(90°-35'-00" Rec. M.B. 6-161)
34'-55"
Conc. Apron
Set L+T
Set L+T
Tang 34.24
Across 31.57
GAGE
AVE
To ℄ Compton
Prop'n ℄ M. 359.90
369.89
Set nail by intersection
Tang 36.56
Across 32.70
Set L+T
Set L+T
20.04
19.84
Fd. 2x2+TK
Lot 12-M.B. 9-37
Lot 14-M.B. 9-37
2x2
29.94
30.06
29.96
MAKEE
(89°-19' Rec. M.B. 9-37)
89°-20'-20"
70th
ST.
Set P.M. by ties F.M. 3-186
0.06
19.85
19.79
(89-20-15)
(357-21-15)
89°-20'-18¾"
19.93
19.84
FLORENCE
AVE
Fd. L+T curb
0.03
9/11/36
W.S. 7 B-4,5
RETURN TO
LOS ANGELES COUNTY SURVEYOR
700 HALL OF RECORDS
Do not extend notes this side of this line
Note: ANY ADDITIONS OR CHANGES ON THIS SHEET MUST BE MADE OR CIRCLED IN Red Ink WITH DATE AND NAME OF PERSON MAKING CHANGE.

Notes Ck'd by A. A. R.	Survey of Gage Ave.	F.B. 645 Pg. 19
Map No. B-1245	W. O. 8157 Tape No. 072 St'd 84°F.	
Office Work Cox	Surveyed by Evans	
Checked aar	Notes HE Date 9/8/36	
Date Mar. 37	Indexed	

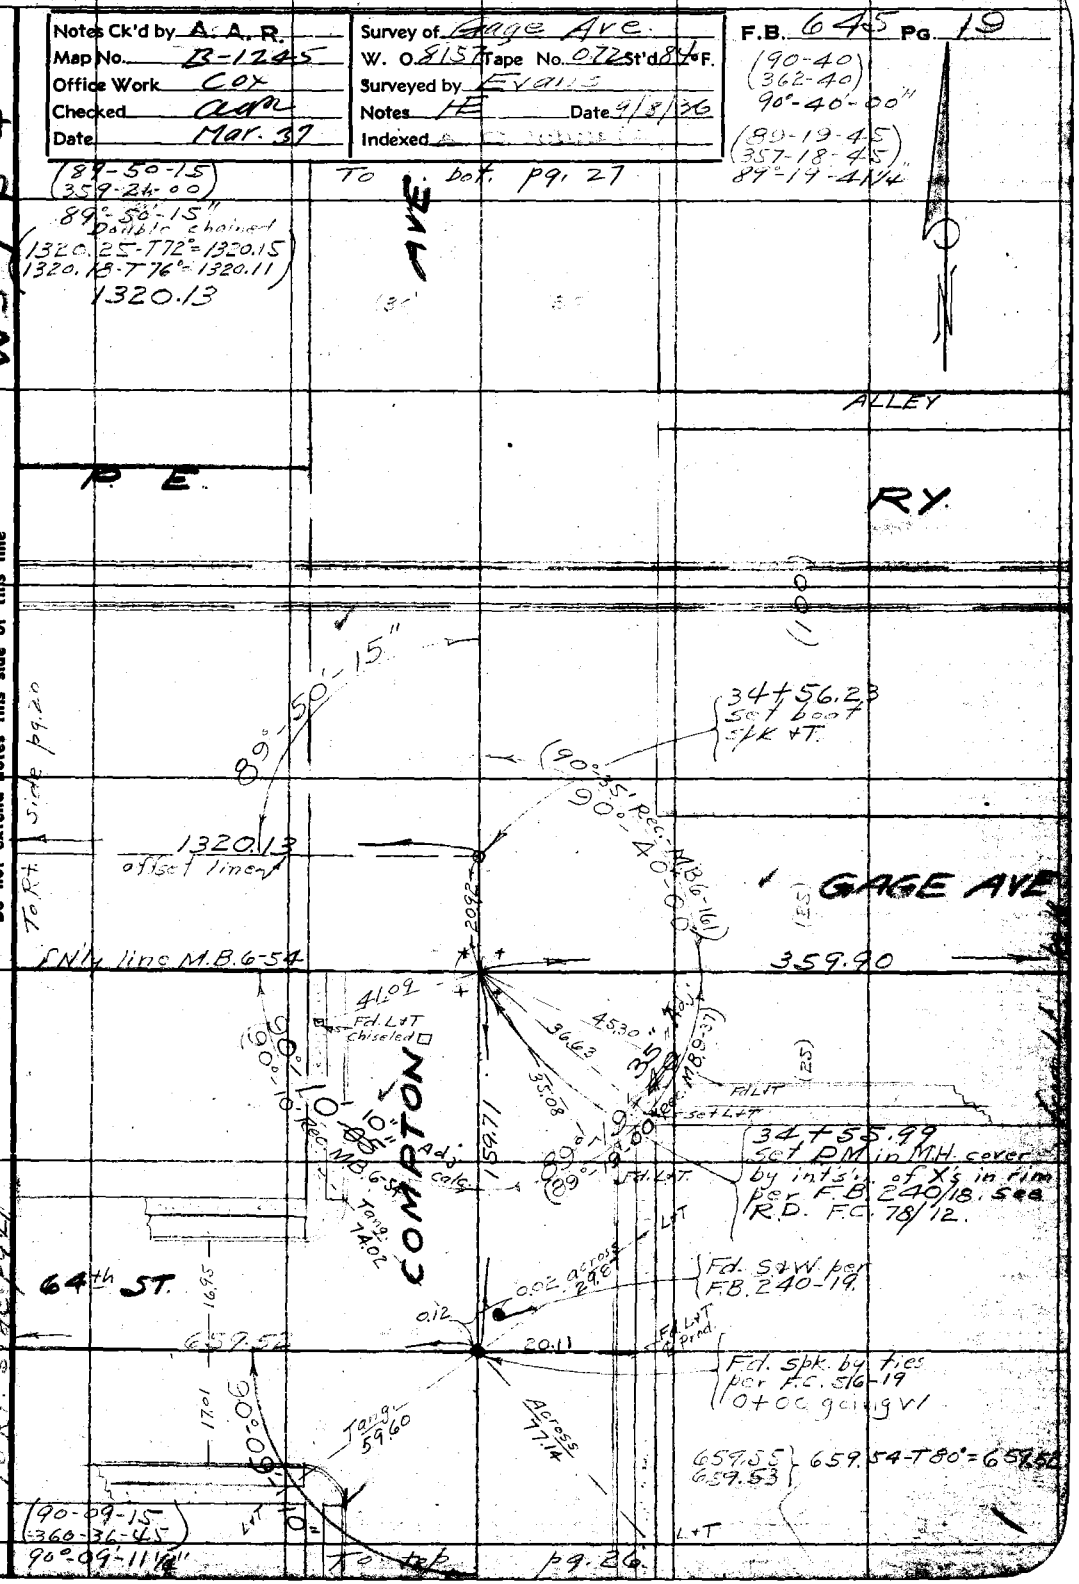

Note: Any Additions or Changes on This Sheet Must be Made or Circled in Red Ink With Date and Name of Person Making Change.

Do not extend notes this side of this line

RETURN TO
LOS ANGELES COUNTY SURVEYOR
700 HALL OF RECORDS

FORM 247 10M 11-35

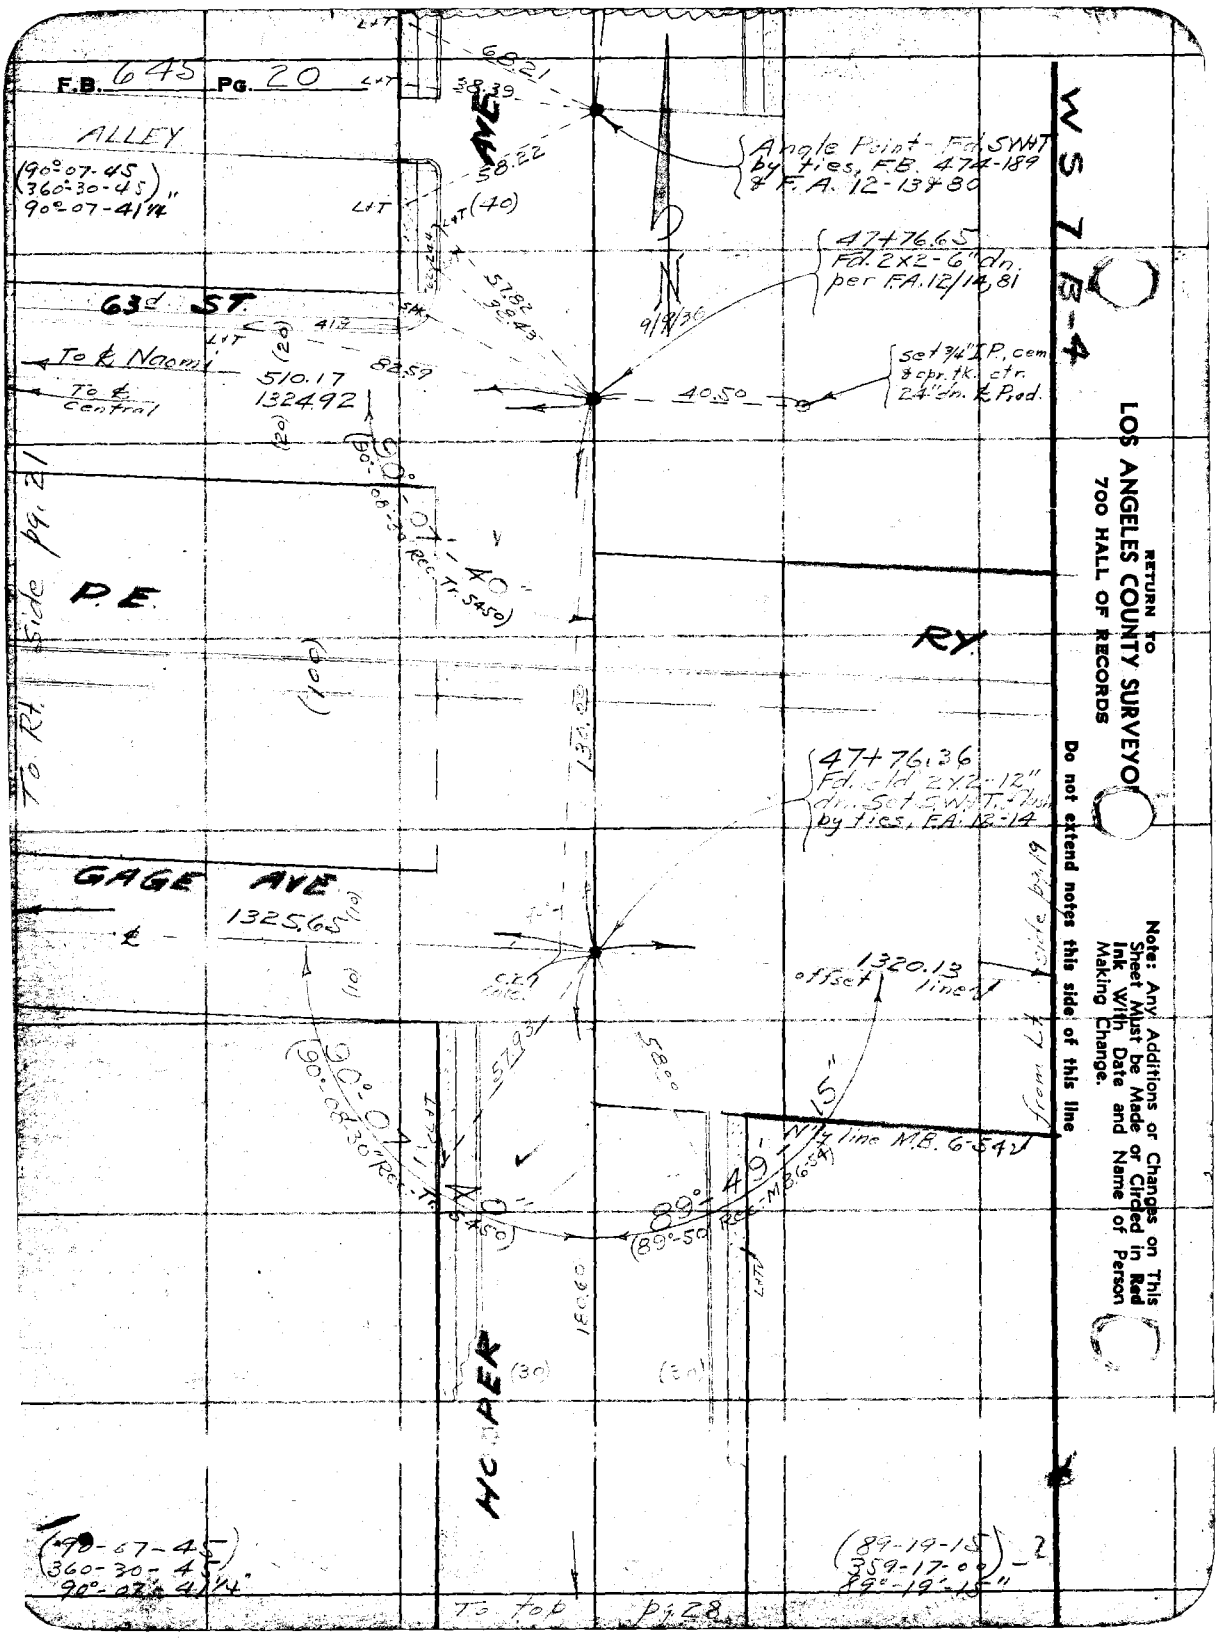
F.B. 645 Pg. 20
ALLEY
(90°-07-45)
(360°-30-45)
90°-07-41¼"
63d ST.
To ℄ Naomi
To ℄ Central
510.17
1324.92
68.21
58.39
58.22
(40)
57.82
38.43
82.59
(20)
(20)
Angle Point - Fd. SWHT by ties, F.B. 474-189 & F.A. 12-13 & 80
47+76.65
Fd. 2X2-6" dn. per F.A. 12/14, 81
9/8/36
set 3/4" I.P. cem & cpr. tk. ctr. 24" dn. ℄ Prod.
40.50
90°-07'-40"
(90°-08'-30" Rec. Tr. 5450)
P.E.
RY.
(100)
130.00
To Rt. Side pg. 21
47+76.36
Fd. old 2X2-12" dn. Set SWHT. flush by ties, F.A. 12-14
GAGE AVE
1325.65
(10)
(10)
C.L.T. calc.
1320.13
offset line
from Lt. side pg. 19
90°-07'-40"
(90°-08'-30" Rec. Tr. 5450)
57.93
58.00
15"
N'ly line M.B. 6-54
89°-49'-
(89°-50 Rec. M.B. 6-54)
180.60
(30)
(30)
HOOPER
(90-07-45)
(360-30-45)
90°-07-41¼"
(89-19-15)
(359-17-00)
89°-19'-15"
To top pg. 28
WS 7 B-4
RETURN TO
LOS ANGELES COUNTY SURVEYOR
700 HALL OF RECORDS
Do not extend notes this side of this line
Note: Any Additions or Changes on This Sheet Must be Made or Circled in Red Ink With Date and Name of Person Making Change.

Notes Ck'd by A. A. R.	Survey of Gage Ave	F.B. 645 PG. 21
Map No. B-1245	W. O. 8157 Tape No. 072 St'd 84 °F.	1324.95 / 1324.93 / 1324.94 T 82° = 1324.92
Office Work Cox	Surveyed by Evans	
Checked aar	Notes HE Date 9/8/36	
Date Mar. 37	Indexed A. C. Johns	

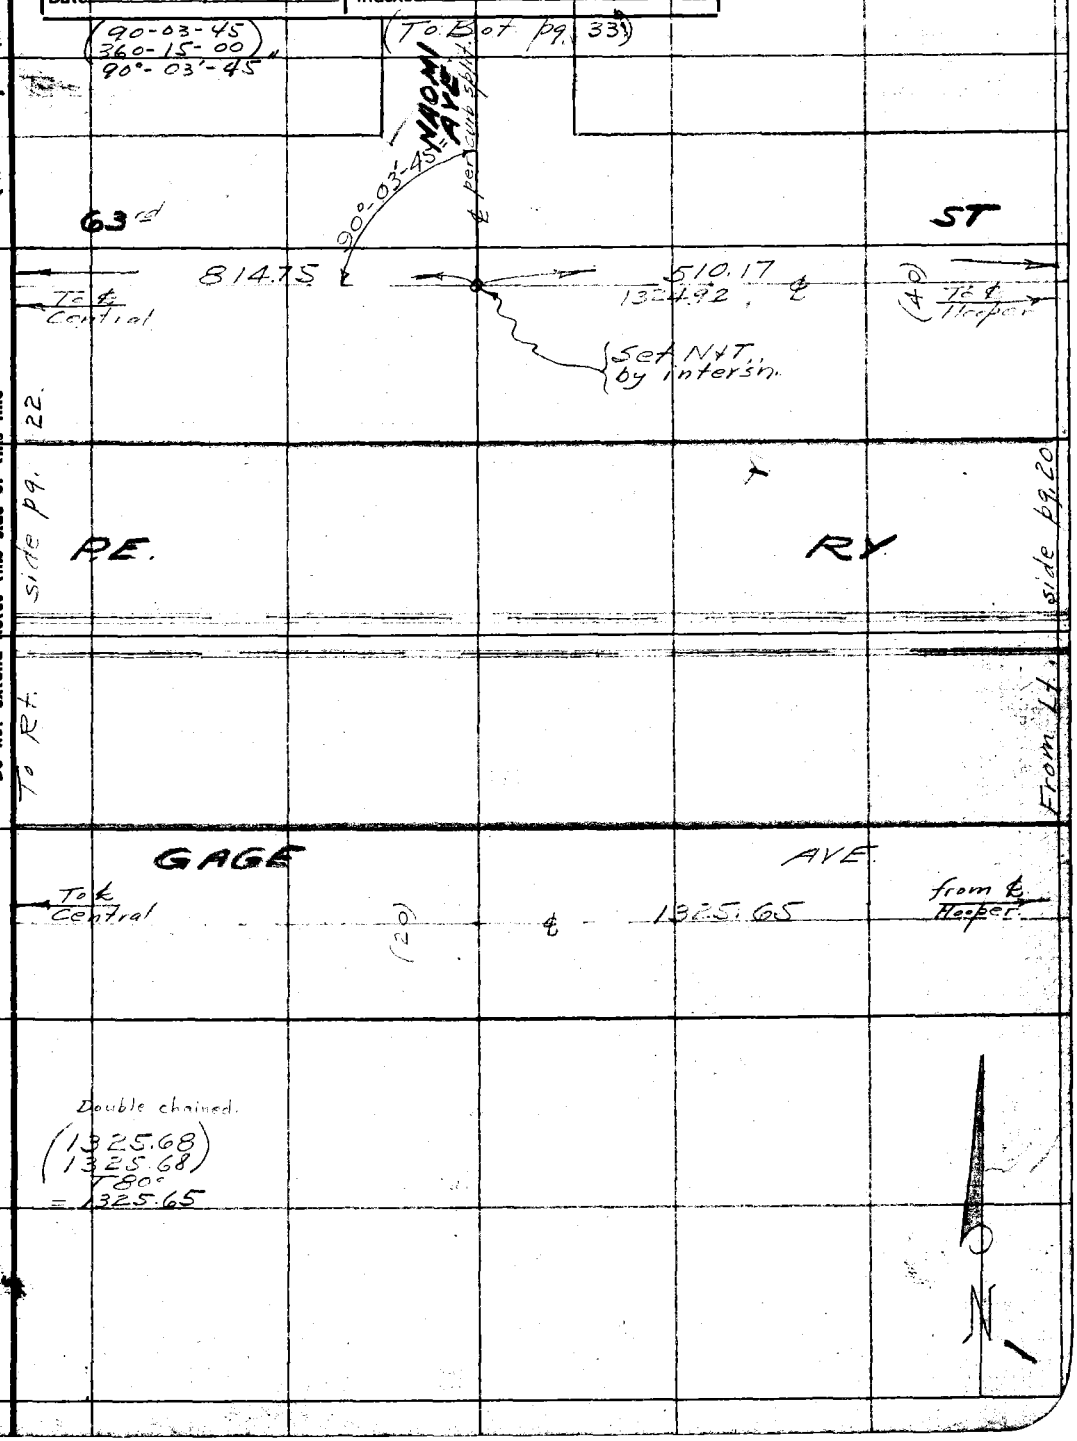

Note: Any Additions or Changes on This Sheet Must be Made or Circled in Red Ink With Date and Name of Person Making Change.

Do not extend notes this side of this line

RETURN TO
LOS ANGELES COUNTY SURVEYOR
700 HALL OF RECORDS

FORM 247 10M 11-35

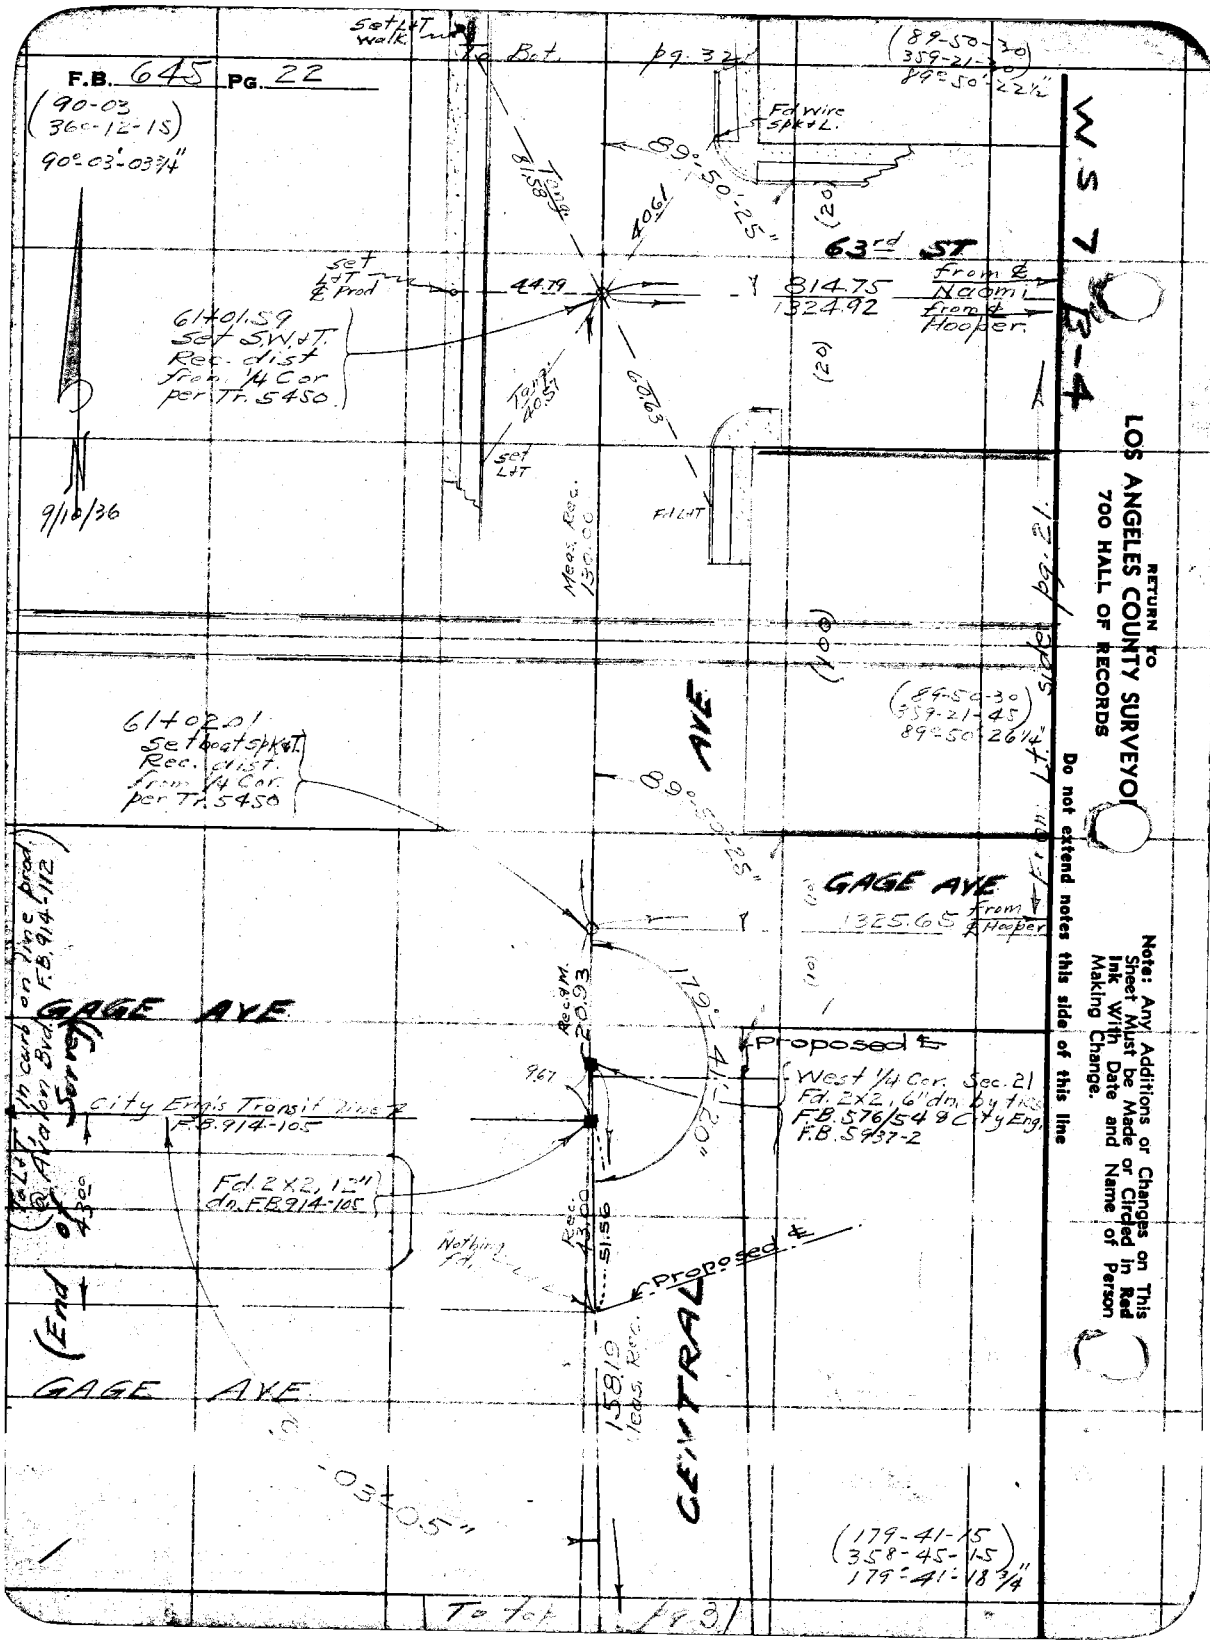
F.B. 645 PG. 22
(90-03
360-12-15)
90°-03'-03¾"
Set L&T walk
To Bot. pg. 32
(89-50-30
359-21-30)
89°-50'-22½"
Fd wire spk & L.
89°-50'-25"
Tang. 81.58
40.61
63rd ST
Set L&T ℄ Prod
44.79
814.75
1324.92
from ℄ Naomi
from ℄ Hooper
61+01.59
Set S.W.&T.
Rec. dist
from ¼ Cor
per Tr. 5450
Tang. 40.51
60.63
Set L&T
Fd L&T
Meas. Rec. 130.00
9/10/36
(89-50-30
359-21-45)
89°-50'-26¼"
61+02.01
Set boat spk & T.
Rec. dist.
from ¼ Cor.
per Tr. 5450
AVE
GAGE AVE
1325.65 from ℄ Hooper
Rec. & M. 20.93
179°-41'-20"
Proposed ℄
West ¼ Cor. Sec. 21
Fd. 2X2, 6" dn. by tree
F.B. 576/54 & City Eng.
F.B. 5937-2
City Eng's Transit line ℄
F.B. 914-105
Fd. 2X2, 12" dn. F.B. 914-105
Rec. 43.00
51.56
Nothing Fd.
Proposed ℄
15819 Meas. Rec.
CENTRAL
GAGE AVE
(To L&T in curb on line prod. @ Avalon Bvd. F.B. 914-112)
(End of Survey)
43.00
GAGE AVE
(179-41-15
358-45-15)
179°-41'-18¾"
To top pg. 3
W.S. 7 B-4
RETURN TO
LOS ANGELES COUNTY SURVEYOR
700 HALL OF RECORDS
Do not extend notes this side of this line
Note: Any Additions or Changes on This Sheet Must be Made or Circled in Red Ink With Date and Name of Person Making Change.

Notes Ck'd by A. A. R.	Survey of Gage Ave
Map No. B-1245	W. O. 8151 Tape No. 072 St'd 8½ °F.
Office Work Cox	Surveyed by Evans
Checked aar	Notes HE Date 9/15/36
Date Mar. 37	Indexed

F.B. 645 Pg. 23

B-4

W.S. 7

Note: Any Additions or Changes on This Sheet Must be Made or Circled in Red Ink With Date and Name of Person Making Change.

Do not extend notes this side of this line

RETURN TO
LOS ANGELES COUNTY SURVEYOR
700 HALL OF RECORDS

FORM 247 10M 11-38

Note
A diligent search was made on Converse Ave for lot corners but nothing found.

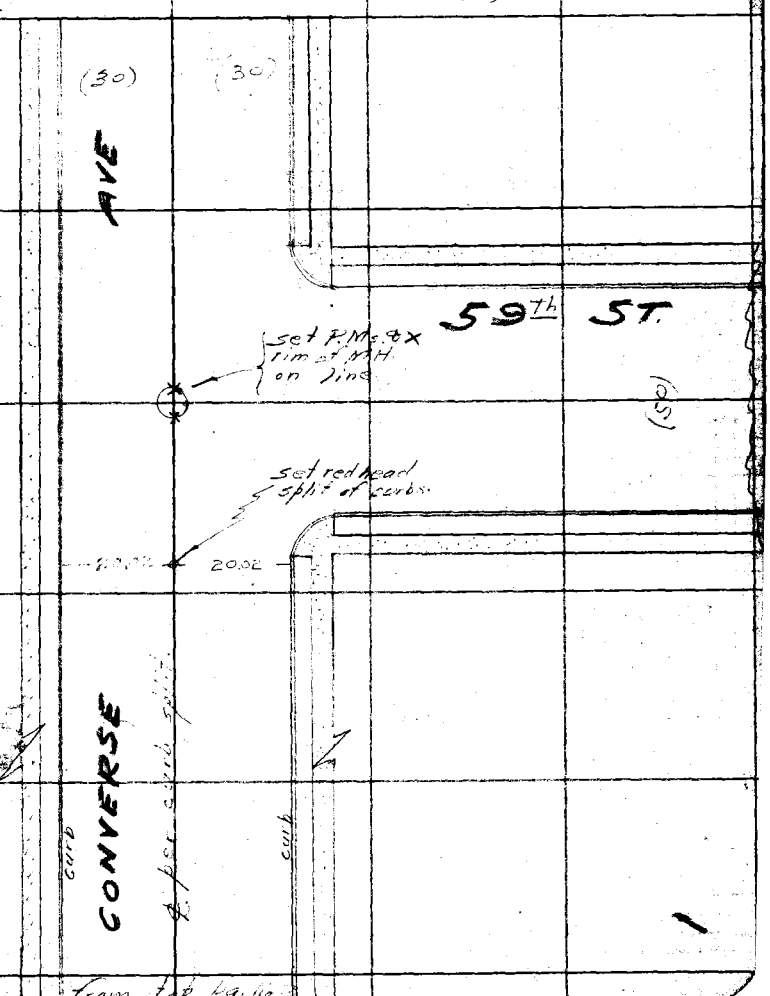

F.B. 645 PG. 24

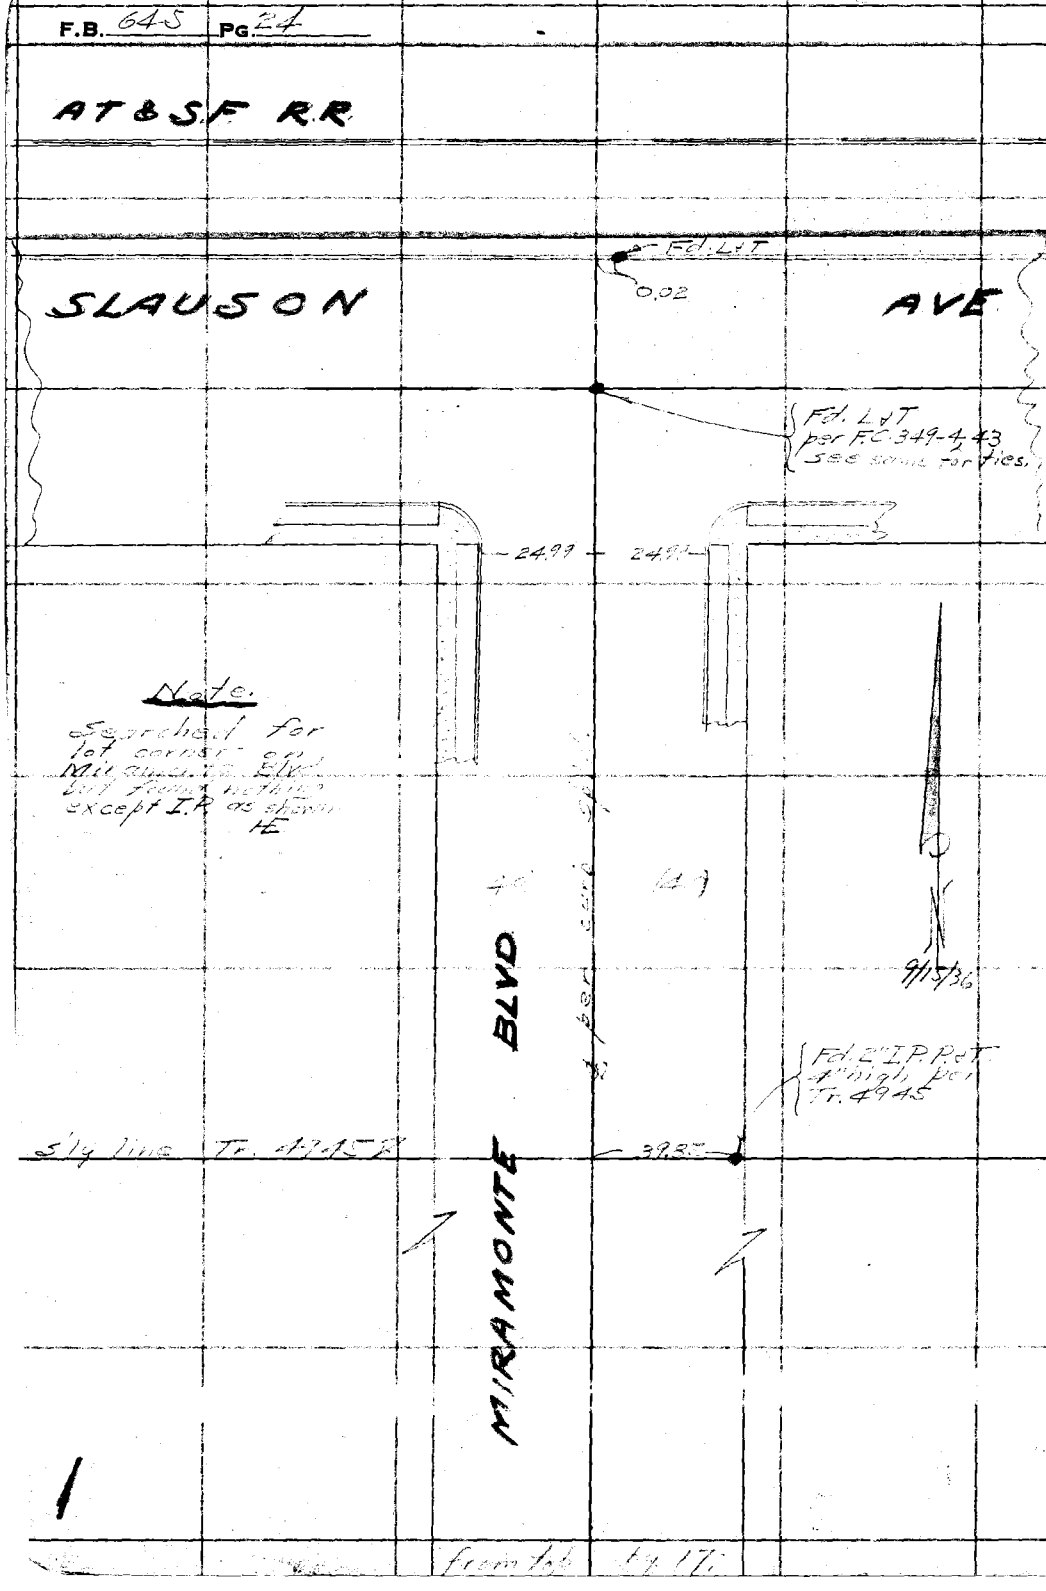

WS 7 B-4

RETURN TO
LOS ANGELES COUNTY SURVEYOR
700 HALL OF RECORDS

Note: Any Additions or Changes on This Sheet Must be Made or Circled in Red Ink With Date and Name of Person Making Change.

Do not extend notes this side of this line

Notes Ck'd by A. A. B.	Survey of Gage Ave	F.B. 645	Pg. 25
Map No. B-1245	W. O. 8187 Tape No. 072 St'd 84 °F.		
Office Work Cox	Surveyed by Evans		
Checked aar	Notes FE Date 9/16/36		
Date Mar. 37	Indexed A. C. Johnson		

W.S. 7 B-4

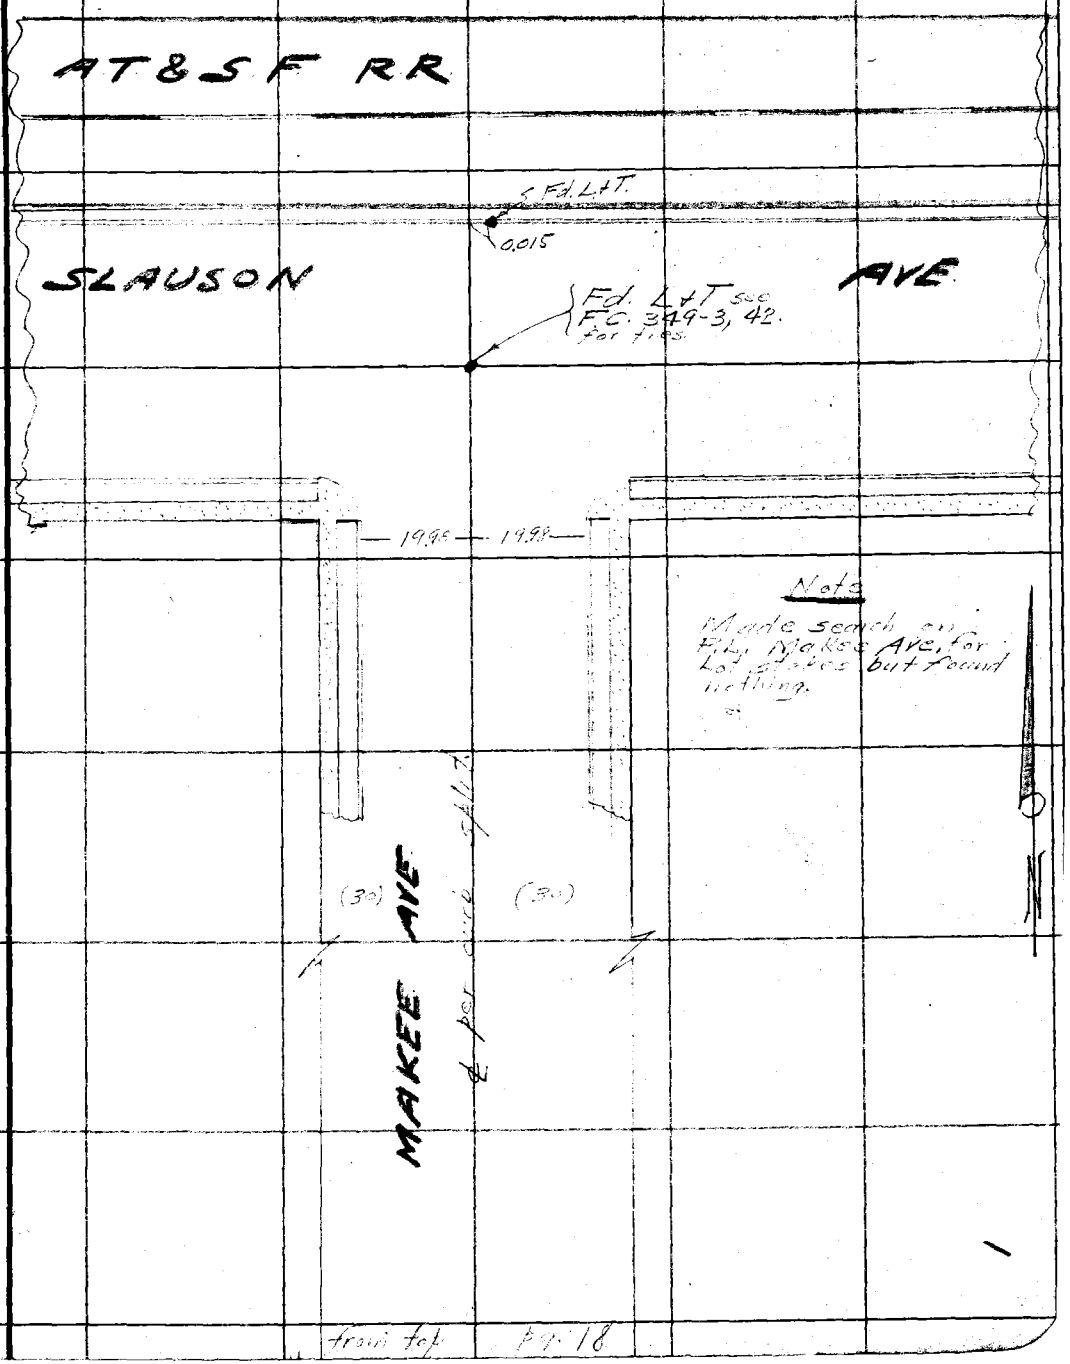

from top pg. 18

Note: Any Additions or Changes on This Sheet Must be Made or Circled in Red Ink With Date and Name of Person Making Change.

Do not extend notes this side of this line

RETURN TO
LOS ANGELES COUNTY SURVEYOR
700 HALL OF RECORDS

FORM 247 10M 11-35

F.B. 645 PG. 26

From bot. pg. 19

W.S. 7 13-5

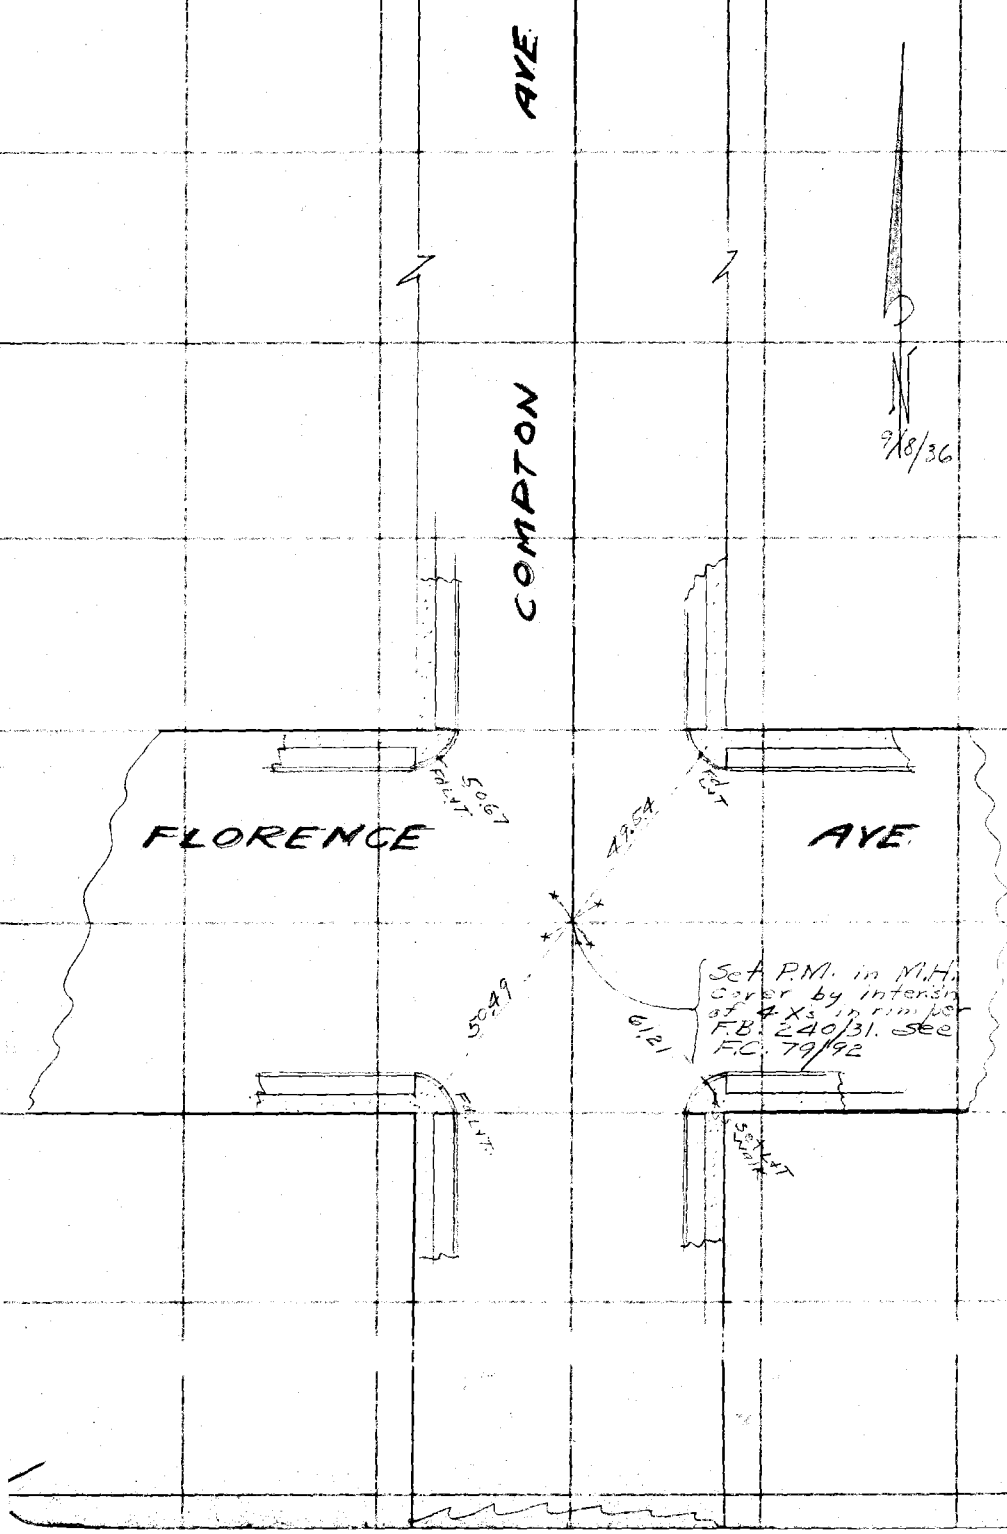

RETURN TO
LOS ANGELES COUNTY SURVEYOR
700 HALL OF RECORDS

Do not extend notes this side of this line

Note: Any Additions or Changes on This Sheet Must be Made or Circled in Red Ink With Date and Name of Person Making Change.

Notes Ck'd by A. A. R.	Survey of Gage Ave	F.B. 645	PG. 27
Map No. B-1245	W. O. 8157 Tape No. 072 St'd 84 F.		
Office Work COK	Surveyed by Evans		
Checked AAR	Notes H. Date 9/8/86		
Date Mar. 37	Indexed A. C. Johnson		

W.S. 7 B-4

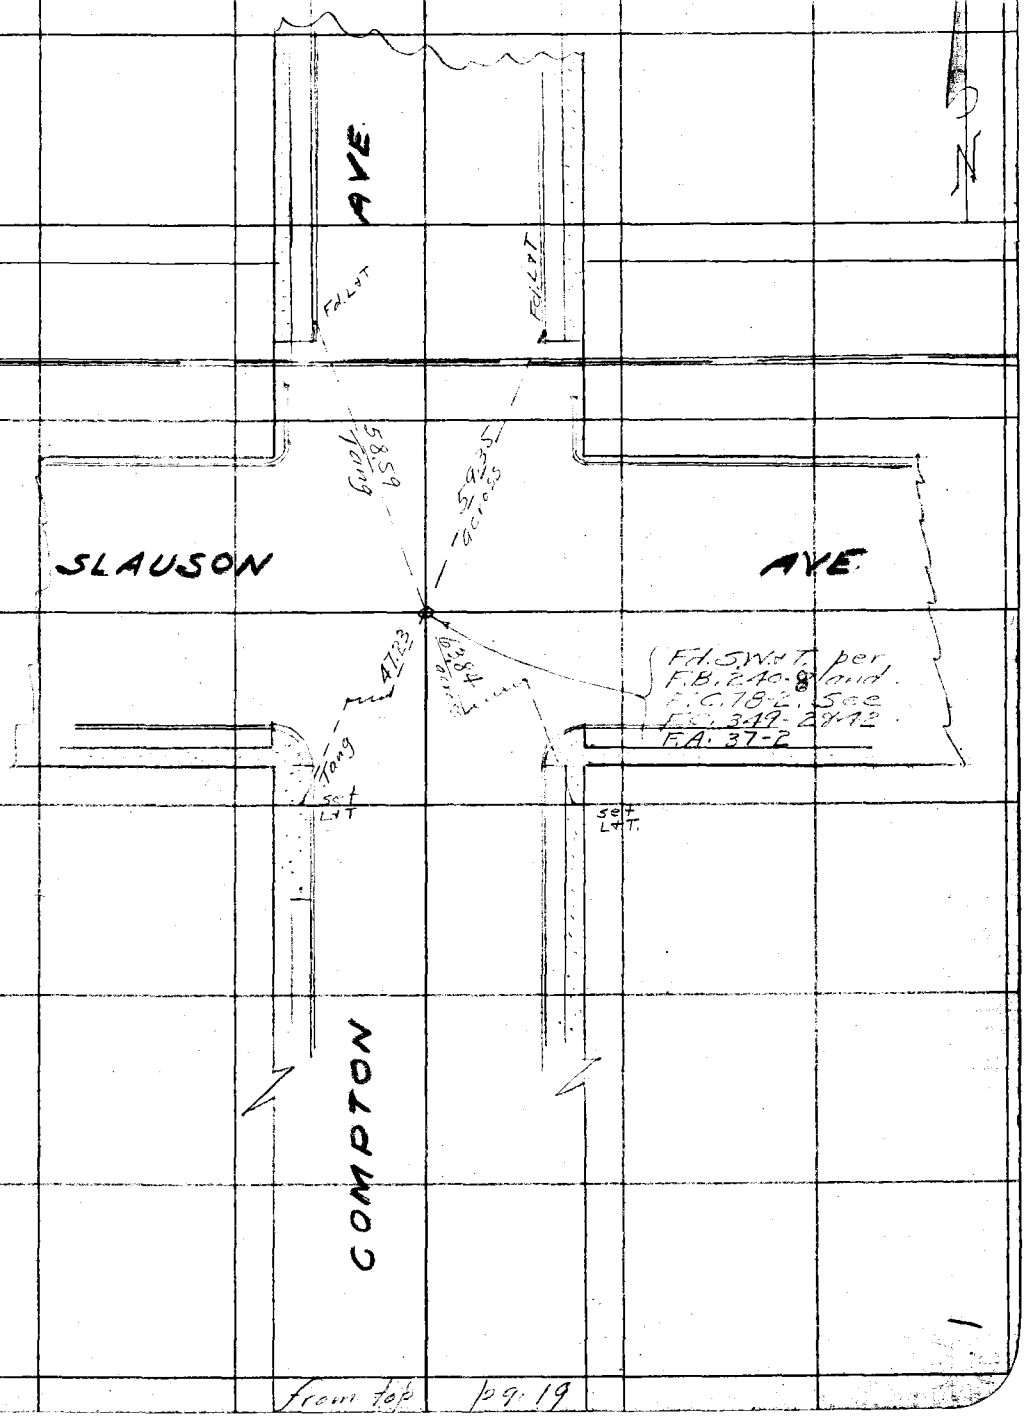

Note: Any Additions or Changes on This Sheet Must be Made or Circled in Red Ink With Date and Name of Person Making Change.

Do not extend notes this side of this line

RETURN TO
LOS ANGELES COUNTY SURVEYOR
700 HALL OF RECORDS

FORM 247 10M 11-35

from top pg. 19

RETURN TO
LOS ANGELES COUNTY SURVEYOR
700 HALL OF RECORDS

Note: Any Additions or Changes on This Sheet Must be Made or Circled in **Red Ink** With Date and Name of Person Making Change.

Do not extend notes this side of this line

W.S. 7 B-4,5

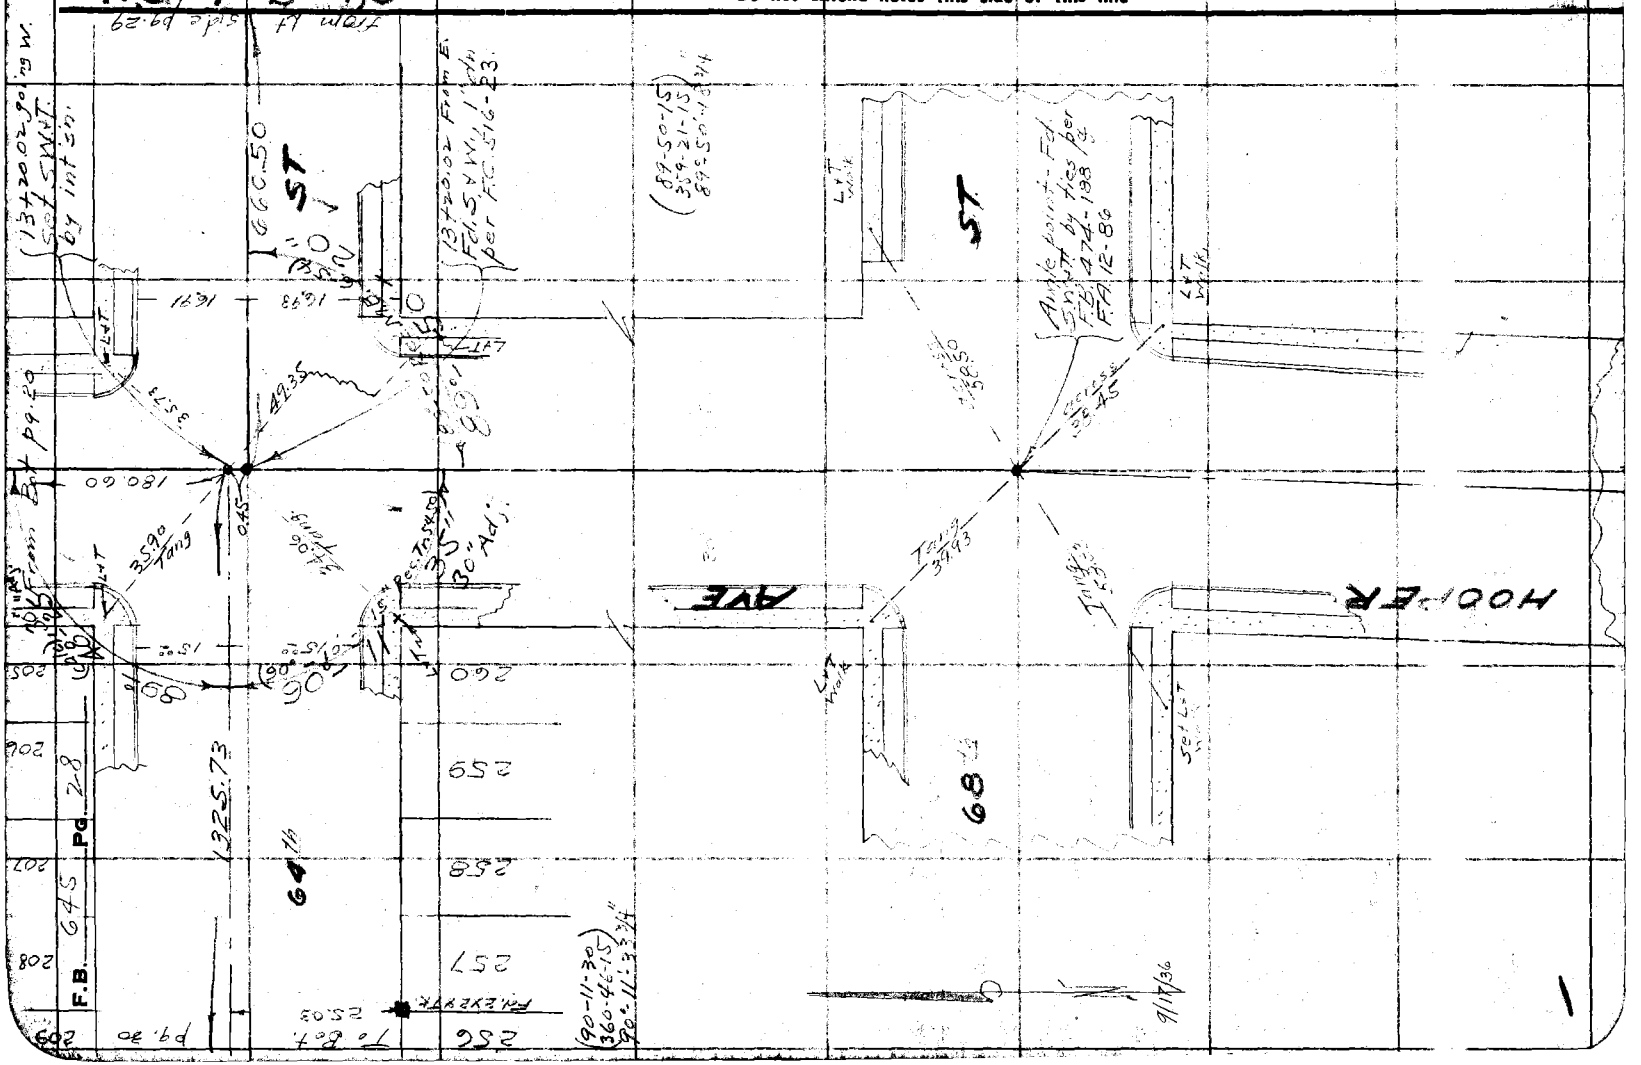

Notes Ck'd by A. A. R.		Survey of Gage Ave	F.B. 645 PG. 29
Map No. B-1245		W. O. 8157 Tape No. 07 St'd 84 °F.	
Office Work Cox		Surveyed by Evans	
Checked aur		Notes H Date 9/17/36	
Date Mar. 37		Indexed A. C. Johnson	

B-4,5

W.S. 7

Note: Any Additions or Changes on This Sheet Must be Made or Circled in Red Ink With Date and Name of Person Making Change.

Do not extend notes this side of this line

RETURN TO
LOS ANGELES COUNTY SURVEYOR
700 HALL OF RECORDS

FORM 247 10M 11-35

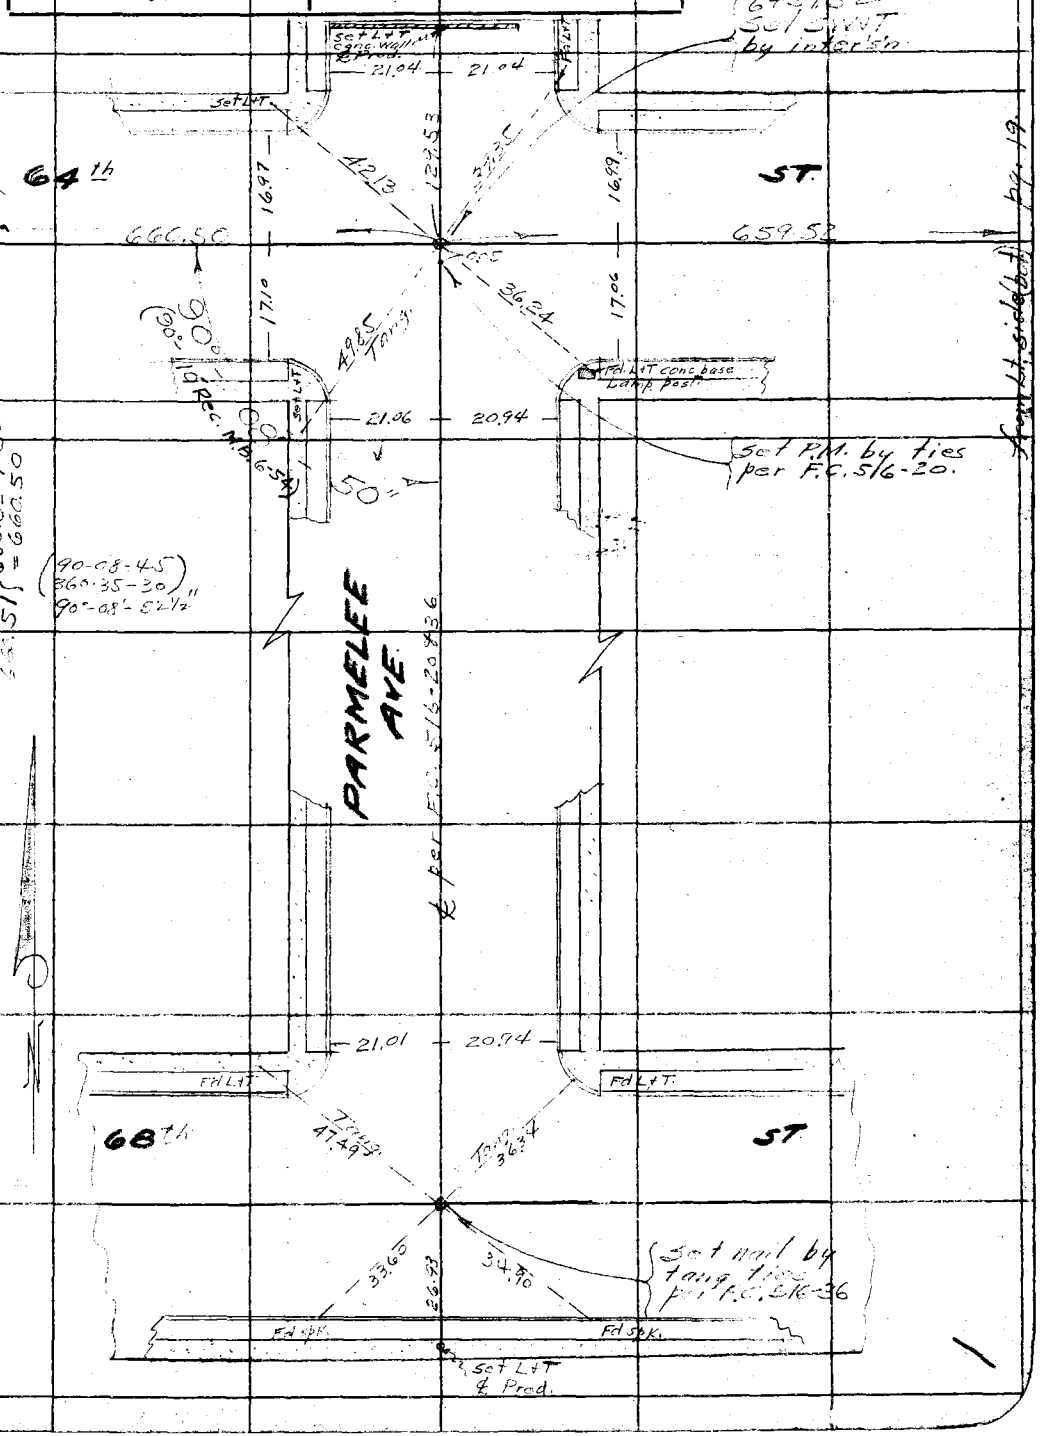

F.B. 645 PG. 30

WS 7 B-4

RETURN TO
LOS ANGELES COUNTY SURVEYOR
700 HALL OF RECORDS

Note: Any Additions or Changes on This Sheet Must be Made or Circled in Red Ink With Date and Name of Person Making Change.

Do not extend notes this side of this line

235	To Rt. side pg. 31	24.94	230
			Fd. 2x2
236			229
237			228
238			227
239			226
240			225
241		64th	224
242			223
243			222
244			221
Fd. 2x2 & T.	25.03		
245		1325.73	220
Fd. 1x2	24.96		
246			219
Fd. 2x2	25.04		
247			218
248		57	217
249			216
Fd. 2x2	25.06		
250			215
251			214
252			213
Fd. old 2x2	25.00		
253			212
Fd. 2x2 & TK	[illegible]		
254			211
255			210
Fd. 2x2 + TK	25.00 set Nail	25.12	Fd. 2x2
256	from Lt.	side pg. 28	209

1325.76 } 1325.76 - T80° = 1325.73
1325.76 }

Notes Ck'd by A. A. R.	Survey of Gage Ave	F.B. 645 Pg. 31
Map No. B-1245	W. O. 8157 Tape No. 072 St'd 84 °F.	
Office Work Cat	Surveyed by Evans	
Checked AAR	Notes HE Date 9/17/36	
Date Mar. 37	Indexed A. C. Johnson	

W.S. 7 B-4,5

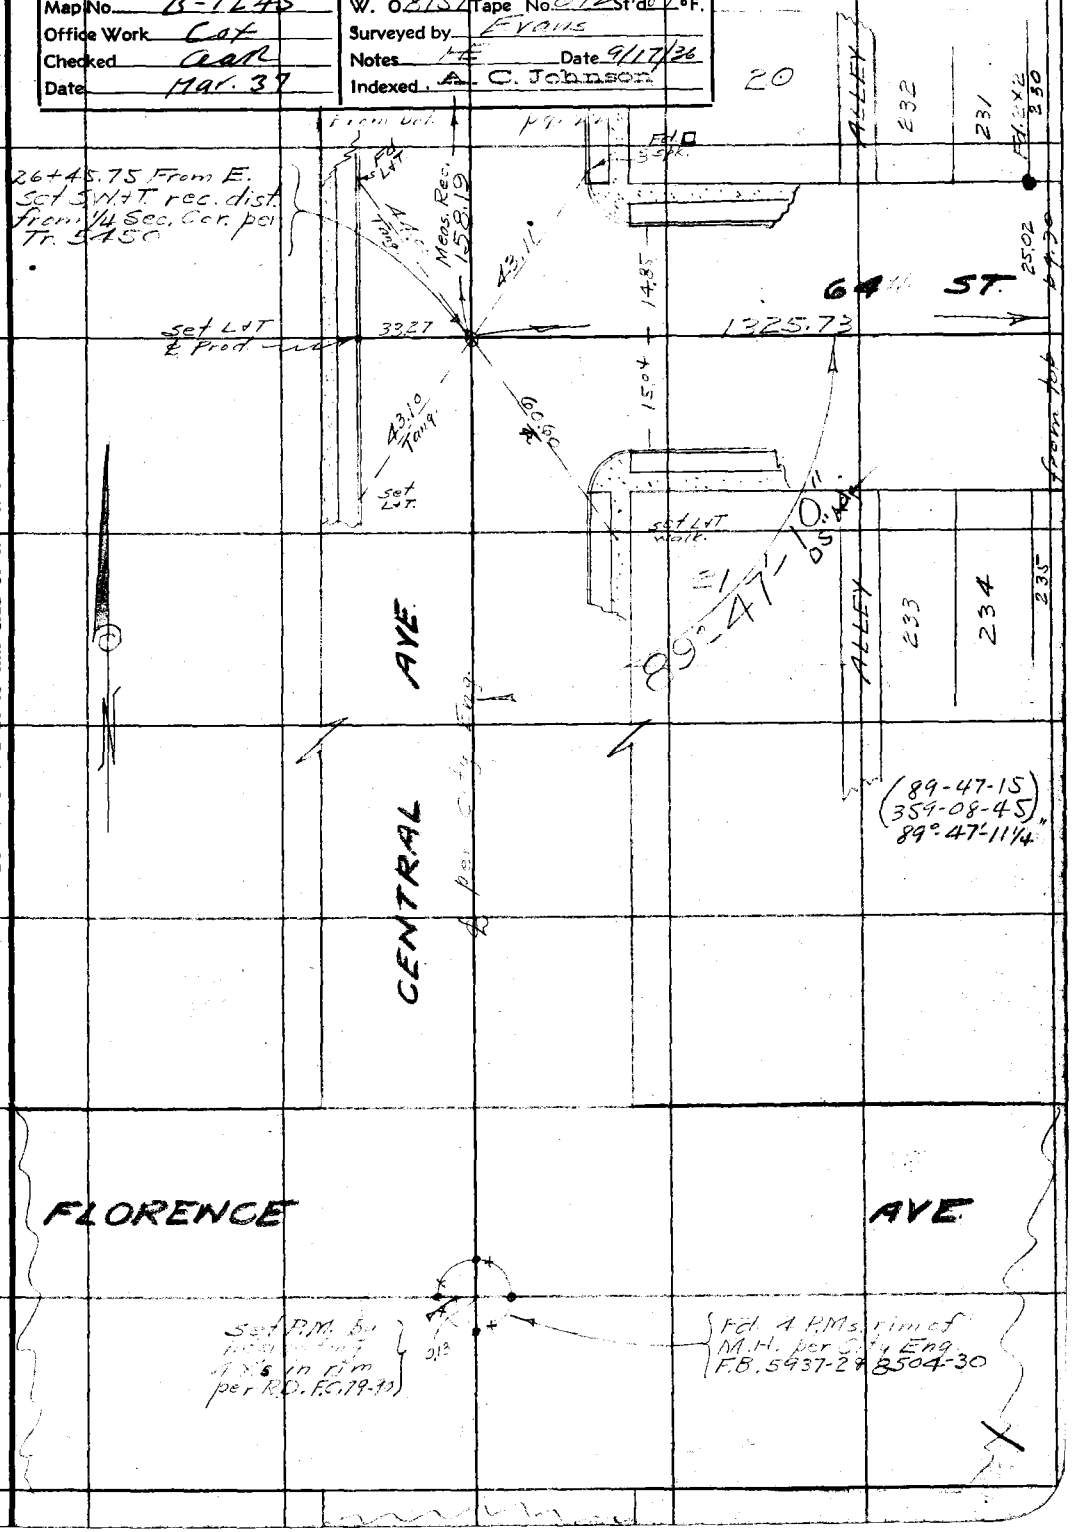

Note: Any Additions or Changes on This Sheet Must be Made or Circled in Red Ink With Date and Name of Person Making Change.

Do not extend notes this side of this line

RETURN TO
LOS ANGELES COUNTY SURVEYOR
700 HALL OF RECORDS

FORM 247 10M 11-35

RETURN TO
LOS ANGELES COUNTY SURVEYOR
700 HALL OF RECORDS

Note: Any Additions or Changes on This Sheet Must be Made or Circled in **Red Ink** With Date and Name of Person Making Change.

Do not extend notes this side of this line

WS 7 B-5

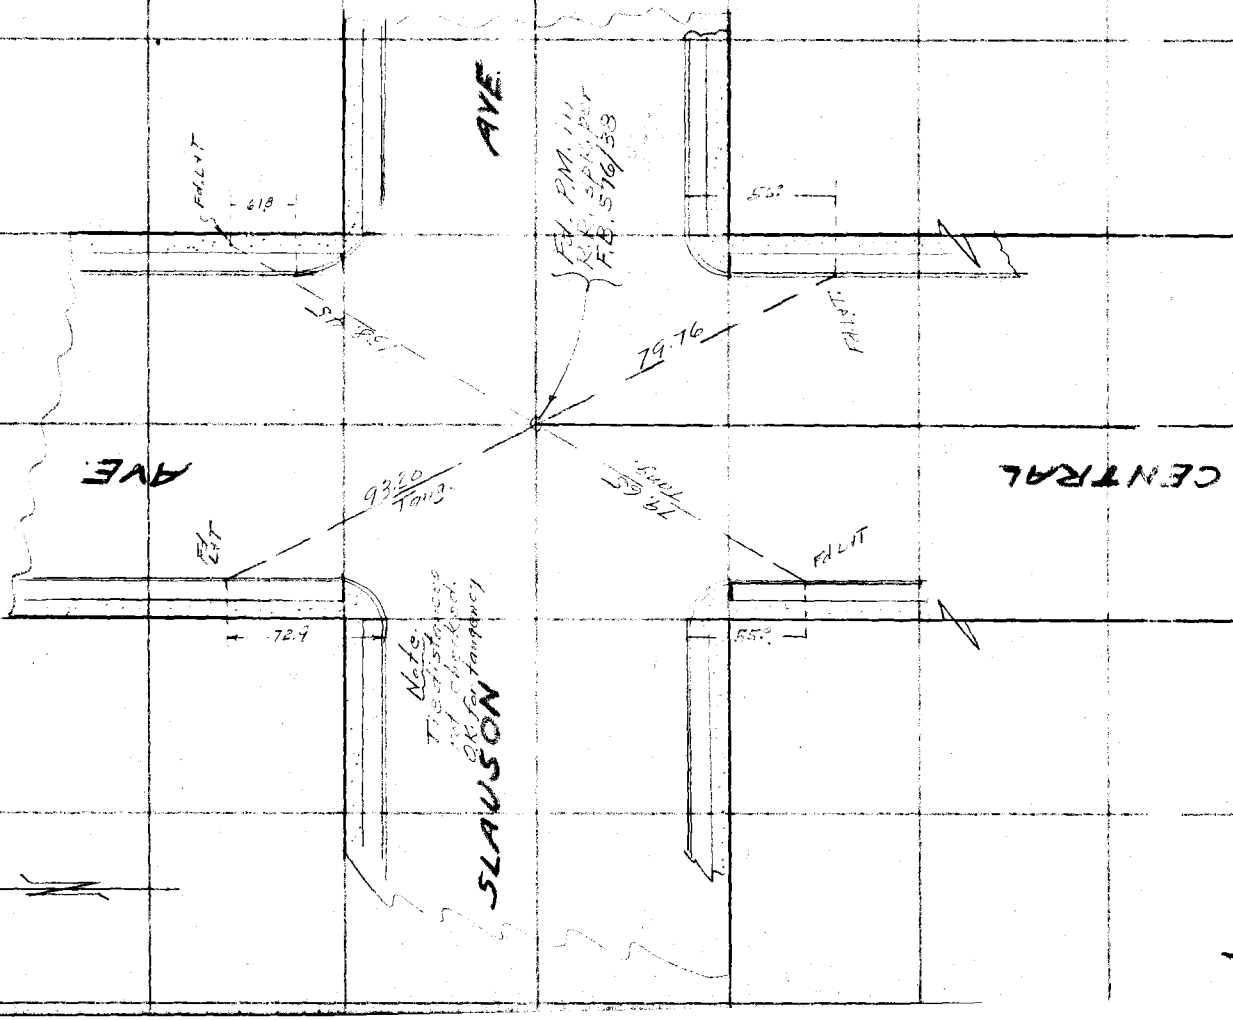

F.B. 645 PG. 32

From Tab pg. 22

Notes Ck'd by A. A. R.	Survey of Gage Ave		F.B. 645 PG. 33
Map No. B-1245	W. O. 8157	Tape No. 072	St'd 84 °F.
Office Work Cox	Surveyed by Evans		
Checked aar	Notes AE	Date 9/8/36	
Date Mar. 37	Indexed A. C. Johnson		

W.S. 7 B-A

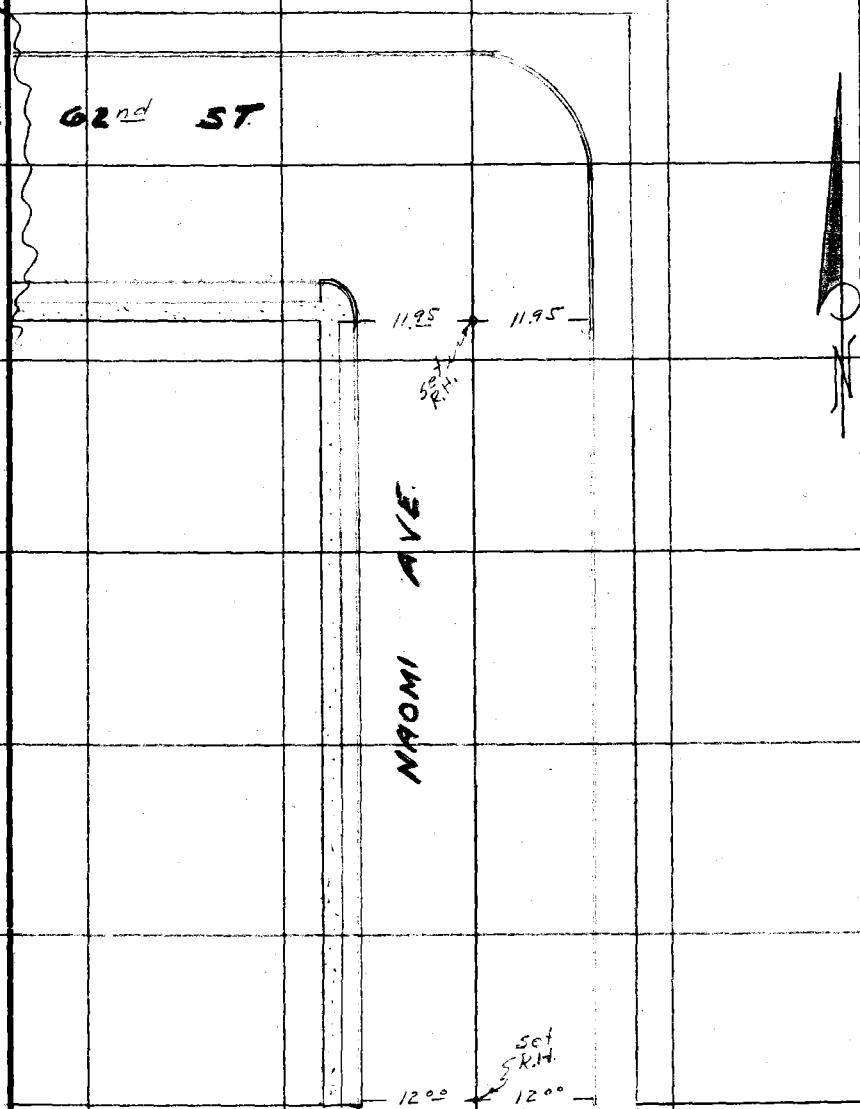

Note: Any Additions or Changes on This Sheet Must be Made or Circled in Red Ink With Date and Name of Person Making Change.

Do not extend notes this side of this line

RETURN TO
LOS ANGELES COUNTY SURVEYOR
700 HALL OF RECORDS

FORM 247 10M 11-35

from top pg. 21

RETURN TO
LOS ANGELES COUNTY SURVEYOR
700 HALL OF RECORDS

Note: Any Additions or Changes on This Sheet Must be Made or Circled in **Red Ink** With Date and Name of Person Making Change.

Do not extend notes this side of this line

F.B. 679 PG. 37

Notes Ck'd by	Survey of Gage Ave	F.B. 645 PG. 35
Map No. B-1245	W. O. 8157 Tape No. 072 St'd 84 °F.	
Office Work Cox	Surveyed by Evans	
Checked aur	Notes HM Date 9-22-36	
Date Mar. 37	Indexed A. C. Johnson 10-31-36	

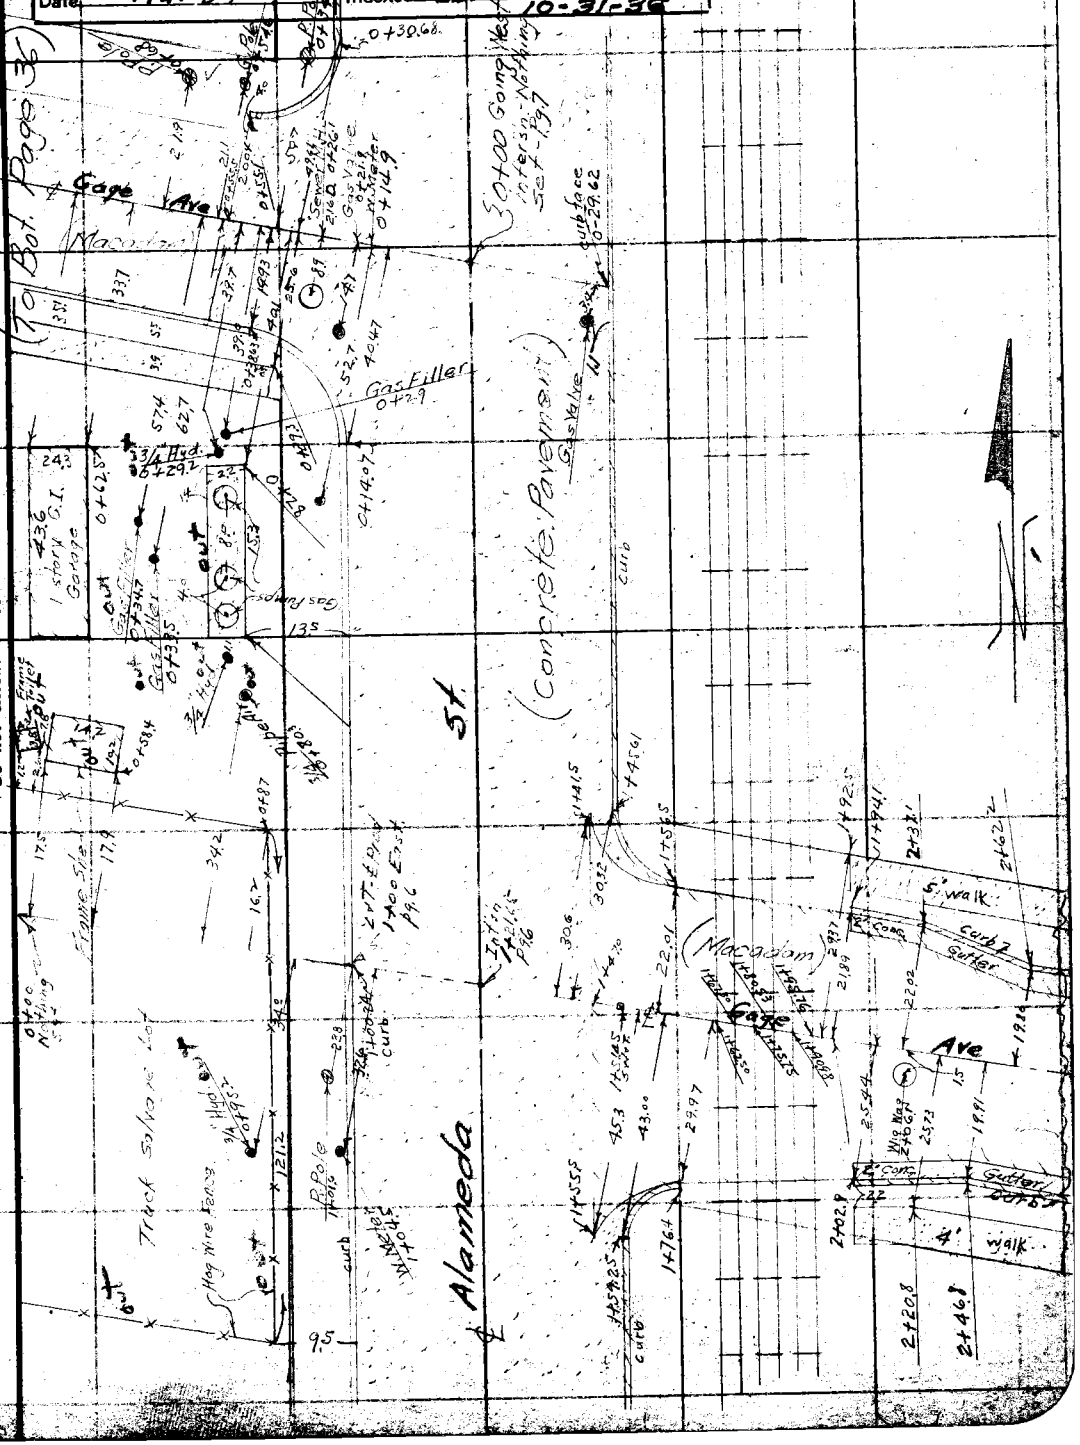

Note: Any Additions or Changes on This Sheet Must be Made or Circled in Red Ink With Date and Name of Person Making Change.

Do not extend notes this side of this line

RETURN TO
LOS ANGELES COUNTY SURVEYOR
700 HALL OF RECORDS

FORM 247 10M 11-35

(To Bat Page 37)

F.B. 645 PG. 36

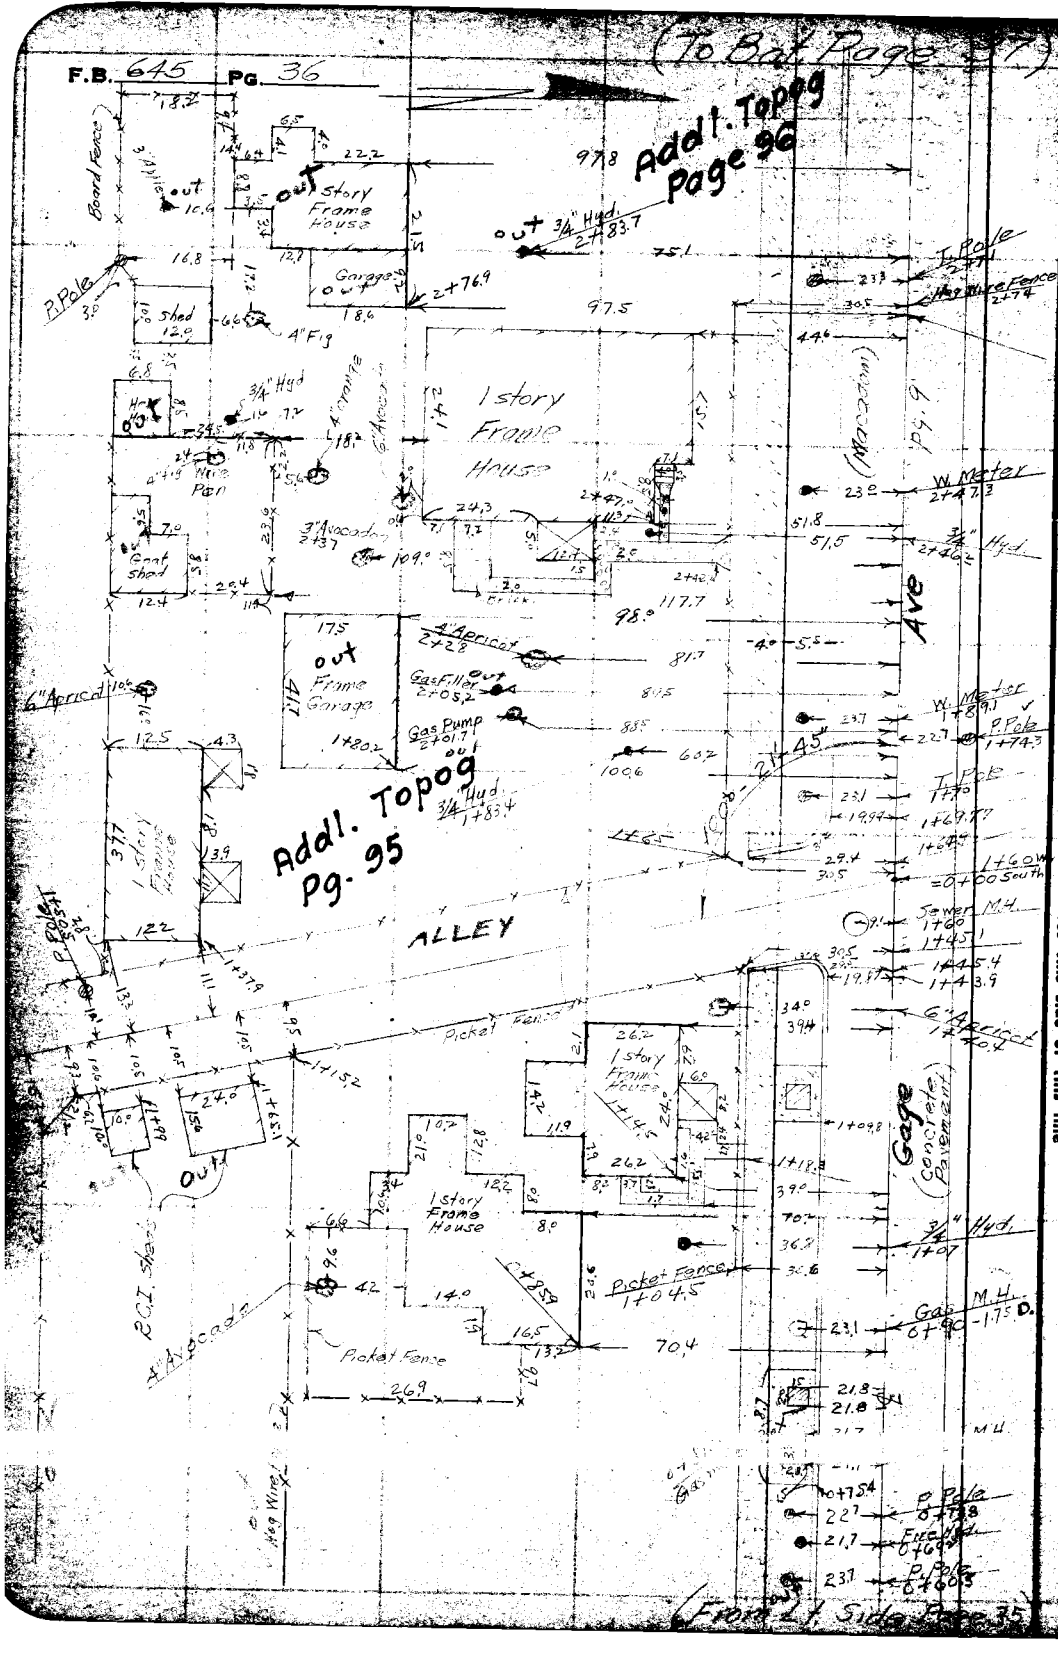

RETURN TO
LOS ANGELES COUNTY SURVEYOR
700 HALL OF RECORDS

Note: Any Additions or Changes on This Sheet Must be Made or Circled in Red Ink With Date and Name of Person Making Change.

Do not extend notes this side of this line

(From 2 Side Page 35)

Notes Ck'd by	Survey of Gage Ave
Map No. B-1245	W. O. 8157 Tape No. 07R St'd 84°F.
Office Work Cox	Surveyed by Evans
Checked aar	Notes Martin Date 9-22-36
Date Mar. 37	Indexed A. C. Johnson

F.B. 645 PG. 37

(To Bot. Page 38)

Notes: Any Additions or Changes on This Sheet Must be Made or Circled in Red Ink With Date and Name of Person Making Change.

Do not extend notes this side of this line

LOS ANGELES COUNTY SURVEYOR
700 HALL OF RECORDS

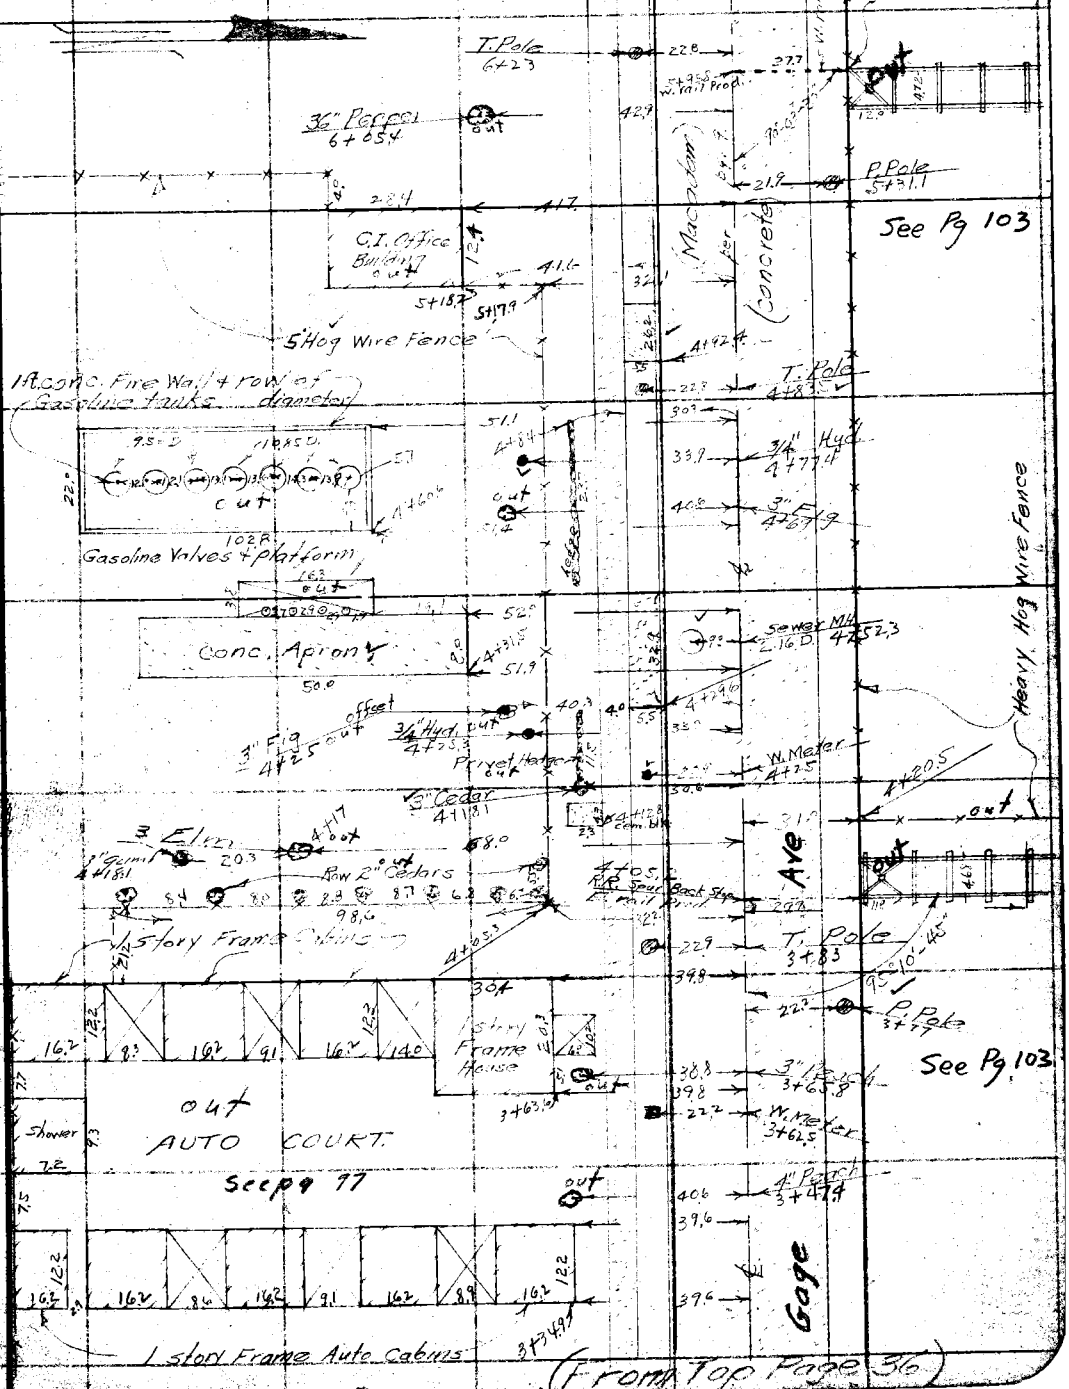

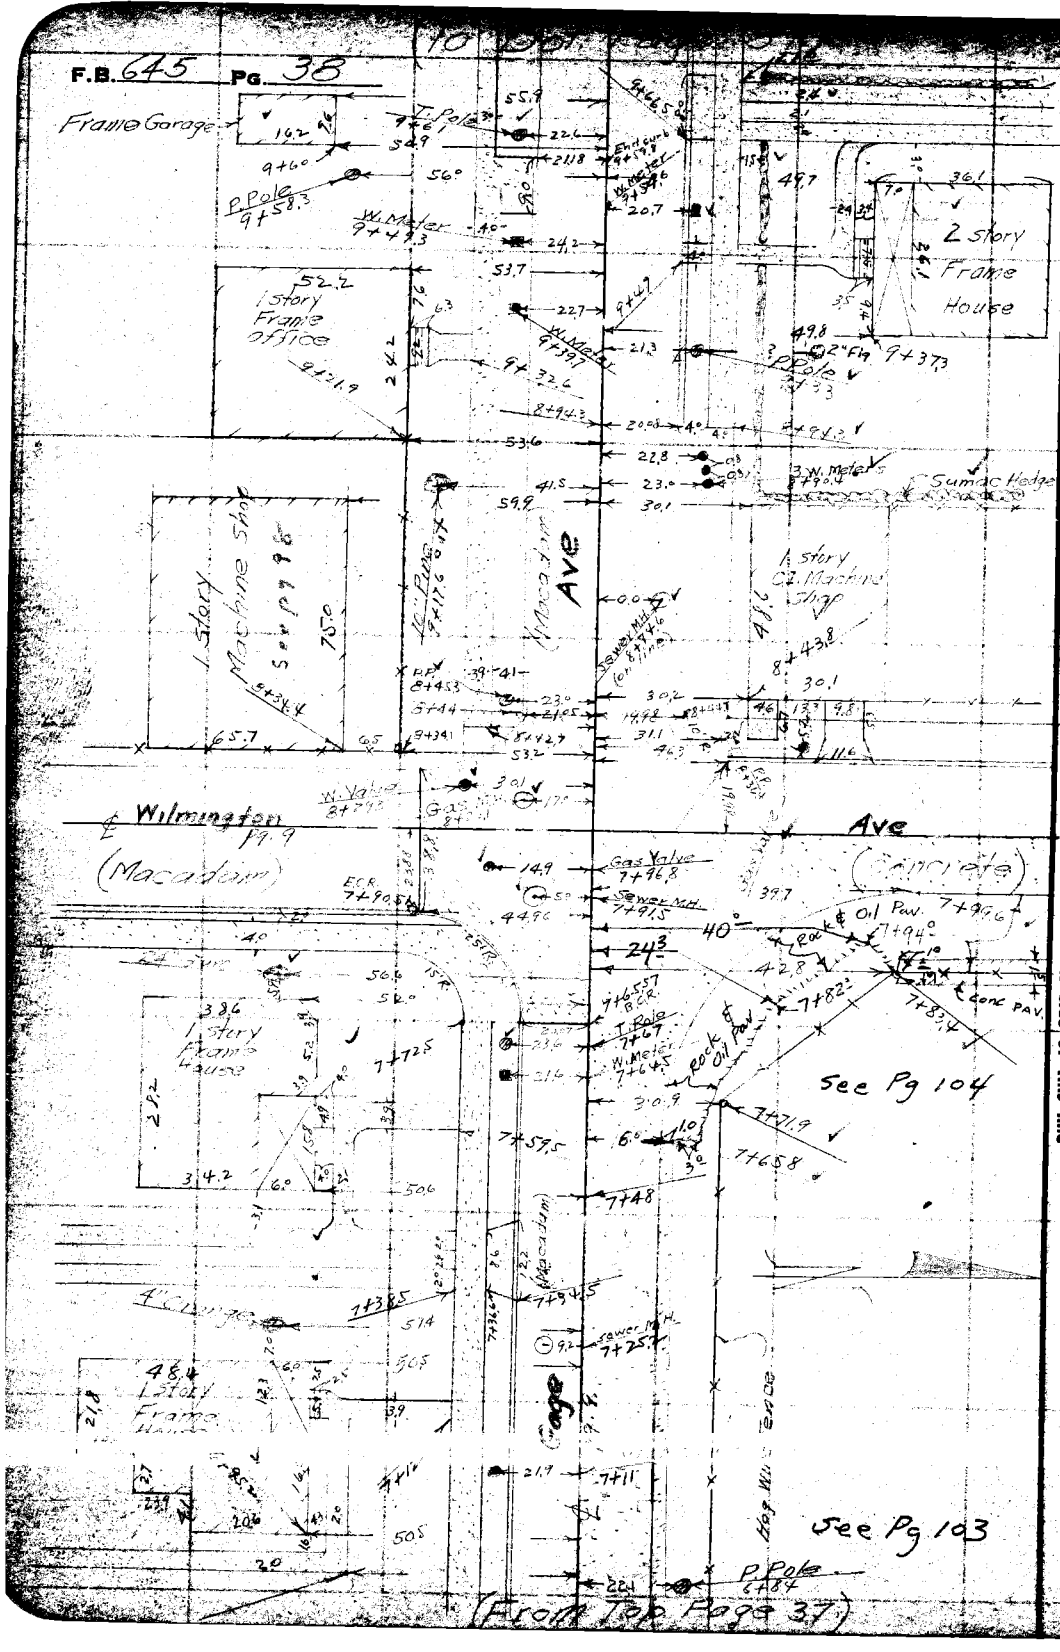

RETURN TO
LOS ANGELES COUNTY SURVEYOR
700 HALL OF RECORDS

Do not extend notes this side of this line

Note: Any Additions or Changes on This Sheet Must be Made or Circled in Red Ink With Date and Name of Person Making Change.

Notes Ck'd by	Survey of Gage Ave	F.B. 645 Pg. 39
Map No. B-1245	W. O. 8157 Tape No. 072 St'd 84 °F.	(To Bot. Page 40)
Office Work Cox	Surveyed by Evans	
Checked AAR	Notes Martin Date 9-23-36	
Date Mar. 37	Indexed A. G. Johnson	

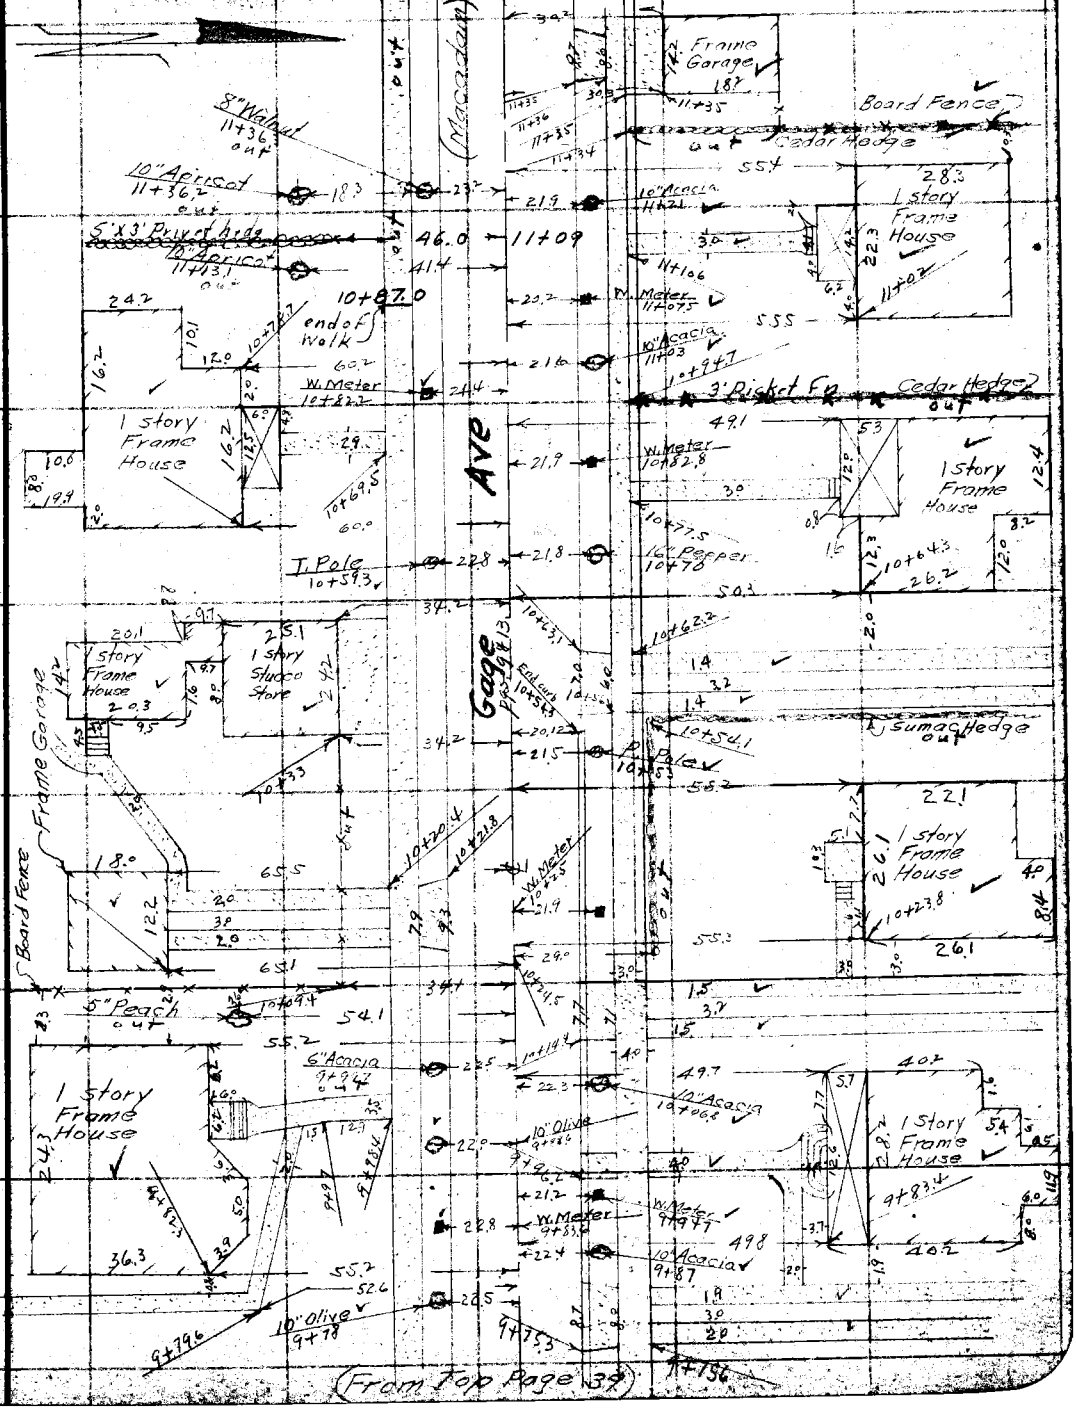

Note: Any Additions or Changes on This Sheet Must be Made or Circled in Red Ink With Date and Name of Person Making Change.

Do not extend notes this side of this line

SUPPLIED TO
LOS ANGELES COUNTY SURVEYOR
700 HALL OF RECORDS

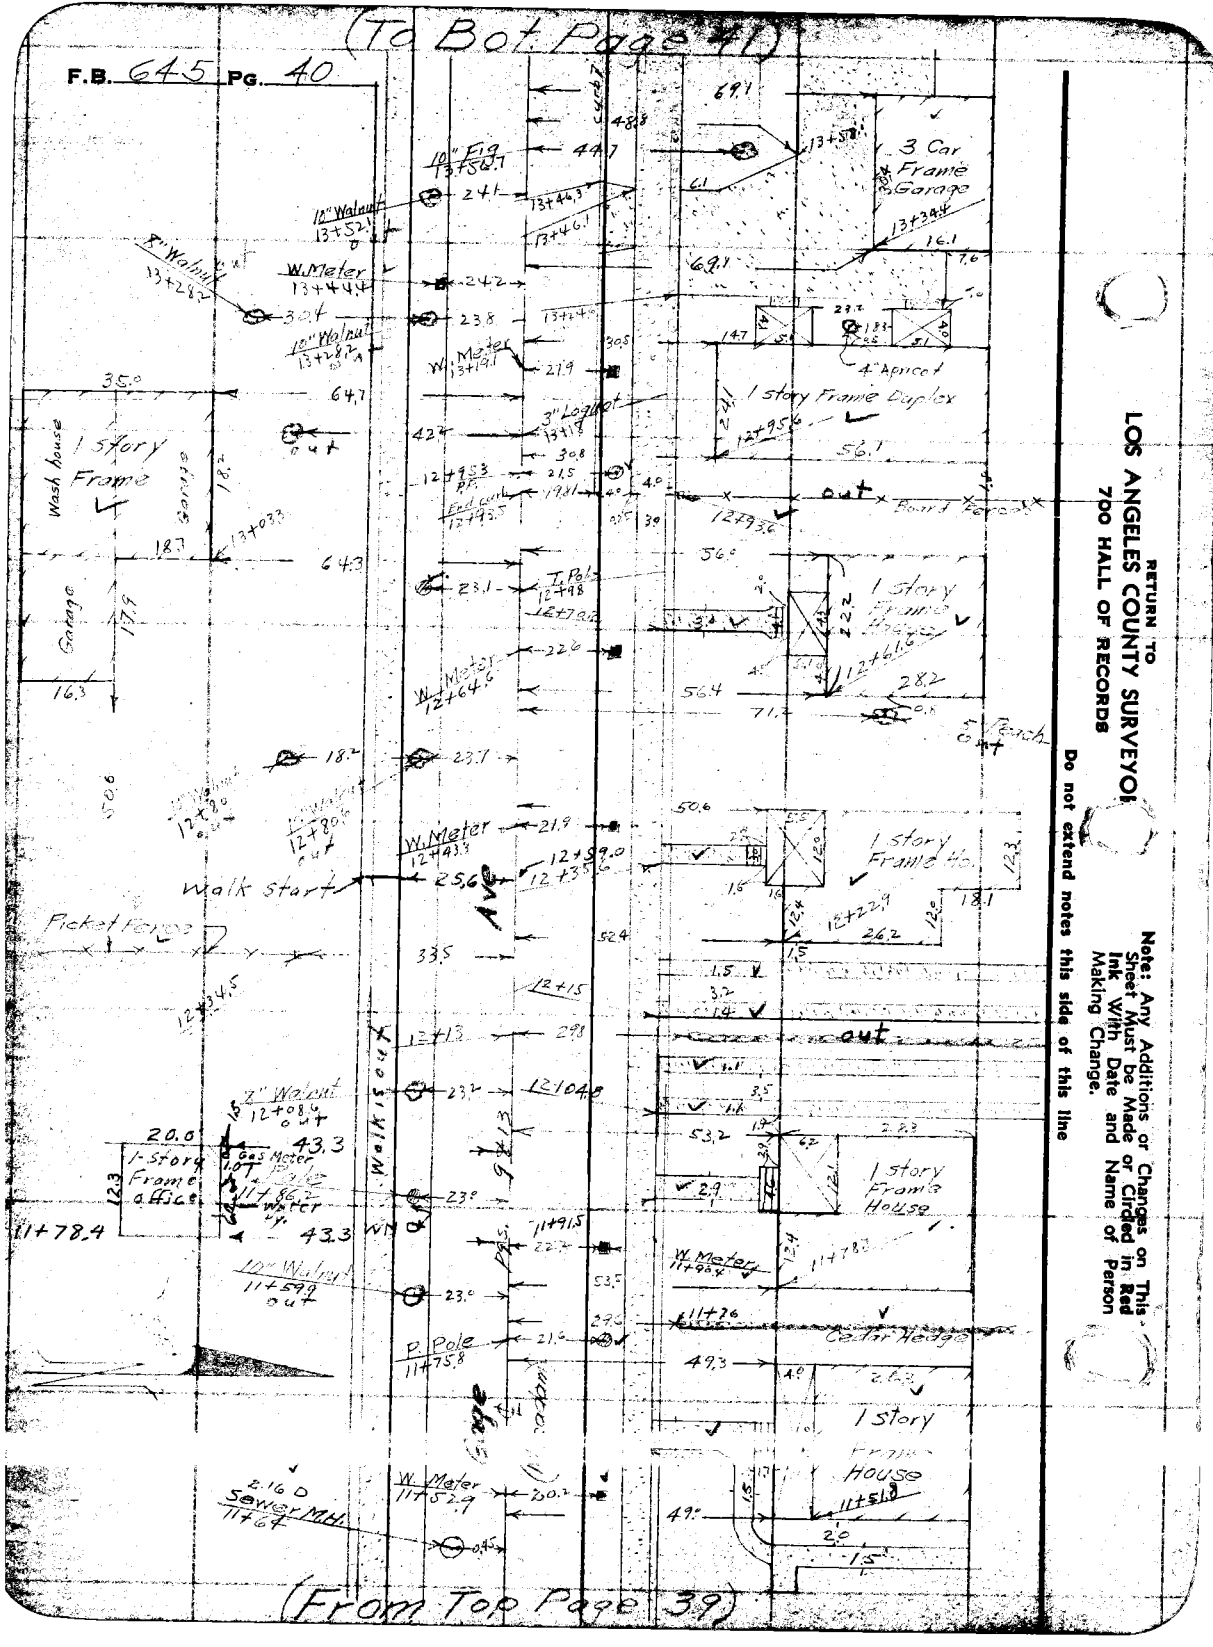
(To Bot Page 41)
F.B. 645 Pg. 40
3 Car Frame Garage
1 Story Frame Duplex
4" Apricot
1 Story Frame
Wash house
Garage
Board Fence
1 Story Frame House
1 Story Frame Ho.
Walk start
Picket Fence
Walk is out
1-Story Frame office
1 Story Frame House
Cedar Hedge
1 Story Frame House
Sewer M.H.
(From Top Page 39)
RETURN TO
LOS ANGELES COUNTY SURVEYOR
700 HALL OF RECORDS
Note: Any Additions or Changes on This Sheet Must be Made or Circled in Red Ink With Date and Name of Person Making Change.
Do not extend notes this side of this line

Notes Ck'd by	Survey of Gage Ave
Map No. B-1245	W. O. 8157 Tape No. 072 St'd 84°F.
Office Work Cox	Surveyed by Evans
Checked aar	Notes Martin Date 9-23-36
Date Mar. 37	Indexed A. C. Johnson

F.B. 645 PG. 41

(To Bot. Page 42)

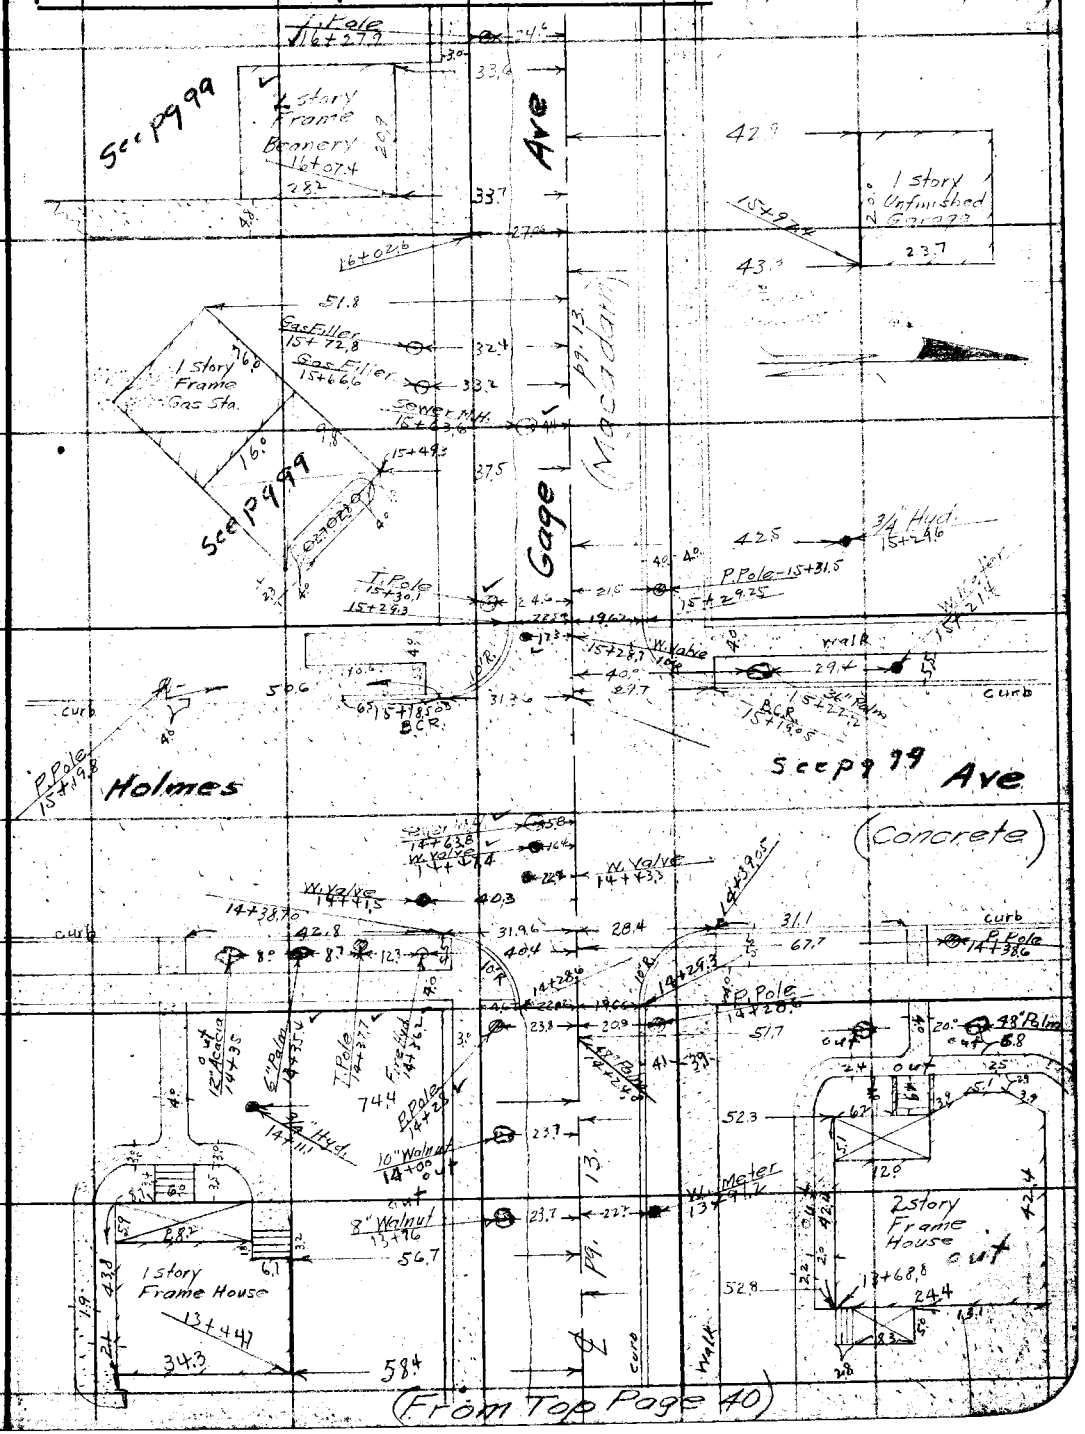

Note: Any Additions or Changes on This Sheet Must be Made or Circled in Red Ink With Date and Name of Person Making Change.

Do not extend notes this side of this line

RETURN TO
LOS ANGELES COUNTY SURVEYOR
700 HALL OF RECORDS

(To Bot. Page 43)

F.B. 645 PG. 42

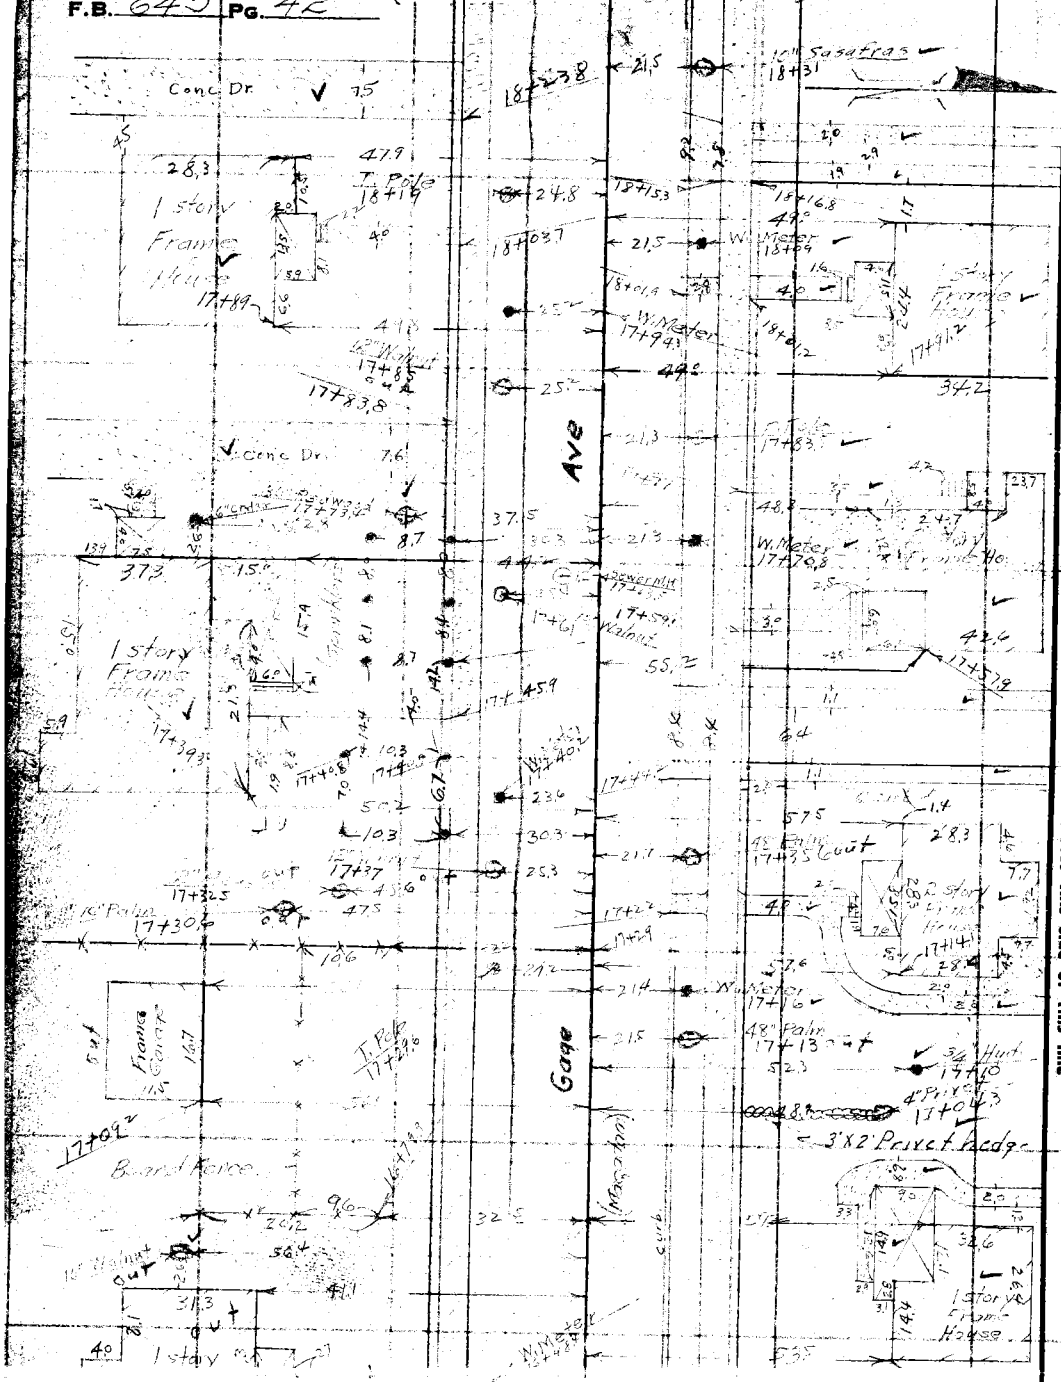

RETURN TO
LOS ANGELES COUNTY SURVEYOR
700 HALL OF RECORDS

Do not extend notes this side of this line

Note: Any Additions or Changes on This Sheet Must be Made or Circled in Red Ink With Date and Name of Person Making Change.

Notes Ck'd by	Survey of Gage Ave	F.B. 645 Pg. 43
Map No. B-1245	W. O. 8157 Tape No. 072 St'd 84 °F.	(To Bot. Page 44)
Office Work Cox	Surveyed by Evans	
Checked Cam	Notes Martin Date 9-23-36	
Date Mar. 37	Indexed A. C. Johnson	

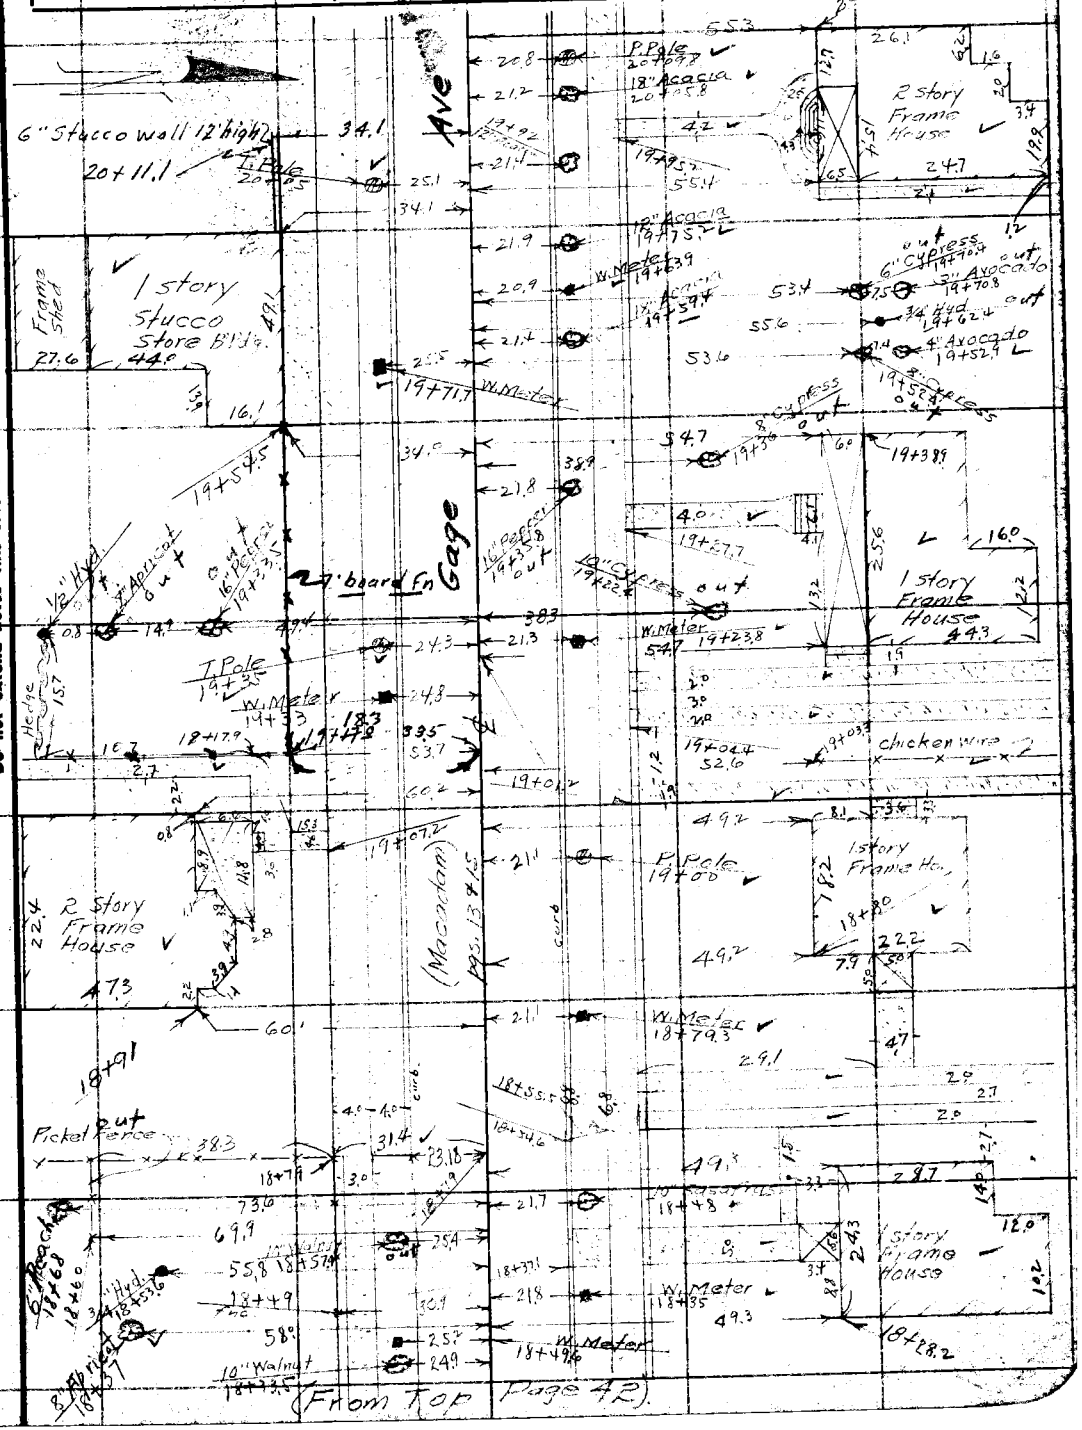

Do not extend notes this side of this line

Never Any Additions or Changes on This Sheet Must be Made or Circled in Red Line With Date and Name of Person Making Change

RETURN TO
LOS ANGELES COUNTY SURVEYOR
700 HALL OF RECORDS

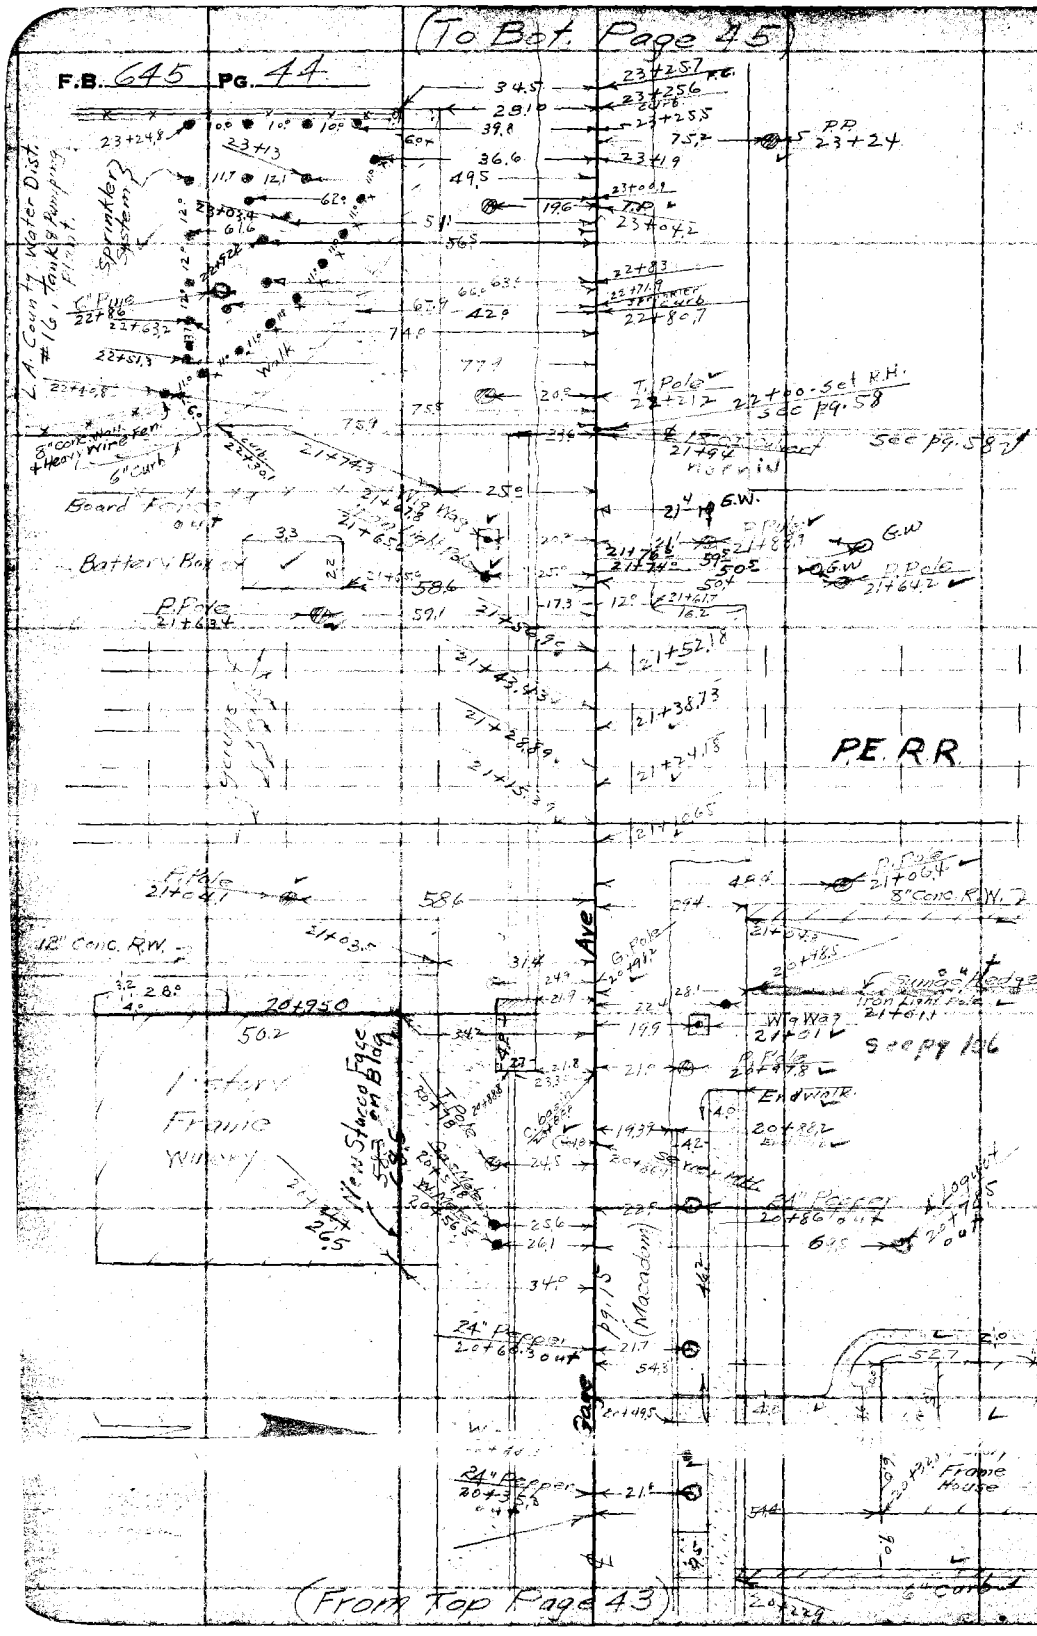

RETURN TO
LOS ANGELES COUNTY SURVEYOR
700 HALL OF RECORDS

Note: Any Additions or Changes on This Sheet Must be Made or Circled in Red Ink With Date and Name of Person Making Change.

Do not extend notes this side of this line

Notes Ck'd by
Map No. B-1245
Office Work Cox
Checked aer
Date Mar. 37

Survey of Gage Ave
W. O. 8157 Tape No. OTR St'd 62° F.
Surveyed by Evans
Notes Martin Date 9-23-36
Indexed ~~A. C. Johnson~~

F.B. 645 PG. 45

(To Back Page 46)

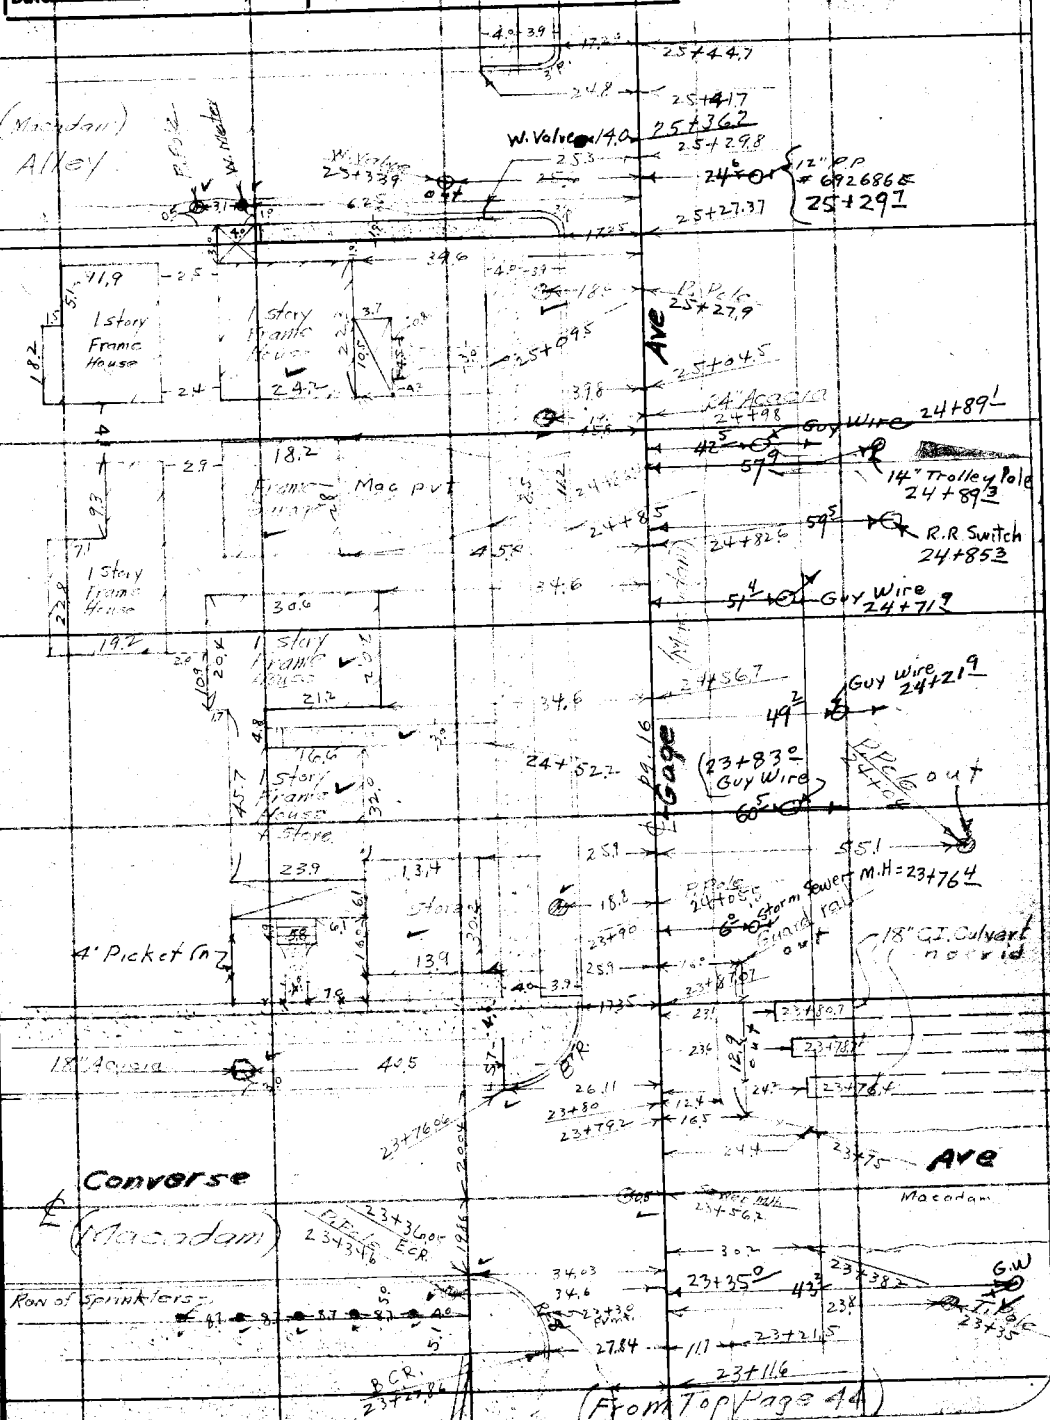

Note: Any Additions or Changes on This Sheet Must be Made or Circled in Red Ink With Date and Name of Person Making Change.

Do not extend notes this side of this line

RETURN TO
LOS ANGELES COUNTY SURVEYOR
700 HALL OF RECORDS

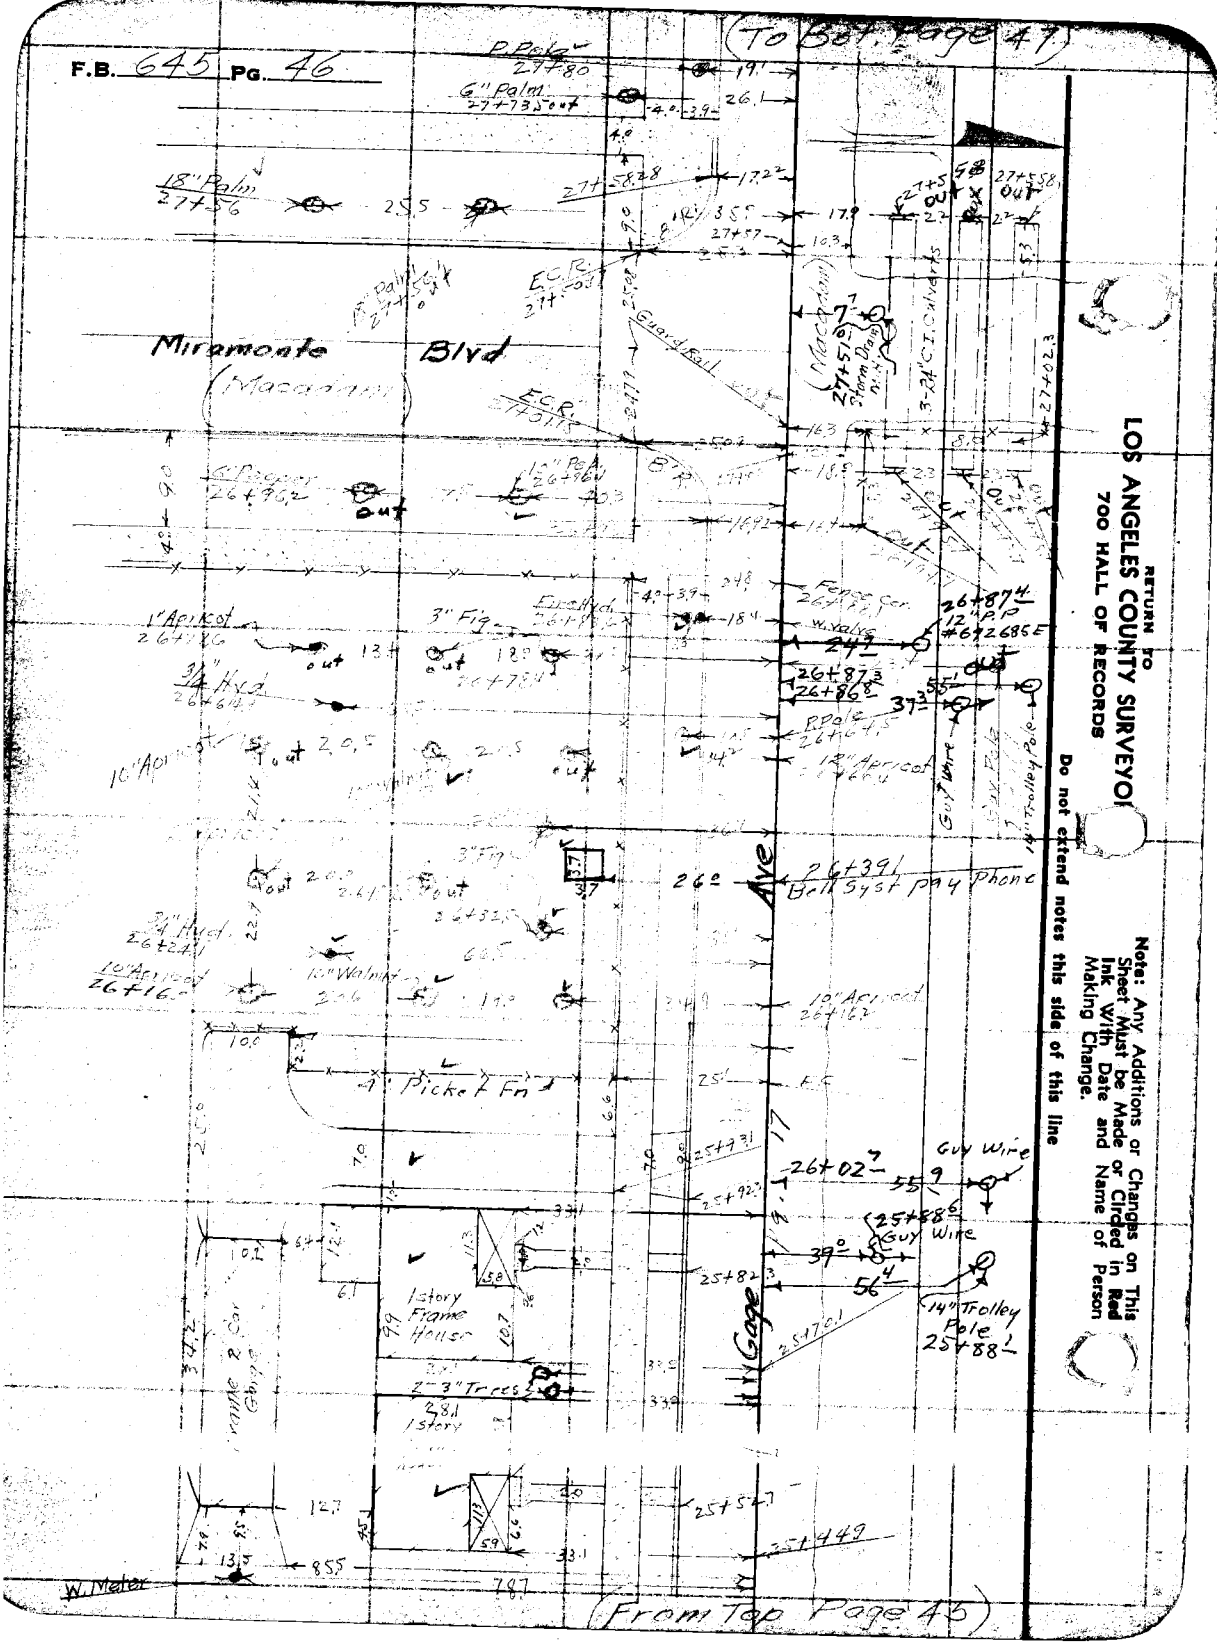
F.B. 645 PG. 46
(To Bot. Page 47)
Miramonte Blvd
(Macadam)
Guard Rail
Storm Drain
3-24" C.I. Culverts
Fence Cor.
W. Valve
Fire Hyd.
3" Fig.
1" Apricot
3/4" Hyd.
10" Apricot
Guy Wire
14" Trolley Pole
Bell Syst pay Phone
Ave
Gage
4" Picket Fn
Guy Wire
14" Trolley Pole
1 story Frame House
2-3" Trees
W. Meter
(From Top Page 45)
RETURN TO
LOS ANGELES COUNTY SURVEYOR
700 HALL OF RECORDS
Note: Any Additions or Changes on This Sheet Must be Made or Circled in Red Ink With Date and Name of Person Making Change.
Do not extend notes this side of this line

Notes Ck'd by	Survey of Gage Ave
Map No. B-1245	W. O. 8157 Tape No. 072 St'd 84°F.
Office Work Cox	Surveyed by Evans
Checked Clark	Notes Martin Date 9-25-36
Date Mar. 37	Indexed E. C. Johnson

F.B. 645 PG. 47

(To Bot. Page 48)

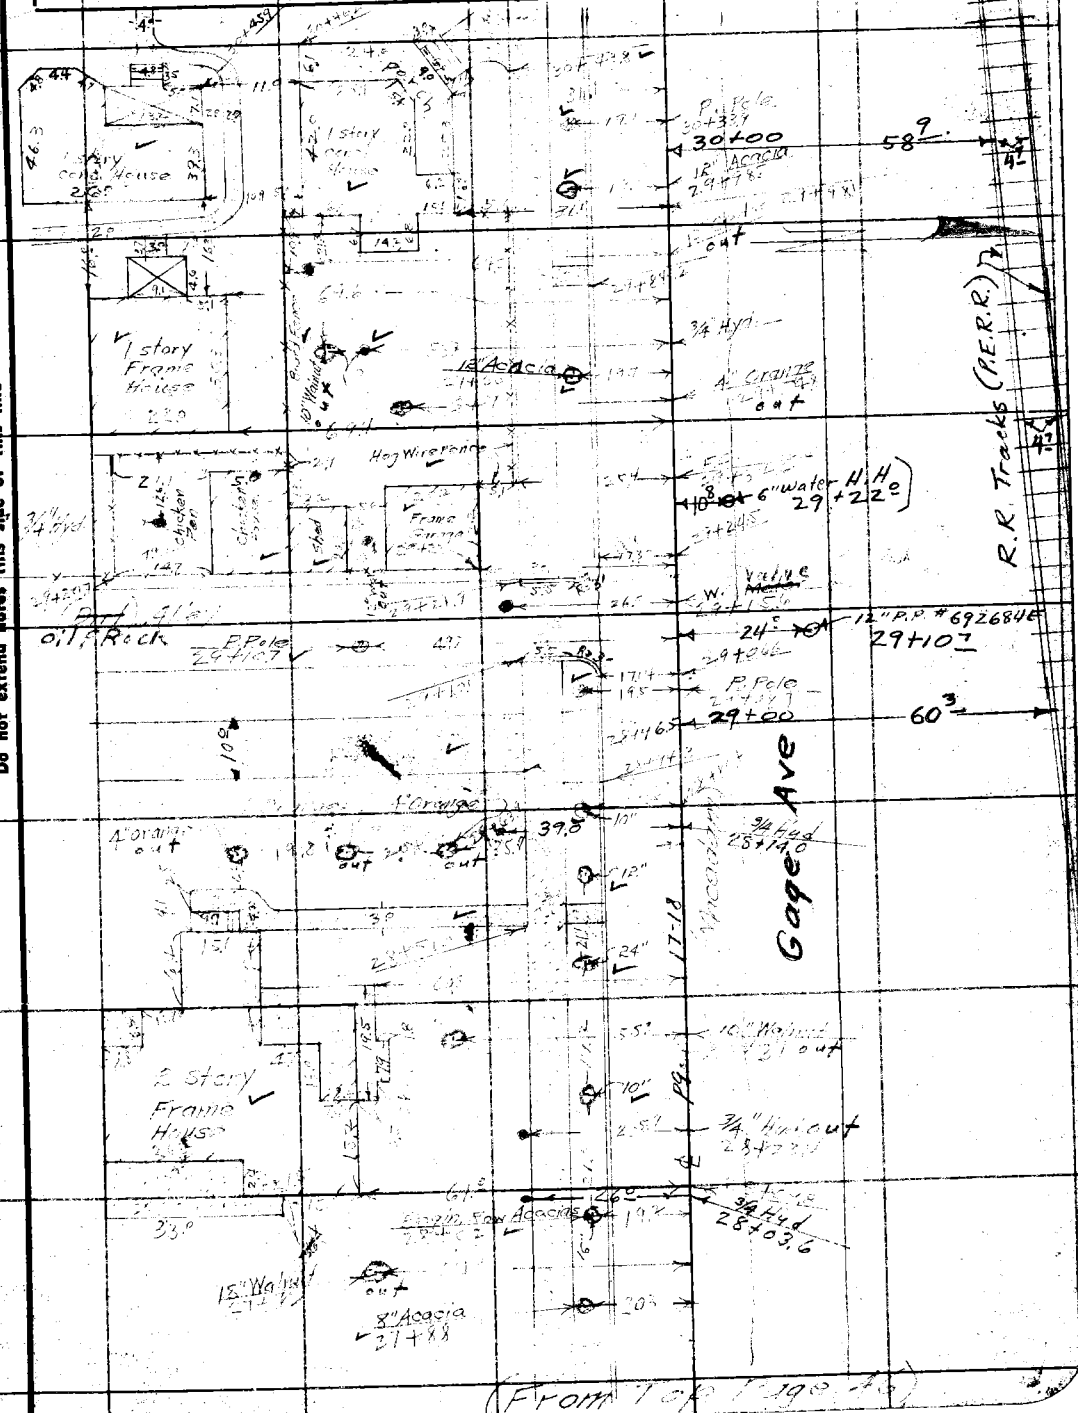

(From Top Page 46)

Note: Any Additions or Changes on This Sheet Must be Made or Circled in Red Ink With Date and Name of Person Making Change.

Do not extend notes this side of this line

RETURN TO
LOS ANGELES COUNTY SURVEYOR
700 HALL OF RECORDS

FORM 847 10M 11-38

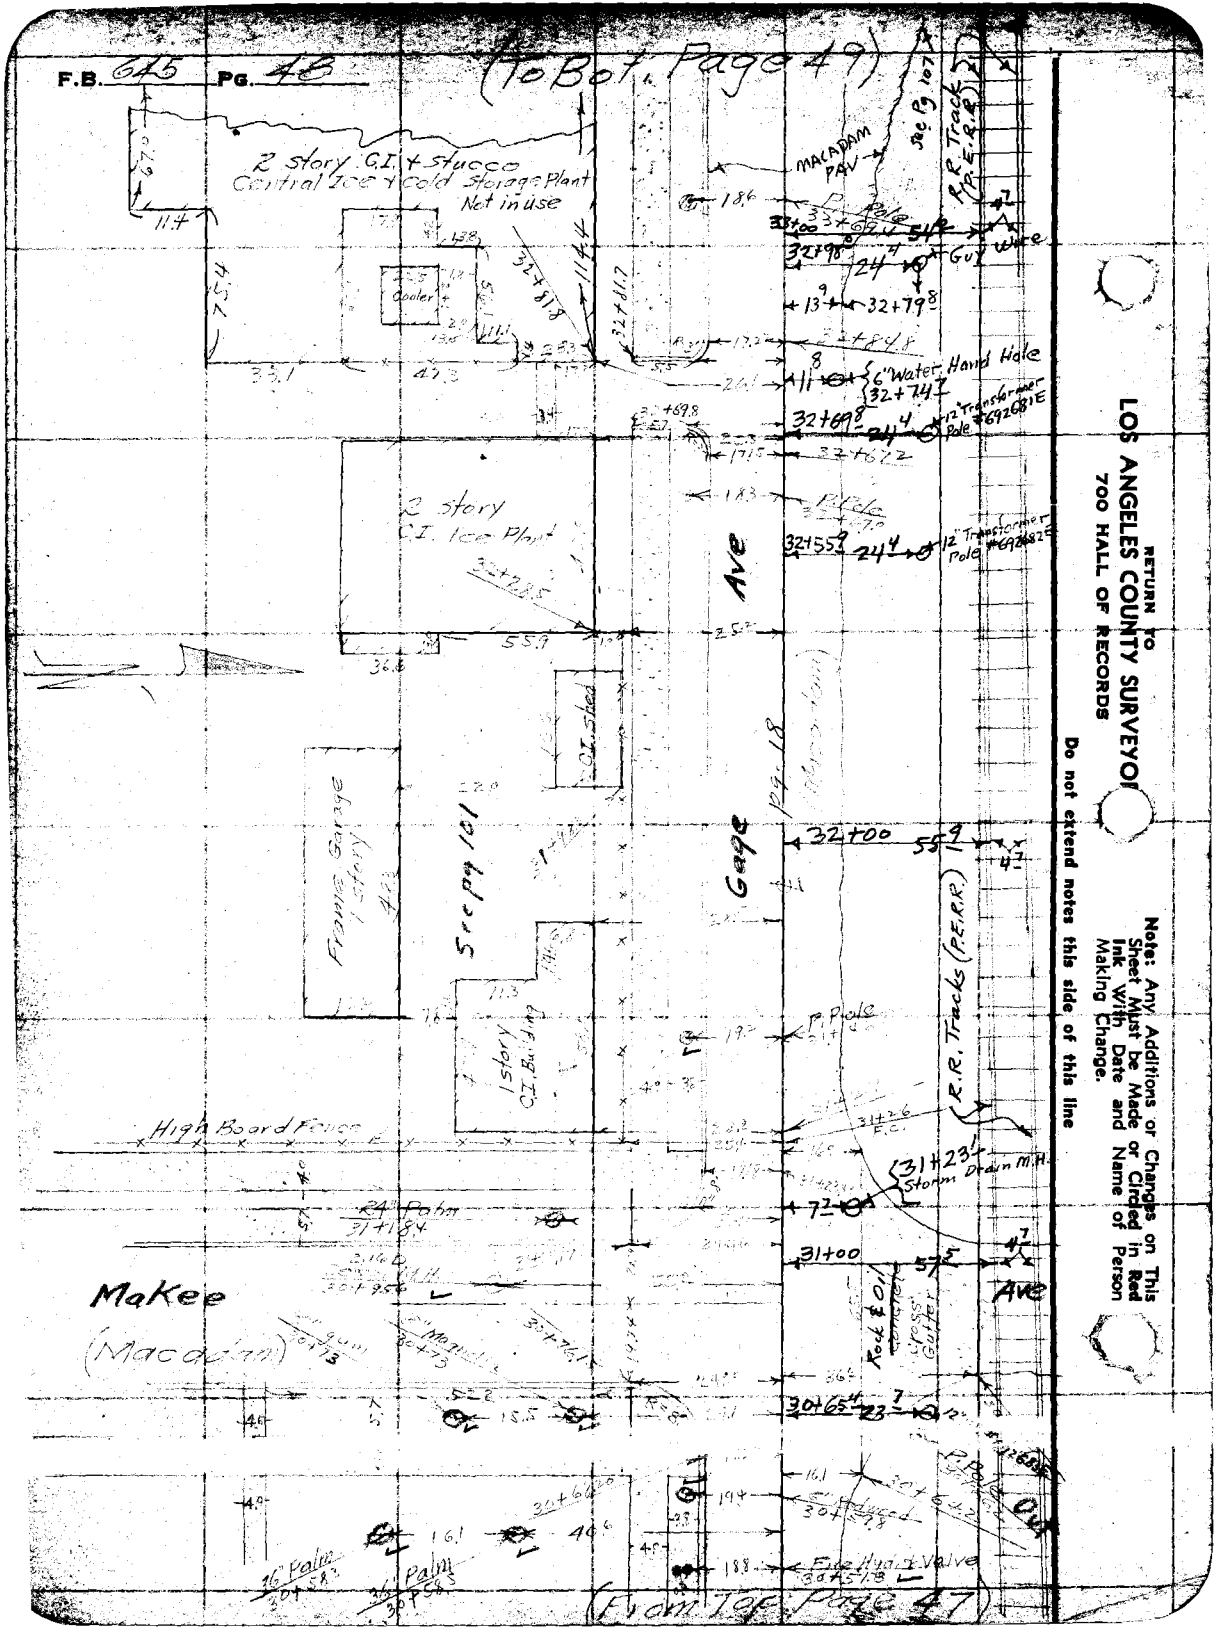

RETURN TO
LOS ANGELES COUNTY SURVEYOR
700 HALL OF RECORDS

Do not extend notes this side of this line

Note: Any Additions or Changes on This Sheet Must be Made or Circled in Red Ink With Date and Name of Person Making Change.

Notes Ck'd by	Survey of Gage Ave
Map No. B-1245	W. O. 8157 Tape No. 072 St'd 84 °F.
Office Work Cox	Surveyed by Evans
Checked aak	Notes Martin Date 9-25-36
Date Mar. 37	Indexed A. C. Johnson

F.B. 645 Pg. 49

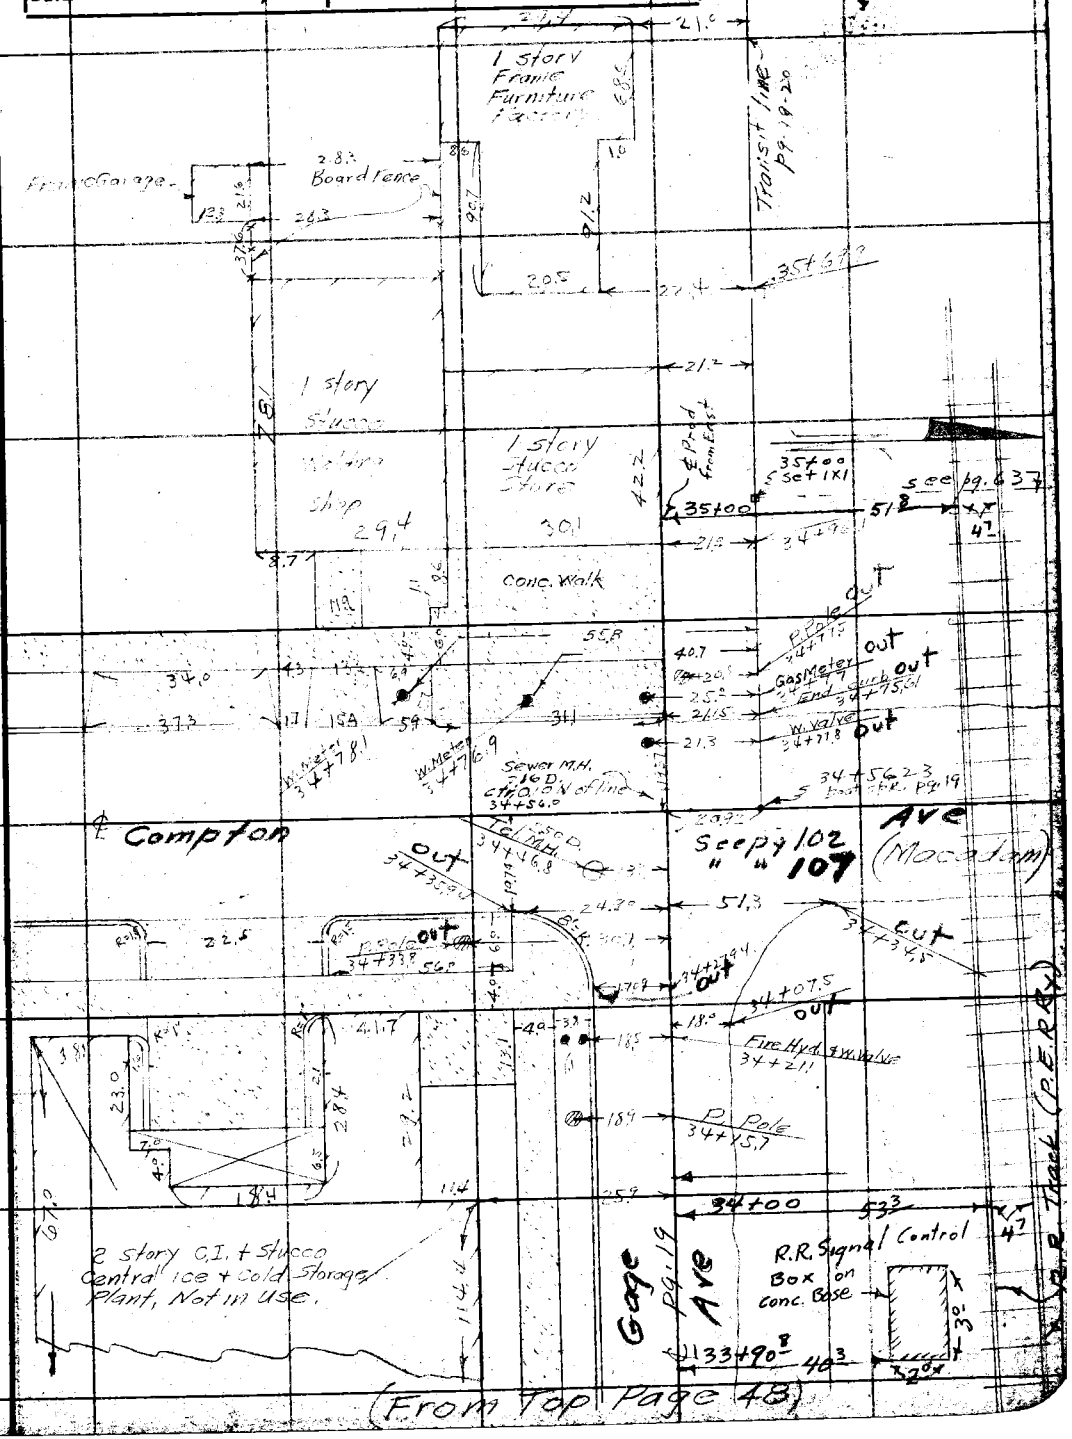

Note: Any Additions or Changes on This Sheet Must be Made or Circled in Red Ink With Date and Name of Person Making Change.

Do not extend notes this side of this line

RETURN TO
LOS ANGELES COUNTY SURVEYOR
700 HALL OF RECORDS

(To Bot. Page 51)

F.B. 645 PG. 50

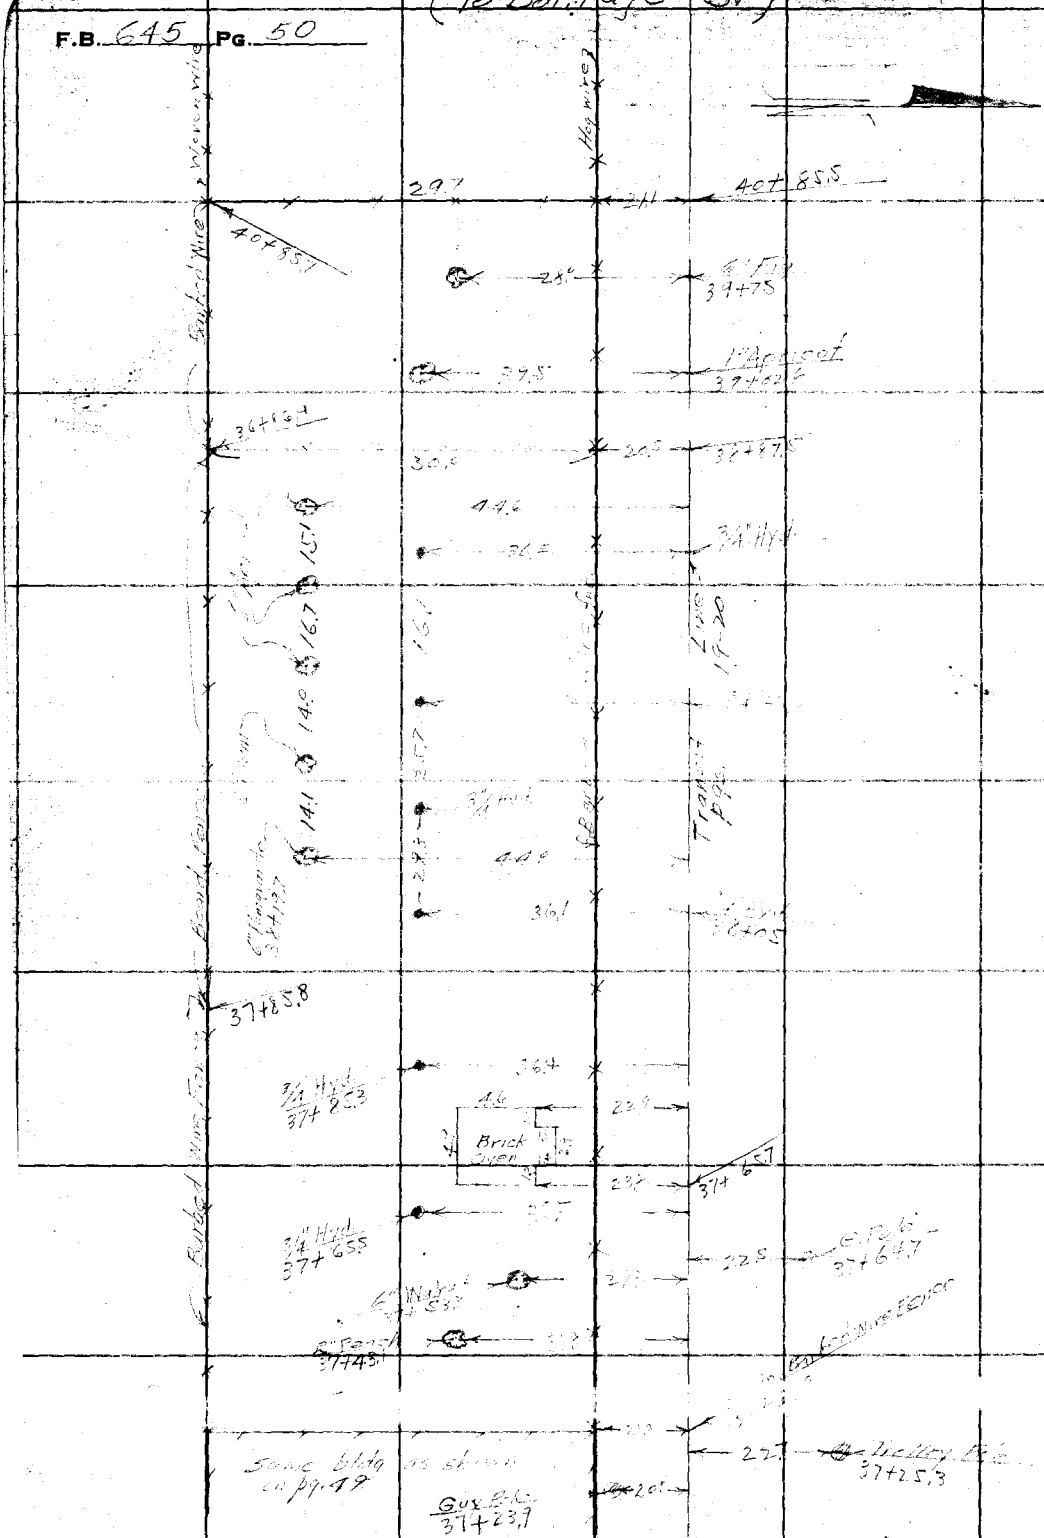

(From Top Page 49)

RETURN TO
LOS ANGELES COUNTY SURVEYOR
700 HALL OF RECORDS

Do not extend notes this side of this line

Note: Any Additions or Changes on This Sheet Must be Made or Circled in Red Ink With Date and Name of Person Making Change.

Notes Ck'd by	
Map No.	B-1245
Office Work	Cox
Checked	aar
Date	Mar. 37

Survey of	Gage Ave
W. O.	8157 Tape No. 072 St'd 54 °F.
Surveyed by	Evans
Notes	[illegible] Date 9-26-36
Indexed	A. C. Johnson

F.B. 645 PG. 51

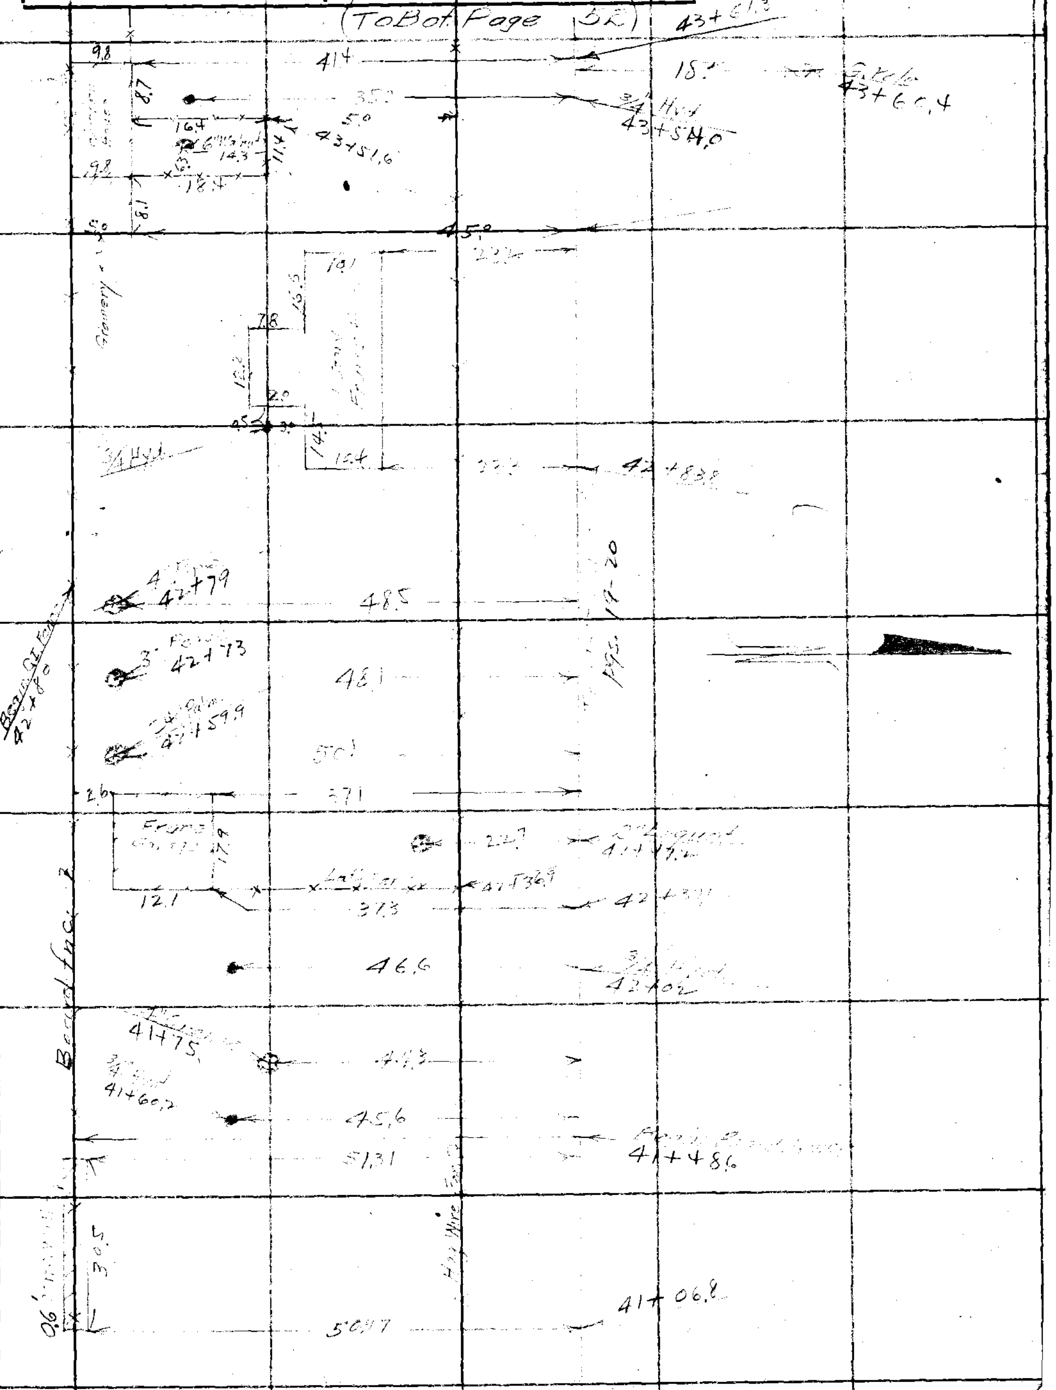

Note: Any Additions or Changes on This Sheet Must be Made or Circled in Red Ink With Date and Name of Person Making Change

Do not extend notes this side of this line

RETURN TO
LOS ANGELES COUNTY SURVEYOR
700 HALL OF RECORDS

FORM 247 10M 11-35

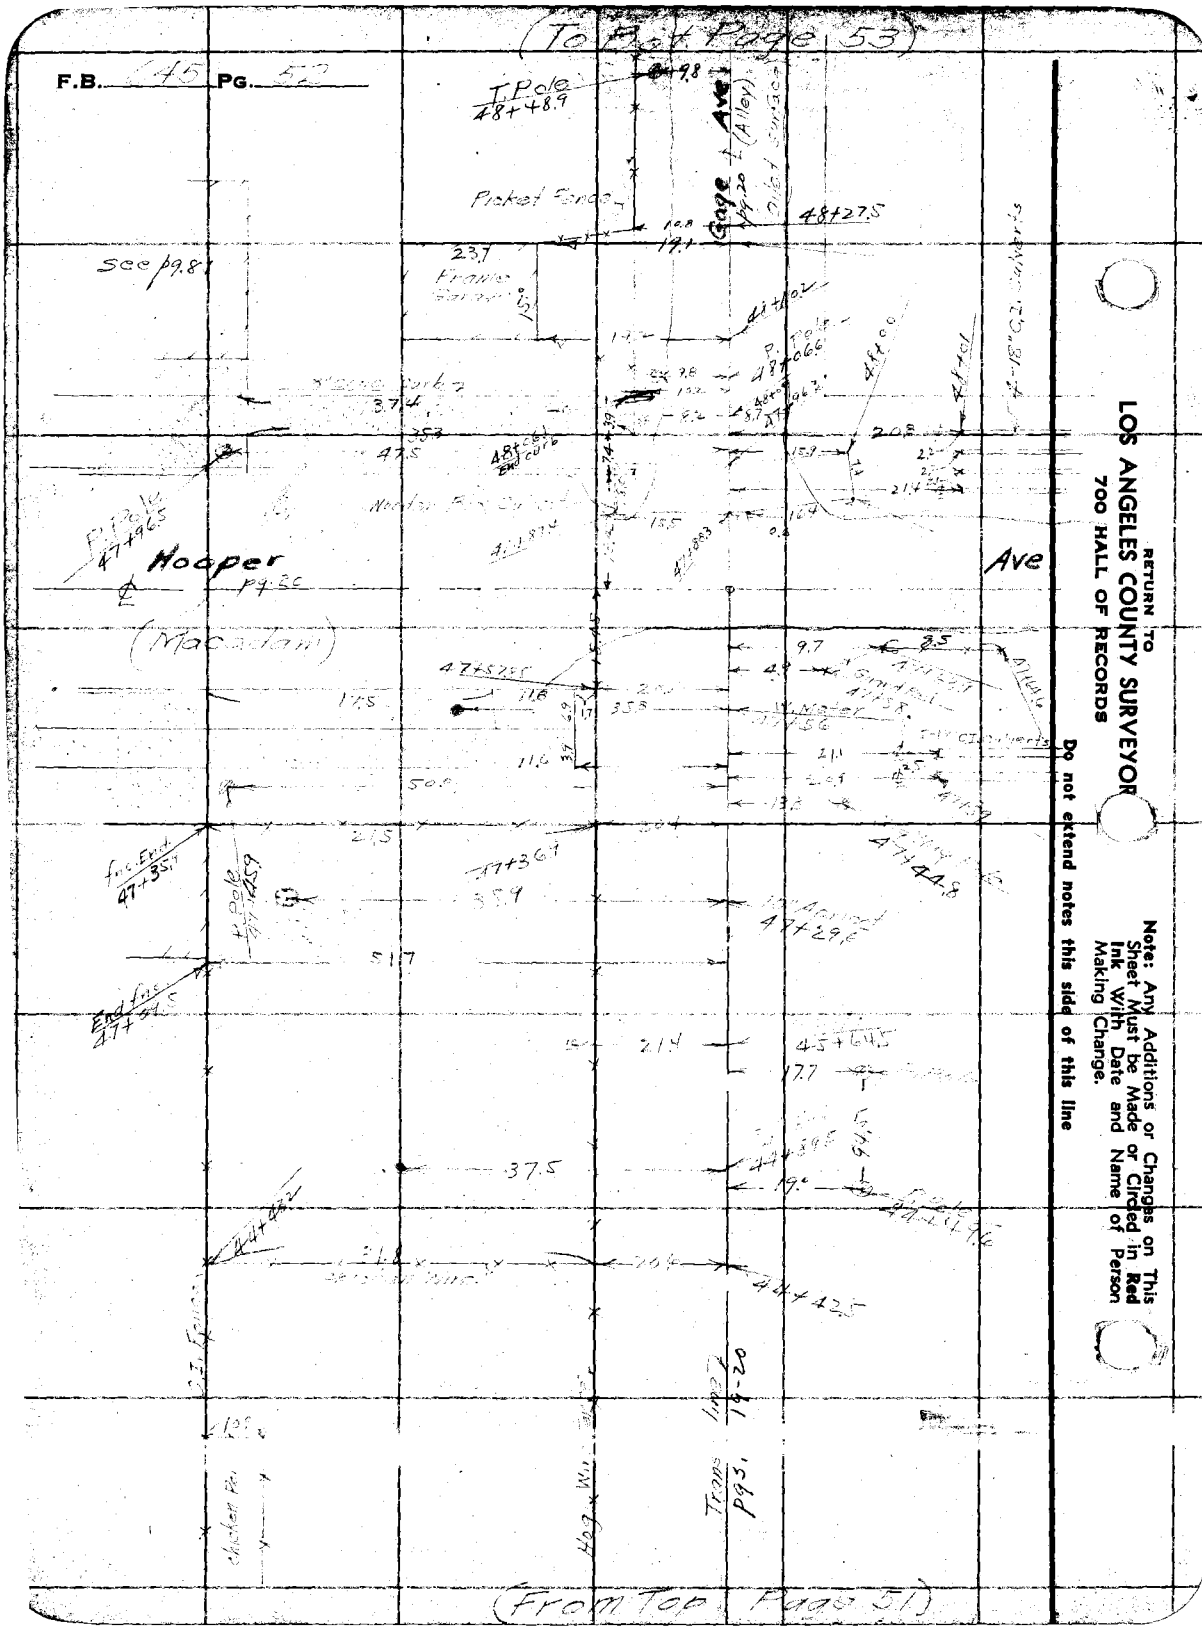

RETURN TO
LOS ANGELES COUNTY SURVEYOR
700 HALL OF RECORDS

Note: Any Additions or Changes on This Sheet Must be Made or Circled in Red Ink With Date and Name of Person Making Change.

Do not extend notes this side of this line

Notes Ck'd by	Survey of Gage Ave
Map No. B-1245	W. 0.8157 Tape No. OTR St'd 84 °F.
Office Work Cox	Surveyed by Evans
Checked AMR	Notes Martin Date 9-28-36
Date Mar. 37	Indexed A. C. Johnson

F.B. 645 PG. 53

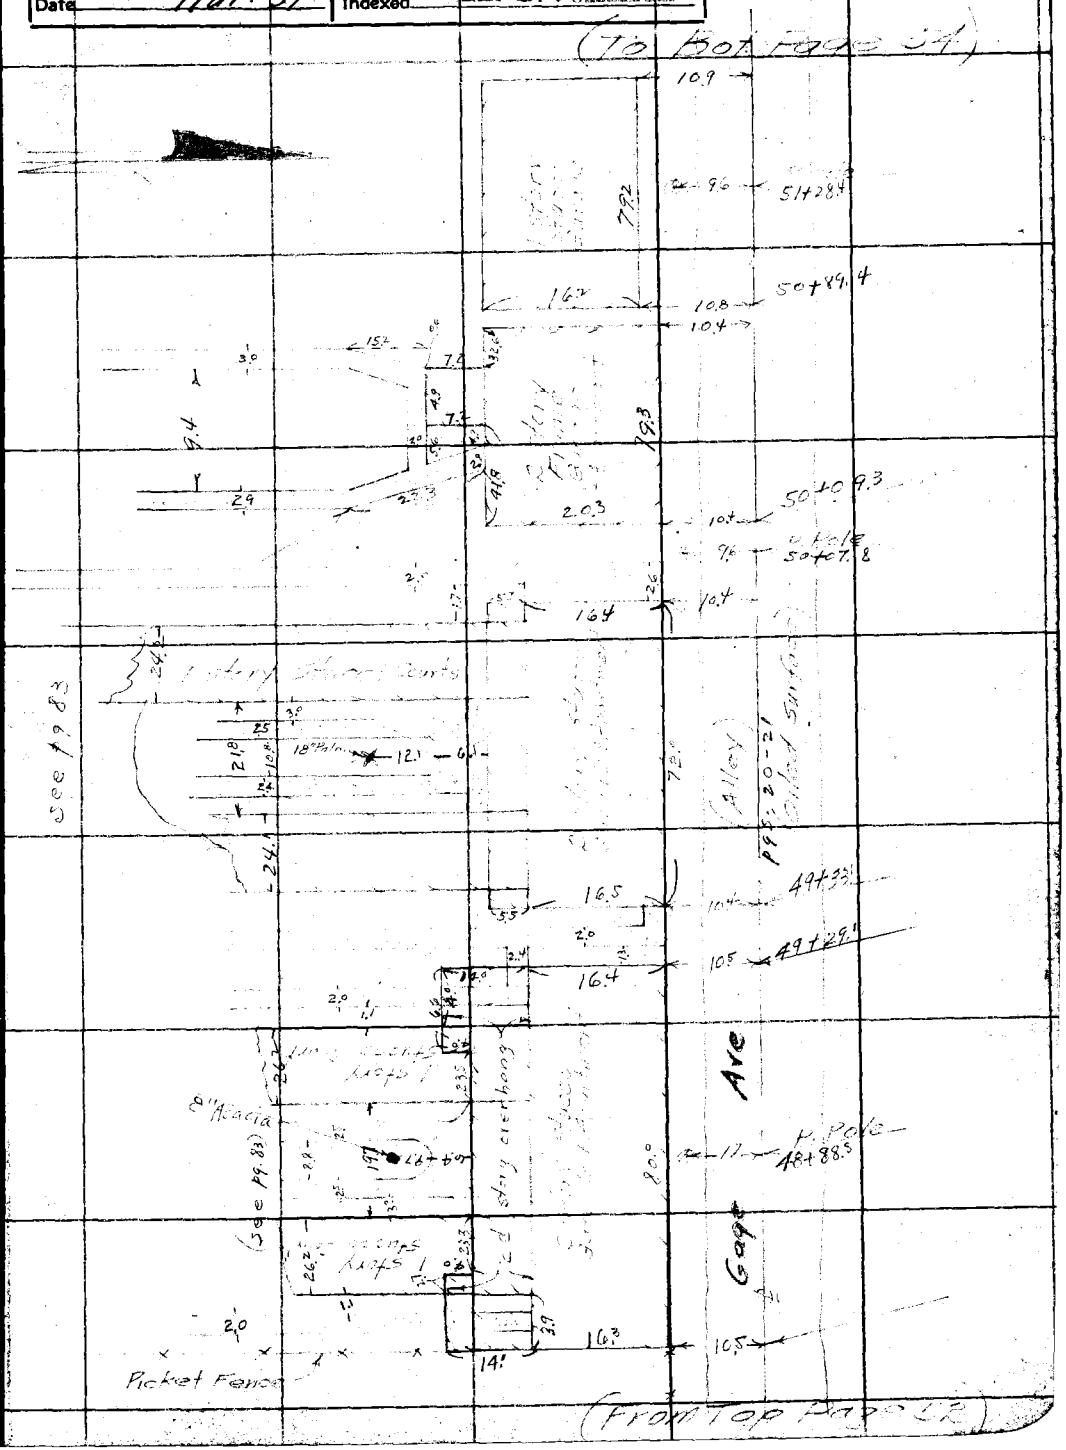

Note: Any Additions or Changes on This Sheet Must be Made or Circled in Red Ink With Date and Name of Person Making Change.

Do not extend notes this side of this line

RETURN TO
LOS ANGELES COUNTY SURVEYOR
700 HALL OF RECORDS

FORM 247 10M 11-35

(To Bot. Page 33)

F.B. 645 PG. 54

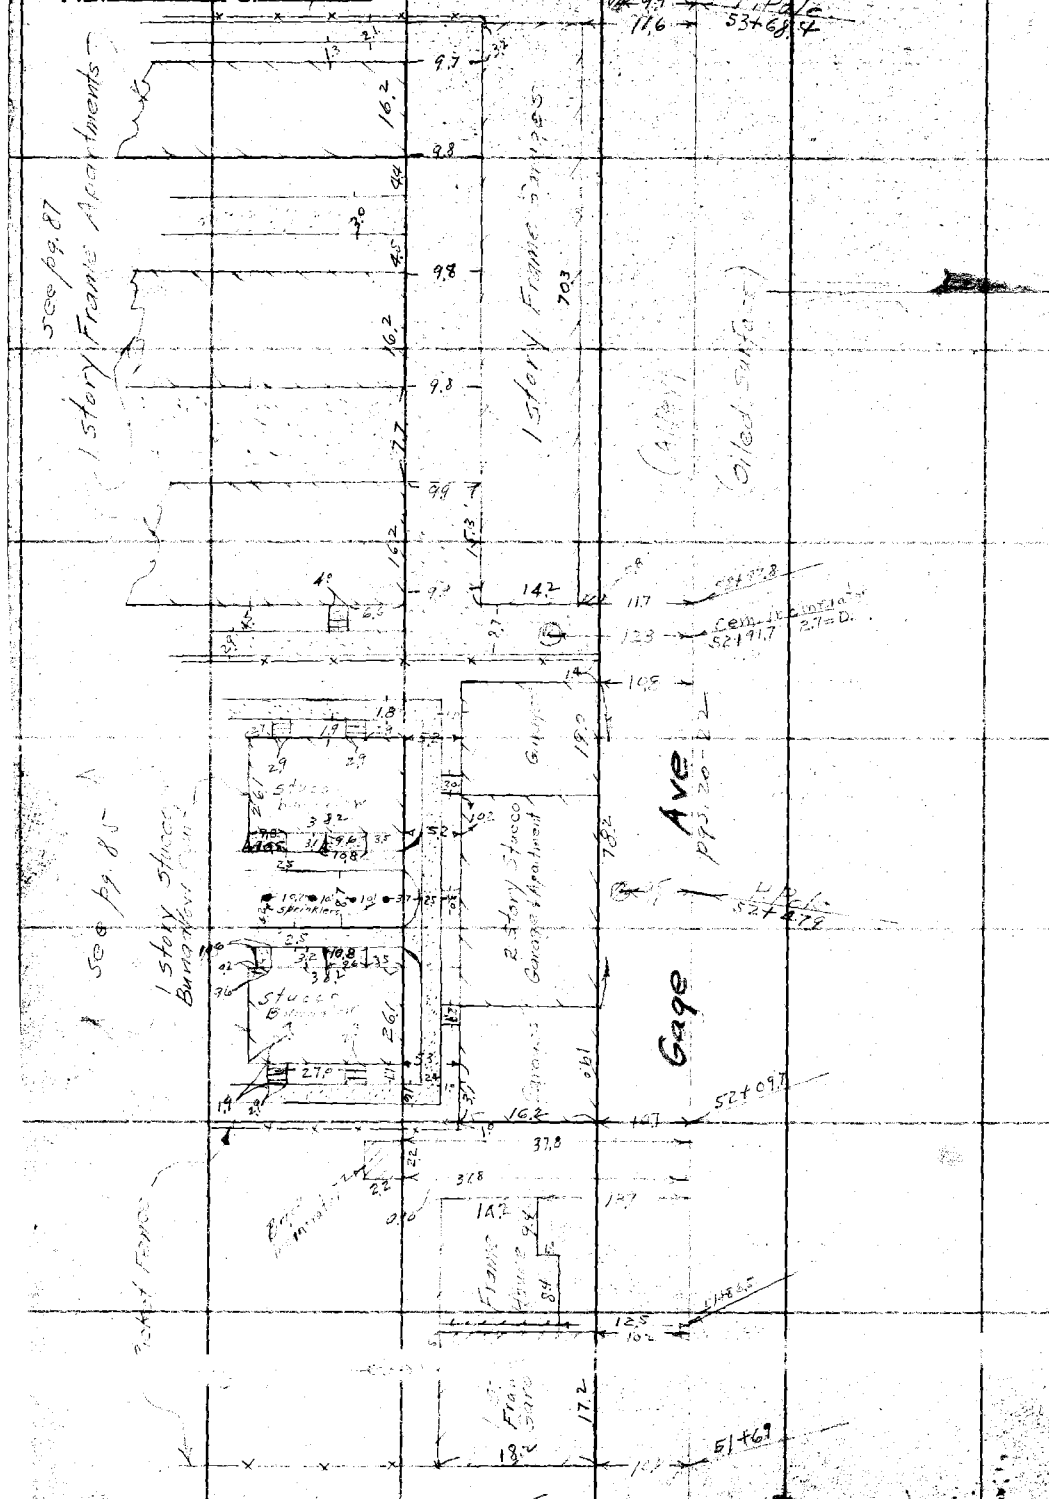

(From Top Page 33)

RETURN TO
LOS ANGELES COUNTY SURVEYOR
700 HALL OF RECORDS

Do not extend notes this side of this line

Note: Any Additions or Changes on This Sheet Must be Made or Circled in Red Ink With Date and Name of Person Making Change.

Notes Ck'd by	Survey of Gage Ave
Map No. B-1245	W. O. 8157 Tape No. 072 St'd 84 °F.
Office Work Cox	Surveyed by Evans
Checked aaR	Notes Martin Date 9-28-36
Date Mar. 37	Indexed A. C. Johnson

F.B. 645 PG. 55

(To Bot. Page 56)

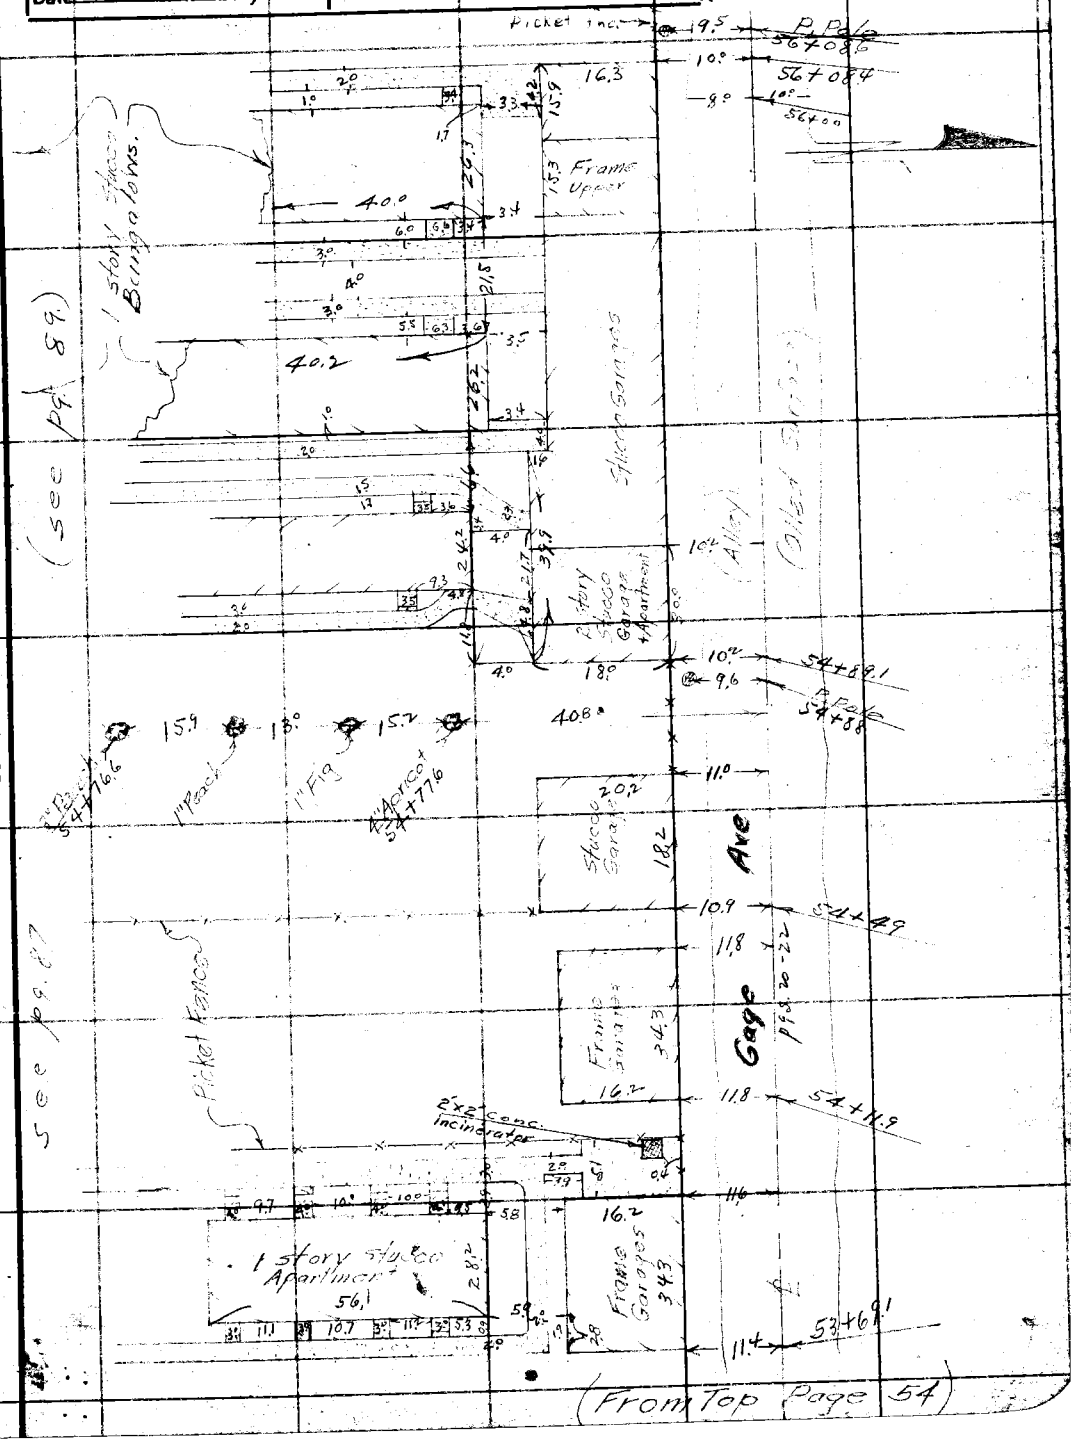

Note: Any Additions or Changes on This Sheet Must be Made or Circled in Red Ink With Date and Name of Person Making Change.

Do not extend notes this side of this line

RETURN TO
LOS ANGELES COUNTY SURVEYOR
700 HALL OF RECORDS

FORM 247 10M 11-35

F.B. 645 PG. 56

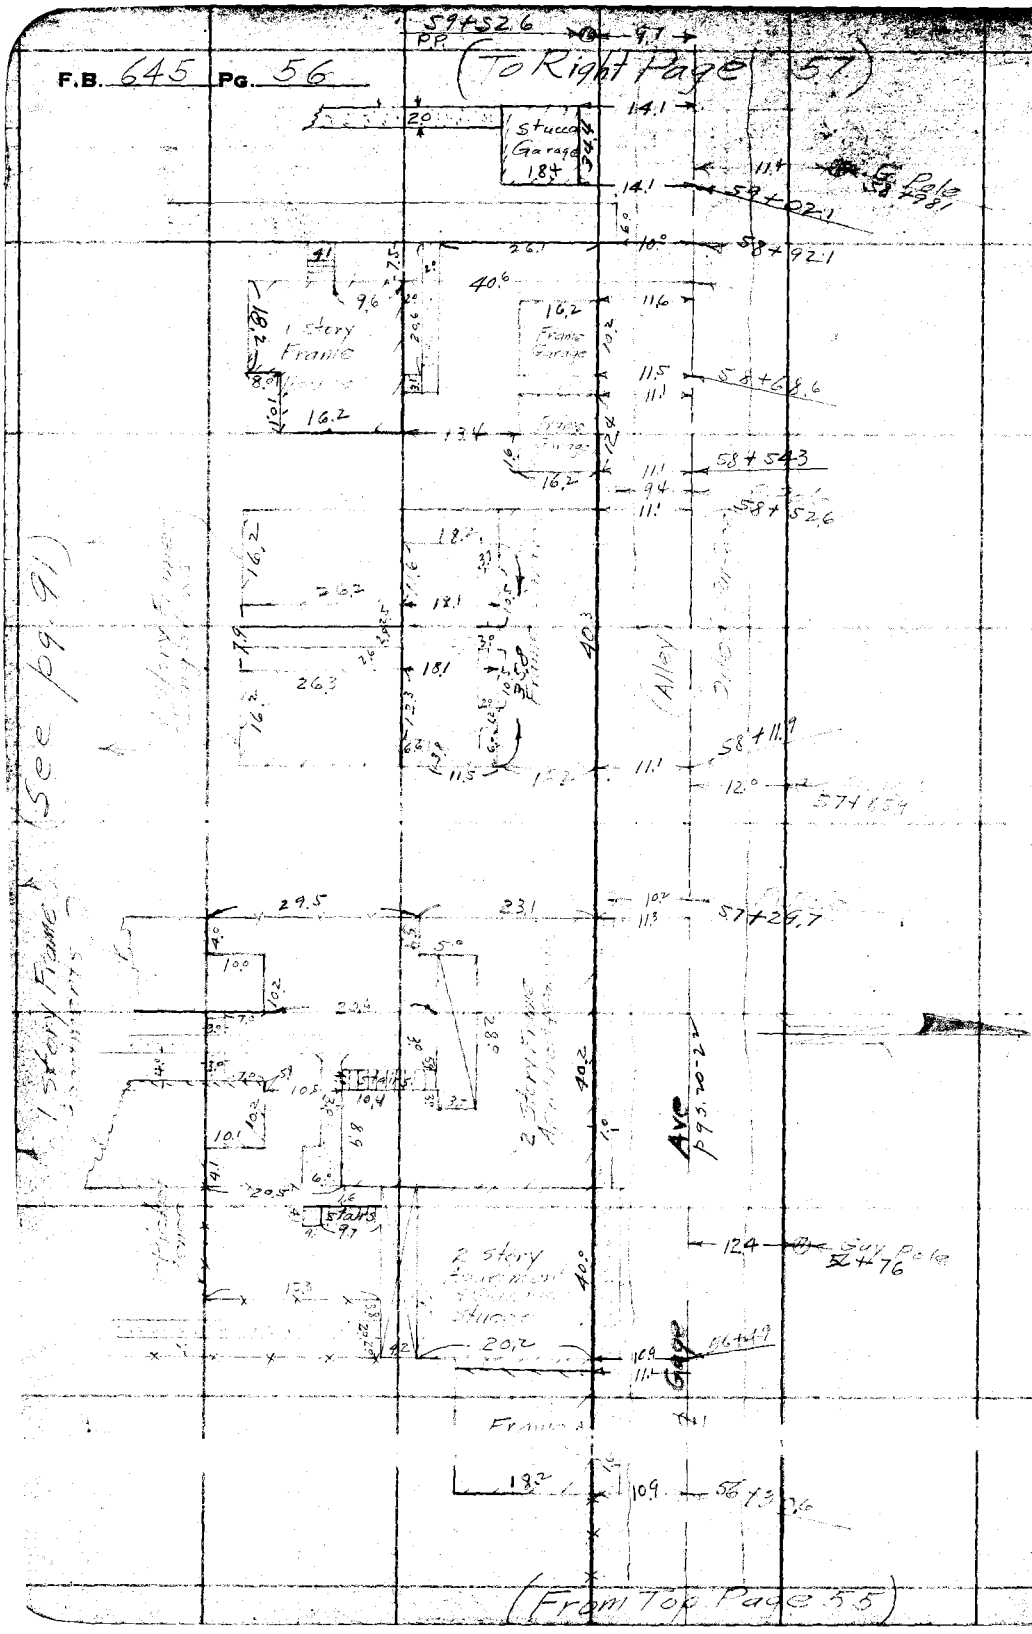

RETURN TO
LOS ANGELES COUNTY SURVEYOR
700 HALL OF RECORDS

Do not extend notes this side of this line

Note: Any Additions or Changes on This Sheet Must be Made or Circled in Red Ink With Date and Name of Person Making Change.

Notes Ck'd by	Survey of Gage Ave
Map No. B-1245	W. O. 8157 Tape No. 072 St'd 84 °F.
Office Work Cox	Surveyed by Evans
Checked aaR	Notes Martin Date 9-29-36
Date Mar. 37	Indexed A. C. Johnson

F.B. 645 Pg. 57

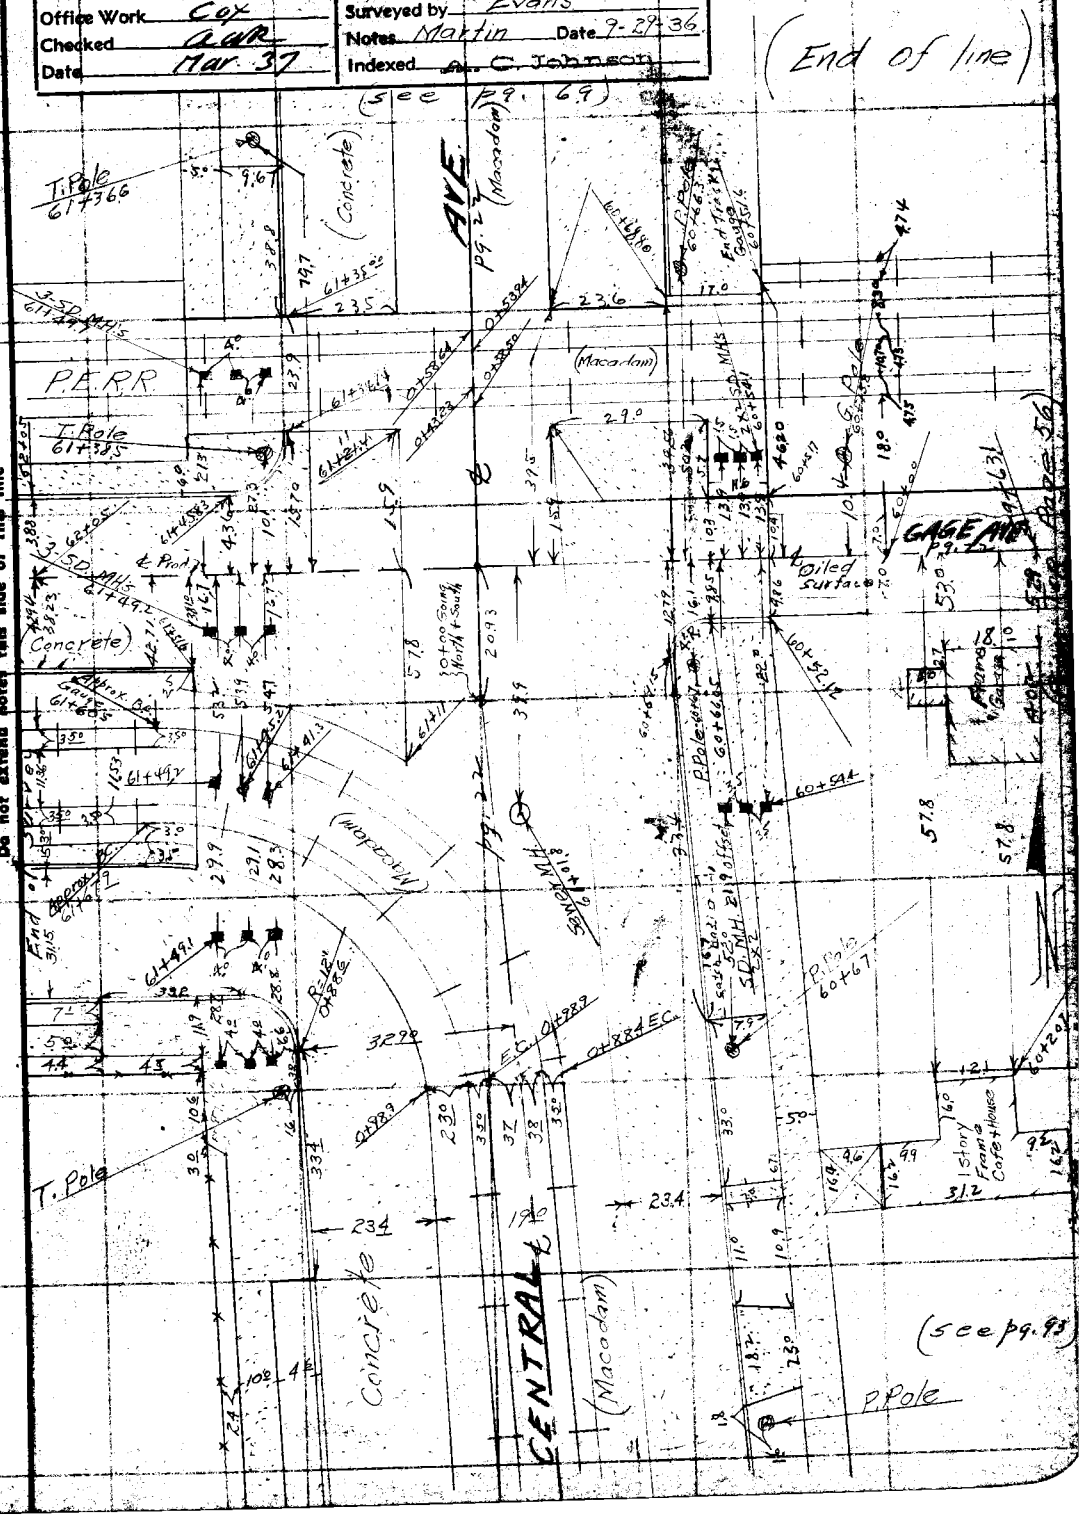

Note: Any Additions or Changes on This Sheet Must be Made or Circled in Red Ink With Date and Name of Person Making Change.

Do not extend notes this side of this line

BROWN TO LOS ANGELES COUNTY SURVEYOR 700 HALL OF RECORDS

(To Bot. Page 57)

F.B. 645 PG. 58

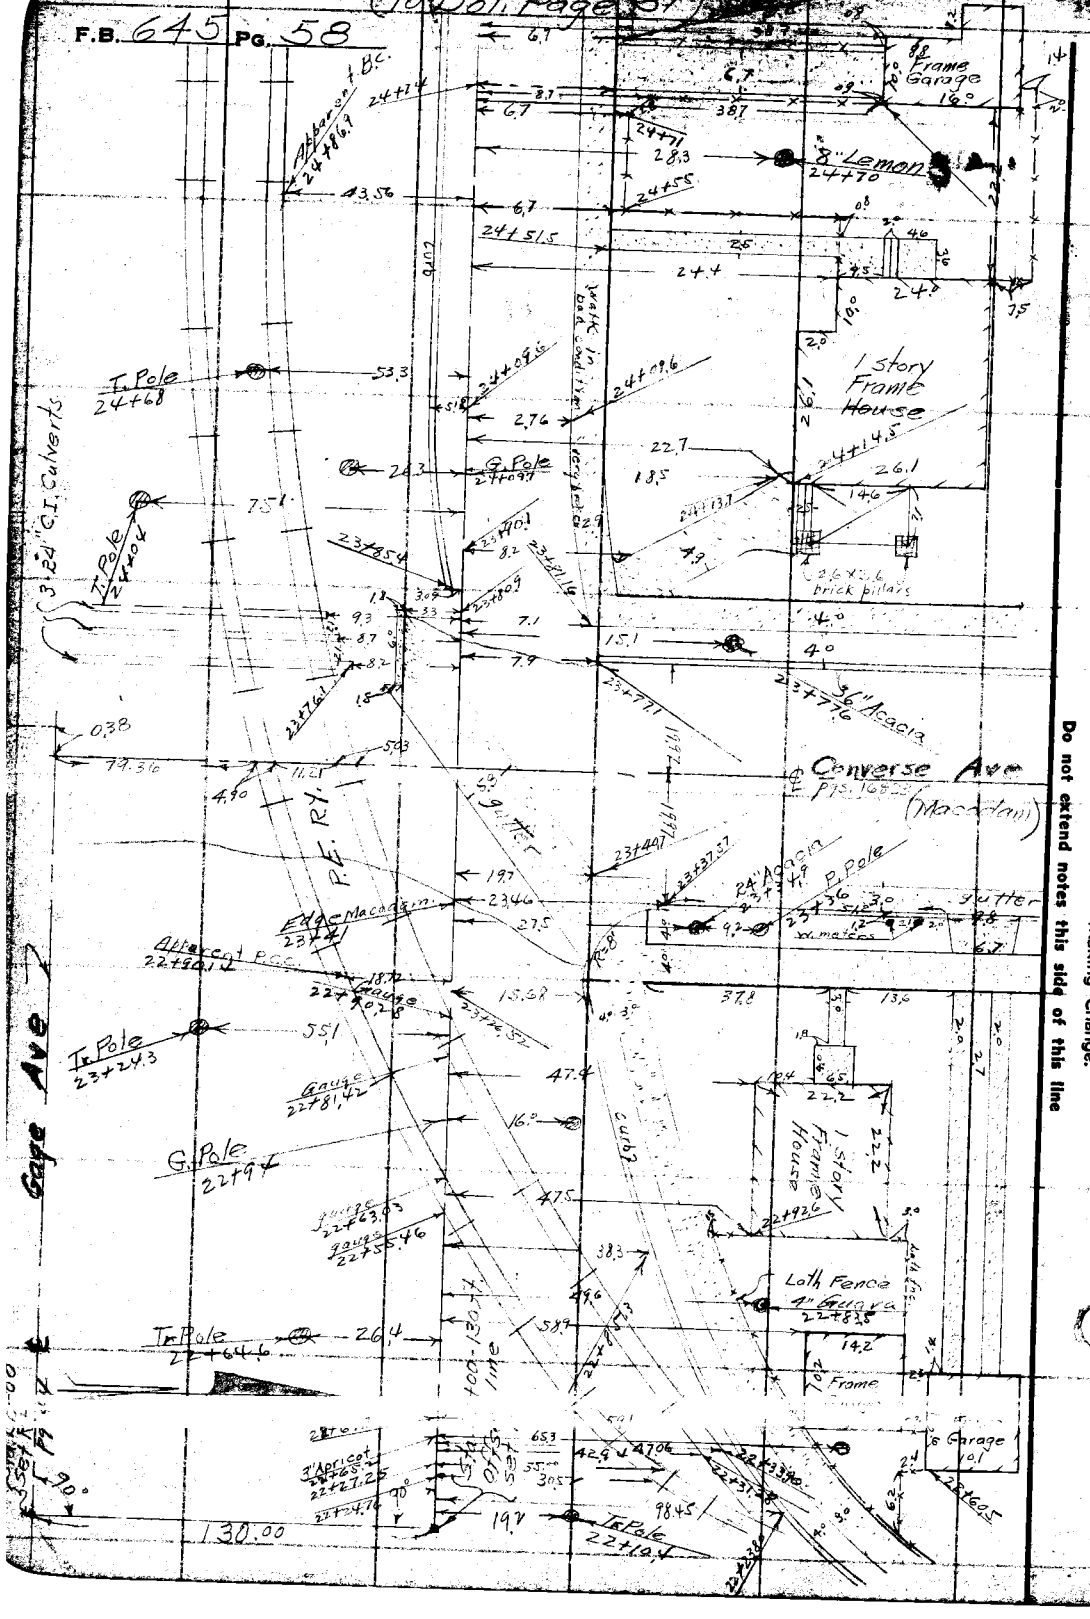

RETURN TO
LOS ANGELES COUNTY SURVEYOR
700 HALL OF RECORDS

Do not extend notes this side of this line

Note: Any Additions or Changes on This Sheet Must be Made or Circled in Red Ink With Date and Name of Person Making Change.

Notes Ck'd by	Survey of Gage Ave	F.B. 645 Pg. 59
Map No. 7	W. O. 8157 Tape No. 072 St'd 84°F.	
Office Work B-1245	Surveyed by Evans	
Checked aar	Notes Martin Date 9-29-36	
Date Mar. 37	Indexed A. C. Johnson	

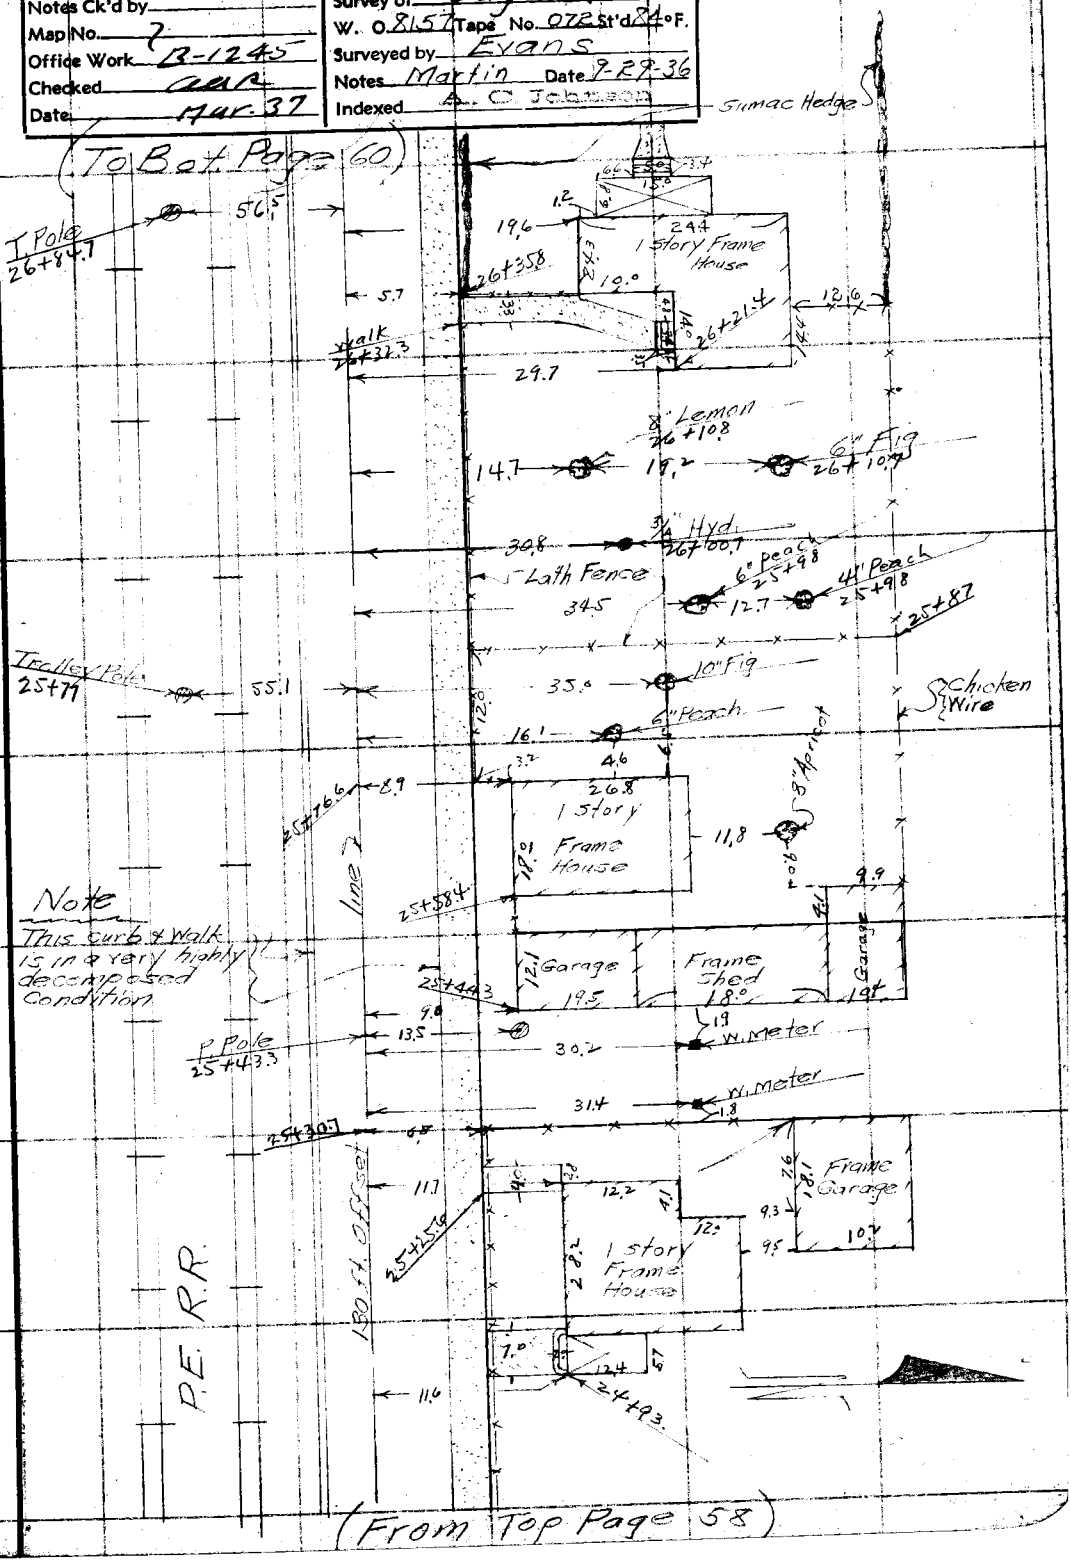

Note: Any Additions or Changes on This Sheet Must be Made or Circled in Red Ink With Date and Name of Person Making Change.

Do not extend notes this side of this line

RETURN TO
LOS ANGELES COUNTY SURVEYOR
700 HALL OF RECORDS

FORM 847 10M 11-35

(To Bot. Page 61)

F.B. 645 PG. 60

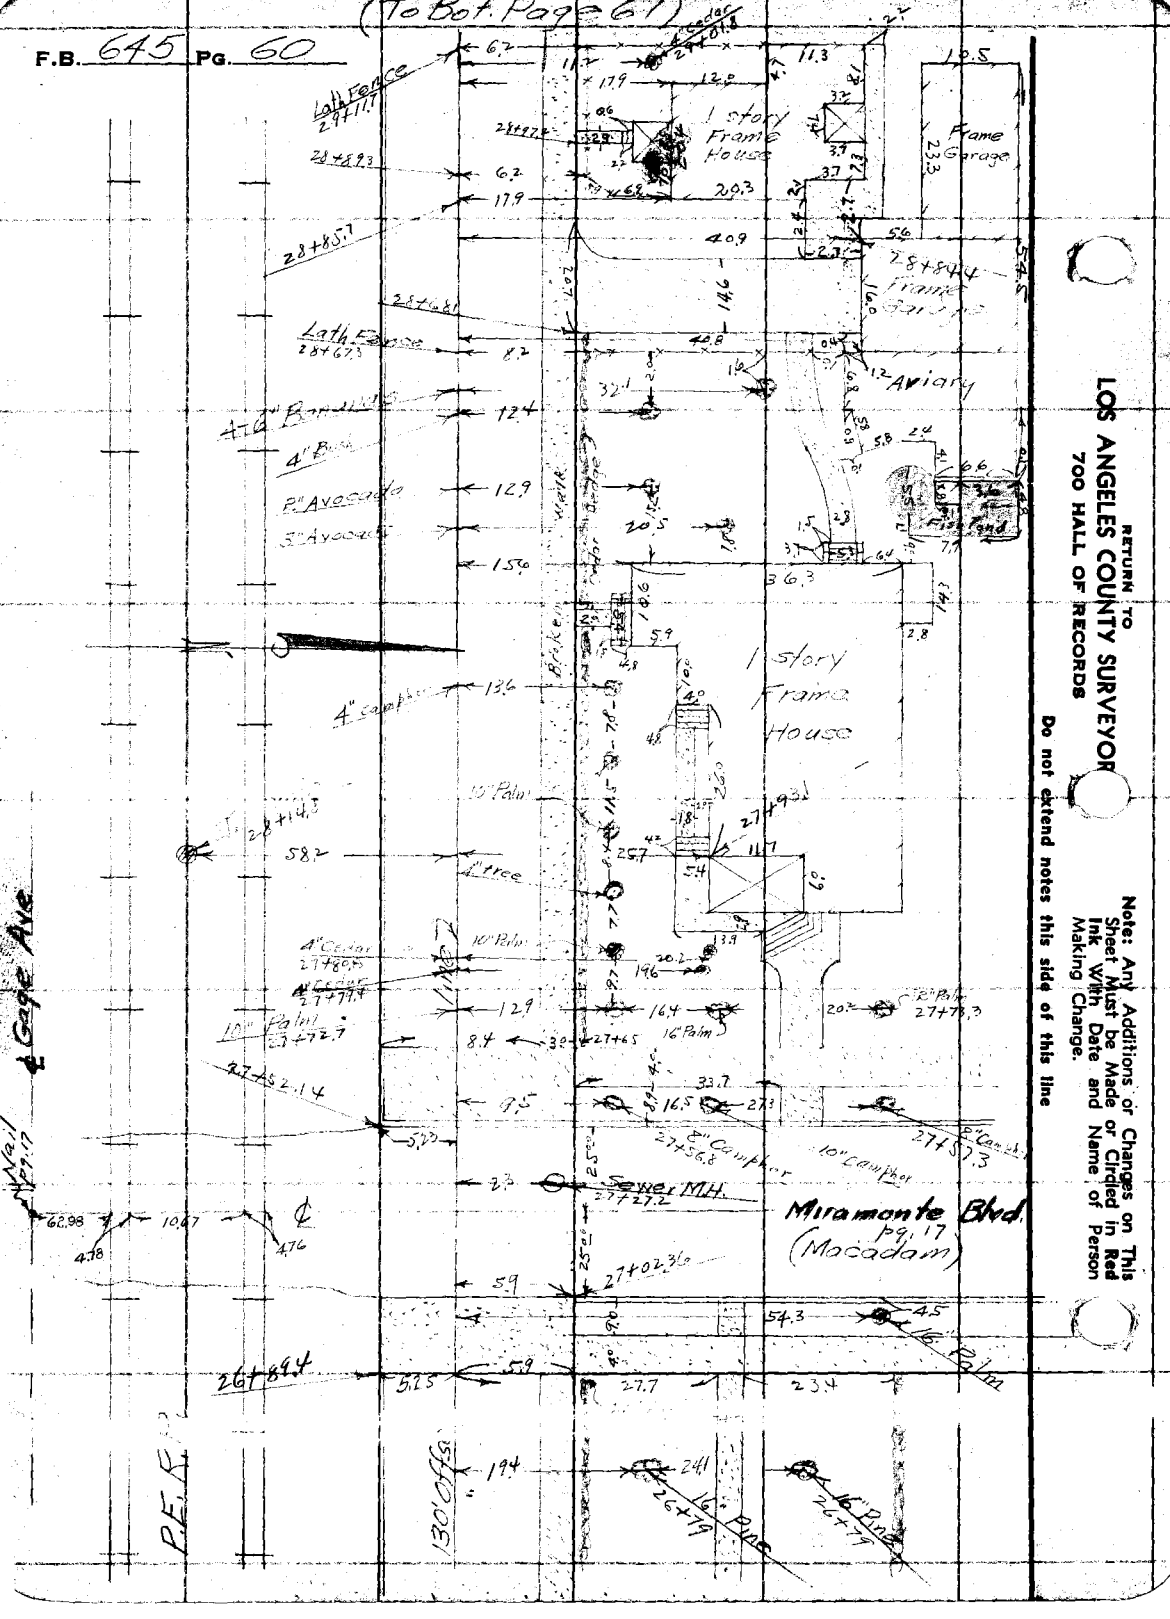

RETURN TO
LOS ANGELES COUNTY SURVEYOR
700 HALL OF RECORDS

Do not extend notes this side of this line

Note: Any Additions or Changes on This Sheet Must be Made or Circled in Red Ink With Date and Name of Person Making Change.

Notes Ck'd by	Survey of Gage Ave
Map No. B-1245	W. O. 8157 Tape No. 072 St'd 84 °F.
Office Work Cox	Surveyed by Evans
Checked aur	Notes Martin Date 9-30-36
Date Mar. 37	Indexed A. C. Johnson

F.B. 645 PG. 61

(To Bot. Page 62)

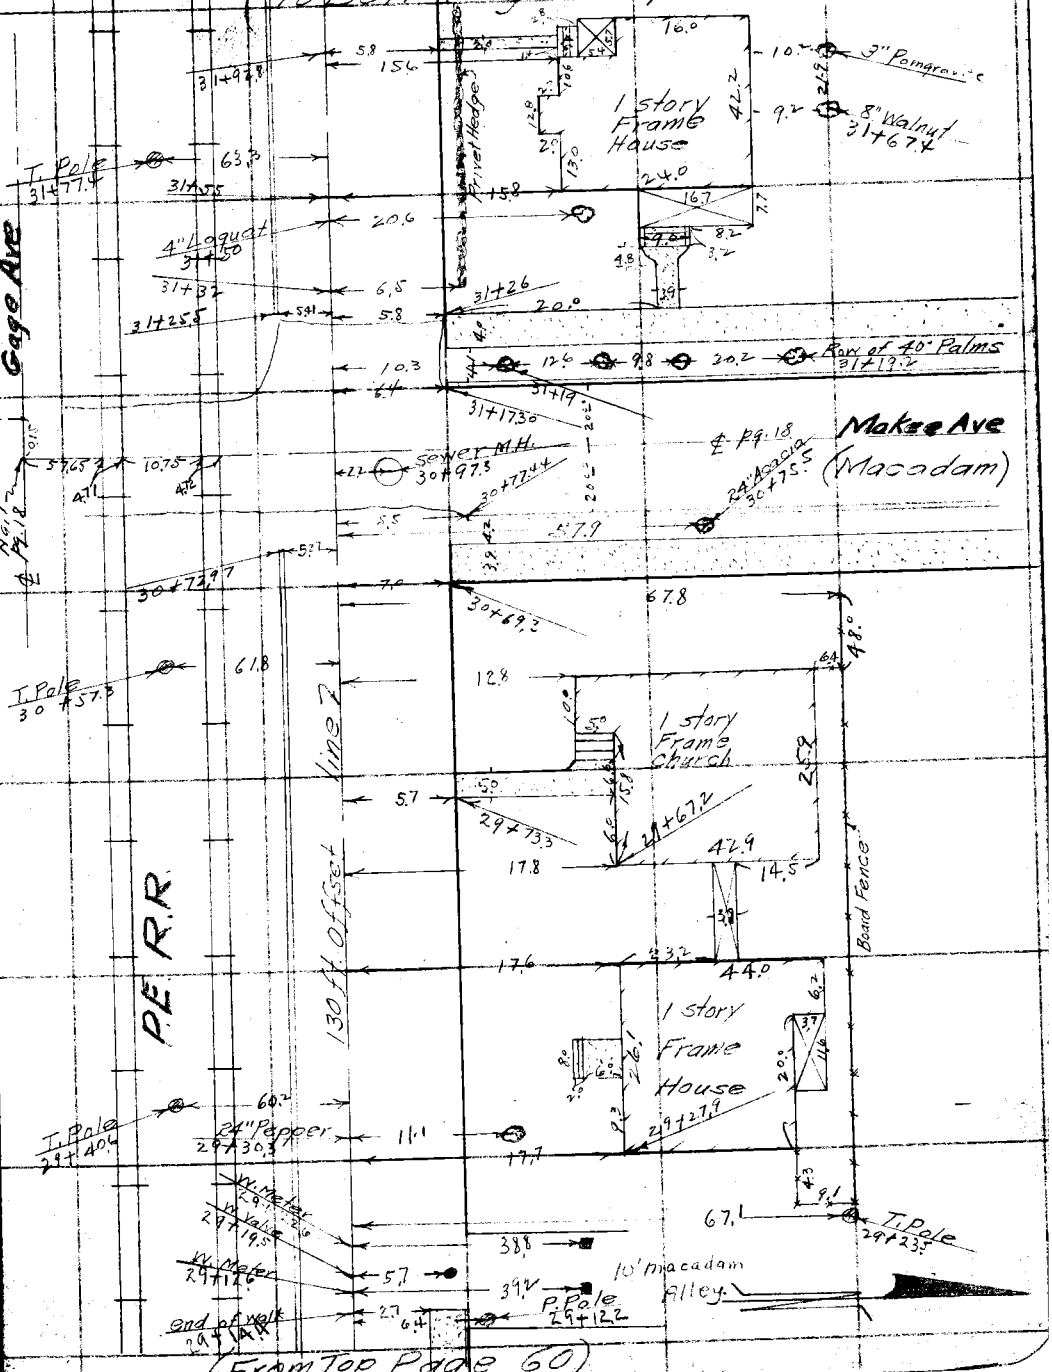

(From Top Page 60)

Note: Any Additions or Changes on This Sheet Must be Made or Circled in Red Ink With Date and Name of Person Making Change
Do not extend notes this side of this line
RETURN TO LOS ANGELES COUNTY SURVEYOR 700 HALL OF RECORDS

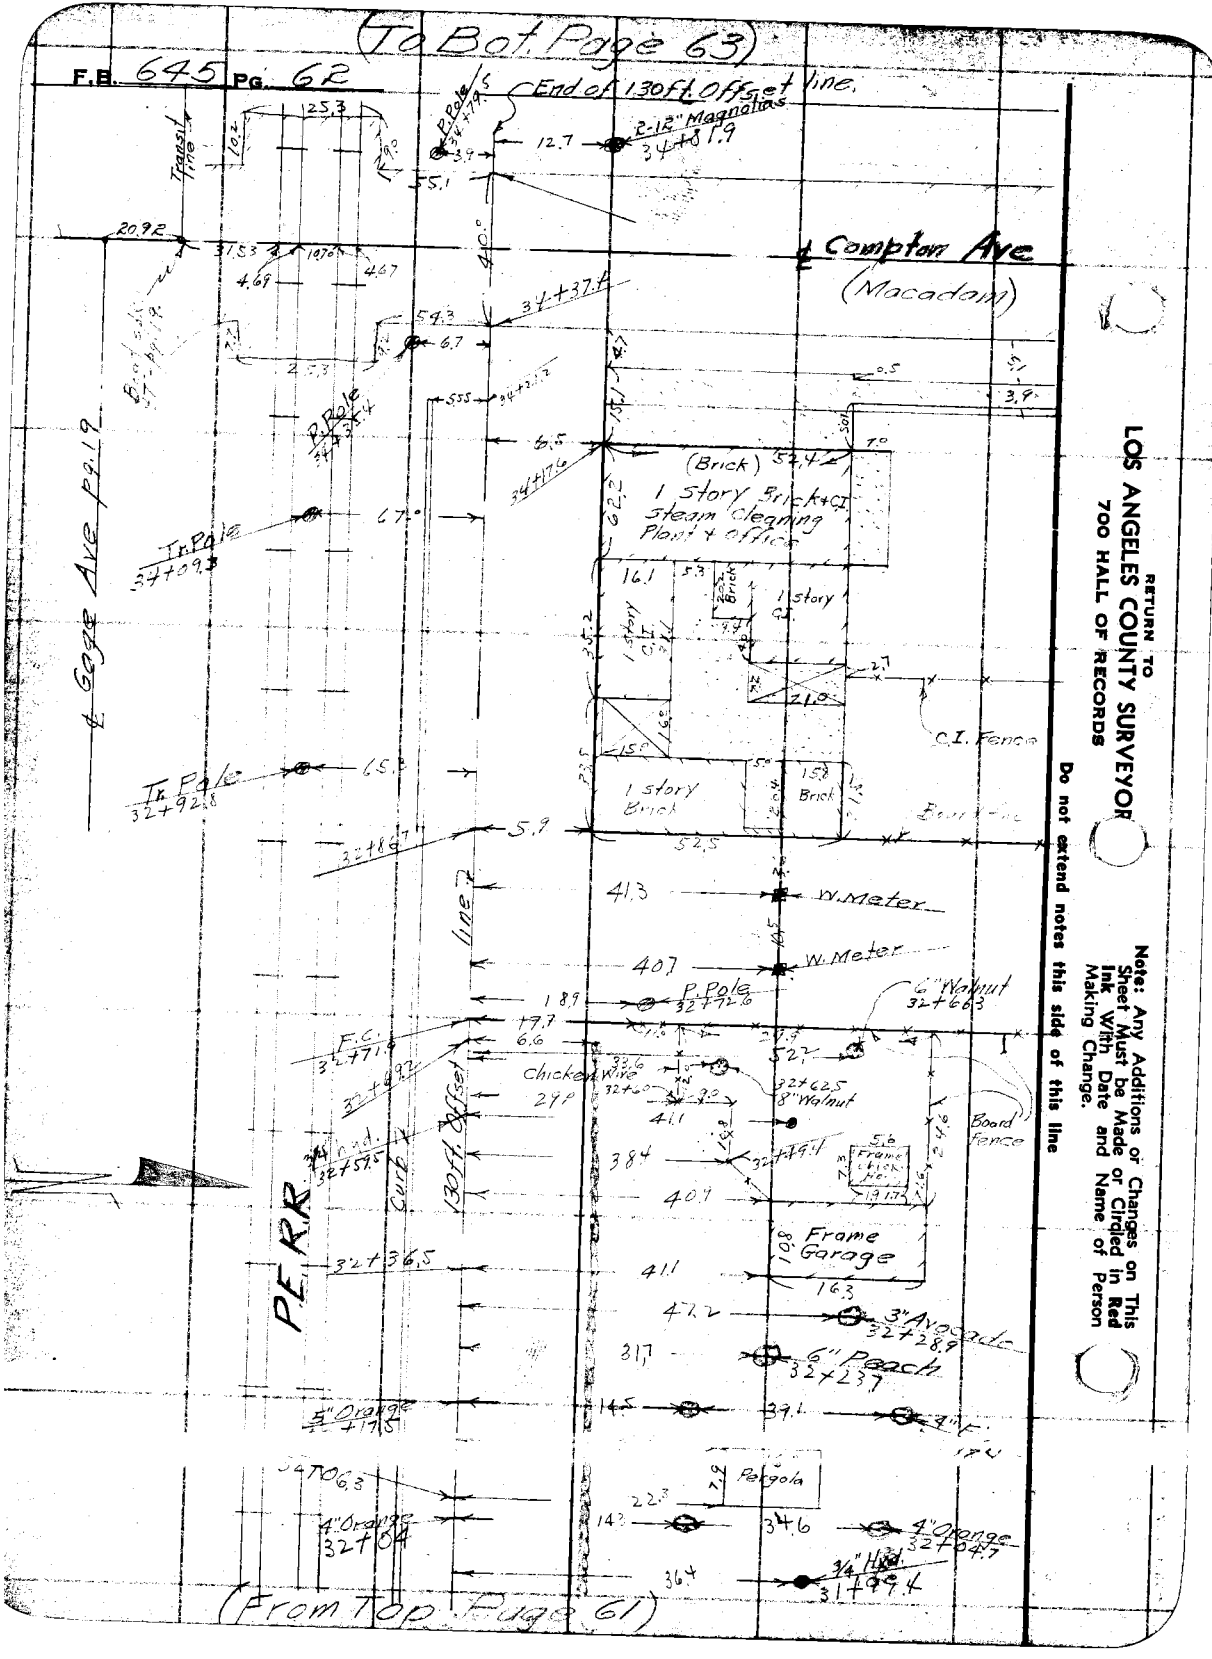

RETURN TO
LOS ANGELES COUNTY SURVEYOR
700 HALL OF RECORDS

Note: Any Additions or Changes on This Sheet Must be Made or Circled in Red Ink With Date and Name of Person Making Change.

Do not extend notes this side of this line

Notes Ck'd by	Survey of Gage Ave
Map No. B-1245	W. 0.8157 Tape No. 072 St'd 84 °F.
Office Work Cox	Surveyed by Evans
Checked aur	Notes Martin Date 9-30-36
Date Mar. 37	Indexed A. C. Johnson

F.B. 645 PG. 63

(To Bot. Page 64)

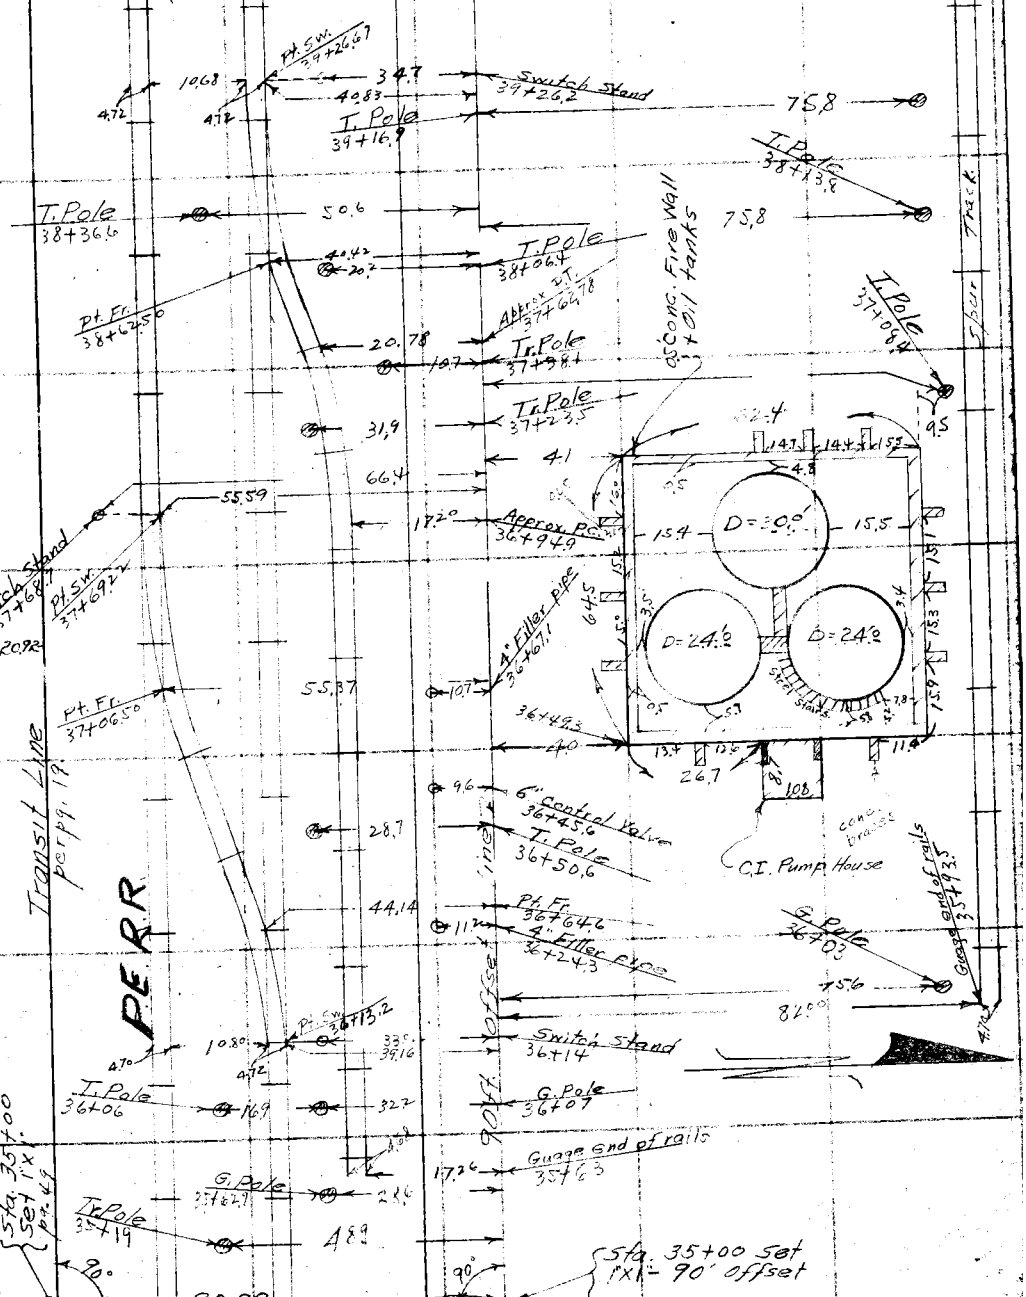

Notes: Any Additions or Changes on This Sheet Must be Made or Circled in Red Ink With Date and Name of Person Making Change.

Do not extend notes this side of this line

LOS ANGELES COUNTY SURVEYOR
700 HALL OF RECORDS

247 10M 11-3

(To Bot Page 65)

F.B. 645 PG. 64

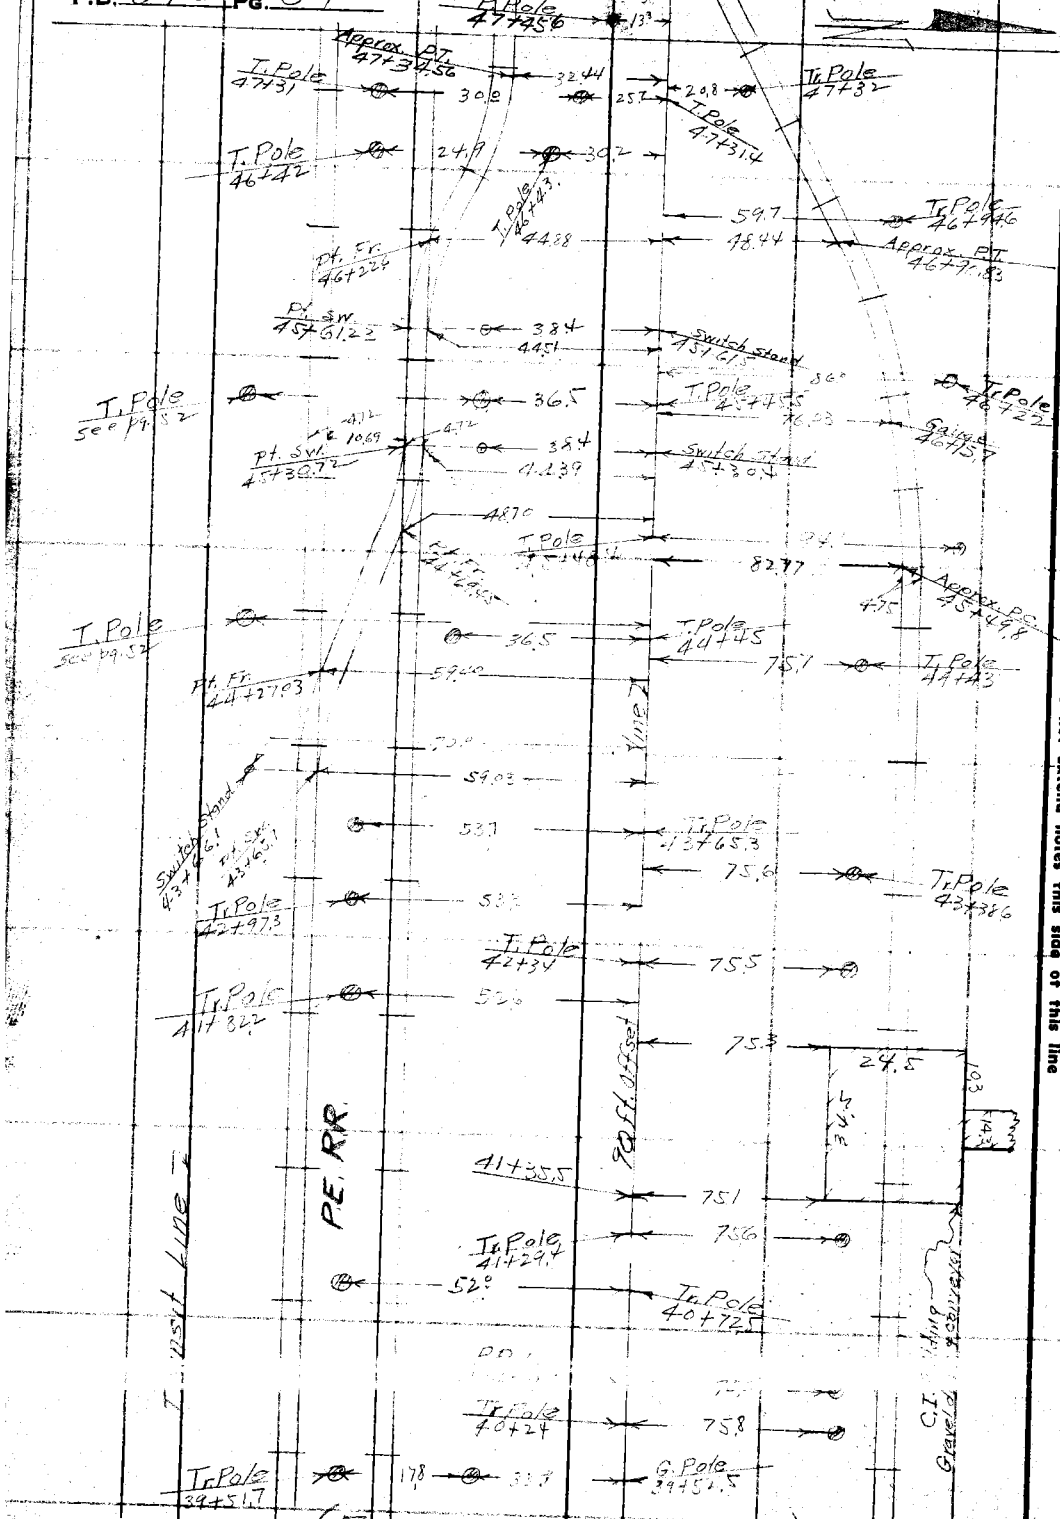

RETURN TO
LOS ANGELES COUNTY SURVEYOR
700 HALL OF RECORDS

Do not extend notes this side of this line

Note: Any Additions or Changes on This Sheet Must be Made or Circled in Red Ink With Date and Name of Person Making Change.

Notes Ck'd by	Survey of Gage Ave
Map No. B-1245	W. O. 8157 Tape No. 072 St'd 84°F.
Office Work Cox	Surveyed by Evans
Checked [illegible]	Notes Martin Date 10-1-36
Date Mar. 37	Indexed A. C. Johnson

F.B. 645 PG. 65

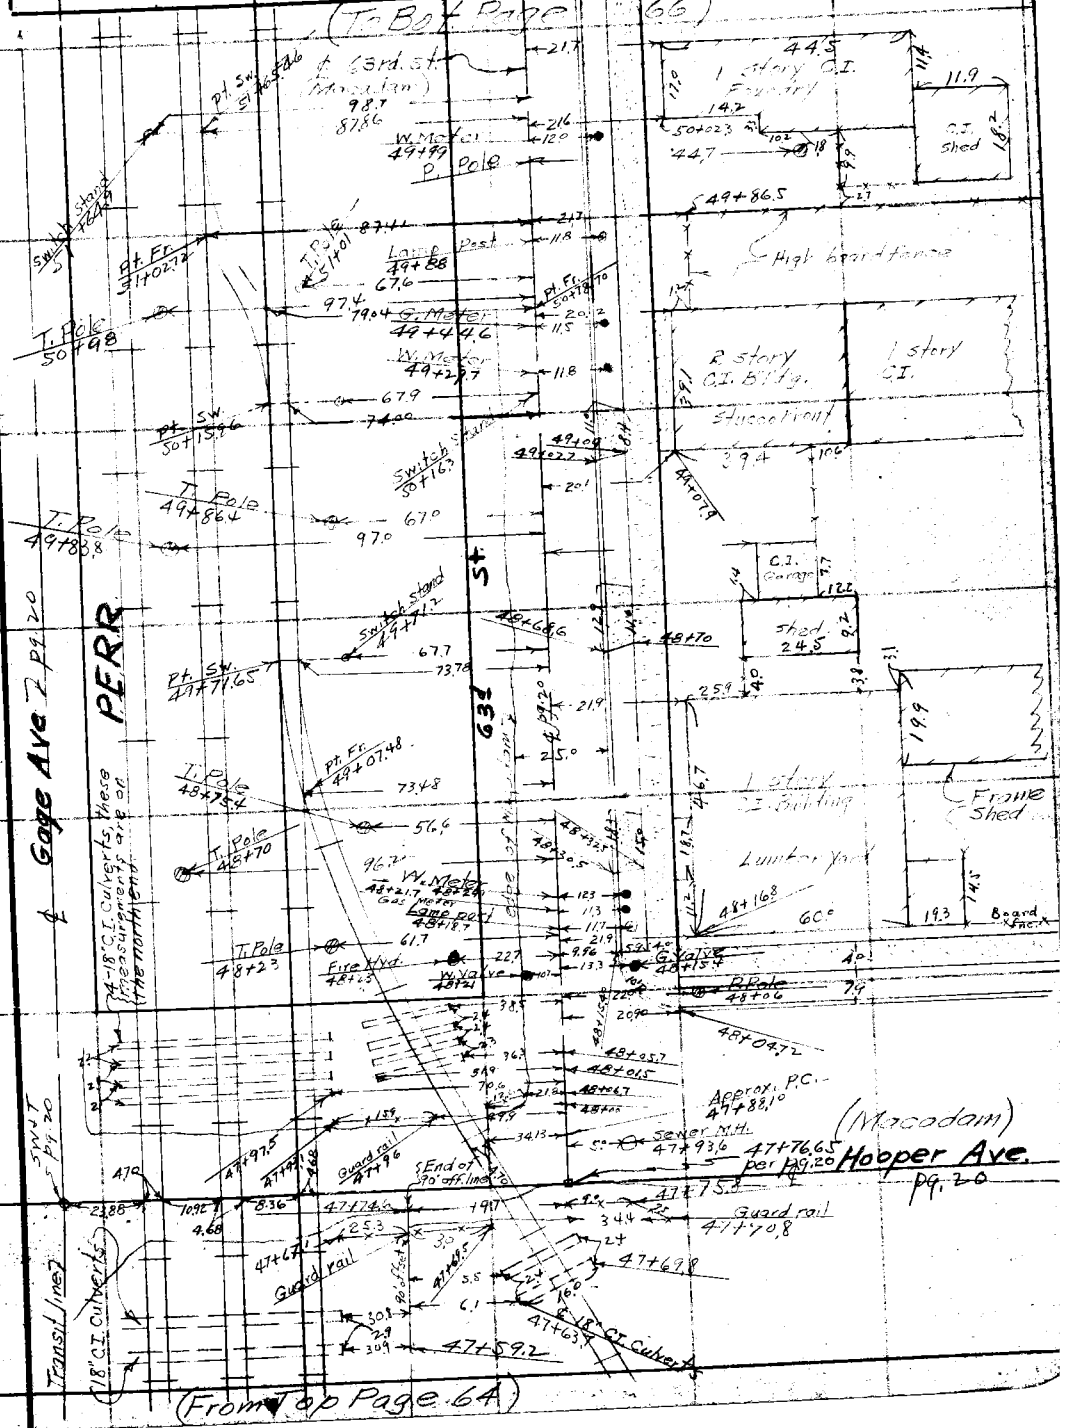

Note: Any Additions or Changes on This Sheet Must be Made or Circled in Red Ink With Date and Name of Person Making Change.

Do not extend notes this side of this line

RETURN TO
LOS ANGELES COUNTY SURVEYOR
700 HALL OF RECORDS

FORM 247 10M 11-35

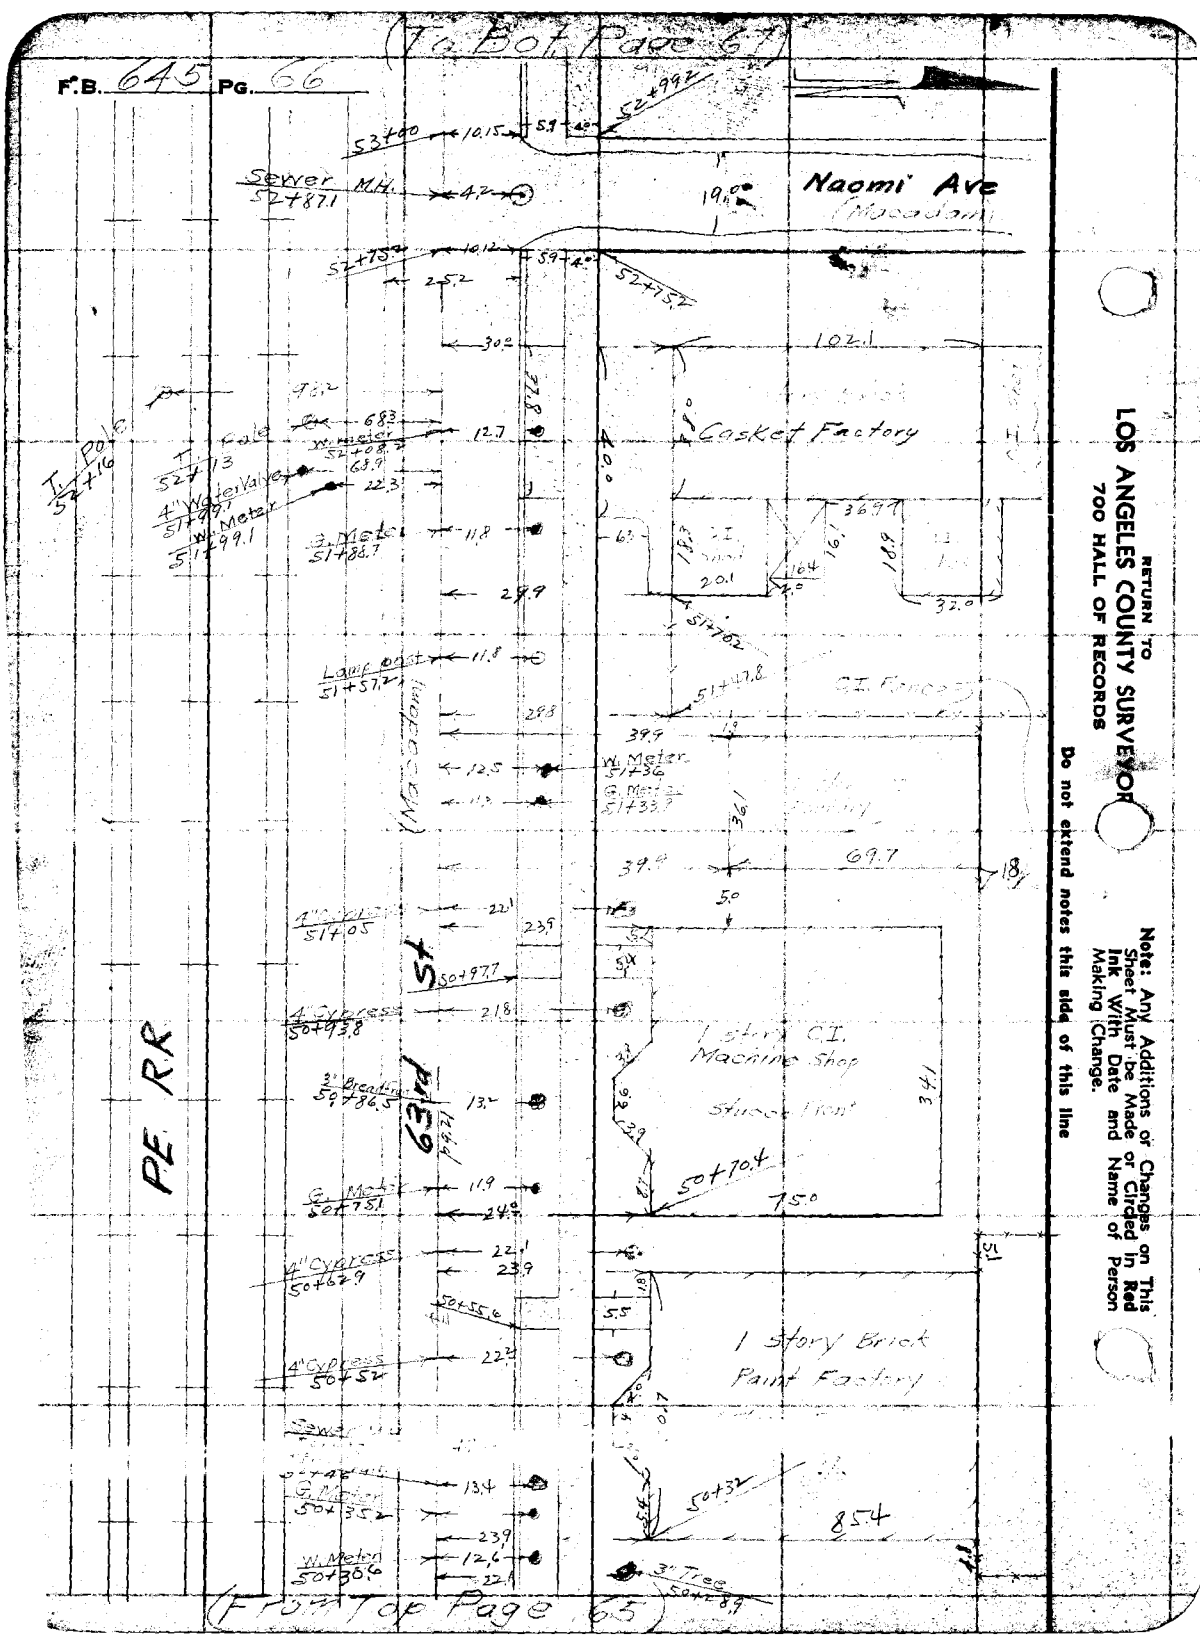

RETURN TO
LOS ANGELES COUNTY SURVEYOR
700 HALL OF RECORDS

Note: Any Additions or Changes on This Sheet Must be Made or Circled in Red Ink With Date and Name of Person Making Change.

Do not extend notes this side of this line

Notes Ck'd by	Survey of Gage Ave
Map No. B-1245	W. O. 8157 Tape No. 07R St'd 84 °F.
Office Work Cox	Surveyed by Evans
Checked aar	Notes Martin Date 10-1-36
Date Mar. 37	Indexed A. C. Johnson

F.B. 645 PG. 67

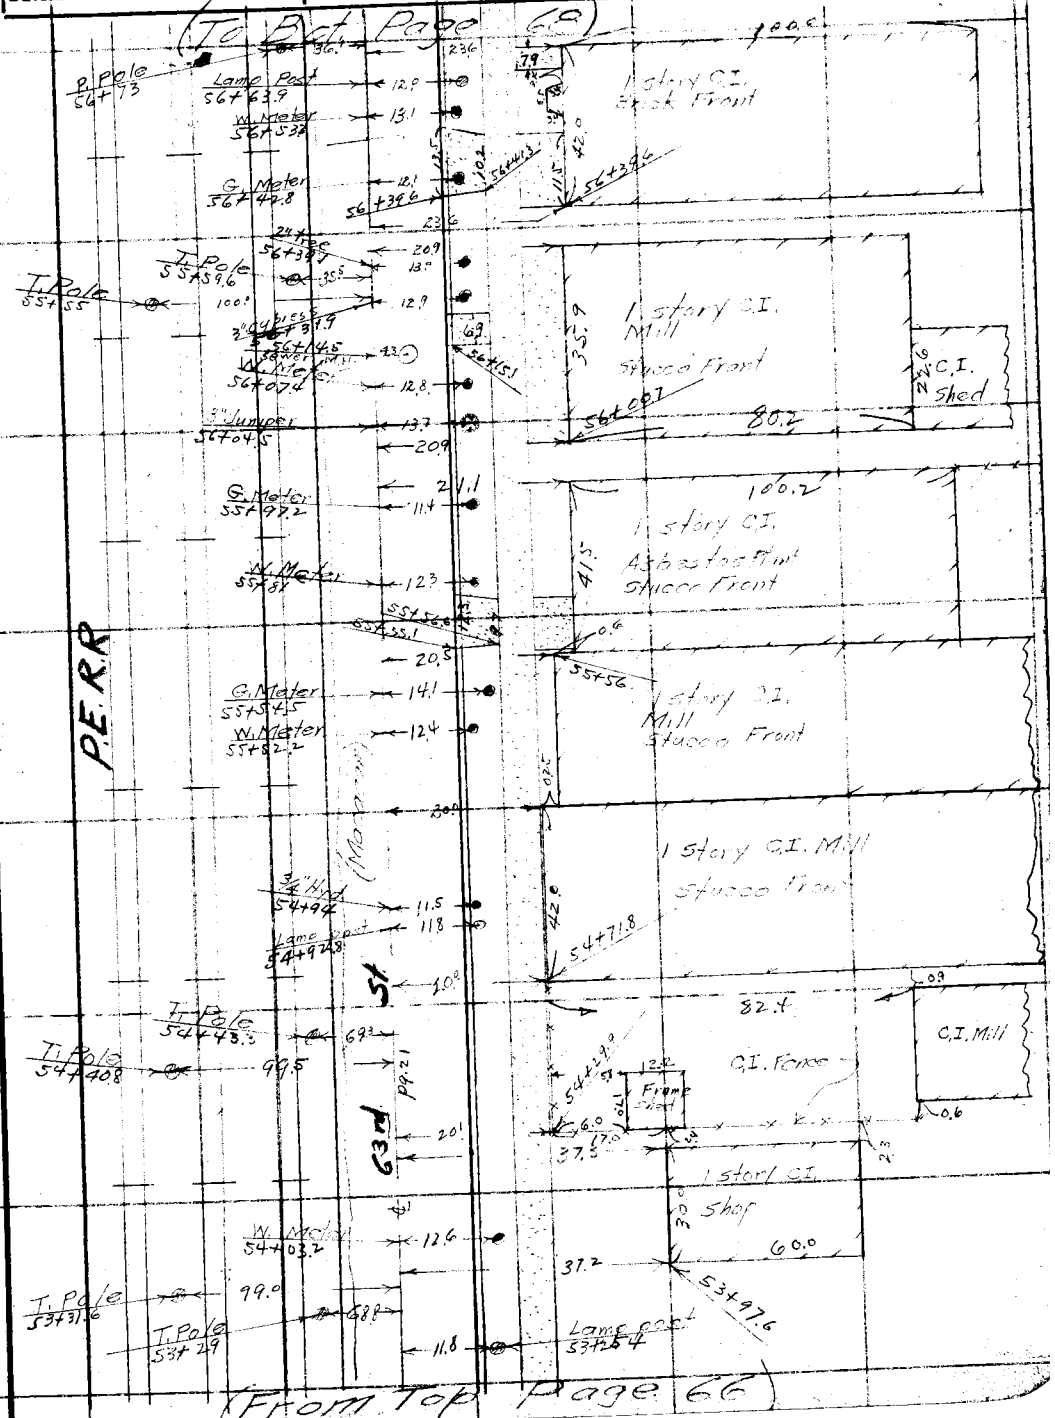

Note: Any Additions or Changes on This Sheet Must be Made or Circled in Red Ink With Date and Name of Person Making Change.

Do not extend notes this side of this line

RETURN TO
LOS ANGELES COUNTY SURVEYOR
700 HALL OF RECORDS

FORM 247 10M 11-35

F.B. 645 PG. 68

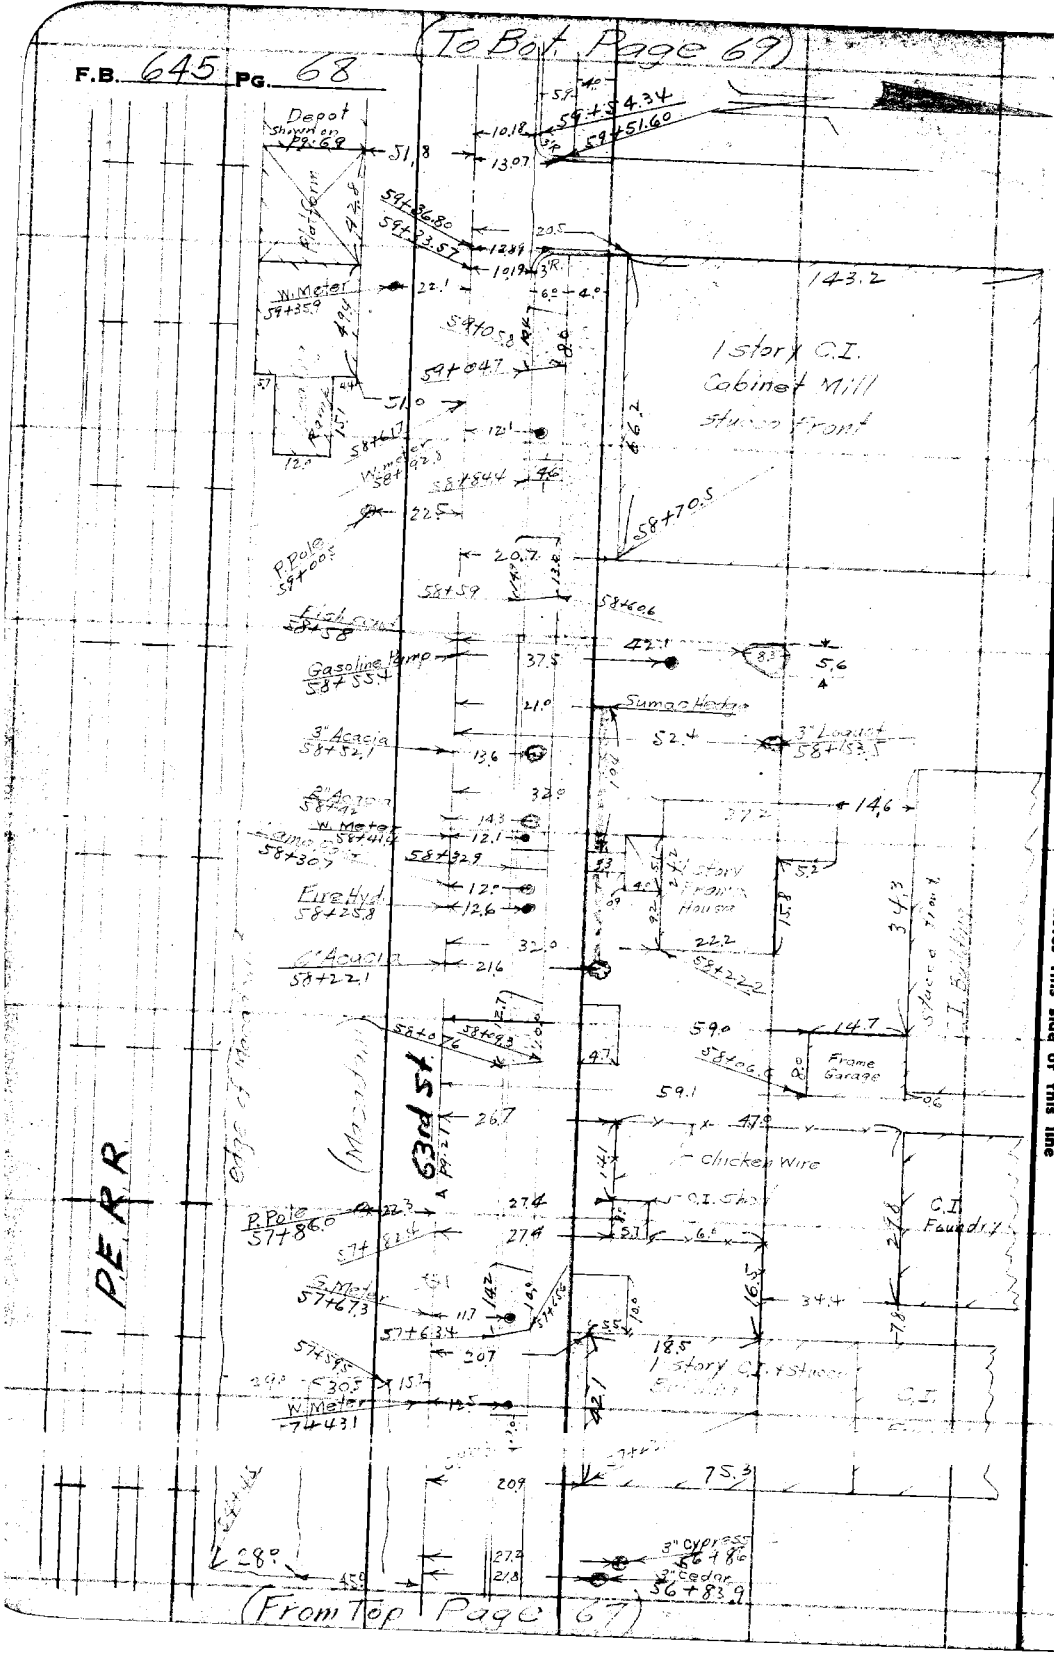

RETURN TO
LOS ANGELES COUNTY SURVEYOR
700 HALL OF RECORDS

Note: Any Additions or Changes on This Sheet Must be Made or Circled in Red Ink With Date and Name of Person Making Change.

Do not extend notes this side of this line

Notes Ck'd by	Survey of: Gage Ave
Map No. B-1245	W. 0.8767 Tape No. 07R St'd 84°F.
Office Work Cox	Surveyed by Evans
Checked AAR	Notes Martin Date 10-1-36
Date Mar. 37	Indexed A. C. Johnson

F.B. 645 PG. 69

(End of Survey)

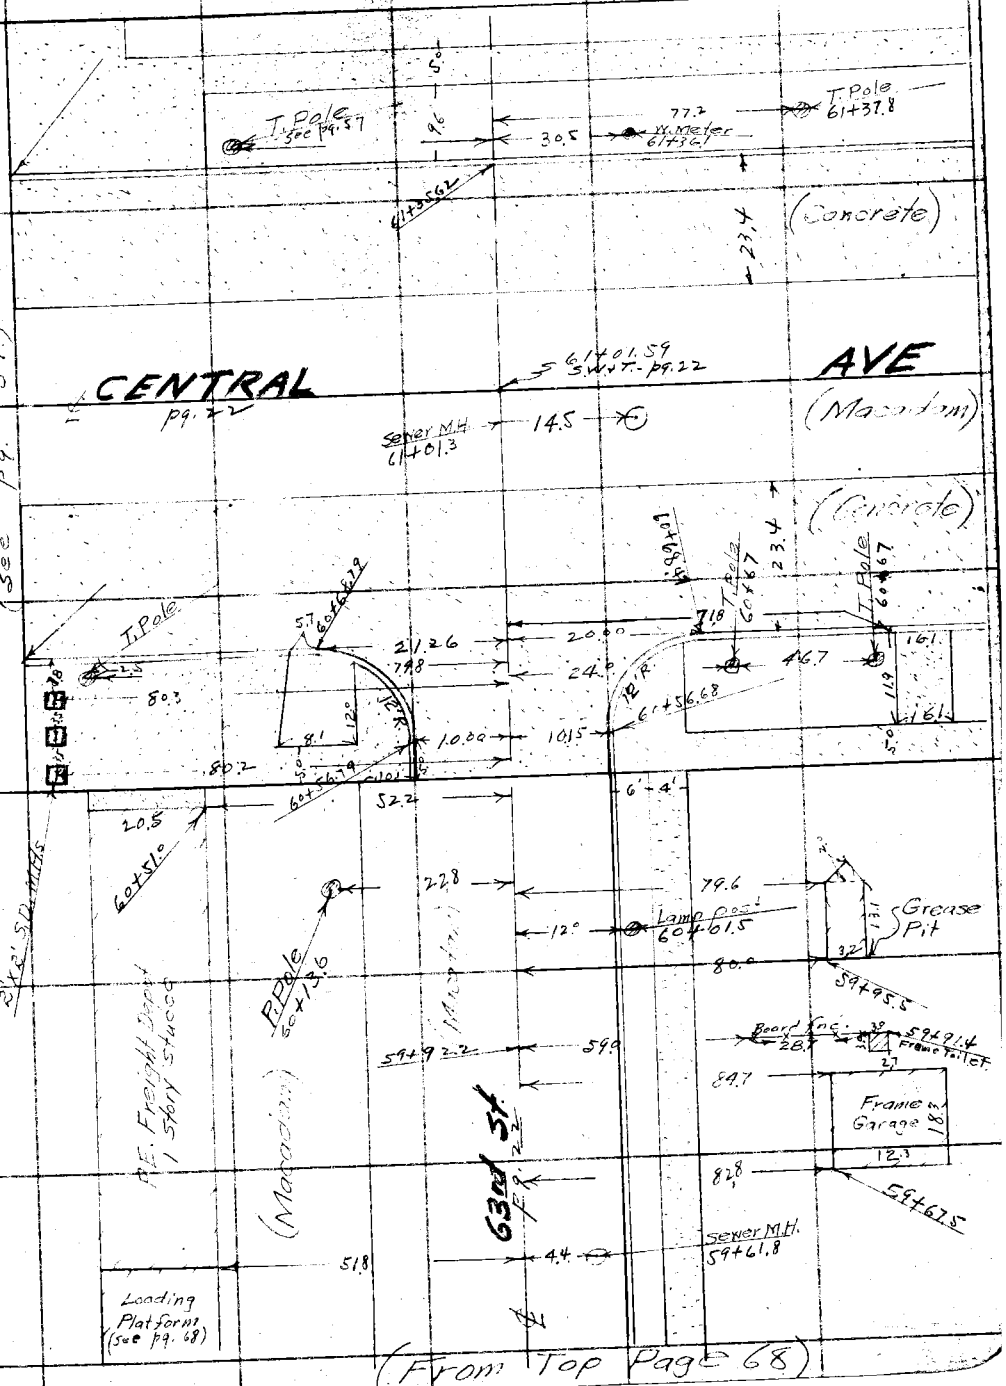

Note: Any Additions or Changes on This Sheet Must be Made or Circled in Red Ink With Date and Name of Person Making Change

Do not extend notes this side of this line

RETURN TO
LOS ANGELES COUNTY SURVEYOR
700 HALL OF RECORDS

FORM 247 10M 11-35

RETURN TO
LOS ANGELES COUNTY SURVEYOR
700 HALL OF RECORDS

Note: Any Additions or Changes on This Sheet Must be Made or Circled in **Red Ink** With Date and Name of Person Making Change.

Do not extend notes this side of this line

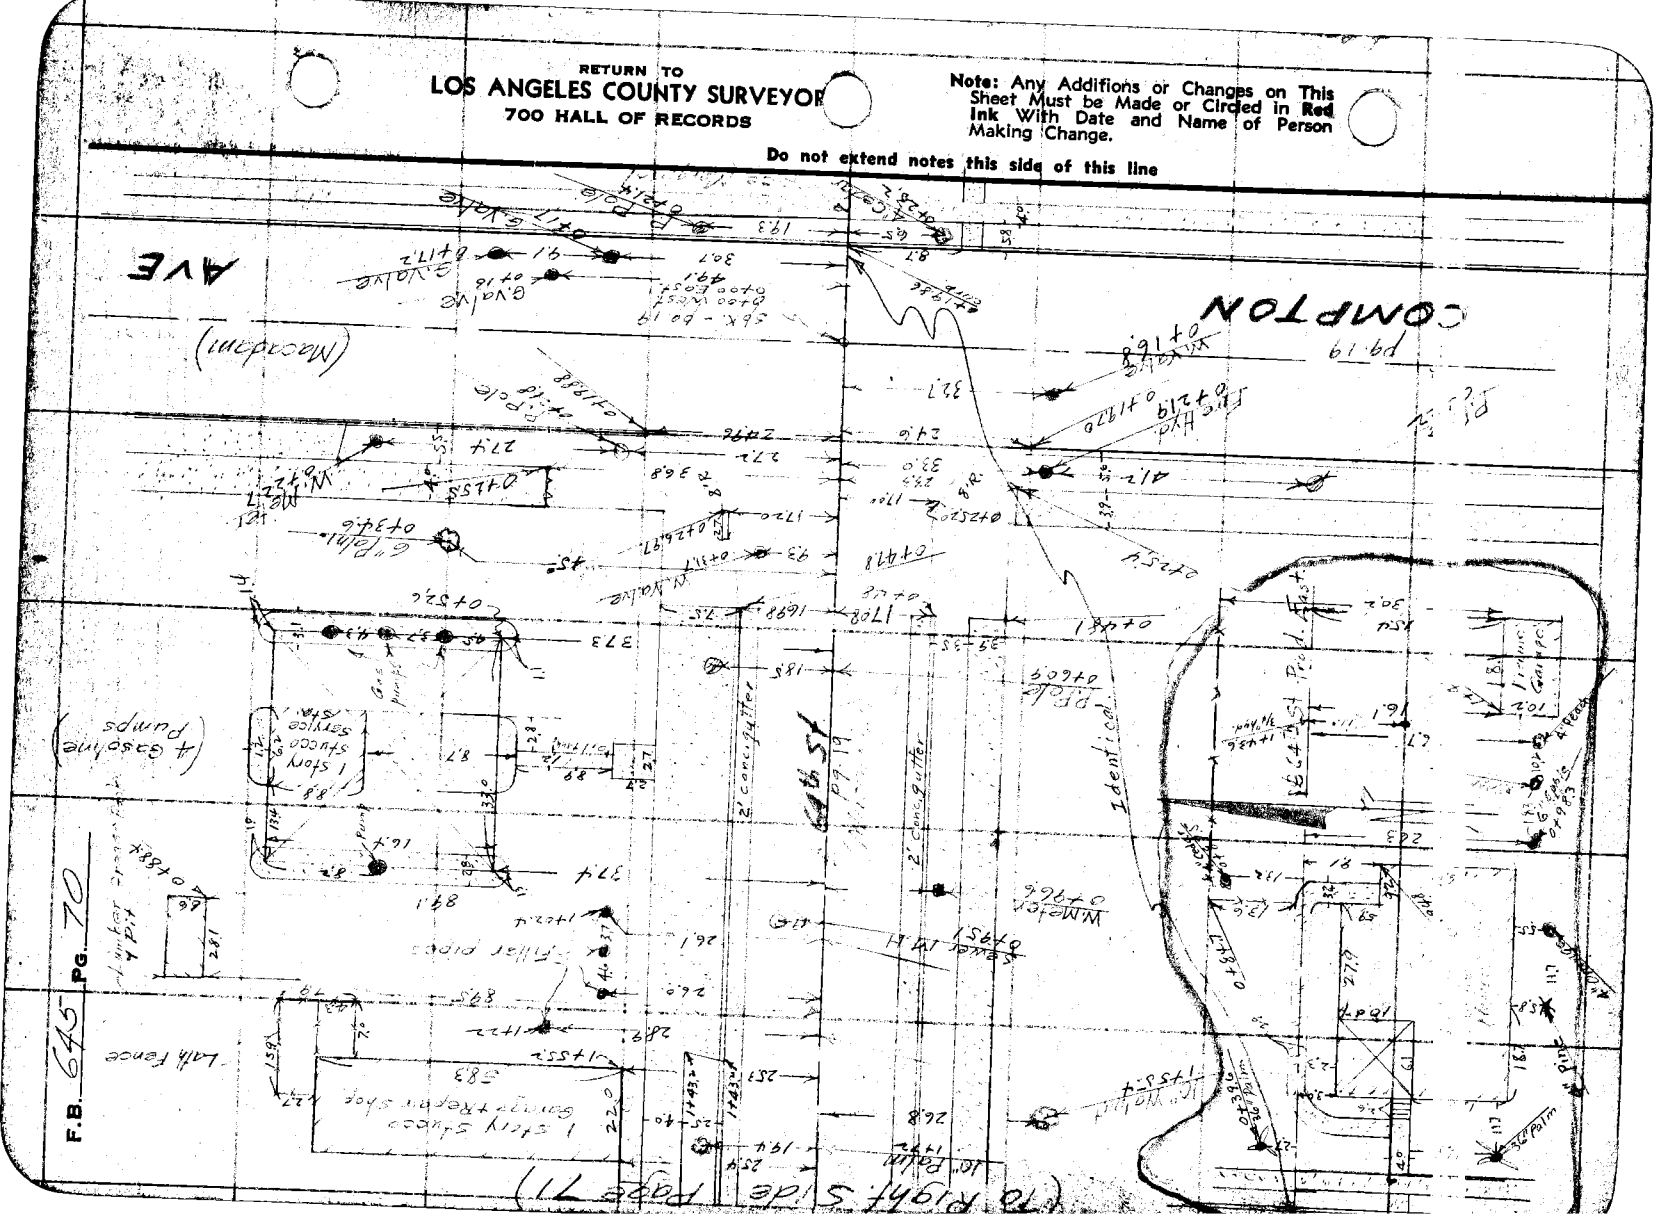

Notes Ck'd by	Survey of Gage Ave
Map No. B-1245	W. O. 8657 Tape No. 07R St'd 84°F.
Office Work Cox	Surveyed by Evans
Checked [illegible]	Notes Martin Date 10-1-36
Date Mar. 37	Indexed A. C. Johnson

F.B. 645 PG. 71

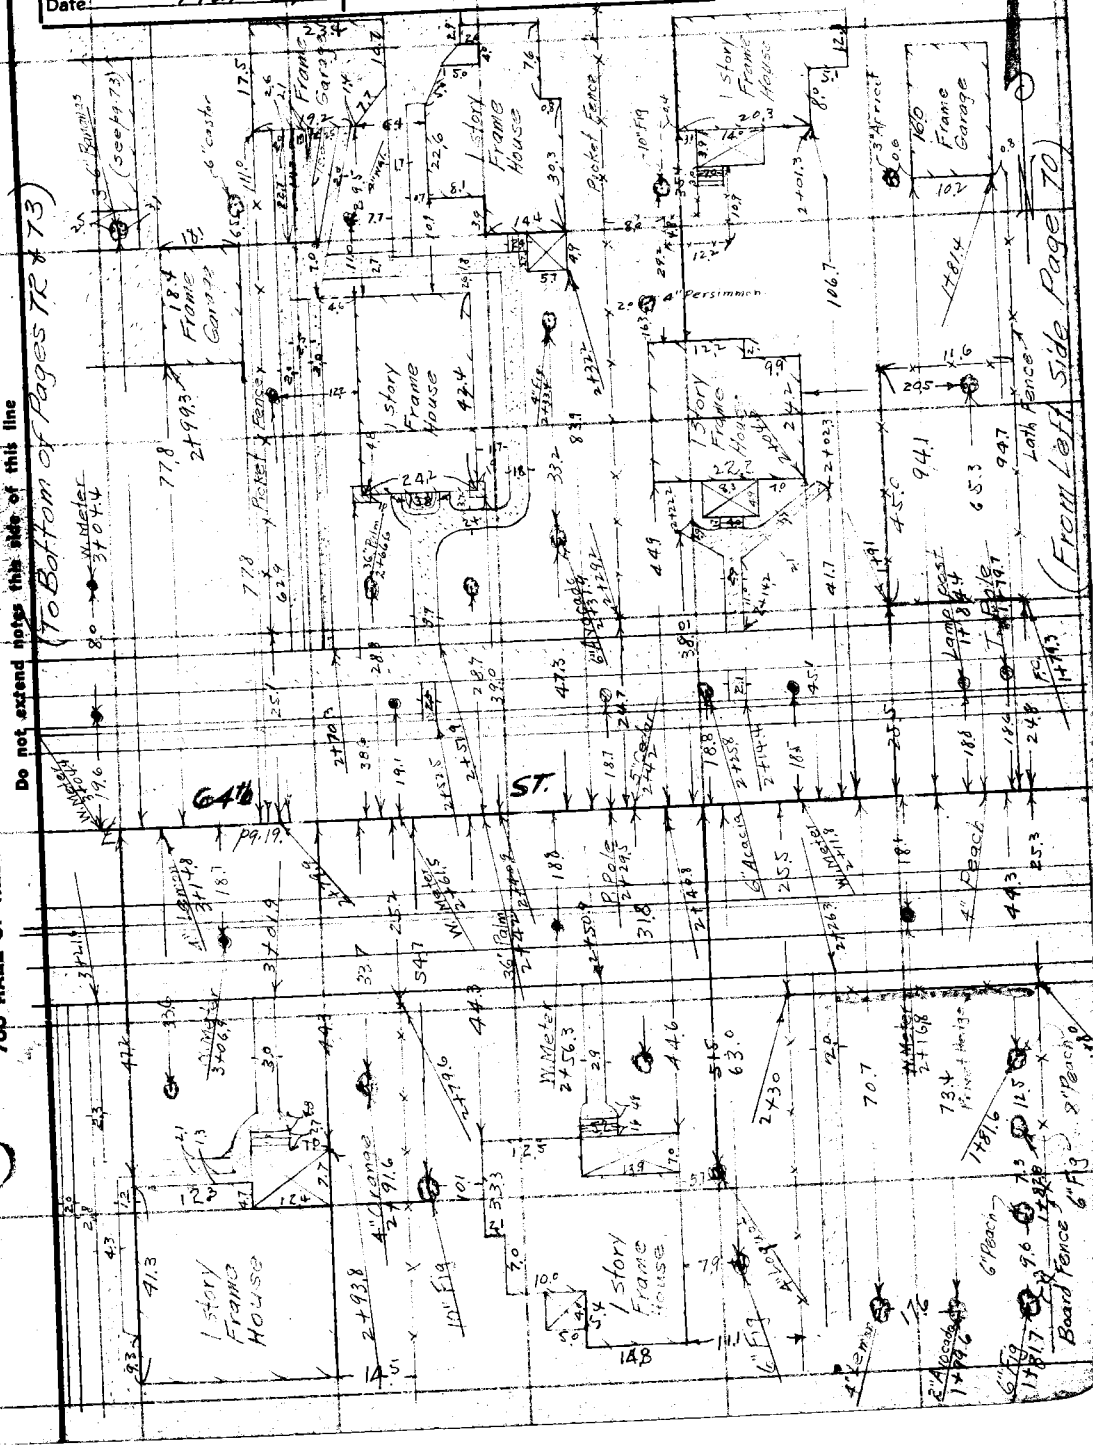

Note: Any Additions or Changes on This Sheet Must be Made or Circled in Red Ink With Date and Name of Person Making Change

Do not extend notes this side of this line

RETURN TO
LOS ANGELES COUNTY SURVEYOR
700 HALL OF RECORDS

FORM 247 10M 11-35

F.B. 645 PG. 72

(To Bot Page 74)

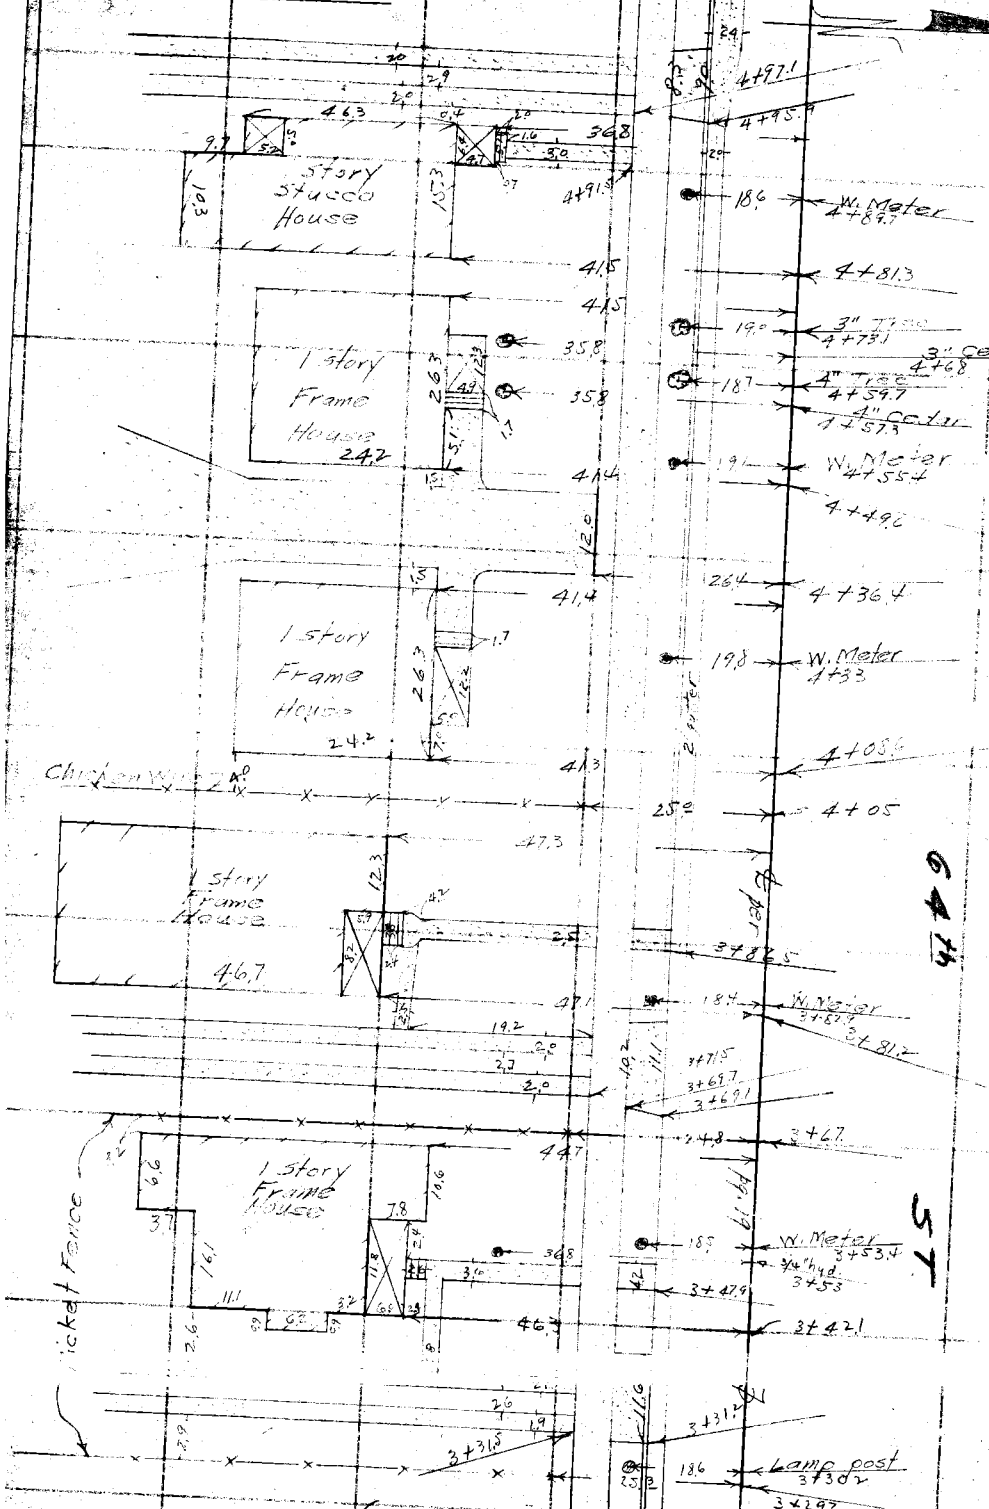

(From Left Side Page 71)

RETURN TO
LOS ANGELES COUNTY SURVEYOR
700 HALL OF RECORDS

Do not extend notes this side of this line

Note: Any Additions or Changes on This Sheet Must be Made or Circled in Red Ink With Date and Name of Person Making Change.

Notes Ck'd by	Survey of Gage Ave
Map No. B-1245	W. O. 8157 Tape No. 072 St'd 84° F.
Office Work Cox	Surveyed by Evans
Checked CWR	Notes Martin Date 10-2-36
Date Mar. 37	Indexed A. C. Johnson

F.B. 645 PG. 73

(To Bot. Page 75)

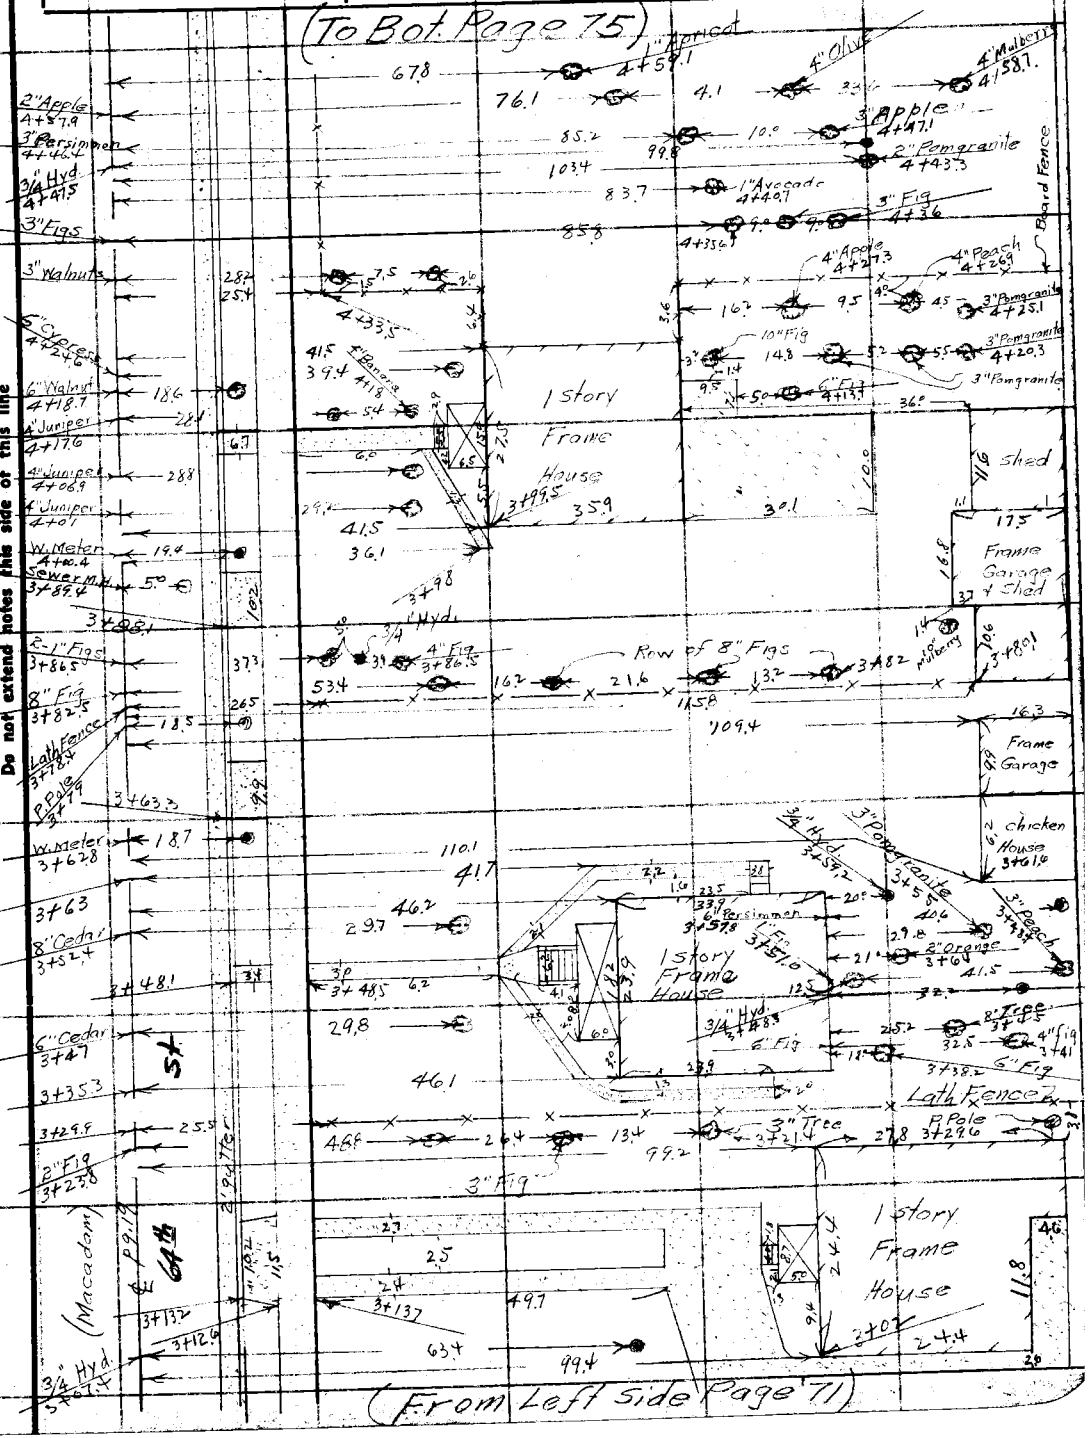

Note: Any Additions or Changes on This Sheet Must be Made or Circled in Red Ink With Date and Name of Person Making Change.

Do not extend notes this side of this line

RETURN TO
LOS ANGELES COUNTY SURVEYOR
700 HALL OF RECORDS

Form 247 10M 11-35

(To Bot. Page 76)

F.B. 645 PG. 74

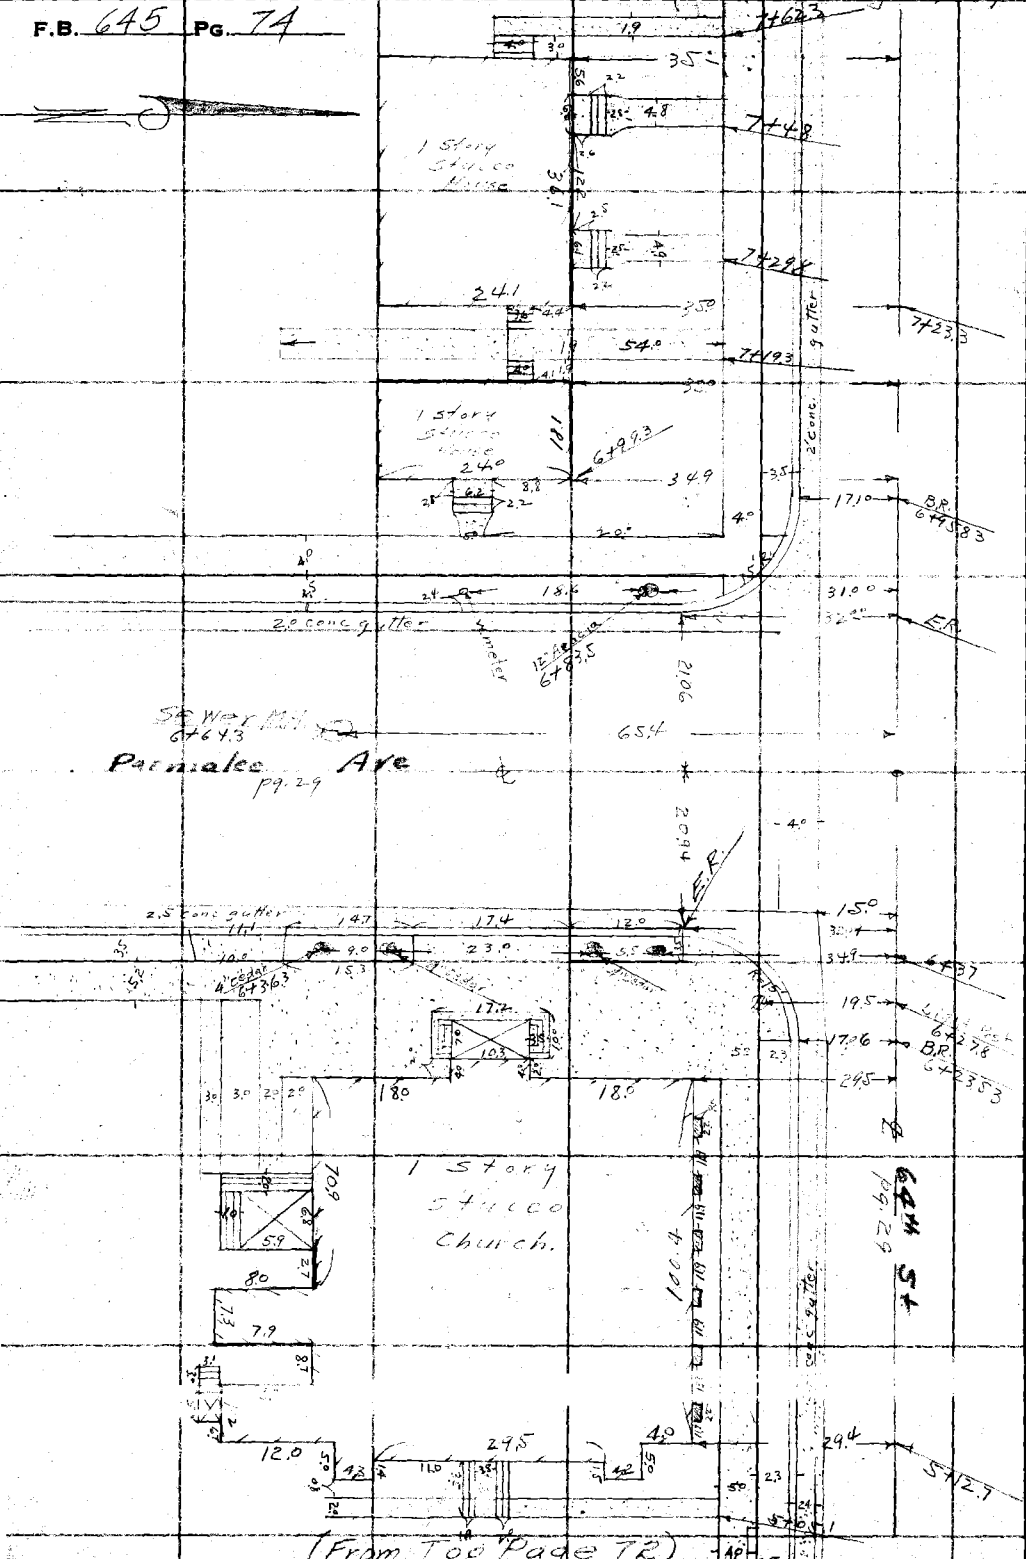

RETURN TO
LOS ANGELES COUNTY SURVEYOR
700 HALL OF RECORDS

Do not extend notes this side of this line

Note: Any Additions or Changes on This Sheet Must be Made or Circled in Red Ink With Date and Name of Person Making Change.

(To Bot. Page 77)

Notes Ck'd by	Survey of Gage Ave
Map No. B-1245	W. O. 8157 Tape No. 078 St'd 84 °F.
Office Work Cox	Surveyed by Evans
Checked aur	Notes Martin Date 10-8-36
Date Mar. 37	Indexed A. C. Johnson

F.B. 645 PG. 75

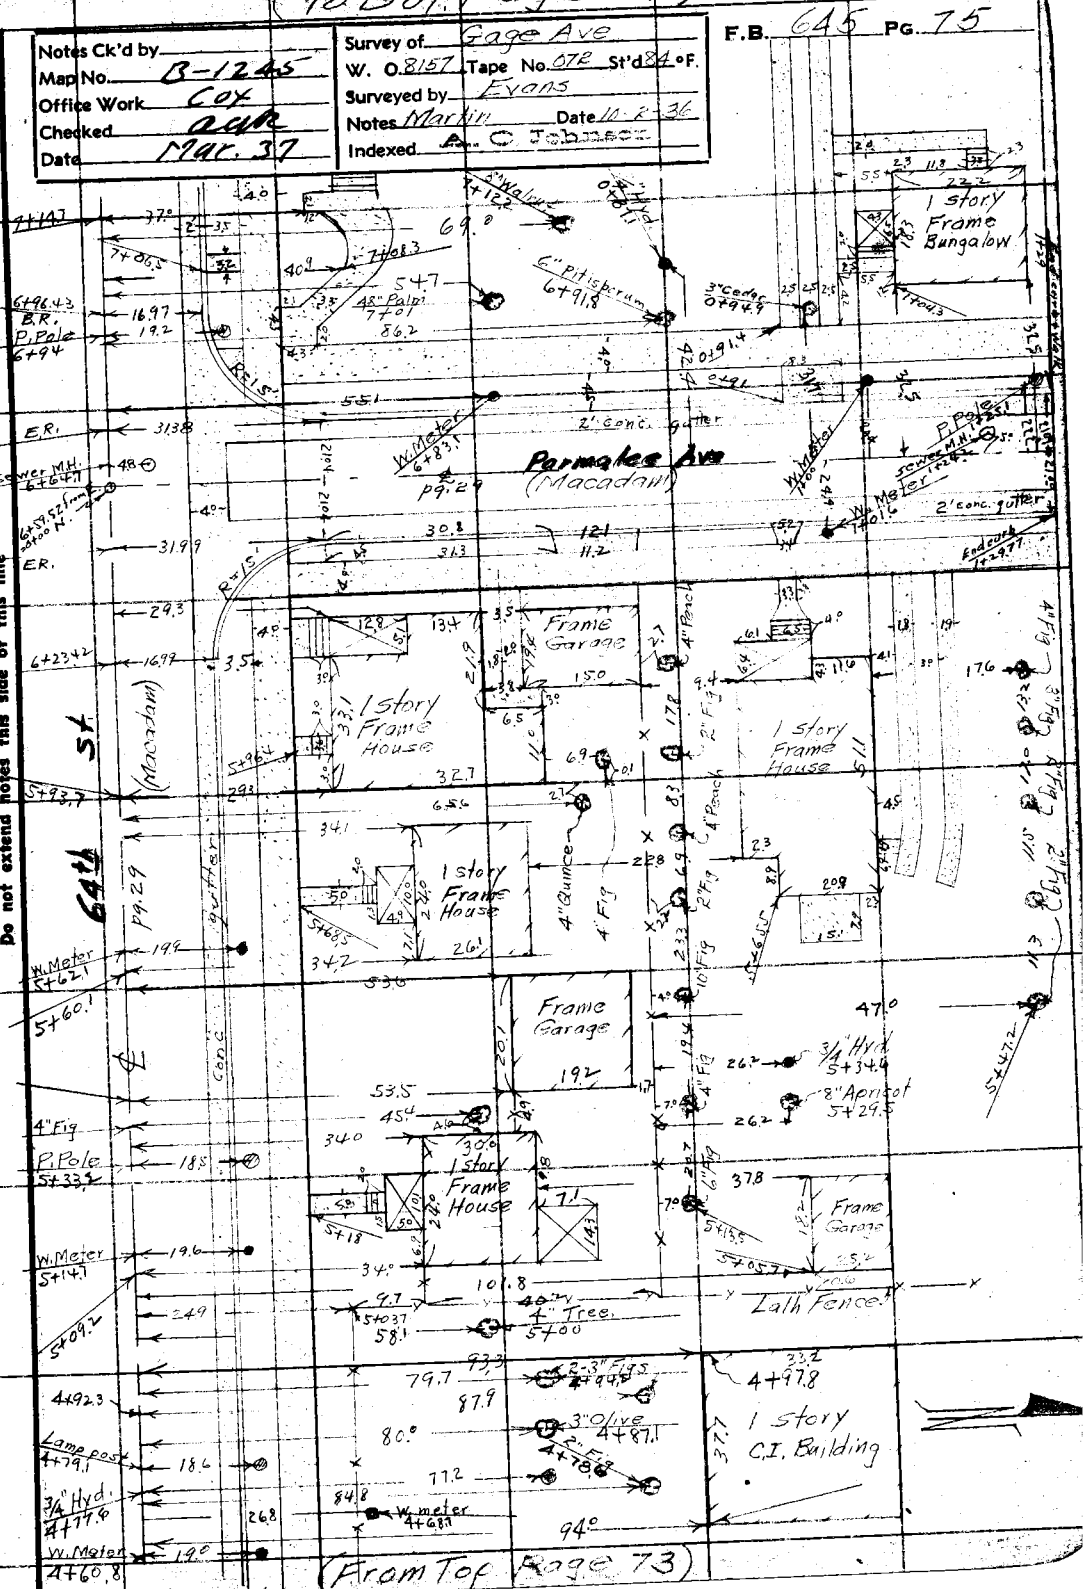

Note: Any Additions or Changes on This Sheet Must be Made or Circled in Red Ink With Date and Name of Person Making Change.

Do not extend notes this side of this line

RETURN TO LOS ANGELES COUNTY SURVEYOR 700 HALL OF RECORDS

FORM 267 10M 11-35

(To Bot. Page 78)

F.B. 645 PG. 76

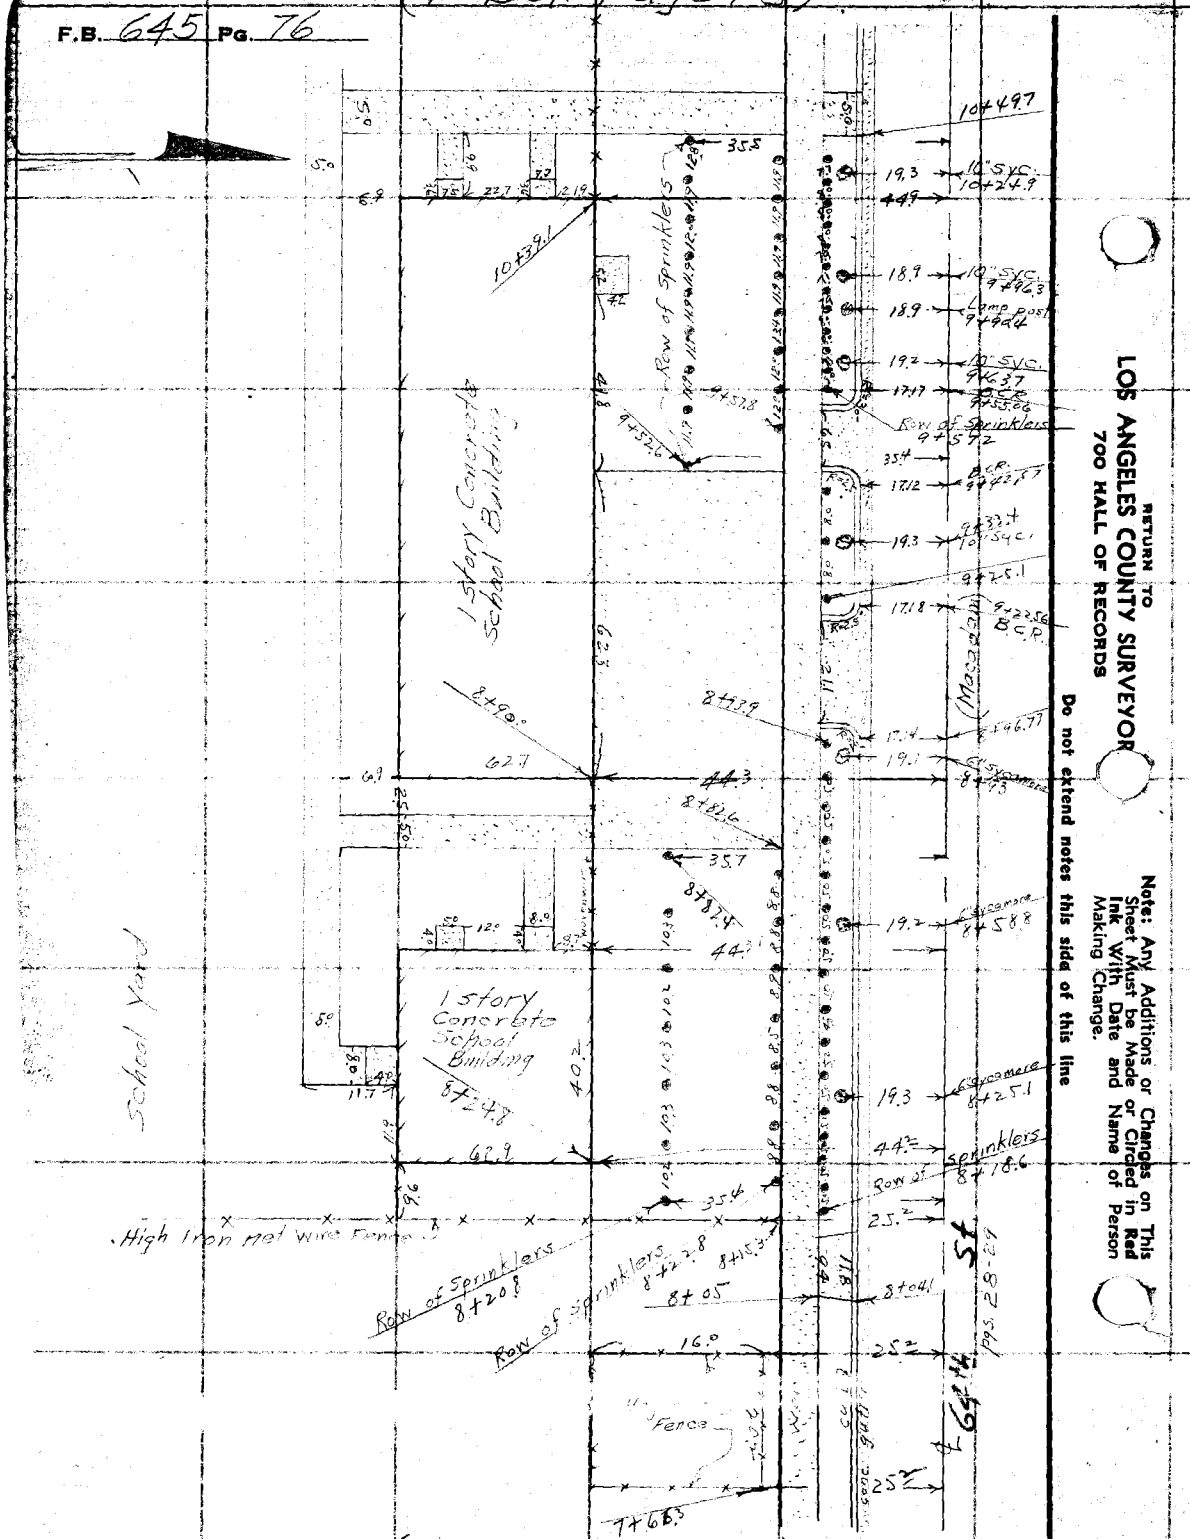

(From Top Page 74)

RETURN TO
LOS ANGELES COUNTY SURVEYOR
700 HALL OF RECORDS

Do not extend notes this side of this line

Note: Any Additions or Changes on This Sheet Must be Made or Circled in Red Ink With Date and Name of Person Making Change.

(To Bot Page 79)

Notes Ck'd by	Survey of Gage Ave
Map No. B-1245	W. O. 8157 Tape No. 078 St'd 84°F.
Office Work Cox	Surveyed by Evans
Checked	Notes Martin Date 10-2-36
Date Mar. 37	Indexed A. C. Johnson

F.B. 645 Pg. 77

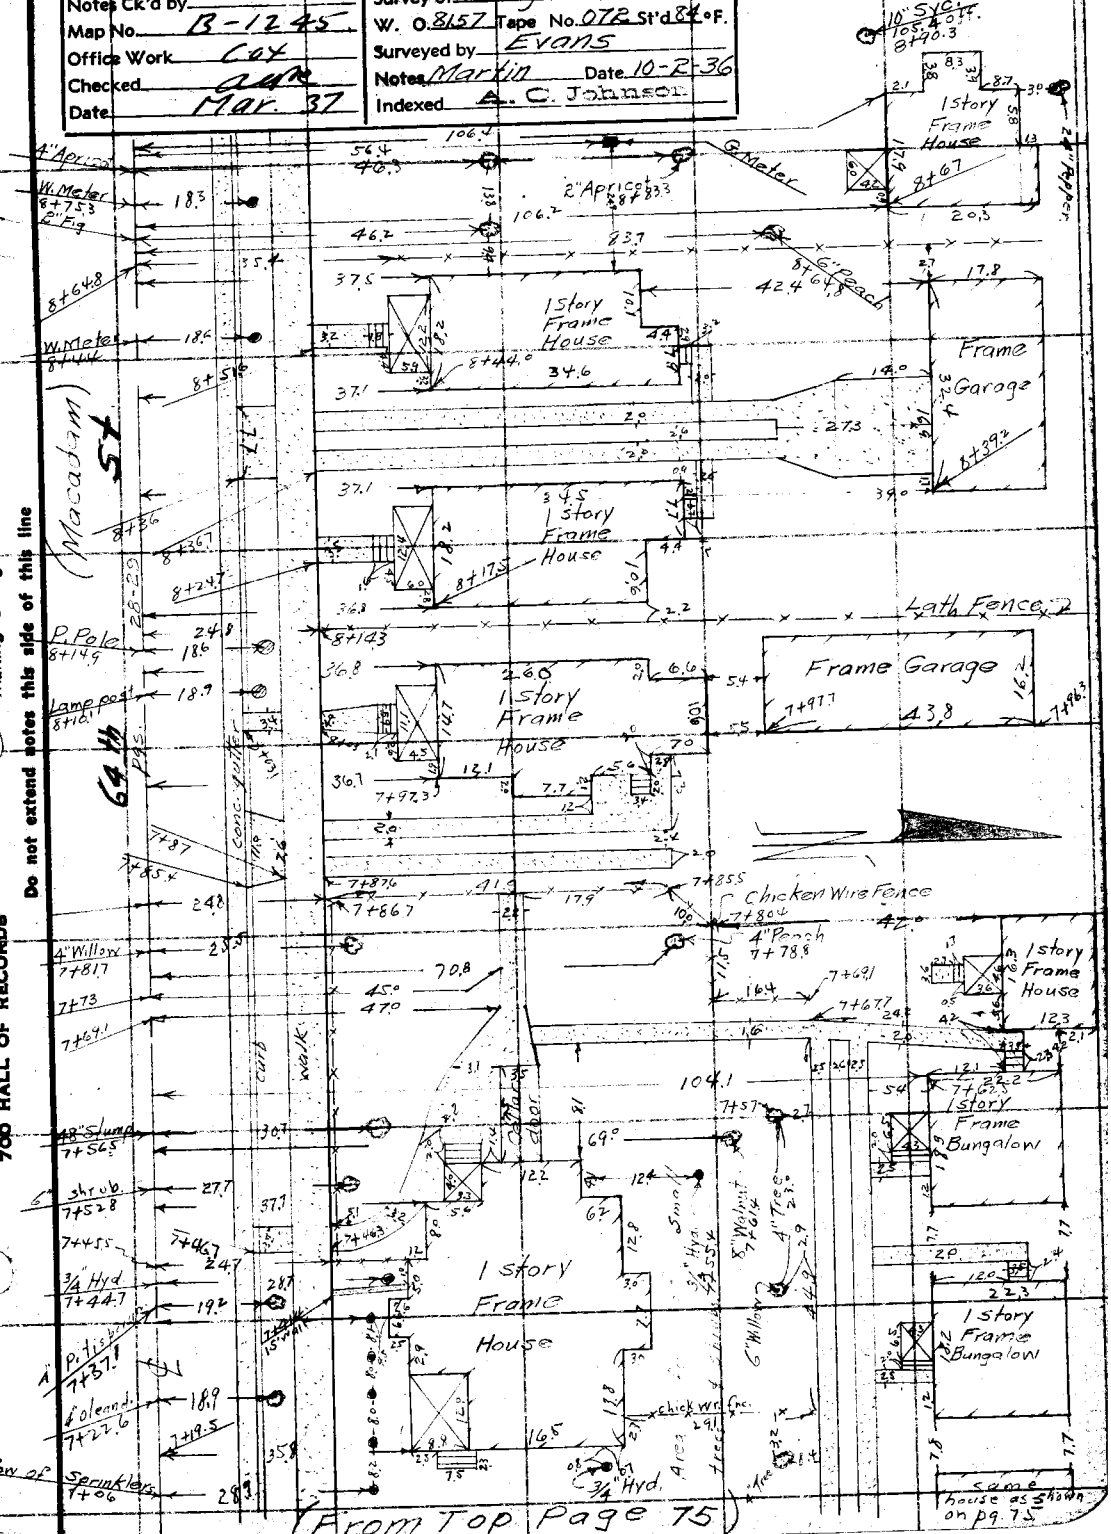

(From Top Page 75)

Note: Any Additions or Changes on This Sheet Must be Made or Circled in Red Ink With Date and Name of Person Making Change.

Do not extend notes this side of this line

RETURN TO LOS ANGELES COUNTY SURVEYOR 700 HALL OF RECORDS

FORM 247 10M 11-35

(To Bot. Page 80)

F.B. 645 PG. 78

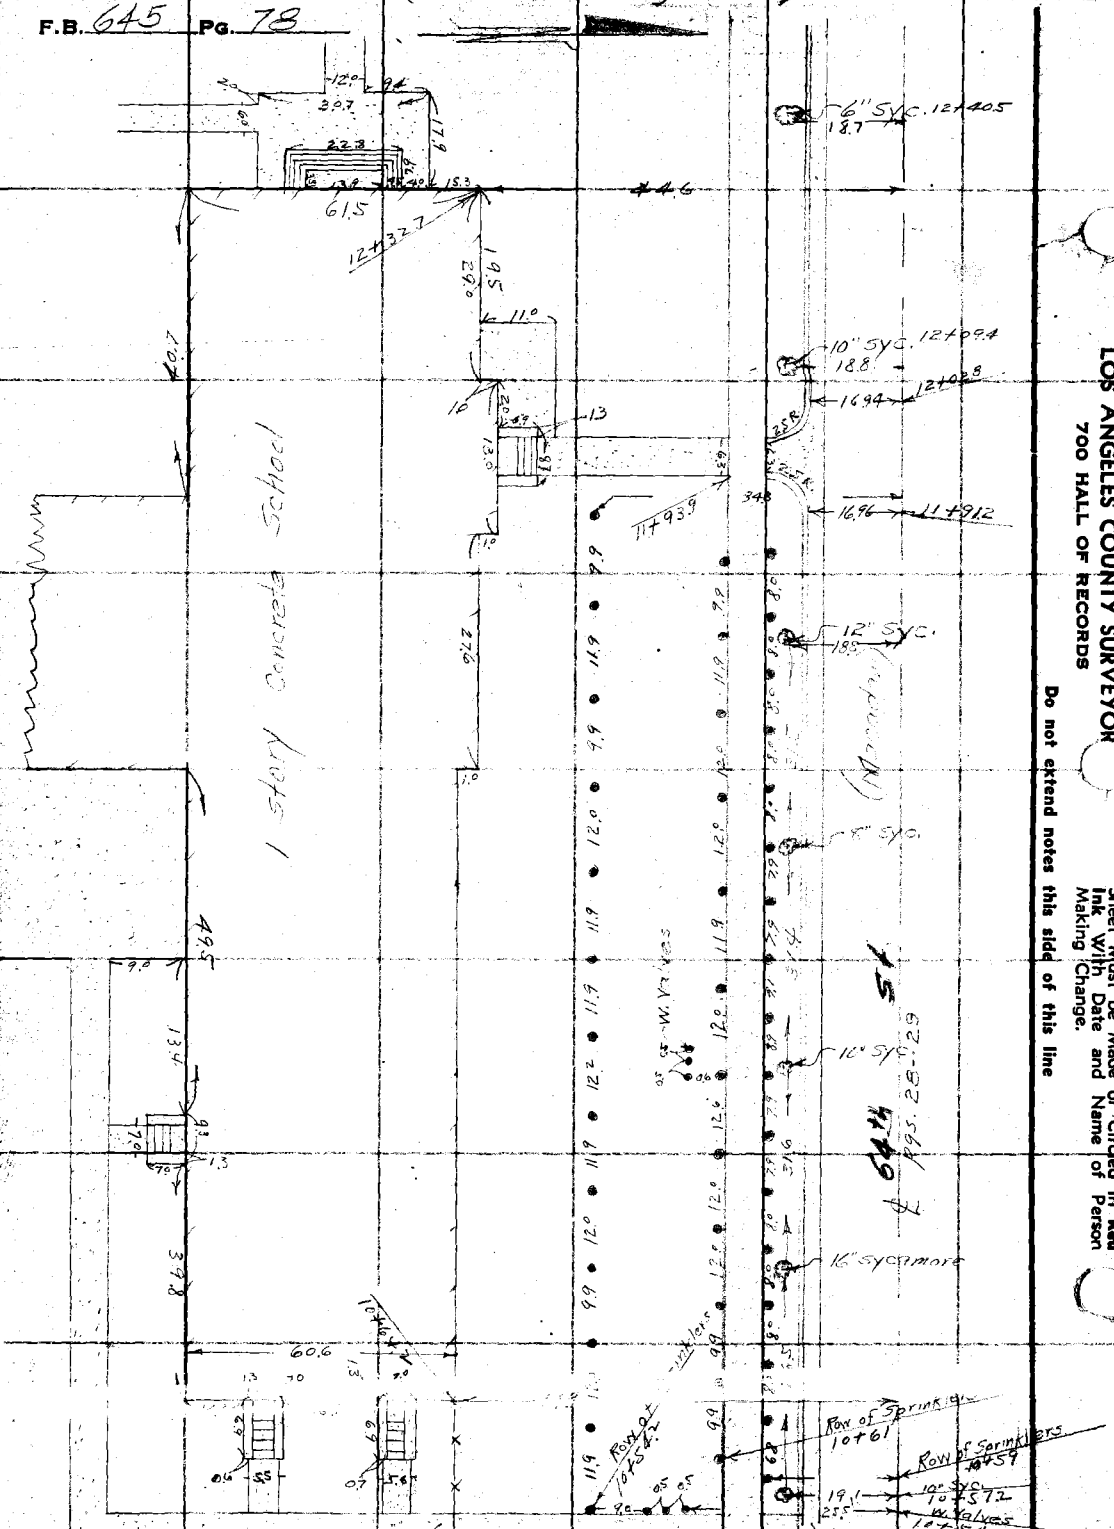

RETURN TO
LOS ANGELES COUNTY SURVEYOR
700 HALL OF RECORDS

Do not extend notes this side of this line

Note: Any Additions or Changes on This Sheet Must be Made or Circled in Red Ink With Date and Name of Person Making Change.

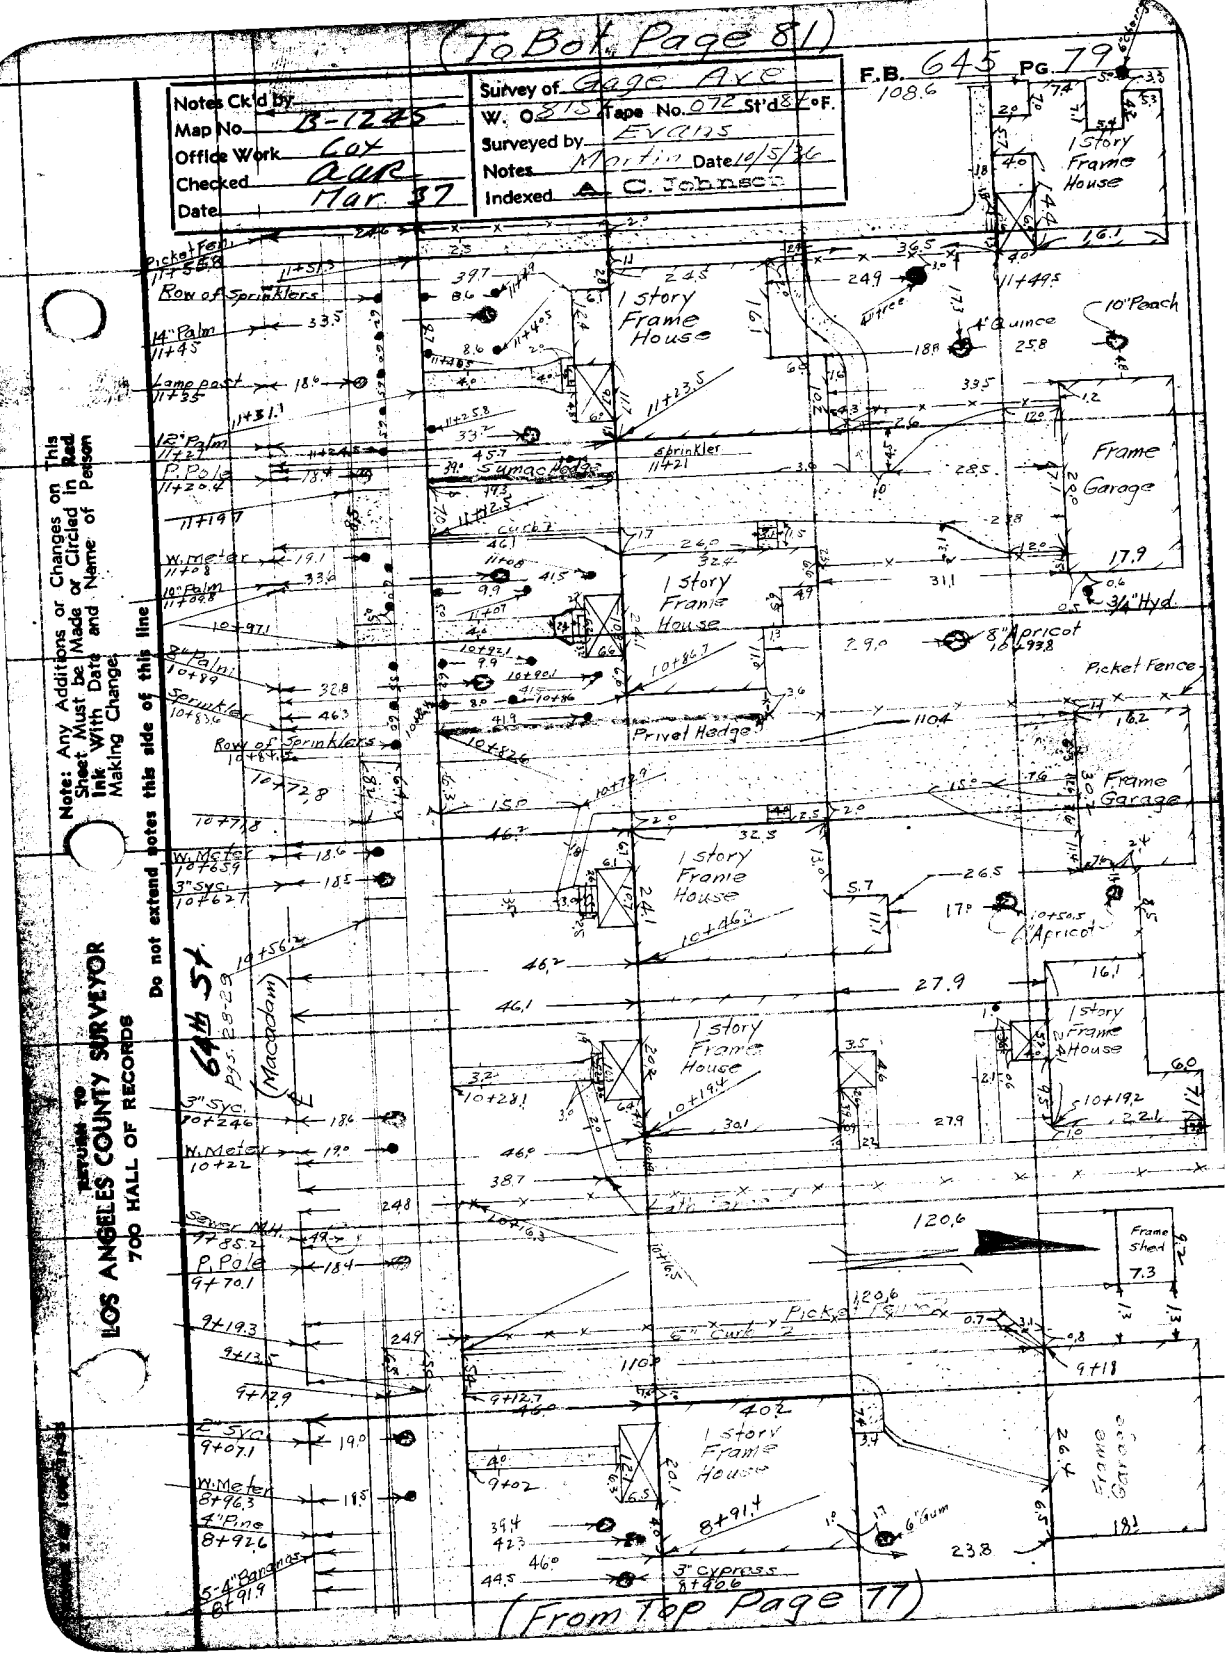
(To Bot. Page 81)
F.B. 645 PG. 79
Notes Ck'd by
Map No. B-1245
Office Work Cox
Checked aur
Date Mar. 37
Survey of Gage Ave
W. O. 815 Tape No. 072 St'd 84 °F.
Surveyed by Evans
Notes Martin Date 10/5/36
Indexed A. C. Johnson
Note: Any Additions or Changes on This Sheet Must be Made or Circled in Red Ink With Date and Name of Person Making Change.
Do not extend notes this side of this line
RETURN TO
LOS ANGELES COUNTY SURVEYOR
700 HALL OF RECORDS
64th St.
pgs. 28-29
(Macadam)
1 Story Frame House
Frame Garage
Picket Fence
Privet Hedge
Sumac Hedge
Sprinkler
Row of Sprinklers
Lamp post
Picket Fen.
Sewer M.H.
P. Pole
W. Meter
3" Syc.
2" Syc.
4" Pine
5-4" Bananas
3" Cypress
6" Gum
4" Quince
10" Peach
8" Apricot
3/4" Hyd.
Frame Shed
(From Top Page 77)

F.B. 645 PG. 80

(To Bot. Page 82)

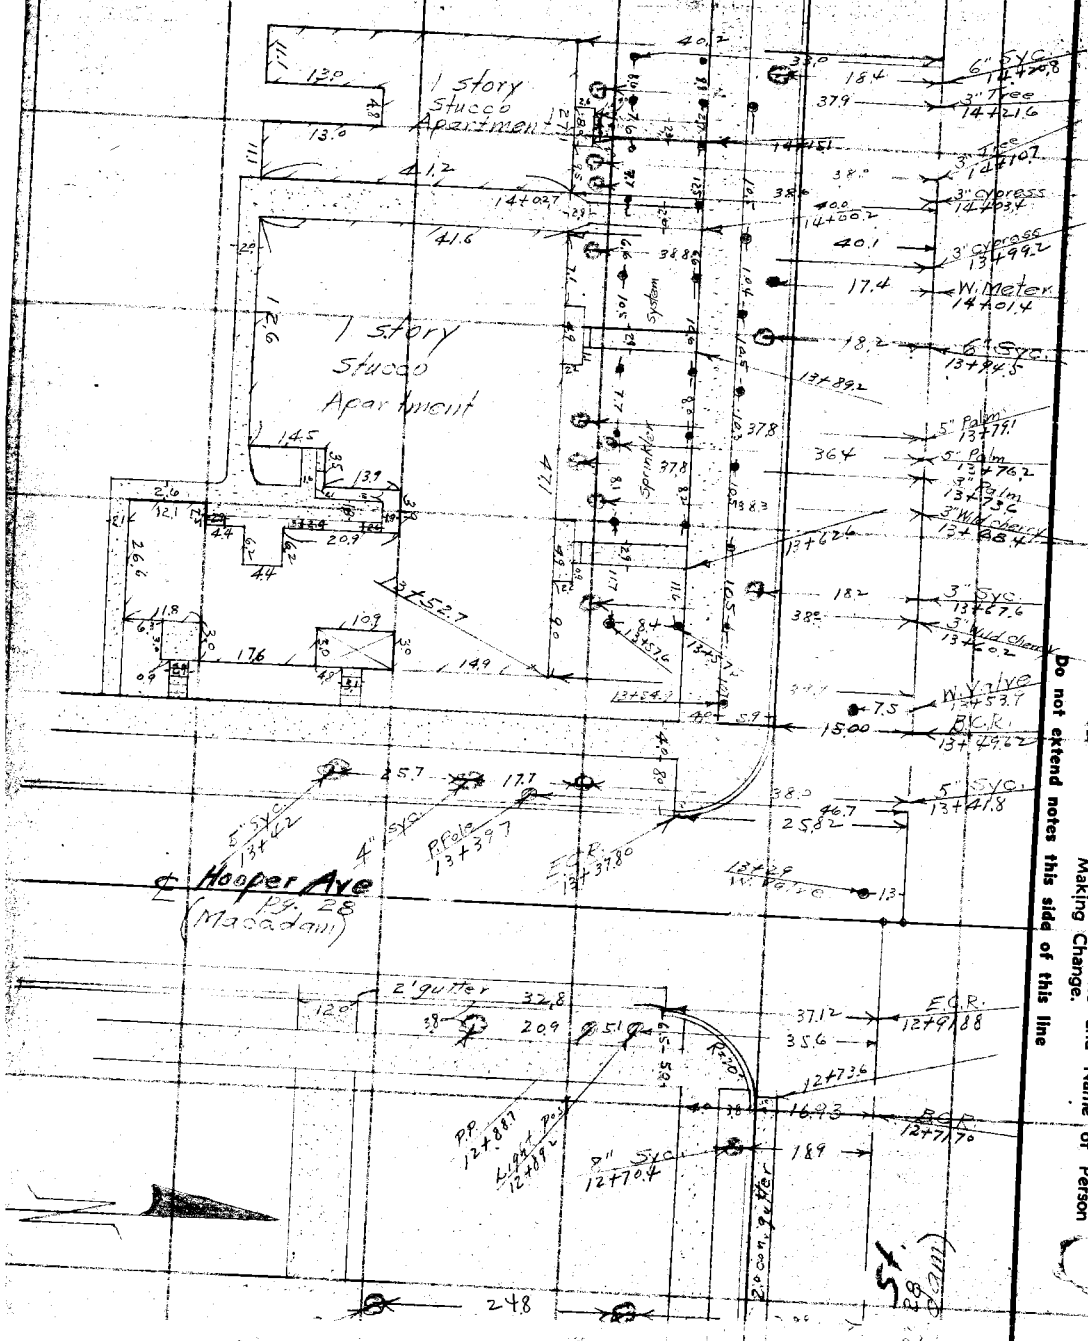

(From Top Page 78)

RETURN TO
LOS ANGELES COUNTY SURVEYOR
700 HALL OF RECORDS

Do not extend notes this side of this line

Note: Any Additions or Changes on This Sheet Must be Made or Circled in Red Ink With Date and Name of Person Making Change.

(To Bk Page 83)

Notes Ck'd by	Survey of Gage Ave
Map No. B-1245	W. O. 8157 Tape No. 072 St'd 84°F.
Office Work Cox	Surveyed by Evans
Checked AAR	Notes Martin Date 10-6-36
Date Mar. 37	Indexed A. C. Johnson

F.B. 645 PG. 81

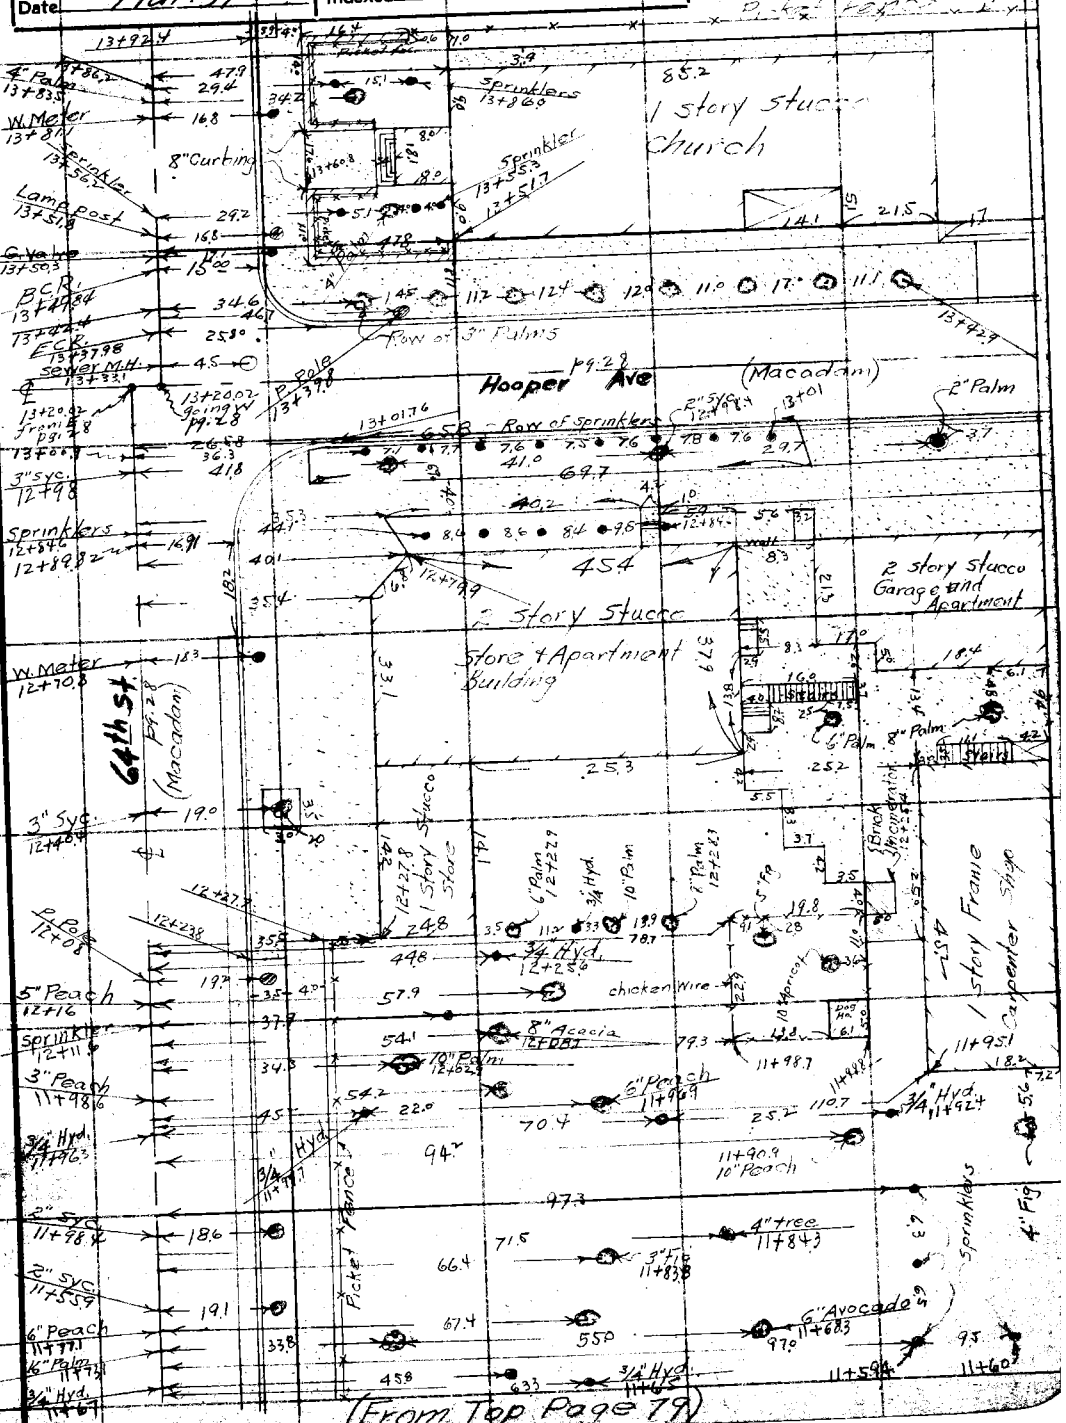

Note: Any Additions or Changes on This Sheet Must be Made or Circled in Red Ink With Date and Name of Person Making Change

Do not extend notes this side of this line

LOS ANGELES COUNTY SURVEYOR
700 HALL OF RECORDS

(To Bot. Page 84)

F.B. 645 PG. 82

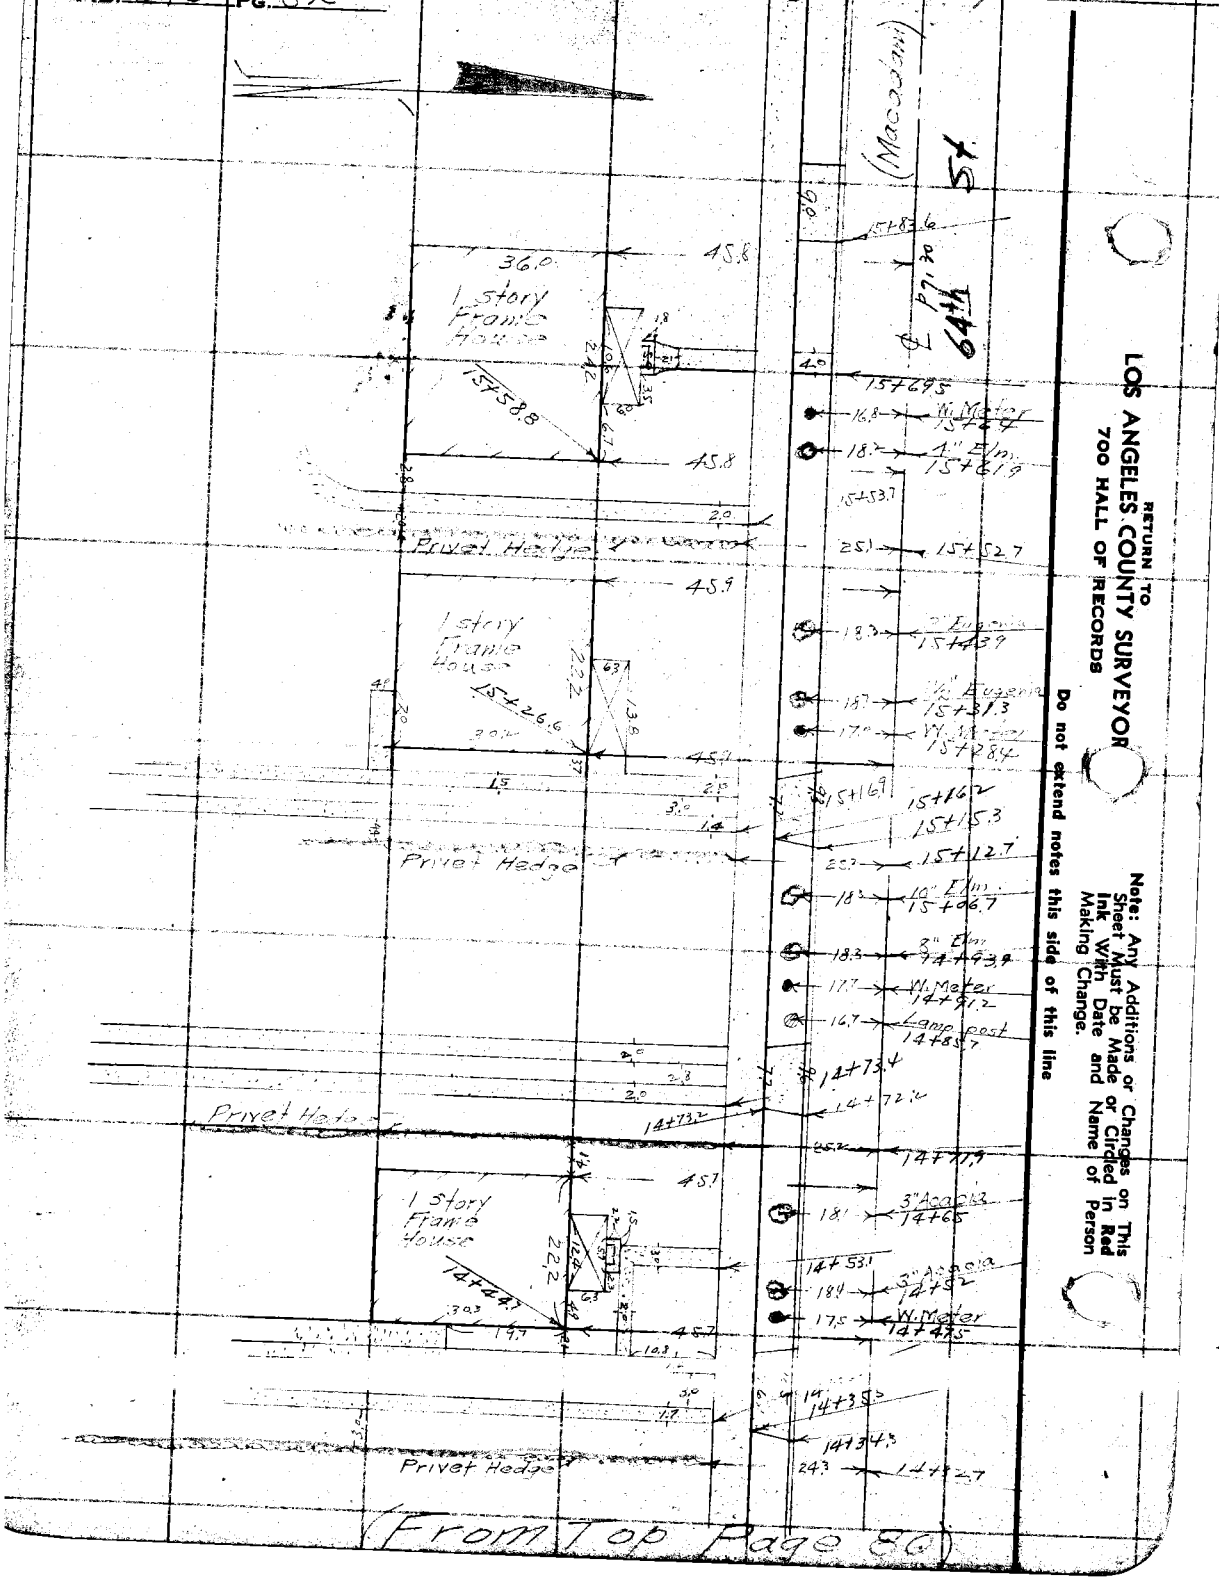

(From Top Page 80)

RETURN TO
LOS ANGELES COUNTY SURVEYOR
700 HALL OF RECORDS

Do not extend notes this side of this line

Note: Any Additions or Changes on This Sheet Must be Made or Circled in Red Ink With Date and Name of Person Making Change.

(To Bot. Page 85)

Notes Ck'd by	Survey of Gage Ave
Map No. B-1245	W. O. 8157 Tape No. 072 St'd 84 °F.
Office Work Cox	Surveyed by Evans
Checked aun	Notes Martin Date 10-6-36
Date Mar. 37	Indexed A. C. Johnson

F.B. 645 PG. 83

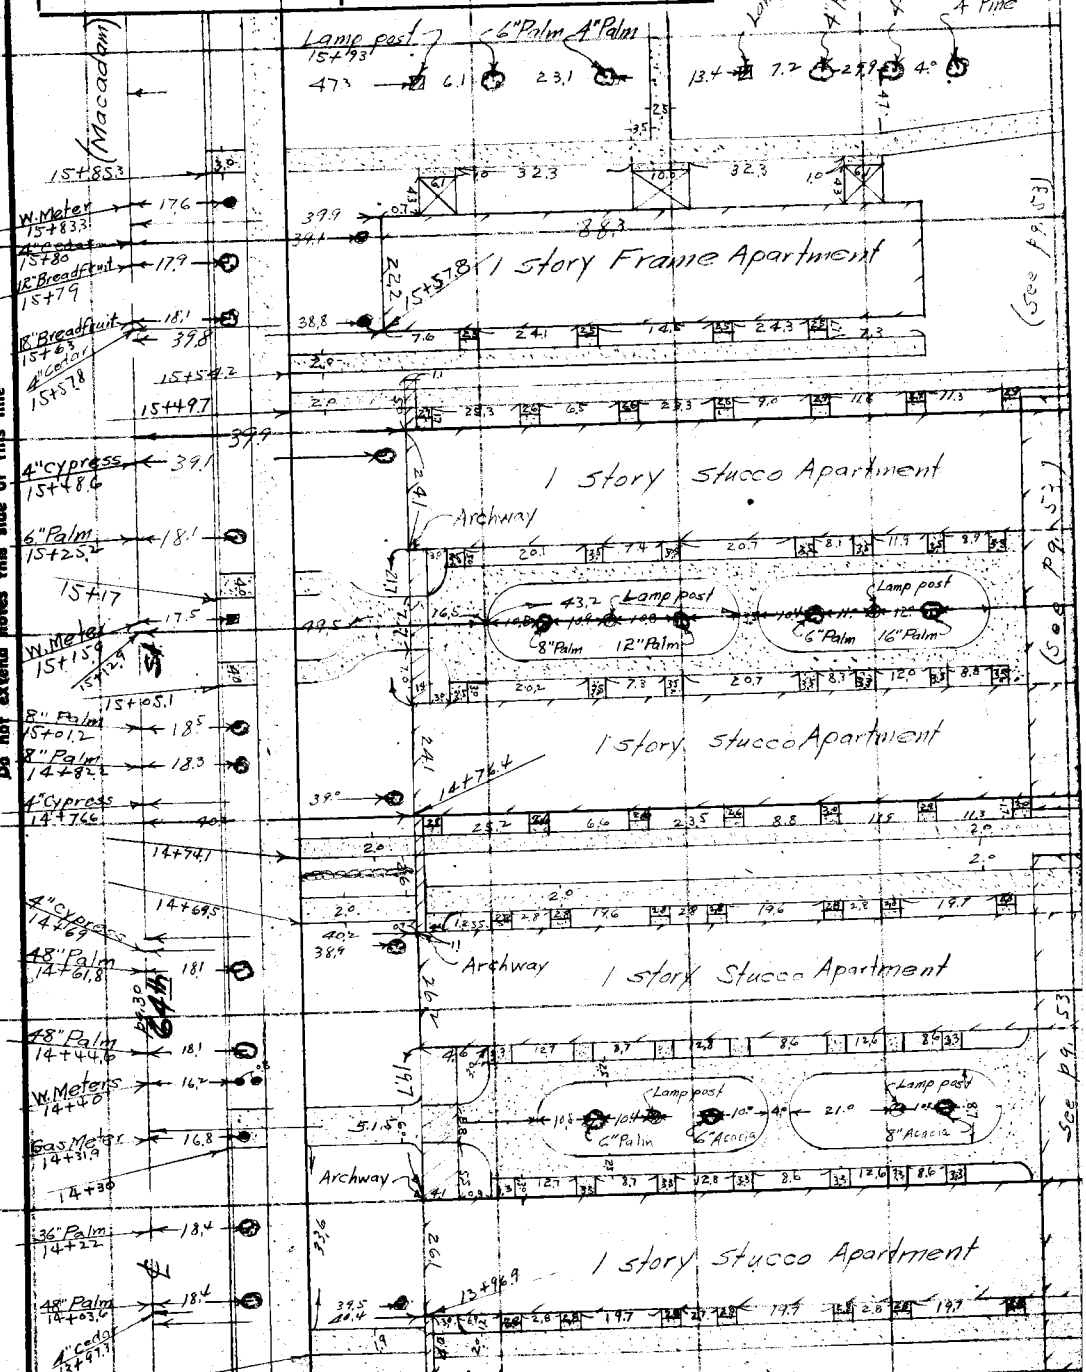

(From Top Page 81)

Note: Any Additions or Changes on This Sheet Must be Made or Circled in Red Ink With Date and Name of Person Making Change.

Do not extend notes this side of this line

RETURN TO
LOS ANGELES COUNTY SURVEYOR
700 HALL OF RECORDS

F.B. 645 PG. 84

(To Bot. Page 86)

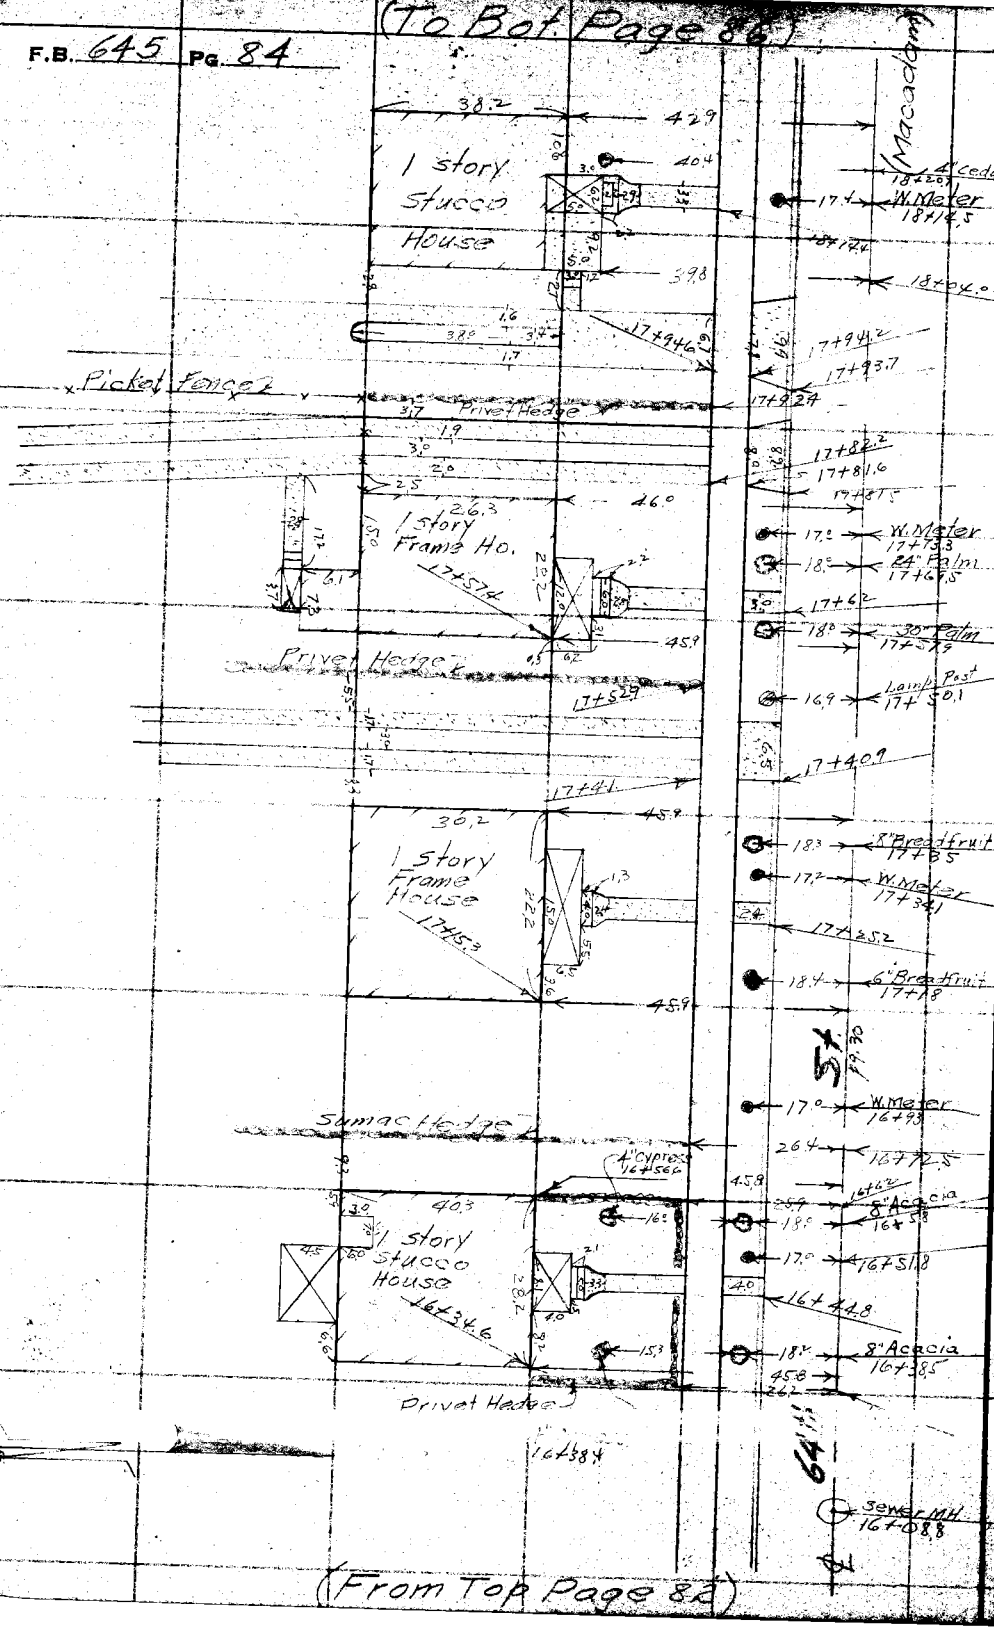

(From Top Page 82)

RETURN TO
LOS ANGELES COUNTY SURVEYOR
700 HALL OF RECORDS

Do not extend notes this side of this line

Note: Any Additions or Changes on This Sheet Must be Made or Circled in Red Ink With Date and Name of Person Making Change.

(To Bk. Page 87)

Notes Ck'd by	Survey of Gage Ave
Map No. B-1245	W. O. 8157 Tape No. 072 St'd 84°F.
Office Work Cox	Surveyed by Evans
Checked aqR	Notes Martin Date 10-7-36
Date Mar. 37	Indexed

F.B. 645 PG. 85

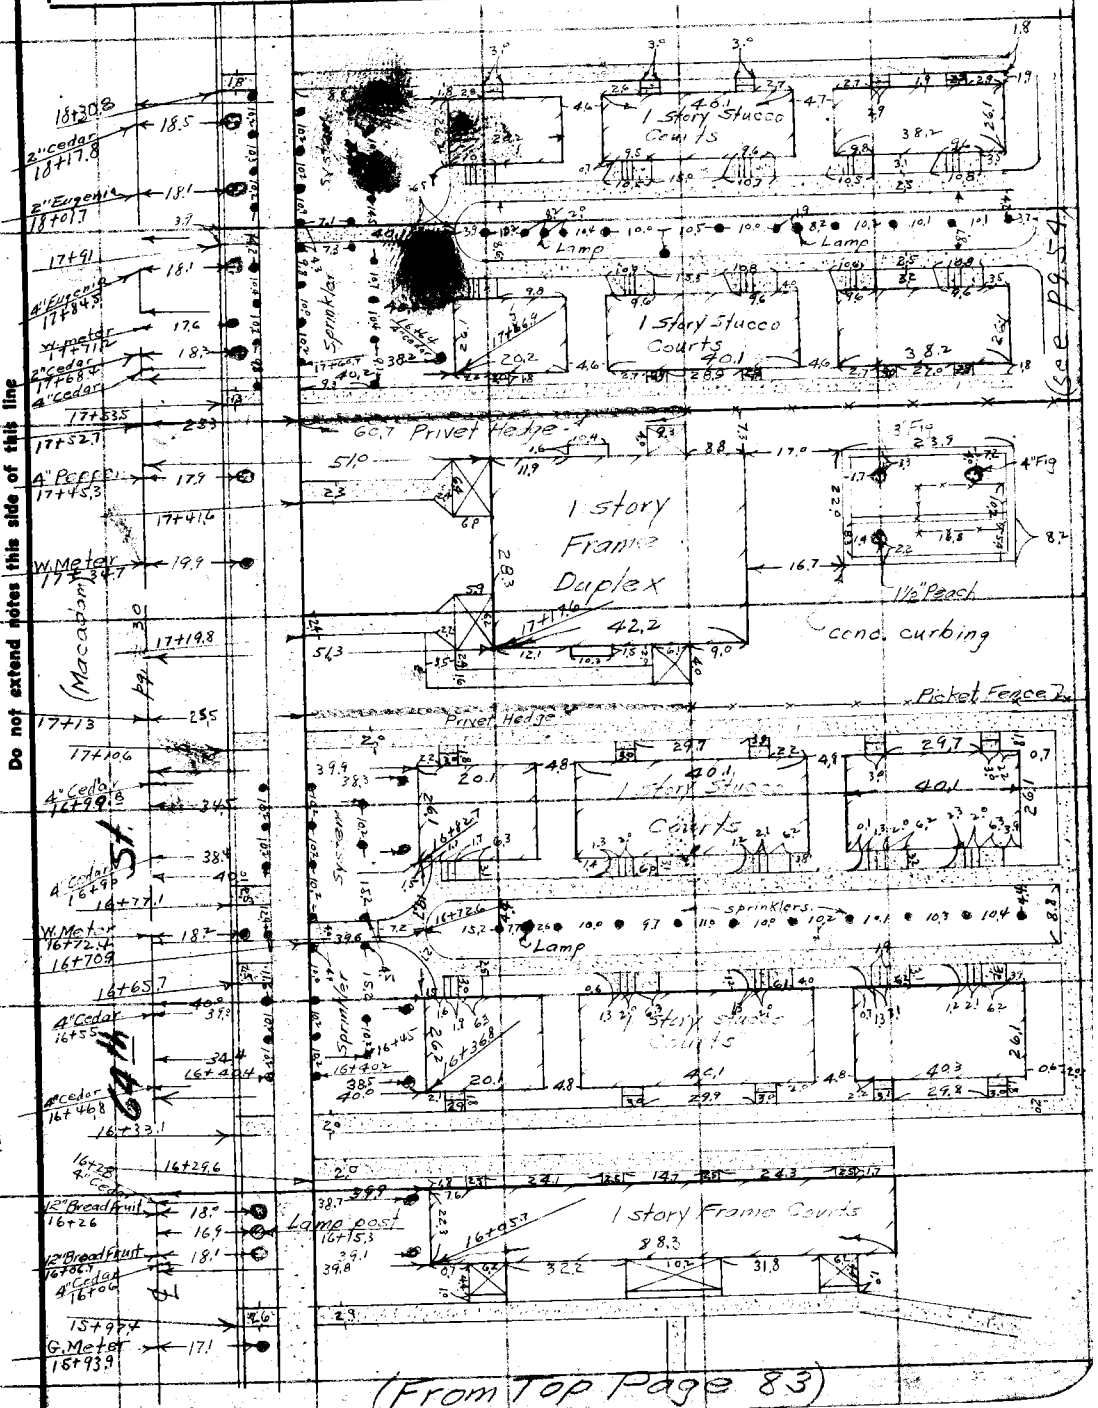

(From Top Page 83)

Note: Any Additions or Changes on This Sheet Must be Made or Circled in Red Ink With Date and Name of Person Making Change

Do not extend notes this side of this line

RETURN TO
LOS ANGELES COUNTY SURVEYOR
700 HALL OF RECORDS

(To Bot Page 88)

F.B. 645 PG. 86

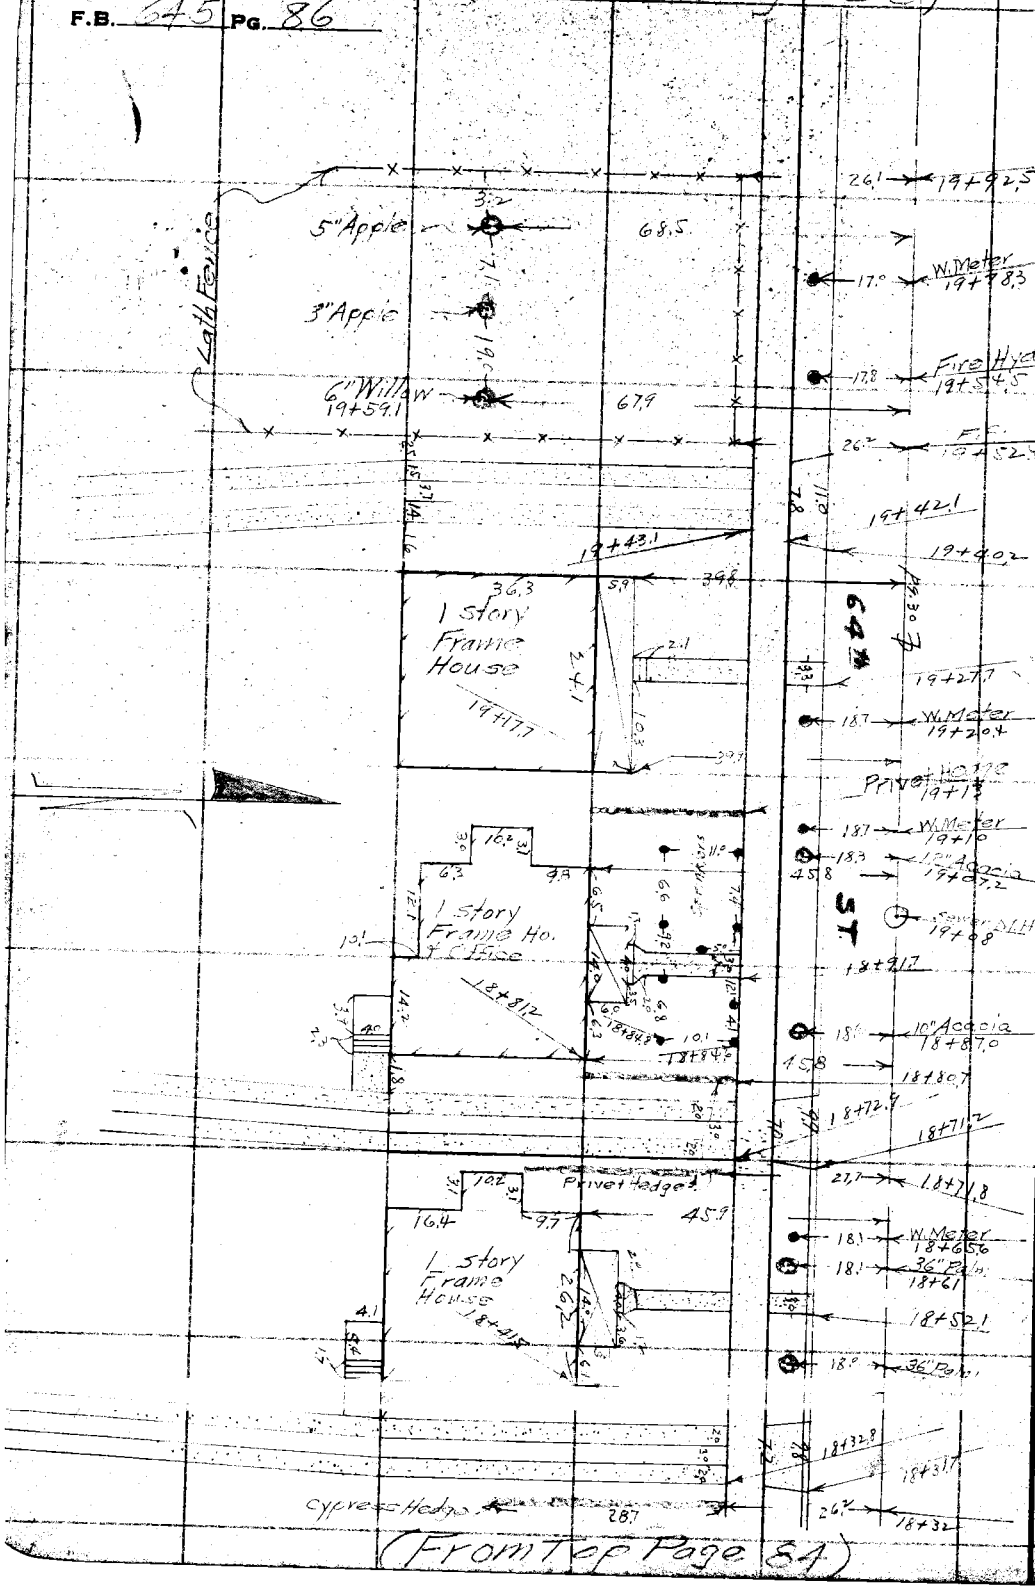

(From Top Page 84)

RETURN TO
LOS ANGELES COUNTY SURVEYOR
700 HALL OF RECORDS

Do not extend notes this side of this line

Note: Any Additions or Changes on This Sheet Must be Made or Circled in Red Ink With Date and Name of Person Making Change.

(To Bot. Page 89)

Notes Ck'd by	Survey of Gage Ave
Map No. B-1245	W. O. 8157 Tape No. 072 St'd 84°F.
Office Work Cox	Surveyed by Evans
Checked aak	Notes Martin Date 10-7-36
Date Mar. 37	Indexed A. C. Johnson

F.B. 645 PG. 87

Note: Any Additions or Changes on This Sheet Must be Made or Circled in Red Ink With Date and Name of Person Making Change.

Do not extend notes this side of this line

LOS ANGELES COUNTY SURVEYOR
700 HALL OF RECORDS

FORM 247 10M 11-36

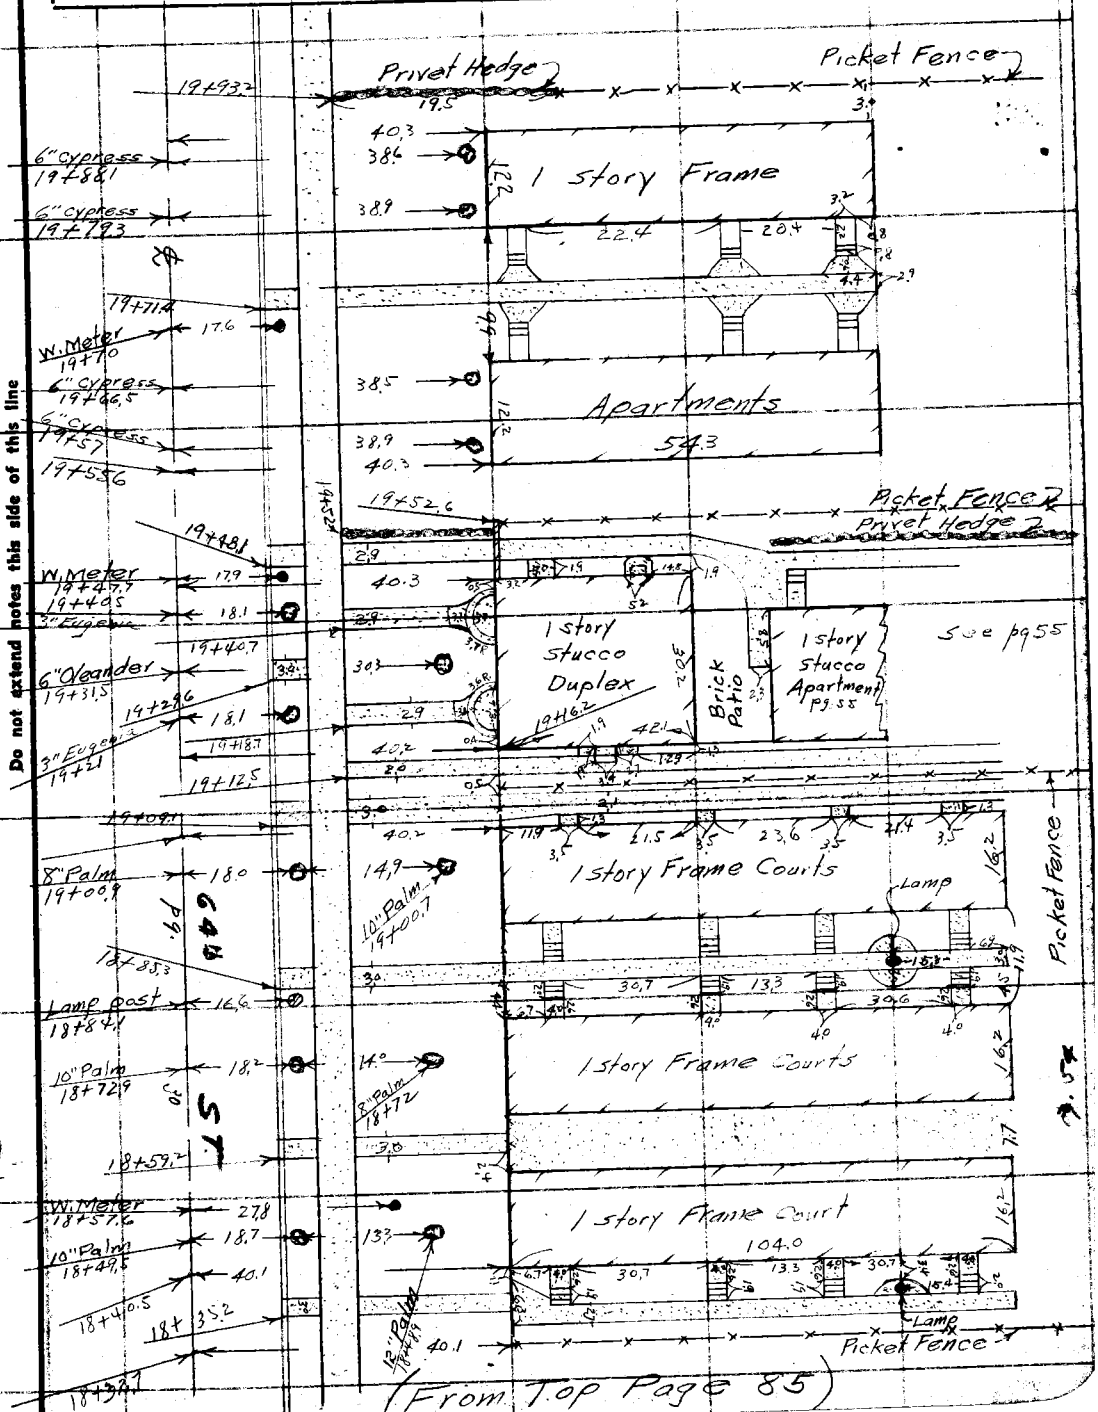

(From Top Page 85)

(To Bot. Page 90)

F.B. 645 PG. 88

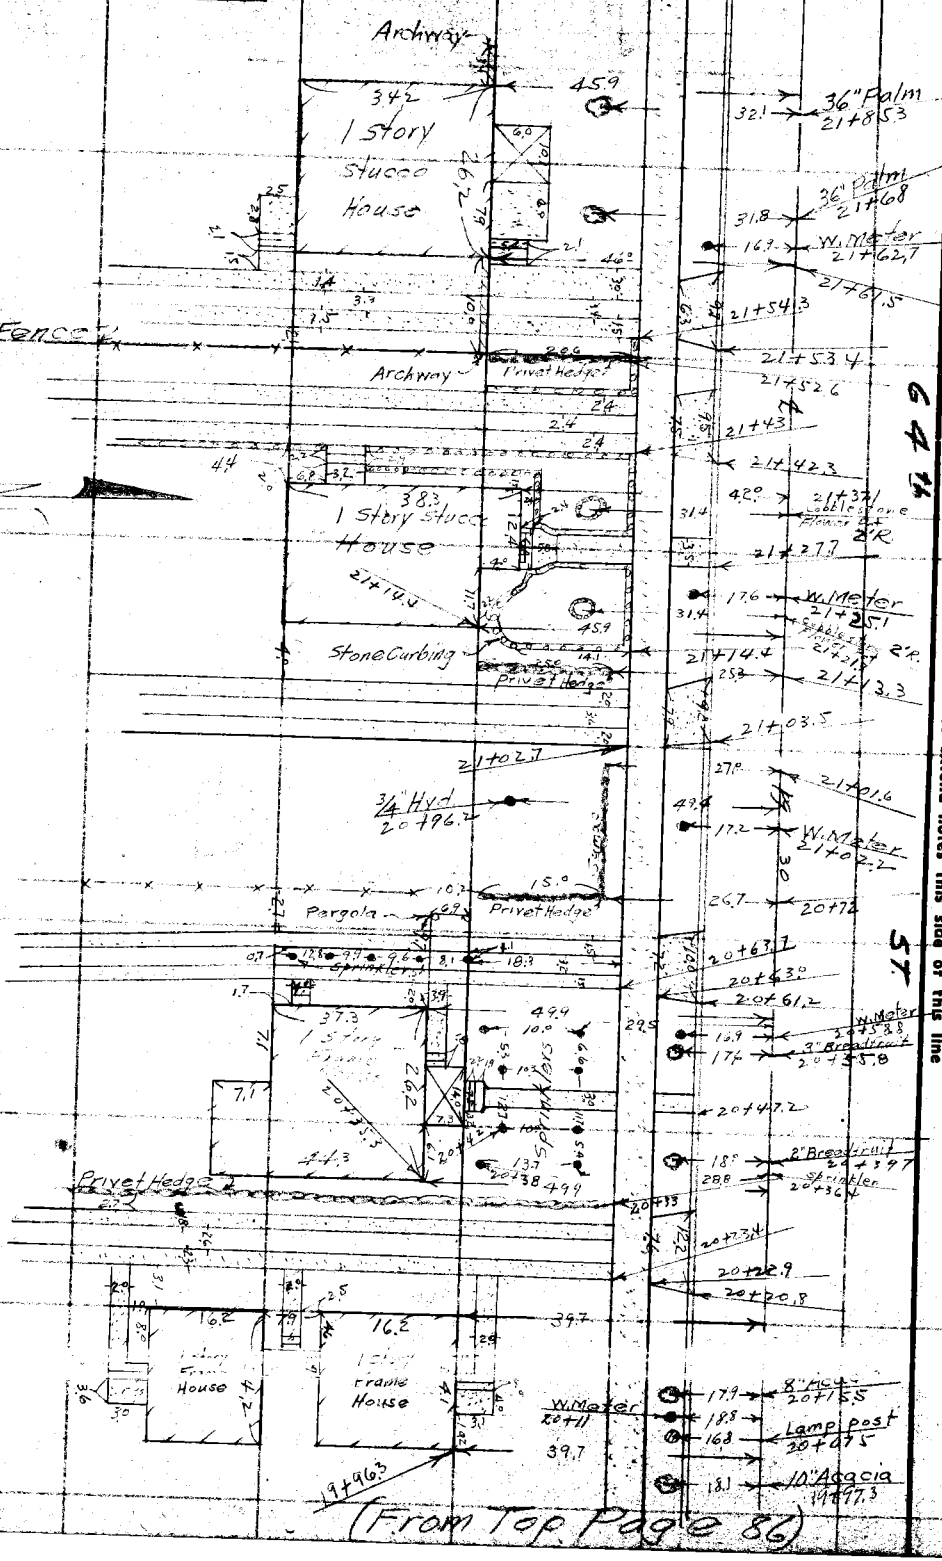

(From Top Page 86)

RETURN TO
LOS ANGELES COUNTY SURVEYOR
700 HALL OF RECORDS

Do not extend notes this side of this line

Note: Any Additions or Changes on This Sheet Must be Made or Circled in Red Ink With Date and Name of Person Making Change.

(To Bot. Page 91)

Notes Ck'd by	Survey of Gage Ave
Map No. B-1245	W. O. 8157 Tape No. 072 St'd 84 °F.
Office Work Cox	Surveyed by Evans
Checked adr	Notes Martin Date 10-8-36
Date Mar. 37	A. C. Johnson
	Indexed

F.B. 645 PG. 89

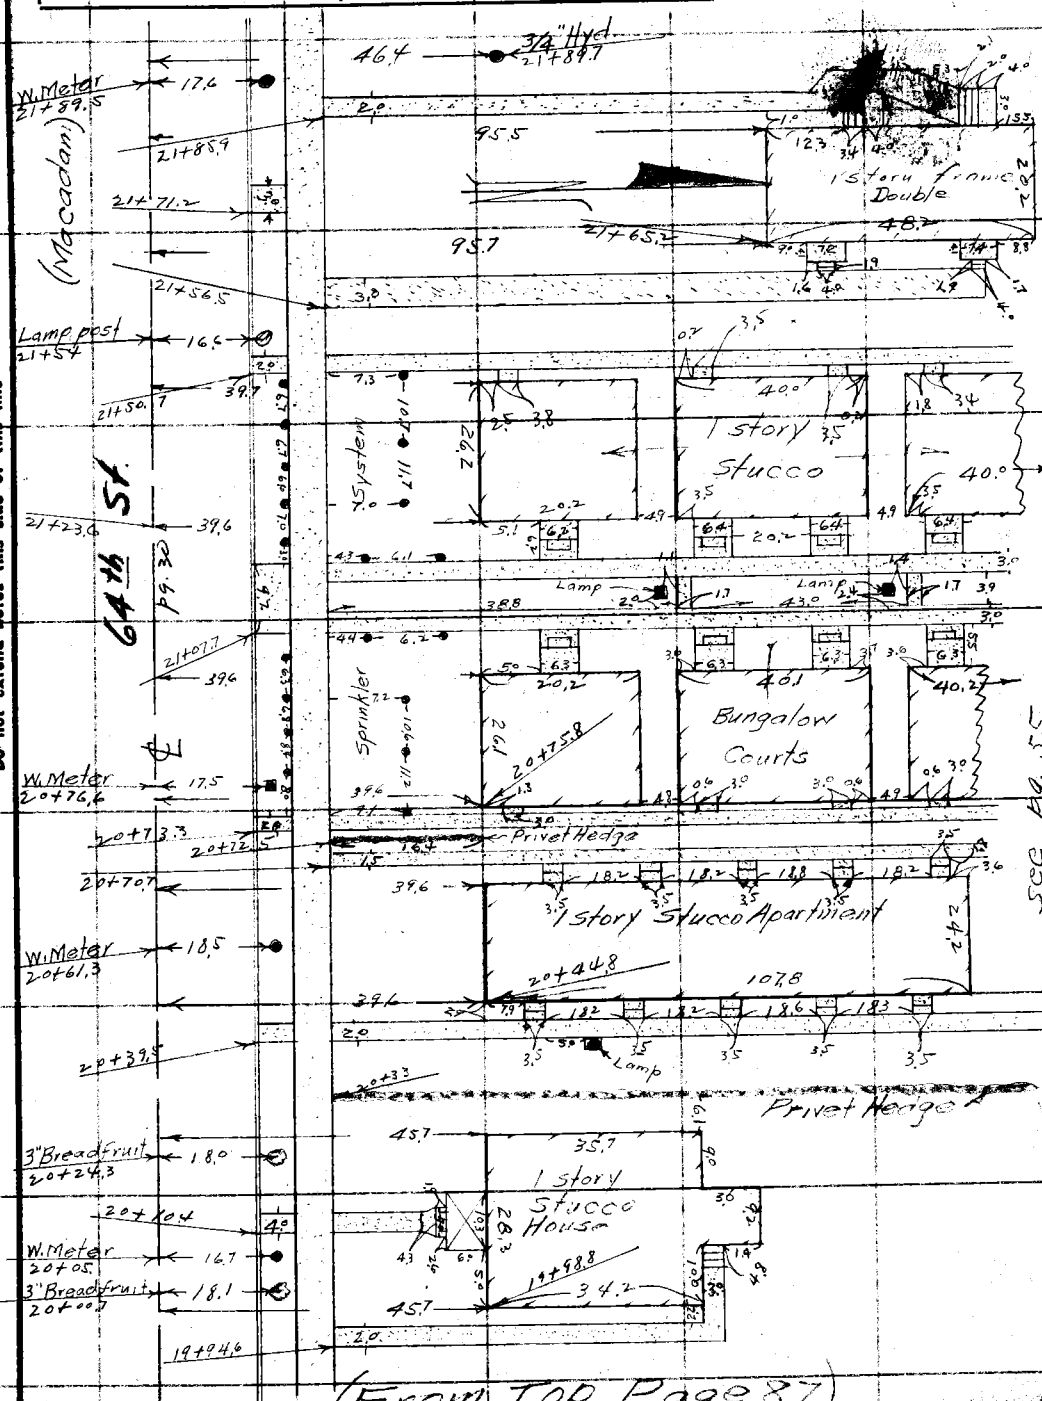

(From Top Page 87)

Notes: Any Additions or Changes on This Sheet Must be Made or Circled in Red Ink With Date and Name of Person Making Change.

Do not extend notes this side of this line

RETURN TO
LOS ANGELES COUNTY SURVEYOR
7OD HALL OF RECORDS

FORM 247 10M 11-35

(To Bot. Page 92)

F.B. 645 Pg. 90

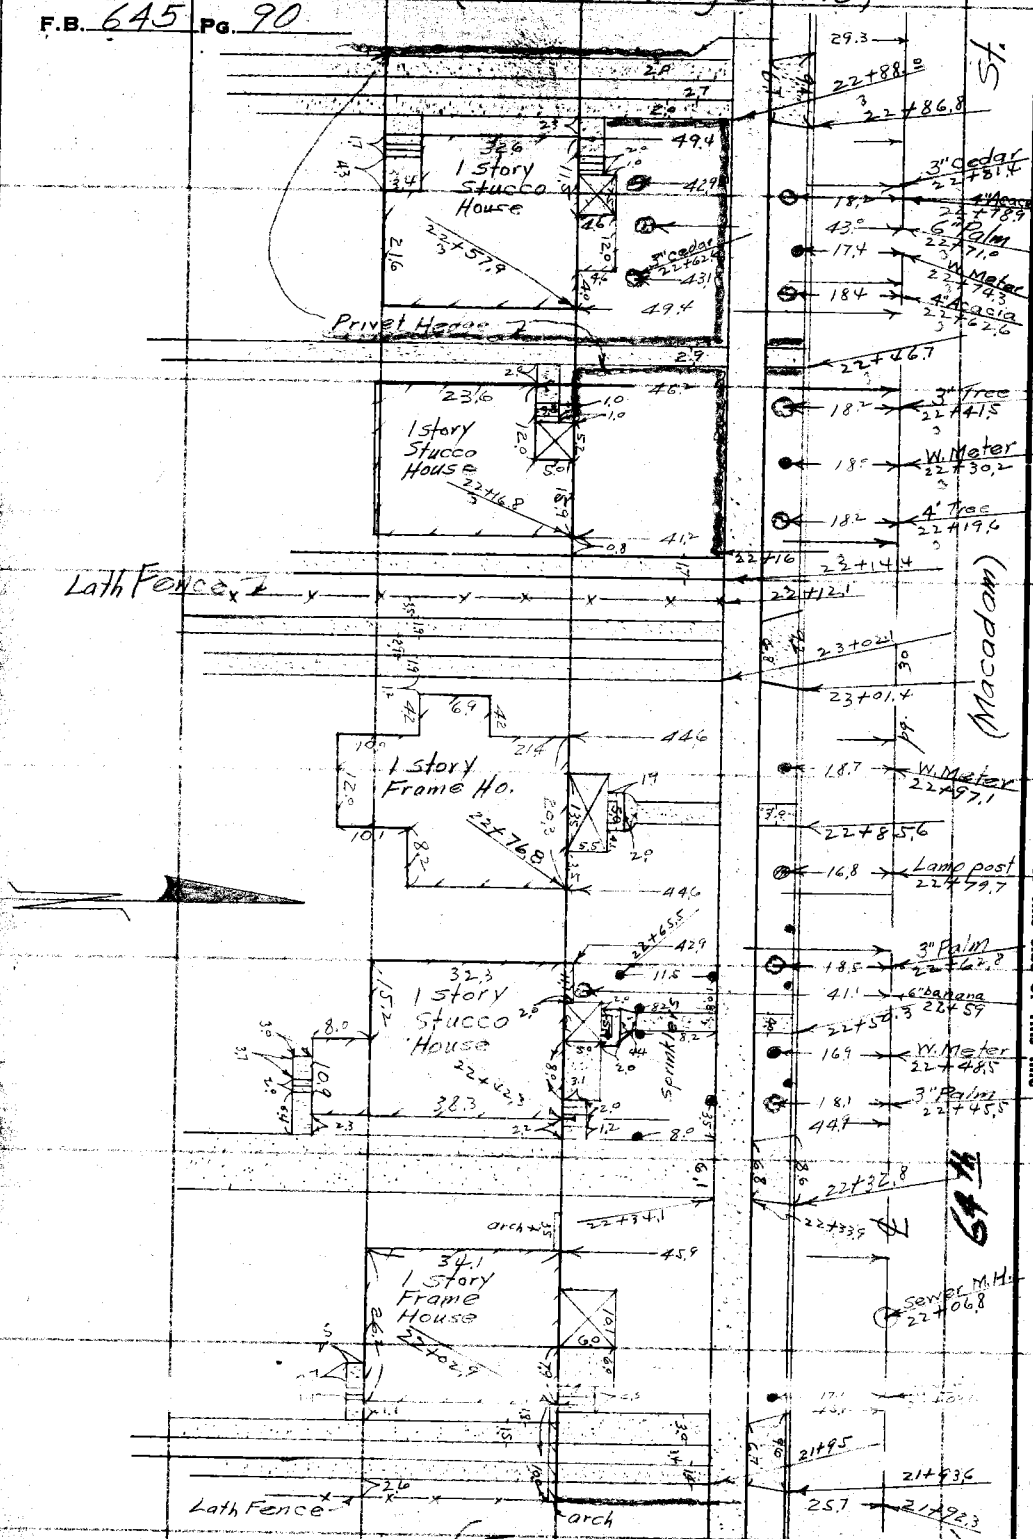

(From Top Page 88)

RETURN TO
LOS ANGELES COUNTY SURVEYOR
700 HALL OF RECORDS

Do not extend notes this side of this line

Note: Any Additions or Changes on This Sheet Must be Made or Circled in Red Ink With Date and Name of Person Making Change.

(To Bot. Page 93)

Notes Ck'd by	Survey of Sage Ave
Map No. B-1245	W. O. 8157 Tape No. 072 St'd 84°F.
Office Work Cox	Surveyed by Evans
Checked AMR	Notes Martin Date 10-8-36
Date Mar. 37	Indexed A. C. Johnson

F.B. 645 PG. 91

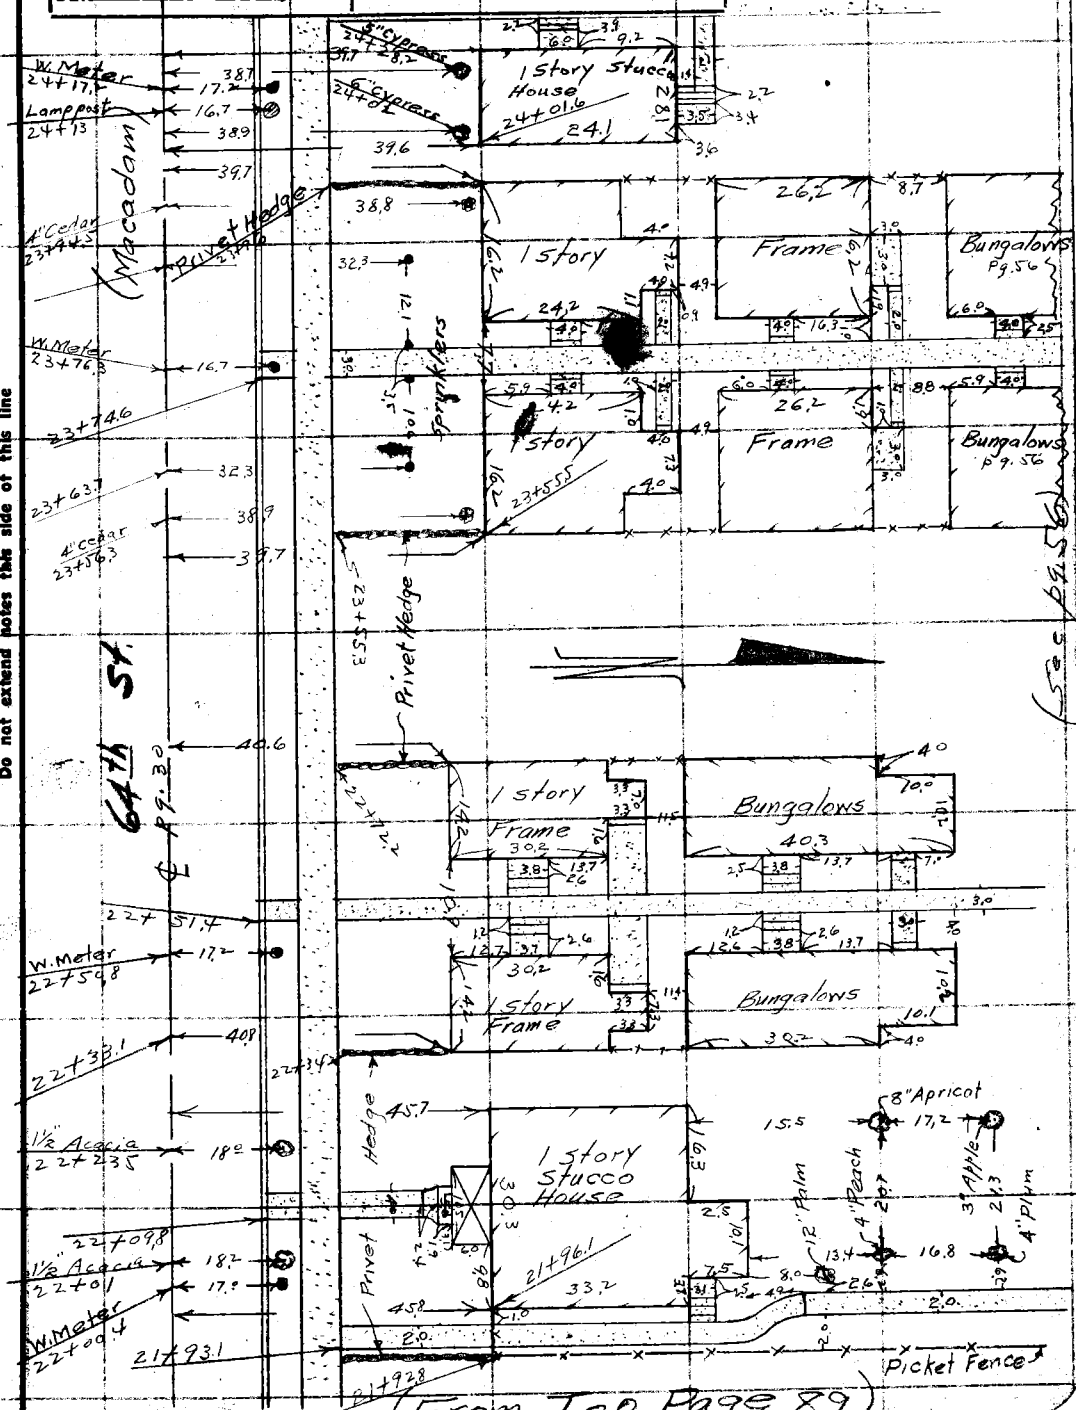

(From Top Page 89)

Note: Any Additions or Changes on This Sheet Must be Made or Circled in Red Ink With Date and Name of Person Making Change.

Do not extend notes this side of this line

RETURN TO
LOS ANGELES COUNTY SURVEYOR
700 HALL OF RECORDS

FORM 247 10M 51-25

F.B. 645 PG. 92

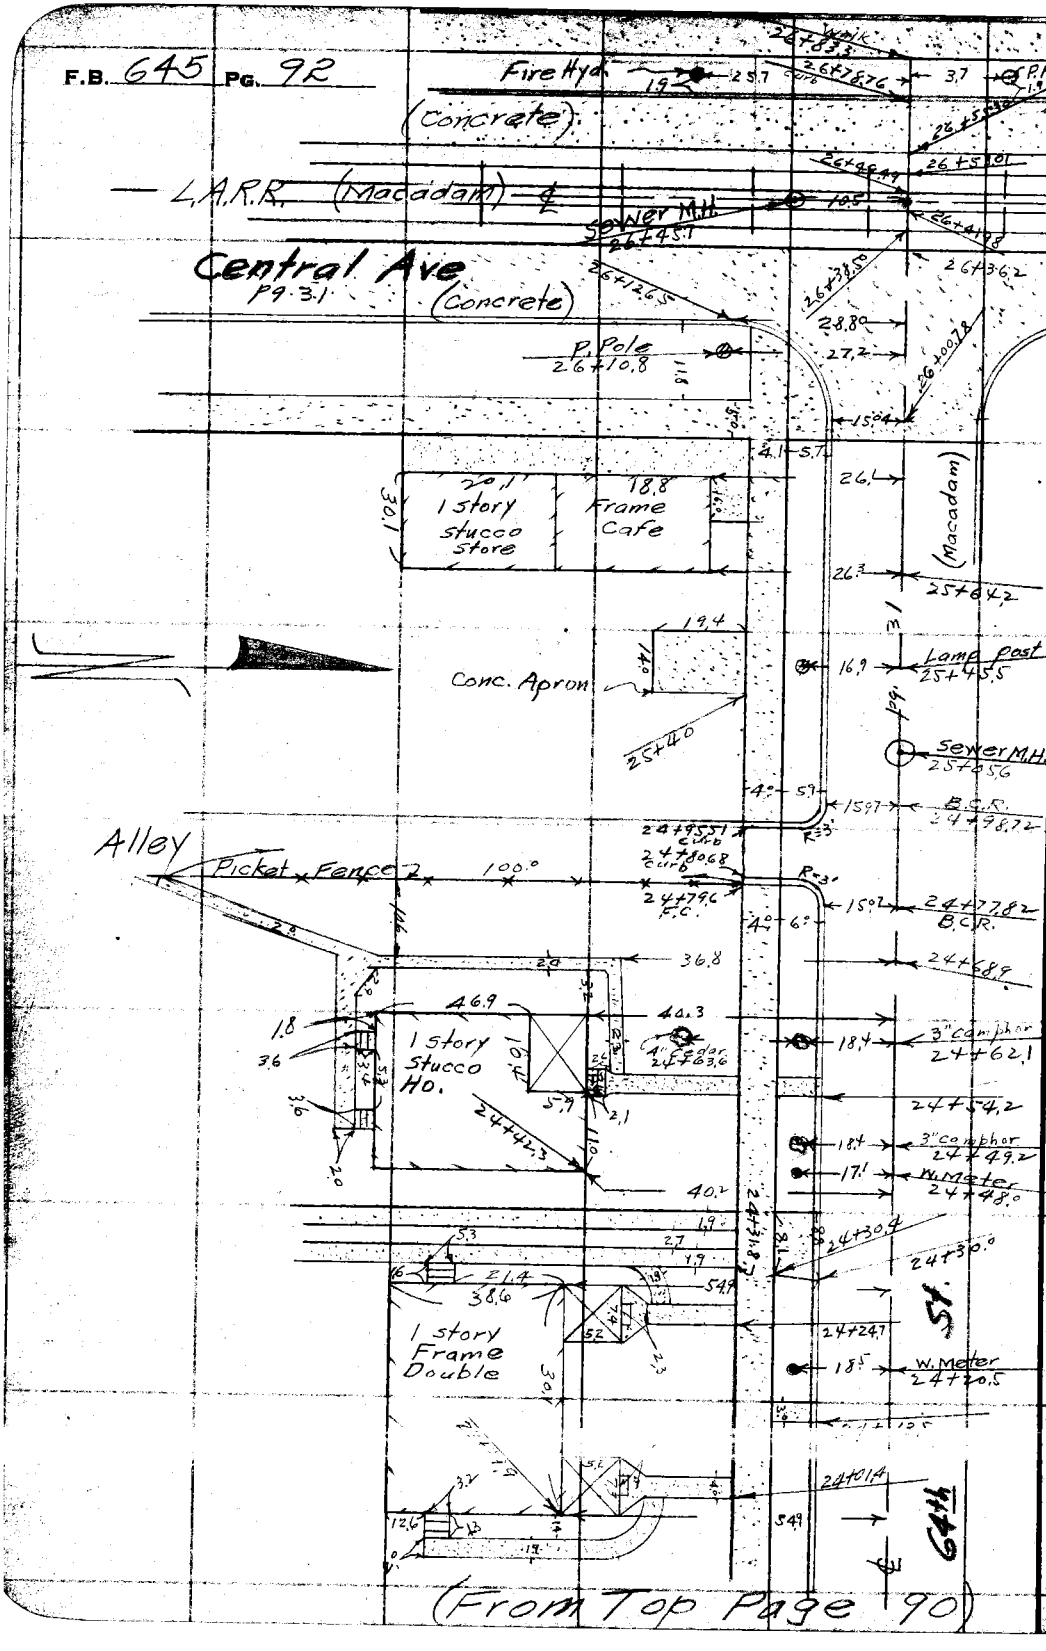

RETURN TO
LOS ANGELES COUNTY SURVEYOR
700 HALL OF RECORDS

Do not extend notes this side of this line

Note: Any Additions or Changes on This Sheet Must be Made or Circled in Red Ink With Date and Name of Person Making Change.

Notes Ck'd by	Survey of Gage Ave
Map No. B-1245	W. 0.8157 Tape No. 072 St'd. 84°F.
Office Work Cox	Surveyed by Evans
Checked aaR	Notes Martin Date 10-8-36
Date Mar. 37	Indexed A. C. Johnson

F.B. 645 PG. 93

Note: Any Additions or Changes on This Sheet Must be Made or Circled in Red Ink With Date and Name of Person Making Change.

Do not extend notes this side of this line

RETURN TO
LOS ANGELES COUNTY SURVEYOR
700 HALL OF RECORDS

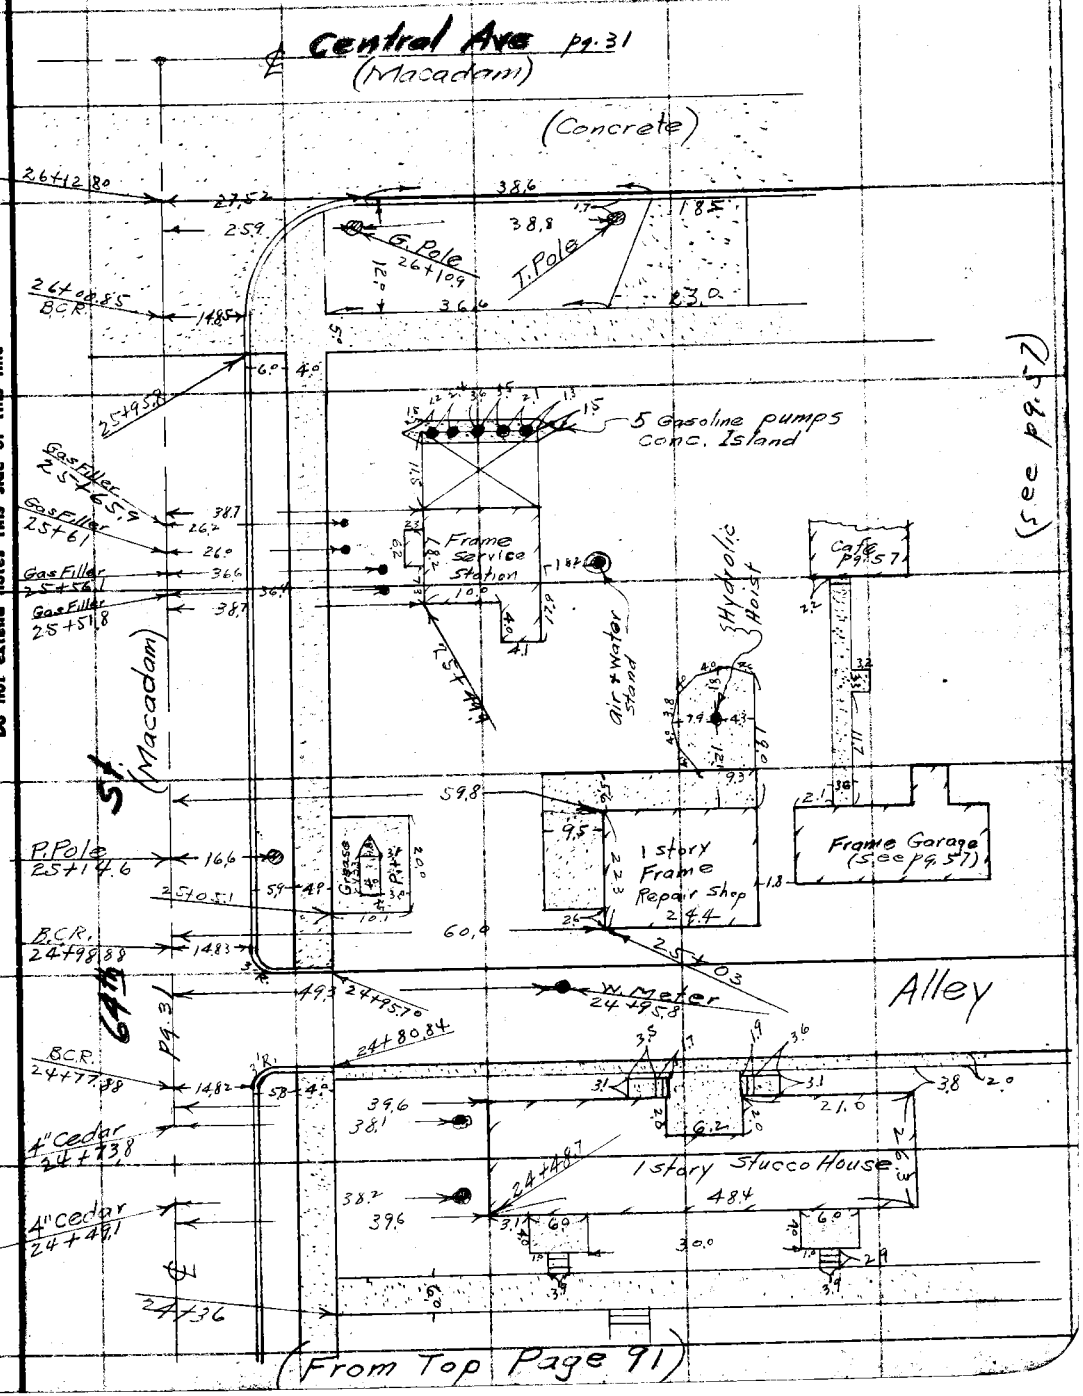

F.B. 645 PG. 94

RETURN TO
LOS ANGELES COUNTY SURVEYOR
700 HALL OF RECORDS

Do not extend notes this side of this line

Note: Any Additions or Changes on This Sheet Must be Made or Circled in Red Ink With Date and Name of Person Making Change.

Notes Ck'd by	Survey of Gage Ave
Map No. B-1245	W. O. 8157 Tape No. St'd °F
Office Work Cox	Surveyed by Moore
Checked Poesse	Notes Moore Date 5-12-42
Date May 1942	Indexed A. C. Johnson 5-13-42

F.B. 640 PG. 95

To bot. Pg 36B

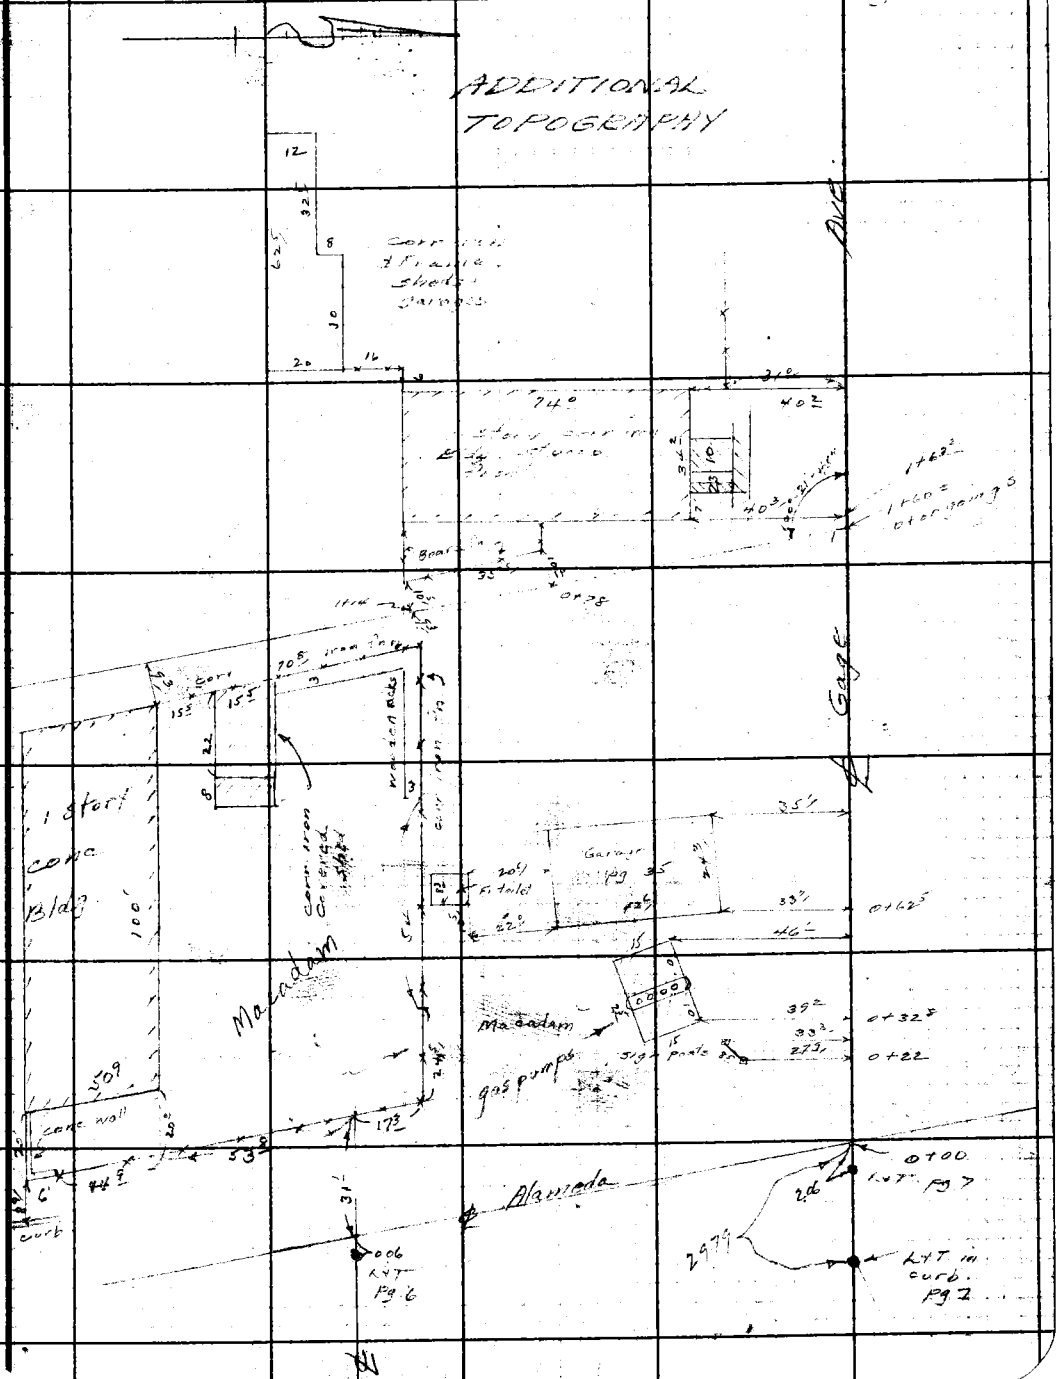

Note: Any Additions or Changes on This Sheet Must be Made or Circled in Red Ink With Date and Name of Person Making Change.

Do not extend notes this side of this line.

RETURN TO
LOS ANGELES COUNTY SURVEYOR
700 HALL OF RECORDS

FORM 247 5M 10-39

F.B. 645 PG. 96

RETURN TO
LOS ANGELES COUNTY SURVEYOR
700 HALL OF RECORDS

Do not extend notes this side of this line.

Note: Any Additions or Changes on This Sheet Must be Made or Circled in **Red Ink** With Date and Name of Person Making Change.

Gage Ave

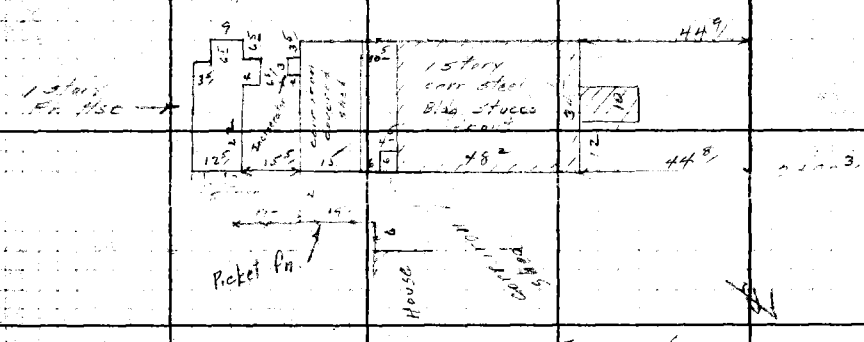

From top Pg. 36A

Notes Ck'd by	Survey of Gage Ave
Map No.	W. O. 8223 Tape No. St'd. °F
Office Work	Surveyed by VanDeren
Checked	Notes Van Date 7-20-51
Date	Indexed A. C. Johnson 7-31-51

F. B. 645 Pg. 77

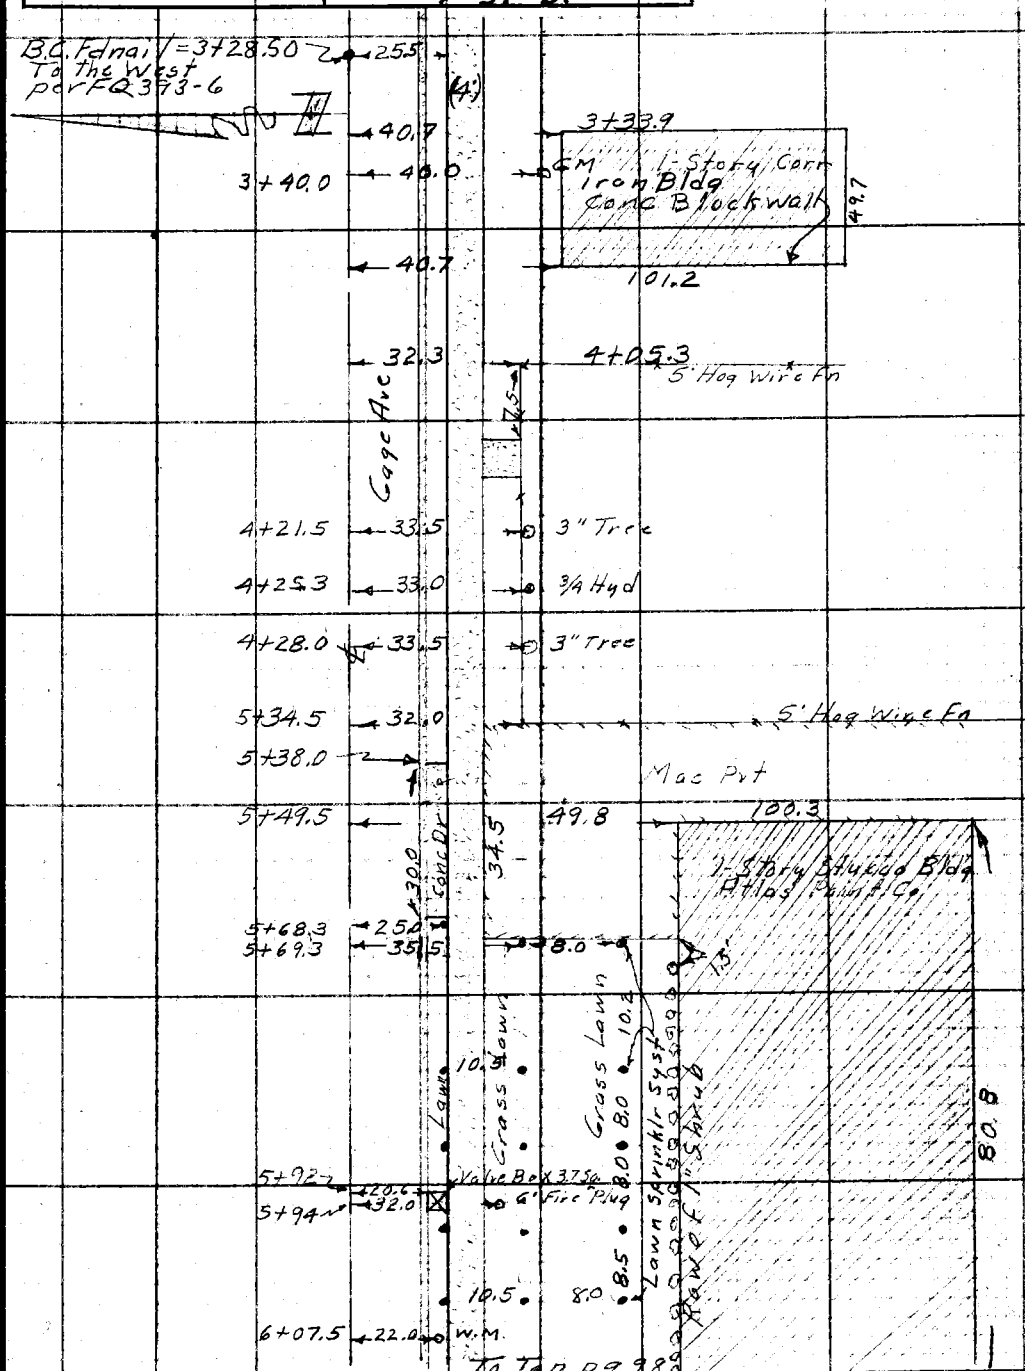

Note: Any Additions or Changes on This Sheet Must be Made or Circled in Red Ink With Date and Name of Person Making Change.

Do not extend notes this side of this line.

RETURN TO
LOS ANGELES COUNTY SURVEYOR
726 LOS ANGELES COUNTY
ENGINEERING BLDG.

76F3098 247 10M 1-49

F. B. 645 PG. 98

From bot pg 97

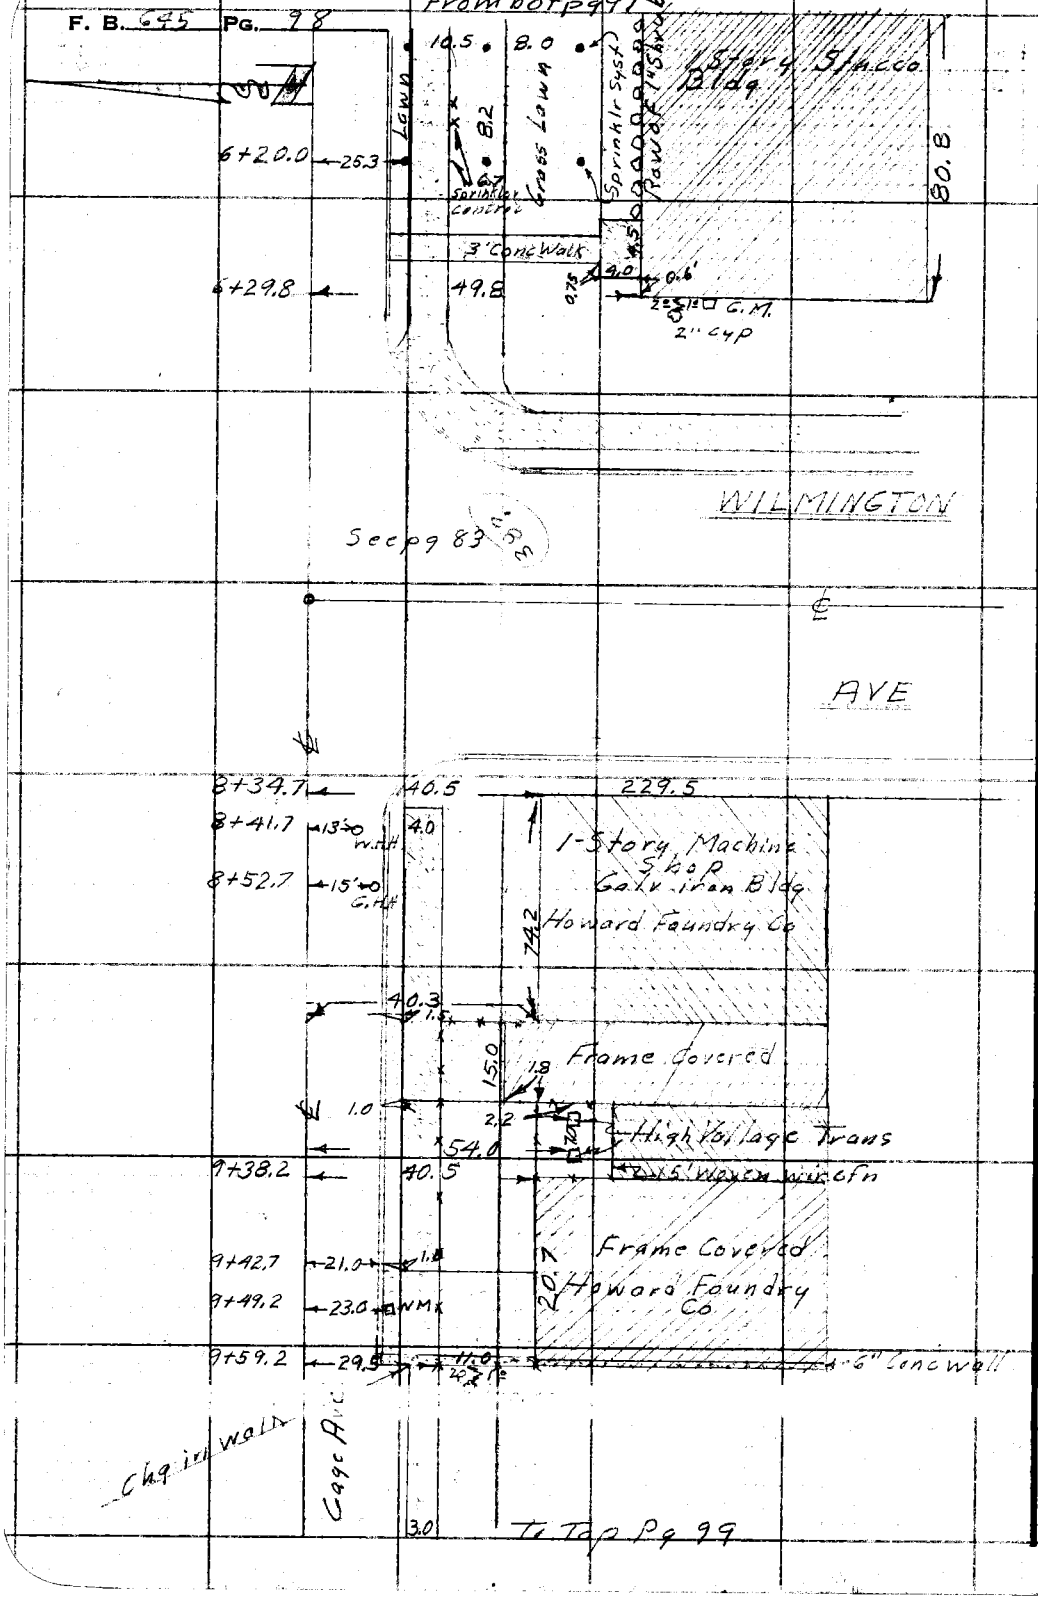

RETURN TO
LOS ANGELES COUNTY SURVEYOR
726 LOS ANGELES COUNTY
ENGINEERING BLDG.

Do not extend notes this side of this line.

Note: Any Additions or Changes on This Sheet Must be Made or Circled in Red Ink With Date and Name of Person Making Change.

Notes Ck'd by	Survey of Gage Ave
Map No.	W. O. R-223 Tape No. St'd. °F
Office Work	Surveyed by Van Doren
Checked	Notes Van Date 7-20-51
Date	Indexed A. C. Johnson

F. B. 645 PG. 99

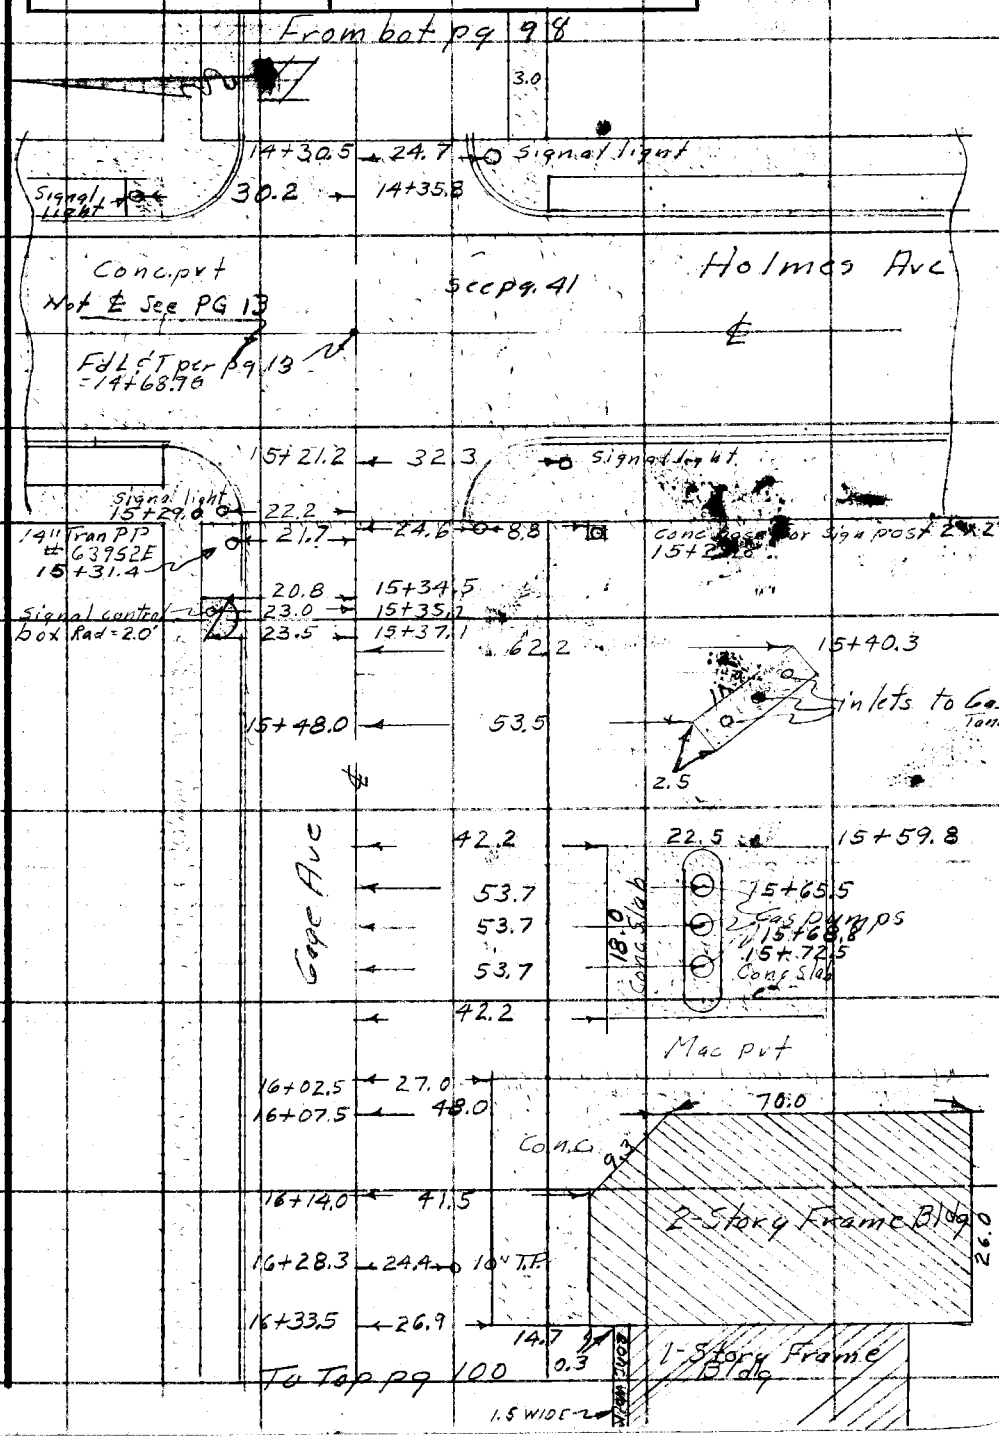

Note: Any Additions or Changes on This Sheet Must be Made or Circled in Red Ink With Date and Name of Person Making Change.

Do not extend notes this side of this line.

RETURN TO
LOS ANGELES COUNTY SURVEYOR
726 LOS ANGELES COUNTY
ENGINEERING BLDG.

76F3098 247 10M 1-49

F. B. 695 PG. 100

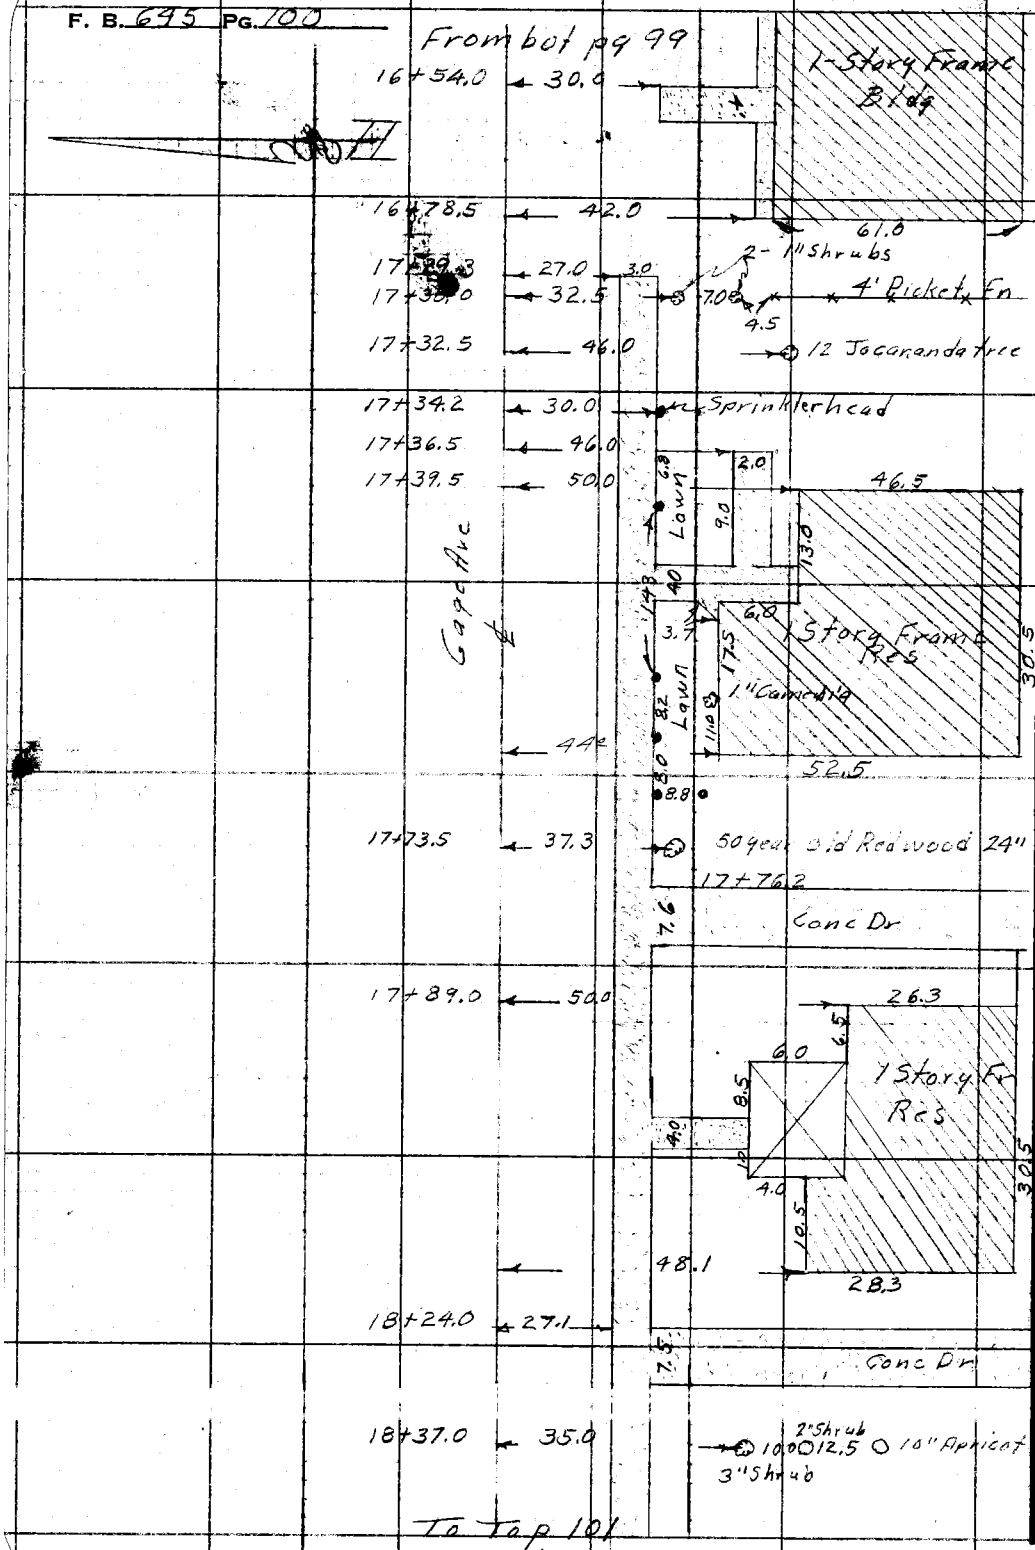

RETURN TO
LOS ANGELES COUNTY SURVEYOR
726 LOS ANGELES COUNTY
ENGINEERING BLDG.

Do not extend notes this side of this line.

Note: Any Additions or Changes on This Sheet Must be Made or Circled in Red Ink With Date and Name of Person Making Change.

Notes Ck'd by	Survey of Gage Ave
Map No.	W. O. R-277 Tape No. St'd. °F
Office Work	Surveyed by M. A. Van Doren
Checked	Notes Van Date 7-26-61
Date	Indexed C. Johnson

F. B. 645 PG. 101

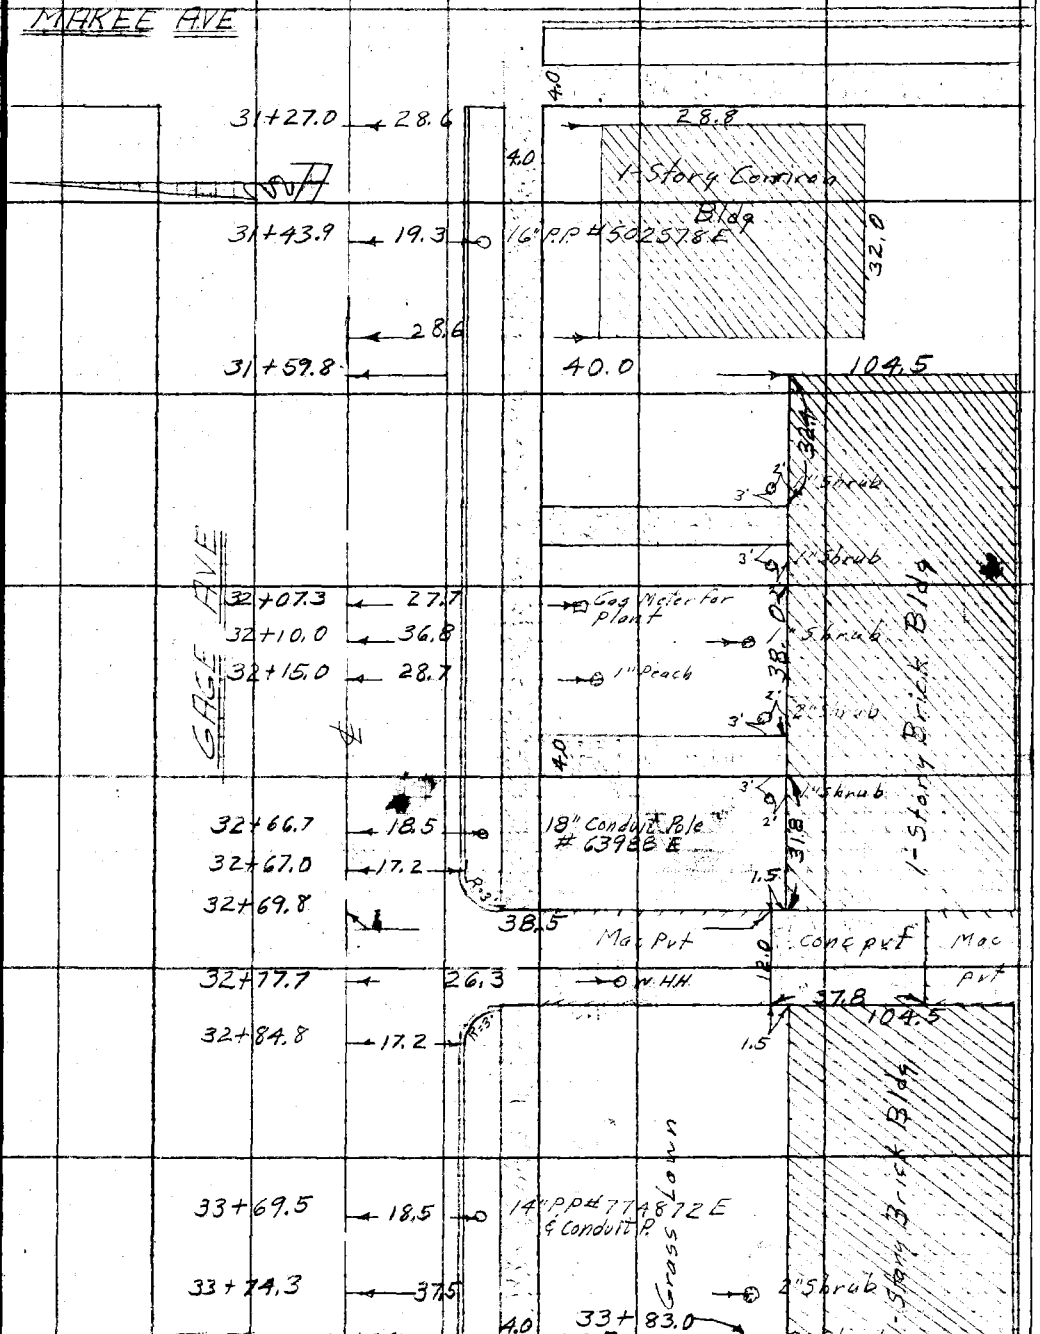

Notes: Any Additions or Changes on This Sheet Must be Made or Circled in Red Ink With Date and Name of Person Making Change.

Do not extend notes this side of this line.

RETURN TO
LOS ANGELES COUNTY SURVEYOR
726 LOS ANGELES COUNTY
ENGINEERING BLDG.

76F3095 247 10M 1-49

F. B. 645 PG. 102

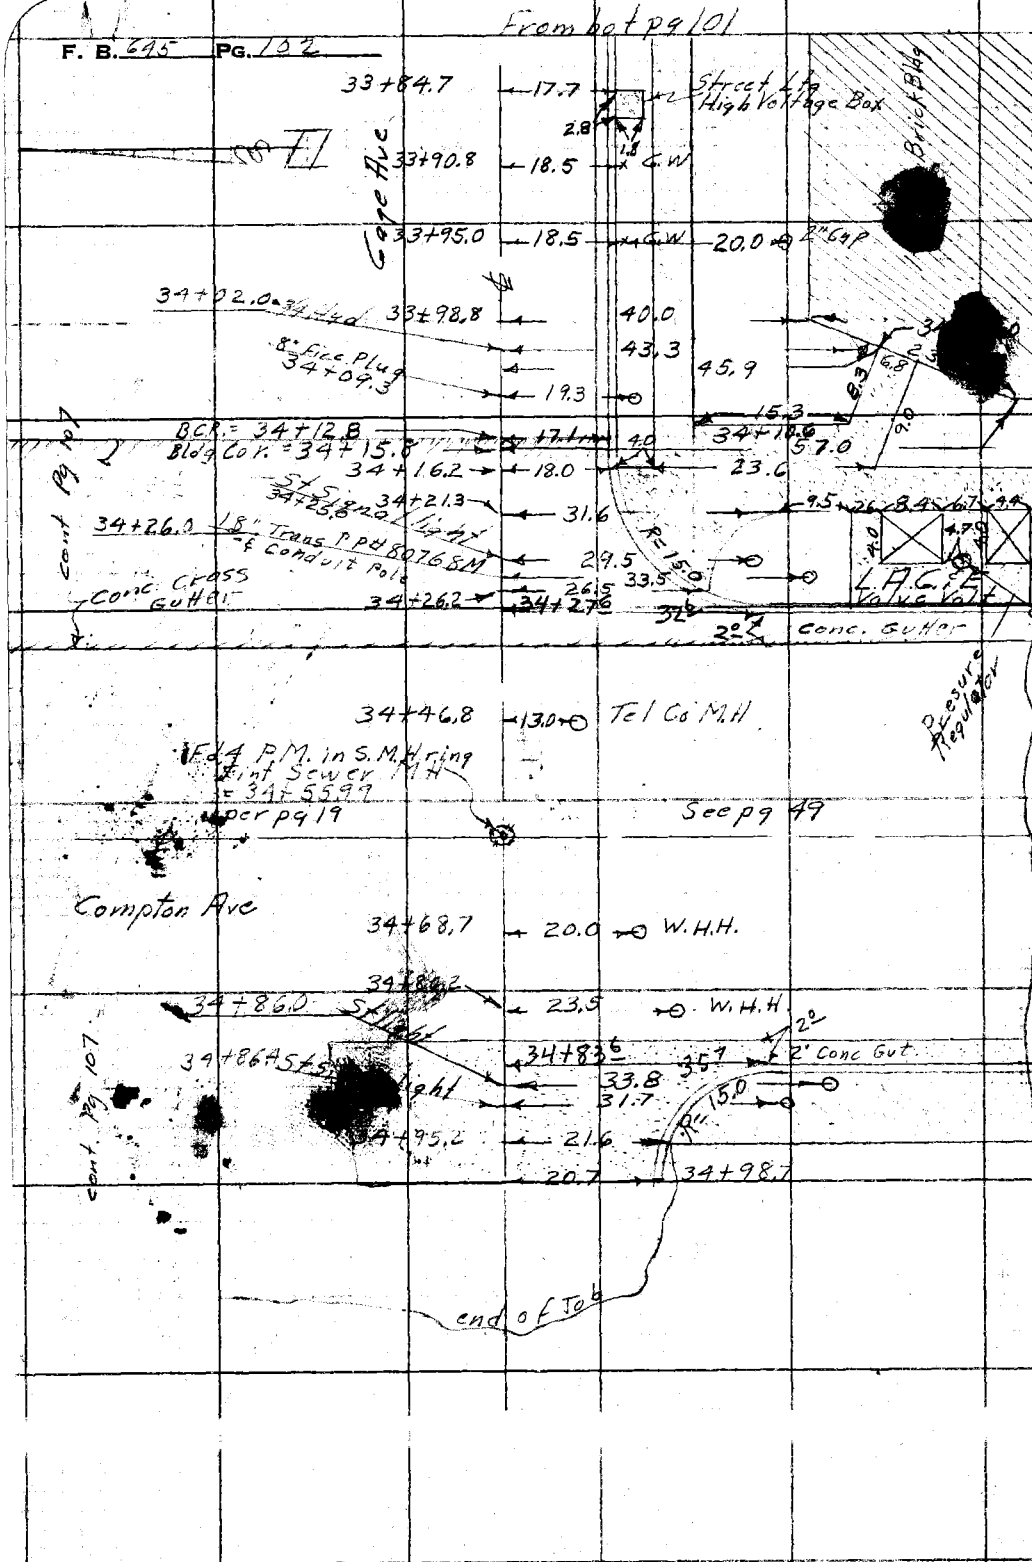

RETURN TO
LOS ANGELES COUNTY SURVEYOR
725 LOS ANGELES COUNTY
ENGINEERING BLDG.

Do not extend notes this side of this line.

Note: Any Additions or Changes on This Sheet Must be Made or Circled in Red Ink With Date and Name of Person Making Change.

Notes Ck'd by	Survey of Gage Ave
Map No.	W. O. R273 Tape No. 0106 St'd. 68 °F
Office Work	Surveyed by M.A. Van Deren
Checked	Notes MACK Date 7-27-51
Date	Indexed C. Johnson

F. B. 645 Pg. 103
cont. Bat Pg 104

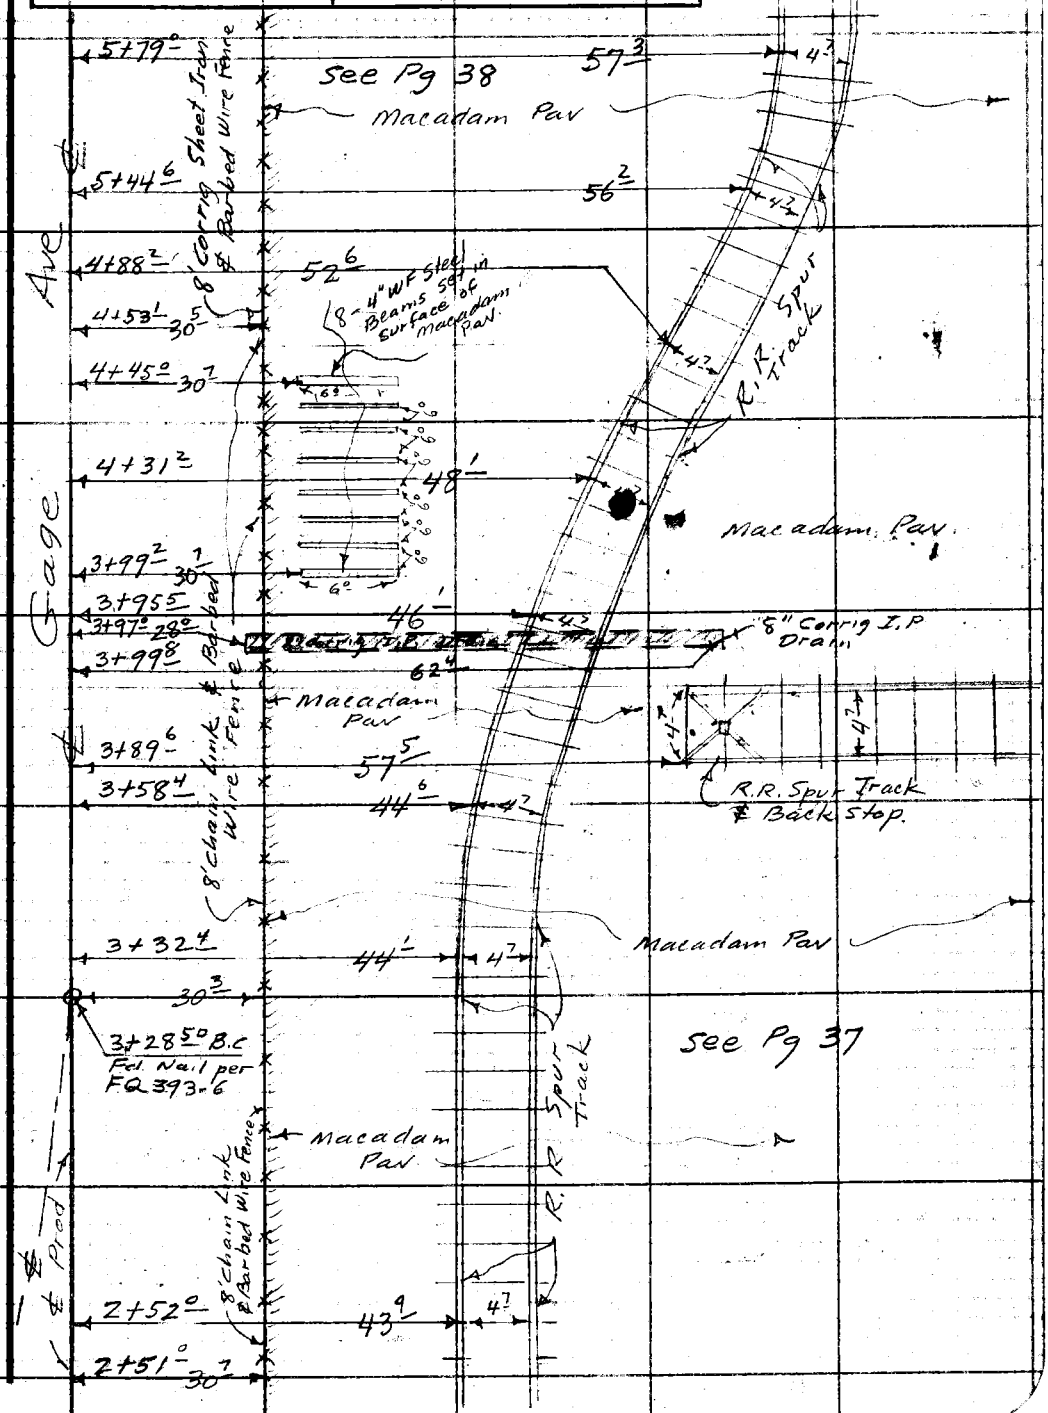

Note: Any Additions or Changes on This Sheet Must be Made or Circled in Red Ink With Date and Name of Person Making Change.

Do not extend notes this side of this line.

RETURN TO
LOS ANGELES COUNTY SURVEYOR
726 LOS ANGELES COUNTY
ENGINEERING BLDG.

76F3095 247 10M 1-49

F. B. 645 PG. 104

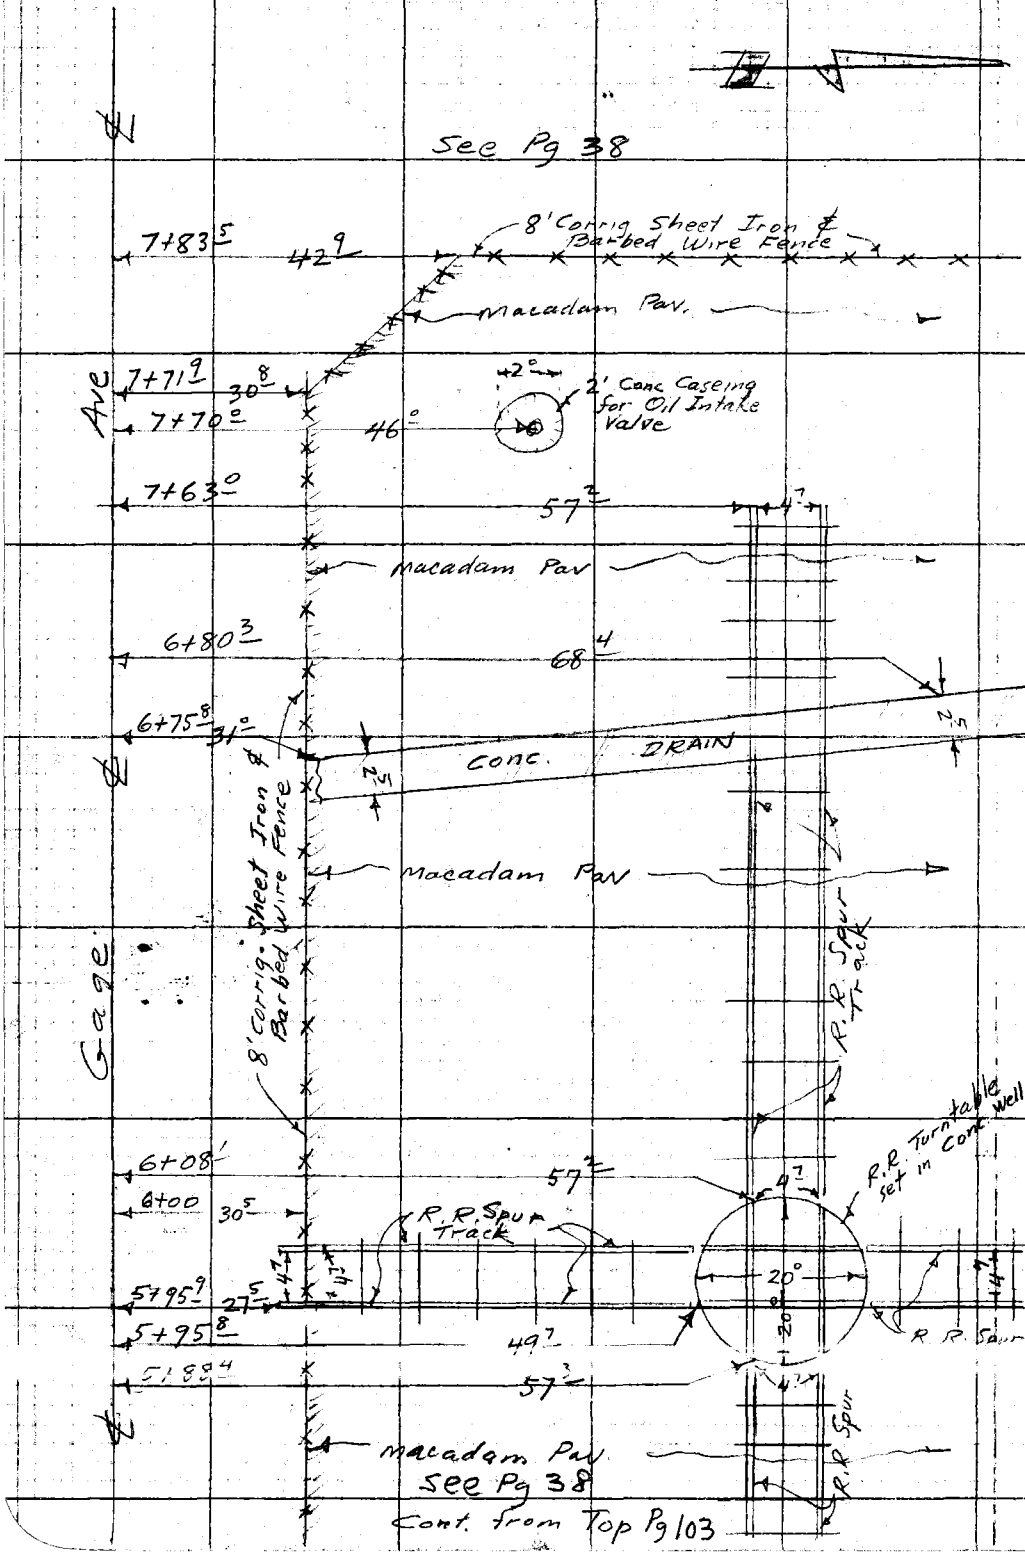

RETURN TO
LOS ANGELES COUNTY SURVEYOR
726 LOS ANGELES COUNTY
ENGINEERING BLDG.

Do not extend notes this side of this line.

Note: Any Additions or Changes on This Sheet Must be Made or Circled in Red Ink With Date and Name of Person Making Change.

Notes Ck'd by	Survey of Gage Ave
Map No.	W. O. R273 Tape No. 0106 St'd. 68 °F
Office Work	Surveyed by M. A. Van Deren
Checked	Notes Van Date 7-27-51
Date	Indexed C. Johnson

F. B. 645 PG. 105

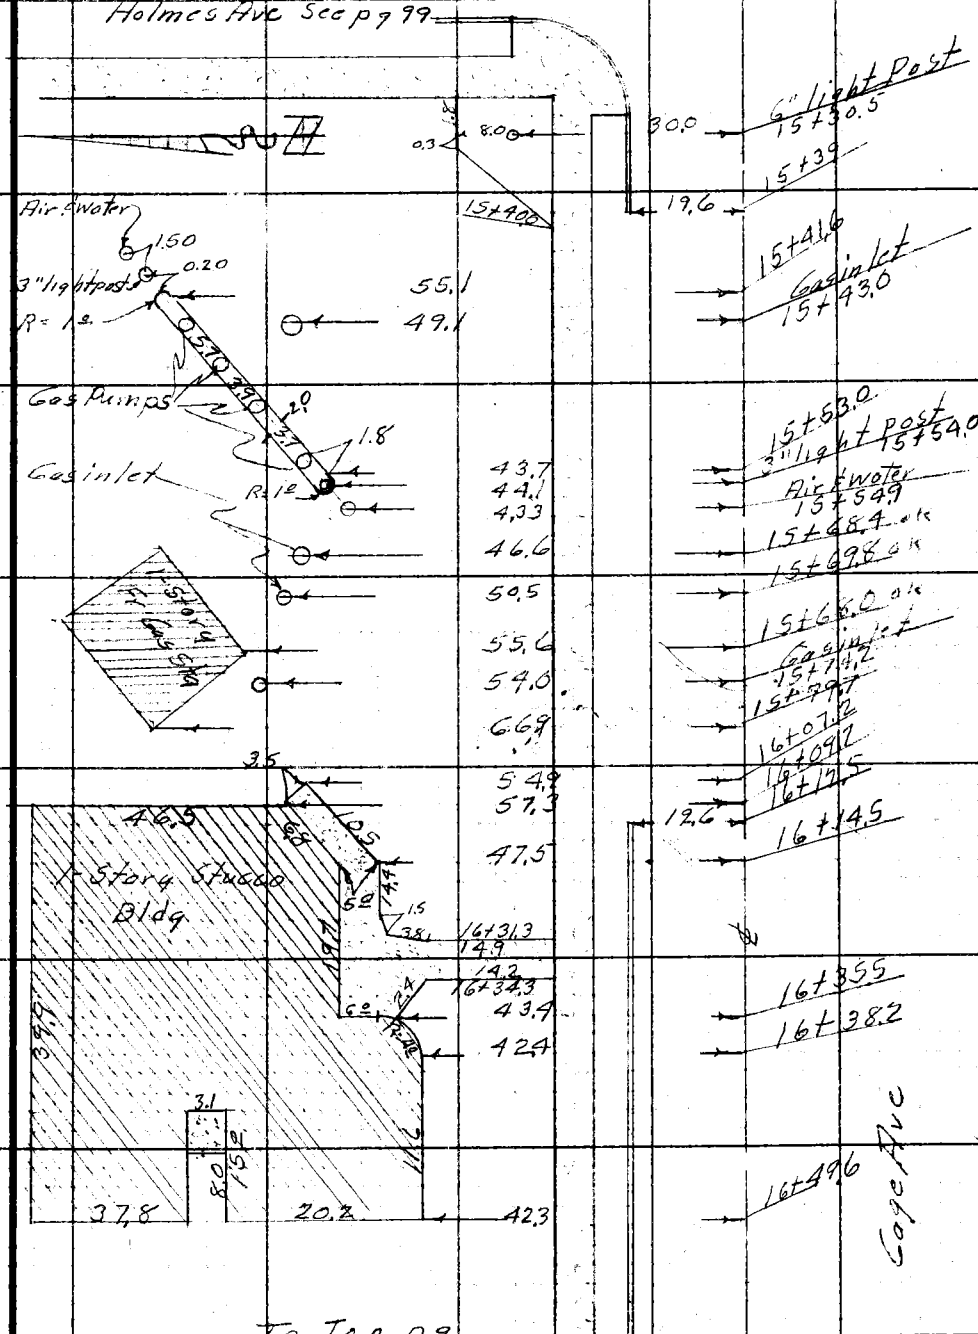

Note: Any Additions or Changes on This Sheet Must be Made or Circled in Red Ink With Date and Name of Person Making Change.

Do not extend notes this side of this line.

RETURN TO
LOS ANGELES COUNTY SURVEYOR
726 LOS ANGELES COUNTY
ENGINEERING BLDG.

76F3098 247 10M 1-49

F. B. 645 PG. 106

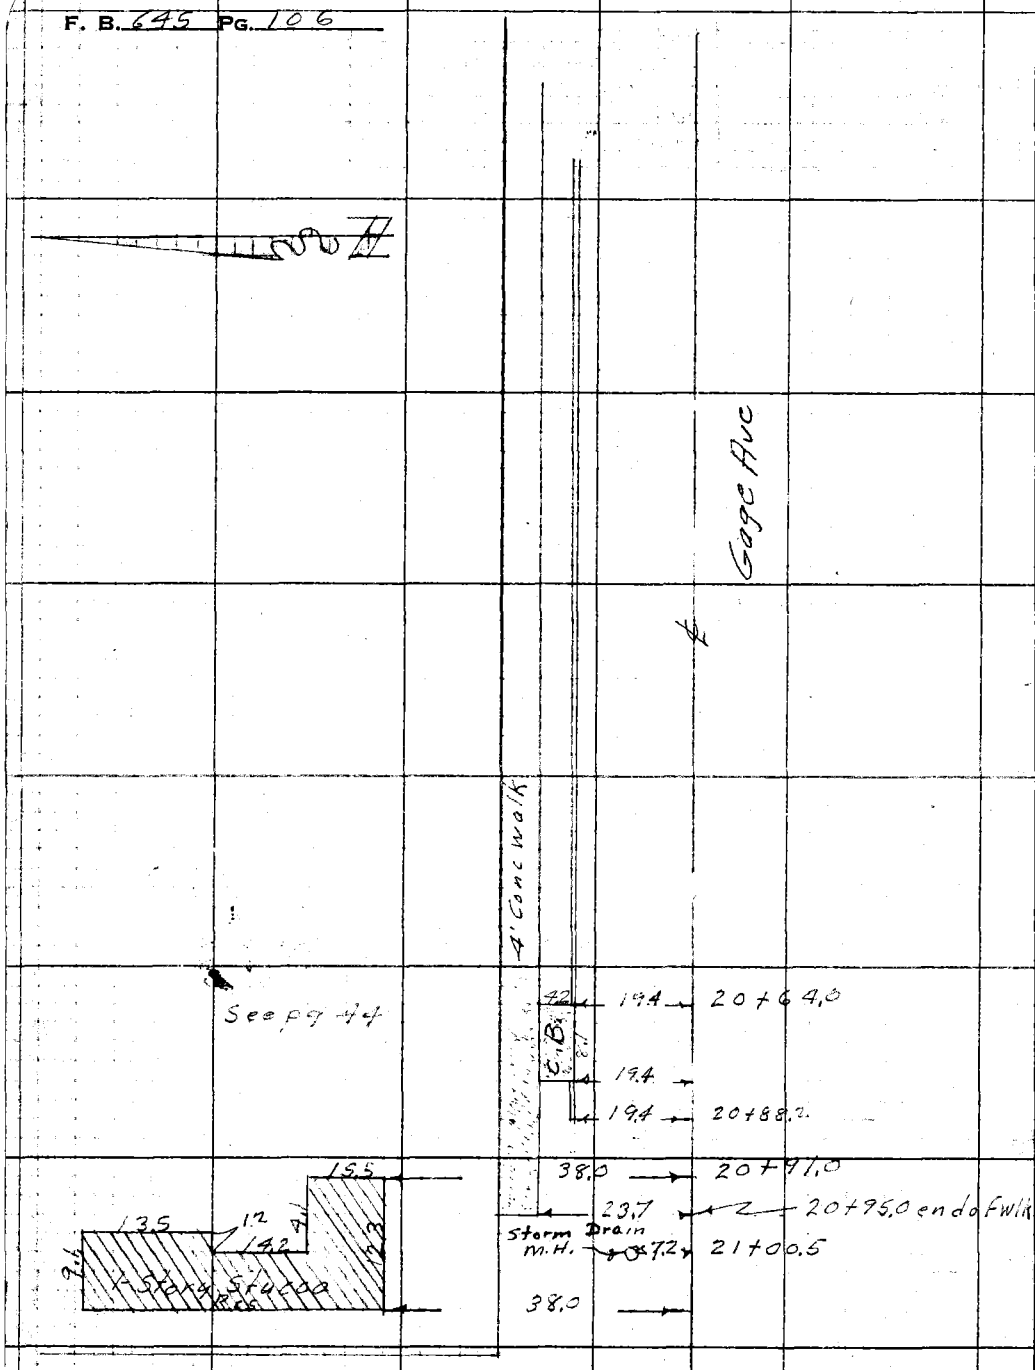

RETURN TO
LOS ANGELES COUNTY SURVEYOR
726 LOS ANGELES COUNTY
ENGINEERING BLDG.

Do not extend notes this side of this line.

Note: Any Additions or Changes on This Sheet Must be Made or Circled in Red Ink With Date and Name of Person Making Change.

Notes Ck'd by	Survey of Gage Ave
Map No.	W. O. R-273 Tape No. 8106 St'd. 68° °F
Office Work	Surveyed by Wm. C. MACK
Checked	Notes W.C.M. Date 7-30-51
Date	Indexed A. C. Johnson

F.B. 645 PG. 107

Note: Any Additions or Changes on This Sheet Must be Made or Circled in Red Ink With Date and Name of Person Making Change.

Do not extend notes this side of this line.

RETURN TO:
LOS ANGELES COUNTY SURVEYOR
726 LOS ANGELES COUNTY
ENGINEERING BLDG.

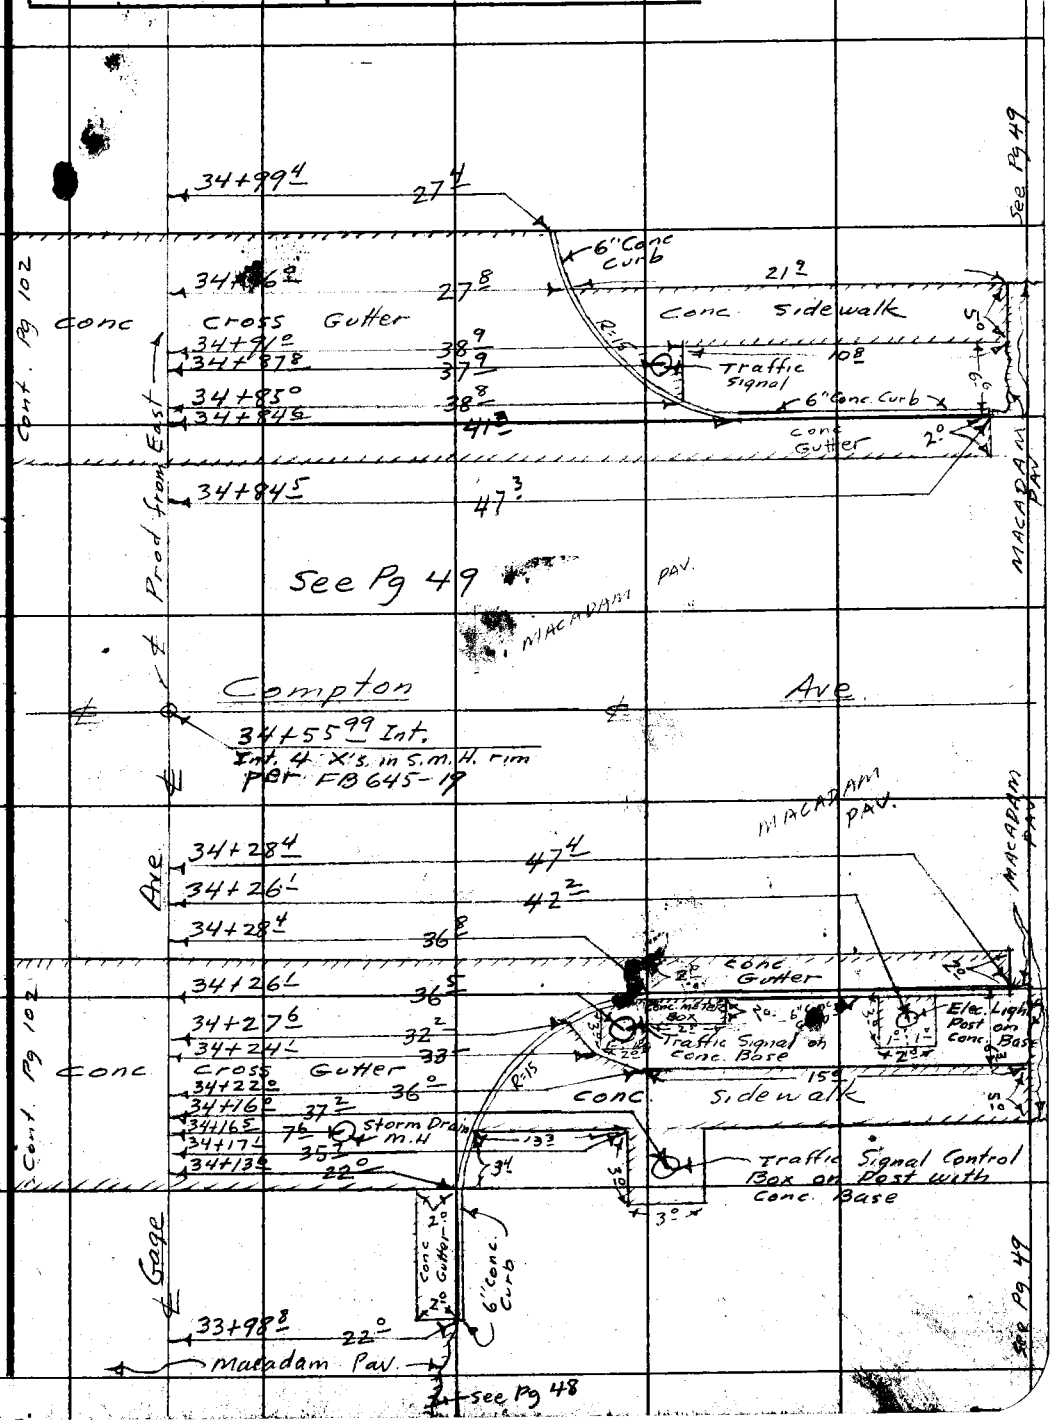

76F3095 247 2-51

RETURN TO
LOS ANGELES COUNTY SURVEYOR
725 LOS ANGELES COUNTY
ENGINEERING BLDG.

Note: Any Additions or Changes on This Sheet Must be Made or Circled in Red Ink With Date and Name of Person Making Change.

Do not extend notes this side of this line.

F. B. 645 PG. 108

Notes Ck'd by	Survey of Gage Ave Appraisal
Map No.	W. O. 0904.87 Tape No. St'd. °F
Office Work	Surveyed by Dougherty
Checked	Notes Dougherty Date 2-6-56
Date	Indexed ~~A. C. Johnson~~ 2-7-56

F. B. 645 PG. 109

J. N. 0904.87
Gage Ave Appraisal

Location of Improvements on the South Side of Gage Ave from Hooper Ave East to Compton Ave

2-6-56

Note
All offset distances were read with Transit & All distances shown to Trees & Poles was taken to Center

Dougherty
Bowles
King
Sandoval

Note: Any Additions or Changes on This Sheet Must be Made or Circled in Red Ink With Date and Name of Person Making Change.

Do not extend notes this side of this line.

RETURN TO
LOS ANGELES COUNTY SURVEYOR
726 LOS ANGELES COUNTY
ENGINEERING BLDG.

76F309S S&E #247. 8-54

F.B. 645 Pg. 110

Cont. on Bot Pg. 111

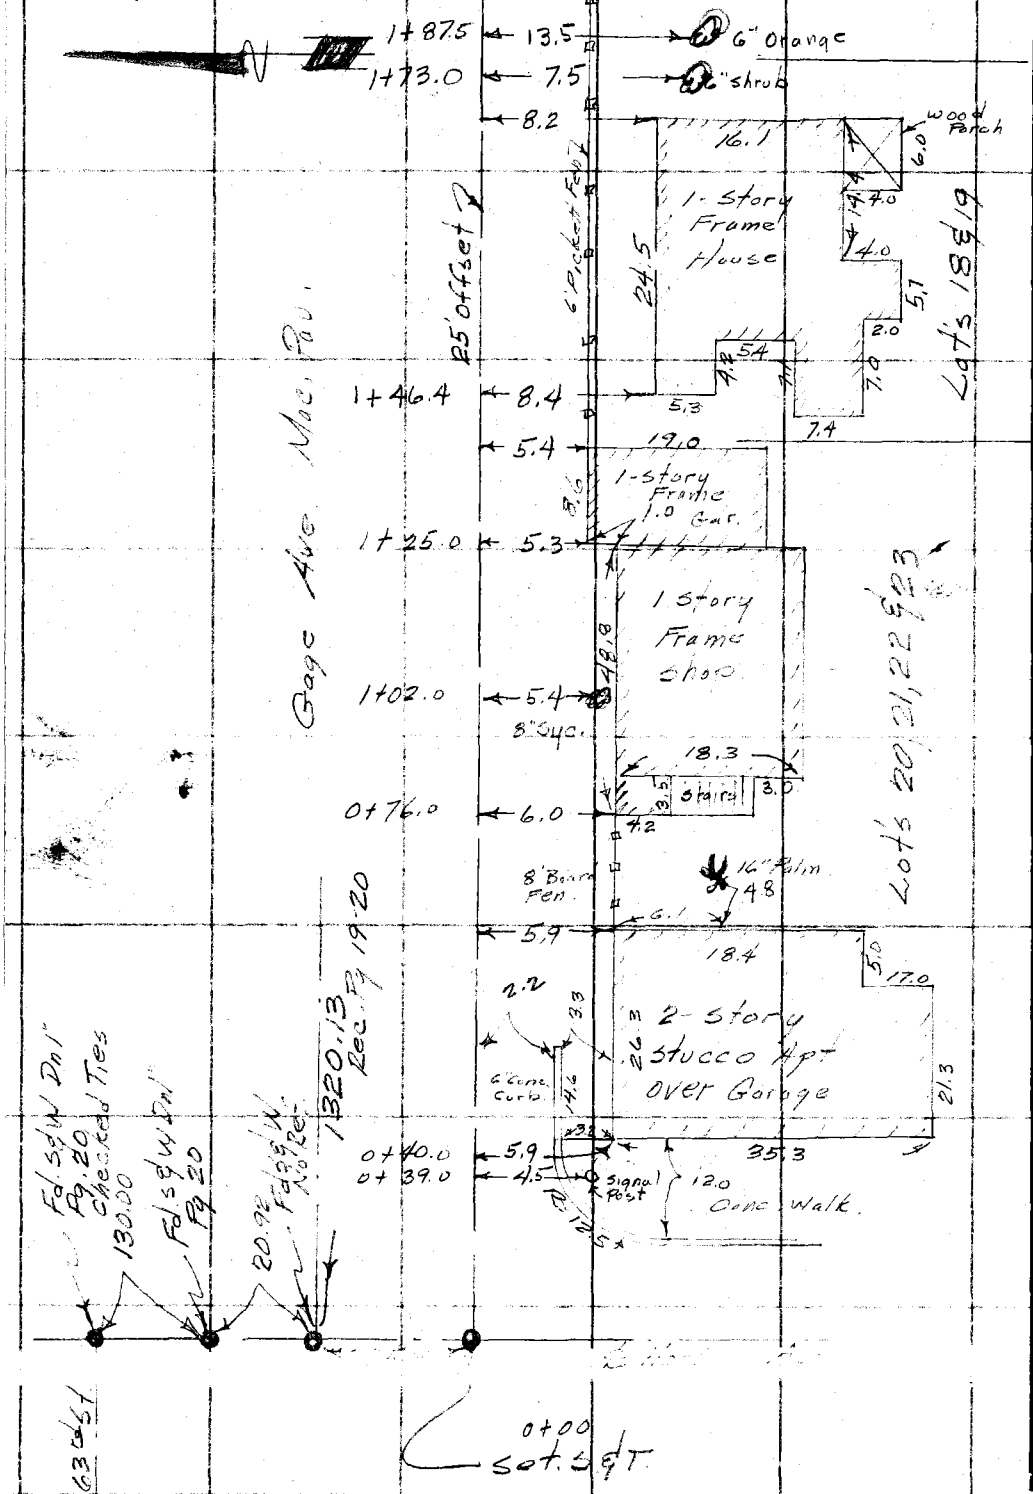

RETURN TO
LOS ANGELES COUNTY SURVEYOR
726 LOS ANGELES COUNTY
ENGINEERING BLDG.
Do not extend notes this side of this line.

Note: Any Additions or Changes on This Sheet Must be Made or Circled in Red Ink With Date and Name of Person Making Change.

Notes Ck'd by	Survey of Gage Ave
Map No.	W. O. 2094.67 Tape No. St'd. °F
Office Work	Surveyed by Daugherty
Checked	Notes Daugherty Date 2-6-56
Date	Indexed M. C. Johnson

F. B. 645 Pg. 111

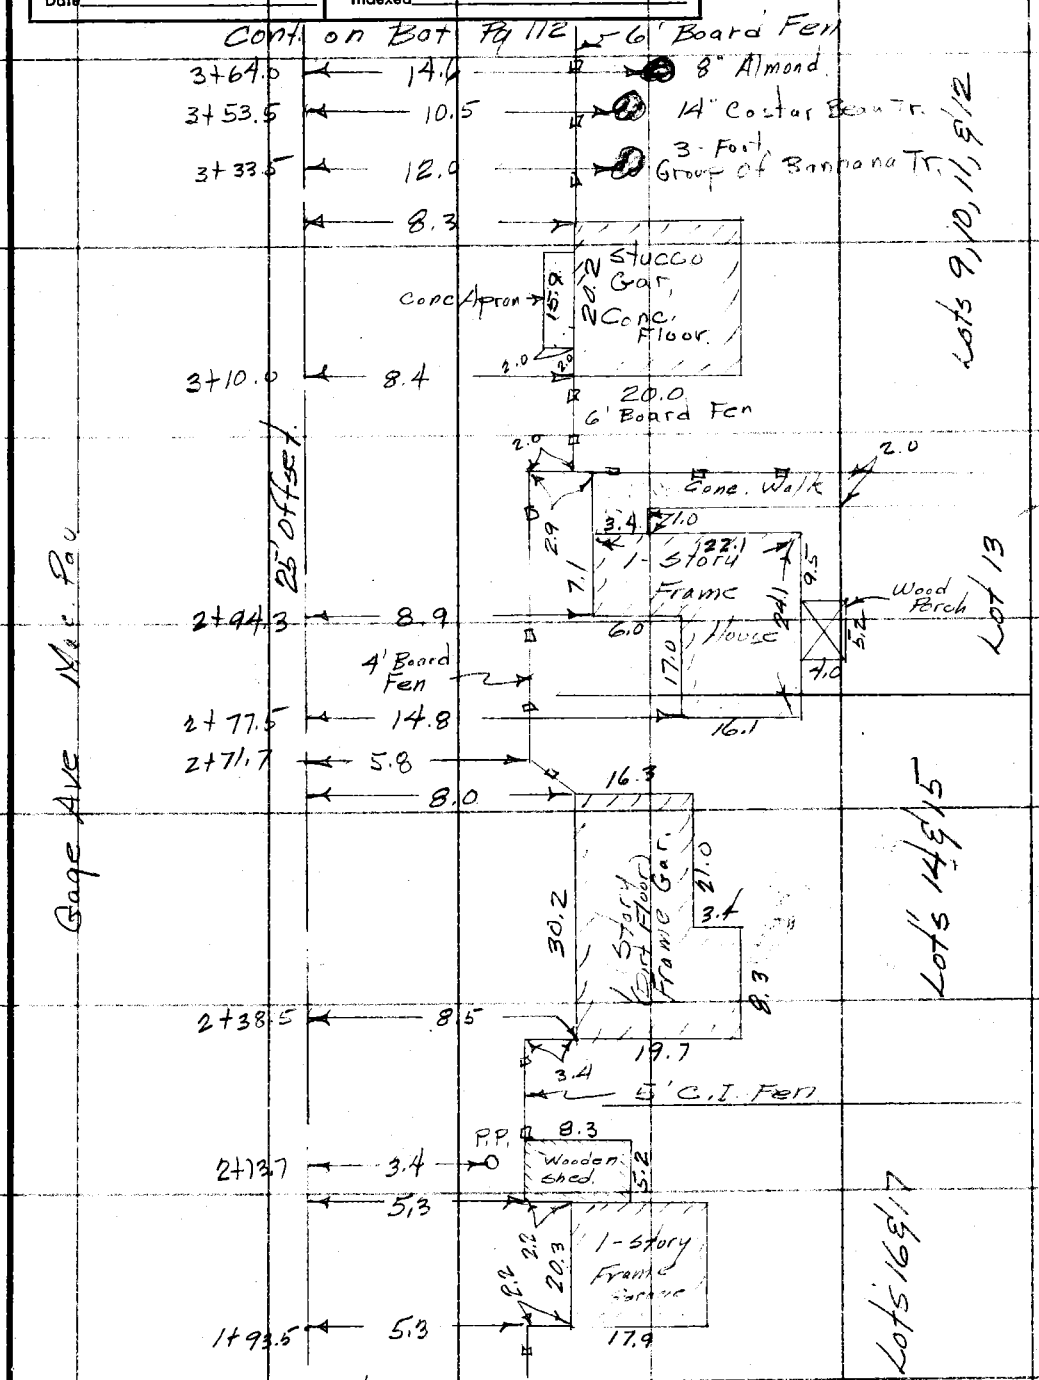

Note: Any Additions or Changes on This Sheet Must be Made or Circled in Red Ink With Date and Name of Person Making Change.

Do not extend notes this side of this line.

RETURN TO
LOS ANGELES COUNTY SURVEYOR
726 LOS ANGELES COUNTY
ENGINEERING BLDG.

76F3095 S&E #247. 8-54

F.B. 645 PG. 112 Cont. on Bot. 113

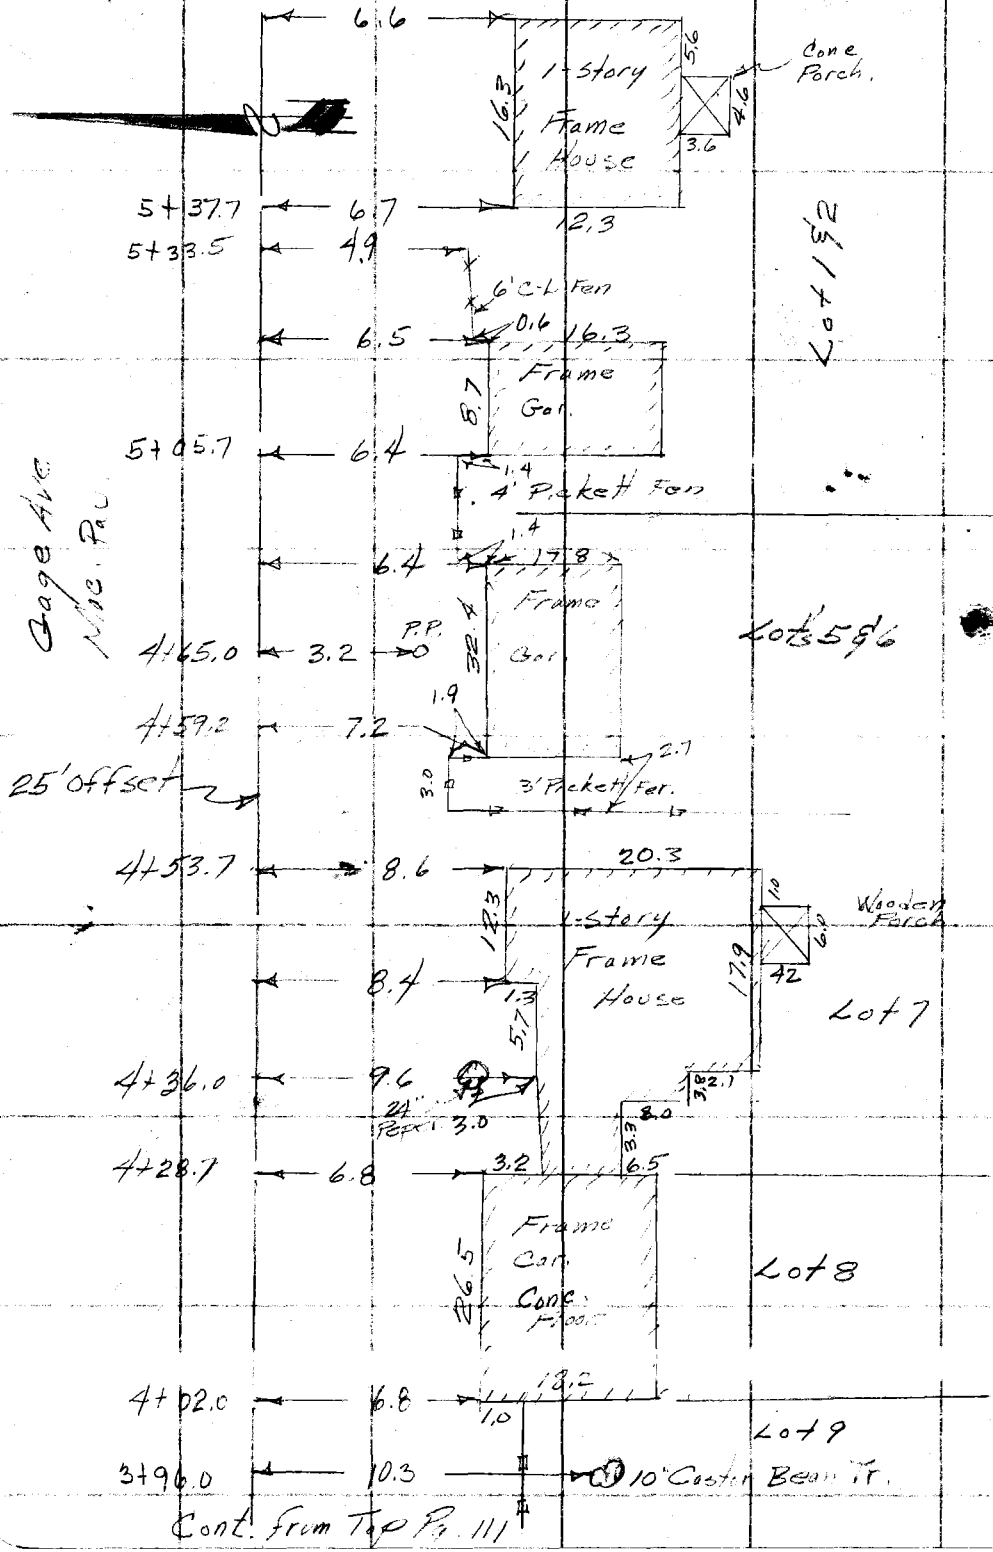

Cont. from Top Pg. 111

RETURN TO
LOS ANGELES COUNTY SURVEYOR
726 LOS ANGELES COUNTY
ENGINEERING BLDG.
Do not extend notes this side of this line.

Note: Any Additions or Changes on This Sheet Must be Made or Circled in Red Ink With Date and Name of Person Making Change.

Notes Ck'd by	Survey of Gage Ave
Map No.	W. O. 8704-87 Tape No. St'd. °F
Office Work	Surveyed by Dougherty
Checked	Notes Dougherty Date 2-6-56
Date	Indexed C. Johnson

F. B. 645 PG. 113

Cont. on Bot. Pg 114

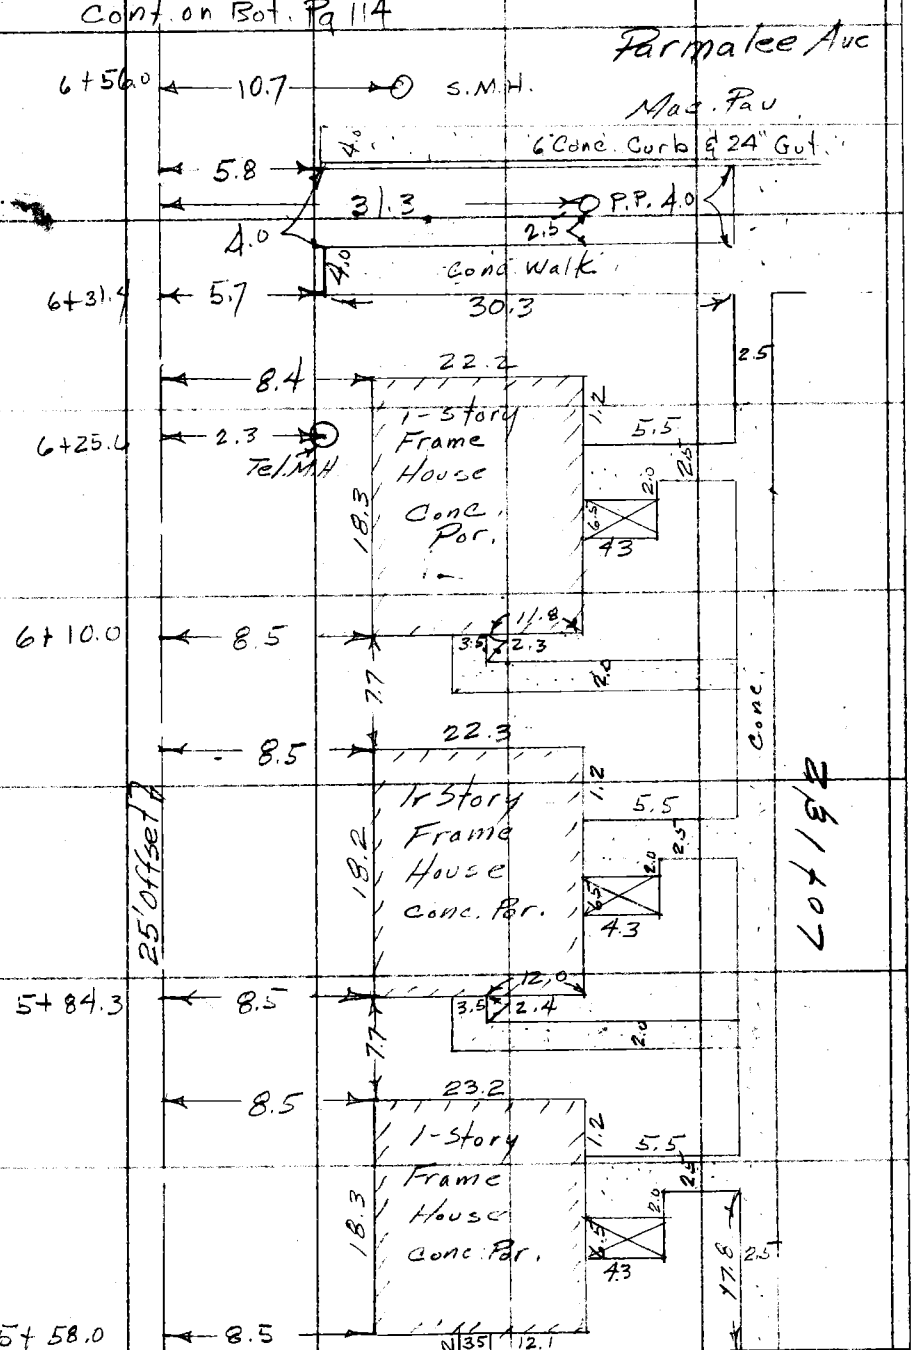

Cont. from Top Pg. 112

Note: Any Additions or Changes on This Sheet Must be Made or Circled In Red Ink With Date and Name of Person Making Change.

Do not extend notes this side of this line.

RETURN TO
LOS ANGELES COUNTY SURVEYOR
726 LOS ANGELES COUNTY
ENGINEERING BLDG.

76F3095 S&E #247. 8-54

F.B. 645 Pg. 114

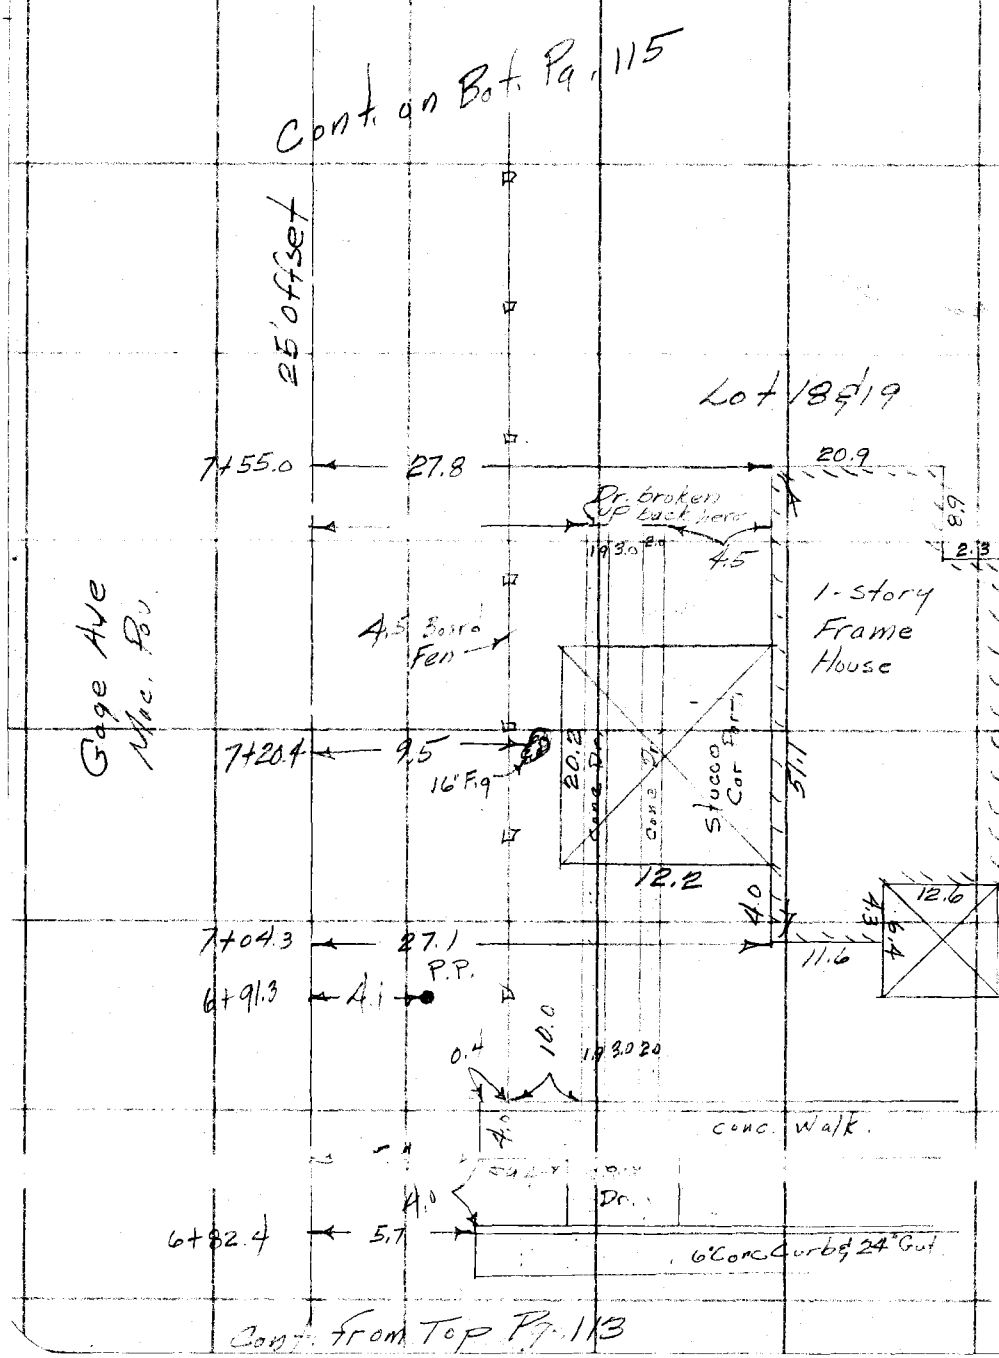

RETURN TO
LOS ANGELES COUNTY SURVEYOR
726 LOS ANGELES COUNTY
ENGINEERING BLDG.
Do not extend notes this side of this line.

Note: Any Additions or Changes on This Sheet Must be Made or Circled in Red Ink With Date and Name of Person Making Change.

Notes Ck'd by	Survey of Gage Ave Approval
Map No.	W. O. 8904-87 Tape No. Sl'd. °F
Office Work	Surveyed by Dougherty
Checked	Notes Bowles Date 2-6-56
Date	Indexed E. C. Johnson

F. B. 645 Pg. 115

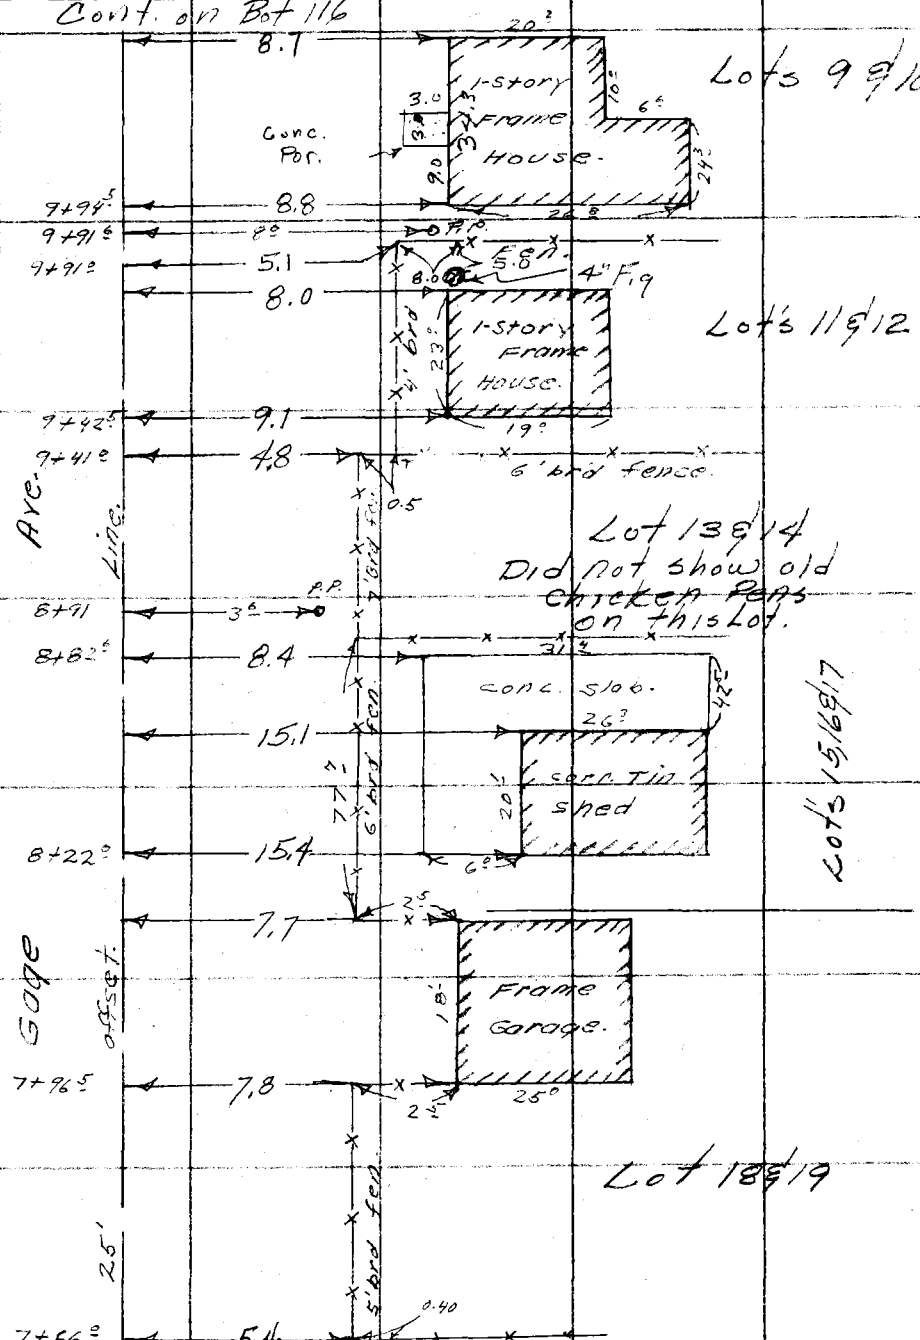

Note: Any Additions or Changes on This Sheet Must be Made or Circled in Red Ink With Date and Name of Person Making Change.

Do not extend notes this side of this line.

RETURN TO
LOS ANGELES COUNTY SURVEYOR
726 LOS ANGELES COUNTY
ENGINEERING BLDG.

76F309S S&E #247. 8-54

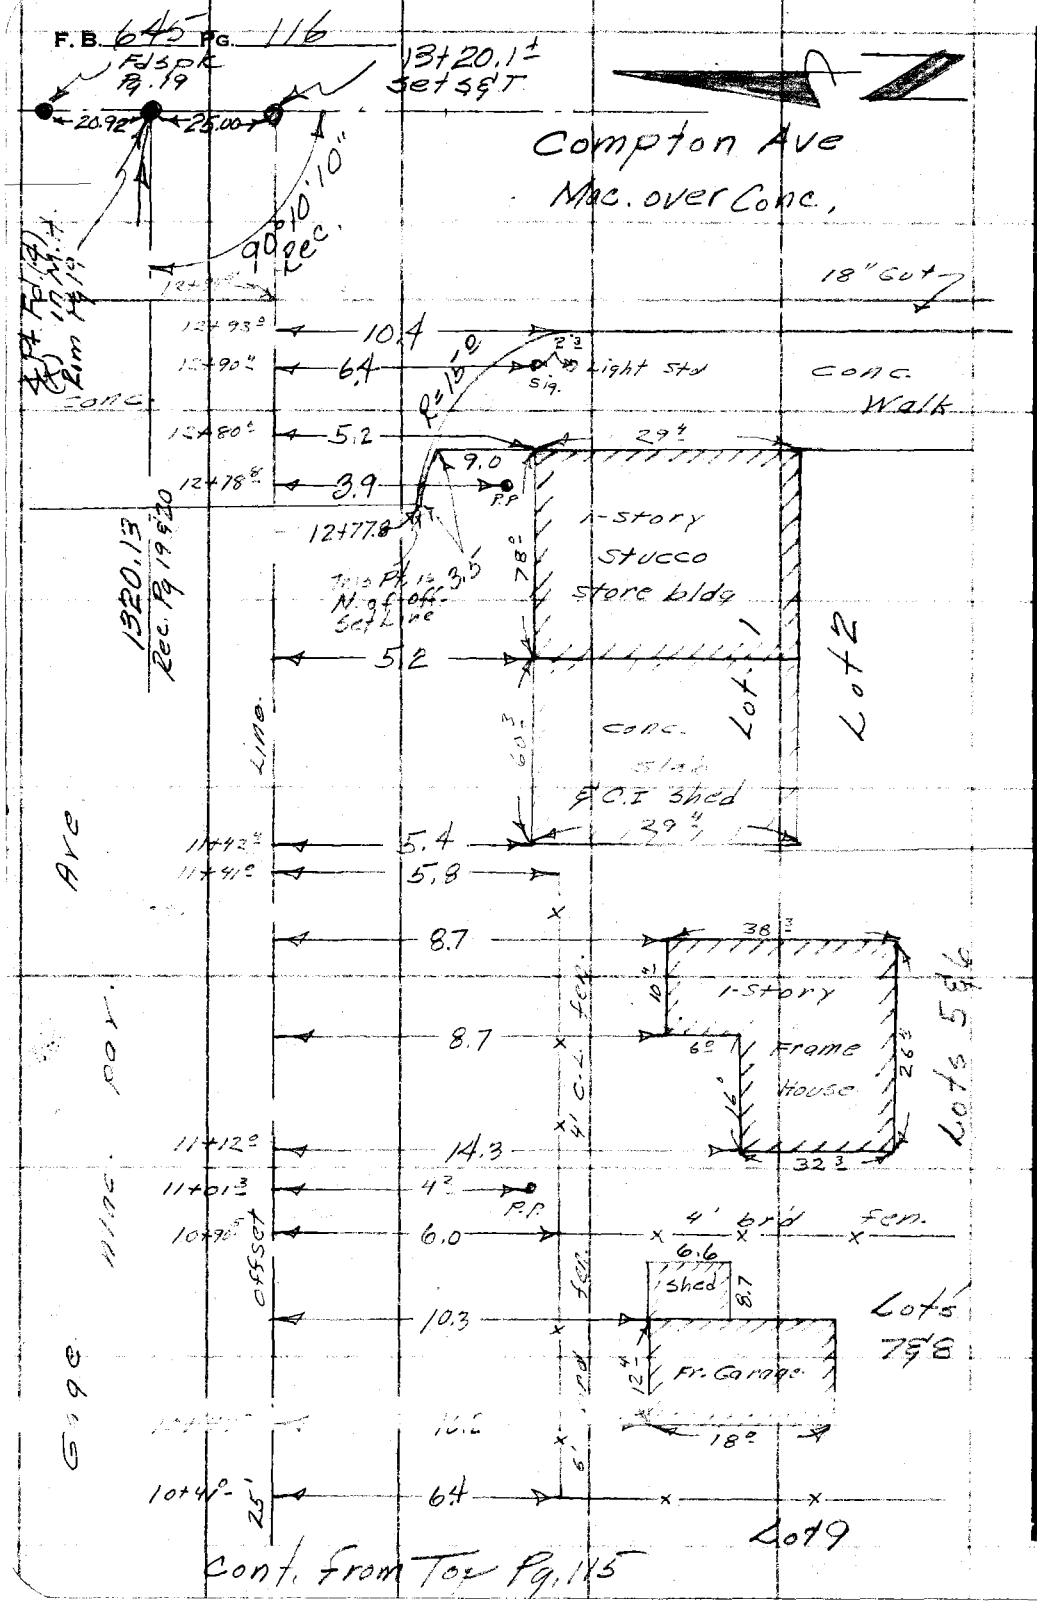

RETURN TO
LOS ANGELES COUNTY SURVEYOR
726 LOS ANGELES COUNTY
ENGINEERING BLDG.
Do not extend notes this side of this line.

Note: Any Additions or Changes on This Sheet Must be Made or Circled in Red Ink With Date and Name of Person Making Change.

Notes Ck'd by	Survey of Gage Ave
Map No.	W. 0904.87 Tape No. St'd. °F
Office Work	Surveyed by Daugherty
Checked	Notes Date 2-21-56
Date	Indexed ~~R.~~ C. Johnson 2-24-56

F. B 645 PG. 117

J.N. 0904.87

Gage Ave Survey

Location of Factory @ S.E. Cor. of Gage & Centeral Ave

2-21-56

Dougherty
Bowles
Sandoval
King

Note: Any Additions or Changes on This Sheet Must be Made or Circled in Red Ink With Date and Name of Person Making Change.

Do not extend notes this side of this line.

RETURN TO
LOS ANGELES COUNTY SURVEYOR
726 LOS ANGELES COUNTY
ENGINEERING BLDG.

76F309S S&E #247. 8-54

F.B. 645 PG. 118

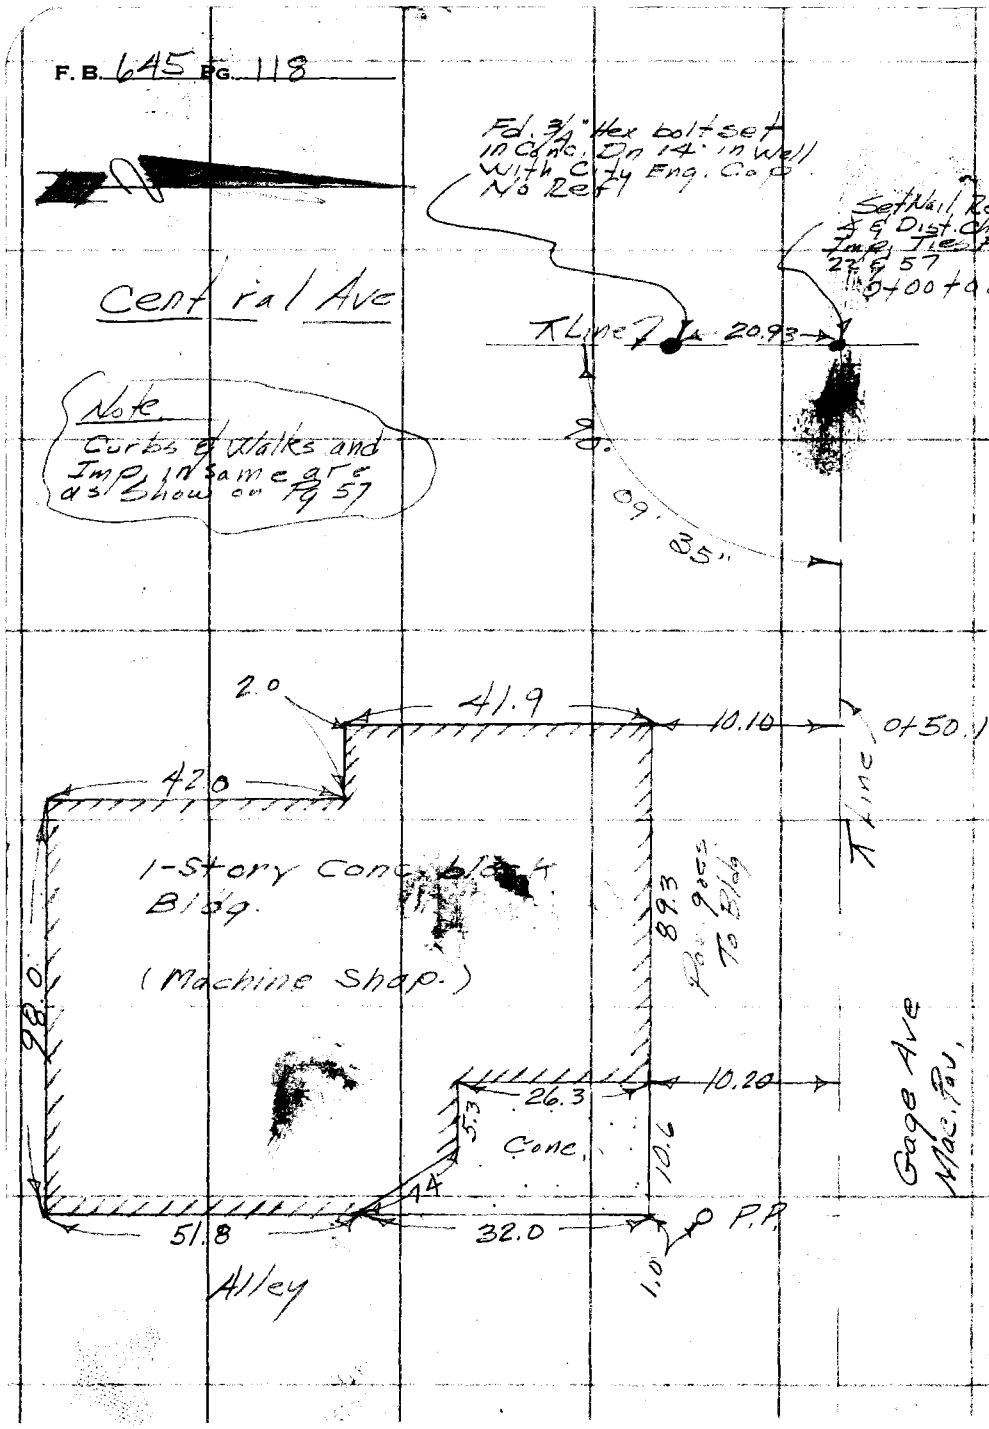

RETURN TO
LOS ANGELES COUNTY SURVEYOR
726 LOS ANGELES COUNTY
ENGINEERING BLDG.

Do not extend notes this side of this line.

Note: Any Additions or Changes on This Sheet Must be Made or Circled In Red Ink With Date and Name of Person Making Change.

Notes Ck'd by	Survey of Gage Ave
Map No.	W. O. 0904.87 Tape No. St'd. °F
Office Work	Surveyed by Dougherty
Checked	Notes Dougherty Date 2-21-56
Date	Indexed A. C. Johnson

F. B. 645 PG. 119

W.N. 0904.87

Gage Ave Survey
Loc. of Church @ S.W.
Cor. of Gage Ave & Hooper Ave
2-21-56

Dougherty
Bowles
Sandoval
King.

Note: Any Additions or Changes on This Sheet Must be Made or Circled In Red Ink With Date and Name of Person Making Change.

Do not extend notes this side of this line.

RETURN TO
LOS ANGELES COUNTY SURVEYOR
726 LOS ANGELES COUNTY
ENGINEERING BLDG.

76F309S S&E #247. 8-54

F. B. 645 PG. 120

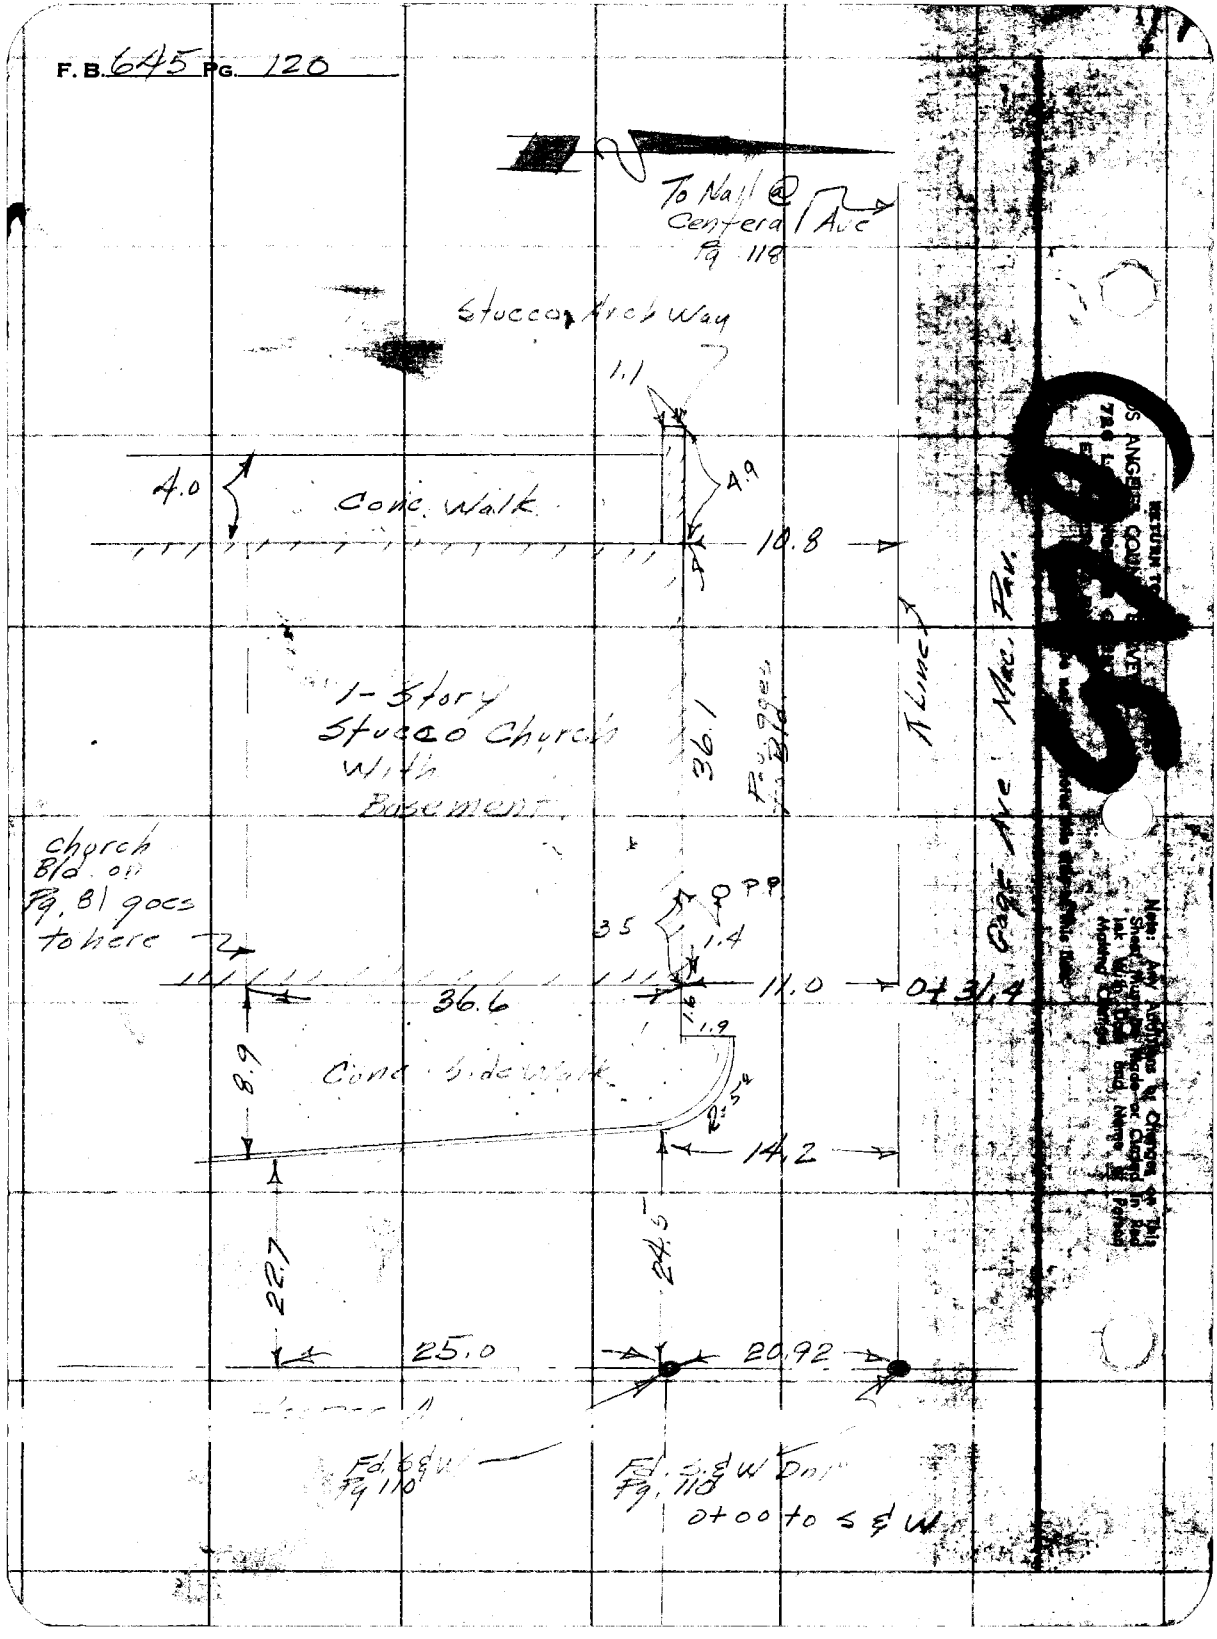

To Nail @ Central Ave Pg 118
Stucco Arch Way
1.1
4.9
4.0
Conc. Walk
10.8
1-Story Stucco Church With Basement
36.1
Pavgges to Bld
Gage Ave Mac. Pav.
Church Bld. on Pg. 81 goes to here
PP
3.5
1.4
11.0
0+31.4
36.6
1.6
1.9
8.9
Conc. Side Walk
R=5'
14.2
22.7
24.5
25.0
20.92
Fd. S&W Pg 110
Fd. S&W Dn Pg. 110
0+00 to S&W