Survey of
W. O. Tape No. St'd °F.
Surveyed by
Notes Date
Indexed A. C. Johnson 7-6-36

F.B. 680 Pg. 13

MT. WILSON TOLL ROAD

J.N. 8149

FROM FOOTHILL BLVD. ALTADENA
TO
SUMMIT OF MT. WILSON

F.B. 650 Pg. 4

INDEX.

C.S.B-1217

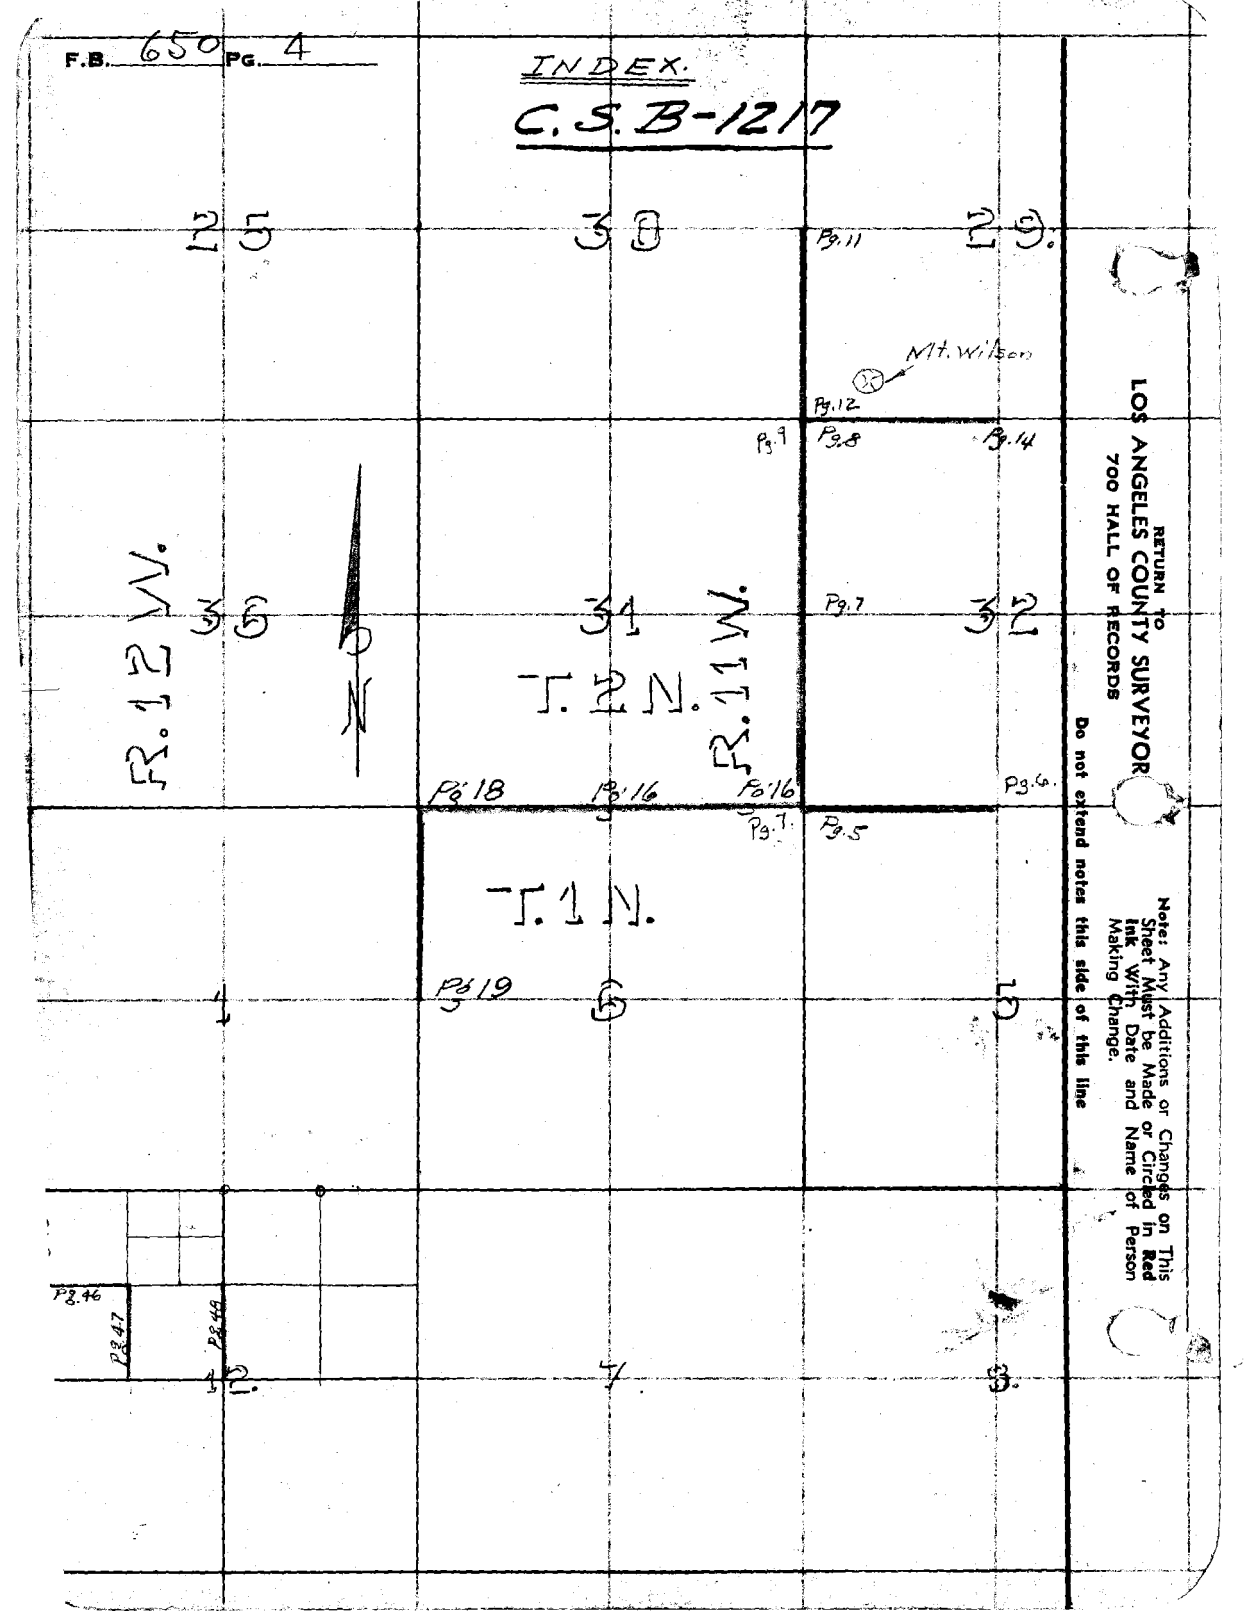

RETURN TO
LOS ANGELES COUNTY SURVEYOR
700 HALL OF RECORDS

Do not extend notes this side of this line

Note: Any Additions or Changes on This Sheet Must be Made or Circled in Red Ink With Date and Name of Person Making Change.

(To Bk. pg. 6)

Notes Ck'd by Drew	Survey of Mt. Wilson Traverse
Map No. B-1217	W. 08 48 Tape No. 25 St'd 84° F.
Office Work	Surveyed by Evans
Checked Drew	Notes E Date 6/9/36
Date 12-18-40	Indexed A. C. Johnson

F.B. 650 Pg. 5

Note

500ft. tape #25 used on these Sec. Lines calibrated 6/10/36 with 100' tape #672 Normal @ 84°

To Intsn. "P" Line per pg. 6

To 1/4 Sec. Cor.

{17.745 @ 41°38-1/2" = 132.62
{17.10 @ 41°52 = 132.63
T84°

Line

132.62

T. 1 N. R. 11 W. S.B.M.

{218.25 @ 4-24 = 217.61
{218.11 @ 3-55-45 = 217.60
217.60

{419.38 @ 10-35 = 412.25
{419.59 @ 10-44 = 412.25
T84°
412.25
629.85

"A" Set 1/2" Iron Pipe Brk.

1.(78-32-(-1/2")
6.(111-13-3/4")
78°32'15"

S. 32

S. 33

S. 5

S. 4

S. 31

S. 6

S. 7

S. 8

S. 9

S. 16

S. 17

S. 18

S. 19

S. 20

S. 21

S. 28

S. 29

S. 30

T. 2 N.

T. 1 N.

R. 11 W.

R. 12 W.

1.(80-40-15")
6.(124-01-45")
80°40-17"

T84°

1555

Fire break

8°

40'15"

S 5.33

626.63 Calc.

15-31-50"

237.37

5°47'30"

629.85

237.37 @ 0°0-T84°

Set N+T ch. pt.

Set 1"x2" stake & mound of fire rock

2773.00

Set 1"x2" stake & mound of fire rock

Set 1/2"T in boulders 2446.79

2621

246.79

N+T 4"x4" stake

Set N+T

Transit Line See pg. 7

OFFICE SURVEY FOR REMOVAL

$250

T. 2 N. R. 11 W. S.B.M.

S31 S32 S5 S6 T. 1 N.

U.S. LAND PENALTY

1927

0°00 East

Sec. Cor. Fd. 2" I.P. & B.C. in rock mound per C.S. 9370/28, cor. to 3/32/15 with bearing tree as described

318.73 @ 39°15-30 = 246.79
318.73 @ 39°15-30 = 246.79
Corrected
246.79 (G)

9.97

N+T 3"x4" stake

Note: Any Additions or Changes on This Sheet Must be Made or Circled In Red Ink With Date and Name of Person Making Change

Do not extend notes this side of this line

RETURN TO LOS ANGELES COUNTY SURVEYOR 700 HALL OF RECORDS

FORM 247 10M 11-38

RETURN TO
LOS ANGELES COUNTY SURVEYOR
700 HALL OF RECORDS

Note: Any Additions or Changes on This Sheet Must be Made or Circled in Red Ink With Date and Name of Person Making Change.

Do not extend notes this side of this line

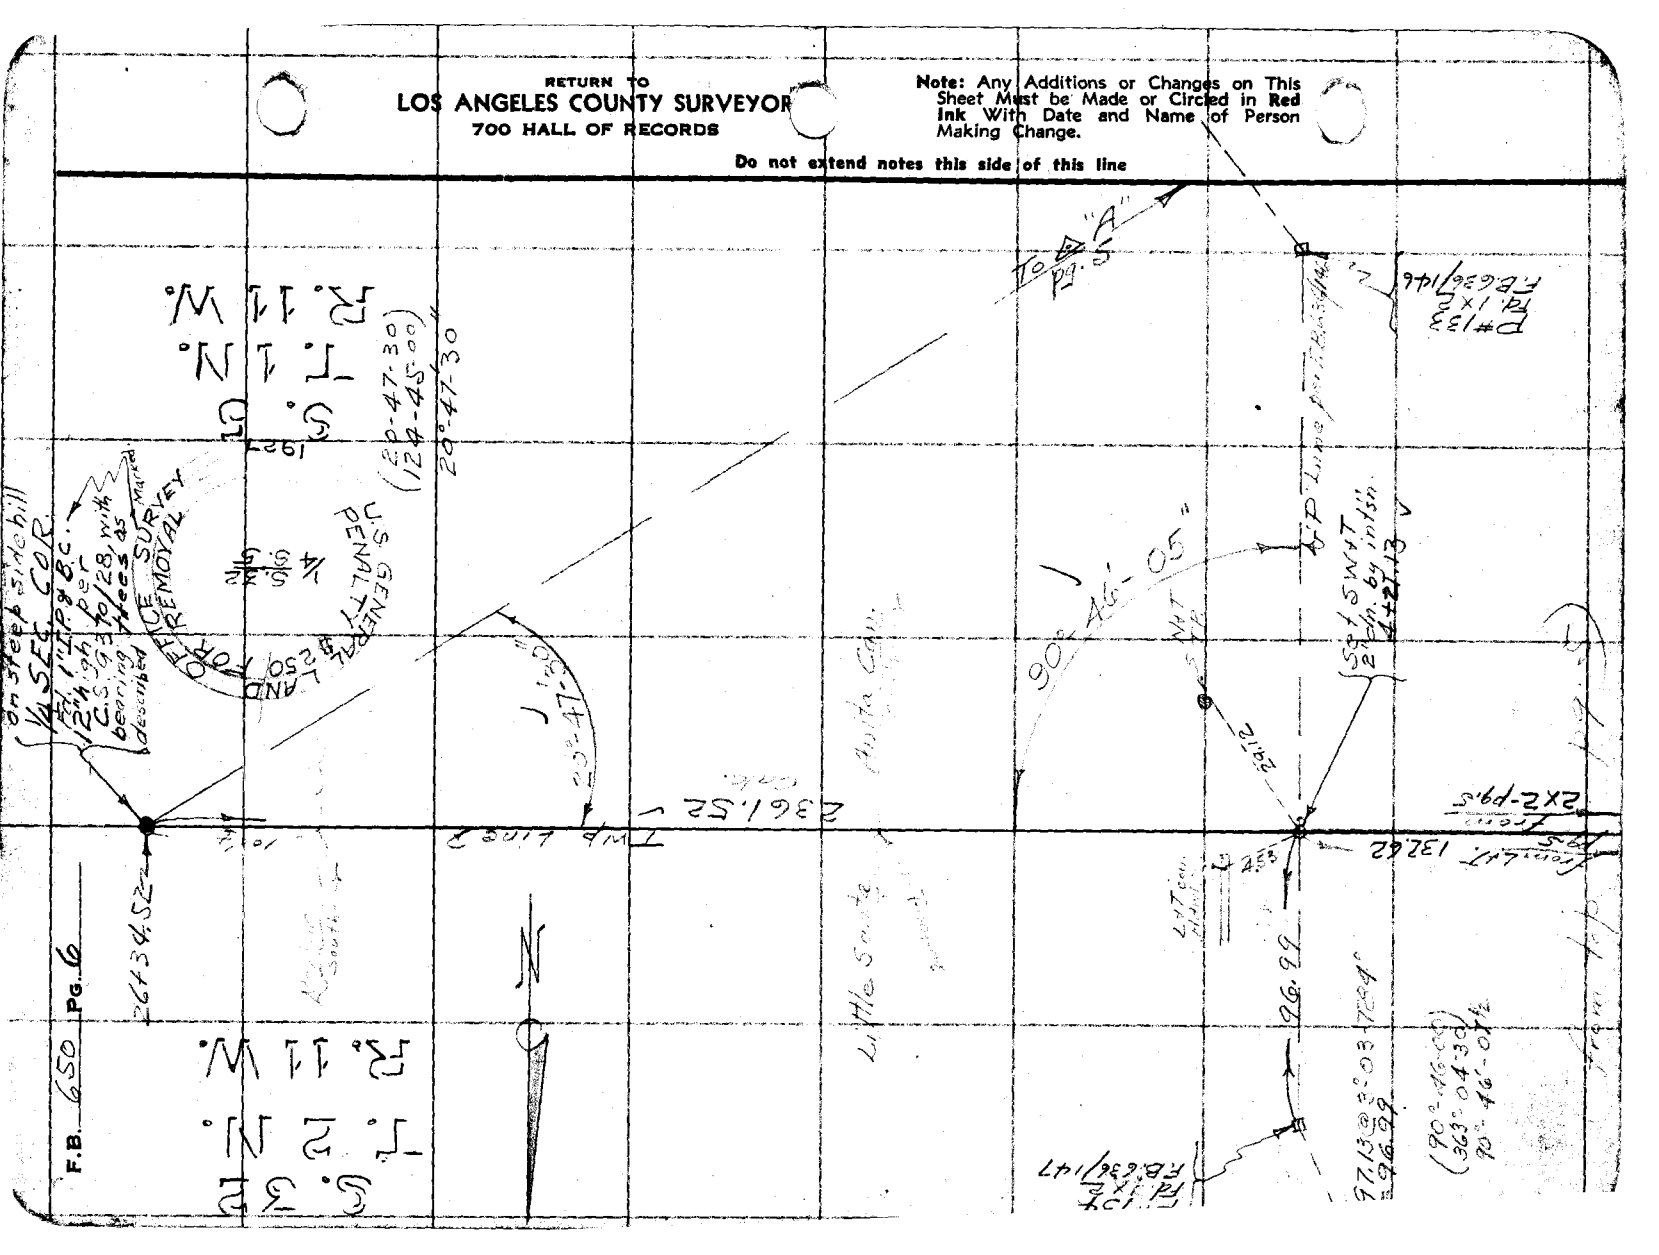

Notes Ck'd by DrCW	Survey of Mt. Wilson Toll Rd.	F.B. 650	PG. 7
Map No. B-127	W. O. 8149 Tape No. 25 St'd 58°F.		
Office Work	Surveyed by Evans		
Checked DrCW	Notes NE Date 6/12/30		
Date 12-19-60	Indexed C. Johnson		

T = 72°

#1 - 150.64 @ 27°39'15" = 133.43
#2 - 150.36 @ 27°27'15"

To Bot. Page 6

Note: Any Additions or Changes on This Sheet Must be Made or Circled in Red Ink With Date and Name of Person Making Change.

Do not extend notes this side of this line

RETURN TO
LOS ANGELES COUNTY SURVEYOR
700 HALL OF RECORDS

Calc. 820.75

Ridge

Set SW'ly Toe of Low Rocky Ridge 27+84.55

Top 1x2 Pg.

29°24'30"

136.51 Calc.

79°55'

Calc. 8.52

"D" Set 1x2

"C" Set 2 x 4 T.

Calc.

"B" Set L.H.T. in Boulder West Top Mt. Harvard.

Rock Gulch

Boulder Mound + Rock 4'xW

Set 2 x 4 T. in Rock Mound

Tie to Cor. Fd. Iron Pipe & Tag C.S. 9370/61

Mkd. 4" Sq. Oak Post Fd. Iron Pipe & Tag C.S. 9370/61

Calc.

GENERAL LAND OFFICE

Set 1x2 Top of High Ridge 7+14.23

Traverse Line

Calc. 7+14.23

S. 31

S. 32.

T. 2 N.

N

20°42'00"

33°17'15"

91°40'00"

67°38'00"

273.00

TWP. LINE per pg. 5

2 x 2 - 2+73.00 per pg. 5

S.W. Cor. Sec. 32 Per. Pg. 5 0+00 North.

T. 1 N. R. 11 W.

S. 5.

S. 5.

1/6 (29°24'30" / 176°2'00" / 29°24'30")

1/6 (32°41'15" / 196°7'30" / 32°41'15")

1/6 (115°56'00" / 335°30'00" / 115°56'00")

1/6 (42°54'45" / 251°53'15" / 42°54'45")

1/6 (109°11'45" / 288°10'30" / 109°11'45")

1/6 (28°17'30" / 169°56'30" / 28°17'30")

1/6 (21°35'00" / 129°30'00" / 21°35'00")

1/6 (115°45'15" / 331°32'00" / 115°45'15")

1/6 (42°39'15" / 255°55'00" / 42°39'10")

1/6 (30°04'00" / 180°24'00" / 30°04'00")

1/6 (116°35'45" / 339°53'00" / 116°38'50")

1/6 (33°17'15" / 199°43'00" / 33°17'10")

1/6 (20°42'00" / 124°2'00" / 20°42'00")

1/6 (67°38'00" / 45°42'00" / 67°38'00")

1/6 (91°40'00" / 550°00'00" / 91°40'00")

FORM 247 10M 11-38

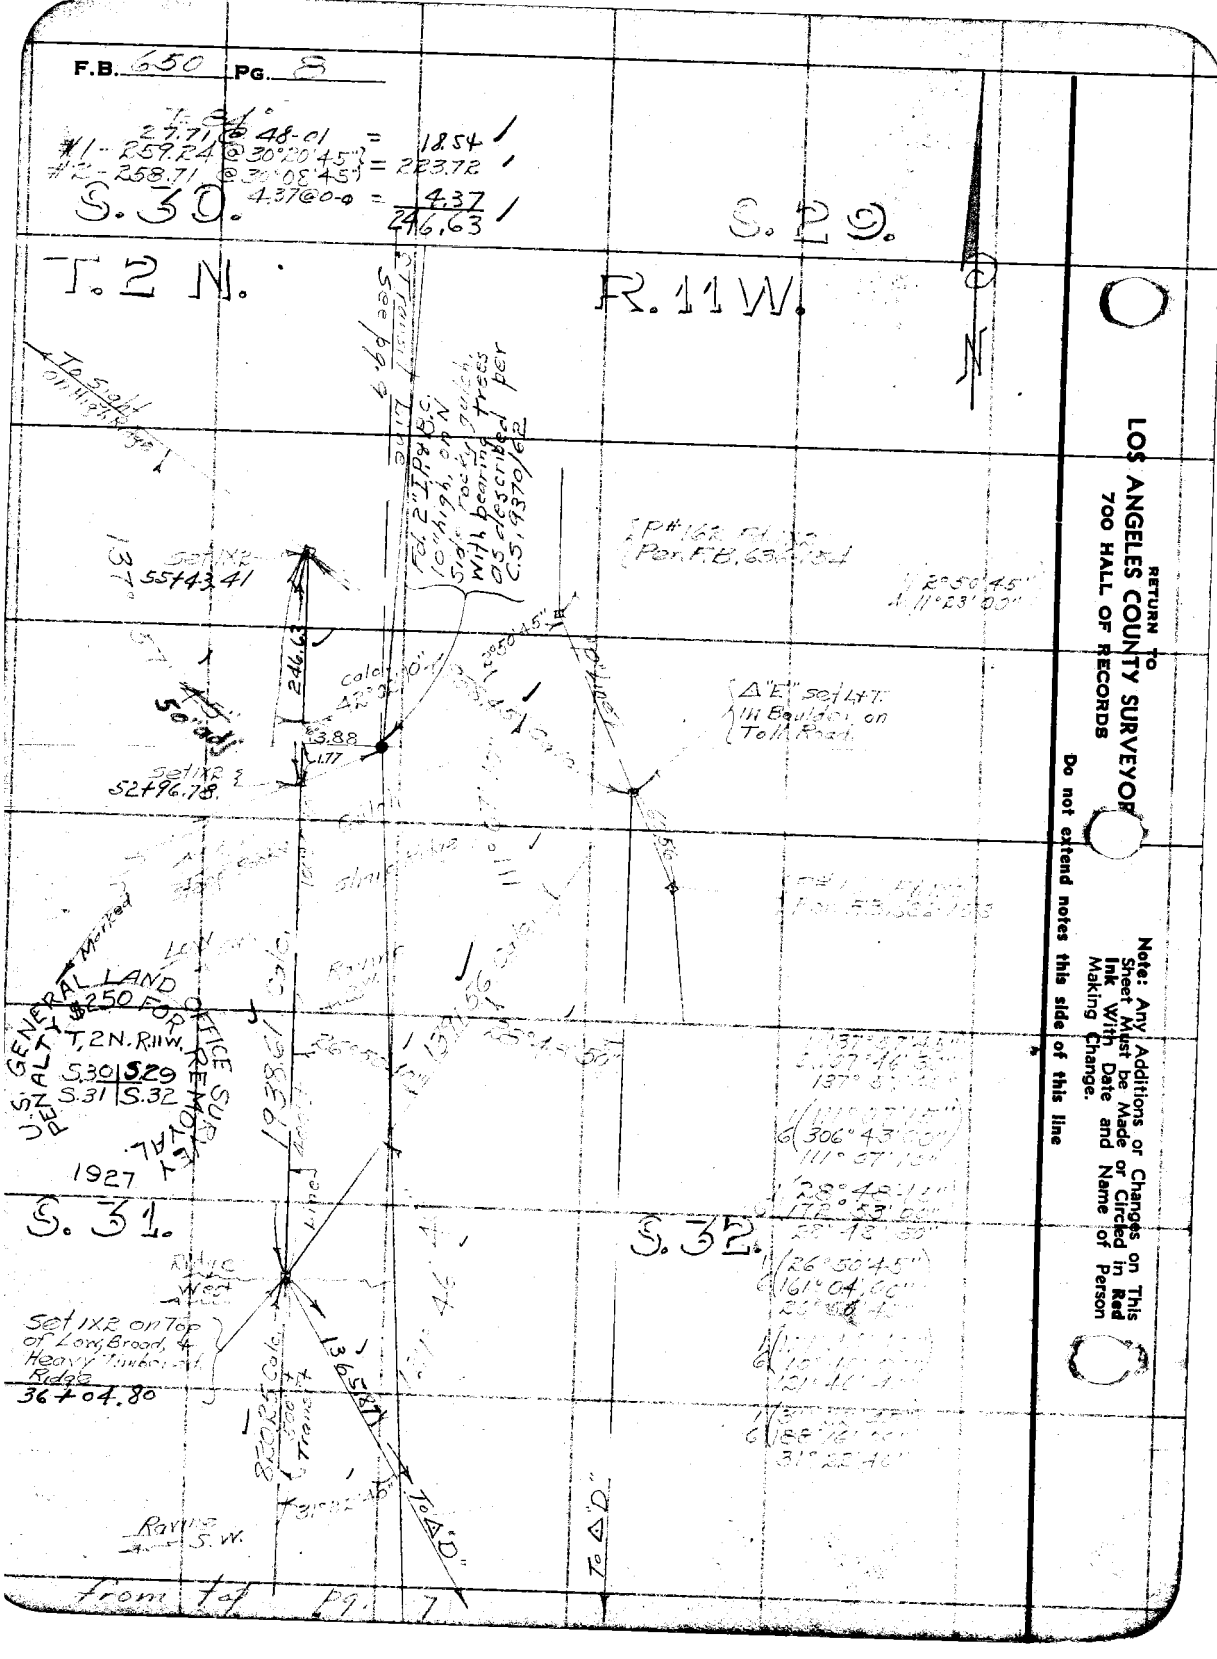
F.B. 650 Pg. 8
#1 - 259.24 @ 30°20'45" = 223.72
#2 - 258.71 @ 30°08'45" = 4.37
S. 30.
4.37 @ 0-0 =
446.63
S. 29.
T. 2 N.
R. 11 W.
N
RETURN TO
LOS ANGELES COUNTY SURVEYOR
700 HALL OF RECORDS
Note: Any Additions or Changes on This Sheet Must be Made or Circled in Red Ink With Date and Name of Person Making Change.
Do not extend notes this side of this line
To S.32
on this line
Set 1X2
1554341
Fd. 2" IP in C.
10" high, on N
side, 10" pine trees
with bearing trees
as described per
C.S. 9370/62
246.63
Calc. point
3.88
1.77
50' adj.
Set 1X2
52+96.78
Set 1X2
Merged
GENERAL LAND OFFICE REMARKS
$250 FOR
PENALTY
T. 2N. R. 11W.
S.30 S.29
S.31 S.32
1927
S. 31.
S. 32.
Set 1X2 on top
of Long Broad &
Heavy Timber
Ridge
36+04.80
Ravine
S.W.
To "D"
from 1st Pg. 7

To Roll pg. 10

Notes Ck'd by Drew	Survey of Mt. Wilson Toll Rd.
Map No. B-1217	W. O. 8149 Tape No. 25 St'd 84 F.
Office Work	Surveyed by Evans
Checked Drew	Notes
Date 12-18-40	Date 6/23/36
	Indexed A. C. Johnson

F.B. 659 Pg. 9

Note: Any Additions or Changes on This Sheet Must be Made or Circled in Red Ink With Date and Name of Person Making Change.

Do not extend notes this side of this line

RETURN TO
LOS ANGELES COUNTY SURVEYOR
720 HALL OF RECORDS

FORM 247 10M 11-38

58.76 @ 26°41'15" = 78.86 } 78.86
87.53 @ 25°43'15" = 78.86 }

149.37 @ 28°40" = 123.16 } 123.17
139.42 @ 27°56'15" = 123.17 }

T 89° 202.03

1/4 (89°22'-15" / 241-28-30)
60°22'-07½"

P#170
F.B. 636/155

27.05 @ 21-31-30 = 25.16 } 25.16
26.73 @ 19-45 = 25.16 }

321.46 @ 28°02'45" = 283.71 } 283.72
320.98 @ 27°52'15" = 283.73 }

114.28 @ 26°40 = 102.12 } 102.13
112.61 @ 25°59 = 102.13 }

411.01
T 90° .02
411.03

#3
Set SWHT by Intsn.

Line 2

Transit Line Sec.

"D" Line - F.B. 636/136

#2 "A" set 1X1

60°-22'-10"

P#171
F.B. 636/138

1/6 (89-25-15 / 176-32-15)
89°25'-22½"

Set 1X2

499.80 @ 34°-21 = 412.63 } 412.64
499.63 @ 34-19-15 = 412.64 }

7.51 @ 0-0 = 7.51
T 90° 420.15

S 44°43'41" E 420.15 per pg. 8

89°-20'-50"

1504.

S. 30.

T. 2 N.

Set LHT See pg. 12

#1 Set 1X2

S. 1 LHT See pg. 12

S. 29

Transit Line See pg. 12

R. 11 W.

50.74

39.79 @ 51-01-30 = 25.10 } 25.10
38.79 @ 49°40-15 = 25.10 }

54.75 @ 22°03-30 = 50.74 } 50.74
54.39 @ 21°07 = 50.19 }

25.10

52+96.78 per pg. 8

Sec Line

N.W. cor Sec. 32, per pg. 8

Transit Line pg. 8

S. 31

S. 32

F.B. 650 PG. 10

To Bot. pg. 11

145.11 @ 8-27-30 = 143.53
144.95 @ 8-09-00 = 143.54 } 143.53 ✓

227.40 @ 2-45-30 = 227.14
227.47 @ 3-08-30 = 227.14 } 227.14

74.53 @ 26-04-15 = 66.95
74.29 @ 25-41 = 66.95 } 66.95 /

151.12 @ 27-44-30 = 133.75
151.28 @ 27-50-30 = 133.77 } 133.76 /

T 84° 200.71 /

165.21 @ 14-30-45 = 159.94
165.00 @ 14-12-30 = 159.95 } 159.95

331.21 @ 14-20 = 321.87
331.75 @ 14-31 = 321.87 } 321.87
T 54°

109.71 @ 11-37-30 = 107.46 ✓
37.38 @ 0-0 = 37.38
T 99° 144.84 ✓

#9 set 1x2

#8 set 1x2

#7 set 1x2

#6 set 1x2

#5 set 1x2

#4 set 1x2 Top 2 in.

143.53

227.14

200.71

144.84

202.03

M.H. Wilson

RETURN TO
LOS ANGELES COUNTY SURVEYOR
700 HALL OF RECORDS

Note: Any Additions or Changes on This Sheet Must be Made or Circled in Red Ink With Date and Name of Person Making Change.

Do not extend notes this side of this line

Notes Ck'd by DrCaw	Survey of Mt. Wilson Toll Rd
Map No. B-127	W. O. 8142 Tape No. 25 St'd 84°F.
Office Work	Surveyed by Evans
Checked DrCaw	Notes HE Date 2/24/36
Date 12-18-42	Indexed A. C. Johnson

F.B. 630 Pg. 11

U.S. GENERAL LAND OFFICE SURVEY
PENALTY $250 FOR REMOVAL
S.50 S.69

1927

53.54 @ 25°48-30 = 48.20
52.86 @ 24°-15-15 = 48.20 } 48.20

Fd. 1" IP + BC. 8" high on side of small N+S. draw with bearing trees as described per C.S. 9370/65

#12 Set 1x2

0.03

48.20

90°

118.07 @ 9-12 = 116.50
117.87 @ 8-44-15 = 116.50 } 116.50

6.85 @ 0-0 6.85
123.35

123.35

S. 0° W.

T. 2 N.

R. 11 W.

S. 2° E.

Meridian Line

151.11 @ 20°-32-30 = 151.22
160.85 @ 19°-55-15 = 151.23 } 151.22

144.11 @ 20°-24-30 = 135.06
144.32 @ 20°-27-30 = 135.08 } 135.07

286.29
T 80° .01
286.28

286.28

Township Line

#13 Set 1x2

143.53

from top pg. 10

Note: Any Additions or Changes on This Sheet Must be Made or Circled in Red Ink With Date and Name of Person Making Change.

Do not extend notes this side of this line

RETURN TO
LOS ANGELES COUNTY SURVEYOR
700 HALL OF RECORDS

FORM 247 10M 11-38

RETURN TO
LOS ANGELES COUNTY SURVEYOR
700 HALL OF RECORDS

Note: Any Additions or Changes on This Sheet Must be Made or Circled in Red Ink With Date and Name of Person Making Change.

Do not extend notes this side of this line

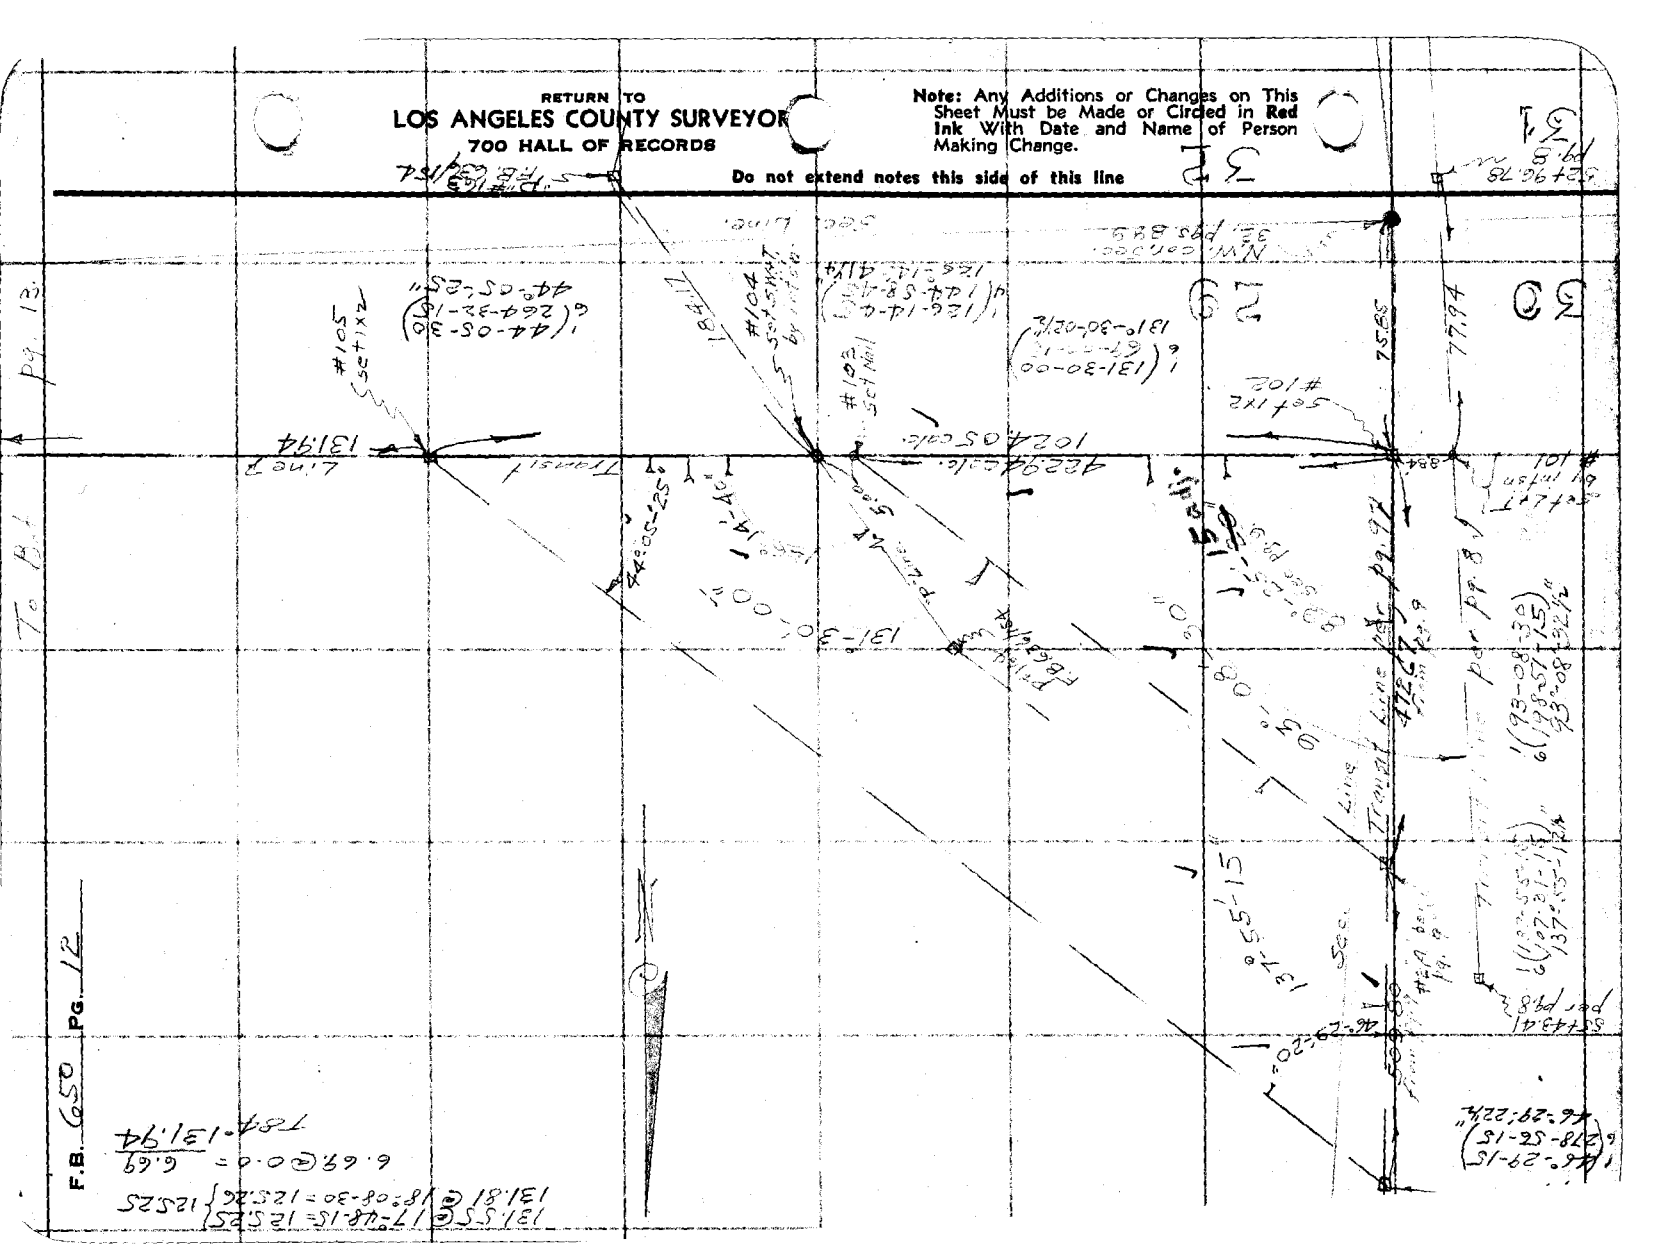
F.B. 650 PG. 12
To Bk
Pg. 13
Line
Transit
#101
#102
#104
#105
Set 1x12
Set Nail
Set 1x12
Set Nail
Set 1x12
Set Nail

Notes Ck'd by Drew	Survey of Mt. Wilson Toll Rd.
Map No. B-127	W. O. 8149 Tape No. 25 St'd 67°F.
Office Work	Surveyed by Evans
Checked Drew	Notes HE Date 7/1/36
Date 12-18-40	Indexed A. C. Johnson

F.B. 650 PG. 13

To Kot. pg. 14

#108-set 1X2 South of Power House

2369

1 (25-32-45) 6 (153-17-15) 25°-32'-52½"

1 (56-08-18) 6 (336-49-00) 56°-08'-10"

1 (98-17-45) 6 (261-47-15) 98°-17'-52½"

1 (80-07-45) 6 (120-47-00) 80°-07'-50"

1294.48 calc.

25°-32'-50"

1 (74°-19'-15) 6 (85-56-15) 74°-19'-22½"

1 (25-34-00) 6 (153-24-00) 25°-34'-00

Winter Str.

△"E" Set L.T. in rock

1294.48

304.65 @ 8°-07-30 = 301.59
304.56 @ 8°-00 = 301.60
301.59 + 78°-21 = 304.58

56°-08'-10"

80°-07'-50"

74°-19'-20"

25°-34'-00"

98°-17'-50"

580.21 calc.

#107-set 5x14 T

Ridge-Divide Str. Bow

#106 set 1X2

Int. Eaton & Winter Sts.

△"G"-Set 1X2 on ridge

1319.94

from top pg. 12

RETURN TO
LOS ANGELES COUNTY SURVEYOR
700 HALL OF RECORDS

Note: Any Additions or Changes on This Sheet Must be Made or Circled in Red Ink With Date and Name of Person Making Change.

Do not extend notes this side of this line

FORM 247 10M 11-38

RETURN TO
LOS ANGELES COUNTY SURVEYOR
700 HALL OF RECORDS

Note: Any Additions or Changes on This Sheet Must be Made or Circled in **Red Ink** With Date and Name of Person Making Change.

Do not extend notes this side of this line

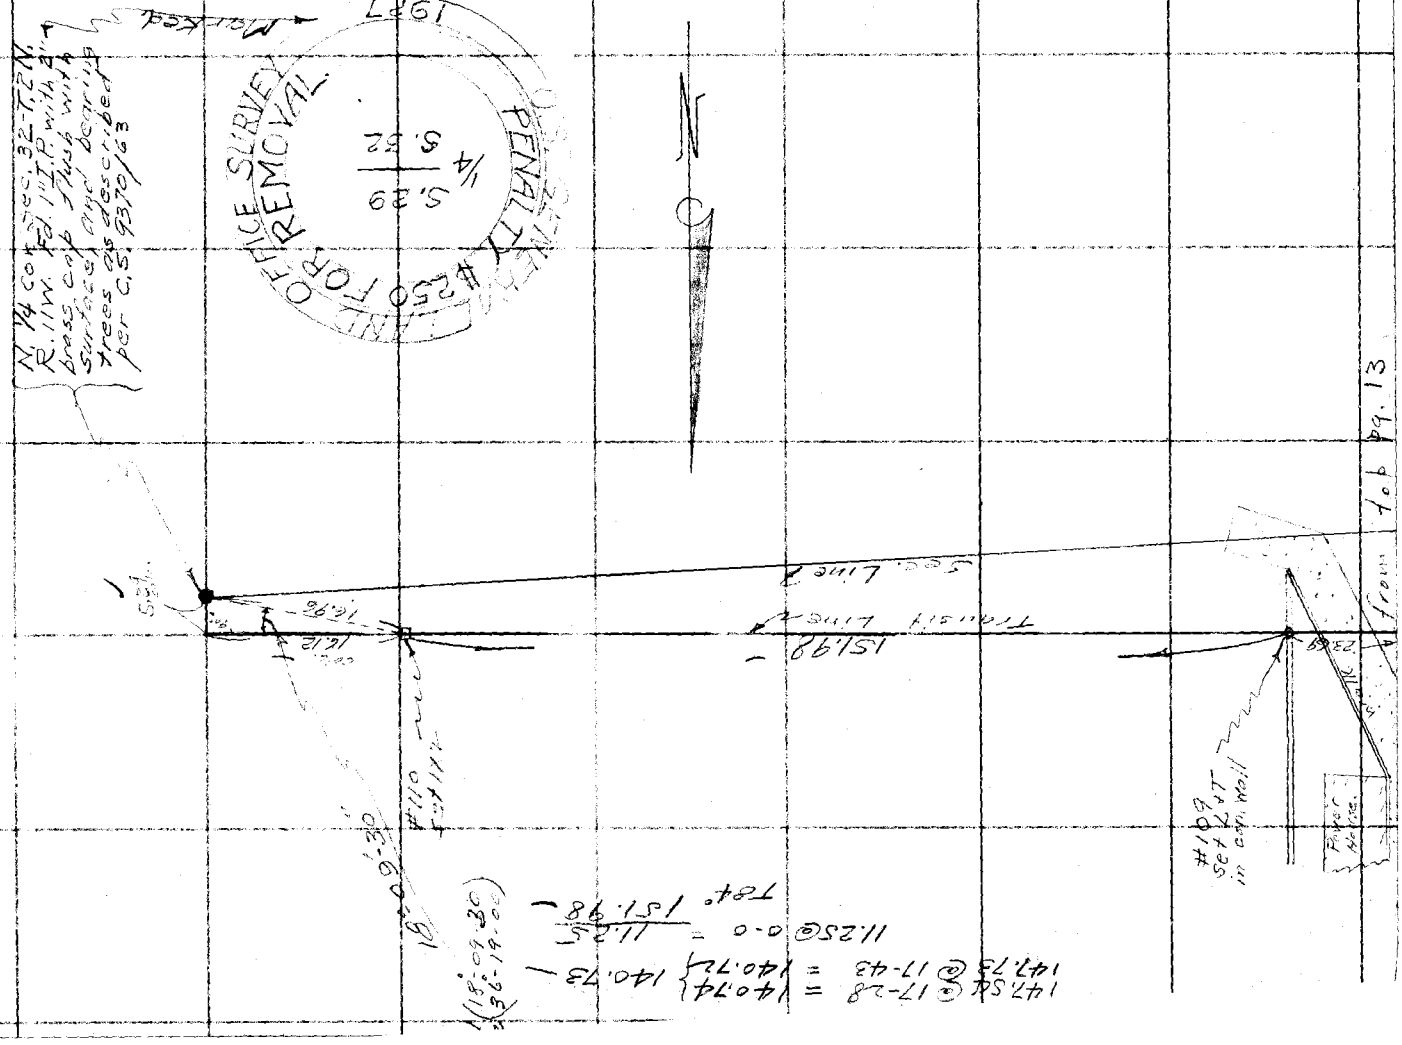

Notes Ck'd by Dr cmw	Survey of Mt Wilson Toll Rd
Map No. B-1217	W. O. 8149 Tape No. 1 St'd 64° F.
Office Work	Surveyed by C.A. Benson
Checked Dr cmw	Notes B. Date 6-17-36
Date 12-15-40	Indexed A. C. Johnson

F.B. 259 PG. 15

Note: Any Additions or Changes on This Sheet Must be Made in Red Ink or Circled in Red With Date and Name of Person Making Change.

Do not extend notes this side of this line

MT. WILSON TOLL ROAD.

U.N. 31-40.

From :- Section 5-3-3 [illegible]

To Mt. Wilson Toll Rd.

RETURN TO
LOS ANGELES COUNTY SURVEYOR
700 HALL OF RECORDS

FORM 247 10M 11-35

F.B. 650 PG. 16

NOTE:- To Arrive at ¼ Sec. Cor. Follow Idle Hour Trail for 1± mi. to Dam. Follow Old Rd. to Bot. Eaton Cn. at Idle Hour Camp. Take Trail up this Canyon ½ mi. to Int. of Ephrata Canyon. Take Lt. (North) Branch which is see 20± in 20± ft Int. Continue Follow See. 20± To ¼ Sec. Cor. 100± Up Steep Hillside

Cont. on bot. pg. 17

Direct & Inverse

2447 Level - T = 59° = 24.47'
6200 @ 1°19' - T = 84° = 60.67'
53.32 @ 41°12' - T = 84° = 40.12'
139.33 @ 25°16' - T = 84° = 124.55'
249.21'

To T.L. #1 per pg. 17

249.21'

Line

To T.L. #1 Per pg. 14

¼ Sec. Cor. 6-31
Fd. 1" I.P. with brass cap stamped as shown 12" above ground on steep S 30° E slope. 100± N 80° W of Bot. Canyon
Fd. 16" oak bearing S 46° E 15 ft. marked "¼ 6 B.T." Fd. 16" oak bearing N 9° E. 20.2 ft. set mark "¼ S. 31 B.T." to fire tree
Per. C.S. 9370 ± 29.

GENERAL LAND OFFICE SURVEY

SEC. 6. T 11 N - R 11 W

SEC 31 T 2 N - R 11 W

CANYON

Cold

Section Corner
Fd. 2" I.P. with Brass Cap stamped as shown 15" above mound of Rock 4' Dia. Avg. 3 ft. on S.W. Slope. 240'± West of Top Divide
Per. C.S. 9370 - 29.

Evans Form B.T. 12 ft. ± for sums.

① 24° 09' 00"
② 36° 30' 45"
③ 144° 55' 30"
24° 09' 15"

① 37° 49' 15"
② 351° 17' 00"
③ 166° 56' 00"
87° 49' 20"

Line per Evans Survey F.B. 650-7

RETURN TO
LOS ANGELES COUNTY SURVEYOR
700 HALL OF RECORDS

Do not extend notes this side of this line

Note: Any Additions or Changes on This Sheet Must be Made or Circled in Red Ink With Date and Name of Person Making Change.

Notes Ck'd by	Survey of MT. WILSON TOLL RD.
Map No. B-121	W. O. 8142 Tape No. 1 St'd 64° F.
Office Work	Surveyed by C.A. BENSON
Checked Dr. CW	Notes (B) Date 6-18-36
Date 12-18-40	Indexed A. C. Johnson

F.B. 650 PG. 17

Note: Any Additions or Changes on This Sheet Must Be Made or Circled in Red Ink With Date and Name of Person Making Change.

Do not extend notes this side of this line

RETURN TO
LOS ANGELES COUNTY SURVEYOR
700 HALL OF RECORDS

To T.L. #9 per Pg. 18

Cont'd on Left Side Pg. 18

T.L. #6
Set 1X2 + TK.
31° 04' 30" calc.

T.L. #5
Set 1X2 + TK.

To T.L. 8

T.L. #4
Set 1X2 + TK.
on Spur Descends No. to W.

148° 55'

2233.N

① 148-55-30
② 235-42-00
③ 173-32-45
148° 55' 30"

To T.L. #1 per Pg. 19

CANYON

MT. WILSON WEST LINE

SEC. 31
T2N-R11W

T.L. #3
Set 1X2 + TK.
on spur Descends to S. 14
(Sec. ± from T.L. #2)

45° 26' 30" calc.

SEC. 6
T1N-R11W

T.L. #2
Set 1X2 + TK. on Spur
Descends S. 30° W.

135° 75' 45" 94° = 134.43

③ 134° 33' 45"
④ 175° 14' 45"
⑤ 37° 22' 30"
134° 33' 40"

T.L. #1
Set 1X2 + TK.
By dead end wiggle

Con't from top pg. 16

FORM 247 10M 11-35

RETURN TO
LOS ANGELES COUNTY SURVEYOR
700 HALL OF RECORDS

Note: Any Additions or Changes on This Sheet Must be Made or Circled in **Red Ink** With Date and Name of Person Making Change.

Do not extend notes this side of this line

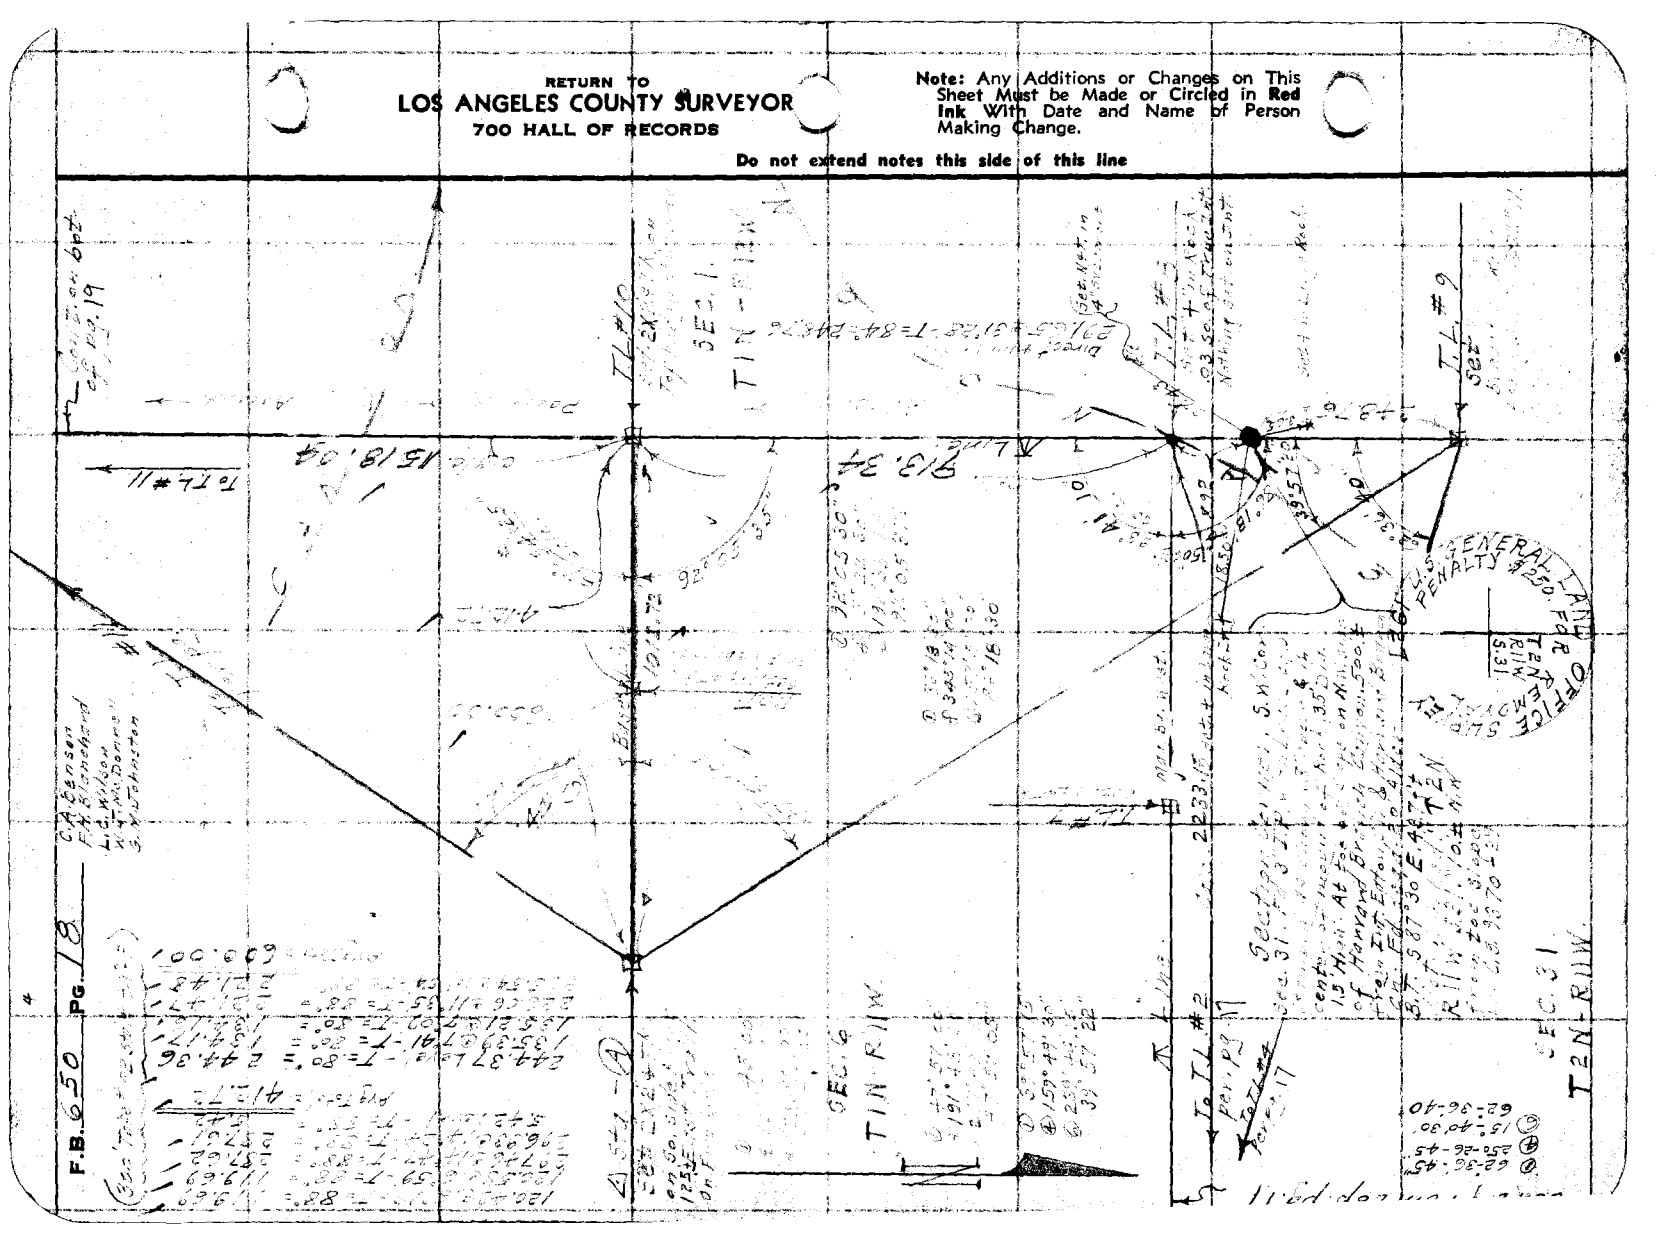

Notes Ck'd by	Survey of MT Wilson Toll Rd
Map No. B-1217	W. O. 8149 Tape No. St'd 84° F.
Office Work	Surveyed by L.A. Benson
Checked Drew	Notes C. Johnson Date 6-
Date 12-18-40	Indexed

F.B. 650 Pg. 19

Note: Any Additions or Changes on This Sheet Must be Made or Circled in Red Ink With Date and Name of Person Making Change.

Do not extend notes this side of this line

RETURN TO
LOS ANGELES COUNTY SURVEYOR
700 HALL OF RECORDS

FORM 247 10M 11-35

#(101)
Fd. 2X2+TK. 20' S. & 2' E.
Top Ridge per F.B. 137-84

#70
Fd. 1X2+TK. ... F.B. ... 132 per F.B. 137-84

#69
Fd. 1X2+TK. per F.B. 636-132

261.77 per F.B. 636-132

78.09 (cond. T; 90°-78.09)

D 108°51'00"
E 71°24'45"
108°51'15"

D 110°22'00"
E 69°37'50"
110°22'10"

D 13°57'00"
E 93°48'00"
323°41'30"
13°56'55"

L261

78.69

D 55°27'30"
E 231°50'30"
332°46'00"
55°27'40"

D 51°45'30"
E 260°01'45"
310°33'00"
51°45'30"

D 19°23'00"
E 77°37'45"
116°15'45"
19°23'10"

D 14°10'00"
E 55°39'45"
69°50'00"
14°10'00"

108°51'00"
113°53'30"
117.36
832.77
340.59
1301.80

Fd. 1 I.P. 6 B. ... 2" up ... Fd. 4X10"x30" Rock ...

SEC. 1
T1N-R12W.

SEC. 6
T1N-R11W.

T.L. #11 X Pt.
Set 2X2+TK. on Top Firebreak ... By Prod. Con. Line from ...

D 40°52'30"
E 163°30'45"
245°13'45"
40°52'40"

D 62°09'30"
E 248°38'30"
62°09'40"

D 34°21'00"
E 137°33'30"
206°45'00"
34°20'50"

D 176°19'45"
E 345°19'15"
337°59'15"
176°19'50"

To S.C.E. Co. Pole #... Pg. 16

To ... Pole #... Pg. 17

To ... Pg. 18

1318.04

Cont'd from ... Top, pg. 18

RETURN TO
LOS ANGELES COUNTY SURVEYOR
700 HALL OF RECORDS

Note: Any Additions or Changes on This Sheet Must be Made or Circled in **Red Ink** With Date and Name of Person Making Change.

Do not extend notes this side of this line

F.B. 650 Pg. 20

LOS ANGELES COUNTY SURVEYOR
700 HALL OF RECORDS

NOTE: ANY ADDITIONS OR CHANGES ON THIS SHEET MUST BE INITIALED AND NAME OF PERSON MAKING CHANGE

Point No.	Sta.	Bearing Distance	Bearing Angle	Bearing Direction	Azimuth Angle	Azimuth Direction	Coordinates N or S	+ Sign	Coordinates E or W	+ Sign	Difference Elevation	+ Sign	Height of Instrument	+ Sign	Vertical Distance	Remarks
P#25	P#24				00 00		16695	5					16747			FB 63 [illegible]
		412	7°		348 34		162 94				454				384	BM #2 [illegible]
		424	9°		754 19		419		6 25		381			+	471	P#26 [illegible]
		92	3°		154 19		91	+	4 22		40			+	70	P#25A
							16787	7					16830			Per above
P#25A	P#25				00 00											
		491	92	4°	0 0		91	—	5 55		135				95	P#25 check sht
		547	48	5°	166 25		47	+	6 48		85			+	56	S. edge [illegible]
		750	51	7°	150 05		50	+	7 31		826			+	66	N. " "
		1081	82	10°	270 20		68	—	23 45		429				302	SM
		554	55	5°	140 45		50	+	16 56		933					T.C.
		1009	103	17°	219 20		86	—	23 35		282					BD
		1018	69	11°	176 15		59	+	21 57		961					T.S.P.
		1419	120	10°	145 50		113	+	14 09		17016					" "
		825	106	8°	155 10		101	+	12 06		16966					T.C.
		1150	151	11°	202 55		145	—	10 52		442					S.H. [illegible]
		704	105	4°	159 35		104	+	5 03		882					N. edge Rd
		903	104	9°	168 25		102	+	8 30		895					S. " "
		1087	186	10°	212 50		176	—	14 [illegible]		283					S.H. [illegible]
		1585	207	8°	174 [illegible]		[illegible]	+	7 27		17017					S. edge Rd.
		1788	209	8°	178 [illegible]		206	+	6 [illegible]		16998					N.

Form 301

PLEASE RETURN TO
LOS ANGELES COUNTY SURVEYOR
700 HALL OF RECORDS

NOTE: ANY ADDITIONS OR CHANGES ON THIS SHEET MUST BE MADE OR CIRCLED IN RED INK. WITH DATE AND NAME OF PERSON MAKING CHANGE

Do not exte— notes this side of this line

Transit at	Sight on	Stadia Intercepts	Stadia Distance	Stadia Rod—	Horizontal Angle 0° to 360° Right	Horiz. Distance	+ Vertical Angle —	Elevation of Point	+ Back Sight	+ Difference — Elevation	Height of Instrument	+ Vertical Distance	REMARKS Station	Left	Right
					° '		° '		1						
25A	25				0 0				4 3		1683 0				
		9.80							2						
		8	181	9°	197 10	176	− 9 18	1645 2					S.H, Brk.		
		11.22							3						
		9	223	10°	201 15	215	− 10 52	31 8					S.H.		
		10.08							4						
		8	209	9°	164 05	197	+ 13 34	1721 8					T.C.		
		11.50							5						
		9	251	10°	193 00	248	− 6 11	1646 2					S.H.		
		9.30							6						
		7	231	8°	156 50	214	+ 15 21	1734 2					T.Sp.		
		10.61							7						
		7	362	9°	167 35	337	+ 15 00	1764 5					S.H.		
		9.37							8						
		6	338	8°	173 40	327	+ 10 19	1734 6					T.C.		
		5.34							1713.1 Adj.						
		2	335	4°	180 00	332	+ 5 55	~~1713 4~~	~~1713 4~~	+ 30 4		+ 34 4	P#26	FB.636/19	
								1713.1 Adj.	10						
								~~1713 4~~	~~1713 4~~		~~1718 2~~ 1713 8 Adj.				
P#26	P#25	8.23						1662.5 1662 8							
		4	424	6°	0 0	418	− 6 44	~~1662 8~~	4 8	55 4 ✓		49 4 ✓	per above.		
		5.21							12						
		5	22	5°	61 10	22	− 3 36	1711 6					N. edge Rd.		
		5.14							13	5 5		0 5	S " "		
		5	15	5°	23 55	15	− 2 05	1709 4							
		3.61							14						
		3	62	3°	187 05	62	+ 3 37	197					N. " "		
		4.61							15						
		4	62	4°	204 10	61	+ 5 54	201					S " "		
		4.93							16						
		4	94	4°	139 50	61	+ 35 23	583					S.H.		
		3.98							17						
		3	99	3°	189 20	98	+ 4 33	226					N. edge rd.		
		2.99							18						
		2	100	2°	195 10	99	+ 4 16	232					S, " "		
		11.72							19						
		10	173	11°	159 40	172	+ 36 01	892					S.H.		
		4.12							20						
		2	213	3°	191 30	211	+ 5 34	353					N. edge rd.		
		3.11							21						
		1	212	2°	194 30	210	+ 5 42	367					S. " "		

Topography Description Legend:
Side of Hill S.H. — Bottom Draw B.D.
Side of Draw S.D. — Bottom Wash B.W.
Side of Ridge S.R. — Top of Ridge T.R.
Head of Draw H.D. — Toe of Slope T.S.

Insert of Draw V.D's — Top of Bank T.B. — Bottom of Bank B.B. — Top of Cut T.C. — Bottom of Cut B.C. — Top of Fill T.F. — Bottom of Fill B.F.
Break in Slope B.S. — Steep Slope S.S. — Top of Cliff T.Cl. — Bottom of Cliff B.Cl. — Top of Spur T.Sp. — Bottom Canyon B.Cn.

Trees Dec.-D. Fir-Fi. — Conif.-Co. Pine-Pi. Cedar-Ce. — Sycamore Eucalyptus — Plus combinations of these and all common standard abbreviations.
Fences Ex. Fe. — Int. Fences V. Fe. — Ditch Dit. — Telephone Pole T.P. — Power Pole P.P. — Culvert Cul.
Roads Trails Tr. — Pvt. — Edge of Road E. Rd.
Stream Str. — Flat Fl. — Pavement Pvt.

F.B. 636 pg 24

Additional Information

Form 391 1000 3-36

PLEASE RETURN TO
LOS ANGELES COUNTY SURVEYOR
700 HALL OF RECORDS

NOTE: ANY ADDITIONS OR CHANGES ON THIS SHEET MUST BE MADE OR CIRCLED IN RED INK, WITH DATE AND NAME OF PERSON MAKING CHANGE

Do not extend notes this side of this line

Transit at	Sight on	Stadia Intercepts	Stadia Distance	Stadia Rod	Horizontal Angle 0° to 360° Right	Horiz. Distance	+ / −	Vertical Angle	Elevation of Point	Back Sight	+ / −	Difference Elevation	Height of Instrument	+ / −	Vertical Distance	REMARKS Station	Left	Right
26	25				0 0					1			17179			per pg 24		
		9.64								2								
		7	265	8°	196 00	261	+	7 03	17422	3						S. edge Rd.		
		9.70																
		7	271	8°	194 15	267	+	7 04	432							N " "		
		6.58							17486	Adj.								
		4	259	5°	225 00	254	+	8 01	17482		+	308		+	358	P#27-F.B. 636/119		
									17486	Adj.								
													17532					
		4.57							17313	Adj.								
P#27	P#26	2	258	3°	0 0	252	−	8 27	17314	51		405			375			
		10.71								7								
		8	272	9°	54 55	241	+	19 29	18302	8						S.H.		
		5.90																
		4	191	5°	93 05	188	+	6 29	17702	9						B.D.		
		5.97																
		3	298	4°	71 30	289	+	21 00	18492	10						S.H.		
		4.10																
		2	211	3°	85 05	204	+	10 39	17889	11						"		
		4.87																
		2	283	4°	86 05	256	+	17 54	18327							"		
		4.58								12								
		3	159	4°	75 40	157	+	5 55	17660							T.C.		
		3.82								13								
		2	183	3°	69 00	177	+	10 37	17839							T.C.		
		4.55								14								
		3	256	3°	94 15	244	+	12 10	18034							B.D.		
		4.61								15								
		3	162	4°	58 20	160	+	5 58	17663							T.C.		
		4.35								16								
		2	236	3°	100 25	219	+	15 31	18116							S.H.		
		3.95								17								
		2	196	3°	45 25	189	+	10 39	17862							T.C.		
		11.55								18								
		9	256	12°	108 20	220	+	21 43	18298							S.H.		
		3.71								19								
		2	172	3°	31 45	172	+	0 39	17526							T.C.		
		10.98								20								
		9	187	10°	115 20	157	+	26 26	18422							S.H.		
		8.64								21								
		7	165	8°	121 55											T.S.P.		

Right of Inform.

Date AUG 27 1936 Checked
Survey by E. Lewis Notes
Map No. 3-29 H-A Traced
Date Checked

LEVELS Page 25

Form 301 10M 8-34

PLEASE RETURN TO
LOS ANGELES COUNTY SURVEYOR
700 HALL OF RECORDS

NOTE: ANY ADDITIONS OR CHANGES ON THIS SHEET MUST BE MADE OR CIRCLED IN RED INK, WITH DATE AND NAME OF PERSON MAKING CHANGE

Do not extend notes this side of this line

F.B. 650 Pg. 28

Topography Description Legend:
Slide Hill ..... S.H. | Bottom Drew B.D. | Bottom Wash B.W.
Side of Drew S.D. | Bottom of Ridge B.R. | Top of Ridge T.R.
Side of Ridge S.R. | Top of Slope ..T.S.
Head of Draw H.D. | Toe of Slope ..T.S.

Inters. of Draws, V.D's | Side of Canyon S.Cn.
Break in Slope ..Bk.S. | Top of Bank ..T.B.
Steep Slope ..... S.S. | Bottom of Bank B.B.
Top of Cliff ..... T.Cl. | Top of Cut ..... T.C.
Bottom of Cliff ..B.Cl. | Bottom of Cut ..B.C.
Top of Spur ..... T.Sp. | Top of Fill ..... T.F.
Bottom Canyon..B.Cn. | Bottom of Fill B.F.

Saddle ..... Sa. | Traveled Rd. Tr.Rd.
Swale ..... Sw. | Fence ..... Fe.
Flat ..... Fl. | Int. Fences ..V.Fns.
Stream ..... Str. | Ditch ..... Di.
Trail ..... Tr. | Telephone Pole ..T.P.
Pavement ..... Pvt. | Power Pole ..P.P.
Edge of Road E.Rd. | Culvert ..... Cul.

Oak ..... O. | Fir-Fr.
Pine-Pi. | Cedar-Ce.
Sycamore ..... Sy.
Eucalyptus ..... Eu.
Plus combinations of these and all common standard abbreviations.

Transit at	Sight on	Stadia Intercepts	Stadia Distance	Stadia Rod—	Horizontal Angle 0° to 360° Right	Horiz. Distance	+ Vertical — Angle	Elevation of Point	+ Back Sight	+ Difference — Elevation	Height of Instrument	+ Vertical — Distance	REMARKS Station	Left	Right
27	26			—	0 0		—	—			1753		See pg. 27		
		2.42													
		2	43	2	120 10	38	+ 19 50	1765					T.Sp. - T.C.		
		5.02													
		3	203	4	15 00	202	- 3 57	358					T.C.		
		11.90													
		11	91	11	106 15	81	+ 19 02	707					T.C.		
		10.24													
		9	125	10	102 25	118	+ 13 50	727					"		
		4.28													
		3	129	4	96 30	129	+ 1 50	538					"		
		4.30													
		3	131	4	92 05	131	+ 1 11	524					"		
		8.12													
		7	113	8	94 0	113	- 0 58	439					B.C.		
		8.03													
		7	104	8	87 30	104	- 0 37	446					T.F.		
		3.60													
		3	61	3	98 40	61	- 4 18	462					B.C.		
		3.62													
		3	63	3	89 05	63	- 4 24	460					T.F.		
		3.31													
		3	32	3	108 40	32	- 4 35	483					B.C.		
		4.22													
		4	23	4	62 40	23	- 2 18	488					T.F.		
		5.19													
		5	20	5	333 55	20	- 2 43	478					"		
		4.80													
		4	81	4	301 50	75	+ 15 24	703					T.Sp. & T.C.		
		9.73													
		9	24	9	294 50	23	+ 8 58	484					B.C.		
		11.76													
		11	77	11	287 05	75	+ 8 46	542					T.F.	Trail	
		5.20													
		5	21	5	262 50	21	+ 0 30	488					"	"	
		3.20													
		3	21	3	187 50	21	+ 0 43	508					"	Rd.	
		5.30													
		5	31	5	134 0	31	+ 1 44	492					B.C.		
		4.83													
		4	84	4	153 25	84	+ 403	556					"		

Add'nl Inform.

Form 361 10M 3-34

PLEASE RETURN TO
LOS ANGELES COUNTY SURVEYOR
700 HALL OF RECORDS

NOTE: ANY ADDITIONS OR CHANGES ON THIS SHEET MUST BE MADE OR CIRCLED IN RED INK, WITH DATE AND NAME OF PERSON MAKING CHANGE

Do not extend notes this side of this line

Transit at	Sight on	Stadia Intercepts	Stadia Distance	Stadia Rod—	Horizontal Angle 0° to 360° Right	Horiz. Distance	+ / −	Vertical Angle	Elevation of Point	+ Back Sight	+ / −	Difference Elevation	Height of Instrument	+ / −	Vertical Distance	REMARKS Station	Left	Right
27	26				0 0								17537			see pg. 27		
		582 / 5	83	5	162 45	82	+	5 14	17562							T.F.		
		634 / 5	135	6	172 30	133	+	6 52	637							"		
		529 / 4	130	5	163 40	129	+	5 34	612							B.C.		
		442 / 3	143	4	159 50	137	+	11 15	771							T.C.		
		603 / 2	204	5	138 45	174	+	22 20	18207							S.H.		
		405 / 3	106	4	147 45	99	+	14 25	17752							T.C.		
		895 / 8	96	8	137 15	82	+	21 30	784							"		
		831 / 3	332	5	165 23	329	+	5 46	17819		+	282		+	332	P #28-FB. 636/19		
		687 / 4	288	5	165 23	285	+	6 00	~~13283~~ 17786	Adj.	+	249		+	299	P #27 "B" - set IXI		
		523 / 2	124	5	84 54	124	−	2 38	17430			107			57	P #27 "C" - set nail		
									17430				17482					
P #27C	P #27	473 / 3	124	4	0 0	124	+	2 00	~~1748.6~~ 17485	Adj.	+	03		+	43	per above		
		827 / 8	28	8	45 05	21	−	28 30	282							B.D.		
		652 / 9	53	9	15 50	52	−	8 50	311							S.H.		
		1193 / 11	94	11	49 0	74	−	26 37	16994							B.D.		
		787 / 7	88	7	42 20	75	−	21 50	17106							S.H.		
									17787				17835					
P #27B	P #27	587 / 5	288	5	0 0	285	−	5 59	17486	Adj.	+	349			299	per above.		

Add'l Inform.

Notes Checked _____ Date _____ Checked _____ Date _____

Survey by _____ Date _____
Map No. 2-79-1A Inked by _____ Notes _____ Date _____

Form 301 10M 3-34

PLEASE RETURN TO
LOS ANGELES COUNTY SURVEYOR
700 HALL OF RECORDS

NOTE: ANY ADDITIONS OR CHANGES ON THIS SHEET MUST BE MADE OR CIRCLED IN RED INK. WITH DATE AND NAME OF PERSON MAKING CHANGE

Do not extend notes this side of this line

Fir-Fr. Cedar-Ce. Sy. Eu. Plus combinations of these and all common standard abbreviations.

Oak-O. Pine-Pi. Sycamore Eucalyptus

Trussed Rd. Tr.Rd. Fence F.Fe. Inst. Fences V.Fe. Ditch Ft. Telephone Pole T.P. Power Pole P.P. Culvert Cul.

Saddle Sa. Swale Sw. Flat Fl. Stream Str. Trail Tr. Pavement Pvt. Edge of Road E.Rd.

Canyon S.Cn. Bank T.B. Bottom of Bank B.B. Top of Cut T.C. Bottom of Cut B.C. Top of Fill T.F. Bottom of Fill B.F.

Side of Draw S.D. Top of Cliff T.Cl. Bottom of Cliff B.Cl. Top of Spur T.Sp. Bottom Canyon B.Cn.

Inters. of Draws V.D's Break in Slope Bk.S. Steep Slope S.S.

Topography & Description Legend:
Hill S.H. Bottom Draw B.D.
Side of Draw S.D. Bottom Wash B.W.
Side of Ridge S.R. Top of Ridge T.R.
Head of Draw H.D. Toe of Slope T.S.

PG. 30

Transit at	Sight on	Stadia Intercepts	Stadia Distance	Stadia Rod	Horizontal Angle 0° to 360° Right	Horiz. Distance	+ Vertical Angle —	Elevation of Point	+ Back Sight	+ Difference — Elevation	Height of Instrument	+ Vertical Distance —	REMARKS Station	Left	Right
27B	27			—	0 00 00		—	—	1	—	17835	—	per pg 29		
		6.32							2						
		5	133	6	2 20	132	— 5 43	17644					B.C.		
		5.27							3						
		4	128	5	355 50	127	— 5 20	662					T.F.		
		11.68							4						
		11	69	11	339 20	49	— 32 13	414					B.D.		
		5.67							5						
		5	68	5	23 20	67	— 5 33	719					B.C.		
		5.59							6						
		5	60	5	15 15	59	— 5 36	727					T.F.		
		4.50							7						
		4	51	4	43 25	50	— 6 02	742					B.C.		
		4.42							8						
		4	43	5	30 10	43	— 5 30	745					T.F.		
		5.21							9						
		5	22	5	79 25	22	— 4 16	768					B.C.		
		5.14							10						
		5	15	5	33 15	15	— 5 48	770					T.F.		
		8.92							11						
		8	93	8	329 05	70	— 29 10	358					S.H.		
		5.18							12						
		5	19	5	133 05	19	— 0 06	785					B.C.		
		2.12							13						
		2	13	2	226 10	13	— 2 34	809					T.F.		
		4.33							14						
		4	34	4	148 05	34	+ 1 24	802					B.C.		
		9.41							15						
		9	42	9	186 50	40	+ 11 07	823					T.F.		
		10.12							16						
		9	113	14	282 20	92	— 24 58	262					S.H.		
		5.50							17						
		4	151	5	280 50	133	— 20 05	299					T.Sp.		
		3.34							18						
		3	35	3	123 50	27	+ 26 32	944					T.C.		
		11.22							19						
		10	123	11	268 10	104	— 22 48	286					T.Sp.		
		2.52							20						
		2	53	2	53 30	53	+ 3 42	848					T.C.		
		16.62							21						
		7	163	8	81 45	118	+ 31 11	18482					S.H.		

Add'n'l Interm.

Form 391 10M 3-34

PLEASE RETURN TO
LOS ANGELES COUNTY SURVEYOR
700 HALL OF RECORDS

NOTE: ANY ADDITIONS OR CHANGES ON THIS SHEET MUST BE MADE OR CIRCLED IN RED INK, WITH DATE AND NAME OF PERSON MAKING CHANGE

Do not extend notes this side of this line

Notes ALBERT E. TIMMONS Plotted ALBERT E. TIMMONS Job No. 8448 Division No. F.B. 6552 Page 36
Date AUG 27 1936 Ded AUG 28 1936 Survey of MISC. Tel. Rd.
Notes Chkd. Checked Survey by Evans Notes LF Date 8/17/36
Date Date Map No. 3-29-1A Inked C. Johnson

Transit at	Sight on	Stadia Intercepts	Stadia Distance	Stadia Rod—	Horizontal Angle 0° to 360° Right	Horiz. Distance	+ −	Vertical Angle	Elevation of Point	+ Back Sight	+ −	Difference Elevation	Height of Instrument	+ −	Vertical Distance	REMARKS Station	Left	Right
					° '			° '										
27B	27				0 0		−			1			17835					
		10.0								2								
		8.0	201	9°	71 30	149	+	29 58	18616							B.D.		
		4.0								3								
		3.82	101	3°	14 40	101	+	2 44	17852							T.C.		
		5								4								
		5	83	5°	24 30	81	+	7 32	17893							"		
		11.30								5								
		10	131	11°	59 55	99	+	29 04	18282							B.D.		
		2.80								6								
		2	91	2°	54 20	77	+	22 05	132							S.H.		
		11.57								7								
		10	158	13°	100 05	111	+	32 34	424							S.H.		
		5								8								
							−		17819				17869					
	P#28	8.31							17848	Adj 5.0								
P#28	P#27	5	332	6°	0 0	329	−	5 37	17848	5		384			324	pg. 29		
		5.64								10								
		4	165	5°	87 40	127	+	28 02	18507							T.Sp.		
		3.76								11								
		3	77	3°	63 50	69	+	28 01	18160							"		
		3.44								12								
		3	45	3°	56 55	37	+	24 03	18008							T.C.		
		5.88								13								
		4	189	5°	96 55	154	+	25 20	553							S.H.		
		6.22								14								
		4	223	5°	102 20	186	+	23 52	647							"		
		2.23								15								
		2	24	1°	47 45	24	+	0 38	17802							B.C.		
		5.09								16								
		5	10	5°	132 30	10	+	5 35	829							TF		
		5.51								17								
		5	52	5°	95 25	51	+	5 24	867							B.C.		
		4.49								18								
		4	50	4°	105 50	50	+	4 44	870							T.F.		
		4.98								19								
		4	99	5°	112 45	98	+	6 13	926							B.C.		
		3.95								20								
		3	96	3°	118 05	95	+	5 52	932							T.F.		
		6.36								21								
		5	137	6°	120 25	135	+	6 15	958							B.C.		

Adopted Uniform.

Form 301 10M 3-34

PLEASE RETURN TO
LOS ANGELES COUNTY SURVEYOR
700 HALL OF RECORDS

NOTE: ANY ADDITIONS OR CHANGES ON THIS SHEET MUST BE MADE OR CIRCLED IN RED INK, WITH DATE AND NAME OF PERSON MAKING CHANGE

Do not extend notes this side of this line

Transit at	Sight on	Stadia Intercepts	Stadia Distance	Stadia Rod—	Horizontal Angle 0° to 360° Right	Horiz. Distance	+ / − Vertical Angle	Elevation of Point	Back Sight	+ / − Difference Elevation	Height of Instrument	+ / − Vertical Distance	REMARKS Station	Left	Right
28	27				0 0						17869				
		5.32													
		4	133	5	126 45	131	+ 6 19	17966					T.F.		
		11.75													
		9	276	10	103 20	232	+ 23 28	18779					S.H.		
		4.39													
		3	140	4	118 45	137	+ 8 40	18038					T.C.		
		1.97													
		1	98	0	110 10	95	+ 9 43	033					"		
		0.58													
		0	59	0	91 20	58	+ 8 22	955					"		
		11.38													
		7	439	9	342 47	437	− 3 42	17496		373		283	B.M. #03-LB488 5 El. = 1749.65		
		5.47													
		4	148	5	127 15	146	+ 6 08	17976		+ 107		+ 152	P#29		
								17997.6	Adj.		18025	Adj.			
								17972			18026				
P#29	P#28	5.48													
		4	149	5	0 0	147	− 6 04	17819	49	207		157			
		5.57				58		18013							
		5	58	5	150 20	147	+ 4 22	18133		06		+ 44	B.C.		
		4.59													
		4	60	4	161 35	60	+ 2 42	014					T.F.		
		5.07													
		4	108	5	155 30	107	+ 5 04	072					B.C.		
		6.06													
		5	107	6	162 00	106	+ 5 52	075					T.F.		
		8.46													
		7	147	8	162 00	145	+ 6 32	11 2					B.C.		
		8.43													
		7	144	8	167 0	142	+ 6 55	118					T.F.		
		9.64													
		8	165	9	165 55	162	+ 7 01	136					B.C.		
		8.51													
		7	152	8	169 45	150	+ 6 56	128					T.F.		
		9.65													
		8	166	9	175 15	163	+ 7 00	132					B.C.		
		8.49													
		7	150	8	175 40	148	+ 7 14	133					T.F.		
		9.62													
		8	163	9	200 15	160	+ 7 25	146					B.C.		

Add'n'l Inform.

Topography Description Legend:
Road ... R.D. Bottom of Draw ... B.D.
Side Hill ... S.H. Bottom Wash ... B.W.
Side of Draw ... S.D. Top of Ridge ... T.R.
Side of Ridge ... S.R. Toe of Slope ... T.S.

Intersect. of Drawn, V.D.'s
Break in Slope ... Bk.S.
Steep Slope ... S.S.
Top of Cliff ... T.Cl.
Bottom of Cliff ... B.Cl.
Top of Spur ... T.Sp.
Bottom Canyon ... B.Cn.

Saddle ... Sa.
Swale ... Sw.
Flat ... Fl.
Stream ... St.
Trail ... Tr.
Pavement ... Pvt.
Edge of Road ... E.Rd.

Canyon S.Cn.
Bank ... T.B.
Bottom of Bank ... B.B.
Top of Cut ... T.C.
Bottom of Cut ... B.C.
Top of Fill ... T.F.
Bottom of Fill ... B.F.

Side of
Top of
Bottom of
Top of
Bottom of
Top of
Bottom of

Traveled Rd. ... Tr. Rd.
Fence ... Fe.
Int. Fence ... V. Fnc.
Ditch ... Di.
Telephone Pole ... T.P.
Power Pole ... P.P.
Culvert ... Cul.

Oak ... O.
Pine ... Pi.
Cedar ... Ce.
Fir ... Fir
Sycamore ... Sy.
Eucalyptus ... Eu.
Plus combinations of these and all common standard abbreviations.

Form 301 10M 3-34

PLEASE RETURN TO
LOS ANGELES COUNTY SURVEYOR
700 HALL OF RECORDS

NOTE: ANY ADDITIONS OR CHANGES ON THIS SHEET MUST BE MADE OR CIRCLED IN RED INK, WITH DATE AND NAME OF PERSON MAKING CHANGE

Do not extend notes this side of this line

Transit at	Sight on	Stadia Intercepts	Stadia Distance	Stadia Rdg.	Horizontal Angle 0° to 360° Right	Horiz. Distance	+ −	Vertical Angle	Elevation of Point	+ Back Sight	+ −	Difference Elevation	Height of Instrument	+ −	Vertical Distance	REMARKS Station	Left	Right
29	28				0 0								18025					
		8.57								2								
		7	155	8°	201 50	152	+	7 36	18150							T.F.		
		8.90								3								
		7	191	8°	210 25	188	+	6 36	164							B.C.		
		8.82								4								
		7	183	8°	213 30	180	+	6 47	162							T.F.		
		11.14								5								
		10	115	11°	143 00	79	+	33 20	445							T.C.		
		8.42								6								
		6	243	7°	198 35	215	+	19 35	726							T.Sp.		
		4.22								7								
		2	223	3°	191 55	194	+	20 52	739							S.H.		
		5.16								8								
		3	217	4°	185 05	196	+	17 56	622							B.D.		
		4.05								9								
		2	206	3°	178 30	185	+	18 14	609							S.H.		
		4.18								10								
		2	219	3°	169 25	195 24	+	19 20	682	X	+	654		+	684	S.H.		
		3.86								11								
		2	187	3°	178 45	170	+	17 09	523	X	+	496		+	526	T.C.		
		2.78								12								
		1	179	2°	185 30	173	+	10 41	332							T.C. & B.D.		
		4.90								13								
		3	191	4°	188 10	179	+	14 32	450							T.C.		
		4.02								14								
		2	203	3°	206 25	192	+	13 08	442							T.C.		
		3.72								15								
		2	173	3°	165 20	170	+	7 50	230							T.C. & B.D.		
		5.09								16								
		3	210	4°	163 35	196	+	14 59	512							B.D.		
		3.87								17								
		2	188	3°	214 35	186	+	5 13	181 65		+	140		+	170	P#29A Set N.+T. (#30 is gone)		
									181 65				182 14					
P#29A	P#29	3.89			0 0				179 36									
		2	190	3°		188	−	6 22	179 14	49		239			209	P#29 P.I. 32		
		5.18								20								
		3	219	4°	40 25	211	+	10 43	185 74							B.D.		
		2.32								21								
		2	88	2°	151 10	88	−	2 00	183							B.C.		

Add'n'l Interm.

Notes Robert E. Timmons Platting Division No. 1 Book AUG 27 1936 Date AUG 28 1936 Survey of Hill Wilson Tr. No. 7811 Rec. Surveyed by E. Lewis Notes by C. Jones Date 8/17/36 Map No. 3-79:1-A Indexed C. Jones Checked Date

Form 301 (rev. 3-34)

PLEASE RETURN TO
LOS ANGELES COUNTY SURVEYOR
700 HALL OF RECORDS

NOTE: ANY ADDITIONS OR CHANGES ON THIS SHEET MUST BE MADE OR CIRCLED IN RED INK. WITH DATE AND NAME OF PERSON MAKING CHANGE

Do not extend notes this side of this line

F.B. 650 PG. 34

Topography Description Legend:
Hill ..... S.H. | Bottom of Draw S.D. | Bottom Wash B.W. | Side of Ridge S.R. | Top of Ridge T.R. | Toe of Slope T.S. | Head of Draw H.D.

Inters. of Draws V.D's | Break in Slope Bk.S. | Steep Slope ..... S.S. | Top of Cliff ..... T.Cl. | Bottom of Cliff B.Cl. | Top of Spur ..... T.Sp. | Bottom Canyon B.Cn.

Side of Canyon S.Cn. | Top of Bank ..... T.B. | Bottom of Bank B.B. | Top of Cut ..... T.C. | Bottom of Cut B.C. | Top of Fill ..... T.F. | Bottom of Fill B.F.

Saddle ..... Sa. | Swale ..... Sw. | Flat ..... Fl. | Stream ..... Str. | Trail ..... Tr. | Pavement ..... Pvt. | Edge of Road E.Rd.

Traveled Rd. Tr.Rd. | Fence ..... Fn. | Lt. Fences V.Fn. | Ditch ..... Di. | Telephone Pole T.P. | Power Pole ..... P.P. | Culvert ..... Cul.

Oak-O. | Pine-Pi. | Cedar-Cr. | Sycamore ..... Sy. | Eucalyptus ..... Eu.

Use combinations of these and all common standard abbreviations.

Transit at	Sight on	Stadia Intercepts	Stadia Distance	Stadia Rod—	Horizontal Angle 0° to 360° Right	Horiz. Distance	+ Vertical Angle —	Elevation of Point	+ Back Sight	+ Difference — Elevation	Height of Instrument	+ Vertical Distance	REMARKS Station	Left	Right
289	29				° '		° '		1		182 14				
		2.34							2						
		2	35	2°	172 10	35	− 1 13	18186					T.F.		
		4.98							3						
		4	99	5°	151 45	98	+ 5 04	252					B.C.		
		4.98							4						
		4	99	4°	159 0	98	+ 4 47	252					T.F.		
		10.85							5						
		9	186	10°	38 50	184	+ 6 25	321					B.D.		
		4.82							6						
		3	183	4°	155 20	181	+ 5 21	344					B.C.		
		4.83							7						
		3	184	4°	159 50	182	+ 5 23	347					T.F.		
		6.31							8						
		4	232	5°	154 40	230	+ 5 30	386					B.C.		
		6.37							9						
		4	233	5°	157 20	231	+ 5 29	386					T.F.		
		5.87							10						
		3	288	5°	156 45	285	+ 5 32	442					B.C.		
		5.86							11						
		3	287	5°	159 30	284	+ 5 37	444					T.F.		
		5.65							12						
		2	366	4°	157 10	362	+ 5 58	553					B.C.		
		4.65							13						
		1	366	3°	159 55	362	+ 6 02	568					T.F.		
		8.30							14						
		6	231	7°	51 30	205	+ 19 32	872					T Sp.		
		3.92							15						
		2	193	3°	148 25	177	+ 16 18	705					S.H.		
		9.08							16						
		7	209	8°	49 10	190	+ 17 16	728					T. Sp.		
		9.14							17						
		8	115	9°	147 0	106	+ 15 52	427					T.C.		
		4.75							18						
		3	176	4°	59 25	173	+ 6 57	387					V of D's.		
		4.05							19						
		1	306	2°	62 30	267	+ 20 48	1921 2					H.D.		
		11.18							20						
		10	119	10°	124 15	70	+ 39 03	1869 2					S.H.		
		7.25							21						
		7	96	7°	138 10	66	+ 33 19	587					T.C.		

Add'n'l Inform.

Form 301 10M 3-34

PLEASE RETURN TO
LOS ANGELES COUNTY SURVEYOR
700 HALL OF RECORDS

NOTE: ANY ADDITIONS OR CHANGES ON THIS SHEET MUST BE MADE OR CIRCLED IN RED INK, WITH DATE AND NAME OF PERSON MAKING CHANGE

Do not extend notes this side of this line

Transit at	Sight on	Stadia Intercepts	Stadia Distance	Stadia Rod—	Horizontal Angle 0° to 360° Right	Horiz. Distance	+ −	Vertical Angle	Elevation of Point	+ Back Sight	+ −	Difference Elevation	Height of Instrument	+	Vertical Distance	REMARKS Station	Left	Right
294	29				0 0								1821 4			P9.33		
		5.87								1								
		2	388	4 0	159 47	383	+	6 13	1859 2	2	+	37 8		+	41 8	P#31 F.B. 636/20		
										3								
									18592	4			1864 0					
P# 31	P# 29A	10.85																
		7	386	9 0	0 0	382	−	5 45	1816 5	48		47 5			38 5	per above		
		10.44								5								
		10.	45	10	357 0	42	−	15 25	435							B.D.		
		9.47								6								
		8	148	5 0	11 35	148	−	2 48	518							T.C.		
		2.94								7								
		2	95	2 0	13 20	95	−	2 43	576							"		
		9.75								8								
		9	76	9 0	286 15	61	−	26 20	247							T.Sp.		
		11.75								9								
		11.	76	21 0	324 0	59	−	27 22	120							B.D.		
		7.57								10								
		7	58	7 0	235 45	38	−	34 42	292							S.H.		
		6.11								11								
		6	12	6 0	292 55	12	−	6 38	567							T.Sp.		
		2.50								12								
		2	51	2 0	20 45	49	−	11 41	519							T.C.		
		1.28								13								
		1	29	1 0	59 30	29	+	6 15	662							T.C.		
		1.23								14								
		1	24	1 0	71 45	23	−	8 58	593							B.C.		
		3.10								15								
		3	11	3 0	139 25	11	−	4 25	602							T.F.		
		4.06								16								
		3	10.7	4 0	60 20	90	+	22 48	983							T.C.		
		1.34								17								
		1	35	1 0	77 10	35	−	0 18	628							Wedge Rd		
		2.39								18								
		2	40	2 0	116 30	40	+	3 35	644							E. " "		
		7.40								19								
		6	14.1	7 0	45 00	110	+	27 35	1915 2							T.C. & T.Sp.		
		10.88								20								
		9	189	10 0	63 25	149	+	27 17	31 1							S.H.		
		1.46								21								
		1	47	2 0	66 45	47	+	4 44	1865 8							S. edge Rd.		

Addn'l Inform.

Notes ALBERT E. TIMMONS Platted ALBERT E. TIMMONS No. 21742 Division No. ____
Date AUG 27 1936 Date AUG 28 1936 Survey of Wilson Trail Rd
Notes Checked Survey by [illegible] Notes LE
Date Date Map No. 5-794-A Indexed A. C. Johnson Date 8/27/36

Form 301 10M 3-34

PLEASE RETURN TO
LOS ANGELES COUNTY SURVEYOR
700 HALL OF RECORDS

NOTE: ANY ADDITIONS OR CHANGES ON THIS SHEET MUST BE MADE OR CIRCLED IN RED INK, WITH DATE AND NAME OF PERSON MAKING CHANGE

Do not extend notes this side of this line

Transit at	Sight on	Stadia Intercepts	Stadia Distance	Stadia Rod—	Horizontal Angle 0° to 360° Right	Horiz. Distance	+ Vertical Angle —	Elevation of Point	+ Back Sight	+ Difference Elevation —	Height of Instrument	+ Vertical Distance —	REMARKS Station	Left	Right
					° '		° '								
31	29A			—	0 0		—	—	1	—	1864	—	per pg. 35		
		1.62							2						
		1.26	63	1	83 10	62	+ 5 03	18685					N. edge Rd.		
		7	227	8	56 35	173	+ 28 46	19518	3				S.H.		
		5.87							4						
		5	88	5	78 55	84	+ 11 16	18758					B.D.		
		4.85							5						
		4	86	4	114 20	69	+ 25 42	936					T.C.		
		11.17							6						
		10	235	10	49 15	179	+ 28 53	19536					T.Sp.		
		2.42							7						
		2	43	2	63 40	42	+ 7 40	676					T.C.		
		9.14							8						
		8	115	9	128 55	90	+ 27 34	023					S.H.		
		3.69							9						
		3	70	3	36 10	67	+ 10 55	18740					S. edge Rd.		
		10.83							10						
		10	84	10	45 50	79	+ 13 26	730					N. 11 " B.C.		
		3.44							11						
		2	145	3	119 10	107	+ 30 27	19246					S.H.		
		8.14							12						
		7	115	8	31 35	110	+ 11 15	18780					B.C.		
		6.10							13						
		5	111	6	24 25	106	+ 11 23	794					T.F.		
		5.52							14						
		4	153	5	92 40	121	+ 26 44	19207					S.H.		
		5.58							15						
		5	159	9	28 05	154	+ 10 10	18826					B.C.		
		8.56							16						
		7	157	8	24 15	152	+ 10 20	936					T.F.		
		9.51							17						
		8	152	9	77 20	132	+ 21 07	19062					B.D.		
		10.95							18						
		9	196	10	24 00	190	+ 9 48	18867					B.C.		
		8.89							19						
		7	190	8	21 05	184	+ 9 39	873					T.F.		
		6.31							20						
		5	132	6	81 15	117	+ 19 24	993					B.D.		
		9.18							21						
		7	219	8	20 10	213	+ 9 10	903					B.C.		

Topography Description Legend:
Bank..B.K. Bottom Draw..B.D.
Bldg..Bldg. Bottom Wash..B.W.
Cliff..Cliff Top of Ridge..T.R.
Draw..Draw Toe of Slope..T.S.
Road of Draw..H.D.

Inters. of Draws V.D's
Break in Slope..Bk.S.
Steep Slope..S.S.
Top of Cliff..T.Cl.
Bottom of Cliff..B.Cl.
Top of Spur..T.Sp.
Bottom Canyon..B.Cn.

Side of Canyon S.Cn.
Top of Bank..T.B.
Bottom of Bank..B.B.
Top of Cut..T.C.
Bottom of Cut..B.C.
Top of Fill..T.F.
Bottom of Fill..B.F.

Saddle
Swale
Flat
Stream
Trail
Pavement
Edge of Road

Traveled Rd. Tr.Rd.
Fence
Fence..V.Fn.
Sycamore
Eucalyptus
Plus combinations of those and all common standard abbreviations.

Oak..O. Fir..Fr.
Pine..Pi. Cedar..Ce.
Sycamore..Sy.
Eucalyptus..Eu.

Bldg..Bldg.
Fence..Fn.
Bldg. Fence..Bldg. Fn.
Telephone Pole..T.P.
Power Pole..P.P.
Culvert..Culv.

PB 8 PG. 36

Addn'l Inform.

Form 301 10M 3-34

PLEASE RETURN TO
LOS ANGELES COUNTY SURVEYOR
700 HALL OF RECORDS

NOTE: ANY ADDITIONS OR CHANGES ON THIS SHEET MUST BE MADE OR CIRCLED IN RED INK, WITH DATE AND NAME OF PERSON MAKING CHANGE

Do not extend notes this side of this line

Transit at	Sight on	Stadia Intercepts	Stadia Distance	Stadia Rod—	Horizontal Angle 0° to 360° Right	Horiz. Distance	+ −	Vertical Angle	Elevation of Point	+ Back Sight	+ −	Difference Elevation	Height of Instrument	+	Vertical Distance	REMARKS Station	Left	Right
31	29A				0 0					1			18640			per pg 3		
		5.17								2								
		3	218	4°	16 20	213	+	8 37	18922							T.F.		
		9.52								3								
		6	253	8°	19 20	247	+	8 51	944							B.C.		
		9.51								4								
		7	252	8°	17 05	246	+	8 52	943							T.F.		
		10.37							1905.3	Adj.								
		7	338	9°	16 18	331	+	8 37	~~1905.1~~		+	41		+	501	P#32 FB 636/20		
		4.27								6								
		3	128	4°	24 22	124	+	10 02	18820		+	180		+	220	P#31A set 1x1		
									18820	7								
		2.29							~~18592~~	Adj.			18866					
P#31A	P#31	1	130	2°	0 0	125	−	11 34	~~18541~~	4	−	275			255	per Above		
		11.89								9								
		10	190	11°	213 30	135	+	32 15	19616	10						B.D.		
		11.06																
		7	207	10°	197 35	148	+	31 54	692							T.Sp.		
		3.60																
		3	61	3°	193 20	59	+	10 30	18944							T.C. & B.D.		
		8.37								12								
		7	138	8°	188 45	106	+	28 26	19366							T.Sp.		
		8.22								13								
		7	123	8°	178 50	104	+	22 38	225							T.C.		
		3.62								14								
		3	63	3°	229 20	42	+	34 08	132							T.C.		
		6.04								15								
		5	105	6°	203 30	86	+	24 41	205							B.D.		
									19053									
		10.37							~~18592~~	17 Adj.			19106					
P#32	P#31	7	338	9°	0 0	332	−	7 17	~~18591~~	53	−	515			425	per above.		
		4.12								18								
		2	213	3°	355 13	210	−	6 58	18820		−	286			256	P31A per above		
		7.98								19								
		7	99	7°	336 50	92	+	15 02	19284							T.C.		
		2.93								20								
		2	94	2°	316 30	72	+	28 15	478							T.C.		
		11.52								21								
		10	153	11°	295 35	90	+	39 15	742							T.Sp.		

Date AUG 27 1936 Date AUG 28 1936 Date 8/28/36

Recd ALBERT E. TIBBENS Plotted ALBERT E. TIBBENS Job No. 8169 Division No.
Notes Checked Checked Survey of Mt Wilson Trail Rd.
Survey By [illegible] Notes MF Date
Map No. 3-74-1-A Indexed A. C. Johnson

F.B. 636 Pg. 31

ALB 8-1 Teform.

Form 301 10M 3-34

PLEASE RETURN TO
LOS ANGELES COUNTY SURVEYOR
700 HALL OF RECORDS

NOTE: ANY ADDITIONS OR CHANGES ON THIS SHEET MUST BE MADE OR CIRCLED IN RED INK, WITH DATE AND NAME OF PERSON MAKING CHANGE

Do not extend notes this side of this line

Transit at	Sight on	Stadia Intercepts	Stadia Distance	Stadia Rod—	Horizontal Angle 0° to 360° Right	Horiz. Distance	+ Vertical Angle —	Elevation of Point	+ Back Sight	+ Difference Elevation —	Height of Instrument	+ Vertical Distance —	REMARKS Station	Left	Right
32	31								1		1910 6				
		2.91							2						
		2.90	92	2°	299 40'	59	+ 3 55'	1952 3					T.C.		
		7	191	8°	283 15'	121	+ 36 35'	94 0	3						
		11.47							4				T.Sp.		
		11.44.7	48	11°	341 30'	48	- 0 6'	1899 4					B.C.		
		4	48	4°	356 0'	47	- 7 08'	1900 6	5				T.F.		
		11.28							6						
		9	229	10°	271 45'	153	+ 34 52'	2007 8					T.Sp.		
		3.83							7						
		3	84	3°	287 05'	56	+ 34 17'	1946 8					S.H.		
		9.24							8						
		9	25	9°	321 0'	25	+ 1 51'	02 4					B.C.		
		7.16							9						
		7	17	7°	6 50'	17	+ 3 46'	04 7					T.F.		
		9.37							10						
		7	238	8°	264 05'	172	+ 31 32'	2008 8					S.H.		
		8.21							11						
		8	22	8°	284 40'	22	+ 4 32'	1904 3					B.C.		
		5.08							12						
		5	9	5°	230 40'	9	+ 1 57'	04 8					T.F.		
		8.17							13						
		8	18	8°	122 20'	18	- 2 46'	00 0					Point of spur.		
		3.06							14						
		2	107	3°	267 40'	87	+ 25 28'	49 2					S.H.		
		5.29							15						
		5	30	5°	266 20'	30	+ 0 42'	04 8					B.C.		
		5.24							16						
		5	25	5°	242 15'	25	+ 3 17'	07 0					T.F.		
		3.68							17						
		3	69	3°	249 30'	69	+ 2 49'	11 0					B.C.		
		3.68							18						
		3	69	3°	237 50'	68	+ 4 44'	13 2					T.F.		
		4.92							19						
		4	93	4°	246 05'	92	+ 4 36'	14 1					B.C.		
		3.91							20						
		3	92	3°	240 05'	91	+ 4 15'	14 4					T.F.		
		7.42							21						
			143	7°	239 10'	141	+ 6 35'	19 8					B.C.		

Add'n'l Inform.

Topography Description Legend:
Hill...H. Bottom Draw...B.D.
Saddle...Sa. Bottom Wash...B.W.
Swale...Sw. Top of Ridge...T.R.
Flat...Fl. Top of Slope...T.S.
Stream...Str.
Trail...Tr.
Pavement...Pvt.
Edge of Road...E.Rd.

Intern. of Draw. Y.D's
Break in Slope...Bk.S.
Steep Slope...S.S.
Top of Cliff...T.Cl.
Bottom of Cliff...B.Cl.
Top of Spur...T.Sp.
Bottom Canyon...B.Cn.

Side of Canyon S.Cn.
Top of Bank...T.B.
Bottom of Bank...B.B.
Top of Cut...T.C.
Bottom of Cut...B.C.
Top of Fill...T.F.
Bottom of Fill...B.F.

Traveled Rd. Tr.Rd.
Fence...Fn.
Ind. Fence...Ind. Fn.
Ditch...D.
Telephone Pole...T.P.
Power Pole...P.P.
Culvert...Cul.

Orch'd. Fir-Fr.
Pine-Pi. Cedar-Ce.
Sycamore...Sy.
Eucalyptus...Eu.
Plus combinations of these and all common standard abbreviations.

P.B. 6 PG. 38

Form 381 10M 3-34

PLEASE RETURN TO
LOS ANGELES COUNTY SURVEYOR
700 HALL OF RECORDS

NOTE: ANY ADDITIONS OR CHANGES ON THIS SHEET MUST BE MADE OR CIRCLED IN RED INK, WITH DATE AND NAME OF PERSON MAKING CHANGE

Do not extend notes this side of this line

Transit at	Sight on	Stadia Intercepts	Stadia Distance	Stadia Rod—	Horizontal Angle 0° to 360° Right	Horiz. Distance	+ − Vertical Angle	Elevation of Point	+ Back Sight	+ − Difference Elevation	Height of Instrument	+ − Vertical Distance	REMARKS Station	Left	Right
					° '		° '								
32	31								1		19.06		P9. 36		
		7.39							2						
		6	140	7	235 10	138	+ 6 58	19 205					T.F.		
		8.30							3						
		5	321	7	248 50	269	+ 23 28	20 210					W. side draw		
		2.16							4						
		1	117	2	258 30	99	+ 23 00	19 507					S.H.		
		14.23							5						
		8	324	10	245 15	262	+ 25 39	20 272					S.H.		
		10.62							6						
		10	63	10	333 50	62	+ 6 24	19 075					S.H.		
		3.50							7						
		3	51	3	333 15	50	+ 5 58	127					T.G.		
		0.29							8						
		0	30	0	278 00	27	+ 18 16	195					11		
		10.04							9						
		7	305	9	239 15	249	+ 25 05	20 188					T.Sp.		
		7.49							10						
		7	50	7	269 05	46	+ 15 51	19 167					S.H.		
		10.23							11						
		7	324	9	233 30	275	+ 22 39	20 168					B.D.		
		10.03							12						
		7	304	8	226 55	260	+ 22 12	088					T.Sp.		
		6.66							13						
		5	167	6	234 0	165	+ 6 00	19 218					B.C.		
		8.61							14						
		7	162	8	231 10	159	+ 7 03	223					T.F.		
		11.56							15						
		8	357	10	228 15	292	+ 25 03	20 377					T.Sp.		
		9.46							16						
		8	147	9	256 45	124	+ 22 58	19 544					S.H.		
		4.0							17						
		2	201	3	228 0	199	+ 4 50	243					B.C.		
		3.93							18						
		2	194	3	225 25	193	+ 4 54	241					T.F.		
		10.73							19						
		7	374	9	224 30	309	+ 24 27	20 425					S.H.		
		8.75							20						
		7	176	8	244 30	158	+ 18 29	19 555					11		
		14.86							21						
		8	397	10	219 30	341	+ 21 48	20 374					T.Sp.		

Agent Inform.

Notes Rod. Date AUG 27 1936 Date AUG 28 1936 Survey of MTN. Views Notes Job No. 8149 Division No. F.B. 750 Pg. 38

Plotted ROBERT E. TIMMONS

Meter Cited Checked Survey by Evans & Notes Tall Rod

Date Date Map No. 3-MA Index A. C. Johnson Date 9/21/36

Form 301 10M 3-34

PLEASE RETURN TO
LOS ANGELES COUNTY SURVEYOR
700 HALL OF RECORDS

NOTE: ANY ADDITIONS OR CHANGES ON THIS SHEET MUST BE MADE OR CIRCLED IN RED INK, WITH DATE AND NAME OF PERSON MAKING CHANGE

Do not extend notes this side of this line

F.B. 658 Pg. 40

Topography Description Legend:
Side Hill...S.H. Bottom Draw B.D.
Side of Draw..S.D. Bottom Wash B.W.
Side of Ridge..S.R. Top of Ridge T.R.
Head of Draw H.D. Toe of Slope...T.S.

Inters. of Draws..Y.D's | Break in Slope...Bk.S. | Steep Slope.....S.S. | Top of Cliff.....T.Cl. | Bottom of Cliff..B.Cl. | Top of Spur.....T.Sp. | Bottom Canyon..B.Cn.

Side of Canyon..S.Cn. | Top of Bank...T.B. | Bottom of Bank..B.B. | Top of Cut.....T.C. | Bottom of Cut...B.C. | Top of Fill.....T.F. | Bottom of Fill..B.F.

Saddle .....Sd. | Swale .....Sw. | Flat .....Fl. | Stream .....Str. | Trail .....Tr. | Pavement ...Pvt. | Edge of Road E.Rd.

Traverse Rds. Tr.Rd. | Fence .....Fe. | Int. Fences..V.Fns. | Ditch .....Dt. | Telephone Pole T.P. | Power Pole...P.P. | Culvert .....Cul.

Side-Hill Flume...Fl. | Pine-Pi. Fir-Fr. | Cedar-Ce. | Sycamore .....Sy. | Eucalyptus .....Eu. | Plus combinations of these and all common standard abbreviations.

Transit at	Sight on	Stadia Intercepts	Stadia Distance	Stadia Rod—	Horizontal Angle 0° to 360° Right	Horiz. Distance	+ Vertical Angle —	Elevation of Point	+ Back Sight	+ Difference — Elevation	Height of Instrument	+ Vertical — Distance	REMARKS Station	Left	Right
					° '		° '								
32	31			—	0 0		—	—			1.91 06	—			
		5.20 / B	221	4 °	221 25	219	+ 5 27	19 274					B.C.		
		4.10 / 2	211	3 °	221 0	209	+ 5 20	271					T.F.		
		10.86 / 7	387	9 °	213 30	347	+ 18 46	20 193					T.Sp.		
		10.53 / 7	354	9 °	214 50	318	+ 18 28	079					B.D.		
		11.35 / 9	236	10 °	213 10	232	+ 6 54	19 286					B.C.		
		10.25 / 7	326	9 °	219 30	284	+ 20 55	20 102	×	+ 908		+ 1088	S.H.		
		10.40 / 7	341	9 °	223 30	297	+ 20 55	154					"		
		11.11 / 9	212	10 °	211 45	208	+ 7 42	19 287					T.F.		
		10.05 / 7	306	9 °	210 10	287	+ 14 13	743					B.D.		
		10.35 / 7	336	9 °	203 35	316	+ 13 50	795					T.Sp.		
		8.86 / 7	197	8 °	209 50	196	+ 4 40	19 185					"		
		10.15 / 7	316	8 °	197 35	307	+ 9 52	558					" & T.C.		
		9.78 / 7	279	9 °	201 30	271	+ 9 54	488					T.C.		
		7.50 / 5	251	6 °	207 05	248	+ 5 54	302					B.C.		
		9.73 / 7	274	8 °	205 35	266	+ 9 47	485					T.C. & B.D.		
		4.44 / 2	245	3 °	204 35	243	+ 5 27	302					T.F.		
		4.58 / 2	259	3 °	210 20	250	+ 10 22	534					T.C.		
		9.44 / 7	245	8 °	203 40	243	+ 4 42	225					H.D.		
		9.68 / 7	269	8 °	214 30	250	+ 15 09	705	×	+ 592		+ 672	T.C.		
		9.78 / 7	279	8 °	220 35	260	+ 15 09	731	×	+ 624		+ 704	S.H.		

Add'l Inform.

Form 301 10M 3-34

PLEASE RETURN TO
LOS ANGELES COUNTY SURVEYOR
700 HALL OF RECORDS

NOTE: ANY ADDITIONS OR CHANGES ON THIS SHEET MUST BE MADE OR CIRCLED IN RED INK, WITH DATE AND NAME OF PERSON MAKING CHANGE

Do not extend notes this side of this line

Notes ALBERT E. TIMMONS Platted ALBERT E. TIMMONS Job No. 8449 Division No. F.B. 652 Pg. 49
Date AUG 27 1936 Date AUG 28 1936 Survey of Traverse Tell Rd. Notes TE Date 8/28/36
Notes Checked Survey by Notes Date
Date Map No. 379-I-A Indexed C. J. [illegible]

Transit at	Sight on	Stadia Intercepts	Stadia Distance	Stadia Rod—	Horizontal Angle 0° to 360° Right	Horiz. Distance	+ −	Vertical Angle	Elevation of Point	+ Back Sight	+ −	Difference Elevation	Height of Instrument	+	Vertical Distance	REMARKS Station	Left	Right
32	31				0 0								19106					
		4.68								1								
		7	269	3°	200 35	266	+	5 33	19334	2						B.C.		
		8.64								3								
		7	165	8°	237 55	160	+	10 07	311	4						T.C. + B.D.		
		5.57								5								
		3	258	4°	199 05	255	+	6 03	336	6						T.F.		
		5.95								7								
		3	296	4°	195 50	293	+	5 53	362	8						B.C.		
		4.87								9								
		2	288	3°	193 15	285	+	5 57	373	10						T.F.		
		6.17								11								
		3	318	4°	194 50	315	+	5 52	389	12						B.C.		
		7.18								13								
		4	319	6°	192 15	315	+	6 27	402	14						T.F.		
		8.74								15								
		5	375	7°	195 07	370	+	6 24	19451	16	+	345		+	415	P#33 F.B. 634/21		
		5.50								17								
		4	151	5°	233 08	149	+	6 09	19217	18	+	111		+	161	P# 32A set		
									19217				19267					
P32A	P32	3.52			0 0				19053	19 Adj.								
		2	153	3°		151	−	7 01	19052	5 0		215			185	per above		
		11.23								20								
		10	124	11°	228 0	90	+	31 15	19707	21						B.D.		
									19451				19492					
P#33	P#32	10.73			0 0				19053	19 Adj.								
		7	374	9°		370	−	5 29	19052	4 6		446			356	per above		
		1.37								22								
		1	38	1°	333 05	33	+	19 28	19608	23						T.C.		
		4.26								24								
		4	27	4°	343 40	27	−	5 17	432	25						B.C.		
		3.10								26								
		3	11	3°	30 50	11	−	8 55	449	27						T.F.		
		3.25								28								
		3	26	3°	283 25	26	−	0 22	465	29						B.C.		
		5.19								30								
		5	20	5°	255 40	19	+	8 50	478	31						T.F.		
		2.72								32								
		2	73	2°	288 50	53	+	30 06	795	33						T.C.		

ABS-N-1
Inform.

Form 301 10M 3-34

PLEASE RETURN TO
LOS ANGELES COUNTY SURVEYOR
700 HALL OF RECORDS

NOTE: ANY ADDITIONS OR CHANGES ON THIS SHEET MUST BE MADE OR CIRCLED IN RED INK. WITH DATE AND NAME OF PERSON MAKING CHANGE

Do not extend notes this side of this line

F.B. 650 PG. 42

Topography Description Legend:
Side Hill....S.H. | Bottom Draw..B.D. | Side of Draw..S.D. | Bottom Wash..B.W. | Side of Ridge..S.R. | Top of Ridge..T.R. | Head of Draw..H.D. | Toe of Slope..T.S.

Inters. of Draw. V.D's | Break in Slope..Bk.S. | Steep Slope.....S.S. | Top of Cliff...T.Cl. | Bottom of Cliff..B.Cl. | Top of Spur.....T.Sp. | Bottom Canyon..B.Ca.

Side of Canyon S.Cn. | Top of Bank...T.B. | Bottom of Bank..B.B. | Top of Cut....T.C. | Bottom of Cut..B.C. | Top of Fill....T.F. | Bottom of Fill..B.F.

Saddle.....Sa. | Swale.....Sw. | Flat.....Fl. | Stream.....Str. | Trail.....Tr. | Pavement.....Pvt. | Edge of Road..E.Rd.

Traveled Rd. Tr.Rd. | Fence.....Fn. | Int. Fences..V.Fns. | Ditch.....Di. | Telephone Pole T.P. | Power Pole...P.P. | Culvert.....Cul.

Dbl.-O. | Pine-Pi. | Sycamore | Eucalyptus | Plus combinations of these and all common standard abbreviations.

Fir-Fr. | Cedar-Ce. | Sy. | Eu.

Transit at	Sight on	Stadia Intercepts	Stadia Distance	Stadia Rod→	Horizontal Angle 0° to 360° Right	Horiz. Distance	+ Vertical Angle −	Elevation of Point	+ Back Sight	+ Difference − Elevation	Height of Instrument	+ Vertical Distance −	REMARKS Station	Left	Right
33	32	2.59		—	0 0		—	—			19492	—			
		2	60	2	261 20	60	+ 2 53	19502				—	B.C.		
		6.62	63	6	249 10	62	+ 8 09	526				—	T.F.		
		5.96	97	5	263 25	96	+ 6 23	555				—	B.C.		
		5 4.00	101	3	258 40	100	+ 6 15	572				—	T.F.		
		3 8.88	89	8	270 45	74	+ 2 01	749				—	T.C.		
		8 9.08	209	8	242 21	205	+ 8 12	1971.3 ~~1971.3~~	Adj.	+ 215		+ 295	P#33A	Set 1x1	
		1 10.32	333	9	218 50	326	+ 8 00	19866		+ 369		+ 459	P#34	FB. 636/21	
		7					—	19713			19762	—			
33A	33	5.07	208	4	0 0	202	— 7 33	19451	49	311		271	perabove		
		3 4.42	143	4	335 20	139	+ 8 50	938				—	T.C.		
		3 5.05	106	5	330 20	105	— 6 11	598				—	B.C.		
		4 4.85	96	4	333 50	95	— 6 30	614				—	T.F.		
		4 3.78	79	3	308 45	78	— 5 54	651				—	B.C.		
		3 4.67	68	4	315 00	67	— 5 42	654				—	T.F.		
		4 3.38	139	3	276 20	114	+ 24 29	20258				—	B.D.		
		2 4.50	51	4	285 05	51	— 5 05	19677				—	B.C.		
		4 5.41	42	5	300 05	42	— 4 13	682				—	T.F.		
		5 4.95	96	4	282 05	88	+ 15 57	974				—	B.D.		
		4 5.16	17	5	256 0	17	— 6 17	693				—	B.C.		
		5 5.10	11	5	297 10	11	— 8 40	695				—	T.F.		
		5													

Over
Unders

Form 301 1M 3-34

PLEASE RETURN TO
LOS ANGELES COUNTY SURVEYOR
700 HALL OF RECORDS

NOTE: ANY ADDITIONS OR CHANGES ON THIS SHEET MUST BE MADE OR CIRCLED IN RED INK, WITH DATE AND NAME OF PERSON MAKING CHANGE

Do not extend notes this side of this line

Book No. [illegible] Plotted ALBERT E. TIMMONS Job No. 1442 Division No. [illegible]
Date AUG 27 1936 Date AUG 28 1936 Survey of MT. WILCOX Toll Rd.
Notes Circled Date Checked Date Survey by EVANS Notes C.E. Job No. 42-74-1A Indexed Date 8/29/36
F.B. 6 PG. 43

Transit at	Sight on	Stadia Intercepts	Stadia Distance	Stadia Red—	Horizontal Angle 0° to 360°, Right	Horiz. Distance	+ —	Vertical Angle	Elevation of Point		+ Back Sight	+ —	Difference Elevation	Height of Instrument	+ —	Vertical Distance	REMARKS Station	Left	Right
33A	33				0 0									1976.2					
		3.78															B.D. + T.C.		
		3.27	79	3°	288 15	78	+	6 42	1982.2										
		6															S.H.		
		3.45	168	7°	308 0	135	+	26 05	2035.2										
		2															"		
		6.49	146	3°	292 35	113	+	27 58	337										
		5															"		
		5.61	150	6°	297 50	121	+	25 39	288										
		4	162	5°	125 50	160	+	5 28	1986			+	10 4		+	15 4	P#34 pg. 42		
									1986					1991.8					
		10.29									1								
P#34	P#33	7	330	9°	0 0	326	−	6 36	1945	1	5 2		46.2			37.2	per above		
		11.44							1749	8	Adj.		2420			234.0	B.M. #03 - per L.S. 4885		
		5	645	8°	61 29	545	−	23 12	1971	3							El. = 1749.65 (backsight)		
		8.61							1971.2		10 Adj.		20.6			12.6	P# 33A pg. 42		
		7	162	8°	329 22	161	−	4 28			11								
											12								
											13								
											14								
											15								
											16								
											17								
											18								
											19								
											20								
											21								

Add'l Inform.

Form 301 IGM 5-34

PLEASE RETURN TO
LOS ANGELES COUNTY SURVEYOR
TOWNHALL OF RECORDS

NOTE: ANY ADDITIONS OR CHANGES ON THIS SHEET MUST BE MADE OR CIRCLED IN RED INK, WITH DATE AND NAME OF PERSON MAKING CHANGE

Do not extend notes this side of this line

Transit at	Sight on	Stadia Intercepts	Stadia Distance	Stadia Rod—	Horizontal Angle 0° to 360° Right	Horiz. Distance	+ Vertical Angle —	Elevation of Point	+ Back Sight	+ Difference Elevation —	Height of Instrument	+ Vertical Distance —	REMARKS Station	Left	Right
									1						
									2						


Notes Ck'd by Drew	Survey of Mt. Wilson Toll Rd	F.B. 650	Pg. 45
Map No. 8-121	W. 08149 Tape No. 25 St'd 84° F.		
Office Work Wood	Surveyed by Evans		
Checked Drew	Notes C. C. Johns	Date 11/6/36	
Date 12-30-36	Indexed 11-12-96		

Note: Any Additions or Changes on This Sheet Must be Made or Circled in Red Ink With Date and Name of Person Making Change.

Do not extend notes this side of this line

RETURN TO
LOS ANGELES COUNTY SURVEYOR
700 HALL OF RECORDS

2 1

11 12

N.W. cor. Sec. 12-T 1N-R12W
Fd. 2" I.P. + B.C. in conc., C.S.;
Mon., Marked as shown in
F.B. 137-74 - See C.S. "B"-453.

T. 1 N. R. 12 W.

C #81 - Fd. 3/4" I.P. No plug. F.B. 473-? Top of ridge 0.03

C #83 - Fd. 3/4" I.P. No Plug F.B. 473-31, 59 & F.B. 636-16 0.03

P #16 - F.B. 636-16
C #84 - F.B. 473-31, 59
Fd. 3/4" I.P. cem + nail
ctr. per 636-16 0.03

S 65° 14' - 30" W
Per F.B. 636-16

S 28° 33' - 15" E
Per F.B. 636 Pg. 16

250.56

P. Line

SP #17 F.B. 636-16

C #85 - Fd. 3/4" I.P. F.B. 473-? 0.04

54.16

N.W. cor. of S.W. 1/4 of N.W. 1/4 Sec. 12 Fd. 3/4" I.P. + B.C. in con. - C.S. Mon. Marked as shown in F.B. 137-78 & C.S. "B" 453 See F.B. 636-16.

T 74 = 247.04 ✓

276.47 @ 26° 40 = 247.06
276.39 @ 26° 38 = 247.06

247.04
3.52 @ 0.0
250.56 ✓

To P # 15 F.B. 636-16

(42.89 @ 30° 32' 15" = 54.17
42.66 @ 30° 32' 15" = 54.15)
= 54.16

Q Line

FORM 247 10M 11-35

F.B. 650 Pg. 46

RETURN TO
LOS ANGELES COUNTY SURVEYOR
700 HALL OF RECORDS

Note: Any Additions or Changes on This Sheet Must be Made or Circled in Red Ink With Date and Name of Person Making Change.

Do not extend notes this side of this line

486.88 @ 32° 33 = 410.40 ✓
486.23 @ 32°-25-15 = 410.44

410.42-T 70° = 410.38 ✓

1 (57-54-30)
G (57-27-30)
57°-54-35"

Sec. Line pg. 45

⊙ - Set 1x2

410.38 T Base Line

11-6-36

12.

11.

57°54'35" 400'

90°-07'40"

90°-07'40"

31°57'40"

1 (31-57-41)
G (191-46-00)
31°-57'-40

T° P#21
11°03'-20" per FB 636-17

656.82 calcd.

N.W. cor of S.W.1/4 of N.W. 1/4 Sec. 12 C.S. Map. per pg. 45

1 (90-07-45)
G (180-46-00)
90°-07'-40"

1 (89-02-15)
4 (356-08-30)
89°-02-07½"

P Line

T° P#23

T° P#22 - Fd. 3/4" I.P. concr. nail & tin, per FB 636-17

Notes Ck'd by Drew	Survey of Mt. Wilson Toll Rd	F.B. 650	Pg. 47
Map No. B-127	W. O. 8149 Tape No. 25 St'd 84 °F.		
Office Work Wood	Surveyed by Evans.		
Checked Drew	Notes HE Date 11-9-36		
Date 12-20-42	Indexed A. C. Johnson		

(113.46 @ 31-19-45 = 96.66)
(113.35 @ 31-30-15 = 96.64)
= 96.65
21.80 @ 0-0 = 21.80
118.45 - 784°

P#25 - Fd 1X2 per F.B. 636-18

"P" Line

79-10-00

(79-10
316-40)
79°10'-00"

(71.08 @ 10°-56 = 69.79
71.26 @ 11-41-30 = 69.78)
784 = 69.78

S.W. cor. of N.E. 1/4 of N.W. 1/4 Sec. 12. Fd. 2" I.P. + B.C. in conc. C.S. Mon. per F.B. 137-77 & C.S. "B"-453.

P#26 - Fd 1X2 - F.B. 636-19

S 4° 81'

69.18

S 0° 00' W

SEC. 12. HILL ADDITION.

1350.18 Rec.

set 1X2 on ridge below Edison towers by transiting in.

CAPITOL

S.E. cor. of S.W. 1/4 of N.W. 1/4 Sec. 12. Fd. 2" I.P. + B.C. in con. C.S. Mon. marked as shown on F.B. 137-77 & C.S. "B"-453.

Note: Any Additions or Changes on This Sheet Must be Made or Circled in Red Ink With Date and Name of Person Making Change.

Do not extend notes this side of this line

RETURN TO
LOS ANGELES COUNTY SURVEYOR
700 HALL OF RECORDS

FORM 247 10M 11-35

F.B. 650 Pg. 48

(207.99 @ 36°-48'-45" = 166.52)
(208.21 @ 36°-54' = 166.50)
= 166.51 - T 78° = 166.50

N.E. cor. of S.E. 1/4 of N.W. 1/4 Sec. 12. Fd. 2" I.P. & B.C. in conc., C.S. Mon. marked as shown in F.B. 137-80 & C.S. - B-453.

166.50

P#32 - F.B. 636-20 Fd. 1X2 Stake.

P#31 - Fd. 1X2 F.B. 636-20

11.91

"P" Line

P Line Prod. T. Flag on ridge.

92.00

0-17-20

(92-18-00)
(369-11-45)
92°-17'-56 1/4"

92°-17'-56"

set 1X2 in ground by

"P" Line

SEC. 12.

P#30 - Pot. F.B. 636-20 out.

760.1

CAPITOL HILL ADDITION

set 1X2 top ridge.

(1373.63 Rec. per C.S. B-453)

Tract Line

Center of Sec. 12. Fd. 2" I.P. & B.C. in conc. C.S. Mon., marked as shown in F.B. 137-80 & C.S. B-453.

11-10-36

6.94

RETURN TO
LOS ANGELES COUNTY SURVEYOR
700 HALL OF RECORDS

Do not extend notes this side of this line

Note: Any Additions or Changes on This Sheet Must be Made or Circled in Red Ink With Date and Name of Person Making Change.

Notes Ck'd by DR CW	Survey of Mt. Wilson Toll Rd
Map No. B-121	W. O. 8149 Tape No. 25 St'd 84 °F.
Office Work Wood	Surveyed by Evans
Checked DR CW	Notes HE
Date 12-28-36	Date 11-10-36
	Indexed A. C. Johnson

F.B. 650 Pg. 49

RETURN TO
LOS ANGELES COUNTY SURVEYOR
700 HALL OF RECORDS

Note: Any Additions or Changes on This Sheet Must be Made or Circled in Red Ink With Date and Name of Person Making Change.

Do not extend notes this side of this line

R. 11 W.
R. 12 W.

6 | 7

1 | 12

Section Corner
Fd. 4"x4" iron post
conc. filled & L.T.
Ctr. marked as
shown in F.B. 137-62
& C.S. B-453.

250±

0.02

C.S. Mon.
#16.
Top spur.
See F.B. 137-109

T. 1 N.

Sec. Line.
C.S. B-453.

1.

12.

P#62 - Fd. 1"x2"
per F.B. 636-30

P#61A - Fd. 3/4"
I.P. conv. nail ctr.
per F.B. 636-30

P#61 - Fd. 1"x2"
per F.B. 636-30

0.05

10°-47'-10"

454.17

(N.W. cor. of N.E. 1/4
of N.E. 1/4 - Fd. 2"
I.P. & B.C. in conc.
C.S. Mon., in
as shown in F.B.
137-79 & C.S. B-453.

(18449 @ 15°-26) = 177.83
(184.74 @ 15°-43)

(105.91 @ 9°-56) = 104.31
(106.09 @ 10°-15)

63.97 @ 0-0 = 63.97

(110.71 @ 12°-28) = 108.10
(110.62 @ 12°-15)

454.21
T 72°.04
454.17

(107-47-15
71-08-45
107°-47'-11¼"

FORM 247 10M 11-35

RETURN TO
LOS ANGELES COUNTY SURVEYOR
700 HALL OF RECORDS

Note: Any Additions or Changes on This Sheet Must be Made or Circled in **Red** Ink With Date and Name of Person Making Change.

Do not extend notes this side of this line

F.B. 6550 Pg. 50

FORM 247. 10M 11-38

RETURN TO
LOS ANGELES COUNTY SURVEYOR
700 HALL OF RECORDS

Note: Any Additions or Changes on This Sheet Must be Made or Circled in **Red Ink** With Date and Name of Person Making Change.

Do not extend notes this side of this line

Notes Ck'd by _____
Map No. 3-1217
Office Work
Checked
Date 12-14-42

Survey of
W. O. _____ Tape No. _____ St'd _____ °F.
Surveyed by
Notes
Indexed _____ Date 1-28-37

F.B. 2500 Pg. 57

RETURN TO
LOS ANGELES COUNTY SURVEYOR
700 HALL OF RECORDS

Note: Any Additions or Changes on This Sheet Must be Made or Circled in **Red Ink** With Date and Name of Person Making Change.

Do not extend notes this side of this line

F.B. 4850 PG. 52

Notes Ck'd by: Drew	Survey of: Mt Wilson Toll Rd
Map No.: B-1217-1	W. O. 8149 Tape No. St'd °F.
Office Work: F. A. W.	Surveyed by: C. A. Benson
Checked: Drew	Notes: Blanchard Date: 1-27-41
Date: 12-5-40	Indexed: C. S. Johnson

F.B. 650 PG. 53

Note: Any Additions or Changes on This Sheet Must be Made or Circled in Red Ink With Date and Name of Person Making Change.

Do not extend notes this side of this line

RETURN TO
LOS ANGELES COUNTY SURVEYOR
700 HALL OF RECORDS

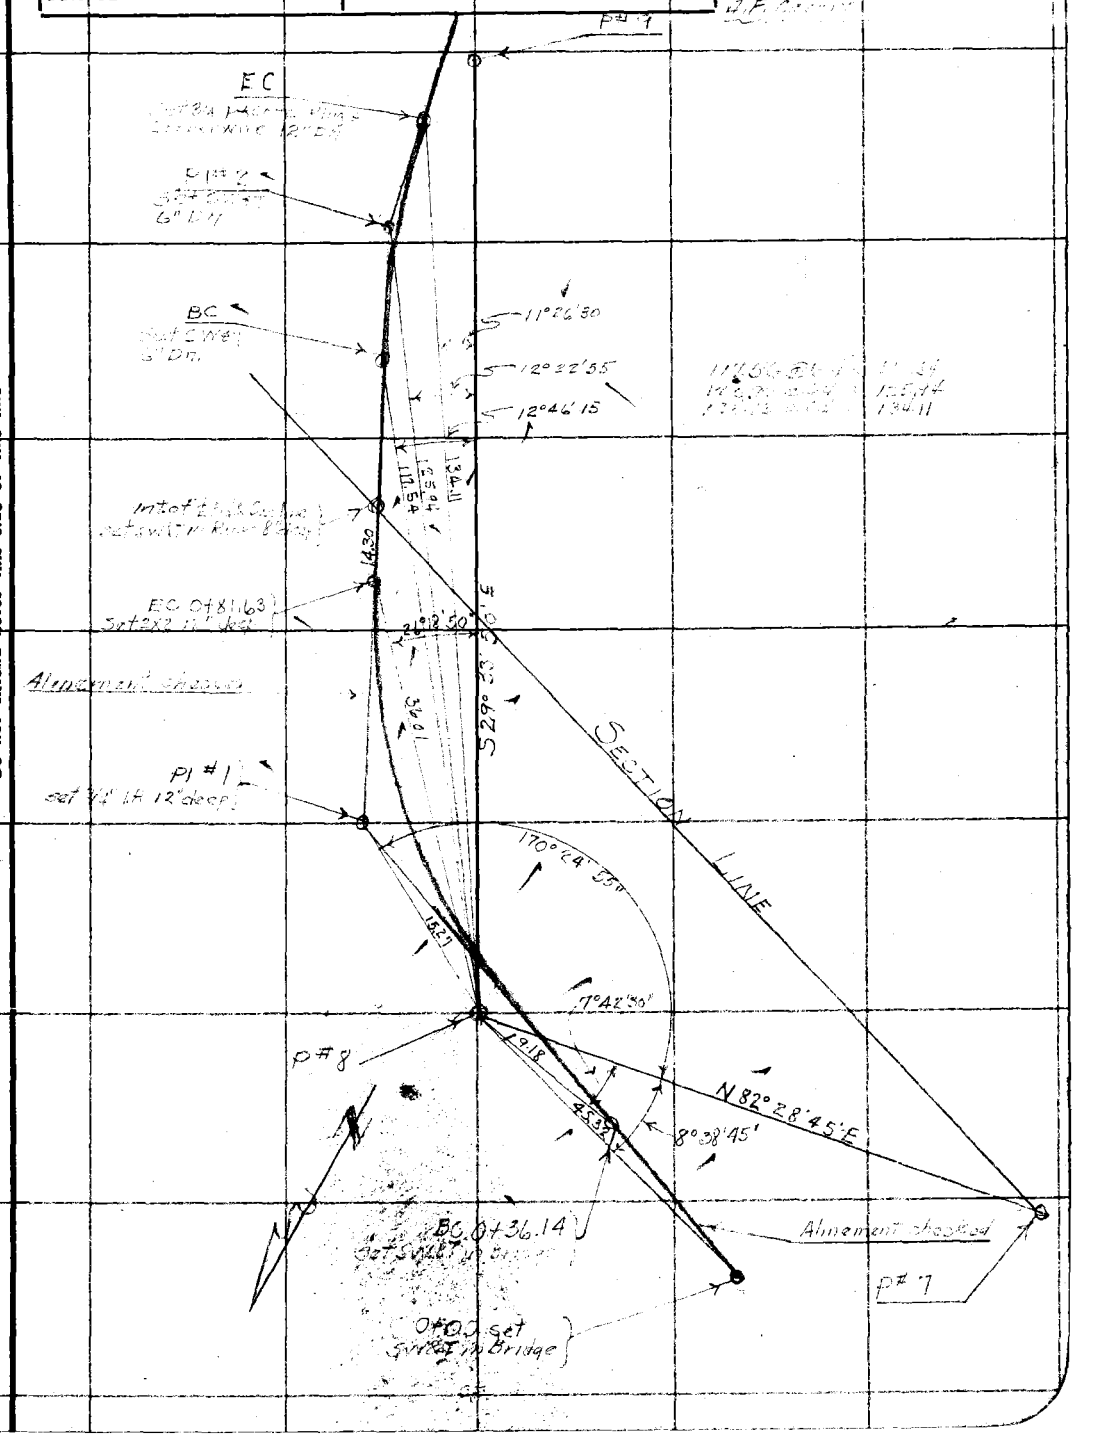

FORM 247 10M 11-38

RETURN TO
LOS ANGELES COUNTY SURVEYOR
700 HALL OF RECORDS

Note: Any Additions or Changes on This Sheet Must be Made or Circled in **Red Ink** With Date and Name of Person Making Change.

Do not extend notes this side of this line

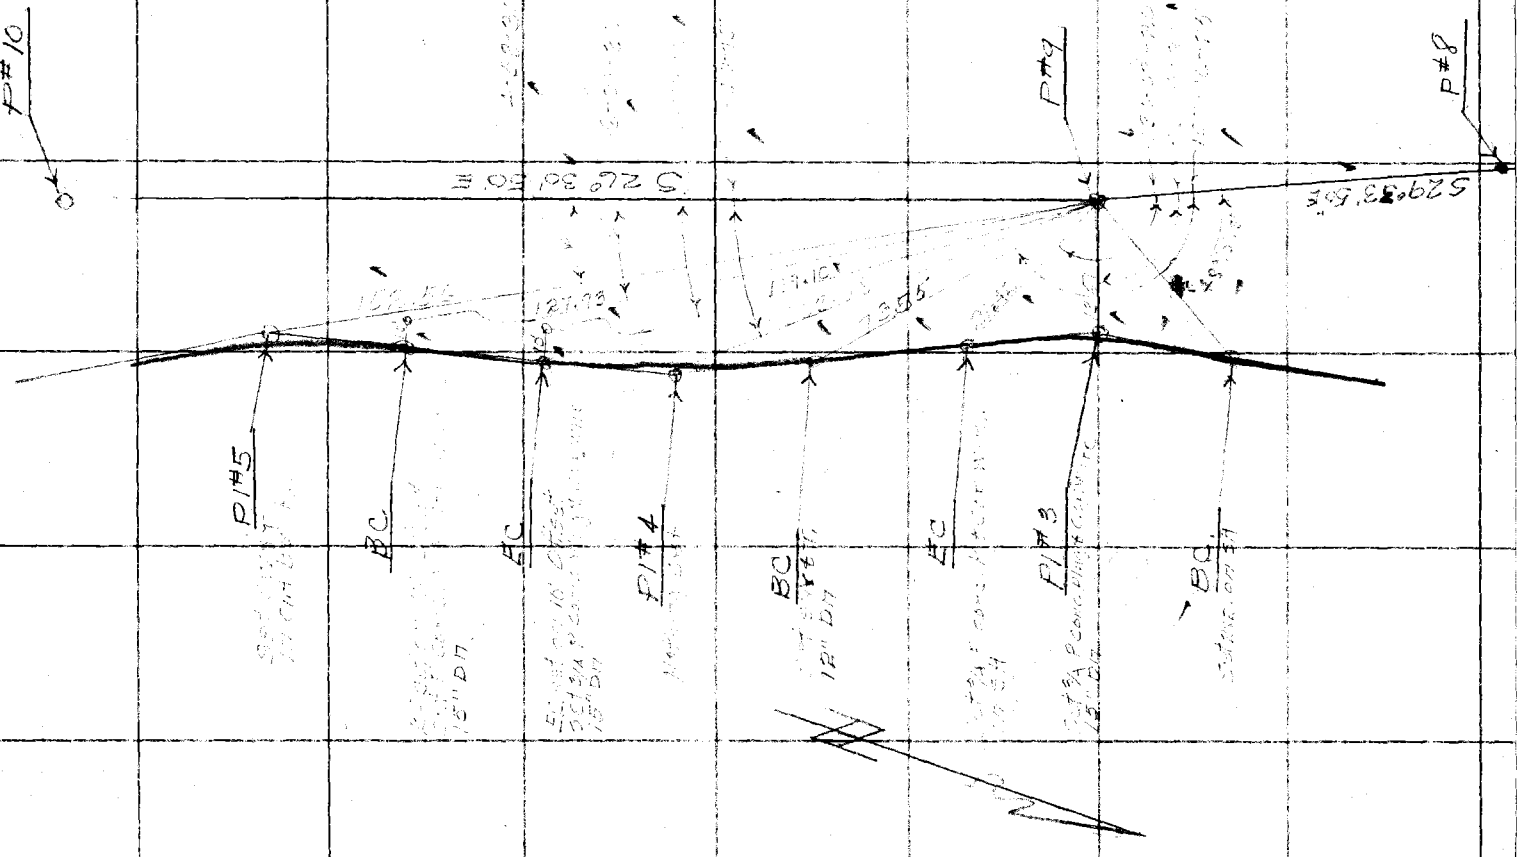

F.B. 6550 Pg. 54

Notes Ck'd by Drew	Survey of [illegible]
Map No. B-1217-1	W. O. 3149 Tape No. 07 St'd [illegible] °F.
Office Work F. A. W.	Surveyed by [illegible]
Checked Drew	Notes [illegible] Date [illegible]
Date 12-5-47	Indexed C. Johnson

F.B. 650 Pg. 55

Note: Any Additions or Changes on This Sheet Must be Made or Circled in Red Ink With Date and Name of Person Making Change

Do not extend notes this side of this line

RETURN TO
LOS ANGELES COUNTY SURVEYOR
700 HALL OF RECORDS

FORM 247 10M 11-35

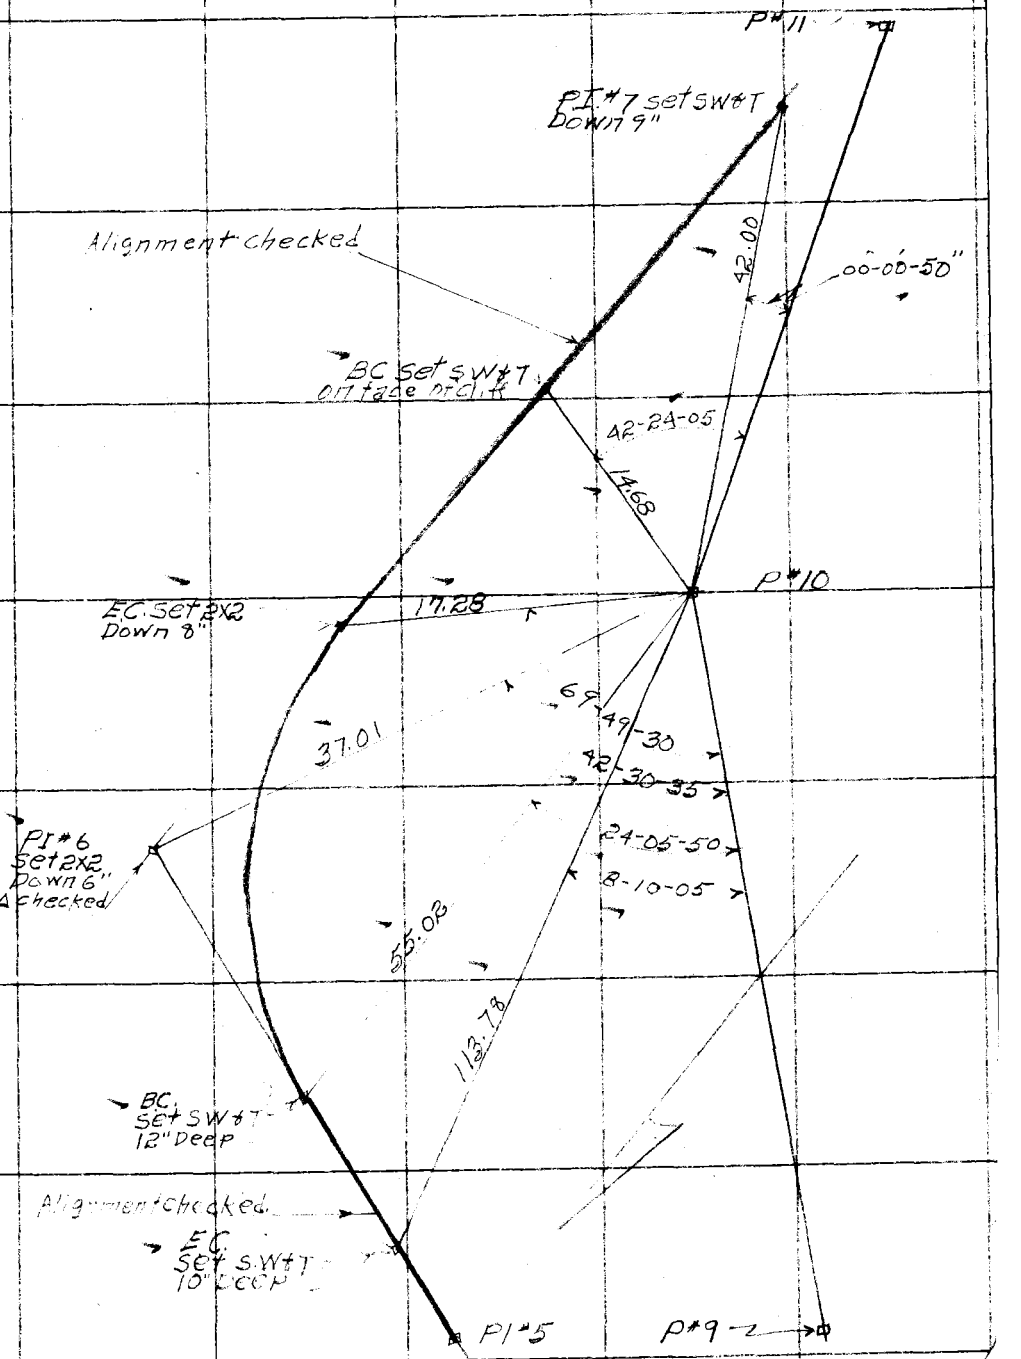

F.B. 650 Pg. 56

① 5-03-10	167.77	169.16 @ T-20 T 72
② 11-00-25	144.47	145.78 @ T-40 T 70
③ 19-57-40	121.62	121.63 T 70
④ 21-31-50	90.89	90.90 T 72
⑤ 31-40-00	34.95	T 74
⑥ 51-38-50	16.59	
⑦ 121-49-15	18.41	

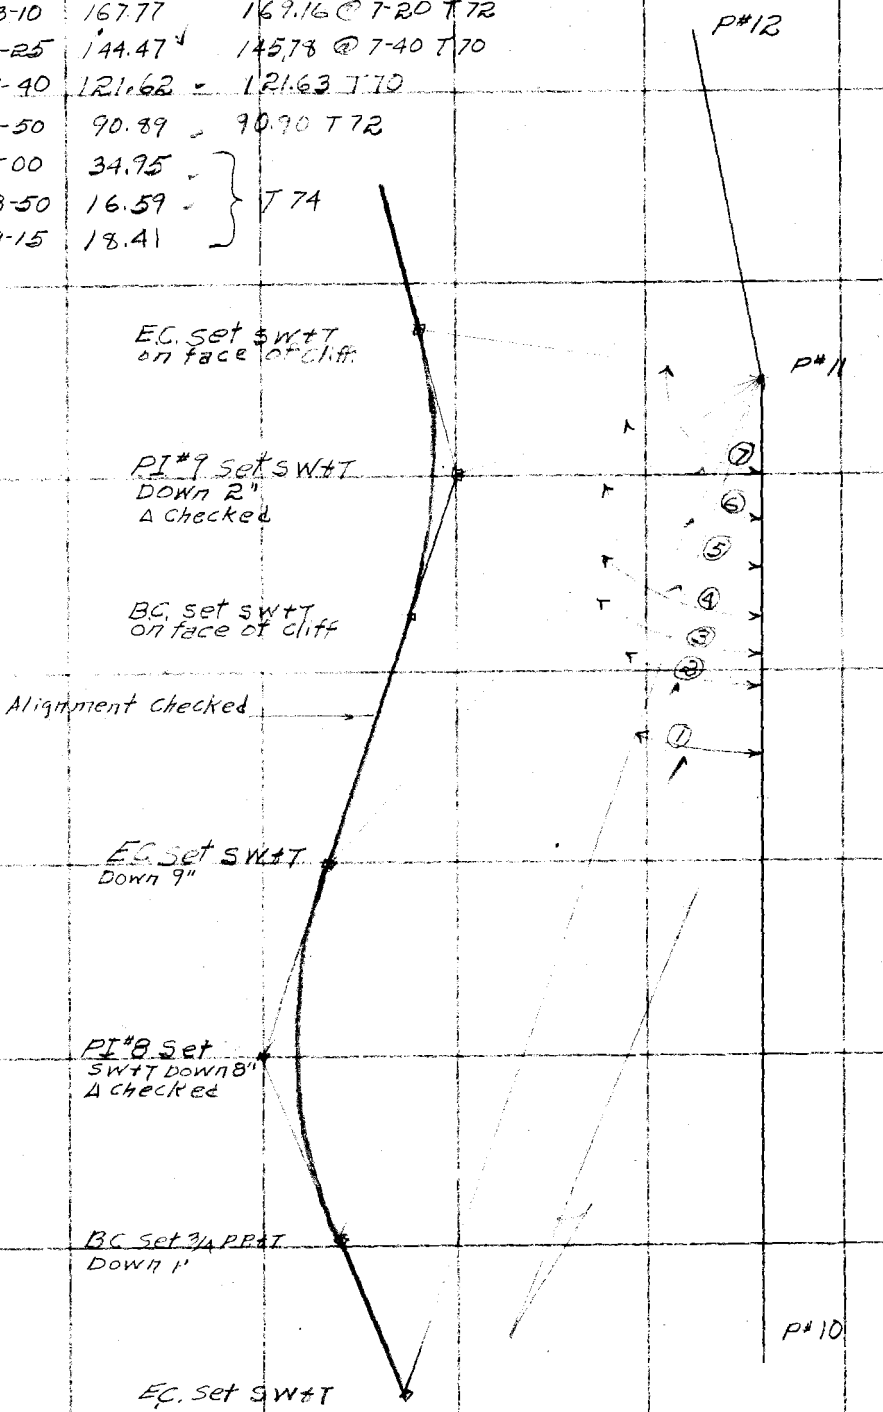

RETURN TO
LOS ANGELES COUNTY SURVEYOR
700 HALL OF RECORDS

Do not extend notes this side of this line

Note: Any Additions or Changes on This Sheet Must be Made or Circled in Red Ink With Date and Name of Person Making Change.

Notes Ck'd by	Drew	Survey of	Mt Wilson Toll Rd
Map No.	B-1287	W. O.	8149 Tape No. 07 St'd 34 F.
Office Work	F. A. W.	Surveyed by	Bentson
Checked	Drew	Notes	JAW Date 2-10-37
Date	12-6-45	Indexed	A. C. Johnson

F.B. 650 PG. 57

RETURN TO
LOS ANGELES COUNTY SURVEYOR
700 HALL OF RECORDS

Note: Any Additions or Changes on This Sheet Must be Made or Circled in Red Ink With Date and Name of Person Making Change.

Do not extend notes this side of this line

① 14-00-25 56.13
② 47-19-25 17.70
③ 85-51-10 53.57 = 53.58 T 5A
④ 91-45-25 85.83 = 85.84 T 54
⑤ 57-34-50 141.79 = 142.01 @ 3-04 T 60
⑥ 29-46-20 162.35 = 163.09 @ 5-20 T 60
⑦ 23-49-20 173.23 = 174.08 @ 5-35 T 64
⑧ 20-35-40 191.02 = 192.12 @ 6-05 T 66

178.32 @ 2-45 T 64 = 178.10

P13

EC. Set 3/4 PP&T Down 1'

PI Reset 3/4 PP&T Down 1'

BC Set 3/4 PP&T Down 1'

A Checked

178.10

Alignment Checked

EC. Set 3/4 PP&T Down 6"

PI # 11 Set 2x2 Flush

BC Set 3/4 PP&T Down 9"

EC. Set 3/4 PP&T Down 10"

P # 12

PI # 10 Set 3/4 PP&T Down 1'
Δ Checked

B.C. Set 3/4 PP&T Down 8"

P11

FORM 247 10M 11-35

F.B. 650 PG. 38

①	32-23-15	L.C.51	105.52 @ T64	Set 3/4 PP+T	Down 1'	BC	#13	
②	35-17-40	99.55	99.56 T64	Set 3/4 PP+T	Down 8"	PI	#13	
③	35-17-50	87.38 L	87.39 T62	Set 3/4 PP+T	" 1'	EC	13	
④	35-18-05	60.05	60.06 T64	Set 3/4 PP+T	" 1'	BC	14	
⑤	105-17-55	30.97	Not Set.					
⑥	30-10-00	66.32	66.33 T66	Set 3/4 PP+T	" 1'	EC	14	
⑦	32-25-30	79.02	79.03 T70	Set 3/4 PP+T	" 1'	BC	15	
⑧	35-13-40	104.08 L	104.09 T68	Set 3/4 PP+T	" 1'	PI	#15	
⑨	30-06-25	127.35	127.36 T70	Set 2x2 Flush		EC	15	

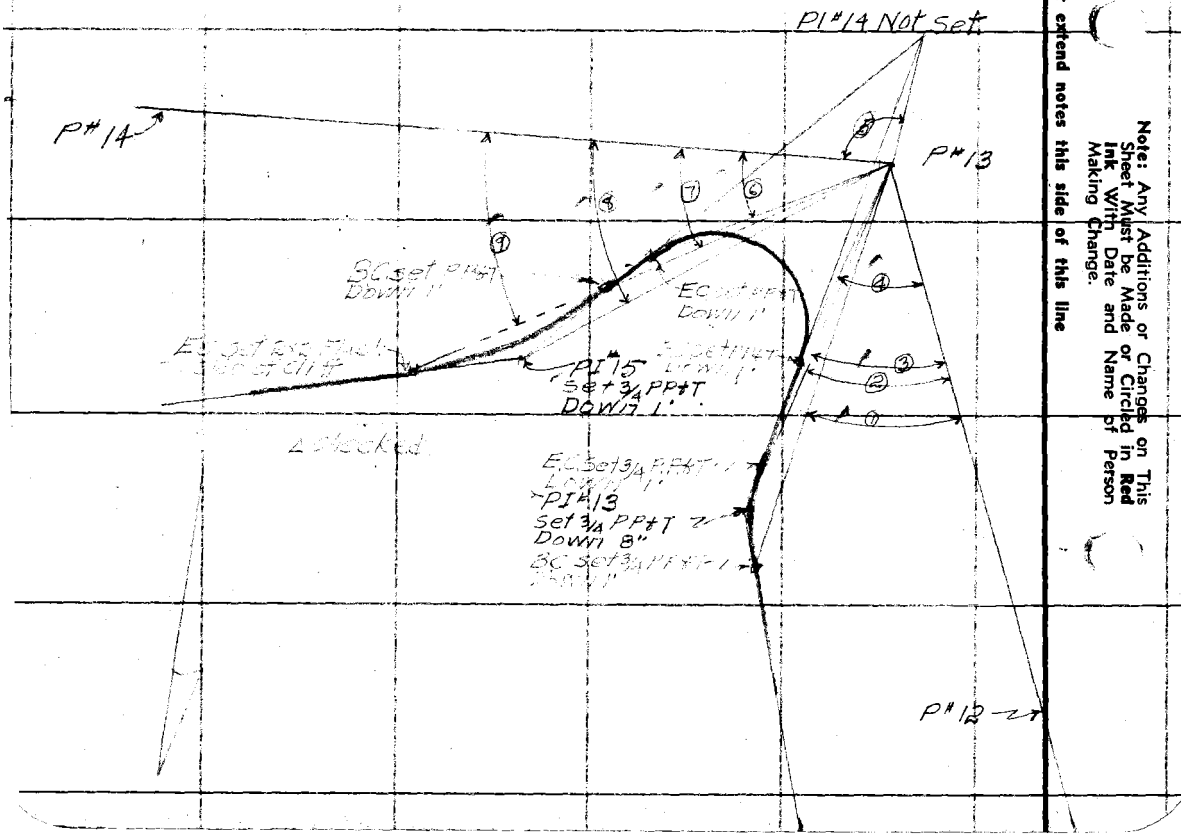

RETURN TO
LOS ANGELES COUNTY SURVEYOR
700 HALL OF RECORDS

Note: Any Additions or Changes on This Sheet Must be Made or Circled in Red Ink With Date and Name of Person Making Change.

Do not extend notes this side of this line

Notes Ck'd by Drew	Survey of Mt Wilson Toll Rd
Map No. B-1217-1	W. O. 8149 Tape No. 07 St'd 84° F.
Office Work F. A. W.	Surveyed by Benson
Checked Drew	Notes J.A.W. Date 2-10-37
Date 12-6-40	Indexed A. C. Johnson

F.B. 650 Pg. 59

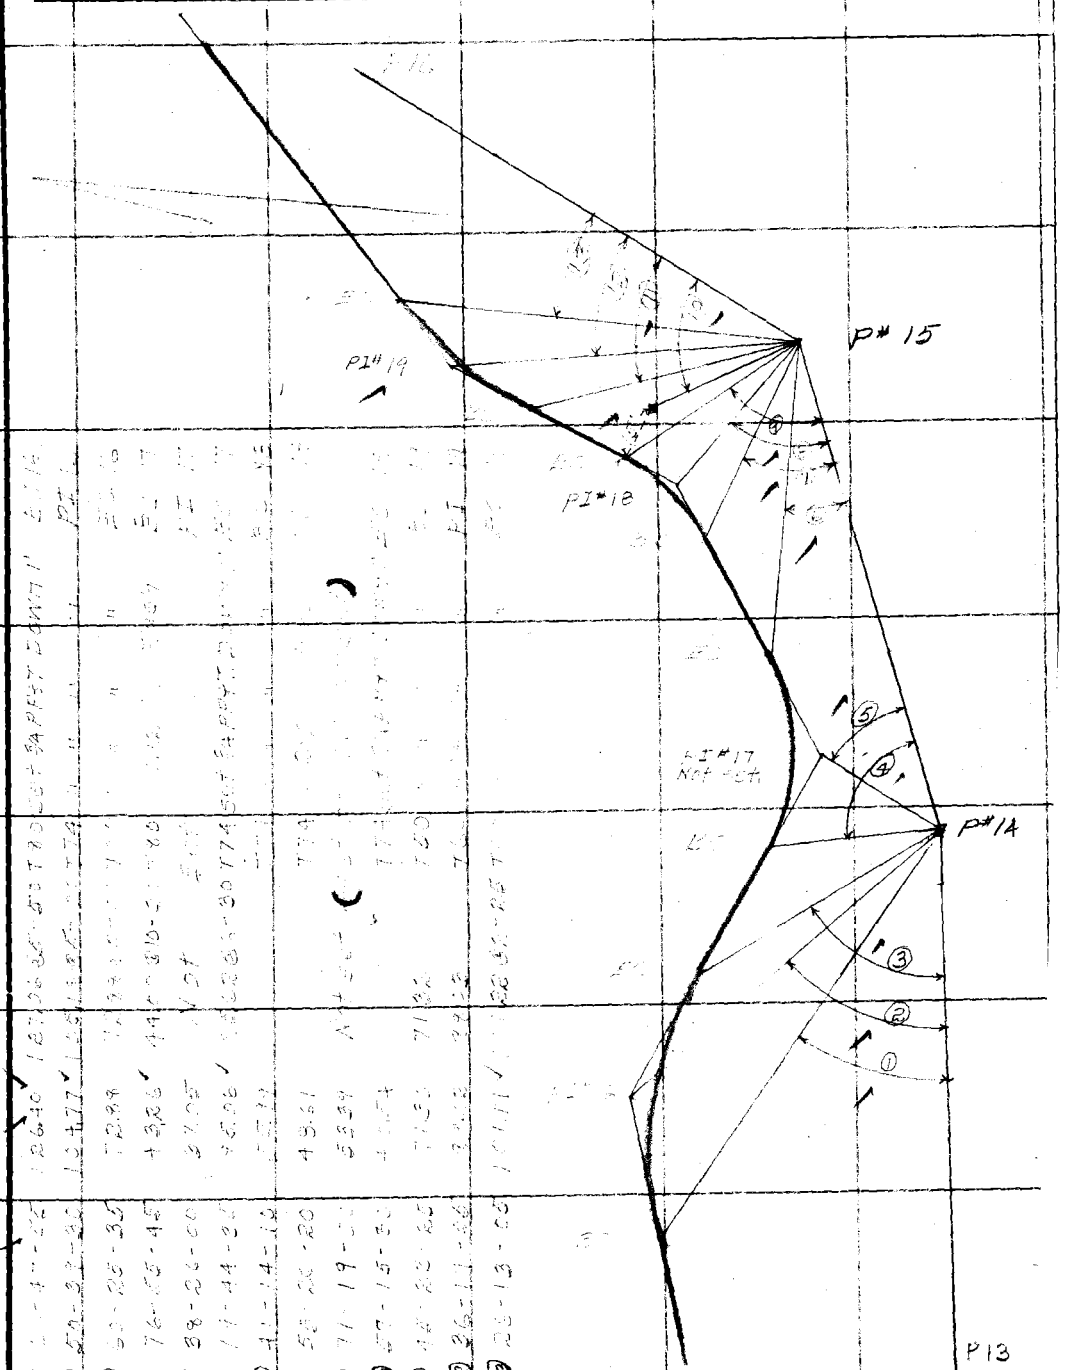

Note: Any Additions or Changes on This Sheet Must be Made or Circled in Red Ink With Date and Name of Person Making Change.

Do not extend notes this side of this line

RETURN TO
LOS ANGELES COUNTY SURVEYOR
700 HALL OF RECORDS

FORM 247 10M 11-35

RETURN TO
LOS ANGELES COUNTY SURVEYOR
700 HALL OF RECORDS

Note: Any Additions or Changes on This Sheet Must be Made or Circled in **Red Ink** With Date and Name of Person Making Change.

Do not extend notes this side of this line

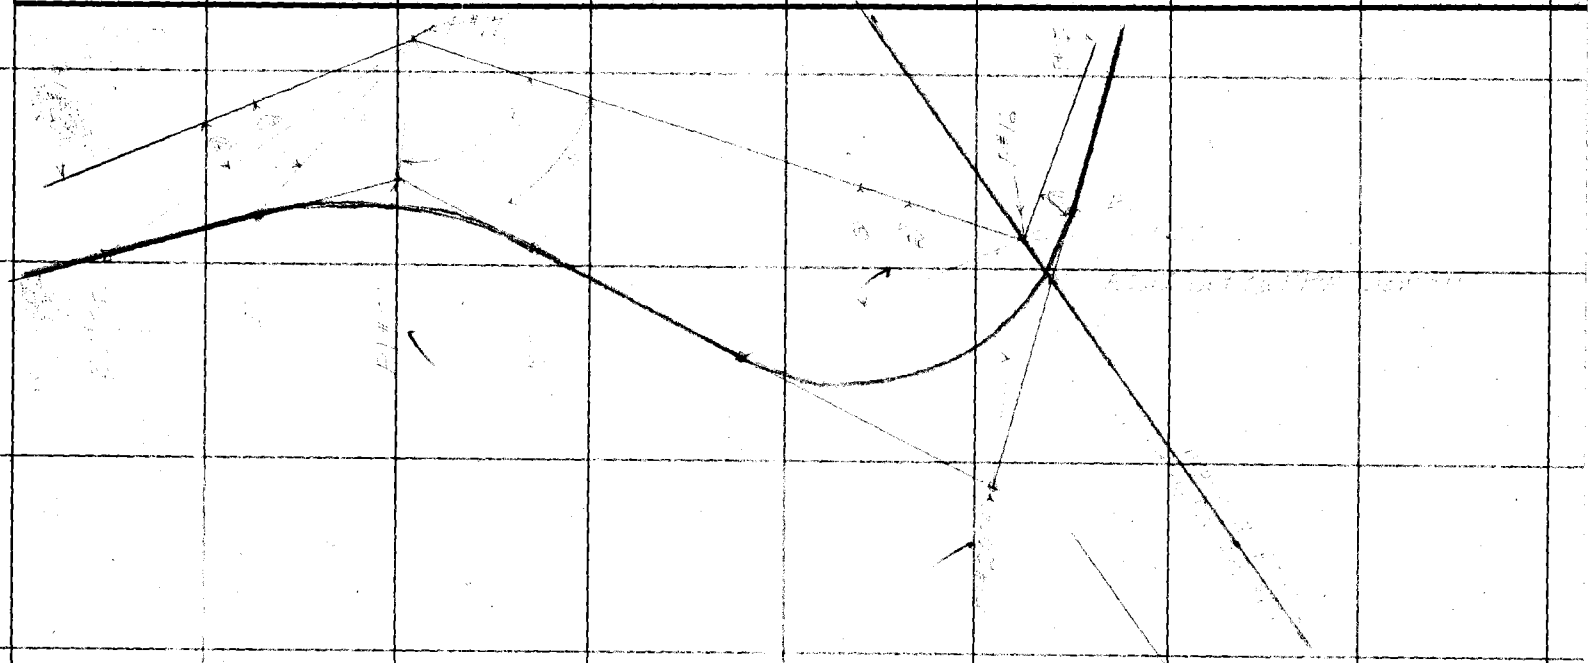

F.B. 650 PG. 60

FORM 247 10M 11-35

RETURN TO
LOS ANGELES COUNTY SURVEYOR
700 HALL OF RECORDS

Note: Any Additions or Changes on This Sheet Must be Made or Circled in Red Ink With Date and Name of Person Making Change.

Do not extend notes this side of this line

Notes Ck'd by _____
Map No. B-1217-1
Office Work F. A. W.
Checked _____
Date 12-6-40

Survey of MT Wilson Toll Rd
W. O. 3144 Tape No. 01 St'd 84°F.
Surveyed by CABenson
Notes JAW Date 2-16-31
Indexed _____

F.B. 650 Pg. 61

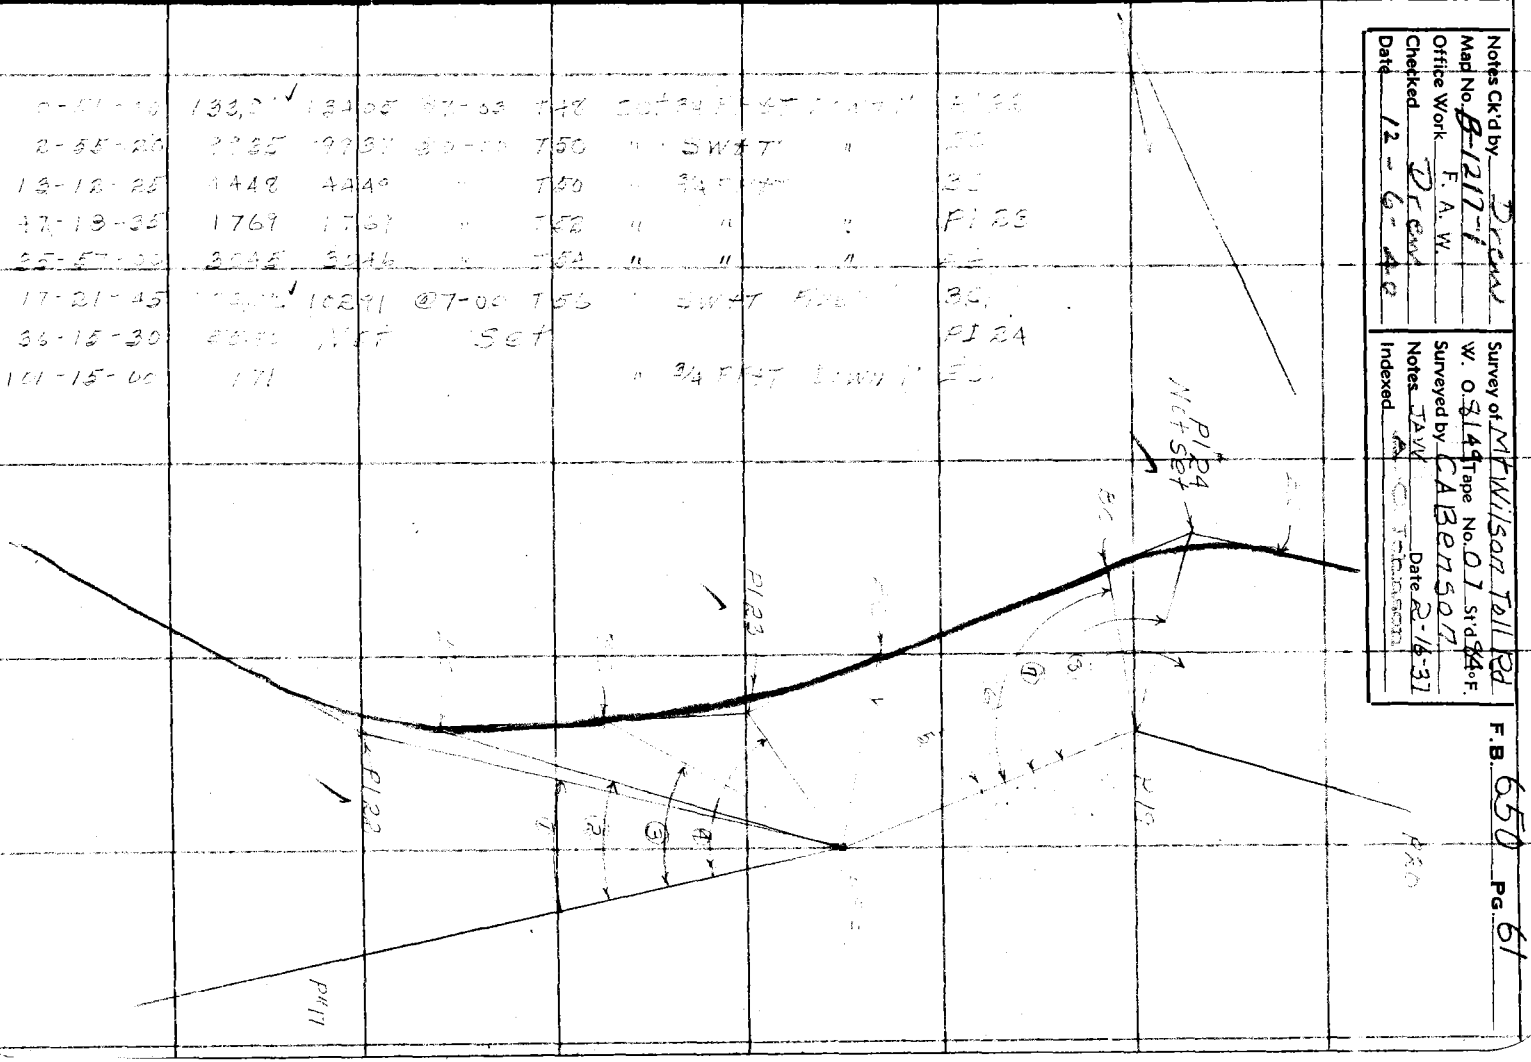

RETURN TO
LOS ANGELES COUNTY SURVEYOR
700 HALL OF RECORDS

Note: Any Additions or Changes on This Sheet Must be Made or Circled in **Red Ink** With Date and Name of Person Making Change.

Do not extend notes this side of this line

F.B. 650 PG. 62

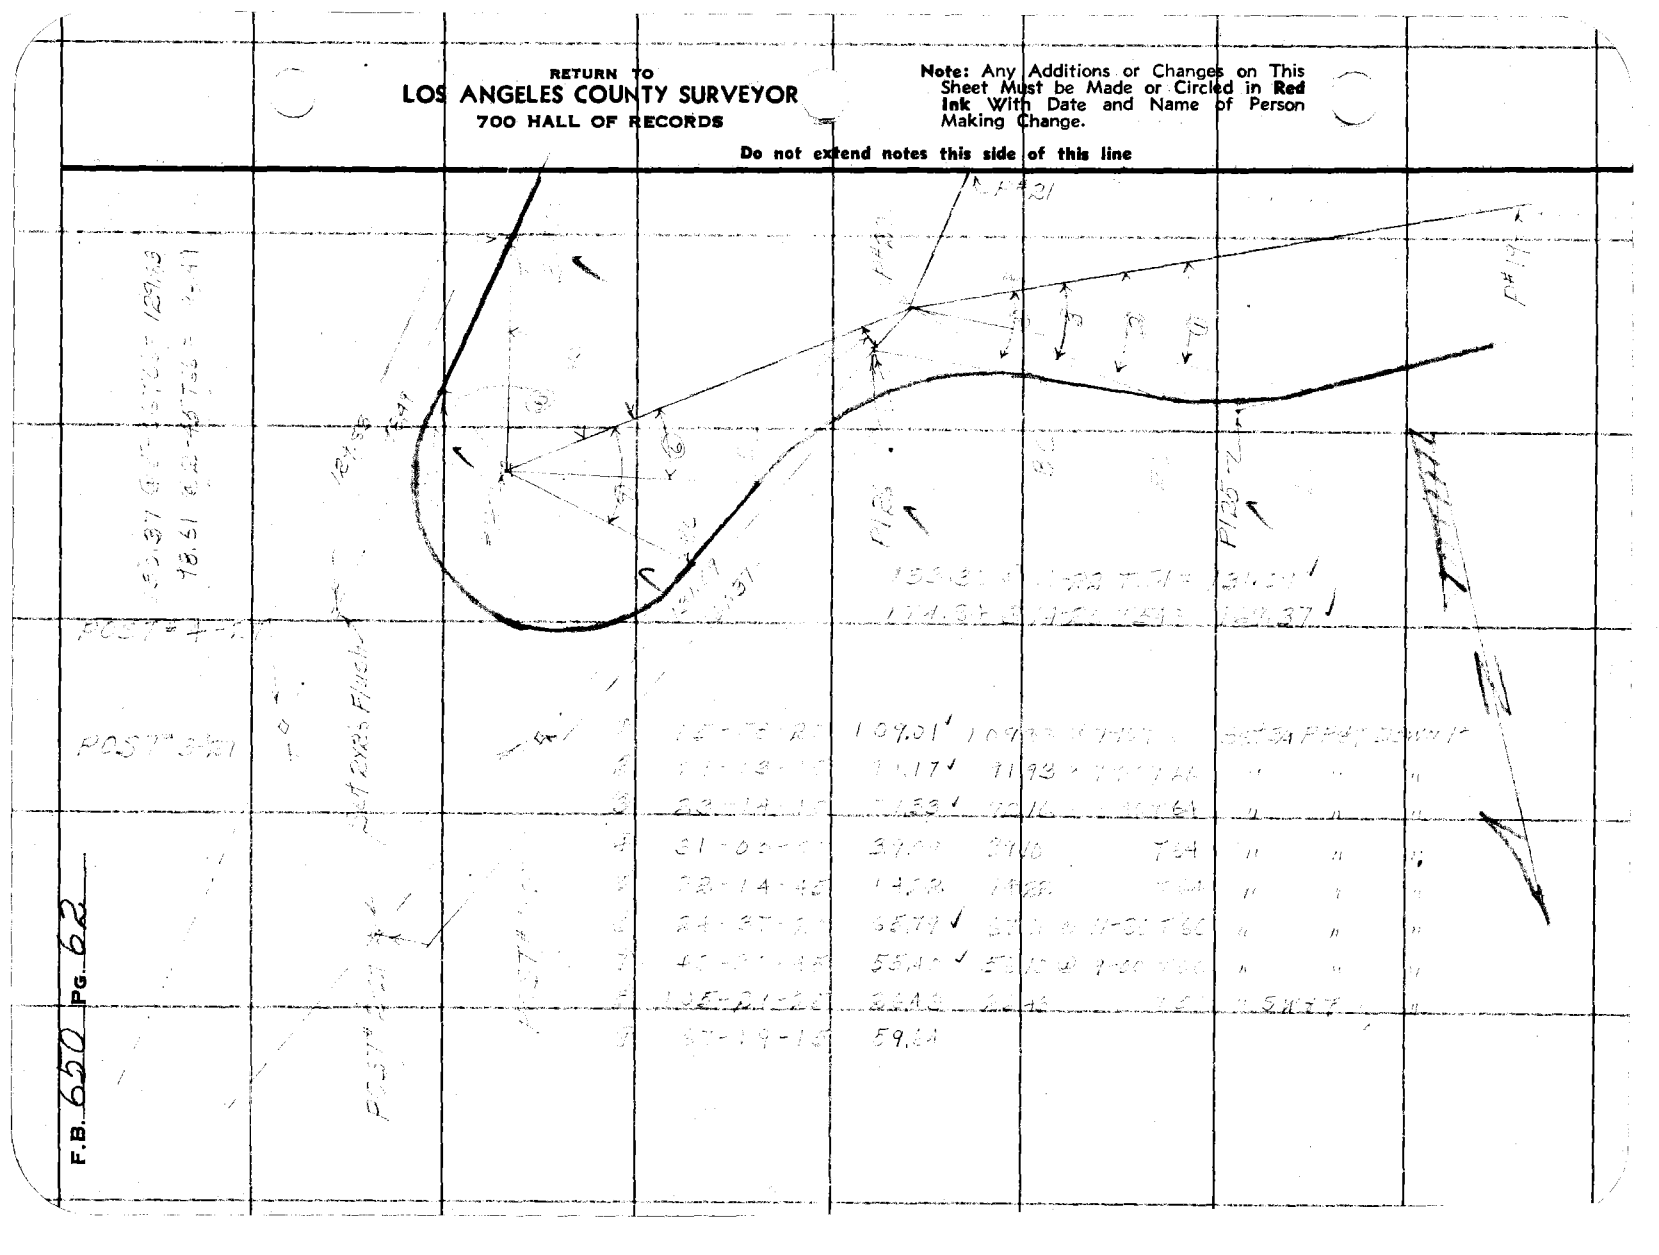

FORM 247 10M 11-35

RETURN TO
LOS ANGELES COUNTY SURVEYOR
700 HALL OF RECORDS

Note: Any Additions or Changes on This Sheet Must be Made or Circled in Red Ink With Date and Name of Person Making Change.

Do not extend notes this side of this line

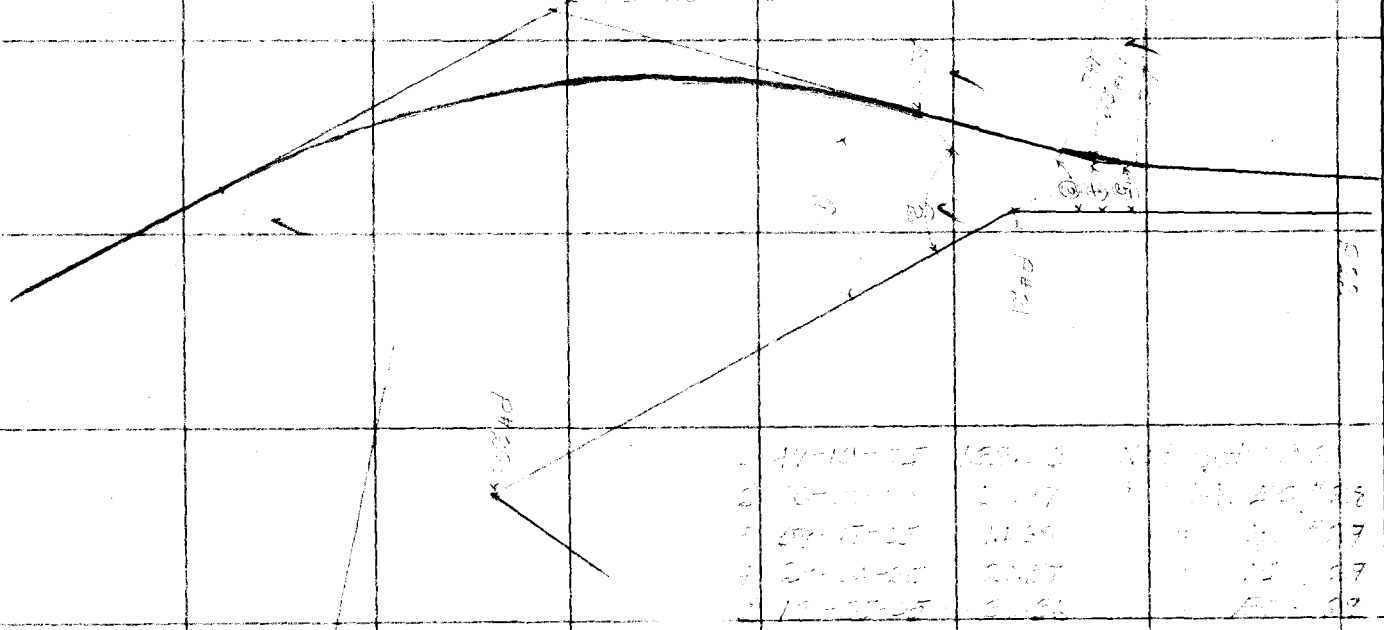

Notes Ck'd by TT BW
Map No. 8-1217-1
Office Work F. A. W.
Checked Drew
Date 12-6-40

Survey at Mt Wilson Talk
W. O. 8149 Tape No. 07 std 94° F.
Surveyed by C A Beason
Notes
Indexed A. C. Johnson Date 2/17/36

F.B. 550 PG. 69

RETURN TO
LOS ANGELES COUNTY SURVEYOR
700 HALL OF RECORDS

Note: Any Additions or Changes on This Sheet Must be Made or Circled in **Red Ink** With Date and Name of Person Making Change.

Do not extend notes this side of this line

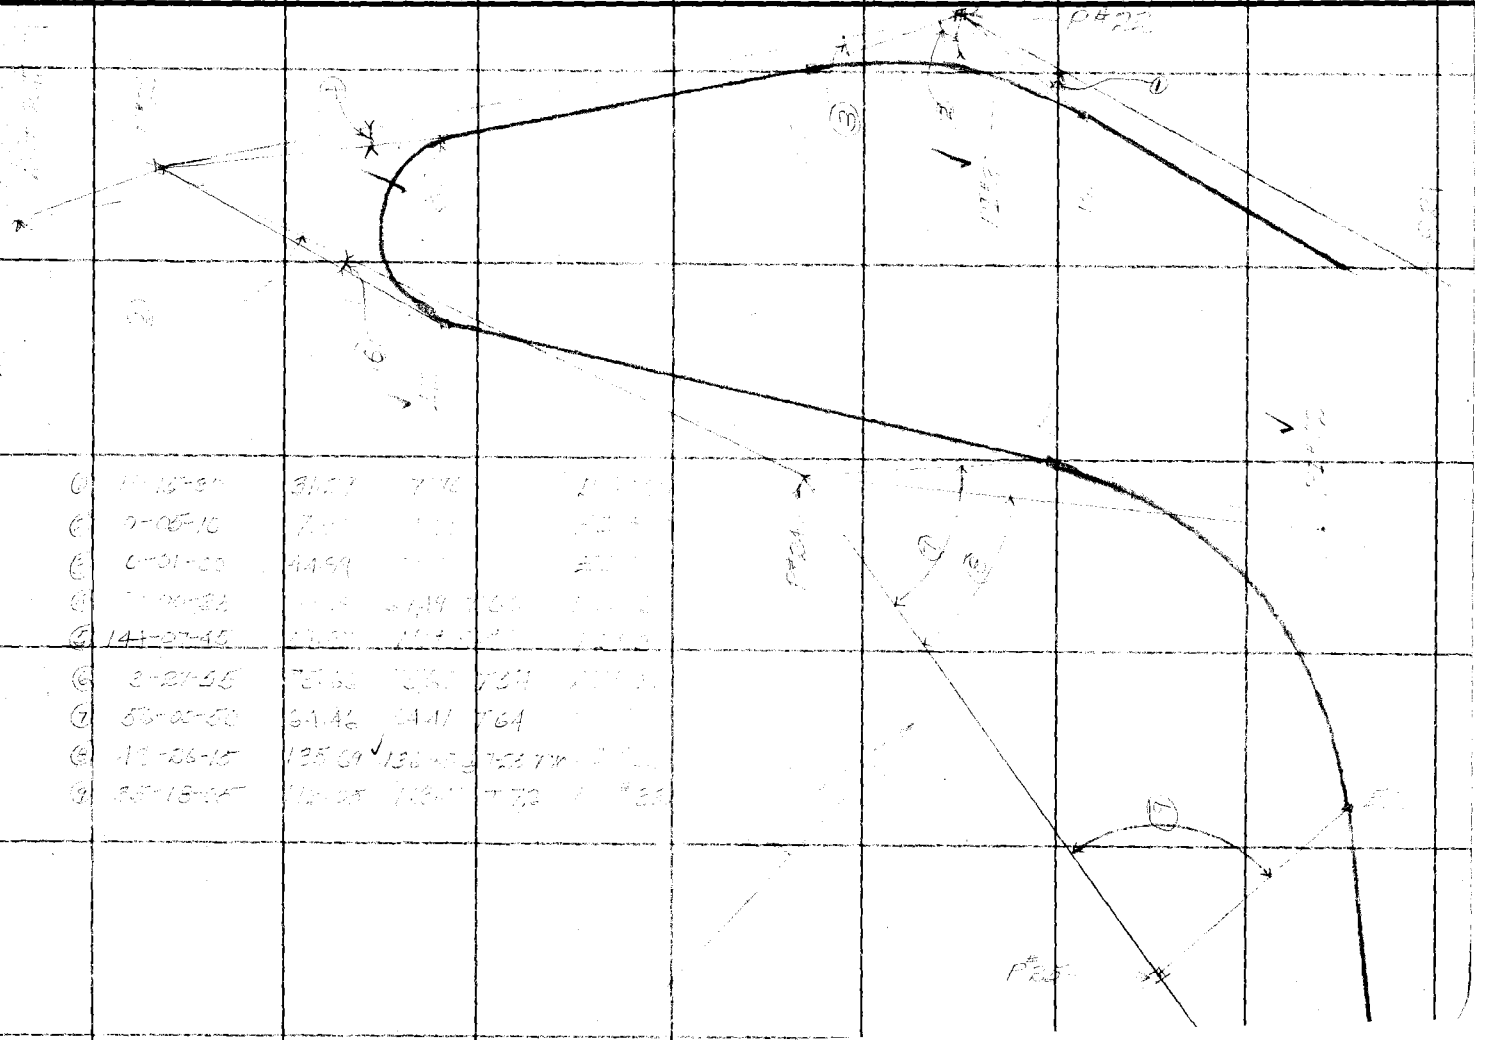

F.B. 650 Pg. 64

Notes Ck'd by DCW	Survey of MT WILSON TOLL RD	F.B. 650	Pg. 65
Map No. B-1217	W. O. 8149 Tape No. St'd °F.		
Office Work F. A. W.	Surveyed by W.A. Miller		
Checked DCW	Notes Miller Date 1977		
Date 12-6-46	Indexed A. O Johnson		

MT WILSON TOLL ROAD
SURVEY
STATION & POINTS
FOR
RE-ESTABLISHMENT
FIELD TO OFFICE 1"=86 feet

Jan 29 - Apr 12

Note: Any Additions or Changes on This Sheet Must be Made or Circled in Red Ink With Date and Name of Person Making Change.

Do not extend notes this side of this line

RETURN TO
LOS ANGELES COUNTY SURVEYOR
700 HALL OF RECORDS

FORM 247 10M 11-35

F.B. 650 Pg. 66

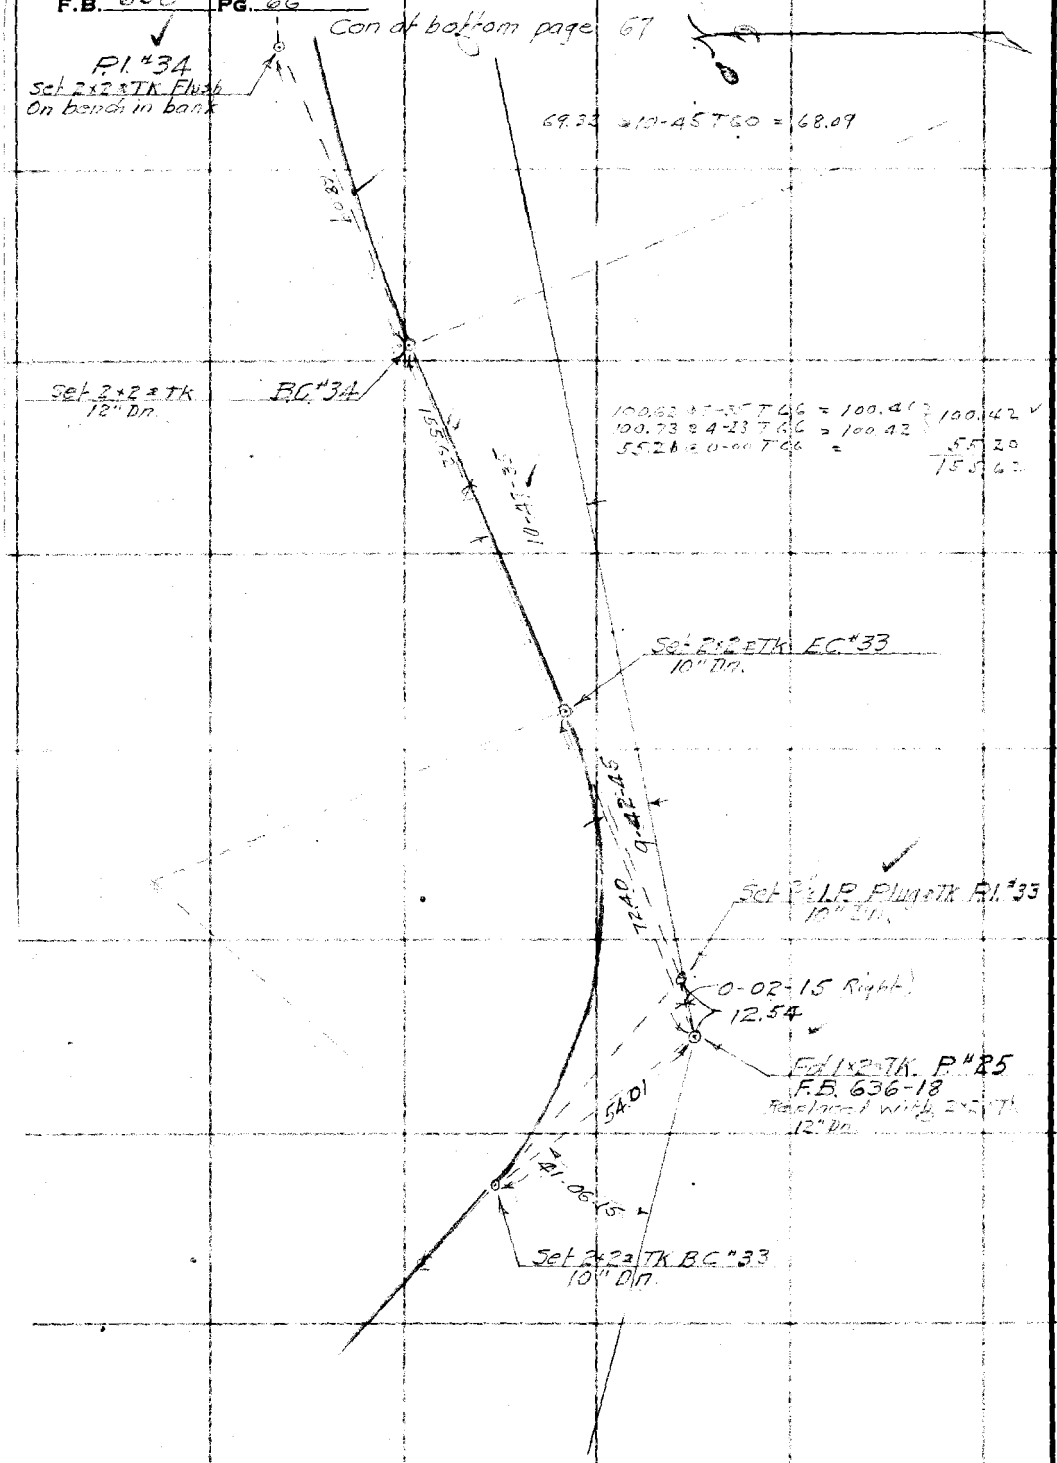

RETURN TO
LOS ANGELES COUNTY SURVEYOR
700 HALL OF RECORDS

Note: Any Additions or Changes on This Sheet Must be Made or Circled in Red Ink With Date and Name of Person Making Change.

Do not extend notes this side of this line

Notes Ck'd by Drew	Survey of MT. WILSON TOLL RD
Map No. ~~B-12~~ B-12?	W. O. 8149 Tape No. 06 St'd 94 °F.
Office Work F. A. W.	Surveyed by W. A. Miller
Checked Drew	Notes Miller Date 12-9-1937
Date 12-10-37	Indexed E. C. Johnson

F.B. 650 Pg. 67

Note: Any Additions or Changes on This Sheet Must be Made in Red Ink or Circled With Date and Name of Person Making Change.

Do not extend notes this side of this line

RETURN TO
LOS ANGELES COUNTY SURVEYOR
700 HALL OF RECORDS

Set 3/4" I.P. Plug-Tk EC "35
12" Dn

82-16-45

16.94

Fd 1½" Tk P "26
F.B. 636-49

25.43

54.18

Set 3/4" I.P. Plug-Tk P.L. "35
12" Dn

46

38-45

Set S.W.T. in Rock E.C. "35
6" Dn.

24-47-05

100.15 @ 6-42 T 60 = 99.75 99.75
100.35 @ 6-12 T 60 = 99.75
38.45 @ 0-00 T 60 = 38.45
138.20

138.20

14-14-35

Set 2-F.-Tk E.C. "34
12" Dn.

Set 2x2-Tk Flush P.L. "34
On bench in bank

FORM 247 10M 11-35

F.B. 650 Pg. 68

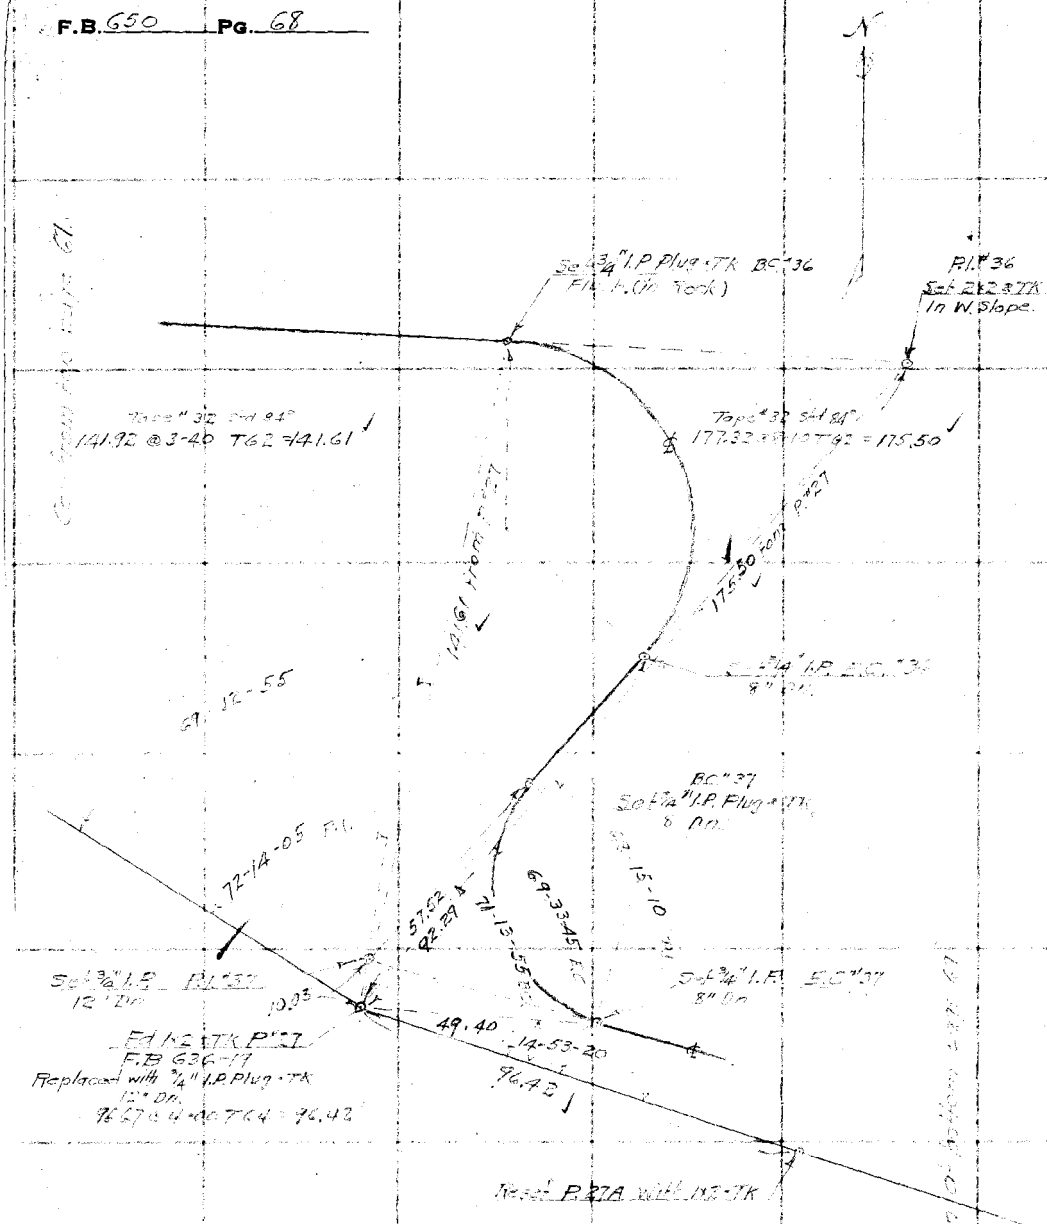

RETURN TO
LOS ANGELES COUNTY SURVEYOR
700 HALL OF RECORDS

Note: Any Additions or Changes on This Sheet Must be Made or Circled in Red Ink With Date and Name of Person Making Change.

Do not extend notes this side of this line

Notes Ck'd by JW ew	Survey of MT WILSON TOLL RD
Map No. B-1217-1	W. O. 8149 Tape No. 06 St'd 84 °F.
Office Work F. A. W.	Surveyed by W.A.M. Jr.
Checked JW ew	Notes Miller Date Jan 1937
Date 12-10-40	Indexed A. C. Johnson

F.B. 652 Pg. 69

Note: Any Additions or Changes on This Sheet Must be Made or Circled in Red Ink With Date and Name of Person Making Change.

Do not extend notes this side of this line

RETURN TO
LOS ANGELES COUNTY SURVEYOR
706 HALL OF RECORDS

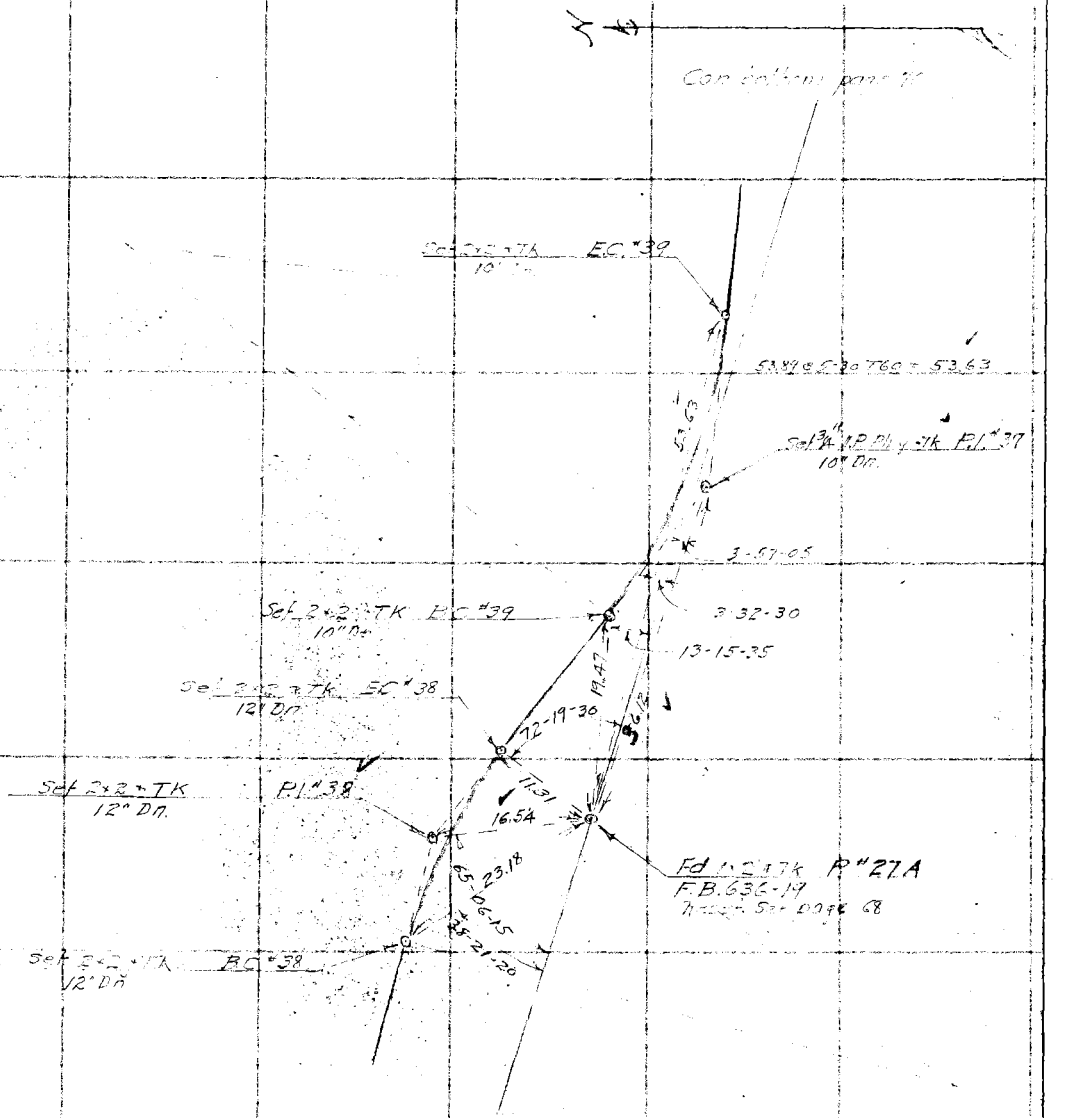

FORM 247 10M 11-38

F.B. 650 Pg. 70

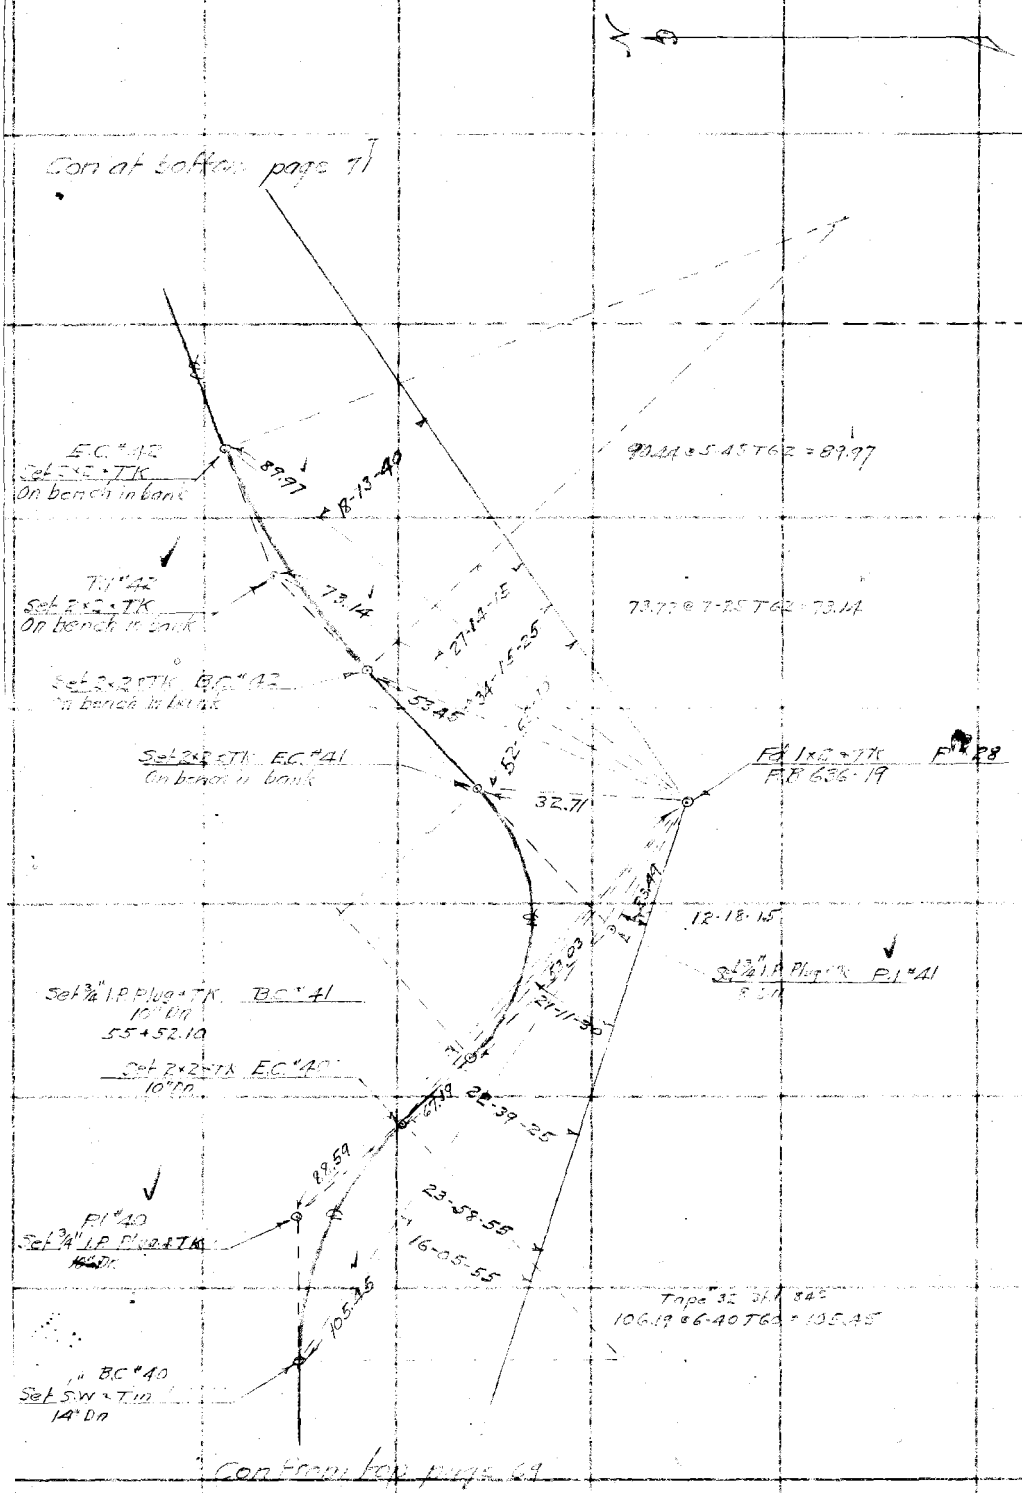

RETURN TO
LOS ANGELES COUNTY SURVEYOR
700 HALL OF RECORDS

Note: Any Additions or Changes on This Sheet Must be Made or Circled in Red Ink With Date and Name of Person Making Change.

Do not extend notes this side of this line

Map No. B-1217-1	W. O. 8147 Tape No. 06 St'd 74°F.
Office Work F. A. W.	Surveyed by W. A. Miller
Checked Drew	Notes Miller Date Feb 1937
Date 12-10-40	Indexed C. Johnson

F.B. 650 Pg. 71

Con. at Last Sta. page 72

Set 3/4" I.P. Plug & TK in Rocky bank

37-30

48.12 @ 6-20 T60 = 47.82

P #30
Set 2x2 & TK
F.B. 636-20

P.I. #45
Set 2x2 & TK
0.04 Chs East of P #30 3" Un

Set 3/4" I.P. Plug & TK 10" Dn. B.C. #45

47.76

63-56-05

Set 2x2 & TK 10" Dn. E.C. #44

72-14

156.17 @ 4-33 T60 = 155.66
156.25 @ 4-55-30 T60 = 155.66 } 155.66

Set 3/4" I.P. Plug & TK Rocky bank on E. Side of Ivins St.

155.66 from P.I. #45

54-45

P.I. #44 Not Set

Set 2x2 & TK Flush in Sidewalk B.C. #44

105.45 @ 5-00 T60 = 105.47

59-53-40

105.03

71-31-05

P #29
Set 2x2 & TK
F.B. 636-20

Set 2x2 & TK In rock bank E.C. #43

136.84

Set 3/4" I.P. Plug & TK 10" Dn.

P.I. #43

90-08-25

35.91

33.12

Set 2x2 & TK 10" Dn. B.C. #43

Con. from top page 70

Note: Any Additions or Changes on This Sheet Must be Made or Circled in Red Ink With Date and Name of Person Making Change.

Do not extend notes this side of this line

RETURN TO
LOS ANGELES COUNTY SURVEYOR
700 HALL OF RECORDS

FORM 247 10M 11-38

F.B. 650 Pg. 72

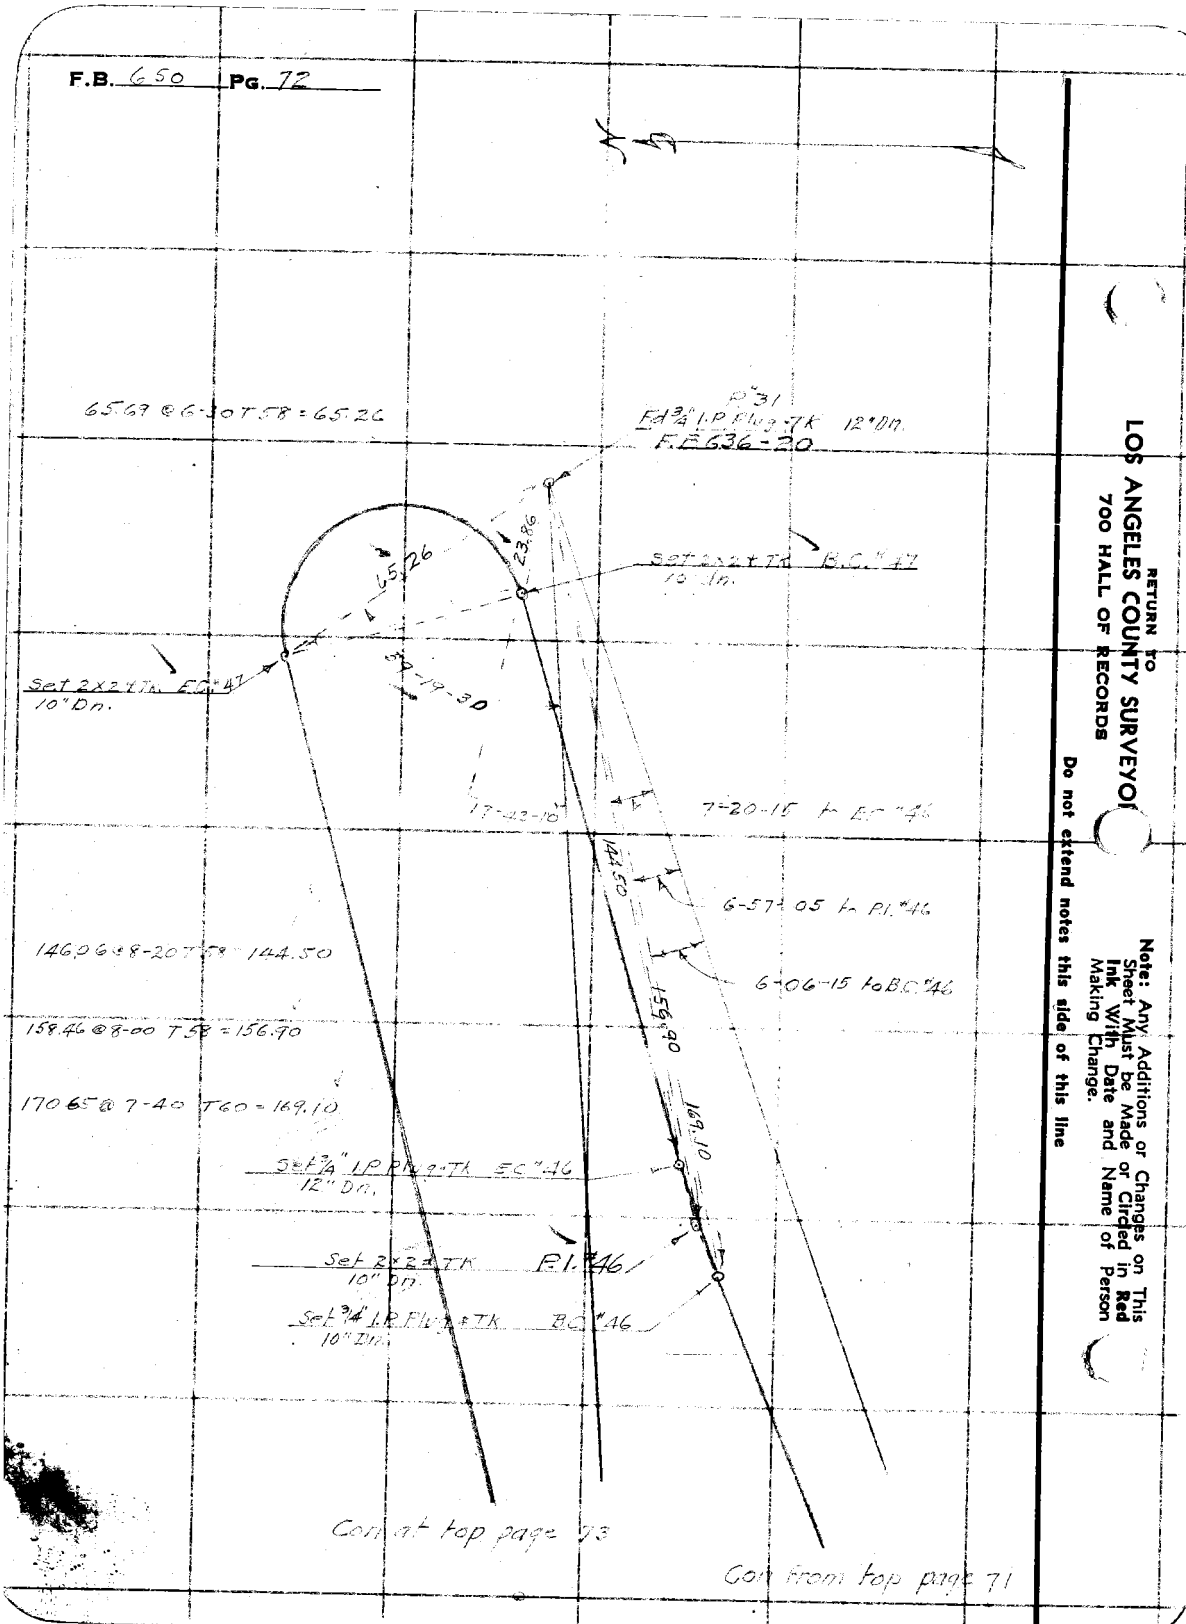

Cont. top page 73

Con from top page 71

RETURN TO
LOS ANGELES COUNTY SURVEYOR
700 HALL OF RECORDS

Do not extend notes this side of this line

Note: Any Additions or Changes on This Sheet Must be Made or Circled in Red Ink With Date and Name of Person Making Change.

Notes Ck'd by: Drew	Survey of: MT WILSON TOLL RD	F.B. 630	Pg. 78
Map No. B-1217-1	W. O. 2149 Tape No. 06 St'd 44 °F.		
Office Work: F. A. W.	Surveyed by: W. A. Miller		
Checked: Drew	Notes: Miller Date: Feb 1927		
Date: 12-10-40	Indexed: C. Johnson		

Note: Any Additions or Changes on This Sheet Must be Made or Circled in Red Ink With Date and Name of Person Making Change.

Do not extend notes this side of this line

RETURN TO
LOS ANGELES COUNTY SURVEYOR
700 HALL OF RECORDS

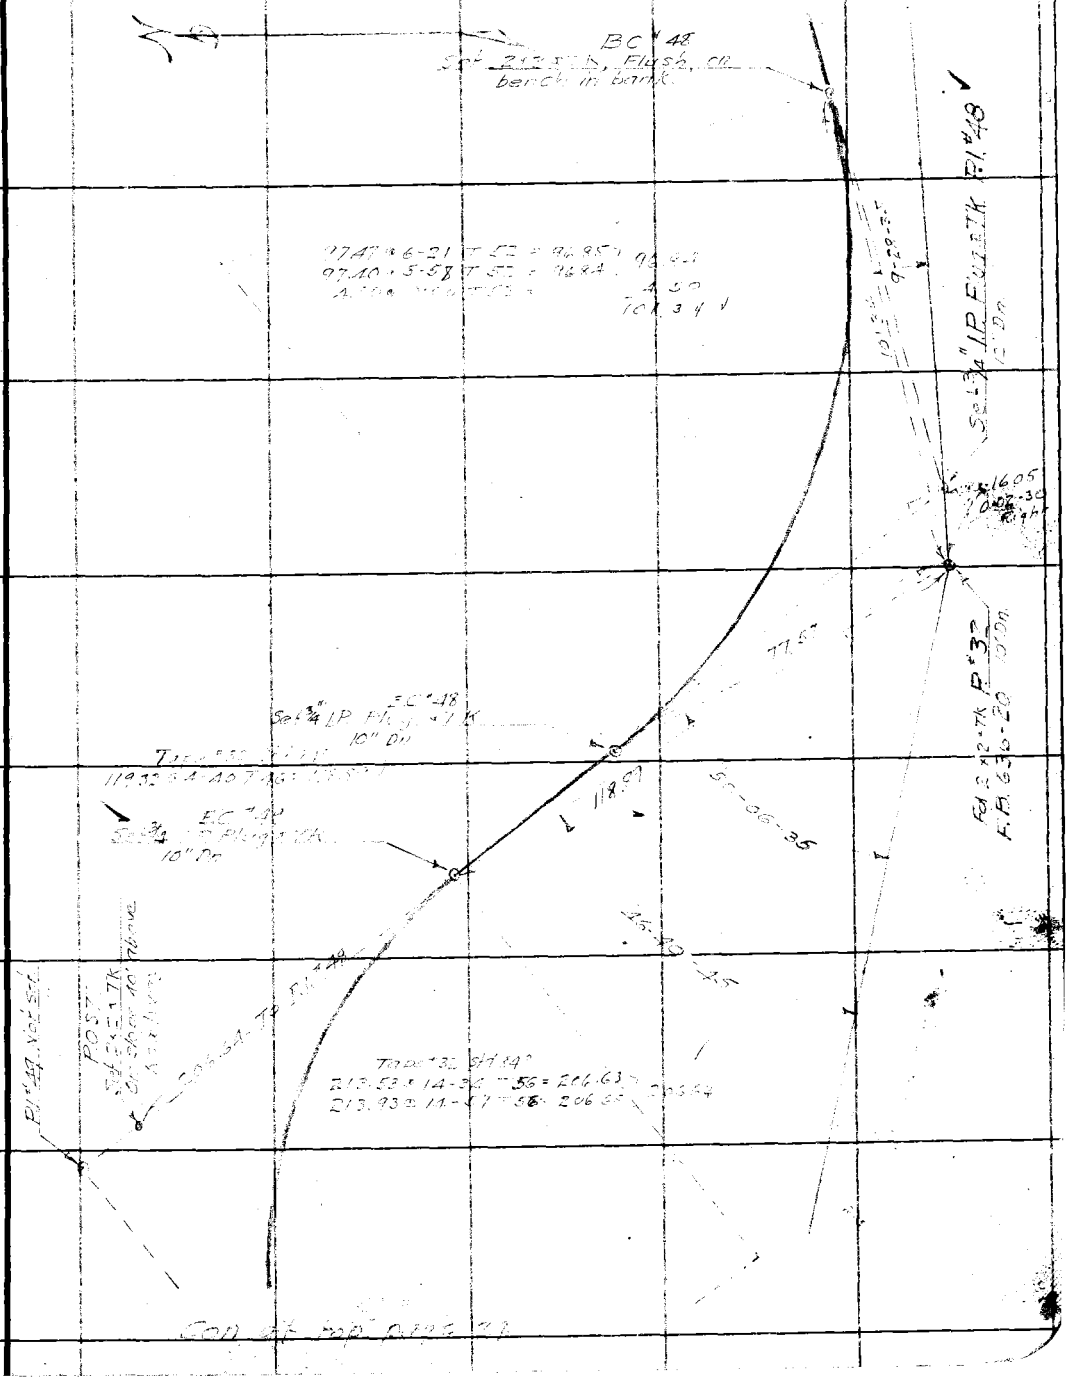
BC 48
Sq. 2½" D, Flush, on bench in bank
Set ¾" IP Flush with TK
10" Dn

F.B. 650 PG. 74

Con from bottom page 73

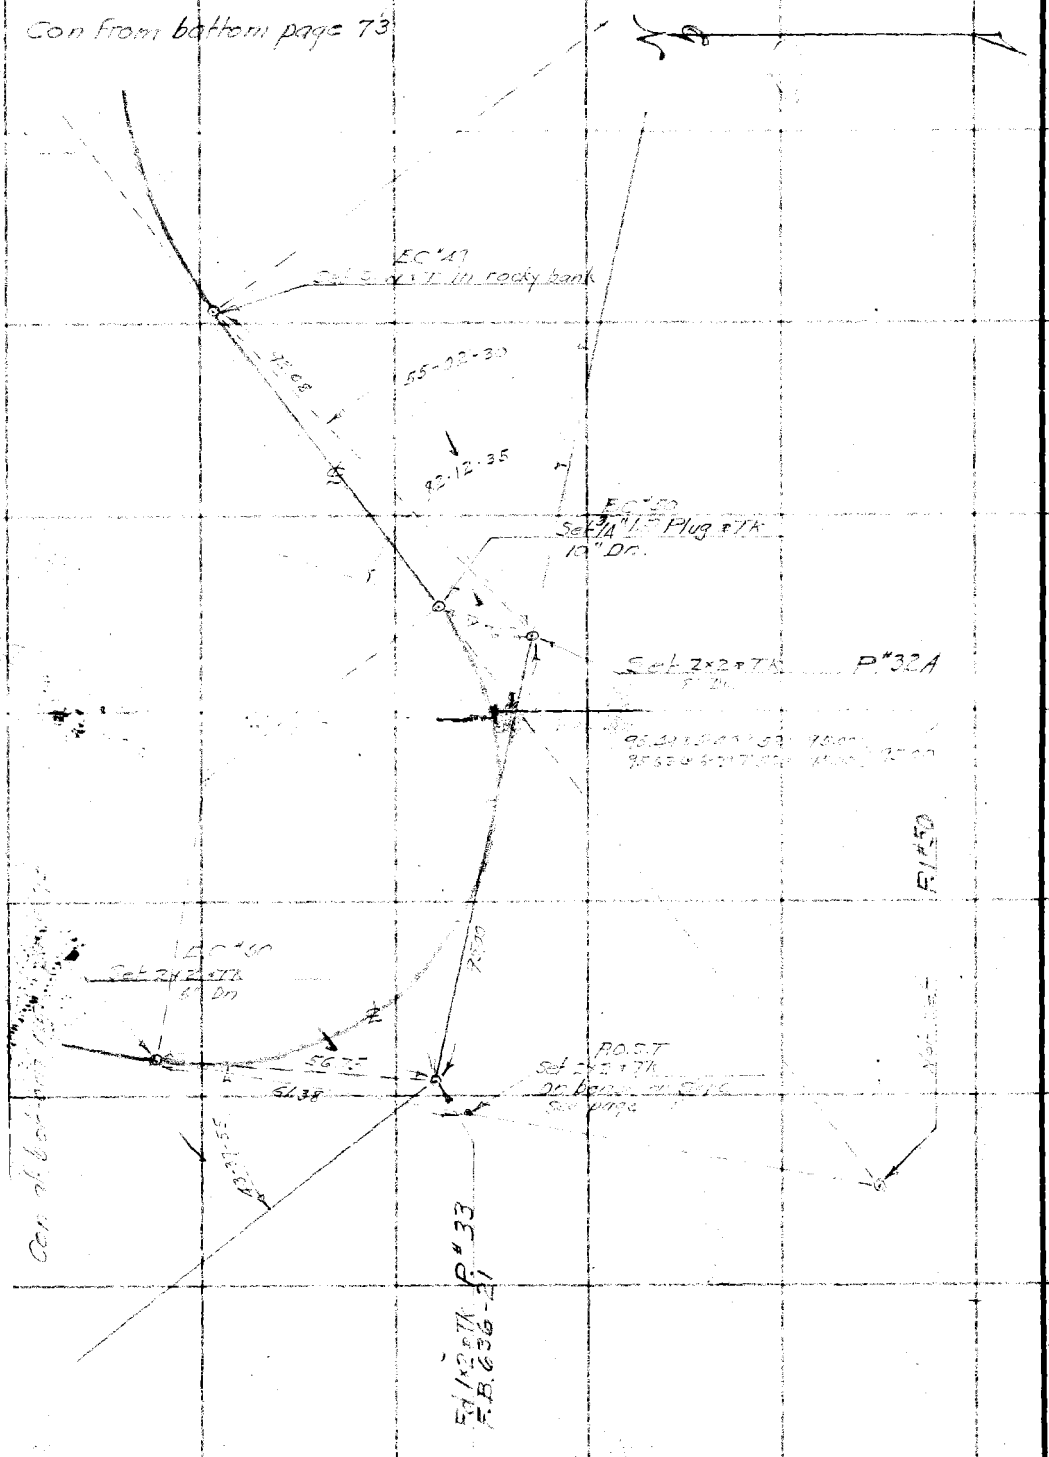

RETURN TO
LOS ANGELES COUNTY SURVEYOR
700 HALL OF RECORDS

Note: Any Additions or Changes on This Sheet Must be Made or Circled in Red Ink With Date and Name of Person Making Change.

Do not extend notes this side of this line

Notes Ck'd by Drew	Survey of Mt Wilson - Idlewild
Map No. B-1217-1	W. O. 8149 Tape No. 26 St'd 84 °F.
Office Work F. A. W.	Surveyed by W. A. [illegible]
Checked Drew	Notes Mills Date 5-6 1927
Date 12-10-40	Indexed C. Johnson

F.B. 650 Pg. 75

Note: Any Additions or Changes on This Sheet Must be Made or Circled In Red Ink With Date and Name of Person Making Change.

Do not extend notes this side of this line

RETURN TO
LOS ANGELES COUNTY SURVEYOR
700 HALL OF RECORDS

FORM 247 10M 11-35

F.B. 650 Pg. 76

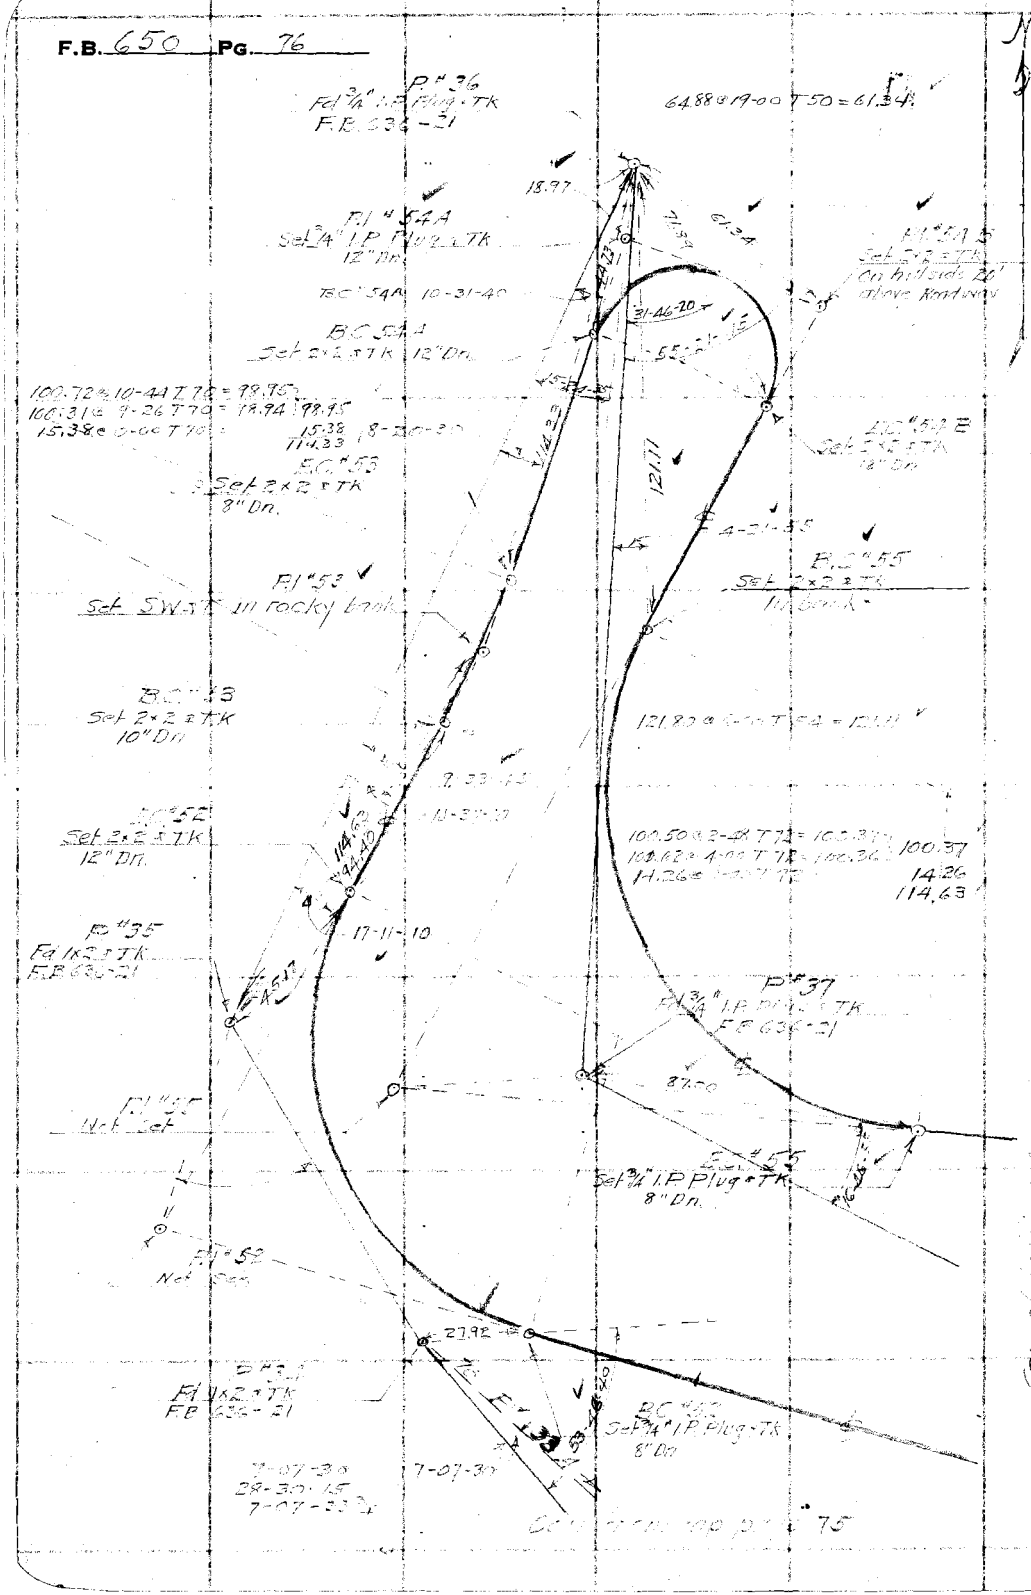

RETURN TO
LOS ANGELES COUNTY SURVEYOR
700 HALL OF RECORDS

Note: Any Additions or Changes on This Sheet Must be Made or Circled in Red Ink With Date and Name of Person Making Change.

Do not extend notes this side of this line

Notes Ck'd by Drew	Survey of MT WILSON TOLL RD
Map No. B-1217-1	W. O. 8149 Tape No. 06 St'd 84 °F.
Office Work F. A. W.	Surveyed by W. A. Miller
Checked Drew	Notes Miller Date Feb 1937
Date 12-10-40	Indexed A. C. Johnson

F.B. 650 Pg. 77

Note: Any Additions or Changes on This Sheet Must be Made or Circled in Red Ink With Date and Name of Person Making Change.

Do not extend notes this side of this line

RETURN TO
LOS ANGELES COUNTY SURVEYOR
700 HALL OF RECORDS

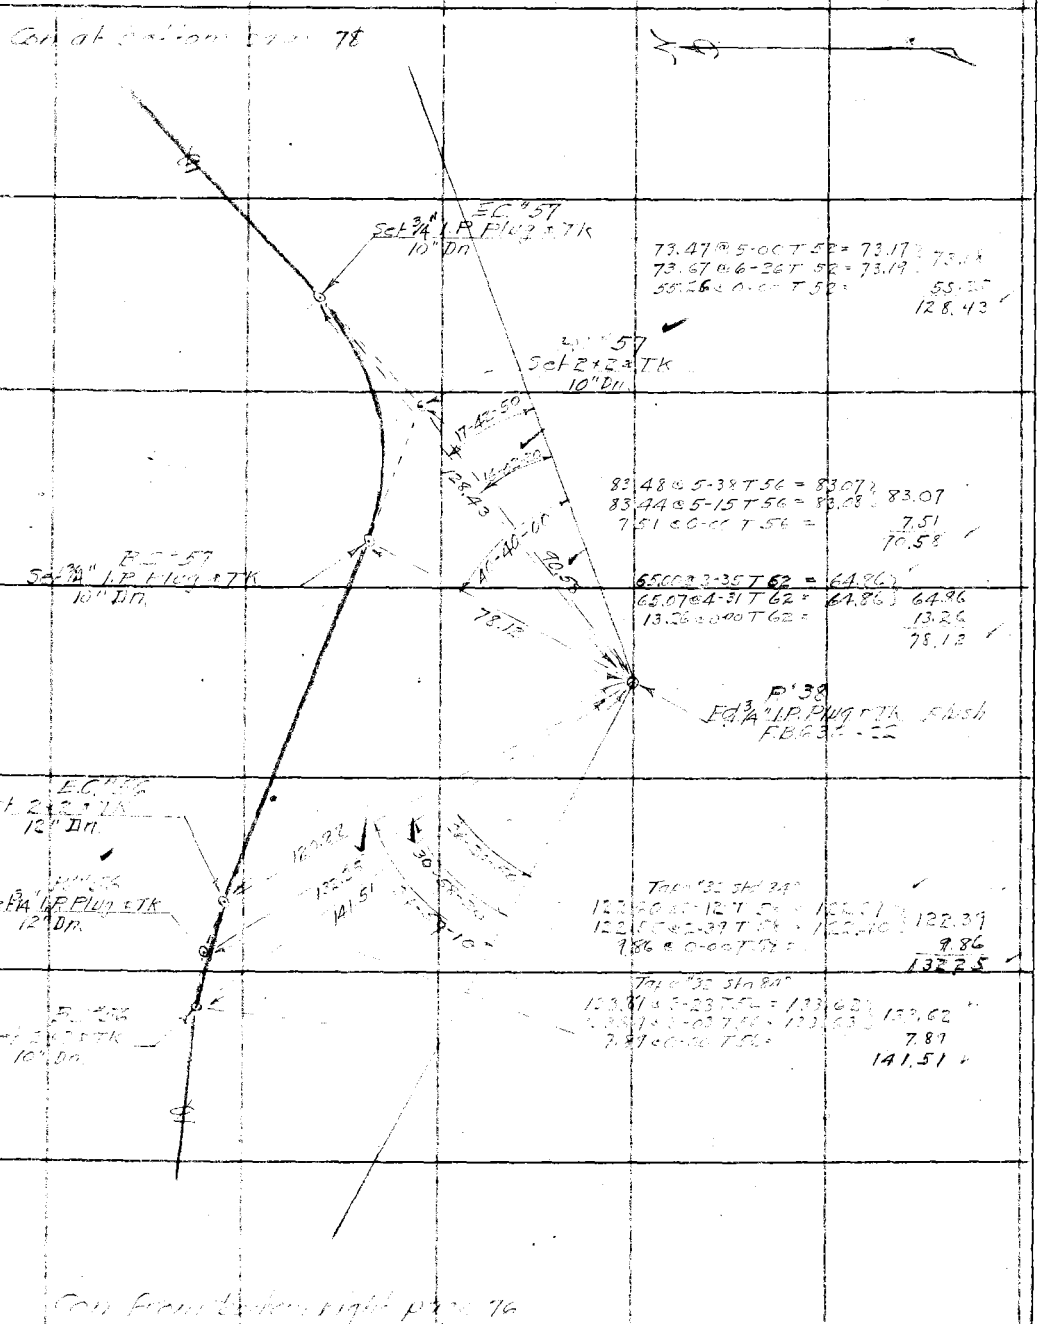

73.47 @ 5-00 T 58 = 73.17
73.67 @ 6-26 T 58 = 73.19
55.26 @ 0-00 T 58 = 55.26
128.43

83.48 @ 5-38 T 56 = 83.07
83.44 @ 5-15 T 56 = 83.07
7.51 @ 0-00 T 56 = 7.51
70.58

65.00 @ 3-35 T 62 = 64.86
65.07 @ 4-31 T 62 = 64.86
13.26 @ 0-00 T 62 = 13.26
78.12

122.39
9.86
132.25

122.39
7.87
141.51

Can. from Section right p[illegible] 76

FORM 247 10M 11-35

F.B. 650 Pg. 78

Con'd. bottom pg = 79

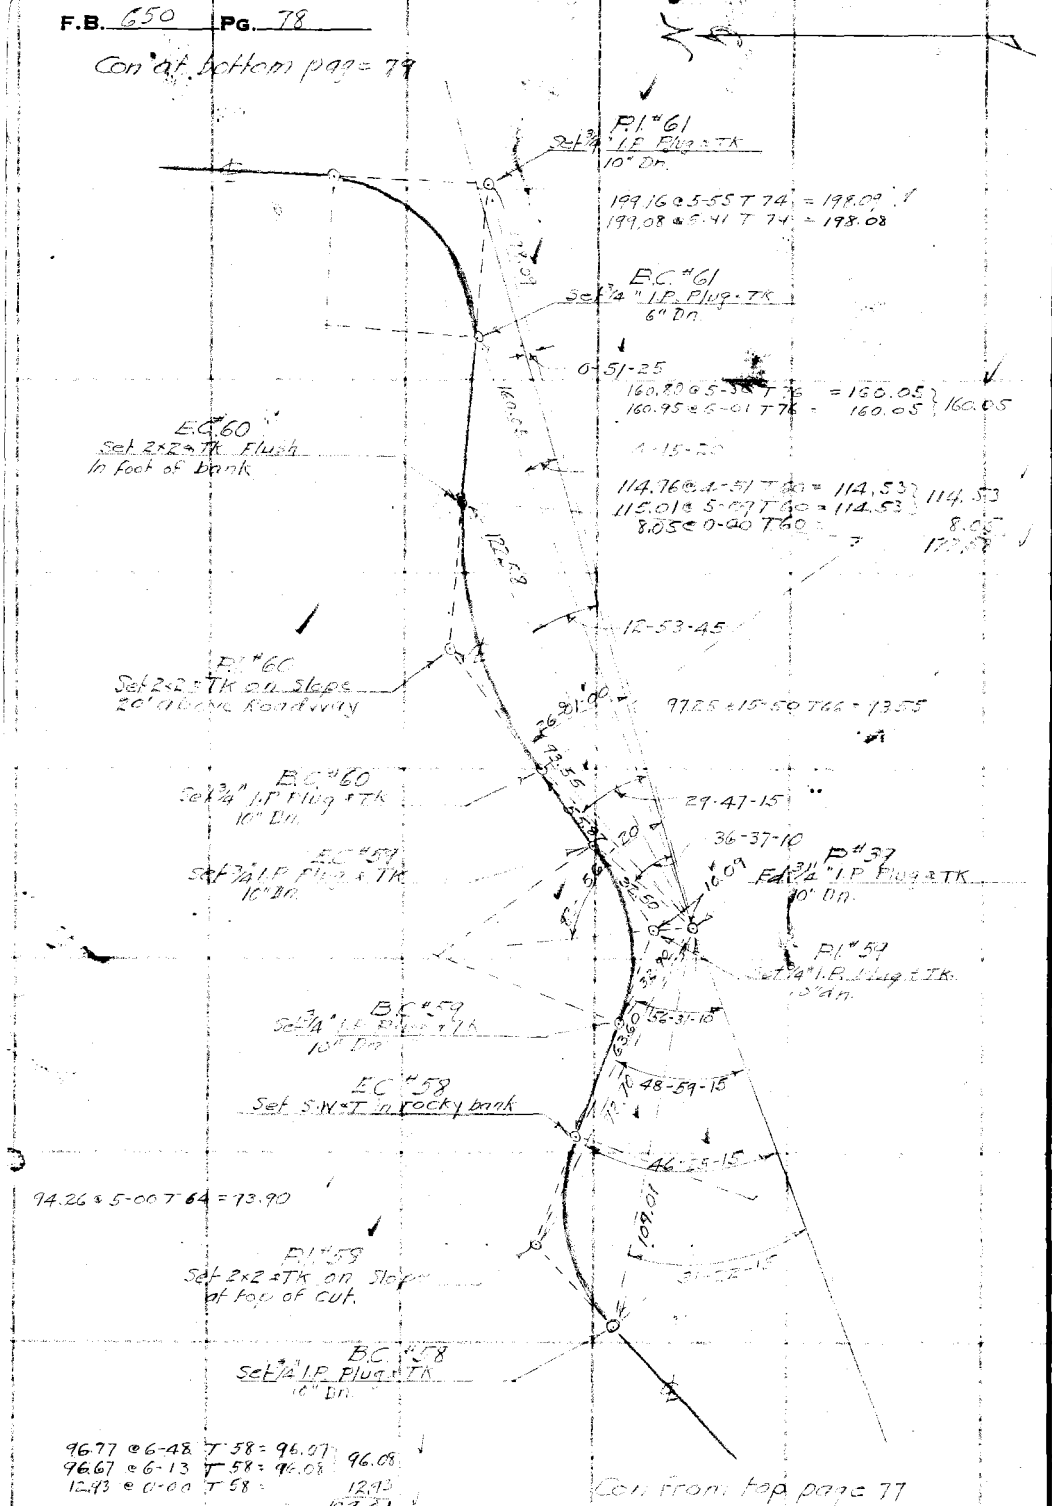

RETURN TO
LOS ANGELES COUNTY SURVEYOR
700 HALL OF RECORDS

Note: Any Additions or Changes on This Sheet Must be Made or Circled in Red Ink With Date and Name of Person Making Change.

Do not extend notes this side of this line

Notes Ck'd by DRCW	Survey of MT WILSON TOLL RD
Map No. B-1217-1 F. A. W.	W. O. 8149 Tape No. 32 St'd 71 °F.
Office Work	Surveyed by WA Miller
Checked DRCW	Notes Miller Date Mar 1937
Date 12-11-40	Indexed A. C. Johnson

F.B. 650 PG. 79

Note: Any Additions or Changes on This Sheet Must be Made or Circled in Red Ink With Date and Name of Person Making Change.

Do not extend notes this side of this line

RETURN TO
LOS ANGELES COUNTY SURVEYOR
700 HALL OF RECORDS

FORM 247 10M 11-38

Cou'r bolt in rock 80

LC "63
Set SW 1"
in Rock bank

E 1¾" I.P. in Plug "TK
F.B. 536-23

E "63
Set 1¾" I.P. Plug "TK
8" Dn.

12-07-30

"63
Set SW 1"
in Rock bank

158.99 @ 6-10 T80 = 158.07
159.97 @ 6-31 T80 = 159.08

39-59-35

38-58-25

214.39 @ 6-45 T76 = 212.87
214.34 @ 6-39 T76 = 212.87

E "63
Set 1¾" I.P.
in bank Plug "TK"

21-30-05

210.60 @ 6-44 T76 = 208.15
210.34 @ 6-43 T76 = 208.16

215.89

P.I. "62
Set 1¾" I.P. Elev.
On Slope 25' above Road
W'ly

Set 1¾" I.P. Plug "TK
8" Dn.

78

F.B. 650 PG. 80

Con of bottom page 81

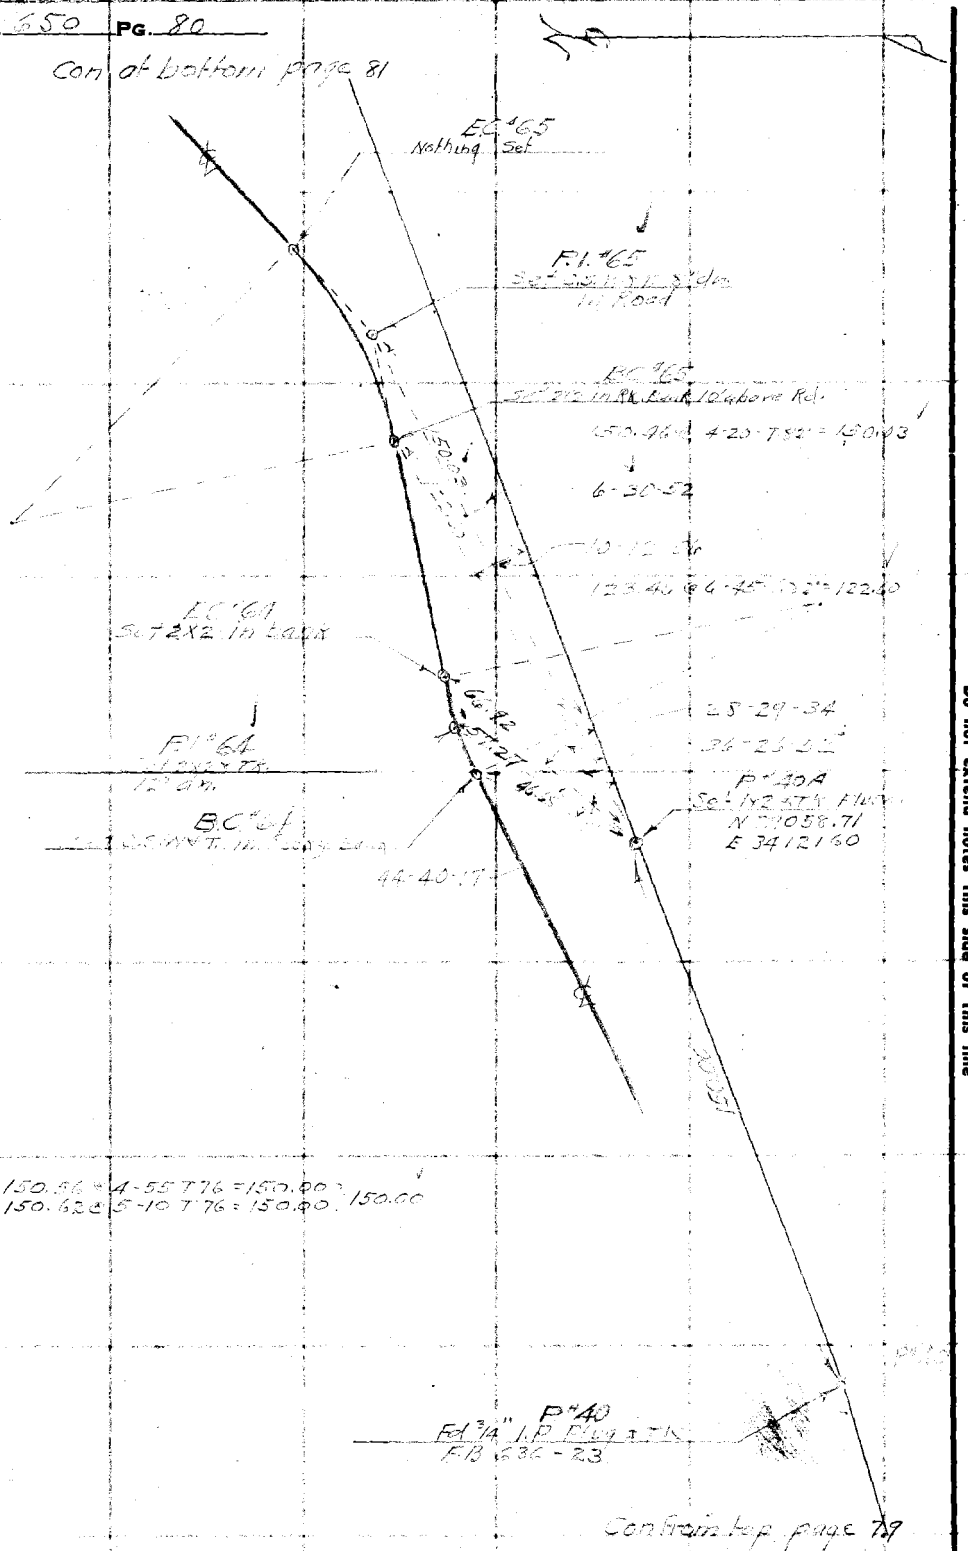

Continue top page 79

RETURN TO
LOS ANGELES COUNTY SURVEYOR
700 HALL OF RECORDS

Note: Any Additions or Changes on This Sheet Must be Made or Circled in Red Ink With Date and Name of Person Making Change.

Do not extend notes this side of this line

Notes Ck'd by Drew	Survey of MT WILSON TOLL RD
Map No. B-1217-1	W. O. 8149 Tape No. 63 St'd 87 °F.
Office Work F. A. W.	Surveyed by W.A. Miller
Checked Drew	Notes Miller Date Apr 1937
Date 12-11-40	Indexed C. Johnson

F.B. 600 Pg. 81

Note: Any Additions or Changes on This Sheet Must be Made or Circled in Red Ink With Date and Name of Person Making Change.

Do not extend notes this side of this line

RETURN TO
LOS ANGELES COUNTY SURVEYOR
700 HALL OF RECORDS

FORM 247 10M 11-35

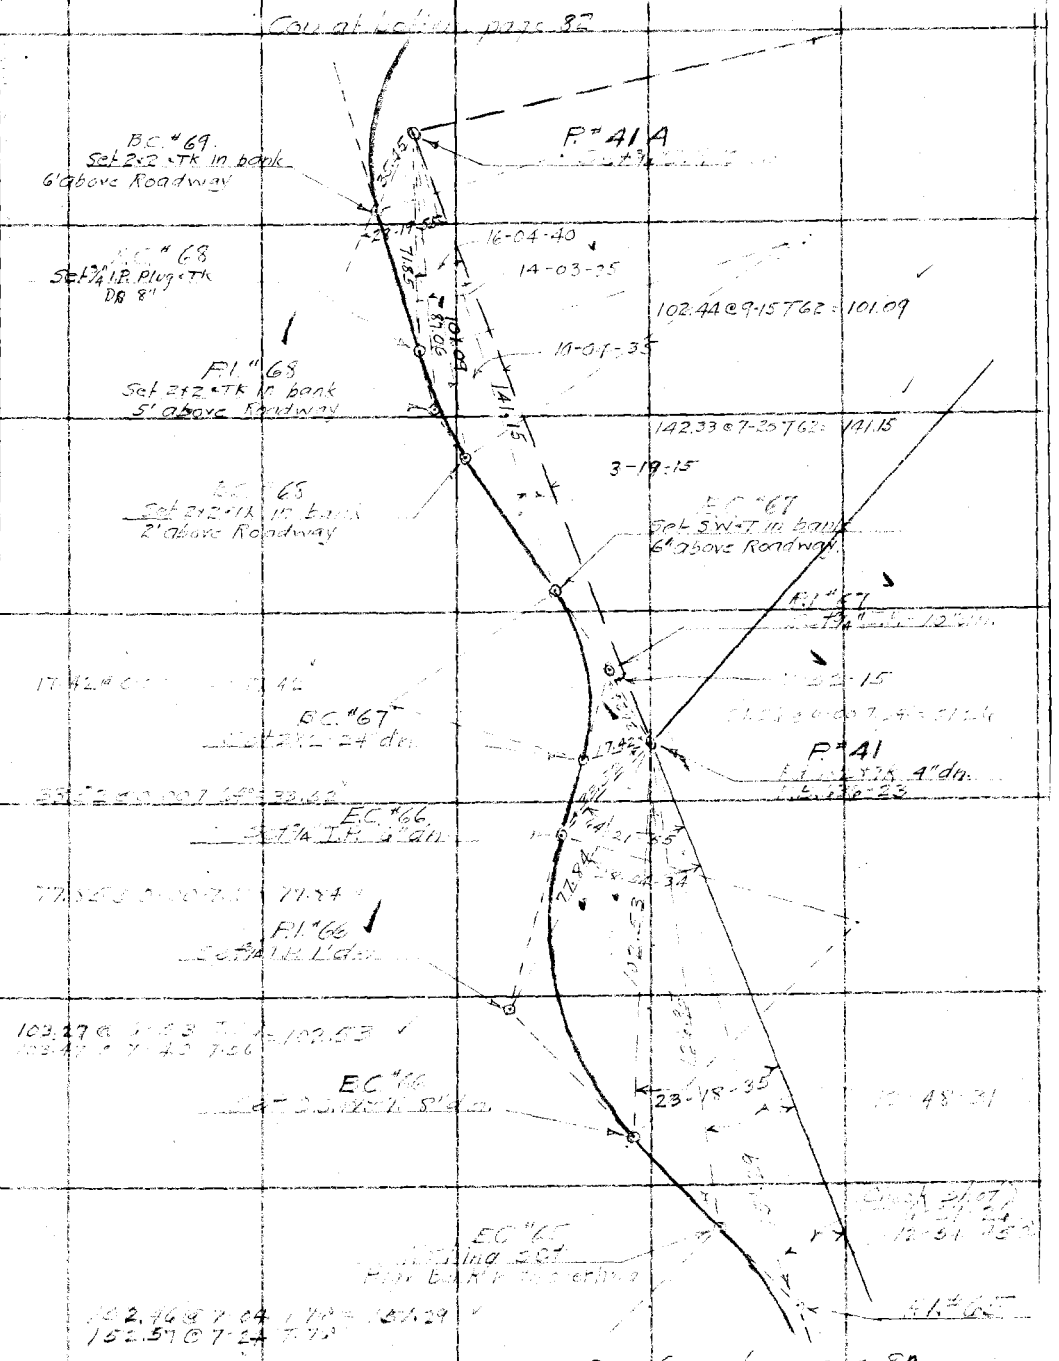

F.B. 655 Pg. 82

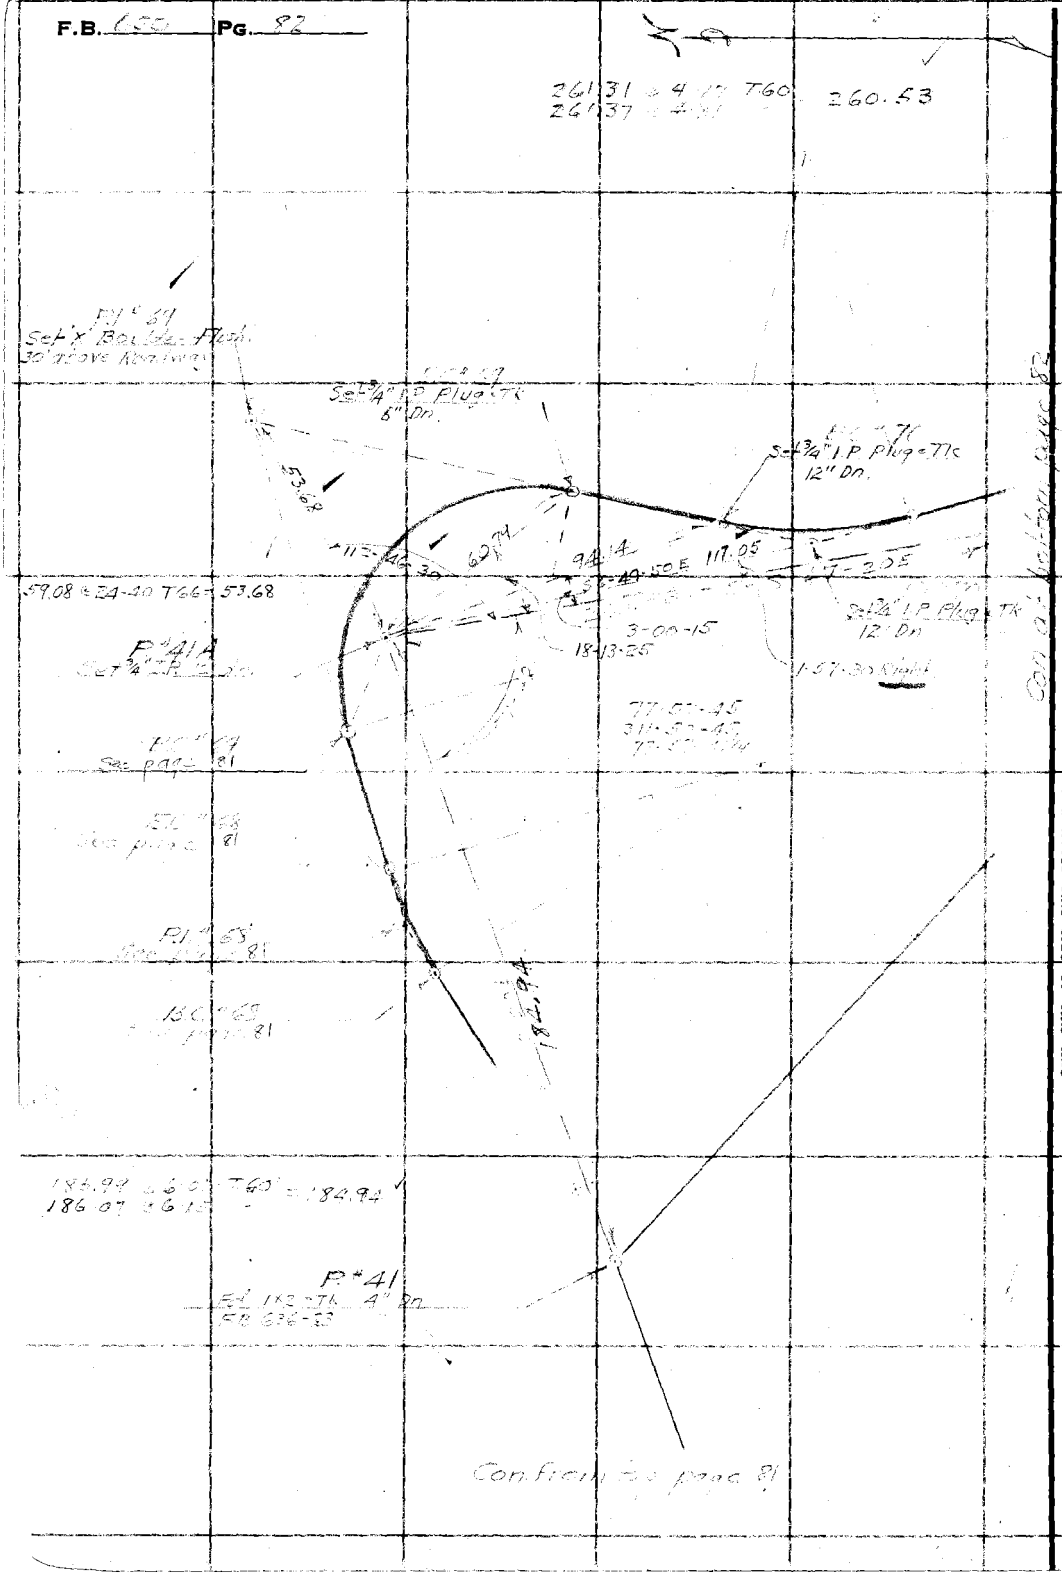

RETURN TO
LOS ANGELES COUNTY SURVEYOR
700 HALL OF RECORDS

Note: Any Additions or Changes on This Sheet Must be Made or Circled in Red Ink With Date and Name of Person Making Change.

Do not extend notes this side of this line

Notes Ck'd by	Drew	Survey of	MT WILSON Topo
Map No.	B-1217-1	W. O.	8149
Office Work	F. A. W.	Tape No.	St'd °F.
Checked	Drew	Surveyed by	W. A. [illegible]
Date	12-11-42	Notes	Miller Date Apr [illegible]
		Indexed	C. C. Johnson

F.B. [illegible] Pg. 83

Note: Any Additions or Changes on This Sheet Must be Made or Circled in Red Ink With Date and Name of Person Making Change.

Do not extend notes this side of this line

RETURN TO
LOS ANGELES COUNTY SURVEYOR
700 HALL OF RECORDS

FORM 247 10M 11-35

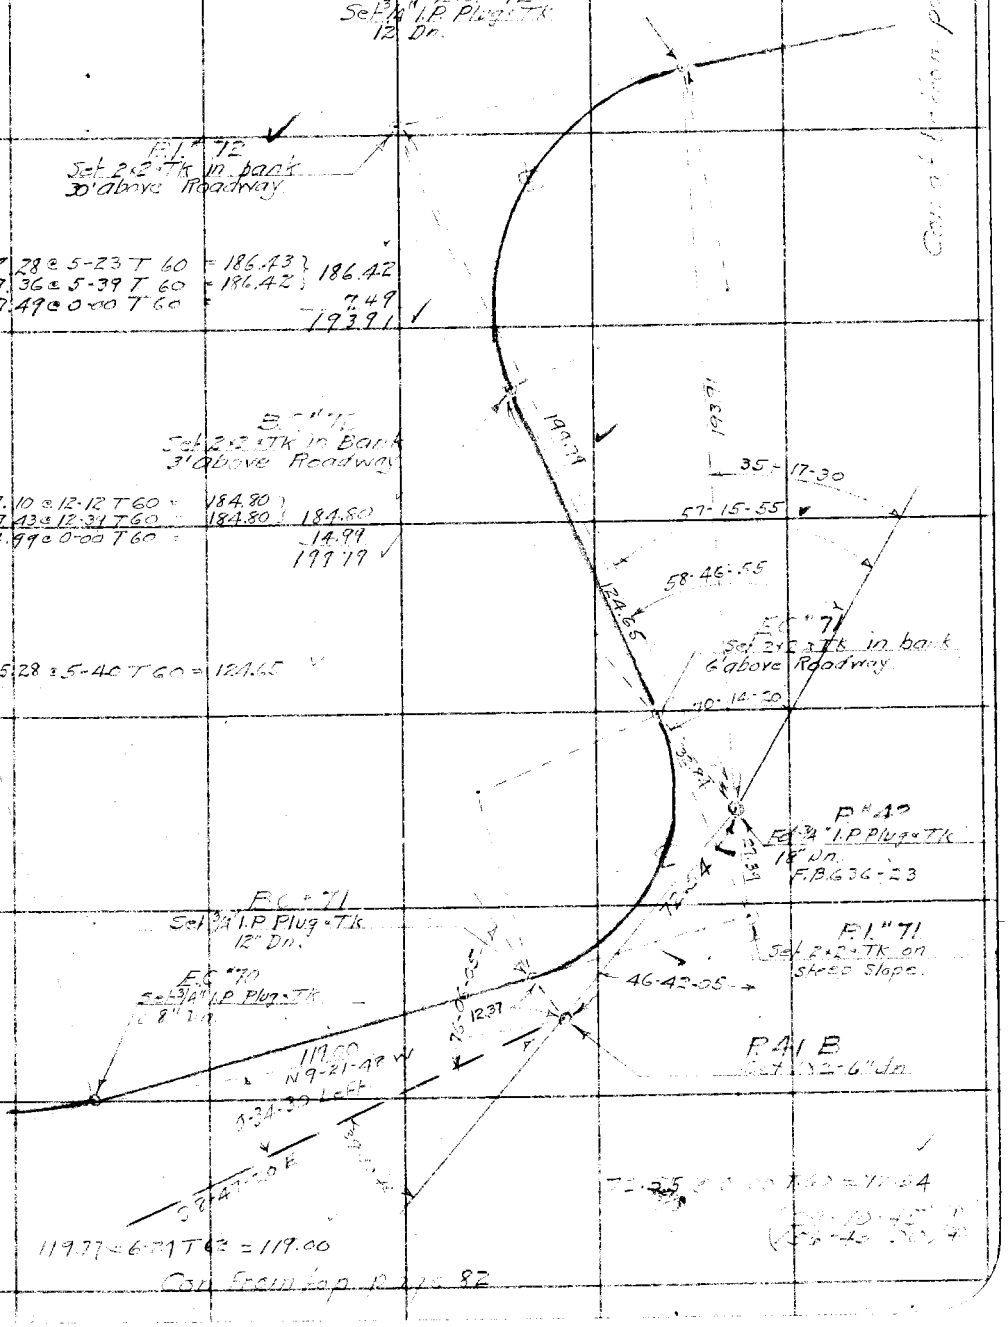

F.B. 650 Pg. 84

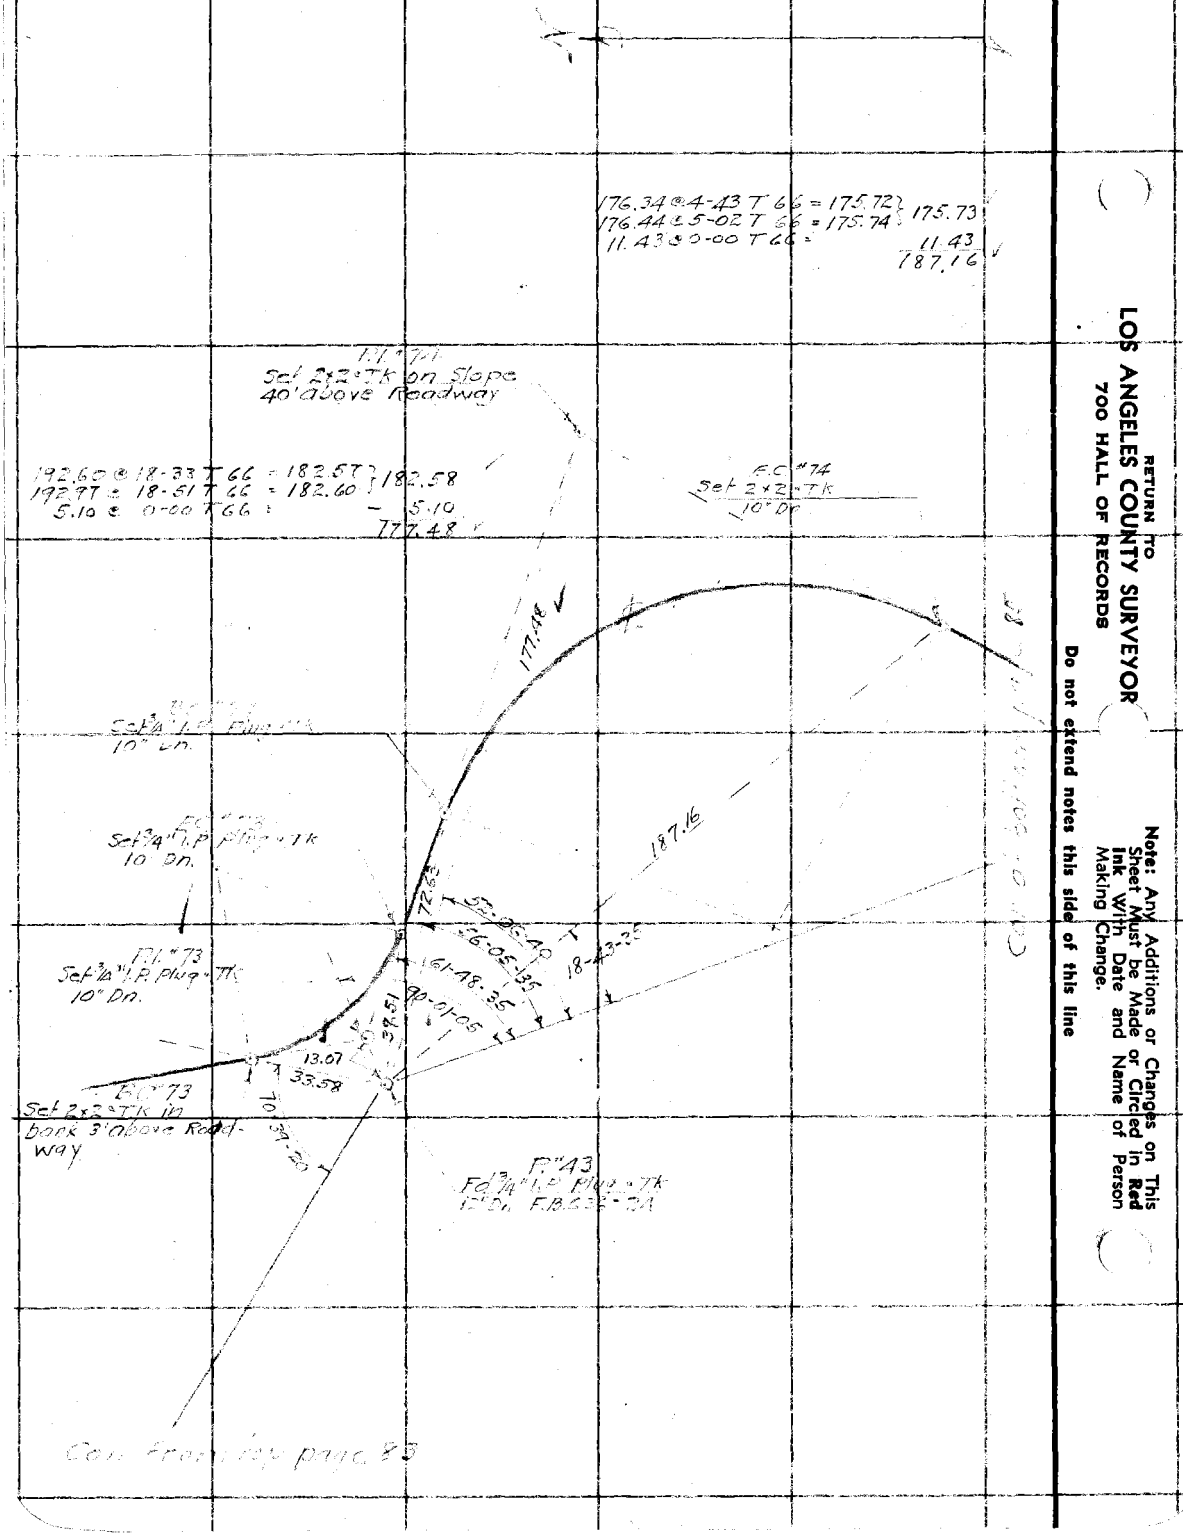

RETURN TO
LOS ANGELES COUNTY SURVEYOR
700 HALL OF RECORDS

Note: Any Additions or Changes on This Sheet Must be Made in Red Ink With Date and Name or Circled of Person Making Change.

Do not extend notes this side of this line

Notes Card by D.T. Cox	Survey of MT WILSON TOLL RD	F.B. 650	Pg. 85
Map No. 8-1217-1	W. O. 8149 Tape No. St'd 84 °F.		
Office Work F. A. W.	Surveyed by W.A. Miller		
Checked D.T. Cox	Notes Miller Date Apr 1937		
Date 12-11-40	Indexed [illegible] C. Johnson		

Correct bearings: page 84

118.39 @ 5-19 T 64 = 118.17 ? 118.17
118.60 @ 4-50 T 64 = 118.16 ✓

118.17

Set 3/4" I.P. Plug - TK
6" Dn.
E.C. # 76

14.59

P # 44 A
Set 1x2 - TK

16.82

26.74

P.I. # 76
Set 5 W-T
6" Dn.

B.C. # 76
Set 5 W-T
8" Dn.

8°-06-25
40-55 40
22.40.60

203.50 @ 4-51 T 64 = 203.74 ? 203.74
203.67 @ 5-25 T 64 = 203.75 ✓

203.74

E.C. # 75
Set 2x2 - TK
10" Dn.

3-09-35

52.07

P # 44
Fd 3/4" I.P. Plug - TK
10" Dn. F.B. 636 - 24

62.94

B.C. # 75
Set 3/4" I.P. Plug - TK
8" Dn.

Cal. Pub. Rds. page 84

35-33.20

17.81

P.I. # 75
Set 2x2 - TK
on slope 6' below Roadway.

71-57
43

Note: Any Additions or Changes on This Sheet Must be Made or Circled in Red Ink With Date and Name of Person Making Change.

Do not extend notes this side of this line

RETURN TO
LOS ANGELES COUNTY SURVEYOR
700 HALL OF RECORDS

FORM 247 10M 11-35

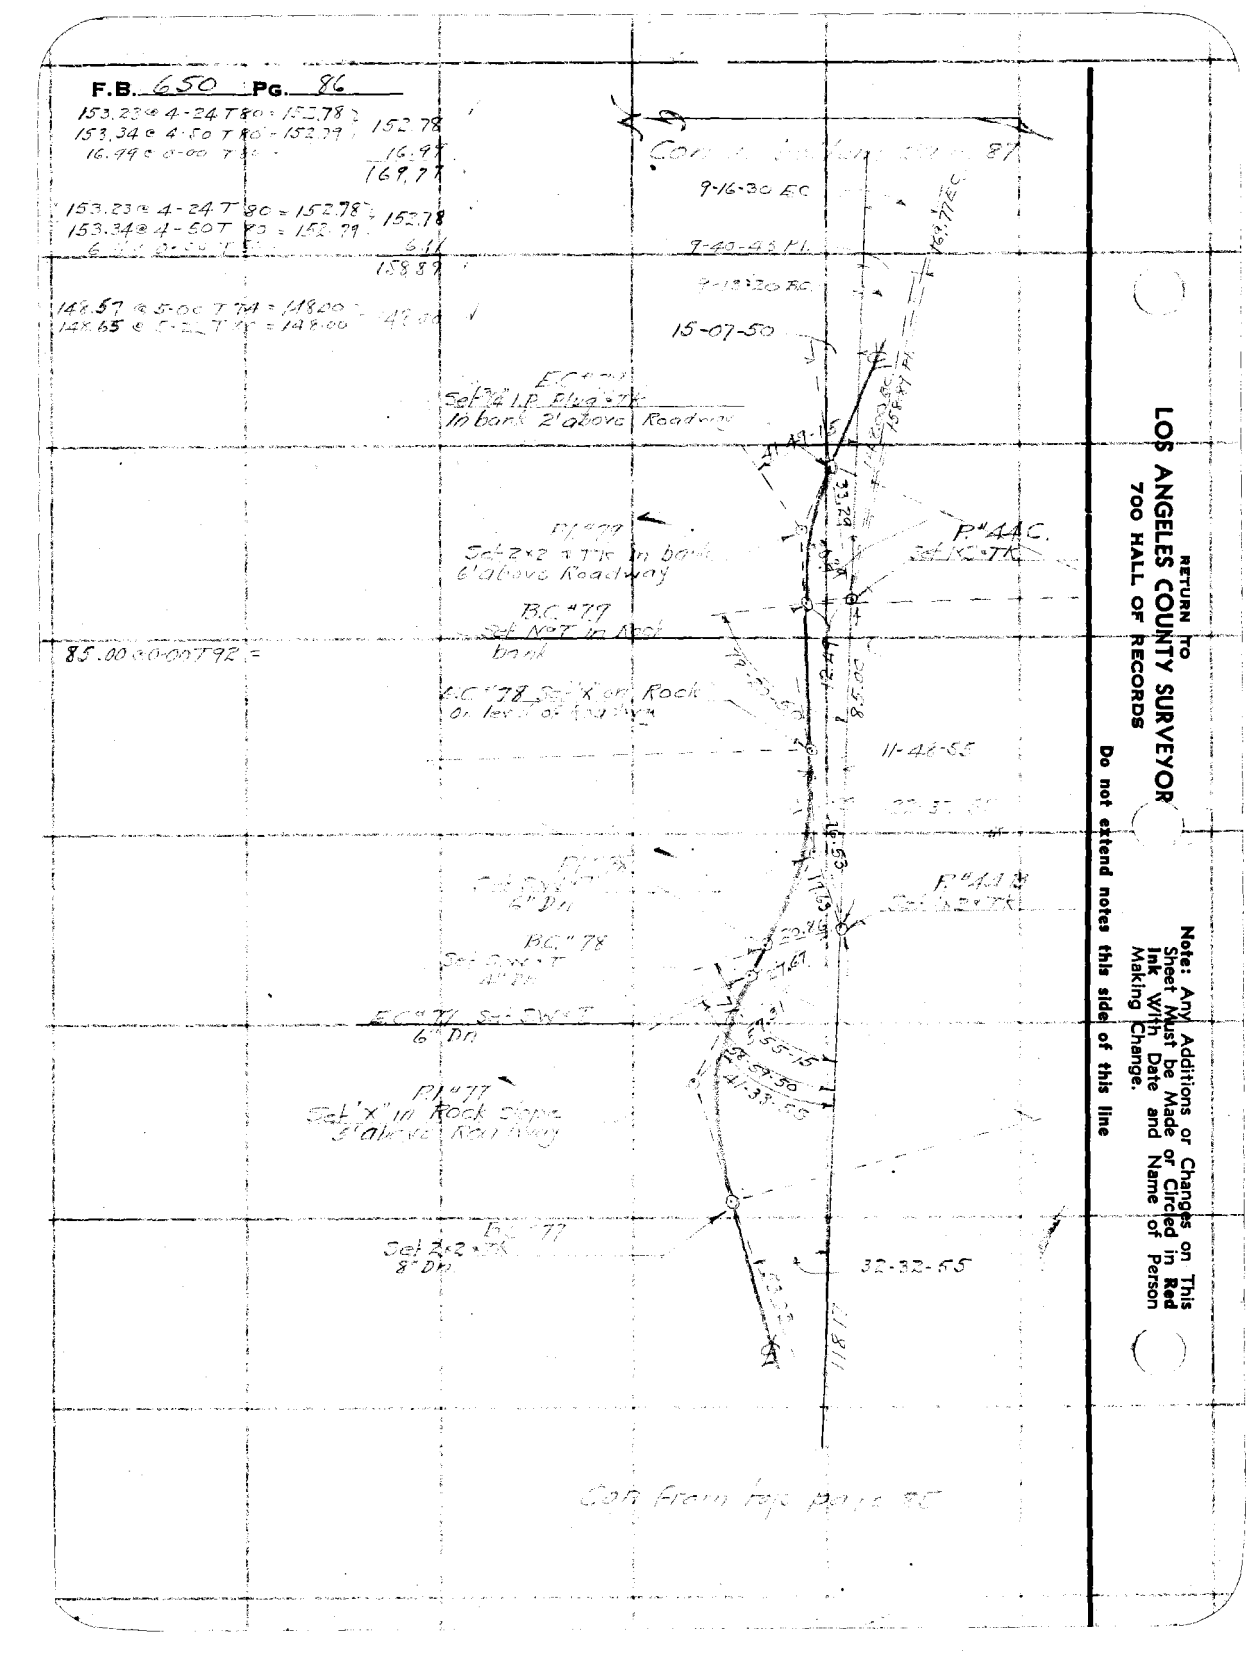

RETURN TO
LOS ANGELES COUNTY SURVEYOR
700 HALL OF RECORDS

Note: Any Additions or Changes on This Sheet Must be Made or Circled in Red Ink With Date and Name of Person Making Change.

Do not extend notes this side of this line

Notes Ck'd by D Rew	Survey of MT WILSON TOLL RD
Map No. B-1217-1	W. O. 3149 Tape No. St'd 84 °F.
Office Work F. A. W.	Surveyed by W A Miller
Checked D R Cw	Notes M 1167 Date
Date 12-11-40	Indexed A. C. Johnson

F.B. 650 Pg. 87

Note: Any Additions or Changes on This Sheet Must be Made or Circled in Red Ink With Date and Name of Person Making Change.

Do not extend notes this side of this line

RETURN TO
LOS ANGELES COUNTY SURVEYOR
700 HALL OF RECORDS

78.35 ± 11-33 ' 78 = 76.76
78.20 ± 10-28 ' 78 = 76.77 76.76
12.20 ± 0.00 ' 78 = 12.20
64.56

L.C. #81
Set 3/4" I.P. Plug + Tk
16' In.

F.C. #81
Set 2x2 + Tk
6" Dn.

F.C. #82
Set 2x2 + Tk in bank
5' above Roadway

E.C. #80
Set 2x2 + Tk
6" Dn.

F.C. #82
Set 2x2 + Tk in bank
5' above Roadway

F.C. #80
Set 3/4 I.P. Plug + Tk
12" Dn.

E.C. #82
Set 2x2 + T in bank
1' above Roadway

P. #45
Fd 2x2 + Tk
12" In. F.B. 636-24

20-16-40
23-49-10
600'
133-56-40
33.83
18.09
N 19-29-45 W
N 36-31-10 W
9.16.20
Pl. 9.30.45
158.40'

Con at bottom page 88

Con from top page 86

FORM 247 10M 11-38

F.B. 650 PG. 88

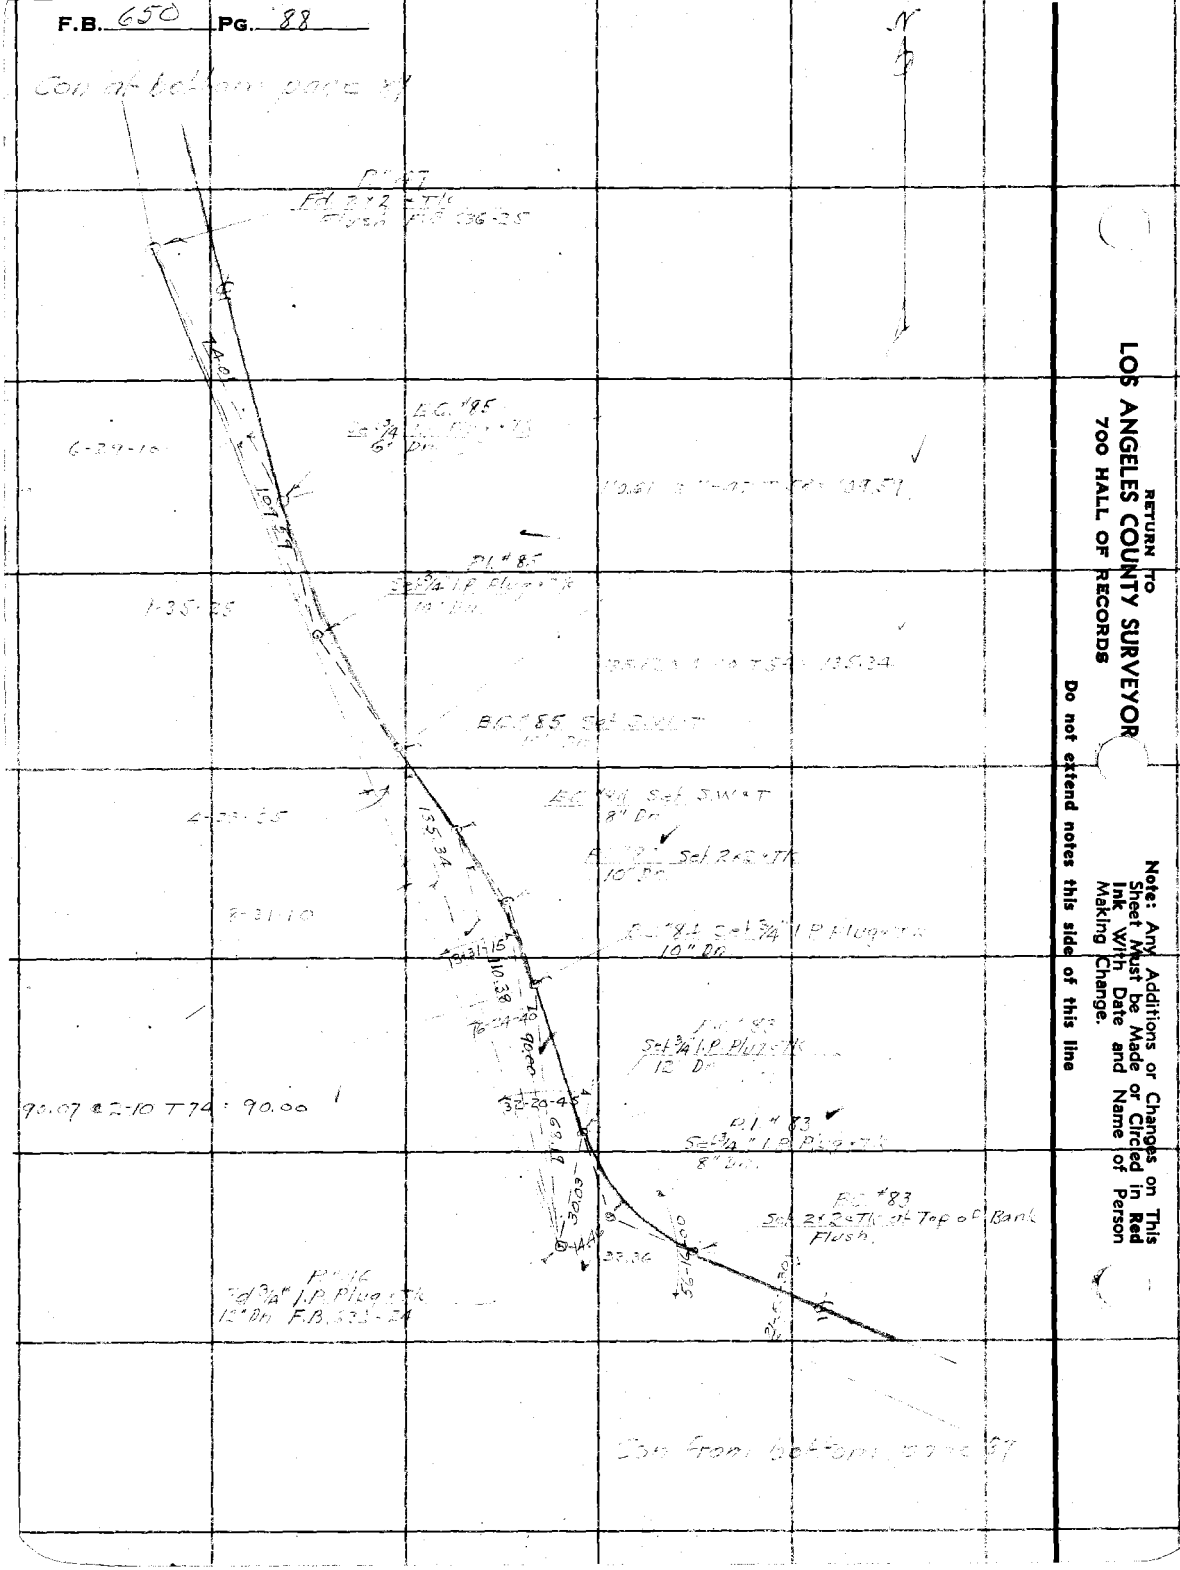

RETURN TO
LOS ANGELES COUNTY SURVEYOR
700 HALL OF RECORDS

Note: Any Additions or Changes on This Sheet Must be Made or Circled in Red Ink With Date and Name of Person Making Change.

Do not extend notes this side of this line

Notes Ck'd by Dr Can	Survey of MT WILSON TOLL RD
Map No. B-1217-1	W. O. 8149 Tape No. St'd 84 °F.
Office Work F. A. W	Surveyed by W. A. Miller
Checked Dr Can	Notes Miller Date Apr 1937
Date 12-11-40	Indexed A. C. Johnson

F.B. 650 PG. 89

Note: Any Additions or Changes on This Sheet Must be Made or Circled in Red Ink With Date and Name of Person Making Change.

Do not extend notes this side of this line

RETURN TO
LOS ANGELES COUNTY SURVEYOR
700 HALL OF RECORDS

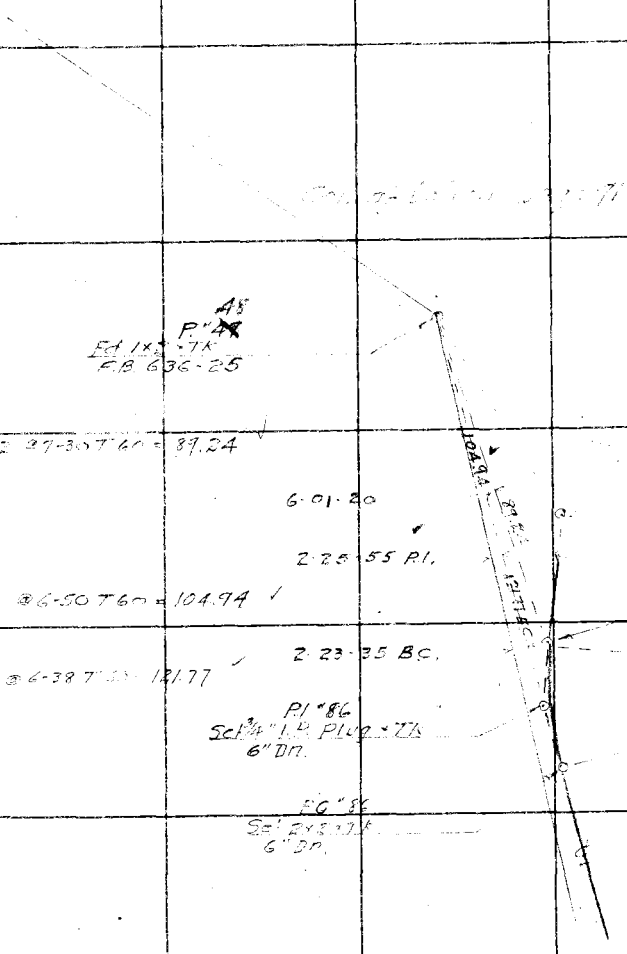

FORM 247 10M 11-35

RETURN TO
LOS ANGELES COUNTY SURVEYOR
700 HALL OF RECORDS

Note: Any Additions or Changes on This Sheet Must be Made or Circled in **Red Ink** With Date and Name of Person Making Change.

Do not extend notes this side of this line

F.B. 650 PG. 90

FORM 247 10M 11-35

RETURN TO
LOS ANGELES COUNTY SURVEYOR
700 HALL OF RECORDS

Note: Any Additions or Changes on This Sheet Must be Made or Circled in Red Ink With Date and Name of Person Making Change.

Do not extend notes this side of this line

①	150-50-05	73.18 TSR	70.98	
②	156-35-15	60.40 TSR	6041	
③	151-51-40	49.09		
④	98-55-40	92.57 TSR		
⑤	59-36-15			
⑥	38-32-40			

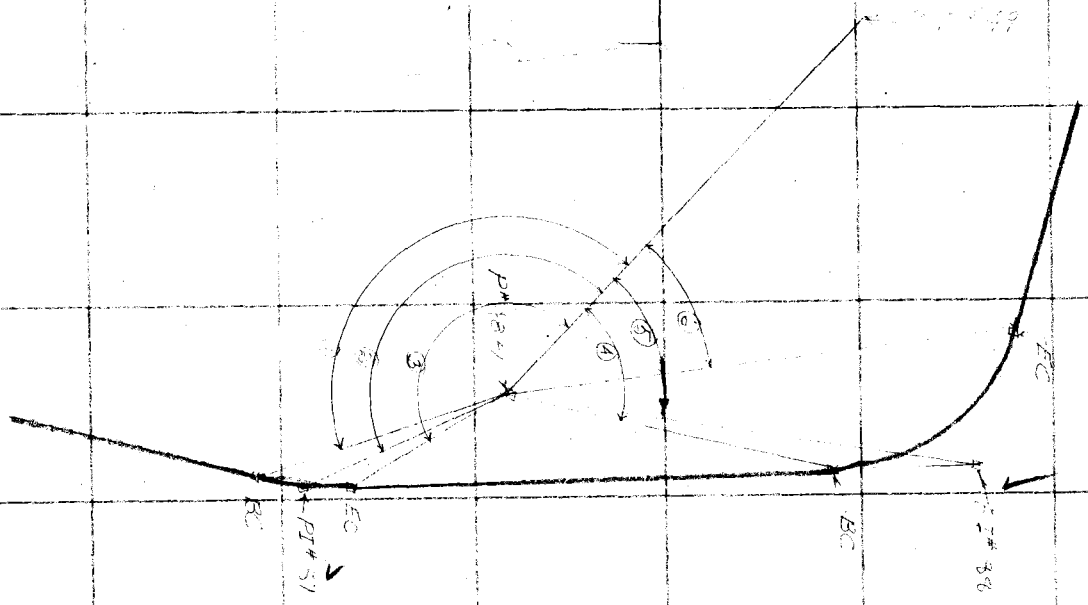

Notes Ck'd by [illegible]
Map No. B-217-2
Office Work F. A. W.
Checked [illegible]
Date 12-11-[illegible]

Survey of [illegible]
W. O. [illegible] Tape No. [illegible] Std. 66 °F.
Surveyed by [illegible]
Notes [illegible]
Date 2-22-37
Indexed [illegible]

F.B. [illegible] PG. [illegible]

RETURN TO
LOS ANGELES COUNTY SURVEYOR
700 HALL OF RECORDS

Note: Any Additions or Changes on This Sheet Must be Made or Circled in **Red Ink** With Date and Name of Person Making Change.

Do not extend notes this side of this line

F.B. 650 PG. 75

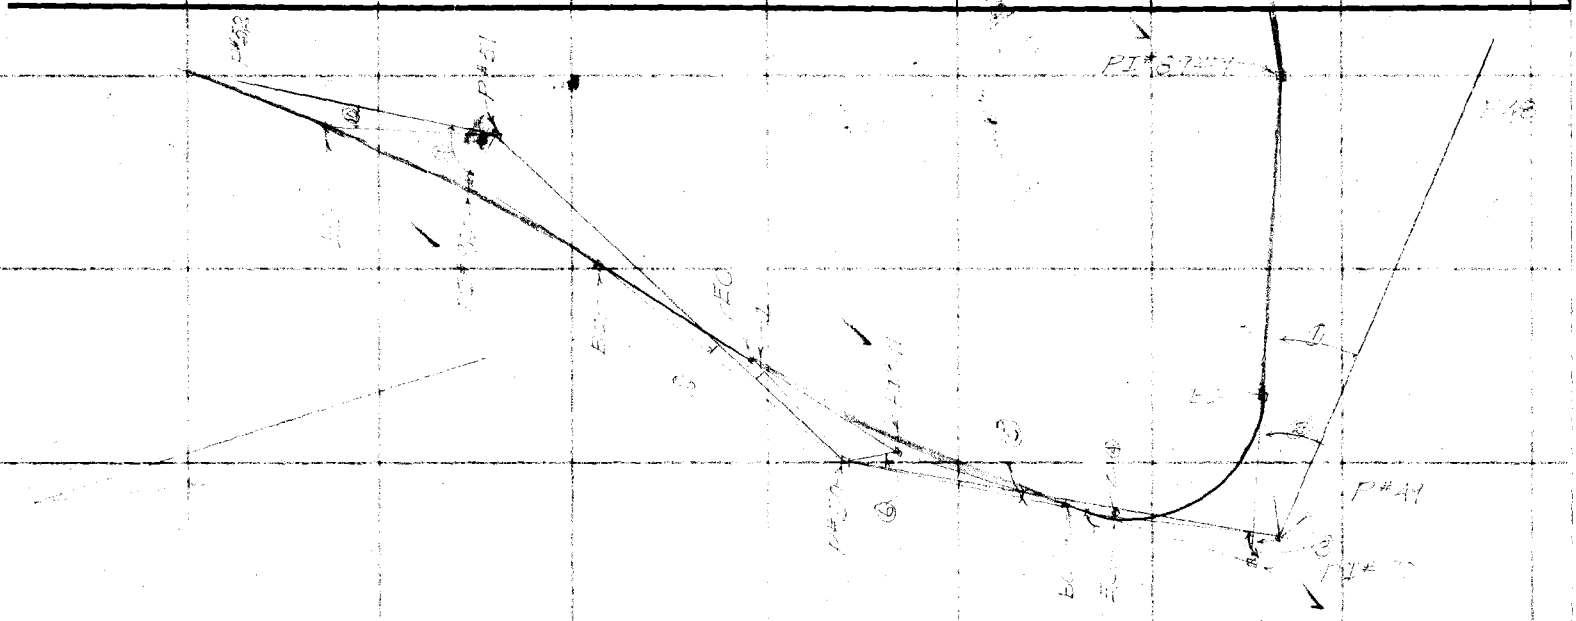

Notes Ck'd by Drew	Survey of Mt. Wilson - Toll Rd
Map No. 8-1217-1	W. O. 8149 Tape No. 07 St'd 64 °F.
Office Work F. A. W.	Surveyed by CABeirson
Checked Drew	Notes Date 3-14-40
Date 12-11-40	Indexed A. C. Johnson

F.B. 650 Pg. 73

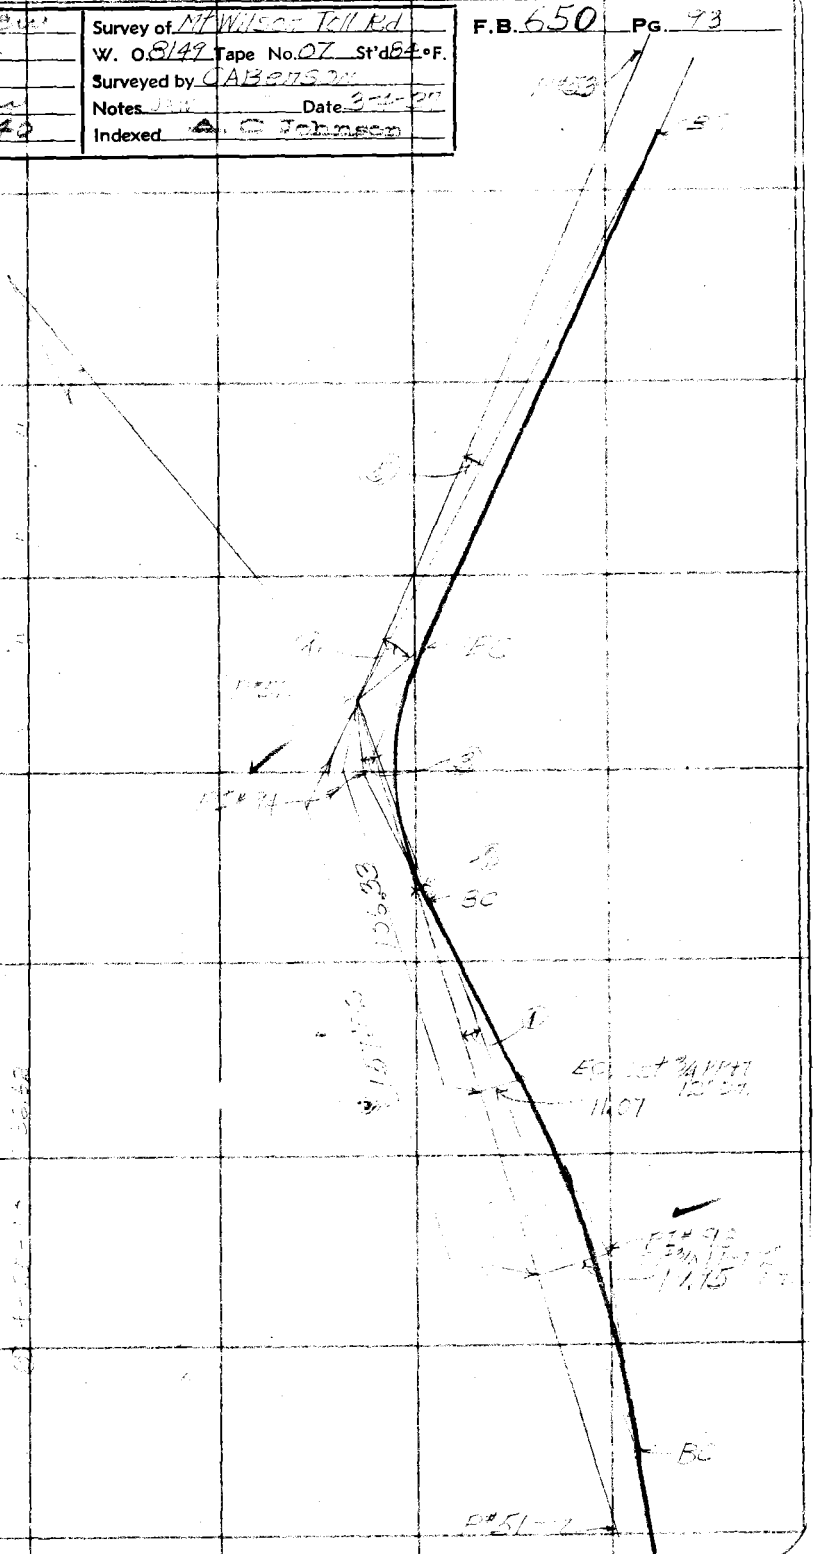

Note: Any Additions or Changes on This Sheet Must be Made or Circled in Red Ink With Date and Name of Person Making Change

Do not extend Notes this side of this line

RETURN TO
LOS ANGELES COUNTY SURVEYOR
700 HALL OF RECORDS

FORM 247 10M 11-38

RETURN TO
LOS ANGELES COUNTY SURVEYOR
700 HALL OF RECORDS

Note: Any Additions or Changes on This Sheet Must be Made or Circled in **Red Ink** With Date and Name of Person Making Change.

Do not extend notes this side of this line

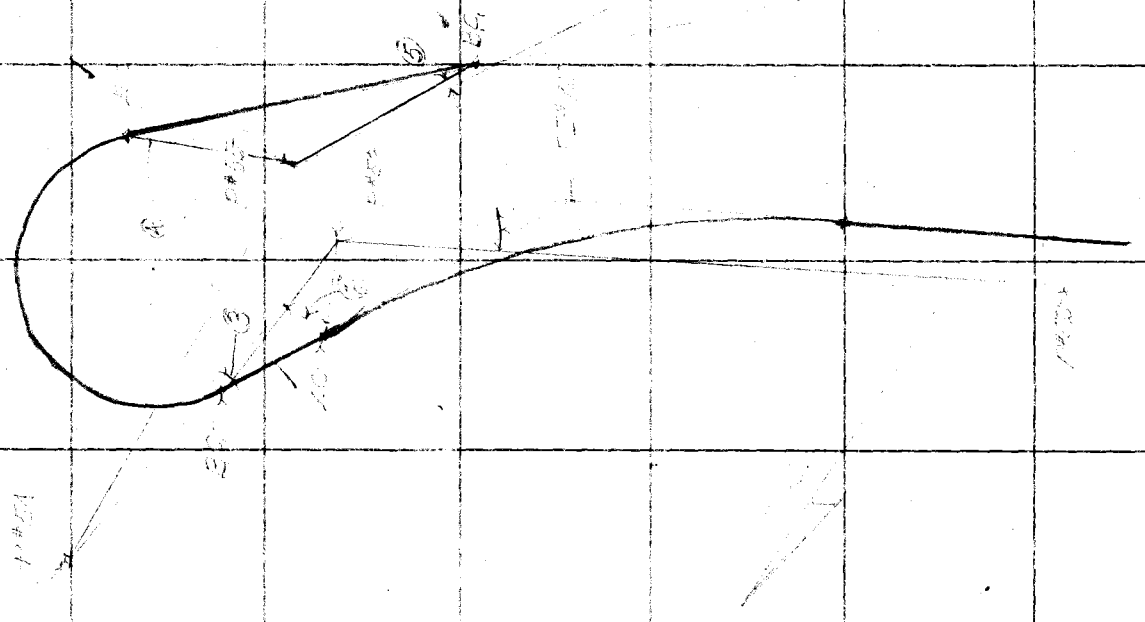

F.B. 550 PG. 11

9	10-33-10	1284	25-3[illegible]7-03	79	1284	84	1	MONU
3	34-16-10	2422					2	"
	[illegible]	1970						
4	67-52-05	14.55		9	"	"	"	
5	0-42-10	5248	5248	6C	"	"	"	

FORM 247 10M 11-35

RETURN TO
LOS ANGELES COUNTY SURVEYOR
700 HALL OF RECORDS

Note: Any Additions or Changes on This Sheet Must be Made or Circled in **Red Ink** With Date and Name of Person Making Change.

Do not extend notes this side of this line

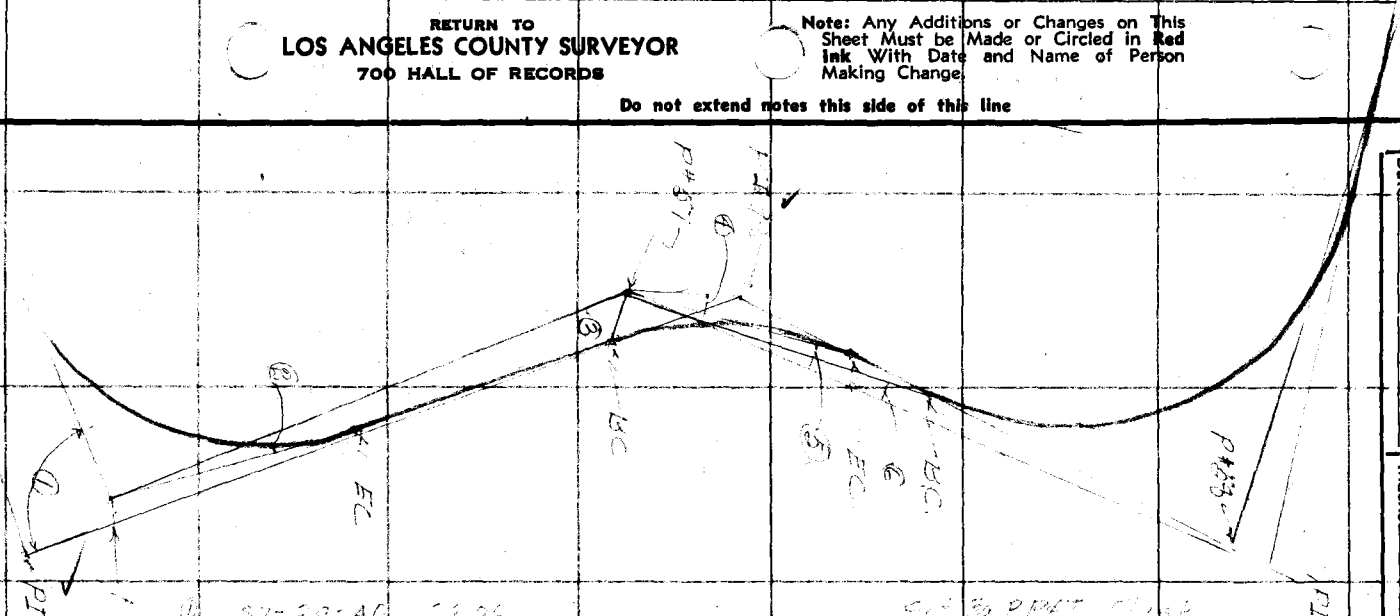

1	37-29-40	22.06			S.S. 3/4 PAST CURVE
2	3-22-30	64.92	64.93	T58	SUT 3/4 FT DOWN
3	0-07-35	21.67		"	" "
4	37-01-50	12.90		"	" "
5	3-31-40	10.99	11.00	T59	" "
6	0-14-35	65.66	65.67	T65	" "

Notes Ck'd by [illegible]
Map No. B-1217-2 F. A. W.
Office Work [illegible]
Checked [illegible]
Date 12-14-40

Survey of MT WILSON 7½ Rd
W. O. 8149 Tape No. C-1 Std. 34° F.
Surveyed by C. A. [illegible]
Notes [illegible] Date 5-24-37
Indexed [illegible] C. Johnson

F.B. 650 Pg. 25

RETURN TO
LOS ANGELES COUNTY SURVEYOR
700 HALL OF RECORDS

Note: Any Additions or Changes on This Sheet Must be Made or Circled in **Red Ink** With Date and Name of Person Making Change.

Do not extend notes this side of this line

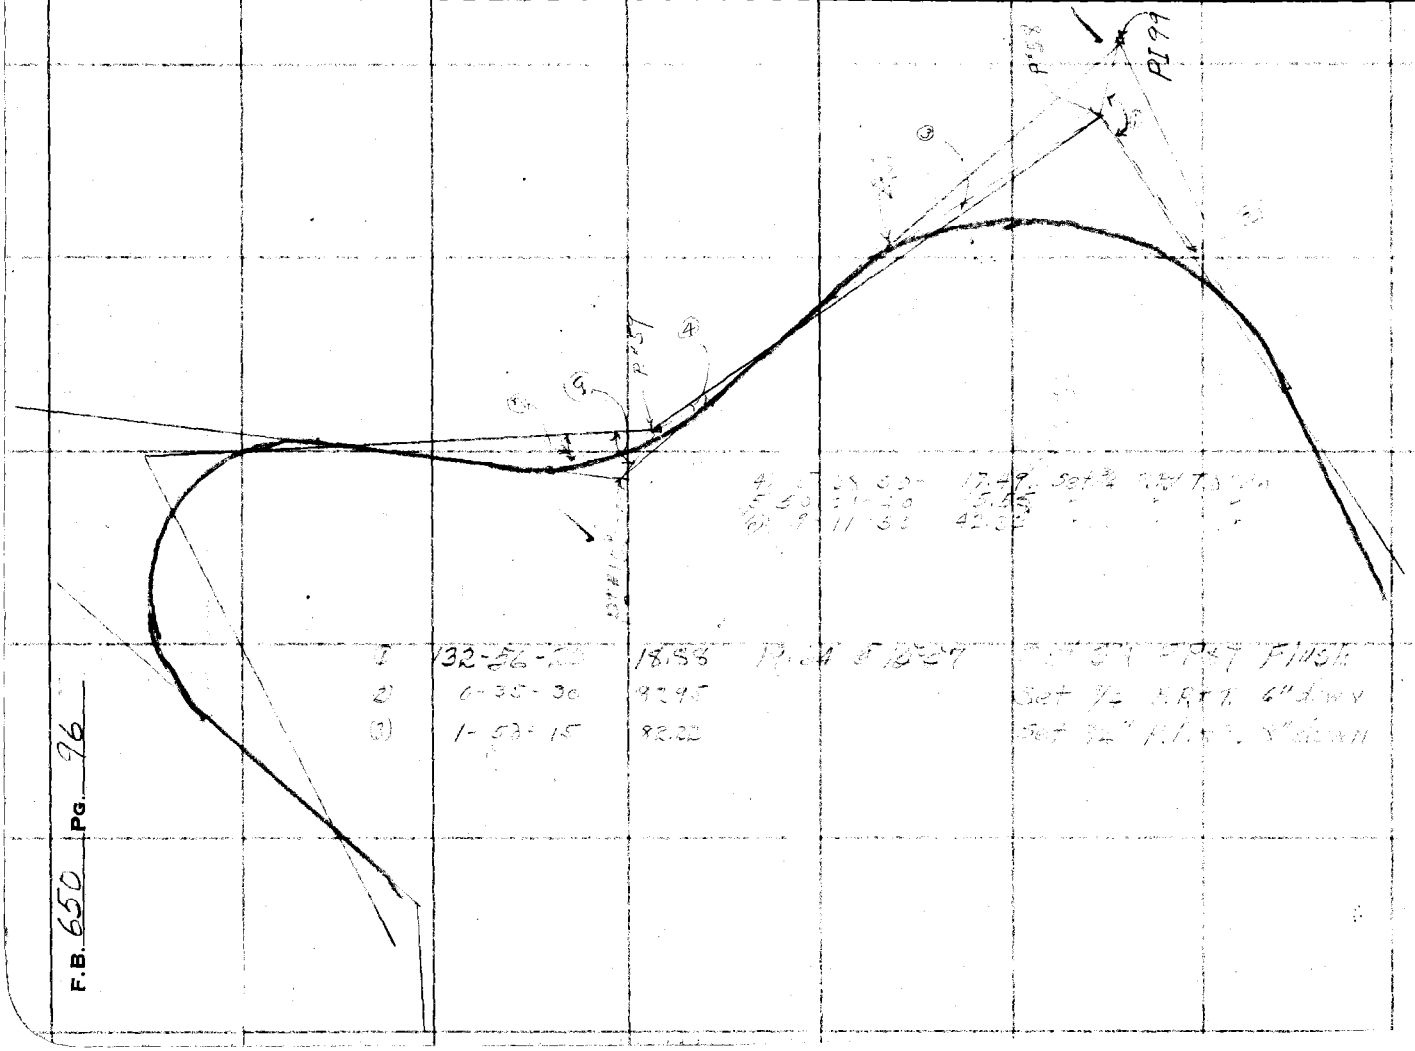

1	132-56-15	185.55	P.C. at 1827
2	6-35-30	97.95	
3	1-53-15	82.22	

F.B. 650 Pg. 96

Notes Ck'd by Drew	Survey of WILSON TRAIL NO. 2
Map No. B-1217-2	W. O. 8149 Tape No. 253 St'd 24 °F.
Office Work F. A. W.	Surveyed by W.A. Miller
Checked Drew	Notes Miller Date 7-17-1941
Date 12-12-40	Indexed C. Johnson


Note: Any Additions or Changes on This Sheet Must be Made in Red Ink or Circled in Red With Date and Name of Person Making Change.

Do not extend notes this side of this line

RETURN TO
LOS ANGELES COUNTY SURVEYOR
700 HALL OF RECORDS

FORM 247 10M 11-35

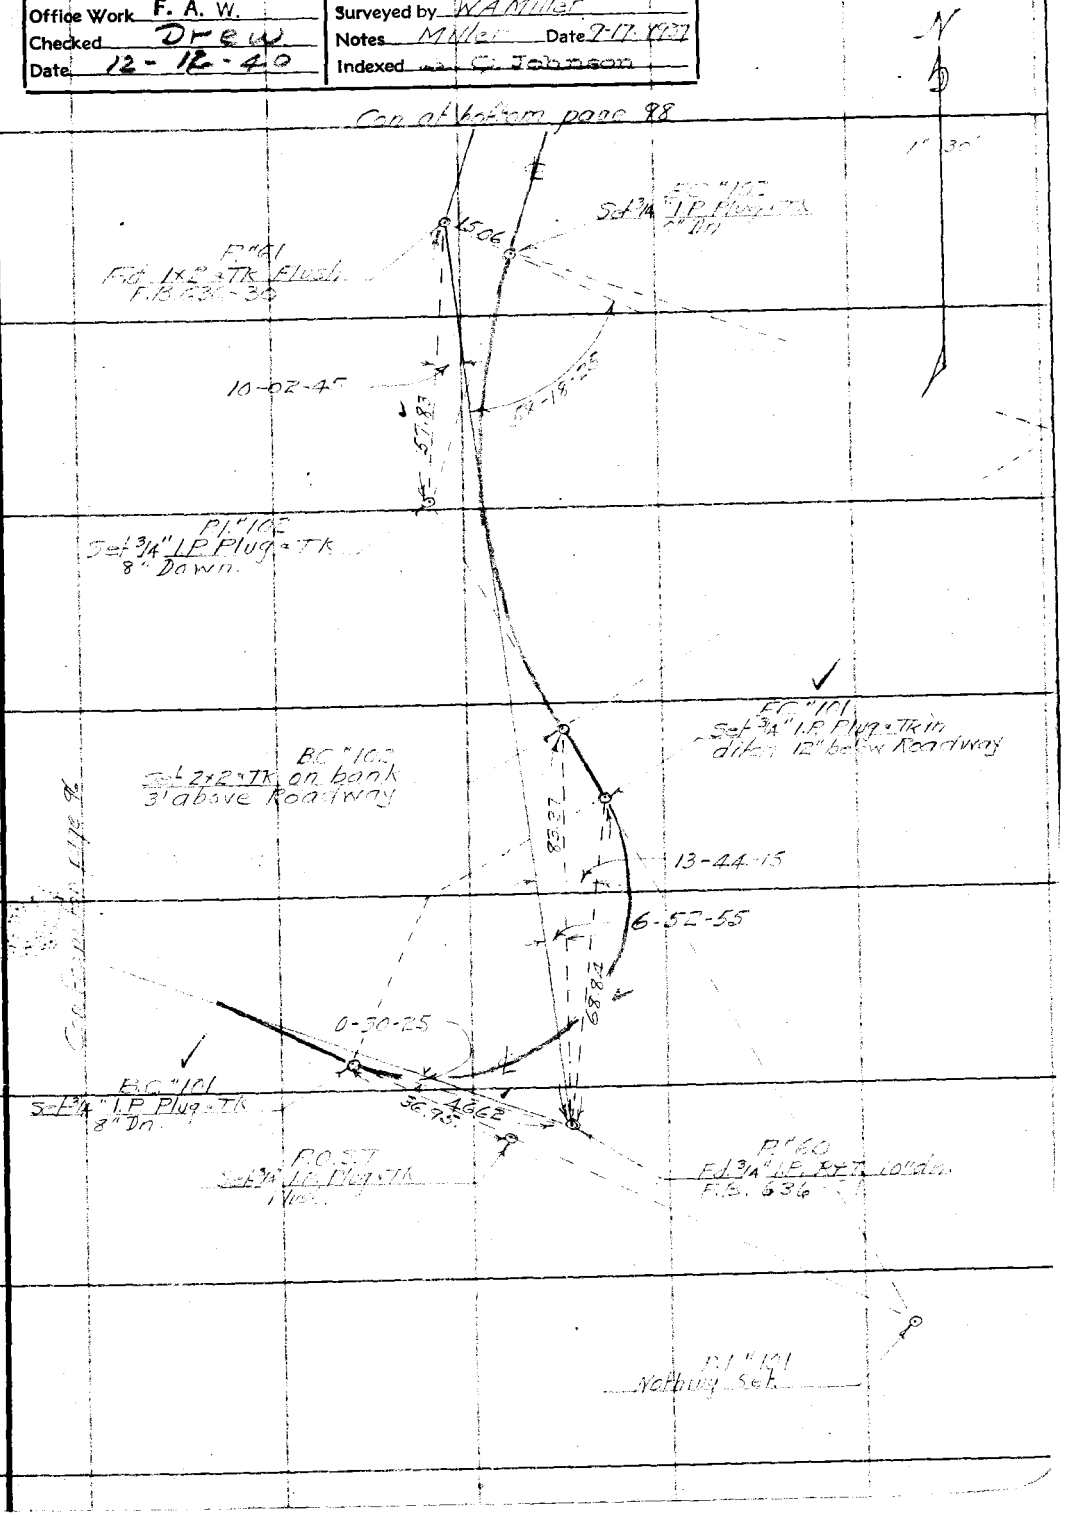

F.B. 650 Pg. 98

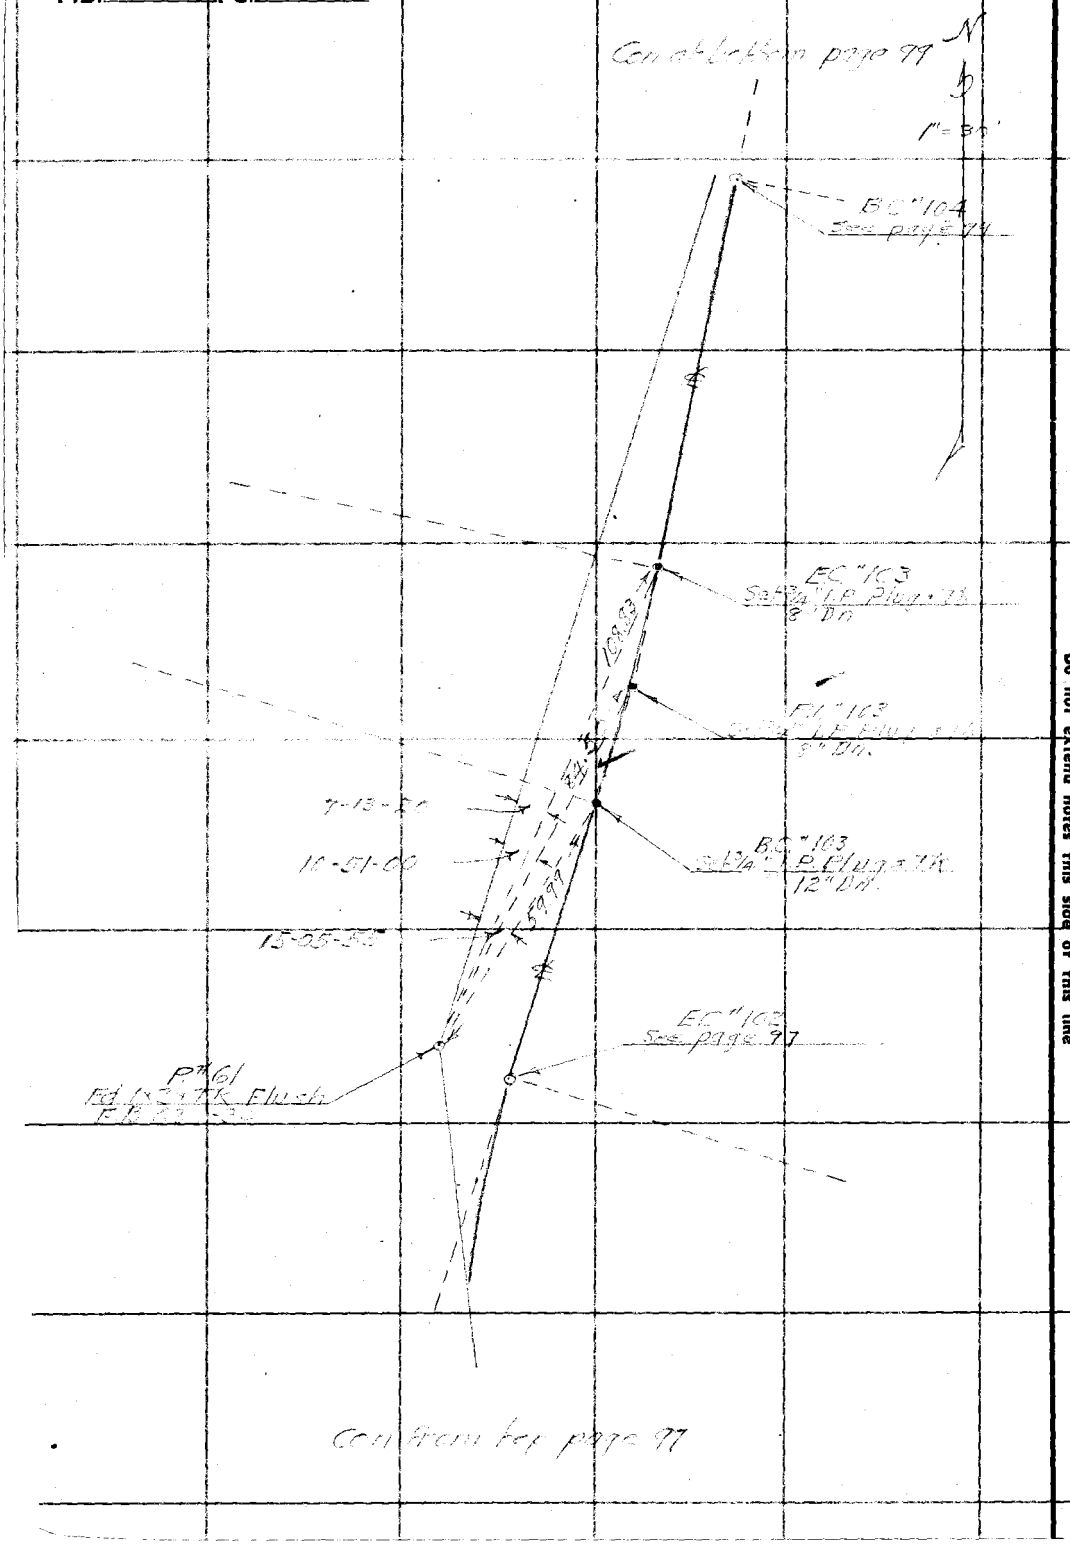

Con't from top page 97

RETURN TO
LOS ANGELES COUNTY SURVEYOR
700 HALL OF RECORDS

Do not extend notes this side of this line

Note: Any Additions or Changes on This Sheet Must be Made or Circled in Red Ink With Date and Name of Person Making Change.

Notes Ck'd by Drew	Survey of MT WILSON TOLL RD
Map No. B-1217-2 F. A. W.	W. O. 8149 Tape No. 253 St'd °F.
Office Work	Surveyed by W.C. MILLER
Checked Drew	Notes Miller Date 9-20-1937
Date 12-12-40	Indexed A. C. JOHNSON

F.B. 650 Pg. 79

N

1" = 10'

Coll at Balloon Barn Rd

EC "105 3/4" I.P. Plug 8" Dn

P "6 B Flush 15 Dn

P1 "105 Flush 5" Dn

BC "105 3/4" I.P. Plug Flush 12" Dn

EC "104 Set 3/4" I.P. Plug Flush 8" Dn

P "6 1/4" I.P. Plug Flush 10" Dn

P "6 B Set 1/2" I.P. Flush

P "6 A Set W.A.M. 12-15-1937

BC "104 Set 3/4" I.P. Plug Flush 12" Dn

Coll from ... page 77

Note: Any Additions or Changes on This Sheet Must be Made or Circled in Red Ink With Date and Name of Person Making Change

Do not extend notes this side of this line

RETURN TO
LOS ANGELES COUNTY SURVEYOR
700 HALL OF RECORDS

FORM 247 10M 11-38

RETURN TO
LOS ANGELES COUNTY SURVEYOR
700 HALL OF RECORDS

Note: Any Additions or Changes on This Sheet Must be Made or Circled in Red Ink With Date and Name of Person Making Change.

Do not extend notes this side of this line

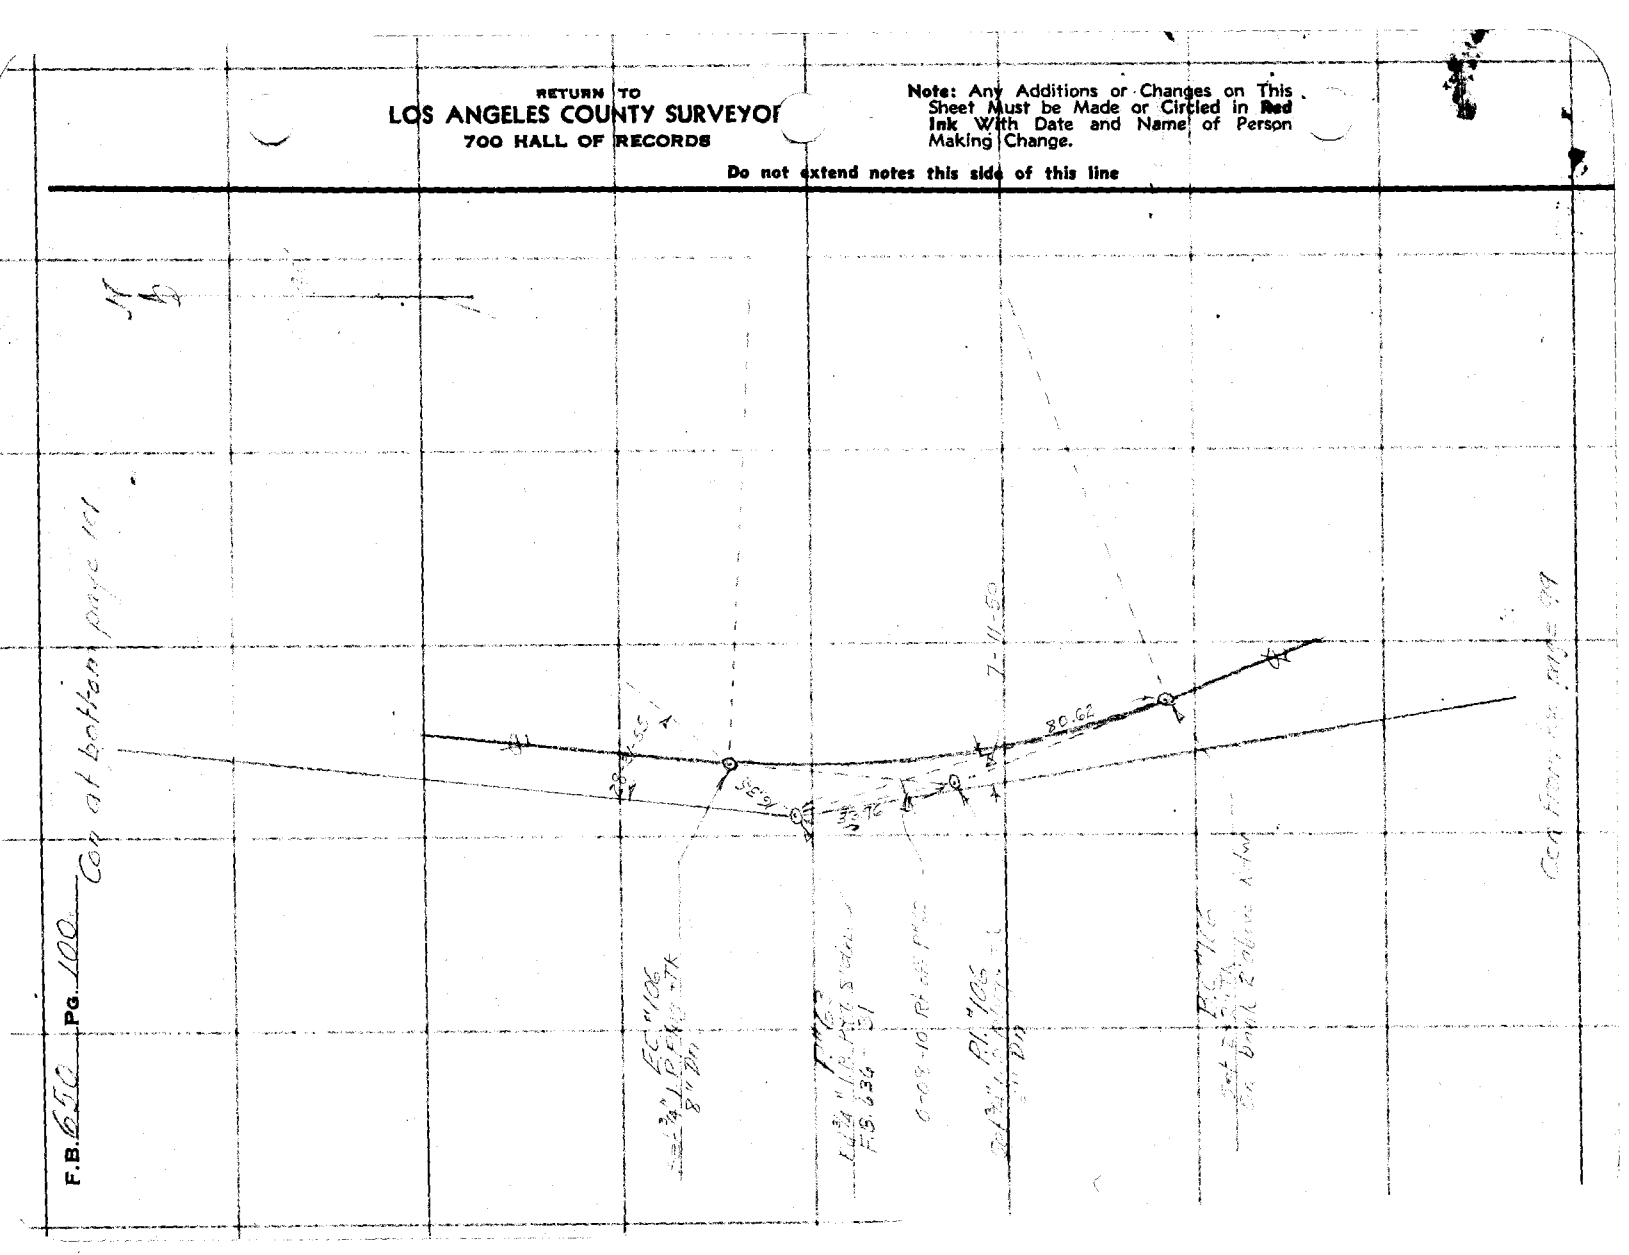

Notes Ck'd by Drew	Survey of MT WILSON TRAIL CO
Map No. B-1217-2	W. O. 8149 Tape No. 653 St'd °F.

F.B. 650 PG. 101

Note: Any Additions or Changes on This Sheet Must be Made in Red Ink With Date and Name of Person Making Change

Do not extend notes this side of this line

RETURN TO
LOS ANGELES COUNTY SURVEYOR
700 HALL OF RECORDS

FORM 247 10M 11-31

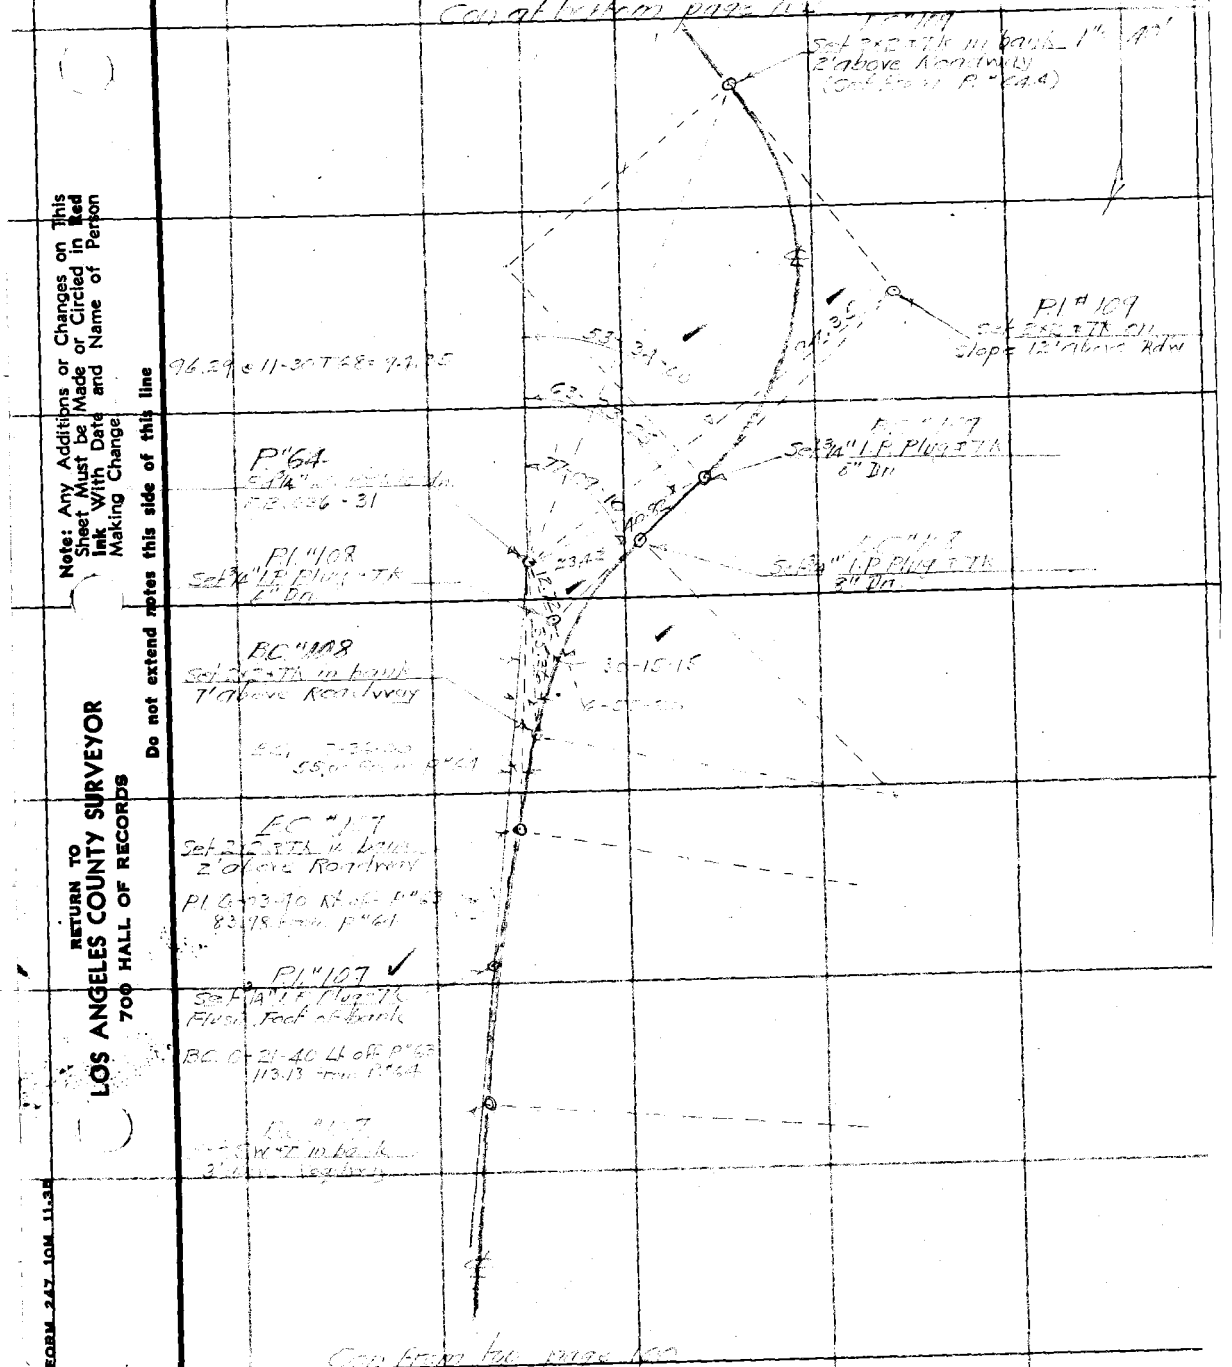

F.B. 650 Pg. 102

Cont'd from page 103

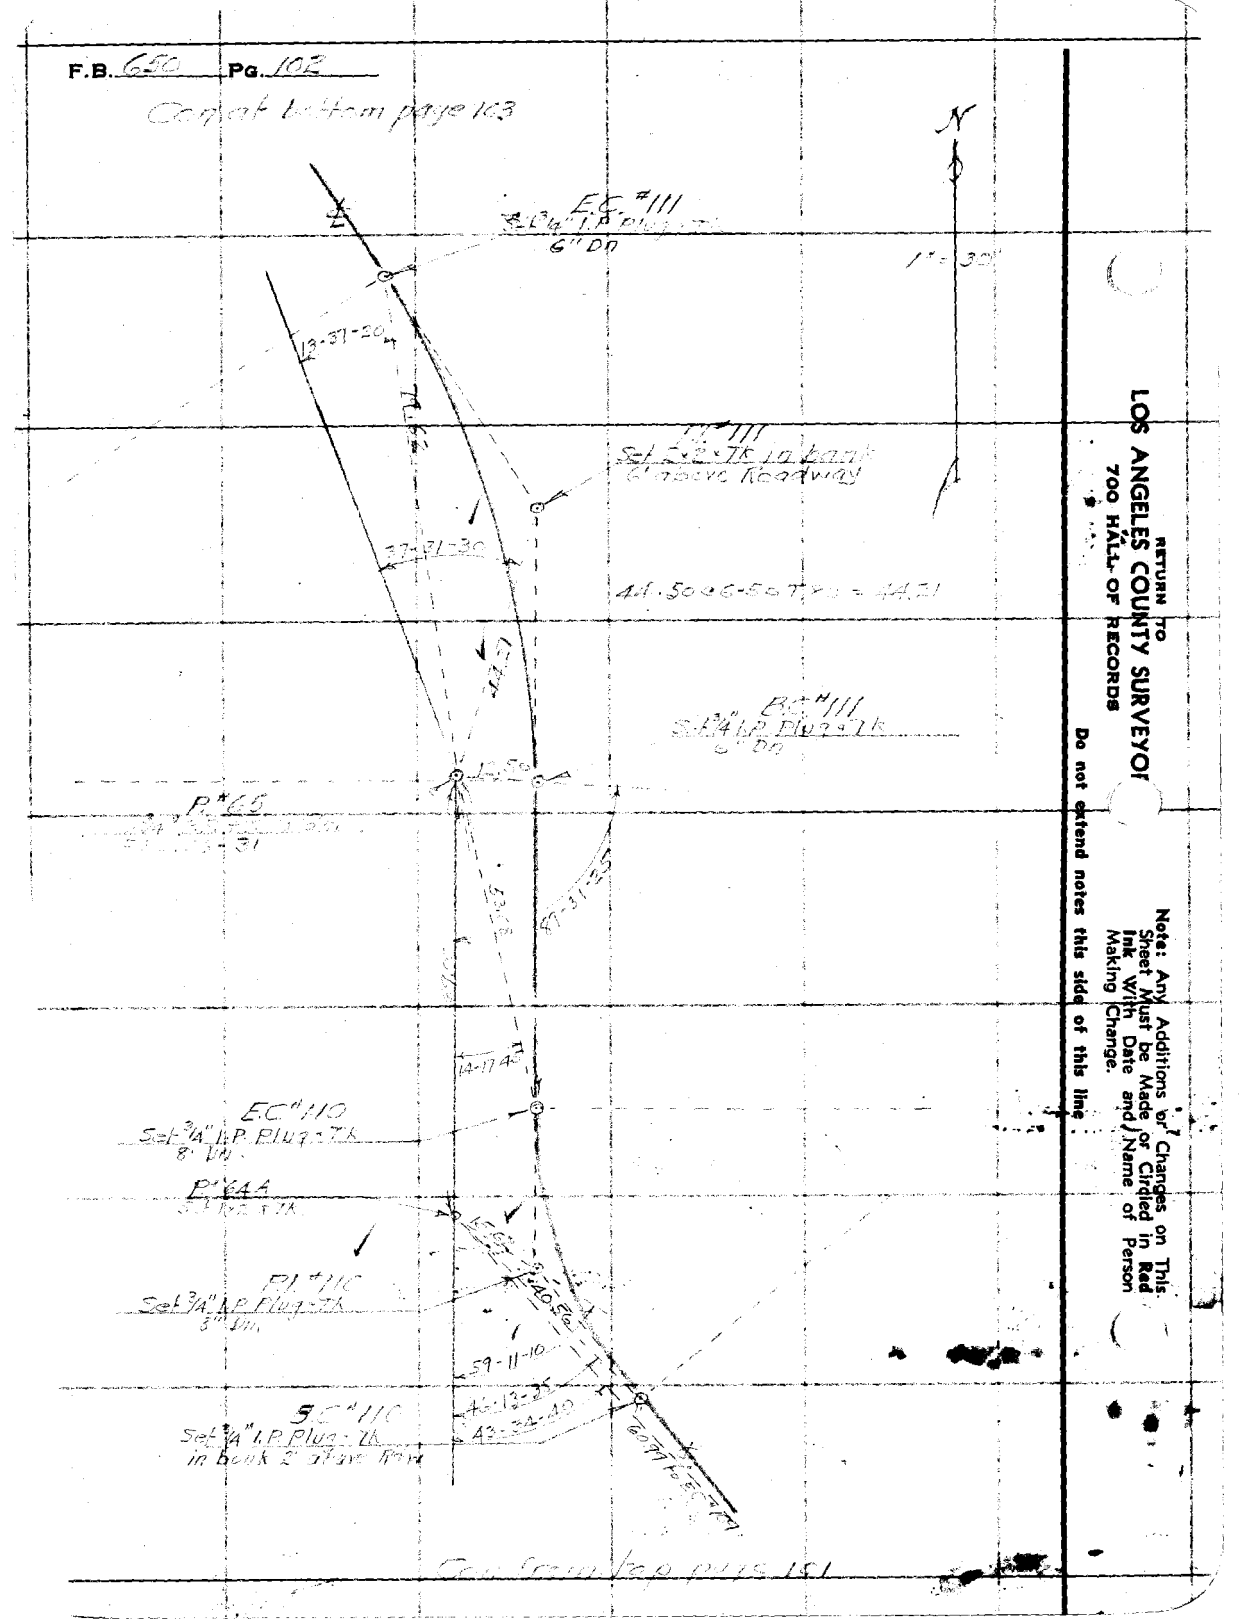

RETURN TO
LOS ANGELES COUNTY SURVEYOR
700 HALL OF RECORDS

Do not extend notes this side of this line

Note: Any Additions or Changes on This Sheet Must be Made or Circled in Red Ink With Date and Name of Person Making Change.

Notes Ck'd by Drew	Survey of MT WILSON TOLL RD
Map No. B-1217-2	W. O. 8141 Tape No. 253 St'd °F.
Office Work F. A. W.	Surveyed by W.A. Miller
Checked Drew	Notes Miller Date
Date 12-12-52	Indexed A. C. Johnson

F.B. 650 Pg. 103

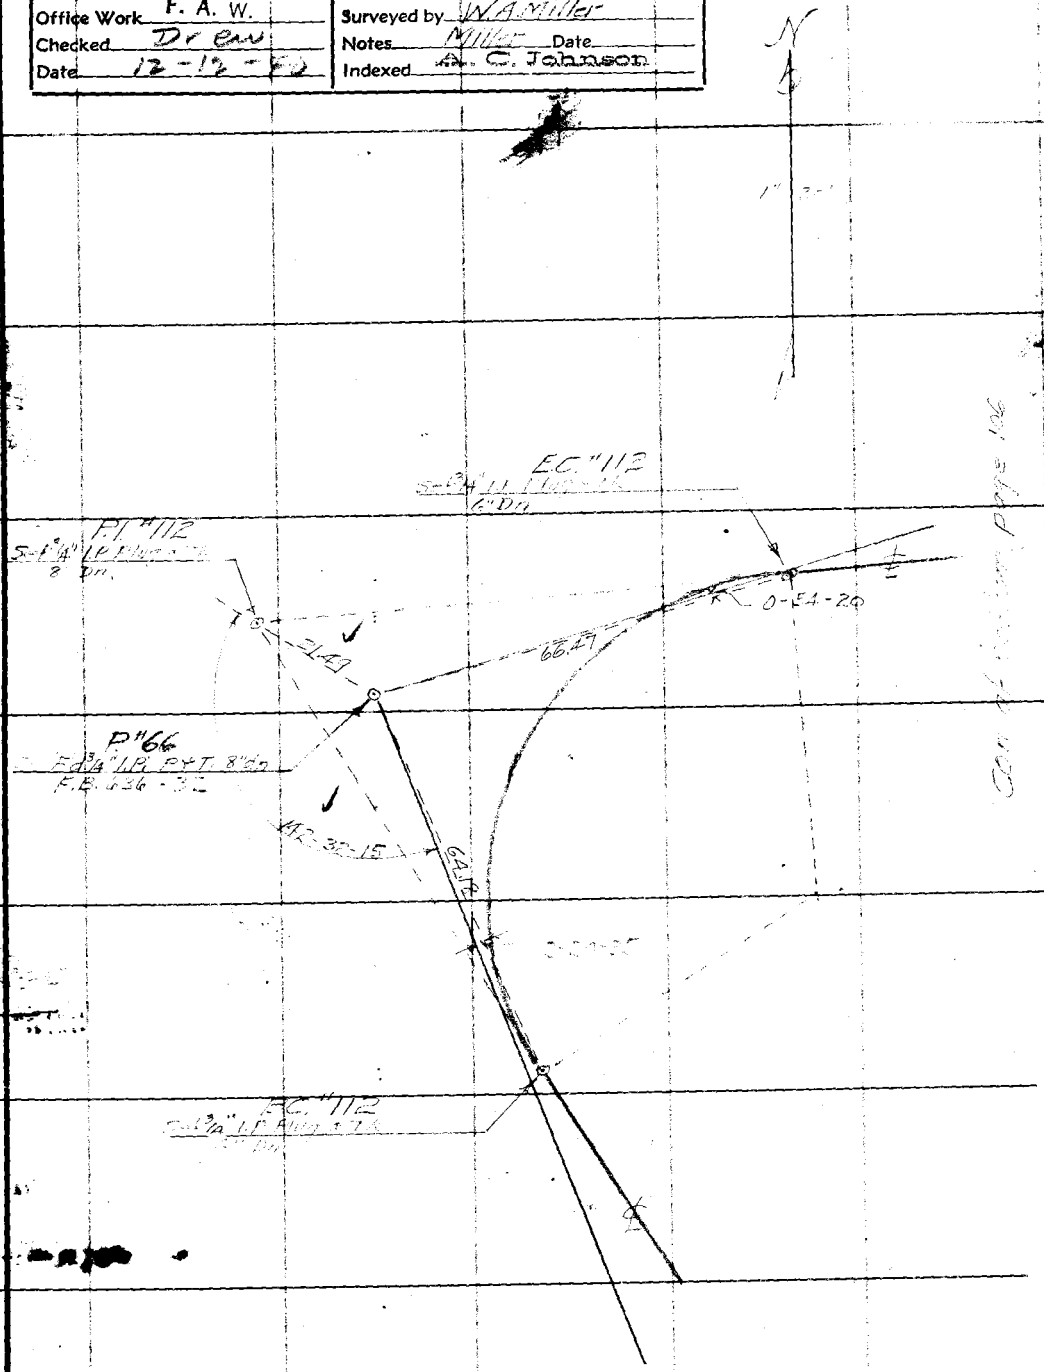

Note: Any Additions or Changes on This Sheet Must Be Made or Circled in Red Ink With Date and Name of Person Making Change.

Do not extend notes this side of this line

RETURN TO
LOS ANGELES COUNTY SURVEYOR
700 HALL OF RECORDS

FORM 247 10M 11-45

RETURN TO
LOS ANGELES COUNTY SURVEYOR
700 HALL OF RECORDS

Note: Any Additions or Changes on This Sheet Must be Made or Circled in **Red** Ink With Date and Name of Person Making Change.

Do not extend notes this side of this line

F.B. 6550 PG. 104

Notes Ck'd by Drew	Survey of MT WILSON TOLL RD
Map No. B-1217-2	W. O. 8149 Tape No. 63 St'd 84 °F.
Office Work F. A. W.	Surveyed by W.A. Miller
Checked Drew	Notes Miller Date
Date 12-12-49	Indexed A. C. Johnson

F.B. 650 Pg. 105

MT WILSON TOLL ROAD
J.N 8149
SETTING ℄ POINTS
FROM
R.L.I.N.E
P.I.#13 TO END OF ROAD

Miller
Braden
Stewart C.A.
Climito
Stewart O.B.

Note: Any Additions or Changes on This Sheet Must be Made or Circled in Red Ink With Date and Name of Person Making Change.

Do not extend notes this side of this line

RETURN TO
LOS ANGELES COUNTY SURVEYOR
700 HALL OF RECORDS

FORM 247 10M 11-35

RETURN TO
LOS ANGELES COUNTY SURVEYOR
700 HALL OF RECORDS

Note: Any Additions or Changes on This Sheet Must be Made or Circled in **Red Ink** With Date and Name of Person Making Change.

Do not extend notes this side of this line

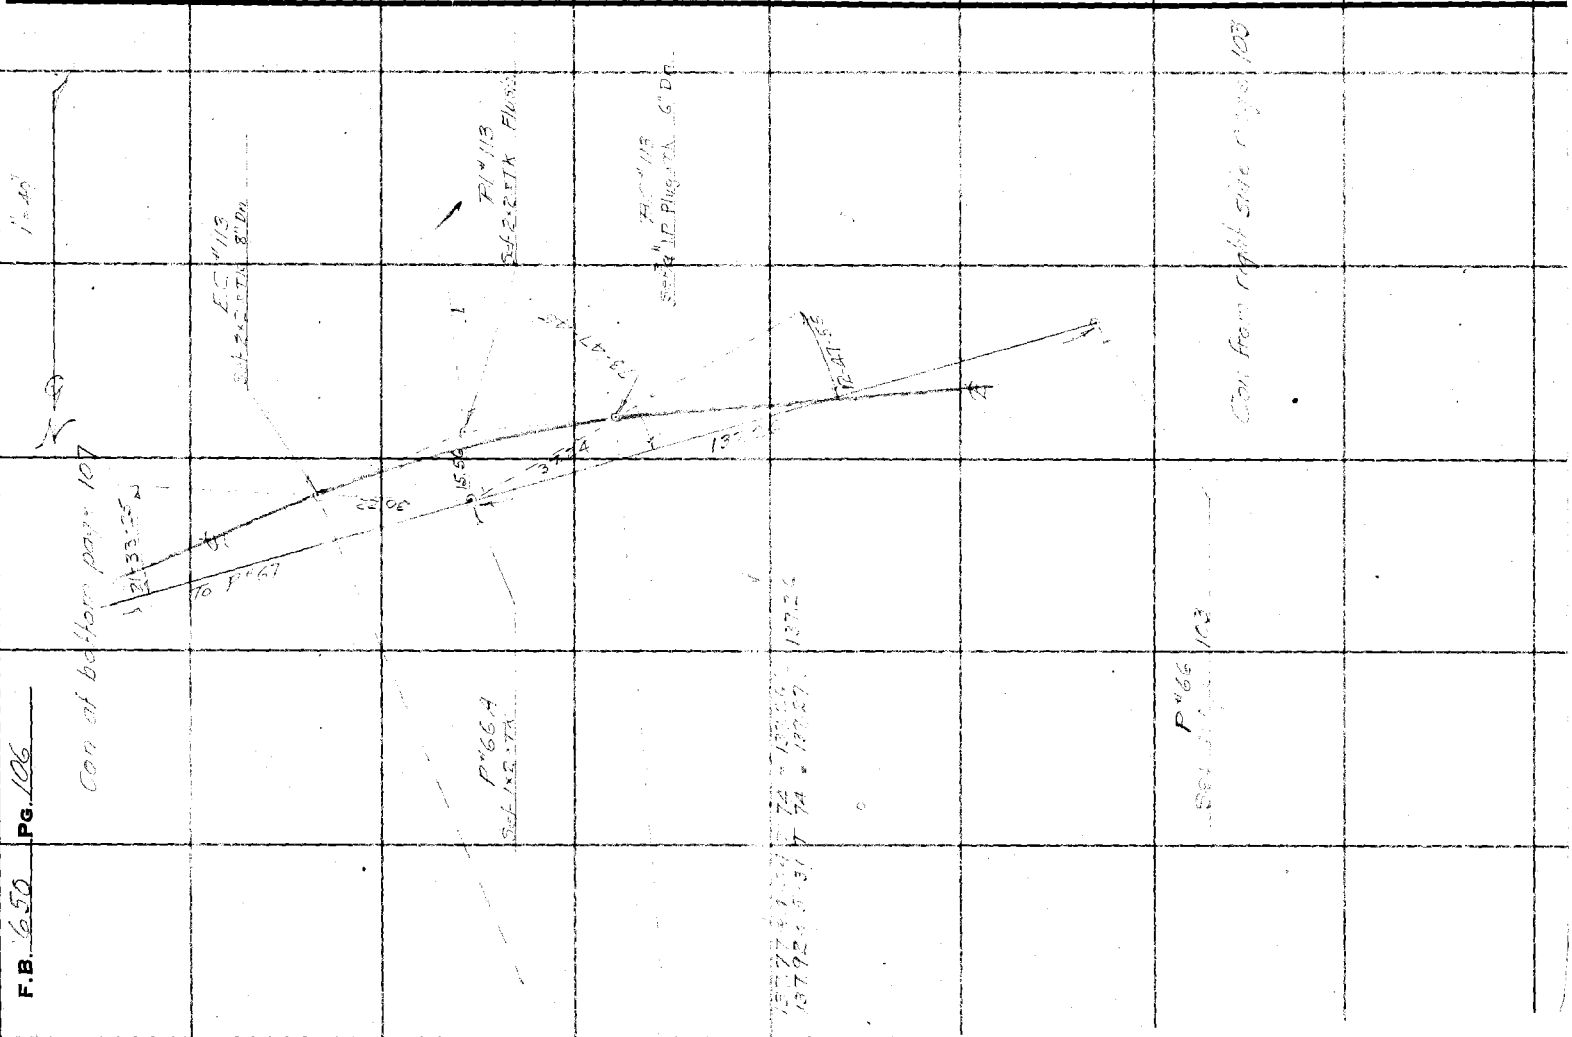

F.B. 650 PG. 106

Notes Ck'd by DV Cm	Survey of MT WILSON TOLL RD	F.B. 650	PG. 107
Map No. B-1217-2	W. O. 8149 Tape No. 63 St'd 84 °F.		
Office Work F. A. W.	Surveyed by W.A. Miller		
Checked DV Cm	Notes Miller Date		
Date 7-12-40	Indexed A. C. Johnson		

Note: Any Additions or Changes on This Sheet Must be Made or Circled in Red Ink With Date and Name of Person Making Change.

Do not extend notes this side of this line

RETURN TO
LOS ANGELES COUNTY SURVEYOR
720 HALL OF RECORDS

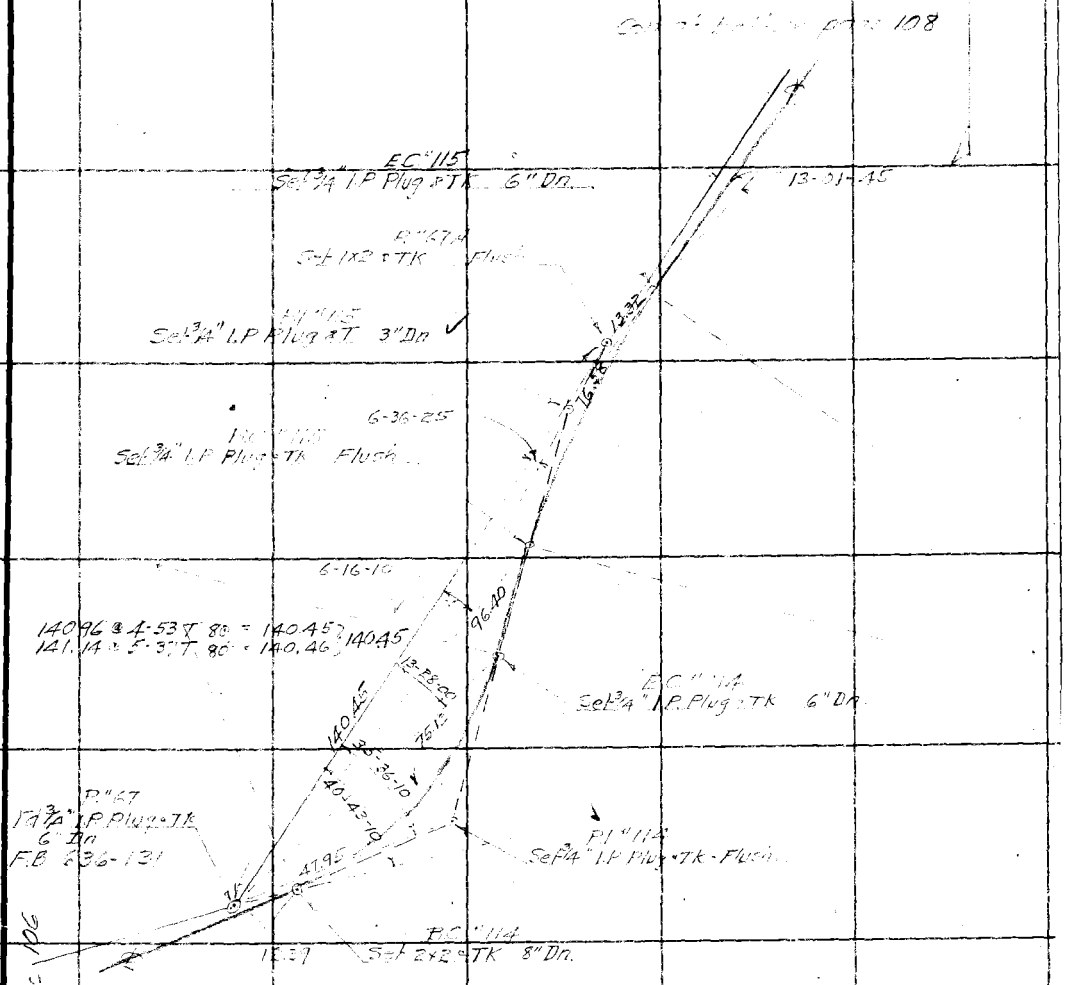

FORM 247 10M 11-35

F.B. 650 Pg. 108

Cor at bottom page 109

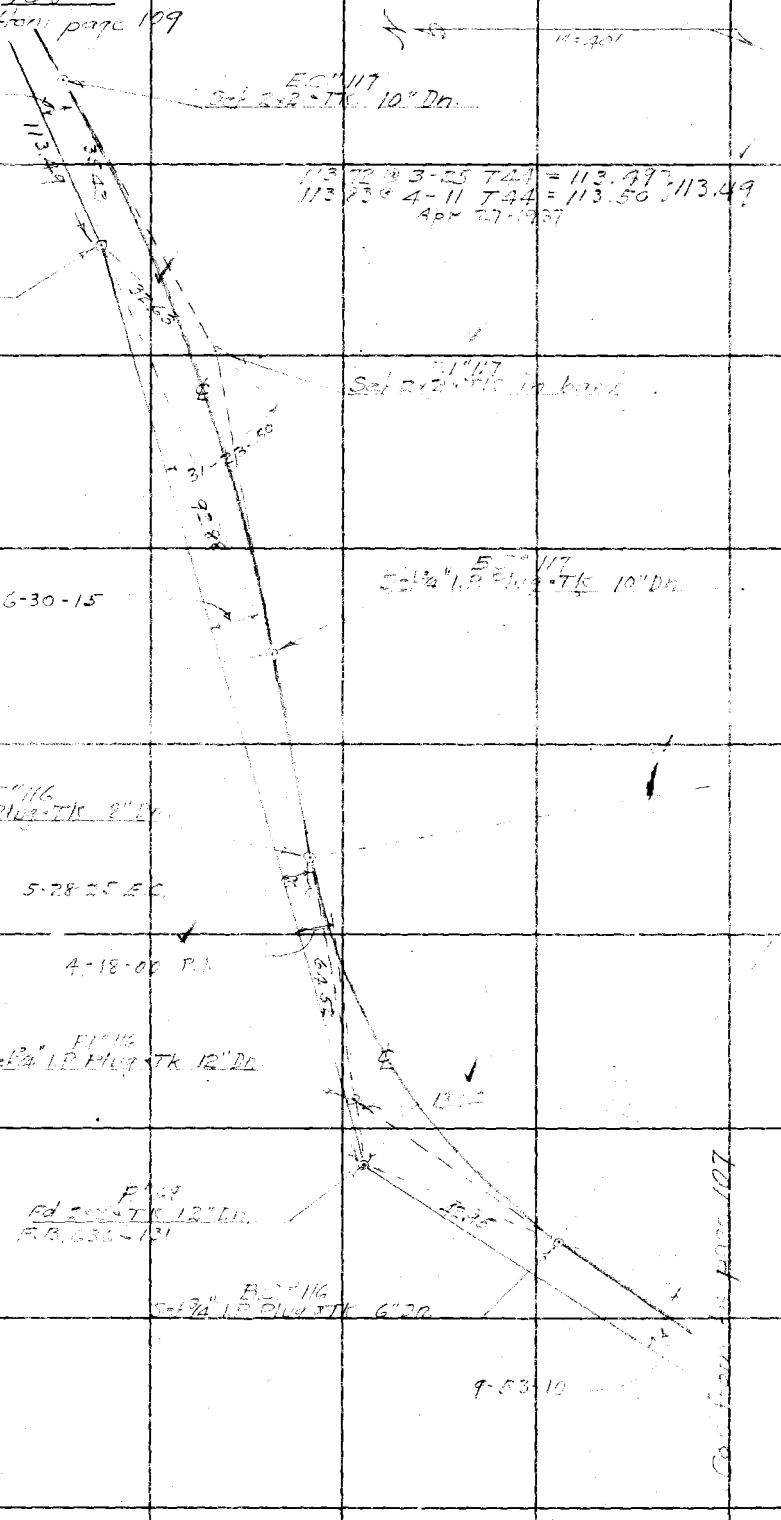

RETURN TO
LOS ANGELES COUNTY SURVEYOR
700 HALL OF RECORDS

Note: Any Additions or Changes on This Sheet Must be Made or Circled in Red Ink With Date and Name of Person Making Change.

Do not extend notes this side of this line

Notes Ck'd by Drew	Survey of MT WILSON TOLL RD	F.B. 650	Pg. 109
Map No. B-1217-2	W. O 8449 Tape No. 63 St'd 84 °F.		
Office Work F. A. W.	Surveyed by W A Miller		
Checked Drew	Notes Miller Date Apl 1937		
Date 12-12-40	Indexed A. C. Johnson		

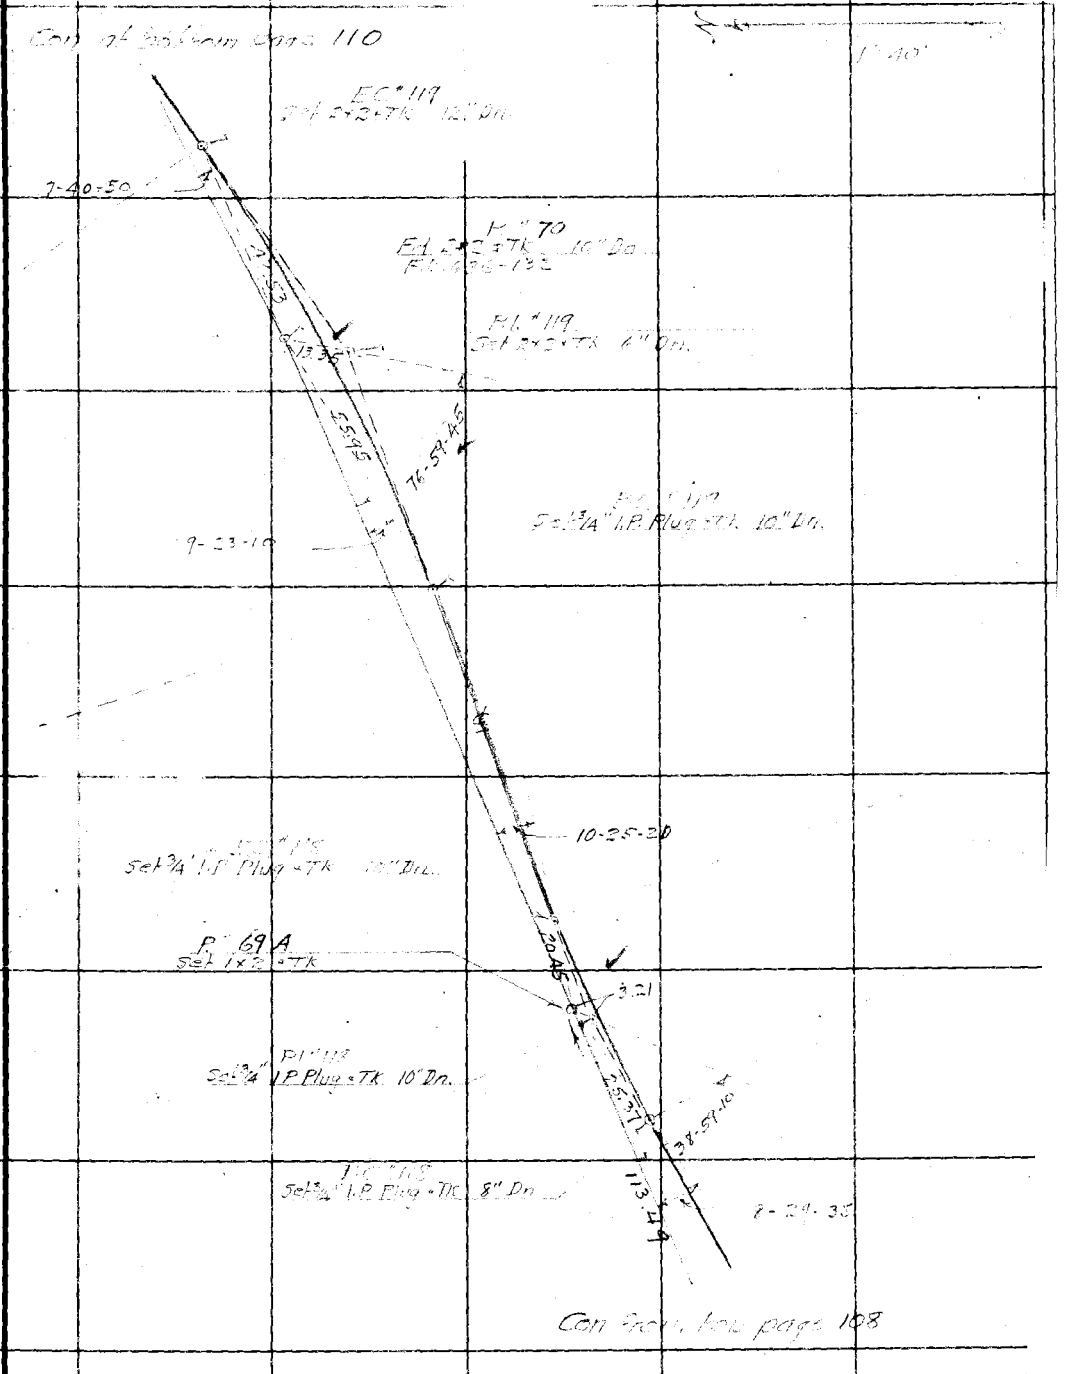

Note: Any Additions or Changes on This Sheet Must be Made or Circled in Red Ink With Date and Name of Person Making Change.

Do not extend notes this side of this line

RETURN TO
LOS ANGELES COUNTY SURVEYOR
700 HALL OF RECORDS

FORM 247 10M 11-38

F.B. 650 Pg. 110

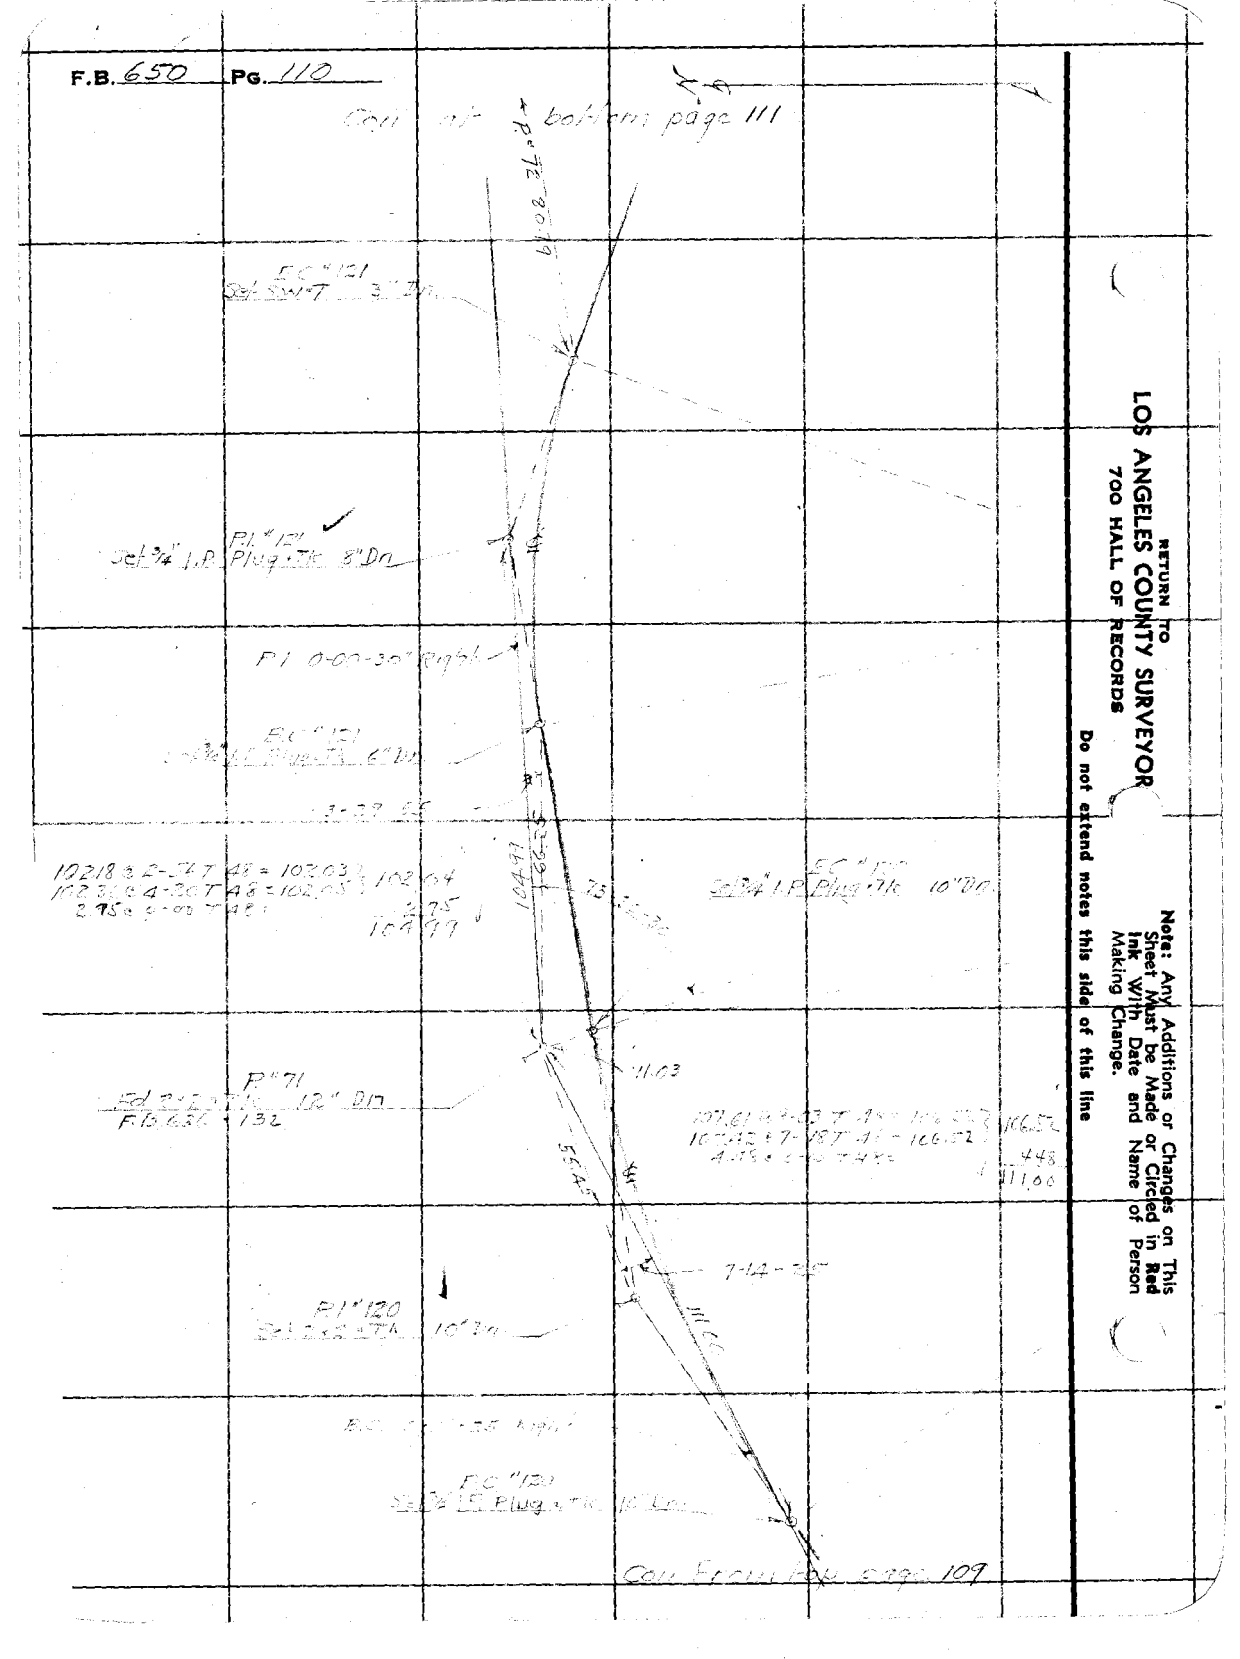
Cont. on bottom page 111
P.C. 72.80
P.T.
P.C.
P.T.
P.C.
P.T.
P.C.

Notes Ck'd by	D. C. W.	Survey of	MT. WILSON TO [illegible]
Map No.	B-1217-2	W. O.	8149
Office Work	F. A. W.	Tape No.	63
Checked	D. C. W.	St'd	84 °F.
Date	12-12-40	Surveyed by	W. A. [illegible]
		Notes	Mills
		Date	Apr. 1937
		Indexed	A. C. Johnson

F.B. 650 Pg. 111

RETURN TO
LOS ANGELES COUNTY SURVEYOR
700 HALL OF RECORDS

Note: Any Additions or Changes on This Sheet Must be Made or Circled in Red Ink With Date and Name of Person Making Change

Do not extend notes this side of this line

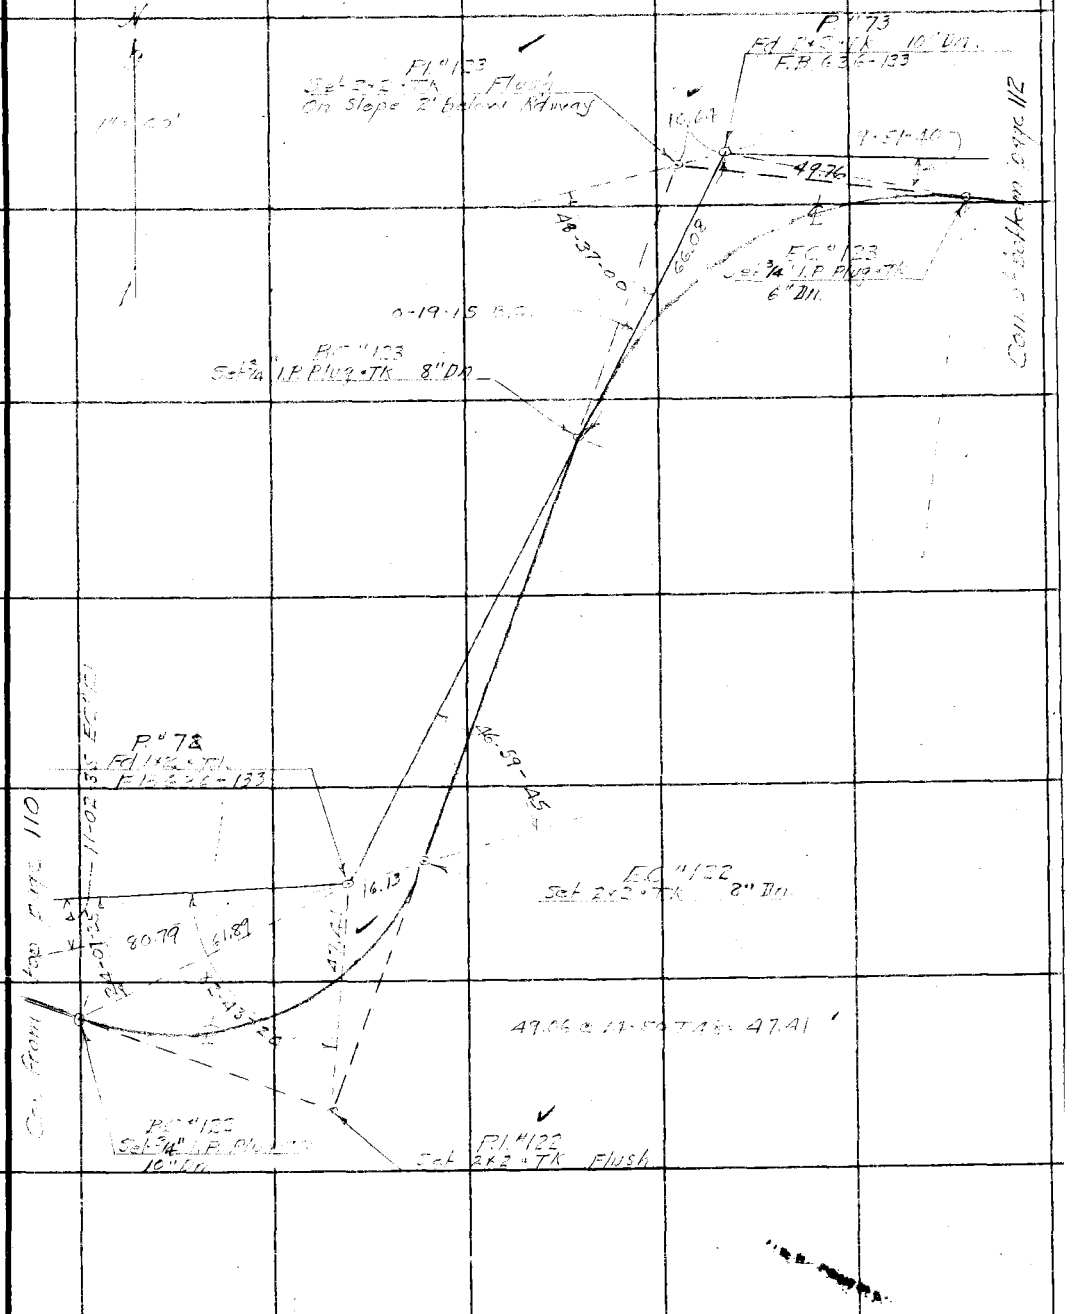

FORM 247 10M 11-38

F.B. 650 Pg. 112

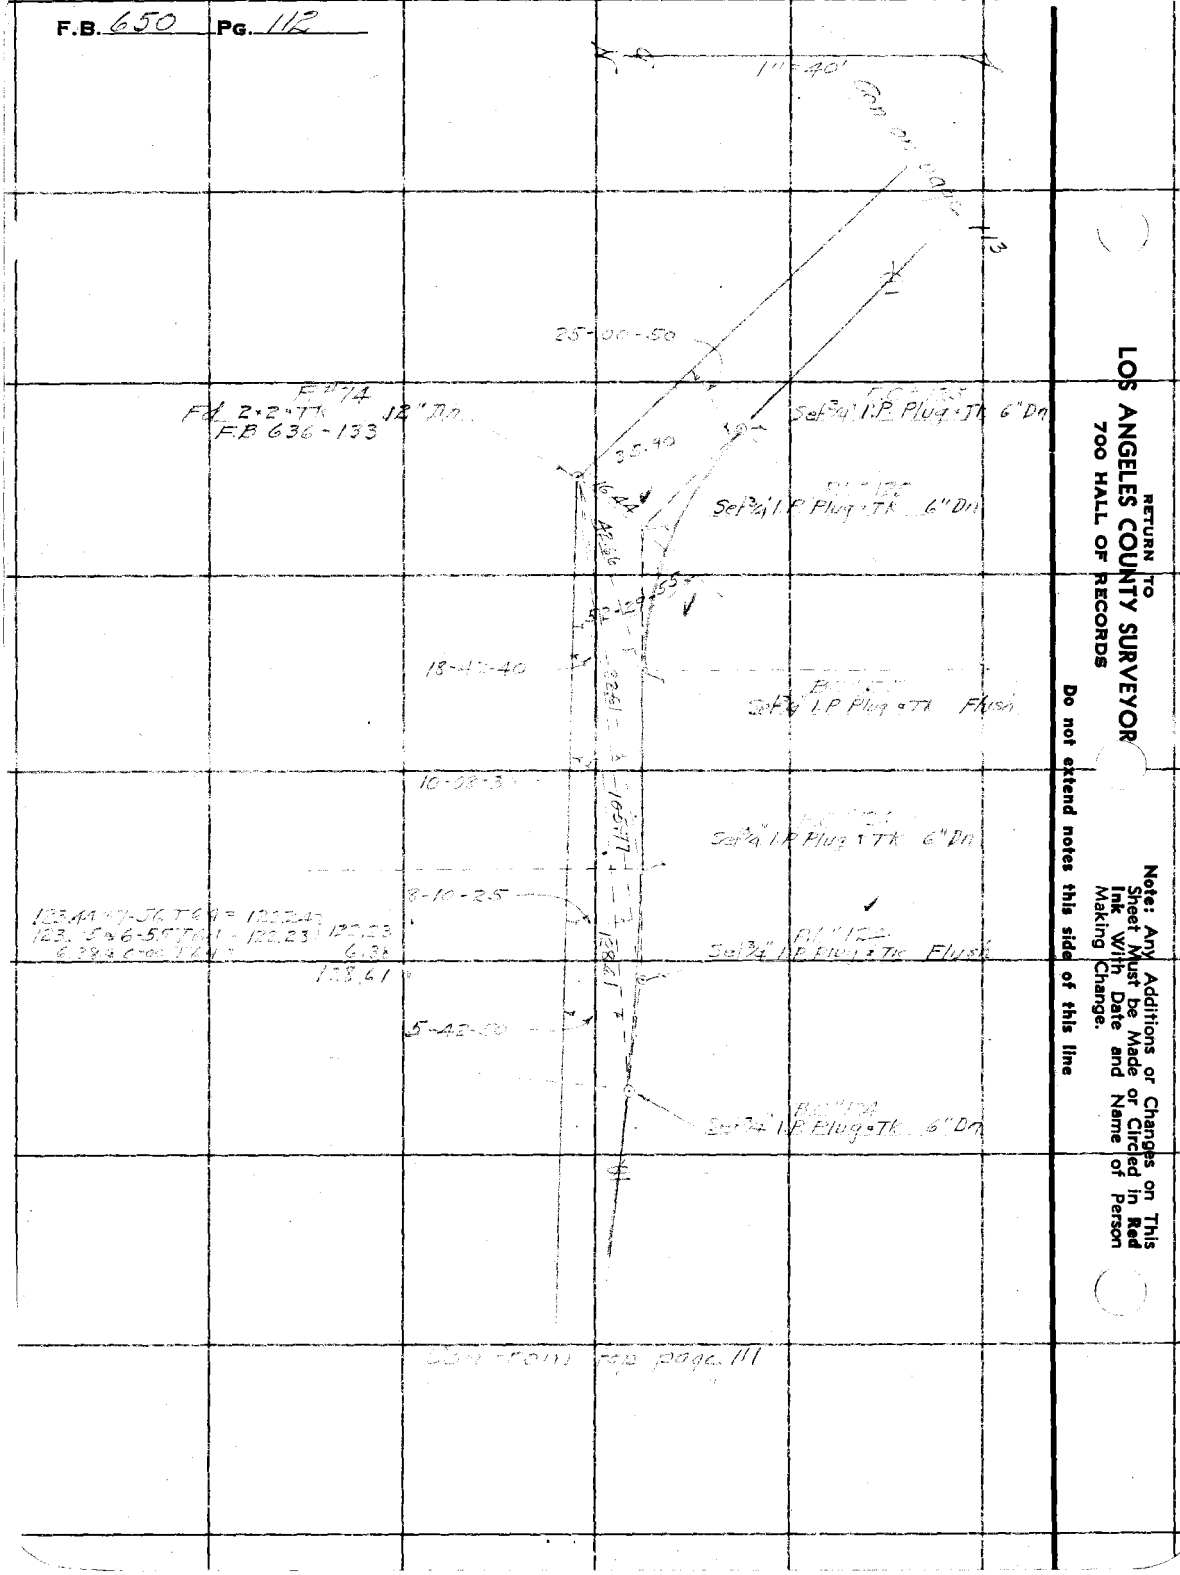

RETURN TO
LOS ANGELES COUNTY SURVEYOR
700 HALL OF RECORDS

Do not extend notes this side of this line

Note: Any Additions or Changes on This Sheet Must be Made or Circled in Red Ink With Date and Name of Person Making Change.

Notes Ck'd by	Survey of MT WILSON TRAIL
Map No. B-1217-2	W. O. 8149 Tape No. 63 St'd 84 °F.
Office Work F. A. W.	Surveyed by W.C. Miller
Checked	Notes Miller Date Apr 1937
Date 12-12-40	Indexed C. Johnson

F.B. 650 PG. 113

Note: Any Additions or Changes on This Sheet Must be Made or Circled in Red Ink With Date and Name of Person Making Change.

Do not extend notes this side of this line

RETURN TO
LOS ANGELES COUNTY SURVEYOR
700 HALL OF RECORDS

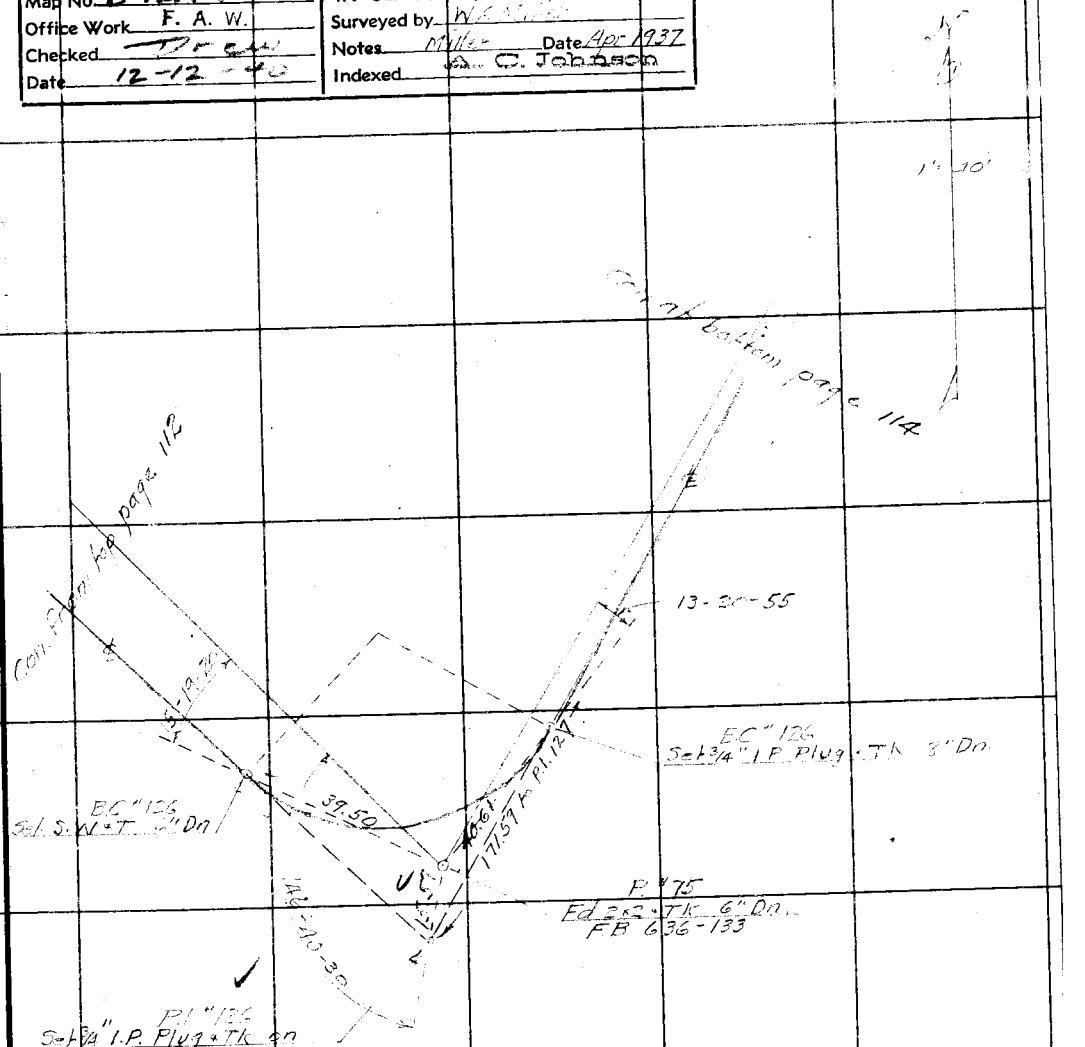

FORM 247 10M 11-35

F.B. 650 PG. 114

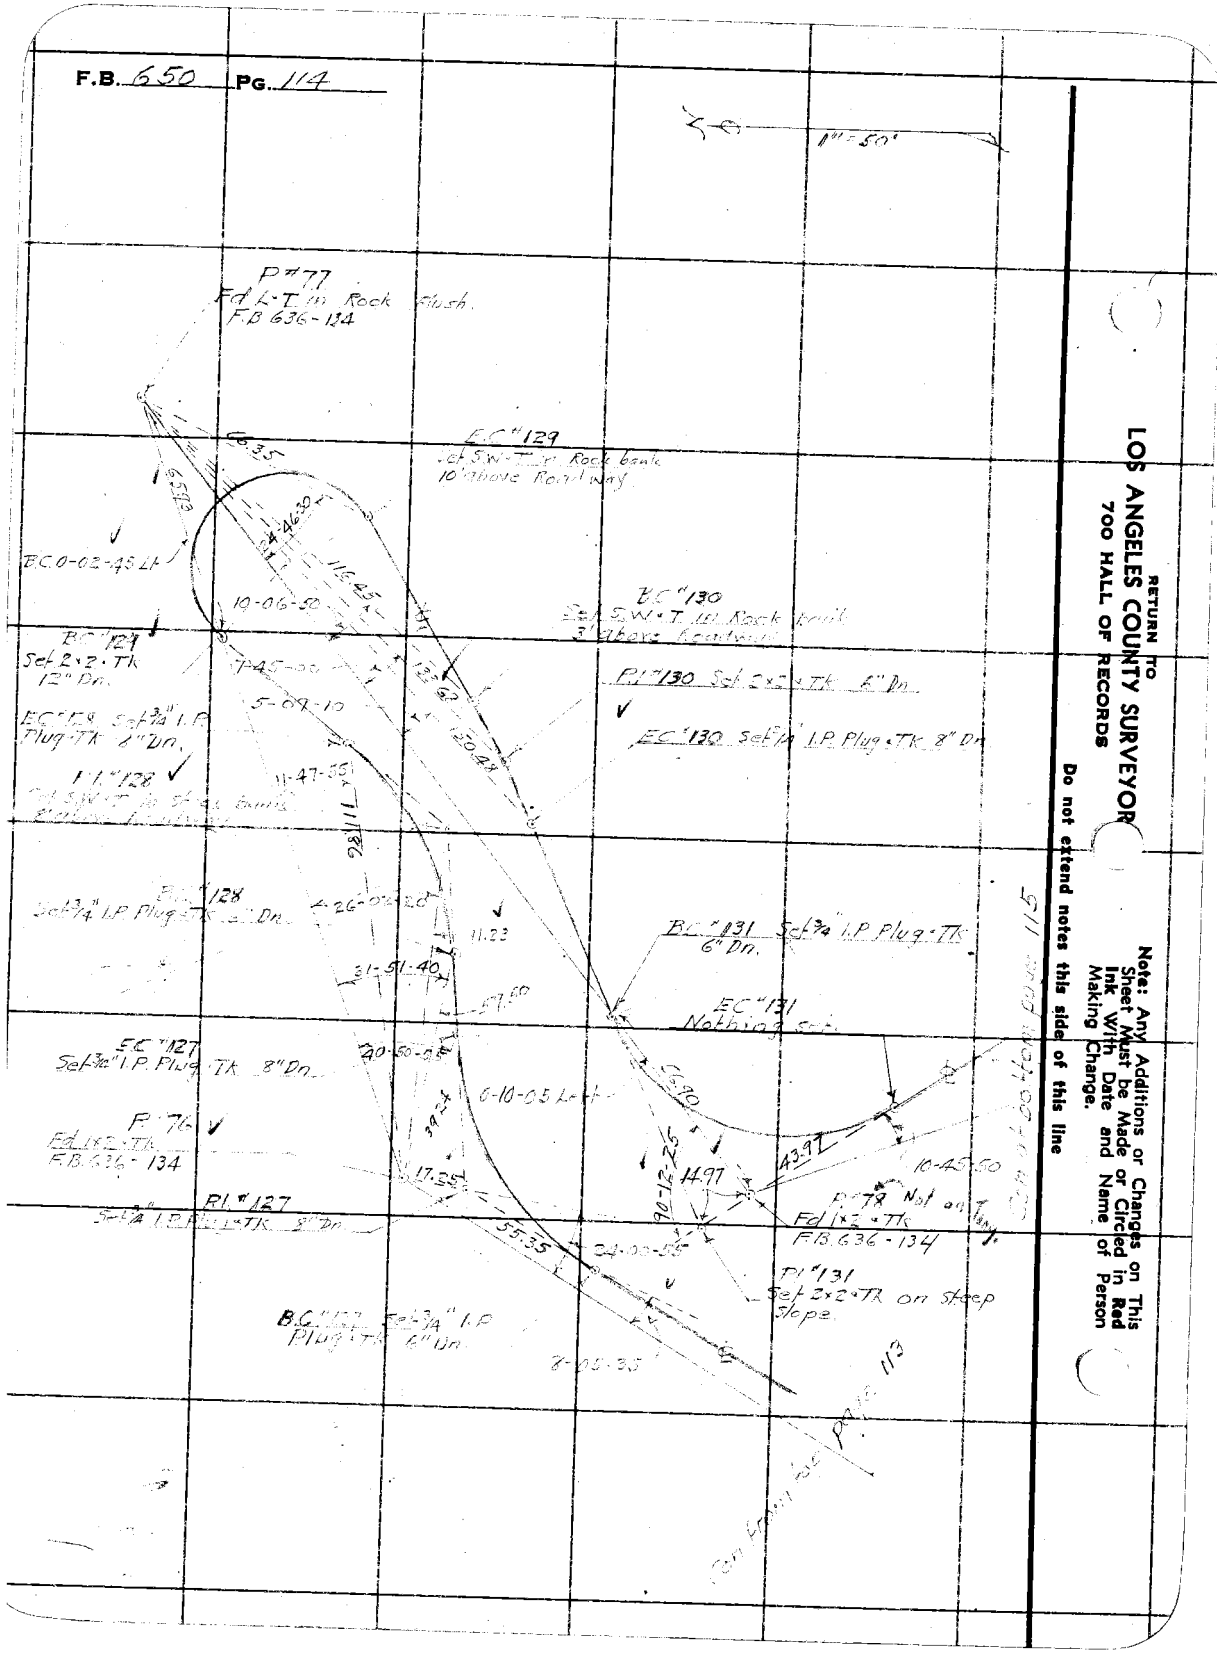

RETURN TO
LOS ANGELES COUNTY SURVEYOR
700 HALL OF RECORDS

Note: Any Additions or Changes on This Sheet Must be Made or Circled in Red Ink With Date and Name of Person Making Change.

Do not extend notes this side of this line

Notes Ck'd by DRCW	Survey of MT WILSON TOLL RD	F.B. 650	Pg. 115
Map No. B-1217-2	W. O. 8149 Tape No. 63 St'd 94 °F.		
Office Work F. A. W.	Surveyed by W.A. Miller		
Checked DRCW	Notes Miller Date May 1937		
Date 12-12-46	Indexed C. Johnson		

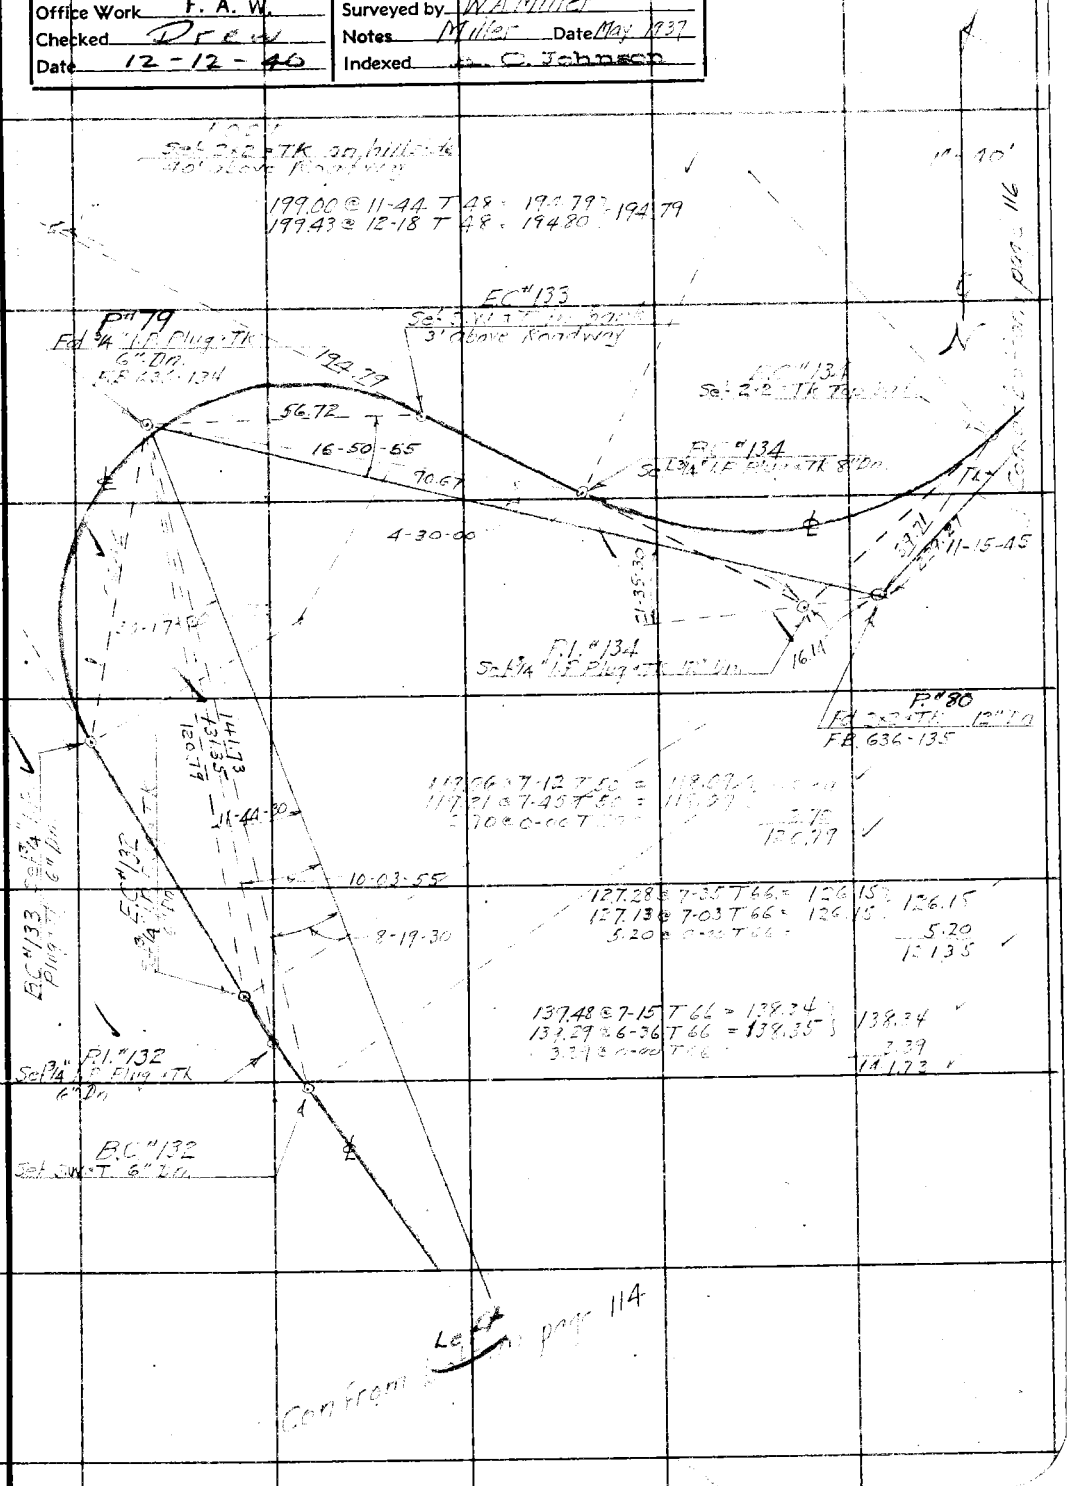

Note: Any Additions or Changes on This Sheet Must be Made or Circled in Red Ink With Date and Name of Person Making Change.

Do not extend notes this side of this line

RETURN TO
LOS ANGELES COUNTY SURVEYOR
700 HALL OF RECORDS

FORM 247 10M 11-38

F.B. 650 PG. 116

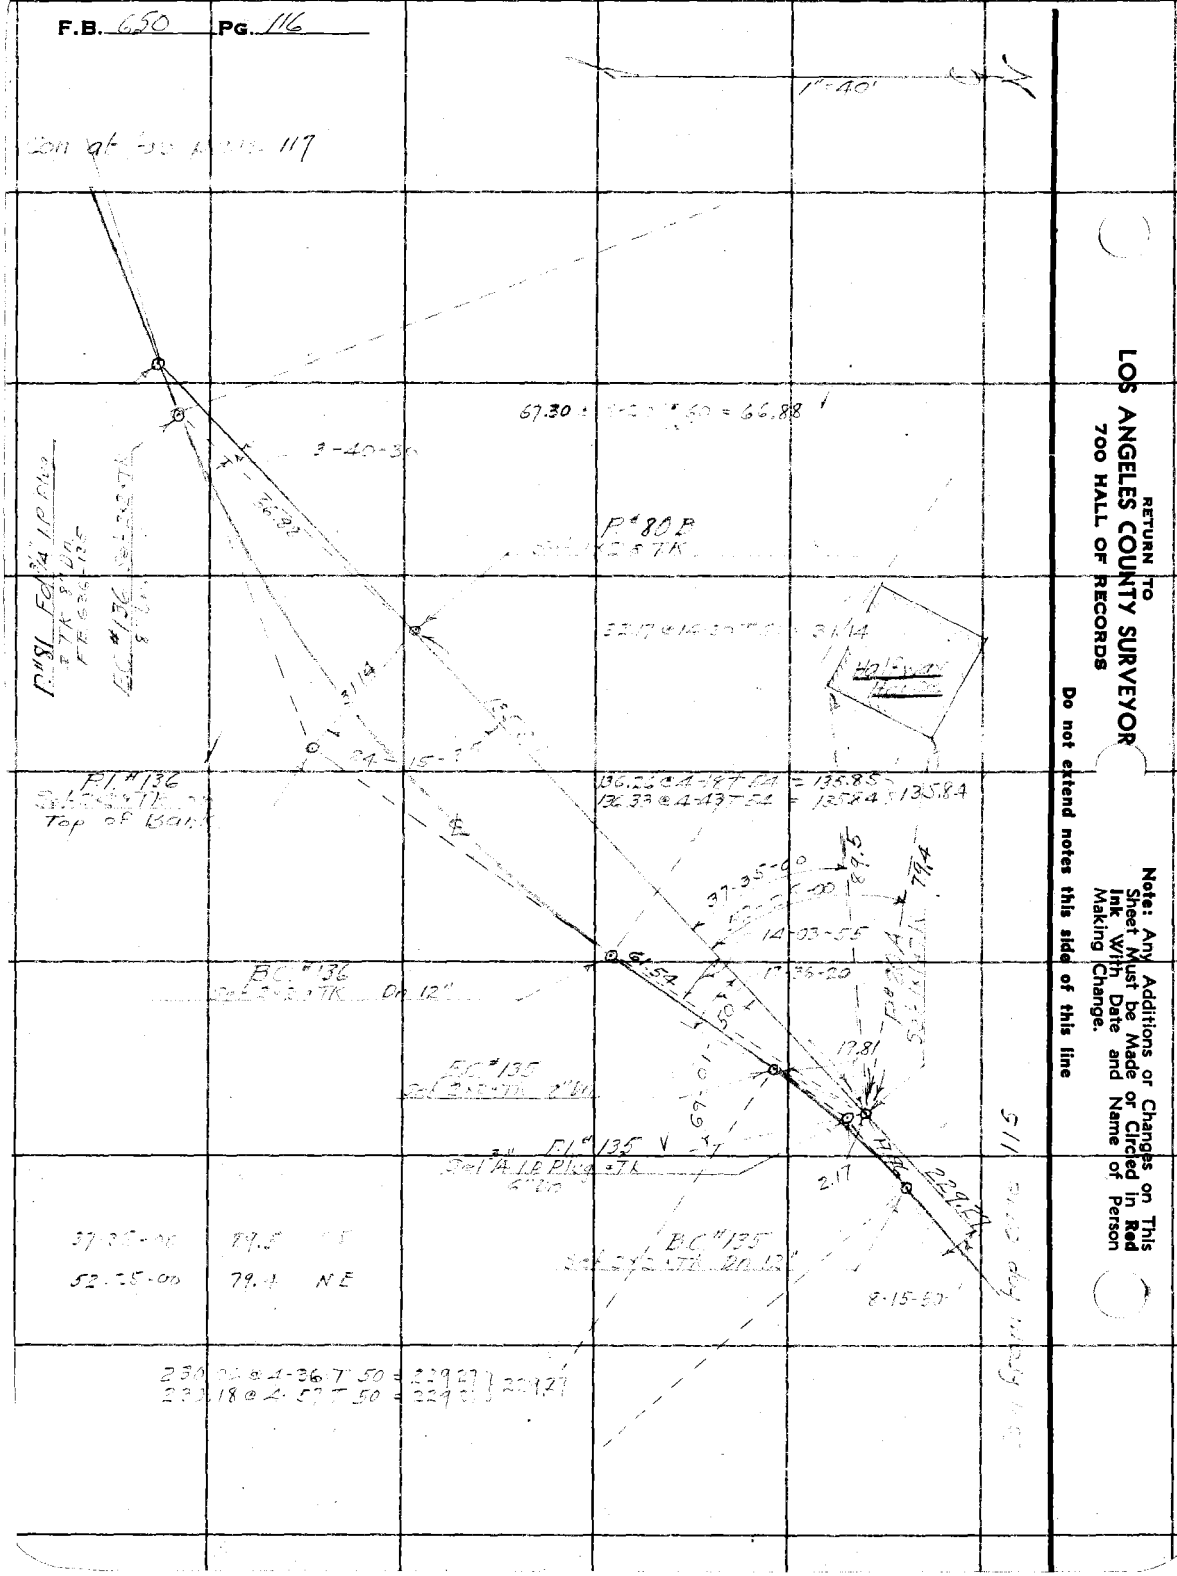

RETURN TO
LOS ANGELES COUNTY SURVEYOR
700 HALL OF RECORDS

Note: Any Additions or Changes on This Sheet Must be Made or Circled in Red Ink With Date and Name of Person Making Change.

Do not extend notes this side of this line

Notes Ck'd by Drew	Survey of Mt. Wilson Toll Rd
Map No. B-1217-2	W. O. 2147 Tape No. 63 St'd 74 °F.
Office Work F. A. W.	Surveyed by W.G. Miller
Checked Drew	Notes Miller Date May 1937
Date 12-12-40	Indexed [illegible]

F.B. 650 Pg. 117

Con from top page 116

Con't bottom page 118

90.45 × 4-13 7 6R = 90.17
90.58 × 5-21 7 6R = 90.17 90.17

P"81
Fd 3/4" I.P. Plug & Tk
8" Dn. F.B. 636-135

Set 3/4" I.P. Plug & Tk 8" Dn

EC "139"

BC "137"
Set 2x2 Tk 8" Dn

1-30-45

4-10-45

P.I. "139"
Set 3/4" I.P. & Tk 8" Dn

P"81A
Set Witness Spk

9.78

P.I. "137"
Set 2x2 Tk in bank
2' above Roadway

1-49-10

BC "139"
Set 2x2 Tk 8" Dn

1-24-20

EC "137"
Set 3/4" I.P. Plug & Tk 8" Dn

9-37-40

EC "138"

8-52-10

BC "138"
Set 2x2 Tk 10" Dn

P"82
Fd 3/4" I.P. Plug & Tk 6" Dn.
F.B. 636-135

Note: Any Additions or Changes on This Sheet Must be Made or Circled in Red Ink With Date and Name of Person Making Change.

Do not extend notes this side of this line

RETURN TO
LOS ANGELES COUNTY SURVEYOR
700 HALL OF RECORDS

FORM 247 10M 11-38

F.B. 650 Pg. 118

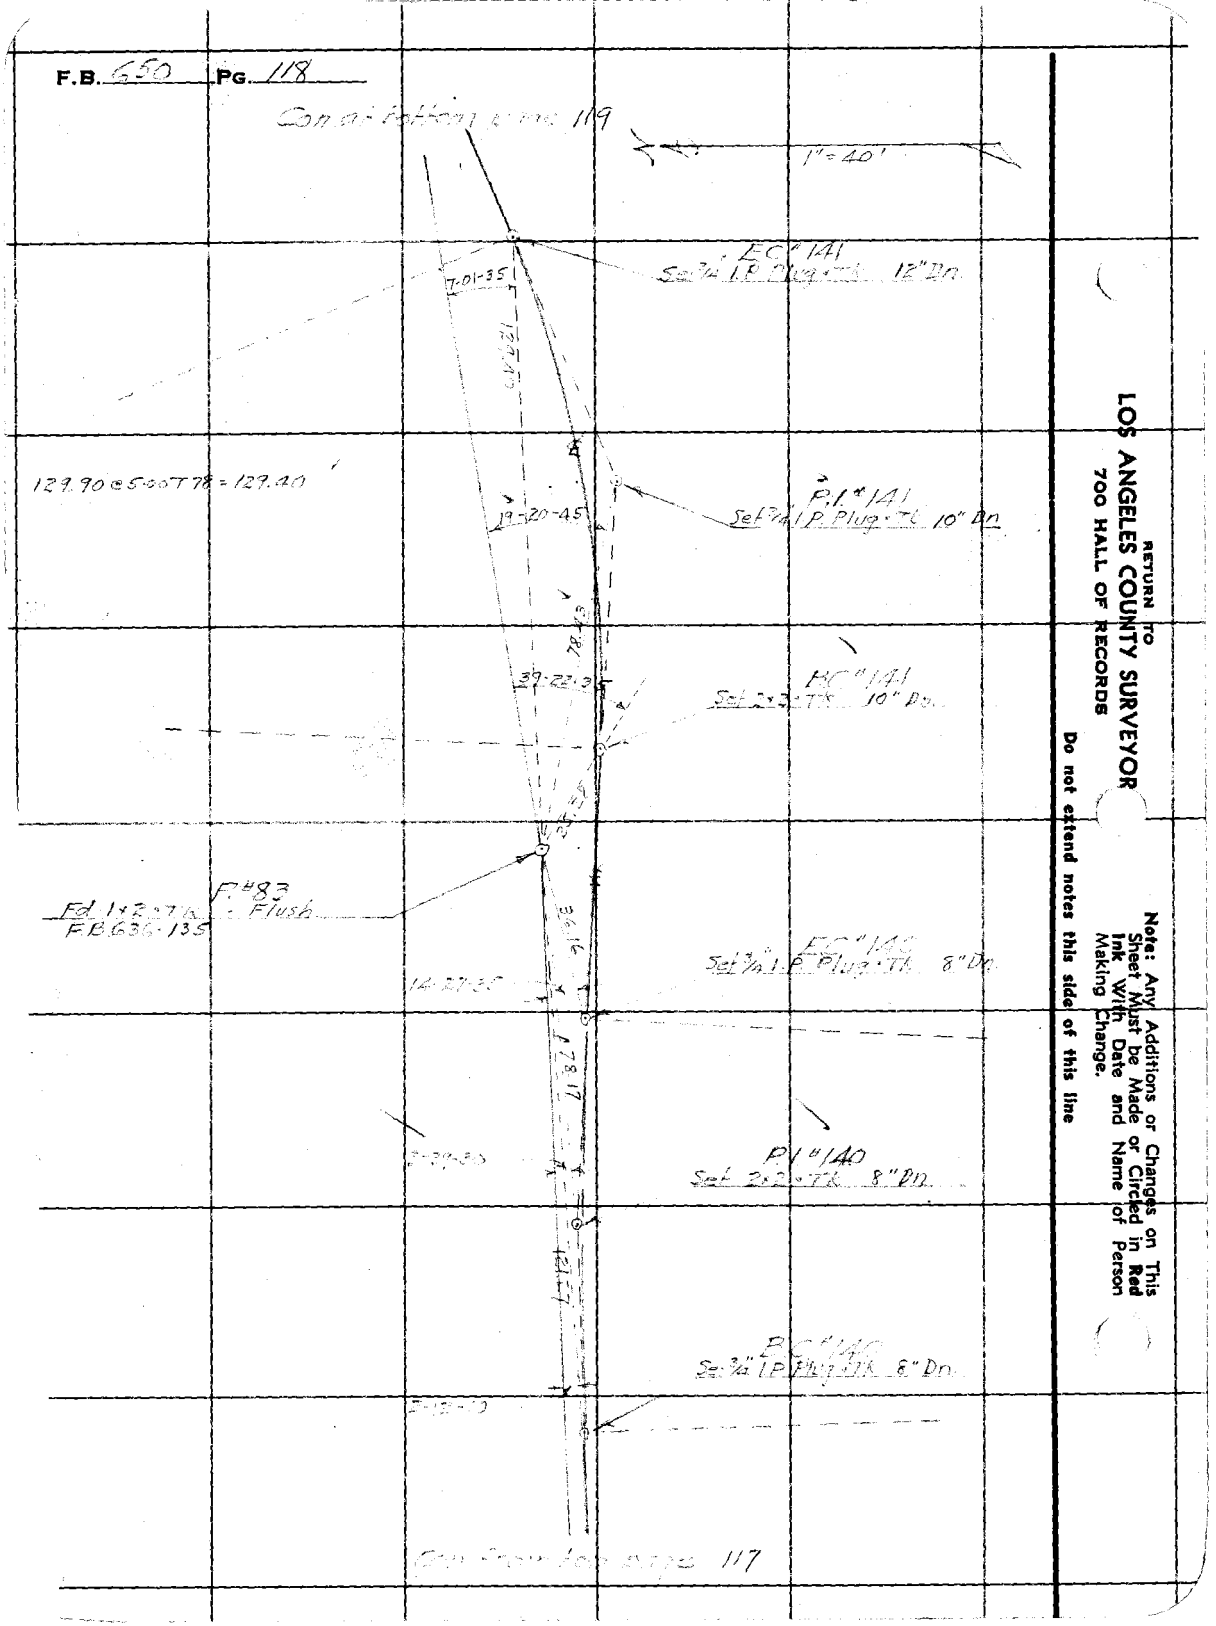

RETURN TO
LOS ANGELES COUNTY SURVEYOR
700 HALL OF RECORDS

Note: Any Additions or Changes on This Sheet Must be Made or Circled in Red Ink With Date and Name of Person Making Change.

Do not extend notes this side of this line

Notes Ck'd by Drew	Survey of MT WILSON TOLL RD
Map No. B-12.17-T.	W. O 8149 Tape No. 63 St'd 84 °F.
Office Work F. A. W.	Surveyed by N.A. Miller
Checked Drew	Notes Miller Date
Date 12-13-40	Indexed C. Johnson

F.B. 650 Pg. 117

Note: Any Additions or Changes on This Sheet Must be Made or Circled in Red Ink With Date and Name of Person Making Change.

Do not extend notes this side of this line

RETURN TO
LOS ANGELES COUNTY SURVEYOR
700 HALL OF RECORDS

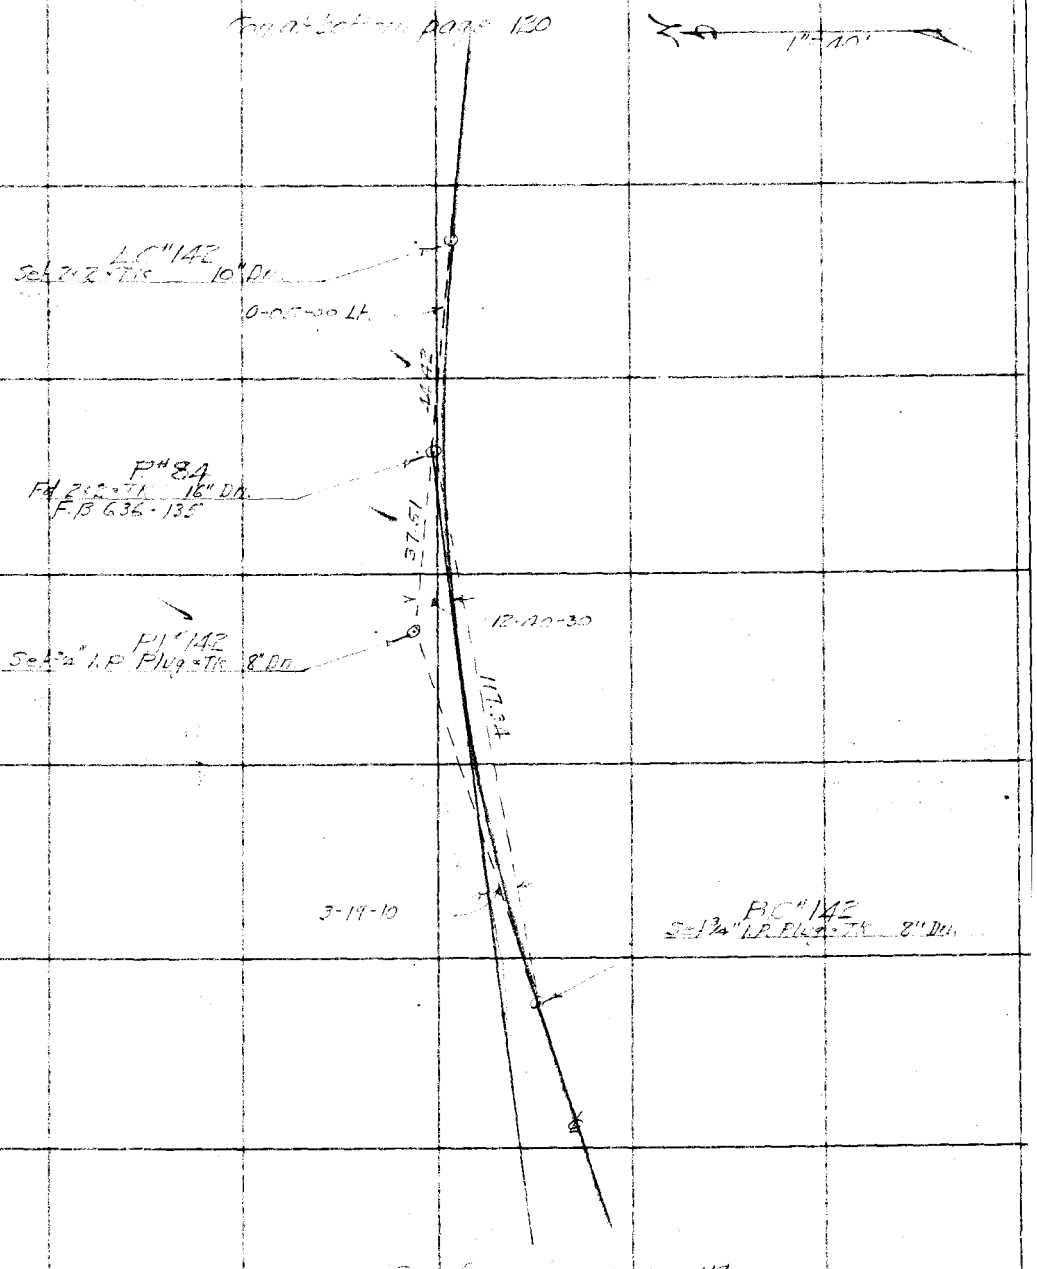

FORM 247 10M 11-38

F.B. 50 Pg. 120

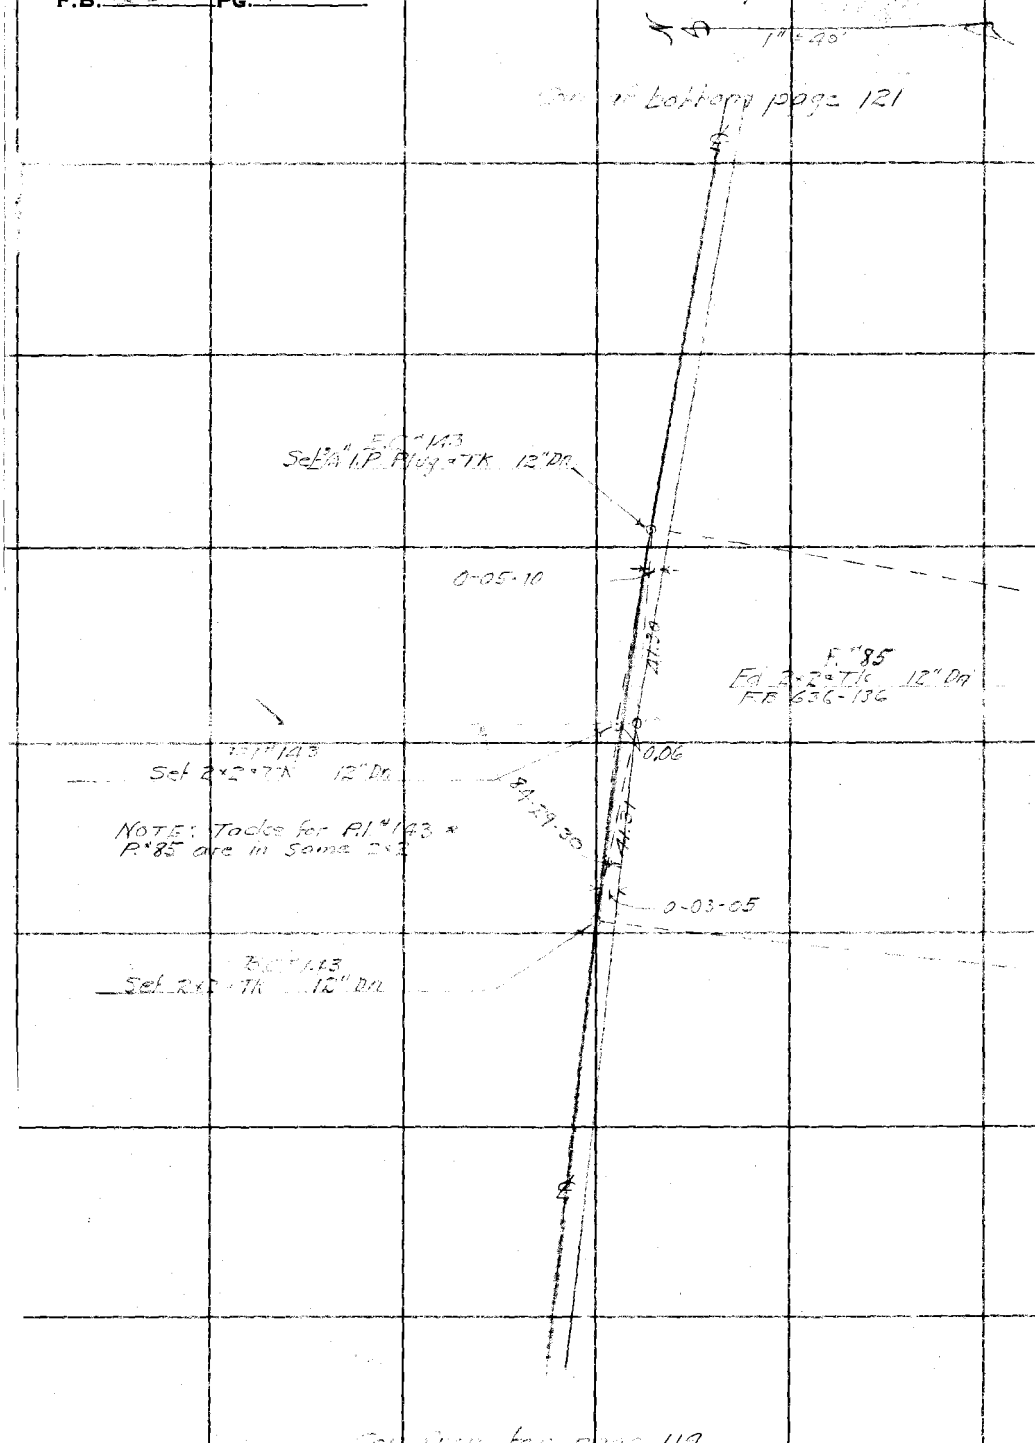

RETURN TO
LOS ANGELES COUNTY SURVEYOR
700 HALL OF RECORDS

Note: Any Additions or Changes on This Sheet Must be Made or Circled in Red Ink With Date and Name of Person Making Change.

Do not extend notes this side of this line

Notes Ck'd by DF	Survey of MT. WILSON TOLL RD.
Map No. B-1217-2	W. O. 5149 Tape No. 63 St'd 68° F.
Office Work F. A. W.	Surveyed by W.A. Miller
Checked Draw	Notes Miller Date MAY 1937
Date 12-13-40	Indexed C. Johnson

F.B. 650 PG. 121

1" = 40'

Note: Any Additions or Changes on This Sheet Must be Made or Circled in Red Ink With Date and Name of Person Making Change.

Do not extend notes this side of this line

RETURN TO
LOS ANGELES COUNTY SURVEYOR
700 HALL OF RECORDS

11.31 + 28.00 T 24 = 119

68.85 + 9.45 T 24 = 67.85

E.C. "145"
Set 3/4" I.P. Plug + Tk
Flush in Rock Face
P above No. 1 Hung

67.85

43.21

45.36

14-21-10

61.68

7-26-05

BC "116"
Set 3/4" I.P. Plug + Tk 6" Dn

P.I. "144"
Set 3/4" I.P. Plug + Tk Flush
Reference Monument

P.I. "145"
Set 2x2 + Tk Flush
Reference Monument

999

6.94

P "87A"
Fd S.W. + T
F.B. 636-136

B.C. "145"
Set 3/4" I.P. Plug + Tk 2" Dn

E.C. "145"
Set 3/4" I.P. Plug + Tk 8" Dn

P "87"
Fd S.W. + T 4" Dn
F.B. 636-136

9-33-50

E.C. "146"
Set 2x2 + Tk

112.67 + 5.20 T 24 = 112.17

1-01-30 Left
Off P "87"

P "86"
Fd S.W. + T Flush
F.B. 636-136

B.C. "144"
Set 3/4" I.P. Plug + Tk 8" Dn

Con. from top page 120

FORM 247 10M 11-35

F.B. 650 Pg. 182

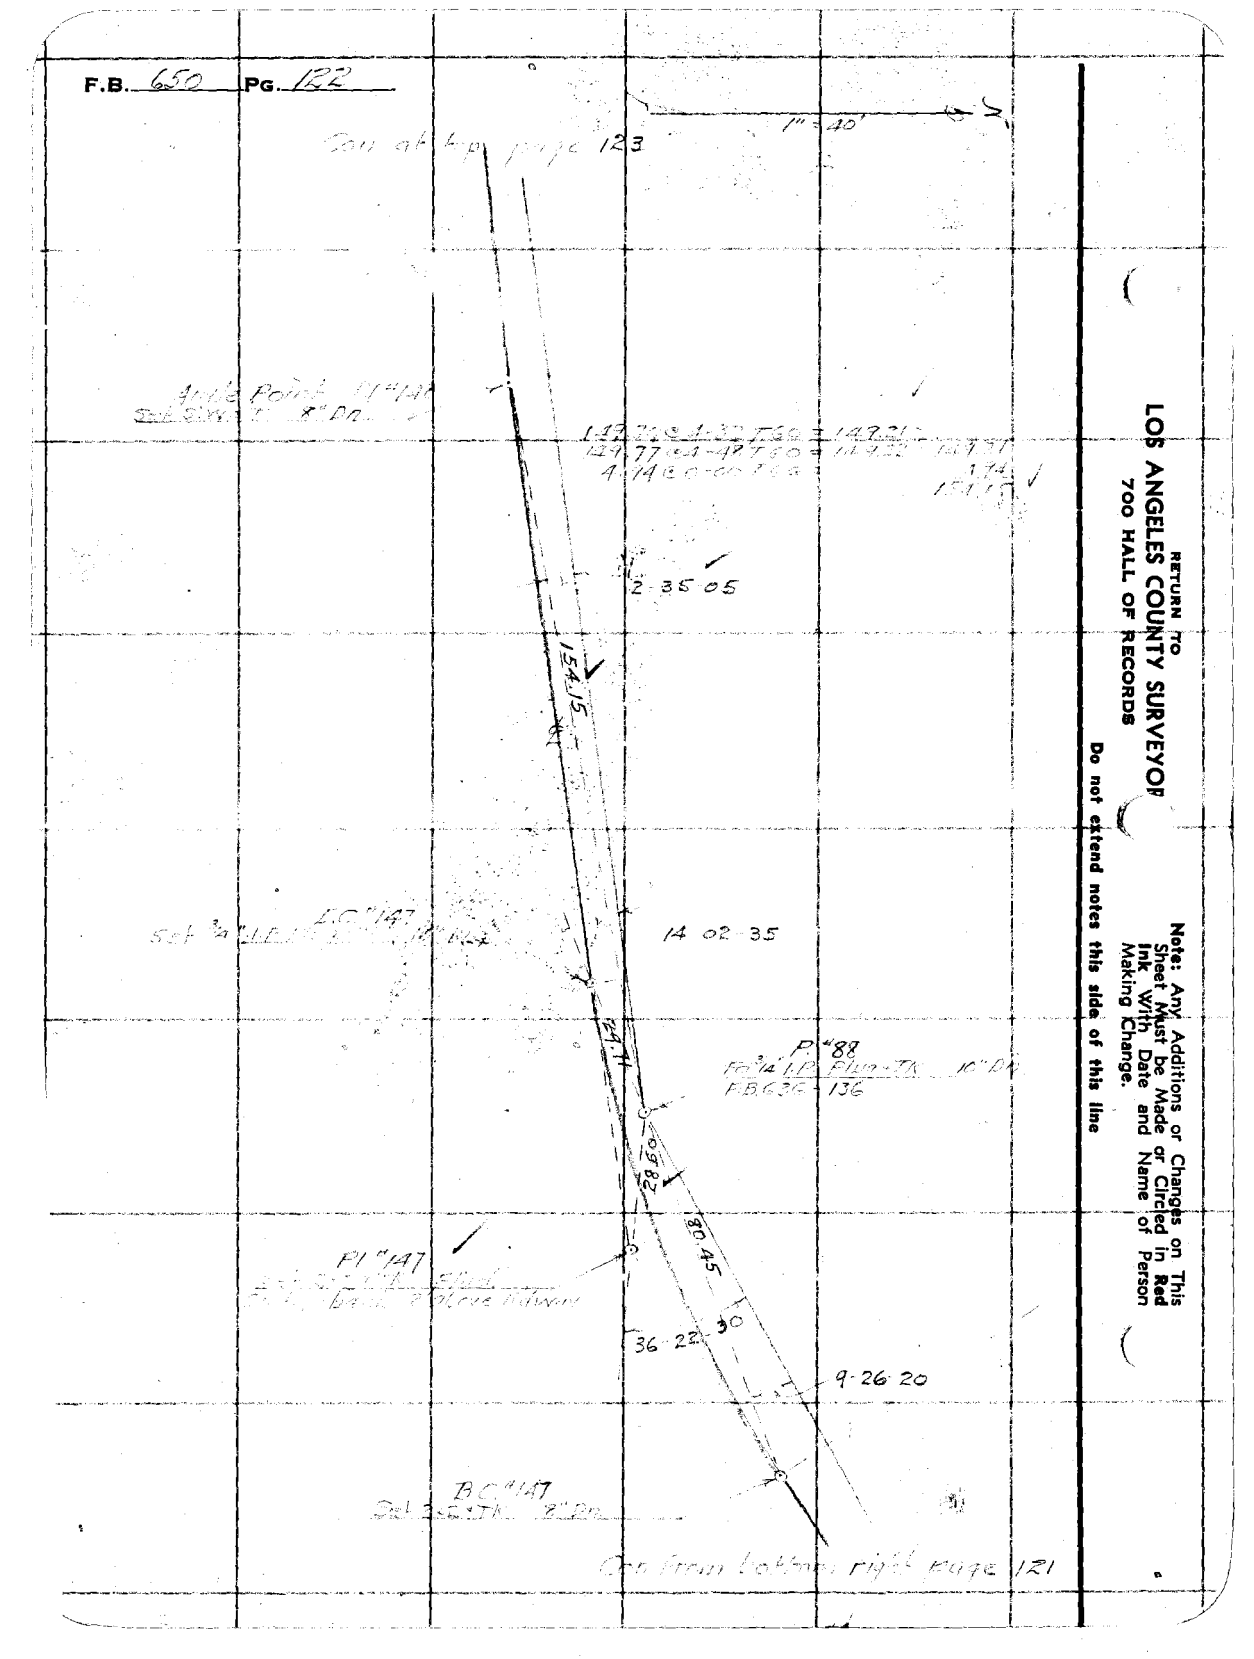

RETURN TO
LOS ANGELES COUNTY SURVEYOR
700 HALL OF RECORDS

Note: Any Additions or Changes on This Sheet Must be Made or Circled in Red Ink With Date and Name of Person Making Change.

Do not extend notes this side of this line

Notes Ck'd by Drew
Map No. B-1217-2
Office Work F. A. W.
Checked Drew
Date 12-13-40

Survey of MT WILSON TOLL RD
W. O. 8149 Tape No. 63 St'd 84 °F.
Surveyed by W. A. Miller
Notes Miller Date May 1937
Indexed A. C. Johnson

F.B. 650 Pg. 123

1" = 40'

Con from top pag- 122

BC "149
Set 2x2 TK 10" Dn.

P.I. "149
Set 2x2 TK 10" Dn

EC "149
Set 3/4" I.P. Plug TK 8" Dn

E.C. 0-18-35 Rt
113.01 From P "88A

P.I. 0-02-35 Lt.
96.13 From P "88A

E.C. 0-20-15 Rt
78.64 From P "88A

BC "150
Set 3/4" I.P. Plug TK 8" Dn

P "88A
Set 1x2 TK Flush

EC "150
Set 2x2 TK 10" Dn

BC "151 - 0-05-20 Lt

BC "151
Set 2x2 TIC 12" Dn

Con at bottom page 124

135.26 @ 4-17 T84 = 134.88
135.39 @ 4-56 T84 = 134.89
4.17 @ 0-00 T84 =
134.88
4.17
139.05

EC "152
Set 2x2 TK 6" Dn

103.75
103.75
103.75

3.23
To 98

EC "152
18-52-15

P.I. "152
Set SWET 4" Dn

24-32-20

P.I. "150
Set 2x2 TK 8" Dn

18-26-05

104.12 @ 4-51 T84 =
144.00 @ 3-58 T84 =
3.83 @ 0-00 T84 =

8.50
3.23
8.87
64-49-50
137.05 EC "152
106.99 P.I. "152
12-28-00

BC "152
Set 2x2 TK in Rock bank
4' above Roadway

82.56 @ 5-00 T84 = 82.25

E.C. "151
Set 1x1 in Rock Bank
9' above Roadway

46-31-35

13-37-15
82.25
67.36
70.00
42.62

68.21 @ 9-00 T60 = 67.36

P "87
Fd 2x2 TK 12" Dn.
F.B. 636-136

Note: ANY ADDITIONS OR CHANGES ON THIS SHEET MUST BE MADE OR CIRCLED IN Red Ink, WITH DATE AND NAME OF PERSON MAKING CHANGE.

Do not extend notes this side of this line

RETURN TO
LOS ANGELES COUNTY SURVEYOR
700 HALL OF RECORDS

FORM 247 16M 8-31

F.B. 8 Pg. 124

1"=50'

Con at bottom page 125

Set 3/4" I.P. Plug - Tk 8" Dn

EC #153

2-30-55

180.74

177.24 @ 5-13 T74 = 176.50
177.34 @ 5-33 T74 = 176.58 } 176.50
4.24 @ 0-00 T74 = 4.24
180.74

41-50-05

24.49 @ 23-15 T74 = 22.50

EC #153
Set 2x2x8 Tk Flush
Top of bank

P #90
Fd S.W.T. Flush
F.B. 636-136

145.16 @ 6-18 T74 = 144.27 } 144.27
145.04 @ 5-51 T74 = 144.27 }
5.09 @ 0-00 T74 = 5.09
149.36

142.32

3-06-25

EC #153
Set S.W.T. 6" Dn.

Con from top page 123

RETURN TO
LOS ANGELES COUNTY SURVEYOR
700 HALL OF RECORDS
Do not extend notes this side of this line

Note: ANY ADDITIONS OR CHANGES ON THIS SHEET MUST BE MADE OR CIRCLED IN Red Ink. WITH DATE AND NAME OF PERSON MAKING CHANGE.

Notes Ck'd by Drew	Survey of MT WILSON TOLL RD	F.B. 650	Pg. 125
Map No. B-1217-2	W. O. 8149	Tape No. 63	St'd 84 °F.
Office Work F. A. W.	Surveyed by W. A. Miller		
Checked Drew	Notes Miller	Date June 1937	
Date 12-13-40	Indexed L. C. Johnson		

Note: ANY ADDITIONS OR CHANGES ON THIS SHEET MUST BE MADE OR CIRCLED IN Red Ink WITH DATE AND NAME OF PERSON MAKING CHANGE.

Do not extend notes this side of this line

RETURN TO
LOS ANGELES COUNTY SURVEYOR
700 HALL OF RECORDS

Con. at bottom page 126

E.C. #155
Set 2x2 T.K. 12" Dn.

2-10-15

P.I. #155
Set 3/4" I.P. Plug - T.K. 12" Dn.

P.I. #155 0-00-05 Rt.

B.C. #155
Set 3/4" I.P. Plug - T.K. 12" Dn.

215.16 @ 5-29 7/8" = 214.17
215.17 @ 5-30 7/8" = 214.18 } 214.18

214.18

83.15

B.C. #155 0-00-15 Rt.

E.C. #154
Set 3/4" I.P. Plug - T.K. 12" Dn.

E.C. 0-00-30 Rt.

P.I. #154
Set 2x2 - T.K. 12" Dn.

61.60

6.49

P.I. #91
Set 2x2 T.K. 12" Dn.
F.B. G36 - 127

P.I. 0-03-15 Rt.

S 5° 35' E

1-22-25

B.C. #154
Set 2x2 - T.K. 12" Dn.

Con. from top page 124

FORM 247 10M 8-31

F.B. 650 Pg. 126

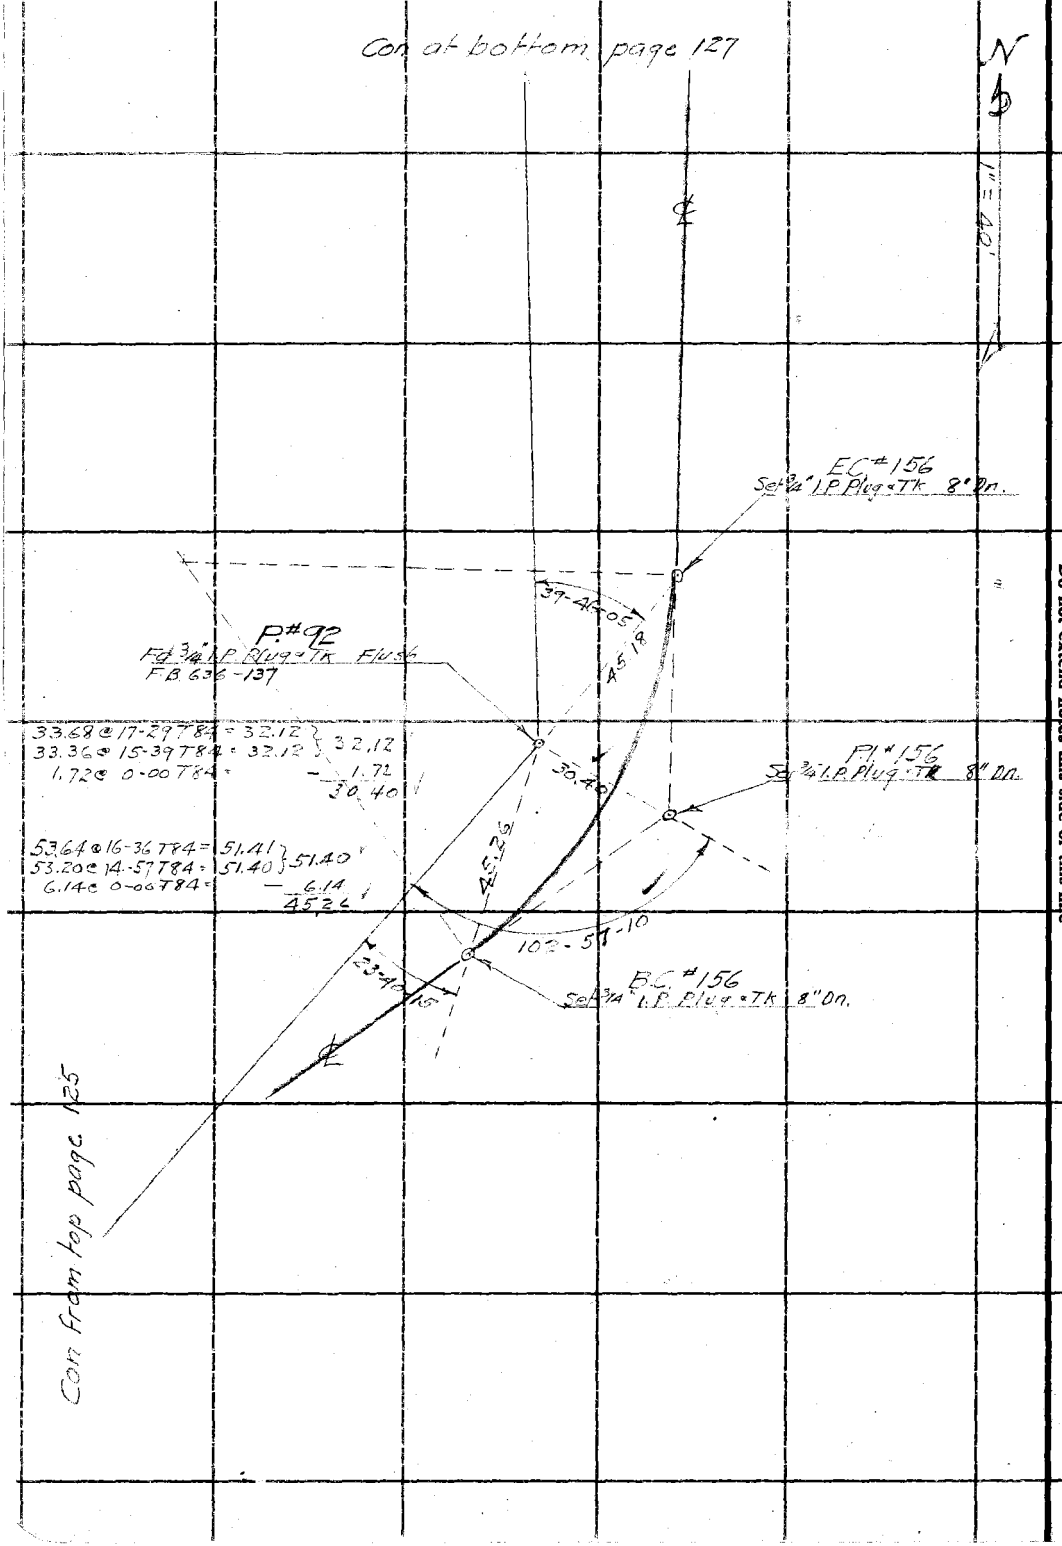

RETURN TO
LOS ANGELES COUNTY SURVEYOR
700 HALL OF RECORDS
Do not extend notes this side of this line

Note: ANY ADDITIONS OR CHANGES ON THIS SHEET MUST BE MADE OR CIRCLED IN Red Ink. WITH DATE AND NAME OF PERSON MAKING CHANGE.

Notes Ck'd by Drew	Survey of MT WILSON TOLL RD
Map No. B-1217-2	W. O. 8149 Tape No. 63 St'd 84 °F.
Office Work F. A. W.	Surveyed by W.A. Miller
Checked Drew	Notes Miller Date June 1937
Date 12-13-40	Indexed A. C. Johnson

F.B. 650 PG. 127

Con at bottom page 128

P.I. "159 Set S.W.T 8" Dn.

52-37-05

25.16

P."94 Fd 1x2 "TK F.B. 636-137

37.98

BC "159 Set S.W.T 4" Dn.

17-20-50

77.83

3-12-05

E.C. "158 Set S.W.T 4" Dn.

32-38-10

P.I. "158 Set S.W.T 6" Dn.

0-01-40 Lt.

41.00

B.C. "158 Set S.W.T 8" Dn.

16.78

E.C. "157 Set S.W.T 6" Dn.

21.91

P."93 Fd 2x2 "TK 12" Dn F.B. 636-137

62.23

96.09

61-44-05

P.I. "157 Set S.W.T in bank

43-40-55

95.00 @ 3-25 T82 = 94.83
94.93 @ 2-35 T82 = 94.83 } 94.83
1.26 @ 0-00 T82 = 1.26
96.09

25-14-20

B.C. "157 Set 3/4" I.P. Plug "TK 6" Dn.

Con from top page 136

N

1" = 40'

Note: ANY ADDITIONS OR CHANGES ON THIS SHEET MUST BE MADE OR CIRCLED IN Red Ink, WITH DATE AND NAME OF PERSON MAKING CHANGE.

Do not extend notes this side of this line

RETURN TO
LOS ANGELES COUNTY SURVEYOR
700 HALL OF RECORDS

FORM 247 10M 8-31

F.B. 650 Pg. 128

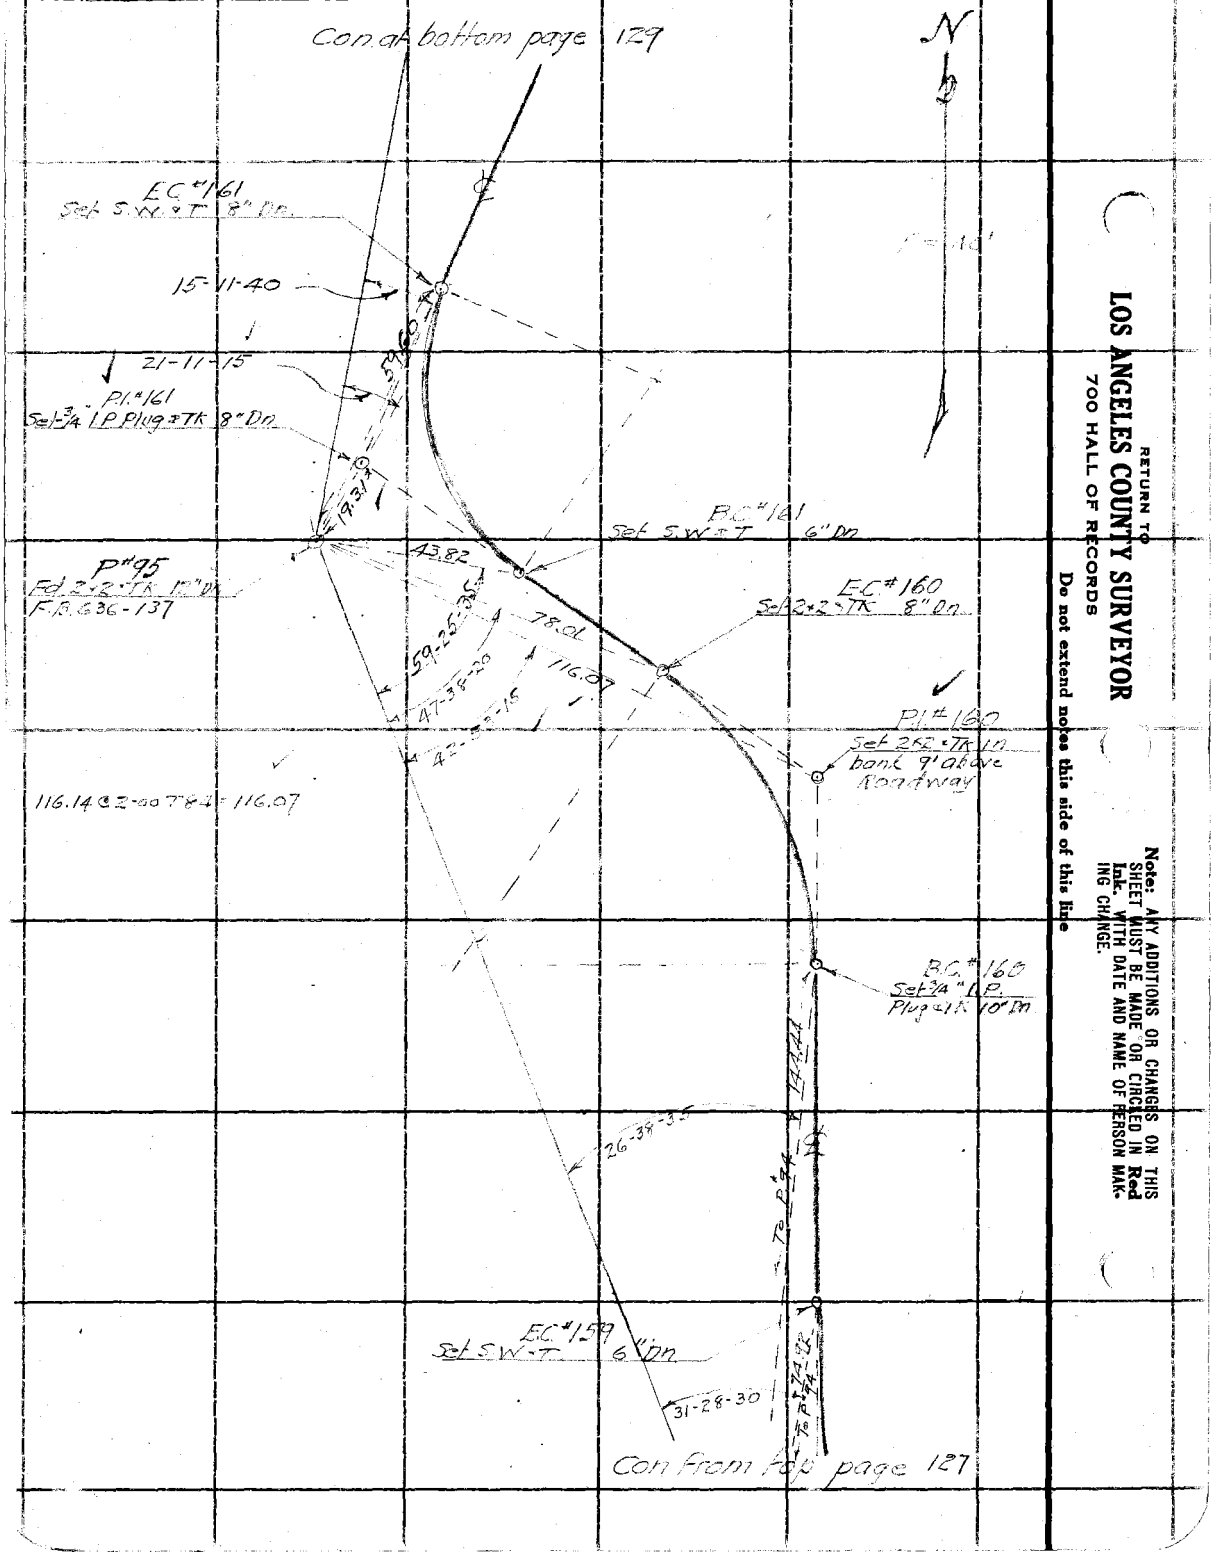

RETURN TO
LOS ANGELES COUNTY SURVEYOR
700 HALL OF RECORDS
Do not extend notes this side of this line

Note: ANY ADDITIONS OR CHANGES ON THIS SHEET MUST BE MADE OR CIRCLED IN Red Ink WITH DATE AND NAME OF PERSON MAKING CHANGE.

Notes Ck'd by	Survey of MT WILSON TOLL RD
Map No. B-1217-I	W. O. 8149 Tape No. 63 St'd 84 °F.
Office Work F. A. W.	Surveyed by N. S. Miller
Checked	Notes Miller Date 1927
Date 12-13-40	Indexed A. C. Johnson

F.B. 650 Pg. 129

Note: Any Additions or Changes on This Sheet Must be Made in Red Ink or Circled With Date and Name of Person Making Change.

Do not extend notes this side of this line

RETURN TO
LOS ANGELES COUNTY SURVEYOR
700 HALL OF RECORDS

FORM 247 10M 11-35

Cor. of bottom Data 135

Set S.W.T 3" Dn.

42-41-40

56-55-40

P.L. #163 Set ¾" I.P. Plug & Tk 10" Dn.

P.#96 Fd ¾" I.P. Illegible ½" Dn C.S. 630-138

38-13-45

29-51-00

P.L. #163 Set ¾" I.P. Plug & Tk on Slope 12' above Roadway

26-50-15

Set ¾" I.P. Plug & Tk in Rock Bank 6' above Roadway

19-24-40

Set S.W.T in Rock Bank 2' above Roadway

126.86 + 7.58 T90 = 125.44
126.80 + 6.45 T90 = 125.42
4.79 @ 0.00 T90 = 125.43
4.79
130.22

Set ¾" I.P. Plug & Tk 10" Dn.


F.B. 650 Pg. 130

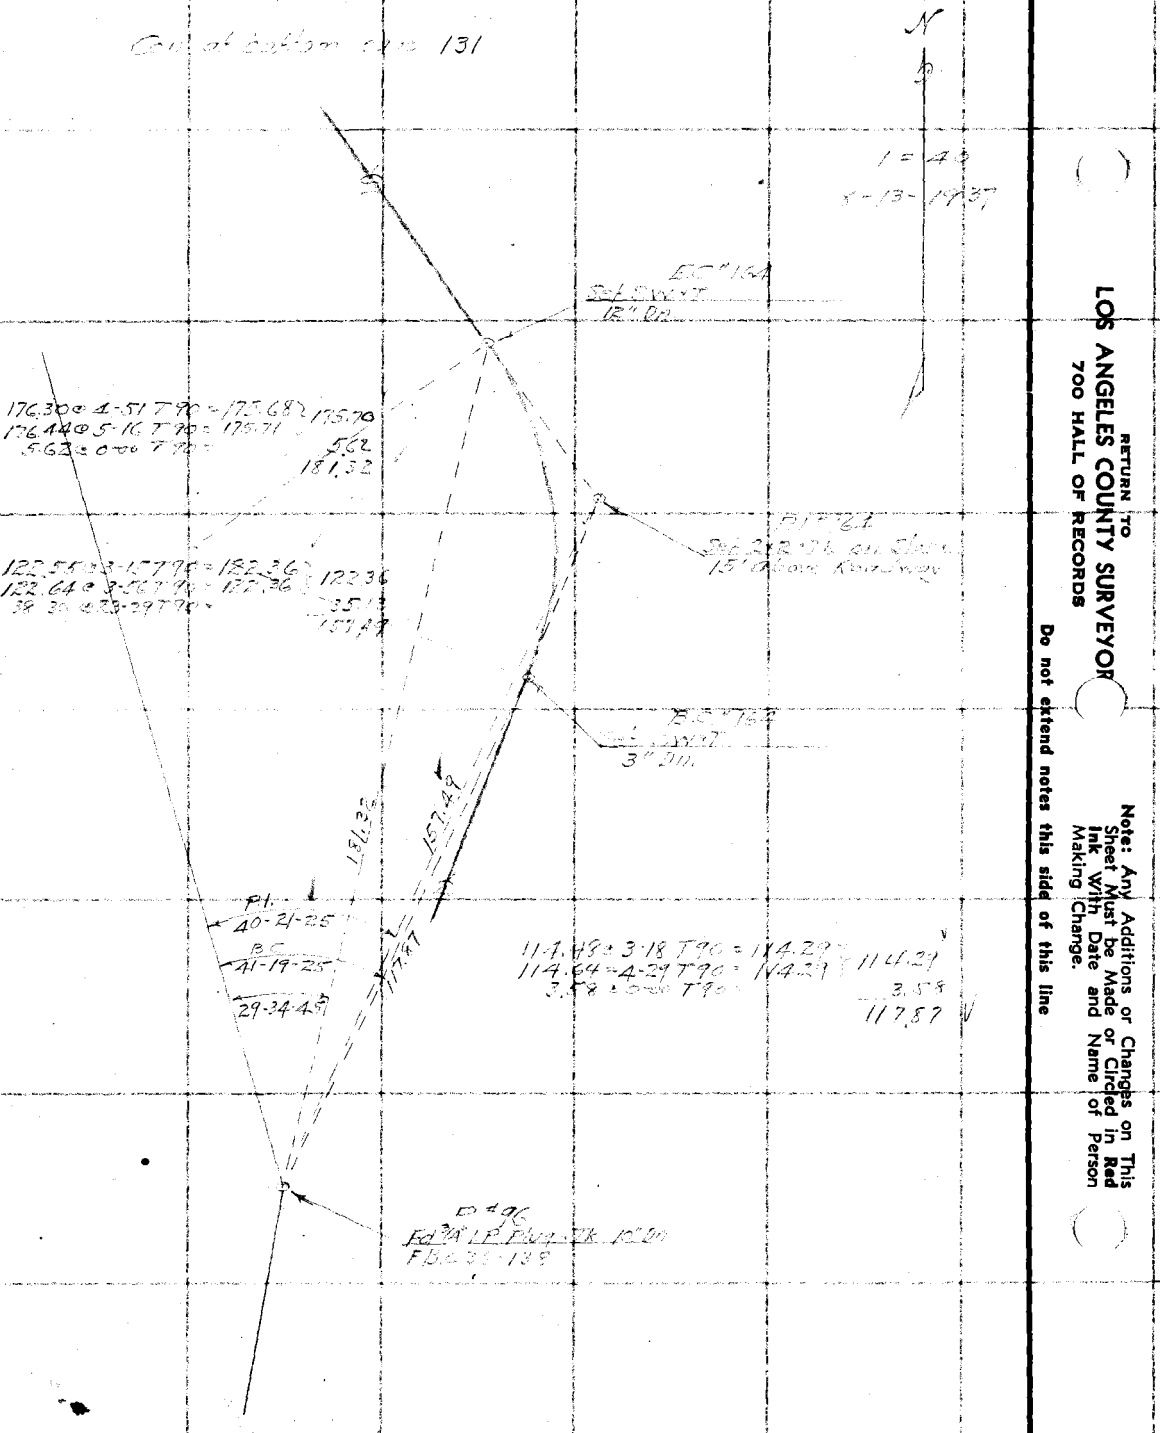

RETURN TO
LOS ANGELES COUNTY SURVEYOR
700 HALL OF RECORDS

Note: Any Additions or Changes on This Sheet Must be Made or Circled in Red Ink With Date and Name of Person Making Change.

Do not extend notes this side of this line

Notes Ck'd by Drew	Survey of MT WILSON TOLL RD	F.B. 650	Pg. 131
Map No. B-1217-3	W. O. 8149 Tape No.	St'd	°F.
Office Work F. A. W.	Surveyed by W.A. Miller		
Checked Drew	Notes: Miller	Date Aug. 1937	
Date 12-13-40	Indexed A. C. Johnson		

N

1" = 40'

8-13-1937

Con at bottom page 132

E.C. #166
See next page

B.C. #166
Set 2"x2"x Tk top of Bank
12' above Roadway.

P.I. #166
See next page

9-20-10
76.80
91.60

94.76 0.14-50 T. 92 = 91.60

E.C. #165
Set S.K.'T'
6" Dn.

P.I. #165
Set 2"x2"x Tk
in bank 8'
above Rdw.

37.74
58.63

64-31-15
56-39-45
46-31-10
76.98

P. #97
Fd 3/4" I.P. Plug & Tk 12" Dn
F.B. 636-138

B.C. #165
Set 3/4" I.P. Plug & Tk
10" Dn.

Con from top page 130

Note: ANY ADDITIONS OR CHANGES ON THIS SHEET MUST BE MADE OR CIRCLED IN Red Ink, WITH DATE AND NAME OF PERSON MAKING CHANGE.

Do not extend notes this side of this line

RETURN TO
LOS ANGELES COUNTY SURVEYOR
700 HALL OF RECORDS

FORM 247 10M 8-31

F.B. 650 Pg. 132

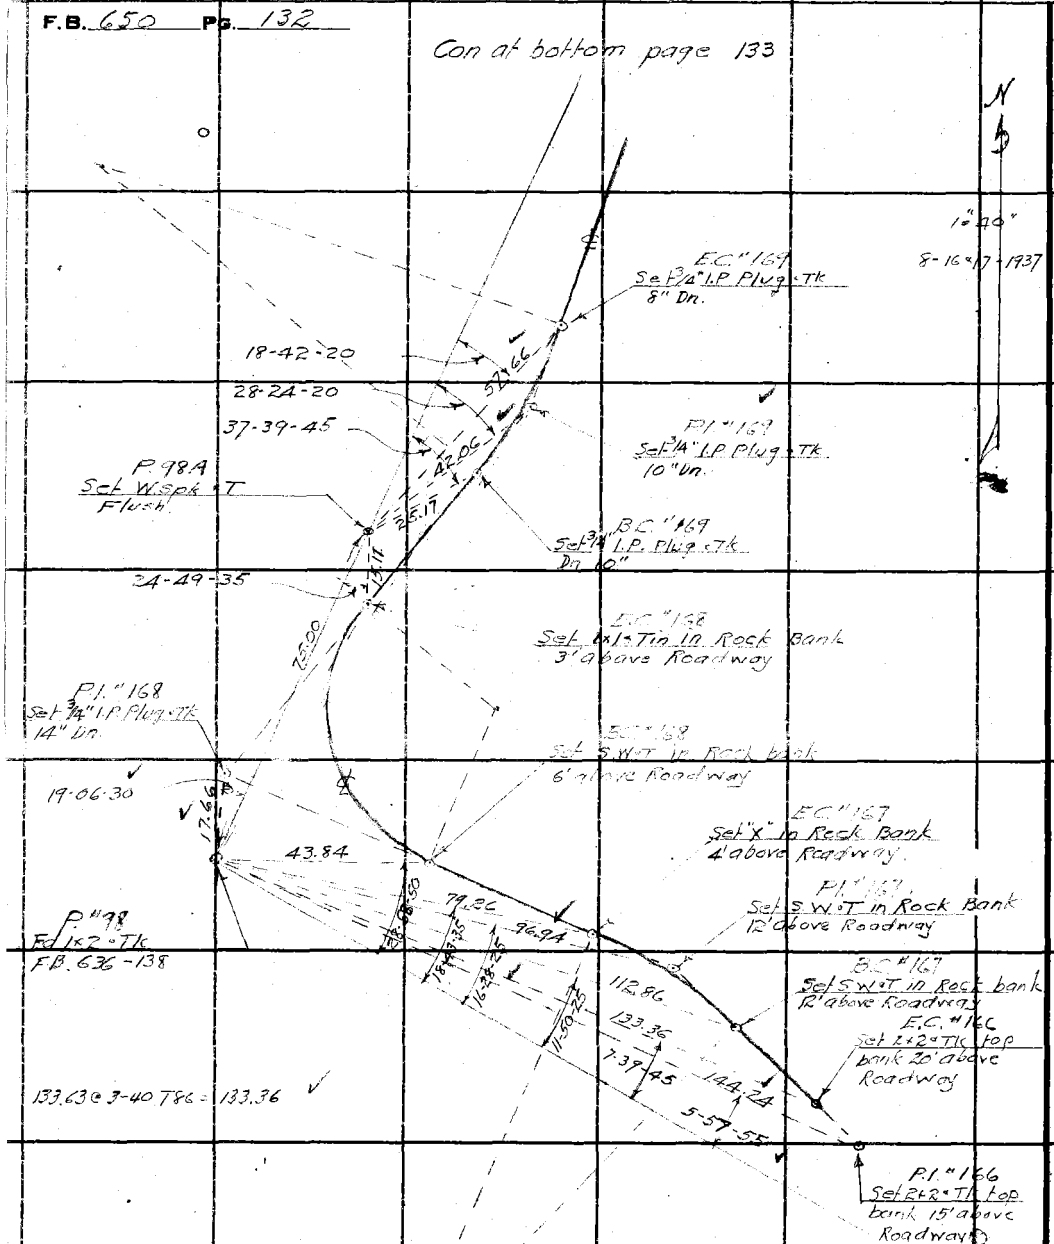

RETURN TO
LOS ANGELES COUNTY SURVEYOR
700 HALL OF RECORDS
Do not extend notes this side of this line

Note: ANY ADDITIONS OR CHANGES ON THIS SHEET MUST BE MADE OR CIRCLED IN Red Ink. WITH DATE AND NAME OF PERSON MAKING CHANGE.

Notes Ck'd by Drew	Survey of MT WILSON TOLL RD	F.B. 650	Pg. 138
Map No. B-1217-3	W. O. 8149 Tape No. St'd of.		
Office Work F. A. W.	Surveyed by W.A.Miller		
Checked Drew	Notes Miller Date		
Date 12-13-40	Indexed A. C. Johnson		

N

1" = 40'

8-17-1937

P." 100
Fd 3/4" I.P. Plug • Tk. 12" Dn.
F.B. 636-139

E.C." 171
Set S.W.T.
8" Dn.

P.I." 172
Set 3/4 I.P. Plug • Tk
10 Dn.

P." 101
Fd 1x2 - Tk
F.B. 636-139

P.I." 171
Set 3/4" I.P. Plug • Tk
8" Dn.

38-27-40

22.51

86.56

3-48-05

6-13-10

14-35-10

45.14

15.31

25.00

53-54-15

86.72

B.C." 172
Nothing set

B.C." 171
Set S.W.T. in Rock bank 8' above R/W.

E.C." 170
Set S.W.T. at East Rock Bank

E.C." 172
Set "X" in Rock at base of Rock bank.

Con. at bottom page 134

23-29-35

88.38 @ 5-27 T84 = 187.98
88.57 @ 6-33 T84 = 87.98
5.88 @ 00 T84 = 5.88
93.86

87.98

P.I." 170
Nothing Set.

51-04-45

B.C." 170
Set "X" in Rock bank
8' above Roadway

30.77 @ 11-30 T24 = 30.15

P." 99
Set 1x1 x Tin by Ties
per F.B. 636-139

Con from top page 132

RETURN TO
LOS ANGELES COUNTY SURVEYOR
720 HALL OF RECORDS

Note: ANY ADDITIONS OR CHANGES ON THIS SHEET MUST BE MADE OR CIRCLED IN Red Ink, WITH DATE AND NAME OF PERSON MAKING CHANGE.

Do not extend notes this side of this line

FORM 247 10M 8-31

F.B. 650 Pg. 134

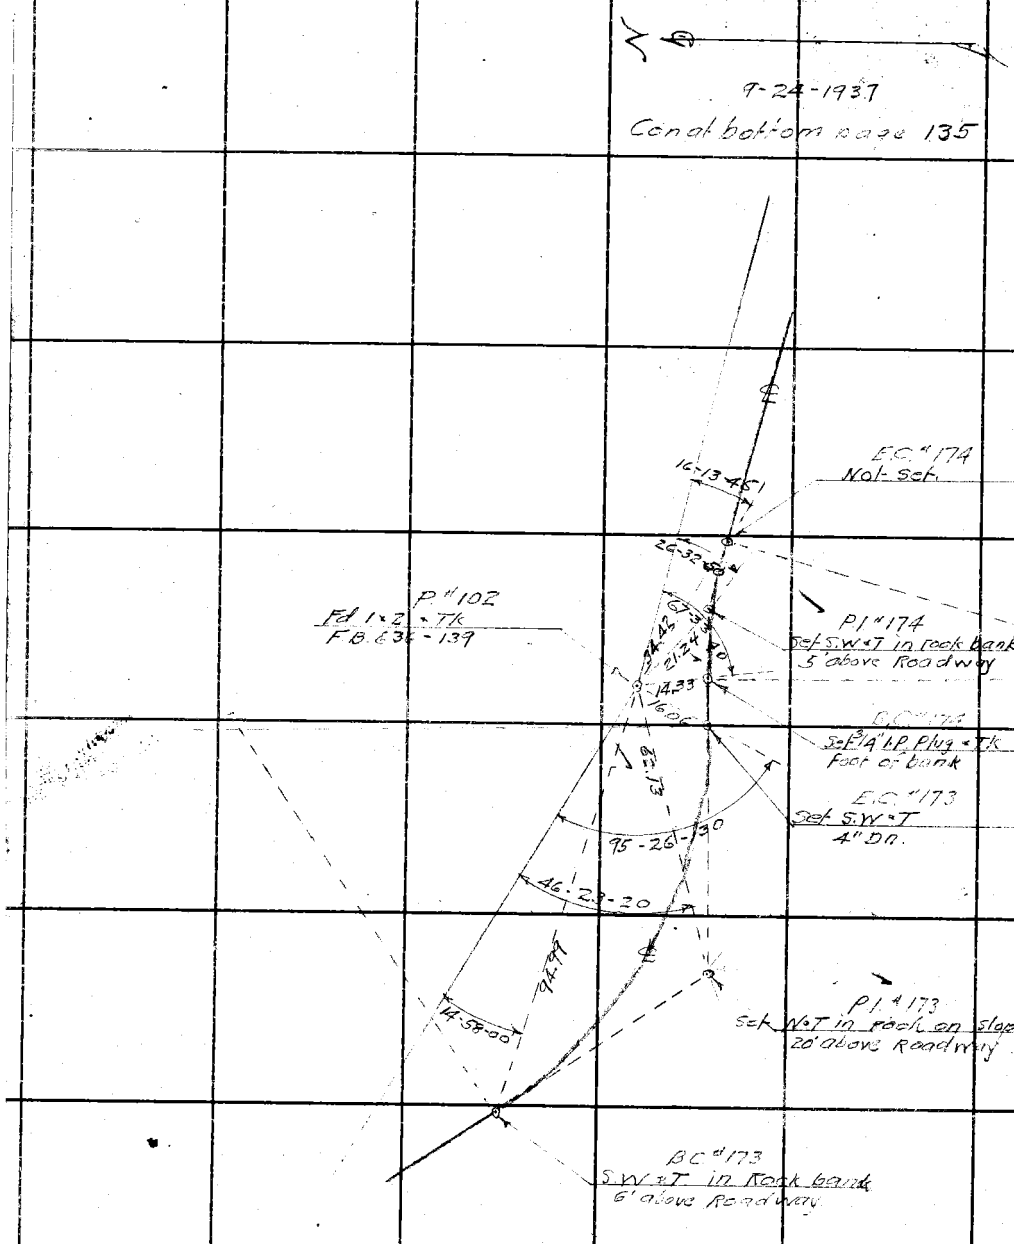

RETURN TO
LOS ANGELES COUNTY SURVEYOR
700 HALL OF RECORDS

Do not extend notes this side of this line

Note: ANY ADDITIONS OR CHANGES ON THIS SHEET MUST BE MADE OR CIRCLED IN Red Ink. WITH DATE AND NAME OF PERSON MAKING CHANGE.

Notes Ck'd by Drew	Survey of
Map No. B-1217-3	W. O.	Tape No.	St'd °F.
Office Work F. A. W.	Surveyed by
Checked Drew	Notes	Date 9-27-1937
Date 12-13-40	Indexed E. C. Johnson

F.B. [illegible] Pg. 135

136

Set 2"x2"x7" on slope 50' [illegible] Highway

Set 2"x2" T in bank 10' above Roadway

116.31

120.00 @ 1-11-00 T 84 = 116.31 ✓

114-10-35

Set SW T 6" Dn at toe of Bank

Fd 3/4" I.P. Plug - flush 12" Dn F.B. 636-140

Set SW T 8" Dg at toe of Bank

56-37-20

37-31-30

P.C. 103 Fd 1x2"x7" F.B. 636-140

1596 @ 37-30 T 76 = 13.41

13.41 ✓

P.T. 175 Set 2x2"x7" in bank 12" above Road.

9-33-00

6-26-10

Set 3/4" I.P. Plug 6" Dn.

134

Note: Any Additions or Changes on This Sheet Must be Made or Circled in Red Ink With Date and Name of Person Making Change

Do not extend notes this side of this line

RETURN TO
LOS ANGELES COUNTY SURVEYOR
700 HALL OF RECORDS

FORM 247 10M 11-38

F.B. 650 Pg. 136

Con at bottom of page 137

Set 2"x2"-Tk 10 bank 4' above Roadway

177.00 @ 4-2 = T84 = 176.47
177.09 @ 4-4 = T84 = 176.18

176.47

3.53 1" 40'

18000

9-27-1937

7-07-05

Set 3/4" I.P. Plug-Tk 6" Dp

14-55-55

Set 3/4" I.P. at top of bank

P" 105
Fd 1/2" Tk
FB 636-140

Set 2"x2"-Tk on P 105A 4' above Roadway

Set 3/4" I.P. Plug-Tk 6" Dp

Set 5/8"x24" Rebar & Cap at top of bank

Set 5/8"x24" Rebar & Cap 4' above Roadway

57-15-50

41-05-05

Set 1"x2" Tk in Bank 7' above Roadway

P" 104A
Set 1"x2"-Tk

43-01-15

86-19-15

Set 5/8"x24" Rebar & Cap

P" 104
Fd 3/4" I.P. Plug-Tk
12" Dp FB 536-140

Con cont'd on page 135

RETURN TO
LOS ANGELES COUNTY SURVEYOR
700 HALL OF RECORDS

Note: Any Additions or Changes on This Sheet Must be Made or Circled in Red Ink With Date and Name of Person Making Change.

Do not extend notes this side of this line

Map No.	B-1217-2	W. O.	3149
Office Work	F. A. W.	Tape No.	St'd °F.
Checked	Drew	Surveyed by	K.A. Miller
Date	12-16-40	Notes	Mills Date
		Indexed	A. C. Johnson

F.B. 650 Pg. 137

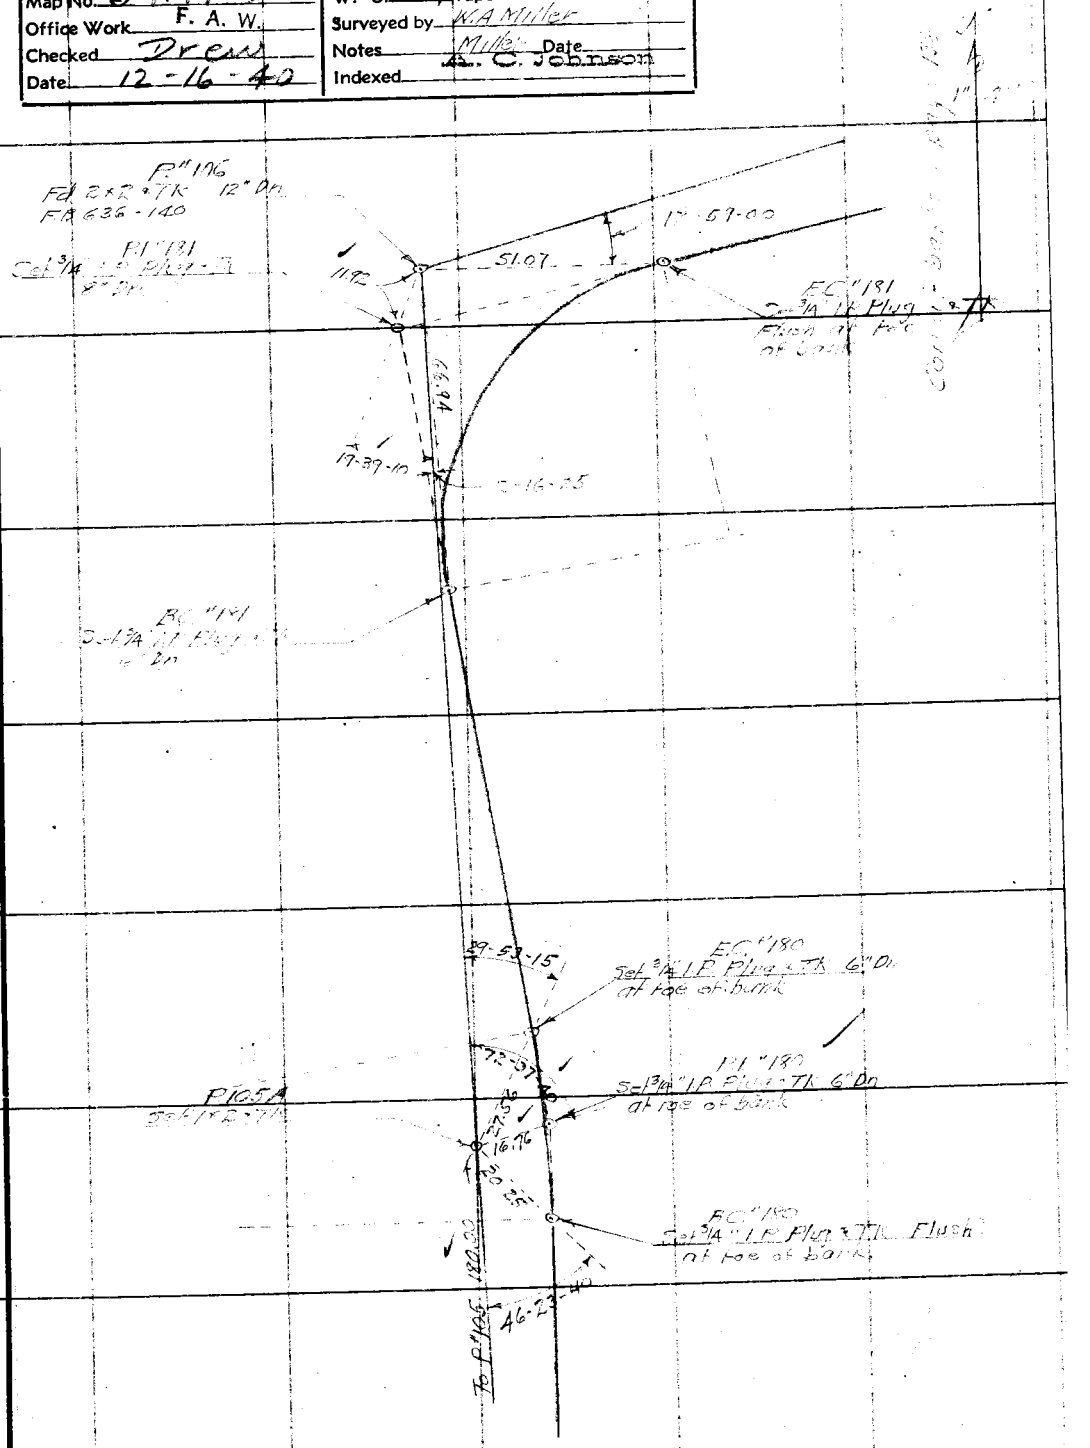

Note: Any Additions or Changes on This Sheet Must be Made or Circled in Red Ink With Date and Name of Person Making Change.

Do not extend notes this side of this line

RETURN TO
LOS ANGELES COUNTY SURVEYOR
700 HALL OF RECORDS

FORM 247 10M 11-38

F.B. 650 Pg. 138

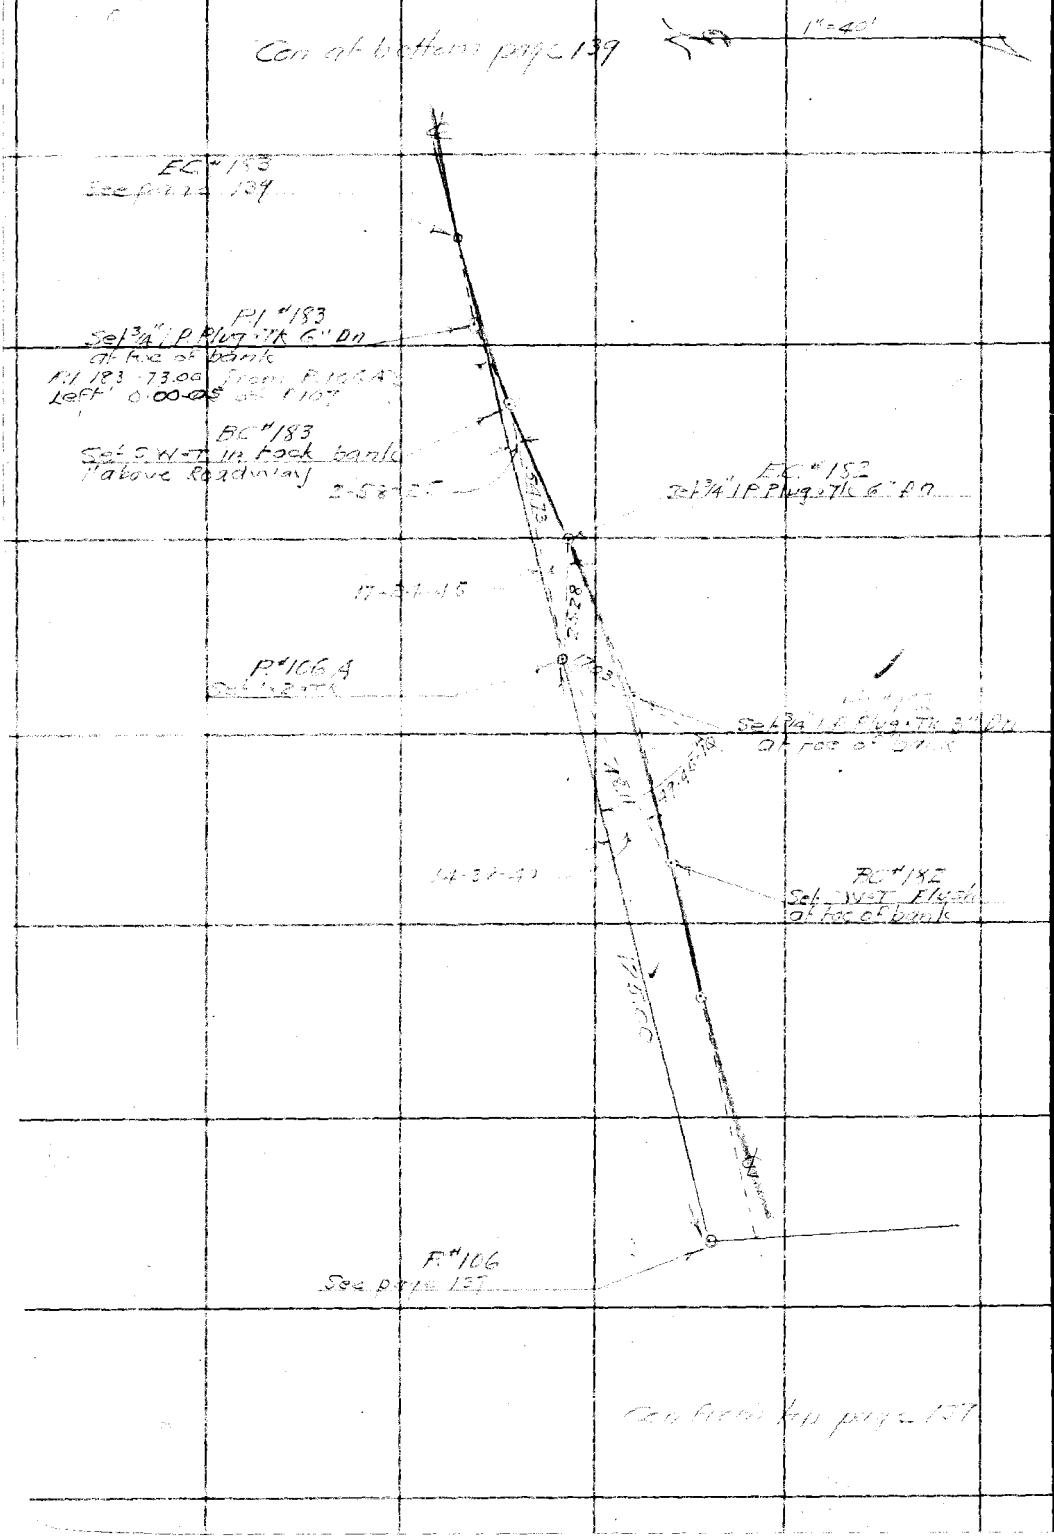

RETURN TO
LOS ANGELES COUNTY SURVEYOR
700 HALL OF RECORDS

Note: Any Additions or Changes on This Sheet Must be Made or Circled in Red Ink With Date and Name of Person Making Change.

Do not extend notes this side of this line

Notes Ck'd by Drew	Survey of MT WILSON TOLL RD
Map No. B-1217-2	W. O. 8129 Tape No. St'd °F.
Office Work F. A. W.	Surveyed by W.A. Miller
Checked Drew	Notes Miller Date
Date 12-16-59	Indexed C. Johnson

F.B. Pg.

Note: Any Additions or Changes on This Sheet Must be Made or Circled in Red Ink With Date and Name of Person Making Change.

Do not extend notes this side of this line

RETURN TO:
LOS ANGELES COUNTY SURVEYOR
700 HALL OF RECORDS

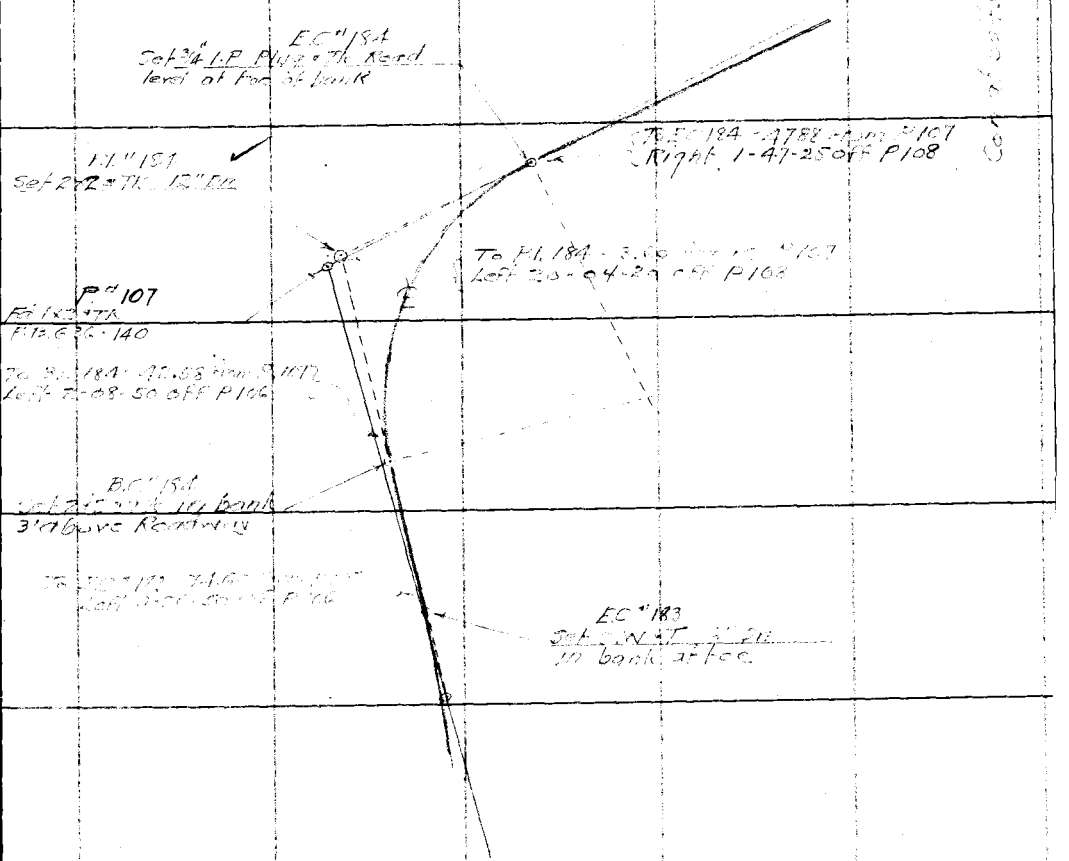

Con from top page 137

FORM 247 10M 11-35

F.B. 50 PG. 140

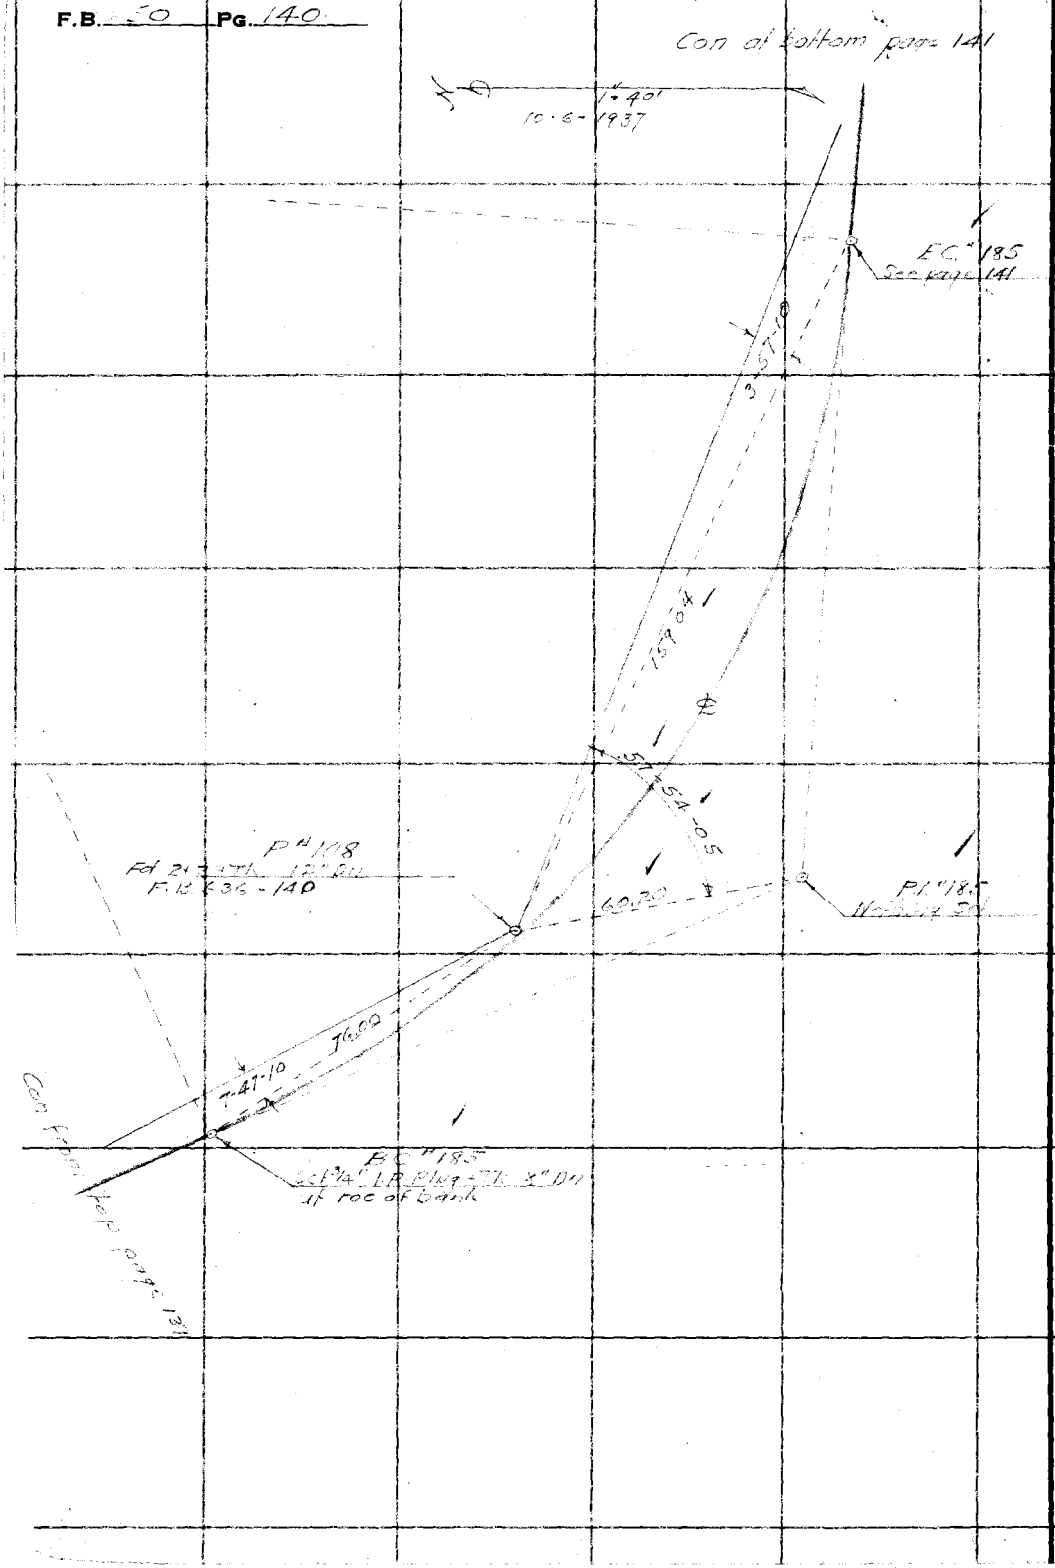

RETURN TO
LOS ANGELES COUNTY SURVEYOR
700 HALL OF RECORDS

Note: Any Additions or Changes on This Sheet Must be Made or Circled in Red Ink With Date and Name of Person Making Change.

Do not extend notes this side of this line

Notes Ck'd by Dr ew	Survey of MT WILSON TOLL RD
Map No. [illegible]	W. O. 8109 Tape No. St'd °F.
Office Work F. A. W.	Surveyed by W.A. Miller
Checked Dr ew	Notes Miller Date Apl 1931
Date 12-16-40	Indexed Samson

F.B. 650 PG. 141

Con at bottom page 142

B.S. #186
Set 3/4" I.P. Plug in Tk 3' Dn
at toe of bank

4-13-25

P.I. #109
Fd S.W.T. 6" Dn
F.B. 636-141

14-57-10 42.72

P.I. #185
Set S.W.T. 8" Dn
at toe of bank

P.I. #185

Con front top page 140

Note: Any Additions or Changes on This Sheet Must be Made or Circled in Red Ink With Date and Name of Person Making Change.

Do not extend notes this side of this line

RETURN TO
LOS ANGELES COUNTY SURVEYOR
700 HALL OF RECORDS

FORM 247 10M 11-38

RETURN TO
LOS ANGELES COUNTY SURVEYOR
700 HALL OF RECORDS

Note: Any Additions or Changes on This Sheet Must be Made or Circled in **Red Ink** With Date and Name of Person Making Change.

Do not extend notes this side of this line

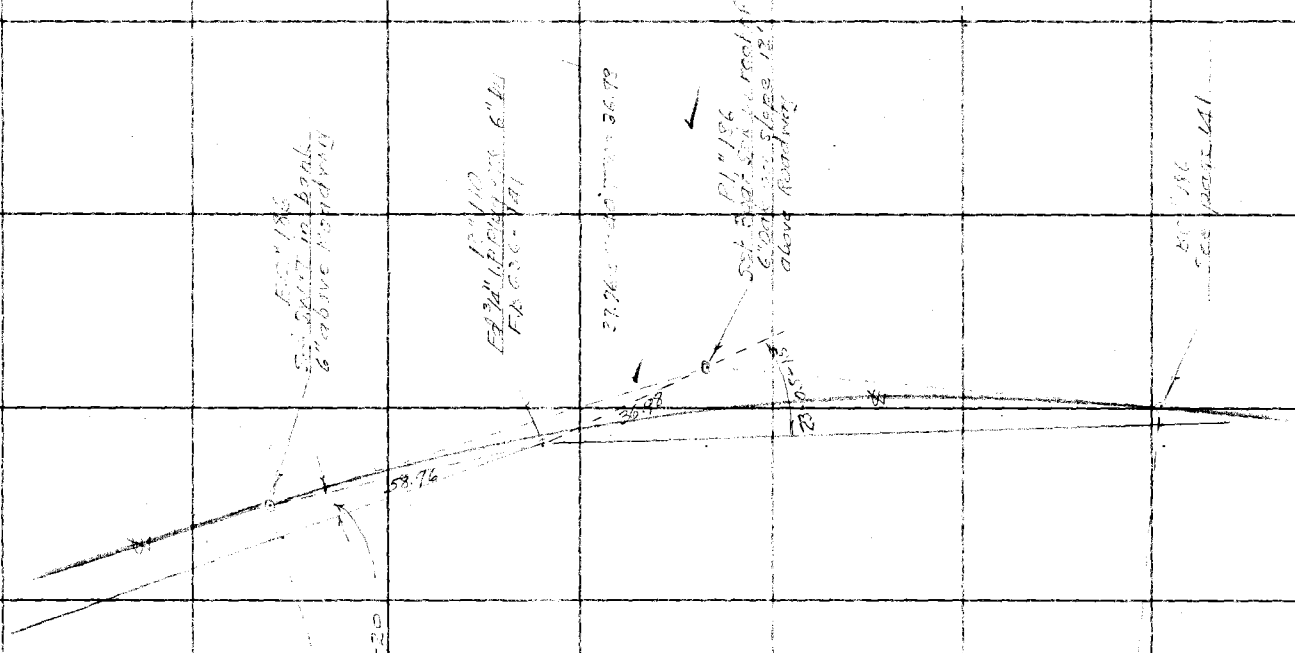

F.B. 630 PG. 42

Notes Ck'd by Draw
Map No. 6-125-2
Office Work F. A. W.
Checked Draw
Date 12-16-40

Survey of MT WILSON TOLL RD
W. O. 8149 Tape No. St'd °F.
Surveyed by W.A. Miller
Notes Miller Date 10-6-1937
Indexed A. C. Johnson

F.B. 650 PG. 143

1" = 40'

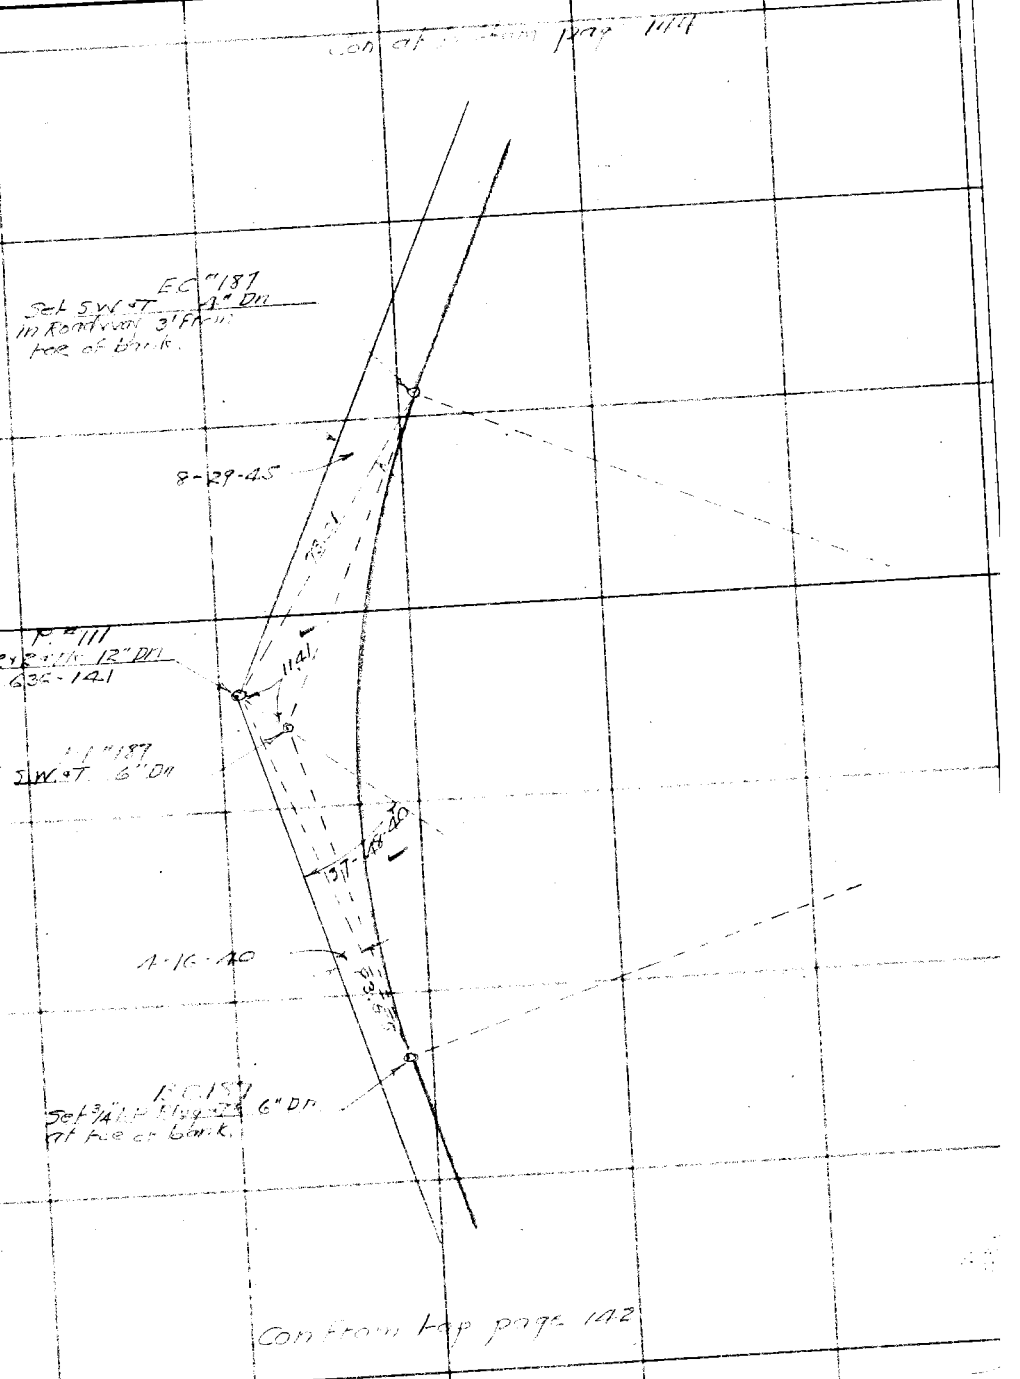

Note: Any Additions or Changes on This Sheet Must be Made or Circled in Red Ink With Date and Name of Person Making Change.

Do not extend notes this side of this line

RETURN TO
LOS ANGELES COUNTY SURVEYOR
700 HALL OF RECORDS

FORM 247 10M 11-35

F.B. 650 Pg. 144

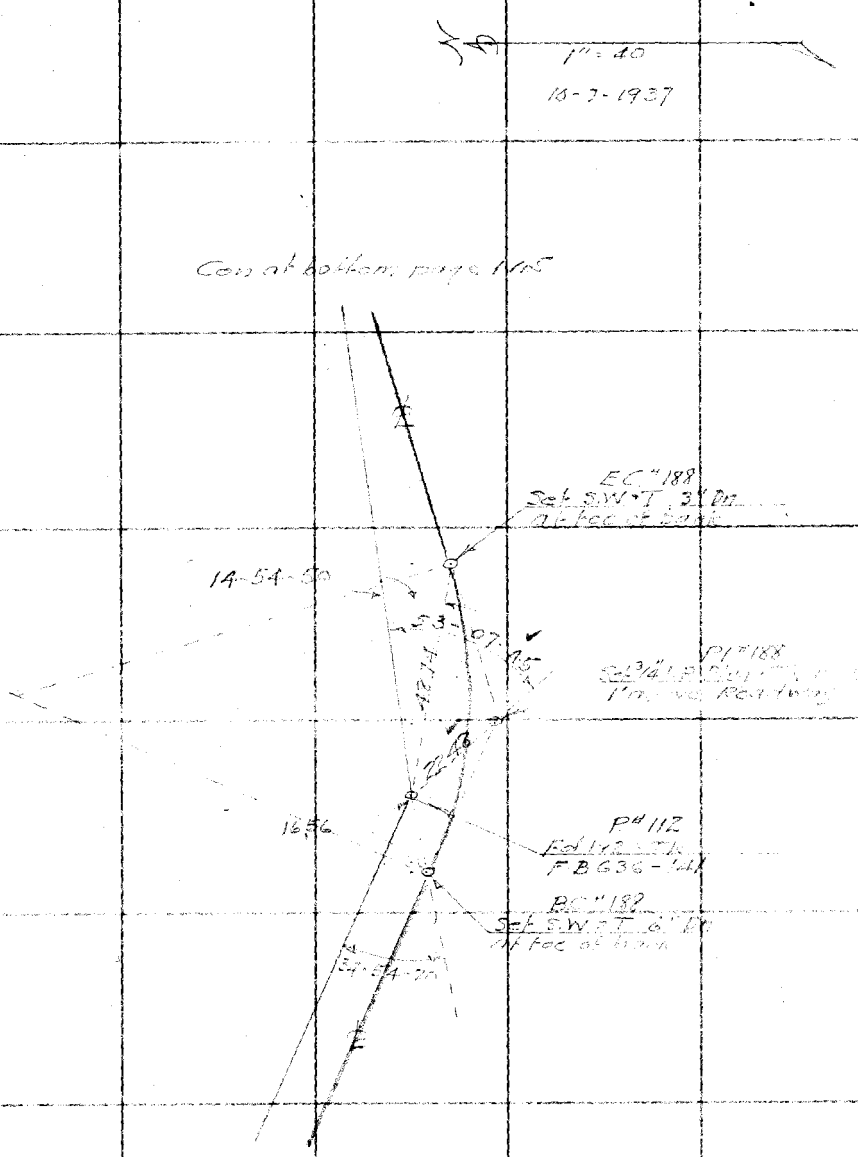

RETURN TO
LOS ANGELES COUNTY SURVEYOR
700 HALL OF RECORDS

Do not extend notes this side of this line

Note: Any Additions or Changes on This Sheet Must be Made or Circled in Red Ink With Date and Name of Person Making Change.

Notes Ck'd by Dr Ewd	Survey of MT WILSON TOLL RD
Map No. B-12,17-3	W. O. 8149 Tape No. St'd °F.
Office Work F. A. W.	Surveyed by W.A. Wilke
Checked Dr Ewd	Notes Mike C. Johnson Date Oct 1937
Date 12-16-40	Indexed

F.B. 650 Pg. 145

Con at bottom pg 146

E.C. "189 Set S.W.T. 6" Dn in Roadway

To E.C. "189 - 81.91 from P 113 Left 0-45-45 Left P 117

P. "113 Rd 2x2-TK 8" On F.B. 536 - 142

P.I. "189 Set 2x2 TK on Rock 8" below road level

Δ 69-00-00

R 101.74

1-14-45

B.C. "189 Set 1" Nail & Tag on Southerly Roadway

Con from top pg 144

Note: Any Additions or Changes on This Sheet Must be Made or Circled in Red Ink With Date and Name of Person Making Change.

Do not extend notes this side of this line

RETURN TO
LOS ANGELES COUNTY SURVEYOR
700 HALL OF RECORDS

FORM 247 10M 11-35

F.B. 650 PG. 146

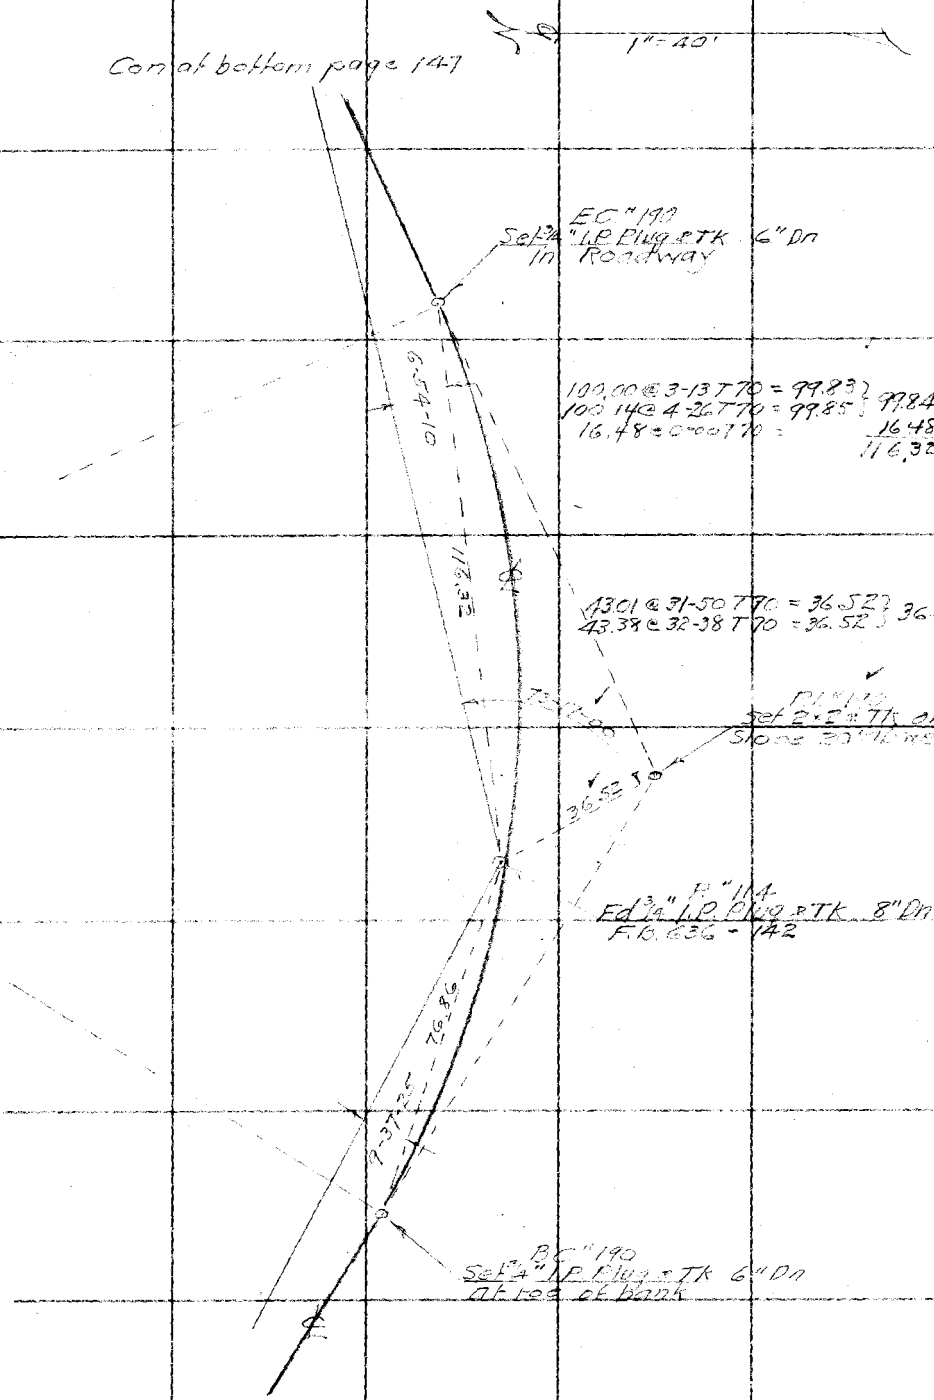

RETURN TO
LOS ANGELES COUNTY SURVEYOR
700 HALL OF RECORDS

Do not extend notes this side of this line

Note: Any Additions or Changes on This Sheet Must be Made or Circled in Red Ink With Date and Name of Person Making Change.

Notes Ck'd by: Dixon	Survey of: MT WILSON PK NO	F.B. 650	Pg. 147
Map No. B-121-3	W. O. 8149 Tape No. St'd °F.		
Office Work: F. A. W.	Surveyed by: W. A. Miller		
Checked: Dixon	Notes: Miller Date: Oct 1937		
Date: 12-16-40	Indexed: ... C. Johnson		

1" = 10'

Note: Any Additions or Changes on This Sheet Must be Made or Circled in Red Ink With Date and Name of Person Making Change.

Do not extend notes this side of this line

RETURN TO
LOS ANGELES COUNTY SURVEYOR
7DO HALL OF RECORDS

FORM 247 10M 11-35

Coral bottom page 148

P.I. "192"
Set S.W.T. 2" On
In Roadway

4-22-10

112.84

EC "192"
Set S.W.T. 6" On
Edge of Roadway

9-48-30

P.I. "115"
Fd 2"x2"x1'K 8" On
F.B. 636-142

EC "191"
Set S.W.T. 8" On
Edge of Roadway

8.69

41.05

63-24-50

5-45-00

P.I. "191"
Set S.W.T. 8" On
In Roadway 2' Sth.
of 36" Pine.

68.80

2-34-05

EC "191"
Set S.W.T. 6" On
3' From Toe of Bank

Curve from bar page 148

F.B. 650 PG. 148

1" = 40'

10-8-1937

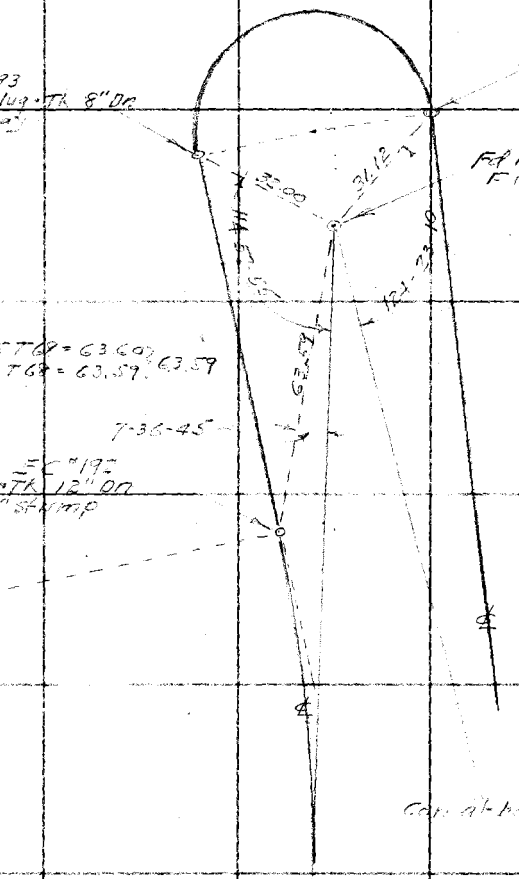

Cont. at bottom page 149

Cont. from top of page 149

RETURN TO
LOS ANGELES COUNTY SURVEYOR
700 HALL OF RECORDS

Note: Any Additions or Changes on This Sheet Must be Made or Circled in Red Ink With Date and Name of Person Making Change.

Do not extend notes this side of this line

Notes Ck'd by	Drew	Survey of	MT WILSON TOLL RD
Map No.	B-1217-3	W. O.	8149
Office Work	F. A. W.	Tape No.	St'd °F.
Checked	Drew	Surveyed by	W.A. Miller
Date	12-16-40	Notes	Miller Date Oct 1937
		Indexed	C. Johnson

F.B. 650 PG. 149

1"=40'

Note: ANY ADDITIONS OR CHANGES ON THIS SHEET MUST BE MADE OR CIRCLED IN Red Ink WITH DATE AND NAME OF PERSON MAKING CHANGE.

RETURN TO
LOS ANGELES COUNTY SURVEYOR
700 HALL OF RECORDS
Do not extend notes this side of this line

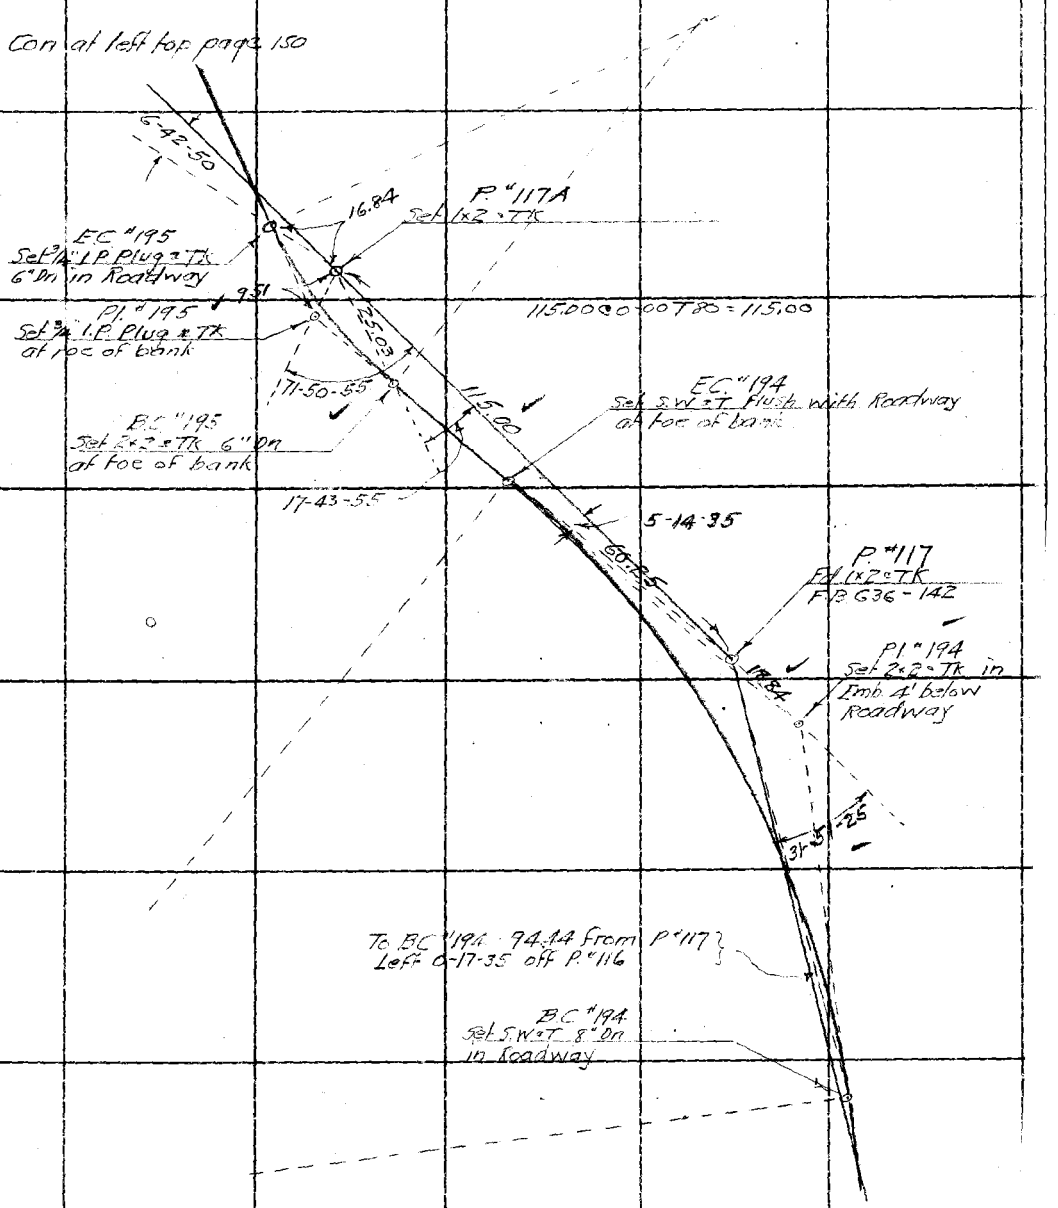

FORM 247 10M 5-31

F.B. 650 Pg. 150

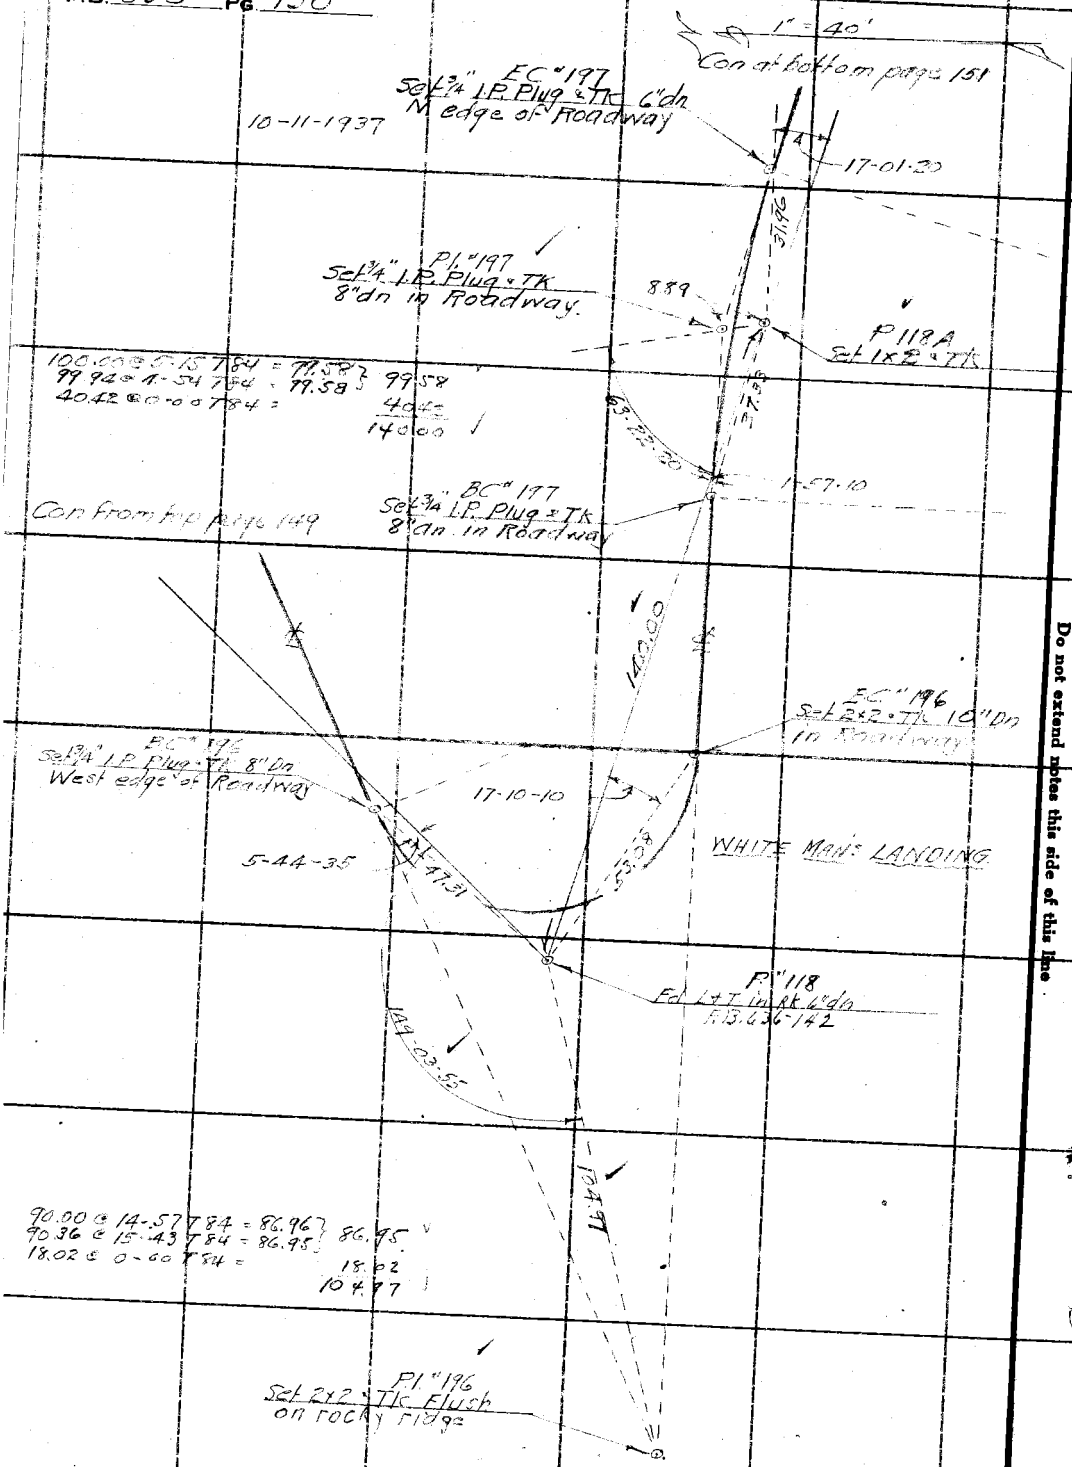

RETURN TO
LOS ANGELES COUNTY SURVEYOR
700 HALL OF RECORDS

Do not extend notes this side of this line

Note: ANY ADDITIONS OR CHANGES ON THIS SHEET MUST BE MADE OR CIRCLED IN Red Ink. WITH DATE AND NAME OF PERSON MAKING CHANGE.

Notes Ck'd by	Drew	Survey of	MT WILSON TOLL RD
Map No.	B-1217-3	W. O.	8149
Office Work	F. A. W.	Tape No.	St'd °F.
Checked	Drew	Surveyed by	W. A. Miller
Date	12-16-40	Notes	Miller Date Oct 1937
		Indexed	C. Johnson

F.B. 650 Pg. 151

Note: ANY ADDITIONS OR CHANGES ON THIS SHEET MUST BE MADE OR CIRCLED IN Red Ink, WITH DATE AND NAME OF PERSON MAKING CHANGE.

Do not extend notes this side of this line

RETURN TO
LOS ANGELES COUNTY SURVEYOR
700 HALL OF RECORDS

FORM 247 10M 5-51

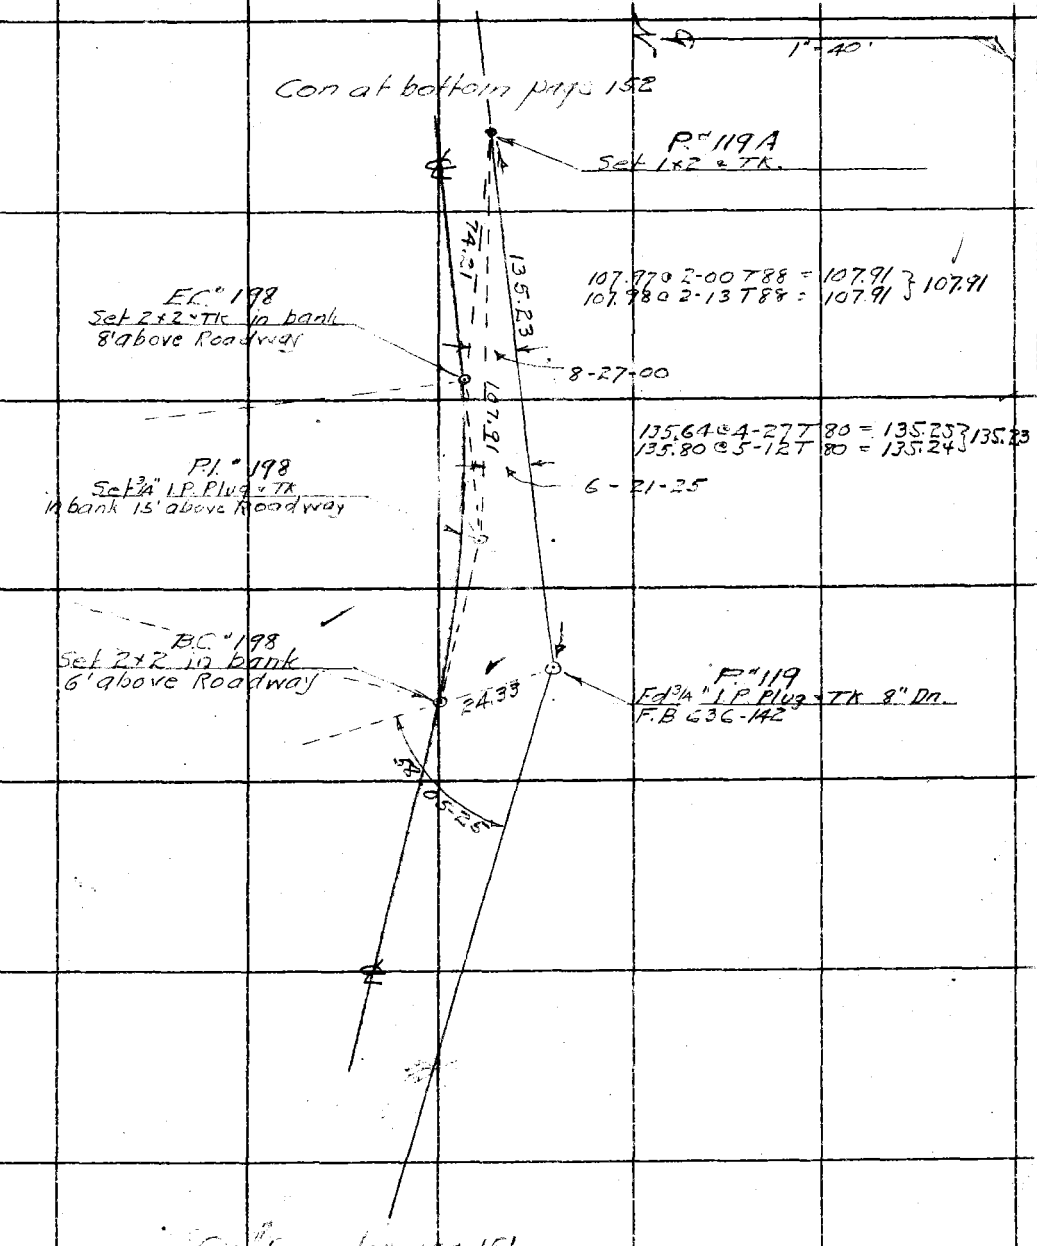

F.B. 650 Pg. 152

1" = 40'

10-26-1937

Con at bottom page 153

P#120A
Set 1x2" TK

55.66

179 02 ⊕ 5.21 788 = 178.24
179 13 ⊖ 5.41 788 ✓ 178.25
-.25 ⊖ 0.00 788 - 178.25
- 3.25
175.00 ✓

EC "200
Set SW-T in rock
bank 2' above Rdw

27-50-25

22-59-15

107.81

84.72

175.00

P.I." 200
Set SW-T in rock
bank 7' above Roadway

R-37-15

BC "300
Set SW-T in rock bank
8' above Roadway

18-32-30

15-58-15

P.I." 199
Set SW-T Elev. 6
in Roadway

EC "199
Set N-T in rock bank
8' above Roadway

51.00

7.27

5.11 ⊖ 11-50 788 = 51.00

P#120
Fd 1x2" TK
F.B. 636-143

76.85

9-09-45

BC "199
Set N-T in rock bank
8' above Roadway

Con from for page 151

RETURN TO
LOS ANGELES COUNTY SURVEYOR
700 HALL OF RECORDS
Do not extend notes this side of this line

Note: ANY ADDITIONS OR CHANGES ON THIS SHEET MUST BE MADE OR CIRCLED IN Red Ink WITH DATE AND NAME OF PERSON MAKING CHANGE.

Notes Ck'd by Dr ew		Survey of MT WILSON TOLL RD	F.B. 650 PG. 153
Map No. B-1217-3		W. O. 8149 Tape No. 053 St'd 84 °F.	
Office Work F. A. W		Surveyed by W.A. Miller	
Checked Dr ew		Notes Miller C. Johnson Date Oct 1937	
Date 12-16-40		Indexed	

Note: ANY ADDITIONS OR CHANGES ON THIS SHEET MUST BE MADE OR CIRCLED IN Red Ink, WITH DATE AND NAME OF PERSON MAKING CHANGE.

Do not extend notes this side of this line

RETURN TO
LOS ANGELES COUNTY SURVEYOR
700 HALL OF RECORDS

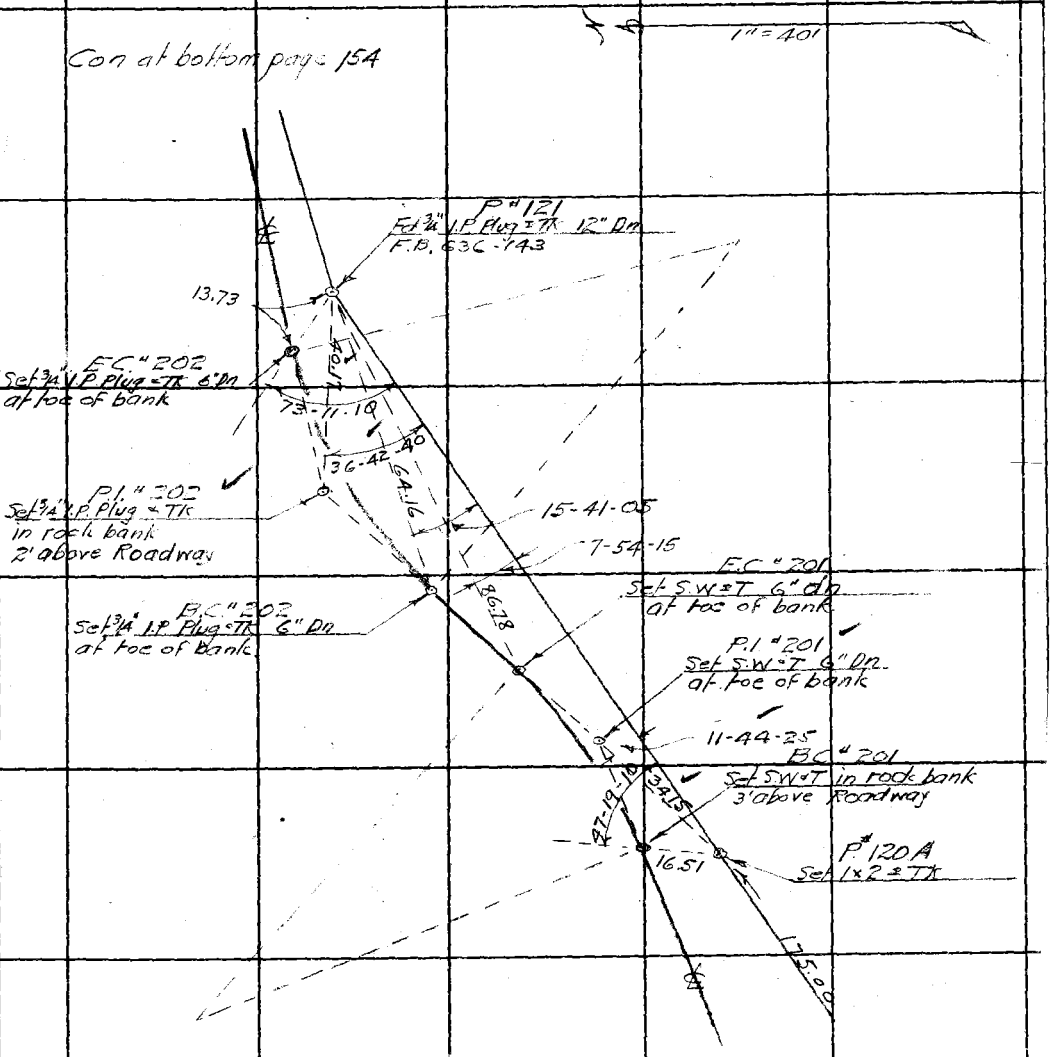

F.B. 650 Pg 154

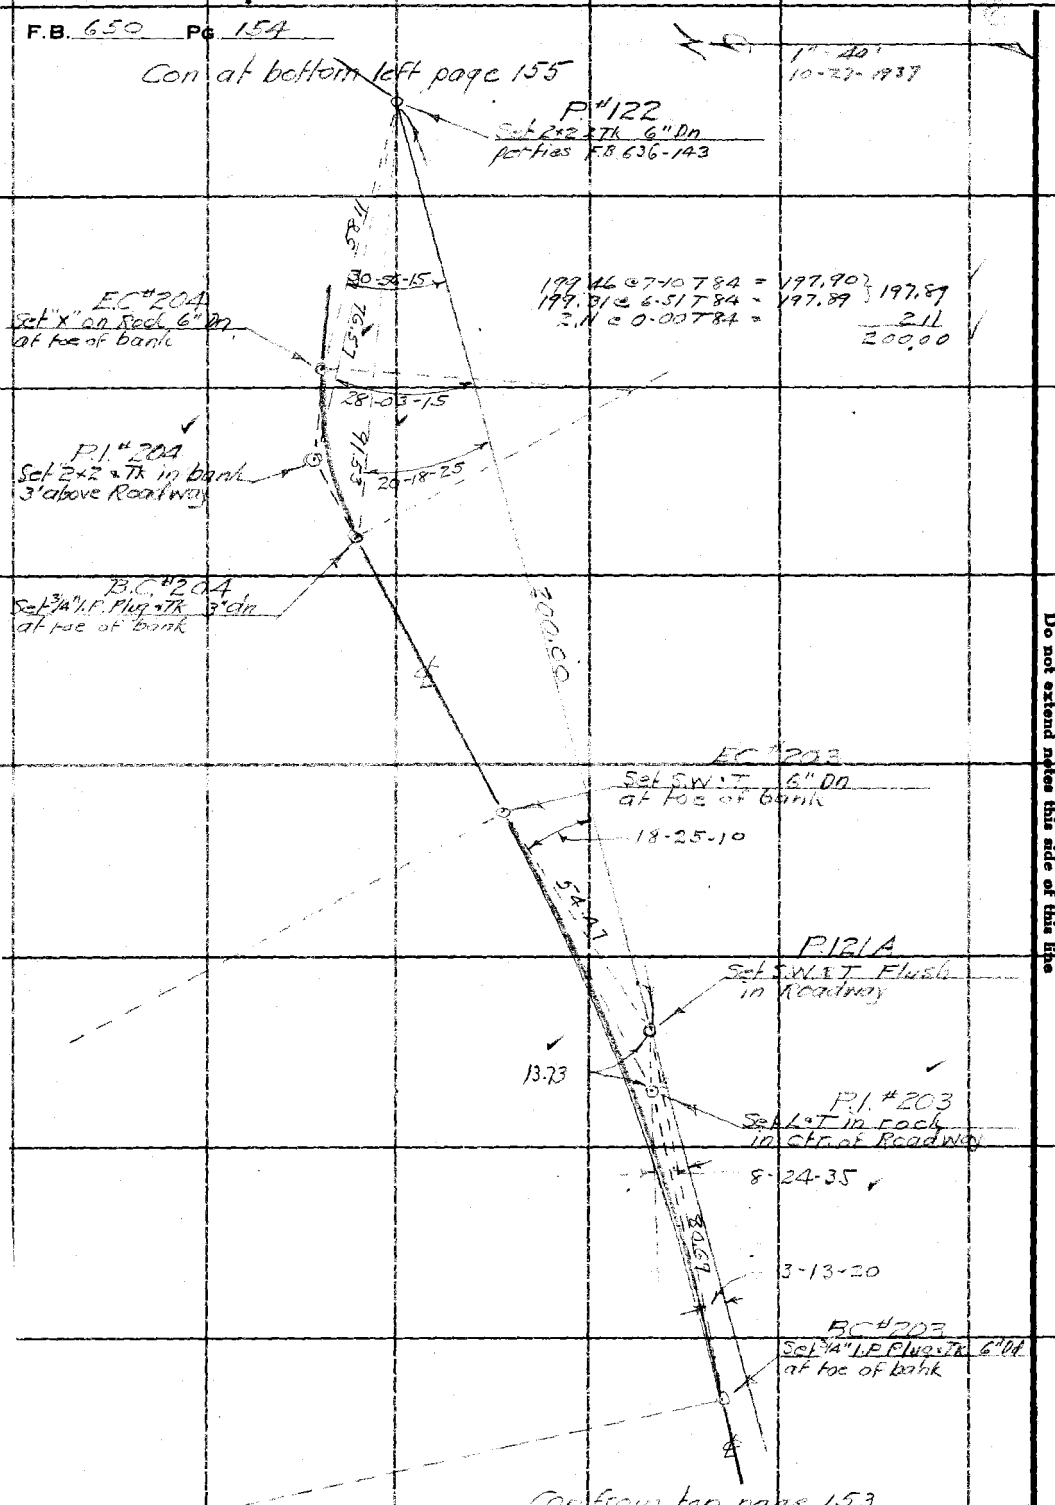

RETURN TO
LOS ANGELES COUNTY SURVEYOR
700 HALL OF RECORDS
Do not extend notes this side of this line

Note: ANY ADDITIONS OR CHANGES ON THIS SHEET MUST BE MADE OR CIRCLED IN Red Ink, WITH DATE AND NAME OF PERSON MAKING CHANGE.

Notes Ck'd by Dr cw	Survey of MT WILSON TOLL RD
Map No. B-1217-3	W. O. 8149 Tape No. 053 St'd 84 of.
Office Work F. A. W.	Surveyed by W A Miller
Checked Dr cw	Notes Miller Date Oct 1937
Date 12-16-40	Indexed A. C. Johnson

F.B. 650 PG. 155

N

1" = 40'

Note: ANY ADDITIONS OR CHANGES ON THIS SHEET MUST BE MADE OR CIRCLED IN Red Ink, WITH DATE AND NAME OF PERSON MAKING CHANGE.

Do not extend notes this side of this line

RETURN TO
LOS ANGELES COUNTY SURVEYOR
700 HALL OF RECORDS

E.C. "206" Con at right bottom page 156

Set "X" in rock cliff 12' above Roadway

91.13 @ 12-50 T84 = 88.85
90.77 @ 11-45 T84 = 88.87 } 88.85

P.I. "206"
Set 3/4" I.P. Plug - Tk in large boulder 35' above Roadway

88.85

29.42

73-25-35

35.8

P.I. "122A"
Set 1X2 Tk

44-26-50

B.C. "206"
Set 3/4" I.P. Plug - Tk in rock wall 3' above Rdw.

29-55-05

79.93

E.C. "205"
Set N-T in rock bank 8' above Roadway

80.08 @ 3-39 T82 = 79.93
80.20 @ 4-38 T82 = 79.94 } 79.93

32-03-18

151-19-35

P.I. "205"
Set 3/4" I.P. Plug - Tk 6" Dn in Roadway

44.62

12.81

39.12

36-49-25

P.I. "122"
Set 2x2 - Tk 6" Dn per ties F.B. 636-143

B.C. "205"
Set N-T in rock bank 8' above Roadway

Con from top page 154

FORM 247 10M 8-31

F.B. 650 Pg 156

Con at bottom page 157

1" = 40'
9-28-1937

EC "209
Set 3/4" I.P. Plug 7/8 6" Dn
Middle of Roadway

49-26-30

32.06

P "122A
Fd 1x2 Tk
F.B. 636-143

25.02

P.I. "209
Set S.W.T. 6" Dn
N. edge of Roadway

40.34

89-57-35

55-31-50

BC "209
Set S.W.T. 6" Dn
N. edge of Roadway

16.66

44-26-50

EC "208
Set S.W.T. 6" Dn
N. edge of Roadway

P.I. "208
Set X in rock slide
10' above Roadway

116.16 @ 9-00 T84 = 114.73
116.31 @ 9-28 T84 = 114.71

10-49-30

9-24-15

BC "208
Set L.T. in rock in bank
1' above Roadway

114.73

F "122 - FWD Prof

139

EC "207
Set S.W.T. 6" Dn
at W. edge of Roadway

P "123
Fd 1x2 Tk
F.B. 636-143

P.I. "207 Set 1/2" I.P. Plug Tk
6" Dn at base of rock slide

To EC "207 - 43.09 from P "122A
Right 3-13-15 off P "123

7-22-15

P "122A
Set 1x2 Tk

3.55

29.14

17.35

65 Set

BC "207
Set X in rock cliff
12' above Roadway

29.42

EC "206
Set X in rock cliff
12' above Roadway

79-25-35

49-26-50

55 ± Good day wall to

91.13 @ 12-50 T84 = 88.85
90.72 @ 11-45 T84 = 88.87
88.85

P.I. "206
Set 3/4" I.P. Plug 2 Tk in large boulder
35' above Roadway

RETURN TO
LOS ANGELES COUNTY SURVEYOR
700 HALL OF RECORDS
Do not extend notes this side of this line

Note: ANY ADDITIONS OR CHANGES ON THIS SHEET MUST BE MADE OR CIRCLED IN Red Ink. WITH DATE AND NAME OF PERSON MAKING CHANGE.

Notes Ck'd by	Drew	Survey of	MT WILSON TOLL RD.
Map No.	B-1217-3	W. O.	8149
Office Work	F. A. W.	Tape No.	053
Checked	Drew	St'd	84 of.
Date	12-17-40	Surveyed by	W.A. Miller
		Notes	Miller
		Date	Oct 1937
		Indexed	A. C. Johnson

F.B. 650 PG. 157

1" = 40'

Con at bottom left page 158

E.C. "212"
Set I-T in rock 6" Dn
N. edge of Roadway

P.I. "212"
Set S.W.-T 10" Dn
at toe of bank

B.C. "212"
Set I-T in rock 6" Dn
at toe of bank

15-20-40
17-51-45
19-43-35
68.10
60.44
42.50
E.C. "211"
Set S.W.-T in rock bank
2' above Roadway
P.I. "211"
Set S.W.-T in rock bank
6' above Roadway
74.57
13.29
P "124 A"
Set 1 x 2" TK
B.C. "211"
Set S.W.-T in rock bank
12' above Roadway
50-56-25
E.C. 210
Set S.W.-T in rock
18' above Roadway
23.90 @ 13-20 T74 = 23.26
23.62 @ 9-57 T74 = 23.26 } 23.26
18-48-00
130.00
P.I. "210"
Set 3/4" I.P. Plug & TK 6" Dn
at toe of bank
28-14-15
B.C. "210"
Set 3/4" I.P. Plug & TK 6' Dn
S. edge of Roadway
131.36 @ 6-18 T74 = 130.57 } 130.57
131.45 @ 6-36 T74 = 130.58
0.57 @ 0-00 T74 =
- 0.57
130.00
36-18-50
85.61
69.30
67.35
P "124"
Fd 1 x 2" TK
F.B. 636 - 143

Con from top page 156

RETURN TO
LOS ANGELES COUNTY SURVEYOR
700 HALL OF RECORDS
Do not extend notes this side of this line
Note: ANY ADDITIONS OR CHANGES ON THIS SHEET MUST BE MADE OR CIRCLED IN Red Ink. WITH DATE AND NAME OF PERSON MAKING CHANGE.
FORM 247 10M 5-51

F.B. 650 Pg. 158

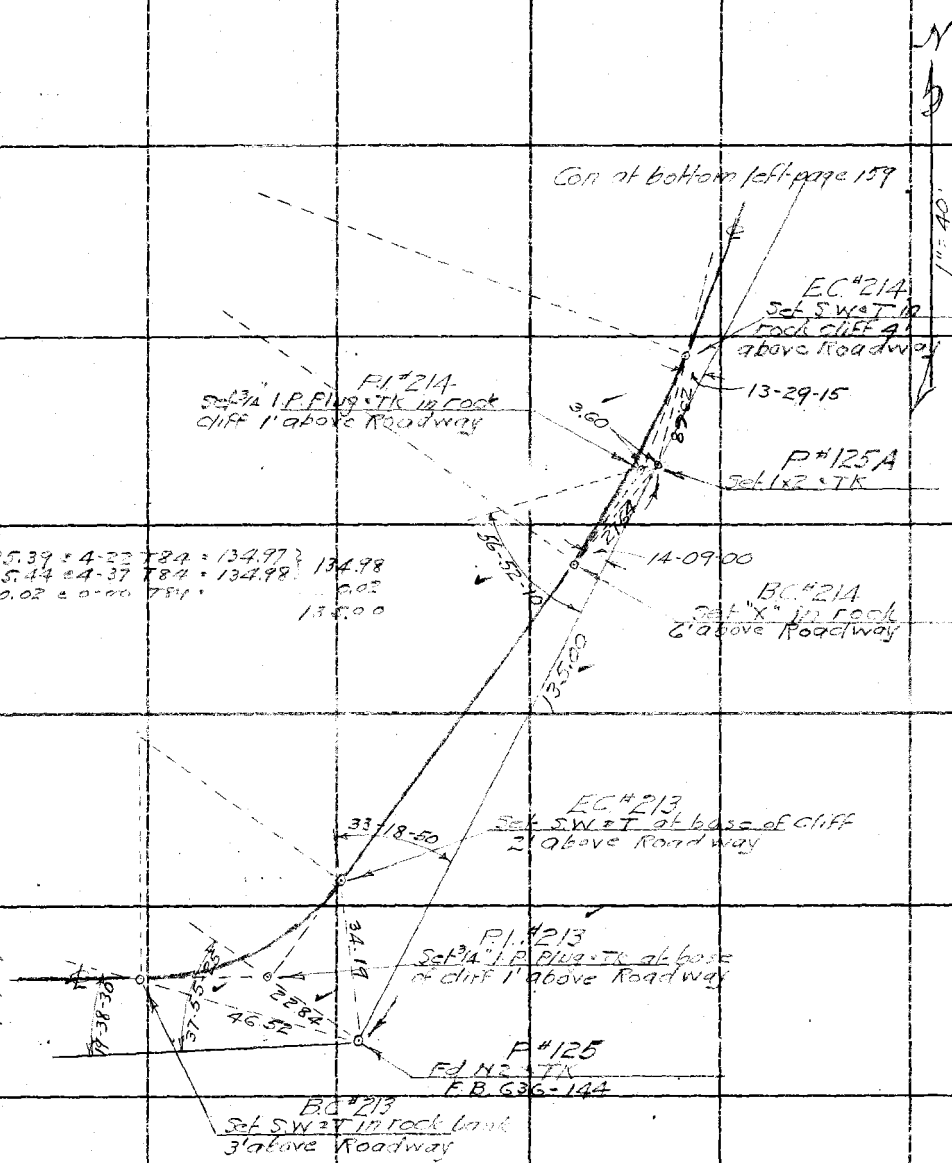

RETURN TO
LOS ANGELES COUNTY SURVEYOR
700 HALL OF RECORDS

Do not extend notes this side of this line

Note: ANY ADDITIONS OR CHANGES ON THIS SHEET MUST BE MADE OR CIRCLED IN Red Ink. WITH DATE AND NAME OF PERSON MAKING CHANGE.

Notes Ck'd by Drew	Survey of MT WILSON TOLL RD
Map No. B-1217-3	W. O. 8149 Tape No 653 St'd 84 °F.
Office Work F. A. W.	Surveyed by W. A. Miller
Checked Drew	Notes Miller Date Nov 1937
Date 12-17-40	Indexed A. C. Johnson 6-2-39

F.B. 650 Pg. 159

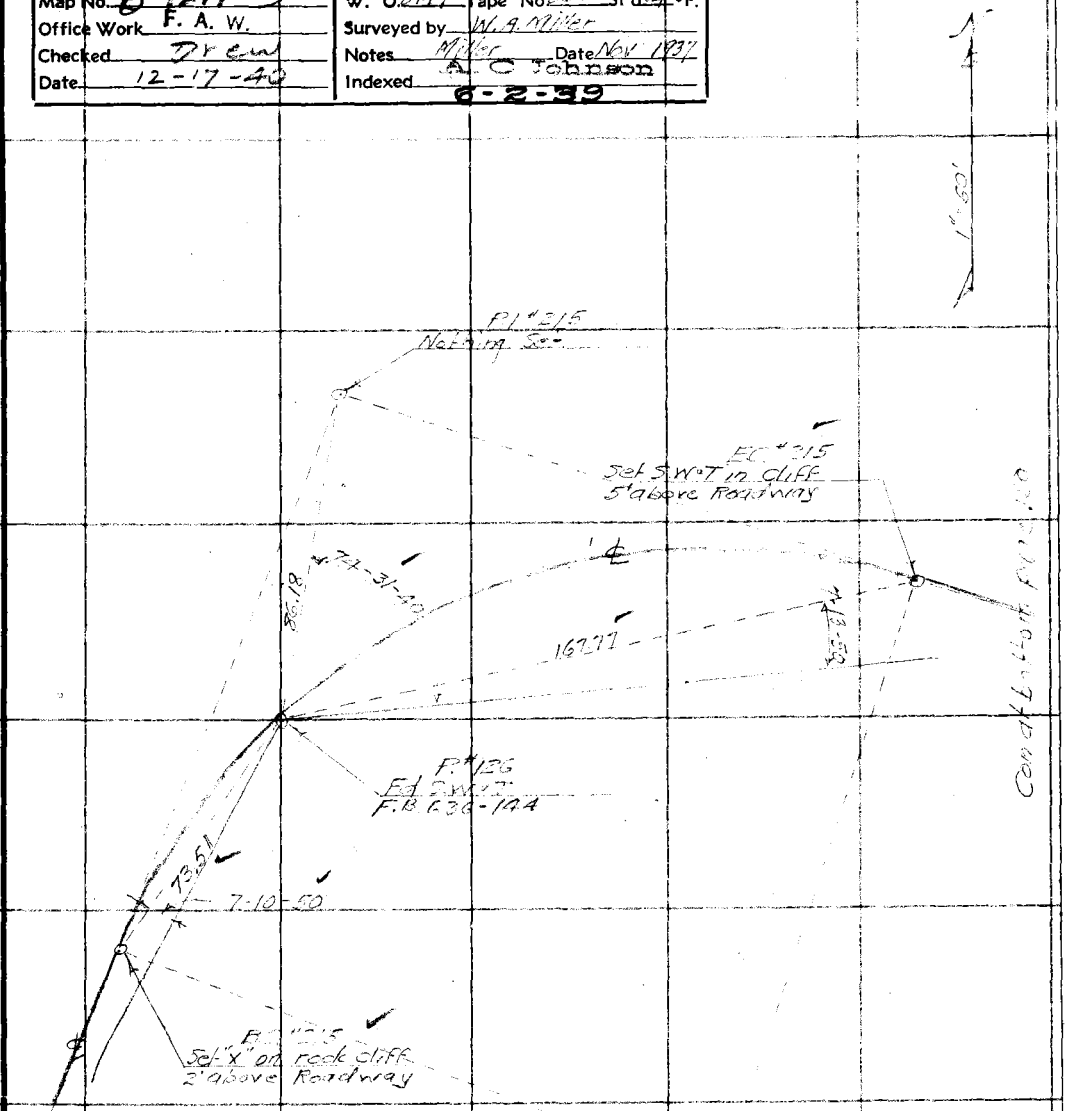

Note: Any Additions or Changes on This Sheet Must be Made or Circled in Red Ink With Date and Name of Person Making Change

Do not extend notes this side of this line

RETURN TO
LOS ANGELES COUNTY SURVEYOR
700 HALL OF RECORDS

FORM 247 10M 11-38


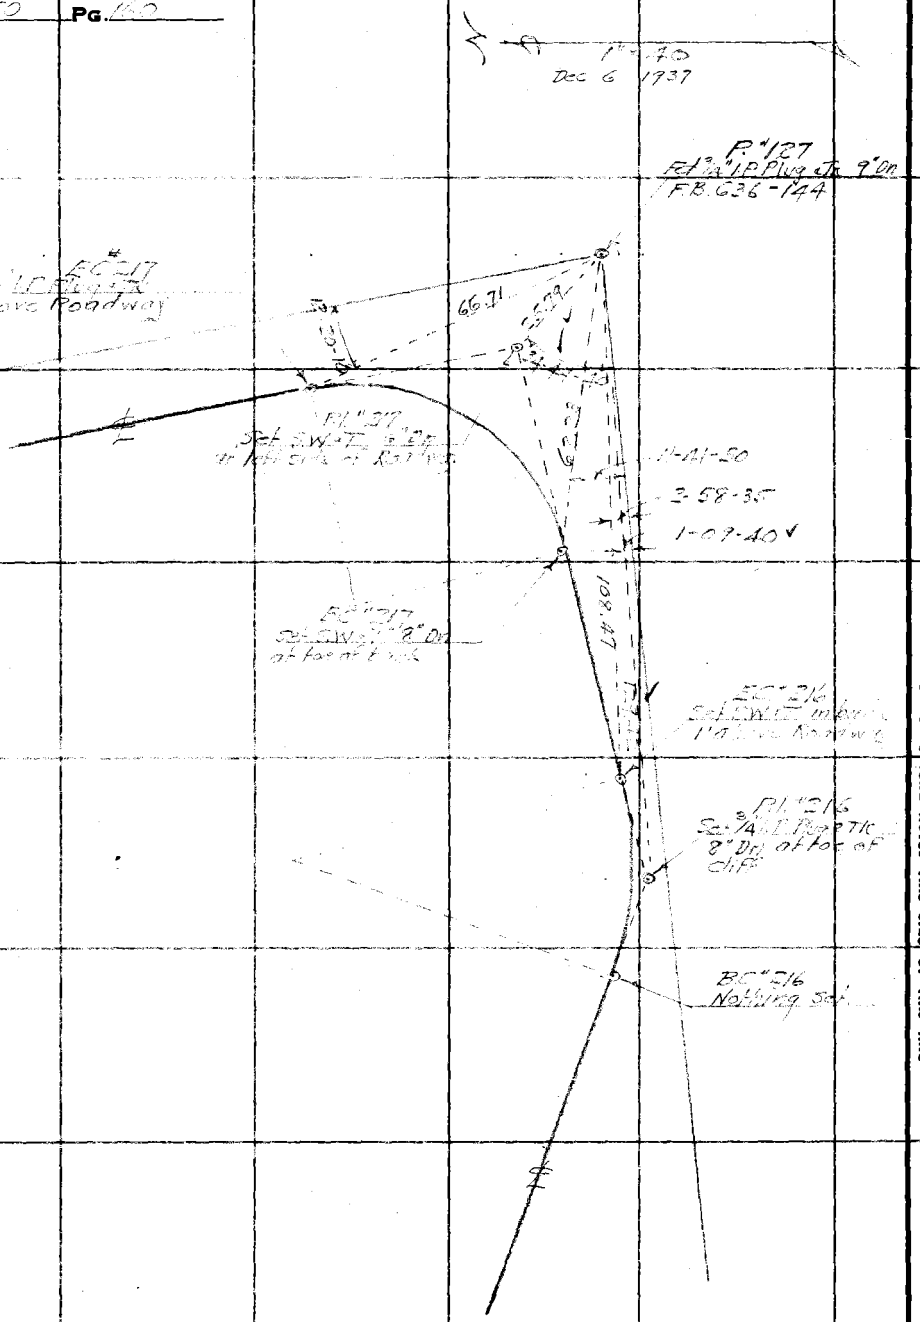
1"=20
Dec 6 1937

Notes Ck'd by. Drew	Survey of MT WILSON TOLL RD
Map No. B-12.17-1	W. O. 8149 Tape No. 253 St'd 84 °F.
Office Work F. A. W.	Surveyed by W.A. Miller
Checked Drew	Notes Miller Date Nov 1937
Date 12-17-40	Indexed A. O. Johnson

F.B. 650 Pg. 163

Note: Any Additions or Changes on This Sheet Must be Made in Red Ink With Date and Name of Person Making Change.

Do not extend notes this side of this line

RETURN TO
LOS ANGELES COUNTY SURVEYOR
700 HALL OF RECORDS

FORM 247 10M 11-35

Con on p 164

93.53 @ 4-15 TAF = 93.27
93.60 @ 4-52 TAF = 93.26
1.70 @ 0-0 TAF =
93.26
1.74
15.00

P "130.A
Set LKZ °T/S

Set 3/4" I.P Plug °Tk 6" Dn at toe of bank

P "221
Set 3/4" I.P Plug °Tk 6" Dn in Roadway

P "222
Set 3/4 I.P Plug °Tk 12" Dn at toe of bank

P "130
Set 2x2 °Tk 6" Dn
F.B. 636 - 19 S

Set 3/4 I.P Plug °T 6" Dn at toe of Bank

Set 3/4 I.P Plug °Tk 6" Dn at toe of bank

4-30-10

P "220
Set 3/4 I.P Plug °Tk 6" Dn in Roadway

P.C. "220
Set 3/4 I.P Plug °Tk 4" Dn at toe of bank

Con from top p 162

RETURN TO
LOS ANGELES COUNTY SURVEYOR
700 HALL OF RECORDS

Note: Any Additions or Changes on This Sheet Must be Made or Circled In **Red Ink** With Date and Name of Person Making Change.

Do not extend notes this side of this line

1" = 40'

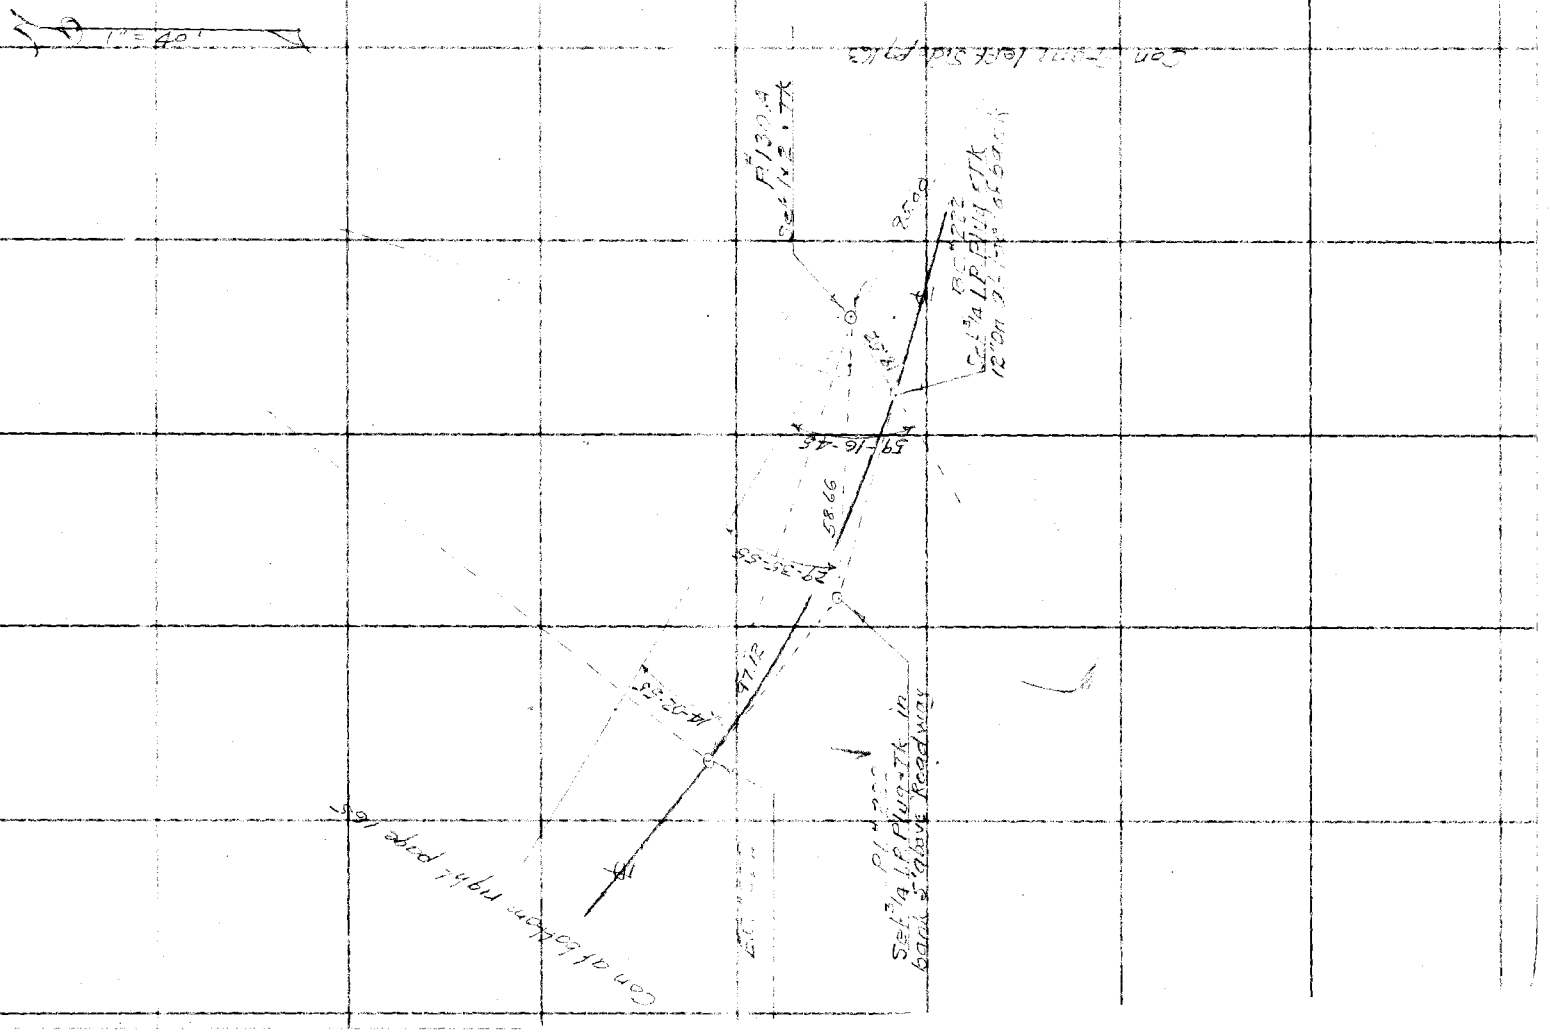

F.B. 650 Pg. 164

Notes Ck'd by Drew	Survey of MT WILSON 10" SD
Map No. B-12-7-1	W. O. 8149 Tape No 053 St'd 84°F.
Office Work F. A. W.	Surveyed by W.A. Miller
Checked Drew	Notes Miller Date Nov 1937
Date 12-17-40	Indexed A. C. Johns

F.B. 650 PG. 165

Note: Any Additions or Changes on This Sheet Must be Made in Red Ink or Circled With Date and Name of Person Making Change.

Do not extend notes this side of this line

RETURN TO
LOS ANGELES COUNTY SURVEYOR
700 HALL OF RECORDS

FORM 247 10M 11-38

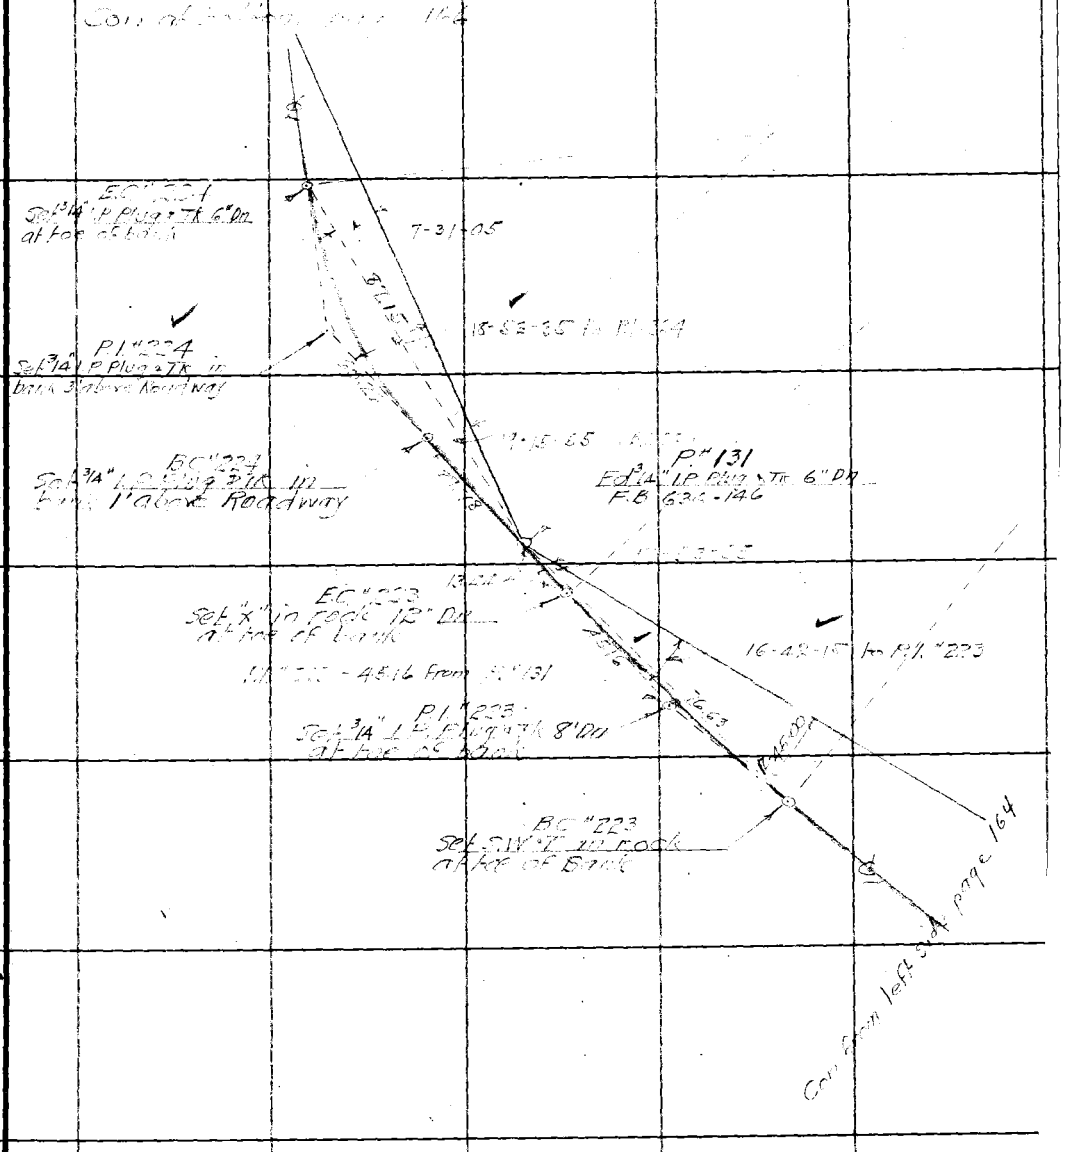

F.B. 650 Pg. 166

RETURN TO
LOS ANGELES COUNTY SURVEYOR
700 HALL OF RECORDS

Do not extend notes this side of this line

Note: Any Additions or Changes on This Sheet Must be Made or Circled in Red Ink With Date and Name of Person Making Change.

Notes Ck'd by Drew	Survey of Mt Wilson Toll Rd	F.B. 650	Pg. 161
Map No. B-21	W. O. 8149 Tape No. 253 St'd 84 °F.		
Office Work F. A. W.	Surveyed by W.A. Miller		
Checked Drew	Notes Miller Date Dec '40		
Date 12-17-40	Indexed A. C. Johnson		

N

1" = 40'

Cor. of Hobson right page 162

EC "218"
Set 3/4" I.P. Plug & Tk in bank
1' above Roadway

17-04-05

P "128"
Fd 3/4" I.P. & Tk 8" Dn
F.B. 636-145

35.33

12.36

37.46

P1 "218"
Set 3/4" I.P. Plug & Tk 8" Dn
At left-side of Roadway

18-17-45

BC "218"
Set 3/4" I.P. Plug & Tk in bank
2' above Roadway

Cor From Left Side page 160

RETURN TO
LOS ANGELES COUNTY SURVEYOR
700 HALL OF RECORDS

Note: Any Additions or Changes on This Sheet Must be Made in Red Ink or Circled in Red With Date and Name of Person Making Change

Do not extend notes this side of this line

FORM 247 10M 11-38

F.B. 650 PG. 162

Con at bottom page 163

N

1"=40'

RETURN TO
LOS ANGELES COUNTY SURVEYOR
700 HALL OF RECORDS

Note: Any Additions or Changes on This Sheet Must be Made or Circled in Red Ink With Date and Name of Person Making Change.

Do not extend notes this side of this line

Set SW & I E.C. 4-19 6" Dn at top of bank

11-37-40

87.52

Set 3/4" I.P. P.L. 4-19 10' above roadway

Set 1" x 12" rock E.C. 6" Dn

43.71 @ 20-00 T 20 = 41.07
43.77 @ 19-28 T 20 = 41.08 } 41.07

11.01

Set SW & I E.C. 4-19 6" Dn at top of bank

9-42-25

11-4-1937

Cor. Grant top of bank

Notes Ck'd by	Prud	Survey of	M.T. Wilson Tol. Co.
Map No.	8-027-4	W. O.	8149 Tape No. St'd °F.
Office Work	F. A. W.	Surveyed by	W. A. Miller
Checked	Dreed	Notes	M. Miller Date 12-3-1937
Date	12-17-40	Indexed	C. Johnson

F.B. 650 Pg. 167

Note: Any Additions or Changes on This Sheet Must be Made or Circled in Red Ink With Date and Name of Person Making Change

Do not extend notes this side of this line

RETURN TO
LOS ANGELES COUNTY SURVEYOR
700 HALL OF RECORDS

FORM 247 10M 11-38

N

1" = 40'

Con at bottom, page 168

E.C. #230
Set SW I.T. 6" Dia
at toe of bank

P.I. #230
Set SW I.T. 6" Dia
at toe of bank

P.C. #230
Set SW I.T. 6" Dia
at toe of bank










P. 133
Set SW I.T. 6" Dia
by Hirs F.B. 636-146

35-23-50

21-57-25

12-26-00

52.13

97.15

210.00

2-08-55

6-28-55

39.42

10.00

24.84

16-37-20

End Survey Page 166

F.B. 650 Pg. 168

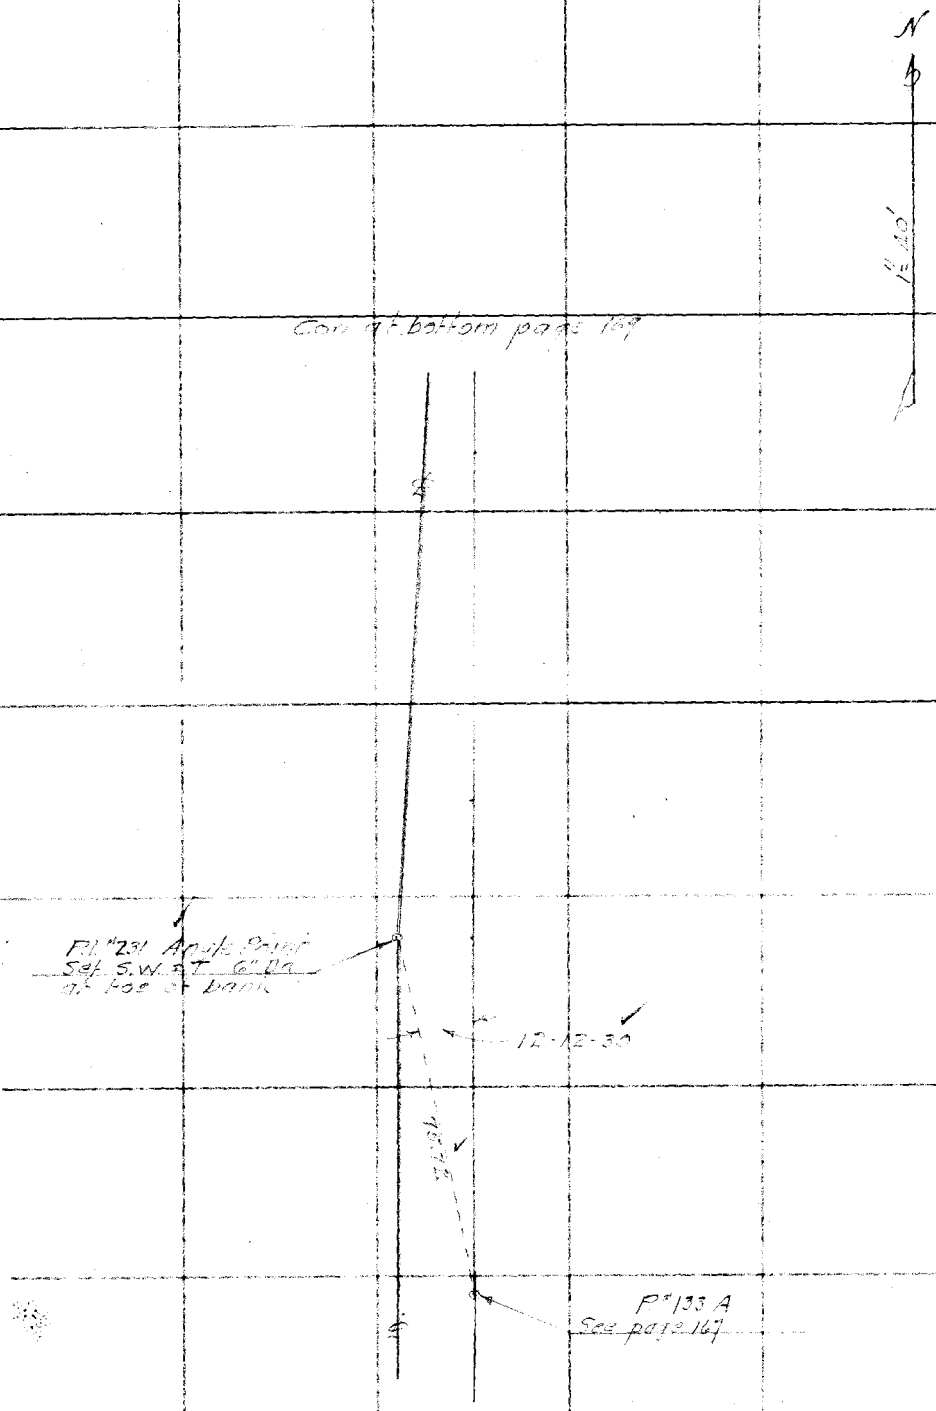

RETURN TO
LOS ANGELES COUNTY SURVEYOR
700 HALL OF RECORDS

Note: Any Additions or Changes on This Sheet Must be Made or Circled in Red Ink With Date and Name of Person Making Change.

Do not extend notes this side of this line

Notes Ck'd by DR C.W.	Survey of MT. WILSON TOLL RD.
Map No. B-1217-3	W. O. 8149 Tape No. 053 St'd 84 °F.
Office Work F. A. W.	Surveyed by W.A. MILLER
Checked D R C.W.	Notes M.M.'s Date Dec 1927
Date 12-17-40	Indexed A. C. Johnson

F.B. 650 PG. 169

Note: Any Additions or Changes on This Sheet Must be Made or Circled in Red Ink With Date and Name of Person Making Change

Do not extend notes this side of this line

RETURN TO
LOS ANGELES COUNTY SURVEYOR
700 HALL OF RECORDS

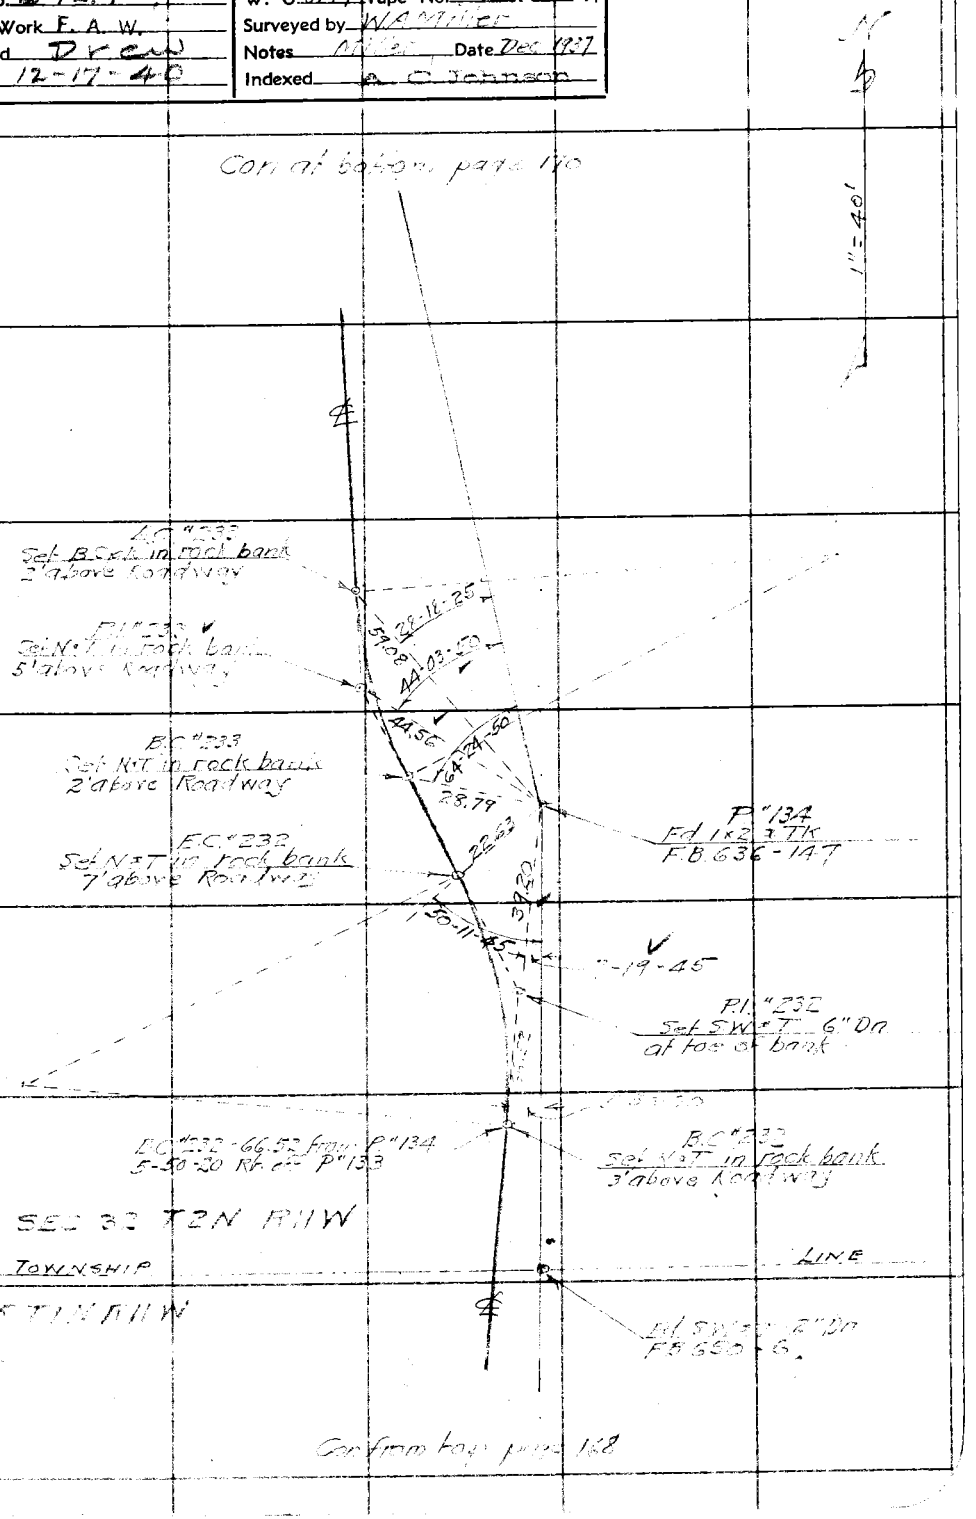

FORM 247 10M 11-38

F.B. 650 Pg. 170

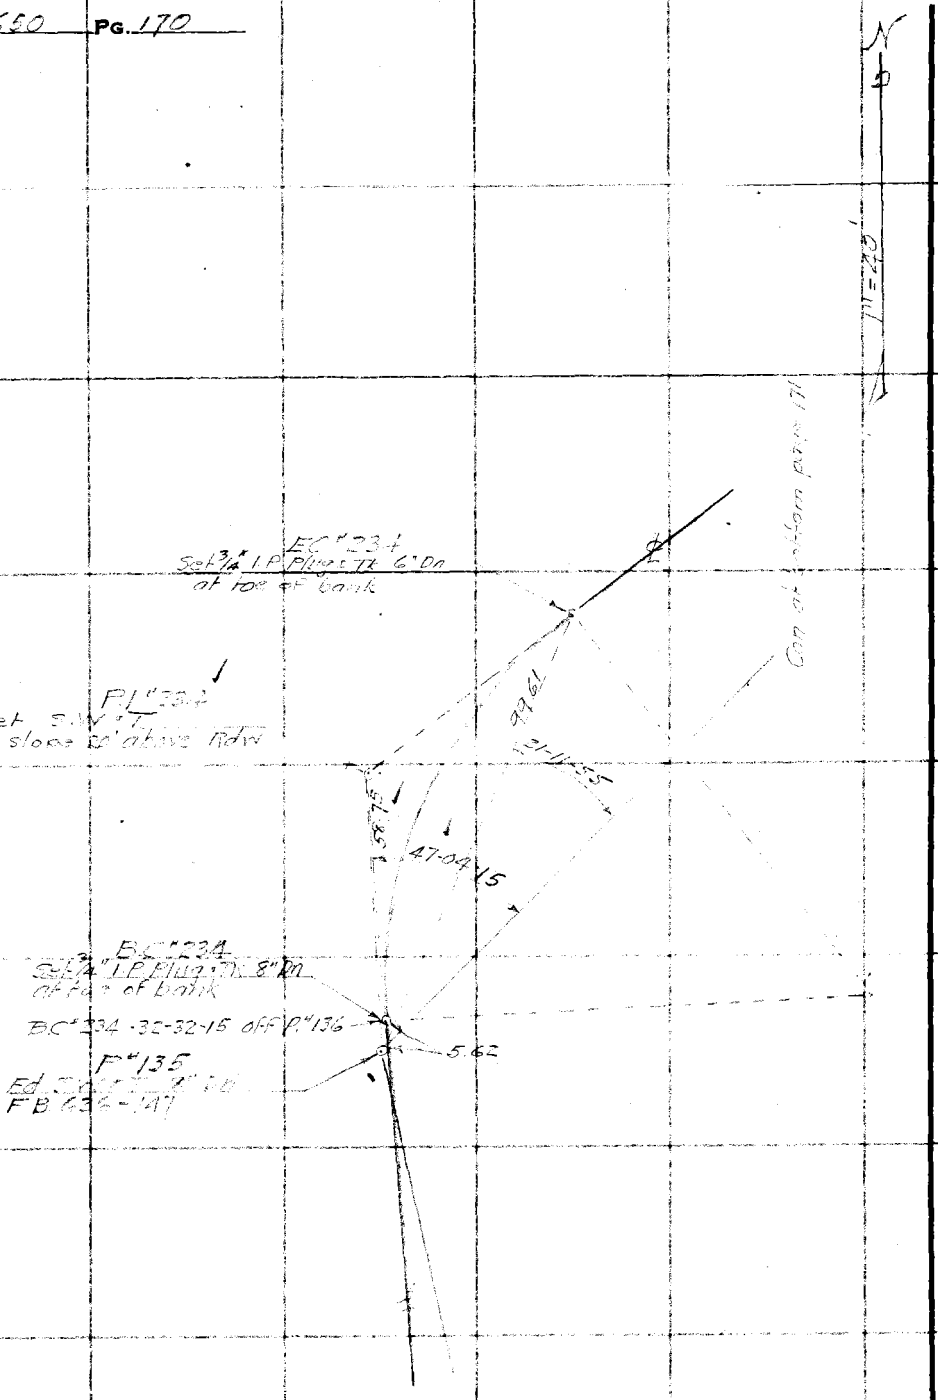

RETURN TO
LOS ANGELES COUNTY SURVEYOR
700 HALL OF RECORDS

Note: Any Additions or Changes on This Sheet Must be Made or Circled in Red Ink With Date and Name of Person Making Change.

Do not extend notes this side of this line

Notes Ck'd by Dr E&W	Survey of Mt Wilson Toll Rd
Map No. B-12147-5	W. O. 8149 Tape No. C53 St'd 34 °F.
Office Work F. A. W.	Surveyed by W
Checked Dr E&W	Notes Miller Date Dec 1937
Date 12-17-40	Indexed A. C. Johnson

F.B. 650 Pg. 171

Note: Any Additions or Changes on This Sheet Must be Made or Circled in Red Ink With Date and Name of Person Making Change.

Do not extend notes this side of this line

RETURN TO
LOS ANGELES COUNTY SURVEYOR
700 HALL OF RECORDS

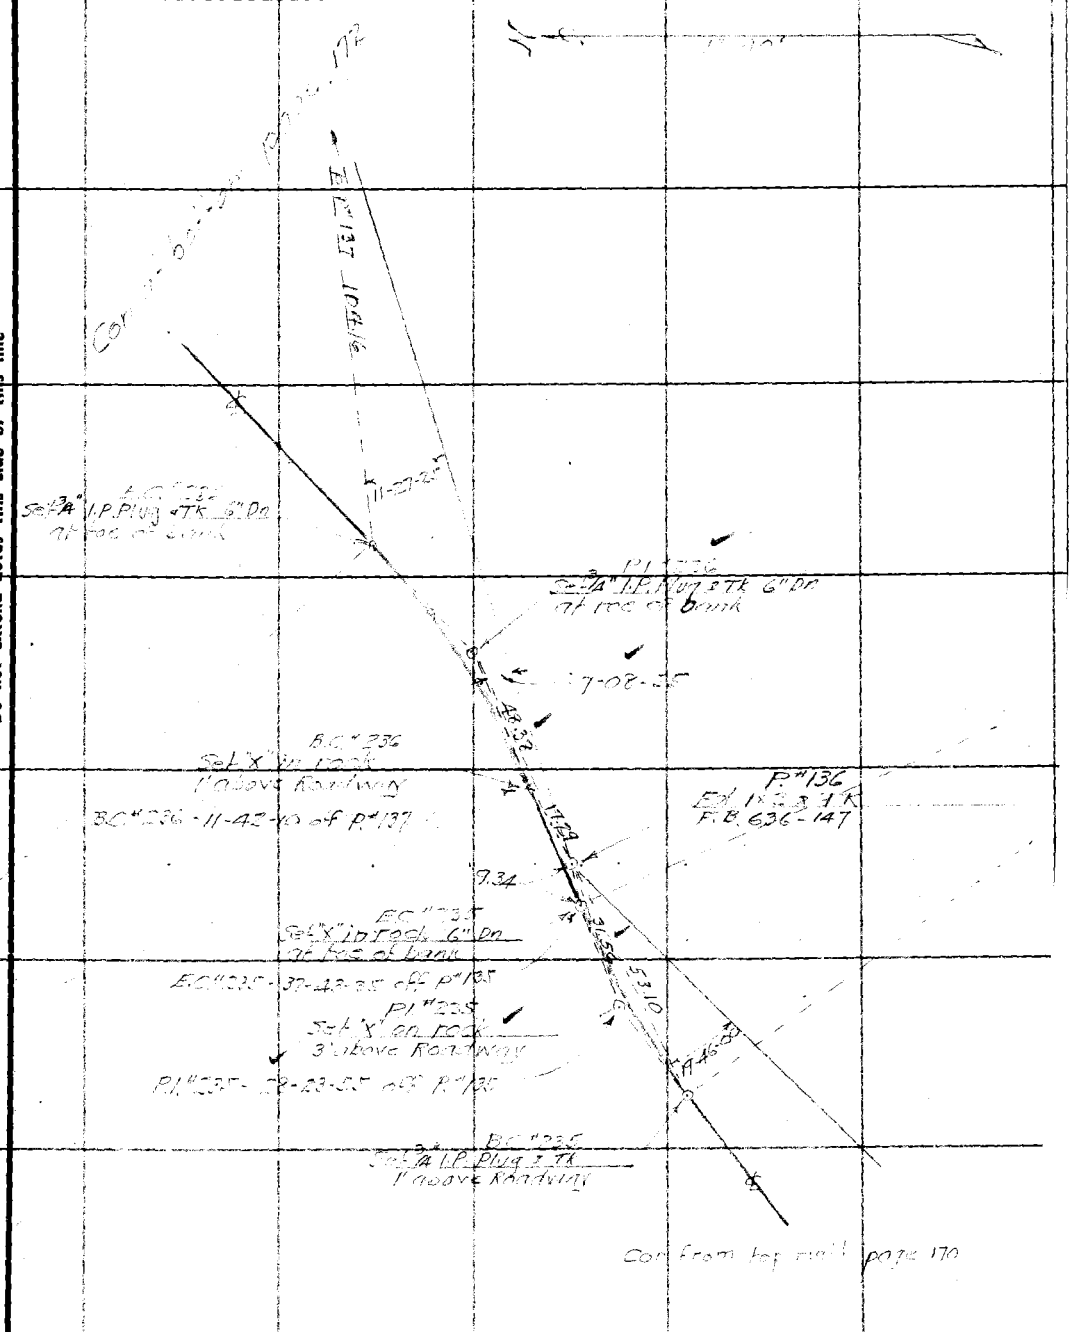

FORM 247 10M 11-38

F.B. 650 Pg. 172

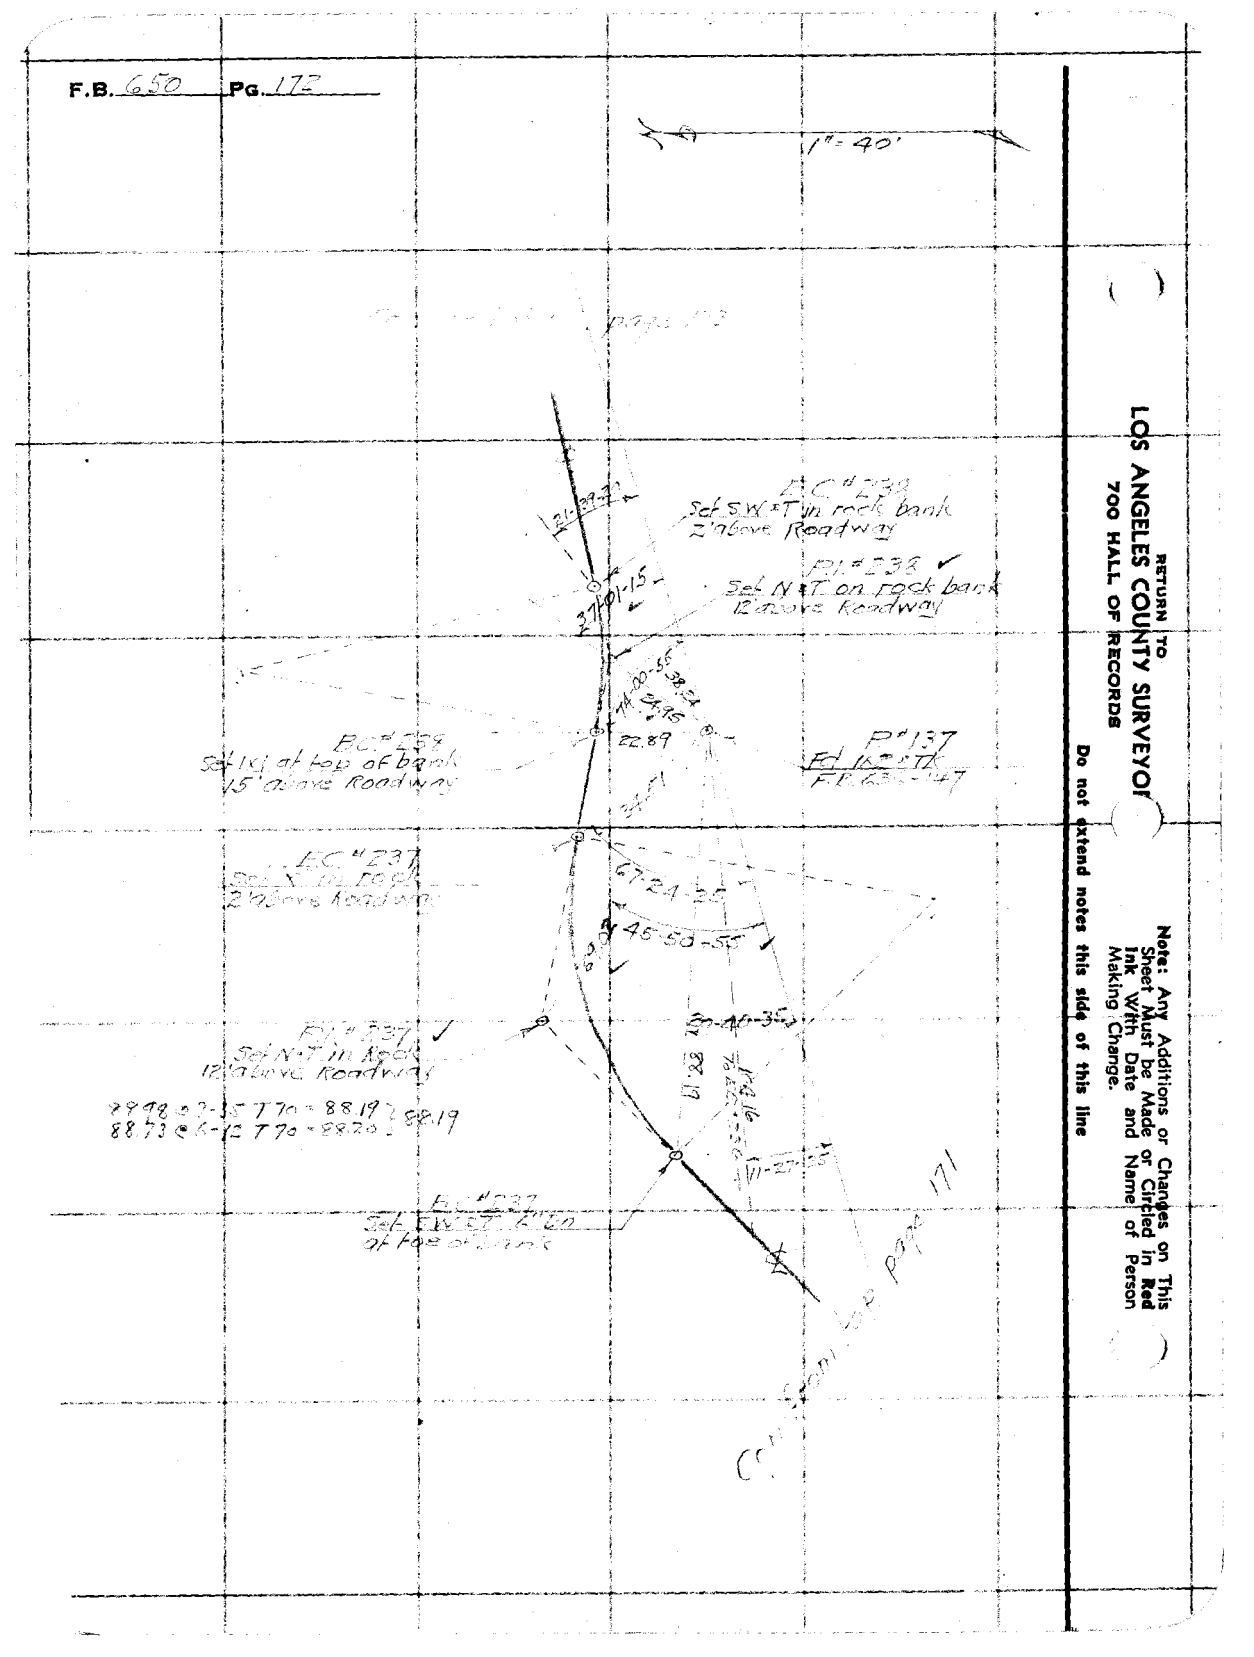

RETURN TO
LOS ANGELES COUNTY SURVEYOR
700 HALL OF RECORDS

Note: Any Additions or Changes on This Sheet Must be Made or Circled in Red Ink With Date and Name of Person Making Change.

Do not extend notes this side of this line

Notes Ck'd by Drew	Survey of MT WILSON TOLL RD
Map No. B-121	W. O. 8149 Tape No. C53 St'd °F.
Office Work F. A. W.	Surveyed by W. A. Miller
Checked Drew	Notes Miller Date
Date 12-17-40	Indexed A. C. Johnson

F.B. 650 Pg. 173

1" = 40

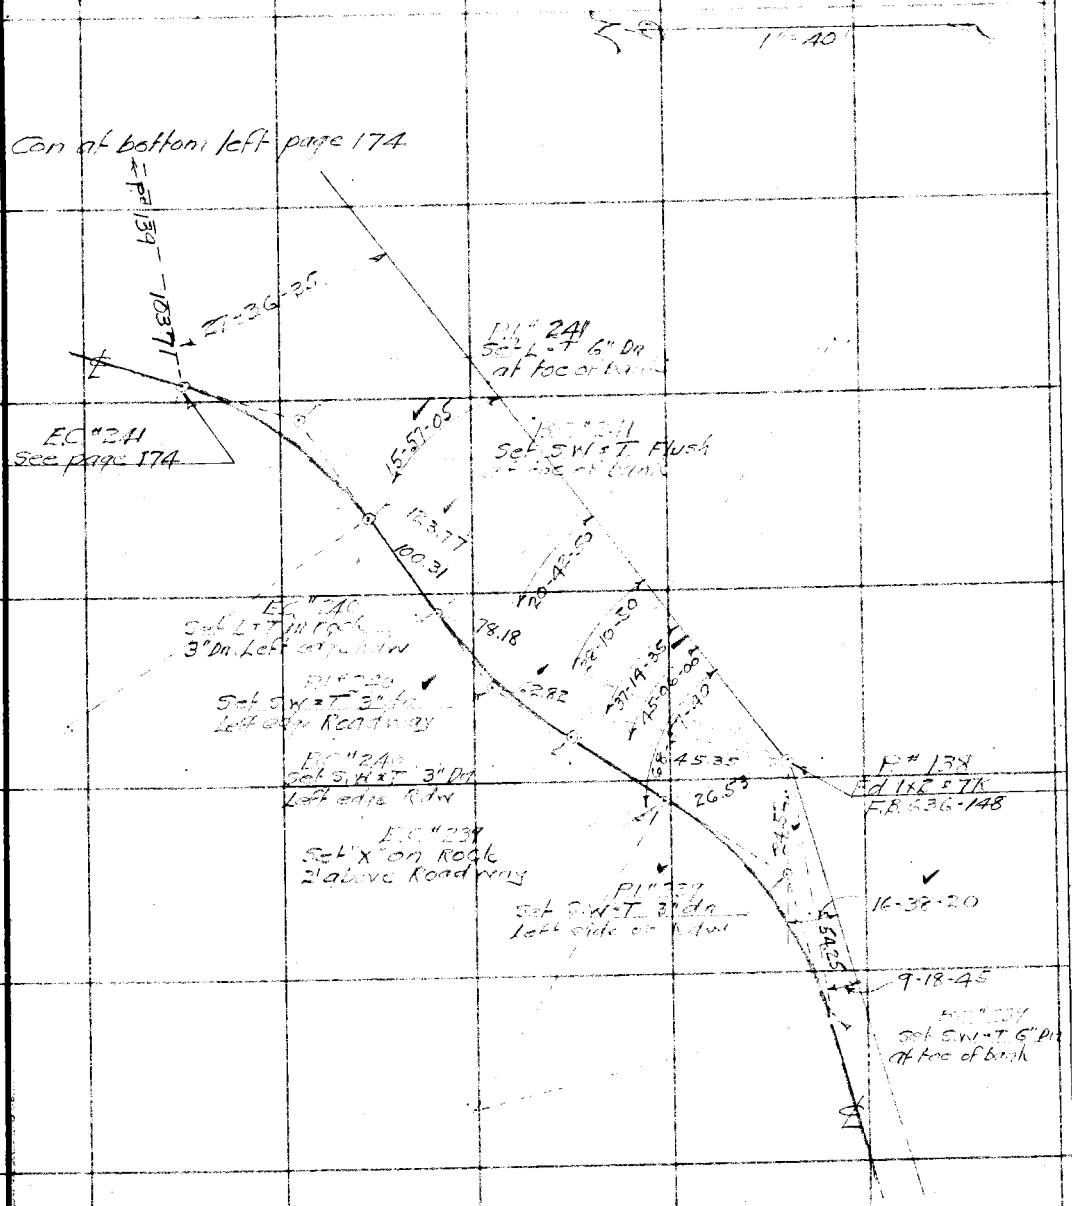

RETURN TO
LOS ANGELES COUNTY SURVEYOR
700 HALL OF RECORDS

Note: Any Additions or Changes on This Sheet Must be Made or Circled in Red Ink With Date and Name of Person Making Change.

Do not extend notes this side of this line

FORM 247 10M 11-35

F.B. 650 Pg. 174

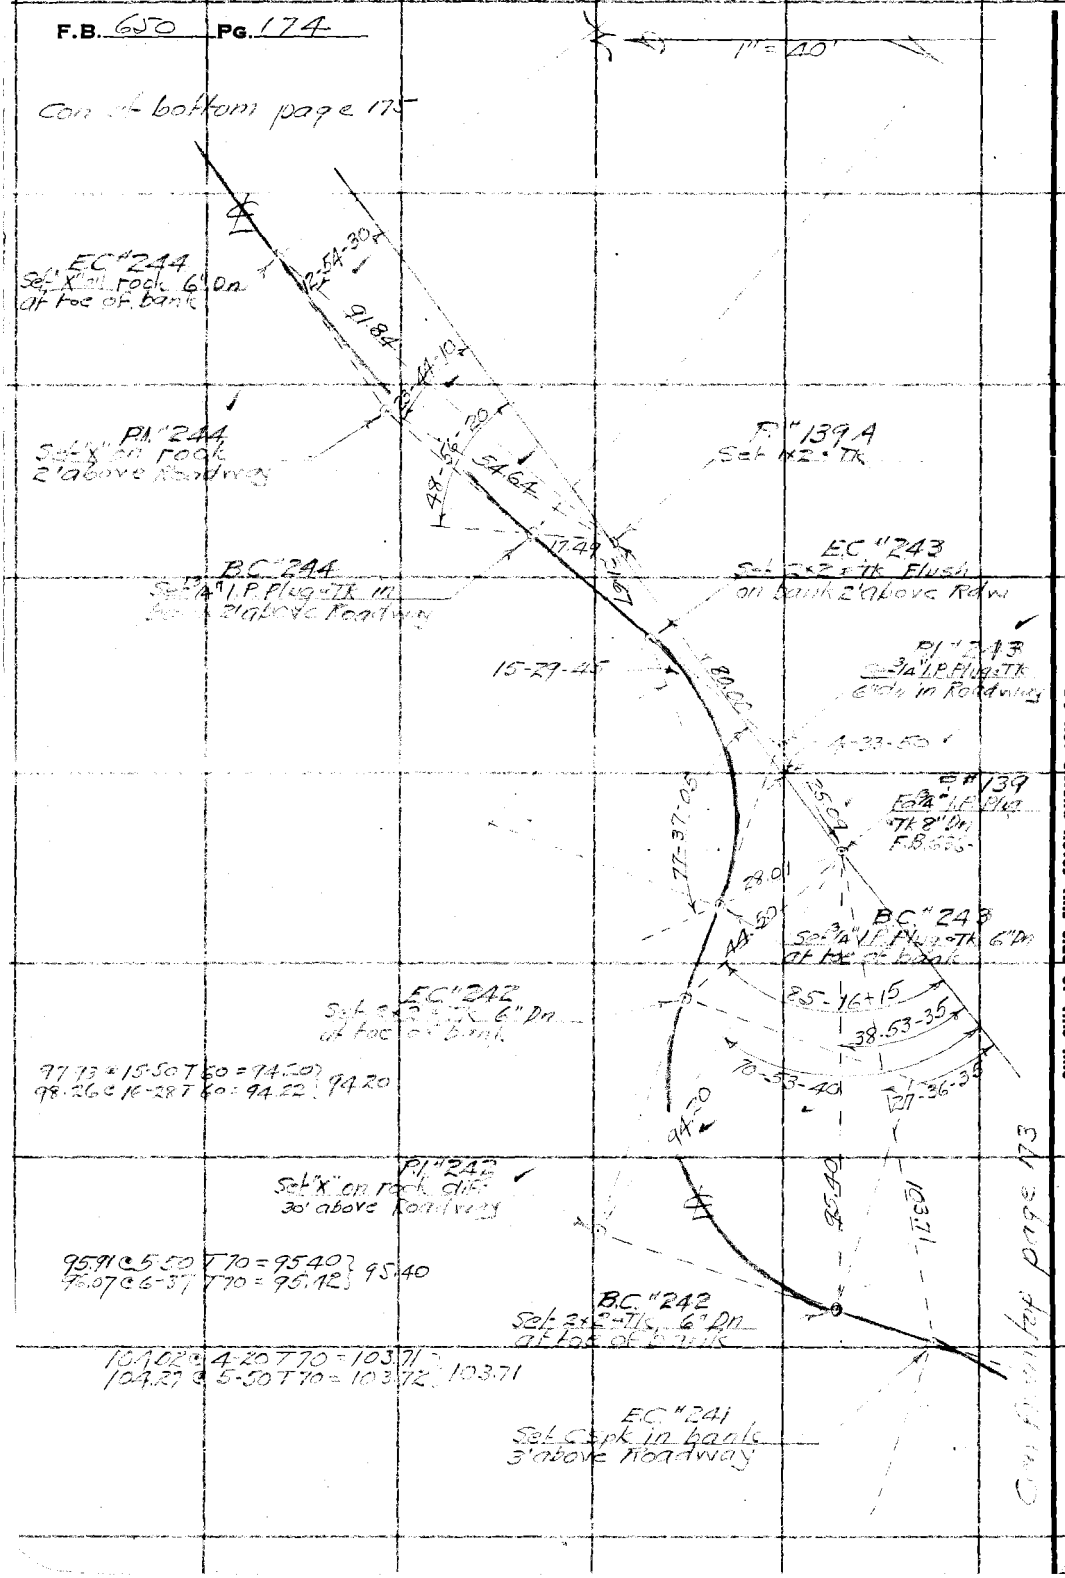

RETURN TO
LOS ANGELES COUNTY SURVEYOR
700 HALL OF RECORDS

Note: Any Additions or Changes on This Sheet Must be Made or Circled in Red Ink With Date and Name of Person Making Change.

Do not extend notes this side of this line

Notes Ck'd by Drew	Survey of MT WILSON TOLL RD
Map No. B-1217-5	W. O. 8149 Tape No. 053 St'd 52 °F.
Office Work F. A. W.	Surveyed by WAXMUTH
Checked Drew	Notes Miller Date Dec 1937
Date 12-17-37	Indexed

F.B. 650 Pg. 175

1"=40'

Con a' bolder left page 174

P.I. "247 Set SW ¾" 2" Dn at toe of bank.

3-37-25

BC "247 Set ¾" I.P. Plug + Tk 6" Dn at toe of bank

142.93 @ 5-15 T 52 = 142.30
143.00 @ 5-33 T 52 = 142.30 } 142.30

111.24 @ 5-55 T 52 = 110.63
111.31 @ 6-01 T 52 = 110.64 } 110.63

91.95 @ 6-35 T 52 = 91.33
91.76 @ 5-26 T 52 = 91.33 } 91.32

EC "246 Set SW ¾ 6" Dn at toe of bank

R=45

110.63

91.32

P.I. "246 Set ¾" I.P. Plug + Tk in bank 3' above datum

71.04

BC "246 Set ¾ I.P. Plug + Tk 6" Dn at toe of bank

EC "245 Set SW ¾ 6" Dn at toe of bank

P.I. "140 Set ¾" I.P. Plug + Tk 10" Dn FB 636 - 148

P.I. "245 Set ¾" I.P. Plug + Tk 8" Dn at toe of Bank

BC "245 Set SW ¾ in rock at toe of bank

Con from top page 174

RETURN TO
LOS ANGELES COUNTY SURVEYOR
700 HALL OF RECORDS

Note: Any Additions or Changes on This Sheet Must be Made or Circled in Red Ink With Date and Name of Person Making Change.

Do not extend notes this side of this line

FORM 247 10M 11-35

F.B. 650 Pg. 176

1" = 40'

Con. at bottom page 177

FI "249
Set "X" on rock
12' above Row

106.12

107.72 @ 9-30 T 44 = 106.13
107.90 @ 10-25 T 44 = 106.11 106.12

FI "241
Fd 1x3 x 11"
EB 63 - 142

EC "249
Set 2x2 4" Tk in back
3' above Roadway

58.34

55.67

EC "248
Set "X" on rock
2' above Roadway

FI "248
Set "X" on rock
10' above Roadway

EC "248
Set SW-T in rock
3' above Roadway

EC "247
Set "X" on rock
5' above Roadway

RETURN TO
LOS ANGELES COUNTY SURVEYOR
700 HALL OF RECORDS

Notes: Any Additions or Changes on This Sheet Must be Made or Circled in Red Ink With Date and Name of Person Making Change.

Do not extend notes this side of this line

Notes Ck'd by Drew	Survey of MT WILSON TRAIL CO
Map No. B-121-4	W. O. 8179 Tape No. 033 St'd 31 °F.
Office Work F. A. W.	Surveyed by VKA Miller
Checked Drew	Notes Miller Date Dec 1940
Date 12-17-40	Indexed A. C. Johnson

F.B. 650 Pg. 177

1" = 100'

Con at bottom page 178

EC "250
Set SW. T in bank
2' above roadway

P1 "250
Set 2x3" Tk on slope
6' above roadway

38 58 @ 13-30 T64 = 37.51 } 37.51
38 71 @ 14-17 T64 = 37.51 }

B.C. "250 - 80-18-05 left
off P 143

BC "250
Set L&T in rock 6' Dn
at toe of bank

3.36

P "142
Fd 3/4" IP & Disc & Tk 8" Dn
F.B. 636-149

64.77

28-15-35

53-07-35

59.67

23-26-05

EC "249
Set X on rock
at toe of bank

Con from top page 176

RETURN TO
LOS ANGELES COUNTY SURVEYOR
700 HALL OF RECORDS

Note: Any Additions or Changes on This Sheet Must be Made or Circled in Red Ink With Date and Name of Person Making Change

Do not extend notes this side of this line

FORM 247 10M 11-38

F.B. 650 Pg. 178

Con left side page 179

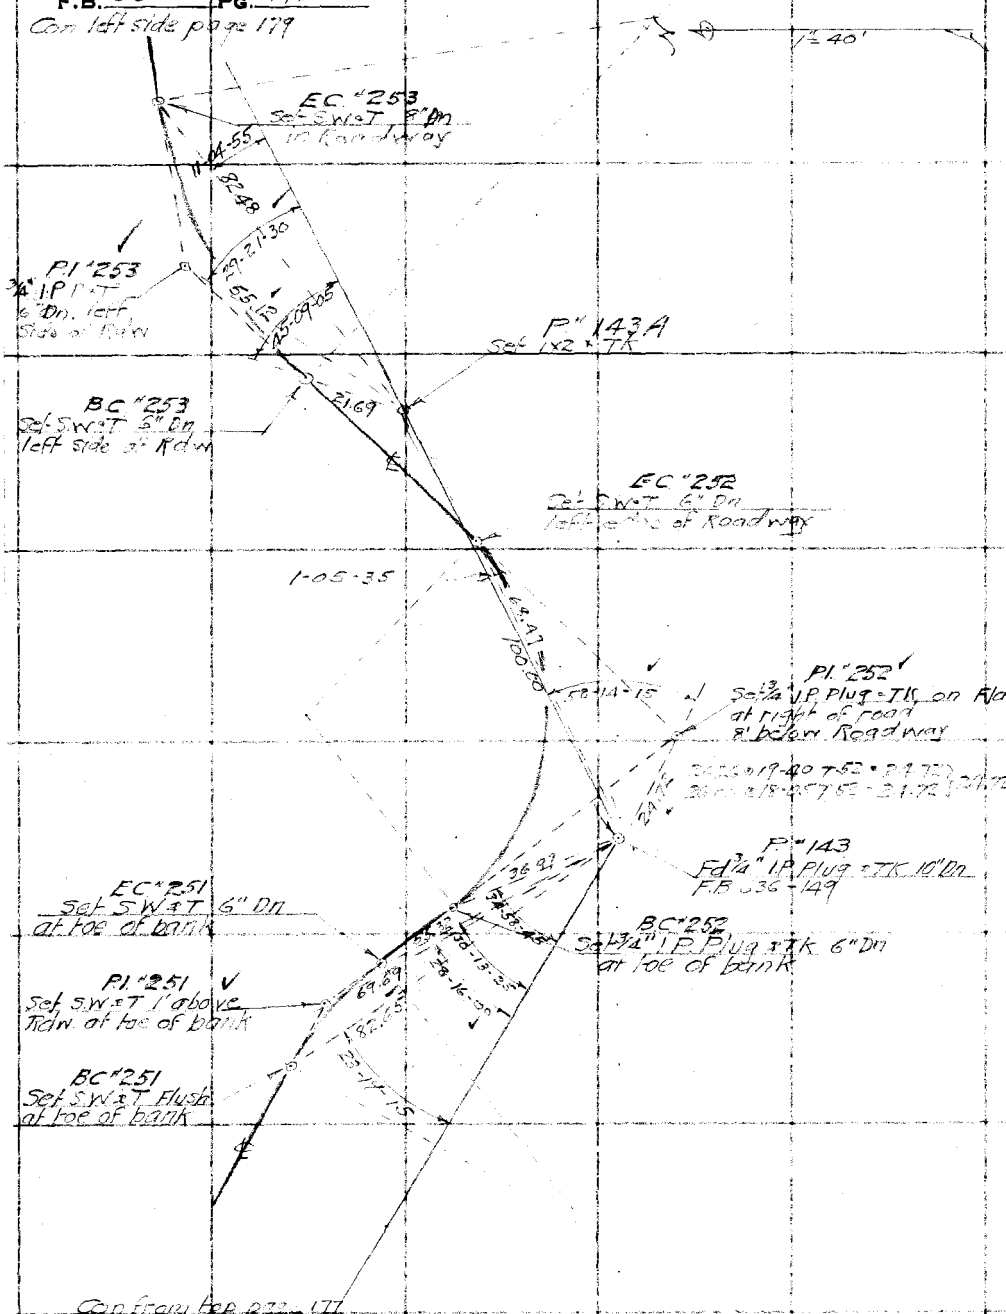

RETURN TO
LOS ANGELES COUNTY SURVEYOR
700 HALL OF RECORDS

Do not extend notes this side of this line

Note: Any Additions or Changes on This Sheet Must be Made or Circled in Red Ink With Date and Name of Person Making Change.

Notes Ck'd by Draw	Survey of MT WILSON TOLL RD
Map No. 8-117-4	W. O. 8149 Tape No. 253 St'd 57 °F.
Office Work F. A. W.	Surveyed by W. A. Miller
Checked Draw	Notes Miller Date
Date 12-17-40	Indexed A. C. Jones

F.B. 650 PG. 179

Note: Any Additions or Changes on This Sheet Must be Made in Red Ink With Date and Name of Person Making Change

Do not extend notes this side of this line

RETURN TO
LOS ANGELES COUNTY SURVEYOR
700 HALL OF RECORDS

FORM 247 10M 11-38

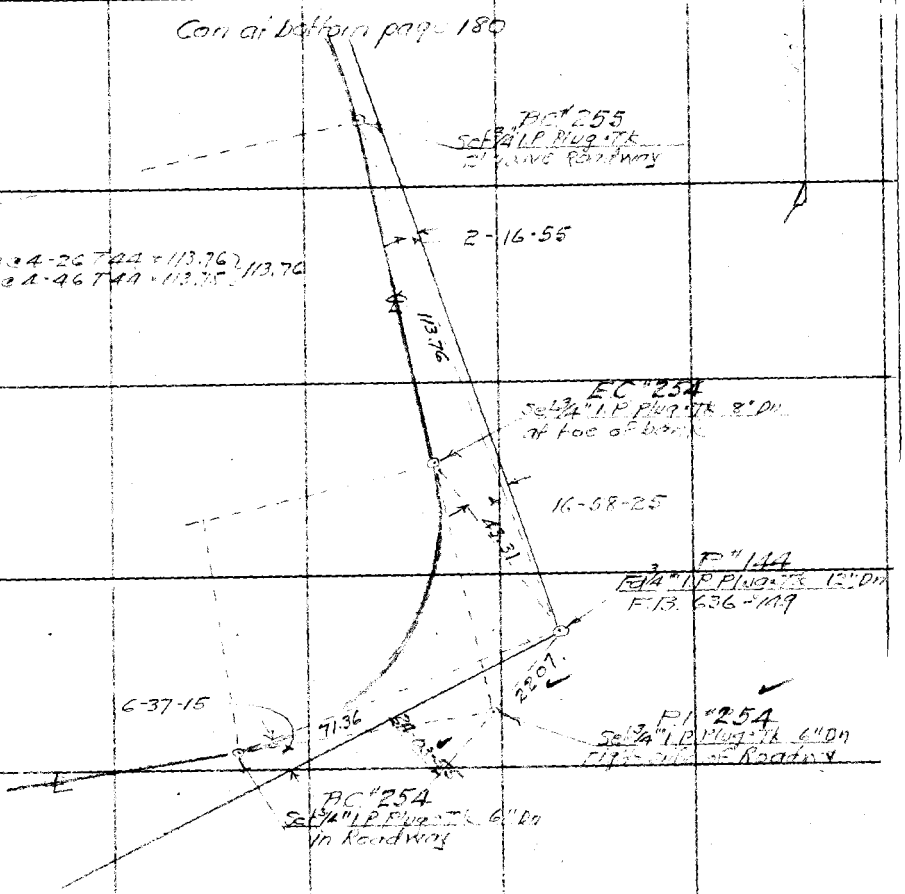

F.B. 650 Pg. 180

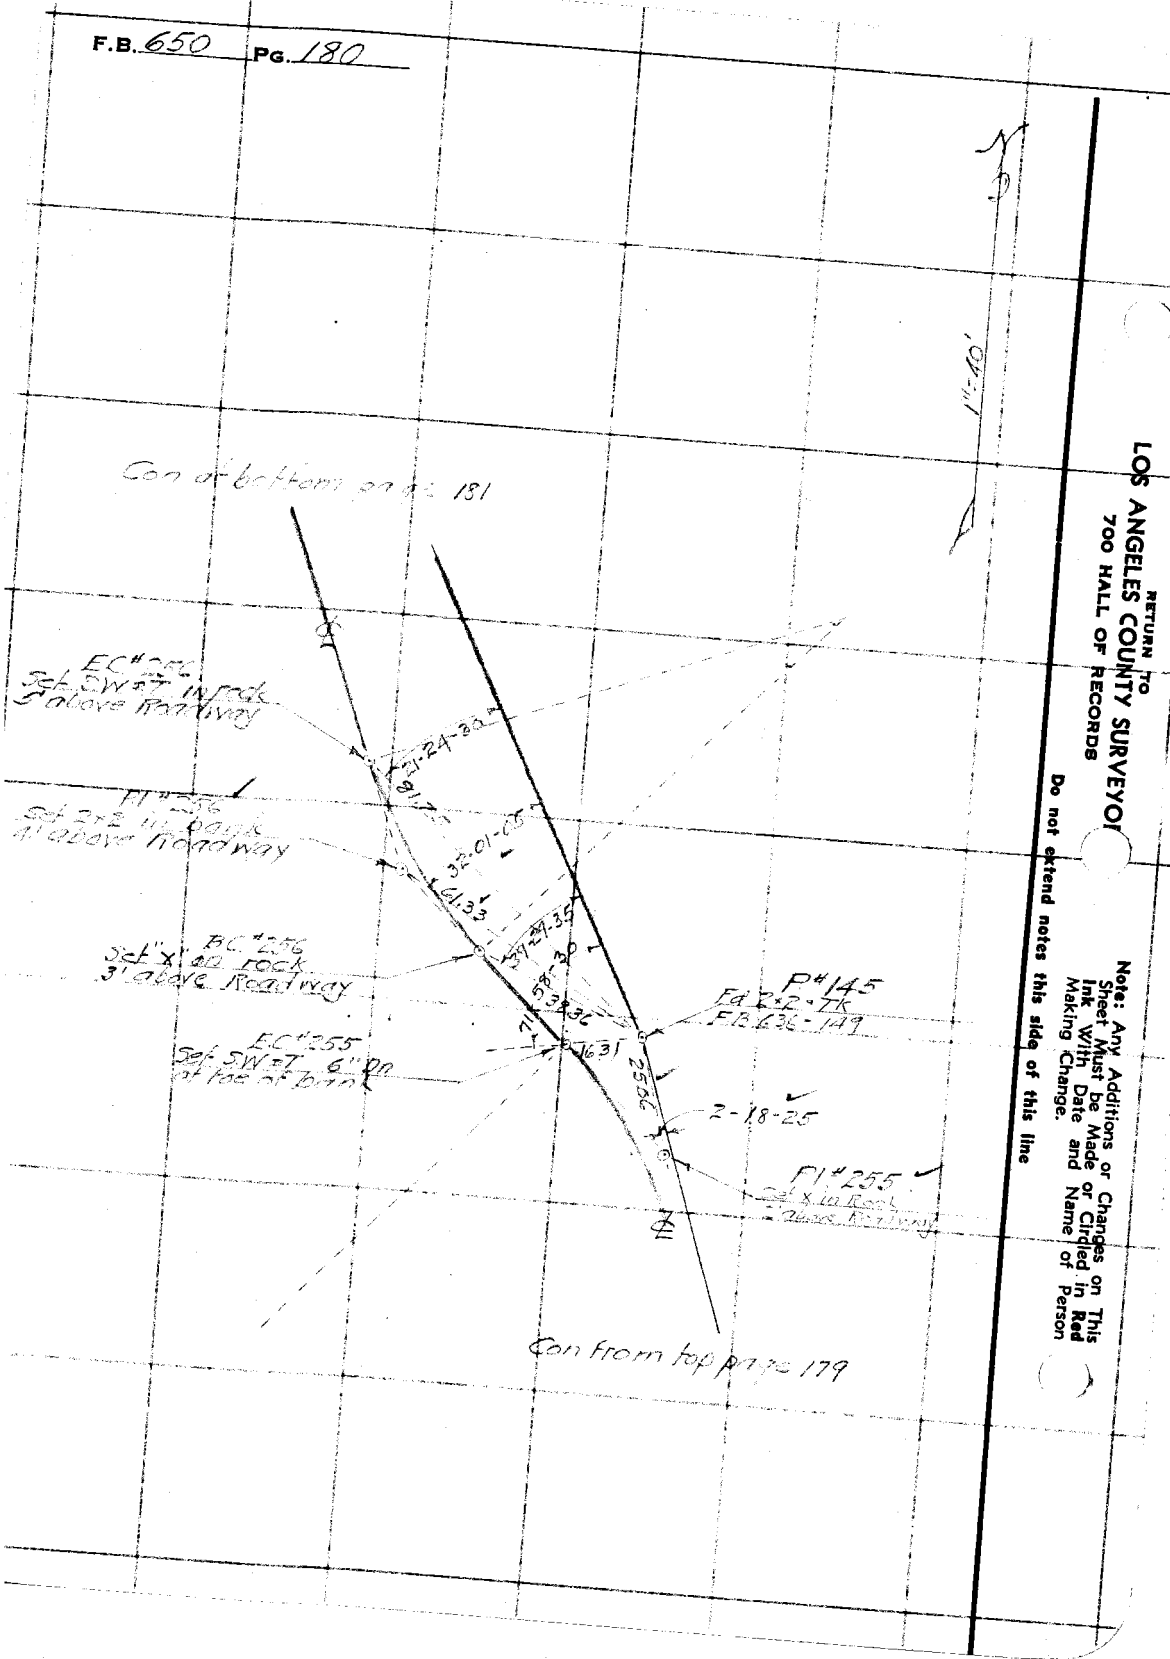

RETURN TO
LOS ANGELES COUNTY SURVEYOR
700 HALL OF RECORDS

Note: Any Additions or Changes on This Sheet Must be Made or Circled in Red Ink With Date and Name of Person Making Change.

Do not extend notes this side of this line

Notes Ck'd by: Drew	Survey of: MT WILSON TOLL RD
Map No.: B-1217-4	W. O. 8149 Tape No.: St'd: °F.
Office Work: F. A. W.	Surveyed by: W.A. Miller
Checked: Drew	Notes: Miller Date: 10-3-1938
Date: 12-17-40	Indexed: A. C. Johnson

F.B. 650 Pg. 181

Note: Any Additions or Changes on This Sheet Must be Made or Circled in Red Ink With Date and Name of Person Making Change

Do not extend notes this side of this line

RETURN TO
LOS ANGELES COUNTY SURVEYOR
700 HALL OF RECORDS

FORM 247 10M 11-38

N

1" = 40'

P.I. "259
Set S.W.T. 4" on
toe of bank

4-34-10

BC "259
Set X on Rock Flush
0' toe of bank

P.I. "14K-A
Set Spk & Tin
in Roadway

EC "258
Set Spk T Flush
at toe of Bank

P.I. "258
Set X on Rk Cliff
7' above Roadway

BC "258
Set X in Stone
3' above Roadway

P.I. "146
Fd 1" S.P. Tk
F.R. 6.3E - 1.50

EC "257
Set X on Rock
2' above Roadway

21-35-15

P.I. "257
Set S.W.T. 6.2N
at toe of bank

15-44-1E

BC "257
Set S.W.T. in
rock 8' above
roadway

Centerline tan point 180

F.B. 650 Pg. 182

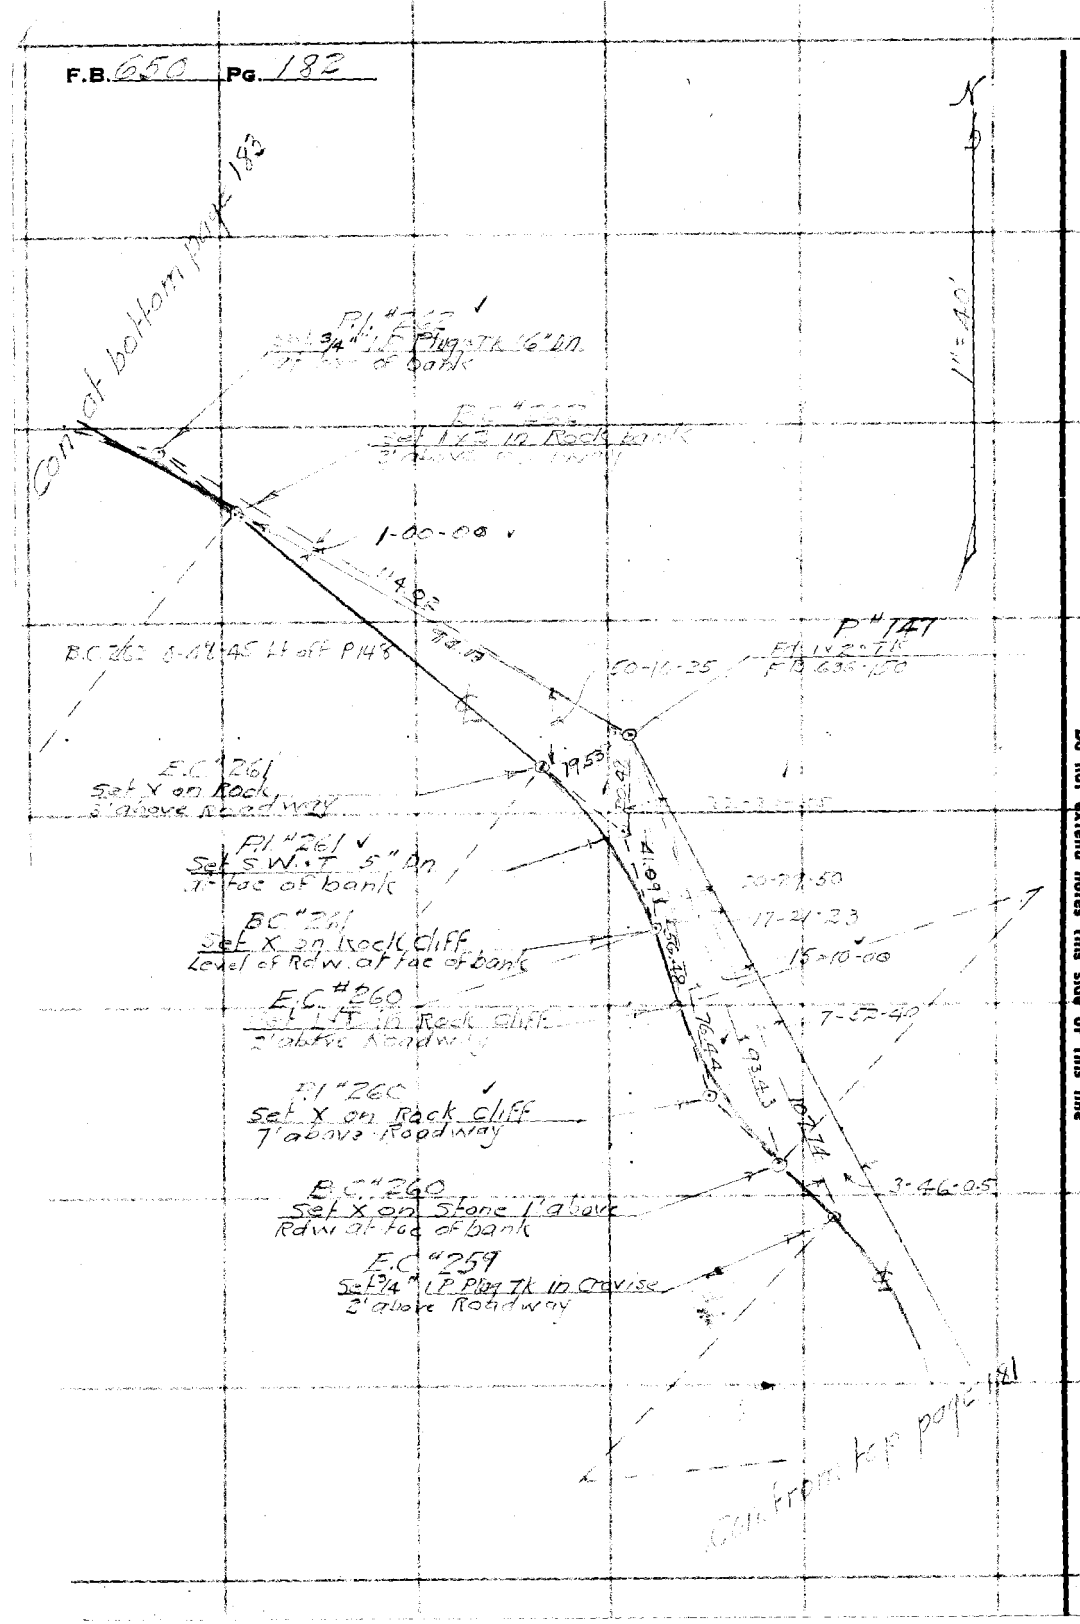

RETURN TO
LOS ANGELES COUNTY SURVEYOR
700 HALL OF RECORDS

Note: Any Additions or Changes on This Sheet Must be Made or Circled in Red Ink With Date and Name of Person Making Change.

Do not extend notes this side of this line

Notes Ck'd by Drew	Survey of MT WILSON TOLL RD
Map No. B-1217-S	W. O. 8149 Tape No. St'd °F.
Office Work F. A. W.	Surveyed by W. A. Miller
Checked Drew	Notes Miller Date Oct 1938
Date 12-18-40	Indexed A. C. Tomlson

F.B. 650 Pg. 183

Note: Any Additions or Changes on This Sheet Must be Made or Circled in Red Ink With Date and Name of Person Making Change.

Do not extend notes this side of this line

RETURN TO
LOS ANGELES COUNTY SURVEYOR
700 HALL OF RECORDS

FORM 247 10M 11-38

P.I. "264
Set 2+2 TK on slope
20' above Roadway

60.00 @ 28.14 T 64 = 53.85 52.86
60.12 @ 28.26 T 64 = 52.86
0.81 @ 0-00 T 64 = 81
53.67

63-26-20

1265

B.C. 574

1-43-10

P.I. 148
E.I. x C. TK
1.5 E 36 - 1500

B.C. "261
2+2 TK on Slope
3' above Roadway

140.00

Con. of Mt. Wilson Toll Rd. page 184

F.C. "263
Set S.W.T. 4" Dn
at Toe of Bank

67.37

P.I. "147A
E.I. x C. TK on

P.I. "263
Set S.W.T. 4" Dn
Left side Roadway

25-42-00

19-14-25

13-31-15

B.C. "263
Set S.W.T. 4" Dn
Left side Roadway

2-15-55

E.C. "262
Set X on Rock on bank
6' above Roadway

Con from top page 182

F.B. 650 Pg. 184

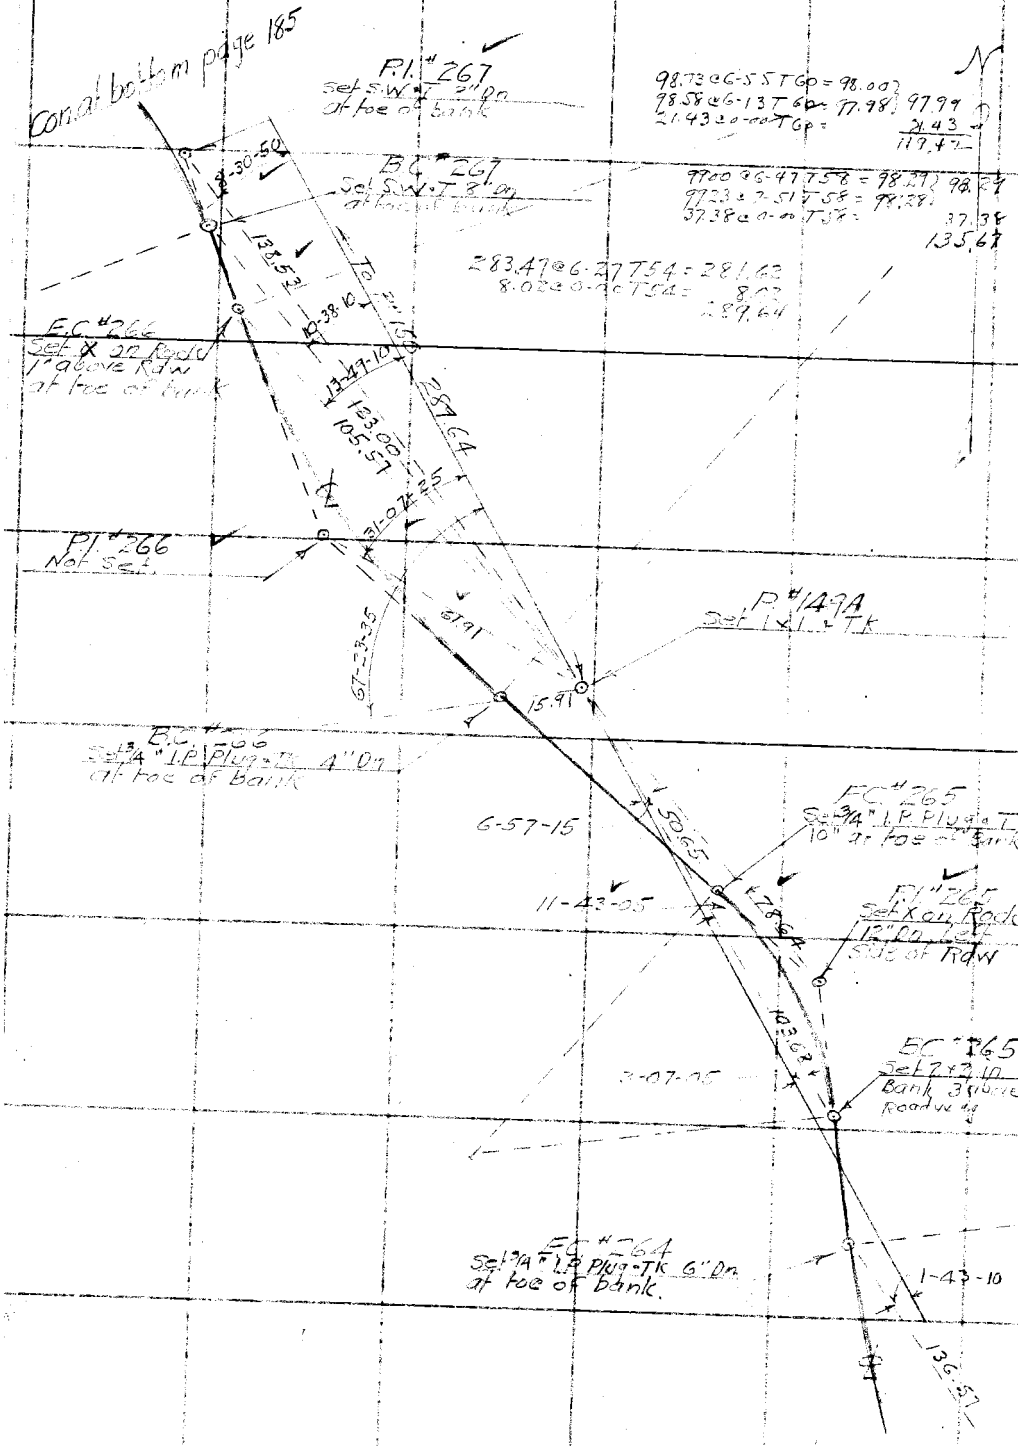

RETURN TO
LOS ANGELES COUNTY SURVEYOR
700 HALL OF RECORDS

Note: Any Additions or Changes on This Sheet Must be Made in Red Ink With Date and Name of Person Making Change.

Do not extend notes this side of this line

Notes Ck'd by DrCAW	Survey of MT WILSON TOLL RD
Map No. B-1217-5	W. O. 8147 Tape No. St'd °F.
Office Work F. A. W.	Surveyed by W A Miller
Checked DrCAW	Notes Miller Date Oct 1940
Date 12-18-40	Indexed A. O. Johnson

F.B. 650 PG. 185

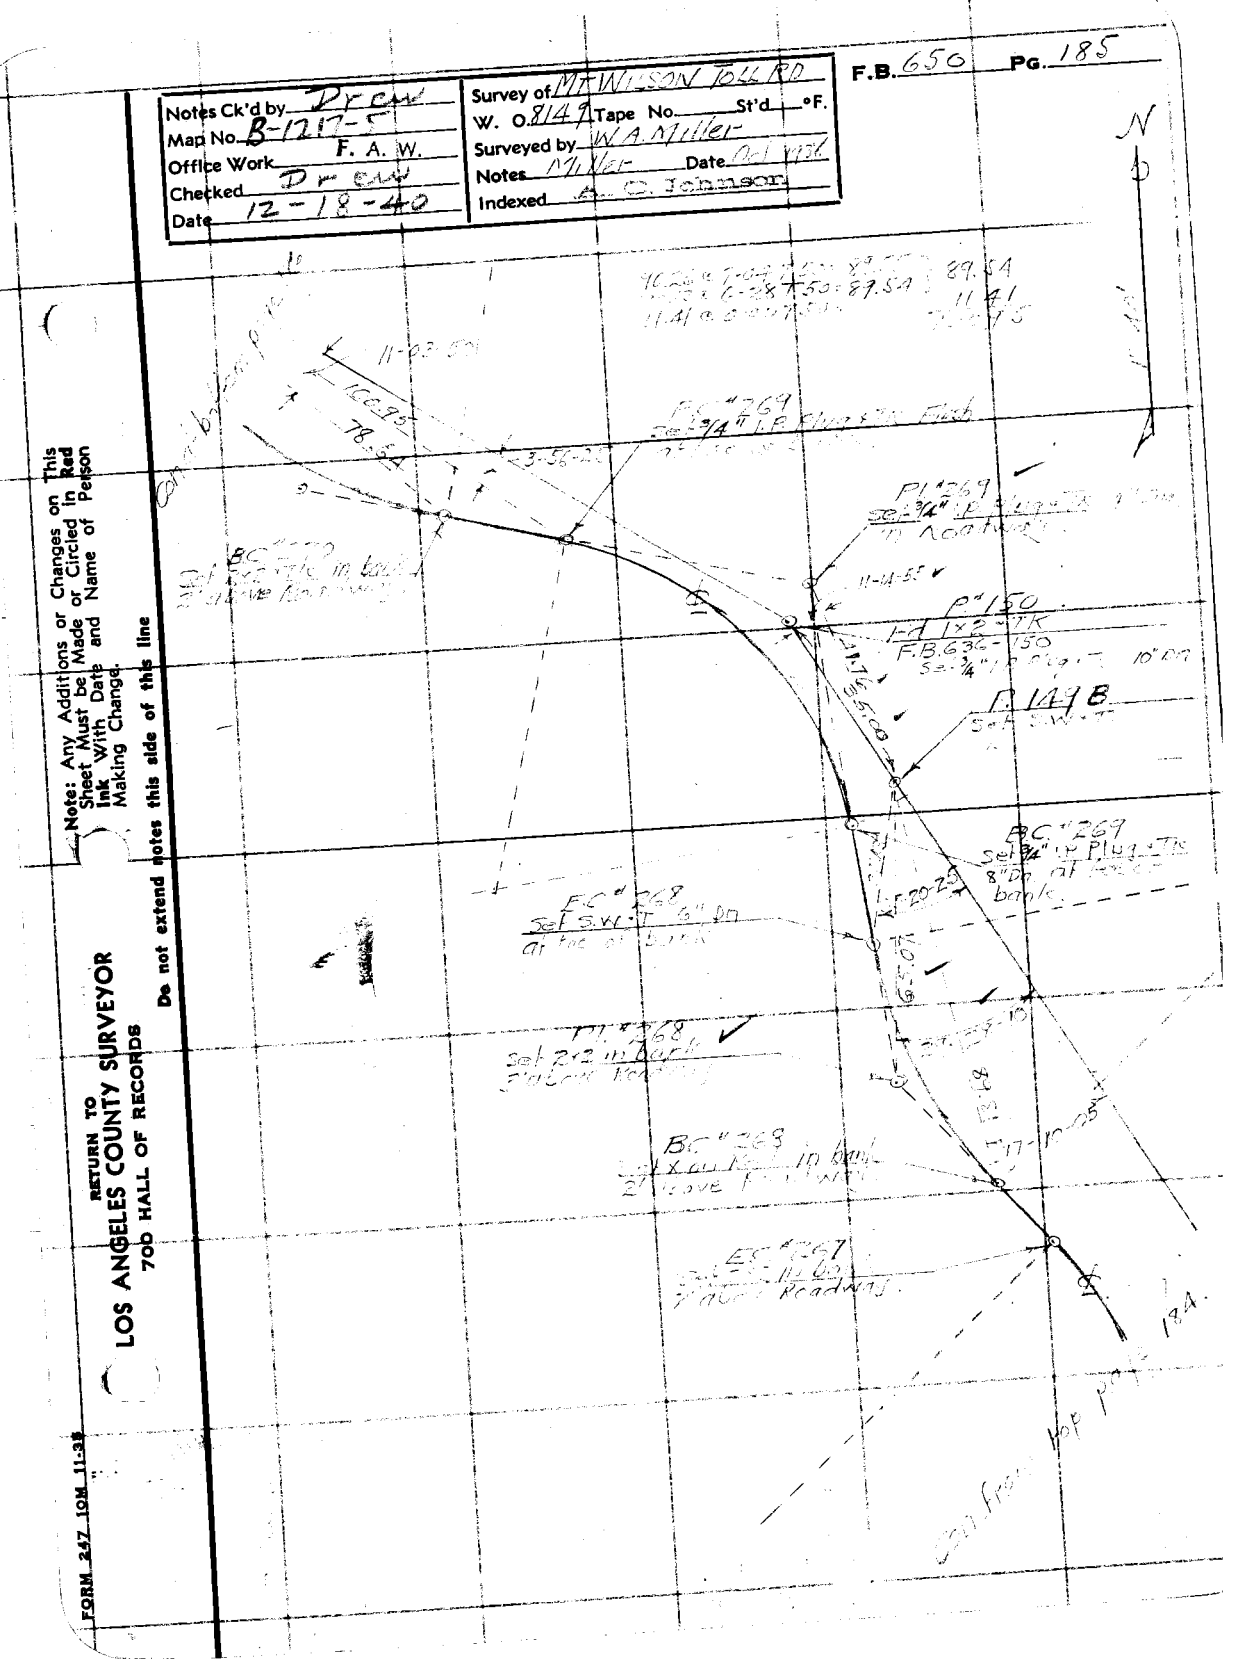
N
11-11-55

F.B. 650 Pg. 186

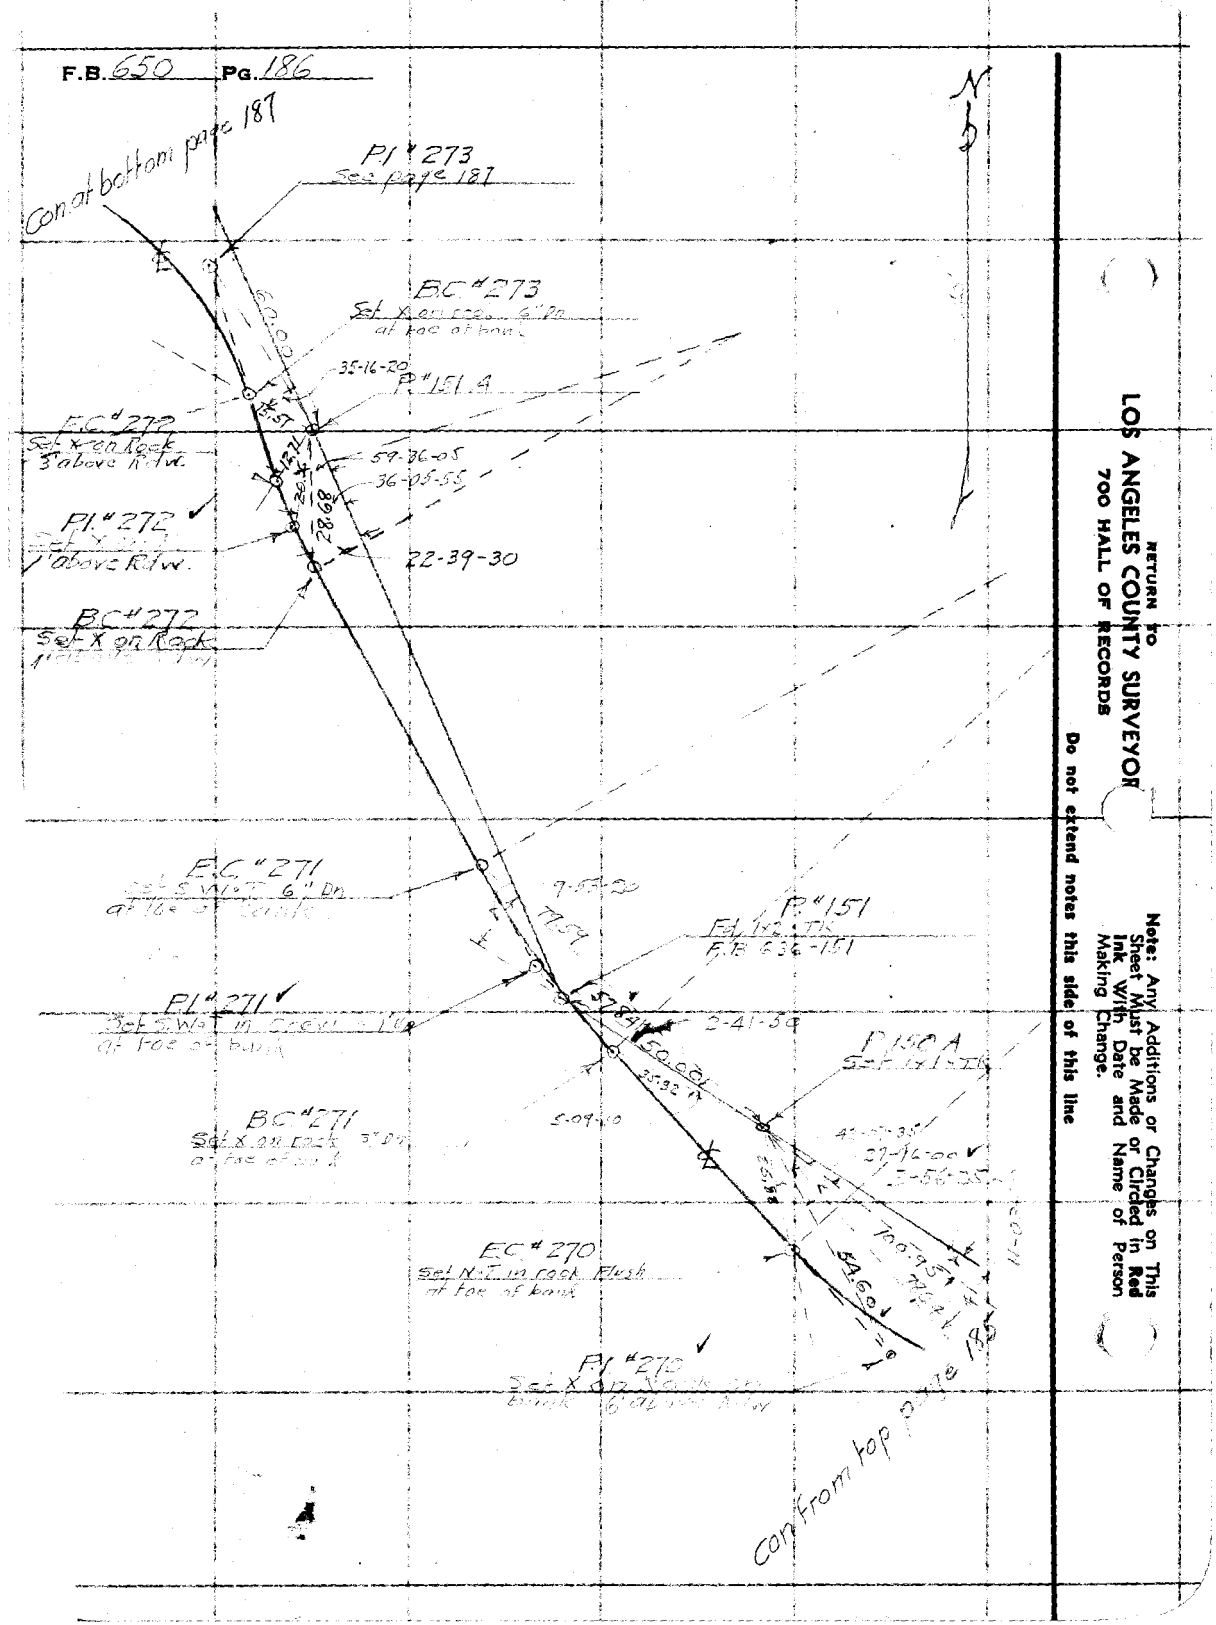

RETURN TO
LOS ANGELES COUNTY SURVEYOR
700 HALL OF RECORDS

Note: Any Additions or Changes on This Sheet Must be Made or Circled in Red Ink With Date and Name of Person Making Change.

Do not extend notes this side of this line

Notes Ck'd by Drew	Survey of MT WILSON TOLL RD
Map No. B-1217-5	W. O. 8179 Tape No. St'd °F.
Office Work F. A. W.	Surveyed by W A Miller
Checked Drew	Notes Miller Date 6-1936
Date 12-18-40	Indexed A. C. Johnson

F.B. 650 Pg. 187

Note: Any Additions or Changes on This Sheet Must be Made or Circled in Red Ink With Date and Name of Person Making Change

Do not extend notes this side of this line

RETURN TO
LOS ANGELES COUNTY SURVEYOR
700 HALL OF RECORDS

FORM 247 10M 11-35

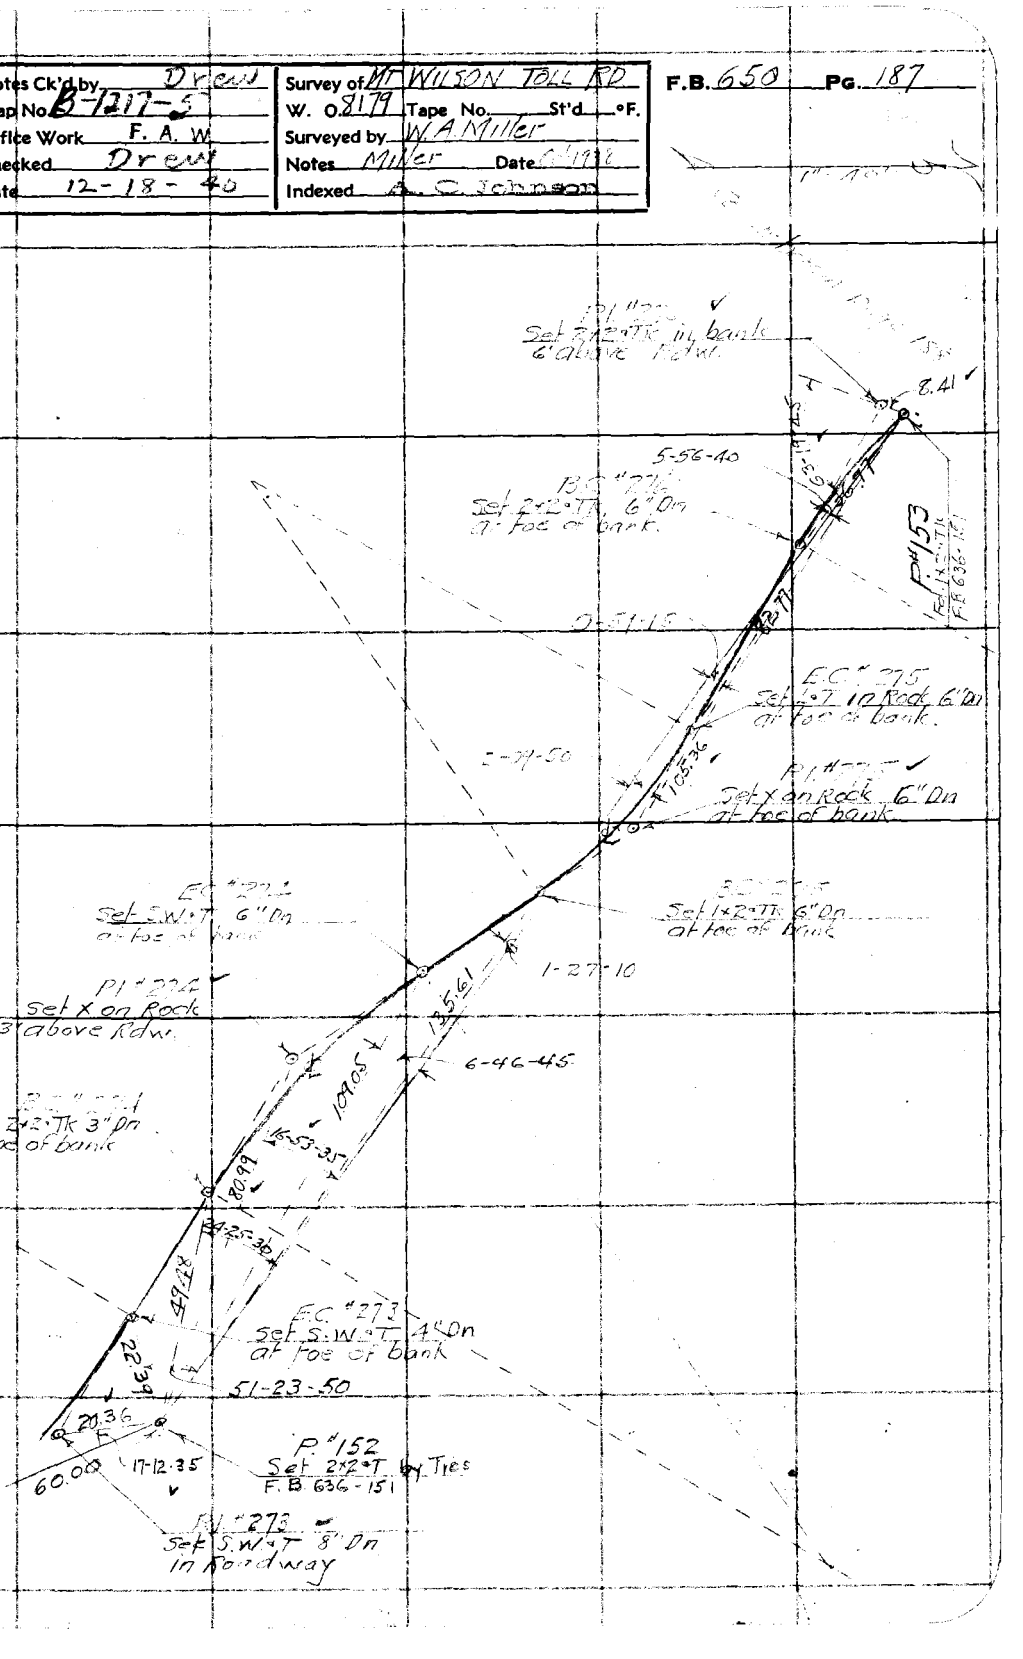

F.B. 650 Pg. 188

Con at bottom page 189

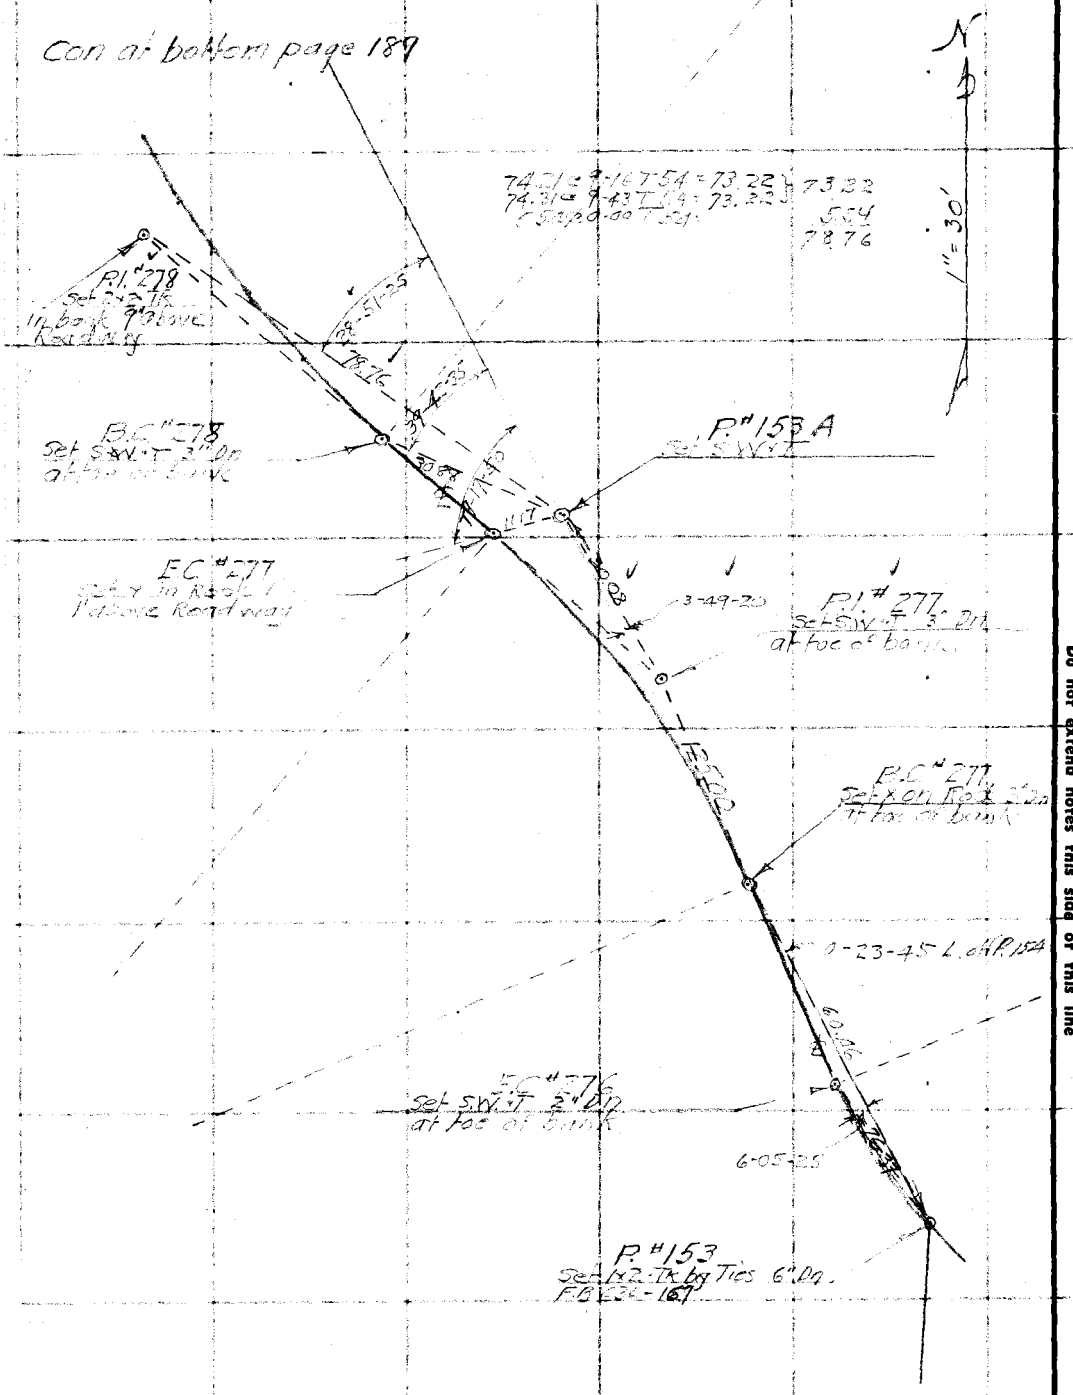

Con from top page 187

RETURN TO
LOS ANGELES COUNTY SURVEYOR
700 HALL OF RECORDS

Note: Any Additions or Changes on This Sheet Must be Made or Circled in Red Ink With Date and Name of Person Making Change.

Do not extend notes this side of this line

Notes Ck'd by Drew	Survey of MT WILSON TO ___ RD
Map No. B-1217-F	W. O. 8149 Tape No. ___ St'd ___ °F.
Office Work F. A. W.	Surveyed by W. A. Miller
Checked Drew	Notes Miller Date Oct 1938
Date 12-18-40	Indexed

F.B. 650 Pg 189

Note: Any Additions or Changes on This Sheet Must be Made or Circled in Red Ink With Date and Name of Person Making Change.

Do not extend notes this side of this line

RETURN TO
LOS ANGELES COUNTY SURVEYOR
700 HALL OF RECORDS

FORM 247 10M 11-38

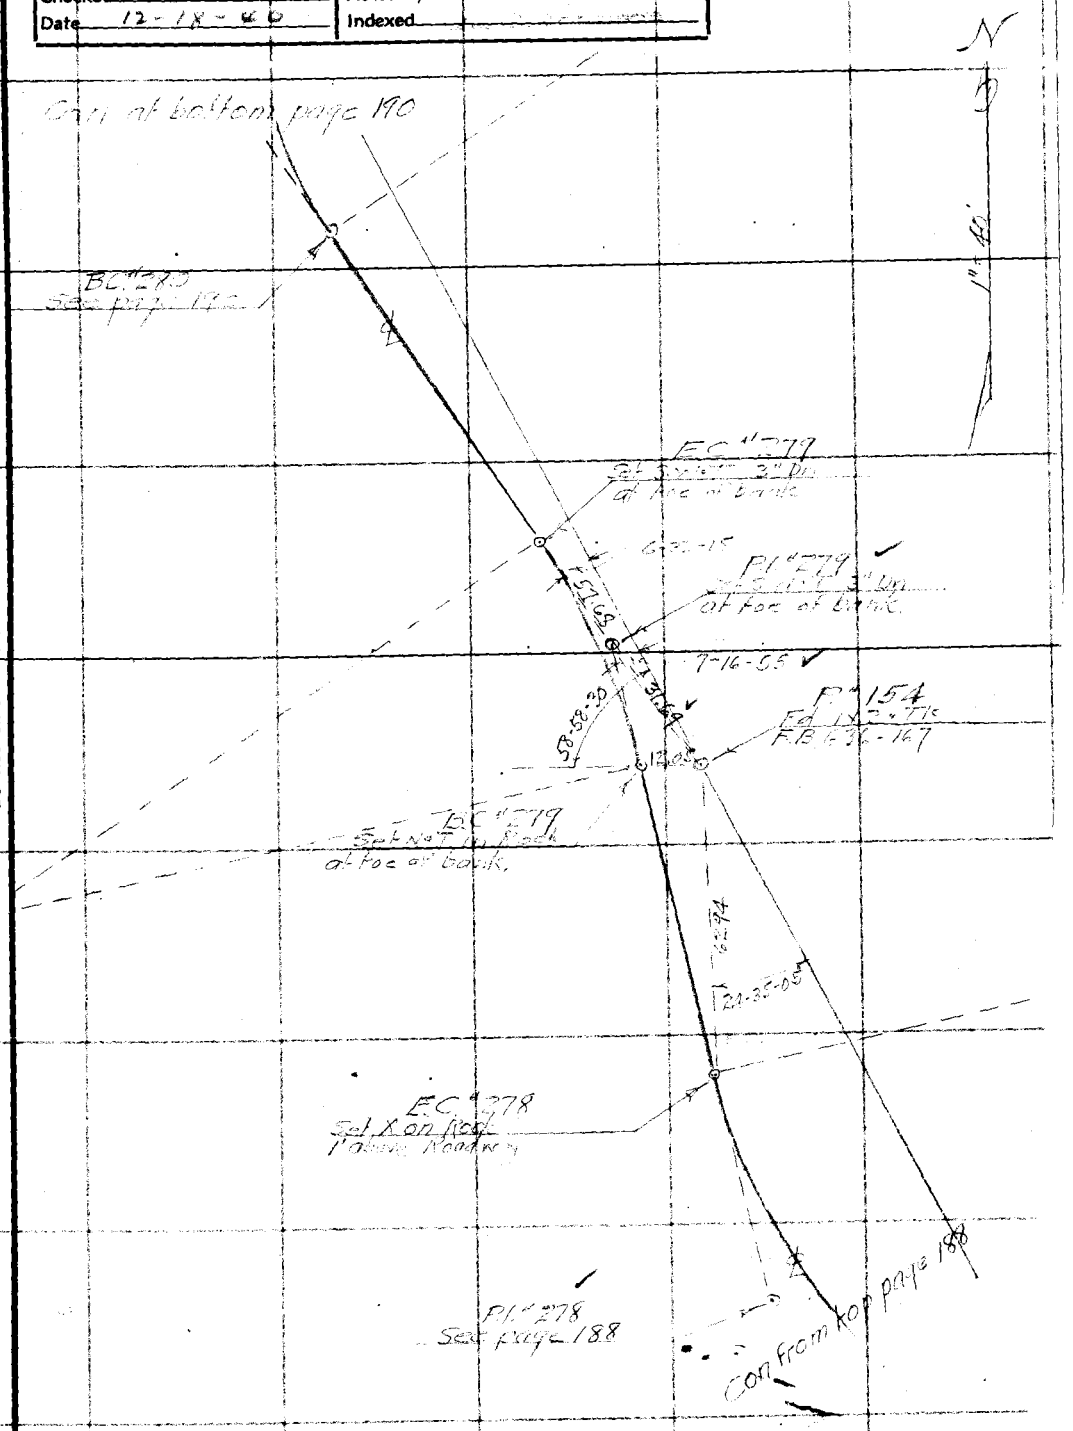

F.B. 650 Pg. 190

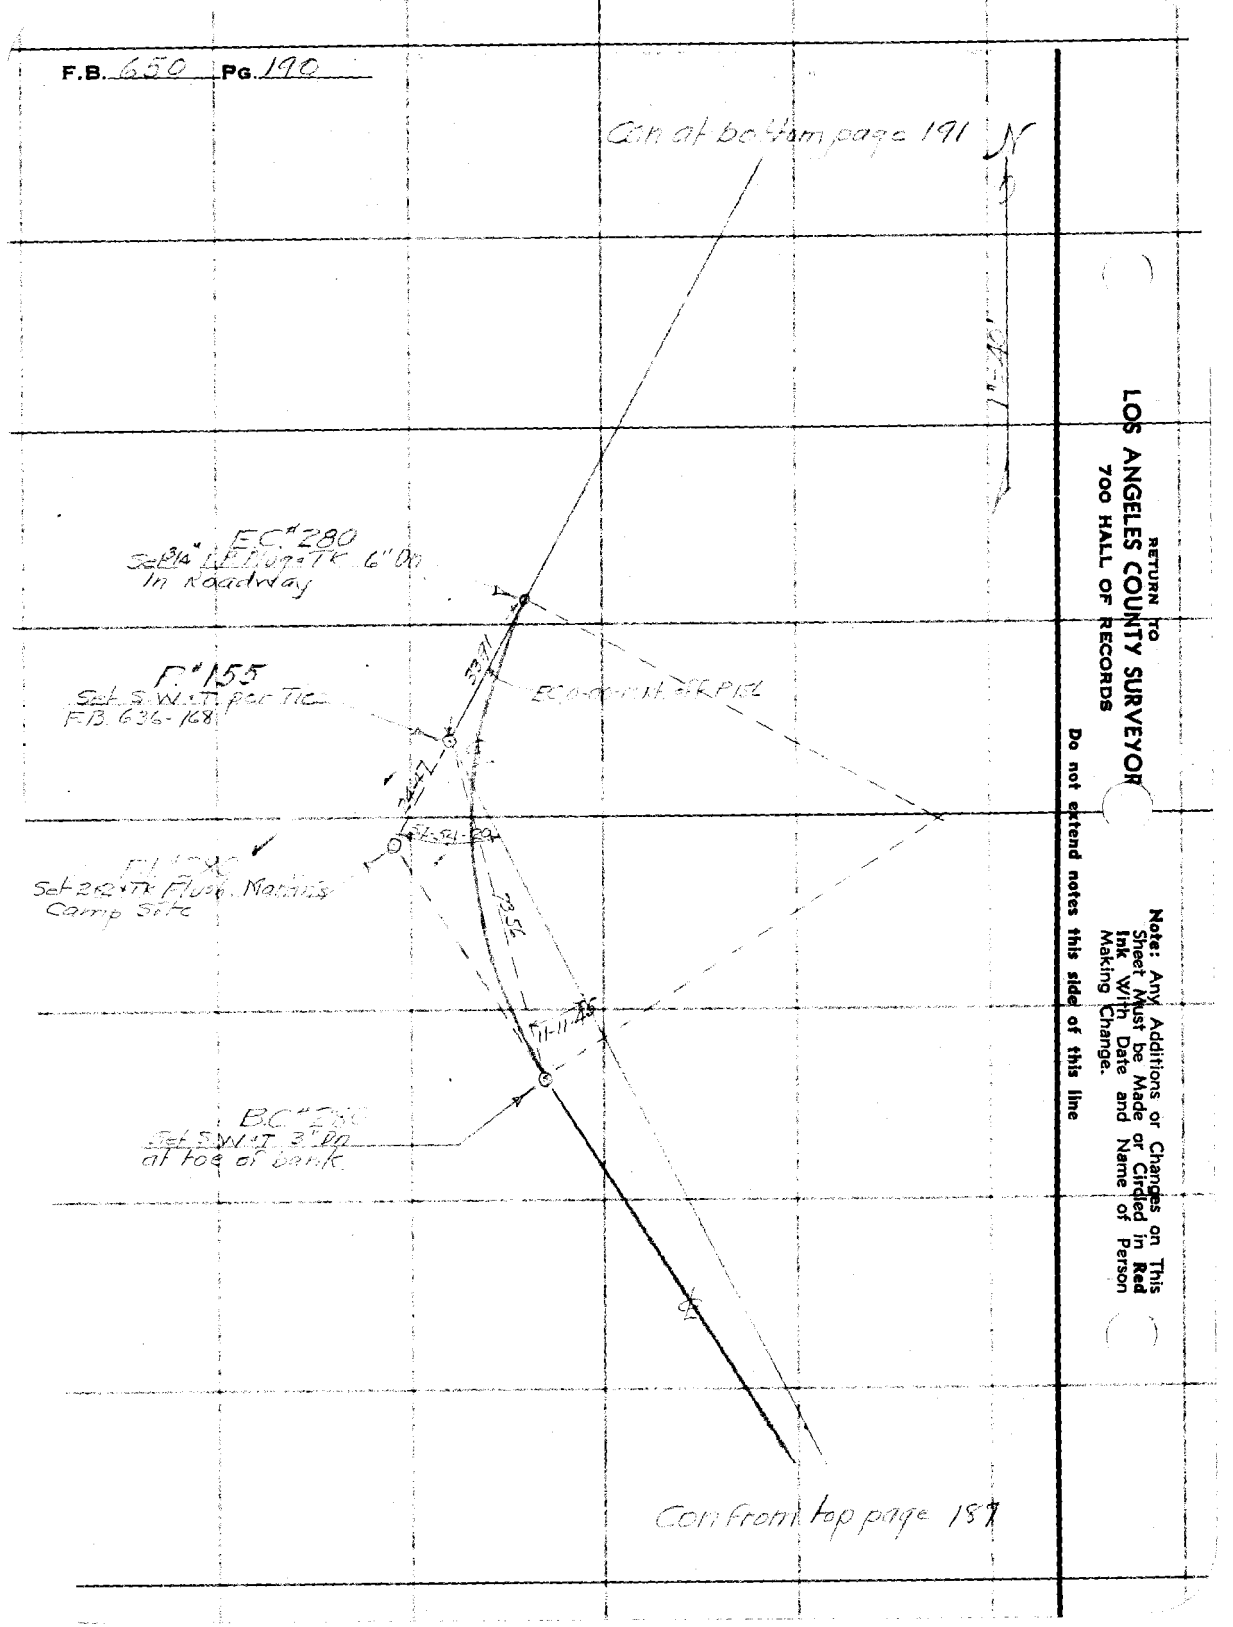

RETURN TO
LOS ANGELES COUNTY SURVEYOR
700 HALL OF RECORDS

Note: Any Additions or Changes on This Sheet Must be Made or Circled in Red Ink With Date and Name of Person Making Change.

Do not extend notes this side of this line

Notes Ck'd by Drew	Survey of MT WILSON TOLL RD
Map No. B-1217-5	W. O. 8149 Tape No. St'd °F.
Office Work F. A. W.	Surveyed by W. A. Miller
Checked Drew	Notes Miller Date Oct 1938
Date 12-18-40	Indexed A. C. S.

F.B. 650 Pg. 191

Con at bottom page 192

EC" 281
Set SW-T 6" DD
in Roadway

1"=40'

136.46

P1" 281
Set 5/8" Iron Pipe
at top of bank, 8 links Radial

P" 156
Set SW-T per Tie
A.B. 636-168

RC" 281
Set 3/4" Iron Pipe
at toe of bank

Con from top page 190

Note: Any Additions or Changes on This Sheet Must be Made or Circled in Red Ink With Date and Name of Person Making Change.

Do not extend notes this side of this line

RETURN TO
LOS ANGELES COUNTY SURVEYOR
700 HALL OF RECORDS

FORM 247 10M 11-38

F.B. 650 PG. 192

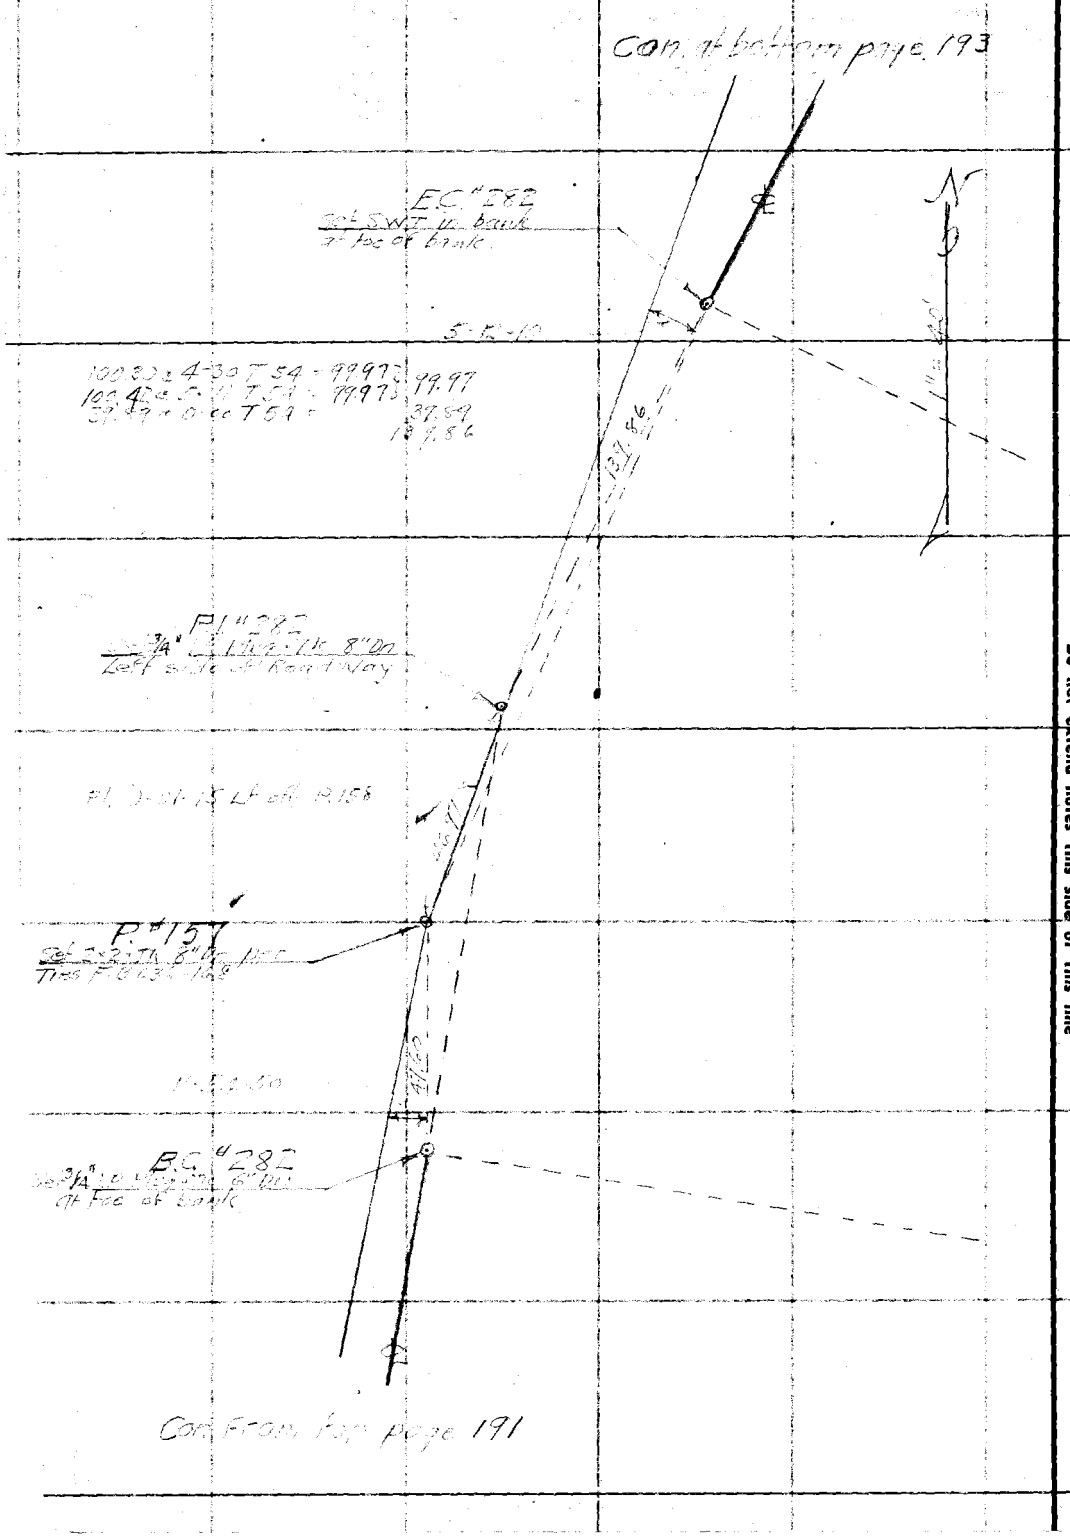

RETURN TO
LOS ANGELES COUNTY SURVEYOR
700 HALL OF RECORDS

Note: Any Additions or Changes on This Sheet Must be Made or Circled in Red Ink With Date and Name of Person Making Change.

Do not extend notes this side of this line

Notes Ck'd by Drew	Survey of MT WASH. TOLL DR	F.B. 552	Pg. 193
Map No. B-1217-5	W. 0814? Tape No. St'd °F.		
Office Work F. A. W.	Surveyed by W A Miller		
Checked Drew	Notes Miller Date Oct 1938		
Date 12-18-40	Indexed A. D. Johnson		

Cont at bottom page 194

EC "28-F
Set 3/4" LP Plug & Tic 6" Dn.
2' out from face of bank

150.37 @ 4-33 T 70 = 149.83
150.49 @ 5-01 T 70 = 149.90
5.33 @ 0-0 T 70 =
149.89
5.33
155.22

6-58-10

N 15°51'22" E

FD "284
Set 3/4" LP Plug & Tic
In bank 2' above Rdwy

13-14-15

99.92 @ 4-51 T 70 = 99.55
99.82 @ 4-09 T 70 = 99.56
22.16 @ 0-0 T 70 =
99.55
22.66
122.21

FD "284
Set 3/4" LP Plug & Tic 3" Dn.
at toe of bank

N 30°42'26" E 122.93

FD "158
Ed Set 1" Empty
FB 632 - P 3

EC "283
Set 3/4" LP Plug & Tic 6" Dn.
at toe of bank

FD "283
Set 3/4" LP Plug & Tic 3" Dn.
3" toe of bank

EC "283
Set 3/4" LP Plug & Tic 3" Dn.
at toe of bank

Cont from top page 192

RETURN TO
LOS ANGELES COUNTY SURVEYOR
700 HALL OF RECORDS

Note: Any Additions or Changes on This Sheet Must be Made or Circled in Red Ink With Date and Name of Person Making Change

Do not extend notes this side of this line

FORM 247 10M 11-38

F.B. 650 PG. 194

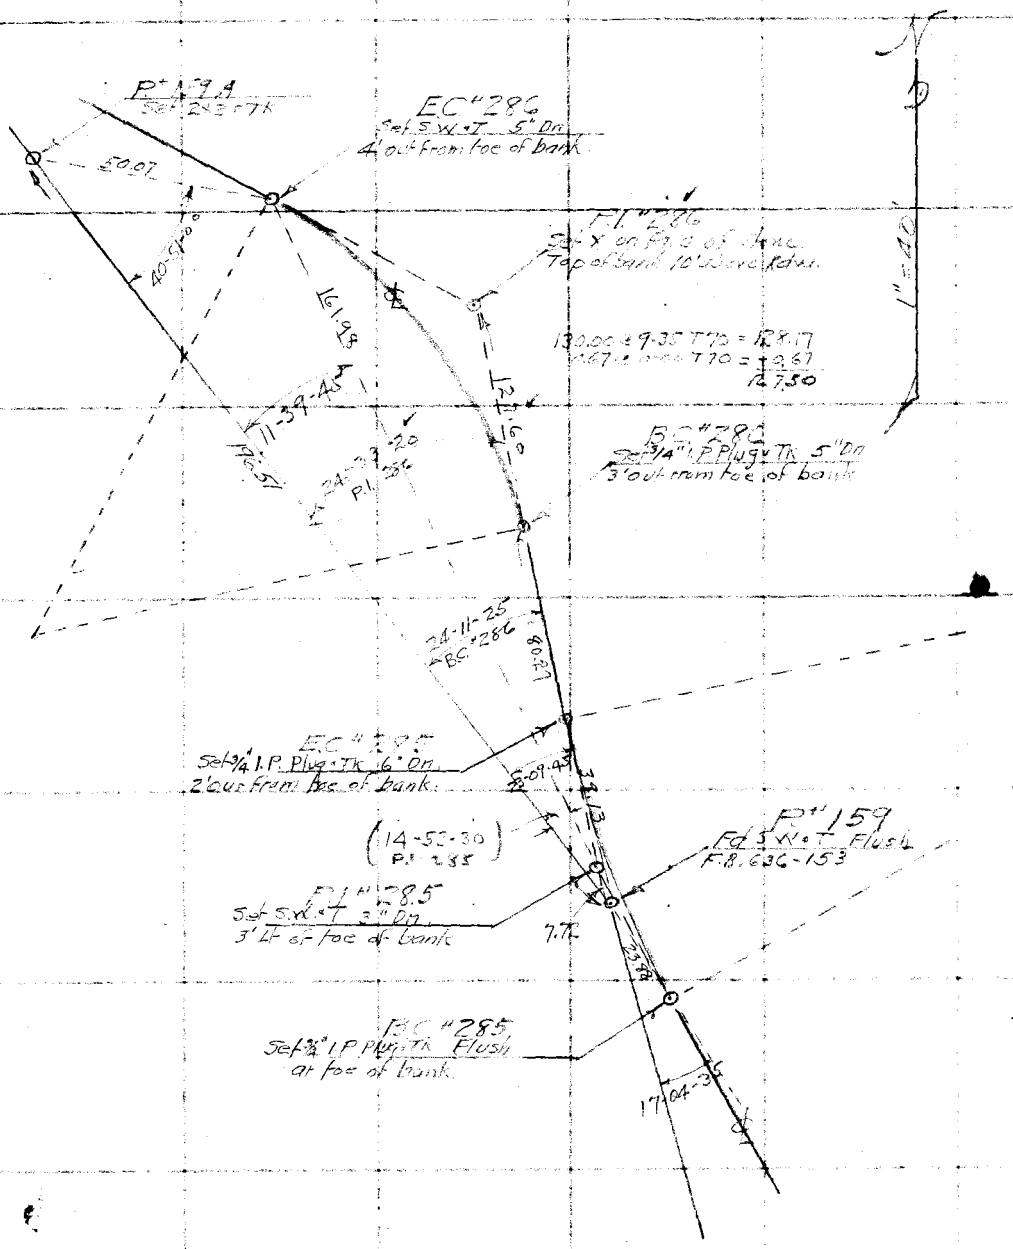

RETURN TO
LOS ANGELES COUNTY SURVEYOR
700 HALL OF RECORDS

Note: Any Additions or Changes on This Sheet Must be Made or Circled in Red Ink With Date and Name of Person Making Change.

Do not extend notes this side of this line

Notes Ck'd by	Survey of M F Wilson Tol Rd
Map No. B-12-F	W. O. 8147 Tape No. St'd °F.
Office Work F. A. W.	Surveyed by W.A. Miller
Checked	Notes M.I. Hol Date Jul 1938
Date 12-18-40	Indexed K. C. Johnson

F.B. 655 Pg. 135

Note: Any Additions or Changes on This Sheet Must be Made or Circled in Red Ink With Date and Name of Person Making Change.

Do not extend notes this side of this line

RETURN TO
LOS ANGELES COUNTY SURVEYOR
700 HALL OF RECORDS

FORM 247 10M 11-38

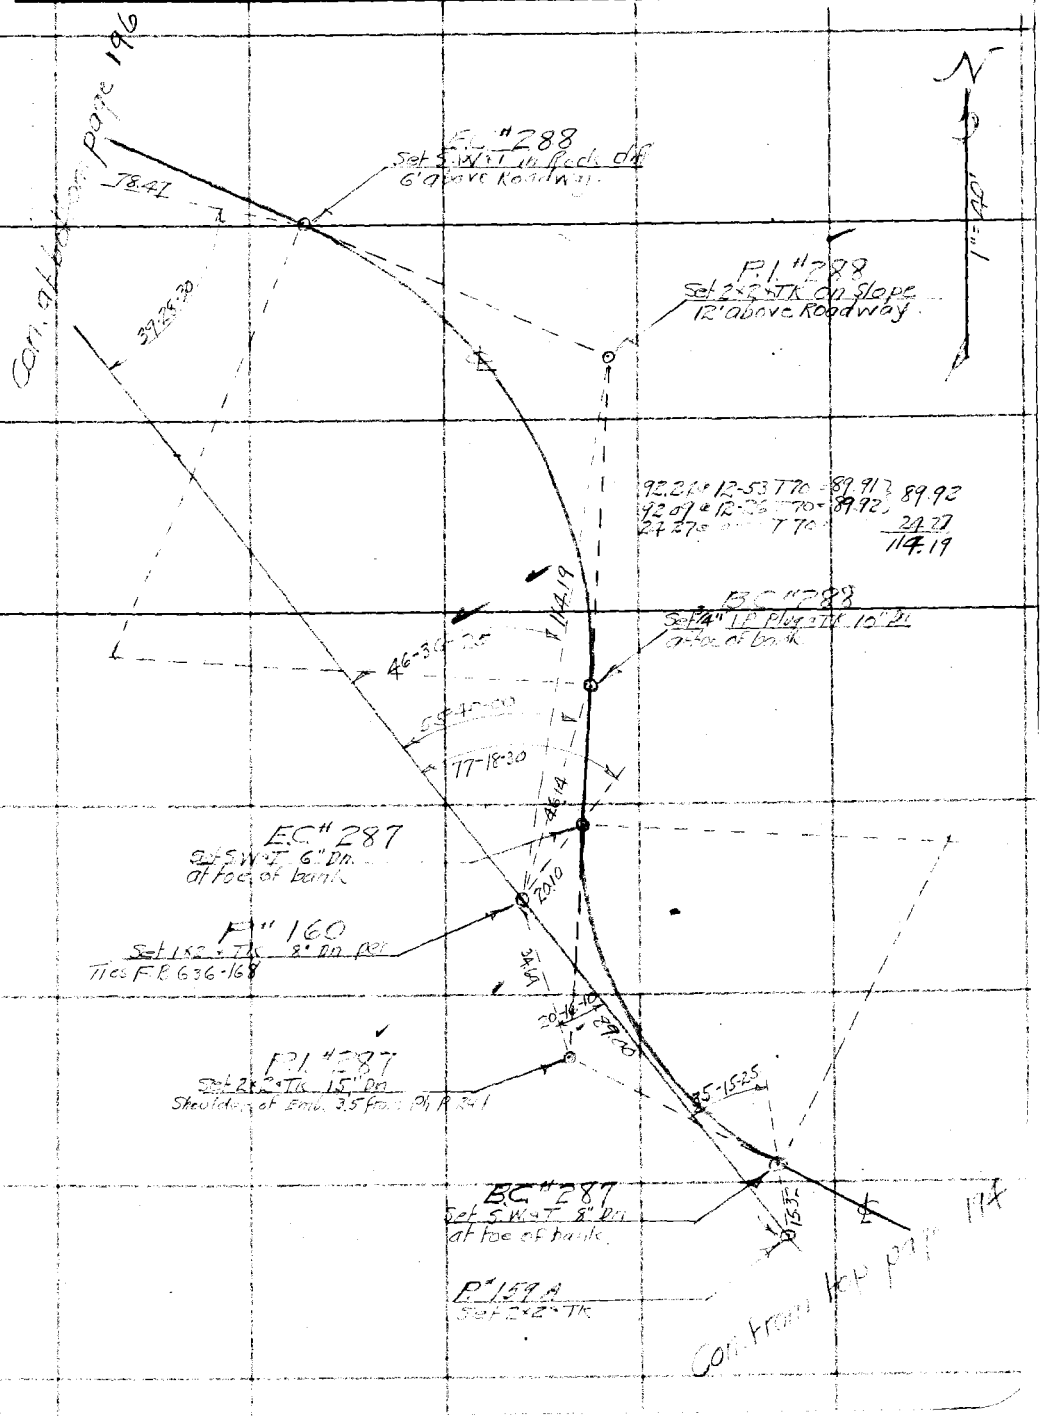

F.B. 653 PG. 196

Con of bottom Sheet 197

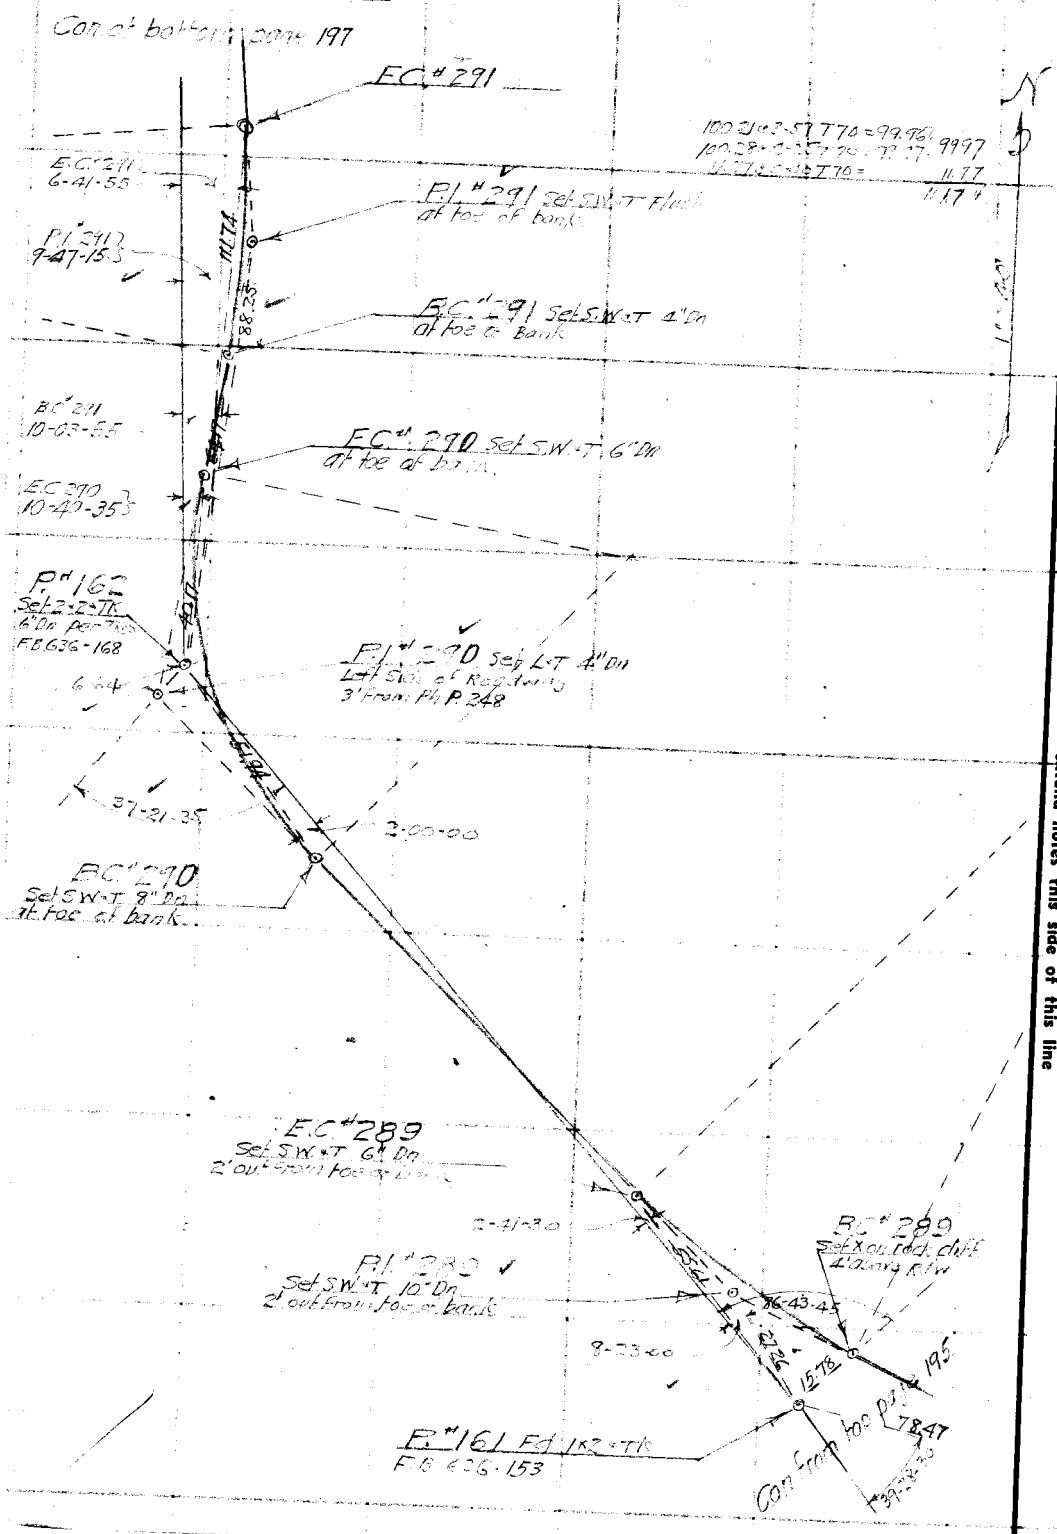

RETURN TO
LOS ANGELES COUNTY SURVEYOR
700 HALL OF RECORDS

Note: Any Additions or Changes on This Sheet Must be Made or Circled in Red Ink With Date and Name of Person Making Change.

Do not extend notes this side of this line

Notes Ck'd by Drew	Survey of MT WILSON TOLL RD.
Map No. B-1217-F	W. O. 8149 Tape No. St'd °F.
Office Work F. A. W.	Surveyed by W.A. Miller
Checked Drew	Notes Miller Date 11-7 to 24-1938
Date 12-18-40	Indexed C. Johnson

F.B. 650 Pg. 197

Con at bottom page 198

EC #295 Set SW-T 6" Dn at toe of cliff

PI #295 L-T in Rock Cliff 6" above roadway.

BC #295 Set [illegible] at toe of cliff

EC #294 Set [illegible] at toe of cliff

PI #294 Set [illegible] at toe of cliff

BC #294 Set SW-T 6" Dn at toe of bank

P #163A Set [illegible] 3" Dn

EC #293 Set SW-T 5" Dn at toe of bank

PI #293 Set L-T 3" Dn at toe of bank

BC #293 Set 3/4" I.P. Plug-Tk Dn 6" at toe of bank

EC #292 Set SW-T 6" Dn at toe of bank

PI #292 Set 2-Tk at top of bank 8' above Rdw

BC #292 Set 3/4" I.P. T 6" Dn at toe of bank

P #163 Fd 1x2 Tk FB 656-154

Con from top page 196

Note: Any Additions or Changes on This Sheet Must be Made or Circled in Red Ink With Date and Name of Person Making Change

Do not extend notes this side of this line

RETURN TO LOS ANGELES COUNTY SURVEYOR 700 HALL OF RECORDS

FORM 247 10M 11-38

F.B. 650 Pg. 198

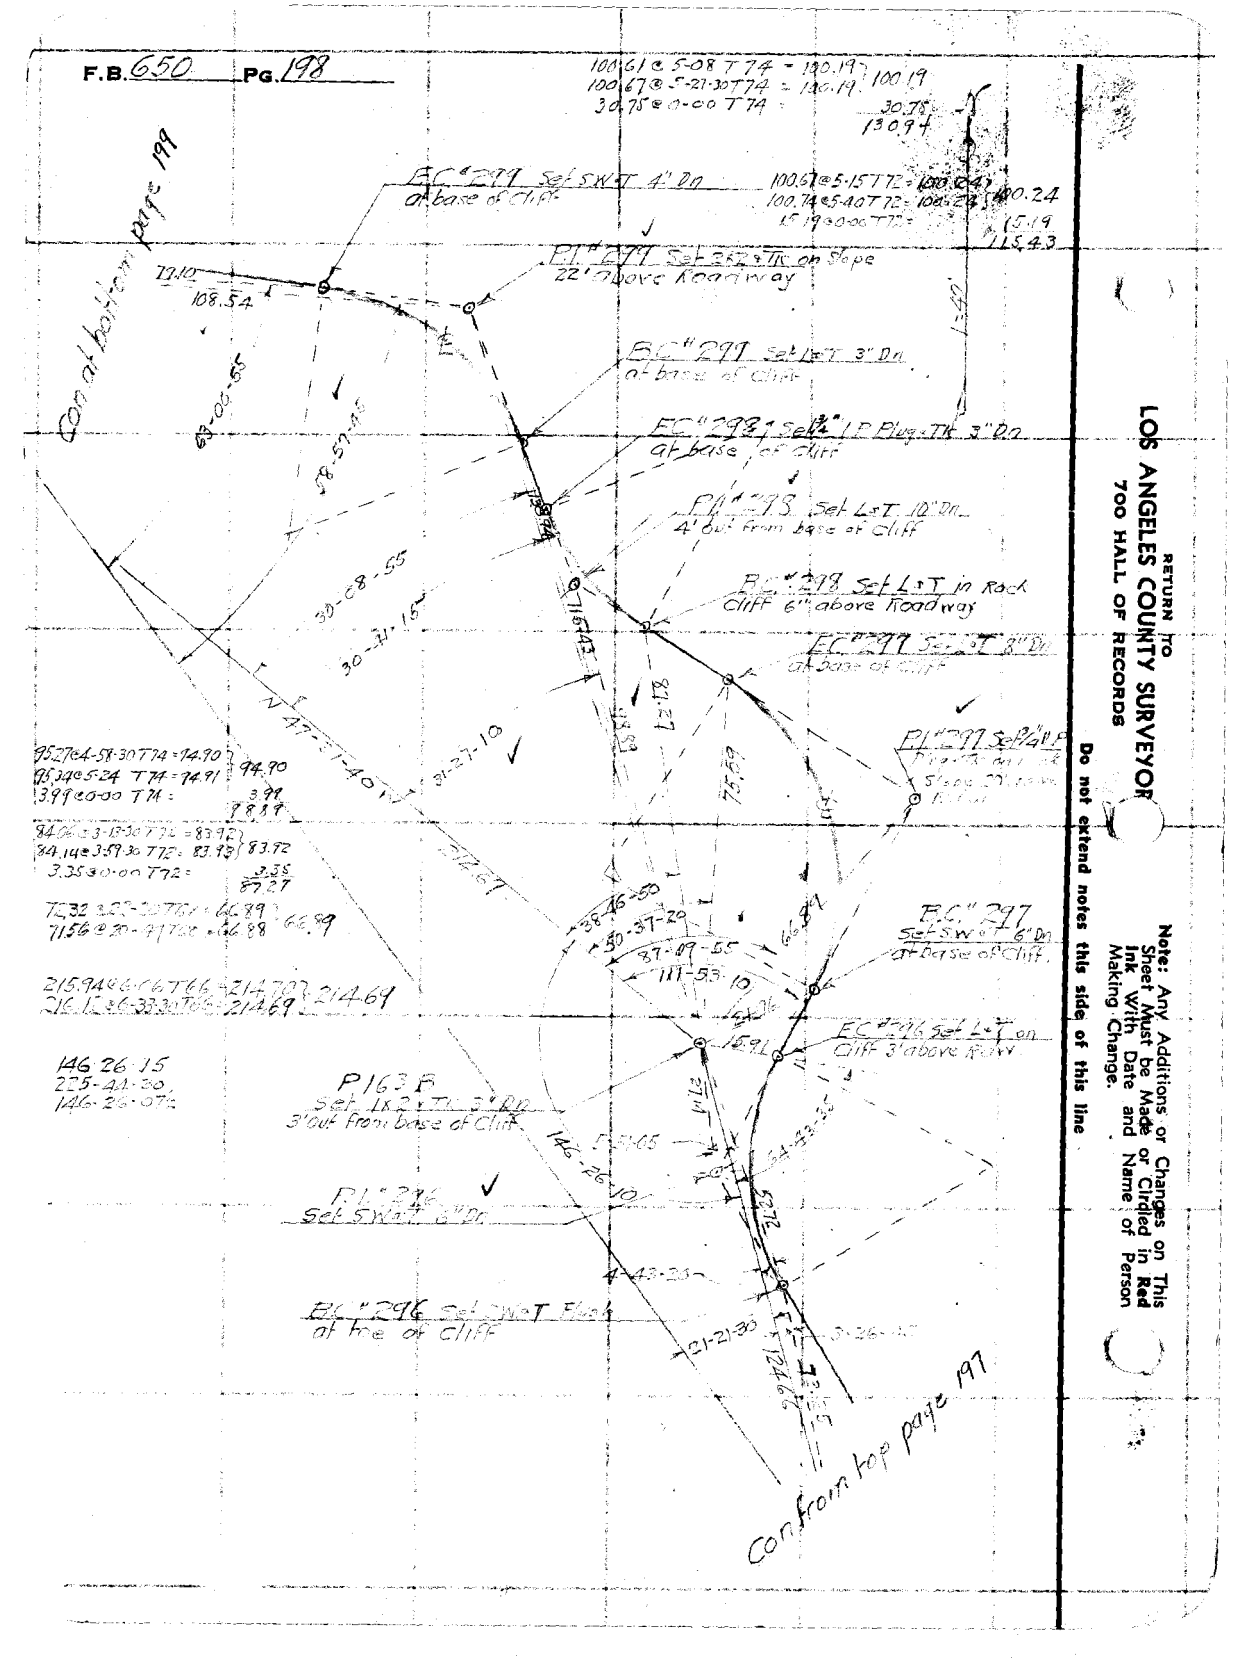

RETURN TO
LOS ANGELES COUNTY SURVEYOR
700 HALL OF RECORDS

Note: Any Additions or Changes on This Sheet Must be Made or Circled in Red Ink With Date and Name of Person Making Change.

Do not extend notes this side of this line

Notes Ck'd by Drew	Survey of Mt. Wilson Toll Road
Map No. B-1217-5	W. O. 8149 Tape No. St'd °F.
Office Work F. A. W.	Surveyed by W. A. V.
Checked Drew	Notes Miller Date 12-1938
Date 12-18-40	Indexed Johnson


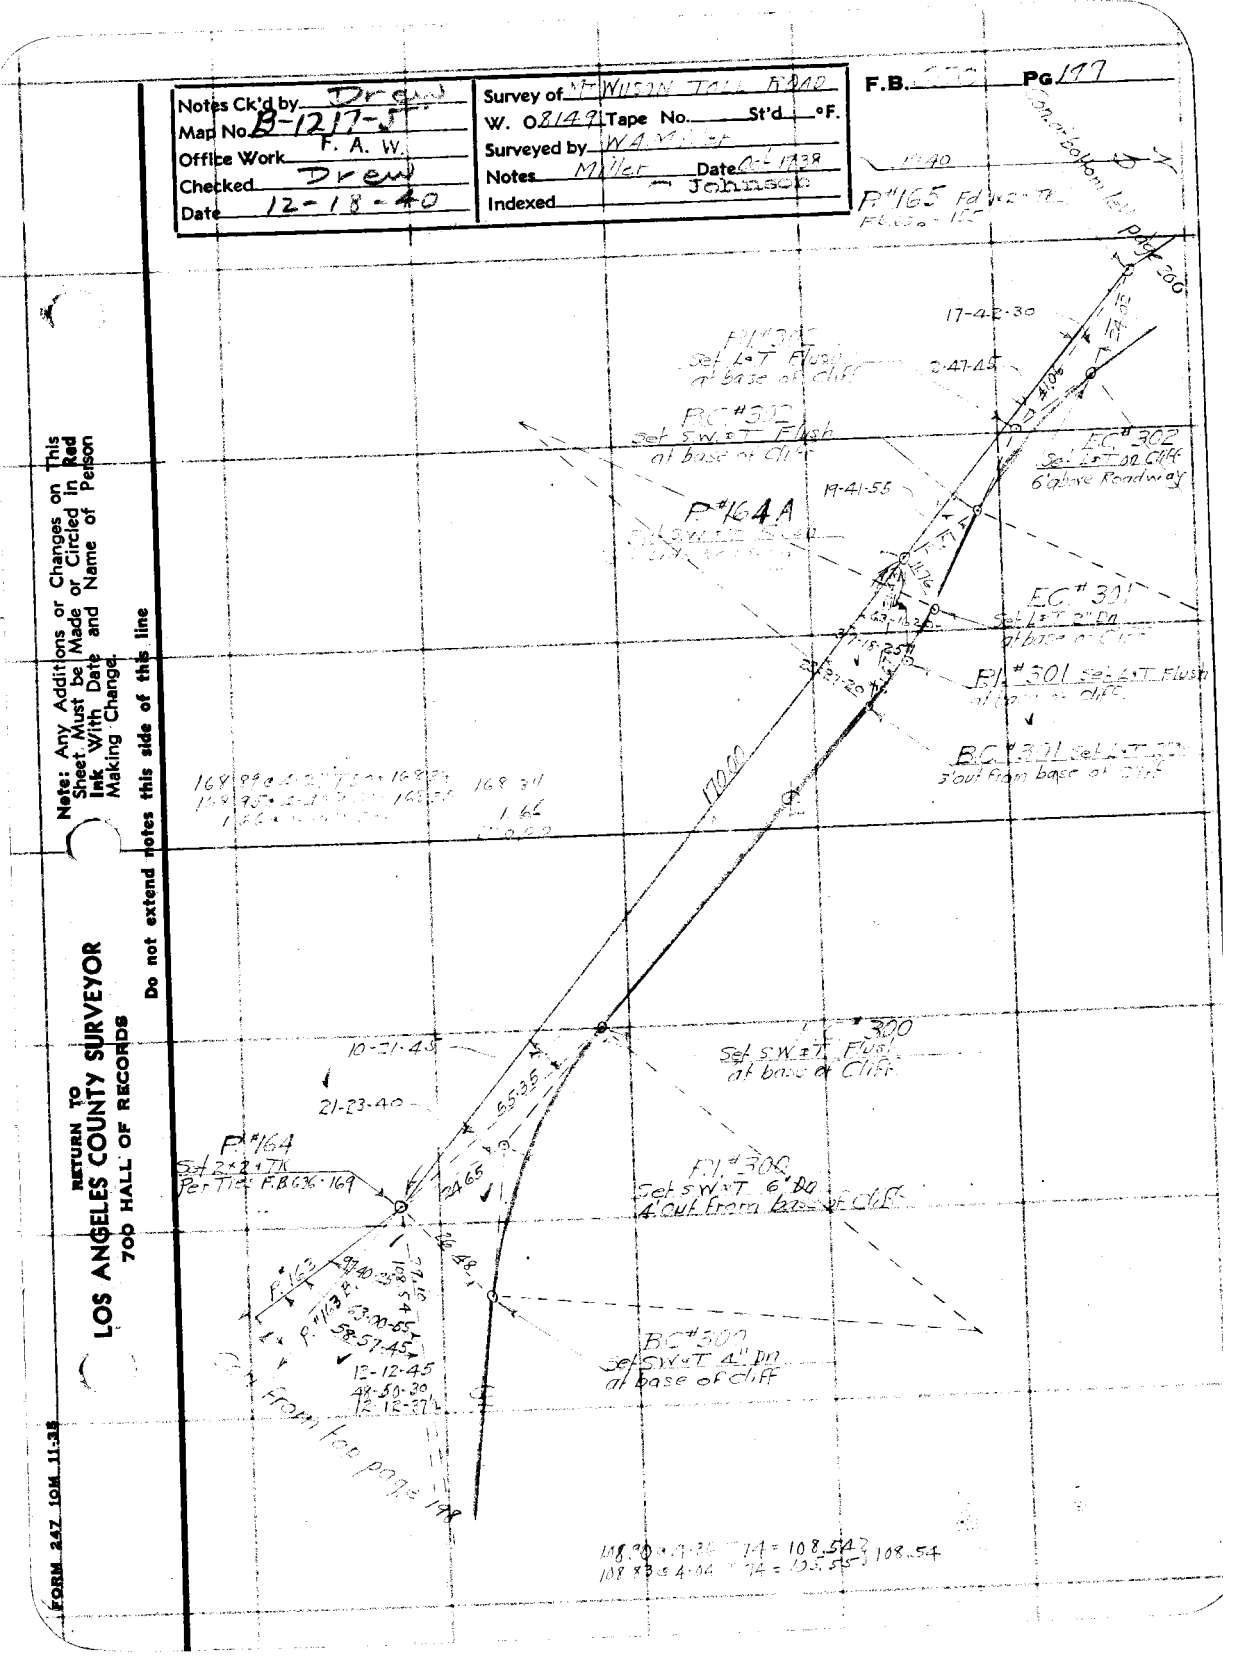

Note: Any Additions or Changes on This Sheet Must be Made or Circled in Red Ink With Date and Name of Person Making Change

Do not extend notes this side of this line

RETURN TO
LOS ANGELES COUNTY SURVEYOR
700 HALL OF RECORDS

FORM 247 10M 11-38

F.B. 650 Pg. 200

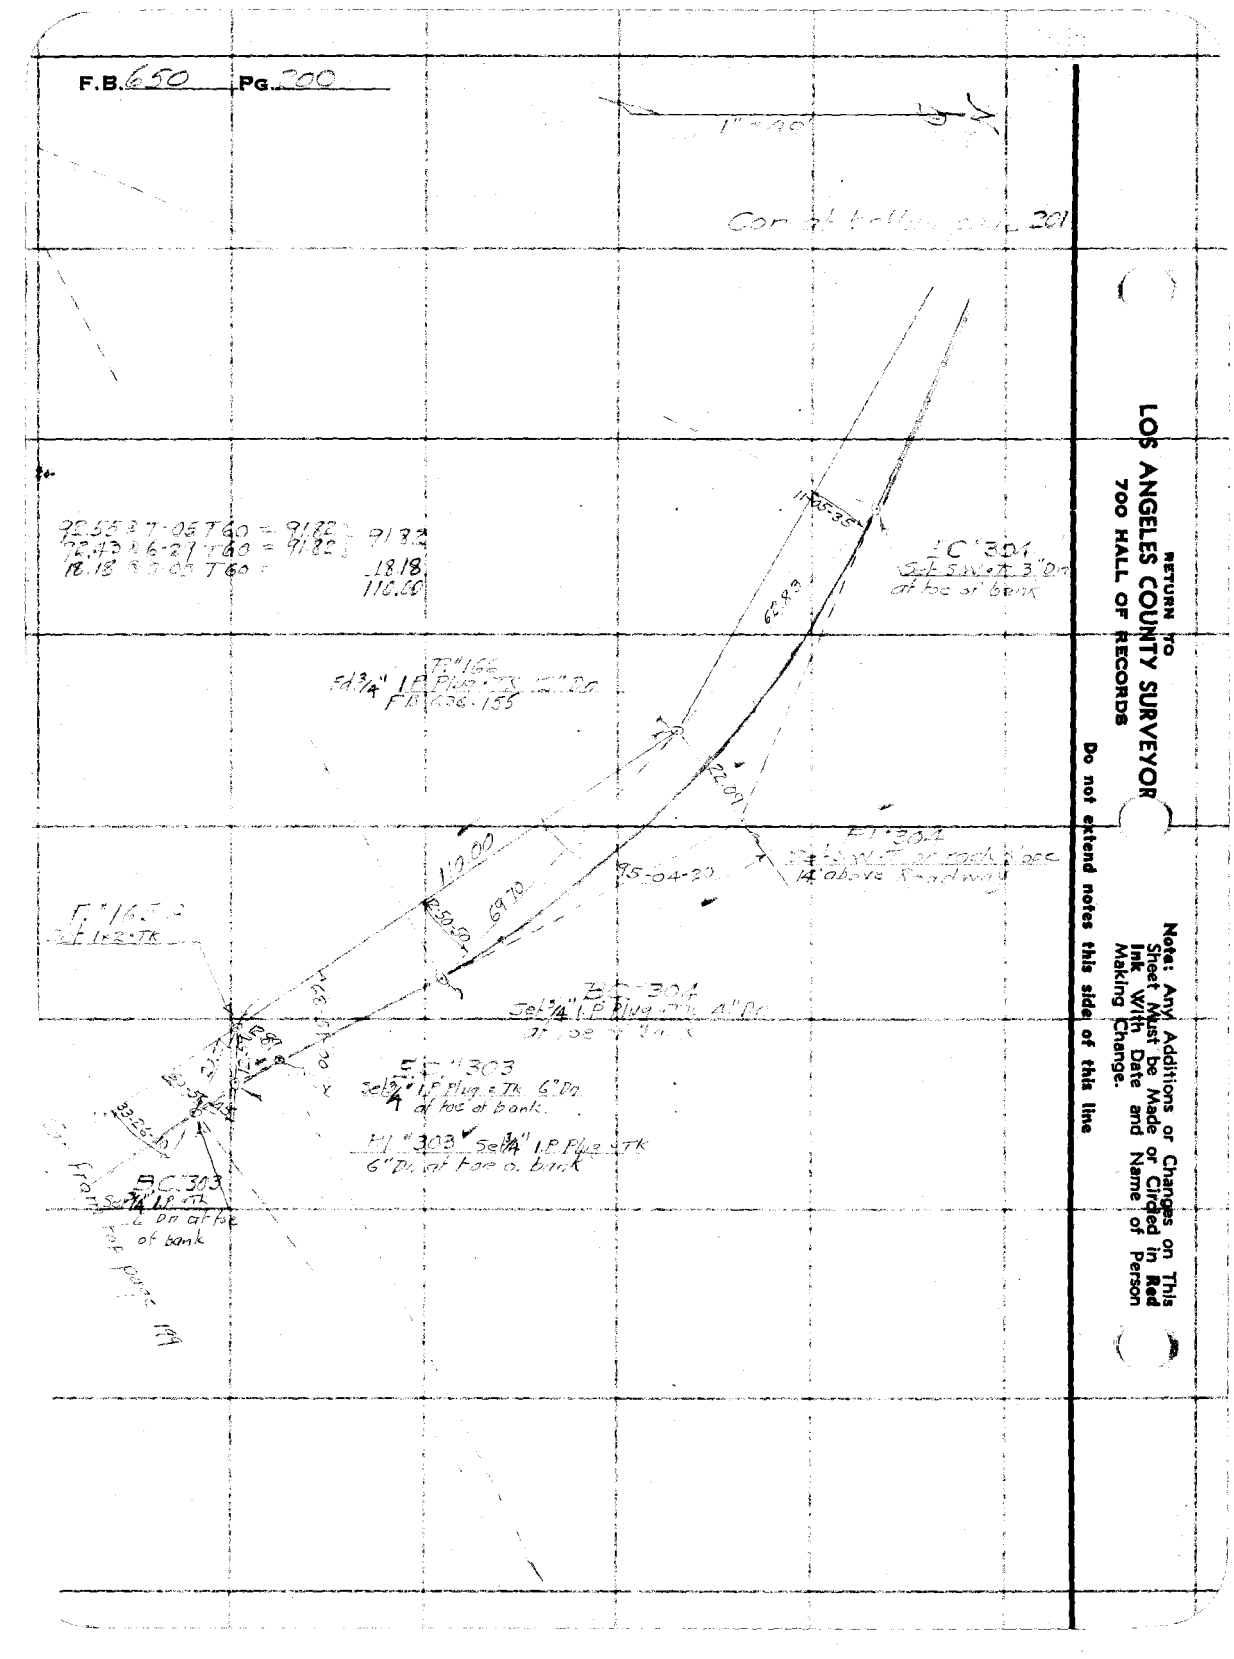
1" = 20'
Set 1x2 Tk.
Set 3/4" I.P. Plug & Tk. 4" Dp.
at toe of bank
5 C 303
Set 3/4" I.P. Plug & Tk. 6" Dp.
at toe of bank.
1 C 303 Set 3/4" I.P. Plug & Tk
6" Dp. at toe of bank
5 C 303
Set 3/4" I.P. Plug & Tk. 6" Dp. at toe of bank
33.26 D
Set 3/4" I.P. Plug & Tk. 4" Dp. at toe of bank

Notes Ck'd by Drew	Survey of Mt Wilson Toll Rd
Map No. B-1217-5	W. O. 8149 Tape No. [illegible] St'd [illegible] °F.
Office Work F. A. W.	Surveyed by W. A. Miller
Checked Drew	Notes Miller Date [illegible] 1938
Date 12-18-40	Indexed [illegible] C. Johnson

F.B. [illegible] Pg. 201

Note: Any Additions or Changes on This Sheet Must be Made or Circled in Red Ink With Date and Name of Person Making Change.

Do not extend notes this side of this line

RETURN TO
LOS ANGELES COUNTY SURVEYOR
700 HALL OF RECORDS

FORM 247 10M 11-38

F.B. 650 Pg. 202

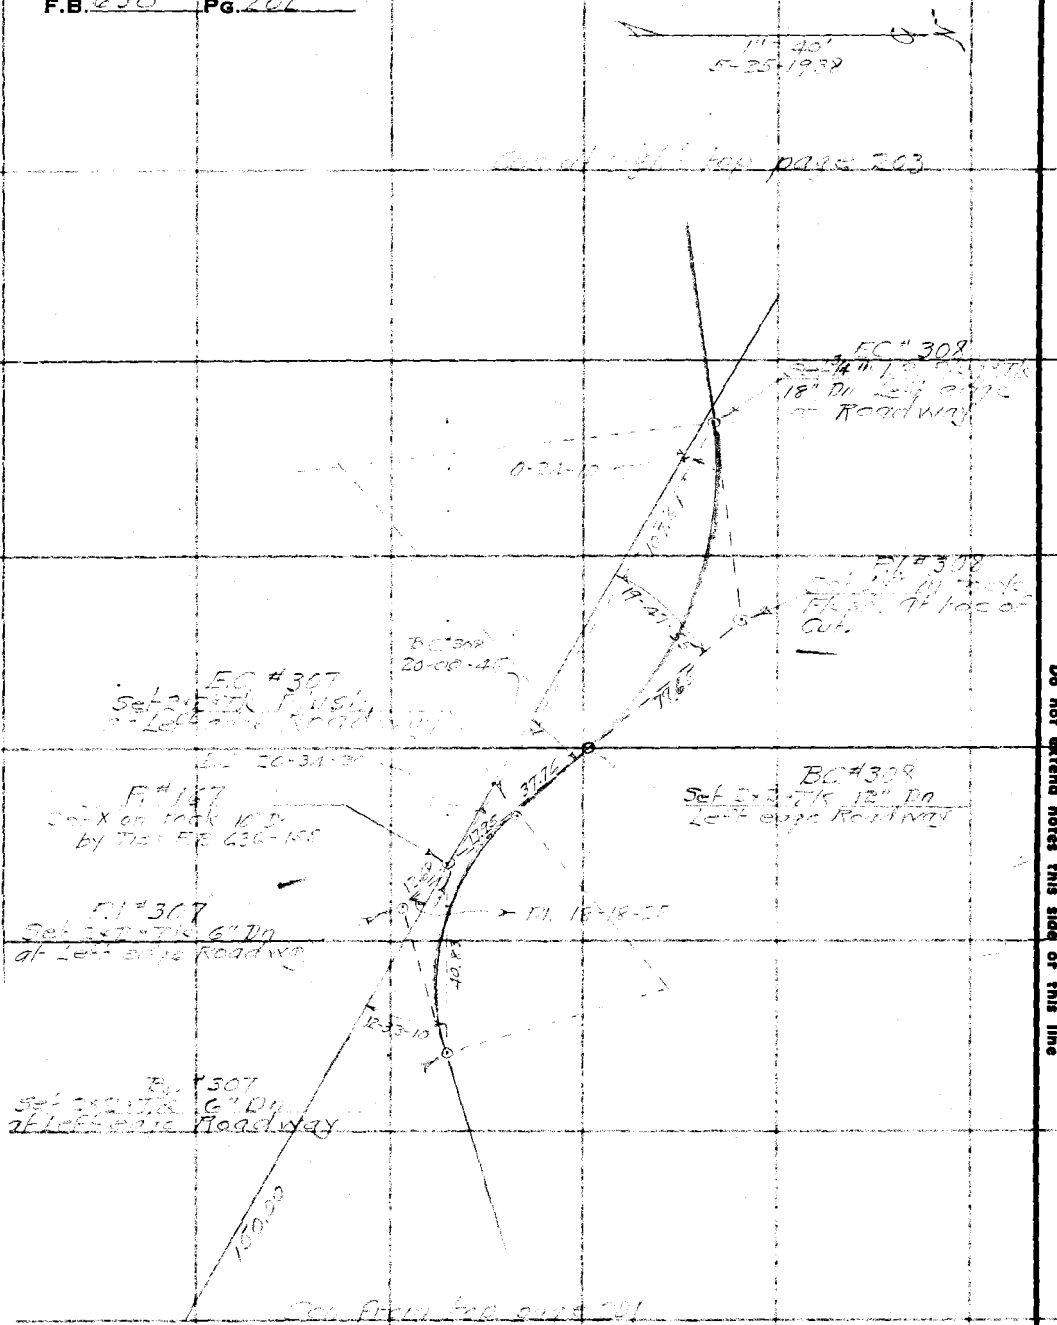

RETURN TO
LOS ANGELES COUNTY SURVEYOR
700 HALL OF RECORDS

Do not extend notes this side of this line

Note: Any Additions or Changes on This Sheet Must be Made or Circled in Red Ink With Date and Name of Person Making Change.

Notes Ck'd by	Survey of
Map No. B-127-5	W. O. 3149 Tape No. St'd °F.
Office Work F. A. W.	Surveyed by W. A. Miller
Checked Drew	Notes Mike Date 1-19-1938
Date 12-15-40	Indexed A. O. Johnson

F.B. 450 Pg. 202

Note: Any Additions or Changes on This Sheet Must be Made in Red Ink or Circled With Date and Name of Person Making Change.

Do not extend notes this side of this line

RETURN TO
LOS ANGELES COUNTY SURVEYOR
700 HALL OF RECORDS

FORM 247 10M 11-38

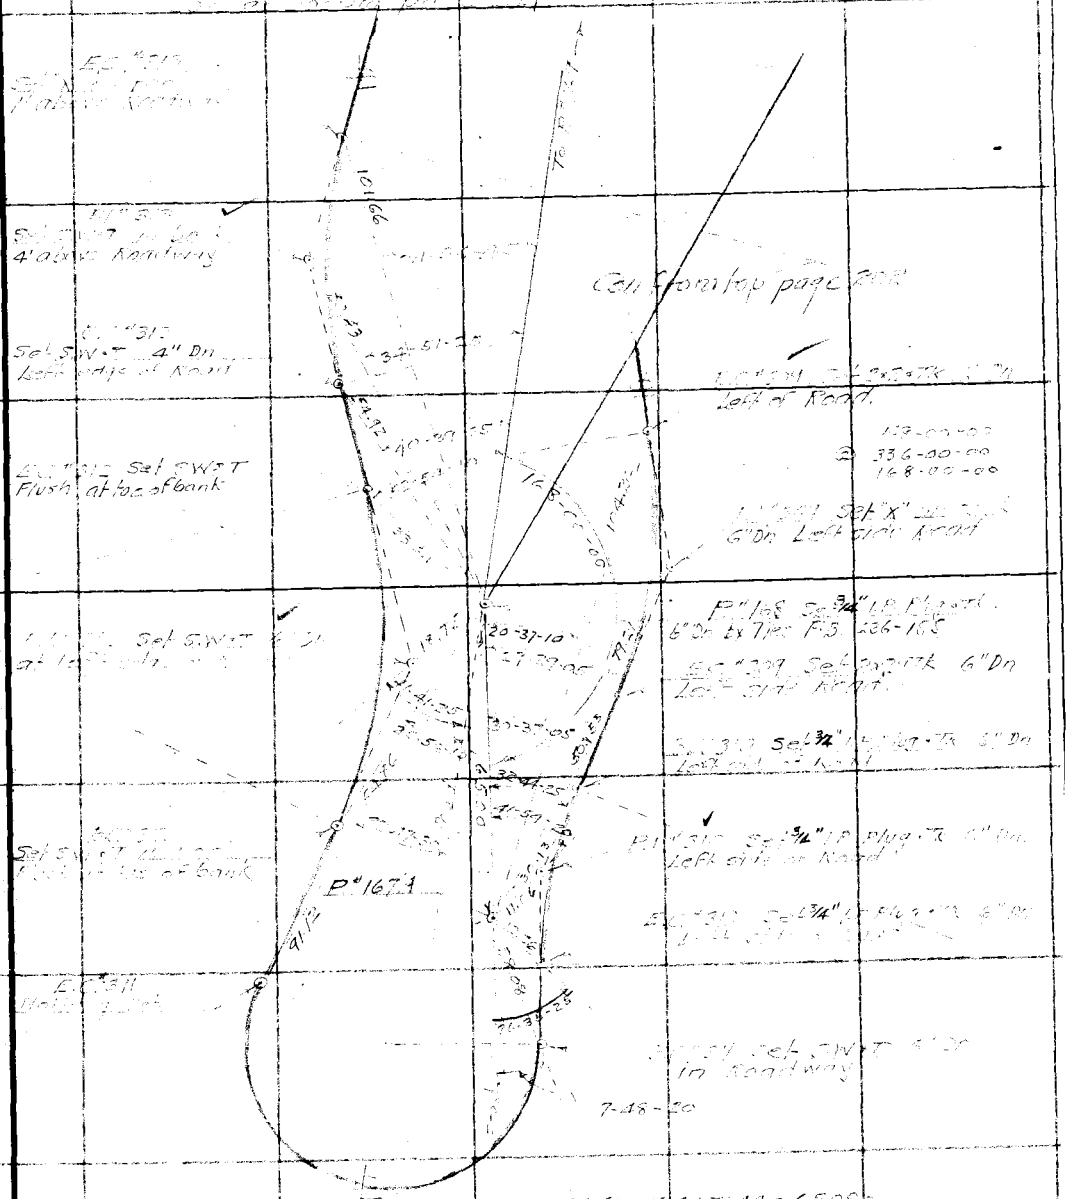

F.B. 650 PG. 204

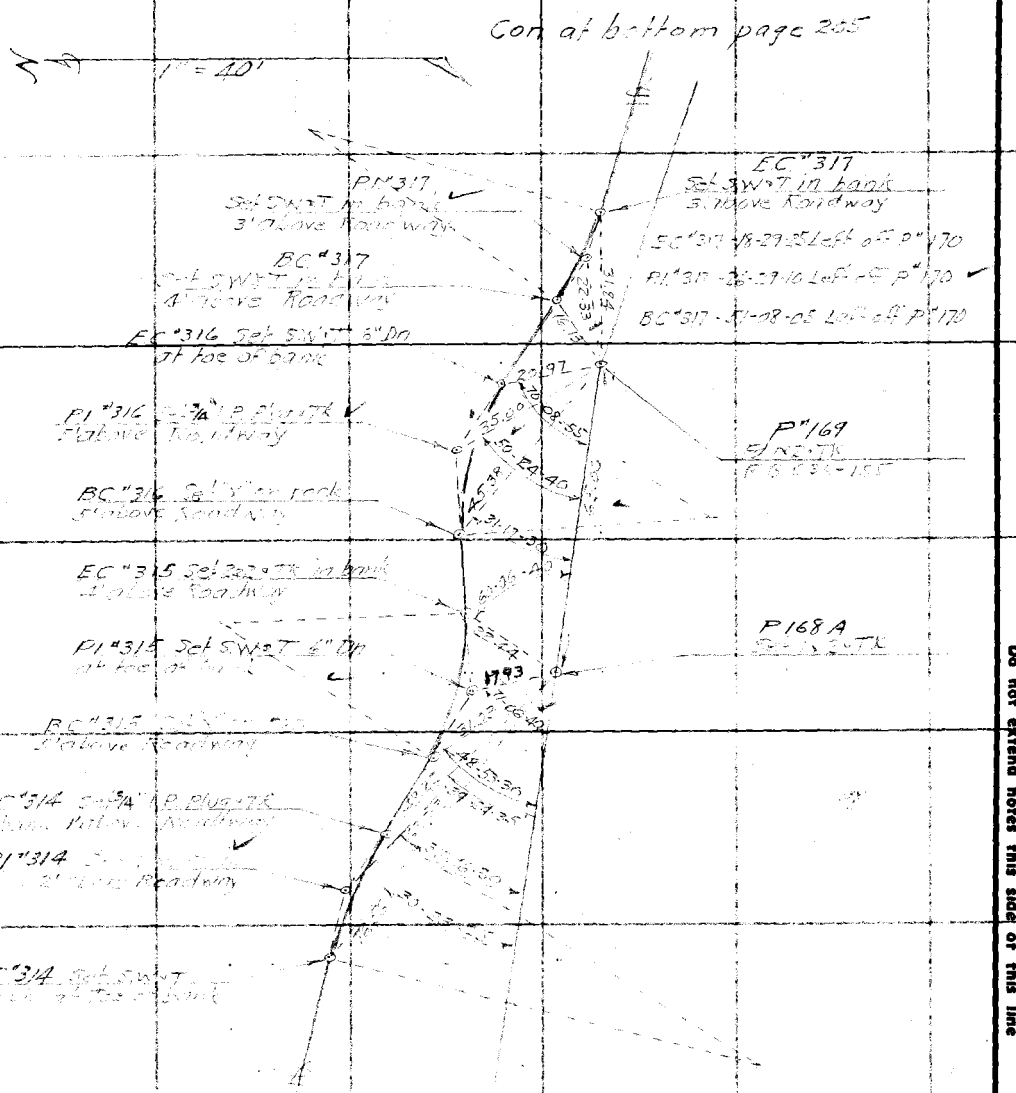

RETURN TO
LOS ANGELES COUNTY SURVEYOR
700 HALL OF RECORDS

Note: Any Additions or Changes on This Sheet Must be Made or Circled in Red Ink With Date and Name of Person Making Change.

Do not extend notes this side of this line

Notes Ck'd by Dr C W	Survey of MT WILSON TOLL RD
Map No. 6-1217-2	W. O 8149 Tape No 053 St'd 84 °F.
Office Work F. A. W.	Surveyed by W. A. Miller
Checked Dr C W	Notes M. Date 12-28-1937
Date 12-15-38	Indexed A. C. Johnson

F.B. 557 PG. 26

RETURN TO
LOS ANGELES COUNTY SURVEYOR
700 HALL OF RECORDS

Note: Any Additions or Changes on This Sheet Must be Made or Circled in Red Ink With Date and Name of Person Making Change

Do not extend notes this side of this line

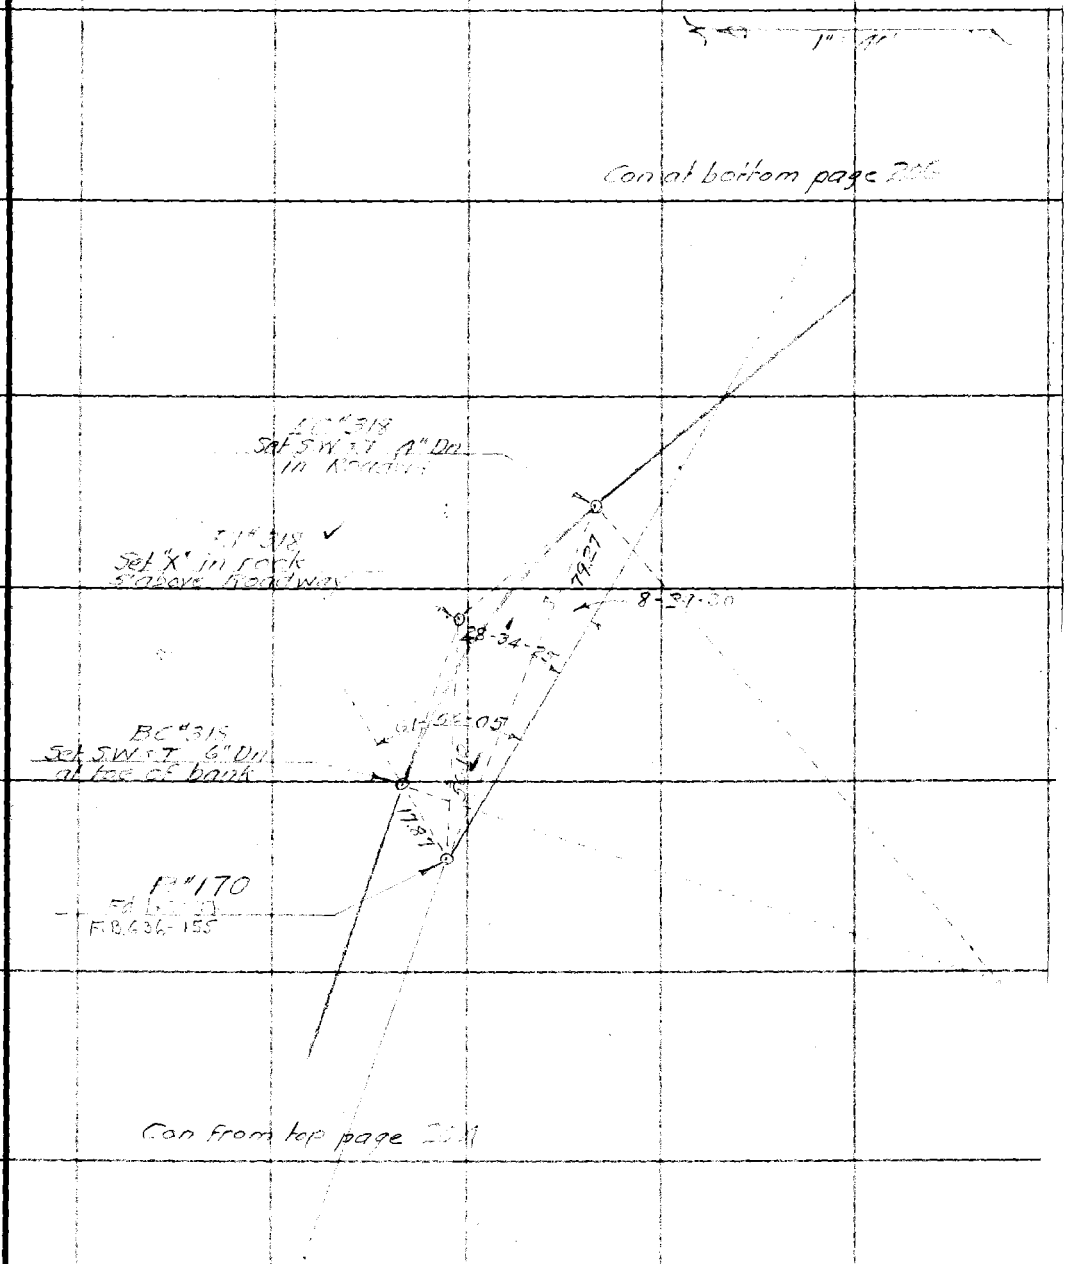

FORM 247 10M 11-38

F.B. 650 PG. 206

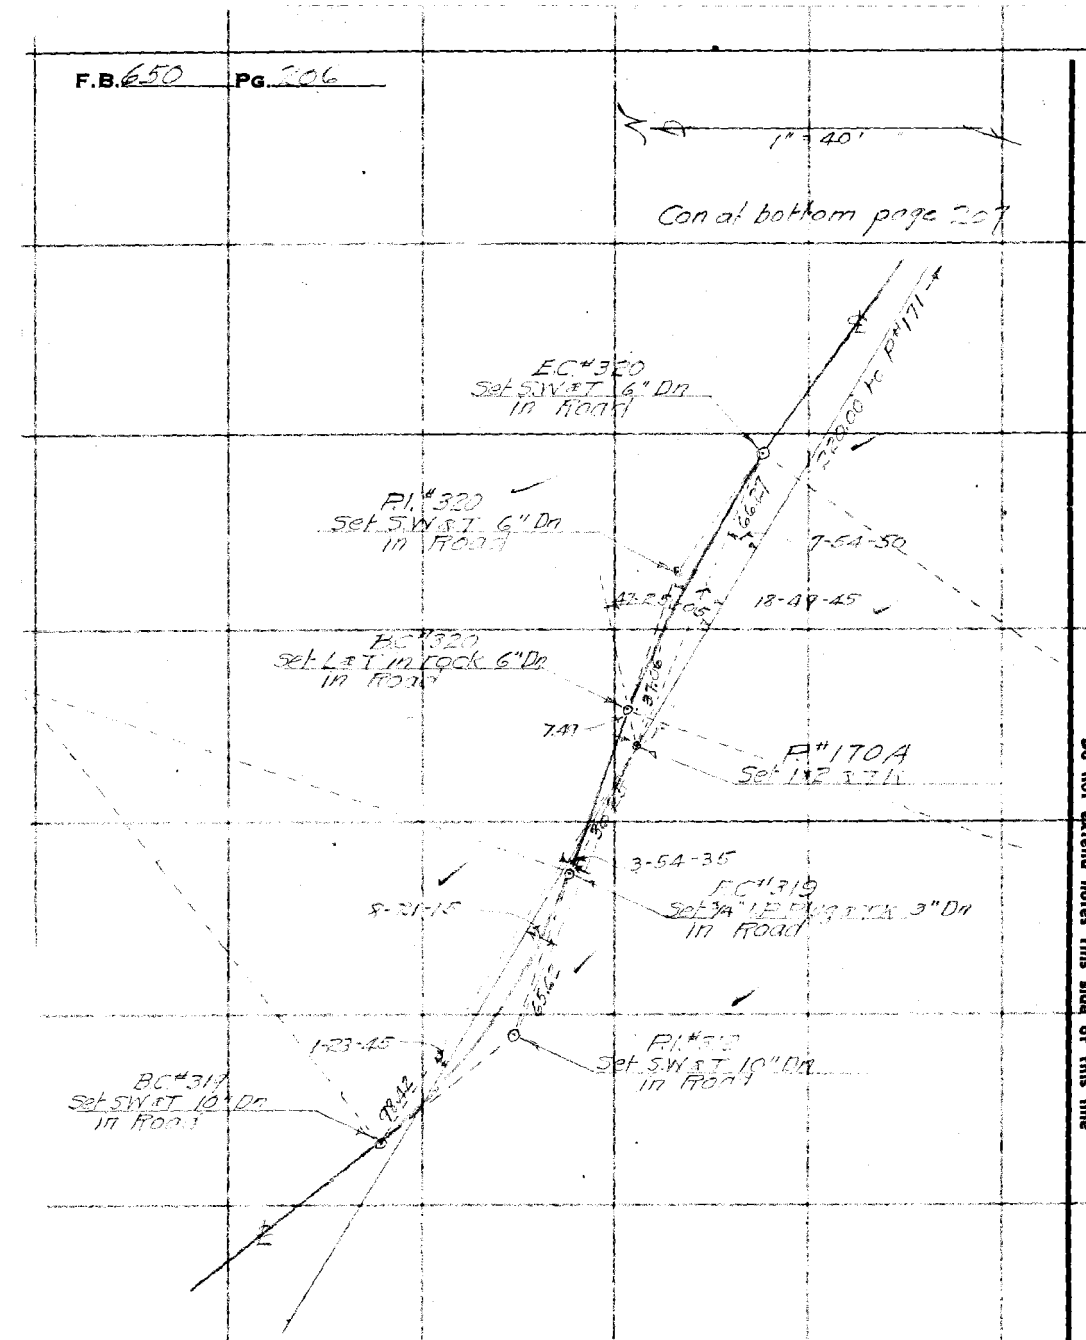

RETURN TO
LOS ANGELES COUNTY SURVEYOR
700 HALL OF RECORDS

Note: Any Additions or Changes on This Sheet Must be Made or Circled in Red Ink With Date and Name of Person Making Change.

Do not extend notes this side of this line

Notes Ck'd by	Survey of MT WILSON 10" SC
Map No. B-1217-5	W. O 8149 Tape No 053 St'd 84 °F.
Office Work F. A. W.	Surveyed by W.A. Miller
Checked	Notes Miller Date 6-22-1937
Date 12-18-46	Indexed C. Johnson

F.B. 620 PG. 207

Note: Any Additions or Changes on This Sheet Must be Made or Circled in Red Ink With Date and Name of Person Making Change

Do not extend notes this side of this line

RETURN TO
LOS ANGELES COUNTY SURVEYOR
700 HALL OF RECORDS

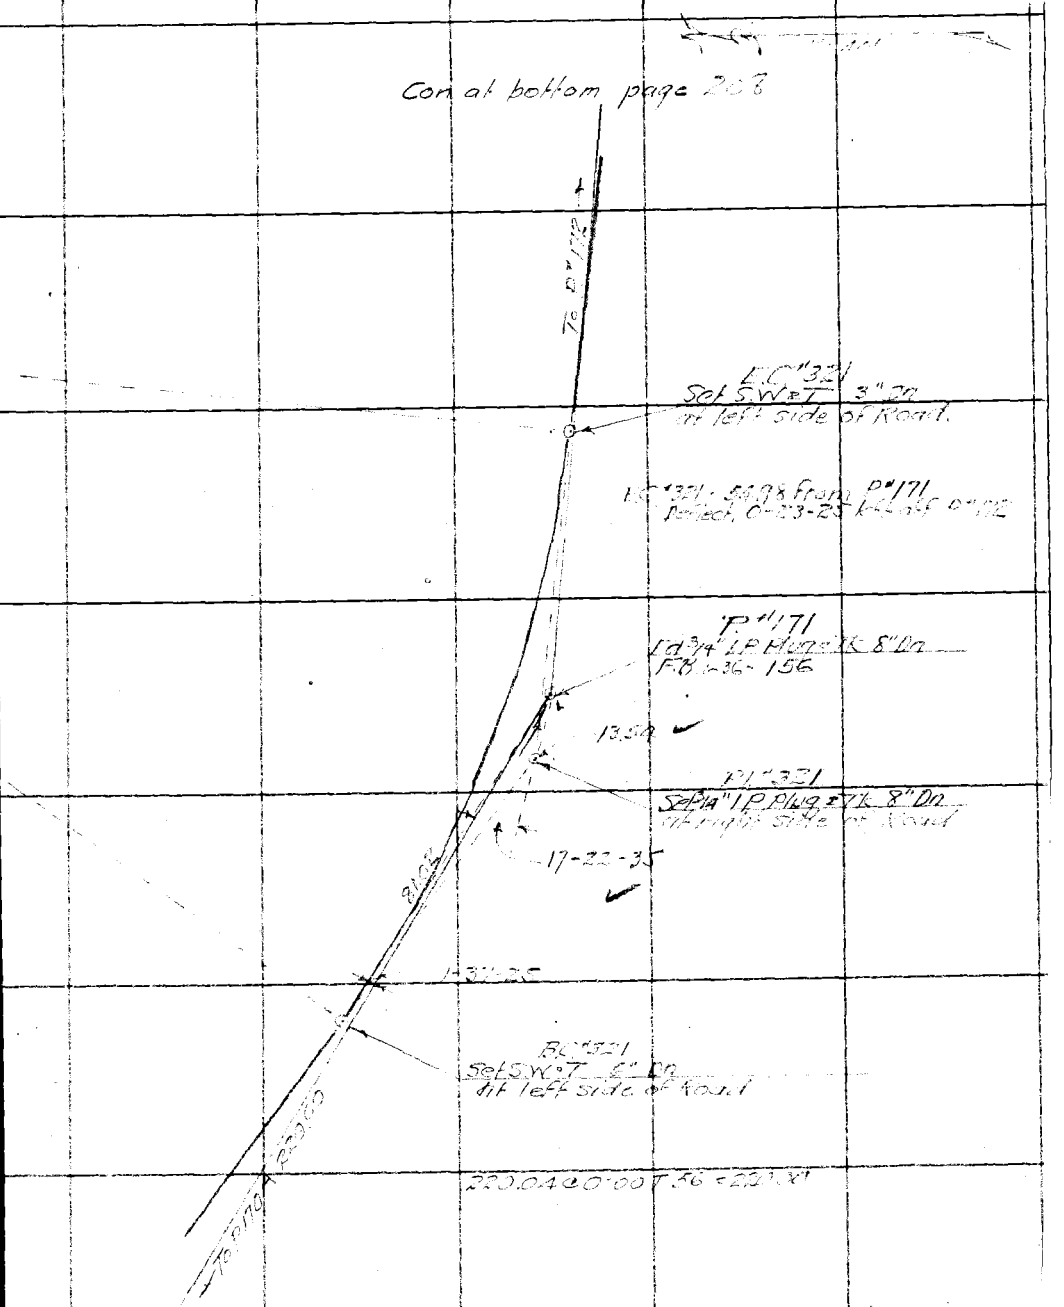

FORM 247 10M 11-35

F.B. 650 PG. 208

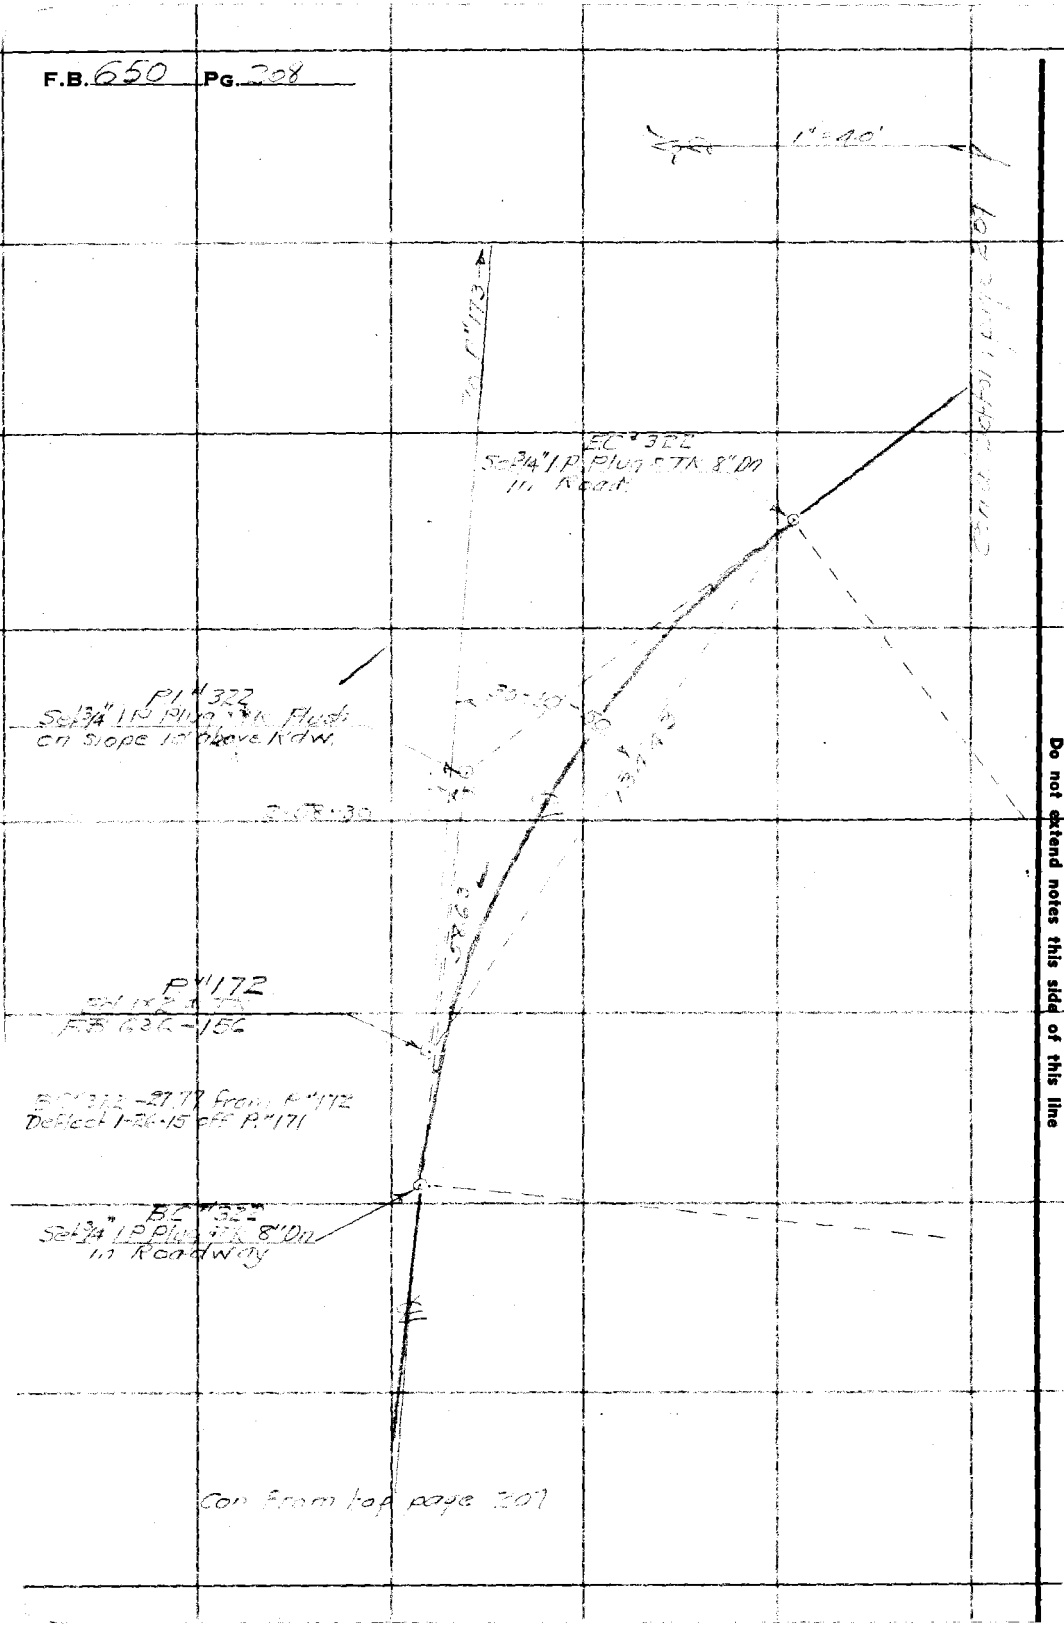

RETURN TO
LOS ANGELES COUNTY SURVEYOR
700 HALL OF RECORDS

Note: Any Additions or Changes on This Sheet Must be Made or Circled in Red Ink With Date and Name of Person Making Change.

Do not extend notes this side of this line

Notes Ck'd by Drew
Map No. B-1217-5
Office Work F. A. W
Checked Drew
Date 12-18-40

Survey of MT WILSON TRAIL RE
W. O. 3149 Tape No 053 St'd. 71°F.
Surveyed by W. A. Miller
Notes Miller Date 5-24-1939
Indexed


Note: Any Additions or Changes on This Sheet Must be Made or Circled in Red Ink With Date and Name of Person Making Change

Do not extend notes this side of this line

RETURN TO
LOS ANGELES COUNTY SURVEYOR
700 HALL OF RECORDS

FORM 247 10M 11-38

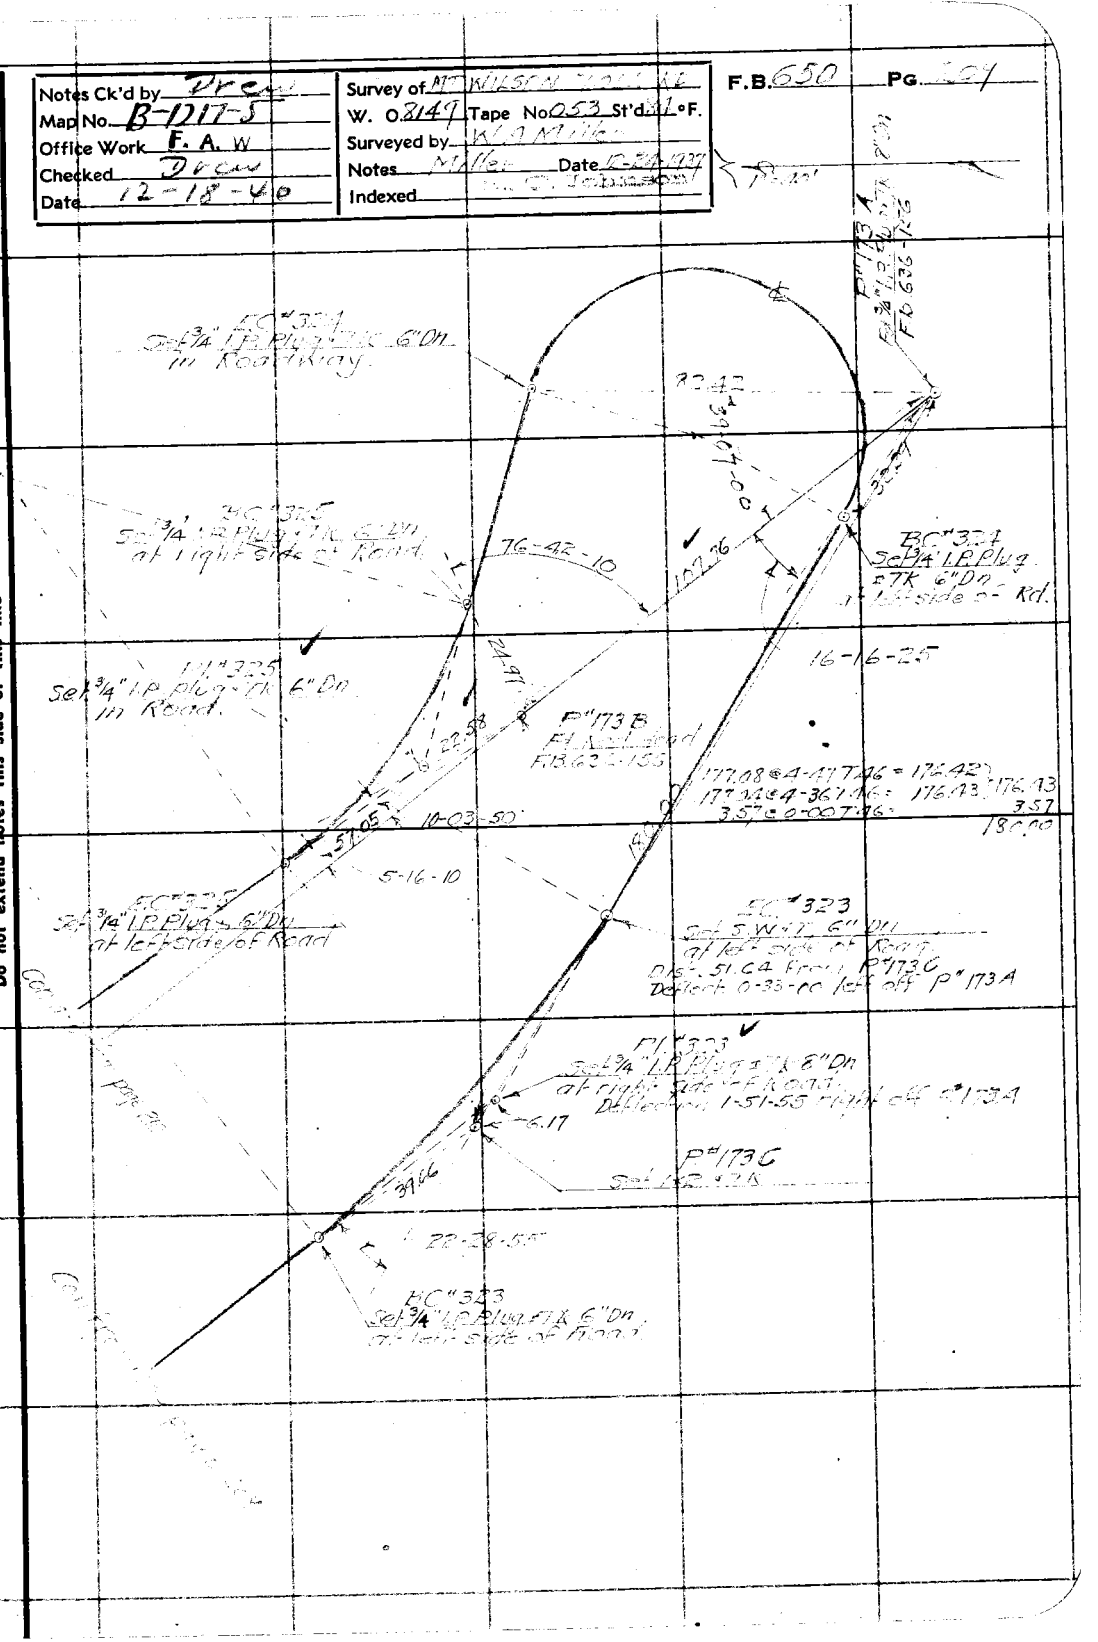

RETURN TO
LOS ANGELES COUNTY SURVEYOR
700 HALL OF RECORDS

Note: Any Additions or Changes on This Sheet Must be Made or Circled in **Red Ink** With Date and Name of Person Making Change.

Do not extend notes this side of this line

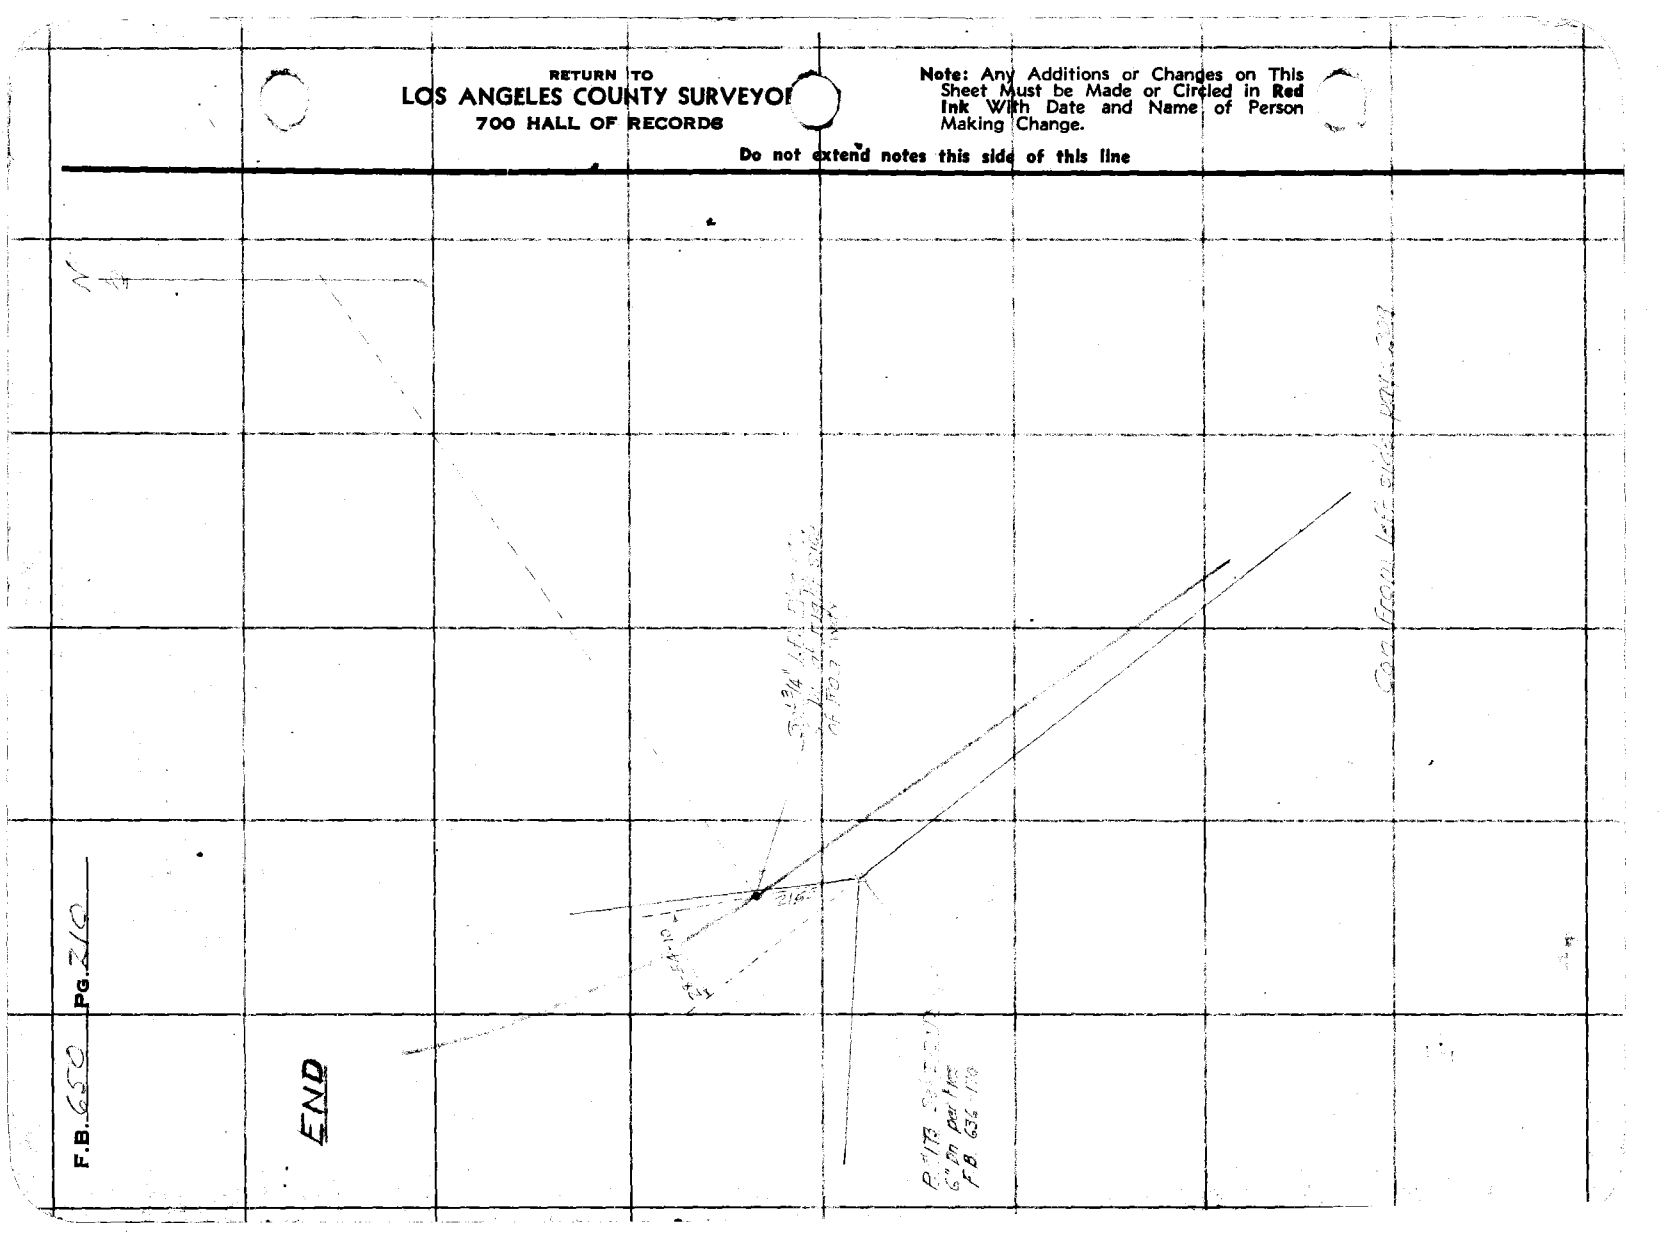

FORM 247 SM 11-41

RETURN TO
LOS ANGELES COUNTY SURVEYOR
700 HALL OF RECORDS

Note: Any Additions or Changes on This Sheet Must be Made or Circled in Red Ink With Date and Name of Person Making Change.

Do not extend notes this side of this line.

Notes C'k'd by
Map No.
Office Work
Checked
Date

Survey of
W. O. Tract No. St'd °F
Surveyed by
Notes
Indexed Date

F.B. PG.

F.B. _____ PG. _____