FORM 247 5M 10-57

RETURN TO
LOS ANGELES COUNTY SURVEYOR
700 HALL OF RECORDS

Note: Any Additions or Changes on This Sheets Must be Made or Circled in Red Ink With Date and Name of Person Making Change.

Do not ex[illegible] this side of this line

686

Notes Ck'd by
Map No.
Office Work
Checked
Date

Survey of
W. O. Tape No. Std. of
Surveyed by
Notes Date
Indexed

F.B. PG.

F.B. 686 Pg. Index

F.B. 686

PAGES: Index, 1 , 3,4,5, , 7 to 21 incl.,
, 23, ,25,26,27, , 29 to 35 incl.,
, 37 to 87 90 incl., 91 to 133 incl.,
135 to 142 incl.,

201, , 203, 204,205,
, 207, , 209 to 213 incl., , 215
to 219 incl.,

RETURN to
LOS ANGELES COUNTY SURVEYOR
700 HALL OF RECORDS

Note: Any Additions or Changes on This Sheets Must be Made or Circled in Red Ink With Date and Name of Person Making Change.

Do not extend notes this side of this line

Notes Ck'd by D. M. Finley	Survey of [illegible]	F.B. 686	PG. 5
Map No. CSB 13052	W. O. 8173 Tape No.	St'd	°F.
Office Work RW. MS	Surveyed by W. A. Miller		
Checked D. M. Finley	Notes Miller Date Dec 1936 Jan 1937		
Date June 1938.	Indexed A. C. Jones		

Transit Line 'A' staked parallel with East boundary and West boundary of Subdivision.

Pages 25 to 27 inc. for topography of area adjoining and forming any immediately adjacent Transit Line 'A' as base.

Pages 37 to 38 inc. for location of tie and Crosses set for Lot and Block corners by W.B. Stanford Co. 1911. Transit Line 'A' as base.

Transit Line "B" staked parallel with and from 40' at S.W. Cor Lot 4 Blk N to I.P. of N.W. Cor Lot 1 Blk R, and 15' West-erly at right angles. See pages 39 & 40

Pages 41 to 42 inc. for topography. Transit Line "B" as base

Note: Any Additions or Changes on This Sheet Must be Made or Circled in Red Ink With Date and Name of Person Making Change.

Do not extend notes this side of this line

RETURN TO
LOS ANGELES COUNTY SURVEYOR
700 HALL OF RECORDS

FORM 247 10M 11-38

RETURN TO
LOS ANGELES COUNTY SURVEYOR
700 HALL OF RECORDS

Note: Any Additions or Changes on This Sheet Must be Made or Circled in **Red Ink** With Date and Name of Person Making Change.

Do not extend notes this side of this line

F.B. 686 PG. 6

Notes Ck'd by D. M. Finley	Survey of		F.B. 686 Pg. 3
Map No. CSD-1308-2	W. O.	Tape No. St'd °F.	
Office Work RWM	Surveyed by		
Checked D. M. Finley	Notes	Date	
Date June 1938	Indexed A. C. Johnson		

KEY MAP A

Set 2x2 Page 21

WORK WITHIN CEMETERY

Set 1x1 x Tin Page 21

Set 2x2 Page 21

170

125

26.89

2.50

3.30

0.36

Fd 1" I.P.

94° 42' 30"

LITTLE LANE CEMETERY

1076.83 Page 21

Page 21

Page 21

91° 31' 30"

Set 2x2 Page 21

30.02

170

LAKELAND

125

ROAD

Fd 2" I.P. Page 21

30.02

Set 2x2 page 21

25.00

Set 1x1 x Tin page 21

Set 1x1 x Tin Page 21

Set 2x2 Page 21

Note: Any Additions or Changes on This Sheet Must be Made or Circled in Red Ink With Date and Name of Person Making Change

Do not extend notes this side of this line

RETURN TO
LOS ANGELES COUNTY SURVEYOR
700 HALL OF RECORDS

FORM 247 10M 11-38

F.B. 686 Pg. 4

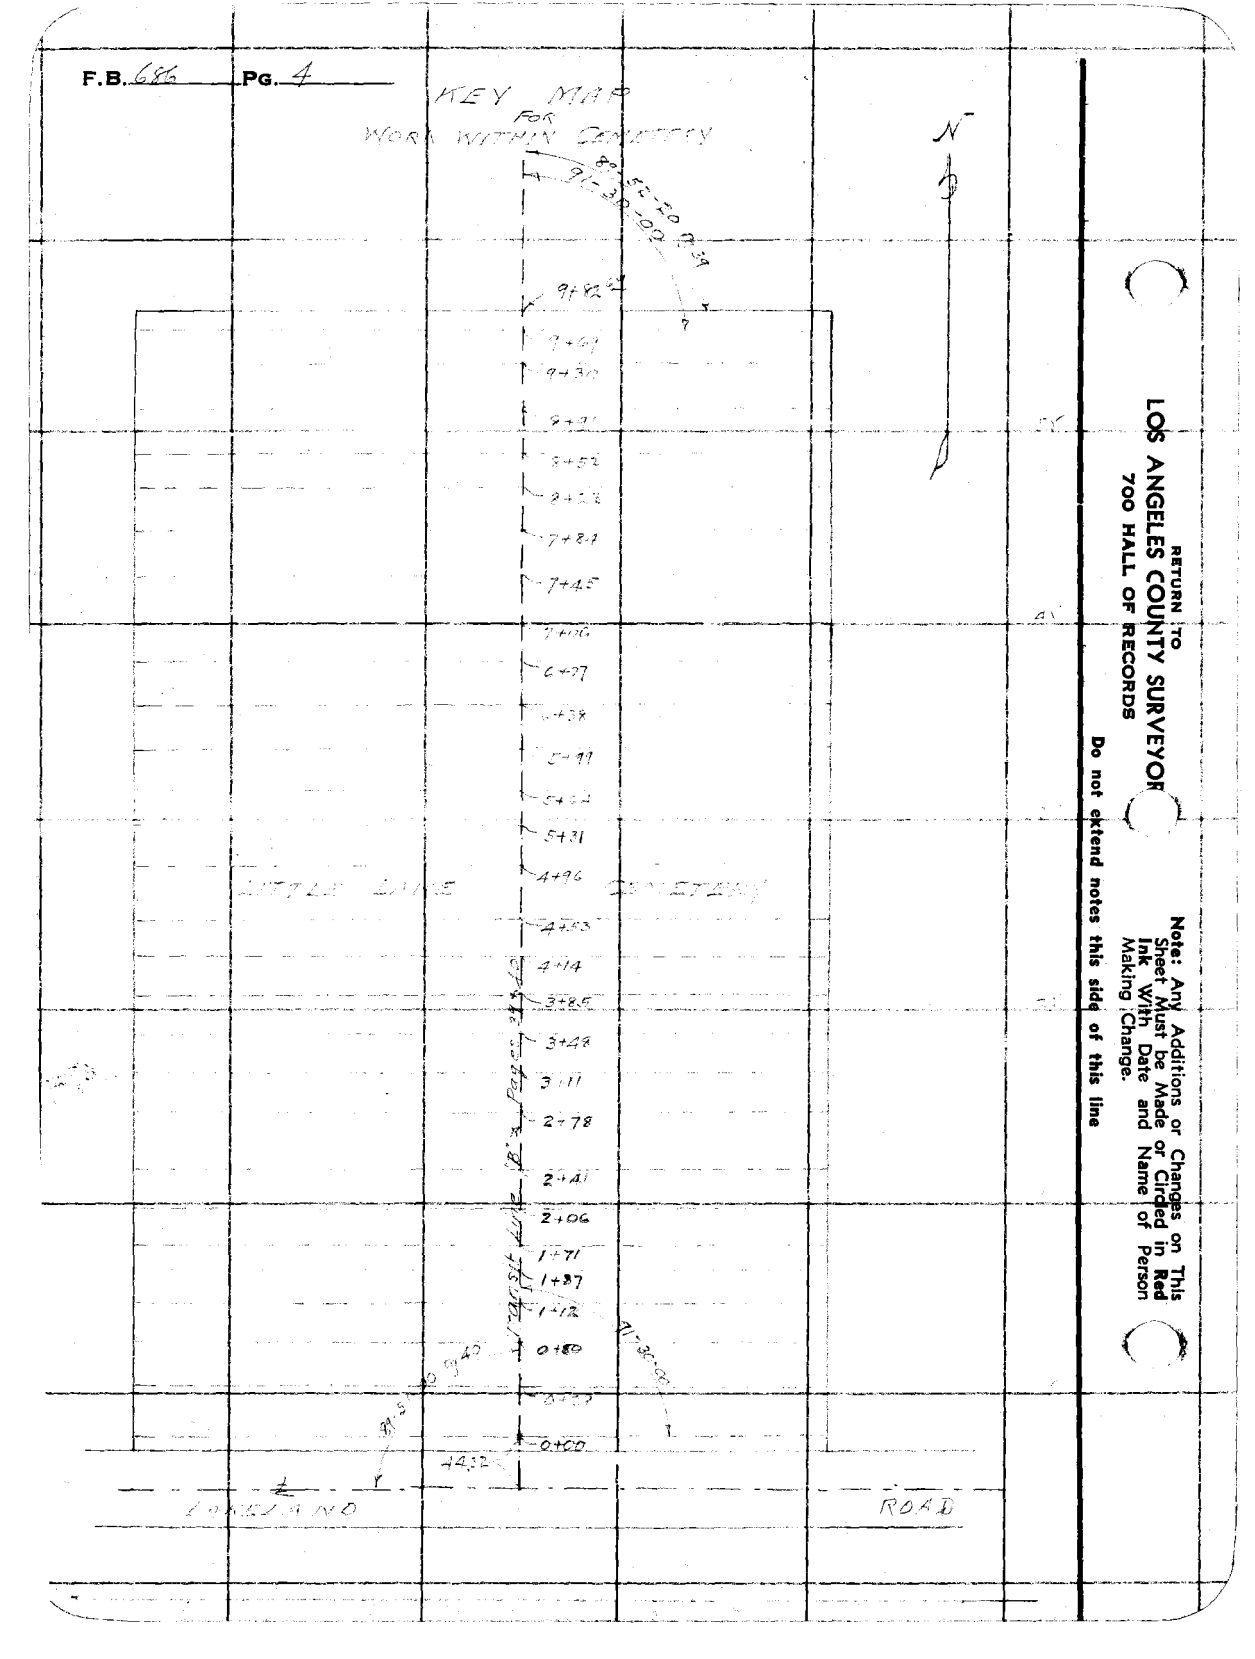

RETURN TO
LOS ANGELES COUNTY SURVEYOR
700 HALL OF RECORDS

Note: Any Additions or Changes on This Sheet Must be Made or Circled in Red Ink With Date and Name of Person Making Change.

Do not extend notes this side of this line

Notes Ck'd by D.M. Finley	Survey of LITTLE LAKE CEMETERY	F.B. 686	Pg. 1
Map No. CSB 1308:2	W. 08/73 Tape No. St'd °F.		
Office Work RW. M.P.	Surveyed by W.A. Miller		
Checked D.M. Finley	Notes MILLER Date		
Date June 1938	Indexed C. Jan 28 1937 2-1-37		

Note: Any Additions or Changes on This Sheet Must be Made or Circled in Red Ink With Date and Name of Person Making Change.

Do not extend notes this side of this line

RETURN TO
LOS ANGELES COUNTY SURVEYOR
700 HALL OF RECORDS

FORM 247 10M 11-35

SURVEY
LITTLE LAKE CEMETERY
SANTE FE SPRINGS
J.N. 7193

Dec 17 1936 to Jan 21 1937

Miller
Brazen
Shaw
Climie

RETURN TO
LOS ANGELES COUNTY SURVEYOR
700 HALL OF RECORDS

Note: Any Additions or Changes on This Sheet Must be Made or Circled in **Red Ink** With Date and Name of Person Making Change.

Do not extend notes this side of this line

F.B. 686 PG. 2

Notes Ck'd by Mc Pherson	Survey of LITTLE LAKE CEMTERY
Map No. B-1308	W. O. 8173 Tape No. 061 St'd 76° F.
Office Work R.W.Mc	Surveyed by W A Miller
Checked D. M. Finley	Notes Miller Date 12-17-36
Date June 1938	Indexed A. C. Johnson 1-6-37

F.B. 686 Pg. 7

Note: Any Additions or Changes on This Sheet Must be Made or Circled in Red Ink With Date and Name of Person Making Change!

Do not extend notes this side of this line

RETURN TO
LOS ANGELES COUNTY SURVEYOR
700 HALL OF RECORDS

FORM 247 10M 11-35

N

Con 2' to from page 8

NORWALK & PUENTE MILLS RD.

706.31 @ 0-30' T 58 = 706.23 ✓ 706.23 ✓
706.32 @ 0-00' T 58 = 706.24 ✓

Fd X in Iron Post Fr Cor
Rd Dept FT 33-191
Rd Dept FO 388-10

Fd I" I.P. Plug & Nail Flush
Rd Dpt FT 33-191
Rd Dpt FO 388-10
20.09 Off ℄ Lakeland Rd

Fd N & T in Cor Fo Post
Rd Dept FT 33-191
Rd Dept FO 388-10

Fd Conc Mon C.Spk &
Tin 18" Down
Rd Dpt FT 33-191
Rd Dpt FO 388-10

Fd N & T in
PP 1436.72 E

See Pg 12

Fd 2x2 x 1ft 6" Down
Rd Dpt FT 33-191
Rd Dpt FO 388-10
0.04 Sth of Line

LAKELAND RD.

Fd L & T in Conc Block 3' High
Rd Dpt FT 33-191
Rd Dpt FO 388-10

Fd C.Spk in Lead over CS
Brass Cap Mon
Rd Dept FT 33-191
Rd Dept FO 388-10
(Did not cut through Pavement)
to CS Mon

1/4 Cor Secs 6/7

Fd Conc Mon C.Spk & T
24" Down
Rd Dept FT 33-191
Rd Dept FO 388-10

Fd 1" I.P. Conc Filled in
Wire Spk & Cross
Rd Dpt FT 33-191
Rd Dpt FO 388-10

F.B. 686 Pg. 8

Con at bottom page 9

7+06.23
6+16.21
13+22.44

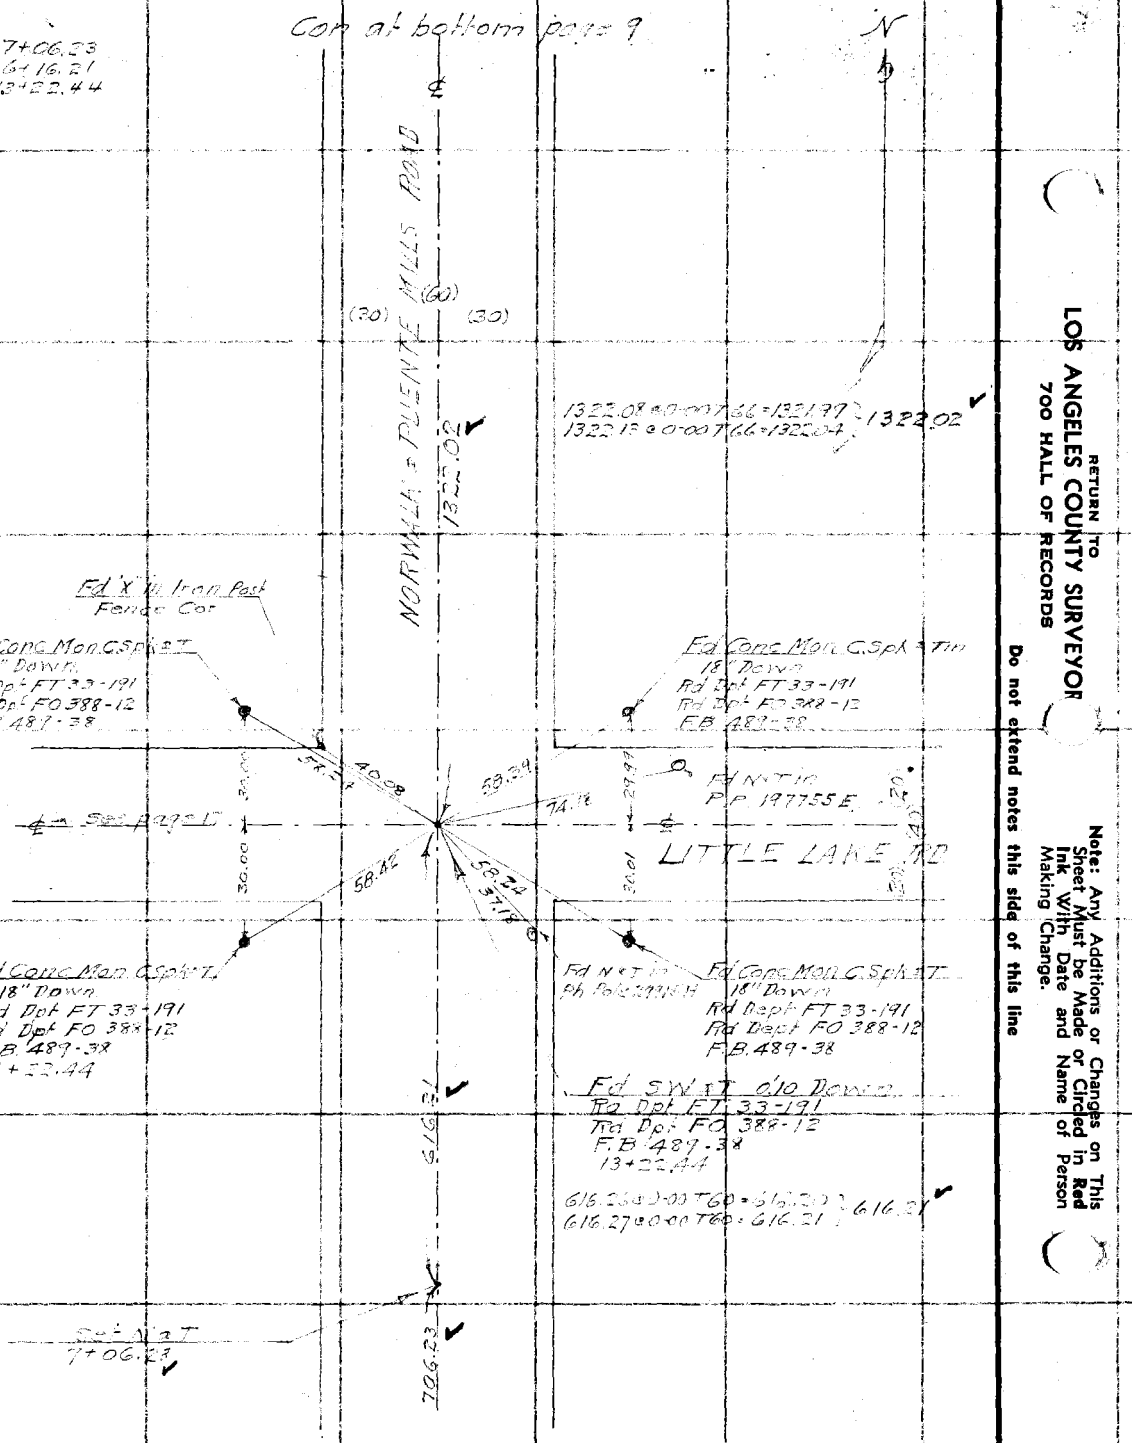

Con from top page 7

RETURN TO
LOS ANGELES COUNTY SURVEYOR
700 HALL OF RECORDS

Do not extend notes this side of this line

Note: Any Additions or Changes on This Sheet Must be Made or Circled in Red Ink With Date and Name of Person Making Change.

Notes Ck'd by McPherson	Survey of LITTLE LAKE CEMETERY	F.B. 686	PG. 9
Map No. B-1308	W. O. 2173 Tape No. 061 St'd 76°F.	13+22.44	
Office Work R.W.M.C.	Surveyed by W.A. Miller	13+22.02	
Checked D. M. Finley	Notes Miller Date 12-22-36	26+44.46	
Date June 1938.	Indexed A.L. C. Johnson		

Note: Any Additions or Changes on This Sheet Must be Made or Circled in Red Ink With Date and Name of Person Making Change.

Do not extend notes this side of this line

RETURN TO
LOS ANGELES COUNTY SURVEYOR
700 HALL OF RECORDS

NORWALK & PUENTE MILLS RD

(30) (30) (60)

Fd X in 6" Iron Post
Fd Nail in P.P. 165.36 E
Fd 'X' in 6" Iron Post Face Cor

Fd C.S. Brass Cap Mon 6" Down
Rd Dpt FT 33-192
Rd Dpt FO 388-14

Fd Nail in P.P. 141.64 E

Fd C.S. Brass Cap Mon 6" Down 0.23 S&W of Prod

CLARK AVE. (33)

30.21
29.94
30.00
20.32

Fd Cross Mon C Spk & Tag 6" Down
Rd Dpt FT 33-192
Rd Dpt FO 388-14

Fd Nail in P.P.

Fd 'X' in Iron Post Face Cor

Fd C.S. Brass Cap Mon 6" Down
Rd Dpt FT 33-192
Rd Dpt FO 388-14

Fd C Spk & W 1" Down
Fd 2x2 & Tk under Spk & W 15" Down. Replaced Spk & W with 2x2 & Tk 1" Down 2. Angle Point Center Section 6
F.B. 208-6
Rd Dpt FT 33-192
Rd Dpt FO 388-14
F.B. 81-78
26+44.46

1322.08

Con From to page 3

FORM 247 10M 11-35

F.B. 686 Pg. 10

Con. at bottom page 11

LITTLE LAKE CEMETERY

Wire fence

(20) (40) (20)

26.00

1440

294.22

294.22 @ 0-00 T 78 = 294.22
294.23 @ 0-00 T 78 = 294.23 } 294.23

Transit Line
See page 18

Set 1x1 ± Tin See page 18
0+00 going North
11+88.25 From West.

Fd 1" I.P. Plug & Nail
4" Down - Loose
Reset 18" Down

29.86

29.42

4.34

Set 1x1 ± Tin
11+58.83

ROAD

1158.79 @ 0-00 T 80 = 1158.82
1158.82 @ 0-00 T 80 = 1158.83 } 1158.83

LAKELAND

1158.81

Set X in Conc. Location
Iron Stand Pipe

Fd Δ in PP 33-8 11E

Set X" Conc. Location
Stand Pipe

13.35

34.85

40.62

(40E)

(30)

See page 3

PIONEER

BLVD

28.76

Fd ½" Pipe in cc 10" Iron
and Move 3/4" I.P. of FB 208-10
F.B. 48-35
F.B. 208-6
F.B. 33-34
0+00

Fd N.T. in End Post of
Guard Rail Fence

RETURN TO
LOS ANGELES COUNTY SURVEYOR
700 HALL OF RECORDS

Do not extend notes this side of this line

Note: Any Additions or Changes on This Sheet Must be Made or Circled in Red Ink With Date and Name of Person Making Change.

Notes Ck'd by McPherson	Survey of LITTLE LAKE CEMTRY	F.B. 686	Pg. 11
Map No. B-1308	W. O. 2173 Tape No. OGL St'd 76 °F.		
Office Work RW.Mc	Surveyed by W.A.Miller		
Checked D. M. Finley	Notes Miller Date 12-18-36		
Date June 1938	Indexed A. C. Johnson		

11-58.83
+294.23
1153.06

Con at bottom page 12

(20) (20)
40

1313.24 @ 0.00 T 76 = 1313.24
1313.26 @ 0.00 T 76 = 1313.26 } 1313.25

1313.25

LAKELAND ROAD

Fd 2" I.P. Plug & Nail
6" Up.

30.02

5.19

Set 1x1 & Tin
14+53.06

294.23
5.19
299.42
295
4.42

14.53.06
5.19
14.58.25
295
1153.25
1153.31
0.06

LITTLE LAKE CEMETERY

Wire Fence

(20) (20)
40

294.23

Con from top page 10

RETURN TO
LOS ANGELES COUNTY SURVEYOR
700 HALL OF RECORDS

Note: Any Additions or Changes on This Sheet Must be Made or Circled in Red Ink With Date and Name of Person Making Change.

Do not extend notes this side of this line

FORM 247 10M 11-35

F.B. 686 Pg. 12

14+53.06
13+13.35
27+66.31

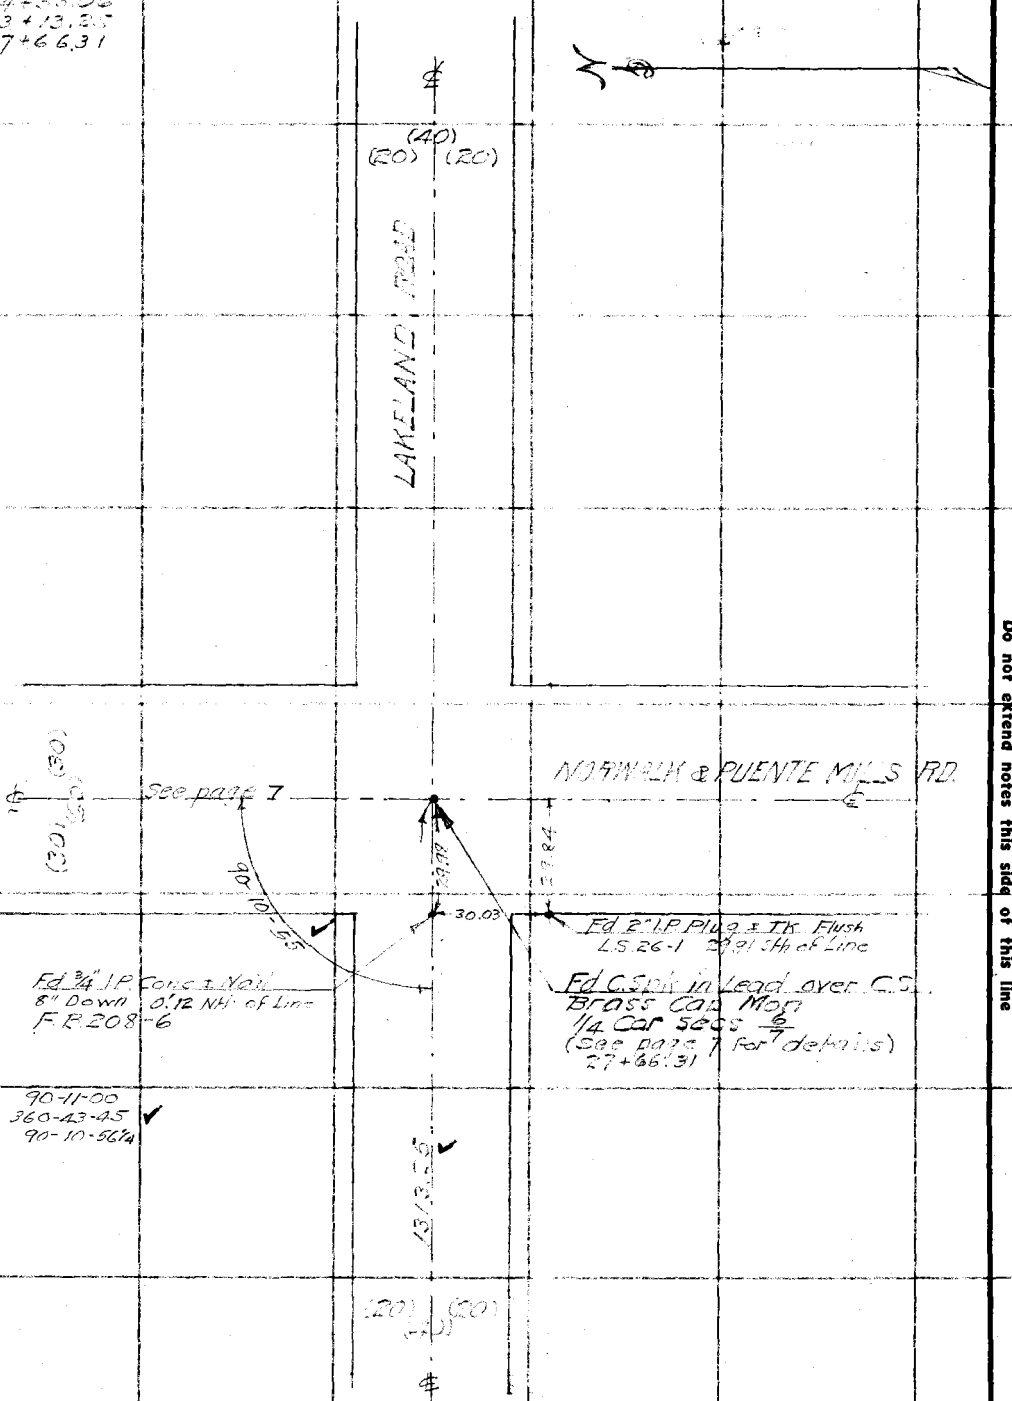

RETURN TO
LOS ANGELES COUNTY SURVEYOR
700 HALL OF RECORDS

Do not extend notes this side of this line

Note: Any Additions or Changes on This Sheet Must be Made or Circled in Red Ink With Date and Name of Person Making Change.

Notes Ck'd by McPherson	Survey of LITTLE LAKE CEMETERY	F.B. 686	Pg. 13
Map No. B-1308	W. O. 8173 Tape No. 061 St'd 76°F.		
Office Work RWMC	Surveyed by W.A.N. Miller		
Checked D. M. Finley	Notes Miller Date 12-22-36		
Date June 1938	Indexed A. C. Johnson		

Note: Any Additions or Changes on this Sheet Must be Made or Circled in Red Ink With Date and Name of Person Making Change

Do not extend notes this side of this line

RETURN TO
LOS ANGELES COUNTY SURVEYOR
700 HALL OF RECORDS

FORM 247 10M 11-35

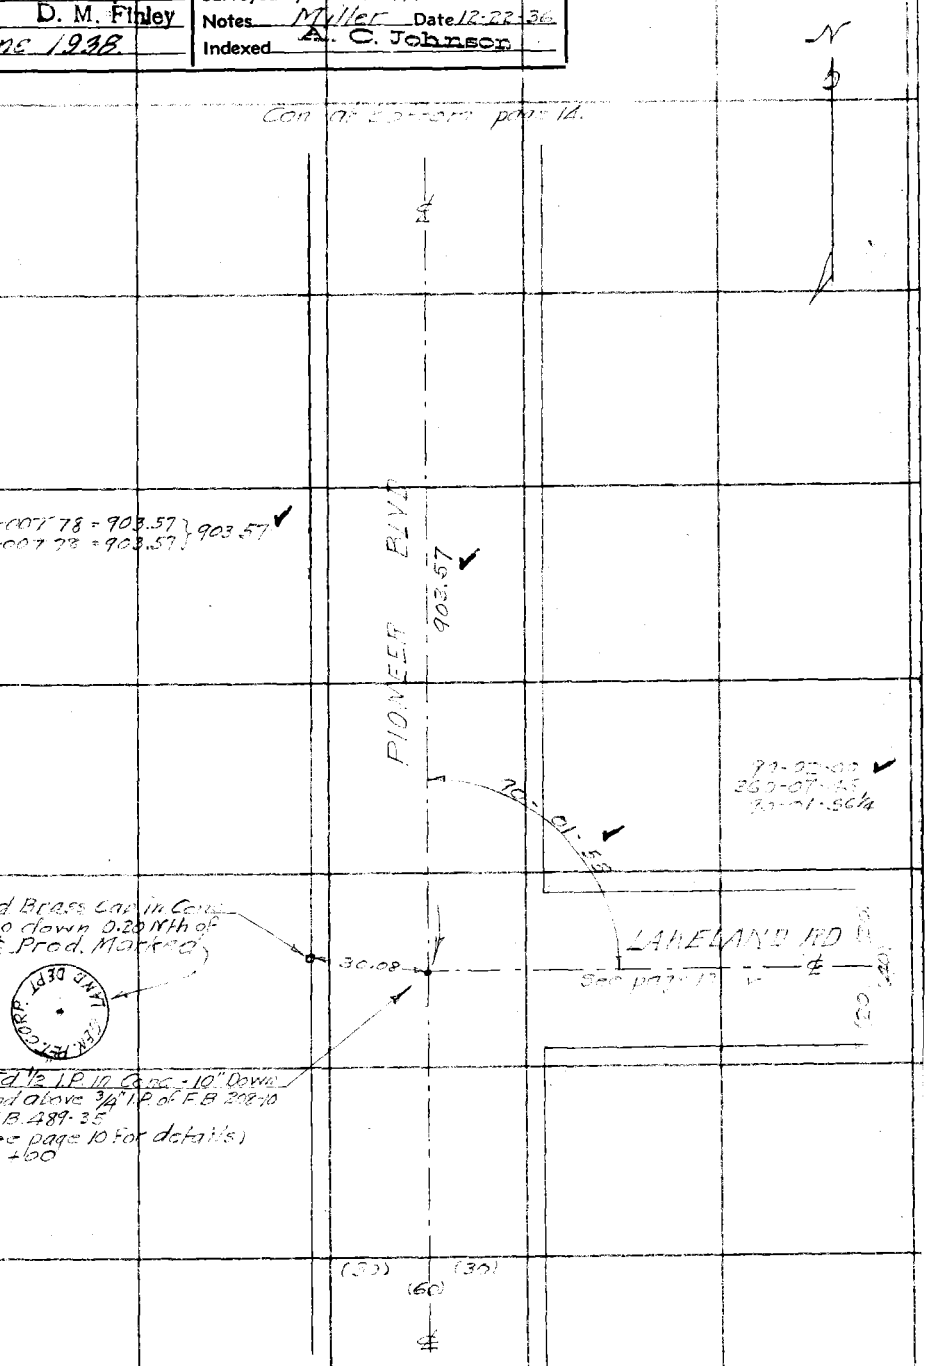

F.B. 686 PG. 14

9+03.57
4+17.75
13+21.32

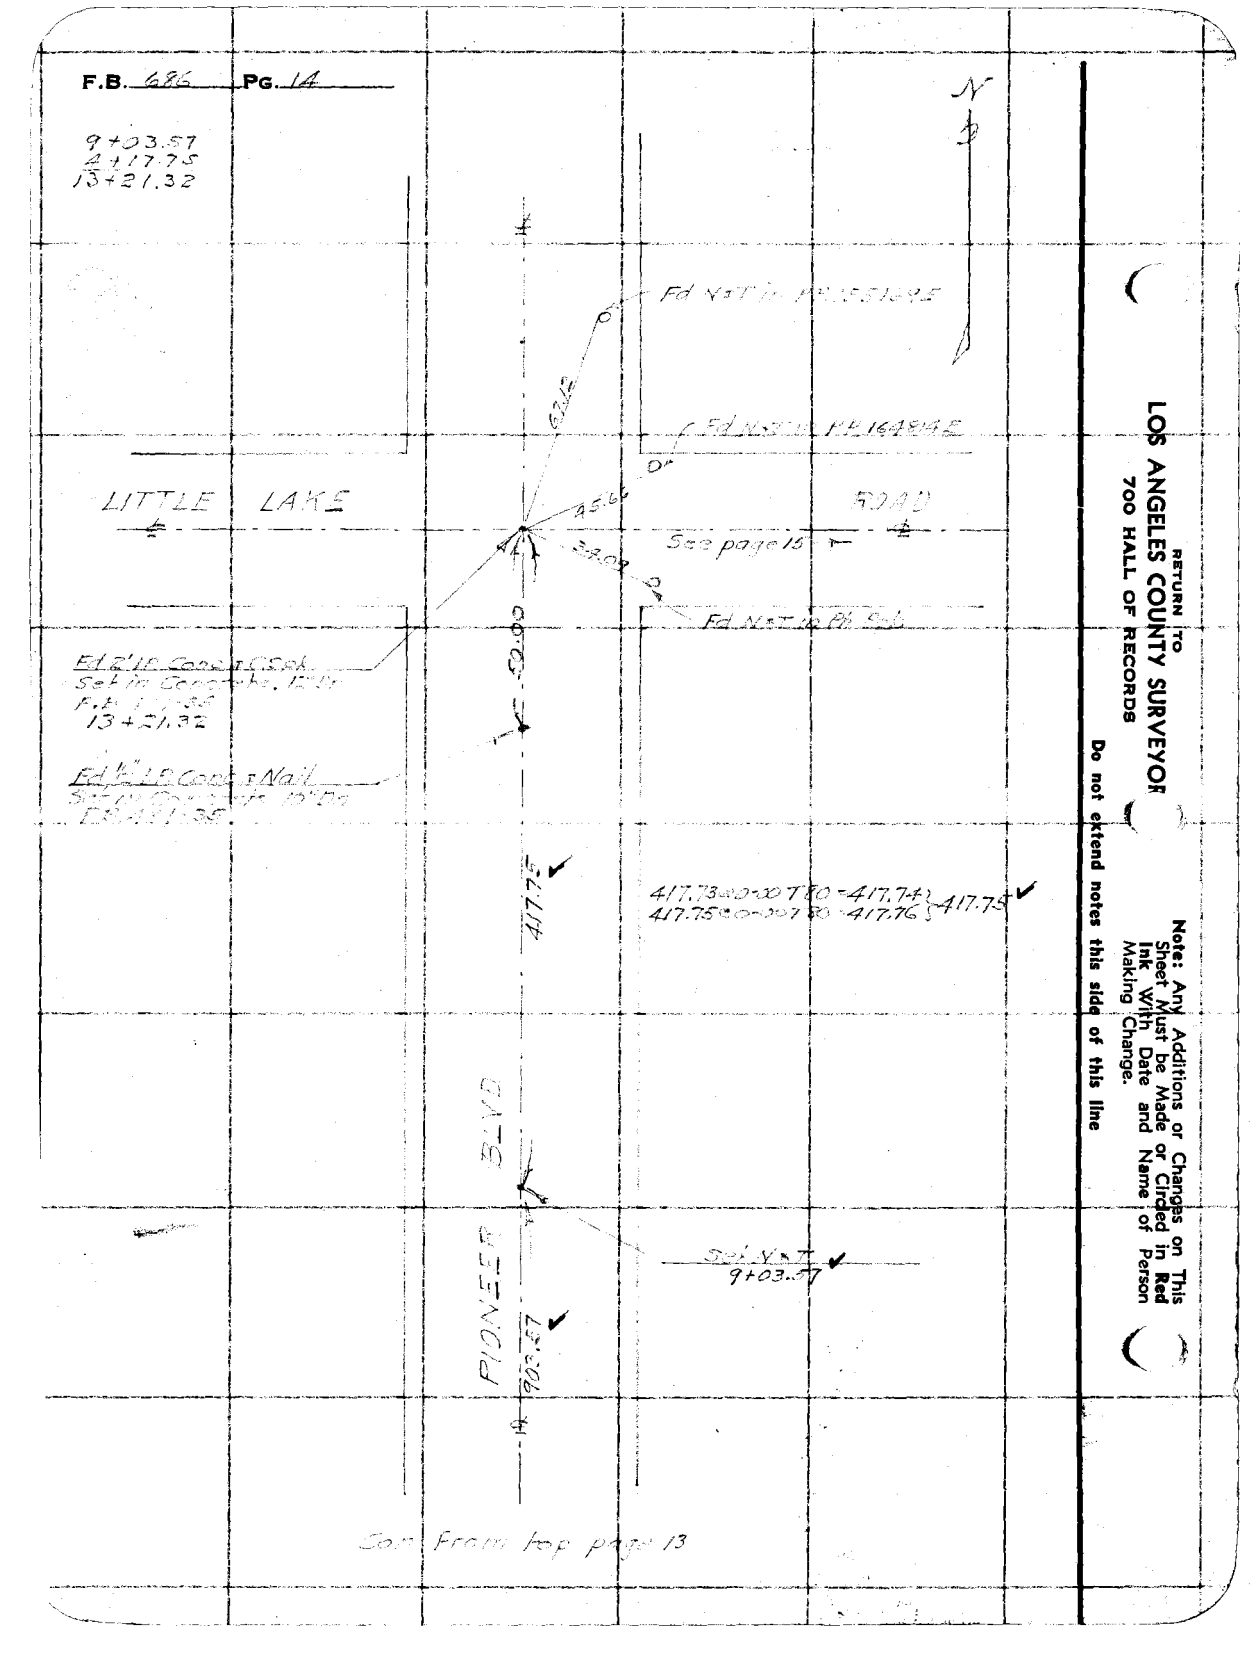

RETURN TO
LOS ANGELES COUNTY SURVEYOR
700 HALL OF RECORDS

Note: Any Additions or Changes on This Sheet Must be Made or Circled in Red Ink With Date and Name of Person Making Change.

Do not extend notes this side of this line

Notes Ck'd by McPherson	Survey of LITTLE LAKE CEM ASS'N	F.B. 686	Pg. 15
Map No. B-1308.	W. O. 8173 Tape No. 061 St'd 76 °F.		
Office Work RWMc	Surveyed by W A Miller		
Checked D. M. Finley	Notes Miller Date 12-23-36		
Date June 1938	Indexed A. C. Johnson		

Note: Any Additions or Changes on This Sheet Must be Made or Circled in Red Ink With Date and Name of Person Making Change.

Do not extend notes this side of this line

RETURN TO
LOS ANGELES COUNTY SURVEYOR
700 HALL OF RECORDS

FORM 247 10M 11-35

Cont. in Book pg. 16

ROAD

503.16 @ 0-00 T 58 = 503.90
503.95 @ 0-00 T 58 = 503.89 } 503.70 ✓

Fd 1" I.P. Conc. Plug No 7 k
18" Down
F.B. 489-37

20.50
5.79

Set 1x1 x 11in
1+51.27

151.29 @ 0-00 T 58 = 151.27
151.29 @ 0-00 T 58 = 151.27 } 151.27 ✓

LITTLE LAKE

151.27 ✓

89-59-15 ✓
3.59-57-15
89-59-18 3/4

(20) (40) (20)

89-59-20 ✓

PIONEER

(30) (60)

See page 14

BLVD.

Fd 2" I.P. conc. & C Spk
Set in Concrete - 12" In
F.B. 489-35

F.B. 686 Pg. 16

1+51.27
5+03.90
6+55.17
5+04.53
11+59.70
2+91.38
12+51.09

Con at bottom page 17

(40)
(20) (20)

227.13 @ 0-00 7.68 = 227.12
227.13 @ 0-00 7.68 = 227.12 } 227.12

TUJUNGA WASH 5TH UNIT

227.12

25.23
3.45

Beg. of high wire fence

Set P.K. Spike Tie
14+51.08

291.41 @ 0-00 7.58 = 291.38
291.42 @ 0-00 7.58 = 291.39 } 291.38

291.38

ROAD

Set Nail
11+84.70 From West
13+21.75 From South

Transit Line
See page 20

26.00

20.20
19.99

11+63.60
High wire fence

Fd. 2" I.P. plug with 12" Dowel
F.B. 489-37
11+59.71

Fd Nail & Shiner
F.B. 421-57
11+59.70

LANE

(40)
(20) (20)

504.60 @ 0-00 7.56 = 504.53
504.60 @ 0-00 7.56 = 504.53 } 504.53

504.53

LITTLE

High wire fence

20.10
14.20

Set Iron Pipe Tie
6+55.17

503.10

Con from top page 15

RETURN TO
LOS ANGELES COUNTY SURVEYOR
700 HALL OF RECORDS

Do not extend notes this side of this line

Note: Any Additions or Changes on This Sheet Must be Made or Circled in Red Ink With Date and Name of Person Making Change.

Notes Ck'd by McPherson	Survey of LITTLE LAKE CEM'TRY	F.B. 656	PG. 19
Map No. B-1308	W. O. 8173 Tape No. 061 St'd 76 °F.		
Office Work RWMc	Surveyed by W.A. Miller	14+51.09	14+51.09
Checked D. M. Finley	Notes Miller Date 12-23-36	51.62	2+27.42
Date June 1938.	Indexed A. C. Johnson	15+19.70	16+78.20
			10+93.66

Note: Any Additions or Changes on This Sheet Must be Made or Circled in Red Ink With Date and Name of Person Making Change

Do not extend notes this side of this line

RETURN TO
LOS ANGELES COUNTY SURVEYOR
700 HALL OF RECORDS

Fd S.W.T. 0.10 Dg.W.
Rd Dpt SF 33-19
Rd Dpt FO 388-12
F.B. 21-71+78
F.B. 208-6
F.B. 189-38
(See page 8 for data)
27 + 71.26

ROAD

NORWALK & PUENTE MILLS

ROAD
See page 8

89-47-40

89-47-45
359-10-45
89-47-41½

1093.10 @ 0+00 / 70 = 1093.10 (A) / 1093.05

1093.03

LITTLE LAKE

(20) (20)

Set N.T.
16+78.20

435
25A

High Wire Fence

Set N.T.
15+19.70

Iron Pipe

High Wire Fence

LITTLE LAKE SCHOOL

Cont from top page 18

FORM 247 10M 11-35

F.B. 686 Pg. 18

Con. of bottom page 19

286.97@0-00+58 = 286.94
286.99@0-00+08 = 286.96 ± 286.95

286.95

Set 1x1 Tin
0+00 going North
11+88.25 from West

Wire Fence

TRANSIT Line

LITTLE LAKE CEMETERY

Wire Fence

89-51-45
3.59-26-45
89-51-41¼

89-51-45

29.42

29.42

To PIONEER BLVD ±

LAKELAND

Ø ROAD

(20) (40)

Ed in Tin page 10
11+58.83

RETURN TO
LOS ANGELES COUNTY SURVEYOR
700 HALL OF RECORDS

Note: Any Additions or Changes on This Sheet Must be Made or Circled in Red Ink With Date and Name of Person Making Change.

Do not extend notes this side of this line

Notes Ck'd by McPherson	Survey of LITTLE LAKE CEMTY	F.B. 626	Pg. 19
Map No. B-1308	W. O. 8173 Tape No. 661 St'd 76 °F.		
Office Work R.W.M.C.	Surveyed by W.A. Miller		
Checked D. M. Finley	Notes Miller Date 12-27-36		
Date June 1938	Indexed A. C. Johnson		

5+70.38
8+86.95
8+77.33
7+77.11
10+51.44

Cont at bottom page 20

267.31

267.33 @ 0-00 T 58 = 267.30
267.35 @ 0-00 T 58 = 267.32 } 267.31

LITTLE LAKE SCHOOL

34.00

30.90

10

Conc.

48.35

1 Sty Stuc Garage

10+48.89

33.90
24.60

Wire fence

10+48.44

Set 1x1 P Tin
10+54.44

177.13 @ 0+00 T 58 = 177.11
177.13 @ 0-00 T 58 = 177.11 } 177.11

High wire fence

177.11 Line

Transit

Wire fence

Fd W Spk + T 0.53 West
8+81.26

High wire Fence
8+81.33

23.10

Set 1x1 & Tin
8+77.33

LITTLE LAKE CEMETERY

38.95

Con from top page 18

Note: Any Additions or Changes on This Sheet Must be Made or Circled in Red Ink With Date and Name of Person Making Change

Do not extend notes this side of this line

RETURN TO
LOS ANGELES COUNTY SURVEYOR
700 HALL OF RECORDS

FORM 247 10M 11-38

F.B. 686 Pg. 20

10+54.44
2+67.31
13+21.75

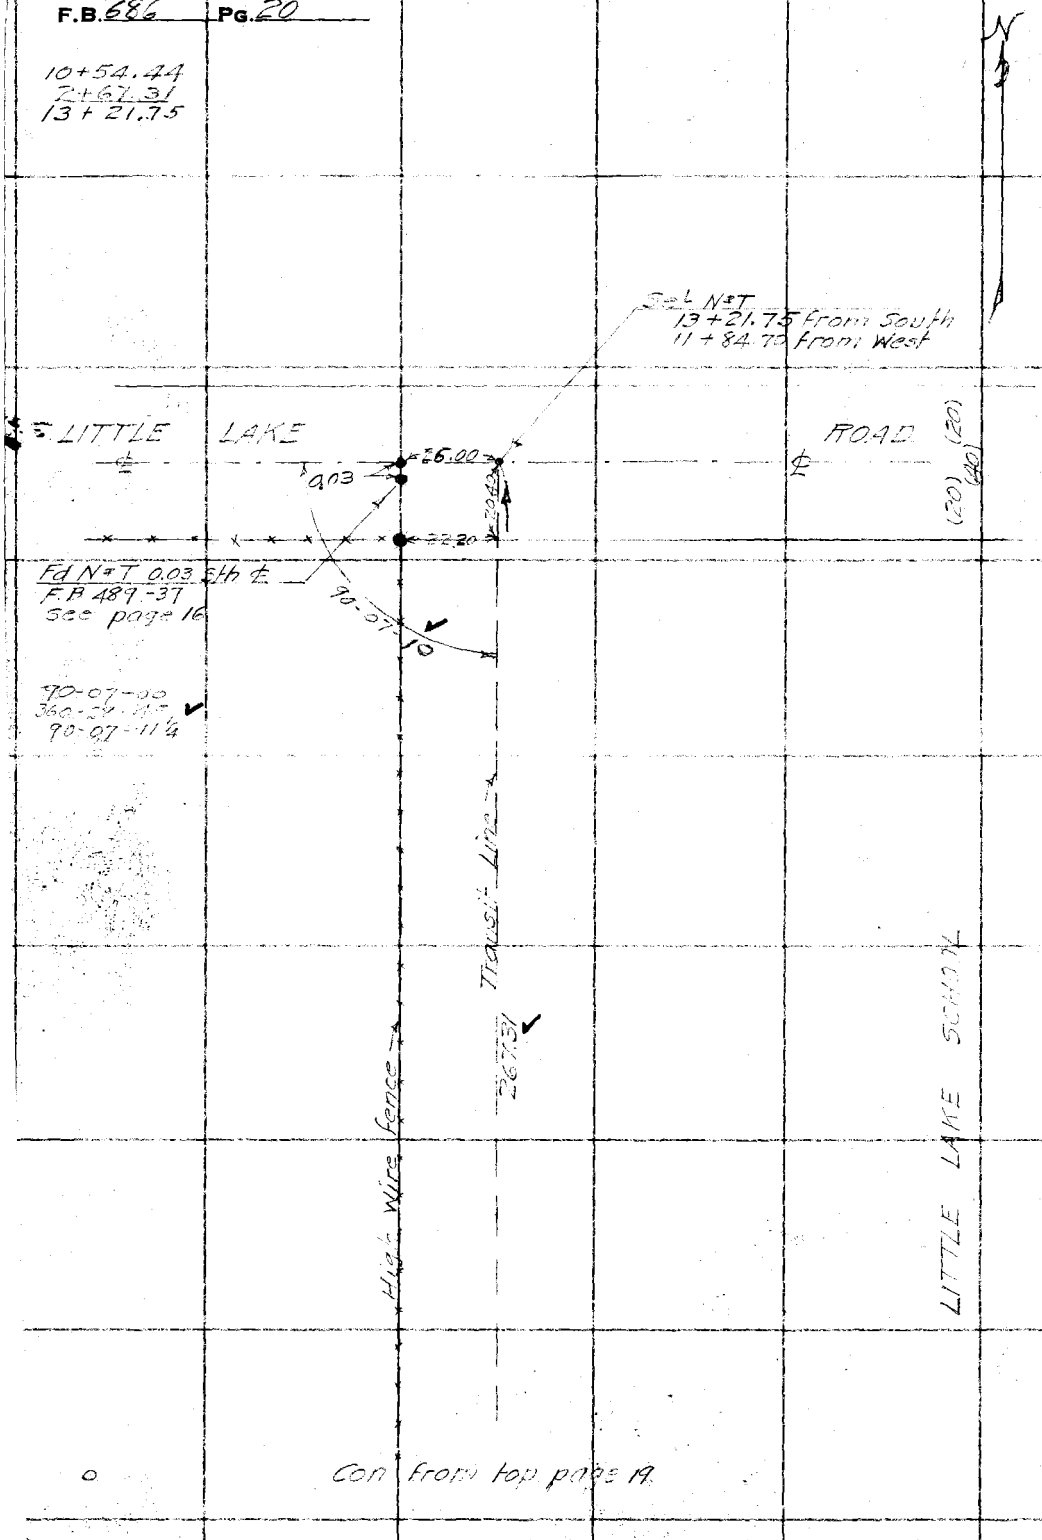

Con from top page 19

RETURN TO
LOS ANGELES COUNTY SURVEYOR
700 HALL OF RECORDS

Note: Any Additions or Changes on This Sheet Must be Made or Circled in Red Ink With Date and Name of Person Making Change.

Do not extend notes this side of this line

Notes Ck'd by	McPherson	Survey of	LITTLE LAKE CEMETERY
Map No.	B-1308.	W. O.	8173 Tape No. St'd °F.
Office Work	R.W.M.	Surveyed by	W.A. Miller
Checked	D. M. Finley	Notes	Miller Date
Date	June 1938	Indexed	A. C. Johnson

F.B. 686 Pg. 21

Note: Any Additions or Changes on This Sheet Must be Made or Circled in Red Ink With Date and Name of Person Making Change

Do not extend notes this side of this line

RETURN TO
LOS ANGELES COUNTY SURVEYOR
7OD HALL OF RECORDS

FORM 247 10M 11-35

997.04 @ 0-00 T 62 = 996.95 996.95
997.04 @ 0-00 T 62 = 996.95

Fd 2" I.P. Plug & Tk No Tag

Set 2x2 & TK

Set 2x2 & TK by Inter 8" Down

Fd 4" I.P. Conc. & Nail 0.03 N. of Line

Fd 1x1 & Tin 14+53.06 See page 11.

LITTLE LAKE ROAD

SCHOOL

CEMETERY

ROAD

LAKELAND

125.02 @ 0-00 T 56 = 125.00
125.02 @ 0-00 T 56 = 125.00

Set 2x2 & TK

125.02 @ 0-00 T 54 = 125.00
125.02 @ 0-00 T 54 = 125.00

Set 1x1 & Tin

145.02 @ 0-00 T 58 = 145.00
145.02 @ 0-00 T 58 = 145.00

170.03 @ 0-00 T 49 = 170.00
170.03 @ 0-00 T 49 = 170.00

295.05 @ 0-00 T 47 = 295.00
295.05 @ 0-00 T 47 = 295.00

Fd 6" I.P. Conc. & Nail 0.05 N. of Line

89-49-45
359-19-00
89-49-45

Set 5 W.I.T.

Set 1x1 & Tin

1026.98 @ 0-00 T 54 = 1026.83
1026.98 @ 0-00 T 54 = 1026.83

1026.83 Transmission Line

Fd 2" I.P. Plug & Nail 11+39.71 From West See page 16

Set C.S. Brass Cap Mon. 18" Dn 5/16/37 W.A.M.

Set C.S. Brass Cap Mon. 18" Dn 5/16/37 W.A.M. S.W. Cor Little Lake Cemetery Replaced C.S. Brass Cap Mon.

Set 2x2 & TK 18" Down

Set 2x2 & TK by Inter 8" Down 11+63.35

Set S.W.I.T. 30' off ℄ 18" Dn by Inter 6-16-1937 W.A.M. 11+59.65 15' From West

Fd 1x1 & Tin 11+58.83 See page 10

90-10-15
360-41-00
90-10-15

89-48-30
359-13-30
89-34-22½

258.40 @ 0-00 T 74 = 258.38
258.40 @ 0-00 T 74 = 258.38

258.38
- 4.18
254.20

RETURN TO
LOS ANGELES COUNTY SURVEYOR
700 HALL OF RECORDS

Note: Any Additions or Changes on This Sheet Must be Made or Circled in **Red Ink** With Date and Name of Person Making Change.

Do not extend notes this side of this line

F.B. 686 PG. 12

 

 

Notes Ck'd by D. M. Finley	Survey of LITTLE LAKE CEMETERY	F.B. 686	PG. 23
Map No. ~~B-1308-2~~ B-1412	W. O. 8173 Tape No. St'd °F.		
Office Work RW.MS	Surveyed by W.A.Miller		
Checked D. M. Finley	Notes Miller Date Jan '37		
Date JUNE 1938	Indexed C. Johnson		

Set 2+2
Page 21
1+25.00

East Boundary of Cemetery

Terry Brownlee
1+06.75

0+86.50

Transit Line

Set P.K.
10+28.89 from South
0+00 West

RETURN TO
LOS ANGELES COUNTY SURVEYOR
700 HALL OF RECORDS

Note: Any Additions or Changes on This Sheet Must be Made or Circled in Red Ink With Date and Name of Person Making Change.

Do not extend notes this side of this line

0+79.45
49.0

St. Line Garage

1+08.10

18.90

1+04.05

Chas H. Weaver
Grave marked Son is most northerly one in this lot.

FORM 247 10M 11-35

RETURN TO
LOS ANGELES COUNTY SURVEYOR
700 HALL OF RECORDS

Note: Any Additions or Changes on This Sheet Must be Made or Circled in **Red Ink** With Date and Name of Person Making Change.

Do not extend notes this side of this line

F.B. 686 PG. 24

Notes Ck'd by D. M. Finley	Survey of LITTLE LAKE CEMETERY
Map No. B-1398-2 B-1412	W. 08173 Tape No. St'd °F.
Office Work RWMS	Surveyed by W.A. Miller
Checked D. M. Finley	Notes Miller Date 1-8-37
Date June 1938	Indexed C. Johnson 2-1-37

F.B. 686 PG. 25

Con. at bottom page 26

N

2+98 15" Palm

2+95 15" Palm

2+65 15" Palm

2+65 15" Palm

2+30 15" Palm

2+30 15" Palm

Gravel Roadway

Fd X in Conc Post 2+15.32

16.31

Lot 3 Blk K

1+94 15" Palm

Set N&T 2+00

1+94 15" Palm

1+61 15" Palm

10.0

10.6

1+61 15" Palm

1+24 15" Palm

1+24 15" Palm

Curb

Lot 3 Blk N

0+91 15" Palm

0+91 15" Palm

16.32

Fd X on Conc Post 0+84.09

0+58 15" Palm

End Curb 0+45.2

9.8

10.2

Lot 4 Blk N

0+58 15" Palm

0+45.2 End Curb

Set N&T 0+50

16.19

Fd 1" I.P. 0+41.02

30.00

LAKELAND

℄

ROAD

Set 1/4 Tim - Angle 21 From West 0+00 North.

Note: Any Additions or Changes on This Sheet Must be Made or Circled in Red Ink With Date and Name of Person Making Change.

Do not extend notes this side of this line

RETURN TO LOS ANGELES COUNTY SURVEYOR 700 HALL OF RECORDS

FORM 247 10M 11-35

F.B. 686 PG. 26

Con at bottom page 27

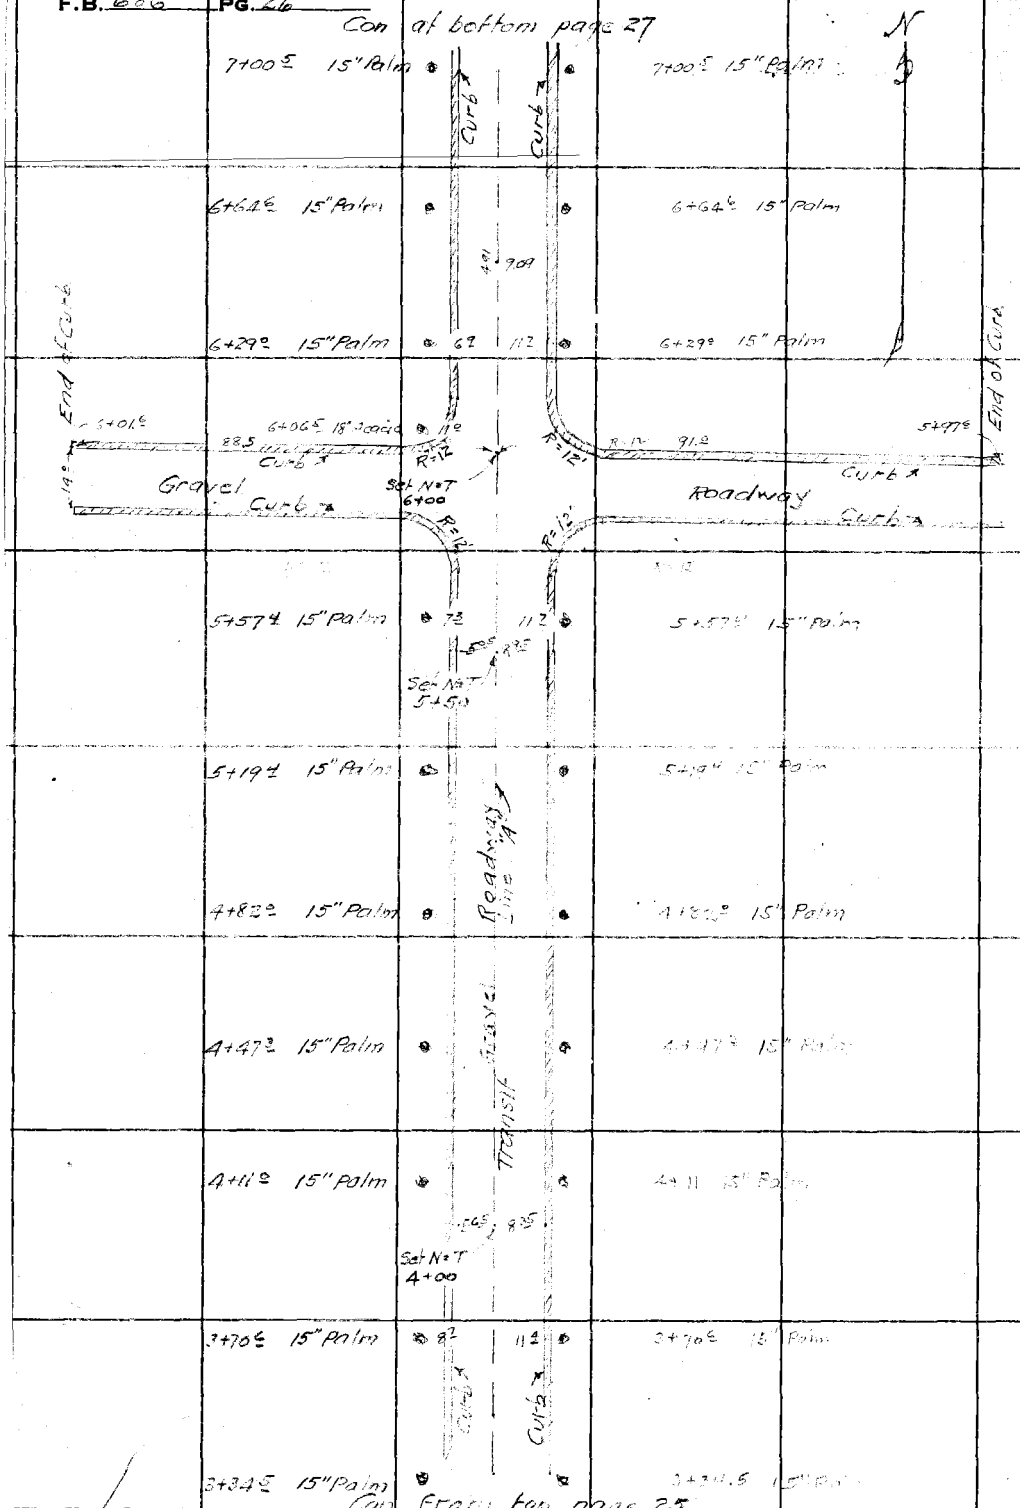

Cont from top page 25

RETURN TO
LOS ANGELES COUNTY SURVEYOR
700 HALL OF RECORDS

Note: Any Additions or Changes on This Sheet Must be Made or Circled in Red Ink With Date and Name of Person Making Change.

Do not extend notes this side of this line

Notes Ck'd by D. M. Finley	Survey of LITTLE LAKE CEMETRY	F.B. 686	PG 27
Map No. ~~B-108-2~~ B-94	W. O. 8173 Tape No.	St'd	°F.
Office Work RW-MC	Surveyed by W.A. Miller		
Checked D. M. Finley	Notes Miller Date 1-8-37		
Date June 1938	Indexed A. C. Johnson		

Note: Any Additions or Changes on This Sheet Must be Made or Circled in Red Ink With Date and Name of Person Making Change.

Do not extend notes this side of this line

RETURN TO
LOS ANGELES COUNTY SURVEYOR
700 HALL OF RECORDS

Set 2 x 2 Page 21
10+26.89
10+11.6 Pine Cone
Fd 1" I.P.
10+12.83
9+16.8 15" Palm
15" Palm 18" Palm
16.93
Lot 1
Block B
9+56.5 15" Palm
9+18.4 15" Palm
9+94 15" Palm
8+52 15" Palm
8+18.2 15" Palm
8+00 15" Palm
Lot 2
Block B
Fd x in Conc Post
7+92.80
7+71.2 15" Palm
Fd x in Conc Post
7+99.84
Lot 23
Block C
7+27.8 15" Palm
Set N & T
7+50
Fd 1" I.P.
7+21.92
Lot 1
Block E
Gravel Road
Con from top page 26

FORM 247 10M 11-35

RETURN TO
LOS ANGELES COUNTY SURVEYOR
700 HALL OF RECORDS

Note: Any Additions or Changes on This Sheet Must be Made or Circled in **Red Ink** With Date and Name of Person Making Change.

Do not extend notes this side of this line

F.B. 686 PG. 28

Notes Ck'd by D. M. Finley	Survey of LITTLE LAKE CEMETERY	F.B. C&S	PG. 29
Map No. ~~B-1308-2~~ B-1417	W. O. 3132 Tape No. St'd °F.		
Office Work RW.MC	Surveyed by W A Miller		
Checked D. M. Finley	Notes Miller Date Jan '37		
Date June 1938.	Indexed A. C. Johnson		

Note: Any Additions or Changes on This Sheet Must be Made or Circled in Red Ink With Date and Name of Person Making Change.

Do not extend notes this side of this line

RETURN TO
LOS ANGELES COUNTY SURVEYOR
700 HALL OF RECORDS

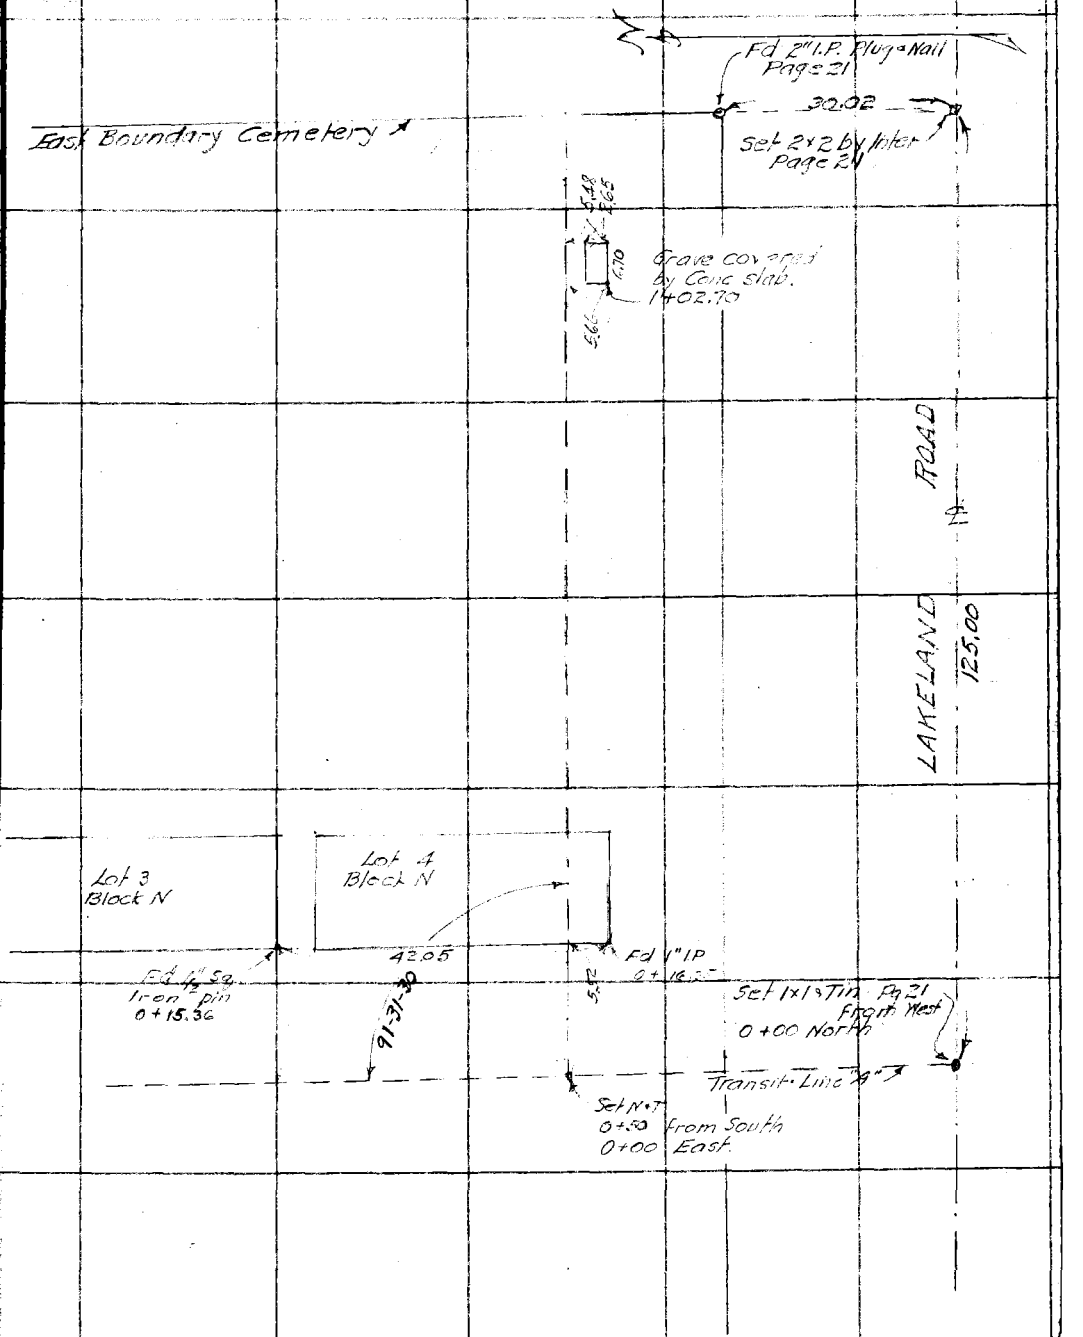

FORM 247 10M 11-35

F.B. 686 PG. 30

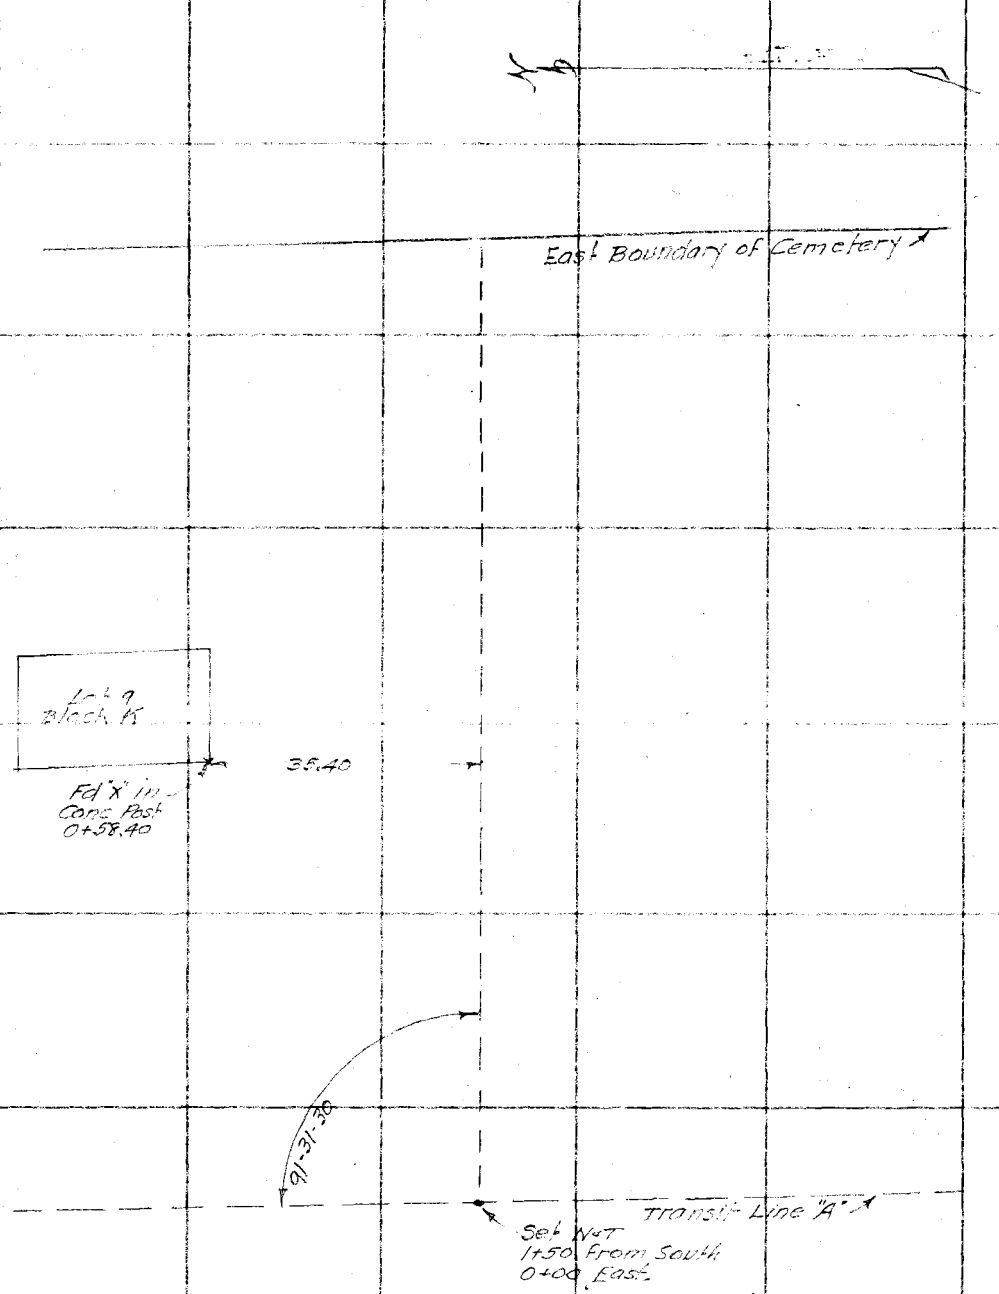

RETURN TO
LOS ANGELES COUNTY SURVEYOR
700 HALL OF RECORDS

Note: Any Additions or Changes on This Sheet Must be Made or Circled in Red Ink With Date and Name of Person Making Change.

Do not extend notes this side of this line

Notes Ck'd by D. M. Finley	Survey of LITTLE LAKE CEMTRY
Map No. B-1388-2 8-1A12	W. O. 8173 Tape No. St'd °F.
Office Work R.W.M.	Surveyed by W.A.Miller
Checked D. M. Finley	Notes Miller Date Jan 1937
Date JUNE 1938.	Indexed A. C. Johnson

F.B. 686 PG. 31

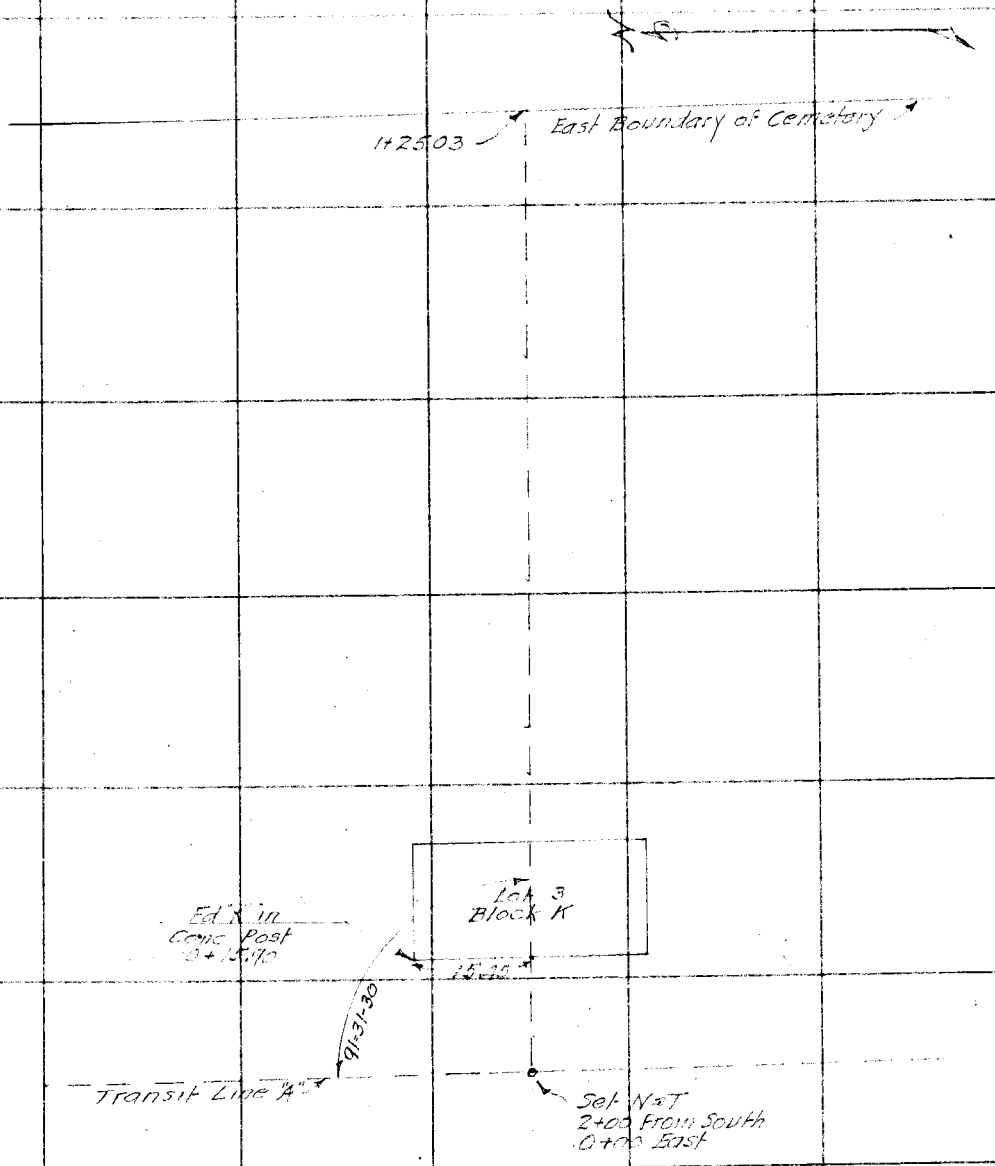

RETURN TO
LOS ANGELES COUNTY SURVEYOR
700 HALL OF RECORDS

Note: Any Additions or Changes on This Sheet Must be Made or Circled in Red Ink With Date and Name of Person Making Change

Do not extend notes this side of this line

FORM 247 10M 11-35

F.B. 686 Pg. 32

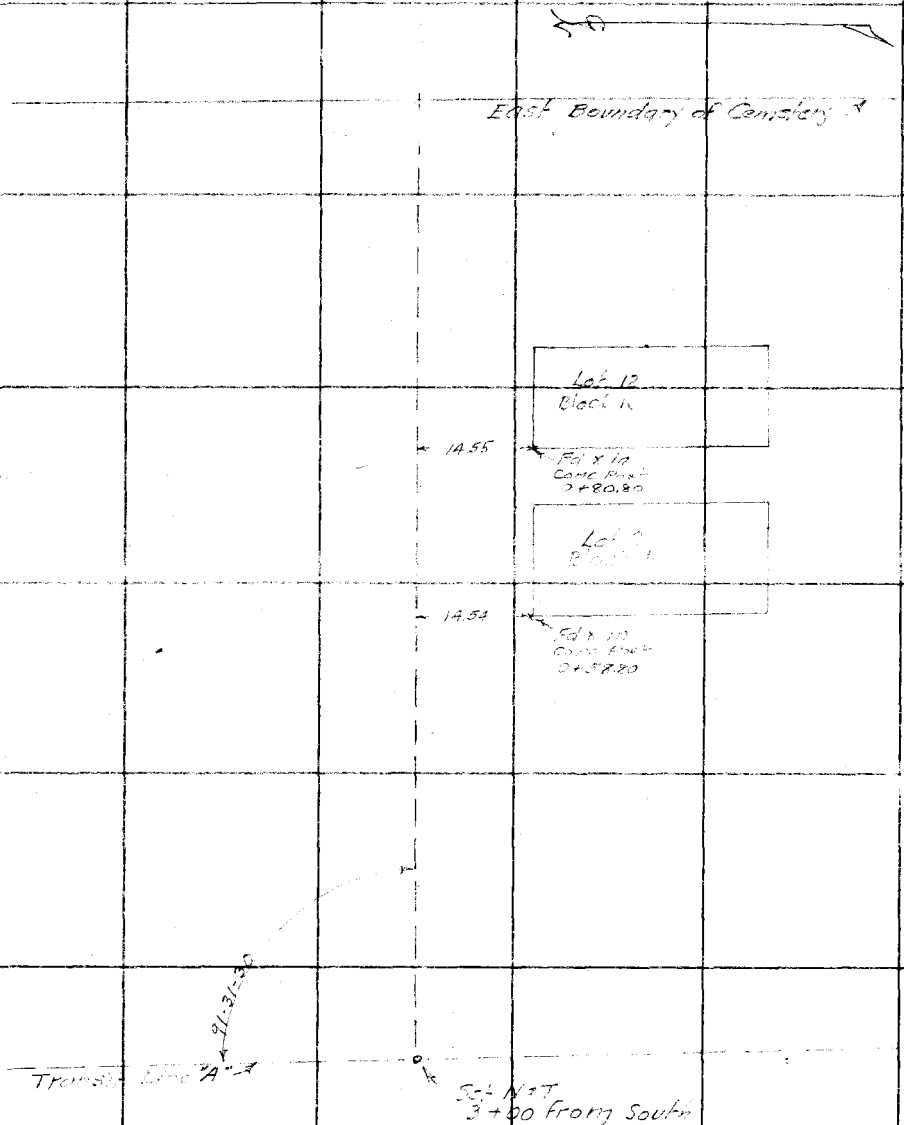

RETURN TO
LOS ANGELES COUNTY SURVEYOR
700 HALL OF RECORDS

Do not extend notes this side of this line

Note: Any Additions or Changes on This Sheet Must be Made or Circled in Red Ink With Date and Name of Person Making Change.

Notes Ck'd by D. M. Finley	Survey of LITTLE LAKE CEMETERY	F.B. 686	Pg. 33
Map No. ~~B-1308 2 B-1447~~	Rec. O.8173 Tape No. St'd °F.		
Office Work R.W.M.S	Surveyed by W.A. Miller		
Checked D. M. Finley	Notes Miller Date Jan 1937		
Date June 1938.	Indexed A. C. Johnson		

East Boundary Cemetery

Fd x in Curb
1+14.35

SAF

Lot No
Block J

9°-31'-30"

Transit Line A"-X

Set Nail
3+50 From South
0+00 East.

RETURN TO
LOS ANGELES COUNTY SURVEYOR
700 HALL OF RECORDS

Note: Any Additions or Changes on This Sheet Must be Made or Circled in Red Ink With Date and Name of Person Making Change.

Do not extend notes this side of this line

FORM 247 10M 11-35

F.B. 686 Pg. 34

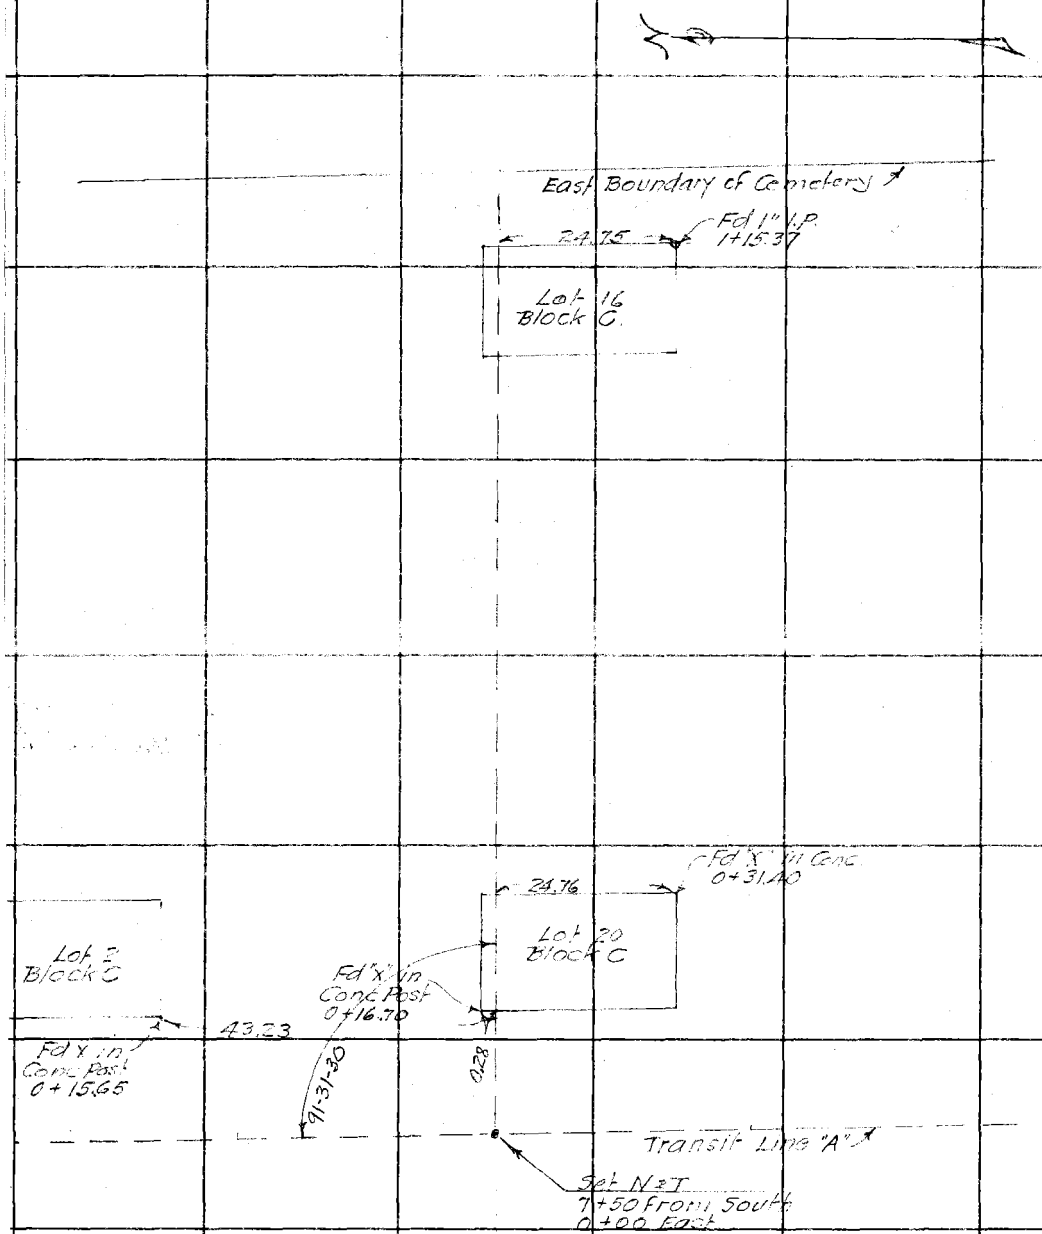

RETURN TO
LOS ANGELES COUNTY SURVEYOR
700 HALL OF RECORDS

Note: Any Additions or Changes on This Sheet Must be Made or Circled in Red Ink With Date and Name of Person Making Change.

Do not extend notes this side of this line

Notes Ck'd by D. M. Finley	Survey of LITTLE LAKE CEMETERY	F.B. 686	Pg. 36
Map No. ~~B-1308-2~~ B-1417	W. O. 8173 Tape No. St'd °F.		
Office Work RW.MC	Surveyed by W.A.Miller		
Checked D. M. Finley	Notes Miller Date Jan 1937		
Date JUNE 1938	Indexed A. C. Johnson		

Note: Any Additions or Changes on This Sheet Must be Made or Circled in Red Ink With Date and Name of Person Making Change.

Do not extend notes this side of this line

RETURN TO
LOS ANGELES COUNTY SURVEYOR
700 HALL OF RECORDS

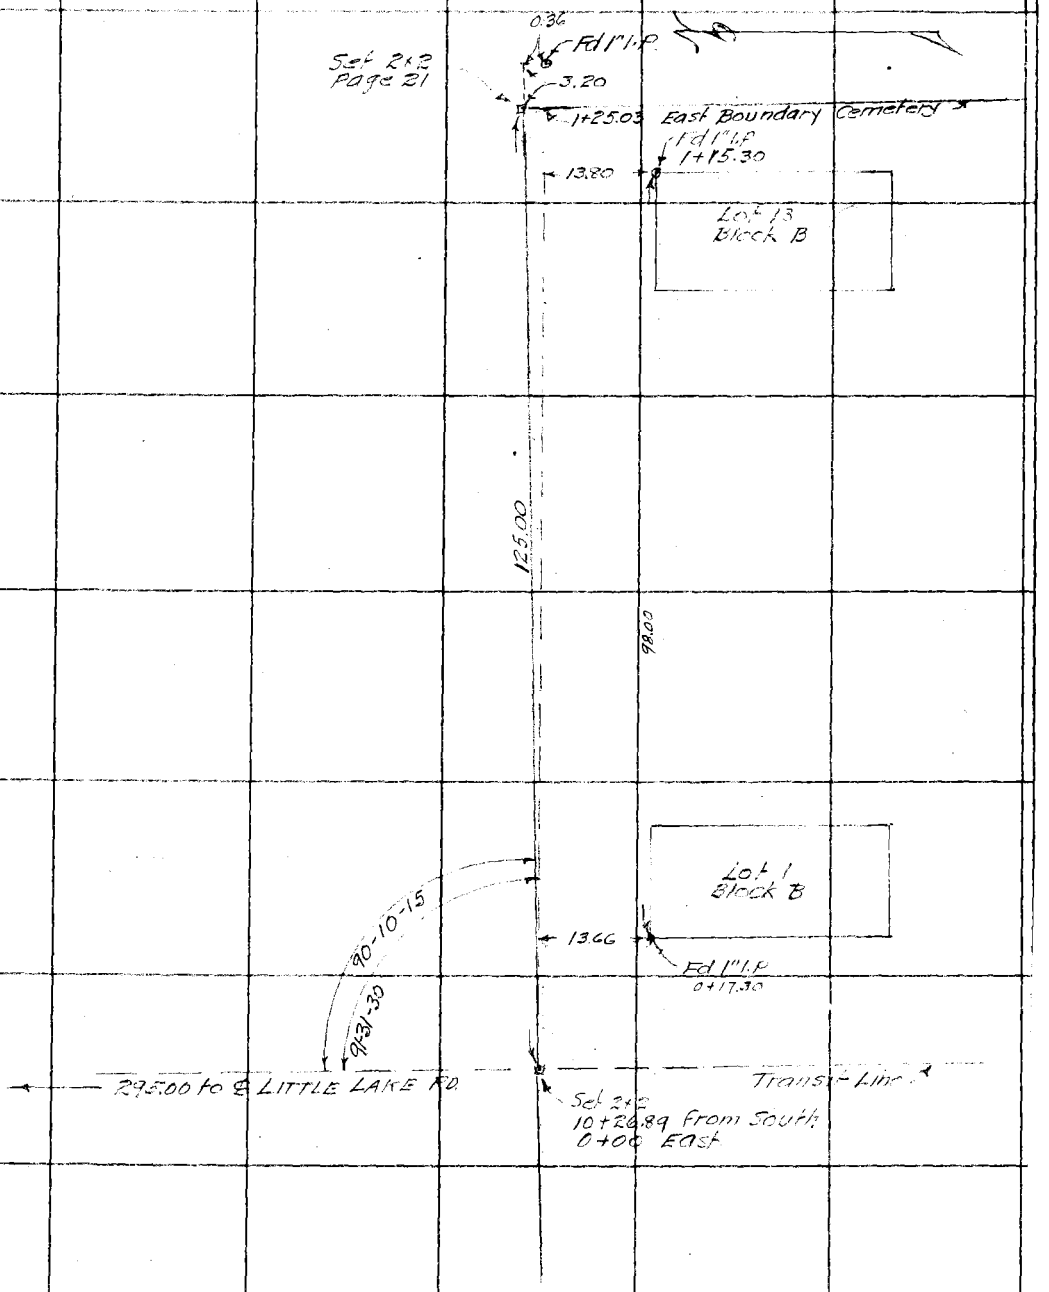

FORM 247 10M 11-35

RETURN TO
LOS ANGELES COUNTY SURVEYOR
700 HALL OF RECORDS

Note: Any Additions or Changes on This Sheet Must be Made or Circled in **Red Ink** With Date and Name of Person Making Change.

Do not extend notes this side of this line

F.B. 686 PG. 36

Notes Ck'd by D. M. Finley	Survey of LITTLE LAKE CEMET'RY
Map No. B-1908-2 B-1917	W. O. 8173 Tape No. St'd °F.
Office Work RW.MC	Surveyed by W.A.Miller
Checked D. M. Finley	Notes Miller Date Jan 1937
Date June 1938.	Indexed A. C. Johnson

F.B. 686 PG. 97

Set Nail
5+50 from Strike
0+00 West

Transit Line "A"

88-29-30

Fd X in Conc Post
0+56.13

25.50

Lot 7
Block A

25.42

Fd X in Conc
0+30.03

Note: Any Additions or Changes on This Sheet Must be Made or Circled in Red Ink With Date and Name of Person Making Change.

Do not extend notes this side of this line

RETURN TO
LOS ANGELES COUNTY SURVEYOR
700 HALL OF RECORDS

FORM 247 10M 11-35

F.B. 686 PG. 38

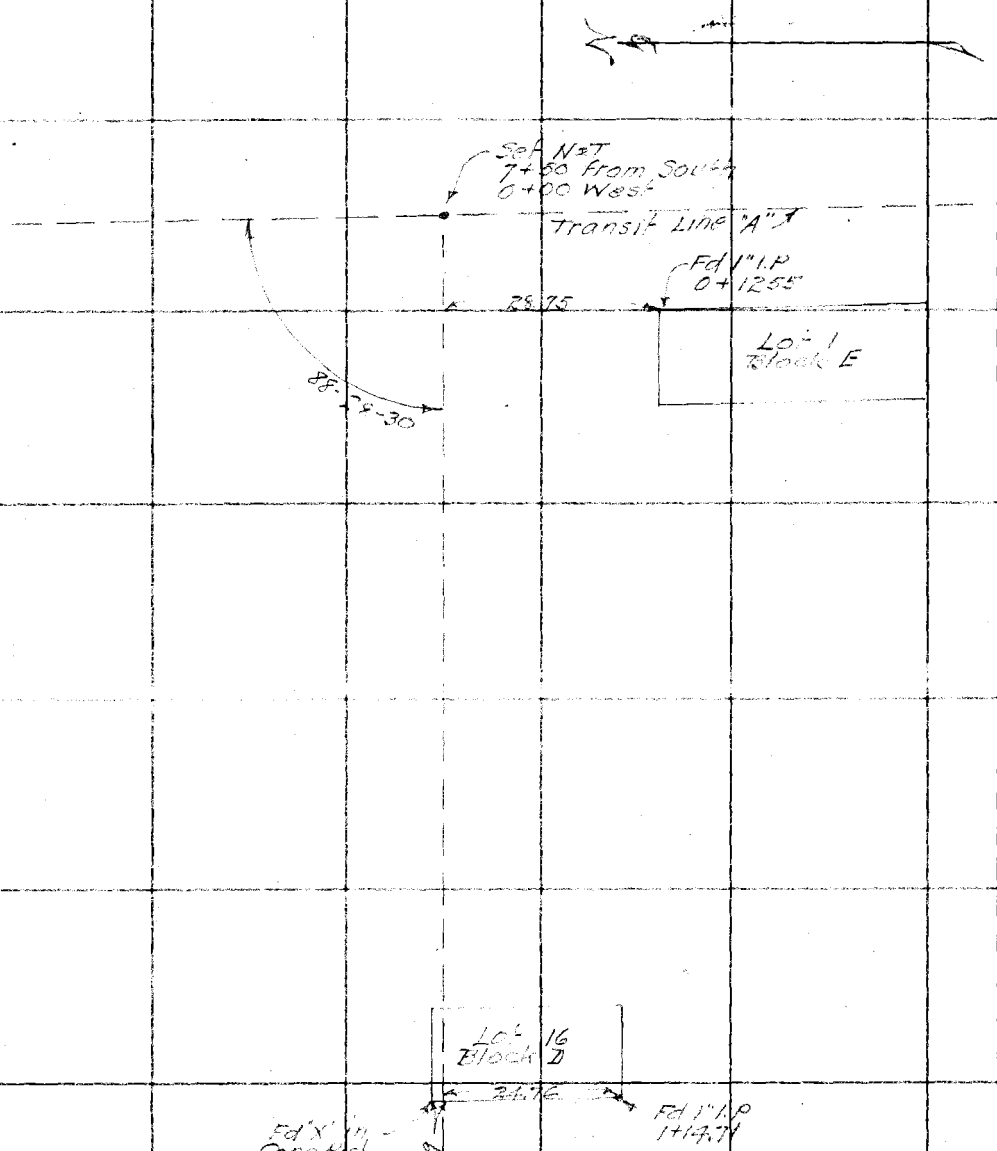

RETURN TO
LOS ANGELES COUNTY SURVEYOR
700 HALL OF RECORDS

Note: Any Additions or Changes on This Sheet Must be Made or Circled in Red Ink With Date and Name of Person Making Change.

Do not extend notes this side of this line

Notes Ck'd by D. M. Finley	Survey of LITTLE LAKE CEMETERY	F.B. 496	Pg. 39
Map No. ~~B-1908-2~~ B-1917	W. O. 8173 Tape No. St'd °F.		
Office Work RW MC	Surveyed by W.A. Miller		
Checked D. M. Finley	Notes Miller Date 1-11-1939		
Date June 1938.	Indexed L. C. Johnson		

Note: Any Additions or Changes on This Sheet Must be Made or Circled in Red Ink With Date and Name of Person Making Change.

Do not extend notes this side of this line

RETURN TO
LOS ANGELES COUNTY SURVEYOR
700 HALL OF RECORDS

FORM 247 10M 11-38

Fd 2x2 Post 3'

Found 1" I.P. No Tag 13 Blk 6

LITTLE LAKE CEMETERY

98.00

125.00

89-52-15
359-29-30
89-52-22½

99.49

Set 2x2 by Iron

Fd 1" I.P. N.Witness L & 1 Blk B

15.00

968.89 Transit Line "B"

13.69

1.94

Transit Line "A"

Fd 2x2 Post 3'

969.04 @ 0-00T50 = 968.88
969.03 @ 0-00T50 = 968.87 } 968.97

969.04 @ 0-00T54 = 968.90
969.05 @ 0-00T54 = 968.91 } 968.91

968.89

F.B. 686 PG. 40

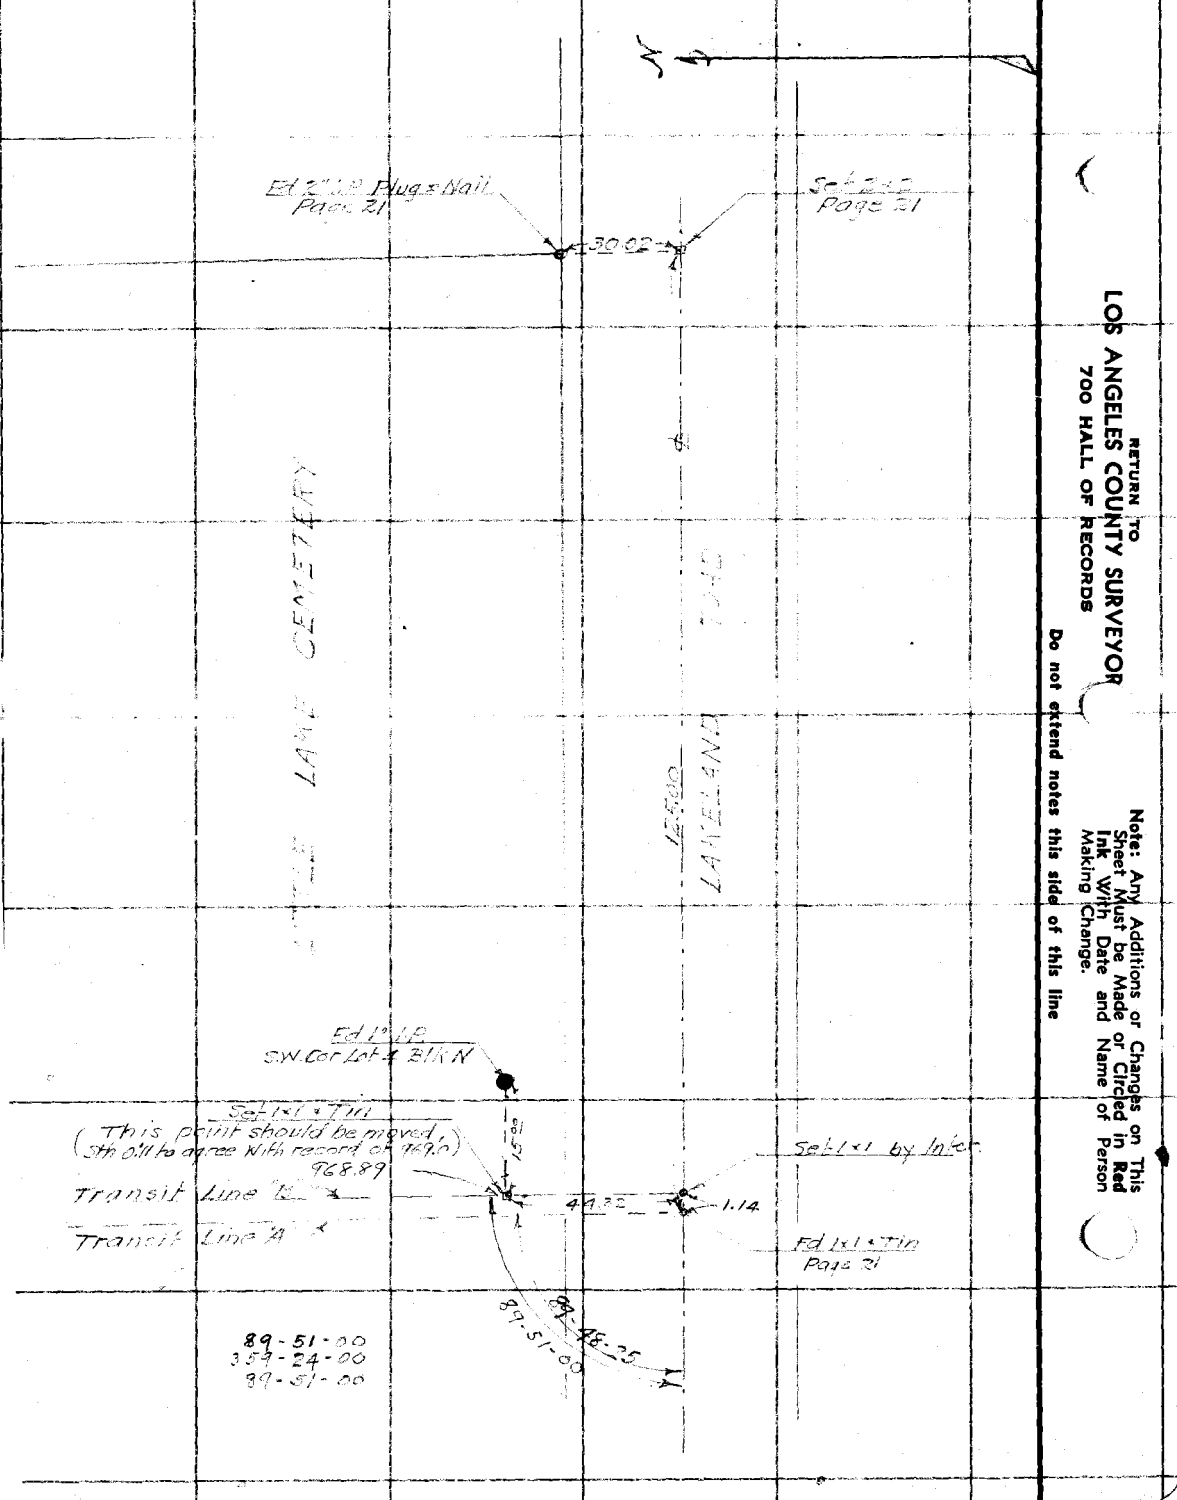

RETURN TO
LOS ANGELES COUNTY SURVEYOR
700 HALL OF RECORDS

Note: Any Additions or Changes on This Sheet Must be Made or Circled in Red Ink With Date and Name of Person Making Change.

Do not extend notes this side of this line

Notes Ck'd by D. M. Finley	Survey of LITTLE LAKE CEMETERY	F.B. 686	PG. 41
Map No. ~~B-1388~~ B-1412	W. O.	Tape No.	St'd 76 °F.
Office Work R.W.M.	Surveyed by W. A. Miller		
Checked D. M. Finley	Notes Miller Date 1-12-1937		
Date June 1938.	Indexed A. C. Johnson		

Fd 2" I.P. Plug + Y
Page 21

20.02

Fd 2 x 2
Page 21

4" Cedar
1+11.3

0.20 N.

Fence
1+08

6" Cedar
1+10.9

34.3

Fence
2.6 x 6.7

1+00.9

34.1

Fence
2.6 x 6.7

1+02

10
on line

(30)

(60)

(30)

6" Cedar Tree
0+84.9

0+78.2

0+80.2

38.2

29.3

Fence
1+37.3

05

6" Cedar
0+61.6

9+56

37.3

0+51.6

18.4

16.8

0+32.2

0+32.4

0+42.4

8" Cedar
0+42.4

6.4

15.3

8" Cedar
0+37.5

LAKELAND ROAD

123.86 Page AC

Fence
0+26.3

0+14.2

0+16.2

0+16.2

0+16.2

13.2

9.9

6.8

2.8

Fd 1" I.P.
0+1.5

0.4

91-30-00.

14.32

Transit Line "B"

Fd 3/4" Dia.
0+00 East
0+00 North.
See page 43

Fd 1 x 1
Page 40

Note: Any Additions or Changes on This Sheet Must be Made or Circled in Red Ink With Date and Name of Person Making Change.

Do not extend notes this side of this line

RETURN TO
LOS ANGELES COUNTY SURVEYOR
700 HALL OF RECORDS

FORM 247 10M 11-35

RETURN TO
LOS ANGELES COUNTY SURVEYOR
700 HALL OF RECORDS

Note: Any Additions or Changes on This Sheet Must be Made or Circled in Red Ink With Date and Name of Person Making Change.

Do not extend notes this side of this line

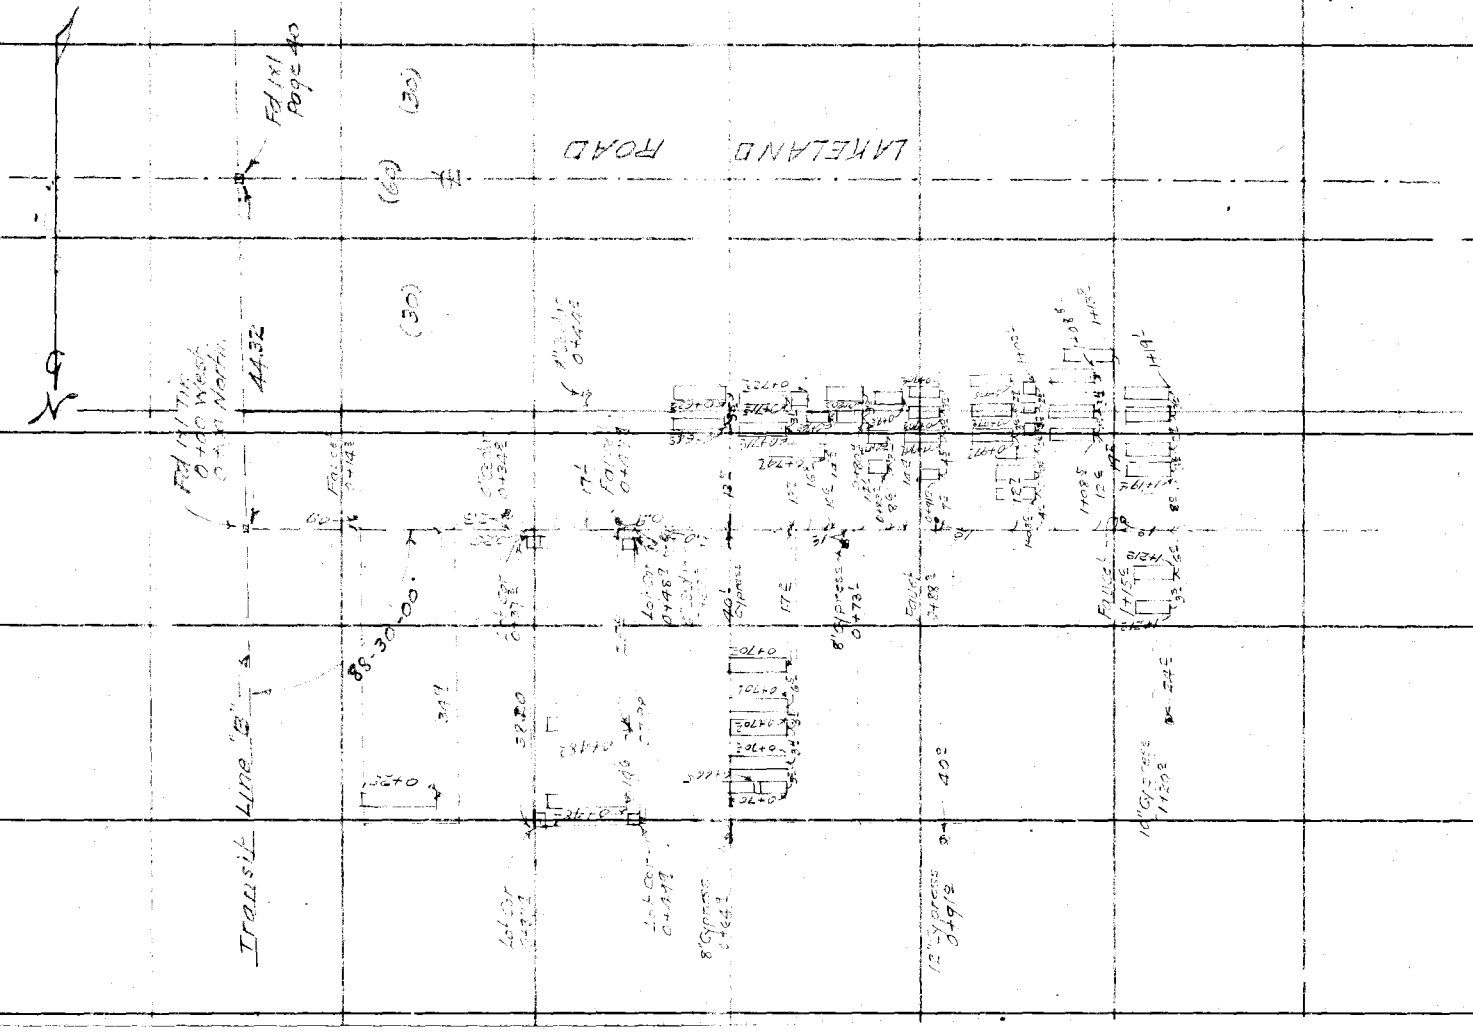
LANDELAND ROAD
Fd 1"I.P.
Pog = 4'0
(30)
(40)
(30)
4432
Fd 1"I.P.
0.40 West
0.40 North
88-30-00
Transit Line "B"
Fence
Fence
Fence

Notes Ck'd by D. M. Finley	Survey of LITTLE LAKE CEMETERY	F.B. 686	Pg. 43
Map No. B-1882 & B-1417	W. O. 8173 Tape No. St'd °F.		
Office Work R.W.M.S	Surveyed by W.A.Miller		
Checked D. M. Finley	Notes Miller Date 4-13-1937		
Date June 1938.	Indexed A. C. Johns		

Note: Any Additions or Changes on This Sheet Must be Made or Circled in Red Ink With Date and Name of Person Making Change.

Do not extend notes this side of this line

RETURN TO
LOS ANGELES COUNTY SURVEYOR
720 HALL OF RECORDS

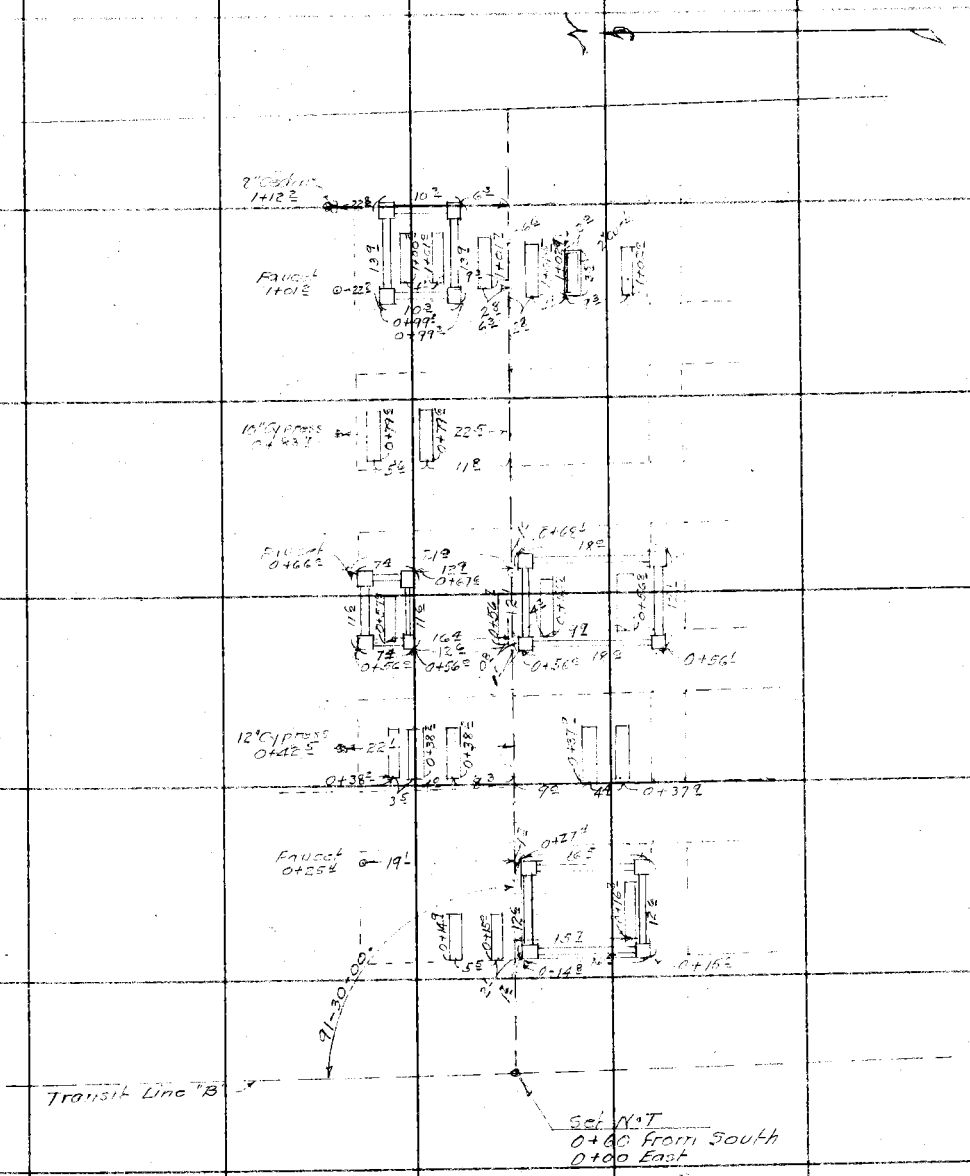

FORM 247 10M 11-35

F.B. 686 PG. 44

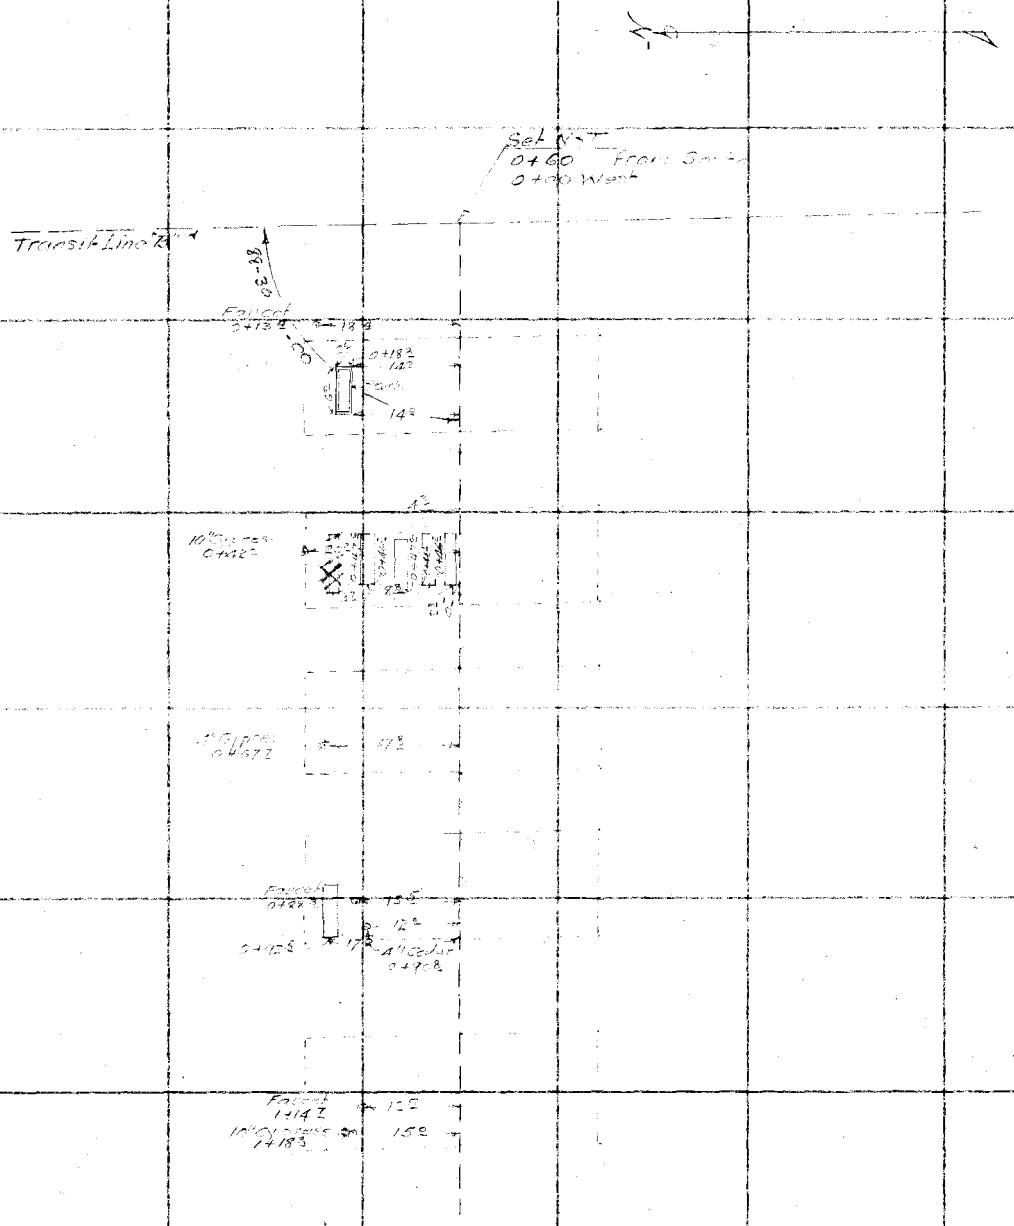

RETURN TO
LOS ANGELES COUNTY SURVEYOR
700 HALL OF RECORDS

Note: Any Additions or Changes on This Sheet Must be Made or Circled in Red Ink With Date and Name of Person Making Change.

Do not extend notes this side of this line

Notes Ck'd by D. M. Finley	Survey of LITTLE LAKE CEM.	F.B. 686	Pg. 45
Map No. ~~B-1482~~ B-1417	W. O. 8173	Tape No.	St'd °F.
Office Work RWMC	Surveyed by W.A.Miller		
Checked D. M. Finley	Notes Miller	Date 1-13-1938	
Date June 1938.	Indexed A. C. Johnson		

Note: Any Additions or Changes on This Sheet Must Be Made or Circled in Red Ink With Date and Name of Person Making Change.

Do not extend notes this side of this line

RETURN TO
LOS ANGELES COUNTY SURVEYOR
700 HALL OF RECORDS

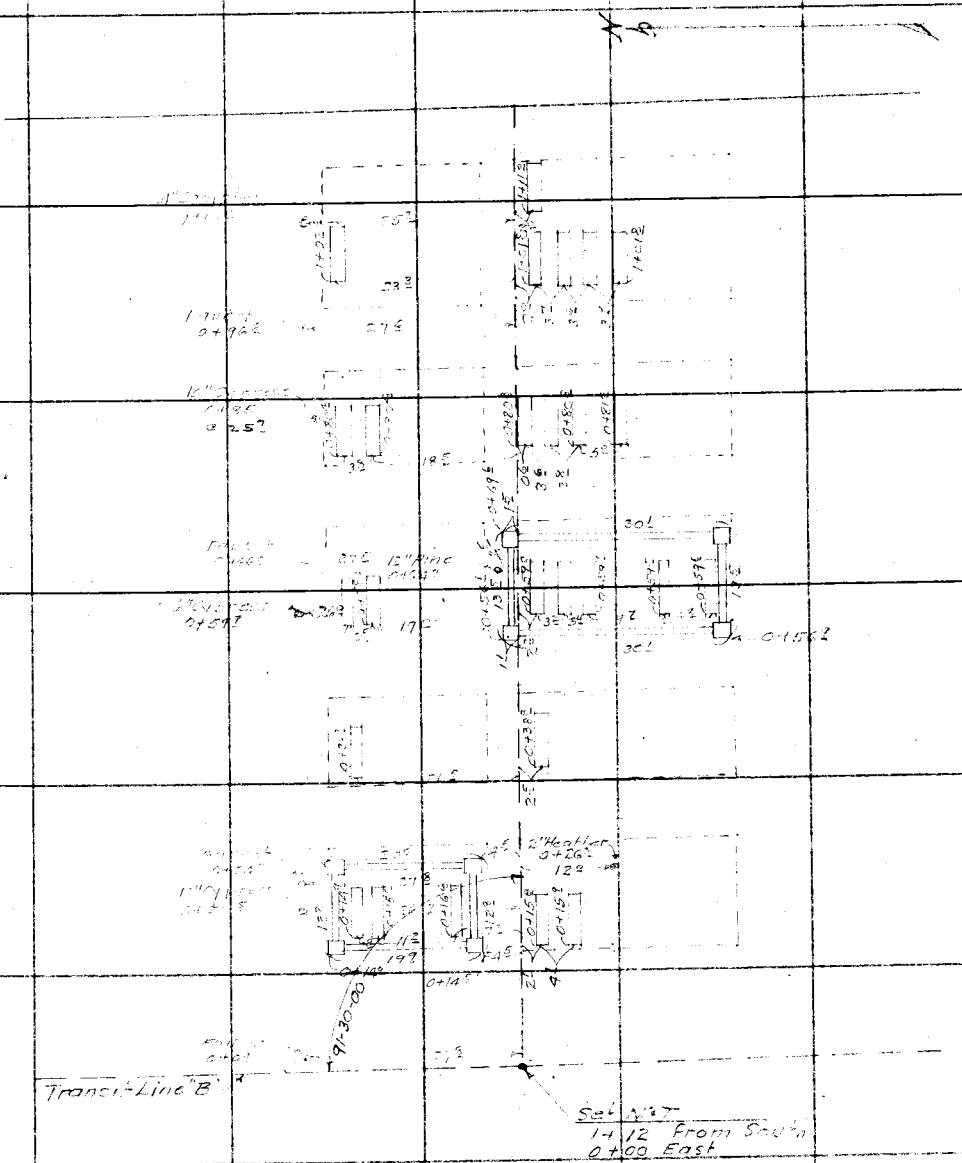

FORM 247 10M 11-35

F.B. 686 Pg. 46

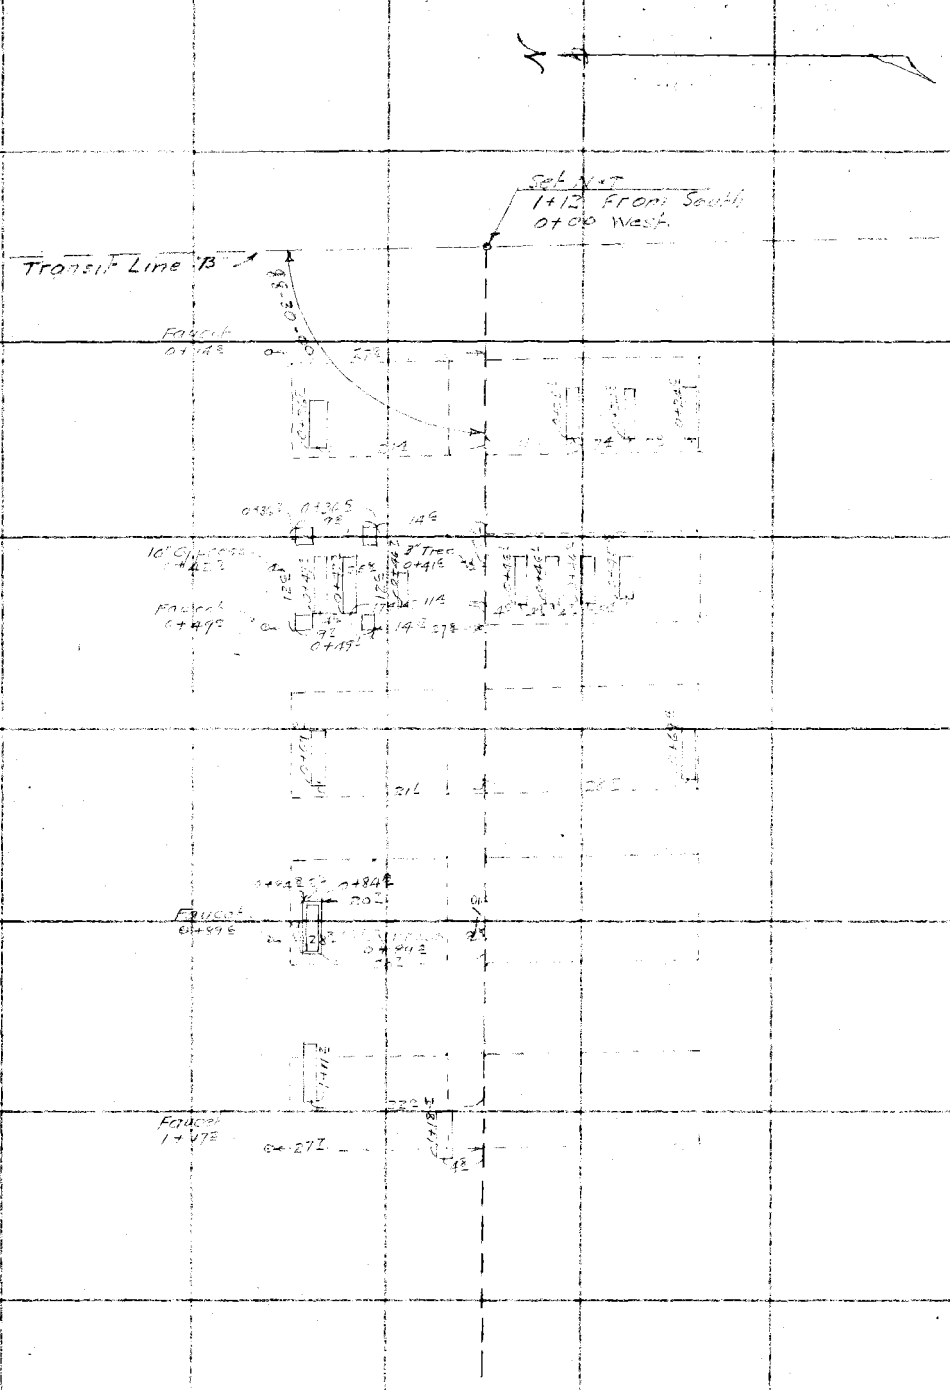

RETURN TO
LOS ANGELES COUNTY SURVEYOR
700 HALL OF RECORDS

Note: Any Additions or Changes on This Sheet Must be Made or Circled in Red Ink With Date and Name of Person Making Change.

Do not extend notes this side of this line

Notes Ck'd by D. M. Finley	Survey of LITTLE LAKE CEM.	F.B. 686	Pg 47
Map No. ~~B-1422~~ B-1412	W. O. 8173 Tape No. St'd °F.		
Office Work RW M[illegible]	Surveyed by W A Miller		
Checked D. M. Finley	Notes Miller Date 1-14-1937		
Date June 1938.	Indexed C. Johnson		

Note: Any Additions or Changes on This Sheet Must be Made or Circled in Red Ink With Date and Name of Person Making Change

Do not extend notes this side of this line

RETURN TO
LOS ANGELES COUNTY SURVEYOR
700 HALL OF RECORDS

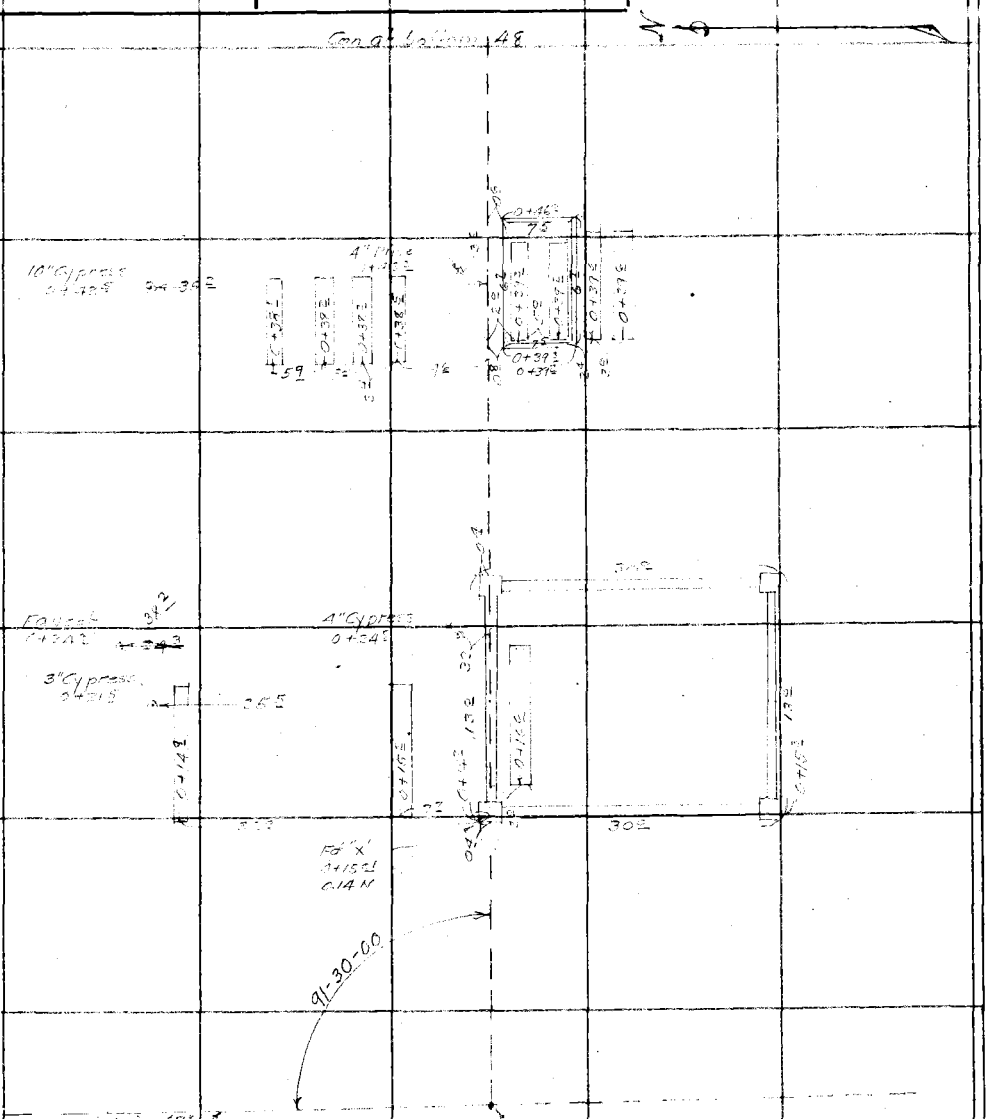

FORM 247 10M 11-35

F.B. 686 Pg. 48

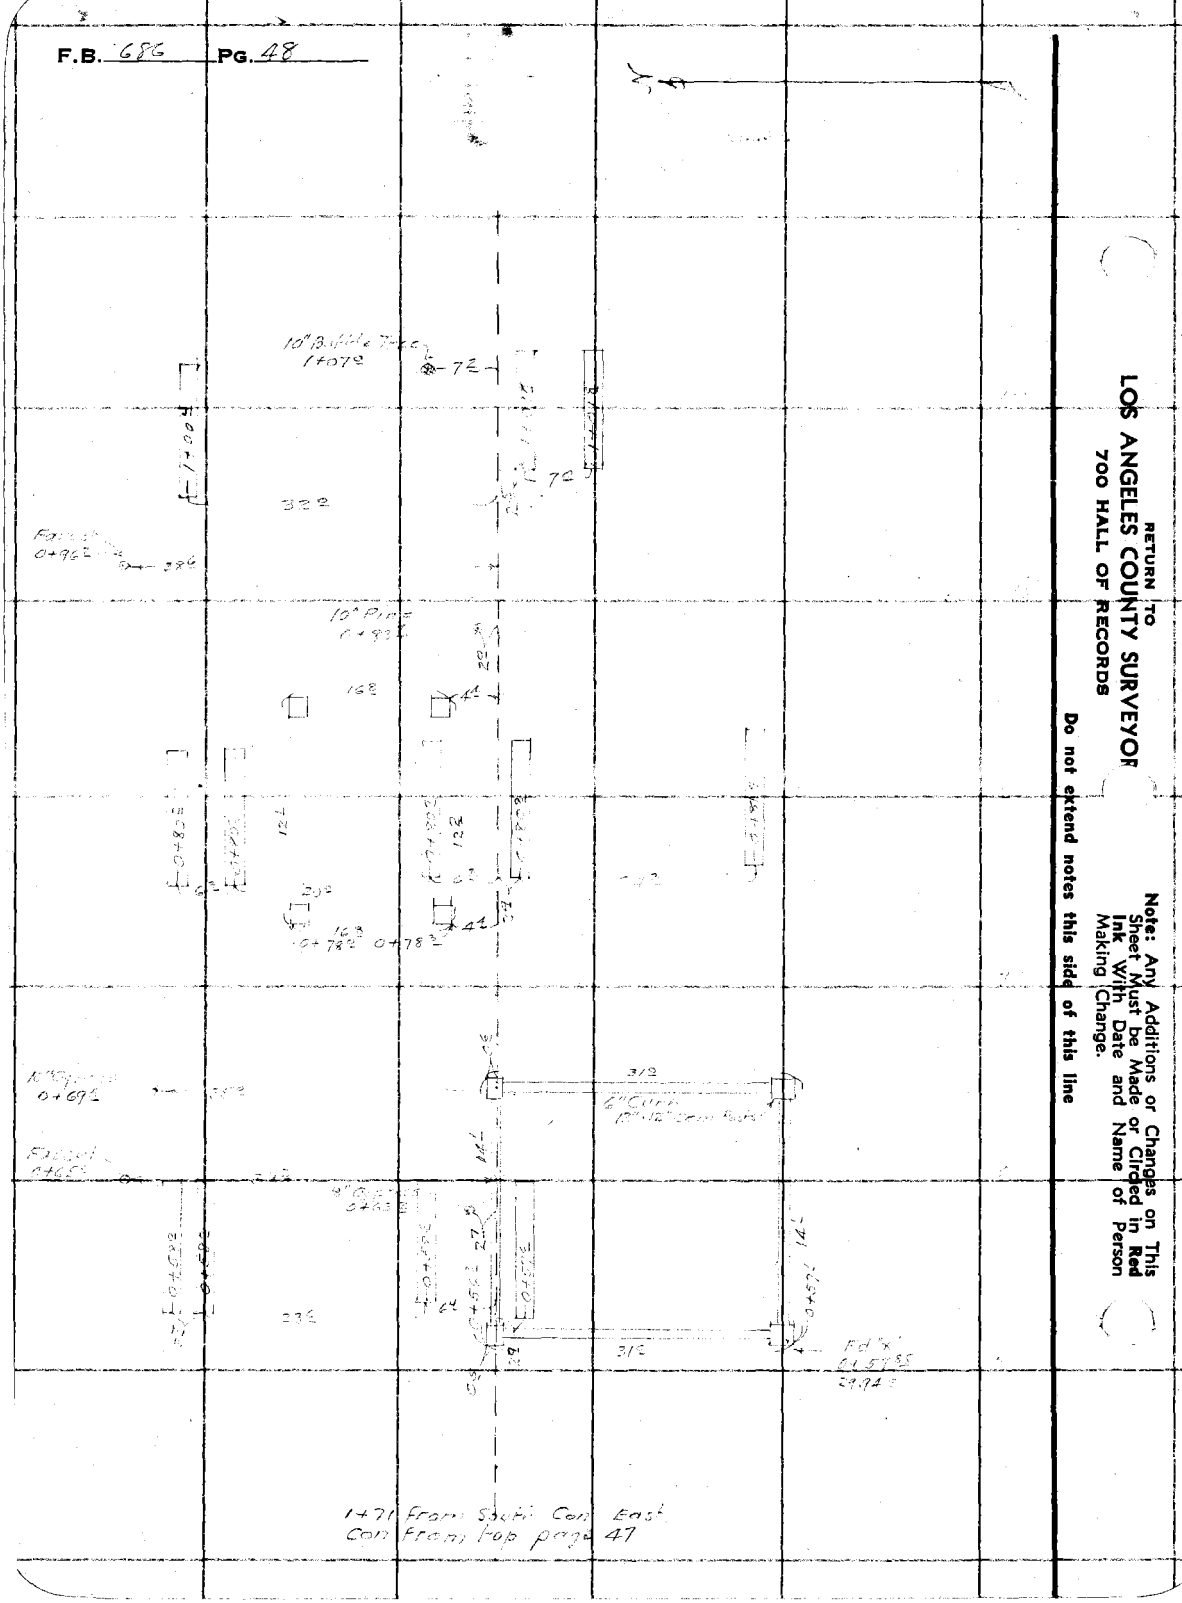

RETURN TO
LOS ANGELES COUNTY SURVEYOR
700 HALL OF RECORDS

Note: Any Additions or Changes on This Sheet Must be Made or Circled in Red Ink With Date and Name of Person Making Change.

Do not extend notes this side of this line

Notes Ck'd by D. M. Finley	Survey of LITTLE LAKE CEM
Map No. ~~B-1348~~ B-1412	W. O. 3113 Tape No. St'd °F.
Office Work RWMc	Surveyed by W.A.Miller
Checked D. M. Finley	Notes Miller Date 1-14-1937
Date June 1938.	Indexed A. C. Johnson

F.B. 686 PG. 49

Set N.T. 1+71 from South 0+00 West

Transit Line "B"

88-30 00

0+14 E

0+13 E

31 E

12.7

8.3

4.3

17 E

0+40 E

15 E

Con. at top page 50

Note: Any Additions or Changes on This Sheet Must be Made or Circled in Red Ink With Date and Name of Person Making Change

Do not extend notes this side of this line

RETURN TO
LOS ANGELES COUNTY SURVEYOR
700 HALL OF RECORDS

FORM 247 10M 11-35

RETURN TO
LOS ANGELES COUNTY SURVEYOR
700 HALL OF RECORDS

Note: Any Additions or Changes on This Sheet Must be Made or Circled in **Red Ink** With Date and Name of Person Making Change.

Do not extend notes this side of this line

F.B. 686 PG. 50

Con't from bottom page 49
1+71

From bottom Corn West
9
N

3+47+

Notes Ck'd by D. M. Finley	Survey of LITTLE LAKE CEM.
Map No. ~~19-1905-2~~ B-14/2	W. 0.8173 Tape No. St'd °F.
Office Work R.W.M.F	Surveyed by W.A.Miller
Checked D. M. Finley	Notes Miller Date
Date June 1938.	Indexed A. C. Johnson

F.B. 686 PG. 51

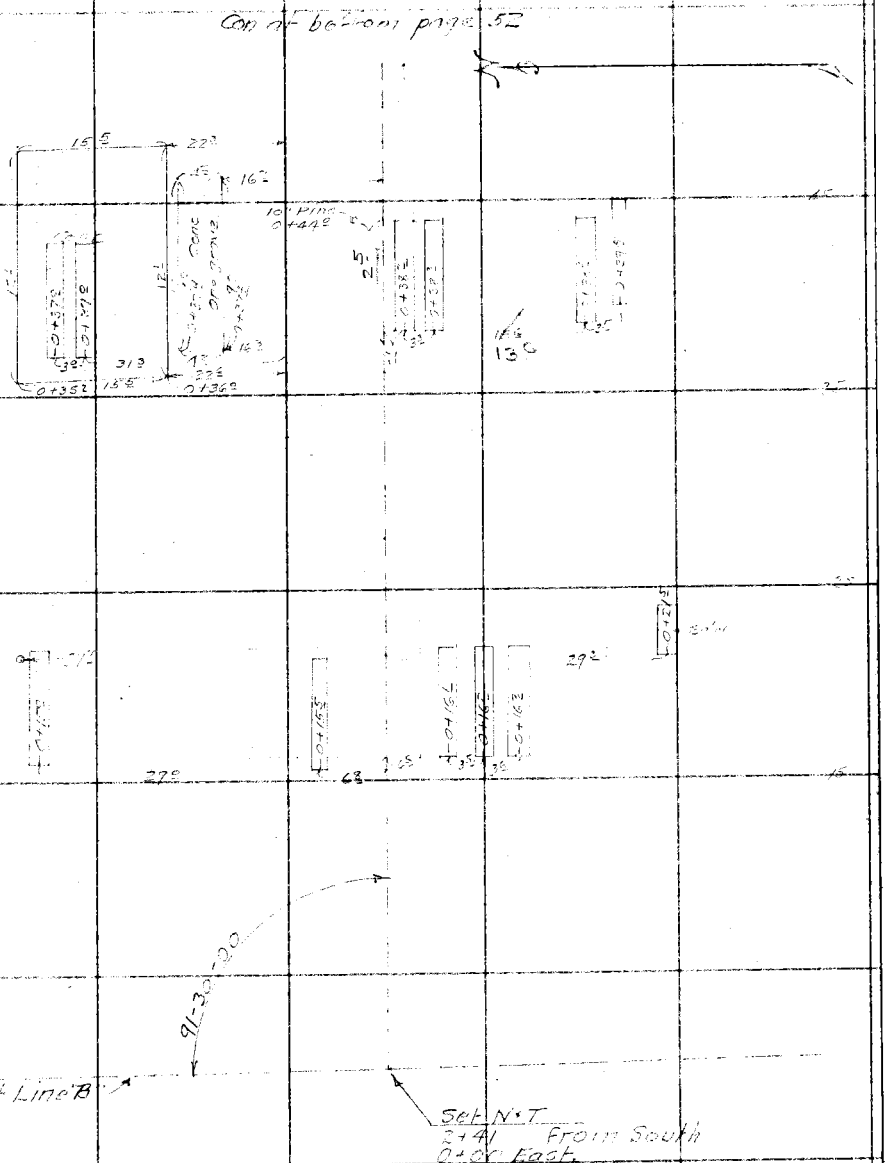

RETURN TO
LOS ANGELES COUNTY SURVEYOR
700 HALL OF RECORDS

Note: Any Additions or Changes on This Sheet Must be Made or Circled in **Red Ink** With Date and Name of Person Making Change.

Do not extend notes this side of this line

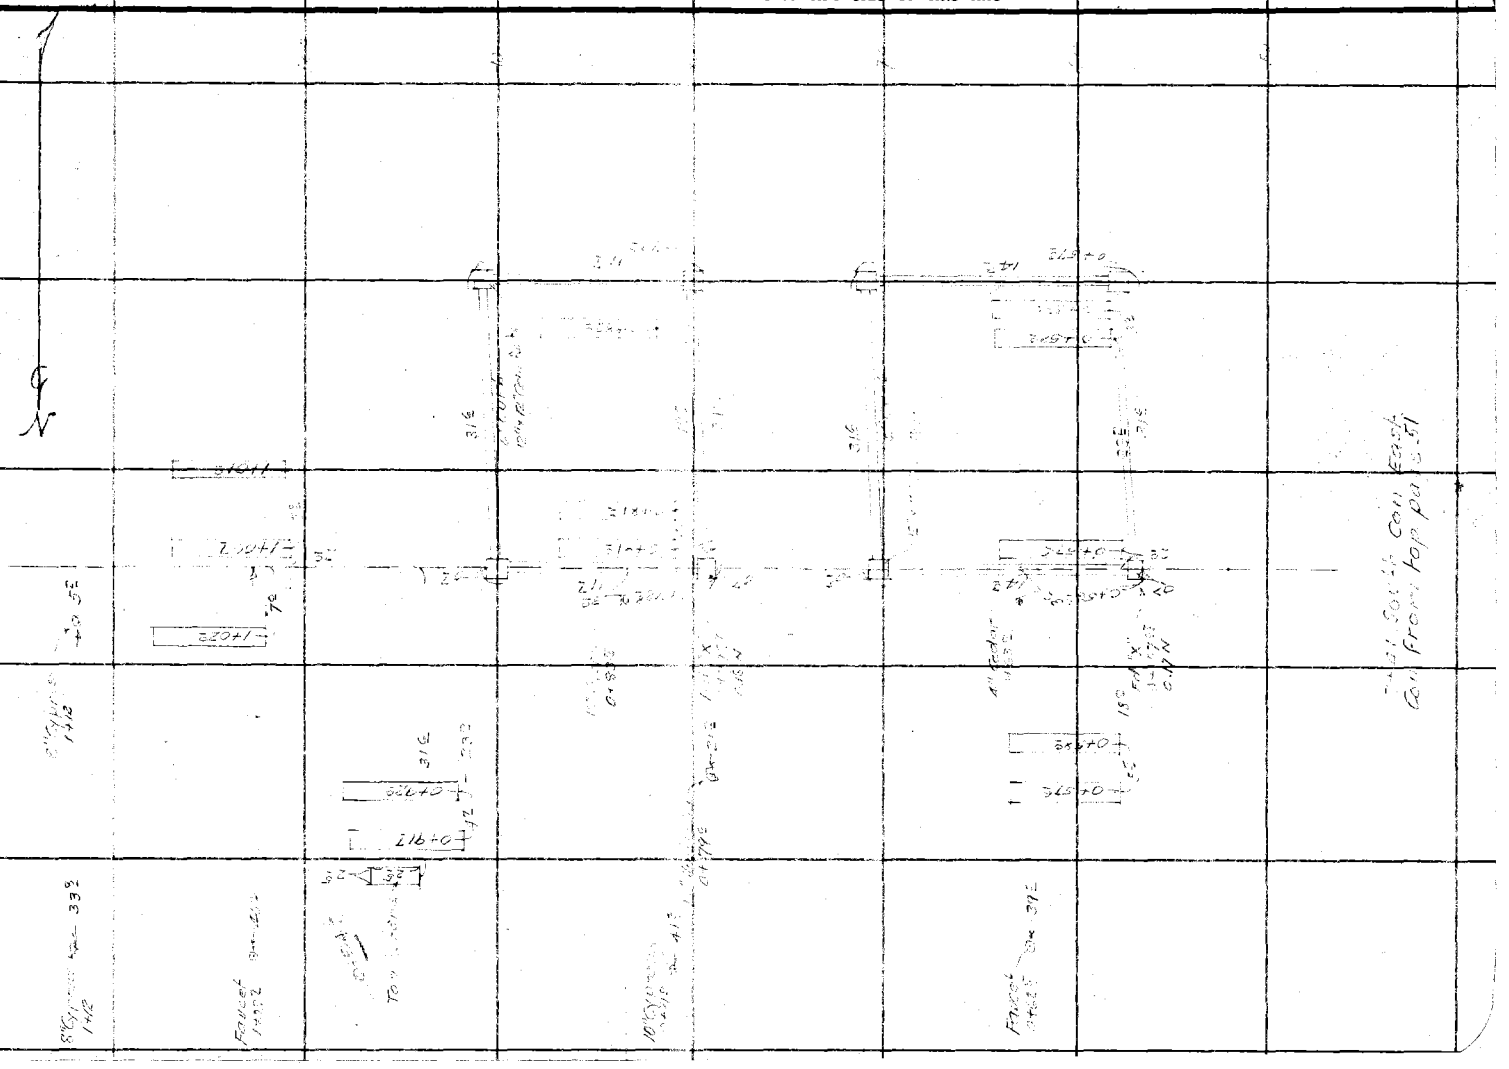

F.B. 1686 PG. 52

Notes Ck'd by D. M. Finley		Survey of LITTLE LAKE CEM.	
Map No. ~~B-1999-2~~ B-1917		W. O. 8173 Tape No.	St'd °F.
Office Work R.W.M.S		Surveyed by W.A. Miller	
Checked D. M. Finley		Notes Miller Date	
Date June 1938		Indexed A. C. Johnson	

F.B. 686 PG. 53

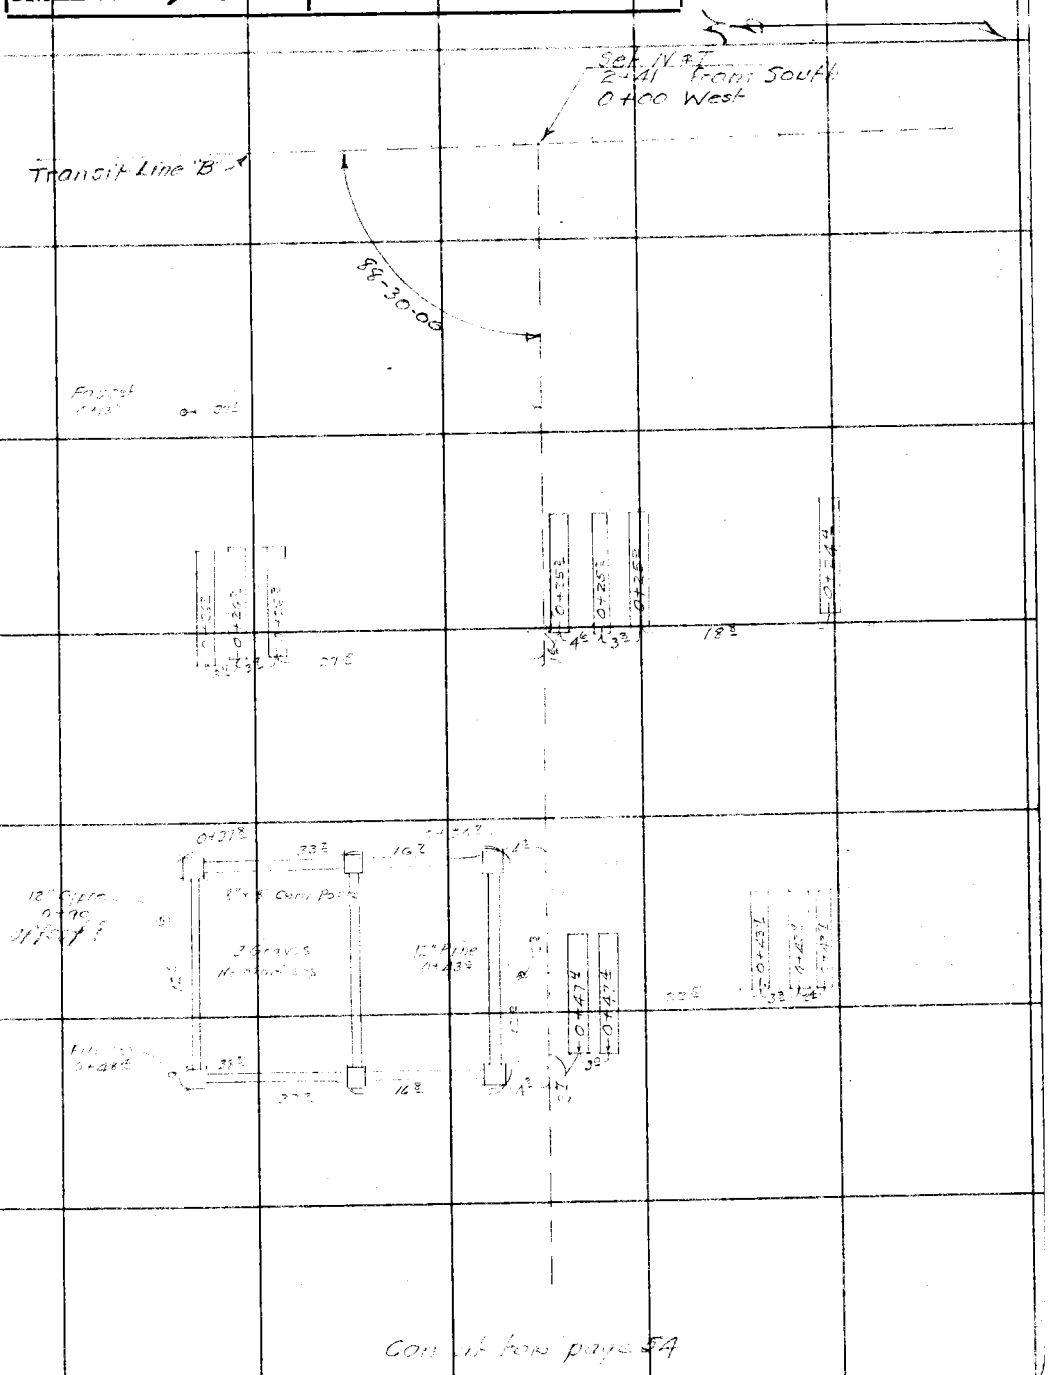

RETURN TO
LOS ANGELES COUNTY SURVEYOR
700 HALL OF RECORDS

Note: Any Additions or Changes on This Sheet Must be Made or Circled in Red Ink With Date and Name of Person Making Change.

Do not extend notes this side of this line

FORM 247 10M 11-38

RETURN TO
LOS ANGELES COUNTY SURVEYOR
700 HALL OF RECORDS

Note: Any Additions or Changes on This Sheet Must be Made or Circled in **Red Ink** With Date and Name of Person Making Change.

Do not extend notes this side of this line

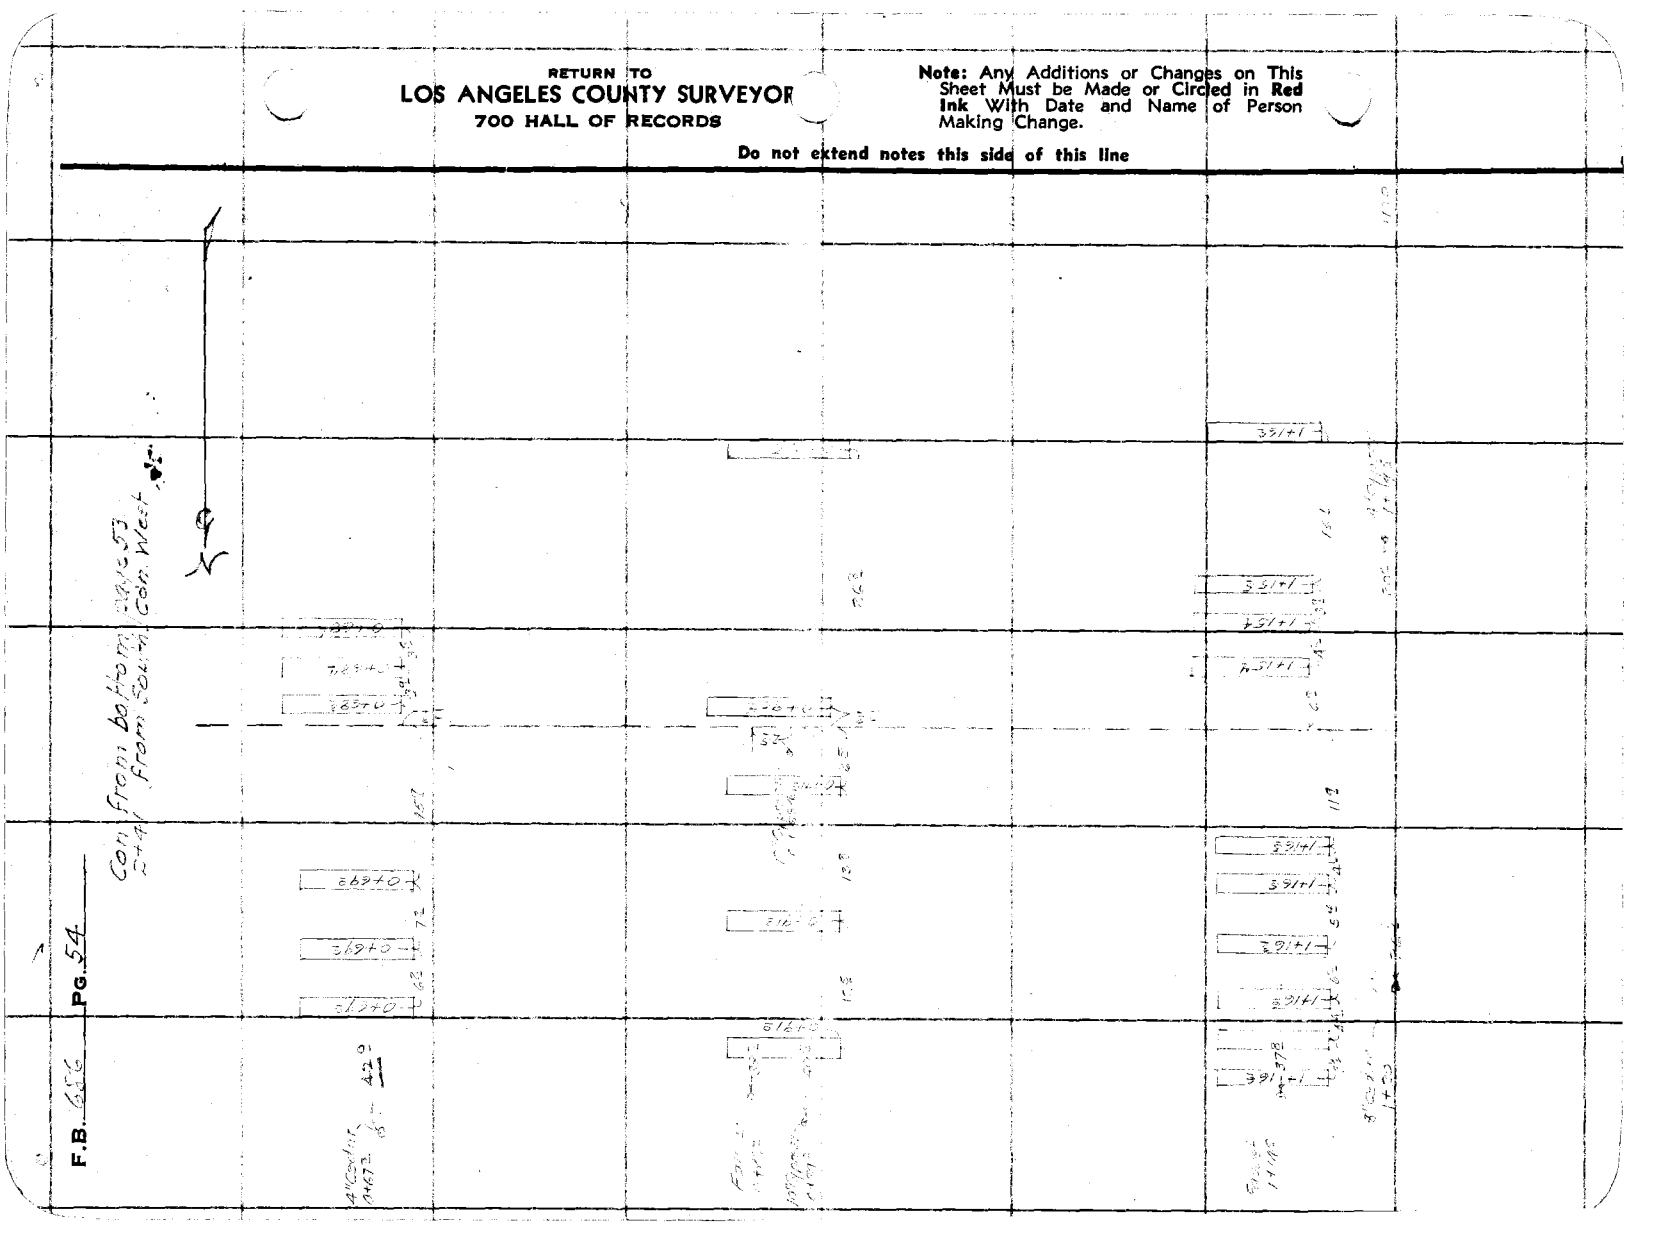

Notes Ck'd by D. M. Finley	Survey of LITTLE LAKE CEM
Map No. ~~B-1308-2~~ B-1467	W. O. 8173 Tape No. St'd °F.
Office Work RWME	Surveyed by W. G. Miller
Checked D. M. Finley	Notes Miller Date 1-15-1937
Date June 1938.	Indexed C. Johnson

F.B. 686 Pg 55

Con at bottom page 56

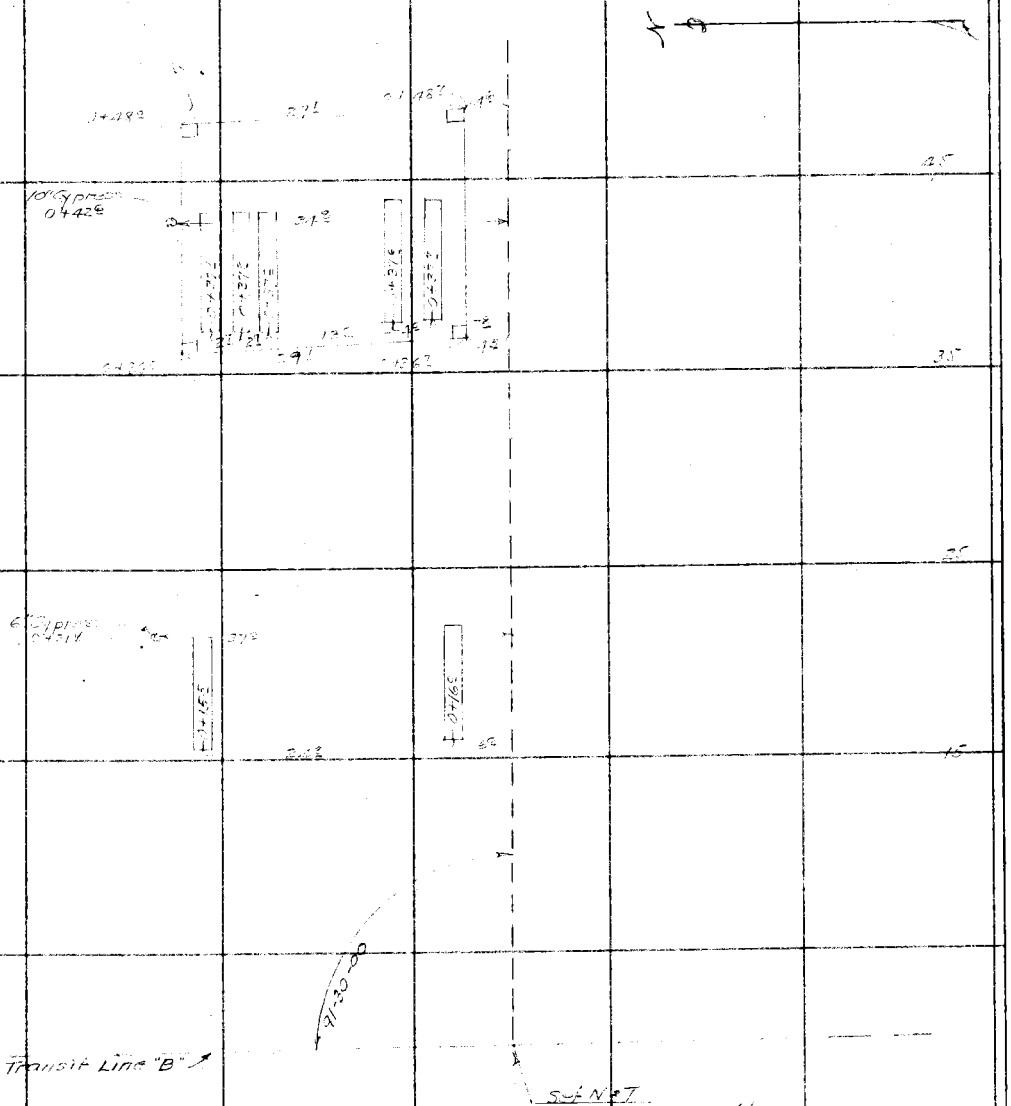

Note: Any Additions or Changes on This Sheet Must be Made or Circled in Red Ink With Date and Name of Person Making Change.

Do not extend notes this side of this line

RETURN TO
LOS ANGELES COUNTY SURVEYOR
700 HALL OF RECORDS

FORM 247 10M 11-35

RETURN TO
LOS ANGELES COUNTY SURVEYOR
700 HALL OF RECORDS

Note: Any Additions or Changes on This Sheet Must be Made or Circled in **Red Ink** With Date and Name of Person Making Change.

Do not extend notes this side of this line

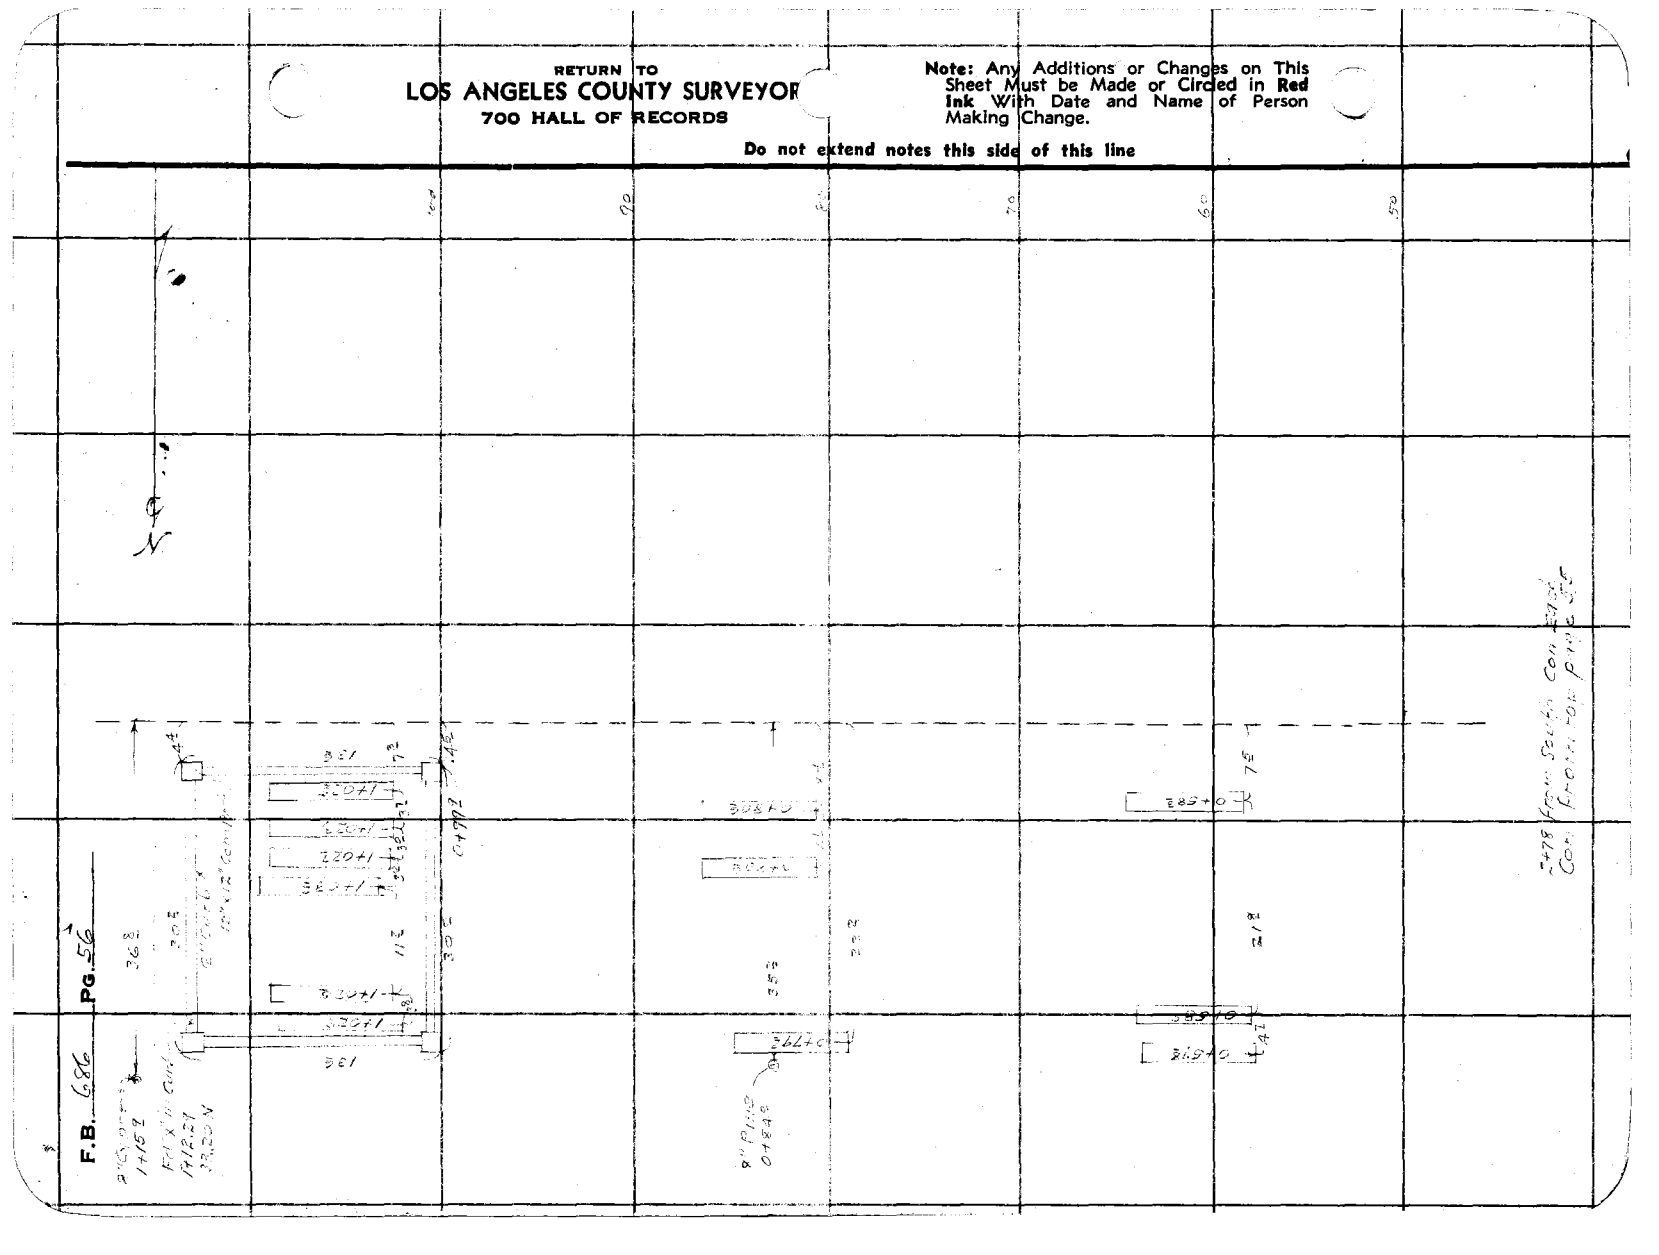
F.B. 686
Pg. 56
N
100
90
80
70
60
50
368
305
112
138
1402
1402
1402

Notes Ck'd by D. M. Finley	Survey of LITTLE LAKE CEM	F.B. 686	Pg 57
Map No. ~~B-1408~~ B-1417	W. O. 8173 Tape No.	St'd °F.	
Office Work RWM	Surveyed by W.A.Miller		
Checked D. M. Finley	Notes Miller Date 1-15-1937		
Date June 1938	Indexed C. C. Johnson		

Note: Any Additions or Changes on This Sheet Must be Made or Circled in Red Ink With Date and Name of Person Making Change

Do not extend notes this side of this line

RETURN TO
LOS ANGELES COUNTY SURVEYOR
700 HALL OF RECORDS

FORM 247 10M 11-35

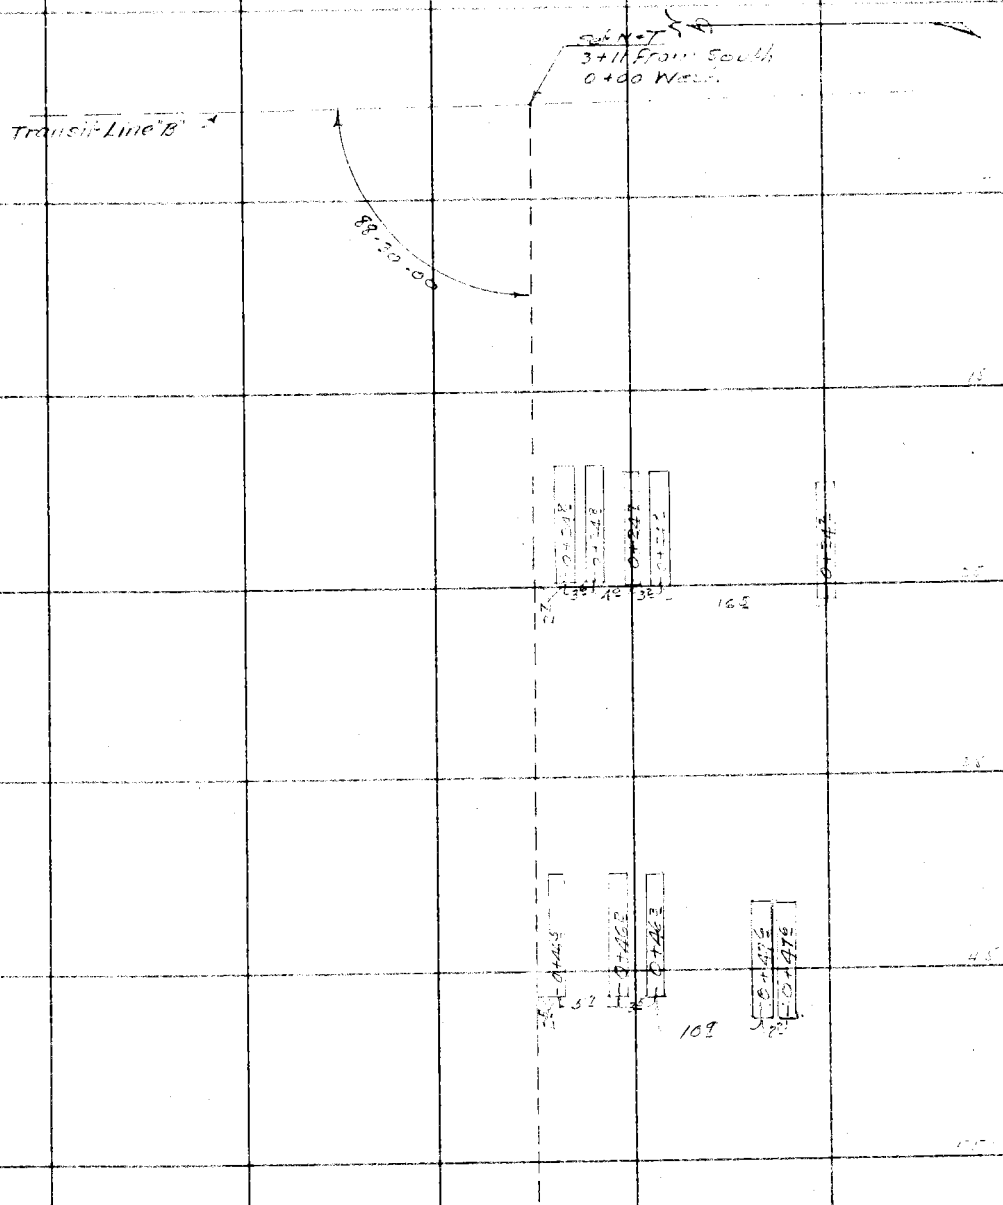

RETURN TO
LOS ANGELES COUNTY SURVEYOR
700 HALL OF RECORDS

Note: Any Additions or Changes on This Sheet Must be Made or Circled in **Red** Ink With Date and Name of Person Making Change.

Do not extend notes this side of this line

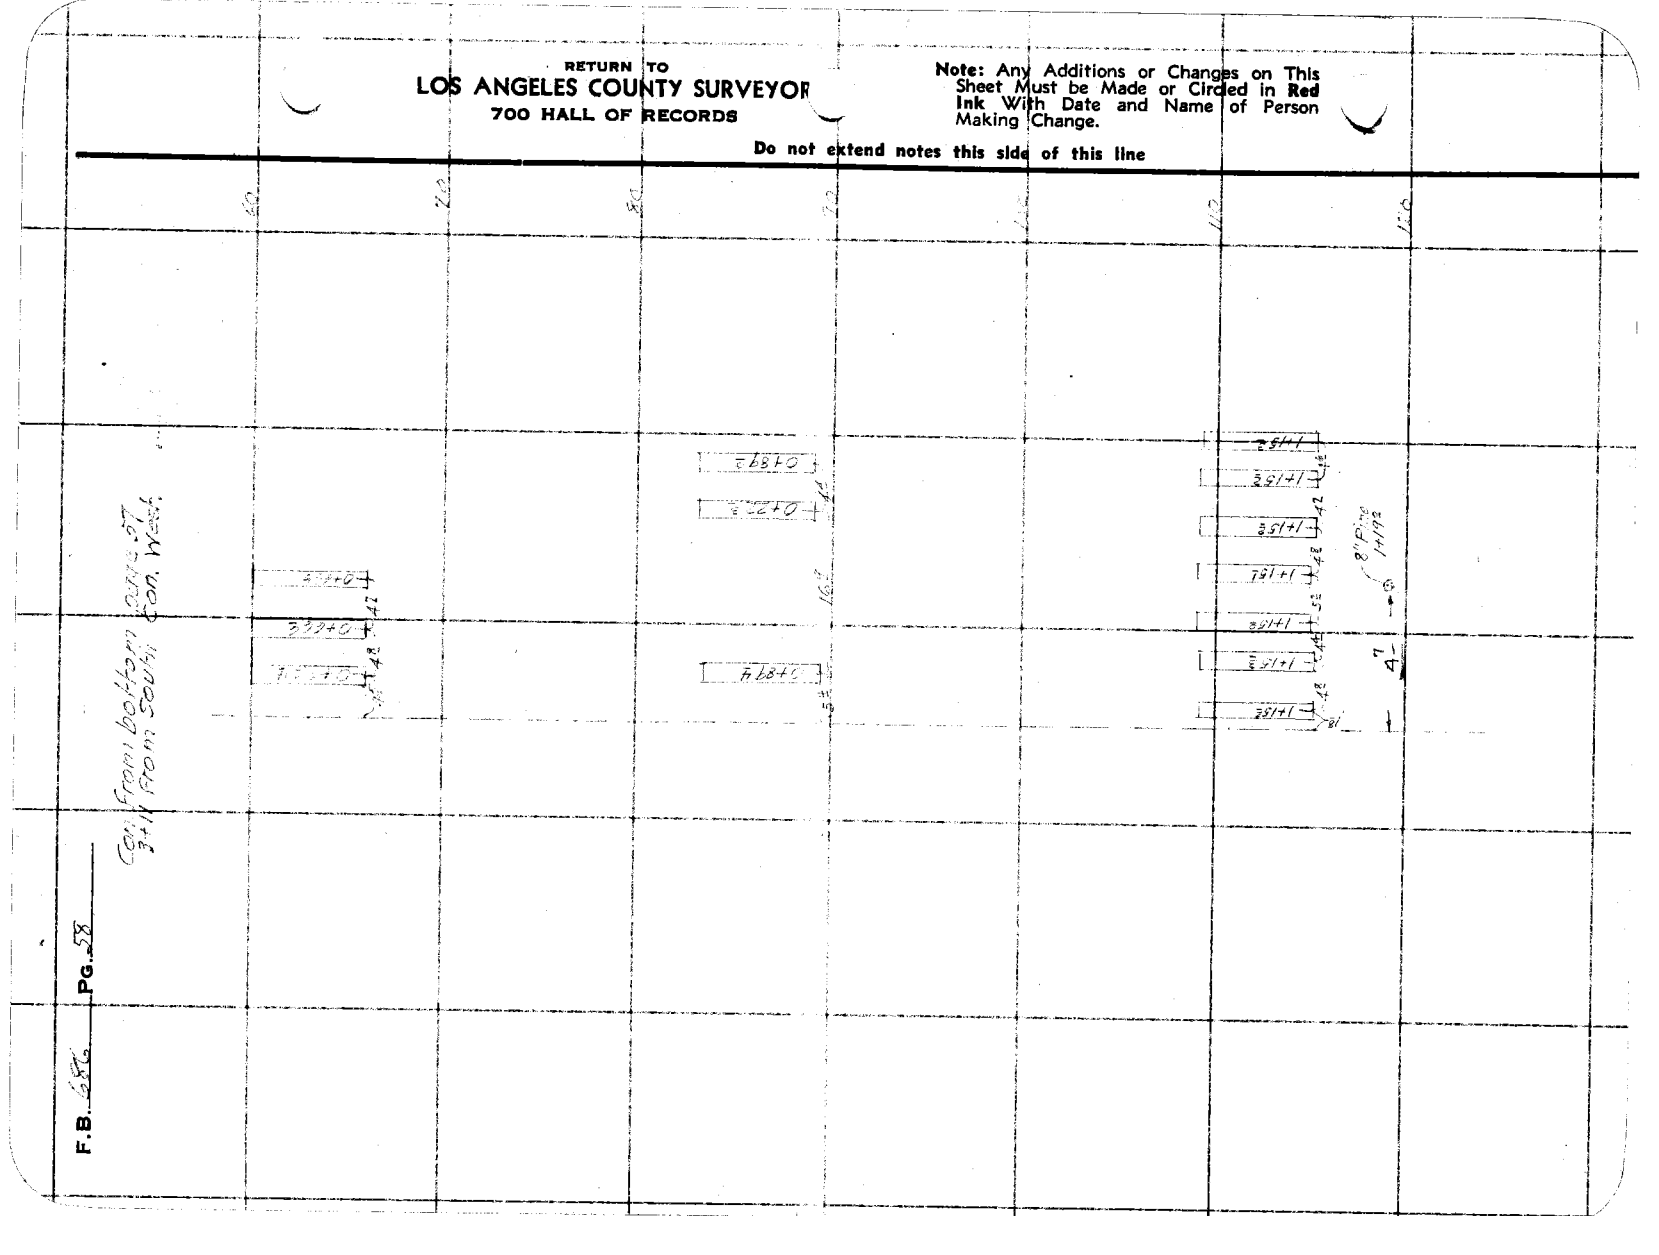

F.B. 686 Pg. 58

Notes Ck'd by D. M. Finley	Survey of LITTLE LAKE CAM.	F.B. 382	Pg. 59
Map No. ~~B-1388-2~~ B-1417	W. O. 8173 Tape No. St'd °F.		
Office Work RWME	Surveyed by W.A Miller		
Checked D. M. Finley	Notes Miller Date 1-15-1937		
Date June 1938	Indexed A. C. Johnson		

Con at bottom page 60

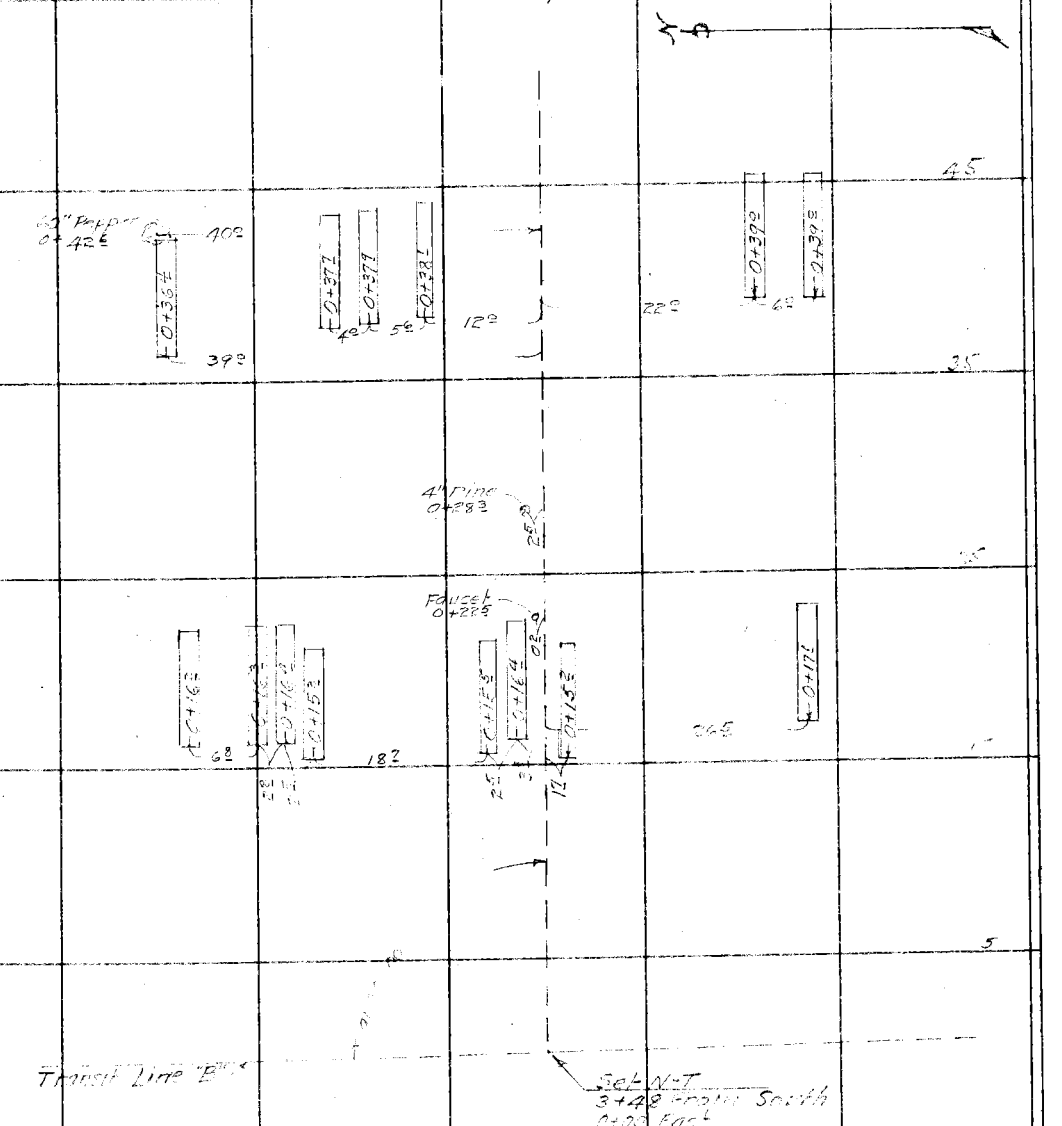

Note: Any Additions or Changes on This Sheet Must be Made or Circled in Red Ink With Date and Name of Person Making Change.

Do not extend notes this side of this line

RETURN TO
LOS ANGELES COUNTY SURVEYOR
700 HALL OF RECORDS

FORM 247 10M 11-35

F.B. 686 PG. 60

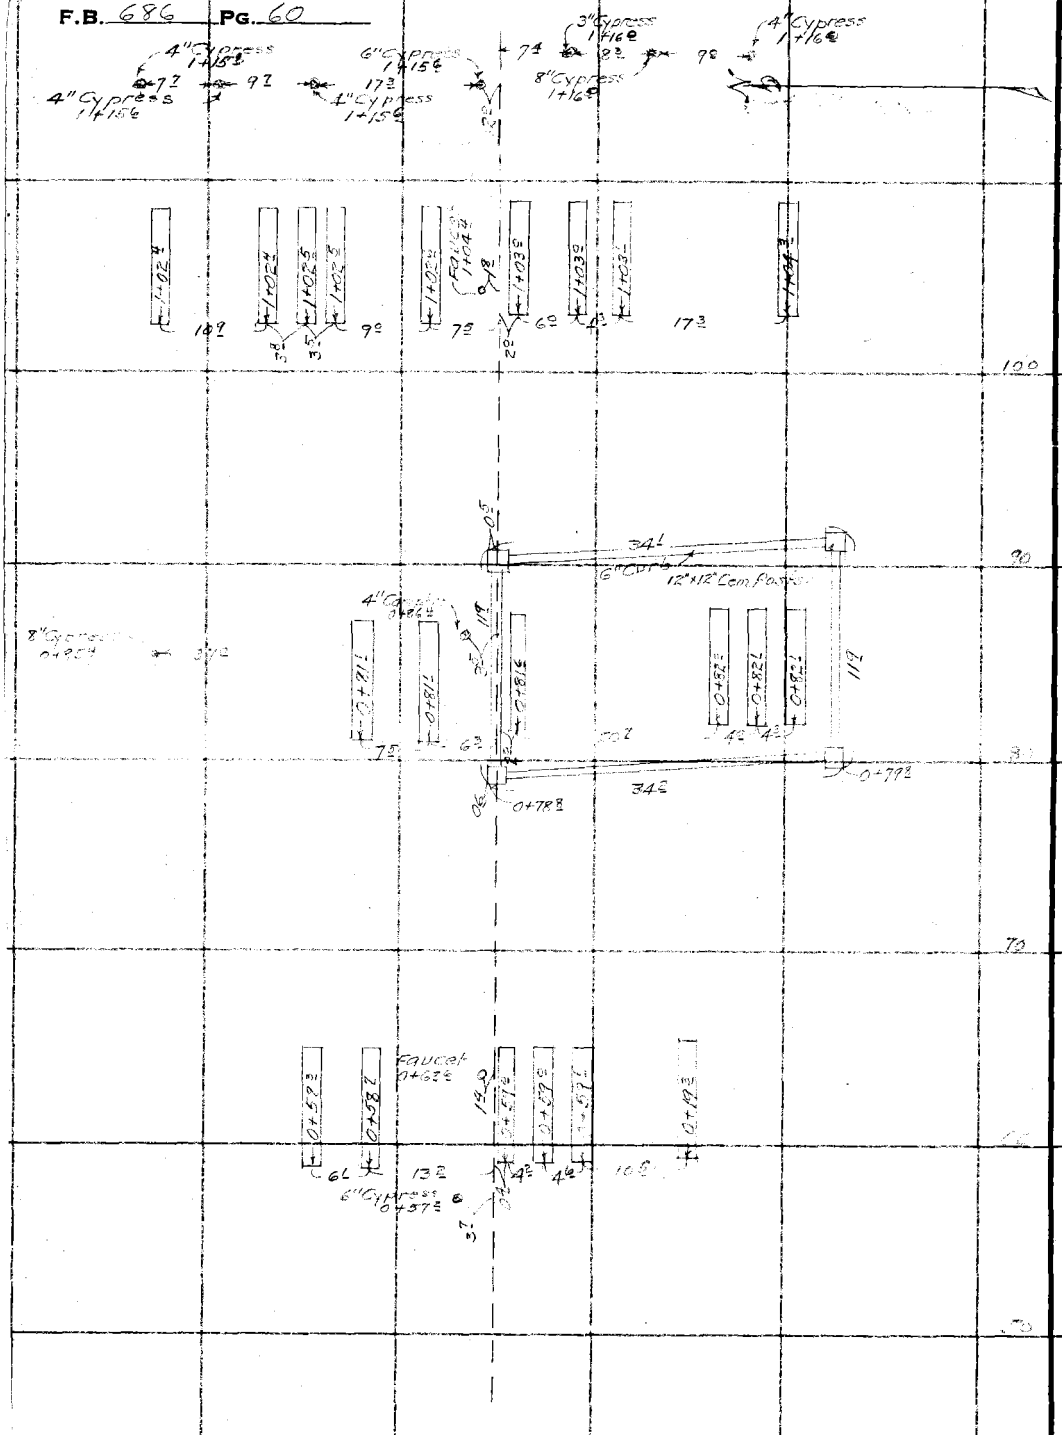

RETURN TO
LOS ANGELES COUNTY SURVEYOR
700 HALL OF RECORDS

Note: Any Additions or Changes on This Sheet Must be Made or Circled in Red Ink With Date and Name of Person Making Change.

Do not extend notes this side of this line

Notes Ck'd by D. M. Finley	Survey of LITTLE LAKE CEM.	F.B. 686	Pg. 61
Map No. ~~B-1308-2~~ B-1412	W.O. 8173 Tape No.	St'd.	*F.
Office Work BUTYE	Surveyed by W.A. Miller		
Checked D. M. Finley	Notes Miller Date 1-15-1937		
Date June 1938	Indexed A. C. Johnson		

Note: Any Additions or Changes on This Sheet Must be Made or Circled in Red Ink With Date and Name of Person Making Change.

Do not extend notes this side of this line

RETURN TO
LOS ANGELES COUNTY SURVEYOR
700 HALL OF RECORDS

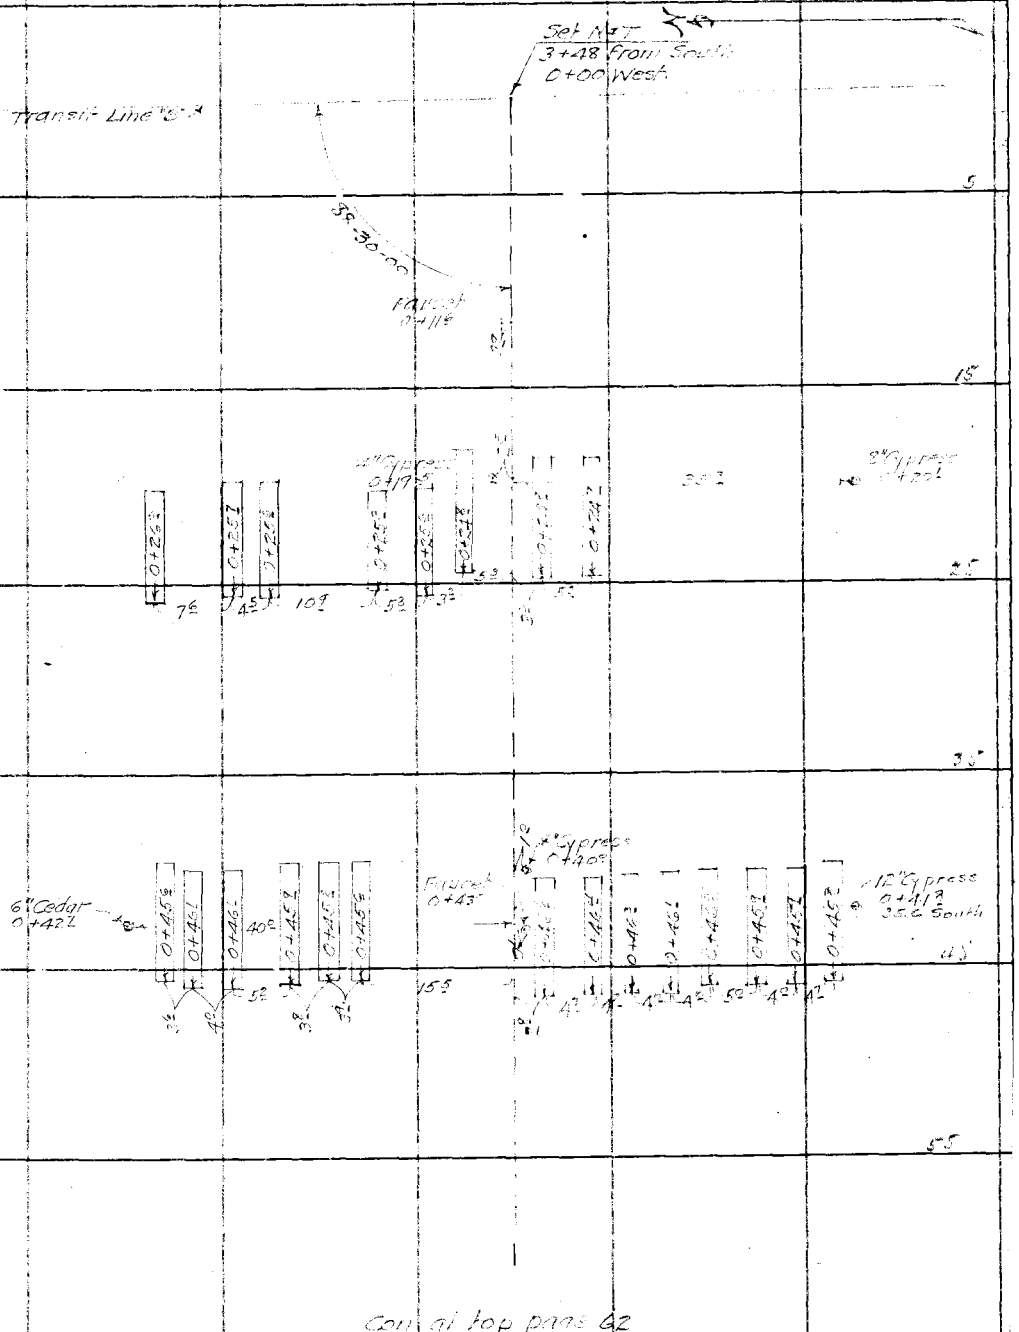

Con. at top page 62

FORM 247 10M 11-38

RETURN TO
LOS ANGELES COUNTY SURVEYOR
700 HALL OF RECORDS

Note: Any Additions or Changes on This Sheet Must be Made or Circled in **Red Ink** With Date and Name of Person Making Change.

Do not extend notes this side of this line

F.B. 686 PG. 62

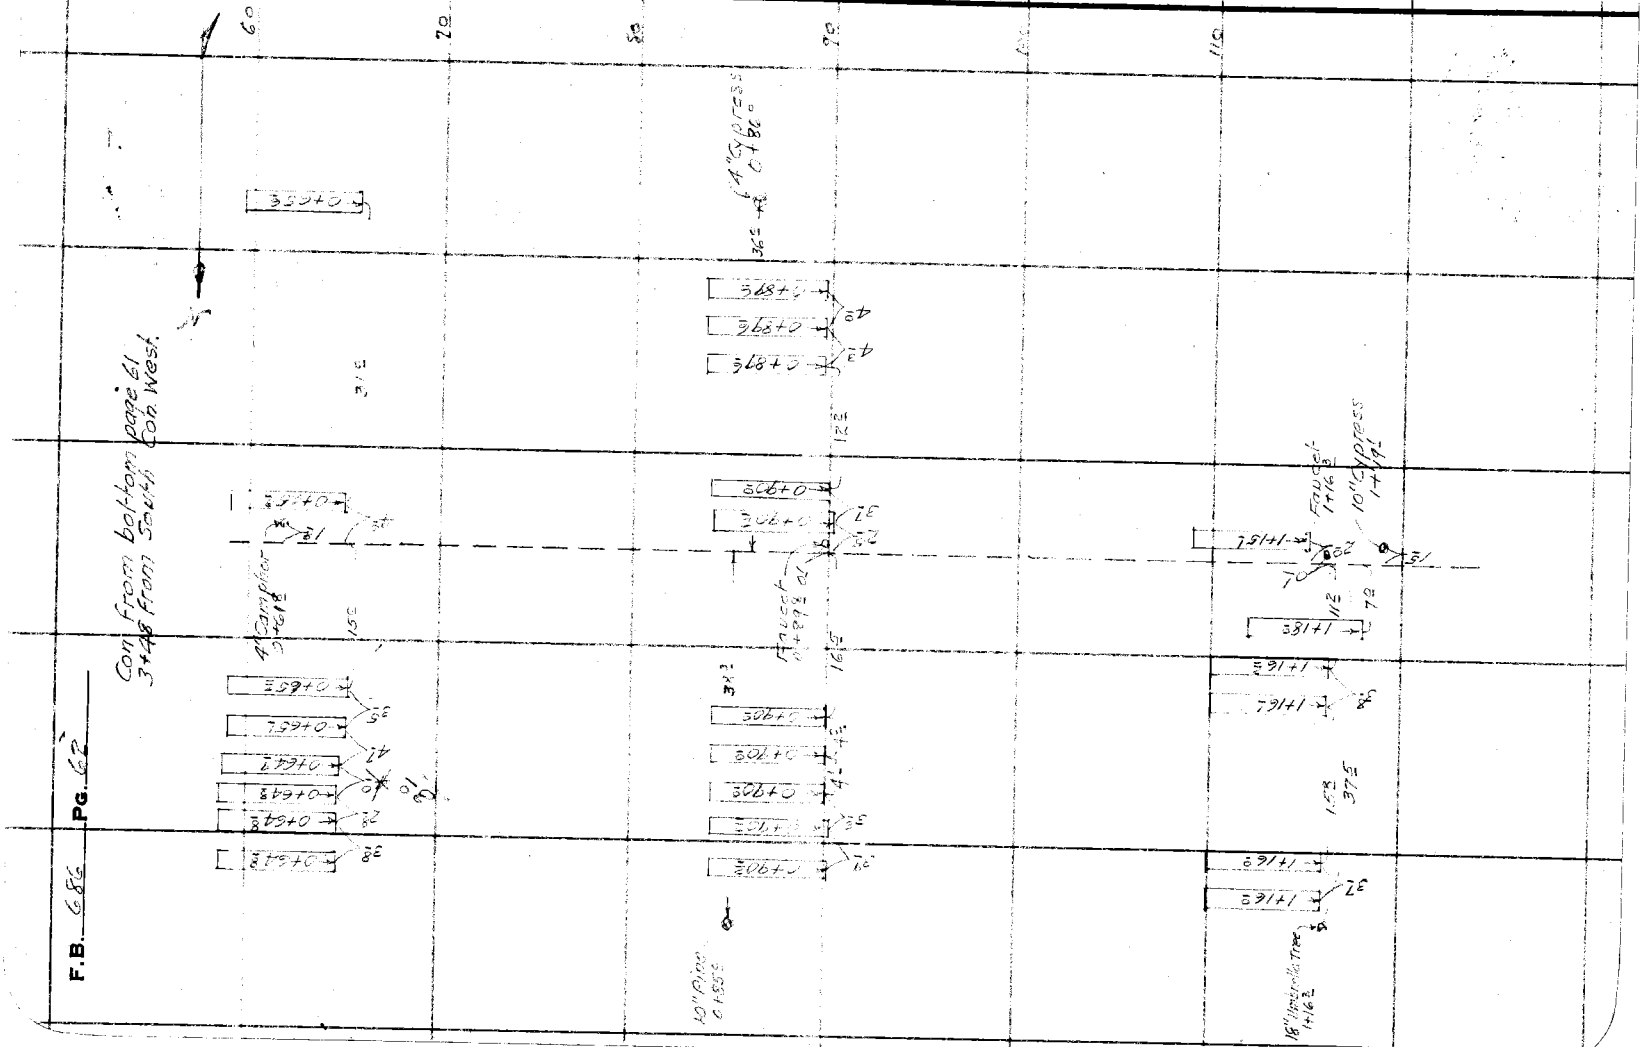

Notes Ck'd by D. M. Finley	Survey of LITTLE LAKE CEM
Map No. ~~B-1302~~ B-1412	W. O. 8173 Tape No. St'd °F.
Office Work RW-MC	Surveyed by W.A. Miller
Checked D. M. Finley	Notes Miller Date 1-8-193
Date June 1938	Indexed ~~A. C. Johnson~~

F.B. 686 PG. 63

Co. Co. bottom page 64

Note: Any Additions or Changes on This Sheet Must be Made or Circled in Red Ink With Date and Name of Person Making Change.

Do not extend notes this side of this line

RETURN TO
LOS ANGELES COUNTY SURVEYOR
700 HALL OF RECORDS

FORM 247 10M 11-38

RETURN TO
LOS ANGELES COUNTY SURVEYOR
700 HALL OF RECORDS

Note: Any Additions or Changes on This Sheet Must be Made or Circled in **Red Ink** With Date and Name of Person Making Change.

Do not extend notes this side of this line

F.B. 686 PG. 64

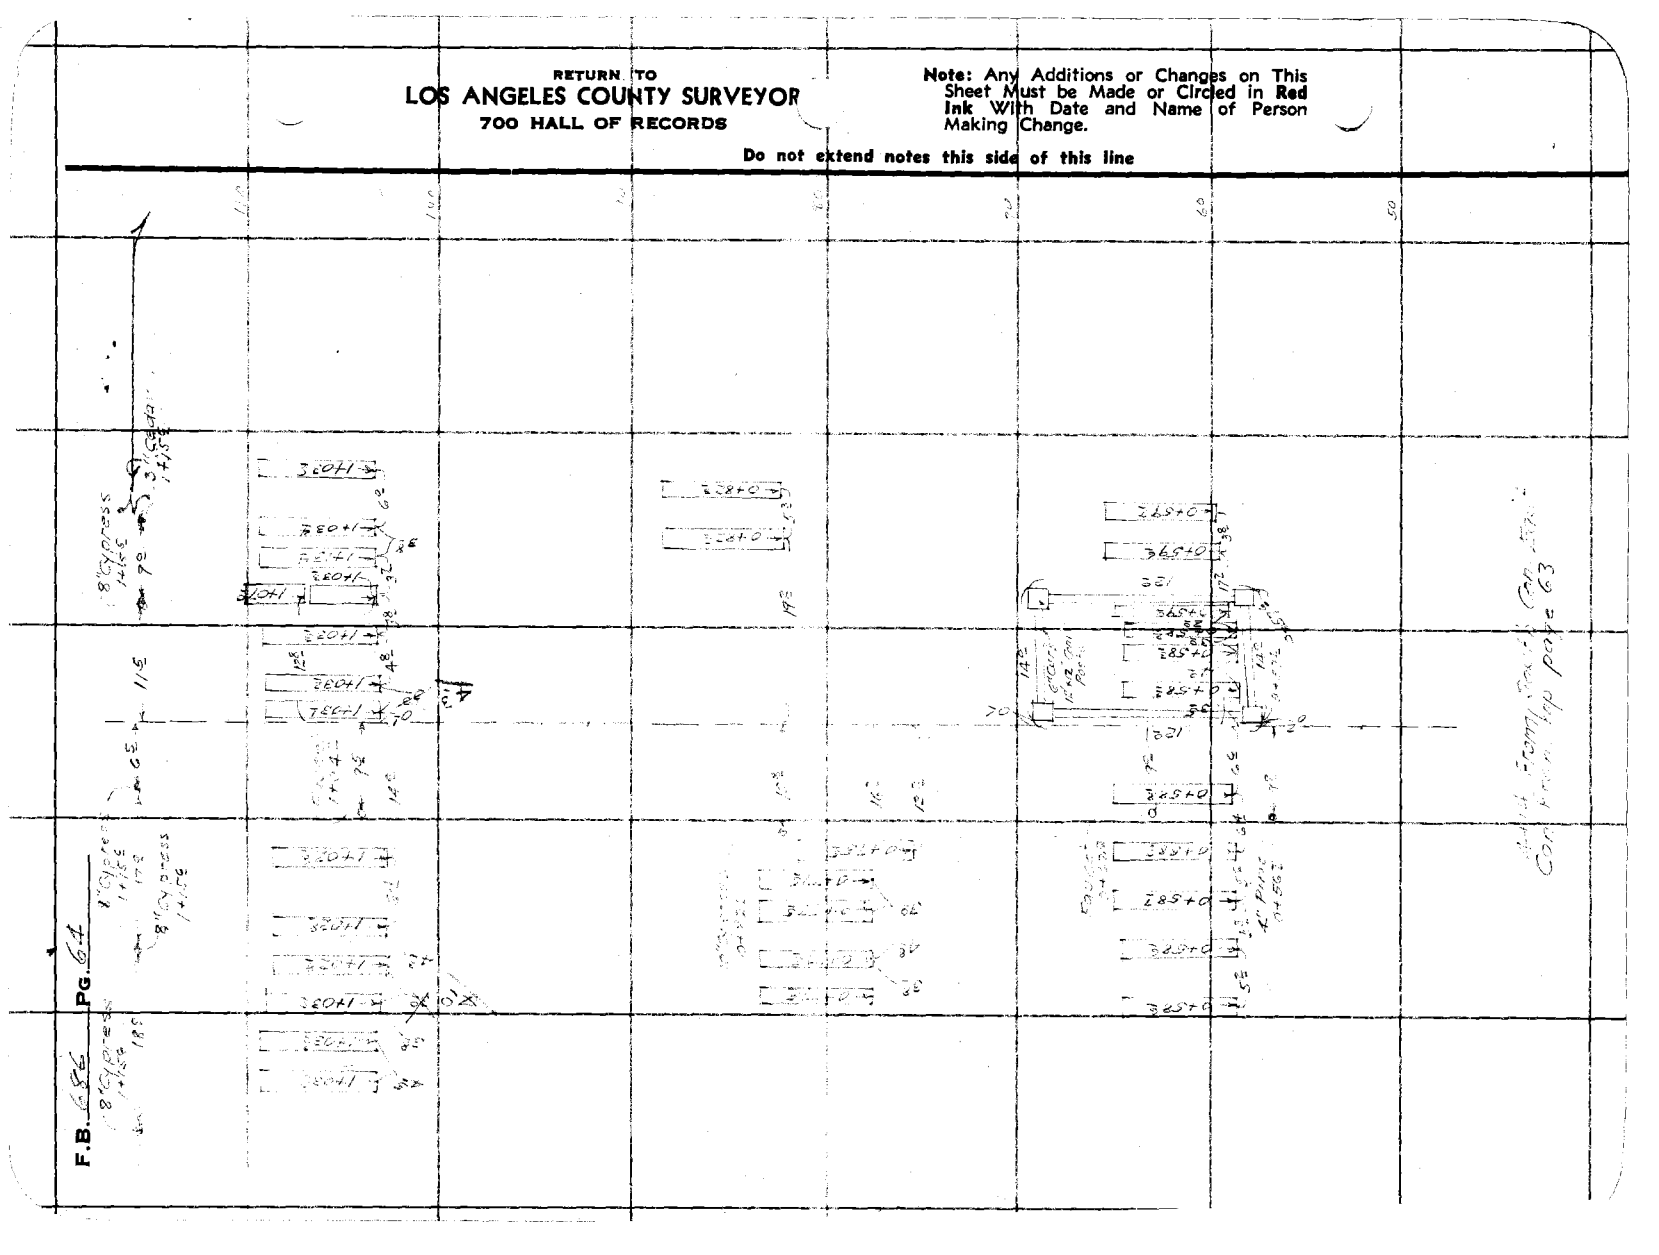

Notes Ck'd by D. M. Finley	Survey of LITTLE LAKE CAN.	F.B. 686	Pg. 65
Map No. ~~B-1302-2~~ B-1412	W. O. 8173 Tape No. St'd °F.		
Office Work RW-MK	Surveyed by W.A. Miller		
Checked D. M. Finley	Notes Miller Date 1-18-1937		
Date JUNE 1938.	Indexed A. C. Johnson		

Note: Any Additions or Changes on This Sheet Must be Made or Circled in Red Ink With Date and Name of Person Making Change.

Do not extend notes this side of this line

RETURN TO
LOS ANGELES COUNTY SURVEYOR
700 HALL OF RECORDS

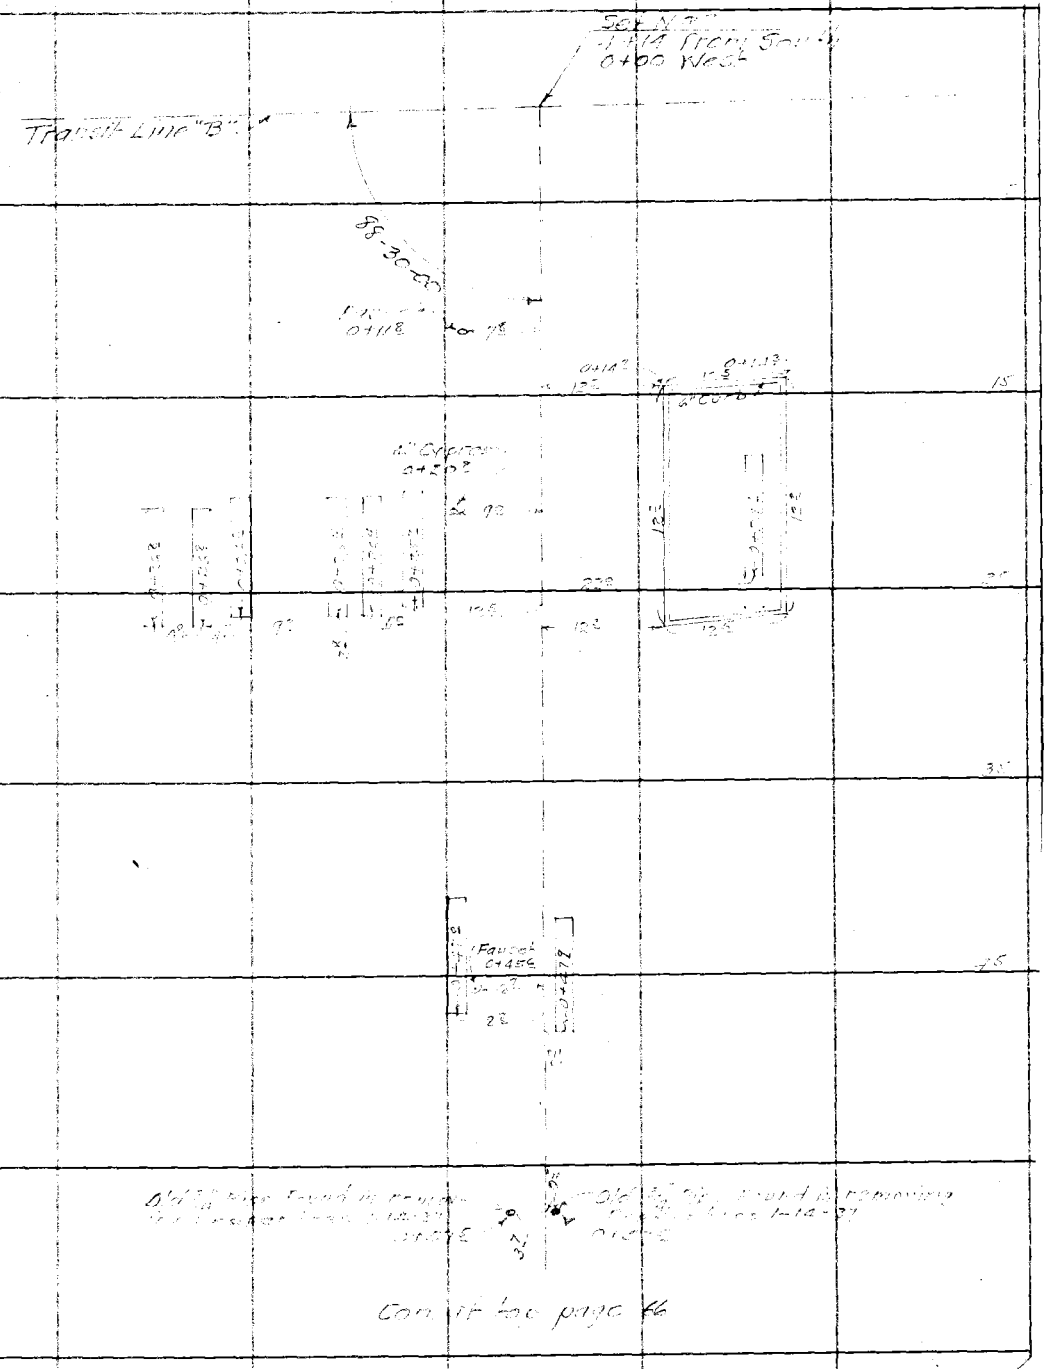

FORM 247 10M 11-35

RETURN TO
LOS ANGELES COUNTY SURVEYOR
700 HALL OF RECORDS

Note: Any Additions or Changes on This Sheet Must be Made or Circled in **Red Ink** With Date and Name of Person Making Change.

Do not extend notes this side of this line

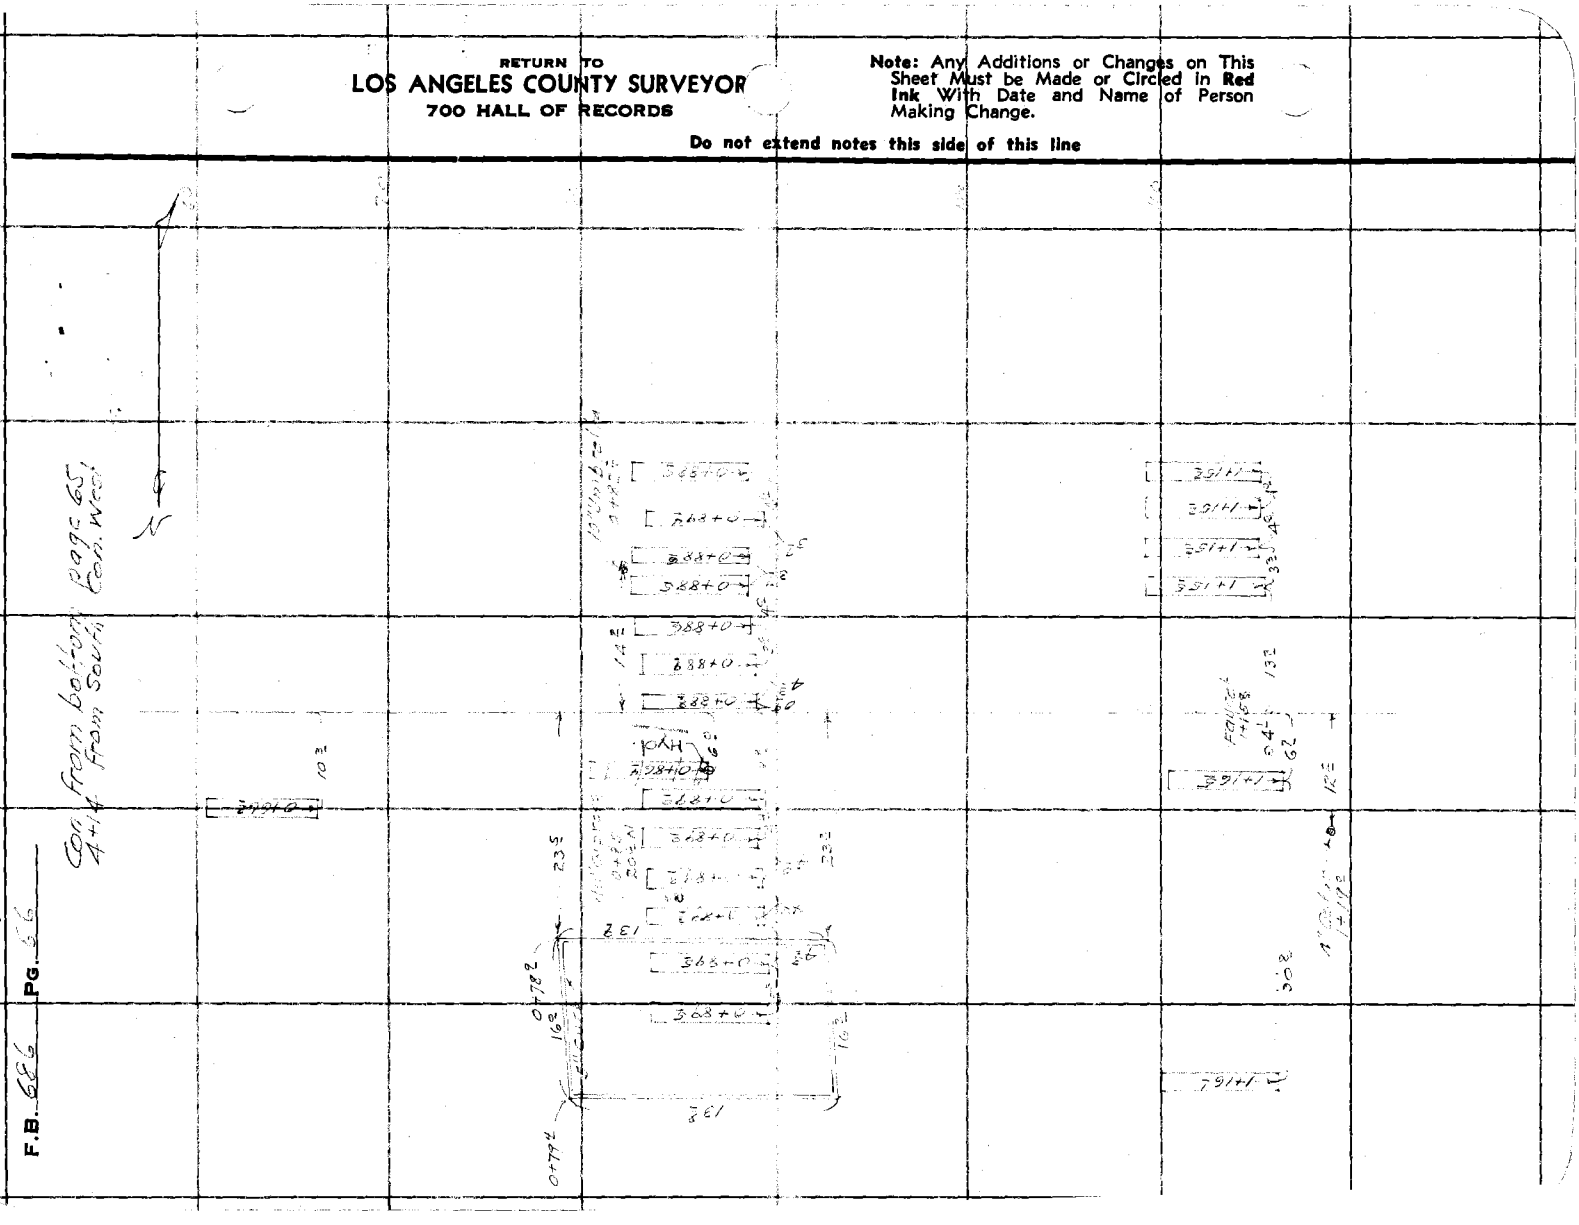

Notes Ck'd by D. M. Finley	Survey of LITTLE LAKE CEM.
Map No. B-1302 & B-1417	W. O. 2103 Tape No. St'd °F.
Office Work RW MC	Surveyed by W. A. Miller
Checked D. M. Finley	Notes Miller Date 1-18-1937
Date JUNE 1938	Indexed A. C. Johnson

F.B. 556 Pg 67

Note: Any Additions or Changes on This Sheet Must be Made or Circled in Red Ink With Date and Name of Person Making Change

Do not extend notes this side of this line

RETURN TO
LOS ANGELES COUNTY SURVEYOR
700 HALL OF RECORDS

10" C.I. Pipe
0+44.5

42°

0+37.2

0+87.5

0+37.7

14L

0+37.5

0+37.3

58°

60°

7.3

45

35

Faucet
0+36.2

13?

25

6" V.C.P.
0+20.4

0+16.2

42°

0+16.5

62

15°

10" C.I. Pipe
0+41.5

0+41.6

15°

25

15

C

21.30

Trail Cr Line "B"

Jct. N. 3°E.
4+58 From Sou-4
0+40 Line

FORM 247 10M 11-36

RETURN TO
LOS ANGELES COUNTY SURVEYOR
700 HALL OF RECORDS

Note: Any Additions or Changes on This Sheet Must be Made or Circled in **Red** Ink With Date and Name of Person Making Change.

Do not extend notes this side of this line


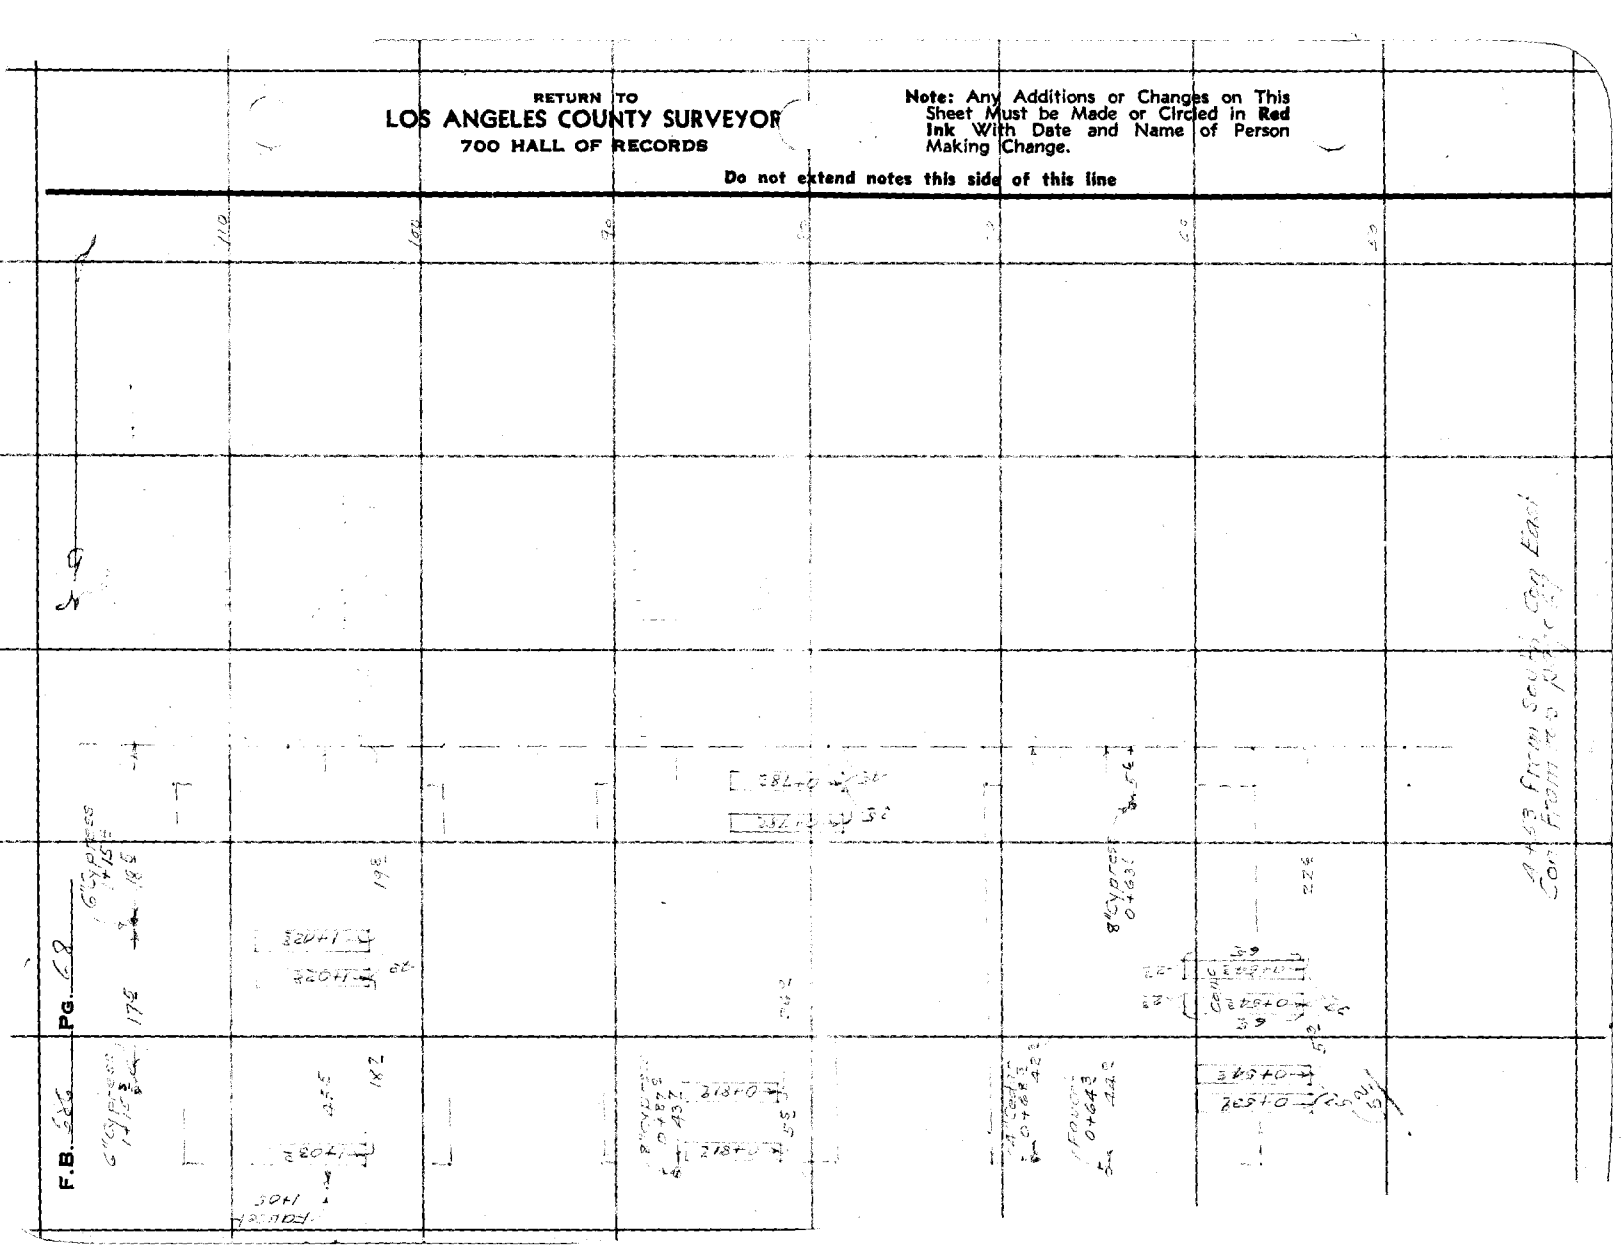

Notes Ck'd by	D. M. Finley	Survey of	LITTLE Lake Cem	F.B.	Pg. 69
Map No.	~~B-1308-2~~ B-14.2	W. O.	2173	Tape No.	St'd °F.
Office Work	RW+MS	Surveyed by	W.A. Miller		
Checked	D. M. Finley	Notes	Miller	Date	
Date	June 1938.	Indexed	A. C. Johnson		

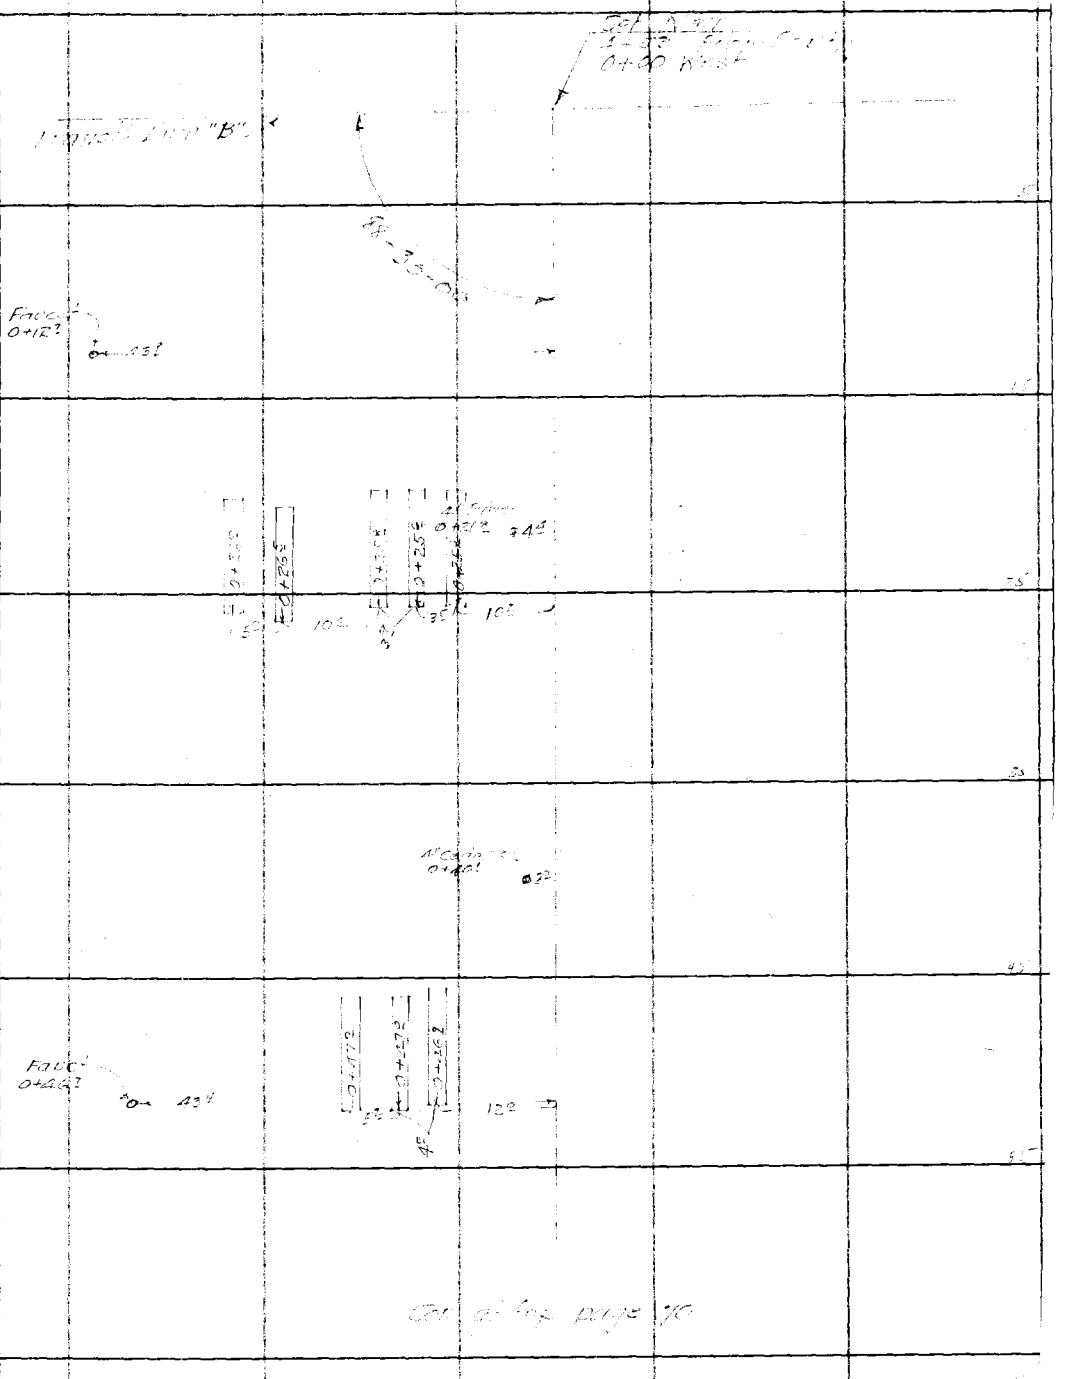

Note: Any Additions or Changes on This Sheet Must be Made in Red Ink With Date and Name of Person Making Change.

Do not extend notes this side of this line

RETURN TO
LOS ANGELES COUNTY SURVEYOR
700 HALL OF RECORDS

FORM 247 10M 11-38

RETURN TO
LOS ANGELES COUNTY SURVEYOR
700 HALL OF RECORDS

Note: Any Additions or Changes on This Sheet Must be Made or Circled in Red Ink With Date and Name of Person Making Change.

Do not extend notes this side of this line


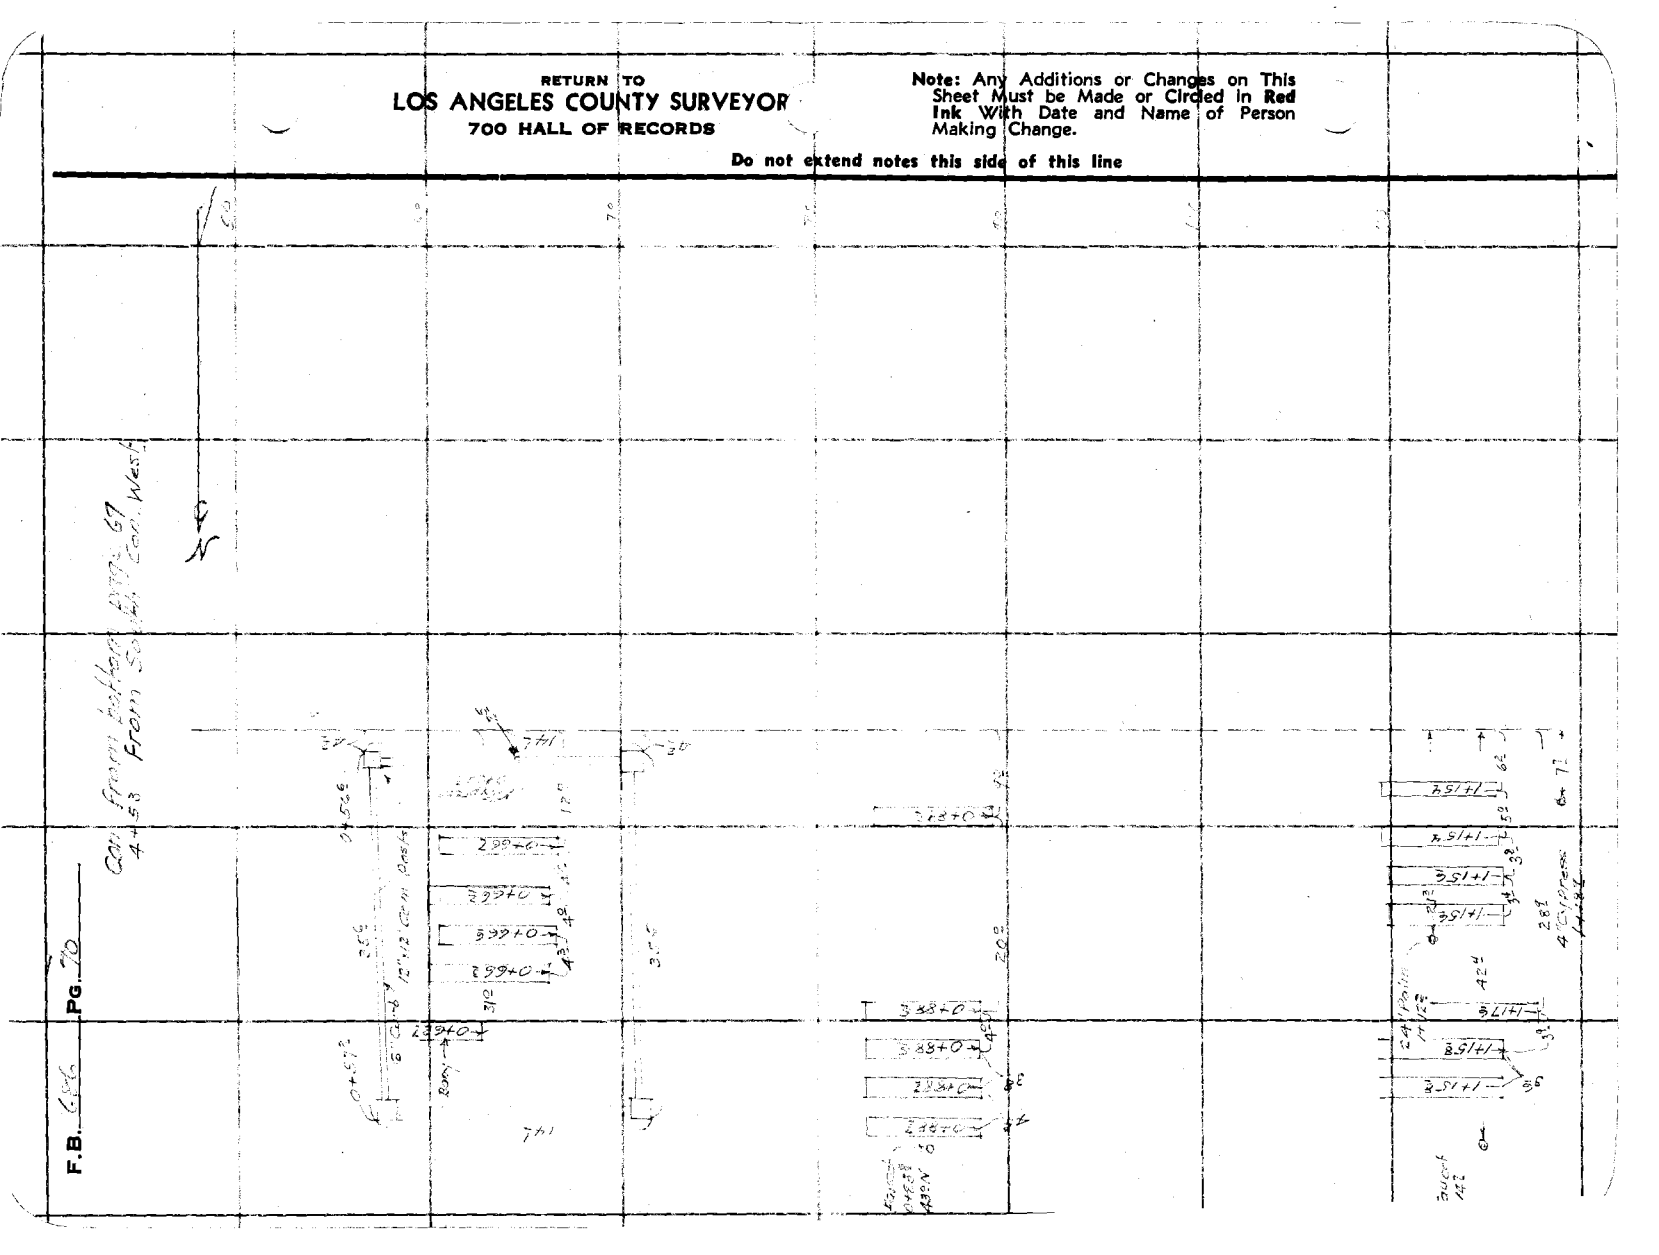
4+53 From Sta. Ex. Cor. West
N
7+71
12"
24"
24"
12"
24"
24"
24

FORM 247 10M 11-35

RETURN TO
LOS ANGELES COUNTY SURVEYOR
700 HALL OF RECORDS

Note: Any Additions or Changes on This Sheet Must be Made or Circled in **Red Ink** With Date and Name of Person Making Change.

Do not extend notes this side of this line

Notes Ck'd by D. M. Finley
Map No. C-1882 8-19-47
Office Work D. M. Finley
Checked
Date June 1948

Survey of LITTLE LAKE [illegible]
W. O. 8173 Tape No. Std. °F.
Surveyed by [illegible] Date 12-19-47
Notes
Indexed A. C. Johnson

F.B. 686 PG. 71

12 — 10+17.5
25 — 10+17.5

27 — 10+43
30 — 10+43

RETURN TO
LOS ANGELES COUNTY SURVEYOR
700 HALL OF RECORDS

Note: Any Additions or Changes on This Sheet Must be Made or Circled in **Red Ink** With Date and Name of Person Making Change.

Do not extend notes this side of this line

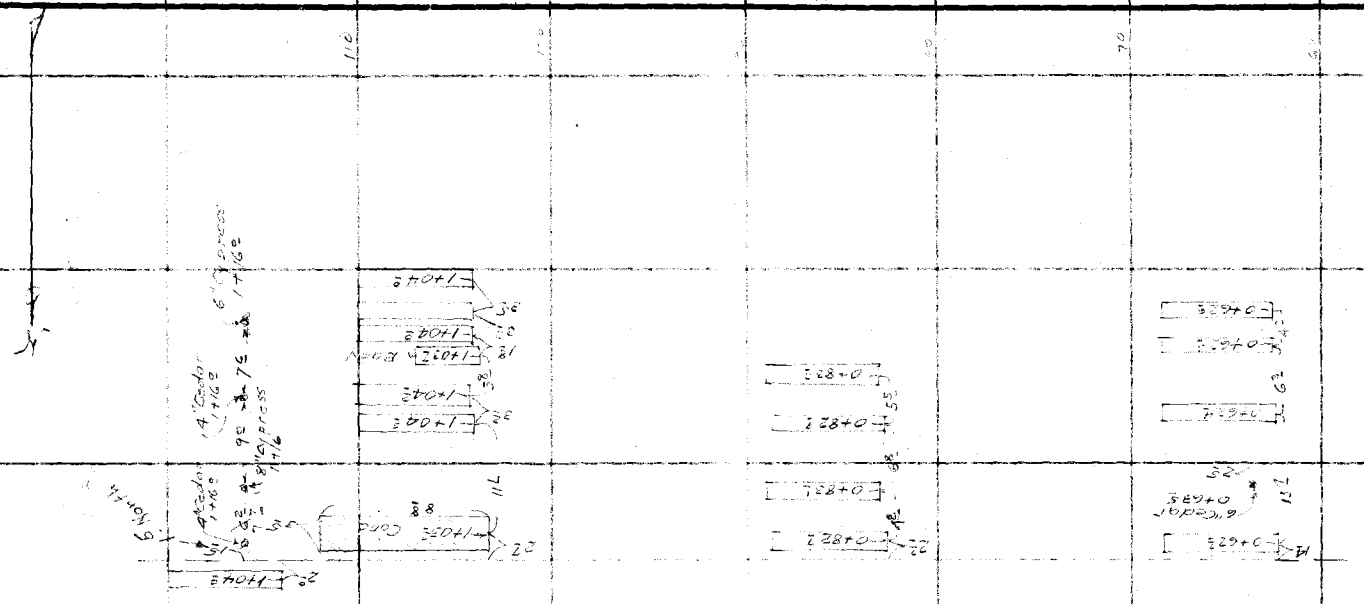

F.B. 686 PG. 22

Notes Ck'd by D. M. Finley	Survey of
Map No. ~~B-1488~~ B-1487	W. O. 5173 Tape No. St'd °F.
Office Work RW.MC	Surveyed by
Checked D. M. Finley	Notes Date 1-19-1937
Date JUNE 1938.	Indexed A. C. Johnson

F.B. 583 Pg. 73

Note: Any Additions or Changes on This Sheet Must be Made or Circled in Red Ink With Date and Name of Person Making Change.

Do not extend notes this side of this line

RETURN TO
LOS ANGELES COUNTY SURVEYOR
700 HALL OF RECORDS

FORM 247 10M 11-35

RETURN TO
LOS ANGELES COUNTY SURVEYOR
700 HALL OF RECORDS

Note: Any Additions or Changes on This Sheet Must be Made or Circled in **Red** Ink With Date and Name of Person Making Change.

Do not extend notes this side of this line

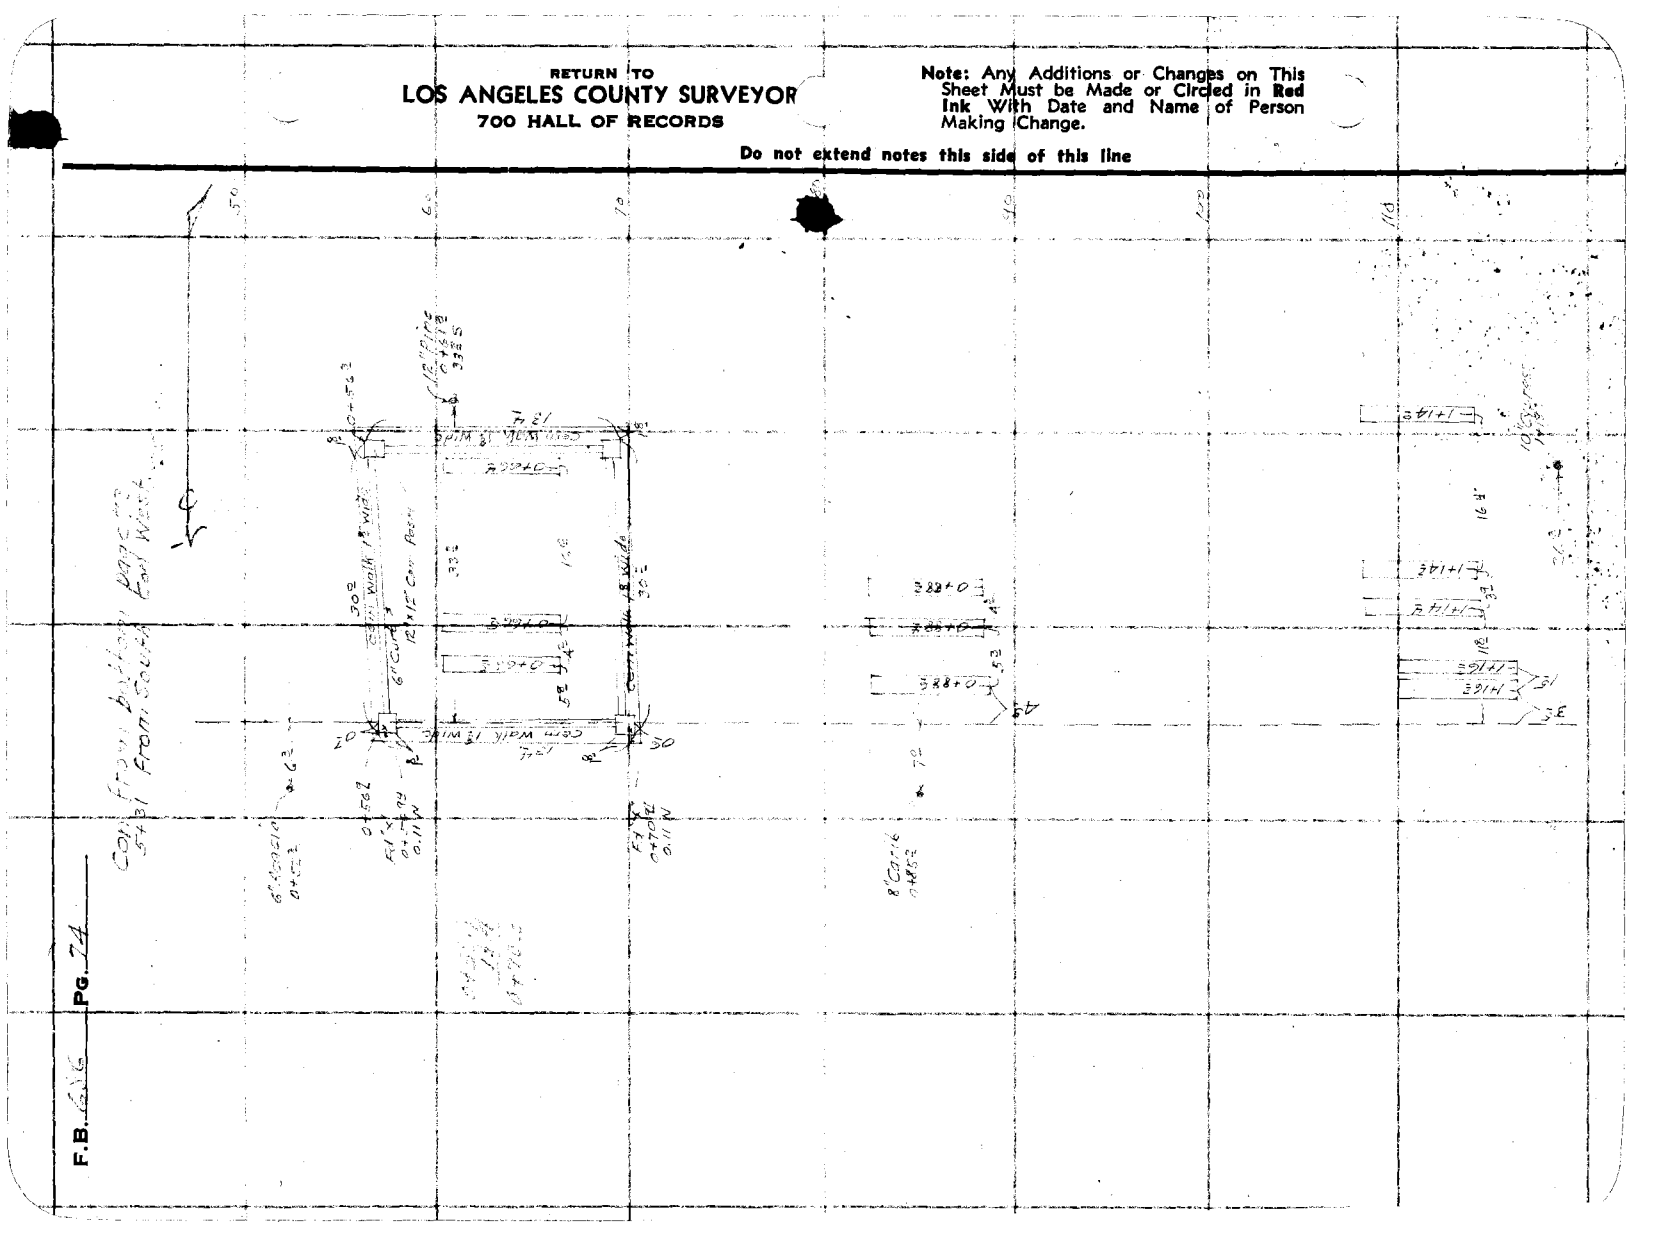

Notes Ck'd by D. M. Finley	Survey of LINCOLN AVE.
Map No. ~~1488-2~~ B-1417	W. O. 8173 Tape No. St'd °F.
Office Work RWMc	Surveyed by W. A. Miller
Checked D. M. Finley	Notes M/Hall Date 4-19-1937
Date JUNE 1938	Indexed A. C. Johnson

F.B. 686 PG 75

Con't bottom page 76

24" Palm 0+42?

12[illegible]

10[illegible]

24" Palm 0+42?

Curb

Curb

7[illegible]5 0+2022

6[illegible]5 0+20?1

5+66.64

5+29.65

Transit Line 'B'

Set Nail 5' East & 5' South of P.I. 5+00 E Line

RETURN TO
LOS ANGELES COUNTY SURVEYOR
700 HALL OF RECORDS

Note: Any Additions or Changes on This Sheet Must be Made or Circled in Red Ink With Date and Name of Person Making Change.

Do not extend notes this side of this line

FORM 247 10M 11-35

RETURN TO
LOS ANGELES COUNTY SURVEYOR
700 HALL OF RECORDS

Note: Any Additions or Changes on This Sheet Must be Made or Circled in **Red** Ink With Date and Name of Person Making Change.

Do not extend notes this side of this line

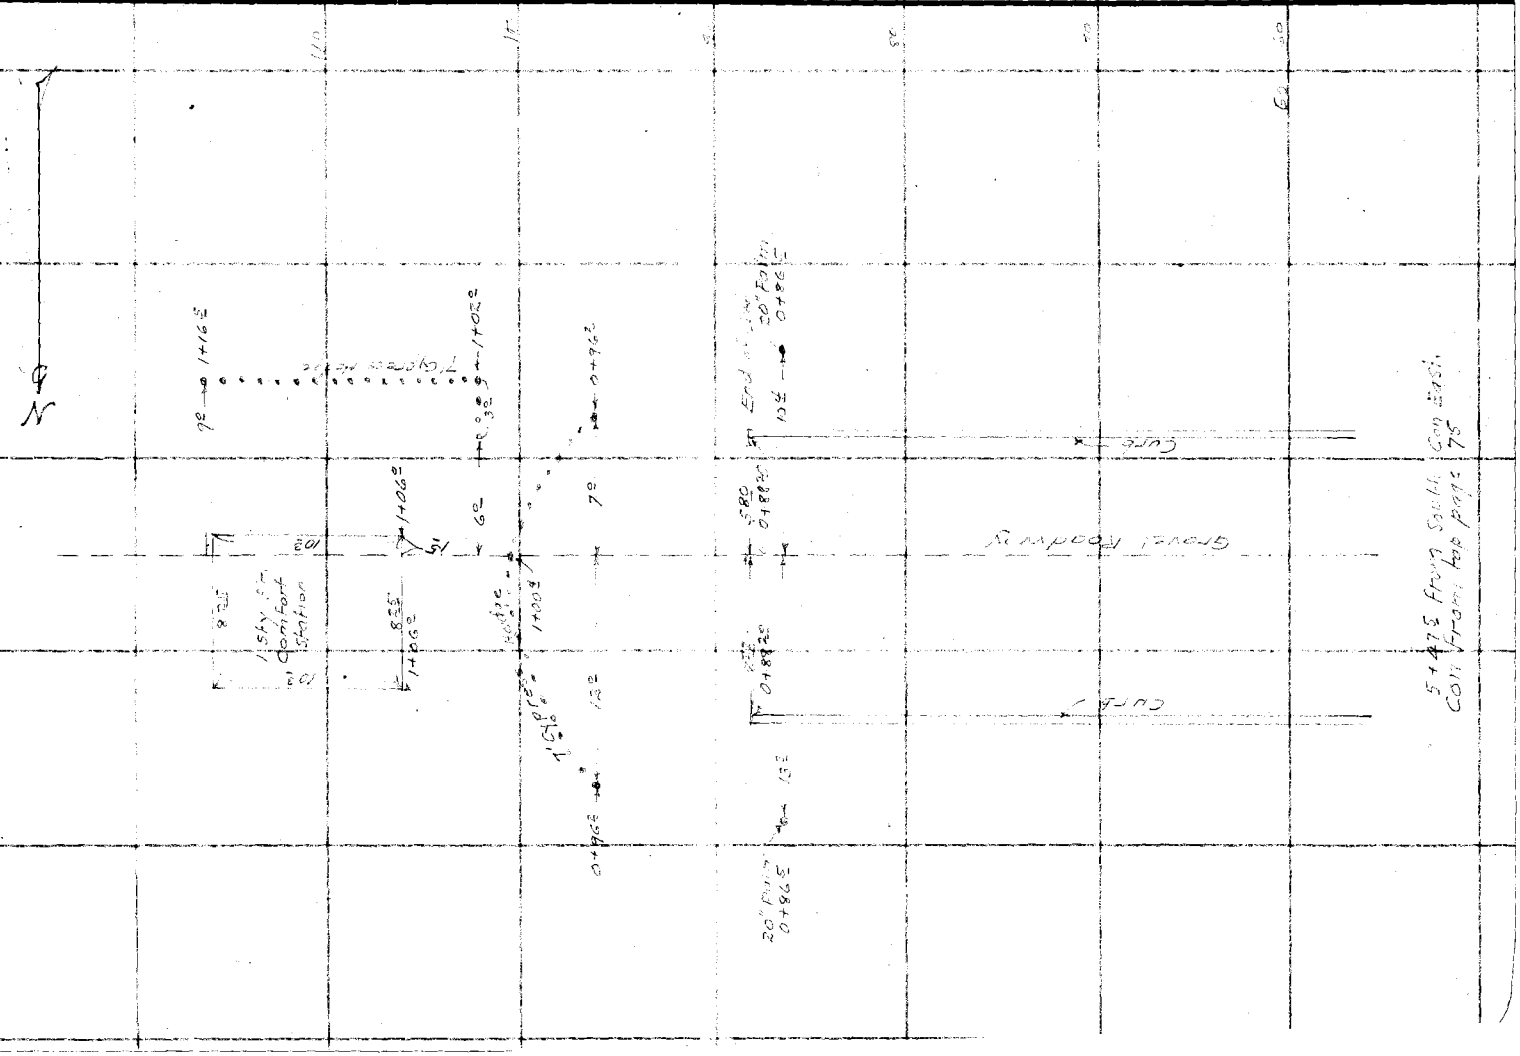
N

Notes Ck'd by D. M. Finley	Survey of LITTLE LAKE Road	F.B. 686	Pg. 74
Map No. ~~B 1308-2~~ B 1907	W. O. 8173 Tape No. St'd °F.		
Office Work RWMc	Surveyed by W. A. Miller		
Checked D. M. Finley	Notes Miller Date 1-12-1938		
Date June 1938	Indexed A. C. Johnson		

Note: Any Additions or Changes on This Sheet Must be Made or Circled in Red Ink With Date and Name of Person Making Change.

Do not extend notes this side of this line

RETURN TO
LOS ANGELES COUNTY SURVEYOR
700 HALL OF RECORDS

FORM 247 10M 11-36

F.B. 686 Pg. 78

Con from bottom page 77
5+49.5 from South Ech West

30" Palm
0+67 ±

11 ±

10 ±

30" Palm
0+67 ±

6" Carob
0+85 ±

10 ±

0+90 ±

74 ±

65

1+09 ±

30" Palm
1+09 ±

10 ±

10 ±

35" Palm
1+09 ±

1+12 ±

68

9 ±

1+12 ±

6' Cypress Hedge

6' Cypress Hedge

41 ±

RETURN TO
LOS ANGELES COUNTY SURVEYOR
700 HALL OF RECORDS

Do not extend notes this side of this line

Note: Any Additions or Changes on This Sheet Must be Made or Circled in Red Ink With Date and Name of Person Making Change.

Notes Ck'd by D. M. Finley
Map No. ~~B-1398-2~~ B-1412
Office Work RWMS
Checked D. M. Finley
Date JUNE 1938

Survey of LITTLE LAKE SEM
W. O. 8173 Tape No. St'd °F.
Surveyed by W. A. Miller
Notes Miller Date 4-19-1937
Indexed C. Johnson

F.B. 686 Pg. 79

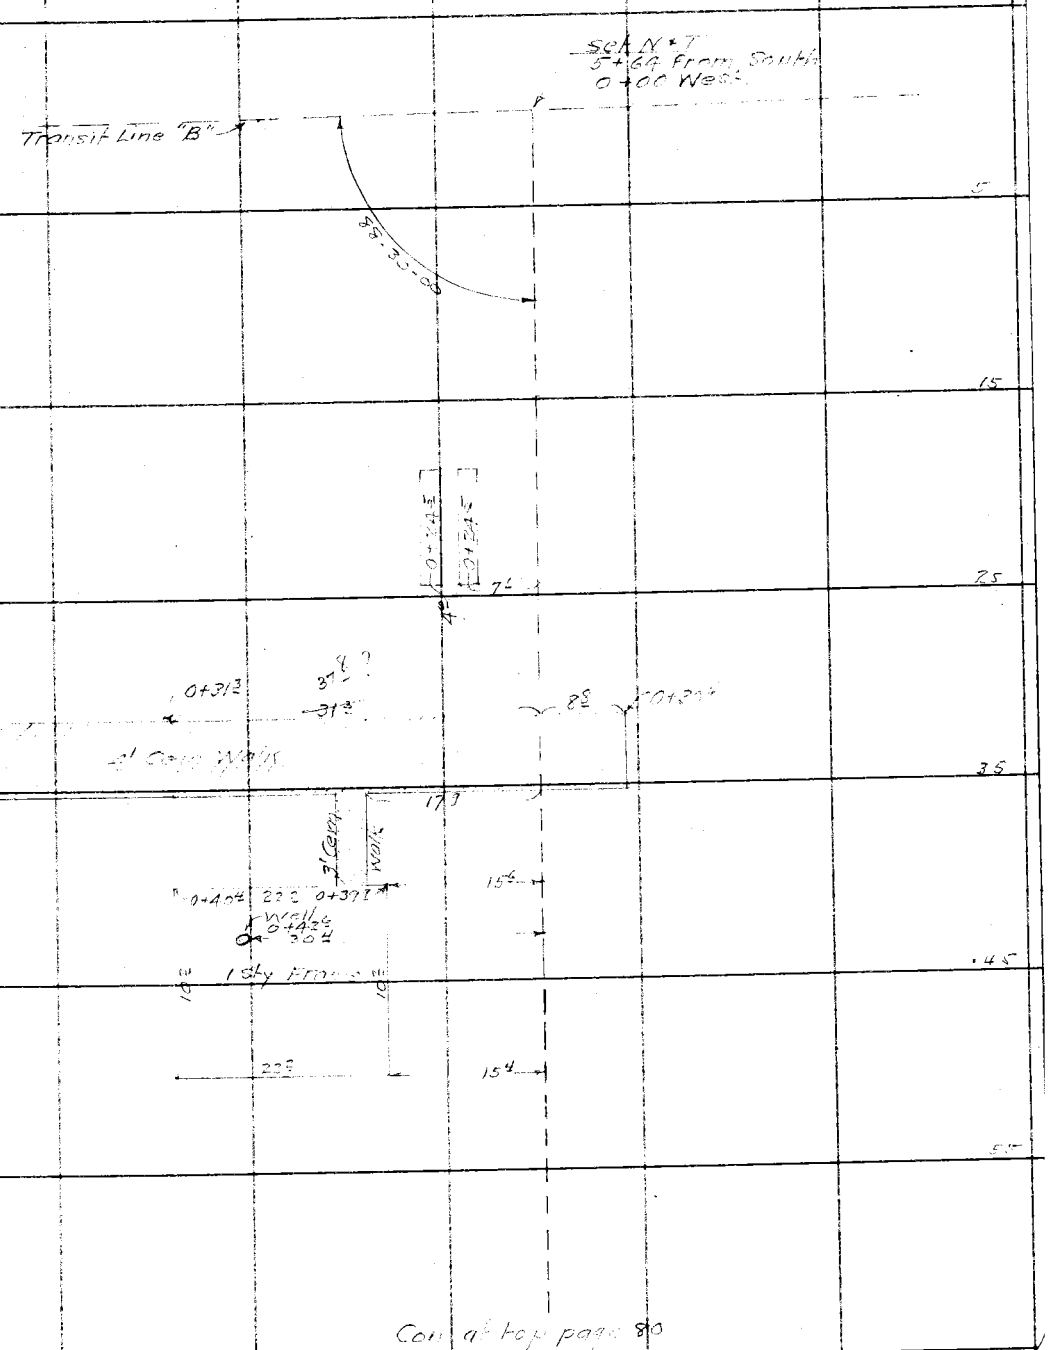

Note: Any Additions or Changes on This Sheet Must be Made or Circled in Red Ink With Date and Name of Person Making Change.

Do not extend notes this side of this line

RETURN TO
LOS ANGELES COUNTY SURVEYOR
700 HALL OF RECORDS

FORM 247 10M 11-38

RETURN TO
LOS ANGELES COUNTY SURVEYOR
700 HALL OF RECORDS

Note: Any Additions or Changes on This Sheet Must be Made or Circled in **Red Ink** With Date and Name of Person Making Change.

Do not extend notes this side of this line

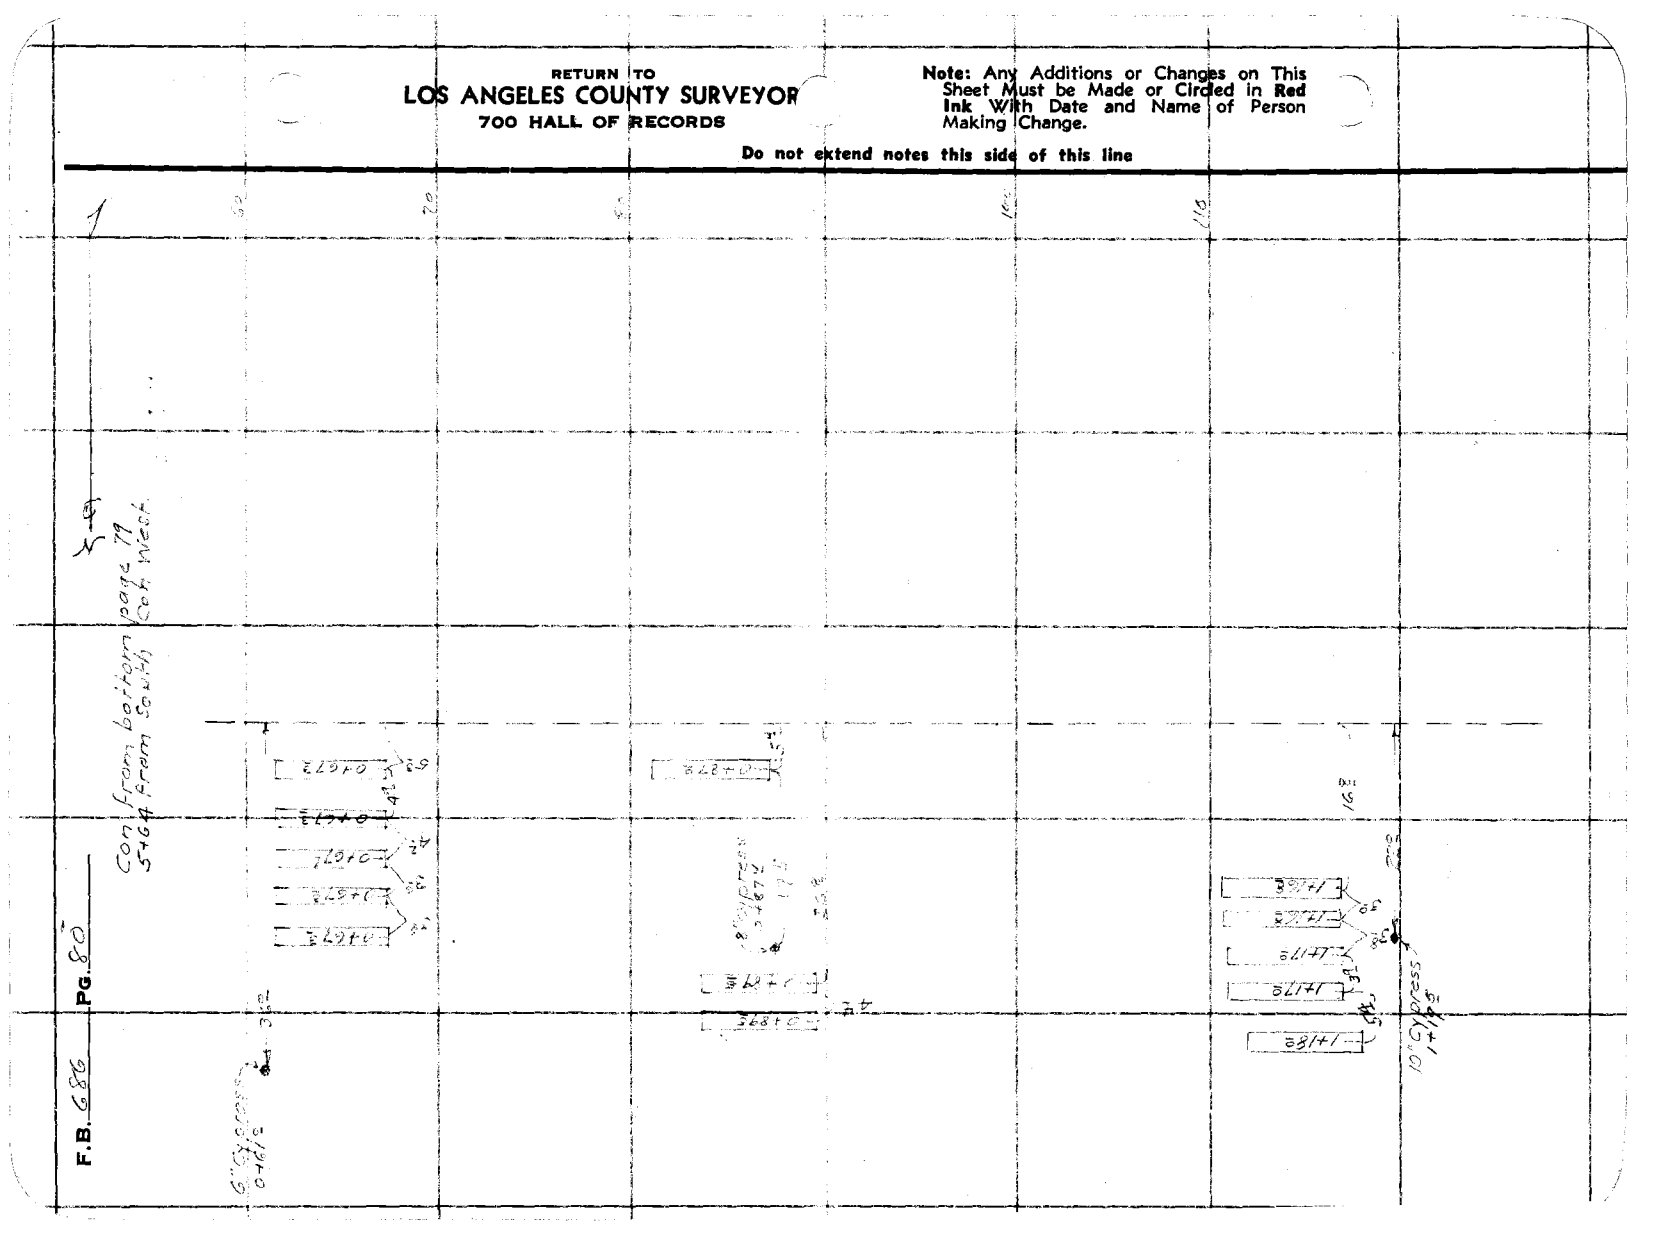

Notes Ck'd by D. M. Finley	Survey of LITTLE LOMA CEM
Map No. B-1302-2 B-1912	W. O. 8173 Tape No. St'd °F.
Office Work RW.ME	Surveyed by R.W.MILLER
Checked D. M. Finley	Notes Date 1-19-1937
Date JUNE 1938	Indexed C. Johnson

F.B. 686 PG 81

Con at bottom page 82

32²

12²

32¹

0+378

0+374

0+375

0+372

0+354

0+359

0+351

36" Pepper

Gate valve 0+279 38 N

0+281

8" Pine 0+214

10" Cypress 0+214

Faucet 0+082

91-30-00

Transit Line 'P'

Set X'' 5+99 From Sta. N 0+00 East

Note: Any Additions or Changes on This Sheet Must be Made or Circled in Red Ink With Date and Name of Person Making Change.

Do not extend notes this side of this line

RETURN TO
LOS ANGELES COUNTY SURVEYOR
700 HALL OF RECORDS

FORM 247 10M 11-38

F.B. 686 PG. 82

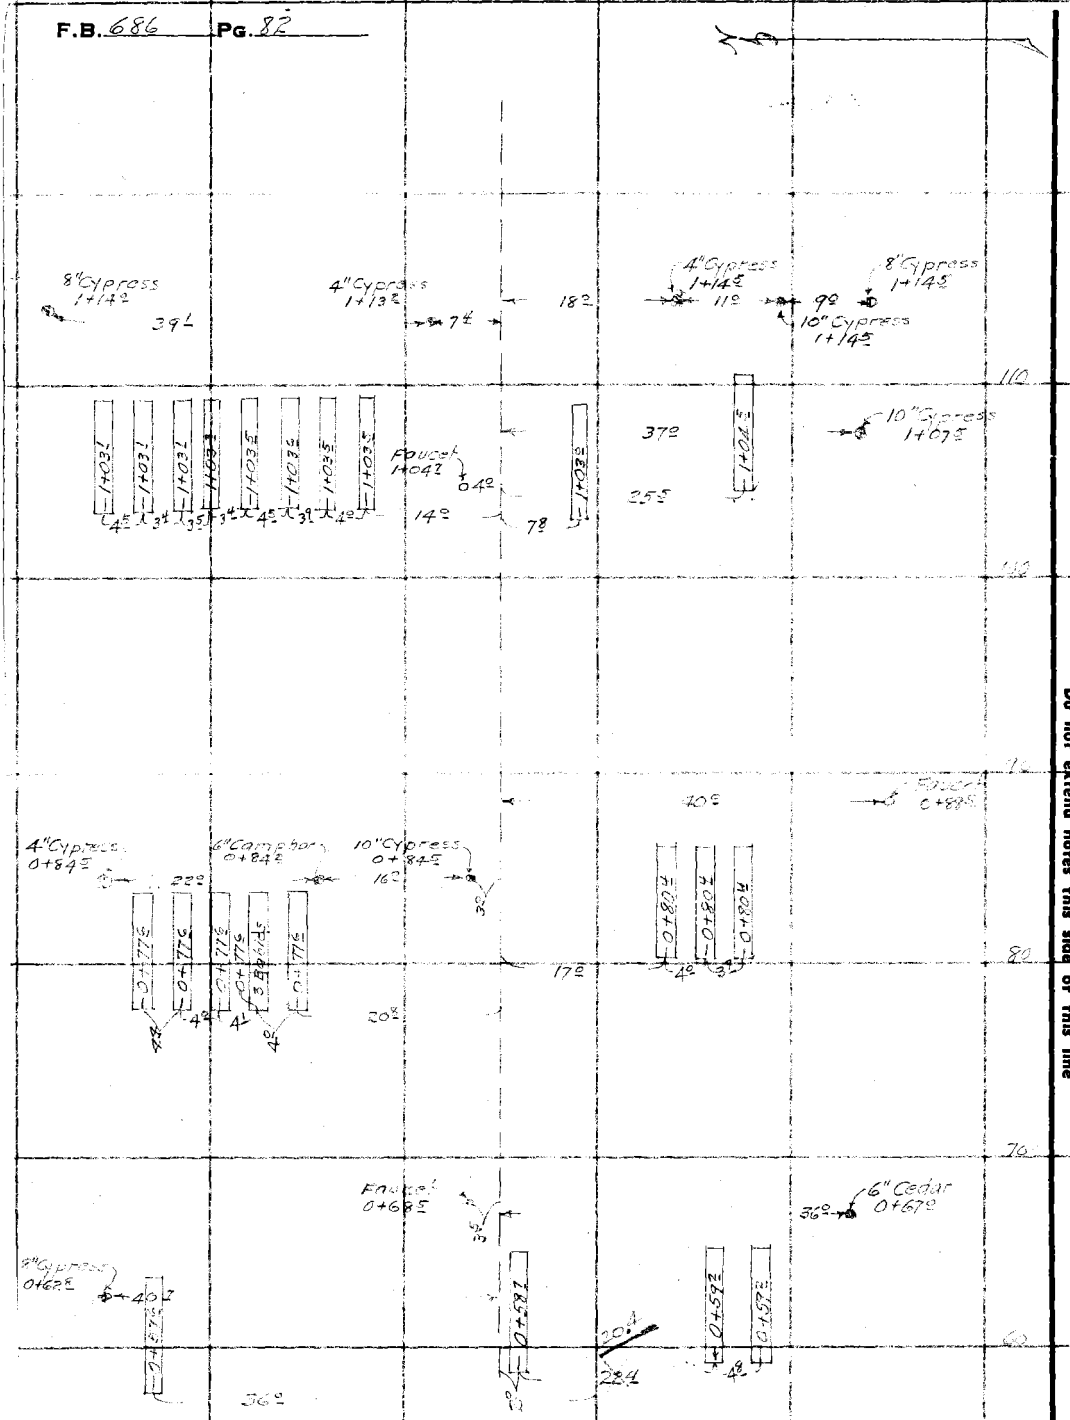

RETURN TO
LOS ANGELES COUNTY SURVEYOR
700 HALL OF RECORDS

Do not extend notes this side of this line

Note: Any Additions or Changes on This Sheet Must be Made or Circled in Red Ink With Date and Name of Person Making Change.

Notes Ck'd by D. M. Finley	Survey of LITTLE LAKE CEM
Map No. ~~B-1308 & B-1147~~	W.O. 8173 Tape No. St'd °F.
Office Work R.W.Mc	Surveyed by W.A.MILLER
Checked D. M. Finley	Notes Miller Date 1-19-1937
Date June 1938.	Indexed A. C. Johnson

F.B. 686 Pg. 83

Note: Any Additions or Changes on This Sheet Must be Made or Circled in Red Ink With Date and Name of Person Making Change.

Do not extend notes this side of this line

RETURN TO
LOS ANGELES COUNTY SURVEYOR
700 HALL OF RECORDS

FORM 247 10M 11-36

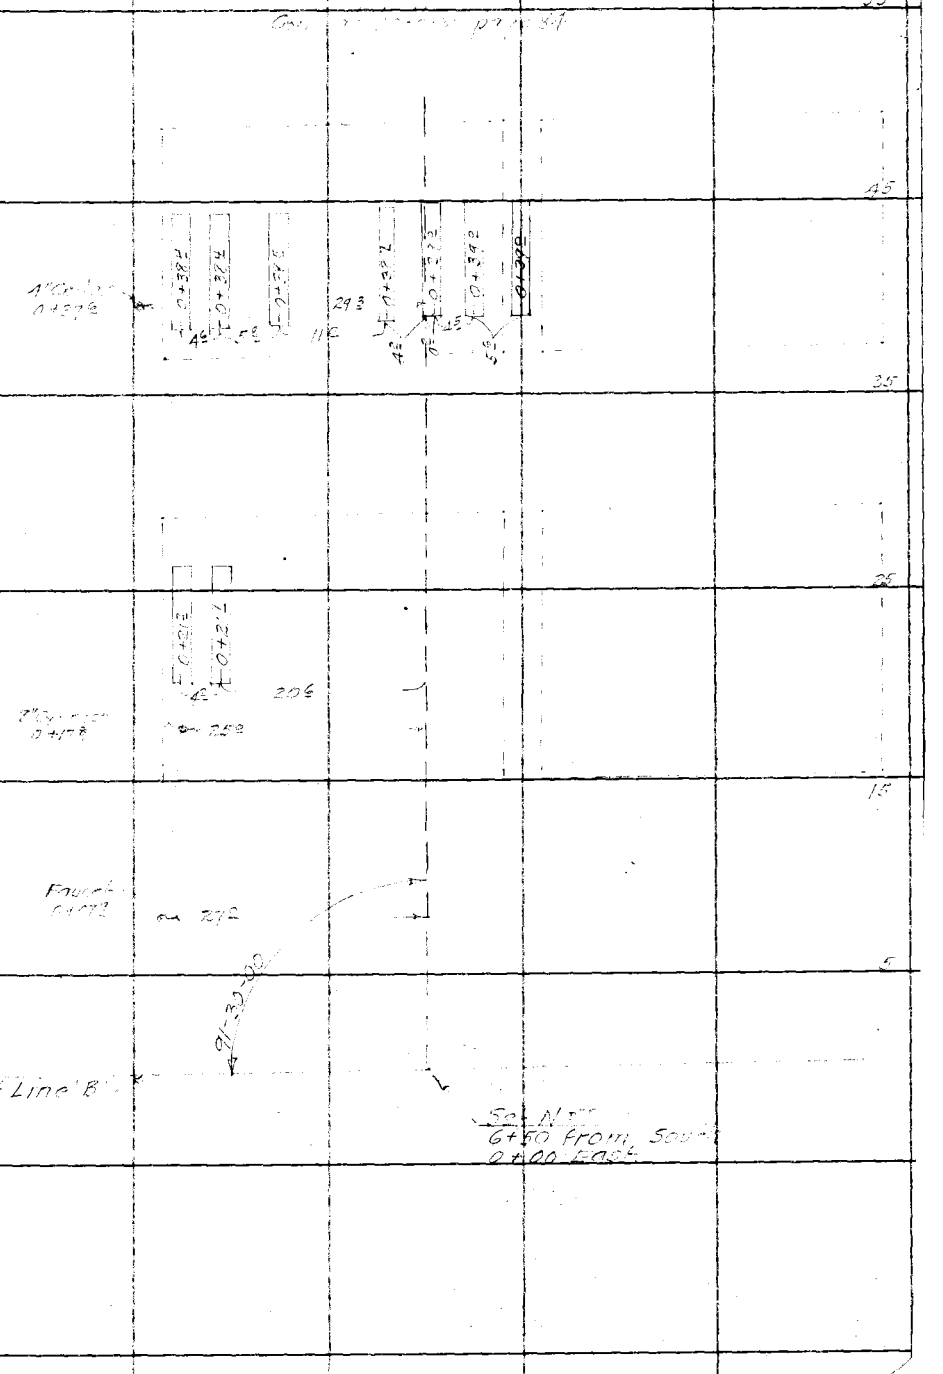

RETURN TO
LOS ANGELES COUNTY SURVEYOR
700 HALL OF RECORDS

Note: Any Additions or Changes on This Sheet Must be Made or Circled in **Red** Ink With Date and Name of Person Making Change.

Do not extend notes this side of this line

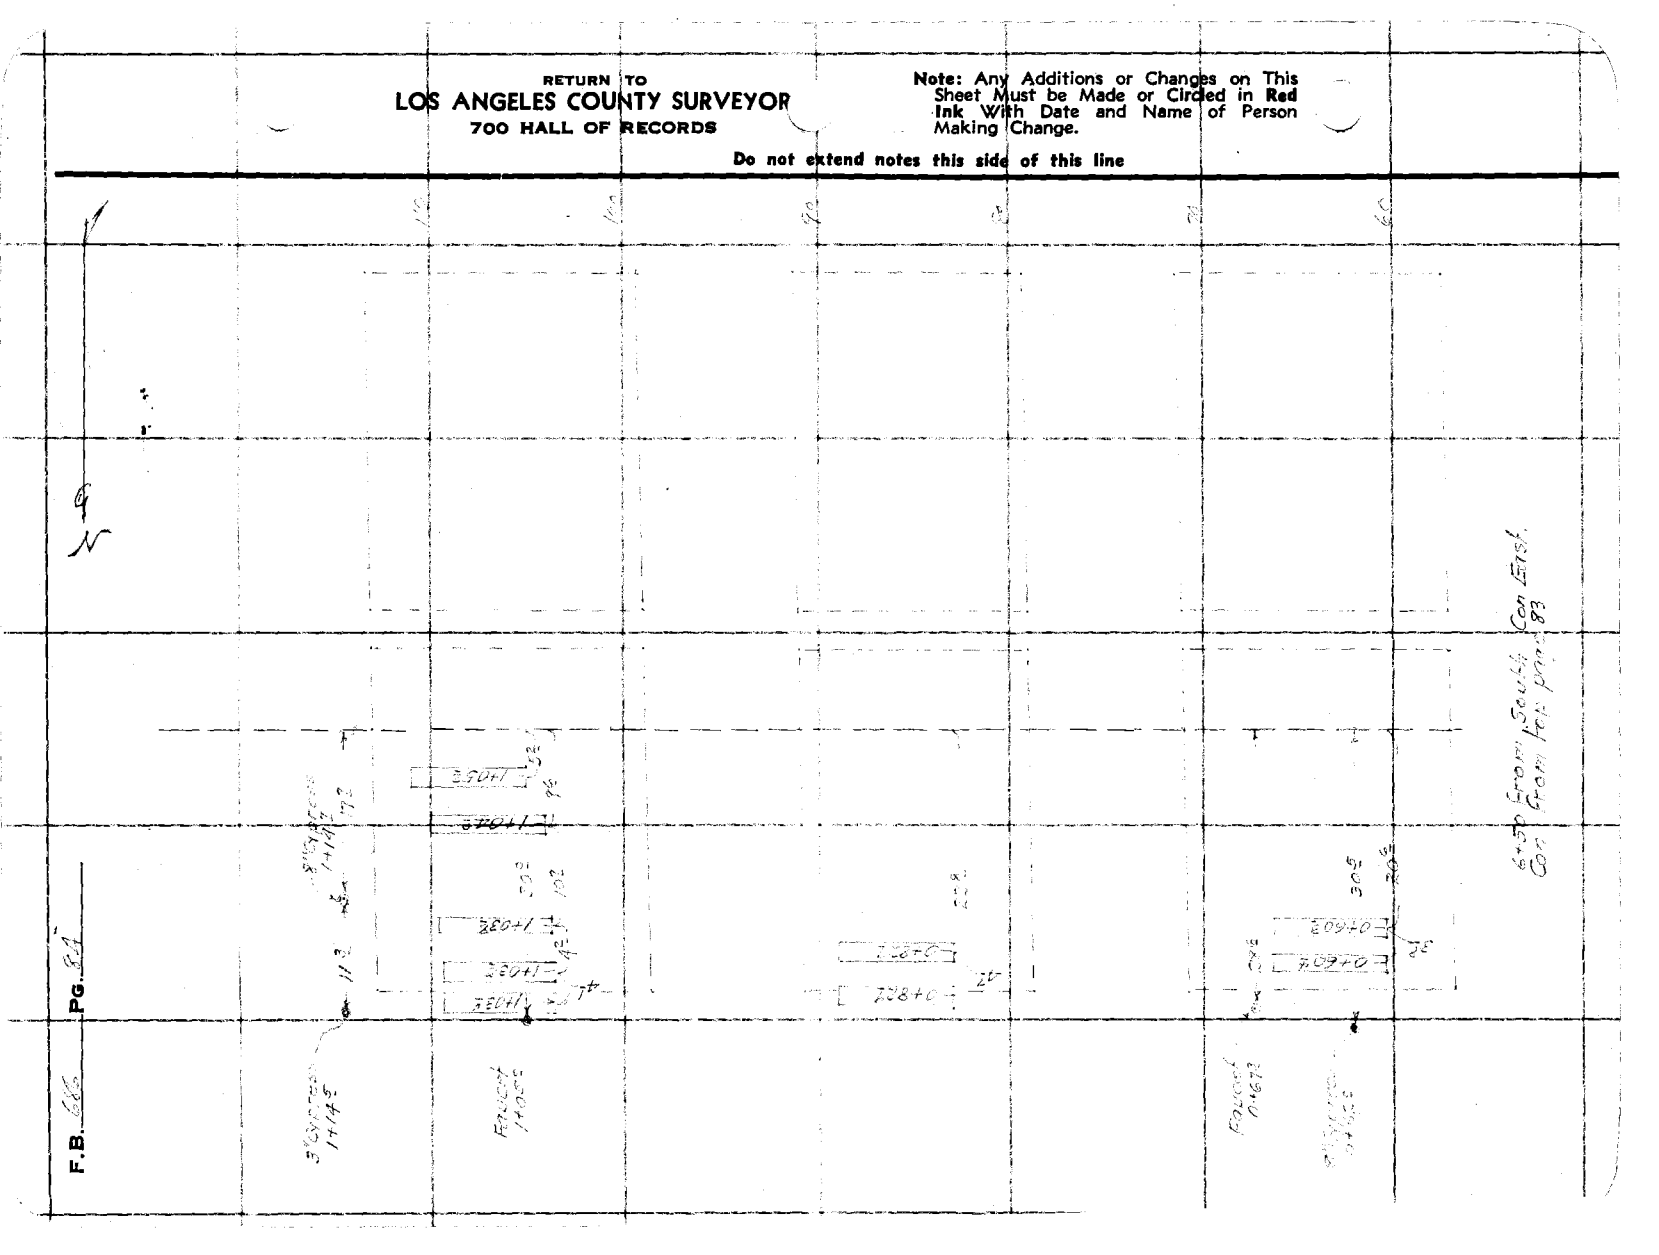
F.B.
Pg.
N
3.50 Ft
2.50 Ft
2.50 Ft
2

Notes Ck'd by D. M. Finley	Survey of LITTLE LAKE CEM
Map No. B-1308 2B-1412	W. O. 2173 Tape No. St'd °F.
Office Work R.W.MS	Surveyed by W. C. Miller
Checked D. M. Finley	Notes Miller Date 1-19-1937
Date June 1938	Indexed A. C. Johnson

F.B. 686 Pg. 85

Note: Any Additions or Changes on This Sheet Must be Made or Circled in Red Ink With Date and Name of Person Making Change.

Do not extend notes this side of this line

RETURN TO
LOS ANGELES COUNTY SURVEYOR
700 HALL OF RECORDS

FORM 247 10M 11-35

RETURN TO
LOS ANGELES COUNTY SURVEYOR
700 HALL OF RECORDS

Note: Any Additions or Changes on This Sheet Must be Made or Circled in Red Ink With Date and Name of Person Making Change.

Do not extend notes this side of this line

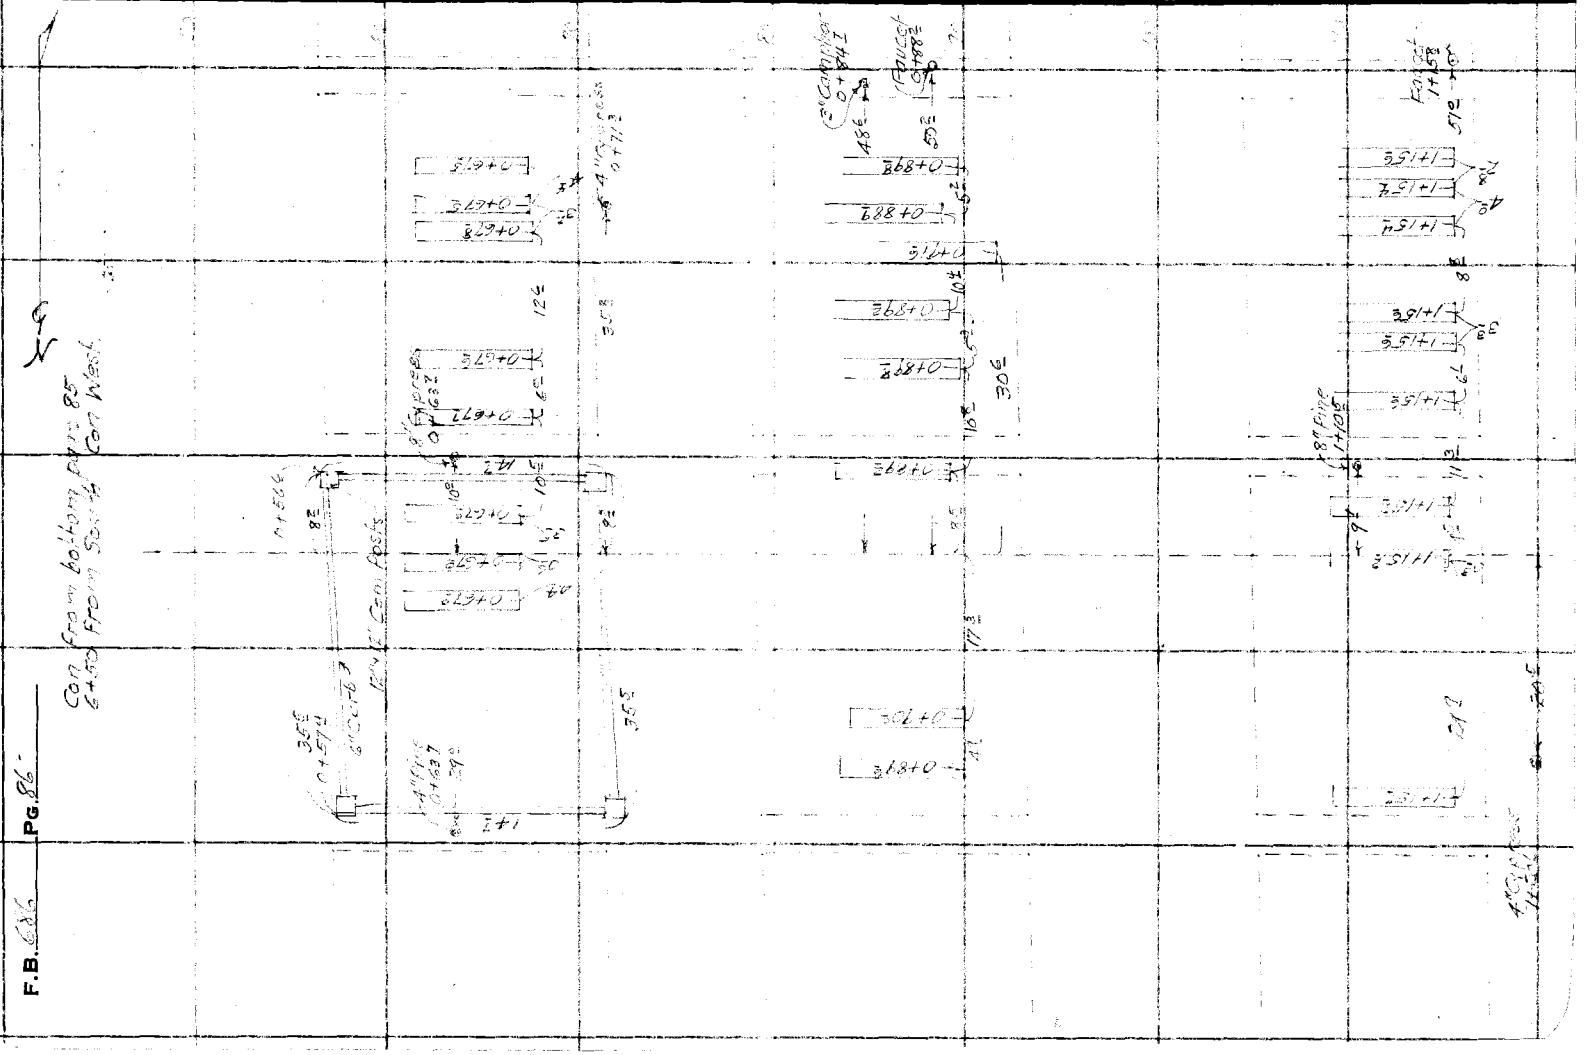

Notes Ck'd by D. M. Finley	Survey of LITTLE LAKE CEM
Map No. ~~B 1308 & B-1417~~ 8173	Tape No. St'd °F.
Office Work RW-MC	Surveyed by W.A. Miller
Checked D. M. Finley	Notes Miller Date 1-20-1937
Date June 1938	Indexed A. C. Johnson

F.B. 686 PG 87

Note: Any Additions or Changes on This Sheet Must be Made or Circled in Red Ink With Date and Name of Person Making Change.

Do not extend notes this side of this line

RETURN TO
LOS ANGELES COUNTY SURVEYOR
700 HALL OF RECORDS

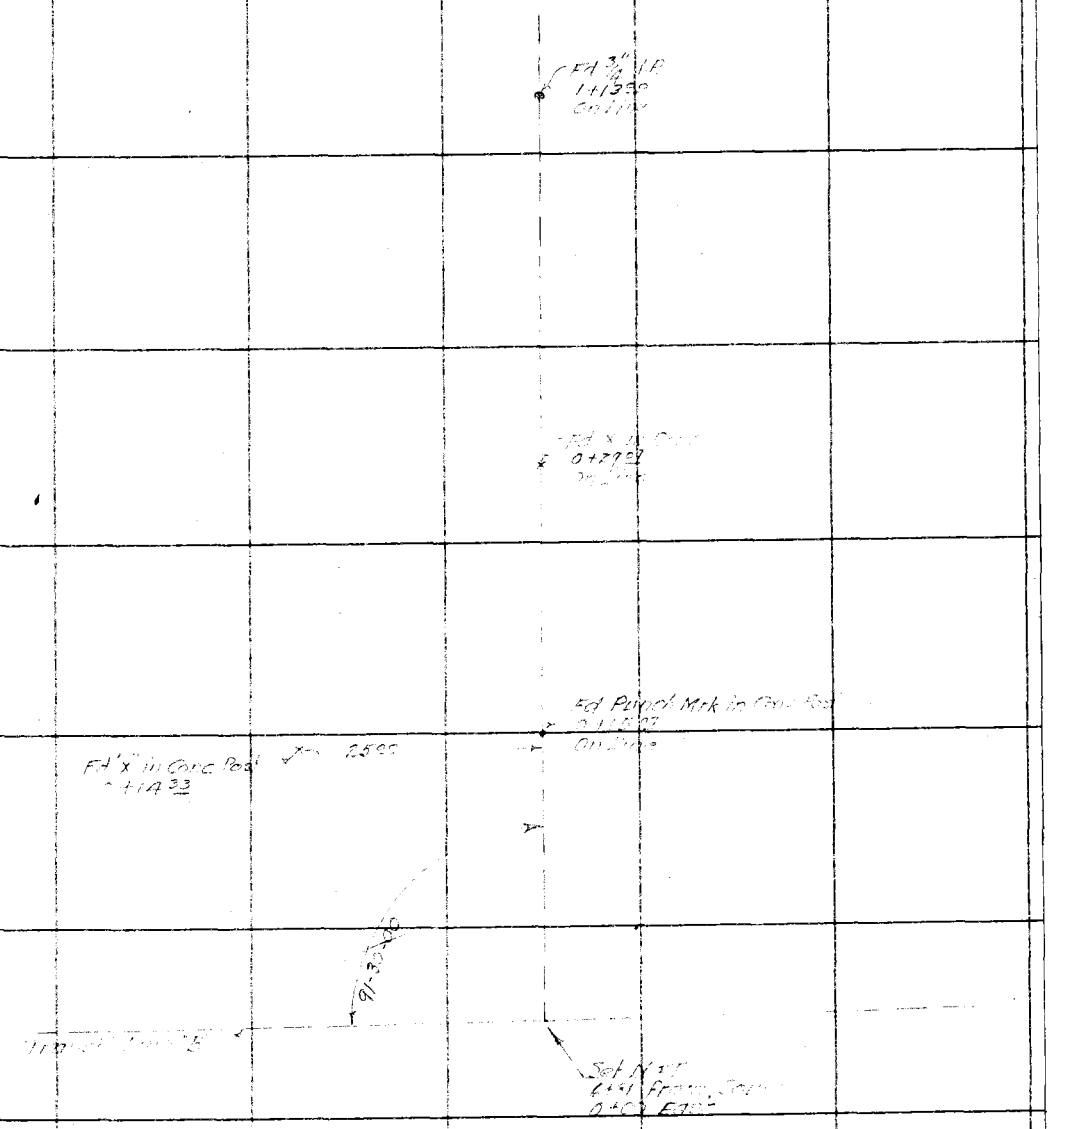

FORM 247 10M 11-35

RETURN TO
LOS ANGELES COUNTY SURVEYOR
700 HALL OF RECORDS

Note: Any Additions or Changes on This Sheet Must be Made or Circled in **Red Ink** With Date and Name of Person Making Change.

Do not extend notes this side of this line

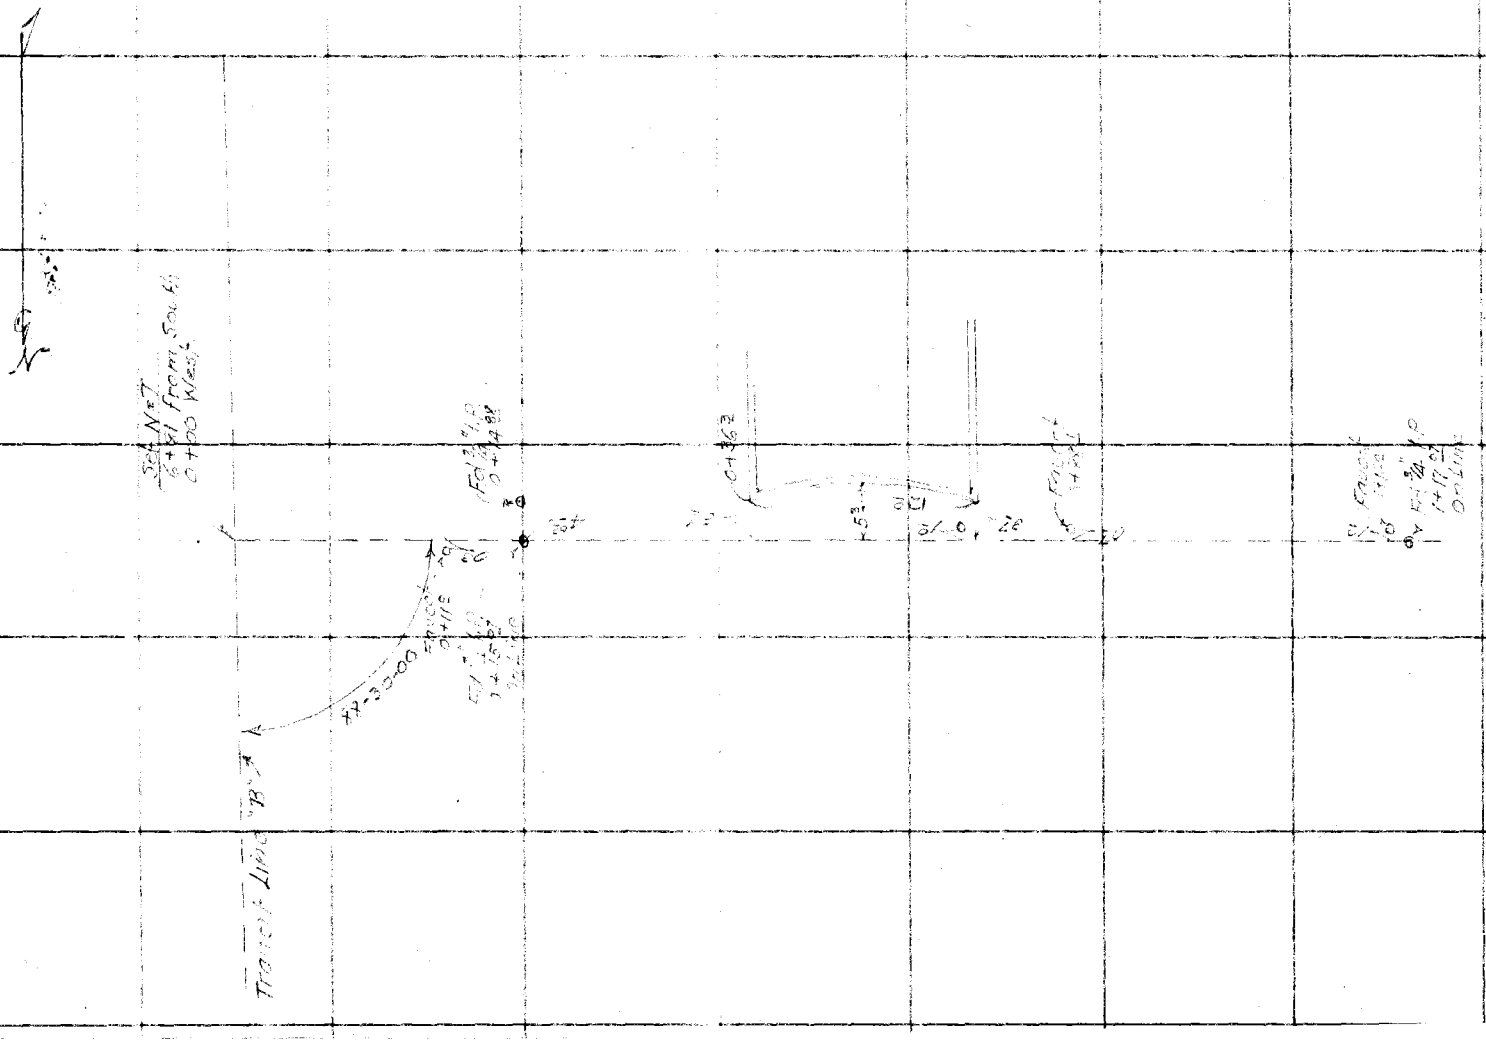
N
Sta N 87
6+91 From Sta 46
0+00 West
Sta 46
0+00
Sta 46
0+00
Sta
0+63
Sta
1+18.50
On Line
Sta
0+00
Sta
0+00
Sta
0+00

Notes Ck'd by D. M. Finley	Survey of LITTLE LAKE CREEK	F.B. 686	Pg 91
Map No. ~~B-1308-2~~ B-1461	W. O. 8173 Tape No.	St'd	°F.
Office Work R.W.M?	Surveyed by W.A.A?		
Checked D. M. Finley	Notes Miller Date 1-20-1937		
Date June 1938.	Indexed A. C. Johnson		

Note: Any Additions or Changes on This Sheet Must be Made or Circled in Red Ink With Date and Name of Person Making Change.

Do not extend notes this side of this line

RETURN TO
LOS ANGELES COUNTY SURVEYOR
700 HALL OF RECORDS

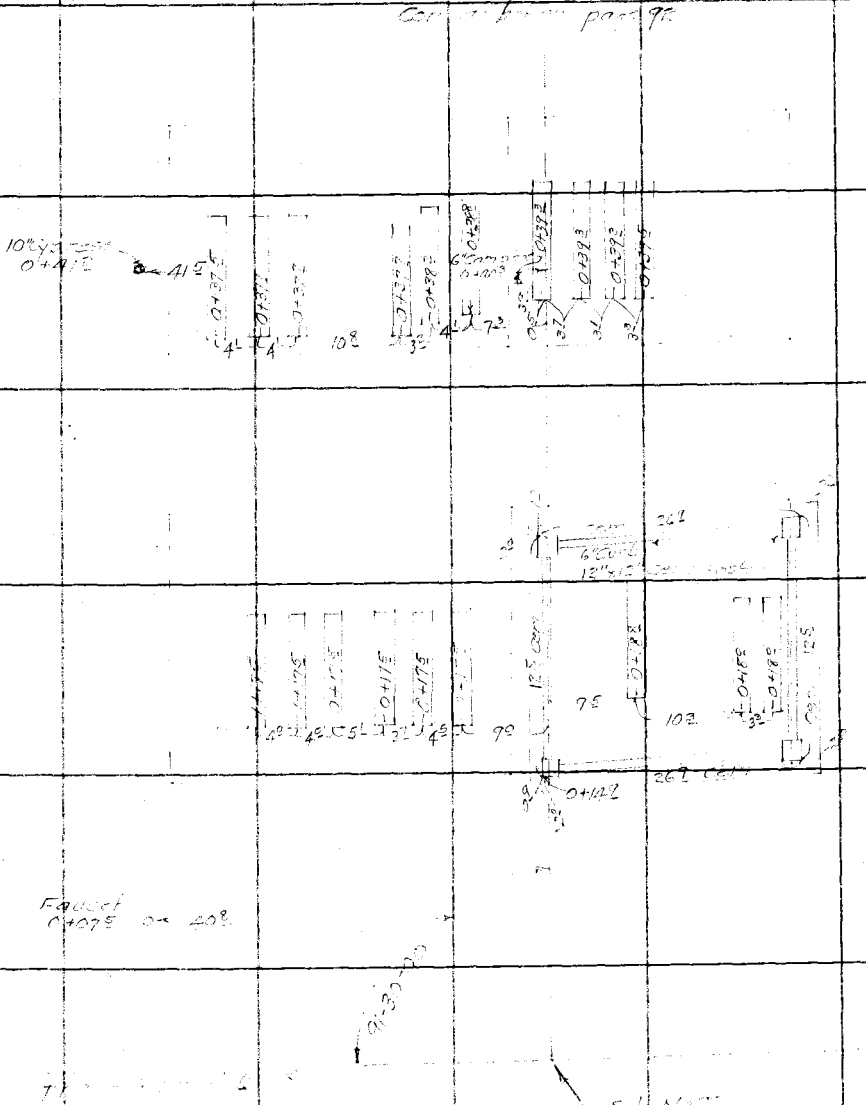
Continued from page 90
10½ Y.C. Elm
0+41.5
41.5
0+37.5
0+33.7
10.8
0+27.2
0+28.8
6" Elm
0+40.3
0+30.8
0+32.3
0+32.3
0+37.6
0+37.6
26.2
0+41.5
0+41.5
0+41.5

RETURN TO
LOS ANGELES COUNTY SURVEYOR
700 HALL OF RECORDS

Note: Any Additions or Changes on This Sheet Must be Made or Circled in **Red Ink** With Date and Name of Person Making Change.

Do not extend notes this side of this line

F.B. 686 PG. 98

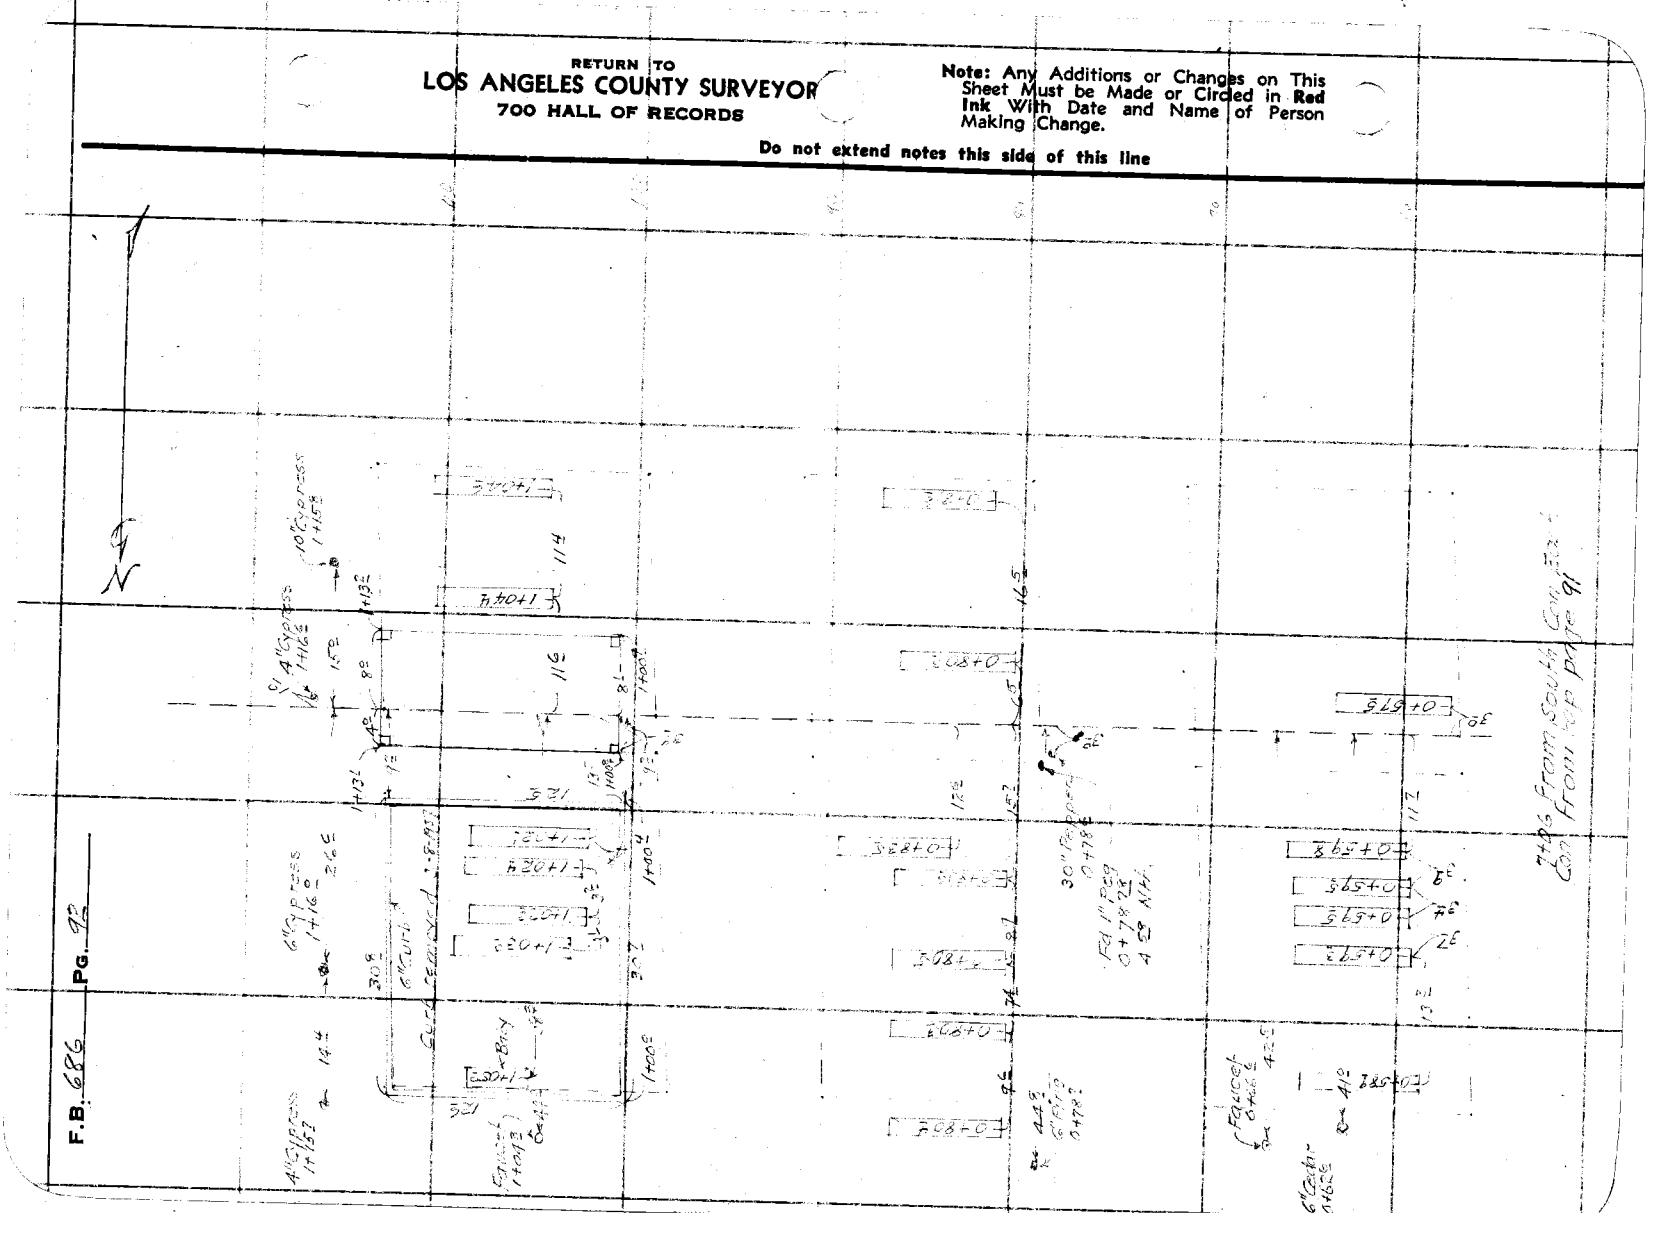

Notes Ck'd by D. M. Finley	Survey of LITTLE LAKE CEM	F.B. 686	PG. 93
Map No. ~~B-1348-2~~ B-14	W.O. 8173 Tape No. St'd °F.		
Office Work R.W.M.E	Surveyed by W.A. Miller		
Checked D. M. Finley	Notes Miller Date 1-20-1932		
Date June 1938	Indexed A. C. Johnson		

Note: Any Additions or Changes on This Sheet Must be Made or Circled in Red Ink With Date and Name of Person Making Change.

Do not extend notes this side of this line

RETURN TO
LOS ANGELES COUNTY SURVEYOR
700 HALL OF RECORDS

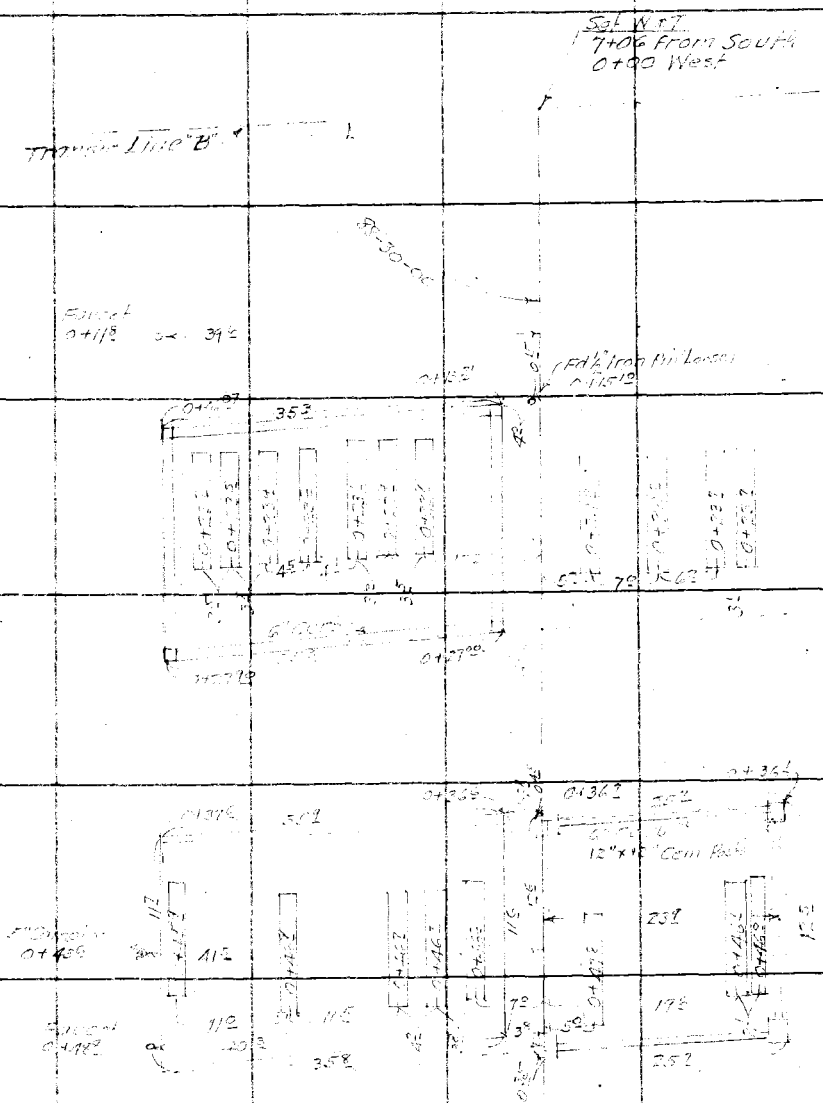
Sgl W.P.T.
7+06 From South
0+90 West
Transit Line "B"
Fence
0+11.8
Fence
0+11.8
12"x12" Conc Post
Conc Post
Conc Post

RETURN TO
LOS ANGELES COUNTY SURVEYOR
700 HALL OF RECORDS

Note: Any Additions or Changes on This Sheet Must be Made or Circled in **Red Ink** With Date and Name of Person Making Change.

Do not extend notes this side of this line

F.B. 686 PG. 94

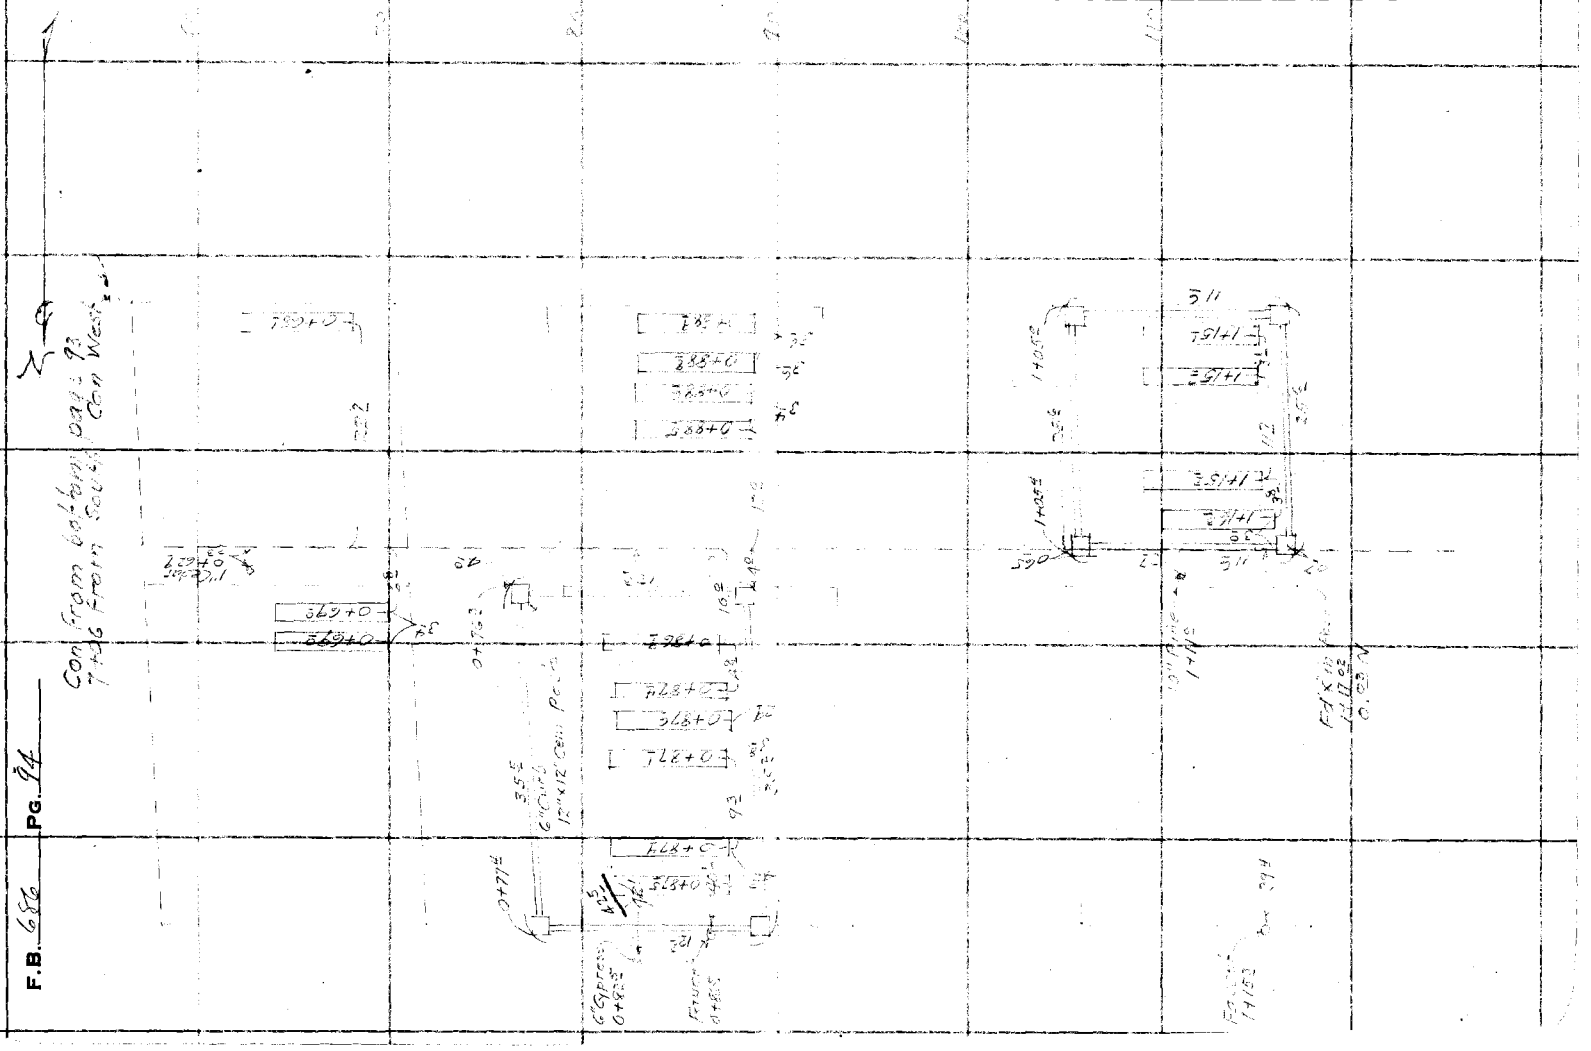

Notes Ck'd by D. M. Finley	Survey of LITTLE LAKE CAN
Map No. ~~B-1388~~ B-1417-0.8173	Tape No. ___ St'd ___ °F.
Office Work R.W.Mc	Surveyed by W.A.Miller
Checked D. M. Finley	Notes Miller Date 1-20-1937
Date June 1938	Indexed A. C. Johnson

F.B. 686 PG. 95

Set N&T
7+45 from Sta 4
0+40 West

Transit Line "B"

15°-30'-00"

0+225 0+232 0+230 0+229

41 40 61 8?

257
285

0+478 0+476 0+468 0+468

12° 53 32 32 31 55 62

1.5 2.5 3.5 4.5 5.

Con on top page 96

Note: Any Additions or Changes on This Sheet Must be Made or Circled in Red Ink With Date and Name of Person Making Change.

Do not extend notes this side of this line

RETURN TO
LOS ANGELES COUNTY SURVEYOR
700 HALL OF RECORDS

FORM 247 10M 11-38

F.B. 686 PG. 96

Con from bottom page 95
7145 From South & on West.

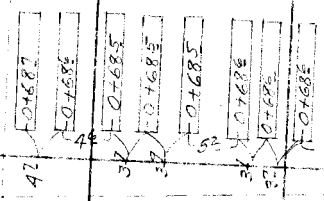

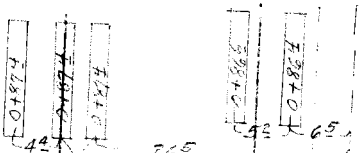

12" Cypress
1+18 E

72

RETURN TO
LOS ANGELES COUNTY SURVEYOR
700 HALL OF RECORDS

Note: Any Additions or Changes on This Sheet Must be Made or Circled in Red Ink With Date and Name of Person Making Change.

Do not extend notes this side of this line

Notes Ck'd by D. M. Finley	Survey of LITTLE LAKE CEM
Map No. B-1908 & B-1917	W. O. 8173 Tape No. St'd °F.
Office Work R.W.M.S.	Surveyed by W.A. Miller
Checked D. M. Finley	Notes Miller Date 12-1937
Date June 1938.	Indexed C. Johnson

F.B. 576 PG. 97

Cor. at junction pg. 98

Note: Any Additions or Changes on This Sheet Must be Made or Circled in Red Ink With Date and Name of Person Making Change.

Do not extend notes this side of this line

RETURN TO
LOS ANGELES COUNTY SURVEYOR
7th HALL OF RECORDS

341

6" Curb & Gutter

12" x 12" Conc. Posts

117

0+439 P.C.

341

0+137 P.C. on line

359

6" Curb & Gutter

12" x 12" Conc. Posts

124

324

0+181 on line

0+159 P.C.

Fd Cross, Ft. on line 1.5' Back 24 L.P. 35° S&H

Fd Cross Cut

Transit Line "B"

Set Nail 7+84 ± from Sta. 0+00 Back.

FORM 247 10M 11-35

RETURN TO
LOS ANGELES COUNTY SURVEYOR
700 HALL OF RECORDS

Note: Any Additions or Changes on This Sheet Must be Made or Circled in **Red** Ink With Date and Name of Person Making Change.

Do not extend notes this side of this line

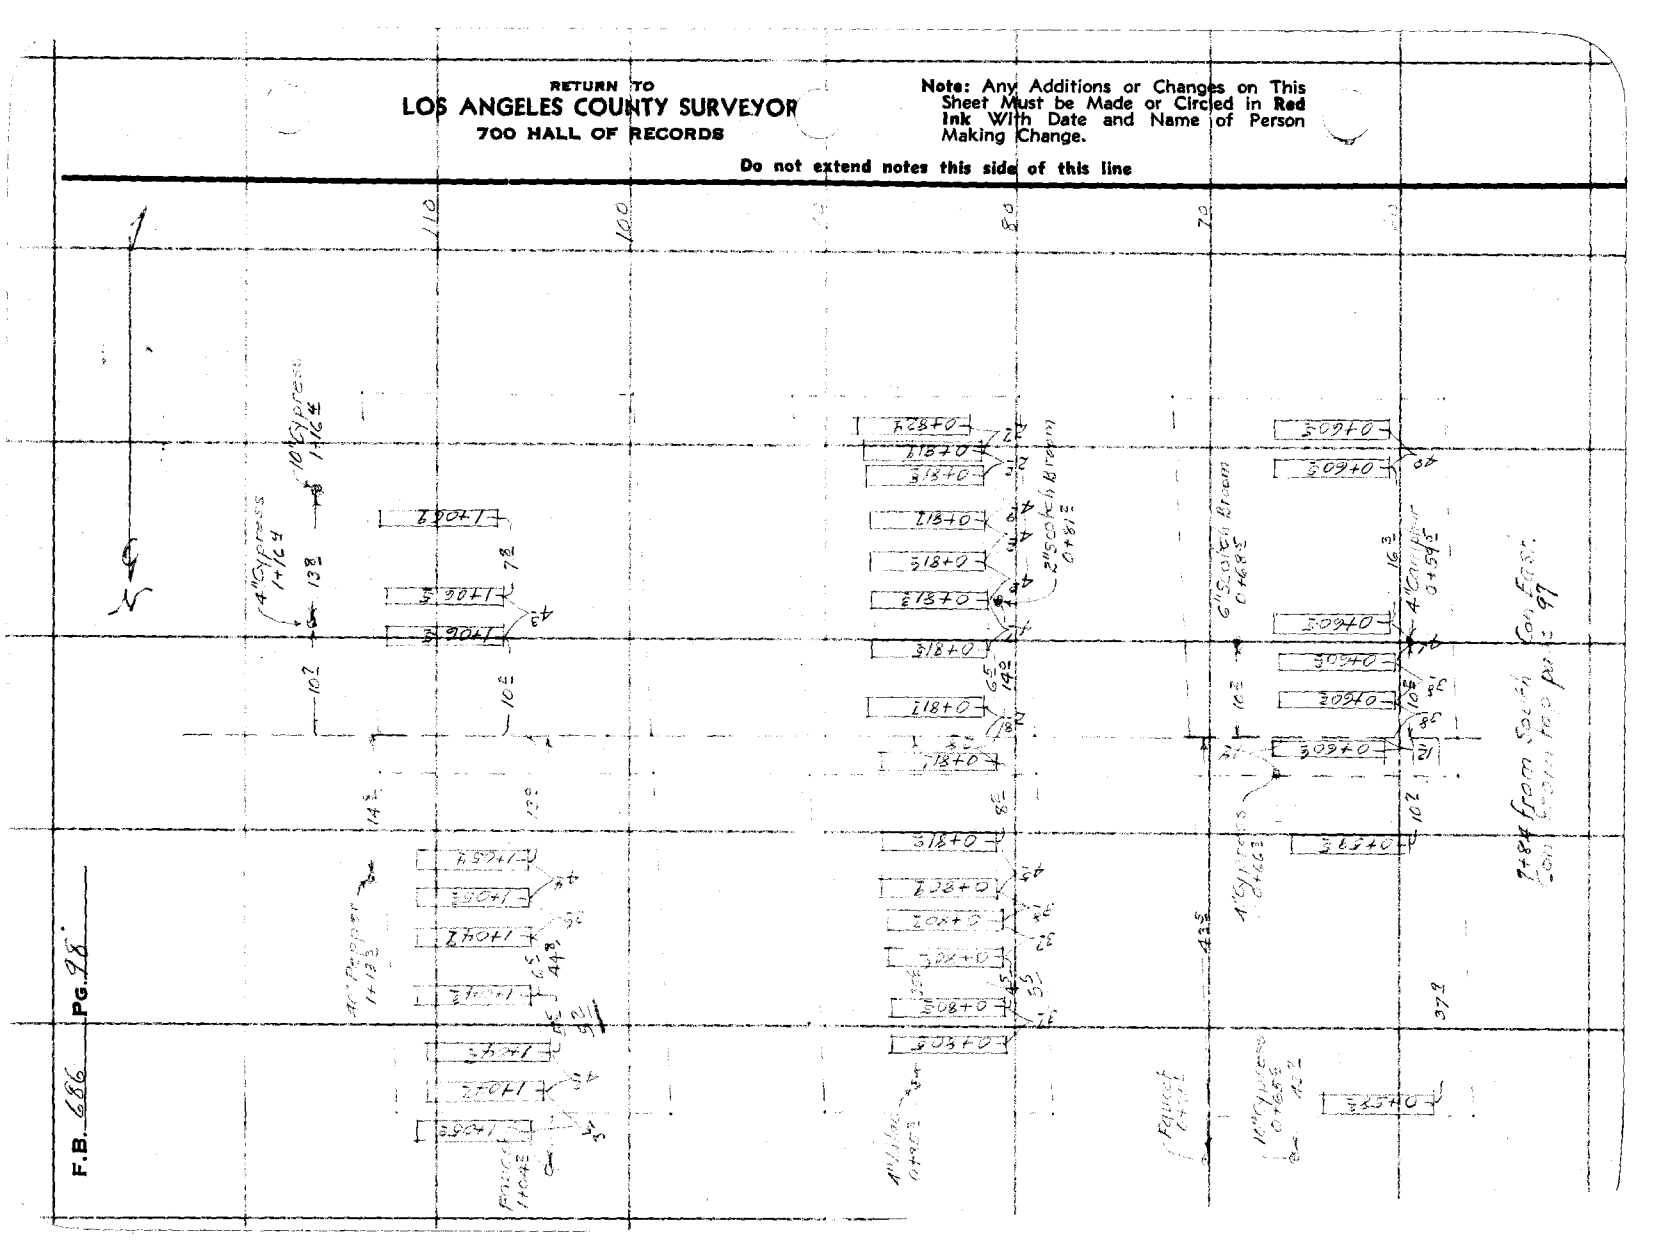

Notes Ck'd by D. M. Finley	Survey of LITTLE LAKE CREEK	F.B. 58	Pg. 99
Map No. B-1308-2, B-1412	W. O. 8173	Tape No.	St'd °F.
Office Work R.W.M.S.	Surveyed by		
Checked D. M. Finley	Notes	Date 1-26-1937	
Date June 1938.	Indexed A. C. Johnson		

Note: Any Additions or Changes on This Sheet Must be Made or Circled in Red Ink With Date and Name of Person Making Change.

Do not extend notes this side of this line

RETURN TO
LOS ANGELES COUNTY SURVEYOR
700 HALL OF RECORDS

FORM 247 10M 11-35

RETURN TO
LOS ANGELES COUNTY SURVEYOR
700 HALL OF RECORDS

Note: Any Additions or Changes on This Sheet Must be Made or Circled in **Red Ink** With Date and Name of Person Making Change.

Do not extend notes this side of this line

F.B. 699 Pg. 11

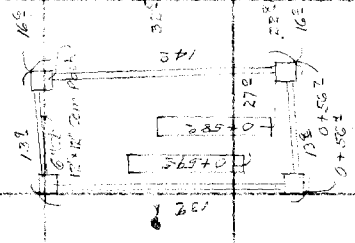

Notes Ck'd by D. M. Finley	Survey of LITTLE LAKE COM
Map No. ~~B-1908~~ B-1912	W. O. 8173 Tape No. St'd °F.
Office Work R.W.Mc	Surveyed by W.A.Miller
Checked D. M. Finley	Notes Miller Date 1-21-1937
Date JUNE 1938.	Indexed C. Johnson

F.B. 686 Pg. 101

RETURN TO
LOS ANGELES COUNTY SURVEYOR
700 HALL OF RECORDS

Note: Any Additions or Changes on This Sheet Must be Made or Circled in Red Ink With Date and Name of Person Making Change.

Do not extend notes this side of this line

FORM 247 10M 11-35

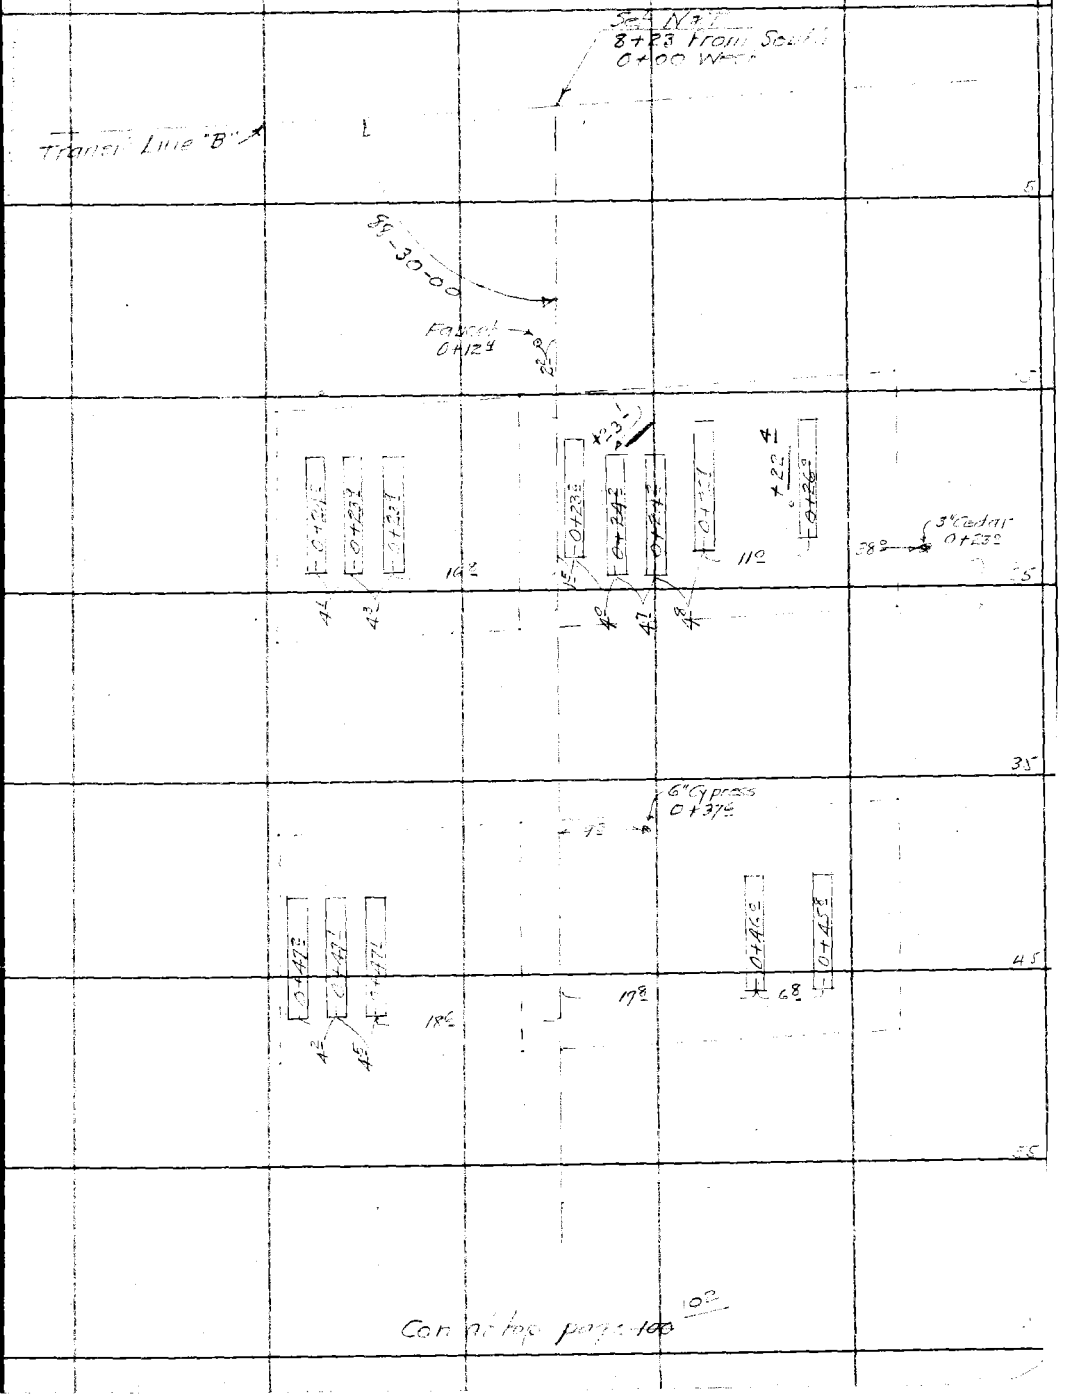

F.B. 686 PG. 102

101

Con from bottom page 99
8+23 from South Cor. West

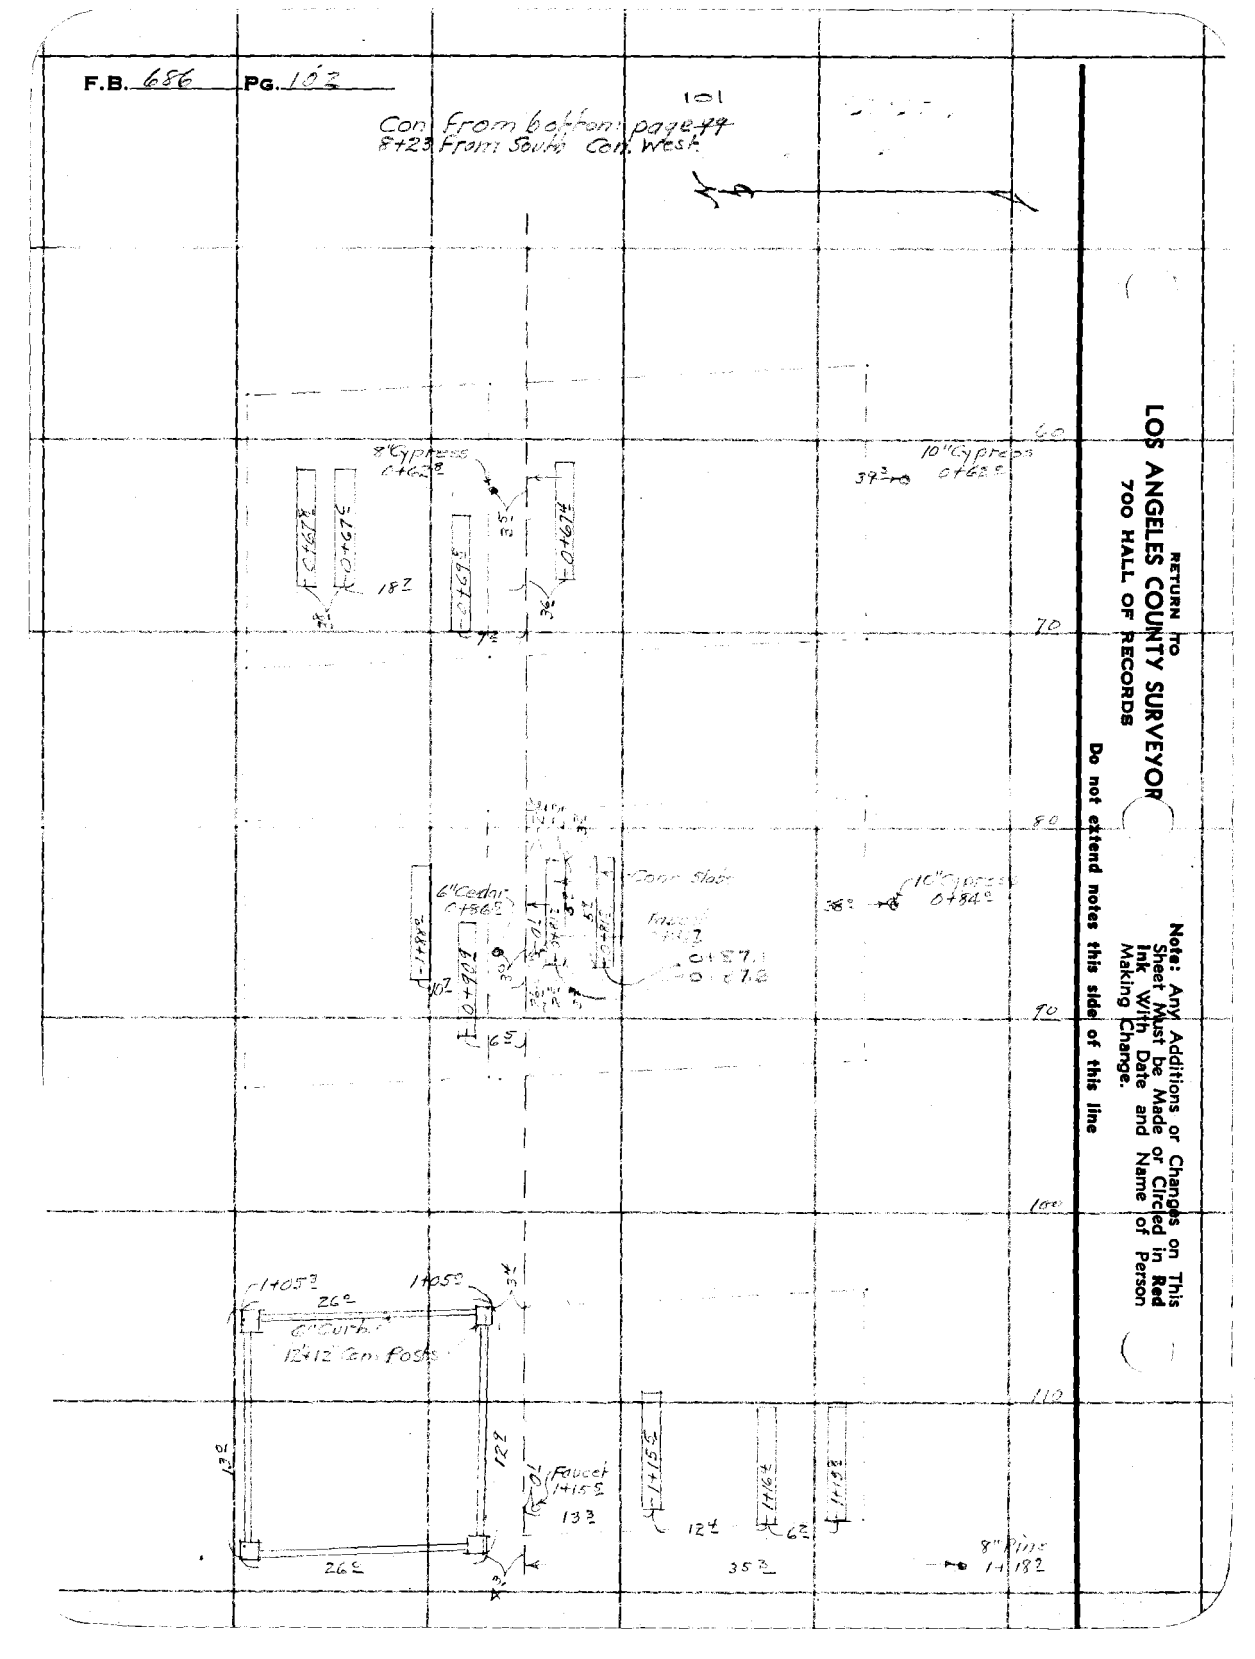

RETURN TO
LOS ANGELES COUNTY SURVEYOR
700 HALL OF RECORDS

Note: Any Additions or Changes on This Sheet Must be Made or Circled in Red Ink With Date and Name of Person Making Change.

Do not extend notes this side of this line

Notes Ck'd by D. M. Finley	Survey of LITTLE LAKE CAMP	F.B. 686	Pg. 103
Map No. B-1388 & B-1412	W. O. 8173 Tape No. St'd °F.		
Office Work R.W.M.S.	Surveyed by W. Miller		
Checked D. M. Finley	Notes Miller Date 1-26-1937		
Date June 1938	Indexed A. C. Johnson		

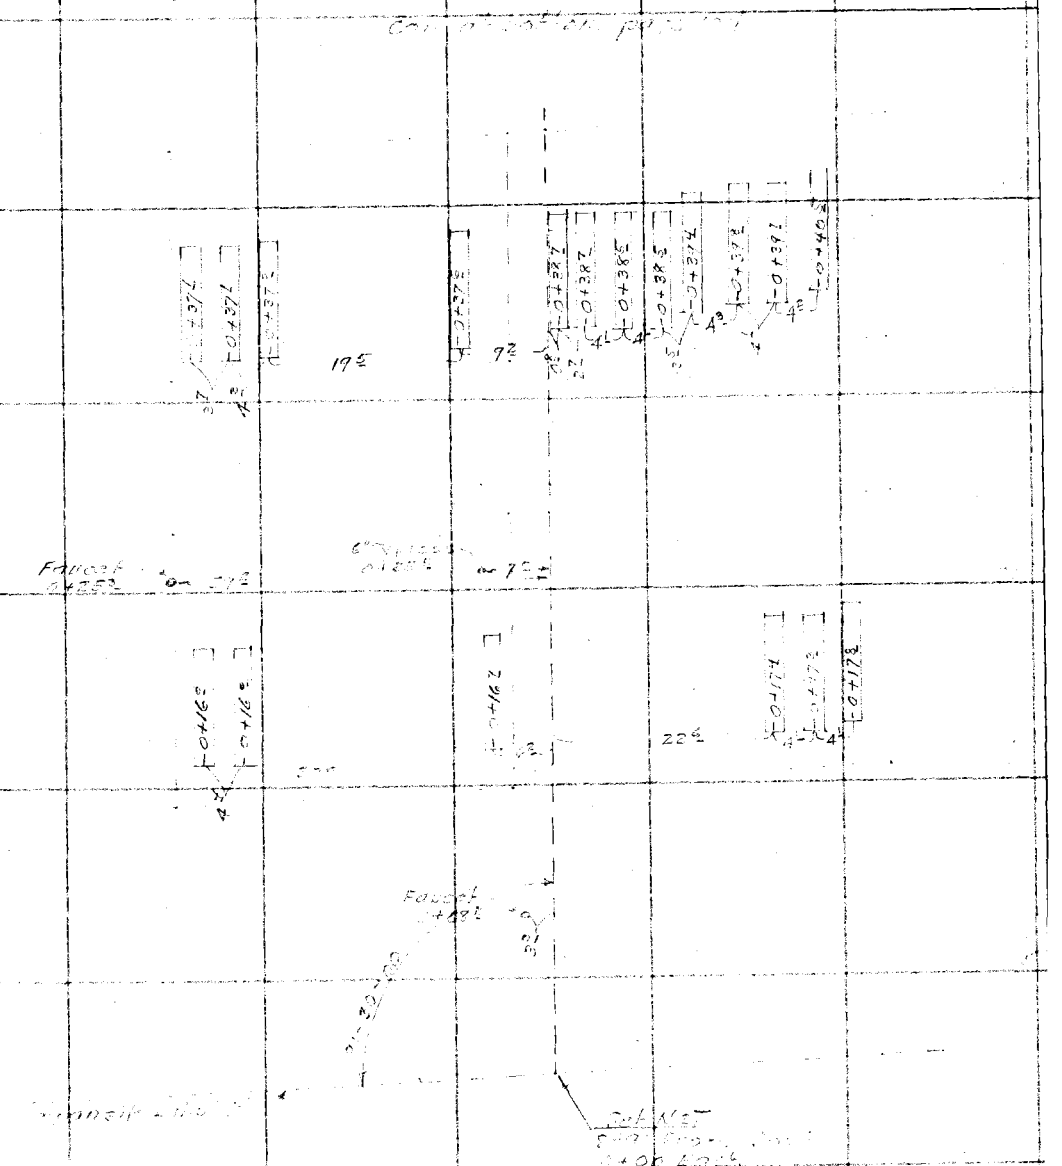

Note: Any Additions or Changes on This Sheet Must be Made or Circled in Red Ink With Date and Name of Person Making Change.

Do not extend notes this side of this line

RETURN TO
LOS ANGELES COUNTY SURVEYOR
700 HALL OF RECORDS

FORM 247 10M 11-38

RETURN TO
LOS ANGELES COUNTY SURVEYOR
700 HALL OF RECORDS

Note: Any Additions or Changes on This Sheet Must be Made or Circled in **Red** Ink With Date and Name of Person Making Change.

Do not extend notes this side of this line

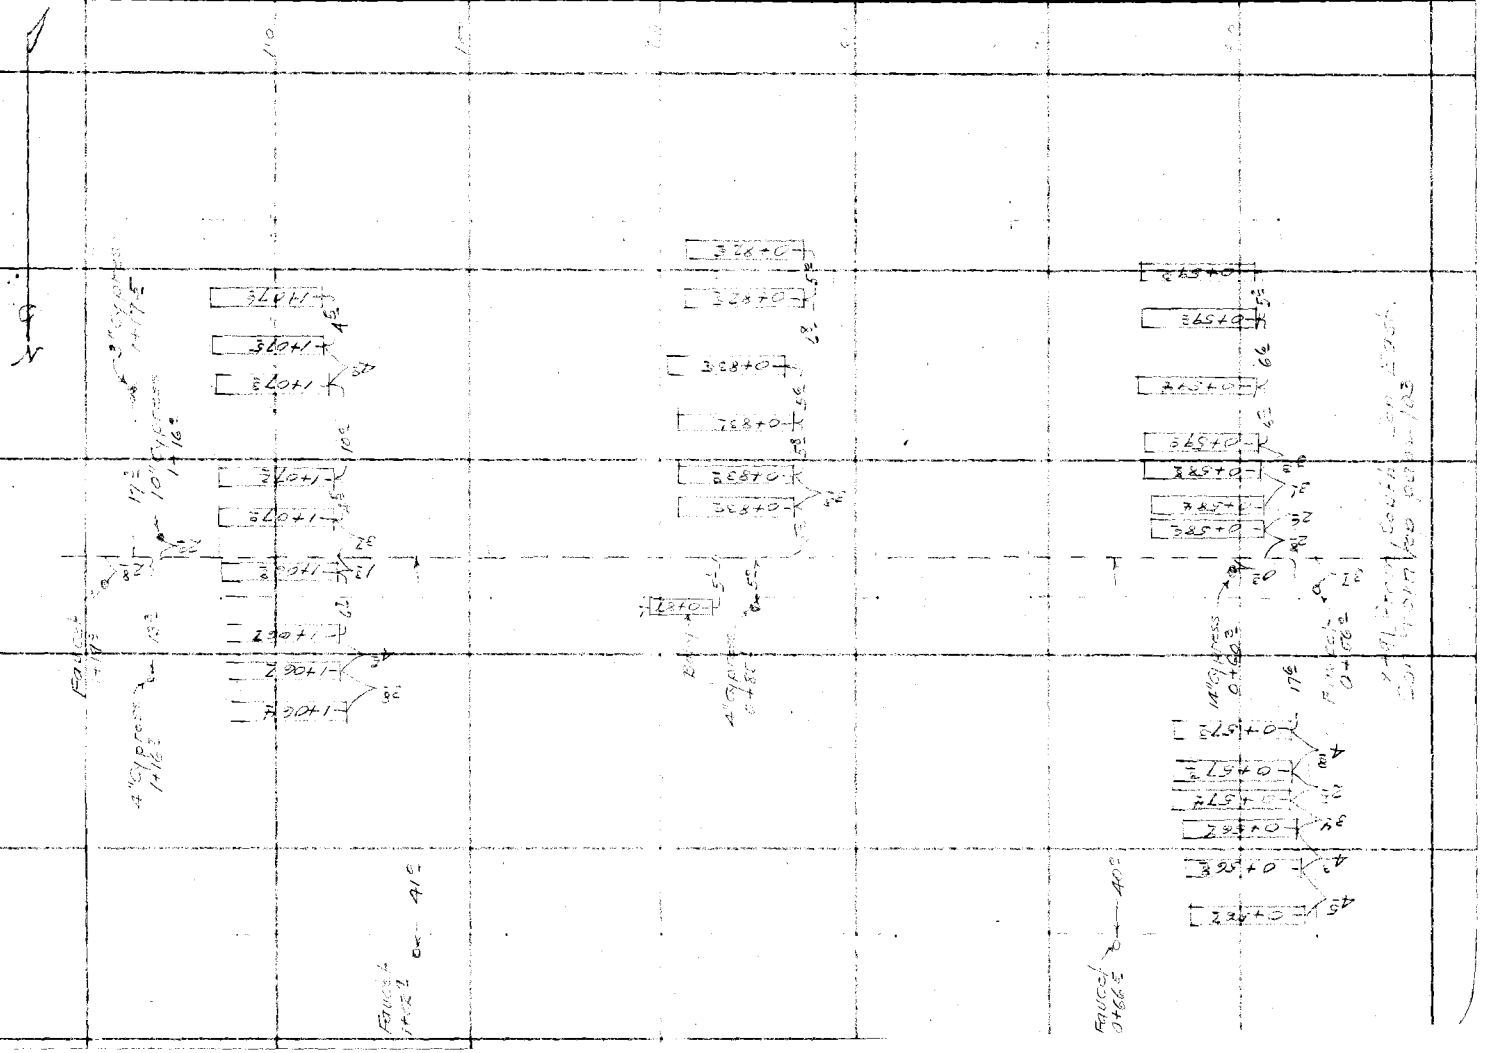

F.B. 686 Pg. 134

Notes Ck'd by D. M. Finley	Survey of LITTLE LAKE CEM	F.B. 686	Pg. 105
Map No. ~~B-1382~~ B-1417	W. O. 8173 Tape No. St'd °F.		
Office Work RW-9-19	Surveyed by W.L.A. Miller		
Checked D. M. Finley	Notes Miller Date 1-25-1937		
Date June 1938	Indexed A. C. Johnson		

Note: Any Additions or Changes on This Sheet Must be Made or Circled in Red Ink With Date and Name of Person Making Change

Do not extend notes this side of this line

RETURN TO
LOS ANGELES COUNTY SURVEYOR
700 HALL OF RECORDS

FORM 247 10M 11-38

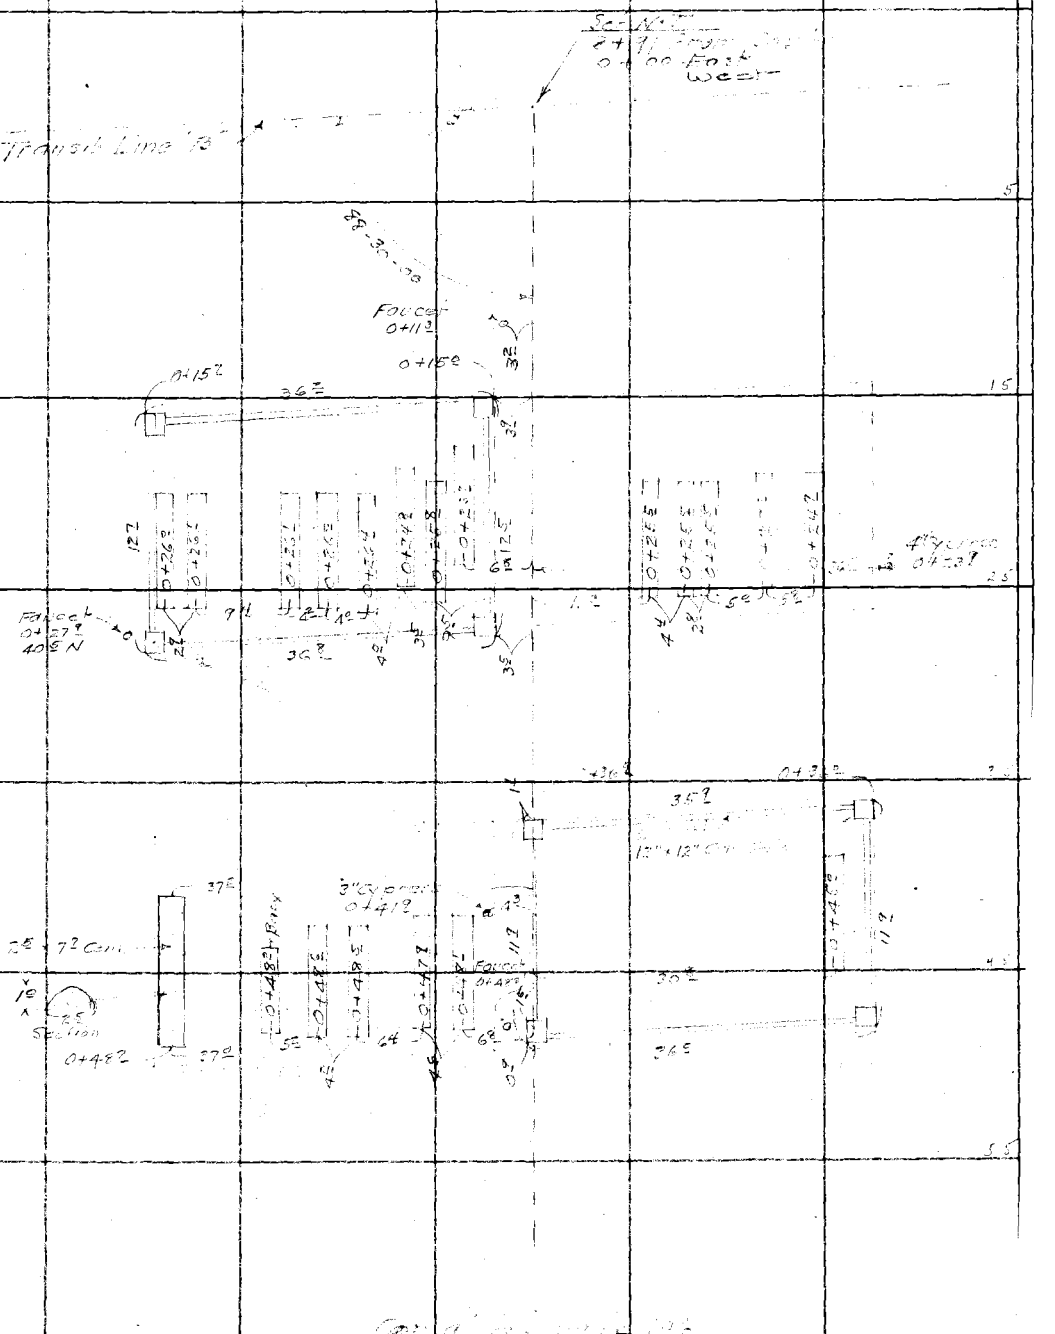

RETURN TO
LOS ANGELES COUNTY SURVEYOR
700 HALL OF RECORDS

Note: Any Additions or Changes on This Sheet Must be Made or Circled in Red Ink With Date and Name of Person Making Change.

Do not extend notes this side of this line

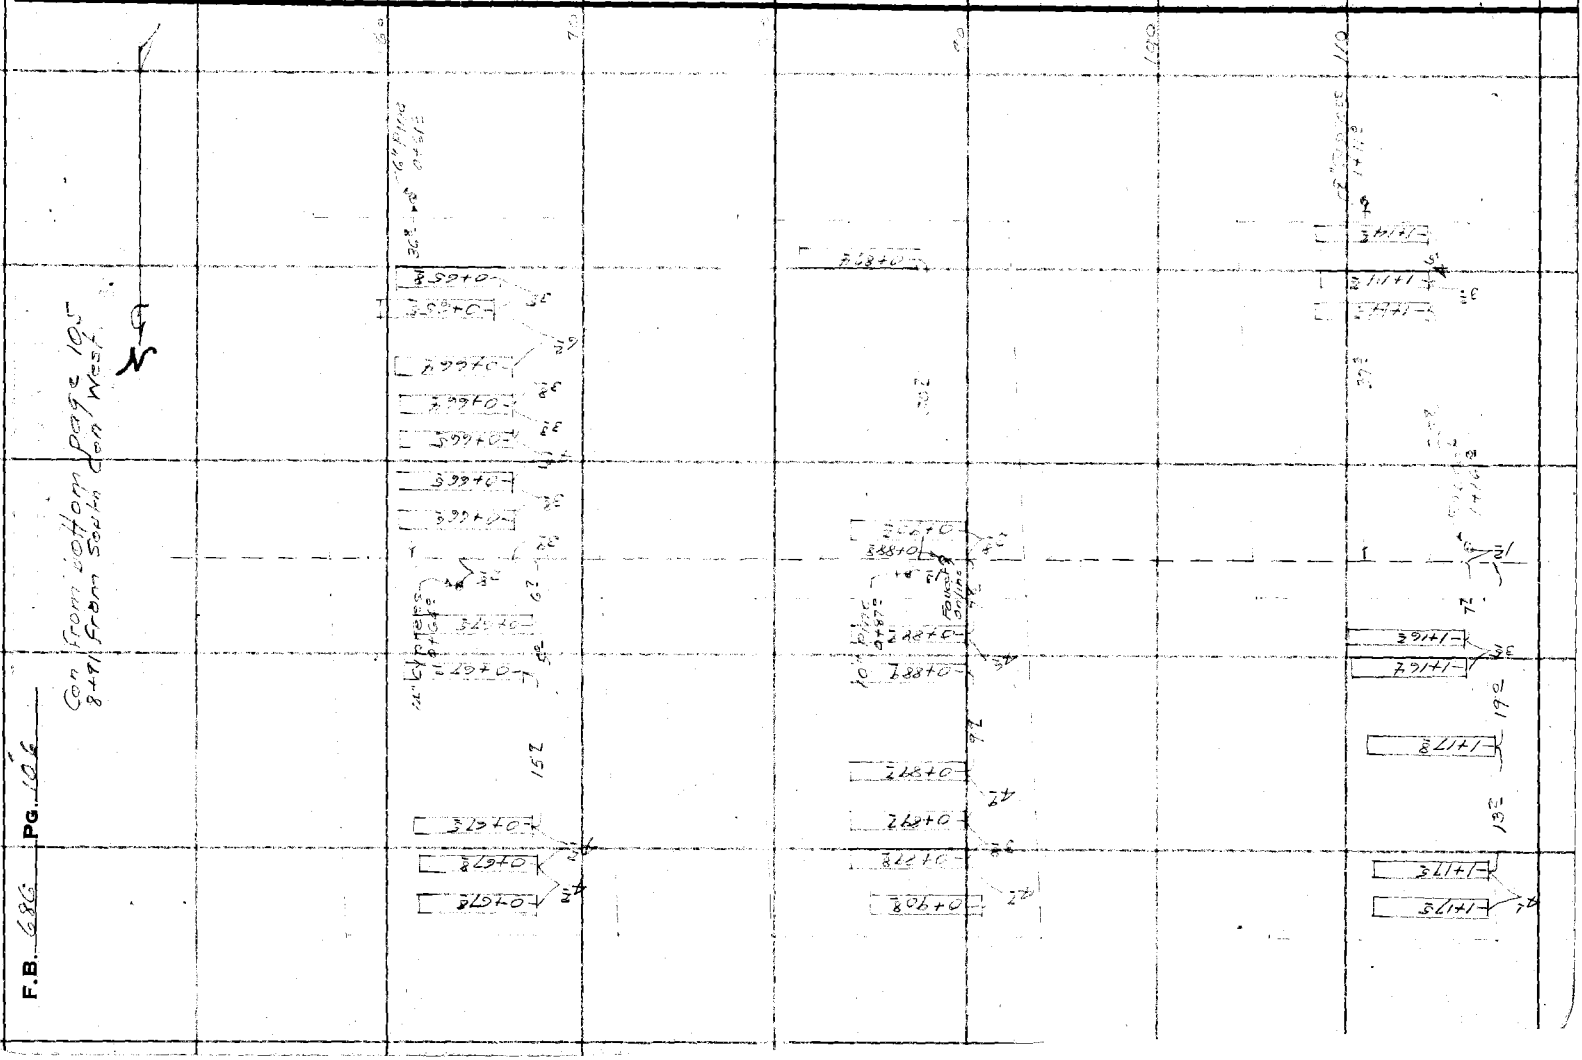

Notes Ck'd by J. M. Finley	Survey of LITTLE LAKE CANAL
Map No. ~~B-1308 & B-1412~~	W. O. 8173 Tape No. St'd °F.
Office Work RWMc	Surveyed by [illegible]
Checked D. M. Finley	Notes Miller Date 1-26-38
Date June 1938	Indexed C. Johnson

F.B. 686 Pg. 107

N

Note: Any Additions or Changes on This Sheet Must be Made or Circled in Red Ink With Date and Name of Person Making Change.

Do not extend notes this side of this line

RETURN TO
LOS ANGELES COUNTY SURVEYOR
700 HALL OF RECORDS

FORM 247 10M 11-38

RETURN TO
LOS ANGELES COUNTY SURVEYOR
700 HALL OF RECORDS

Note: Any Additions or Changes on This Sheet Must be Made or Circled in **Red Ink** With Date and Name of Person Making Change.

Do not extend notes this side of this line

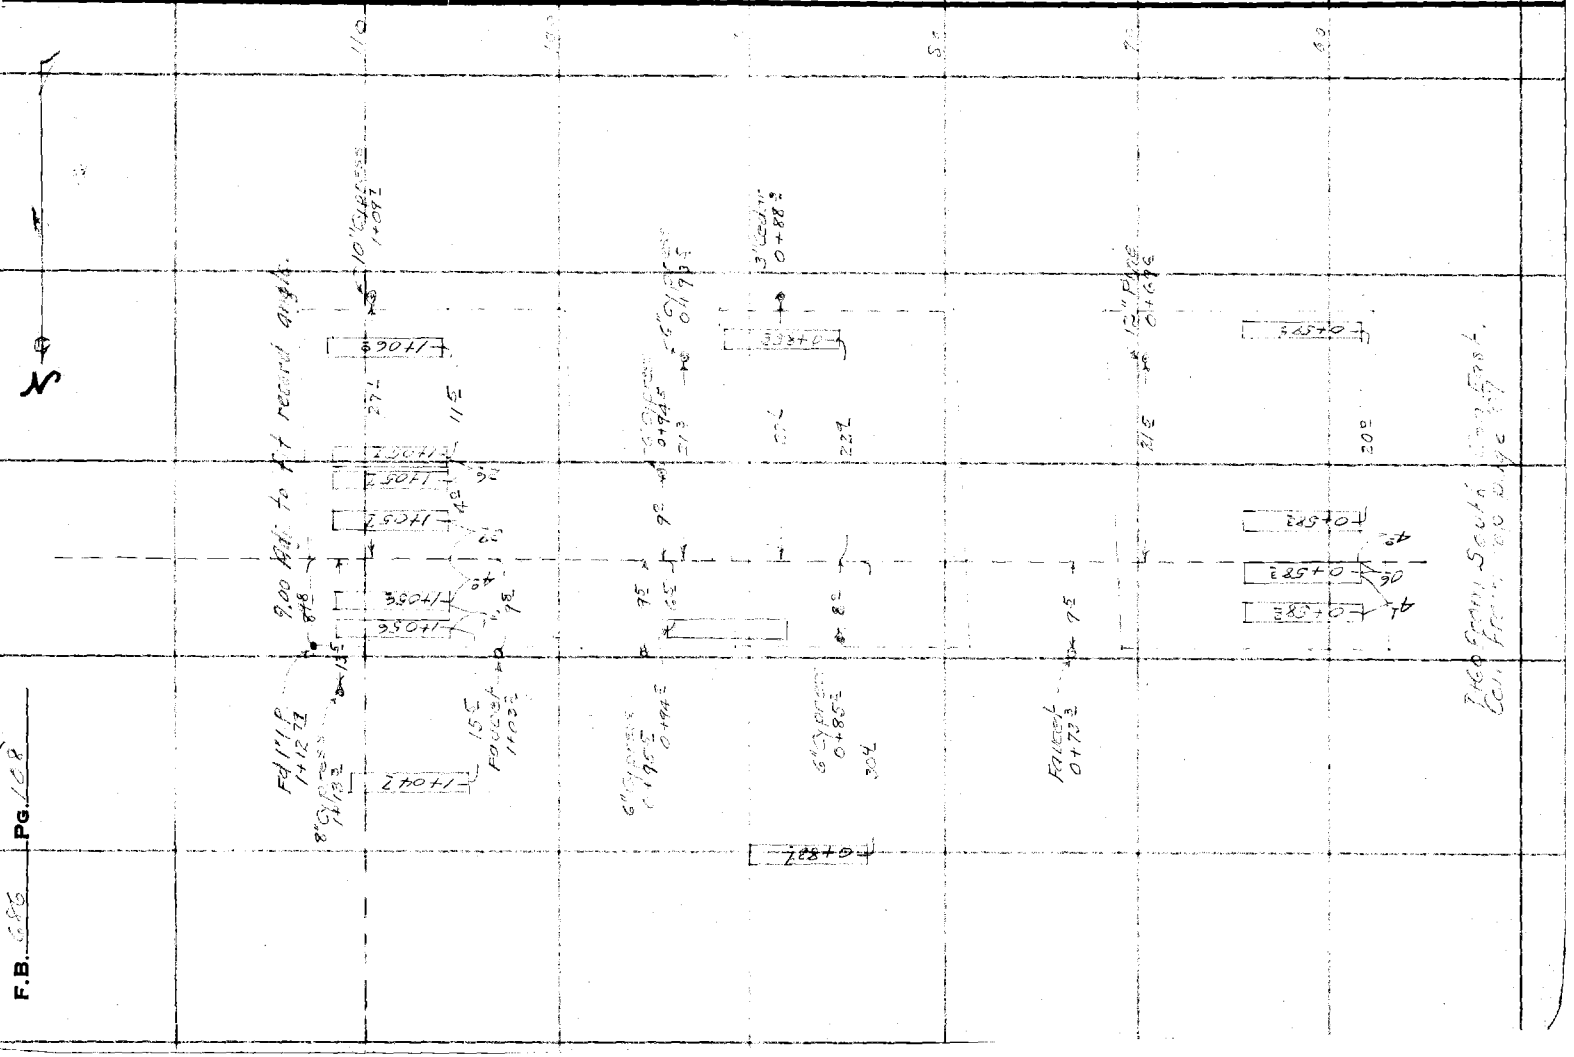
N
Fd 1" I.P. 1.12 ft. radial

Notes Ck'd by M. Finley	Survey of [illegible]	F.B. 685	Pg. 109
Map No. 8-1992 & 8-1993	W. O. 8173 Tape No. St'd °F.		
Office Work BOOMS	Surveyed by [illegible]		
Checked D. M. Finley	Notes Miller Date 1-26-1937		
Date June 1938	Indexed A. C. Johnson		

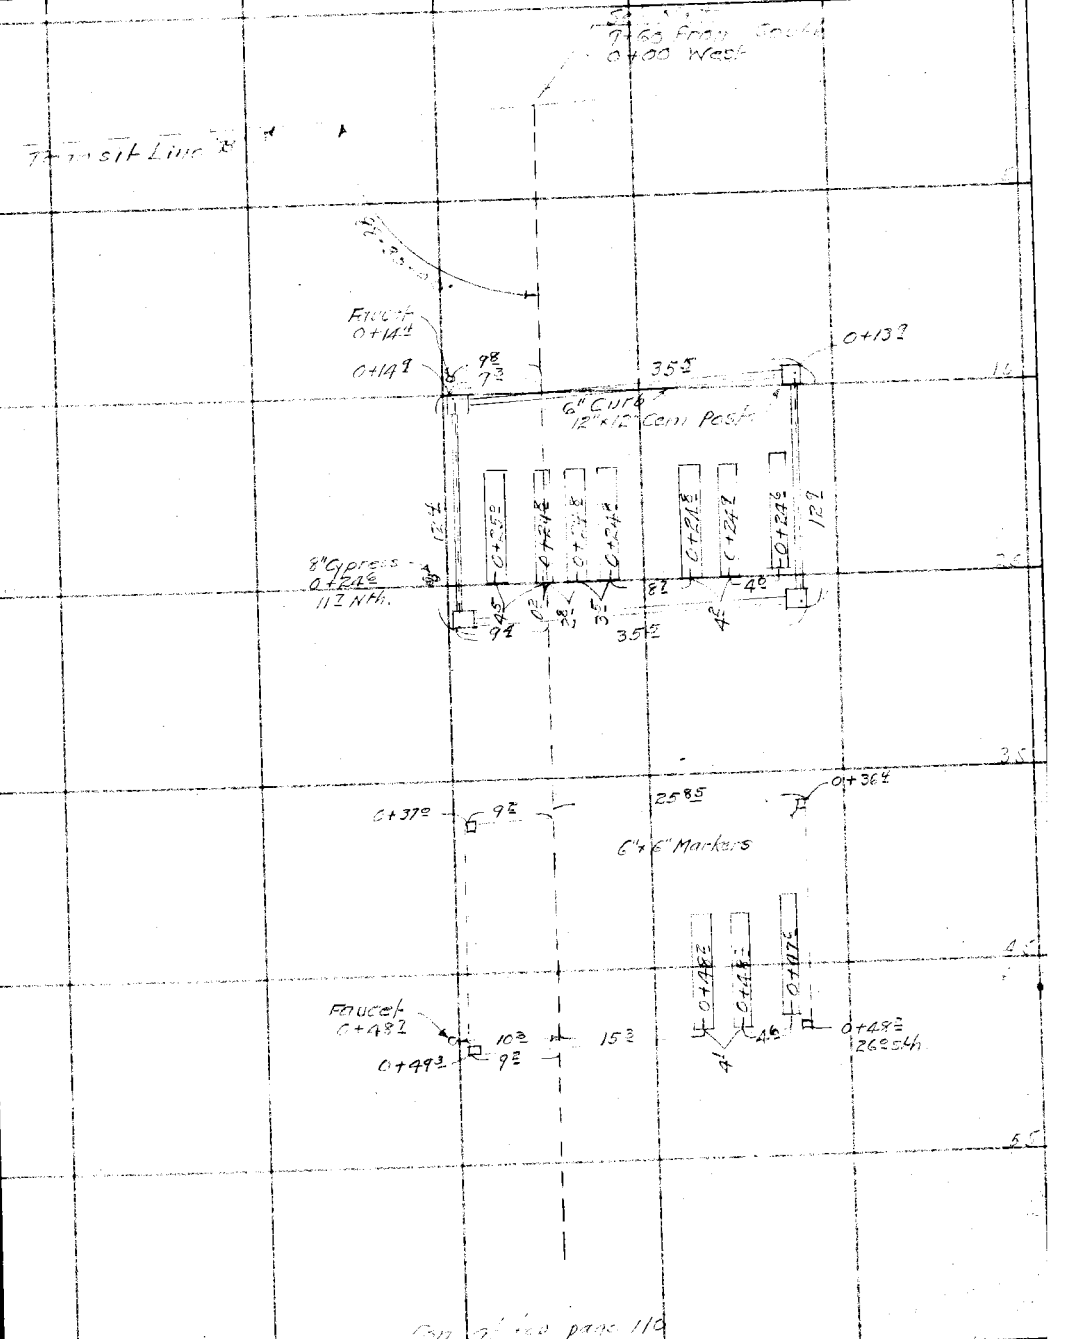

Note: Any Additions or Changes on This Sheet Must be Made or Circled in Red Ink With Date and Name of Person Making Change.

Do not extend notes this side of this line

RETURN TO
LOS ANGELES COUNTY SURVEYOR
700 HALL OF RECORDS

FORM 247 10M 11-35

RETURN TO
LOS ANGELES COUNTY SURVEYOR
700 HALL OF RECORDS

Note: Any Additions or Changes on This Sheet Must be Made or Circled in Red Ink With Date and Name of Person Making Change.

Do not extend notes this side of this line

F.B. 686 PG. 110

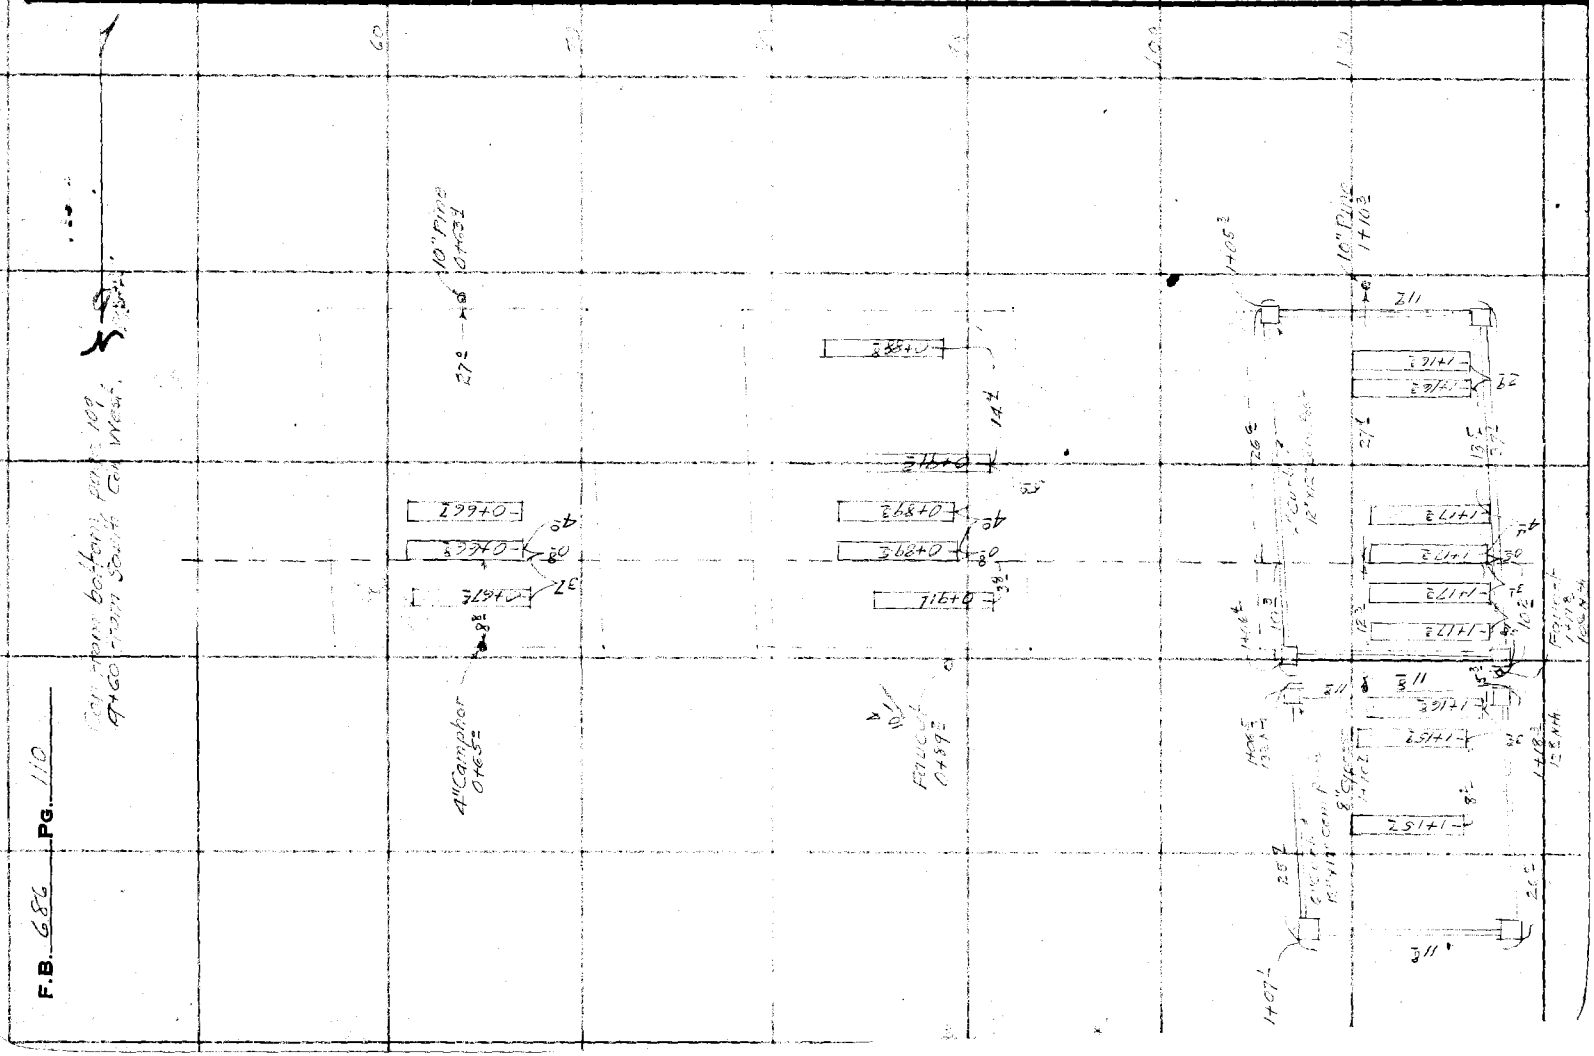

Notes Ck'd by D. M. Finley	Survey of LITTLE LAKE DEV.	F.B. 386	Pg. 1111
Map No. ~~C-1308-2~~ C-1417	W. O. 5123 Tape No.	St'd °F.	
Office Work R.W.M.S.A.	Surveyed by W.A.Miller		
Checked D. M. Finley	Notes Miller Date 3-8-1937		
Date June 1938	Indexed A. C. Johnson 3-15-38		

Note: Any Additions or Changes on This Sheet Must be Made or Circled in Red Ink With Date and Name of Person Making Change

Do not extend notes this side of this line

LOCATION
OF
NEW WATER LINES

Miller
Gray
Shuman
Shiffler
Johnson

Valve, Fluser & offsets are to nearest tenths as of above date. Some New, some Old. Various sizes of Water Pipe noted in notes.

RETURN TO
LOS ANGELES COUNTY SURVEYOR
700 HALL OF RECORDS

FORM 247 10M 11-35

RETURN TO
LOS ANGELES COUNTY SURVEYOR
700 HALL OF RECORDS

Note: Any Additions or Changes on This Sheet Must be Made or Circled in **Red Ink** With Date and Name of Person Making Change.

Do not extend notes this side of this line

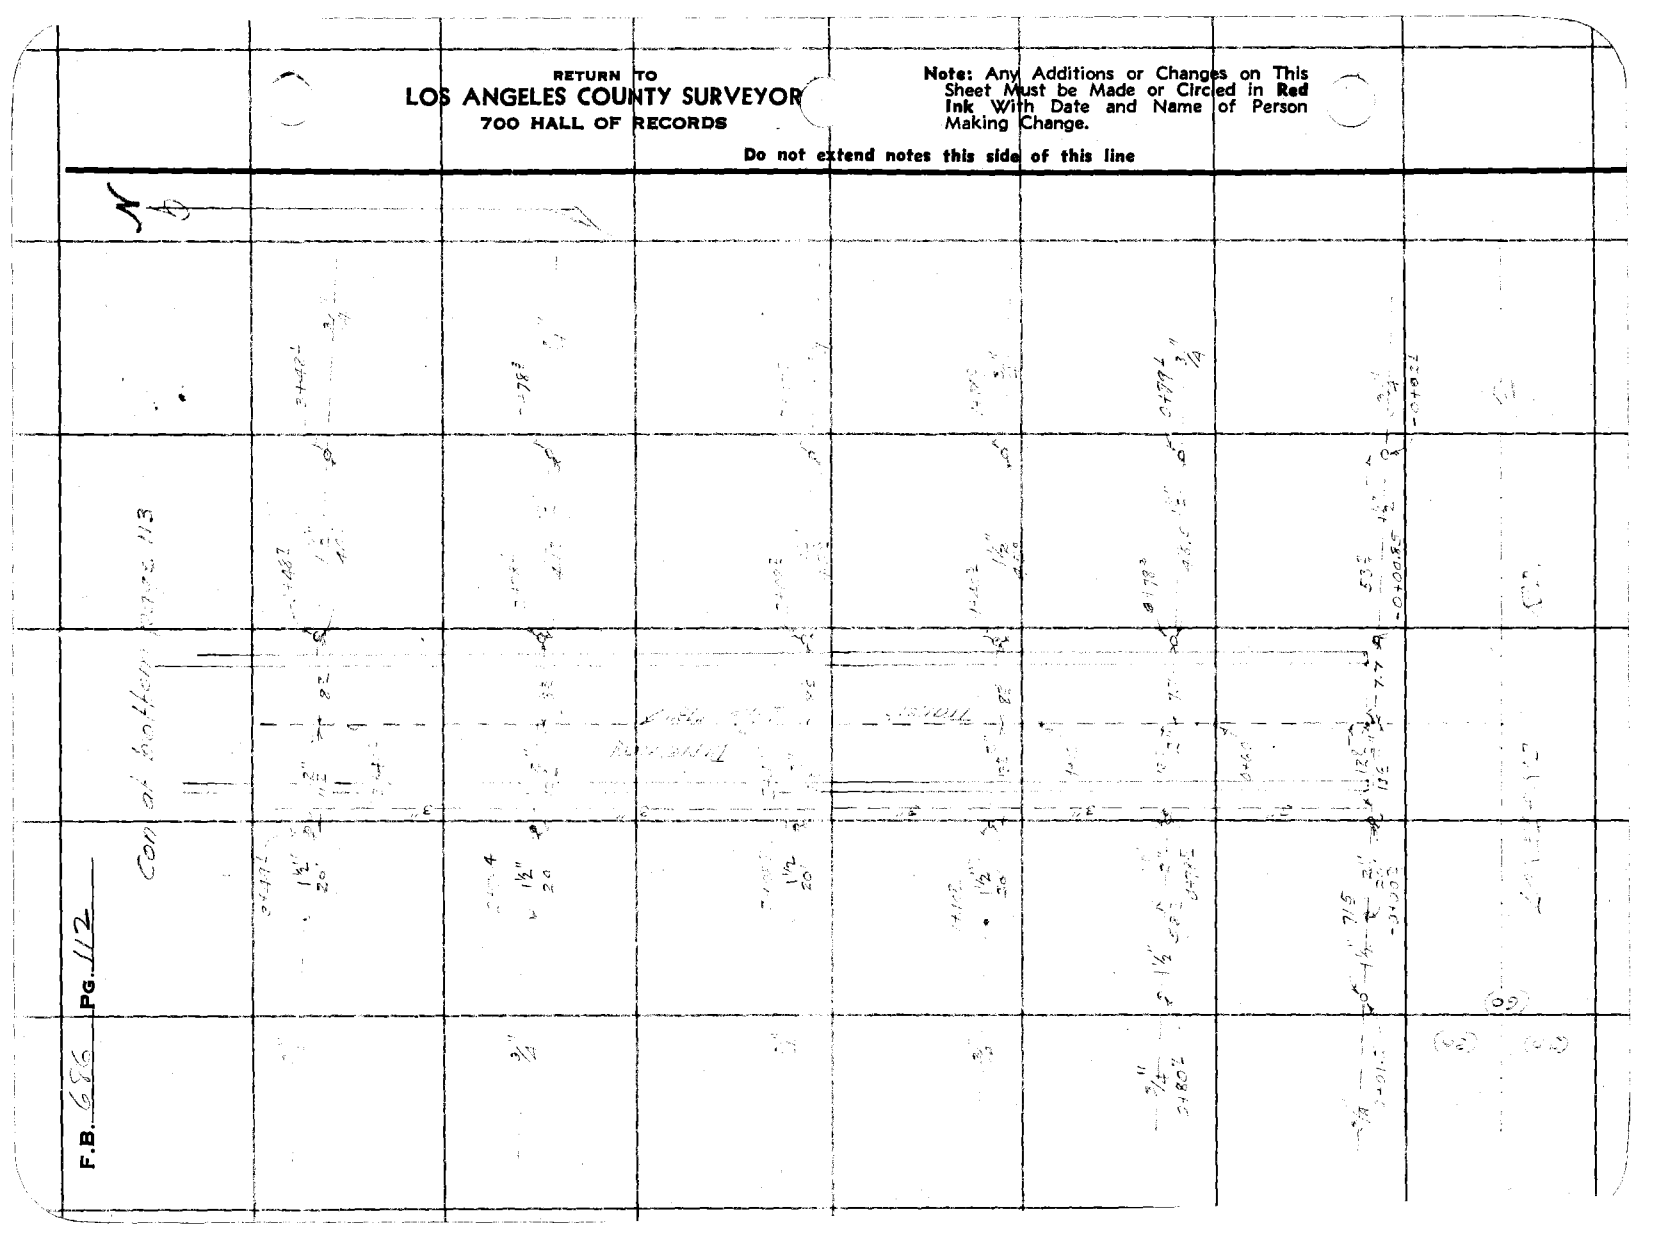

Notes Ck'd by D. M. Finley	Survey of Hill Lake Ave.	F.B.	Pg. 113
Map No. D-1908-2B-1412	W. O. 8173	Tape No.	St'd	°F.
Office Work R.W.M.	Surveyed by		
Checked D. M. Finley	Notes	Date 7-8-1931
Date June 1938	Indexed A. C. Johnson

Note: Any Additions or Changes on This Sheet Must be Made or Circled in Red Ink With Date and Name of Person Making Change.

Do not extend notes this side of this line

RETURN TO
LOS ANGELES COUNTY SURVEYOR
700 HALL OF RECORDS

FORM 247 10M 11-38

F.B. 686 PG. 114

RETURN TO
LOS ANGELES COUNTY SURVEYOR
700 HALL OF RECORDS

Note: Any Additions or Changes on This Sheet Must be Made or Circled in Red Ink With Date and Name of Person Making Change.

Do not extend notes this side of this line

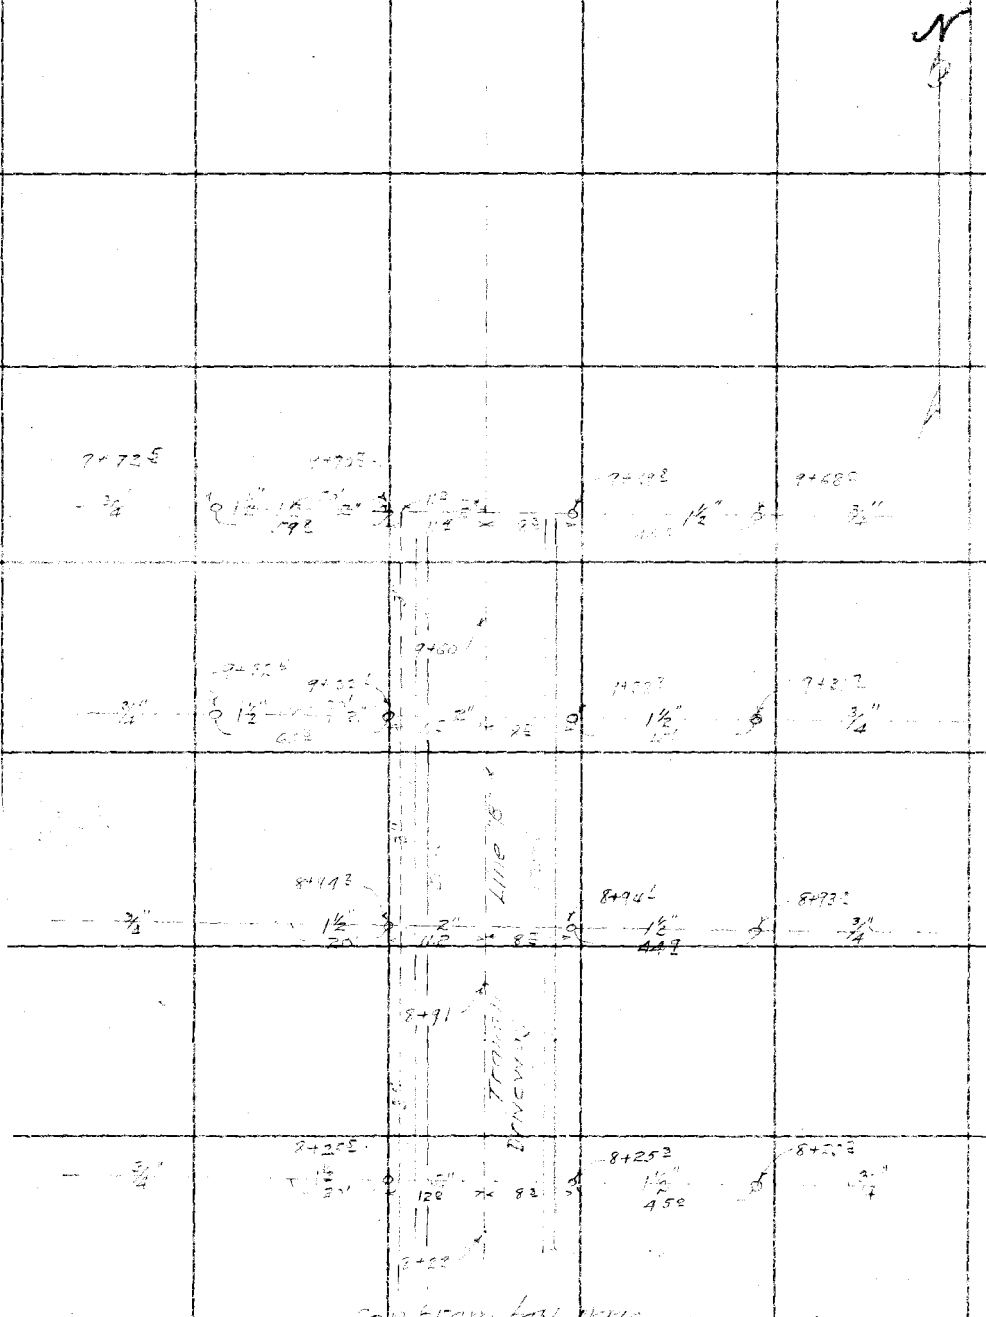

Notes Ck'd by B-1417	Survey of LITTLE LAKE CEMTRY
Map No. 81308a	W. O. 8173 Tape No. ____ St'd ____ °F.
Office Work R.W.M.C	Surveyed by W A Miller
Checked D. M. Finley	Notes W E Braden Date 4/24-37
Date June 1938	Indexed A. C. Johnson MAY 2 '37

F.B. 686 PG. 115

Note: ANY ADDITIONS OR CHANGES ON THIS SHEET MUST BE MADE OR CIRCLED IN Red Ink, WITH DATE AND NAME OF PERSON MAKING CHANGE.

Do not extend notes this side of this line

RETURN TO
LOS ANGELES COUNTY SURVEYOR
700 HALL OF RECORDS

LOCATION of PIPE LINES IN CEMETERY ROAD

Miller
Braden
Stewart C.A.
Clinite
Stewart O.B.

FORM 247 10M 5-31

F.B. 686 Pg. 116

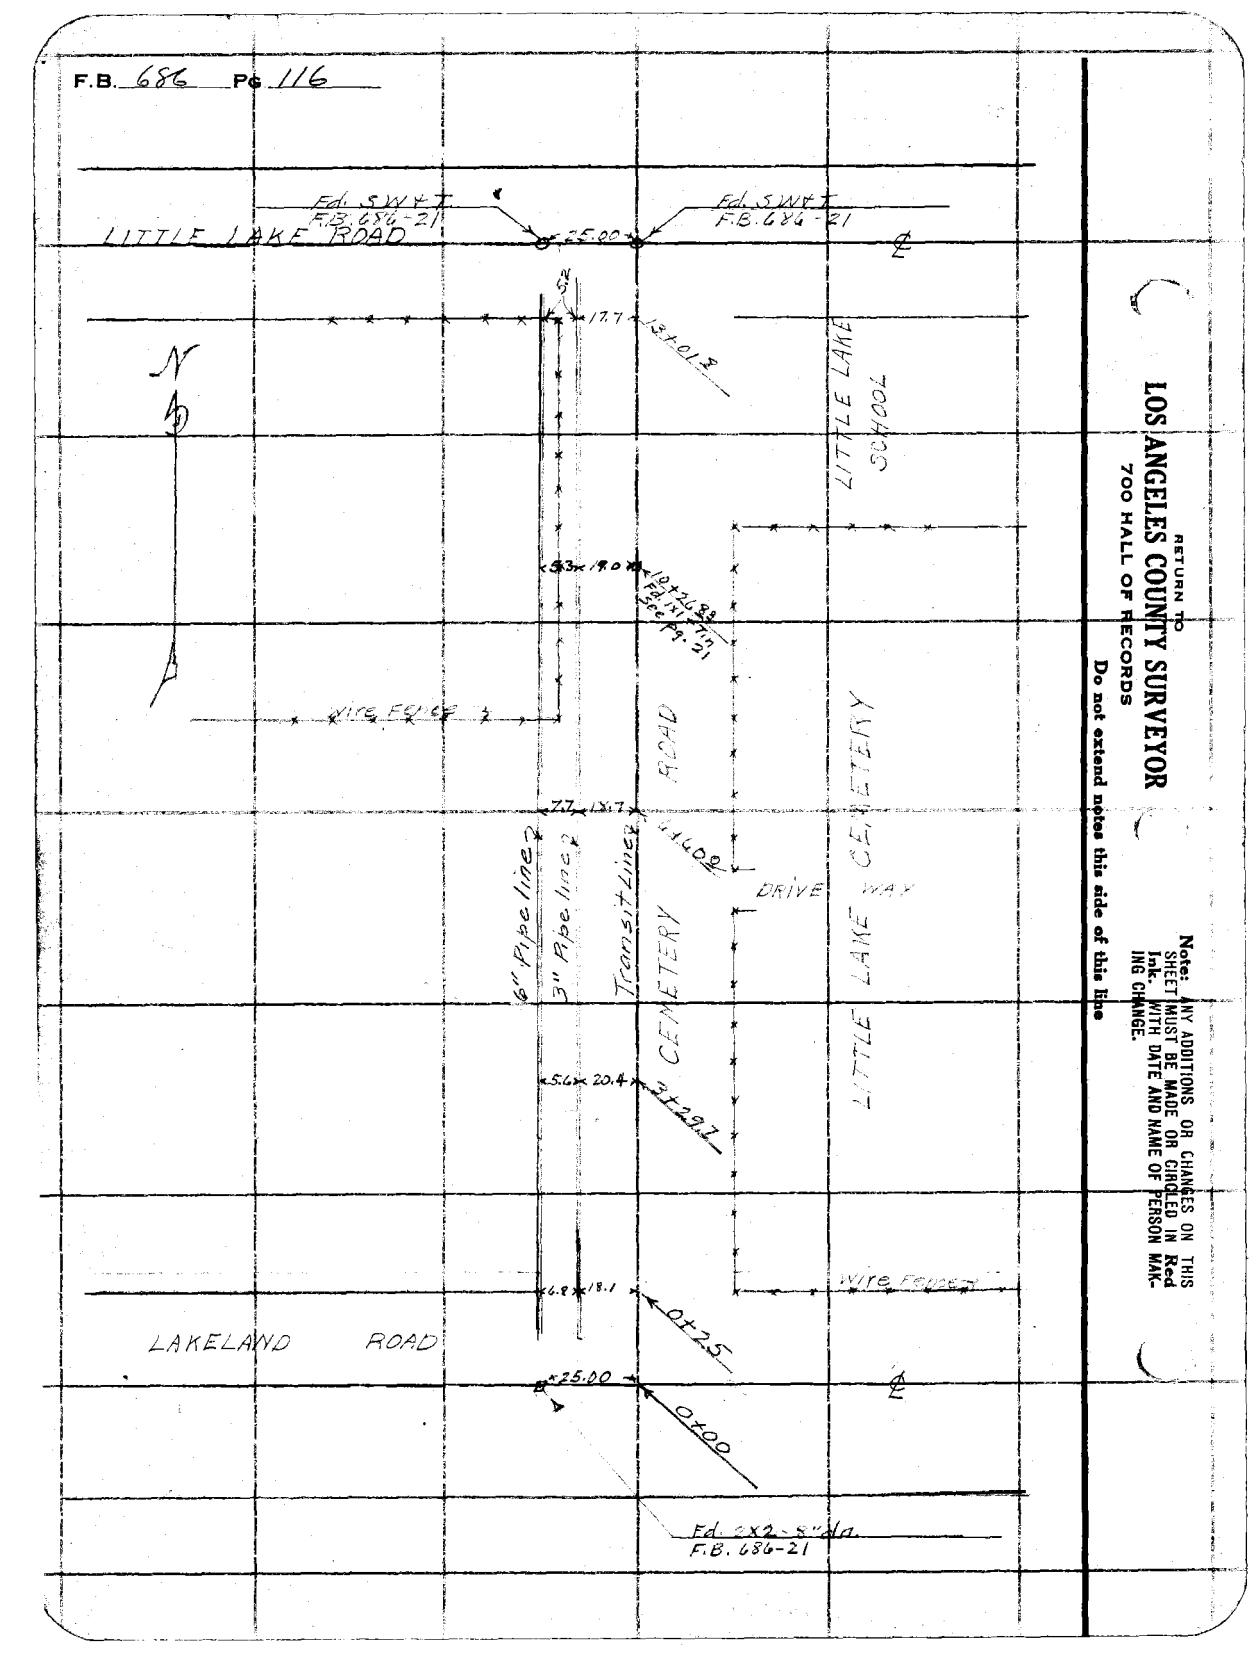

RETURN TO
LOS ANGELES COUNTY SURVEYOR
700 HALL OF RECORDS

Do not extend notes this side of this line

Note: ANY ADDITIONS OR CHANGES ON THIS SHEET MUST BE MADE OR CIRCLED IN **Red** Ink. WITH DATE AND NAME OF PERSON MAKING CHANGE.

Notes Ck'd by D. M. Finley	Survey of LITTLE LAKE CEM	F.B. 686	Pg. 117
Map No. B-1412	W. O. 8173 Tape No.	St'd	°F.
Office Work Wood	Surveyed by W.A. Miller		
Checked D. M. Finley	Notes Miller	Date June 1937	
Date June 1938.	Indexed A. C. Johnson 10-13-37		

LITTLE LAKE CEMETERY
J.N 8173

PROPERTY CORNER MONUMENTS
LITTLE LAKE CEMETERY AND LITTLE LAKE SCHOOL

Miller
Braden
Stewart
Climie

Note: ANY ADDITIONS OR CHANGES ON THIS SHEET MUST BE MADE OR CIRCLED IN Red Ink. WITH DATE AND NAME OF PERSON MAKING CHANGE.

Do not extend notes this side of this line

RETURN TO
LOS ANGELES COUNTY SURVEYOR
700 HALL OF RECORDS

FORM 247 10M 8-31

F.B. 686 Pg. 118

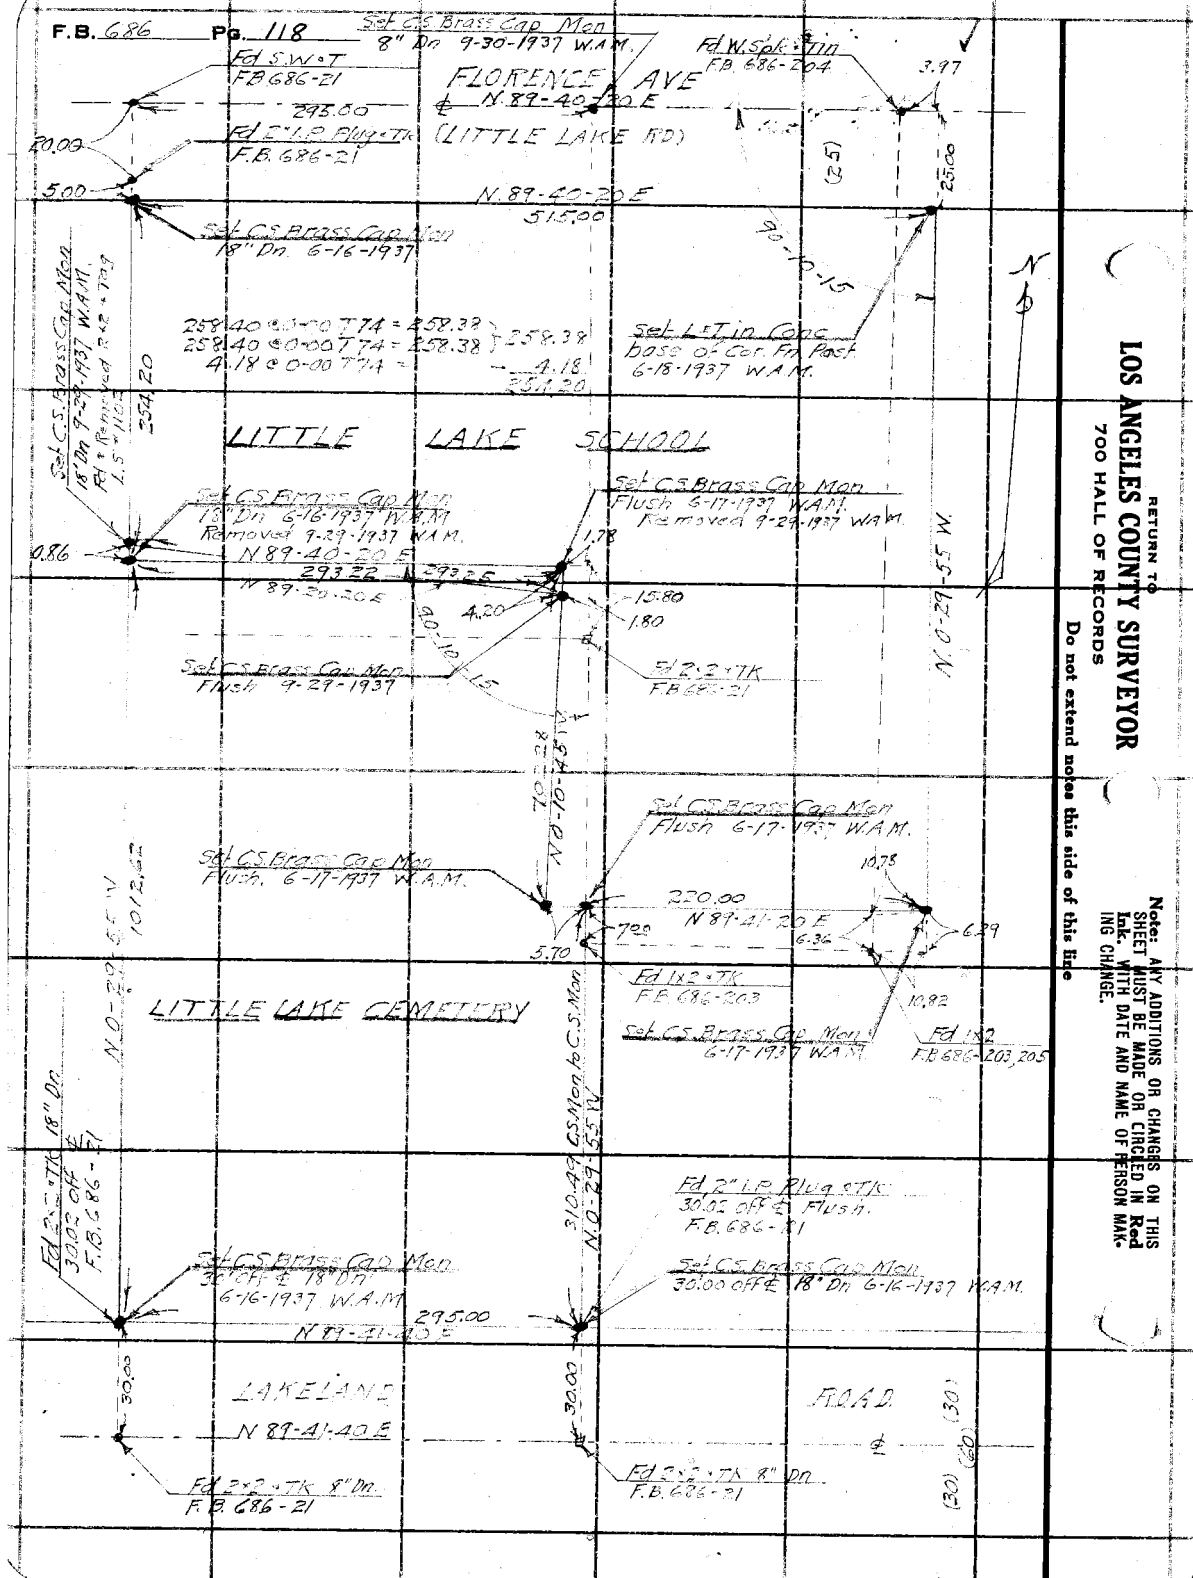

RETURN TO
LOS ANGELES COUNTY SURVEYOR
700 HALL OF RECORDS
Do not extend notes this side of this line

Note: ANY ADDITIONS OR CHANGES ON THIS SHEET MUST BE MADE OR CIRCLED IN Red Ink. WITH DATE AND NAME OF PERSON MAKING CHANGE.

Notes Ck'd by	D. M. Finley	Survey of	LITTLE LAKE CEM	F.B.	686 Pg. 119
Map No.	B-1412	W. O.	8173 Tape No.	St'd	°F.
Office Work	Wood	Surveyed by	W. A. Miller		
Checked	D. M. Finley	Notes	Miller Date		
Date	JUNE 1938	Indexed	A. C. Johnson		

LITTLE LAKE CEMETERY
JN. 8173

MONUMENTING
LOT AND BLOCK CORNERS
OF BURIAL AREA

● indicates C.S. Brass Cap Monument at Block Corners
● indicates 3/4" I.P. Plug & Tk at Lot Corners
X indicates cross where impracticable to set either C.S. Mon or 3/4" I.P.

Miller
Braden
Stewart CA
Elliffe
Stewart O.B.

Note: ANY ADDITIONS OR CHANGES ON THIS SHEET MUST BE MADE OR CIRCLED IN Red Ink. WITH DATE AND NAME OF PERSON MAKING CHANGE.

Do not extend notes this side of this line

RETURN TO
LOS ANGELES COUNTY SURVEYOR
700 HALL OF RECORDS

FORM 247 10M 8-31

F.B. 686 Pg. 120

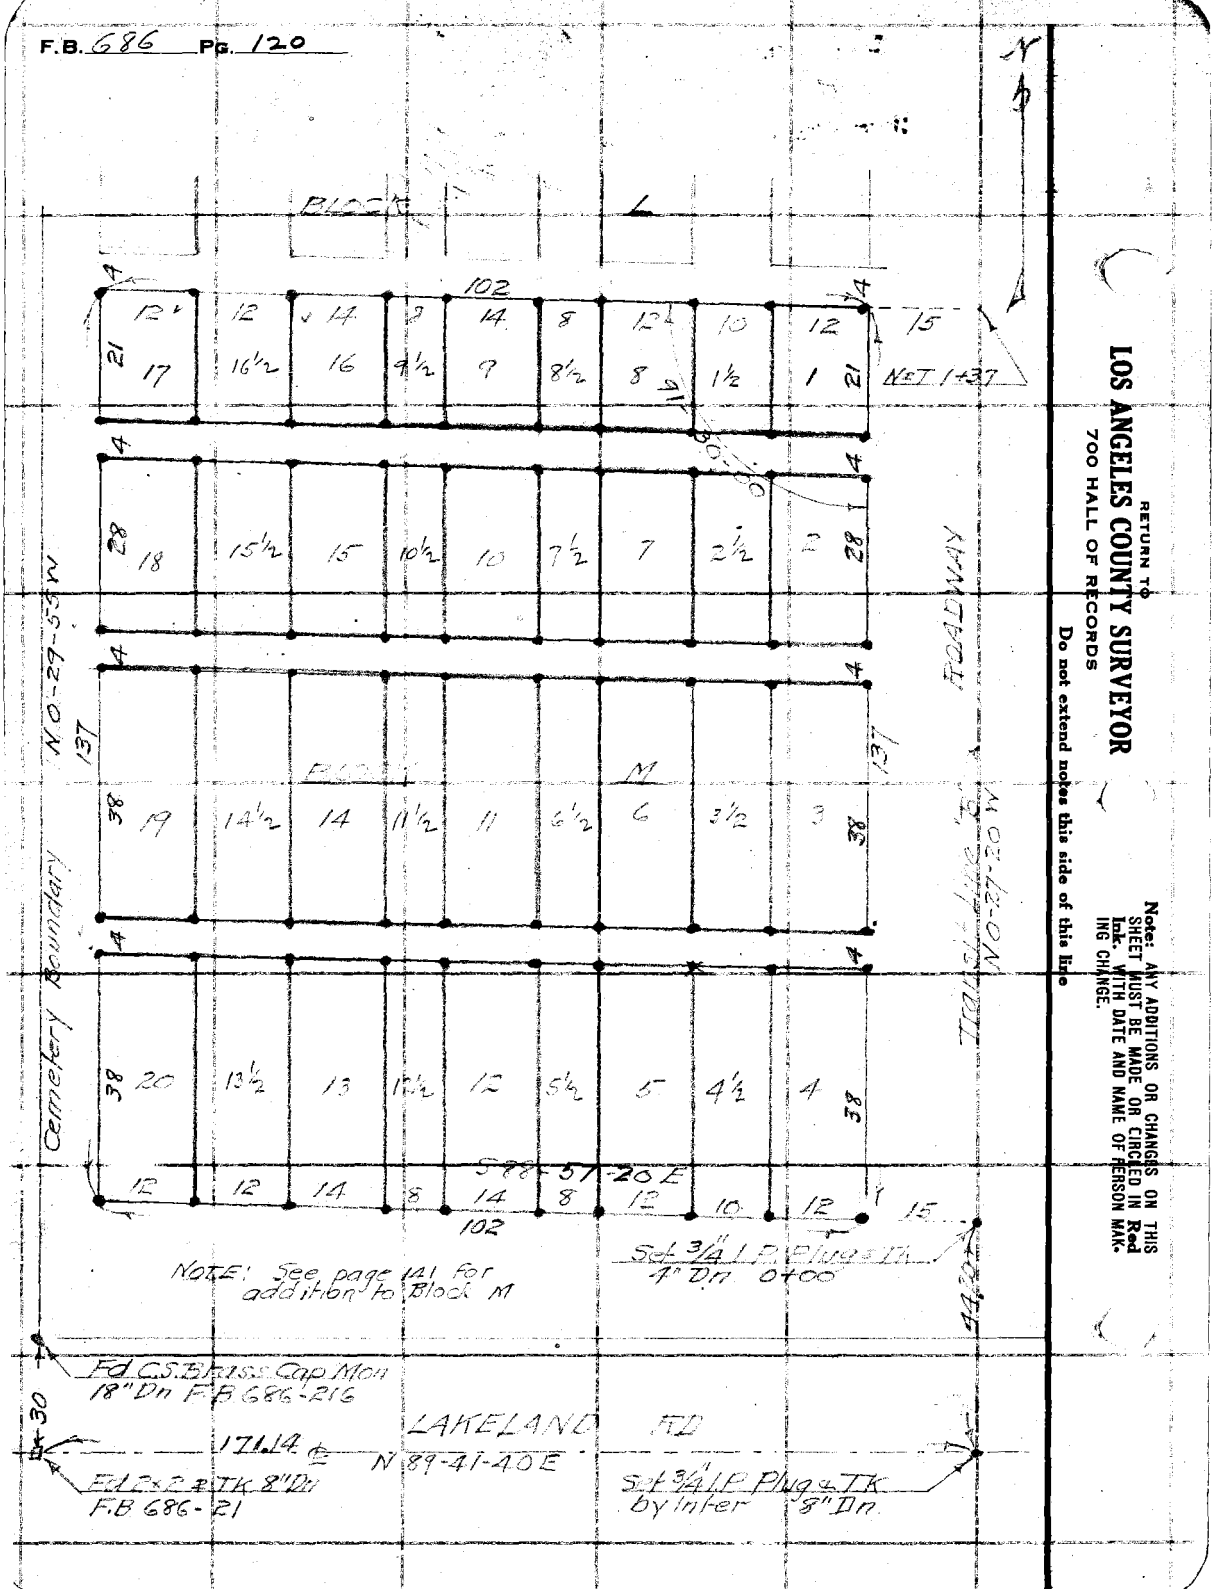

RETURN TO
LOS ANGELES COUNTY SURVEYOR
700 HALL OF RECORDS

Do not extend notes this side of this line

Note: ANY ADDITIONS OR CHANGES ON THIS SHEET MUST BE MADE OR CIRCLED IN Red Ink. WITH DATE AND NAME OF PERSON MAKING CHANGE.

Notes Ck'd by D. M. Finley	Survey of LITTLE LAKE CEM
Map No. B-1417	W. O. 8173 Tape No. St'd °F.
Office Work Wood	Surveyed by W.A. Miller
Checked D. M. Finley	Notes Miller Date
Date June 1938.	Indexed A. C. Johnson

F.B. 686 Pg. 41

Notes: ANY ADDITIONS OR CHANGES ON THIS SHEET MUST BE MADE OR CIRCLED IN Red Ink, WITH DATE AND NAME OF PERSON MAKING CHANGE.

Do not extend notes this side of this line

RETURN TO
LOS ANGELES COUNTY SURVEYOR
700 HALL OF RECORDS

FORM 247 ICM 5-31

N

BLOCK K

98

15 14 8 12 8 14 8 12 8 14

21 1 1½ 8 8½ 9 9½ 16 16½ 17 21

N.T. 1+37

ROADWAY

28 2 2½ 7 7½ 10 10½ 15 15½ 18 28

137

BLOCK N

38 3 3½ 6 6½ 11 11½ 14 14½ 19 38

38 4 4½ 5 5½ 12 12½ 13 13½ 20 38

N 0-27-20 W

Transit Line "B"

N 0-29-55 W

Cemetery Boundary

15 14 8 12 8 14 8 12 8 14

S 88-57-20 E

98

Set ¾" I.P. Plug & Tk
4" Dn. 0+00

4420

Fd C.S. Brass Cap Mon
18" Dn F.B. 686-216

30

LAKELAND RD.

123.86

℄ N 89-41-40 E

Set ¾" I.P. Plug & Tk
by Inter. 8" Dn.

Fd 2"-Tk 8" Dn
F.B. 686-21

RETURN TO
LOS ANGELES COUNTY SURVEYOR
700 HALL OF RECORDS

Note: ANY ADDITIONS OR CHANGES ON THIS SHEET MUST BE MADE OR CIRCLED IN **Red Ink.** WITH DATE AND NAME OF PERSON MAKING CHANGE.

Do not extend notes this side of this line

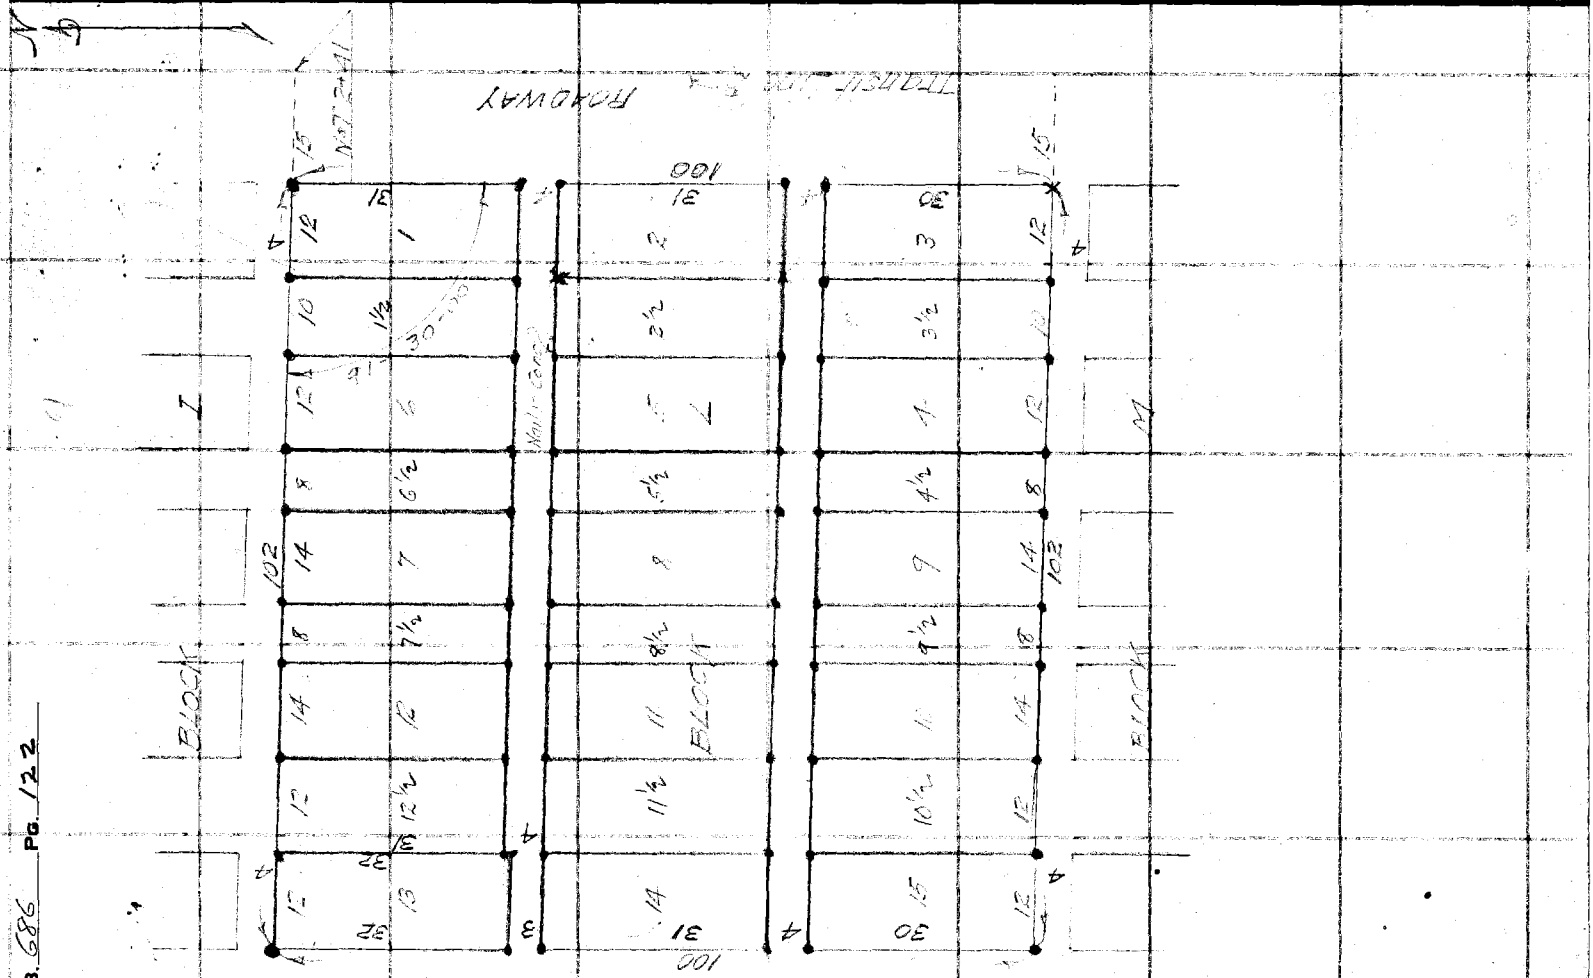

F.B. 686 PG. 122

Notes Ck'd by D. M. Finley	Survey of LITTLE LAKE CEM
Map No. B-1412	W. O. 8173 Tape No. St'd °F.
Office Work Wood	Surveyed by W.A. Miller
Checked D. M. Finley	Notes Miller Date June 1937
Date JUNE 1938	Indexed A. C. Johnson

F.B. 686 Pg. 123

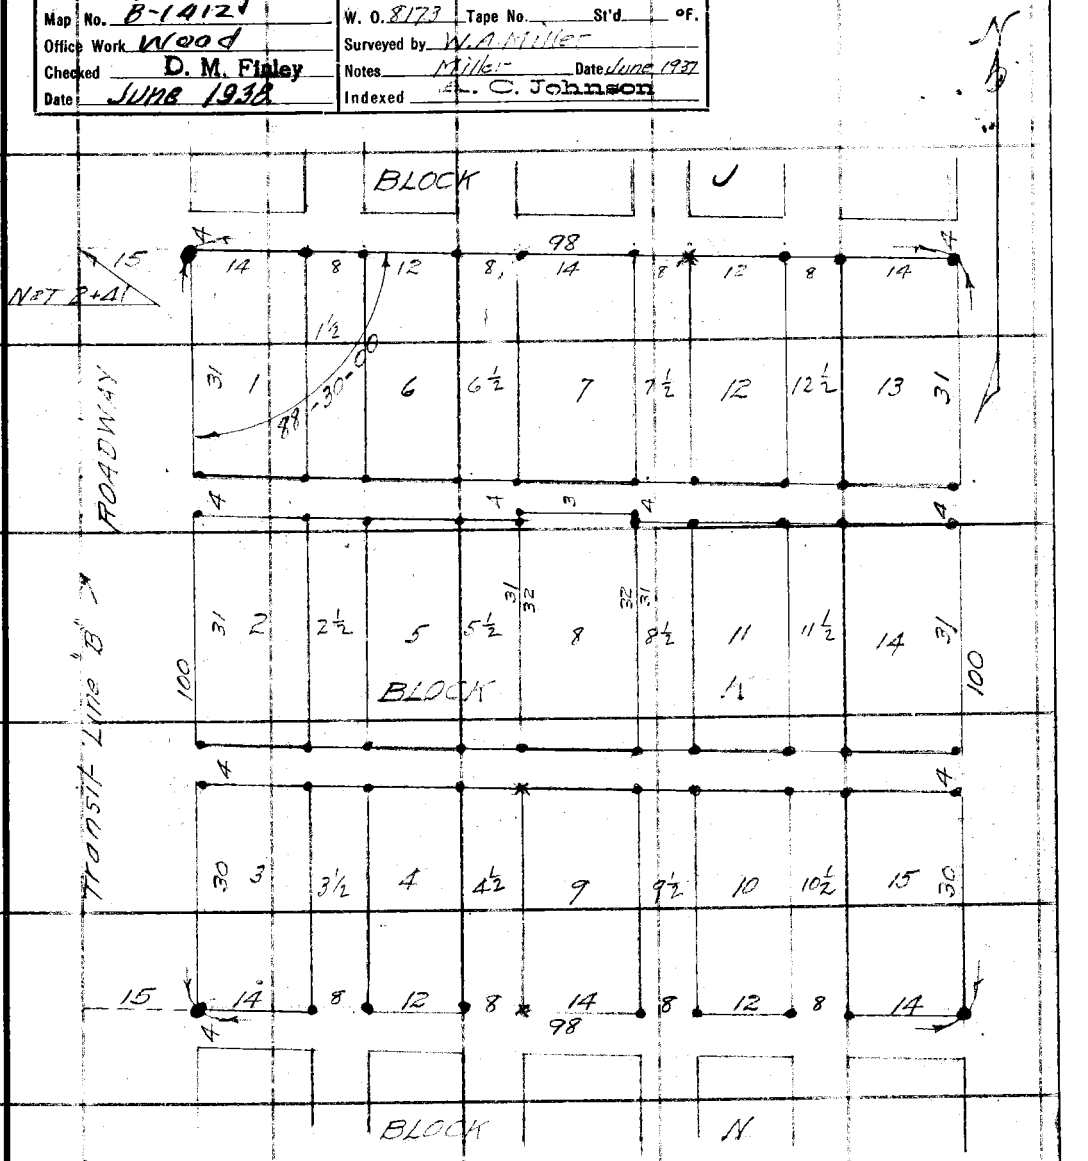

Note: ANY ADDITIONS OR CHANGES ON THIS SHEET MUST BE MADE OR CIRCLED IN Red Ink, WITH DATE AND NAME OF PERSON MAKING CHANGE.

Do not extend notes this side of this line

RETURN TO
LOS ANGELES COUNTY SURVEYOR
700 HALL OF RECORDS

FORM 247 10M 8-31

RETURN TO

LOS ANGELES COUNTY SURVEYOR

700 HALL OF RECORDS

Note: ANY ADDITIONS OR CHANGES ON THIS SHEET MUST BE MADE OR CIRCLED IN **Red Ink.** WITH DATE AND NAME OF PERSON MAKING CHANGE.

Do not extend notes this side of this line

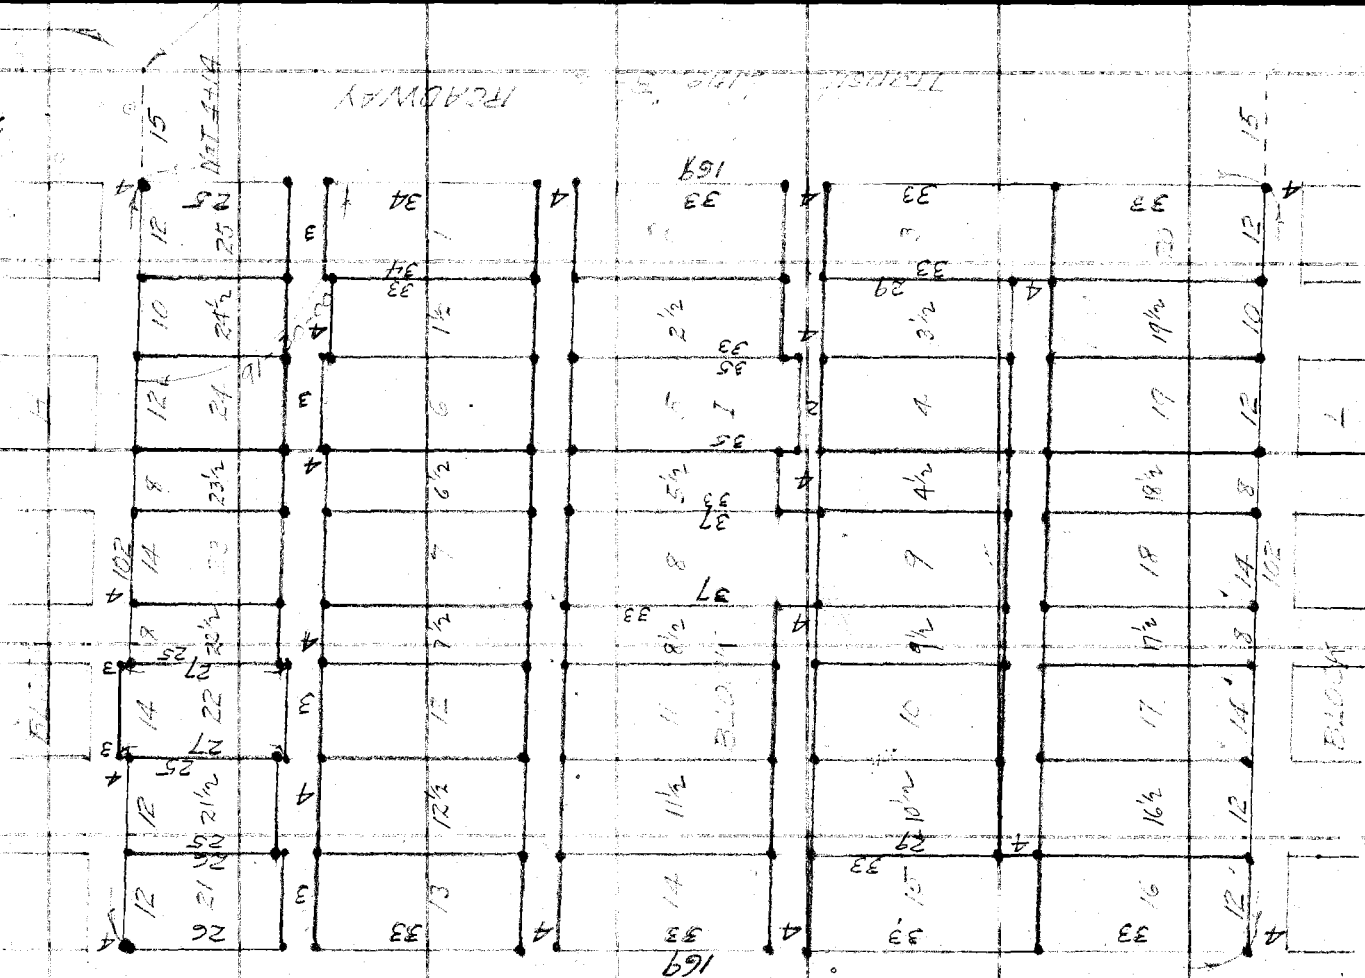

Notes Ck'd by D. M. Finley	Survey of LITTLE LAKE CEM
Map No. B-1412	W. O. 8173 Tape No. St'd of F.
Office Work Wood	Surveyed by W.A.Miller
Checked D. M. Finley	Notes Miller Date
Date June 1938.	Indexed A. C. Johnson

F.B. 686 Pg. 125

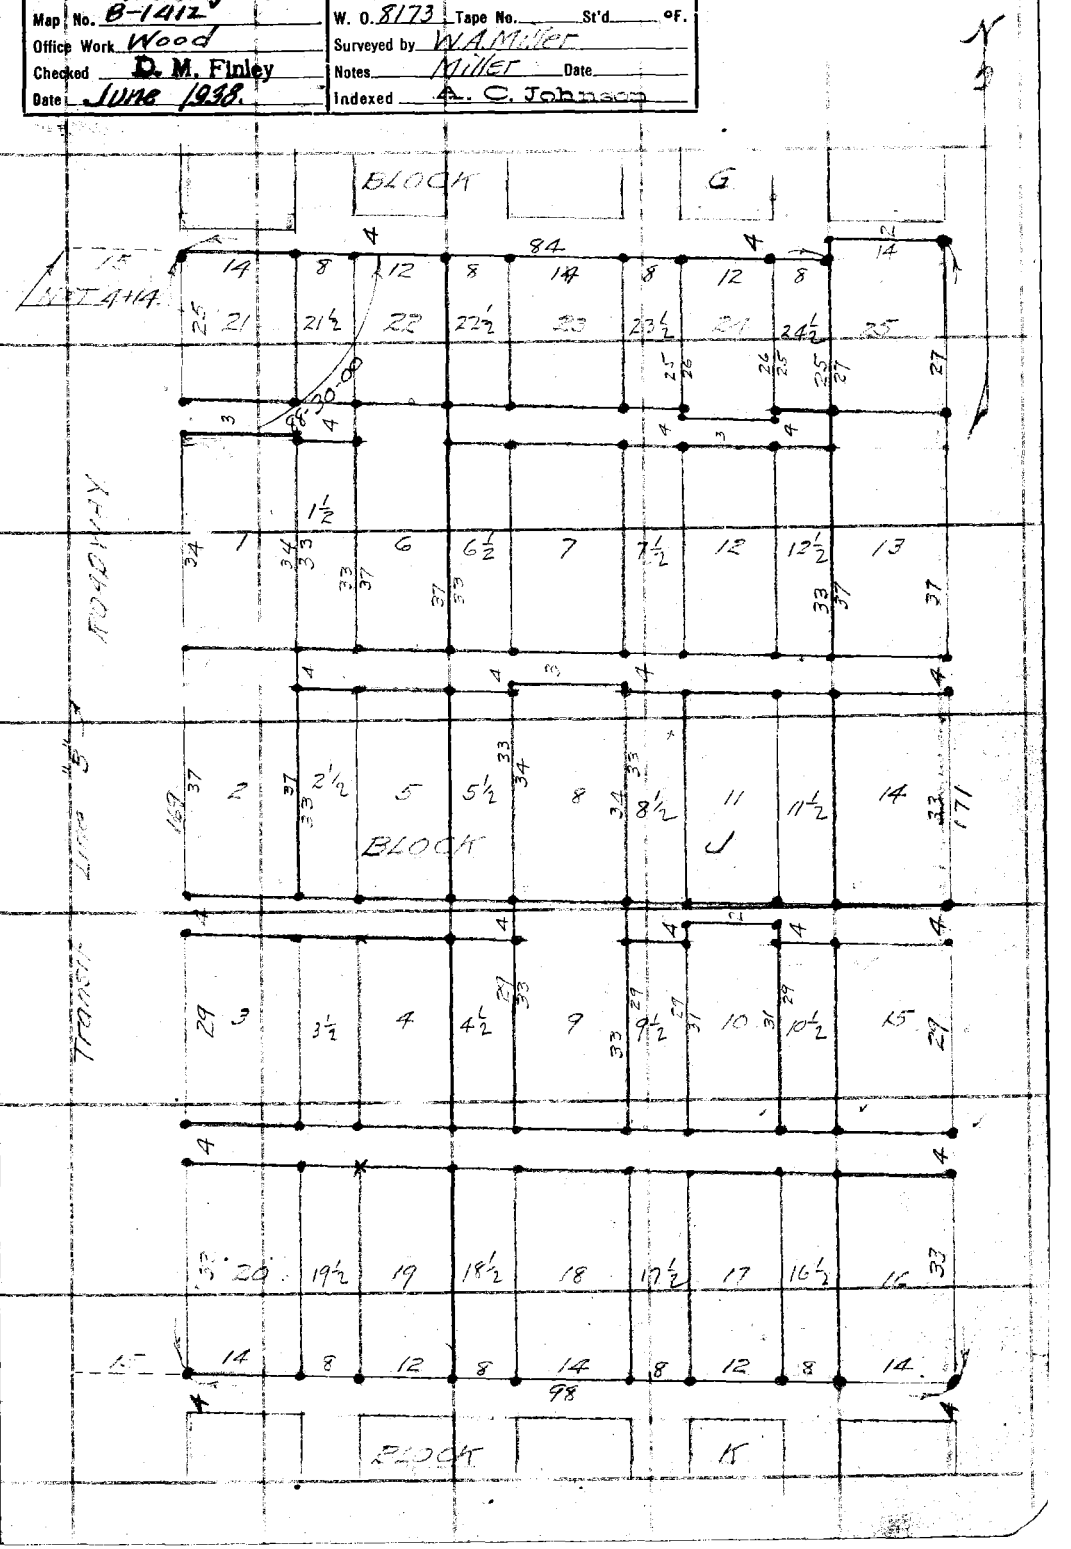

Note: ANY ADDITIONS OR CHANGES ON THIS SHEET MUST BE MADE OR CIRCLED IN Red Ink. WITH DATE AND NAME OF PERSON MAKING CHANGE.

Do not extend notes this side of this line

RETURN TO
LOS ANGELES COUNTY SURVEYOR
7do HALL OF RECORDS

FORM 247 10M 8-51

RETURN TO

LOS ANGELES COUNTY SURVEYOR

700 HALL OF RECORDS

Note: ANY ADDITIONS OR CHANGES ON THIS SHEET MUST BE MADE OR CIRCLED IN **Red Ink.** WITH DATE AND NAME OF PERSON MAKING CHANGE.

Do not extend notes this side of this line

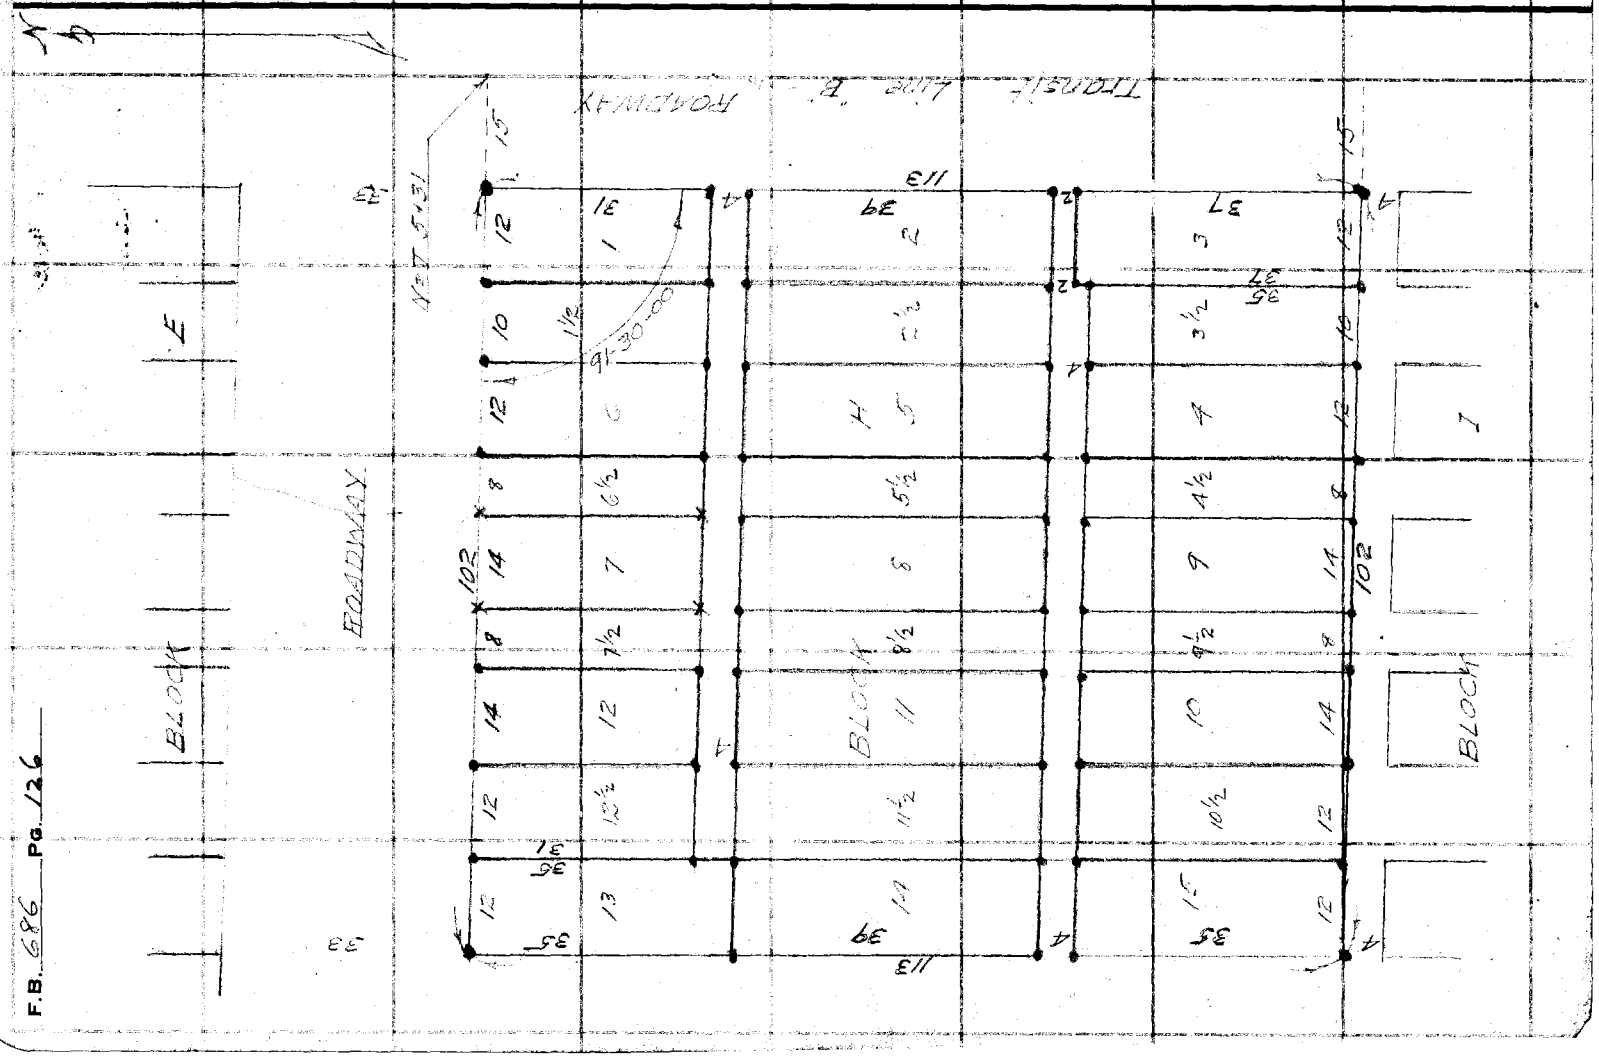
BLOCK
BLOCK
BLOCK

Notes Ck'd by D. M. Finley	Survey of
Map No. B-1412	W. O. 5173 Tape No. St'd °F.
Office Work Wood	Surveyed by
Checked D. M. Finley	Notes Date
Date June 1938	Indexed A. C. Johnson

F.B. 486 Pg. 127

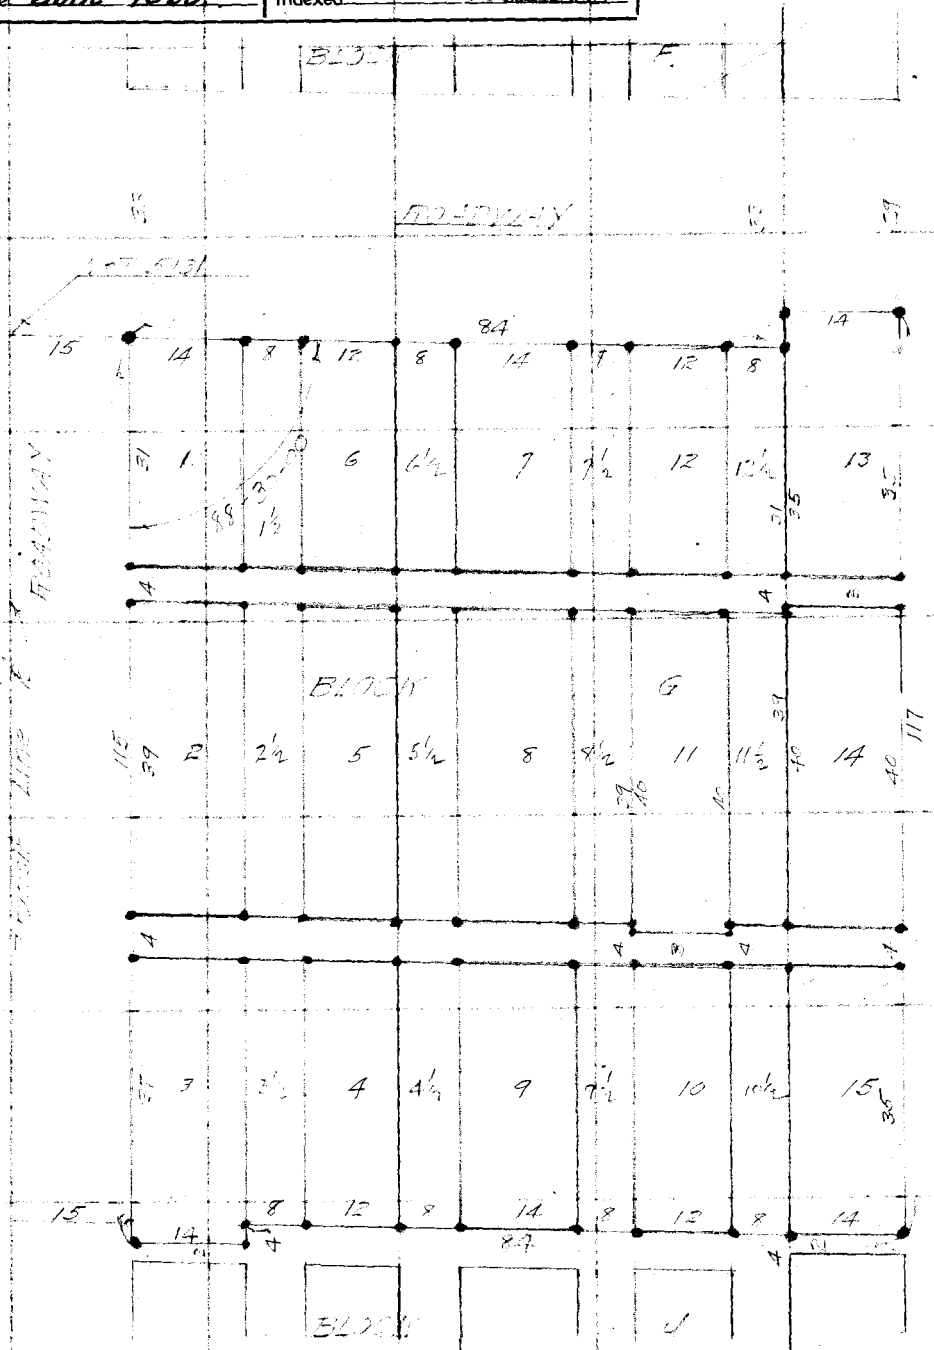

Note: Any Additions or Changes on This Sheet Must be Made or Circled in Red Ink With Date and Name of Person Making Change.

Do not extend notes this side of this line

RETURN TO
LOS ANGELES COUNTY SURVEYOR
7oo HALL OF RECORDS

FORM 247 10M 11-35

F.B. 686 PG. 128

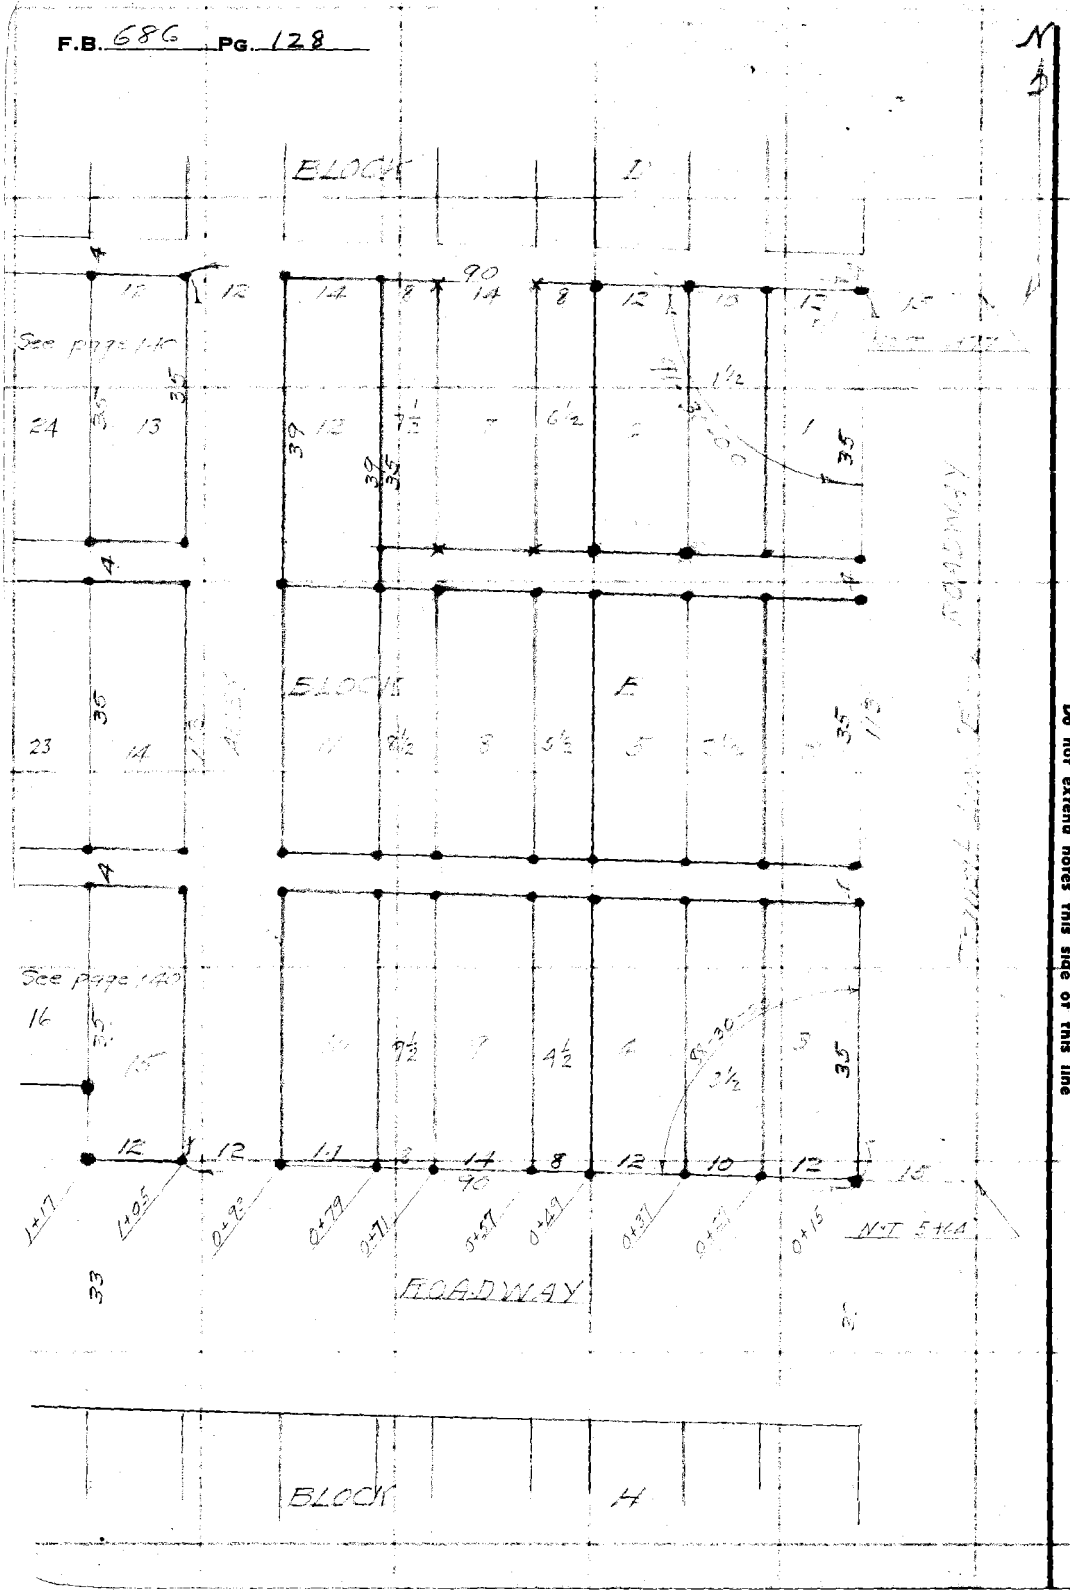

RETURN TO
LOS ANGELES COUNTY SURVEYOR
700 HALL OF RECORDS

Note: Any Additions or Changes on This Sheet Must be Made or Circled in Red Ink With Date and Name of Person Making Change.

Do not extend notes this side of this line

Notes Ck'd by	D. M. Finley	Survey of	LITTLE LAKE COM
Map No.	B-1412	W. O.	8173 Tape No. St'd °F.
Office Work	Wood	Surveyed by	W.A. Miller
Checked	D. M. Finley	Notes	Miller Date
Date	June 1938	Indexed	A. C. Johnson

F.B. 686 Pg. 129

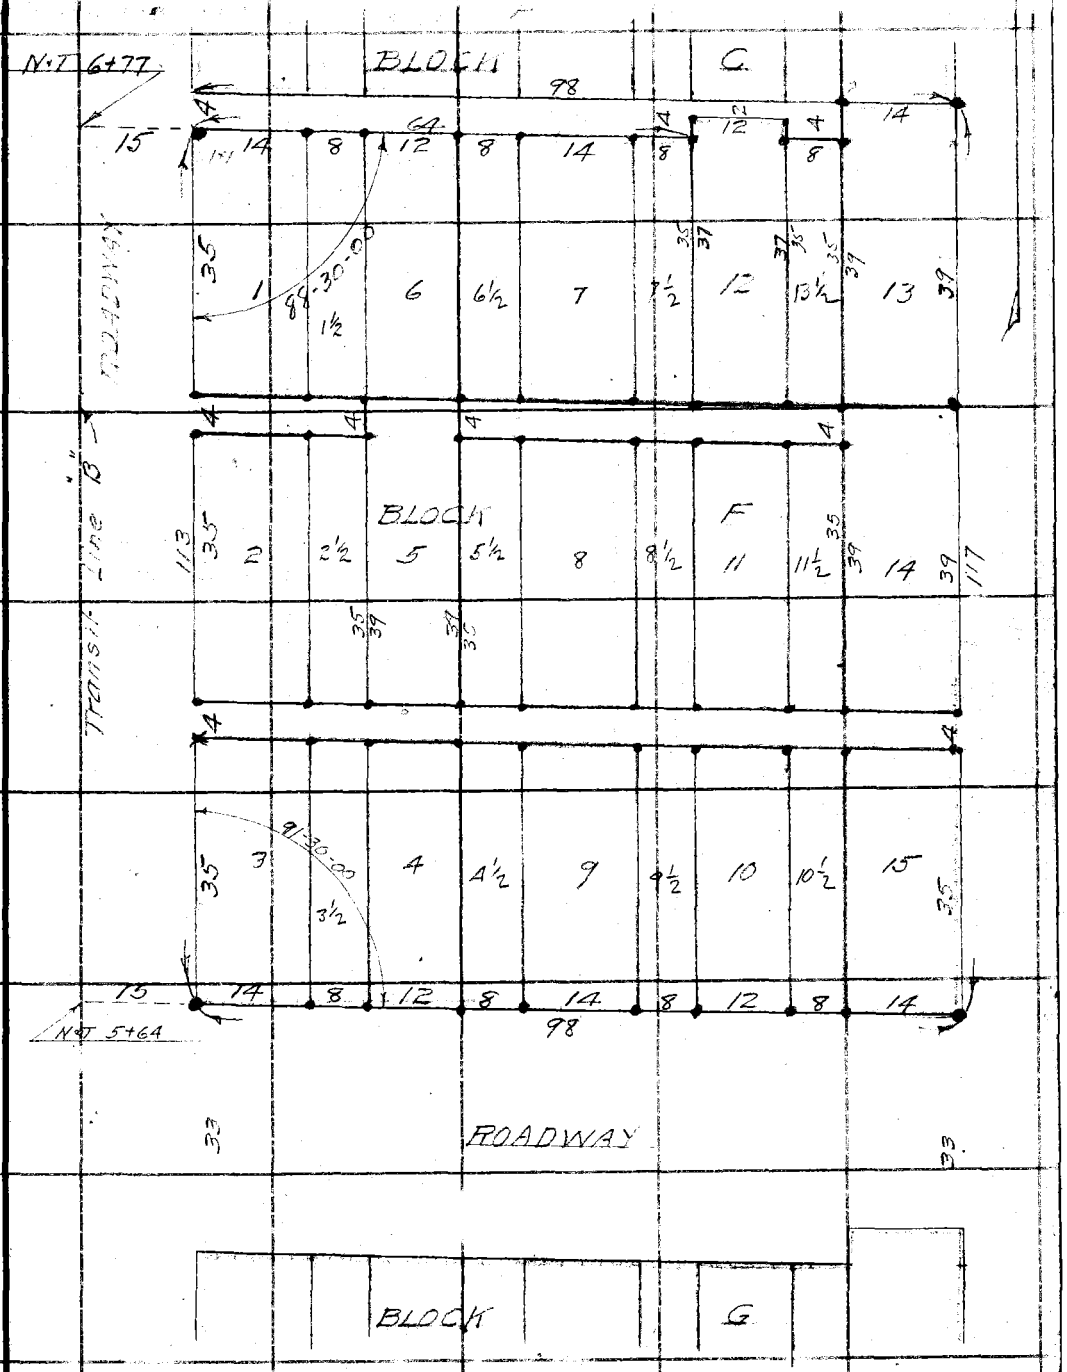

Note: ANY ADDITIONS OR CHANGES ON THIS SHEET MUST BE MADE OR CIRCLED IN Red Ink, WITH DATE AND NAME OF PERSON MAKING CHANGE.

Do not extend notes this side of this line

RETURN TO
LOS ANGELES COUNTY SURVEYOR
700 HALL OF RECORDS

FORM 247 10M 8-31

F.B. 686 PG. 130

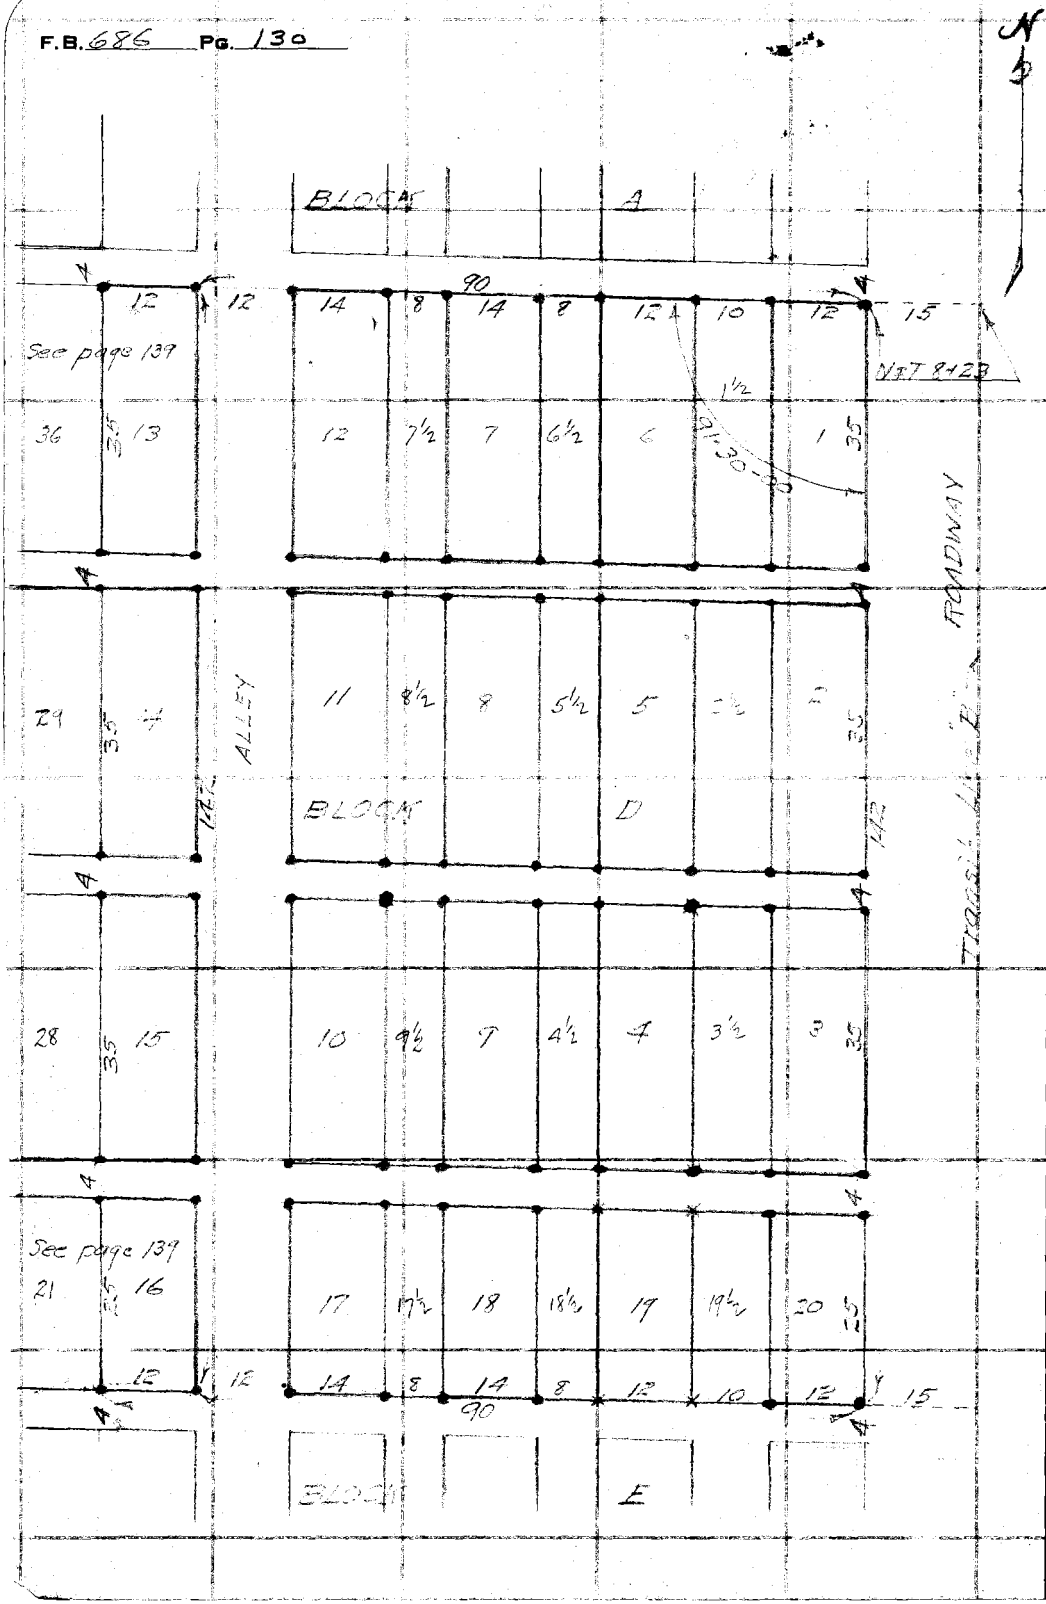

RETURN TO
LOS ANGELES COUNTY SURVEYOR
700 HALL OF RECORDS

Note: ANY ADDITIONS OR CHANGES ON THIS SHEET MUST BE MADE OR CIRCLED IN Red Ink. WITH DATE AND NAME OF PERSON MAKING CHANGE.

Do not extend notes this side of this line

Notes Ck'd by D. M. Finley	Survey of LITTLE LAKE CAM
Map No. B-1412	W. O. 8173 Tape No. ____ St'd ____ °F.
Office Work Wood	Surveyed by W.A. Miller
Checked D. M. Finley	Notes Miller Date July 1937
Date June 1938	Indexed A. C. Johnson

F.B. 686 Pg. 131

Note: ANY ADDITIONS OR CHANGES ON THIS SHEET MUST BE MADE OR CIRCLED IN Red Ink, WITH DATE AND NAME OF PERSON MAKING CHANGE.

RETURN TO
LOS ANGELES COUNTY SURVEYOR
700 HALL OF RECORDS

Do not extend notes this side of this line

FORM 247 10M 8-31

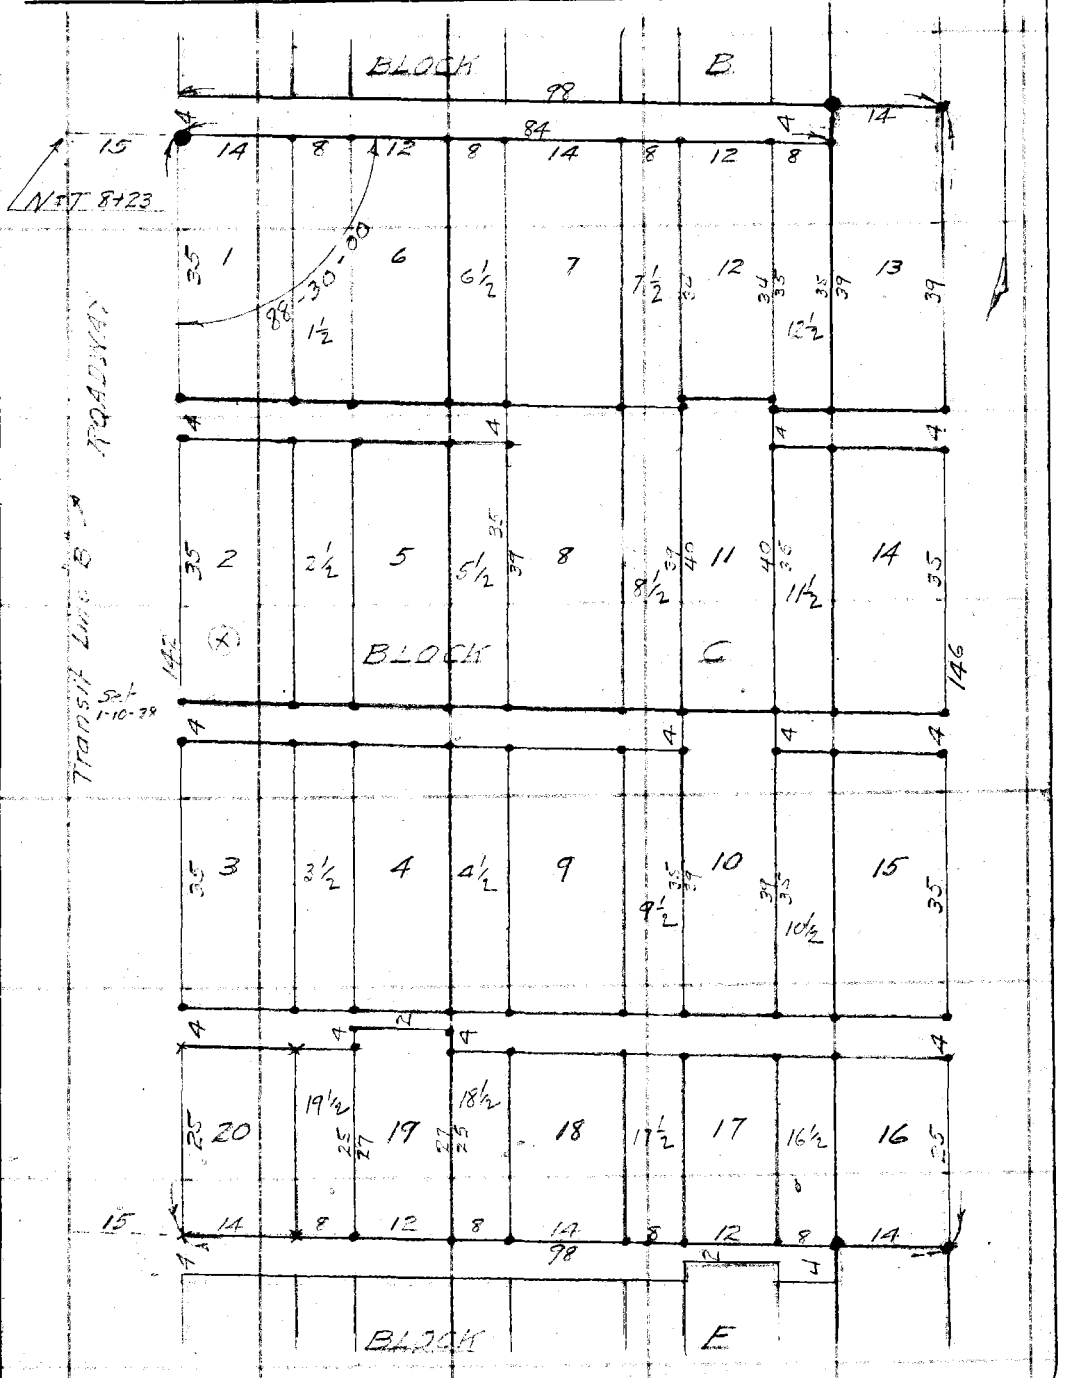

F.B. 686 PG 132

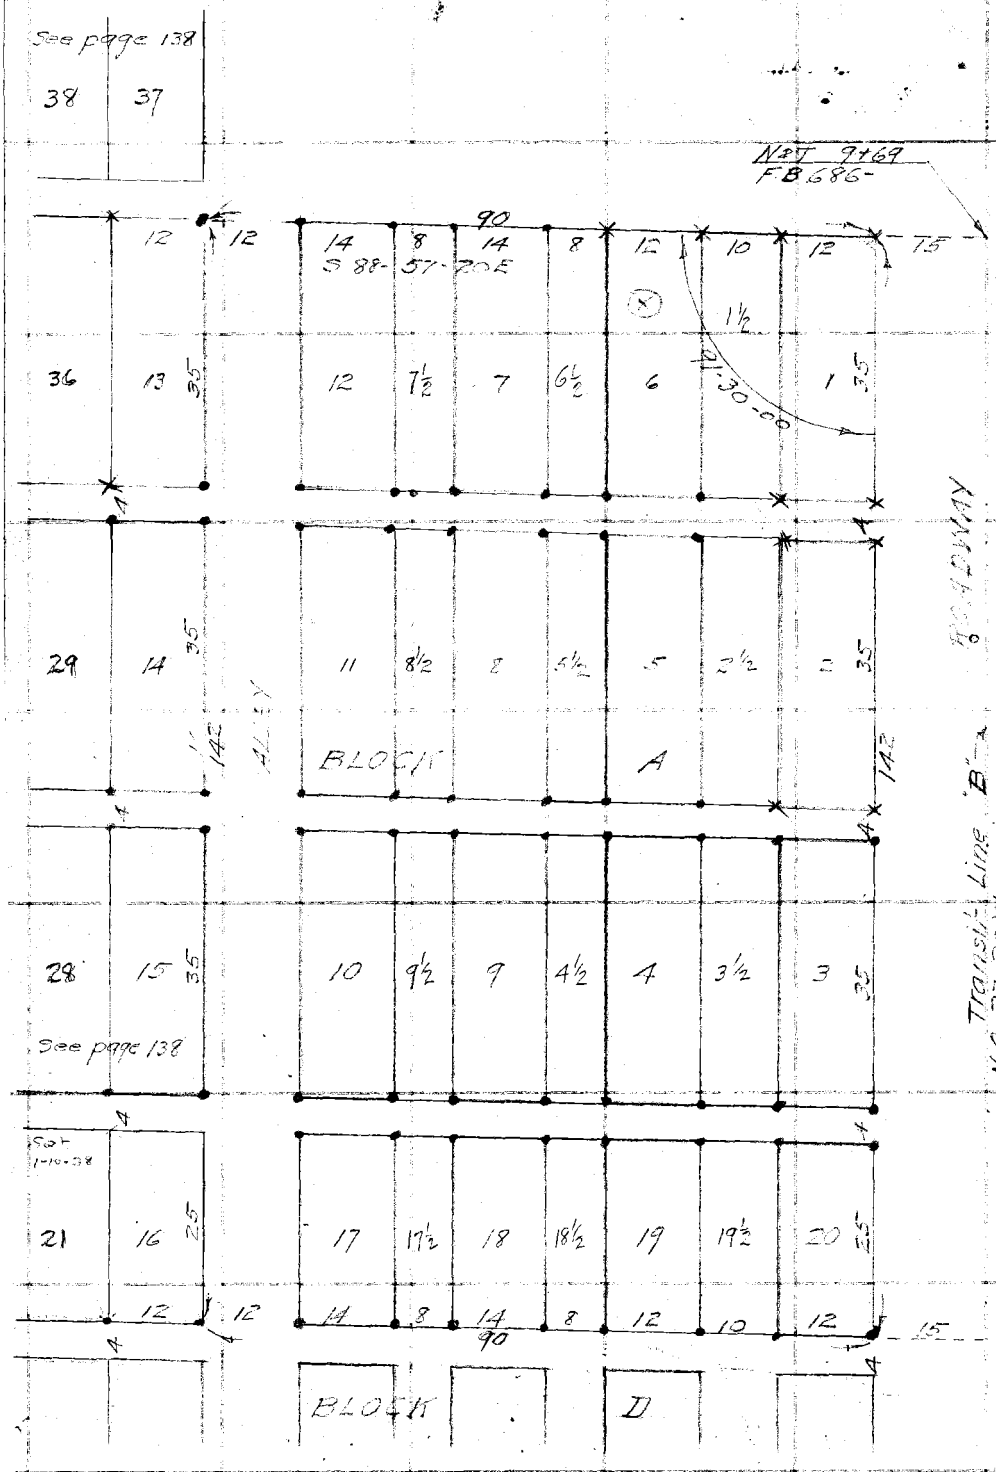

RETURN TO
LOS ANGELES COUNTY SURVEYOR
700 HALL OF RECORDS

Do not extend notes this side of this line

Note: ANY ADDITIONS OR CHANGES ON THIS SHEET MUST BE MADE OR CIRCLED IN Red Ink, WITH DATE AND NAME OF PERSON MAKING CHANGE.

Notes Ck'd by D. M. Finley	Survey of LITTLE LAKE CEM.
Map No. B-1412	W. O. 8173 Tape No. ____ St'd ____ °F.
Office Work Wood	Surveyed by WAM & ____
Checked D. M. Finley	Notes Miller Date ____
Date JUNE 1938	Indexed A. C. Johnson

F.B. 686 PG. 138

N

NET 9+69
F.B. 686-

See page 142

98

15 | 14 | 8 | 14 | 14 | 8 | 12 | 8 | 14

588-57 20 E

35 | 1 | 1½ | 6 | 6½ | 7 | 7½ | 12 | 12½ | 13 | 35

88-30-90

4 4

3.5 | 2 | 2½ | 5 | 5½ | 8 | 8½ | 11 | 11½ | 14 | 36

142 BLOCK B 142

4 4 3 4 4

35 | 3 | 3½ | 4 | 4½ | 9 | 9½ | 10 | 10½ | 15 | 35

3.5 3.5 3.5 3.5

4 4

25 | 20 | 19½ | 19 | 18½ | 18 | 17½ | 17 | 16½ | 16 | 25

15 | 14 | 8 | 12 | 8 | 14 | 8 | 12 | 8 | 14

4 4 98

84

BLOCK C

N 0-27-20 W
TRANSIT LINE "B"

ROADWAY

Note: ANY ADDITIONS OR CHANGES ON THIS SHEET MUST BE MADE OR CIRCLED IN Red Ink, WITH DATE AND NAME OF PERSON MAKING CHANGE.

Do not extend notes this side of this line

RETURN TO
LOS ANGELES COUNTY SURVEYOR
700 HALL OF RECORDS

FORM 247 10M 8-51

RETURN TO

LOS ANGELES COUNTY SURVEYOR

700 HALL OF RECORDS

Note: ANY ADDITIONS OR CHANGES ON THIS SHEET MUST BE MADE OR CIRCLED IN **Red Ink.** WITH DATE AND NAME OF PERSON MAKING CHANGE.

Do not extend notes this side of this line

F.B. 686 Pg. 134

Notes Ck'd by M.S. Hewson	Survey of LITTLE LAKE CEM	F.B. 686	Pg. 135
Map No. B-1308-1	W. O. 8173 Tape No.	St'd	°F.
Office Work Wood	Surveyed by W.A. Miller		
Checked D. M. Finley	Notes Miller	Date 7-20-1937	
Date June 1938.	Indexed A. C. Johnson 7-28-37		

LITTLE LAKE CEMETERY
J.N. 8173

ADDITIONAL DATA
NECESSARY FOR GOVERNMENT

B-1308
LITTLE LAKE
RANCHO

Note: ANY ADDITIONS OR CHANGES ON THIS SHEET MUST BE MADE OR CIRCLED IN Red Ink, WITH DATE AND NAME OF PERSON MAKING CHANGE.

Do not extend notes this side of this line

RETURN TO
LOS ANGELES COUNTY SURVEYOR
700 HALL OF RECORDS

FORM 247 10M 8-31

F.B. 686 Pg. 136

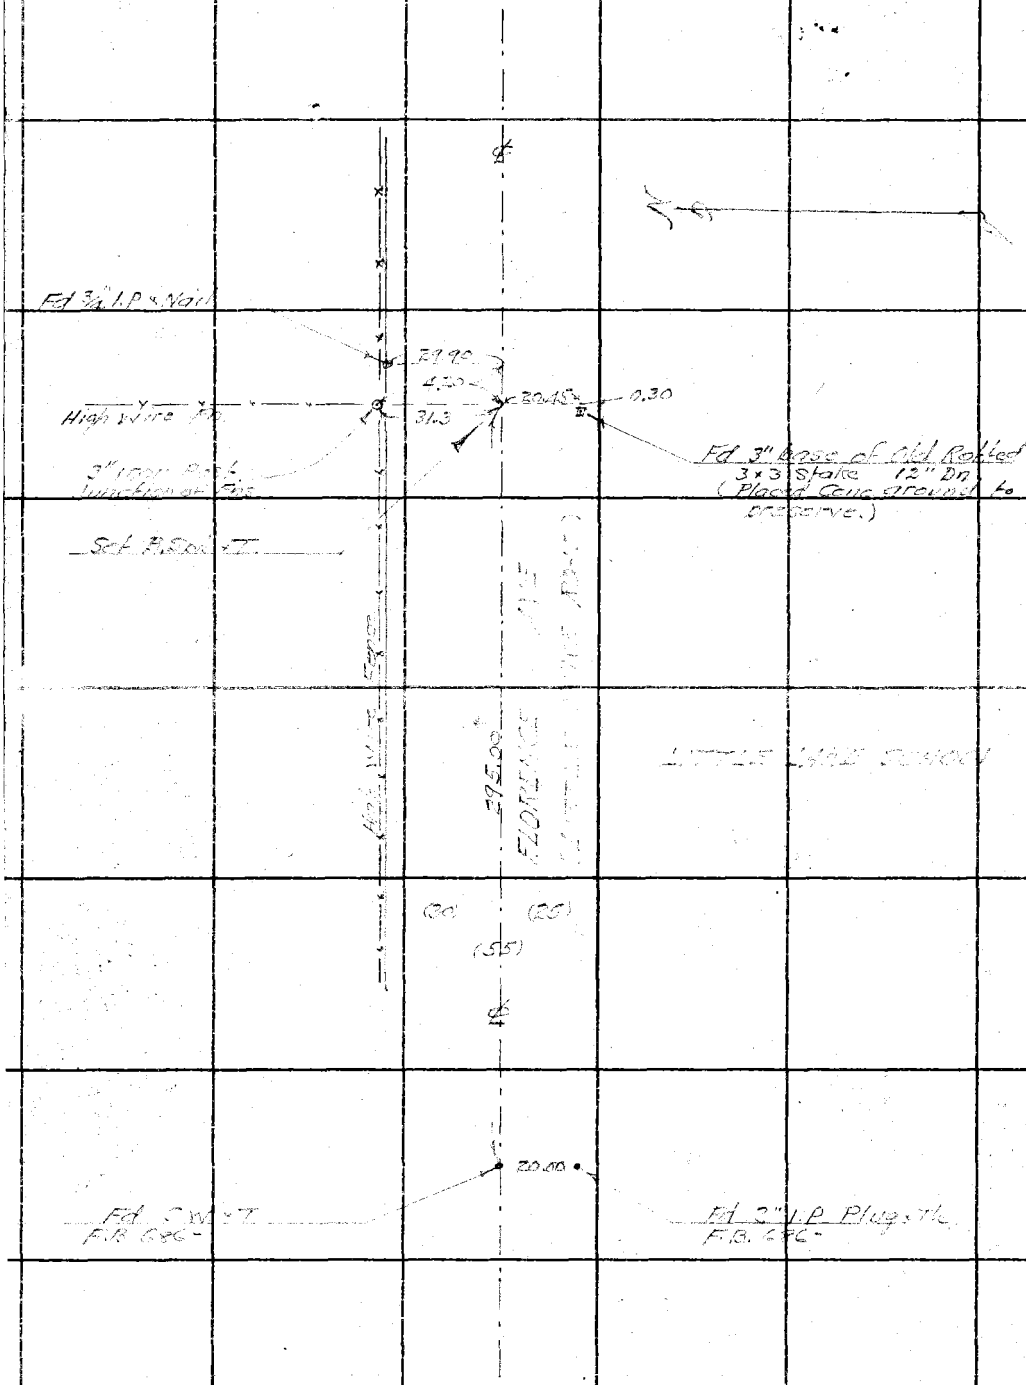

RETURN TO
LOS ANGELES COUNTY SURVEYOR
700 HALL OF RECORDS

Do not extend notes this side of this line

Note: ANY ADDITIONS OR CHANGES ON THIS SHEET MUST BE MADE OR CIRCLED IN **Red Ink.** WITH DATE AND NAME OF PERSON MAKING CHANGE.

Notes Ck'd by D. M. Finley	Survey of LITTLE LAKE CEM	F.B. 686	Pg. 137
Map No. B-1412	W. O. 8173 Tape No. ____ St'd ____ °F.		
Office Work Wood	Surveyed by W.A. Miller		
Checked D. M. Finley	Notes Miller Date Mar 1938		
Date June 1938.	Indexed A. C. Johnson		
	3-25-38		

LITTLE LAKE CEMETERY
J.N. 8173

ADDITIONS
TO
BLOCKS A, D, E, M & B.

Miller
Braden
Gunderson
Walbermire

Note: ANY ADDITIONS OR CHANGES ON THIS SHEET MUST BE MADE OR CIRCLED IN Red Ink. WITH DATE AND NAME OF PERSON MAKING CHANGE.

Do not extend notes this side of this line

RETURN TO
LOS ANGELES COUNTY SURVEYOR
700 HALL OF RECORDS

FORM 247 10M 5-31

RETURN TO
LOS ANGELES COUNTY SURVEYOR
700 HALL OF RECORDS

Note: ANY ADDITIONS OR CHANGES ON THIS SHEET MUST BE MADE OR CIRCLED IN **Red** Ink. WITH DATE AND NAME OF PERSON MAKING CHANGE.

Do not extend notes this side of this line

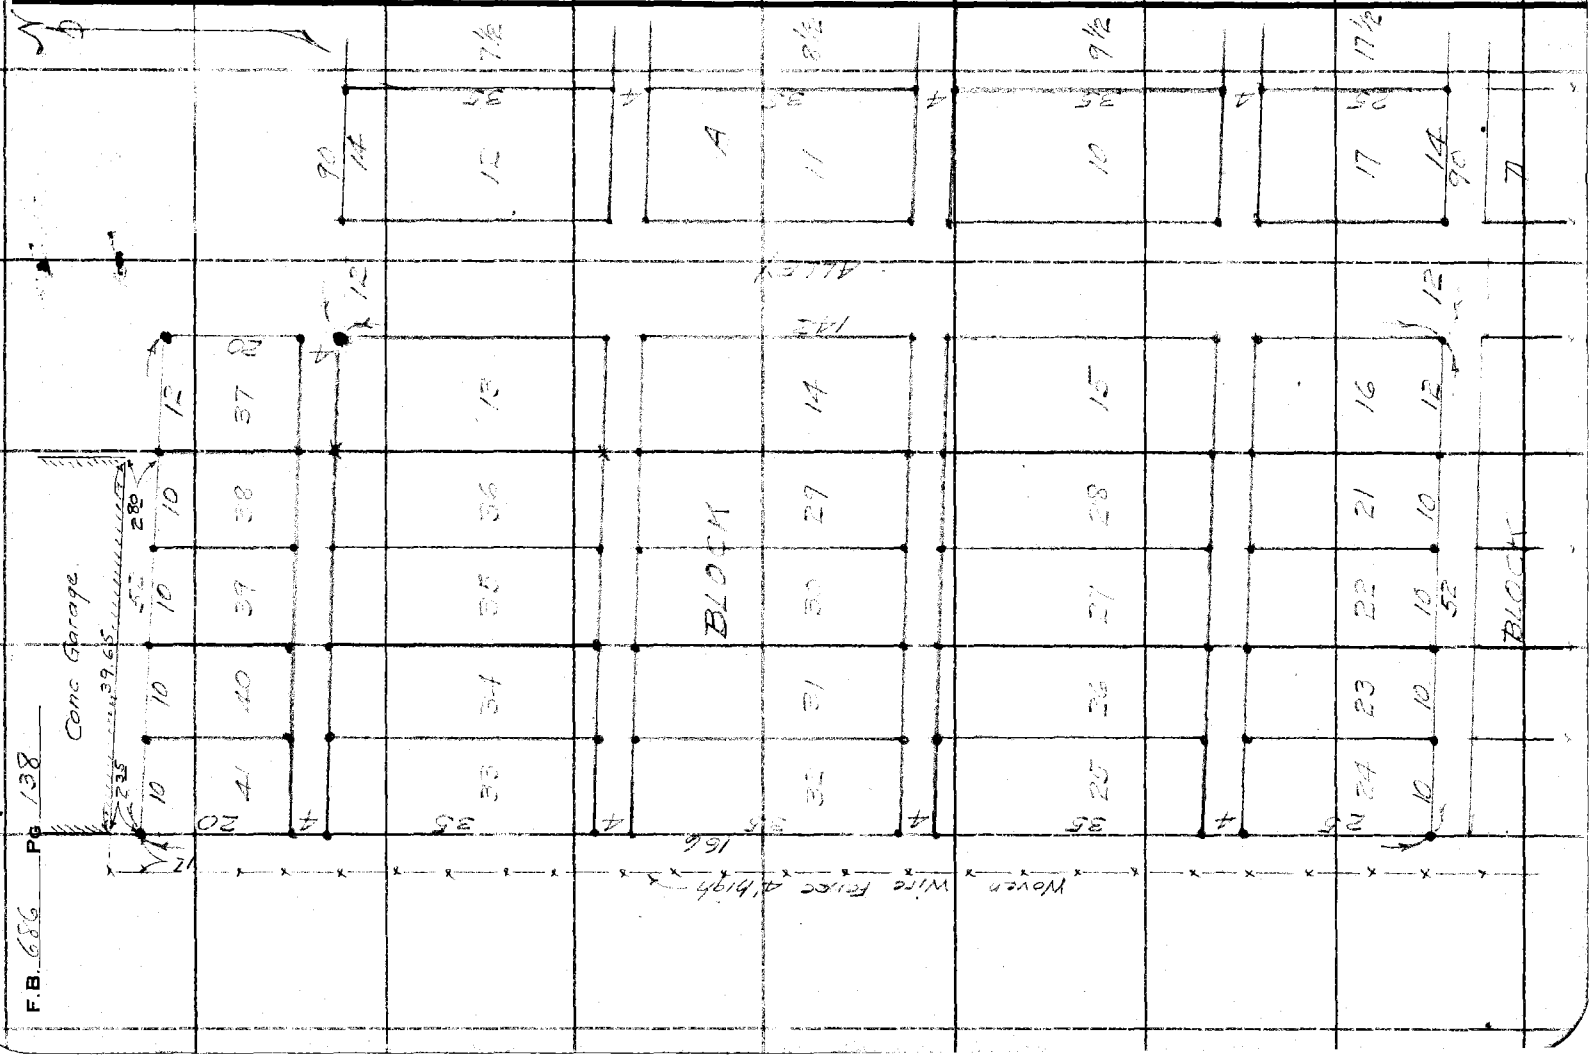

Notes Ck'd by	D. M. Finley	Survey of	LITTLE LAKE CO.
Map No.	B-1412	W. O.	2173 Tape No. St'd °F.
Office Work	Wood	Surveyed by	W. C. Wood
Checked	D. M. Finley	Notes	MINE Date 3-17-1938
Date	JUNE 1938	Indexed	A. C. Johnson

F.B. Pg. 139

Note: Any Additions or Changes on This Sheet Must be Made or Circled in Red Ink With Date and Name of Person Making Change

Do not extend notes this side of this line

RETURN TO
LOS ANGELES COUNTY SURVEYOR
700 HALL OF RECORDS

FORM 247 10M 11-35

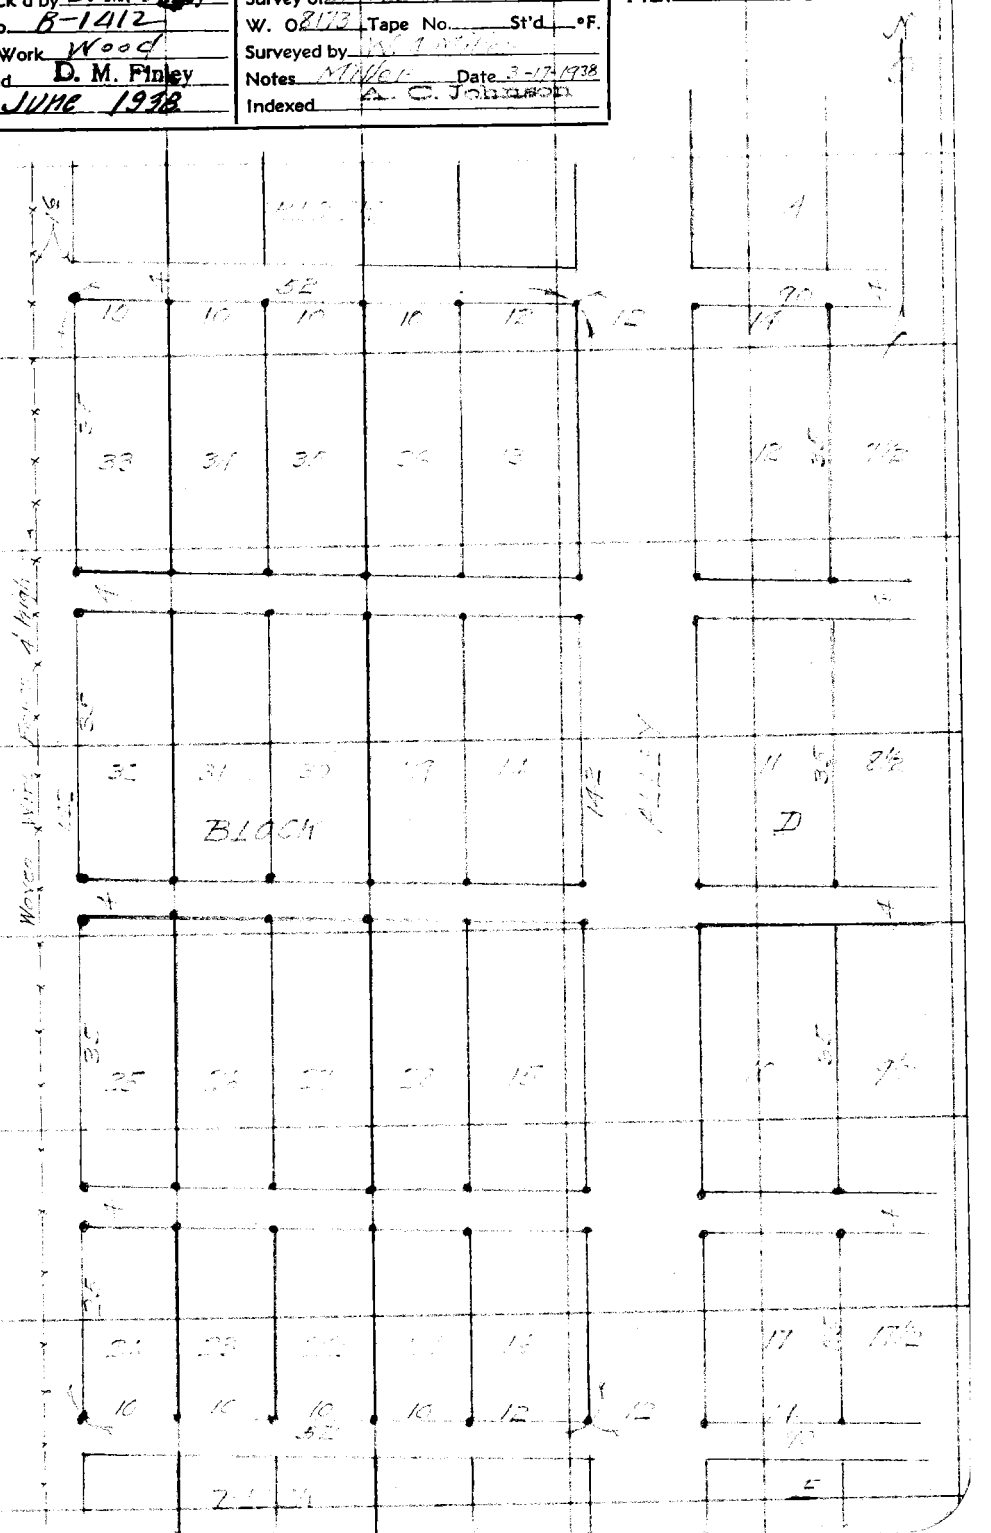

RETURN TO
LOS ANGELES COUNTY SURVEYOR
700 HALL OF RECORDS

Note: Any Additions or Changes on This Sheet Must be Made or Circled in **Red Ink** With Date and Name of Person Making Change.

Do not extend notes this side of this line

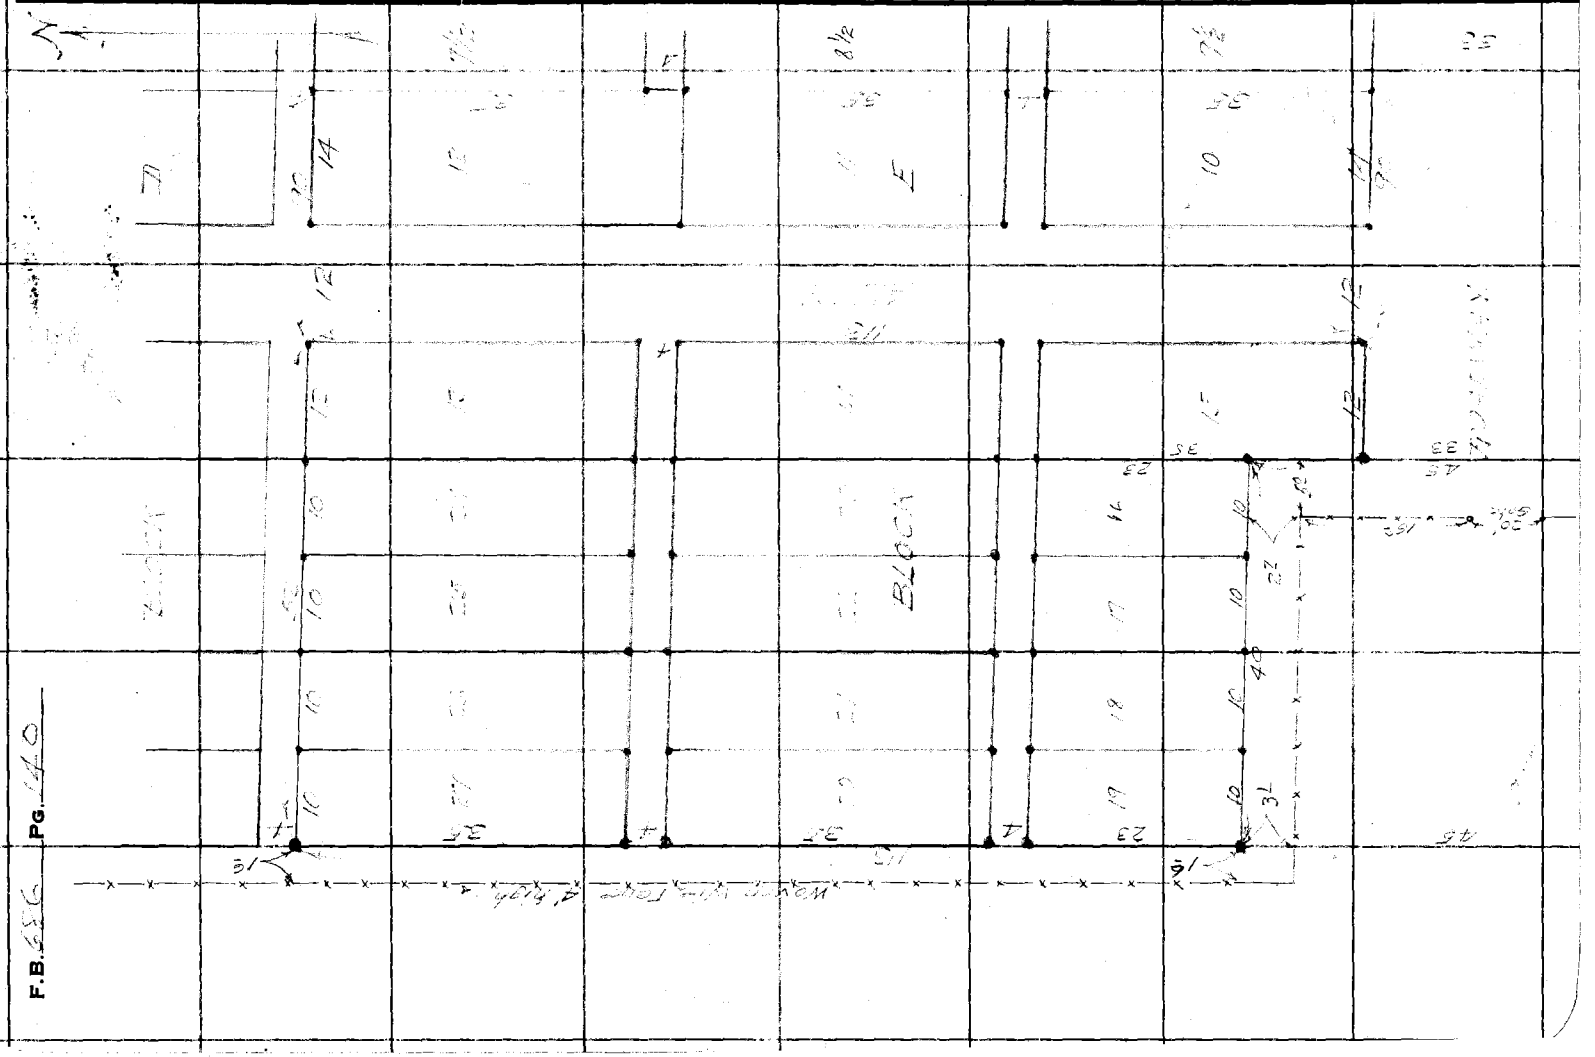

F.B. 656 Pg. 140

Notes Ck'd by D. M. Finley	Survey of LITTLE LAKE TRACT
Map No. B-1412	W. O. 8173 Tape No. St'd °F.
Office Work Wood	Surveyed by W. A. Miller
Checked D. M. Finley	Notes Miller Date 3-16-1938
Date JUNE 1938.	Indexed A. C. Johnson

F.B. 686 PG. 141

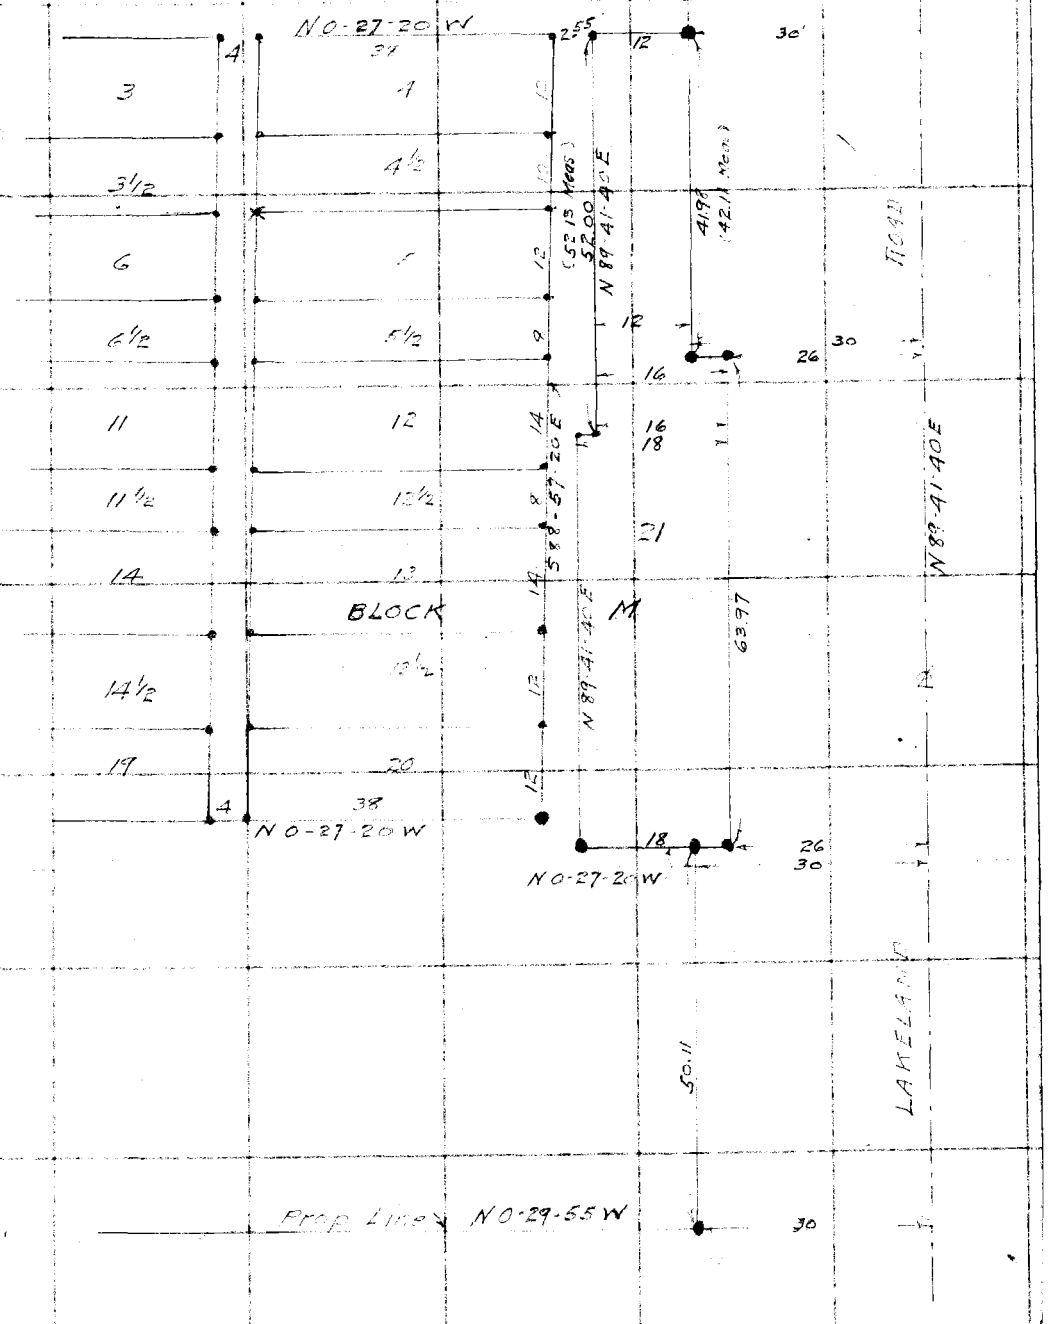

RETURN TO
LOS ANGELES COUNTY SURVEYOR
700 HALL OF RECORDS

Note: Any Additions or Changes on This Sheet Must be Made or Circled in Red Ink With Date and Name of Person Making Change.

Do not extend notes this side of this line

FORM 247 10M 11-38

F.B. 586 Pg. 142

RETURN TO
LOS ANGELES COUNTY SURVEYOR
700 HALL OF RECORDS

Note: Any Additions or Changes on This Sheet Must be Made or Circled in Red Ink With Date and Name of Person Making Change.

Do not extend notes this side of this line

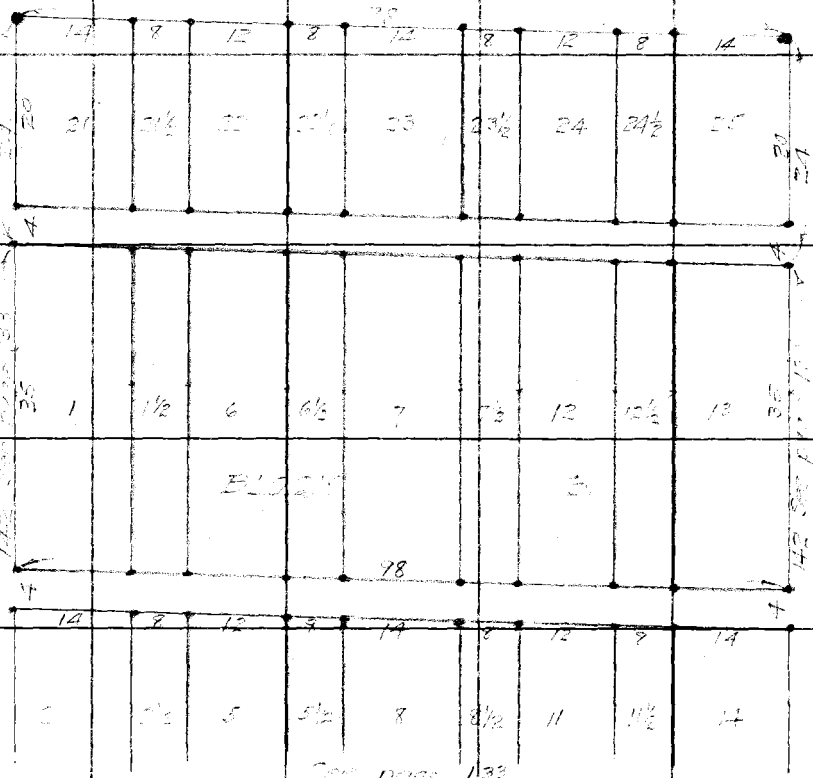

Notes Ck'd by	Survey of Little Lake School
Map No.	W. O. 8179 Tape No. St'd °F.
Office Work	Surveyed by Evans
Checked	Notes H.E. Date Mar 1937
Date	Indexed C. Johnson

F.B. 686 Pg. 201

LITTLE LAKE SCHOOL

J.N. 8179

BETWEEN LAKELAND ROAD AND FLORENCE AVE EAST OF PIONEER BLVD

Note: Any Additions or Changes on This Sheet Must be Made or Circled in Red Ink With Date and Name of Person Making Change.

Do not extend notes this side of this line

RETURN TO
LOS ANGELES COUNTY SURVEYOR
700 HALL OF RECORDS

FORM 247 10M 11-45

RETURN TO
LOS ANGELES COUNTY SURVEYOR
700 HALL OF RECORDS

Note: Any Additions or Changes on This Sheet Must be Made or Circled in **Red Ink** With Date and Name of Person Making Change.

Do not extend notes this side of this line

F.B. _____ PG. _____

FORM 247 10M 11-35

RETURN TO
LOS ANGELES COUNTY SURVEYOR
700 HALL OF RECORDS

Note: Any Additions or Changes on This Sheet Must be Made or Circled in Red Ink With Date and Name of Person Making Change

Do not extend notes this side of this line

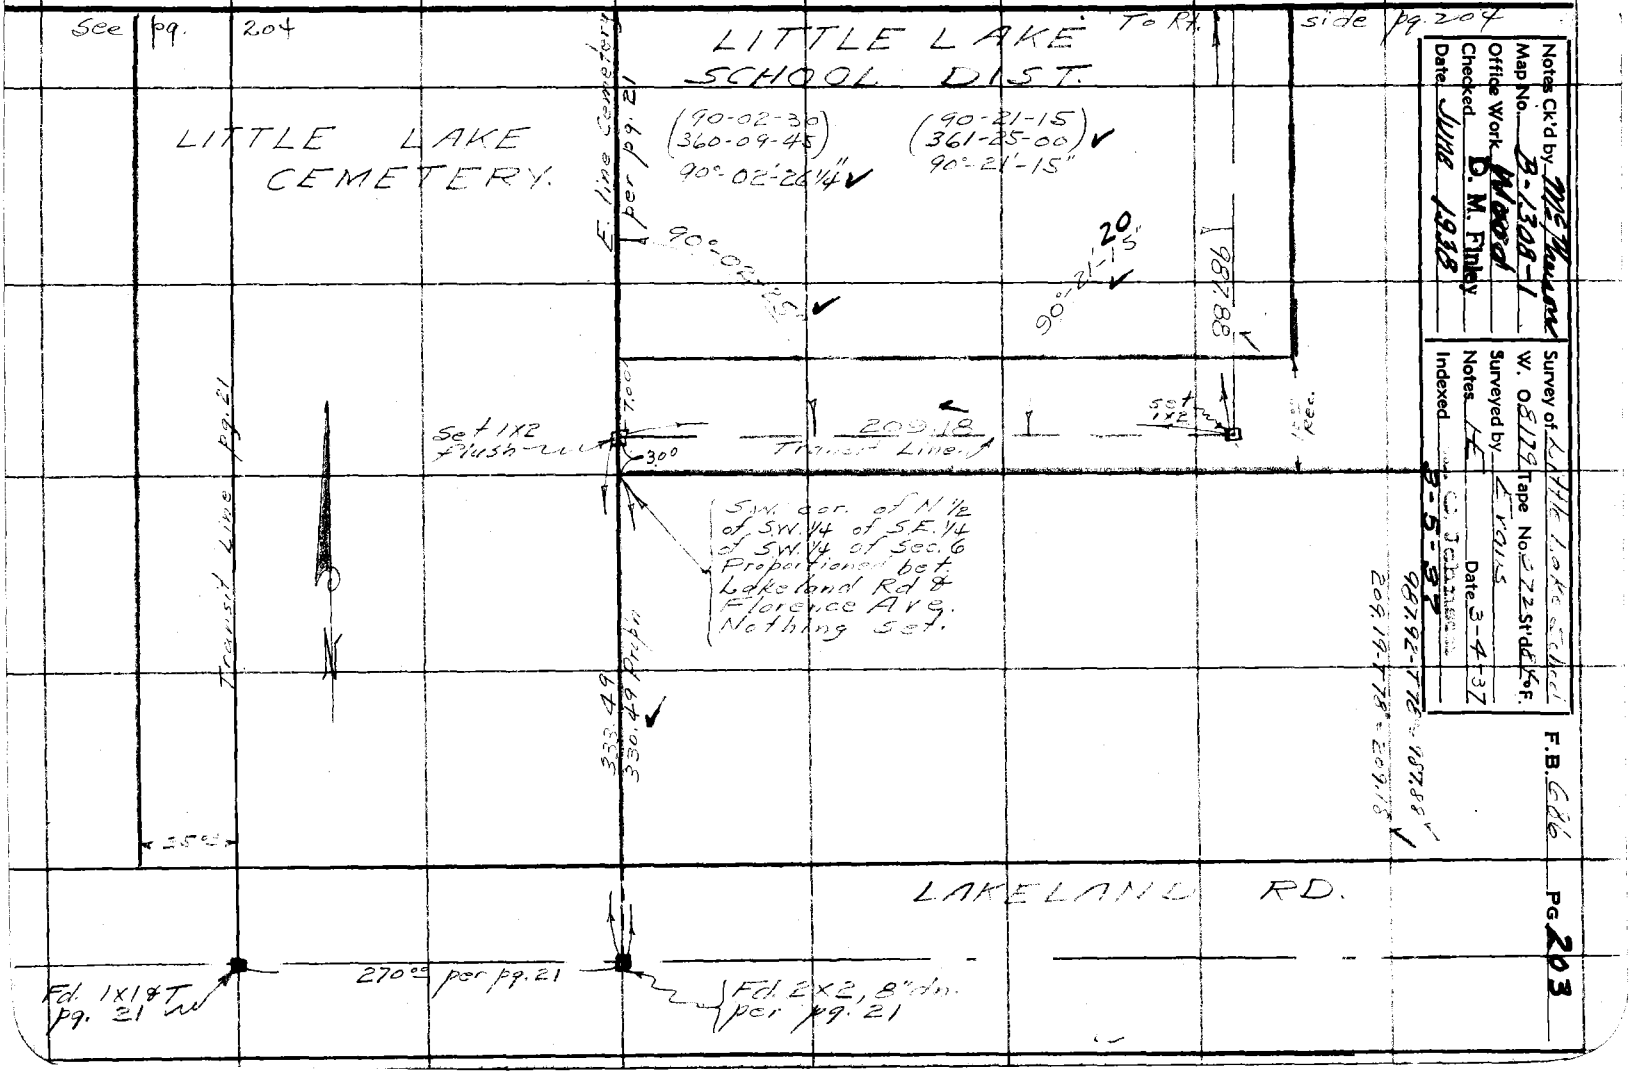

Notes Ck'd by Mc Munn
Map No. B-1308-1
Office Work Mcord
Checked D. M. Finley
Date June 1938

Survey of Little Lake School

F.B. Cke PG 203

RETURN TO
LOS ANGELES COUNTY SURVEYOR
700 HALL OF RECORDS

Note: Any Additions or Changes on This Sheet Must be Made or Circled in **Red Ink** With Date and Name of Person Making Change.

Do not extend notes this side of this line

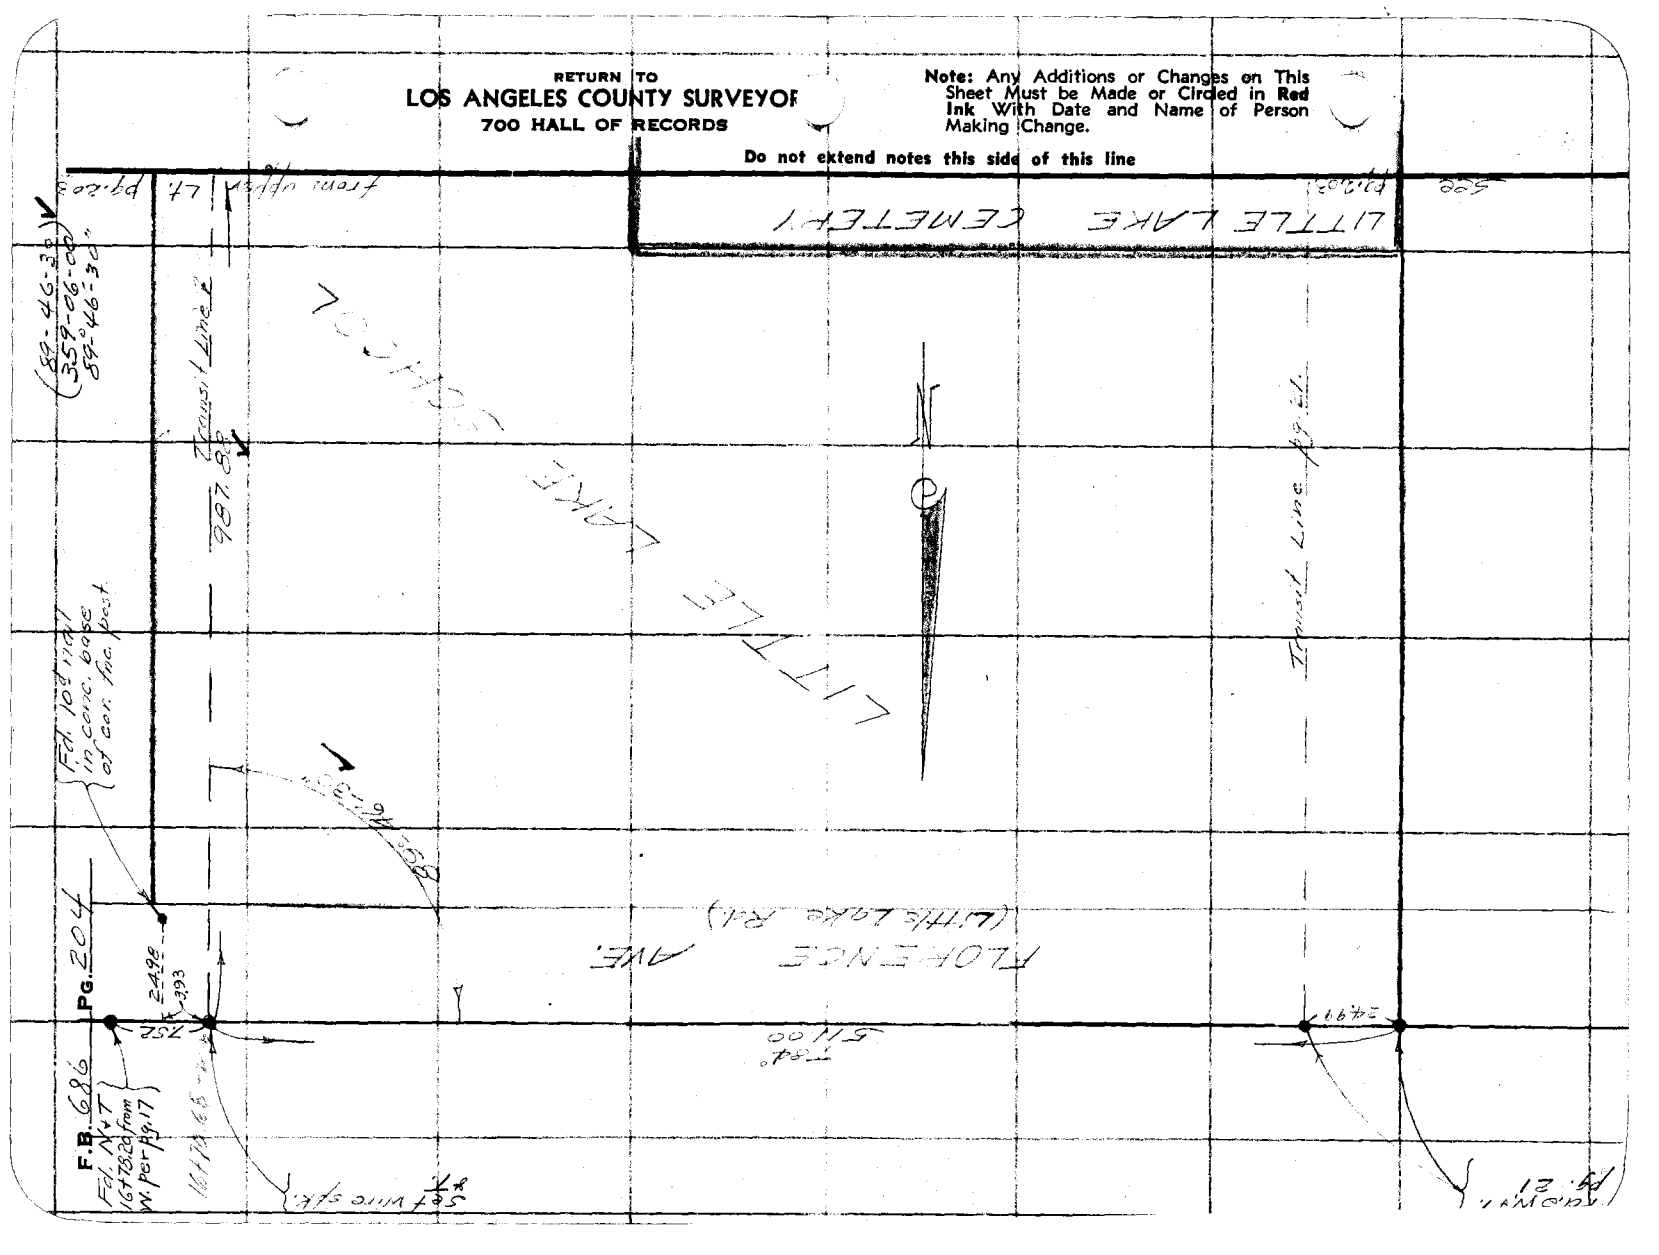
LITTLE LAKE CEMETERY
LITTLE LAKE
FLORENCE AVE.
(Little Lake Rd.)
Pg. 204
F.B. 686
Fd. N+T 16+28.2 from W. Per Pg 17
Set Wire Stk.

Notes Ck'd by McPherson	Survey of Little Lake School	F.B. 686	Pg. 205
Map No. B-1308-1	W. O. 8179 Tape No. 072 St'd 8% F.		
Office Work Wood	Surveyed by Evans		
Checked D. M. Finley	Notes HE Date 3-4-37		
Date June 1938.	Indexed A. C. Johnson		

Note: Any Additions or Changes on This Sheet Must be Made or Circled in Red Ink With Date and Name of Person Making Change

Do not extend notes this side of this line

RETURN TO
LOS ANGELES COUNTY SURVEYOR
700 HALL OF RECORDS

FORM 247 10M 11-35

FLORENCE AVE.

wire spk. & T. - pg. 204

& pg. 204

3.19 90° T

25.36

ctr. of cor fnc. Post.

See pgs. 16-17 for location this fence

LITTLE LAKE SCHOOL

Location of fences

pg. 203-204

Iron posts

See pg 21 for location of these fnc's.

Barbed wire fnc.

East Line Cemetery per pg. 21

LITTLE LAKE CEMETERY

Fd. 1" I.P. Flush 5-17-1938 W.A.M.

6' wayen wire fnc. iron posts.

5.70 90°

ctr. of cor fnc. Post.

intersection of fences

6.52 90°

7.30

1X2 pg. 203

209.18

4.15 90°

2.90

5.17

5.00 90°

Barbwire fnc.

RETURN TO
LOS ANGELES COUNTY SURVEYOR
700 HALL OF RECORDS

Note: Any Additions or Changes on This Sheet Must be Made or Circled in **Red Ink** With Date and Name of Person Making Change.

Do not extend notes this side of this line

F.B. 6586 Pg. 206

Profile No. | Notes Red. | Plotted | Job No. 8179 Division No. | F.B. 686 PG. 207
Date | Date | Survey of LITTLE LAKE SCHOOL
X-Sec. No. | Notes Chkd. | Checked | Survey by T. WALSH Notes WALSH Date MAR. 8, 1937
Date | Date | Map No. | Indexed [illegible] Date 9-11-37

NOTE: ANY ADDITIONS OR CHANGES ON THIS SHEET MUST BE MADE OR CIRCLED IN RED INK, WITH DATE AND NAME OF PERSON MAKING CHANGE

Do not extend notes this side of this line

PLEASE RETURN TO
LOS ANGELES COUNTY SURVEYOR
700 HALL OF RECORDS

Form 307 5M 11-35

STATION	B. S.	H. I.	F. S.	ELEV.

BENCH LEVELS
LITTLE LAKE SCHOOL

A LINE OF BENCH LEVELS FROM U.S.B.M. Nº 2690 IN NORWALK TO LITTLE LAKE SCHOOL & RETURN

T. WALSH
F. GREENWOOD "
W. RINNER "

J.N. 8179

BASED UPON 1934 ADJ.

F. B. 686 PG. 208 | Job No. | Division No. | Notes Red. | Plotted | Profile

Survey of | Date | Date | No.

Survey by | Notes | Notes Chkd. | Checked | X-Sec.

Indexed | Date | Date | Date | No.

STATION	B. S.	H. I.	F. S.	ELEV.

Form 307 5M 11-35

PLEASE RETURN TO
LOS ANGELES COUNTY SURVEYOR
700 HALL OF RECORDS

NOTE: ANY ADDITIONS OR CHANGES ON THIS SHEET MUST BE MADE OR CIRCLED IN RED INK, WITH DATE AND NAME OF PERSON MAKING CHANGE

Do not extend notes this side of this line

Profile No.____ X-Sec. No.____

Notes Red. KRM. Plotted____ Job No.____ Division No.____
Date 2-11-37 Date____ Survey of LITTLE LAKE SCHOOL
Notes Chkd.____ Checked____ Survey by J.M.WALSH Notes WALSH Date 3-5-37
Date____ Date____ Map No.____ Indexed A. C. Johnson

F.B. 686 PG. 209

STATION	B. S.	H. I.	F. S.	ELEV.	
U.S. 2690				99.390	US 2690 - V 98 At Norwalk, L.A. County, at the N.W. Corner of the intersection of Front & Sears Sts., and in the S.E. Corner of the Bank of America Bldg. A Standard disk stamped "V 98 1932" and set Vertically 1932 Adj = 99.495 1934 " = 99.380
	0008	99.395			
			1060	98.328	
	2623	100.956			
			2053	98.903	
	3158	102.061			
			4903	97.158	
	4472	101.730			
B.M. 67-B			3780	97.950	B.M. 67-B Cut Spk. in Walk, under US EM 2689. See Below, for more detail
	4177	102.127			
U.S. 2689			1437	100.640	U.S. 2689 - U 98 At Norwalk, L.A. County at the N.E. Corner of First & Broadway in the W. face of the Norwalk Commercial and Savings Bank bldg and at the S.W. Corner a standard disk, stamped "U 98 1932" and set vertically 1932 Adj = 100.761 1934 " = 100.630
	1481	102.121			
			4171	97.950	
	3826	101.776			
			5097	96.679	
	4713	101.392			
			4972	96.420	
	4528	100.948			
			4520	96.428	

Form 307 5M 11-35

PLEASE RETURN TO
LOS ANGELES COUNTY SURVEYOR
700 HALL OF RECORDS

NOTE: ANY ADDITIONS OR CHANGES ON THIS SHEET MUST BE MADE OR CIRCLED IN RED INK, WITH DATE AND NAME OF PERSON MAKING CHANGE

Do not extend notes this side of this line

F. B. 686 Pg. 210 | Job No. 8179 Division No. | Notes Red. | Plotted | Profile
Survey of LITTLE LAKE SCHOOL | Date | Date | No.
Survey by T. M. WALSH Notes WALSH | Notes Chkd. | Checked | X-Sec.
Indexed A. C. Johnson Date MAR. 5. 1937 | Date | Date | No.

STATION	B. S.	H. I.	F. S.	ELEV.	
				96 428	
	5058	101 486	4708	96 778	
	4313	101 071	4713	96 358	
	4870	101 238	4375	96 863	
	5280	102 093	4073	99 020	
	5470	103 190	1995	101 455	
	1863	103 358	3867	99491	
	5078	104 569	4200	100 369	
	5494	105 863	3902	101 961	
	5273	107 234	3590	103 644	
T.B.M. No 1	5668	109 312	3226	106086	T.B.M. No 1 Pioneer Blvd & Imperial Hiwy. N.W. Corner. Set Cut Spk. in P.P. #3346 T.L. Pole is 75± North of ℄ Imperial.
	2820	108 906	1972	106 934	
	2679	109 612	4052	105 560	
	5265	110 825	4507	106 318	
	5190	111 508	4108	107 400	
	4878	112 278	4405	107 873	
	5130	113 003	4658	108 345	
	5203	113 548	3744	109 808	
	5510	115 318	3945	111 373	
	5115	116 815	4090	112 725	
	5220	117 948	3985	113 963	

Form 307 5M 11-35

PLEASE RETURN TO
LOS ANGELES COUNTY SURVEYOR
700 HALL OF RECORDS

NOTE: ANY ADDITIONS OR CHANGES ON THIS SHEET MUST BE MADE OR CIRCLED IN RED INK, WITH DATE AND NAME OF PERSON MAKING CHANGE

Do not extend notes this side of this line

Profile No. ____ X-Sec. No. ____

Notes Red. 4-2-37 Plotted ____ Job No. 8179 Division No. ____

Date ____ Date ____ Survey of LITTLE LAKE SCHOOL

Notes Chkd. ____ Checked ____ Survey by JOE WILLSON Notes WILLSON Date MAR. 5 37

Date ____ Date ____ Map No. ____ Indexed A. C. John Bacon

F.B. 686 PG. 2M

STATION	B. S.	H. I.	F. S.	ELEV.		
				113 963		
	5638	119 601	4454	115 147		
	5040	120 187	4140	115 747		
	5153	120 900	2115	118 755		
	2505	121 355	4017	117 238		
	4982	122220	4573	117 647		
T.B.M. N°2	4637	122284	2362	119 922	T.B.M. N°2	Pioneer Blvd. & Lakeland Rd. N.E. Corner. Cut spk. in East side of P. Pole #2268 1E
	3330	123 272	3540	119 742		
	4478	124 190	6690	117 500		
	4995	122495	2967	119 528		
T.B.M. N°3	5946	125 474	0510	124 964	T.B.M. N°3	Lakeland Rd. 35' So. & 40' W. of S. W. Cor of Cemetery C.S.W.&T. in top of 24" Stump.
	1038	126 002	433.5	121 667		
	5655	127 332	4080	122 252		
T.P.	5295	128 540	2358	126 182	T.P.	N.E. Cor. of Cemetery Cut spk. in E. side P. Pole # 476380E
	3517	129 699				
			3495	126 204		
	5502	131 706				
BM #1			3406	128 300	BM #1.	Little Lake School. N.E. Corner. In Front of Class Room Building. set a boot spk in curb 1' West of West side of Walk.

Form 307 5M 11-35

PLEASE RETURN TO
LOS ANGELES COUNTY SURVEYOR
700 HALL OF RECORDS

NOTE: ANY ADDITIONS OR CHANGES ON THIS SHEET MUST BE MADE OR CIRCLED IN RED INK, WITH DATE AND NAME OF PERSON MAKING CHANGE

Do not extend notes this side of this line

F. B. 686 Pg. 212 | Job No. 8172 Division No. | Notes Red. | Plotted | Profile No.
Survey of LITTLE LAKE SCHOOL | Date | Date | X-Sec. No.
Survey by TED WALSH Notes WAYNE ST. | Notes Clkd. | Checked
Indexed Date MAR. 8 1937 Date | Date

STATION	B. S.	H. I.	F. S.	ELEV.	Return
				128 309	
T.P.	4816	133116	0 478	132 638	T.P. Top of Fence Post Front of
	0360	132 998			Auditorium Bldg First Post West of Walk
			5059	127 939	
	3205	131 170	5152	125 918	
	4278	130 196	3664	126 892	1x2 stk
T.P.	3048	129 880	3399	126 832	T.P. Cut spike in Fence post S.E. Cor. of
	1520	128 207			school Property.
T.B.M.#1			1035	126 972	T.B.M. No. 1. Lakeland Rd. So. side
	2172	129 144			60' E. of East Fence line of Little
			4200	124 944	Lake School produced.
	5115	130 059	3537	126 522	
	5003	131 525	5393	126 132	
	3857	129 989	5610	124 379	
	3923	128 302	5880	122 422	
	3854	126 276	5957	120 319	
	3673	123 991	6102	117 890	
	3615	121 509	5990	115 515	
	3885	119 103	5640	113 763	
	4315	118 081	5305	112 776	
	3996	116 772	5203	111 569	

Form 307 5M 11-35

PLEASE RETURN TO
LOS ANGELES COUNTY SURVEYOR
700 HALL OF RECORDS

NOTE: ANY ADDITIONS OR CHANGES ON THIS SHEET MUST BE MADE OR CIRCLED IN RED INK, WITH DATE AND NAME OF PERSON MAKING CHANGE

Do not extend notes this side of this line

STATION	B. S.	H. I.	F. S.	ELEV.		
				111 569		
	1573	116 142	5782	110 360		
	3 999	111 353	5 250	109 103		
	5 128	113 226	5218	108 008		
	3915	111 923	5108	106 815		
	4014	110 663	5213	105 590		
BM #1	1305	109 798	2514	107 251	BM No 1. Norwalk & Imperial Highway	
	2 190	109 411			N.W Corner, L&T. in Concrete	
			5720	103 721	Headwall of Culvert Marked B.M.	
	4157	107 878	4820	103058		
	4180	107 238	4937	102 301		
	4178	106 479	5172	101 307		
	4344	105651	4909	100 743		
	3772	104515	5160	99 355		
	3695	103 050	5247	97 803		
	4638	102 441	5676	96 765		
U.S 2689	4693	101 458	0816	100 642	U.S. BM # 2689 U98	see page 209

Profile

No. _____ Notes Red. KLM Plotted _____ Job No. 8172 Division No. _____

X-Sec. _____ Date 3-11-37 Date _____ Survey of LITTLE LAKE SCHOOL

No. _____ Notes Chkd. _____ Checked _____ Survey by TRAUT Notes KLM Date MAR 8 1937

Date _____ Date _____ Map No. _____ Indexed _____

F.B. 686 PG. 213

F. B. 686 PG. 214 | Job No. | Division No. | Notes Red. | Plotted | Profile

Survey of | Date | Date | No.

Survey by | Notes | Notes Chkd. | Checked | X-Sec.

Indexed A. C. Johnson | Date | Date | Date | No.

STATION	B. S.	H. I.	F. S.	ELEV.

Form 307 5M 11-35

PLEASE RETURN TO
LOS ANGELES COUNTY SURVEYOR
700 HALL OF RECORDS

Do not extend notes this side of this line

NOTE: ANY ADDITIONS OR CHANGES ON THIS SHEET MUST BE MADE OR CIRCLED IN RED INK, WITH DATE AND NAME OF PERSON MAKING CHANGE

Notes Ck'd by D. M. Finley	Survey of LITTLE LAKE CEM.	F.B. 684	Pg. 215
Map No.	W. O. 8173 Tape No. St'd °F.		
Office Work	Surveyed by W.A.Mike		
Checked	Notes Mike Date 9-30-1937		
Date	Indexed A. C. Johnson 10-13-37		

LITTLE LAKE CEMETERY
JN 8173

TRIANGULATION STA. EAST SIDE
LITTLE LAKE SCHOOL DISTRICT PROP.

Mike Little Lake Survey Book

Note: Any Additions or Changes on This Sheet Must be Made or Circled in Red Ink With Date and Name of Person Making Change

Do not extend notes this side of this line

RETURN TO
LOS ANGELES COUNTY SURVEYOR
700 HALL OF RECORDS

FORM 247 10M 11-36

F.B. 686 Pg. 216

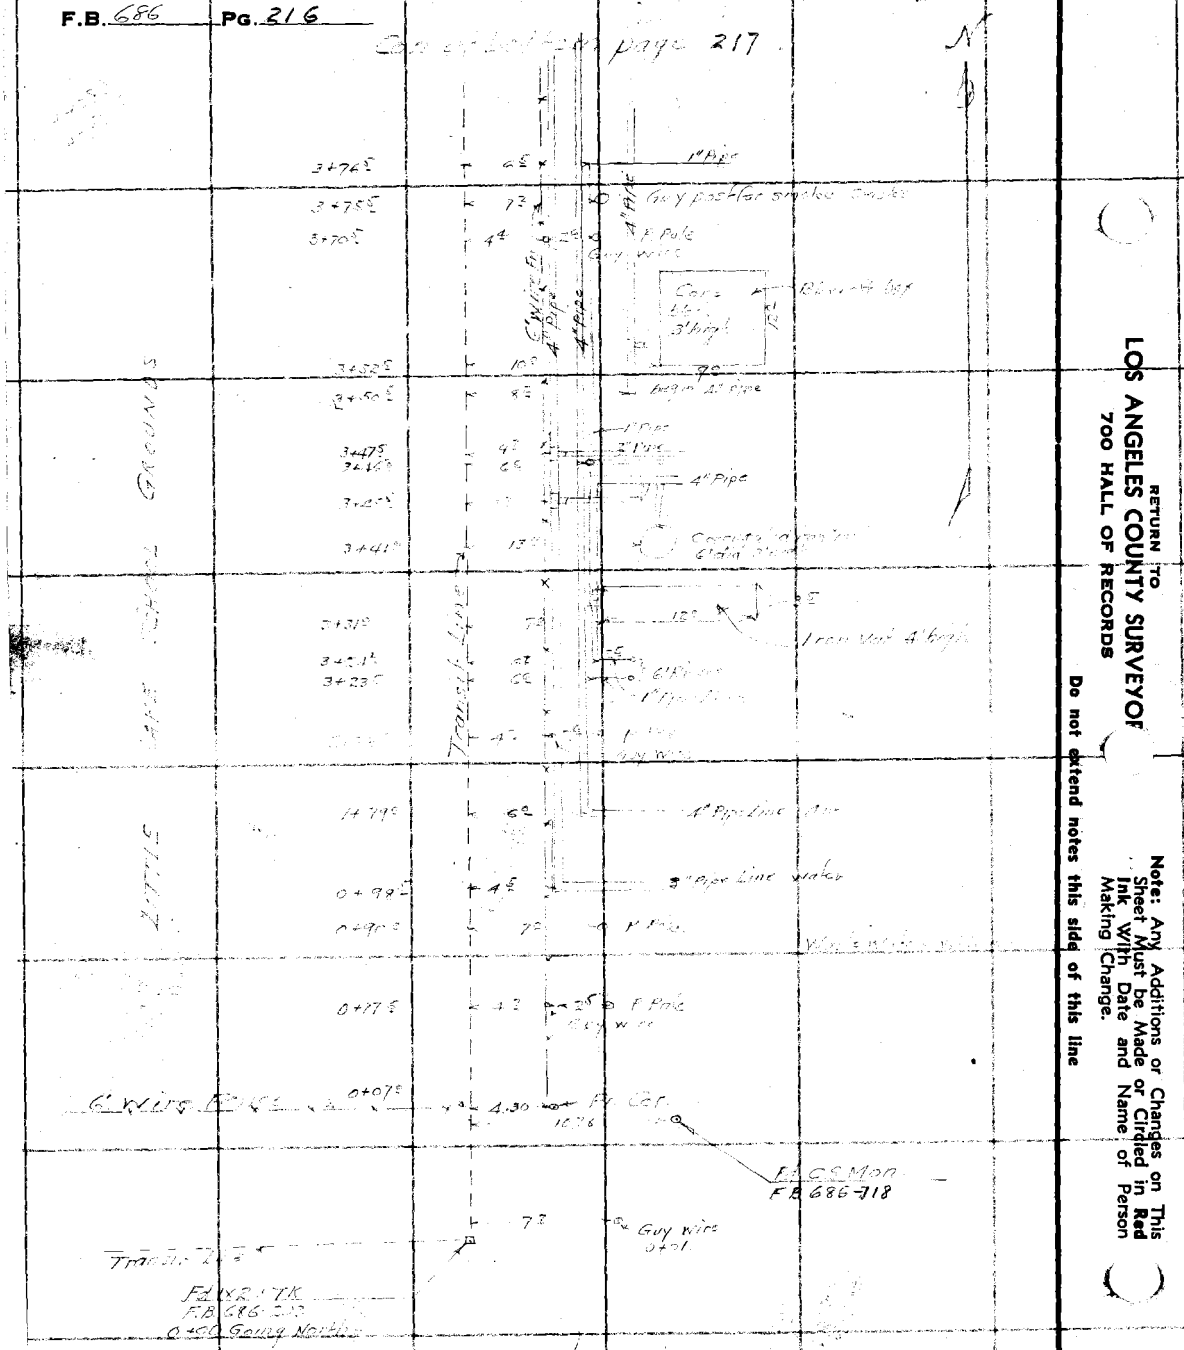

RETURN TO
LOS ANGELES COUNTY SURVEYOR
700 HALL OF RECORDS

Note: Any Additions or Changes on This Sheet Must be Made or Circled in Red Ink With Date and Name of Person Making Change.

Do not extend notes this side of this line

Notes Ck'd by D. M. Finley	Survey of LITTLE LAKE CEM.	F.B. 686	Pg. 217
Map No.	W. O. 8173 Tape No.	St'd	°F.
Office Work	Surveyed by W.A. Miller		
Checked	Notes Miller	Date 9-30-1937	
Date	Indexed A. C. Johnson		

Con at bottom page 218

7+43 — 6 — P. Pole
7+40 — 6 — Guy Post for Smoke stacks

High wire Fn — 3 — 7+36 Fn Cor — P Pole

Tennis Courts.

6+38 — 6 — P Pole

6+01 — 6 — Guy Post for smoke stacks

High wire Fn — 3 — 5+93 Fn Cor

5+75 — 6 — Guy post for Smoke Stacks

5+61 — 6 — Guy wire

5+49 — 7 — Guy Post for Smoke Stacks

5+43 — 4 — 2" Pipe
5+42 — 4" Pipe

5+38 — 4 — P Pole

Guy Wire — Transit Line — 6' Wire Fence

LITTLE LAKE SCHOOL GROUNDS

5+25 — 6 — Cone block 30" high — Blowoff Box
5+18 — 10 — Guy Wire
5+13 — 4 — 4" Pipe

5+11 — 4 — 2" Pipe

5+05 — 7 — Guy post for Smoke Stacks
5+02 — 5 — 4" Pipe

4+54 — 6 — P Pole

4+24 — 7 — Guy post for Smoke stacks

Con from top page 216

RETURN TO
LOS ANGELES COUNTY SURVEYOR
700 HALL OF RECORDS

Note: ANY ADDITIONS OR CHANGES ON THIS SHEET MUST BE MADE OR CIRCLED IN Red Ink. WITH DATE AND NAME OF PERSON MAKING CHANGE.

Do not extend notes this side of this line

FORM 247 10M 5-31

F.B. 686 Pg. 218

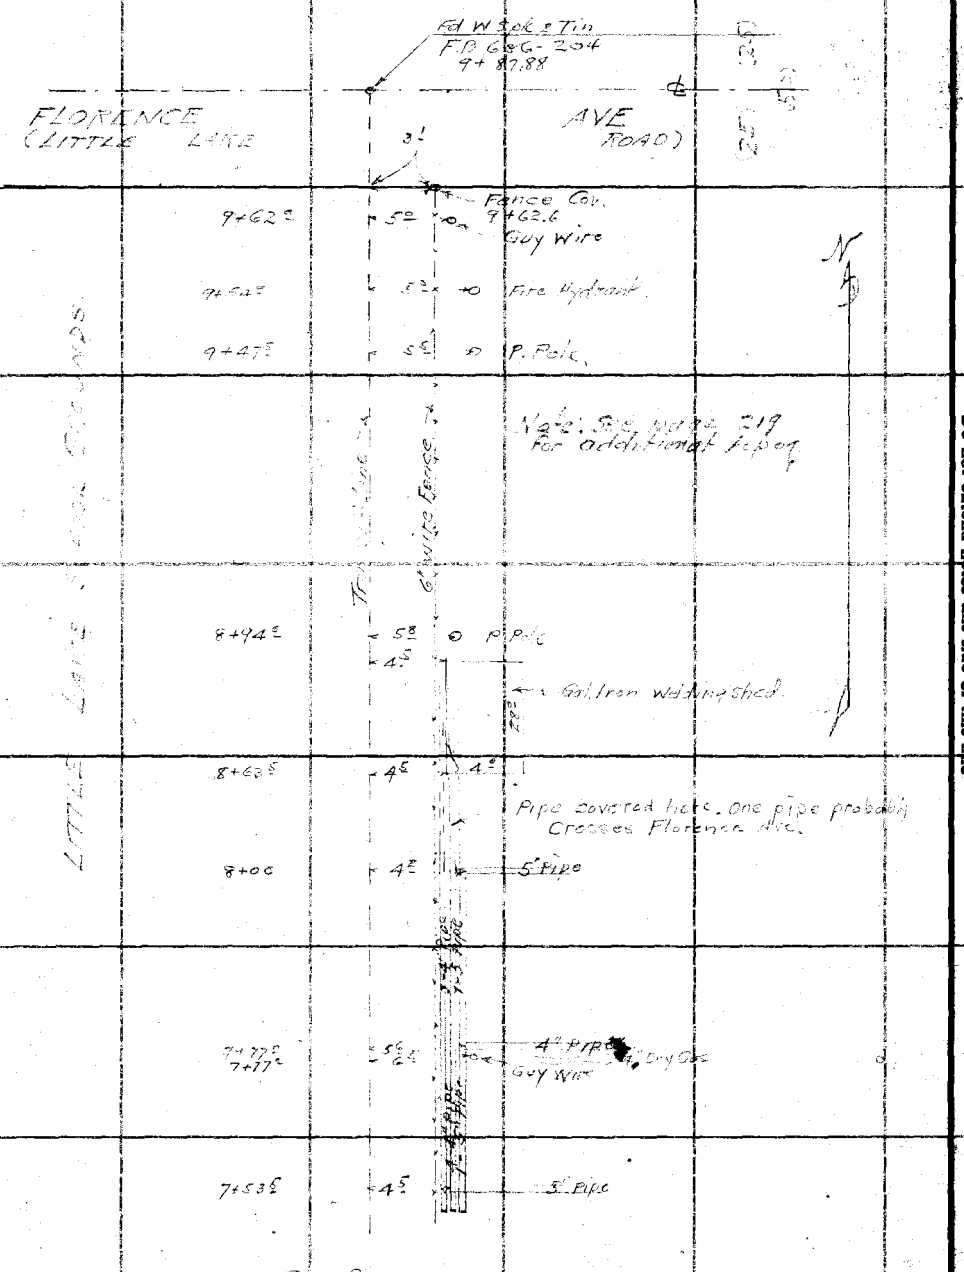

RETURN TO
LOS ANGELES COUNTY SURVEYOR
700 HALL OF RECORDS
Do not extend notes this side of this line

Note: ANY ADDITIONS OR CHANGES ON THIS SHEET MUST BE MADE OR CIRCLED IN Red Ink. WITH DATE AND NAME OF PERSON MAKING CHANGE.

Notes Ck'd by D. M. Finley		Survey of LITTLE LAKE SCHOOL	
Map No. B-1308-1		W. O. 8179 Tape No.	St'd °F.
Office Work WOOD		Surveyed by W.A.Miller	
Checked D. M. Finley		Notes Miller Date 12-3-37	
Date JUNE 1938		Indexed A. C. Johnson 1-4-38	

F.B. 686 PG. 219

Note: ANY ADDITIONS OR CHANGES ON THIS SHEET MUST BE MADE OR CIRCLED IN Red Ink. WITH DATE AND NAME OF PERSON MAKING CHANGE.

Do not extend notes this side of this line

RETURN TO
LOS ANGELES COUNTY SURVEYOR
700 HALL OF RECORDS

FORM 647 10M 8-31

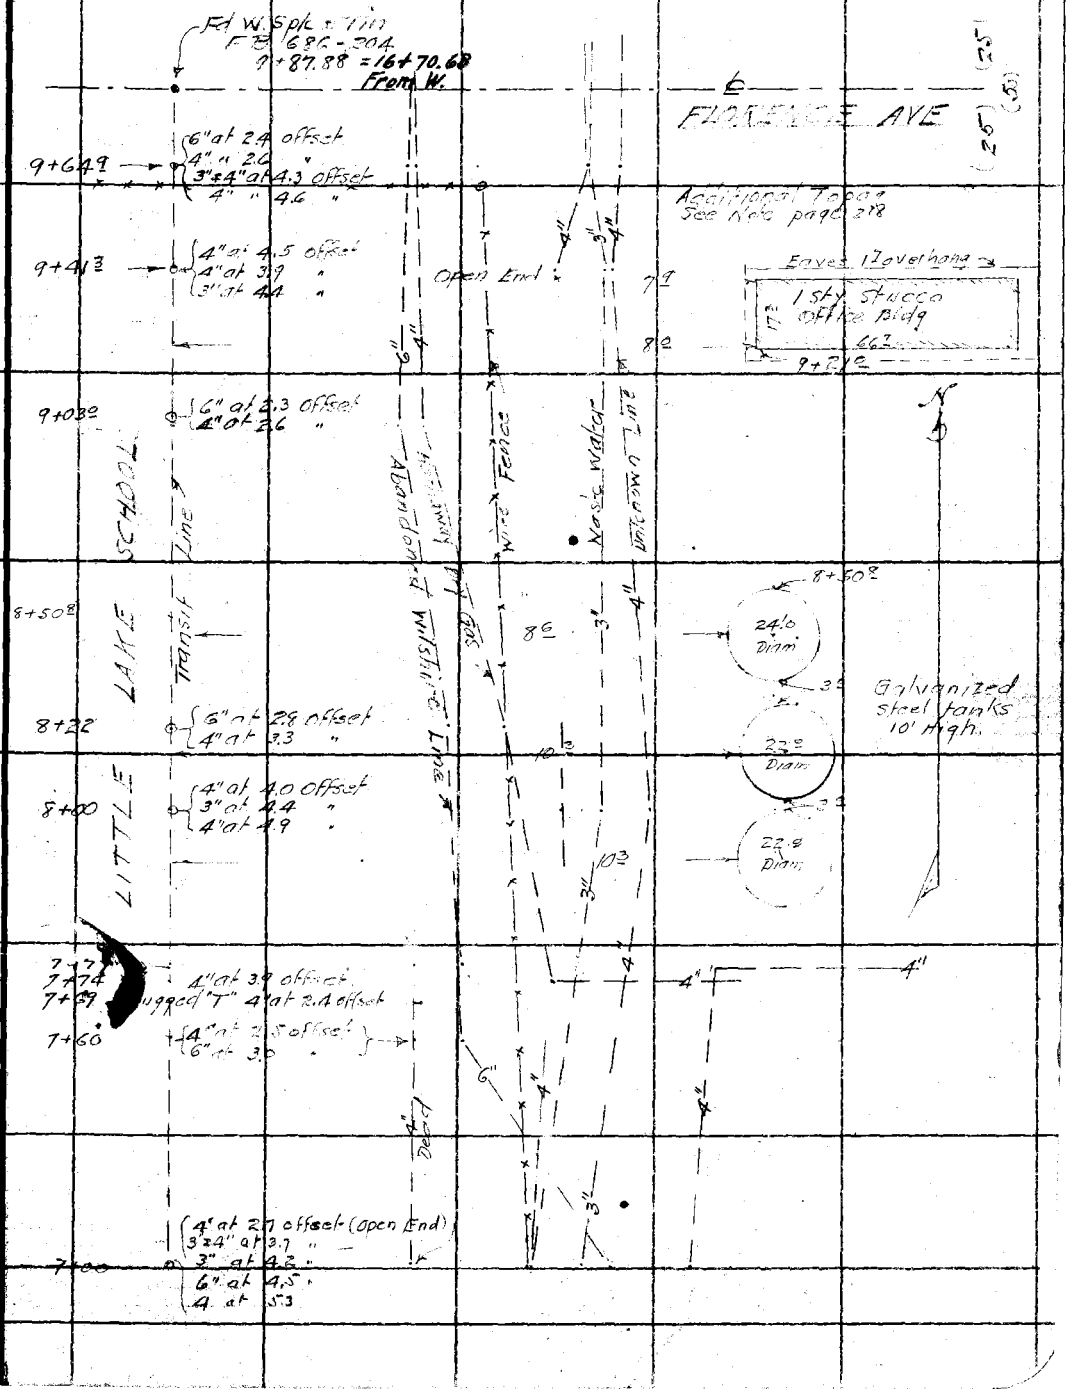

Return to
LOS ANGELES COUNTY SURVEYOR
320 HALL OF RECORDS

Note: ANY ADDITIONS OR CHANGES ON THIS SHEET MUST BE MADE OR CIRCLED IN Red INK WITH DATE AND NAME OF PERSON MAKING CHANGE.

Do not extend lettering into this area

686

F.B. _____ P.G. _____