Notes Ck'd by
Office Work

Survey of
W. O. Tape No. St'd. °F
Surveyed by
Notes Date
Indexed

F. B. Pg.

LOS ANGELES COUNTY ENGINEER

Corrections or Additions to This Survey Should Be Noted in Red and Signed by the Person Making Them

1969

2-8995 247 10M 1-69

RETURN TO
LOS ANGELES COUNTY SURVEYOR
725 LOS ANGELES COUNTY
ENGINEERING BLDG.

Note: Any Additions or Changes on This Sheet Must be Made or Circled in Red Ink With Date and Name of Person Making Change.

Do not extend notes this side of this line.

F. B. _____ Pg. _____

FORM 247 10M 11-35

RETURN TO
LOS ANGELES COUNTY SURVEYOR
700 HALL OF RECORDS

Note: Any Additions or Changes on This Sheet Must be Made or Circled in Red Ink With Date and Name of Person Making Change.

Do not extend notes this side of this line

INDEX TO FIELD BOOK NO. 697

Date	J.N.	Location	Notes	Pages
March 1937	6318	LAUREL CANYON BLVD STUB. (4) Sunset Blvd. from Crescent Hts to Laurel Canyon Bvd.	℄ ties topog	145-148 149-152
	ABANDONED	Laurel Canyon Blvd. from Sunset Blvd. N'ly 200'±	Prof	153-156
"	"	SELMA AVE LATERAL (4) from Crescent Hghts Blvd. and Sunset Blvd. to ~~Monteel~~ Rd.	℄ ties topog prof	157-160 161-164 165-170
"	"	HAYVENHURST DR. ~~LATERAL~~ BRANCH (4) from Fountain Ave to Sunset Blgd.	℄ ties topog prof	171-174 175-178 179-184
	ABANDONED			
June '37	"	HAYVENHURST DR. BRANCH (4) on Subset Blvd. from Hayvenhurst Dr to Selma Ave. on Selma Ave from Sunset Blvd. to Laurel CanyonOBlvd.	C/L ties topog prof	185-192 193-198 199-208
"	"	FOUNTAIN AVE. LATERAL (4) from Hayvenhurst Ave. to Laurel Ave.	C/L ties topog prof.	~~209-214~~ 211 216 " " ~~215-220~~ 217 221

Notes Ck'd by
Map No.
Office Work
Checked
Date

Survey of
W. O. Tape No. St'd F.
Surveyed by
Notes Date
Indexed J. C. Johnson

F.B.

PG.

INDEX TO FIELD BOOK NO.

F B. _____ PG. _____

Date	J.N.	Location	Notes	Pages

RETURN TO
LOS ANGELES COUNTY SURVEYOR
700 HALL OF RECORDS

Note: Any Additions or Changes on This Sheet Must be Made or Circled in Red Ink With Date and Name of Person Making Change.

Do not extend notes this side of this line

Notes Ck'd by	Survey of	F.B. Pg.
Map No.	W. O. Tape No. St'd °F.	
Office Work	Surveyed by	
Checked	Notes Date	
Date	Indexed C. Johnson	

Sheet (3)

Willoughby - Orlando Ave Lateral

Pages. 1-30

Melrose - Orlando Ave Lateral

pages 31- 54

Rosewood - Croft Ave Lateral

pages 55- 76

Beverly - Orlando Ave Lateral

Pages 77-94

Kings Road Stub

Pages 95-108

Sweetzer Ave Branch.

Pages 109-132

DeLongpre Ave Stub

pages 133-144

Note: Any Additions or Changes on This Sheet Must be Made or Circled in Red Ink With Date and Name of Person Making Change.

Do not extend notes this side of this line

RETURN TO LOS ANGELES COUNTY SURVEYOR 700 HALL OF RECORDS

FORM 247 10M 11-35

RETURN TO
LOS ANGELES COUNTY SURVEYOR
700 HALL OF RECORDS

Note: Any Additions or Changes on This Sheet Must be Made or Circled in **Red Ink** With Date and Name of Person Making Change.

Do not extend notes this side of this line

F.B. _____ PG. _____

[redacted]

FORM 247 10M 11-35

RETURN TO
OS ANGELES COUNTY SURVEYOR
700 HALL OF RECORDS

Note: Any Additions or Changes on This Sheet Must be Made or Circled in Red Ink With Date and Name of Person Making Change.

Do not extend ... this side of this line

INDEX TO FIELD BOOK NO 697

Design Surveys — WEST HOLLYWOOD DRAINAGE SYSTEM

Date	J.N.	Location	Notes	Pages
2-15-37	6318	LA CIENEGA BLVD. from Waring Ave to Santa Monica Blvd. (3)	℄ ties	2
	"	Alley E. of LaCienega Blvd. (3) from Waring Ave to Santa Monica Blvd.	"	3
	"	ALFRED ST from Melrose Ave to Santa Monica Blvd. (3)	"	4
	"	CROFT AVE. from Melrose Ave to Santa Monica Blvd. (3)	"	6
	"	ORLANDO AVE. from Waring Ave to Romaine Ave (3)	"	8
2-18-37	"	WILLOUGHBY-ORLANDO AVE LATERAL (3) on Willoughby Ave from La Cienega Blvd. to Orlando Ave.	" topog prof	2-11 13-18 19-30
2-23-37	"	MELROSE-ORLANDO AVE. LATERAL (3) on Melrose Ave from La Cienega Blvd to Orlando Ave.	℄ ties topog prof	31-36 37-42 43-54
3-1-37	"	ROSEWOOD-ORLANDO AV. LATERAL (3) on Rosewood Ave from La Cienega Blvd. to ~~Croft~~ ORLANDO Ave.	℄ ties topog prof	55-62 63-66A 67-76D

(Over)

Notes Ck'd by
Map No.
Office Work
Checked
Date - -

Survey of
W. O. Tape No. St'd °F.
Surveyed by
Notes Date
Indexed by C. Johnson

F.B. 697 Pg.

INDEX TO FIELD BOOK NO. 697

Date	J.N.	Location		Notes	Pages
3-4-37	6318	BEVERLY-ORLANDO LATERAL on Beverly Blvd. from Alfred St to Orlando Ave	(3)	℄ ties topog prof	77-80 81-86 87-94
3-8-37	"	KINGS RD STUB. on Delongpre Ave from Fountain Ave ~~Northerly 405'~~ & Easterly 580'	(3)	℄ ties topog prof	95-98 & 223-226 99-102 & 227-228 103-108 & 229-232
3-10-37	"	SWEETZER AVE BRANCH on Fountain Ave from Flores Ave to Sweetzer Ave on Sweetzer Ave from Fountain Ave to DeLongPre Ave	(3)	℄ ties topog Prof	109-114 115-120 121-132
3-17-37	"	DE LONGPRE AVE STUB. on DeLongpre Ave from Sweetzer Ave to Flores St.	(3)	℄ ties topog prof	133-136 137-140 141-144
7-27-38	6318	WEST HOLLYWOOD D.S. KINGS ROAD STUB		℄ SURVEY	223-226
7-27-38	"	" " " " " "		TOPOGRAPHY	227-228
7-27-38	"	" " " " " "		PROFILE	229-232

FB

Pg

Do not extend notes this side of this line

RETURN TO
LOS ANGELES COUNTY SURVEYOR
700 HALL OF RECORDS

Note: Any Additions or Changes on This Sheet Must be Made or Circled in Red Ink With Date and Name of Person Making Change.

Notes Ck'd by	Survey of Willoughby-Orlando Lat F.B. 627 Pg. 1
Map No.	W. 06318 Tape No. 25 St'd 54°F.
Office Work	Surveyed by Brumby
Checked	Notes " Date 2-15-37
Date	Indexed A. C. JOHNSON

CENTER LINE SURVEY

WEST HOLLYWOOD DRAINAGE SYSTEM

WILLOUGHBY — ORLANDO AVE LATERAL

JN. 6318

SHEET (3)

For Topography See Pgs. 13 to 15 Incl.
For Profile See Pgs. 19 to 30 Incl.

E. Brumby - Chief
H. L. Smith - Transit
J. L. Willey - Notes
N. A. Davidson - Tape

Note: Any Additions or Changes on This Sheet Must be Made or Circled in Red Ink With Date and Name of Person Making Change

Do not extend notes this side of this line

RETURN TO
LOS ANGELES COUNTY SURVEYOR
700 HALL OF RECORDS

RECEIVED MAR 10 1937

PROGRESSED ✓ ✓

BOOK INDEXED ✓ ✓

MAP INDEXED ✓ ✓

RECORD INDEXED ✓ ✓

CARD INDEXED ✓ ✓

FORM 247 10M 11-35

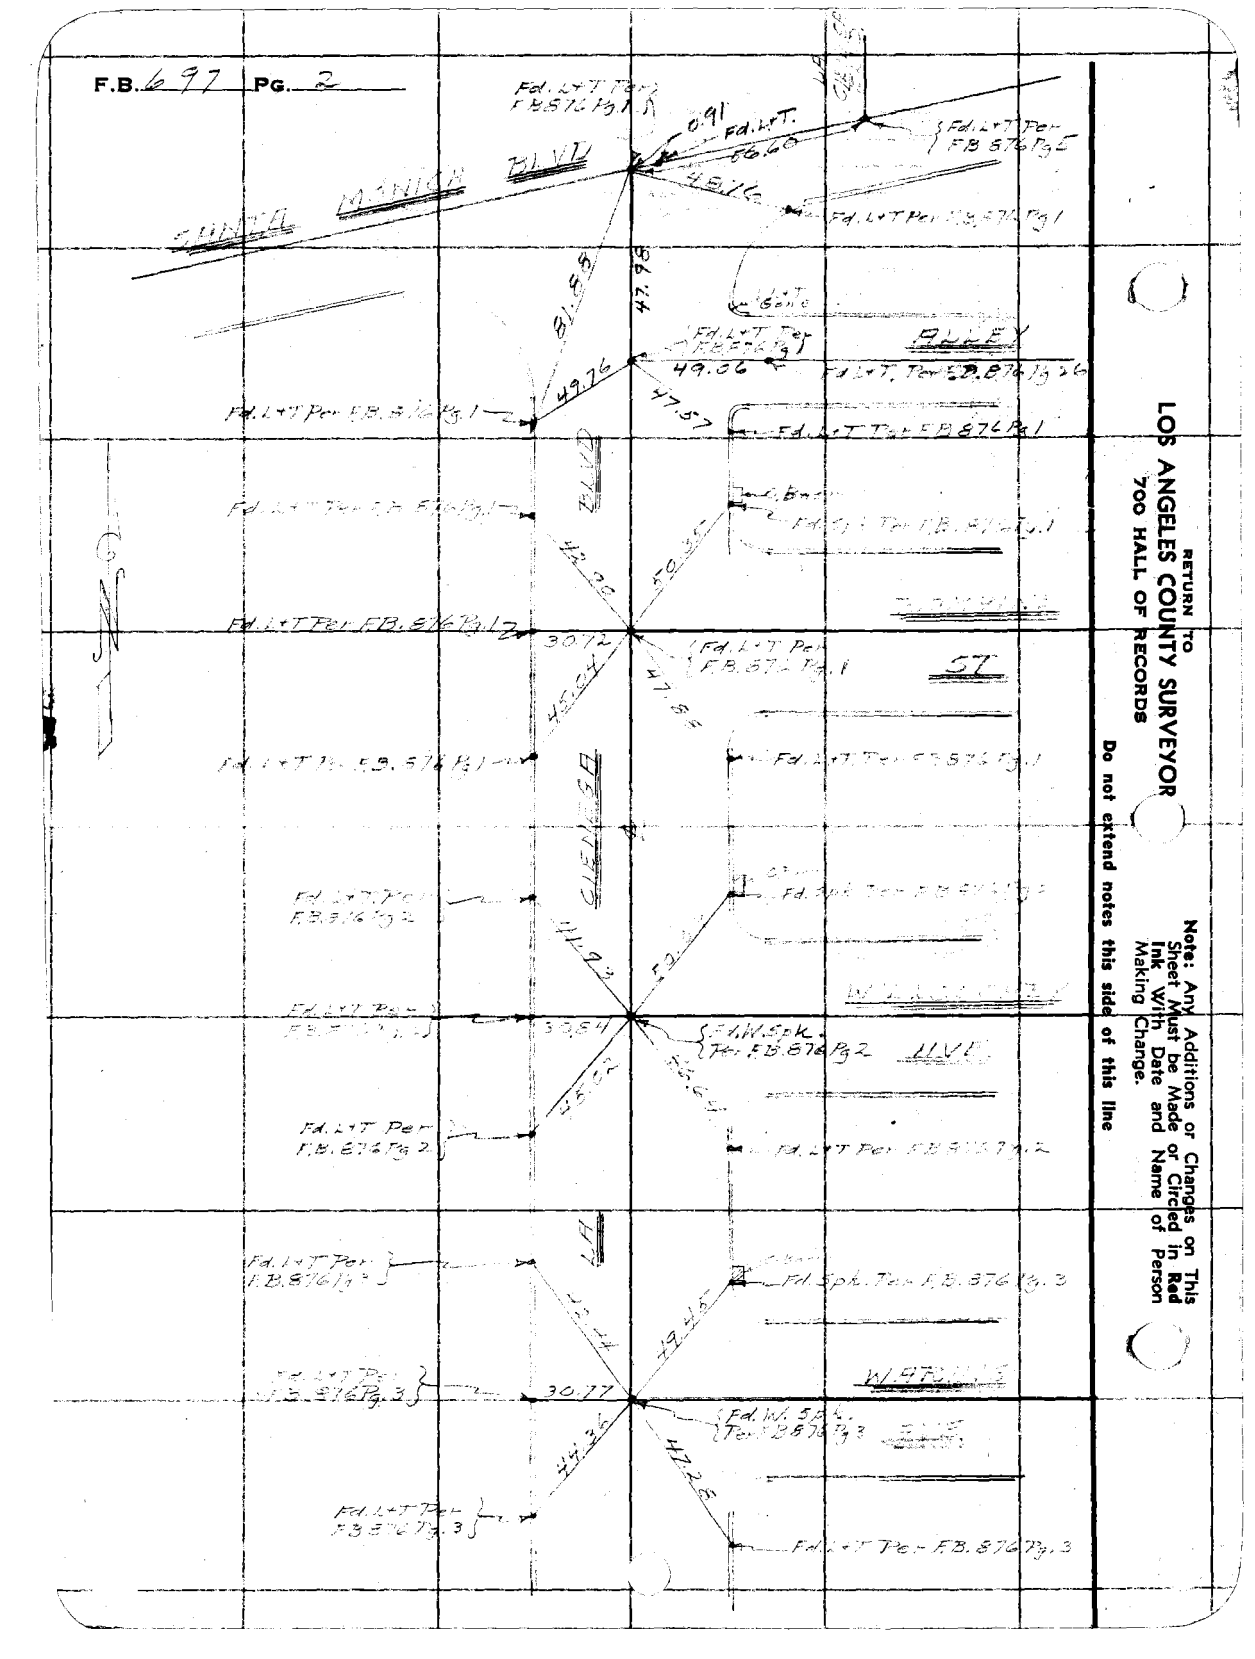
F.B. 697 PG. 2
Fd. L+T Per F.B. 876 Pg. 1
0.91
Fd. L+T.
66.60
Fd. L+T Per F.B. 876 Pg. 2
Fd. L+T Per F.B. 876 Pg. 1
MANICA
Fd. L+T Per F.B. 876 Pg. 1
49.76
49.06
47.57
Fd. L+T Per F.B. 876 Pg. 2
Fd. L+T Per F.B. 876 Pg. 1
Fd. L+T Per F.B. 876 Pg. 1
Fd. L+T Per F.B. 876 Pg. 2
30.72
Fd. L+T Per F.B. 876 Pg. 1
ST
Fd. L+T Per F.B. 876 Pg. 1
Fd. L+T Per F.B. 876 Pg. 1
Fd. L+T Per F.B. 876 Pg. 2
30.54
Fd. L+T Per F.B. 876 Pg. 2
Fd. L+T Per F.B. 876 Pg. 2
Fd. L+T Per F.B. 876 Pg. 3
30.77
Fd. L+T Per F.B. 876 Pg. 3
Fd. L+T Per F.B. 876 Pg. 3
Fd. L+T Per F.B. 876 Pg. 3
RETURN TO
LOS ANGELES COUNTY SURVEYOR
700 HALL OF RECORDS
Do not extend notes this side of this line
Note: Any Additions or Changes on This Sheet Must be Made or Circled in Red Ink With Date and Name of Person Making Change.

Notes Ck'd by
Map No.
Office Work
Checked
Date

Indexed C. Johnson

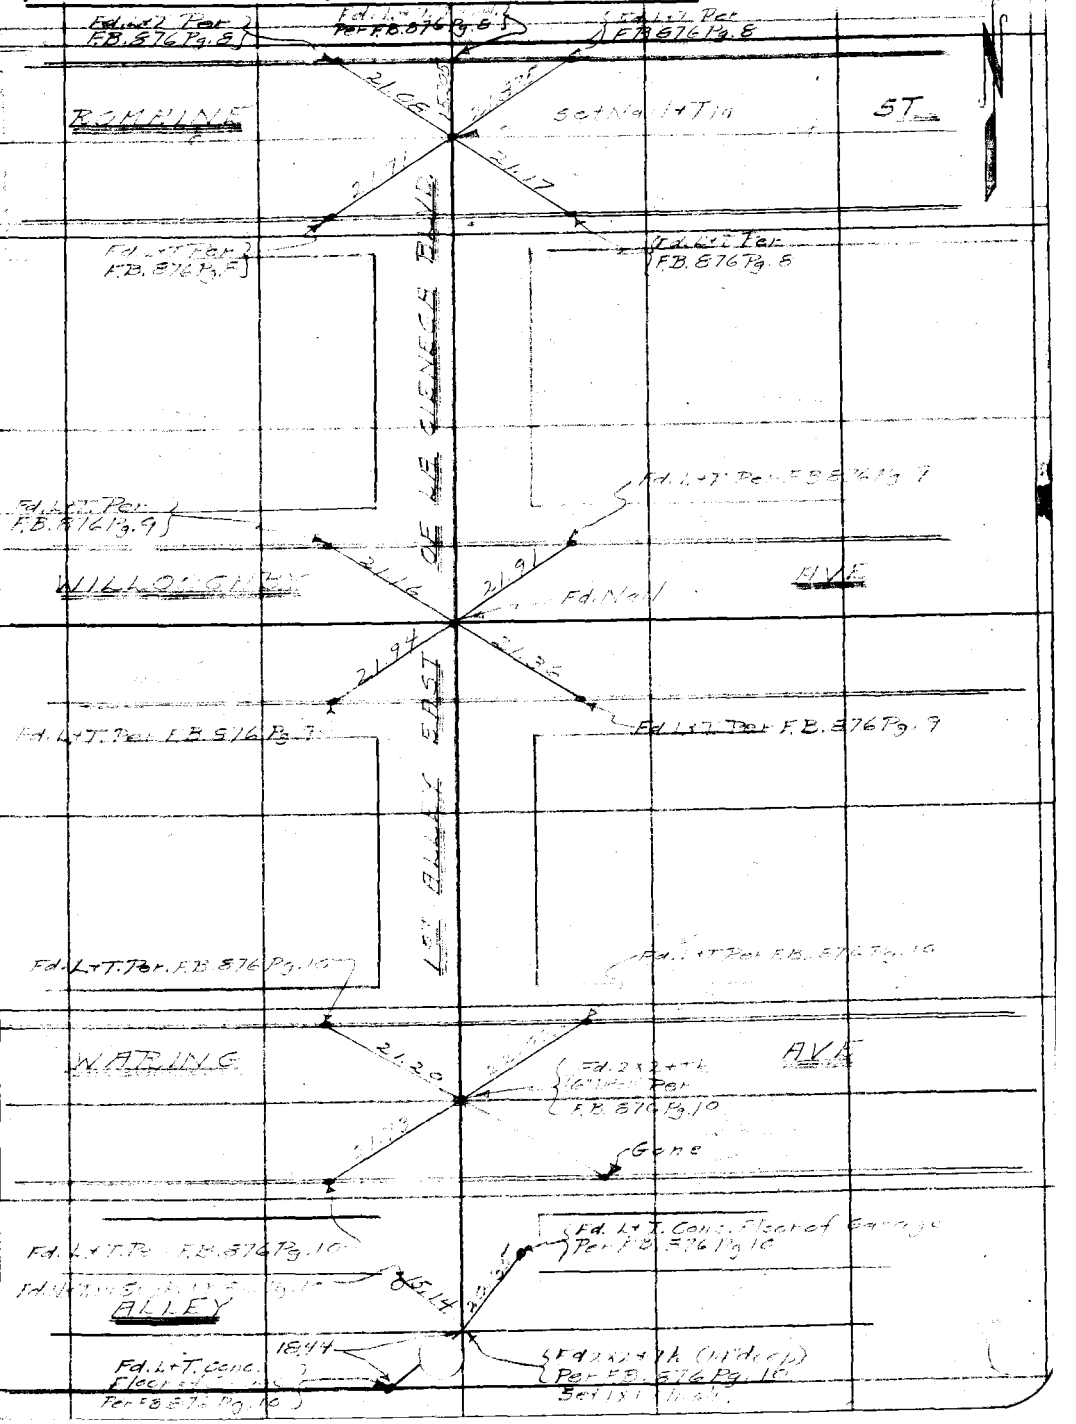

Note: Any Additions or Changes on This Sheet Must be Made or Circled in Red Ink With Date and Name of Person Making Change.

Do not extend notes this side of this line

RETURN TO
LOS ANGELES COUNTY SURVEYOR
700 HALL OF RECORDS

FORM 247 10M 11-35

F.B. 677 PG. 4

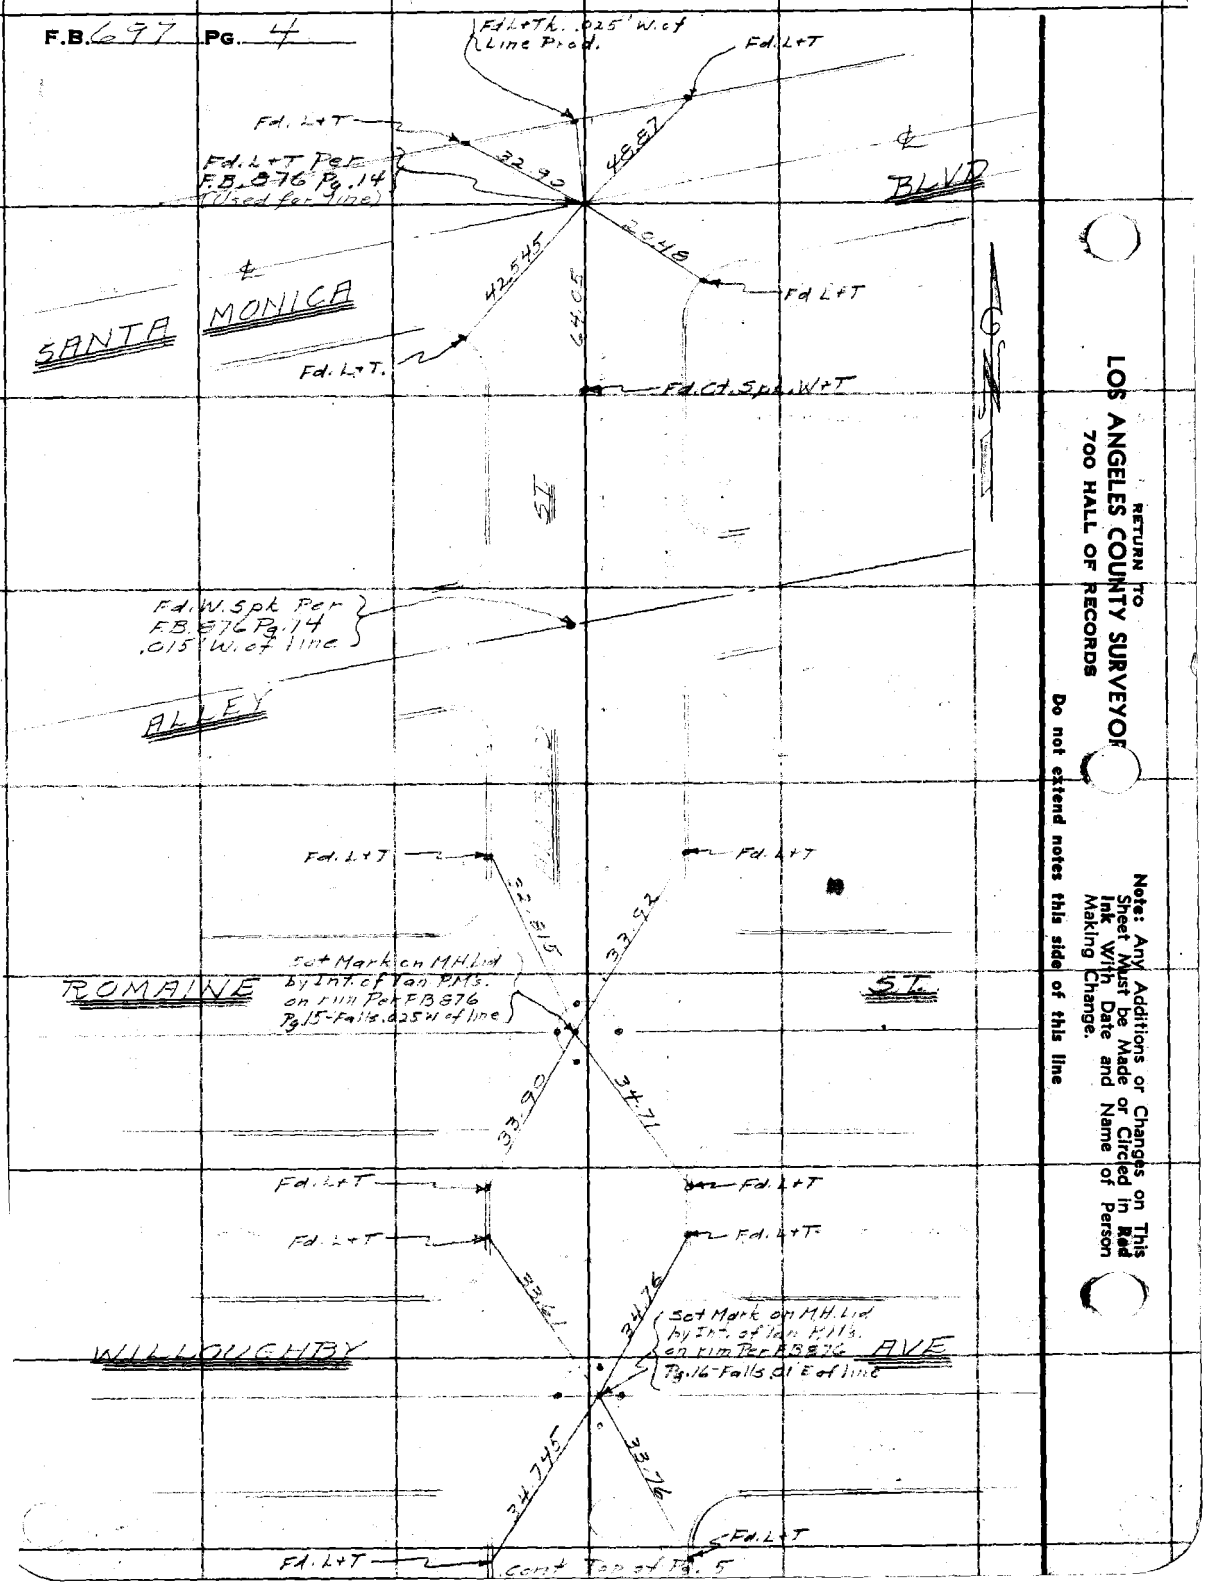

RETURN TO
LOS ANGELES COUNTY SURVEYOR
700 HALL OF RECORDS

Do not extend notes this side of this line

Note: Any Additions or Changes on This Sheet Must be Made or Circled in Red Ink With Date and Name of Person Making Change.

Notes Ck'd by	Survey of Willoughby Ave. to Lat.
Map No.	W. O. 6316 Tape No. 257 St'd 84° F.
Office Work	Surveyed by Brundy
Checked	Notes " Date 2-16-37
Date	Indexed E. Johnson

F.B. 697 PG. 5

From Bot of Pg. 4

WARING AVE

Fd. L+T — 33.47 — 34.27 — Fd. L+T

Set Mark on M.H. Lid by Int. of Tan. P.M's per F.B. 576 Pg. 17 Falls on line

Fd. L+T — 35.43 — 34.34 — Fd. L+T.

ALLEY

Fd. L+T. — 23.15 — 24.10 — Fd. L+T.

ALLEY

Fd. w/ Sph. Per F.B. 576 Pg. 12 Falls .03 Ea. of line

Fd. L+T. — 33.44 — 23.53 — Fd. L+T

Fd. L+T — 47.11 — 40.82 — Fd. L+T

Set Mark on M.H. Lid. by Int. of Tan. P.M's on Line Per F.B. 576 Pg. 18 Falls on line

MELROSE PLACE

40.93 — 24.29 — 40.68

Fd. L+T. — Fd. L+T on line Chd. (Used for line) — Fd. L+T

Note: Any Additions or Changes on This Sheet Must be Made or Circled in Red Ink With Date and Name of Person Making Change

'Do not extend notes this side of this line

RETURN TO
LOS ANGELES COUNTY SURVEYOR
700 HALL OF RECORDS

FORM 247 10M 11-36

F.B. 697 PG. 6

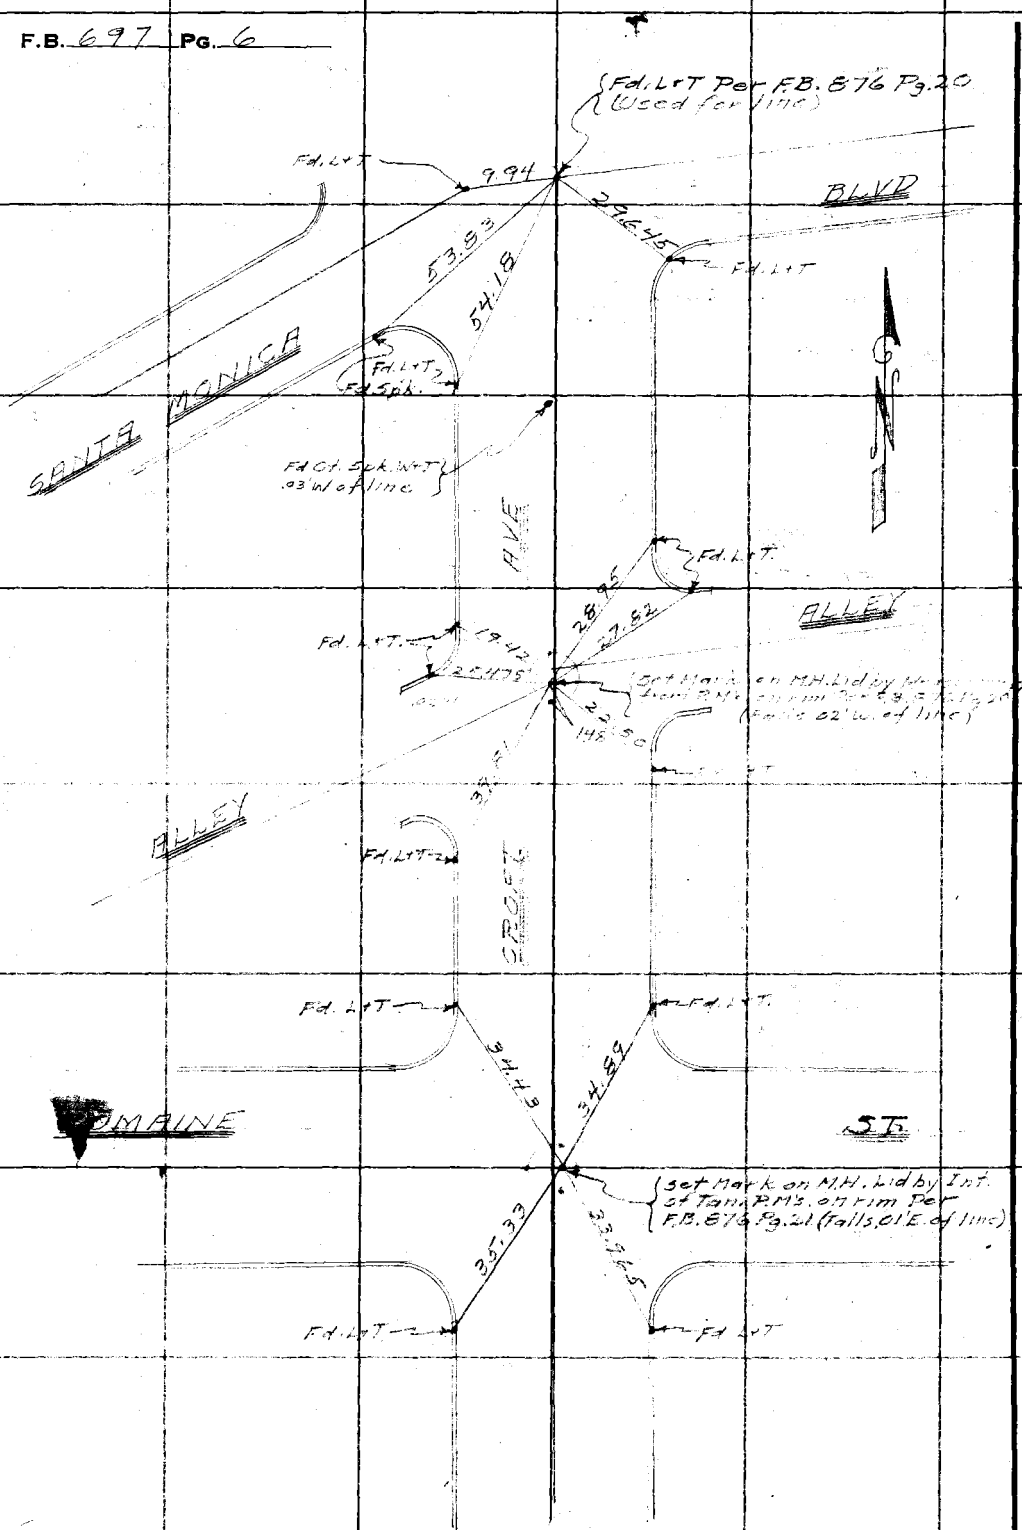

comt Top of Pg 7

RETURN TO
LOS ANGELES COUNTY SURVEYOR
700 HALL OF RECORDS

Note: Any Additions or Changes on This Sheet Must be Made or Circled in Red Ink With Date and Name of Person Making Change.

Do not extend notes this side of this line

Notes Ck'd by	Survey of King's Grade Ext.
Map No.	W. O. 6316 Tape No. 257 St'd 34°F.
Office Work	Surveyed by Bracely
Checked	Notes Date 2-17-37
Date	Indexed C. Johnson

F.B. 677 Pg. 7

From Bk. 67 Pg. 6

Note: Any Additions or Changes on This Sheet Must be Made or Circled in Red Ink With Date and Name of Person Making Change.

Do not extend notes this side of this line

RETURN TO
LOS ANGELES COUNTY SURVEYOR
700 HALL OF RECORDS

FORM 247 10M 11-35

WILLOUGHBY AVE

Fd. L+T. — Fd. L+T

33.17 — 34.92

{Set Mark on MH Lid by Int. of Tan P.M's. on r.i.m. Per F.B. 876 Pg. 22 (Falls on line)

34.55 — 34.35

Fd. L+T — Fd. L+T

Fd. L+T. — Fd. L+T

34.03 — 35.34

WARING AVE

{Set Mark on MH Lid by Int. of Tan P.M's. on r.i.m. Per F.B. 876 Pg. 23 (Falls on line)

34.59 — 35.44

Fd. L+T — Fd. L+T.

Fd. L+T — Fd. L+T

23.35 — 23.39

RILEY

18.31 — Fd. L+T

Fd. W. Spk. Per F.B. 876 Pg. 12 (Falls 0.1' E. of line)

23.35 — 23.55

Fd. L+T

Fd. L+T — Fd. L+T

39.74 — 39.88

{Set Mark on MH. Lid By Int. of Tan P.M's. on r.i.m. Per F.B. 876 Pg. 24 (Used for Tie)

MELROSE PLACE

40.28 — 24.32 — 37.03

Fd. L+T. — Fd L+T Prod. — Fd. L+T

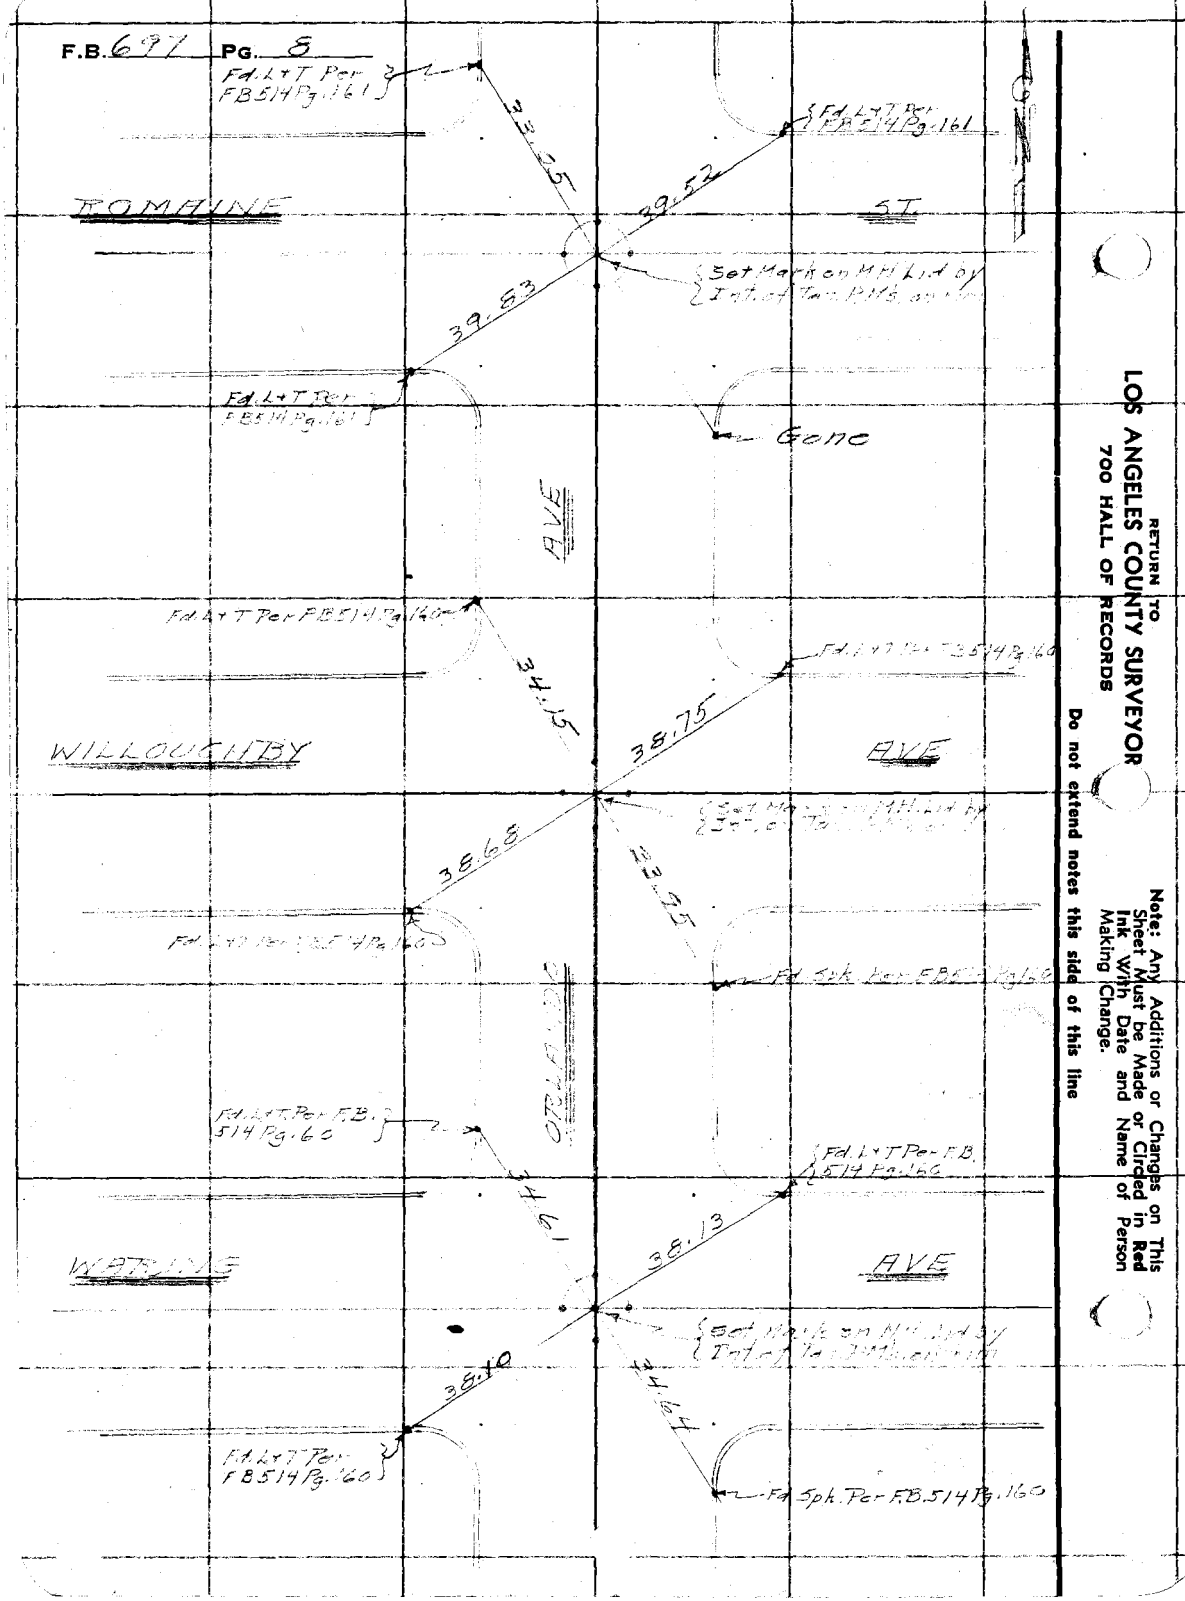

RETURN TO
LOS ANGELES COUNTY SURVEYOR
700 HALL OF RECORDS

Note: Any Additions or Changes on This Sheet Must be Made or Circled in Red Ink With Date and Name of Person Making Change.

Do not extend notes this side of this line

Notes Ck'd by	Survey of
Map No.	W. O.	Tape No.	St'd. °F.
Office Work	Surveyed by
Checked	Notes	Date
Date	Indexed C. Johnson

F.B. Pg.

Note: Any Additions or Changes on This Sheet Must be Made or Circled in Red Ink With Date and Name of Person Making Change.

Do not extend notes this side of this line

RETURN TO
LOS ANGELES COUNTY SURVEYOR
700 HALL OF RECORDS

KINGS

Mark on M.H. Lid Per Pg. 8 Used for line

CRESCENT

Line Per Pgs. 6 & 7

ALFRED

Line Per Pgs. 4 & 5

ALLEY

Line Per Pg. 3

Mark on M.H. Lid Per Pg. 7 (False ch's. of line)

Mark on M.H. Lid per Pg. 4 (on line)

Wire Spk. Per Pg. 2 (used for line)

30.54

Nail Found Per Pg. 1

FORM 247 10M 11-35

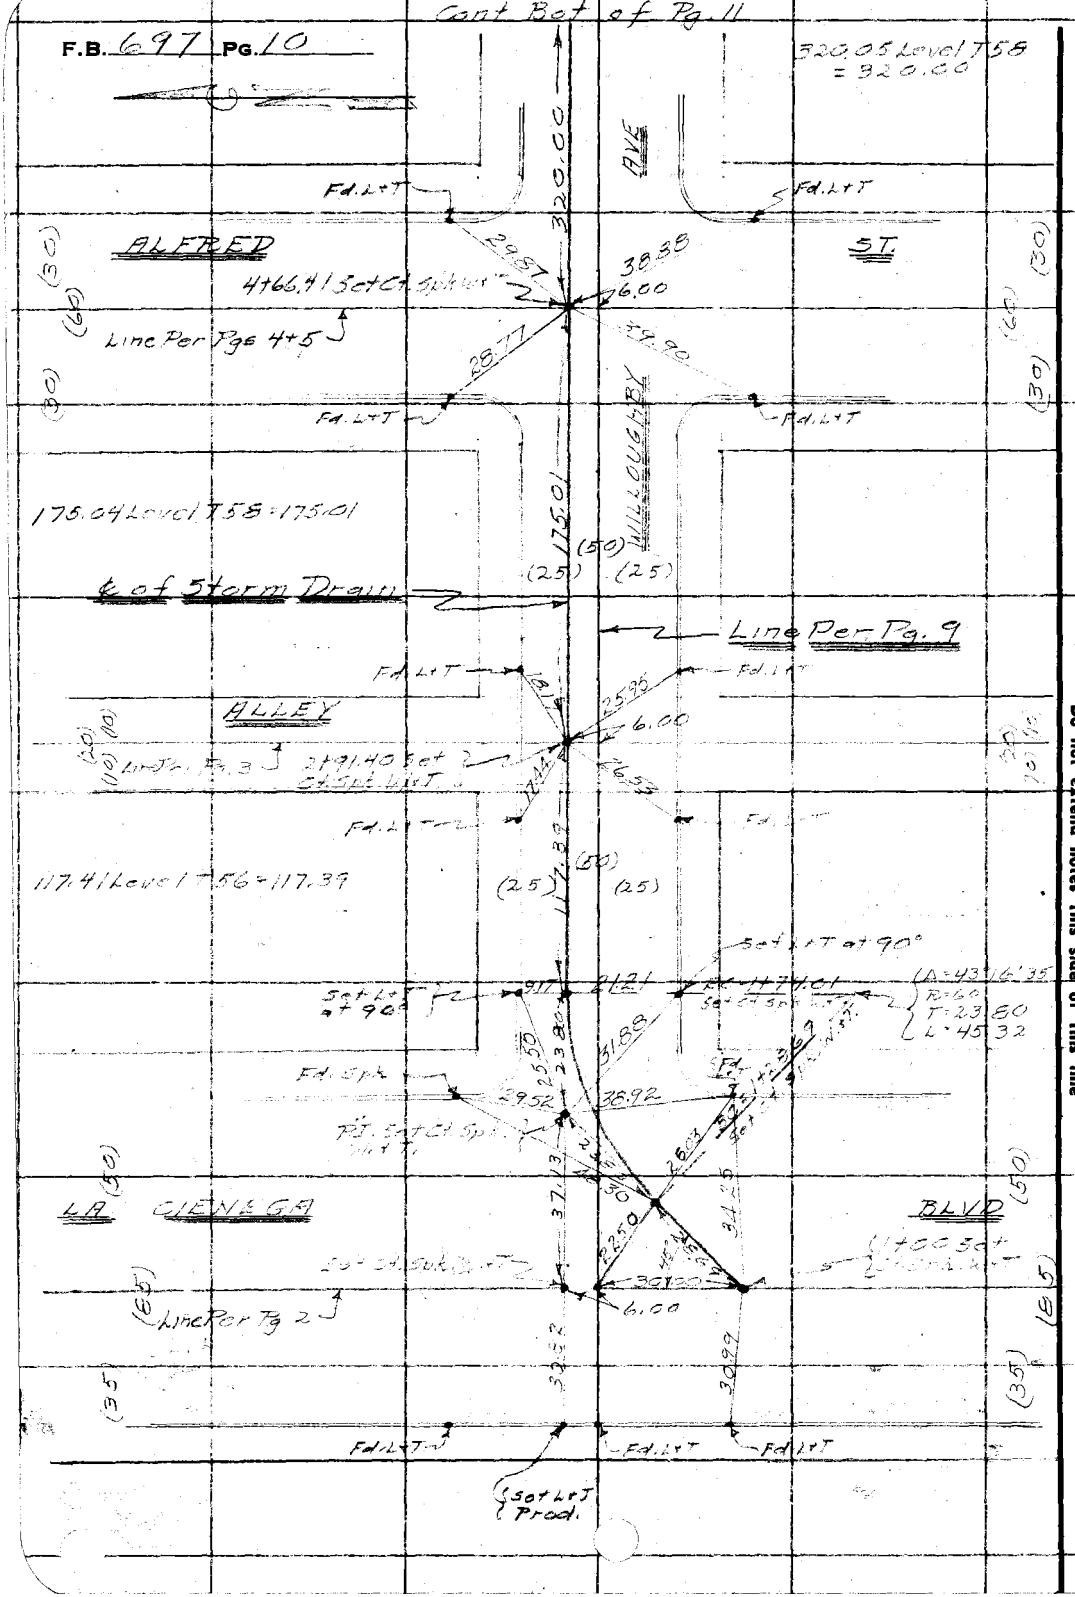

RETURN TO
LOS ANGELES COUNTY SURVEYOR
700 HALL OF RECORDS

Note: Any Additions or Changes on This Sheet Must be Made or Circled in Red Ink With Date and Name of Person Making Change.

Do not extend notes this side of this line

Notes Ck'd by	Survey of Willowbrook Ave. et al
Map No.	W. O. 6316 Tape No. 257 St'd 24° F.
Office Work	Surveyed by Brumby
Checked	Notes " Date 2-16-37
Date	Indexed C. Johnson

F.B. 57 Pg. 11

Note: Any Additions or Changes on This Sheet Must be Made or Circled in Red Ink With Date and Name of Person Making Change

Do not extend notes this side of this line

RETURN TO
LOS ANGELES COUNTY SURVEYOR
700 HALL OF RECORDS

FORM 247 10M 11-35

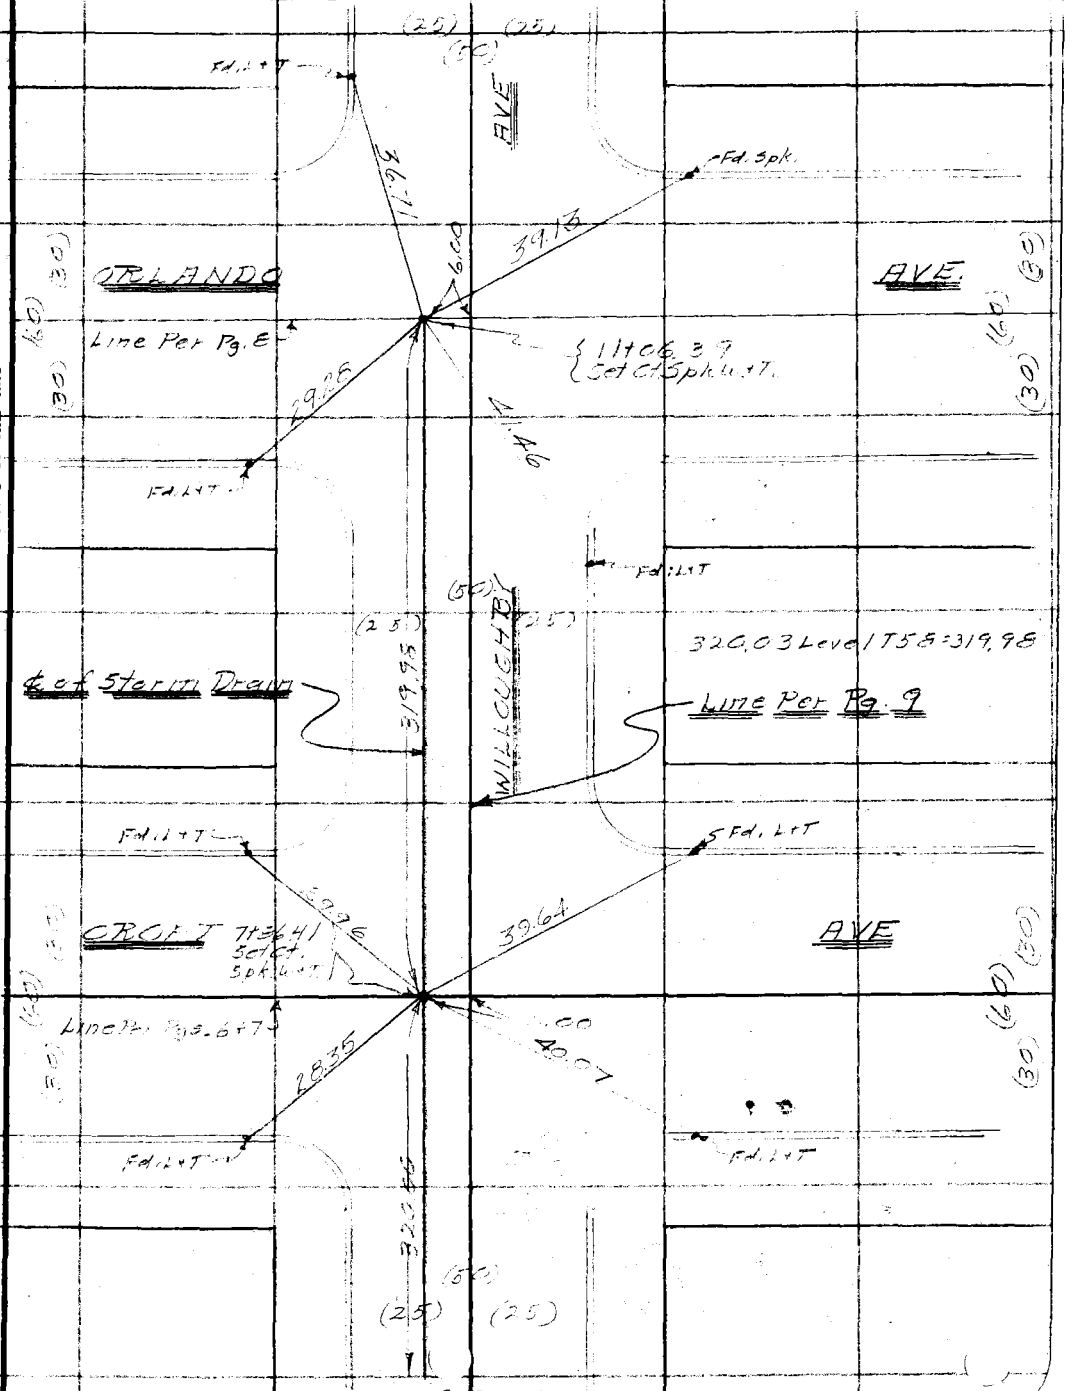

From Top of Pg. 10

RETURN TO
LOS ANGELES COUNTY SURVEYOR
700 HALL OF RECORDS

Note: Any Additions or Changes on This Sheet Must be Made or Circled in **Red** Ink With Date and Name of Person Making Change.

Do not extend notes this side of this line

F.B. 697 PG. 12

Notes Ck'd by		Survey of Willoughby-Orlando Ave.	F.B. 217 Pg. 13
Map No.		W. O 6316 Tape No. 257 St'd 64°F.	
Office Work		Surveyed by Brandy	
Checked		Notes " Date 2-19-37	
Date		Indexed A. C. Johnson	

TOPOGRAPHY

WEST HOLLYWOOD DRAINAGE SYSTEM

WILLOUGHBY — ORLANDO AVE LATERAL

JN 6316

Sheet 3

Plat & Survey See Pgs 1 to 12 Incl.

Prof. Profile See Pgs 19 to 30 Incl.

C E Brandy - Chief
H M Smith - Transit
J L Wiley - Chain
M N Van Buren Rodman

Note: Any Additions or Changes on This Sheet Must be Made or Circled in Red Ink With Date and Name of Person Making Change.

Do not extend notes this side of this line

RETURN TO
LOS ANGELES COUNTY SURVEYOR
700 HALL OF RECORDS

RECEIVED	MAR 10 1937
PROGRESSED	✓ ✓
BOOK INDEXED	✓ ✓
MAP INDEXED	✓ ✓
RECORD INDEXED	✓ ✓
CARD INDEXED	✓ ✓

FORM 247 10M 11-35

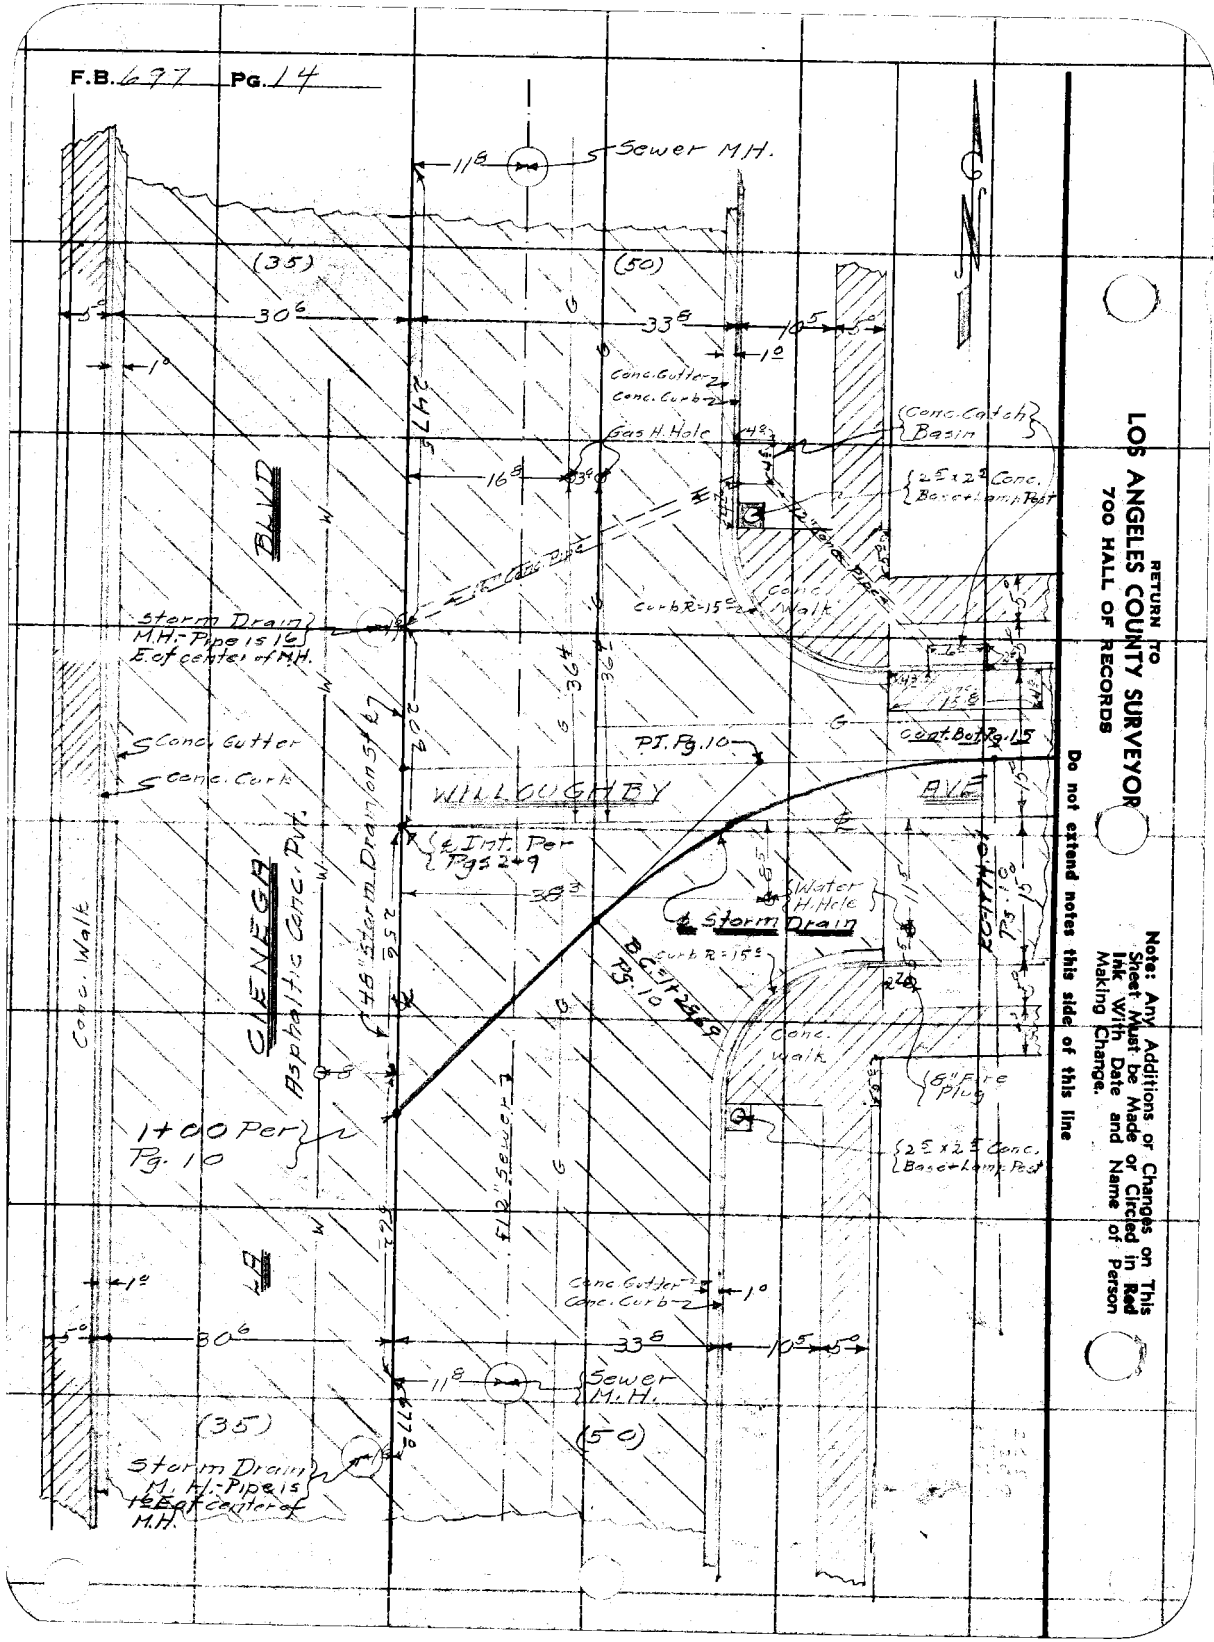

RETURN TO
LOS ANGELES COUNTY SURVEYOR
700 HALL OF RECORDS

Note: Any Additions or Changes on This Sheet Must be Made or Circled in Red Ink With Date and Name of Person Making Change.

Do not extend notes this side of this line

Notes Ck'd by	Survey of Univ. City Orlando Lot
Map No.	W. O. 6316 Tape No. 657 St'd 57 °F.
Office Work	Surveyed by Brunty
Checked	Notes Date 2-19-37
Date	Indexed C. C. Johnson

F.B. 697 PG. 15

Cont. Dot et Pg. 16

ALFRED ST.

Sewer M.H. on St. ℄ (30)

3197

4+66.4 / Per Pg. 10

Sewer M.H. at ℄ Int.

317°

Sewer M.H. on St. ℄ (30)

Asphaltic Conc. Pvt. (Curb to Curb)

19° 30.5

Conc. Gutter

Conc. Lamp Post

Curb

Conc. Walk

20° Curb R=10 Curb R=10

Conc. Lamp Post

Curb

Conc. Walk

4+34.7 - 8" Fire Plug

4+01.5 - 14" P.P.

3+02.2 P.P. + Conduit

5° 5° 9° 21° 5° 5°

℄ of Storm Drain

22'

ALLEY

3+01.9

21° 2+95.2 Beg Cb.

ALLEY

(10) Unimproved

Conc. Drive (Asphaltic Concrete Pavement)

2+91.4 Per Pg. 10 (Unimproved)

Conc. Walk

2+81.5 21°

2+78.4 End of Cb.

(25) (25)

2+31.3

Cont. 1:12

Curb

Conc. Walk

9° 21°

5° 5°

L.A. City - B.P.L. M.H. Sealed

65° 40° 35°

60° 30°

1+80°

1+76.5 L.A. City - B.P.L. Time Switch

1+74.3 Conc. Base

WILLOUGHBY

From Pg. 14 Rt.

RETURN TO
LOS ANGELES COUNTY SURVEYOR
700 HALL OF RECORDS

Note: Any Additions or Changes on This Sheet Must be Made or Circled in Red Ink With Date and Name of Person Making Change.

Do not extend notes this side of this line

FORM 247 10M 11-35

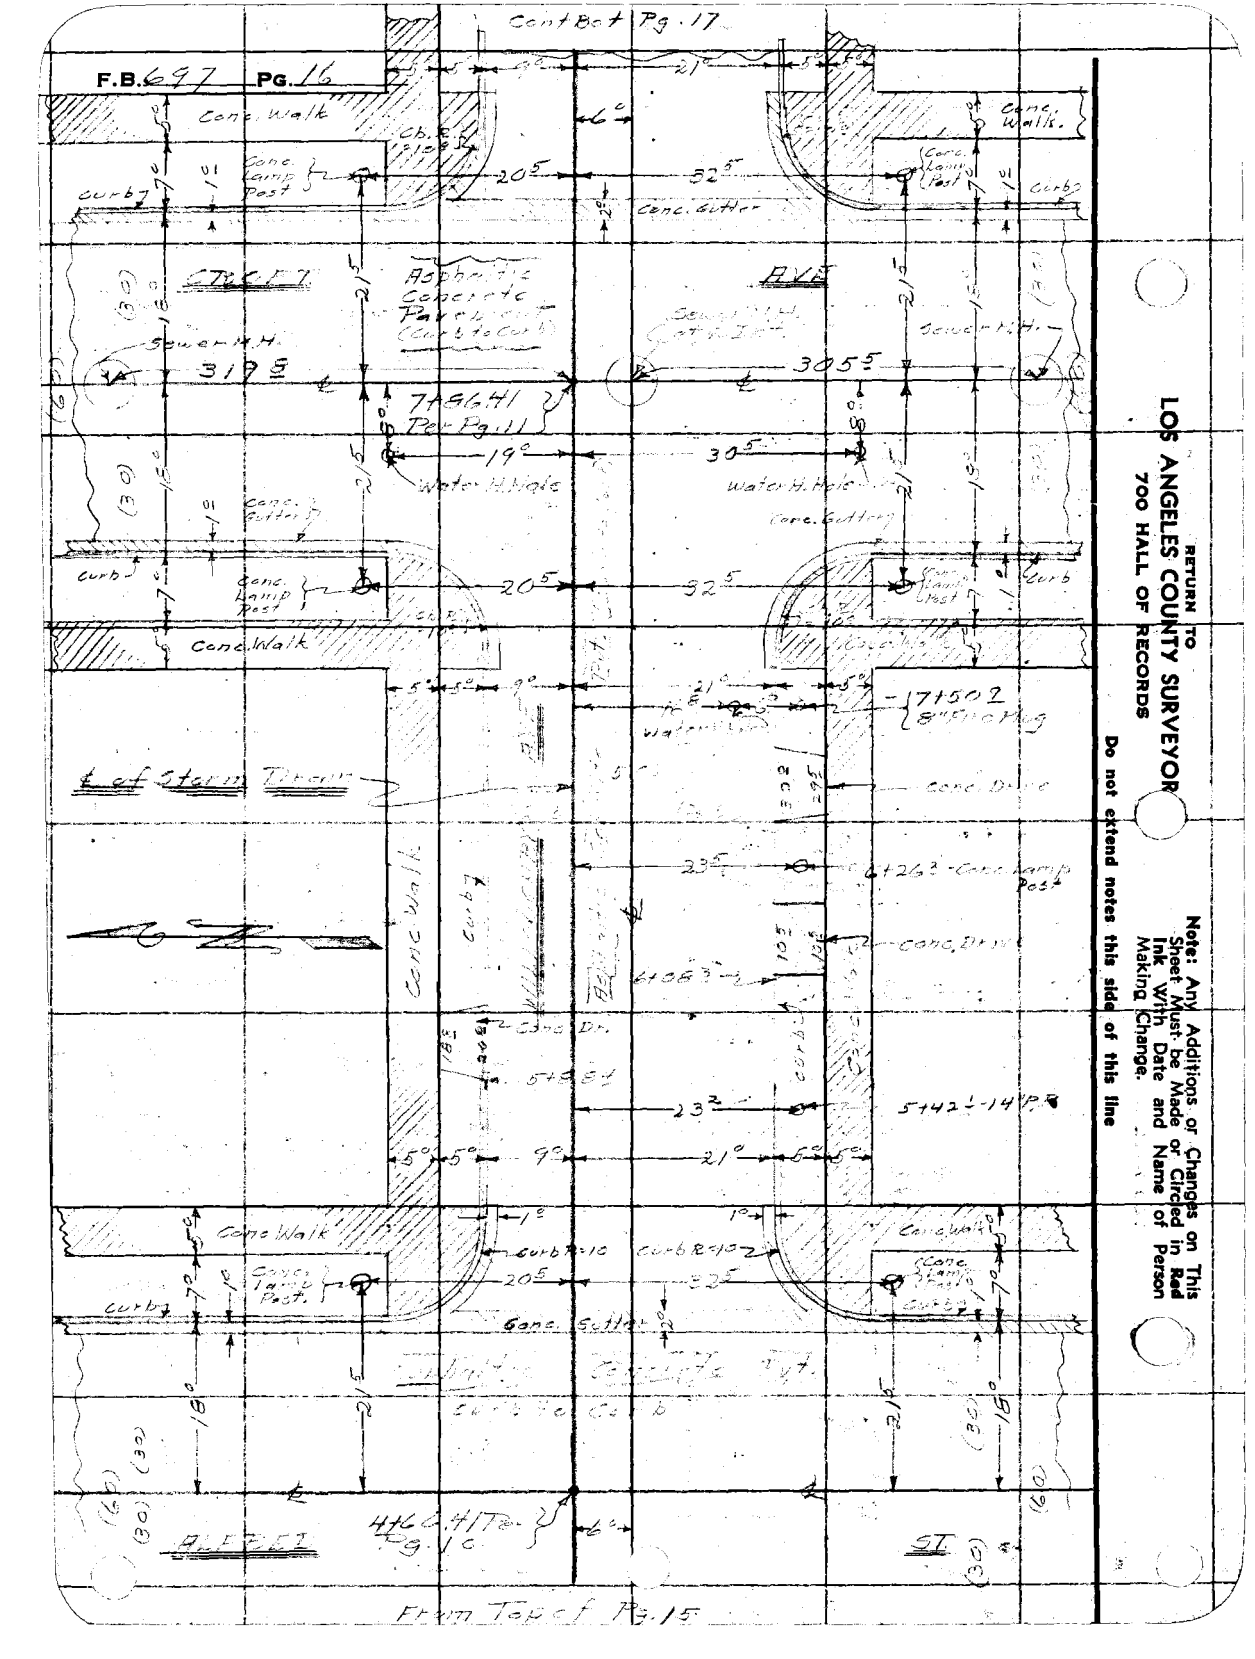

RETURN TO
LOS ANGELES COUNTY SURVEYOR
700 HALL OF RECORDS

Note: Any Additions or Changes on This Sheet Must be Made or Circled in Red Ink With Date and Name of Person Making Change.

Do not extend notes this side of this line

Notes Ck'd by	Survey of
Map No.	W. O. 6315 Tape No. 20 / St'd 57°F.
Office Work	Surveyed by Brown
Checked	Notes Date 2-23-27
Date	Indexed C. Johnson

F.B. PG. 7

Note: Any Additions or Changes on This Sheet Must be Made or Circled in Red Ink With Date and Name of Person Making Change.

Do not extend notes this side of this line

RETURN TO
LOS ANGELES COUNTY SURVEYOR
700 HALL OF RECORDS

FORM 247 10M 11-25

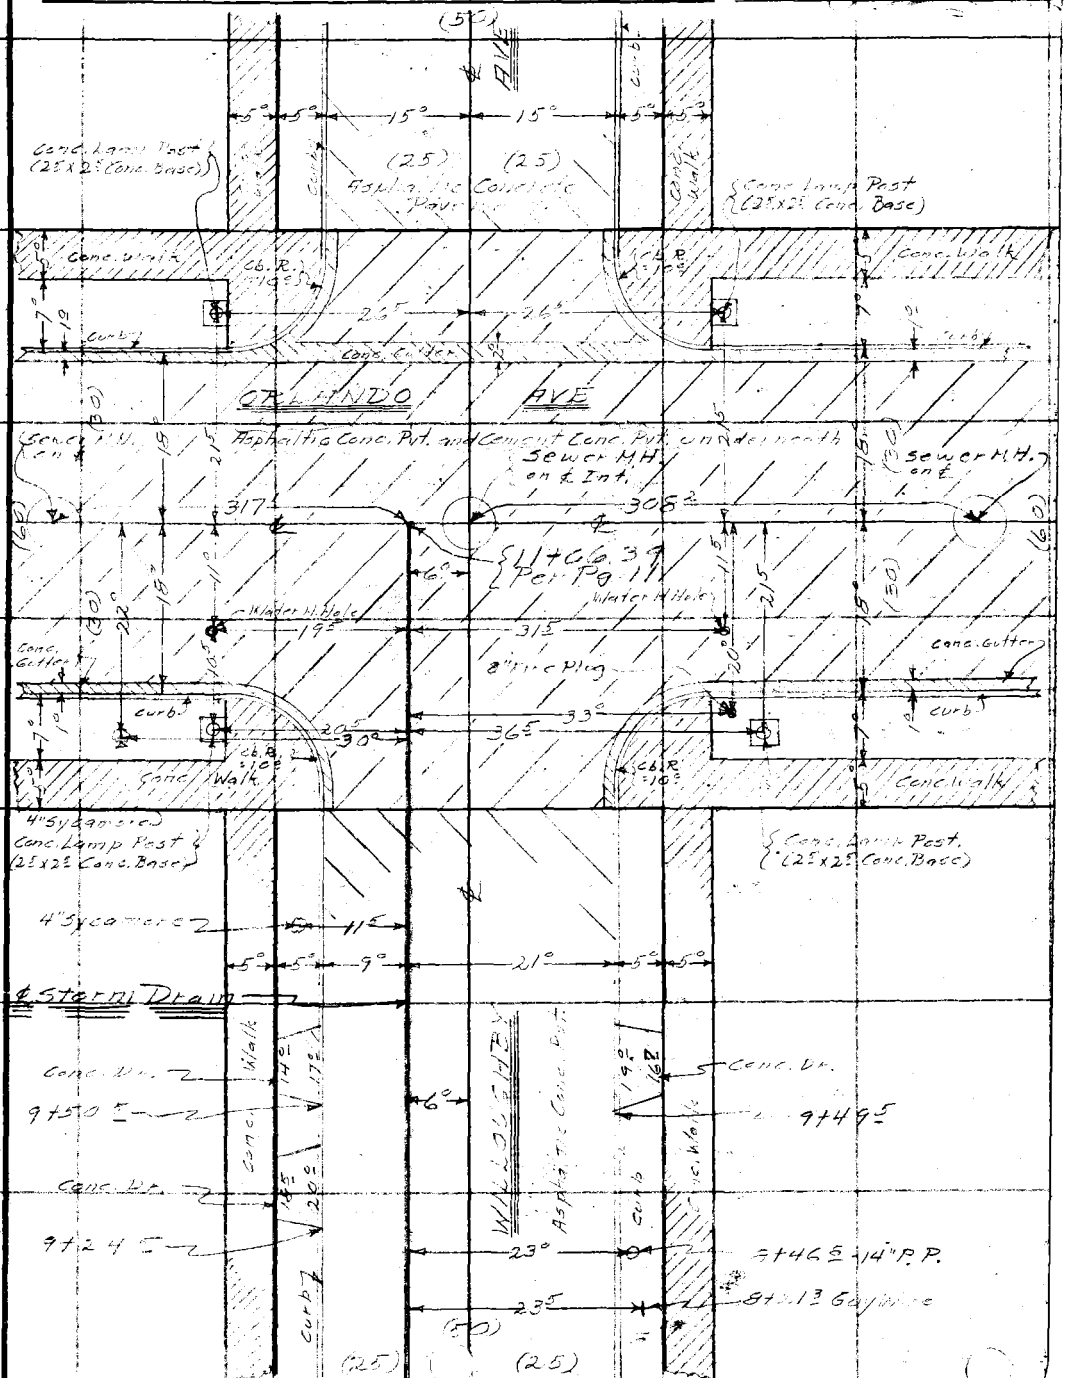

From Bot. of Pg. 16

RETURN TO
LOS ANGELES COUNTY SURVEYOR
700 HALL OF RECORDS

Note: Any Additions or Changes on This Sheet Must be Made or Circled in **Red Ink** With Date and Name of Person Making Change.

Do not extend notes this side of this line

F.B. 627 PG. 18

Profile No. | Notes Red. | Plotted | Job No. | Division No. | F. B. | Pg. 19
Date | Date | Survey of West Hollywood
X-Sec. No. | Notes Chkd. | Checked | Survey by A. C. Johnson | Notes | Date
Date | Date | Map No. | Indexed | Date

CENTER LINE PROFILE

WEST HOLLYWOOD DRAINAGE

WILCOX-BY ORANGE AVE LATERAL

SHEET 3

For Location See Page 1-12 incl

For Topography See Page 13-17 incl

A. C. Bianchy - Chief
R. M. Smith - Notes
J. L. Valley - Level
W. A. VanDeren - Rod

NOTE: ANY ADDITIONS OR CHANGES ON THIS SHEET MUST BE MADE OR CIRCLED IN RED INK, WITH DATE AND NAME OF PERSON MAKING CHANGE

Do not extend notes this side of this line

STATION	B. S.	H. I.	F. S.	ELEV.

RECEIVED MAR 10 1937
PROCESSED
BOOK INDEXED
MAP INDEXED
RECORD INDEXED
CARD INDEXED
REDUCED Field
CHECKED

PLEASE RETURN TO
LOS ANGELES COUNTY SURVEYOR
700 HALL OF RECORDS

Form 307 5M 11-35

Form 307 5M 11-35

PLEASE RETURN TO
LOS ANGELES COUNTY SURVEYOR
700 HALL OF RECORDS

NOTE: ANY ADDITIONS OR CHANGES ON THIS SHEET MUST BE MADE OR CIRCLED IN RED INK, WITH DATE AND NAME OF PERSON MAKING CHANGE

Do not extend notes this side of this line

F. B. 6111 PG. 20 | Job No. 4318 | Division No. 25 | Notes Red. | Plotted | Profile
Survey of West Hollywood | Date | Date | No.
Survey by C.E. Ellis & H.M. Smith | Notes H.M.S. | Notes Chkd. | Checked | X-Sec.
Indexed A. C. Johnson | Date Feb. 23, 1937 | Date | Date | No.

STATION	B. S.	H. I.	F. S.	ELEV.	
B.M.#					B.M.# [illegible]
	5.69	[illegible] 23			[illegible]
S.M.H.					S.M.H. 75.15 ± Willoughby [illegible] 9.65 - FL. to Rim
					FL. 48" Conc. Pipe 13.73
	11.45	20[illegible].79			
S.M.H.			10.27	[illegible].52	B.C.M.H. 20 ± N. & W. Willoughby 7.12.46 6.06
					FL. 46" Conc. Pipe 3.05 ± 3.05 ± 10.27 9.25
"			9.25	197.94	" " 16 " " N.E.
					S.M.H. 81.55 ± W. Willoughby 11.5 E. & La Cienega
S.M.H.			17.37	187.12	12" In. N 13.35 c 13.42
" " "			17.50	119.29	12" " S. 1.00 ± 1.00 ±
					5.02 ± 5.05 ±
					17.37 17.50
To Iron Hydrant [illegible]			4.72	202.07	Cast Manhole 36" ± N. & W. Willoughby 11.5' E. & W. Cienega
Location of Pipe Inserted			6.21	198.58	" M.H. " " " " 19.5 " " "
			3.36	[illegible].71	Int. ± La Cienega & [illegible] Willoughby
			2.42	[illegible].37	100' S. Int. ± La Cienega
			[illegible]	[illegible].12	" " Top of W. Curb La Cienega
			[illegible]	[illegible]	" " " Gutter "
			2.23	200.96	" " " " E. Curb " "

Form 307 5M 11-35

PLEASE RETURN TO
LOS ANGELES COUNTY SURVEYOR
700 HALL OF RECORDS

NOTE: ANY ADDITIONS OR CHANGES ON THIS SHEET MUST BE MADE OR CIRCLED IN RED INK, WITH DATE AND NAME OF PERSON MAKING CHANGE

Do not extend notes this side of this line

STATION	B. S.	H. I.	F. S.	ELEV.		
				2018		
				202 75		
				202 23		
				203 00		
				203 14		
				203 57		
				203 00		
				200 22		
				200 64		
				202 05		

Profile

No. X-Sec. No.

Notes Red. Plotted Job No. Division No.

Date Date Survey of

Notes Chkd. Checked Survey by Notes

Date Date Map No. Indexed J. Johnson Date

F. B. PG.

Form 307 5M 11-35

PLEASE RETURN TO
LOS ANGELES COUNTY SURVEYOR
700 HALL OF RECORDS

NOTE: ANY ADDITIONS OR CHANGES ON THIS SHEET MUST BE MADE OR CIRCLED IN RED INK, WITH DATE AND NAME OF PERSON MAKING CHANGE

Do not extend notes this side of this line

F. B. 697 PG. 22 | Job No. 6318 | Division No. | Notes Red. | Plotted | Profile No.
Survey of | Date | Date | X-Sec. No.
Survey by C. Johnson | Notes | Notes Chkd. | Checked
Indexed A. C. Johnson | Date | Date | Date

STATION	B. S.	H. I.	F. S.	ELEV.		
	5.13					
			6.20			
BC 1+			6.51			
T.P			6.51			
3+19.42						
				204		
				4		
				7		
2.75?						

Form 307 5M 11-35

PLEASE RETURN TO
LOS ANGELES COUNTY SURVEYOR
700 HALL OF RECORDS

NOTE: ANY ADDITIONS OR CHANGES ON THIS SHEET MUST BE MADE OR CIRCLED IN RED INK, WITH DATE AND NAME OF PERSON MAKING CHANGE

Do not extend notes this side of this line

STATION	B. S.	H. I.	F. S.	ELEV.		

Profile No.____ Notes Red.____ Plotted____ Job No.____ Division No.____ F. B.____ PG.____

X-Sec. No.____ Notes Chkd.____ Checked____ Survey by____ Notes____ Date____

Date____ Date____ Map No.____ Traced____ Date____

Form 307 5M 11-35

PLEASE RETURN TO
LOS ANGELES COUNTY SURVEYOR
700 HALL OF RECORDS

NOTE: ANY ADDITIONS OR CHANGES ON THIS SHEET MUST BE MADE OR CIRCLED IN RED INK, WITH DATE AND NAME OF PERSON MAKING CHANGE

Do not extend notes this side of this line

F. B. 617 PG. 24
Job No. 63K Division No. D-3
Survey of Tract 6547 M.R.
Survey by C. Johnson Notes
Indexed Date
Profile No. X-Sec. No.
Plotted Date Checked Date
Notes Red. Date Notes Chkd. Date

STATION	B. S.	H. I.	F. S.	ELEV.		
		212.69				

Form 307 5M 11-35

PLEASE RETURN TO
LOS ANGELES COUNTY SURVEYOR
700 HALL OF RECORDS

NOTE: ANY ADDITIONS OR CHANGES ON THIS SHEET MUST BE MADE OR CIRCLED IN RED INK, WITH DATE AND NAME OF PERSON MAKING CHANGE

Do not extend notes this side of this line

STATION	B. S.	H. I.	F. S.	ELEV.		

Form 307 5M 11-35

PLEASE RETURN TO
LOS ANGELES COUNTY SURVEYOR
700 HALL OF RECORDS

NOTE: ANY ADDITIONS OR CHANGES ON THIS SHEET MUST BE MADE OR CIRCLED IN RED INK, WITH DATE AND NAME OF PERSON MAKING CHANGE

Do not extend notes this side of this line

F. B. 471 PG. 23 | Job No. 6315 | Division No. | Profile No. | X-Sec. No.

Survey of Cahuenga Blvd. Hollywood Area | Plotted | Date | Notes Red | Date | Checked | Date | Notes Chkd. | Date

Survey by C. E. S. & C. Johnson | Notes | Indexed

STATION	B. S.	H. I.	F. S.	ELEV.			
		215.59					
			7.16	208.43	Sta. on top of R.C.P. Cor.		
			5.04		TP on " " " N " "		
			6.20		Gutter " " " " " "		
			5.89		TP on " " " " " "		
					Gutter " " " " " "		
			4.90		TP on " " " E. "		
			3.41		Gutter " " " " "		
			4.76		TP on E " " " "		
			5.32	210.47	Gutter " " " " "		
			6.15	54	TP on S " " S. E "		
			6.11	48	Gutter " " " " "		
			7.11	209	TP on E " " " "		
			7.12	201.15	Gutter " " " "		
2.17641			13.84		5 1/2 S.M.H. 6" D. N	7516	7516
						5598	5598
			14.07				1407.
2.17641			11.93		B05-R5M.H. 5" D. N.	6810	6793
						6710	6713
						1137R	1123R
						1573.	1933.
2.17641			7.42		5 1/2 S.M.H. 6" D. N	6955	7033
						6512	6509
						6621	6665
						1741	1741
5400			5.71		E. SD.		

Form 307 5M 11-35

PLEASE RETURN TO
LOS ANGELES COUNTY SURVEYOR
700 HALL OF RECORDS

NOTE: ANY ADDITIONS OR CHANGES ON THIS SHEET MUST BE MADE OR CIRCLED IN RED INK, WITH DATE AND NAME OF PERSON MAKING CHANGE

Do not extend notes this side of this line

STATION	B. S.	H. I.	F. S.	ELEV.		
T.P						
	6.16	221.52				
1+00			4.15	217.37	℄	
			4.85	216.67	6'R	℄
11+00			4.10	217.42	℄	
~~11+06~~ 11+05					Int.	
T.P			4.19	212.75		
	7.81	219.96				
11+95			7.03	212.93	℄	
			7.17	212.79	6'R	
			8.81	211.15	100'R	
			8.01	211.15	100'R Tp Co. W. side	
			7.45	211.71	" Gutter	
			8.59	211.57	" Tp Co E	
			9.13	210.53	" Gutter	
			4.56	215.40	" L	
			4.79	215.17	" L Tp Co W	
			5.28	214.68	" " Gutter	
			4.38	215.58	" Tp Co E	

Profile No. X-Sec. No.

Notes Red Date Notes Chkd Date

Plotted Date Checked Date

Job No. 22 Division No. Survey of Survey by Map No.

Notes Indexed Date

F. B. PG. 21

Date 7-23-37

Form 307 5M 11-35

PLEASE RETURN TO
LOS ANGELES COUNTY SURVEYOR
700 HALL OF RECORDS

NOTE: ANY ADDITIONS OR CHANGES ON THIS SHEET MUST BE MADE OR CIRCLED IN RED INK, WITH DATE AND NAME OF PERSON MAKING CHANGE

Do not extend notes this side of this line

F. B. 697 PG. 26 Job No. 6316 Division No. Notes Red. Plotted Profile
Survey of West Hollywood Sts. Date Date No.
Survey by C.E. Runft Notes Notes Chkd. Checked X-Sec.
Indexed C. Johnson Date Date Date No.

STATION	B. S.	H. I.	F. S.	ELEV.				
		219.76						
			4.76	[illegible]	Jct 2 Gut E [illegible]			
			7.91	[illegible]	Tpcb Wend [illegible]			
			[illegible]	[illegible]	[illegible]			
			[illegible]	[illegible]	[illegible]			
			[illegible]	[illegible]	[illegible]			
			[illegible]	[illegible]	[illegible]			
			3.19	[illegible]	Tpcb W		NW	"
			7.47	[illegible]	[illegible]			
			[illegible]	[illegible]	Tpcb N			
			4.23	[illegible]	Gut			
			[illegible]	[illegible]	Tpcb N		NE	"
			6.12	[illegible]	Gut			
		213.22	2.22	213.74	Tpcb E			"
			6.77	213.19	Gut			
		212.13	7.13	212.63	Tpcb E		S E	"
			7.12	212.64	Gut			
		212.18	7.42	212.94	Tpcb S			
			7.76	212.42	Gut			
1406.21			15.22	204.96	R.R.C.M.H. 6"In. N		7.43C	7.50C 7.31C
							1.17D	1.17D 1.67D
							7.12R	1.19R 7.15R
			15.36	204.40	8"Cu-S		15.22	15.36 15.13
			15.13	204.63	8" Stub E			

Form 307 5M 11-35

PLEASE RETURN TO
LOS ANGELES COUNTY SURVEYOR
700 HALL OF RECORDS

NOTE: ANY ADDITIONS OR CHANGES ON THIS SHEET MUST BE MADE OR CIRCLED IN RED INK, WITH DATE AND NAME OF PERSON MAKING CHANGE

Do not extend notes this side of this line

STATION	B. S.	H. I.	F. S.	ELEV.		
		219				
			2026		309 R S.M.H.	1260 R 2026.
			2041			2041.
			3.5	211 5	333 L S.M.H.	
			5.25			5.15.
			5.75	213 25		
			3.40	213 56		
				213 16		
				214 2		
				213 7		
TP			6.34	212 82		
	.43	212.65				
				213 64		

Profile
No.
X-Sec.
No.

Notes Red. Plotted Job No. Division No.
Date Date Survey of
Notes Chkd. Checked Survey by Notes
Date Date Map No. Indexed Date

F. B. Pg.

F. B. 697 PG. 30 | Job No. 338 | Division No. | Notes Red. | Plotted | Profile

Survey of West Hollywood | Date | Date | No.

Survey by C. E. Bruns | Notes H. M. Smith | Notes Chkd. | Checked | X-Sec.

Indexed A. C. Johnson | Date | Date | Date | No.

STATION	B. S.	H. I.	F. S.	ELEV.

Form 307 5M 11-35

PLEASE RETURN TO
LOS ANGELES COUNTY SURVEYOR
700 HALL OF RECORDS

Do not extend notes this side of this line

NOTE: ANY ADDITIONS OR CHANGES ON THIS SHEET MUST BE MADE OR CIRCLED IN RED INK, WITH DATE AND NAME OF PERSON MAKING CHANGE

Notes Ck'd by	Survey of
Map No.	W. O. 6318 Tape No. 22 St'd 64° F.
Office Work	Surveyed by Brandy
Checked	Notes " Date 2 [illegible]
Date	Indexed C. Johnson

F.B. 297 PG. 31

CENTER LINE SURVEY

WEST HOLLYWOOD DRAINAGE SYSTEM

MELROSE — ORLANDO AVE LATERAL

JN 6318

SHEET (3)

For Topography See Pgs. 37 to 42 Incl.

For Details See Pgs. 43 to 54 Incl.

[illegible] Chief
[illegible] Draftsman
[illegible] H. Chan
M. A. Van Deren R. Chan

RECEIVED MAR 10 1937

PROGRESSED	✓	✓
BOOK INDEXED	✓	✓
MAP INDEXED	-	✓
RECORD INDEXED	✓	✓
CARD INDEXED	✓	✓

Note: Any Additions or Changes on This Sheet Must be Made or Circled in Red Ink With Date and Name of Person Making Change.

Do not extend notes this side of this line

RETURN TO
LOS ANGELES COUNTY SURVEYOR
7do HALL OF RECORDS

FORM 247 10M 11-35

F.B. 697 Pg. 32

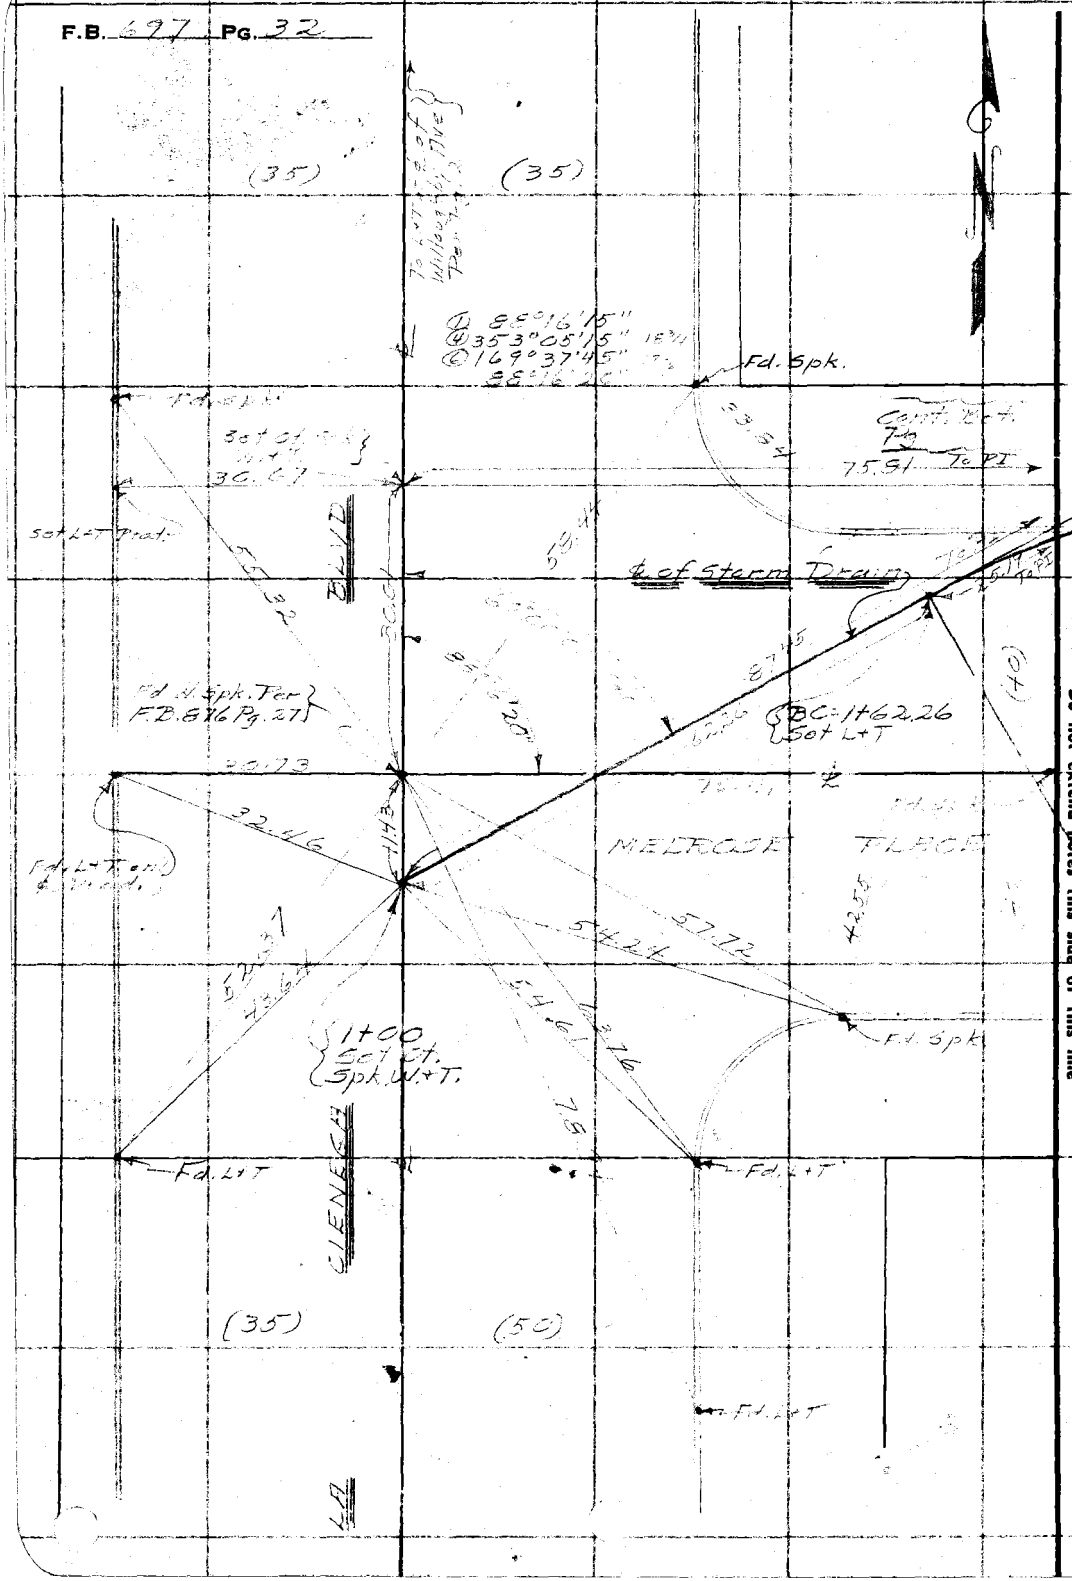
(35)
(35)
Fd. Spk.
Fd. L+T
30' of
30.67
Set L+T Prod.
BLVD
Fd. & Spk. Tan
F.D. 876 Pg. 27
22.73
22.46
1143
MELROSE
42.55
57.72
1+00
Set ct.
Spk. W.+T.
Fd. L+T
CLENEGA
(35)
(50)
Fd. L+T
Fd. L+T
Fd. Spk.
Fd. L+T
Fd. L+T
Fd. L+T

Notes Ck'd by	Survey of
Map No.	W. O. 6316 Tape No. 25 St'd ~~F.~~ F.
Office Work	Surveyed by Brown
Checked	Notes " Date 2-23-31
Date	Indexed C. Johnson

F.B. 177 PG. 23

Note: Any Additions or Changes on This Sheet Must be Made or Circled in Red Ink With Date and Name of Person Making Change.

Do not extend notes this side of this line

RETURN TO
LOS ANGELES COUNTY SURVEYOR
700 HALL OF RECORDS

FORM 247 10M 11-35

D 89°04'30"
D 356°17'30"
D 174°26'00"
S 89°04'30" E

32.41 From

B 2.55

140 (60) 39.31 (40)

PLACE

120'

40.66

89°00'

ALFRED ST.

Tack & Tag Willoughby Ave. Per Pg. 4

30+10.0

Mark on MH Lid Per Pg. 5

24.29 L+T on ℄ Prod

4+60.99 Set L+T

Fd L+T

269.43 Calc / T&L = 269.39

±211

MELROSE

L+T

L+T

Set Storm Drain

EC = 2+11.60 Set 2x2

6.78 Tan.

90°

41.34

Set L+T in Walk

Set L+T in Ch

Δ = 28°16'20" Calc.
R = 100
T = 25.19
L = 49.34

25.19

PT Set 2x2

8.94 Tan.

40

41.30

Set L+T in Walk

Set L+T in Ch

47.84

(40) (47)

(50)

BC = 1+62.26 L+T

22.26

From Pg. 32 Rt.

F.B. 697 Pg. 34

HLS 3-16-38

HLS 3-16-38

Cont. Bat. of Pg. 35

35'

320.12 Level T to S: 320.07

5°

9+62.54
℄ Pt.

40°35'08"

PLACE

(EC)

(40) (40)

℄ of Storm Drain

Fd. L+T.

Fd. L+T.

30'

9+00
℄ Pt.

CLOSE AVE

Total Length of Curve

℄

30.00

24.32

Fd. L+T. on ℄ Prod.

Mark on M.H. Lid per Pg. 7

8+01.10
Set L+T

40°55'20"

90°55'15"
63°41'30"
85°32'50"
70°55'20"

MELROSE

320.16 Level T to S: 320.11

Fd. L+T.

Fd. L+T.

(40) (40)

From Top of Pg. 33

RETURN TO
LOS ANGELES COUNTY SURVEYOR
700 HALL OF RECORDS

Note: Any Additions or Changes on This Sheet Must be Made or Circled in Red Ink with Date and Name of Person Making Change.

Do not extend notes this side of this line

Notes Ck'd by	Survey of Melrose-Orlando Int.
Map No.	W. 06316 Tape No. 257 St'd 5¼ F.
Office Work	Surveyed by Brumby
Checked	Notes " Date 2-23-37
Date	Indexed A. C. Johnson

F.B. 67 Pg. 25

Note: Any Additions or Changes on This Sheet Must be Made or Circled in Red Ink With Date and Name of Person Making Change.

Do not extend notes this side of this line

RETURN TO
LOS ANGELES COUNTY SURVEYOR
7do HALL OF RECORDS

FORM 247 10M 11-35

HLJ 3-16-38

Fd L+T

MELROSE AVE

Fd L+T Pob FB 67 Pg 25

Gone

Fd L+T

Set L+T Prop.

Gone

11.27 M.H

67.40

ORLANDO AVE

Set L+T

11/21/37

30.00

37.21

Fd L+T Pob FB 816 Pg 29

Set L+T

37.14

Set Mark on M.H. Lid by Int. of Tan. P.M's.

Fd L+T

Pob FB 876 Pg 27

Fd L+T.

5.00

35'

① 90°55'00"
④ 363°40'15"
⑥ 185°30'30"
90°55'05"

MELROSE PLACE

MELROSE AVE

HLJ 3-16-38

Ped. Tunnel

734

From top of Pg. 34

RETURN TO
LOS ANGELES COUNTY SURVEYOR
700 HALL OF RECORDS

Note: Any Additions or Changes on This Sheet Must be Made or Circled in **Red Ink** With Date and Name of Person Making Change.

Do not extend notes this side of this line

F.B. 697 Pg. 36

Notes Ck'd by	Survey of
Map No.	W. O. 6316 Tape No. 661 St'd. 61 °F.
Office Work	Surveyed by Brunty
Checked	Notes Date 2-24-37
Date	Indexed C. Johnson

F.B. 227 PG. 37

TOPOGRAPHY

WEST HOLLYWOOD DRAINAGE SYSTEM

MELROSE — ORLANDO AVE LATERAL

J.N. 6316

SHEET (3)

C E Brunty - Chief
H M Smith - Transit
J L Willey - H. Chain
M A Van Deren - R. Chain

For L. Survey See Pgs. 31 to 36 Incl.
For L. Profile See Pgs. 43 to 54 Incl.

Note: Any Additions or Changes on This Sheet Must be Made or Circled in Red Ink With Date and Name of Person Making Change.

Do not extend notes this side of this line

RETURN TO
LOS ANGELES COUNTY SURVEYOR
700 HALL OF RECORDS

RECEIVED MAR 10 1937

PROGRESSED	—	✓
BOOK INDEXED	✓	✓
MAP INDEXED	✓	✓
RECORD INDEXED	✓	✓
CARD INDEXED	✓	✓

FORM 247 10M 11-35

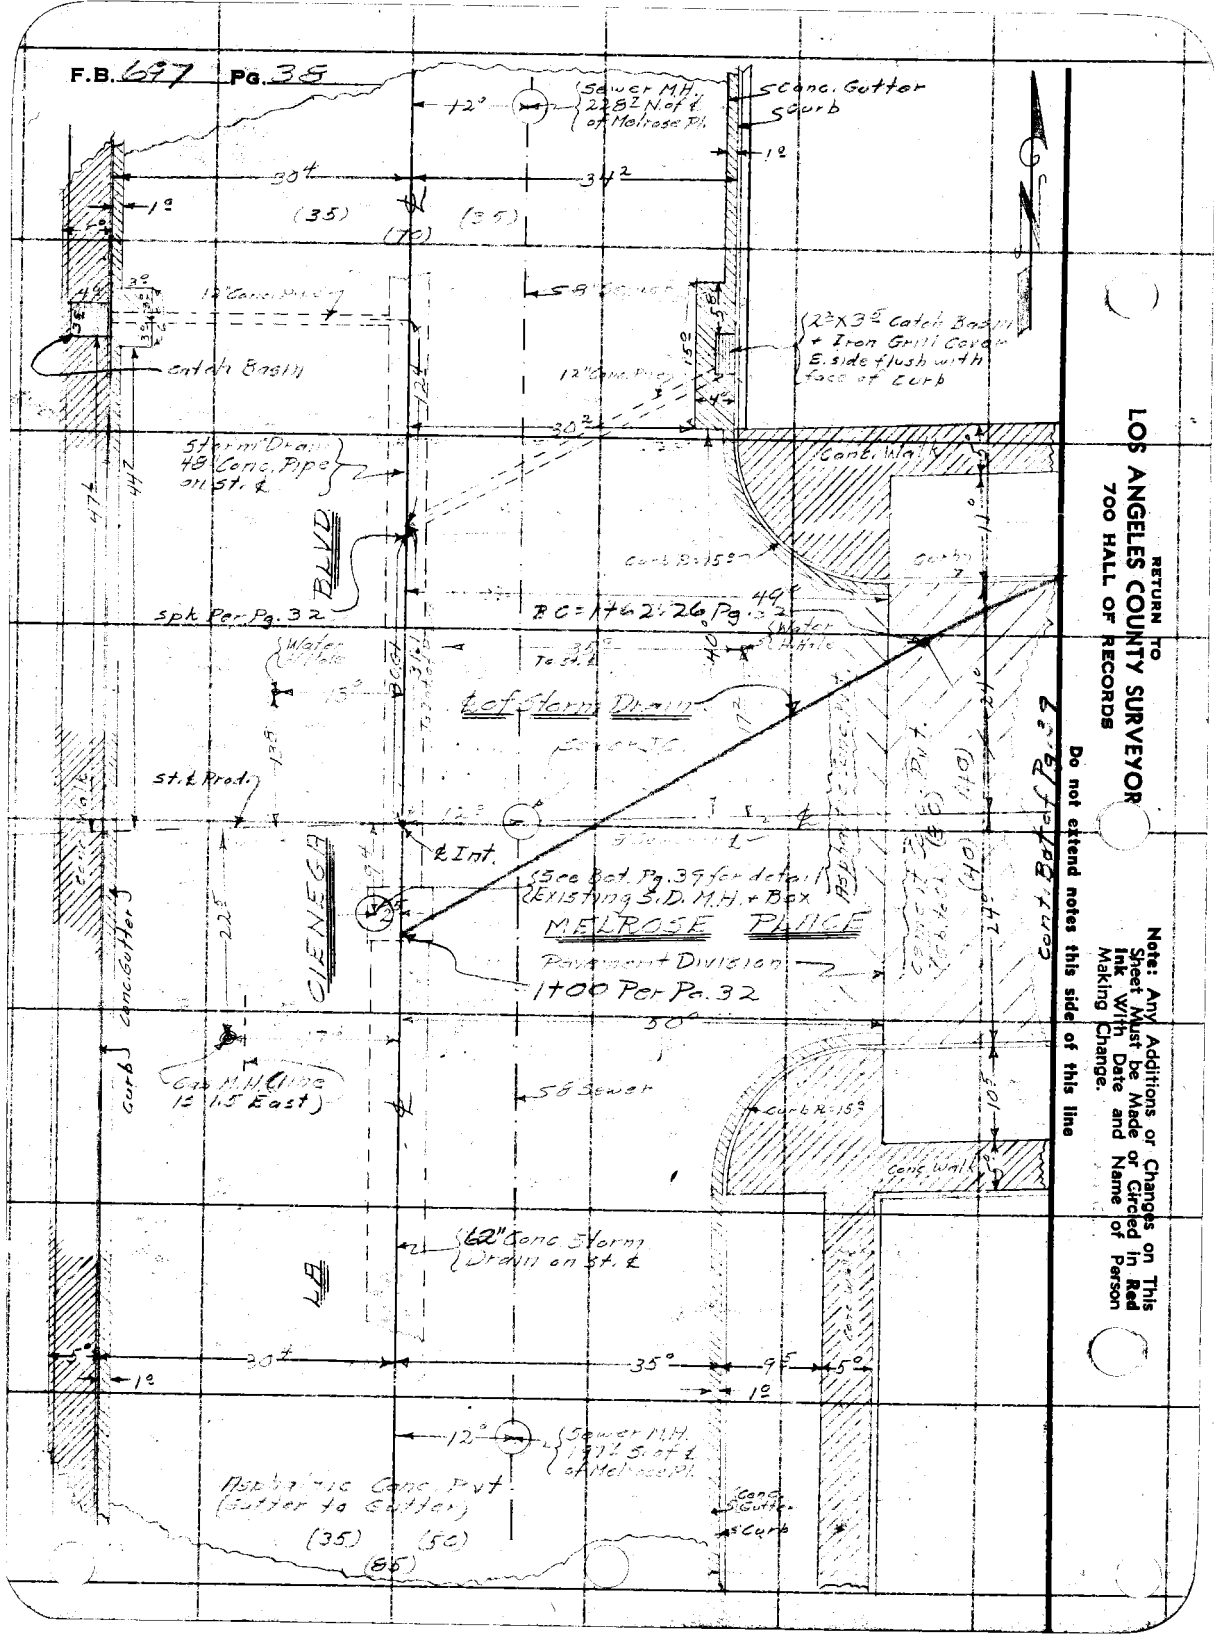

RETURN TO
LOS ANGELES COUNTY SURVEYOR
700 HALL OF RECORDS

Do not extend notes this side of this line

Note: Any Additions or Changes on This Sheet Must be Made or Circled in Red Ink With Date and Name of Person Making Change.

Notes Ck'd by	Survey of Melrose Ave. Hyd.
Map No.	W. 06316 Tape No. 25 / St'd 24 °F.
Office Work	Surveyed by Brunty
Checked	Notes " Date 2-24-37
Date	Indexed C. Johnson

F.B. 697 Pg. 39

Note: Any Additions or Changes on This Sheet Must be Made in Red Ink or Circled in With Date and Name of Person Making Change.

Do not extend notes this side of this line

RETURN TO
LOS ANGELES COUNTY SURVEYOR
700 HALL OF RECORDS

FORM 247 10M 11-35

3+00 Cent. Sta. of Pg. 1C

(40) (42) (40)

Conc. Drive

2+74.3

EC = 2+11.60 Pg. 33

PLACE

Cement Conc. Pvt. (Curb to Curb)

5° 11° 24° 24° 10.5 5°

5 of Storm Drain

MELROSE

Curb

Curb & Gutter

8" Fire Plug

6" Water H. Hole

PI

6.5 3.5 6 2.9 4.2 14" P.P.

Catch Basin 4'x2' Outside 3'x1½' Inside 18" Conc. Pipe Outlet from Cir. Inl. Box.

25'x25' Conc. Base & Lamp Post

1+62.4 Pg. 33

(Cement Conc. Pvt.)

Pvt. Division Curb Pg. 38

Asphaltic Conc. Pvt.

18" Conc. Pipe

Catch Basin 4'x2½' Outside 3'x2' Inside

25'x25' Conc. Base & Lamp Post

Conc. Walk

8" Sewer on ℄

18" Conc. Pipe

Conc. Box

Top View Inside Dimensions

5 pk Per Pg 32

30.01

S.D.M.H. Box Per Pg. 38

23' Drop Across Box

N. S.

LA CIENEGA BLVD.

1+00 Per Pg. 32

N. & S. View of Box

R=16'

Side View Front W. (Inside Dimensions)

Conc. Box

18" Pipe

62" Pipe

From Pg. 38 Rt.

F.B. 697 Pg. 40

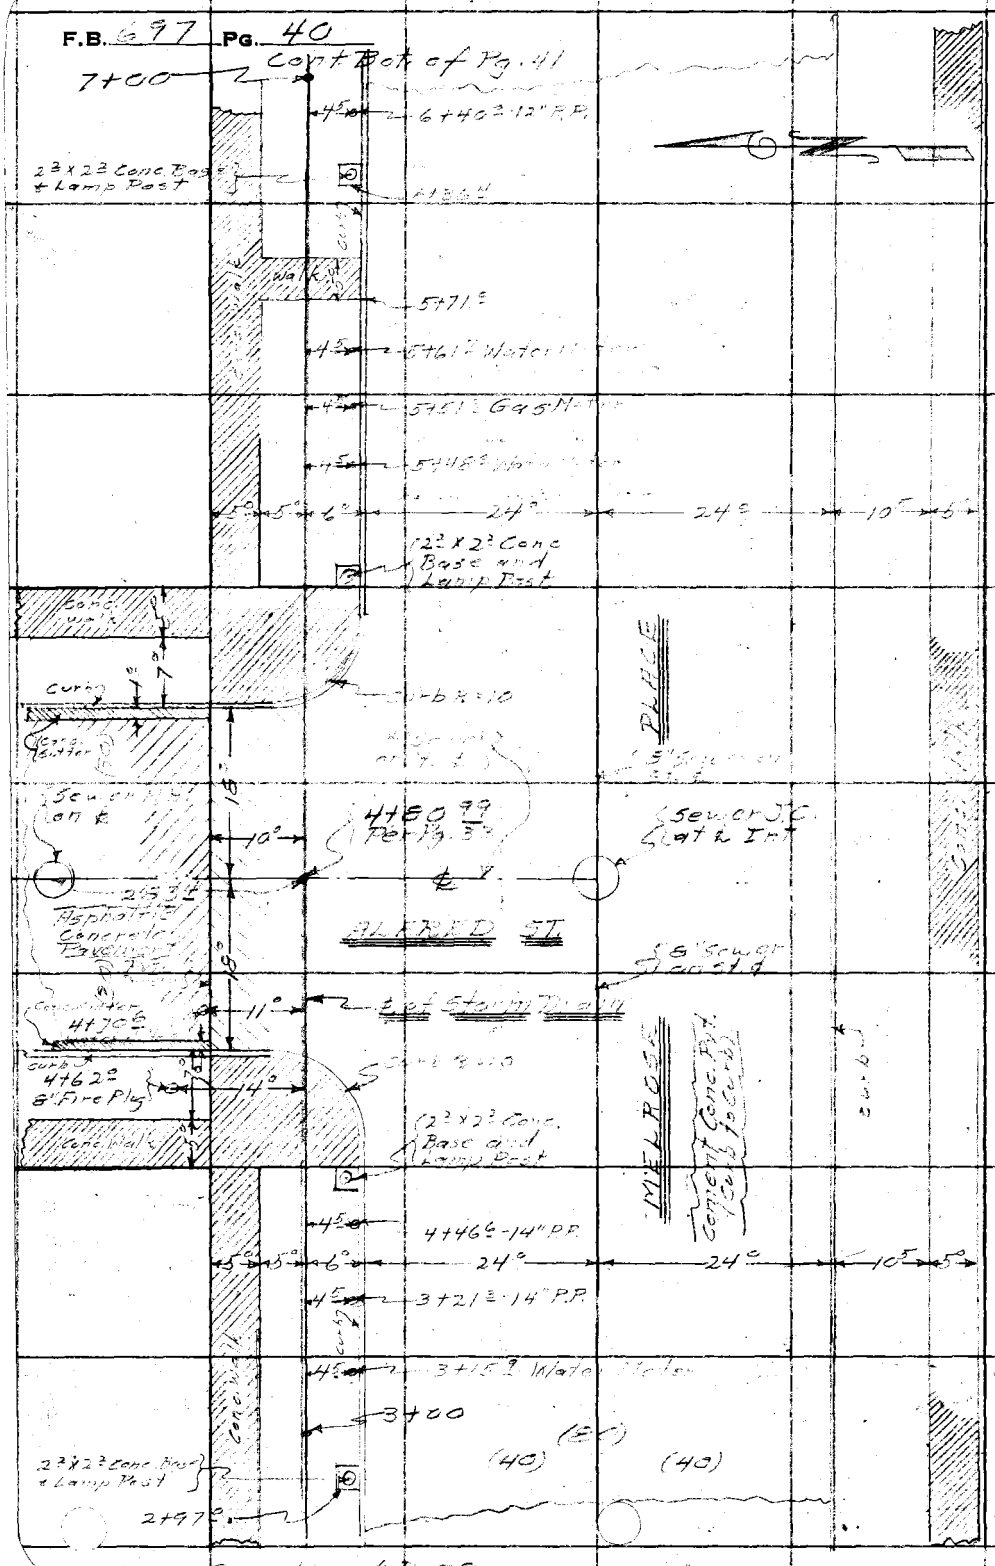

From Top of Pg. 39

RETURN TO
LOS ANGELES COUNTY SURVEYOR
700 HALL OF RECORDS

Note: Any Additions or Changes on This Sheet Must be Made or Circled in Red Ink With Date and Name of Person Making Change.

Do not extend notes this side of this line

Notes Ck'd by
Map No.
Office Work
Checked
Date

W. O. 6318 Tape No. 457 St'd 84°F.
Surveyed by Bellamy
Notes " Date 2-25-31
Indexed A. C. Johnson

F.B. Pg. 41

Note: Any Additions or Changes on This Sheet Must be Made or Circled in Red Ink With Date and Name of Person Making Change.

Do not extend notes this side of this line

RETURN TO
LOS ANGELES COUNTY SURVEYOR
700 HALL OF RECORDS

FORM 247 10M 11-35

9+75
9+62.54
L Pt.
5'
9+00
L Pt.
10'
5' x 2' Conc. Base + Lamp Post
9+62.2
(40)
9+61.8 - 14" I.P. + Tel. Pole
9+61.8 - 14" I.P. + Tel. Pole
58+40.2 S. Wire
9+71.5
9+32.2
2' x 2' Conc. Base and Lamp Post
Curb R=10'
Conc. Walk
Pvt. Driveway
5' of Storm Drain
Sewer M.H. on C.L.
Sewer M.H. Sta. 8+01.1 Int.
8+01.1 Per Pg. 34
CROFT AVE
Asphaltic Conc.
Pvt. Sewer M.H.
Conc. Walk
12' Conc. Walk
Curb R=10'
12' x 2' Conc. Base + Lamp Post
7+71.2
7+91.2
Easement Conc. Pvt. Curb
7+46.9
7+66.2
1/2" R.P.
7+63.2 - 3" Brass Plug
7+63.5
Water M. Note
7+33.2 Water Meter
7+31.4
7+00
Curb Z
Conc. Walk
MEADOWSE
(40)
(40)
(40)
(40)
24'
24'
10.5
5'
From top of Pg. 40

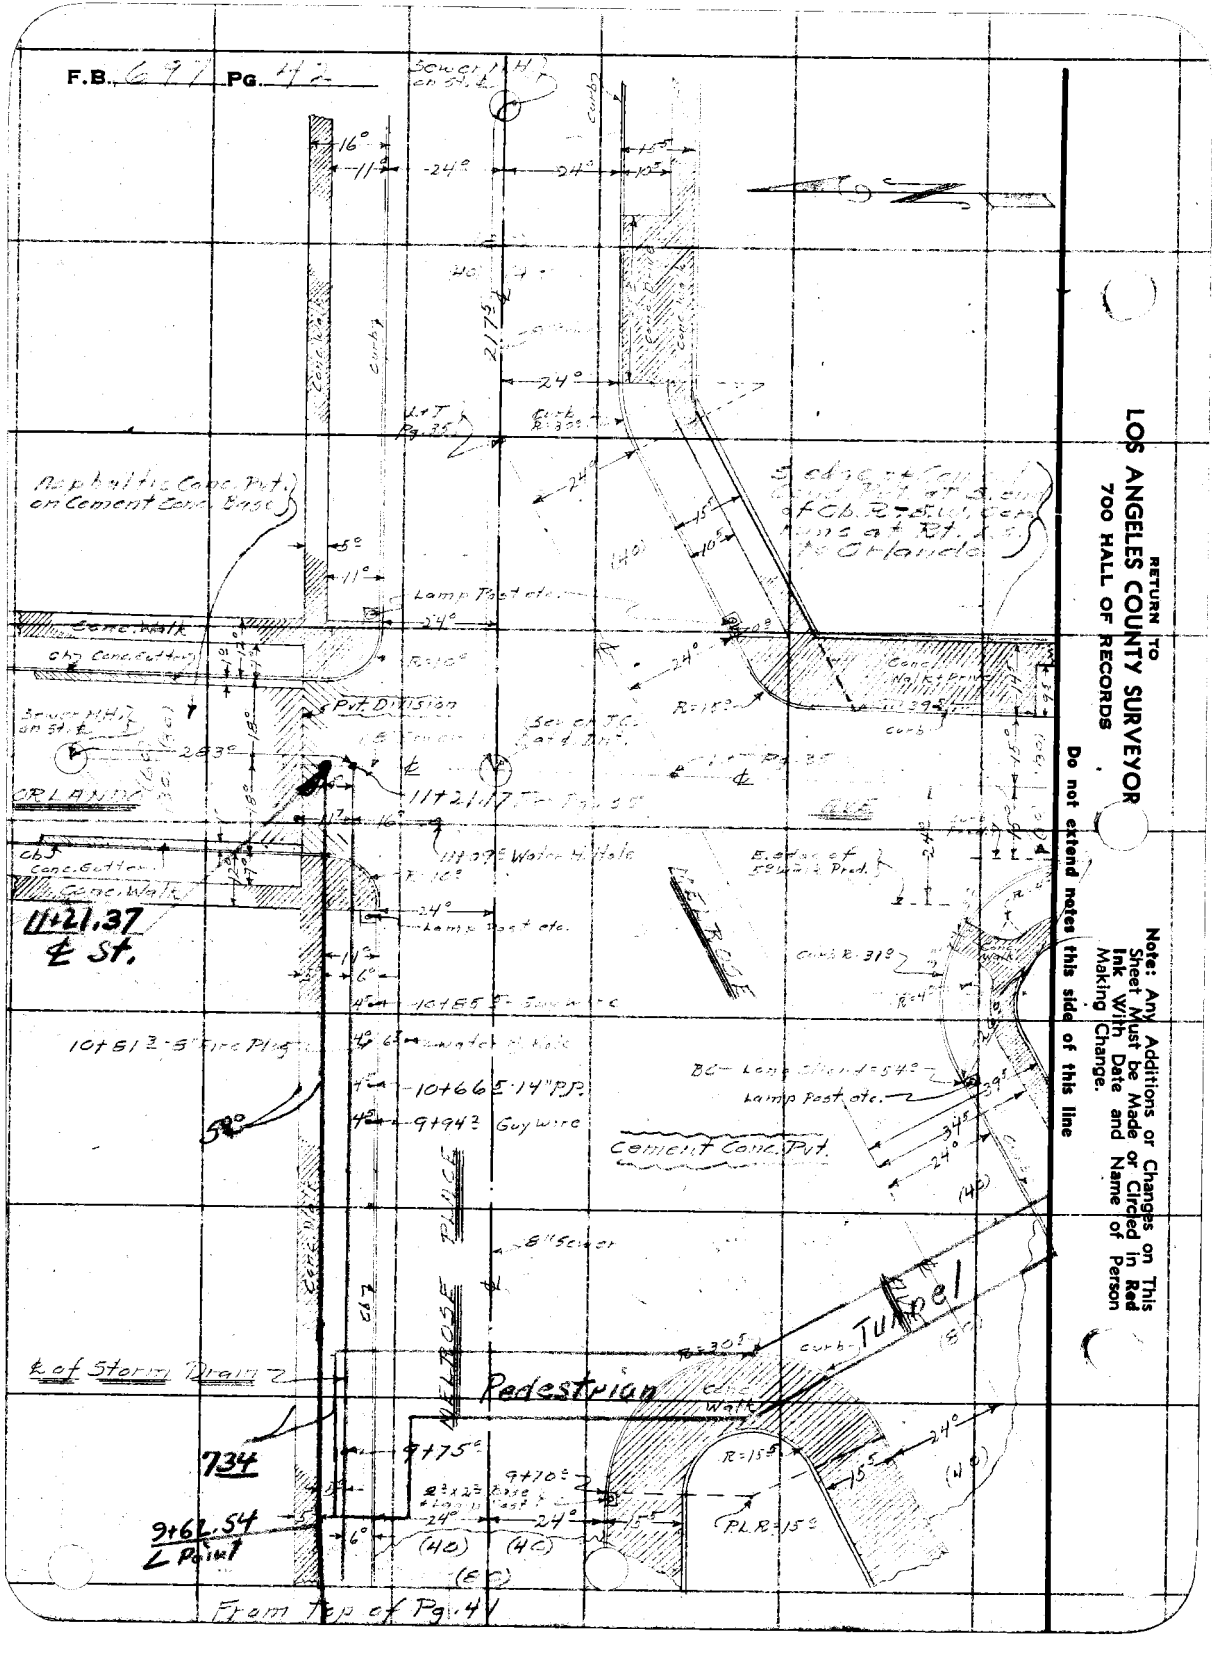
F.B. 697 Pg. 42
Sewer MH
Curb
Asphaltic Conc. Pvt. on Cement Conc. Base
Conc. Walk
Lamp Post ote.
Pvt. Division
Sewer MH on St. ℄
ORLANDO
11+21.37 ℄ St.
Water Hydrant
Conc. Walk
10+61.3 Fire Plug
10+66.5 P.P.
9+94.2 Guy wire
Cement Conc. Pvt.
8" Sewer
Tunnel
℄ of Storm Drain 2
Pedestrian
Walk
734
9+62.54 ℄ Point
9+75
9+70
From Top of Pg. 41
RETURN TO
LOS ANGELES COUNTY SURVEYOR
700 HALL OF RECORDS
Do not extend notes this side of this line
Note: Any Additions or Changes on This Sheet Must be Made in Red Ink With Date and Name of Person Making Change.

Profile No. | Notes Red. | Plotted | Job No. | Division No. | F. B. | PG.
Date | Date | Survey of
X-Sec. No. | Notes Chkd. | Checked | Survey by | Notes | Date
Date | Date | Map No. | Indexed | Date

NOTE: ANY ADDITIONS OR CHANGES ON THIS SHEET MUST BE MADE OR CIRCLED IN RED INK, WITH DATE AND NAME OF PERSON MAKING CHANGE

Do not extend notes this side of this line

STATION	B. S.	H. I.	F. S.	ELEV.

SHEET 3

RECEIVED MAR 10 1937

PROGRESSED

BOOK INDEXED

MAP INDEXED

RECORD INDEXED

CARD INDEXED

REDUCED

CHECKED

PLEASE RETURN TO
LOS ANGELES COUNTY SURVEYOR
700 HALL OF RECORDS

Form 307 5M 11-35

Form 307 5M 11-35

PLEASE RETURN TO
LOS ANGELES COUNTY SURVEYOR
700 HALL OF RECORDS

NOTE: ANY ADDITIONS OR CHANGES ON THIS SHEET MUST BE MADE OR CIRCLED IN RED INK, WITH DATE AND NAME OF PERSON MAKING CHANGE

Do not extend notes this side of this line

F. B. 6971 Pg. 44 | Job No. 4215 | Division No. | Notes Red | Plotted | Profile
Survey of | Date | Date | No.
Survey by | Notes | Notes Chkd. | Checked | X-Sec.
Indexed C. Johnson | Date | Date | Date | No.

STATION	B. S.	H. I.	F. S.	ELEV.		

Form 307 5M 11-35

PLEASE RETURN TO
LOS ANGELES COUNTY SURVEYOR
700 HALL OF RECORDS

NOTE: ANY ADDITIONS OR CHANGES ON THIS SHEET MUST BE MADE OR CIRCLED IN RED INK, WITH DATE AND NAME OF PERSON MAKING CHANGE

Do not extend notes this side of this line

STATION	B. S.	H. I.	F. S.	ELEV.		

F. B. 11 / Pg. 46 | Job No. | Division No. | Notes Red. | Plotted | Profile

Survey of | Date | Date | No.

Survey by | Notes | Notes Chkd. | Checked | X-Sec.

Indexed A. C. Johnson | Date | Date | Date | No.

Form 307 5M 11-35

PLEASE RETURN TO
LOS ANGELES COUNTY SURVEYOR
700 HALL OF RECORDS

NOTE: ANY ADDITIONS OR CHANGES ON THIS SHEET MUST BE MADE OR CIRCLED IN RED INK, WITH DATE AND NAME OF PERSON MAKING CHANGE

Do not extend notes this side of this line

STATION	B. S.	H. I.	F. S.	ELEV.

Form 307 5M 11-35

PLEASE RETURN TO
LOS ANGELES COUNTY SURVEYOR
700 HALL OF RECORDS

NOTE: ANY ADDITIONS OR CHANGES ON THIS SHEET MUST BE MADE OR CIRCLED IN RED INK, WITH DATE AND NAME OF PERSON MAKING CHANGE

Do not extend notes this side of this line

STATION	B. S.	H. I.	F. S.	ELEV.		
				190 7		
				189 84		
				190 34		
				189 74		
				190 44		
				189 90		

Profile No. _____ X-Sec. No. _____

Notes Red _____ Plotted _____ Job No. _____ Division No. _____ F. B. _____ PG. _____

Date _____ Date _____ Survey of _____

Notes Chkd. _____ Checked _____ Survey by _____ Notes Date _____

Date _____ Date _____ Map No. _____ Date _____

Traverse C. Johnson

Form 307 5M 11-35

PLEASE RETURN TO
LOS ANGELES COUNTY SURVEYOR
700 HALL OF RECORDS

NOTE: ANY ADDITIONS OR CHANGES ON THIS SHEET MUST BE MADE OR CIRCLED IN RED INK, WITH DATE AND NAME OF PERSON MAKING CHANGE

Do not extend notes this side of this line

F. B. ____ PG. ____ | Job No. ____ Division No. ____ Notes Red. ____ Plotted ____ Profile ____
Survey of ____ Notes ____ Date ____ Date ____ No. ____
Survey by C. Johnson Notes Chkd. ____ Checked ____ X-Sec. ____
Indexed ____ Date ____ Date ____ Date ____ No. ____

STATION	B. S.	H. I.	F. S.	ELEV.	
			12.66	179.19	Upper 8" Inlet N
			15.17		Lower 8"
					7.52
					5.14
					12.66
					135
					136
					1-2
					5 M H

Form 307 5M 11-35

PLEASE RETURN TO
LOS ANGELES COUNTY SURVEYOR
700 HALL OF RECORDS

NOTE: ANY ADDITIONS OR CHANGES ON THIS SHEET MUST BE MADE OR CIRCLED IN RED INK, WITH DATE AND NAME OF PERSON MAKING CHANGE

Do not extend notes this side of this line

STATION	B. S.	H. I.	F. S.	ELEV.		
				1928 3		
			2 15	9 2		

Profile

No. Notes Red Plotted Job No. Division No.

No. X-Sec. Date Date Survey of

Notes Chkd. Checked Survey by Notes Date

Date Date Map No. Indexed Date

F. B. Pg.

Form 307 5M 11-35

PLEASE RETURN TO
LOS ANGELES COUNTY SURVEYOR
700 HALL OF RECORDS

NOTE: ANY ADDITIONS OR CHANGES ON THIS SHEET MUST BE MADE OR CIRCLED IN RED INK, WITH DATE AND NAME OF PERSON MAKING CHANGE

Do not extend notes this side of this line

Profile No. ____ X-Sec. No. ____

Plotted ____ Date ____ Checked ____ Date ____

Notes Red. ____ Date ____ Notes Chkd. ____ Date ____

Division No. ____ Job No. ____

Notes ____ Date ____

Survey of ____

Survey by C. Johnson

Indexed ____

F. B. 697 PG. 50

STATION	B. S.	H. I.	F. S.	ELEV.
			11.63	185.07
			1420	250
				4

Form 307 5M 11-35

PLEASE RETURN TO
LOS ANGELES COUNTY SURVEYOR
700 HALL OF RECORDS

NOTE: ANY ADDITIONS OR CHANGES ON THIS SHEET MUST BE MADE OR CIRCLED IN RED INK, WITH DATE AND NAME OF PERSON MAKING CHANGE

Do not extend notes this side of this line

STATION	B. S.	H. I.	F. S.	ELEV.		
			3 55	4		
			4 01			
D.M.H. S.C.			16 05	83 41	Int Main 8"	
			13 14	188.92	Upper 8" Inlet N	
			15.72	72 74	Lower 8"	
			16 18	185 28		
S.M.H.						
			1420	187 26	10' East & Int.	
			14 30	187 16		
			3 17	191 29	100' East & Int. & Center Line	
			2 54	191 52	" " Curb Line	
			2 00	191	" "	
			3 70	191 76	" " Top Cb	
			4 33	191 13	" " Gutter	

Profile

No. ____ Notes Red ____ Plotted ____ Job No. ____ Division No. ____

X-Sec. No. ____ Date ____ Date ____ Survey of ____ F. B. ____ PG. ____

Notes Chkd ____ Checked ____ Survey by ____ Date ____

Date ____ Date ____ Map No. ____ Notes Indexed ____ Date ____

Form 307 5M 11-35

PLEASE RETURN TO
LOS ANGELES COUNTY SURVEYOR
700 HALL OF RECORDS

NOTE: ANY ADDITIONS OR CHANGES ON THIS SHEET MUST BE MADE OR CIRCLED IN RED INK, WITH DATE AND NAME OF PERSON MAKING CHANGE

Do not extend notes this side of this line

F. B. 677 Pg. 52 | Job No. 6211 | Division No. | Notes Red. | Date | Plotted | Date | Profile No. | X-Sec. No.

Survey of | Notes | Notes Chkd. | Checked

Survey by C. Johnson | Date | Date | Date

Indexed | Date | Date | Date

STATION	B. S.	H. I.	F. S.	ELEV.		
		20'				

Form 307 5M 11-35

PLEASE RETURN TO
LOS ANGELES COUNTY SURVEYOR
700 HALL OF RECORDS

NOTE: ANY ADDITIONS OR CHANGES ON THIS SHEET MUST BE MADE OR CIRCLED IN RED INK, WITH DATE AND NAME OF PERSON MAKING CHANGE

Do not extend notes this side of this line

STATION	B. S.	H. I.	F. S.	ELEV.		

F. B. [illegible] PG. [illegible] | Job No. [illegible] | Division No. | Notes Red. | Plotted | Profile

Survey of | Date | Date | No.

Survey by | Notes | Notes Chkd. | Checked | X-Sec.

Indexed A. C. Johnson | Date | Date | Date | No.

Form 307 5M 11-35

PLEASE RETURN TO
LOS ANGELES COUNTY SURVEYOR
700 HALL OF RECORDS

Do not extend notes this side of this line

NOTE: ANY ADDITIONS OR CHANGES ON THIS SHEET MUST BE MADE OR CIRCLED IN RED INK, WITH DATE AND NAME OF PERSON MAKING CHANGE

STATION	B. S.	H. I.	F. S.	ELEV.

Notes Ck'd by	Survey of Rockwood-Craft Tract
Map No.	W. O. 631-B Tape No. 057 St'd 84 °F.
Office Work	Surveyed by Brunty
Checked	Notes " Date 3-1-37
Date	Indexed A. C. Johnson

F.B. 671 Pg. 55

CENTER LINE SURVEY

WEST HOLLYWOOD DRAINAGE SYSTEM

ROSEWOOD — ORLANDO GROFF AVE LATERAL

J.N. 631E

SHEET (3)

For Topography See Pgs. 63 to 66A Incl.
For L Profile See Pgs. 67 to 76C Incl.

C E Brunty - Chief
H M Smith - Transit
J L Willey - H Chain
M A Van Deren - R Chain

RECEIVED MAR 10 1937

PROGRESSED ✓ ✓

BOOK INDEXED ✓ ✓

MAP INDEXED ✓ ✓

RECORD INDEXED ✓ ✓

CARD INDEXED ✓ ✓

RETURN TO
LOS ANGELES COUNTY SURVEYOR
700 HALL OF RECORDS

Note: Any Additions or Changes on This Sheet Must be Made or Circled in Red Ink With Date and Name of Person Making Change.

Do not extend notes this side of this line

FORM 247 10M 11-35

RETURN TO
LOS ANGELES COUNTY SURVEYOR
700 HALL OF RECORDS

Note: Any Additions or Changes on This Sheet Must be Made or Circled in **Red** Ink With Date and Name of Person Making Change.

Do not extend notes this side of this line

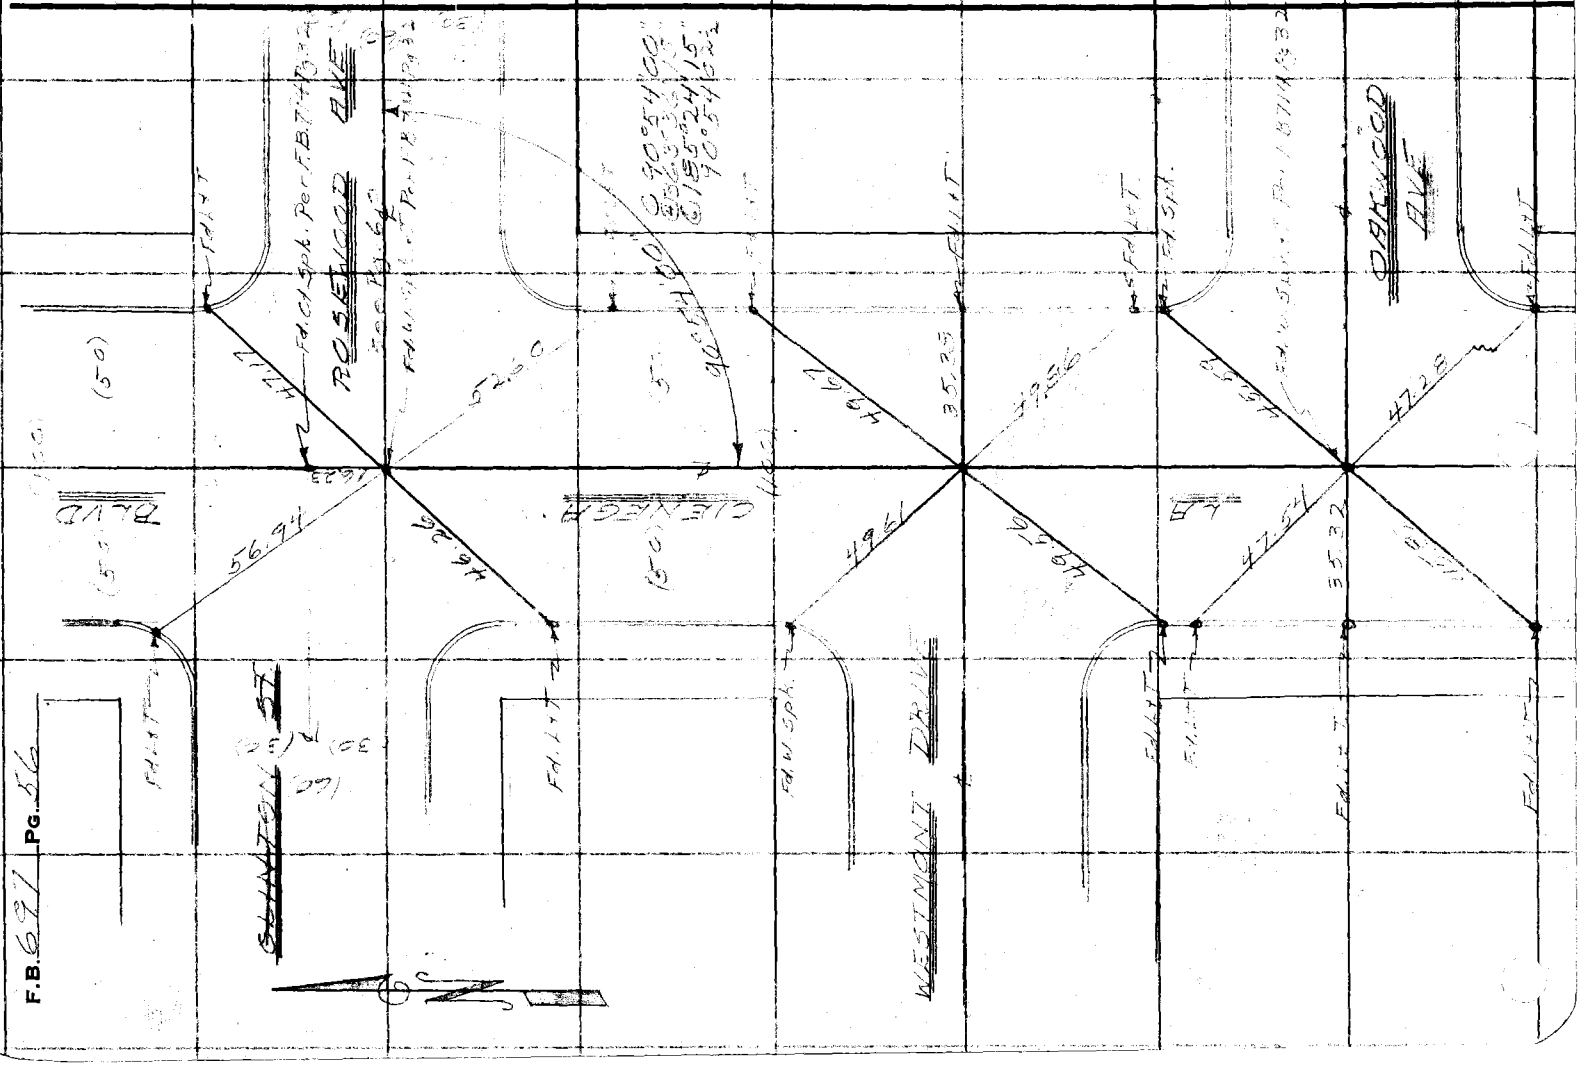

Notes Ck'd by		Survey of Rosewood-Oakwood Ltd	F.B. 697 Pg. 57
Map No.		W. 0631 Tape No 057 St'd 34° F.	
Office Work		Surveyed by Brumby	
Checked		Notes " Date 3-1-37	
Date		Indexed A. C. Johnson	

Fd 2x2 (10" Dn.)

Set Mark on MH Lid by ties Per F.B. 714 Pg 27

1st ALLEY SOUTH OF CLINTON AVE

LA BRENEGA BLVD.

Fd. 2x2 (10" Dn)

Δ 89°09'45"
R 356°39'15" 1°c.y.
L 174°59'15" 52½
89°09'52½

Fd. L+T.

Fd. L+T.

Gone

Set Nail by Ties per F.B. 714 Pg. 32

See Pg. 61

Fd. Nail by Ties Per F.B. 714 Pg 32

See Pg. 61

ROSEWOOD AVE

Fd L+T

Fd L+T on ℄ Prod.

Fd L+T

1ST ALLEY EAST OF

90°54'10"

Δ 90°54'15"
R 363°36'30" 1¼
L 185°25'00"
90 54'10"

Fd. L+T.

Fd L+T

Set Nail by Ax. of Ties Per F.B. 714 Pg 32

OAKWOOD AVE

Fd. L+T.

Fd. L+T

RETURN TO
LOS ANGELES COUNTY SURVEYOR
720 HALL OF RECORDS

Note: Any Additions or Changes on This Sheet Must be Made or Circled in Red Ink With Date and Name of Person Making Change.

Do not extend notes this side of this line

FORM 247 10M 11-36

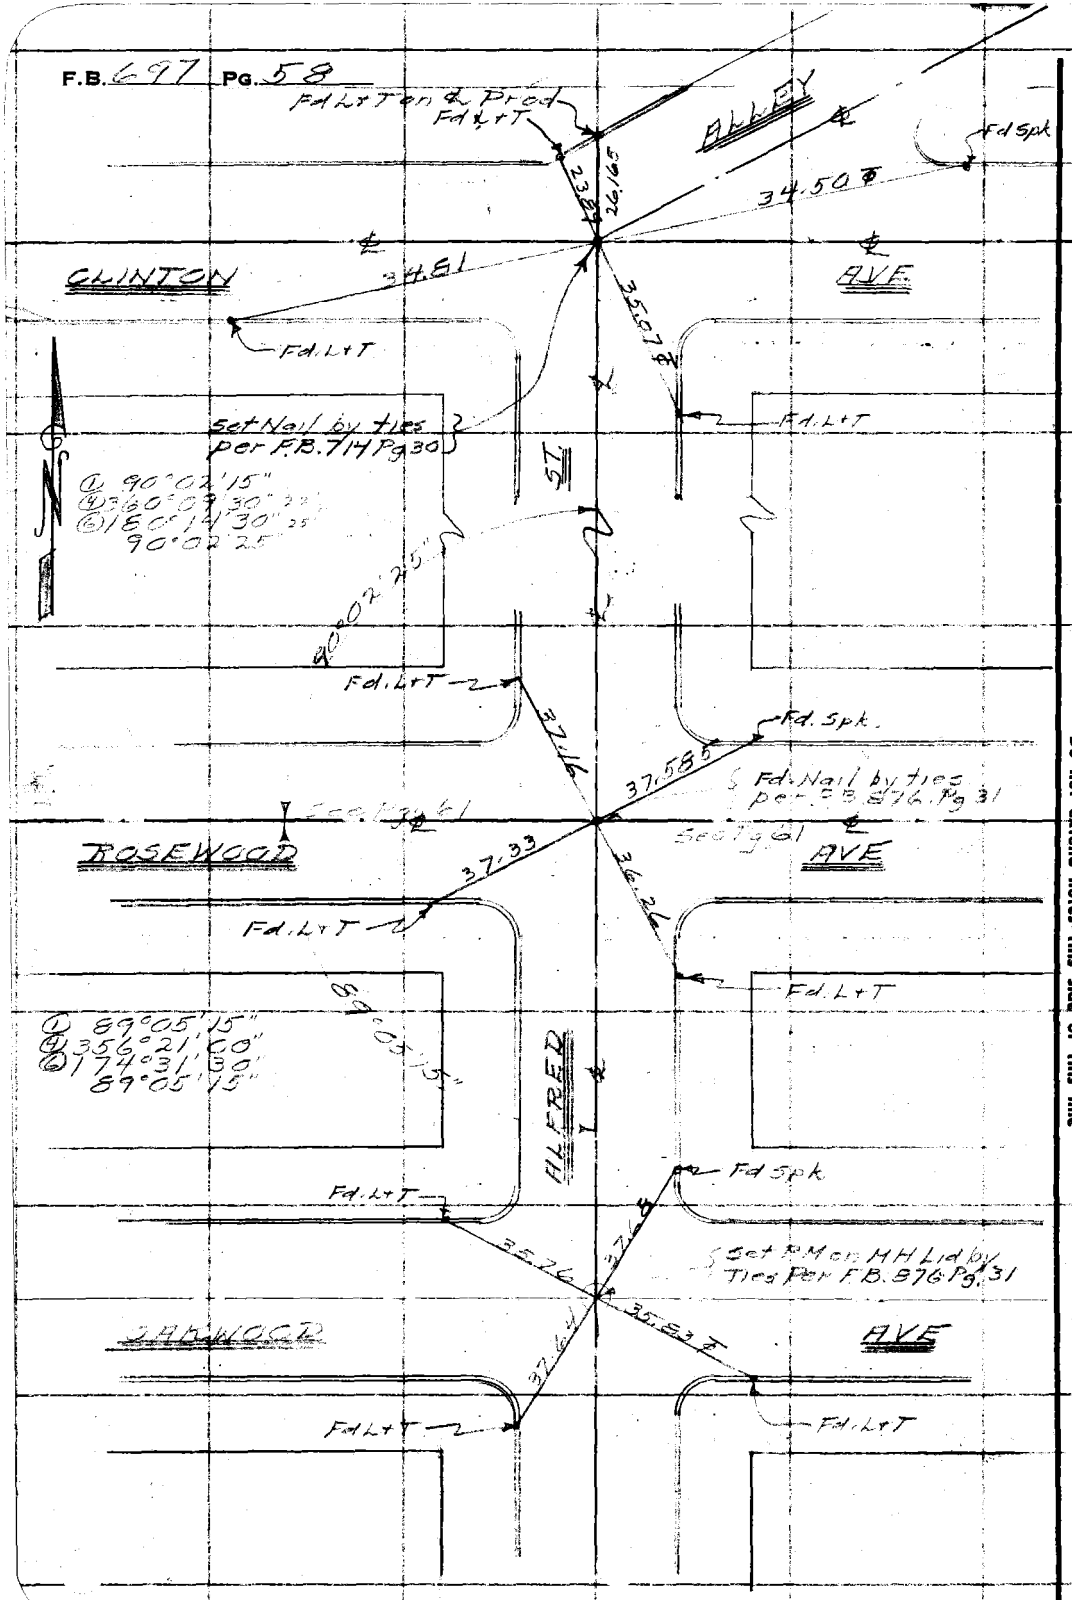

RETURN TO
LOS ANGELES COUNTY SURVEYOR
700 HALL OF RECORDS

Do not extend notes this side of this line

Note: Any Additions or Changes on This Sheet Must be Made or Circled in Red Ink With Date and Name of Person Making Change.

Map No.	W. O. 6318 Tape No. 257 St'd 94° F.
Office Work	Surveyed by [illegible]
Checked	Notes Date 3-1-27
Date	Indexed C. Johnson

F.B. 677 PG. 59

Note: Any Additions or Changes on This Sheet Must be Made or Circled in Red Ink With Date and Name of Person Making Change.

Do not extend notes this side of this line

RETURN TO
LOS ANGELES COUNTY SURVEYOR
700 HALL OF RECORDS

FORM 247 10M 11-35

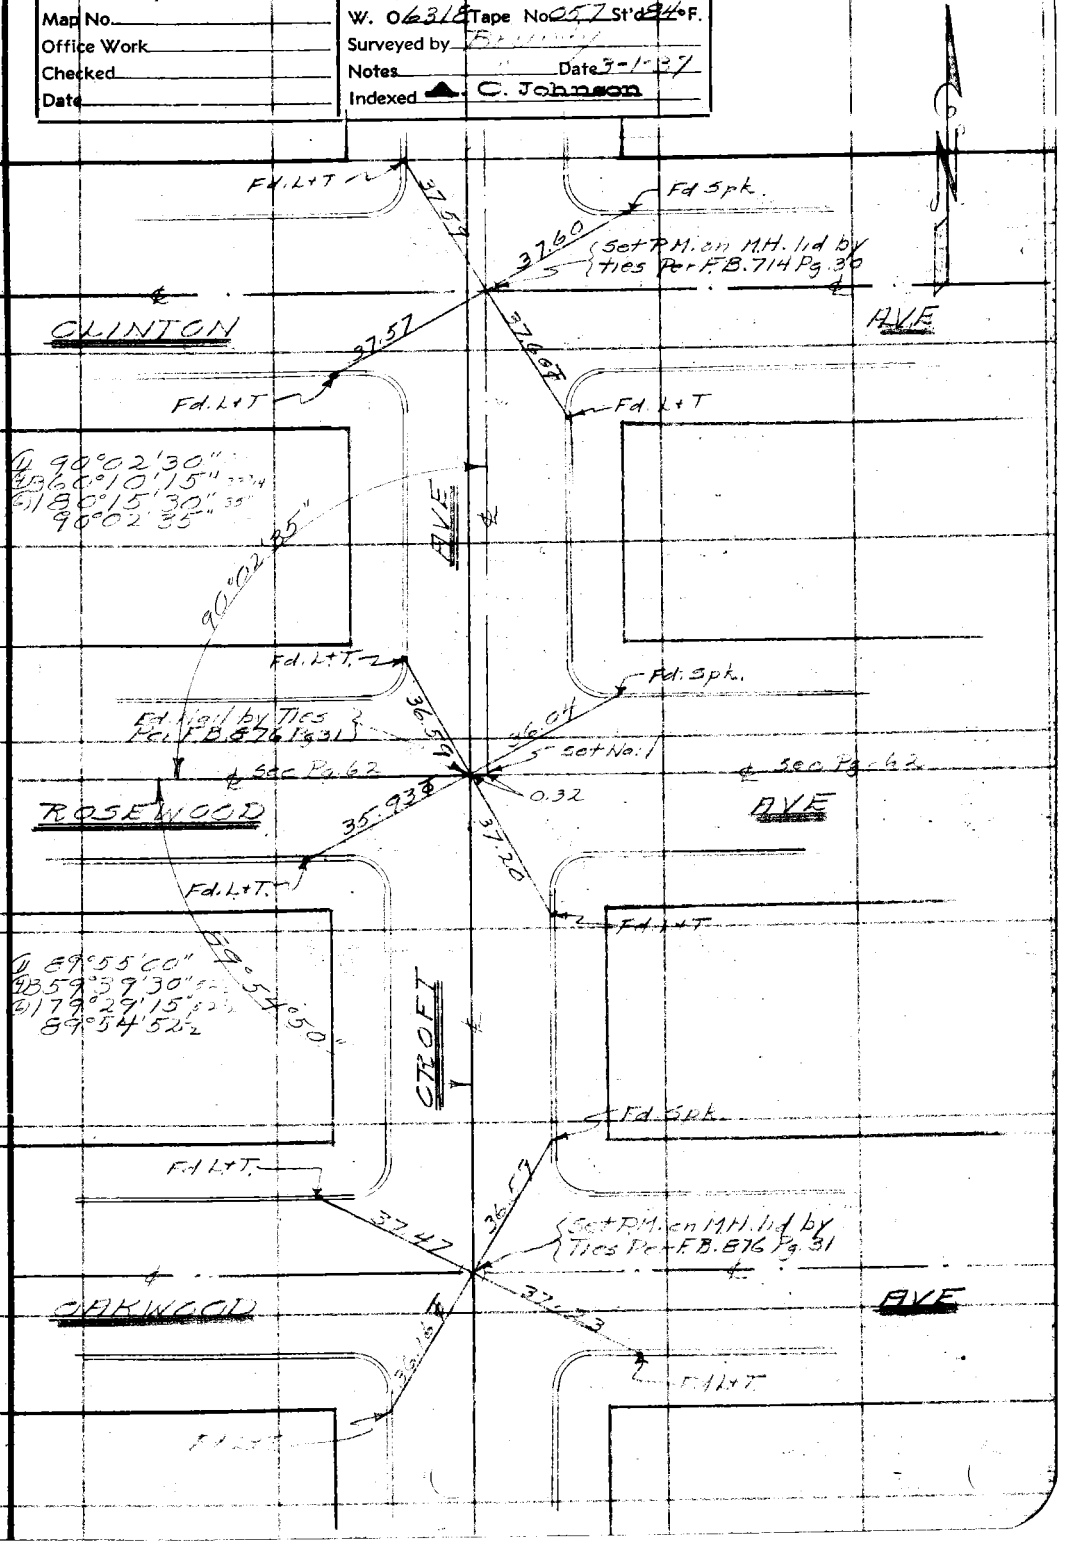

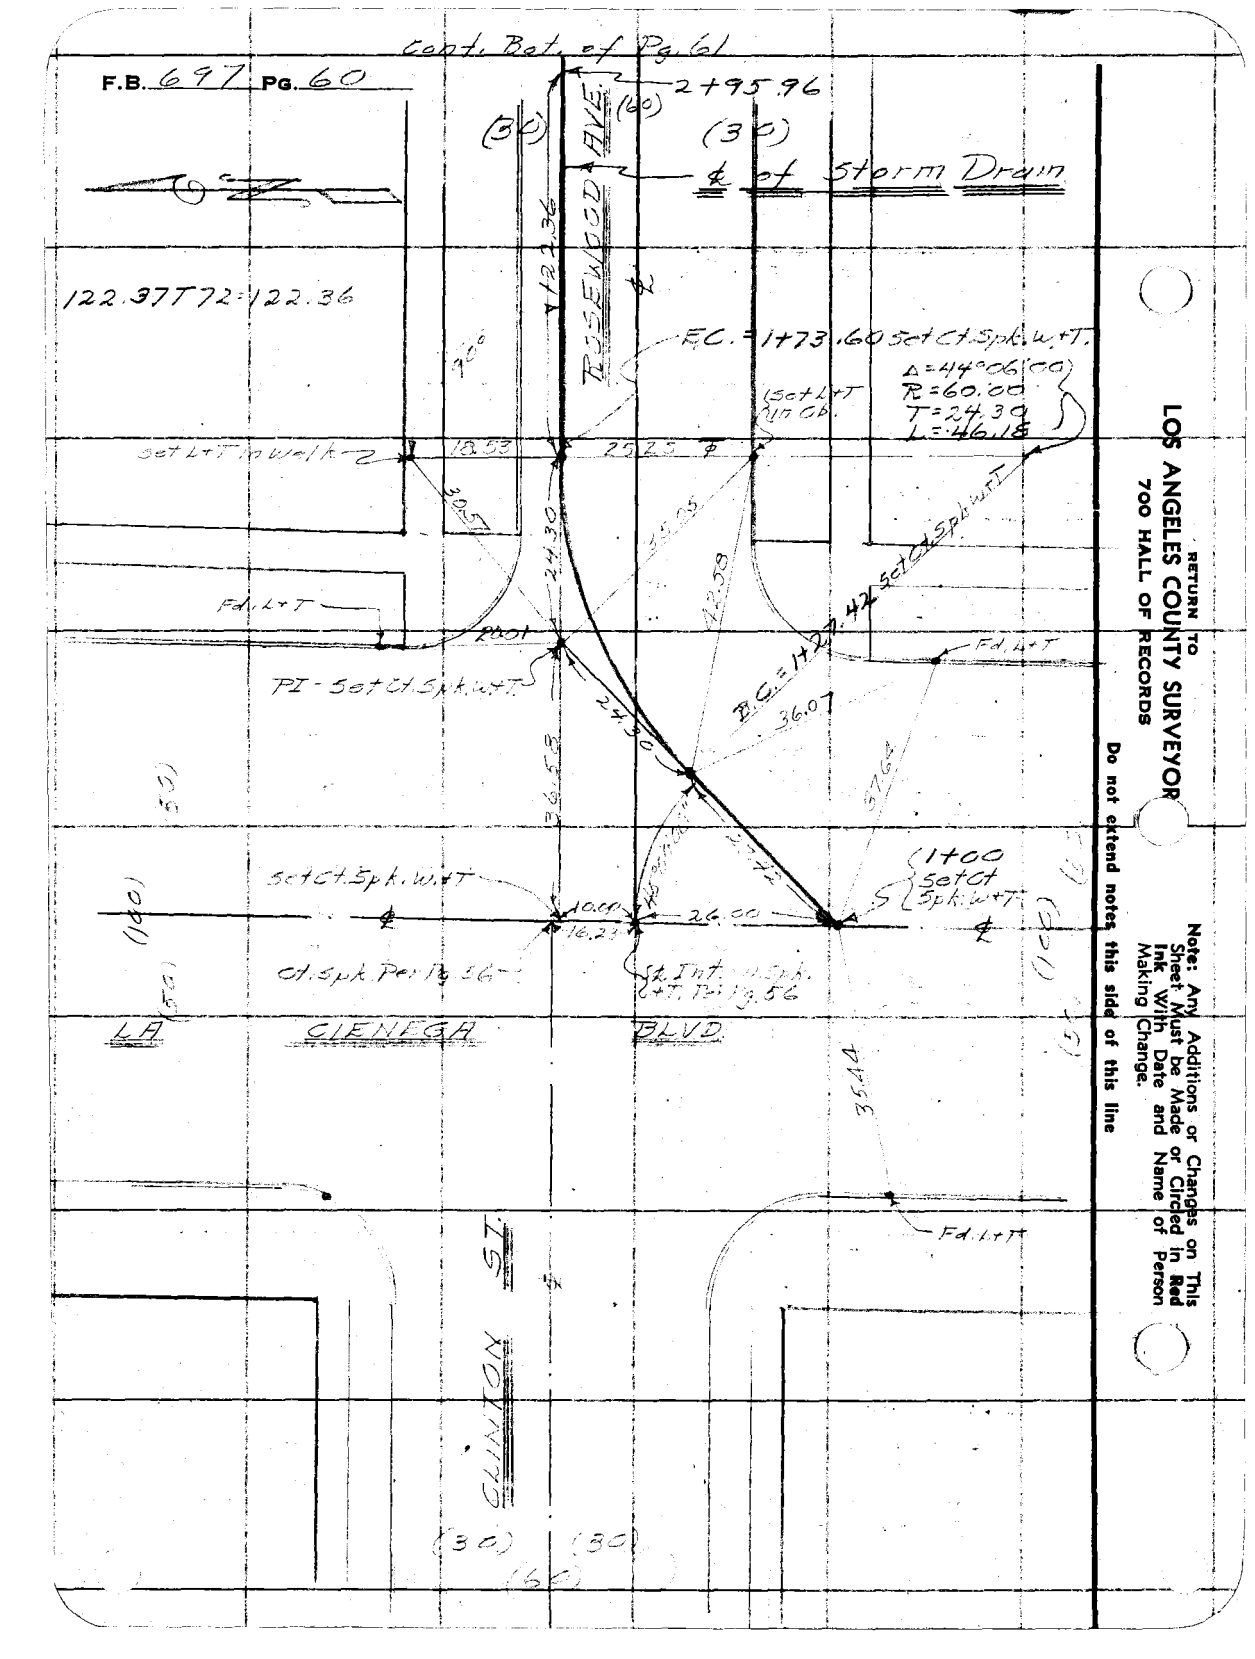

RETURN TO
LOS ANGELES COUNTY SURVEYOR
700 HALL OF RECORDS

Do not extend notes this side of this line

Note: Any Additions or Changes on This Sheet Must be Made or Circled in Red Ink With Date and Name of Person Making Change.

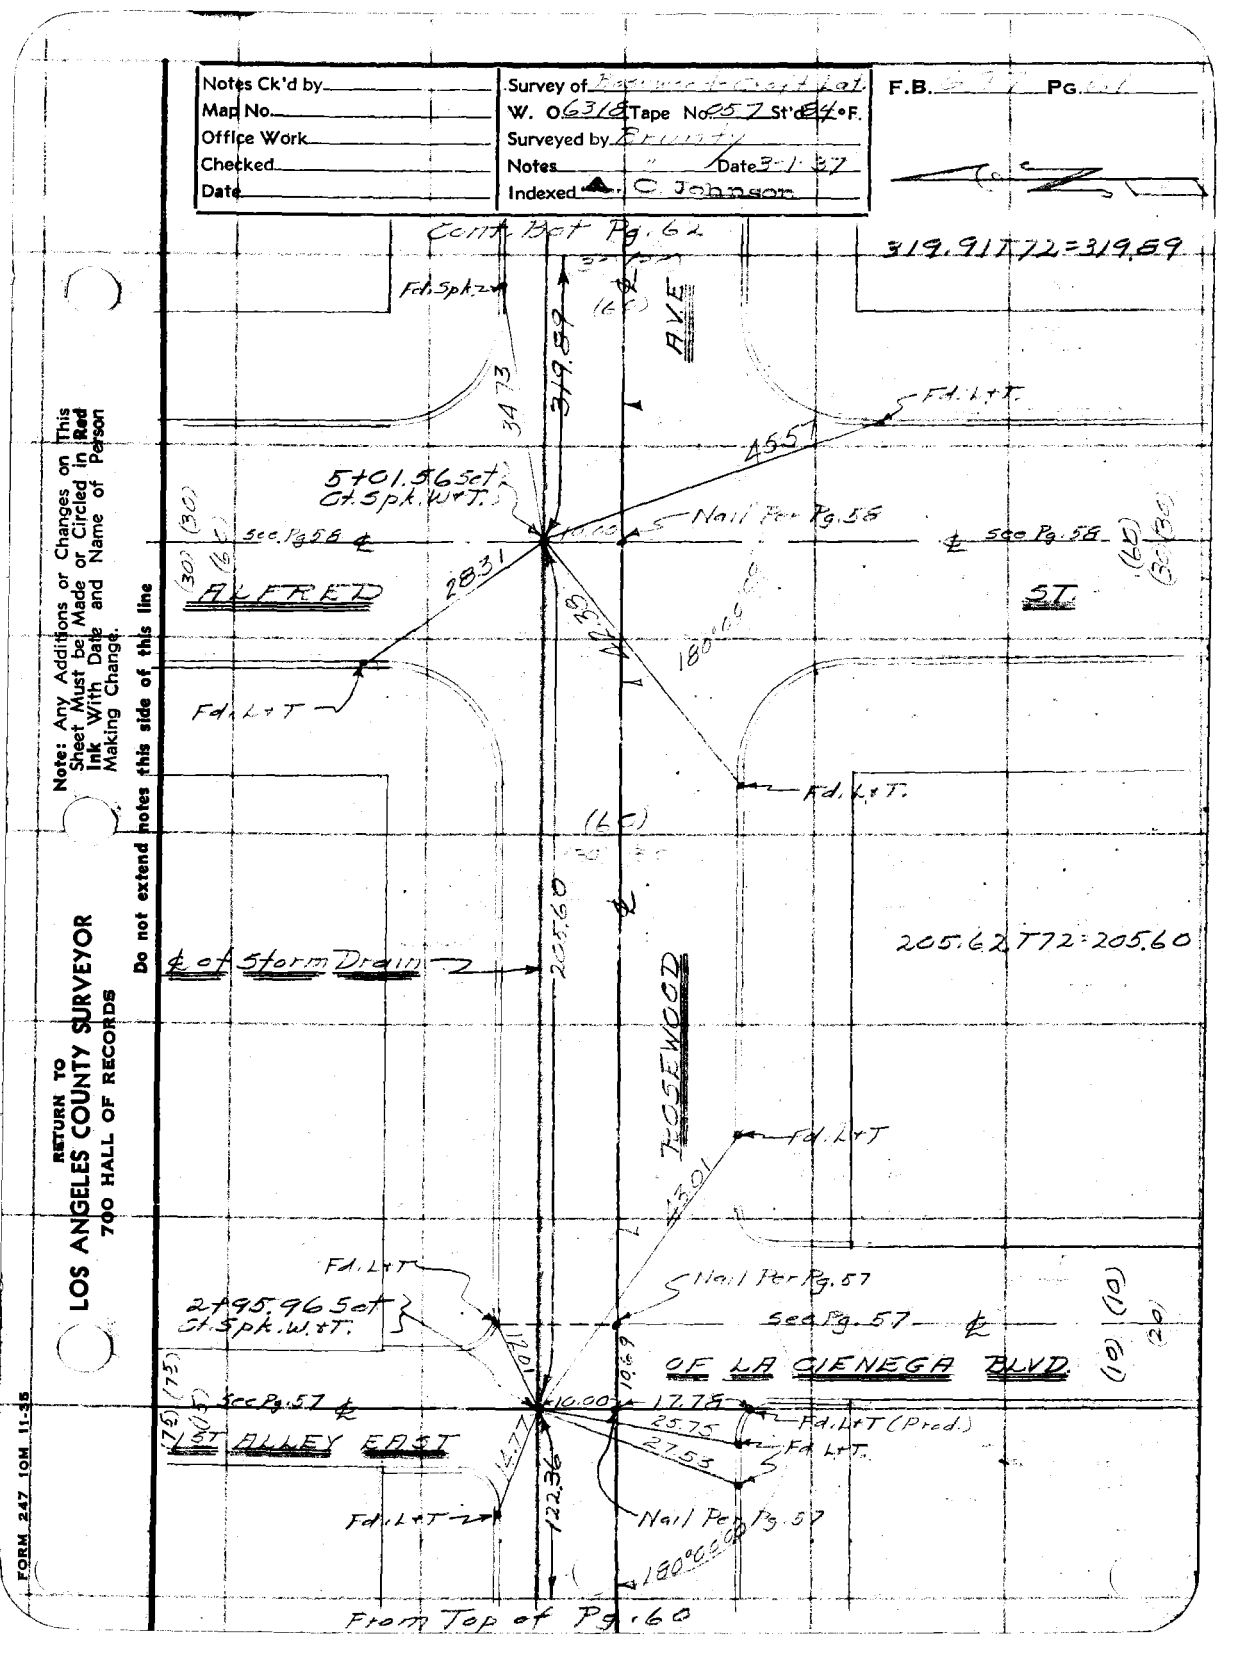
Notes Ck'd by
Map No.
Office Work
Checked
Date
Survey of
W. O. 6318 Tape No. 257 St'd 64°F.
Surveyed by
Notes
Date 3-1-37
Indexed C Johnson
F.B. Pg.
Cont. Bot Pg. 62
319.91 T 72 = 319.89
Fd. Spk.
AVE
319.89
34.73
Fd. L+T.
45.51
5701.56 Set Ct. Spk. W+T.
See Pg. 58
Nail Per Pg. 56
See Pg. 58
ALFRED
ST.
28.31
180°16'
Fd. L+T
Fd. L+T.
(LC)
Note: Any Additions or Changes on This Sheet Must be Made or Circled in Red Ink With Date and Name of Person Making Change.
Do not extend notes this side of this line
RETURN TO
LOS ANGELES COUNTY SURVEYOR
700 HALL OF RECORDS
℄ of Storm Drain 2
205.60
205.62 T 72 = 205.60
ROSEWOOD
Fd. L+T
43.01
Fd. L+T
2495.96 Set Ct. Spk. W. +T.
Nail Per Pg. 57
See Pg. 57
OF LA CIENEGA BLVD
See Pg. 57
1ST ALLEY EAST
10.00
17.78
25.75
Fd. L+T (Prod.)
27.53
Fd. L+T.
Fd. L+T
122.36
Nail Per Pg. 57
180°06'30"
From Top of Pg. 60
FORM 247 10M 11-35

F.B. 697 Pg. 62

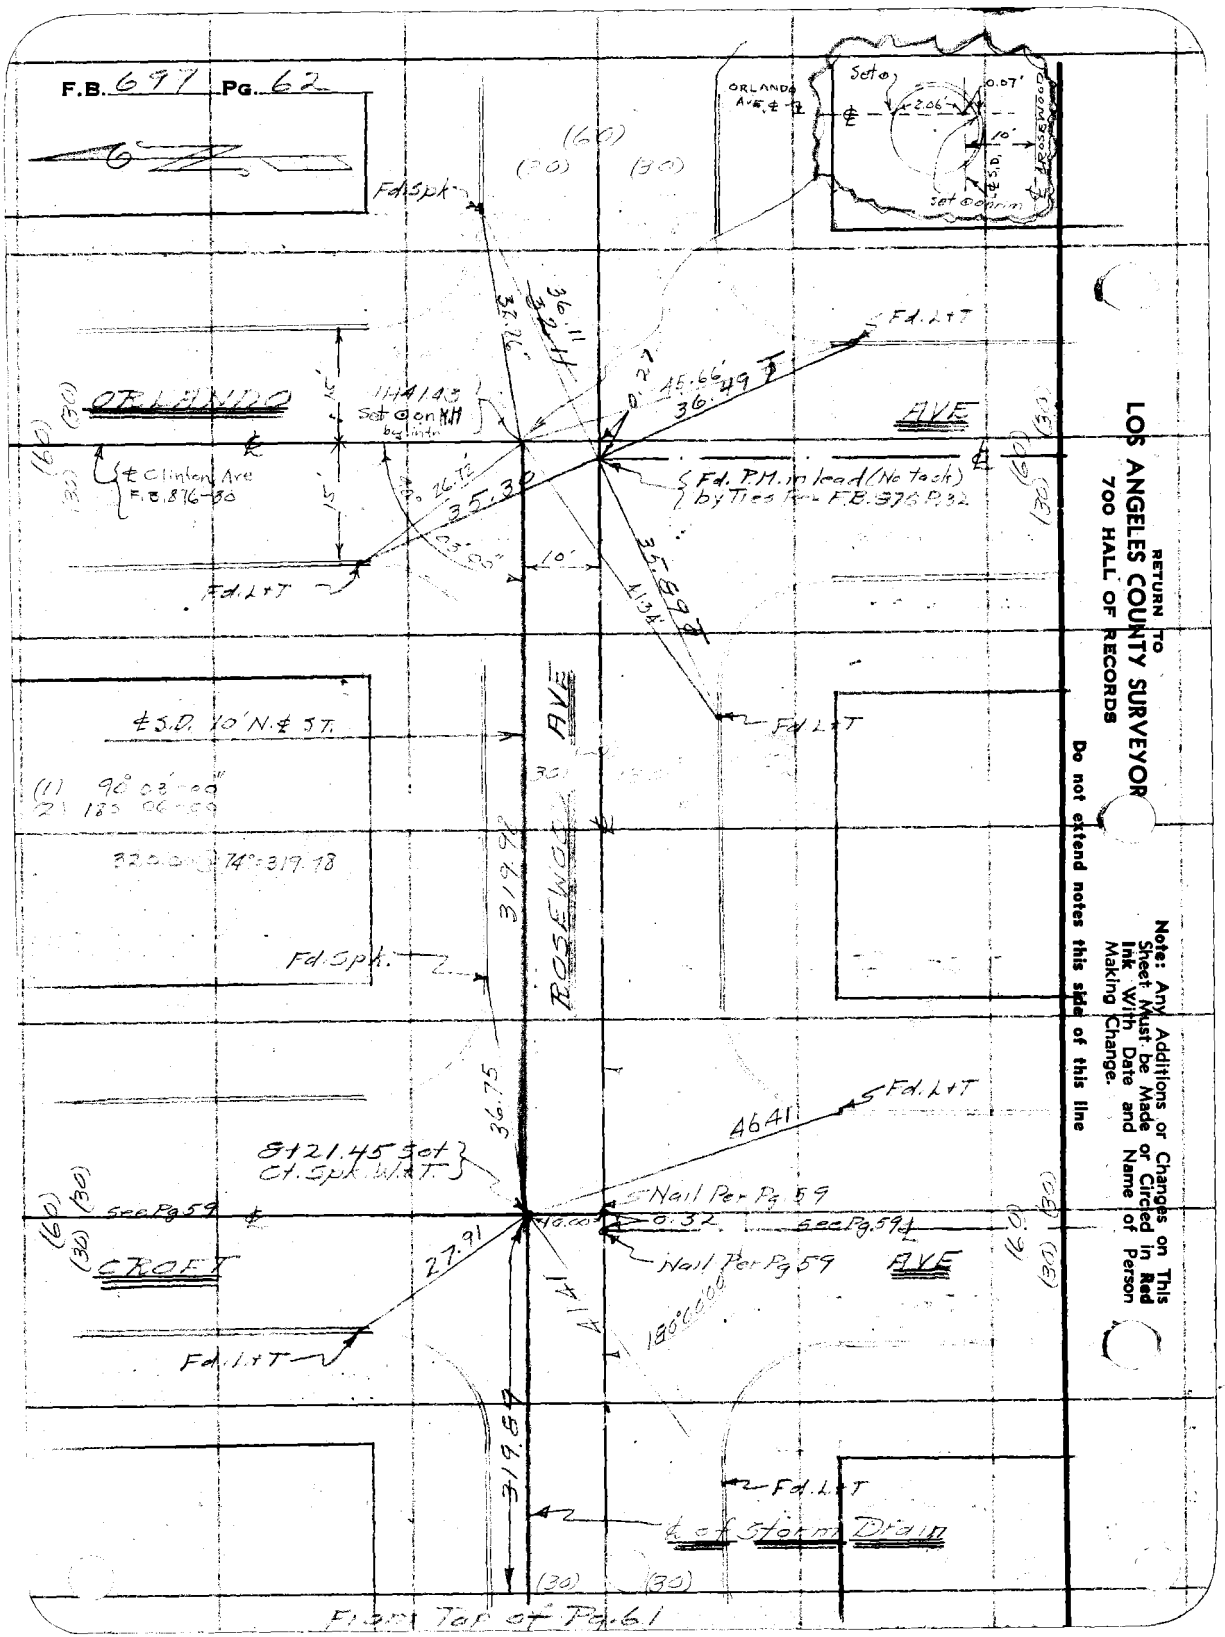

RETURN TO
LOS ANGELES COUNTY SURVEYOR
700 HALL OF RECORDS

Note: Any Additions or Changes on This Sheet Must be Made or Circled in Red Ink With Date and Name of Person Making Change.

Do not extend notes this side of this line

Notes Ck'd by	Survey of Rosewood Ave Lat
Map No.	W. O 6318 Tape No 052 St'd 84° F.
Office Work	Surveyed by Brunty
Checked	Notes " Date 3-2-37
Date	Indexed C. Johnson

F.B. 217 PG. 63

TOPOGRAPHY

WEST HOLLYWOOD DRAINAGE SYSTEM

ROSEWOOD - ~~CROFT~~ ORLANDO AVE LATERAL

J.N. 6318

SHEET (3)

For ℄ Survey see Pge. 55 to 62 Incl.
For ℄ Profile see Pge 67 to 76 Incl.

C.E. Brunty - Chief
H.M. Smith - Transit
J.L. Willey - Notes
M.A. Van Deren - R. Chain

Note: Any Additions or Changes on This Sheet Must be Made or Circled in Red Ink With Date and Name of Person Making Change.

Do not extend notes this side of this line

RETURN TO
LOS ANGELES COUNTY SURVEYOR
700 HALL OF RECORDS

MAR 10 1937

RECEIVED ✓ ✓
PROGRESSED ✓ ✓
BOOK INDEXED ✓ ✓
MAP INDEXED ✓ ✓
RECORD INDEXED ✓ ✓
CARD INDEXED ✓ ✓

FORM 247 10M 11-35

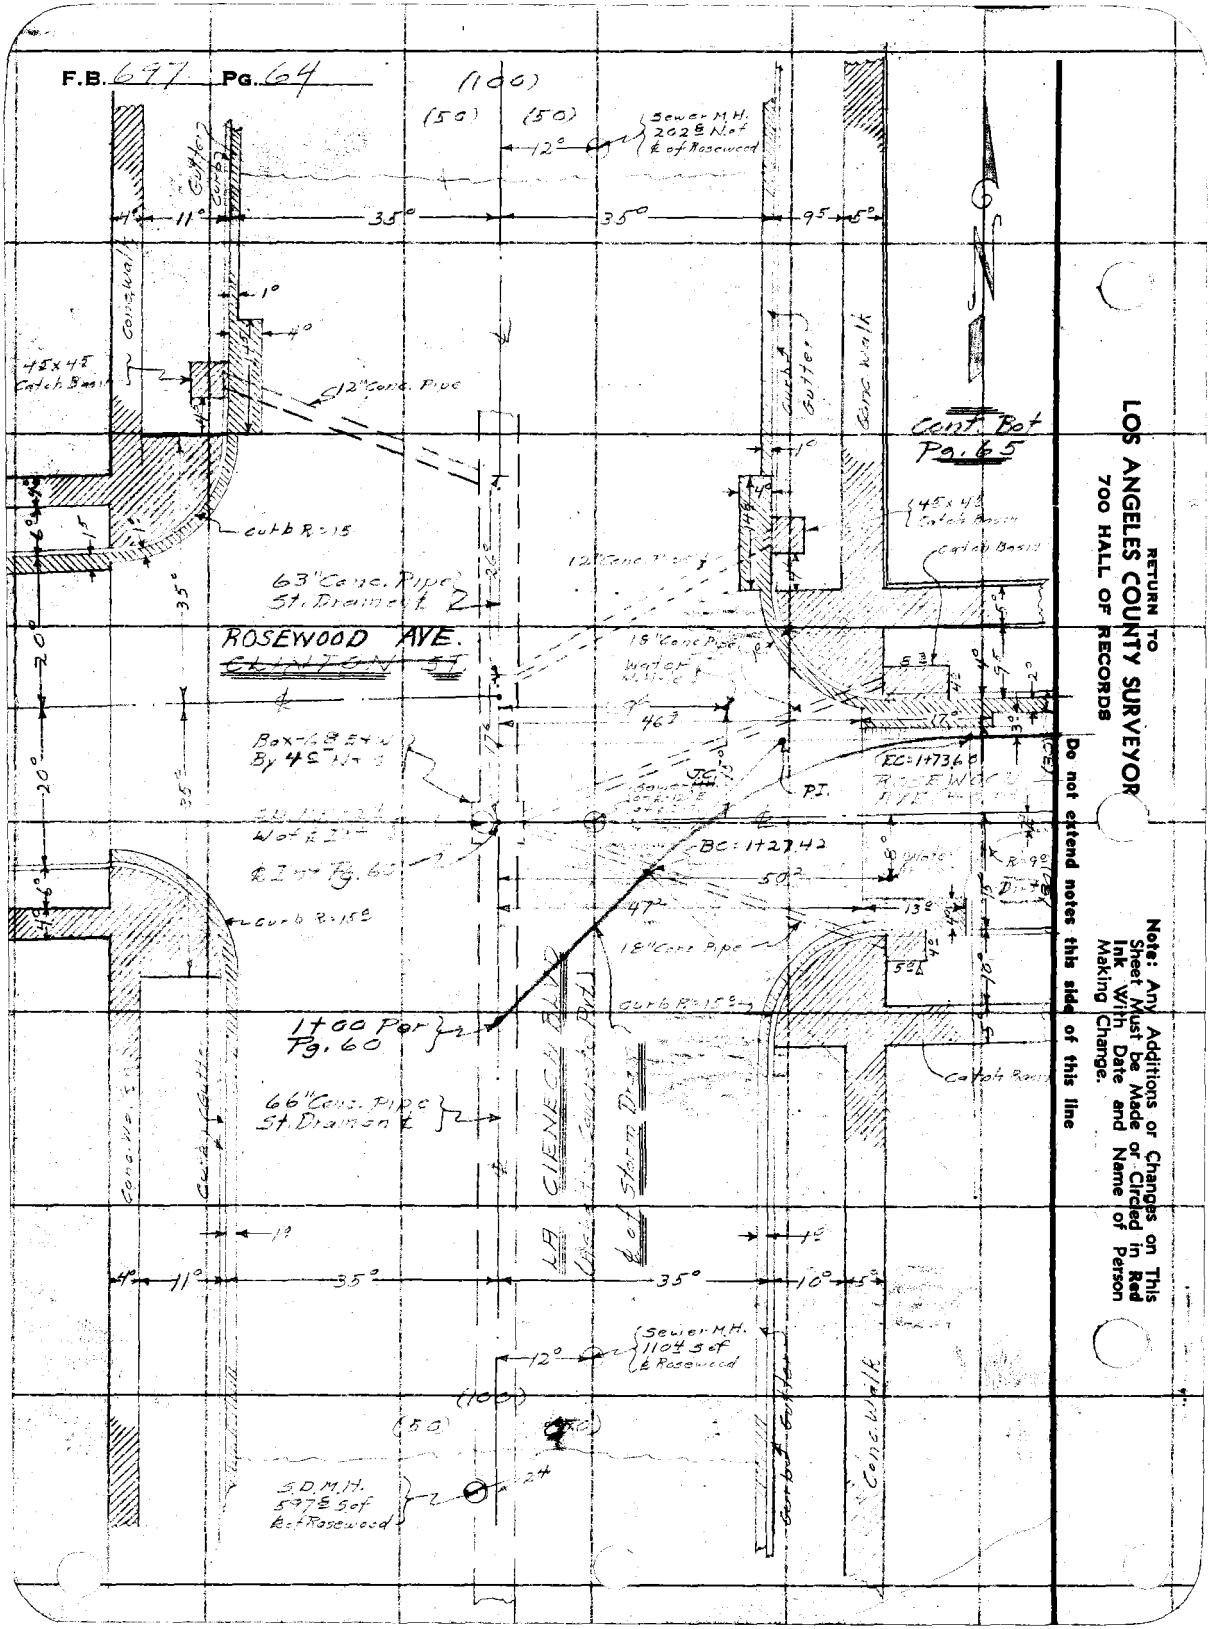

RETURN TO
LOS ANGELES COUNTY SURVEYOR
700 HALL OF RECORDS

Note: Any Additions or Changes on This Sheet Must be Made or Circled in Red Ink With Date and Name of Person Making Change.

Do not extend notes this side of this line

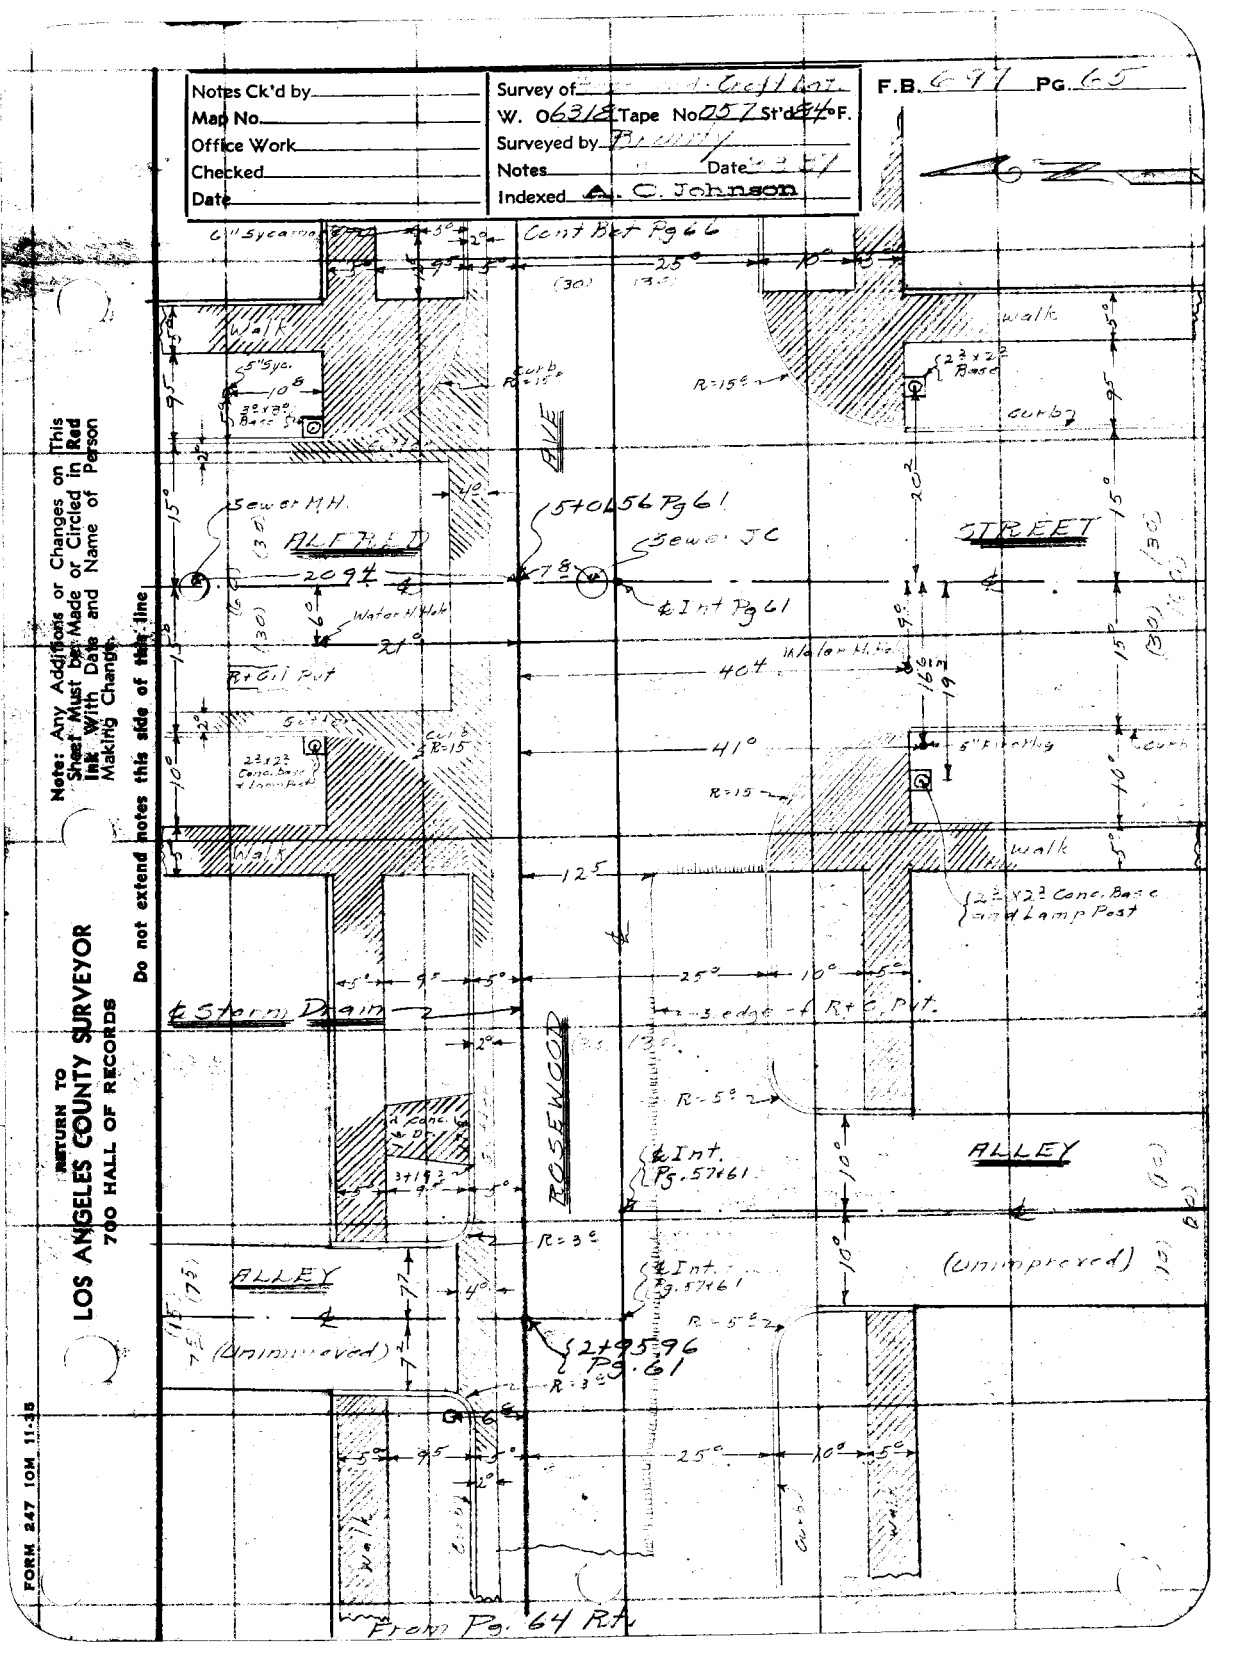
Notes Ck'd by
Map No.
Office Work
Checked
Date
Survey of 1 Cycl Anz
W. 0631 Tape No 057 St'd 54°F.
Surveyed by PS County Date 2-27
Notes
Indexed A. C. Johnson
Cont Bkt Pg 66
6" Sycamore
walk
curb
R=15
ALLEY
Sewer MH
540/56 Pg 61
Sewer JC
STREET
℄ Int Pg 61
Water M/H
R+G.I Put
404
41°
5" Fir
walk
2½ x 2½ Conc. Base & Lamp Post
125
℄ Storm Drain
3 edge of R+G Put.
ROSEWOOD
℄ Int. Pg. 57/61
ALLEY
(Unimproved)
2795/96 Pg. 61
From Pg. 64 RA
Note: Any Additions or Changes on This Sheet Must be Made or Circled in Red Ink With Date and Name of Person Making Change
Do not extend notes this side of this line
RETURN TO
LOS ANGELES COUNTY SURVEYOR
700 HALL OF RECORDS
FORM 247 10M 11-55

F.B. 697 PG. 66

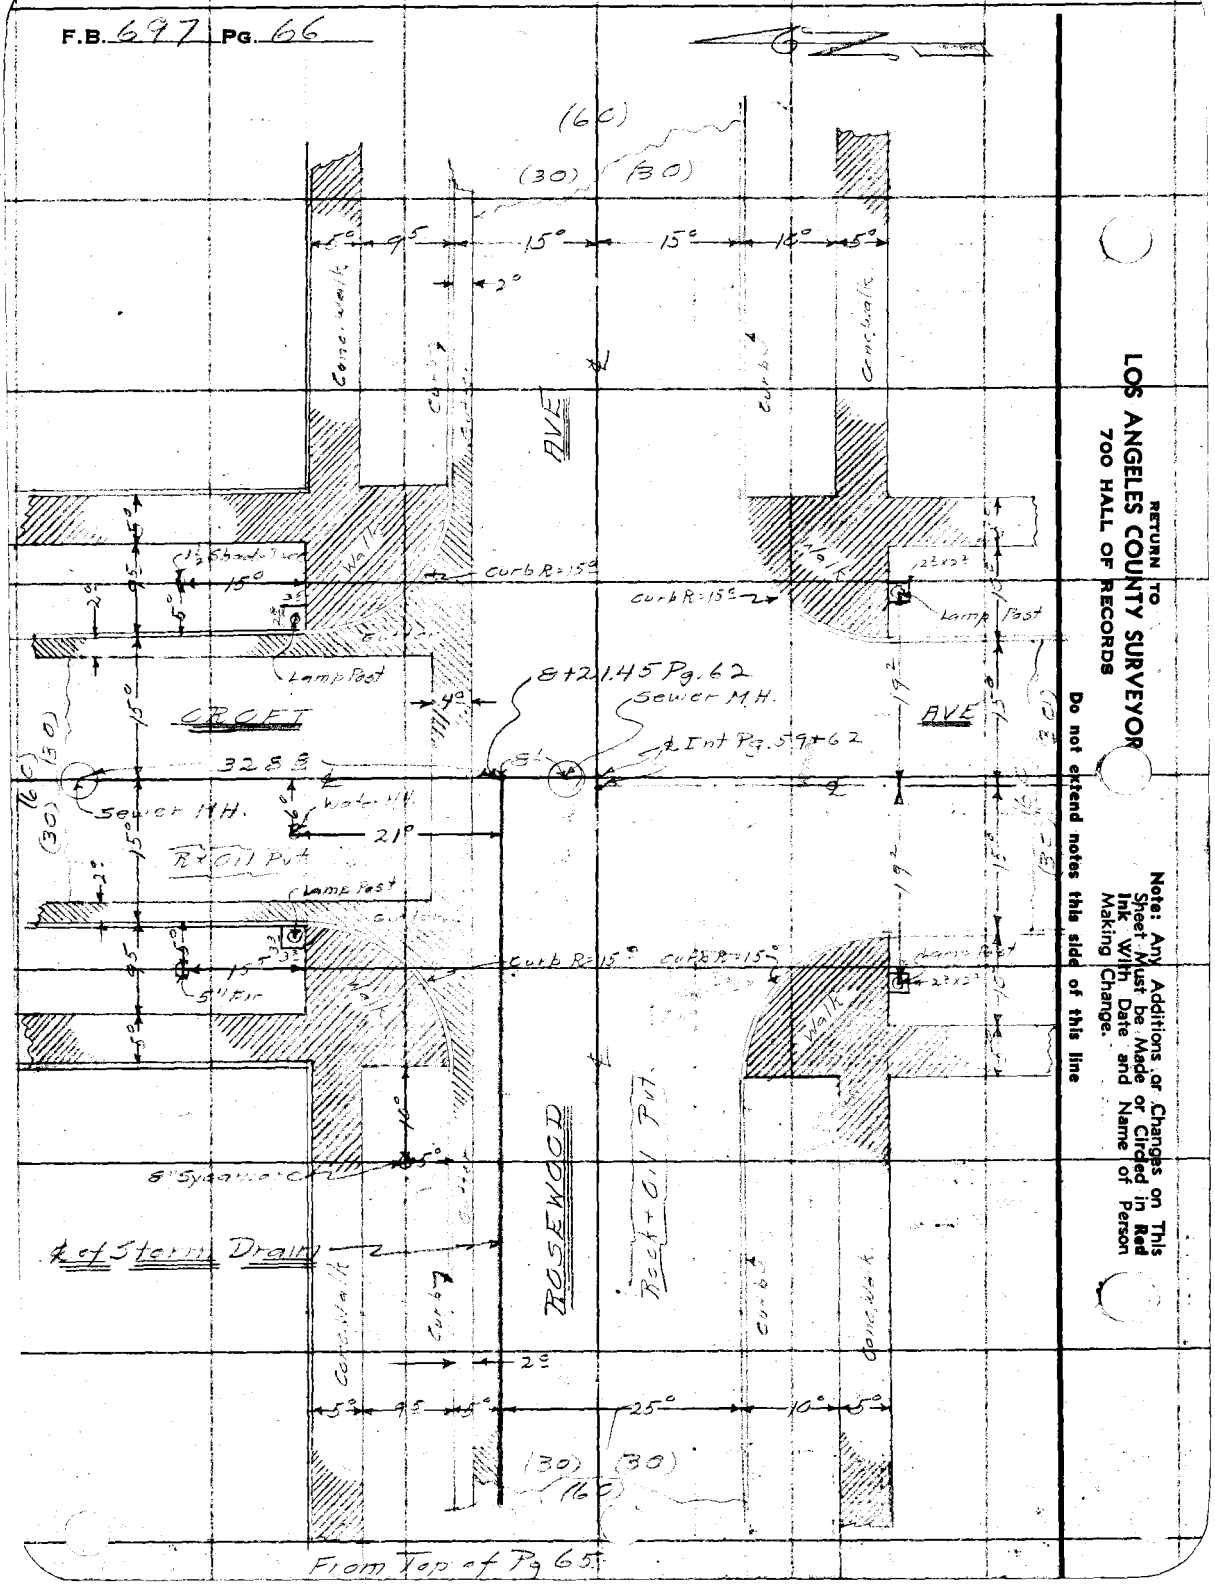

RETURN TO
LOS ANGELES COUNTY SURVEYOR
700 HALL OF RECORDS

Note: Any Additions or Changes on This Sheet Must be Made or Circled in Red Ink With Date and Name of Person Making Change.

Do not extend notes this side of this line

E 2+21.45 Pg. 62
Sewer M.H.
2 Int Pg. 59+62

From Top of Pg 65

Notes Ck'd by	Survey of
Map No.	W. O. 6338 Tape No. St'd °F.
Office Work	Surveyed by
Checked	Notes Date 5-37
Date	Indexed A. C. Johnson

F.B. 317 PG. 66A

Note: Any Additions or Changes on This Sheet Must be Made or Circled in Red Ink With Date and Name of Person Making Change.

Do not extend notes this side of this line

RETURN TO
LOS ANGELES COUNTY SURVEYOR
700 HALL OF RECORDS

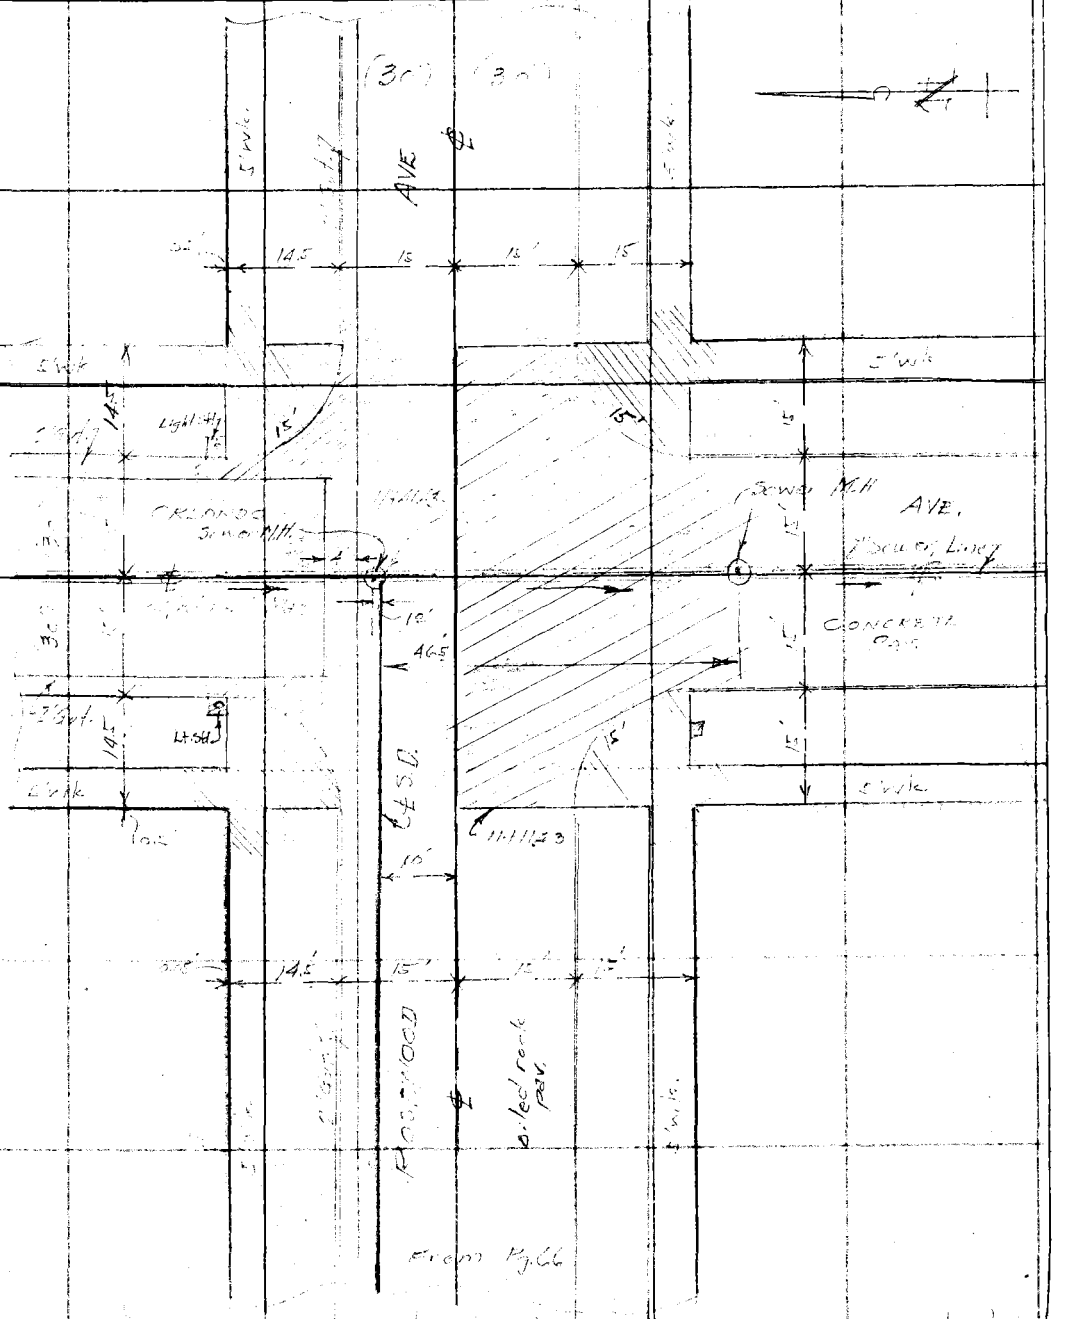

FORM 247 10M 11-38

RETURN TO
LOS ANGELES COUNTY SURVEYOR
700 HALL OF RECORDS

Note: Any Additions or Changes on This Sheet Must be Made or Circled in **Red Ink** With Date and Name of Person Making Change.

Do not extend notes this side of this line

F.B. 697 PG. 66B

Profile No. | Notes Red | Plotted | Job No. | Division No. | F. B. | Pg. 47

X-Sec. No. | Notes Chkd | Checked | Survey by | Notes | Date

Date | Date | Survey of | Indexed C Johnson | Date

NOTE: ANY ADDITIONS OR CHANGES ON THIS SHEET MUST BE MADE OR CIRCLED IN RED INK, WITH DATE AND NAME OF PERSON MAKING CHANGE

Do not extend notes this side of this line

STATION | B. S. | H. I. | F. S. | ELEV.

CENTER LINE PROFILE

WEST HOLLYWOOD DRAINAGE SYSTEM

ORLANDO

ROSEWOOD ~~CREEK~~ AVE LATERAL

SHEET (3)

For Continuity - See Pgs. 55 to 62 Incl.

For Topography - See Pgs 63 to 66 Incl.

C.E. Blunty - Chief

H.M. Smith - Notes

[illegible] - Level

M.A. VanDeren - Rod.

RECEIVED MAR 10 1937

PROGRESSED

BOOK INDEXED

MAP INDEXED

RECORD INDEXED

CARD INDEXED

REDUCED Field

CHECKED

PLEASE RETURN TO
LOS ANGELES COUNTY SURVEYOR
700 HALL OF RECORDS

Form 307 5M 11-35

Form 307 5M 11-35

PLEASE RETURN TO
LOS ANGELES COUNTY SURVEYOR
700 HALL OF RECORDS

NOTE: ANY ADDITIONS OR CHANGES ON THIS SHEET MUST BE MADE OR CIRCLED IN RED INK, WITH DATE AND NAME OF PERSON MAKING CHANGE

Do not extend notes this side of this line

F. B. [illegible] Pg. 68 | Job No. [illegible] | Division No. [illegible] | Notes Red. | Plotted | Profile No.
Survey of [illegible] | Date | Date | X-Sec. No.
Survey by [illegible] C. Johnson | Notes | Notes Chkd. | Checked
Indexed [illegible] | Date | Date | Date

STATION	B. S.	H. I.	F. S.	ELEV.	
B.M. [illegible]	4.00	179.52		175.52	{B.M. [illegible] Elev. 175.52 Reinforced tie-rod Orange Strd. - N.W. cor. Wire up 0.2 ± [illegible] Road Sta. 8
Intersection			2.03	177.49	Int. [illegible] Ave. & Orange Strd
			5.44	174.08	100' So. " " " " " " " "
			6.38	173.14	" " P.C. W. side " "
			5.54	173.98	" " Gut " " " "
			7.31	172.21	" " P.C. E " " "
			5.80	173.72	Sta. " " " "
Intersection			4.48	175.34	Int. & Clinton St. " " "
			3.64	176.18	Sta. No. " " " "
			4.47	175.35	" " P.C. W. side " " "
			2.60	177.22	" " " Gut " " " "
			3.52	176.30	" " " P.C. " " "
			4.05	175.77	" " " Gut " " "
			3.83	176.00	" Int. Orange & Clinton St.
			5.58	174.25	" " " " P.C. W. side Clinton St.
			6.16	173.67	" " " " Gut " " " "
			5.50	174.33	" " " " P.C. " " "
			5.96	173.87	" " " " Gut " " " "

Form 307 5M 11-35

PLEASE RETURN TO
LOS ANGELES COUNTY SURVEYOR
700 HALL OF RECORDS

NOTE: ANY ADDITIONS OR CHANGES ON THIS SHEET MUST BE MADE OR CIRCLED IN RED INK, WITH DATE AND NAME OF PERSON MAKING CHANGE

Do not extend notes this side of this line

STATION	B. S.	H. I.	F. S.	ELEV.		
		179 82				
			561	[illegible]	Tp. Co. Cord [illegible] SW Cor. Ch. [illegible]	
			616	[illegible]	Gutter " " " " " " " " " "	
			642	114 45	Tp Ch " " " " " " " " " "	
			542	123 90	Gut. " " " " " " " " " "	
			510	94 15	Tp Ch " " " " N.W. " " "	
			536	142 16	Gut " " " " " " " " " "	
			704	132 75	Tp Ch " " " " " " " " " "	
			550	132 27	Gut " " " " " " " " " "	
			501	142 16	Tp Ch. " " " " N.E. " Reference Line	
			456	175 23	Gut " " " " " " " " " "	
			402	115 21	Tp Ch " " " " " " " " " "	
			158	174 98	Gut. " " " " " " " " " "	
			421	175 41	Tp Ch " " " " S.E " " " "	
			490	174 92	Gut " " " " " " " " " "	
			458	170 24	Tp Ch " " " " " " " " " "	
			417	174 65	Gut " " " " " " " " " "	
			151	172 01	FL 12" [illegible] Pipe catch basin N.W. Cor	
			753	172 27	FL 12" [illegible] Pipe Nord CBR. N.E. Cor	
			672	173 10	" 18" " " E " " " " "	
			712	172 70	" 18" " " " " " " S.E "	

No. [illegible] Profile
No. [illegible] Notes Red [illegible] Plotted [illegible] Job No. [illegible] Division No. [illegible]
X-Sec. Date [illegible] Date [illegible] Survey of [illegible]
Notes Chkd. [illegible] Checked [illegible] Survey by [illegible] Notes Johnson Date 2-3-37
Date [illegible] Date [illegible] Map No. [illegible] Indexed [illegible] Date [illegible]

F. B. PG. 69

Form 307 5M 11-35

PLEASE RETURN TO
LOS ANGELES COUNTY SURVEYOR
700 HALL OF RECORDS

NOTE: ANY ADDITIONS OR CHANGES ON THIS SHEET MUST BE MADE OR CIRCLED IN RED INK, WITH DATE AND NAME OF PERSON MAKING CHANGE

Do not extend notes this side of this line

Profile No. ____ X-Sec. No. ____

Job No. ____ Division No. ____ Notes Red. ____ Plotted ____ Date ____

Survey of ____ Date ____ Notes Chkd. ____ Checked ____ Date ____

Survey by A. C. Johnson Notes ____ Date ____ Date ____ Date ____

Indexed ____

F. B. 87 Pg. 70

STATION	B. S.	H. I.	F. S.	ELEV.		
		179.82				
D.C.			11.65	162.22	D.C. 12" RCP ... 15" ... N	
			[illegible]	[illegible]	[illegible]	
			16.54	163.28	[illegible]	
S.M.H.					S.M.H. No 1-1252 ...	
			18.45	161.37	F.L. 15" ... N	
			18.50	161.32	F.L. 15" ...	
S.M.H.					S.M.H. ... N ... E & I ...	
			13.11	166.71	F.L. 15" ... N	
			13.84	166.39	F.L. 15" ... S.	
S. M.H.			13.42	[illegible]	E & Int F.L. 32 ... N	
			13.22		F.L. 66" ...	
			12.27		... 15" ... E	
			12.27	[illegible]	... 5" ... E	
S.M.H.			18.34	161.48	S.M.H. ... Int F.L. 66" ... N	
			18.50	161.32	F.L. 66" ...	
1+00			4.78	175.04	E.S.D. Int ... Blvd.	
1+27.42 E.C.			4.53	175.29	E.S.D.	
1+75 ± E.C.			4.32	175.50	E.S.D.	
2+00			4.18	175.64	E.S.D.	

1) 0.5
1.25 D
1.40 R
11.40

11.40
1.25 D
1.41 R
11.54

1.179 1.188
1.25 D 1.25 D
5.41 R 5.43 R
18.45 18.56

1.538 1.571
1.25 D 1.25 D
2.90 R 2.93 R
16.77 16.89

900 900 775 775
1.52 R 1.52 R 1.52 R 1.52 R
13.52 13.52 12.27 12.27

955 N 955 N
18.34 18.50

Form 307 5M 11-35

PLEASE RETURN TO
LOS ANGELES COUNTY SURVEYOR
700 HALL OF RECORDS

NOTE: ANY ADDITIONS OR CHANGES ON THIS SHEET MUST BE MADE OR CIRCLED IN RED INK, WITH DATE AND NAME OF PERSON MAKING CHANGE

Do not extend notes this side of this line

Profile No. X-Sec. No.

Notes Red Plotted Job No. Division No.
Date Date Survey of
Notes Chkd. Checked Survey by
Date Date Map No.

F. B. PG.

Notes Indexed Date
C. Johnson Date 3-30

STATION	B. S.	H. I.	F. S.	ELEV.		
		179 12				
2+00			2 00	175 12	C.L. & Intersecting line.	
2+95.95	Int.		2 99	176 83	S.D. Int. & Alley	Cor. To.
			2 38	177 44	20'L " "	N.P.L.
			14	178 4	100'L " "	
			2 75	177 01	Tp. Cb. Corner Co. & W. side Alley.	
			3 41	176 41	" " " " " "	
			2 57	177 25	Tp Cb " " " E "	
			3 21	176 61	Gut " " " " "	
			2 44	177 38	Tp Cb. N end Cb. W side Alley. No. H.	
			2 20	177 62	" " " " E " "	
3+00			2 93	176 84	℄ S.D.	
Int.			2 73	177 09	℄ Int. & Redwood Ave & Alley Cor.	
			3 0	176 8	30'R S.P.L.	4 " "
			2 6	177 2	100'R	" " "
			3 16	176 66	Tp Cb. Cent. Cor. R/W Cor. Alley So.	
			3 87	175 95	Gutter " " " "	
			2 92	176 90	Tp Cb. " " " E "	
			3 52	176 30	Gut. " " " " "	
			2 81	177 01	Tp. Cb. Sand Cb. N. side	
			2 62	177 20	" " " " " "	

Form 307 5M 11-35

PLEASE RETURN TO
LOS ANGELES COUNTY SURVEYOR
700 HALL OF RECORDS

NOTE: ANY ADDITIONS OR CHANGES ON THIS SHEET MUST BE MADE OR CIRCLED IN RED INK, WITH DATE AND NAME OF PERSON MAKING CHANGE

Do not extend notes this side of this line

F. B. 1 PG. 72 | Job No. | Division No. | Notes Red | Plotted | Profile No.
Survey of | Date | Date | X-Sec. No.
Survey by C. Johnson | Notes | Notes Chkd | Checked
Indexed | Date | Date | Date

STATION	B. S.	H. I.	F. S.	ELEV.		
		179'82				
T.P			2.30	177 52		
	6.01	183'53				
4+00			5.71	177 82	4 S.D.	
			5.51	178 02	10' R & Redwood Tree	
3+01.6 B.T.			4.59	178 94	4 S.D & & Alfred St	
			3.78	179 75	100' L " " "	
			3.98	179 55	" " TpCb W Side	Alfred St
			4.54	178 99	" " Cut " "	" "
			3.56	179 97	" " TpCb E. "	" "
			4.05	179 48	" " Cut " "	" "
			4.50	179 03	10' R & Tnt. Redwood	Ave & Alfred St.
			5.41	178 12	110' R	& " "
			6.03	177 50	" " TpCb W Side	Alfred St
			6.90	177 63	" " Cut " "	" "
			8.46	175 07	" " TpCb " "	" "
			9.47	174 06	" " Cut " "	" "
			4.61	178 92	TpCb W end No. R	Mission
			5.17	178 36	Cut " " " "	" " "
			4.11	179 42	TpCb " " " "	" " "
			4.14	178 59	Cut " " " "	" " "

Form 307 5M 11-35

PLEASE RETURN TO
LOS ANGELES COUNTY SURVEYOR
700 HALL OF RECORDS

NOTE: ANY ADDITIONS OR CHANGES ON THIS SHEET MUST BE MADE OR CIRCLED IN RED INK, WITH DATE AND NAME OF PERSON MAKING CHANGE

Do not extend notes this side of this line

Profile No. X-Sec. No.
Notes Red. Date Notes Chkd. Date Map No.
Plotted Date Checked Date
Job No. Division No. Survey of Survey by Indexed
Notes Date Date
F.B. PG. 73

STATION	B. S.	H. I.	F. S.	ELEV.					
		178 53							
			5.15	178 38	Tp Cb W Cor.				
			5 66	177 87	Gut.				
			5 18	178 30	Tp Cb S "				
			5 69	177 34	Gut "				
			1 [illegible]	178 81	Tp Cb "				
			[illegible] 33	178 20	Gut "				
			4 54	178 79	Tp Cb E "				
			0 23	178 30	Gut "				
			[illegible]	[illegible]	Tp Cb "				
			[illegible]	[illegible]	Gut "				
			3 76	[illegible] 57	Tp Cb N "				
			4 04	[illegible]	Gut "				
D.C.					[illegible] N. Int. [illegible]				
			[illegible]	[illegible]	F" In. N	9.20 C 67D 9.14 R	9.14 C 67D 9.08 R	9.76 C 67 9.70 R	9.26 67 9.20 R
			[illegible] 40	169 13	8" In. E	4.60 R 14.47	4.67 R 13.40	4.67 R 12.50	4.56 [illegible]
			12 00	171 53	8" Drop In E.				
			2 03	167 [illegible]	8" Out W.				
[illegible]			13 47	170 [illegible]	209 [illegible] S.D.	8" In. N	9.68 C 67D 3.12 R 13 47	9.76 67 3.12 13 55	
			13 55	170 98		8" Out S.			
[illegible] 1403			3 94	179 59	[illegible] S D.				

Form 307 5M 11-35

PLEASE RETURN TO
LOS ANGELES COUNTY SURVEYOR
700 HALL OF RECORDS

NOTE: ANY ADDITIONS OR CHANGES ON THIS SHEET MUST BE MADE OR CIRCLED IN RED INK, WITH DATE AND NAME OF PERSON MAKING CHANGE

Do not extend notes this side of this line

Profile No. _____ X-Sec. No. _____

F. B. 1077 Pg. 74 Job No. _____ Division No. _____ Notes Red. _____ Plotted _____

Survey of _____ Date 2-3-37 Date _____

Survey by A. C. Johnson Notes _____ Notes Chkd. _____ Checked _____

Indexed _____ Date _____ Date _____ Date _____

STATION	B. S.	H. I.	F. S.	ELEV.		
6+00			3 53	179 63	N 44° E & Proposed Ave.	
T.P.			3 37		"	
	5 20	185 36				
			5 08	18 28	" " "	
			4 90	180 46	" " "	
8+00			4 54	180 82	" S.O.	
8+21.45 Station			4 35	15 01	" " " Int. Left line Verth.	
			3 49	181 87	100' North & " "	
			3 30	182 86	" " TpCb Westerly line	
			3 26	182 90	" " Cut " " " "	
			3 41	181 95	" " TpCb E " " "	
			3 96	181 40	" " Cut " " " "	
T.P.			1 17	181 19	" Int. Left line South of S Boundary Ave.	
			5 30	180 06	100' S. Left " "	
			5 20	180 16	" " " TpCb Westerly " "	
			3 73	179 63	" " " Cut " " " "	
			5 10	180 26	" " " TpCb E " " "	
			5 62	179 74	" " " Cut " " " "	
			3 84	5 52	100' E & Intersect Left Ave. V & Boundary Ave.	

Form 307 5M 11-35

PLEASE RETURN TO
LOS ANGELES COUNTY SURVEYOR
700 HALL OF RECORDS

NOTE: ANY ADDITIONS OR CHANGES ON THIS SHEET MUST BE MADE OR CIRCLED IN RED INK, WITH DATE AND NAME OF PERSON MAKING CHANGE

Do not extend notes this side of this line

Profile No.
X-Sec. No.
Notes Rcd. Date
Notes Chkd. Date
Plotted Date
Checked Date
Job No.
Survey of
Survey by
Map No.
Division No.
Notes Indexed
Date
Date
F. B.
Pg.

STATION	B. S.	H. I.	F. S.	ELEV.		
		185 36				
			3 82	181 54	100' E & Int. Tp Cb. S	[illegible] Sherwood Ave.
			4 30	181 06	" " " Cut. "	"
			3 43	181 43	" " " Tp Cb. S	" "
			4 46	180 90	" " " Cut. "	" " "
			4 46	180 90	Tp Cb. W end Cb. R	5 W. Cor.
			4 90	180 46	Cut. " " " "	" " "
			4 45	180 91	Tp Cb. S " " "	" " "
			4 93	180 43	Cut " " " "	" " "
			4 23	181 13	Tp Cb. N " " "	N. W. "
			4 78	180 58	Cut " " " "	" " "
			3 99	181 37	Tp Cb N " " "	" " "
			4 51	180 85	Cut. " " " "	" " "
			4 08	181 28	Tp Cb " " " "	N. E "
			4 58	180 78	Cut " " " "	" " "
			3 98	181 38	Tp Cb E. " "	" " "
			4 51	180 85	Cut. " " " "	" " "
			4 26	181 10	Tp Cb E " "	S. E "
			4 89	180 47	Cut. " " " "	" " "
			4 31	181 05	Tp Cb S. " " "	" " "
			5 03	180 33	Cut. " " " "	" " "

Indexed C. Johnson Date

Form 307 5M 11-35

PLEASE RETURN TO
LOS ANGELES COUNTY SURVEYOR
700 HALL OF RECORDS

NOTE: ANY ADDITIONS OR CHANGES ON THIS SHEET MUST BE MADE OR CIRCLED IN RED INK, WITH DATE AND NAME OF PERSON MAKING CHANGE

Do not extend notes this side of this line

F.B. 697 Pg. 76 | Job No. 4318 Division No. | Notes Red. | Plotted | Profile No.
Survey of West Hollywood D.S. | Date | Date | X-Sec. No.
Survey by C.E. Shurtleff Notes 1" = 20' Smith | Notes Chkd. | Checked
Indexed A. C. Johnson Date | Date | Date

STATION	B. S.	H. I.	F. S.	ELEV.		
		5'9" 36				
S.M.H.					12N & Int. Rosewood Ave & Orange Grove Ave.	
			12 30	175 06	E" I.N.	7.43C 7.60C
			12.18	172 88	E" Out. W.	4 20R 4 21R 12 35 12 48
S.M.H.					32.8 SN & S.D. on & Crest Ave.	
			9 48	175 85	E" In N.	7.09 7.17C
			9 31	175 85	E" Out S.	6 7D 6 7D 1 72R 1 67R 9.48 9.51
S.M.F.D-70	5 78	181 14	2 00	179 36	E.M.F.D-70 Elev. 181.357 F.B. 682 P. 55 Rosewood Ave & Crescent Ave N.E. cor. Use spk 2'E of E. end C.L.R	
					Rosewood Ave.	
9+00			5 91	181 5	℄ S.D.	
10+00			5 53	181 4	"	
			5 31	181	℄ ST 10' Rt	
			5 32	181 42	Top ch. 25 Rt	
			5 38	181 26	Gut "	
			5 12	180 02	ch. 5' Lt	
			5 74	181 40	Gut "	
11+00			5 14	180 00	℄ S.D.	
+11.4			4 96	182 18	℄ ST. edge conc. Pav.	

Form 307 5M 11-35

PLEASE RETURN TO
LOS ANGELES COUNTY SURVEYOR
700 HALL OF RECORDS

NOTE: ANY ADDITIONS OR CHANGES ON THIS SHEET MUST BE MADE OR CIRCLED IN RED INK, WITH DATE AND NAME OF PERSON MAKING CHANGE

Do not extend notes this side of this line

Profile No. ____ Notes Red ____ Plotted ____ Job No. 6318 Division No. ____
X-Sec. No. ____ Date ____ Date ____ Survey of Whittier Woods D.S. F.B. 197 PG. 71
Notes Chkd ____ Checked ____ Survey by ____ Date 6-3-37
Date ____ Date ____ Map No. ____ Indexed J. Johnson Date ____

STATION	B. S.	H. I.	F. S.	ELEV.	Rosewood Ave (cont)	
		187 14				
			-		Orlando Ave.	
			481	182 33	W. end C.L. & W. Cor	
			534	181 84	Gut " " "	
			476	182 38	S. " " "	
			534	181 80	Gut " " "	
			473	182 41	W. " "	N. W. Cor
			536	181 78	Gut " "	"
			460	182 54	N. " "	"
			525	181 89	Gut " "	"
11+44.43			494	182 20	± intr. of Orlando St	
			515	181 99	Top of M.H. 465 S. & S.D. on ℄ Orlando St	
			14.12	173 02	8" outlet on N.	5.15 / 8.30 / .67 = 14.12 — 5.10 / 8.33 / .67 = 14.19
			14.19	172 95	8" outlet on S.	
			503	182 06	Top of S.M.H. 19' N. & S.D. on ℄ Orlando St	
			12.91	174 23	8" inlet on N.	N. 5.12 / 7.12 / .67 = 12.91 — S. 5.04 / 7.77 / .67 = 13.48
			13.48	173 66	8" outlet on S.	

Form 307 5M 11-35

PLEASE RETURN TO
LOS ANGELES COUNTY SURVEYOR
700 HALL OF RECORDS

NOTE: ANY ADDITIONS OR CHANGES ON THIS SHEET MUST BE MADE OR CIRCLED IN RED INK, WITH DATE AND NAME OF PERSON MAKING CHANGE

Do not extend notes this side of this line

Profile No. ____ X-Sec. No. ____

Job No. 6515 Division No. ____ Notes Red. ____ Plotted ____

Survey of ____ Date ____ Date ____

Survey by Wallace & Johnson Notes ____ Notes Chkd. ____ Checked ____

Indexed ____ Date ____ Date ____ Date ____

F.B. 697 PG. 76B

STATION	B. S.	H. I.	F. S.	ELEV.		
		187 14			ORLANDO ST.	
11+41.43			6 00	181 14	℄ Orlando St.	100' S ℄ int. Rosewood
"			5 41	181 45	W. ob. " "	" " "
"			6 27	180 57	W. Gut " "	" " "
"			5 41	181 13	E. ob " "	" " "
"			6 36	180 78	W. Gut " "	" " "
"			5 27	181 87	x Gutter 5' N ℄ S.D.	
			3 80	183 34	℄ Orlando Ave.	100' N ℄ Rosewood Ave
			3 72	183 42	E. ob. " "	" "
			4 12	182 12	E. Gut " "	" "
			3 15	183 39	W. ob. " "	" "
			4 34	182 80	W. Gut " "	" "
			153	185 61	Top of S.M.H. 30.45' N ℄ of S.D.	
			1057	176 57	1.53	1.14
			1060	176 54	.97	8.29
					.67	.67
					10.57	10.50

Form 307 5M 11-35

PLEASE RETURN TO
LOS ANGELES COUNTY SURVEYOR
700 HALL OF RECORDS

NOTE: ANY ADDITIONS OR CHANGES ON THIS SHEET MUST BE MADE OR CIRCLED IN RED INK, WITH DATE AND NAME OF PERSON MAKING CHANGE

Do not extend notes this side of this line

STATION	B. S.	H. I.	F. S.	ELEV.		
		187 14			Rosemead Blvd.	
					Orig. no Sta.	
			434	182 36	S. end C.R.	S E. Cor
			544	181 76	Cent " "	"
			465	187 47	E. " "	"
			528	181 80	Cent " "	"
			457	182 57	N end C.R.	N.E Cor
			542	182 00	Cent " "	"
			455	182 57	E. " "	"
			521	181 93	Cent " "	"
			487	182 27	E. cor [illegible] int. ℄ Rosemead Blvd	
			439	182 75	℄ Rosemead Blvd [illegible] int. S.E. [illegible]	
			455	182 57	S. cb "	" "
			509	182 42	S. end "	" "
			490	182 52	N. cb "	" "
			501	182 18	N. end "	" "
B.M. 356			257	182 57	B.M. B.69. Elev. 182.57 - Rosemead Blvd. Orig. sta.	
					W. Sub. 32. of 2. on C.R. N. to S.	

Profile

No. _____ Notes Red _____ Job No. 1211 Division No. _____

X-Sec. No. _____ Date _____ Plotted _____ Date _____ Survey of 1951 Rosemead Blvd. Date _____

Notes Chkd _____ Date _____ Checked _____ Date _____ Survey by _____ Map No. _____ Indexed _____ Notes by C. Johnson Date 6-3-52 Date _____

F. B. 697 Pg. 76C

F. B. 697 PG. 76D | Job No. | Division No. | Notes Red. | Plotted | Profile

Survey of | Date | Date | No.

Survey by | Notes | Notes Chkd. | Checked | X-Sec.

Indexed A. C. Johnson | Date | Date | Date | No.

Form 307 5M 11-35

PLEASE RETURN TO
LOS ANGELES COUNTY SURVEYOR
700 HALL OF RECORDS

NOTE: ANY ADDITIONS OR CHANGES ON THIS SHEET MUST BE MADE OR CIRCLED IN RED INK, WITH DATE AND NAME OF PERSON MAKING CHANGE

Do not extend notes this side of this line

STATION	B. S.	H. I.	F. S.	ELEV.

Notes Ck'd by	Survey of Beverly Orlando
Map No.	W. O. 6318 Tape No. 95 St'd 84° F.
Office Work	Surveyed by Brumby
Checked	Notes Date 3-4-37
Date	Indexed C. Johnson

F.B. 611 PG. 77

CENTER LINE SURVEY

WEST HOLLYWOOD DRAINAGE SYSTEM

BEVERLY ORLANDO AVE LATERAL

JN 6318

SHEET (3)

For Topography See Pgs. 81 to

For & Profile See Pgs

CE Brumby - Chief

HH Smith - Transit

JL Wilkey - H Chain

MA Van Der [illegible] - R Chain

MAR 10 1937

RECEIVED

PROGRESSED

BOOK INDEXED

MAP INDEXED

RECORD INDEXED

CARD INDEXED

RETURN TO
LOS ANGELES COUNTY SURVEYOR
700 HALL OF RECORDS

Note: Any Additions or Changes on This Sheet Must be Made or Circled in Red Ink With Date and Name of Person Making Change.

Do not extend notes this side of this line

FORM 247 10M 11-35

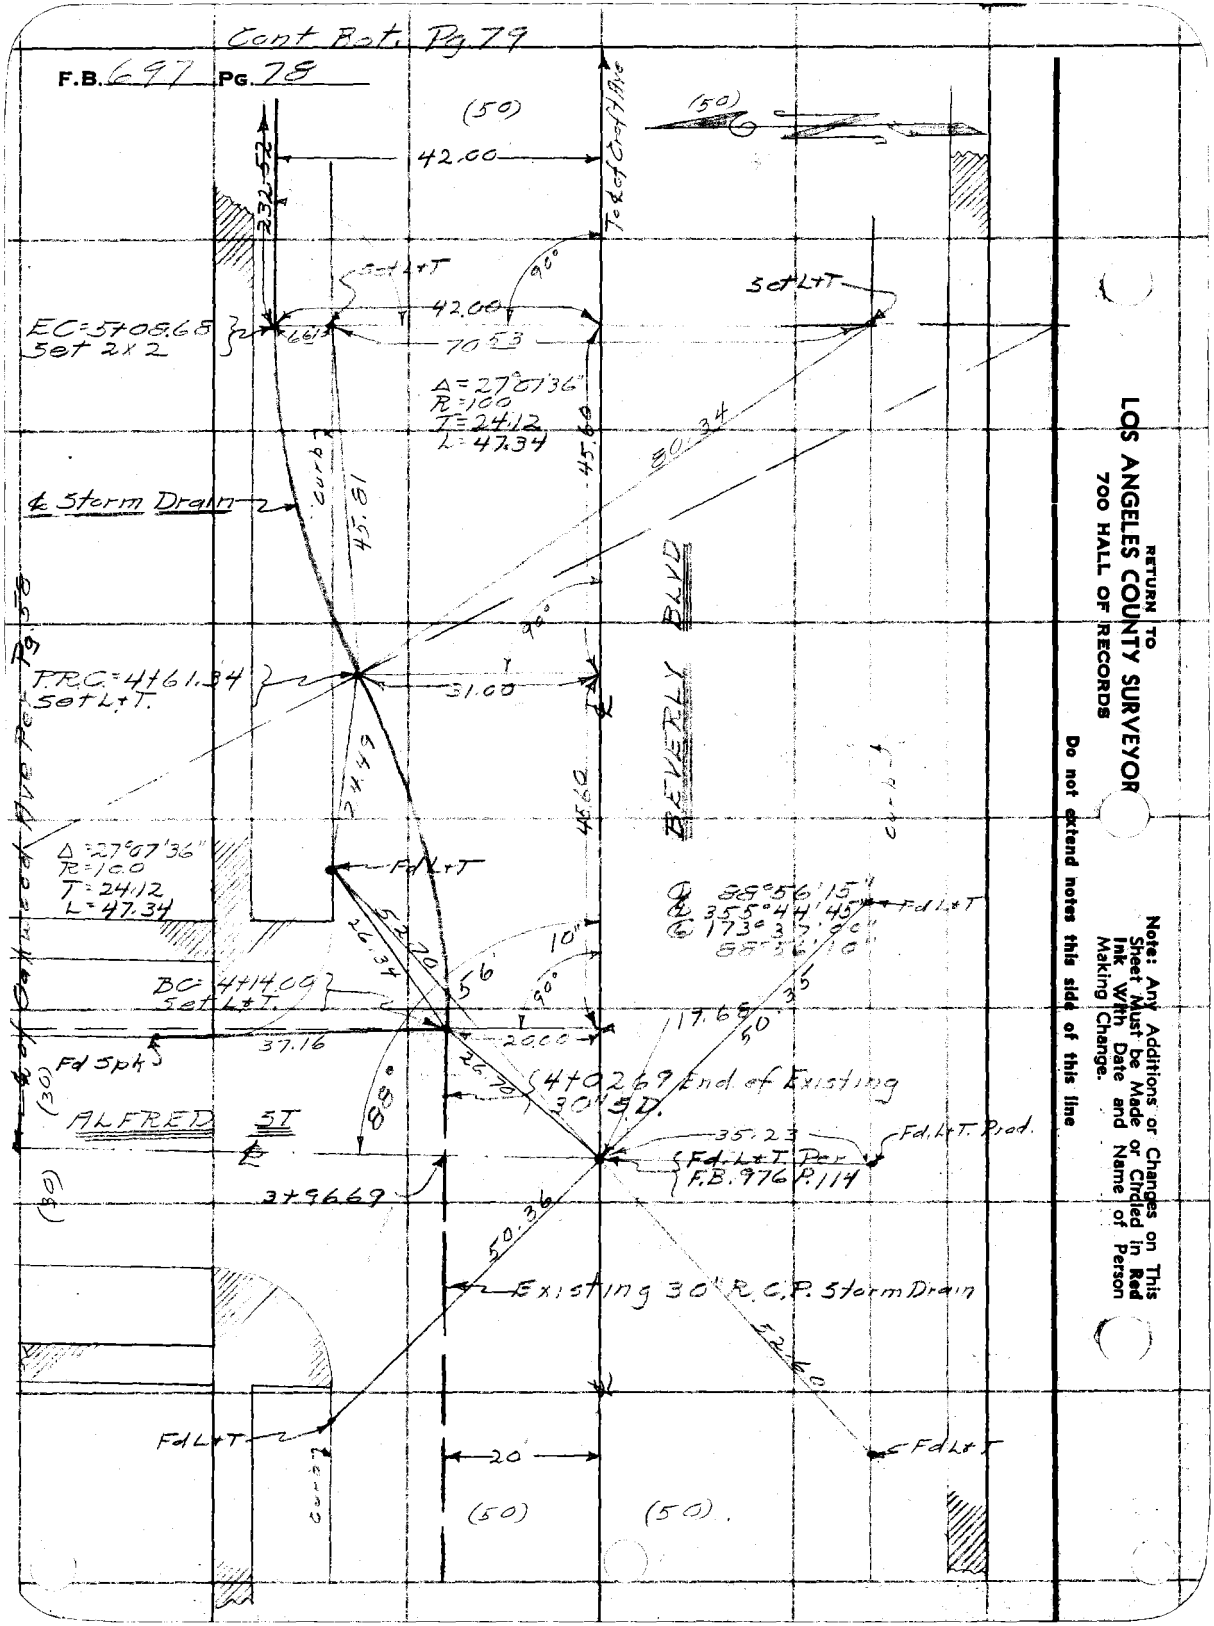
Cont Bot. Pg. 79
F.B. 697 Pg. 78
(50)
42.00
232.52
Tc of Curb Rtn
Set L+T
90°
42.00
EC=5+08.65
Set 2x2
66'
70.53
Δ=27°07'36"
R=100
T=24.12
L=47.34
45.60
45.61
Curb
& Storm Drain
90°
BEVERLY BLVD
P.R.C.=4+61.34
Set L+T.
31.00
34.49
Fd L+T
Δ=27°07'36"
R=100
T=24.12
L=47.34
45.60
Fd L+T
Δ 89°56'15"
Δ 355°44'45"
Δ 173°37'30"
Fd L+T
10"
26.34
5.56
90°
BC 4+14.09
Set L+T.
37.16
L=20.00
17.69
50'
Fd Spk
(30)
ALFRED ST
89°
22.70
4+09.69 End of Existing
30" S.D.
35.23
Fd L+T. Prod.
Fd L+T. Per
F.B. 976 P. 114
3+96.69
50.36
Existing 30" R.C.P. Storm Drain
Fd L+T
Curb
20'
(50)
(50)
Fd L+T
RETURN TO
LOS ANGELES COUNTY SURVEYOR
700 HALL OF RECORDS
Do not extend notes this side of this line
Note: Any Additions or Changes on This Sheet Must be Made or Circled in Red Ink With Date and Name of Person Making Change.

Notes Ck'd by	Survey of Bev. Hills Lot
Map No.	W. 0631 Tape No. 251 St'd 84° F.
Office Work	Surveyed by Brunty
Checked	Notes Date 3-5-37
Date	Indexed C. Johnson

F.B. 477 Pg. 79

Note: Any Additions or Changes on This Sheet Must be Made or Circled in Red Ink With Date and Name of Person Making Change.

Do not extend notes this side of this line

RETURN TO
LOS ANGELES COUNTY SURVEYOR
700 HALL OF RECORDS

FORM 247 10M 11-35

cent. Bet. ℄ of Pg. 66

℄ of Oakwood Ave. Per. Pg. 59

320.41 To ℄ of Orlando

(50) BLVD (50)

Fd. L & T

Fd. L & T

Fdt in walk

@ 89°45'30"
@ 35 89°02'15"
@ 61 89°33'30"
@ 89°45'35"

31.07

35.67

89°

45' 35"

49.78

67.98

CROFT AVE

(30)

(30)

Fd. L & T Per F.B. 976 P 114

7+41.20 Set L & T

42.00

36.05

49.67

49.60

232.62

Fd. L & T

Fd L & T

℄ of Storm Drain

To ℄ Eg.

BEVERLY

(50) (50)

From FD-1 Pg 78

F.B. 697 Pg. 50

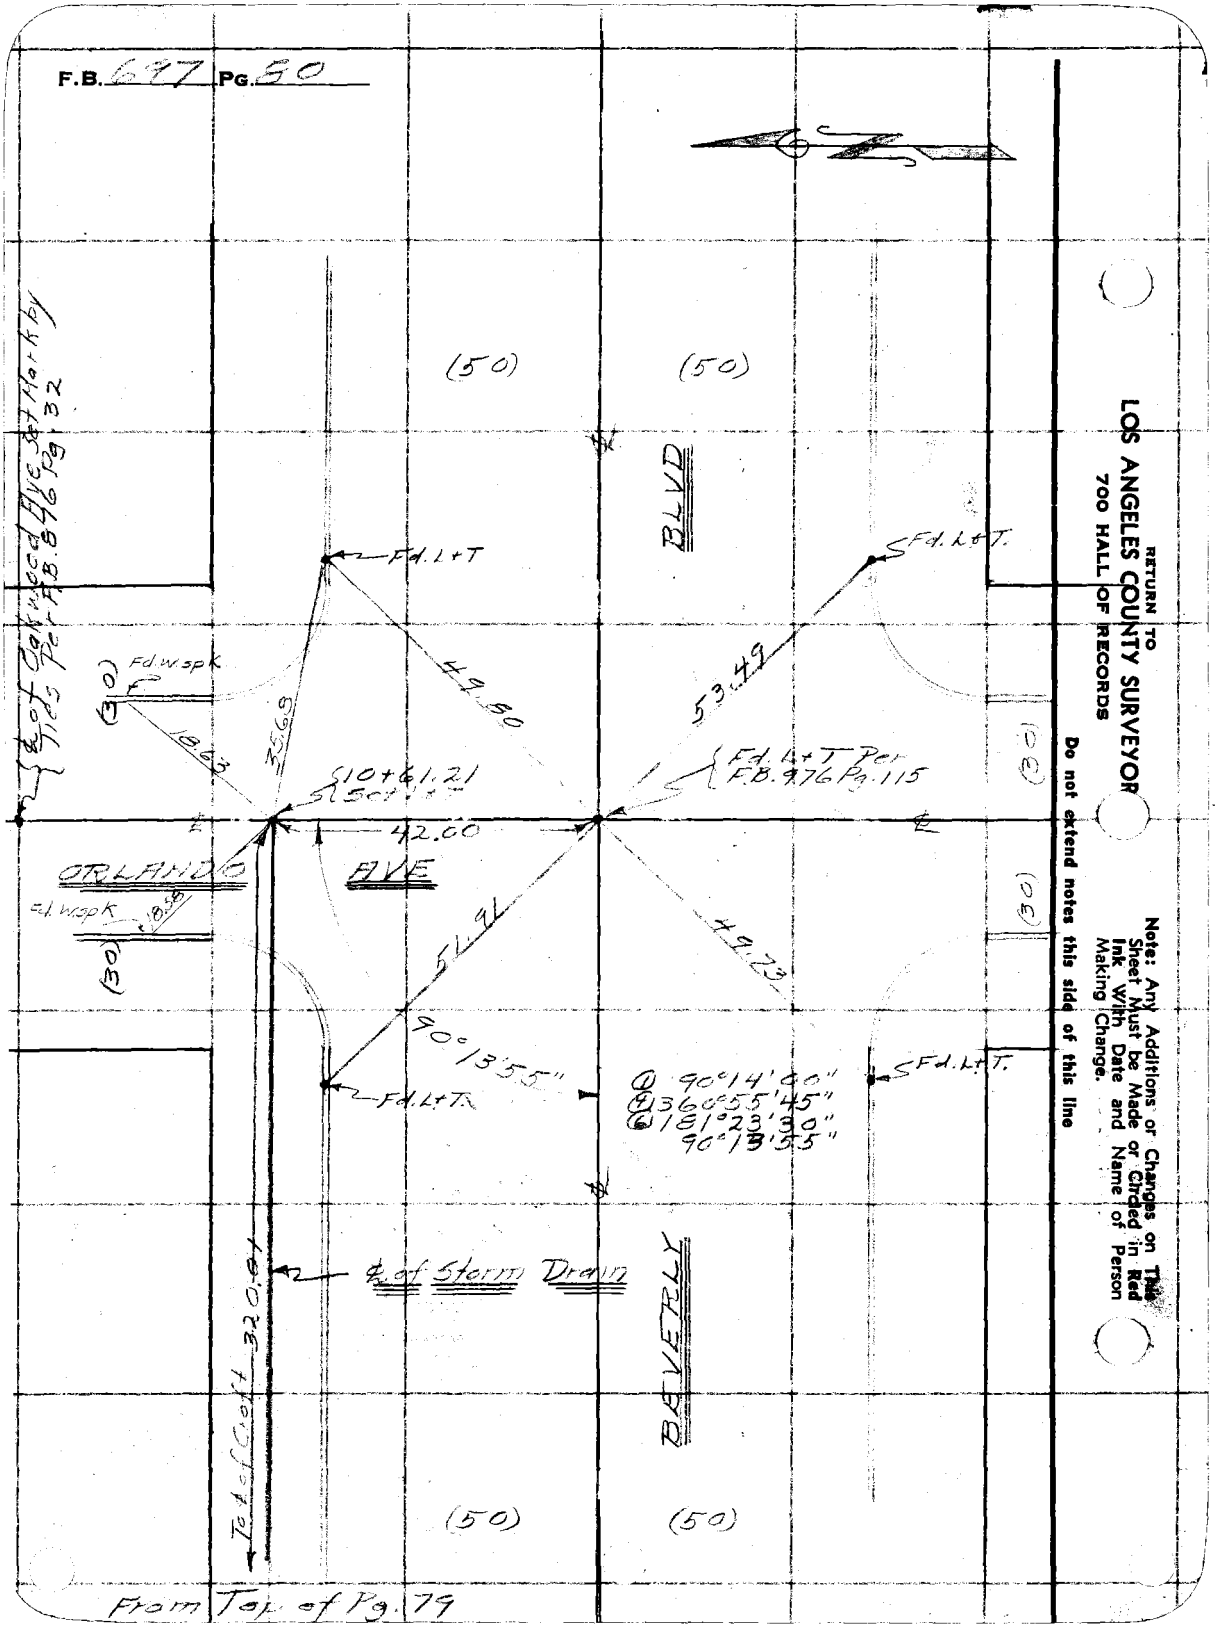

RETURN TO
LOS ANGELES COUNTY SURVEYOR
700 HALL OF RECORDS

Note: Any Additions or Changes on This Sheet Must be Made or Circled in Red Ink With Date and Name of Person Making Change.

Do not extend notes this side of this line

Notes Ck'd by	Survey of Beverly Orlando Lateral
Map No.	W. O. 6318 Tape No. 952 St'd 34 °F.
Office Work	Surveyed by Brunty
Checked	Notes ✓ Date
Date	Indexed C. Johnson

F.B. 697 Pg. 81

TOPOGRAPHY

WEST HOLLYWOOD DRAINAGE SYSTEM

BEVERLY ORLANDO AVE LATERAL

JN 6318

SHEET ③

For ℄ Survey See Pgs. 77 to 81 Incl.

For ℄ Profile See Pgs.

CE Brunty - Chief
HM Smith - Transit
J L Willey - H. Chain
M A Van Deren - R. Chain

Note: Any Additions or Changes on This Sheet Must be Made or Circled in Red Ink With Date and Name of Person Making Change

Do not extend notes this side of this line

RETURN TO
LOS ANGELES COUNTY SURVEYOR
700 HALL OF RECORDS

RECEIVED MAR 10 1937 Smalley
PROGRESSED ✓ ✓
BOOK INDEXED ✓ ✓
MAP INDEXED ✓ ✓
RECORD INDEXED ✓ ✓
CARD INDEXED ✓ ✓

FORM 247 10M 11-36

RETURN TO
LOS ANGELES COUNTY SURVEYOR
700 HALL OF RECORDS

Note: Any Additions or Changes on This Sheet Must be Made or Circled in Red Ink With Date and Name of Person Making Change.

Do not extend notes this side of this line

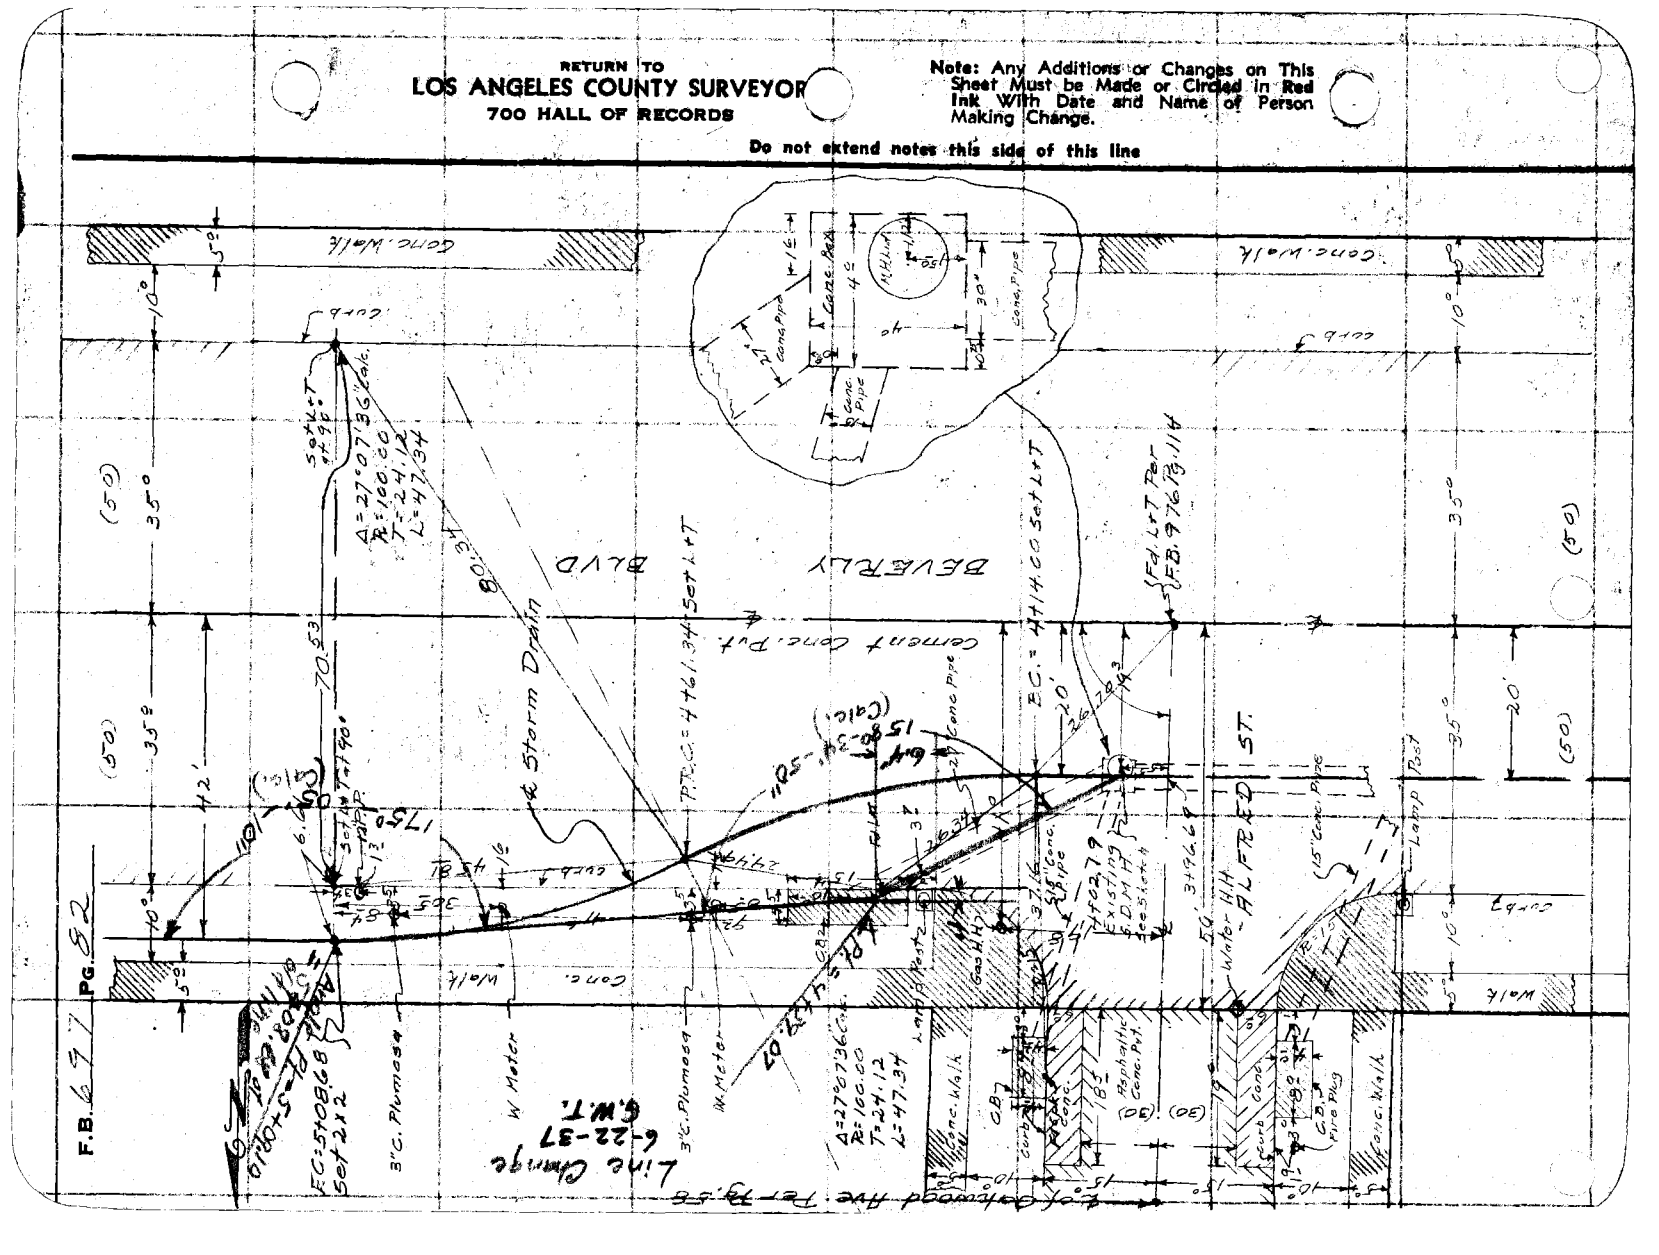
BEVERLY BLVD
ALFRED ST.
Conc. Walk
Curb
Storm Drain
Cement Conc. Pvt.
Conc. Pipe
Water H.H
Gas H.H
Lamp Post
Fire Plug
Catch Basin
Parkway Conc. Pvt.
Asphaltic Conc. Pvt.

Do not extend notes this side of this line

RETURN TO
LOS ANGELES COUNTY SURVEYOR
700 HALL OF RECORDS

Note: Any Additions or Changes on This Sheet Must be Made or Circled in Red Ink With Date and Name of Person Making Change

FORM 247 10M 11-35

RETURN TO
LOS ANGELES COUNTY SURVEYOR
700 HALL OF RECORDS

Note: Any Additions or Changes on This Sheet Must be Made or Circled in; Red Ink With Date and Name of Person Making Change.

Do not extend notes this side of this line

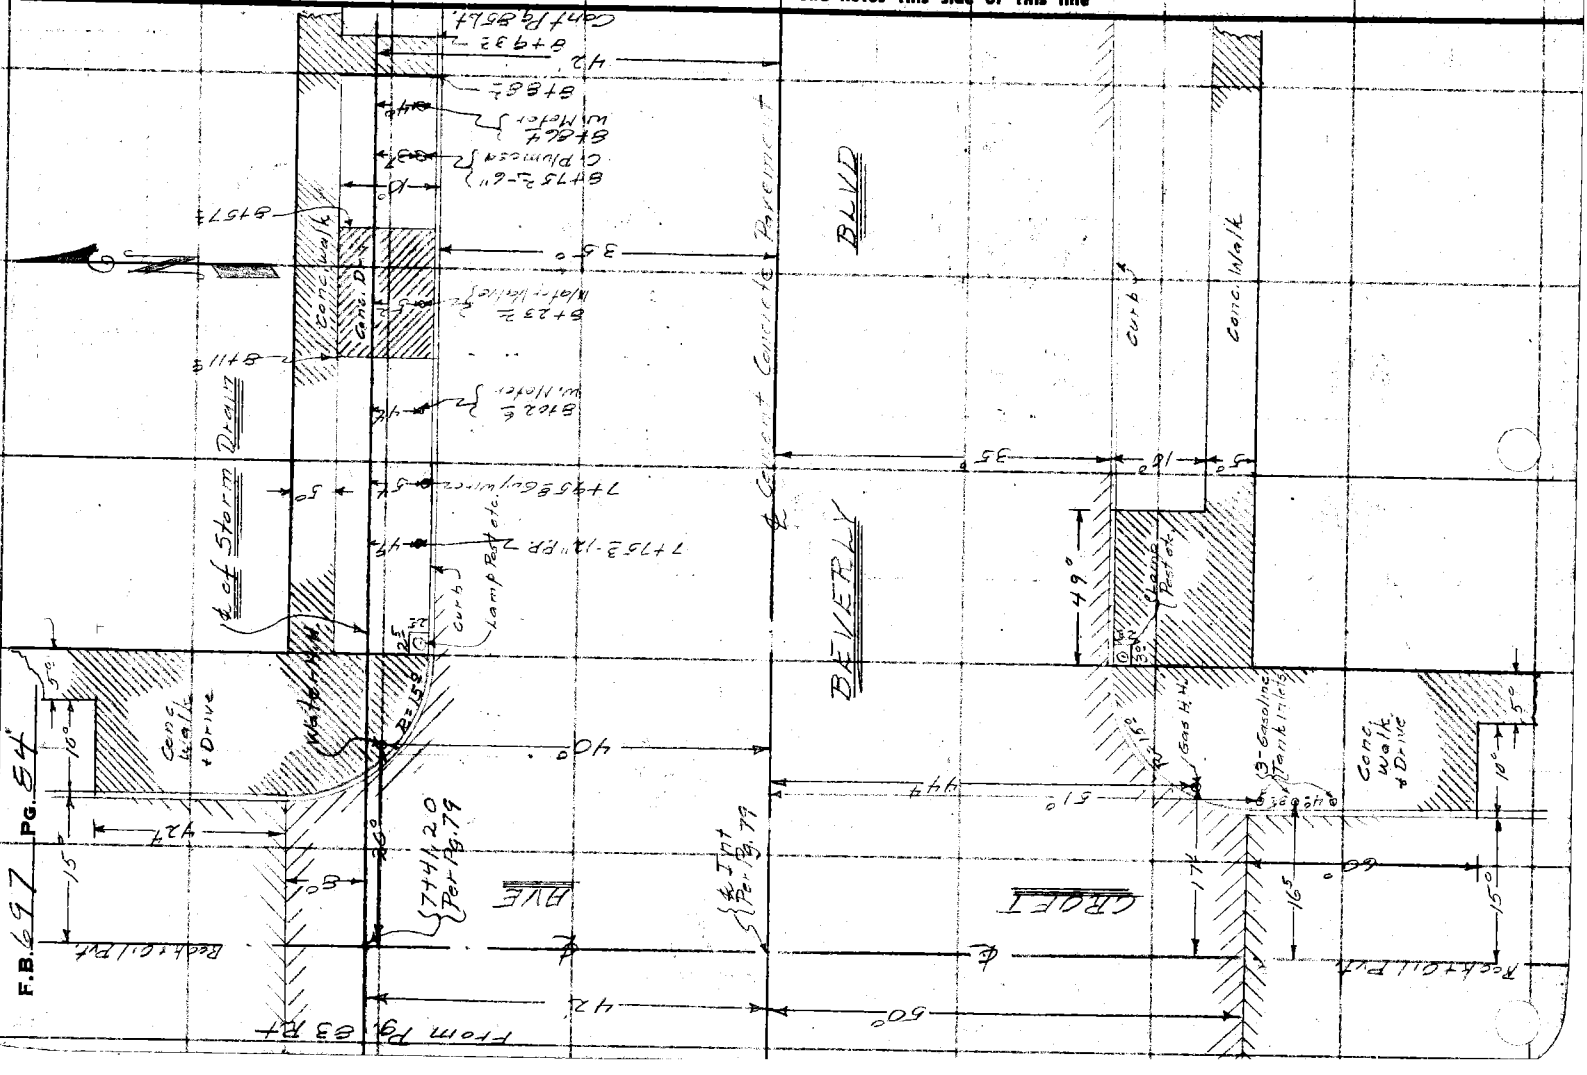

FORM 247 10M 11-35

RETURN TO
LOS ANGELES COUNTY SURVEYOR
700 HALL OF RECORDS

Note: Any Additions or Changes on This Sheet Must be Made or Circled in Red Ink With Date and Name of Person Making Change.

Do not extend notes this side of this line

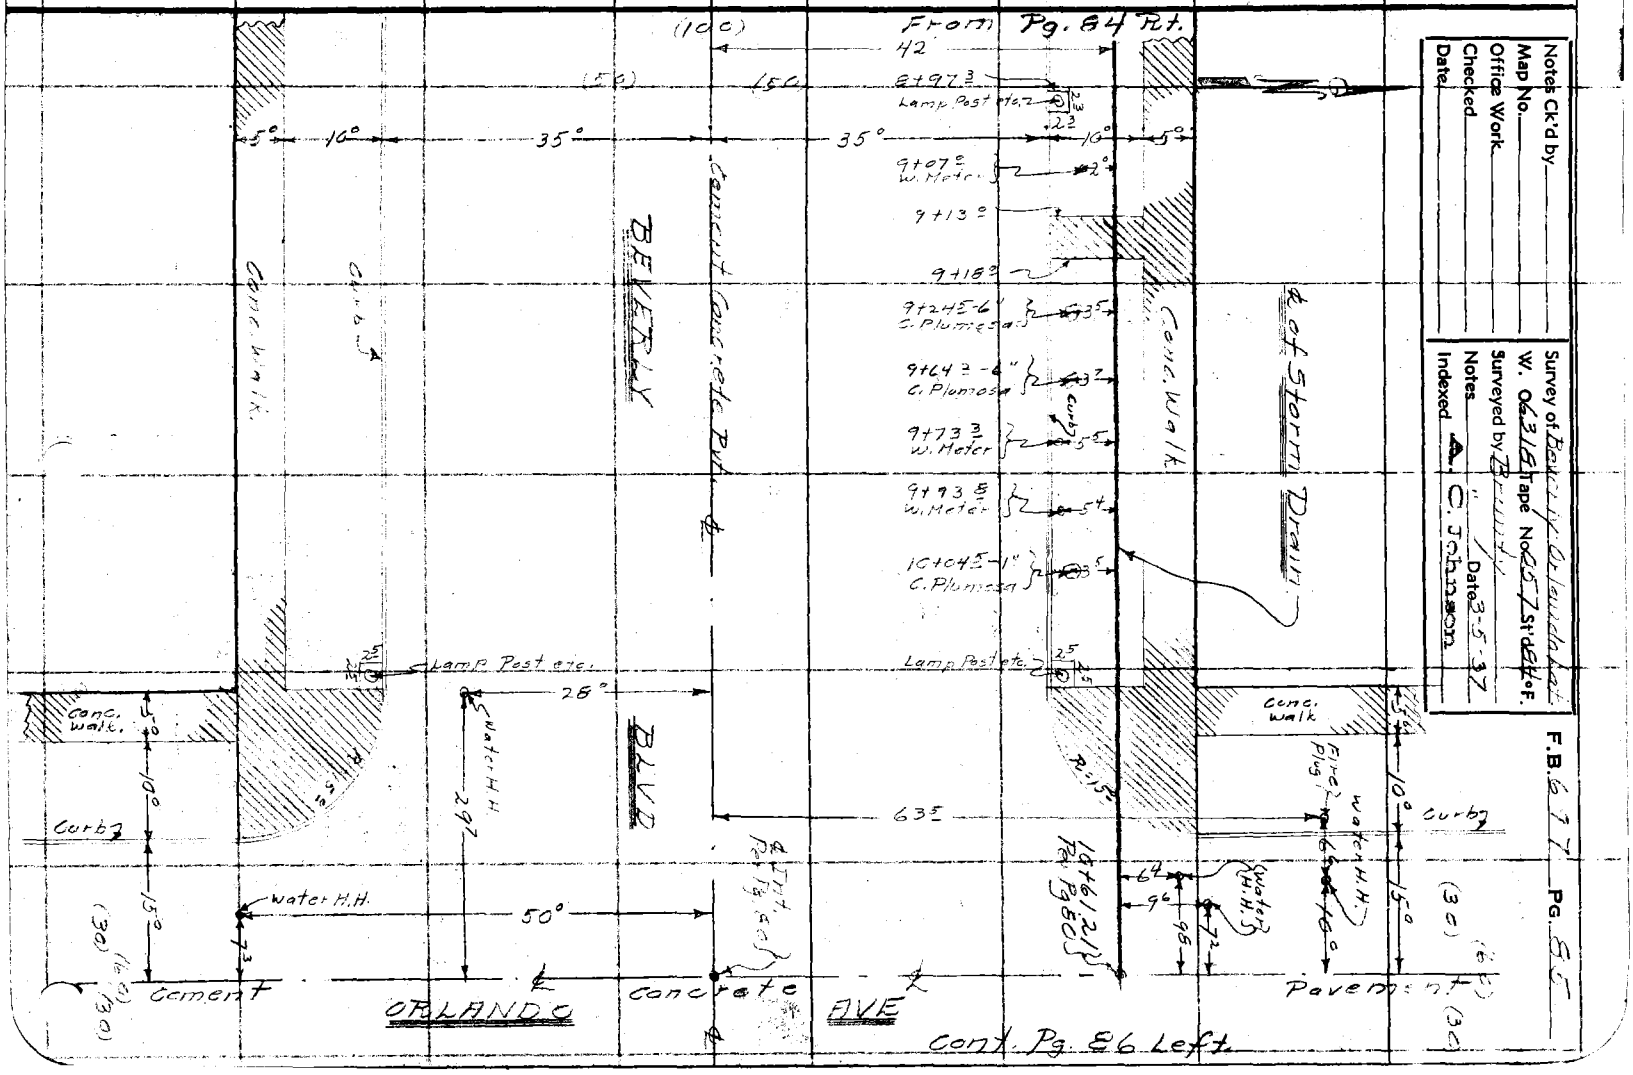

RETURN TO
LOS ANGELES COUNTY SURVEYOR
700 HALL OF RECORDS

Note: Any Additions or Changes on This Sheet Must be Made or Circled in **Red** Ink With Date and Name of Person Making Change.

Do not extend notes this side of this line

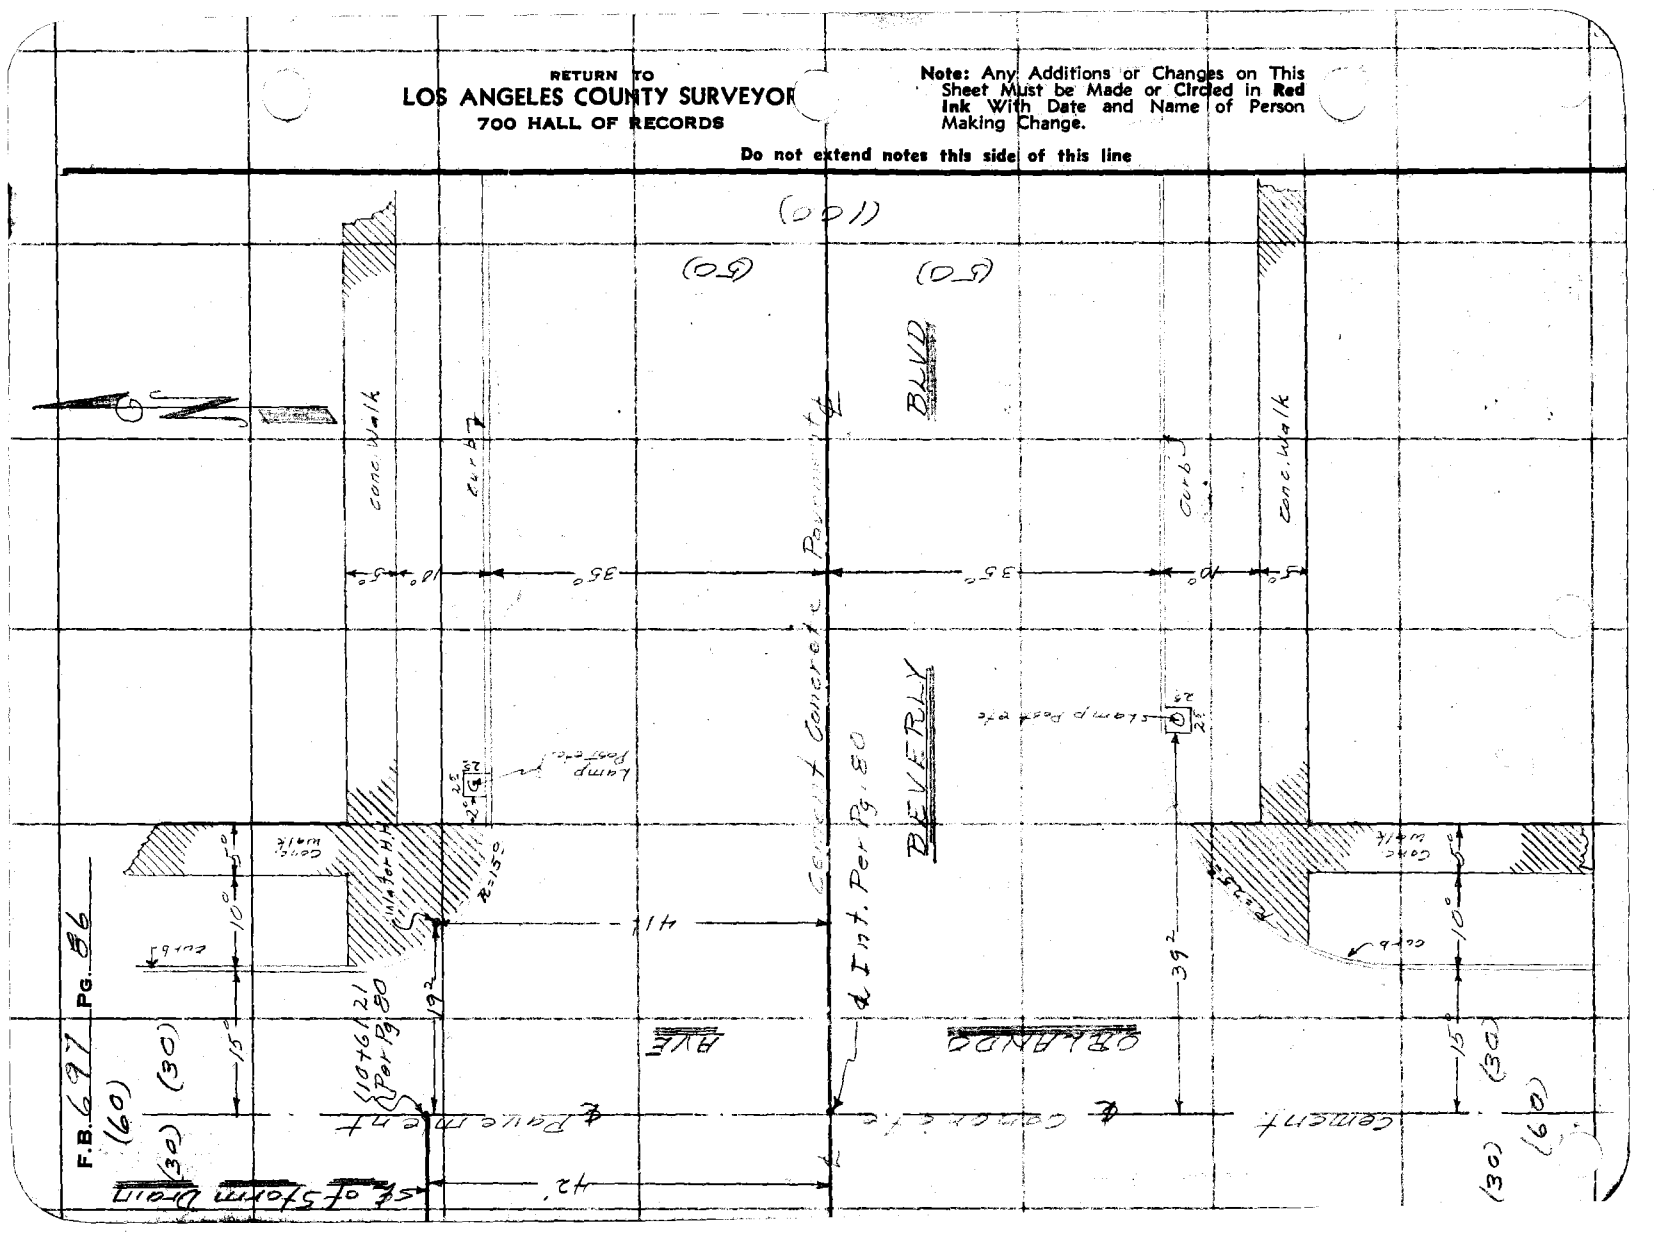

Profile No. | Notes Red. | Plotted | Job No. 6318 | Division No. | F. B. 6977 PG. 87
Date | Date | Survey of West Hollywood D.S.
X-Sec. No. | Notes Chkd. | Checked | Survey by C.E. Bluett, H.H.S. | Notes H.H.S. | Date 3-5-37
Date | Date | Map No. | Indexed A. C. Johnson | Date

CENTER LINE PROFILE.

WEST HOLLYWOOD DRAINAGE SYSTEM.

J.N 6318

BEVERLY-ORLANDO "E" LATERAL

SHEET (3)

For ℄ Survey See Pages Incl.

" ℄ Topograph See Pages. Incl.

NOTE: ANY ADDITIONS OR CHANGES ON THIS SHEET MUST BE MADE OR CIRCLED IN RED INK, WITH DATE AND NAME OF PERSON MAKING CHANGE

Do not extend notes this side of this line

PLEASE RETURN TO LOS ANGELES COUNTY SURVEYOR 700 HALL OF RECORDS

Form 307 5M 11-35

STATION	B. S.	H. I.	F. S.	ELEV.

RECEIVED MAR 10 1937

PROGRESSED ✓ ✓

BOOK INDEXED ✓ ✓

MAP INDEXED ✓

RECORD INDEXED ✓

CARD INDEXED ✓ ✓

REDUCED Filed

CHECKED ✓ ✓

Form 307 5M 11-35

PLEASE RETURN TO
LOS ANGELES COUNTY SURVEYOR
700 HALL OF RECORDS

NOTE: ANY ADDITIONS OR CHANGES ON THIS SHEET MUST BE MADE OR CIRCLED IN RED INK, WITH DATE AND NAME OF PERSON MAKING CHANGE

Do not extend notes this side of this line

F. B. 697 Pg. 28 | Job No. 6316 Division No. | Notes Red. | Plotted | Profile
Survey by C.E.B. | Notes H.M.S. | Notes Chkd. | Checked | X-Sec. No.
Indexed A. C. Johnson | Date | Date | Date

STATION	B. S.	H. I.	F. S.	ELEV.	
D 139				159	B.M.# 130 Elev. 165.88 Pub. 682 Beverly Blvd & Alfred St. N.E.Cor. W. spk 3'N of W end Cb. R.
	506	170 64			
Int			560	163 04	& Int. Beverly Blvd & Stanford St. N.
			610	164 54	10C West & Int. & Beverly Blvd.
			668	163 96	" " " " Tp Cb S side " "
			738	163 26	" " " " Cut " " " "
			772	164 62	" " " " Tp Cb N " " "
			636	164 28	" " " " Cut. " " " "
			467	165 97	" North " " & Alfred St.
			485	165 79	" " " " Tp Cb W side " "
			543	165 21	" " " " Cut. " " " "
			455	166 09	" " " " Tp Cb E " " "
			520	165 44	" " " " Cut " " " "
			630	164 34	35' South Tp Cb. & Alfred St.
			691	163 73	" " Cut. " " " "
			533	165 31	P.C. W end Cb. & N.W. Cor
			594	163 70	Cut " " " " " " "
			515	165 49	Tp Cb N " " " " " "
			517	163 87	Cut " " " " " " "

Form 307 5M 11-35

PLEASE RETURN TO
LOS ANGELES COUNTY SURVEYOR
700 HALL OF RECORDS

NOTE: ANY ADDITIONS OR CHANGES ON THIS SHEET MUST BE MADE OR CIRCLED IN RED INK, WITH DATE AND NAME OF PERSON MAKING CHANGE

Do not extend notes this side of this line

STATION	B. S.	H. I.	F. S.	ELEV.		
		170 64				
			5 11	165 53	Tp Cb. N end Cb R	N.E.Cor
			5 73	164 91	Gut. " " " "	" " "
			5 10	165 54	Tp Cb. E " " "	" " "
			5 70	165 94	Gut. " " "	" " "
			9.40	161 24	F.L. 15" Conc. Pipe N.W. Cor.	
			9 98	160 66	" " " " "	E " N end CR.
			9 39	161 25	" " 27" " "	" E " " "
S.D.M.H. 4+02.42			13 50	157 14	" " 30" " "	Cut W.
			13 45	157 19	" " 27" " "	N.E.
			13 48	157 16	" " 15" " "	"
4+14.00 B.C.			5 46	165 18	℄ S.D.	
4+61.34 P.R.C.			5 48	165 16	" " "	
5+08.68 E.C.			44	166 2	" " "	
			4 73	165 91	7' R Tp Cb	
			5 39	165 25	" " Gutter	
			4 36	166 28	9' L N.P.L.	
6+00			4 04	166 60	℄ S.D.	
			4 27	166 37	7' R Tp Cb.	
			4 90	165 74	" " Gut.	
			3 97	166 67	8' L N.P.L.	

Profile No. _____ Notes Red. _____ Plotted _____ Job No. 6318 Division No. _____
X-Sec. No. _____ Date _____ Date _____ Survey of _____
Notes Chkd. _____ Checked _____ Survey by _____ Notes Johnson Date 3-5-37
Date _____ Date _____ Map No. _____ Indexed _____ Date _____

F. B. 627 PG. 59

Form 307 5M 11-35

PLEASE RETURN TO
LOS ANGELES COUNTY SURVEYOR
700 HALL OF RECORDS

NOTE: ANY ADDITIONS OR CHANGES ON THIS SHEET MUST BE MADE OR CIRCLED IN RED INK, WITH DATE AND NAME OF PERSON MAKING CHANGE

Do not extend notes this side of this line

F. B. 697 Pg. 98 | Job No. 6318 | Division No. | Profile No. | Notes Rad. | Plotted | Survey of [illegible] Beverly Hollywood D.S. | Date | X-Sec. No. | Date | Survey by [illegible] Beverly Hills H.M.S. | Notes | Checked | Notes Chkd. | Indexed A. C. Johnson | Date | Date | Date

STATION	B. S.	H. I.	F. S.	ELEV.		
		170' 64				
T.P.			361	167 03		
	5 05	172' 08				
7+00			5 0	166 71	℄ S.D	
7+41.20			5 41	166 67	" " " ℄ Ilt. & Croft Ave.	
			5 33	166 75	42' R ℄ " ℄ " " " ℄ Beverly Blvd	
			6 45	165 63	92' R S. edge Conc. Pav.	
			6 93	165 15	162' R " " " " South	
			670	165 38	" R " " " Top Cb W. side Croft Ave.	
			738	164 70	" " " " " Gut. " " " "	
			660	165 48	" R " " " Tp Cb ≡ " " "	
			725	164 83	" " " " " Gut. " " " "	
			516	166 92	8' ℄ S.D. N. edge Conc. Pav.	
			419	167 97	100 ℄ S.D ℄ Croft Ave	
			417	167 91	" " " " Tp Cb W side Croft Ave.	
			475	167 33	" " " " Gut " " " "	
			408	168 00	" " " " Tp Cb ≡ " " "	
			461	167 47	" " " " Gut " " " "	
			506	167 02	Tp Cb. W. end Cb R. N W. Cor.	
			574	166 34	Gut " " " " " " "	
			495	167 13	Tp Cb N " " " " " "	
			545	166 63	Gut. " " " " " " "	

Form 307 5M 11-35

PLEASE RETURN TO
LOS ANGELES COUNTY SURVEYOR
700 HALL OF RECORDS

NOTE: ANY ADDITIONS OR CHANGES ON THIS SHEET MUST BE MADE OR CIRCLED IN RED INK, WITH DATE AND NAME OF PERSON MAKING CHANGE

Do not extend notes this side of this line

Profile No. ____ Notes Red. ____ Plotted ____ Job No. 4218 Division No. ____
X-Sec. No. ____ Date ____ Date ____ Survey of ____ F.B. 477 Pg. 74
Notes Chkd. ____ Checked ____ Survey by C.E. Blunt & Notes H.M.S. Date 3-5-37
Date ____ Date ____ Map No. ____ Indexed T. Johnson Date ____

STATION	B. S.	H. I.	F. S.	ELEV.		
		172.98				
			484	167.24	N end Co. R. N.E Cor Tp Cb	
			547	166.61	Cut N. " " " " "	
			485	167.23	Tp Cb E " " " " " "	
			552	166.56	Cut. " " " " " " "	
			581	166.27	Tp. Cb. E. end Cb. R. & E. Cor.	
			652	165.56	Cut. " " " " " " "	
			610	165.98	Tp Cb. S. " " " " " "	
			677	165.31	Cut. " " " " " " "	
			622	165.86	Tp Cb S. " " " S.W. "	
			683	165.25	Cut. " " " " " "	
			612	165.96	Tp Cb. W " " " " " "	
			680	165.28	Cut. " " " " " "	
			+42	165.67	& S.D	
8+00						
8+11			548	167.60	" " " W. end Conc. Drive	
8+42			418	167.90	" " " E " "	
8+59			400	168.08	" " " W edge conc. Walk	
9+08			3.9	168.2	" " "	
			406	168.02	7' R Tp Cb	
			479	167.31	" " Cut	
			386	168.22	8' L. N.P.L	
T.P.			389	168.19		

Form 307 5M 11-35

PLEASE RETURN TO
LOS ANGELES COUNTY SURVEYOR
700 HALL OF RECORDS

NOTE: ANY ADDITIONS OR CHANGES ON THIS SHEET MUST BE MADE OR CIRCLED IN RED INK, WITH DATE AND NAME OF PERSON MAKING CHANGE

Do not extend notes this side of this line

F. B. 697 Pg. 92 | Job No. 2214 Division No. Profile
Survey of Hollywood D.S. No.
Survey by C.E.B. Notes H.N.S. X-Sec. No.
Indexed C. Johnson Date Notes Red. Plotted
Date Notes Chkd. Checked
Date Date

STATION	B. S.	H. I.	F. S.	ELEV.		
	5.54	173.73		168.19		
9+13 ℄			5.33	168.40	℄ S.D. W. edge Conc. walk	
10+00			5.0	168.7	" " "	
			3.30	170.43	7' R Tp Cb.	
			5.96	167.77	" " Gutter	
			4.91	168.82	8' L N.P.L.	
10+61.2			5.40	168.33	℄ S.D. ℄ Int. Orlando Ave.	
			5.65	168.08	7' R Cross Gutter	
			5.30	168.43	42' R ℄ Int. Beverly Blvd & Orlando Ave.	
			6.42	167.31	77' R Cross-gutter	
			6.90	166.83	142' R	℄ " Ave
			6.67	167.06	" " Tp Cb. W side	" "
			7.35	166.38	" " Gut. " "	" "
			6.69	167.04	" " Tp Cb. E "	" "
			7.31	166.42	" " Gut. " "	" "
			4.26	169.47	100' L ℄ S.D.	℄ " "
			4.03	169.70	" " " Tp Cb W. side	" "
			4.68	169.05	" " " " Gut. "	" "
			3.96	169.77	" " " " Tp Cb E	" " "
			4.60	169.13	" " " " Gut. "	" " "

Form 307 5M 11-35

PLEASE RETURN TO
LOS ANGELES COUNTY SURVEYOR
700 HALL OF RECORDS

NOTE: ANY ADDITIONS OR CHANGES ON THIS SHEET MUST BE MADE OR CIRCLED IN RED INK, WITH DATE AND NAME OF PERSON MAKING CHANGE

Do not extend notes this side of this line

Profile No. ____ X-Sec. No. ____

Notes Red. ____ Date ____ Notes Chkd. ____ Date ____

Plotted ____ Date ____ Checked ____ Date ____

Job No. ____ Survey of ____ Survey by ____ Map No. ____

Division No. ____ Notes Johnson Indexed ____

Date ____ Date ____

F. B. ____ PG. ____

STATION	B. S.	H. I.	F. S.	ELEV.		
		173.73				
			479	168 94	100' E. & Int. Beverly & Redondo Ave. & Beverly	
			452	169 2	" " " " Tp. Cb. N. side Beverly Blvd	
			515	168 58	" " " " Gut.	
			563	168 16	" " " " Tp. Cb. " " "	
			628	167 45	" " " " Gut. " " "	
			514	168 59	Tp. Cb. W. end Cb. R. N.W. Cor.	
			578	167 25	Gut. " " " " " "	
			480	168 93	Tp Cb N " " " " W. "	
			549	168 24	" " " " " " "	
			481	168 92	Tp Cb. " " " " N. E "	
			540	168 33	" " " " " " "	
			478	168 93	Tp Cb. E " " " " " "	
			549	168 24	Gut " " " " " " "	
			540	168 33	Tp Cb " " " " E. "	
			657	167 16	Gut " " " " " " "	
			595	167 11	Tp Cb S " " " " " "	
			662	166 87	Gut " " " " " " "	
			616	167 57	Tp Cb " " " " S.W. "	
			652	166 91	Gut " " " " " " "	

Form 307 5M 11-35

PLEASE RETURN TO
LOS ANGELES COUNTY SURVEYOR
700 HALL OF RECORDS

NOTE: ANY ADDITIONS OR CHANGES ON THIS SHEET MUST BE MADE OR CIRCLED IN RED INK, WITH DATE AND NAME OF PERSON MAKING CHANGE

Do not extend notes this side of this line

F. B. 91 Pg. 94 | Job No. 6316 Division No. | Notes Red | Date | Plotted | Date | Profile No. | X-Sec. No.

Survey of [illegible] | Notes | Notes Chkd. | Checked | Date | Date

Survey by [illegible] | Date | Date

Indexed [illegible] | Date | Date

STATION	B. S.	H. I.	F. S.	ELEV.		
		73' 73				
			[illegible]		Tp Co. W end Co. R. S.W. Cor.	
			[illegible]		Cal. " " " " "	
					B.M. #D-141 Elev. [illegible]	682
B.M. #D-141			4.78	168.95	[illegible]	
					[illegible]	

Notes Ck'd by	Survey of Kings Road Stub
Map No.	W. O 6315 Tape No 057 St'd 64° F.
Office Work	Surveyed by [illegible]
Checked	Notes [illegible] Date 3-6-37
Date	Indexed A. C. Johnson

F.B. 697 PG. 95

CENTER LINE SURVEY
WEST HOLLYWOOD DRAINAGE SYSTEM
KINGS ROAD STUB

J.N. 6315

SHEET ③

For Topography See Pgs 99 to 102 Incl

For L & Profile See Pgs 103 to 105 Incl

C.E. Brumby — Chief
H.M. Smith — Transit
J.L. Willey — H. Chain
M.A. VanDeCar — R. Chain

This is final survey - Revised 4-3-40 C.E.B.

See "Note" Pg. 223

Const. J.N. = 6347 (W.O.)

RECEIVED MAR 10 1937

PROGRESSED

BOOK INDEXED

MAP INDEXED

RECORD INDEXED

CARD INDEXED

RETURN TO
LOS ANGELES COUNTY SURVEYOR
700 HALL OF RECORDS

Note: Any Additions or Changes on This Sheet Must be Made or Circled in Red Ink With Date and Name of Person Making Change.

Do not extend notes this side of this line

FORM 247 10M 11-38

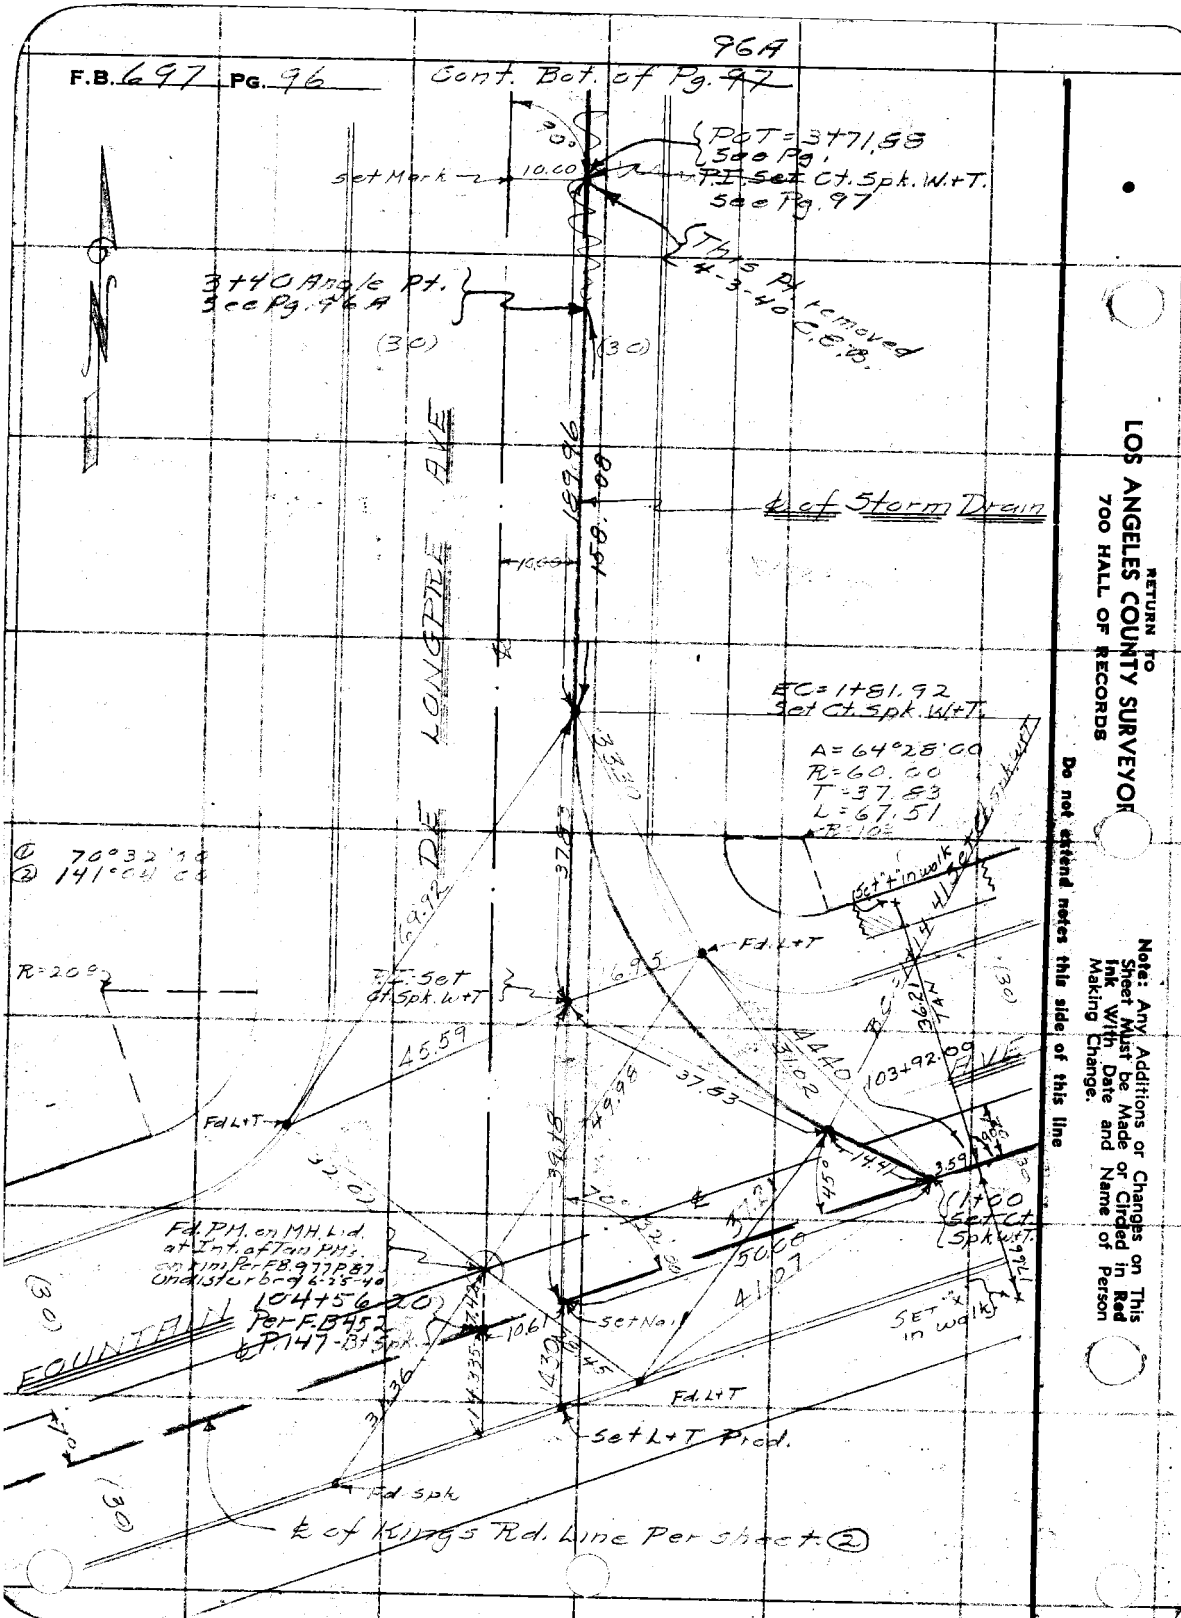
964
F.B. 697 PG. 96
Cont. Bot. of Pg. 97
POT = 371.58
See Pg.
P.T. Set Ct. Spk. W+T.
See Pg. 97
Th.'s Pt. removed
4-3-40 C.E.D.
3+40 Angle Pt.
See Pg. 96A
Set Mark
10.00
(30)
(30)
℄ of Storm Drain
LONGPRE AVE
EC = 1+81.92
Set Ct. Spk. W+T.
A = 64°28'00"
R = 60.00
T = 37.83
L = 67.51
R = 10'
Set 4" in walk
Fd. L+T
R = 200
Set Ct. Spk. W+T.
45.59
37.63
Fd L+T
103+92.09
AVE
(1.00 Set Ct. Spk. W+T.
Fd. PM. on MH. Lid at Int. of Tan PM's. Contl. Per FB. 977 P. 87 Cond. Str. bred 6-25-40
104+56.20
Per FB 452 & P. 147-151
Set Nail
Fd. L+T
Set L+T Pi'd.
Fd Spk
℄ of Kings Rd. Line Per Sheet ②
FOUNTAIN
Set "X" in walk
RETURN TO
LOS ANGELES COUNTY SURVEYOR
700 HALL OF RECORDS
Note: Any Additions or Changes on This Sheet Must be Made or Circled in Red Ink With Date and Name of Person Making Change.
Do not extend notes this side of this line

Notes Ck'd by		Survey of W. Hollywood D.S.	F.B. 697 Pg. 96A
Map No.		W. 063 Tape No. 077 St'd 64 OF	Cont. Bot. of Pg. 96
Office Work		Surveyed by	
Checked		Notes	Date 4-3-40
Date		Indexed	

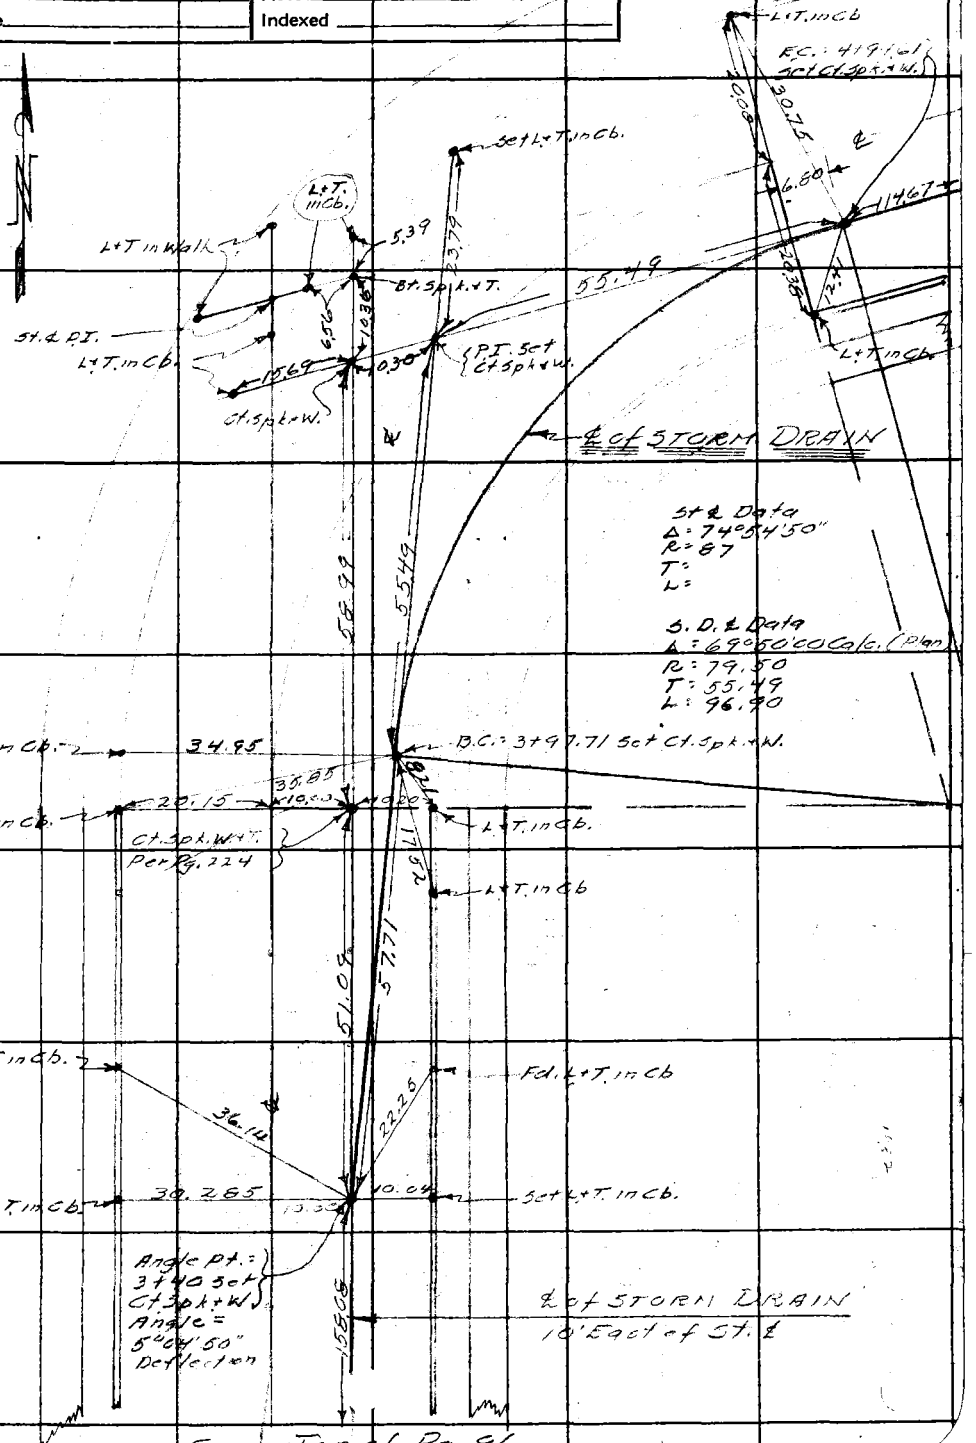

Note: Any Additions or Changes on This Sheets Must be Made or Circled in Red Ink With Date and Name of Person Making Change.

Do not extend notes this side of this line

RETURN TO
LOS ANGELES COUNTY SURVEYOR
700 HALL OF RECORDS

FORM 247 5M 10-37

F.B. 697 Pg. 96B

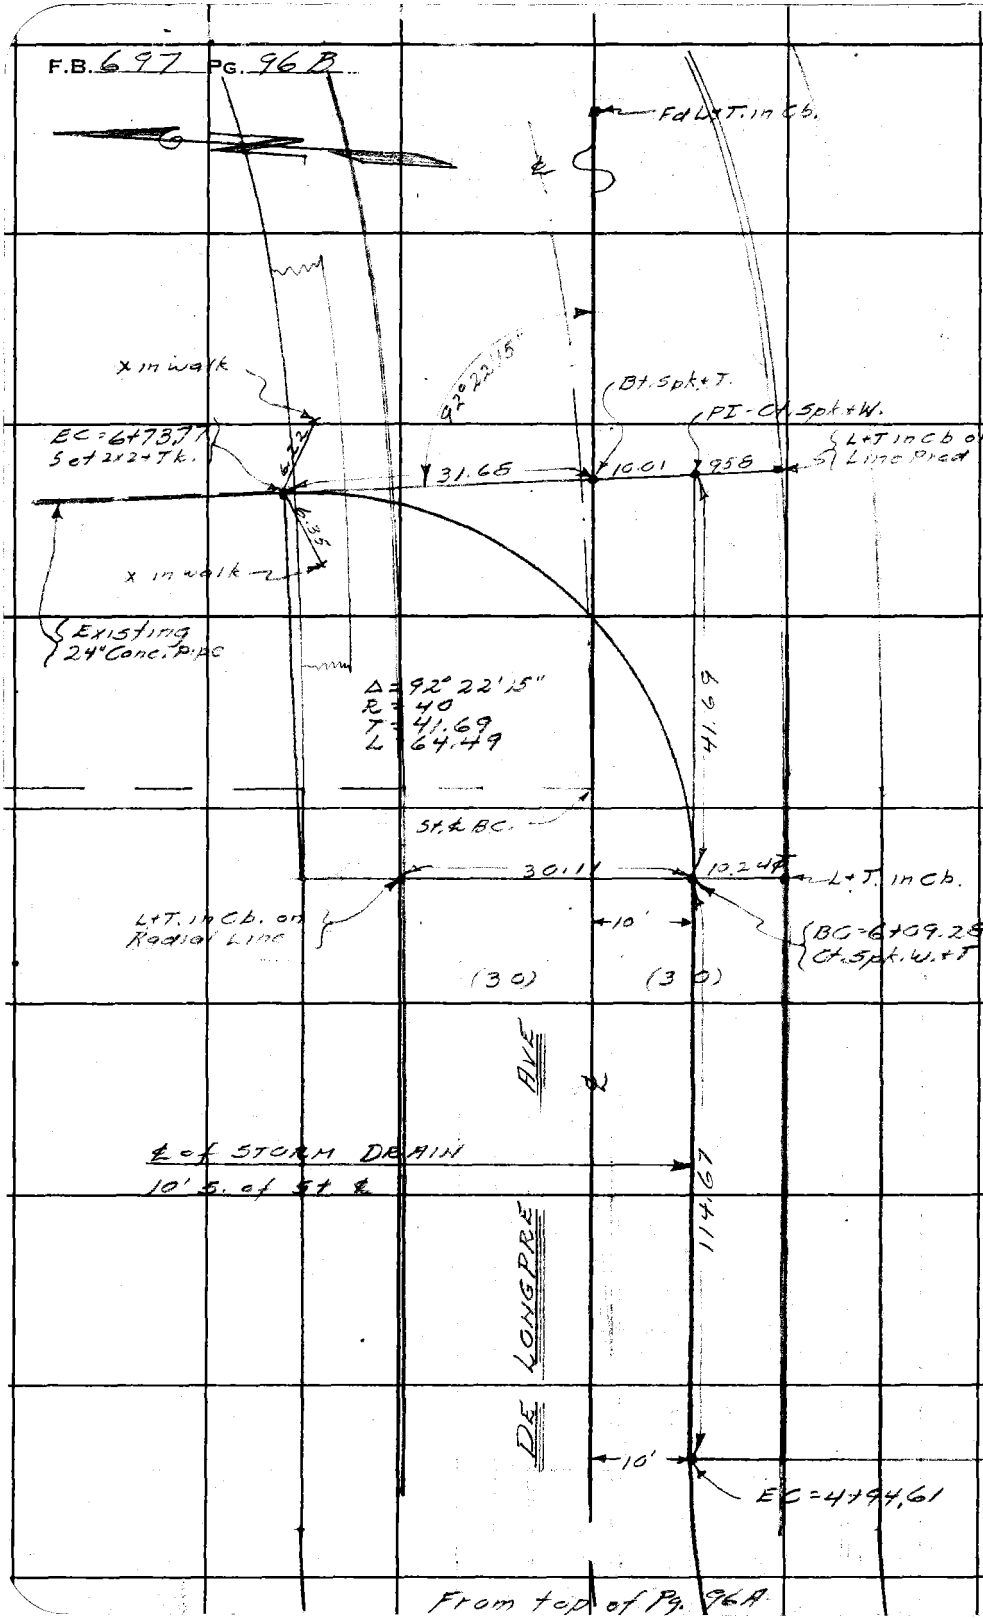

From top of Pg. 96A

RETURN TO
LOS ANGELES COUNTY SURVEYOR
700 HALL OF RECORDS

Note: Any Additions or Changes on This Sheets Must be Made or Circled in Red Ink With Date and Name of Person Making Change.

Do not extend notes this side of this line

Notes Ck'd by	Survey of Kings Rd. Stub
Map No.	W. O. 6316 Tape No. 057 St'd 2% F.
Office Work	Surveyed by Brumly
Checked	Notes " Date 3-8-37
Date	Indexed A. C. JOHNSON

F.B. 697 PG. 97

- VOID - SEE Pgs. 96A + 96B

Note: Any Additions or Changes on This Sheet Must be Made or Circled in Red Ink With Date and Name of Person Making Change.

Do not extend notes this side of this line

RETURN TO
LOS ANGELES COUNTY SURVEYOR
700 HALL OF RECORDS

FORM 247 10M 11-38

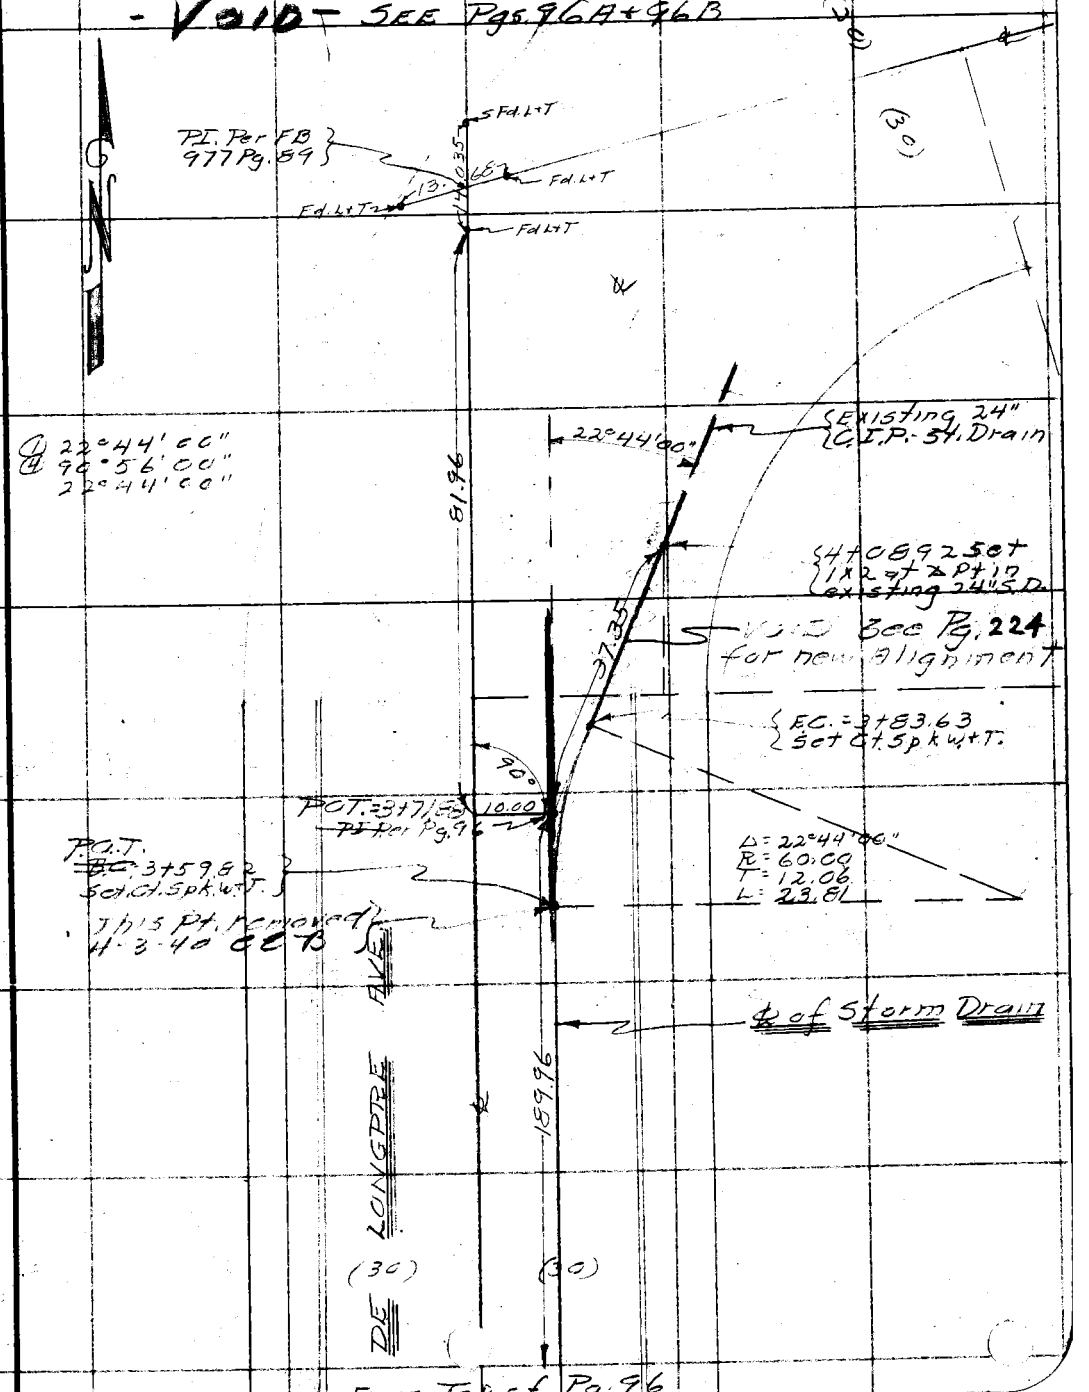

VOID See Pgs 96A + 96B

F.B. 697 PG. 98

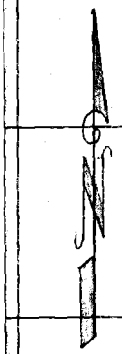

4+08.92 Pg 97

Curb

Conc Walk

12.37

set x

12.37

set x

set L+T in Cb

& Storm Drain

37.42

90°

E.C. = 3+83.63 Pg 97

set L+T

39.31

13.42

VOID See Pg. 224
For New Alignment

P.O.T. = 3+71.65
P.T. Per Pg. 97

32.53

15.76

30.21

0.42

set L+T in Cb

set L+T

90°

POT
B.C. = 3+59.82 Pg. 97

RETURN TO
LOS ANGELES COUNTY SURVEYOR
700 HALL OF RECORDS

Note: Any Additions or Changes on This Sheet Must be Made or Circled in Red Ink With Date and Name of Person Making Change.

Do not extend notes this side of this line

Notes Ck'd by	Survey of Kings Rd. Stub
Map No.	W. O. 6318 Tape No. 257 St'd 5½° F.
Office Work	Surveyed by Brunty
Checked	Notes Brunty Date 3-8-37
Date	Indexed C. Johnson

F.B. 677 PG. 97

TOPOGRAPHY

WEST HOLLYWOOD DRAINAGE SYSTEM

KINGS ROAD STUB

JN 6318

SHEET (5)

For ℄ Survey See Pgs. 95 to 98 Incl.

For ℄ Profile See Pgs 103 to 108 Incl.

CE Brunty · Chief
HM Smith · Transit
JL Willey · H.Ch.
MH Van Dyck · R.Ch.

Note: Any Additions or Changes on This Sheet Must be Made or Circled in Red Ink With Date and Name of Person Making Change.

Do not extend notes this side of this line

RETURN TO
LOS ANGELES COUNTY SURVEYOR
700 HALL OF RECORDS

RECEIVED MAR 10 1937 Smelser

PROGRESSED ✓ ✓

BOOK INDEXED ✓ ✓

MAP INDEXED ✓ ✓

RECORD INDEXED ✓ ✓

CARD INDEXED ✓ ✓

FORM 247 10M 11-36

F.B. 697 Pg. 100

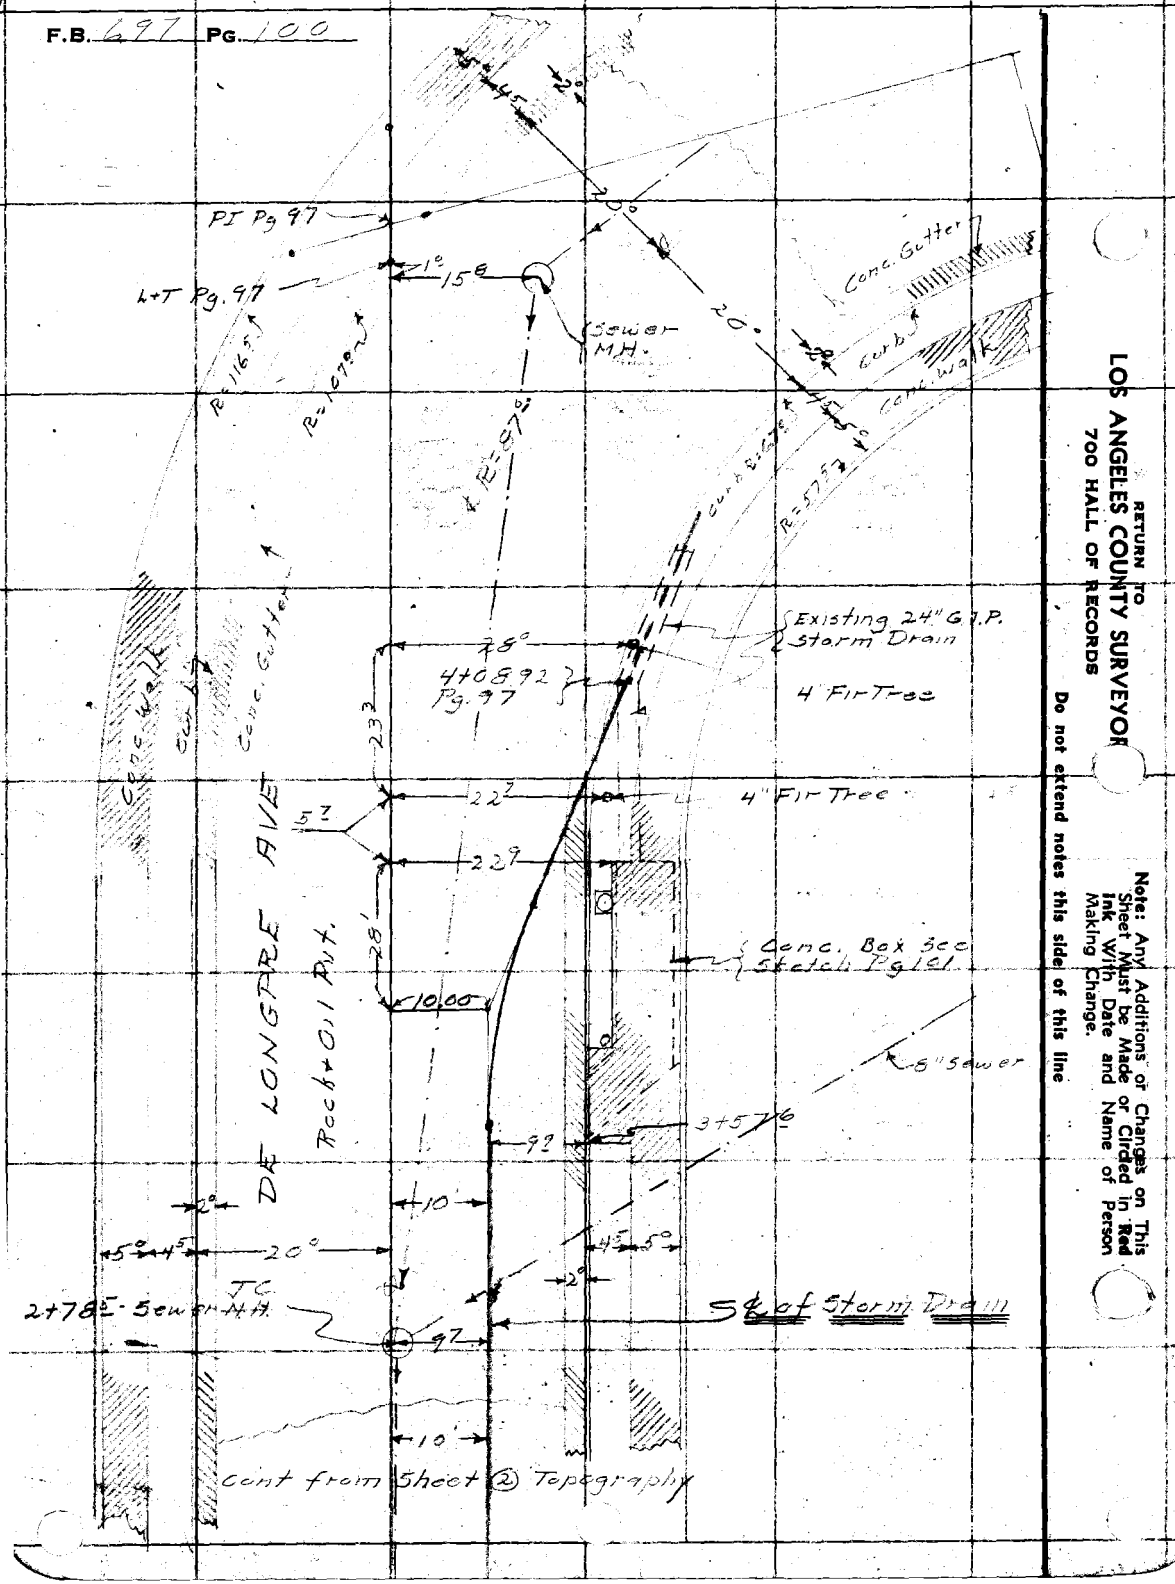

RETURN TO
LOS ANGELES COUNTY SURVEYOR
700 HALL OF RECORDS

Do not extend notes this side of this line

Note: Any Additions or Changes on This Sheet Must be Made or Circled in Red Ink With Date and Name of Person Making Change.

Notes Ck'd by	Survey of Kings Road Stub
Map No.	W. O 6316 Tape No. 657 St'd 24°F.
Office Work	Surveyed by Bailey
Checked	Notes Date 3-6-37
Date	Indexed C. Johnson

F.B. 697 PG. 101

Note: Any Additions or Changes on This Sheet Must be Made or Circled in Red Ink With Date and Name of Person Making Change.

Do not extend notes this side of this line

RETURN TO
LOS ANGELES COUNTY SURVEYOR
700 HALL OF RECORDS

FORM 247 10M 11-35

DE LONGPRE AVE

47 C.S. 92 Pg. 97

Existing 24" G.I.P.

20'

45'

5'

23'

To Inside of Rail 6" walls

EC = 3+83.63 Pg 97

Conc. Base + Lamp Post

Conc. Box under walk

SKETCH OF BOX SHOWN ON PG. 100

9°

4" P.T.

BC = 3+59.22 Pg 97

60°

15'

95'

℄

3+57.6

45'

5°

℄ Storm Drain

Conc. Curb

Curb Line

Curb Walk

Prop. Line

RETURN TO
LOS ANGELES COUNTY SURVEYOR
700 HALL OF RECORDS

Note: Any Additions or Changes on This Sheet Must be Made or Circled in **Red Ink** With Date and Name of Person Making Change.

Do not extend notes this side of this line

F.B. 697 Pg. 102

Profile No. | Notes Red. | Plotted | Job No. | Division No. | F. B. | PG.

Date | Date | Survey of

X-Sec. No. | Notes Chkd. | Checked | Survey by | Notes A. C. Johnson | Date

Date | Date | Map No. | Indexed | Date

STUB.

NOTE: ANY ADDITIONS OR CHANGES ON THIS SHEET MUST BE MADE OR CIRCLED IN RED INK, WITH DATE AND NAME OF PERSON MAKING CHANGE

Do not extend notes this side of this line

PLEASE RETURN TO
LOS ANGELES COUNTY SURVEYOR
700 HALL OF RECORDS

Form 307 5M 11-35

STATION	B. S.	H. I.	F. S.	ELEV.

RECEIVED MAR 10 1937

PROGRESSED

BOOK INDEXED

MAP INDEXED

RECORD INDEXED

CARD INDEXED

REDUCED

CHECKED

Form 307 5M 11-35

PLEASE RETURN TO
LOS ANGELES COUNTY SURVEYOR
700 HALL OF RECORDS

NOTE: ANY ADDITIONS OR CHANGES ON THIS SHEET MUST BE MADE OR CIRCLED IN RED INK, WITH DATE AND NAME OF PERSON MAKING CHANGE

Do not extend notes this side of this line

F. B. 1417 PG. 124 | Job No. 4215 | Division No. | Notes Red | Plotted | Profile
Survey of | Date | No.
Survey by | Notes | Notes Chkd. | Checked | X-Sec.
Indexed A. C. Johnson | Date | Date | Date | No.

STATION	B. S.	H. I.	F. S.	ELEV.	
					BM #2-6 Elev. 318.58 FB 682-Pio
				31[illegible]	[illegible] Ave & Wilmington Ave N.W. Cor.
					Bt spk S'W [illegible] W cur [illegible]
Int.			6 52	31[illegible]	Int. Fountain Ave & [illegible] Ave
			9 02	31[illegible]	30' West & Int. " Fountain Ave
			6 10	31[illegible]	" " " Top Ch. S. side " "
			[illegible]	[illegible]	" " " " Cut " " "
			[illegible]	31[illegible]	" " " " Top Ch. N. " " "
			[illegible]	31[illegible]	" " " " Cut " " "
			8 53	31[illegible]	" East " " " " " "
			9 50	31[illegible]	" " " " Top Ch. S. " " "
			7 [illegible]	31[illegible]	" " " " Cut " " "
			8 57	31[illegible]	" " " " Top Ch " " "
			4 07	31[illegible]	" " " " Cut " " "
			7 11	31[illegible]	21[illegible] S/L Int. Top Ch Delaware Ave N.W.
			5 [illegible]	31[illegible]	" " " " Cut " " "
			5 42	[illegible]	Top Ch. [illegible]
			[illegible]	[illegible]	Cut " " " " " "
			[illegible]	[illegible]	Top Ch N " " " " " "
			3 33	[illegible]	Cut " " " " " "

Form 307 5M 11-35

PLEASE RETURN TO
LOS ANGELES COUNTY SURVEYOR
700 HALL OF RECORDS

NOTE: ANY ADDITIONS OR CHANGES ON THIS SHEET MUST BE MADE OR CIRCLED IN RED INK, WITH DATE AND NAME OF PERSON MAKING CHANGE

Do not extend notes this side of this line

Profile No. ____ Notes Red. ____ Plotted ____ Job No 6351 Division No. ____ F.B. 5111 PG. 43

X-Sec. No. ____ Date ____ Date ____ Survey of ____

Notes Chkd. ____ Checked ____ Survey by [illegible] Notes ____ Date 3-9-37

Date ____ Date ____ Map No. ____ Indexed John Date ____

STATION	B. S.	H. I.	F. S.	ELEV.			
		324.77					
			7.72	[illegible]	Tp Co [illegible]		
			5.23	[illegible]	Cut [illegible]		
			8.72	316.05	Tp Co " "		
			8.73	316.04	" "		
			7.19	315.58	22' R & I to [illegible]		
1+00			8.15	314.62	24" Dist. Bridge [illegible]		
1+44.3 Sc.			9.33	313.44	" "		
1+48.3 E.C.			3.75	319.02	" "		
			1.34	318.43	10' R Tp Co		
			5.21	317.56	" "		
			7.72	315.05	15' R & I to [illegible]		
			7.15	317.62	5-2 [illegible]		
			1.85	320.92	" "		
T.P.			2.66	322.11			
	11.52	334.03					
2+50			7.86	326.17	℄ to D.		
2+78.2 D.C.			10.74	323.29	10' L D.C. Drop 8"	6.48 C 6.74 3.79 R	6.16 C 6.74 3.56 R
"			10.39	323.64	8" In N	10.74	10.34
"			10.50	323.53	8" In E.	6.03 C 6.74 3.80 R	5.69 C 6.74 3.50 R
"			8.16	325.87	8" Drop In E	10.50	5.16

See Page 108 for F.M.H. to east.

Form 307 5M 11-35

PLEASE RETURN TO
LOS ANGELES COUNTY SURVEYOR
700 HALL OF RECORDS

NOTE: ANY ADDITIONS OR CHANGES ON THIS SHEET MUST BE MADE OR CIRCLED IN RED INK, WITH DATE AND NAME OF PERSON MAKING CHANGE

Do not extend notes this side of this line

F. B. 697 Pg. 106 | Job No. 6318 Division No. | Profile No. | X-Sec. No.

Survey of [illegible] | Notes Red. | Plotted

Survey by C.E.S. | Date | Date

Indexed A. C. Johnson | Notes Chkd. | Checked

Date | Date

STATION	B. S.	H. I.	F. S.	ELEV.	
		334 [illegible]			
3+00			2 46	331 54	L.S.D.
			3 [illegible]	3[illegible]	10R Tp Cb
			3 69	[illegible] 30	" Cor.
			1 09	333 [illegible]	10L & Intersect &c.
			5 64	328 36	30L Tp Cb
			1 63	332 42	" Cor.
T.P.			6 14	326 50	
	-	345 36			
3+59.82 B.C.			2 82	342 54	L.S.D.
			7 22	338 14	15R Tp Cb
			8.22	" 14	" " Cor.
			5 75	339 61	10L & Intersect
			5 76	339 60	30L Tp Cb
			3 [illegible]	341 [illegible]	" Cor.
3+[illegible] E.C.			1 75	[illegible] 50	L.S.D.
B.C.			2 46	[illegible] 74	L Intersect Inc. (L.S.D.)
			3 43	341 77	20R Tp Cb
			4 21	341 43	" " Cor.
			3 3[illegible]	3[illegible] 47	29R Back in
			2 46	342 22	20L Tp Cb.

Form 307 5M 11-35

PLEASE RETURN TO
LOS ANGELES COUNTY SURVEYOR
700 HALL OF RECORDS

NOTE: ANY ADDITIONS OR CHANGES ON THIS SHEET MUST BE MADE OR CIRCLED IN RED INK, WITH DATE AND NAME OF PERSON MAKING CHANGE

Do not extend notes this side of this line

STATION	B. S.	H. I.	F. S.	ELEV.		
		345.35				
B.C.			345	344.51	Ex	
				342.10	Ex Ft Bar on Ft	
T.P.			5.10	340.25		
			5.21	339.14	Ex Ft Bar on Ft	
4+05 Ex			3.05	342.30	Ex Ft Bar on Ft	
			3.07	342.28	Grade	
			3.94	341.41	"	
			10.55	334.80	" Soil	
			5.45	339.90	19 ± Ex Delaguna Ave	
			8.12	337.23	39' ± Top of Ex	
			5.96	339.39	" Soil	
SMH. (Pol Down 19 ins)			11.65	333.70	SMH @ Ex E	7.30 6.70 3.55 11.65
			11.86	333.49	@ Ex S	2.37 1.36
EC.			1.34	343.01	± Delaguna Ave	
			1.86	342.49	Top of Ex	
			3.48	340.87	" Soil	
			1.78	342.57	" N Top of Ex	
			1.58	342.77	" " Soil	

Profile
No.
X-Sec.
No.
Notes Red
Date
Notes Chkd
Date
Plotted
Date
Checked
Date
Job No.
Survey of
Survey by
Map No.
Division No.
Notes
Indexed Johnson
Date
Date
F. B.
PG.

Form 307 5M 11-35

PLEASE RETURN TO
LOS ANGELES COUNTY SURVEYOR
700 HALL OF RECORDS

NOTE: ANY ADDITIONS OR CHANGES ON THIS SHEET MUST BE MADE OR CIRCLED IN RED INK, WITH DATE AND NAME OF PERSON MAKING CHANGE

Do not extend notes this side of this line

F.B. ___ PG. ___ | Job No. 2318 Division No. ___ Notes Red. ___ Plotted ___ Profile
Survey of Tract 6449 No. ___ Date ___ No. ___
Survey by C.L.B. Notes ___ Notes Chkd. ___ Checked ___ X-Sec.
Indexed by C. Johnson Date ___ Date ___ Date ___

STATION	B. S.	H. I.	F. S.	ELEV.	
B.M.# D-1	709	350 12		349.64	B.M.#D-1 Lkr. 344 on FB 682 P11 Set in mon. case Northeasterly Wall Westerly Right of Way 6449
T.P.		313.54	9.78	340.94	
T.P.	340	341 70	9.76	341.94	Sept 3, 1931 W. Hill Ferris Murray Hill Title
		H.I.	F.S.		Set in end of C.C. @ Sta. 7+05 DeLongpre Ave. FB.677/100
			9.77 / 2.67	349.03	
T.P.	1137	350 0.35	9.78	340.57	
T.P.	746	349 01	1.00	340.25	
B.M. D-8			5.81	351.20	B.M.D-8 El. 351.194 FB.682/ DeLongpre Ave. 200' ± West St. Mon. Nob. Wt. P.L. 1 foot S. of end

Notes Ck'd by	Survey of Sweetzer Ave Branch
Map No.	W. 0631B Tape No. 057 St'd 84° F.
Office Work	Surveyed by Brady
Checked	Notes Date 3-37
Date	Indexed A. C. Johnson

F.B. 697 PG. 109

CENTER LINE SURVEY

WEST HOLLYWOOD DRAINAGE SYSTEM

SWEETZER AVE BRANCH

JN631E

SHEET (3)

For Topography See Pgs

For Detail See Pgs

J. Brady - Chief
H.H. Smith - Transit
J.L. Willey - H. Chain
M.D. Van Horn - R. Chain

Note: Any Additions or Changes on This Sheet Must be Made or Circled in Red Ink With Date and Name of Person Making Change.

Do not extend notes this side of this line

RETURN TO
LOS ANGELES COUNTY SURVEYOR
700 HALL OF RECORDS

RECEIVED Sheila MAR 1 8 1937
PROGRESSED
BOOK INDEXED
MAP INDEXED
RECORD INDEXED
CARD INDEXED

FORM 247 10M 11-36

F.B. 697 Pg. 110

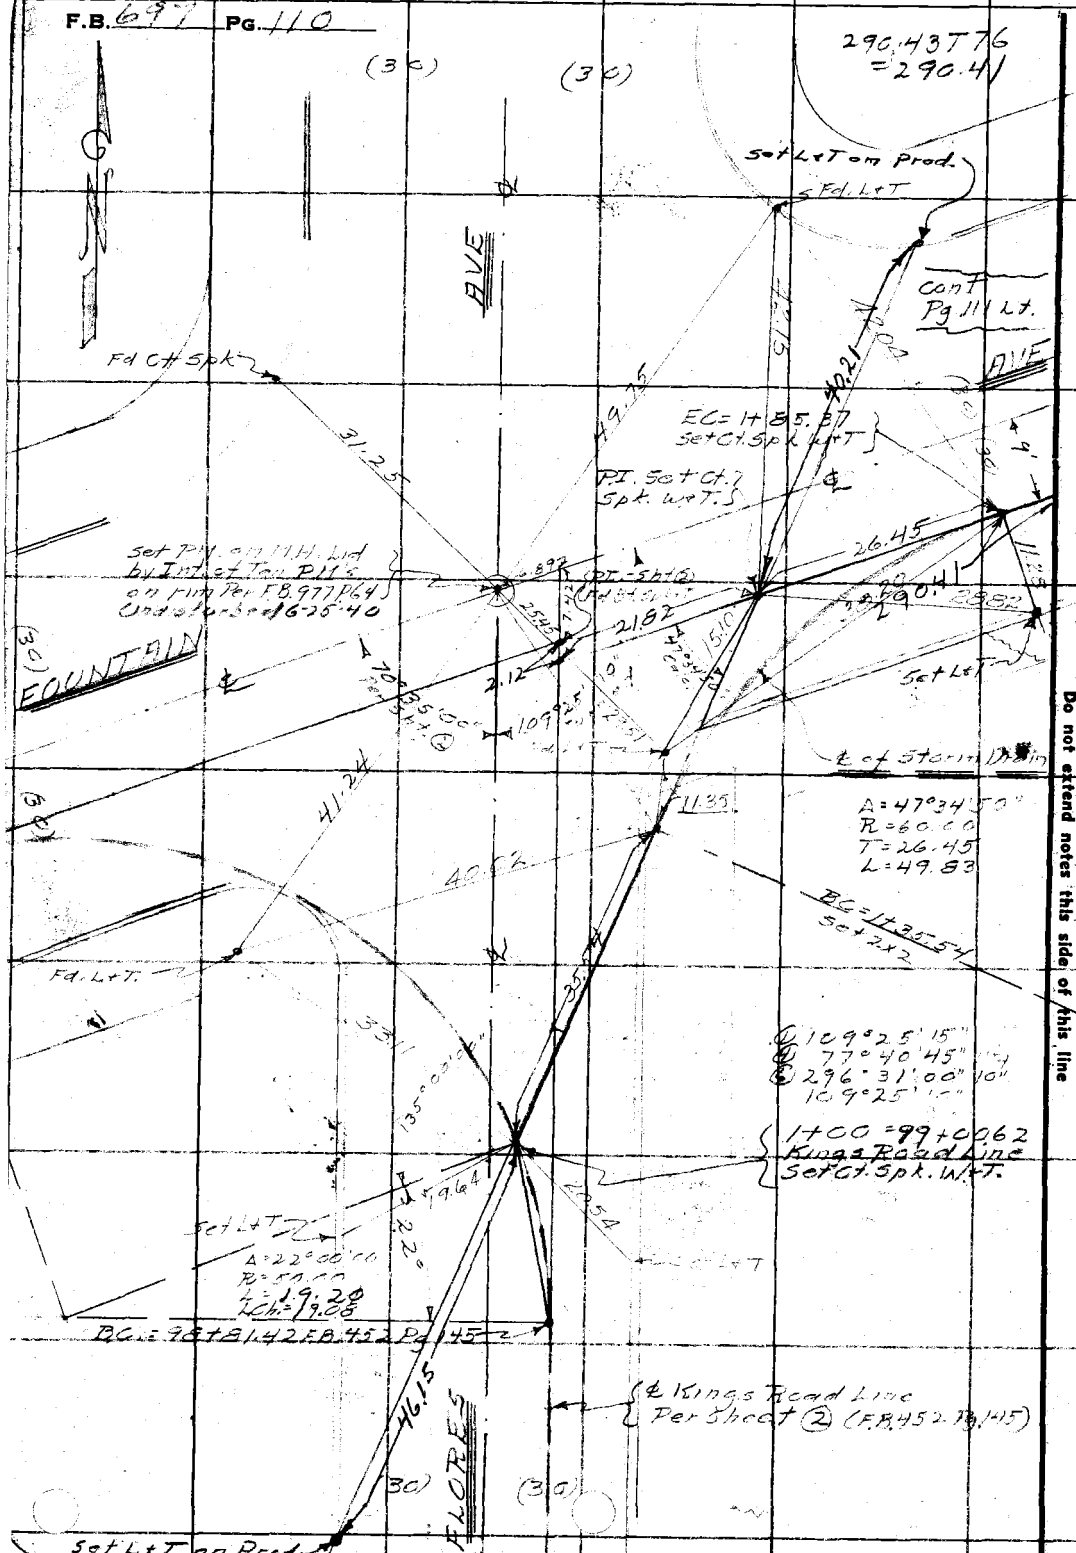

RETURN TO
LOS ANGELES COUNTY SURVEYOR
700 HALL OF RECORDS

Do not extend notes this side of this line

Note: Any Additions or Changes on This Sheet Must be Made or Circled in Red Ink With Date and Name of Person Making Change.

Notes Ck'd by	Survey of Sweetzer Ave Branch
Map No.	W. 06316 Tape No. 257 St'd 57° F.
Office Work	Surveyed by Brandy
Checked	Notes Date 2-10-37
Date	Indexed C. Johnson

F.B. 671 Pg. 111

Cont Bot of Pg. 112

345.00 T 74
= 344.98

Ave
To ℄ of Delongpre
Pg. 112
To ℄ of Longwood

344.98

℄ Storm Drain

Δ 109°25'15"
Ⓐ 177°40'45" 11¼
Ⓑ 296°31'00" 10"
109°25'10"

EC=5749.69
Set Ct. Spk. W+T

Δ = 70°34'50"
R = 60
T = 42.47
L = 73.91

3200

23.37

Fd Spk

Fd. L+T.

Fd. L+T
on ℄ Prod

42.47

30.03

A340

109°25'10"

30.03

47.70

Ⓐ 69°04'15
Ⓑ 178°08'30"

Undisturbed C-25-40
Fd W. Spk Per
F.B. 977 Pg. 65

5.085

Set P.M. on M.T. Lid
by Jas. P.L.S. on M.T.
Per F.B. 977 P. 65

4.155

P.I. Set Ct. Spk. W+T.

Undisturbed C-25-40

42.47

FOUNTAIN AVE

29.41

BC=4775.78
Set Ct Spk W+T

3.281

Fd. L+T.

F to ℄ Pg
110 Rad.

SWEETZER

(30)

(30)

(30)

(30)

℄ of Harper Ave Set PM on M.T. Lid by Ties per F.B. 977 Pg. 66

RETURN TO
LOS ANGELES COUNTY SURVEYOR
700 HALL OF RECORDS

Note: Any Additions or Changes on This Sheet Must be Made or Circled in Red Ink With Date and Name of Person Making Change.

Do not extend notes this side of this line

FORM 247 10M 11-36

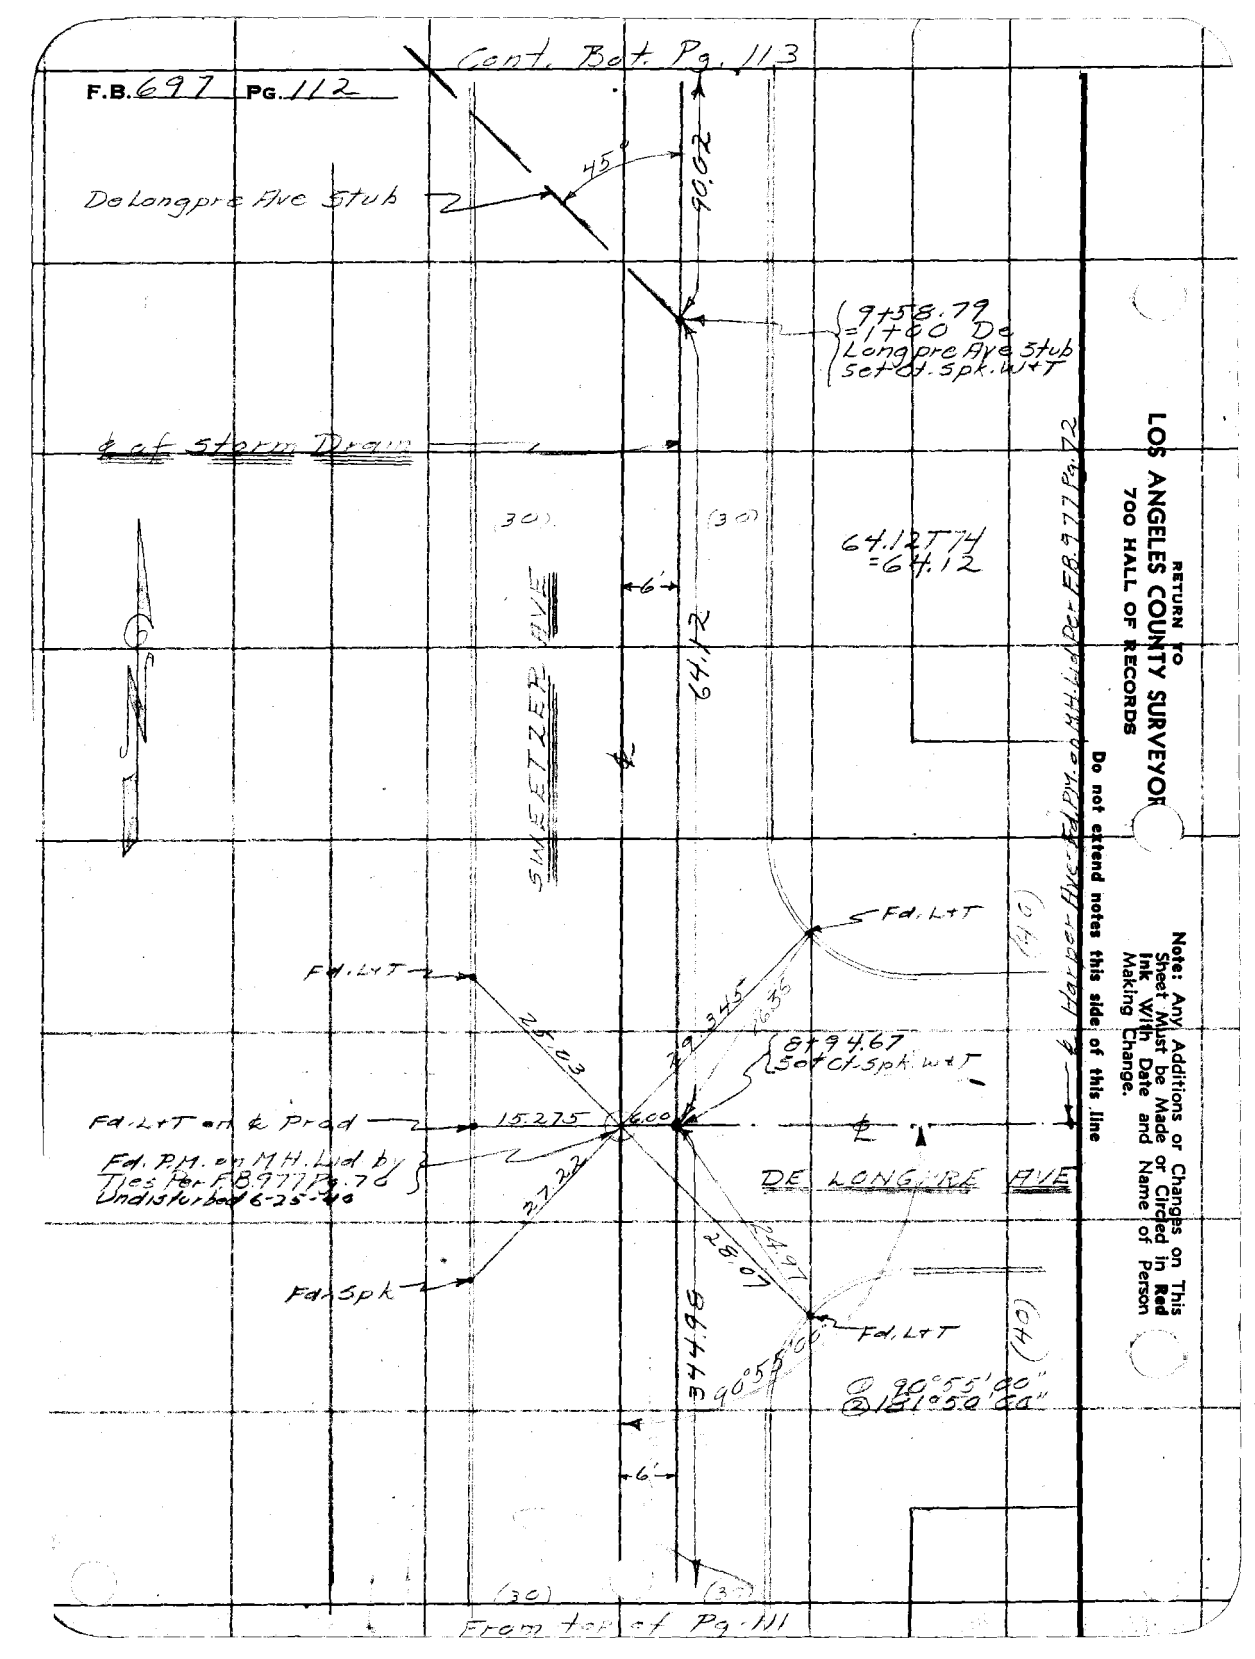
Cont. Bot. Pg. 113
F.B. 697 PG. 112
DeLongpre Ave Stub
45°
90.02
Longpre Ave Stub
set Cut Spk. w/ T
℄ of Storm Drain
30'
30'
64.12 T 74
=64.12
6'
64.12
SWEETZER AVE
℄
RETURN TO
LOS ANGELES COUNTY SURVEYOR
700 HALL OF RECORDS
Harper Ave. Fd. PK. on M.H. Lid per F.B. 977 Pg. 72
Do not extend notes this side of this line
Note: Any Additions or Changes on This Sheet Must be Made or Circled in Red Ink With Date and Name of Person Making Change.
Fd. L+T
Fd. L+T
26.03
9.345
16.35
87 94.67
50 of Ct. Spk. w/ T
Fd. L+T on ℄ Prod
15.275
6.00
℄
Fd. P.M. on M.H. Lid by
Dies Per F.B. 977 Pg. 76
Undisturbed 6-25-90
DE LONGPRE AVE
27.24
24.97
28.07
Fd. Spk
Fd. L+T
90°55'
90°55'00"
181°50'00"
6'
(30)
(30)
From top of Pg. 111

Notes Ck'd by	Survey of Sweetzer Ave Bridge
Map No.	W. O. 6318 Tape No. 257 St'd 3/4 F.
Office Work	Surveyed by Brandy
Checked	Notes " Date 3-10-37
Date	Indexed C. Johnson

F.B. 627 PG. 113

Note: Any Additions or Changes on This Sheet Must be Made or Circled in Red Ink With Date and Name of Person Making Change.

Do not extend notes this side of this line

RETURN TO
LOS ANGELES COUNTY SURVEYOR
700 HALL OF RECORDS

FORM 247 10M 11-38

Existing RCP Storm Drain

BC = 11+13.97
Set 4" in steel guard at Catch Basin

Δ = 18°38'53"
R = 100
T = 16.33
L = 32.53

16.50

31.95

90°

Fd. L+T.

11.2

Fd. L+T.

P.R.C. = 10+81.34
Set Ct Spk. W+T.

46.40

25.00

Fd. L+T. Stone Prod.

Δ = 18°38'53"
R = 100
T = 16.33
L = 32.53

34.29

16.89

Fd. W. Spk. Per F.B. 977 Pg. 94
Undisturbed 6-26-40

3.96

6.00

BC = 10+48.81
Set Ct Spk. W+T.

AVE

DE LONGPRE

To PI Per F.B. 977 Pg. 93

90°

13.76

10.84

Fd. L+T.

63°44'45"
254°59'30" 53
22°29'00" 17
63°44'50"

63°44'50"

17.77

90.03 T 74° = 90.02

St & Storm Drain

SWEETZER AVE

90.02

Fd. L+T.

Delongpre Ave Stub

9+58.79 = 1+00
Delongpre Ave Stub

From Top of Pg. 112

RETURN TO
LOS ANGELES COUNTY SURVEYOR
700 HALL OF RECORDS

Note: Any Additions or Changes on This Sheet Must be Made or Circled in **Red Ink** With Date and Name of Person Making Change.

Do not extend notes this side of this line

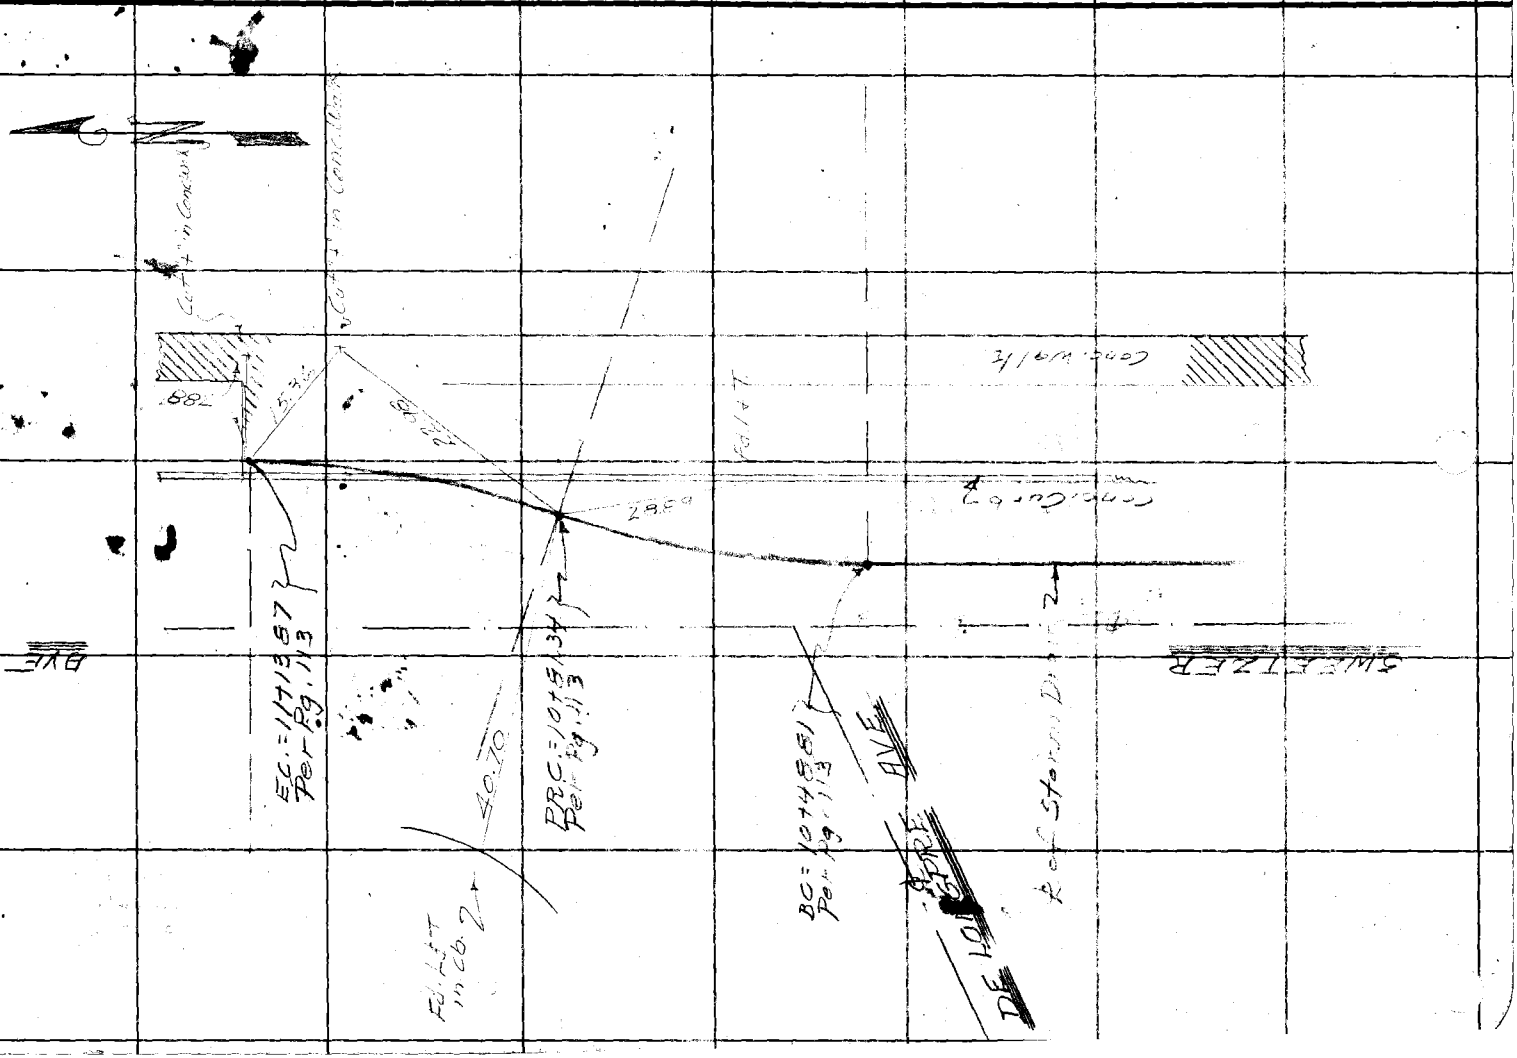

F.B. 677 PG. 114

Map No.	W. 0631 Tape No. 057 St'd 34° F.
Office Work	Surveyed by Brouty
Checked	Notes Date
Date	Indexed C. Johnson

F.B. 577 Pg. 115

TOPOGRAPHY

WEST HOLLYWOOD DRAINAGE SYSTEM

SWEETZER AVE BRANCH

JW 631E

SHEET ③

For ℄ Survey See Pgs. 109-110-111

For ℄ Profile See Pgs. 112-113

C E Brouty - Chief
F M Smith - Transit
J L Wiley - H Chain
M A Van Deren - R Chain

Note: Any Additions or Changes on This Sheet Must be Made or Circled in Red Ink With Date and Name of Person Making Change

Do not extend notes this side of this line

RETURN TO
LOS ANGELES COUNTY SURVEYOR
700 HALL OF RECORDS

RECEIVED HCS MAR 18 1937
PROGRESSED ✓ ✓
BOOK INDEXED ✓ ✓
MAP INDEXED ✓ ✓
RECORD INDEXED ✓ ✓
CARD INDEXED ✓ ✓

FORM 247 10M 11-36

F.B. 697 PG. 116

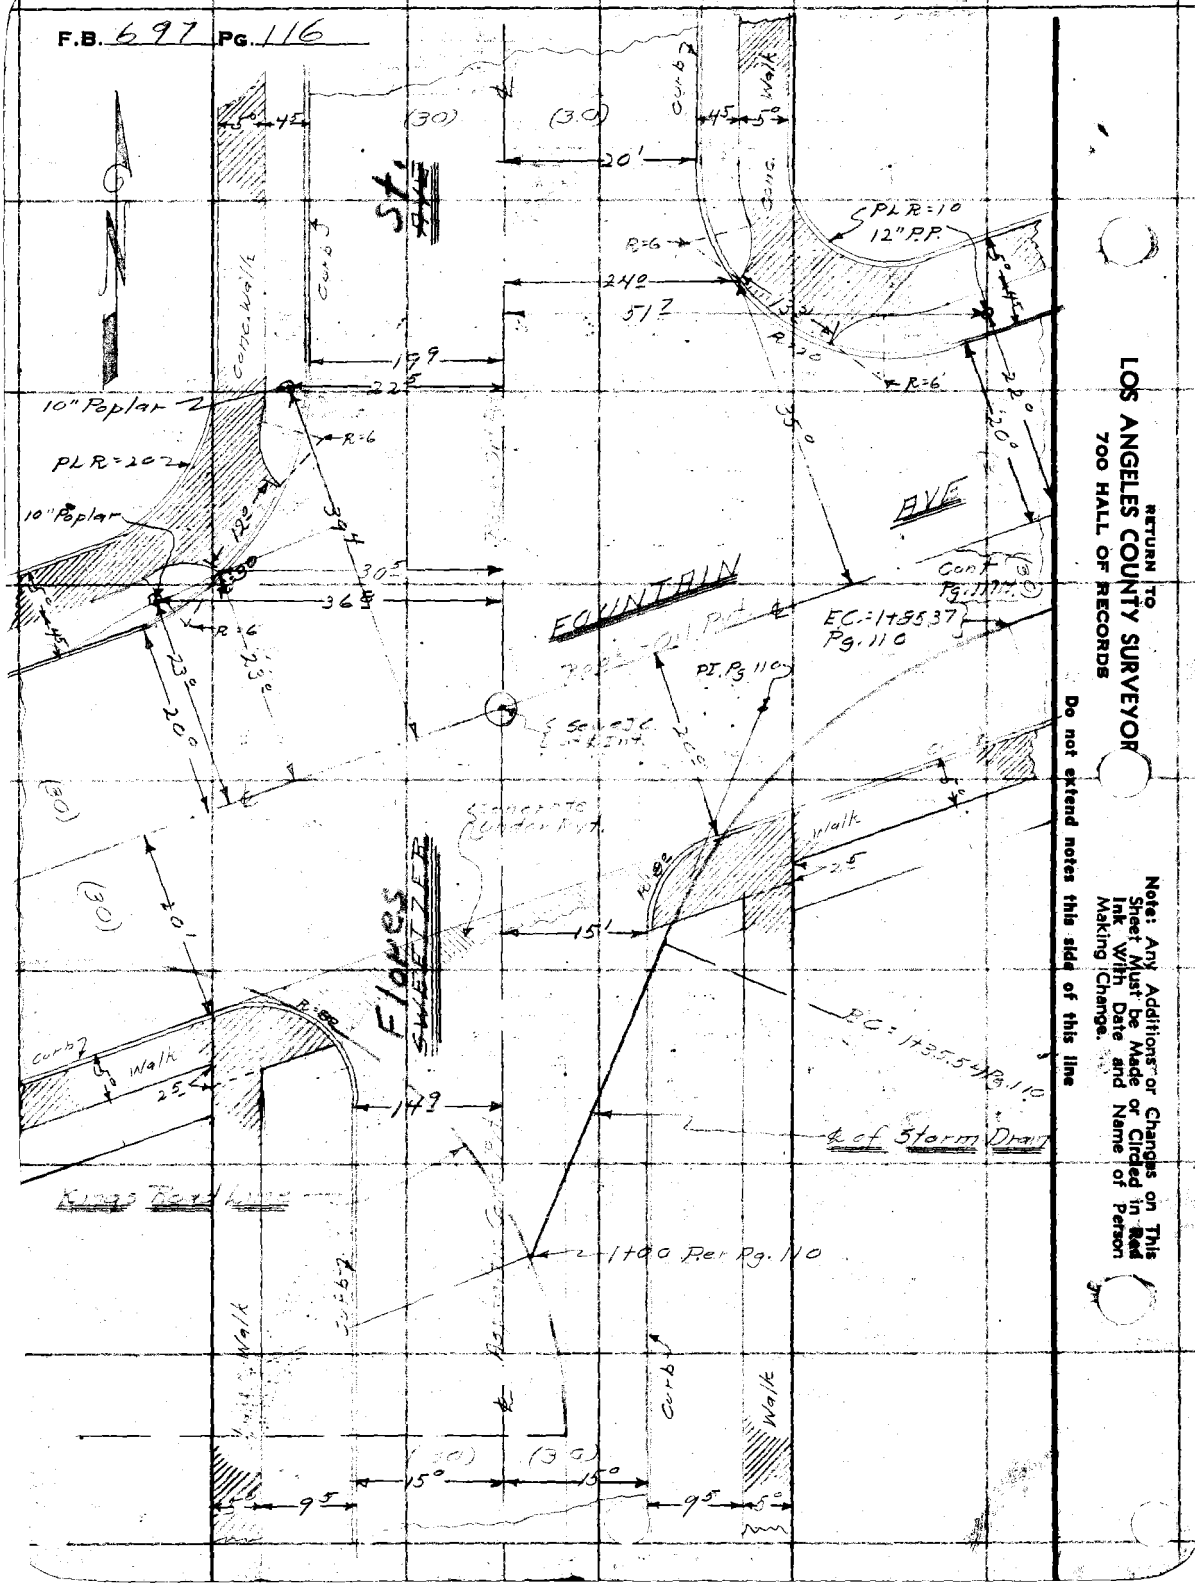

RETURN TO
LOS ANGELES COUNTY SURVEYOR
700 HALL OF RECORDS

Note: Any Additions or Changes on This Sheet Must be Made or Circled in Red Ink With Date and Name of Person Making Change.

Do not extend notes this side of this line

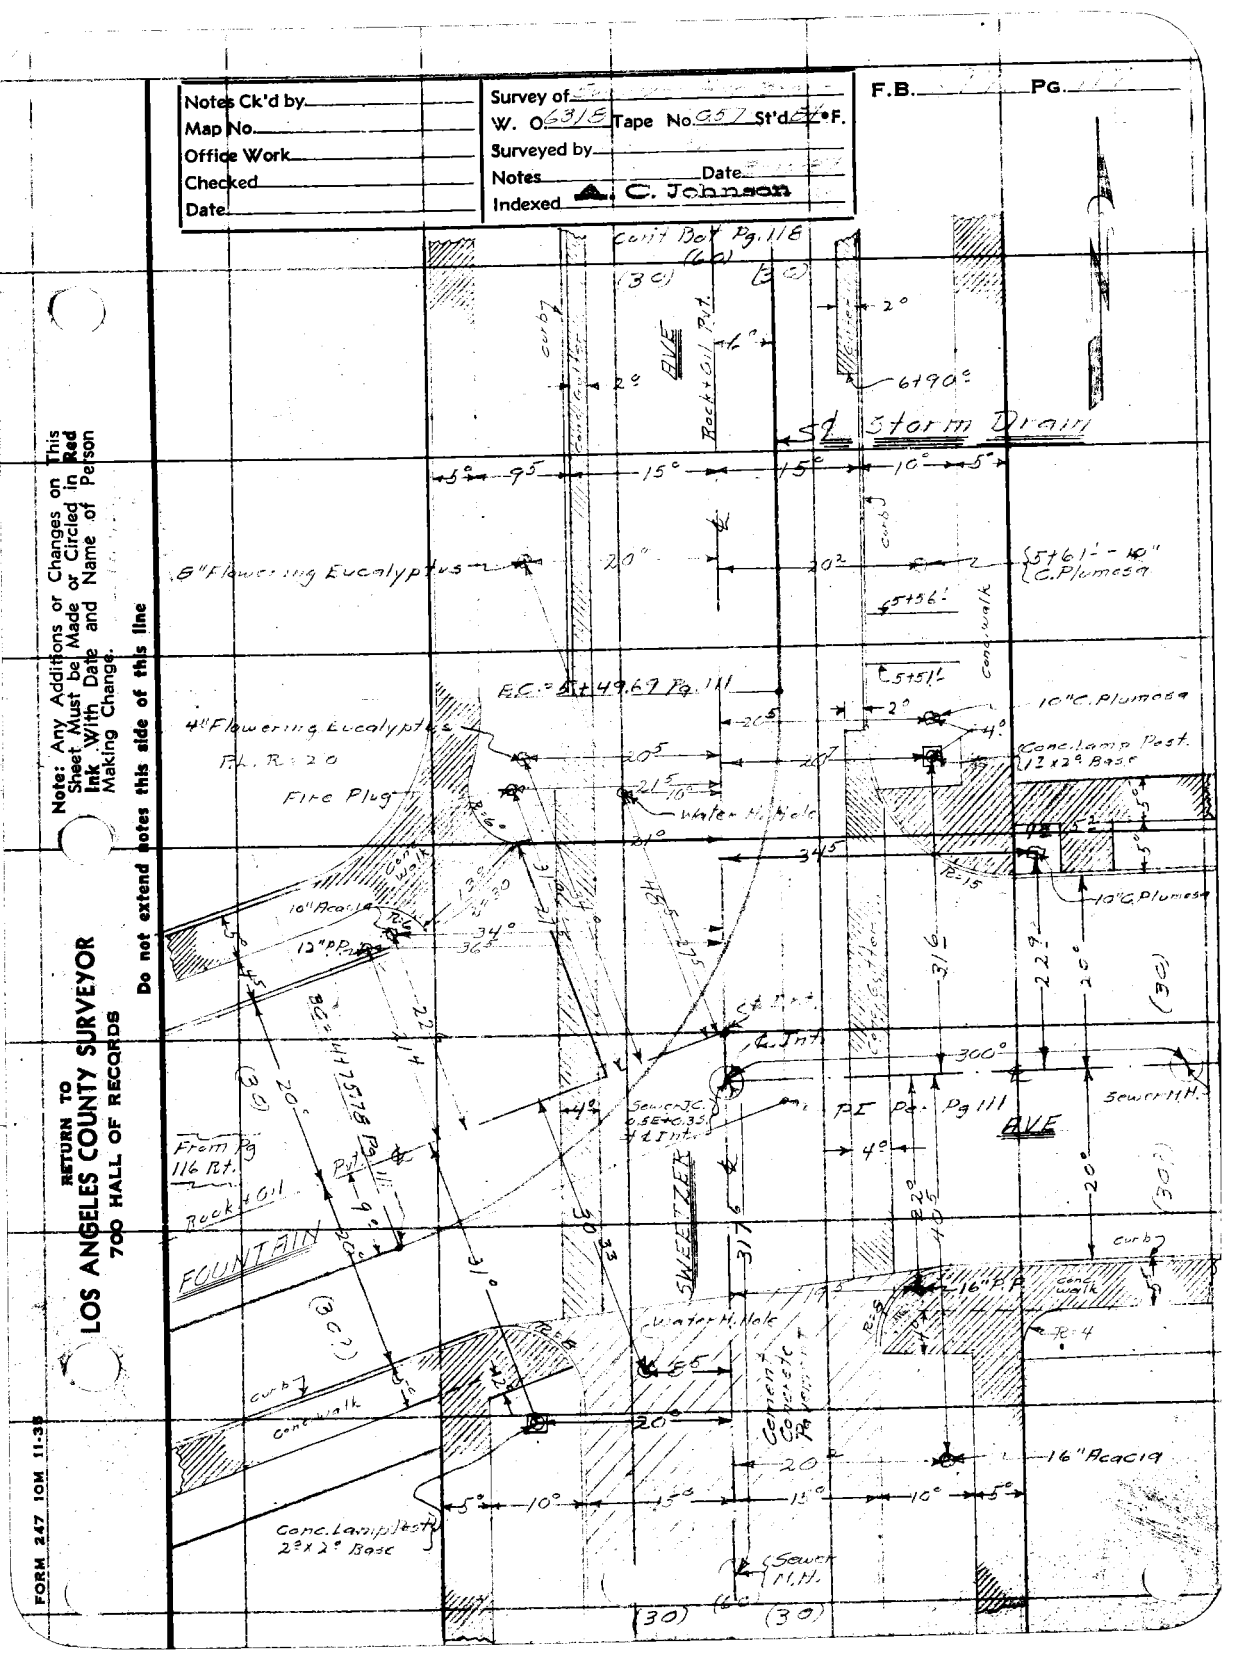

RETURN TO
LOS ANGELES COUNTY SURVEYOR
700 HALL OF RECORDS

Note: Any Additions or Changes on This Sheet Must be Made or Circled in Red Ink With Date and Name of Person Making Change.

Do not extend notes this side of this line

FORM 247 10M 11-38

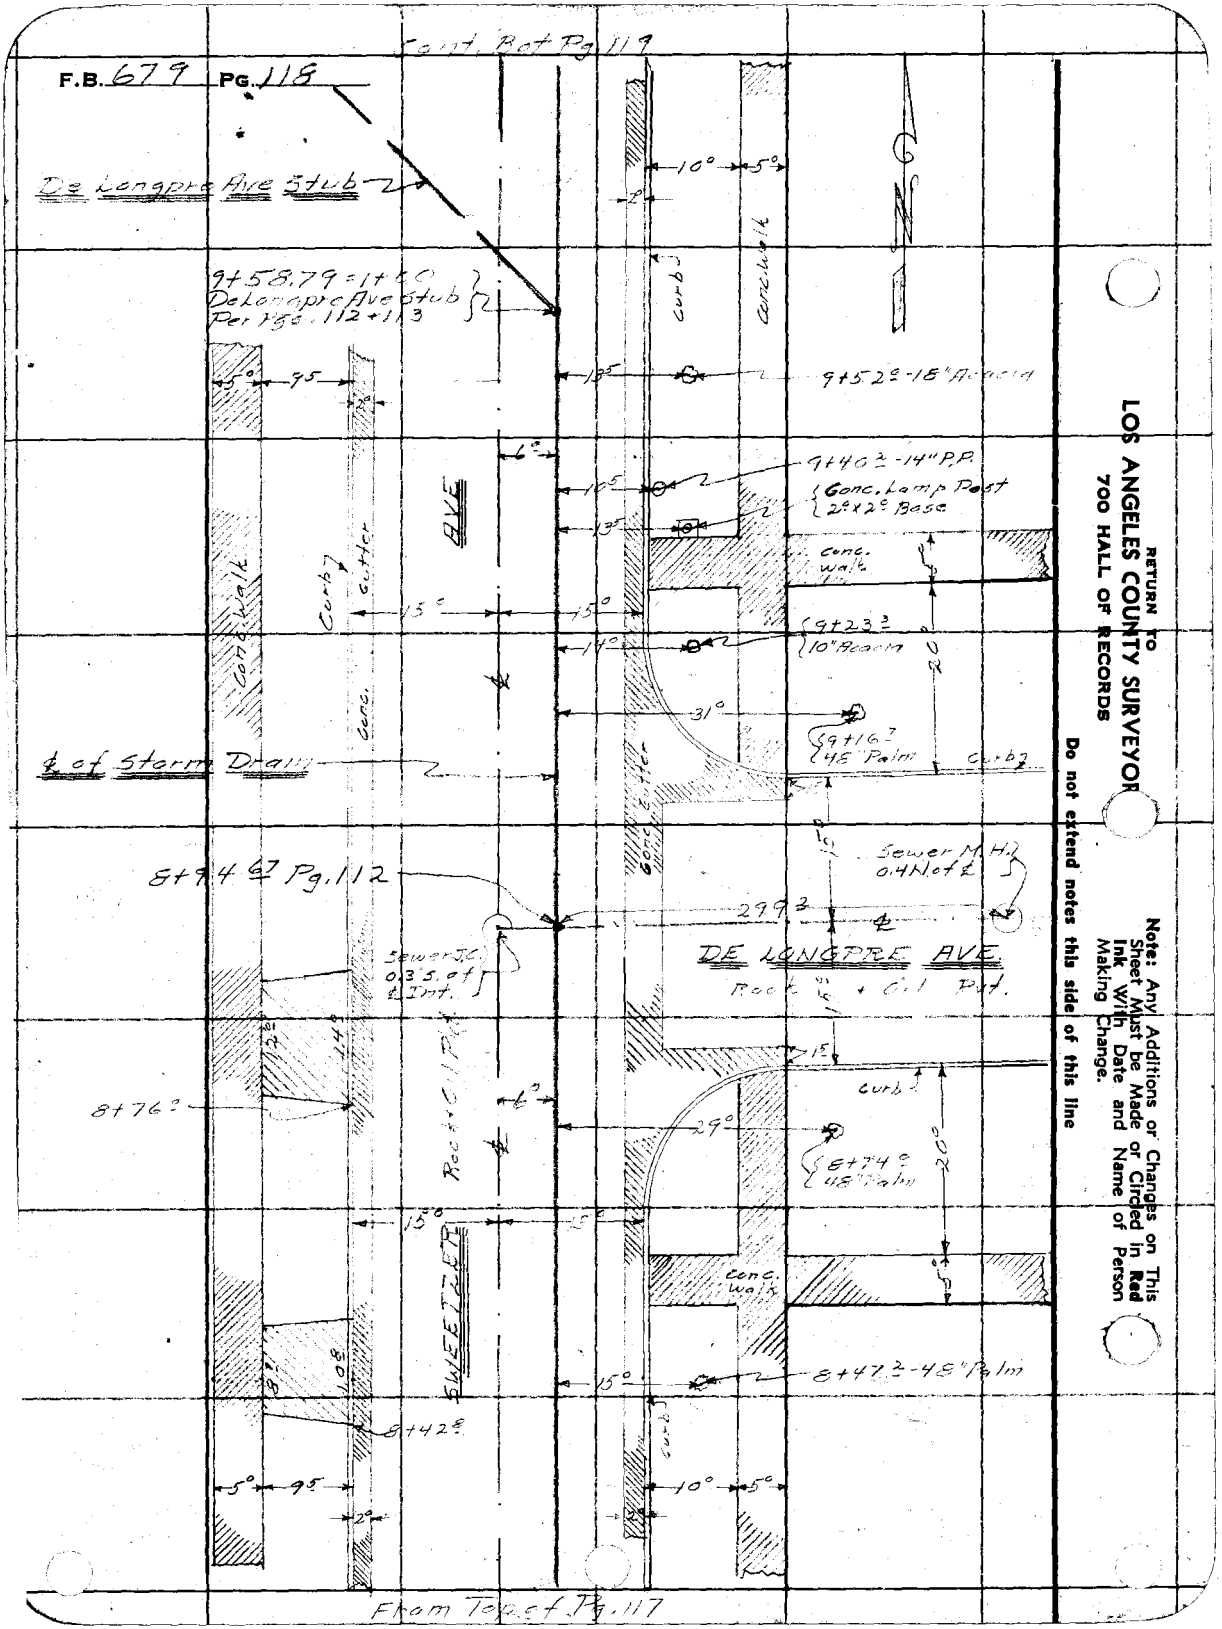
Cont. Ref Pg. 119
F.B. 679 Pg. 118
De Longpre Ave Stub
9+58.79 = 1+ P.C.
De Longpre Ave Stub
Per Bk. 112 + 113
curb
Curb Walk
9+52 ± - 18" Acacia
9+40 ± - 14" P.P.
Conc. Lamp Post
2'x2' Base
Conc. Walk
9+23 ±
10" Beech
9+16 ±
48' Palm
Curb
Cont. Walk
Curb & Gutter
Conc.
AVE
Cont. Curb
℄ of Storm Drain
8+94 & Pg. 112
Sewer M.H.
0.4 N of ℄
Sewer J.C.
0.3 S of
℄ Int.
DE LONGPRE AVE
Rock + Oil Pvt.
8+76 ±
Rock + Oil Pvt.
curb
8+74 ±
48' Palm
Conc. Walk
SWEETZER
8+47 ± - 48" Palm
8+42 ±
Conc.
From Top of Pg. 117
RETURN TO
LOS ANGELES COUNTY SURVEYOR
700 HALL OF RECORDS
Note: Any Additions or Changes on This Sheet Must be Made or Circled in Red Ink With Date and Name of Person Making Change.
Do not extend notes this side of this line

Notes Ck'd by	Survey of Sweetzer Avenue
Map No.	W. 06316 Tape No. 057 St'd 64 °F.
Office Work	Surveyed by Brown
Checked	Notes Date 3-16-37
Date	Indexed A. C. Johnson

F.B. 679 PG. 119

Note: Any Additions or Changes on This Sheet Must be Made or Circled in Red Ink With Date and Name of Person Making Change.

Do not extend notes this side of this line

RETURN TO
LOS ANGELES COUNTY SURVEYOR
700 HALL OF RECORDS

Cont. Bot Pg. 120

Rock & Cl Put.

Cint Per Pg. 113

AVE

L

BC=10+45.61
Per Pg. 113

LONGFORD

DE

Asphaltic Conc. Pvt.

Delongpre Ave Stub

Rock & Cl Put.

8" Sewer on St. ℄

10+10
Sewer J.C.

S ℄ Storm Drain

16" Reinforced Conc. Pipe

8" Sewer Sta Pg.

16" Reinforced Conc. Pipe

8" Sewer on St. ℄

22°

R=45'

5-5'

13°

29'

59+85

℄

Curb & Gutter

Conc. Walk

PL R. 30

P.C.

Curve Length 45.51

Comb R=45'

R=30.55

6°

SWEETZER

59+58.79
Tan Delongpre Ave Stub

59+50
B.C.

(30)

(30)

5°

9.5'

15°

15°

10°

5°

2%

2%

From Top of Pg. 11E

FORM 247 10M 11-35

F.B. 679 Pg. 120

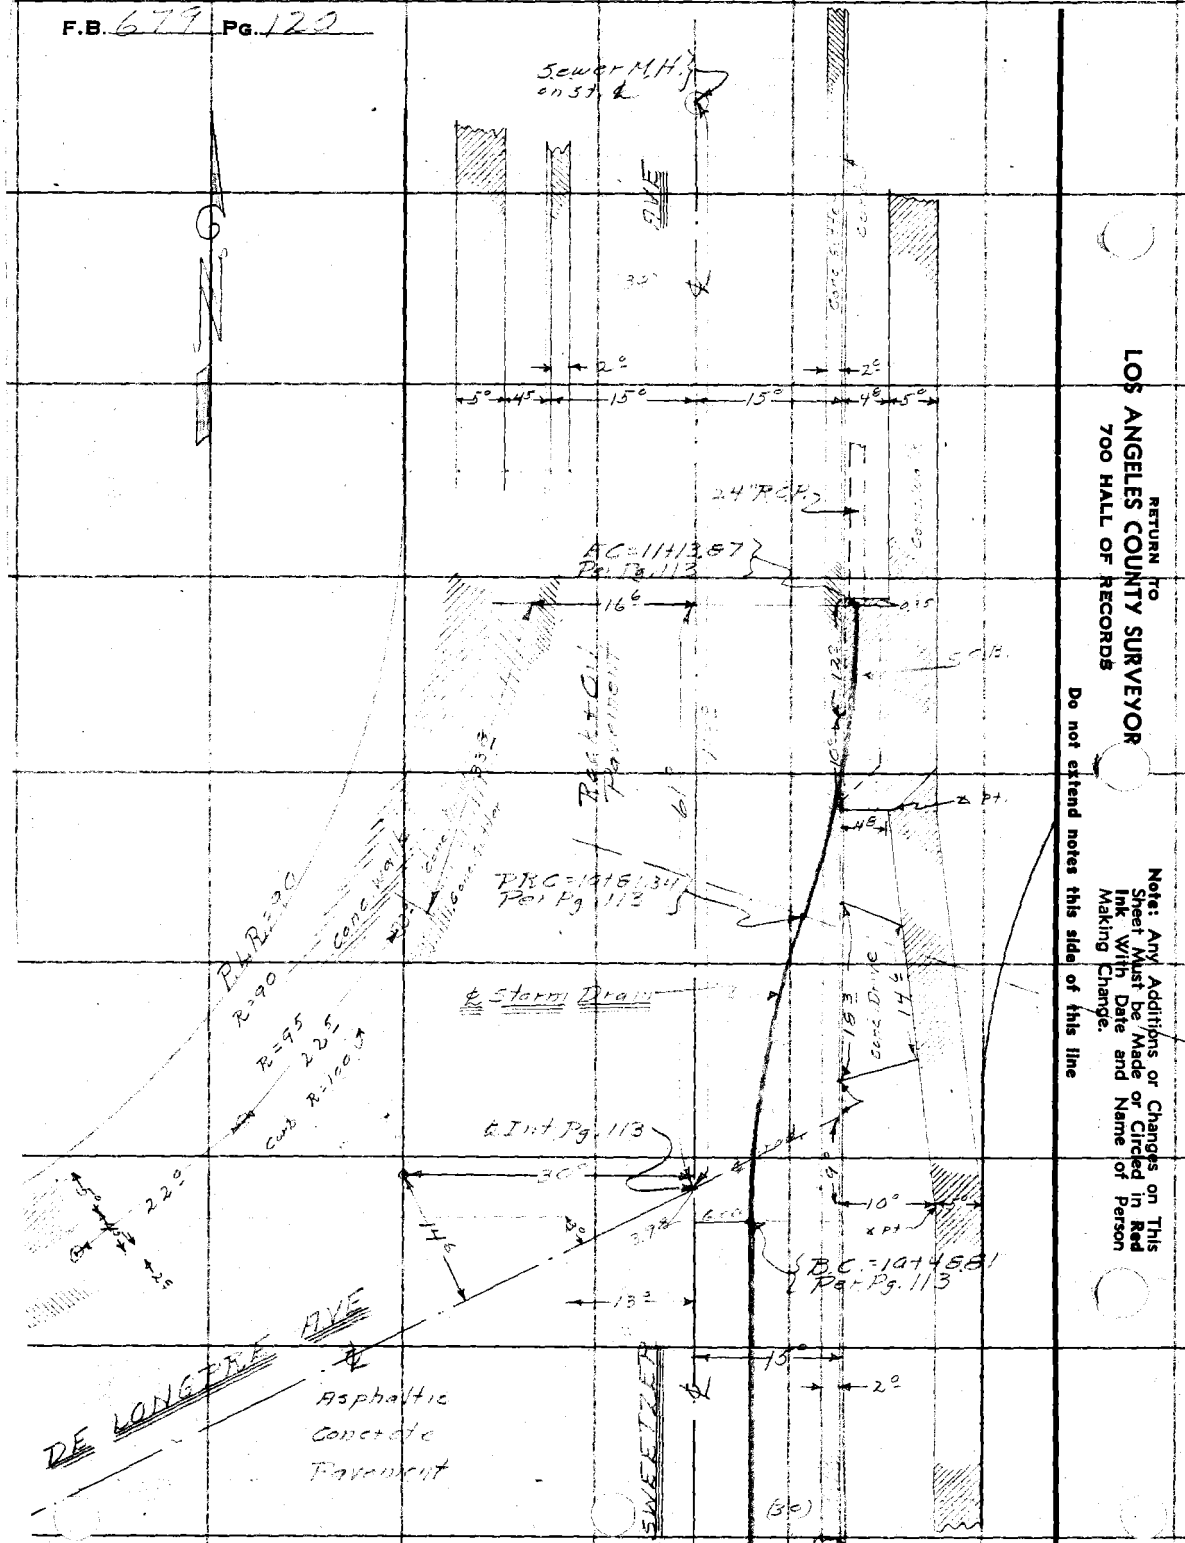

RETURN TO
LOS ANGELES COUNTY SURVEYOR
700 HALL OF RECORDS

Note: Any Additions or Changes on This Sheet Must be Made or Circled in Red Ink With Date and Name of Person Making Change.

Do not extend notes this side of this line

Profile No. | Notes Red. | Date | Plotted | Date | Job No. | Division No. | F. B. | Pg.

X-Sec. No. | Notes Chkd. | Date | Checked | Date | Survey of | Survey by C.E.B. A. C. Johnson | Notes | Date 3-16-37 | Map No. | Indexed | Date

NOTE: ANY ADDITIONS OR CHANGES ON THIS SHEET MUST BE MADE OR CIRCLED IN RED INK, WITH DATE AND NAME OF PERSON MAKING CHANGE

Do not extend notes this side of this line

PLEASE RETURN TO
LOS ANGELES COUNTY SURVEYOR
700 HALL OF RECORDS

Form 307 5M 11-35

STATION	B. S.	H. I.	F. S.	ELEV.

RECEIVED Smelser MAR 15 1937

PROCESSED

BOOK INDEXED

MAP INDEXED

RECORD INDEXED

~~CARD INDEXED~~

~~REDUCED~~ Field

CHECKED

Form 307 5M 11-35

PLEASE RETURN TO
LOS ANGELES COUNTY SURVEYOR
700 HALL OF RECORDS

NOTE: ANY ADDITIONS OR CHANGES ON THIS SHEET MUST BE MADE OR CIRCLED IN RED INK, WITH DATE AND NAME OF PERSON MAKING CHANGE

Do not extend notes this side of this line

F. B. ___ Pg. ___ | Job No. ___ Division No. ___ Notes Red. ___ Plotted ___ Profile No. ___ X-Sec. No. ___

Survey of ___ Date ___

Survey by ___ Notes ___ Notes Chkd. ___ Checked ___

Indexed ___ Date ___ Date ___ Date ___

STATION	B. S.	H. I.	F. S.	ELEV.		

Form 307 5M 11-35

PLEASE RETURN TO
LOS ANGELES COUNTY SURVEYOR
700 HALL OF RECORDS

NOTE: ANY ADDITIONS OR CHANGES ON THIS SHEET MUST BE MADE OR CIRCLED IN RED INK, WITH DATE AND NAME OF PERSON MAKING CHANGE

Do not extend notes this side of this line

STATION	B. S.	H. I.	F. S.	ELEV.		
TP		312.28				
				309.62		
				309.26	Gut	
				310.79	TpCb	
533				310.32	Gut	
540				312.25	TpCb	
				309.38	Gut	
365				311.91	TpCb	
406				311.39	Gut	
361				312.04	TpCb	
395				311.70	Gut	
428				312.57	TpCb	
565				312.00	Gut	
425				311.32	33' North Int.	
					25'	
143				312.22	TpCb	E side Fore St
195				313.71	Gut	

Profile
No. X-Sec.
Notes Red Plotted Job No. Division No.
Date Date Survey of
Notes Chkd Checked Survey by
Date Date Map No.
Notes Entered Johnson Date
F.B. PG.

Form 307 5M 11-35

PLEASE RETURN TO
LOS ANGELES COUNTY SURVEYOR
700 HALL OF RECORDS

NOTE: ANY ADDITIONS OR CHANGES ON THIS SHEET MUST BE MADE OR CIRCLED IN RED INK, WITH DATE AND NAME OF PERSON MAKING CHANGE

Do not extend notes this side of this line

Profile No. ____ X-Sec. No. ____

Notes Red. ____ Date ____ Plotted ____ Date ____

Notes Chkd. ____ Date ____ Checked ____ Date ____

Job No. ____ Division No. ____ Notes ____ Date ____

Survey of ____

Survey by ____ C. Johnson

Indexed ____

P.B. 197 PG. 124

STATION	B. S.	H. I.	F. S.	ELEV.		
		315 ±				
			0 00	310 ±	10' ht. Triangle	
			0 56	31	" " " Cut	" " " "
			6 74	30	16' Curb & Gutter	
P.C.			16.14	299	Tie to Monument	
			3 [illegible]	[illegible]	6" Inv. W. 10.25 C 570	10.24 5.07 R
			[illegible]	[illegible]	5" [illegible] S. - 6.82 R 16.14	6.08 C 17.02
1+85.32 EC			5 80	304	Curb & G.	
2+00			5 76	30	" " "	
3+00			4 [illegible]	31	" " "	
			[illegible]	31	11' ht. Tr. Co	
			[illegible]	31	" " Cut	
			4 00	31	8' ht. Tr. Co.	
T.P.			4 72	310		
		314 ±				
3+00			7 72	31	21' ht. Tr. Co.	
"			5 [illegible]	31	" " Cut	
4+00			7 [illegible]			
			6 79	30	9½ ht. Tr. Co.	
4+75 EC	EC		5 81		Curb & G.	
			[illegible]		[illegible]	

Form 307 5M 11-35

PLEASE RETURN TO
LOS ANGELES COUNTY SURVEYOR
700 HALL OF RECORDS

NOTE: ANY ADDITIONS OR CHANGES ON THIS SHEET MUST BE MADE OR CIRCLED IN RED INK, WITH DATE AND NAME OF PERSON MAKING CHANGE

Do not extend notes this side of this line

STATION	B. S.	H. I.	F. S.	ELEV.		
4+75 ±		317 ±				
Int.			1.70		4' Int. to [illegible]	[illegible] W. and Swatara, [illegible]
			[illegible]		100'S	"
			[illegible]		" " Tank	"
			10.15		" " " Int	"
			9.11		" " " Tp. [illegible]	"
			[illegible]		" " " Int	"
Int.			[illegible]		Int. Fairview [illegible]	[illegible]
			[illegible]		15' E Int.	"
			3.75	313.14	35' E Int	"
			2.13	317.59	100' E Int	"
			2.77	314.95	" " " " Tp. cb.	"
			3.22	316.50	" " " " Int	"
			1.97	317.55	" " " " Tp. cb	"
			[illegible]	317.10	" " " " Int	
			6.35		Tp. cb. W and cb. [illegible] N. Cor	
			6.60		Int	"
			6.53		Tp. cb	"
			7.31		Int	"
			5.86		Tp. cb	"
			6.57		Int	"

Profile
Notes Red _____ Plotted _____ Job No. _____ Division No. _____
No. _____ Date _____ Date _____ Survey of _____ F. B. _____ PG. _____
X-Sec. Notes Chkd _____ Checked _____ Survey by _____ Notes _____ Date _____
No. _____ Date _____ Date _____ Map No. _____ Indexed _____ Date _____

Form 307 5M 11-35

PLEASE RETURN TO
LOS ANGELES COUNTY SURVEYOR
700 HALL OF RECORDS

NOTE: ANY ADDITIONS OR CHANGES ON THIS SHEET MUST BE MADE OR CIRCLED IN RED INK, WITH DATE AND NAME OF PERSON MAKING CHANGE

Do not extend notes this side of this line

F. B. 211 PG. 26 | Job No. 3212 | Division No. | Notes Red. | Plotted | Profile No.
Survey of [illegible] | Date | Date | X-Sec. No.
Survey by C. Johnson | Notes | Notes Chkd. | Checked
Indexed | Date | Date | Date

STATION	B. S.	H. I.	F. S.	ELEV.		
4475±		3[illegible]72				
			[illegible]	3[illegible]12	Proc. [illegible]	R. 5 E. Sec.
			[illegible]	[illegible]18	[illegible]	
			[illegible]71	3[illegible]16	To [illegible]	
			[illegible]12	[illegible]10	Con.	
			[illegible]04	[illegible]16	[illegible] N	
			[illegible]22	[illegible]13	[illegible]	
			[illegible]02	[illegible]14	Proc.	
			[illegible]	[illegible]	[illegible]	
			[illegible]30	[illegible]37	[illegible]	
			[illegible]52	[illegible]12	[illegible]	
D.C.M.H.					Int. Found. to Int. E. & Section Ave.	
			13[illegible]	30[illegible]12	8" In. N. 7.72	7.79 8.91
			13[illegible]	30[illegible]44	5" In. E. 13.94	4.91 4.85
			13[illegible]	30[illegible]11	3" [illegible] 13.29	13.28 13.53
T.P.			11[illegible]3	3[illegible]24		
	111	3[illegible]32				
S.M.H.					S.M.H. to Int. & Int. E. & Section Ave.	
					5" In. N. 7.94 6.70	8.95 6.71
					5" Int. S. 5.24	4.84
I.P.			[illegible]2	[illegible]3	4.14	11.37

Form 307 5M 11-35

PLEASE RETURN TO
LOS ANGELES COUNTY SURVEYOR
700 HALL OF RECORDS

NOTE: ANY ADDITIONS OR CHANGES ON THIS SHEET MUST BE MADE OR CIRCLED IN RED INK, WITH DATE AND NAME OF PERSON MAKING CHANGE

Do not extend notes this side of this line

STATION	B. S.	H. I.	F. S.	ELEV.		
TP						
	10.54					
	6.44					
T.P.						
54+42	EC			6		
16+00						
7+00						

Form 307 5M 11-35

PLEASE RETURN TO
LOS ANGELES COUNTY SURVEYOR
700 HALL OF RECORDS

NOTE: ANY ADDITIONS OR CHANGES ON THIS SHEET MUST BE MADE OR CIRCLED IN RED INK, WITH DATE AND NAME OF PERSON MAKING CHANGE

Do not extend notes this side of this line

F. B. 127 Pg. 125 | Job No. 6318 Division No. | Notes Red. Date | Plotted Date | Profile No.
Survey of 1163 C.E.B. | Notes Date | Notes Chkd. Date | Checked Date | X-Sec. No.
Survey by A. C. Johnson

Indexed

STATION	B. S.	H. I.	F. S.	ELEV.	

Form 307 5M 11-35

PLEASE RETURN TO
LOS ANGELES COUNTY SURVEYOR
700 HALL OF RECORDS

NOTE: ANY ADDITIONS OR CHANGES ON THIS SHEET MUST BE MADE OR CIRCLED IN RED INK, WITH DATE AND NAME OF PERSON MAKING CHANGE

Do not extend notes this side of this line

STATION	B. S.	H. I.	F. S.	ELEV.		
		336.66				
					Tp cb. E and cb. R. N.E. cor.	
					Got. " " " " " " "	
					Tp cb. " " " " " "	
			3.65		" "	
T.P.			2.74			
E.M.L.		337				
O T.P.		3.5				
P-3C					T R Tp cb	
					Got	
N 50E					Tpcb S and cb R.	
					Got	
1+35E						
10+0				0		
10+0			13.12			
			3.57			
			1.64		Tp cb. W and cb. R. S.W. cor.	
			1.50		Got " " " "	

Profile
No.
X-Sec.
No.
Notes Red Plotted Job No. Division No.
Date Date Survey of
Notes Chkd Checked Survey by Notes
Date Date Map No. Indexed
F. B.
PG.

Form 307 5M 11-35

PLEASE RETURN TO
LOS ANGELES COUNTY SURVEYOR
700 HALL OF RECORDS

NOTE: ANY ADDITIONS OR CHANGES ON THIS SHEET MUST BE MADE OR CIRCLED IN RED INK, WITH DATE AND NAME OF PERSON MAKING CHANGE

Do not extend notes this side of this line

F.B. 697 Pg. 120 | Job No. 4318 Division No. | Profile No. | X-Sec. No.

Survey of West | Notes Red. | Plotted | Date | Date

Survey by C.E.B. | Notes | Notes Chkd. | Checked | Date

Indexed A. C. Johnson | Date | Date | Date

STATION	B. S.	H. I.	F. S.	ELEV.		
		825				
T.P.						
		363				
Int.			7.12		Int. Bldg. on the West	
			2.77		10 West	& Del Amo Ave.
			7.95		55' "	
			9.21		95' "	
			7.81		125' "	
					B.C.	
T.P.						
			12.58		5' Int W.	6.36
			12.5	-5	5' Int E.	7.36
			9.33		15' X Tp. Cb.	16.56
			9.11			
			2.86		Tp. Cb. West	
			7.64		Int	
			1.36		L.S.D.	
T.P.			0.93	34.47		
	10.91	36.38				
1/4 1982	E.C.		5.21		L.S.D. Tag	
			1.03		EL. Conc. Tpc.	

Form 307 5M 11-35

PLEASE RETURN TO
LOS ANGELES COUNTY SURVEYOR
700 HALL OF RECORDS

NOTE: ANY ADDITIONS OR CHANGES ON THIS SHEET MUST BE MADE OR CIRCLED IN RED INK, WITH DATE AND NAME OF PERSON MAKING CHANGE

Do not extend notes this side of this line

STATION	B. S.	H. I.	F. S.	ELEV.		
T.P.			173			
			1932			
			1951			
			212			
			281			
T.P.			1142			
	243					
B.M. #-17						

Profile
Notes Red ____ Plotted ____ Job No. ____ Division No. ____
No. ____ Date ____ Date ____ Survey of ____
X-Sec. Notes Chkd ____ Checked ____ Survey by ____ Notes ____ F. B. ____ PG. ____
No. ____ Date ____ Date ____ Map No. ____ Indexed ____ Date ____

F. B. 207/PG. 132 | Job No. [illegible] | Division No. _____ | Notes Red. _____ | Plotted _____ | Profile No. _____

Survey of [illegible] | Date _____ | Date _____

Survey by E. A. Hunt / Notes [illegible] | Notes Chkd. _____ | Checked _____ | X-Sec. No. _____

Indexed A. C. Johnson | Date _____ | Date _____ | Date _____

STATION	B. S.	H. I.	F. S.	ELEV.

Form 307 5M 11-35

PLEASE RETURN TO
LOS ANGELES COUNTY SURVEYOR
700 HALL OF RECORDS

Do not extend notes this side of this line

NOTE: ANY ADDITIONS OR CHANGES ON THIS SHEET MUST BE MADE OR CIRCLED IN RED INK, WITH DATE AND NAME OF PERSON MAKING CHANGE

Notes Ck'd by	Survey of Preliminary Surv. F.B. 11 Pg. 133
Map No.	W. O. 6347 Tape No. 257 St'd 64°F.
Office Work	Surveyed by Crew
Checked	Notes Date 2-17-37
Date	Indexed A. C. Johnson

CENTER LINE SURVEY

WEST HOLLYWOOD DRAINAGE SYSTEM

DE LONGPRE AVE STUB

JN 6318

SHEET ③

For Topography See Sheets 131 to 135 Incl.
For Profile See Sheets 141 to 143 Incl.

C. E. Bailey - Chief
H. L. Stevens - Asst.
J. L. Willey - Helman
M. A. Van Deren - Helman

Const. J.N. = 6347
(W.O.)

RECEIVED MAP ON HLS

~~PROCESSED~~

BOOK INDEXED

MAP INDEXED

RECORD INDEXED

CARD INDEXED

RETURN TO
LOS ANGELES COUNTY SURVEYOR
700 HALL OF RECORDS

Note: Any Additions or Changes on This Sheet Must be Made or Circled in Red Ink With Date and Name of Person Making Change.

Do not extend notes this side of this line

FORM 247 10M 11-35

F.B. 697 PG. 134

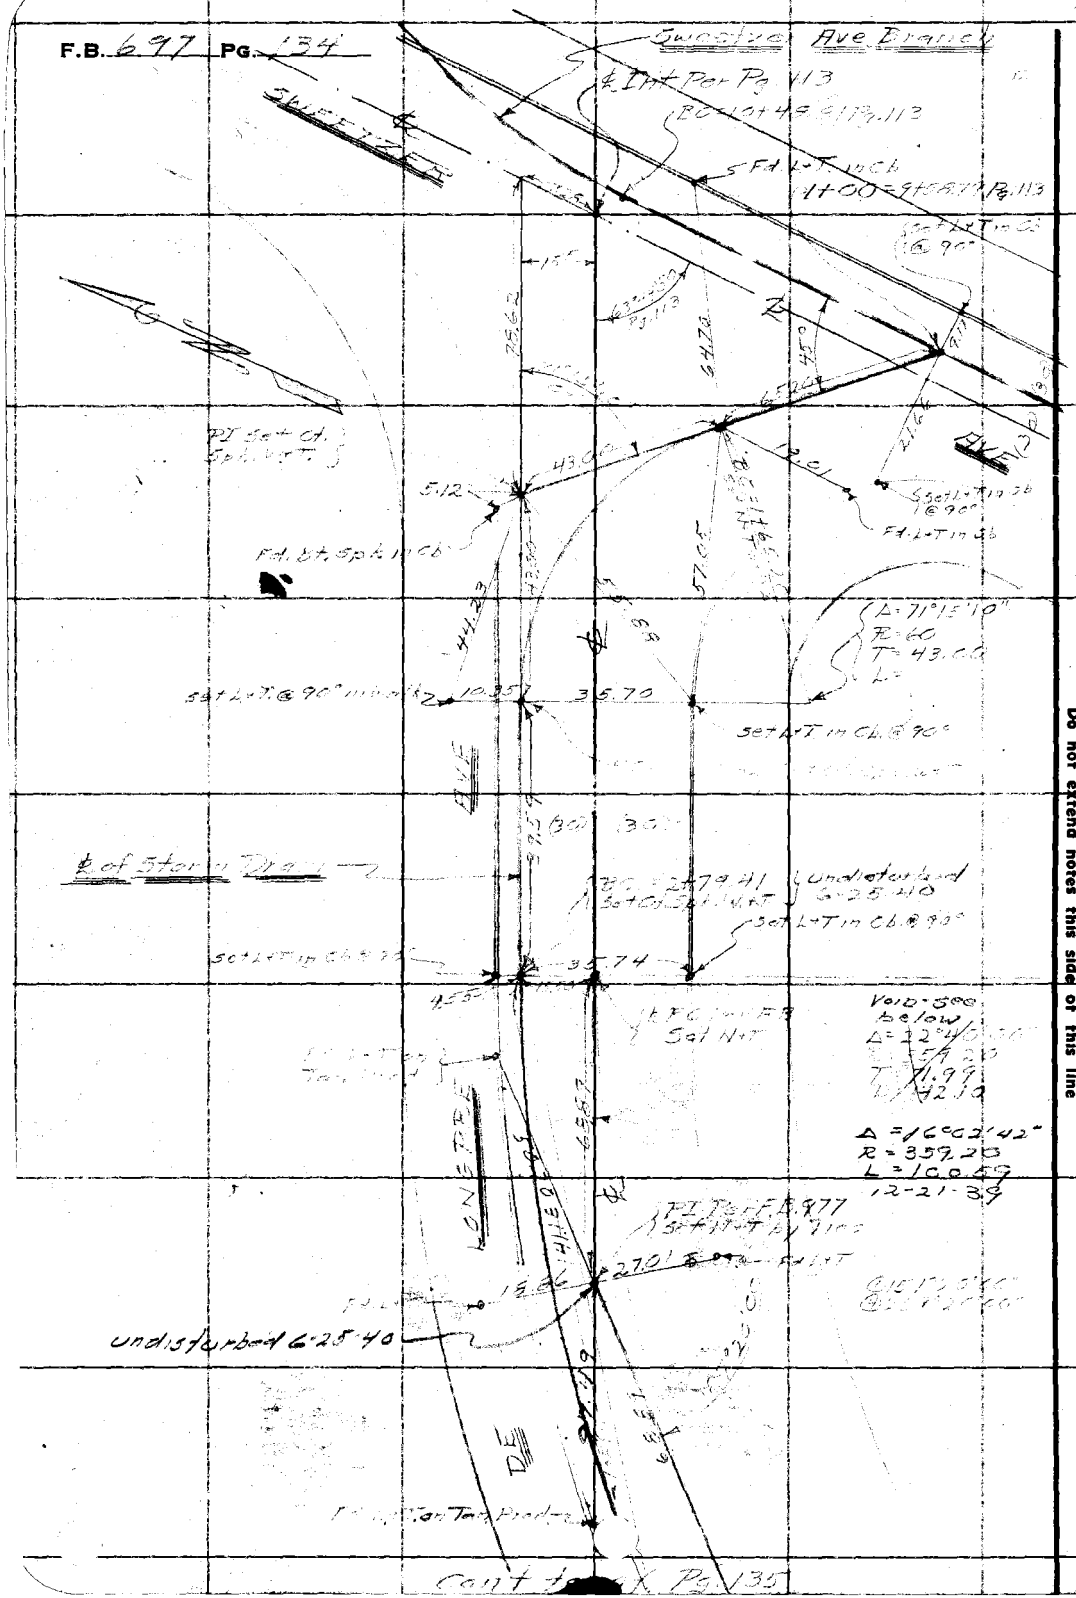
Undisturbed 6.28.40
Undisturbed 6.28.40
Undisturbed 6.28.40
Void-See below
Sta 1+00 = Sta 97+83.77 Pg. 113
Set L+T in CL @ 90°
Set L+T in CL @ 90°
Set L+T in CL @ 90°
Set L+T in CL @ 90°
Set L+T in CL @ 90°
Set L+T in CL @ 90°
Fd. L+T in CL @ 90°
Fd. L+T in CL @ 90°
Fd.

Notes Ck'd by	Survey of
Map No.	W. O. 6918 Tape No. 25 / St'd 54 °F.
Office Work	Surveyed by
Checked	Notes " Date 3-17-37
Date	Indexed C. Johnson

F.B. Pg.

Note: Any Additions or Changes on This Sheet Must be Made or Circled in Red Ink With Date and Name of Person Making Change.

Do not extend notes this side of this line

RETURN TO
LOS ANGELES COUNTY SURVEYOR
700 HALL OF RECORDS

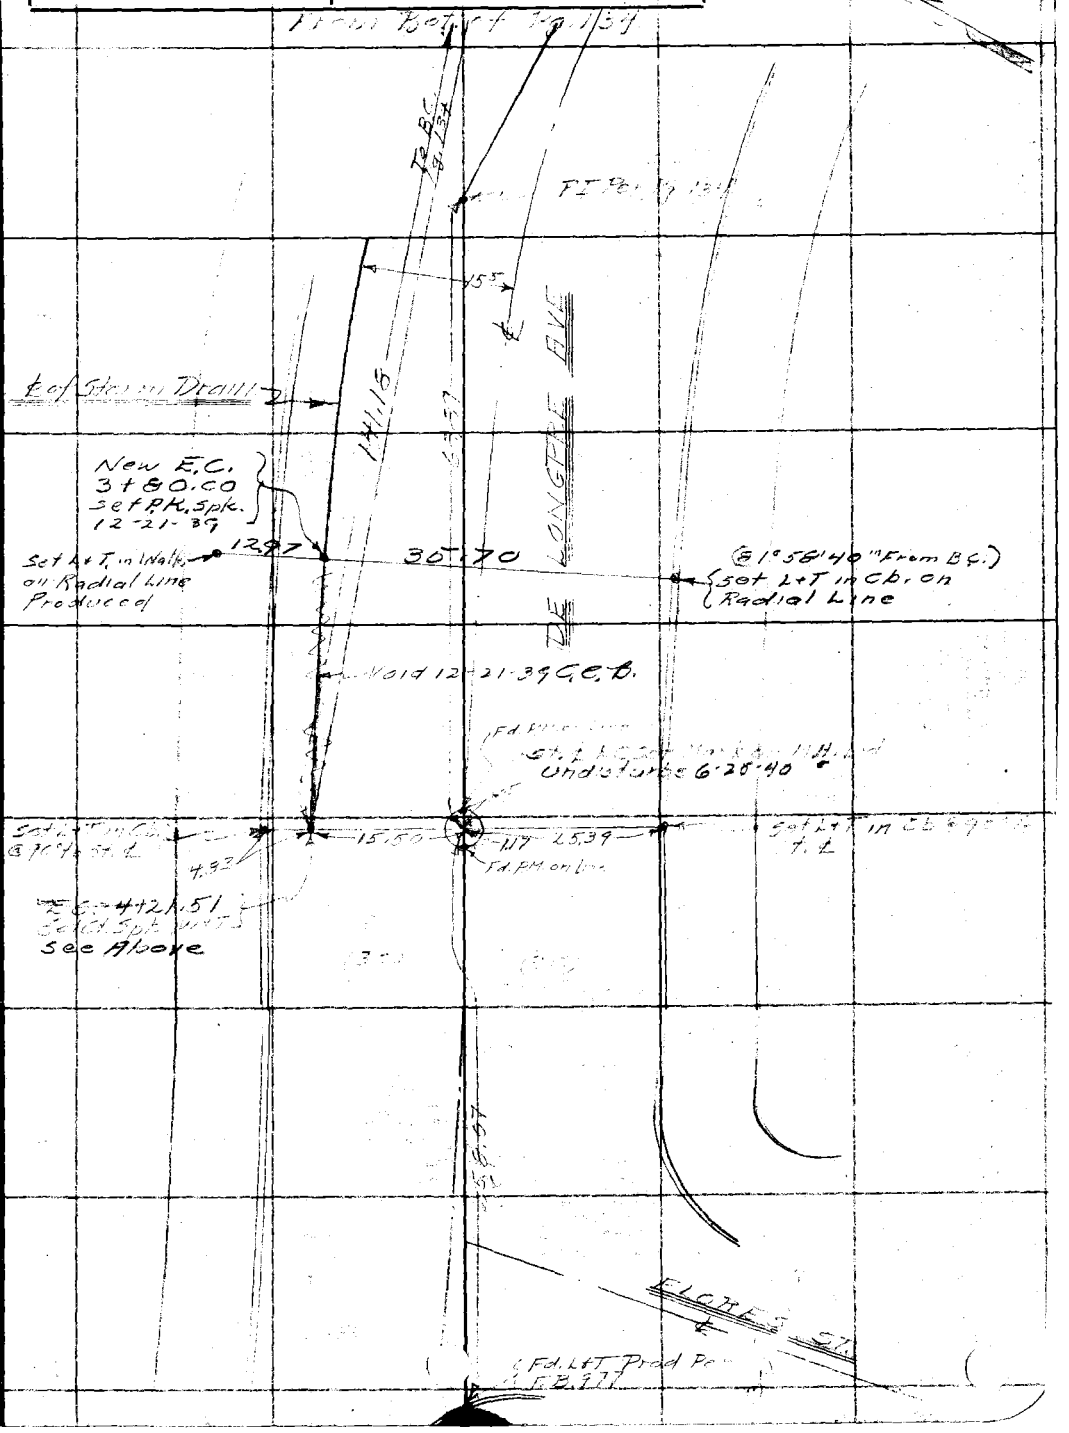

FORM 247 10M 11-35

RETURN TO
LOS ANGELES COUNTY SURVEYOR
700 HALL OF RECORDS

Note: Any Additions or Changes on This Sheet Must be Made or Circled in **Red Ink** With Date and Name of Person Making Change.

Do not extend notes this side of this line

F.B. 6971 Pg. 136

Notes Ck'd by	Survey of Delongpre Ave.
Map No.	W. O. 6315 Tape No. 257 St'd 64°F.
Office Work	Surveyed by [illegible]
Checked	Notes [illegible] Date 2-11-37
Date	Indexed C. Johnson

F.B. 679 PG. 13

TOPOGRAPHY

WEST HOLLYWOOD DRAINAGE SYSTEM

DE LONGPRE AVE. UNIT

JNG 316

SHEET ③

For ℄ Survey See Pgs 133 to 136 Incl.

For ℄ Profile See Pgs 141 to 144 Incl.

CE Bu[illegible] - Chief

HM Sm[illegible] - Transit

J L Wi[illegible] - Chain

[illegible] - Chain

Note: Any Additions or Changes on This Sheet Must be Made in Red Ink or Circled With Date and Name of Person Making Change.

Do not extend notes this side of this line

RETURN TO
LOS ANGELES COUNTY SURVEYOR
700 HALL OF RECORDS

RECEIVED MAR 18 1937

PROGRESSED

BOOK INDEXED

MAP INDEXED

RECORD INDEXED

CARD INDEXED

FORM 247 10M 11-36

Cont. from Pgs. 119 + 120 1+00 Pg 134

F.B. 697 Pg. 135

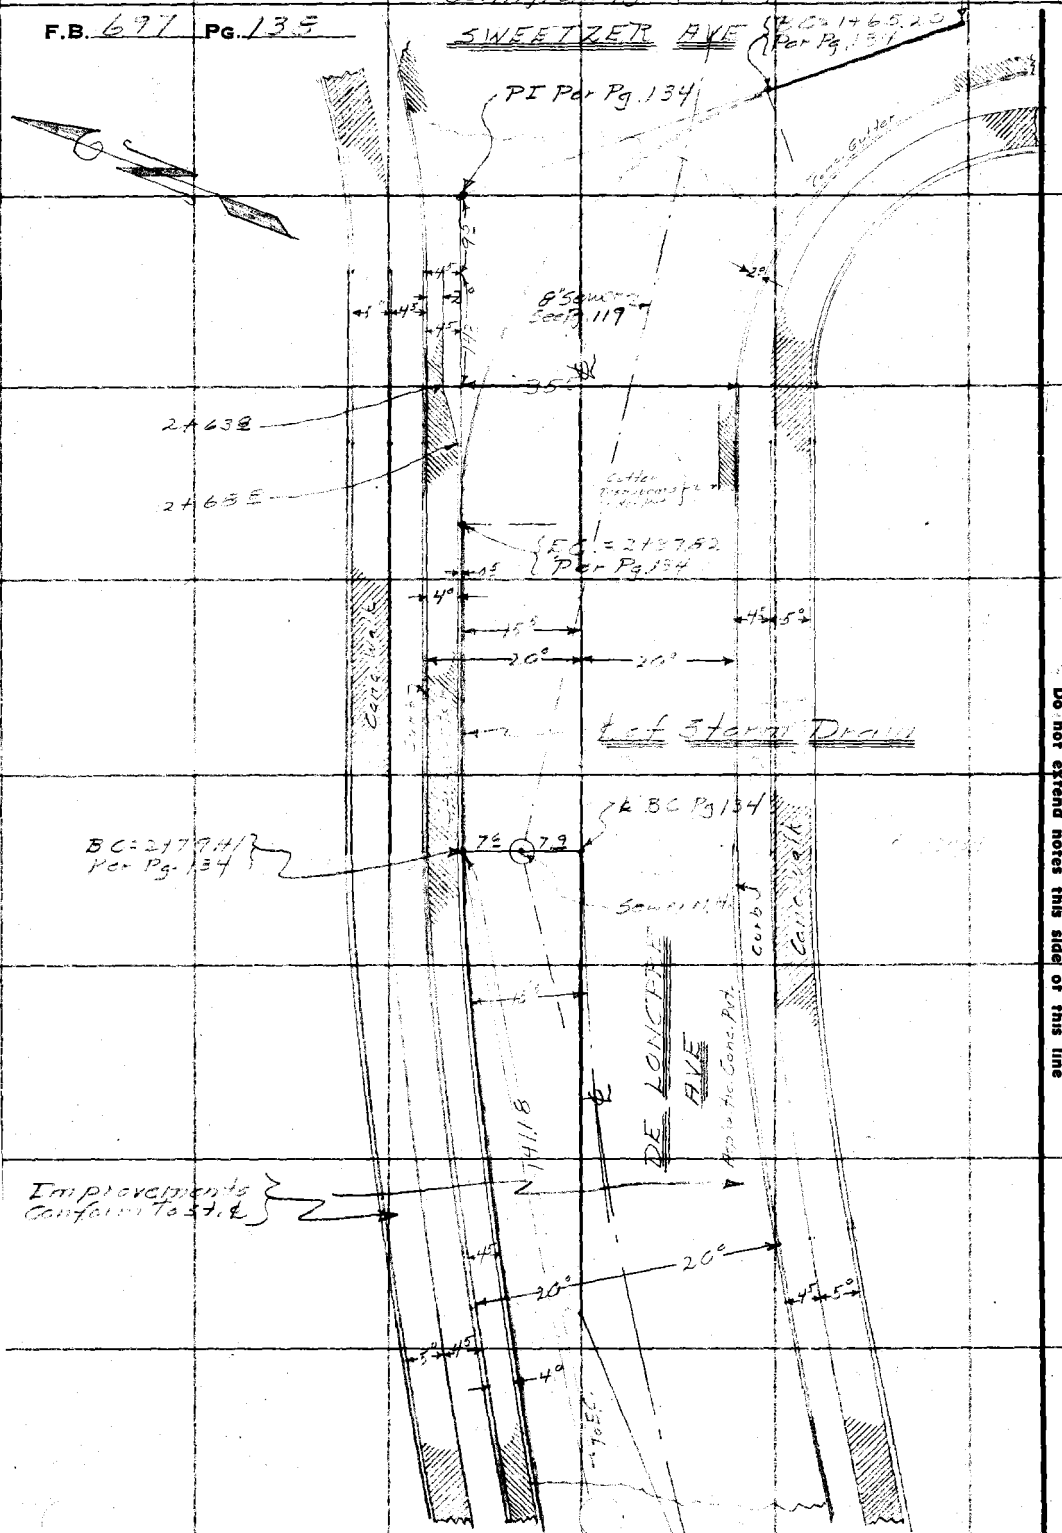

RETURN TO
LOS ANGELES COUNTY SURVEYOR
700 HALL OF RECORDS

Note: Any Additions or Changes on This Sheet Must be Made or Circled in Red Ink With Date and Name of Person Making Change.

Do not extend notes this side of this line

Notes Ck'd by
Map No.
Office Work
Checked
Date

W. O. 6376 Tape No. 057 St'd 8% F.
Surveyed by [illegible]
Notes Date 2-17-37
Indexed C. Johnson

F.B. 277 PG. 127

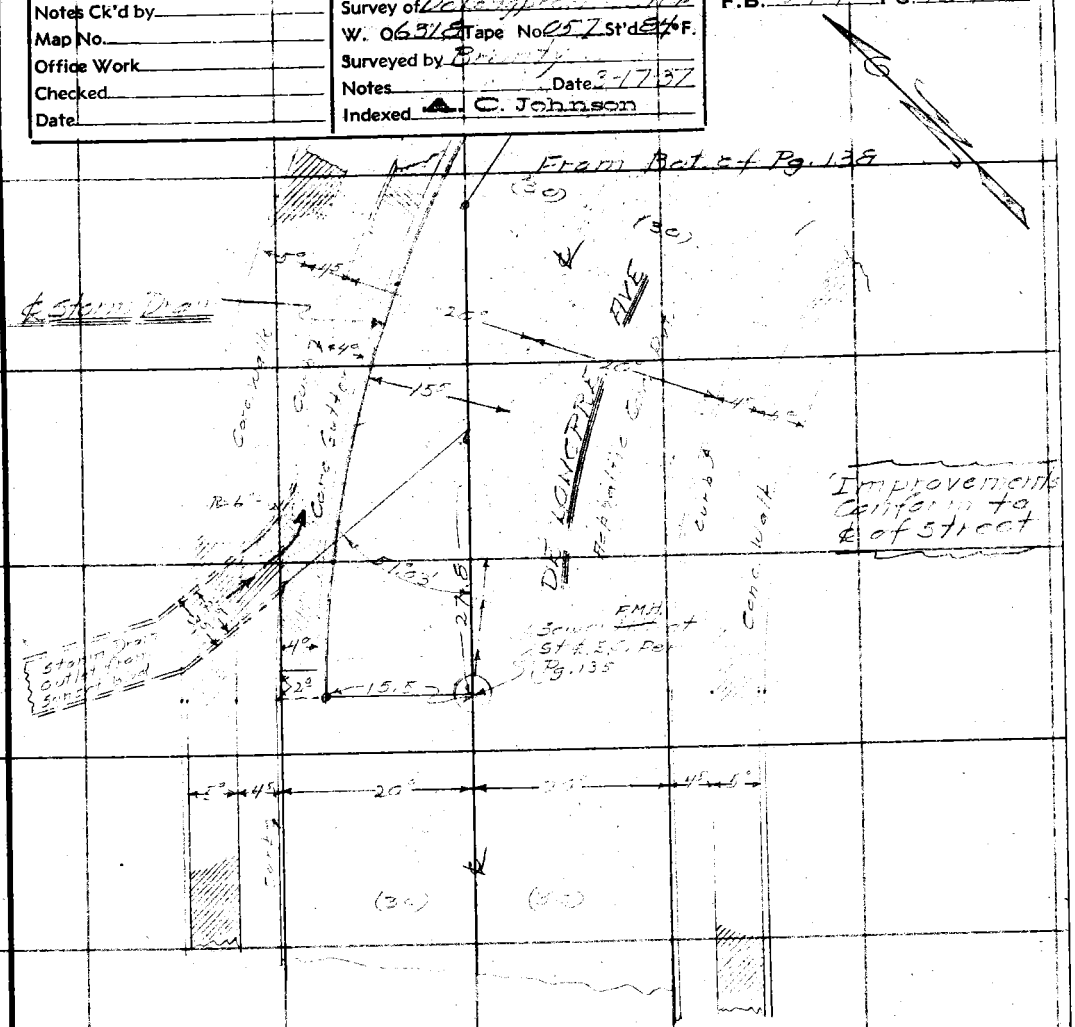

Note: Any Additions or Changes on This Sheet Must be Made in Red Ink With Date and Name of Person Making Change.

Do not extend notes this side of this line

RETURN TO
LOS ANGELES COUNTY SURVEYOR
700 HALL OF RECORDS

FORM 247 10M 11-36

RETURN TO
LOS ANGELES COUNTY SURVEYOR
700 HALL OF RECORDS

Note: Any Additions or Changes on This Sheet Must be Made or Circled in **Red Ink** With Date and Name of Person Making Change.

Do not extend notes this side of this line

F.B. 691 Pg. 110

Profile No. ____ X-Sec. No. ____

Notes Red. ____ Date ____ Plotted ____ Date ____ Job No. 632 Division No. ____

Notes Chkd. ____ Date ____ Checked ____ Date ____ Survey of ____

Survey by C. E. B. Notes 4115 Date 3-1-37

Map No. ____ Indexed C. Johnson Date ____

F. B. PG. 41

NOTE: ANY ADDITIONS OR CHANGES ON THIS SHEET MUST BE MADE OR CIRCLED IN RED INK, WITH DATE AND NAME OF PERSON MAKING CHANGE.

Do not extend notes this side of this line

STATION	B. S.	H. I.	F. S.	ELEV.

RECEIVED Scales MAR 18 1937

PROGRESSED ✓ ✓

BOOK INDEXED ✓ ✓

~~MAP INDEXED~~ ✓ ✓

RECORD INDEXED ✓ ✓

CARD INDEXED ✓ ✓

REDUCED Field ✓ ✓

CHECKED ✓ ✓

PLEASE RETURN TO
LOS ANGELES COUNTY SURVEYOR
700 HALL OF RECORDS

Form 307 5M 11-35

F. B. PG. 42 | Job No. | Division No. | Notes Red. | Plotted | Profile

Survey of | Date | Date | No.

Survey by | Notes | Notes Chkd. | Checked | X-Sec.

Indexed | Date | Date | Date | No.

Form 307 5M 11-35

PLEASE RETURN TO
LOS ANGELES COUNTY SURVEYOR
700 HALL OF RECORDS

NOTE: ANY ADDITIONS OR CHANGES ON THIS SHEET MUST BE MADE OR CIRCLED IN RED INK, WITH DATE AND NAME OF PERSON MAKING CHANGE

Do not extend notes this side of this line

STATION	B. S.	H. I.	F. S.	ELEV.

Form 307 5M 11-35

PLEASE RETURN TO
LOS ANGELES COUNTY SURVEYOR
700 HALL OF RECORDS

NOTE: ANY ADDITIONS OR CHANGES ON THIS SHEET MUST BE MADE OR CIRCLED IN RED INK, WITH DATE AND NAME OF PERSON MAKING CHANGE

Do not extend notes this side of this line

STATION	B. S.	H. I.	F. S.	ELEV.		
		352.1K				
3+179.2	B.C.					
3+10						
3+20						
3+30						
3+75						
4+00						
4+21.2						

Form 307 5M 11-35

PLEASE RETURN TO
LOS ANGELES COUNTY SURVEYOR
700 HALL OF RECORDS

NOTE: ANY ADDITIONS OR CHANGES ON THIS SHEET MUST BE MADE OR CIRCLED IN RED INK, WITH DATE AND NAME OF PERSON MAKING CHANGE

Do not extend notes this side of this line

F. B. [illegible] Pg. [illegible]

Job No. [illegible] Division No. [illegible] Notes Red. [illegible] Plotted [illegible] Profile No. [illegible]

Survey of [illegible] Notes [illegible] Date [illegible] Date [illegible] X-Sec. No. [illegible]

Survey by C.E. Pumphrey C. Johnson Notes Chkd. [illegible] Checked [illegible]

Indexed [illegible] Date [illegible] Date [illegible]

STATION	B. S.	H. I.	F. S.	ELEV.		

Notes Ck'd by	Survey of
Map No.	W. O. 6318 Tape No. 055 St'd 64 °F.
Office Work	Surveyed by
Checked	Notes Date
Date	Indexed A. C. Johnson

F.B. 697 Pg. 1-15

LOS ANGELES COUNTY FLOOD CONTROL DISTRICT

& SURVEY

WEST [illegible] U.S.

SHEET #4

Note: Any Additions or Changes on This Sheet Must be Made or Circled in Red Ink With Date and Name of Person Making Change

Do not extend notes this side of this line

RETURN TO
LOS ANGELES COUNTY SURVEYOR
700 HALL OF RECORDS

RECEIVED Smolen APR 2 - 1937

PROGRESSED

BOOK INDEXED

MAP INDEXED

RECORD INDEXED

CARD INDEXED

FORM 247 10M 11-35

F.B. 697 PG. 146

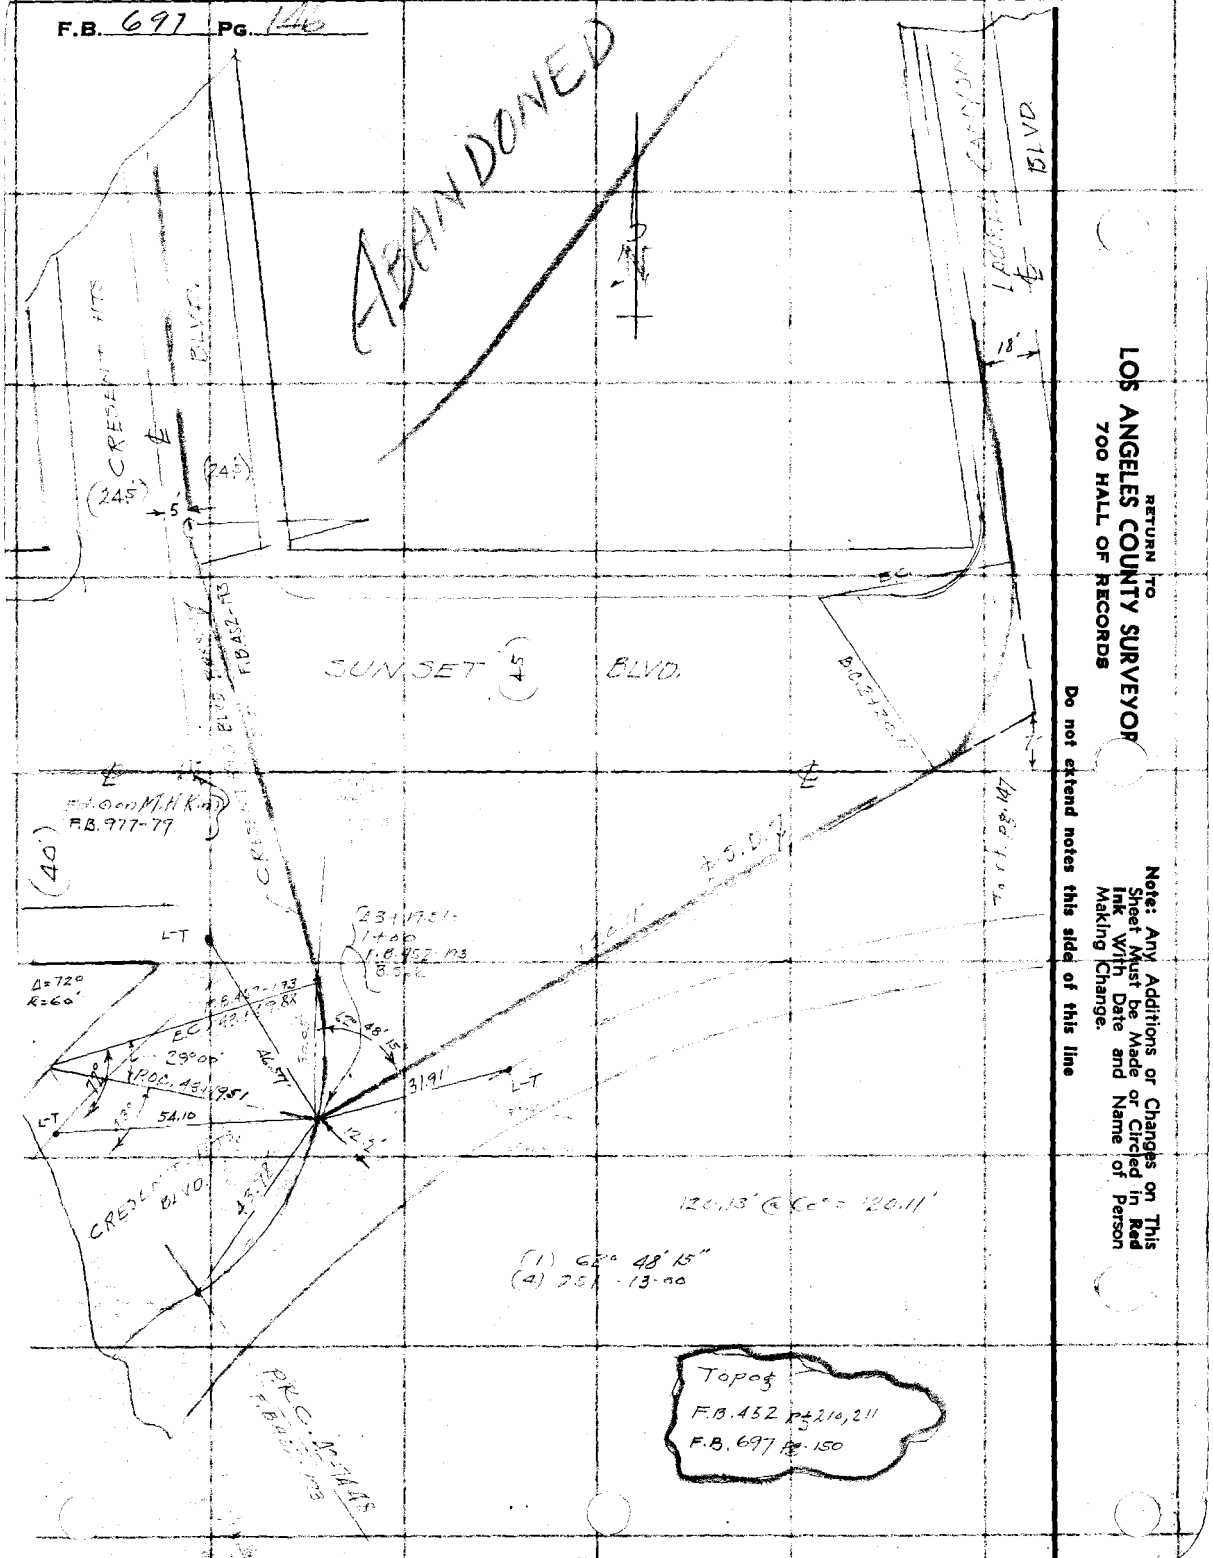

RETURN TO
LOS ANGELES COUNTY SURVEYOR
700 HALL OF RECORDS

Note: Any Additions or Changes on This Sheet Must be Made or Circled in Red Ink With Date and Name of Person Making Change.

Do not extend notes this side of this line

Notes Ck'd by	Survey of Wilcox Road &
Map No.	W. O. 6318 Tape No. 055 St'd 34 °F.
Office Work	Surveyed by [illegible]
Checked	Notes KV Date 1-20-[illegible]
Date	Indexed C. Johnson

F.B. 697 Pg. [illegible]

Note: Any Additions or Changes on This Sheet Must be Made or Circled in Red Ink With Date and Name of Person Making Change

Do not extend notes this side of this line

RETURN TO
LOS ANGELES COUNTY SURVEYOR
700 HALL OF RECORDS

FORM 247 10M 11-35

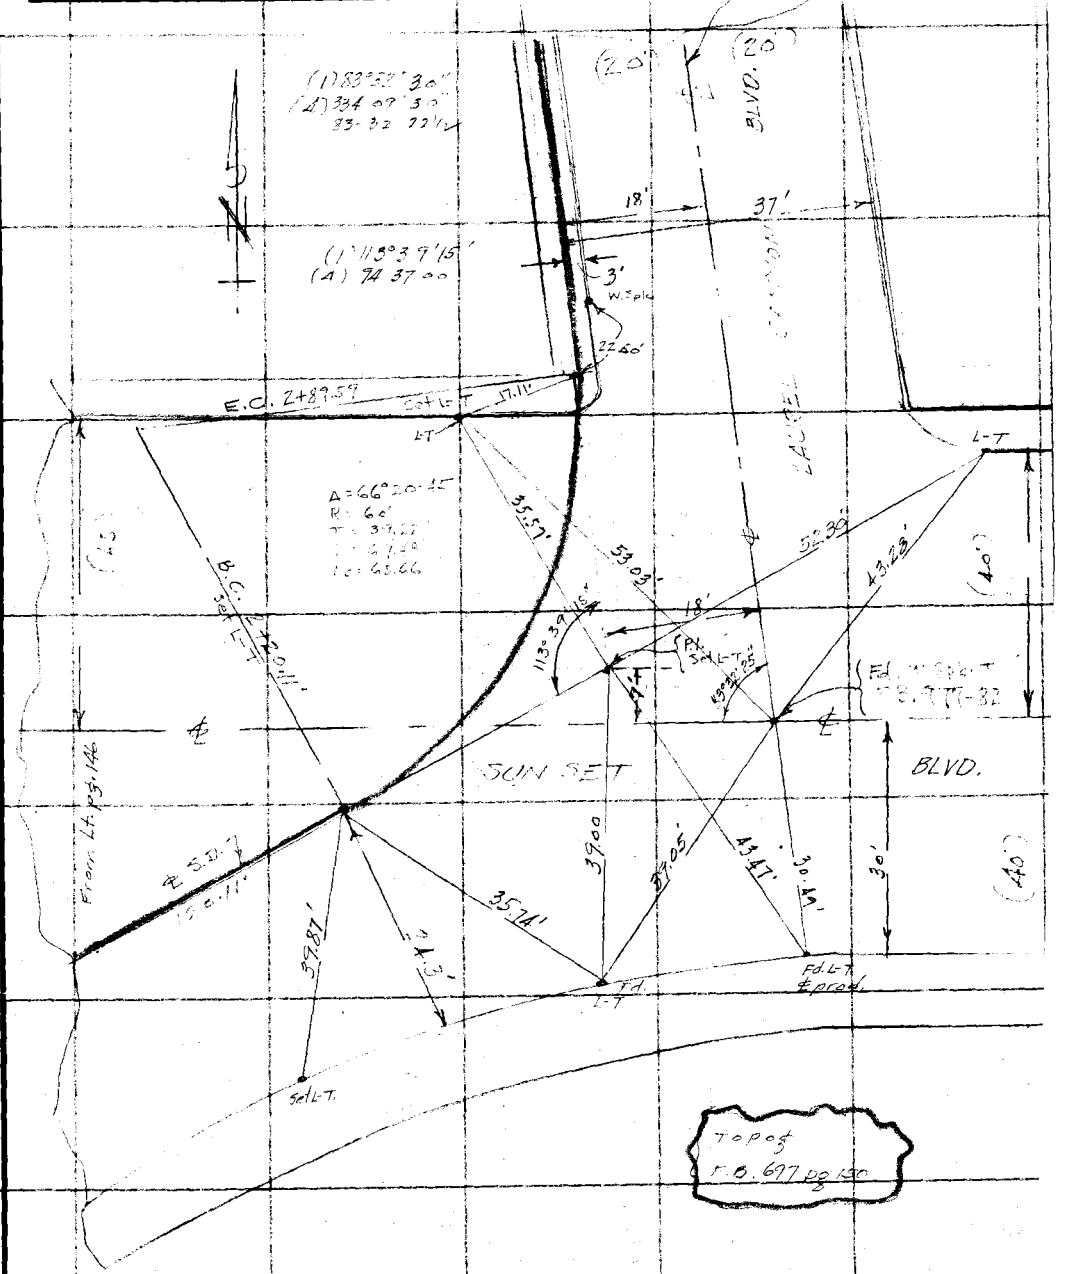

RETURN TO
LOS ANGELES COUNTY SURVEYOR
700 HALL OF RECORDS

Note: Any Additions or Changes on This Sheet Must be Made or Circled in **Red Ink** With Date and Name of Person Making Change.

Do not extend notes this side of this line

F.B. 697 PG. 48

Notes Ck'd by	Survey of Hollywood U.S.
Map No.	W. O. 638 Tape No. St'd °F.
Offlte Work	Surveyed by WALKER
Checked	Notes W Date Nov 1937
Date	Indexed A. C. Johnson

F.B. 697 Pg. 1 of 1

LAUREL CANYON SEWER

TOPOG

WEST HOLLYWOOD U.S.

J.N. 638

& Survey F.B. 697

Profile F.B. 697

SHEET # 1

WALKER
CAVEN
MURRAY
FISHER

Note: Any Additions or Changes on This Sheet Must be Made or Circled in Red Ink With Date and Name of Person Making Change

Do not extend notes this side of this line

RETURN TO
LOS ANGELES COUNTY SURVEYOR
700 HALL OF RECORDS

RECEIVED Sheldon APR 2 1937

PROGRESSED

BOOK INDEXED

MAP INDEXED

RECORD INDEXED

CARD INDEXED

FORM 247 10M 11-35

F.B. 697 Pg. 150

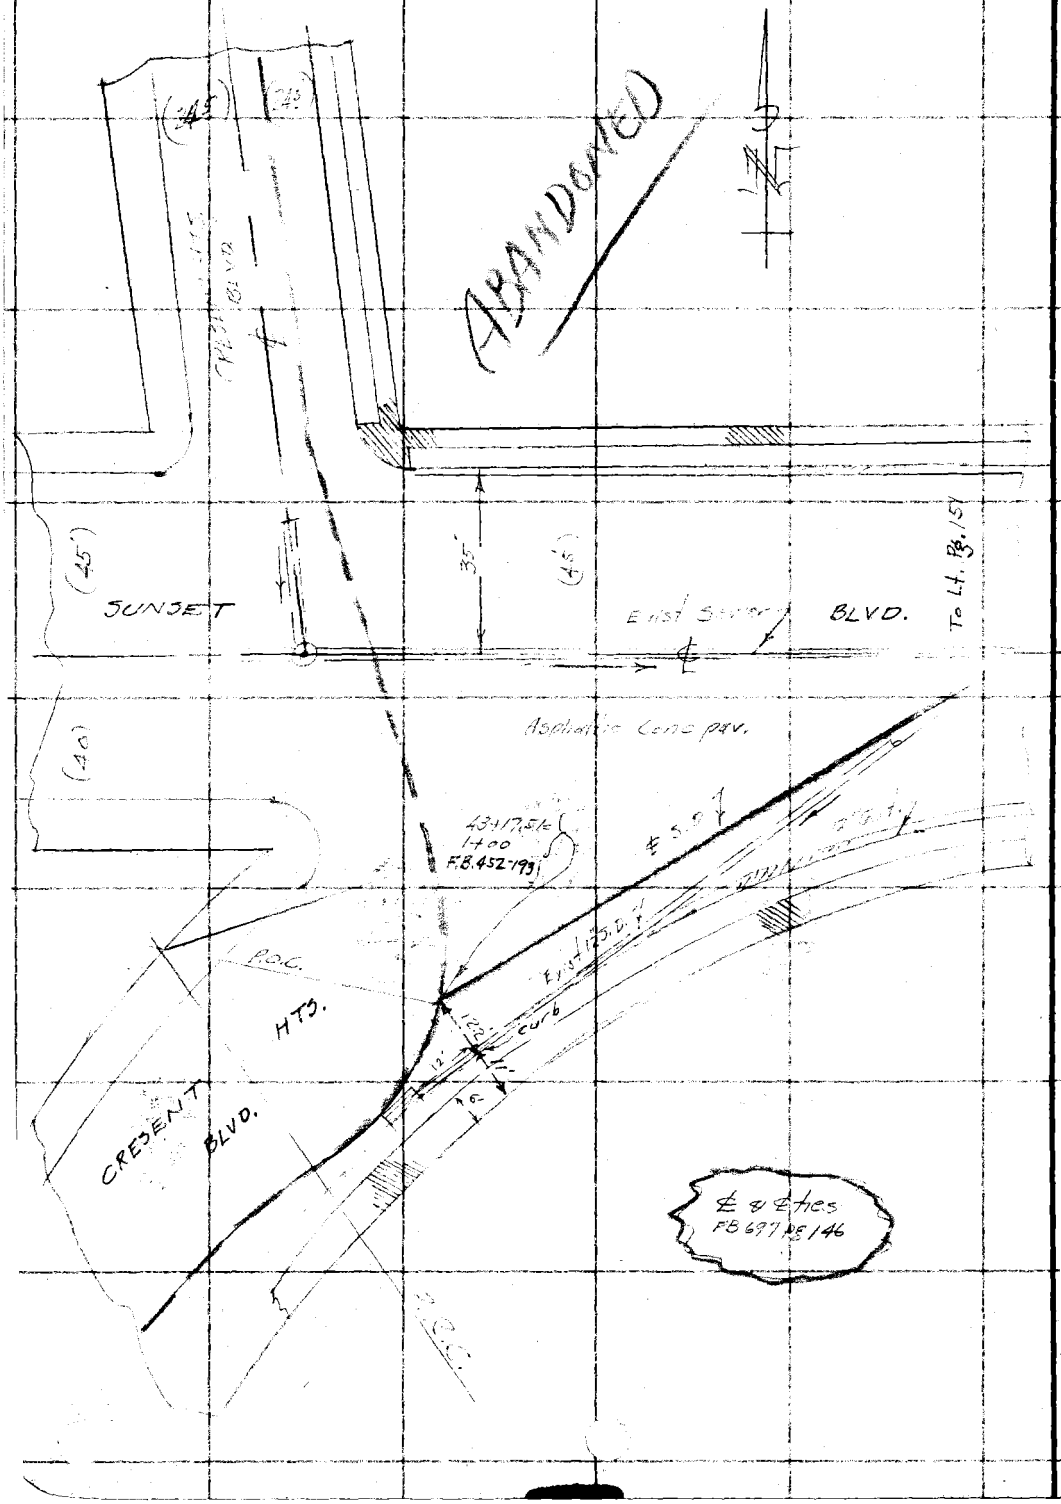

RETURN TO
LOS ANGELES COUNTY SURVEYOR
700 HALL OF RECORDS

Note: Any Additions or Changes on This Sheet Must be Made or Circled in Red Ink With Date and Name of Person Making Change.

Do not extend notes this side of this line

Notes Ck'd by	Survey of W. Hollywood Sd.
Map No.	W. O. 6318 Tape No. St'd °F.
Office Work	Surveyed by Wallace
Checked	Notes VV. Date Mar. 1937
Date	Indexed C. Johnson

F.B. 697 Pg. 151

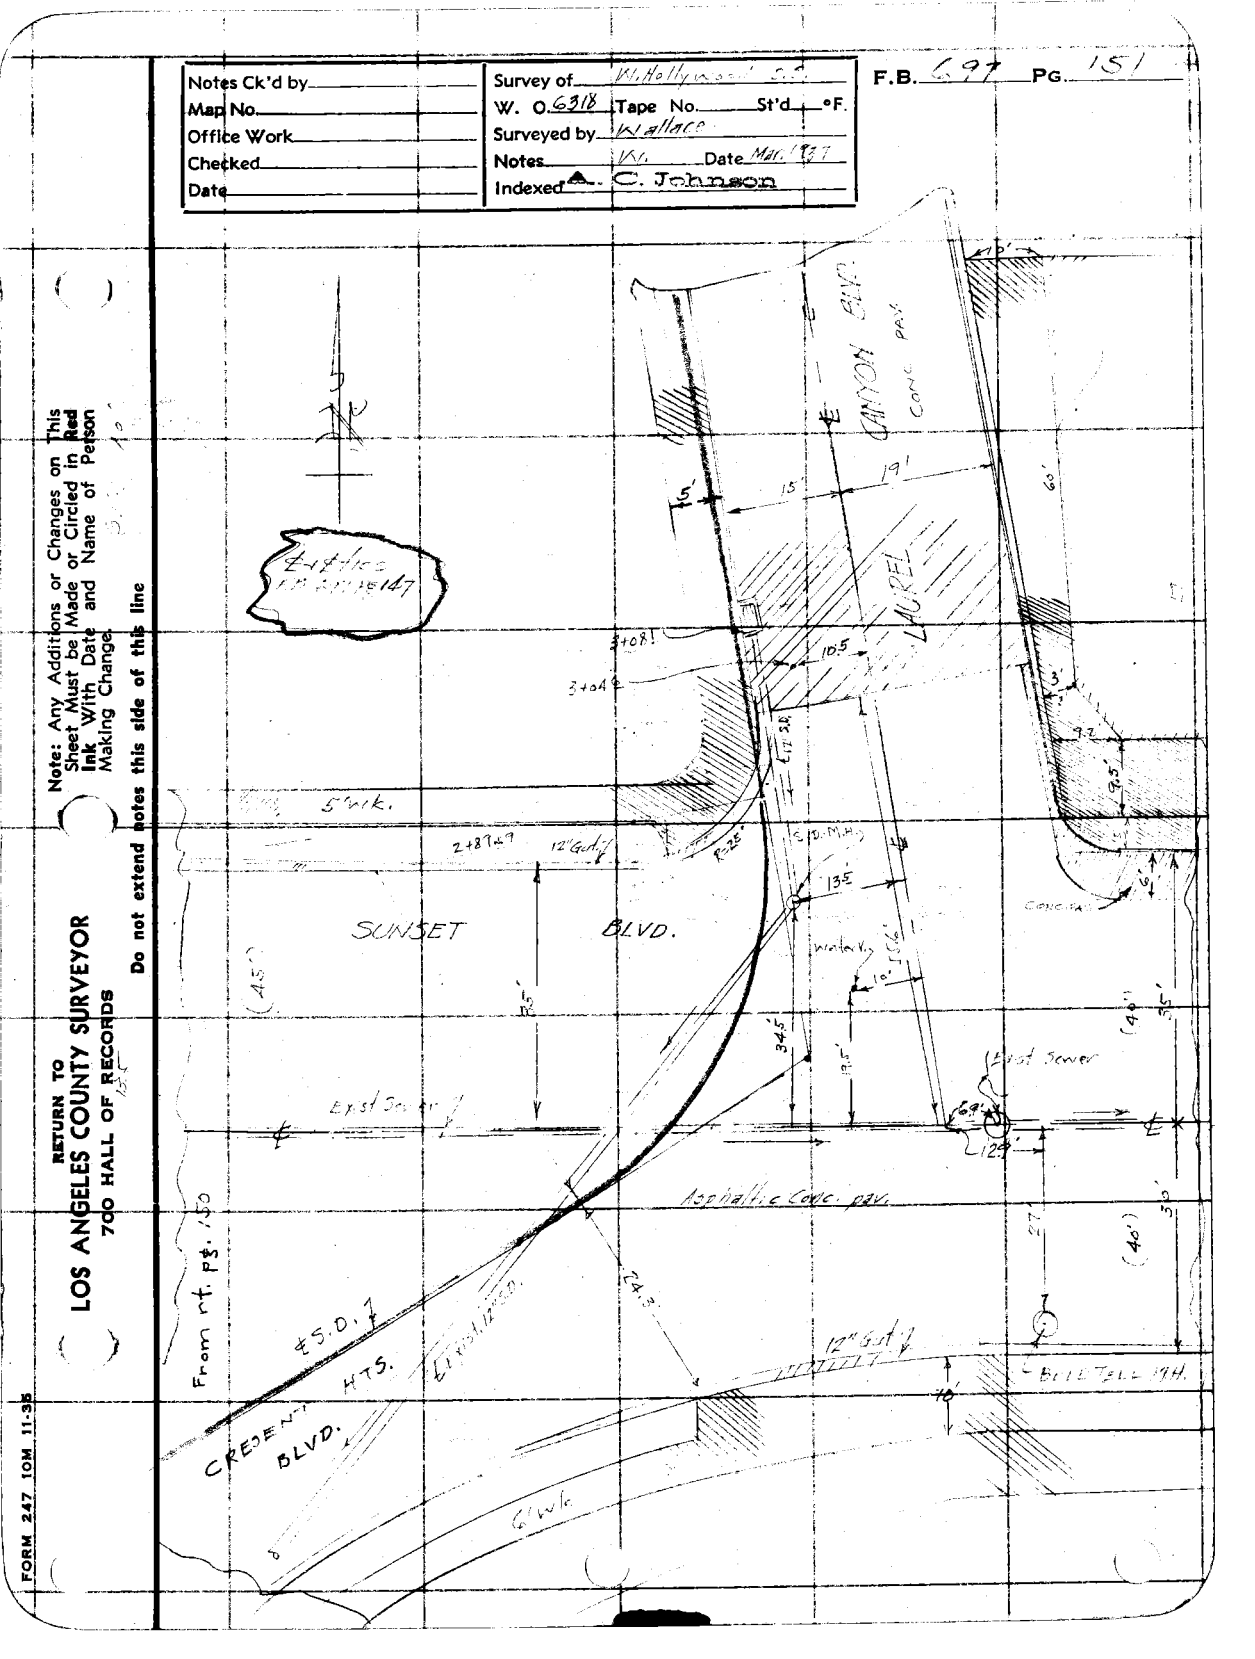

Note: Any Additions or Changes on This Sheet Must be Made or Circled in Red Ink With Date and Name of Person Making Change

Do not extend notes this side of this line

RETURN TO
LOS ANGELES COUNTY SURVEYOR
7do HALL OF RECORDS

FORM 247 10M 11-35

RETURN TO
LOS ANGELES COUNTY SURVEYOR
700 HALL OF RECORDS

Note: Any Additions or Changes on This Sheet Must be Made or Circled in **Red Ink** With Date and Name of Person Making Change.

Do not extend notes this side of this line

F.B. 697 Pg. 152

Profile No.	Notes Red.	Plotted	Job No.	Division No.
	Date	Date	Survey of	
X-Sec. No.	Notes Chkd.	Checked	Survey by	Notes
	Date	Date	Map No.	Indexed

F. B. 697 PG. 102

Date

Date

NOTE: ANY ADDITIONS OR CHANGES ON THIS SHEET MUST BE MADE OR CIRCLED IN RED INK, WITH DATE AND NAME OF PERSON MAKING CHANGE

Do not extend notes this side of this line

PLEASE RETURN TO
LOS ANGELES COUNTY SURVEYOR
700 HALL OF RECORDS

Form 307 5M 11-35

STATION | B. S. | H. I. | F. S. | ELEV.

F B 697 PG 116
F B 697 PG 150

SHEET #1

ABANDONED

RECEIVED Swelson APR 2 1937
PROGRESSED
BOOK INDEXED
MAP INDEXED
RECORD INDEXED
CARD INDEXED
REDUCED Field
CHECKED LCM

Form 307 5M 11-35

PLEASE RETURN TO
LOS ANGELES COUNTY SURVEYOR
700 HALL OF RECORDS

NOTE: ANY ADDITIONS OR CHANGES ON THIS SHEET MUST BE MADE OR CIRCLED IN RED INK, WITH DATE AND NAME OF PERSON MAKING CHANGE

Do not extend notes this side of this line

F.B. 697 PG. 154 | Job No. 6288 Division No. Notes Red. Plotted. Profile
Survey of Date No.
Survey by Notes Notes Ckd. Checked X-Sec.
Indexed A. C. Johnson Date Date Date No.

STATION	B. S.	H. I.	F. S.	ELEV.	
					NIKEL CANYON BLVD STUB
[illegible]	1.48	417.03		415.55	BM-D22-EL.408.54 [illegible]
1400			[illegible]	405.28	± [illegible]
			1220	404.13	[illegible]
			[illegible]	404.43	[illegible]
1+20			[illegible]	[illegible]	± T.D.
B.C.					
2+20.11			[illegible]	[illegible]	"
			136	[illegible]	Top -6.243'R±
			8+11	401.02	[illegible]
T.P.	2.03	417.05	[illegible]	[illegible]	
			[illegible]	[illegible]	[illegible]
			719	410.46	[illegible]
			613	411.52	[illegible]
			697	410.65	[illegible]
			[illegible]	[illegible]	[illegible]
			[illegible]	[illegible]	[illegible]

Form 307 5M 11-35

PLEASE RETURN TO
LOS ANGELES COUNTY SURVEYOR
700 HALL OF RECORDS

NOTE: ANY ADDITIONS OR CHANGES ON THIS SHEET MUST BE MADE OR CIRCLED IN RED INK, WITH DATE AND NAME OF PERSON MAKING CHANGE

Do not extend notes this side of this line

STATION	B. S.	H. I.	F. S.	ELEV.		
			5 40	412 35		
			12 12	399 23	Invert 15" Outlet E	
			12 42	399 93	" 15" Inlet W	1 / 13 50 / 83 / 1374
			4 96	412 69		496 / 714 below / 1210
			12 10	405 55	Bottom	
			4 13	413 22		
			4 13	412 50		
			3 50	412 04		
			4 01	413 12		
			3 00	412 25		
			4 19	412 16		
			4 50	413 17		
			4 13	412 72		
			4 60	412 07		
			4 35	413 19		
			4 40	413 20		
			3 90	412 81		

Profile
No. X-Sec.
Notes Red. Plotted Job No. Division No.
Date Date Survey of
Notes Chkd. Checked Survey by
Date Date Map No.
Indexed
Notes Johnson Date
Date Date

F. B. 627 PG. 152

Form 307 5M 11-35

PLEASE RETURN TO
LOS ANGELES COUNTY SURVEYOR
700 HALL OF RECORDS

NOTE: ANY ADDITIONS OR CHANGES ON THIS SHEET MUST BE MADE OR CIRCLED IN RED INK, WITH DATE AND NAME OF PERSON MAKING CHANGE

Do not extend notes this side of this line

F. B. 697 PG. 15 | Job No. 538 | Division No. | Profile
Survey of | No. | Plotted
Survey by | Notes Red. | No.
Indexed by C. Johnson | Notes | Date | X-Sec.
Date | Notes Chkd. | Date | Checked
Date | Date

STATION	B. S.	H. I.	F. S.	ELEV.		
			831	409.34	Invert 12" Outlet to South	421 -12 831 -
TP	1.21	421.46	545	410.15		
TP	2.33	420.99	970	411.16		
						FB 682 - p
BM				409.50		

Notes Ck'd by	Survey of [illegible] 35
Map No.	W. O. 6318 Tape No. 055 St'd 14 °F.
Office Work	Surveyed by Wallace
Checked	Notes W.L. Date Mar 1937
Date	Indexed C. Johnson

F.B. 697 PG. 157

& SURVEY

SELMA AVE LATERAL

WEST HOLLYWOOD D.S.

J.N. 6318

Topog F.B. 697 pg. 161

Profile F.B. 697 pg. 165

SHEET #4

APPROVED

WALLACE
GRAGG
MURRAY
TELLEZ
LUNIER

RECEIVED HCS APR 2 1937

PROGRESSED

BOOK INDEXED

MAP INDEXED

RECORD INDEXED

CARD INDEXED

RETURN TO
LOS ANGELES COUNTY SURVEYOR
700 HALL OF RECORDS

Note: Any Additions or Changes on This Sheet Must be Made or Circled in Red Ink With Date and Name of Person Making Change

Do not extend notes this side of this line

FORM 247 10M 11-36

F.B. 697 PG. 158

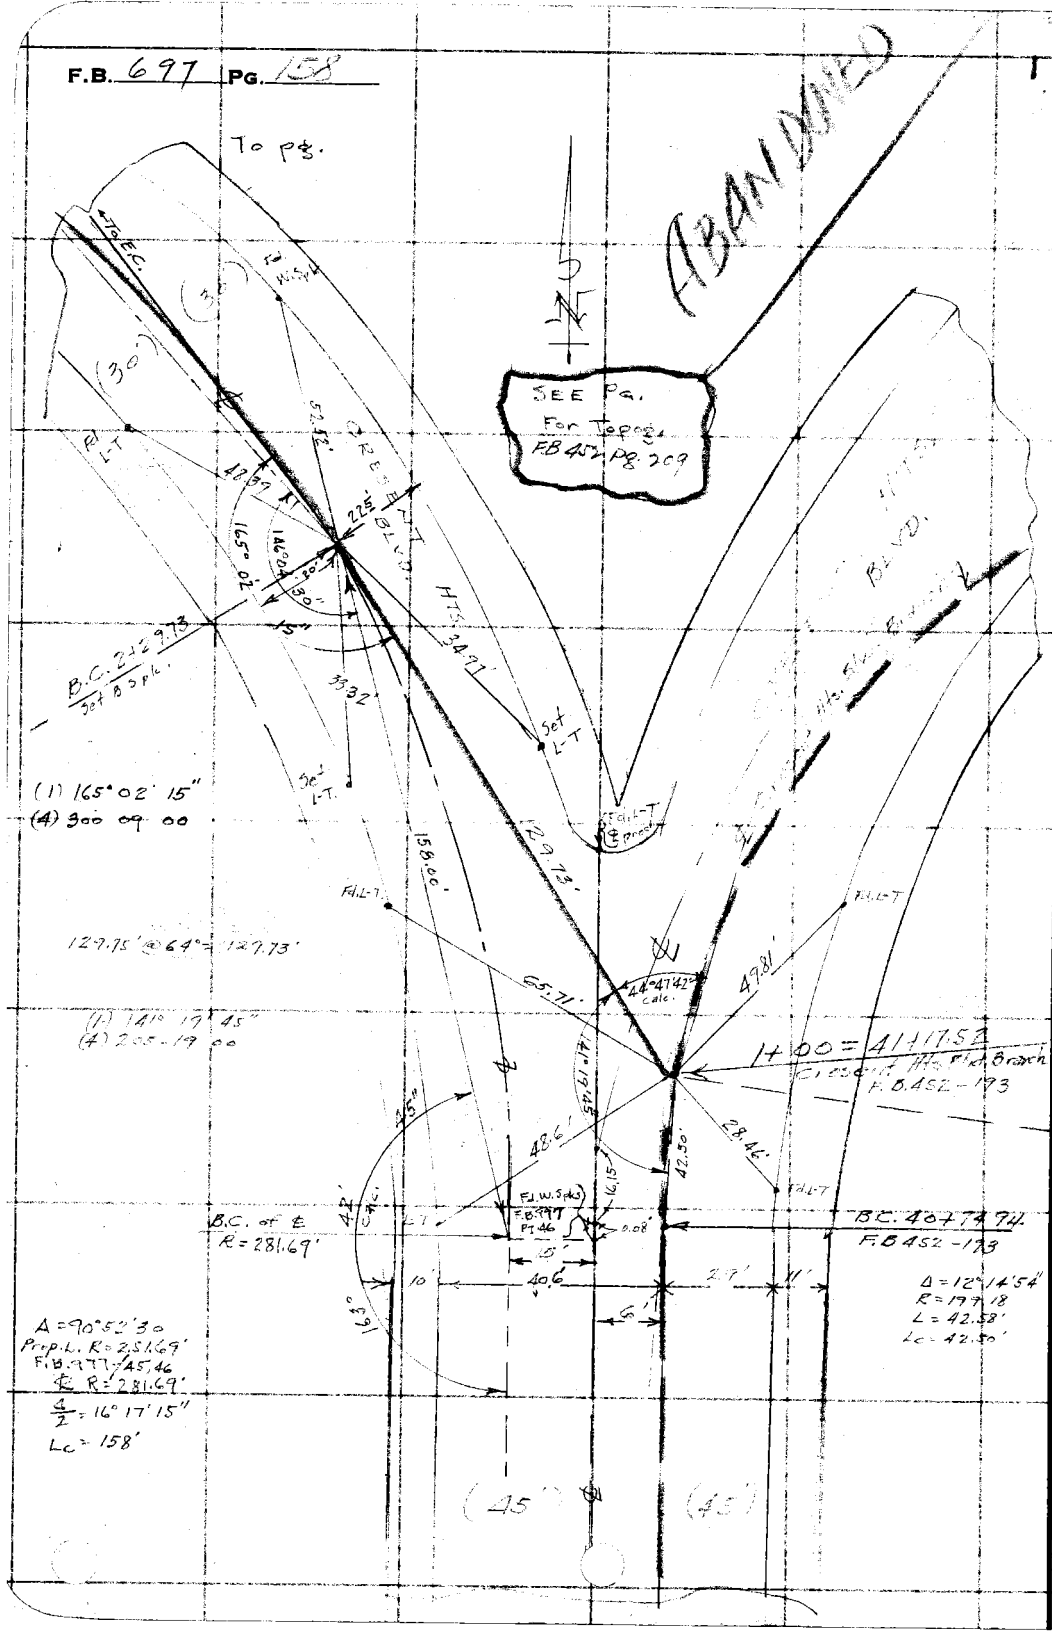
To Pts.
ATSF E.C.
(ABANDONED)
SEE Pg.
For Topo
F.B. 452 Pg. 209
CREEN
BLVD.
HTS.
Set L-T
Set L-T
Set L-T

Notes Ck'd by	Survey of
Map No.	W. O. 6813 Tape No. St'd °F.
Office Work	Surveyed by
Checked	Notes Date MAR 1931
Date	Indexed C. Johnson

F.B. 197 PG. 159

231.13 @ 26' - 281.70

To page

(1) 147° 42' 45"
(4) 238° 56' 30"
147 42 40

Δ = 60° 34' 40"
R = 60'
T =
L = 63.44'
Lc = 60.52'

(1) 141 54 00
(4) 207 35 30
141 53 - 52½

(1) 78° 32' 30"
(2) 197 05 00

Δ = 35° 17' 00"
R = 287.25'
T =
L = 178.12'
Lc = 175.32'

(1) 162° 21' 30"
(4) 287 56 00

SEE Pg. 163
For Tapes

B.C. 2+29.73

Note: Any Additions or Changes on This Sheet Must be Made or Circled in Red Ink With Date and Name of Person Making Change

Do not extend notes this side of this line

RETURN TO
LOS ANGELES COUNTY SURVEYOR
700 HALL OF RECORDS

FORM 247 10M 11-38

F.B. 697 PG. 160

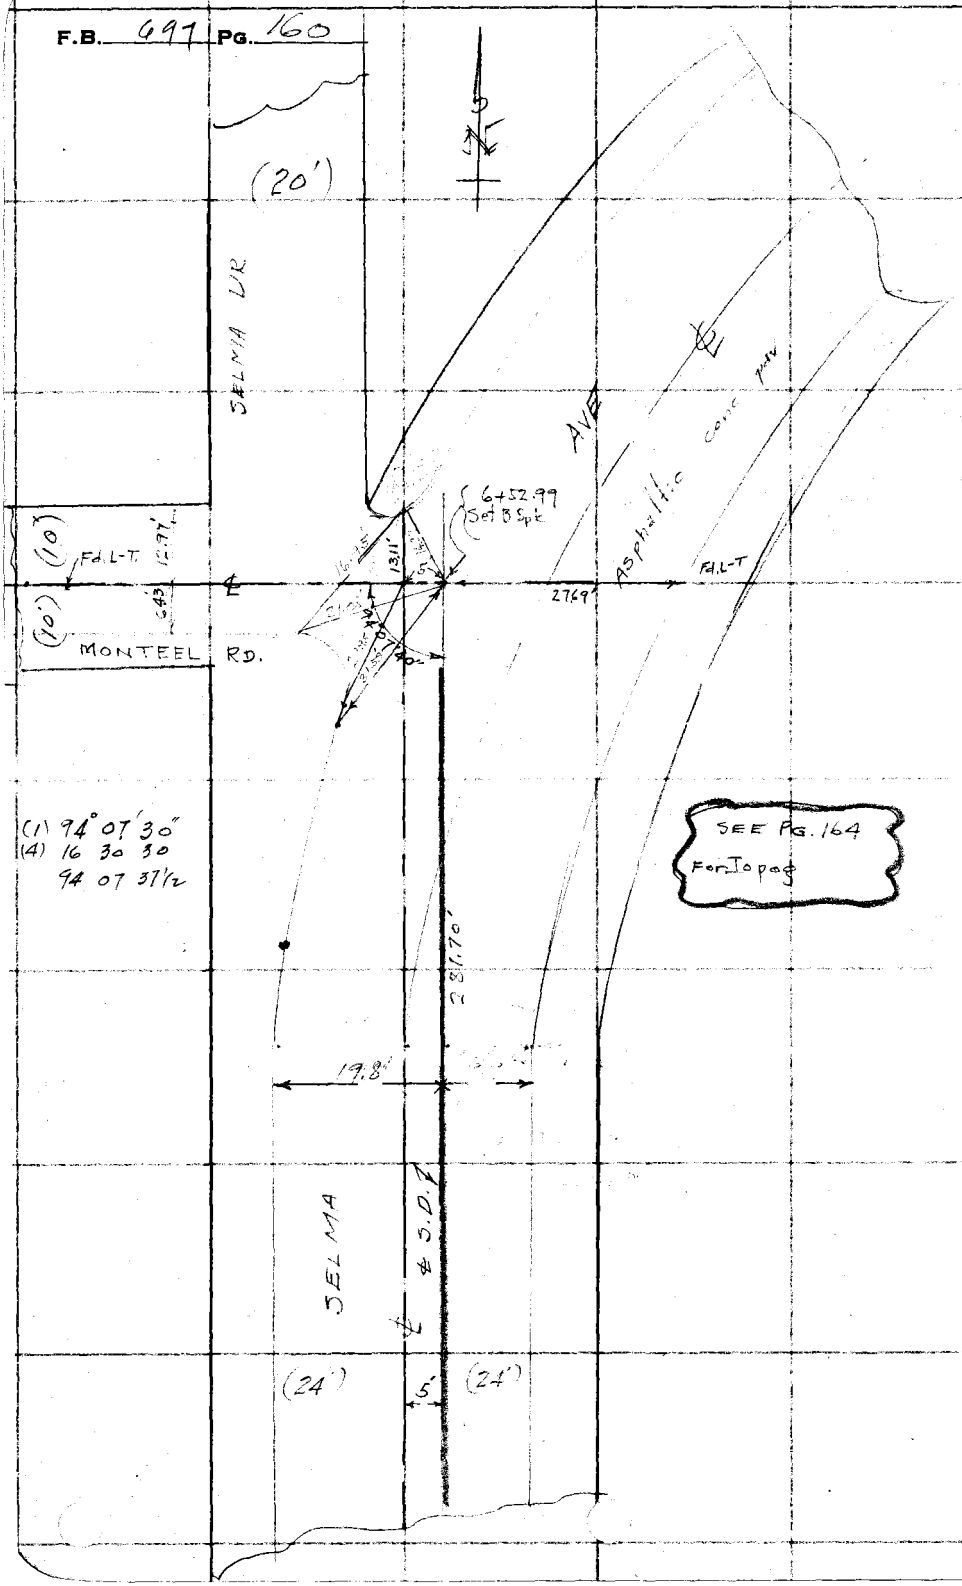

RETURN TO
LOS ANGELES COUNTY SURVEYOR
700 HALL OF RECORDS

Note: Any Additions or Changes on This Sheet Must be Made or Circled in Red Ink With Date and Name of Person Making Change.

Do not extend notes this side of this line

Notes Ck'd by	Survey of W. Hollywood D.S.
Map No.	W. O. 6318 Tape No. St'd °F.
Office Work	Surveyed by Wallace
Checked	Notes M.L. Date May 1937
Date	Indexed A. C. Johnson

F.B. 697 Pg. 157

TOPOGRAPHY

JELMA AVE. LATERAL

WEST HOLLYWOOD D.S.

J.N. 6318

& SURVEY F.B. 697 Pg 157

PROFILE F.B. 697 Pg 165

SHEET #1

ABANDONED

WALLACE
GREGORY
MURRAY
TELLEZ
ETNIER

RECEIVED Smelser APR 2 1937

PROGRESSED ✓

BOOK INDEXED ✓

MAP INDEXED ✓

RECORD INDEXED ✓

CARD INDEXED ✓

Note: Any Additions or Changes on This Sheet Must be Made or Circled in Red Ink With Date and Name of Person Making Change

Do not extend notes this side of this line

RETURN TO
LOS ANGELES COUNTY SURVEYOR
700 HALL OF RECORDS

FORM 247 10M 11-35

F.B. 697 Pg. 102

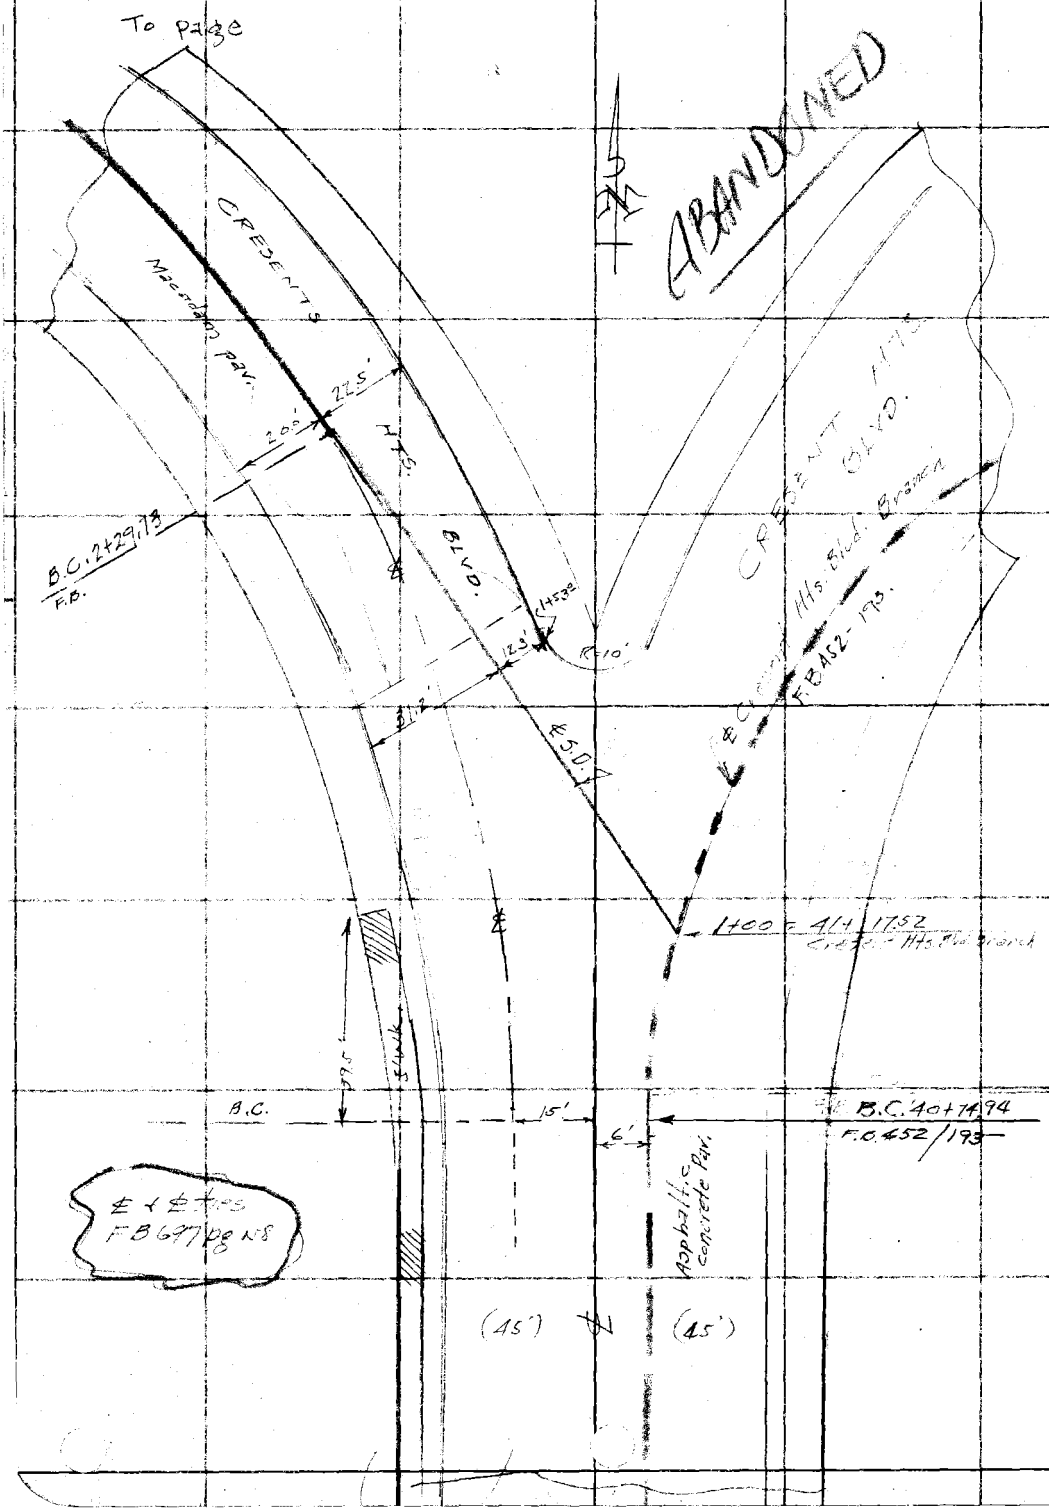

RETURN TO
LOS ANGELES COUNTY SURVEYOR
700 HALL OF RECORDS

Note: Any Additions or Changes on This Sheet Must be Made or Circled in Red Ink With Date and Name of Person Making Change.

Do not extend notes this side of this line

FORM 247 10M 11-35

RETURN TO
LOS ANGELES COUNTY SURVEYOR
700 HALL OF RECORDS

Note: Any Additions or Changes on This Sheet Must be Made or Circled in **Red Ink** With Date and Name of Person Making Change.

Do not extend notes this side of this line

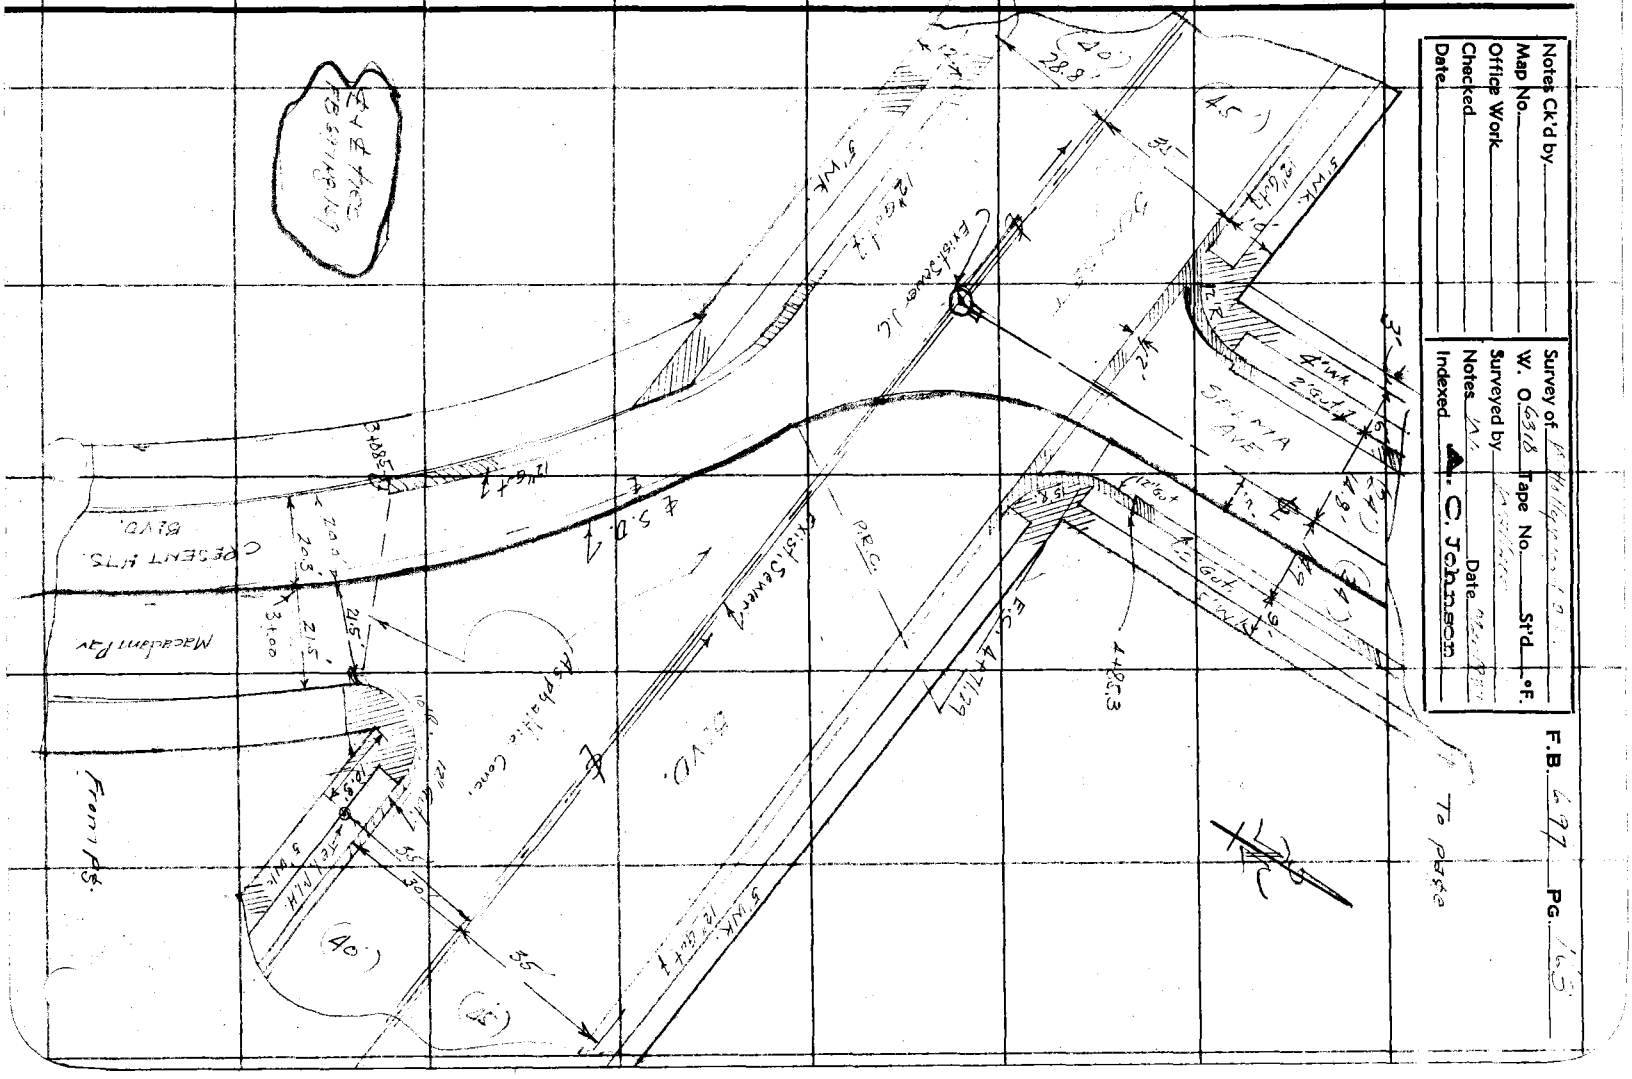
Existing Sewer
Existing Sewer
Existing Sewer

RETURN TO
LOS ANGELES COUNTY SURVEYOR
700 HALL OF RECORDS

Note: Any Additions or Changes on This Sheet Must be Made or Circled in **Red Ink** With Date and Name of Person Making Change.

Do not extend notes this side of this line

F.B. 697 PG. 44

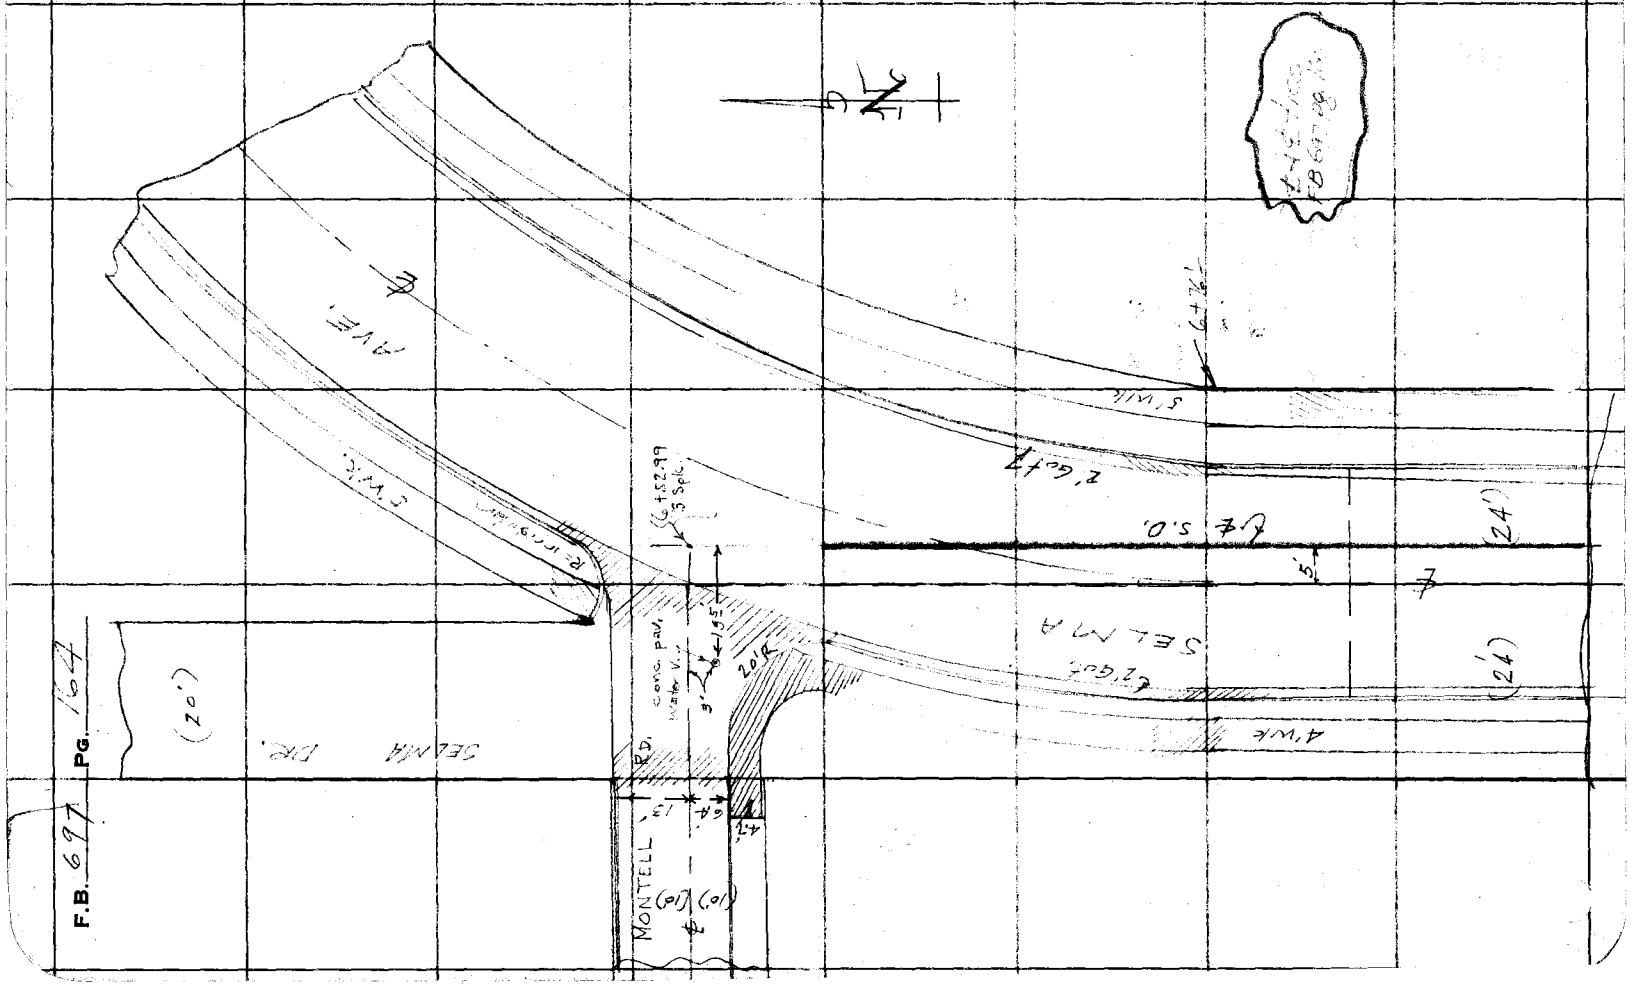

Profile No.	Notes Red.	Plotted	Job No.	Division No.	F. B. 697 Pg. 165
	Date	Date	Survey of N. La Brea		
X-Sec. No.	Notes Chkd.	Checked	Survey by	Notes C. Johnson	Date
	Date	Date	Map No.	Indexed	Date

NOTE: ANY ADDITIONS OR CHANGES ON THIS SHEET MUST BE MADE OR CIRCLED IN RED INK, WITH DATE AND NAME OF PERSON MAKING CHANGE

Do not extend notes this side of this line

PLEASE RETURN TO
LOS ANGELES COUNTY SURVEYOR
700 HALL OF RECORDS

Form 307 5M 11-35

PROFILE

SELMA AVE. LATERAL

East Hollywood Dist.

SAN [illegible]

[illegible] / [illegible] Pg. 15 162

SHEET #4

(ABANDONED)

STATION	B. S.	H. I.	F. S.	ELEV.

RECEIVED Smelser APR 2 1937

PROGRESSED ✓ ✓

BOOK INDEXED ✓ ✓

MAP INDEXED ✓

RECORD INDEXED ✓ ✓

CARD INDEXED ✓ ✓

REDUCED Field

CHECKED LCM

Form 307 5M 11-35

PLEASE RETURN TO
LOS ANGELES COUNTY SURVEYOR
700 HALL OF RECORDS

NOTE: ANY ADDITIONS OR CHANGES ON THIS SHEET MUST BE MADE OR CIRCLED IN RED INK, WITH DATE AND NAME OF PERSON MAKING CHANGE

Do not extend notes this side of this line

F.B. 697 PG. 166

Job No. 6318 Division No. Notes Red. Plotted
Survey of Profile
Survey by W. C. Johnson Notes Date Date
Indexed Date Notes Chkd. Checked
No. X-Sec. No.
Date Date

STATION	B. S.	H. I.	F. S.	ELEV.		
					SELMA AVE LATERAL	
BM D-21	1.07	401.57		400.50	(BM D-21 El. 406.495 FB 682-17 Sunset Blvd + Crescent Hts Blvd in Triangle (N. 0.5 ft ± E. of C.R. at N.W. Cor. Triangle S. Side Sunset Blvd	
			9.30	391.27	E ⊃	
			7.50	393.77	E Crescent Hts Blvd Center Line	
			6.10	395.17	TC E Side	
			5.80	395.47	Gutter	
			8.50	393.07	TC W Side	
			9.20	392.37	Gutter	
			6.45	395.12	℄ ⊃	
			5.78	395.79	℄ ⊃	
			4.40	397.17		
			3.60	397.97	TC E Side	
			3.47	398.10	Gutter	
			5.48	396.09	TC	
			6.78	394.79	Gutter	
			1.30	400.27	PC E end SE CR	
			1.84	399.73	Gutter	

Form 307 5M 11-35

PLEASE RETURN TO
LOS ANGELES COUNTY SURVEYOR
700 HALL OF RECORDS

NOTE: ANY ADDITIONS OR CHANGES ON THIS SHEET MUST BE MADE OR CIRCLED IN RED INK, WITH DATE AND NAME OF PERSON MAKING CHANGE

Do not extend notes this side of this line

STATION	B. S.	H. I.	F. S.	ELEV.	
				403 97	
	7.71				
			29.40		

Profile

No. _____ Notes Red _____ Plotted _____ Job No. _____ Division No. _____

X-Sec. Date _____ Date _____ Survey of _____

No. _____ Notes Chkd. _____ Checked _____ Survey by _____ Notes _____

Date _____ Date _____ Map No. _____ Indexed _____ Date _____

F. B. 697 PG. 167

F. B. 697 PG. 162 | Job No. 6318 | Division No. | Notes Red. | Plotted | Profile

Survey of | Date | Date | No.

Survey by | Notes | Notes Chkd. | Checked | X-Sec.

Indexed C. Johnson | Date | Date | Date | No.

Form 307 5M 11-35

PLEASE RETURN TO
LOS ANGELES COUNTY SURVEYOR
700 HALL OF RECORDS

NOTE: ANY ADDITIONS OR CHANGES ON THIS SHEET MUST BE MADE OR CIRCLED IN RED INK, WITH DATE AND NAME OF PERSON MAKING CHANGE

Do not extend notes this side of this line

STATION	B. S.	H. I.	F. S.	ELEV.

Form 307 5M 11-35

PLEASE RETURN TO
LOS ANGELES COUNTY SURVEYOR
700 HALL OF RECORDS

NOTE: ANY ADDITIONS OR CHANGES ON THIS SHEET MUST BE MADE OR CIRCLED IN RED INK, WITH DATE AND NAME OF PERSON MAKING CHANGE

Do not extend notes this side of this line

STATION	B. S.	H. I.	F. S.	ELEV.		

Form 307 5M 11-35

PLEASE RETURN TO
LOS ANGELES COUNTY SURVEYOR
700 HALL OF RECORDS

NOTE: ANY ADDITIONS OR CHANGES ON THIS SHEET MUST BE MADE OR CIRCLED IN RED INK, WITH DATE AND NAME OF PERSON MAKING CHANGE

Do not extend notes this side of this line

F.B. 697 Pg. 170 | Job No. 5215 | Division No. | Profile No. | X-Sec. No.

Survey of W. Hawaiian Dr. | Notes Red. Geary | Plotted | Date | Notes Chkd. | Checked | Date

Survey by C. Johnson | Notes Sketch | Date | Date

Indexed | Date | Date

STATION	B. S.	H. I.	F. S.	ELEV.	
		430 61			
					D146 El 43.995 - F.B. 682 P. 116
D-146	3.44	432.44		42[illegible]	
	0.89	432.29			
	0.10	432.39			
					BM D-214 El 40.205 F.B. [illegible] - 18
				40.23	Brass Disc + Hydrant Dr (C.V. Cal.)
					2.2' N 30.2' W of W.P.L. of Hydrant Mod.

F.B. 697 Pg. 172

RETURN TO
LOS ANGELES COUNTY SURVEYOR
700 HALL OF RECORDS

Note: Any Additions or Changes on This Sheet Must be Made or Circled in Red Ink With Date and Name of Person Making Change.

Do not extend notes this side of this line

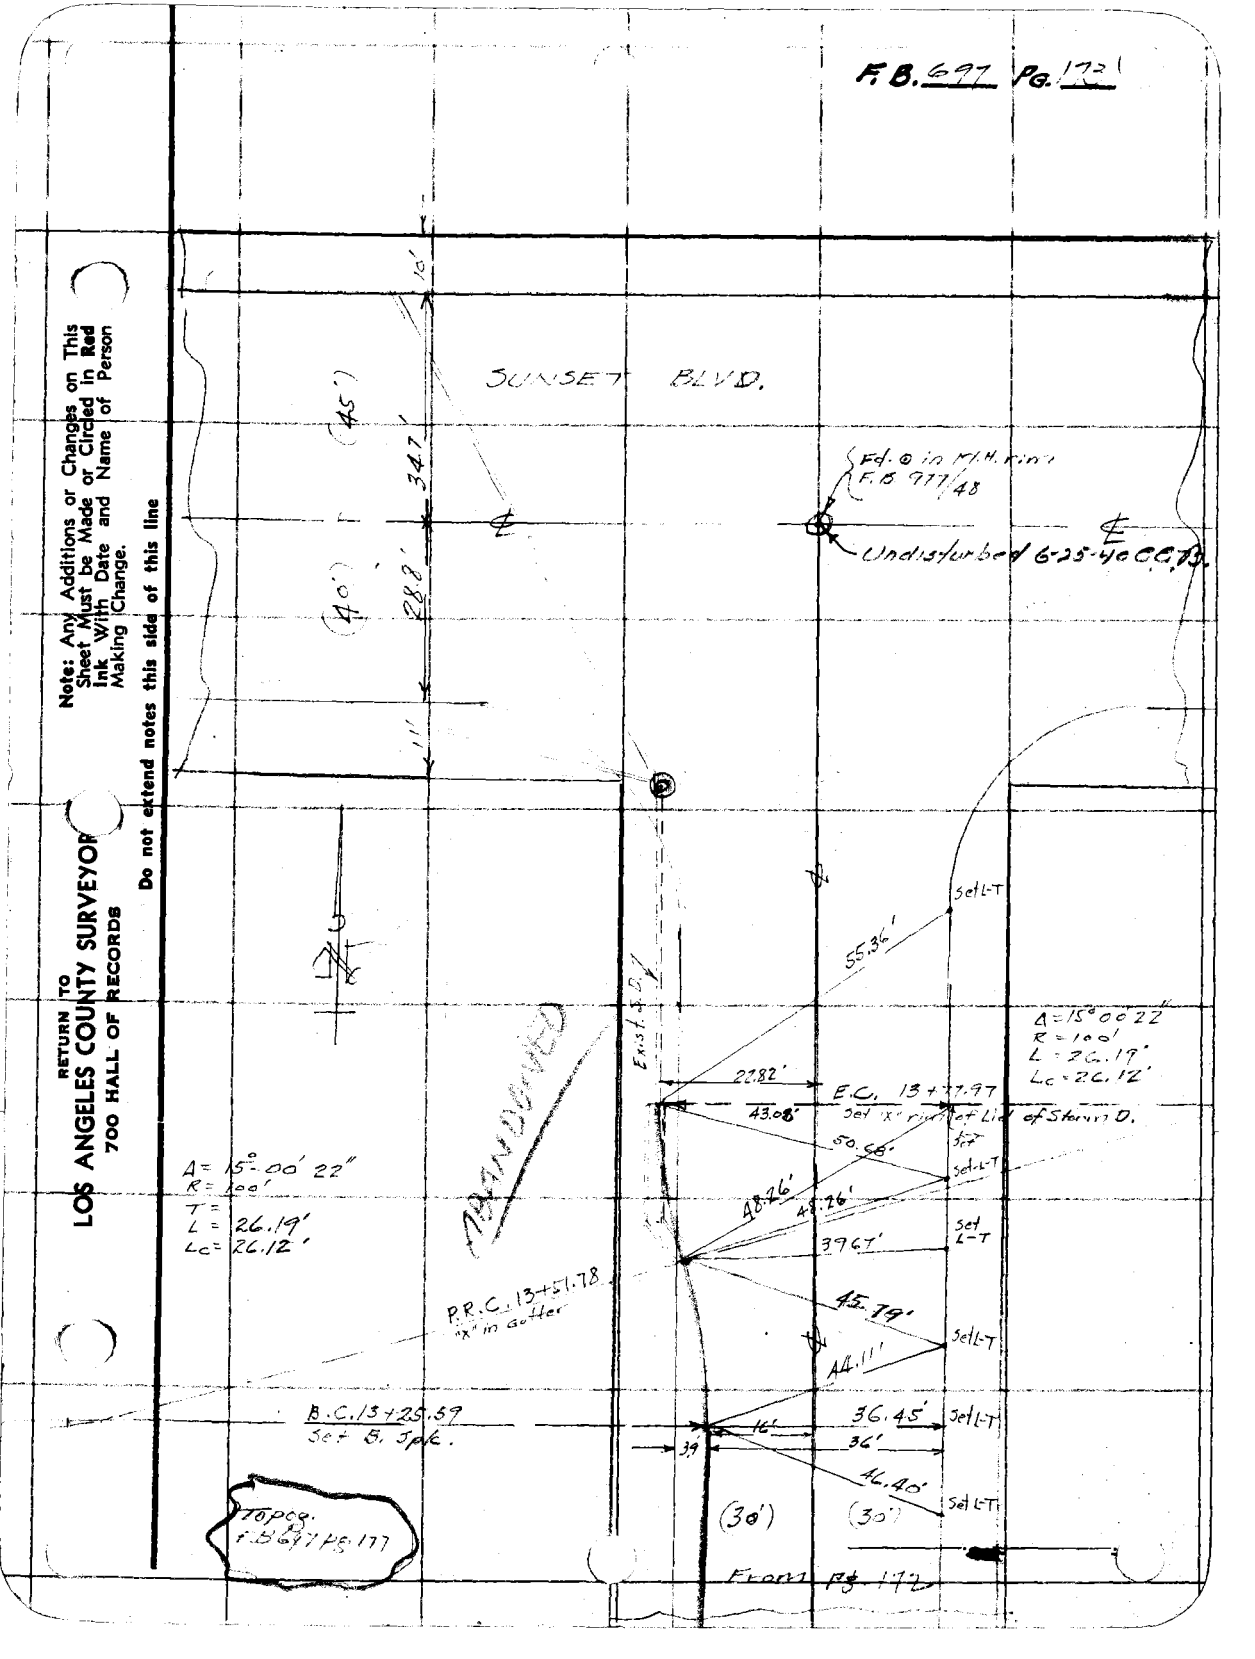

FORM 247 10M 11-35

RETURN TO
LOS ANGELES COUNTY SURVEYOR
700 HALL OF RECORDS

Note: Any Additions or Changes on This Sheet Must be Made or Circled in **Red Ink** With Date and Name of Person Making Change

Do not extend notes this side of this line

Notes Ck'd by
Map No.
Office Work
Checked
Date

Survey of
W. O.
Surveyed by
Notes
Indexed

Tape No. St'd. °F.
Date

F.B. PG.

F.B. 227 PG. 144

Notes Ck'd by	Survey of N. Hollywood S.D.
Map No.	W. O. 6318 Tape No. 055 St'd 84 °F.
Office Work	Surveyed by WALLACE
Checked	Notes W Date 4-1-37
Date	Indexed C. Johnson

F.B. 697 PG. 171

& SURVEY
HAYVENHURST PL. LATERAL
WEST HOLLYWOOD S.D.
J.N. 6318

Topog. F.B. 697 pg. 175
Profile F.B. 697 pg. 177

Sht. #4

Wallace
Gregory
Mahan
Riley
Lucio

Const. J.N. = 6347
(W.O.)

RECEIVED APR 2 1937
PROGRESSED
BOOK INDEXED
MAP INDEXED
RECORD INDEXED
CARD INDEXED

RETURN TO
LOS ANGELES COUNTY SURVEYOR
700 HALL OF RECORDS

Note: Any Additions or Changes on This Sheet Must be Made or Circled in Red Ink With Date and Name of Person Making Change.

Do not extend notes this side of this line

FORM 247 10M 11-35

F.B. 697 Pg. 172

To bot Pg. 186
To bot Pg. 173

1176.12' @ 58° = 1175.93'

(30') (30')

℄ S.D. 16' W. & S.T.

DR.

1274.10' BR.

℄ S.D.'s E. & S.T.

4' 36'

1175.93 This line abandoned

HAVENHURST

Fd. L-T

W. Spk

FOUNTAIN

(30')

77.44'

Fountain Ave. L.m. F.B. 697/210

AVE.

F.B. 697-73 F.B. 452-17

S.D.

(30')

Undisturbed 6-25-40 CE

61.74'

E.C. 1+47.66 Est B.C. pk

B.L.Y.D.

Line Adjusted

26+25.13 = 1400 Fountain tr. Ln.

P.I. Set B.C. pk

36.72'

1+101.39

W. ℄ pk

Δ = 15° 00' 00"
R = 50'
T = 20.11'
L = 39.27'
Lc = 38.27

Fd. L-T

19.77'

23.25'

16'

6'

25.9'

14'

HAVENHURST

B.C. 25+90.00
F.B. 452-191

From Top pg 190

F.B. 452

To bot. FB 697 PG 176

RETURN TO
LOS ANGELES COUNTY SURVEYOR
700 HALL OF RECORDS

Do not extend notes this side of this line

Note: Any Additions or Changes on This Sheet Must be Made or Circled in Red Ink With Date and Name of Person Making Change.

Notes Ck'd by		Survey of W. Hollywood D.S.	F.B. 697 Pg. 175
Map No.		W. O. 6318 Tape No.	St'd °F.
Office Work		Surveyed by WALLACE	
Checked		Notes W.	Date 4-1-37
Date		Indexed A. C. Johnson	

TOPOG.

HAYVENHURST DR. LATERAL

WEST HOLLYWOOD D.S.

J.N. 6318

& Survey F.B. 697 Pg. 172
Profile F.B. 697 Pg. 179

SHEET #2

Wallace
Graves
Murray
Topog
Eng'r

RECEIVED H(C) APR 2 1937

PROGRESSED C C

BOOK INDEXED C C

~~MAP INDEXED~~

RECORD INDEXED C C

CARD INDEXED C C

RETURN TO
LOS ANGELES COUNTY SURVEYOR
700 HALL OF RECORDS

Note: Any Additions or Changes on This Sheet Must be Made or Circled in Red Ink With Date and Name of Person Making Change.

Do not extend notes this side of this line

FORM 247 10M 11-35

F.B. 697 PG. 176

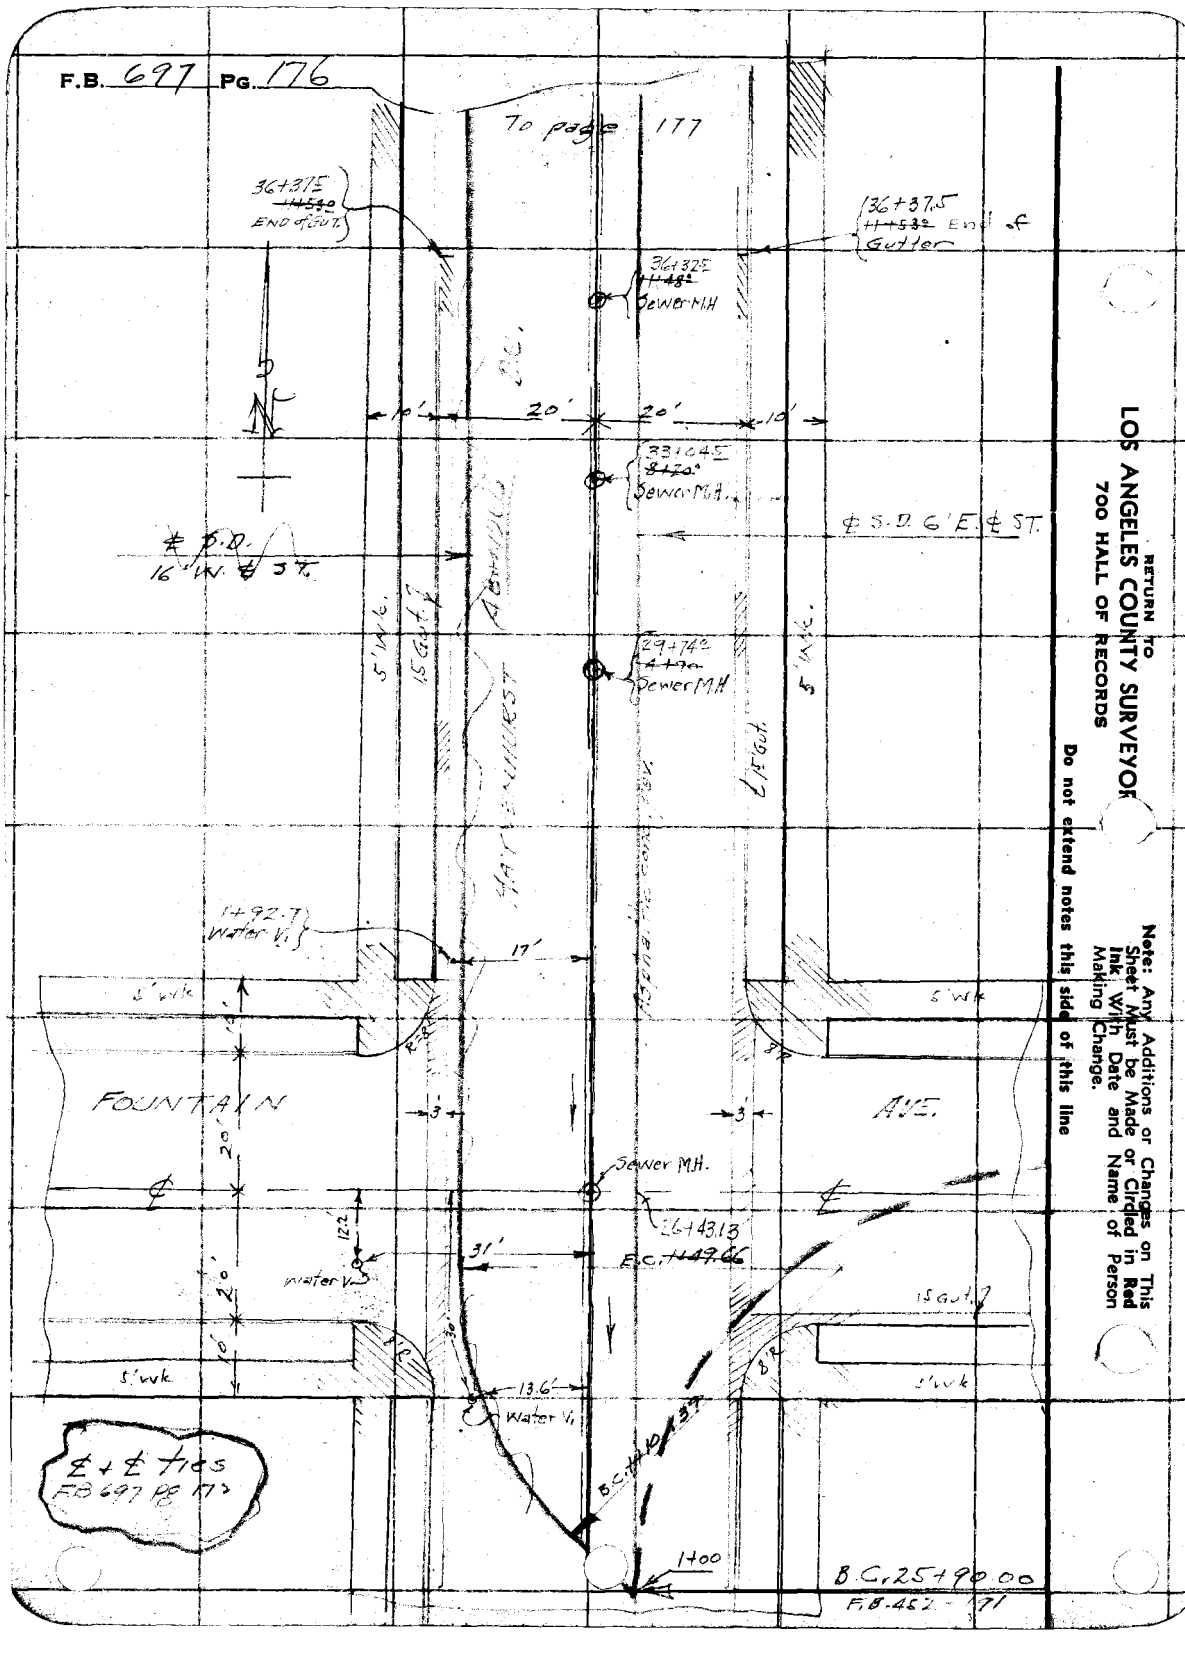

Note: Any Additions or Changes on This Sheet Must be Made or Circled in Red Ink With Date and Name of Person Making Change.

Do not extend notes this side of this line

RETURN TO
LOS ANGELES COUNTY SURVEYOR
700 HALL OF RECORDS

Notes Ck'd by	Survey of Hollywood Div.
Map No.	W. O. 6918 Tape No. 055 St'd 24 °F.
Office Work	Surveyed by W. Jeffers
Checked	Notes WALLACE Date 4-1-37
Date	Indexed C. Johnson

F.B. 677 PG. 177

Note: Any Additions or Changes on This Sheet Must be Made or Circled in Red Ink With Date and Name of Person Making Change

Do not extend notes this side of this line

RETURN TO
LOS ANGELES COUNTY SURVEYOR
7do HALL OF RECORDS

FORM 247 10M 11-35

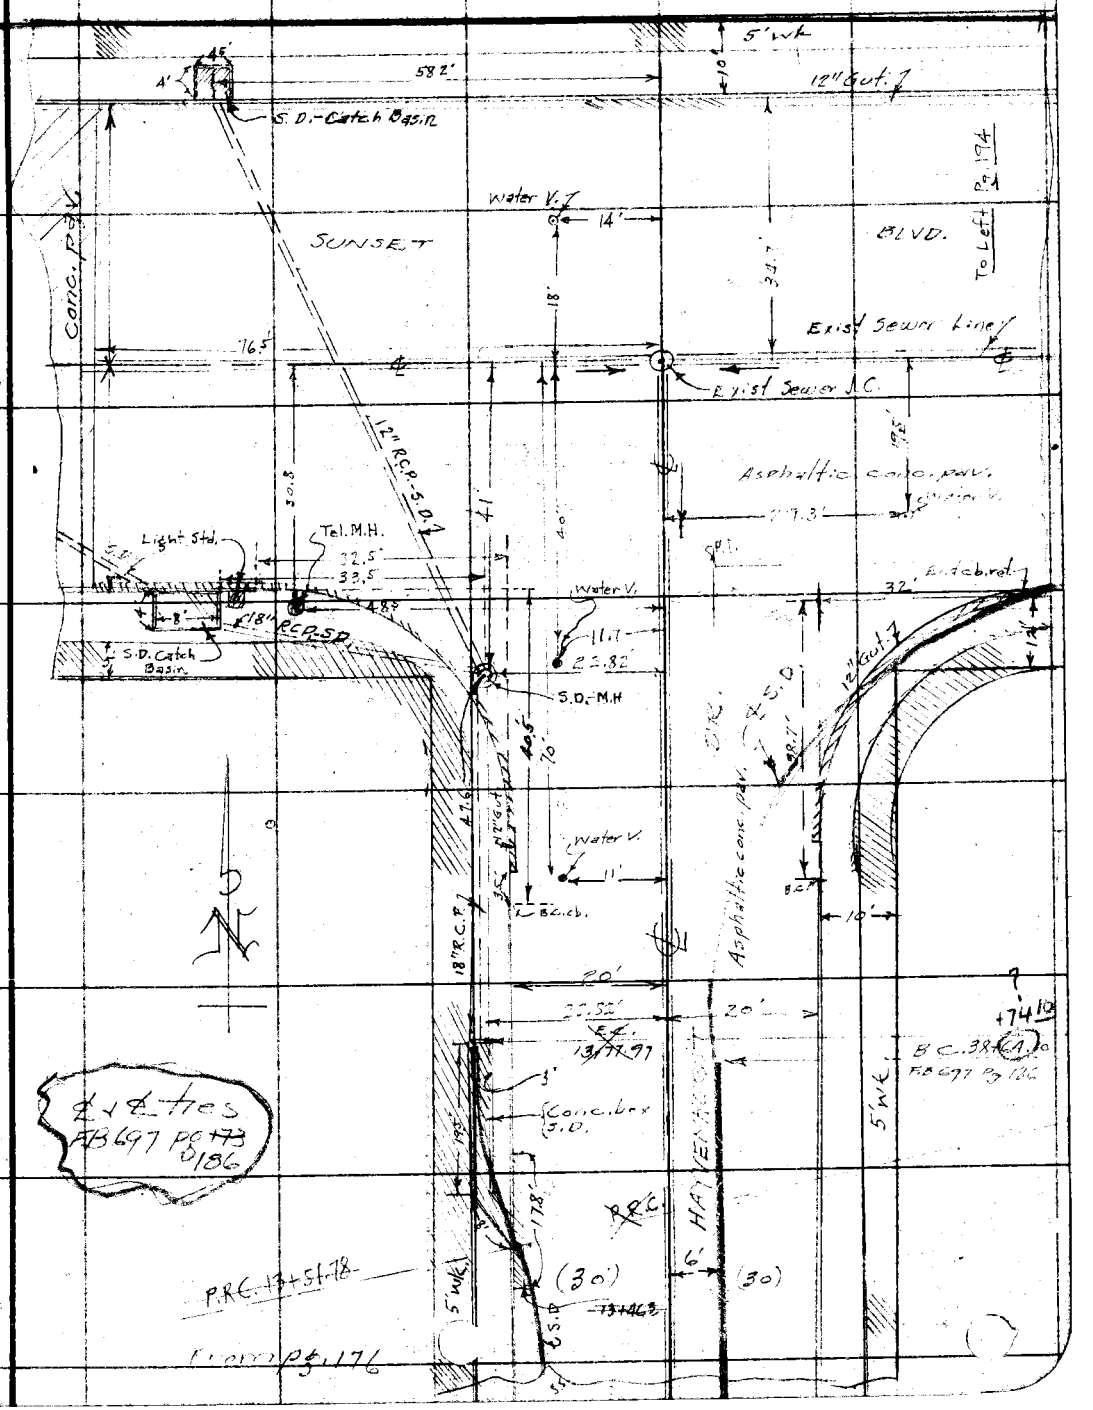

RETURN TO
LOS ANGELES COUNTY SURVEYOR
700 HALL OF RECORDS

Note: Any Additions or Changes on This Sheet Must be Made or Circled in **Red Ink** With Date and Name of Person Making Change.

Do not extend notes this side of this line

F.B. 697 PG. 178

Profile No. | Notes Red. | Plotted | Job No. | Division No. | F. B. 1 PG. 179

X-Sec. No. | Date | Date | Survey of W. Hollywood DS

Notes Chkd. | Checked | Survey by A. C. Johnson | Notes | Date

Date | Date | Map No. 4 | Indexed | Date

NOTE: ANY ADDITIONS OR CHANGES ON THIS SHEET MUST BE MADE OR CIRCLED IN RED INK, WITH DATE AND NAME OF PERSON MAKING CHANGE

Do not extend notes this side of this line

PLEASE RETURN TO
LOS ANGELES COUNTY SURVEYOR
700 HALL OF RECORDS

Form 307 5M 11-35

STATION	B. S.	H. I.	F. S.	ELEV.

Sheet 4

RECEIVED HLS APR 2 1927

PROGRESSED ✓ ✓

BOOK INDEXED ✓ ✓

MAP INDEXED ✓ ✓

RECORD INDEXED ✓ ✓

CARD INDEXED ✓ ✓

REDUCED Folder

CHECKED LCM

Form 307 5M 11-35

PLEASE RETURN TO
LOS ANGELES COUNTY SURVEYOR
700 HALL OF RECORDS

NOTE: ANY ADDITIONS OR CHANGES ON THIS SHEET MUST BE MADE OR CIRCLED IN RED INK, WITH DATE AND NAME OF PERSON MAKING CHANGE

Do not extend notes this side of this line

F. B. 697 Pg. 180

Job No. [illegible] Division No. [illegible] Profile No.

Notes Red. Date Plotted Date X-Sec. No.

Survey of

Survey by C. Johnson Notes Date Checked Date

Indexed Notes Chkd. Date

STATION	B. S.	H. I.	F. S.	ELEV.	
					Fountain, 4'0
BM D-24	3.25	334.21		330.96	BM D-24 El 330.962 FB 682-21 Fountain, 4' x 4' Sq. concrete Dr. S W Com Bk Sdk. S 0.4 S Conc. Curb
			10.64		
					Conc E
					TC E
					TC
					TC W
					Conc
					Conc
					TC

Form 307 5M 11-35

PLEASE RETURN TO
LOS ANGELES COUNTY SURVEYOR
700 HALL OF RECORDS

NOTE: ANY ADDITIONS OR CHANGES ON THIS SHEET MUST BE MADE OR CIRCLED IN RED INK, WITH DATE AND NAME OF PERSON MAKING CHANGE

Do not extend notes this side of this line

STATION	B. S.	H. I.	F. S.	ELEV.		

F. B. 677 PG. 182 | Job No. | Division No. | Notes Red. | Plotted | Profile No.

Survey of | Date | Date | X-Sec. No.

Survey by | Notes | Notes Chkd. | Checked

Indexed C. Johnson | Date | Date | Date

Form 307 5M 11-35

PLEASE RETURN TO
LOS ANGELES COUNTY SURVEYOR
700 HALL OF RECORDS

NOTE: ANY ADDITIONS OR CHANGES ON THIS SHEET MUST BE MADE OR CIRCLED IN RED INK, WITH DATE AND NAME OF PERSON MAKING CHANGE

Do not extend notes this side of this line

STATION	B. S.	H. I.	F. S.	ELEV.

Form 307 5M 11-35

PLEASE RETURN TO
LOS ANGELES COUNTY SURVEYOR
700 HALL OF RECORDS

NOTE: ANY ADDITIONS OR CHANGES ON THIS SHEET MUST BE MADE OR CIRCLED IN RED INK, WITH DATE AND NAME OF PERSON MAKING CHANGE

Do not extend notes this side of this line

STATION	B. S.	H. I.	F. S.	ELEV.		
11+43		384 45		383		
			2.71	382 74		
			3.46	382		
12+00			0.00	381		
			0.00	383		
				383		
				381		
TP			2.71	382 03		
12+00				382		
13+00				382		
				381		
	10.64					
			4.41	381 74		
			4.38	382		
				382		
				385		
			3.45	384 70		
			4.06	384		

Profile
No. X-Sec.
Notes Red. Plotted Job No. Division No.
Date Date Survey of
Notes Chkd. Checked Survey by Notes
Date Date Map No. Indexed Johnson
Date Date

F. B. 607 PG. 152

Form 307 5M 11-35

PLEASE RETURN TO
LOS ANGELES COUNTY SURVEYOR
700 HALL OF RECORDS

NOTE: ANY ADDITIONS OR CHANGES ON THIS SHEET MUST BE MADE OR CIRCLED IN RED INK, WITH DATE AND NAME OF PERSON MAKING CHANGE

Do not extend notes this side of this line

F. B. 697 Pg. 124 | Job No. 6258 | Division No. | Profile No. | X-Sec. No.

Survey of | Notes | Plotted | Date

Survey by C. Johnson | Notes Red. | Date

Indexed | Notes Chkd. | Date | Checked | Date

STATION	B. S.	H. I.	F. S.	ELEV.	

Notes Ck'd by		Survey of Hollywood Tie	F.B. 697 Pg. 185
Map No.		W. O. 6318 Tape No. 055 St'd 24 °F.	
Office Work		Surveyed by Wallace	
Checked		Notes KY Date July 1937	
Date		Indexed A. C. Johnson	

Note: Any Additions or Changes on This Sheet Must be Made or Circled in Red Ink With Date and Name of Person Making Change.

Do not extend notes this side of this line

RETURN TO
LOS ANGELES COUNTY SURVEYOR
700 HALL OF RECORDS

& SURVEY

HAYVENHURST AVE. BRANCH

WEST HOLLYWOOD D.S.

LA 6318

Topo F.B. 697 Pgs. 176, 177 and 195 to 200

Profile F.B. 697 Pgs. 179 to 184 and 201 to 210

Wallace
Fowler
Murray
Teller
Lima

RECEIVED JUL 6 1937

PROGRESSED

BOOK INDEXED

MAP INDEXED

RECORD INDEXED

CARD INDEXED

FORM 247 10M 11-35

F.B. 697 PG. 186

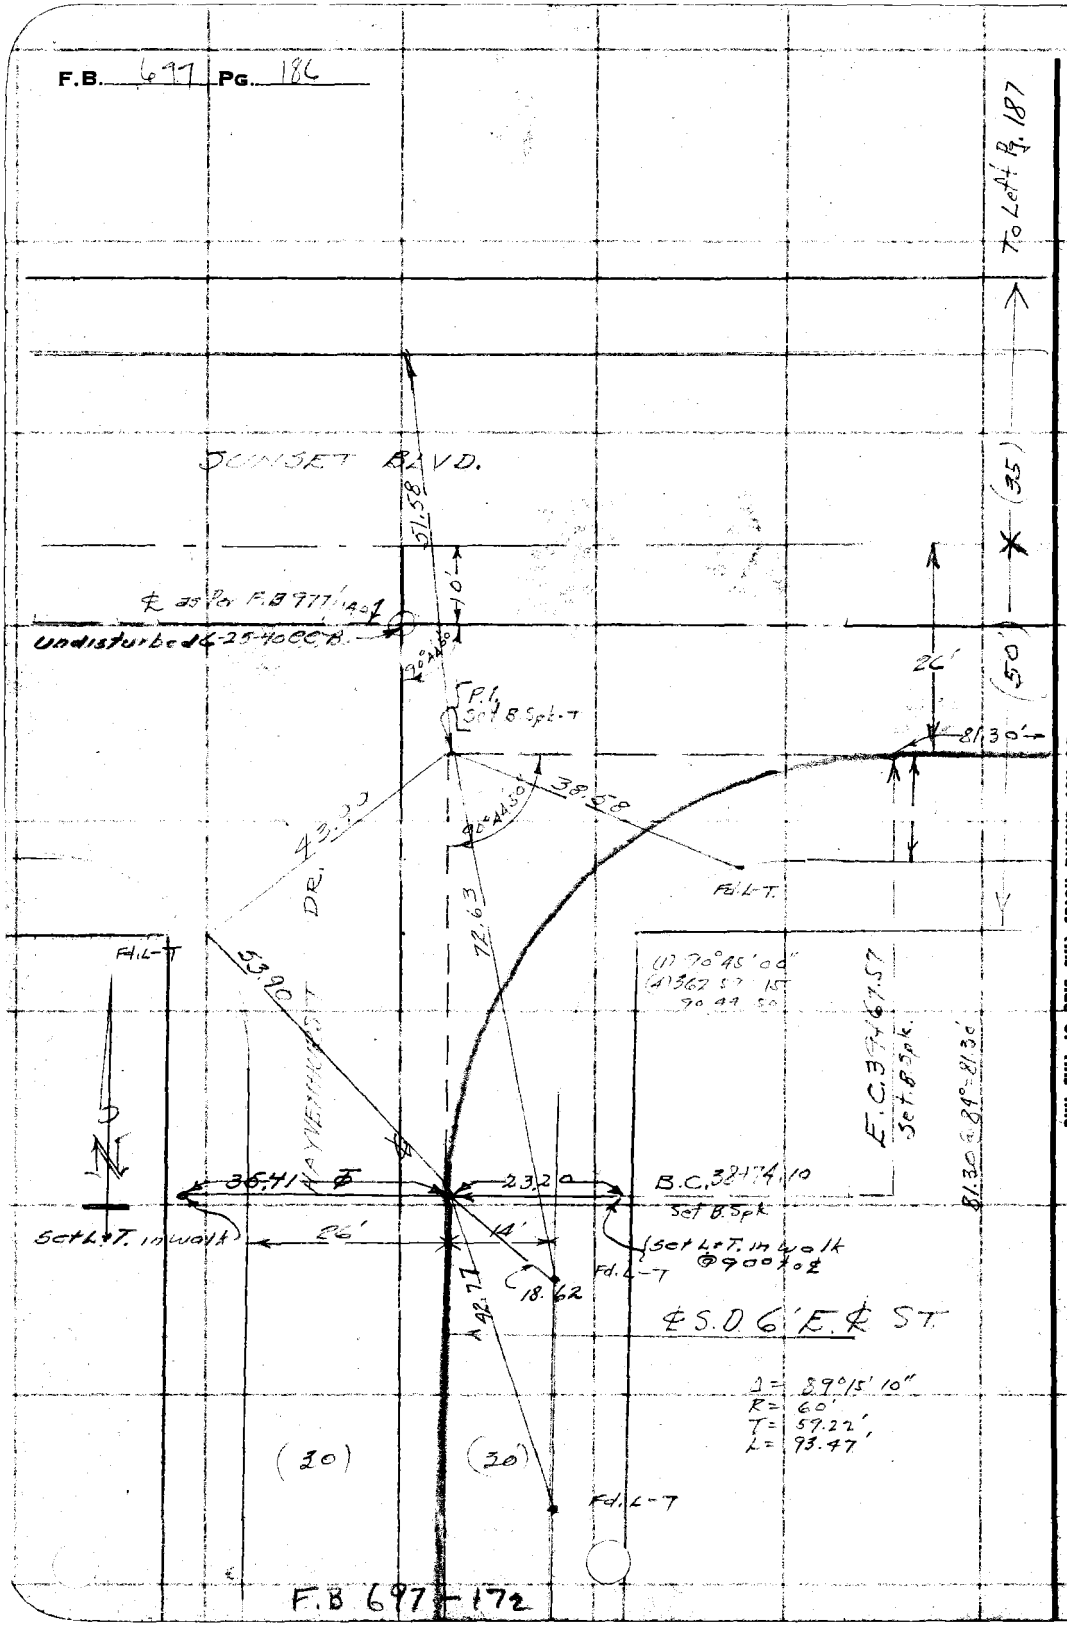

RETURN TO
LOS ANGELES COUNTY SURVEYOR
700 HALL OF RECORDS

Note: Any Additions or Changes on This Sheet Must be Made or Circled in Red Ink With Date and Name of Person Making Change.

Do not extend notes this side of this line

F.B 697 - 172

Notes Ck'd by	Survey of Willoughby et al.
Map No.	W. O. 6318 Tape No. 055 St'd 84 °F.
Office Work	Surveyed by Wallace
Checked	Notes W. Date July 1937
Date	Indexed A. C. Johnson

F.B. 697 PG. 187

To bet. Pg. 186

(24') (24')

8.8 20.7'

(1) 8142O-30
(A) 325-22-15

℄ S.D.G.W. ℄ S.T.

Δ = 98°39'25"
R = 60'
T = 69.23
L = 103.31

R/W 80.06'

℄ AVE.

SELMA

EC. 41+52.18
Set B.Spk.

SUNSET BLVD.

BC. 40+48.87
Set ℄ Spk.

35'

℄ S.D.

81°20'35"

10'

℄ as per F.B. 977-79

Fd. ⊙ on M.M.
F.B. 977-79
undisturbed 6.25 40 0.8 B.

26'

8°20'35"

16'

81.30'

P.1.
Set B Spk-T

20.08

10.42

Fd. L-T & Prod

Set L-T

Fd L-T

Set L-T

From Pg. 186

Note: Any Additions or Changes on This Sheet Must be Made or Circled in Red Ink With Date and Name of Person Making Change.

Do not extend notes this side of this line

RETURN TO
LOS ANGELES COUNTY SURVEYOR
700 HALL OF RECORDS

FORM 247 10M 11-35

F.B. 697 PG. 188

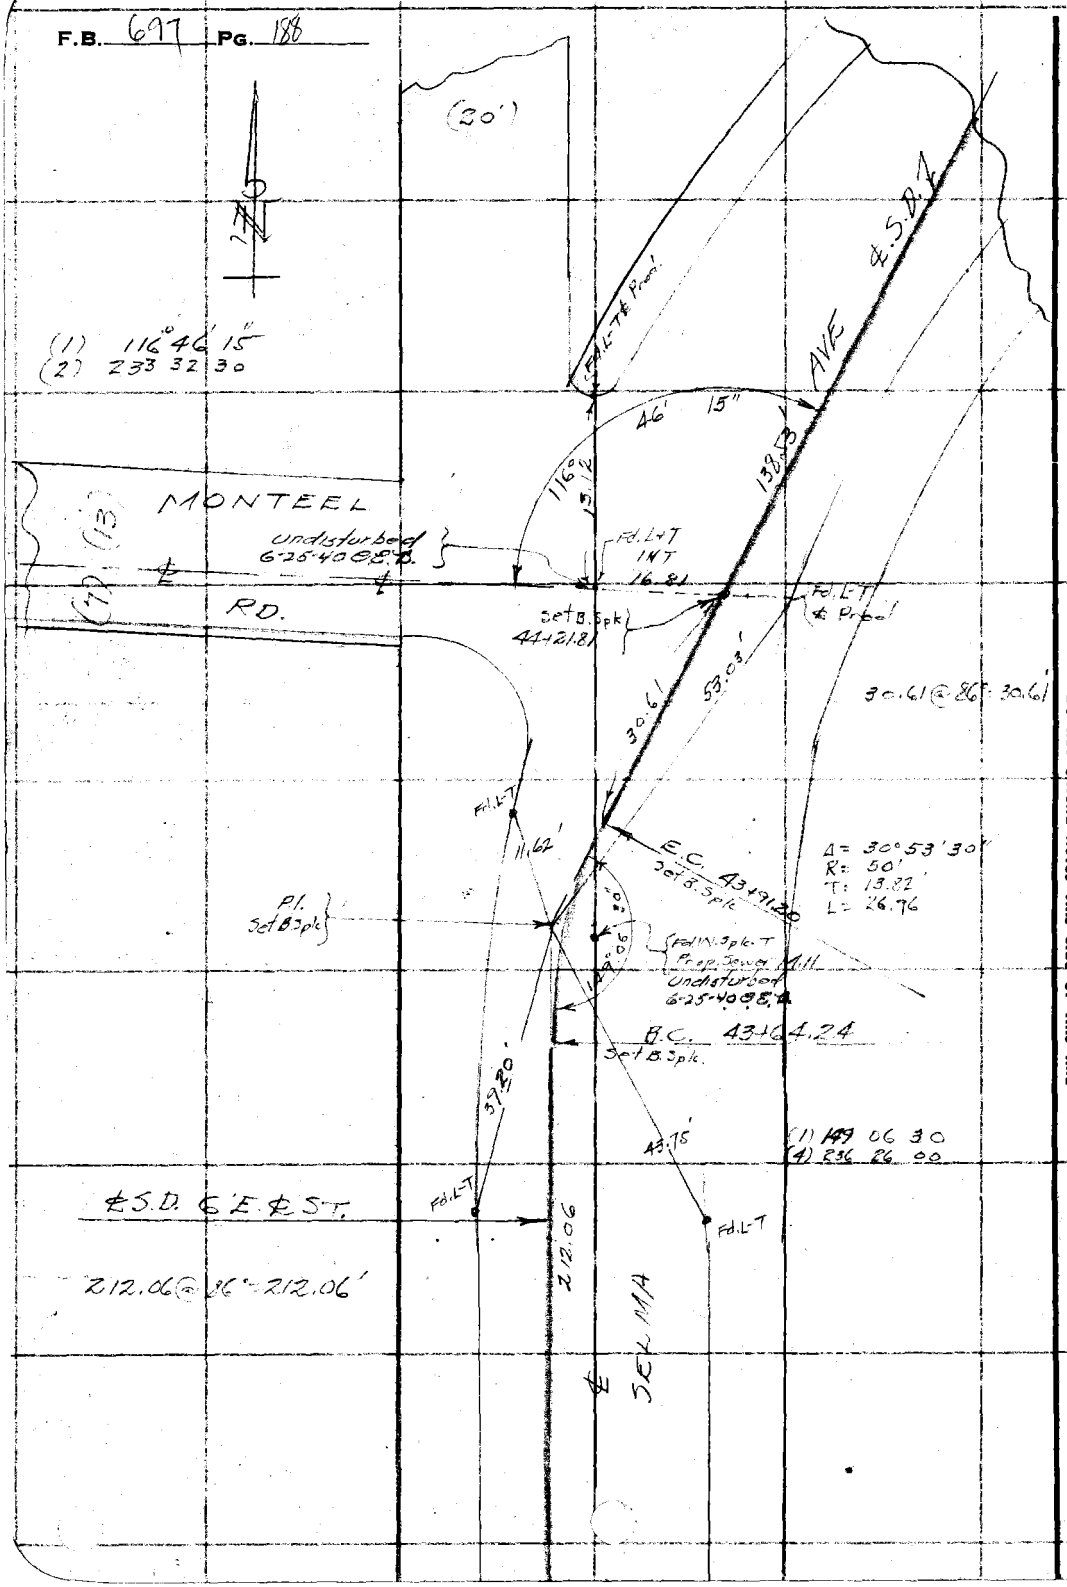

RETURN TO
LOS ANGELES COUNTY SURVEYOR
700 HALL OF RECORDS

Note: Any Additions or Changes on This Sheet Must be Made or Circled in Red Ink With Date and Name of Person Making Change.

Do not extend notes this side of this line

Notes Ck'd by	Survey of W. Hollywood Sub.
Map No.	W. O. 6318 Tape No. 84 St'd 55°F.
Office Work	Surveyed by W.
Checked	Notes KI Date July 1937
Date	Indexed A. C. Johnson

F.B. 629 Pg. 189

Note: Any Additions or Changes on This Sheet Must be Made or Circled in Red Ink With Date and Name of Person Making Change.

Do not extend notes this side of this line

RETURN TO
LOS ANGELES COUNTY SURVEYOR
700 HALL OF RECORDS

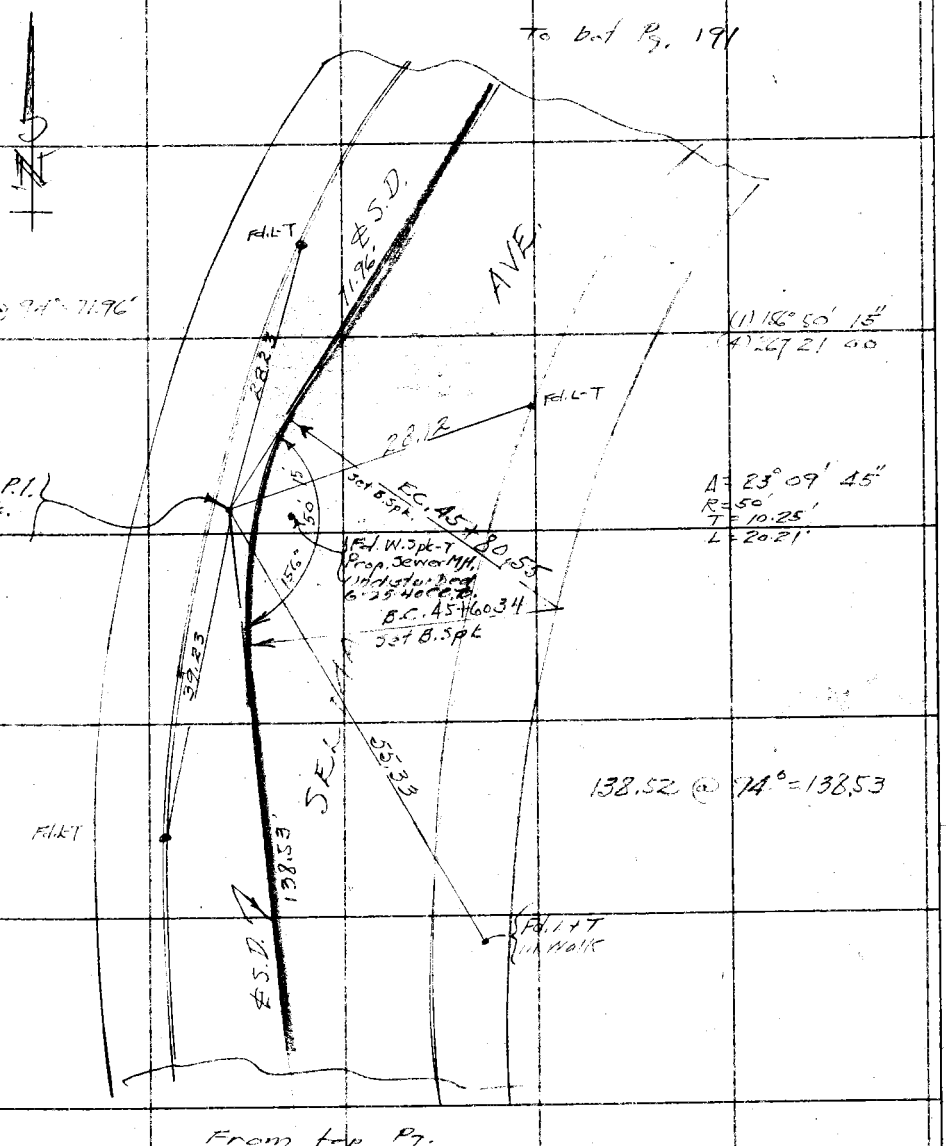

FORM 247 10M 11-35

RETURN TO
LOS ANGELES COUNTY SURVEYOR
700 HALL OF RECORDS

Note: Any Additions or Changes on This Sheet Must be Made or Circled in **Red** Ink With Date and Name of Person Making Change.

Do not extend notes this side of this line

F.B. 697 PG. 190

Notes Ck'd by	Survey of W. Hollywood U.S.
Map No.	W. O. 6318 Tape No. 055 St'd 89 °F.
Office Work	Surveyed by Wallace
Checked	Notes "A" Date July 1937
Date	Indexed A. C. Johnson.

F.B. 677 PG. 171

To bot. Pg. 192

Note: Any Additions or Changes on This Sheet Must be Made or Circled in Red Ink With Date and Name of Person Making Change

Do not extend notes this side of this line

RETURN TO
LOS ANGELES COUNTY SURVEYOR
700 HALL OF RECORDS

FORM 247 10M 11-35

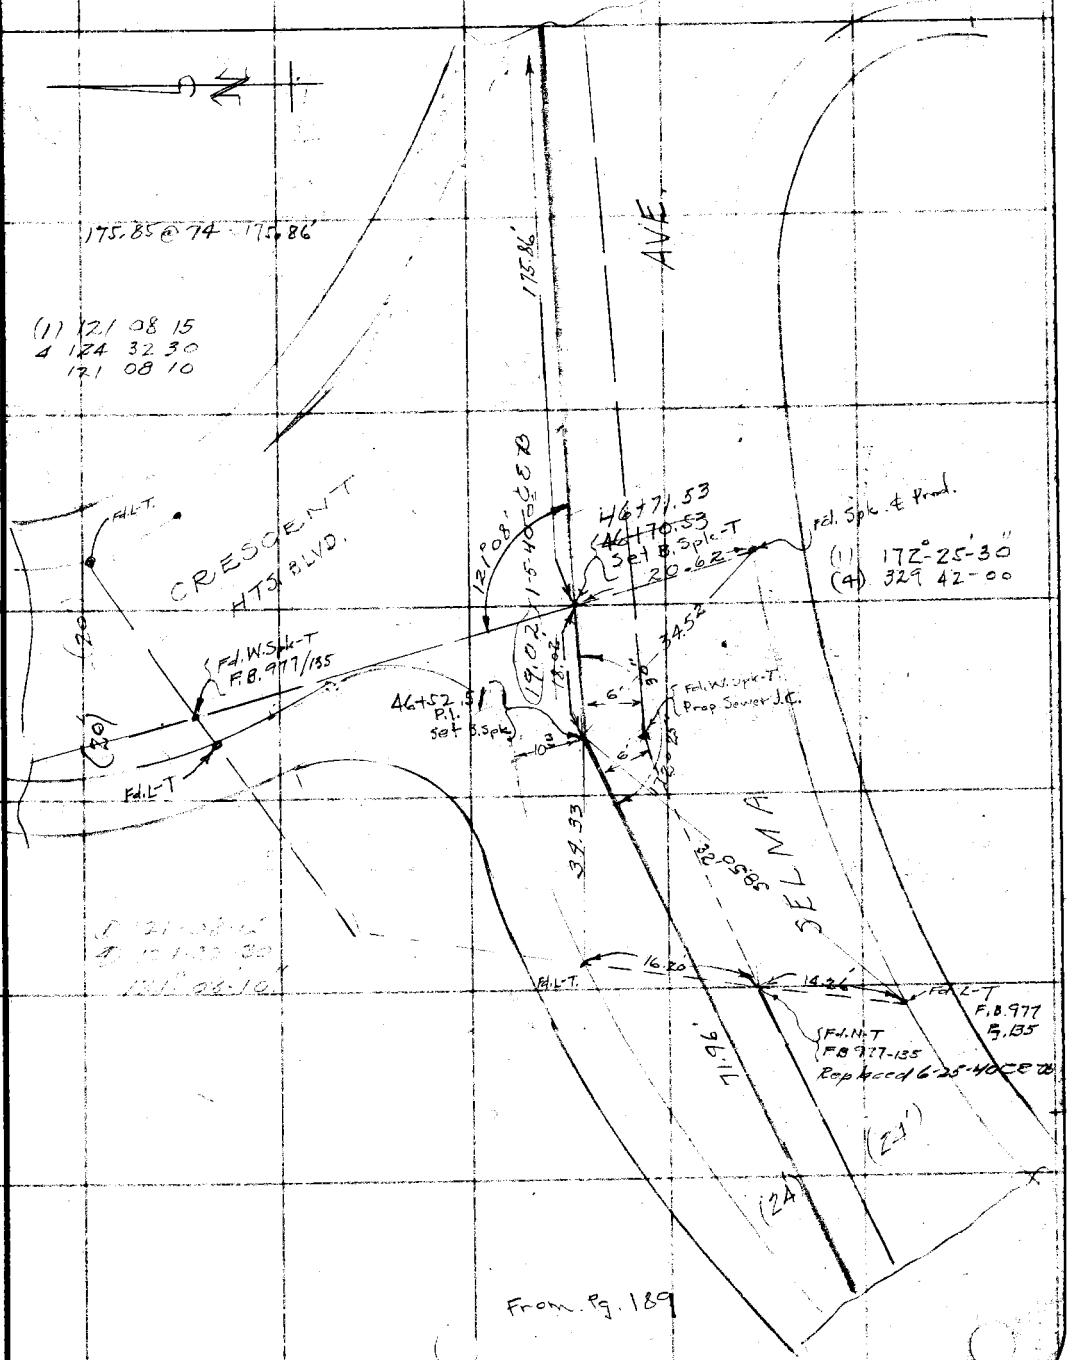

F.B. 697 Pg. 192

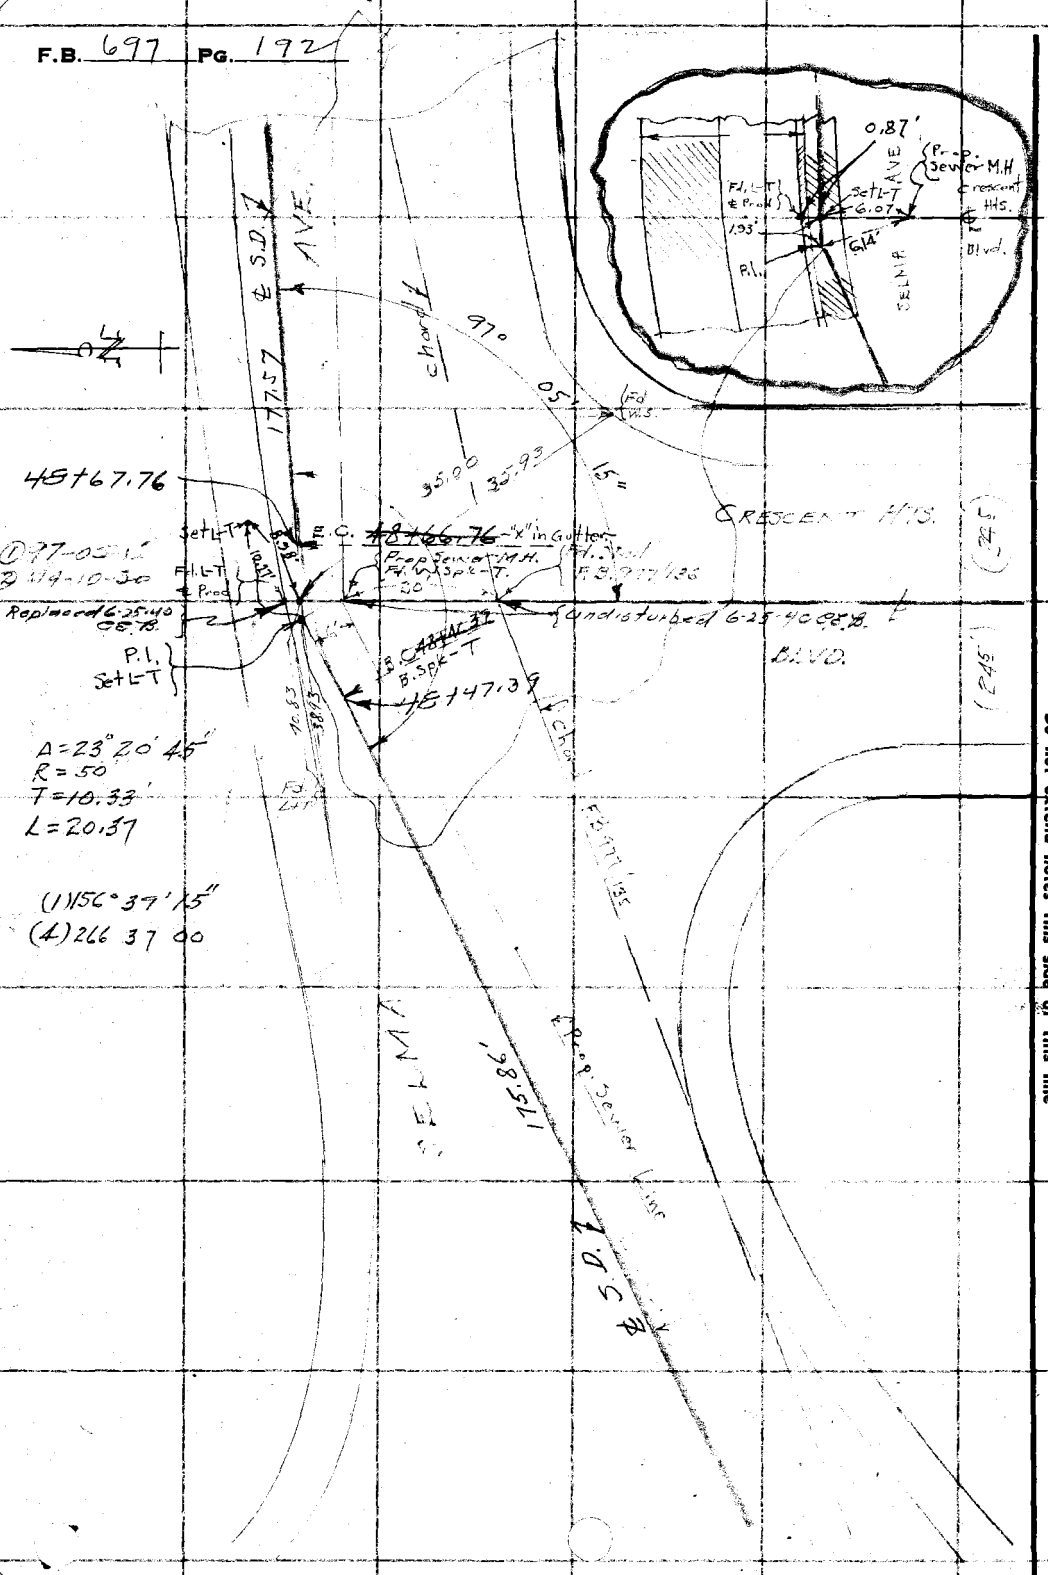

RETURN TO
LOS ANGELES COUNTY SURVEYOR
700 HALL OF RECORDS

Note: Any Additions or Changes on This Sheet Must be Made or Circled in Red Ink With Date and Name of Person Making Change.

Do not extend notes this side of this line

Notes Ck'd by	Survey of W. Hollywood Dist.
Map No.	W. O. 6318 Tape No. 055 St'd 84° F.
Office Work	Surveyed by WALL & C
Checked	Notes W. Date June 1937
Date	Indexed A. C. Johnson

F.B. 677 PG. 193

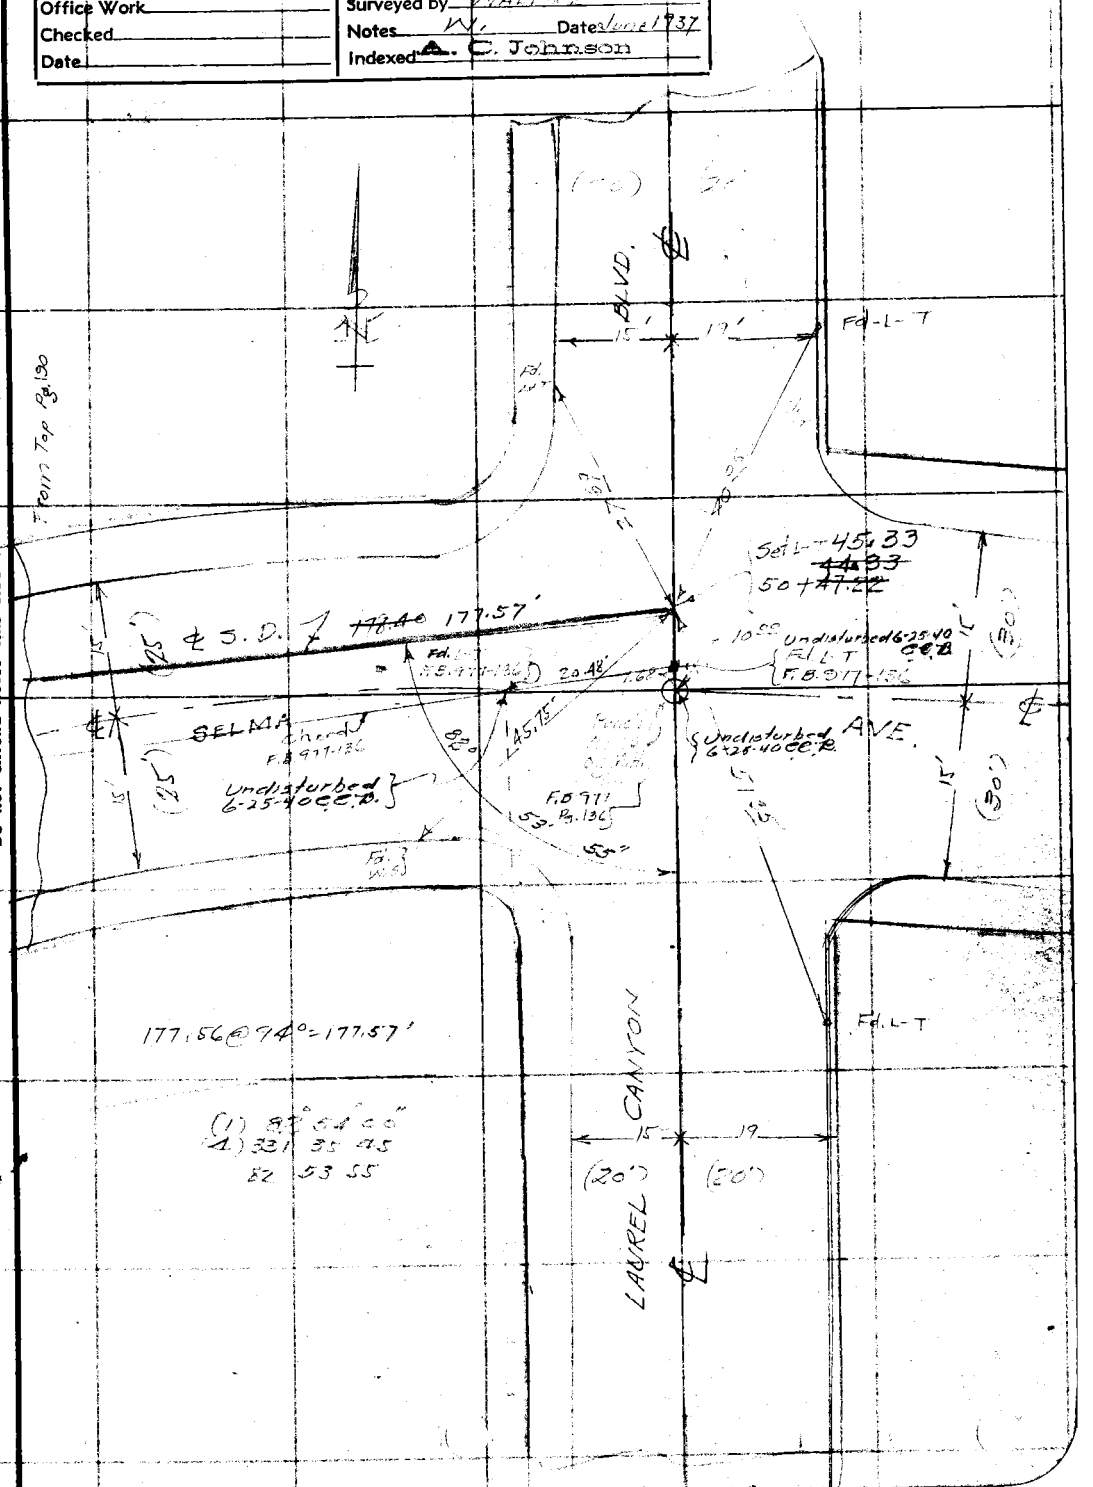

Note: Any Additions or Changes on This Sheet Must be Made or Circled in Red Ink With Date and Name of Person Making Change.

Do not extend notes this side of this line

RETURN TO
LOS ANGELES COUNTY SURVEYOR
700 HALL OF RECORDS

FORM 247 10M 11-38

RETURN TO
NGELES COUNTY SURVEYOR
OO HALL OF RECORDS

Note: Any Additions or Changes on This Sheet Must be Made or Circled in **Red Ink** With Date and Name of Person Making Change.

Do not extend notes this side of this line

F.B. 677 Pg. 17

Notes Ck'd by	Survey of
Map No.	W. O. 6338 Tape No. St'd °F.
Office Work	Surveyed by
Checked	Notes K Date
Date	Indexed A. C. Johnson

F.B. Pg. 5

TOPOG

HAWTHORNE JR. HIGH

MAP OF SECTION 3 T2S R14W

LANDS OF

SURVEY M 9271 - Pgs. 172, 173

BOOK M - Pg. 200 to 210

SHEET 4

Note: Any Additions or Changes on This Sheet Must be Made or Circled in Red Ink With Date and Name of Person Making Change.

Do not extend notes this side of this line

RETURN TO
LOS ANGELES COUNTY SURVEYOR
700 HALL OF RECORDS

RECEIVED Shelton JUN 14 1937

PROGRESSED ✓ ✓

BOOK INDEXED ✓ ✓

MAP INDEXED ✓ ✓

RECORD INDEXED ✓ ✓

CARD INDEXED ✓ ✓

FORM 247 10M 11-35

RETURN TO
LOS ANGELES COUNTY SURVEYOR
700 HALL OF RECORDS

Note: Any Additions or Changes on This Sheet Must be Made or Circled in **Red** Ink With Date and Name of Person Making Change.

Do not extend notes this side of this line

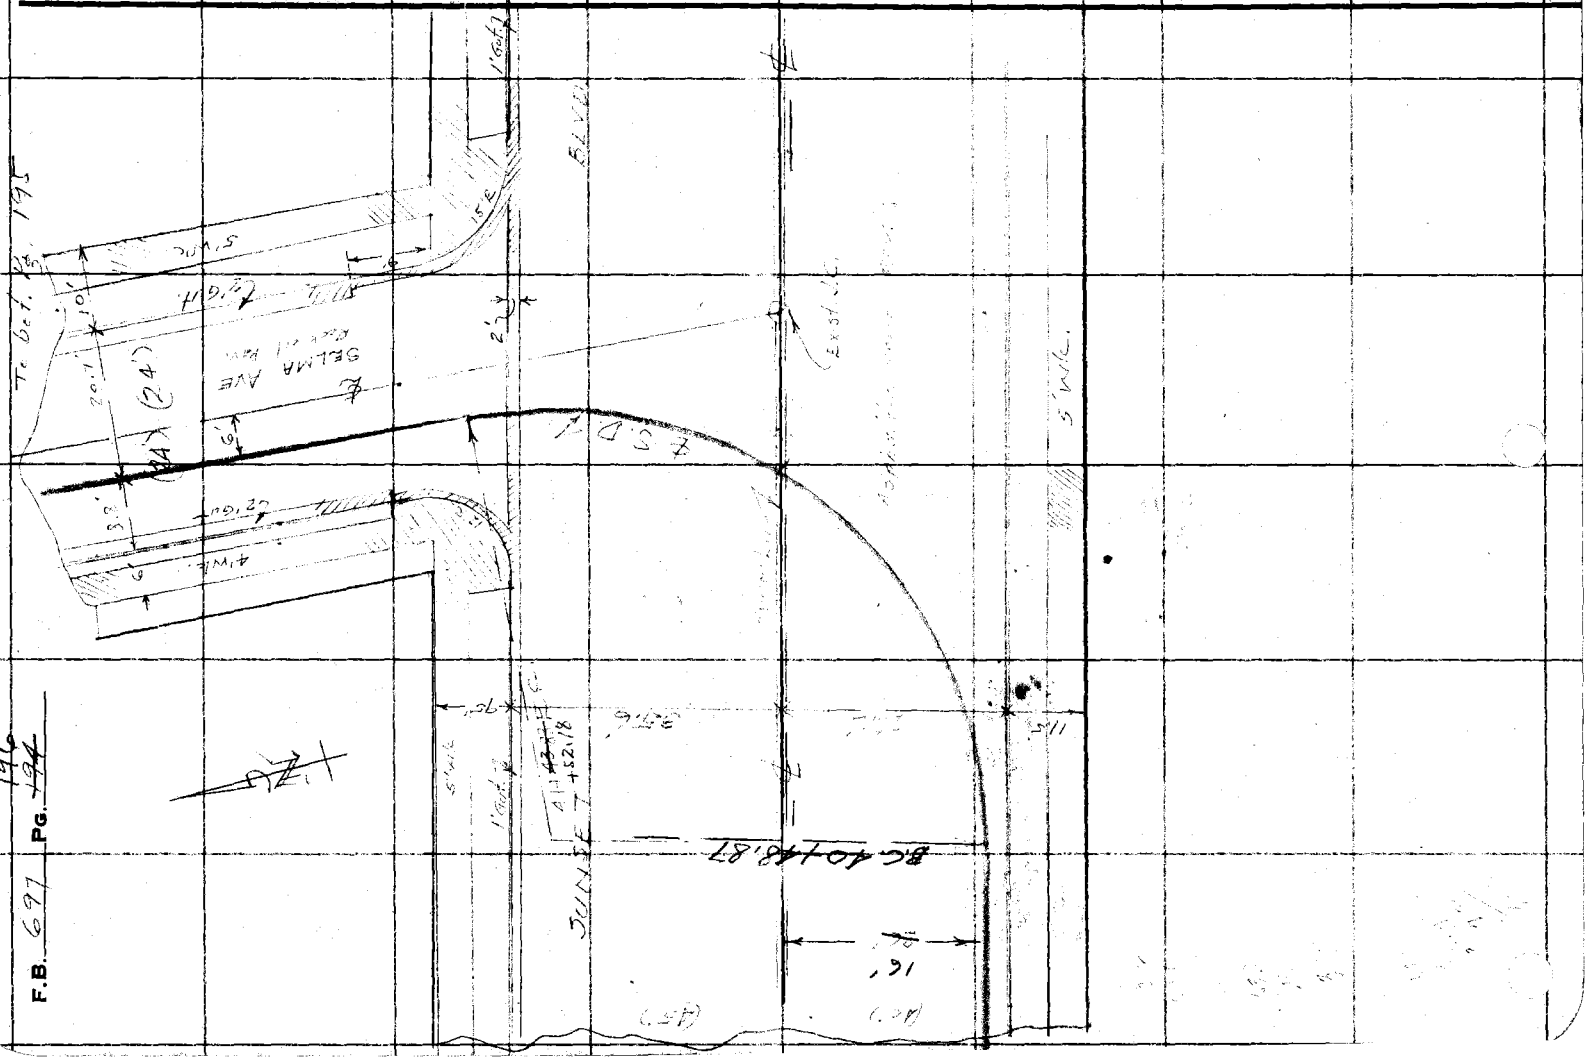

Notes Ck'd by	Survey of
Map No.	W. O. 4311 Tape No. St'd °F.
Office Work	Surveyed by
Checked	Notes Date
Date	Indexed C. Johnson

F.B. 611 PG. 197

Note: Any Additions or Changes on This Sheet Must be Made or Circled in Red Ink With Date and Name of Person Making Change

Do not extend notes this side of this line

RETURN TO
LOS ANGELES COUNTY SURVEYOR
700 HALL OF RECORDS

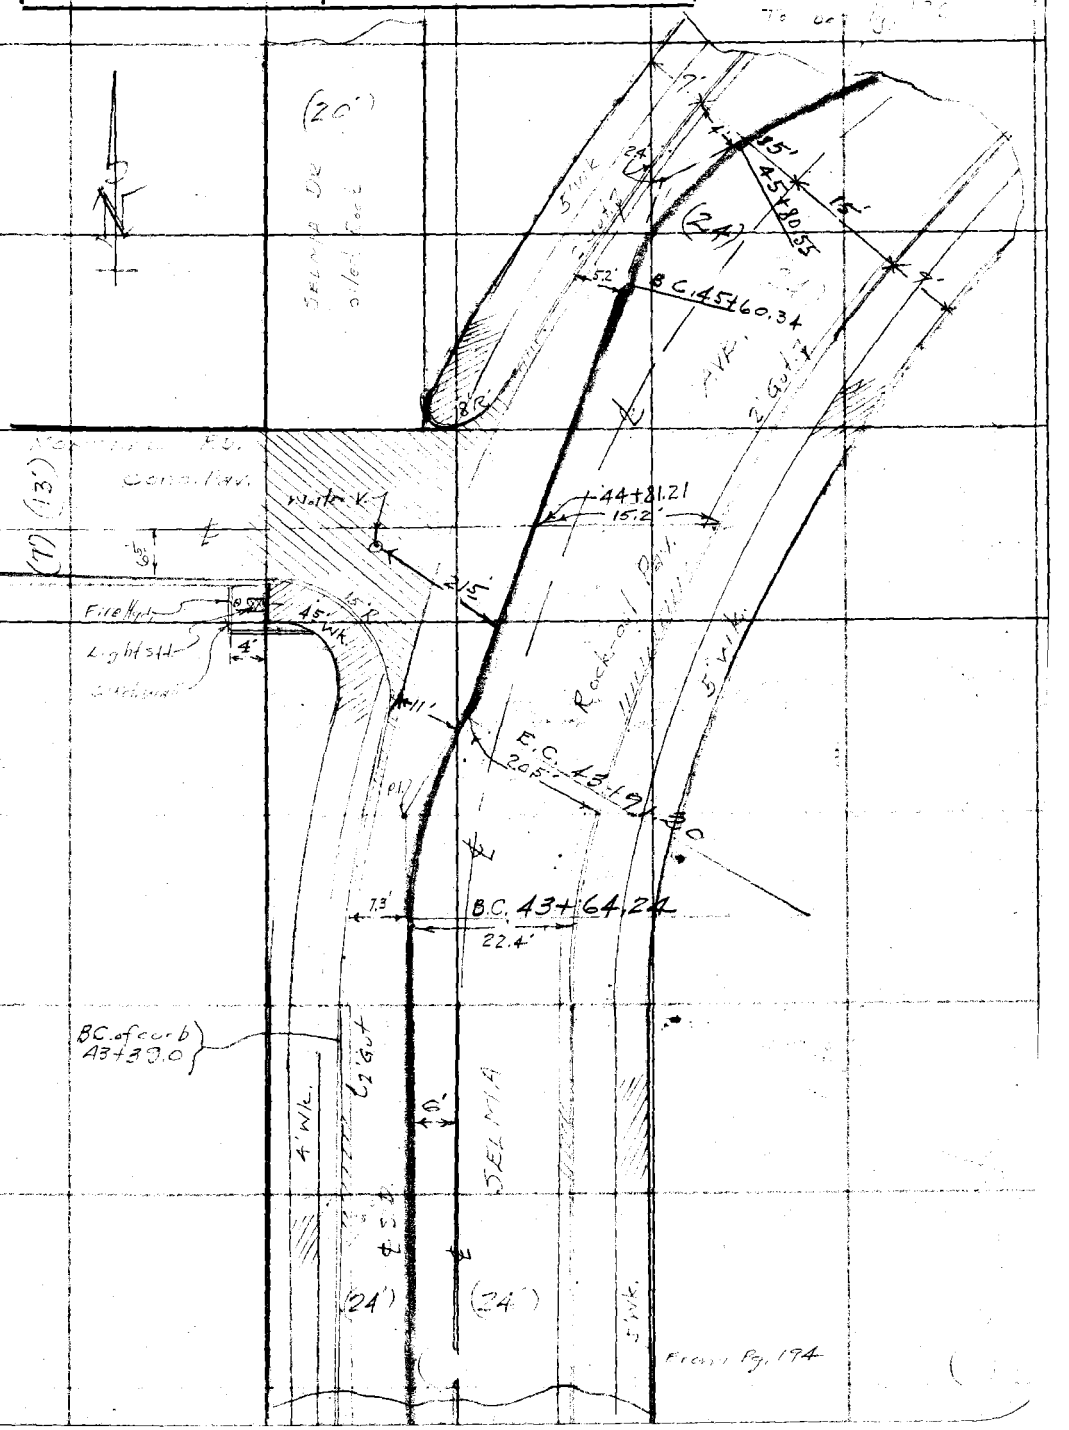

FORM 247 10M 11-38

RETURN TO
LOS ANGELES COUNTY SURVEYOR
700 HALL OF RECORDS

Note: Any Additions or Changes on This Sheet Must be Made or Circled in **Red Ink** With Date and Name of Person Making Change.

Do not extend notes this side of this line

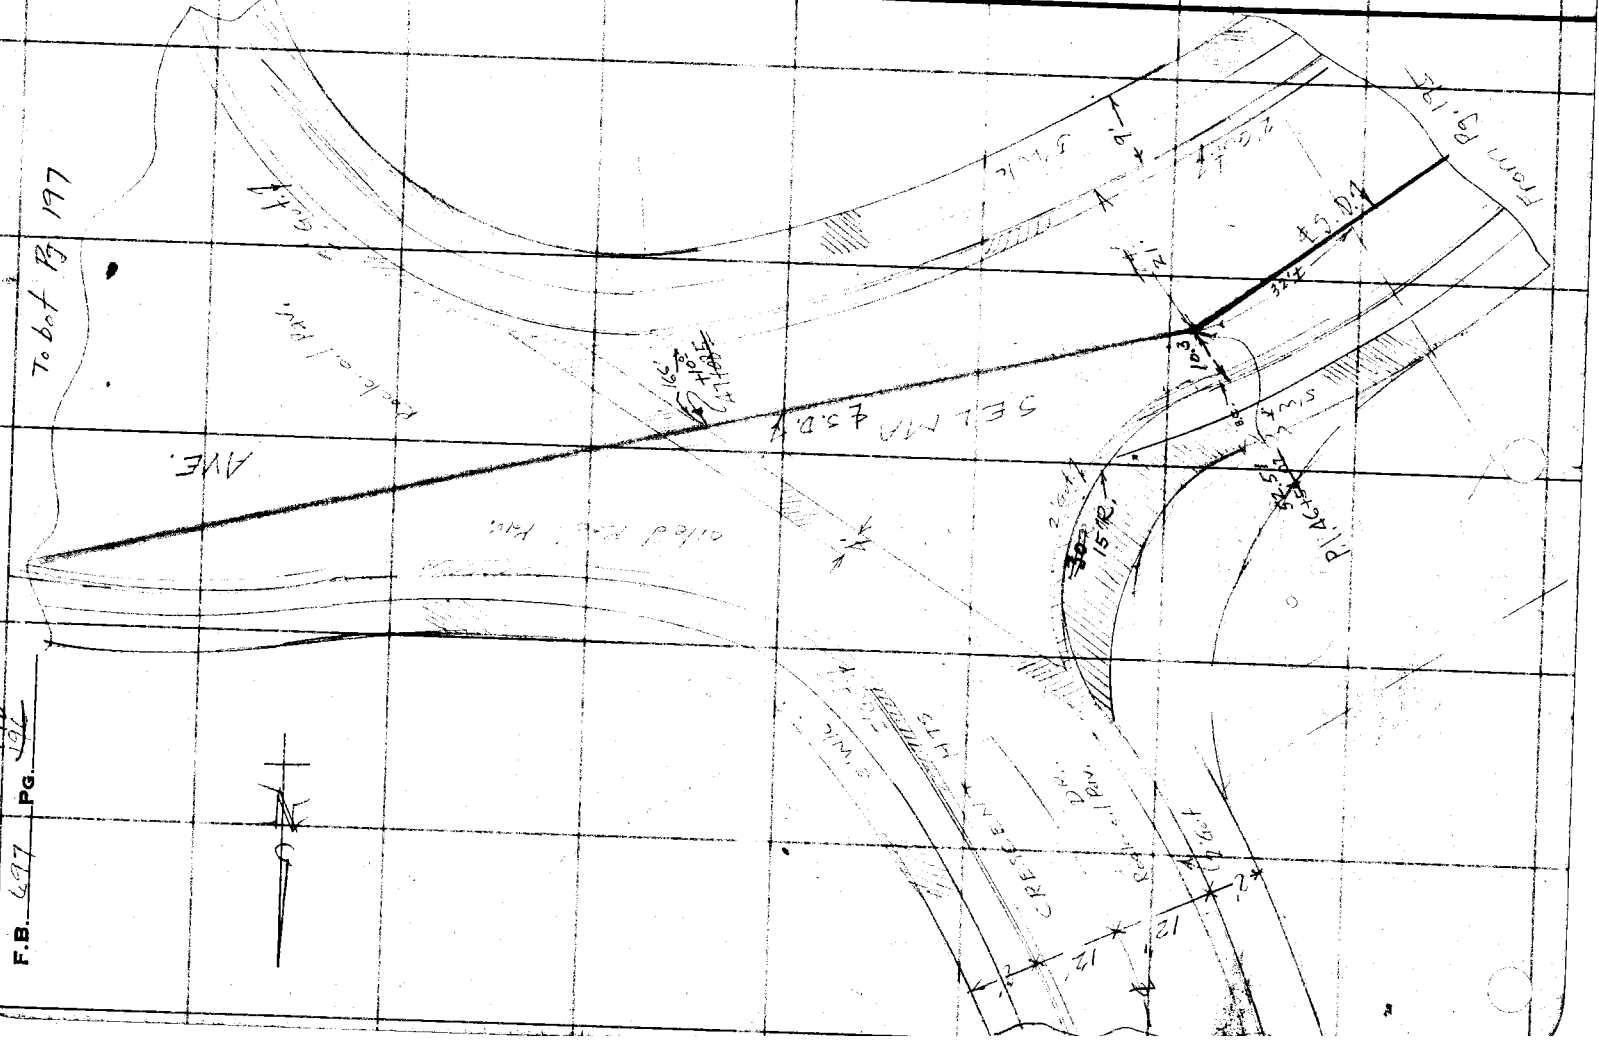

FORM 247 10M 11-35

RETURN TO
LOS ANGELES COUNTY SURVEYOR
700 HALL OF RECORDS

Note: Any Additions or Changes on This Sheet Must be Made or Circled in Red Ink With Date and Name of Person Making Change.

Do not extend notes this side of this line

Notes Ck'd by
Map No.
Office Work
Checked
Date

Survey of
W. O. 6318 Tape No. Std. °F.
Surveyed by
Notes
Indexed C. Johnson Date

F.B. 2071 PG. 119

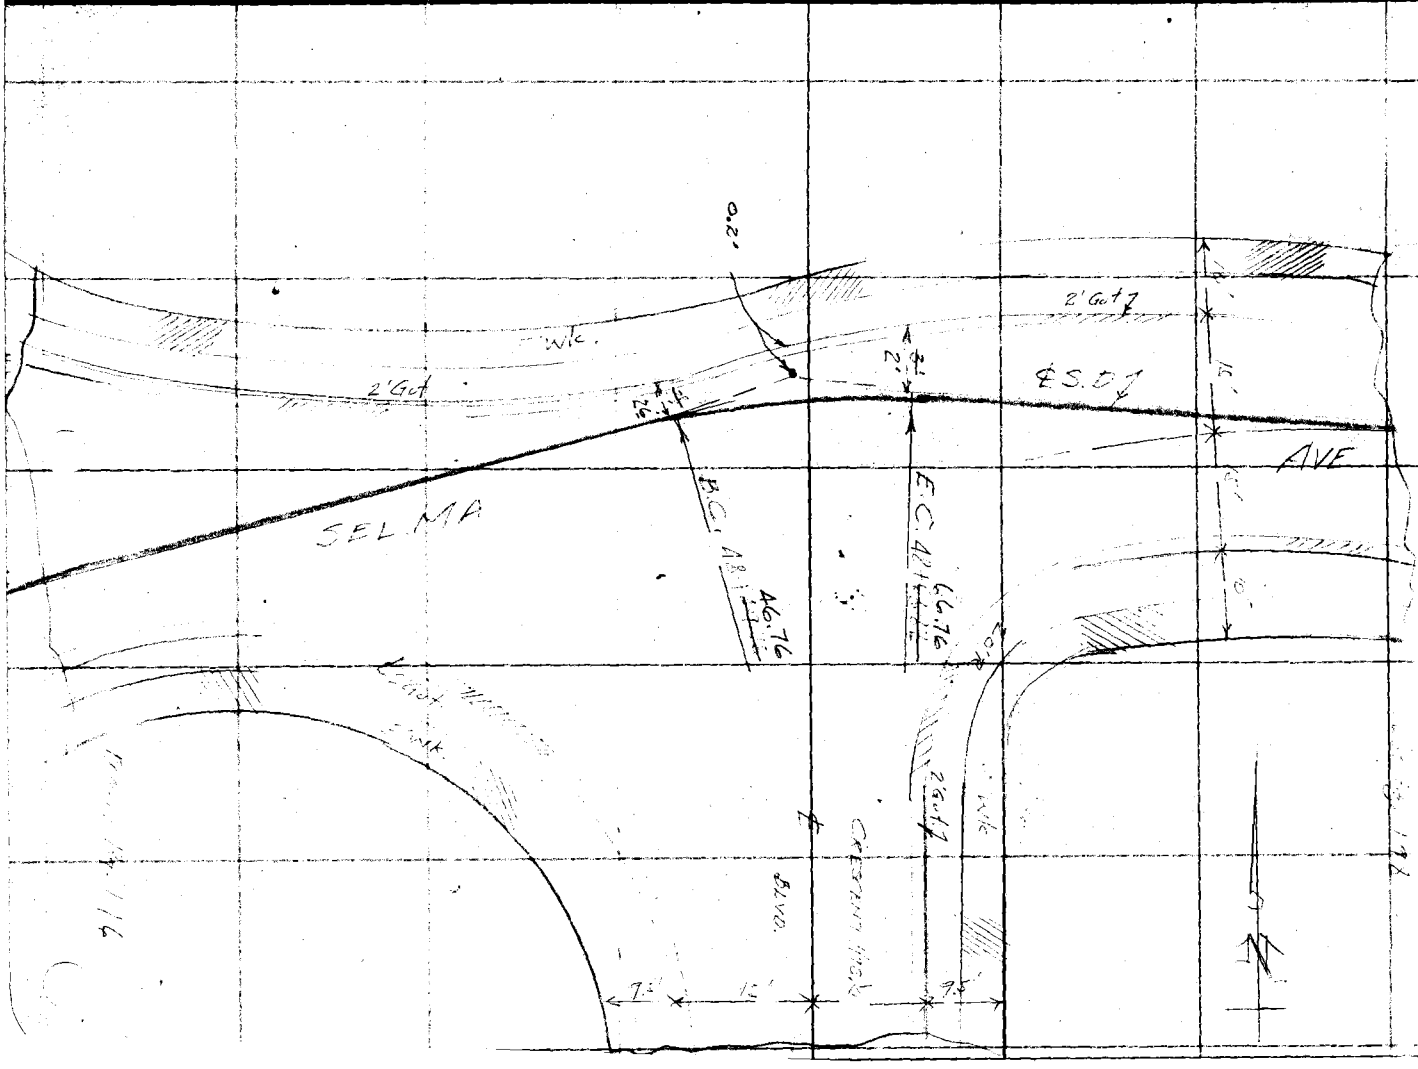

F.B. 671 200 Pg. 199

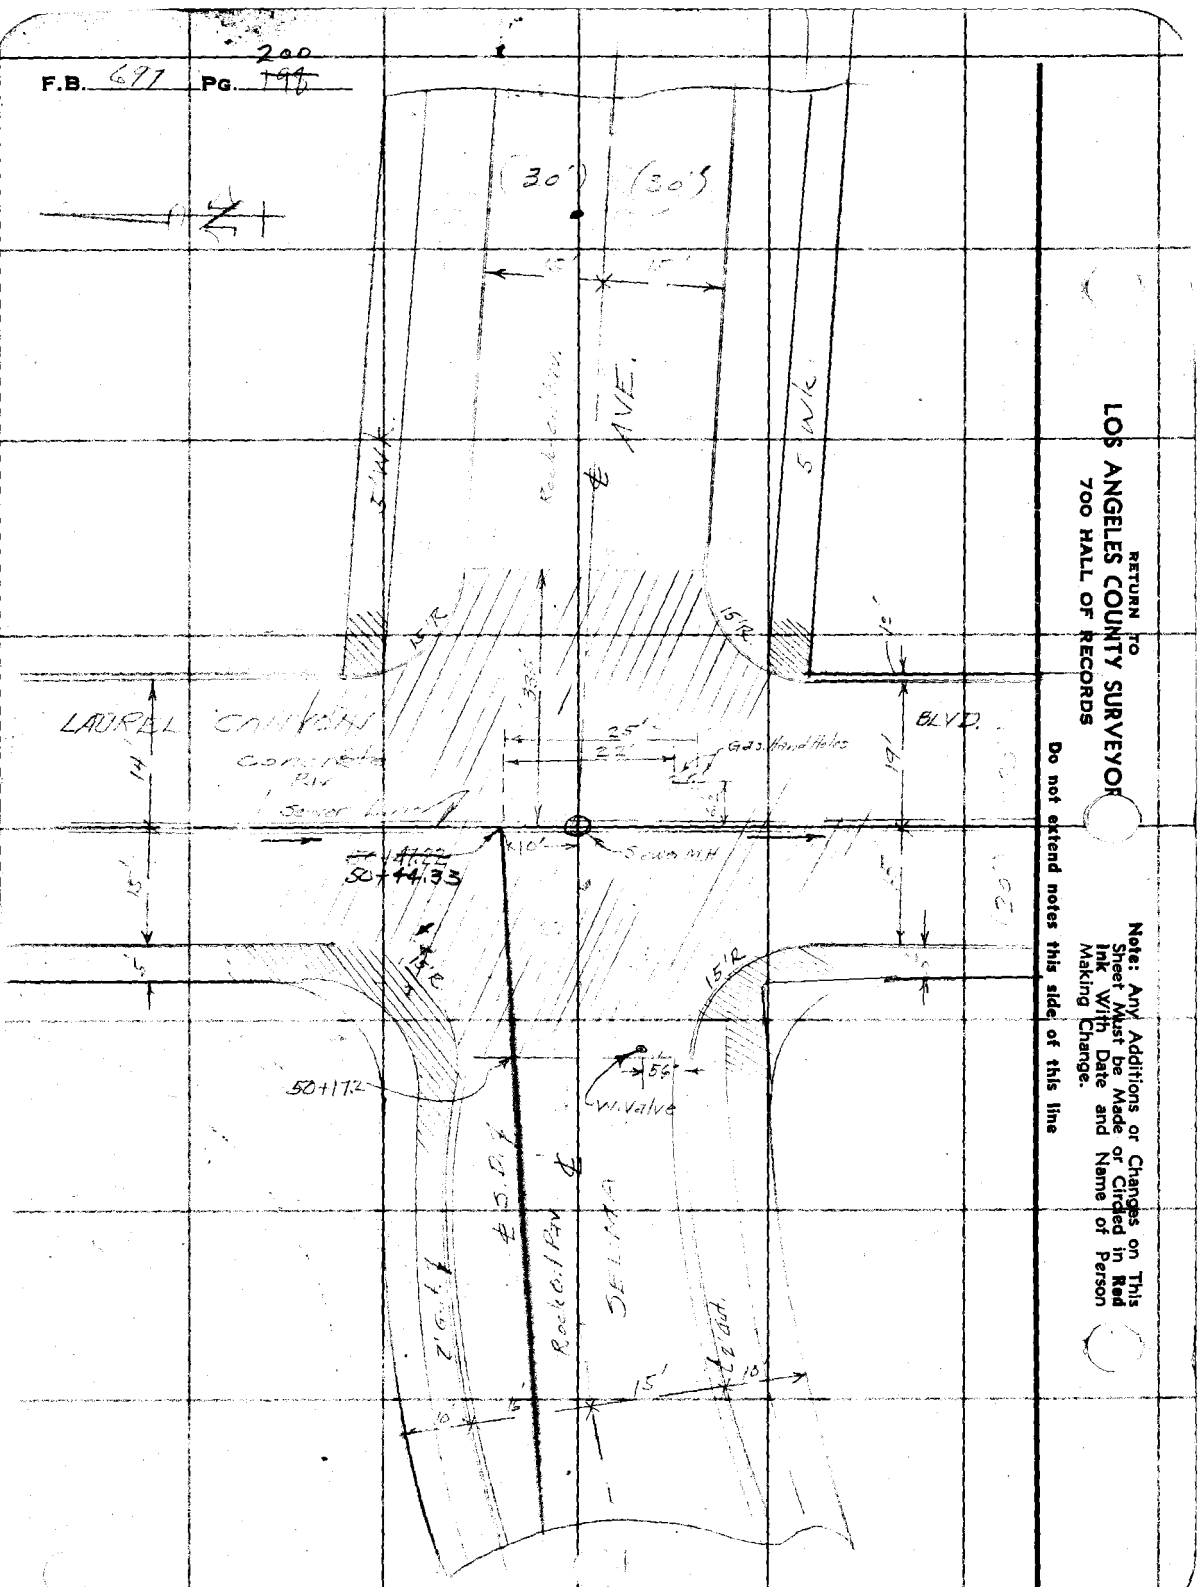

RETURN TO
LOS ANGELES COUNTY SURVEYOR
700 HALL OF RECORDS

Note: Any Additions or Changes on This Sheet Must be Made or Circled in Red Ink With Date and Name of Person Making Change.

Do not extend notes this side of this line

Profile No.	Notes Red.	Plotted	Job No. 6318	Division No.	F.B. 697	Pg. 221/479
	Date	Date	Survey of W. Hollywood D.S.			
X-Sec. No.	Notes Chkd.	Checked	Survey by Wallace	Notes W	Date June 1937	
	Date	Date	Map No.	Indexed C. Johnson	Date	

NOTE: ANY ADDITIONS OR CHANGES ON THIS SHEET MUST BE MADE OR CIRCLED IN RED INK, WITH DATE AND NAME OF PERSON MAKING CHANGE

Do not extend notes this side of this line

PLEASE RETURN TO
LOS ANGELES COUNTY SURVEYOR
700 HALL OF RECORDS

Form 307 5M 11-35

PROFILE

HAYVENHURST DR. BRANCH

West Hollywood D.S.

J.N. 6318

& Survey F.B. 697 - Pgs. 172, 186 to 197

Topog. F.B. 697 Pgs. 176, 177, 195 to 200

3 2 1 (4)

Wallace
Fenton
Murray
Talley
Ethier

STATION	B.S.	H.I.	F.S.	ELEV.

RECEIVED JUN 14 1937

PROGRESSED ✓ ✓

BOOK INDEXED ✓ ✓

MAP INDEXED ✓ ✓

RECORD INDEXED ✓ ✓

CARD INDEXED ✓ ✓

REDUCED Finished

CHECKED ✓

Form 307 5M 11-35

PLEASE RETURN TO
LOS ANGELES COUNTY SURVEYOR
700 HALL OF RECORDS

NOTE: ANY ADDITIONS OR CHANGES ON THIS SHEET MUST BE MADE OR CIRCLED IN RED INK, WITH DATE AND NAME OF PERSON MAKING CHANGE

Do not extend notes this side of this line

F. B. 697 Pg. 2202 | Job No. 6318 | Division No. | Notes Red | Plotted | Profile
Survey of Mt. Hollywood D.S. | Date | Date | No.
Survey by C. Johnson | Notes W & F | Notes Clkd. | Checked | X-Sec.
Indexed | Date | Date | Date | No.

STATION	B. S.	H. I.	F. S.	ELEV.	(Hayvenhurst Dr. Branch)
B.M.	10.988	346.23		335.962	D-24 {Fountain Ave. & Hayvenhurst Dr. & Bk. S'ly S of S. L. C.L. S.W. Cor
25+00			11.20	335.57	L S.D.
26+00			10.76	336.09	L S.D.
+43.5			9.6	336.64	INT. L S.D. & Mont. Dr.
27+00			7.22	339.13	L S.D.
28+00			2.30	344.05	L S.D.
T.P.	11.50	355.77	3.52	344.27	
29+00			8.42	347.37	L S.D.
30+00			5.39	350.49	L S.D.
T.P.	11.31	361.18	0.22	349.85	
31+00			10.50	350.68	L S.D.
32+00			8.83	352.35	L S.D.
32+80			1.98	359.88	L S.D.
T.P.	11.69	371.69	0.41	360.00	
34+00			7.60	364.09	L S.D.
35+00			2.61	367.08	L S.D.
T.P.	11.03	381.77	0.90	370.74	
36+00			7.63	374.14	L S.D.
37+00			2.96	378.71	L S.D.
T.P.	12.33	379.73	0.55	367.40	
38+00			6.82	372.91	L S.D.

Form 307 5M 11-35

PLEASE RETURN TO
LOS ANGELES COUNTY SURVEYOR
700 HALL OF RECORDS

NOTE: ANY ADDITIONS OR CHANGES ON THIS SHEET MUST BE MADE OR CIRCLED IN RED INK, WITH DATE AND NAME OF PERSON MAKING CHANGE

Do not extend notes this side of this line

Profile No. ____ X-Sec. No. ____

Notes Red. ____ Plotted ____ Job No. 6276 Division No. ____
Date ____ Date ____ Survey of HAYVENHURST DR. BRANCH
Notes Chkd. ____ Checked ____ Survey by W Notes W.F. Date June 1937
Date ____ Date ____ Map No. ____ Indexed Johnson Date ____

F.B. 677 PG 22

STATION	B. S.	H. I.	F. S.	ELEV.	HAYVENHURST DR. BRANCH
		571.75		Hayvenhurst Dr.	
7410					
			3.31		
			2.96		
			3.61		
			1.64	398.11	
T.P.	2.40	400.47	0.39	398.08	
B.M.			4.35	396.12	
B.M.	4.22	400.45			
67.4					
			3.82		
			4.68		
43.87					
			4.72		
			2.42		
			1.07		
	4.28	416.64	2.54		
41752.18					
			10.73		
			1.69		
T.P.	11.16	427.52	3.31	416.36	
437.02			1.55	417.97	
464.24			3.79	423.78	

Form 307 5M 11-35

PLEASE RETURN TO
LOS ANGELES COUNTY SURVEYOR
700 HALL OF RECORDS

NOTE: ANY ADDITIONS OR CHANGES ON THIS SHEET MUST BE MADE OR CIRCLED IN RED INK, WITH DATE AND NAME OF PERSON MAKING CHANGE

Do not extend notes this side of this line

F. B. 671 PG. 24 | Job No. 6318 Division No. | Notes Red. | Plotted | Profile
Survey of Ws | Date | Date | No.
Survey by C. Johnson | Notes W | Notes Chkd. | Checked | X-Sec.
Indexed | Date | Date | Date | No.

STATION	B. S.	H. I.	F. S.	ELEV.	HANDE HUCHISON & N. BRANCH (Cont.)
		42[illegible]		SELMIA AVE. —	
T.P. 91.20					
B.C. 43+[illegible]	1085	437 55	[illegible]	[illegible].70	E.S.D.
44+21.81			783	427 "2	INT ℄ S.D.E & Monteel Rd.
B.M. D 146			557	431 98	B.M. D 146 El. 431.995 FB 682 P 116 Monteel Rd & Selma Ave B Spk. 5' S. of N. end C.R. – N.W. Cor
44+50			510	432 45	℄ S.D.
"			508	432 47	E. ob. Selma Ave
"			585	431 70	E. Gut " " Sta to S.D. ℄
"			382	433 73	W. ob " "
"			458	432 77	W. Gut " "
T.P.	1102	447 64	095	436 60	
45+00			785	433 79	℄ S.D.
"			978	433 86	E. ob. Selma Ave
"			1053	433 41	E Gut "
"			955	436 09	W. ob "
"			1042	433 22	W. Gut "
BC. 45+60.34			362	444.02	
[illegible].0	[illegible]0.55		232	445.32	

Form 307 5M 11-35

PLEASE RETURN TO
LOS ANGELES COUNTY SURVEYOR
700 HALL OF RECORDS

NOTE: ANY ADDITIONS OR CHANGES ON THIS SHEET MUST BE MADE OR CIRCLED IN RED INK, WITH DATE AND NAME OF PERSON MAKING CHANGE

Do not extend notes this side of this line

Profile No. ____ X-Sec. No. ____ Notes Rod Date ____ Notes Chkd Date ____ Date ____ Map No. ____ Plotted Date ____ Checked Date ____ Indexed Date ____ Job No. 533 Division No. ____ Survey of ____ Survey by K. Notes W. Johnson Date June 1937

F.B. 617 PG. 205

STATION	B. S.	H. I.	F. S.	ELEV.	HAYVENHURST DR.	BRANCH
		449 64		— St. [illegible] A.E. —		
T.P. 46+00	10 48	457 58	054	447 10		
P.I. 46-54.7			1045	446.73	℄ S.D.	
			75	450.1	℄ S.D.	
				CRESCENT HTS. DR.		
+70.53						
46+72.04			17	449.9	℄ S.D. into Crescent Hts Dr.	
46+54			45	451 13	N. end C.R. NW Cor.	
			120	450 36	Gut " "	" "
			170	448 84	N. " "	" "
			230	448 07	Gut " "	" "
			01	447.1	℄ Crescent Hts.	55' N. ℄ S.D.
			118	458 76	E. cb " "	" "
			56	458 [illegible]	E. Gut " "	" "
			021	457 87	W. cb. " "	" "
			104	456 [illegible]	W. Gut. " "	" "
47+00			81	440 5	℄ S.D.	
12.0			140	438 18	℄ S.D. & X. Gutter	
+50			102	[illegible]	℄ S.D.	
			12 81	428 70	S. cb. Solano Ave. (20.71) Rt	
			13 53	444 05	S. Gut " "	"

Form 307 5M 11-35

PLEASE RETURN TO
LOS ANGELES COUNTY SURVEYOR
700 HALL OF RECORDS

NOTE: ANY ADDITIONS OR CHANGES ON THIS SHEET MUST BE MADE OR CIRCLED IN RED INK, WITH DATE AND NAME OF PERSON MAKING CHANGE

Do not extend notes this side of this line

F. B. 697 PG. 906 | Job No. 318 Division No. Hollywood S.S. | Survey of Wallace | Survey by C. Johnson | Indexed | Notes | Notes Red | Notes Chkd | Date | Date | Date | Date | Plotted | Checked | Profile No. | X-Sec. No.

STATION	B. S.	H. I.	F. S.	ELEV.	Harvard Blvd. Branch
		457 58			
47+50			7 85	44 73	N. ⌀ 16.5± Lt. ℄ S.D.
			8 60	4 48 98	N. Gut " "
48+00			11.0 ~~10 8~~	446 C	℄ S.D.
BC. 28+~~49.72~~ 16.39			11 4	446 2	℄ "
					CR. & SCHMIT HTS. BLVD.
			10 38	44 [illegible]	T.P. N. ⌀ Selma & Crescent Hts. Blvd. Prod.
			11.65	445 93	Gut. " " " " "
T.P. 46.76 48+~~28.87~~ E.C.	7 43	448 59	11 42	446 16	
			2 7	44 ~~5~~ 9	℄ S.D.
			7 25	4 4 34	S. and C.R. & S.E. Cor.
			7 95	4 4 0 64	Gut " " "
			5 68	4 4 [illegible]	E. " " "
			6 2 9	4 4 30	Gut " " "
49+00			3 3	4 4 5 3	℄ S.D.
"			1 3 7	4 4 6 22	Top ⌀ 7' Lt. (N. ⌀)
"			3 7 0	4 4 5 49	Gut "
"			5 2 4	4 4 3 35	Top ⌀ 23' Rt. (S. ⌀)
"			2 7 0	4 4 5 65	Gut "
50+00			4 0	4 4 4 6	℄ S.D.
T.P.	6 2 0	450 35	4 4 4	4 4 4 15	

Form 307 5M 11-35

PLEASE RETURN TO
LOS ANGELES COUNTY SURVEYOR
700 HALL OF RECORDS

NOTE: ANY ADDITIONS OR CHANGES ON THIS SHEET MUST BE MADE OR CIRCLED IN RED INK, WITH DATE AND NAME OF PERSON MAKING CHANGE

Do not extend notes this side of this line

Profile No. X-Sec. No.

Notes Red Date Plotted Date Notes Chkd Date Checked Date Map No.

Job No. 6318 Division No. Survey of LN Hr. Survey by W Notes W Indexed C. Johnson

F. B. 677 Pg. 227 Date June 1934

STATION	B. S.	H. I.	F. S.	ELEV.	HANCOCK DR. BRANCH		
		450 35			Laurel Canyon Blvd		
			600	444 35	℄ S.P. beg conc. pav.		
			635	443 50	W. end C.R. S.W.Cor		
			747	442 38	Gut. " " "		
			785	442 50	S. " " "		
			840	441 95	Gut " " "		
			514	445 21	W end C.R. N.W. Cor.		
			582	444 53	Gut " " " "		
			480	445 55	N end " " "		
			530	445 05	Gut " " " "		
50+44.33			580	444 55	℄ intr. S.D. & L Laurel Canyon Blvd		
			6+6	440 09	Top Sewer M.H. 10'S.℄ S.D. on ℄ Laurel Cyn		
N			13.62	436.73	10" inlet on N.	N 6.23, 6.56, .83 = 13.62	E 6.27, 6.65, 1.00 = 15.92
E			13.92	436.43	12" outlet on E		
W			13.63	436.72	8" inlet on W		W 6.27, 6.69, .67 = 13.63

Form 307 5M 11-35

PLEASE RETURN TO
LOS ANGELES COUNTY SURVEYOR
700 HALL OF RECORDS

NOTE: ANY ADDITIONS OR CHANGES ON THIS SHEET MUST BE MADE OR CIRCLED IN RED INK, WITH DATE AND NAME OF PERSON MAKING CHANGE

Do not extend notes this side of this line

F. B. 697 Pg. 20 | Job No. 638 Division No. | Notes Red | Plotted | Profile No.
Survey of W. Hollywood D.S. | Date | Date | X-Sec. No.
Survey by W. C. Johnson | Notes W | Notes Clkd. | Checked | Date
Indexed | Date | Date | Date

STATION	B. S.	H. I.	F. S.	ELEV.	HAVENHURST DR. SWANEE
		450 35			
					Laurel Canyon Blvd.
			763	442 72	S end C.R. SE. Cor
			806	442 29	Gut. " " "
			737	442 75	E. " " "
			796	442 39	Gut " " " "
			490	445 45	N end C.R. NE Cor
			530	445 05	Gut "
			626	444 09	E "
			685	443 50	
			700	443 35	edge conc pav. & Selma
			750	442 85	& Selma Ave
			785	442 50	S. cb. Selma Ave, 100' E. & Laurel Can. Blk.
			862	441 73	Gut " " " " "
			677	442 58	N. " " " " "
			755	442 80	Gut " " " " "

Form 307 5M 11-35

PLEASE RETURN TO
LOS ANGELES COUNTY SURVEYOR
700 HALL OF RECORDS

NOTE: ANY ADDITIONS OR CHANGES ON THIS SHEET MUST BE MADE OR CIRCLED IN RED INK, WITH DATE AND NAME OF PERSON MAKING CHANGE

Do not extend notes this side of this line

STATION	B. S.	H. I.	F. S.	ELEV.	HAYVENHURST DR. BRANCH (cont.)	
		450 85			Laurel Canyon Blvd.	
			020	450 15	℄ Laurel Canyon Blvd 100'N ℄ S.T.	
			+0.14	450 49	Top E.cb. " " " "	
			030	450 05	Gut " " " " "	
			020	450 15	W.cb. " " " "	
			070	449 65	Gut " " " " "	
T.P.	5.78	455 93	020	450 15		
			2.65	453 28	Top of Sewer M.H. on ℄ Laurel Can. Blvd	
			11.98	443 95	10" inlet on N.	2.62, 8.53, .83 = 11.78
			12.16	443 77	10" inlet on S.	2.68, 8.65, .83 = 12.16
B.M. D-144			9.95	445 98	B.M. D-144 El. 445.973 (682 P.5) Laurel Canyon Blvd & Selma Ave 8.5 pl. 6' N. of N. end C.R. N.W. cor.	

Profile
No. X-Sec.
Notes Red. Date
Notes Chkd. Date
Plotted Date
Checked Date
Job No. 4378 Division No. D.5.
Survey of Hollywood
Survey by KL Notes KL Date June 1937
Map No. Indexed C. Johnson Date
F. B. 697 Pg. 2 of

F. B. 697 PG. 210 | Job No. | Division No. | Notes Red. | Plotted | Profile No.

Survey of | Date | Date

Survey by | Notes | Notes Chkd. | Checked | X-Sec. No.

Indexed A. C. Johnson | Date | Date | Date

STATION	B. S.	H. I.	F. S.	ELEV.

Form 307 5M 11-35

PLEASE RETURN TO
LOS ANGELES COUNTY SURVEYOR
700 HALL OF RECORDS

Do not extend notes this side of this line

NOTE: ANY ADDITIONS OR CHANGES ON THIS SHEET MUST BE MADE OR CIRCLED IN RED INK, WITH DATE AND NAME OF PERSON MAKING CHANGE

214

Notes Ck'd by	Survey of W. Hollywood D.S.
Map No.	W. O. 6318 Tape No. 055 St'd 3 & F.
Office Work	Surveyed by [illegible]
Checked	Notes W Date June 1937
Date	Indexed A. C. Johnson

F.B. 697 Pg. Survey

Note: Any Additions or Changes on This Sheet Must be Made or Circled in Red Ink With Date and Name of Person Making Change

Do not extend notes this side of this line

RETURN TO
LOS ANGELES COUNTY SURVEYOR
700 HALL OF RECORDS

& SURVEY OF
FOOTHILL BLVD. LATERAL
WEST HOLLYWOOD D.S.
J.N. C 315

TOPOG. F.B. 452 Pgs. 207, 208 & F.B. 697 p. 214
PROFILE F.B. 697 Pgs. 216 : 220

SHEET 4

Wallace
Fallis
Murray
Tetzel
Elmer

Const. J.N. = 6347

RECEIVED W.I.G. JUN 22 1937
PROGRESSED
BOOK INDEXED
MAP INDEXED
RECORD INDEXED
CARD INDEXED
REDUCED In Field
CHECKED W.I.G. 6-23-'37
B. M.s ADJUSTED " "
B. M.s LISTED " "

FORM 247 10M 11-35

F.B. 697 Pg. 212

To bot Pg. 211

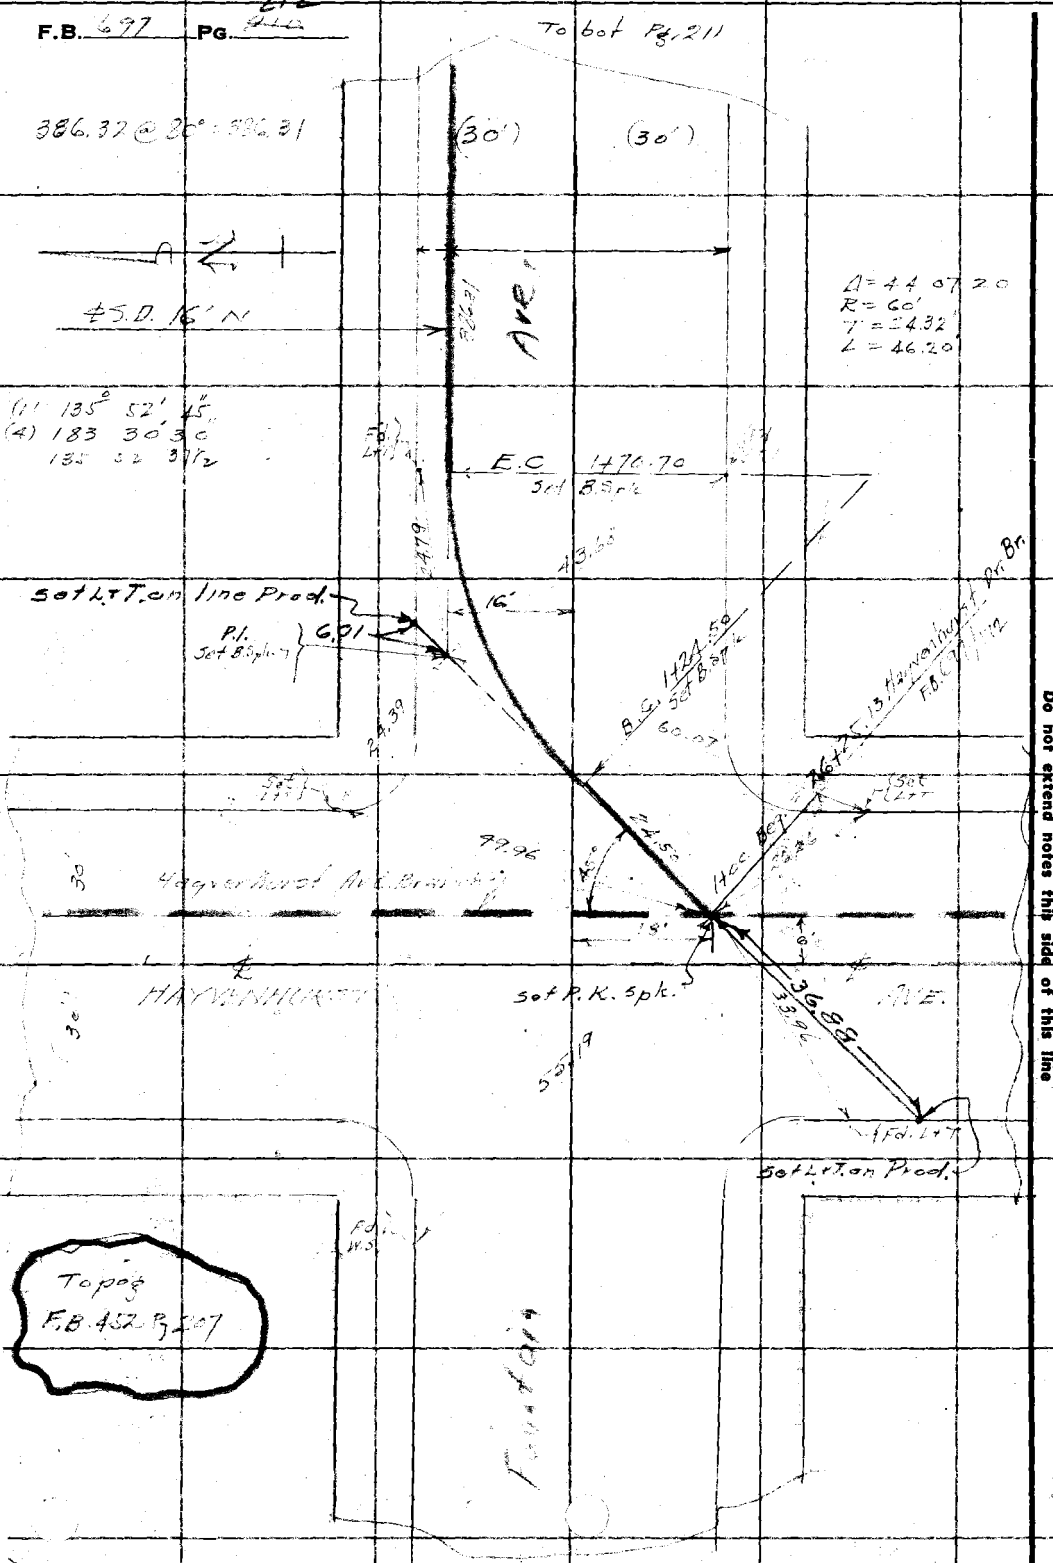
386.32 @ 28° 386.31
(30')
(30')
℄ S.D. 16' N
Δ = 44 07 20
R = 60'
T = 24.32'
L = 46.20'
(1) 135° 52' 45"
(4) 183 30 30
135 52 37½
E.C 1470.70
Set L.T.T. on line Prod.
P.I. Set B.S. plug
6.01
16'
B.C. 1424.50 Set B.S.P.
60.07
Set L.T.T.
Set L.T.T.
Set L.T.T.

Notes Ck'd by		Survey of Hollywood [illegible]	F.B. 52 Pg. 213
Map No.		W. O. 6318 Tape No.	St'd 24 °F.
Office Work		Surveyed by	
Checked		Notes	Date 6-1937
Date		Indexed	C. Johnson

Note: Any Additions or Changes on This Sheet Must be Made or Circled in Red Ink With Date and Name of Person Making Change.

Do not extend notes this side of this line

RETURN TO
LOS ANGELES COUNTY SURVEYOR
700 HALL OF RECORDS

FORM 247 10M 11-35

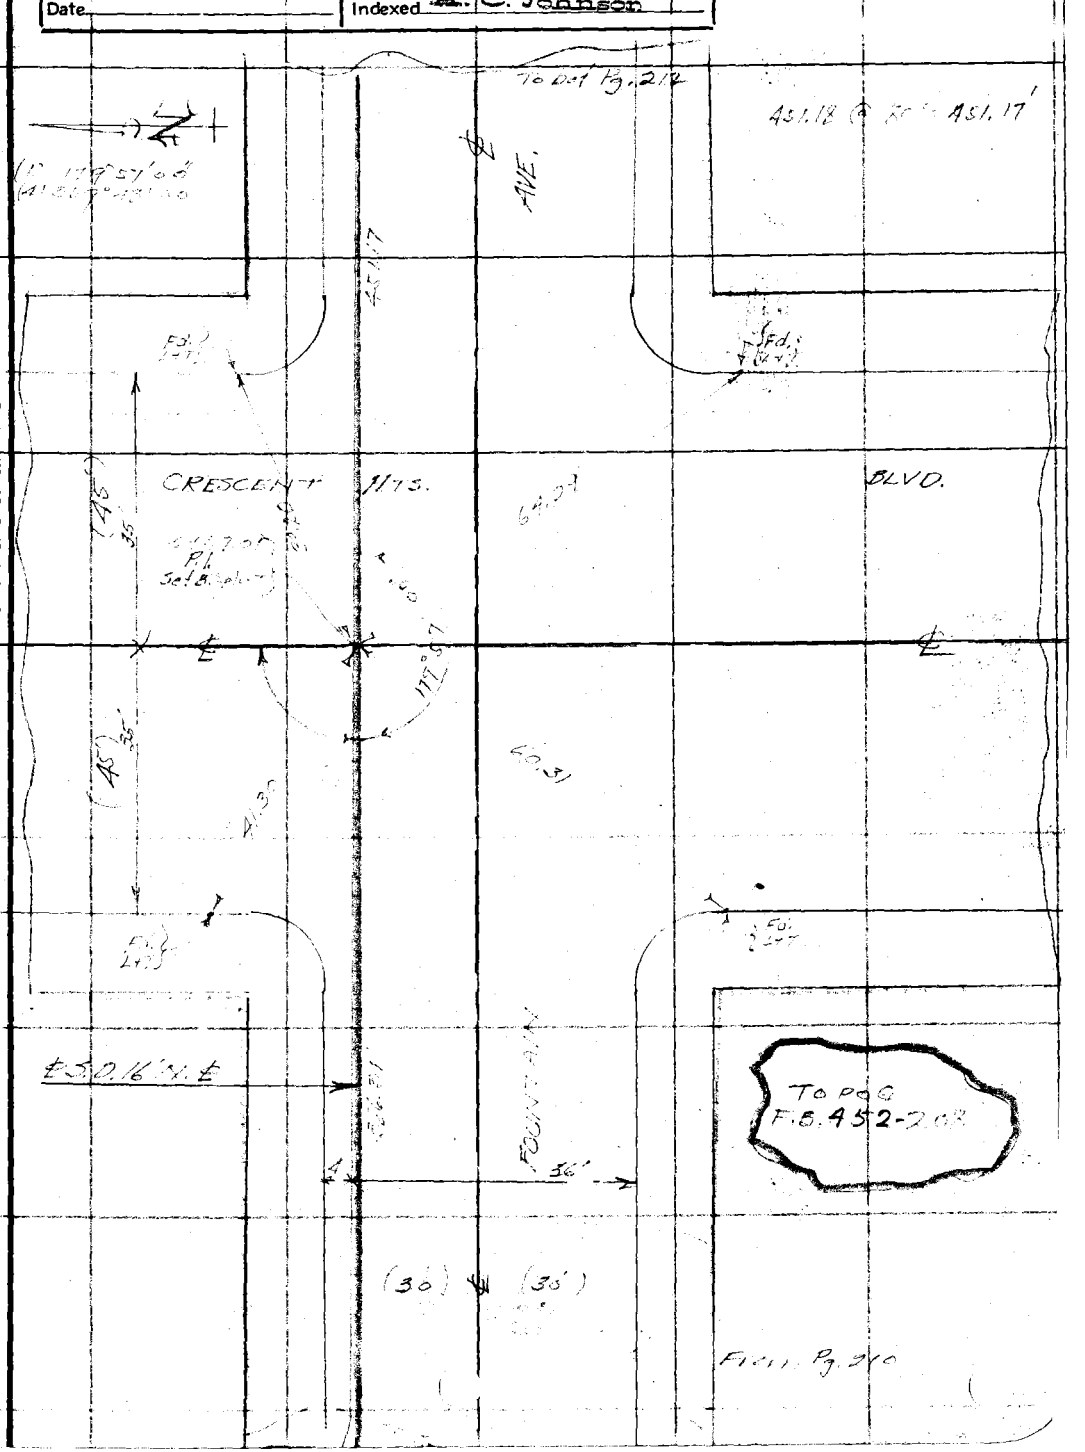

F.B. 697 PG. 214

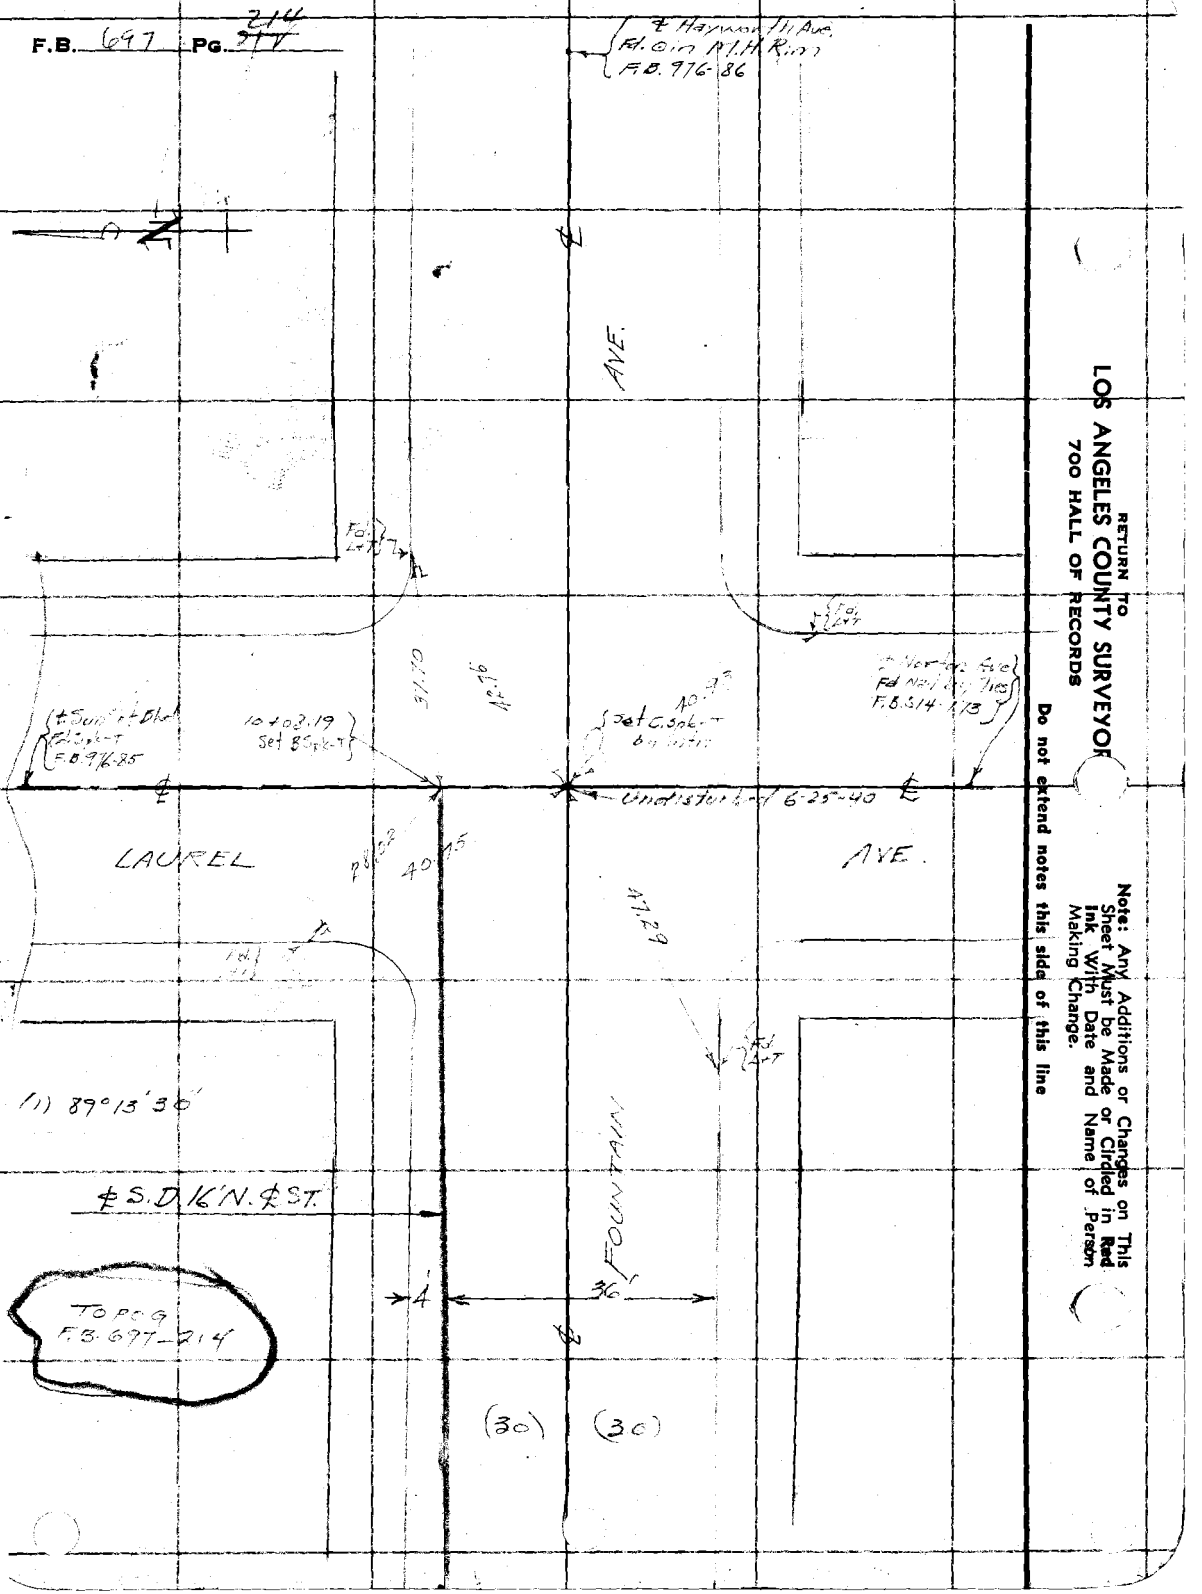

RETURN TO
LOS ANGELES COUNTY SURVEYOR
700 HALL OF RECORDS

Do not extend notes this side of this line

Note: Any Additions or Changes on This Sheet Must be Made or Circled in Red Ink With Date and Name of Person Making Change.

Notes Ck'd by	Survey of
Map No.	W. O. 6318 Tape No. St'd °F.
Office Work	Surveyed by Wallace
Checked	Notes A. C. Johnson Date Dec 27
Date	Indexed

F.B. 677 Pg. 213

TOPOG.
FOUNTAIN AVE. EAST
West Hollywood Q.S.
JM 638
& Survey F.B. 677 Pg. 209 to 212
Profile F.B. 677 Pg. 213 to 220

SHEET (4)

RETURN TO
LOS ANGELES COUNTY SURVEYOR
700 HALL OF RECORDS

Note: Any Additions or Changes on This Sheet Must be Made or Circled in Red Ink With Date and Name of Person Making Change.

Do not extend notes this side of this line

FORM 247 10M 11-58

RETURN TO
LOS ANGELES COUNTY SURVEYOR
700 HALL OF RECORDS

Note: Any Additions or Changes on This Sheet Must be Made or Circled in **Red Ink** With Date and Name of Person Making Change.

Do not extend notes this side of this line

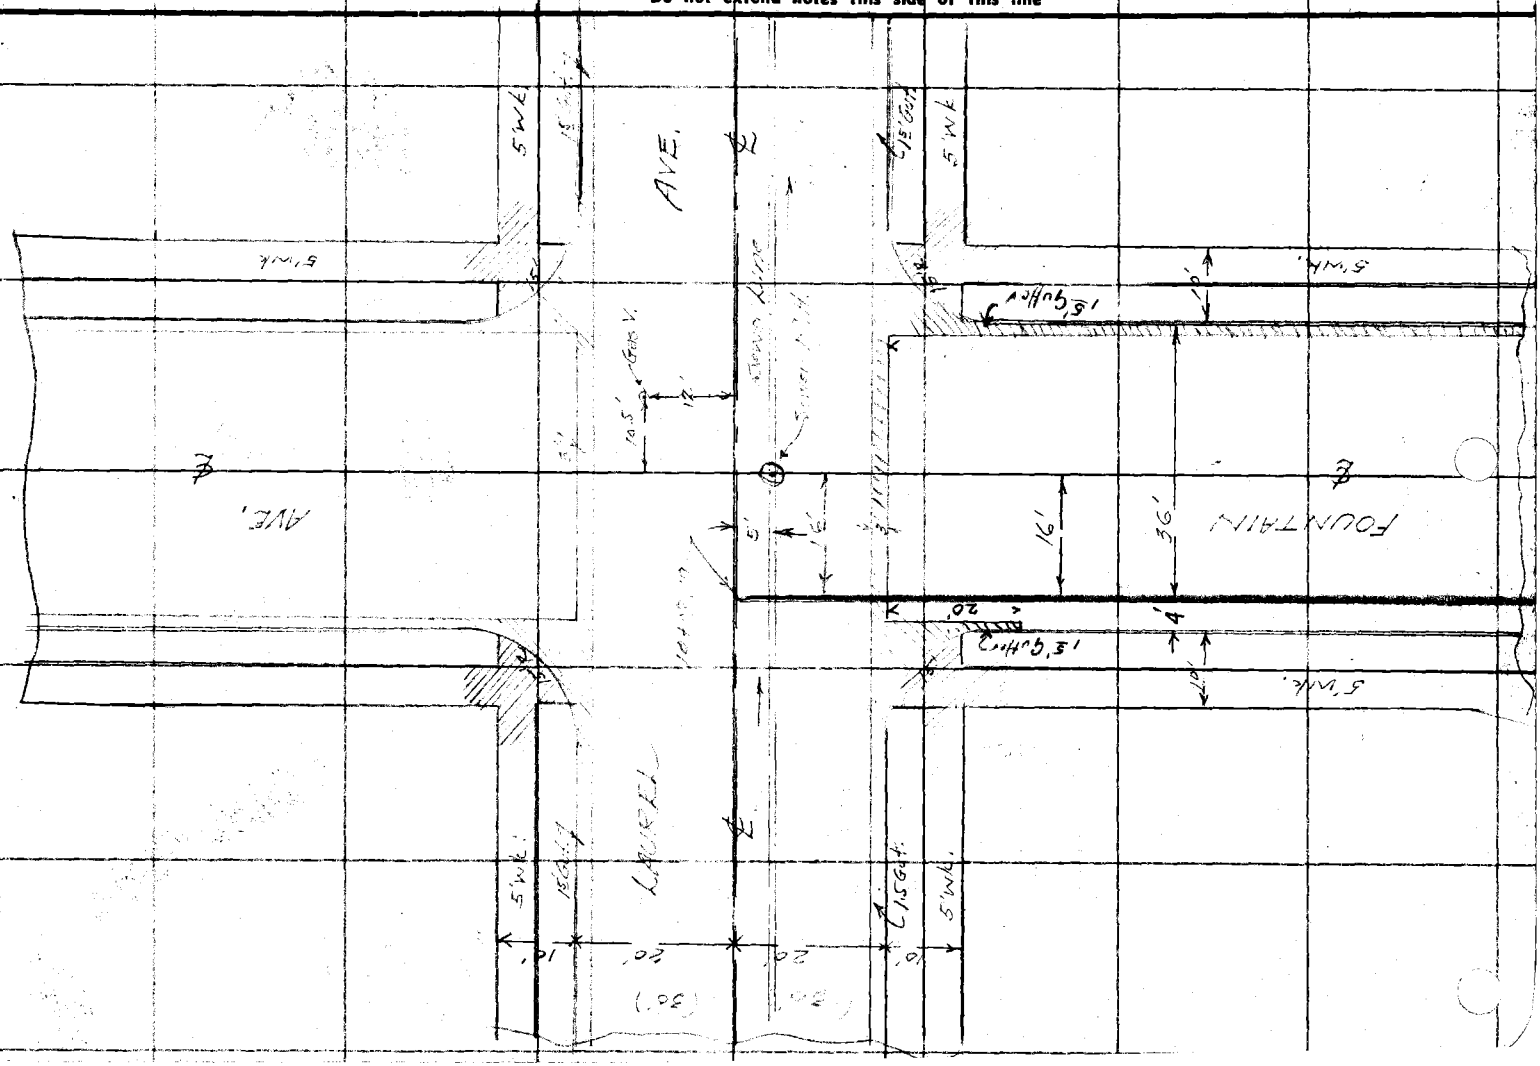

F.B. 697 Pg. 216

Profile No. | Notes Red. | Date | Plotted | Date | Job No. 6318 | Division No. | F. B. 6[illegible] Pg. 217

X-Sec. No. | Notes Chkd. | Date | Checked | Date | Survey of | Survey by WALLACE | Notes N | Date [illegible] | Indexed C. Johnson | Date

PROFILE

FOUNTAIN AVE LATERAL

N. HOLLYWOOD D.S.

JN 6318

& SURVEY TOPOG. FB. 697 p. 209 to 212
FB. 697 p. 214
FB. 452 p 208.

SHEET (4)

WALLACE
FENNELL
MURRAY
TELLEZ
ETNIER.

STATION	B. S.	H. I.	F. S.	ELEV.

NOTE: ANY ADDITIONS OR CHANGES ON THIS SHEET MUST BE MADE OR CIRCLED IN RED INK, WITH DATE AND NAME OF PERSON MAKING CHANGE

Do not extend notes this side of this line

PLEASE RETURN TO
LOS ANGELES COUNTY SURVEYOR
700 HALL OF RECORDS

Form 307 5M 11-35

Form 307 5M 11-35

PLEASE RETURN TO
LOS ANGELES COUNTY SURVEYOR
700 HALL OF RECORDS

NOTE: ANY ADDITIONS OR CHANGES ON THIS SHEET MUST BE MADE OR CIRCLED IN RED INK, WITH DATE AND NAME OF PERSON MAKING CHANGE

Do not extend notes this side of this line

F. B. 697 PG. 24 & 25 | Job No. 6315 | Division No. | Notes Red. | Plotted | Profile
Survey of | Date | No.
Survey by C. Johnson | Notes | Date | Notes Chkd. | Checked | X-Sec.
Indexed | Date | Date | Date | No.

STATION	B. S.	H. I.	F. S.	ELEV.	Description & Remarks
					Fountain Ave.
B.M. D24	9 59	345 35		335.46	B.M. D-24 El. 335.46' Fountain & Keyes
2+00 Fountain Ave. Hayvenhurst Blvd.			84	337.2	+ 5 D
474.58 B.C.			81	337.5	"
1470.10 E.C.			70	339.6	"
2+00			63	339.3	"
3+00			40	338.0	"
"			473	340.0	Top ob. 3.6' Rt
"			536	340.1	Gut "
"			365	341.0	Top 4' Lt
"			414	340.1	Gut "
4+00			37	342.7	+ 5 D
5+00			19	343.7	"
+22			200	343.55	" on N. Curb Keyes
5+59.01			01	343.5	" S. Curb Crescent Hts. Blvd.
B.M. D23	3 25	348 35	043	345.40 / 345.12	B.M. D-23 El. 345.40 Crescent Hts. & Fountain Ave W.Spk. 1'E of L. and C.R. - N.E. Cor.

Form 307 5M 11-35

PLEASE RETURN TO
LOS ANGELES COUNTY SURVEYOR
700 HALL OF RECORDS

NOTE: ANY ADDITIONS OR CHANGES ON THIS SHEET MUST BE MADE OR CIRCLED IN RED INK, WITH DATE AND NAME OF PERSON MAKING CHANGE

Do not extend notes this side of this line

Profile No. ____ X-Sec. No. ____ Notes Red ____ Plotted ____ Job No. ____ Division No. ____ Date ____ Date ____ Notes Chkd ____ Checked ____ Survey of ____ Survey by ____ Notes ____ Date ____ Date ____ Date ____ Map No. ____ Indexed J. Johnson Date ____ F. B. ____ PG. 24

STATION	B. S.	H. I.	F. S.	ELEV.	FOUNTAIN AVE. Cont'd	L.A.T.
		348 25				
5+92			4 00	3443	£50 & X Cutting	
			3 9	3	4.37	
7+00			3 7	3	"	
8+00			4.1	3443	"	
			4 7	34	-0.36 RT	
			3 4 1	342	Cut "	
			3 1	34	0.3 2' LT	
			2 9	34	Cut "	
			1 4	34		
3rd B.M. 1.049	3 20	347 39	1 63	344	3rd B.M. 1.049 El [illegible] Ave. [illegible] E. of [illegible]	
		At Locust Ave.				
9+32			4 68	342	Wtr. of CR. [illegible]	
			1 98	342 41	" " "	
			1 87	342	" " "	
			5 53	341 86	Cut "	

Form 307 5M 11-35

PLEASE RETURN TO
LOS ANGELES COUNTY SURVEYOR
700 HALL OF RECORDS

NOTE: ANY ADDITIONS OR CHANGES ON THIS SHEET MUST BE MADE OR CIRCLED IN RED INK, WITH DATE AND NAME OF PERSON MAKING CHANGE

Do not extend notes this side of this line

F. B. 627 PG. 220 | Job No. [illegible] | Division No. [illegible] | Notes Red. ____ Date ____ | Plotted ____ Date ____ | Profile No. ____ | X-Sec. No. ____

Survey of ____ Notes ____ Date ____

Survey by C. Johnson Notes Chkd. ____ Date ____ | Checked ____ Date ____

Indexed ____

STATION	B. S.	H. I.	F. S.	ELEV.	Fountain Ave. (cont.)
		347 37			
					At Laurel Ave. (cont.)
9+73.2			21	341 28	W. end CR - N.W. Cor
"			370	348 07	Cut " " "
78.2			290	341 47	N. end " "
"			383	340 36	Cut " " "
9+82.2			5.7	340 5	℄ S.D. & ℄ Cut
10+02.19			32	340 2	" & ℄ with Laurel Ave.
					" S. X. Cut
10+03.19			228	340 3	Top - MH 16' Rt. ℄ S.D. 5' W ℄ Laurel Ave.
			12.18	338 31	8" inlet N. 12.18 − 7.85 − .67 = 10.66 ; 7.85 − .67 = 7.18
			12.46	338 33	8" inlet S. 12.46 − 7.85 − .67 = 10.94 ; 7.85 − .67 = 7.18
10+23.19			38	343	℄ S.D. prod & X Cut
"			486	337 53	E end CR. SE Cor
"			547	337 39	Cut " " "
10+43.19			473	342 26	E. end " "
"			503	342 36	cut " " "

Form 307 5M 11-35

PLEASE RETURN TO
LOS ANGELES COUNTY SURVEYOR
700 HALL OF RECORDS

NOTE: ANY ADDITIONS OR CHANGES ON THIS SHEET MUST BE MADE OR CIRCLED IN RED INK, WITH DATE AND NAME OF PERSON MAKING CHANGE

Do not extend notes this side of this line

STATION	B. S.	H. I.	F. S.	ELEV.	Fountain Ave (cont'd)	
		341 37				
			AT Laurel Ave.			
10478.19			285	344 [illegible]	W. [illegible] E. & W. [illegible]	
			328	344 [illegible]	Gut " " "	
1437			318	343 [illegible]	E. " " "	
"			385	343 [illegible]	Gut " " "	
10478.19	"		81	338 [illegible]	℄ Laurel Ave. 100' S. & in str.	
			218	339 [illegible]	W. eb. " " " "	
			367	339 [illegible]	W. Gut " " " "	
			811	341 28	E. eb. " " " "	
			871	335 68	E. Gut " " " "	
			415	342 24	℄ Fountain Ave 100' E. & Laurel	
			518	343 [illegible]	S. eb. " " " "	
			560	341 79	S. Gut " " " "	
			865	341 [illegible]	N. eb. " " " "	
			412	343 [illegible]	N. Gut " " " "	
7	1195	338 71	063	346 76		

Profile No. ____ Notes Red. ____ Plotted ____ Job No. 6[illegible] Division No. ____

X-Sec. No. ____ Date ____ Date ____ Survey of ____

Notes Chkd. ____ Checked ____ Survey by ____ Notes ____

Date ____ Date ____ Map No. ____ Indexed C. Johnson Date ____ Date ____

F. B. [illegible] PG. 224

Form 307 5M 11-35

PLEASE RETURN TO
LOS ANGELES COUNTY SURVEYOR
700 HALL OF RECORDS

NOTE: ANY ADDITIONS OR CHANGES ON THIS SHEET MUST BE MADE OR CIRCLED IN RED INK, WITH DATE AND NAME OF PERSON MAKING CHANGE

Do not extend notes this side of this line

F. B. 277 Pg. 222 Job No. 2814 Division No. Notes Red. Plotted
Survey of Date Date
Survey by Notes Notes Chkd. Checked
Indexed A. C. Johnson Date Date Date

STATION	B. S.	H. I.	F. S.	ELEV.	Fountain Ave
		353 71	B.M.	Local Method	
			10.0	343 71	℄ Laurel Ave. 100' N. of Fountain
			10.25	343 45	E.of. " " " "
			10.87	342 84	E.of. " " " "
			10.30	343 41	W.of. " " " "
			10.85	342 86	W.of. " " " "
T.P.	669	363 62	178	356 73	
					Top of Mh. 20' N. of ℄ of S.D. & S.W. ℄ Laurel Ave
			10.27	353 35	8" V.C.P. N. 2.54 7.55 .67 10.27 — S 7.69 .90
			10.90	352 72	Scaffer Mark
T.P.	143	356 [illegible]	11.21	345 51	
B.M. [illegible]	4.90	352 [illegible]	7.85	344.70	B.M. [illegible] El. 344.70
B.M. [illegible]			8.38	345 14	B.M. [illegible] El. 345.14 Crescent Hts. Blvd. [illegible] W. Spk. 1' E. of E. end C.R. - N.E. Cor.

Notes Ck'd by	Survey of Kings Road Stub F.B. 697 Pg. 228
Map No.	W. O. 631 Tape No. 777 St'd 64 F.
Office Work	Surveyed by Brunty
Checked	Notes Date 7-27-38
Date	Indexed

ADDITIONAL & SURVEY

WEST HOLLYWOOD DRAINAGE SYSTEM

KINGS ROAD STUB

For Topography See Pgs 227 228

For Profile See Pgs 229-232

C E Brunty
H M Smith
J L Willey
N R Smith

Note - This survey supplemented by that shown in F.B. 697 Pg. 95 to 98 Incl.

- Note - This survey Void - See Pgs 95, 96, 96A and 96B for new Alignment 4-3-40 C.E.B.

RECEIVED W.I.C. 7-28-38
PROGRESSED " 7-29-38
BOOK INDEXED " "
MAP INDEXED " "
RECORD INDEXED " "
CARD INDEXED " "

Note: Any Additions or Changes on This Sheet Must be Made or Circled in Red Ink With Date and Name of Person Making Change

Do not extend notes this side of this line

RETURN TO
LOS ANGELES COUNTY SURVEYOR
700 HALL OF RECORDS

FORM 247 10M 11-38

F.B. 697 PG. 224

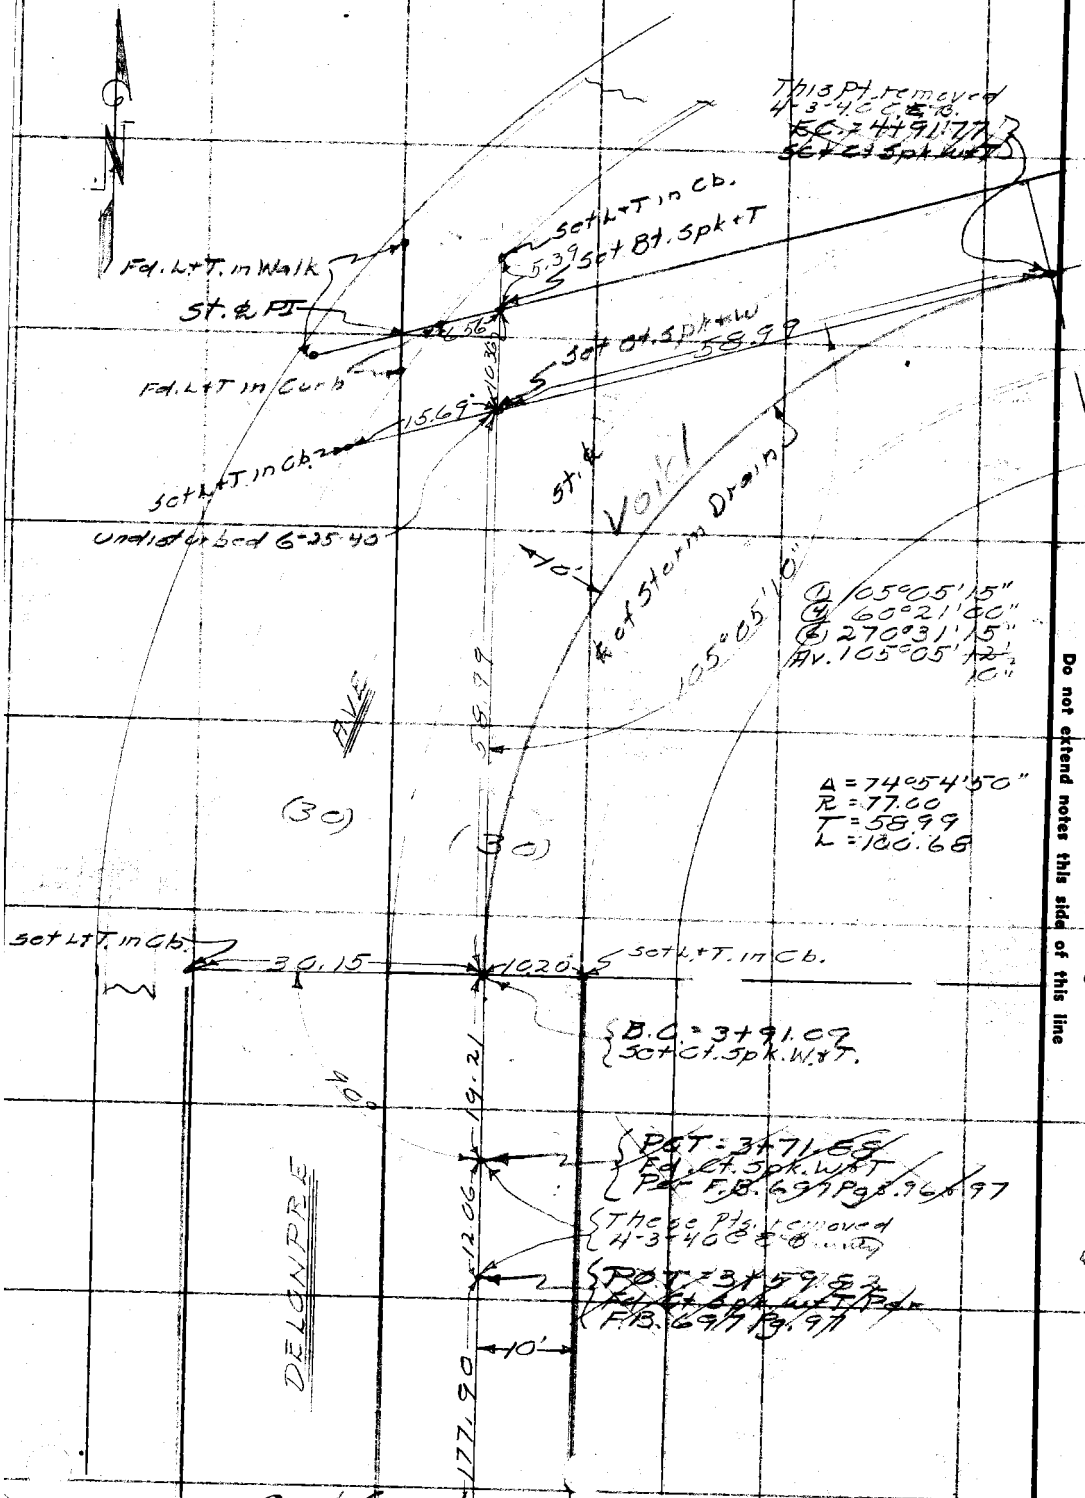

RETURN TO
LOS ANGELES COUNTY SURVEYOR
700 HALL OF RECORDS

Note: Any Additions or Changes on This Sheet Must be Made or Circled in Red Ink With Date and Name of Person Making Change.

Do not extend notes this side of this line

Notes Ck'd by	Survey of Kings Road Stub
Map No.	W. 0631S Tape No. 077 St'd 64°F.
Office Work	Surveyed by Brunty
Checked	Notes " Date 7-27-38
Date	Indexed

F.B. 697 PG. 225

Note: Any Additions or Changes on This Sheet Must be Made or Circled in Red Ink With Date and Name of Person Making Change

Do not extend notes this side of this line

RETURN TO
LOS ANGELES COUNTY SURVEYOR
700 HALL OF RECORDS

FORM 247 10M 11-38

Δ 92°22'15"
2 184°44'30"
Av. 92°22'15"

92°22'15"

F&L+T in Cb.

Set + in walk

E.C. = 477.73
Set 2x2 + Tk.

Existing 24" Pipe

Set X in walk

31.65

10.01

9.58

Set L+T. in Cb. on line Prod.

Set Ct. Spk. + W

Set Bt. Spk. + W by Int.

Δ = 92°22'15"
R = 40
T = 41.69
L = 64.49

41.69

30.11

10.24

Set L+T in Cb.

Set L+T. in Cb.

BC = 6+13.24 Set Ct. Spk W/T

FILE

90°

10'

(30) (30)

℄ of Storm Drain

DELONG PRE-

72.47

90°

This Pk. removed 4-3-40 C.E.B.

B.C. [illegible] Pk. Pg.

Set L+T. in Cb. 2

30.00

10.35

Set L+T. in Cb.

58.99

F.B. 697 PG. 226

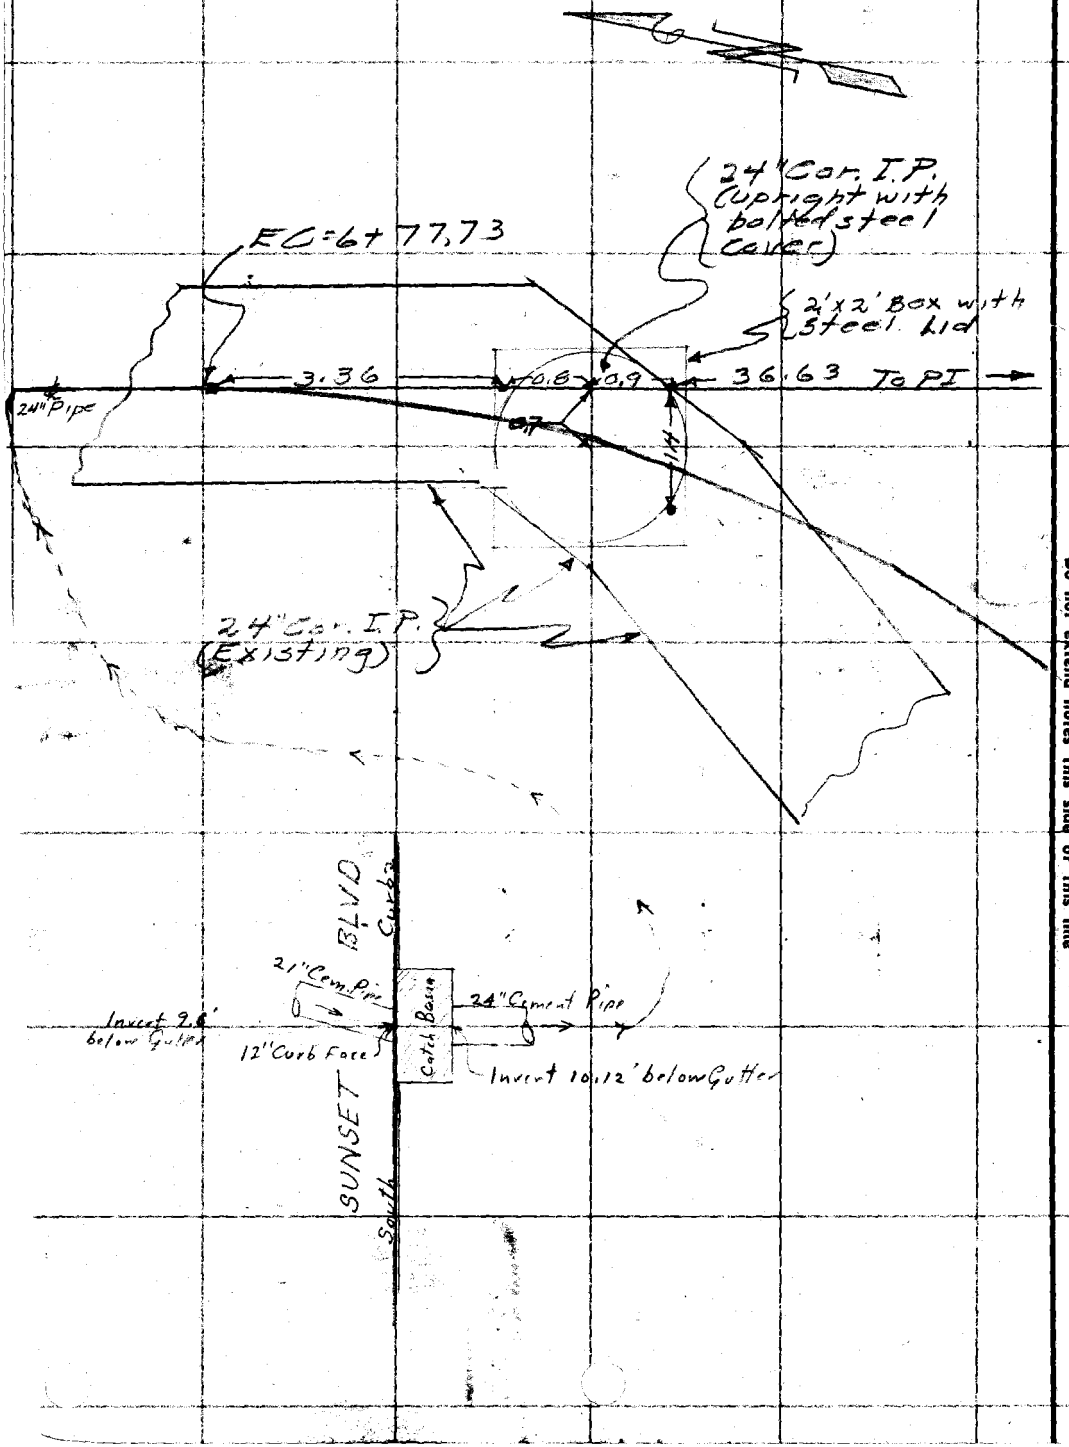

RETURN TO
LOS ANGELES COUNTY SURVEYOR
700 HALL OF RECORDS

Note: Any Additions or Changes on This Sheet Must be Made or Circled in Red Ink With Date and Name of Person Making Change.

Do not extend notes this side of this line

Notes Ck'd by	Survey of Kings Rd. Stub
Map No.	W. O. 6318 Tape No. 077 St'd 67° F.
Office Work	Surveyed by Brunty
Checked	Notes " Date 7-27-38
Date	Indexed

F.B. 697 Pg. 227

ADDITIONAL TOPOGRAPHY

WEST HOLLYWOOD DRAINAGE SYSTEM

KINGS ROAD STUB

J.N. 6318

For ℄ Survey See Pgs 223-226

For Profile See Pgs 229-232

C E Brunty
H M Smith
J L Willey
N R Smith

Note - This Topography supplemented by that shown in F.B. 697 Pgs. 99 to 101 Incl.

Note: Any Additions or Changes on This Sheet Must be Made or Circled in Red Ink With Date and Name of Person Making Change.

Do not extend notes this side of this line

RETURN TO
LOS ANGELES COUNTY SURVEYOR
700 HALL OF RECORDS

FORM 247 10M 11-38

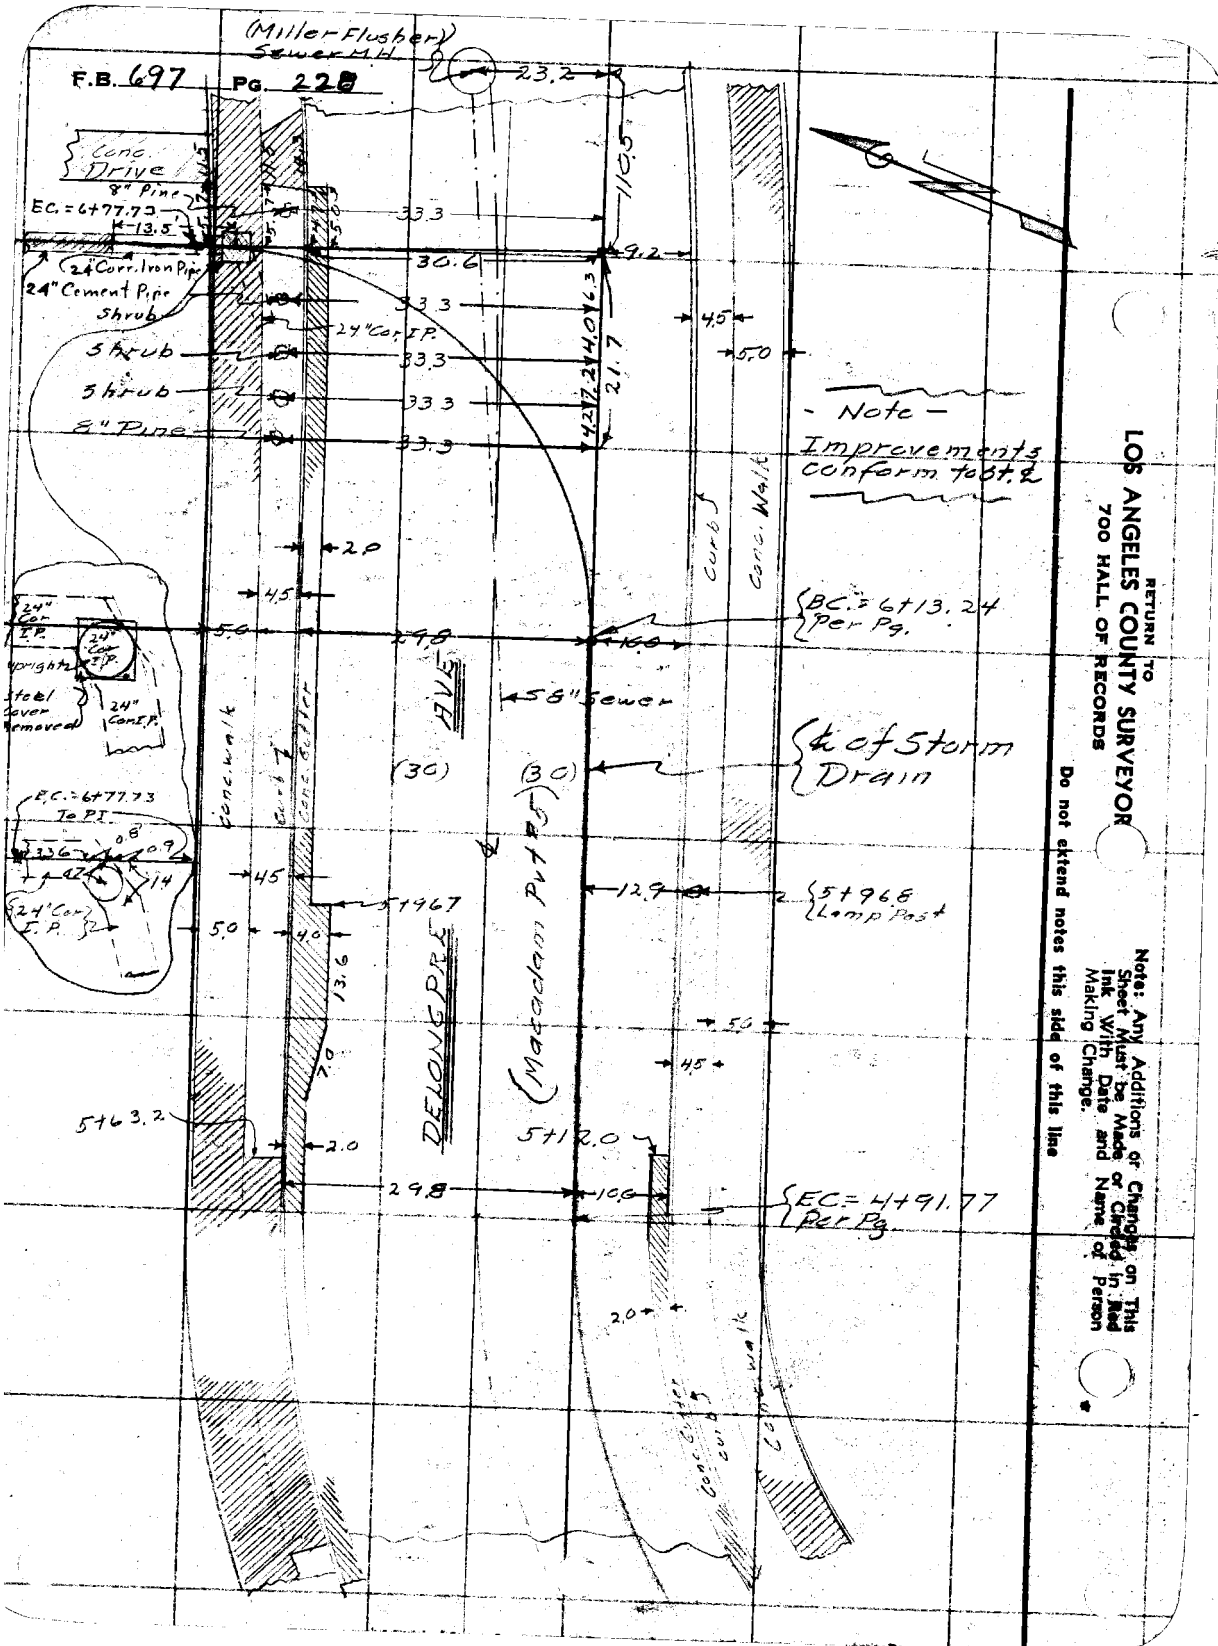
(Miller Flusher) Sewer MH
F.B. 697 Pg. 228
Conc. Drive
8" Pine
EC. = 6+77.73
13.5
24" Corr. Iron Pipe
24" Cement Pipe
Shrub
Shrub
Shrub
8" Pine
24" Cor. I.P.
23.2
33.3
30.6
9.2
11.5
4.5
5.0
21.7
Note
Improvements conform to St. 2
Conc. Walk
Curb
2.0
4.5
5.0
24" Cor. I.P.
20" Cor. I.P.
24" Cor. I.P.
Upright Steel Cover Removed
BC. = 6+13.24 Per Pg.
58" Sewer
St. of Storm Drain
Conc. Walk
Conc. Gutter
(30)
(30)
EC. = 6+77.73 To PI
0.8
0.9
42°
14
45
5+96.8 Lamp Post
5+96.7
5.0
4.0
13.6
7.0
5+63.2
2.0
DELONG PRE
5+12.0
29.8
10.6
EC. = 4+91.77 Per Pg.
2.0
Conc. Gutter
Conc. Walk
RETURN TO
LOS ANGELES COUNTY SURVEYOR
700 HALL OF RECORDS
Note: Any Additions or Changes on This Sheet Must be Made or Circled in Red Ink With Date and Name of Person Making Change.
Do not extend notes this side of this line

Profile No. | Notes Red. | Plotted | Job No 6318 | Division No. | F.B. 697 PG. 229

X-Sec. No. | Notes Chkd. | Checked | Survey of Kings Road Stub 3 | Survey by B | Notes 5 | Date 7-27-28

Date | Date | Map No. | Indexed | Date

PROFILE

WEST HOLLYWOOD DRAINAGE SYSTEM

J. NO 318

KINGS ROAD STUB

SHEET (3)

FOR L SURVEY SEE PAGES 223-226

FOR TOPOGRAPHY SEE PAGES 227-228

NOTE—
THESE NOTES SUPPLEMENTED FROM NOTES OF F.B. 697 - PAGES 103 TO 108 INCL.

C.E. BRUNTY
H.M. SMITH
W.L. WILLEY
N.R. SMITH

STATION	B. S.	H. I.	F. S.	ELEV.

NOTE: ANY ADDITIONS OR CHANGES ON THIS SHEET MUST BE MADE OR CIRCLED IN RED INK, WITH DATE AND NAME OF PERSON MAKING CHANGE

Do not extend notes this side of this line

PLEASE RETURN TO
LOS ANGELES COUNTY SURVEYOR
700 HALL OF RECORDS

Form 307 5M 10-37

Form 307 5M 10-37

PLEASE RETURN TO
LOS ANGELES COUNTY SURVEYOR
700 HALL OF RECORDS

NOTE: ANY ADDITIONS OR CHANGES ON THIS SHEET MUST BE MADE OR CIRCLED IN RED INK, WITH DATE AND NAME OF PERSON MAKING CHANGE

Do not extend notes this side of this line

F. B. 697 PG. 230 | Job No. 6318 Division No. 5 | Profile No. | X-Sec. No.
Survey of ALLESS ROAD STUDY | Plotted | Notes Red. | Date | Date
Survey by B | Date | Notes Chkd. | Date | Checked | Date
Indexed | Date | Notes | Date

STATION	B. S.	H. I.	F. S.	ELEV.		
B.M# D7				349628	B.M#D-7 Elev. 349.628 F.B.682-P.11 W. Cb. DeLongpre Ave 350' N of Fountain Ave Let in W Cb. Front of House #8449.	
T	352	353,13				
3+91.09	B.C.		1108	34205	℄ S.D	
T.P.	694	35815	192	35121		
4+91.77	E.C.		694	35121		
"			581	35231	10'L ℄ DeLongpre Ave	
"			605	35216	30'L Top Cb	
"			527	35288	" Gut	
"			736	35079	10'R Tp Cb	
"			818	34997	" Gut	
5+00			684	35131	℄ S.D	
"			589	35226	10'L	
"		Cork Drive			30'L Tp Cb	
"			597	35218	" Gut	
"			723	35092	10'R Tp Cb	
"			805	35010	" Gut	
6+00			571	35226	℄ S.D	
"			490	35323	10'L ℄ DeLongpre	
"			467	35348	30'L Tp Cb	
"			546	35269	" Gut	

Form 307 5M 10-37

PLEASE RETURN TO
LOS ANGELES COUNTY SURVEYOR
700 HALL OF RECORDS

NOTE: ANY ADDITIONS OR CHANGES ON THIS SHEET MUST BE MADE OR CIRCLED IN RED INK, WITH DATE AND NAME OF PERSON MAKING CHANGE

Do not extend notes this side of this line

STATION	B. S.	H. I.	F. S.	ELEV.		
6+00		358.15				
"			563	351.52	10'R Tp Cb	
"			725	350.90	" Gut	
6+13.24	B.C		590	352.25	℄ S.D	
"			483	353.32	10'L ℄ DeLongpre	
"			459	353.57	30'L Tp Cb	
"			538	352.77	" Gut	
"			652	351.63	10'R Tp Cb.	
"			710	351.05	" Gut.	
P.I.			588	352.27	S.D. Line Int.	
			648	351.67	10' R Tp Cb	
			691	351.24	" Gut	
			454	353.61	15'L ℄ DeLongpre Ave (Crown)	
			436	353.79	30'L Tp Cb	
			515	353.00	" Gut	
			454	353.61	℄ DeLongpre Ave ℄ S.D Prod N.	
			520	352.95	100' E of Int S.D. Prod ℄ DeLongpre.	
			664	351.51	" 20' S. Top Cb	
			725	350.90	" " Gut.	
			458	353.57	" 20' N Tp Cb	
			517	352.98	" " Gut.	

Profile
No. Notes Rcd. Plotted Job No. Division No.
X-Sec. Date Date Survey of Kings Road Tract
No. Notes Chkd. Checked Survey by B Notes S Date 7-22-28
Date Date Map No. Indexed Date

F. B. 697 PG. 231

Form 307 5M 10-37

PLEASE RETURN TO
LOS ANGELES COUNTY SURVEYOR
700 HALL OF RECORDS

NOTE: ANY ADDITIONS OR CHANGES ON THIS SHEET MUST BE MADE OR CIRCLED IN RED INK, WITH DATE AND NAME OF PERSON MAKING CHANGE

Do not extend notes this side of this line

F.B. 97 PG. 232
Survey of
Survey by
Indexed
Job No. 6318
Division No.
Notes
Date
Notes Red.
Date
Notes Chkd.
Date
Plotted
Date
Checked
Date
Profile
No.
X-Sec.
No.

STATION	B. S.	H. I.	F. S.	ELEV.	
		35815 DEPTH + ROD 538+526			
F.M.H.	CH.		1064	34751	EAST / NORTH . F.M.H. Elkton Floor MILLER Flush.
			605	35010	36.6 N.S.D.P.I.-1.4W. SEMI-TANG.
			788	35027	37.5 " " " " " 0.7W. " " FLOW
			724	35091	38.3 " " " " " ON & 24" C.I.P NORTH LINE.
6+16.4			414	35401	℄ S.D. Box [illegible]
6+77	E.C.		31	35451	℄ S.D.
T.P			519	35296	
X	A36	35732			
					B.M# D 8 Elev. 35194 F.B 682-12
B.M# D 8			614	35118	DELONGPRE AVE & FLORES ST. N. CURB
					60D SPK N.C.O DELONGPRE ET
					10'W OF W.P.L FLORES ST. Prod

Notes Ck'd by	Survey of
Map No.	W. O. 3118 Tape No. 085 St'd 24 °F.
Office Work	Surveyed by
Checked	Notes Date
Date	Indexed A. C. Johnson

F.B. [illegible] Pg. 145

SHEET 4

VOID

RECEIVED JUN 1 1937

PROGRESSED

BOOK INDEXED

MAP INDEXED

RECORD INDEXED

CARD INDEXED

HLS
6-15-37

RETURN TO
LOS ANGELES COUNTY SURVEYOR
700 HALL OF RECORDS

Note: Any Additions or Changes on This Sheet Must be Made or Circled in Red Ink With Date and Name of Person Making Change.

Do not extend notes this side of this line

FORM 247 10M 11-36

F.B. 697 PG. ~~186~~

(4)

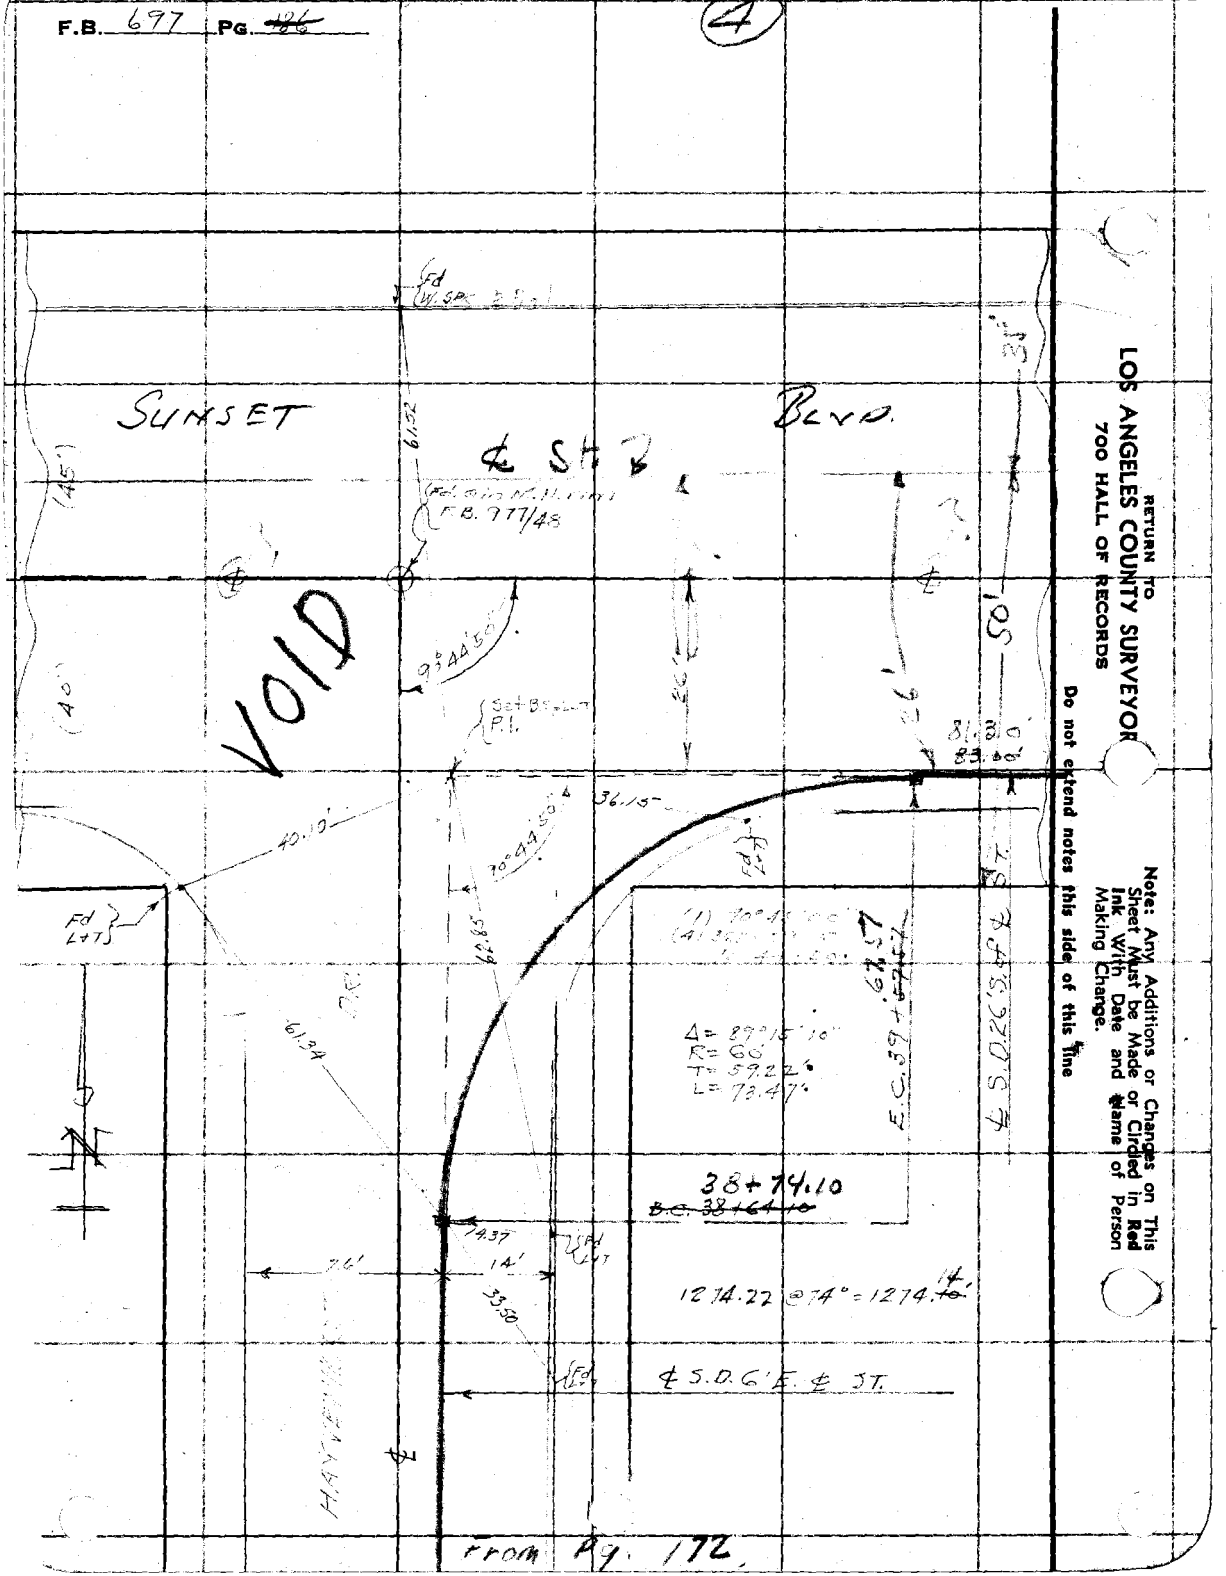

From Pg. 172

RETURN TO
LOS ANGELES COUNTY SURVEYOR
700 HALL OF RECORDS

Do not extend notes this side of this line

Note: Any Additions or Changes on This Sheet Must be Made or Circled in Red Ink With Date and Name of Person Making Change.

Notes Ck'd by	Survey of
Map No.	W. 06318 Tape No. 035 St'd 74 °F.
Office Work	Surveyed by
Checked	Notes K/L Date June 1977
Date	Indexed A. C. Johnson

F.B. PG. 127

Note: Any Additions or Changes on This Sheet Must be Made or Circled in Red Ink With Date and Name of Person Making Change.

Do not extend notes this side of this line

RETURN TO
LOS ANGELES COUNTY SURVEYOR
700 HALL OF RECORDS

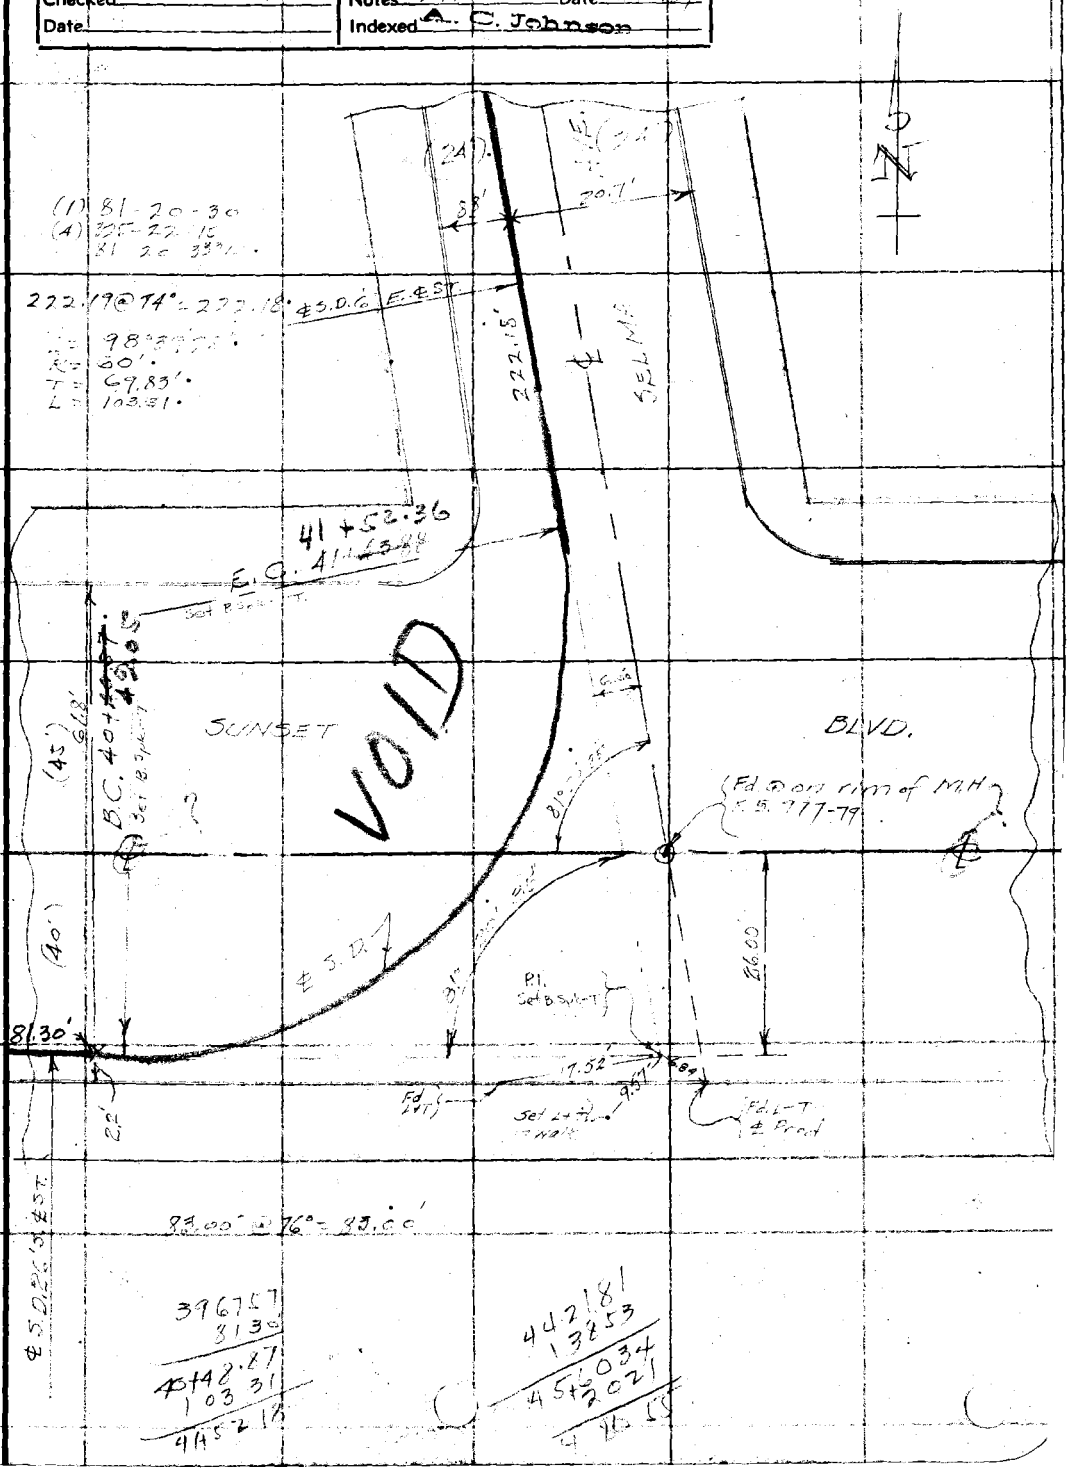

FORM 247 10M 11-58

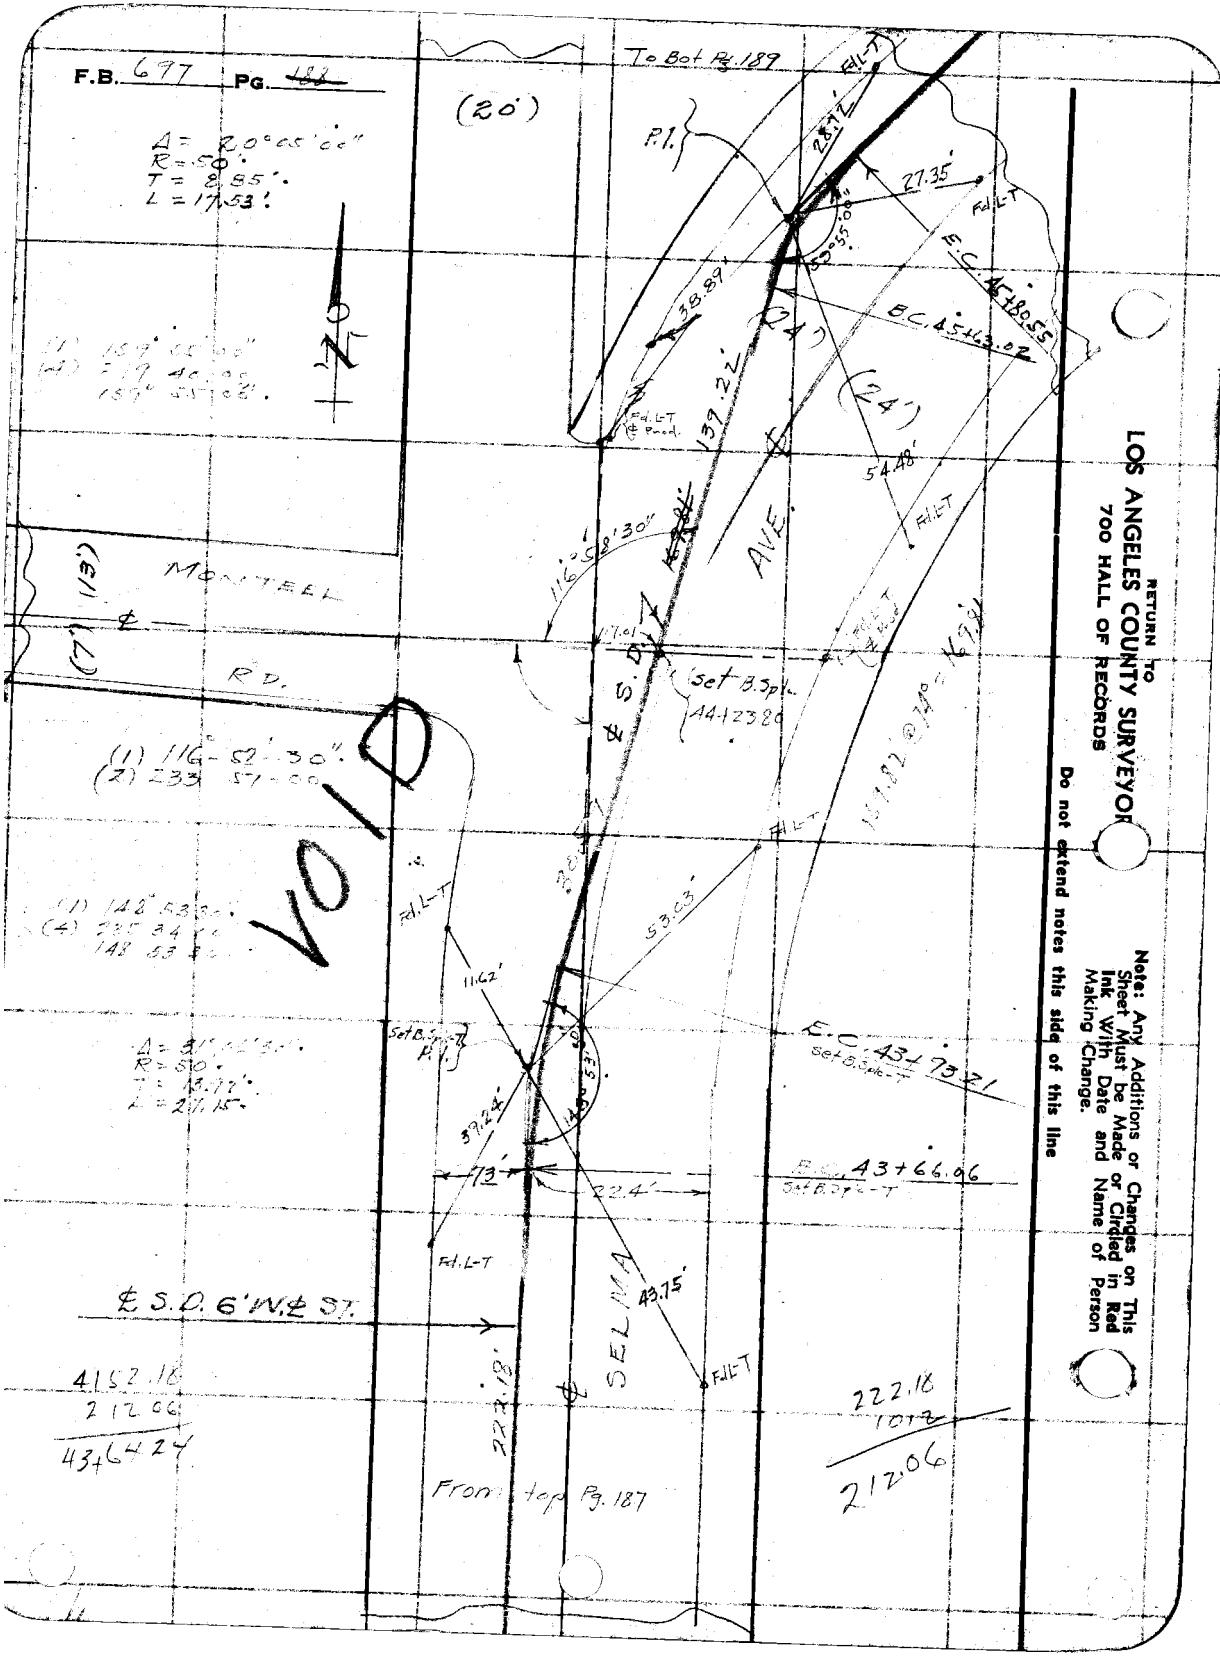
To Bot Pg. 189
(20')
P.I.
Fd L-T
28.12'
27.35'
Fd L-T
E.C. Sta 180.55
BC. Sta 5+43.02
38.89'
(24')
139.22'
54.48'
Fd L-T
Fd L-T & Pond.
MONTREAL
RD.
(11')
(7')
AVE.
Set B.3pk. A4-12380
Fd L-T
Fd L-T
20.0'
53.03'
Fd L-T
11.62'
Set B.3pk. P.I.
E.C. 43+73.21
Set B.3pk E-T
37.24'
73'
22.4'
B.C. 43+66.06
Set B.3pk C-T
Fd L-T
S.D. 6' W.L. ST.
43.75'
Fd L-T
227.18'
SELMA
VOID
(1) 116° 52' 30"
(2) 233 57 00
(1) 148° 53' 30"
(2) 297 34 00
148 53 30
Δ = 91° 42' 30"
R = 50'
T = 48.72'
L = 211.15'
Δ = 120° 05' 00"
R = 50'
T = 85'
L = 174.53'
4152.18
2120.6
4364.24
222.18
1012
212.06
From top Pg. 187
RETURN TO
LOS ANGELES COUNTY SURVEYOR
700 HALL OF RECORDS
Do not extend notes this side of this line
Note: Any Additions or Changes on This Sheet Must be Made or Circled in Red Ink With Date and Name of Person Making Change.

Notes Ck'd by	Survey of W. Hollywood Dist.
Map No.	W. O. 6318 Tape No. 055 St'd 84°F.
Office Work	Surveyed by W
Checked	Notes W Date June 1937
Date	Indexed A. C. Johnson

F.B. 177 Pg. 48

To b.t. Pg. 190

177.72' @ 14° 111.71'

(1) 122° 15' 00"
(2) 2 A.S. 30.00

Fd. L-T

2° 15' 00"

℄ S.D. 177.71'

AVE.

(46+72.04

Fd. W. Spk. & Prod

23.72'

Fd. L-T

CREMONA HTS. BLVD.

(20') (20')

Fd. W. Spk. & Prod 135

Fd. L-T

46+07 = P.I. Sec 18 S.L.

(1) 168°25'00"
(4) 313°40'00"

Fd. L-T

℄ S.D. 73.52' MAY ST.

(24') (24')

13.52' @ 14° @ 73.52'

VOID

From Top Pg. 188

RETURN TO
LOS ANGELES COUNTY SURVEYOR
700 HALL OF RECORDS

Note: Any Additions or Changes on This Sheet Must be Made or Circled in Red Ink With Date and Name of Person Making Change.

Do not extend notes this side of this line

FORM 247 10M 11-38

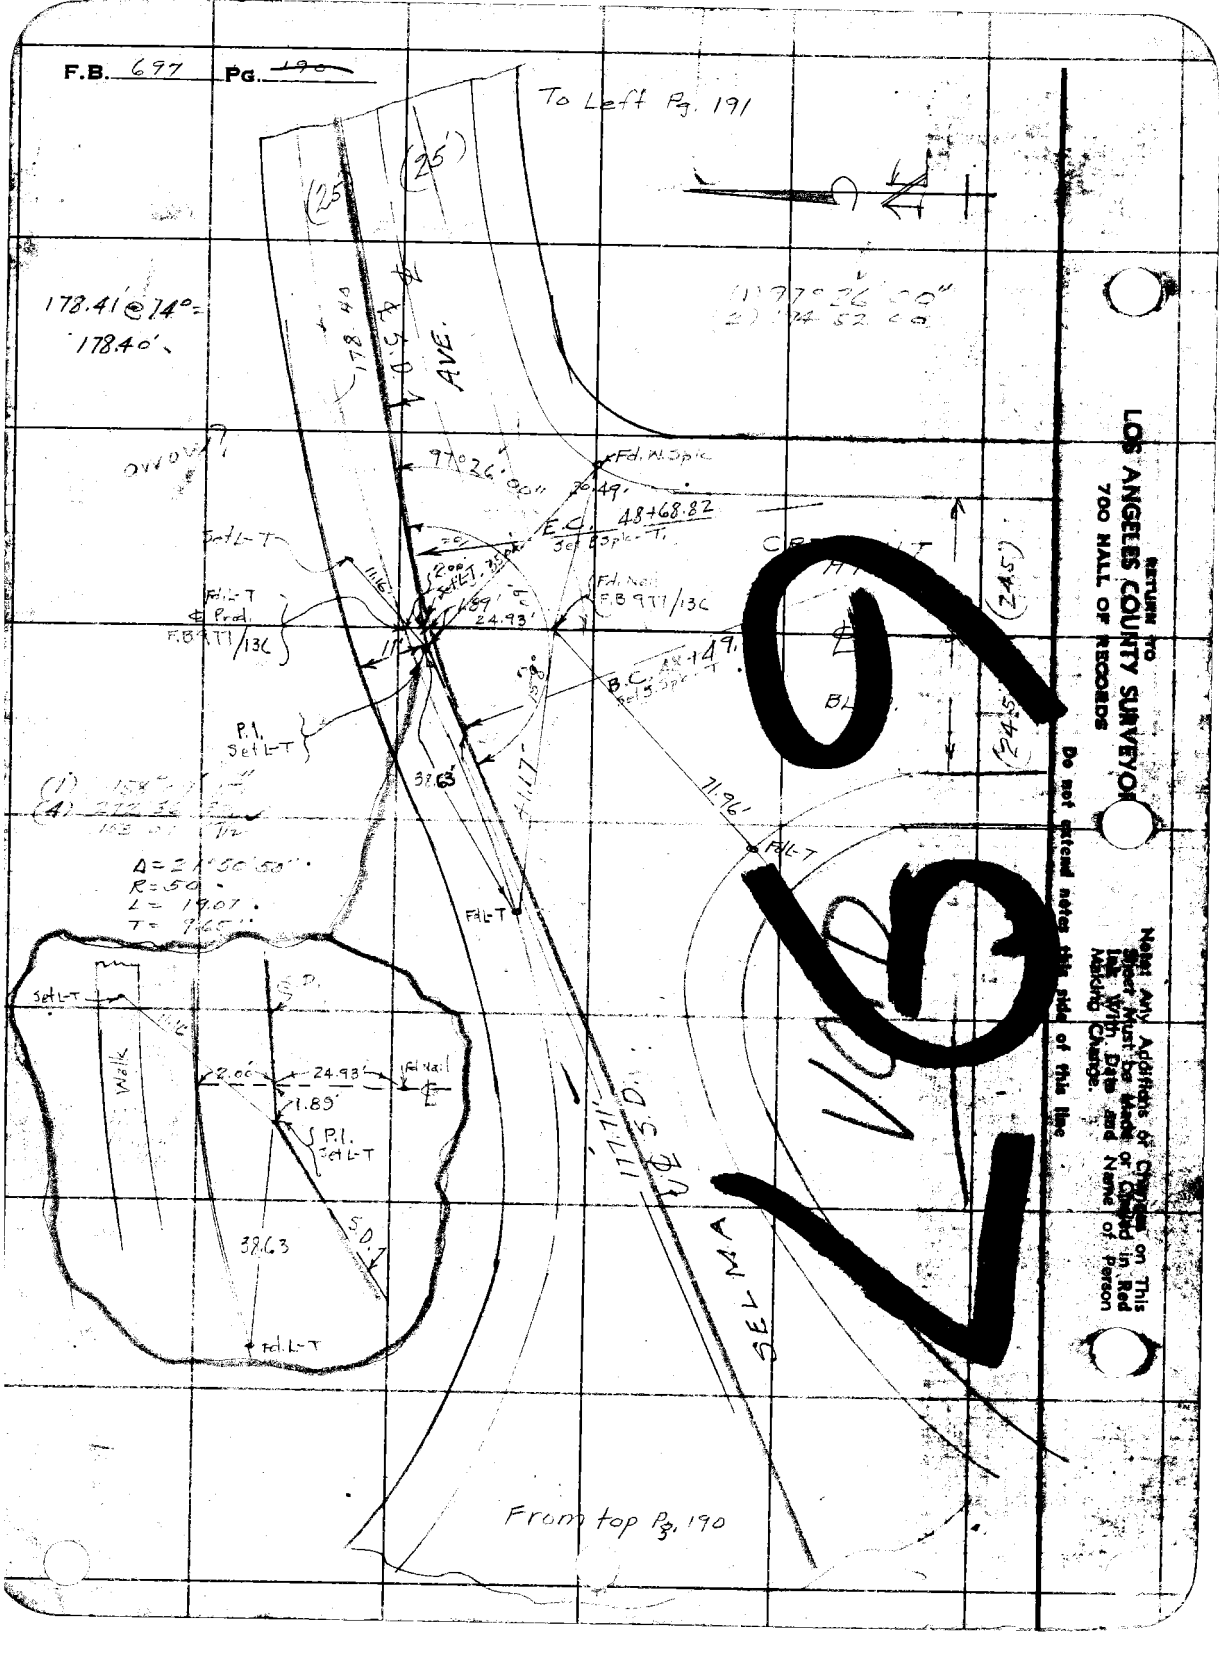
F.B. 697 Pg. 190
To Left Pg. 191
(25')
(25')
178.41 @ 14° =
178.40'.
AVE.
Fd. W. Spike
97°26'
E.C. 48+68.82
Set Spike-T
Set L-T
Fd L-T
Prod
F.B. 977/136
Fd. Nail
F.B. 977/136
24.93'
1.89'
P.I.
Set L-T
B.C. AH+49.
Set Spike-T
38.63'
71.96'
Fd L-T
Δ = 21°50'50"
R = 50.
L = 19.07'
T = 9.65'
Set L-T
S.D.
Walk
22.00'
24.93'
Fd Nail
1.89'
P.I.
Set L-T
38.63
S.D.
Fd. L-T
SELMA
From top Pg. 190
(24.5')
(24.5')
RETURN TO
LOS ANGELES COUNTY SURVEYOR
700 HALL OF RECORDS
Do not extend notes this side of this line
Note: Any Additions or Changes on This Sheet Must be Made or Okayed in Red Ink With Date and Name of Person Making Change.