Notes Ck'd by
Map No.
Comp. Work
Drawn by

Survey of
W. O. Tape No. St'd. °F
Surveyed by
Notes Date
Indexed

F. B. Pg.

Note: Any Additions or Changes on This Sheet Should be Detailed in Red by the Party Chief or Person Making Them.

LOS A

78E

RETURN TO
LOS ANGELES COUNTY SURVEYOR
726 LOS ANGELES COUNTY
ENGINEERING BLDG.

Note: Any Additions or Changes on This Sheet Must be Made or Circled in Red Ink With Date and Name of Person Making Change.

Do not extend notes this side of this line.

F. B. _____ PG. _____

| | |
|---|---|
| Notes Ck'd by | Survey of Forestry Telephone |
| Map No. | W. O. 8094 Tape No. 68 St'd 84 °F. |
| Office Work | Surveyed by C.V. Crumley |
| Checked | Notes C.V.C. Date 3-4-37 |
| Date | Indexed 8-16-37 |

F.B. 703 PG. 1

QUAIL LAKE - LEBEC

FORESTRY DEPARTMENT

TELEPHONE LINE No. 109

J.N. 8094

"NOTE"

POLE LOCATIONS CHECKED BY WSC 6-12-50

MAJOR POLE LINE CHANGES NOTED - SEE GENERAL PETROLEUM CO. FOR LOCATIONS

C.V. Crumley
F.S. Livingston
W.F. Harris
H.H. Baker
J.A. Hupe
L.R. McGuire

Note: Any Additions or Changes on This Sheet Must be Made or Circled in Red Ink With Date and Name of Person Making Change.

Do not extend notes this side of this line

RETURN TO
LOS ANGELES COUNTY SURVEYOR
700 HALL OF RECORDS

FORM 247 10M 11-35

Prev. file F.B. 704

F.B. 703 Pg. 2

Note:- 3rd Pole is Junction Pole
6 Wires Going South, To Building
2 Wires Going East
2 Wires Going N.W. To U.S. Gov. Sta.
4 Wires Going West.

2 North Wires are Forestry Line 109

55°-16-00"
221-54-30

55°-16-00"

297.13 @ 1°-32 @ T = 54° = 296.96
2 24.93 @ 3°-05 @ T = 54° = 24.56

521.52

INVENTORY IN F.B. 1640-136

Fd 2x2 F.B. # 131R
Per F.B.

Fd. C.S. Monument
Pt. of Curve

Guy Pole

Guy Wire

Tum 1 Left
2 Right

Pole

Set 1x2

S. 60°18'30" W.

Set 1x2 By Intersect.

Guy Wire

7th Pole

(1) 120-16-30
(4) 121-06-15
120°-16-30

N. 5°02'25" E.

perCS. B-340

(1) 149°-21'-35"
(4) 237-20-30
149°-21-25

Fd 2x2 F.B. # 132R Per F.B.

P. # 1

Fd. X on 6"x6" Conc. Mon. 5.00 ft. of Fill S.C. of Hwy Per C.S. B-340

Contd. To 702 pg. 3

73.57 @ 3°-08 @ T = 58° = 73.45

161.77 @ 2°-05 @ T = 58° = 161.53

RETURN TO
LOS ANGELES COUNTY SURVEYOR
700 HALL OF RECORDS

Note: Any Additions or Changes on This Sheet Must be Made or Circled in Red Ink With Date and Name of Person Making Change.

Do not extend notes this side of this line

| | |
|---|---|
| Notes Ck'd by Drew L. M.S.P. | Survey of Sanitary Tie-in #107 |
| Map No. | W. O. 2074 Tape No. 62 St'd 74°F. |
| Office Work | Surveyed by C.V. Crumley |
| Checked | Notes V.C. Date 2-4-51 |
| Date | Indexed C. Johnson |

F.B. 703 Pg. 3

P-109

Cont'd To Station 4+4

(1) 129°-47-00
(2) 119°-08-30
29°-47-05

29°47'

S. 66°39'50"W.

5.69 ft.

242.17

244.22 = 7°-22' @ T. 68 =

Junction Pole
14½ Pole

14 Wires From N.E.
2 Wires Going S.W.
2 Wires Going West = Lateral
Line

4 Pl. P. #5
Set 1½

153.2 @ 2°-30' = 149.9

N 13th Pole

S 36°52'45"W.

549.51

INVENTORY N. F. B. 1640-137

295.38 @ 3°-30' T = 60° = 294.67
256.50 @ 6°-27' T = 60° = 254.84
549.51

12th Pole

11th Pole

4 Pl. P. #4
Set 1½

10th Pole

(1) 172°-47-15
(2) 331°-08-30
112°-47-10

S 29°39'55"W.

9th Pole

297.14 @ 12°-00' T = 148.72 = 296.57
244.24 @ 7°-30' T = 122 = 244.59
123.05 @ 7°-30' T = 61.54 = 123.04
6 @ 9.17

Ugly Pole

Cont'd From Left Side

Pg. 2

Note: Any Additions or Changes on This Sheet Must be Made in Red Ink or Circled in Red With Date and Name of Person Making Change.

Do not extend notes this side of this line

RETURN TO
LOS ANGELES COUNTY SURVEYOR
700 HALL OF RECORDS

FORM 247 10M 11-38

F.B. 703 PG. 4/4

Cont'd To Bottom Pg. 5

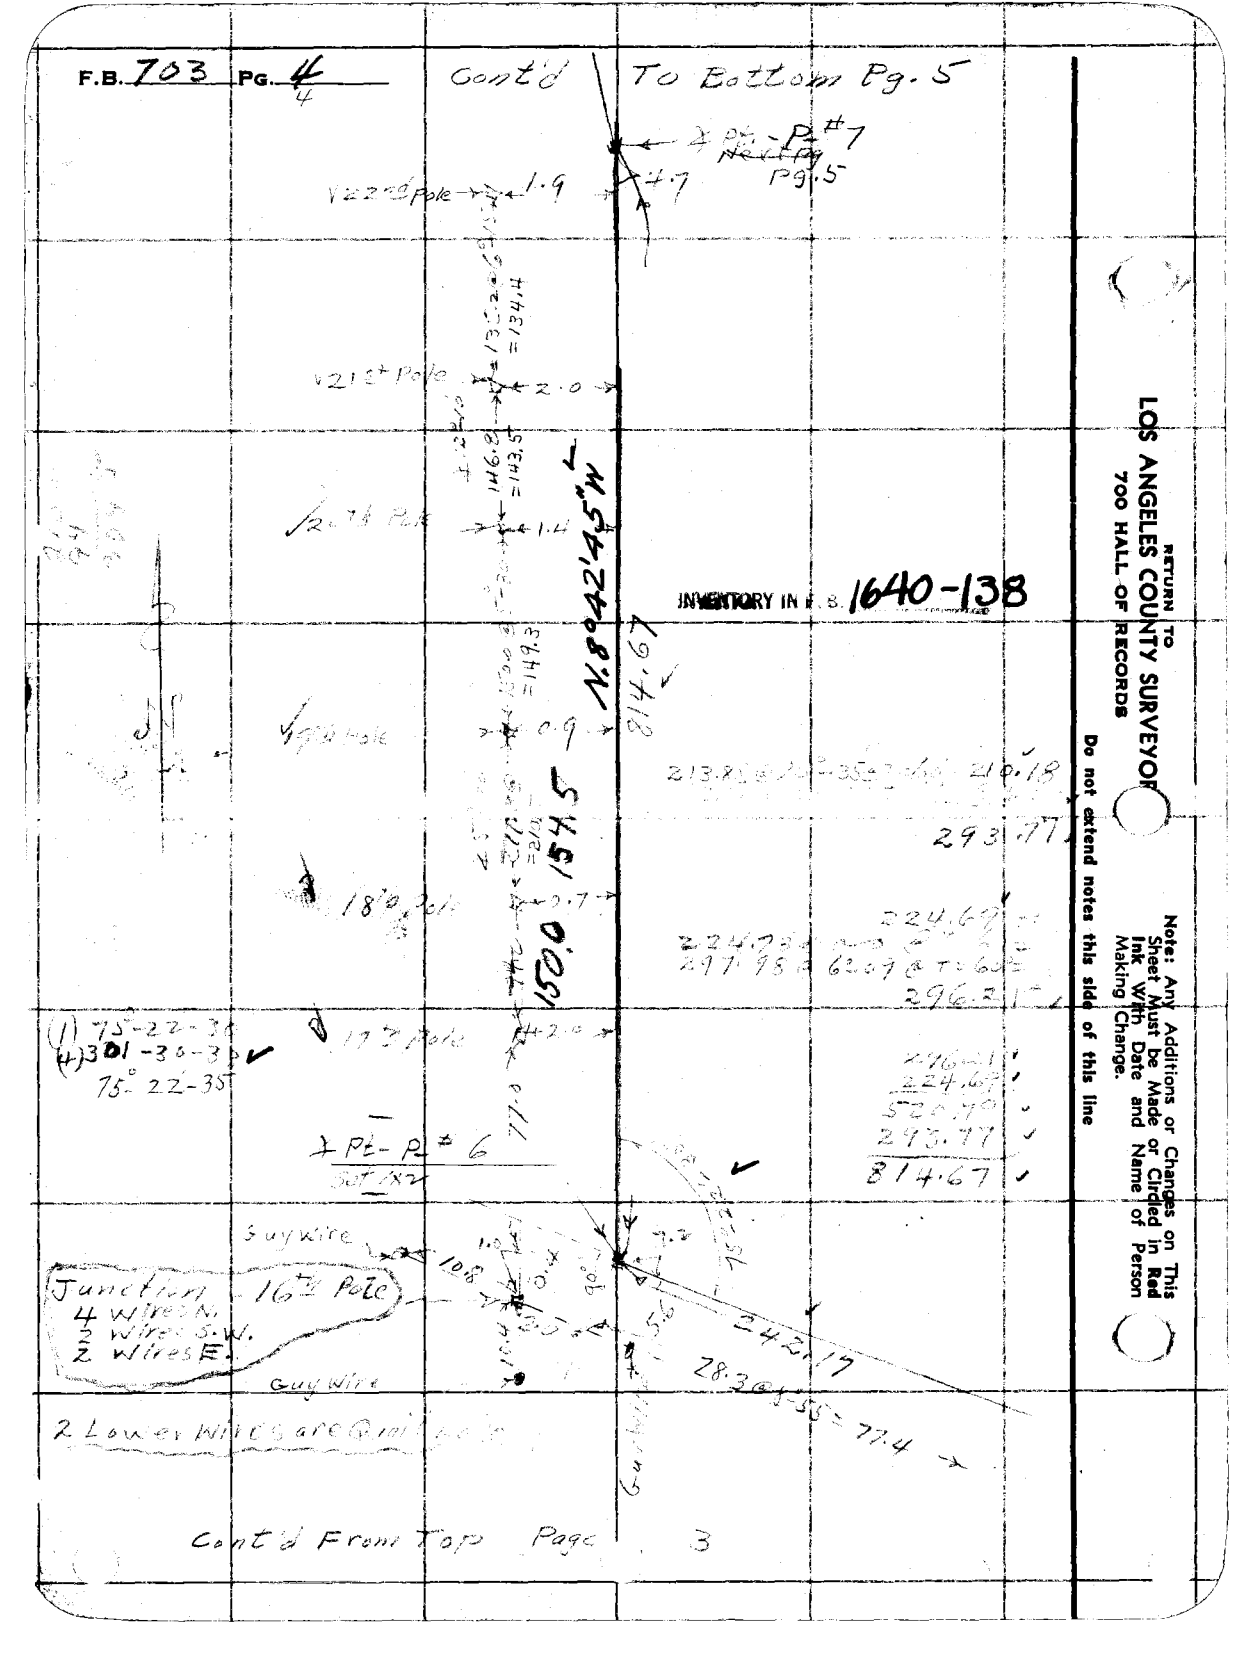


INVENTORY IN F. B. 1640-138

RETURN TO
LOS ANGELES COUNTY SURVEYOR
700 HALL OF RECORDS

Do not extend notes this side of this line

Note: Any Additions or Changes on This Sheet Must be Made or Circled in Red Ink With Date and Name of Person Making Change.

| | |
|---|---|
| Notes Ck'd by Drew & MSP | Survey of |
| Map No. | W. O. 8[illegible] Tape No. St'd °F. |
| Office Work | Surveyed by V. Crum [illegible] |
| Checked | Notes [illegible] Date 3-[illegible]-27 |
| Date | Indexed A. C. Johnson |

F.B. 703 Pg. 5

R109

Note: Any Additions or Changes on This Sheet Must be Made or Circled in Red Ink With Date and Name of Person Making Change.

Do not extend notes this side of this line

RETURN TO
LOS ANGELES COUNTY SURVEYOR
700 HALL OF RECORDS

30th Pole

179°55'00"

126.0 @ 5°50 = 124.1

29th Pole

28th Pole

27th Pole

Waste Pole

N. 0°04'51" W.

S. 179°55'00" E.

Δ Pt. - P. #8
Set 1X2

(1) 179°55-00
(2) 359-40-00
179°-55-00

INVENTORY IN F. B. 1640-139

149.13 @ 4-46 = 148.61
294.08 @ 4-52 = 294.96
293.12 @ 4-60 = 293.12
127.99 @ 11°-50 = 127.31
1761.99

Δ Pt. - P. #7 Pg. 4
Set 1X2

(1) 179°-57-00
(2) 359-24-30
179°-57-15

Cont'd From Top Pg. 4

FORM 247 10M 11-25

F.B. 703 PG. 6

Cont'd To Bottom Pg. 7.

206.7 @ 6°-30' = 206.7

39th Pole

Guy Wire

13 @ 9.2 = 125.8

38th Pole

Guy Wire

37th Pole

INVENTORY IN F. B. 1640-140

98.92 @ T = 60° = 98.70

36th Pole

Guy Wire

N 5° 49' 20" W

Point of

293.49 @ 3 - 3 Sta. Adj. = 292.8

92.72 @ T = 60° = 92.71

335+51.

35th Pole

Guy Wire

153.0 @ 5°-30' = 152.4

1/5°-3

138.2 Pole

Guy Wire

Wood Pole

113.8 @ 5°-25' = 113.3

32nd Pole

160.3 @ 7°-30' = 158.9

N 31.5° W

447.30 N 89°55'00" W

Cont'd From Top Pg. 5

RETURN TO
LOS ANGELES COUNTY SURVEYOR
700 HALL OF RECORDS

Do not extend notes this side of this line

Note: Any Additions or Changes on This Sheet Must be Made or Circled in Red Ink With Date and Name of Person Making Change.

| | |
|---|---|
| Notes Ck'd by Drew Cmp | Survey of Forest Fire # |
| Map No. | W. O. 8[illegible]4 Tape No. St'd °F. |
| Office Work | Surveyed by C.V. Crumley |
| Checked | Notes Date |
| Date | Indexed A. C. Johnson |

F.B. 703 PG. 7

Cont'd To Bk [illegible] Pg 2

N49°12'20"W.

49½ Pole

147.0 @ 4-2 = 148.6

48½ Pole

145.7 @ 7°-20 = 114.8

(1) 161-52-00
(4) 287-28-00
161°-52'-00

2 Guy Wire

47½ Pole

2 P.L. P-11

Set 1"x2"

291.21 @ 5°-45 @ T=64 = 293.34
294.23 @ 5°-16 @ T=64 = 295.34
236.15 @ 18-31 @ T=64 = 233.38
290.46 @ 20-17 @ T=64 = 273.40
123.71 @ 5-34 @ T=64 = 123.31
298.40 @ 2-10 @ T=64 = 298.15
211.16 @ 13-48 @ T=64 = 225.03
175.56 @ 4-35 @ T=64 = 174.97
118.20 @ 3-53 @ T=64 = 117.90
1909.27

INVENTORY IN F.B. 1640 - 140, 141

45½ Pole

11 5½ Pole

8.2 — Guy Wire

44½ Pole

143.7 @ 4-[illegible] = 143.3

N31°04'20"W.

1257.44'

43½ Pole

145.7 @ 6°-[illegible] = 150.9

[illegible] Pole

52.83 @ 3-0 @ T=64 = [illegible]
253.84 @ 11-[illegible] = [illegible]
292.14 @ 1-58 @ T=64 = [illegible]
141.23 @ 1-32 @ T=64 = 141.13
248.92 @ 5-18 @ T=64 = 247.84
275.13 @ 7-[illegible] = 275.00
1257.44

11½ Pole

[illegible] Pole

Cont'd From Pg 6

Note: Any Additions or Changes on This Sheet Must be Made or Circled in Red Ink With Date and Name of Person Making Change

Do not extend notes this side of this line

RETURN TO
LOS ANGELES COUNTY SURVEYOR
7do HALL OF RECORDS

FORM 247 10M 11-36

F.B. 703 PG. 8

8

Cont'd To Bottom Pg. 9

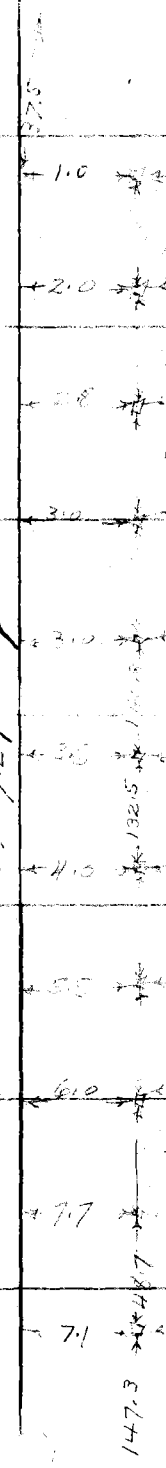


INVENTORY IN F.B. 1640 - 142

Cont'd From Top Pg. 7

RETURN TO
LOS ANGELES COUNTY SURVEYOR
700 HALL OF RECORDS

Note: Any Additions or Changes on This Sheet Must be Made or Circled in Red Ink With Date and Name of Person Making Change.

Do not extend notes this side of this line

| | |
|---|---|
| Notes Ck'd by Drew L. Miller | Survey of |
| Map No. | W. O. 74 Tape No. 52 St'd. 62 °F. |
| Office Work | Surveyed by C. V. Grundy |
| Checked | Notes N-4 Date 3-24-37 |
| Date | Indexed |

F.B. 703 Pg. 9

Note: Any Additions or Changes on This Sheet Must be Made or Circled in Red Ink With Date and Name of Person Making Change

Do not extend notes this side of this line

RETURN TO
LOS ANGELES COUNTY SURVEYOR
7do HALL OF RECORDS

N.22° 26' 20"W.

575.79

302.99 @ 1° 35' = 64° = 298.93
299.30 @ 2° 41' = 64° = 298.93
74.7 @ 3° 20' = 74.56
575.79

(1) 161° 32' 00"
(4) 286° 08' 30"
161° 32' 05"

4 pkt - P.K. #14
Set 1x2

Guy wire

Pole

N.40° 58' 15"W.

249.24 @ 1° 22' = 64° = 245.52

Guy wire

Pole

135.5 @ 8° 10' = 133.6

Pole

INVENTORY IN F. B. 1640-143

N.50° 26' 15"W.

218.52

219.52 @ 5° 25' = 64° = 218.52

4 pkt - P.K. #12
Set 1x2

(1) 178° 46' 00"
(4) 1° 35' 00"
178° 11' 05"

1909.27

Continued on P. Pg. 8

FORM 247 10M 11-36

F.B. 703 PG. 10

Cont'd To Bottom Pg 11



75th Pole on Line

N.22° 12' 25" W.

851.63

INVENTORY IN F.B. 1640-143, 144

P.O.T. #15A

277.44

277.61

Set 1X2

Cont'd From Top Pg. 9

RETURN TO
LOS ANGELES COUNTY SURVEYOR
700 HALL OF RECORDS

Note: Any Additions or Changes on This Sheet Must be Made or Circled in Red Ink With Date and Name of Person Making Change.

Do not extend notes this side of this line

| | |
|---|---|
| Notes Ck'd by DRM 6-MS2 | Survey of Tower Tract #17 |
| Map No. | W. O. 2-14 Tape No. 65 St'd 74 °F. |
| Office Work | Surveyed by C.V. Crumley |
| Checked | Notes C.V.C. Date 3-5-41 |
| Date | Indexed A. O. Johnson |

F.B. 733 PG. 11

Note: Any Additions or Changes on This Sheet Must be Made or Circled in Red Ink With Date and Name of Person Making Change.

Do not extend notes this side of this line.

RETURN TO
LOS ANGELES COUNTY SURVEYOR
700 HALL OF RECORDS

INVENTORY IN F. B. 1640 - 144

N. 39°28'25"W.

N. 23°50'25"W.

Carried From Top Pg. 10

FORM 247 10M 11-38

F.B. 703 PG. 12

Contd To Bottom Pg. 13

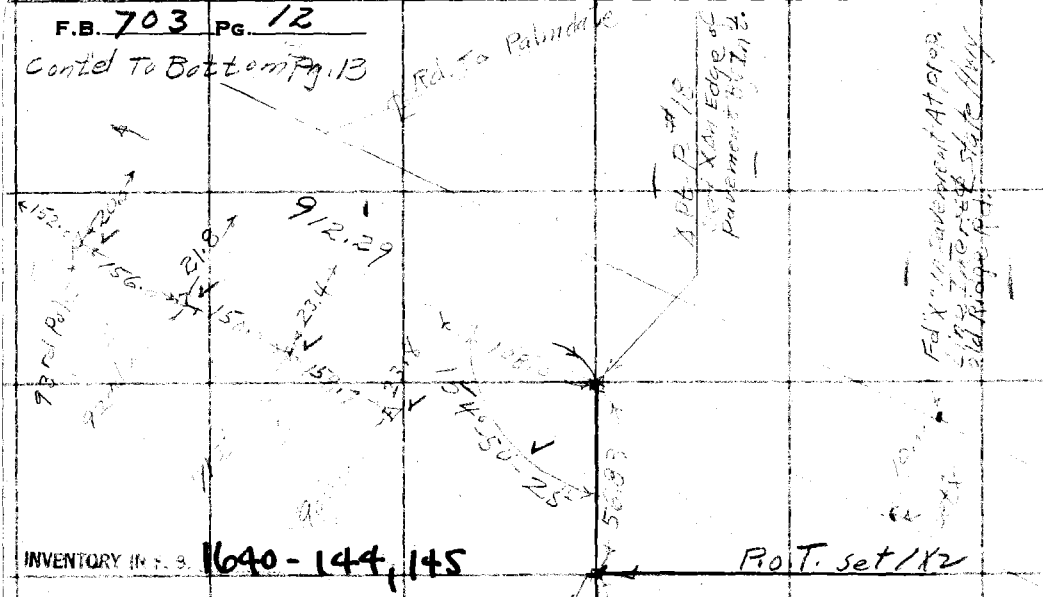
Rd. To Palmdale
9 12.29
Pavement
Edge
Fd X on Centerline At 10.0
Pole
Pole
Pole

| | |
|---|---|
| Notes Ck'd by Drew L. MSP | Survey of |
| Map No. | W. O. 2094 Tape No. 68 St'd ° F. |
| Office Work | Surveyed by C.V.Crumley |
| Checked | Notes C.V.C. Date 3-5-37 |
| Date | Indexed |

F.B. 703 Pg. 13

13

Note: Any Additions or Changes on This Sheet Must be Made or Circled in Red Ink With Date and Name of Person Making Change

Do not extend notes this side of this line

RETURN TO
LOS ANGELES COUNTY SURVEYOR
700 HALL OF RECORDS

INVENTORY NO. 1640-146

N. 65° 25' 25" W.

706.84

298.87
300.53
108.14
706.84

99.9 Pole

136.25 - 20 = 135.7

On Line 99.9 Pole

(1) 179° 12' 00"
(4) 356-50-36
179-12-35

K.P. P. ± 19
Set 1X2

Main A.P.I.
Station
Culvert
K-1414/5

95.6 Pole

299.25
300.05
210.56
102.88
912.29

N. 66° 40' 00" W.

912.29

Old Right

Cont'd From

Top Pg. 12

FORM 247 10M 11-36

F.B. 703 PG. 14

Cont'd To Bottom Pg. 15

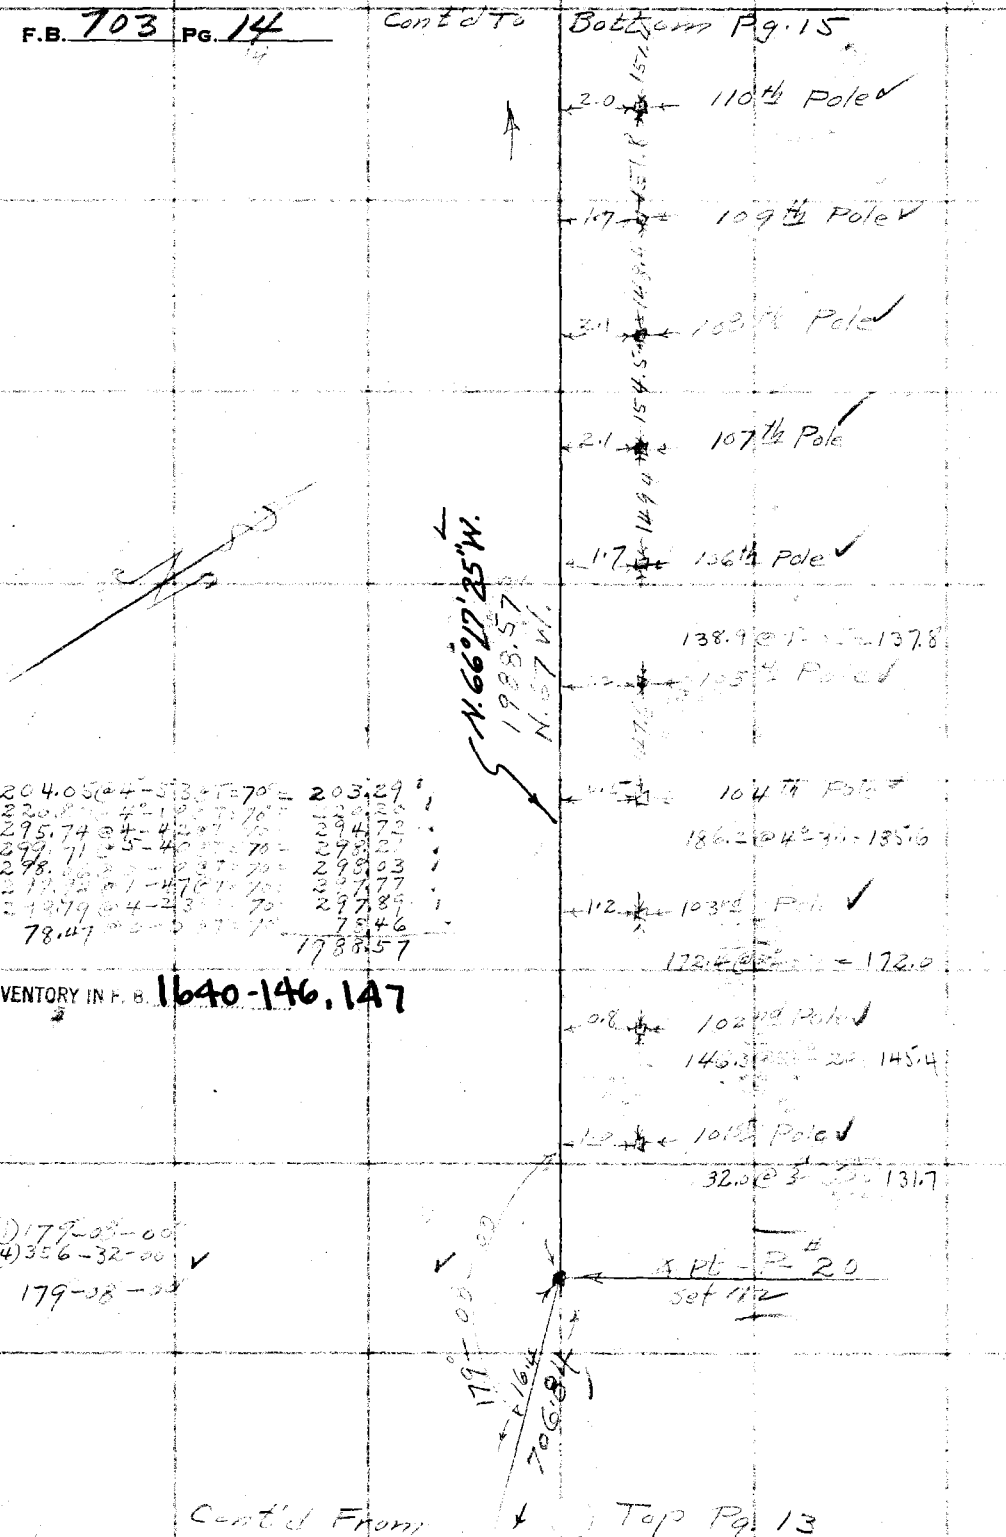


RETURN TO
LOS ANGELES COUNTY SURVEYOR
700 HALL OF RECORDS

Do not extend notes this side of this line

Note: Any Additions or Changes on This Sheet Must be Made or Circled in Red Ink With Date and Name of Person Making Change.

| | |
|---|---|
| Notes Ck'd by Drwd. R.E.M. | Survey of Level Line #107 |
| Map No. | W. O. 8094 Tape No. 58 St'd 24° F. |
| Office Work | Surveyed by C.V. Crumley |
| Checked | Notes C.V.C. Date 3-5 & 8-51 |
| Date | Indexed A. C. Sorensen |

F.B. 703 PG. 15

Note: Any Additions or Changes on This Sheet Must be Made or Circled in Red Ink With Date and Name of Person Making Change.

Do not extend notes this side of this line

RETURN TO
LOS ANGELES COUNTY SURVEYOR
700 HALL OF RECORDS

FORM 247 10M 11-35

Pole #19-45

Pole #20-45

Pole #21-45

N 82° 06' 50" W

N 81° 51' 50" W

2623.67

78.5

124.3

349.00

296.70

52.32

349.00

297.59 64° 22' 30" = 74 =

164° - 25' - 35"

(1) 164° - 25' - 30"

(4) 297° - 42' - 30"

INVENTORY IN ... 1640-147, 148

NEW JUNCTION T3/2

Pole #22-45

Trunk Line

Pt - P. # 22

Pt - P. # 21

Cut

Fill

OUT

2 Lower Wires

4 Wires

Quail Lake Line

3 Wires

Pole #22-45

Cont'd From Top Pg 14

F.B. 703 PG. 16

Cont'd To Bottom Pg. 17

199.2 @ 4°-0 = 198.7

#8-45 1.5

198.0 @ 6°-10' = 196.9

#9-45 2.3

#10-45 1.6

#11-45 2.2

INVENTORY IN F. B. 1640-148, 149

#12-45 1.8

#14-45 1.6

N. 82°06' 50" W.

299.83 @ 1°-38' BET = 74° 299.69

212.94 @ 1-38 BET = 74 212.88

292.34 @ 2-29 BET = 74 292.08

1058.25

1565.42

2623.67

111.29 @ 2-30 BET = 74 = 117.28

296.00 @ 1-38 BET = 74 = 297.40 #15-45

301.74 @ 4-29 BET = 74 = 306.19

252.29 @ 1-00 BET = 74 = 252.23

299.29 @ 1-00 BET = 74 = 299.27

279.25 @ 1-58 BET = 74 = 292.05

1565.42

N. 82° 06' 50" W. 2623.67

201.4

Pole #16-45 1.7

2102

150.0

1526

Pole #17-45 1.7

1877

Pole #18-45

Cont'd From Top Pg. 15

RETURN TO
LOS ANGELES COUNTY SURVEYOR
700 HALL OF RECORDS

Note: Any Additions or Changes on This Sheet Must be Made or Circled in Red Ink With Date and Name of Person Making Change.

Do not extend notes this side of this line

| | |
|---|---|
| Notes Ck'd by Drew C.K.R.M. | Survey of [illegible] |
| Map No. | W. O. 2994 Tape No. 62 St'd 64 °F. |
| Office Work | Surveyed by C.V. Crumley |
| Checked | Notes C.V.C. Date 2-8-27 |
| Date | Indexed A. C. Johnson |

F.B. 733 Pg. 17

Note: Any Additions or Changes on This Sheet Must be Made or Circled in Red Ink With Date and Name of Person Making Change.

Do not extend notes this side of this line

RETURN TO
LOS ANGELES COUNTY SURVEYOR
7do HALL OF RECORDS

Pole # 26-44

(1) 19°-42-20"
(4) 78-47-30
19°-41-55"

N. 62° 38' 55" W.

2245.35

#1-45

Pole # 2-45

Pole # 3-45

Pole # 4-45

INVENTORY No. 1640-149

Pole # 5-45

Pole # 6-45

N. 82° 20' 50" W.

5561.20

Pole # 7-45

Cont'd From Top Pg. 16

F.B. 703 PG. 18

Cont'd To Bottom Pg 19

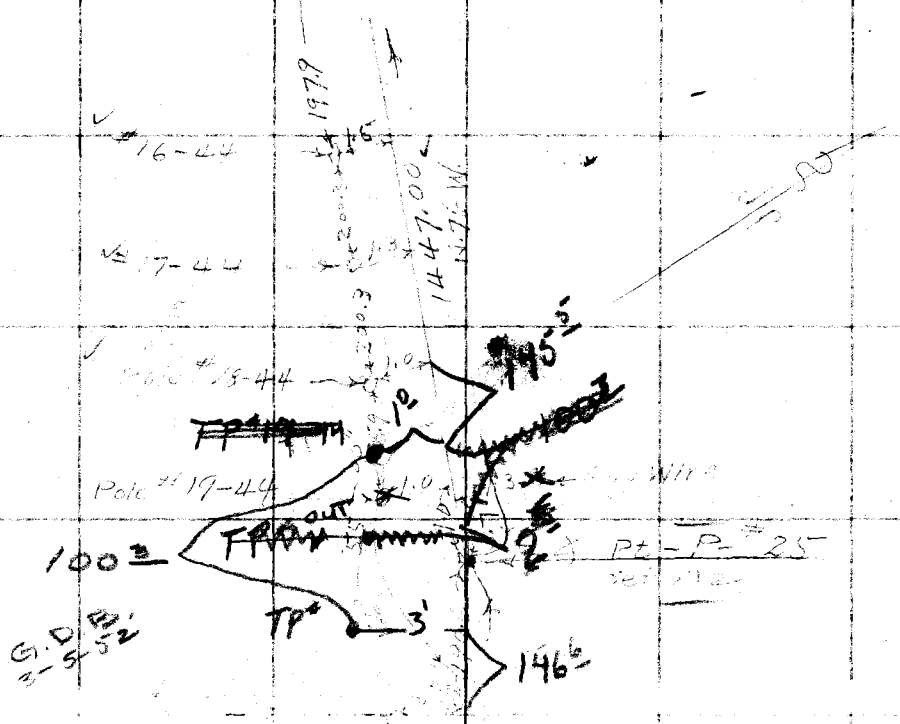


INVENTORY IN F. B. 1640-150, 151

Pole #22-44

Pole #23-44

Pole #24-44

Pole #25-44

Cont'd From Top Pg. 19

RETURN TO
LOS ANGELES COUNTY SURVEYOR
700 HALL OF RECORDS

Note: Any Additions or Changes on This Sheet Must be Made or Circled in Red Ink With Date and Name of Person Making Change.

Do not extend notes this side of this line

| | |
|---|---|
| Notes Ck'd by Drawn by KBM | Survey of Forestry Tower #2 |
| Map No. | W. O. 8094 Tape No. 62 St'd 84 °F. |
| Office Work | Surveyed by C.V. Crumley |
| Checked | Notes C.V.C. Dated 3-9-61 |
| Date | Indexed |

F.B. 722 PG. 12

Note: Any Additions or Changes on This Sheet Must be Made or Circled in Red Ink With Date and Name of Person Making Change.

Do not extend notes this side of this line

RETURN TO
LOS ANGELES COUNTY SURVEYOR
7do HALL OF RECORDS

INVENTORY NO. 1640-151

298.51 @ 0-0 @ T=68° = 298.48
300.00 @ 0-0 @ T=68° = 299.97
177.64 @ 0-0 @ T=72° = 177.63
To P.I. 77°-00'

Pt. P.I.

# 9-44

# 1-44

Pole # 11-44

N. 71°-54'-55" W.

776.08

Pt-P.I. 26
Set 1X2

Guywire
Pole # 12-44

# 13-44

176°-11'-00"

N. 25°-43'-55" W.

1447.00

Cont'd From Top Pg. 13

FORM 247 10M 11-35

F.B. 703 PG. 20

Cont'd To Bottom Pg: 21

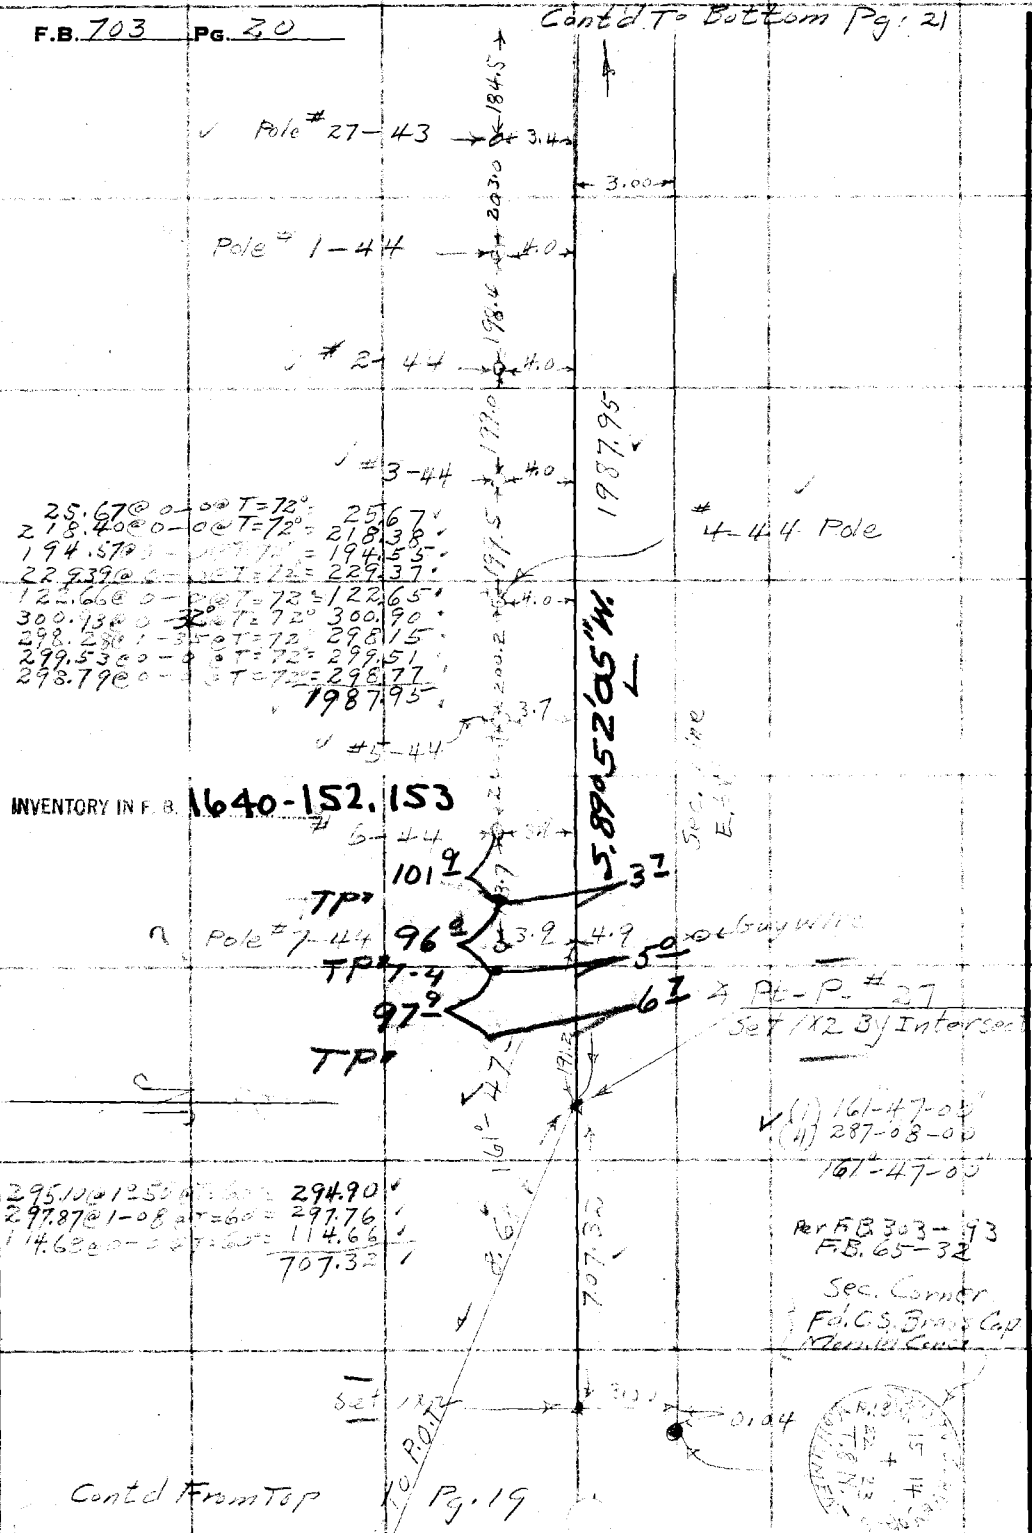


25.67 @ 0-00 T=72° = 25.67
218.40 @ 0-00 T=72° = 218.36
194.57 @ 0-00 T=72° = 194.55
229.39 @ 0-00 T=72° = 229.37
122.66 @ 0-00 T=72° = 122.65
300.13 @ 0-00 T=72° = 300.90
298.28 @ 0-00 T=72° = 298.15
299.53 @ 0-00 T=72° = 299.51
298.79 @ 0-00 T=72° = 298.77
1987.95

295.10 @ 125-00 T=60° = 294.90
297.87 @ 1-08 T=60° = 297.76
114.62 @ 0-00 T=60° = 114.66
707.32

INVENTORY IN F. B. 1640-152, 153

RETURN TO
LOS ANGELES COUNTY SURVEYOR
700 HALL OF RECORDS

Note: Any Additions or Changes on This Sheet Must be Made or Circled in Red Ink With Date and Name of Person Making Change.

Do not extend notes this side of this line

| | |
|---|---|
| Notes Ck'd by Drew & MSP | Survey of Forestry Tel. Line # 1009 |
| Map No. | W. O. 8094 Tape No. 65 St'd 74° F. |
| Office Work | Surveyed by C.V. Crumley |
| Checked | Notes C.V.C. Date 3-2-37 |
| Date | Indexed A. C. Johnson |

F.B. 703 PG. 21

Note: Any Additions or Changes on This Sheet Must be Made or Circled in Red Ink With Date and Name of Person Making Change.

Do not extend notes this side of this line

RETURN TO
LOS ANGELES COUNTY SURVEYOR
700 HALL OF RECORDS

FORM 247 10M 11-38

Cont'd From ( Top ) Page 20

Pole # 18-43 1.5

+ 3.0

V # 19-43 2.0

Pole # 20-43 2.0

200.1

197.0

INVENTORY NO. 1640-153,154

| | | |
|---|---|---|
| 300.72 | @ 1-53 CT = | 70° = 300.72 |
| 299.84 | @ 0- 0 CT = | 70° = 299.84 |
| 299.71 | @ 3-30 CT = | 70° = 299.71 |
| 298.53 | @ 2-35 CT = | 70° = 298.53 |
| 297.94 | @ 2-00 CT = | 70° = 297.94 |
| 296.77 | @ 0-0 CT = | 70° = 296.77 |
| 300.43 | @ 2-32 CT = | 70° = 300.43 |
| 244.67 | @ 1-25 CT = | 70° = 244.67 |
| 233.61 | @ 1-45 CT = | 70° = 233.61 |
| | | 2561.42 |

#21-43 2.4

#22-43 2.7

2561.42

201.5

#23-43 3.2

200.9

Pole # 24-43 2.8

201.6

197.1

Pole # 25-43 3.1

P.O.T.

Set 1/2" I.P. W/Stake Found at Quail Lake School

5.0

192.0

E. & W.

#119 Per Meserve Forestry

121.3

T.P.

201.5

97½

1757.95

3.0

184.1

3.00

F.B. 703 Pg. 22

Cont'd To Bottom Pg. 23

298.10 @ 11°-50' @ T=70° = 272.16'
70.89 @ 10°-44' @ T=70° = 69.64'
341.80'

(1) 179°-52-30"
(4) 359-30-00
179°-52-30"

Calc # 9-43

196.00 @ 5°-20' = 195.52

N.65°41'55"W. 261.69'

Pole # 10-43

E.A.F. 1-6-42

4 Pt. P-29 Set 1x2

Sec. Cor
Fd. Brass Cap Mon.
Marked As Shown
Per F.B. 303-93
F.B. 65-32

Set 1x2

129.5

127.9

1.8

N.65°34'55"W. 341.80'

118.30 @ T=70° = 118.29

141.8 @ 13-30 = 137.9

Guy Wire

4 Pole # 12-43

4 Pt. P-28
Set 1x2

INVENTORY IN F.B. 1640-154,155

# 13-43

# 14-43

# 15-43

Pole # 17-42

S.89°52'05"W. 2561.42

Sec. Line
E & W.

(1) 155°-26-30
(4) 261-46-10
155°-26-30

Cont'd From Top Pg. 21

RETURN TO
LOS ANGELES COUNTY SURVEYOR
700 HALL OF RECORDS

Do not extend notes this side of this line

Note: Any Additions or Changes on This Sheet Must be Made or Circled in Red Ink With Date and Name of Person Making Change.

| | | | |
|---|---|---|---|
| Notes Ck'd by | | Survey of | F.B. PG. 82 |
| Map No. | | W. O. 8094 Tape No. | St'd °F. |
| Office Work | | Surveyed by E.V. Crumley | |
| Checked | | Notes | Date |
| Date | | Indexed | |

Cont'd To

Note: Any Additions or Changes on This Sheet Must be Made or Circled in Red Ink With Date and Name of Person Making Change.

Do not extend notes this side of this line

RETURN TO
LOS ANGELES COUNTY SURVEYOR
7dO HALL OF RECORDS

INVENTORY IN 1640 - 155,156

Cont'd From Top Pg. 22

FORM 247 10M 11-35

F.B. 703 Pg. 24

Cont'd To Bottom Pg. 25

Pole #16-42

At Hwy Crossing

Pole #17-42

1.0 on Line

INVENTORY NO. 1640-157

N. 64°13'25" W.

1443.00

Pole #33-42

Pole #24-42

Cont'd From Top Pg. 23

RETURN TO
LOS ANGELES COUNTY SURVEYOR
700 HALL OF RECORDS

Note: Any Additions or Changes on This Sheet Must be Made or Circled in Red Ink With Date and Name of Person Making Change.

Do not extend notes this side of this line

| | | | |
|---|---|---|---|
| Notes Ck'd by Drew Chisp. | Survey of | | F.B. 743 Pg. 25 |
| Map No. | W. O. | Tape No. St'd °F. | |
| Office Work | Surveyed by | | |
| Checked | Notes | Date | |
| Date | Indexed | | |

Cont'd To Bk. 2 Lvl 1 Pg. 26

Pole #9-45

402.59

P.O.T. Sta 1 X 2

102.59 + 55 = 157.57

P.O.T. Sta 1 X 2

(1) 157°-59-00
(+) 0-11-56-30
157°-47-05

Pole #8-42

Note: Any Additions or Changes on This Sheet Must be Made in Red Ink With Date and Name of Person Making Change.

Do not extend notes this side of this line

INVENTORY IN F. B. 1640-158

N. 64° 13' 25" W.

Pole #11-42

Pole #12-42

Pole #13-42

1626.79

254.50 @ 1° 00' = 254.37
294.00 @ 0° 05' = 294.76
246.64 @ 1° 47' 50" = 246.68
298.00 @ 1° 15' 56" = 298.27
298.50 @ 3° 15' 56" = 297.97
234.00 @ 0° 30' = 234.33
1626.79

Pole #14-42

Pole #15-42

RETURN TO
LOS ANGELES COUNTY SURVEYOR
700 HALL OF RECORDS

Cont'd From Top Pg. 24

FORM 247 10M 11-35

Cont'd To Bottom Pg. 27

F.B. 703 Pg. 26

(1) 172° 14' 00"
(4) 328 - 56 - 00
172 - 14 - 00 ✓

Pole #1-42 2.5

172° 14' 00" 456.62

Soft 1.2

138.48

N. 58° 03' 00" W.

(1) 15 27 - 30
(4) 207 - 50 - 30
159 - 27 - 30 ✓

Pole #2-42 Soft 1.2

INVENTORY IN F. B. 1640 - 158, 159

Pole #3-42

129'

104'

N. 78° 35' 25" W.

275.71 275.56
203.83 203.83
214.40 214.40
693.14

Pole #4-42 1.7

693.14

189.5
44.0
233.5

Pole #5-42

106.00 - 56 = 105.96
296.18 296.21
402.59

Pole #6-42

(1) 172 - 21 - 05
(4) 327 - 24 - 30
172 - 21 - 05

N. 18° 04' 20" W.

402.59

E.A.P. 1-6-42

Cont'd From Top Pg. 25

RETURN TO
LOS ANGELES COUNTY SURVEYOR
700 HALL OF RECORDS

Note: Any Additions or Changes on This Sheet Must be Made in Red Ink or Circled and Name of Person Making Change.

Do not extend notes this side of this line

| | |
|---|---|
| Notes Ck'd by Dixon 6/1952 | Survey of |
| Map No. | W. O. 1094 Tape No. 68 St'd 84 °F. |
| Office Work | Surveyed by C.V. Crumley |
| Checked | Notes C.V.C. Date 3-30-37 |
| Date | Indexed A. C. Johnson |

F.B. 7 Pg. 27

Cont'd To Balloon Page 28

N. 72°10'45" W.

Note: Pole #27-41 Tag 12
Attached to Pole #26-41
this line - 400 ft.

254.65 @ T=58° = 354.61
117.77 @ T=58° = 117.75
372.36

#26-41

#28-41

150°-36'-00"
209-24
150-36-05

S 78°26'00" W.

INVENTORY IN F.B. 1640-159

T 17 29 4N

16

#36
set 1/2"

90.4

90.5 @ 2°-5'

N. 62°48'35" W.

52.5

141°-06'-00"
209-24-30
141-06-05

295.40

TP

42

169.8

Pole #30-41

300.75
155.67
456.02

176°-51'-05"

N. 65° 49'00" W.

Cont'd From Top Pg. 26

Note: Any Additions or Changes on This Sheet Must be Made or Circled in Red Ink With Date and Name of Person Making Change.

Do not extend notes this side of this line

RETURN TO
LOS ANGELES COUNTY SURVEYOR
700 HALL OF RECORDS

FORM 247 10M 11-38

F.B. 703 PG. 28

Cont'd To Bottom Pg. 29

SEE GENERAL PLAT

CO FOR NEW POLE LOCATIONS

TO HOTEL

N.60°40'25"W. 10 MM

Pole #17-41

Pole #18-41

Pole #19-41

Pole #20-41

Pole #21-41

Pole #22-41

Pole #25-41 - Lower Cross Arm 4 Wires Running Thru 2 Wires Connecting Line Arm S.W. Shown on Middle Cross Arm

Pole #25-41 - Top Cross Arm 4 Wires Running Thru 3 Wires Connecting Line S.W. From S.W.

Pole #25-41 - Middle Cross Arm 10 Wires Coming In From S.W. At ±90°

Pole #25-41

Pole #25-41

Forestry Line

Cont'd From Top Pg. 27

RETURN TO
LOS ANGELES COUNTY SURVEYOR
700 HALL OF RECORDS

Note: Any Additions or Changes on This Sheet Must be Made or Circled in Red Ink With Date and Name of Person Making Change.

Do not extend notes this side of this line

| | |
|---|---|
| Notes Ck'd by Drew & M.S.F. | Survey of |
| Map No. | W. O. 8094 Tape No. St'd 74°F. |
| Office Work | Surveyed by C.V. Crumley |
| Checked | Notes C.V.C. Date 4-5-37 |
| Date | Indexed A. C. Johnson |

F.B. 703 Pg. 29

Cont'd To Bottom Pg. 30

N 70° 38' 45" W.

N 70° 34' 45" W.

N 65° 57' 00" W.

Pole #10-41

Pole #11-41

Pole #12-41

Pole #13-41

Pole #14-41

Pole #15-41

Pole #16-41

Cont'd From Top Pg. 28

Note: Any Additions or Changes on This Sheet Must be Made or Circled in Red Ink With Date and Name of Person Making Change

Do not extend notes this side of this line

RETURN TO
LOS ANGELES COUNTY SURVEYOR
700 HALL OF RECORDS

FORM 247 10M 11-35

F.B. 703 PG. 30

Cont'd To Bottom Pg. 31

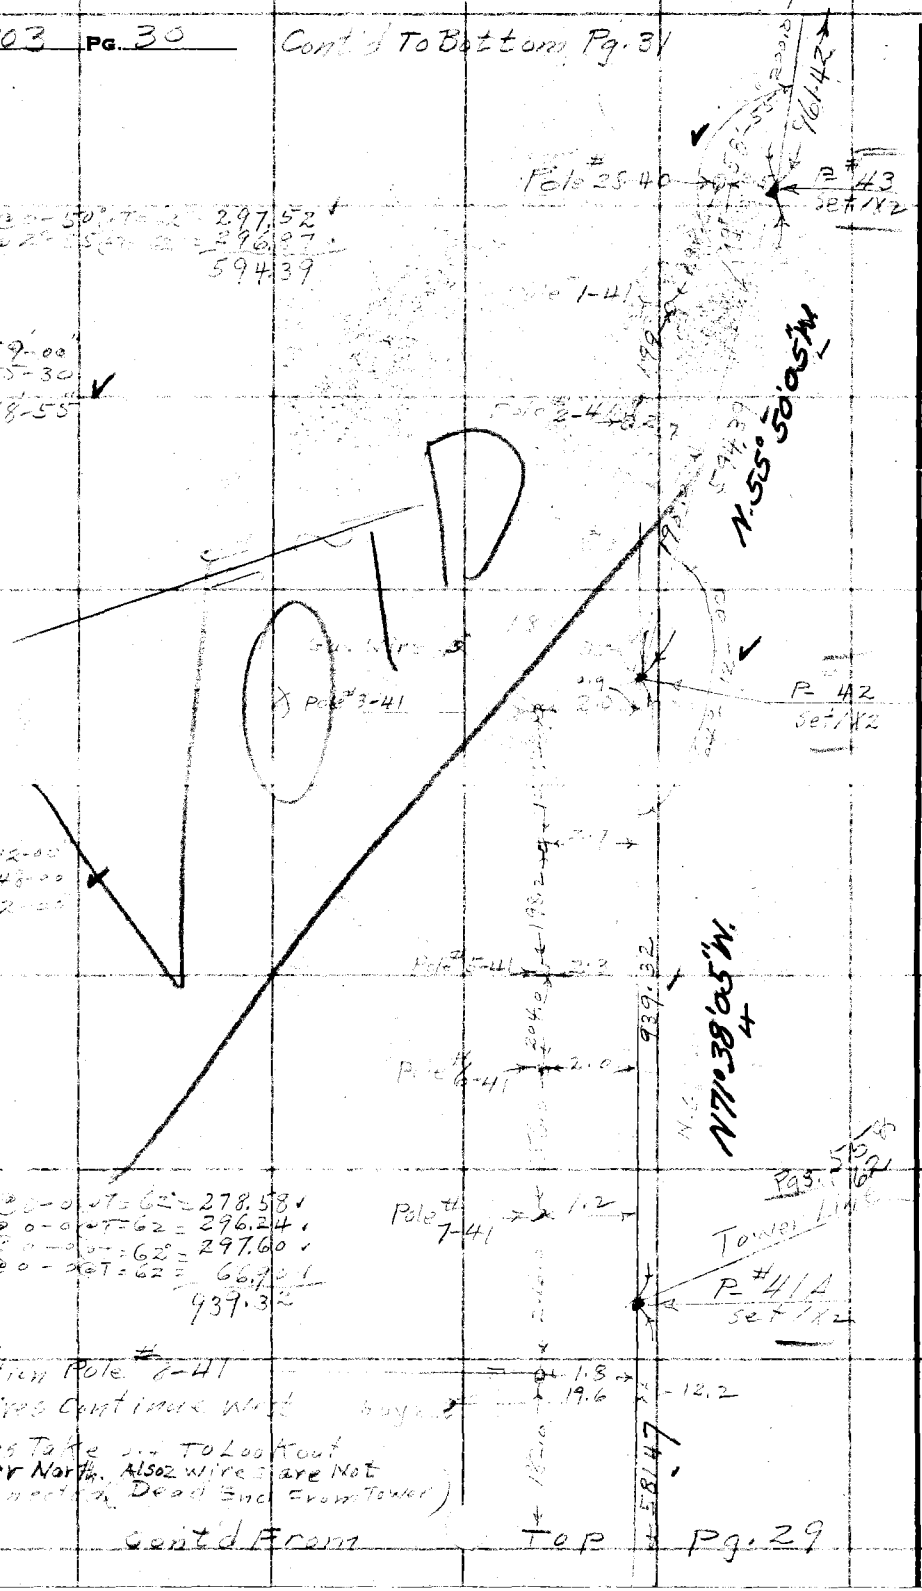


(1) 179-59-00
(4) 359-55-30
179°-58'-55"

(1) 164-12-00
(4) 296-48-00
164-12-00

RETURN TO
LOS ANGELES COUNTY SURVEYOR
700 HALL OF RECORDS

Note: Any Additions or Changes on This Sheet Must be Made or Circled in Red Ink With Date and Name of Person Making Change.

Do not extend notes this side of this line

| | |
|---|---|
| Notes Ck'd by Lam. | Survey of |
| Map No. | W. O. 2914 Tape No. St'd °F. |
| Office Work | Surveyed by C.K. Crumley |
| Checked | Notes Date |
| Date | Indexed A. C. Johnson |

F.B. 7-3 Pg. 31

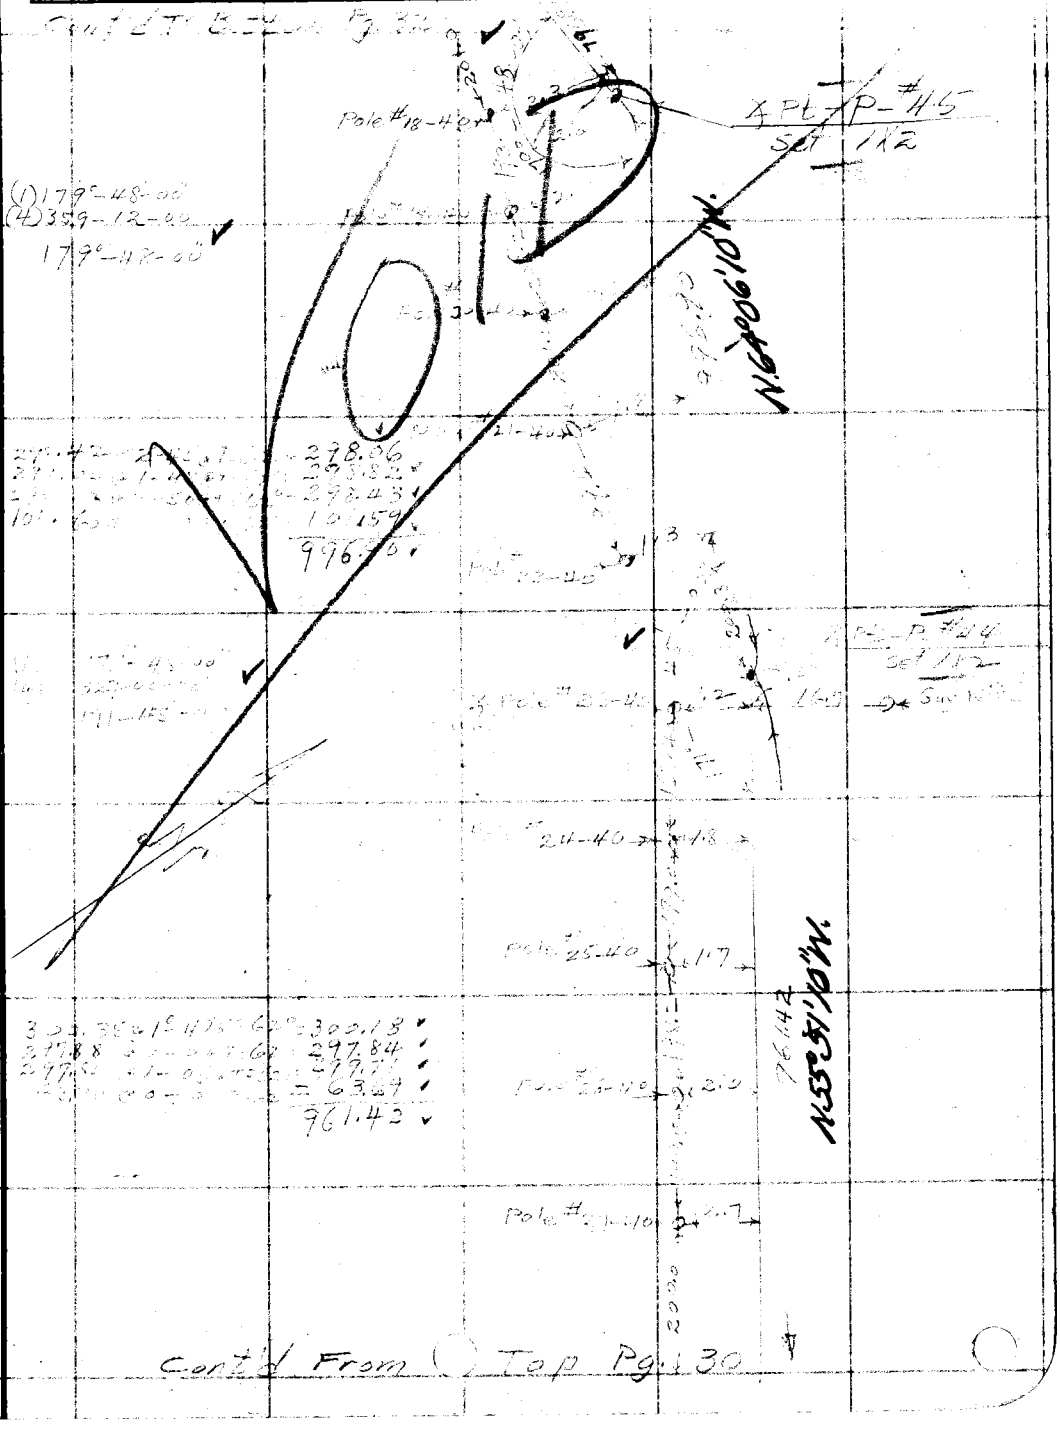


Cont'd From Top Pg. 30

RETURN TO
LOS ANGELES COUNTY SURVEYOR
7OD HALL OF RECORDS

Note: Any Additions or Changes on This Sheet Must be Made or Circled in Red Ink With Date and Name of Person Making Change.

Do not extend notes this side of this line

FORM 247 10M 11-38

F.B. 703 PG. 32

Cont'd To Bottom Pg. 33

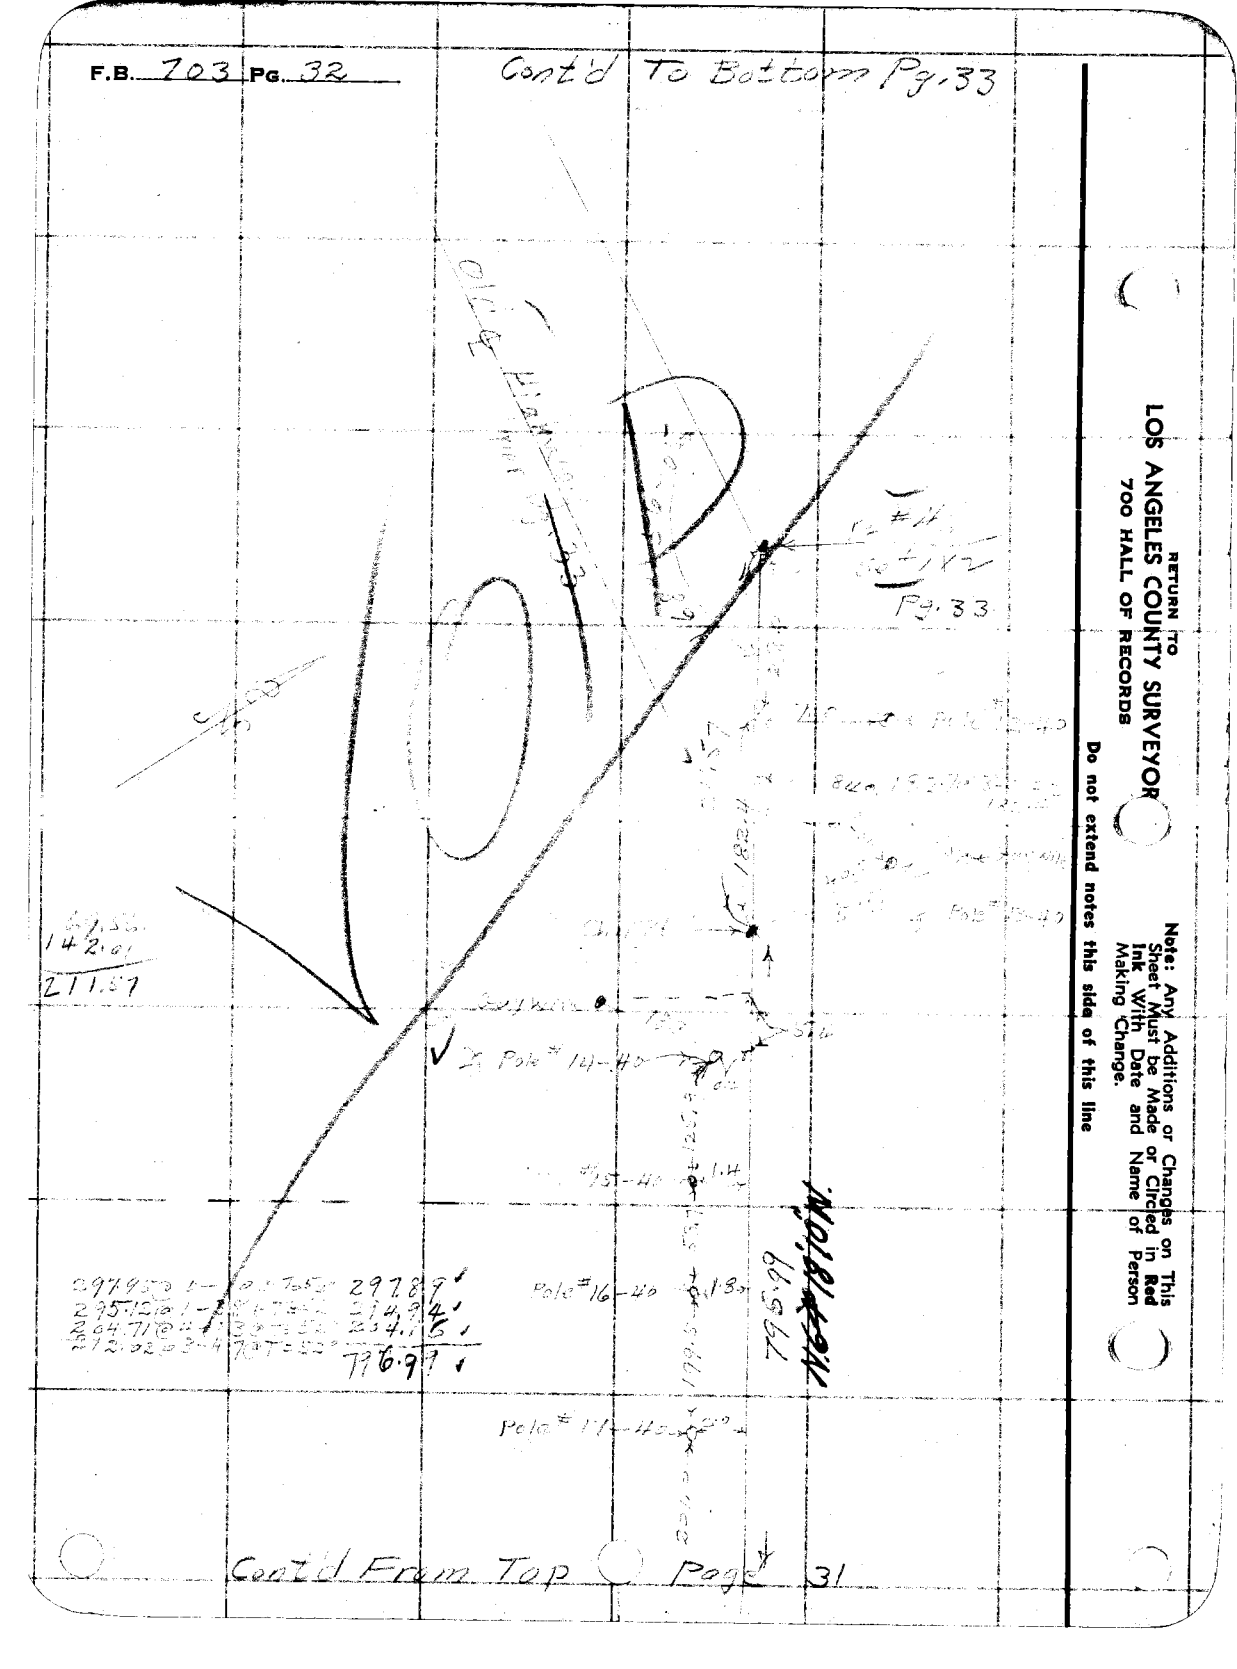


RETURN TO
LOS ANGELES COUNTY SURVEYOR
700 HALL OF RECORDS

Note: Any Additions or Changes on This Sheet Must be Made or Circled in Red Ink With Date and Name of Person Making Change.

Do not extend notes this side of this line

Cont'd From Top Page 31

| | |
|---|---|
| Notes Ck'd by R.A.M. | Survey of Forestry Trail #1 |
| Map No. | W. O. 8094 Tape No. 68 St'd 74° F. |
| Office Work | Surveyed by T. V. Crumley |
| Checked | Notes Calc. Date 4-6-37 |
| Date | Indexed |

F.B. 702 Pg. 33

Cont'd To Next Pg. 34

B.C. ± 20 Lt. Fd. 6" Nail
± 20 Ft. E. of Culvert #
K 459+50

N. 75° 22' 45" W.
116.42

Note: Any Additions or Changes on This Sheet Must be Made in Red Ink or Circled With Date and Name of Person Making Change

Do not extend notes this side of this line

RETURN TO
LOS ANGELES COUNTY SURVEYOR
700 HALL OF RECORDS

State Highway
Old Ridge Route

"P" Line

(1) 168°-56'-05"
(4) 315°-44'-55"
168°-56'-05"

142.70 @ 2°-30' @ T=54° = 142.01

69.57 @ T=54° = 47.06

76.54 - T = 54° = 76.33
76.55 - T = 54 = 76.54

Pg. 32 - Chiseled

± 40 W. - Culvert # K-453+50

E.C. - Fd. 6"x6" Conc. Mon.

Fd. 6" L Nail

37.95
40.36

E.C. Fd. 6"x6" Conc. Mon.

Fd. Shingle Nail

Cont'd From Top Pg. 32

FORM 247 10M 11-35

F.B. 703 PG. 34 Cont'd To Bottom Pg. 35

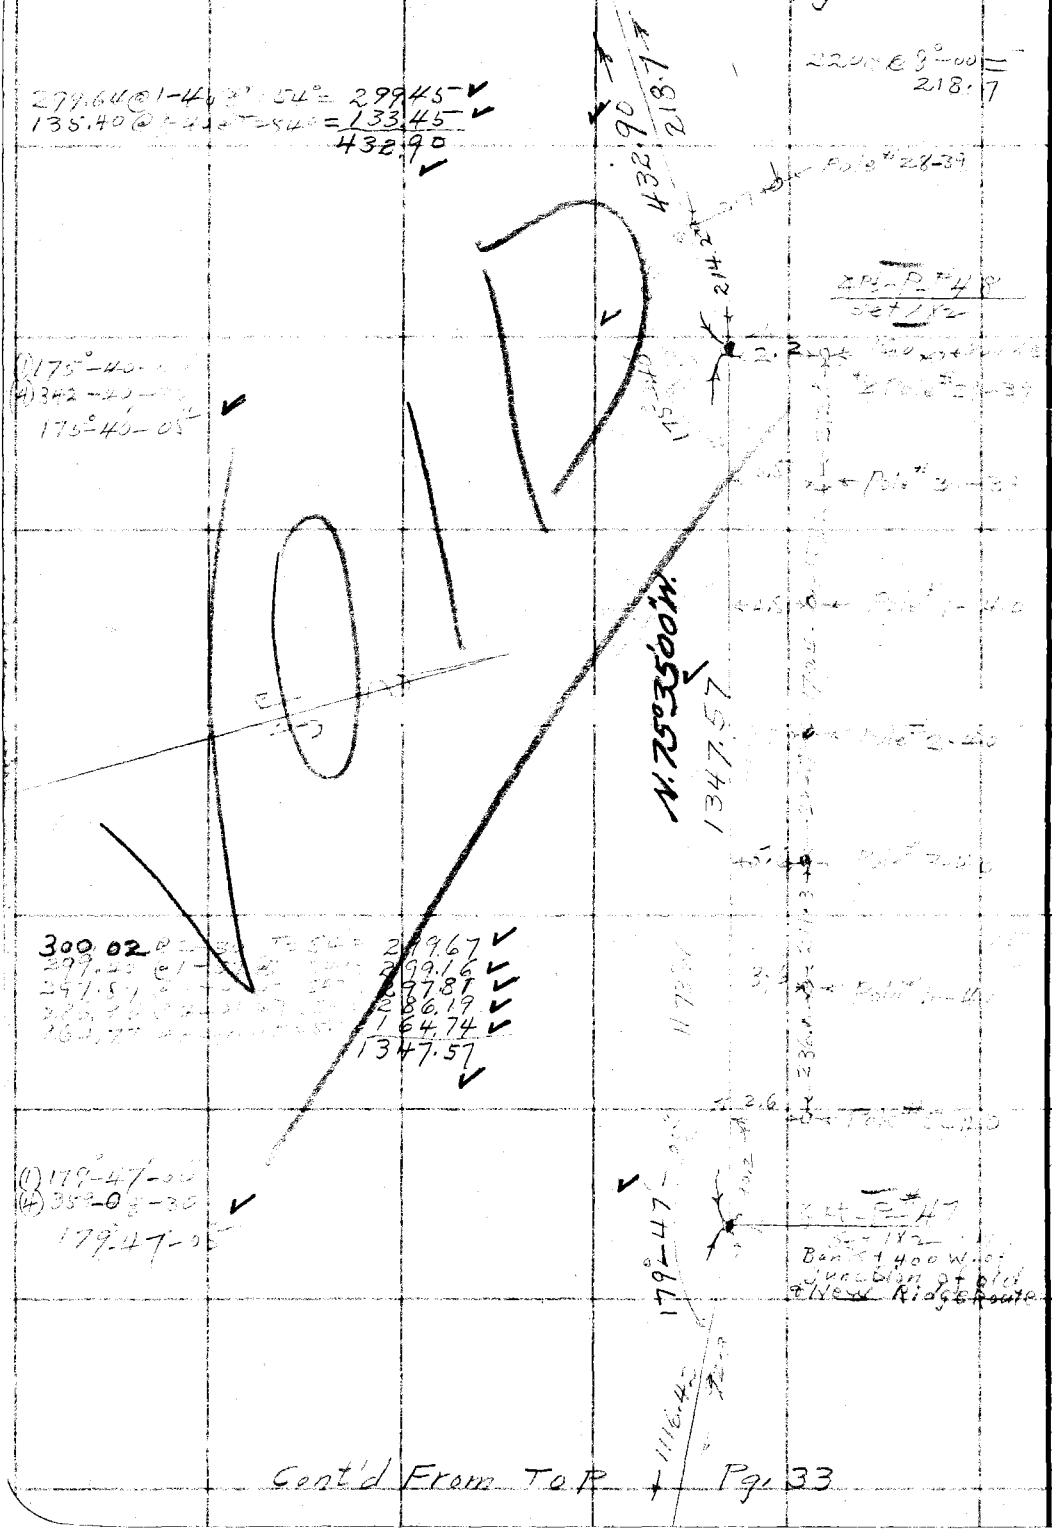


RETURN TO
LOS ANGELES COUNTY SURVEYOR
700 HALL OF RECORDS

Note: Any Additions or Changes on This Sheet Must be Made or Circled in Red Ink With Date and Name of Person Making Change.

Do not extend notes this side of this line

| | |
|---|---|
| Notes Ck'd by | Survey of |
| Map No. | W. O. Tape No. St'd • F. |
| Office Work | Surveyed by C.V. Crumley |
| Checked | Notes C.V.C. Date |
| Date | Indexed A. C. Johnson |

F.B. 703 Pg. 35

Cont'd To Page No. 36

Note: Any Additions or Changes on This Sheet Must be Made or Circled in Red Ink With Date and Name of Person Making Change

Do not extend notes this side of this line

RETURN TO
LOS ANGELES COUNTY SURVEYOR
700 HALL OF RECORDS

Guy Pole

Pole 23-39

Pole 24-39

Pole 21-39

Guy Wire

N. 25° 33' 30" W.

N. 79° 54' 55" W.

N. 25° 33' 30" W.

Cont'd From Pg. 34

FORM 247 10M 11-38

F.B. 703 PG. 36

Cont'd To Bottom Pg. 37

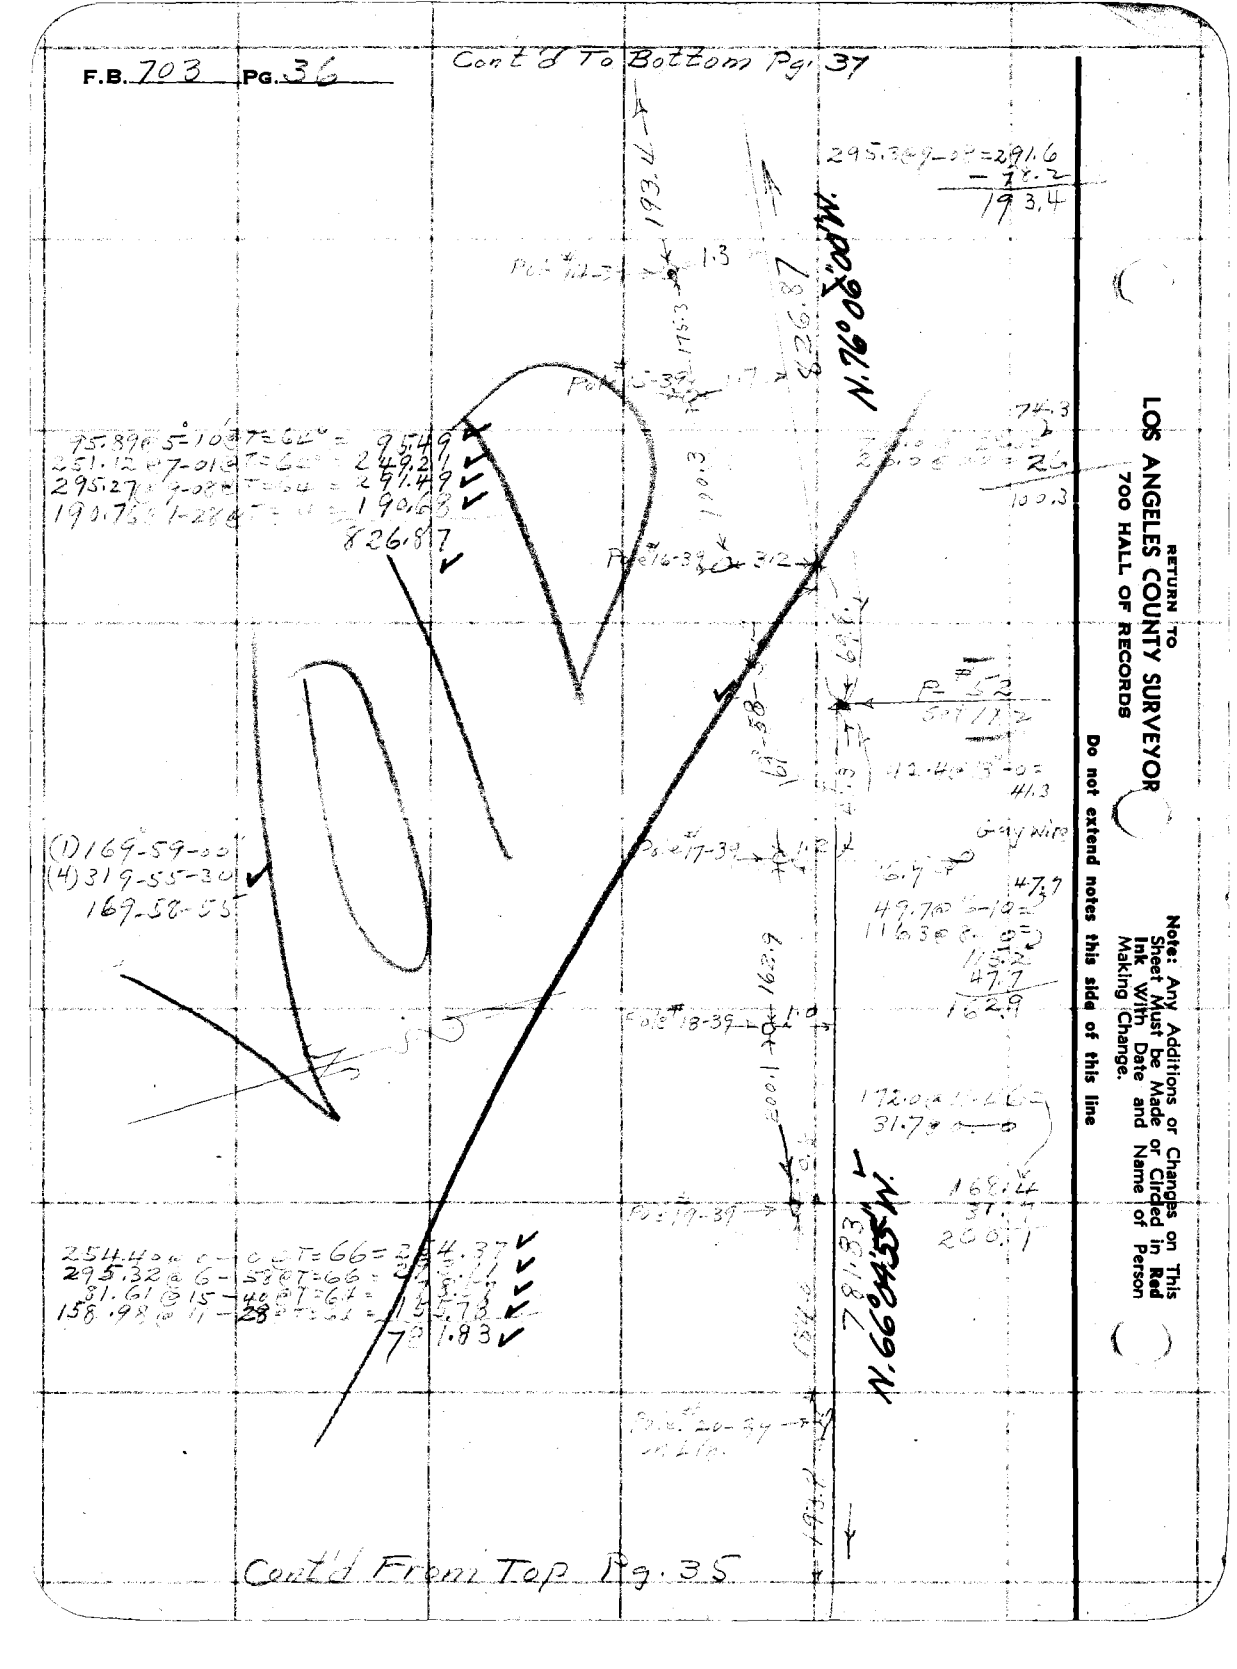


Cont'd From Top Pg. 35

RETURN TO
LOS ANGELES COUNTY SURVEYOR
700 HALL OF RECORDS

Note: Any Additions or Changes on This Sheet Must be Made or Circled in Red Ink With Date and Name of Person Making Change.

Do not extend notes this side of this line

| | |
|---|---|
| Notes Ck'd by K.R.M. | Survey of Forestry Tennis Flag |
| Map No. | W. O. 5694 Tape No. 68 St'd 54 °F. |
| Office Work | Surveyed by C.V. Crumley |
| Checked | Notes C.V.C. Date |
| Date | Indexed E. C. Johnson |



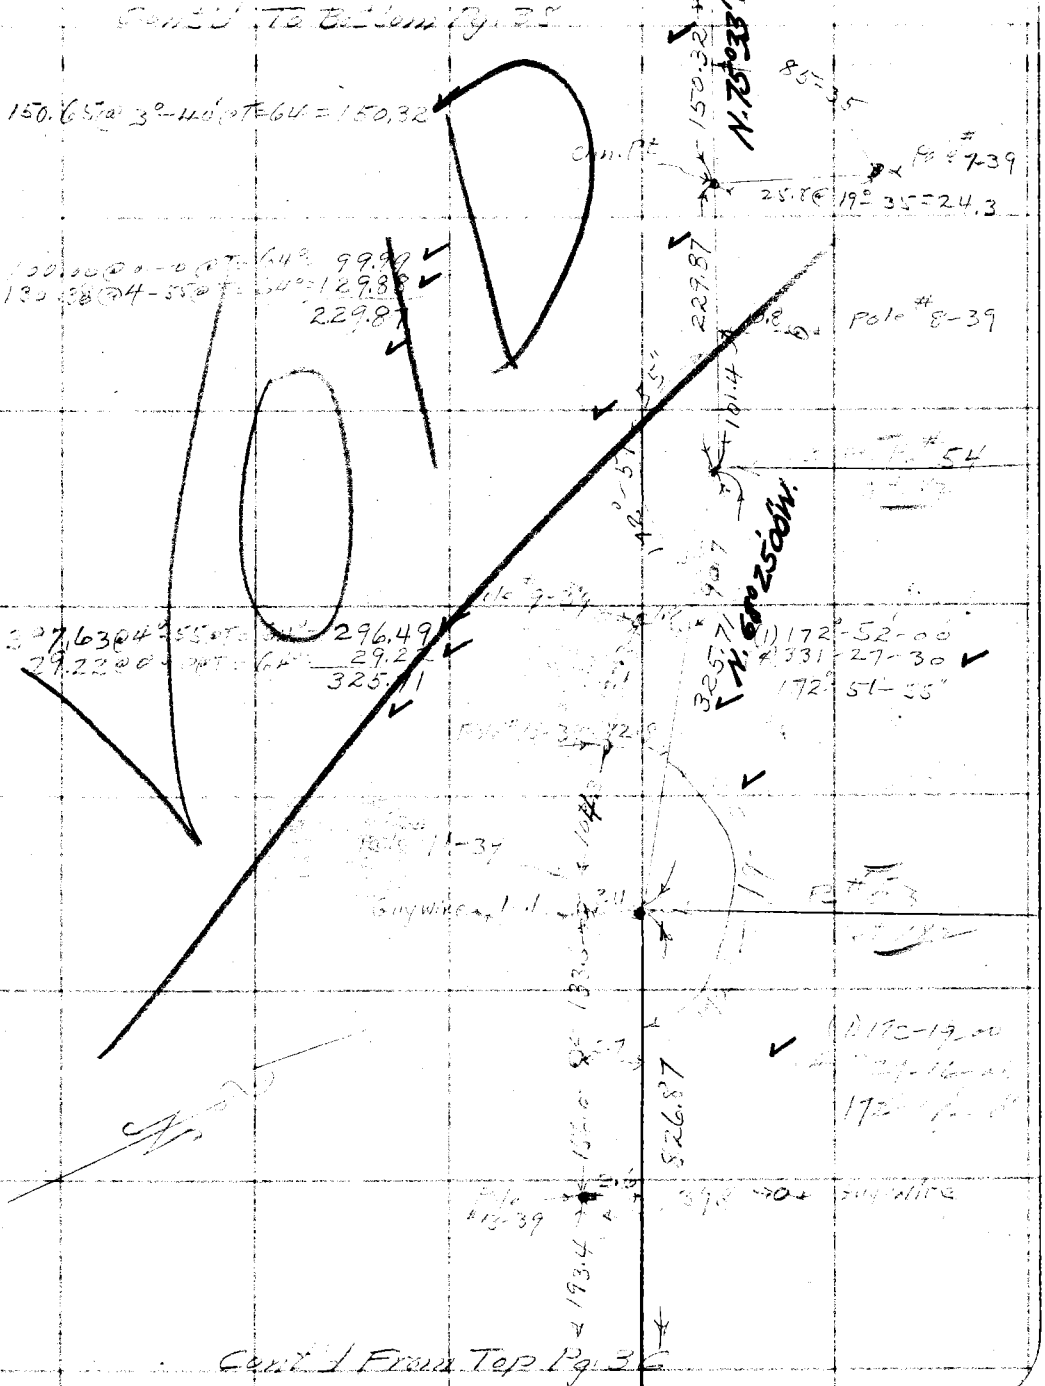



RETURN TO
LOS ANGELES COUNTY SURVEYOR
700 HALL OF RECORDS

Note: Any Additions or Changes on This Sheet Must be Made or Circled in Red Ink With Date and Name of Person Making Change.

Do not extend notes this side of this line

FORM 247 10M 11-38

F.B. 703 Pg. 38

Cont'd To Bottom Pg. 39



Pole # 1-39

Pole # 2-39

Pole # 3-39

Pole # 4-39

Pole # 5-39

Pole # 6-39

Cont'd From Top Pg. 37

RETURN TO
LOS ANGELES COUNTY SURVEYOR
700 HALL OF RECORDS

Note: Any Additions or Changes on This Sheet Must be Made or Circled in Red Ink With Date and Name of Person Making Change.

Do not extend notes this side of this line

143
(Reserve For: Dept.)

| | |
|---|---|
| Notes Ck'd by R.A.M. | Survey of Forest of Tellus Map |
| Map No. | W. O. 2594 Tape No. 68 St'd 8-4 F. |
| Office Work | Surveyed by C.V. Crumley |
| Checked | Notes C.V.C. Date [illegible] |
| Date | A. C. Johnson Indexed |

F.B. 733 Pg. 39

Cont'd From Bottom Pg 40

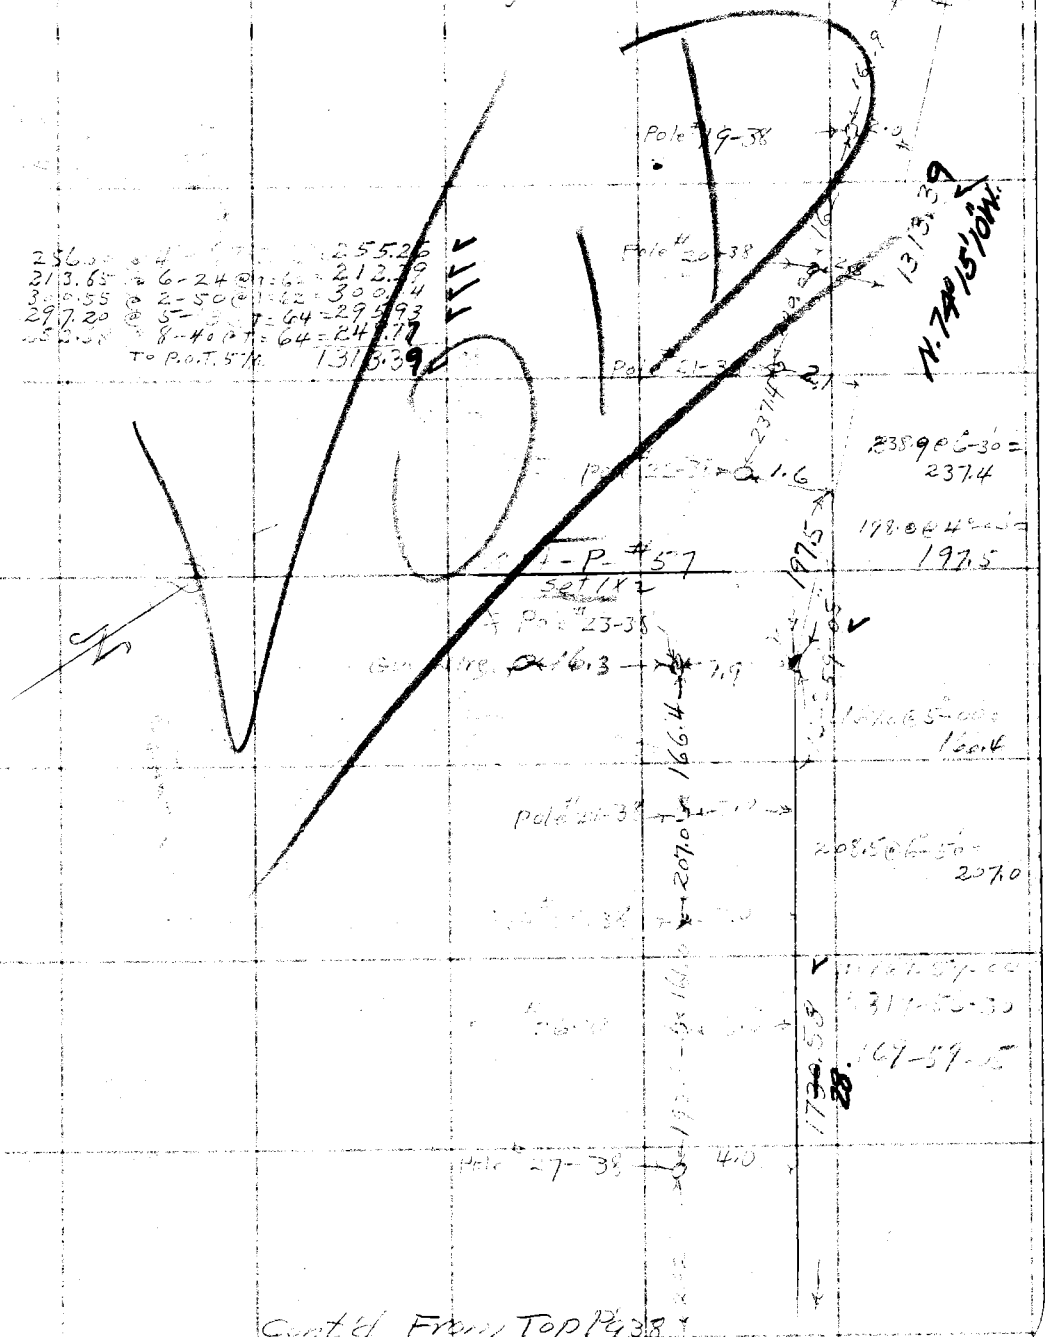
Pole 19-38
Pole 20-38
Pole 21-38
Pole 23-38
Pole 27-38
N. 74°15'10" W.
1313.39
237.4
197.5
166.4
207.0

F.B. 703 PG. 40 Cont'd To Bottom Pg 41

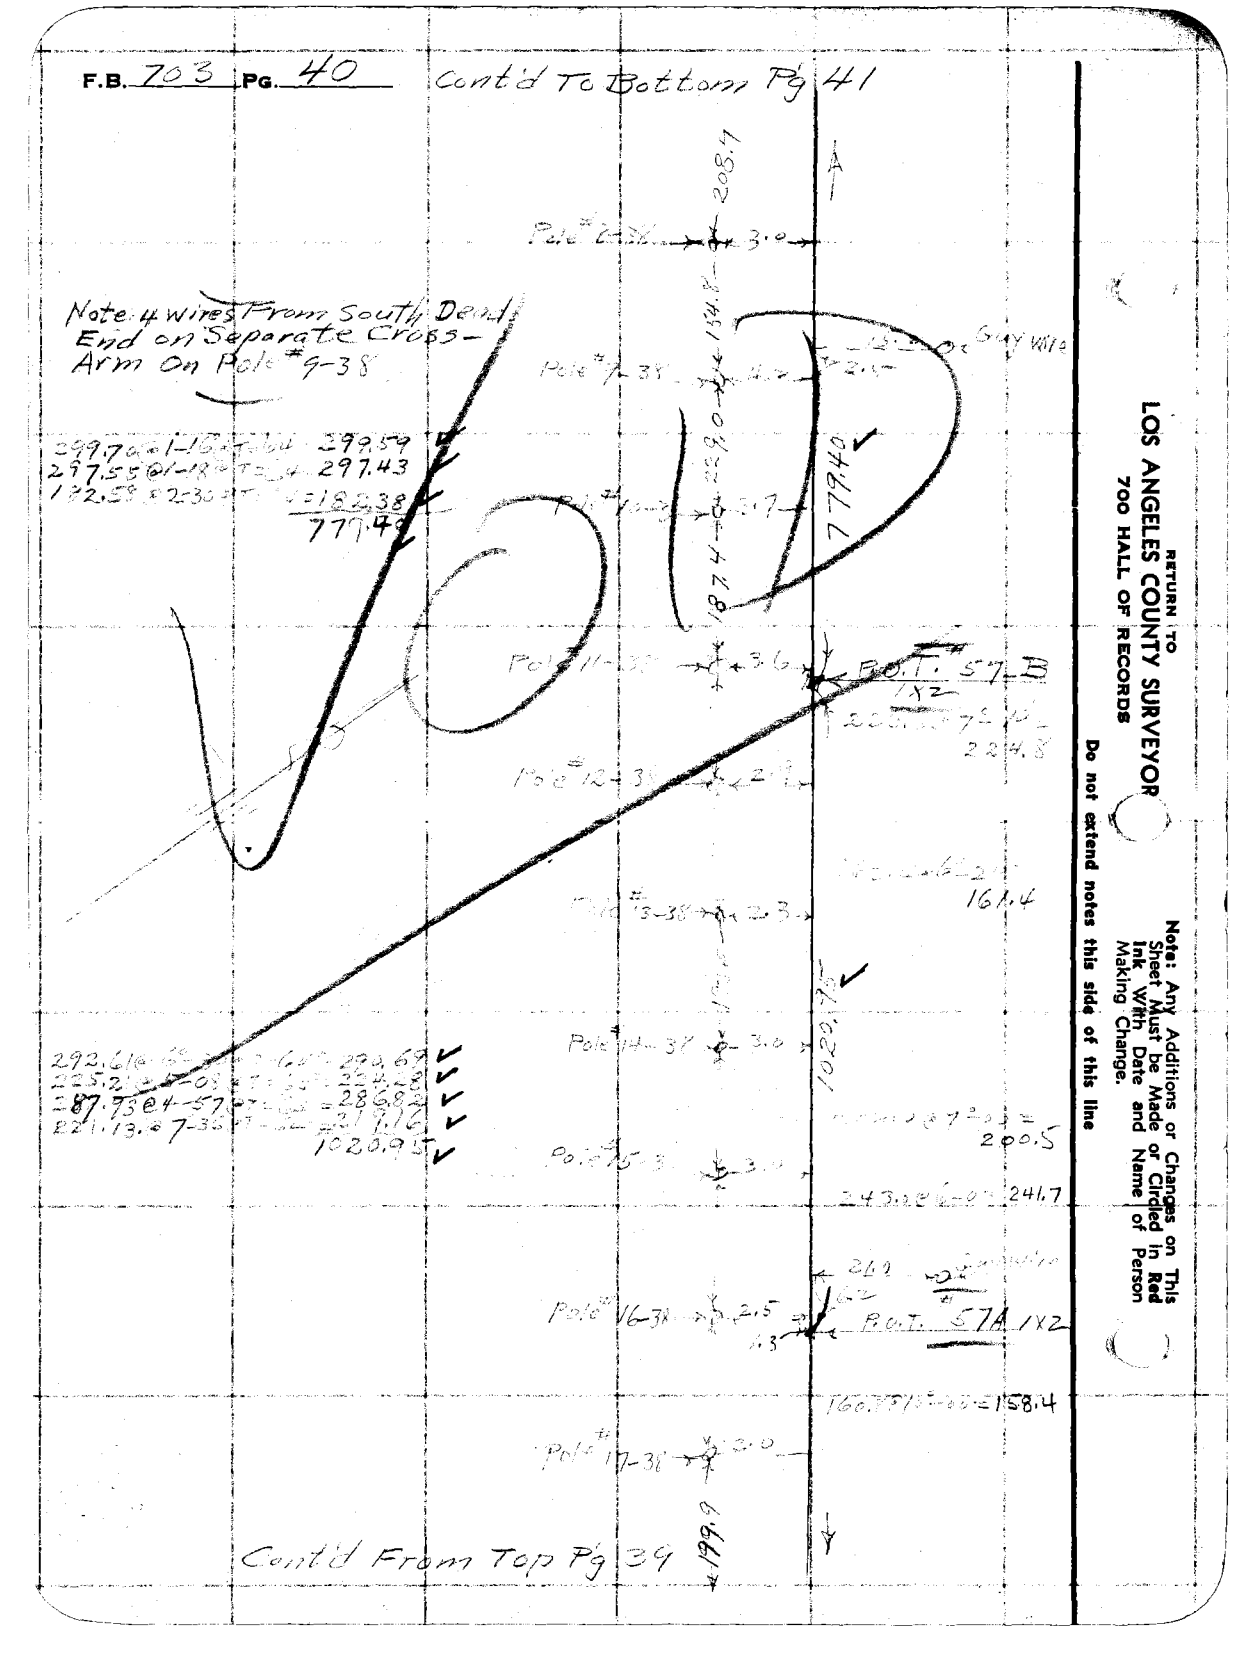


RETURN TO
LOS ANGELES COUNTY SURVEYOR
700 HALL OF RECORDS

Note: Any Additions or Changes on This Sheet Must be Made or Circled in Red Ink With Date and Name of Person Making Change.

Do not extend notes this side of this line

| | |
|---|---|
| Notes Ck'd by | Survey of Forestry Tract #147 |
| Map No. | W. O. 8094 Tape No. 68 St'd. 24 °F. |
| Office Work | Surveyed by C.V. Crumley |
| Checked | Notes C.V.C. Date 4-12-1 |
| Date | Indexed |

F.B. 703 PG. 41

Sta 1+12 Bottom Pg 42

N.68°39'05"W.

N.68°06'12"W.

Pole #6-32

Pole #7-35

Pole #8-34

Pole #5-33

Sta 1+12

Sta 2+20

Sta 3+59

179°33'-00"

179°32'-57"

173°57'-00"

335°24'-00"

173°57'-00"

Cont'd From Top Pg 40

209.03°00=

FORM 247 10M 11-38

RETURN TO
LOS ANGELES COUNTY SURVEYOR
700 HALL OF RECORDS

Note: Any Additions or Changes on This Sheet Must be Made or Circled in Red Ink With Date and Name of Person Making Change.

Do not extend notes this side of this line

F.B. 703 Pg. 42

Cont'd To Bottom Pg. 43

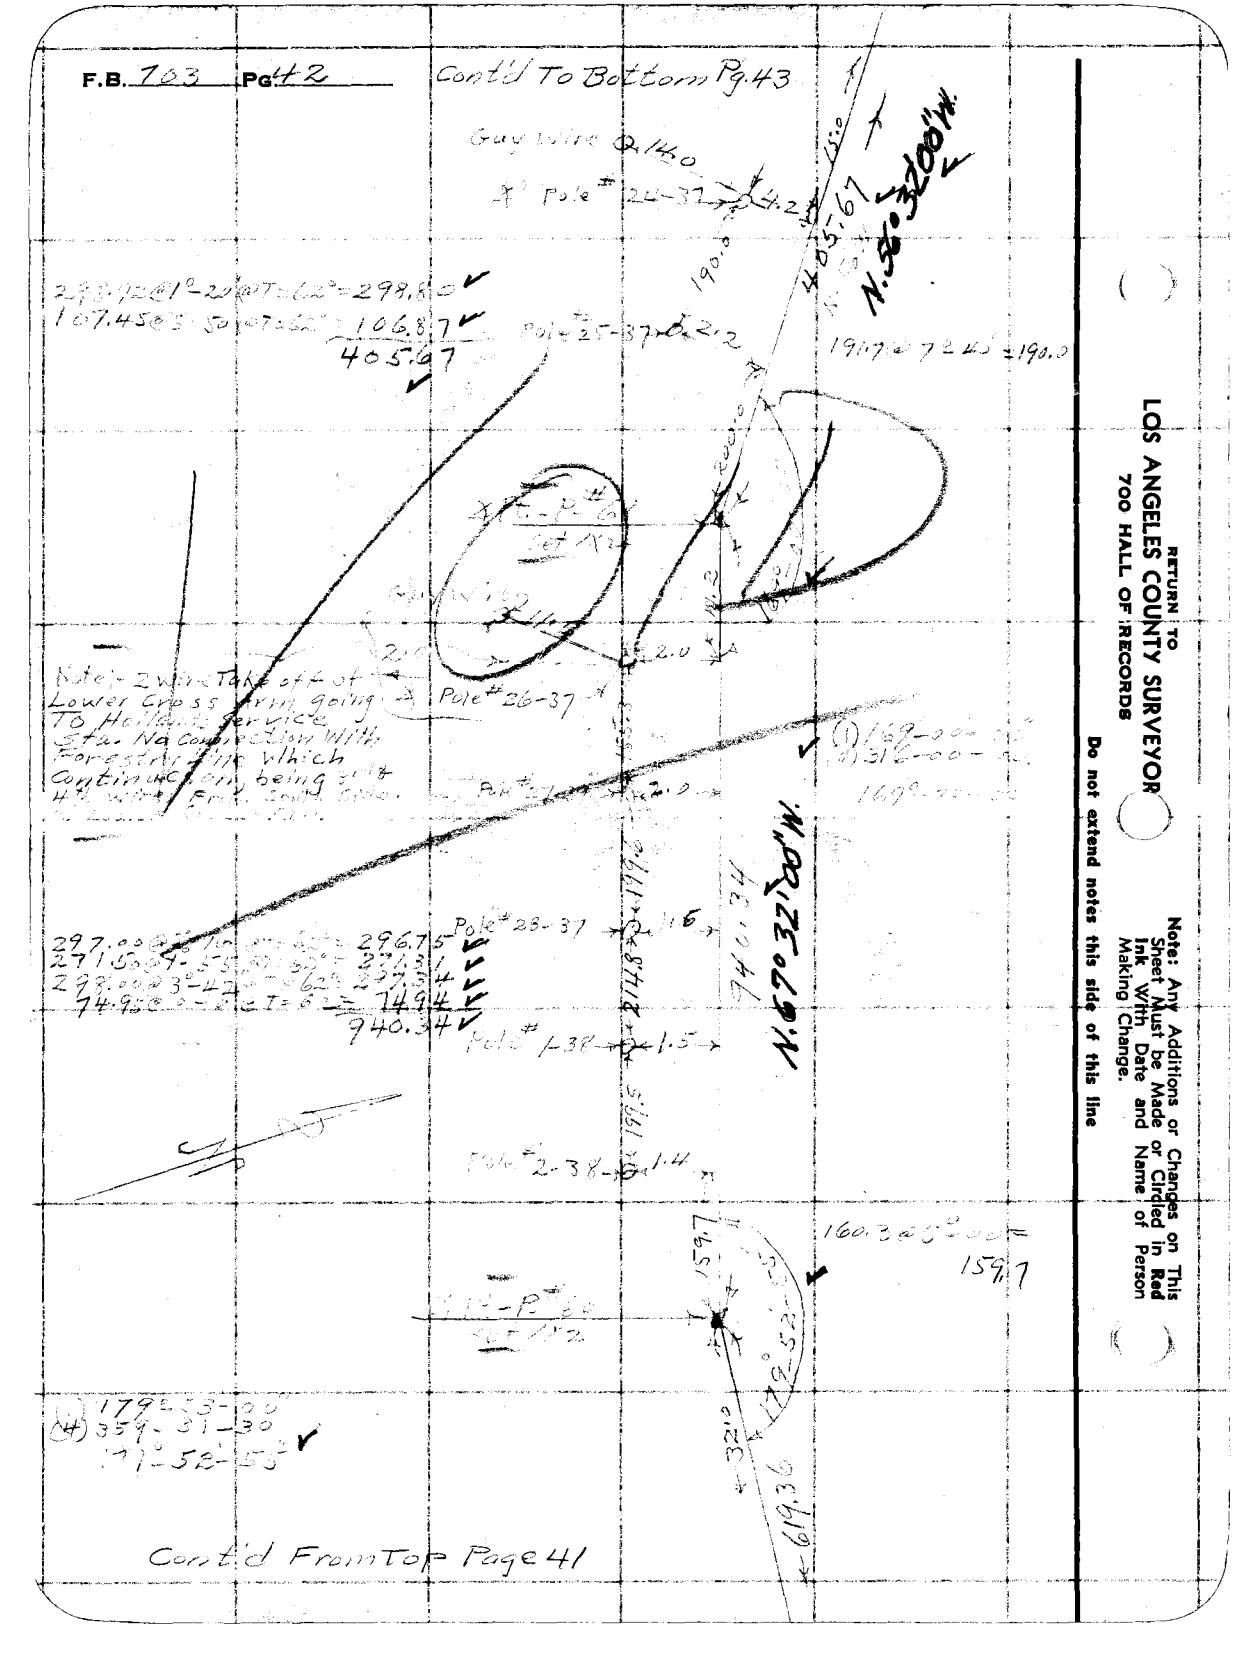


RETURN TO
LOS ANGELES COUNTY SURVEYOR
700 HALL OF RECORDS

Note: Any Additions or Changes on This Sheet Must be Made or Circled in Red Ink With Date and Name of Person Making Change.

Do not extend notes this side of this line

| | |
|---|---|
| Notes Ck'd by K.R.M. | Survey of Forestry Planting #6 |
| Map No. | W. O. 8074 Tape No. 65 St'd 64 °F. |
| Office Work | Surveyed by C.V. Grumley |
| Checked | Notes C.V.G. Date 4-13-37 |
| Date | Indexed A. C. Johnson |

F.B. 7 3 PG. 41

Note: Any Additions or Changes on This Sheet Must be Made or Circled in Red Ink With Date and Name of Person Making Change.

Do not extend notes this side of this line

RETURN TO
LOS ANGELES COUNTY SURVEYOR
700 HALL OF RECORDS

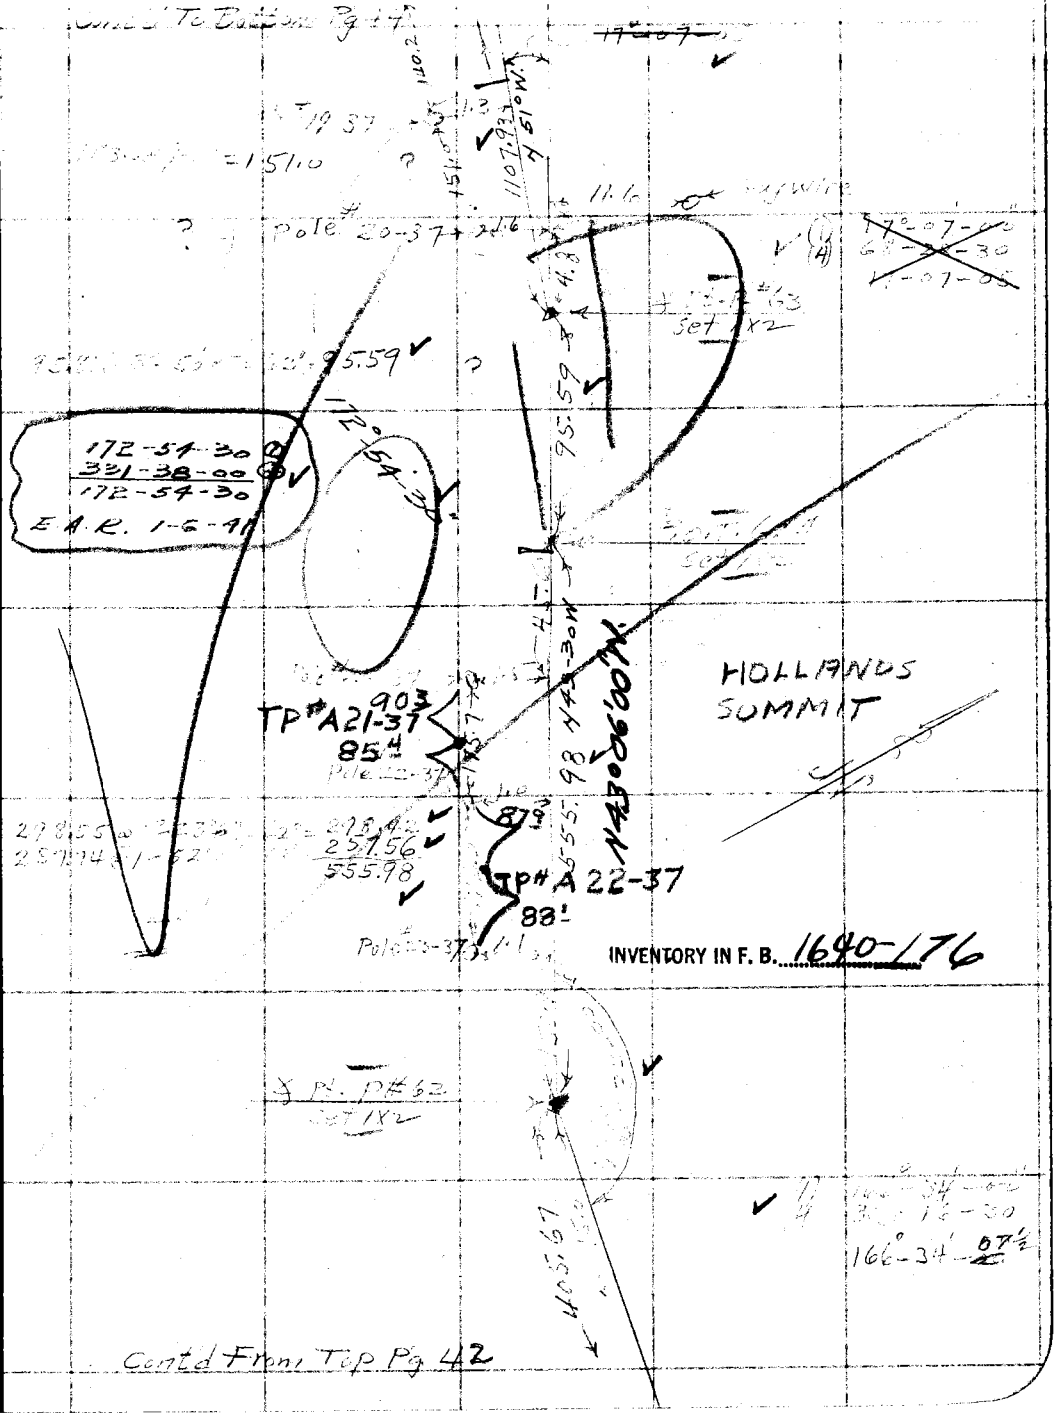


FORM 247 10M 11-36

F.B. 703 Pg. 44 Cont'd To Bottom Pg 45

SEE G.P. For Pole LOCATIONS

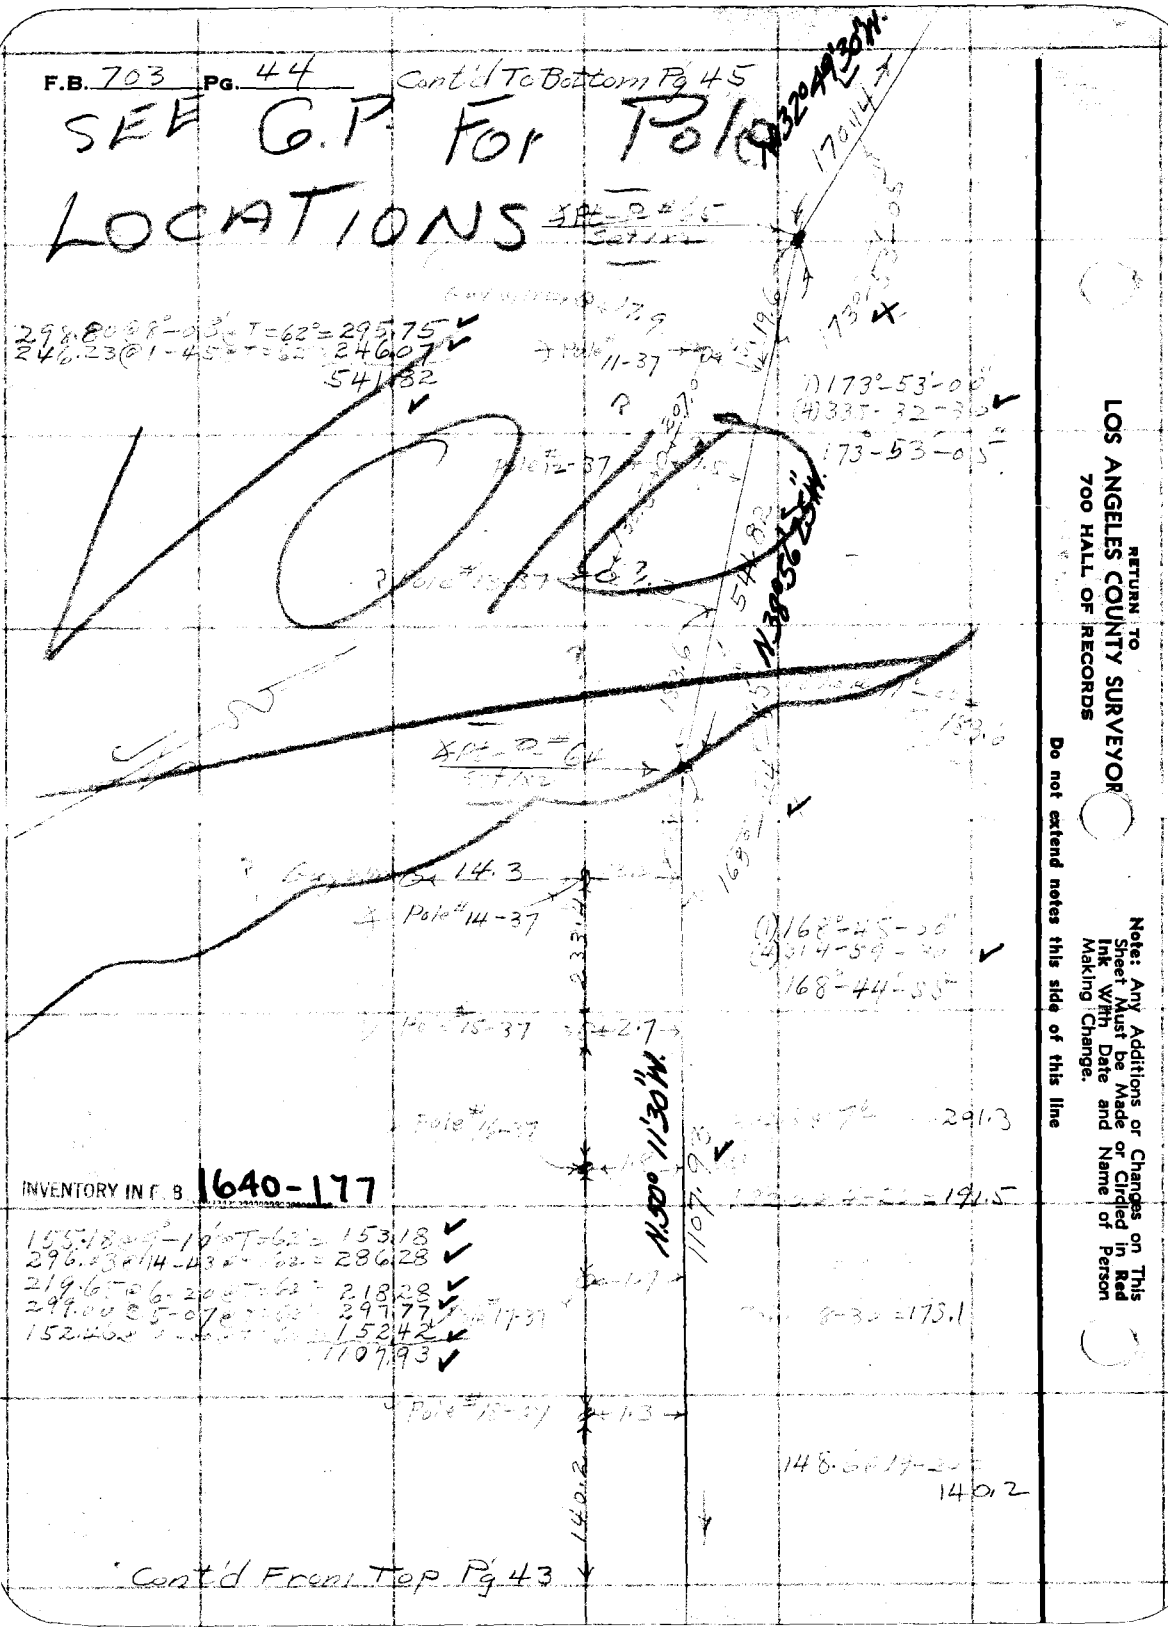


INVENTORY IN F. B. 1640-177

RETURN TO LOS ANGELES COUNTY SURVEYOR 700 HALL OF RECORDS

Note: Any Additions or Changes on This Sheet Must be Made or Circled in Red Ink With Date and Name of Person Making Change.

Do not extend notes this side of this line

| | |
|---|---|
| Notes Ck'd by K.R.M. | Survey of Eng. Lyndale Tract |
| Map No. | W. O. 8014 Tape No. 69 St'd 4 °F. |
| Office Work | Surveyed by C.V. Tumlin |
| Checked | Notes C.V.T. Date 4-13-37 |
| Date | Indexed |

F.B. 703 Pg. 11 C

Cont'd To Bottom Pg 12

N. 19°32'35" W.

297.54 297.26
297.80 297.58
298.34 298.19
298.13 298.76
291.23 290.88
40.16
1584.05

Pole #5-37

1524.0

196.0

Pole #6-37

167°-52'-00"
311°-28'-00"
167°-52'-00"

INVENTORY IN F.B. 1640-178

132.4

Pole #7-37 1.4

N. 31°40'33" W.

723.08

Pole #8-37 1.0

297.92
295.58
129.58

Pole #9-37

215.2

Pole #10-37

S.F.P. 6-66

170.14

Cont'd From Top Pg 44

RETURN TO
LOS ANGELES COUNTY SURVEYOR
700 HALL OF RECORDS

Note: Any Additions or Changes on This Sheet Must be Made or Circled in Red Ink With Date and Name of Person Making Change

Do not extend notes this side of this line

FORM 247 10M 11-36

F.B. 703 Pg. 46

Cont'd To Bottom Page 47

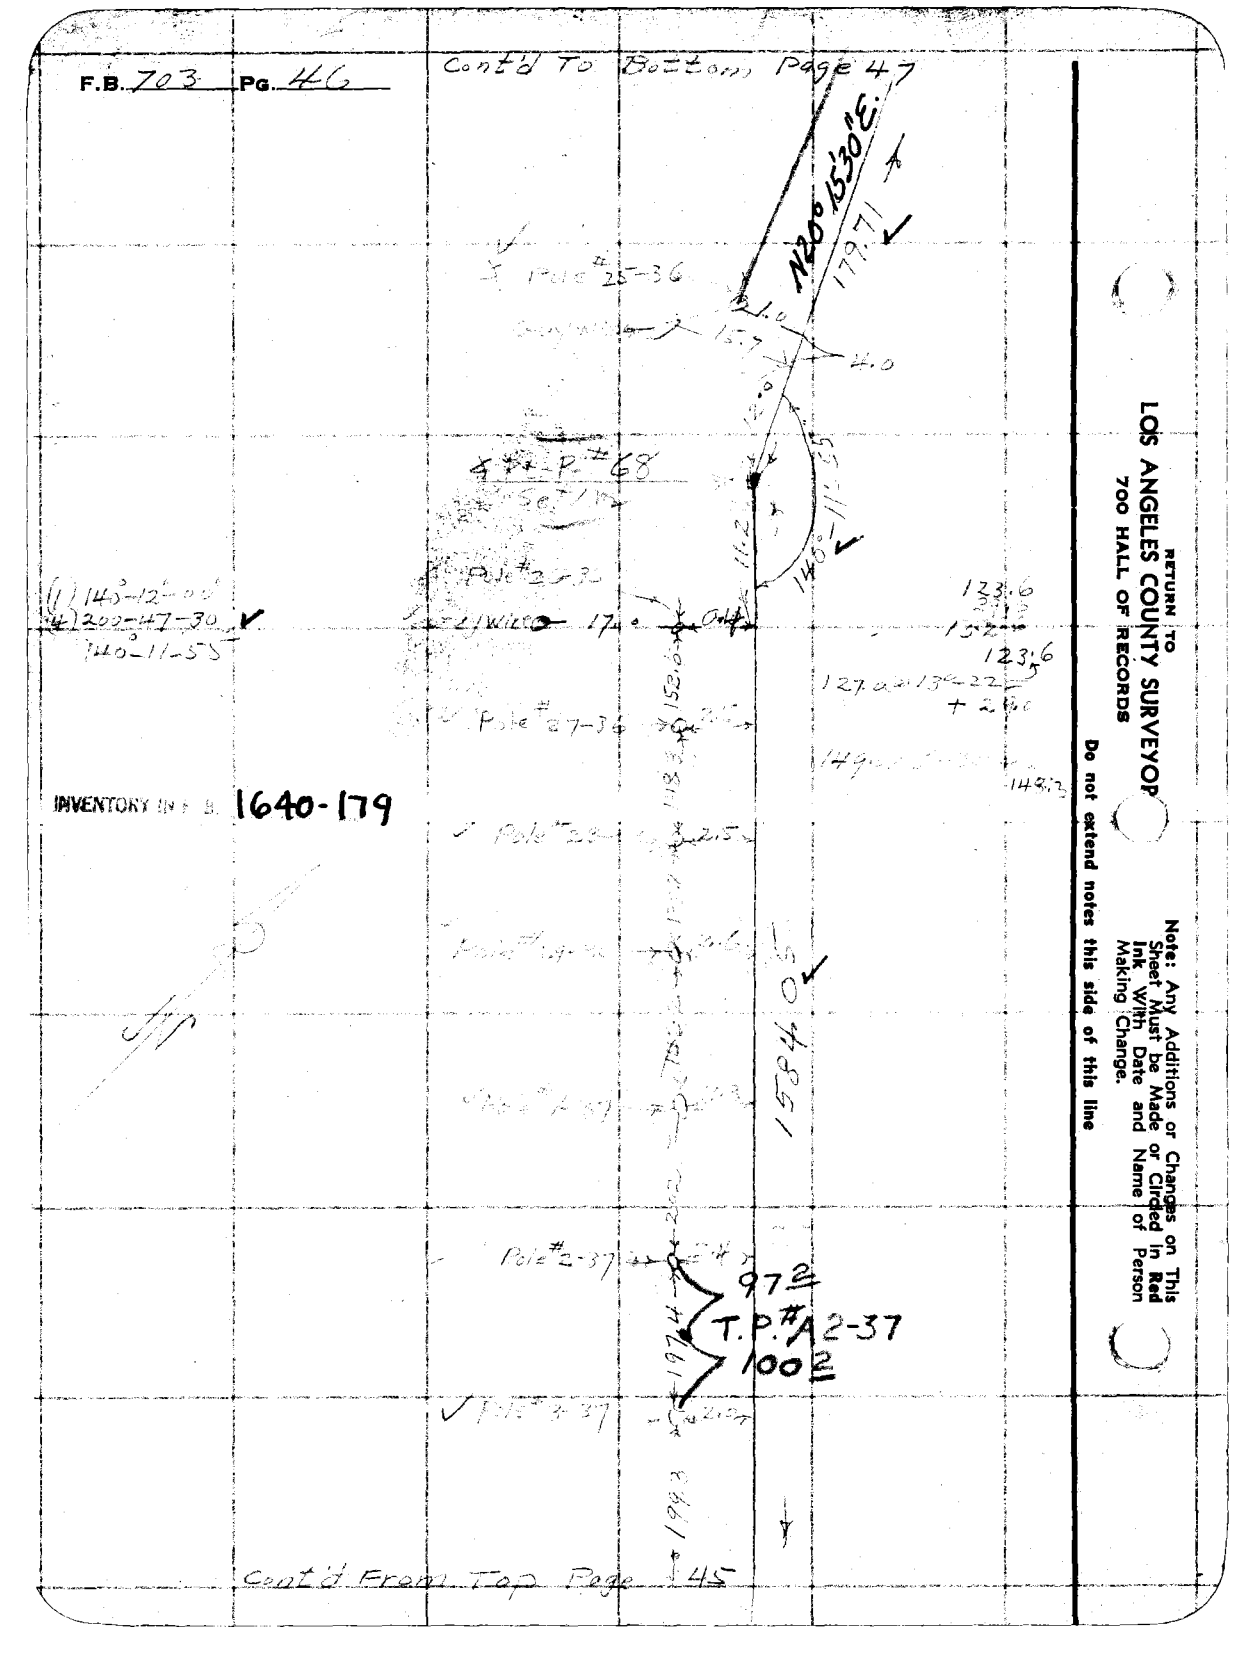


INVENTORY IN F. B. 1640-179

RETURN TO
LOS ANGELES COUNTY SURVEYOR
700 HALL OF RECORDS

Do not extend notes this side of this line

Note: Any Additions or Changes on This Sheet Must be Made or Circled in Red Ink With Date and Name of Person Making Change.

| | |
|---|---|
| Notes Ck'd by R.R.M. | Survey of Foothill Tollway #7 |
| Map No. | W. O. 8094 Tape No. 65 St'd 68° F. |
| Office Work | Surveyed by C.V. Crumley |
| Checked | Notes C.V. Crumley Date 4-15-57 |
| Date | Indexed |

F.B. 7[illegible] PG. 47

Note: Any Additions or Changes on This Sheet Must be Made or Circled in Red Ink With Date and Name of Person Making Change!

Do not extend notes this side of this line

RETURN TO
LOS ANGELES COUNTY SURVEYOR
700 HALL OF RECORDS

FORM 247 10M 11-38

INVENTORY IN F. B. 1640-180

TP A18-36

TP A19-36

TP A20-36

TP 21-36

Pole 22-36

Pole 22A-36

Guy Wire
Pole # 23-36

Pole # 24A-36

OUT

OUT

Guy Wire

Cont'd From Top Page 46

Cont'd To Top Page 48

F.B. 703 Pg. 48

Cont'd To Bottom Pg. 49

Pole #10-36

TP "A 10-36

Pole #11-36

Pole #12-36

Pole #13-36

Fd. C.S. 1/4 Sec. Brass Cap Mon. At Fence Cor

Rec. taken from C.S.B. 111-3

Kern Co.

L.A. Co.

Set 1/2

By Inters.

Fd 12"x12" Conc Mon 8" Above Ground E R/W of Old Ridge Road State Highway - Sec County Line F.B.

INVENTORY IN F.B. 1640-181

Pole #17-36

TP "A 17-36"

Pole #18-36

Cont'd From Top Pg. 47

RETURN TO LOS ANGELES COUNTY SURVEYOR 700 HALL OF RECORDS

Do not extend notes this side of this line

Note: Any Additions or Changes on This Sheet Must be Made or Circled in Red Ink With Date and Name of Person Making Change.

| | |
|---|---|
| Notes Ck'd by R.R.M. | Survey of Forestry Survey (cont) |
| Map No. | W. O. 8094 Tape No. 69 St'd 24 °F. |
| Office Work | Surveyed by C.V. Crumley |
| Checked | Notes C.V.C. Date 5-12-37 |
| Date | A. C. Johnson Indexed |

F.B. 742 PG. 47

Cont'd To Bottom Pg. 50

Pole #30-35 2.1 — 279.7

TP #31-35 — 97.1 — 101.8

Pole #1-36 2.4 — 198.9 — Chn Pt.

Pole #2-36 2.4 — 228.2

INVENTORY IN F. B. 1640-182

Pole #3-36 2.2 — 180.1

Pole #4-36 2.2 — 220.9

Forestry Wires Back To 3rd & 4th Wires (From Xl. or Lower Cross-Arm) — Pole #5-36 2.0 — 204.5 — N. 31° E. 255.6

Forestry Wires Attached To Pole Not Cross Arm — Pole #6-36 — 200.3

Pole #7-36 2.0 — 199.8

Pole #8-36 2.0 — 265.3 — N. 38° [illegible] E. 17.40

Pole #9-36 1.9 — 195.5

Cont'd From Top Pg. 48

RETURN TO
LOS ANGELES COUNTY SURVEYOR
700 HALL OF RECORDS

Note: Any Additions or Changes on This Sheet Must be Made or Circled in Red Ink With Date and Name of Person Making Change.

Do not extend notes this side of this line

FORM 247 10M 11-35

F.B. 703 Pg. 50 cont'd To Bottom Pg. 51

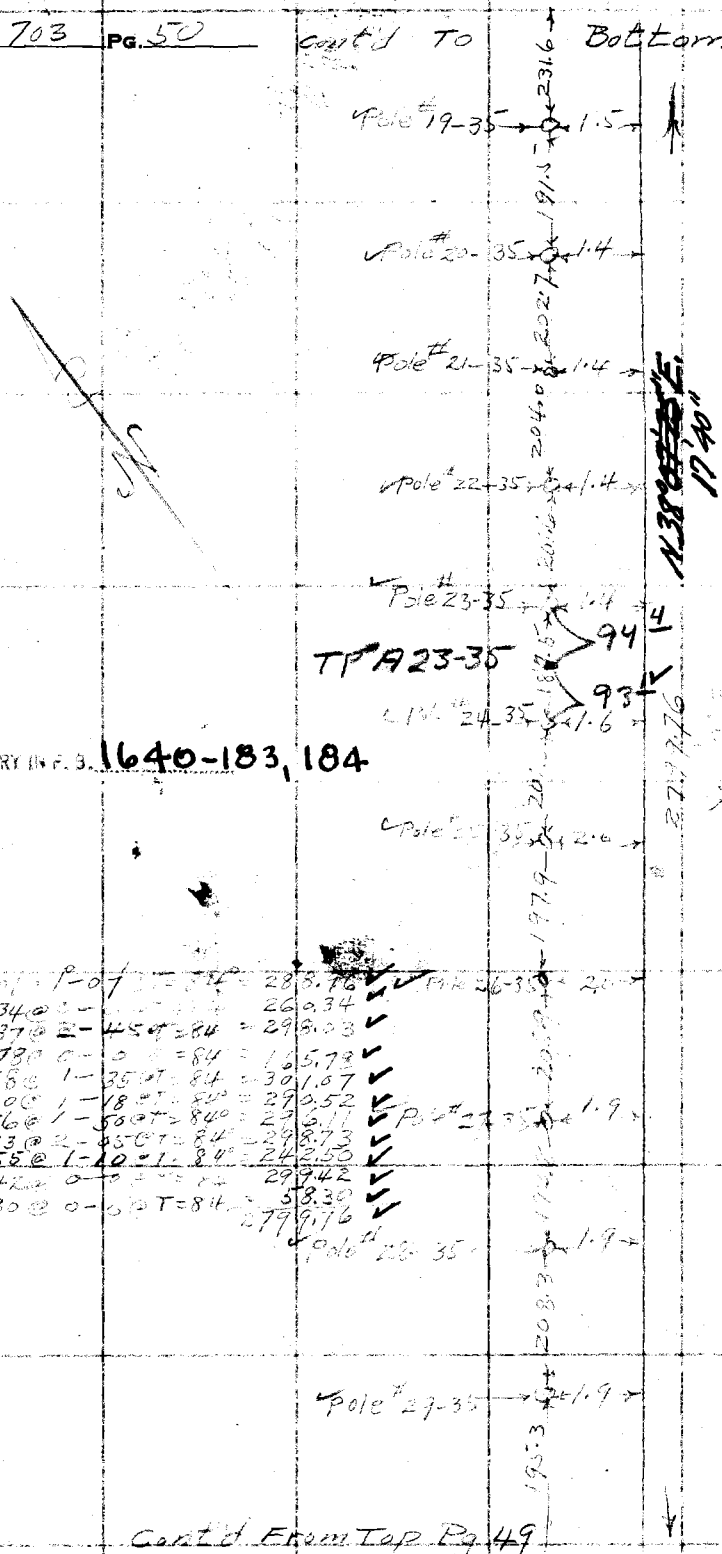


INVENTORY IN F.B. 1640-183, 184

RETURN TO
LOS ANGELES COUNTY SURVEYOR
700 HALL OF RECORDS

Note: Any Additions or Changes on This Sheet Must be Made or Circled in Red Ink With Date and Name of Person Making Change.

Do not extend notes this side of this line

Cont'd From Top Pg. 49

| | |
|---|---|
| Notes Ck'd by R.R.M. | Survey of Forestry Tel Line |
| Map No. | W. O. 8094 Tape No. 68 St'd 64° F. |
| Office Work | Surveyed by C.V. Crumley |
| Checked | Notes C.V.C. Date 5-12-37 |
| Date | Indexed A. C. Johnson |

F.B. 163 PG. 57

Cont'd To Bottom Page 56

2.97.53 @ 2°-00 @ T = 86° = 297.315
256.43 @ 0-0 @ T = 86° = 256.43
52.88 @ 0-0 @ T = 86° = 52.88
606.66

INVENTORY 1640-184,185

(1) 172°-58'-00"
(4) 331-52-30
172-58-05

297.57 @ 1-25 @ T = 86 = 297.48
300.25 @ 1-0 @ T = 86 = 300.20
202.85 @ 1-20 @ T = 86 = 202.80
800.48

(1) 176°-05'-00"
(4) 3[illegible]
176-05-00

Pole 1.7
3rd Pole 1.6
2nd No. Number 1.4
Guy Wire
Pole #16-35 1.5
Green Pole No Number 1.7
Pole #17-35 2.0
Brace Pole
Pole #16-35 1.9

N. 35° E. 10'-45" E.
N. 42° E. 12'-40" E.

P = 72 Set 1x2
P = 71 Set 1x2

606.66
800.48
279.76

Cont'd From Top Pg. 56

Note: Any Additions or Changes on This Sheet Must be Made or Circled in Red Ink With Date and Name of Person Making Change.

Do not extend notes this side of this line

RETURN TO
LOS ANGELES COUNTY SURVEYOR
7do HALL OF RECORDS

FORM 247 10M 11-35

F.B. 703 Pg. 52

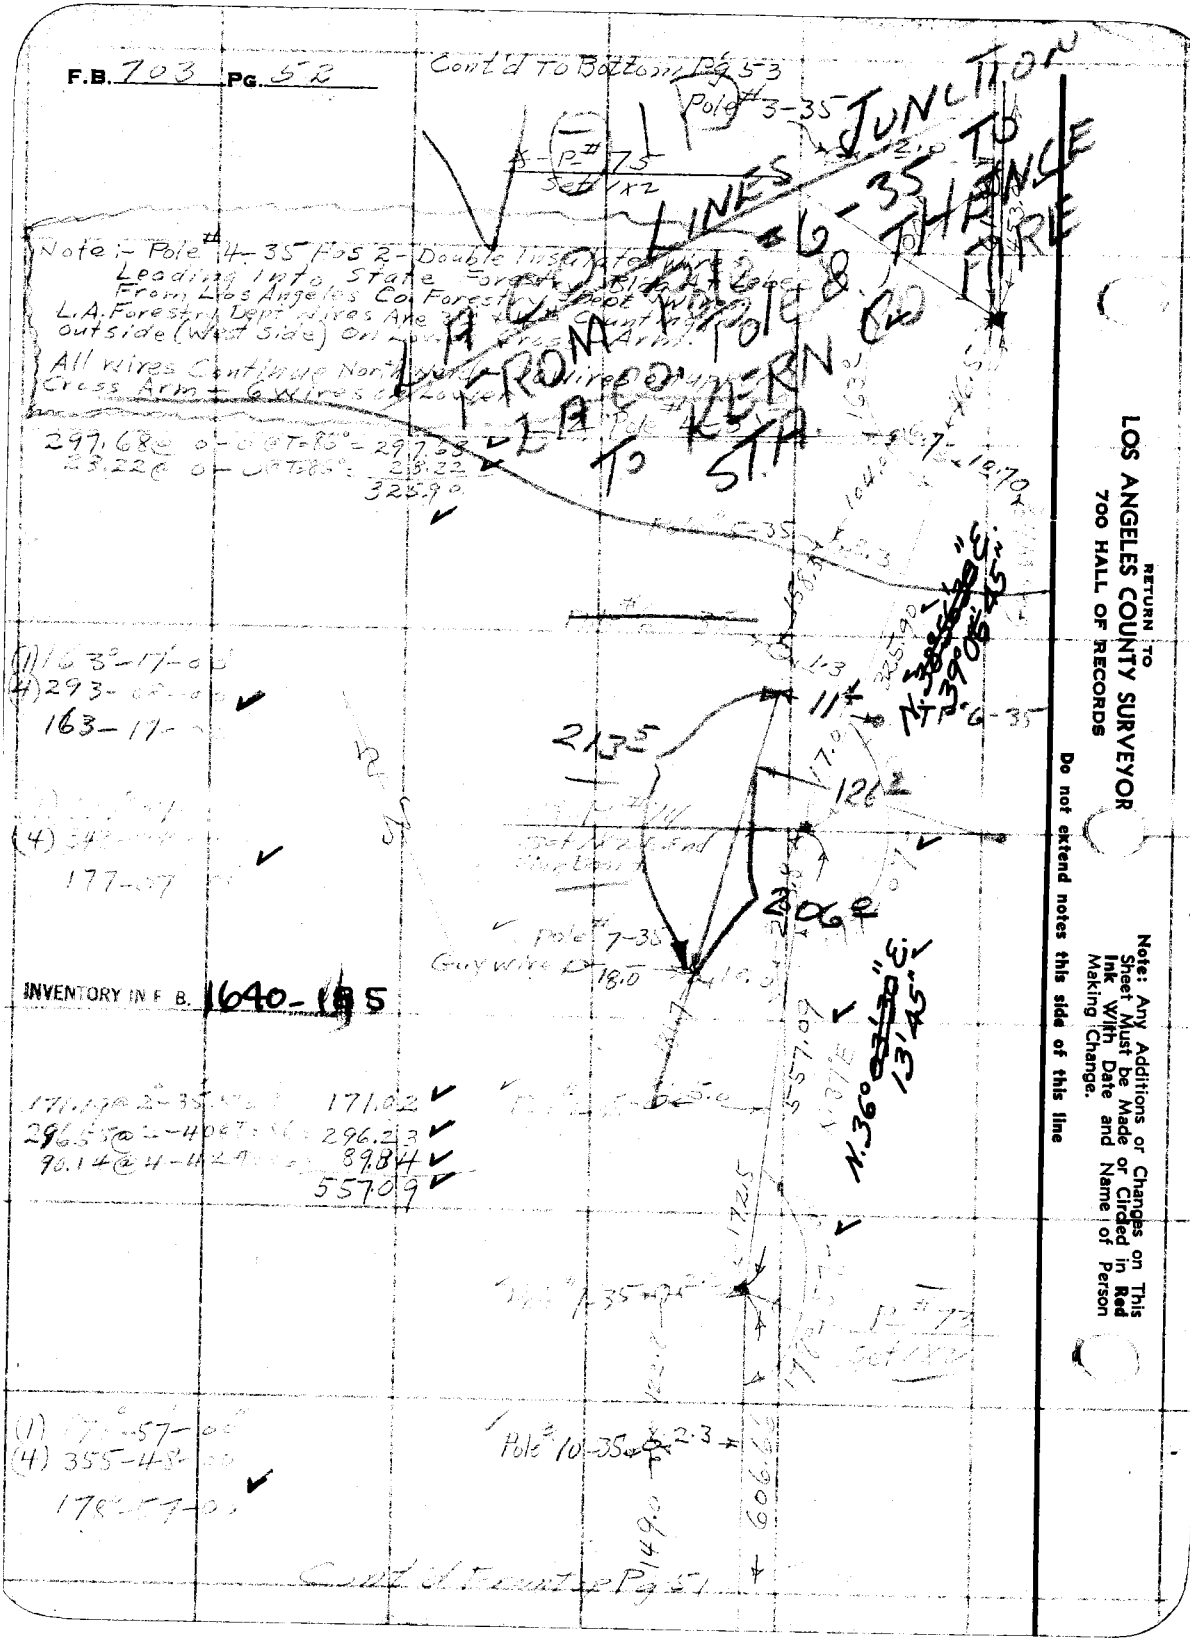


INVENTORY IN F. B. 1640-185

171.02
296.23
89.84
557.09

RETURN TO
LOS ANGELES COUNTY SURVEYOR
700 HALL OF RECORDS

Note: Any Additions or Changes on This Sheet Must be Made or Circled in Red Ink With Date and Name of Person Making Change.

Do not extend notes this side of this line

| | |
|---|---|
| Notes Ck'd by K.A.M. | Survey of Forestry Telephone Line #109 |
| Map No. | W. O. 8094 Tape No. 68 St'd 84°F. |
| Office Work | Surveyed by C.V. Crumley |
| Checked | Notes C.V.C. Date 5-14-37 |
| Date | Indexed |

F.B. 123 Pg. 53

Note: Any Additions or Changes on This Sheet Must be Made or Circled in Red Ink With Date and Name of Person Making Change.

Do not extend notes this side of this line

RETURN TO
LOS ANGELES COUNTY SURVEYOR
700 HALL OF RECORDS

Note: Type [illegible] #154 ... Upper X" Arm
6 Wires Running Thru on 2nd X" Arm (N.&S.)
Forestry Wires = 3rd & 4th

4 Wires Cut ... From North - Going S.W. 3rd X-Arm

14 Wires From N. Join Cable & Going S.W. To Lodge
Hotel Switch Board.

4 Wires From N. Join Cable

Cable Run To Lodge Hotel Switch Board

T.P.T.&T. Co.
End of Survey Junction Pole
#154

Guy W. to

Guy Wire

Guy Wires

Set Nail

41.78

P. #76
Set Nail

set Nail
P.#32-34

453.07
N. 23° E.

N. 27°13'30" E.
23'45"

197.59
265.48
453.07

Pole - 35

Cont'd From Top Pg. 52

FORM 247 10M 11-35

RETURN TO
LOS ANGELES COUNTY SURVEYOR
700 HALL OF RECORDS

**Note:** Any Additions or Changes on This Sheet Must be Made or Circled in **Red Ink** With Date and Name of Person Making Change.

**Do not extend notes this side of this line**

F.B. 703 PG. 54

| | |
|---|---|
| Notes Ck'd by | Survey of Forestry Tel. Line # |
| Map No. | W. O. 8094 Tape No. 65 St'd 84 °F. |
| Office Work | Surveyed by C.V. Crumley |
| Checked | Notes C.V.C. Date 5-13-37 |
| Date | Indexed |

F.B. 703 PG. 55

Note: Any Additions or Changes on This Sheet Must be Made or Circled in Red Ink With Date and Name of Person Making Change

Do not extend notes this side of this line

RETURN TO
LOS ANGELES COUNTY SURVEYOR
7do HALL OF RECORDS

FORM 247 10M 11-36

# TEJON TOWER
# FORESTRY DEPARTMENT
# TELEPHONE LINE

O.K

J.N. 8094

MAY 13th 1937.

C.V. Crumley
F.S. Livingston
W.F. Harris
H.H. Baker.
L.R. McGuire.

"NOTE"
POLE LOCATIONS CHECKED by W.S.C. - 6-12-50 - NO CHANGES EXCEPT TWO ADDED POLES NEAR TOWER

From Tejon Tower To Quail Lake-Lodoc #109 Line At Old Ridge Route Highway.

F.B. 703 Pg. 56

Cont'd To Bottom Page 57

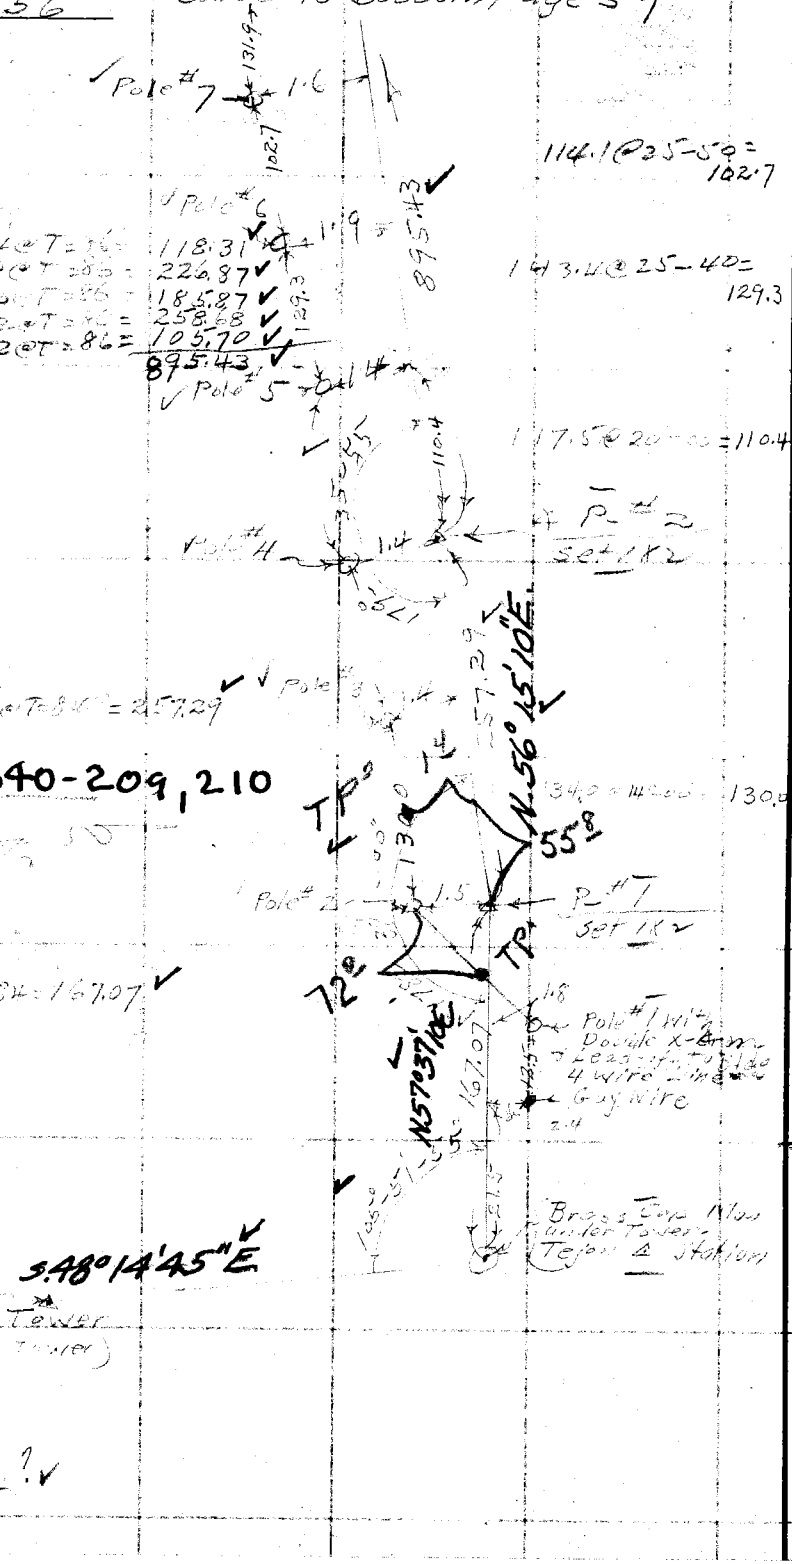


RETURN TO
LOS ANGELES COUNTY SURVEYOR
700 HALL OF RECORDS

Do not extend notes this side of this line

Note: Any Additions or Changes on This Sheet Must be Made or Circled in Red Ink With Date and Name of Person Making Change.

| | |
|---|---|
| Notes Ck'd by K.A.M. | Survey of Tejon Tower Tel. Line |
| Map No. | W. O. 8094 Tape No. 69 St'd 24 °F. |
| Office Work | Surveyed by G.V. Crumley |
| Checked | Notes G.V.C. Date 5-13-37 |
| Date | Indexed E. C. Johnson |

F.B. 153 PG. 57

Note: Any Additions or Changes on This Sheet Must be Made or Circled in Red Ink With Date and Name of Person Making Change.

Do not extend notes this side of this line

RETURN TO
LOS ANGELES COUNTY SURVEYOR
700 HALL OF RECORDS

INVENTORY NO. 1640-209

FORM 247 10M 11-35

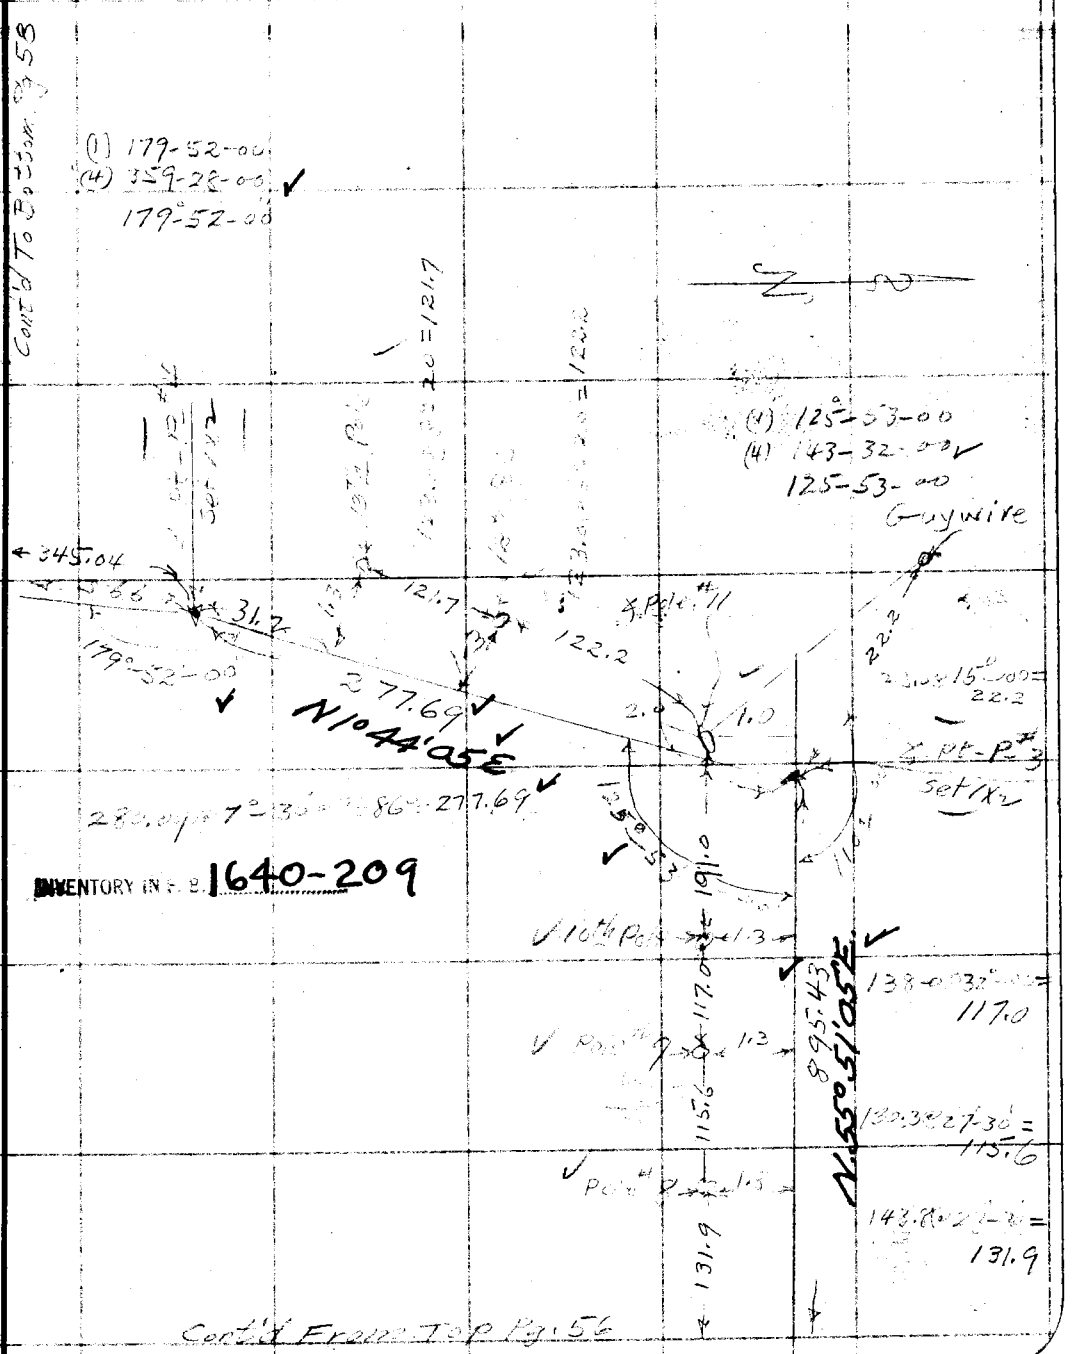

F.B. 703 PG. 58

Cont'd To Bottom Page 59

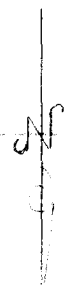

297.72 @ 1-30 T=14 = 297.62
215.36 @ C-C T=82 = 215.36
51.90 @ T=11 = 51.90
564.88

INVENTORY IN F.B. 1640-208

(1) 179-53-00
(4) 359-32-00
179-53-00

297.97 47.21 @ = 297.83 47.21
345.04

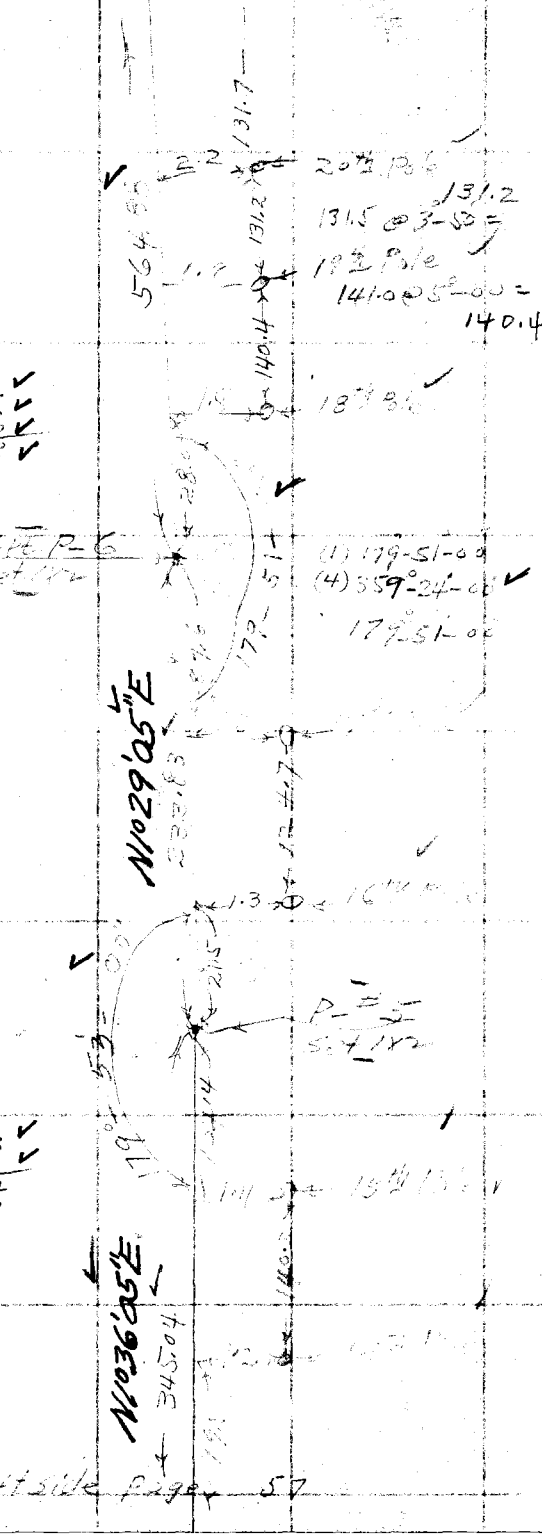


Cont'd From Left side Page 57

RETURN TO
LOS ANGELES COUNTY SURVEYOR
700 HALL OF RECORDS

Do not extend notes this side of this line

Note: Any Additions or Changes on This Sheet Must be Made or Circled in Red Ink With Date and Name of Person Making Change.

| | |
|---|---|
| Notes Ck'd by K.E.M. | Survey of Tejon Tower Tenth |
| Map No. | W. O. 2294 Tape No. 6' St'd 84° F. |
| Office Work | Surveyed by C.V.Crumley |
| Checked | Notes C.V.C. Date 5-13-37 |
| Date | Indexed: A. C. Johnson |

F.B. 703 PG. 57

Cont'd To Bottom Page 6

1780.67

INVENTORY IN F.B. 1640-207, 208

119.69 @ 11-55 @ T=84° = 117.14
266.62 @ 9-36-01 @ T=84° = 256.27
207.16 @ 13-[illegible] @ T=84° = 195.03
257.81 @ 24-10 @ T=84° = 235.21
286.85 @ 10-12 @ T=84° = 282.31
206.52 @ 17-32 @ T=84° = 196.92
293.25 @ 3-41 @ T=84° = 292.61
148.58 @ [illegible] @ T=84° = 146.90
58.15 @ 0-0 @ T=84° = 58.15
1780.67

(1) 179-43-00
41358-52-00
179°43'-00

Cont'd From Top Pg. 58

172.2 @ 25-00 = 173.7

2.4 — 28th Pole

153.7
168.5 @ 24-10 =

27th Pole

137.0 @ 21-00 = 127.9

2.8 — 26th Pole

183.7
142.0 @ 19-40 =

2.8 — 25th Pole

130.0 @ 13-00 = 130.4

2.4 — 24th Pole

131.5 @ 17-00 = 125.8

2.4 — 23rd Pole

119.7 @ 11-55 = 117.2

117.2

119°43'-00

5-Pt R# 7

6.9

1.3 — 22nd Pole

127.0

N 1°38'05" E

1.6 — 21st Pole

Note: Any Additions or Changes on This Sheet Must be Made or Circled in Red Ink With Date and Name of Person Making Change.

Do not extend notes this side of this line

RETURN TO
LOS ANGELES COUNTY SURVEYOR
700 HALL OF RECORDS

FORM 247 10M 11-48

F.B. 703 PG. 60

Cont'd To Bottom Page 61

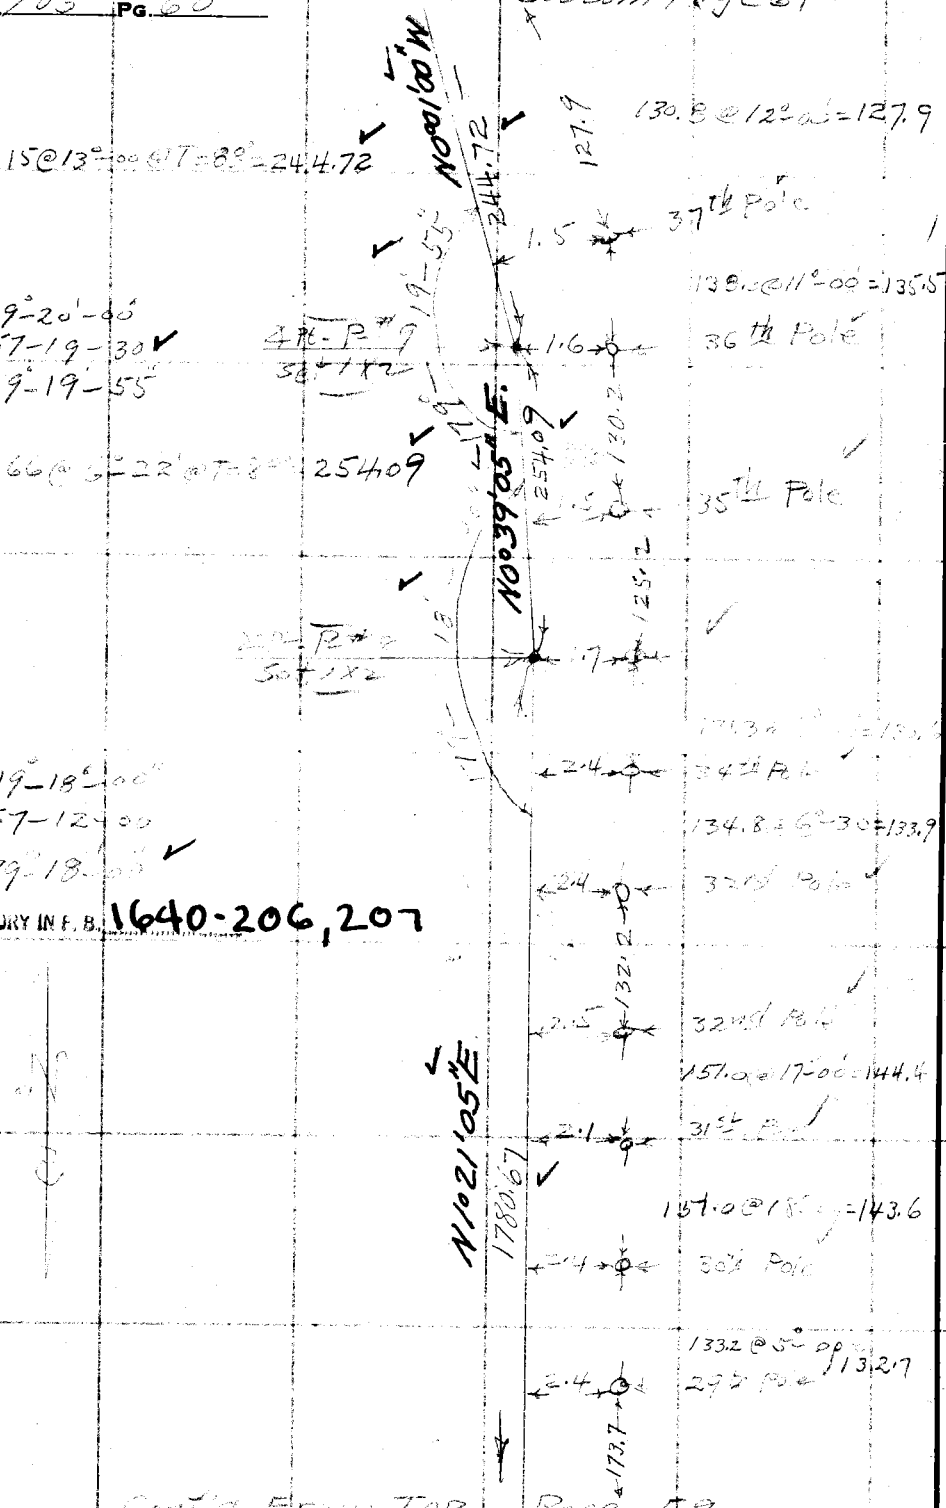


RETURN TO
LOS ANGELES COUNTY SURVEYOR
700 HALL OF RECORDS

Note: Any Additions or Changes on This Sheet Must be Made or Circled in Red Ink With Date and Name of Person Making Change.

Do not extend notes this side of this line

| | |
|---|---|
| Notes Ck'd by KRM. | Survey of Tejon Tower Tel. Line |
| Map No. | W. O. 8094 Tape No. 68 St'd 64 °F. |
| Office Work | Surveyed by C.V.C. Grimmer |
| Checked | Notes C.V.C. Date 5-18-37 |
| Date | Indexed A. C. Johnson |

F.B. 703 PG. 61

Cont'd. From Last Page 60

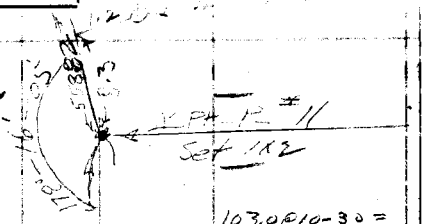


103.0@10-30 = 101.3

1.1 45th Pole

131.8

1.8 44th Pole

123.3
125.5@10°-40' =

43rd Pole

130.9
133.2@10°-40' =

42nd Pole

129.2@15°-00' = 124.8

1.0 41st Pole

138.0@14°-40' = 133.5

1.4 40th Pole

138.0@19°-00' = 131.2

1.6

129.4@18°-11' = 121.6

1.2 38th Pole

Pt. P = 10

(1) 178°-16'-00"
(4) 353°-04'-30" ✓
178°-16'-0"

N 00°03'05" W.
1016.02

INVENTORY IN F. B. 1640-205, 206

299.64@18-20@7-88 = 284.44 ✓
299.28@14-00@7-88 = 290.40 ✓
299.12@9-20@7-88 = 29.576 ✓
22.13@0-0-0@7-88 = 6.213 ✓
84.26@7-45@7-88 = 83.29 ✓
1016.02 ✓

(1) 179°-58'-00"
(4) 359°-5'-30" ✓
179°-57'-55"

Cont'd. From Top Pg. 60

RETURN TO
LOS ANGELES COUNTY SURVEYOR
700 HALL OF RECORDS

Note: Any Additions or Changes on This Sheet Must be Made or Circled in Red Ink With Date and Name of Person Making Change.

Do not extend notes this side of this line

FORM 247 10M 11-35

F.B. 703 Pg. 62

RETURN TO
LOS ANGELES COUNTY SURVEYOR
700 HALL OF RECORDS

Note: Any Additions or Changes on This Sheet Must be Made or Circled in Red Ink With Date and Name of Person Making Change.

Do not extend notes this side of this line

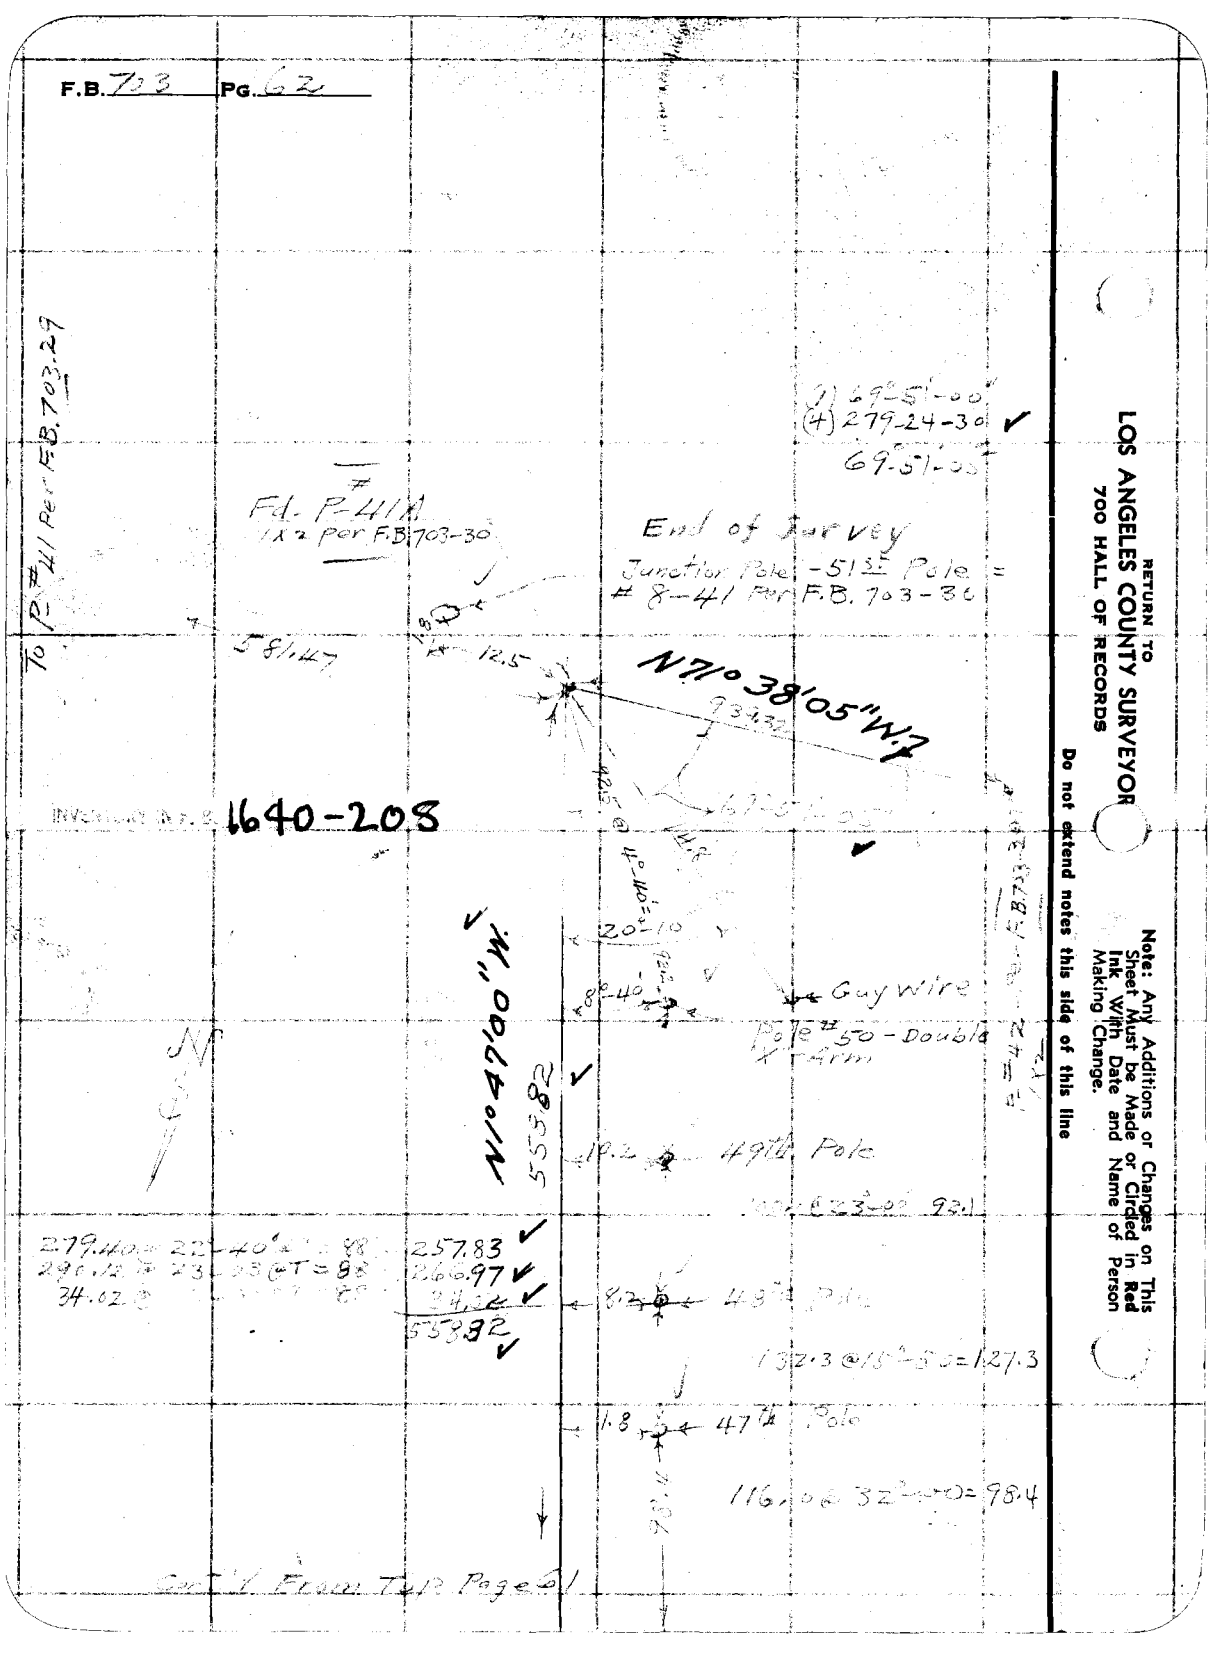

| | |
|---|---|
| Notes Ck'd by | Survey of Forestry Tel. Line # 109 |
| Map No. | W. O. 8094 Tape No. 68 St'd 84 °F. |
| Office Work | Surveyed by C.V. Crumley |
| Checked | Notes C.V.C. Date 5-14-37 |
| Date | Indexed A. C. Johnson 8-16-37 |

F.B. [illegible] PG. 53

PINE CANYON

FORESTRY DEPARTMENT

TELEPHONE LINE Nº 109

J.N. 8094

NOTE

POLE LOCATIONS CHECKED by

NEW POLES IN ALONG SIDE OLD W.S.C. 5-25-50

C.V. Crumley POLES BUT LINES HAVENT BEEN

F.S. Livingston TRANSFERED AS OF (5-25-50)

W.F. Harris NEW POLES LOCATED by + &

H.H. Barker OFF SET TO OLD POLES - NOTED

L.R. McGuire IN RED

From Quail Lake Ranger Station On Old Ridge Route Highway Easterly To "Three Points", Thence S.E.Sly To

Note: Any Additions or Changes on This Sheet Must be Made or Circled in Red Ink With Date and Name of Person Making Change.

Do not extend notes this side of this line

RETURN TO
LOS ANGELES COUNTY SURVEYOR
700 HALL OF RECORDS

FORM 247 10M 11-36

F.B. 703 Pg. 64

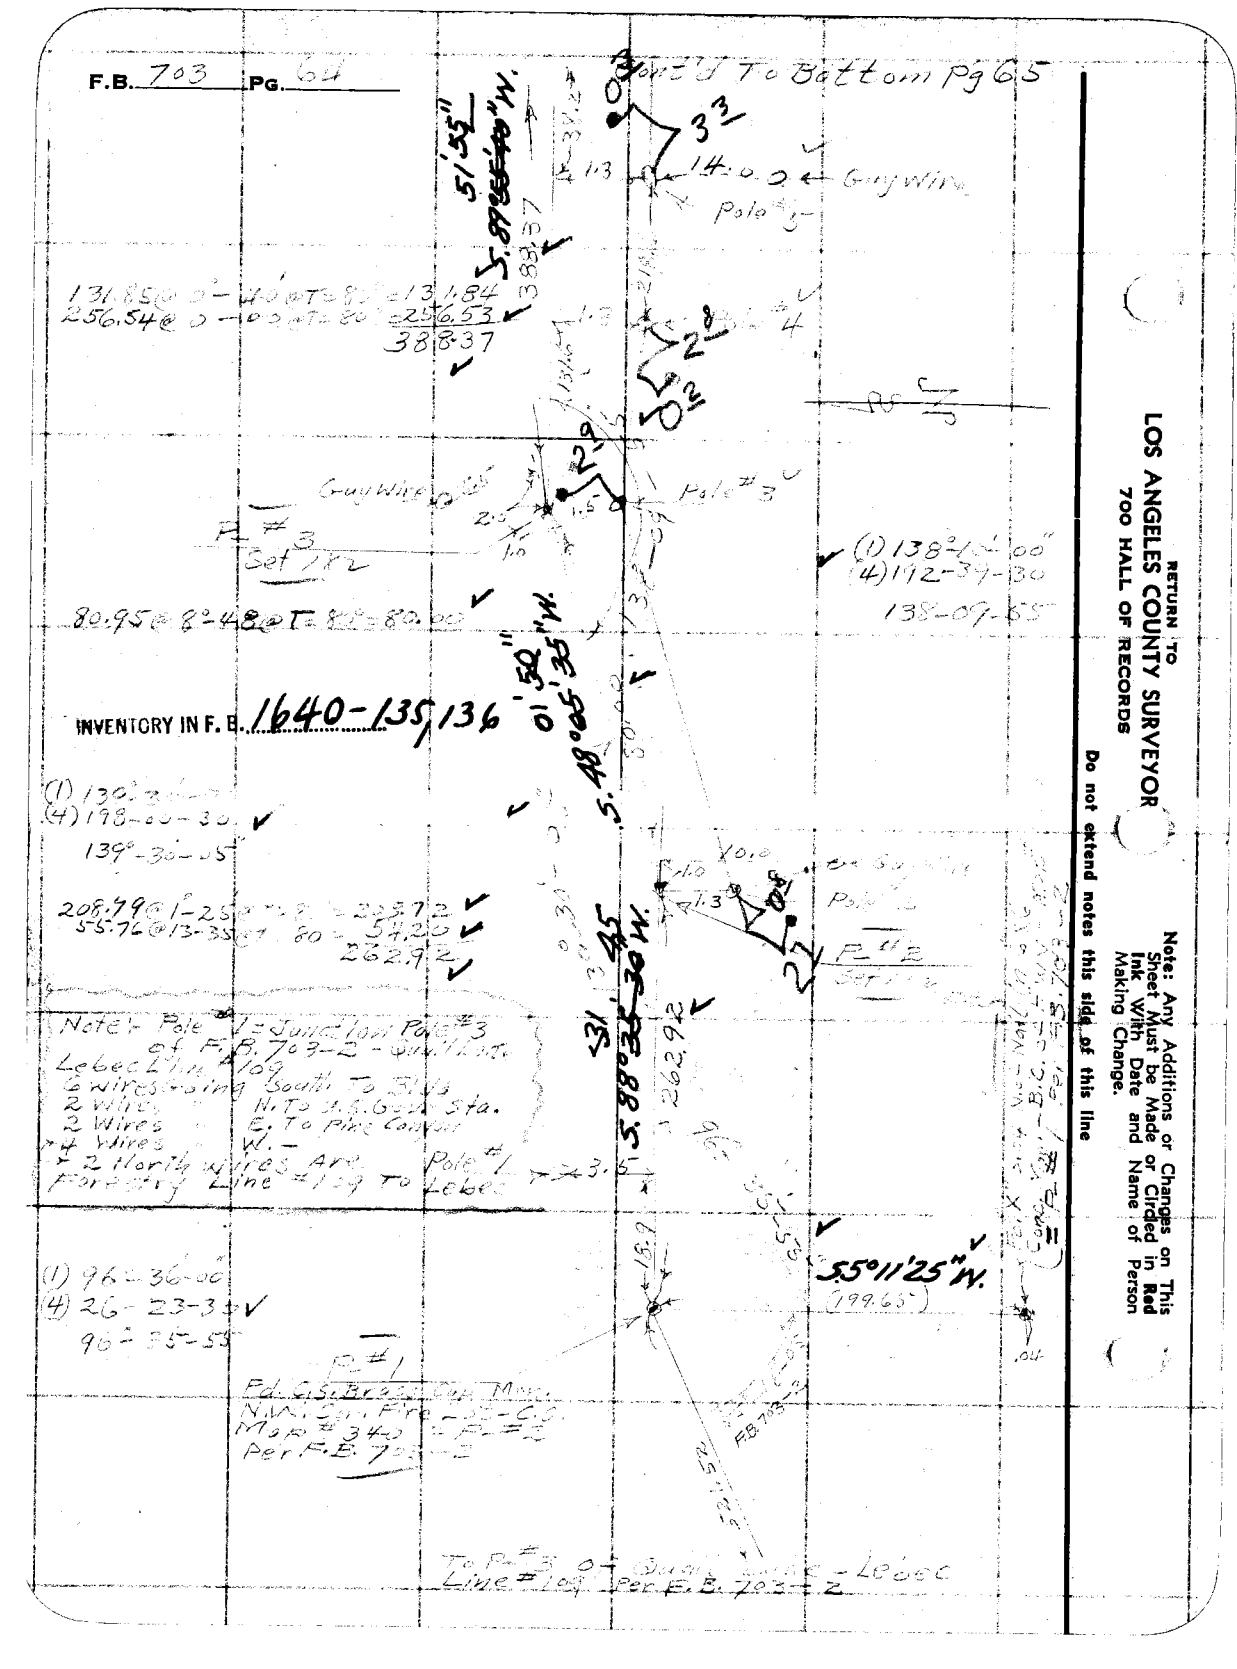


RETURN TO
LOS ANGELES COUNTY SURVEYOR
700 HALL OF RECORDS

Note: Any Additions or Changes on This Sheet Must be Made or Circled in Red Ink With Date and Name of Person Making Change.

Do not extend notes this side of this line

| | |
|---|---|
| Notes Ck'd by | Survey of Lot 1 Tract 2094 |
| Map No. | W. O. 2094 Tape No. 68 St'd 81 °F. |
| Office Work | Surveyed by S. K. Grunder |
| Checked | Notes C.K.C. Date 5-14-37 |
| Date | Indexed |

F.B. 723 PG. 54

Note: Any Additions or Changes on This Sheet Must be Made or Circled in Red Ink With Date and Name of Person Making Change.

Do not extend notes this side of this line

RETURN TO
LOS ANGELES COUNTY SURVEYOR
700 HALL OF RECORDS

INVENTORY IN F. B. 1640 - 135

Guy wire

Pole #8

P.# 7
Set 1X2

(1) 178°-05-05
(4) 352-
178°-05-05

133.17 @ 10°-19' @ T=84° = 131.02

1321.05
S. 76° 35' W.

Pole #1

P.# 6
Set 1X2

(1) 175°-41-05
(4) 343-13-30
175-40-55

1744.16 @ 4°-15' @ T=84 = 1743.51

S. 72° 15' W.
1744.16
N. 72° 15' E.

P.# 5
Set 1X2

139.72 @ 4°-15' @ T=84° = 139.34

Pole #6

S. 68° 18' 00" W.
1401.53

(1) 176°-22-05
(4) 344-01-30
176-21-35

P.# 4
Set 1X2
Edge of Road

(1) 153-
(4) 273-32-
158-23-

S. 35° 38' 37" W.
1389.37

Cont'd From Tape Pg. 54

FORM 247 10M 11-35

F.B. 703 PG. 66

Cont'd To Bottom Page 67

To ch. Pt.
300.70@5°-50'@T=90°=299.15
— 53.95
245.20

(1) 177-31-00
(4) 350-04-30
177°-31'-05"

INVENTORY IN F. B. 1640-134, 135

243.14@15°-22'@T=90°=234.27
109.05@ 0°-0'@T=90°=109.05
190.23@ 5°-32'@T=90°=189.34
129.48@ 8°-42'@T=90°=129.50
660.66

RETURN TO
LOS ANGELES COUNTY SURVEYOR
700 HALL OF RECORDS

Note: Any Additions or Changes on This Sheet Must be Made or Circled in Red Ink With Date and Name of Person Making Change.

Do not extend notes this side of this line

163.82@7-32@T=90°=167.37
41.37@10°-00'@T=90°=42.74
208.11

(1) 169-27-00
(4) 347-48-00
169-21-00

Cont'd To Top Page 65

| | |
|---|---|
| Notes Ck'd by | Survey of |
| Map No. | W. O. | Tape No. | St'd °F. |
| Office Work | Surveyed by |
| Checked | Notes | Date |
| Date | Indexed |

F.B. PG.

Note: Any Additions or Changes on This Sheet Must be Made or Circled in Red Ink With Date and Name of Person Making Change.

Do not extend notes this side of this line

RETURN TO
LOS ANGELES COUNTY SURVEYOR
708 HALL OF RECORDS

FORM 247 10M 11-35

INVENTORY IN F. B. 1640-134

274.58 @ 3°-50'-0"T = 90° = 274.5
299.93 @ 4-00-00 = 90° = 299.21
287.27 @ 0-0-0 T = 90° = 287.29
151.45 @ 20-19-30 = 90° = 142.17
126.77 @ 16-38-00 = 90° = 121.57
1124.80

(1) 29-00-00
(4) 116-00-00
29°-00-00

53.95 @ T = 90° = 53.95

127.5 @ 17-00 = 121.9

21st Pole on Line

20th Pole on Line

117.0 @ 20°-40' = 109.5

OAK ON RD

19th Pole on Line

1124.9 Tan @ N 53° E

18th Pole on Line

29°-00-00

17th Pole

16th Pole

64.7

1.9

Ch. Pt.

53.95

P.I. 10 Set 1/2"

Guy Wire

Pole #15

Continued From Top Page 66

F.B. 703 PG. 68

Cont'd To Bottom Pg. 69

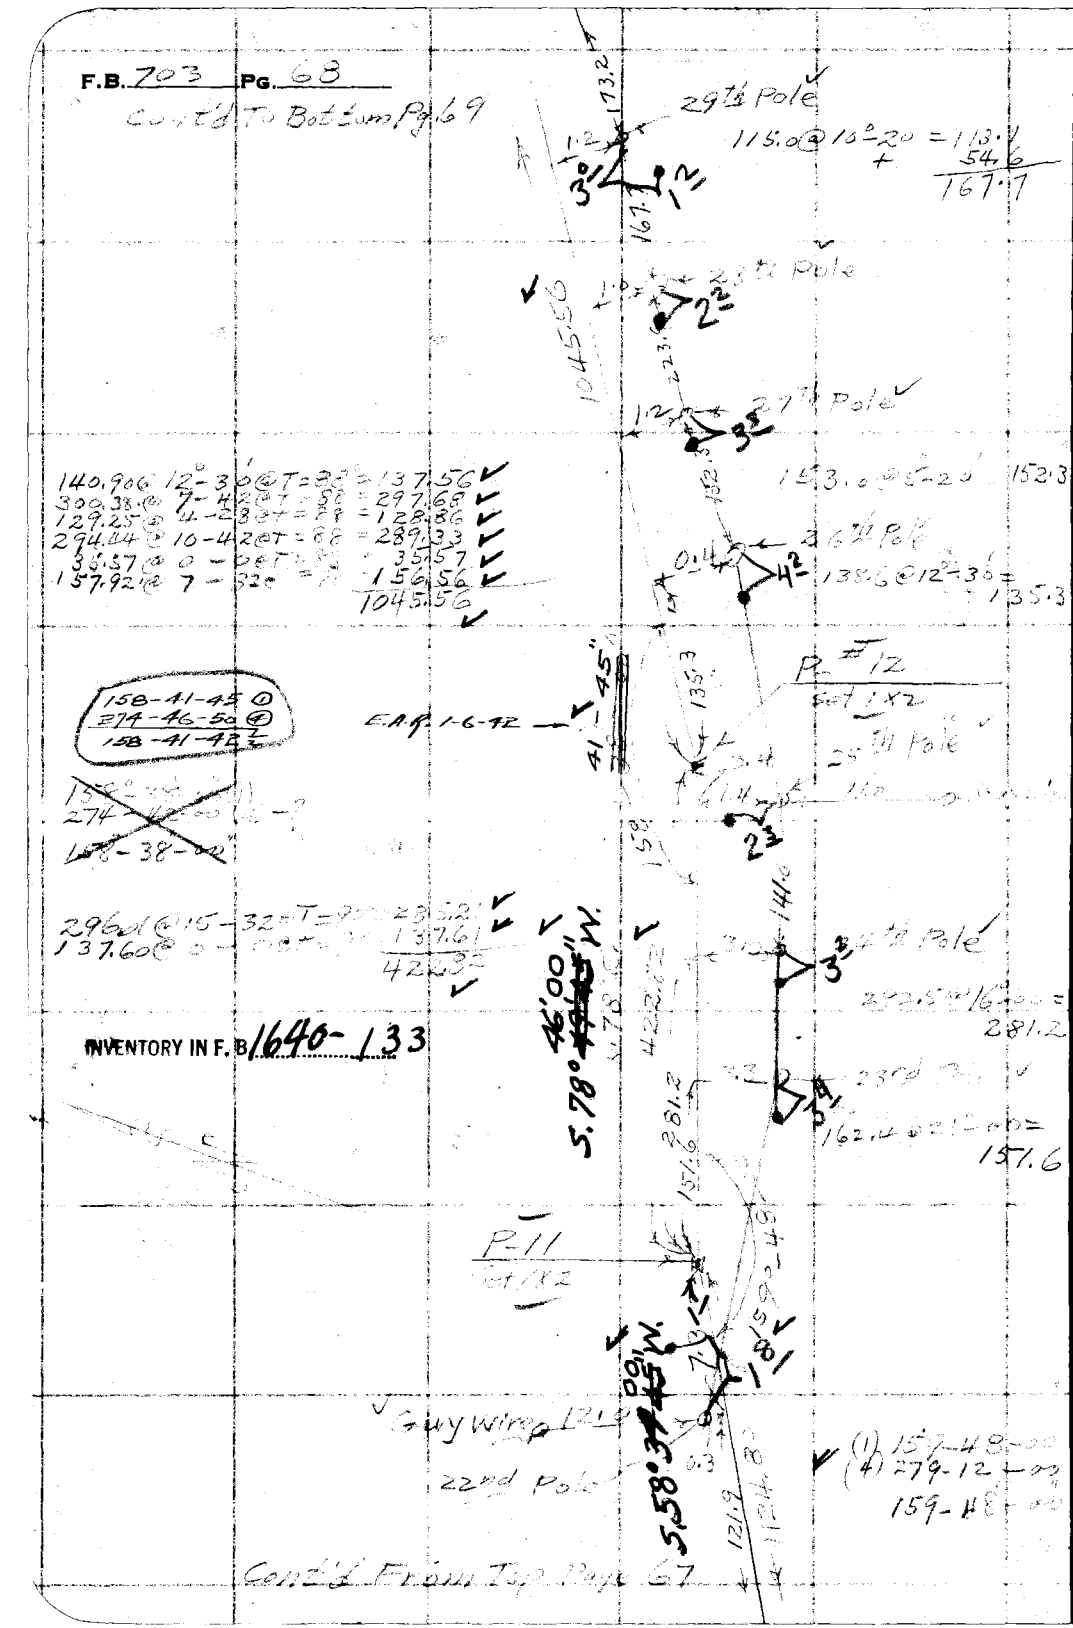


140.90 @ 12-30 @ T = 9 = 137.56
300.38 @ 7-42 @ T = 5 = 297.69
129.25 @ 4-28 @ T = 2 = 128.86
294.04 @ 10-42 @ T = 6 = 289.33
36.57 @ 0-00 @ T = 0 = 35.57
157.92 @ 7-52 @ T = 1 = 156.56
1045.56

158-41-45 ①
274-46-50 ④
158-41-42

E.A.P. 1-6-42

296.16 @ 15-32 = T = 9 = 283.2
137.60 @ 0-00 = T = 0 = 137.61
421.35

INVENTORY IN F.B. 1640-133

(1) 159-48-00
(4) 279-12-00
159-48-00

RETURN TO
LOS ANGELES COUNTY SURVEYOR
700 HALL OF RECORDS

Do not extend notes this side of this line

Note: Any Additions or Changes on This Sheet Must be Made or Circled in Red Ink with Date and Name of Person Making Change.

| | |
|---|---|
| Notes Ck'd by | Survey of |
| Map No. | W. O. 8094 Tape No. 65 St'd 84 °F. |
| Office Work | Surveyed by C.V. Crumley |
| Checked | Notes Date 3-24-37 |
| Date | Indexed Ck. |

F.B. 732 PG. 69

RETURN TO
LOS ANGELES COUNTY SURVEYOR
700 HALL OF RECORDS

Note: Any Additions or Changes on This Sheet Must be Made or Circled in Red Ink With Date and Name of Person Making Change.

Do not extend notes this side of this line

35" Pole

34" Pole

33"? Pole

E.A.K. - 1-7-41

165.0 @ 5-10 = 164.3

INVENTORY IN F. B. 1640 - 132, 133

32" Pole

31" Pole

(1) 23°-42'-00"
(4) 74°-48'-00"
23°-42'-00"

5.57°27'45"W.

Cont'd From Top Pg. 69

F.B. 703 Pg. 70

Cont'd To Bat Book Page 71

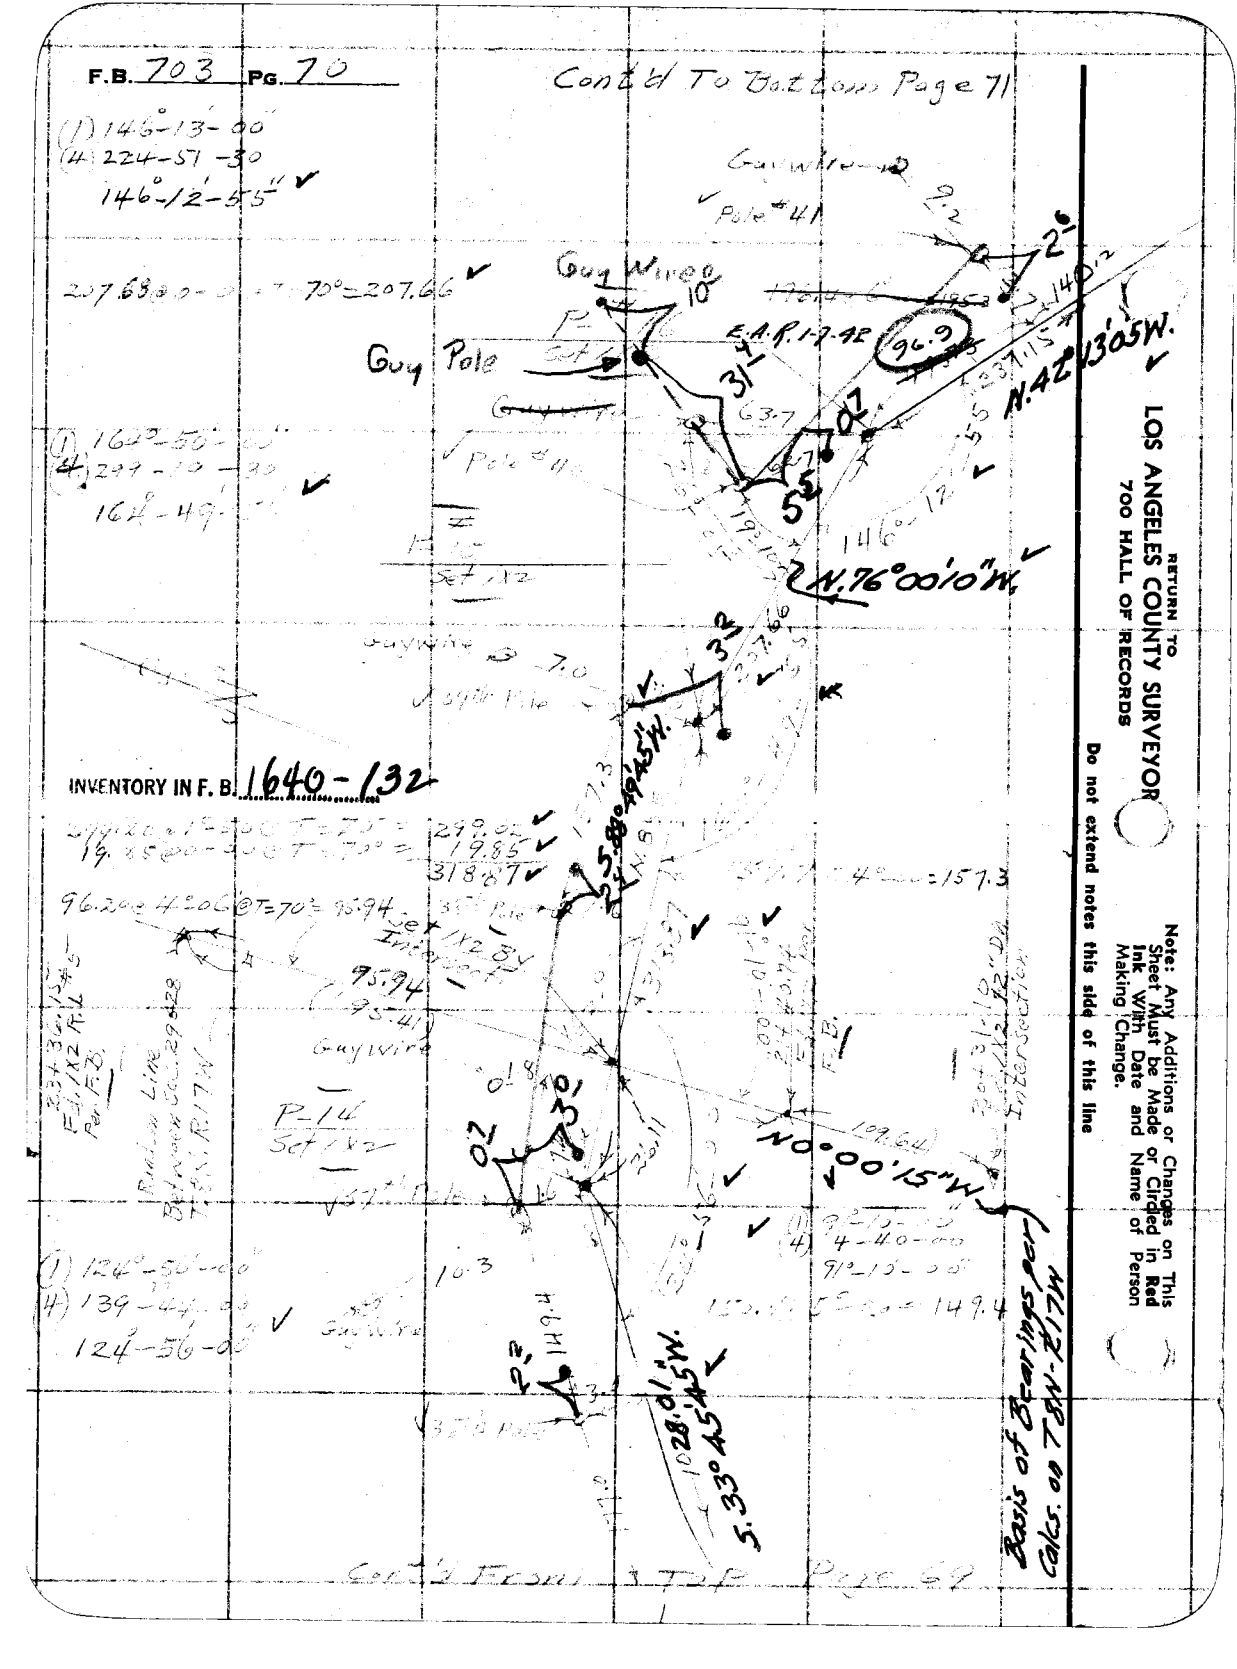


RETURN TO
LOS ANGELES COUNTY SURVEYOR
700 HALL OF RECORDS

Note: Any Additions or Changes on This Sheet Must be Made or Circled in Red Ink With Date and Name of Person Making Change.

Do not extend notes this side of this line

| | |
|---|---|
| Notes Ck'd by | Survey of |
| Map No. | W. O. 8294 Tape No. 65 St'd 74 °F. |
| Office Work | Surveyed by C.V. Crimes |
| Checked | Notes C.V.C. Date 5-24-37 |
| Date | Indexed C. V. Johnson |

F.B. 1-3 PG. 71

Note: Any Additions or Changes on This Sheet Must be Made or Circled in Red Ink With Date and Name of Person Making Change.

Do not extend notes this side of this line

RETURN TO LOS ANGELES COUNTY SURVEYOR 700 HALL OF RECORDS

FORM 247 10M 11-35

10 Z.0 @ 4-00 = 151.6

Pole #46

P.# 19 Set 1X2

(1) 159°-30-00
(4) 21°-30-00
159-30-10 ✓

T.P. 2.0 @ 0-0 T = 70° = 19.92
1.1 2.0 @ 0-0 T = 70° = 17.20
6.12 ✓

316.20 T 44 = 316.12

E.A.R. = 1-7-42

P.# 18 Set 1X2

INVENTORY IN F.B. 1640-131, 132 ✓

144.40 @ 0-0 @ T = 70° = 144.39

N. 75° 00' W.

N. 63° 27' 30" W.

S. 64° 33' 30" E. 144.39

168°-27-00
313-48-00
168°-27-00

(1) 158°-46-00
(4) 275-04-00 ✓
158-46-00

238.0 2.04-50 @ T = 70° = 237.15

P.# 17 Set 1X2

Cont'd From Top Page 70

F.B. 703 Pg. 72

Cont'd To Bottom Page 73

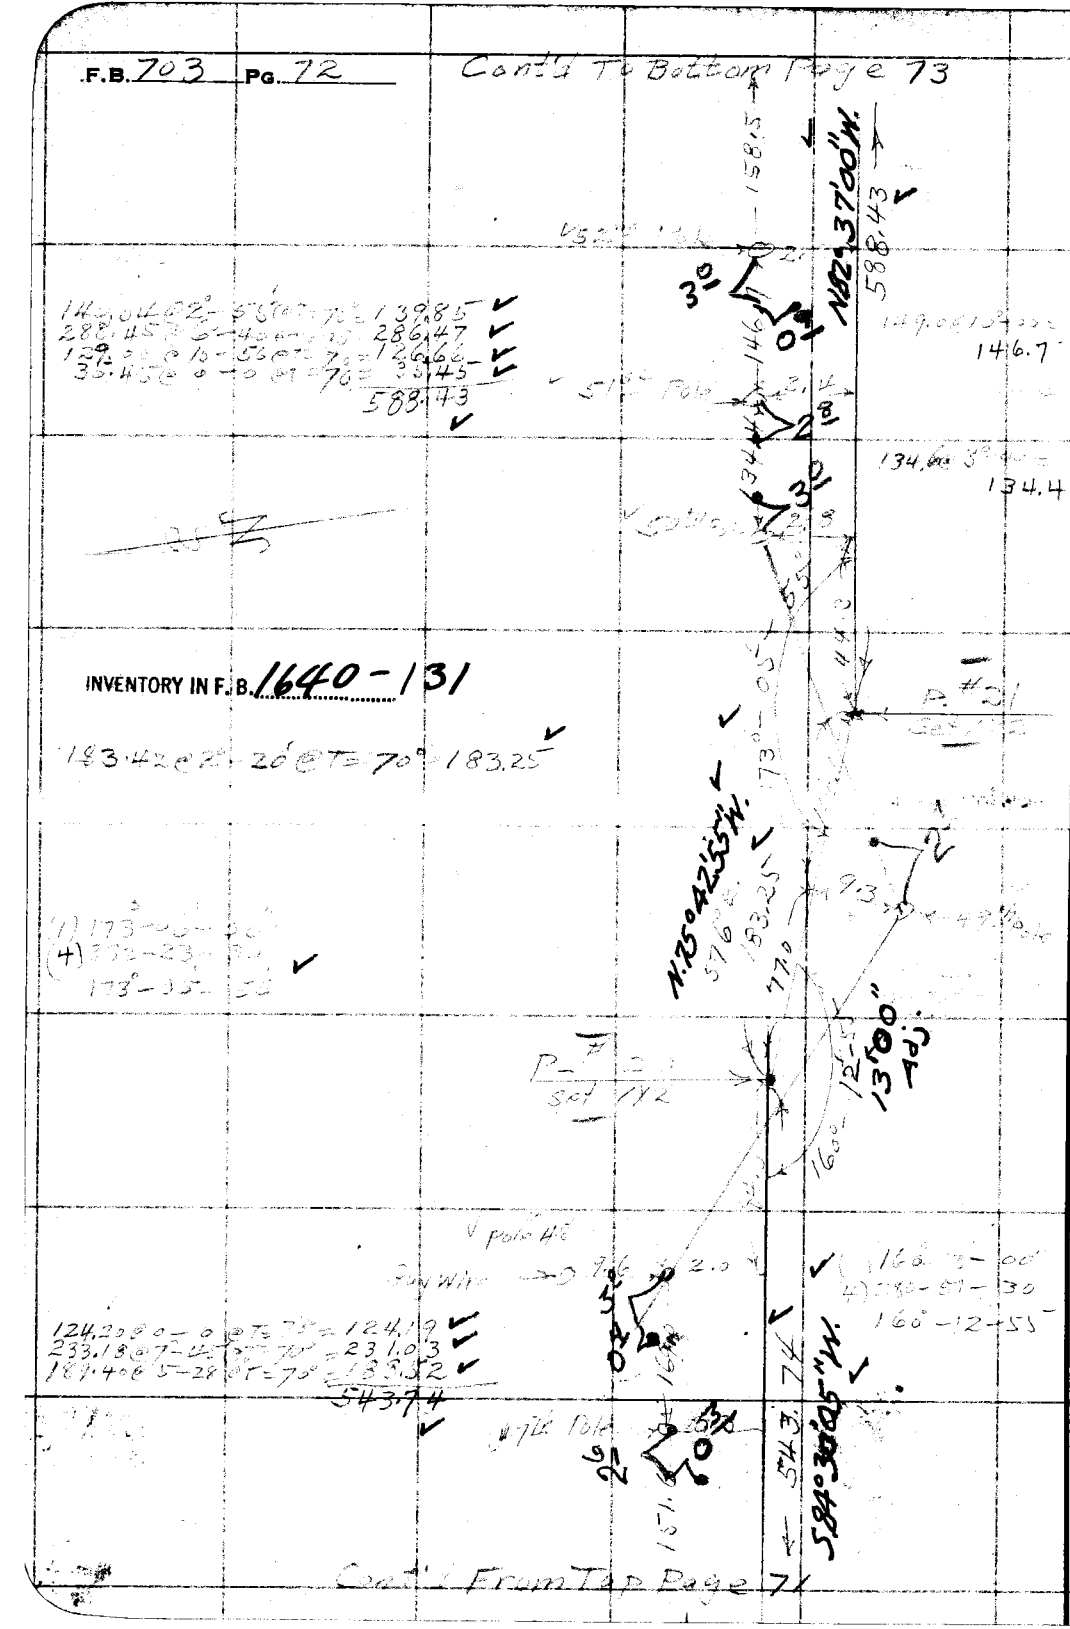


INVENTORY IN F.B. 1640 - 131

Cont'd From Top Page 71

RETURN TO
LOS ANGELES COUNTY SURVEYOR
700 HALL OF RECORDS

Note: Any Additions or Changes on This Sheet Must be Made or Circled in Red Ink With Date and Name of Person Making Change.

Do not extend notes this side of this line

| | |
|---|---|
| Notes Ck'd by | Survey of |
| Map No. | W. O. | Tape No. | St'd. °F. |
| Office Work | Surveyed by |
| Checked | Notes | Date |
| Date | Indexed |

F.B. 7-3 PG. 73

Cont'd from Pg. 74

N. 80°00' W. 124.00'

124.3 = 124.0

(1) 178°-17-55"
(4) 353-11-36
178°-17-55" ✓

INVENTORY IN F. B. 1640-130

224.49 @ 3° 13 30" = 70° 224.13 ✓
76.15 @ 0° 0 7 = 70° 76.14 ✓
300.27 ✓

N. 22°00' W.

125.30 @ 35 20' = 125.1

300.27

141.9

(1) 179-45-00
(4) 359-00-00
179°-45-00" ✓

583.43

67.3
35.5
102.8

Cont'd From Top Pg. 72

RETURN TO
LOS ANGELES COUNTY SURVEYOR
700 HALL OF RECORDS

Note: Any Additions or Changes on This Sheet Must be Made or Circled in Red Ink With Date and Name of Person Making Change.

Do not extend notes this side of this line

FORM 247 10M 11-55

F.B. 703 Pg. 74

Cont'd To Bottom Page 75

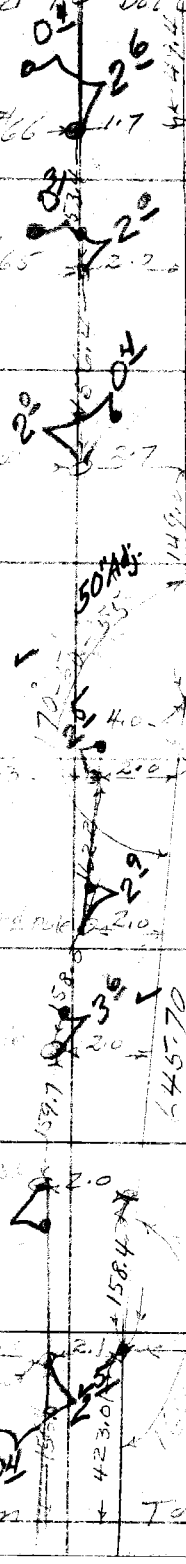


INVENTORY IN F. B. 1640 - 129,130

Cont'd From Top Page 73

RETURN TO
LOS ANGELES COUNTY SURVEYOR
700 HALL OF RECORDS

Note: Any Additions or Changes on This Sheet Must be Made or Circled in Red Ink With Date and Name of Person Making Change.

Do not extend notes this side of this line

| | |
|---|---|
| Notes Ck'd by | Survey of |
| Map No. | W. O. | Tape No. | St'd |
| Offide Work | Surveyed by C. V. Crum |
| Checked | Notes | Date |
| Date | Indexed A. C. Johnson |

F.B. PG.

"NOTE" LINES HAVE TAPS "GO SOUTH 866' SOUTH TO BLE WITH CELL BOX #45 ON OAK ON RD AT ENTRANCE TO RANCH

Note: Any Additions or Changes on This Sheet Must be Made in Red Ink With Date and Name of Person Making Change.

Do not extend notes this side of this line

INVENTORY IN F. B. 1640-129

RETURN TO
LOS ANGELES COUNTY SURVEYOR
700 HALL OF RECORDS

FORM 247 10M 11-35

F.B. 703 PG. 76

Contd To Bottom Pg. 77

RETURN TO
LOS ANGELES COUNTY SURVEYOR
700 HALL OF RECORDS

Note: Any Additions or Changes on This Sheet Must be Made or Circled in Red Ink With Date and Name of Person Making Change.

Do not extend notes this side of this line

INVENTORY IN F. B. 1640-128

20" Adj.

N. 5° 41' 45" W.

From Top Page 75

| | |
|---|---|
| Notes Ck'd by | Survey of |
| Map No. | W. O. Tape No. St'd °F. |
| Office Work | Surveyed by C.K. Crumrine |
| Checked | Notes Date |
| Date | Indexed |

F.B. 703 PG. 77

Note: Any Additions or Changes on This Sheet Must be Made or Circled in Red Ink With Date and Name of Person Making Change.

Do not extend notes this side of this line

RETURN TO
LOS ANGELES COUNTY SURVEYOR
700 HALL OF RECORDS

INVENTORY IN F. B. 1640-127

N.65° 26' 55"W.

N.72° 45' 25"W.

Cont'd From Top Page 76

FORM 247 10M 11-35

F.B. 703 Pg. 78

Cont'd To Bottom Page 79

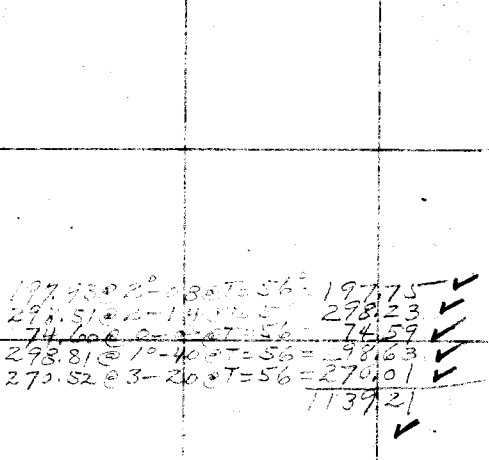

INVENTORY IN F. B. 1640-126, 127

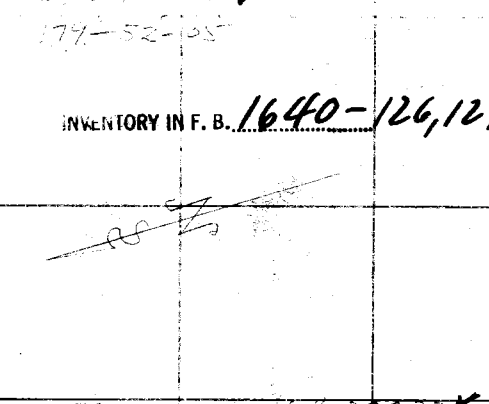

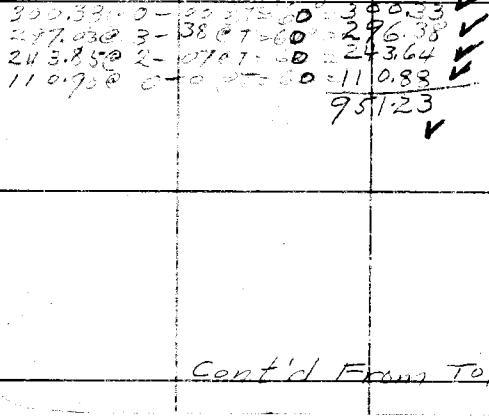

Cont'd From Top Pg 77

RETURN TO
LOS ANGELES COUNTY SURVEYOR
700 HALL OF RECORDS

Do not extend notes this side of this line

Note: Any Additions or Changes on This Sheet Must be Made or Circled in Red Ink With Date and Name of Person Making Change.

| | |
|---|---|
| Notes Ck'd by | Survey of |
| Map No. | W. O. 8094 Tape No. 68 St'd 84°F. |
| Office Work | Surveyed by C.V. Crumley |
| Checked | Notes C.V.C. Date 5-25-37 |
| Date | Indexed A. C. Johnson |

F.B. 703 Pg. 79

Cont'd from bottom Page 80

183.29 N 4°-20'E = 182.73
78.22
280.95
Mole 103

N. 7°15'10"W.

Cont'd from Top Page 78

N. 65°30'20"W.

INVENTORY IN F. B. 1640-126

Note: Any Additions or Changes on This Sheet Must be Made or Circled in Red Ink With Date and Name of Person Making Change.

Do not extend notes this side of this line

RETURN TO
LOS ANGELES COUNTY SURVEYOR
700 HALL OF RECORDS

FORM 247 10M 11-35

F.B. 703 PG. 80

Cont'd To Bottom Pg. 81



INVENTORY IN F. B. 1640-125,

Cont'd From Top Pg 79

RETURN TO
LOS ANGELES COUNTY SURVEYOR
700 HALL OF RECORDS

Note: Any Additions or Changes on This Sheet Must be Made or Circled in Red Ink With Date and Name of Person Making Change.

Do not extend notes this side of this line

| | |
|---|---|
| Notes Ck'd by | Survey of |
| Map No. | W. O. 8094 Tape No. 60 St'd °F. |
| Office Work | Surveyed by C.V. Grumley |
| Checked | Notes C.V.G. Date 5-24-37 |
| Date | Indexed A. C. Johnson |

F.B. 752 PG. 21

Cont'd From Bottom Page 8a

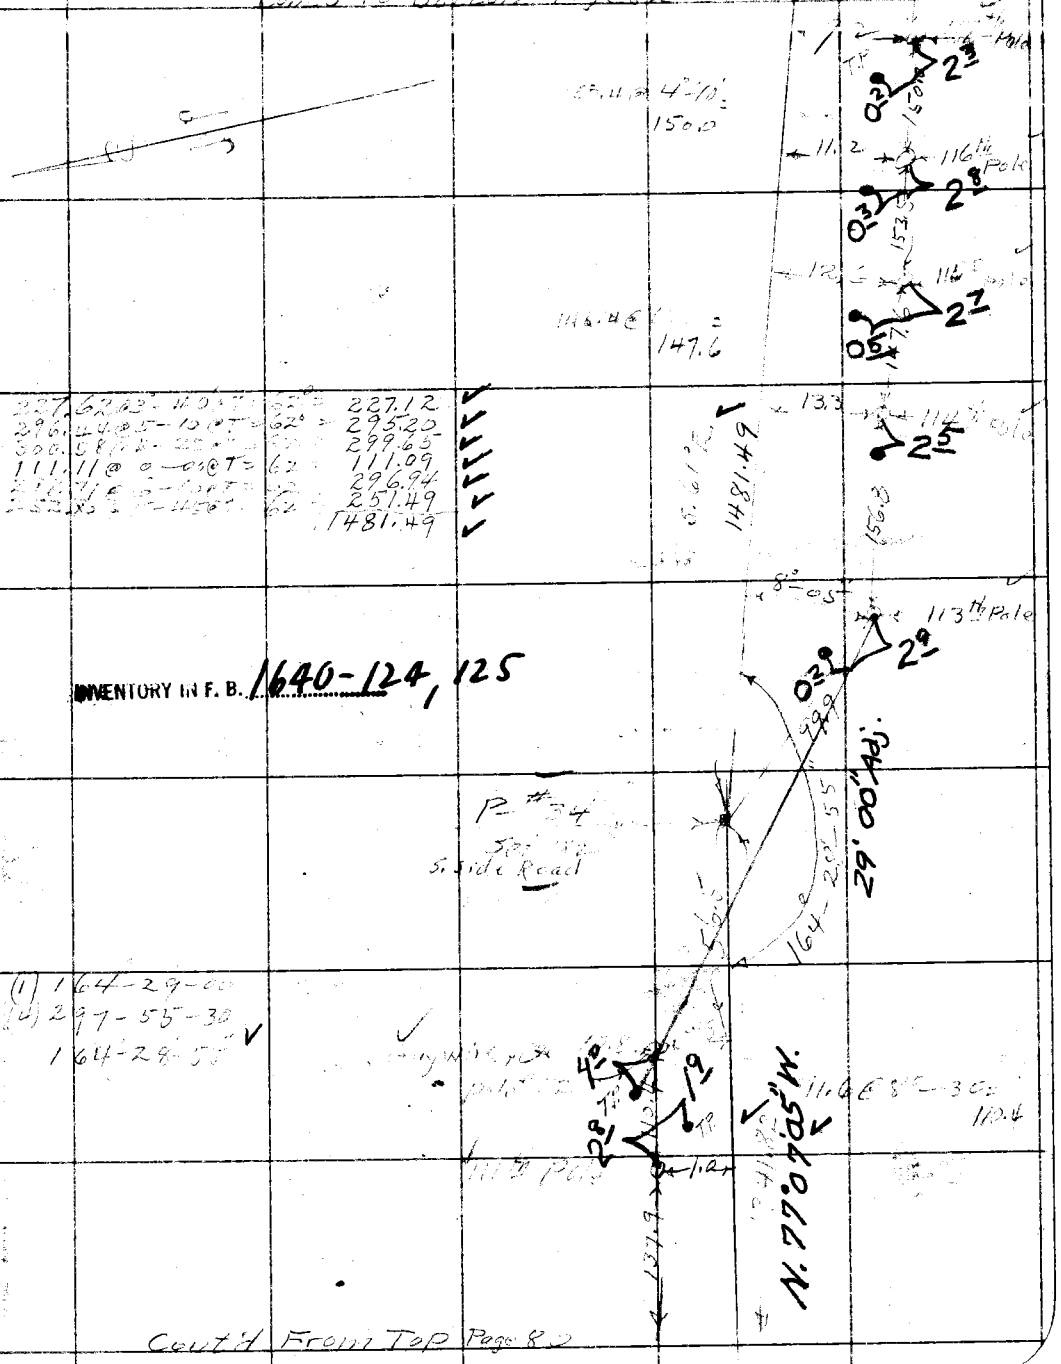


INVENTORY IN F. B. 1640-124, 125

RETURN TO
LOS ANGELES COUNTY SURVEYOR
700 HALL OF RECORDS

Note: Any Additions or Changes on This Sheet Must be Made or Circled in Red Ink With Date and Name of Person Making Change.

Do not extend notes this side of this line

FORM 247 10M 11-35

F.B. 703 Pg. 82

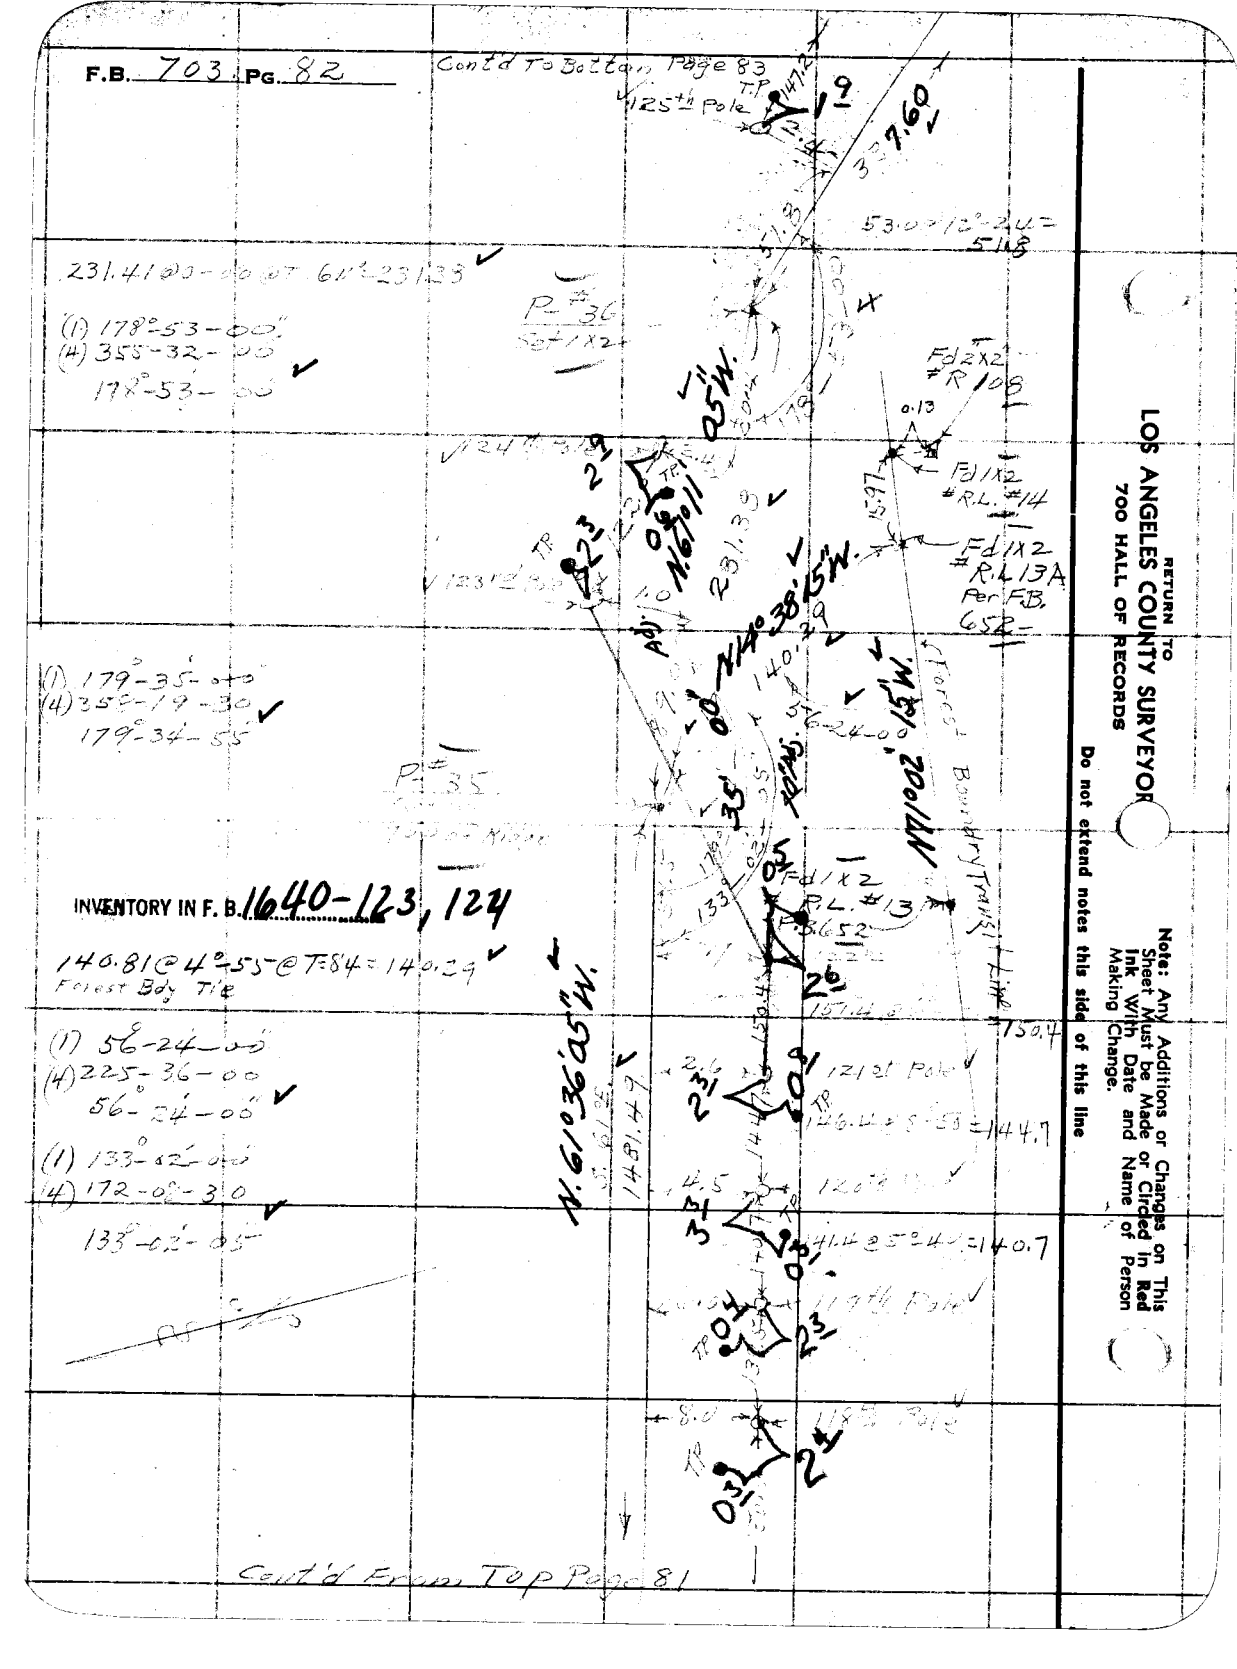


INVENTORY IN F. B. 1640-123, 124

140.81 @ 4°-55 @ T=84 = 140.29
Forest Bdy Tie

RETURN TO
LOS ANGELES COUNTY SURVEYOR
700 HALL OF RECORDS

Note: Any Additions or Changes on This Sheet Must be Made or Circled in Red Ink With Date and Name of Person Making Change.

Do not extend notes this side of this line

| | |
|---|---|
| Notes Ck'd by | Survey of |
| Map No. | W. O. 8074 Tape No. 28 St'd 84 °F. |
| Office Work | Surveyed by C.V. Carmichael |
| Checked | Notes C.V.C. Date 2 Oct 37 |
| Date | Indexed E. C. Schaffner |

F.B. 133 Pg. 83

Cont'd from Front Page 84

132nd Pole 17.3 TP

300.00 @ 5° 15' E T = 70° = 298.73
138.35 @ 0-00 E T = 70° = 138.34
437.07 Guy Wire

N. 79° 02' 15" W.

131st Pole 19.7 TP

167.0 @ 2-30 = 167.0

130th Pole 20.5

50' adj.

P = 38
Set S. & T.

(1) 178°-21-00"
(4) 353-23-30
178°-20-53" ✓

172.0 @ 2-00 = 171.9

129th Pole 16.6 TP

300.71 @ 3° 15' T = 70° = 300.20
163.25 @ 2-00 E T = 70° = 163.14
463.34

172.0

128th Pole 13.7 TP

S. 76° E.

463.34

N. 77° 23' 45" W.

INVENTORY IN F. B. 1640-123

(1) 162°-41-00"
(4) 290-44-00
162°-41-00" ✓

P = 37
50' adj.

4973
295.00 @ 12-35 E T = 64° = 287.87
339.6 ✓

Guy wire

N. 60° 04' W.

338.60

156.0 @ 1° 20' = 147.2

Cont'd From Top Page 82

RETURN TO
LOS ANGELES COUNTY SURVEYOR
700 HALL OF RECORDS

Note: Any Additions or Changes on This Sheet Must be Made or Circled in Red Ink With Date and Name of Person Making Change.

Do not extend notes this side of this line

FORM 247 10M 11-35

F.B. 703 PG. 84

Cont'd To Bottom Page 85




RETURN TO
LOS ANGELES COUNTY SURVEYOR
700 HALL OF RECORDS

Note: Any Additions or Changes on This Sheet Must be Made or Circled in Red Ink With Date and Name of Person Making Change.

Do not extend notes this side of this line

| | |
|---|---|
| Notes Ck'd by | Survey of |
| Map No. | W. O. Tape No. St'd °F. |
| Office Work | Surveyed by |
| Checked | Notes Date 5-26 |
| Date | Indexed |

F.B. 700 PG. 85

Note: Any Additions or Changes on This Sheet Must be Made in Red Ink With Date and Name of Person Making Change.

Do not extend notes this side of this line

RETURN TO
LOS ANGELES COUNTY SURVEYOR
720 HALL OF RECORDS

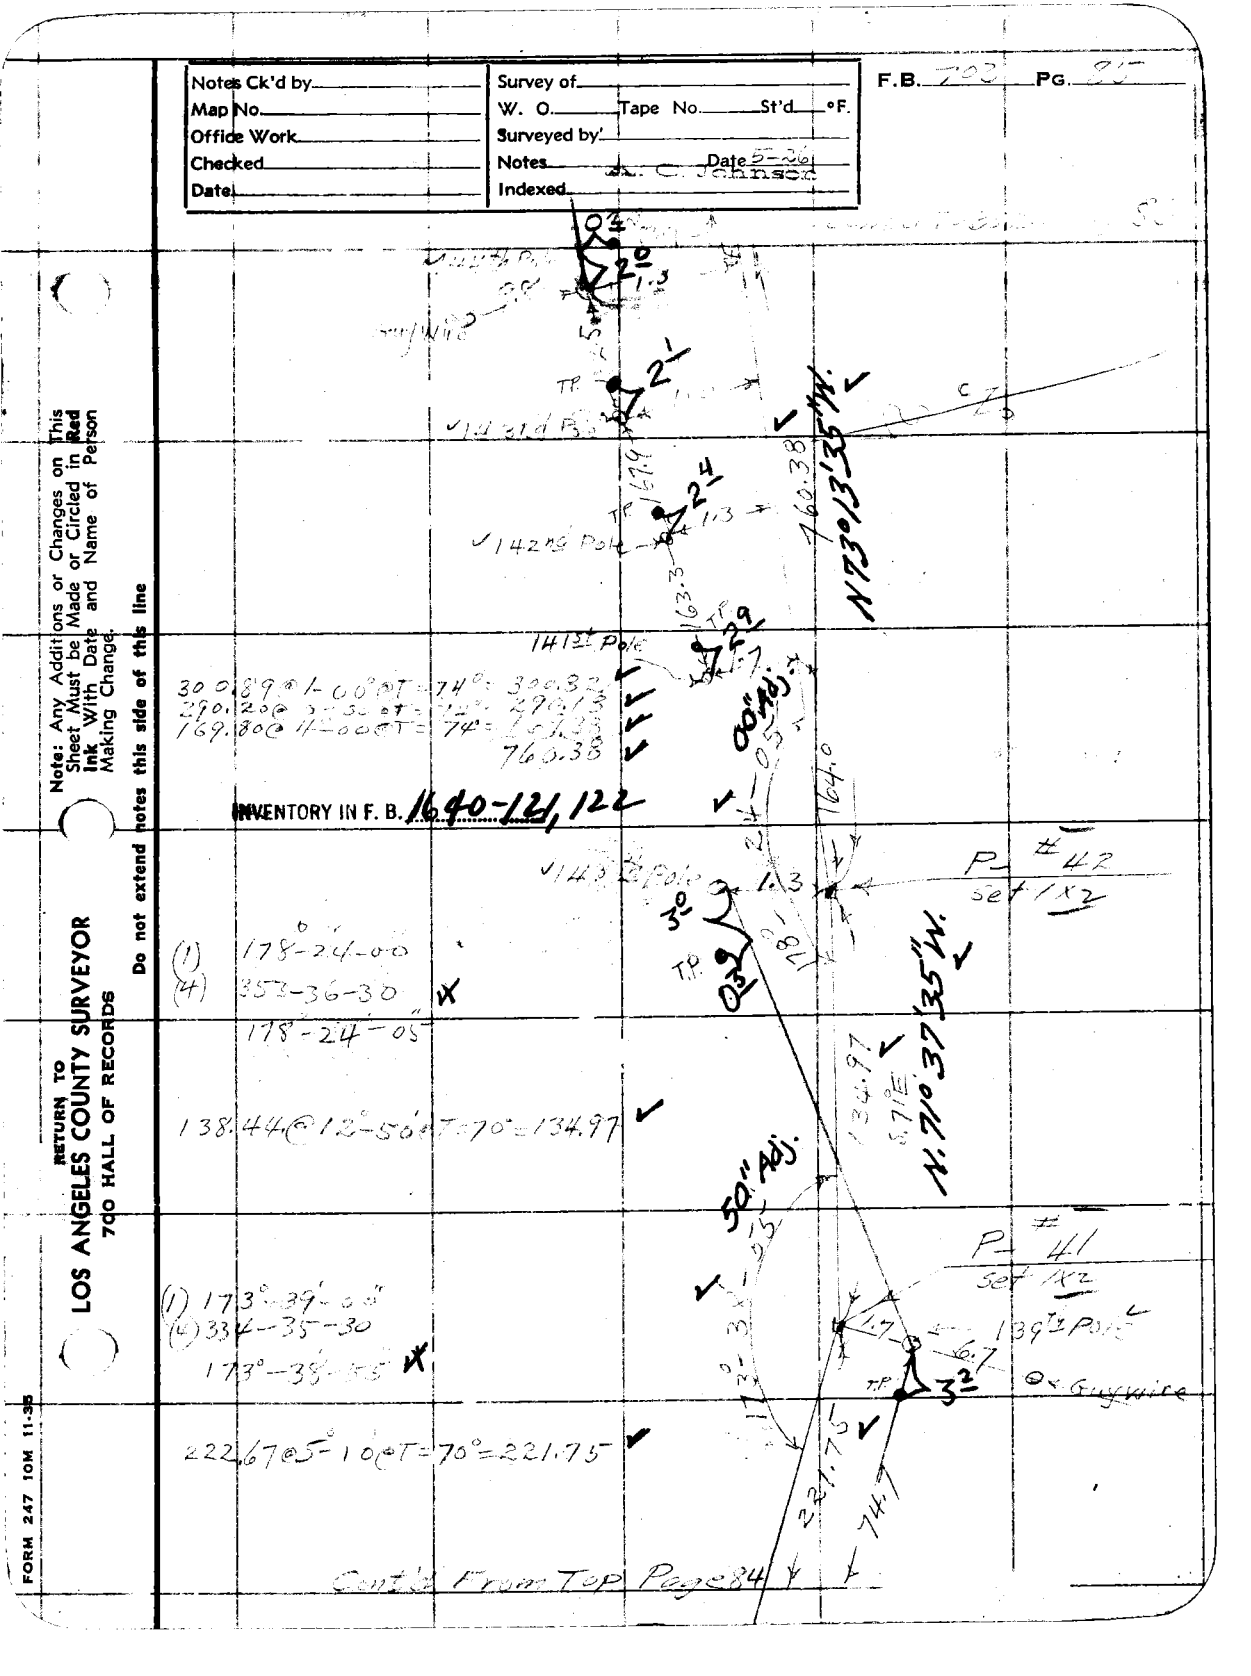


INVENTORY IN F. B. 1640-121, 122

(1) 178-24-00
(4) 353-36-30
178-24-05

138.44 @ 12°-50' = 70° = 134.97

(1) 173°-39'-00"
(4) 334-35-30
173°-39'-35"

222.67 @ 5°-10' = 70° = 221.75

Cont'd From Top Page 84

FORM 247 10M 11-35

F.B. 703 PG. 86

Cont'd To Bottom Page 87

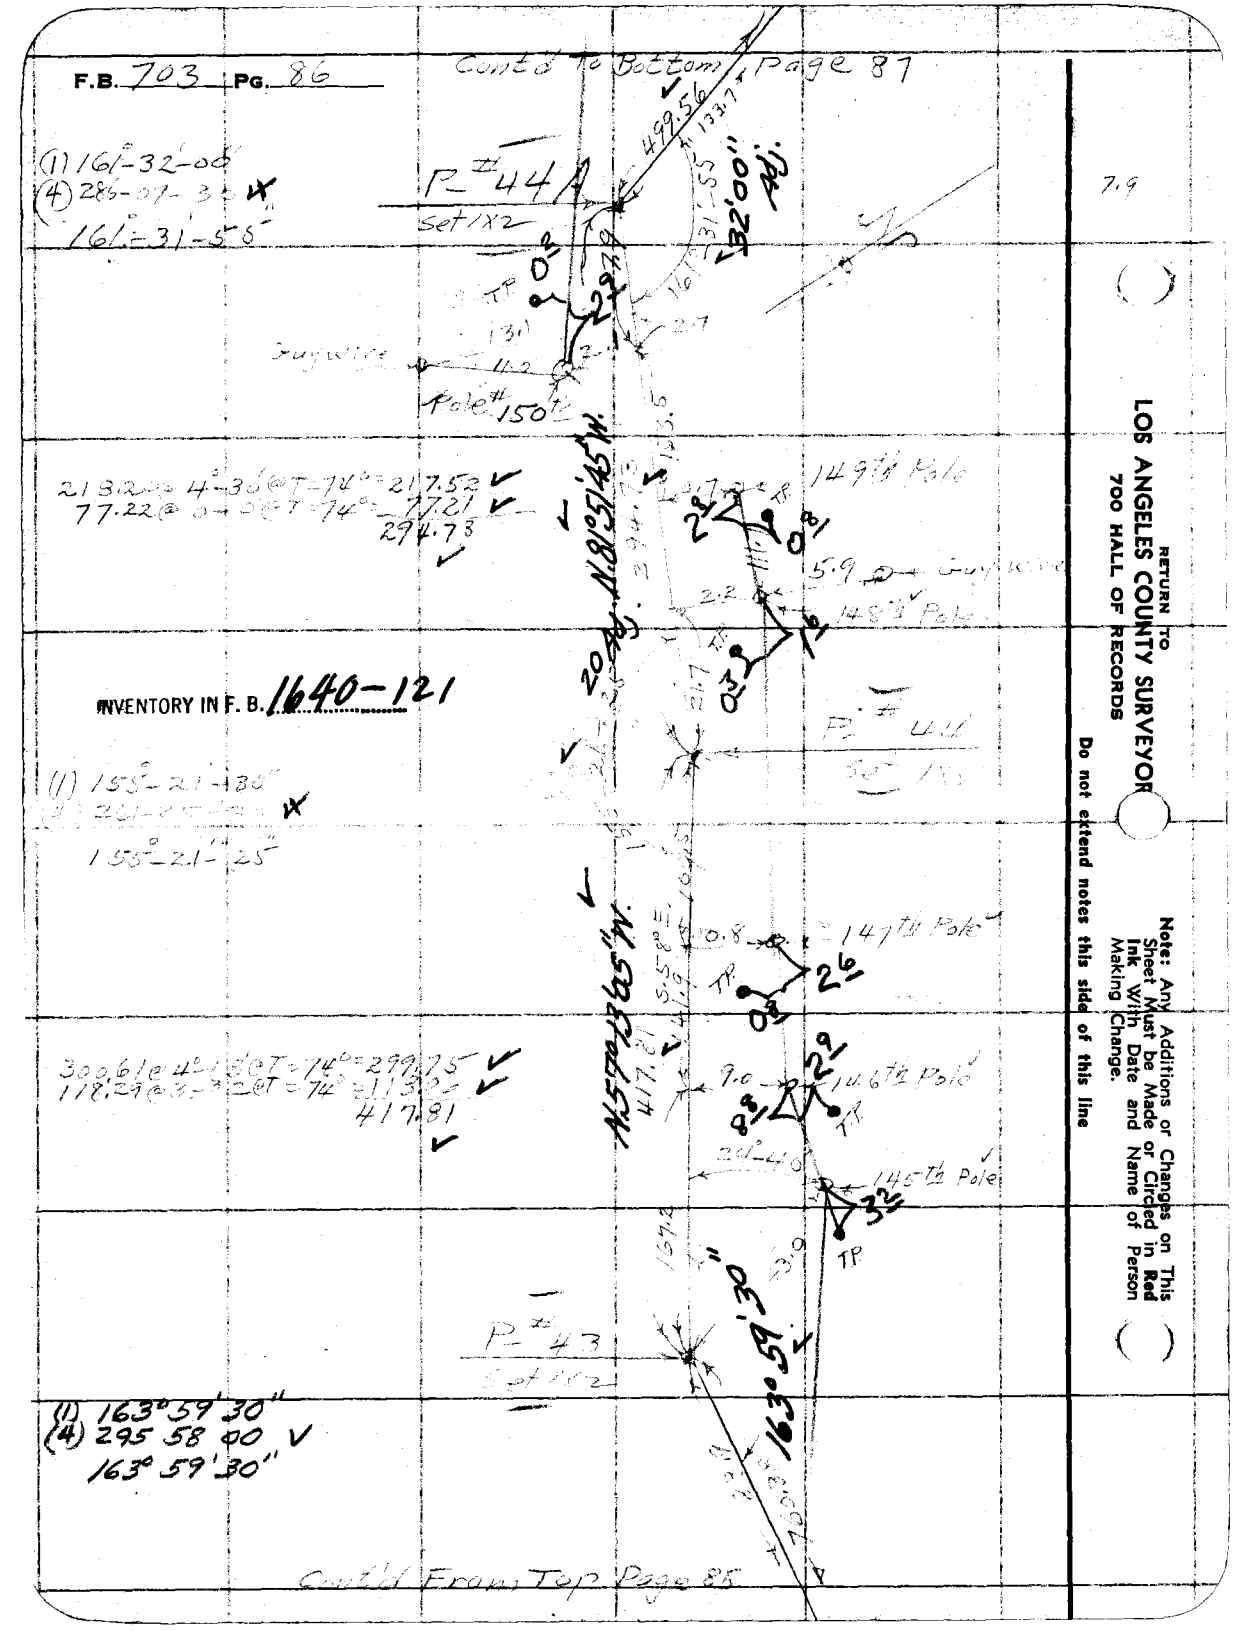


INVENTORY IN F. B. 1640-121

7.9

RETURN TO
LOS ANGELES COUNTY SURVEYOR
700 HALL OF RECORDS

Note: Any Additions or Changes on This Sheet Must be Made or Circled in Red Ink With Date and Name of Person Making Change.

Do not extend notes this side of this line

| | |
|---|---|
| Notes Ck'd by | Survey of Boundary Traverse |
| Map No. | W. O. 8094 Tape No. 62' St'd 84°F. |
| Office Work | Surveyed by C.V. Crumbaker |
| Checked | Notes C.V.C. Date 6-20-37 |
| Date | Indexed |

F.B. 723 PG. 87

Note: Any Additions or Changes on This Sheet Must be Made or Circled in Red Ink With Date and Name of Person Making Change

Do not extend notes this side of this line

RETURN TO
LOS ANGELES COUNTY SURVEYOR
700 HALL OF RECORDS

INVENTORY IN F. B. 1640-120, 121

Cont'd To Back Line of 83

BM #156

N 30° 24' 45" W.

(1) 174° 24' 00"
(4) 337° 36' 00"
174° 24' 00"

Guy Wire

155 th Pole

P 46
set 1X1

N 63° 23' 45" W.

154 th Pole

P 45
Set 1X2

(1) 179° 23' 05"
(4) 357° 32' 30"
179° 23' 05"

N. 63° 23' 45" W.

Cont'd From Top Pg. 56

FORM 247 10M 11-38

F.B. 703 Pg. 88

Cont'd To Bottom Page 89

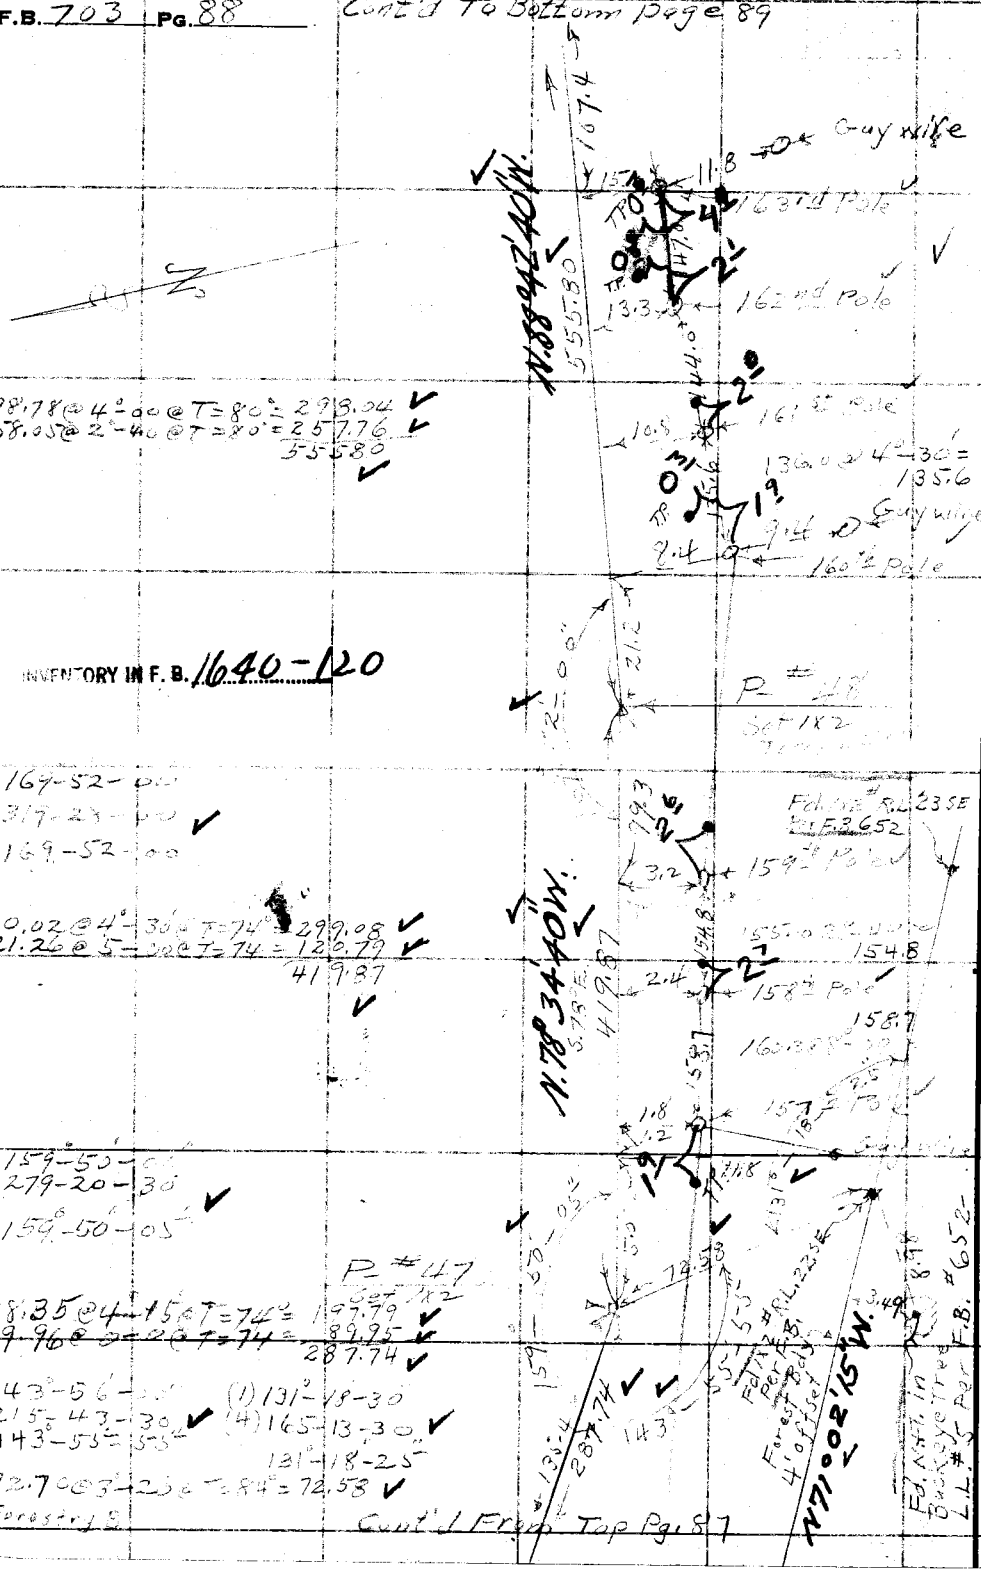
N.10°44'E.
N.78°43'W.
N.71°02'15"W.
Guy wire
Guy wire
Fd. 1/2" I.P. 2.35 SE
Fd. #RL 2352

| | |
|---|---|
| Notes Ck'd by R.R.M. | Survey of Existing Traverse |
| Map No. | W. O. 3094 Tape No. 59 St'd 84°F. |
| Office Work | Surveyed by C.V.C. Cramlick |
| Checked | Notes C.V.C. Date 2-27-37 |
| Date | Indexed |

F.B. 773 Pg. 39

Note: Any Additions or Changes on This Sheet Must be Made or Circled in Red Ink With Date and Name of Person Making Change

Do not extend notes this side of this line

RETURN TO
LOS ANGELES COUNTY SURVEYOR
700 HALL OF RECORDS

INVENTORY IN F. B. 1640-119

(1) 175°-41'-00"
(4) 342-43-30
175°-40'-55"

161.00 @ 1-30 ΔT = 84° = 160.95

N. 77°04'35" W.

(1) 162°-15'-00
(4) 288-47-30
162°-11'-55"

Guy Wire

=99.61 @ 6°-40 Δ T = 84° = 297.58
170.80 @ 3-40 Δ T = 84° = 170.45
468.03

S. 85°02'20" W.

(1) 173°-50-00
(4) 335-20-00
173°-50-00

Cont'd From Top Page 38

169 M Pole with Call Box 146

131.0 @ 10° = 128.9

P # 51
Set S. & T. on Ridge N.W. of Shed.

167 M Pole

134.6 @ 4°-00 = 134.3

165 M Pole

137.20 @ 7° = 136.1

164 M Pole

P # 49
Set 1 X 2

Cont'd On Page 38

FORM 247 10M 11-35

F.B. 703 PG. 90

Cont'd To Bo-Zam Page 91

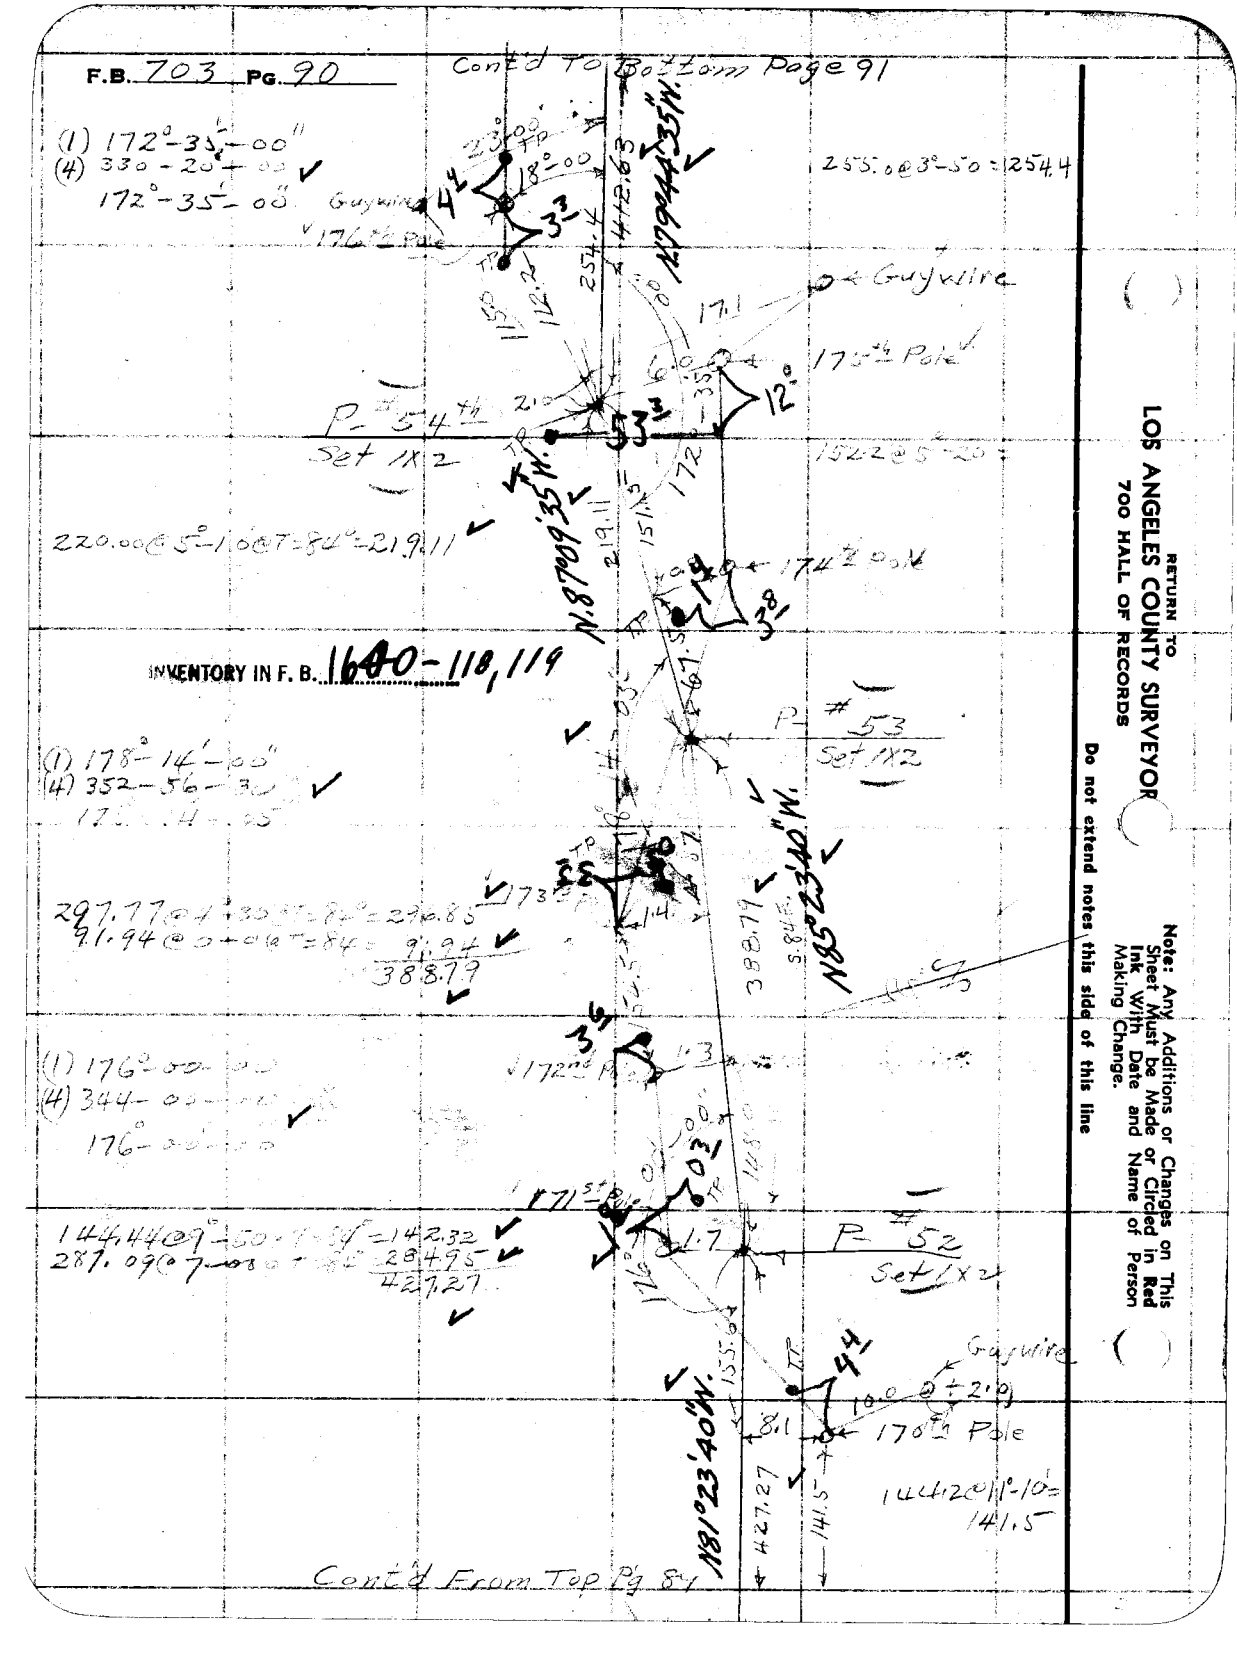


RETURN TO
LOS ANGELES COUNTY SURVEYOR
700 HALL OF RECORDS

Note: Any Additions or Changes on This Sheet Must be Made or Circled in Red Ink With Date and Name of Person Making Change.

Do not extend notes this side of this line

| | |
|---|---|
| Notes Ck'd by R.R.M. | Survey of Forestry Tie Work |
| Map No. | W. O. 8074 Tape No. 62 St'd S.W.F. |
| Office Work | Surveyed by C.V. Cervantes |
| Checked | Notes C.V.C. Date 5-27-37 |
| Date | Indexed A. C. Johnson |

F.B. 723 PG. 21

Note: Any Additions or Changes on This Sheet Must be Made or Circled in Red Ink With Date and Name of Person Making Change.

Do not extend notes this side of this line

RETURN TO
LOS ANGELES COUNTY SURVEYOR
700 HALL OF RECORDS

INVENTORY IN F. B. 1640-118

FORM 247 10M 11-35

Cont'd From Top Page 90

F.B. 703 PG. 92

Cont'd To Bottom Pg. 93

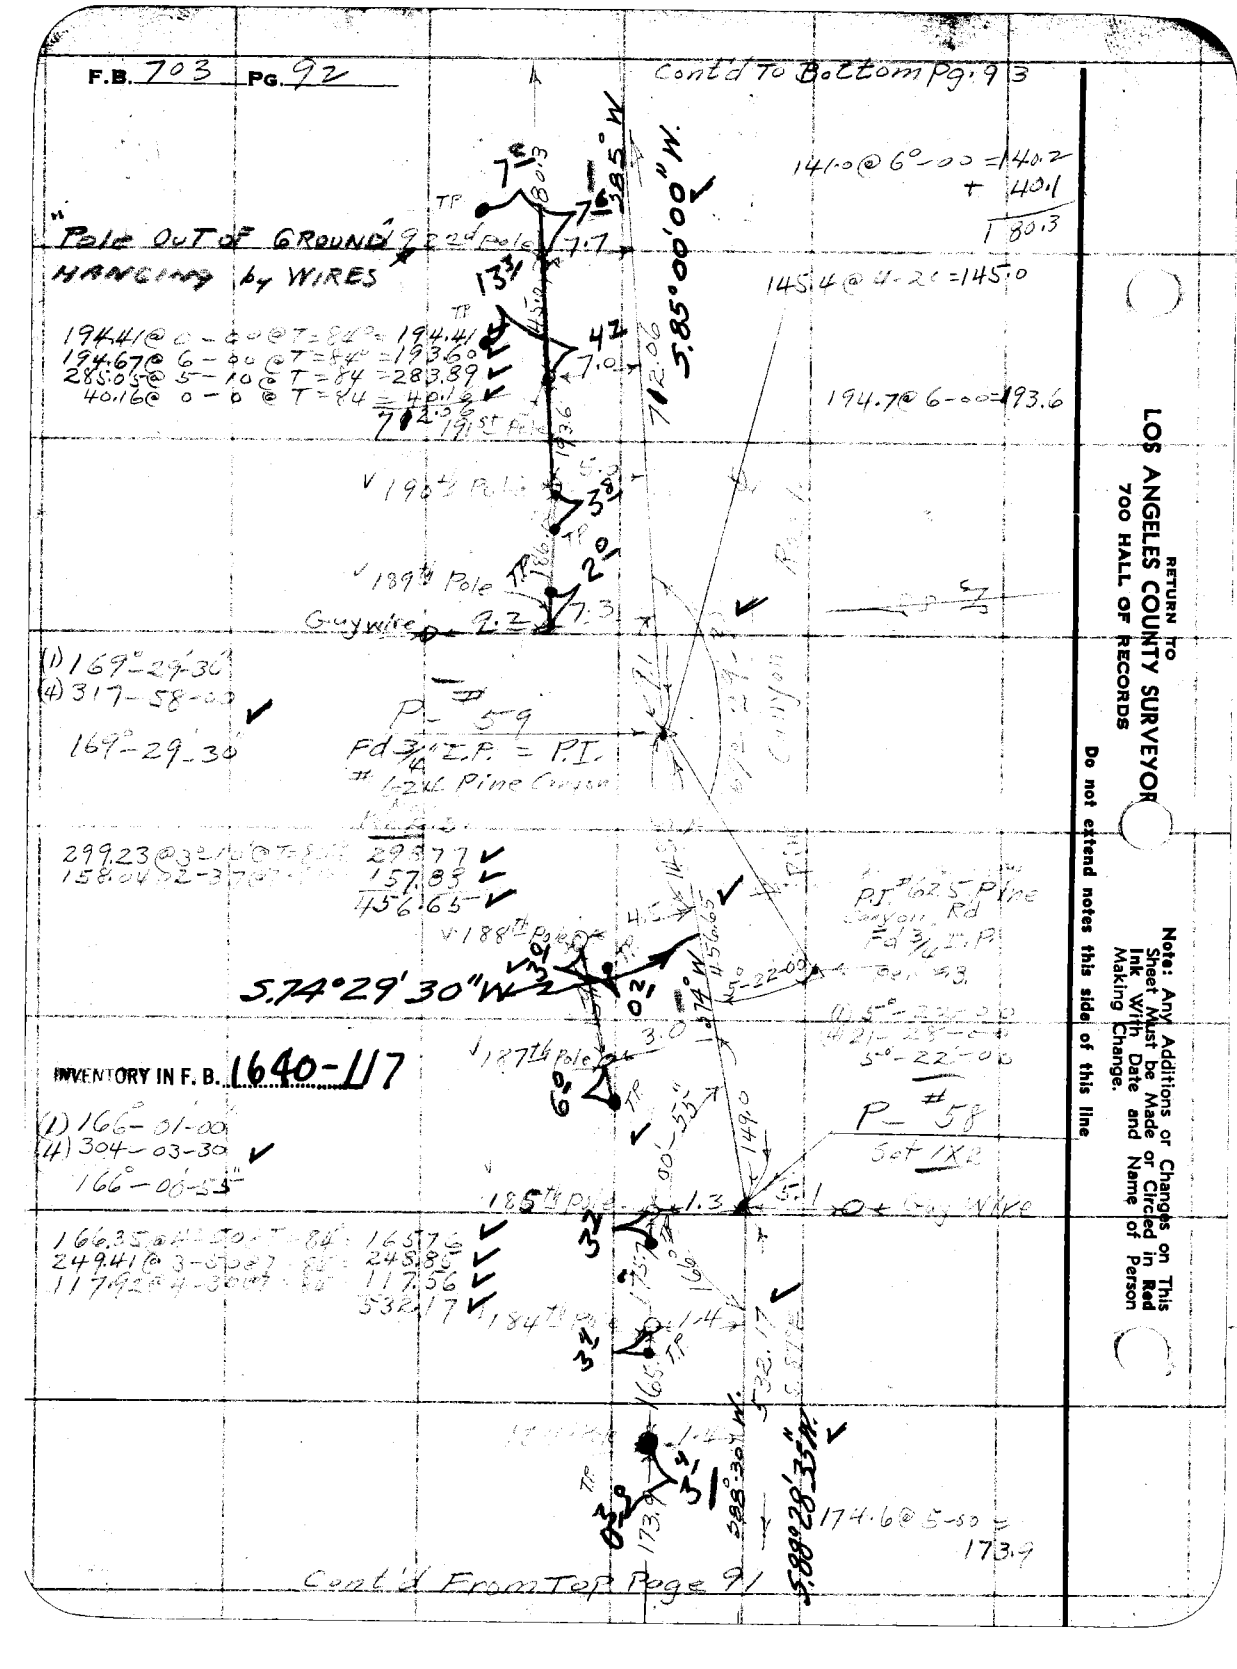


Cont'd From Top Page 91

RETURN TO
LOS ANGELES COUNTY SURVEYOR
700 HALL OF RECORDS

Note: Any Additions or Changes on This Sheet Must be Made or Circled in Red Ink With Date and Name of Person Making Change.

Do not extend notes this side of this line

| | |
|---|---|
| Notes Ck'd by R.M. | Survey of [illegible] |
| Map No. | W. O. 8294 Tape No. [illegible] St'd. 54° F. |
| Office Work | Surveyed by C.V.C. Crowley |
| Checked | Notes C.V.C. Date 5-1-43 |
| Date | Indexed A. C. Johnson |

F.B. 783 PG. 93

Note: Any Additions or Changes on This Sheet Must be Made or Circled in Red Ink With Date and Name of Person Making Change

Do not extend notes this side of this line

RETURN TO
LOS ANGELES COUNTY SURVEYOR
700 HALL OF RECORDS

FORM 247 10M 11-38

197th Pole 15.9 2.5 TP

(1) 169°-23-05
(4) 317-31-30
169°-22-55 P. #62 Set 1/2

27.3

256.9 @ 8°-05' = 254.3 - 2.0 = 252.3

Guy wire

196th Pole

195th Pole

INVENTORY IN F. B. 1640-116

105.51 @ 11°-20' ET = 84 = 103.45
255.71 @ 8°-05' ET = 84 = 256.34
359.79

105.5 @ 11°-20 = 103.4 + 2.0 = 105.4

P. #61 Set 1/2

194th Pole

(1) 176°-26-00
(4) 345-44-00
176°-26-00

175.82 @ 2°-34' ET CH = 175.65

(1) 176°-27-30
(4) 345-49-30
176°-27-25

P. #60 Set 1/2

193rd Pole

2.0

Cont'd From Top Page 92

F.B. 703 Pg. 94

Cont'd To Bottom Page 95

RETURN TO
LOS ANGELES COUNTY SURVEYOR
700 HALL OF RECORDS

Note: Any Additions or Changes on This Sheet Must be Made in Red Ink With Date and Name or Circled Making Change.

Do not extend notes this side of this line.

INVENTORY IN F. B. 1640-115,116

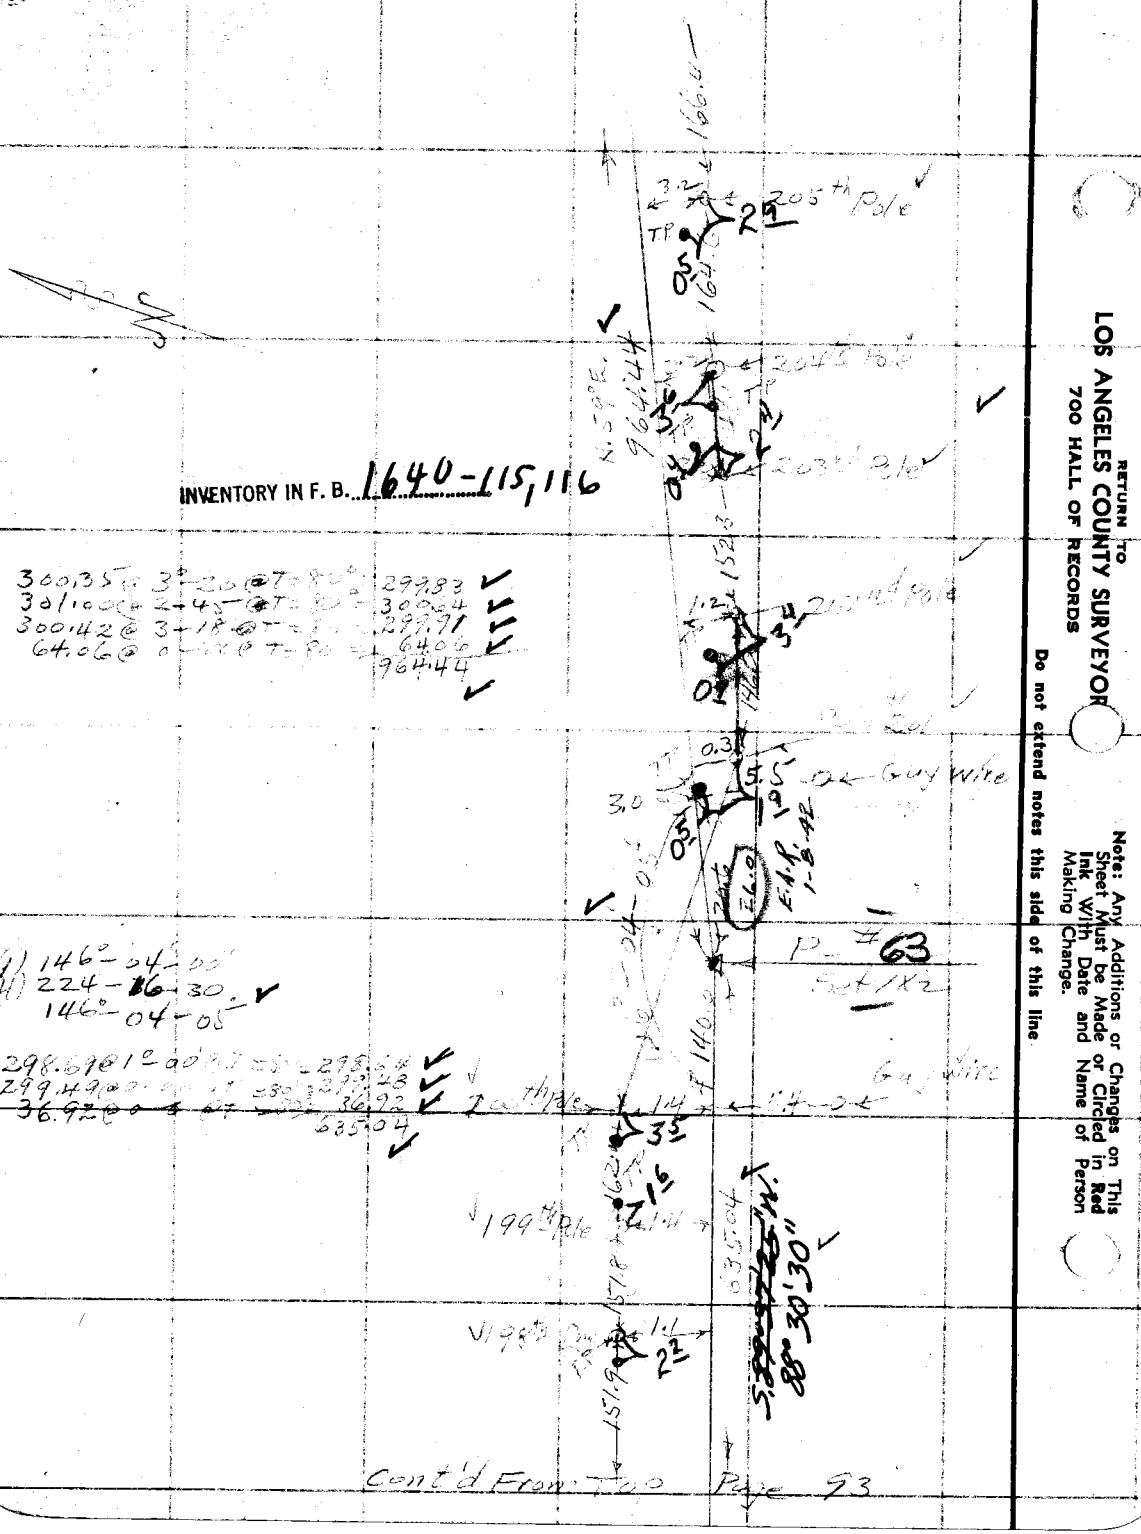

| | |
|---|---|
| Notes Ck'd by R.A.M. | Survey of Topanga Terrace Tract |
| Map No. | W. O. 8094 Tape No. 63 St'd 84°F. |
| Office Work | Surveyed by E.V. Dunlap |
| Checked | Notes C.K.G. Date 5-24-37 |
| Date | Indexed C. Johnson |

F.B. 705 PG. 75

Cont'd To Book ___ Page ___

RETURN TO
LOS ANGELES COUNTY SURVEYOR
700 HALL OF RECORDS

Note: Any Additions or Changes on This Sheet Must be Made or Circled in Red Ink With Date and Name of Person Making Change.

Do not extend notes this side of this line

INVENTORY IN F. B. 1640-115

N. 63° 02' 20" W.

Guy Wire

P. 465

3 Ct 1/2

(1) 132°-11'-00"
(4) 168°-44'-00"
132°-11'-00"

S. 69° 08' 40" W.

441.01

Guy Wire

P. 64

3 Ct 1/2

(1) 165°-26'-00"
(4) 301°-43'-30"
165°-26'-00"

S. 54° 34' 35" W.

Cont'd From Top Page 94

FORM 247 10M 11-33

F.B. 703 Pg. 96

Cont'd To Bottom Page 97

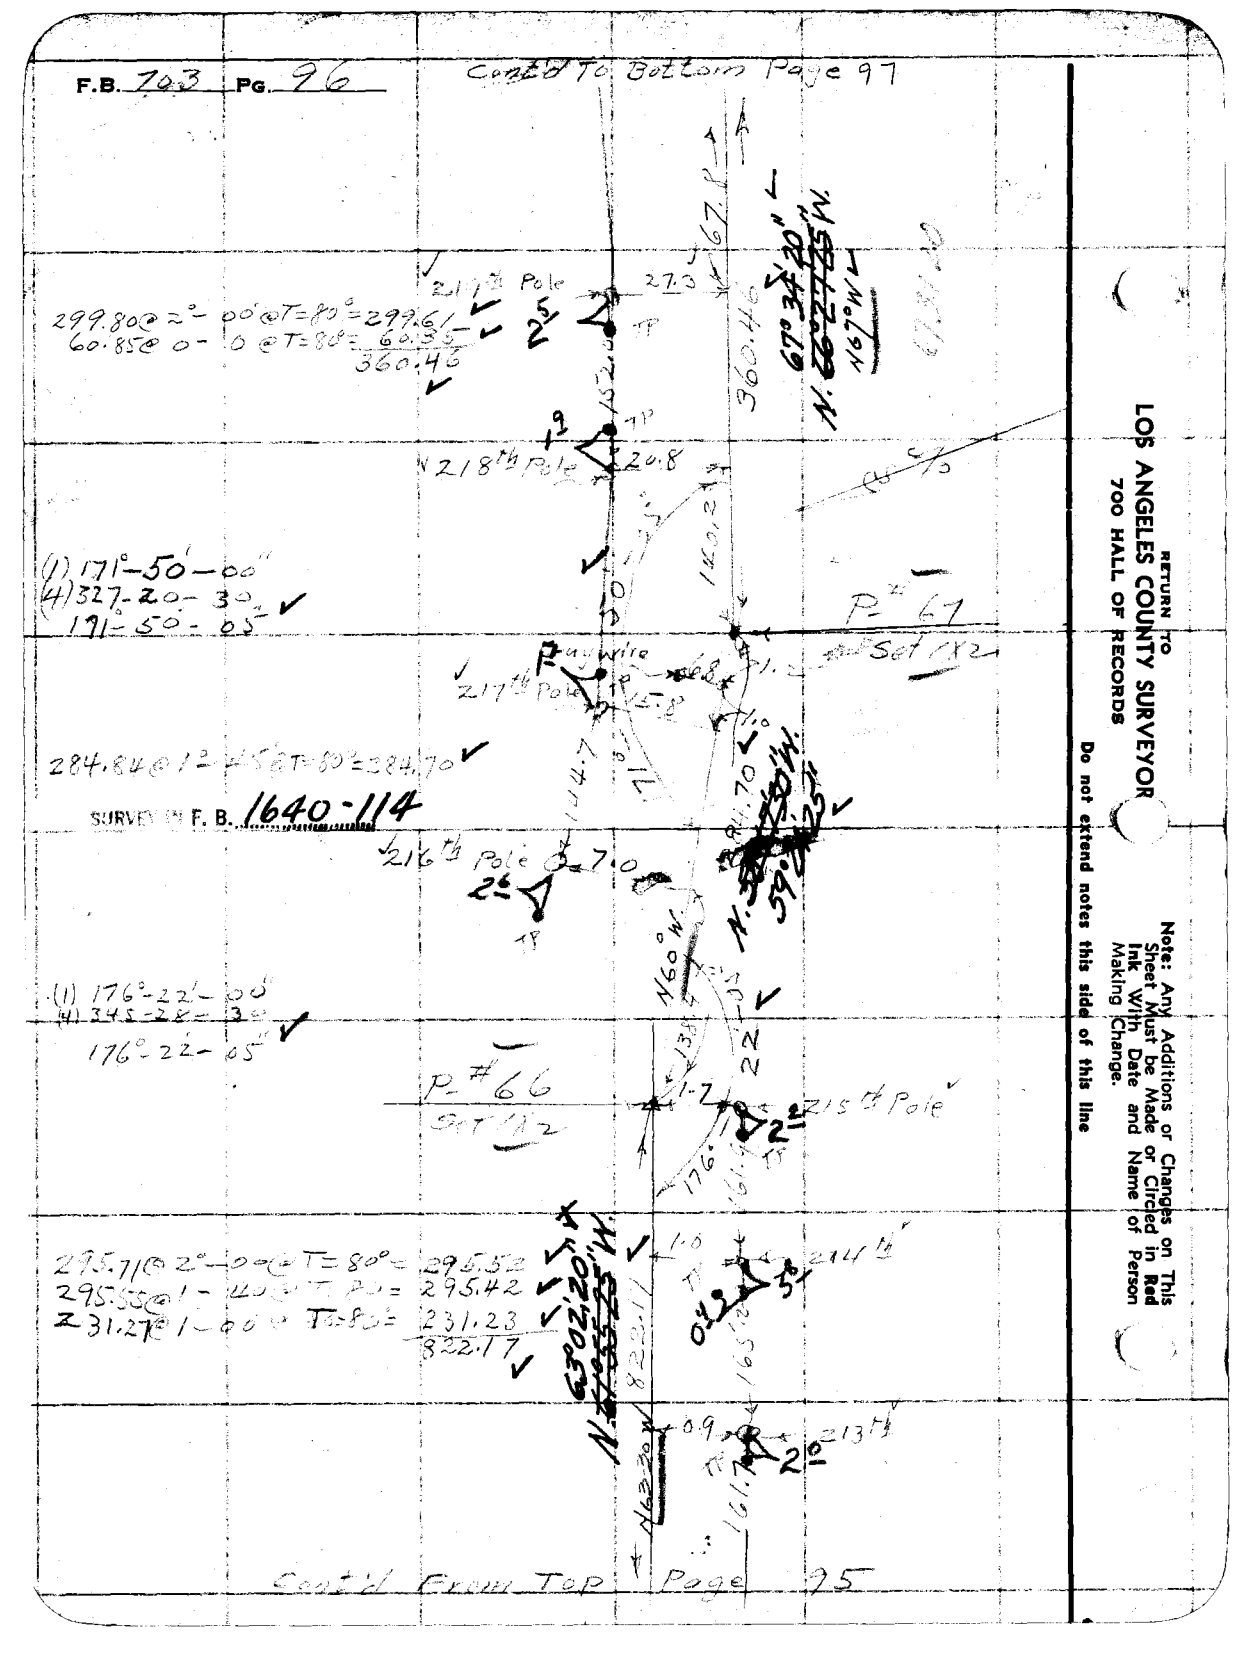


RETURN TO
LOS ANGELES COUNTY SURVEYOR
700 HALL OF RECORDS

Do not extend notes this side of this line

Note: Any Additions or Changes on This Sheet Must be Made or Circled in Red Ink With Date and Name of Person Making Change.

| | |
|---|---|
| Notes Ck'd by RRM. | Survey of [illegible] |
| Map No. | W. O. 8094 Tape No. 69 St'd 84 °F. |
| Office Work | Surveyed by C.V. Crumley |
| Checked | Notes C.V.C. Date 5-28-37 |
| Date | Indexed [illegible] |

F.B. 23 Pg. 97

163.91@3°40'T=84°=163.57 ✓

P # 70
Set S.&T.

(1) 157°-21-00
(4) 269-24-00
157°-21-05 ✓

191.71@3°18'T=84°=191.37 ✓

SURVEY IN F. B. 1640-114

P # 69
Set 1/2

(1) 174°-05-00"
(4) 336-19-.30
174°-04-55

288.714@1°00'@T=84°=288.70 ✓

P # 68
Set 1/2

(1) 154°-53-00"
(4) 259-32-30
154°-53-05"

Guywire TP
Guywire Pole
222nd Pole
221st Pole
220th P
Guy Wire

Cont'd From Top Page 96

Note: Any Additions or Changes on This Sheet Must be Made in Red Ink or Circled With Date and Name of Person Making Change.

Do not extend notes this side of this line

RETURN TO
LOS ANGELES COUNTY SURVEYOR
700 HALL OF RECORDS

FORM 247 10M 11-35

F.B. 703 PG. 98

Cont'd To Bottom Pg. 99

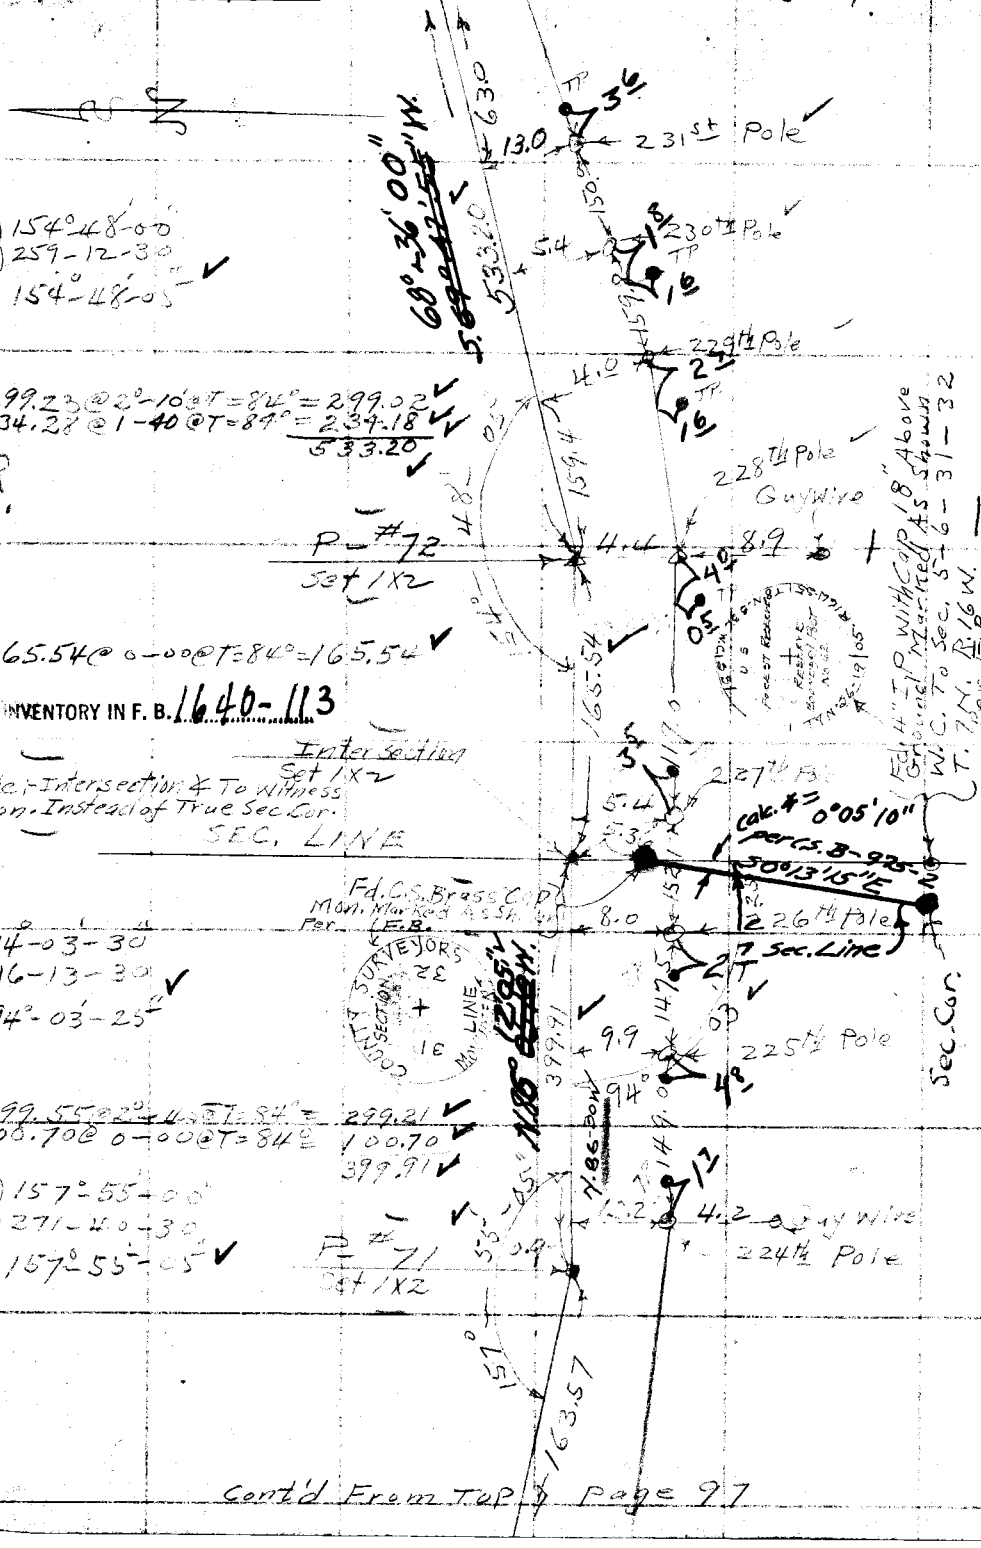


Cont'd From T.U.P. 3 Page 97

RETURN TO
LOS ANGELES COUNTY SURVEYOR
700 HALL OF RECORDS

Do not extend notes this side of this line

Note: Any Additions or Changes on This Sheet Must be Made in Red Ink With Date and Name of Person Making Change or Circled.

| | |
|---|---|
| Notes Ck'd by R.R.M. | Survey of Forestry Tract #33 |
| Map No. | W. O. 8294 Tape No. 2-3 St'd 84° F. |
| Office Work | Surveyed by C.V. Crumley |
| Checked | Notes C.V.C. Date 5-24-51 |
| Date | Indexed A. O. Johnson |

F.B. 723 PG. 99

Cont'd from Top Pg. 98

Note: Pole #239 is Junction Pole
2 Wires Going South
2 Wires From West
4 Wires Going East

INVENTORY IN F. B. 1640-112, 113

| | |
|---|---|
| 128.58 @ 0-00 @ T = 84° | = 128.58 |
| 297.80 @ 1-00 @ T = 84° | = 297.76 |
| 299.45 @ 0-30 @ T = 84° | = 299.45 |
| 300.75 @ 1-30 @ T = 84° | = 300.23 |
| 300.72 @ 1-40 @ T = 84° | = 300.59 |
| 294.82 @ 0-0 @ T = 84° | = 294.32 |
| 102.43 @ 0-0 @ T = 84° | = 102.43 |
| | 1724.28 |

S. 19° 43' 30" W.
1724.28

(1) 168-53-00
(14) 315-31-30
168-52-55

539.20

TP Junction Pole
239th Pole
238th Pole
237th Pole
236th Pole
235th Pole
234th Pole
233rd Pole
232nd Pole
Guy wire
Tie point Set 2x2 on Fence Line
P.H. 73 Set 1x2
Set 2"x2" under Fence

Note: Any Additions or Changes on This Sheet Must be Made or Circled in Red Ink With Date and Name of Person Making Change.

Do not extend notes this side of this line

RETURN TO
LOS ANGELES COUNTY SURVEYOR
700 HALL OF RECORDS

FORM 247 10M 11-35

F.B. 703 PG. 100

RETURN TO
LOS ANGELES COUNTY SURVEYOR
700 HALL OF RECORDS

Note: Any Additions or Changes on This Sheet Must be Made or Circled in Red Ink With Date and Name of Person Making Change.

Do not extend notes this side of this line

INVENTORY IN F. B. 1640 - 112

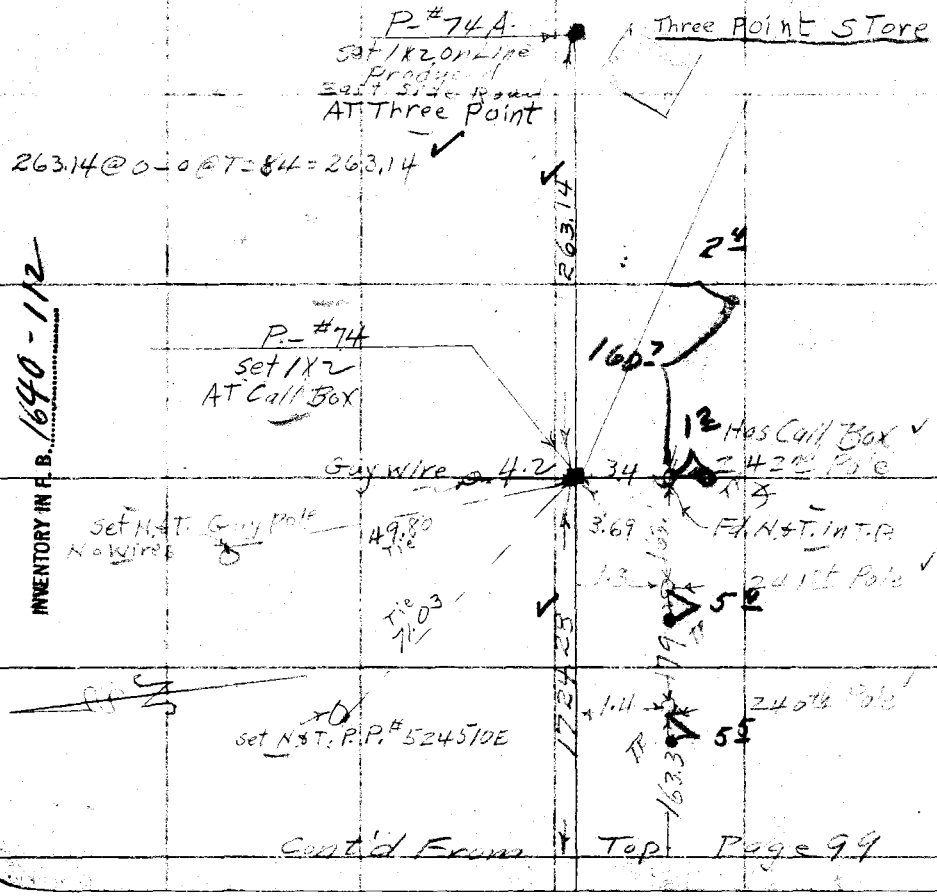

F.B. 703-101

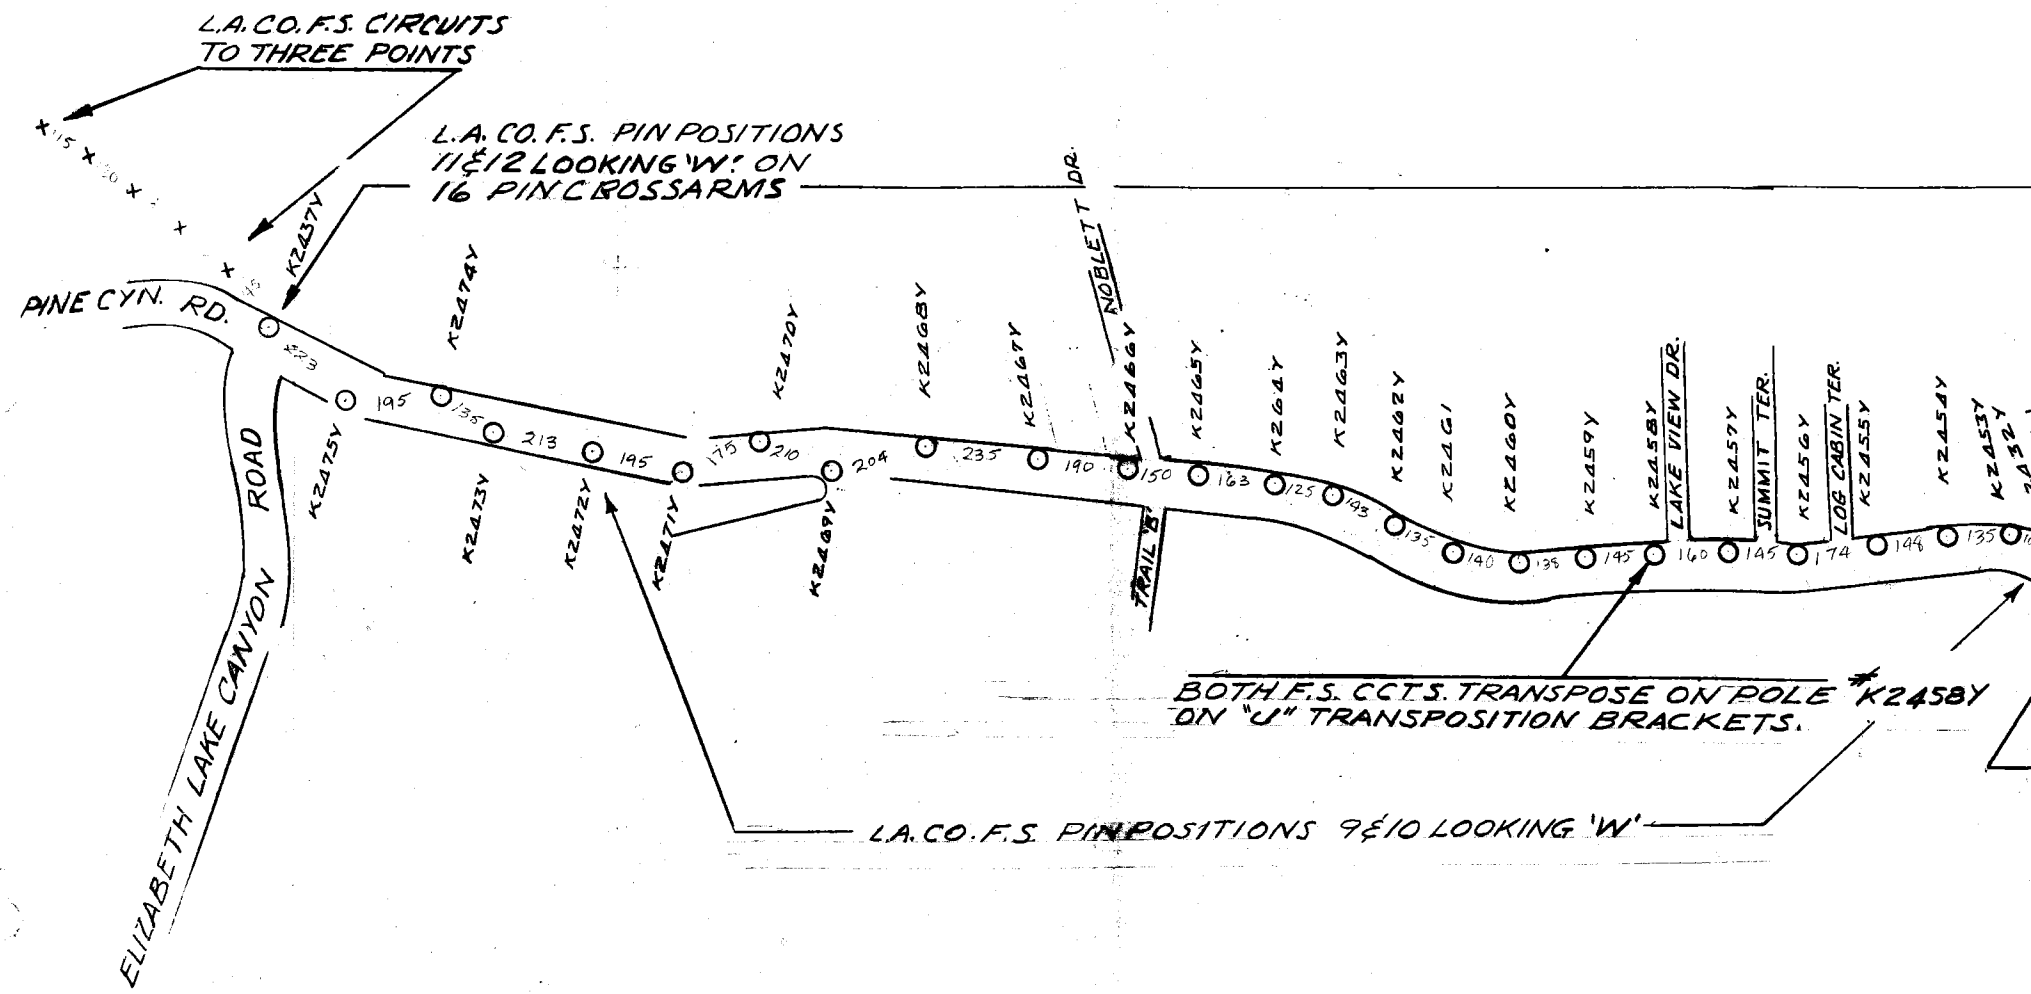
L.A. CO. F.S. CIRCUITS TO THREE POINTS
L.A. CO. F.S. PIN POSITIONS 11 & 12 LOOKING 'W' ON 16 PIN CROSSARMS
K2437Y
PINE CYN. RD.
ELIZABETH LAKE CANYON ROAD
K2474Y
K2475Y
K2473Y
K2472Y
K2471Y
K2469Y
K2470Y
K2468Y
K2467Y
K2466Y
NOBLETT DR.
K2465Y
K2464Y
K2463Y
K2462Y
K2461
K2460Y
K2459Y
K2458Y
LAKE VIEW DR.
K2457Y
SUMMIT TER.
K2456Y
LOG CABIN TER.
K2455Y
K2454Y
K2453Y
K2452Y
TRAIL 'B'
BOTH F.S. CCTS. TRANSPOSE ON POLE *K2458Y ON "U" TRANSPOSITION BRACKETS.
L.A. CO. F.S. PIN POSITIONS 9 & 10 LOOKING 'W'

101-203 F.B.

| ASSOCIATED TELEPHONE CO. LTD. | | | |
|---|---|---|---|
| LOCATION ELIZABETH LAKE PINE CYN. RD. | | | |
| EXCHANGE LAKE HUGHES | | | |
| ISSUE DATE | DISTRICT | GENERAL OFFICE | |
| 11-15-51 | JMD | | |
| | DISTRICT MANAGER | | |
| | VICE PRESIDENT AND CHIEF ENGINEER | | |
| DWG. NO. | RELATED DWGS. | PROJECT | WORK ORDER |

SCALE 1"=400'

L.A. Co. F.S. PLANT ON
N/S OF ROAD
EDISON & TELEPHONE CO.
ON S/S OF ROAD.

L.A. COUNTY FORESTRY
SERVICE STATION

23 24
26 25 T7N, R15W.

K2970

ELIZABETH LAKE PINE CANYON ROAD.

N F.S. ARMS.
2972Y&
EPLACED
O. F.S., 25' POLES.
EPLACED EDISON
487264E.
NT BEING
D DATED 12-26-50.

LEGEND

○ TELEPHONE CO POLES & CROSSARMS UNLESS OTHERWISE NOTED.

As built on our records & in field.

PRINTED ON CLEARPRINT NO. 1000-H

Notes Ck'd by K.R.M.
Map No.
Office Work
Checked
Date

Survey of Forestry Tel. Line
W. O. 8094 Tape No 66 St'd 5# OF.
Surveyed by Rozecrans
Notes Date 12/1/37
Indexed A. C. Johnson 12-6-37

F.B. 203 Pg. 105

POLE LINE III

cont. bottom next page

to P #40

25.5

6.0

10.1

P.O. #111-372

L.A. Co. Lines

Sch 1x2 Fl.

54°

P.O. #111-370

ON Tele. Co Poles

16.6

15.8

13.0

P.O. #111-371

P.O. #111-369

TO OAK TOP

#115

P.O. #111-368

P.O. #111-367

P.O. #111-366

11.6

7 wire

P.O. #111-365

NOTE

#38 Sch 1x2 Fl.

See Tele. Co. For

Pole LOCATION

ALL OTHER CHANGES NOTED IN RED

P.O. #111-363

N66°40'35"W.

P.O. #111-362

to P #37 A Sec

F.B. 598 Pg 214

NOTE - This line cont. from F.B. 598-214

Note: ANY ADDITIONS OR CHANGES ON THIS SHEET MUST BE MADE OR CIRCLED IN Red Ink WITH DATE AND NAME OF PERSON MAKING CHANGE.

Do not extend notes this side of this line

RETURN TO
LOS ANGELES COUNTY SURVEYOR
700 HALL OF RECORDS

FORM 247 5M 2-34

RETURN TO
**LOS ANGELES COUNTY SURVEYOR**
700 HALL OF RECORDS

**Note:** ANY ADDITIONS OR CHANGES ON THIS SHEET MUST BE MADE OR CIRCLED IN **Red Ink** WITH DATE AND NAME OF PERSON MAKING CHANGE.

**Do not extend notes this side of this line**

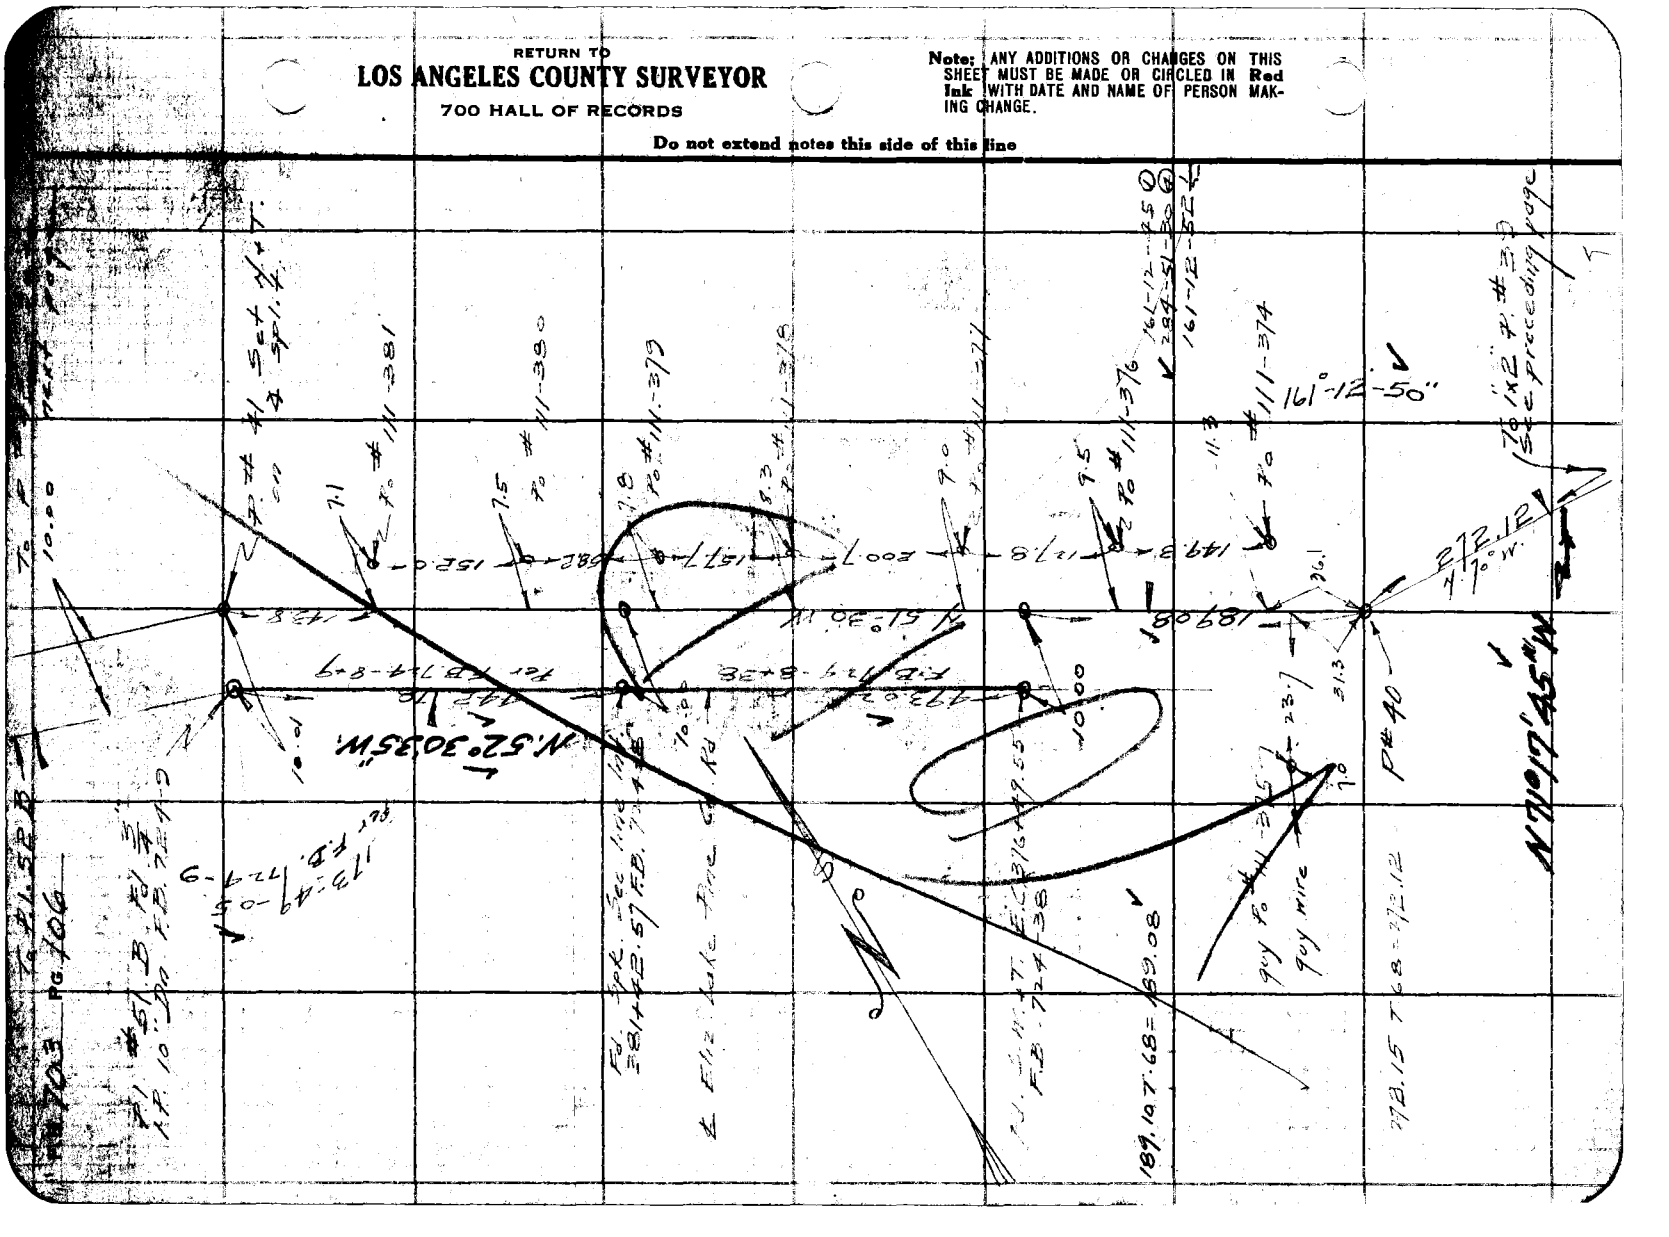
N.52° 30'35"W.
N 61° 30' W
189.08
272.12
N 7° W.
161°-12'-50"
PT 40
#111-374
#111-376
#111-379
#111-381
#111-390
#111-377
#111-378
guy wire
guy wire
guy wire

| Notes Ck'd by K.R.M. | Survey of Forestry Tel line | F.B. 703 Pg. 107 |
|---|---|---|
| Map No. | W. O. 8094 Tape No 55 St'd 8ft of. | P-111 |
| Office Work | Surveyed by Rosecrans | |
| Checked | Notes Date 12-1-37 | |
| Date | Indexed A. C. Johnson | |


RETURN TO
LOS ANGELES COUNTY SURVEYOR
700 HALL OF RECORDS

Do not extend notes this side of this line

Note: ANY ADDITIONS OR CHANGES ON THIS SHEET MUST BE MADE OR CIRCLED IN Red Ink WITH DATE AND NAME OF PERSON MAKING CHANGE.

FORM 247 5M 2-34


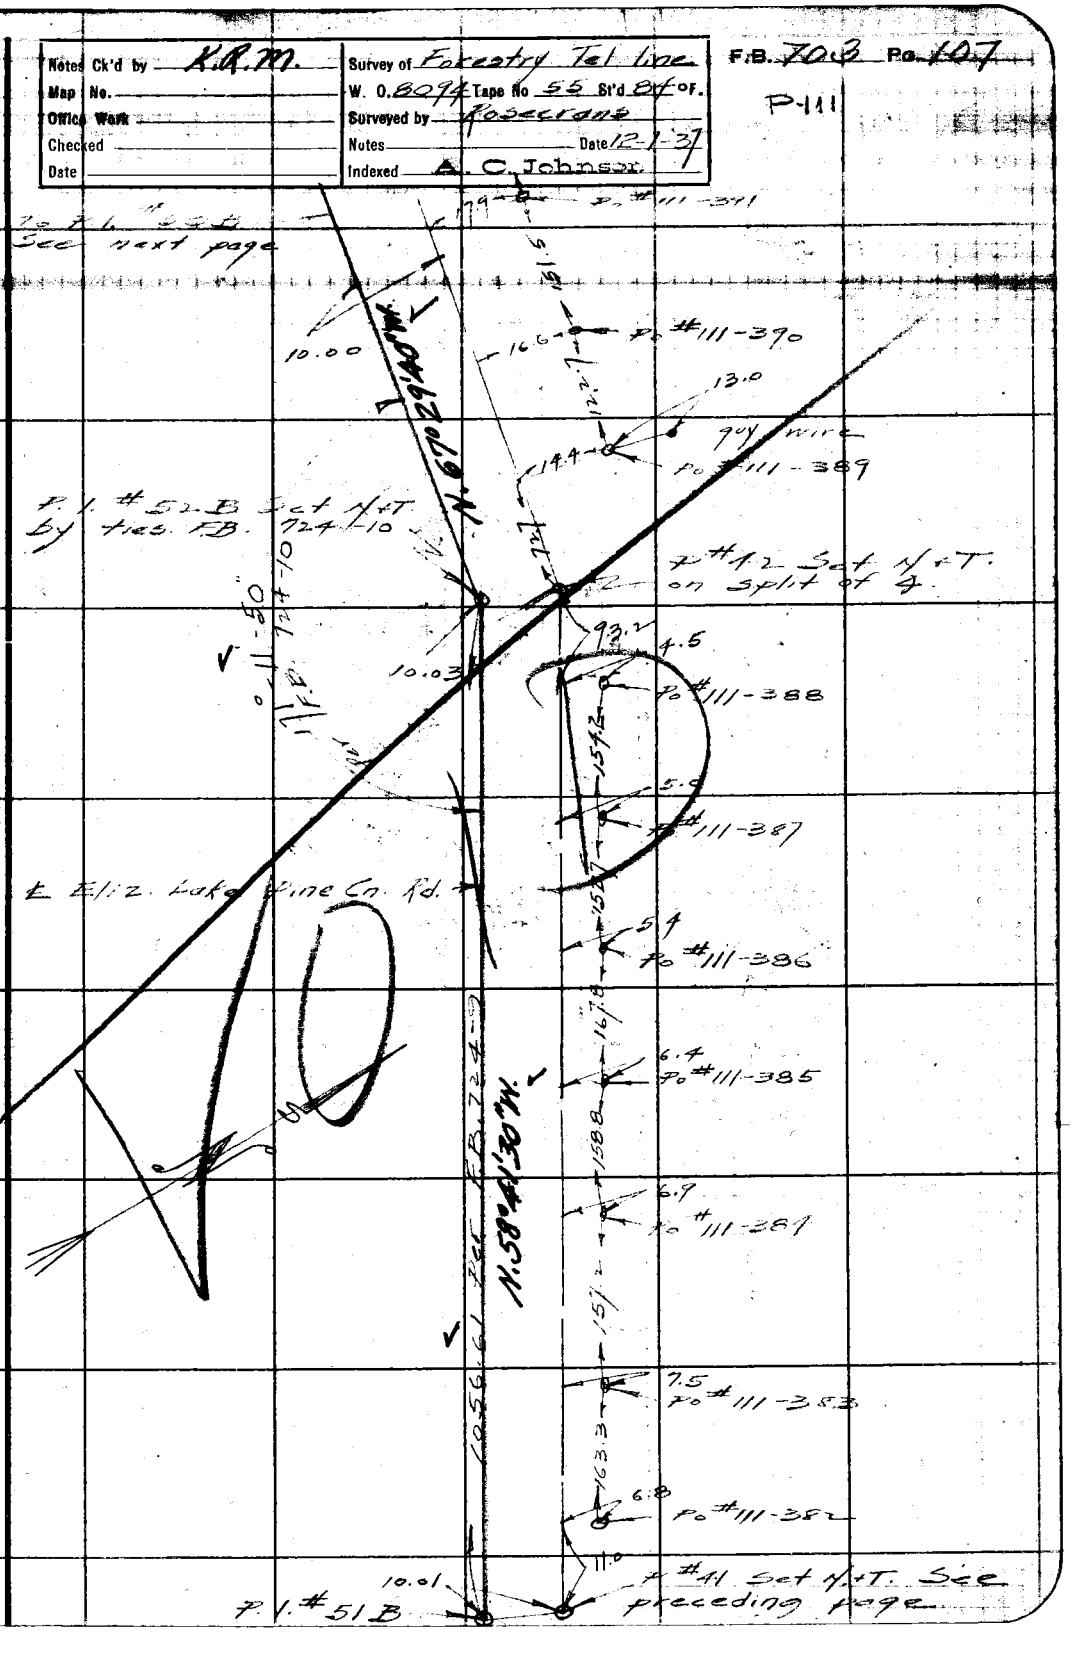

RETURN TO
**LOS ANGELES COUNTY SURVEYOR**
700 HALL OF RECORDS

**Note;** ANY ADDITIONS OR CHANGES ON THIS SHEET MUST BE MADE OR CIRCLED IN **Red Ink** WITH DATE AND NAME OF PERSON MAKING CHANGE.

**Do not extend notes this side of this line**

F.B. 703 Pg. 108
Cont. of Southern Pac. Co.
E. Elk. Lake Tide Co.
Guy wire
Guy wire
Guy wire

| | | | |
|---|---|---|---|
| Notes Ck'd by K.R.M. | Survey of Forestry Tel. line | F.B. 703 | Pg. 109 |
| Map No. | W. O. 8094 Tape No 55 St'd 64 | | |
| Office Work | Surveyed by Rosecrans | | |
| Checked | Notes | Date 12-1-37 | |
| Date | Indexed | A. C. Johnson | |

T.P. 1 55 P 1

Cont bottom next page

Po # 111-414

15.2

19.7 Po # 111-413

153.9

E. Eliz. Lake Pine St. Co. Rd.

18.8 Po # 111-412

18.3

18.0 Po # 111-411 Cell box 114

N 44°30' 00" W.

17.5 Po # 111-410

167.6

16.8 Po # 111-409

152.9

155.8

16.0 Po # 111-408

152.5

15.2 Po # 111-407

151.2

14.8 Po # 111-406

150.7

14.0 Po # 111-405

166.0

To T.P. # 54B

See preceding page

RETURN TO
LOS ANGELES COUNTY SURVEYOR
700 HALL OF RECORDS

Note: ANY ADDITIONS OR CHANGES ON THIS SHEET MUST BE MADE OR CIRCLED IN Red Ink WITH DATE AND NAME OF PERSON MAKING CHANGE.

Do not extend notes this side of this line

FORM 247 BM 2-34

RETURN TO
**LOS ANGELES COUNTY SURVEYOR**
700 HALL OF RECORDS

**Note:** ANY ADDITIONS OR CHANGES ON THIS SHEET MUST BE MADE OR CIRCLED IN **Red Ink** WITH DATE AND NAME OF PERSON MAKING CHANGE.

**Do not extend notes this side of this line**

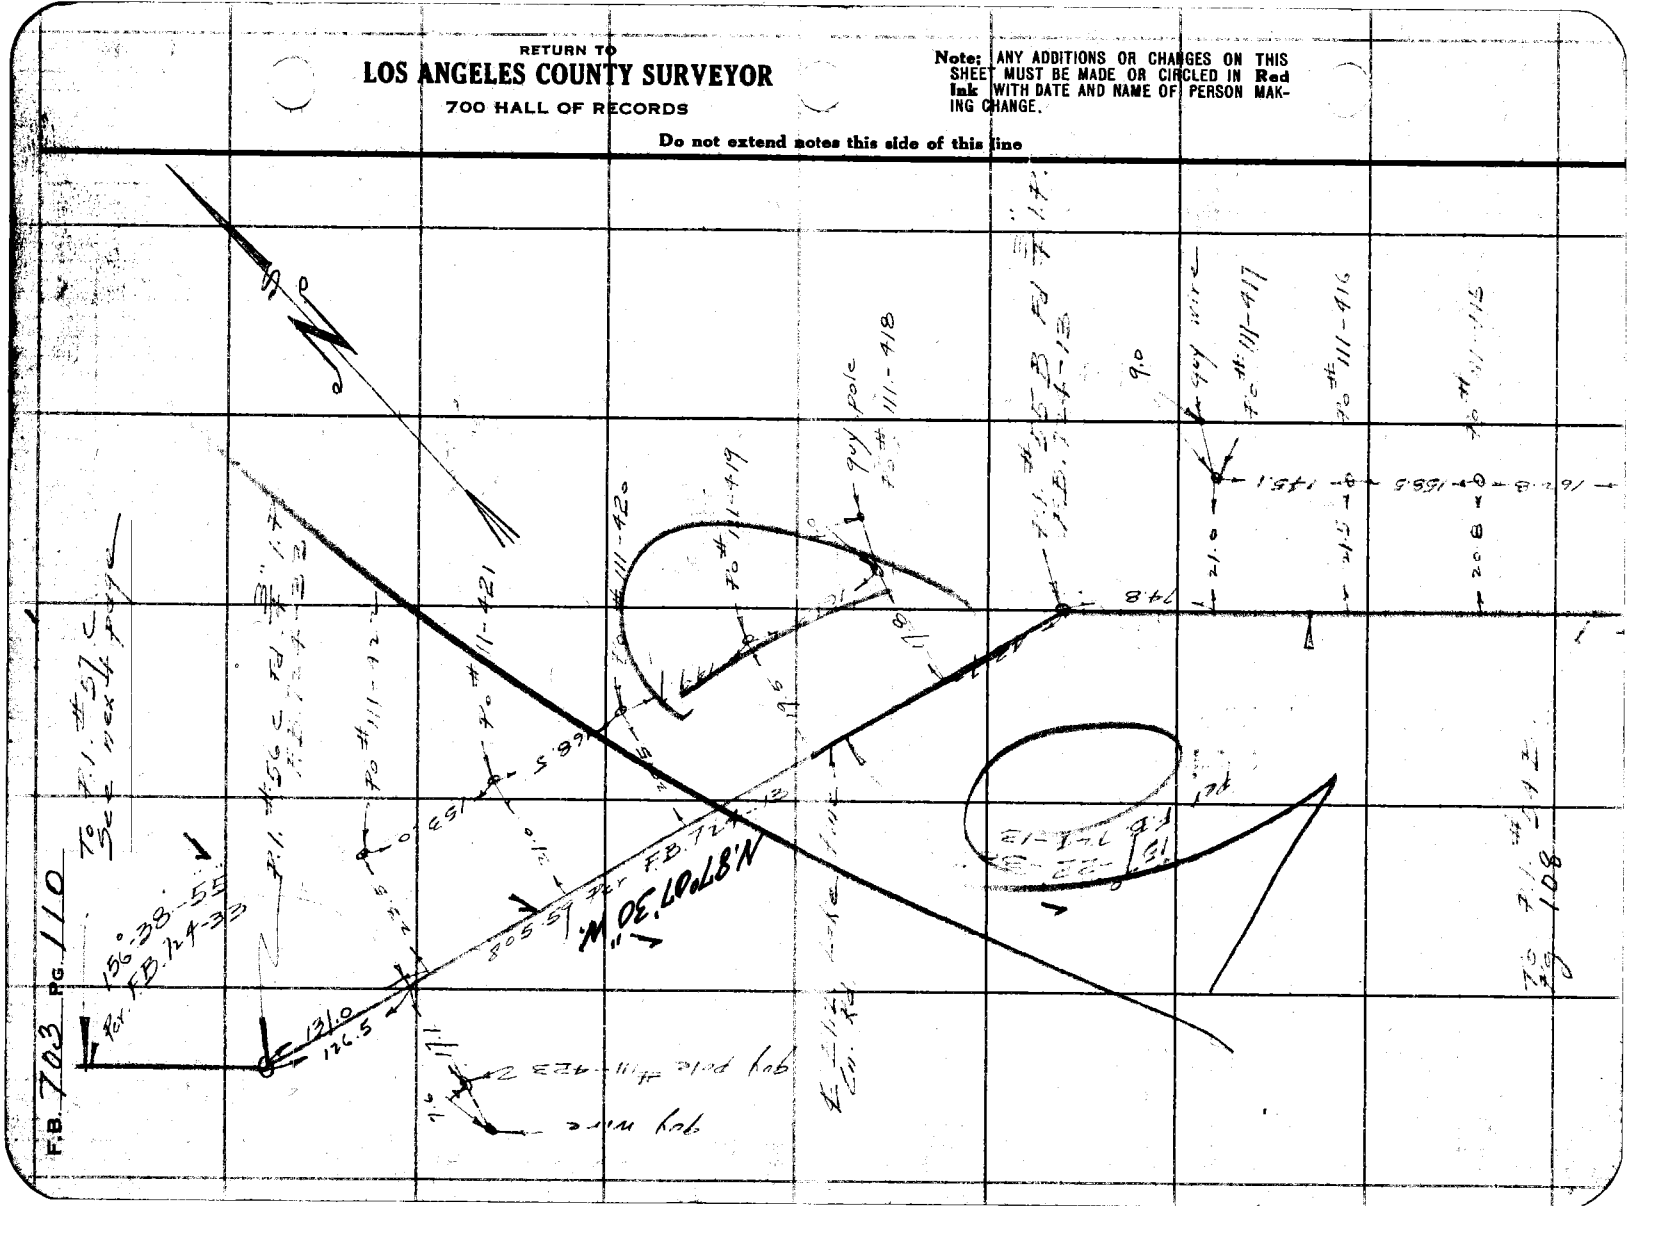

| | |
|---|---|
| Notes Ck'd by K.R.M. | Survey of Forestry Tel. line |
| Map No. | W. O. 8074 Tape No 55 St'd 84 of. |
| Office Work | Surveyed by Rosecrans |
| Checked | Notes Date 12-2-37 |
| Date | Indexed A. C. John |

F.B. 703 Pg 111

Cont. to th-on next page

P.I. #56c Fd 3" I.P. LE 724-24

Po #111-434 — 7.4 — 14.0

Po #111-433 — 3.9

0.1

Po #111-432

4.3

Po #111-431

E. Eliz. Lake Rd. — Co. Rd.

7.6

Po #111-430

5.8

Po 111-429

N63°46'25"W. 1583.0' M

2.7

Po #111-428

Po #111-427

Po #111-426

Po #111-429

guy wire 7.0

guy pol #111-425

P.I. #56c Fd 3" I.P. See preceding page

Note: ANY ADDITIONS OR CHANGES ON THIS SHEET MUST BE MADE OR CIRCLED IN Red Ink WITH DATE AND NAME OF PERSON MAKING CHANGE.

Do not extend notes this side of this line

RETURN TO
LOS ANGELES COUNTY SURVEYOR
700 HALL OF RECORDS

FORM 247 5M 2-34

RETURN TO
**LOS ANGELES COUNTY SURVEYOR**
700 HALL OF RECORDS

**Note:** ANY ADDITIONS OR CHANGES ON THIS SHEET MUST BE MADE OR CIRCLED IN **Red Ink** WITH DATE AND NAME OF PERSON MAKING CHANGE.

**Do not extend notes this side of this line**

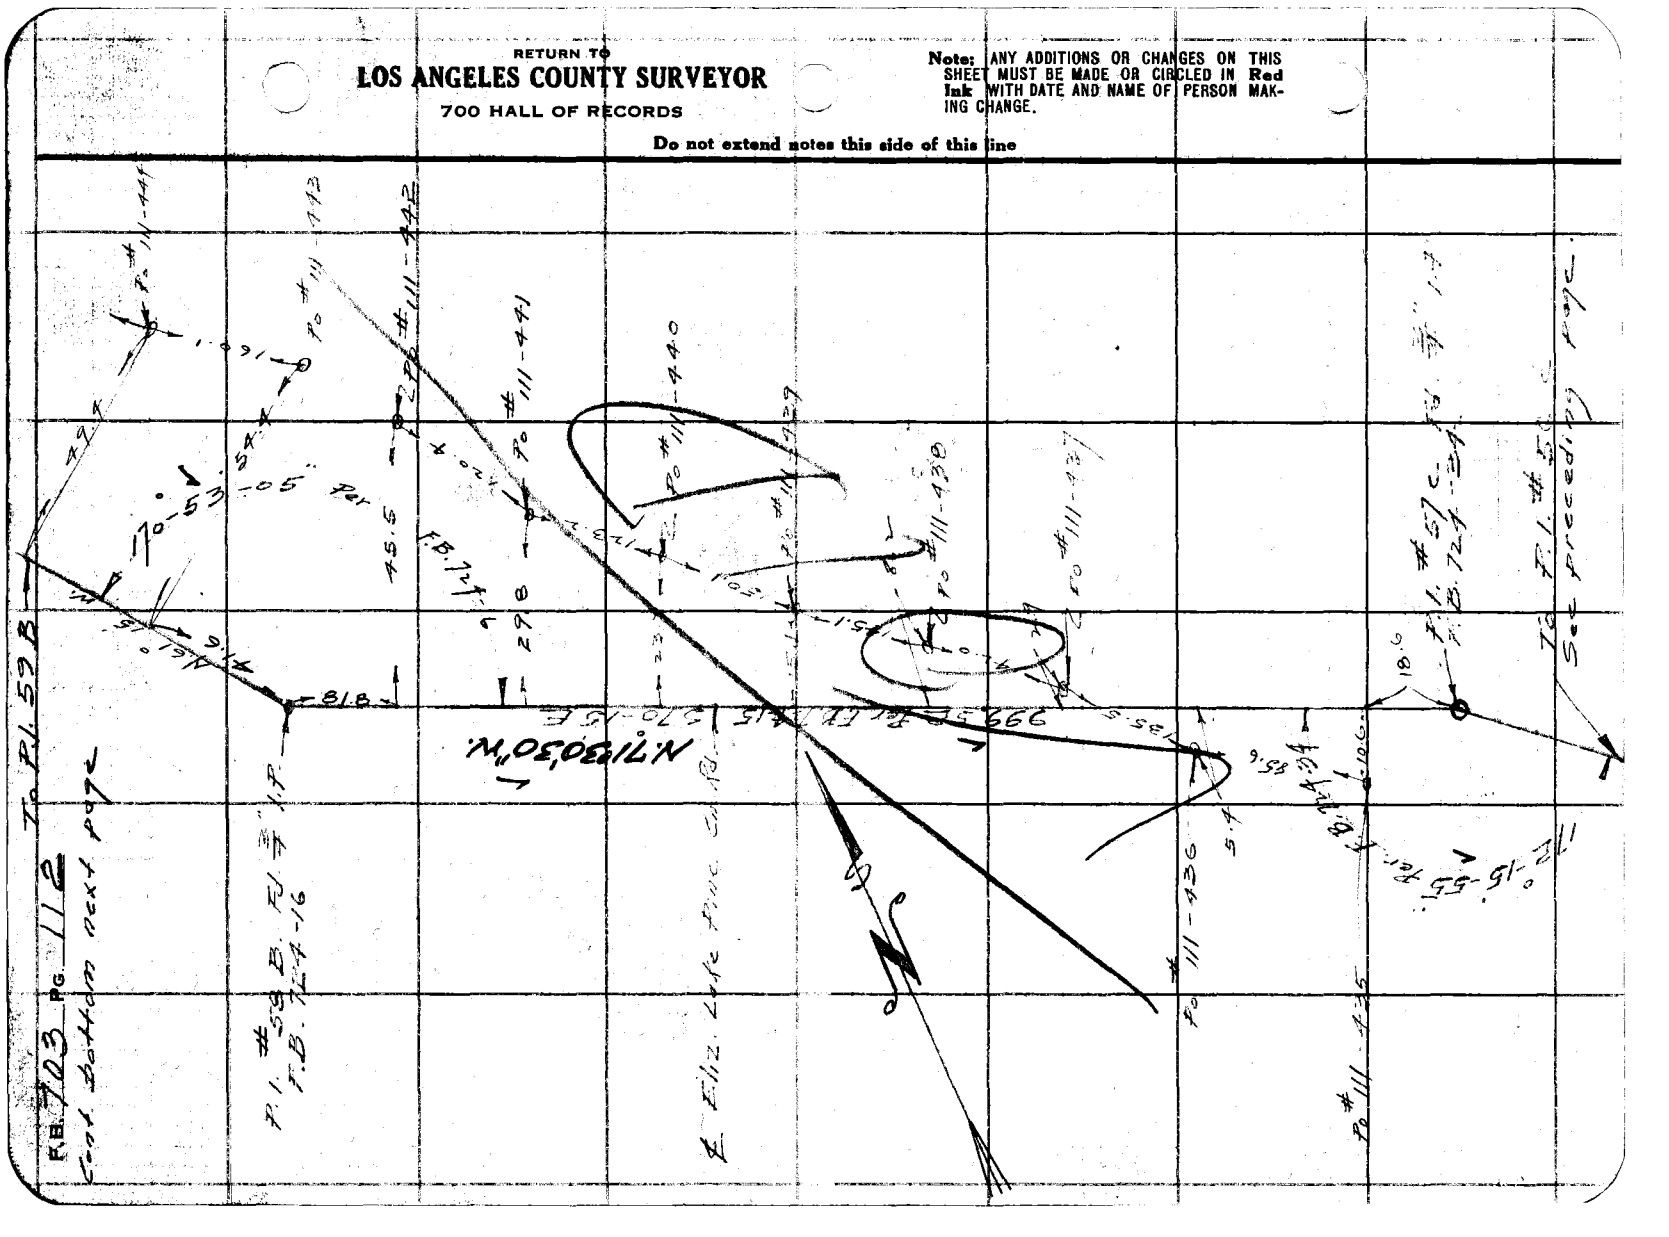

| | | | |
|---|---|---|---|
| Notes Ck'd by K.R.M. | | Survey of Forestry Tel. Rte | F.B. 70B Pg. 163 |
| Map No. | | W. O. 8094 Tape No 55 St'd 84 of. | |
| Office Work | | Surveyed by Peacock | |
| Checked | | Notes | Date 12-7-37 |
| Date | | Indexed A. C. John | |

To P.I. #60 B

Cont. bottom next page

To P.I. #58 B See preceding page

N. 69° 11' 00" W.

N. 62° 23' 33" W.

Per F.B. 724-17

| | |
|---|---|
| 13.5 | P.O. #111-454 |
| 10.1 | P.O. #111-453 |
| 27.7 | P.O. #111-452 |
| | P.I. #59 B. Fd. Sig. I.P. F.B. 724-17 |
| 18.4 | P.O. #111-451 |
| 23.0 | P.O. #111-450 |
| 27.5 | P.O. #111-449 |
| 31.9 | P.O. #111-448 |
| 36.2 | P.O. #111-447 |
| 40.2 | P.O. #111-446 |
| 44.8 | P.O. #111-445 |

RETURN TO
LOS ANGELES COUNTY SURVEYOR
700 HALL OF RECORDS

Note: ANY ADDITIONS OR CHANGES ON THIS SHEET MUST BE MADE OR CIRCLED IN Red Ink WITH DATE AND NAME OF PERSON MAKING CHANGE.

Do not extend notes this side of this line

FORM 247 5M 2-34

RETURN TO

**LOS ANGELES COUNTY SURVEYOR**

700 HALL OF RECORDS

**Note;** ANY ADDITIONS OR CHANGES ON THIS SHEET MUST BE MADE OR CIRCLED IN **Red Ink** WITH DATE AND NAME OF PERSON MAKING CHANGE.

**Do not extend notes this side of this line**

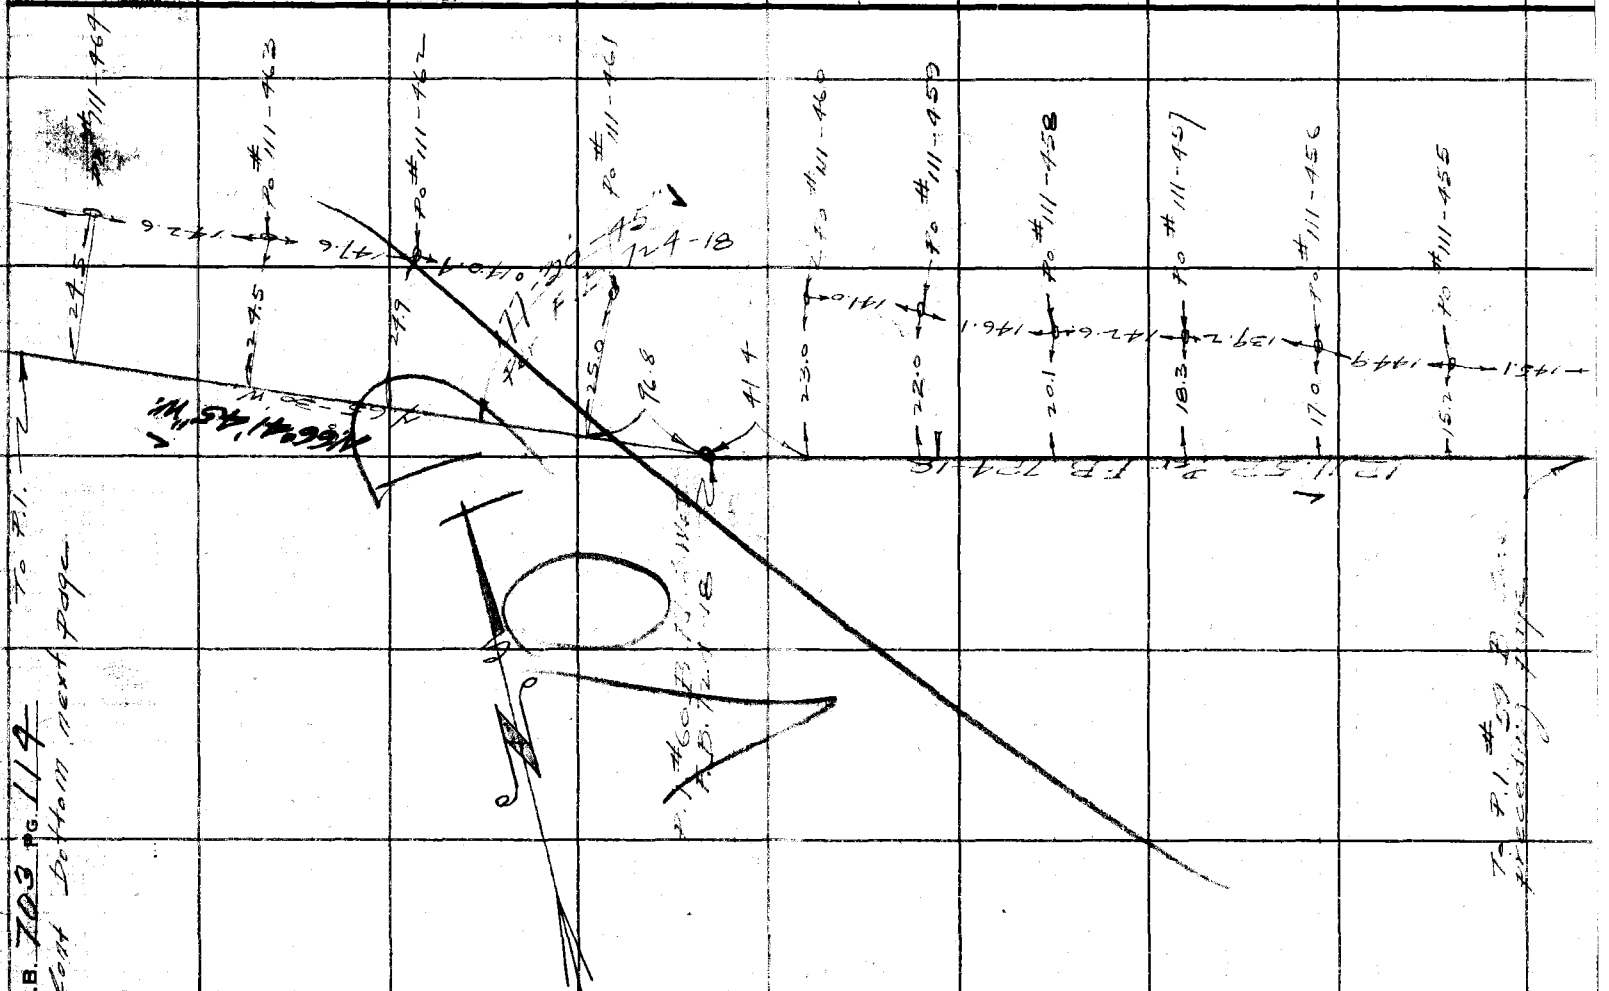

| | | | |
|---|---|---|---|
| Notes Ck'd by K.R.M. | Survey of Forestry Tel. Line | F.B. 703 | Pg. 145 |
| Map No. | W. O. 8094 Tape No 35 St'd 84 OF. | | |
| Office Work | Surveyed by Rosecrans | | |
| Checked | Notes | Date 12-27 | |
| Date | Indexed A. C. Johnson | | |

T.P. 1. 48162.12
Cont. bottom next page

VOID

23.2 — P.O. # 111-474
146.4
23.6 — P.O. # 111-473
149.0
24.0 — P.O. # 111-472
148.1
24.3 — P.O. # 111-471
146.1
24.3 — P.O. # 111-470
144.8
24.7 — P.O. # 111-469
143.7
24.6 — P.O. # 111-468
146.0
24.8 — P.O. # 111-467
144.5
24.8 — P.O. # 111-466
144.7
24.5 — P.O. # 111-465

To T.P. 1. # 60 B
See preceding page

Note: ANY ADDITIONS OR CHANGES ON THIS SHEET MUST BE MADE OR CIRCLED IN Red Ink WITH DATE AND NAME OF PERSON MAKING CHANGE.

Do not extend notes this side of this line

RETURN TO
LOS ANGELES COUNTY SURVEYOR
700 HALL OF RECORDS

FORM 247 BM 2-34

F.B. 703 PG. 116

Cont. bottom next page

INVENTORY IN F. B. 1634-230

LOS ANGELES COUNTY SURVEYOR
700 HALL OF RECORDS

RETURN TO

Do not extend notes this side of this line

Note: ANY ADDITIONS OR CHANGES ON THIS SHEET MUST BE MADE OR CIRCLED IN Red Ink WITH DATE AND NAME OF PERSON MAKING CHANGE.

189.0
22.2 Po #111-484
134.1
22.2 Po #111-483
147
22.2 Po #111-482
152.2
22.0 Po #111-481
Point
Sta. 18+63.13 P.I.
Sta. 7+ P.B. 704-70
21.8 Po #111-180
Cal Zinc #115
22.2 Po #111-479
22.2 Po #111-478
22.6 Po #111-477
22.8 Po #111-476
22.7 Po #111-475
N 64° E
END OF Pole LINE
Pole
VOID
To P.I. # 602 E
See P.B. 114

| Notes | Ck'd by K.R.M. | Survey of Forestry Tel. line | F.B. 703 Pg. 117 |
|---|---|---|---|
| Map | No. | W. O. 8094 Tape No 55 St'd 54 OF. | |
| Office | Work | Surveyed by Rosecrans | |
| Checked | | Notes A. C. Johnson Date 12-7-37 | |
| Date | | Indexed | |

To P.I. 67+00.12
Sec. preceding page.

22.5 — P.O. #111-495 — 144.6
22.3 — P.O. #111-494 — 141.2
22.0 — P.O. #111-493 — 145.5
22.1 — P.O. #111-492 — 137.0
22.0 — P.O. #111-491 — 144.8
22.2 — P.O. #111-490 — 130.3
22.2 — P.O. #111-489 — 149.5
22.2 — P.O. #111-488 — 145.7
22.1 — P.O. #111-487 — 142.1
22.3 — P.O. #111-486

N. 66° 46' 15" W.

3537.59 Feet

To P.I. 28+63.13
See preceding page

INVENTORY IN F. B. 1634-231,232

RETURN TO
LOS ANGELES COUNTY SURVEYOR
700 HALL OF RECORDS

Note: ANY ADDITIONS OR CHANGES ON THIS SHEET MUST BE MADE OR CIRCLED IN Red Ink WITH DATE AND NAME OF PERSON MAKING CHANGE.

Do not extend notes this side of this line

FORM 247 SM 2-34

F.B. 703 PG. 118

Cont bottom next page

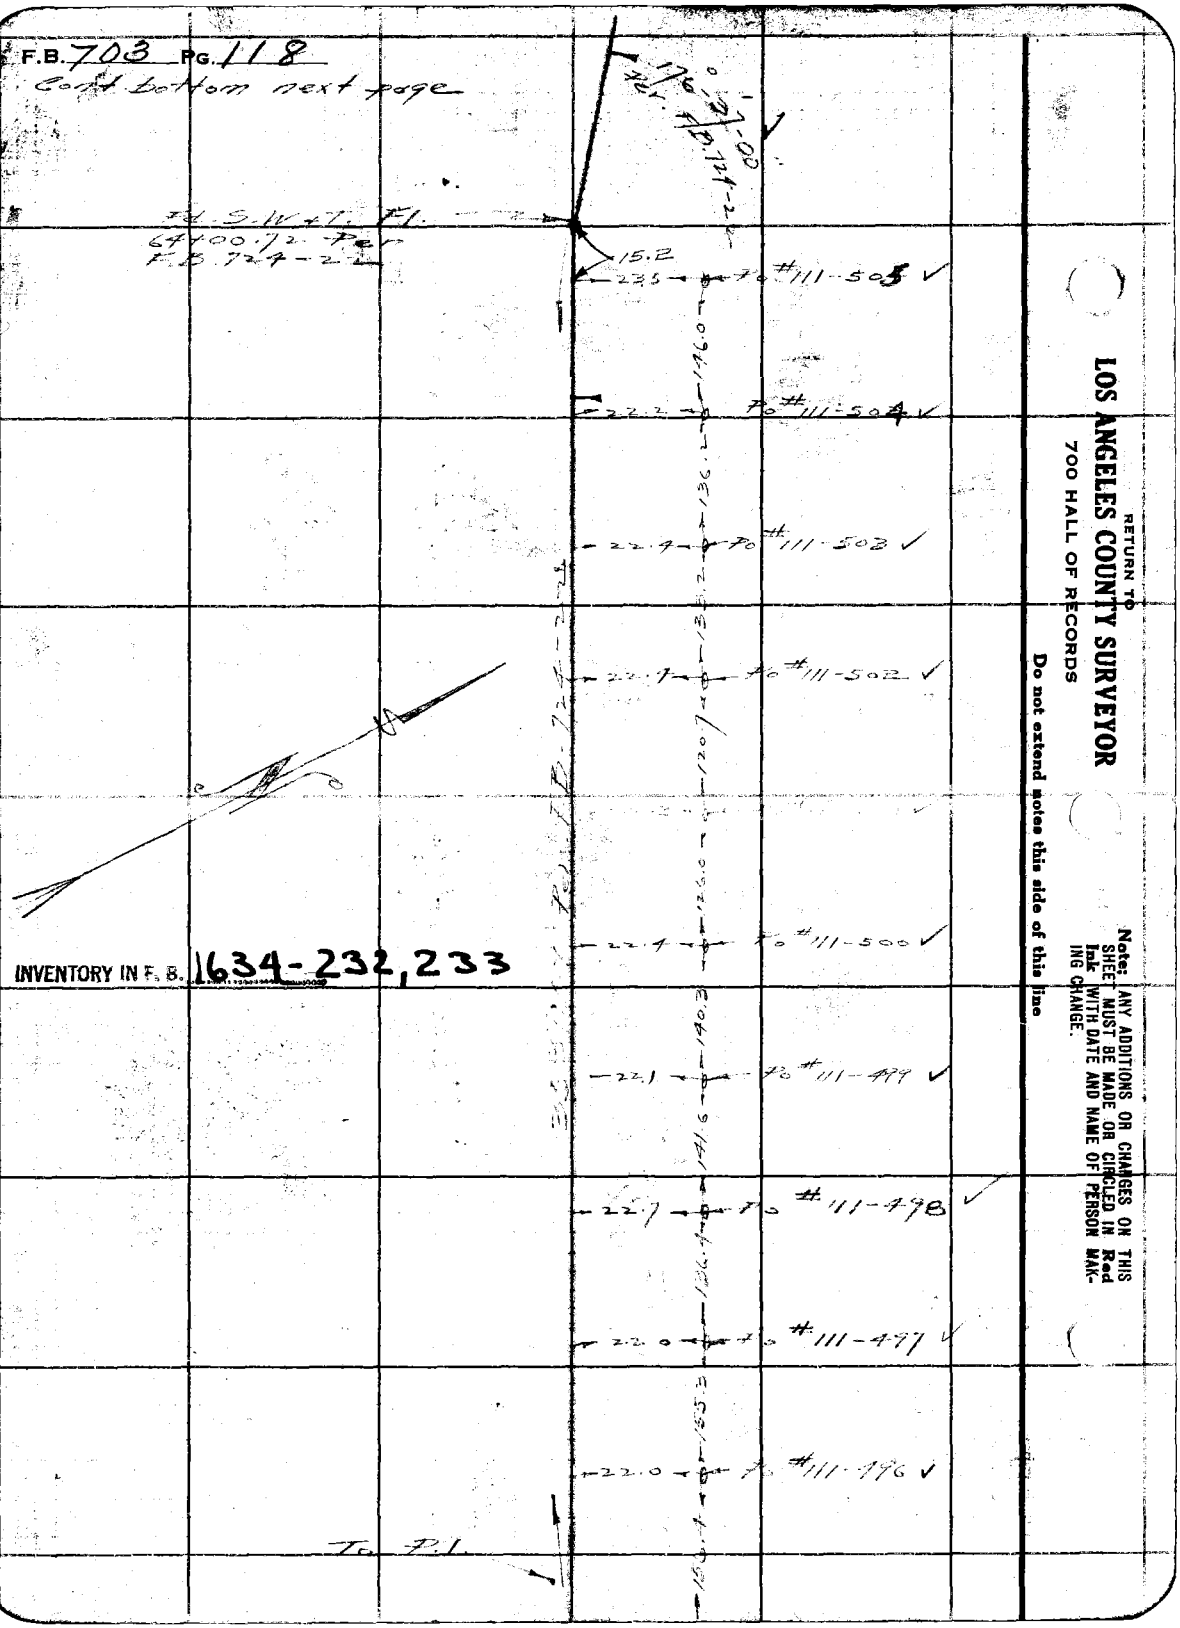


INVENTORY IN F.B. 1634-232,233

RETURN TO
LOS ANGELES COUNTY SURVEYOR
700 HALL OF RECORDS

Do not extend notes this side of this line

Note: ANY ADDITIONS OR CHANGES ON THIS SHEET MUST BE MADE OR CIRCLED IN Red Ink WITH DATE AND NAME OF PERSON MAKING CHANGE.

| | | | |
|---|---|---|---|
| Notes | Ck'd by K.A.M. | Survey of Kinneloa Tel line | F.B. 708 Pg. 119 |
| Map | No. | W. O. 2094 Tape No 55 St'd 84 of. | |
| Office | Work | Surveyed by Rosecrans | |
| Checked | | Notes A. C. Johnson Date 12-27-37 | |
| Date | | Indexed 3-21-38 | |

T. P.C.T.

Cont bottom next page

Po # 111-515 V

237 — 144.0 — Po # 111-514 V

Cold Rd.

24.2 — 138.1 — Po # 111-513 V

24.0 — 138.7 — Po # 111-512 V

E. Fl. Lake Pine Co. Rd.

23.9 — 144.10 — Po # 111-511 V

N21°E. S. 8750 E 1382.15

INVENTORY IN F. B. 1634-233, 234

23.5 — 136.8 — Po # 111-510 V

23.5 — 142.2 — Po # 111-509 V

N.63° 23'15"W. 1.14 M.

23.3 — 145.1 — Po # 111-508 V

23.3 — 143.7 — Po # 111-507 V

23.4 — 144.3 — Po # 111-506 V

P.I. 64400.72 See preceding page

13.

40

506

Note: ANY ADDITIONS OR CHANGES ON THIS SHEET MUST BE MADE OR CIRCLED IN Red Ink WITH DATE AND NAME OF PERSON MAKING CHANGE.

Do not extend notes this side of this line

RETURN TO
LOS ANGELES COUNTY SURVEYOR
700 HALL OF RECORDS

FORM 247 5M 2-34

F.B. 703 PG. 120

To P.I. #10 See next page

INVENTORY IN F. B. 1634-234, 235

Fd. 3 in. + T. E. P.O.T. 519+78.23 F.B. 712

E. Eliz. Lake Pipe Co. Rd.

2131.59 per F.B. 724-22

T. 7:1 6-1-50-12

See 3 1/2" Alum. Mon.

RETURN TO
LOS ANGELES COUNTY SURVEYOR
700 HALL OF RECORDS

Do not extend notes this side of this line

Note: ANY ADDITIONS OR CHANGES ON THIS SHEET MUST BE MADE OR CANCELED IN Red Ink WITH DATE AND NAME OF PERSON MAKING CHANGE.

Notes Ck'd by K.R.M.
Map No.
Office Work
Checked
Date

Survey of Forestry Tab Area F.B. 703 Pg. 121
W. O. 8094 Tape No. 55 Sht. of.
Surveyed by Rosecrans
Notes Date 1-7
Indexed R. O. Johnson

To P.I. #71

Cont. bottom next page

P.I. #111-536 V
P.I. #111-536 V
P.I. #111-534 V
P.I. #111-533 V
P.I. #111-532 V
P.I. #111-531 V
P.I. #111-530 V
P.I. #111-529 V
guy wire
P.I. #111-528 V

N. 74° 09' 35" W.

to Eliz. Lake Pine Cr. Fd.

P.I. #70 Fd. 2" I.P. plug + No. 8 Dr. F.B. 97-2

To P.O.T. See preceding page

INVENTORY IN F B 1634-235, 236

RETURN TO
LOS ANGELES COUNTY SURVEYOR
700 HALL OF RECORDS

Note: ANY ADDITIONS OR CHANGES ON THIS SHEET MUST BE MADE OR CIRCLED IN Red Ink WITH DATE AND NAME OF PERSON MAKING CHANGE.

Do not extend notes this side of this line

FORM 247 SM 2-34

F.B. 702 Pg. 122 To P.I. #71

Cont. bottom next page

21.5 — Po #111-547 ✓

21.5 — Po #111-546 ✓

21.8 — Po #111-545 ✓

& Elizabeth Lake Fire Co. #2

21.8 — Po #111-544 ✓

21.7 — Po #111-543 ✓

21.8 — Po #111-541 ✓

21.5 — Po #111-540 ✓

21.3 — Po #111-539 ✓

21.6 — Po #111-538 ✓

21.5 — Po #111-537 ✓

To P.I. #72 on the preceding page

INVENTORY IN F. B. 1634-236, 237

RETURN TO
LOS ANGELES COUNTY SURVEYOR
700 HALL OF RECORDS

Do not extend notes this side of this line

Note: ANY ADDITIONS OR CHANGES ON THIS SHEET MUST BE MADE OR CANCELED IN Red Ink WITH DATE AND NAME OF PERSON MAKING CHANGE.

| | | | |
|---|---|---|---|
| Notes Ck'd by K.R.M. | Survey of Forestry Tel. Line | F.B. 703 Pg. 12-3 |
| Map No. | W. O. 8094 Tape No 55 St'd 8 ft of. | |
| Office Work | Surveyed by Rosecrans | |
| Checked | Notes Date 12-3-37 | |
| Date | Indexed D. C. Thomson | |

Note: ANY ADDITIONS OR CHANGES ON THIS SHEET MUST BE MADE OR CIRCLED IN Red Ink WITH DATE AND NAME OF PERSON MAKING CHANGE.

Do not extend notes this side of this line

RETURN TO
LOS ANGELES COUNTY SURVEYOR
700 HALL OF RECORDS

FORM 247 BM 2-34

South Baldwin West [illegible]

guy wire

14.5

guy pole #111-556

P.I. #72 Fd. 2" I.P.
12" Dn. F.B. 97-3
Set 2x2" Fl.

N.68° 37' 55"W.

377.10

1.64 Ft.

3750

1.5

1.5

1.5

RETURN TO
**LOS ANGELES COUNTY SURVEYOR**
700 HALL OF RECORDS

Note; ANY ADDITIONS OR CHANGES ON THIS SHEET MUST BE MADE OR CIRCLED IN **Red Ink** WITH DATE AND NAME OF PERSON MAKING CHANGE.

**Do not extend notes this side of this line**

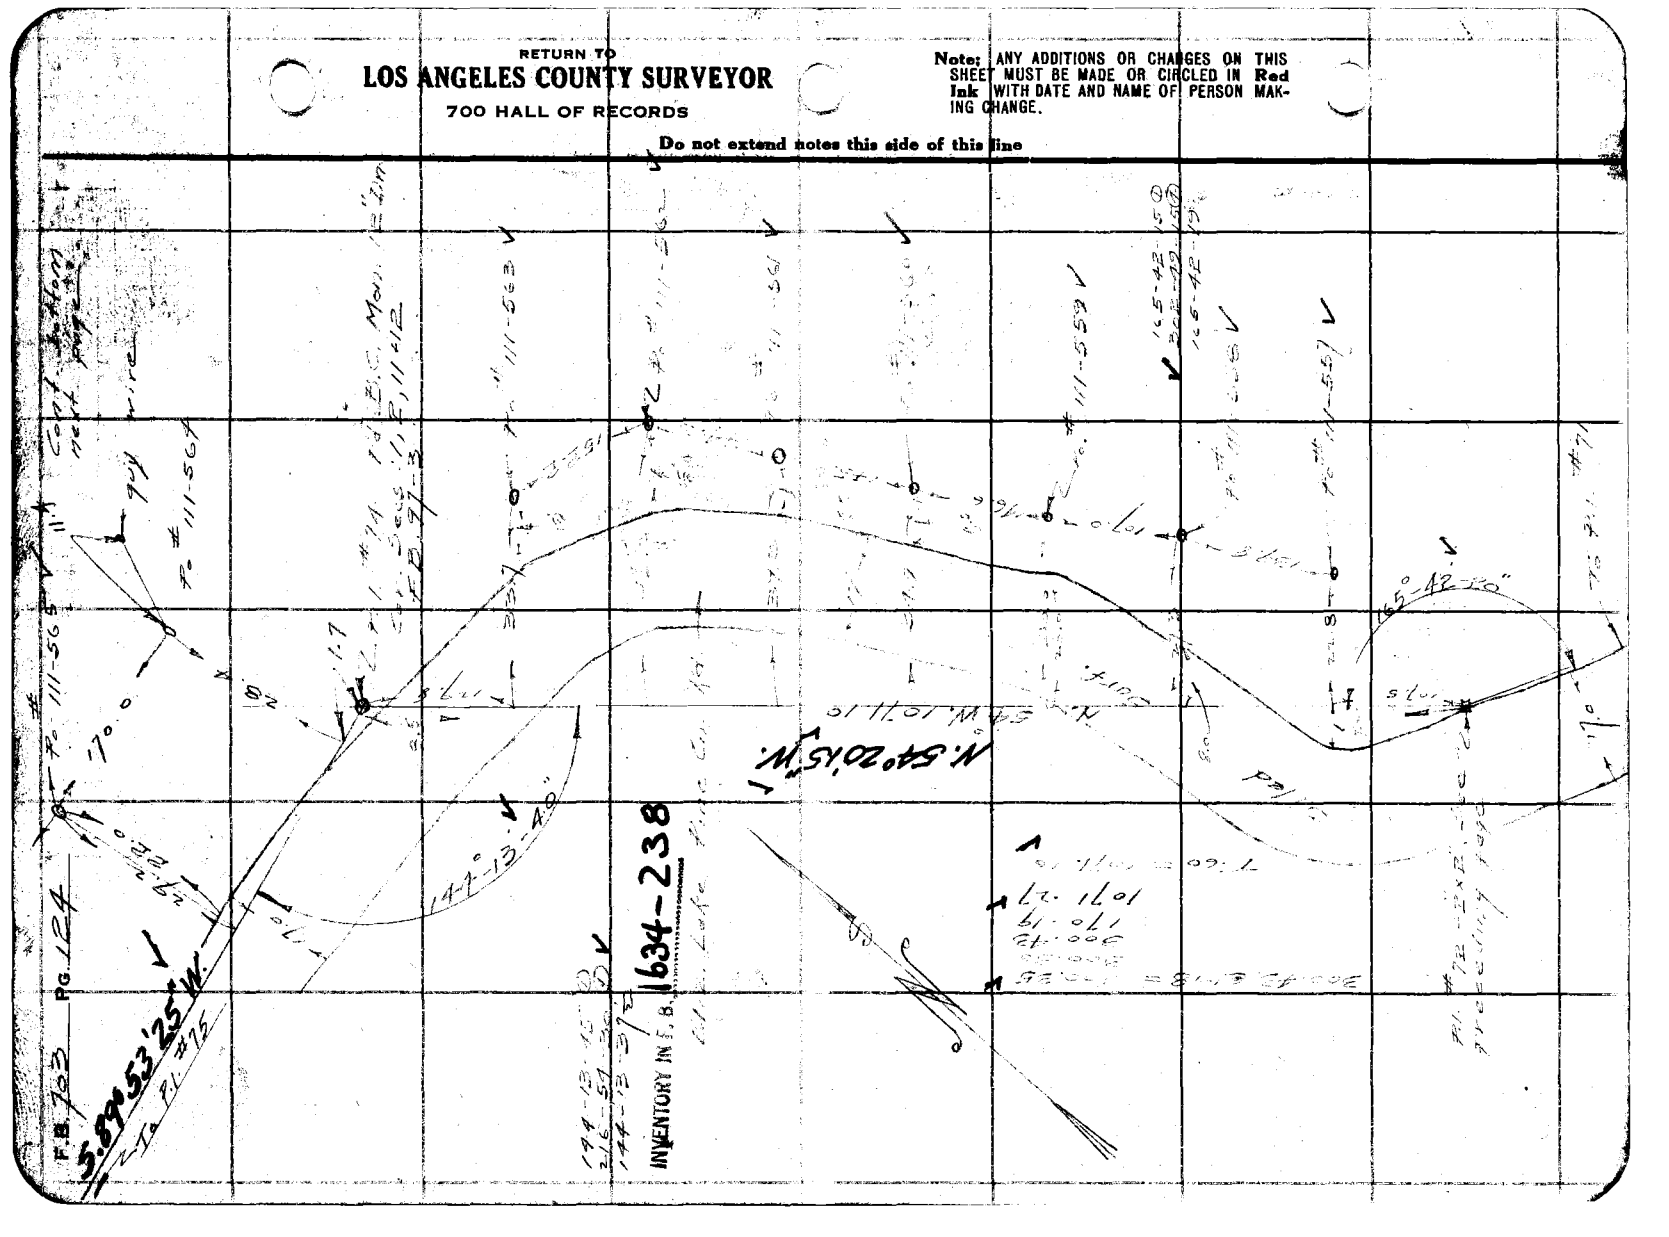

| | |
|---|---|
| Notes Ck'd by | Survey of Laraway Ln Line |
| Map No. | W. O 8079 Tape No. 55 St'd 81 °F |
| Office Work | Surveyed by Roscrans |
| Checked | Notes Date 1-3-38 |
| Date | Indexed |

F.B. 703 PG. 122

Note: Any Additions or Changes on This Sheets Must be Made or Circled in Red Ink With Date and Name of Person Making Change.

Do not extend notes this side of this line

RETURN TO
LOS ANGELES COUNTY SURVEYOR
700 HALL OF RECORDS

INVENTORY IN F.B. 1634-239

FORM 247 5M 10-37

F.B. 703 PG. 126

To P.I. #76 See next page

N. 46° 52' 35" W.

P.I. #75 2x1½" G. Pipe Tie See Field Book 1891

Guy Wire

Guy Wire

Guy Wire

Guy Wire

Fd. 1" I.P. No Tag

Fd. 1" I.P. No Tag

Fd. 1" I.P. No Tag

| | | | |
|---|---|---|---|
| Notes Ck'd by K.R.M | Survey of | F.B. 703 | Pg. 127 |
| Map No. | W. O. 8094 Tape No. 56 St'd 44 of | | |
| Office Work | Surveyed by Rosecrans | | |
| Checked | Notes | Date 1-3-50 | |
| Date | Indexed | | |

Note: Any Additions or Changes on This Sheets Must be Made or Circled in Red Ink With Date and Name of Person Making Change.

Do not extend notes this side of this line

RETURN TO
LOS ANGELES COUNTY SURVEYOR
700 HALL OF RECORDS

FORM 247 5M 10-37

To 7+47 next page

N.50° 41'55"W.

Tied to W.L.

INVENTORY IN F.B. 1634-241

Set 2"x2"-18" Dn

Set 1"x1"

Set 2"x2"-18" Dn

Fd. 1" Pk 1d. 1"x1"-14" Dn Replaced with 2"x2"-14" Dn

Set 1.E. 27-4

Po #111-588

Po #111-587

Po #111-586

To 7+47 See preceding page

F.B. 703 PG. 128

RETURN TO
LOS ANGELES COUNTY SURVEYOR
700 HALL OF RECORDS

Note: Any Additions or Changes on This Sheets Must be Made or Circled in Red Ink With Date and Name of Person Making Change.

Do not extend notes this side of this line

INVENTORY IM[illegible] 1634-242

| | |
|---|---|
| Notes Ck'd by: K.R.M | Survey of: |
| Map No. | W. O. 80-74 Tape No. 25 St'd 82° F. |
| Office Work | Surveyed by: [illegible] |
| Checked | Notes: K. Date: 1-[illegible]-80 |
| Date | Indexed |

F.B. [illegible] Pg. 120

Note: Any Additions or Changes on This Sheet Must be Made or Circled in Red Ink With Date and Name of Person Making Change.

Do not extend notes this side of this line

RETURN TO
LOS ANGELES COUNTY SURVEYOR
700 HALL OF RECORDS

INVENTORY IN F. B. 1634-243

FORM 247 10M 11-35

F.B. 703 Pg. 120

See #20 P.I. Page 11 & 12

RETURN TO
LOS ANGELES COUNTY SURVEYOR
700 HALL OF RECORDS

Do not extend notes this side of this line

Note: Any Additions or Changes on This Sheet Must be Made or Circled in Red Ink With Date and Name of Person Making Change.

INVENTORY IN F.B. 1634-244

| | | | |
|---|---|---|---|
| Notes Ck'd by KM. | Survey of Valve Locations | F.B. | PG. |
| Map No. | W. O. 8614 Tape No. 65 St'd 61° F. | | |
| Office Work | Surveyed by Pasecrous | | |
| Checked | Notes " Date 1-4-38 | | |
| Date | Indexed | | |

RETURN TO
LOS ANGELES COUNTY SURVEYOR
700 HALL OF RECORDS

Note: Any Additions or Changes on This Sheet Must be Made or Circled in Red Ink With Date and Name of Person Making Change.

Do not extend notes this side of this line

N.66°57'25"W.

INVENTORY IN F. B. 1634-245

Elk Lake Rive Co. Rd.

N.74°23'25"W.

Page 129

FORM 247 10M 11-38

RETURN TO
LOS ANGELES COUNTY SURVEYOR
700 HALL OF RECORDS

Note: Any Additions or Changes on This Sheet Must be Made or Circled in **Red Ink** With Date and Name of Person Making Change.

**Do not extend notes this side of this line**

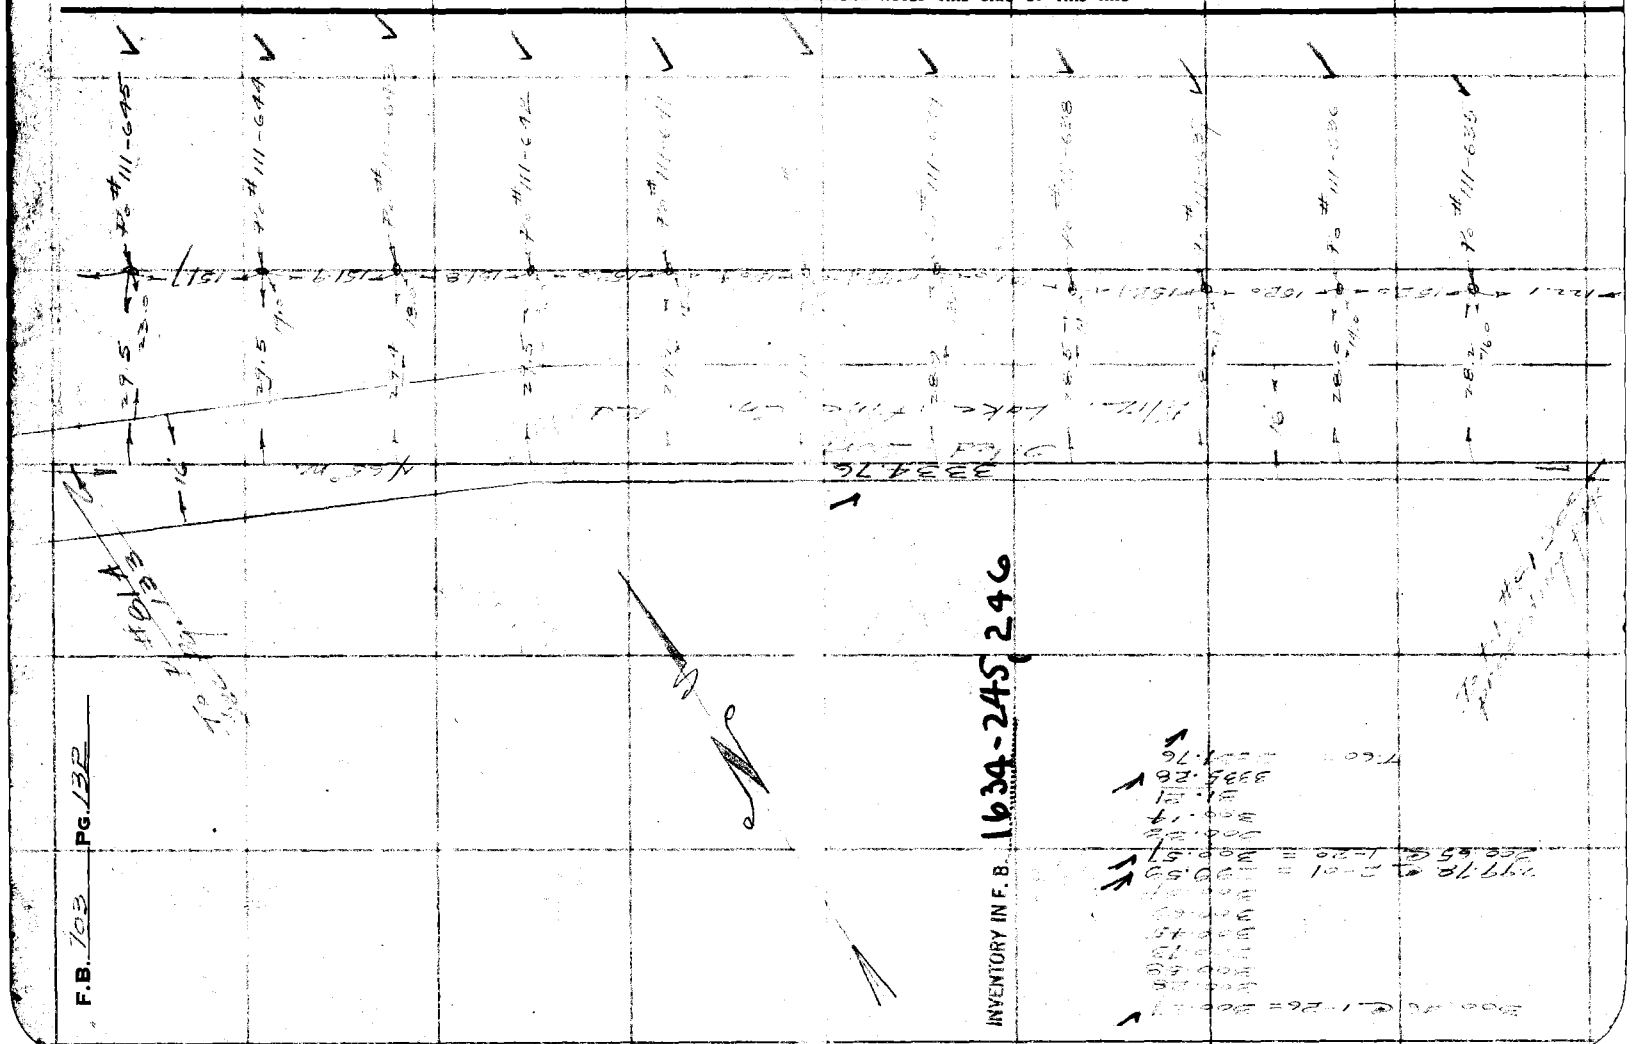

F.B. 103 PG. 132

INVENTORY IN F. B. 1634-245 246

| | | | |
|---|---|---|---|
| Notes Ck'd by KAM | Survey of | F.B. | Pg. |
| Map No. | W. O. | Tape No. | St'd |
| Office Work | Surveyed by | | |
| Checked | Notes | Date | |
| Date | Indexed | | |

Note: Any Additions or Changes on This Sheets Must be Made or Circled in Red Ink With Date and Name of Person Making Change.

Do not extend notes this side of this line

INVENTORY IN F. B. 1634-246, 247

RETURN TO
LOS ANGELES COUNTY SURVEYOR
700 HALL OF RECORDS

FORM 247 5M 10-37

RETURN TO
LOS ANGELES COUNTY SURVEYOR
700 HALL OF RECORDS

**Note:** Any Additions or Changes on This Sheets Must be Made or Circled in **Red Ink** With Date and Name of Person Making Change.

**Do not extend notes this side of this line**

INVENTORY IN F.B. 1634-247, 248

F.B. 703 PG. 134

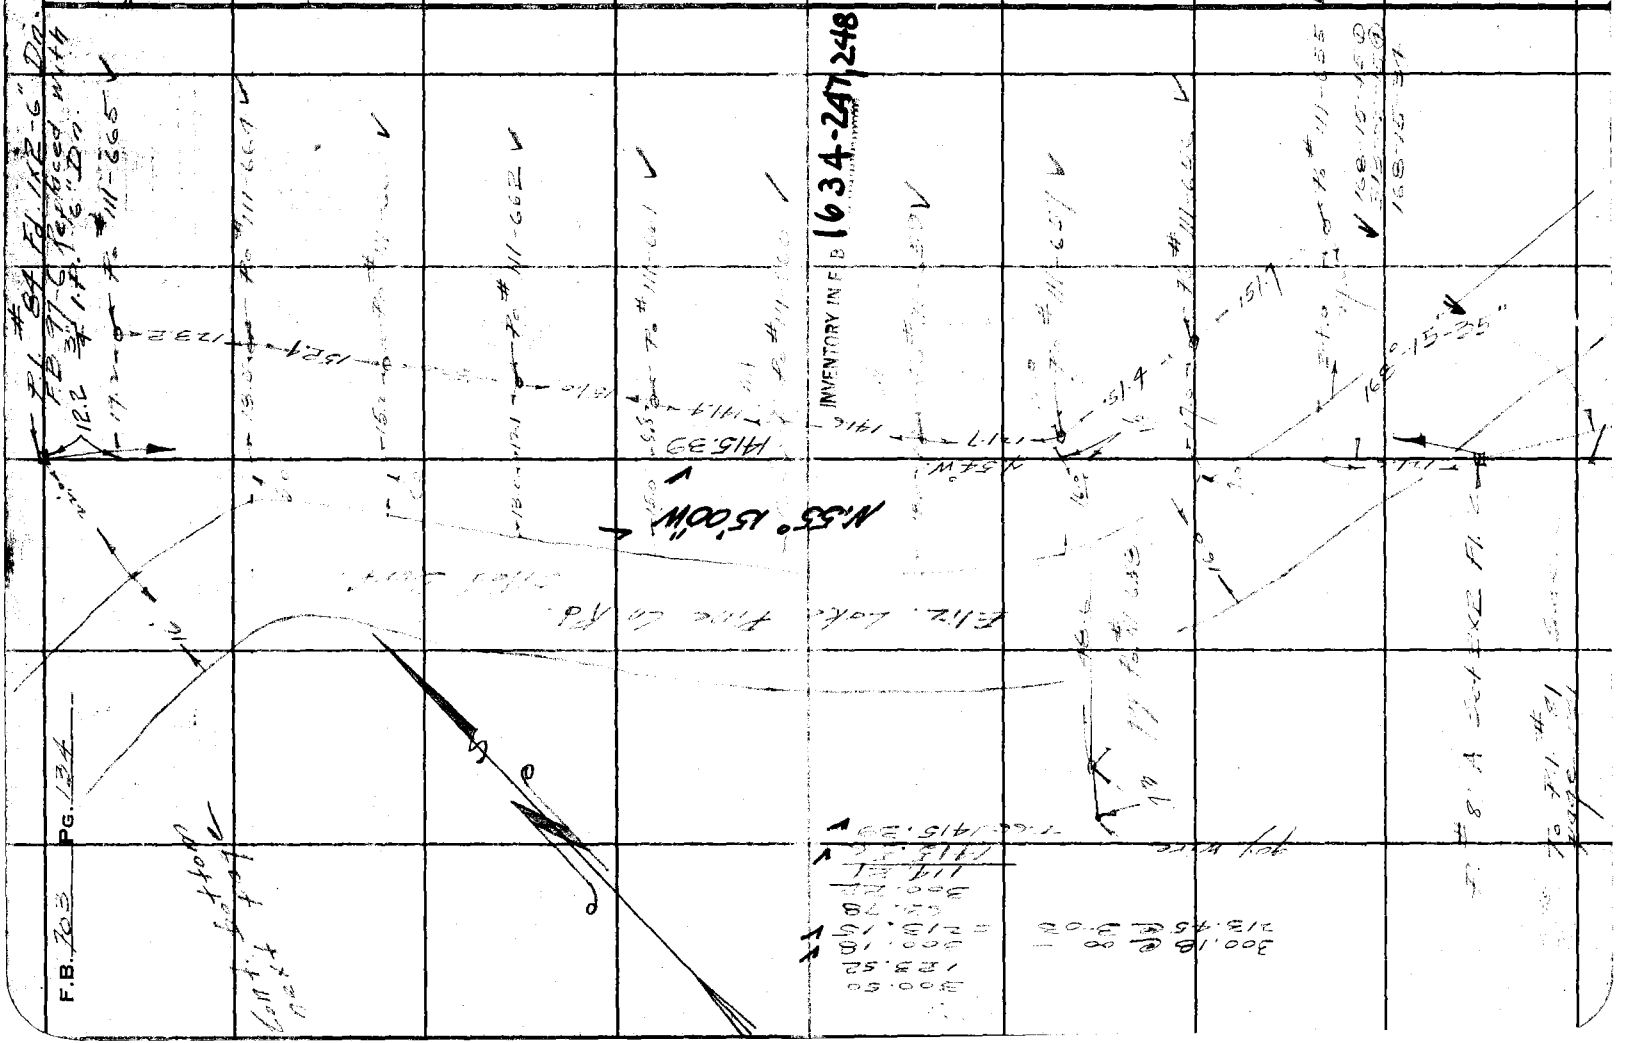

Notes Ck'd by K.L.M.
Map No.
Office Work
Checked
Date

Survey of
W. O. 2094 Tape No. 55 St'd 64 OF
Surveyed by Rosecrans
Notes Date 1-27
Indexed

F.B. 703 PG. 135

Cont. bottom next page

500.12
199.99
500.21

T.64 = 500.14

N 76°22'20" W

P. # 85 & Cor. 3 = 0.38 E
T. 6 S. R. 14 W. Fd C.S.
Mon. F.B. 27-6

guy wire
guy to # 111-671

INVENTORY IN F. B. 1634-248, 249

S. 89°32'30" W.

(S. 89°41'30" W per C.S. 8750-2)

144°-47'-30"

1227.7

Note: Any Additions or Changes on This Sheets Must be Made or Circled in Red Ink With Date and Name of Person Making Change.

Do not extend notes this side of this line

RETURN TO
LOS ANGELES COUNTY SURVEYOR
700 HALL OF RECORDS

FORM 247 5M 10-37

F.B. 703 Pg. 136

VOID
See FB 1634-250

INVENTORY IN F 1634-249,250

Oiled Surface

Lake Rd.

RETURN TO
LOS ANGELES COUNTY SURVEYOR
700 HALL OF RECORDS

Note: Any Additions or Changes on This Sheets Must be Made or Circled in Red Ink With Date and Name of Person Making Change.

Do not extend notes this side of this line

| | |
|---|---|
| Notes Ck'd by | Survey of Pole Line Survey |
| Map No. | W. O. 3014 Tape No. 55 St'd 54° F. |
| Office Work | Surveyed by Rozecrans |
| Checked | Notes Date 1-6-55 |
| Date | Indexed |

F.B. 7 PG. 37

To F. # 91

P-111

Cont. to Row next page

END OF POLE LINE #111 N20°51'10"W.

AT CALL BOX #116

START OF POLE LINE #110

N57°44'20"W.

300 FT

1634-260

Note: Any Additions or Changes on This Sheet Must be Made or Circled in Red Ink With Date and Name of Person Making Change.

Do not extend notes this side of this line

RETURN TO
LOS ANGELES COUNTY SURVEYOR
700 HALL OF RECORDS

FORM 247 10M 11-35

Cont. bottom next page

F.B. 703 Pg. 138

P. 110

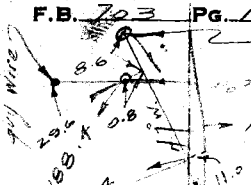

N.8°01'45"W.

P. #92 Set ½" I. Pl.

Pole Line "110"

Pole Locations checked by

Changes noted in Red W.S.C. 5-11-59

INVENTORY IN F.B. 1640 - 17, 18

N.11°36'00"E.

Lake

guy wire

3 Wire two arm pole #1-92.36M Junction (San Francisquito Tributaries)

#111-677

3 wire pole from E

#111-695

N.33°40'45"W.

OLD

1 Arm E wire to #1-92.37M from S.

RETURN TO
LOS ANGELES COUNTY SURVEYOR
700 HALL OF RECORDS

Note: Any Additions or Changes on This Sheet Must be Made or Circled in Red Ink With Date and Name of Person Making Change.

Do not extend notes this side of this line

| | |
|---|---|
| Notes Ck'd by | Survey of |
| Map No. | W. O. 8094 Tape No. 55 St'd. 97°F. |
| Office Work | Surveyed by |
| Checked | Notes Date |
| Date | Indexed |

F.B. 7 Pg. 139

P. 110

INVENTORY IN F. B. 1640 - 18

Note: Any Additions or Changes on This Sheet Must be Made or Circled in Red Ink With Date and Name of Person Making Change.

Do not extend notes this side of this line

RETURN TO
LOS ANGELES COUNTY SURVEYOR
700 HALL OF RECORDS

FORM 247 10M 11-35

F.B. 703 PG. 140

P-110 Cont. bottom next page

to P.#95
See next page

N.60°48'30"W.

P.#11
C.T. Sec. 28, 29, 32 & 33
T.4 S. R.14 W. SB
C.T. Mon. F.B. 64-113

INVENTORY IN F. B. 1640-19

P.#292-11 M.

P.#292-18 M

119-25-31
119-30-36
119-30-24

P.#292-19 M

P.#292-20 M

P.#292-21 M

P.#292-22 M

P.#292-23 M

preceding page

RETURN TO
LOS ANGELES COUNTY SURVEYOR
700 HALL OF RECORDS

Do not extend notes this side of this line

Note: Any Additions or Changes on This Sheet Must be Made or Circled in Red Ink With Date and Name of Person Making Change.

| | |
|---|---|
| Notes Ck'd by | Survey of Forestry Tel. Line |
| Map No. | W. O. 8074 Tape No. 55 St'd 37 OF |
| Office Work | Surveyed by |
| Checked | Notes Date 4-4-38 |
| Date | Indexed |

F.B. 902 PG. 11

P-110

To P. 93

189 P.I. # 32.09 M.

17

19 # 32.12 M.

173.0

# 32.11 M.

# 32.12 M.

INVENTORY IN F. B. 1640-19,20

21.2 # M.

17.8

18.2 # 32.14 M.

227.12 @ 0.37 = 84.11

1628.98

Y.58 = 1685.70

Note: Any Additions or Changes on This Sheets Must be Made or Circled in Red Ink With Date and Name of Person Making Change.

Do not extend notes this side of this line

RETURN TO
LOS ANGELES COUNTY SURVEYOR
700 HALL OF RECORDS

FORM 247 SM 10-37

RETURN TO
LOS ANGELES COUNTY SURVEYOR
700 HALL OF RECORDS

Note: Any Additions or Changes on This Sheets Must be Made or Circled in **Red Ink** With Date and Name of Person Making Change.

**Do not extend notes this side of this line**

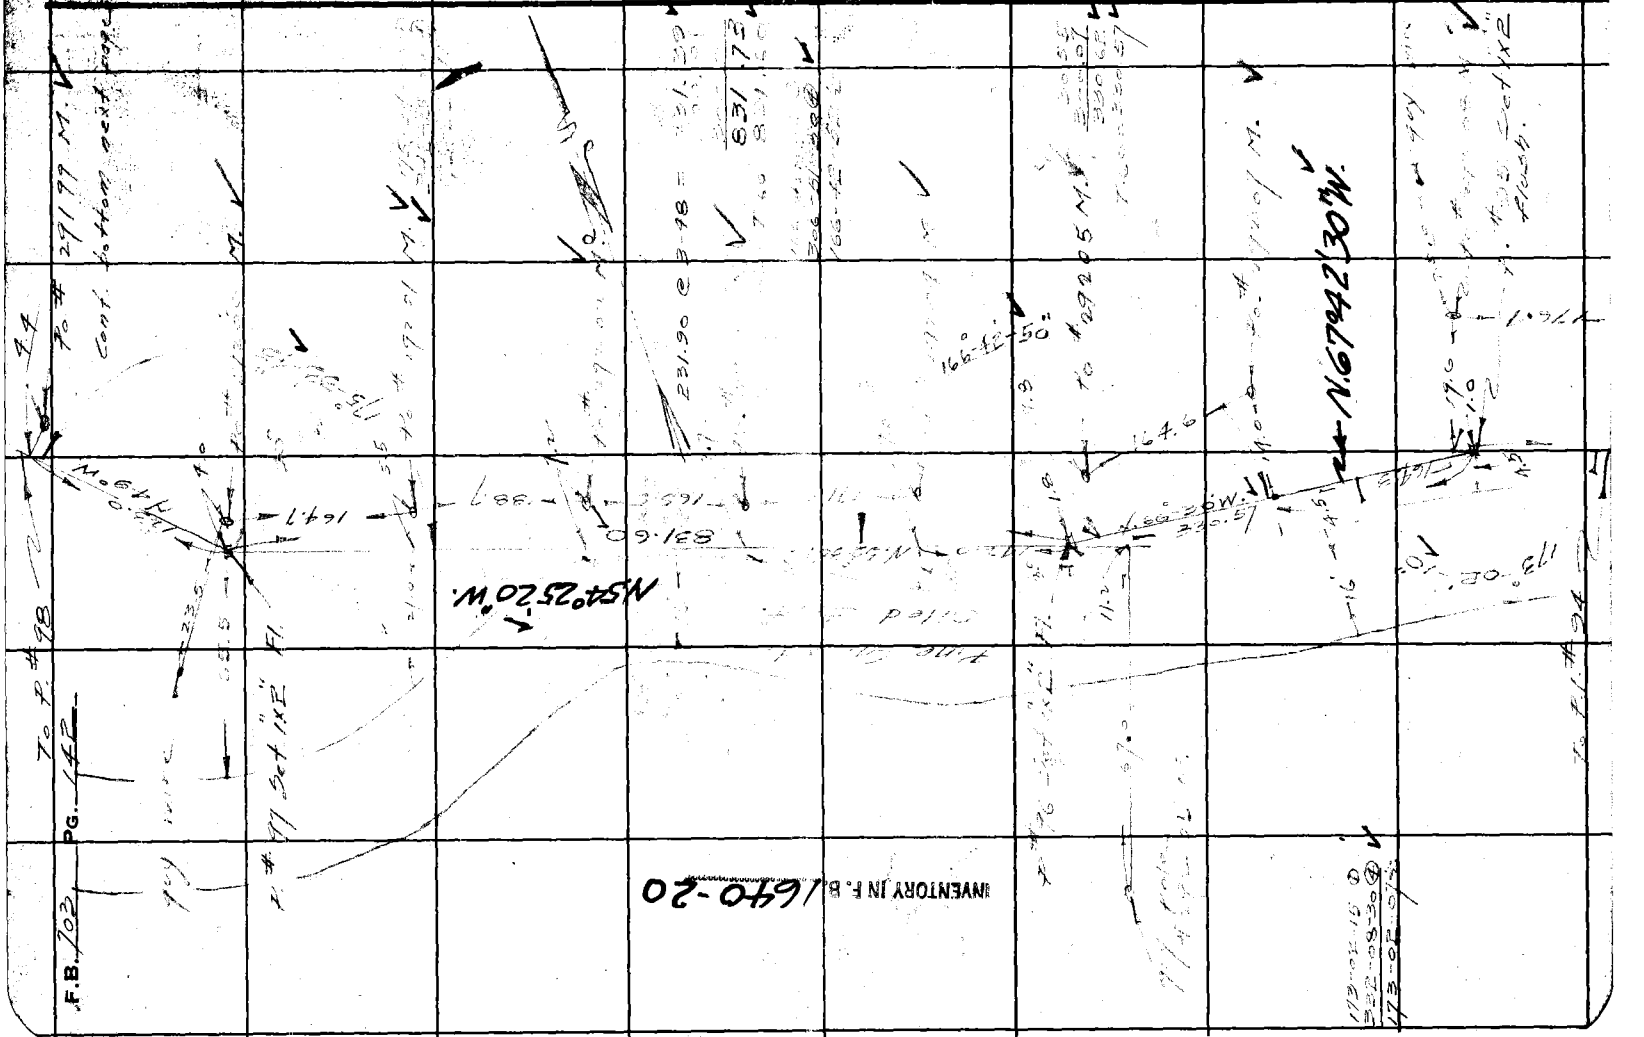

FORM 247 5M 10-37

RETURN TO
**LOS ANGELES COUNTY SURVEYOR**
700 HALL OF RECORDS

**Note:** Any Additions or Changes on This Sheets Must be Made or Circled in Red Ink With Date and Name of Person Making Change.

**Do not extend notes this side of this line**

Notes Ck'd by
Map No.
Office Work
Checked
Date

Survey of
W. O.
Surveyed by
Notes
Indexed

Tape No. Std. of
Date

F.B. Pg.

N. 49° 59' 05" W.

N 65° 25' 50" W.

INVENTORY IN F. B. 1640-21

F.B. 703 PG. 144

P-110

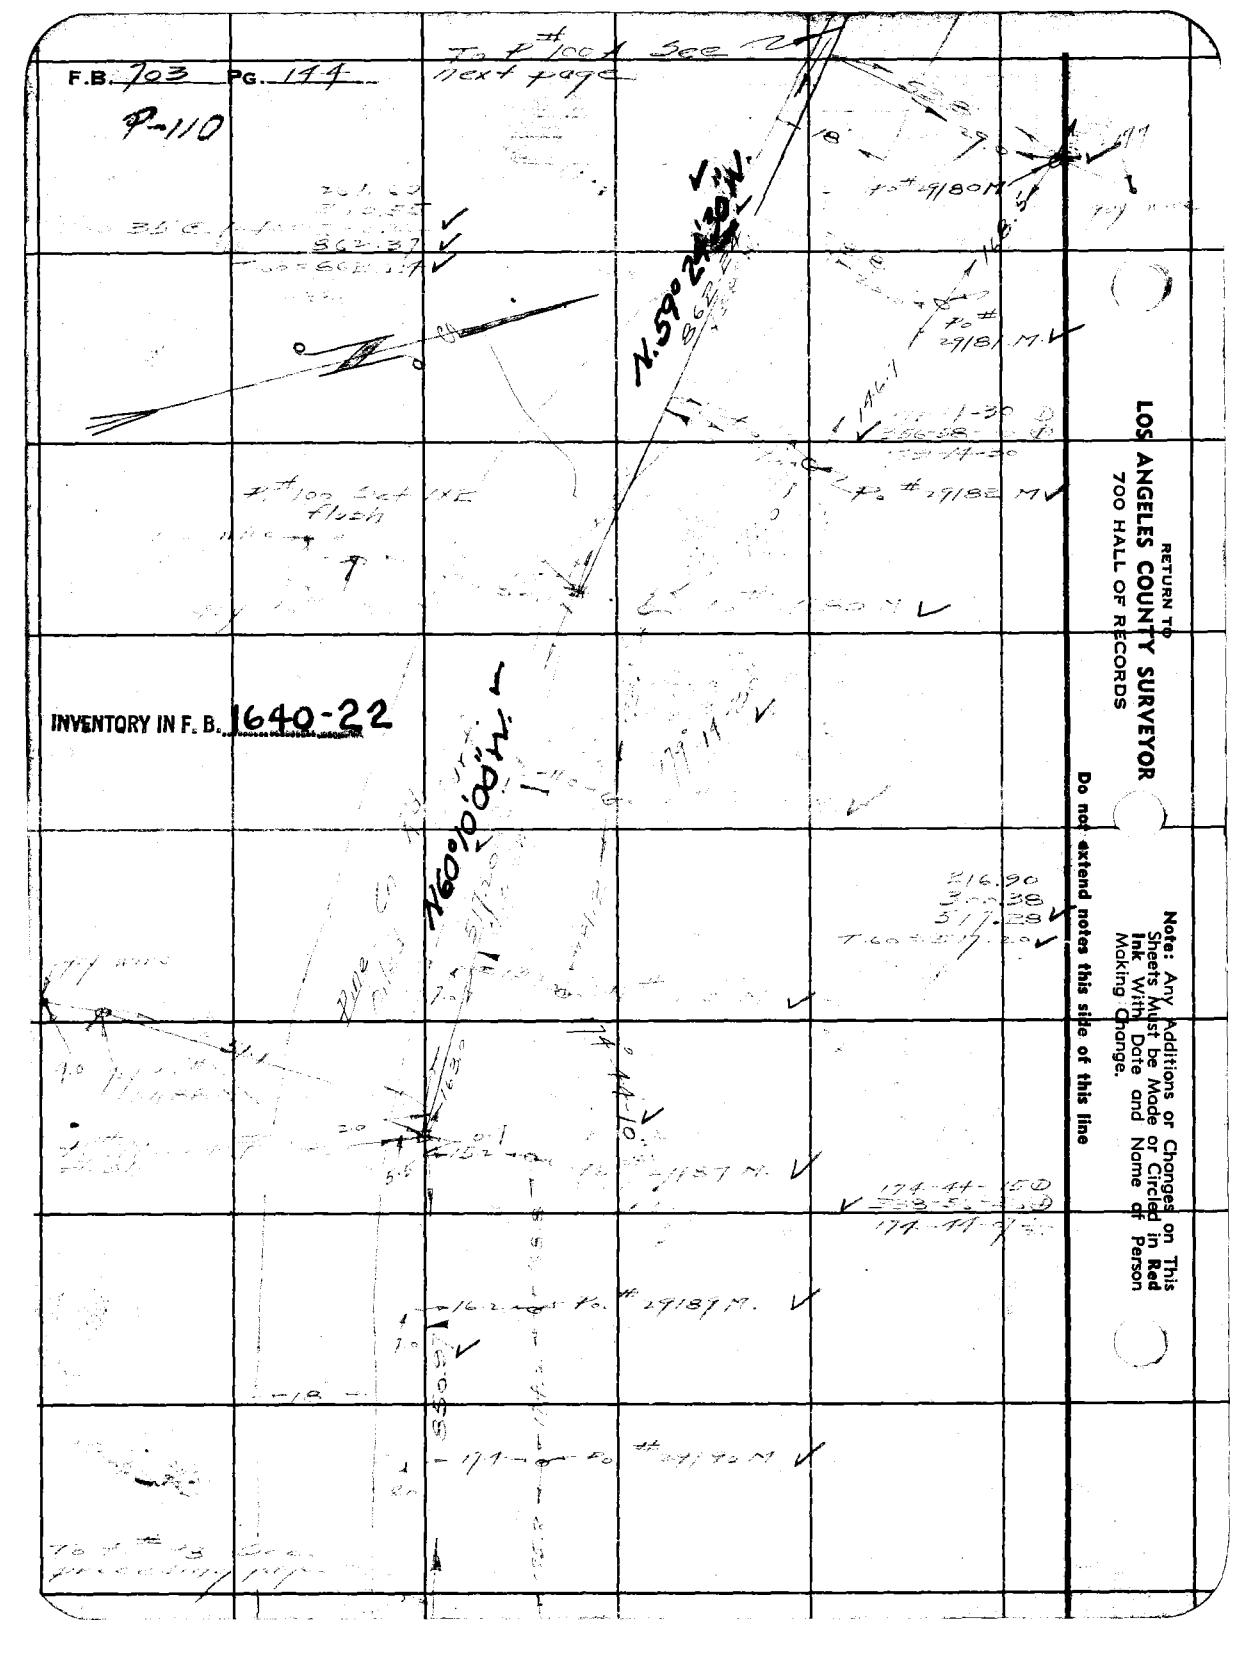


INVENTORY IN F. B. 1640-22

RETURN TO
LOS ANGELES COUNTY SURVEYOR
700 HALL OF RECORDS

Note: Any Additions or Changes on This Sheets Must be Made or Circled in Red Ink With Date and Name of Person Making Change.

Do not extend notes this side of this line

| | |
|---|---|
| Notes Ck'd by | Survey of Priority Power Line |
| Map No. | W. O. 80[illegible] Tape No. 25 St'd 21 of |
| Office Work | Surveyed by Pasadena |
| Checked | Notes Date 1-4-28 |
| Date | Indexed |

F.B. 102 Pg. 175

P-110

S 49° 05' 15" W

INVENTORY IN F. B. 1640-23

Note: Any Additions or Changes on This Sheets Must be Made or Circled in Red Ink With Date and Name of Person Making Change.

Do not extend notes this side of this line

RETURN TO
LOS ANGELES COUNTY SURVEYOR
700 HALL OF RECORDS

FORM 247 BM 10-37

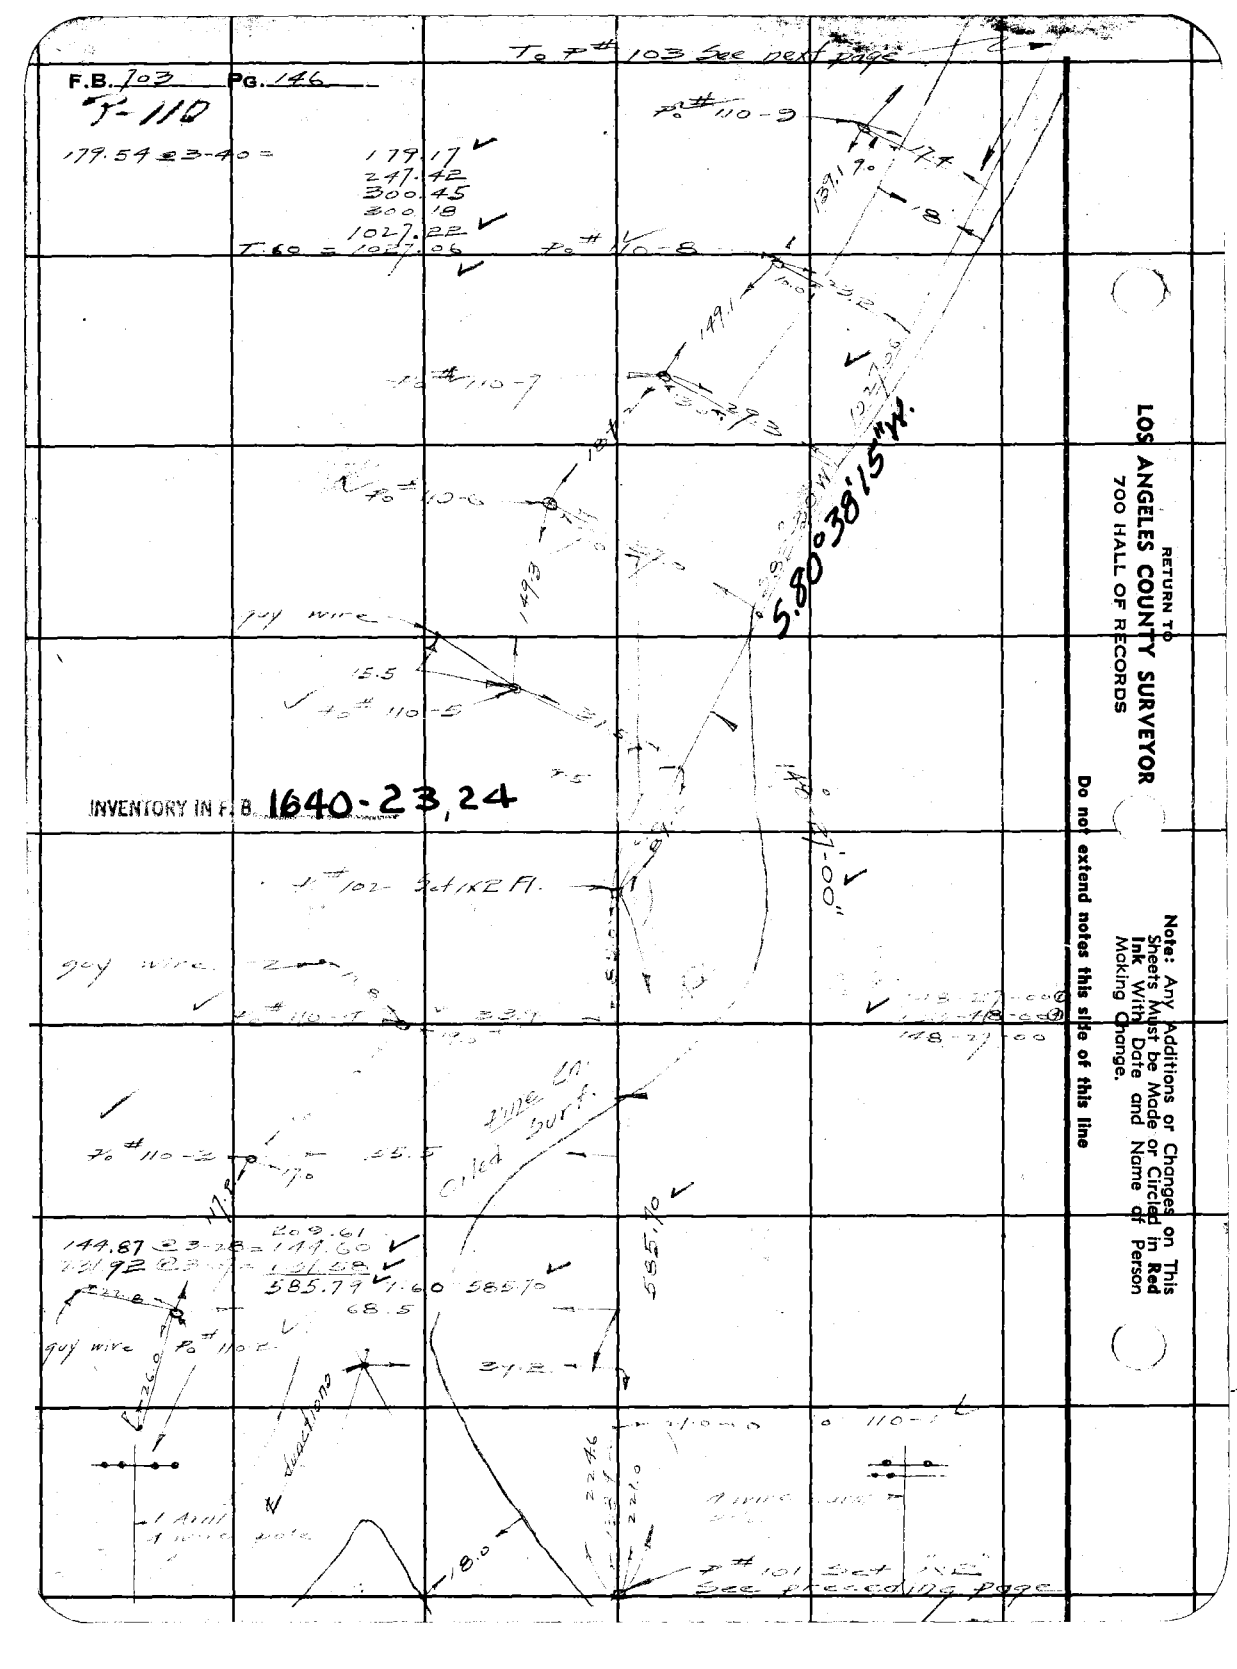
F.B. 103 PG. 146
T-110
To # 103 See next page
To # 110-9
To # 110-8
To # 110-7
To # 110-6
To # 110-5
To # 110-4
To # 110-3
To # 110-2
To # 110-1
To # 101 Set IKR
See preceding page
INVENTORY IN F.B. 1640-23,24
S 80° 38' 15" W.
guy wire
RETURN TO
LOS ANGELES COUNTY SURVEYOR
700 HALL OF RECORDS
Note: Any Additions or Changes on This Sheets Must be Made or Circled in Red Ink With Date and Name of Person Making Change.
Do not extend notes this side of this line

| | |
|---|---|
| Notes Ck'd by | Survey of Forestry Rel. 111 C |
| Map No. | W. O. 6074 Tape No. 55 St'd 37 OF |
| Office Work | Surveyed by Rosecrans |
| Checked | Notes Date 1-11-38 |
| Date | Indexed |

F.B. 102 Pg. 147

R 110

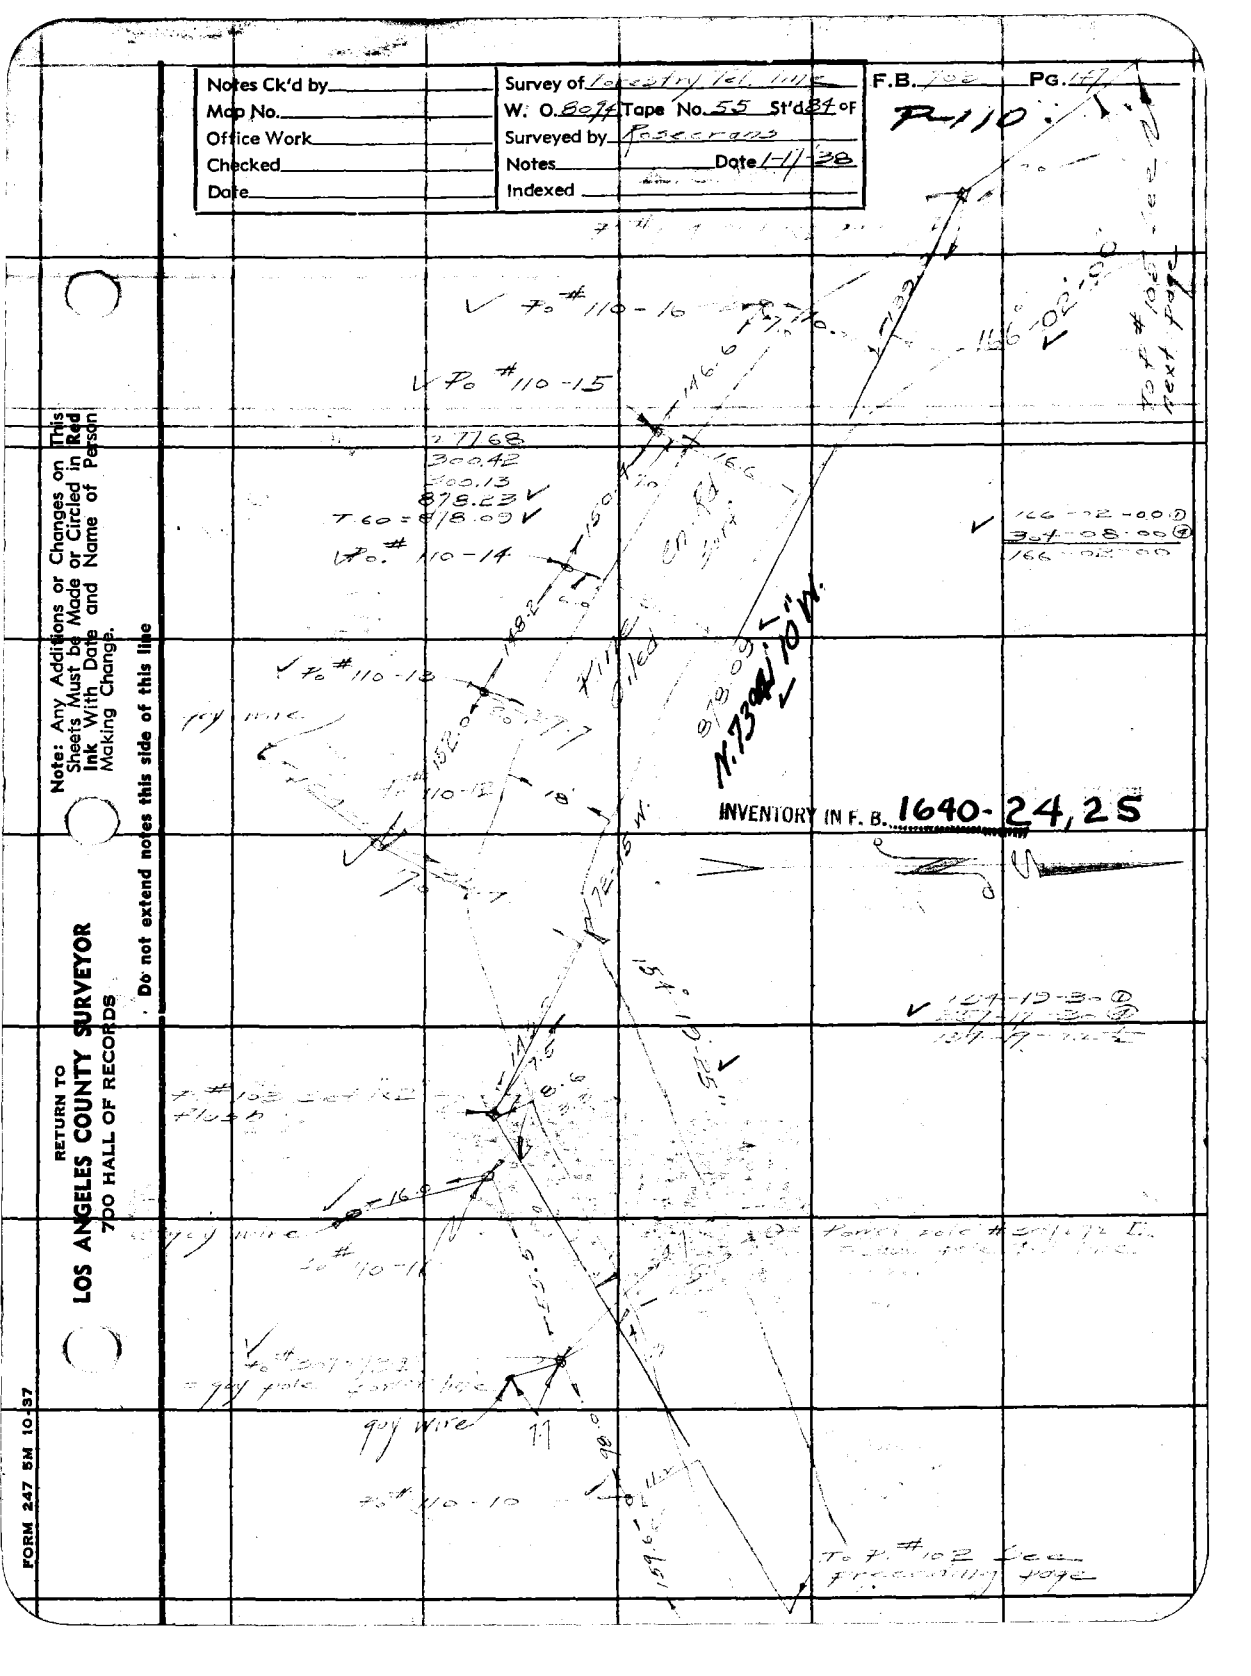


Note: Any Additions or Changes on This Sheets Must be Made or Circled in Red Ink With Date and Name of Person Making Change.

Do not extend notes this side of this line

RETURN TO
LOS ANGELES COUNTY SURVEYOR
700 HALL OF RECORDS

FORM 247 SM 10-37

F.B. 703 PG. 148

P-110

238.26
153.13
30.59 @ 0-37 = 220.51
69.96
.750 = 69.81

RETURN TO
LOS ANGELES COUNTY SURVEYOR
700 HALL OF RECORDS

Note: Any Additions or Changes on This Sheets Must be Made or Circled in Red Ink With Date and Name of Person Making Change.

Do not extend notes this side of this line

INVENTORY IN F. B. 1640-25,26

104.41 @ 7-24 = 103.57
242.27
30.71 @ 7-32 = 098.11
642.32
7.24 = 642.75

S 84° 15' 50" W.

N 73° 18' 40" W.

N 59° 43' 10" W.

preceding page

| | |
|---|---|
| Notes Ck'd by K.R.M. | Survey of |
| Map No. | W. O. 8044 Tape No. 55 St'd 33 OF |
| Office Work | Surveyed by |
| Checked | Notes Date 10-21 |
| Date | Indexed |

F.B. PG.

T-110

See next page

To # 110 of

To # 110 - 33

To # 108 - 16

To # 110 - 16

To # 110 - 17

To # 106

N. 76° 41' 25" W.

147.2

N. 13° 18' 35" E.

N. 19° 55' 25" W.





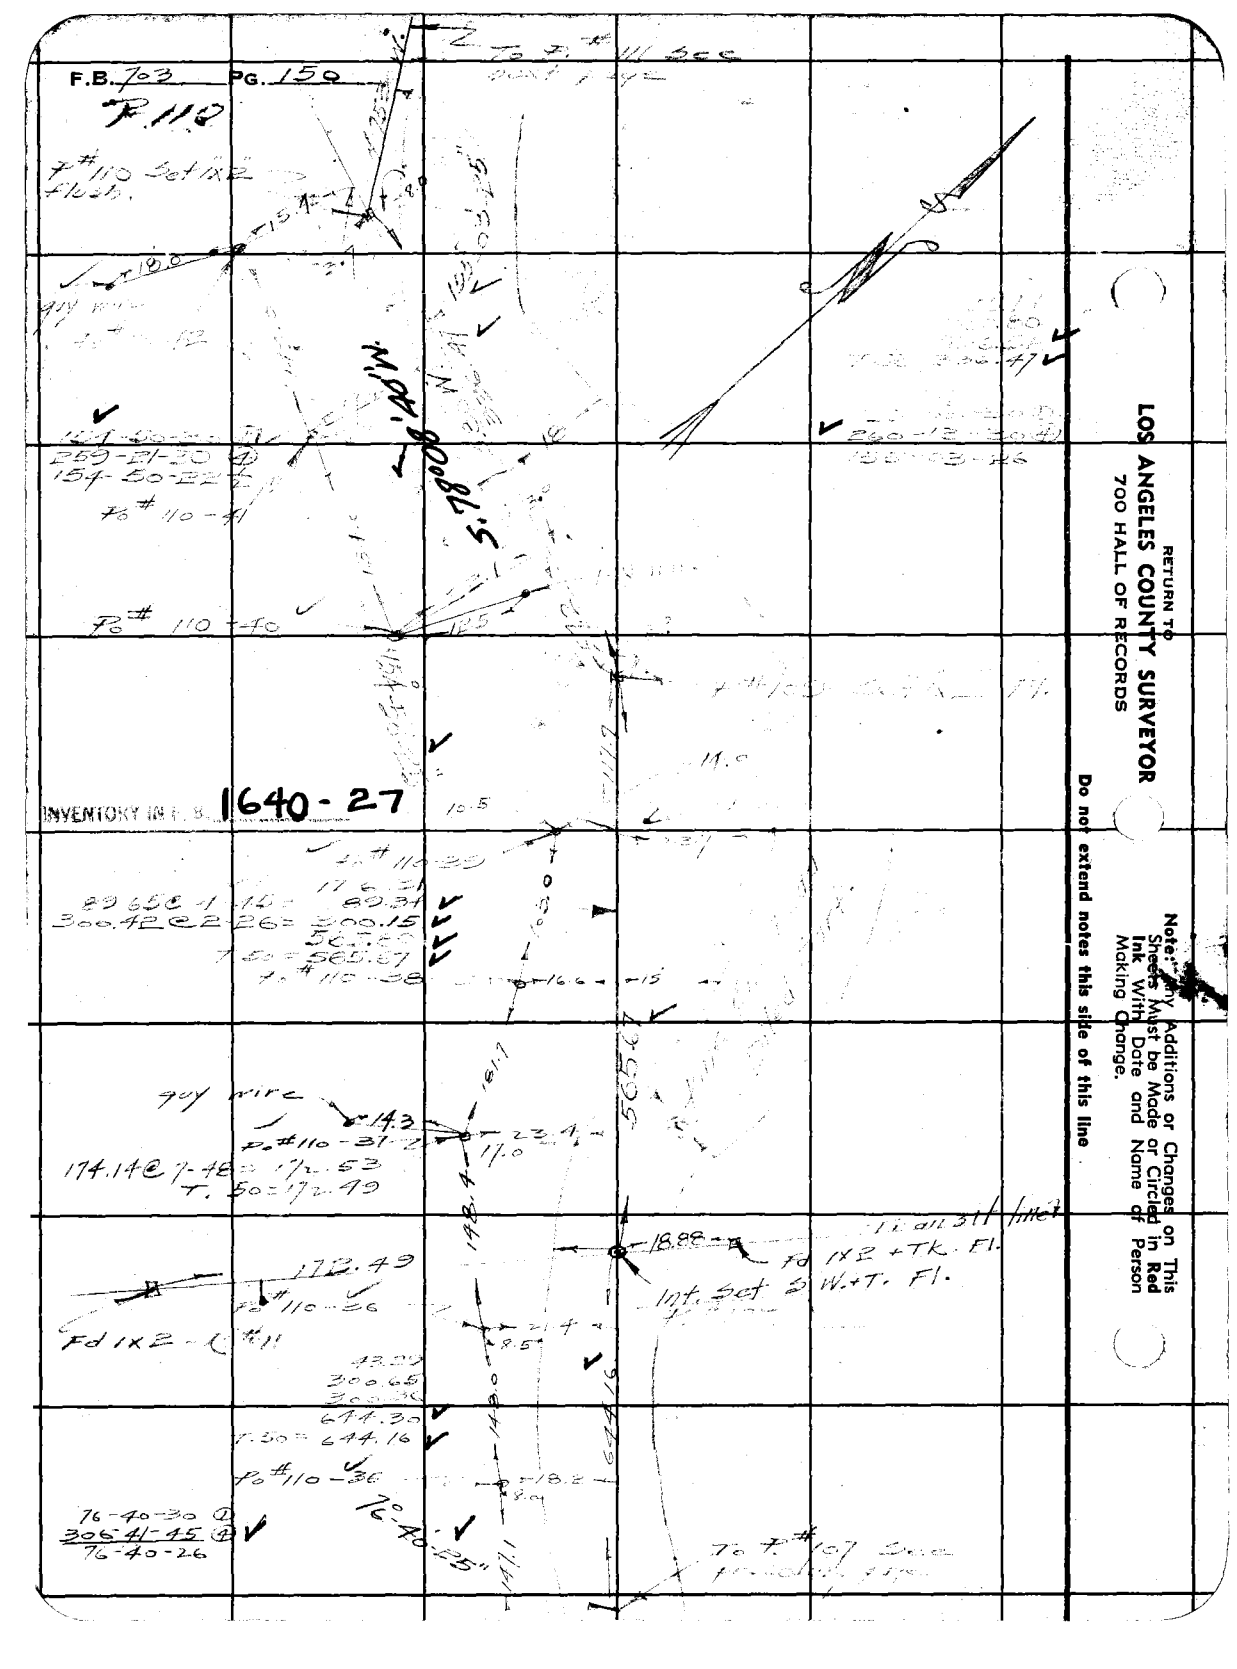


RETURN TO
LOS ANGELES COUNTY SURVEYOR
700 HALL OF RECORDS

Note: Any Additions or Changes on This Sheets Must be Made or Circled in Red Ink With Date and Name of Person Making Change.

Do not extend notes this side of this line

| | | | |
|---|---|---|---|
| Notes Ck'd by K.R.M. | Survey of Forestry Tel. Line | F.B. | Pg. |
| Map No. | W. O. 6074 Tape No. 55 St'd 21 of | | |
| Office Work | Surveyed by Rosecrans | | |
| Checked | Notes Date 1-6-21 | | |
| Date | Indexed | | |

Note: Any Additions or Changes on This Sheets Must be Made or Circled in Red Ink With Date and Name of Person Making Change.

Do not extend notes this side of this line

RETURN TO
LOS ANGELES COUNTY SURVEYOR
700 HALL OF RECORDS

FORM 247 SM 10-37

INVENTORY IN F. B. 1640-28

166° 05' 25" W.

N. 76° 54' E.

1269

1904

RETURN TO
LOS ANGELES COUNTY SURVEYOR
700 HALL OF RECORDS

**Note:** Any Additions or Changes on This Sheets Must be Made or Circled in **Red Ink** With Date and Name of Person Making Change.

**Do not extend notes this side of this line**

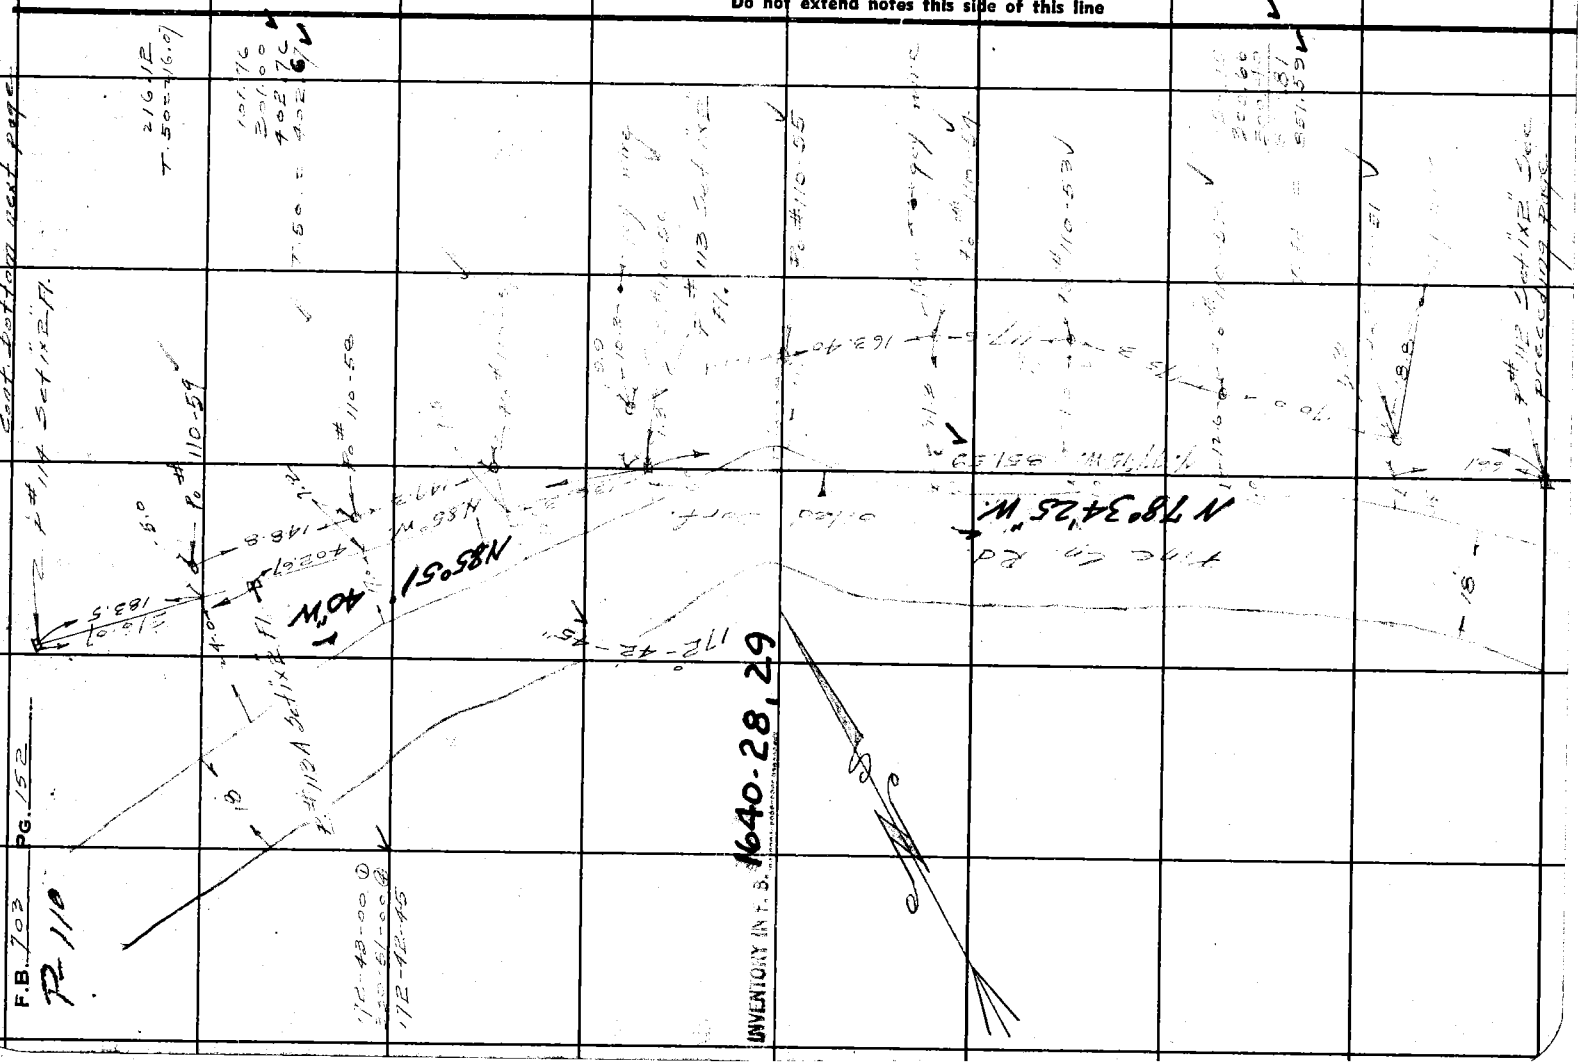

Notes Ck'd by K.R.M.
Map No.
Office Work
Checked
Date

Survey of Tentative Tel. Line F.B. 102 PG.
W. O. 6072 Tape No. 52 St'd 51 of
Surveyed by
Notes Date 1-11-37
Indexed

P. #110

cont. bottom next page

P. #110-68

P. #110-67

P. #110-66

P. #110-65

P. #110-64

P. #115 Set 1"x2"

P. #110-63

P. #110-62

P. #110-61

P. #110-60

P. #110-59

P. #113 Set preceding page

INVENTORY IN F. B. 1640-29,30

166-03-45 ①
304.9-30 ②
166-03-37 ½

166-03-40

170-05-07 ½

N. 75° 56' 50" W.

N 62° 00' 30" W.

Note: Any Additions or Changes on This Sheets Must be Made or Circled in Red Ink With Date and Name of Person Making Change.

Do not extend notes this side of this line

RETURN TO
LOS ANGELES COUNTY SURVEYOR
700 HALL OF RECORDS

FORM 247 SM 10-37

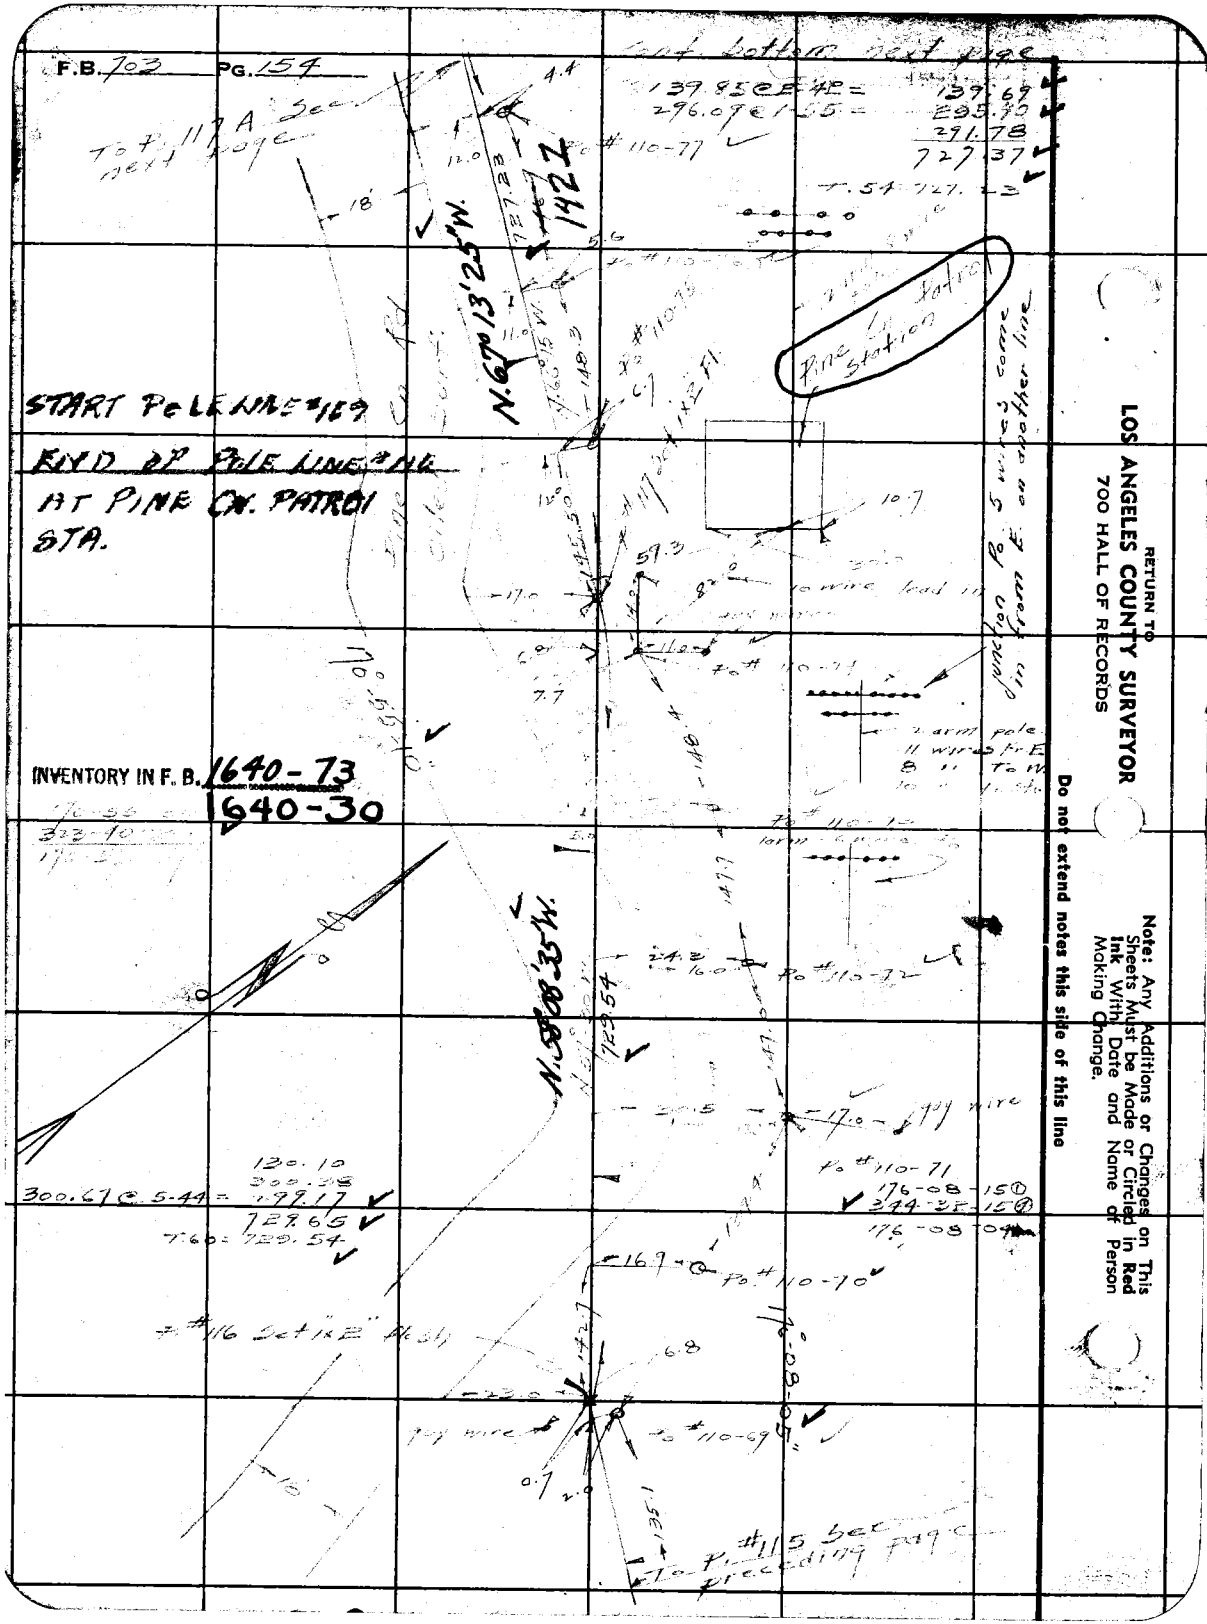
F.B. 102 PG. 154
START POLE LINE #169
END OF POLE LINE #116 AT PINE CK. PATROL STA.
INVENTORY IN F. B. 1640-73
1640-30
N.6°13'25"W.
N.88°23"W.
Pine Ck. Patrol Station
RETURN TO
LOS ANGELES COUNTY SURVEYOR
700 HALL OF RECORDS
Do not extend notes this side of this line
Note: Any Additions or Changes on This Sheets Must be Made or Circled in Red Ink With Date and Name of Person Making Change.

Notes Ck'd by K.A.M.
Map No.
Office Work
Checked
Date

Survey of Los Angeles County
W. O. 6[illegible] Tape No. 51 St'd 51 OF
Surveyed by [illegible]
Notes 1 Date 1-18-37
Indexed A. C. Jones

F.B. 102 PG. 55

P-107

Cont. bottom next page

P.O.T. on ixc Fl.

17'

148.4

110.84

S 89° 45' W.

171.35
300.40
471.75

T.68 - 471.70

152.30 - 11.00 = 149.50
T.68 - 119.15

154.58-30 D
154.54-30 D
154.58-30 L

149.48
S 89° 45' W.

P.I. #223 Fd. 2x2
F.B. 611-185

1 Arm 4 wire Po.

INVENTORY IN F. B. 1640-73, 74

#110-80

3 arm 8 wire Po.

P. #118 Set 1x2" Fl.

99.88 7.54 = 99.86

17'

155

Note: Any Additions or Changes on This Sheets Must be Made or Circled in Red Ink With Date and Name of Person Making Change.

Do not extend notes this side of this line

RETURN TO
LOS ANGELES COUNTY SURVEYOR
700 HALL OF RECORDS

FORM 247 5M 10-37

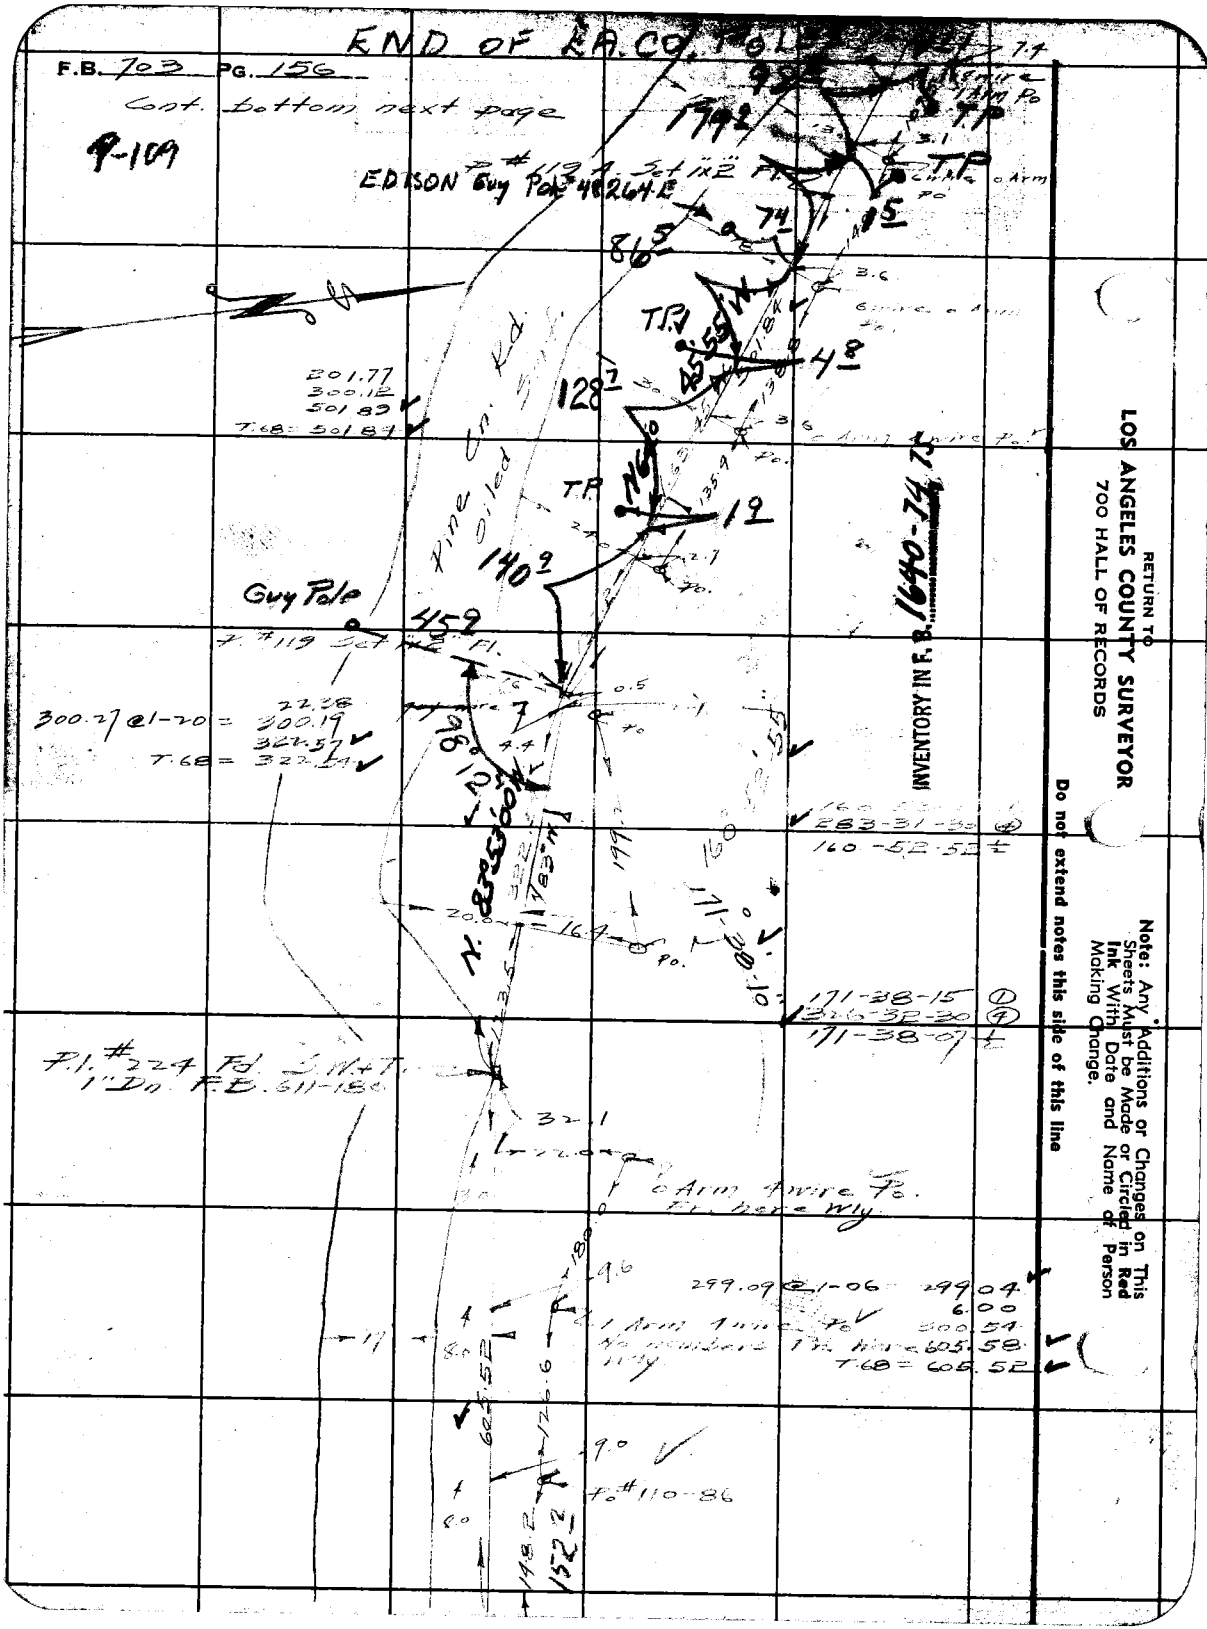
END OF LA. CO. 16L
F.B. 703 PG. 156
Cont. bottom next page
9-109
Guy Pole
T.P.
Pine Cr. Rd
Oiled Surf.
INVENTORY IN F.B. 1640-74, 75
RETURN TO
LOS ANGELES COUNTY SURVEYOR
700 HALL OF RECORDS
Note: Any Additions or Changes on This Sheets Must be Made in Red Ink With Date and Name of Person Making Change.
Do not extend notes this side of this line

| | |
|---|---|
| Notes Ck'd by K.A.M. | Survey of [illegible] |
| Map No. | W. O. 8094 Tape No. [illegible] St'd 34 OF |
| Office Work | Surveyed by Rosecrans |
| Checked | Notes Date [illegible] |
| Date | Indexed |

F.B. [illegible] PG. 157

Note: Any Additions or Changes on This Sheets Must be Made or Circled in Red Ink With Date and Name of Person Making Change.

Do not extend notes this side of this line

RETURN TO
LOS ANGELES COUNTY SURVEYOR
700 HALL OF RECORDS

FORM 247 5M 10-37

VOID
T.P. Co. LINES ON
ASSOCIATED
Tel Co
SEE Tel Co FOR
LOCATIONS
Tel Co Pole

INVENTORY IN F. B. 1640-75

RETURN TO
**LOS ANGELES COUNTY SURVEYOR**
700 HALL OF RECORDS

**Note:** Any Additions or Changes on This Sheets Must be Made or Circled in **Red Ink** With Date and Name of Person Making Change.

**Do not extend notes this side of this line**

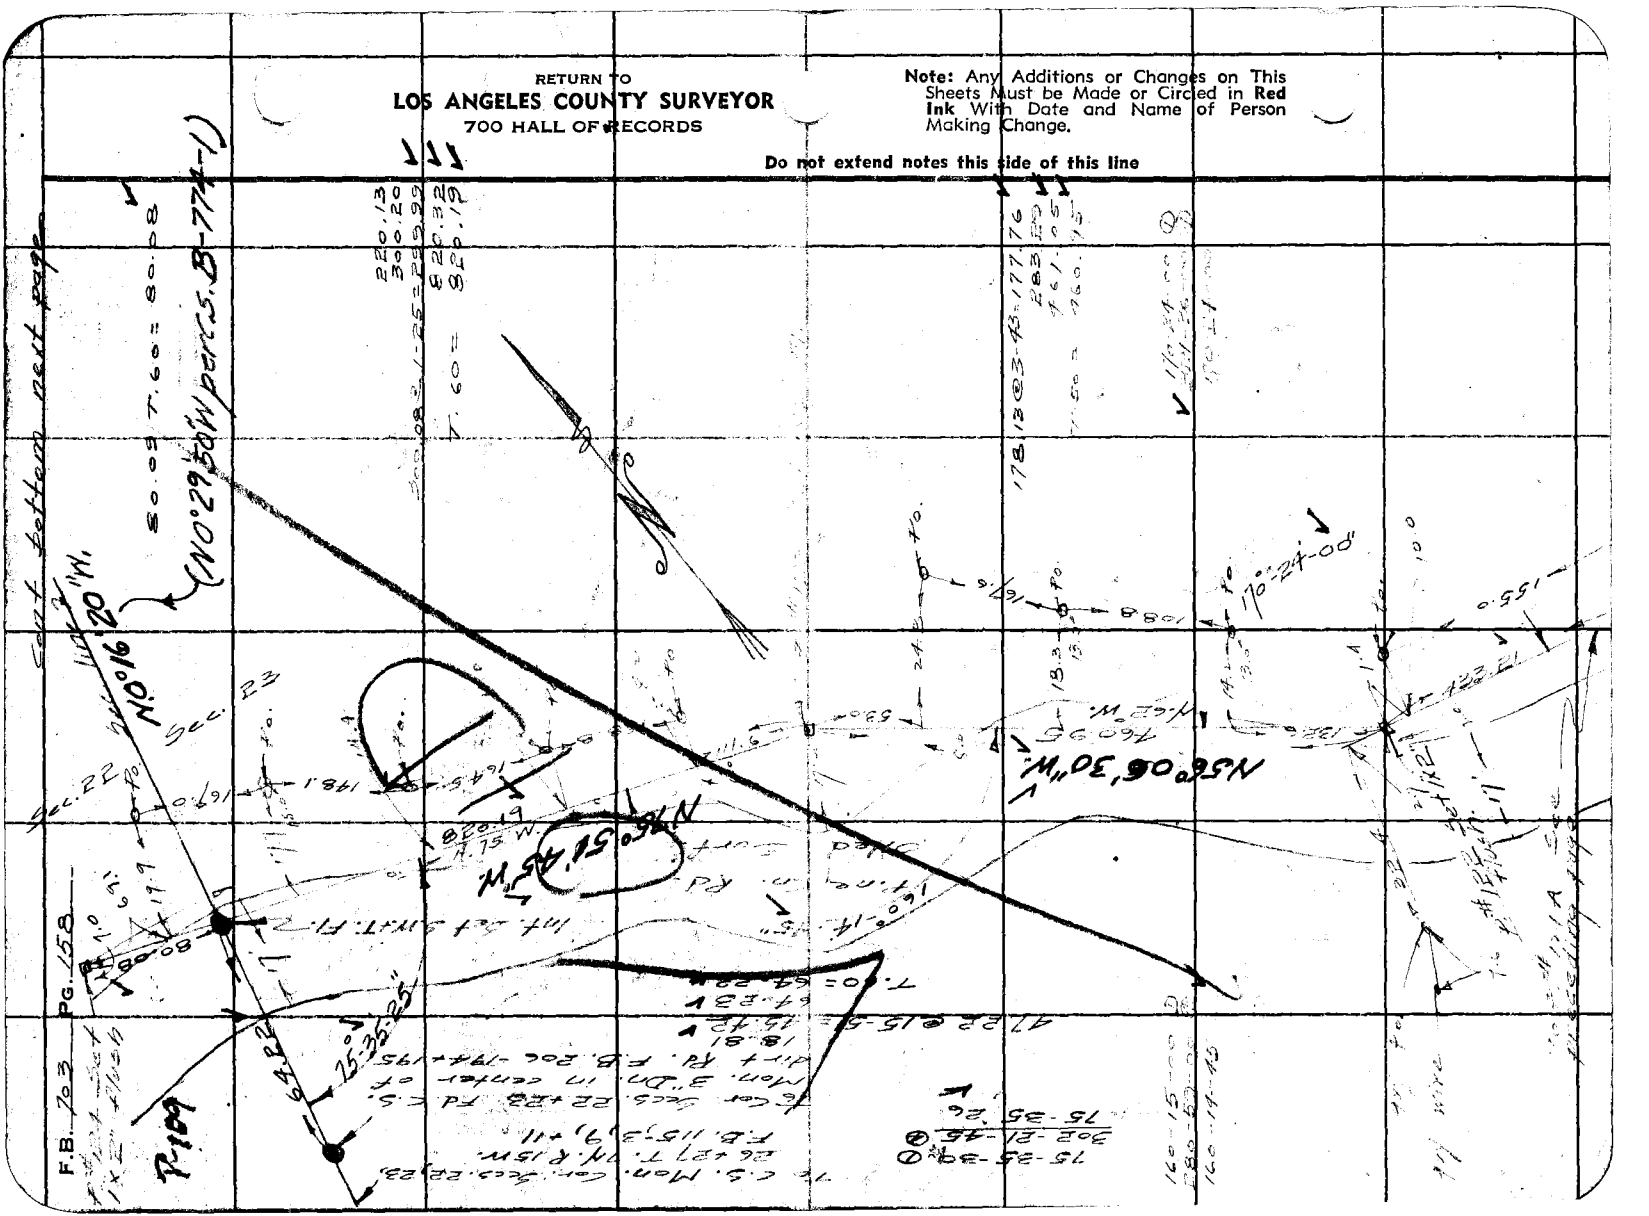

| | | | |
|---|---|---|---|
| Notes Ck'd by K.R.M. | Survey of Imperial Hwy. 121 line | F.B. 702 | Pg. 159 |
| Map No. | W. O. 8071 Tape No. 56 St'd 84 of | | |
| Office Work | Surveyed by Rosecrans | | |
| Checked | Notes Date 1-24-38 | P-169 | |
| Date | Indexed C. Jenkins | | |

RETURN TO
LOS ANGELES COUNTY SURVEYOR
700 HALL OF RECORDS

Note: Any Additions or Changes on This Sheets Must be Made or Circled in Red Ink With Date and Name of Person Making Change.

Do not extend notes this side of this line

FORM 247 5M 10-37

P.# 127 Set 1x2" Fl.

guy wire

13.6

14.0

12.9

0 Alum. Spike

To P.# 128 Next page

149-35-30

238-22-00

393

176-37-30

171-17-00

176-22-00

P.# 126 Set 1x2" Fl.

guy wire

95

1.69'W

236.03

235.99

P.# 124 Set 1x2" Fl.

To P.# 123 Preceding page

165-31-00

302-04-20

165-31-07½


F.B. 103 PG. 160

To P. #129 See next page
P-160

SEE

POLE CHANGES MARKED IN RED

VOID START POINT

USE LINE TO POINTS

P. #128A 5 gT IV.2 Fl.

P. #128 5 gT "2" Fl.

P. #127 Det 1 "2" Fl.
See preceding page

1 Arm, 6 wire to P. #128 Fr here W/F.

1 Arm to E. — 2 wires
" to S. — 6 "
" to W. — 3 "

2 guy wire

RETURN TO
LOS ANGELES COUNTY SURVEYOR
700 HALL OF RECORDS

Note: Any Additions or Changes on This Sheets Must be Made or Circled in Red Ink With Date and Name of Person Making Change.

Do not extend notes this side of this line

| | |
|---|---|
| Notes Ck'd by KLM. | Survey of Forestry Tel line |
| Map No. | W. O. 8074 Tape No 52 St'd BM OF. |
| Office Work | Surveyed by Pasecranz |
| Checked | Notes |
| Date | Date 11-28 |
| | Indexed A. C. Tenman |

F.B. 703 Pg. 161

P-109

Cont. bottom next page

268.81 @ 2-06 = 268.63
300.35 @ 1-07 = 300.29
300.26 @ 1-39 = 300.14
286.12 @ 6-02 = 287.83
1153.89
T.60 = 1153.71

5.88 N 49°35' W. 1153.71

Fine Cp. 4" oiled surf

Po. 10.2 15.0 Po. 19.0 Po. 23.0 Po. 7.0 Po. 8.0 Po. 22.2 Po. 66.0 Po.

guy wire

P. #129A. Set 1x2" Flag

750.00 @ 6-23 = 256.40
189.45
445.85
T. 60 = 445.78

guy wire

INVENTORY IN F. B. 1640-78, 79

150-52-00 ①
243-28-00 ②
150-52-00

150.52

P. #129 Set 4x4 T.

guy wire

P. #129A Set 4x4 T. preceding pole

600.37

F.B. 1640-78, 79

Note: ANY ADDITIONS OR CHANGES ON THIS SHEET MUST BE MADE OR CIRCLED IN Red Ink WITH DATE AND NAME OF PERSON MAKING CHANGE.

Do not extend notes this side of this line

RETURN TO
LOS ANGELES COUNTY SURVEYOR
700 HALL OF RECORDS

FORM 247 BM 2-34

F.B. 702 Pg. 162

P-179

P.#131 Set 1x2 Fl.

Cont. bottom next page

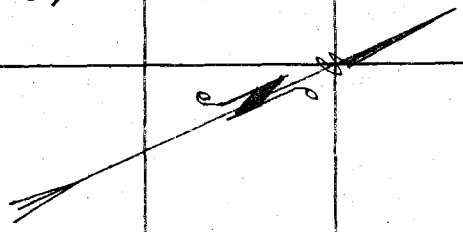

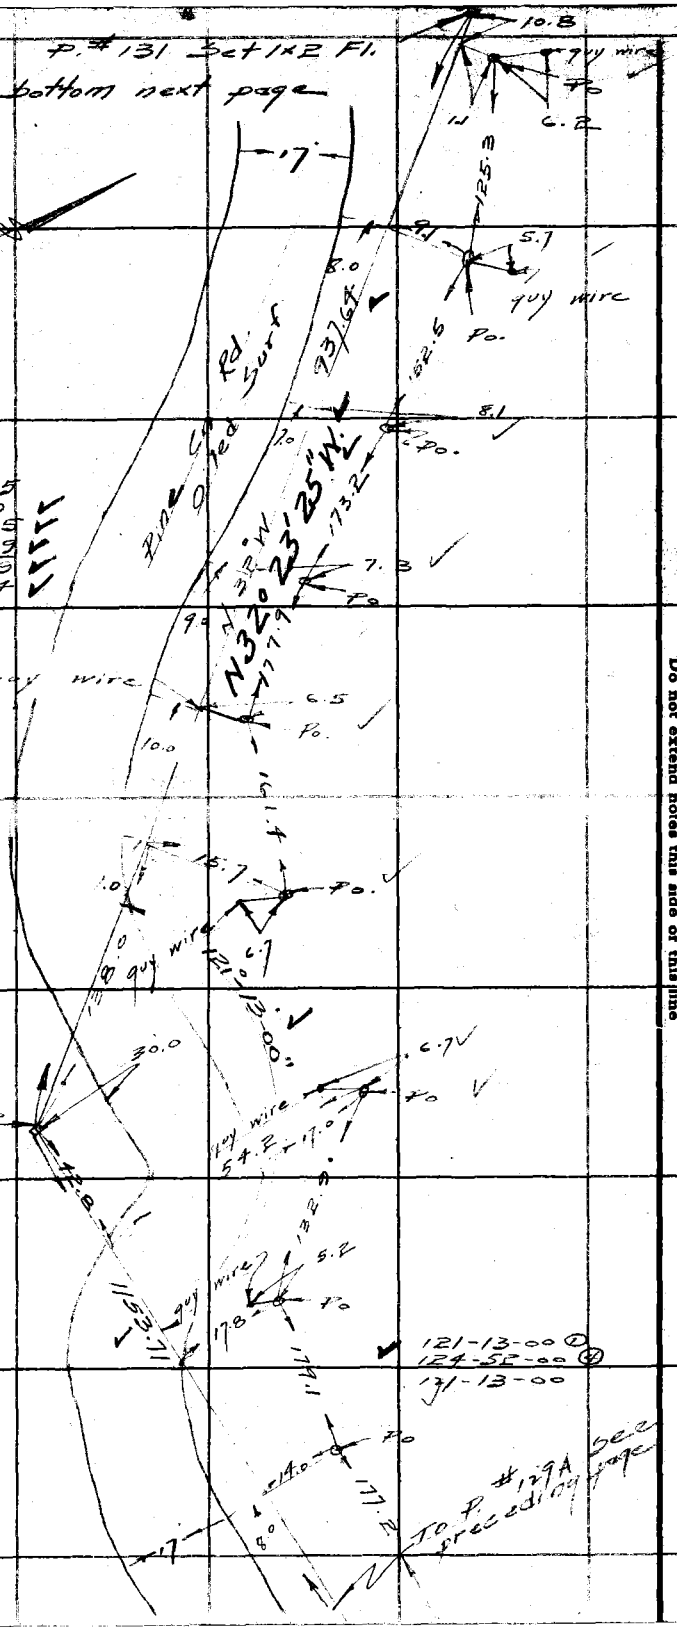


37.45

300.04 @ 1-44 = 279.90

300.21 @ 1-51 = 300.05

300.45 @ 1-11 = 300.39

937.79

T.60 937.64

INVENTORY IN F. B. 1640-79

F.B. 1640-79

RETURN TO
LOS ANGELES COUNTY SURVEYOR
700 HALL OF RECORDS

Do not extend notes this side of this line

Note: ANY ADDITIONS OR CHANGES ON THIS SHEET MUST BE MADE OR CANCELED IN Red Ink WITH DATE AND NAME OF PERSON MAKING CHANGE.

| | |
|---|---|
| Notes Ck'd by L.R.M. | Survey of Forestry Tel. line |
| Map No. | W. O. 8014 Tape No 55 St'd 84' OF. |
| Office Work | Surveyed by Rosecrans |
| Checked | Notes Date 1-27-38 |
| Date | Indexed A. C. [illegible] |

F.B. 702 Pg. 163

P 109

Cont. from previous page

Note: ANY ADDITIONS OR CHANGES ON THIS SHEET MUST BE MADE OR CIRCLED IN Red Ink WITH DATE AND NAME OF PERSON MAKING CHANGE.

Do not extend notes this side of this line

F.B. 1640-80

RETURN TO
LOS ANGELES COUNTY SURVEYOR
700 HALL OF RECORDS

INVENTORY IN F. B. 1640-80

105.42
300.59 @ 1-26 = 300.50
300.35 @ 2-12 = 300.13
300.27 @ 1-37 = 300.45
1006.50
T.64 = 1006.37

152-15-15 ①
253-00-00 ④
153-15-00

To P.T. Sta. 1+30 Page 2

P.T. Sta. 1+58 Surv. Rd. Ind.

N. 55°08'25" W.

1006.37

1435

1337

1621

1+42 P.T.

9.6 Po. guy wire 5.2

6.0 guy wire Po.

Po.

Po.

Po.

Po.

Po.

guy wire

153°-15'-00"

P.T. Sta. 1+31 Set 1/2" B Fl.

FORM 347 BM 2-34

Top #132

F.B. 703 Pg. 164

Cont. bottom next page

R-109

RETURN TO
LOS ANGELES COUNTY SURVEYOR
700 HALL OF RECORDS

Do not extend notes this side of this line

Note: ANY ADDITIONS OR CHANGES ON THIS SHEET MUST BE MADE OR CIRCLED IN Red Ink WITH DATE AND NAME OF PERSON MAKING CHANGE.

F.B. 1640-81

INVENTORY IN F. B. 1640-81

N 61°22'00" W

Old Surf.

P.C. P.T.

R=238.93 Ft.

Δ=77°-2

30' W.

96.80 T.68 = 96.79

82.87 T.68 = 92.86

Set S.M. + T. Fl. 2

90°

30.00

R/W. P.C. Fd 3"x3" Fl.

Set 1x2" P. #132 See preceding page

Set 1x2" P. #131 See preceding page

Int. Set S.M. + T. Fl.

96.79

129.0

117.0

125.2

136.1

122.2

134.1

31.2

28.0

21.0

27.5

26.5

25.4

25.0

23.4

20.0

19.0

15.5

Po

| | | | |
|---|---|---|---|
| Notes Ck'd by K.A.M. | Survey of Forestry Tel line | F.B. 703 | Pg. 165 |
| Map No. | W. O. 8094 Tape No 55 St'd 84 OF. | | |
| Office Work | Surveyed by Pozecrans | P-109 | |
| Checked | Notes | Date 4-4-38 | |
| Date | Indexed | | |

P#133 Set 4"x4"x T. Fl.

15.6 9.0 90° 9.0 30.00 Fd. 3"x2" P.C. R/W. TL Fl.

51.0 W. 96.8 P#134 See next page

169-26-A0 72.9 66.0 Po.

51.0 40.0 177 Po.

190° 7.5 guy wire 31.8 23.0 Po

169-26-95 ⊙ 31-46-45 ⊙ 169-26-41

F.B. 1640-82

Fd. 3/4" I.P. 0.3' Lo. 0.3' Hi. Set 3/4" I.P. 0.3' Lo. 0.3' Hi.

F.B. 702 PG. 166

R109

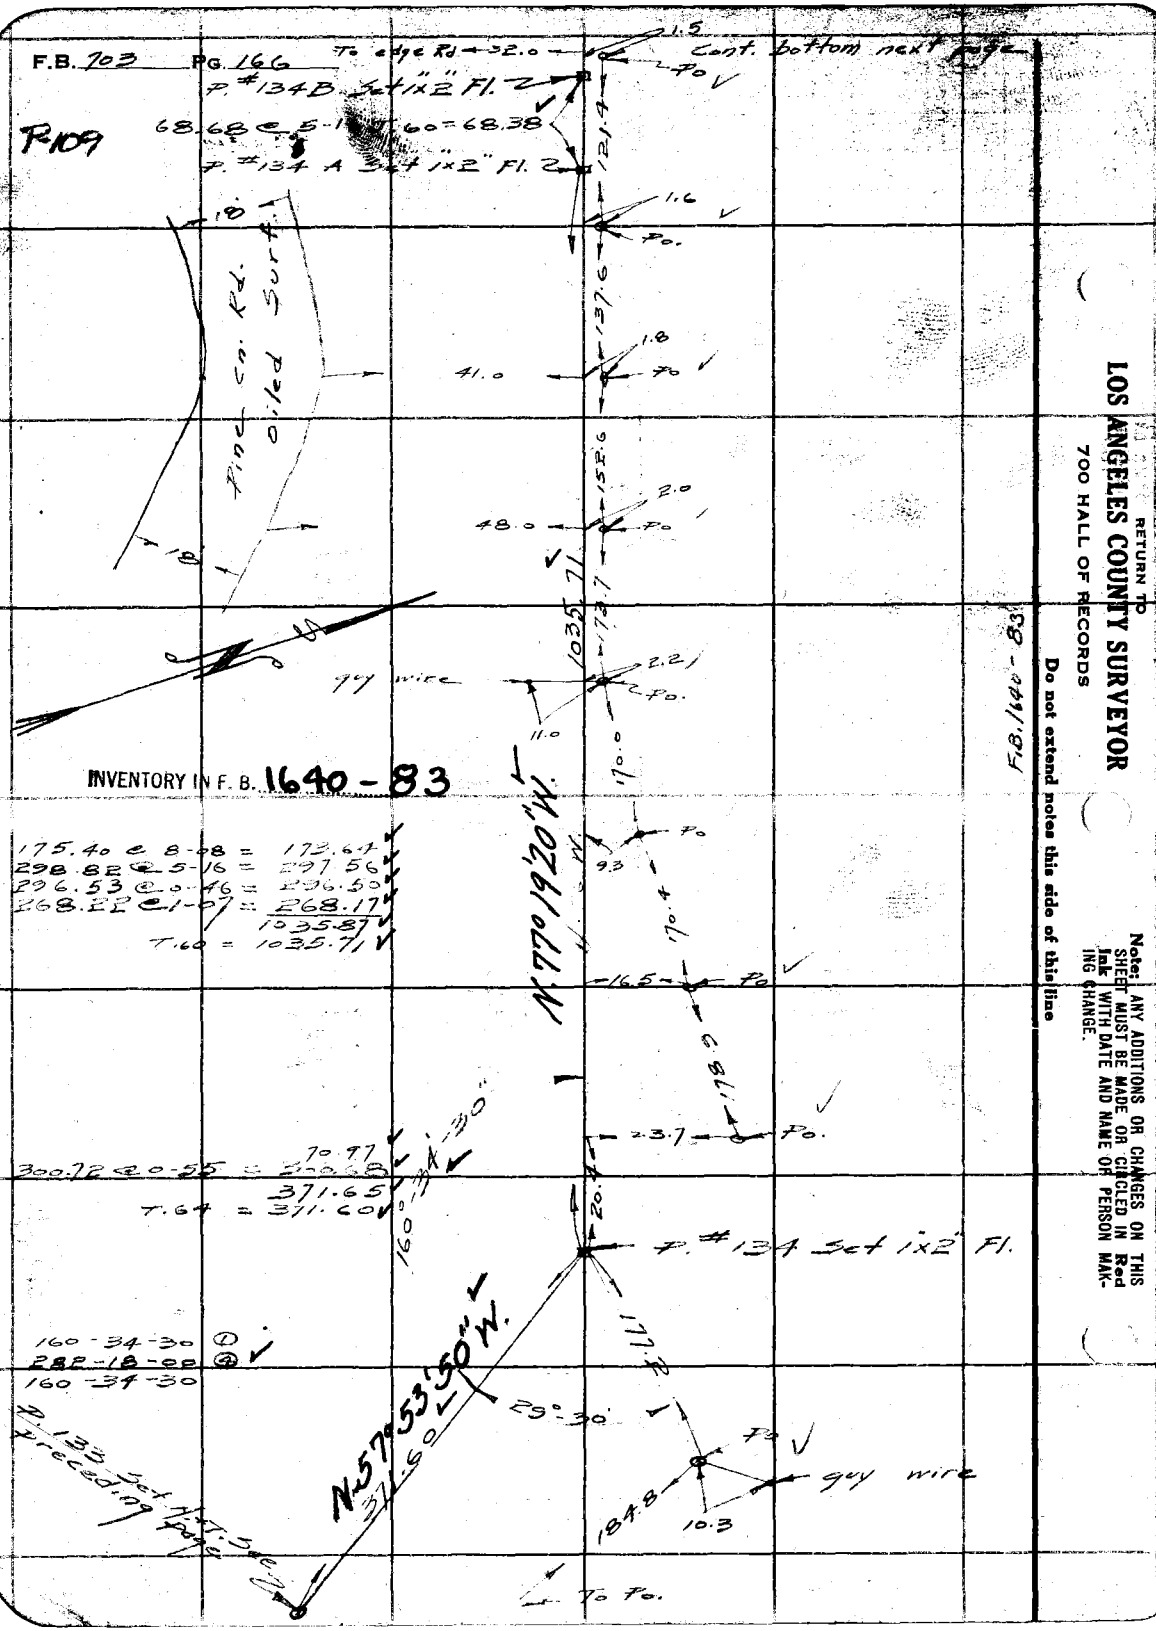


RETURN TO
LOS ANGELES COUNTY SURVEYOR
700 HALL OF RECORDS

Do not extend notes this side of this line

Note: ANY ADDITIONS OR CHANGES ON THIS SHEET MUST BE MADE OR CIRCLED IN Red Ink WITH DATE AND NAME OF PERSON MAKING CHANGE.

| | |
|---|---|
| Notes Ck'd by K.R.M. | Survey of Forestry Tel. line |
| Map No. | W. O. 8094 Tape No 65 St'd 84 of. |
| Office Work | Surveyed by Foresters |
| Checked | Notes Date 1-28-38 |
| Date | Indexed A. C. Johnson |

F.B. 702 Pg. 167

T-109

Court Lottery next page

P. #136 Set 1x2 Fl. 2

131.70 @ 2-59 T.60 = 131.50

P. #135 C Set 1x2 Fl. 2

145.86 T.50 = 145.83

P. #135B Set 1x2 Fl. 2

165.02 @ 1-37 T.60 = 165.82

INVENTORY IN F. B. 1640-84

122.64 @ 6-42 T.60 = 121.78

P. #135A Set 1x2 Fl.

P. #135 Set 1x2 Fl. 2

159.86 @ 5-06 = 159.23
300.52 @ 1-55 = 300.35
T.60 = 459.51

guy wire

fine oil pipe

P. #134B See page following

167-04-15 (1)
308-13.00 (4)
167-04-15

F.B. 1640-84

Note: ANY ADDITIONS OR CHANGES ON THIS SHEET MUST BE MADE OR CHANGED IN Red Ink WITH DATE AND NAME OF PERSON MAKING CHANGE.

Do not extend notes this side of this line

RETURN TO
LOS ANGELES COUNTY SURVEYOR
700 HALL OF RECORDS

FORM 247 5M 2-34

F.B. 703 PG. 168

P-104

Cont. bottom next page

2 to P. #137 A

Po.

13.0

5.2

18.1

14.0

Po.

6.2

18.

14.0

Po.

7.1

14.0

N. 10° 25' W. 1469.

Po. 2

8.1

15.0

15.2

15.8

N. 11° 09' W.

Po.

9.2

11.0

6.1

guy wire

40.

17.9

48.0

178.7

Fence on Rd. 0.1 of Sec. 21

P. #137 Set ½" Fl.

guy wire

6.0

3.0

Po.

16.0

178.31

11.0

171-19-45 ①
315-18-30 ②
171-19-37½

12.6

Po.

N. 39° 50' 50" W.

P. #136 A. Set ½" Fl.

300.11 @ 1-54 = 300.10
60.68
360.78
T. 60 = 360.78

INVENTORY IN F. B. 1640-85

175-27-15 ①
341-42-00 ②
175-27-15

Guy wire

Po.

10.0

3.0

10.2

360.72

N. 45° 53' W.

1329

9.5

15.1

15.

18

229.3

P. #136 Set ½" Fl.

P. #135 Set ½" Fl. Leading to P. #134

300.08 @ 1-51 = 299.92
299.59 @ 2-06 = 299.39
300.62 @ 1-09 = 300.56
916.02
T. 60 = 915.88

16.15

198.9 @ 4-33 T. 60 = 198.31

RETURN TO
LOS ANGELES COUNTY SURVEYOR
700 HALL OF RECORDS

Do not extend note this side of this line

Note: ANY ADDITIONS OR CHANGES ON THIS SHEET MUST BE MADE OR CHGED IN Red Ink WITH DATE AND NAME OF PERSON MAKING CHANGE.

| | | | |
|---|---|---|---|
| Notes Ck'd by K.R.M. | Survey of Forestry Tel. Line | F.B. 703 | Pg. 162 |
| Map No. | W. O. 8094 Tape No 55 St'd 84 or. | P-109 | |
| Office Work | Surveyed by Rezeczano | | |
| Checked | Notes Date 1-31-38 | | |
| Date | Indexed A. C. Johnson | | |

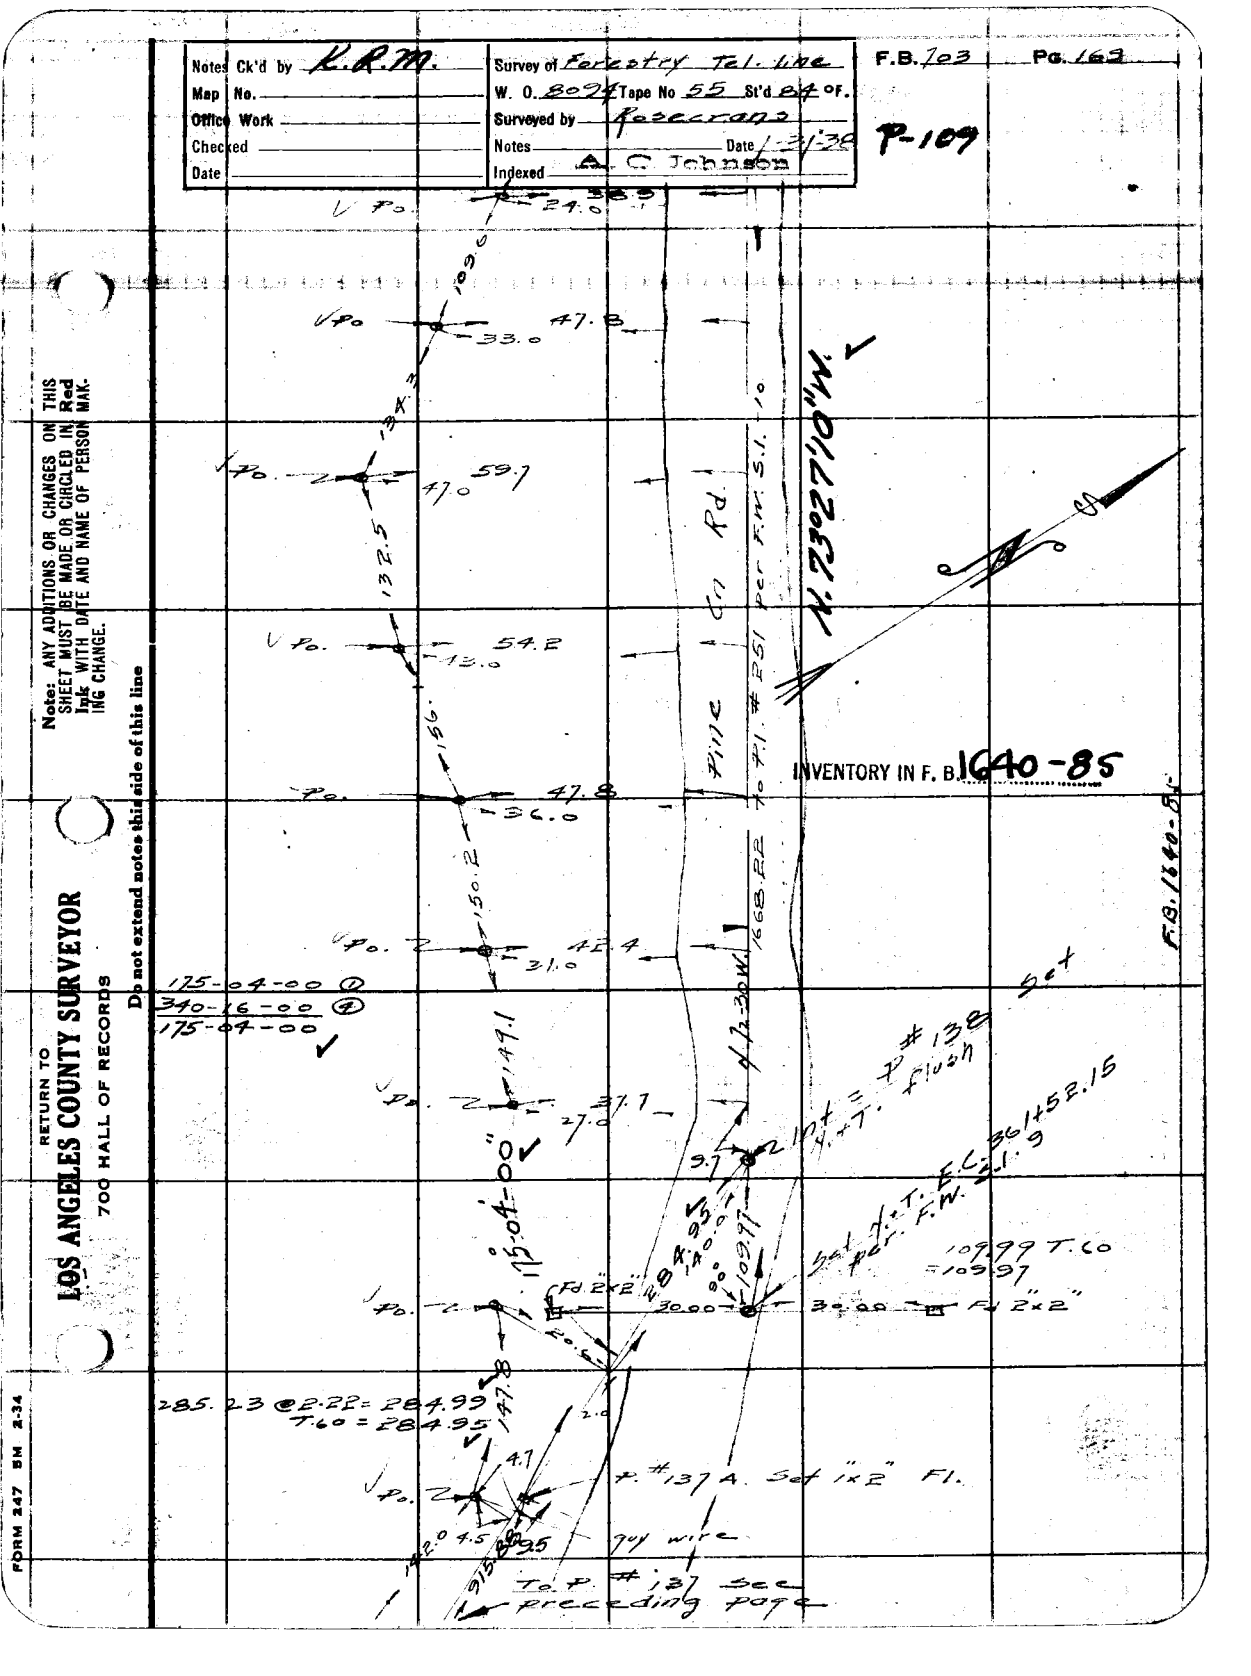

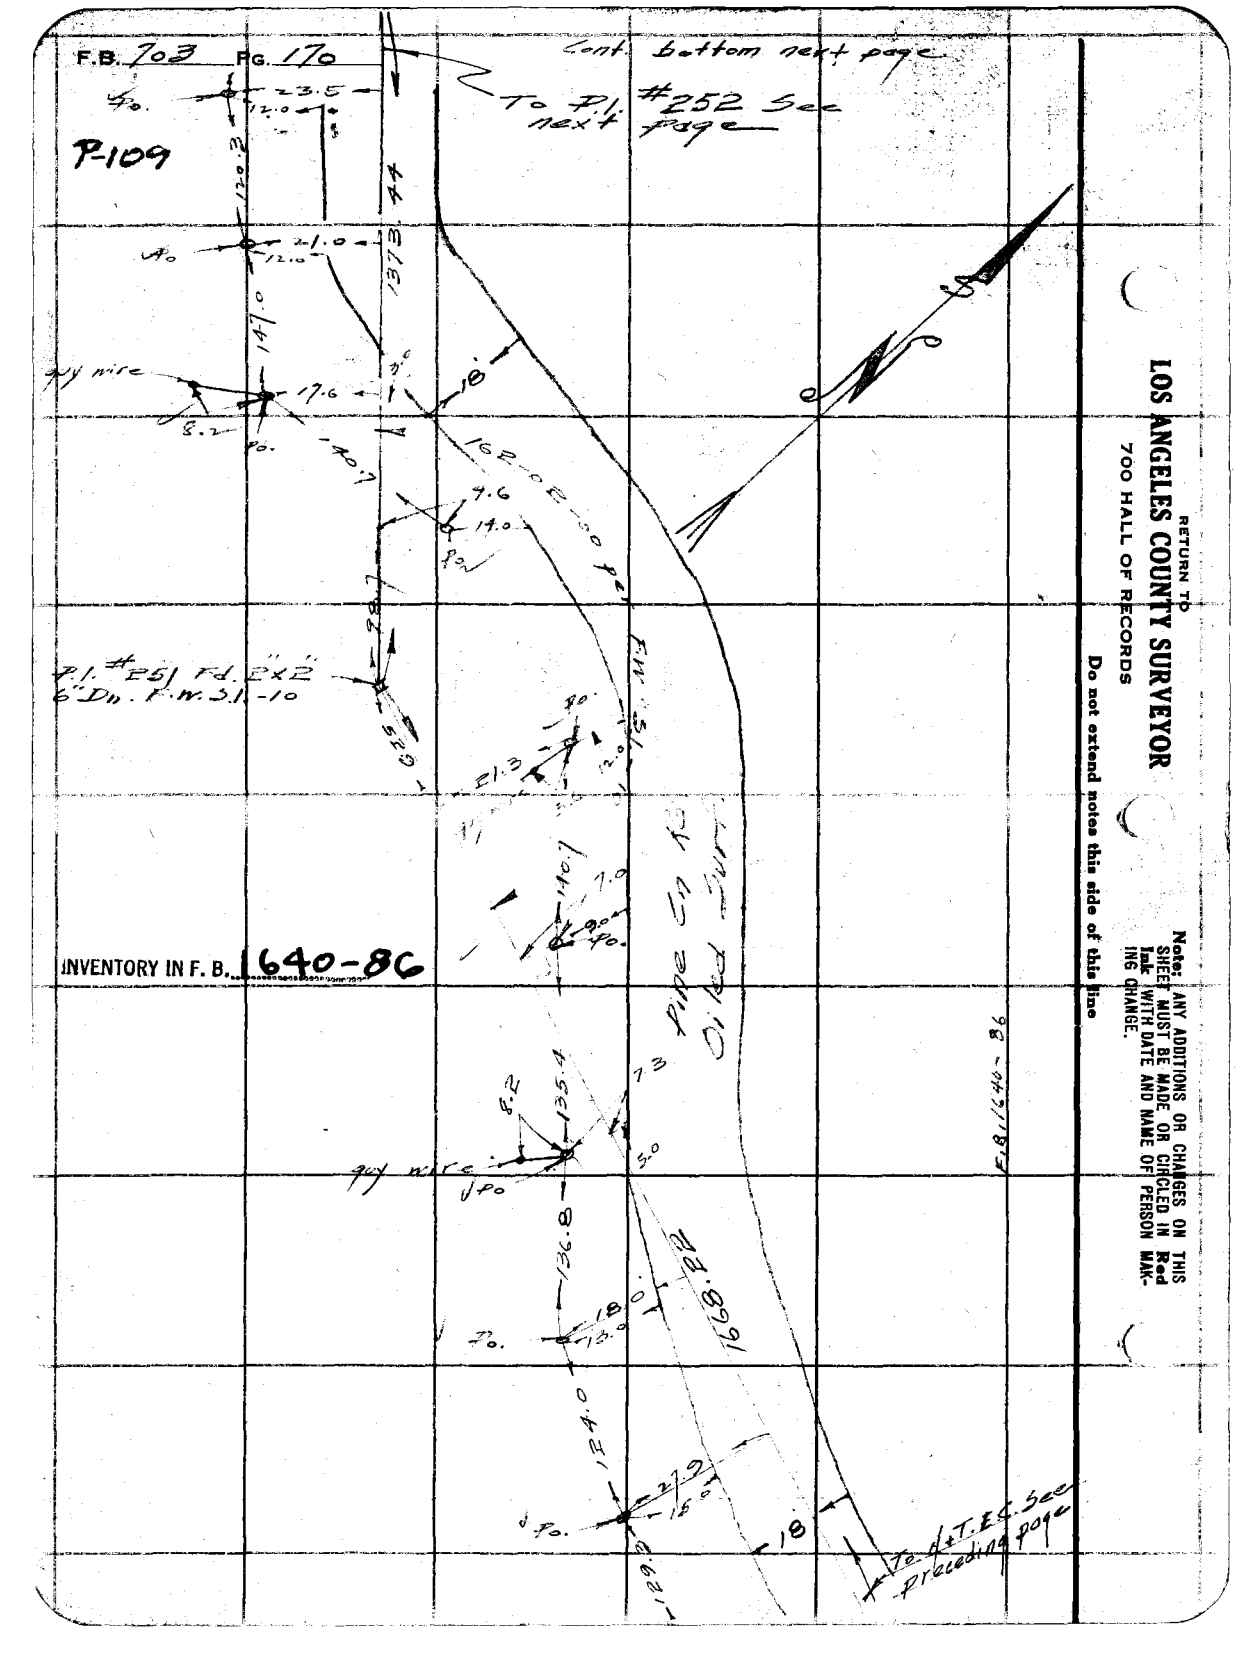
F.B. 703 PG. 170
Cont. bottom next page
To P.I. #252 See next page
P-109
Po.
23.5
12.0
12.0
21.0
12.0
guy wire
17.6
8.2
Po.
140.7
137.3
147.0
18'
16.2 E 300 ft.
9.6
14.0
Po.
P.I. #251 Fd. 2"x2" 6"Dn. F.W. 3.1-10
629.1
21.3
Po.
12.0
140.7
7.0
Po.
INVENTORY IN F. B. 1640-86
8.2
135.4
guy wire
Po.
18.0
13.0
Po.
15.0
18'
To P.I. #252 See preceding page
RETURN TO
LOS ANGELES COUNTY SURVEYOR
700 HALL OF RECORDS
Do not extend notes this side of this line
Note: ANY ADDITIONS OR CHANGES ON THIS SHEET MUST BE MADE OR CIRCLED IN Red Ink WITH DATE AND NAME OF PERSON MAKING CHANGE.

Notes Ck'd by K.R.M.
Map No.
Office Work
Checked
Date

Survey of Tel lines Soledad Dr
W. O 8094 Tape No 55 St'd 84 of.
Surveyed by Rosecrans
Notes
Date 1-31-38
Indexed

F.B. 703 Pg. 171

P-107

To P.I. # 252 next page

N. 76°46'55" W.
1312.93

INVENTORY IN F. B. 1640-87

Note: ANY ADDITIONS OR CHANGES ON THIS SHEET MUST BE MADE OR CIRCLED IN Red Ink WITH DATE AND NAME OF PERSON MAKING CHANGE.

Do not extend notes this side of this line

RETURN TO
LOS ANGELES COUNTY SURVEYOR
700 HALL OF RECORDS

F.B. 1140-87

168°-42'-15" per R.W.S.I. 11

Pine Co. Rd. Surv.

P.I. # 252 Set 2"x2" by ties R.W. 3.1-11

guy wire

N. 55°29'10" W.
1373.44

To P.I. # 251 See preceding page

FORM 247 BM 2-34

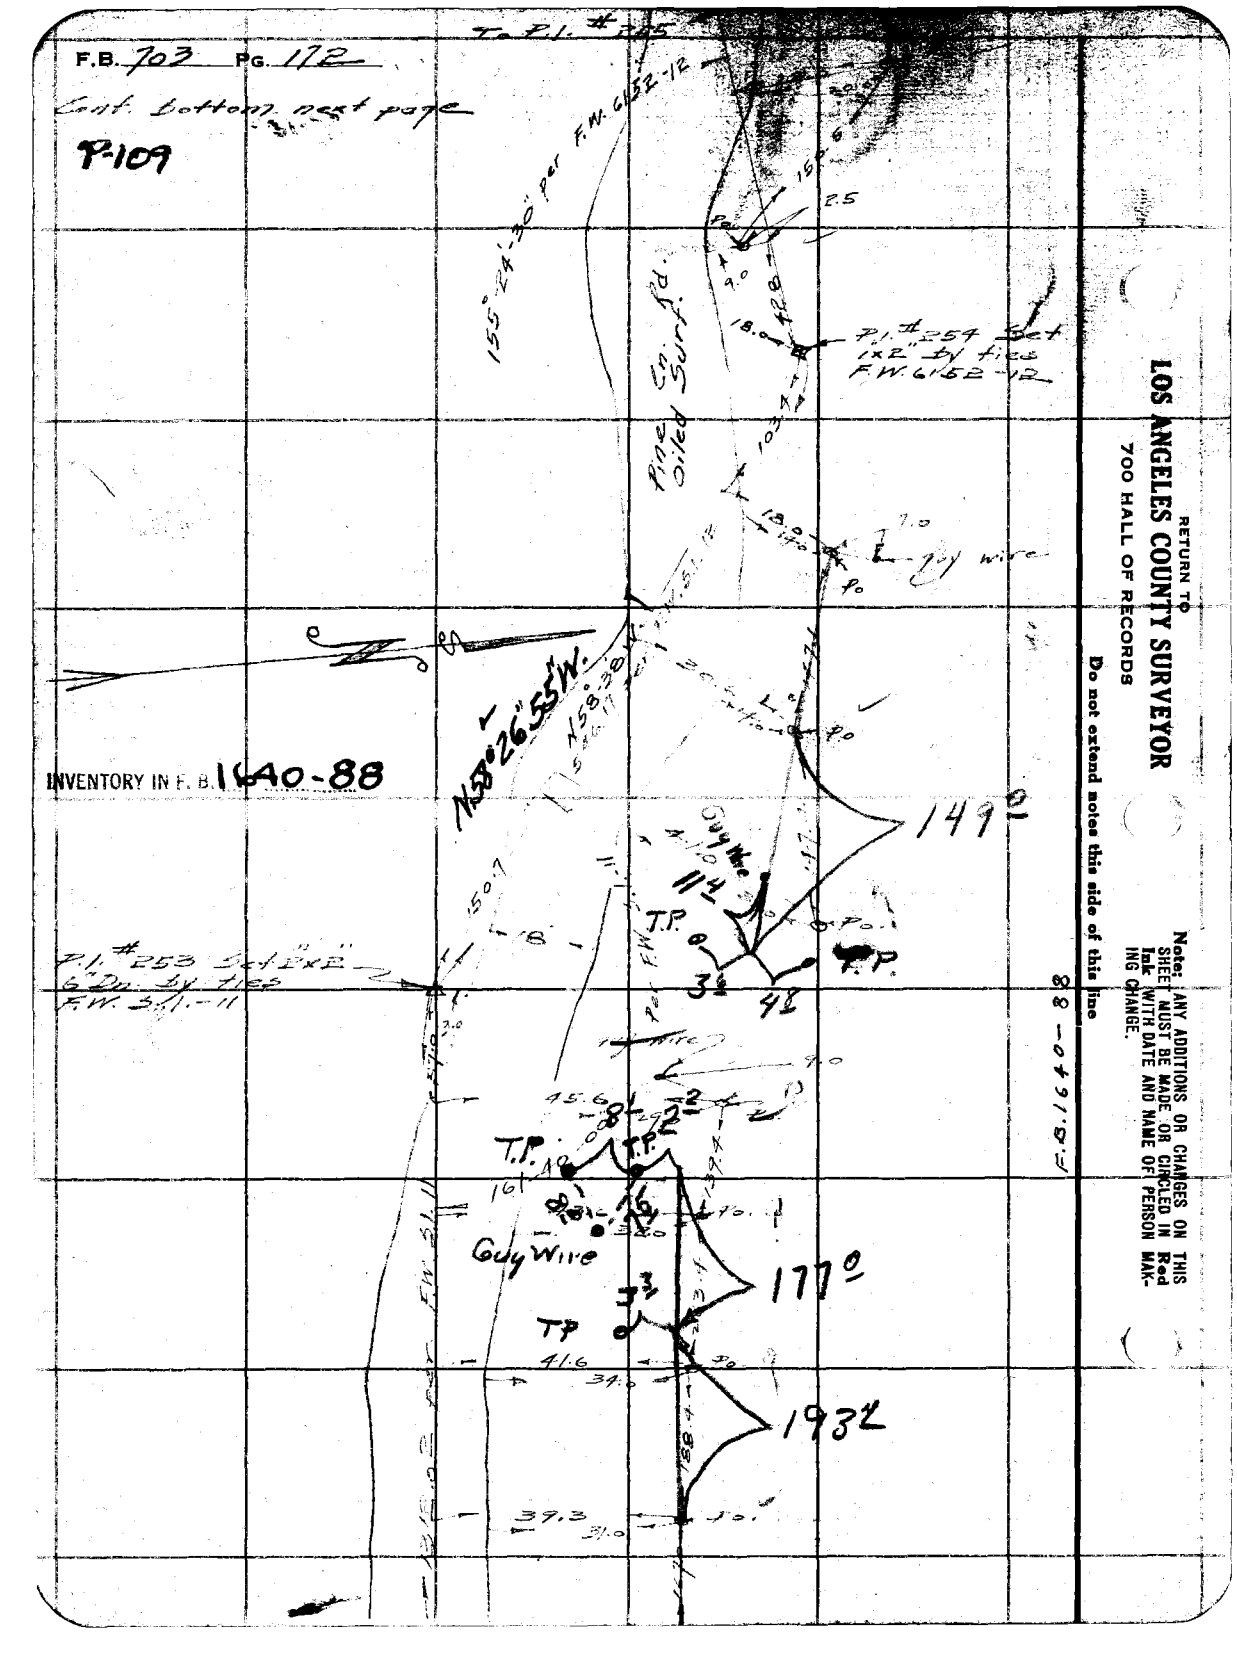
F.B. 703 PG. 172
Cont. bottom next page
P-109
To P.I. #245
155°24'-30" per F.W. 6152-12
Pipe Co. Surf'd.
P.I. #254 Set 1x2" by ties F.W. 6152-12
Guy wire
N58°26'55"W.
INVENTORY IN F.B. 1640-88
149.0
T.P.
P.I. #253 Set 1"x2" 6" Dn. by ties F.W. 5411-11
Guy Wire
177.0
193.2
RETURN TO
LOS ANGELES COUNTY SURVEYOR
700 HALL OF RECORDS
Do not extend notes this side of this line
Note: ANY ADDITIONS OR CHANGES ON THIS SHEET MUST BE MADE OR CIRCLED IN Red Ink WITH DATE AND NAME OF PERSON MAKING CHANGE.

Notes Ck'd by K.R.M.
Map No.
Office Work
Checked
Date

Survey of T.L. line Soledad Div F.B. 703 Pg. 172
W. O. 8284 Tape No 40 St'd 84 of.
Surveyed by Rosecrans
Notes Date 2-7-38
Indexed

P-109

Cont. to show next page

Note: ANY ADDITIONS OR CHANGES ON THIS SHEET MUST BE MADE OR CIRCLED IN Red Ink WITH DATE AND NAME OF PERSON MAKING CHANGE.

Do not extend notes this side of this line

RETURN TO
LOS ANGELES COUNTY SURVEYOR
700 HALL OF RECORDS

FORM 247 BM 2-34

INVENTORY IN F. B. 1640-89

F.B. 1640-89

P.I. #255 Set 1"x2" by tics. F.W. 6152-12

To P.I. preceding #254 page

N. 55°40'15" W.

N. 83°02'25" W.

Oiled Surf.

Guy wire

Guy Wire

TP

Fo.

F.B. 703 PG. 174

P-109

Cont bottom next page

To #258

168-50-00 ✓
315-20-00 ✓
168-50-00

#257 A Set 1½" F.I.

231.56 @ 1-05 T.60 = 231.48

Set #257 Set N.T. by ties T.W. 6152-14

Curb

Po.

guy wire

Fd. Cross Per F.M. 6152-12

N. 61° 45' 45" W.

#256

RETURN TO
LOS ANGELES COUNTY SURVEYOR
700 HALL OF RECORDS

Do not extend notes this side of this line

Notes: ANY ADDITIONS OR CHANGES ON THIS SHEET MUST BE MADE OR CIRCLED IN Red Ink WITH DATE AND NAME OF PERSON MAKING CHANGE.

INVENTORY IN F. B. 1640-90

| | |
|---|---|
| Notes Ck'd by K.E.M. | Survey of Forestry Tel. line |
| Map No. | W. O. 8074 Tape No 40 St'd 8/ or. |
| Office Work | Surveyed by Peterson |
| Checked | Notes Date 7-1-38 |
| Date | Indexed A. C. Johnson |

F.B. 702 Pg. 175

P-109

To P #259
Last bottom next page 2.8

1 Arm - 6 wire pole

E wire lead in to Federal Forestry Patrol Station. — 2 — S 8°30' E

119.2

2.8 Po.

2.7 Po.

1535.97 — 351.1 — 159.5 — 174.30 — 159.7

INVENTORY IN F. B. 1640-90,91

2.6 Po.

1.7 Po.

N. 75° 12' 15" W.

0.7 Po.

guy wire

8.6

176°

105.1

135.7

7.3 guy wire Po.

32.3

10.3

P. #258 Set 1x2 F 1

N. 27° 00' 45" W.

10.3 Po.

#251 A Set 1x2 F. P. See preceding page

221.35 @ 5-38 = 220.28
244.88 @ 1-27 = 244.80
174.30 @ 3-51 = 173.91
300.33 @ 2-32 = 300.04
296.49 @ 1-27 = 296.40
300.80 @ 0-43 = 300.78
1536.21
T. 60 = 1535.97

176-01-30
354-10-00
176-01-30

300.60 @ 3-51 = 12.89 / 299.92
312.81
T. 60 = 312.76

F.B. 1640-90,91

Do not extend notes this side of this line

Note: ANY ADDITIONS OR CHANGES ON THIS SHEET MUST BE MADE OR CIRCLED IN Red Ink WITH DATE AND NAME OF PERSON MAKING CHANGE.

RETURN TO
LOS ANGELES COUNTY SURVEYOR
700 HALL OF RECORDS

FORM 247 RM 2-34

F.B. 703 Pg. 176

Cont. bottom next page

R-109

240.74 @ 4.15 = 240.08
T.60 = 240.04

177-07-30 ①
348-29-30 ②
177-07-22½

151.75 @ 8-19 = 150.15
185.17 @ 3-19 = 184.88
112.26 @ 2-05 = 112.19
447.22
T.60 = 447.15

INVENTORY IN F. B. 1640-91, 92

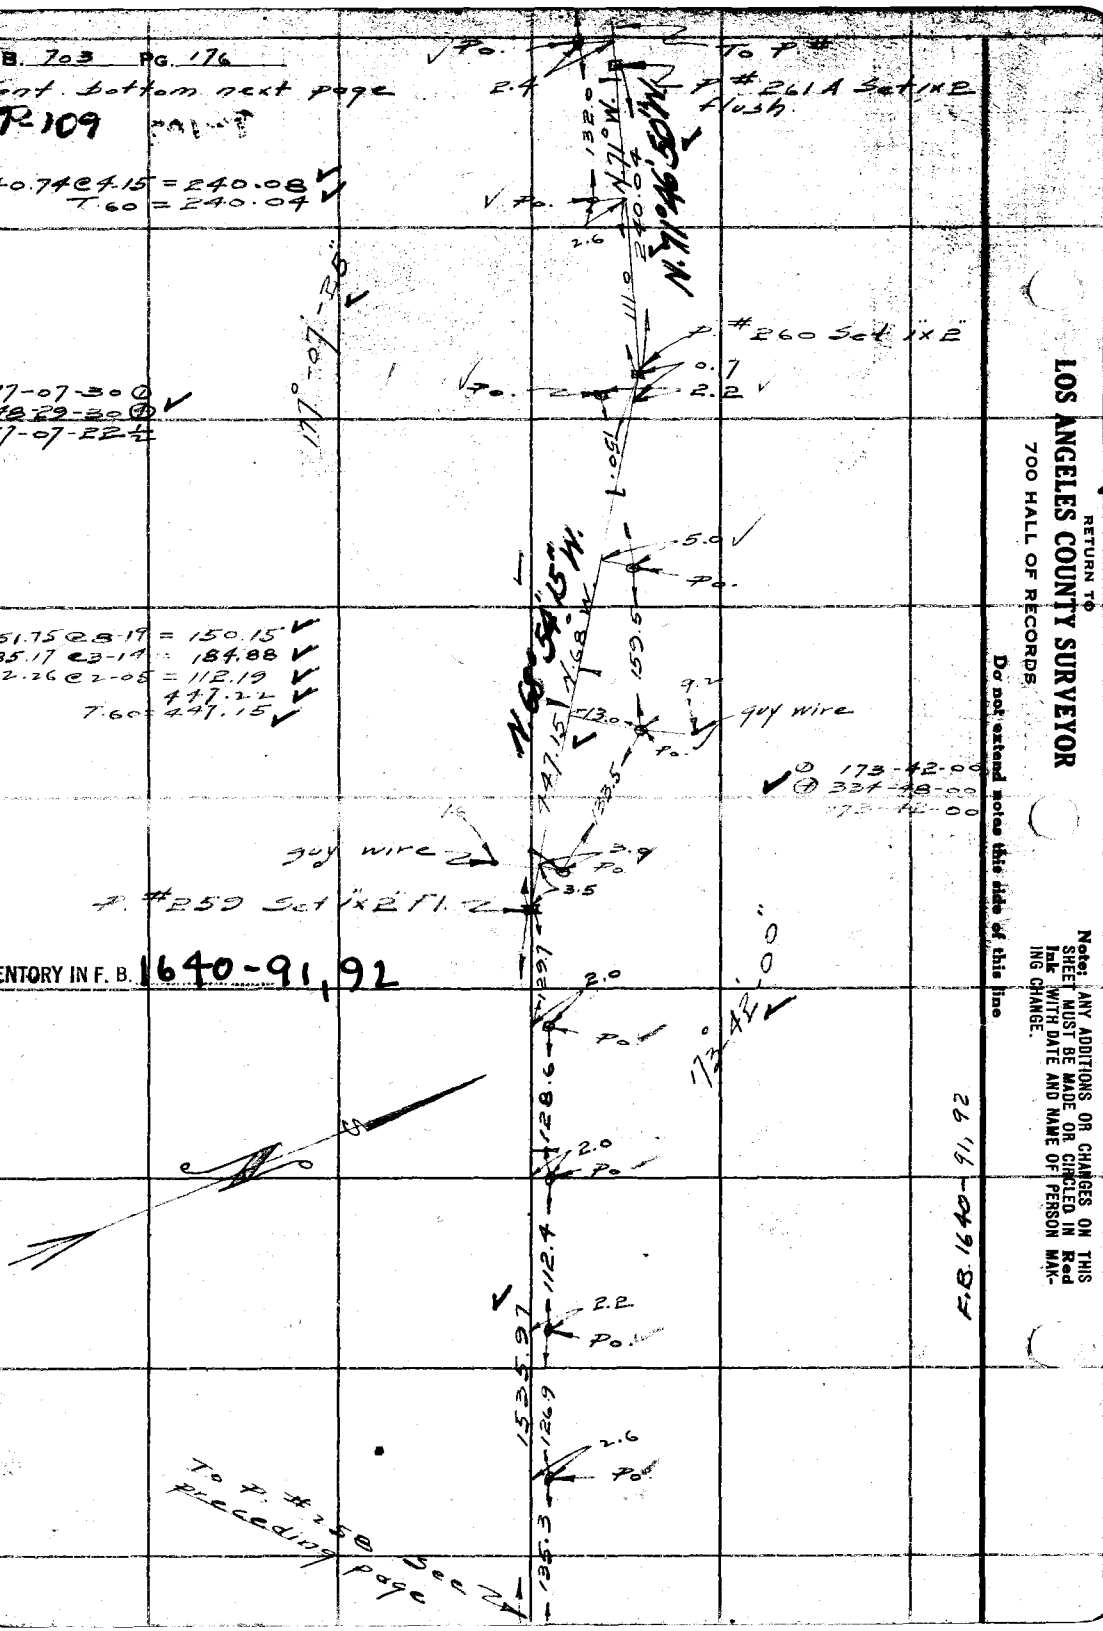


RETURN TO
LOS ANGELES COUNTY SURVEYOR
700 HALL OF RECORDS

Do not extend notes this side of this line

Note: ANY ADDITIONS OR CHANGES ON THIS SHEET MUST BE MADE OR CIRCLED IN Red Ink WITH DATE AND NAME OF PERSON MAKING CHANGE.

F.B. 1640-91, 92

| | | | |
|---|---|---|---|
| Notes Ck'd by KR.M | Survey of Forestry Tel. line | F.B. 793 | PG. 177 |
| Map No. | W. O. 8077 Tape No 40 St'd 99 OF. | P-109 | |
| Office Work | Surveyed by Rezecrans | | |
| Checked | Notes Date 2-8-38 | | |
| Date | Indexed A. C. Johnson | | |

Cont. bottom next page

guy wire 2.5 Po.

P. #263 A Set 1x2" Fl 9.3 202.4

2.2 Po. 140.6 3.0 Po. 142.3 3.0 Po.

N.80°59'50"W. 478.81

211.11 @ 4-02 = 210.59
170.06
98.30 @ 1-31 = 98.27
478.92
T.50 = 478.81

168-26-30 ①
313-46-00 ②
168-26-30

31.0

N.80° 116.0 2.6 Po. 8.4

INVENTORY IN F. B. 1640.92

Old Rd.

P. #263 Set 1x2" Fl.

174.74 @ 2-42 = 174.55
300.23 @ 00 = 300.23
474.78
T.60 = 474.71 Rd.

N.69°26'20"W. 139.0

Pine Cr. 1.0 474.71 226.4 Po. guy wire

guy wire 4.0 Po.

177-39-45 ①
350-38-00 ②
177-39-30

P. #262 Set 1x2" Fl. 0.5 Po. 2.0 102.8 Ft. 176.80 173.4

N.9°-30'-0"

176.96 @ 2-10 = 176.85
T.60 = 176.80

To P. #264 See preceding page

RETURN TO
LOS ANGELES COUNTY SURVEYOR
700 HALL OF RECORDS

Note: ANY ADDITIONS OR CHANGES ON THIS SHEET MUST BE MADE OR CIRCLED IN Red Ink WITH DATE AND NAME OF PERSON MAKING CHANGE.

Do not extend notes this side of this line

F.B. 1640-92

FORM 247 SM 2-34

F.B. 703 Pg. 178

Cont. bottom next page

P-109

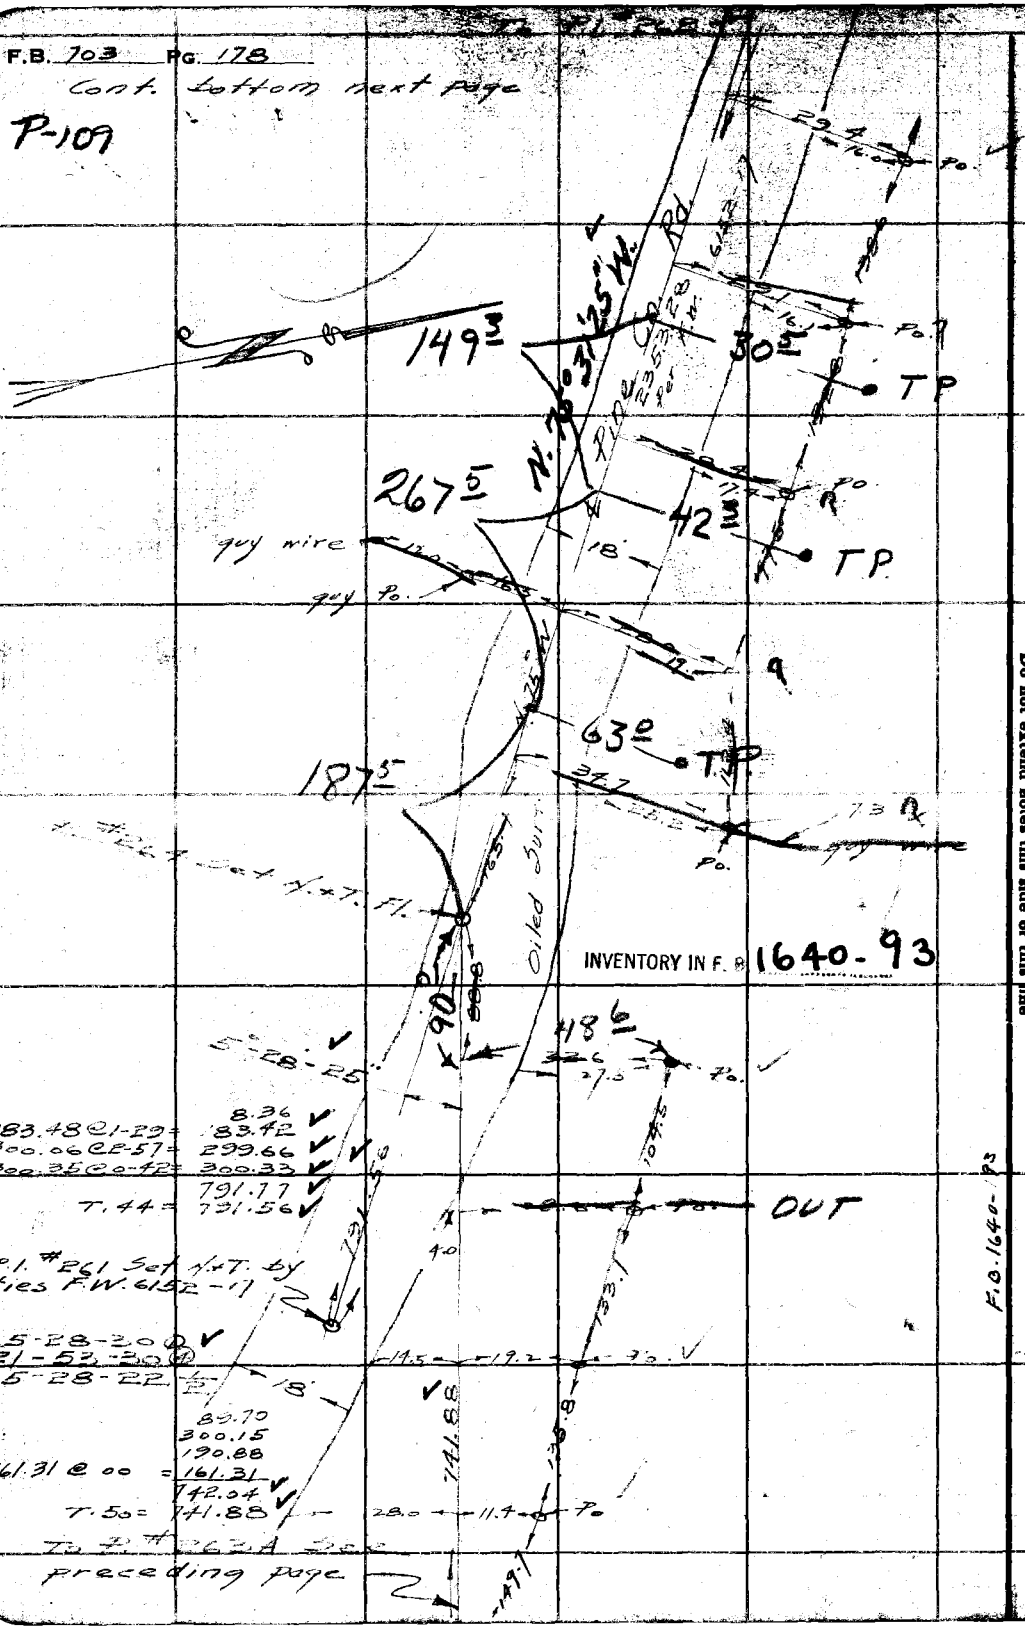

Notes Ck'd by K.R.M.
Map No.
Office Work
Checked
Date

Survey of Fire Co. Tel. Line
W. O. 8094 Tape No 40 St'd 8 ft of.
Surveyed by Foscrans
Notes
Date 2-15-38
Indexed


P-109

To P. #264 A See next page

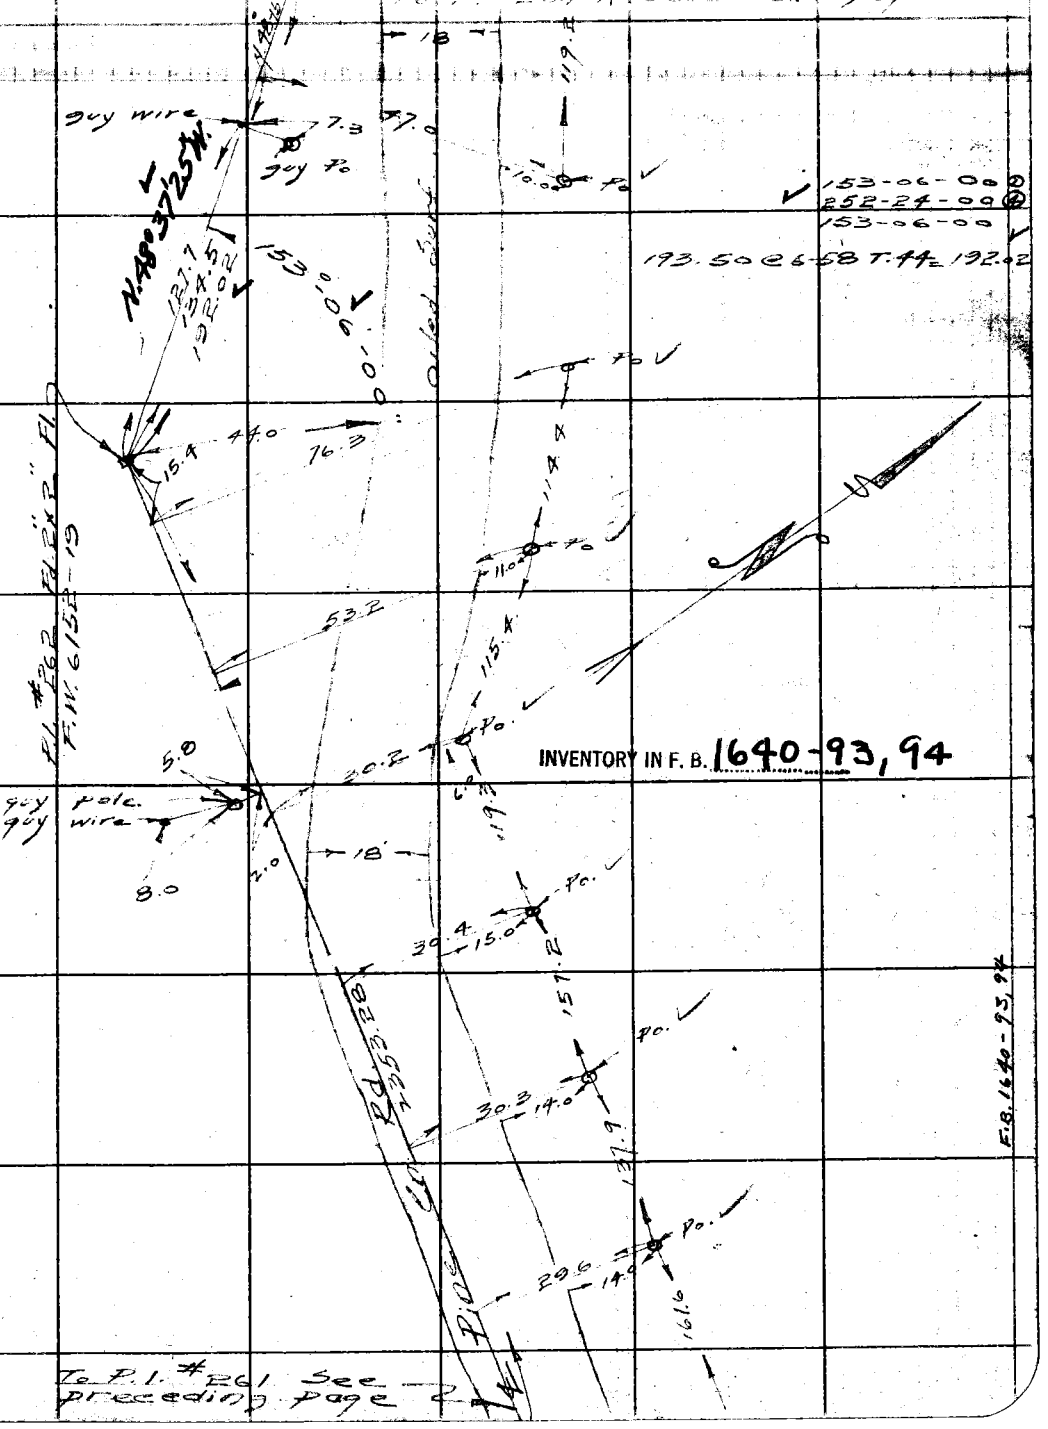


RETURN TO
LOS ANGELES COUNTY SURVEYOR
700 HALL OF RECORDS

Note: ANY ADDITIONS OR CHANGES ON THIS SHEET MUST BE MADE OR CIRCLED IN Red Ink WITH DATE AND NAME OF PERSON MAKING CHANGE.

Do not extend notes this side of this line

FORM 247 BM 2-34

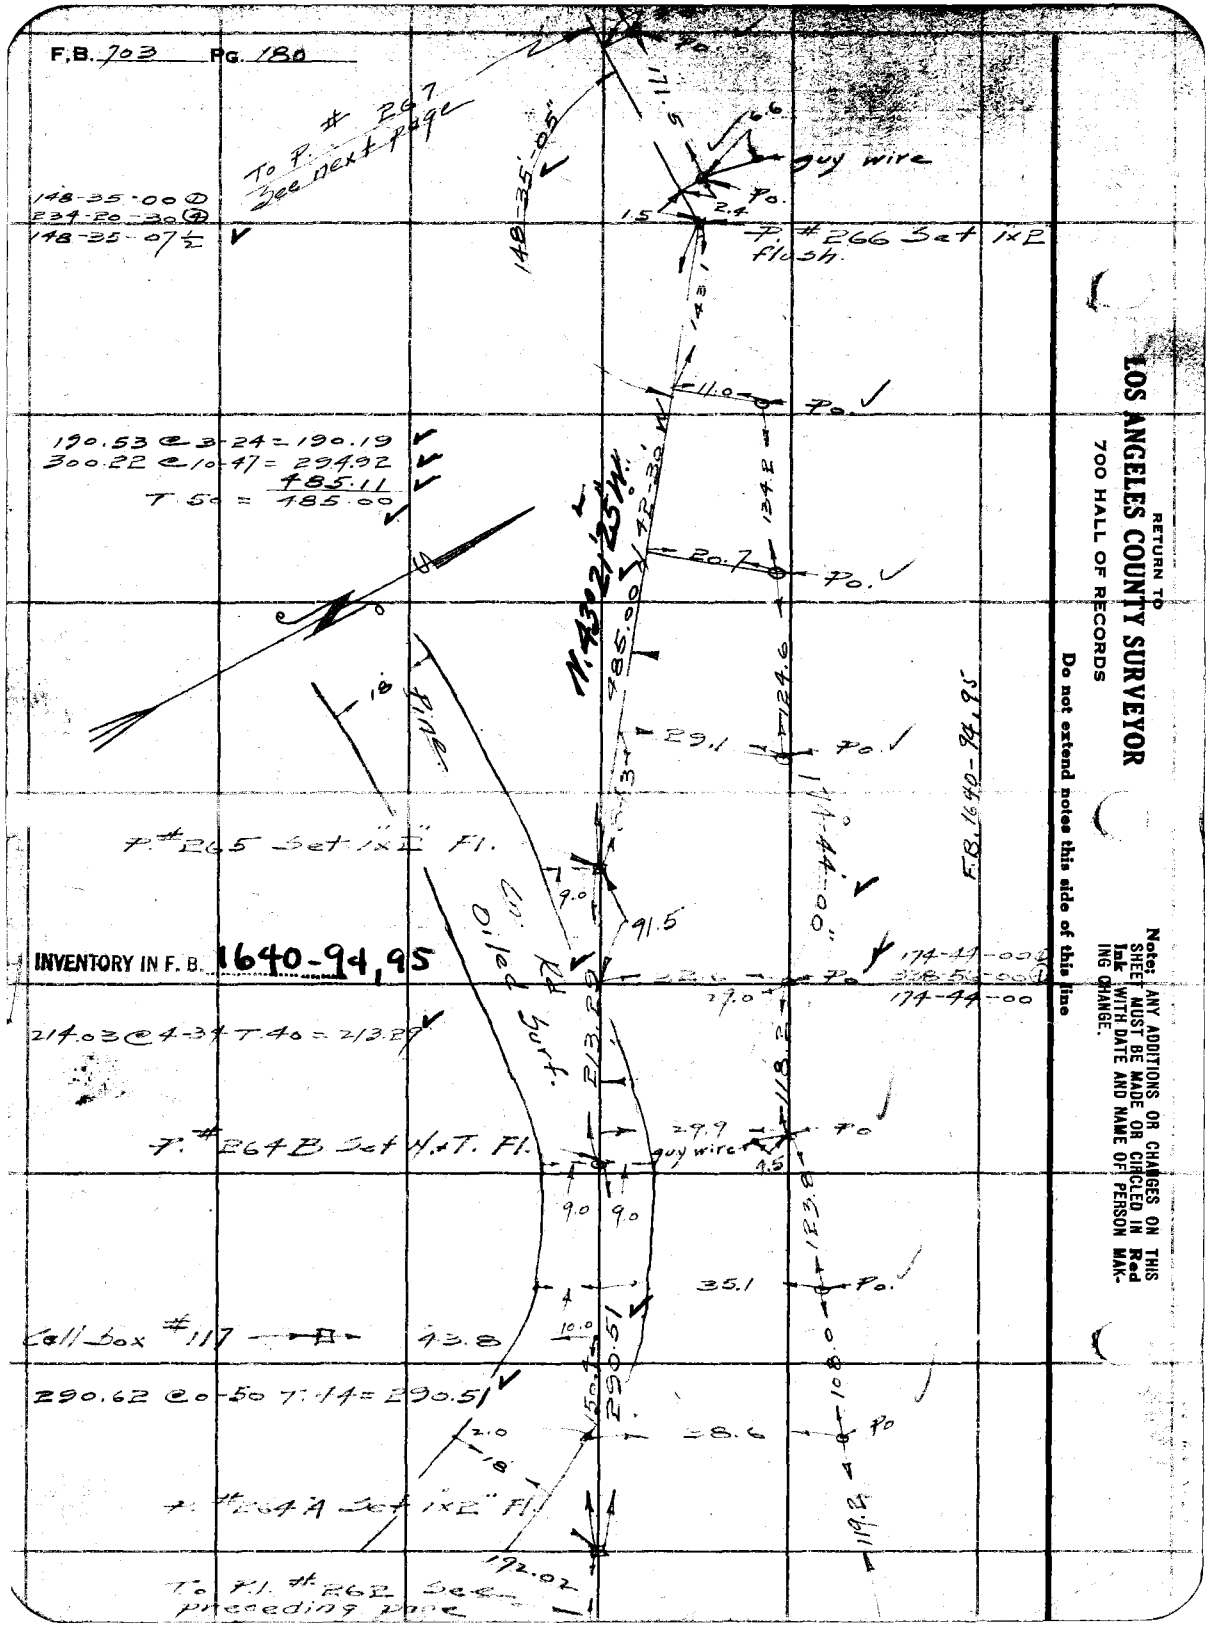


RETURN TO
LOS ANGELES COUNTY SURVEYOR
700 HALL OF RECORDS

Do not extend notes this side of this line

Note: ANY ADDITIONS OR CHANGES ON THIS SHEET MUST BE MADE OR CIRCLED IN Red Ink WITH DATE AND NAME OF PERSON MAKING CHANGE.

| | |
|---|---|
| Notes Ck'd by K.R.M. | Survey of Pine Cn. Tel. line |
| Map No. | W. O. 8094 Tape No 40 St'd 84 of. |
| Office Work | Surveyed by Rosecrans |
| Checked | Notes Date 2-1-38 |
| Date | Indexed A. C. Johnson |

F.B. 703 Pg. 181

Note: ANY ADDITIONS OR CHANGES ON THIS SHEET MUST BE MADE OR CIRCLED IN Red Ink WITH DATE AND NAME OF PERSON MAKING CHANGE.

Do not extend notes this side of this line

RETURN TO
LOS ANGELES COUNTY SURVEYOR
700 HALL OF RECORDS

FORM 247 BM 2.34

P #268 Sat 1x2 Fl. — See next page

3.2 Po — 7W wire

8.7 — 6.5

140.4

2.4 Po

105.0

2.0 Po

123.4

1.2 Po

146.8

1.4 Po

N. 63° 28' 25" W. 802.19

N. 61° 15' W.

INVENTORY IN F. B. 1640-95,96

2° Po

P59.31 C 3-29 = 258.86
278.58 C 4-24 = 277.76
266.56 C 4-36 = 265.70
802.32
T.60 = 802.19

168-42-00 (1)
214-47-09 (2)
168-41-45

110.0+

5.1

2.1 Po
3.4

168° 41' 45"

P #267 Sat 1x2 Fl.

N. 68° 41' 45" W. 110.0

3.6 Po

N. 68° 41' 45" W. 110.0

232.14 C 1-40 = 232.14
300.36 C 4-31 = 298.97
531.11
T.60 = 531.03

3.5 Po

6.0

To P. #266
See preceding page

F.B. 703 PG. 182

P.# 270 Set 1x2 Fl. 2

Cont bottom next page

P109

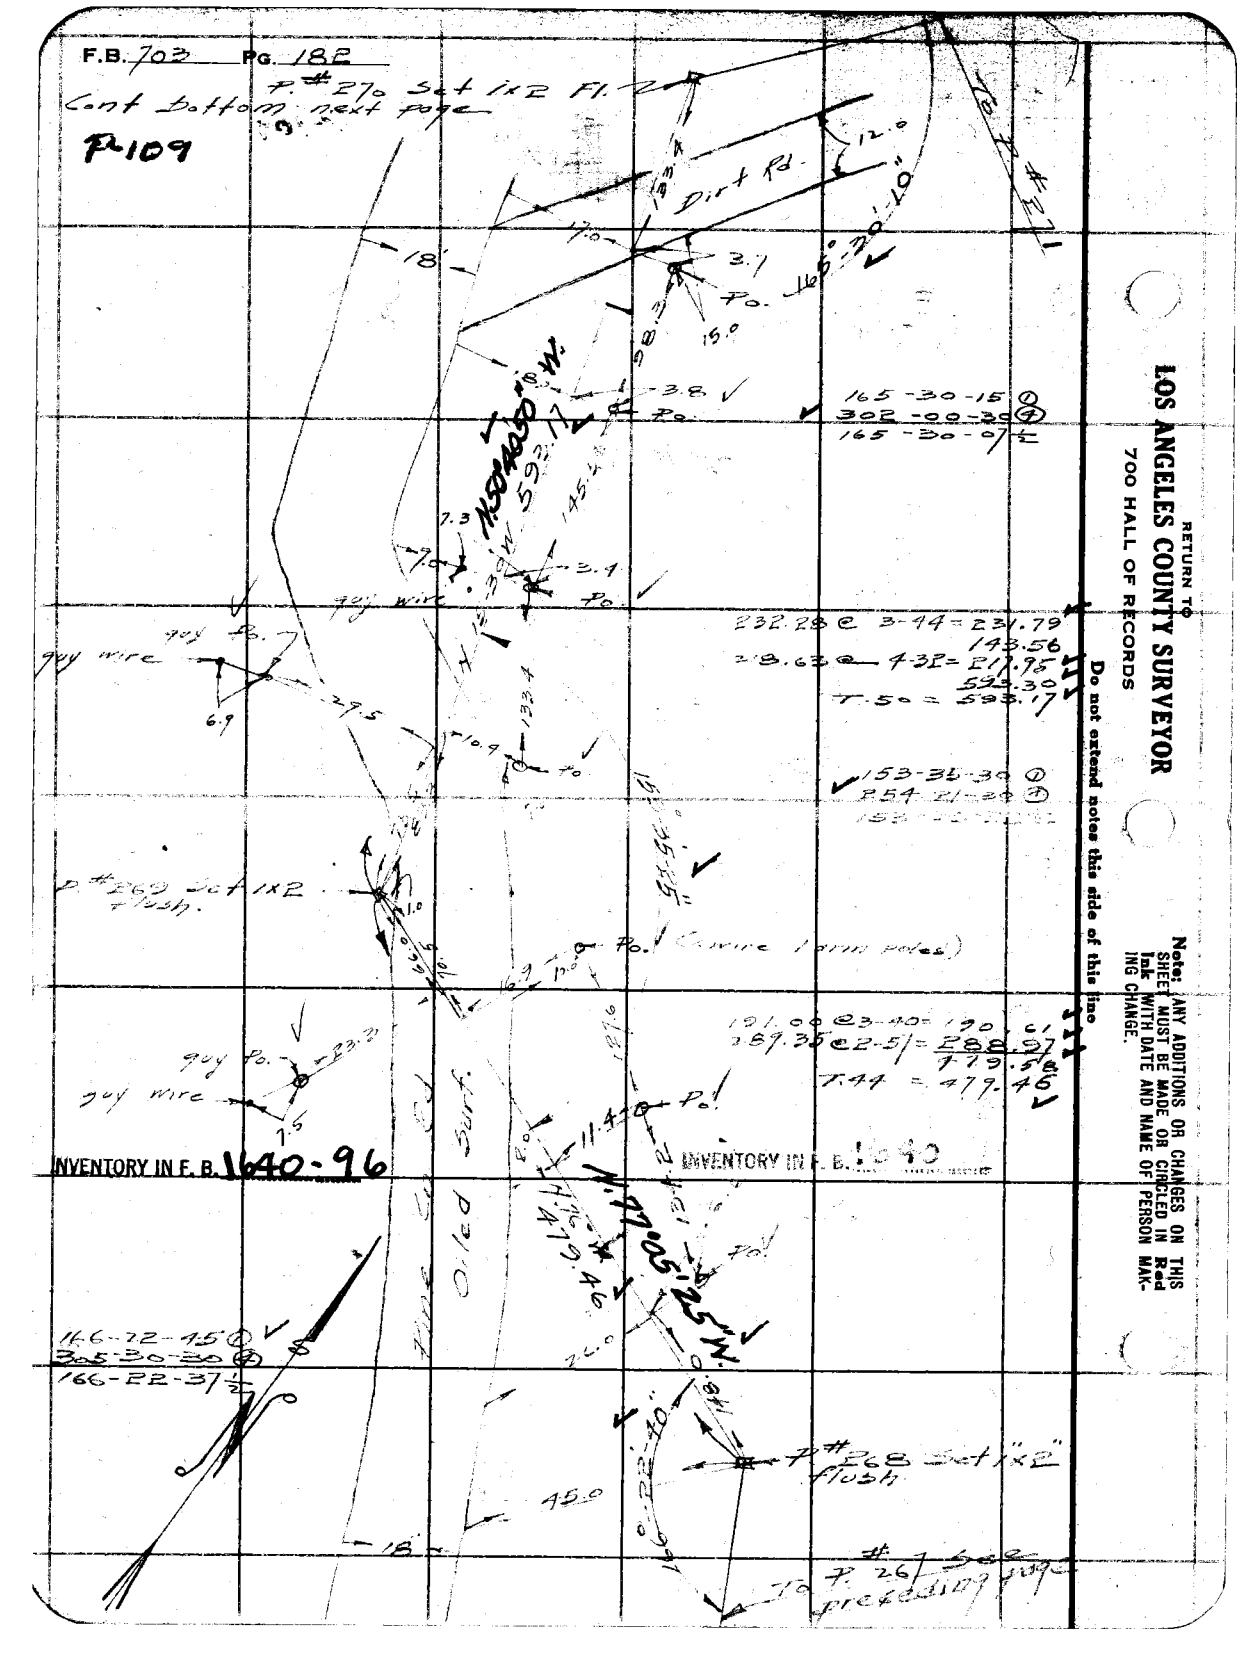


RETURN TO
LOS ANGELES COUNTY SURVEYOR
700 HALL OF RECORDS

Do not extend notes this side of this line

Note: ANY ADDITIONS OR CHANGES ON THIS SHEET MUST BE MADE OR CIRCLED IN Red Ink WITH DATE AND NAME OF PERSON MAKING CHANGE.

| | | | |
|---|---|---|---|
| Notes | Ck'd by K.R.M. | Survey of | Pine Cr. Tel. line |
| Map | No. | W. O. | 8094 Tape No 90 St'd of. |
| Office | Work | Surveyed by | Pozecrans |
| Checked | | Notes | " Date 2-17-38 |
| Date | | Indexed | A. C. Johnson |

F.B. 703 Pg. 183

P-109

cont bottom next page

To P. #21A set 1x2 next page

P #27 set 1x2

P #27a set 1x2

See preceding page.

Dirt Road.

INVENTORY IN F. B. 1640-97

122-14-45 ①
128-58-30 ②
122-14-37½

300.24 @ 5-44 = 298.74
192.40 @ 1-34 = 190.86
300.42 @ 1-38 = 300.30
173.27
969.13
T.50 = 968.98

131.62 @ 1-56 = 131.54
300.11 @ 2-33 = 299.81
300.30 @ 3-31 = 299.74
300.31 @ 5-16 = 299.04
1030.13
T.50 = 1029.90

Note: ANY ADDITIONS OR CHANGES ON THIS SHEET MUST BE MADE OR CIRCLED IN Red Ink WITH DATE AND NAME OF PERSON MAK-ING CHANGE.

Do not extend notes this side of this line

RETURN TO
LOS ANGELES COUNTY SURVEYOR
700 HALL OF RECORDS

FORM 247 BM 2-34

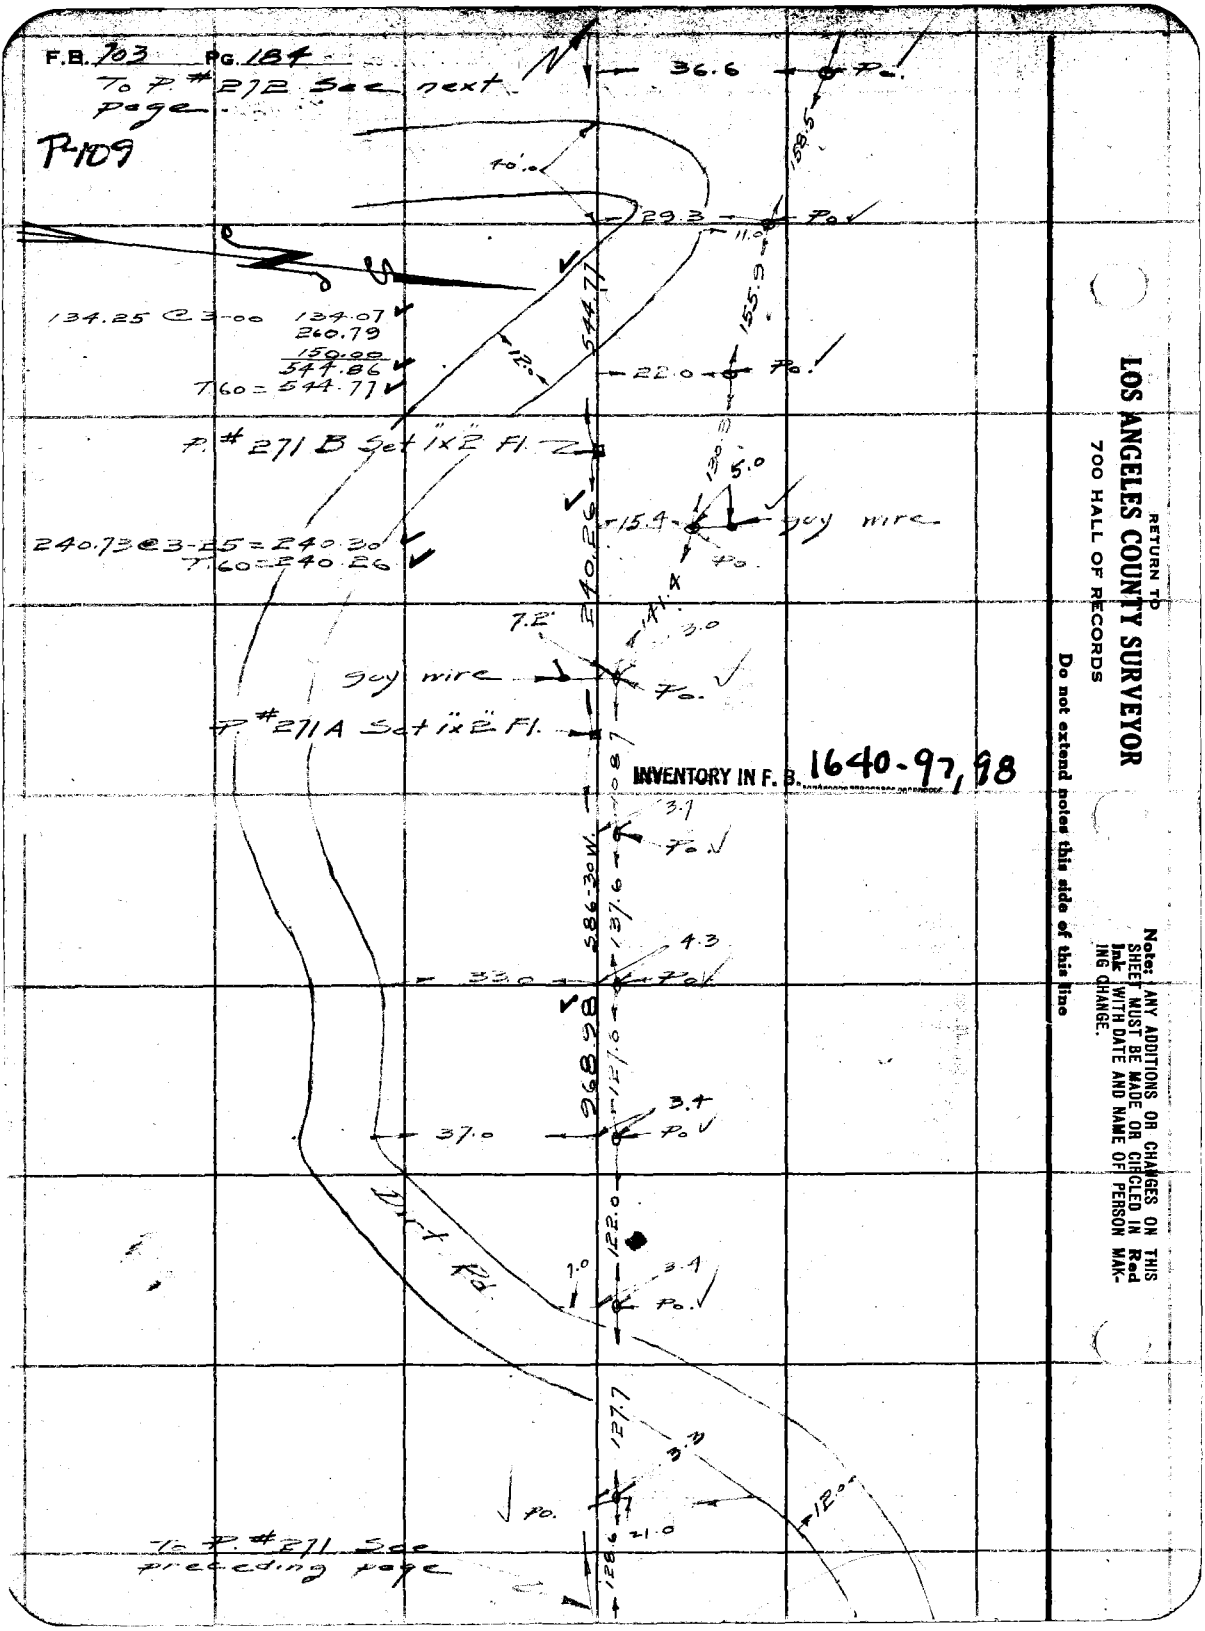


RETURN TO
**LOS ANGELES COUNTY SURVEYOR**
700 HALL OF RECORDS

**Do not extend notes this side of this line**

**Note: ANY ADDITIONS OR CHANGES ON THIS SHEET MUST BE MADE OR CIRCLED IN Red Ink WITH DATE AND NAME OF PERSON MAKING CHANGE.**

| | | | |
|---|---|---|---|
| Notes Ck'd by K.R.M. | Survey of P. de Co. Tel. Line | F.B. 703 | Pg. 185 |
| Map No. | W. O. 8094 | Tape No 40 | St'd 8' of. |
| Office Work | Surveyed by Rosecrans | | |
| Checked | Notes | Date 12-38 | |
| Date | Indexed A. C. Johnson | | |

P-109

To P. #273 A. See next page

P. #273 Set tack in T. Fl. on parement.

11°-31'-40"

64.2

7.0

7.0 guy wire

7.0 Po.

146.3

171-27-45 ①
325-21-00 ②
171-27-45

5.5 Po.

Blue Cr. Ed. Oiled Surf.

INVENTORY IN F. B. 1640-98, 99

554.12

149.0

3.5 Po.

N. 75° 31' 50" W.

130.5

2.1 Po.

105°-01'-00"

254.56 @ 4-10 = 253.71
300.50
554.21
T.60 = 554.12

P. #272. B Set 1/2" Fl.

105-01-00 ①
60-09-00 ②
105-01-00

Fd. C.S. Mon. E. Cor. S.W. 1/4 N.W. 1/4 S. Sec 11

120.7

11.0

1.9 Po.

150.96 @ 4-00 = 150.56
T.60 = 150.54
159.87 @ 13-20 = 155.56
T.60 = 155.54

Fd. C.S. Mon. W. Cor. N.E. 1/4 S.E. 1/4 S. of Sec. 11

155.54

155.54

161-35-30 ②
286-58-00 ②
161-35-30

9.5

guy wire

guy Po.

44.3

13.0

0.8 Po.

153.8

151.6

Po.

Po.

Po.

P.O.S. 74 @ 5-22 = 204.84
T.60 = 204.84

Just to correct sketched wrong.

1.3

43.0

14.3

14.54

#272 Set 1/2" Fl.

18

161°-35'-30"

To Po.

To P. #271 B See preceding page

Note: ANY ADDITIONS OR CHANGES ON THIS SHEET MUST BE MADE OR CIRCLED IN Red Ink WITH DATE AND NAME OF PERSON MAKING CHANGE.

Do not extend notes this side of this line

RETURN TO
LOS ANGELES COUNTY SURVEYOR
700 HALL OF RECORDS

FORM 247 BM 2-34

F.B. 703 PG. 186

P.# 214 Set 1x2" Fl.
Cont. bottom next page

150.7
P.O.
10.0
4.1
134.6
P.O.
12.2
3.6
145.3
P.O.
17.0
18'
3.7
159.5
P.O.
23.0
3.3
174.6
13½ E.P.
P.O.
20.0
3.3
158.8
P.O.
30.0
3.3
160.0
P.O.
30.0
3.7
141.7
P.O.
27.0
3.3
139.6
P.O.
18.0
3.3
120.3
P.O.
5.0
18'
2.8
120.0

Pine Co. Rd.
O. H. L. Surf.

N 18° 04' 45" W

128.60 @ 5-01 = 128.11
300.31 @ 3-06 = 299.88
300.43 @ 4-50 = 299.36
289.85 @ 2-08 = 289.65
300.56 @ 1-34 = 300.15
1317.45
T. 60 = 1317.24

INVENTORY IN F. B. 1640-99, 100

T. # 273 A. Set 1"x2" Fl.

21.10
300.20 @ 4-[illegible] = 299.39
320.44
T. 60 = 320.39

T. # 273 Set x-x T.
See preceding page

RETURN TO
LOS ANGELES COUNTY SURVEYOR
700 HALL OF RECORDS

Do not extend notes this side of this line

Note: ANY ADDITIONS OR CHANGES ON THIS SHEET MUST BE MADE OR CIRCLED IN Red Ink WITH DATE AND NAME OF PERSON MAKING CHANGE.

| | |
|---|---|
| Notes Ck'd by K.R.M. | Survey of Forestry T.L. line |
| Map No. | W. O. 8094 Tape No. 40 St'd 84 °F. |
| Office Work | Surveyed by Rosecrans |
| Checked | Notes A. C. Fossner Date 2-1-38 |
| Date | Indexed |

F.B. 703 Pg. 187

Note: ANY ADDITIONS OR CHANGES ON THIS SHEET MUST BE MADE OR CIRCLED IN Red Ink, WITH DATE AND NAME OF PERSON MAKING CHANGE.

Do not extend notes this side of this line

RETURN TO
LOS ANGELES COUNTY SURVEYOR
700 HALL OF RECORDS

Cont. Letter next page

N. 67° 20' 55" W.

F. # 276 Set 1x2 Fl.

22.8
1.0
1.3
4.0
Po.
guy wire

174-52-00 ①
333-27-45 ②
174-51-54

174° 51' 54"

152.8

1.2
Po.

N. 62° 12' 50" W.

1.6
Po

0.1 ± Surf.

153.59
150.84
2.75
300.21 @ 2-54 = 299.83
607.42
T.50 = 607.13

11.0
1.9
Po
4.4

INVENTORY IN F. B. 1640-100,101

F. # 275 A Set 1x2 Fl.

293.91 @ 2-30 7.50 = 293.55

19.0
12.0
Po.

181.3

24.0
11.0
4.2
guy wire
Po.

28.2
29.55

158-09-00 ④
21P-35-00 ⑧
158-08-45

F. # 275 Set 1x2 Fl. 2

13.9
Po.
3.0
guy wire
9.0
2.3
158° 08' 45"

27.74 T. 50 = 27.73

F. # 274 Set 1x2 See preceding page

180° 00' 00"

FORM 247 10M 8-31

F.B. 703 Pg. 188

R-109

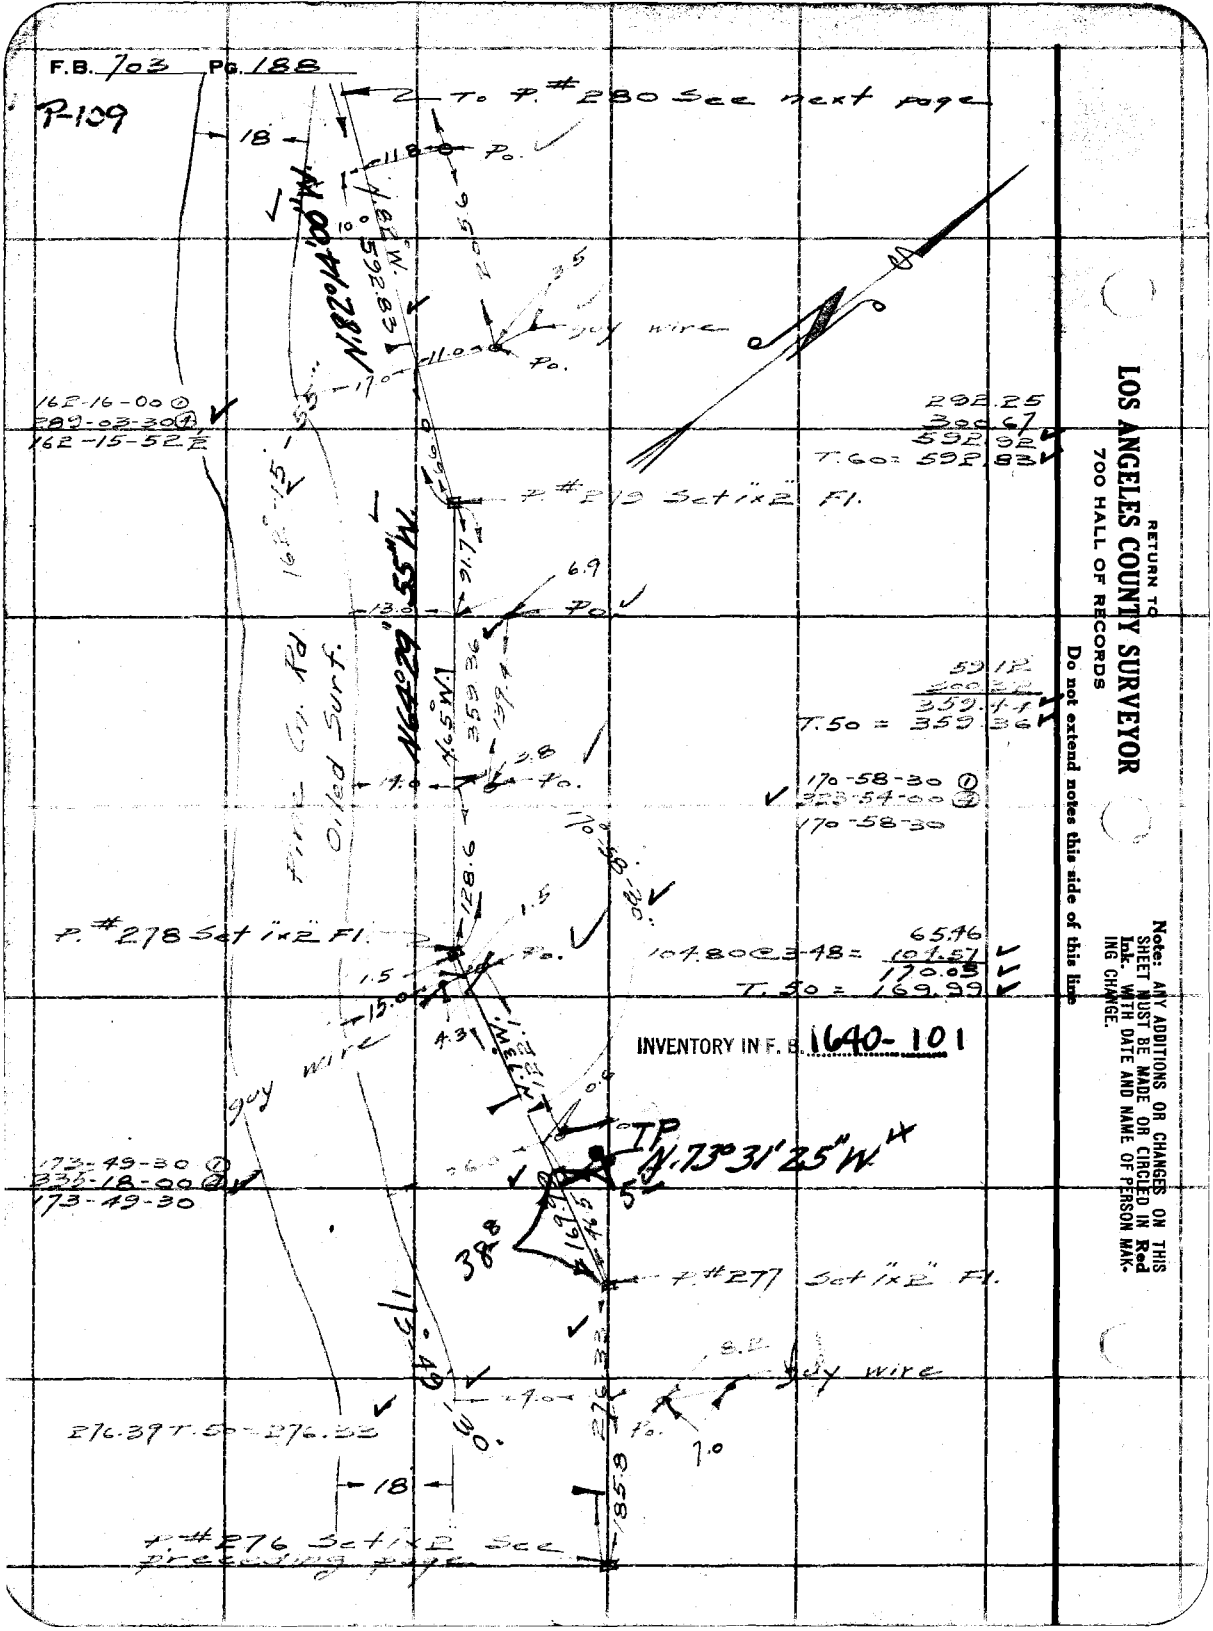


RETURN TO
**LOS ANGELES COUNTY SURVEYOR**
700 HALL OF RECORDS

Do not extend notes this side of this line

Note: ANY ADDITIONS OR CHANGES ON THIS SHEET MUST BE MADE OR CIRCLED IN Red Ink WITH DATE AND NAME OF PERSON MAKING CHANGE.

| | |
|---|---|
| Notes Ck'd by K.R.M. | Survey of Pipe Cr. Tel. Line |
| Map No. | W. O. 8094 Tape No. 40 St'd 84 °F. |
| Office Work | Surveyed by Rosecrans |
| Checked | Notes " Date 2-8-38 |
| Date | Indexed |

F.B. 703 PG. 189

P-109

Note: ANY ADDITIONS OR CHANGES ON THIS SHEET MUST BE MADE OR CIRCLED IN Red Ink, WITH DATE AND NAME OF PERSON MAKING CHANGE.

Do not extend notes this side of this line

RETURN TO
LOS ANGELES COUNTY SURVEYOR
700 HALL OF RECORDS

INVENTORY IN F. B. 1640-101,102

FORM 247 10M 8-51

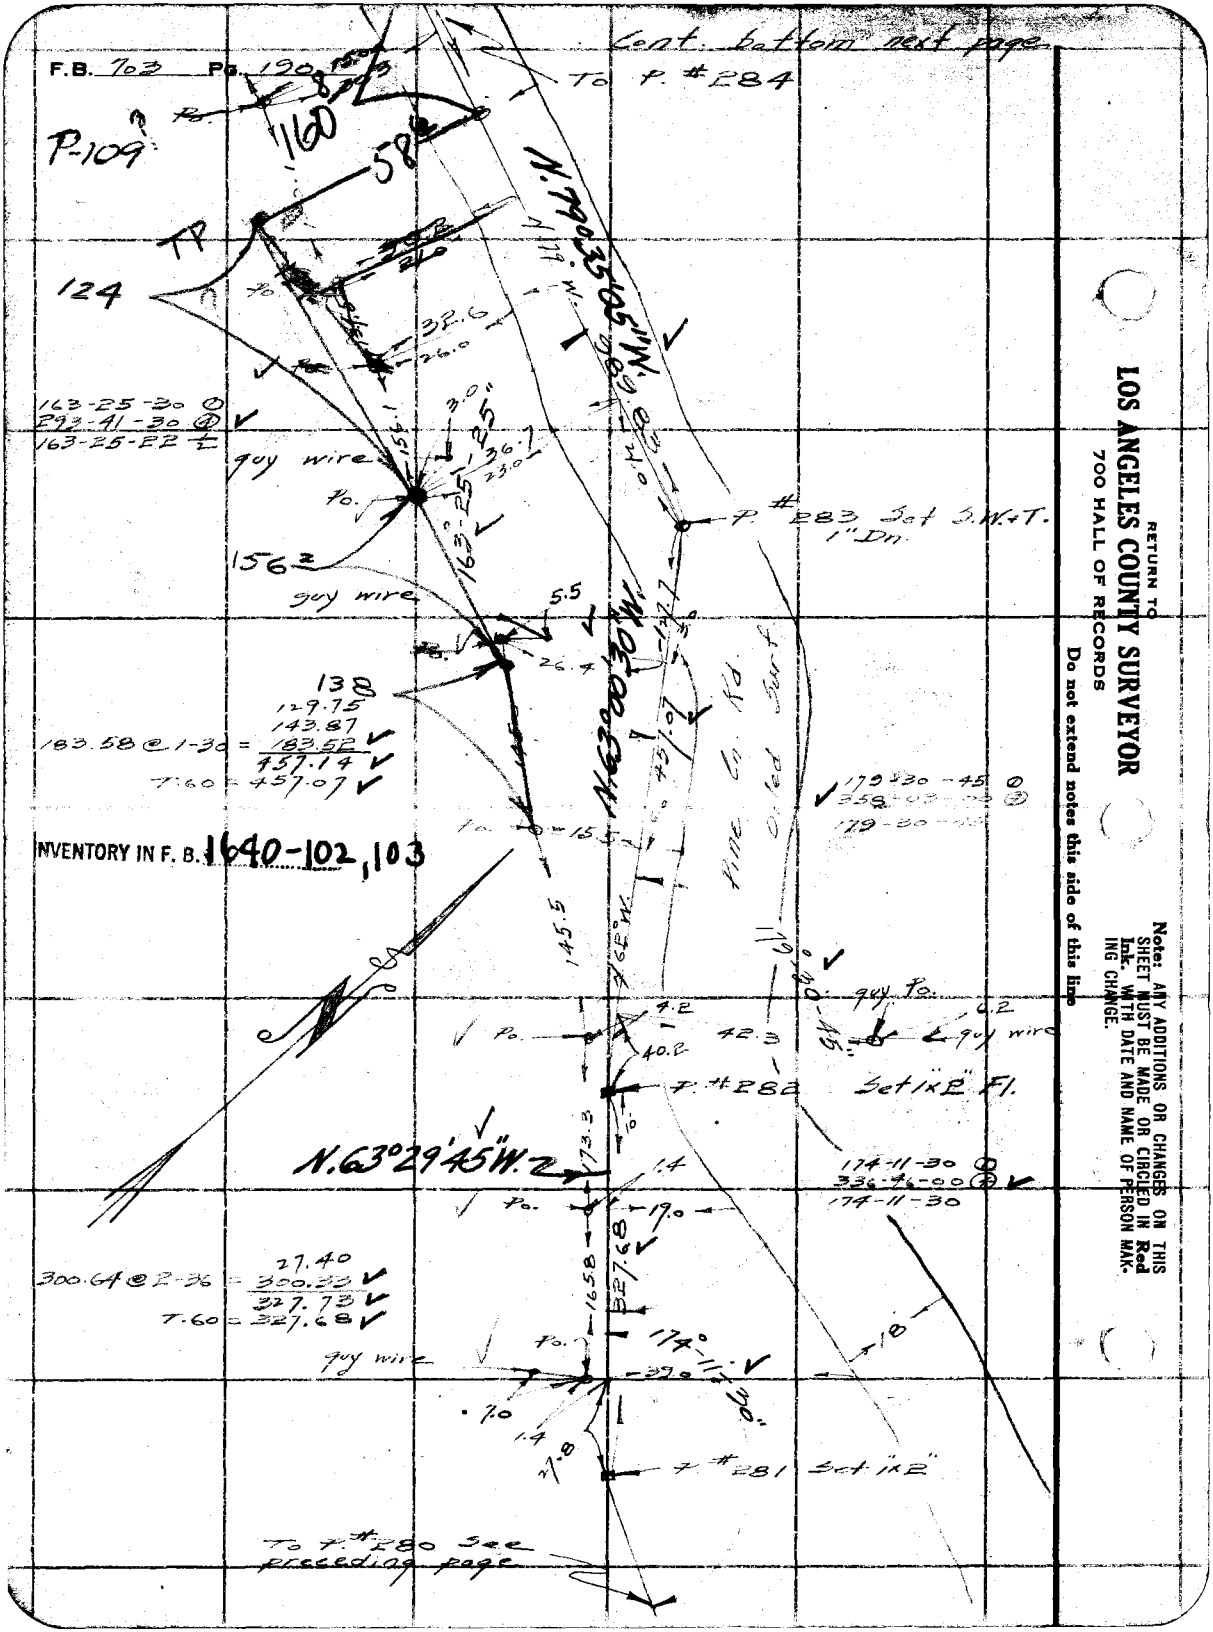
Cont. bottom next page
To P. #284
P-109
124
TP
N.79°35'05"W. 988.8
P. #283 Set S.M.&T. 1" Dn.
N.63°29'45"W.
INVENTORY IN F. B. 1640-102, 103
guy wire
guy Po.
Set 1x2" Fl.
To P. #280 See preceding page
RETURN TO
LOS ANGELES COUNTY SURVEYOR
700 HALL OF RECORDS
Do not extend notes this side of this line
Note: ANY ADDITIONS OR CHANGES ON THIS SHEET MUST BE MADE OR CIRCLED IN Red Ink WITH DATE AND NAME OF PERSON MAKING CHANGE.

| | | | |
|---|---|---|---|
| Notes Ck'd by K.R.M. | Survey of Tej Ave. Toledo L.D. | F.B. 703 | Pg. 191 |
| Map No. | W. O. 8094 Tape No. 40 St'd 87 °F. | To P. # 285 | |
| Office Work | Surveyed by Rosecrans | | |
| Checked | Notes Date 3-14-38 | P-109 | |
| Date | Indexed Wm. C. Johnson | | |

Cont. bottom next page

Note: ANY ADDITIONS OR CHANGES ON THIS SHEET MUST BE MADE OR CIRCLED IN Red Ink. WITH DATE AND NAME OF PERSON MAKING CHANGE.

Do not extend notes this side of this line

RETURN TO
LOS ANGELES COUNTY SURVEYOR
700 HALL OF RECORDS

FORM 247 10M 8-31

P.o. — P.o

12.9

P.o. — E.7

N. 79° 35' W.
154.00

P.o. — E.8

N. 50° 30' W.
130.8
846.77

132.51
300.52 @ 7-05 = 298.23
125.33 @ 7-59 = 124.86
293.50 @ 7-00 = 291.31
846.91
T.58 = 846.77

INVENTORY IN F. B. 1640-103, 104

P.o. — E.3

115.4

P.o. — E.1

guy wire

7.0

10.0

P. # 284 Set "X" Fl. 2

126.3

guy wire — P.o. — E.7.8

84

150° - 54' - 30"

243° - 38' - 00"

150° - 54' - 30"

T.P. — 43.5

P.o. — E.8.4

126.3

283.3

141.6

T.P. — 52.4

P.o. — E.9.5

E.2.0

137.4

T.P. — 68.3

160.8

| | | |
|---|---|---|
| 300.06 | @ 5-29 = | 95.76 |
| 145.26 | @ 3-09 = | 298.71 |
| 140.28 | @ 2-52 = | 145.06 |
| 133.32 | @ 2-25 = | 140.10 |
| 177.42 | @ 3-03 = | 133.20 |
| | | 177.17 |
| | | 990.00 |

T. 58 = 989.83

To P. # 283 See preceding page

F.B. 703 Pg. 192

P-109

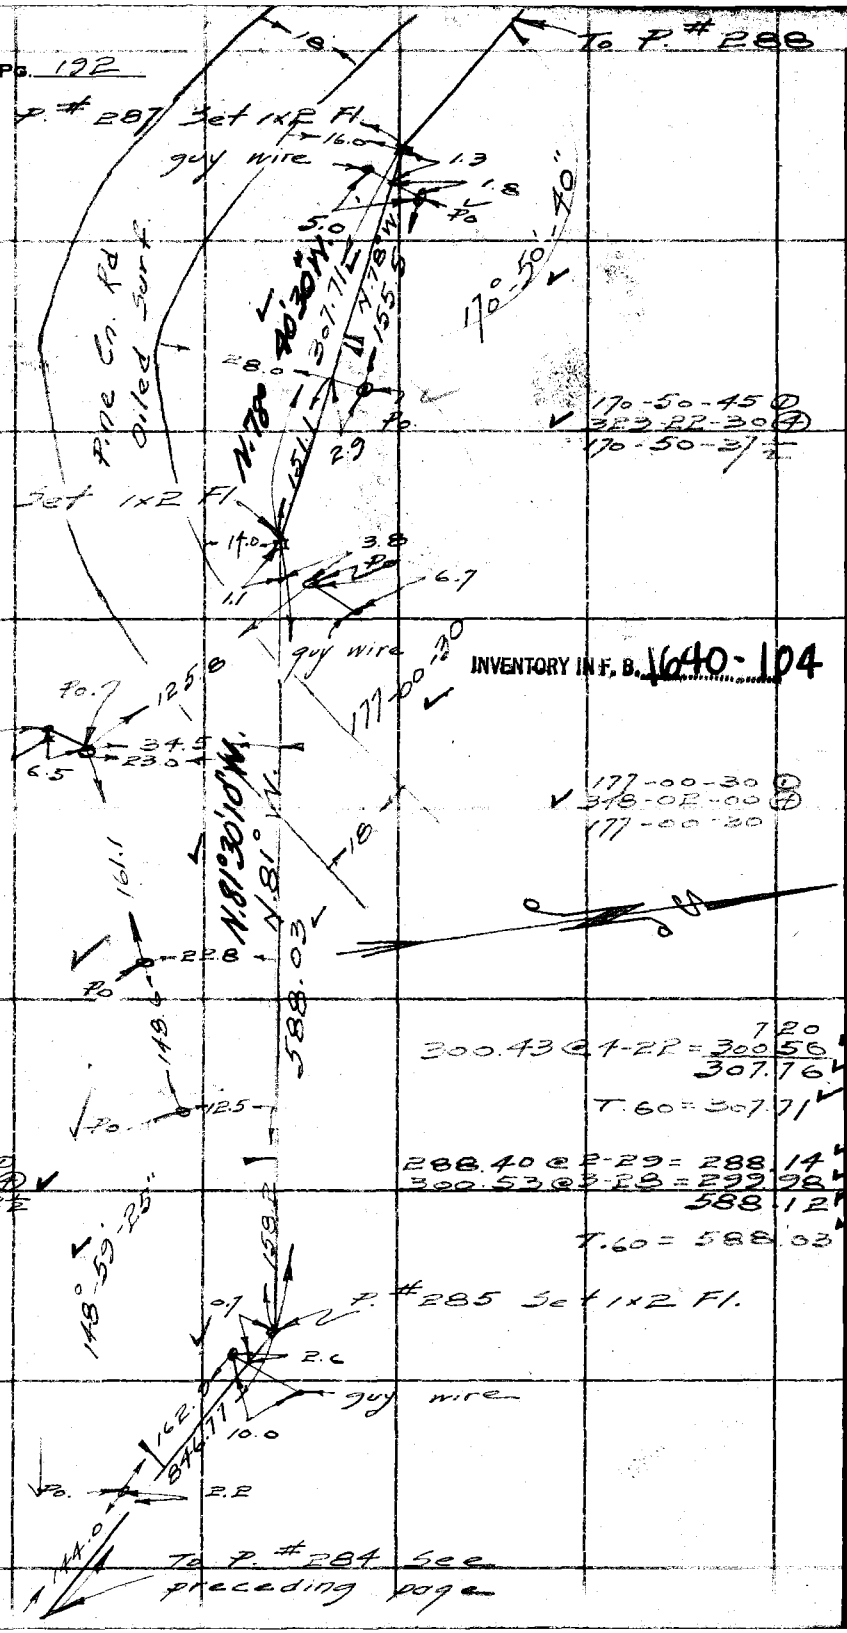


INVENTORY IN F. B. 1640-104

RETURN TO
LOS ANGELES COUNTY SURVEYOR
700 HALL OF RECORDS

Do not extend notes this side of this line

Note: ANY ADDITIONS OR CHANGES ON THIS SHEET MUST BE MADE OR CIRCLED IN Red Ink. WITH DATE AND NAME OF PERSON MAKING CHANGE.

300.43 @ 1-22 = 300.56
307.76
T. 60 = 307.71

288.40 @ 2-29 = 288.14
300.53 @ 3-28 = 299.98
588.12
T. 60 = 588.03

148-59-30
235-57-30
148-59-22½

| | | | |
|---|---|---|---|
| Notes Ck'd by K.R.M. | Survey of Sch. 1 Pr. T. Line | F.B. 703 | Pg. 193 |
| Map No. | W. O. 80# Tape No. 40 St'd 66 °F. | | |
| Office Work | Surveyed by Rosecrans | | |
| Checked | Notes | Date 3/10/38 | |
| Date | Indexed | | |

Note: ANY ADDITIONS OR CHANGES OF THIS SHEET MUST BE MADE OR CIRCLED IN Red Ink, WITH DATE AND NAME OF PERSON MAKING CHANGE.

Do not extend notes this side of this line

RETURN TO
LOS ANGELES COUNTY SURVEYOR
700 HALL OF RECORDS

FORM 247 10M 8-31

To P. # 289A P-109

Cont bottom next page

191.07 @ 1-43 = 190.98
135.93 @ 3-31 = 135.66
570.74
T.60 = 570.67

N40°33'20"W.

INVENTORY IN F. B. 640-105

153-50-00
255-20-00
153-50-00

78.02 @ 2-01 = 77.97
181.15 @ 1-36 = 181.08
259.05
T.60 = 259.01

N.68°43'20"W.

177-22-00
345-20-00
177-22-00

298.93 @ 4-34 = 297.98
T.60 = 297.93

N.69°21'20"W.

P. # 287 Set 1x2
See preceding page

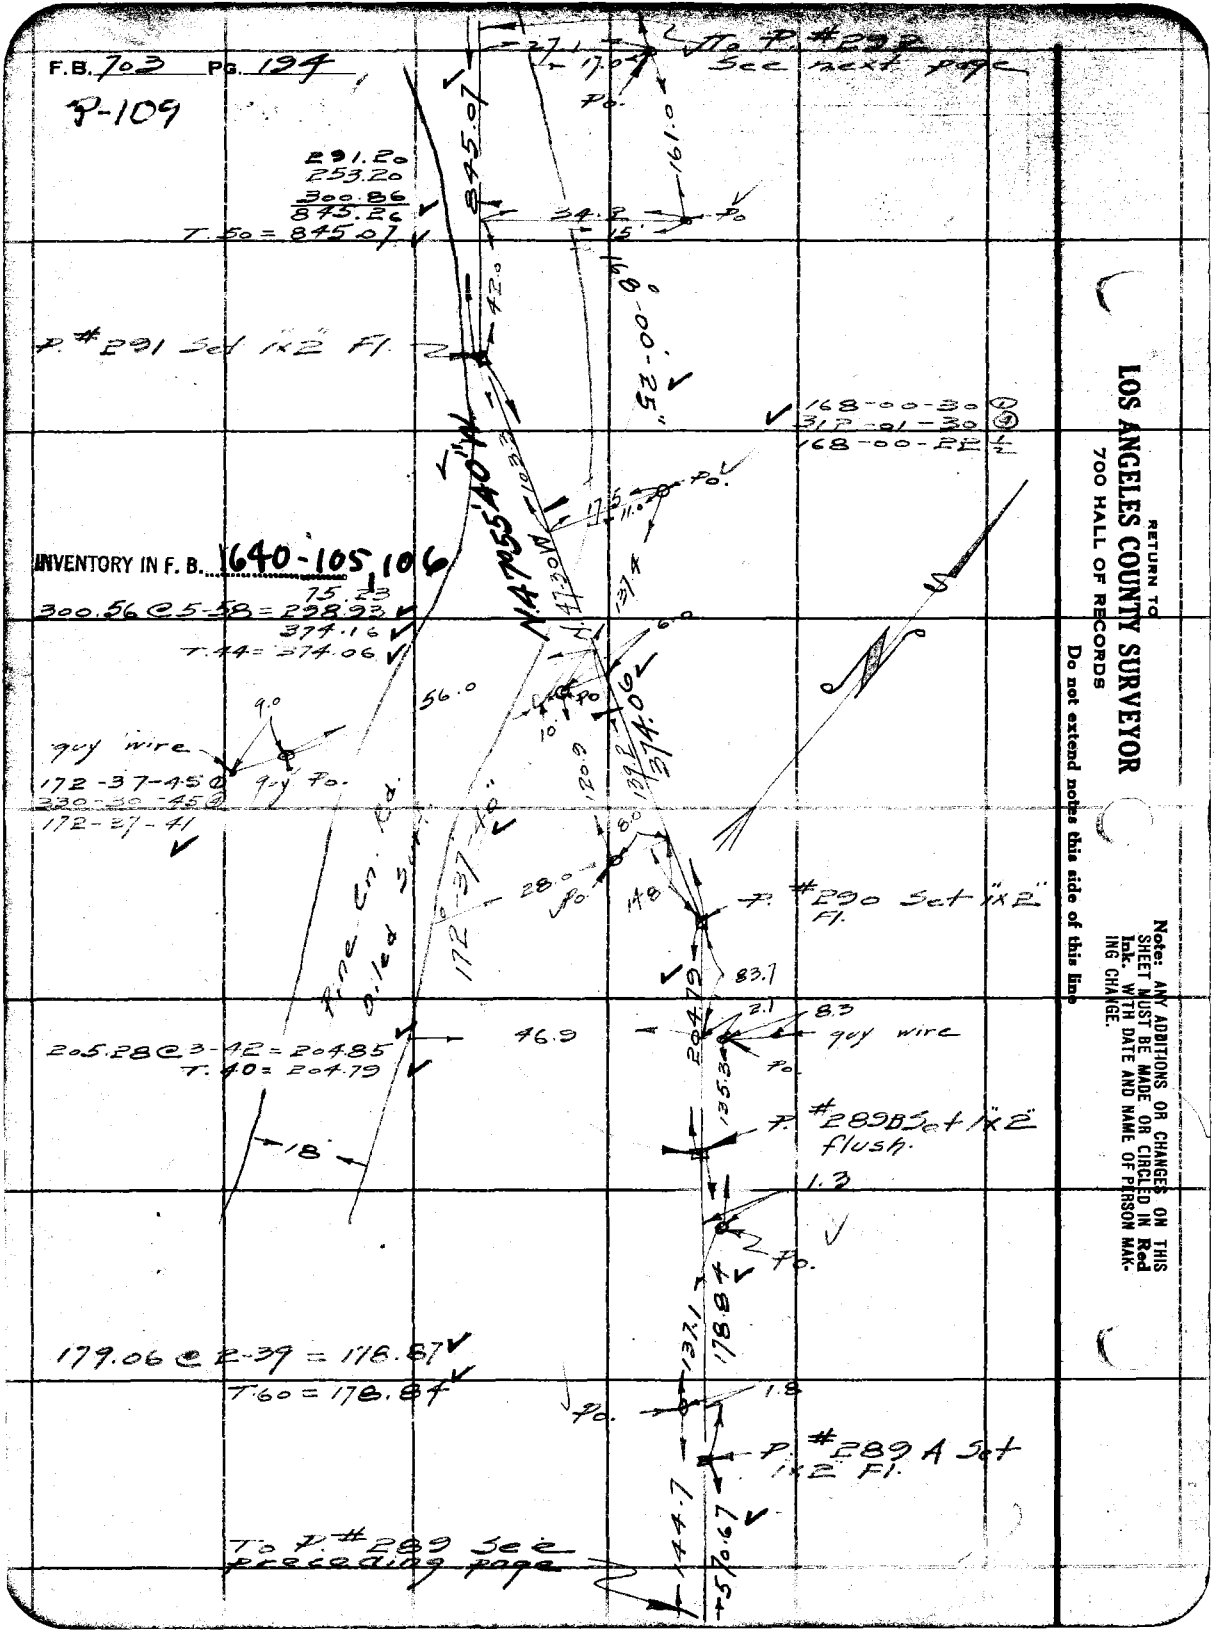
P-109
291.20
253.20
300.86
843.26
T. 50 = 845.01
P. #291 Set 1x2 Fl.
845.01
168-00-30
312-01-30
168-00-22
INVENTORY IN F. B. 1640-105 106
75.23
300.56 @ 5-58 = 298.93
374.16
T. 44 = 374.06
guy wire
172-37-45
172-37-41
56.0
To P. #292 See next page
To P. #290 Set 1x2" Fl.
83.7
guy wire
205.28 @ 3-42 = 204.85
T. 40 = 204.79
46.9
P. #289B Set 1x2 flush.
1.3
179.06 @ 2-39 = 178.87
T. 60 = 178.84
P. #289A Set 1x2 Fl.
To P. #289 See preceding page
RETURN TO
LOS ANGELES COUNTY SURVEYOR
700 HALL OF RECORDS
Do not extend notes this side of this line
Note: ANY ADDITIONS OR CHANGES ON THIS SHEET MUST BE MADE OR CIRCLED IN Red Ink. WITH DATE AND NAME OF PERSON MAKING CHANGE.

Notes Ck'd by K.R.M.
Map No.
Office Work
Checked
Date

Survey of Lot Line Agreement
W. O. B-3/1 Tape No. 10 St'd 1 of
Surveyed by Rosecrans
Notes Date 3-11-38
Indexed A. C. Jones

F.B. 162 Pg. 75

P-109

Note: Any Additions or Changes on This Sheets Must be Made or Circled in Red Ink With Date and Name of Person Making Change.

Do not extend notes this side of this line

INVENTORY IN F. B. 1640-106, 107

RETURN TO
LOS ANGELES COUNTY SURVEYOR
700 HALL OF RECORDS

FORM 247 5M 10-37

To P. #293 See next page

To edge Rd

To P. #292 See preceding page

N. 6°41'20" W.

N. 35°56' 05" W.

154-44-45 ①
256-59-00 ②
154-44-45 ①

252.95 @ 1-58 = 252.80
300.46 @ 2-05 = 300.26
224.21 @ 5-30 = 223.18
206.80 @ 6-10 = 205.60
7.60 = 981.84
981.69

Set 1"x2" Fl.

Rd. Surf.

F.B. 703 PG. 196

Cont. bottom next page

P-109

To P.# 294

104.40 @ 3-13 = 104.22
300.82 @ 3-13 = 300.34
265.34 @ 2-18 = 265.13
255.63 @ 1-02 = 255.57
300.54 @ 5-22 = 299.22
109.67
300.18 @ 3-18 = 299.68
1633.82
7.60 = 1633.57

N. 54° 27' 40" W.

1633.57

INVENTORY IN F. B. 1640.107, 108

Pine Co Rd. Oiled Surf.

N. 55° W. 1436

guy wire

P.# 293 Set 1x2 Flag

173-16-15 ⊙
350-05-30 ⊙
172-16-15 ⊙

guy wire

173-16-20

To P.# 292 See Preceding page

RETURN TO
LOS ANGELES COUNTY SURVEYOR
700 HALL OF RECORDS

Note: Any Additions or Changes on This Sheets Must be Made or Circled in Red Ink With Date and Name of Person Making Change.

Do not extend notes this side of this line

| | |
|---|---|
| Notes Ck'd by K.A.M. | Survey of Tel. line Toledo, Inc. F.B. 102 Pg. 121 |
| Map No. | W. O. 8074 Tape No. 40 St'd 32° P-109 |
| Office Work | Surveyed by Pasadena |
| Checked | Notes Date 3-14-38 |
| Date | Indexed A. C. Jenkins |

Cont. bottom next page

157.150 @ 3-00 = 156.93
286.50 @ 1-55 = 286.37
6-1 @ 1-30 = 300.21
T.60 = 743.51
743.47

N.36° E.

guy wire

INVENTORY IN F. B. 1640-108,109

162-14-00 ①
288-56-00 ②
162-14-00

guy wire

Pine Co. Rd.
Oiled Surf.

1633.57

To P. # 1293 Sec. preceding page

Note: Any Additions or Changes on This Sheets Must be Made or Circled in Red Ink With Date and Name of Person Making Change.

Do not extend notes this side of this line

RETURN TO
LOS ANGELES COUNTY SURVEYOR
700 HALL OF RECORDS

FORM 247 5M 10-37

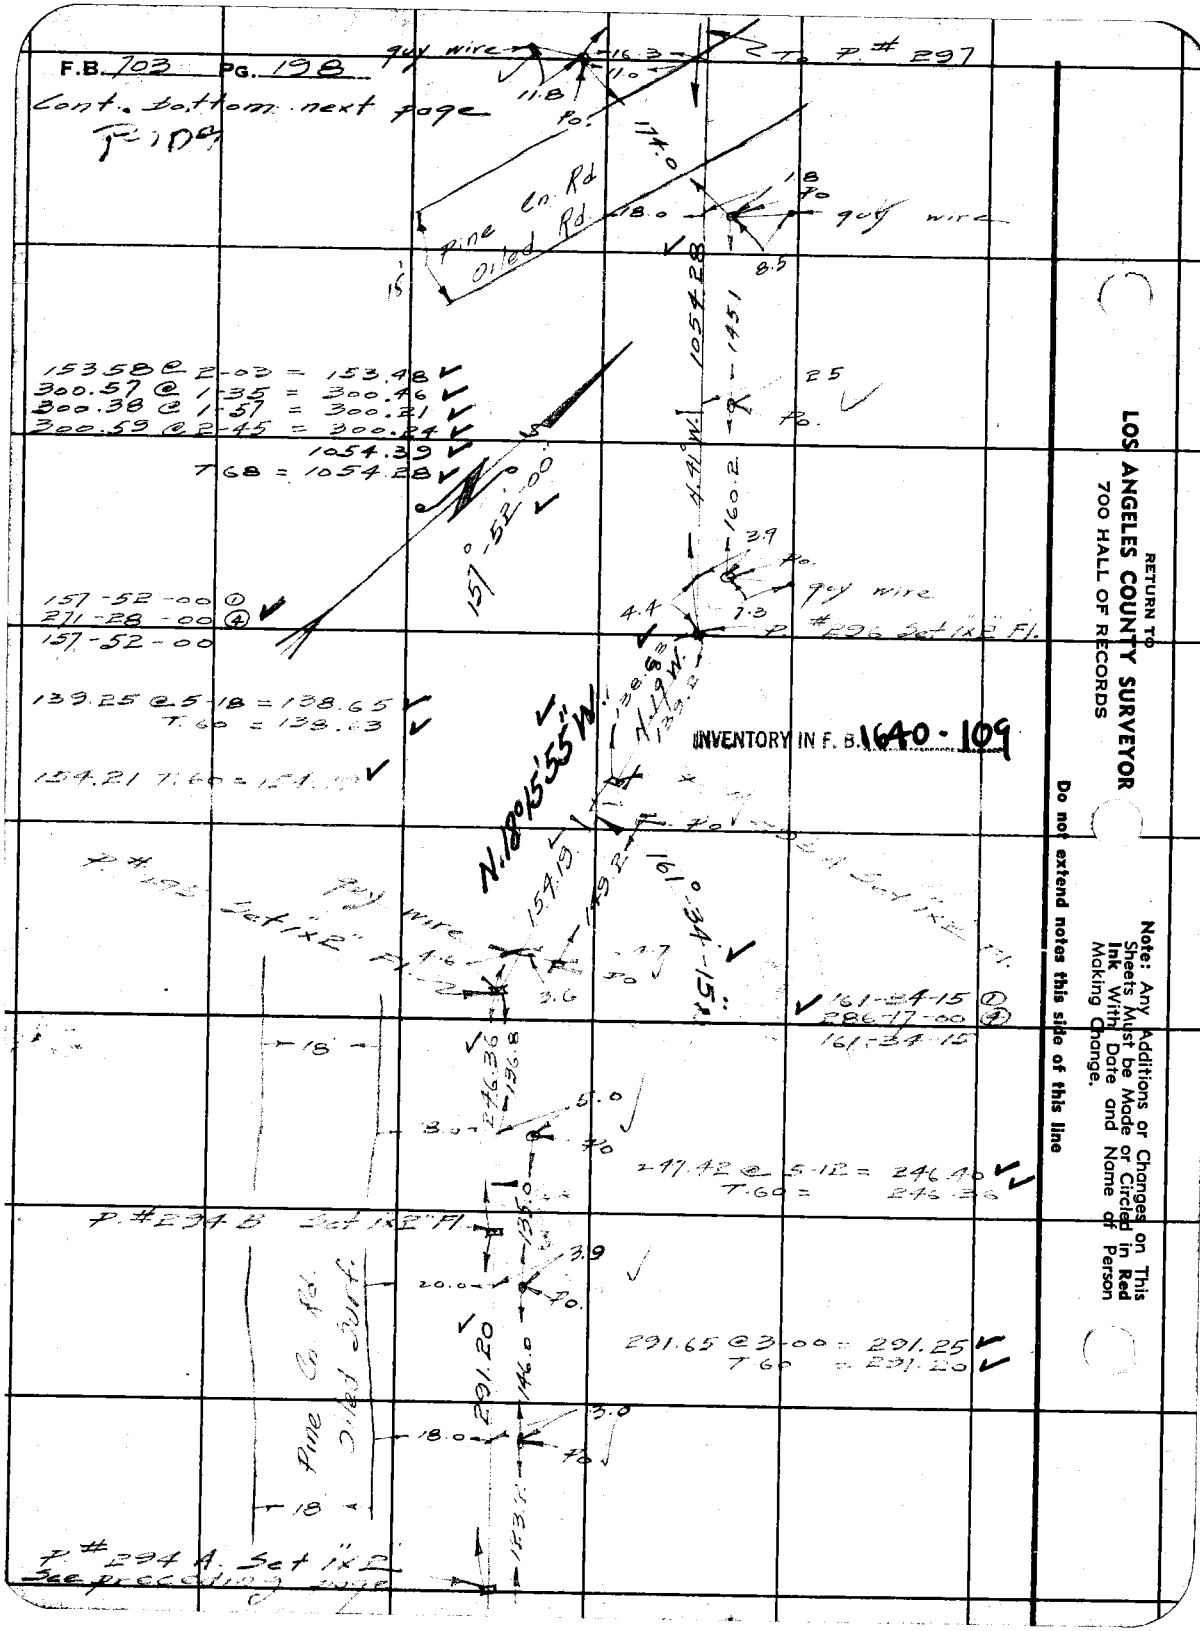


RETURN TO
LOS ANGELES COUNTY SURVEYOR
700 HALL OF RECORDS

Note: Any Additions or Changes on This Sheets Must be Made or Circled in Red Ink With Date and Name of Person Making Change.

Do not extend notes this side of this line

| | |
|---|---|
| Notes Ck'd by K.R.M. | Survey of Tel. Line Toledo-Luz F.B. 202 Pg. 199 |
| Map No. | W. O. 8074 Tape No. 40 St'd 22°F |
| Office Work | Surveyed by Rosecrans |
| Checked | Notes Date 2-15-38 |
| Date | Indexed |

















Note: Any Additions or Changes on This Sheets Must be Made or Circled in Red Ink With Date and Name of Person Making Change.

Do not extend notes this side of this line

RETURN TO
LOS ANGELES COUNTY SURVEYOR
700 HALL OF RECORDS

FORM 247 5M 10-37

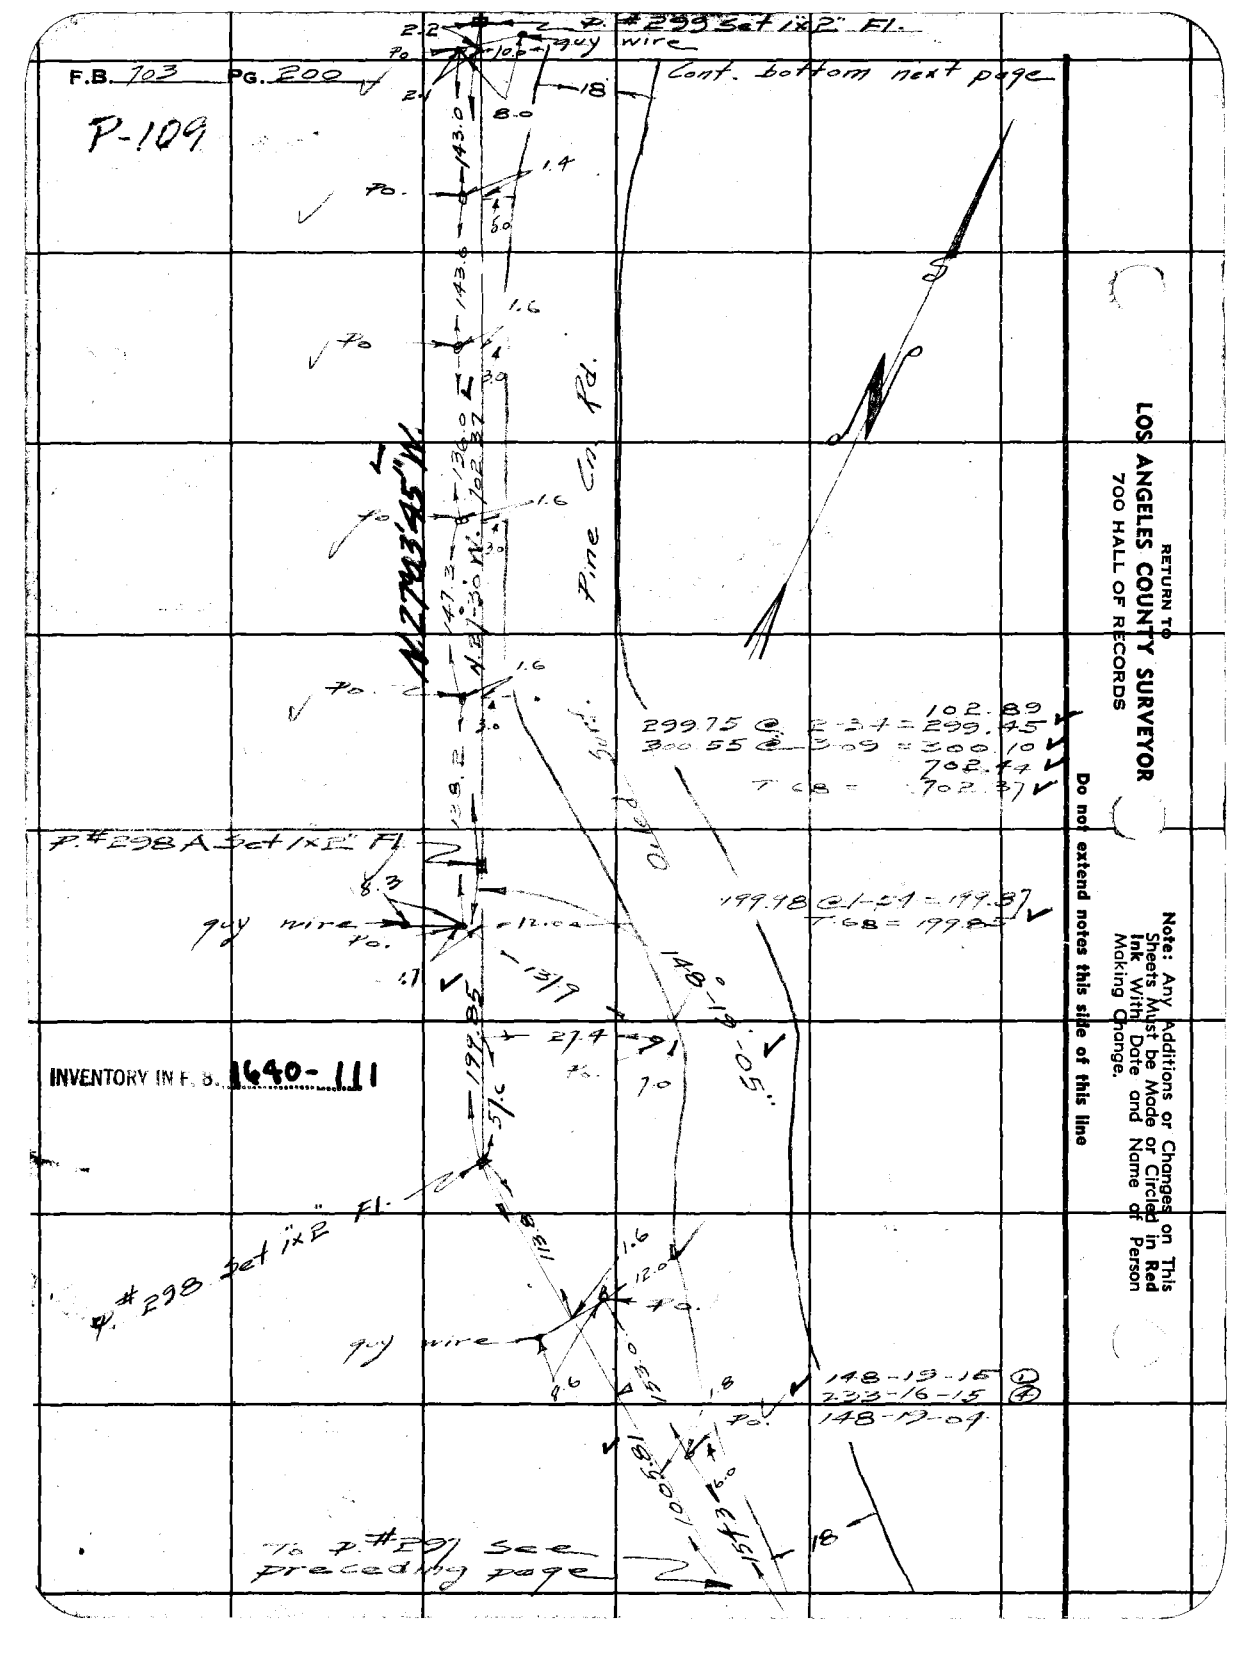
F.B. 703 PG. 200
P-109
P. #299 Set 1x2" Fl.
guy wire
Cont. bottom next page
Pine Cn. Rd.
RETURN TO
LOS ANGELES COUNTY SURVEYOR
700 HALL OF RECORDS
Note: Any Additions or Changes on This Sheets Must be Made or Circled in Red Ink With Date and Name of Person Making Change.
Do not extend notes this side of this line
299.75 @ 2-34 = 299.45
300.55 @ 2-09 = 300.10
702.44
T-68 = 702.37
P. #298A Set 1x2" Fl.
guy wire
199.98 @ 1-24 = 199.87
T-68 = 199.85
148-19-05"
INVENTORY IN F.B. 1640-111
P. #298 Set 1x2" Fl.
guy wire
148-13-16
233-16-15
148-17-09
To P. #297 see preceding page

| | |
|---|---|
| Notes Ck'd by K.R.M. | Survey of Lincoln Ave |
| Map No. | W. O. 8094 Tape No. 10 St'd 37 of |
| Office Work | Surveyed by Rosecrans |
| Checked | Notes " Date 2-15-38 |
| Date | Indexed |

F.B. 703 Pg. 201

P-107

P #73 Set 1x2 by tie per F.B. 703-199

Location for P #73 of Pg. 99. Questionable

"NOTE"

END OF U.S.E.S. Poles

AT 3 POINTS

S. 80°50'00" W. 1319.20 M.

150-52-15 ⊙
242-29-00 ⊙
150-52-15

150°52'15"

Fd 1x2 P #71.00 per F.B. 703-100

N. 70°02'15" W.

42°58'30"

297.65 @ 2-21 = 297.40
T 68 = 297.37

42-58-30 ⊙
71-54-00 ⊙
42-58-30

1319.17 M.

P #233 Set 1x2
See preceding page

To P #233 See preceding page

RETURN TO
LOS ANGELES COUNTY SURVEYOR
700 HALL OF RECORDS

Note: Any Additions or Changes on This Sheets Must be Made or Circled in Red Ink With Date and Name of Person Making Change.

Do not extend notes this side of this line

FORM 247 5M 10-37

F.B. 703 PG. 20

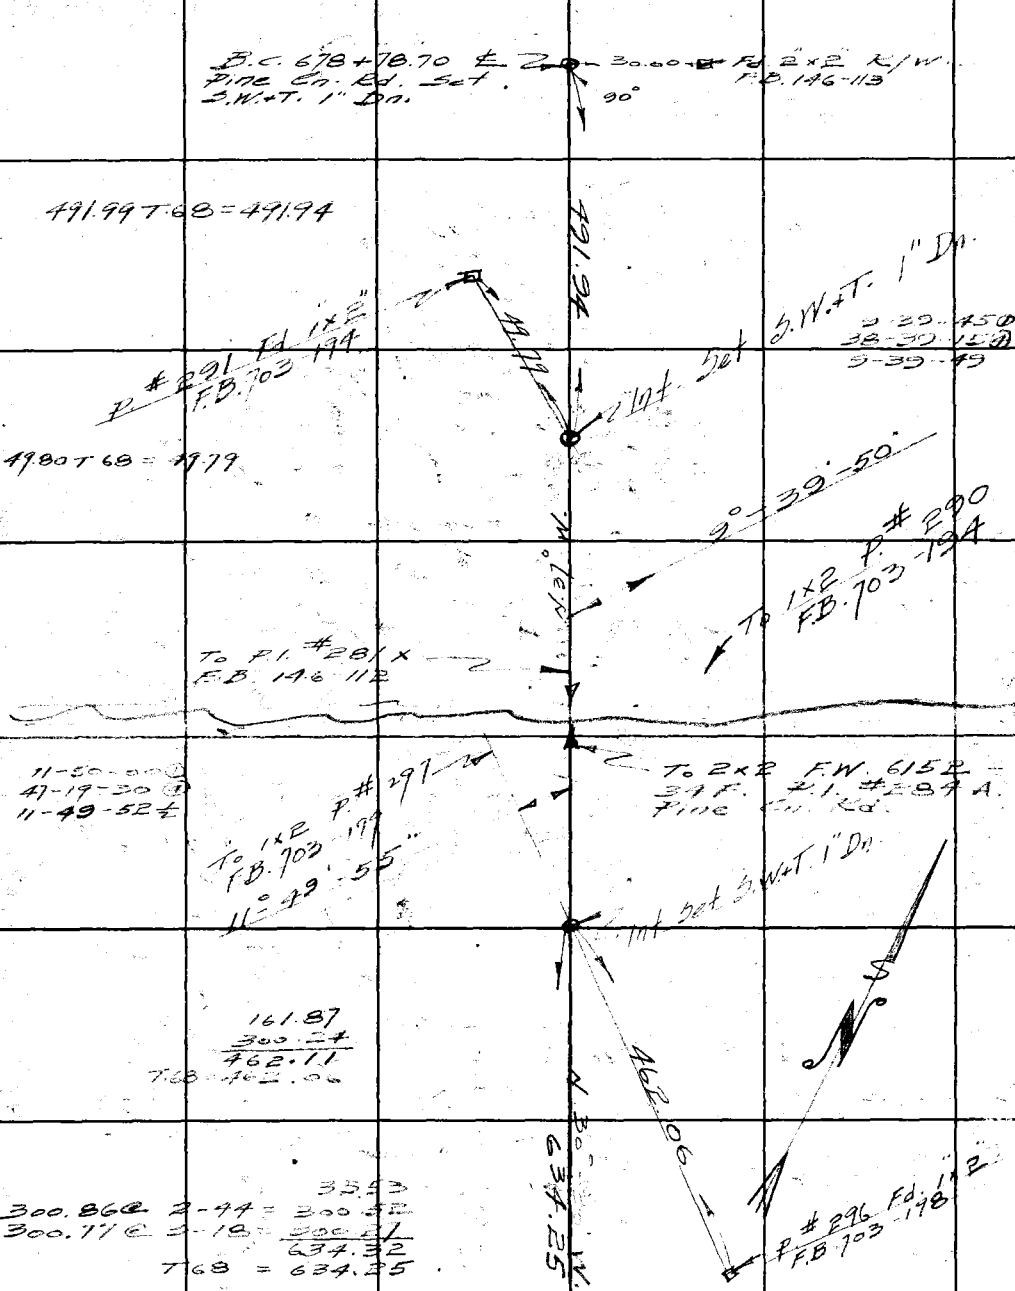


RETURN TO
LOS ANGELES COUNTY SURVEYOR
700 HALL OF RECORDS

Note: Any Additions or Changes on This Sheets Must be Made or Circled in Red Ink With Date and Name of Person Making Change.

Do not extend notes this side of this line

| | | |
|---|---|---|
| Notes Ck'd by | Survey of Grass Mt. Tel. line #118 | F.B. 703 PG. 203 |
| Map No. | W. O. 8094 Tape No. 12 St. [illegible] °F | |
| Office Work | Surveyed by Rosecrans | |
| Checked | Notes [illegible] Date 12-24-41 | |
| Date | Indexed [illegible] 1-22-42 | |

GRASS MOUNTAIN LOOKOUT SPUR TEL. LINE
#118

From junction on Pine Cn. Rd., at entrance to Munz Ranch, to Grass Mt Lookout Station.

J. N. 8094

Party.

Rosecrans
Grinnell
Pierce
Morrison

"NOTE"
POLE LOCATIONS CHECKED by W.S.C.
5-15-50
CHANGES NOTED IN RED

Note; Offsets taken to center of poles

Note: Any Additions or Changes on This Sheet Must be Made or Circled in Red Ink With Date and Name of Person Making Change.

Do not extend notes this side of this line.

RETURN TO
LOS ANGELES COUNTY SURVEYOR
700 HALL OF RECORDS

FORM 247 5M 10-39

F.B. 703 PG. 204

← To 1x2 T. #2

Cont. bottom next page 205

5.1
Po. No number

N 10°40'45"E
2.1'

105.0

5.0
Po. No number

15.0

107.0

5.1
Po. No. number

93-17-00 ①
13-08-00 ②
93-17-00

INVENTORY IN F.B. 1640-41

Oiled Rd.

108.2

5.2
Po No number

300.48 @ 2-53 = 300.10
20.57
260.63 @ 2-24 = 260.40
766.2
T.40 = 766.01

T.#1 = 300.28
135.02
#135.39
T.40 = #135.48

Tel. wires
300.36

Private Tel. wires

County wires

766.01

116.0

5.4
1 arm Po. 2 power wires
5 private wires and
2 county wires
No number

County Tel. line

Line Cn. Rd

Oiled Surf.

67.6

T. of Island

Po. #134
FD. 1.52 to 2.15

Fd. 1x2

18.

To 1x2

3.2

T.#1. Set 1x2

N. 33° W.
195.10

11.4

32.8

Take off pole #110-56
1 arm Po. 5 wires to E.
7 to W and 2 to S.

Three arm Po. 5 Tel. wires to E
7 Tel. wires to W 5 Tel. wires to
S. 2 power wires to S
5.2 No 2 p.a. County wires

RETURN TO
LOS ANGELES COUNTY SURVEYOR
700 HALL OF RECORDS

Do not extend notes this side of this line

Note: Any Additions or Changes on This Sheet Must Be Made or Circled in Red Ink With Date and Name of Person Making Change.

| | | | |
|---|---|---|---|
| Notes Ck'd by K.R.M. | Survey of Cross M to Line #118 | F.B. 703 | PG. 205 |
| Map No. | W. O. 5824 Tape No. 13 | Sta. 47°F | |
| Office Work | Surveyed by Pescerano | | |
| Checked | Notes R | Date 12-26-6 | |
| Date | Indexed S. Johnson | 1-22-42 | |

To T. #5 See next page 206

T. #4 Set 1x2 Fl.

2 County Tel wires 174-52-3 Pow.
and 2 Pow. " 133-43-24

2 Dorris Po 2 Pow wires Bear 1/2° W, 5 Pow wires Bear N. 75 W, 2 Tel wires Bear N 42° W. 2 Pow wires Bear S. 20° E. 2 Pow wires Bear S. 81 E and wires shown in sketch.

N 42° 06' 40" W.

129.39 C 1-54 T 40 = 129.13

T #3 Set 1x2" Fl.

End of oiled Rd.
" " " Dirt Rd.

150.12 C 1-36 T 40 = 150.02

2 County Tel wires and 2 private wires.

INVENTORY IN F. B. 1640-41

N 36° 52' 20" E.

2 arm Po. No number 5 Pow wires to W to Munz Ranch house 3 Pow wires to E. and 2 County Tel wires

2 Pow. wires and 2 County Tel wires

5 Tel wires to ranch house S. 55° W.

142-48-20 ①
216-13-40 ②
143-48-25

2 Po no number

37° — 13.5 — Guy Poke

T. #2 Set 1x2 Fl.

143° 48' 25"

15.0 Rd

104 E.

Oiled

15.5

2 Po No number

106.0

To T. #1 See preceding page Pg 204

Power wires — Private phone wires — County Tel wires

Note: Any Additions or Changes on This Sheet Must be Made or Circled in Red Ink With Date and Name of Person Making Change.

Do not extend notes this side of this line.

RETURN TO
LOS ANGELES COUNTY SURVEYOR
700 HALL OF RECORDS

FORM 247 5M 10-39

F.B. 703 Pg. 206

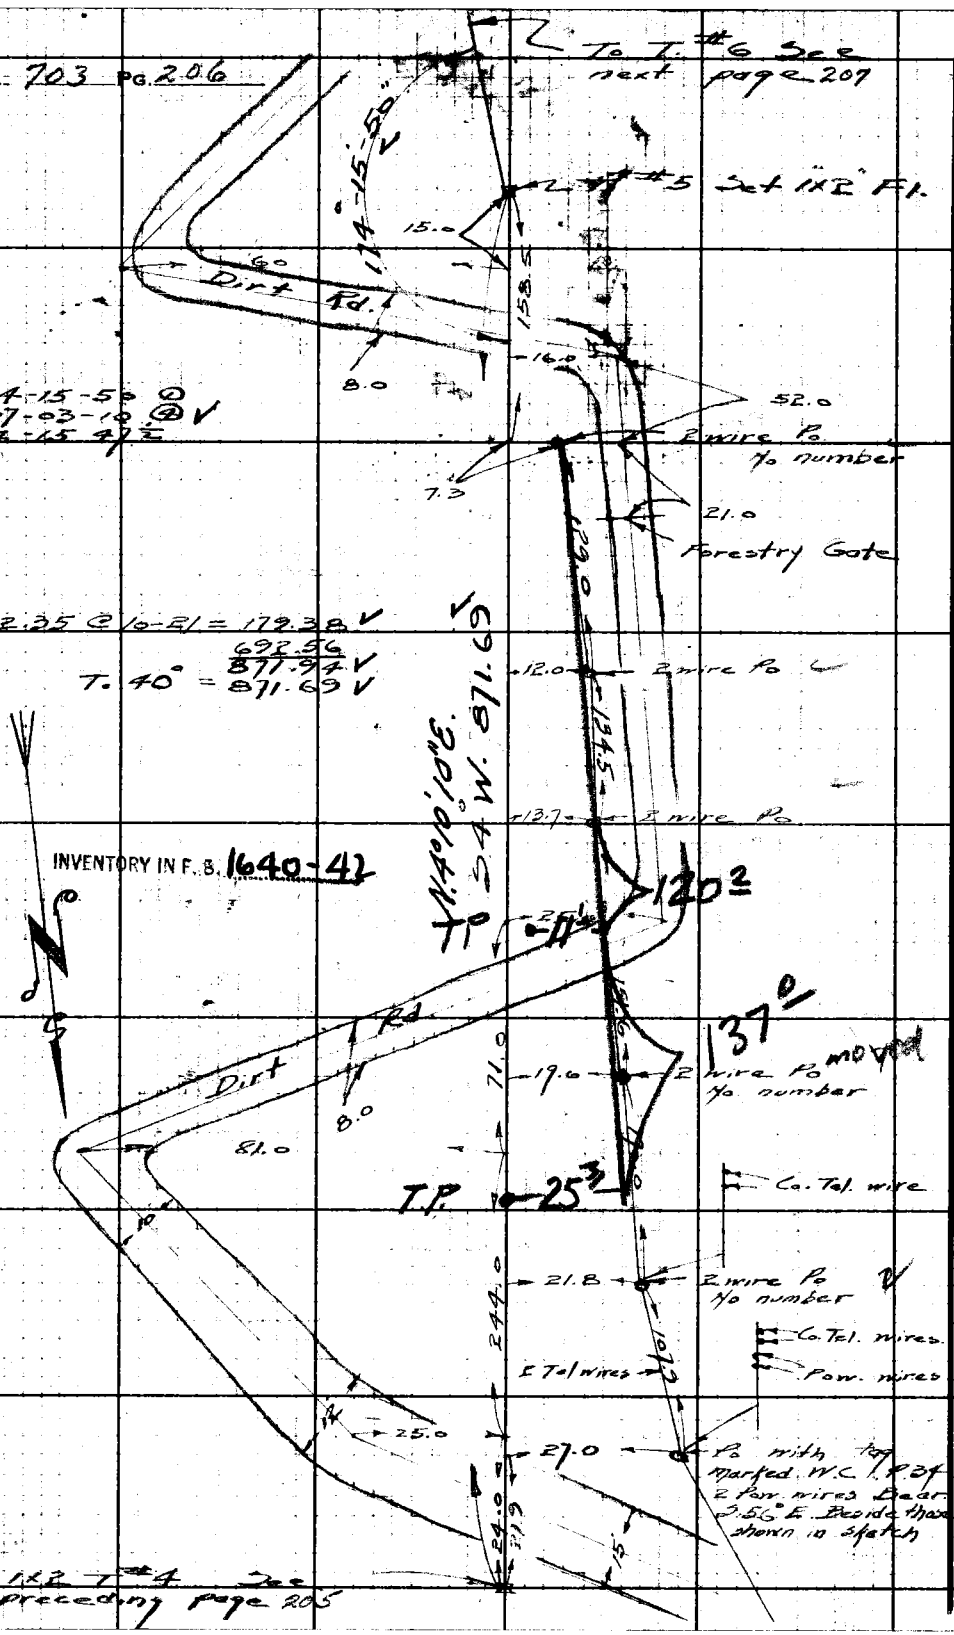


RETURN TO
LOS ANGELES COUNTY SURVEYOR
700 HALL OF RECORDS

Note: Any Additions or Changes on This Sheet Must be Made or Circled in Red Ink With Date and Name of Person Making Change.

Do not extend notes this side of this line.

Notes Ck'd by K.L.M.
Map No.
Office Work
Checked
Date

Survey of Grass Mt. Tel. line
W. O. 8021 Tape No. 13 Std. 99°F
Surveyed by Pasecrans
Notes K. Date 12-28-41
Indexed A. D. Johnson 1-22-42

F.B. 783 PG. 209

To T. #8

Cont. bottom next page 208

Tel. Po

10.5

132.6

135-33-40 ①
182-14-20 ②
135-33-35

T #7 Set 1"x2" Fl

1.4

16.2

15.3

Guy wire and split.

INVENTORY IN F. B. 1640-42

N 65° W

53.60

Tel. Po

9.0

14.0

Guy wire on 4 split.

287.15 T.44 = 287.08

Tel. Po. = P.I. R. L

1.8

T #6 Set 1x2" Fl.

4.0

125°-40-10 ①
142-40-40 ②
125-40-10

358.81 T.44 = 358.72

Tel. Po

8.0

N. 1°34'00" W.

3.2 : E. 358.72

79.4

11.0

Tel. Po

21

Dirt

135.2

Tel. Po

10.0

21

1"x2" T #5 See preceding page 206

RETURN TO
LOS ANGELES COUNTY SURVEYOR
700 HALL OF RECORDS

Note: Any Additions or Changes on This Sheet Must be Made or Circled in Red Ink With Date and Name of Person Making Change.

Do not extend notes this side of this line.

FORM 247 5M 10-39

F.B. 703 Pg. 208

To T. #9 See next page 209




To T. #7 See preceding page 207

103.43 @ 4-04 = 103.17
300.12 @ 1-32 = 300.01
403.18
T. 40 = 403.06

150-32-20
242-02-20
150-32-20

185.25 @ 3-02 = 184.99
166.93
238.88
251.46 @ 1-42 = 251.25
842.15
T 40 = 841.91

INVENTORY IN F. B. 1640-43

RETURN TO
LOS ANGELES COUNTY SURVEYOR
700 HALL OF RECORDS

Do not extend notes this side of this line.

Note: Any Additions or Changes on This Sheet Must be Made or Circled in Red Ink With Date and Name of Person Making Change.

Notes Ck'd by K.R.M.
Map No.
Office Work
Checked
Date

Survey of Terraza Mt. Po. Inc. #2
W. O. 8654 Tape No. 13 St. 69° F
Surveyed by Rosecrans
Notes 4 Date 12-26-41
Indexed L. Johnson 1-22-42

F.B. 703 PG. 209

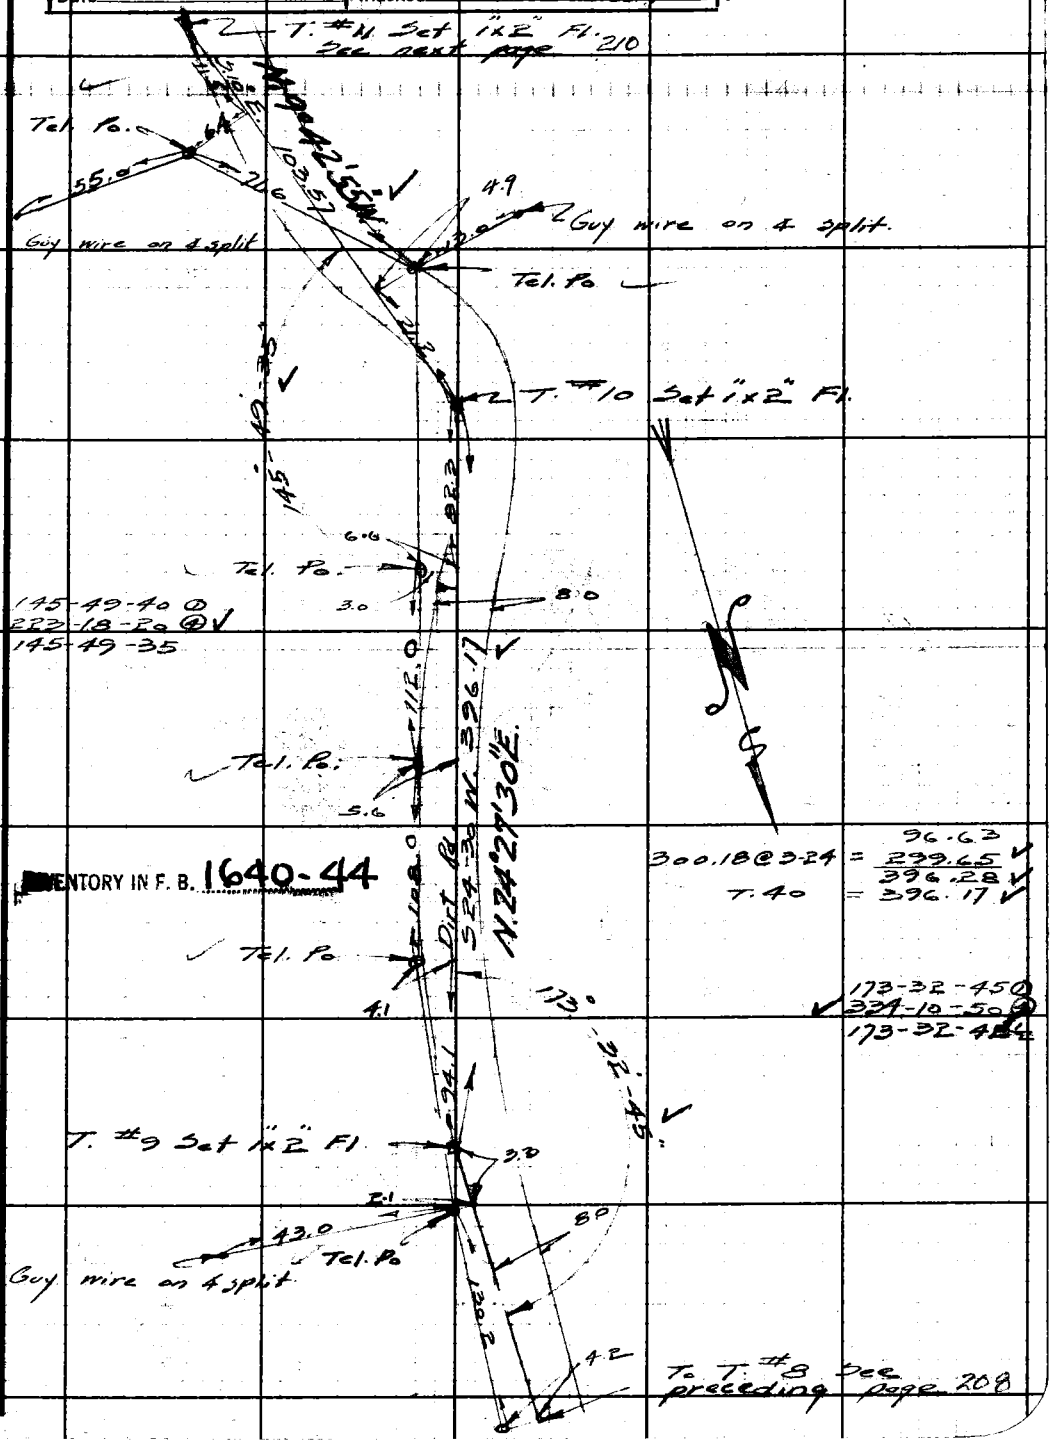


Note: Any Additions or Changes on This Sheet Must be Made or Circled in Red Ink With Date and Name of Person Making Change.

Do not extend notes this side of this line.

RETURN TO
LOS ANGELES COUNTY SURVEYOR
700 HALL OF RECORDS

FORM 247 BM 10-39

F.B. 703 PG. 210

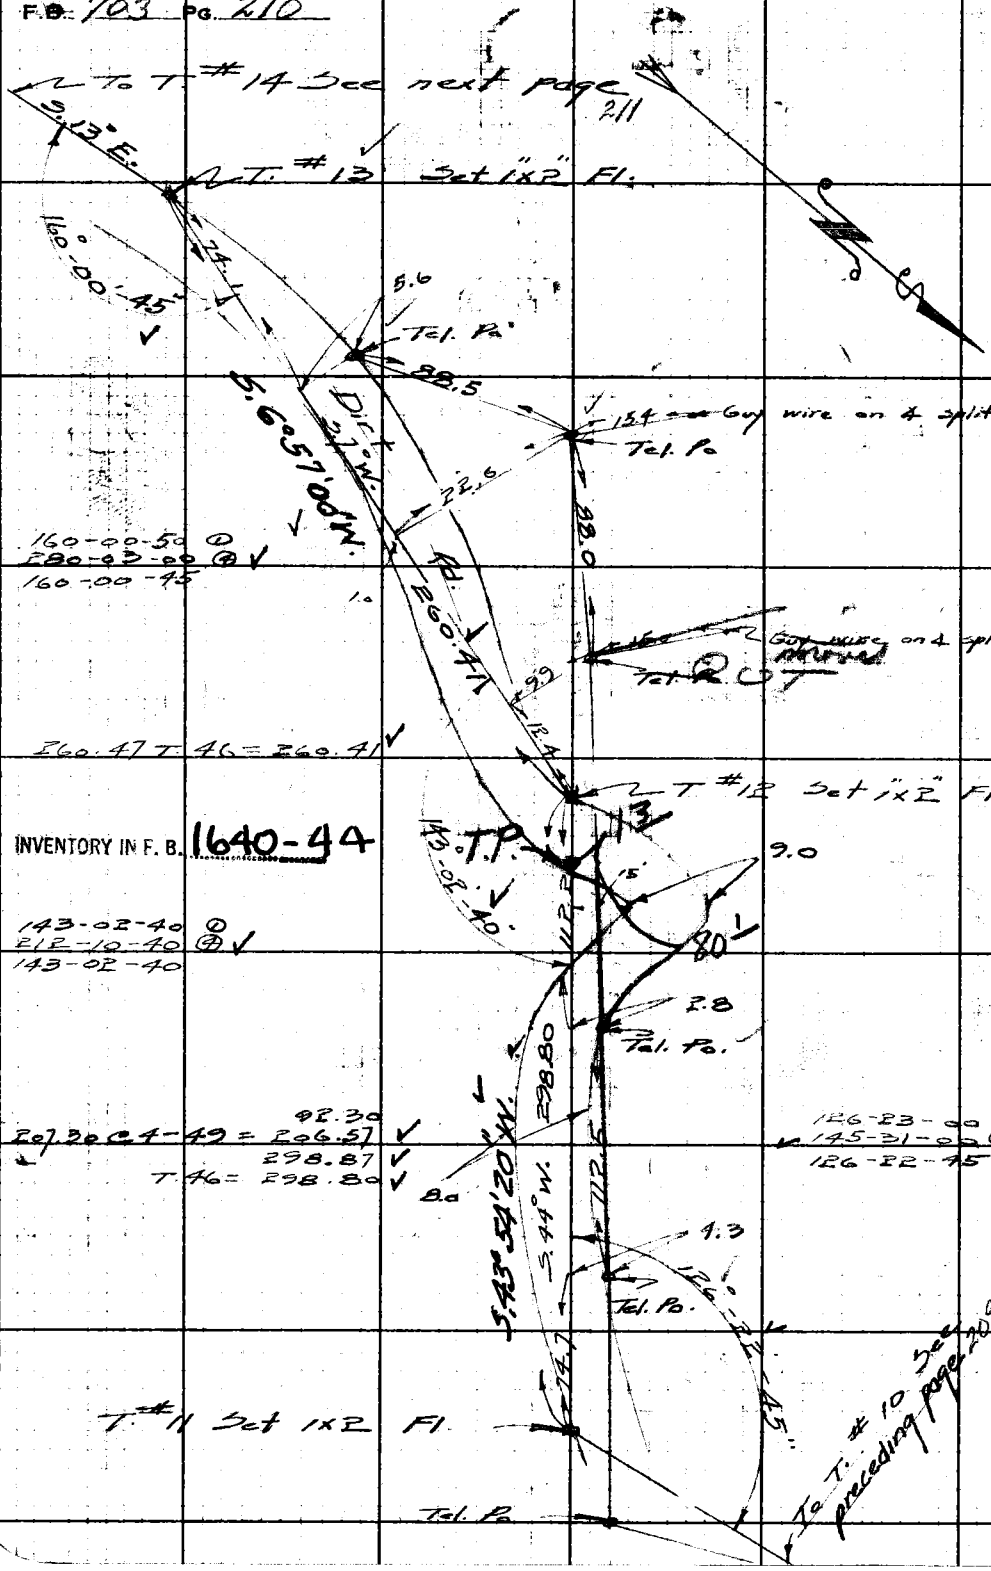


RETURN TO
LOS ANGELES COUNTY SURVEYOR
700 HALL OF RECORDS

Note: Any Additions or Changes on This Sheet Must be Made or Circled in Red Ink With Date and Name of Person Making Change.

Do not extend notes this side of this line.

| | |
|---|---|
| Notes Ck'd by K.A.M. | Survey of Gas Mt. Pole Line #118 |
| Map No. | W. O. 8044 Tape No. 12 Std 84°F |
| Office Work | Surveyed by Passarano |
| Checked | Notes Date 12-29-91 |
| Date | Indexed |

F.B. 703 PG. 211

T. #14 A. Set 1x2" Fl. -

Cont. bottom next page 212

Tel. Po

1.6

1.0

14.8

3.9

Tel. Po

Dist. Rd.

S 15° W. 428.08

S 8° 44' 45" W.

110.5

194.56 @ 6-00 = 193.49
234.93 @ 2-31 = 234.70
428.19
T. 46 = 428.08

4.5

13.7

4.5

Tel. Po

INVENTORY IN F. B. 1640-45

T. #14 Set 1x2" Fl.

N 18° 13' 00" W

148-13-00 ©
232-52-00 ©
148-13-00

Guy Po. on 4 split

26.8

31.0

2.0

Tel. Po

295.84 @ 3-56 T. 46 = 295.07

17.9

Tel. Po

S 13° 02' 15" E 295.07

124.5

Tel. Po

0.8

67.5

T. #13 Set 1x2"

See preceding page 210

Note: Any Additions or Changes on This Sheet Must be Made or Circled in Red Ink With Date and Name of Person Making Change.

Do not extend notes this side of this line.

RETURN TO
LOS ANGELES COUNTY SURVEYOR
700 HALL OF RECORDS

FORM 247 5M 10/39

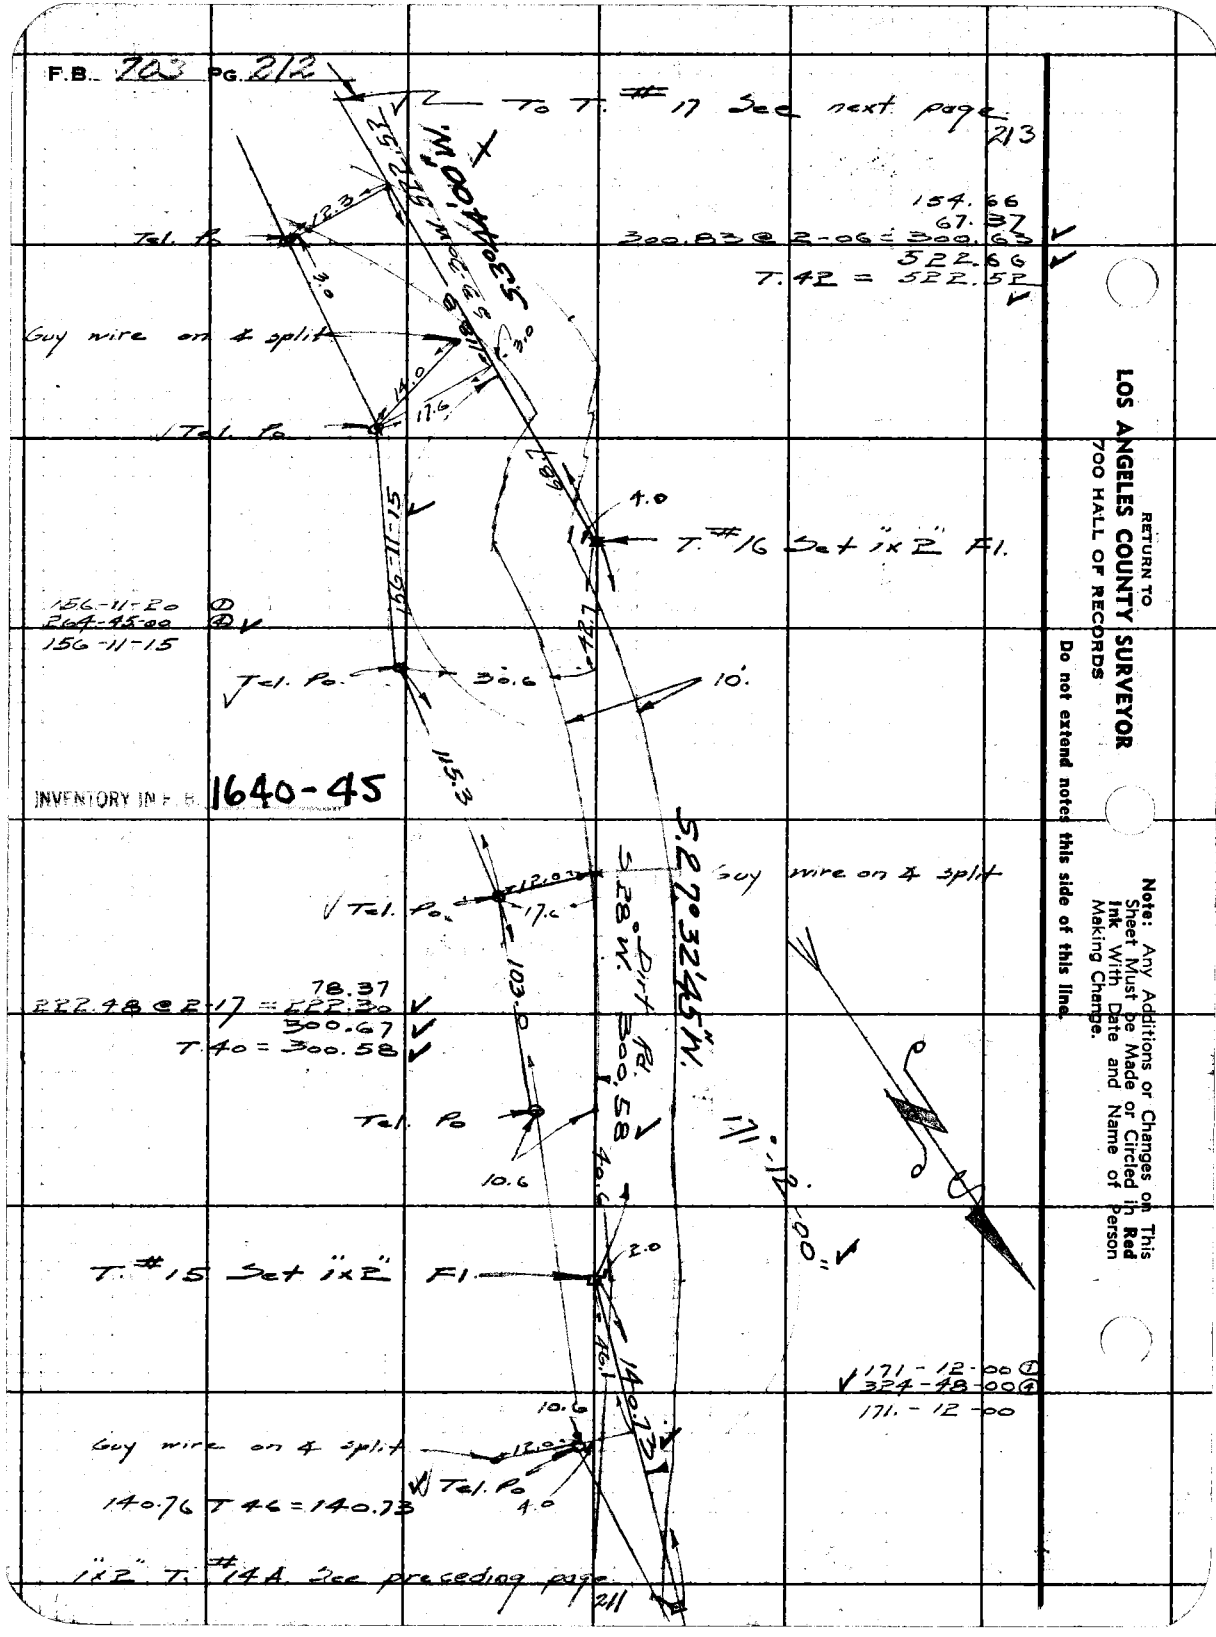
F.B. 203 PG. 212
To T. #17 See next page 213
154.66
67.37
300.83 @ 2-06 = 300.63
322.66
T. 42 = 322.52
Tel. Po
Guy wire on ∠ split
Tel. Po
156-11-20 ①
264-45-00 ②
156-11-15
Tel. Po.
T. #16 Set 1"x2" Fl.
INVENTORY IN F 5
1640-45
Tel. Po.
Guy wire on ∠ split
S. 2° 32' 45" W.
78.37
222.48 @ 2-17 = 222.30
300.67
T. 40 = 300.58
Tel. Po
Pg. 300.58
T. #15 Set 1"x2" Fl.
171-12-00 ①
324-48-00 ②
171-12-00
Guy wire on ∠ split
Tel. Po
140.76 T 46 = 140.73
1"x2" T. #14A See preceding page
211
Note: Any Additions or Changes on This Sheet Must be Made or Circled in Red Ink With Date and Name of Person Making Change.
Do not extend notes this side of this line.
RETURN TO
LOS ANGELES COUNTY SURVEYOR
700 HALL OF RECORDS

| | | | |
|---|---|---|---|
| Notes Ck'd by K.R.M. | Survey of Grass Mt Spur Po. line #118 | F.B. 703 | Pg. 213 |
| Map No. | W. O. 8024 Tape No. 13 St. 81°F | | |
| Office Work | Surveyed by Rosecrans | | |
| Checked | Notes P Date 12-30-41 | | |
| Date | Indexed [illegible] 1-22-42 | | |

To T. #19 See next page 214

To T. #18 Set 1x2 Ft.

62.4

54.9

148°-47'-10"

148-47-10 ①
225-08-20 ②
148-47-07½

70.2

10.0

136.0

256.46 @ 2-51 T. 42 = 254.07

INVENTORY IN F. B. 1640-46

Tel. Po

S. 1°00'40" E.

124.4

S 1°E

Tel. Po

128

15'-20"

41.1

Rd

Dirt

T. #17 Set S.W. & T. 1" Dn.

159-15-30 ①
277-01-30 ②
159-15-22½

157

28.5

4.7

3.0

Guy Po

17.1

Guy wire

Tel. Po

2.0

28

123.0

6.0

Tel. Po

7.9

322.52

133.0

10.0

To T. #16 See preceding page 212

12.3

Tel. Po

RETURN TO
LOS ANGELES COUNTY SURVEYOR
700 HALL OF RECORDS

Note: Any Additions or Changes on This Sheet Must be Made or Circled in Red Ink With Date and Name of Person Making Change.

Do not extend notes this side of this line.

FORM 247 5M 10-39

F.B. 703 PG. 214

T.# 20 A Set 1x2 Fl.

Cont. bottom next page 215

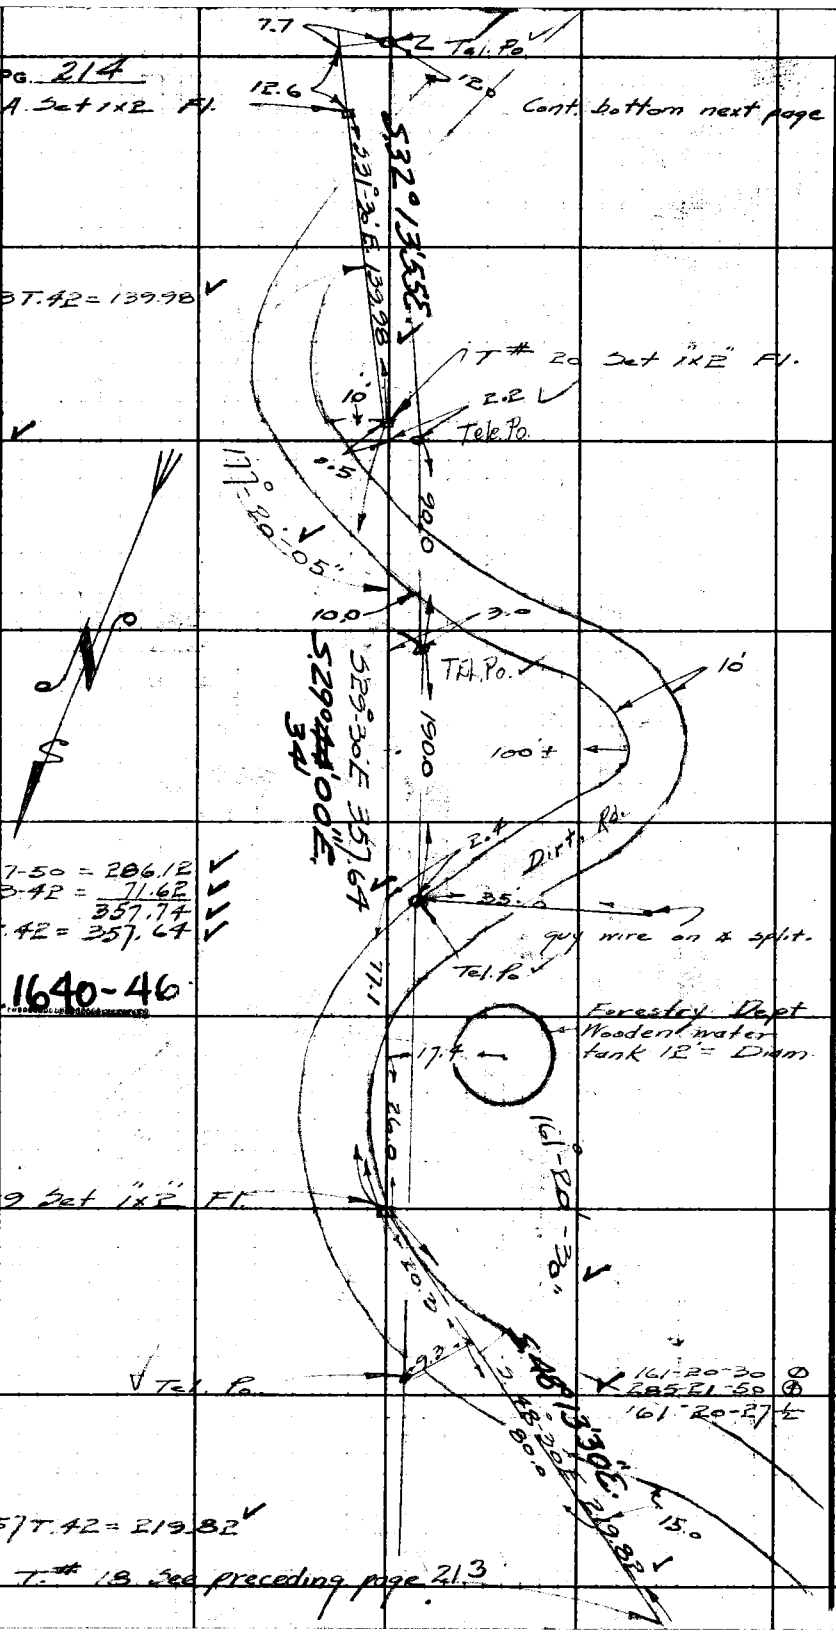


140.31 @ 3-48 T.42 = 139.98

177-20-00 ⊙
349-20-29 ⊕
177-20-05

288.81 @ 7-50 = 286.12
71.77 @ 3-42 = 71.62
357.74
T.42 = 357.64

INVENTORY IN F. B. 1640-46

161-20-30 ⊙
685 El 50 ⊕
161-20-27 ⊥

220.70 @ 4-57 T.42 = 219.82

To T.# 18 See preceding page 213.

RETURN TO
LOS ANGELES COUNTY SURVEYOR
700 HALL OF RECORDS

Note: Any Additions or Changes on This Sheet Must be Made or Circled in Red Ink With Date and Name of Person Making Change.

Do not extend notes this side of this line.

Notes Ck'd by K.R.M.
Map No.
Office Work
Checked
Date

Survey of Grass Mt. Spur & Base #4
W. O. 8024 Tape No. 13 St. 84°F
Surveyed by Rosecrans
Notes Date 12-22-41
Indexed S. Johnson 1-22-42

F.B. 703 PG. 215

To T #22 Sec next page 216

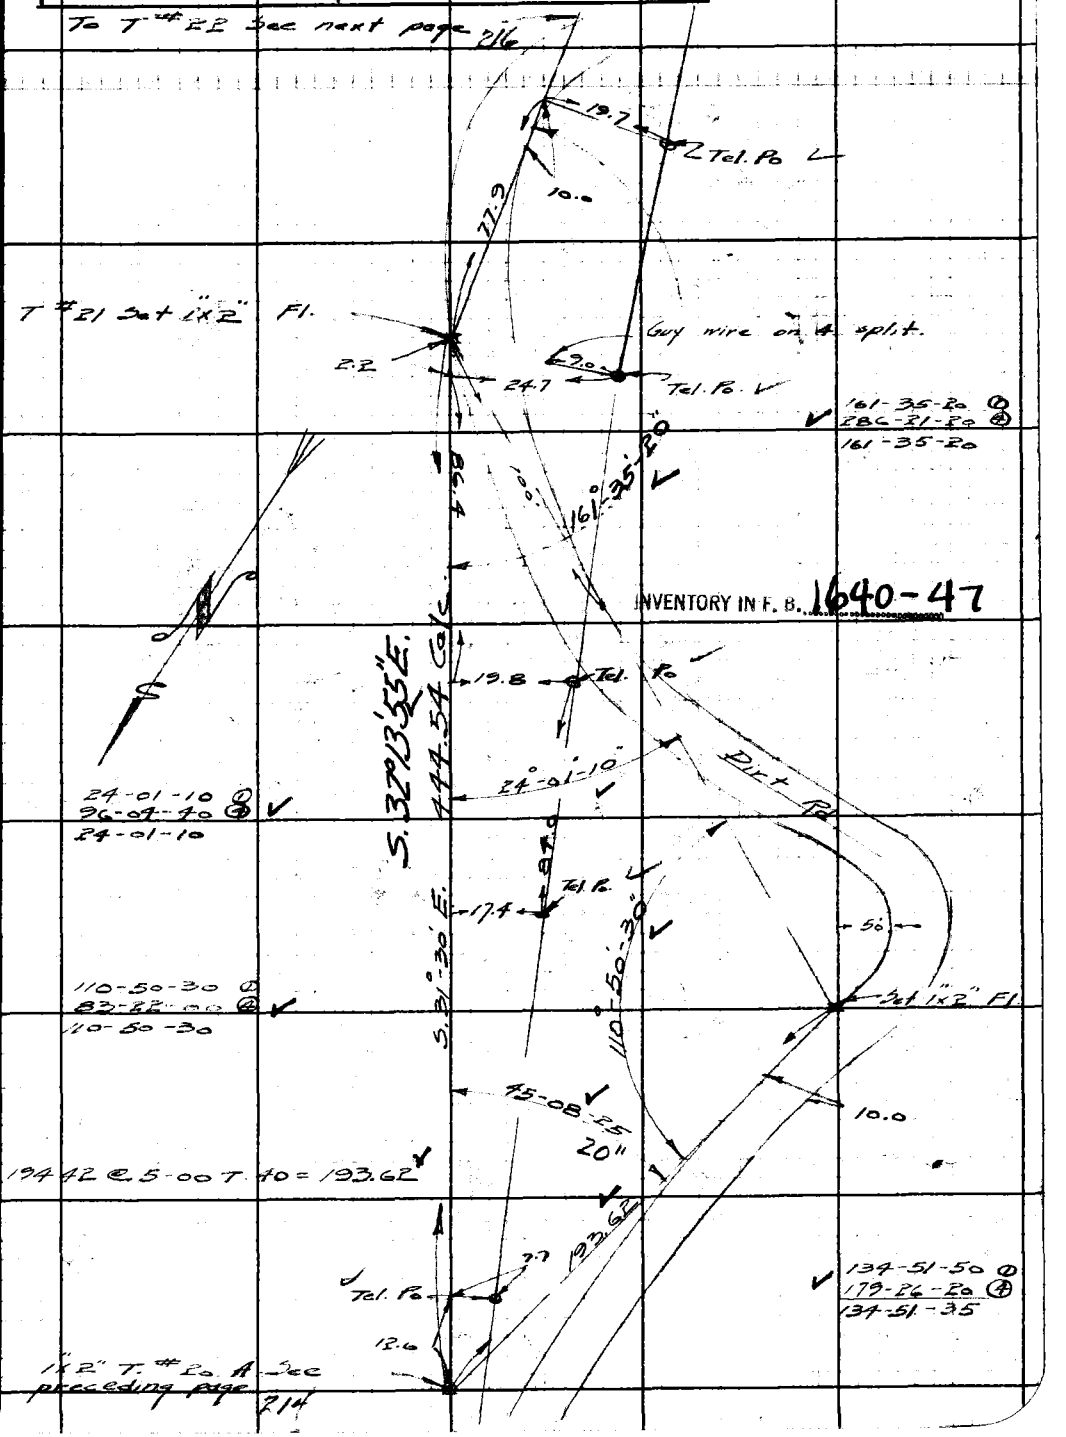


RETURN TO
LOS ANGELES COUNTY SURVEYOR
700 HALL OF RECORDS

Note: Any Additions or Changes on This Sheet Must be Made or Circled in Red Ink With Date and Name of Person Making Change.

Do not extend notes this side of this line.

FORM 247 5M 10/39

F.B. 703 PG. 216

Cont. bottom next page 217

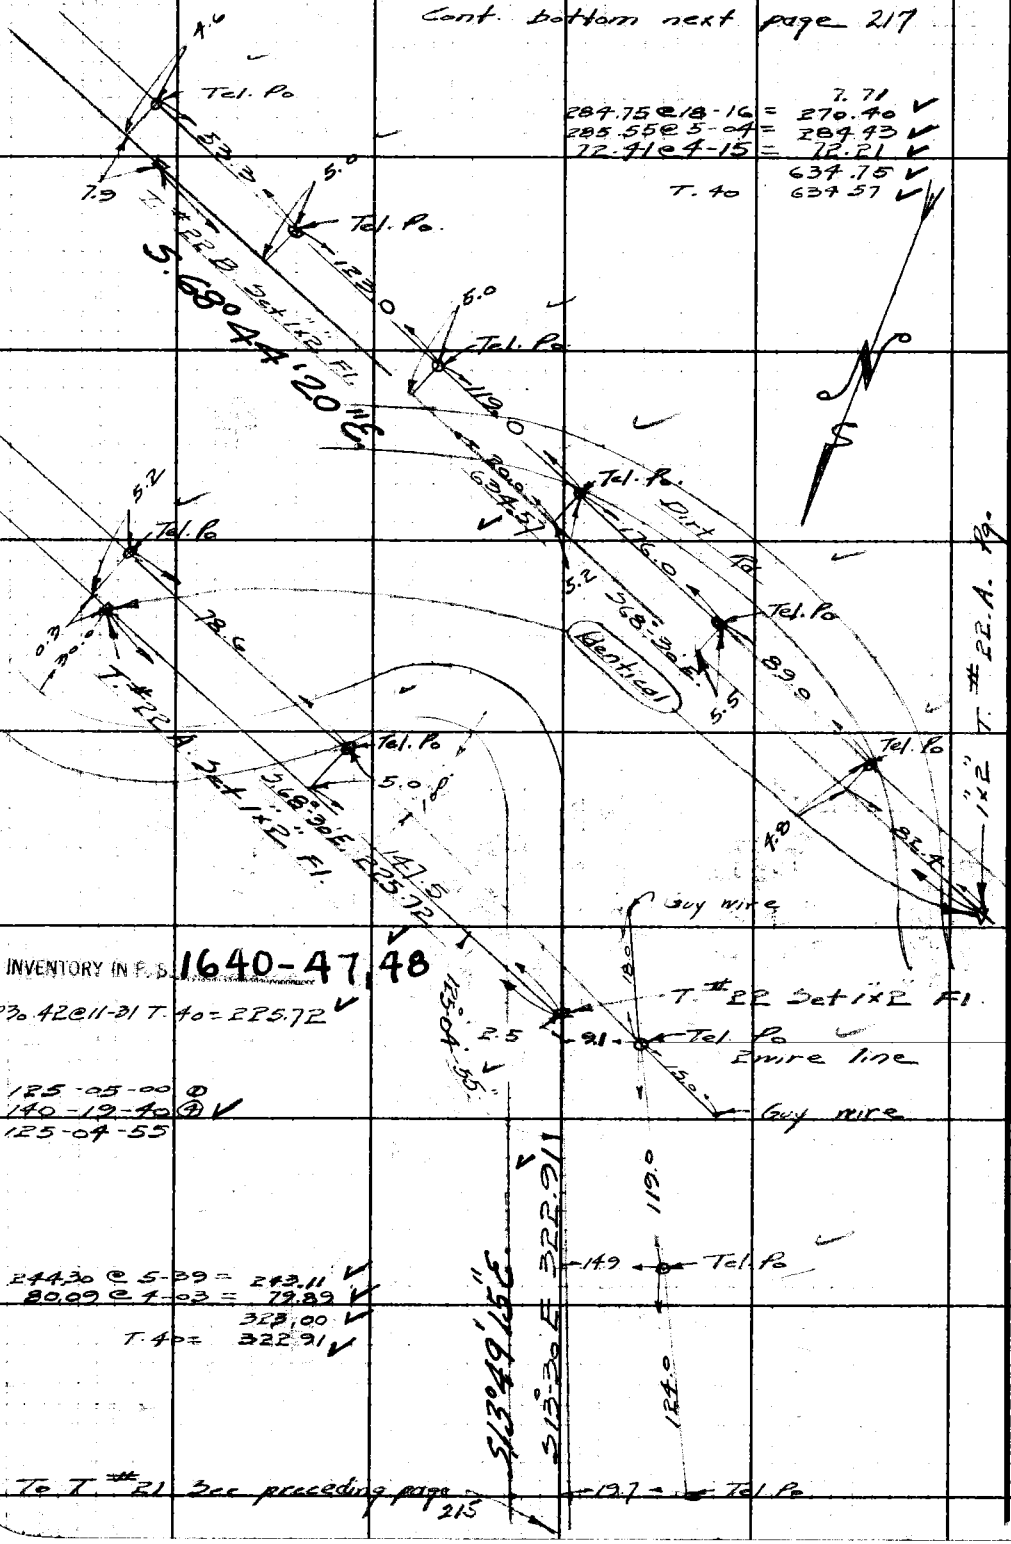


284.75 @ 18-16 = 270.40
285.55 @ 5-04 = 284.93
72.41 @ 4-15 = 72.21
7.71
T. 40 637.75
637.57

INVENTORY IN F.B. 1640-47, 48

230.42 @ 11-31 T. 40 = 225.72

125-05-00 D
140-19-40 A
125-04-55

244.30 @ 5-39 = 243.11
80.09 @ 4-03 = 79.89
323.00
T. 40 = 322.91

To T. #21 See preceding page 215

RETURN TO
LOS ANGELES COUNTY SURVEYOR
700 HALL OF RECORDS

Note: Any Additions or Changes on This Sheet Must Be Made or Circled in Red Ink With Date and Name of Person Making Change.

Do not extend notes this side of this line.

| | |
|---|---|
| Notes Ck'd by K.R.M. | Survey of Grass Mt Lookout Spur Tel. Line No. F.B. 7?? Pg. 217 |
| Map No. | W. O. 8024 Tape No. 13 Std. 66° F |
| Office Work | Surveyed by Spencer |
| Checked | Notes Date 12-21-41 |
| Date | Indexed C. Johnson 1-22-42 |

Cont. bottom next page To T. # 22D

T. # 22A

629.30

Rd.

44.0

20.0

10.0

Tel. Po.

S 30° W First Rd.

Forestry Dept. gate

10'

87.5

12'

42.32 @ 5-14 = 42.14 ✓
164.02 @ 15-04 = 158.38 ✓
200.47 @ 5-19 = 199.18 ✓
40.11 @ 12-44 = 39.12 ✓
91.14 @ 5-44 = 90.68 ✓
629.50 ✓
T. 36 = 629.30 ✓

T. # 22C Set 1x2 Fl.

58.4

71.3

12.7

8.7

Tel. Po.

5.0

INVENTORY IN F. B. 1640-48.49

S 68° 44' 20" E

398.59

150.9

8.9

Tel. Po.

6.7

Tel. Po.

100.16 @ 11-92 = 98.14 ✓
300.70 @ 1-43 = 300.56 ✓
T. 40 = 398.70 ✓
398.59 ✓
10.0

87.0

161.7

4.6

Tel. Po.

7.9

L T # 22B. Set 1x2

See preceding page 216

Note: Any Additions or Changes on This Sheet Must be Made or Circled in Red Ink With Date and Name of Person Making Change.

Do not extend notes this side of this line.

RETURN TO
LOS ANGELES COUNTY SURVEYOR
700 HALL OF RECORDS

FORM 247 5M 10-39

F.B. 703 PG. 218

To T. #24 Sec next page

| | | |
|---|---|---|
| 107.28 @ 18-26 | = | 101.87 |
| 112.19 @ 25-05 | = | 101.61 |
| Boo.72 @ 20-56 | = | 257.95 |
| 300.46 @ 16-55 | = | 287.46 |
| 131.44 @ 8-11 | = | 130.57 |
| 300.09 @ 9-46 | = | 29905 |
| | | 113.41 |
| | | 1291.92 |
| T. 42 = | | 1291.57 |

Pg 219

Tel. Po

S 31°00'40" E

1291.57

Tel. Po

S 31°00'40" E

Guy wire on & split

Tel. Po

T. #23 Set 1"x2" Fl.

T. #22 D Set 1"x2" Fl.

Tel. Po

INVENTORY IN F.B. 1640-49

Tel. Po

Tel. Po

Tel. Po

Fire Break

Dirt Rd

Dirt Rd

To T. #22.C Sec preceding page

217

RETURN TO
LOS ANGELES COUNTY SURVEYOR
700 HALL OF RECORDS

Do not extend notes this side of this line.

Note: Any Additions or Changes on This Sheet Must Be Made or Circled in Red Ink With Date and Name of Person Making Change.

| | |
|---|---|
| Notes Ck'd by K.R.M. | Survey of Grass Mt Tel Line #118 |
| Map No. | W. O. 8024 Tape No. 12 Sta 187+F |
| Office Work | Surveyed by Reserans |
| Checked | Notes Date 1-2-42 |
| Date | Indexed C Johnson 1-22-42 |

F.B. 703 PG. 219

To T. #24 See next page

220

3.7 35 Tel. Po.

70.1

3.1 20 30 Tel. Po

87.5

2.6 30 Tel. Po

129.5

2.0 38 1.2 Tel. Po

Fire Break

INVENTORY IN F. B. 1640-50

32.6

1.1 41 Tel. Po

S 31° E

119.3

1.0 50 Tel. Po

127.4

0.9 50 Tel. Po

123.4

To T. #23 See preceding page

218

Note: Any Additions or Changes on This Sheet Must be Made or Circled In Red Ink With Date and Name of Person Making Change.

Do not extend notes this side of this line.

RETURN TO
LOS ANGELES COUNTY SURVEYOR
700 HALL OF RECORDS

FORM 247 SM 10-39

F.B. 703 Pg. 220

To T.# 26 See next page

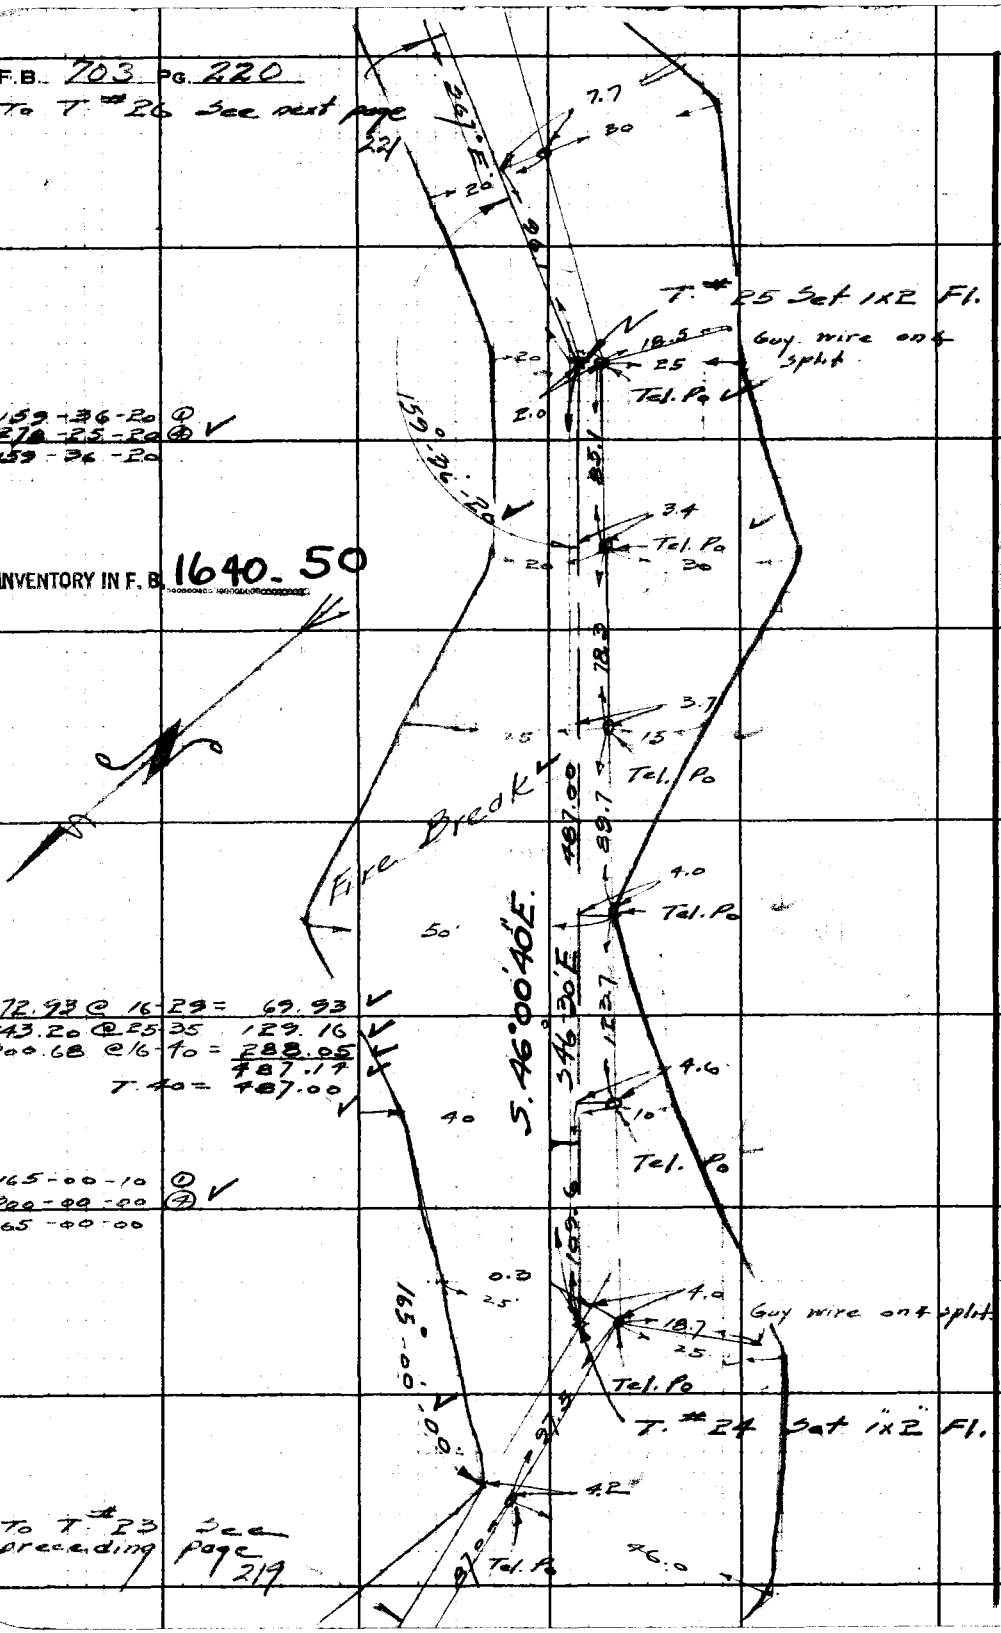


INVENTORY IN F. B. 1640.50

72.93 @ 16-29 = 69.93
143.20 @ 25-35 = 129.16
300.68 @ 16-10 = 288.05
487.14
T. 40 = 487.00

165-00-10 ①
300-00-00 ②
165-00-00

159-36-20 ①
278-25-20 ②
159-36-20

RETURN TO
LOS ANGELES COUNTY SURVEYOR
700 HALL OF RECORDS

Note: Any Additions or Changes on This Sheet Must be Made or Circled in Red Ink With Date and Name of Person Making Change.

Do not extend notes this side of this line

| | |
|---|---|
| Notes Ck'd by K.R.M. | Survey of Grass, Mt. Jour Tel. Line |
| Map No. | W. O. 8074 Tape No. 13 Std. 24°F |
| Office Work | Surveyed by Rosecrans |
| Checked | Notes P Date 1-5-42 |
| Date | Indexed C. Johnson 1-22-42 |

F.B. 733 Pg. 221

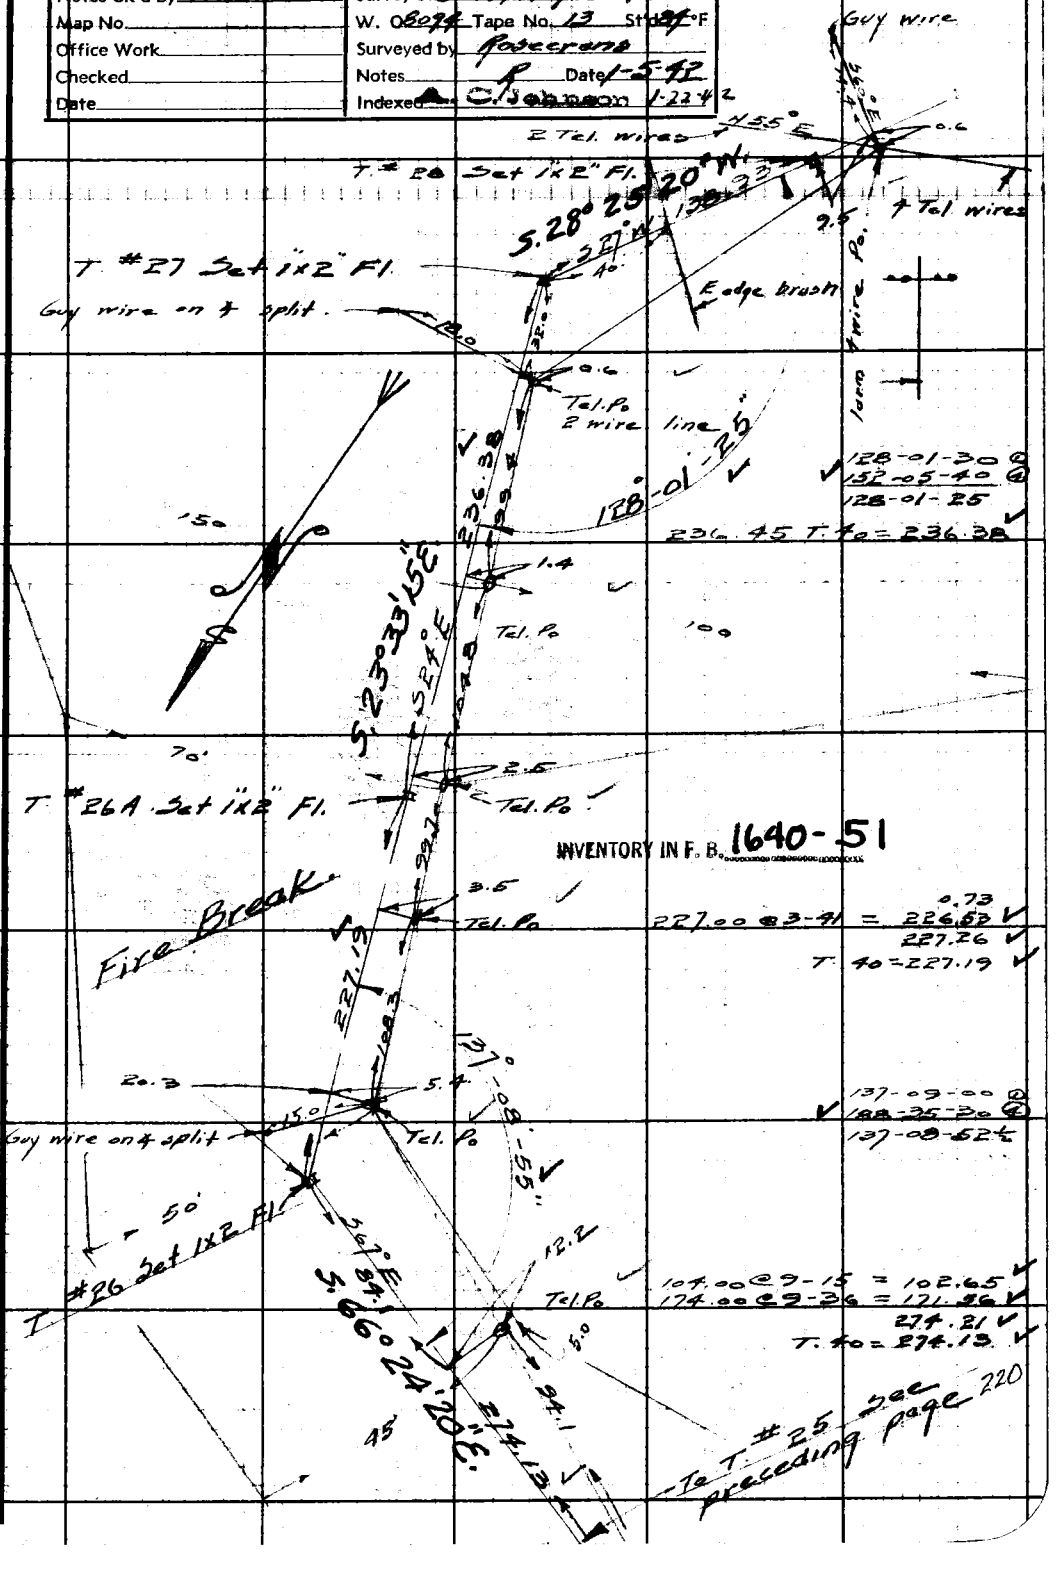


Note: Any Additions or Changes on This Sheet Must be Made or Circled in Red Ink, With Date and Name of Person Making Change.

Do not extend notes this side of this line.

RETURN TO
LOS ANGELES COUNTY SURVEYOR
700 HALL OF RECORDS

FORM 247 5M 10-39

F.B. 703 Pg. 222

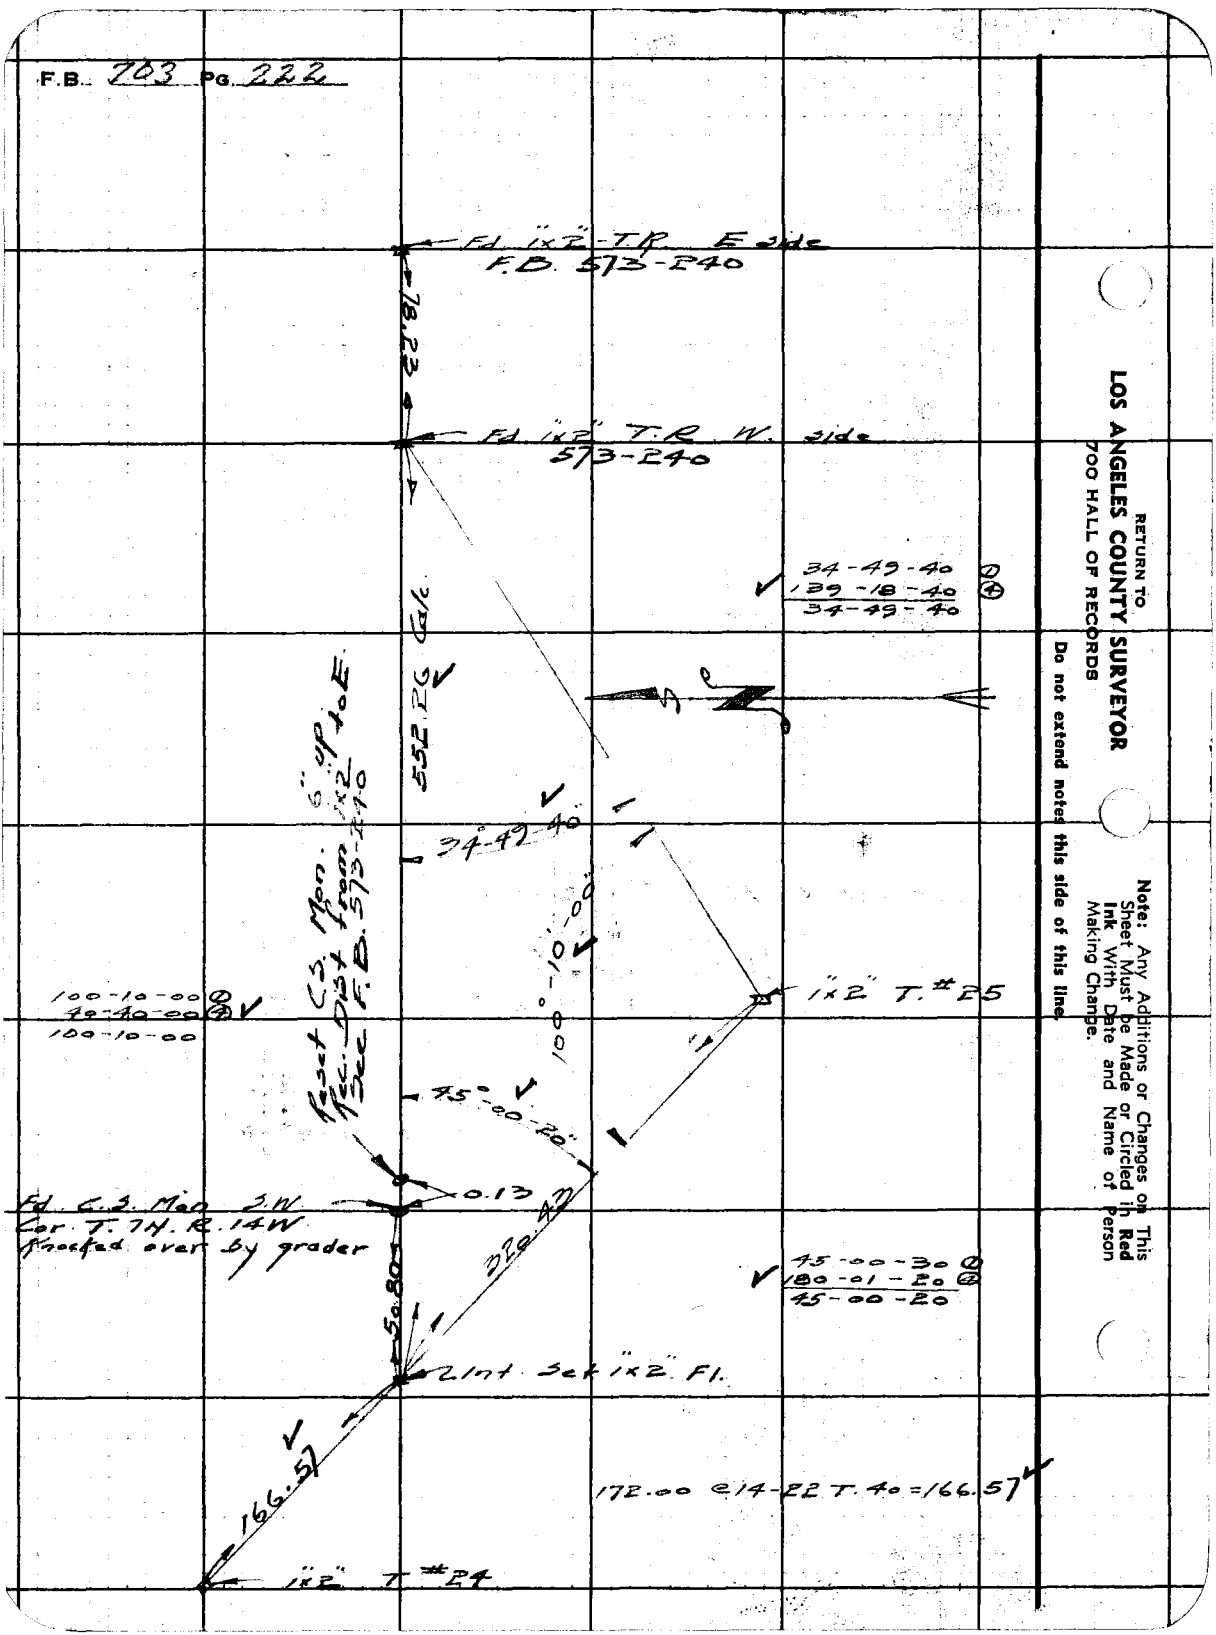


RETURN TO
LOS ANGELES COUNTY SURVEYOR
700 HALL OF RECORDS

Note: Any Additions or Changes on This Sheet Must be Made or Circled in Red Ink With Date and Name of Person Making Change.

Do not extend notes this side of this line.

Notes Ck'd by K.R.M.S.P.
Map No.
Office Work
Checked
Date

Survey of Grass, Mt. Tel line #18
W. O. 80274 Tape No. 22 Sta. 84+F
Surveyed by Peterson
Notes R Date 1-12-11
Indexed C. Jacobsen 1-22-42

F.B. 723 Pg. 223

Note: Any Additions or Changes on This Sheet Must be Made or Circled in Red Ink With Date and Name of Person Making Change.

Do not extend notes this side of this line.

RETURN TO
LOS ANGELES COUNTY SURVEYOR
700 HALL OF RECORDS

FORM 247 5M 10-39

Rd. 1x2 + Tk. Fl.

47.95

87.02 e 3-07 T. 60° = 86.88

Transit Line EB. 273 86.88

2 Fd. 1x2 + Tk. Fl.

U.S.G.S. Lake
Fd. 4" Bronze mark as shown in Conc. 10" above surface

N 0° 30' E.

N 0° 30' 20" E.

Base of Bearings per Triangulation System

U.S. GEOLOGICAL SURVEY IN COOPERATION WITH LOS ANGELES COUNTY

ELEVATION ABOVE SEA LEVEL IN FEET

LAKE

Fd. 3" B.S. P.S. DISTURBING 1929 DOLLARS FINE MARK THIS

70-36-50 ①
70-36-50 ②
70-36-27½

N 70° 56' 50" E T #29 T. 224 To set

1x2 Pg.

U.S.G.S. Grass
Fd. 4" bronze marked identical as the one shown above except the word Grass in place of Lake. in 10" Granite rock.

F.B. 703 PG. 224

T. #29 Set 1x2" Fl.

To U.S.G.S. Grass. See next page

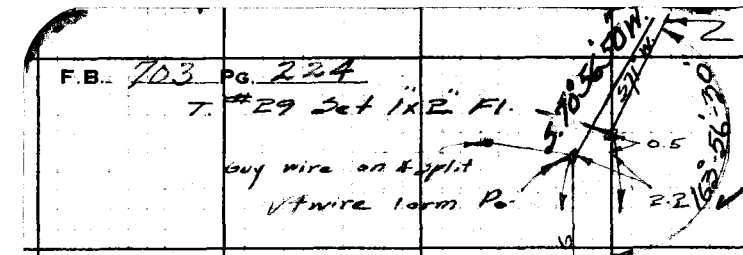


guy wire on ⏚ split

✓ 4 wire 1 arm Po

✓ 163-56-30 ①
295-45-50 ②
163-56-27½

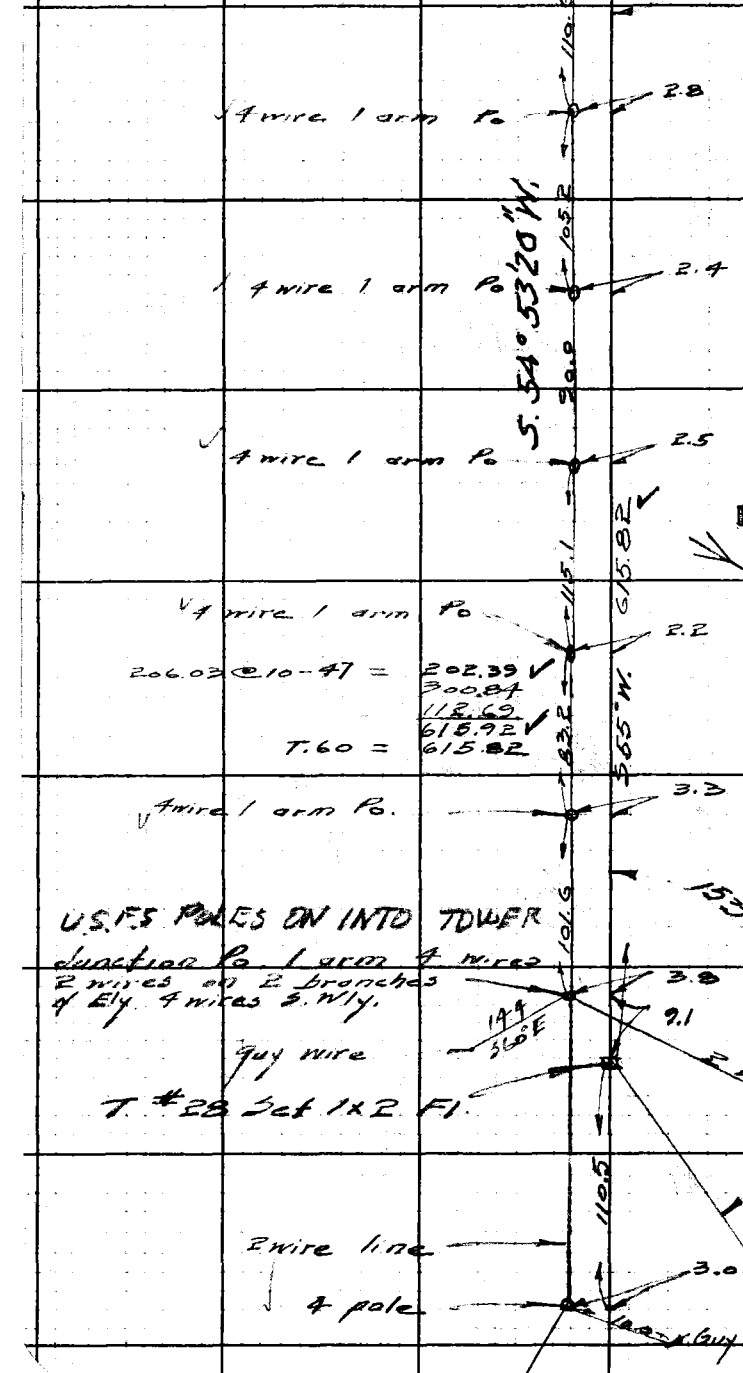


✓ 4 wire 1 arm Po

✓ 4 wire 1 arm Po

✓ 4 wire 1 arm Po

INVENTORY IN F. B. 1640-51 52

✓ 4 wire 1 arm Po

206.03 @ 10-47 = 202.39 ✓
300.84
112.69
T. 60 = 615.92 ✓
615.82

✓ 4 wire 1 arm Po.

U.S.F.S. POLES ON INTO TOWER

Junction Po 1 arm 4 wires 2 wires on 2 branches of Ely 4 wires S. W'ly.

✓ 153-32-10 ①
254-08-00 ②
153-32-00

Guy wire

T. #28 Set 1x2 Fl.

2 wire County line ?

2 wire line

4 pole

Guy wire

To T. # 27 Sol Pg

RETURN TO
LOS ANGELES COUNTY SURVEYOR
700 HALL OF RECORDS

Do not extend notes this side of this line.

Note: Any Additions or Changes on This Sheet Must be Made or Circled in Red Ink With Date and Name of Person Making Change.

Notes Ck'd by K.B.M.
Map No.
Office Work
Checked
Date

Survey of Grass Mt Po line #118
W. O. 8094 Tape No. 22 Std. 84°F
Surveyed by Rosecrans
Notes R Date 1-13-42
Indexed C. Jackson 1-22-42

F.B. 703 PG. 223

Note: Any Additions or Changes on This Sheet Must be Made or Circled in Red Ink With Date and Name of Person Making Change.

Do not extend notes this side of this line.

RETURN TO
LOS ANGELES COUNTY SURVEYOR
700 HALL OF RECORDS

FORM 247 5M 10-39

8.35

16.0

Grass Mt Lookout Tower

3.45

INVENTORY IN F.B. 1640-52

32.7

2 underground cables.

Guy wire

Guy wire

U.S.G.S. Triangulation Station Grass Fd 4" bronze mark in top of 10" granite rock 3.0

1 arm Po. 4 wires to E
Underground cable to Lookout.

3.4

253.46

0.8

4 wire 1 arm Po.

191.93 @ 7-27 = 190.24 (63.20 / 253.51)

T 56 = E52.46

N 70°56'50"E.

75.3

0.8

4 wire 1 arm Po.

N 37° W.

92.0

T. # 29 Set "R.E." See preceding page

224

RETURN TO
**LOS ANGELES COUNTY SURVEYOR**
700 HALL OF RECORDS

**Note:** Any Additions or Changes on This Sheet Must be Made or Circled in **Red Ink** With Date and Name of Person Making Change.

**Do not extend notes this side of this line.**

F.B. 703 Pg. 246

| | |
|---|---|
| Notes Ck'd by K.P.McK. | Survey of Tel. Lines Soledad Div. |
| Map No. S.D. 133-33 | W. O. 8034 Tape No. 77 St'd 68 °F |
| Office Work McKenna | Surveyed by Rosecrans |
| Checked | Notes K Date 8-22-46 |
| Date Sept. 1946 | Indexed A. C. Johnson 8-29-46 |

F.B. 703 PG. 231

PINE CANYON PATROL STATION.

Survey for easement for telephone pole line and radio tower on north side of station.

J.N. 8034.

Party: Rosecrans, Pierce, Snyder, Gibbons, Colgate

Plotted on Survey Div. File No. 133-33.

New ties to 4 Cor. Secs. 23 + 26 T. 7N. R. 15 W.

Tool Shed

Store Shed

Cor.

Set N.+T. in Tel. Po.

N.+T. in post Cor. of shed.

N 58° 30' W 91.12

N 22° 30' W 43.30

N 7° 17' E

¼ Cor. Secs. 23 + 26 T. 7N. R. 15 W. Fd. +T. in rock E.D. 611-184

S 71° W. 178.80

Set N.+T. in Pow. Po

S 7° 17' W 134.29

134.67 @ 4-22 T. 80 = 134.29

Set N.+T. in Tel. Po

RETURN TO LOS ANGELES COUNTY SURVEYOR 700 HALL OF RECORDS

Do not extend notes this side of this line.

Note: Any Additions or Changes on This Sheet Must be Made or Circled in Red Ink With Date and Name of Person Making Change.

FORM 247, RM. 11-41

RETURN TO
**LOS ANGELES COUNTY SURVEYOR**
700 HALL OF RECORDS

Note: Any Additions or Changes on This Sheet Must be Made or Circled in Red Ink With Date and Name of Person Making Change.

**Do not extend notes this side of this line.**

F.B. 703 PG. 75

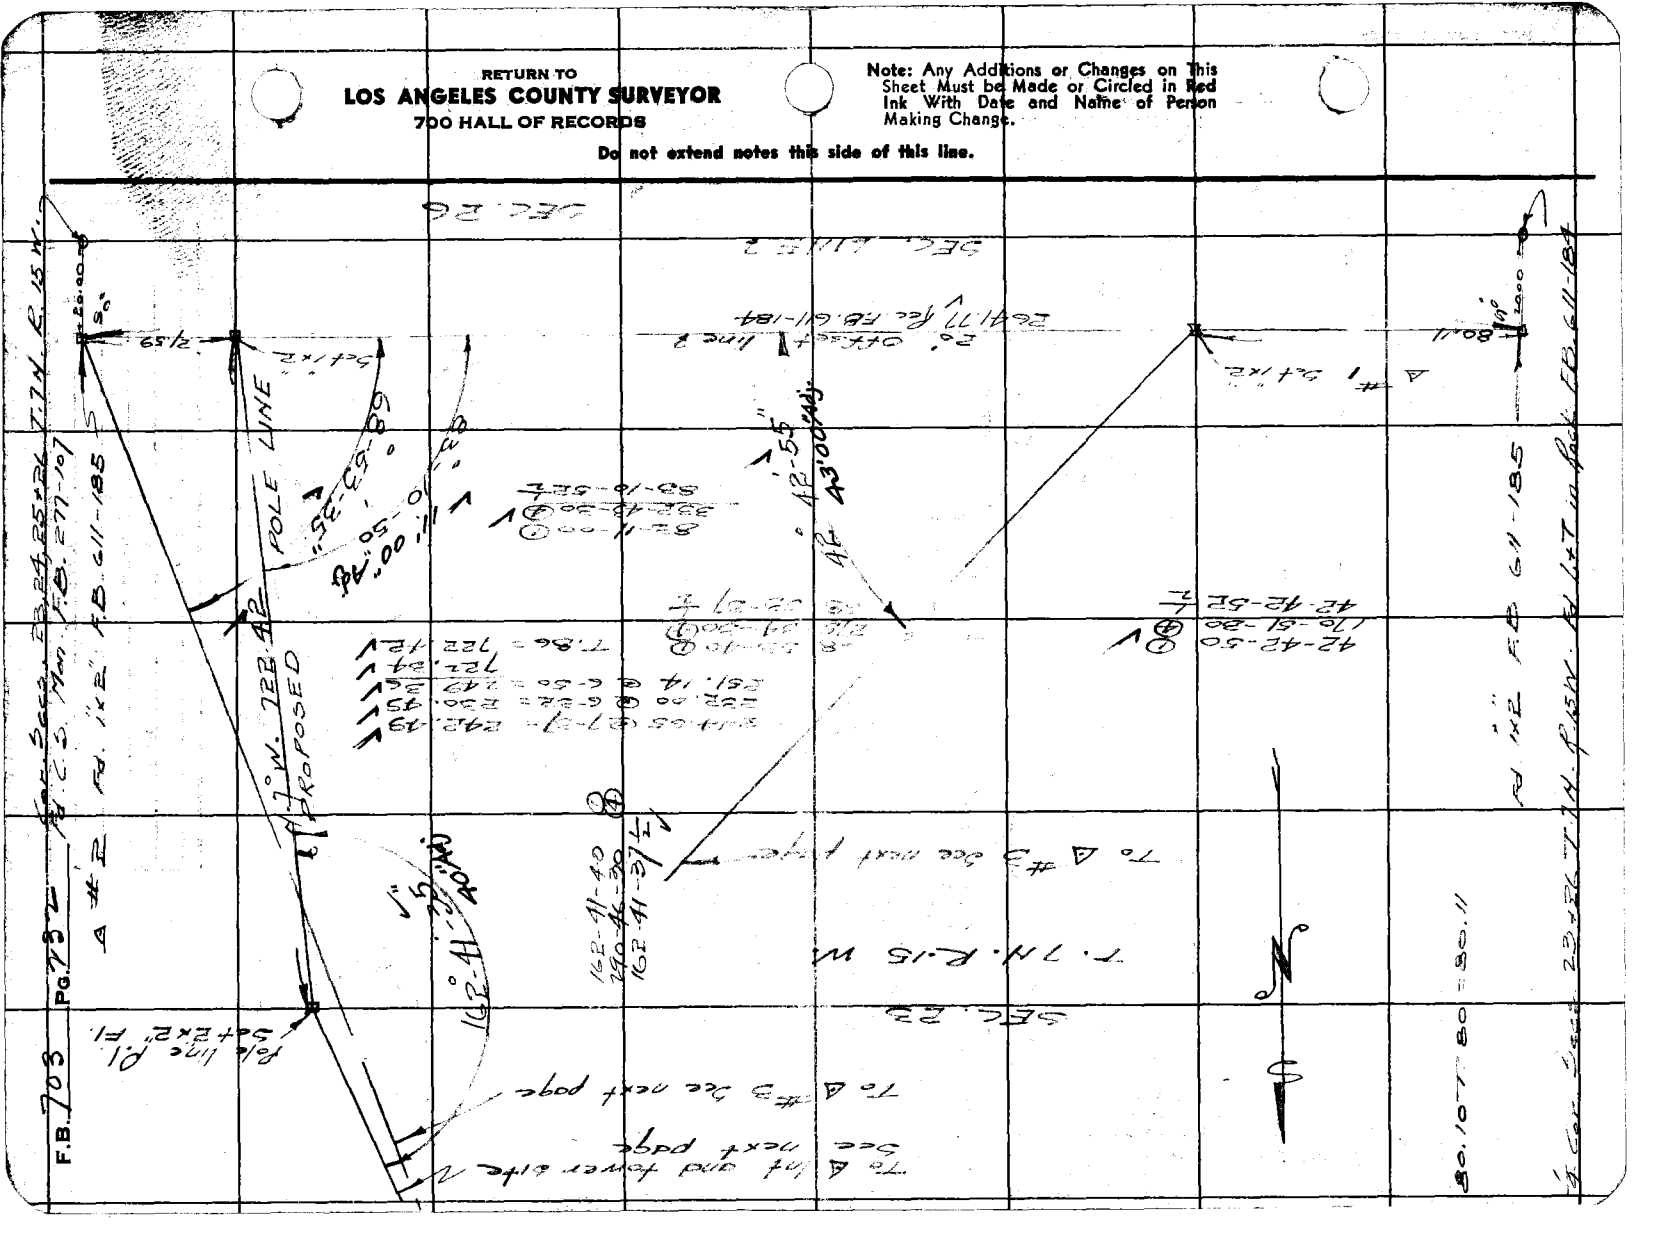
POLE LINE
PROPOSED
Pole line Pl.
5d+2x2" Fl.
Sec. 23
T. 7N. R. 15 W.
Sec. 24
T. 7N. R. 15 W.
Sec. 25
T. 7N. R. 15 W.
Sec. 26
T. 7N. R. 15 W.
Rd. 1x2" F.B. 611-185
Rd. 1x2" F.B. 277-107
Rd. 1x2" F.B. 611-184
Rd. 1x2" F.B. 611-185
A #2
A #1
A #3
To A #3 See next page
To A light and power pole See next page
To A #3 See next page
To A #2 See next page
S 0° 00' 00" E 80.11
S 0° 00' 00" E 80.107
80.11 - 80 = 0.11
80.107 - 80 = 0.11
Adj.
Adj.
Adj.

FORM 247 SM 11-41

RETURN TO
**LOS ANGELES COUNTY SURVEYOR**
700 HALL OF RECORDS

Note: Any Additions or Changes on This Sheet Must be Made or Circled in Red Ink With Date and Name of Person Making Change.

**Do not extend notes this side of this line.**

Notes Ck'd by [illegible]
Map No. S.P. 133-33
Office Work [illegible]
Checked [illegible]
Date Sept 1946

Survey of Tel. line relocated Oct.
W. O. 8024 Tape No. 77 Std. 66 °F
Surveyed by [illegible]
Notes [illegible]
Date 8-[illegible]-46
Indexed

F.B. 703 PG. 2-3

New proposed radio tower site Set 2x2

161.82 @ 2-49 T. 84 = 161.65

161.65

Triangulation line + pole line Int. Set tie

102.09

32.22

Original proposed tower site

Set tie

△ #3 Set 1x2

71°-24'-15" 20" Adj

68°-23'-25"

68-23-10 ②
-73-32-10 ④
68-22-25

71-24-00 ⑧
-85-36-50 ⑥
11-24-12 ⑤
Short 3 sights

1137.14 Proposed pole line 1200.60 Adj. for closure

1137.05
1137.14
180.37

T 80 =

Set 2x2 Tel. line

64.22

| | | |
|---|---|---|
| 161.28 @ 22-00 = | 141.06 | |
| 85.83 @ 88-00 = | 141.98 | |
| 168.50 @ 35-03 = | 137.94 | |
| 255.24 @ 25-35 = | 266.15 | |
| 115.56 @ 54-[illegible] = | 118.99 | |
| 76.43 @ 18-19 = | 72.56 | |
| 190.00 @ 17-10 = | 181.54 | |

T 80 = 1137.14

70 △ #1

70 △ #2

T.P. 2"x2" Pole line
P.I.

F.B. 703 PG. 134




RETURN TO
LOS ANGELES COUNTY SURVEYOR
700 HALL OF RECORDS

Do not extend notes this side of this line.

Note: Any Additions or Changes on This Sheet Must be Made or Circled in Red Ink With Date and Name of Person Making Change.

Form 301 10M 2-54

3830

PLEASE RETURN TO
LOS ANGELES COUNTY SURVEYOR
700 HALL OF RECORDS

NOTE: ANY ADDITIONS OR CHANGES ON THIS SHEET MUST BE MADE ON CIRCLED IN RED INK, WITH DATE AND NAME OF PERSON MAKING CHANGE

Do not extend notes this side of this line

| Transit at | Sight to | Vertical Angle Readings | Stadia Distance | Stadia Rod | Horizontal Angle 0° to 360° Right | Horiz. Distance | + − | Vertical Angle | Elevation of Point | Rod Sight | + − | Difference Elevation | Height of Instrument | + − | Vertical Distance | F.S. Left | F.S. Right |
|---|---|---|---|---|---|---|---|---|---|---|---|---|---|---|---|---|---|
| TOPOGRAPHY AT RADIO TOWER SITE PINE CANYON | | | | | | | | | | | | | | | | | |
| PATROL STATION | | | | | | | | | | | | | | | | | |
| | | | | | | | | | | | | | | | TRANSIT | 4200 | |
| 1"x2" Proposed | | | | | | | | | 3830.0 | 5.2 | | 38352 | | | | | |
| Int. Pole | 6 | 616 | 12 | 15.8 | 00.00 | 17 | | 0.0 | 294 | | | 58 | | | | Edge of | Pavement |
| Pole Line | 11 | 1160 | 61 | 12.0 | 00.00 | 61 | | 4.20 | 189 | | | 166 | | | 16 | S.H. | |
| Pine Tree | 5 | 552 | 53 | 4.6 | 93.32 | 53 | | 0.0 | 306 | | | 46 | | | 00 | Edge of | Pavement |
| + | 11 | 1175 | 76 | 11.0 | 323.40 | 76 | | 4.55 | 180 | | | 175 | | | 6.5 | S.H. | |
| Line | 5 | 598 | 99 | 5.5 | 289.55 | 99 | | 0.0 | 297 | | | 55 | | | | Edge of | Pavement |
| | 11 | 1204 | 105 | 11.0 | 306.00 | 105 | | 3.05 | 189 | | | 166 | | | 5.0 | S.H. | |
| | 9 | 1037 | 138 | 9.5 | 291.33 | 138 | | 0.0 | 25 | | | 95 | | | | Edge of | Pavement |
| | 13 | 1450 | 151 | 14.0 | 302.53 | 151 | | 1.52 | 162 | | | 189 | | | 4.9 | S.H. | |
| | 10 | 1166 | 167 | 11.0 | 294.20 | 167 | | 0.54 | 217 | | | | | | | Edge of | Pavement |
| | 10 | 1180 | 181 | 16.0 | 301.27 | 181 | | 1.45 | 140 | | | | | | | S.H. | |
| | 10 | 1191 | 192 | 11.0 | 280.05 | 192 | | 1.38 | 190 | | | | | | | Trail | |
| | 9 | 1106 | 207 | 15.0 | 262.21 | 207 | | 1.20 | 154 | | | 198 | | | 4.2 | Edge of | Pavement |
| | 9 | 1050 | 151 | 9.3 | 270.10 | 151 | | 0.0 | 259 | | | | | | | Gr. | |
| | 10 | 1182 | 185 | 13.0 | 247.44 | 183 | | 0.0 | 222 | | | | | | | Edge | G |
| | 4 | 512 | 113 | 4.2 | 253.50 | 113 | | 0.0 | 310 | | | | | | 4.7 | Gr. | |
| | 1 | 871 | 172 | 8.0 | 231.22 | 172 | + | 0.25 | 285 | | | | | | | Edge | |

Notes Red. _____ Plotted 2/11/ DRN _____ Job No. 1277 Bridge No. _____

P.S. 109 Pg. 2-33

Form 301 1M 3-54

PLEASE RETURN TO

LOS ANGELES COUNTY SURVEYOR

700 HALL OF RECORDS

NOTE: ANY ADDITIONS OR CHANGES ON THIS SHEET MUST BE MADE OR CIRCLED IN RED INK. WITH DATE AND NAME OF PERSON MAKING CHANGE

Do not extend notes this side of this line

| Transit at | Right or Left | Stadia Readings | Stadia Distance | Stadia Angle | Horizontal Angle 0° to 360° | Right | Horiz. Distance | + or − | Vertical Angle | Elevation of Point | + Back Sight | + or − | Difference Elevation | Height of Instrument | + or − | Vertical Distance | REMARKS: Station | Left | Right |
|---|---|---|---|---|---|---|---|---|---|---|---|---|---|---|---|---|---|---|---|
| Ave | | | | | | | 81 | | | | 1 | | 08 | 3835 | + | 02 | | | |
| Lot | Pole | 180 / 1 | 81 | 1 0 | 276 | 20 | 81 | + | 0 10 | 344 | ✓ | | | | | | Cor. field | | |
| ℄ line | line | 671 / 5 | 172 | 5 0 | 212 | 05 | 172 | + | 1 10 | 340 | 2 | | | | | | Edge Cor. field | | |
| ℄ pole | to S | 187 / 2 | 88 | 1 0 | 191 | 37 | 88 | + | 1 38 | 381 | 3 | | | | | | " | " | |
| | | 687 / 5 | 188 | 5 0 | 195 | 22 | 188 | + | 2 10 | 373 | 4 ✓ | | | | | | " | " | |
| | | 307 / 2 | 108 | 2 0 | 162 | 31 | 108 | + | 1 40 | 367 | 5 ✓ | | | | | | " | " | |
| | | 823 / 6 | 224 | 7 0 | 182 | 59 | 223 | + | 2 32 | 381 | 6 ✓ | | | | | | " | " | |
| | | 296 / 1 | 147 | 1 9 | 144 | 45 | 147 | − | 0 0 | 333 | 7 ✓ | | | | | | " | " | |
| | | 1165 / 9 | 266 | 10 0 | 172 | 35 | 266 | + | 2 19 | 354 | 8 ✓ | | | | | | " | " | |
| | | 593 / 2 | 194 | 4 6 | 137 | 20 | 194 | − | 0 0 | 306 | 9 ✓ | | | | | | " | " | |
| | | 1215 / 9 | 316 | 10 0 | 166 | 00 | 316 | + | 2 01 | 368 | 10 | | | | | | " | " | |
| | | 890 / 6 | 242 | 7 4 | 131 | 20 | 242 | − | 0 0 | 278 | 11 ✓ | | | | | | " | " | |
| | | 1145 / 8 | 346 | 15 0 | 158 | 20 | 346 | + | 1 32 | 288 | 12 | | | | | | " | " | |
| | | 1126 / 9 | 227 | 12 0 | 112 | 50 | 227 | − | 0 0 | 232 | 13 ✓ | | | | | | " | " | |
| | | 783 / 5 | 284 | 6 0 | 153 | 50 | 284 | + | 1 10 | 349 | 14 ✓ | | | | | | " | " | |
| | | 1126 / 9 | 227 | 10 0 | 91 | 42 | 226 | − | 3 38 | 111 | 15 ✓ | | | | | | " | " | |
| | | 1022 / 8 | 223 | 9 0 | 87 | 00 | 221 | − | 4 38 | 082 | 16 ✓ | | | | | | " | | |
| | | 1180 / 10 | 181 | 11 0 | 58 | 35 | 181 | − | 2 48 | 153 | 17 ✓ | | | | | | " | " | |
| | | 1102 / 10 | 133 | 11 0 | 71 | 31 | 133 | − | 2 55 | 177 | 18 ✓ | | | | | | " | | |
| | | 1137 / 10 | 128 | 12 6 | 86 | 50 | 128 | − | 0 0 | 226 | 19 ✓ | | | | | | " | " | |
| | | 1185 / 11 | 86 | 11 2 | 57 | 45 | 86 | − | 0 0 | 233 | 20 ✓ | | | | | | " | | |
| | | 655 / 10 | 56 | 6 8 | 80 | 55 | 56 | − | 0 0 | 226 | 21 | | | | | | " | " | |

Form 301 Rev. 8-56

RETURN TO:
LOS ANGELES COUNTY SURVEYOR
700 HALL OF RECORDS

NOTE: ANY ADDITIONS OR CHANGES ON THIS SHEET MUST BE MADE OR CANCELED IN RED INK, WITH DATE AND NAME OF PERSON MAKING CHANGE

Do not extend notes this side of this line

| Transit at | Sight on | Stadia Intercepts | Stadia Distance | Stadia Rod— | Horizontal Angle 0° to 360° Right | Horiz. Distance | + − | Vertical Angle | Elevation of Point | + Back Sight | + − | Difference Elevation | Height of Instrument | + − | Vertical Distance | B.M. & C.P. Records | B.M.'S Left | B.M.'S Right | Sta. |
|---|---|---|---|---|---|---|---|---|---|---|---|---|---|---|---|---|---|---|---|
| | | | | | ° ′ | | | ° ′ | | 1 | | | | | | | | | |
| | | | | | ° ′ | | | ° ′ | | 2 | | | | | | | | | |
Alt'n'l Interm.

Notes Red. Platted Job No. Division No. F.B. 723 Pg. 21

Notes Blue Date Surveyed

Notes Black Checked Survey by Notes Date

Date Map No. Indexed Data

Data

| | | | |
|---|---|---|---|
| | Saddle | Sad. | |
| | Swale | Sw. | |
| | Flat | Fl. | |
| | Stream | Str. | |
| | Trail | Tr. | |
| | Pavement | Pvt. | |
| | Edge of Road | E. Rd. | |