RETURN TO
LOS ANGELES COUNTY SURVEYOR
720 LOS ANGELES COUNTY
ENGINEERING BLDG.

Note: Any Additions or Changes on this Sheet Must Be Made in Ink or Changes in Red Ink With Date and Name of Person Making Change.

Do not extend notes this side of this line.

706

F. B. _____ Pg. _____

76F309S 247 10M 1-49

RETURN TO
LOS ANGELES COUNTY SURVEYOR
726 LOS ANGELES COUNTY
ENGINEERING BLDG.

Note: Any Additions or Changes or This Sheet Must be Made or Circled in Red Ink With Date and Name of Person Making Change.

Do not extend notes this side of this line.

Notes Ck'd by
Map No.
Office Work
Checked
Date

Survey of
W. O. Tape No. St'd °F
Surveyed by
Notes Date
Indexed

F. B. PG.

FORM 247 10M 11-35

RETURN TO
LOS ANGELES COUNTY SURVEYOR
700 HALL OF RECORDS

Note: Any Additions or Changes on This Sheet Must be Made or Circled in Red Ink With Date and Name of Person Making Change.

Do not extend notes this side of this line

DESIGN SURVEYS — INDEX TO FIELD BOOK No. 706 — WEST HOLLYWOOD DRAINAGE SYSTEM

Date	J.N.	Location		Notes	Pages
April '37	6318	ROSEWOOD - HAYWORTH AVE, Lateral. on Rosewood Ave. from Kings Rd. to Hayworth Ave,	Sheet 5	℄ ties topog. profile	1-11 & 86-88 19-29 & 89-92 35-53 & 92-100
		The old LAUREL AVE. BR. change d to Rosewood -Hayworth Ave. Lateral. ℄ ties, topog,& Profile. from Rosewood Ave. N.on Laurel Ave. not used.		℄ ties topog. profile	1-18 19-34 35-70
"	"	EDINBURGH AVE. STUB. on Melrose Ave. from Laurel Ave.to Edinburgh	(old sheet 6)	℄ ties topog. profile	71-74 75-78 79-84
MAY "	"	SANTA MONICA BLVD. Lateral. from Havenhurst Dr. to Hayworth Ave.	Sheet 4	℄ ties topog. profile	101-110 111-120 121-136
"	"	WILLOUGHBY - HAYWORTH AVE. Lateral on Willoughby Ave. from Kings Rd.to Hayworth Ave.	Sheet 5	℄ ties topog. profile	137-146 147-156 157-182
"	"	WARING AVE. Lateral from Kings Rd. to Harper Ave.	Sheet 5	℄ ties topog. profile	183-186 187-190 191-200
"	"	MELROSE HAYWORTH AVE. Lateral from Kings Rd.to Hayworth Ave.	Sheet 5	℄ ties topog. profile	201-213 213-222 225-246

Notes Ck'd by ____ Map No. ____ Office Work ____ Checked ____ Date ____

Survey of ____ W. O. ____ Tape No. ____ Std. ____ °F.
Surveyed by ____ Date ____
Notes ____
Indexed ____

F.B. 956 Pg. Title x

RETURN TO
LOS ANGELES COUNTY SURVEYOR
700 HALL OF RECORDS

Note: Any Additions or Changes on This Sheet Must be Made or Circled in **Red Ink** With Date and Name of Person Making Change.

Do not extend notes this side of this line

F.B. _____ PG. _____

Notes Ck'd by	Survey of
Map No.	W. O. 5318 Tape No. [illegible] St'd [illegible] °F.
Office Work	Surveyed by WALLACE
Checked	Notes KI Date [illegible] 1937
Date	Indexed C. Johnson

F.B. 706 Pg. 1

CENTER LINE SURVEY

~~LAUREL~~ AVE. BRANCH

WEST HOLLYWOOD D.S.

W.O. 5318

Topog. F.B. 706 Pg. 19 to 34

Prof. L. F.B. 706 Pg. 35 to 70

SHEET 5

ROSEWOOD-HAYWORTH. LATERAL.

Used the old Notes of LAUREL AVE. ~~BR~~.

from Kings Rd to Laurel Ave.

Wallace
Surveyor
Murray
Teller
Taylor

RECEIVED APR 23 1937

PROGRESSED

BOOK INDEXED

~~MAP INDEXED~~

RECORD INDEXED

CARD INDEXED

RETURN TO
LOS ANGELES COUNTY SURVEYOR
700 HALL OF RECORDS

Note: Any Additions or Changes on This Sheet Must be Made or Circled in Red Ink With Date and Name of Person Making Change.

Do not extend notes this side of this line

FORM 247 10M 11-36

F.B. 706 PG. 2

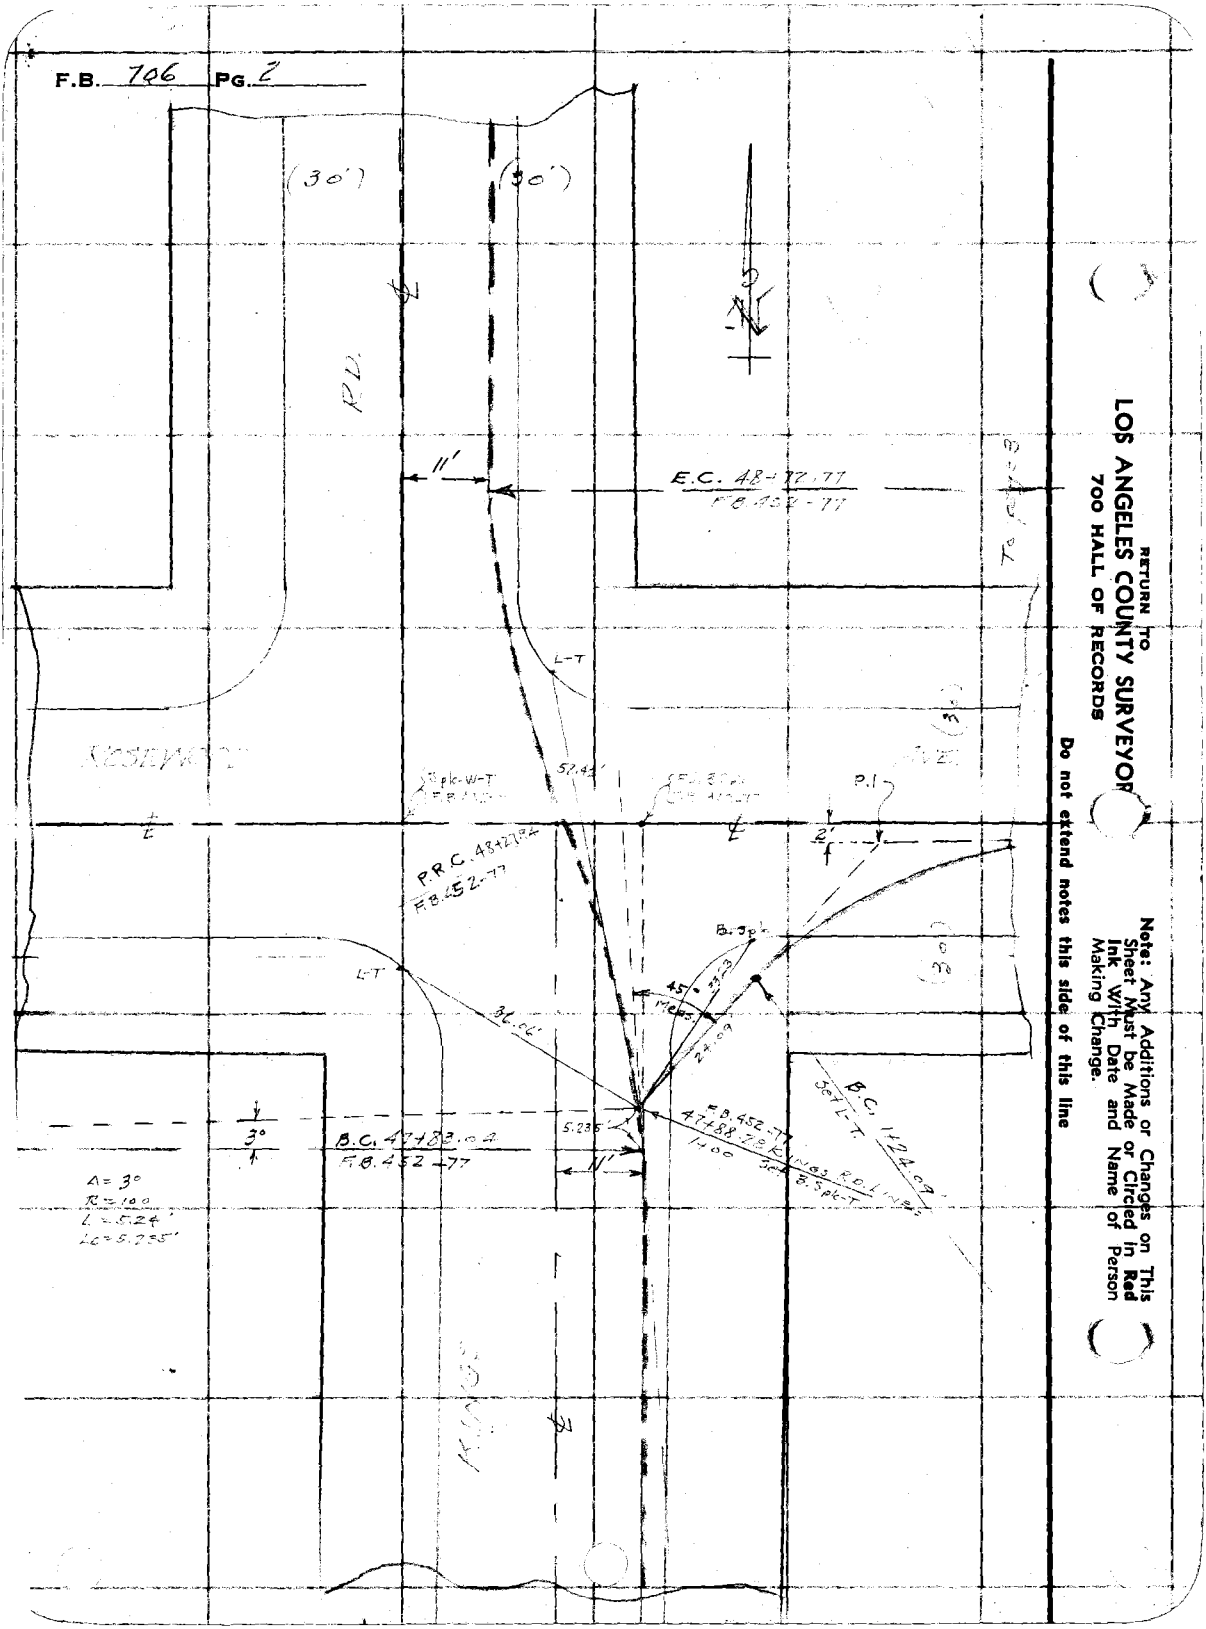

RETURN TO
LOS ANGELES COUNTY SURVEYOR
700 HALL OF RECORDS

Do not extend notes this side of this line

Note: Any Additions or Changes on This Sheet Must be Made or Circled in Red Ink With Date and Name of Person Making Change.

FORM 247 10M 11-25

RETURN TO
LOS ANGELES COUNTY SURVEYOR
700 HALL OF RECORDS

Note: Any Additions or Changes on This Sheet Must be Made or Circled in **Red Ink** With Date and Name of Person Making Change

Do not extend notes this side of this line

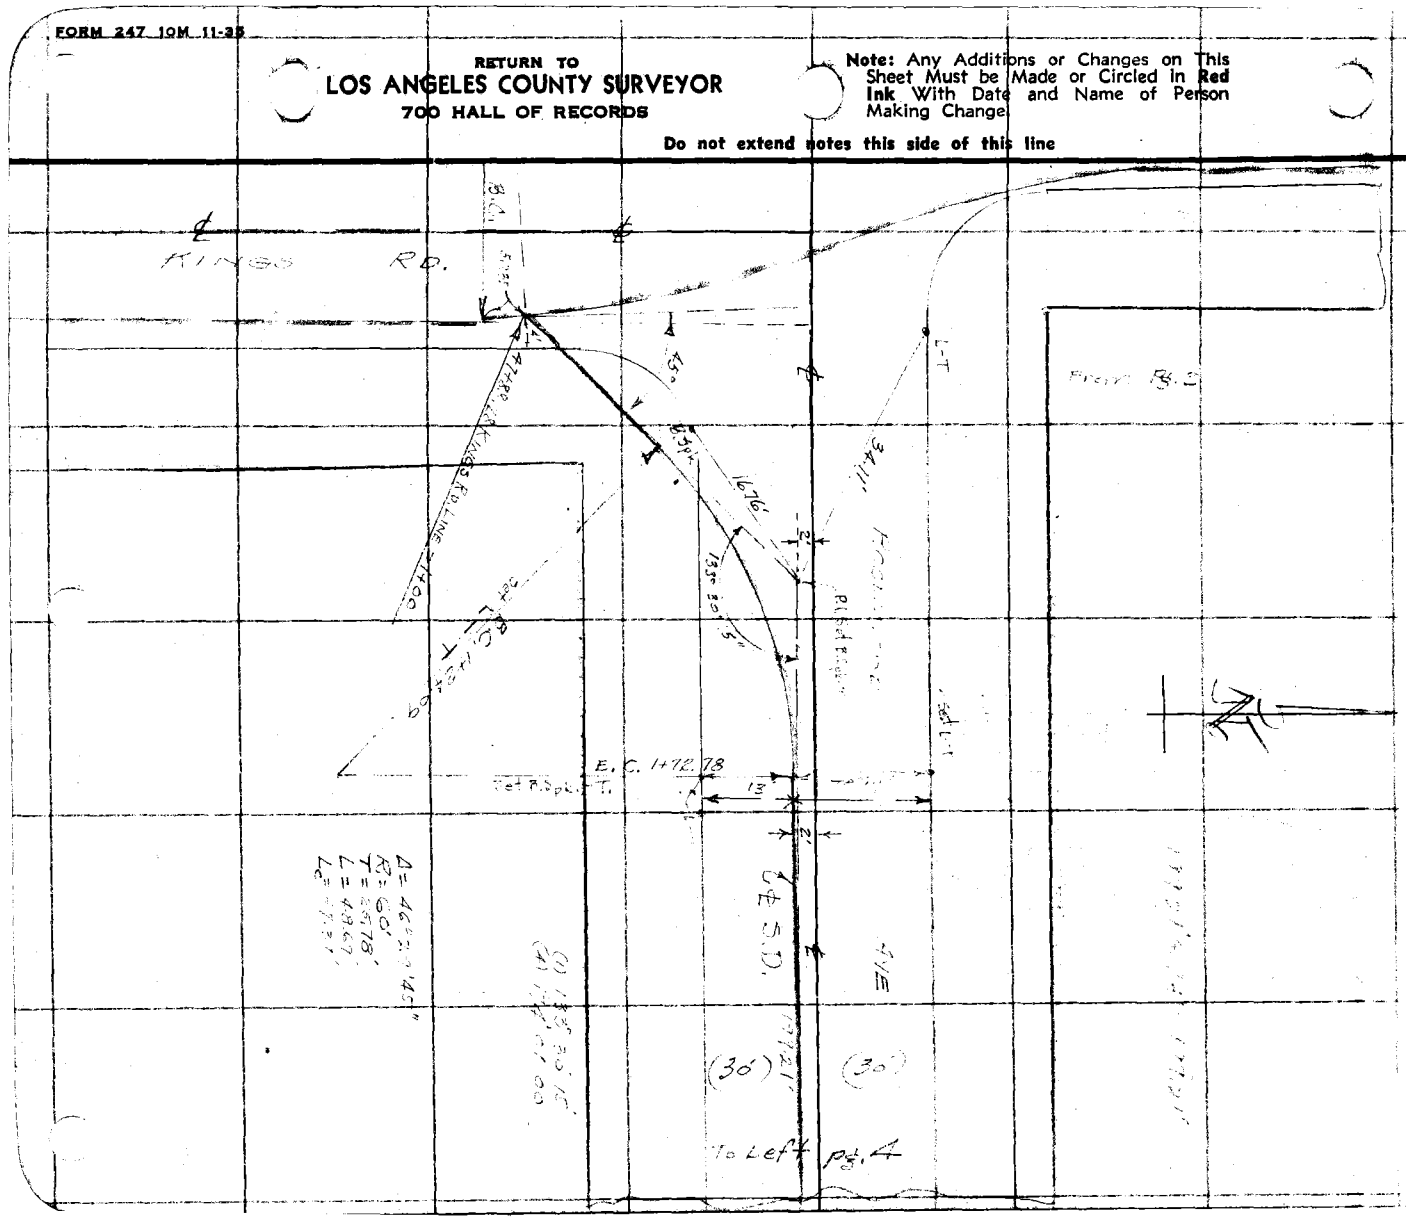

Notes Ck'd by
Map No.
Office Work
Checked
Date

Survey of W. O. 6338 Tape No. 055 Std. 84 °F.
Surveyed by N. Wallace Date 4-13-1
Notes All
Indexed C. Johnson

F.B. 716 PG. 3

F.B. 706 PG. 4

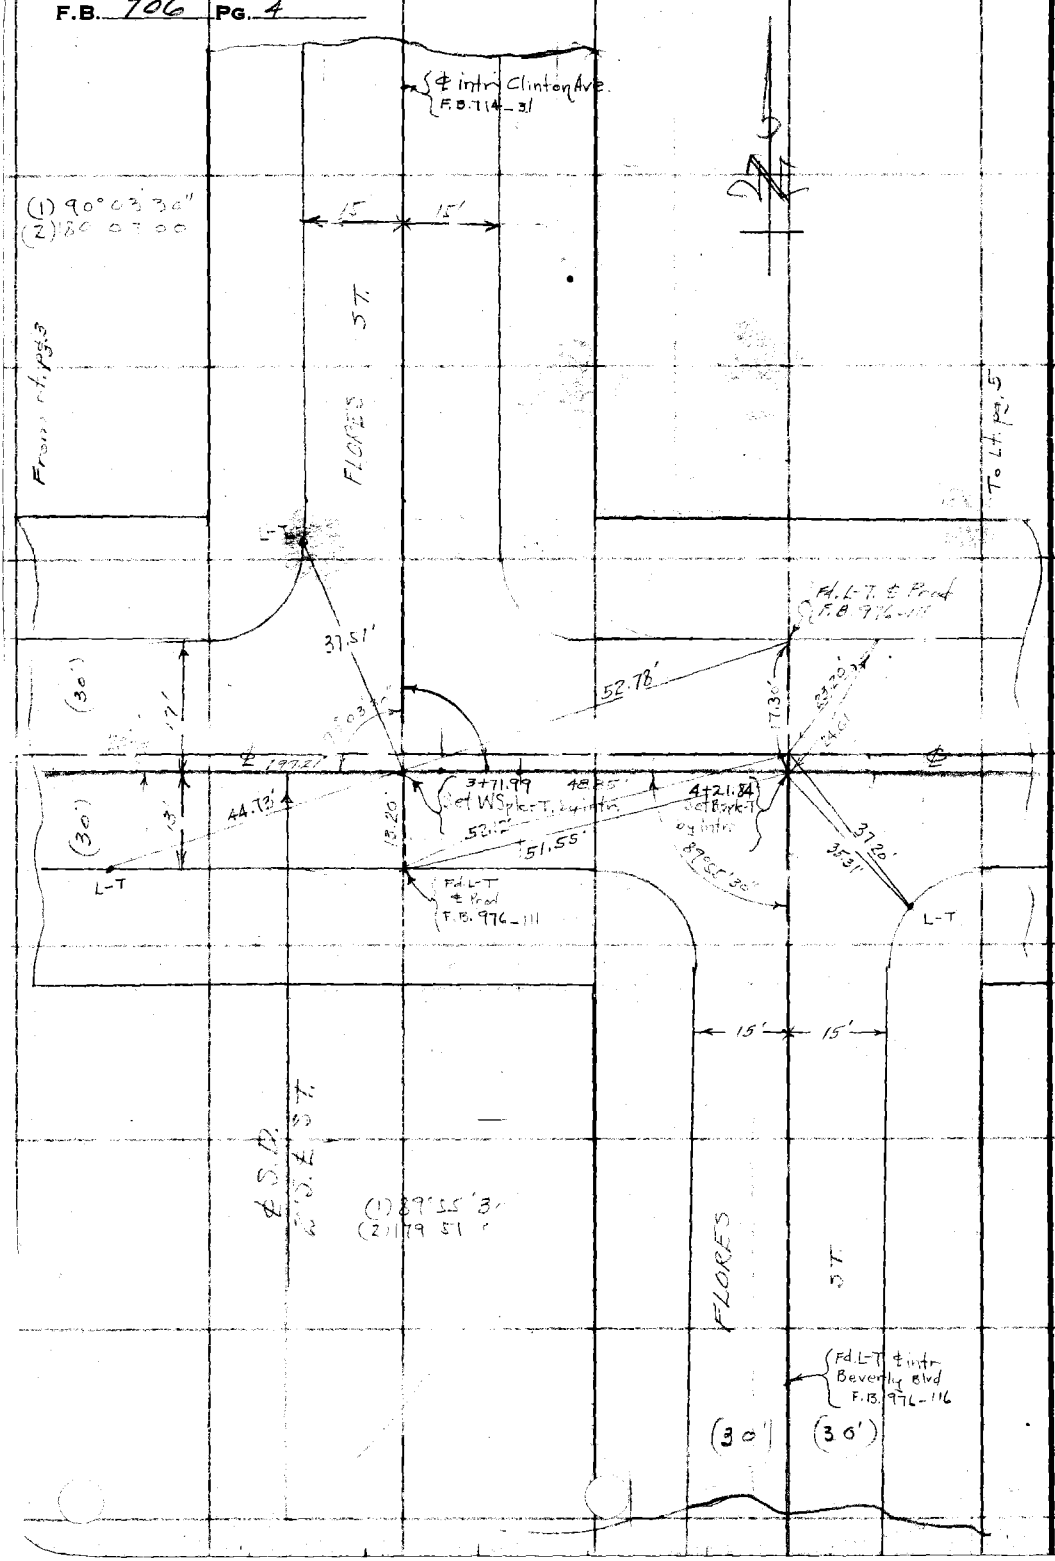

RETURN TO
LOS ANGELES COUNTY SURVEYOR
700 HALL OF RECORDS

Do not extend notes this side of this line

Note: Any Additions or Changes on This Sheet Must be Made or Circled in Red Ink With Date and Name of Person Making Change.

Notes Ck'd by	Survey of
Map No.	W. O. 63.2 Tape No. St'd °F.
Office Work	Surveyed by KVA/LJ 8-54
Checked	Notes W.N. Date April 1954
Date	Indexed C. Johnson

F.B. Pg.

Note: Any Additions or Changes on This Sheet Must be Made or Circled in Red Ink With Date and Name of Person Making Change

Do not extend notes this side of this line

RETURN TO
LOS ANGELES COUNTY SURVEYOR
700 HALL OF RECORDS

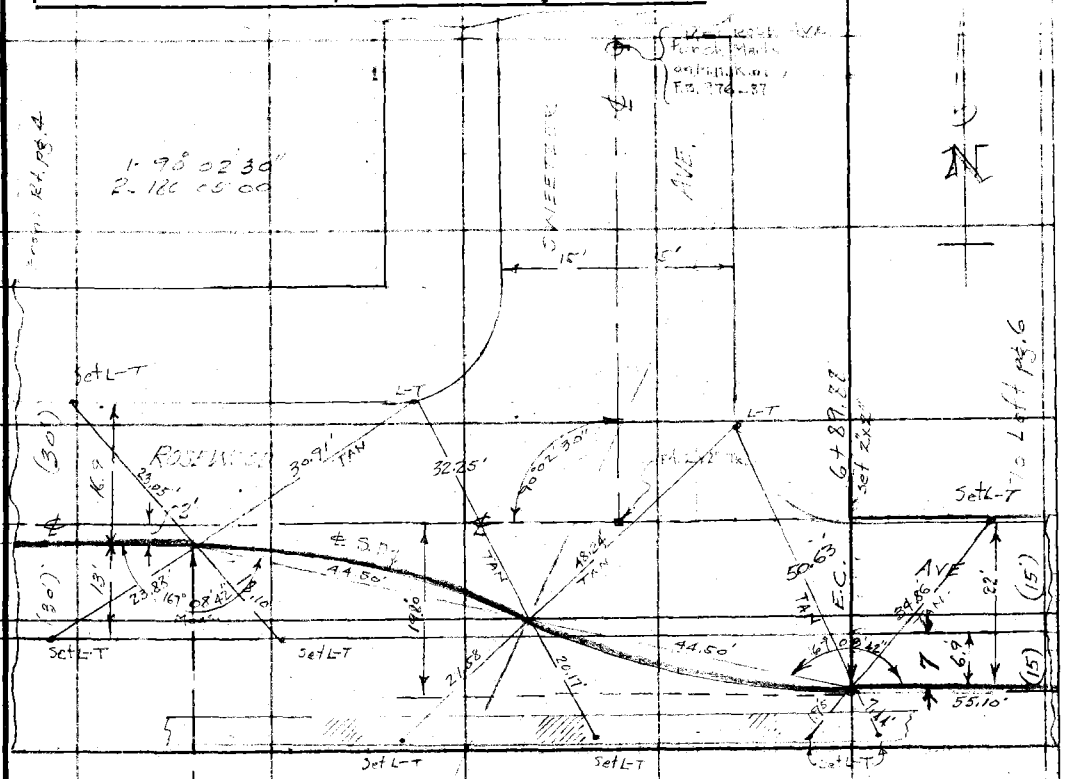

P.R.C. 6+45.00 Set L-T

B.C. 6+00.16 Set L-T

Δ=25°42'36"
R=100'
L=44.86'
Lc=44.50'

Δ=25°42'36"
R=100'
L=44.86'
Lc=44.50'

FORM 247 10M 11-35

F.B. 706 PG. 6

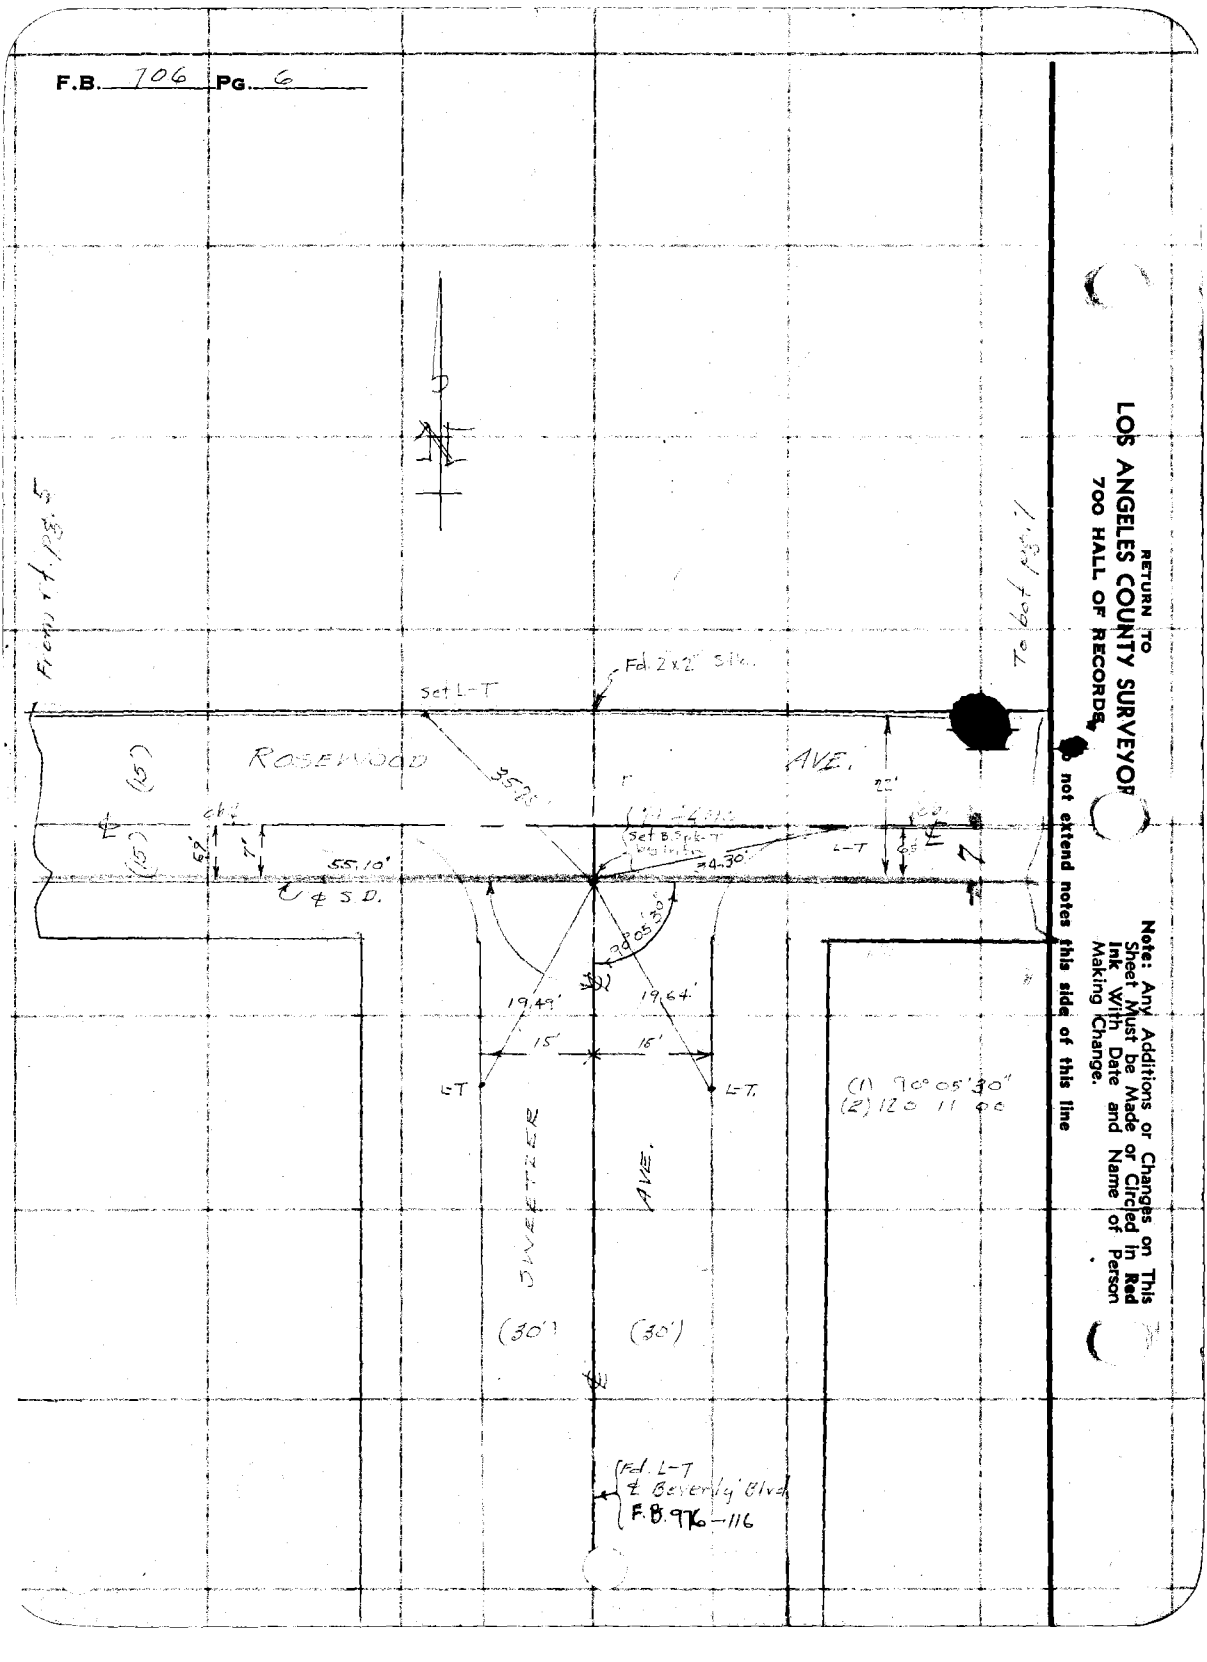
RETURN TO
LOS ANGELES COUNTY SURVEYOR
700 HALL OF RECORDS
Note: Any Additions or Changes on This Sheet Must be Made or Circled in Red Ink With Date and Name of Person Making Change.
Do not extend notes this side of this line
Set L-T
Fd. 2x2" Sq.
ROSEWOOD
AVE.
35.20'
22'
6.8'
7'
55.10'
℄ S.D.
Set B.Spk-T
Position
=4-30'
L-T
20°05'30"
19.49'
19.64'
15'
15'
GT
LT.
SWEETZER
AVE.
(30')
(30')
(1) 70°05'30"
(2) 120 11 00
Fd. L-T
& Beverly Blvd.
F.B. 976-116

Notes Ck'd by	Survey of
Map No.	W. O. 5216 Tape No. 855 St'd 21 °F.
Office Work	Surveyed by
Checked	Notes Date
Date	Indexed

F.B. Pg.

RETURN TO
LOS ANGELES COUNTY SURVEYOR
700 HALL OF RECORDS

Note: Any Additions or Changes on This Sheet Must be Made or Circled in Red Ink With Date and Name of Person Making Change

Do not extend notes this side of this line

FORM 247 10M 11-38

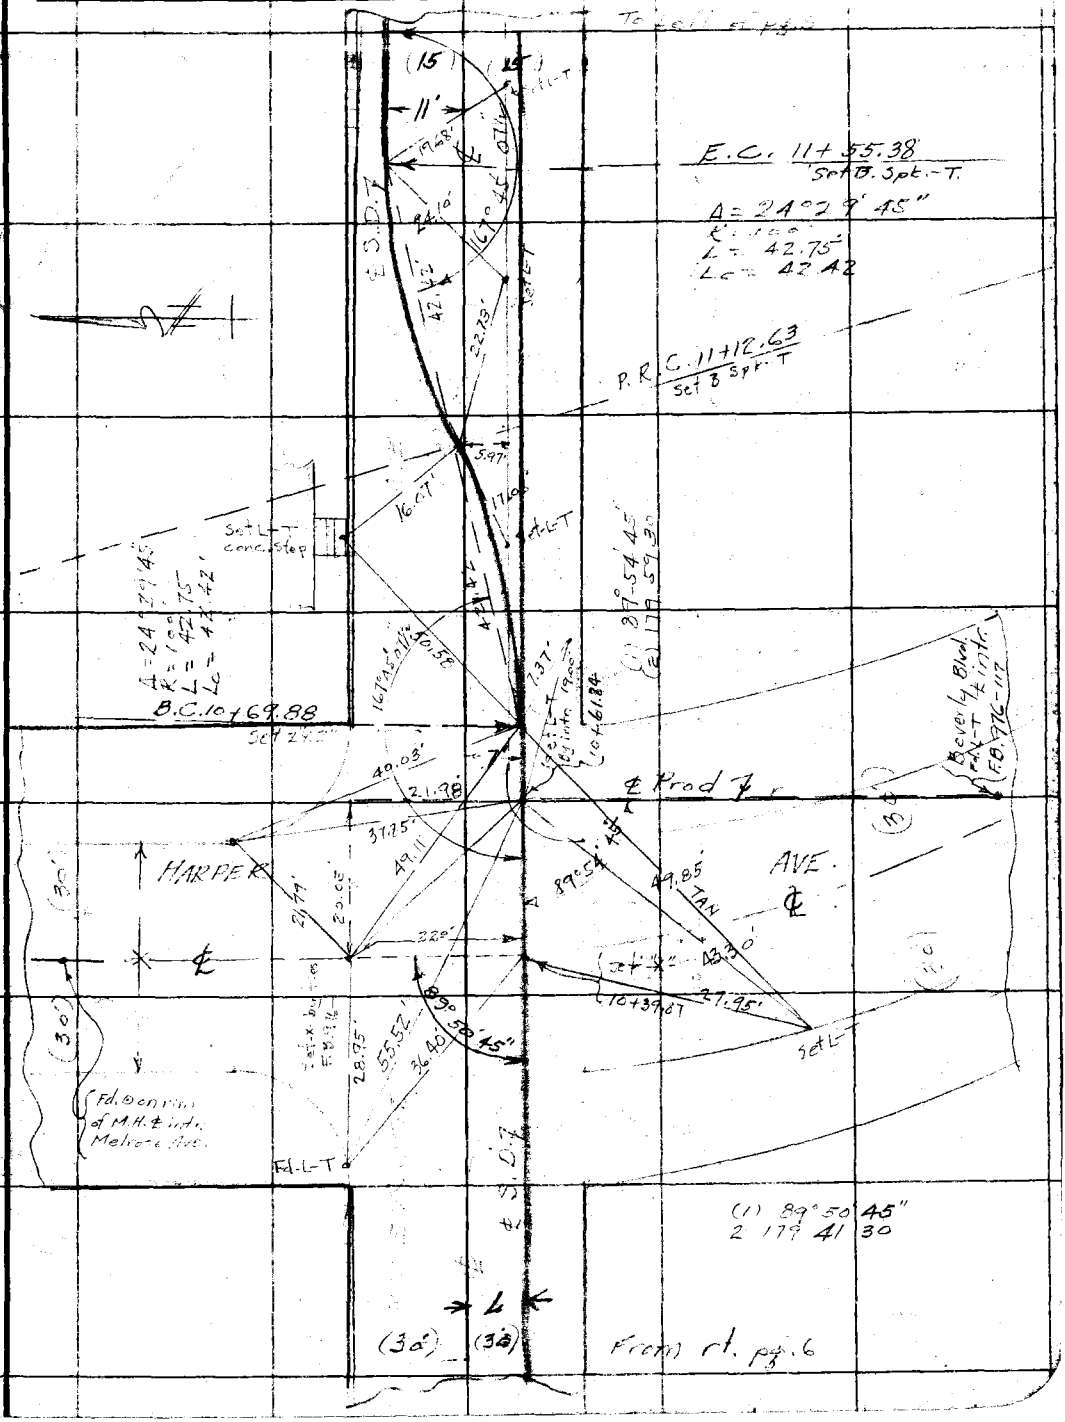

F.B. 706 Pg. 8

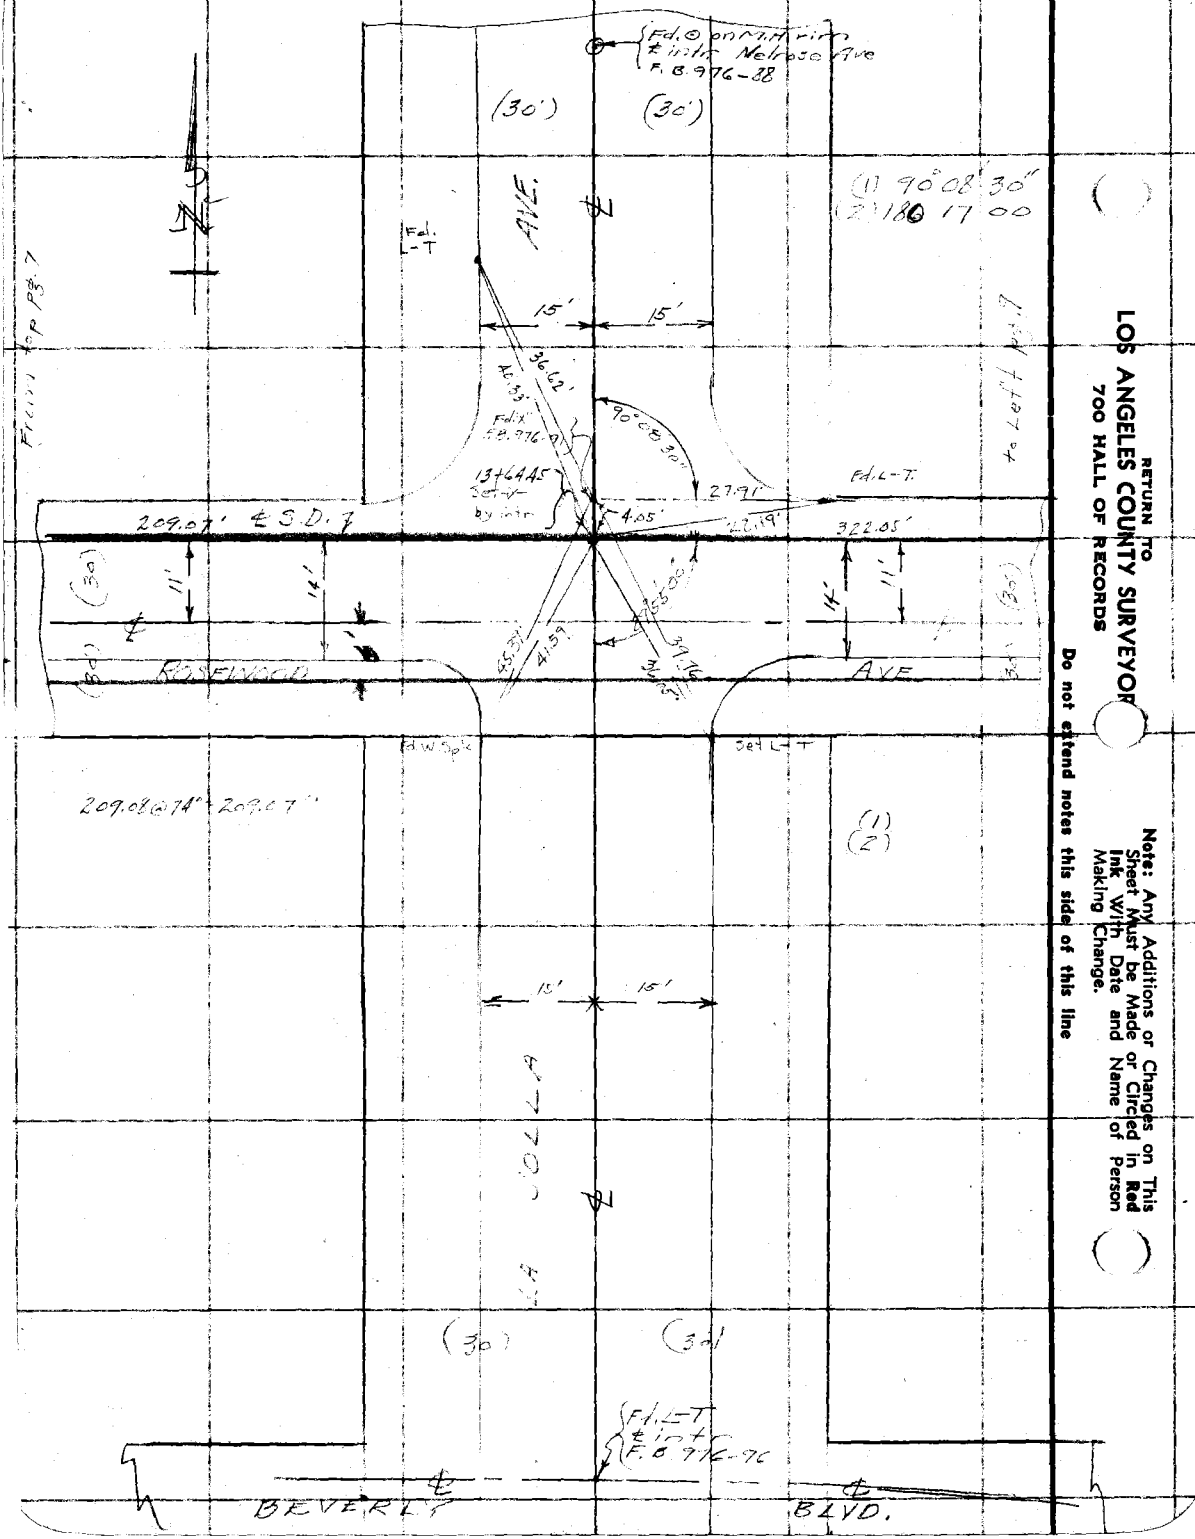

RETURN TO
LOS ANGELES COUNTY SURVEYOR
700 HALL OF RECORDS

Do not extend notes this side of this line

Note: Any Additions or Changes on This Sheet Must be Made or Circled in Red Ink With Date and Name of Person Making Change.

Notes Ck'd by	Survey of
Map No.	W. O. 6318 Tape No. St'd °F.
Office Work	Surveyed by
Checked	Notes Date
Date	Indexed C. Johnson

F.B. Pg.

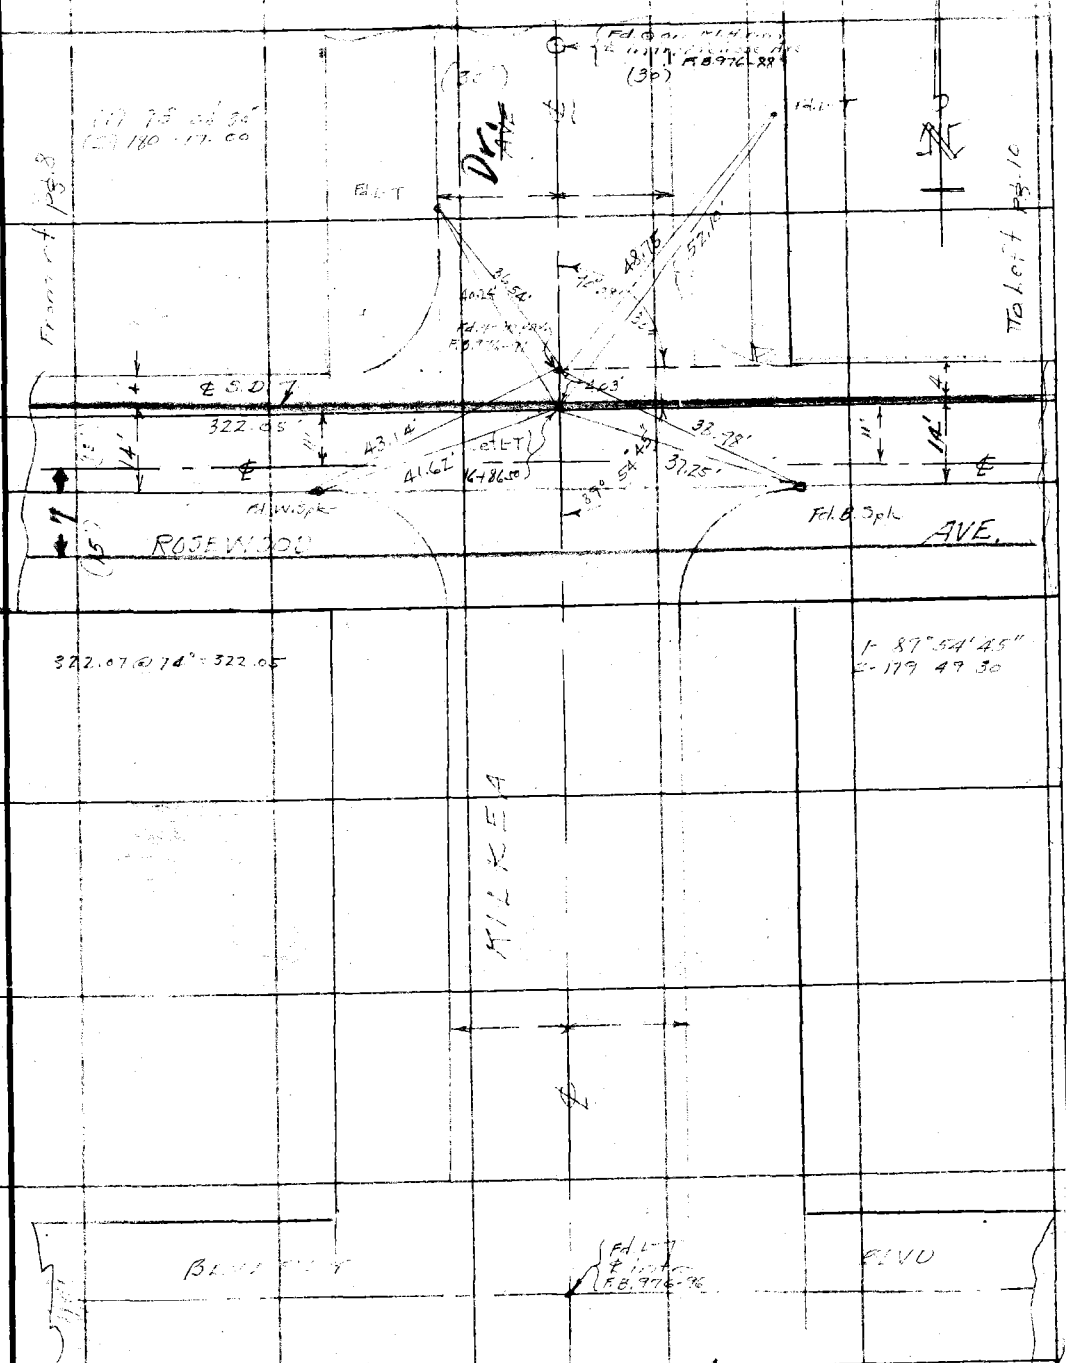

Note: Any Additions or Changes on This Sheet Must be Made or Circled in Red Ink With Date and Name of Person Making Change.

Do not extend notes this side of this line

RETURN TO
LOS ANGELES COUNTY SURVEYOR
700 HALL OF RECORDS

FORM 247 10M 11-35

F.B. 706 Pg. 10

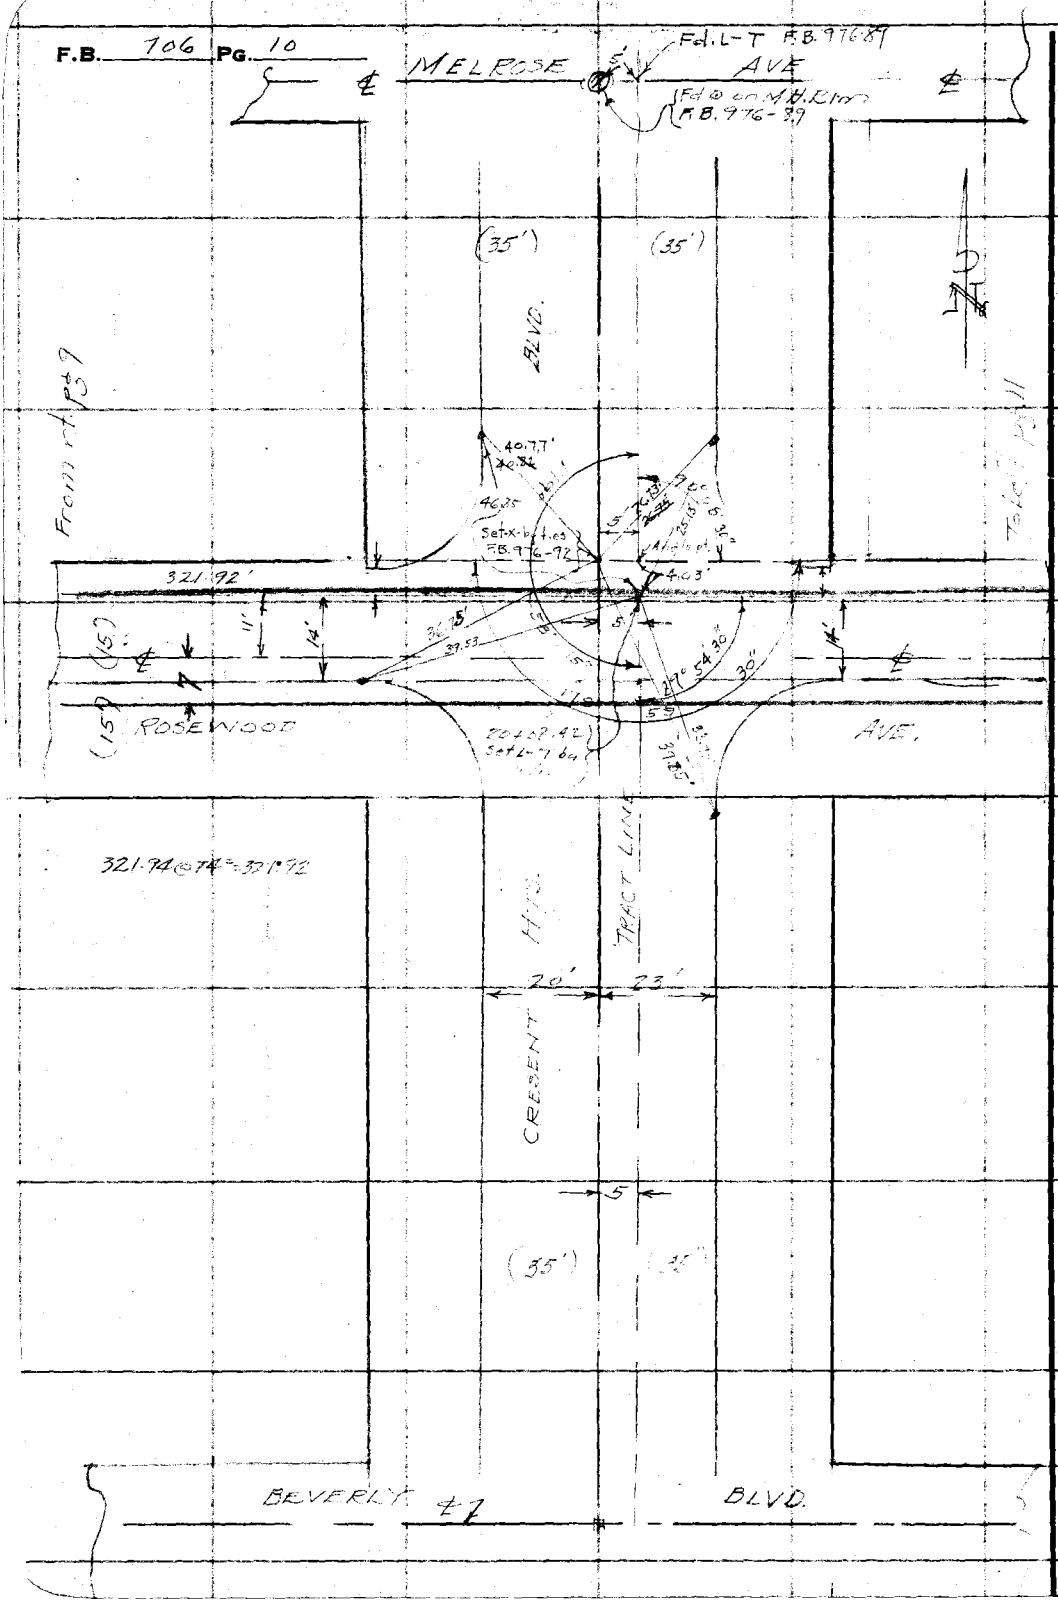

RETURN TO
LOS ANGELES COUNTY SURVEYOR
700 HALL OF RECORDS

Do not extend notes this side of this line

Note: Any Additions or Changes on This Sheet Must be Made or Circled in Red Ink With Date and Name of Person Making Change.

Notes Ck'd by	Survey of
Map No.	W. O. 6318 Tape No. 55 St'd 74°F.
Office Work	Surveyed by Kirkpatrick
Checked	Notes M1. Date Apr. 11 1939
Date	Indexed C. Johnson

F.B. PG.

Note: Any Additions or Changes on This Sheet Must be Made or Circled in Red Ink With Date and Name of Person Making Change.

Do not extend notes this side of this line

RETURN TO
LOS ANGELES COUNTY SURVEYOR
700 HALL OF RECORDS

(30') (30')

24.4' 12.3'

6'

ABANDONED

E.C. 23+64.92

Set B.T. Spk. T.

24.45' 12.3'

90°

20.85'

Set L-T Nail

TAN

(1) 90°-11'-00"
2-180-22-00

(1) 89°-51'-30"
(2) 359°-25'-30"
89°-34'-00"

32°

Δ = 90°08'38"
R = 50'
T = 50.13'
L = 78.67'
Lc = 70.80'

B.C. 22+86.25
Set B.T.

23+14.18
1400
F.B. 96-86

Fd. L-T

(1) 179°-52'-00"
(2) 179°-34'-00"

27.56'

F.B. 96-82

89°-51'-30"

21.31'

19.17'

277.83

11'

14'

36.62'

42°34'

P.I.

Fd. L-T

Fd. L-T

Fd. L-T

ROSEWOOD

Fd. W.S. pk.

AVE.

36.25'

36.25'

Fd. L-T

3°77.85 @ 14°-27'-83'

18' 17.8'

(30') 30'

FORM 247 10M 11-38

F.B. 706 PG. 12

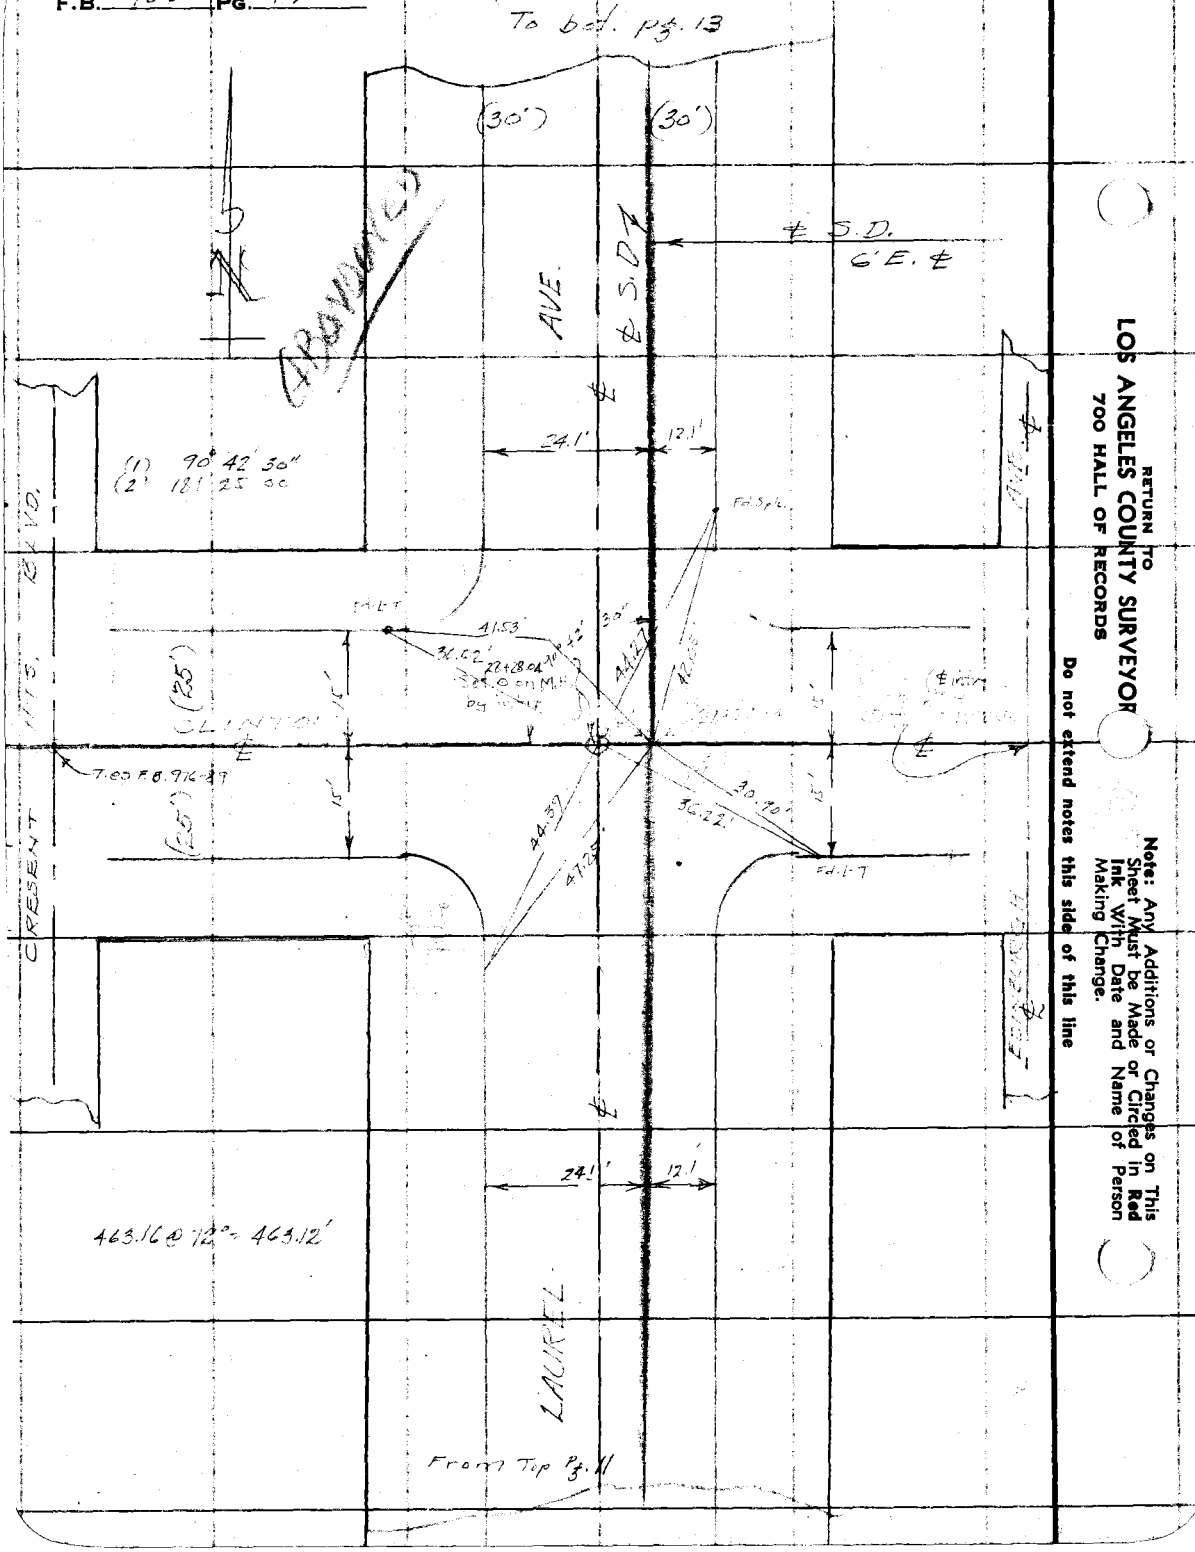

RETURN TO
LOS ANGELES COUNTY SURVEYOR
700 HALL OF RECORDS

Do not extend notes this side of this line

Note: Any Additions or Changes on This Sheet Must be Made or Circled in Red Ink With Date and Name of Person Making Change.

Notes Ck'd by	Survey of
Map No.	W. O. 6318 Tape No. 635 St'd 14 °F.
Offite Work	Surveyed by
Checked	Notes Date
Date	Indexed A. C. Johnson

F.B. Pg.

To bot. pg. 14

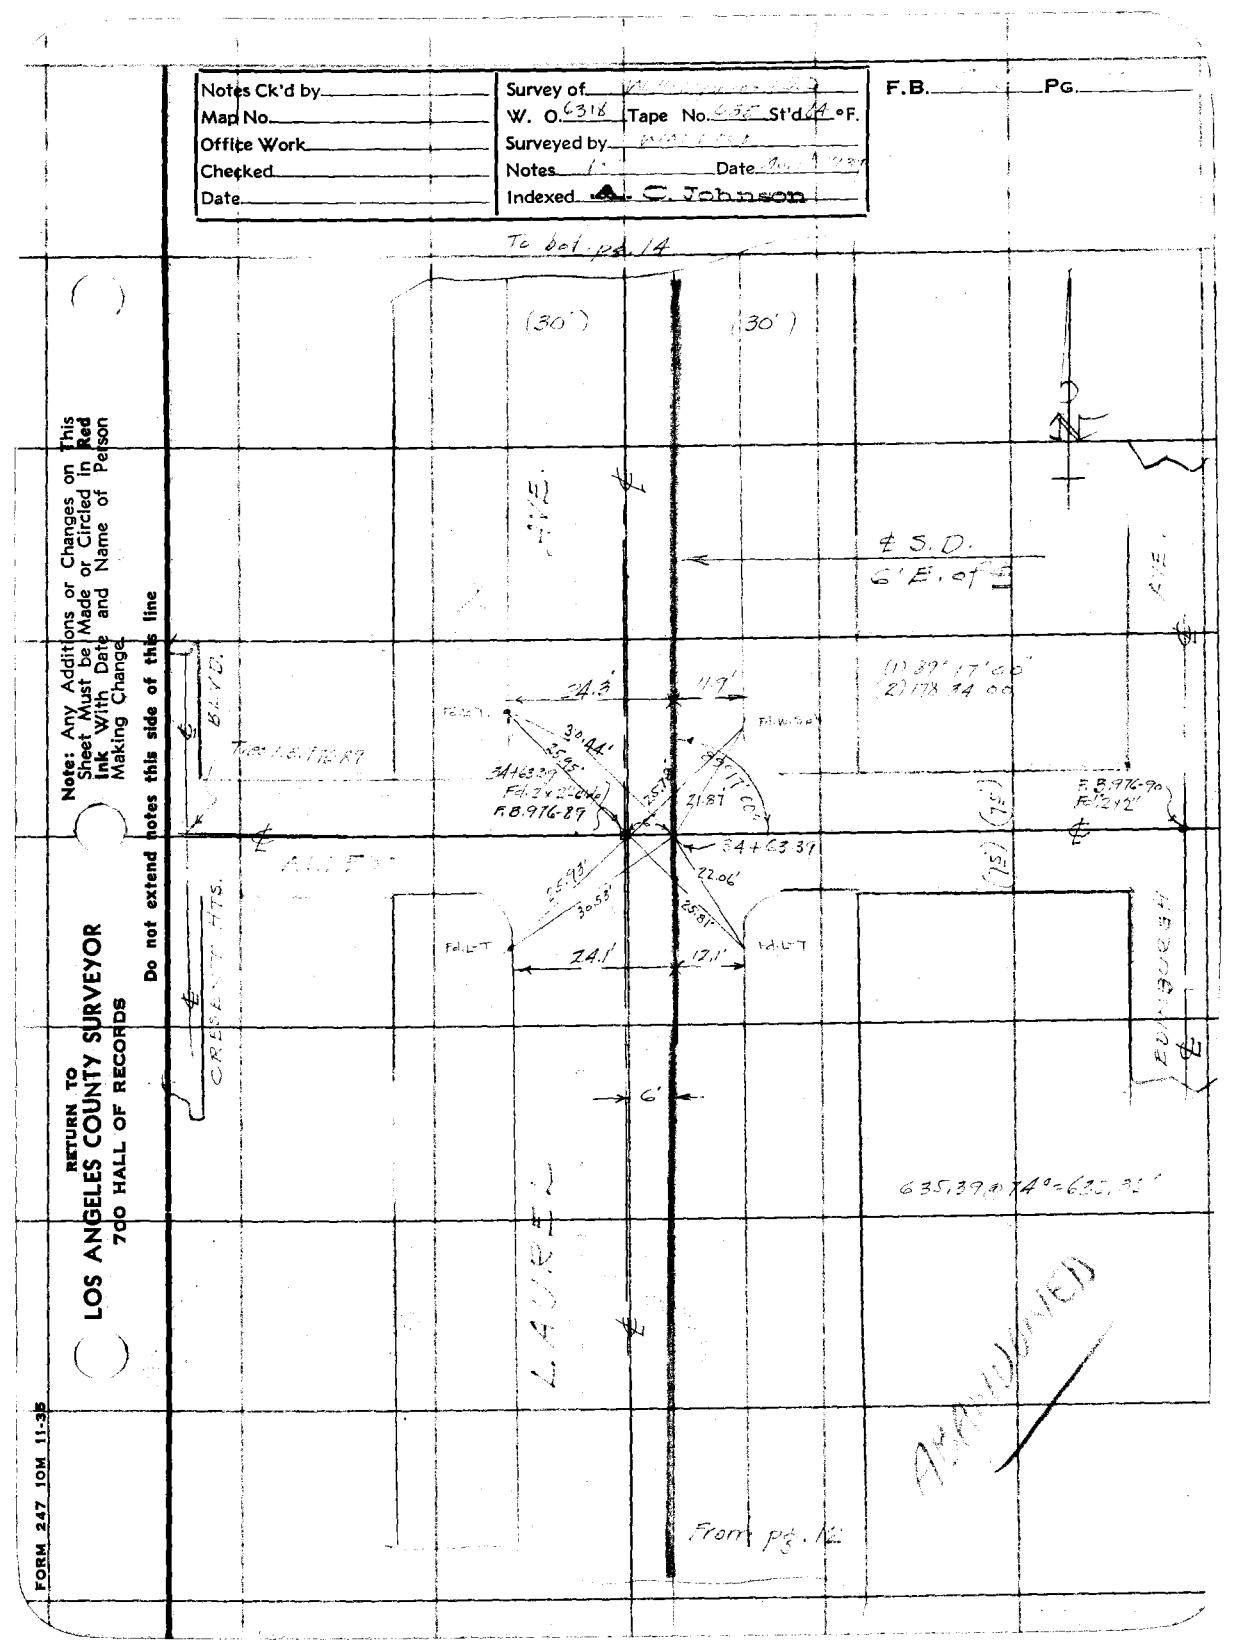

Note: Any Additions or Changes on This Sheet Must be Made or Circled in Red Ink With Date and Name of Person Making Change

Do not extend notes this side of this line

RETURN TO
LOS ANGELES COUNTY SURVEYOR
7dO HALL OF RECORDS

FORM 247 10M 11-35

F.B. 706 Pg. 14

To bef. Pg. 15

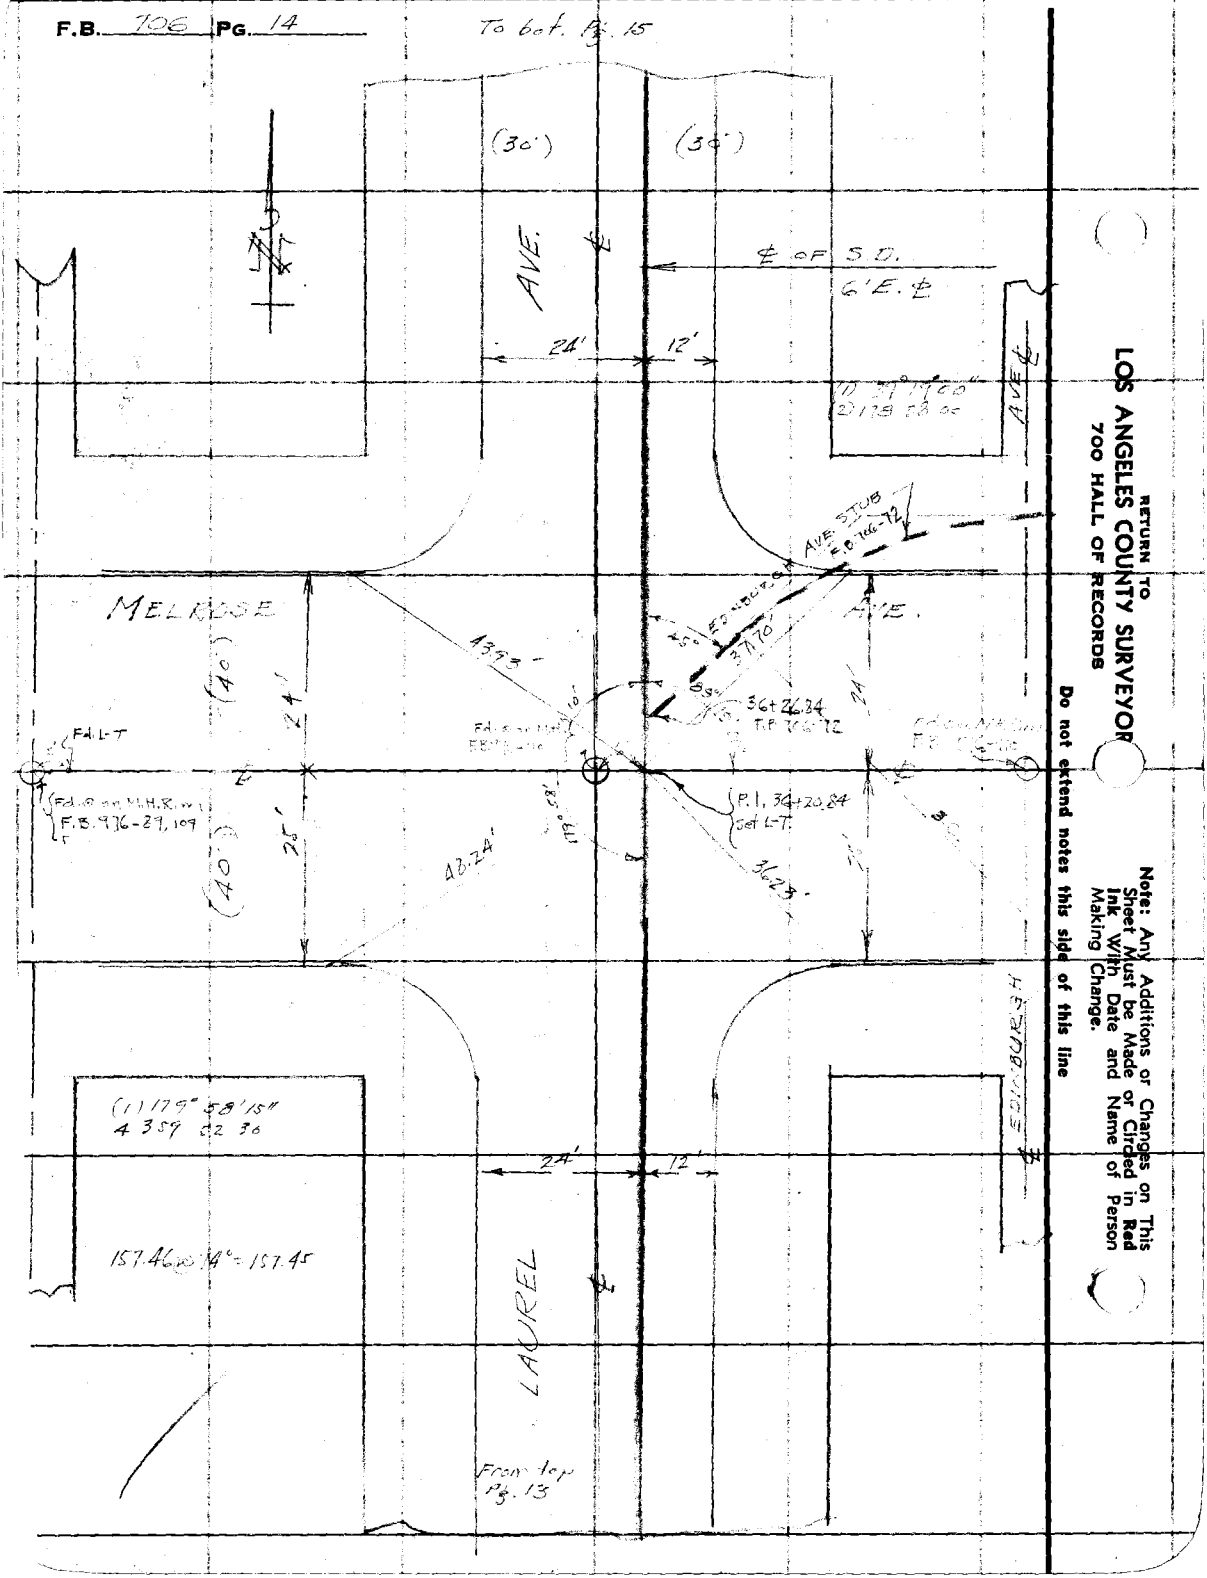

RETURN TO
LOS ANGELES COUNTY SURVEYOR
700 HALL OF RECORDS

Do not extend notes this side of this line

Note: Any Additions or Changes on This Sheet Must be Made or Circled in Red Ink With Date and Name of Person Making Change.

Notes Ck'd by	Survey of Hollywood Blvd
Map No.	W. 0.6318 Tape No. C655 St'd 74 °F.
Office Work	Surveyed by Wolfskill
Checked	Notes [illegible] Date Apr. 1937
Date	Indexed [illegible]

F.B. 104 Pg. 2

To Cont. Pg. 3

S.T.
6' E. & S.T.

AVE.

418.52 @ 76° 418.30

24'

N 90°41'00" E 1181-22 CO

F.B.L-T

26.28'

22.43'

37° 17'25"

Set P.Spk-T by intr.

Set N-T by intr.

F.B. 976 Pg. 108

F.B. 976 Pg. 104

CRESCENT

HAYWORTH AVE

26.14'

25.76'

21.26'

25.69'

F.B. L-T

L-T

1574.20' 1574.41

LAUREL

From Pg. 14

ABANDONED

RETURN TO
LOS ANGELES COUNTY SURVEYOR
700 HALL OF RECORDS

Note: Any Additions or Changes on This Sheet Must be Made or Circled in Red Ink With Date and Name of Person Making Change.

Do not extend notes this side of this line

FORM 247 10M 11-35

F.B. 706 Pg. 16

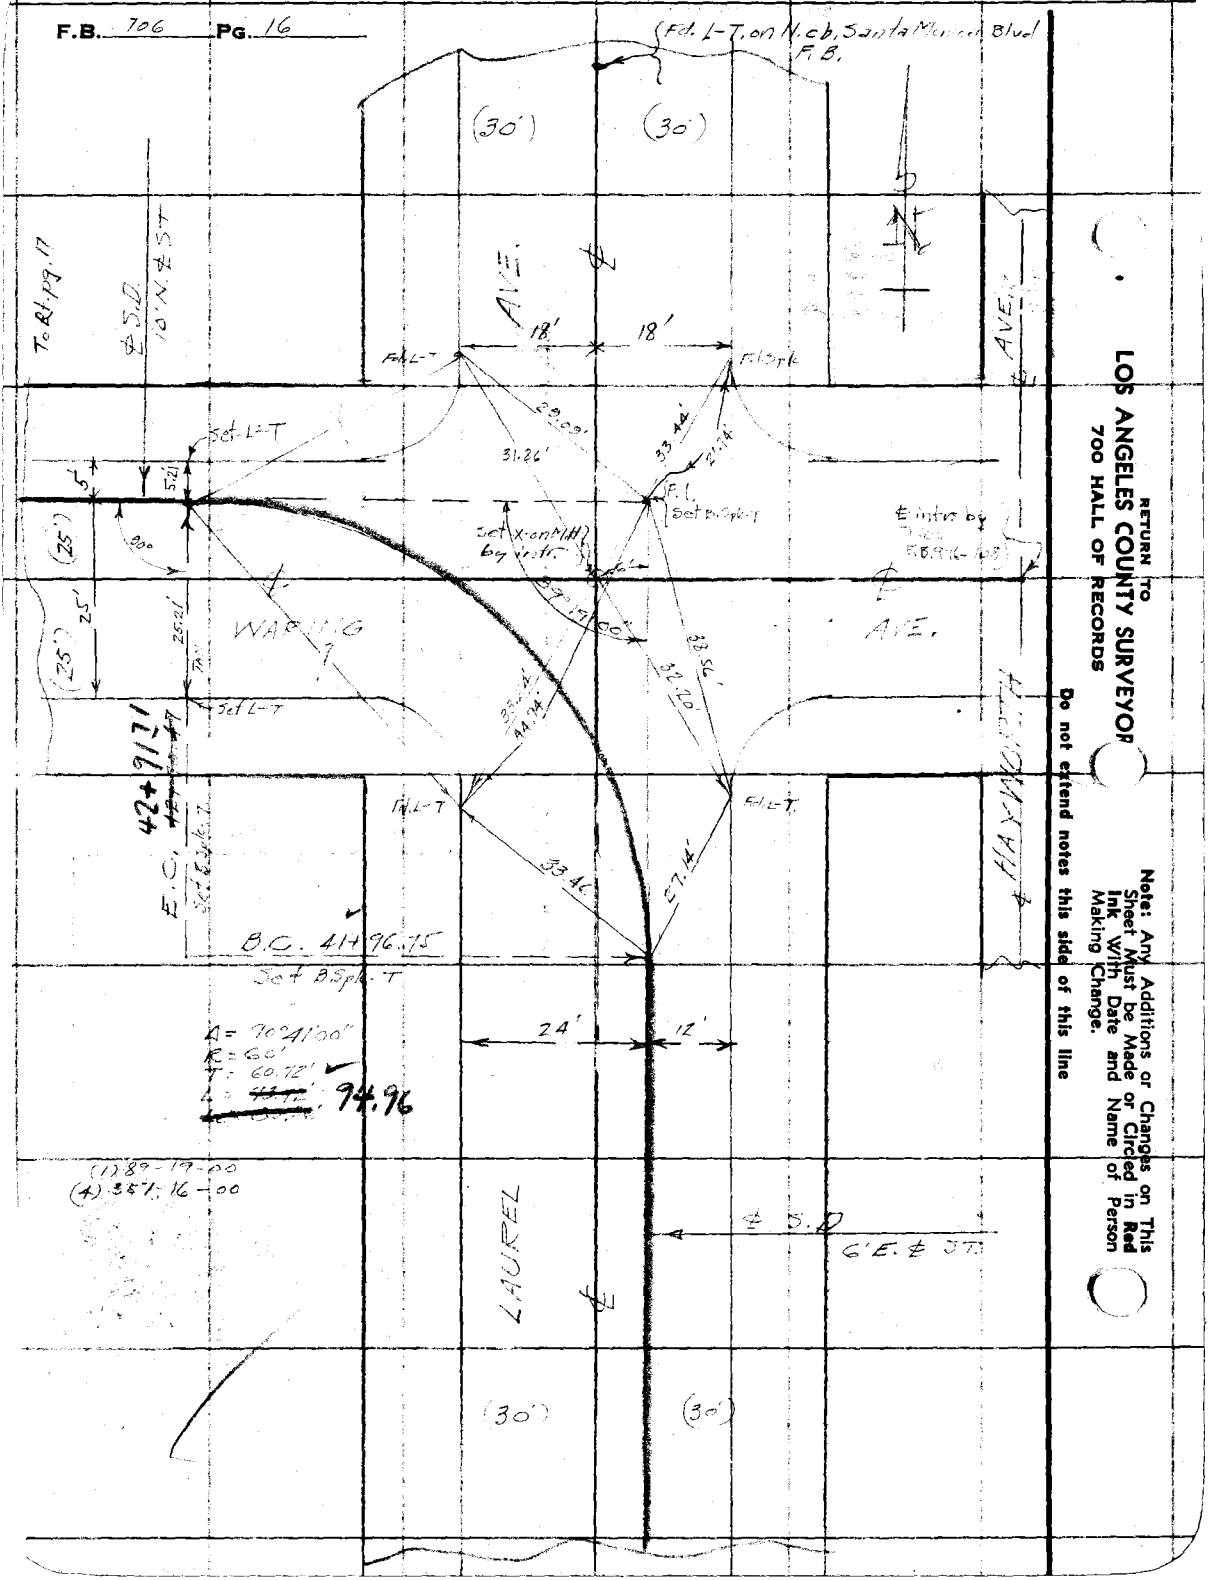

To R1 pg. 17

℄ S.D. 10' N ℄ ST

RETURN TO
LOS ANGELES COUNTY SURVEYOR
700 HALL OF RECORDS

Note: Any Additions or Changes on This Sheet Must be Made or Circled in Red Ink With Date and Name of Person Making Change.

Do not extend notes this side of this line

FORM 247 10M 11-35

RETURN TO
LOS ANGELES COUNTY SURVEYOR
700 HALL OF RECORDS

Note: Any Additions or Changes on This Sheet Must be Made or Circled in **Red Ink** With Date and Name of Person Making Change.

Do not extend notes this side of this line

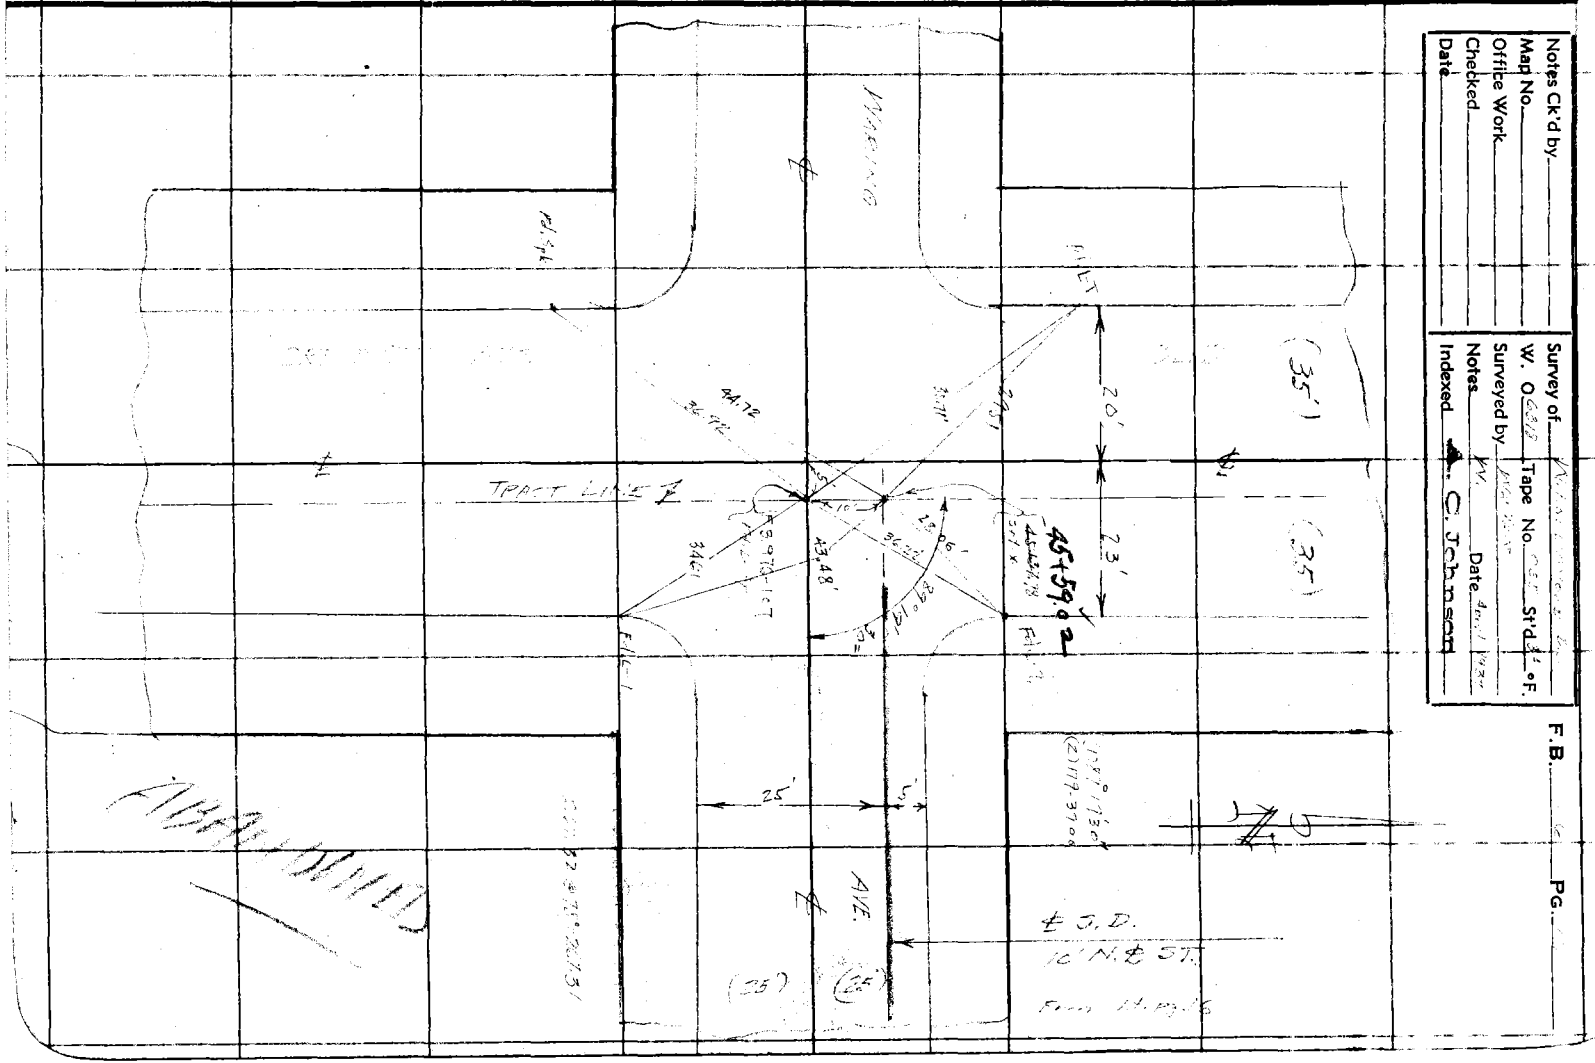

Notes Ck'd by_____
Map No._____
Office Work_____
Checked_____
Date_____

Survey of_____
W. O. 6[illegible] Tape No._____ St'd ____ °F.
Surveyed by _____ Date _____
Notes_____
Indexed C. Johnson

F.B._____ PG._____

F.B. 706 Pg. 18

RETURN TO
LOS ANGELES COUNTY SURVEYOR
700 HALL OF RECORDS

Note: Any Additions or Changes on This Sheet Must be Made or Circled in Red Ink With Date and Name of Person Making Change.

Do not extend notes this side of this line

Notes Ck'd by	Survey of
Map No.	W. O. Tape No. St'd °F.
Office Work	Surveyed by WALLACE
Checked	Notes Date 4-1937
Date	Indexed C. Johnson

F.B. Pg.

TOPOGRAPHY

LAUREL AVE BRANCH.

WEST [illegible] LOS.

JUNE 37

Ø Survey F.B. 706 Pgs. 1 to 4

Profile F.B. 706 Pgs. 35 to 70

SHEET. 5

WALLACE
GREGORY
MURRAY
TELLEZ
ATHEAR

APR 23 1937

APR 23 1937

RECEIVED

PROGRESSED

BOOK INDEXED

MAP INDEXED

RECORD INDEXED

CARD INDEXED

RETURN TO
LOS ANGELES COUNTY SURVEYOR
700 HALL OF RECORDS

Note: Any Additions or Changes on This Sheet Must be Made or Circled in Red Ink With Date and Name of Person Making Change

Do not extend notes this side of this line

FORM 247 10M 11-36

RETURN TO
LOS ANGELES COUNTY SURVEYOR
700 HALL OF RECORDS

Note: Any Additions or Changes on This Sheet Must be Made or Circled in **Red** Ink With Date and Name of Person Making Change.

Do not extend notes this side of this line

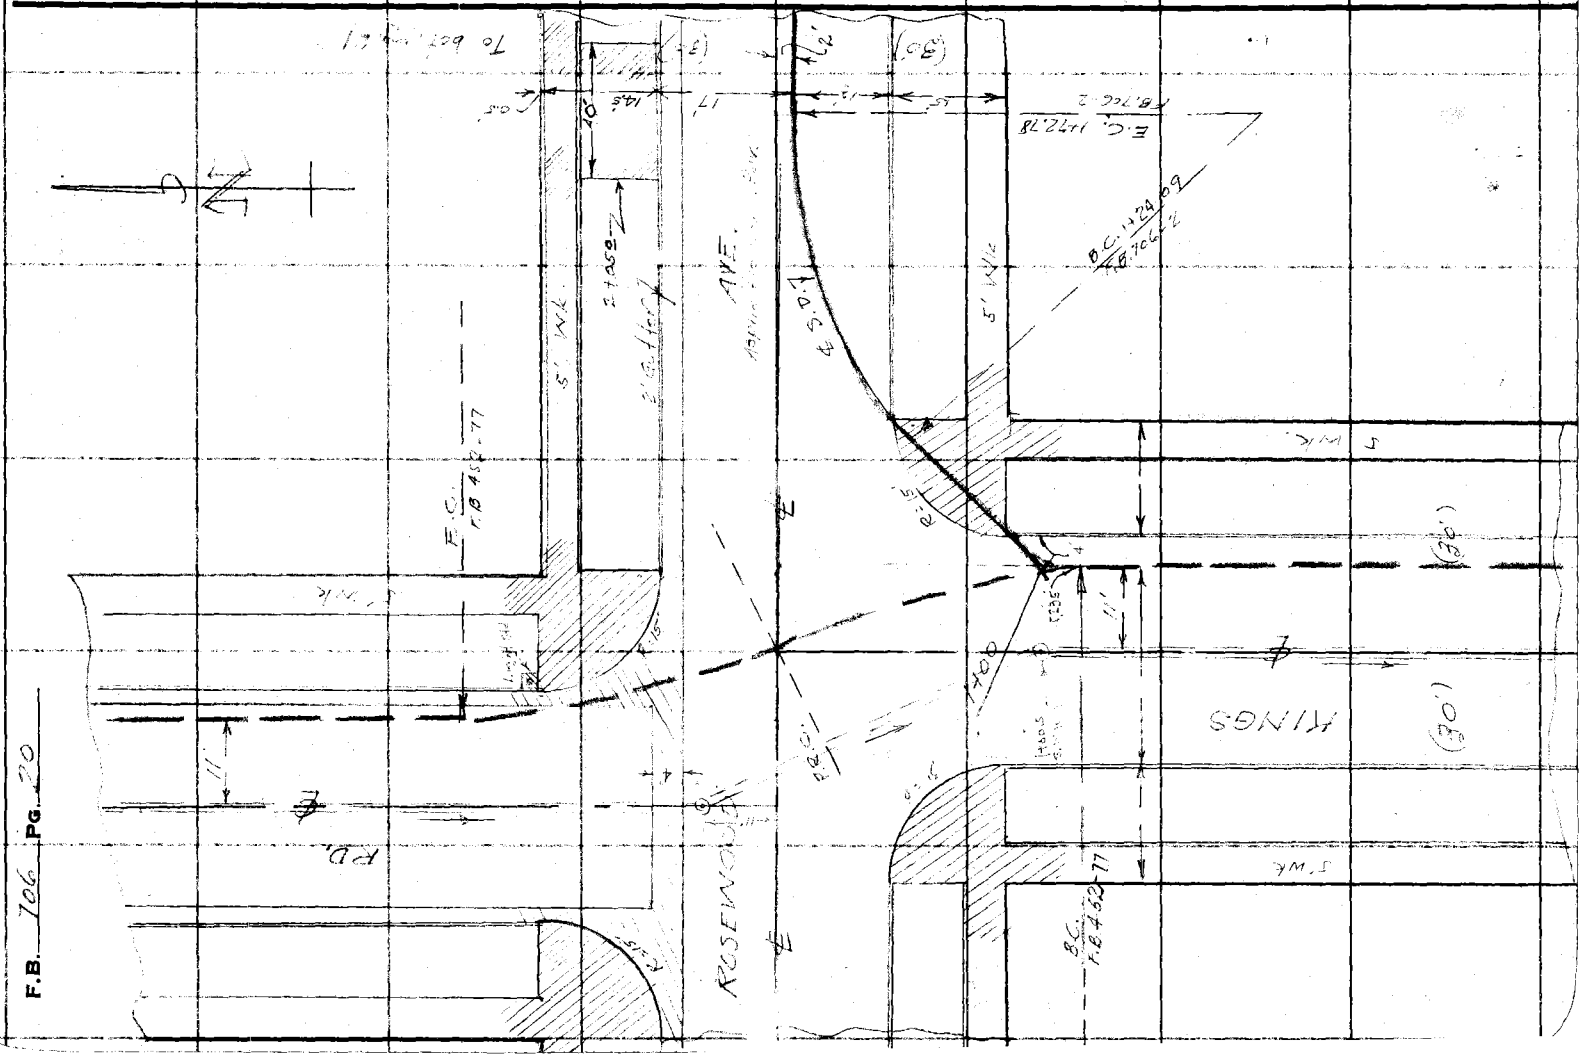

Notes Ck'd by	Survey of
Map No.	W. O.	Tape No.	St'd °F.
Office Work	Surveyed by
Checked	Notes	Date
Date	Indexed

F.B. Pg.

Note: Any Additions or Changes on This Sheet Must be Made or Circled in Red Ink With Date and Name of Person Making Change

Do not extend notes this side of this line

RETURN TO
LOS ANGELES COUNTY SURVEYOR
700 HALL OF RECORDS

FORM 247 10M 11-35

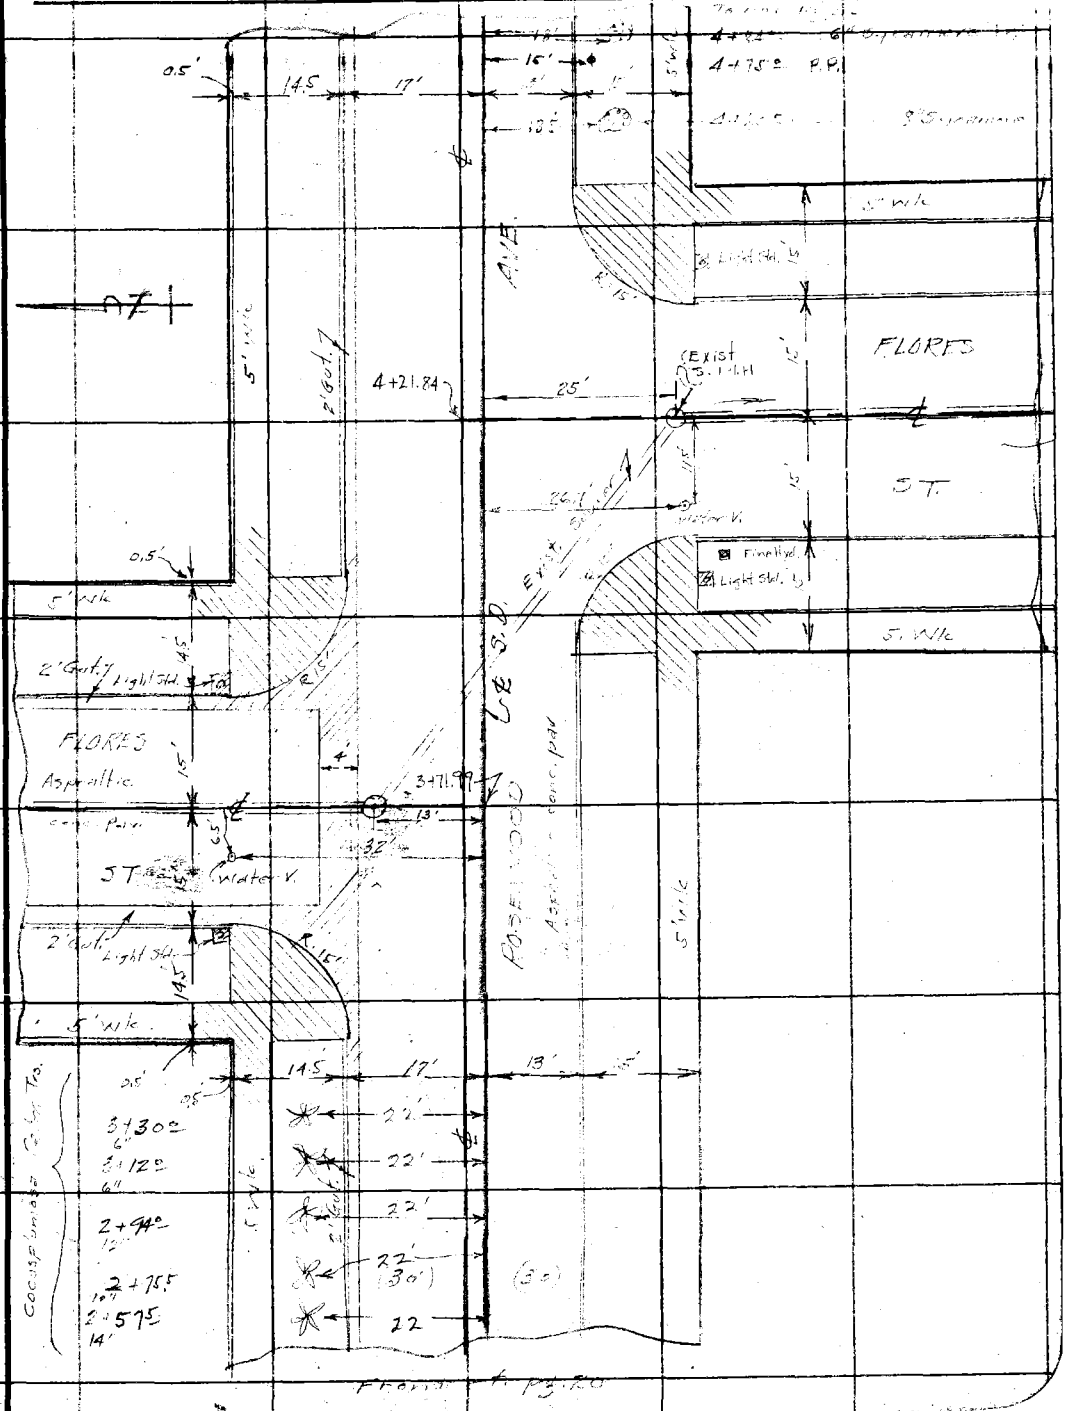

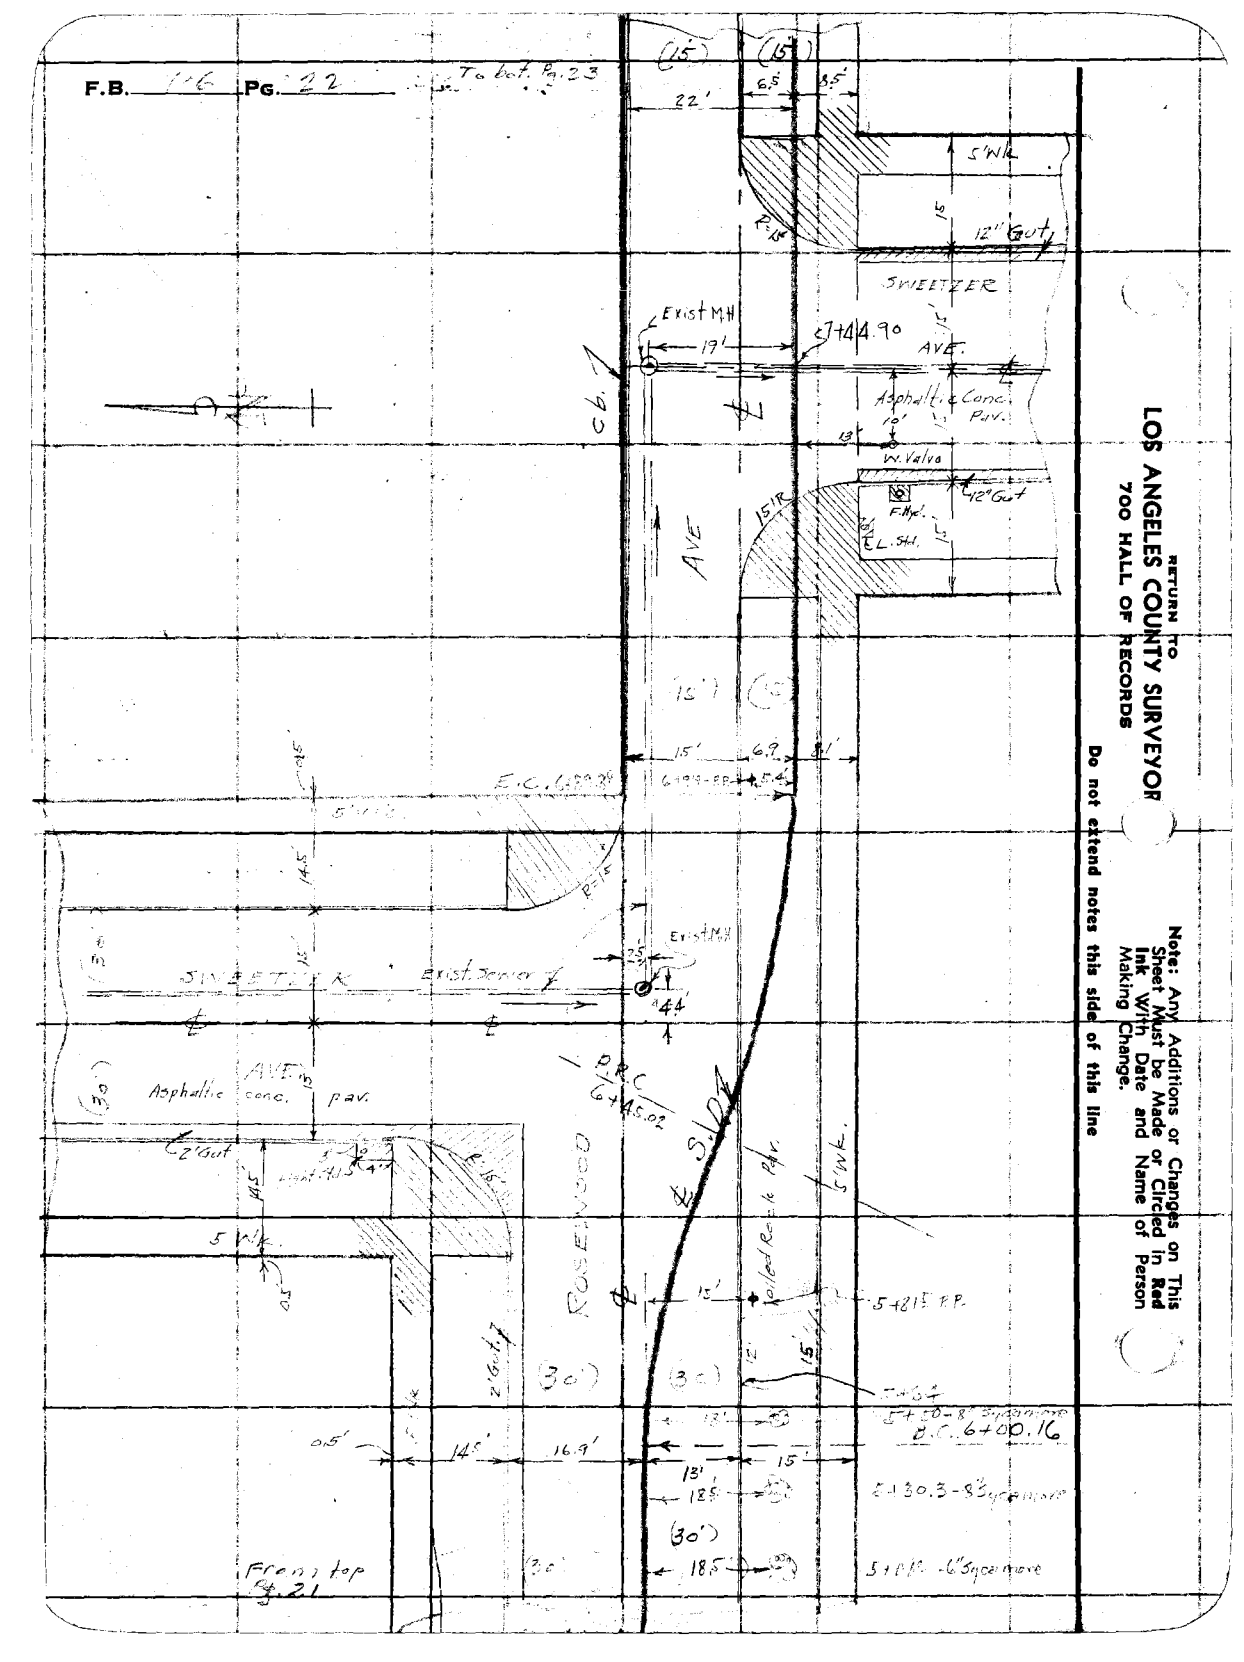
F.B. 1-6 Pg. 22
To bef. Pg. 23
(15')
(15')
6.5'
15'
22'
5' W.K.
12" Gut
SWEETZER
Exist M.H.
17'
744.90
AVE.
Asphalt. & Conc. Pav.
W. Valve
42" Gut
F.H.C.
EL. SW.
15' R
AVE
(15')
15'
6.9'
5.4'
E.C. 1+59.28
6+99-PP
5' W.K.
14.5'
R=15'
Exist M.H.
SWEETZER
Exist Sewer
44'
(30')
Asphaltic conc. pav.
AVE.
12' Gut
Exist. M.H.
14.5'
5' W.K.
0.5'
6' R
45.02'
S.W.K.
Rolled Rock Pav.
SINK.
15'
5+81.5 P.P.
2'6" Gut
(30')
(30')
15'
5+64
5+50-8" Sycamore
B.C. 6+00.16
0.5'
14'
16.9'
15'
13'
18.5'
E. 130.3-8" Sycamore
(30')
18.5'
From top
Pg. 21
5+11.0 -6" Sycamore
RETURN TO
LOS ANGELES COUNTY SURVEYOR
700 HALL OF RECORDS
Do not extend notes this side of this line
Note: Any Additions or Changes on This Sheet Must be Made or Circled in Red Ink With Date and Name of Person Making Change.

Notes Ck'd by	Survey of
Map No.	W. O. 2318 Tape No. St'd °F.
Office Work	Surveyed by
Checked	Notes KV Date
Date	Indexed A. C. Johnson

F.B. Pg.

Note: Any Additions or Changes on This Sheet Must be Made or Circled in Red Ink With Date and Name of Person Making Change.

Do not extend notes this side of this line

RETURN TO
LOS ANGELES COUNTY SURVEYOR
700 HALL OF RECORDS

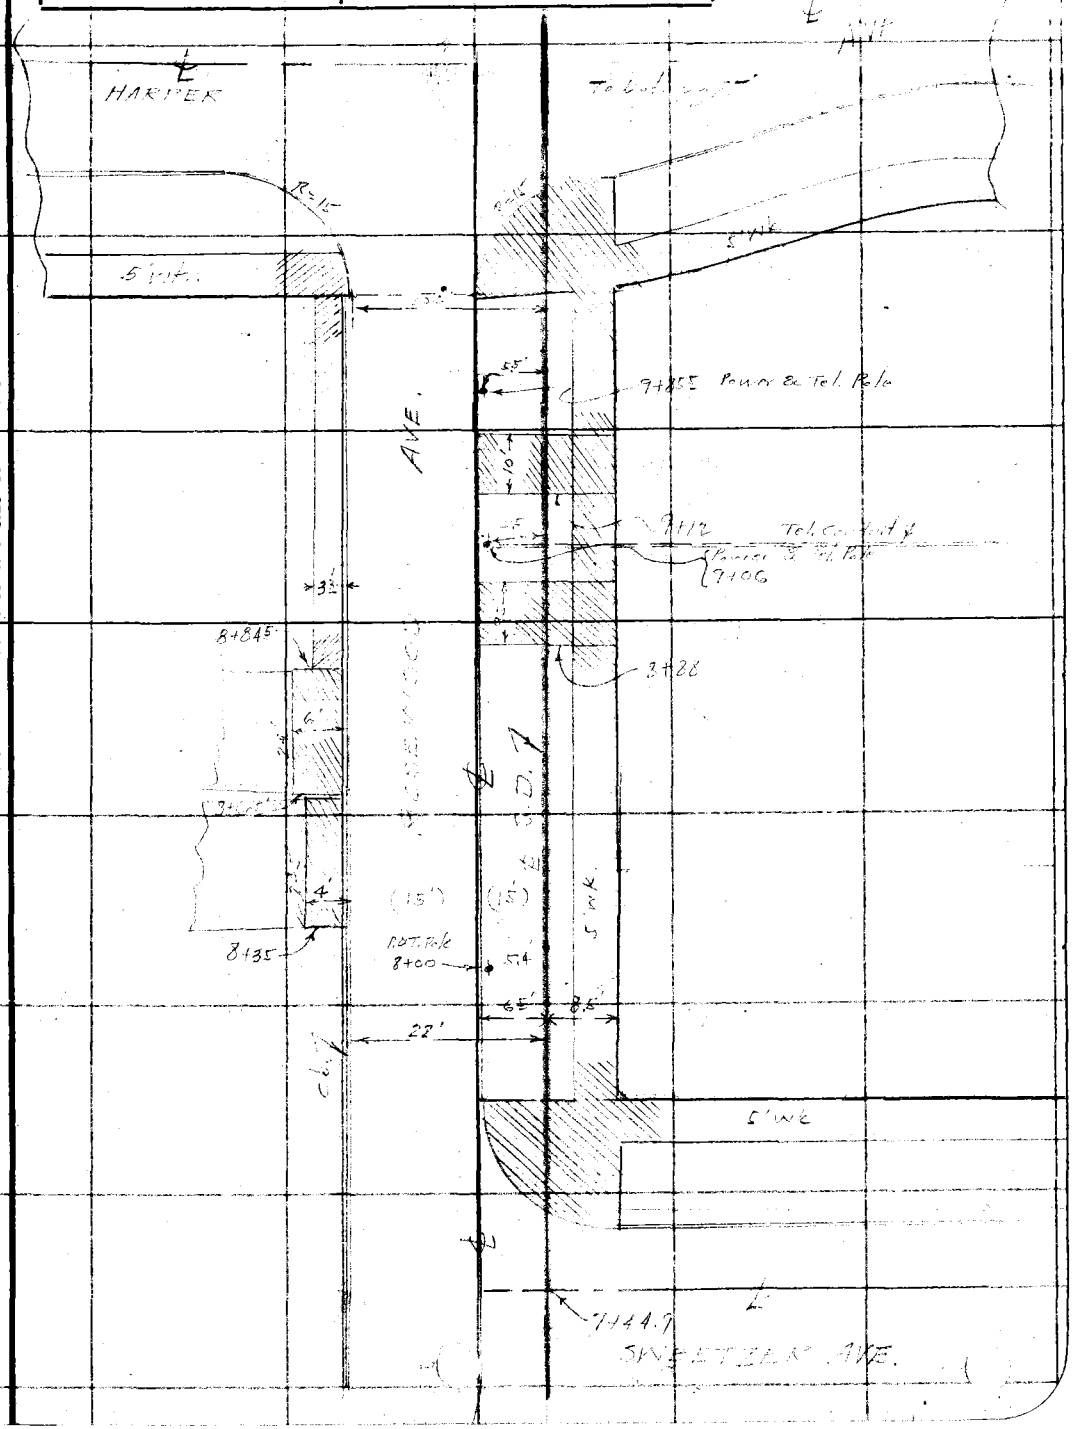

FORM 247 10M 11-38

RETURN TO
LOS ANGELES COUNTY SURVEYOR
700 HALL OF RECORDS

Note: Any Additions or Changes on This Sheet Must be Made or Circled in **Red** Ink With Date and Name of Person Making Change.

Do not extend notes this side of this line

F.B. 106 Pg. 24

Notes Ck'd by	Survey of
Map No.	W. O.	Tape No.	St'd °F.
Office Work	Surveyed by
Checked	Notes	Date
Date	Indexed

F.B. PG. 5

Note: Any Additions or Changes on This Sheet Must be Made or Circled in Red Ink With Date and Name of Person Making Change.

Do not extend notes this side of this line

RETURN TO
LOS ANGELES COUNTY SURVEYOR
7do HALL OF RECORDS

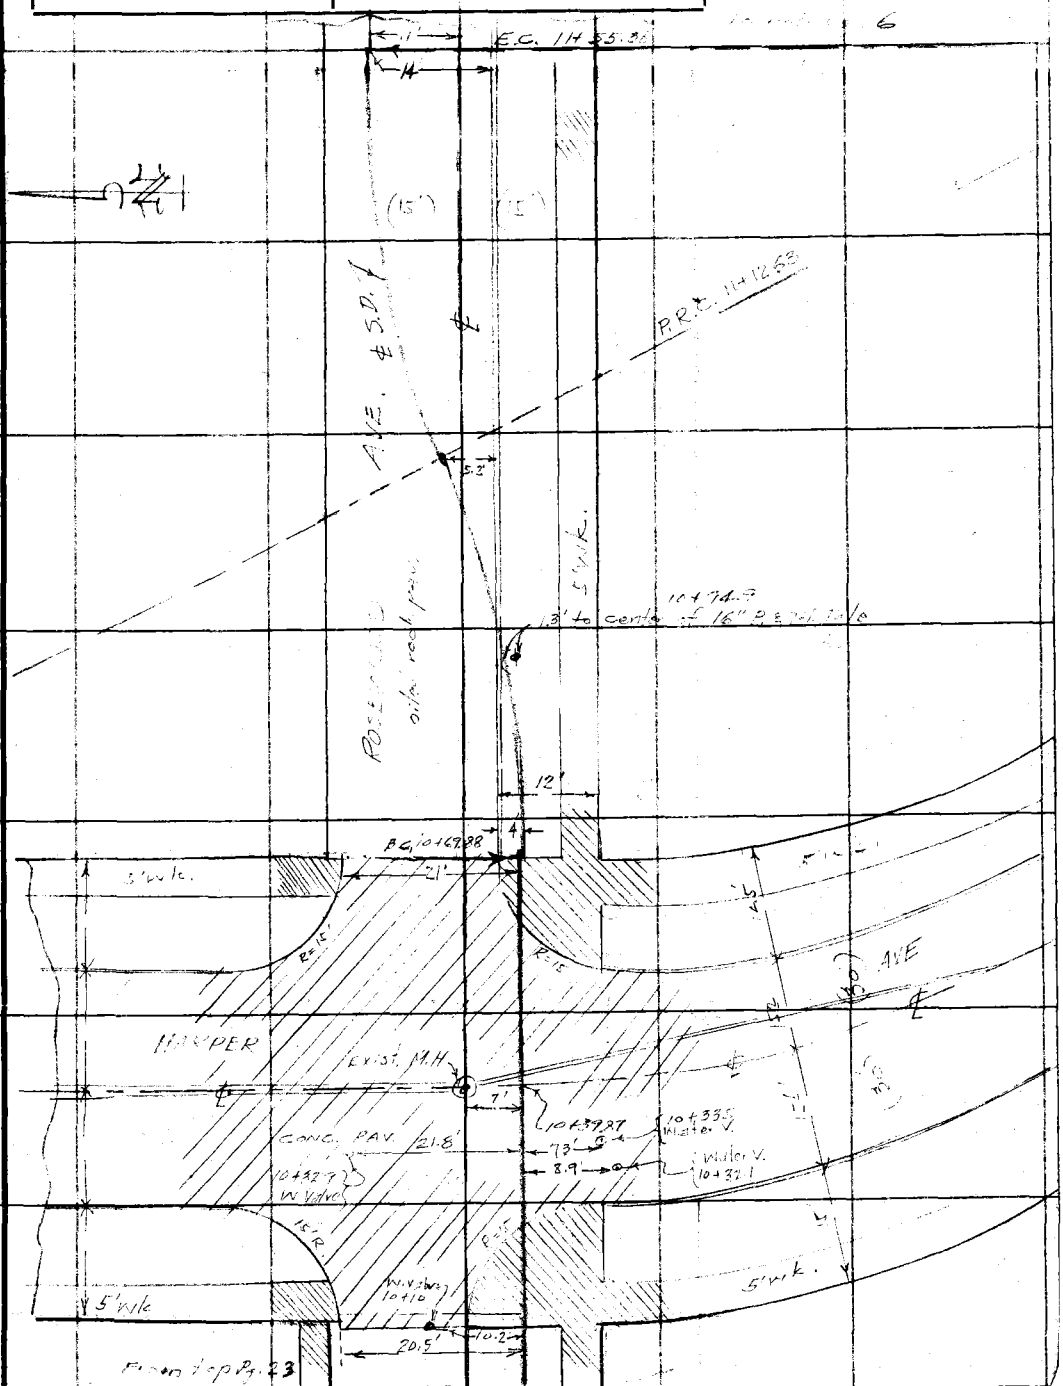

FORM 247 10M 11-35

F.B. 706 PG. 26

→ Cont. pg. 27

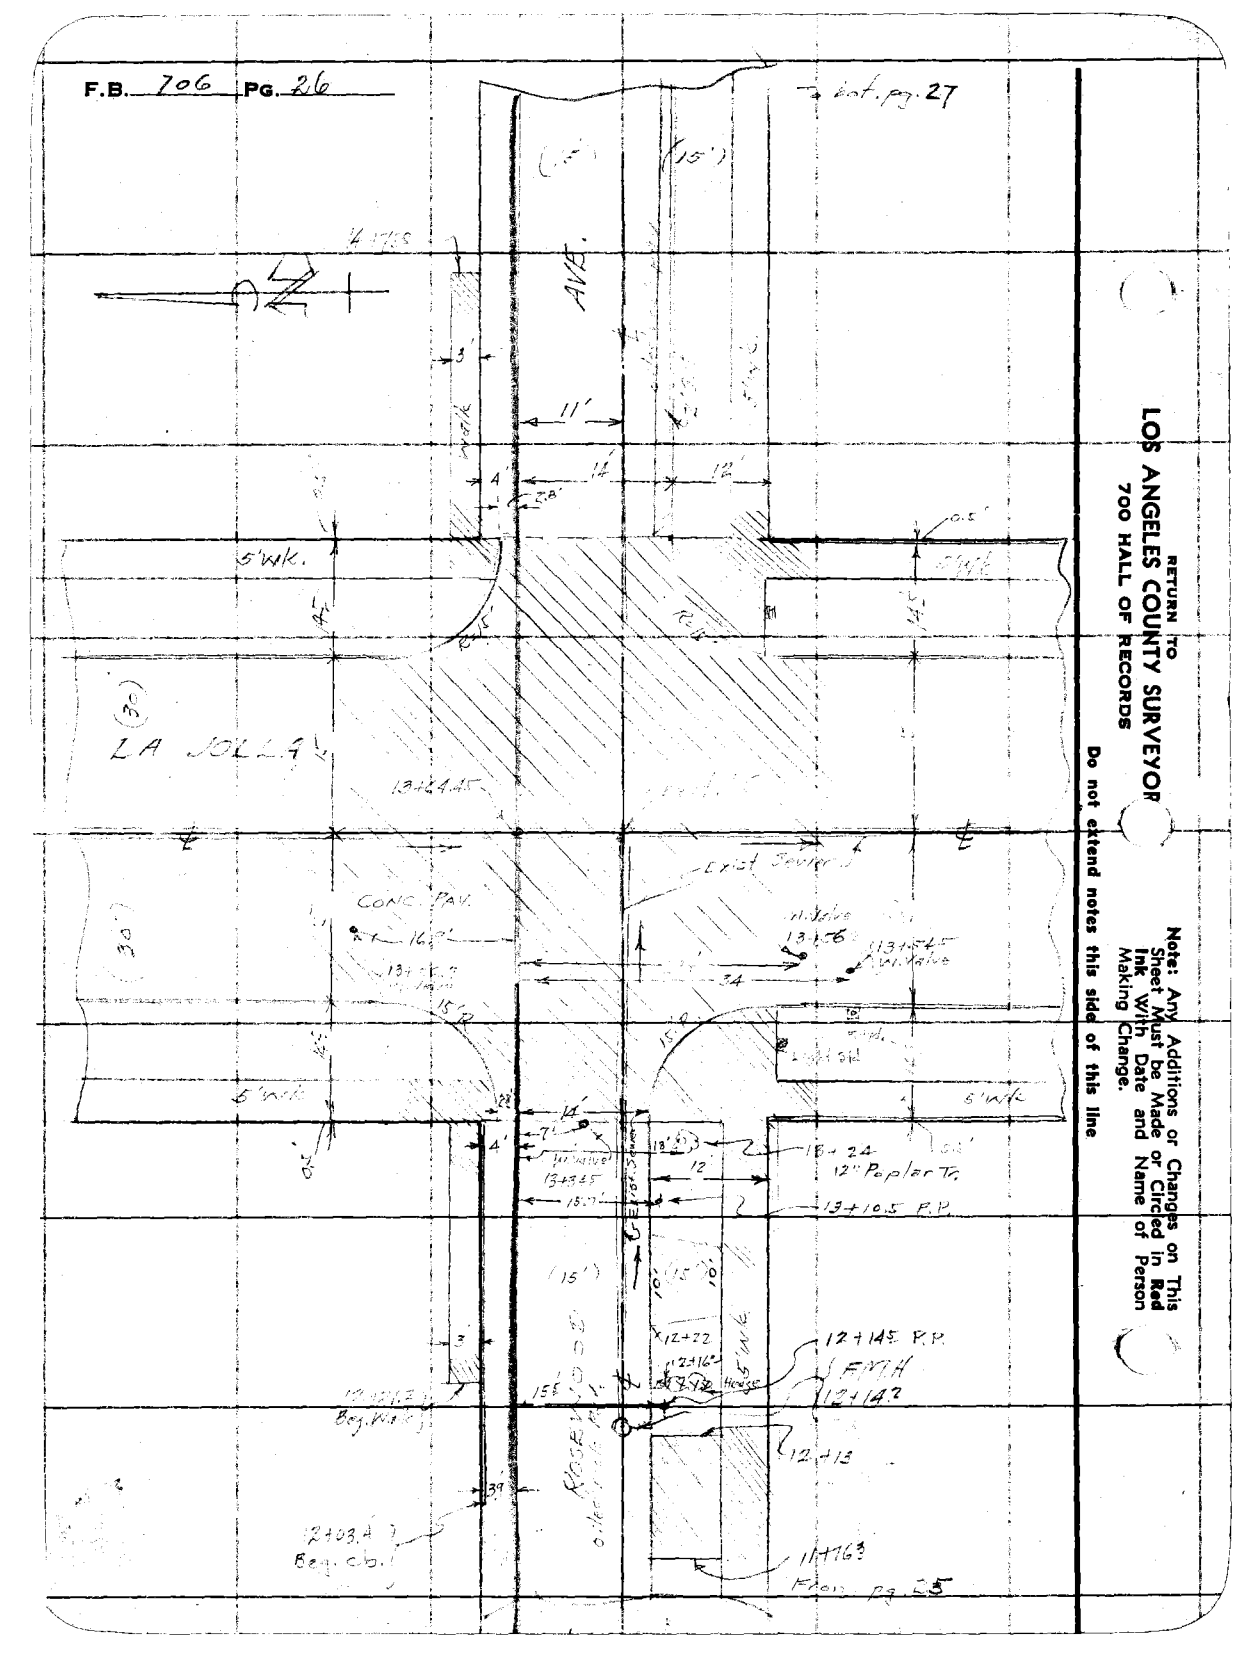

RETURN TO
LOS ANGELES COUNTY SURVEYOR
700 HALL OF RECORDS

Note: Any Additions or Changes on This Sheet Must be Made or Circled in Red Ink With Date and Name of Person Making Change.

Do not extend notes this side of this line

Notes Ck'd by	Survey of W. to V. Woodl
Map No.	W. O. 6315 Tape No. St'd °F.
Office Work	Surveyed by Wallace
Checked	Notes Date Nov. 1951
Date	Indexed C. Johnson

F.B. Pg. 7

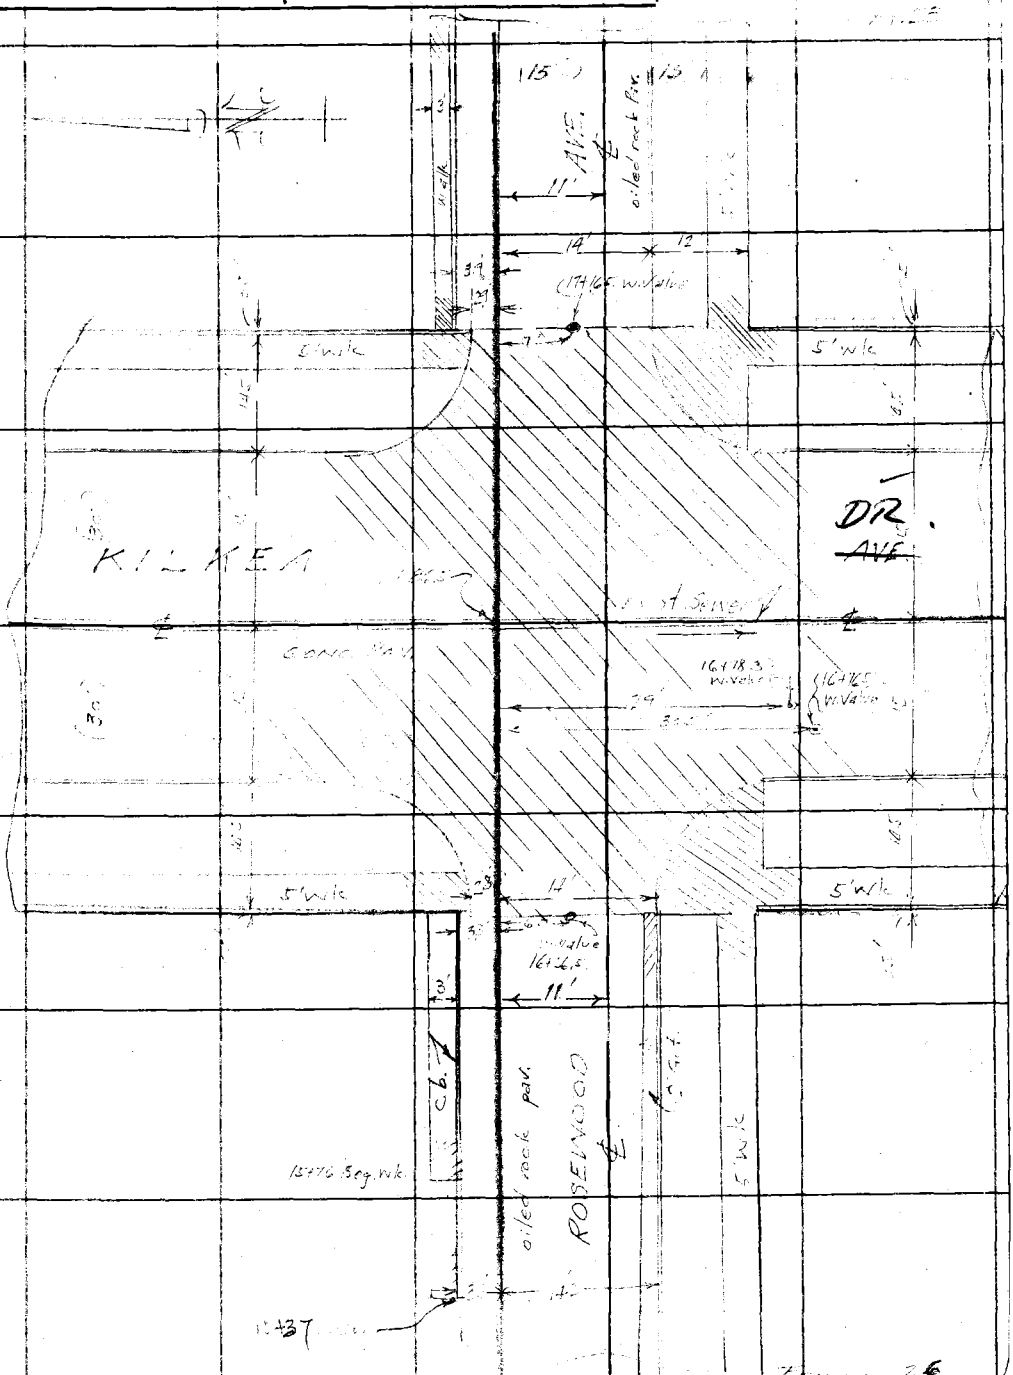

RETURN TO
LOS ANGELES COUNTY SURVEYOR
700 HALL OF RECORDS

Note: Any Additions or Changes on This Sheet Must be Made or Circled in Red Ink With Date and Name of Person Making Change.

Do not extend notes this side of this line

FORM 247 10M 11-38

F.B. 206 Pg. 28

To bot. pg. 27

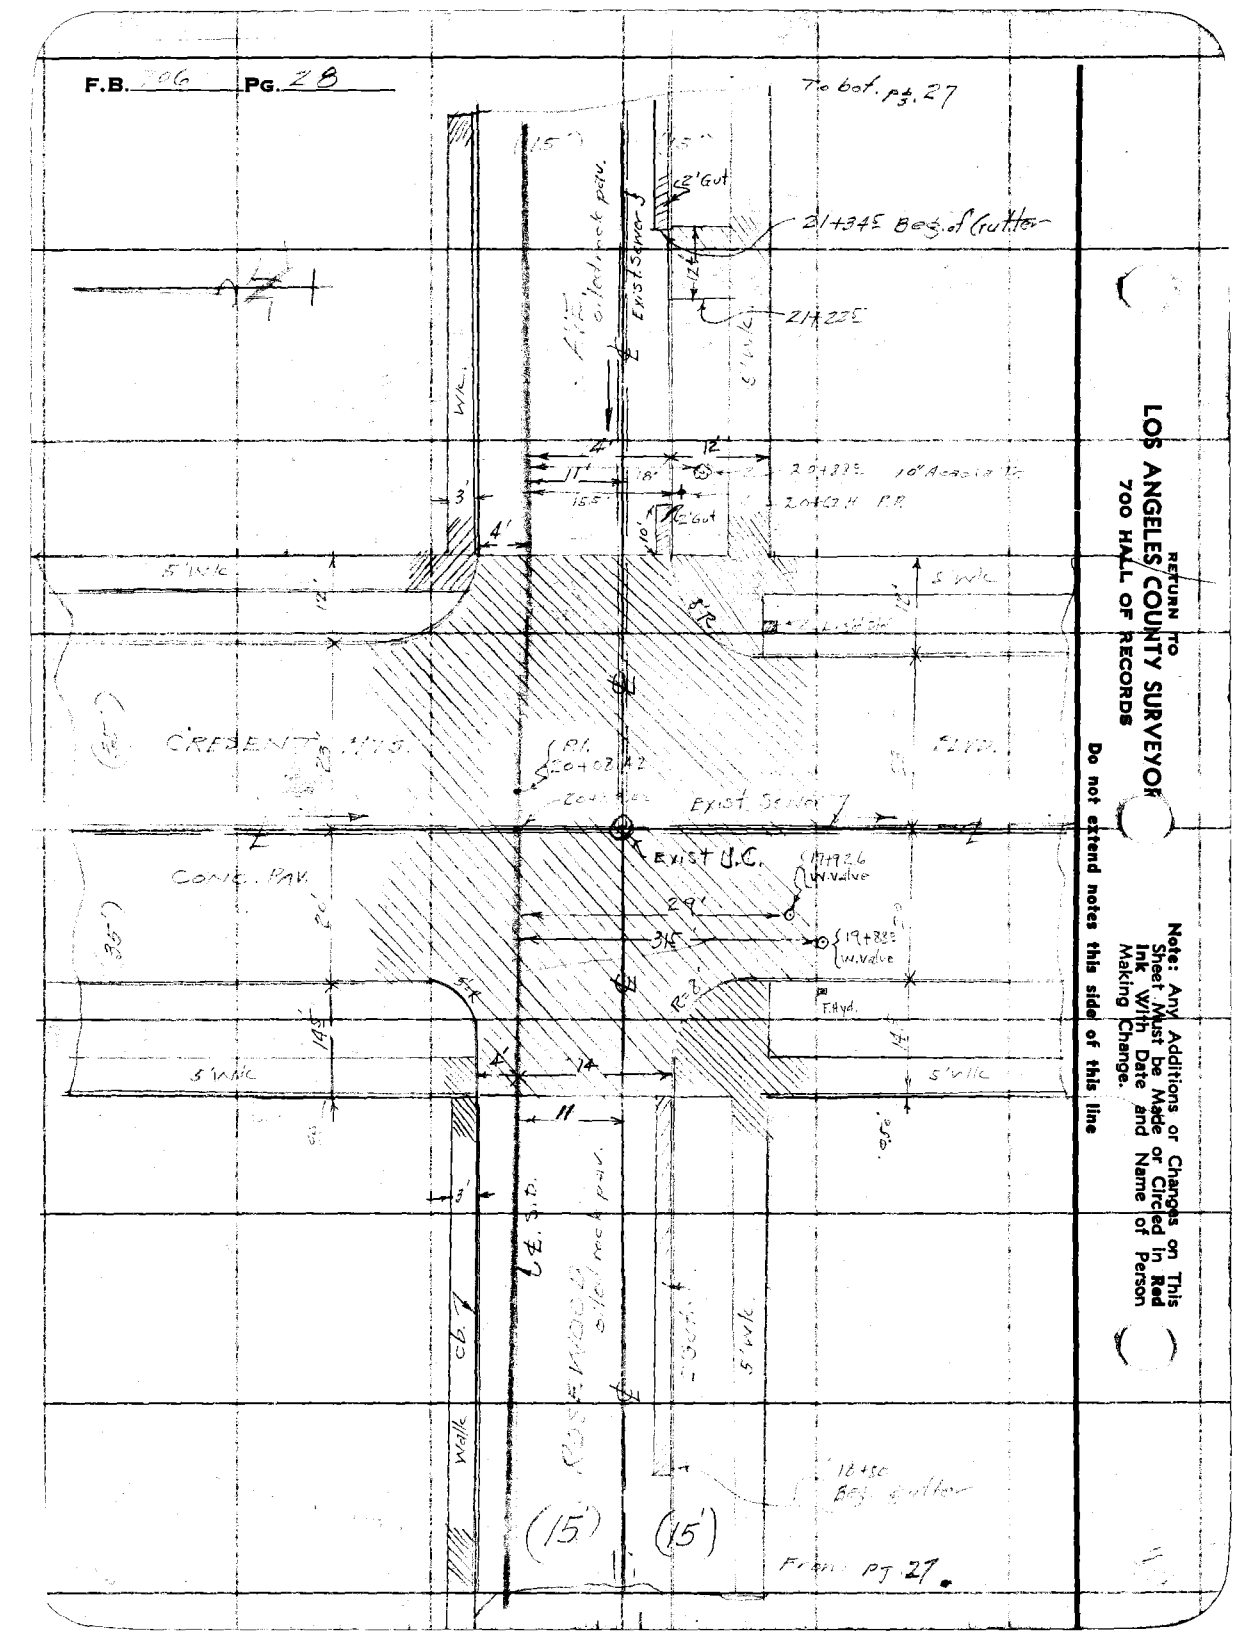

From pg. 27.

RETURN TO
LOS ANGELES COUNTY SURVEYOR
700 HALL OF RECORDS

Note: Any Additions or Changes on This Sheet Must be Made or Circled in Red Ink with Date and Name of Person Making Change.

Do not extend notes this side of this line

Notes Ck'd by	Survey of
Map No.	W. O. 520 Tape No. St'd °F.
Office Work	Surveyed by W
Checked	Notes Date 4-19[illegible]
Date	Indexed A. C. Johnson

F.B. PG. 9

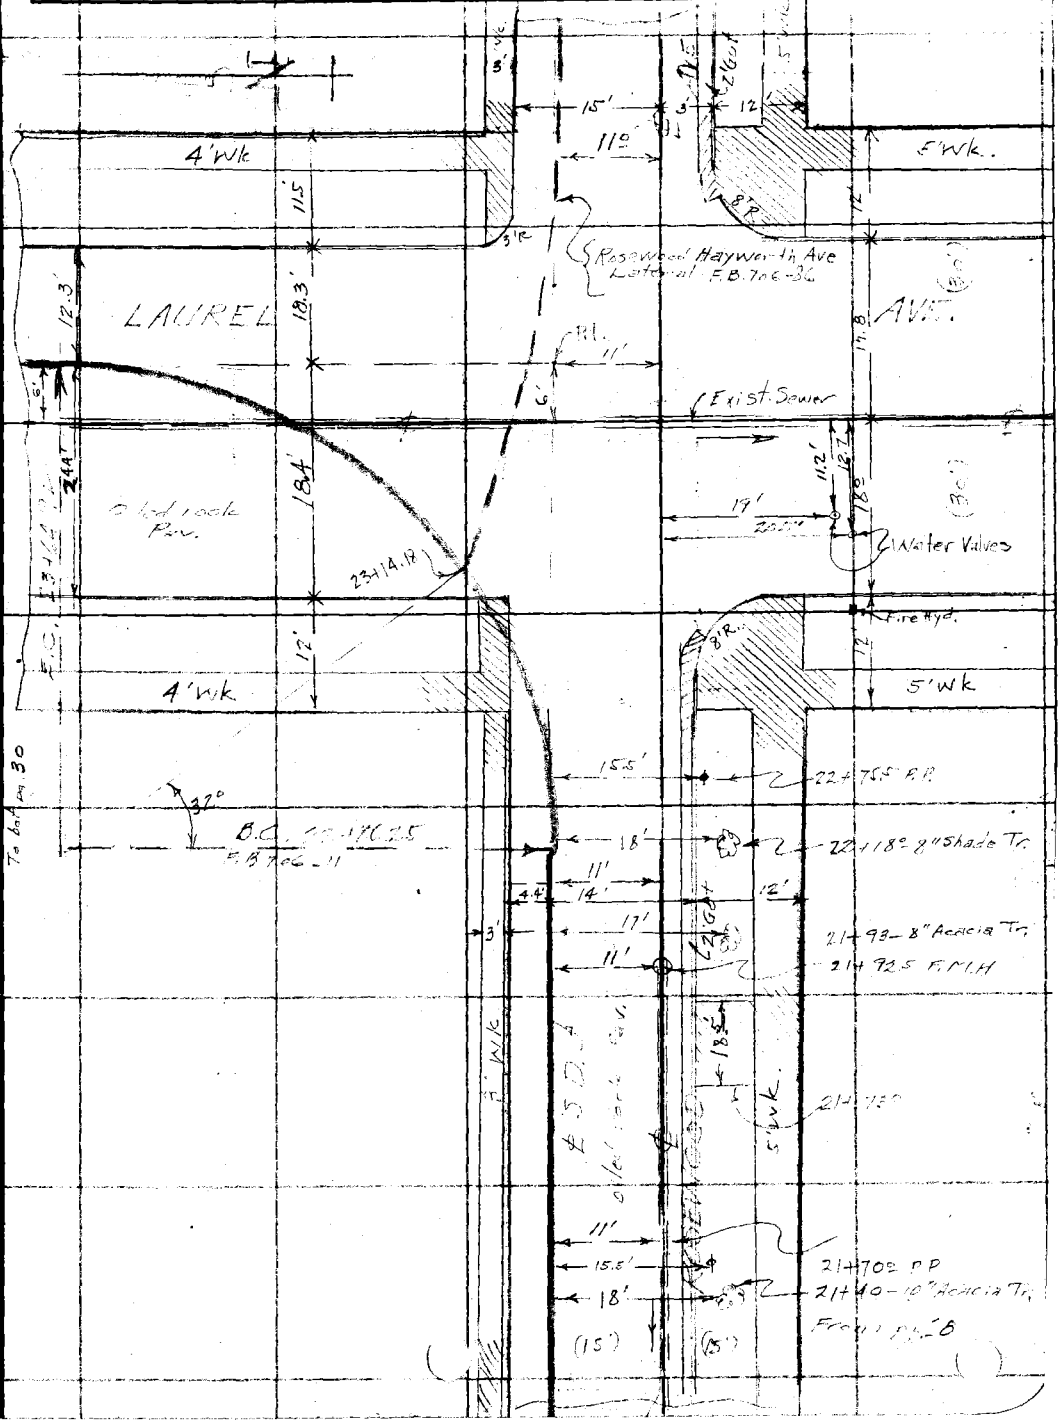

Note: Any Additions or Changes on This Sheet Must be Made in Red Ink or Circled in Red With Date and Name of Person Making Change.

Do not extend notes this side of this line

RETURN TO
LOS ANGELES COUNTY SURVEYOR
700 HALL OF RECORDS

FORM 247 10M 11-35

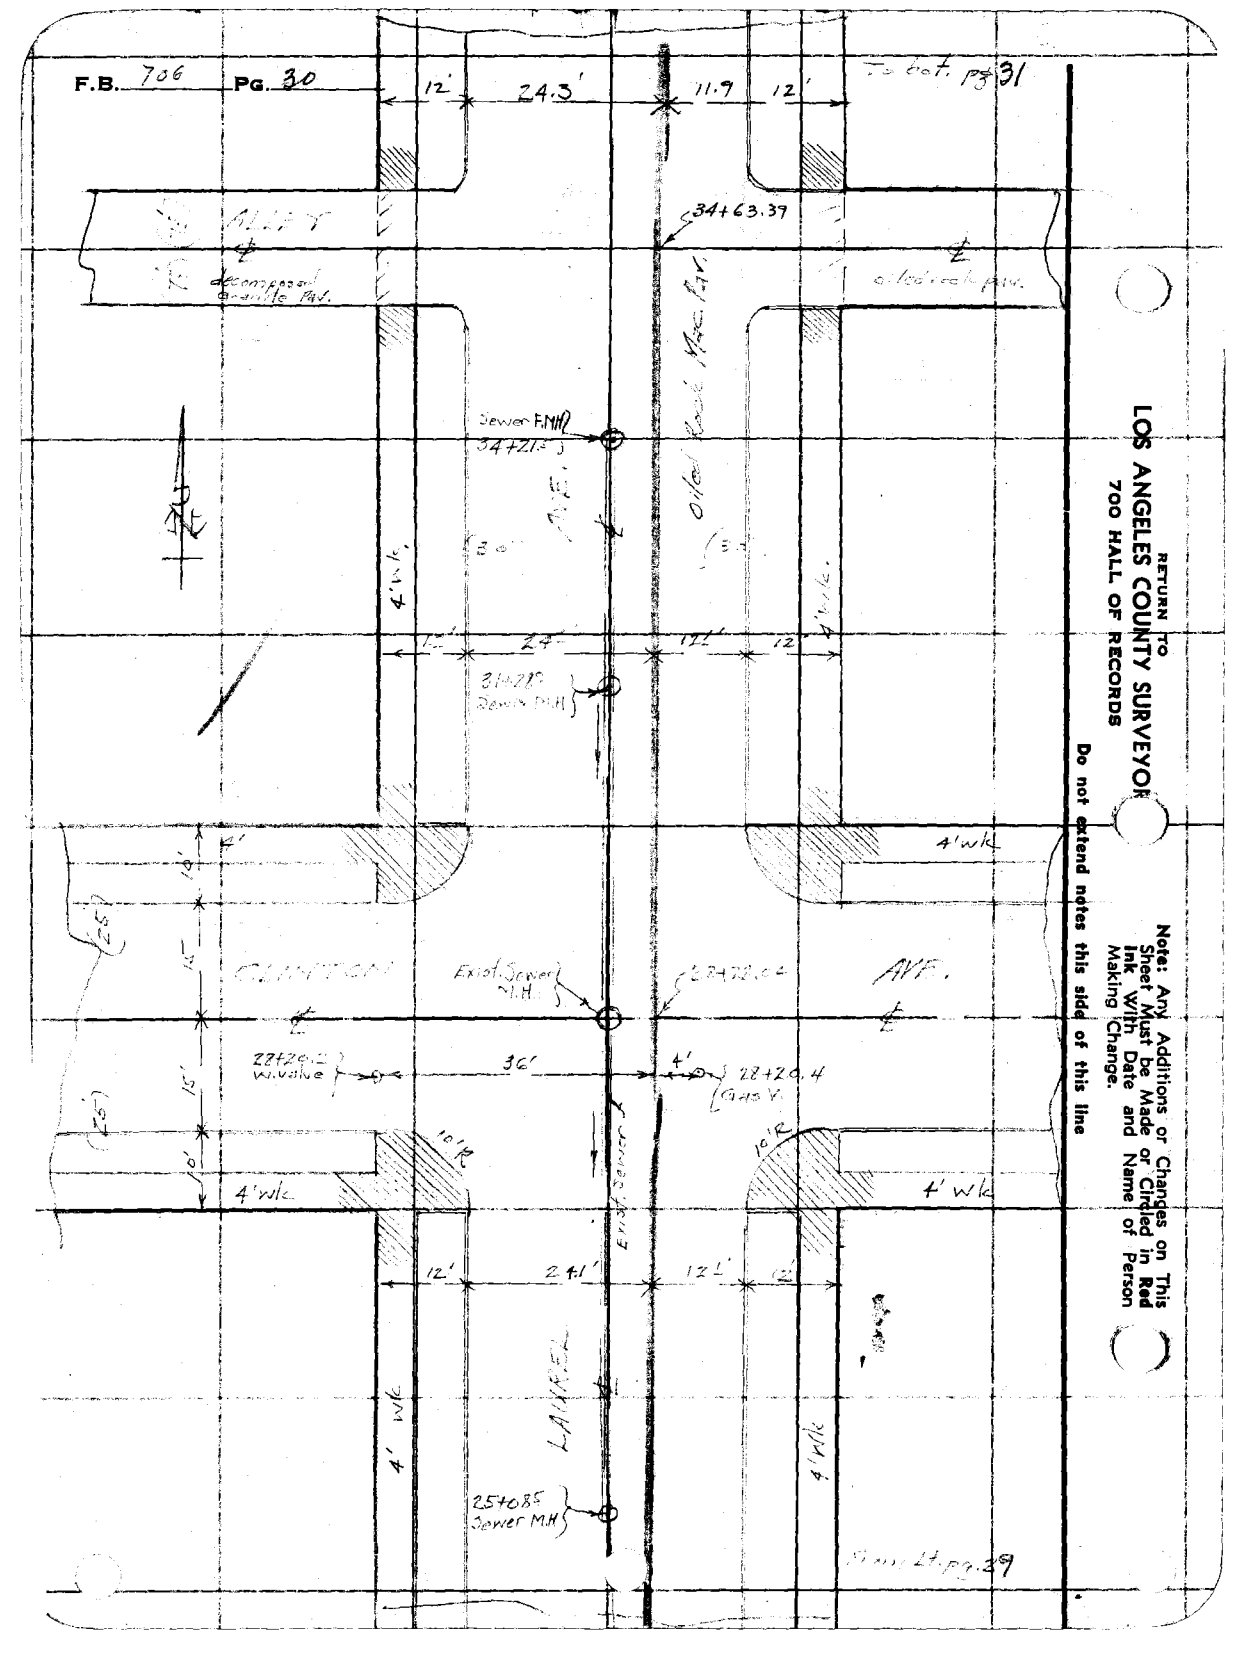

RETURN TO
LOS ANGELES COUNTY SURVEYOR
700 HALL OF RECORDS

Note: Any Additions or Changes on This Sheet Must be Made or Circled in Red Ink With Date and Name of Person Making Change.

Do not extend notes this side of this line

Notes Ck'd by	Survey of
Map No.	W. O.	Tape No.	St'd °F.
Office Work	Surveyed by
Checked	Notes	Date
Date	Indexed C. Johnson

F.B. 106 Pg. 31

Note: Any Additions or Changes on This Sheet Must be Made or Circled in Red Ink With Date and Name of Person Making Change.

Do not extend notes this side of this line

RETURN TO
LOS ANGELES COUNTY SURVEYOR
700 HALL OF RECORDS

FORM 247 10M 11-35

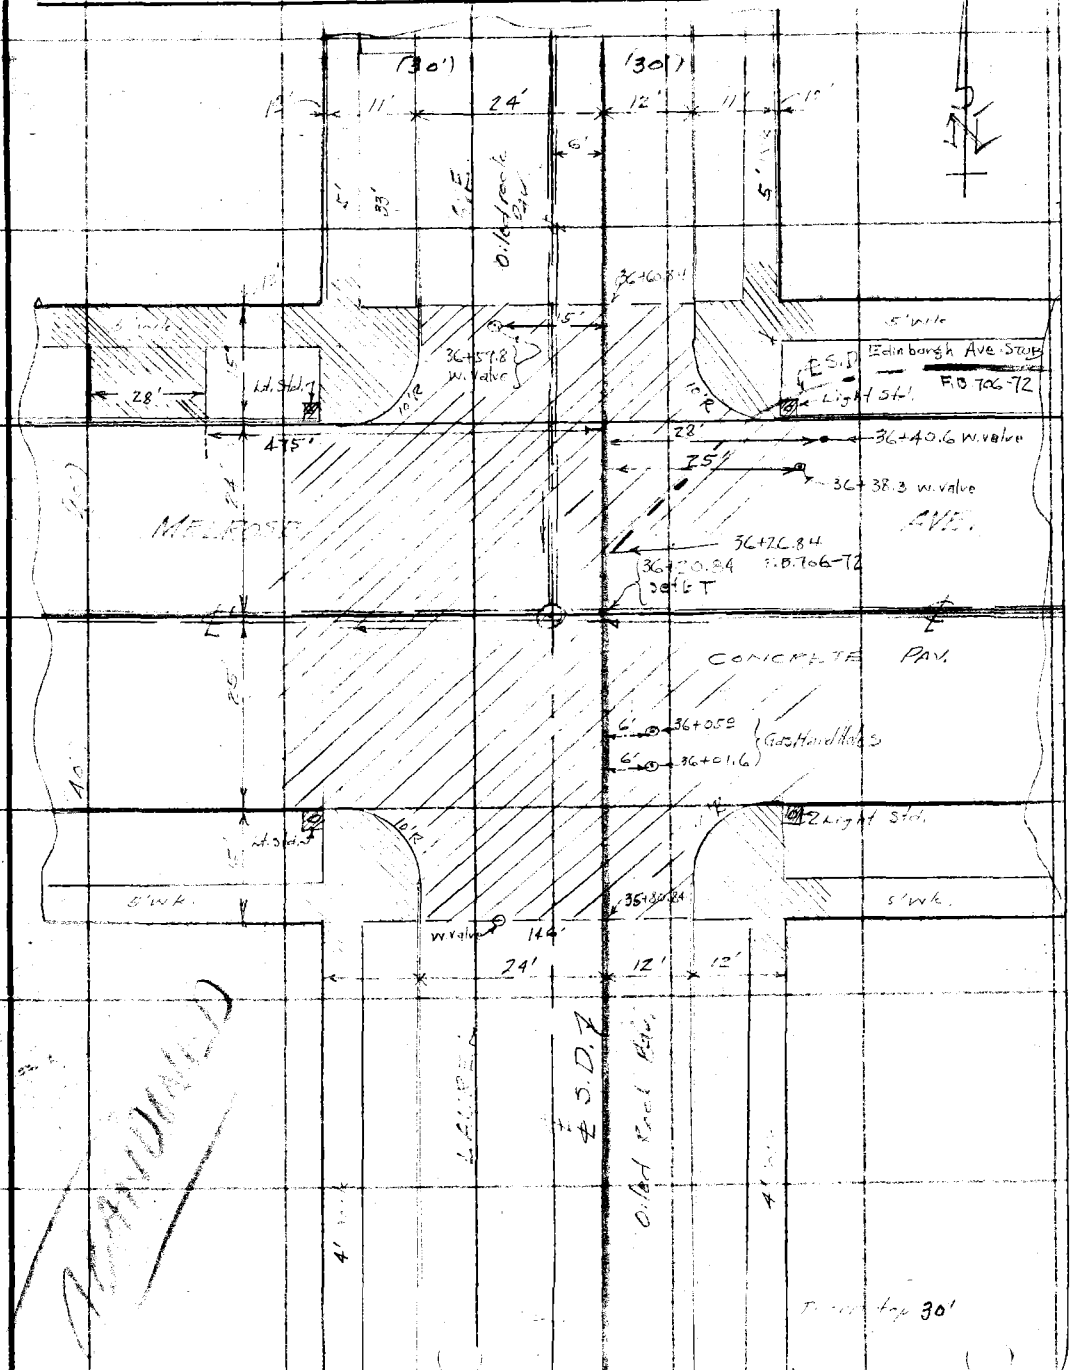

F.B. 706 Pg. 32

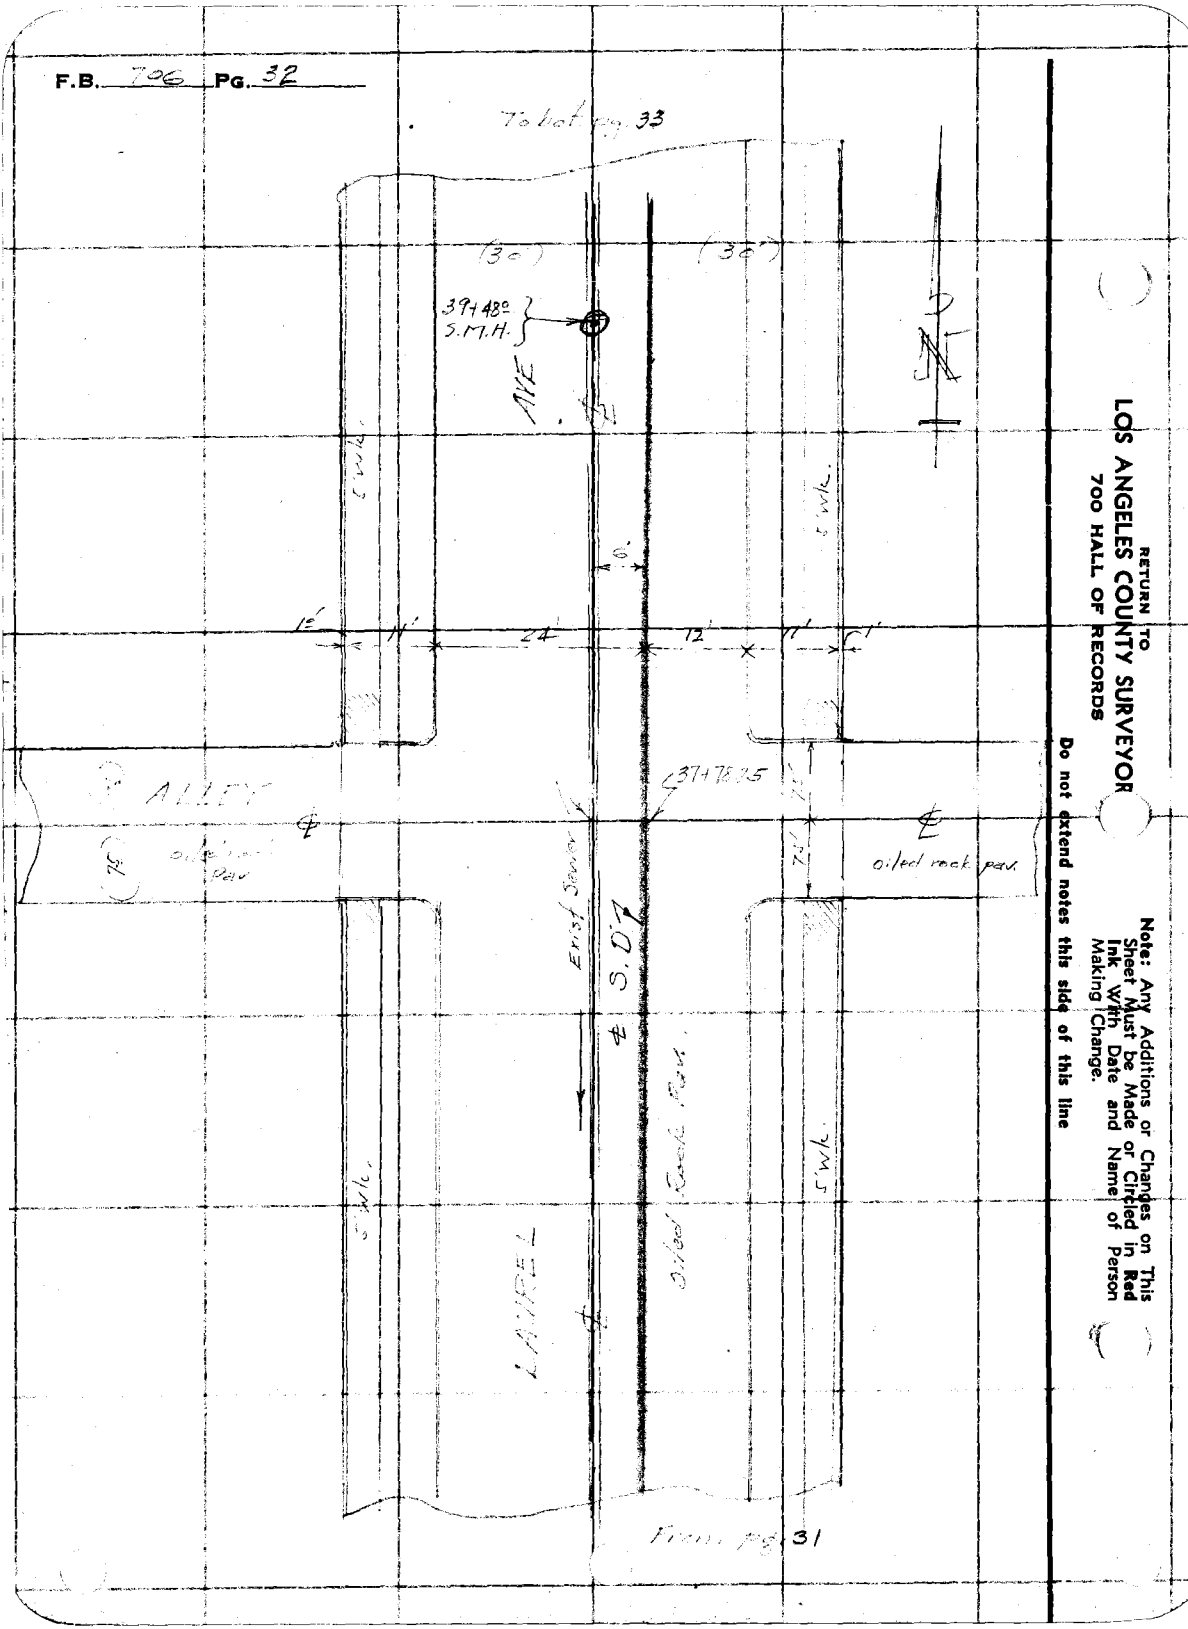

RETURN TO
LOS ANGELES COUNTY SURVEYOR
700 HALL OF RECORDS

Note: Any Additions or Changes on This Sheet Must be Made or Circled in Red Ink With Date and Name of Person Making Change.

Do not extend notes this side of this line

Notes Ck'd by	Survey of
Map No.	W. O. 6213 Tape No. St'd °F.
Office Work	Surveyed by
Checked	Notes Date
Date	Indexed A. C. Johnson

F.B. PG. 33

Note: Any Additions or Changes on This Sheet Must be Made in Red Ink or Circled With Date and Name of Person Making Change.

Do not extend notes this side of this line

RETURN TO
LOS ANGELES COUNTY SURVEYOR
700 HALL OF RECORDS

FORM 247 10M 11-38

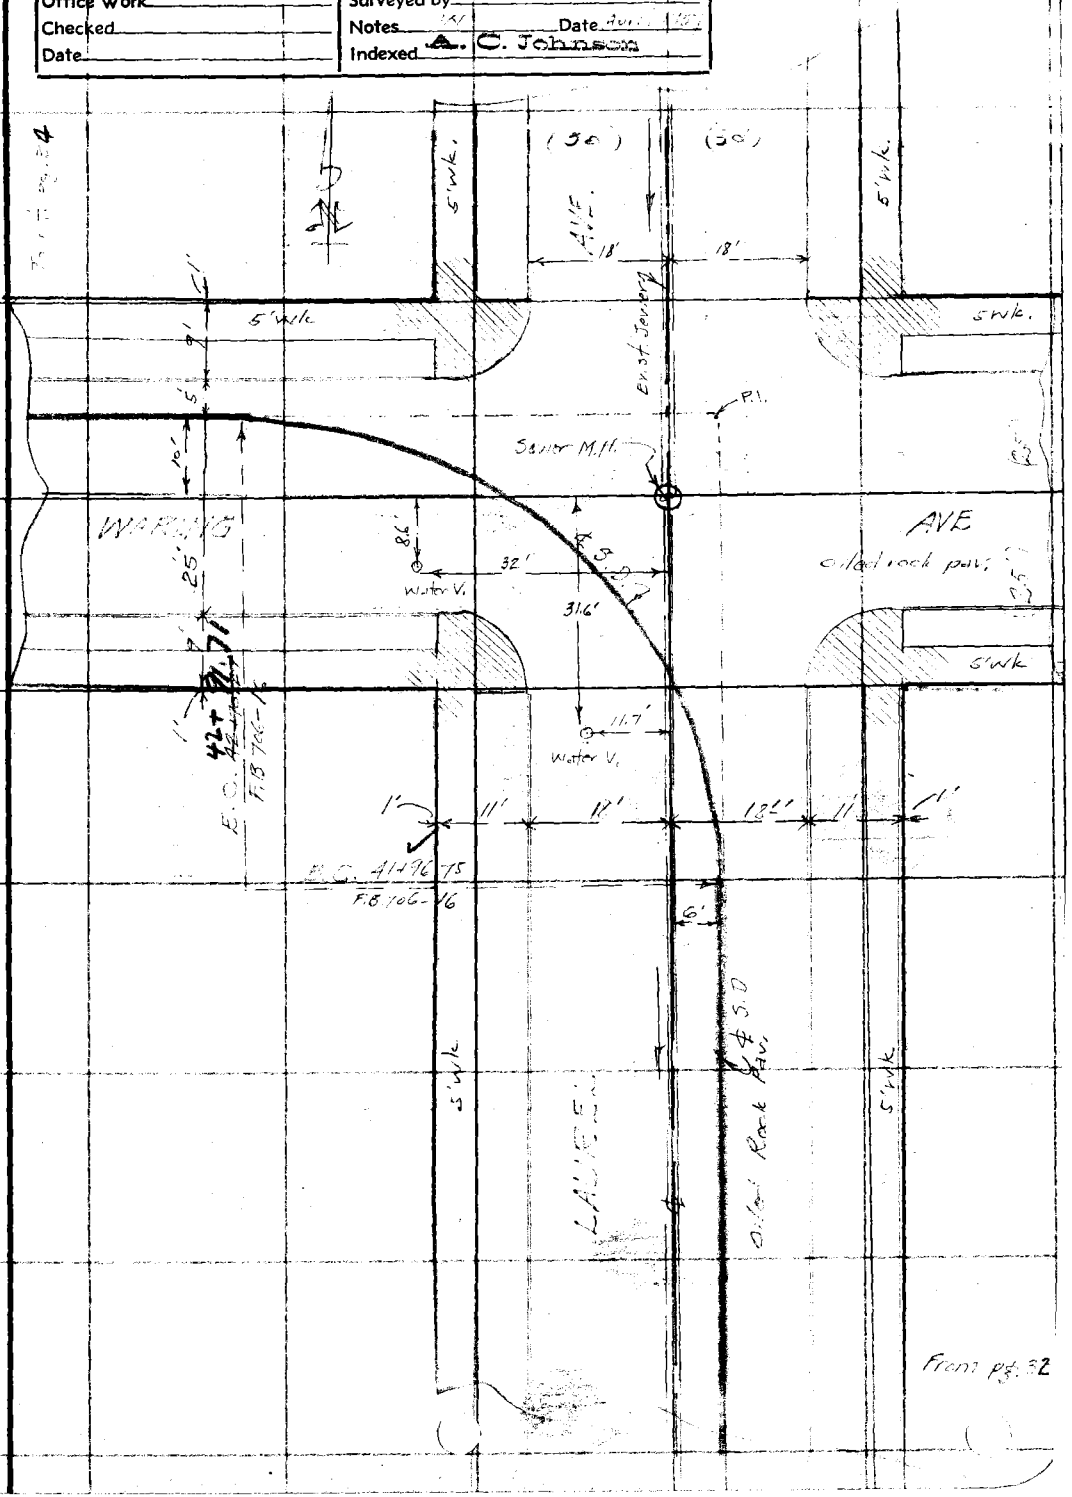

F.B. 706 Pg. 34

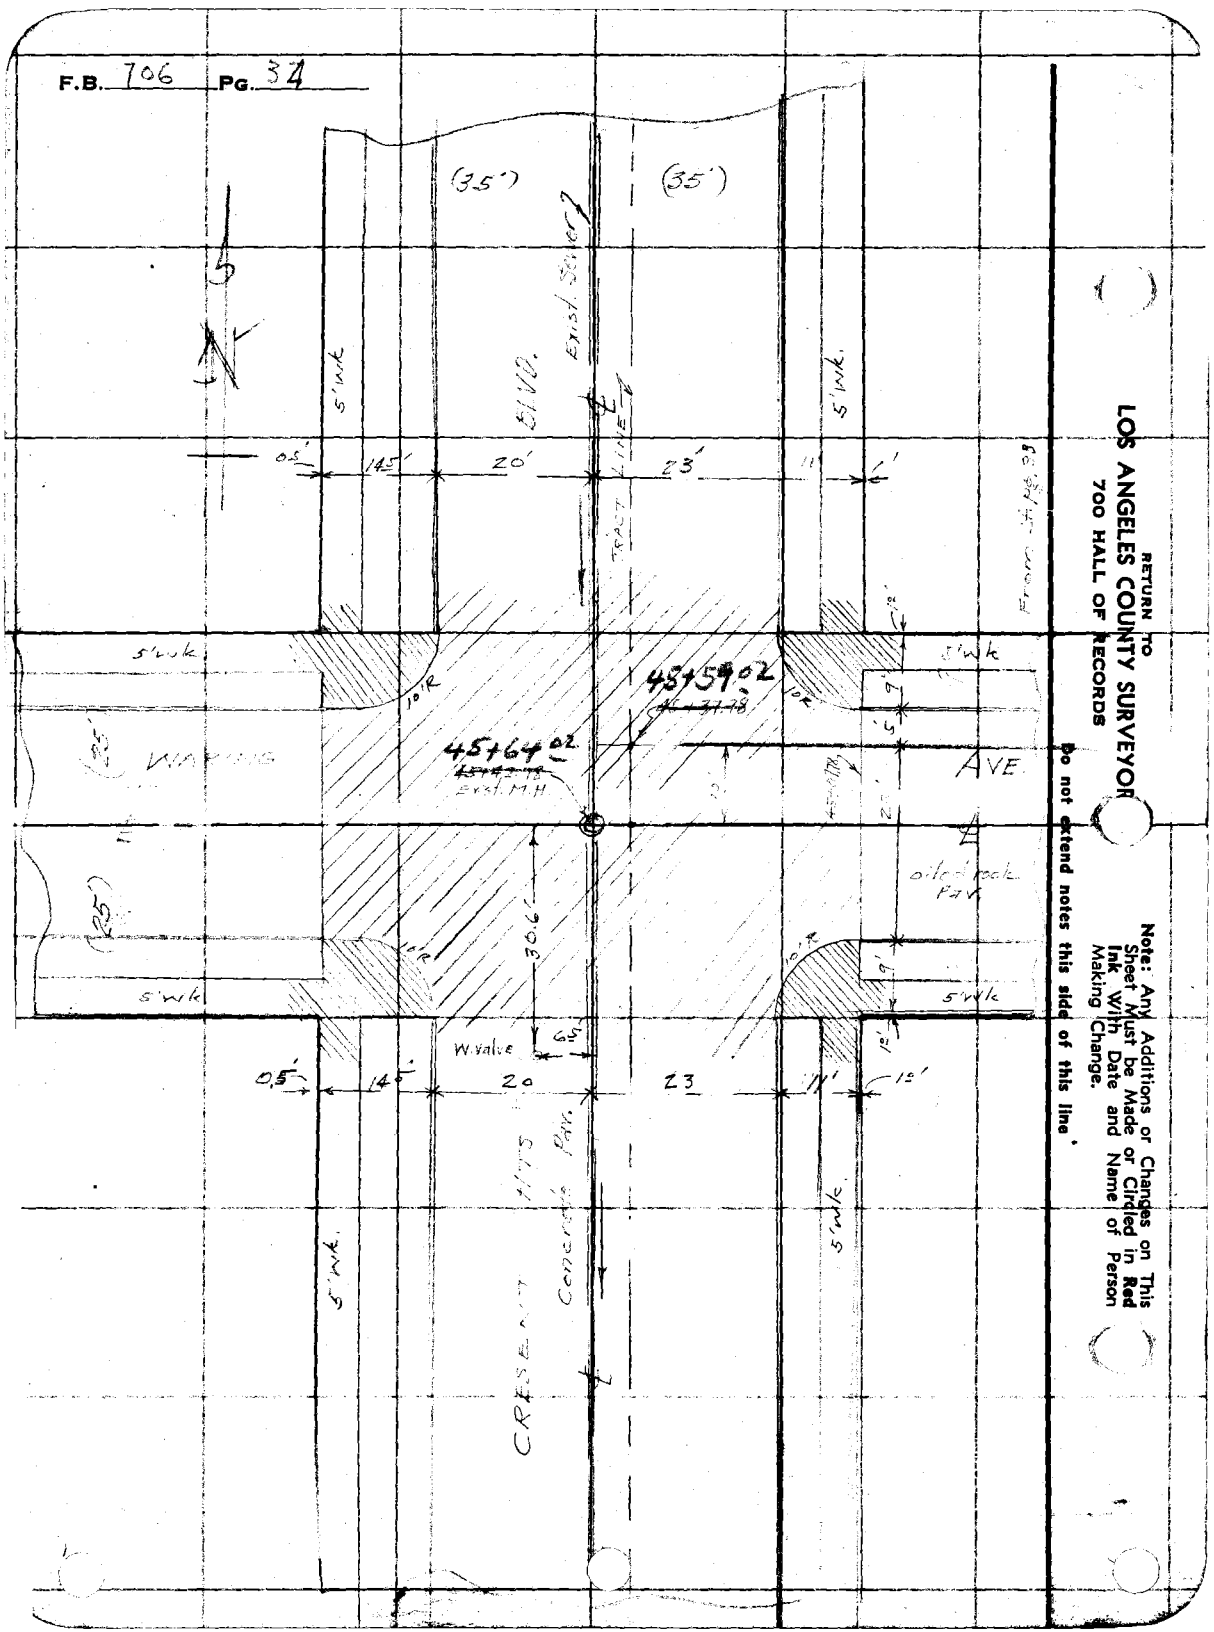

RETURN TO
LOS ANGELES COUNTY SURVEYOR
700 HALL OF RECORDS

Note: Any Additions or Changes on This Sheet Must be Made or Circled in Red Ink With Date and Name of Person Making Change.

Do not extend notes this side of this line

Profile No.	Notes Red.	Plotted	Job No. 6316	Division No.	F. B. 106 Pg. 35
	Date	Date	Survey of [illegible] DS		
X-Sec. No.	Notes Chkd.	Checked	Survey by WALLACE	Notes Gregory	Date Apr. 1937
	Date	Date	Map No.	Indexed C. Johnson	Date

NOTE: ANY ADDITIONS OR CHANGES ON THIS SHEET MUST BE MADE OR CIRCLED IN RED INK, WITH DATE AND NAME OF PERSON MAKING CHANGE

Do not extend notes this side of this line

PROFILE

LAUREL AVE. BRANCH

WEST HOLLYWOOD U.S.

J.N. 5318

Survey F.B. 106 Pgs. 1 to 18
Topography F.B. 106 Pgs 19 to 34

WALLACE
GREGORY
MURRAY
TELLEZ
ETNIER

ELEV.

APR 26 1937

RECEIVED ..... Smelser

PROGRESSED .....

F. S.

BOOK INDEXED .....

MAP INDEXED .....

H. I.

RECORD INDEXED .....

CARD INDEXED .....

REDUCED ..... L.C.M. 4-28-37

CHECKED ..... W.L.G. 4-29-37

B. S.

STATION

PLEASE RETURN TO
LOS ANGELES COUNTY SURVEYOR
700 HALL OF RECORDS

Form 307 5M 11-35

Form 307-SM 11-35

PLEASE RETURN TO
LOS ANGELES COUNTY SURVEYOR
700 HALL OF RECORDS

NOTE: ANY ADDITIONS OR CHANGES ON THIS SHEET MUST BE MADE OR CIRCLED IN RED INK, WITH DATE AND NAME OF PERSON MAKING CHANGE

Do not extend notes this side of this line

F. B. 706 PG. 56 | Job No. 6314 | Division No. | Profile No. | Notes Red. | Plotted | Date | X-Sec. No. | Date | Survey of | Date | Survey by | Notes | Checked | Date | Indexed | Notes Chkd. | Date

STATION	B. S.	H. I.	F. S.	ELEV.	
BM D-68	5.60	189.67		183.92	BM D-68
P.C. 1+00 = 47+68.38 N 0°00'00" W			6.42	183.15	
			5.92	181.61	
			6.42	183.15	
SC 1+24.00			5.64	184.13	
			5.65	184.12	
			6.13	183.44	
			5.31	184.17	
			5.80	183.77	
			5.05	184.52	
			5.15	184.52	
EC 1+21.78			5.34	184.33	
2+00			5.74	184.33	
3+00			4.92	184.15	
3+50	5.44	189.05	5.61	183.61	Flowline
3+49.2			4.81	184.24	
			5.53	183.52	

Form 307 5M 11-35

PLEASE RETURN TO
LOS ANGELES COUNTY SURVEYOR
700 HALL OF RECORDS

NOTE: ANY ADDITIONS OR CHANGES ON THIS SHEET MUST BE MADE OR CIRCLED IN RED INK, WITH DATE AND NAME OF PERSON MAKING CHANGE

Do not extend notes this side of this line

STATION	B. S.	H. I.	F. S.	ELEV.	Laurel Ave. St.	
		187 ~~90~~		Flores St.		
				184 40	TC	
				183 74		
3+71.29			10	183 [illegible]		
			29	183 [illegible]		
			12 17	176 88		
			12 25	176 80		
				183 20		
				184 59		
				185 27		
				185 17		
				184 50		
				185 20		
				184 21		
				183 61		
				183 20		
3+72				184 21	TC	
			29	183 [illegible]		

Profile
No. ____ Notes Red ____ Plotted ____ Job No. ____ Division No. ____
X-Sec. ____ Date ____ Date ____ Survey of ____
No. ____ Notes Chkd ____ Checked ____ Survey by ____ Notes ____
Date ____ Date ____ Map No. ____ Indexed ____ Date ____ Date ____

F. B. ____ PG. ____

Form 307 5M 11-35

PLEASE RETURN TO
LOS ANGELES COUNTY SURVEYOR
700 HALL OF RECORDS

NOTE: ANY ADDITIONS OR CHANGES ON THIS SHEET MUST BE MADE OR CIRCLED IN RED INK, WITH DATE AND NAME OF PERSON MAKING CHANGE

Do not extend notes this side of this line

F. B. 706 Pg. 38 | Job No. 43[illegible] | Division No. | Notes Red. | Plotted | Profile No.
Survey of W. [illegible] Notes | Date | Date | X-Sec. No.
Survey by [illegible] C. Johnson | Notes Chkd. | Checked
Indexed | Date | Date

STATION	B. S.	H. I.	F. S.	ELEV.	
		189 ✓			
4+62					
"					
3+97.84					
"					
7+00					
4+21.84					
			12 2+	176 10	hor. 8"
			12 0+	175 78	hor. 8" Outlet S

Form 307 5M 11-35

PLEASE RETURN TO
LOS ANGELES COUNTY SURVEYOR
700 HALL OF RECORDS

NOTE: ANY ADDITIONS OR CHANGES ON THIS SHEET MUST BE MADE OR CIRCLED IN RED INK, WITH DATE AND NAME OF PERSON MAKING CHANGE

Do not extend notes this side of this line

STATION	B. S.	H. I.	F. S.	ELEV.	Laurel Ave. Br.	
		119 05				
2136 BM			527	183 78		
"				183 19		
2+1184				183 79		
				183 33		
					BM 0-67 El	
			523			
	544	184 72		183 78		
5400			532	184 10		
			472	184 70		
			438	184 04		
				184 35		
				185 08		
			539	184 79		
				184 85		
				186 32		
				185 84		
				185 37		
			548	185 94		
				185 44		

Profile No. ____ X-Sec. No. ____

Notes Red ____ Plotted ____ Job No. ____ Division No. ____

Date ____ Date ____ Survey of ____

Notes Chkd ____ Checked ____ Survey by ____ W ____ Notes ____

Date ____ Date ____ Map No. ____ Indexed Johnson Date ____

F. B. ____ PG. 37

Form 307 5M 11-35

PLEASE RETURN TO
LOS ANGELES COUNTY SURVEYOR
700 HALL OF RECORDS

NOTE: ANY ADDITIONS OR CHANGES ON THIS SHEET MUST BE MADE, OR CIRCLED IN RED INK, WITH DATE AND NAME OF PERSON MAKING CHANGE

Do not extend notes this side of this line

F. B. 716 PG. 40 | Job No. 6315 Division No. | Notes Red. | Plotted | Profile No.
Survey of | Date | Date | X-Sec. No.
Survey by | Notes | Notes Chkd. | Checked
Indexed | Date | Date | Date

STATION	B. S.	H. I.	F. S.	ELEV.	

Form 307 5M 11-35

PLEASE RETURN TO
LOS ANGELES COUNTY SURVEYOR
700 HALL OF RECORDS

NOTE: ANY ADDITIONS OR CHANGES ON THIS SHEET MUST BE MADE OR CIRCLED IN RED INK, WITH DATE AND NAME OF PERSON MAKING CHANGE

Do not extend notes this side of this line

STATION	B. S.	H. I.	F. S.	ELEV.	Laurel Ave Dr.
					Ave.
					T.C.

Form 307 5M 11-35

PLEASE RETURN TO
LOS ANGELES COUNTY SURVEYOR
700 HALL OF RECORDS

NOTE: ANY ADDITIONS OR CHANGES ON THIS SHEET MUST BE MADE OR CIRCLED IN RED INK, WITH DATE AND NAME OF PERSON MAKING CHANGE

Do not extend notes this side of this line

F. B. 726 Pg. 42 | Job No. 334 | Division No. | Notes Red. | Plotted | Profile No.
Survey of | Date | Date | X-Sec. No.
Survey by C. Johnson | Notes | Notes Chkd. | Checked
Indexed | Date | Date | Date

STATION	B. S.	H. I.	F. S.	ELEV.	
BM D-64					

Form 307 5M 11-35

PLEASE RETURN TO
LOS ANGELES COUNTY SURVEYOR
700 HALL OF RECORDS

NOTE: ANY ADDITIONS OR CHANGES ON THIS SHEET MUST BE MADE OR CIRCLED IN RED INK, WITH DATE AND NAME OF PERSON MAKING CHANGE

Do not extend notes this side of this line

STATION	B. S.	H. I.	F. S.	ELEV.	
				18619	
				18651	
				18594	
				18659	
				18604	
				18515	
				18451	
				18521	
				18346	
				18351	
				18290	
				18398	
				18344	
				18524	
				18473	
				18566	
				18514	
				18559	
				18504	

Profile No. ____ X-Sec. No. ____

Notes Rcd. ____ Date ____ Notes Chkd. ____ Date ____ Map No. ____

Plotted ____ Date ____ Checked ____ Date ____

Job No. ____ Division No. ____ Survey of ____ Survey by ____ Notes ____ Date ____ Traced J. Johnson Date ____

F. B. ____ PG. ____

Form 307 5M 11-35

PLEASE RETURN TO
LOS ANGELES COUNTY SURVEYOR
700 HALL OF RECORDS

NOTE: ANY ADDITIONS OR CHANGES ON THIS SHEET MUST BE MADE OR CIRCLED IN RED INK, WITH DATE AND NAME OF PERSON MAKING CHANGE

Do not extend notes this side of this line

F. B. 106 Pg. 44 | Job No. 4214 | Division No. | Notes Red. | Plotted | Profile No.
Survey of | Date | Date | X-Sec. No.
Survey by | Notes | Notes Chkd. | Checked
Indexed C. Johnson | Date | Date | Date

STATION	B. S.	H. I.	F. S.	ELEV.	
				185 41	
				11 31	
				182 94	
				181 08	
				183 19	
				182 58	
T/C	5 67	191 78	4 00		
12+00			5 92	185 85	
12+11			6 00	185 78	(Flashpan)
				181 94	?
				186 52	
134			5 00	181 71	
				181 41	
			5 02	181 39	
			5 00	181 75	
				181 17	

Form 307 5M 11-35

PLEASE RETURN TO
LOS ANGELES COUNTY SURVEYOR
700 HALL OF RECORDS

NOTE: ANY ADDITIONS OR CHANGES ON THIS SHEET MUST BE MADE OR CIRCLED IN RED INK, WITH DATE AND NAME OF PERSON MAKING CHANGE

Do not extend notes this side of this line

STATION	B. S.	H. I.	F. S.	ELEV.	
					Laura Ave N.
					2 Vista Ave
		191.76	4.55	187.23	
			5.08	186.68	
			4.83	186.93	
			5.46	186.37	
1342.55			5.02	186.72	
			5.13	186.63	
			19.02	172.02	
			13.94	177.94	
			13.64	178.14	
			5.65	186.12	
			5.43	186.35	
			6.00	185.87	
			5.42	186.36	
			6.00	185.76	
			5.82	186.02	
			6.00	185.11	
			6.00	185.63	
			6.00	185.14	
			5.42	185.66	

No. _____ Profile
X-Sec. _____ No. _____
Notes Red. _____ Plotted _____ Job No. _____ Division No. _____
Date _____ Date _____ Survey of _____
Notes Chkd. _____ Checked _____ Survey by _____ Notes _____ Date _____
Date _____ Date _____ Map No. _____ Traced Johnson Date _____

F. B. 766 PG. 41

Form 307 5M 11-35

PLEASE RETURN TO
LOS ANGELES COUNTY SURVEYOR
700 HALL OF RECORDS

NOTE: ANY ADDITIONS OR CHANGES ON THIS SHEET MUST BE MADE OR CIRCLED IN RED INK, WITH DATE AND NAME OF PERSON MAKING CHANGE

Do not extend notes this side of this line

F. B. 76 Pg. 46 | Job No. [illegible] | Division No. [illegible] | Notes Red. ____ Date ____ | Plotted ____ Date ____ | Profile No. ____

Survey of [illegible] | Notes [illegible] Date ____ | Notes Chkd. ____ Date ____ | Checked ____ Date ____ | X-Sec. No. ____

Survey by A. C. Johnson

Indexed

STATION	B. S.	H. I.	F. S.	ELEV.	
				11[illegible] 09	
				18[illegible] 56	
				18[illegible] 47	
13+45				18[illegible] 32	
				18[illegible] 75	
				18[illegible] 68	
				18[illegible] 90	
				18624	
				18[illegible] 13	
				18[illegible] 64	
				18[illegible] 34	
				18[illegible] 91	
				18639	
13+				18[illegible] 84	
14+50				18[illegible] 01	

Form 307 5M 11-35

PLEASE RETURN TO
LOS ANGELES COUNTY SURVEYOR
700 HALL OF RECORDS

NOTE: ANY ADDITIONS OR CHANGES ON THIS SHEET MUST BE MADE OR CIRCLED IN RED INK, WITH DATE AND NAME OF PERSON MAKING CHANGE

Do not extend notes this side of this line

STATION	B. S.	H. I.	F. S.	ELEV.	
				18785	
TP	6.07				
				189 14	
				188 98	
				189 21	
				188 78	
				189 19	
				188 70	
				189 43	
				188 90	
				189 58	
				189 06	
				189 46	
				188 95	
				181 12	Inv.
				181 04	Inv.
				188 92	
				188 94	TC
				188 40	

Profile
No. X-Sec.
Notes Red Plotted Job No. Division No.
Date Date Survey of
Notes Chkd. Checked Survey by Notes
Date Date Map No. Indexed C. Johnson Date
F. B. PG.

F. B. 706 PG. 48 | Job No. | Division No. | Notes Red. | Plotted | Profile

Survey of | Date | Date | No.

Survey by | Notes | Notes Chkd. | Checked | X-Sec.

Indexed A. O Johnson | Date | Date | Date | No.

Form 307 5M 11-35

PLEASE RETURN TO
LOS ANGELES COUNTY SURVEYOR
700 HALL OF RECORDS

NOTE: ANY ADDITIONS OR CHANGES ON THIS SHEET MUST BE MADE OR CIRCLED IN RED INK, WITH DATE AND NAME OF PERSON MAKING CHANGE

Do not extend notes this side of this line

STATION	B. S.	H. I.	F. S.	ELEV.

Form 307 5M 11-35

PLEASE RETURN TO
LOS ANGELES COUNTY SURVEYOR
700 HALL OF RECORDS

NOTE: ANY ADDITIONS OR CHANGES ON THIS SHEET MUST BE MADE OR CIRCLED IN RED INK, WITH DATE AND NAME OF PERSON MAKING CHANGE

Do not extend notes this side of this line

STATION	B. S.	H. I.	F. S.	ELEV.	
				190 28	
				189 85	
				189 82	
				190 94	
				191 40	
				190 62	
				191 75	
				192 04	
				191 21	
				191 92	
				192 45	
				191 86	
				191 33	
				191 72	
				191 00	

Profile No.____ X-Sec. No.____

Notes Red____ Date____ Notes Chkd____ Date____ Map No.____

Plotted____ Date____ Checked____ Date____

Job No.____ Survey of____ Survey by____ Notes Anderson Johnson

Division No.____ Date____ Date____

F. B.____ PG.____

F. B. 106 PG. 50 | Job No. | Division No. | Notes Red. | Plotted | Profile

Survey of | Date | Date | No.

Survey by | Notes | Notes Chkd. | Checked | X-Sec.

Indexed A. C. Johnson | Date | Date | Date | No.

Form 307 5M 11-35

PLEASE RETURN TO
LOS ANGELES COUNTY SURVEYOR
700 HALL OF RECORDS

NOTE: ANY ADDITIONS OR CHANGES ON THIS SHEET MUST BE MADE OR CIRCLED IN RED INK, WITH DATE AND NAME OF PERSON MAKING CHANGE

Do not extend notes this side of this line

STATION	B. S.	H. I.	F. S.	ELEV.

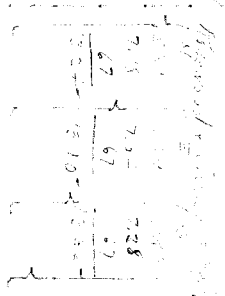

Form 307 5M 11-35

PLEASE RETURN TO
LOS ANGELES COUNTY SURVEYOR
700 HALL OF RECORDS

NOTE: ANY ADDITIONS OR CHANGES ON THIS SHEET MUST BE MADE OR CIRCLED IN RED INK, WITH DATE AND NAME OF PERSON MAKING CHANGE

Do not extend notes this side of this line

Profile No. ____ X-Sec. No. ____

Notes Red. ____ Date ____ Plotted ____ Date ____ Job No. ____ Survey of ____ Division No. ____

Notes Chkd. ____ Date ____ Checked ____ Date ____ Survey by ____ Notes ____ Date ____

Map No. ____ Date ____

F. B. ____ PG. ____

STATION	B. S.	H. I.	F. S.	ELEV.		
				193 55		
				193 37		
				192 71		
				193 63		
				193 17		
				195 26		
			7 52	187.81		
			9 60	187.73		
			5 57	191 76		
			5 35	191 98		
				191 39		
				192 00		
				191 77		
				192 52		
				191 87		
				192 76		
				192 09		
				191.33		

Form 307 5M 11-35

PLEASE RETURN TO
LOS ANGELES COUNTY SURVEYOR
700 HALL OF RECORDS

NOTE: ANY ADDITIONS OR CHANGES ON THIS SHEET MUST BE MADE OR CIRCLED IN RED INK, WITH DATE AND NAME OF PERSON MAKING CHANGE

Do not extend notes this side of this line

F. B. 716 Pg. 57 | Job No. 63 S | Division No. | Notes Red. | Plotted | Profile No.
Survey of | Date | Date | X-Sec. No.
Survey by C. Johnson | Notes | Notes Chkd. | Checked
Indexed | Date | Date | Date

STATION	B. S.	H. I.	F. S.	ELEV.	

Form 307 5M 11-35

PLEASE RETURN TO
LOS ANGELES COUNTY SURVEYOR
700 HALL OF RECORDS

NOTE: ANY ADDITIONS OR CHANGES ON THIS SHEET MUST BE MADE OR CIRCLED IN RED INK, WITH DATE AND NAME OF PERSON MAKING CHANGE

Do not extend notes this side of this line

STATION	B. S.	H. I.	F. S.	ELEV.	
		200 74			
		~~200~~	5 41	195 83	
			5 91	194 33	
			5 [illegible]	195 47	
			5 [illegible]	195 31	
			[illegible]	195 82	
			6 [illegible]	194 66	
			[illegible]	194 54	
			6 [illegible]	194 10	
			[illegible]	194 83	
			[illegible]	194 19	
			6 35	194 39	
			16 23	184 71	Inv. 8" Inlet - N
			16 37	184 37	Inv. 8" Outlet - S
			[illegible]	195 40	
			5 [illegible]	194 91	
			[illegible]	195 76	
			5 [illegible]	195 [illegible]2	
			5 [illegible]	195 71	
			5 [illegible]	195 52	

9.30 − 9.20 = .67 − .67 = 1.23 − 16.37

Profile No. ____ X-Sec. No. ____

Notes Red. ____ Date ____ Notes Chkd. ____ Date ____ Map No. ____

Plotted ____ Date ____ Checked ____ Date ____

Job No. ____ Survey of ____ Survey by ____

Division No. ____ Notes ____ Indexed ____ Date 7-24-37 Johnson Date ____

F. B. ____ PG. ____

Form 307 5M 11-35

PLEASE RETURN TO
LOS ANGELES COUNTY SURVEYOR
700 HALL OF RECORDS

NOTE: ANY ADDITIONS OR CHANGES ON THIS SHEET MUST BE MADE OR CIRCLED IN RED INK, WITH DATE AND NAME OF PERSON MAKING CHANGE

Do not extend notes this side of this line

F. B. ____ Pg. ____ Job No. ____ Division No. ____ Notes Red. ____ Plotted ____ Profile
Survey of ____ Date ____ No. ____
Survey by A. C. Johnson Date ____ Notes Chkd. ____ Checked ____ X-Sec.
Indexed ____ Date ____ Date ____ No. ____

STATION	B. S.	H. I.	F. S.	ELEV.	
	6 16	203 91			
T.P.	6 00	206 69	3 22	200 69	

Form 307 5M 11-35

PLEASE RETURN TO
LOS ANGELES COUNTY SURVEYOR
700 HALL OF RECORDS

NOTE: ANY ADDITIONS OR CHANGES ON THIS SHEET MUST BE MADE OR CIRCLED IN RED INK, WITH DATE AND NAME OF PERSON MAKING CHANGE

Do not extend notes this side of this line

Profile No. ____ X-Sec. No. ____ Notes Red ____ Plotted ____ Job No. ____ Division No. ____ F. B. ____ PG. ____
Date ____ Date ____ Survey of ____
Notes Chkd ____ Checked ____ Survey by ____
Date ____ Date ____ Map No. ____ Indexed ____ Notes ____ Date ____ Date ____

STATION	B. S.	H. I.	F. S.	ELEV.	
		200 69		Clinton	St.
28+05		200 69	515	201 54	± SD
03 04			485	201 84	T.C. S end S.E.C.R.
			539	201 30	Gutter
19 04			470	201 99	T.C. E
			530	201 59	Gutter
02 04			538	201 31	T.C. S end S.W.C.R.
			581	200 88	Gutter
			542	201 27	T.C. W
			590	200 89	Gutter
28+28 24			466	202 03	± [illegible] & Clinton St
			402	201 77	Gutter [illegible]
			356	203 13	100
			400	202 69	T.C. [illegible]
			402	202 27	Gutter
			365	203 01	T.C. N
			404	202 65	Gutter
			468	202 01	S.S. [illegible]
			1469	192 00	Inv. 8" [illegible]
			1477	191 92	Inv. 8 [illegible] S
			1457	192 12	Inv. 8" [illegible] W

N 469 + 7 = 1469 — E 465 — S 68 + 67 = 1477 — W 4.57 = 1457

Form 307 5M 11-35

PLEASE RETURN TO
LOS ANGELES COUNTY SURVEYOR
700 HALL OF RECORDS

NOTE: ANY ADDITIONS OR CHANGES ON THIS SHEET MUST BE MADE OR CIRCLED IN RED INK, WITH DATE AND NAME OF PERSON MAKING CHANGE

Do not extend notes this side of this line

F. B. 766 Pg. 56 | Job No. 2315 | Division No. | Notes Red. | Plotted | Profile No.
Survey of | Date | Date | X-Sec. No.
Survey by | Notes | Notes Chkd. | Checked
Indexed | Date | Date | Date

STATION	B. S.	H. I.	F. S.	ELEV.	Levels via [illegible]
					Cl'ton
		206 [illegible]			
		~~546~~ ~~29~~	562	201 07	[illegible]
			603	200 66	TC
			649	200 20	Gutter
			[illegible]	201 18	TC
			[illegible]	200 69	Gutter
[illegible]			444	200 25	[illegible]
			485	201 84	Gutter
			436	201 33	[illegible]
			178	201 91	[illegible]
[illegible]			500	201 69	[illegible]
			505	201 19	[illegible]
[illegible]			421	201 91	[illegible]
			513	201 56	[illegible]
					BM D-59 Alt 200.446
BM D-59			421	200.42	Laurel & Division St
	819	210 64		200.40	Wr. Spk 3' N of N end CR
			Laurel		
39+00			742	203 22	℄ SD.

F.B. 682-45
NE Cor

Form 307 5M 11-35

PLEASE RETURN TO
LOS ANGELES COUNTY SURVEYOR
700 HALL OF RECORDS

NOTE: ANY ADDITIONS OR CHANGES ON THIS SHEET MUST BE MADE OR CIRCLED IN RED INK, WITH DATE AND NAME OF PERSON MAKING CHANGE

Do not extend notes this side of this line

Profile No. X-Sec. No.

Notes Red Date Plotted Date Job No. Division No.
Notes Chkd Date Checked Date Survey of
Survey by Date Notes
Map No Date Traced Johnson Date

F. B. PG.

STATION	B. S.	H. I.	F. S.	ELEV.	Laurel Ave Bn.	
		210 64 ✓		Laurel Ave		
30+00		~~210 64~~	5 21	205.43	± S.D.	
31+00			3 25	207 39	± S.D.	
3 — 28°			2 50	208 14	SS M.H.	
			12 [illegible]	197 95	1in 8" Main	N 250 1352 0 1229 ✓ — 2 37 9 [illegible] 0 2 3 [illegible]
			12 30	197 81	1in 8" Outlet	
32+00			1 35	209 59	±	
32+ [illegible]			0 85	209 79	T.C.	
[illegible]			1 41	209 24	[illegible]	
[illegible]			1 41	209 23	T.C. W	
[illegible]			1 82	208 78	[illegible]	
T.P.	7 29	217 18 ✓	0 75	209 59 ✓		
33+00			5 [illegible]	211 85	± S.D.	
T.P.	6 55	217 74 ✓	3 [illegible]	[illegible] ✓		
34+00			6 [illegible]	213 85	± [illegible]	
34+21.50			5 66	214 28	SS M.H. (Flushed)	N 62 5 66 5 35 1401 — 1 28
			14 0.	205 93	Bot of [illegible]	

Form 307 5M 11-35

PLEASE RETURN TO
LOS ANGELES COUNTY SURVEYOR
700 HALL OF RECORDS

NOTE: ANY ADDITIONS OR CHANGES ON THIS SHEET MUST BE MADE OR CIRCLED IN RED INK, WITH DATE AND NAME OF PERSON MAKING CHANGE

Do not extend notes this side of this line

F. B. 1-6 PG. 54 | Job No. [illegible] | Division No. [illegible] | Notes Red. | Plotted | Profile
Survey of | Date | Date | No.
Survey by A. C. Johnson | Notes | Notes Chkd. | Checked | X-Sec.
Indexed | Date | Date | Date | No.

STATION	B. S.	H. I.	F. S.	ELEV.	
			[illegible]		
		✓			
		[illegible]	[illegible]	215 29	TC MCP S E Cor.
			[illegible]	214 89	Gutter " " "
			[illegible]	214 74	TC " " "
			[illegible]	211 24	[illegible]
[illegible]			[illegible]	215 24	[illegible]
"			[illegible]	215 03	[illegible]
"			[illegible]	215 46	[illegible]
			[illegible]	211 7	100' " " "
			[illegible]	211 39	" " 24' W " " "
			[illegible]	215 02	[illegible]
			[illegible]	211 2	100' " " "
			[illegible]	215 72	TC " " N S Cor.
			[illegible]	215 21	[illegible]
			[illegible]	215 02	" " " N W Cor.
			[illegible]	214 58	[illegible]
			Lateral [illegible]		
35+00			[illegible]	215 77	℄ S.D.
T.P.	3.31	222.87 ✓	338	219.56	
35+			534	217 53	Edge Conc. Pav.

Form 307 5M 11-35

PLEASE RETURN TO
LOS ANGELES COUNTY SURVEYOR
700 HALL OF RECORDS

NOTE: ANY ADDITIONS OR CHANGES ON THIS SHEET MUST BE MADE OR CIRCLED IN RED INK, WITH DATE AND NAME OF PERSON MAKING CHANGE

Do not extend notes this side of this line

Profile No. ____ X-Sec. No. ____ Notes Red ____ Date ____ Notes Chkd ____ Date ____ Plotted ____ Date ____ Checked ____ Date ____ Job No. ____ Survey of ____ Survey by ____ Map No. ____ Division No. ____ Notes Indexed ____ Date ____ F. B. ____ PG. ____ Date ____

STATION	B. S.	H. I.	F. S.	ELEV.	Laurel Ave Sp
		2.77 ✓	Melrose Ave		
35+33.24		~~2.77~~ 8	4 73	218 14	T.C. S end SE Crk
"			5 44	217 43	C.L. " " "
"			4 55	218 32	T.C. E " "
"			5 16	217 71	C.L. " " "
"				217 42	T.C. " end SW Crk
"			5 01	216 79	C.L. " " "
35+93.24			5 52	217 35	T.C. W " "
"			5 38	216 77	C.L. " " "
36+00			5 14	217 73	℄ ⊃
36+20 Sta			4 63	218 27	℄ Int ⊃ & Melrose Ave
			3 15	219 72	100' E Int ⊃ & ℄ Melrose Ave
			3 60	219 27	T.C. S Crk
			4 24	218 63	C.L. " "
			2 82	220 05	T.C. " "
			3 40	219 41	C.L. " "
			0 34	222 53	Sta on ⊃ of Melrose Ave & Emerson Ave
			11 90	210 97	Inv 8" Line E
			~~7 33~~		
			~~11 67~~	213 84	Inv 8" drop line & N.
			11 96	210 91	Inv 8" Outlet W

0.33	9.34	0.35
10.43	8.32	1.43
.62	.01	.62
11.38	7.33	2.40

Form 307 5M 11-35

PLEASE RETURN TO
LOS ANGELES COUNTY SURVEYOR
700 HALL OF RECORDS

NOTE: ANY ADDITIONS OR CHANGES ON THIS SHEET MUST BE MADE OR CIRCLED IN RED INK, WITH DATE AND NAME OF PERSON MAKING CHANGE

Do not extend notes this side of this line

F. B. 196 Pg. 6 | Job No. 2 | Division No. | Notes Red. | Plotted | Profile No.
Survey of | Date | Date | X-Sec. No.
Survey by A. C. Johnson | Notes | Notes Chkd | Checked
Indexed | Date | Date | Date

STATION	B. S.	H. I.	F. S.	ELEV.	Laurel Ave. E.
				Melrose Ave	
		222.87 ✓	+71	218.16	Surf C.L. Int Melrose & Laurel
			16.29	206.58	Inv 8" out N.
			16.47	206.40	Inv 8" " E
			13.68	209.19	"8" drop" N.
			16.20	206.27	Inv 8" Out W
			525	216.97	100' W of Int on S Melrose Ave
			650	216.37	
			707	215.80	Center
			541	217.38	T.C. N. Side
			613	216.74	Gutter
36+			490	217.95	Gutter & SD
			384	218.85	T.C. E end
			+05	218.22	Center
			391	218.88	T.C. N
			+64	218.23	Center
			450	218.34	T.C. N " NW Cor
			573	217.74	Center
			+66	218.21	T.C. W
			654	217.55	Center

Melrose E		N	W
4.71	4.73	4.71	4.73
11.91	11.10	.67	11.20
.67	.67	8.30	.67
16.29	16.47	13.68	16.60

Form 307 5M 11-35

PLEASE RETURN TO
LOS ANGELES COUNTY SURVEYOR
700 HALL OF RECORDS

NOTE: ANY ADDITIONS OR CHANGES ON THIS SHEET MUST BE MADE OR CIRCLED IN RED INK, WITH DATE AND NAME OF PERSON MAKING CHANGE

Do not extend notes this side of this line

STATION	B. S.	H. I.	F. S.	ELEV.	Laurel Ave Br.
				Laurel Ave	
		222.87	4.58	218.29	Edge Conc. & DD.
					BM D-42 El 218.928 FB 282-34
E.4 D-42			3.92	218.95	Laurel Av. & Melrose Av. N.E. Cor.
	-.65	222.78		218.93	Mn. Spk 6' E of E end C.R.
37+00			6.12	216.41	℄ DD
				ALLEY	
			4.62	220.96	TC. " C.R. S.E. Cor.
			5.10	220.41	Gutter " "
			2.25	220.33	TC. " " " Cor.
			1.68	219.90	Gut. " " "
37+78.35			1.08	220.90	℄ for S.D. & A/C
			5.20	220.58	Gutter " E of W Cor. of E ½ Lot
			4.80	221.18	Gut. " " " "
			2.6	223.0	Top " " " "
			2.48	220.10	Gutter 24' W of W Cor. of E ½ Lot
			5.09	220.39	Gut. 36' " " " "
			5.9	219.7	Top " " " "
			4.32	221.20	TC " C.R. N.E. Cor.
			4.84	220.74	Gutter " " " "
			4.90	220.68	TC " " N.W. Cor.
			5.39	220.19	Gutter " "

Profile
No. X-Sec. No.
Notes Red. Plotted Job No. Division No.
Date Date Survey of F. B. 172 PG.
Notes Chkd. Checked Survey by Notes
Date Date Map No. Indexed Date Date Date

Form 307 5M 11-35

PLEASE RETURN TO
LOS ANGELES COUNTY SURVEYOR
700 HALL OF RECORDS

NOTE: ANY ADDITIONS OR CHANGES ON THIS SHEET MUST BE MADE OR CIRCLED IN RED INK, WITH DATE AND NAME OF PERSON MAKING CHANGE

Do not extend notes this side of this line

F. B. 706 PG. 41 | Job No. 2315 | Division No. 3 | Profile No. | X-Sec. No.

Survey of [illegible] Notes [illegible] Plotted [illegible]

Survey by [illegible] Notes [illegible] Date [illegible] Checked [illegible]

Indexed by C. Johnson Date [illegible] Notes Chkd [illegible] Date [illegible]

STATION	B. S.	H. I.	F. S.	ELEV.	
		225 [illegible]			
38+00		~~225 [illegible]~~	4 26	221 32	[illegible]
39+00			2 16	223 16	[illegible]
39+82			1 73	223 85	[illegible]
			1 19	214 39	1.0' 8" Inlet N
			1 27	214 31	1.0' 8" Inlet S
TP	6 70	230 67	1 61	22[illegible]	
40+00			5 94	220 73	[illegible]
			5 67	225 00	TC [illegible] Side
			6 21	224 47	[illegible]
			6 36	224 31	TC [illegible]
			6 8	223 87	[illegible]
41+00			4 93	226 09	[illegible]
41+42 BC			3 32	227 64	[illegible]
TP	5 11	232 75	3 03	229 64	
				[illegible]	
			4 53	228 22	TC [illegible]
			4 96	227 79	[illegible]

V		5		
172		172		
150		85		
67		67		
11.19		11.37		

Form 307 5M 11-35

PLEASE RETURN TO
LOS ANGELES COUNTY SURVEYOR
700 HALL OF RECORDS

NOTE: ANY ADDITIONS OR CHANGES ON THIS SHEET MUST BE MADE OR CIRCLED IN RED INK, WITH DATE AND NAME OF PERSON MAKING CHANGE

Do not extend notes this side of this line

Profile No. ____ Notes Red ____ Plotted ____ Job No. ____ Division No. ____

X-Sec. No. ____ Notes Chkd ____ Date ____ Checked ____ Date ____ Survey of ____ Survey by ____ Notes Indexed ____ Map No. ____ Date ____ Date ____

F. B. ____ Pg. ____

STATION	B. S.	H. I.	F. S.	ELEV.	Laurel Ave Br.	
		232 75 ✓		Wing Elev		
		~~232 75~~	428	228 47	TC E [illegible]	
			[illegible]	227 98	[illegible]	
			532	227 43	TC [illegible]	
			579	226 96	[illegible]	
			536	227 39	TC W [illegible]	
			581	226 94	[illegible]	
			[illegible]	228 32	[illegible]	[illegible]
			302	229 73	[illegible]	[illegible]
			300	229 75	TC S. Side	
			354	229 21	[illegible]	
			[illegible]	230 10	[illegible]	
			320	229 49	[illegible]	
			448	228 27	[illegible]	Level Nos. 29
			2 829	220 46	Inv 8" Inlet N	N: 448 / 714 / 67 / 329 / 2 — E: 447 / 705 / .7 / 1319 / 2 — 725 / 67 / 1341 / 2
			2 19	220 56	Inv 8" [illegible] E	
			2 41	220 34	Inv. 8" Outlet S	
			450	227 95	[illegible]	
			[illegible]	228 67	Brk [illegible]	

Form 307 5M 11-35

PLEASE RETURN TO
LOS ANGELES COUNTY SURVEYOR
700 HALL OF RECORDS

NOTE: ANY ADDITIONS OR CHANGES ON THIS SHEET MUST BE MADE OR CIRCLED IN RED INK, WITH DATE AND NAME OF PERSON MAKING CHANGE

Do not extend notes this side of this line

F. B. 116 Pg. 64 | Job No. 2314 | Division No. | Notes Red. | Plotted | Profile No.
Survey of | Date | Date | X-Sec. No.
Survey by | Notes | Notes Chkd. | Checked
Indexed | Date | Date | Date

STATION	B. S.	H. I.	F. S.	ELEV.	
					Wilmington Ave
		234.72			
				230.20	
				228.41	
				230.03	
				229.87	
				227.38	
					BM D-21 El 228.427
BM D-21					Curve Sta Avalon Blvd
					(Wm Spk 5' S of Sta)
				227.40	
				226.93	
				227.37	
				226.88	
				225.15	
				227.73	
				227.82	
				227.46	
			390	227.33	
				227.07	
				226.43	

Form 307 5M 11-35

PLEASE RETURN TO
LOS ANGELES COUNTY SURVEYOR
700 HALL OF RECORDS

NOTE: ANY ADDITIONS OR CHANGES ON THIS SHEET MUST BE MADE OR CIRCLED IN RED INK, WITH DATE AND NAME OF PERSON MAKING CHANGE

Do not extend notes this side of this line

Profile No. ____ Notes Red ____ Plotted ____ Job No. 63[illegible] Division No. ____
X-Sec. No. ____ Notes Chkd ____ Date ____ Checked ____ Date ____ Survey of ____ Survey by ____ Date ____ Map No. ____ Notes ____ Indexed ____ Date ____
F. B. ____ Pg. ____

STATION	B. S.	H. I.	F. S.	ELEV.	Laurel Ave to E.
				Hyd	Ave
1. +21		231.23	562	225.61	℄ SD
TP	4.71	230.31	563	225.60	
				Crescent Heights Blvd	
29.02 +5+07.78			506	225.25	Face [illegible] ℄ SD
36.02 +5+14.78			490	225.82	TC E end [illegible]
"			508	225.23	Gutter
+41.02 1+20.78			485	225.86	TC
"			512	225.19	Gutter
+31.02 1+10.78			512	225.19	TC E [illegible]
"			521	224.60	Gutter
+41.02 1+20.78			524	225.07	TC
"			548	224.33	Gutter
+59.02 1+38.78			504	225.27	℄ [illegible]
			523	225.08	[illegible]
			1237	217.94	Inv. 8 Inlet
			1245	217.86	Inv 54 Outlet
			685	223.46	[illegible]
			633	223.98	TC E
			700	223.29	Gutter

(N
524
646
67
1237

Johnson

Form 307 5M 11-35

PLEASE RETURN TO
LOS ANGELES COUNTY SURVEYOR
700 HALL OF RECORDS

NOTE: ANY ADDITIONS OR CHANGES ON THIS SHEET MUST BE MADE OR CIRCLED IN RED INK, WITH DATE AND NAME OF PERSON MAKING CHANGE

Do not extend notes this side of this line

F. B. 766 PG. 66 | Job No. 4316 Division No. | Profile No. | X-Sec. No.

Survey of | Plotted | Notes Red | Date | Notes Chkd | Date

Survey by | Date | Checked | Date

Indexed | Date

STATION	B. S.	H. I.	F. S.	ELEV.	
					Center Ave Br.
		230+31			
		~~229+31~~			
			706	223	
				223	61
			580	224	51
				224	13
				224	55
				224	27
				225	70
				224	77
				225	10
				224	56
				224	70
				224	28
			642	223	87
			69	223	47
				224	26
				223	86
			269	227	64
			225	228	06
			298	227	33

Form 307 5M 11-35

PLEASE RETURN TO
LOS ANGELES COUNTY SURVEYOR
700 HALL OF RECORDS

NOTE: ANY ADDITIONS OR CHANGES ON THIS SHEET MUST BE MADE OR CIRCLED IN RED INK, WITH DATE AND NAME OF PERSON MAKING CHANGE

Do not extend notes this side of this line

STATION	B. S.	H. I.	F. S.	ELEV.	
		238 31			
		~~238 31~~	270	227 61	TC N Side
			325	227 03	
	1.69	238 71	1 24	229 02	
			7 23	231 48	SS 4 - 29 00 N of 2 in S.D. & Wash
			13 64	225 07	Inv 8 out N
			13 73	224 98	Inv 8" D out S
					BM D-39 E 237.980
BM D-39			0.74	237 97	Mission Bell on Air Terminal Hdqrs Bldg - Top of Wh. Spk 2'S of S end of

Profile
No.
X-Sec.
No.
Notes Red
Date
Notes Chkd
Date
Plotted
Date
Checked
Date
Job No.
Survey of
Survey by
Map No.
Division No.
Notes
Indexed
Date
Date
F. B.
PG.

F. B. 16 PG. 68 | Job No. 6318 | Division No. | Notes Red: | Plotted | Profile

Survey of Westwood Dr. | Date | Date | No.

Survey by | Notes Gregory | Notes Chkd. | Checked | X-Sec.

Indexed A. C. Johnson | Date | Date | Date | No.

Form 307 SM 11-35

PLEASE RETURN TO
LOS ANGELES COUNTY SURVEYOR
700 HALL OF RECORDS

NOTE: ANY ADDITIONS OR CHANGES ON THIS SHEET MUST BE MADE OR CIRCLED IN RED INK, WITH DATE AND NAME OF PERSON MAKING CHANGE

Do not extend notes this side of this line

STATION	B. S.	H. I.	F. S.	ELEV.

Form 307 5M 11-35

PLEASE RETURN TO
LOS ANGELES COUNTY SURVEYOR
700 HALL OF RECORDS

NOTE: ANY ADDITIONS OR CHANGES ON THIS SHEET MUST BE MADE OR CIRCLED IN RED INK, WITH DATE AND NAME OF PERSON MAKING CHANGE

Do not extend notes this side of this line

Profile No. X-Sec. No.

Notes Rod Date Notes Chkd Date

Plotted Date Checked Date

Job No. Survey of Survey by Map No.

Division No. Notes Indexed

F. B. PG.

STATION	B. S.	H. I.	F. S.	ELEV.	
					Surface Flow
					BM D-66 El 183.903 F.B. 682-54
34 D-66	5.84	189 85		183 99	Rosewood Ave & Hooper Ave
					Sta 0+00 Set Nail & Tag
			9 33	180 55	32.8 S of Curb Return NW
			17 31	- 172 57	Inlet S
			17 36	- 172 52	Inlet S
					BM D-44 El 185.033 F.B. 682-50
34-L-44			4 77	180 11	Rosewood Ave & Hooper Ave
	5.15	190 26		185 06	Sta 0+00 Set Nail & Tag
			7 83	182 58	55 N of "57" Post E Curb Hooper Ave
			17 40	- 173 01	Inlet N
			17 47	- 172 94	Inlet S

Form 307 5M 11-35

PLEASE RETURN TO
LOS ANGELES COUNTY SURVEYOR
700 HALL OF RECORDS

NOTE: ANY ADDITIONS OR CHANGES ON THIS SHEET MUST BE MADE OR CIRCLED IN RED INK, WITH DATE AND NAME OF PERSON MAKING CHANGE

Do not extend notes this side of this line

F. B. 106 PG. 70 | Job No. 6318 | Division No. | Notes Red | Plotted | Profile No.
Survey of | Date | Date | X-Sec. No.
Survey by | Notes | Notes Chkd. | Checked
Indexed C. Johnson | Date | Date | Date

STATION	B. S.	H. I.	F. S.	ELEV.	
		190 41	Pacwood Ave		
	5.87		4.10	186 31	
12+25			4.20	187 39	Beg. of Const. Work on N. Side
4+75			3.00	185 02	End of work on N Side
BM D-63			2.40	185 68	BM D-63 El. 186.688 / Pacwood Ave & La Salle Ave / Hub Spk in S. of Sewer CL
	5.40	190 64		185 24	
15+00			3.74	186 90	Sta. Eqn.
15+25			3.05	187 99	Beg. of curb return
BM D-62	5.10	195 05	3.14	189 95	BM D-62 El. 190.599 / Pacwood Ave & Rose Ave / Hub & Tack in S. of Sewer CL
19+00			4.90	190 15	Beg. of Const. Curb on S. Side
BM D-61			3.20	191 75	BM D-61 El. 191.813 / Pacwood Ave & Jessamine Ave / Hub & Tack in N. of Sewer CL

Notes Ck'd by	Survey of
Map No.	W. O. Tape No. St'd °F.
Office Work	Surveyed by Wallace
Checked	Notes Date
Date	Indexed

F.B. Pg. 71

CROSS & LINE SURVEY
EDINBURGH AVE. ST. TO
WEST VIOLA AVE. ST.
IN 6319
Topo F.B. 701 Pg. 15 to 18
Profile F.B. 100 Pg. 17 to 24

Wallace
Arroyo
Murray
Teller
Bonner

Note: Any Additions or Changes on This Sheet Must be Made or Circled in Red Ink With Date and Name of Person Making Change

Do not extend notes this side of this line

RETURN TO
LOS ANGELES COUNTY SURVEYOR
700 HALL OF RECORDS

APR 28 1937

RECEIVED ✓
PROGRESSED
BOOK INDEXED ✓
MAP INDEXED ✓
RECORD INDEXED ✓
~~CARD INDEXED~~ ✓

FORM 247 TOM 11-38

F.B. 106 Pg. 72

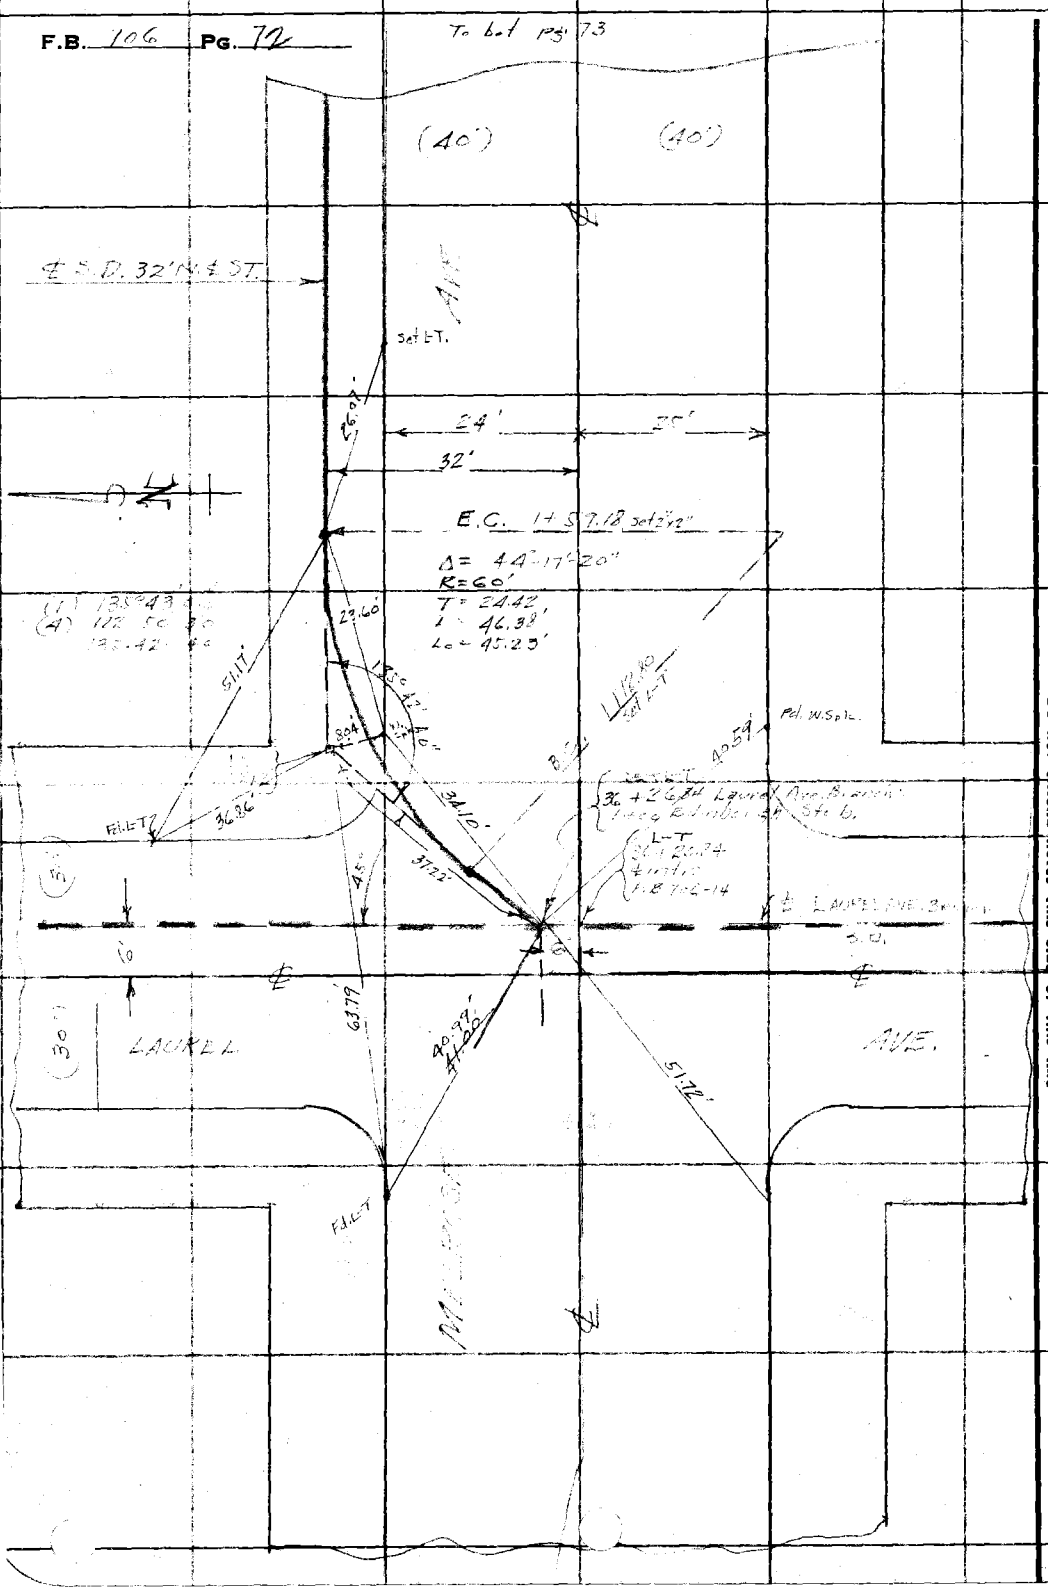

RETURN TO
LOS ANGELES COUNTY SURVEYOR
700 HALL OF RECORDS

Do not extend notes this side of this line

Note: Any Additions or Changes on This Sheet Must be Made or Circled in Red Ink With Date and Name of Person Making Change.

Notes Ck'd by	Survey of
Map No.	W. O. Tape No. St'd °F.
Office Work	Surveyed by
Checked	Notes Date
Date	Indexed A. C. Johnson

F.B. PG.

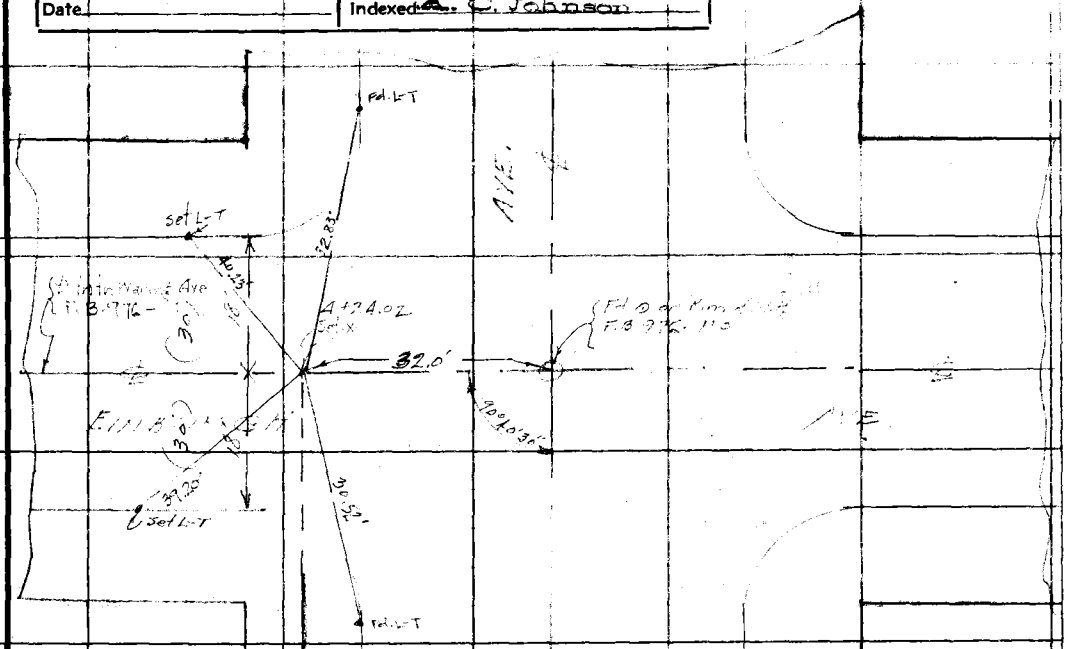

Note: Any Additions or Changes on This Sheet Must be Made or Circled in Red Ink With Date and Name of Person Making Change

Do not extend notes this side of this line

RETURN TO
LOS ANGELES COUNTY SURVEYOR
700 HALL OF RECORDS

FORM 247 10M 11-38

RETURN TO
LOS ANGELES COUNTY SURVEYOR
700 HALL OF RECORDS

Note: Any Additions or Changes on This Sheet Must be Made or Circled in **Red Ink** With Date and Name of Person Making Change.

Do not extend notes this side of this line

F.B. 106 PG. 24

Notes Ck'd by	Survey of W.
Map No.	W. O. 6318 Tape No. 955 St'd °F.
Office Work	Surveyed by Wallace
Checked	Notes W. Date April 1937
Date	Indexed C. Johnson

F.B. [illegible] PG. 75

TOPOGRAPHY

EDINBURGH AVE. STUB.

WEST HOLLYWOOD D.S.

J.N. 6318

E. Johnson [illegible] 91-94

PROFILE [illegible] 79-84

Wallace
Gregory
Mayberry
Hall
Parker

Note: Any Additions or Changes on This Sheet Must be Made or Circled in Red Ink With Date and Name of Person Making Change.

Do not extend notes this side of this line

RETURN TO
LOS ANGELES COUNTY SURVEYOR
700 HALL OF RECORDS

APR 28 1937

RECEIVED ✓

PROGRESSED ✓

BOOK INDEXED ✓

MAP INDEXED ✓

RECORD INDEXED ✓

[illegible] INDEXED

FORM 247 10M 11-36

F.B. 706 PG. 76

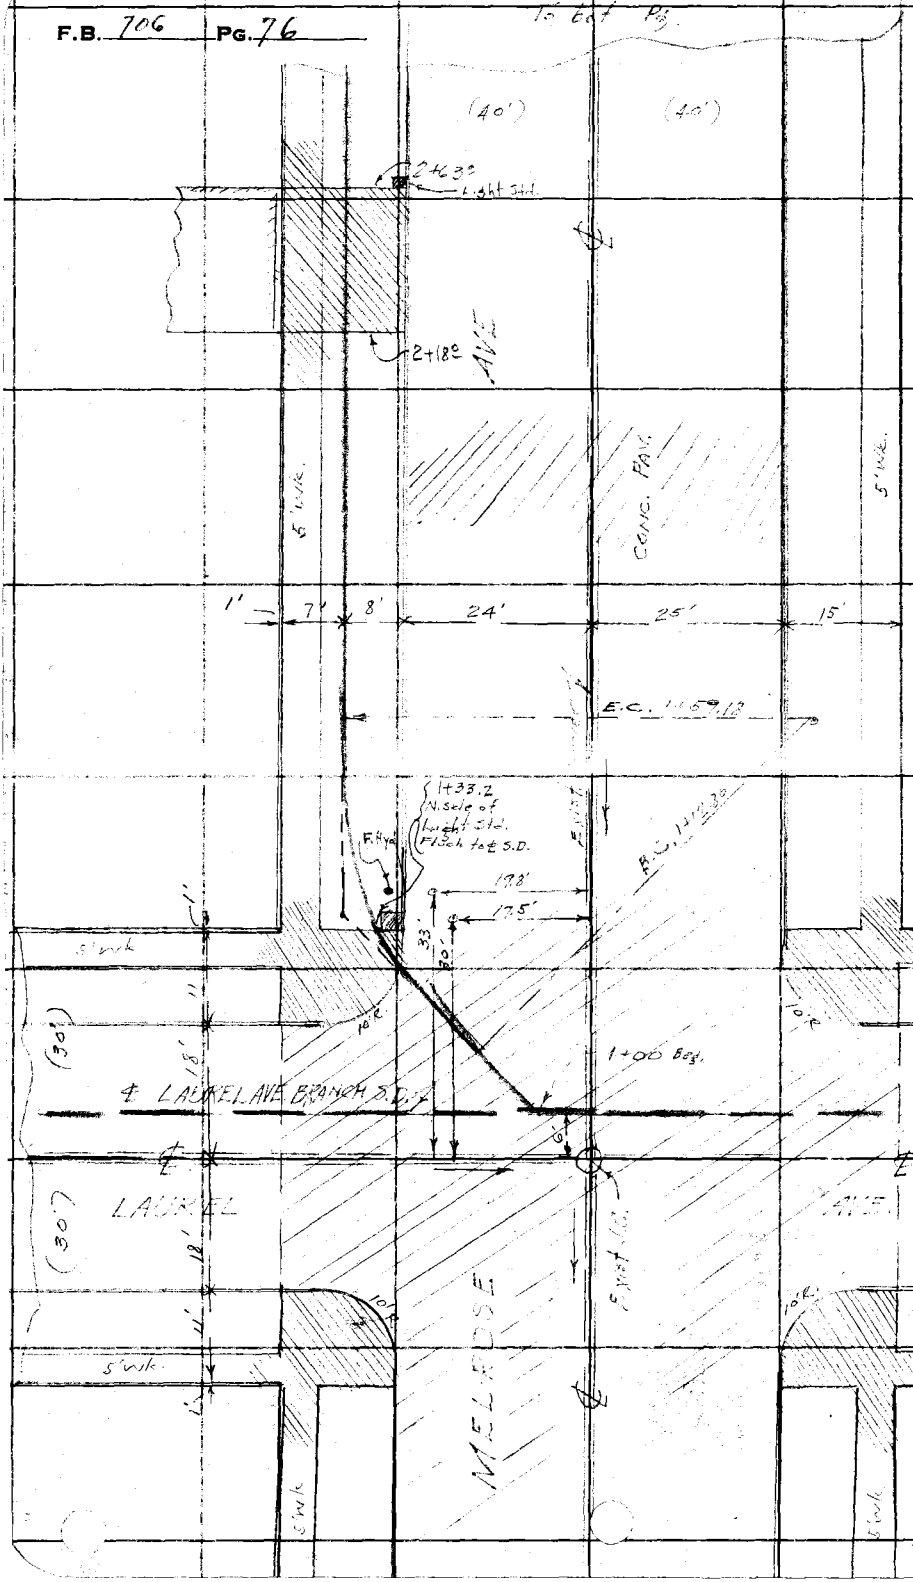

RETURN TO
LOS ANGELES COUNTY SURVEYOR
700 HALL OF RECORDS

Note: Any Additions or Changes on This Sheet Must be Made or Circled in Red Ink With Date and Name of Person Making Change.

Do not extend notes this side of this line

Notes Ck'd by	Survey of
Map No.	W. O. Tape No. St'd °F.
Office Work	Surveyed by
Checked	Notes Date
Date	Indexed A. C. Johnson

F.B. Pg.

Note: Any Additions or Changes on This Sheet Must Be Made or Circled in Red Ink With Date and Name of Person Making Change

Do not extend notes this side of this line

RETURN TO
LOS ANGELES COUNTY SURVEYOR
700 HALL OF RECORDS

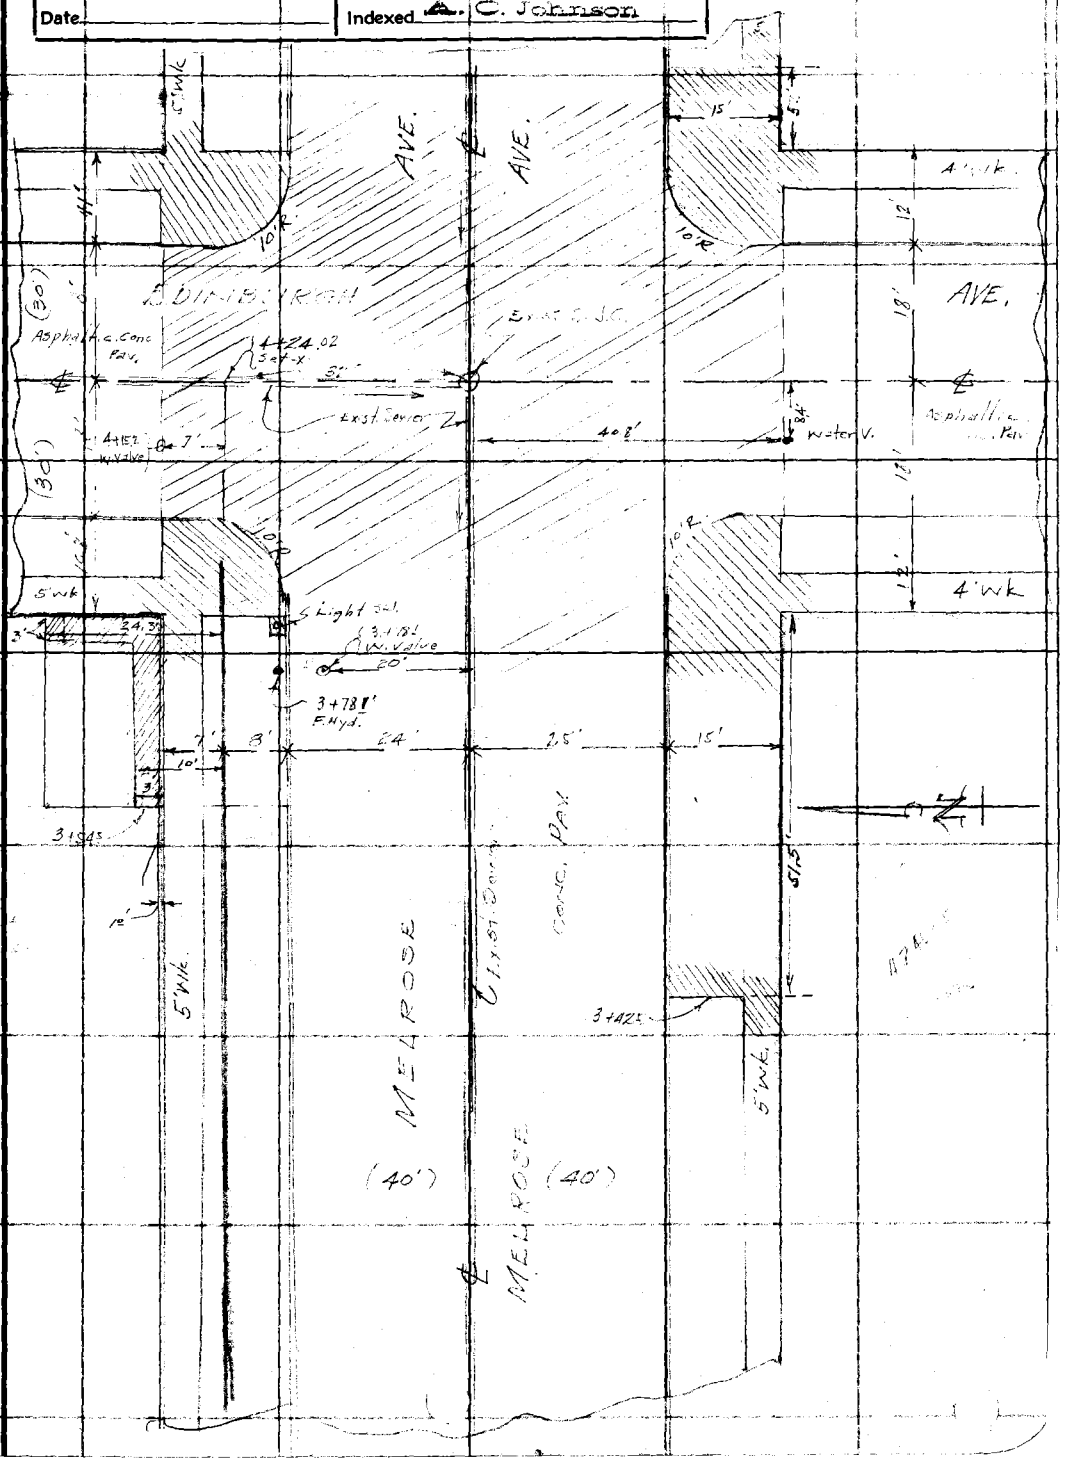

FORM 247 10M 11-38

RETURN TO
LOS ANGELES COUNTY SURVEYOR
700 HALL OF RECORDS

Note: Any Additions or Changes on This Sheet Must be Made or Circled in **Red Ink** With Date and Name of Person Making Change.

Do not extend notes this side of this line

F.B. 106 PG. 78

Profile No. ____ X-Sec. No. ____

Notes Red. ____ Date ____ Notes Chkd. ____ Date ____

Plotted ____ Date ____ Checked ____ Date ____

Job No. ____ Division No. ____ Survey of ____ Survey by ____ Map No. ____

Notes ____ Date ____ Indexed ____ Date ____

F. B. 716 PG. 17

PROJECT

EDINBURGH AVENUE

WEST HOLLYWOOD CO.

JULY

± Survey F.B. 706 Pgs. 71 & 74
Topog U.S. 706 Pgs. 15 & 18

Walker
Perry
Murphy
Miller
Turner

NOTE: ANY ADDITIONS OR CHANGES ON THIS SHEET MUST BE MADE OR CIRCLED IN RED INK, WITH DATE AND NAME OF PERSON MAKING CHANGE

Do not extend notes this side of this line

APR 28 1937

RECEIVED ..... Sutter

PROGRESSED ..... ✓

BOOK INDEXED ..... ✓

MAP INDEXED ..... ✓

RECORD INDEXED ..... ✓

CARD INDEXED ..... ✓

REDUCED ..... in field

CHECKED ..... LCM 4-28-37

STATION	B. S.	H. I.	F. S.	ELEV.

PLEASE RETURN TO
LOS ANGELES COUNTY SURVEYOR
700 HALL OF RECORDS

Form 307 5M 11-35

Form 307 5M 11-35

PLEASE RETURN TO
LOS ANGELES COUNTY SURVEYOR
700 HALL OF RECORDS

NOTE: ANY ADDITIONS OR CHANGES ON THIS SHEET MUST BE MADE OR CIRCLED IN RED INK, WITH DATE AND NAME OF PERSON MAKING CHANGE

Do not extend notes this side of this line

F.B. 706 Pg. 80 | Job No. [illegible] | Division No. | Profile No. | X-Sec. No.

Survey of [illegible] | Notes Red. Gravity | Plotted

Survey by C. Jackson | Notes [illegible] | Date 4-27-37 | Checked | Date

Indexed [illegible] | Date | Notes Chkd. | Date

STATION	B. S.	H. I.	F. S.	ELEV.		
					Melrose Ave	
BM D-42	6.10	225.38		218.28	BM D-42 El 218.928 / Laurel Ave. & Melrose Ave / Wr. Sch. 6' E of E end of C.F.	F.B. 682-38 N E Cr
34+22.84 Laurel Ave = 1133.16 Melrose Sta 56 1-12.80			703	214.30	± S.D.	J.C. at this intersection F.B. 706 p.60
			700	214.33	± S.D.	
			544	214.89	TC Melrose N E C.R.	
			605	215.35	Sidewalk	
			603	215.43	TC E " " "	
			7[illegible]	214.20	[illegible]	
			745	213.81	E curb Laurel Ave N of Melrose	
1733 56 1-12.80			530	214.03	± S.D.	
"			5[illegible]5	214.15	± S.D.	
"			553	214.50	Top Wall	
"			5[illegible]6	214.35	[illegible]	
"			552	214.71	Gutter	
2+00			542	222.11	± S.D.	
"			520	222.13	Top Wall	
"			543	214.10	TC	
"			5[illegible]	214.27	Gutter	

Form 307 5M 11-35

PLEASE RETURN TO
LOS ANGELES COUNTY SURVEYOR
700 HALL OF RECORDS

NOTE: ANY ADDITIONS OR CHANGES ON THIS SHEET MUST BE MADE OR CIRCLED IN RED INK, WITH DATE AND NAME OF PERSON MAKING CHANGE

Do not extend notes this side of this line

STATION	B. S.	H. I.	F. S.	ELEV.		

Form 307 5M 11-35

PLEASE RETURN TO
LOS ANGELES COUNTY SURVEYOR
700 HALL OF RECORDS

NOTE: ANY ADDITIONS OR CHANGES ON THIS SHEET MUST BE MADE OR CIRCLED IN RED INK, WITH DATE AND NAME OF PERSON MAKING CHANGE

Do not extend notes this side of this line

F. B. 76 PG. 58 | Job No. 635 | Division No. | Profile No. | X-Sec. No.

Survey of | Notes | Date | Notes Red. Gregory | Plotted

Survey by C. Johnson | Date | Notes Chkd. | Date | Checked | Date

Indexed

STATION	B. S.	H. I.	F. S.	ELEV.	
		227.94			
			209	225.35	
			636	225.58	
			565	225.29	
			620	225.08	
			[illegible]	225.34	
			458	225.46	
			518	225.76	
			328	225.67	
			338	225.56	
			410	225.74	
			502	225.97	
			435	225.79	
			[illegible]	225.90	
			492	225.92	
			3 [illegible]	225.80	
			290	225.74	
			336	225.78	
			[illegible]	225.41	
			354	225.45	

Form 307 5M 11-35

PLEASE RETURN TO
LOS ANGELES COUNTY SURVEYOR
700 HALL OF RECORDS

NOTE: ANY ADDITIONS OR CHANGES ON THIS SHEET MUST BE MADE OR CIRCLED IN RED INK, WITH DATE AND NAME OF PERSON MAKING CHANGE

Do not extend notes this side of this line

STATION	B. S.	H. I.	F. S.	ELEV.	
		227.94		Elevations etc	
			+0.02	227.97	S.S. N ~ 295.5' N 87° E SD = Edgewood Dr & Fa...
			8.87	227.07	Mon. 8" Brass ...
			9.01	226.93	Mon. 8" Brass ...
BM D-125				222.32	BM D-125 El 222.326 F.B. ... Monument Ave + Edgewood Ave ... Mon Set 3' E ... Edgewood Dr

+0.05 / 8.25 / 8.92 / 9.01

Profile
No. ____ X-Sec. ____ No. ____
Notes Red ____ Plotted ____ Job No. ____ Division No. ____
Date ____ Date ____ Survey of ____ F. B. ____ PG. ____
Notes Chkd ____ Checked ____ Survey by ____ Notes ____
Date ____ Date ____ Map No. ____ Indexed ____ Date ____

F. B. 706 PG. 84 | Job No. | Division No. | Notes Red. | Plotted | Profile

Survey of | Date | Date | No.

Survey by | Notes | Notes Chkd. | Checked | X-Sec.

Indexed A. C. Johnson | Date | Date | Date | No.

STATION	B. S.	H. I.	F. S.	ELEV.

Form 307 5M 11-35

PLEASE RETURN TO
LOS ANGELES COUNTY SURVEYOR
700 HALL OF RECORDS

Do not extend notes this side of this line

NOTE: ANY ADDITIONS OR CHANGES ON THIS SHEET MUST BE MADE OR CIRCLED IN RED INK, WITH DATE AND NAME OF PERSON MAKING CHANGE

Notes Ck'd by	Survey of [illegible]
Map No.	W. O. 6318 Tape No. 055 St'd °F.
Office Work	Surveyed by WALLACE
Checked	Notes [illegible] Date
Date	Indexed C. Johnson

F.B. [illegible] Pg. 95

T. SURVEY

ROSEWOOD - WADSWORTH AVE. LATERAL

WEST HOLLYWOOD U.S.

J.N 6318

TOPOG F.B 706 Pgs. 87 to 92

PROFILE F.B 706 Pgs. 93 to 100

WALLACE
GREGORY
MURRAY
TELLEZ
LINDLEY

APR 28 1937

RECEIVED ✓ Surlee

~~PROGRESSED~~ ✓

BOOK INDEXED ✓

MAP INDEXED ✓

RECORD INDEXED ✓

CARD INDEXED ✓

RETURN TO
LOS ANGELES COUNTY SURVEYOR
700 HALL OF RECORDS

Note: Any Additions or Changes on This Sheet Must be Made in Red Ink or Circled in Red With Date and Name of Person Making Change.

Do not extend notes this side of this line

FORM 247 10M 11-38

RETURN TO
LOS ANGELES COUNTY SURVEYOR
700 HALL OF RECORDS

Note: Any Additions or Changes on This Sheet Must be Made or Circled in **Red Ink** With Date and Name of Person Making Change.

Do not extend notes this side of this line

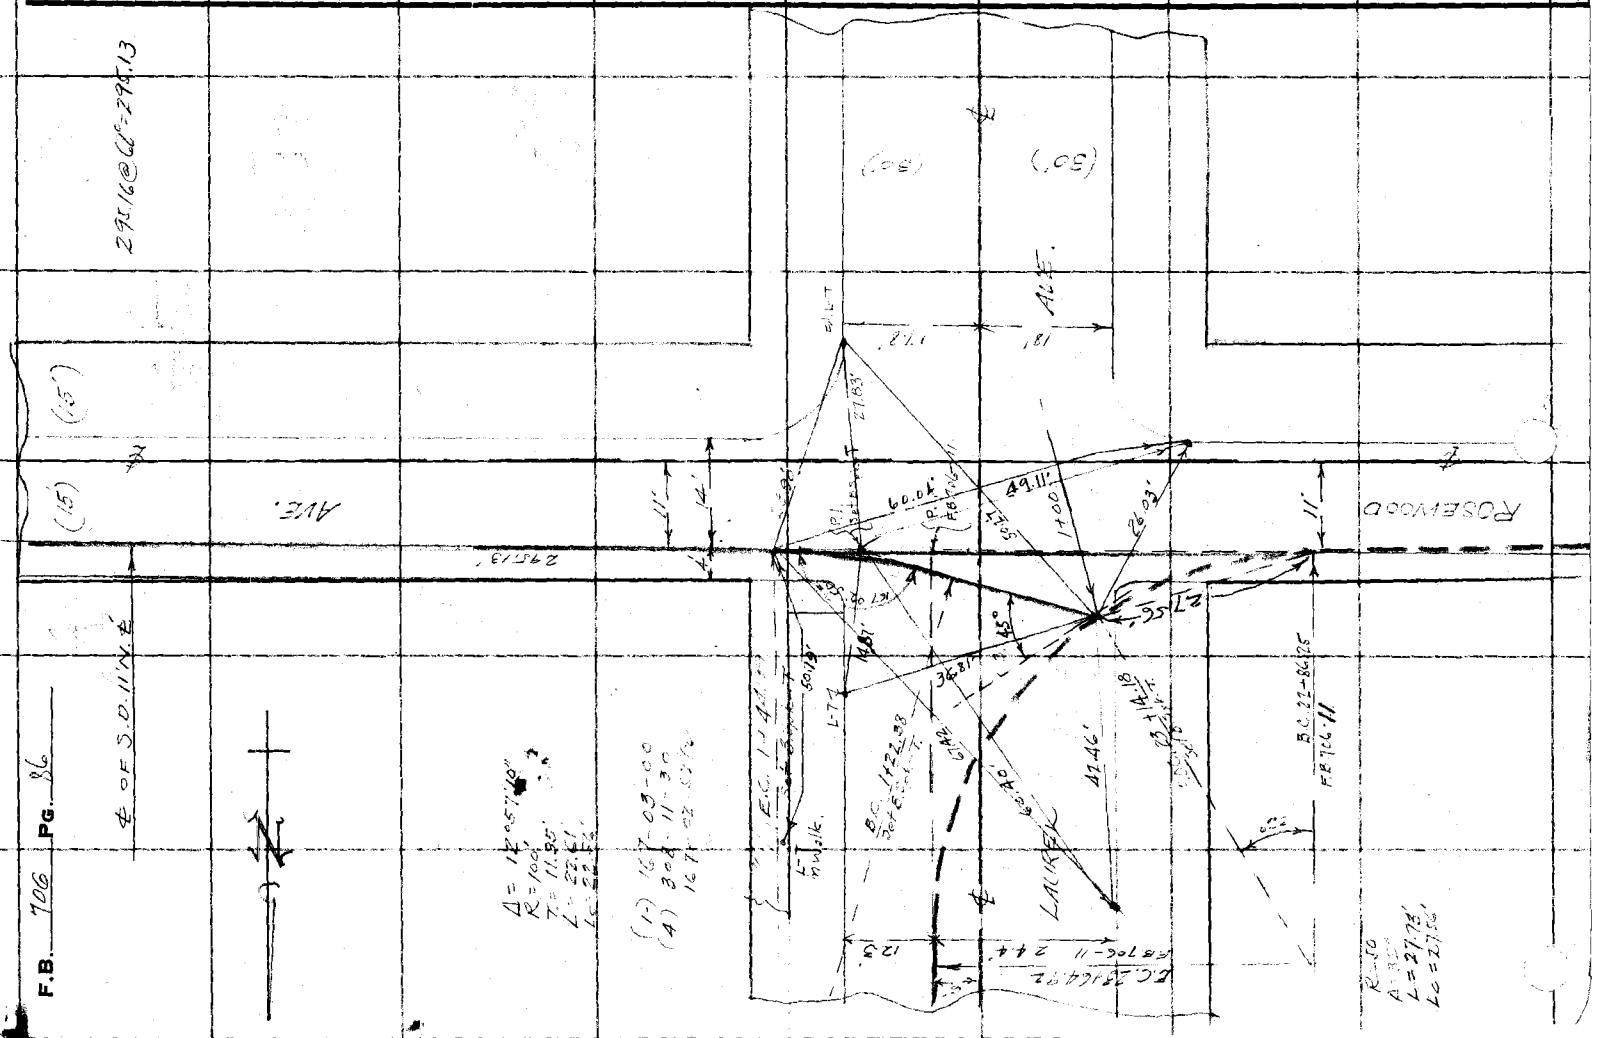

Notes Ck'd by	Survey of
Map No.	W. O. 6215 Tape No. St'd °F.
Office Work	Surveyed by
Checked	Notes Date
Date	Indexed

F.B. 706 Pg. 27

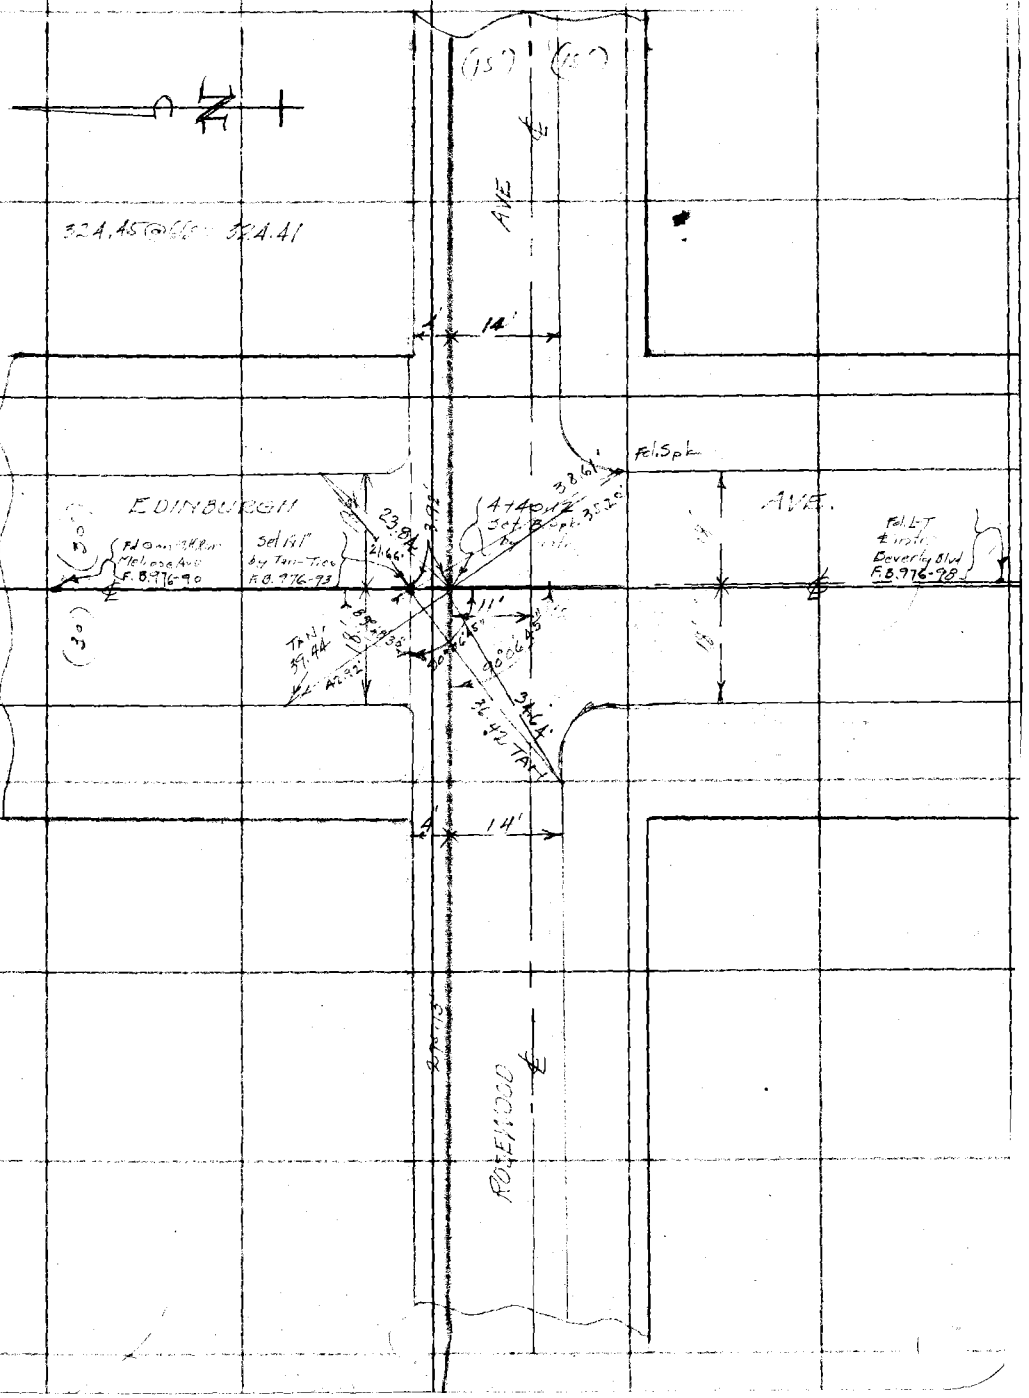

Note: Any Additions or Changes on This Sheet Must be Made or Circled in Red Ink With Date and Name of Person Making Change

Do not extend notes this side of this line

RETURN TO
LOS ANGELES COUNTY SURVEYOR
700 HALL OF RECORDS

FORM 247 10M 11-35

F.B. 706 Pg. 88

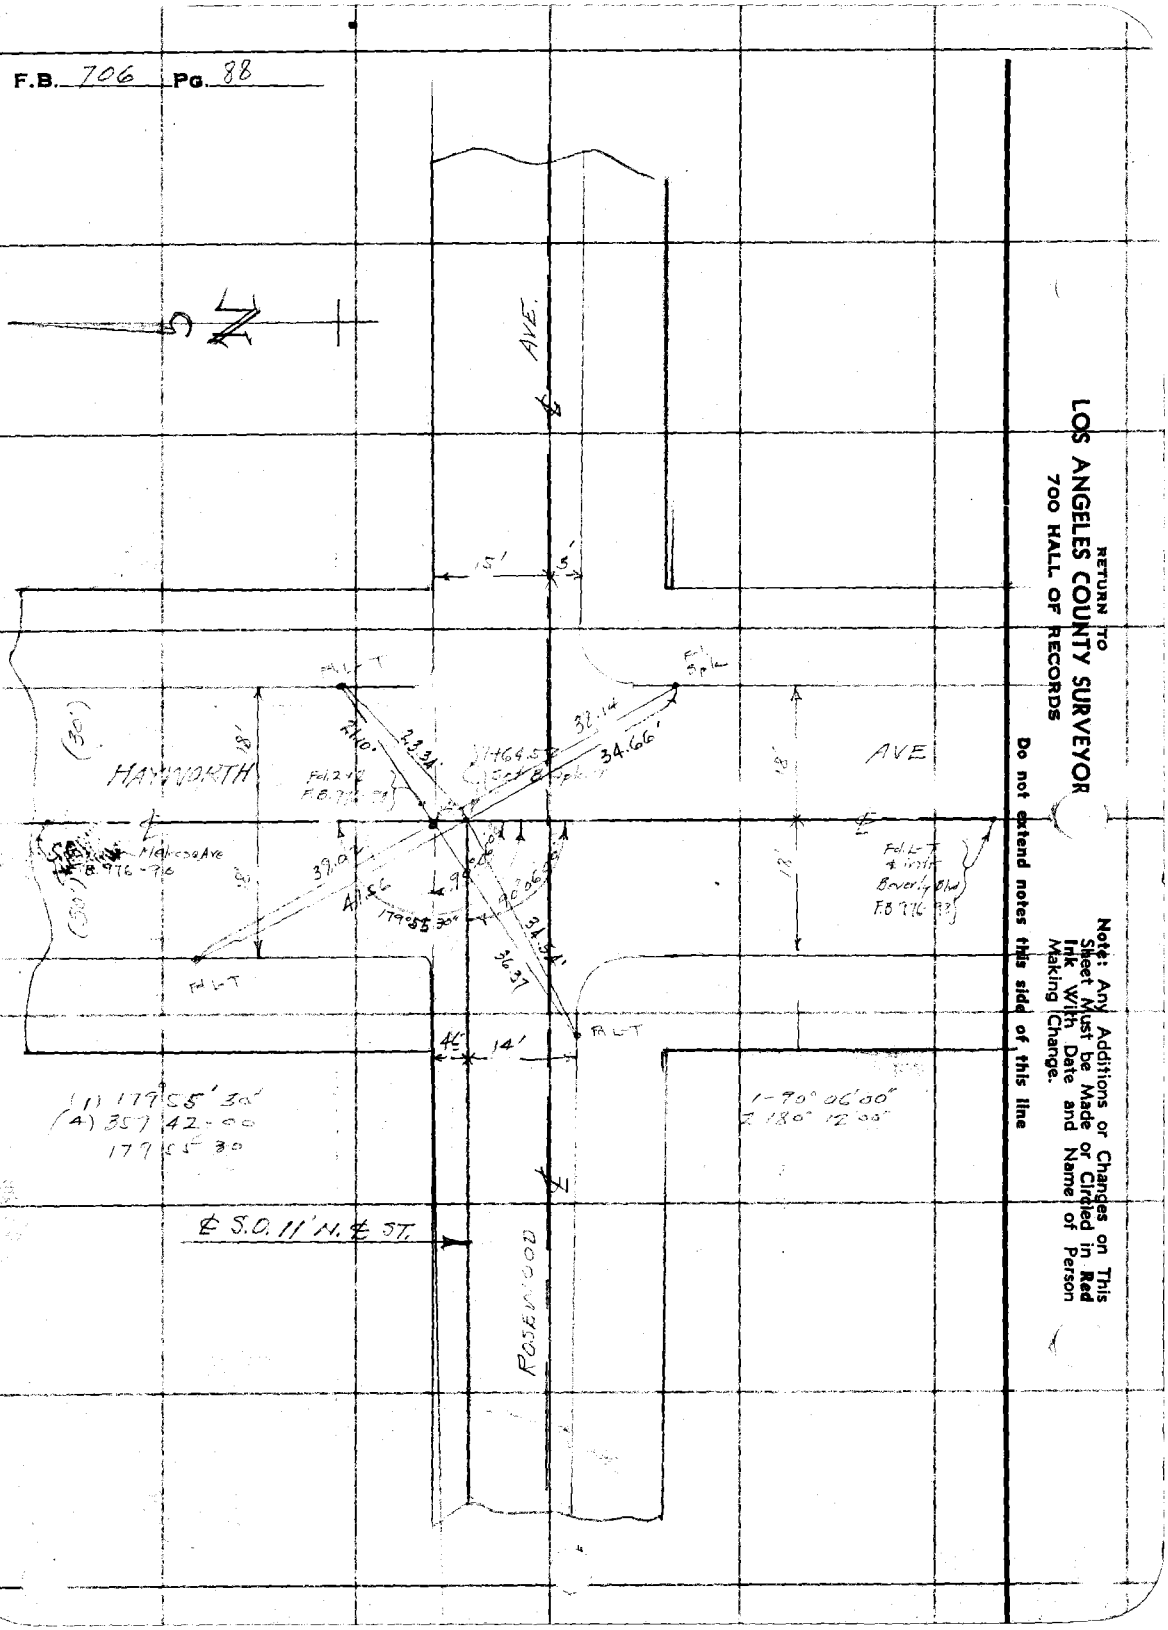

RETURN TO
LOS ANGELES COUNTY SURVEYOR
700 HALL OF RECORDS

Note: Any Additions or Changes on This Sheet Must be Made or Circled in Red Ink With Date and Name of Person Making Change.

Do not extend notes this side of this line

Notes Ck'd by	Survey of Wattles Park
Map No.	W. O. 6318 Tape No. St'd °F.
Office Work	Surveyed by Various
Checked	Notes Date Apr. 1 1937
Date	Indexed A. C. Johnson

F.B. PG.

TOPOS

[illegible] HAWTHORN AVE. LATERAL

WEST HOLLYWOOD CO.

J.N. 6315

L SURVEY A.B. 106 Pgs. 32 to 71

PROFILE A.B. 106 Pgs. 73 to 100

Note: Any Additions or Changes on This Sheet Must be Made or Circled in Red Ink With Date and Name of Person Making Change.

Do not extend notes this side of this line

RETURN TO
LOS ANGELES COUNTY SURVEYOR
700 HALL OF RECORDS

APR 28 1937

RECEIVED ✓

PROGRESSED —

BOOK INDEXED .....

MAP INDEXED ✓

RECORD INDEXED ✓

CARD INDEXED ✓

FORM 247 10M 11-36

RETURN TO
LOS ANGELES COUNTY SURVEYOR
700 HALL OF RECORDS

Note: Any Additions or Changes on This Sheet Must be Made or Circled in **Red Ink** With Date and Name of Person Making Change.

Do not extend notes this side of this line

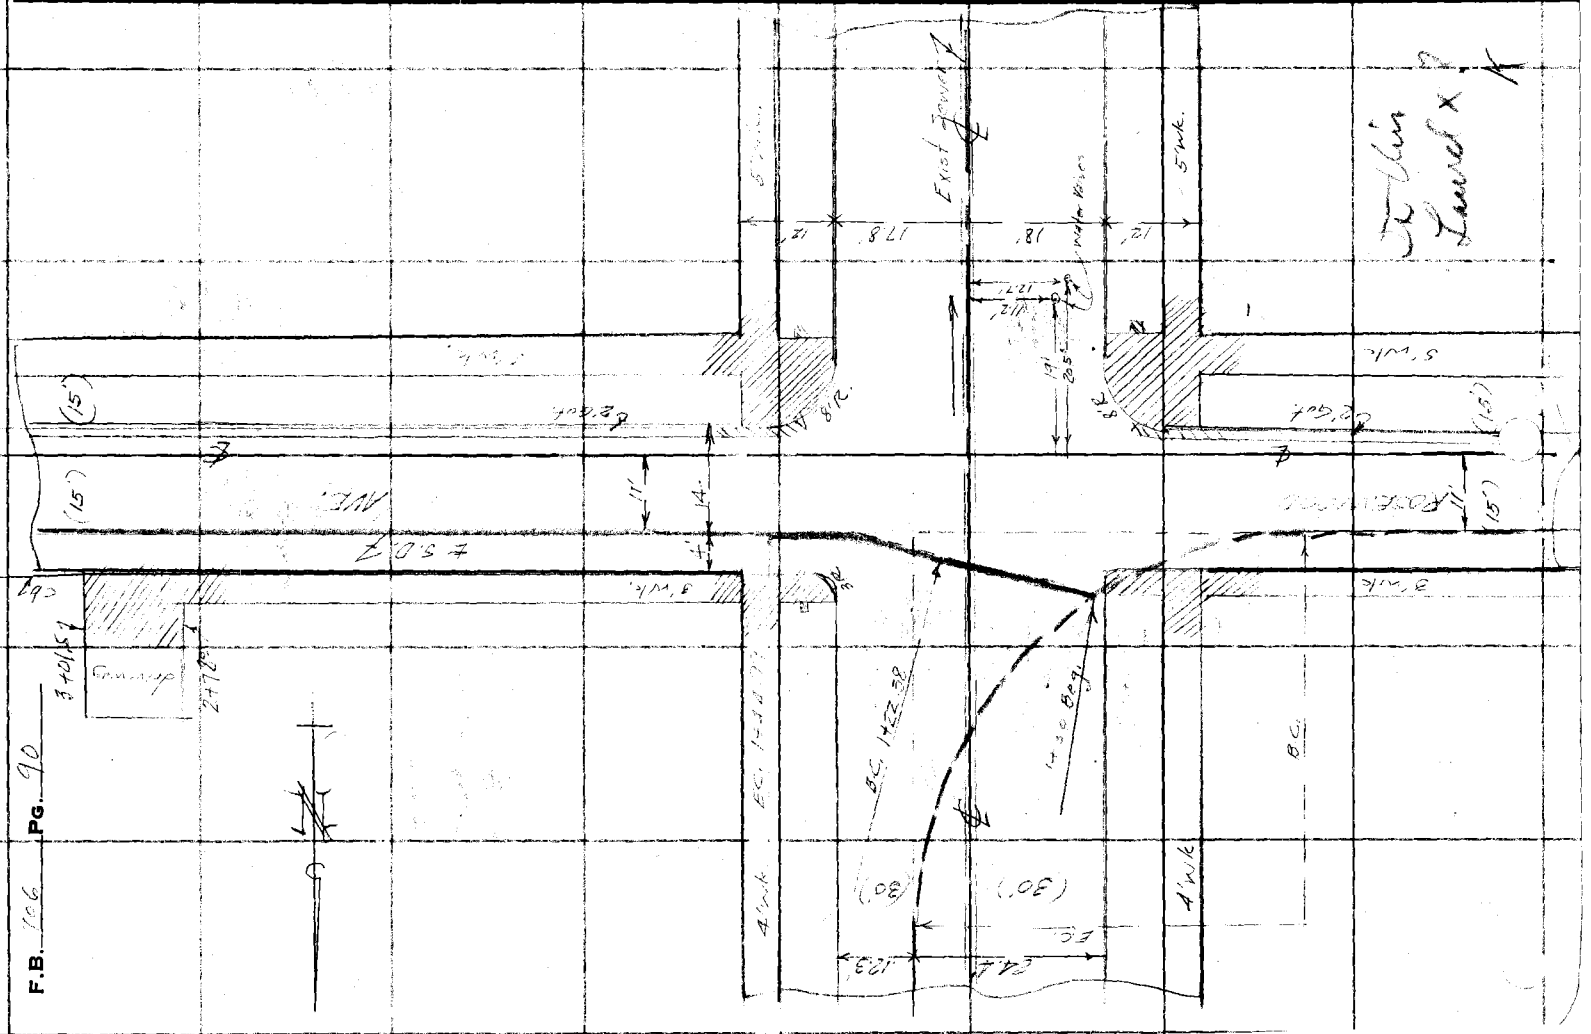

FORM 247 10M 11-38

RETURN TO
LOS ANGELES COUNTY SURVEYOR
700 HALL OF RECORDS

Note: Any Additions or Changes on This Sheet Must be Made or Circled in **Red Ink** With Date and Name of Person Making Change.

Do not extend notes this side of this line

Notes Ck'd by
Map No.
Office Work
Checked
Date

Survey of
W. O. 6318 Tape No. Std. °F.
Surveyed by
Notes Date
Indexed C. Johnson

F.B. PG.

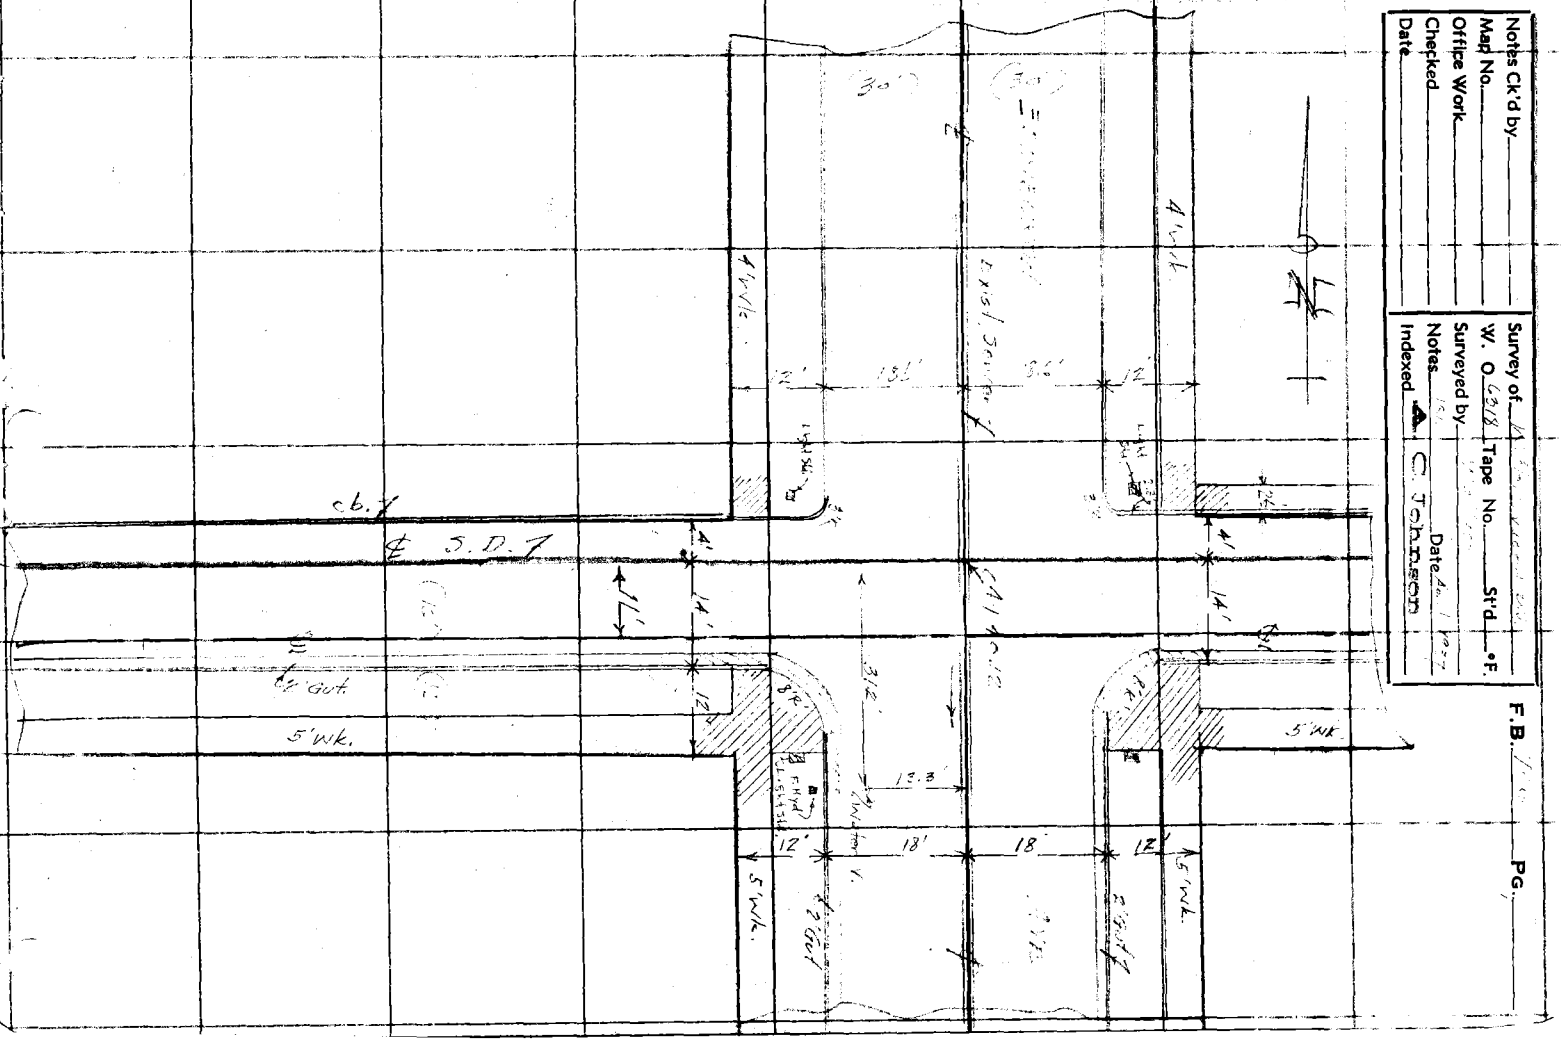

F.B. 766 PG. 97

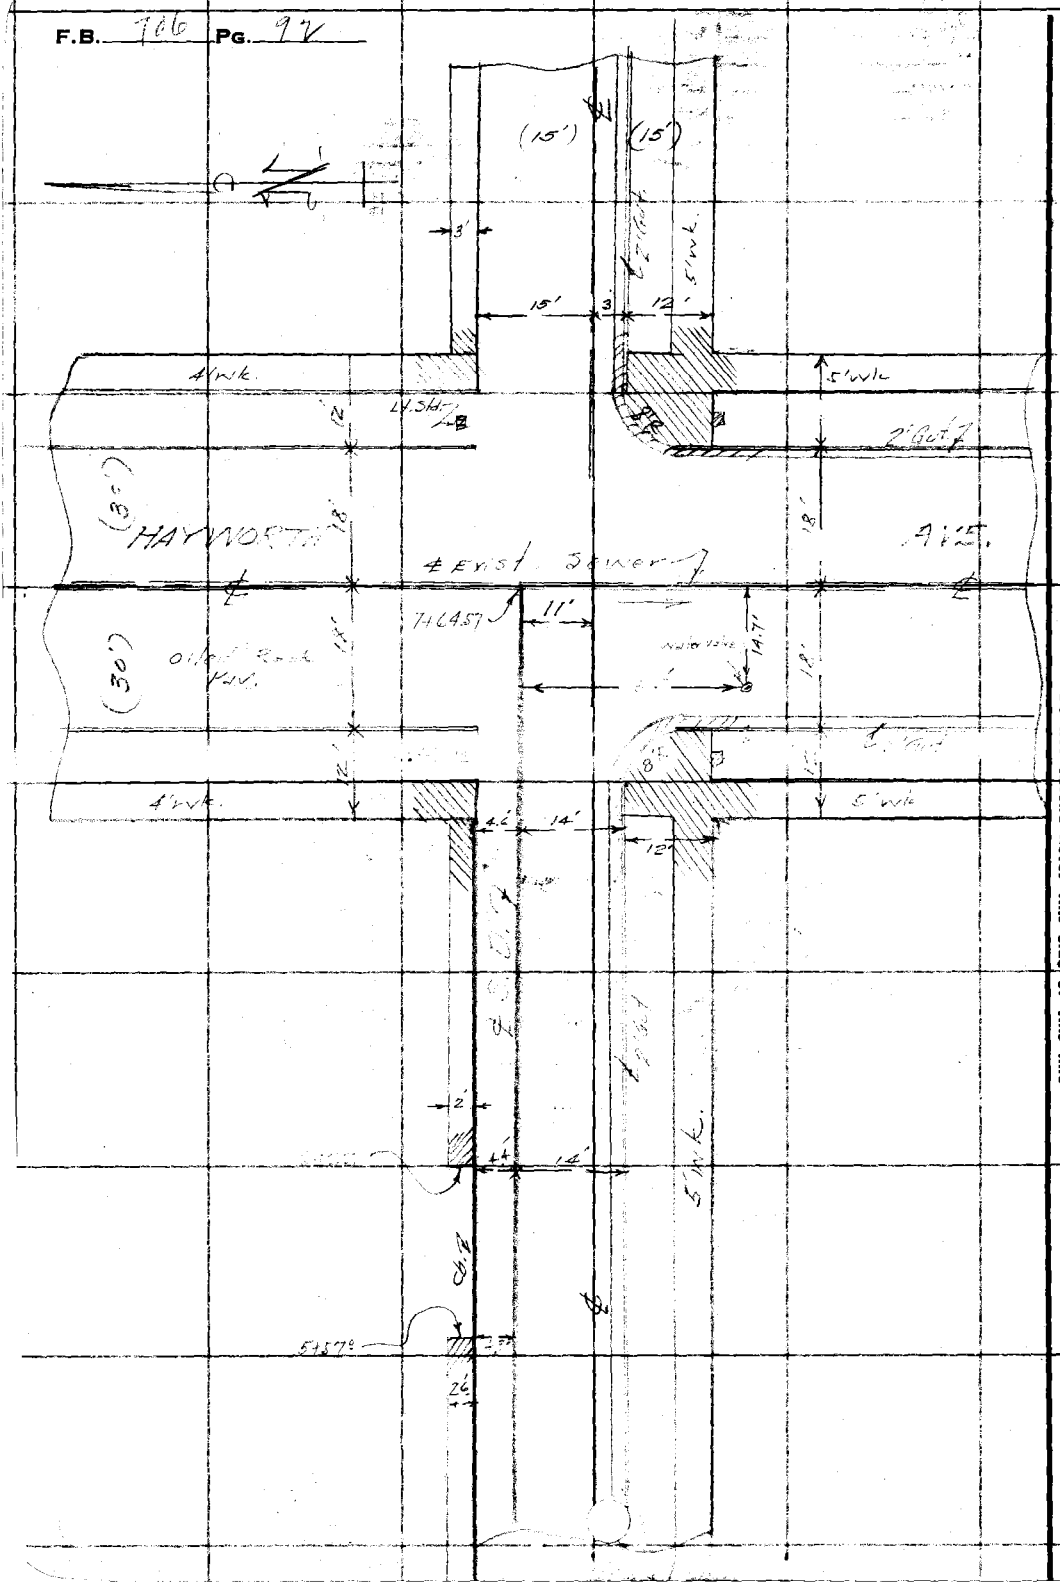

RETURN TO
LOS ANGELES COUNTY SURVEYOR
700 HALL OF RECORDS

Note: Any Additions or Changes on This Sheet Must be Made or Circled in Red Ink With Date and Name of Person Making Change.

Do not extend notes this side of this line

Profile No. _____ X-Sec. No. _____

Notes Red. _____ Plotted _____ Job No. [illegible] Division No. _____ F. B. _____ Pg. _____

Date _____ Date _____ Survey of [illegible] Hollywood U.S.

Notes Chkd. _____ Checked _____ Survey by Wallace & Johnson Notes A. Johnson Date April 1937

Date _____ Date _____ Map No. _____ Indexed _____ Date _____

PROFILE OF

[illegible] SURF - EUNICE AVE. LATERAL

WEST HOLLYWOOD D.S.

JAN C 318

Survey R.B. 106 Pgs. 15-18
Topog R.B. 106 Pgs. 89-92

NOTE: ANY ADDITIONS OR CHANGES ON THIS SHEET MUST BE MADE OR CIRCLED IN RED INK, WITH DATE AND NAME OF PERSON MAKING CHANGE

Do not extend notes this side of this line

Wallace
Gregory
Hornady
Taylor
Ethier

APR 28 1937

RECEIVED ..... Smoler

PROGRESSED ..... ✓

BOOK INDEXED ..... ✓ ✓

MAP INDEXED ..... ✓

RECORD INDEXED ..... ✓ ✓

CARD INDEXED ..... ✓

REDUCED ..... L.C.M. 4-28-37

CHECKED ..... W.A.G. 4-29-37

STATION	B. S.	H. I.	F. S.	ELEV.

PLEASE RETURN TO
LOS ANGELES COUNTY SURVEYOR
700 HALL OF RECORDS

Form 307 5M 11-35

Form 307 5M 11-35

PLEASE RETURN TO
LOS ANGELES COUNTY SURVEYOR
700 HALL OF RECORDS

NOTE: ANY ADDITIONS OR CHANGES ON THIS SHEET MUST BE MADE OR CIRCLED IN RED INK, WITH DATE AND NAME OF PERSON MAKING CHANGE

Do not extend notes this side of this line

F. B. 706 Pg. 94 | Job No. 6215 Division No. D5 | Profile No. | X-Sec. No.

Survey of W. Pomona Blvd. | Notes Red. Greasy | Plotted Date 4-22-37 | Checked Date

Survey by A. C. Johnson | Notes Chkd. | Date

Indexed | Date

STATION	B. S.	H. I.	F. S.	ELEV.	Remarks
					Laurel Ave
BM D-63	642	201 53		195 21	(BM D-63 EL 195.411 F.B. 682-47 Laurel Av. & Rosemont Av. S.W. Cor Mk. Spk 2' W of Mich. L.P.
			640	195 43	
			710	195 73	
			650	195 33	
			700	195 53	
			638	195 45	
			650	195 29	
237.25 Laurel Ave Line =400 Rad Δ = 22.35 1-35			650	195 28	
			597	195 86	
			532	195 51	
			712	195 37	
			690	195 42	
			600	195 1	
			690	195 12	
			610	195 73	
			632	195 53	

Form 307 5M 11-35

PLEASE RETURN TO
LOS ANGELES COUNTY SURVEYOR
700 HALL OF RECORDS

NOTE: ANY ADDITIONS OR CHANGES ON THIS SHEET MUST BE MADE OR CIRCLED IN RED INK, WITH DATE AND NAME OF PERSON MAKING CHANGE

Do not extend notes this side of this line

STATION	B. S.	H. I.	F. S.	ELEV.	
		13		Level	Rosewood Ave and [illegible]
			5+5.	195 97	T.C. [illegible]
			[illegible]	195 78	Gutter
			5+5.	195 97	T.C. [illegible]
			[illegible]	195 01	[illegible] Rosewood Ave
5+24.9			[illegible]	195 91	℄ St.
2+00			[illegible]	196 72	[illegible]
"			4+15	197 38	T.C. [illegible]
			305	198 75	T.C. " "
2+78			351	198 32	Gutter "
"			362	198 21	T.C. [illegible]
"			425	197 18	Gutter "
3+00			347	198 36	℄ St.
3+02			270	199 13	T.C. Beg. CB on N. Side
"			321	198 62	Gutter
T.P.	[illegible]	206 07	355	198 28	
4+00			562	200 43	℄ St. Edinburgh Ave
[illegible]			510	200 97	T.C. W end SW C.R.
"			575	200 29	Gutter " "
4+19.2			512	200 91	T.C. " "
[illegible]			552	200 25	Gutter " "

Profile No. ____ X-Sec. No. ____

Notes Red. ____ Date ____ Notes Chkd. ____ Date ____ Map No. ____

Plotted ____ Date ____ Checked ____ Date ____

Job No. ____ Survey of ____ Survey by ____ Indexed ____

Division No. ____ Notes ____ Date ____ C. Johnson Date ____

F. B. ____ PG. ____

Form 307 5M 11-35

PLEASE RETURN TO
LOS ANGELES COUNTY SURVEYOR
700 HALL OF RECORDS

NOTE: ANY ADDITIONS OR CHANGES ON THIS SHEET MUST BE MADE OR CIRCLED IN RED INK, WITH DATE AND NAME OF PERSON MAKING CHANGE

Do not extend notes this side of this line

F. B. 206 PG. 10 | Job No. 2315 | Division No. | Notes Red. | Plotted | Profile No.
Survey of Edinburgh Est. | Date | Date | X-Sec. No.
Survey by M | Notes Gregory | Notes Chkd. | Checked
Indexed by C. Jorgensen | Date | Date | Date

STATION	B. S.	H. I.	F. S.	ELEV.	
			Edinburgh Ave		Basement Inverts Not Set
		206.92 ✓			
			5.93	201 04	TC. 11" end N. W. C.P.
			5.32	200 75	Gutter "
			5.12	200 94	TC. 11 " " " "
			5.46	200 81	Gutter " " " "
4+05.12			4.93	201 14	℄ In. SD. + Edinburgh Ave
			5.72	200 35	125' S of In. SD. on ℄ Edinburgh
			6.00	200 07	TC W Side
			6.42	199 42	Gutter
			5.75	200 32	TC E "
			6.45	199 62	Gutter
			5.72	200 35	B.C. W+ 125' S of Int. SD. on ℄ Edinburgh Ave
			13.93	192 37	Inv. 8" Inlet N
			13.81	192 26	Inv. 8 Outlet S
			4.04	202 03	TC N of Int SD + Edinburgh and Edinburgh
			4.43	201 59	TC W Side
			4.83	201 19	Gutter " "
			4.12	201 91	TC E "
			4.40	201 61	Gutter " "

5.93 + 7.33 + .07 = 13.70 —

5.74 + 7.40 + .67 = 13.81 —

Form 307 5M 11-35

PLEASE RETURN TO
LOS ANGELES COUNTY SURVEYOR
700 HALL OF RECORDS

NOTE: ANY ADDITIONS OR CHANGES ON THIS SHEET MUST BE MADE OR CIRCLED IN RED INK, WITH DATE AND NAME OF PERSON MAKING CHANGE

Do not extend notes this side of this line

STATION	B. S.	H. I.	F. S.	ELEV.	
		204.37			Previous Hydrant Area
			3.35	202.69	
			1.80	194.22	
			2.92	194.15	
A-3.42			4.91	201.16	T.C.
"			5.56	200.81	Gutter
A-1.62			4.70	201.28	T.C.
"			5.42	200.64	Gutter
			5.05	201.02	T.C.
			5.04	200.98	
			4.50	201.18	T.C.
			5.11	201.07	
			4.65	201.39	
			3.35	202.52	
			4.47	201.60	Gutter
					Set D.H. El. 201.10
					Set Hydrant Area - Existing Elevation
					Water & Set Blue CP
					Previous Hydrant Area
			5.00	201.85	= SC

Profile
No. X-Sec.
Notes Red Plotted Job No. Division No.
Date Date Survey of
Notes Chkd Checked Survey by Notes
Date Date Map No. Indexed Date
F. B. PG.

Form 307 5M 11-35

PLEASE RETURN TO
LOS ANGELES COUNTY SURVEYOR
700 HALL OF RECORDS

NOTE: ANY ADDITIONS OR CHANGES ON THIS SHEET MUST BE MADE OR CIRCLED IN RED INK, WITH DATE AND NAME OF PERSON MAKING CHANGE

Do not extend notes this side of this line

Profile No. ____ X-Sec. No. ____

Plotted ____ Notes Red. ____

Date ____ Date ____

Checked ____ Notes Chkd. ____

Date ____ Date ____

Job No. 6318 Division No. ____

Notes Grade

Date

F. B. 726 Pg. ____

Survey of ____

Survey by ____

Indexed ____

STATION	B. S.	H. I.	F. S.	ELEV.	Proposed Hayworth Ave Lot
					Ave.
		207 54			
6+02			385	203 69	± SD.
"			320	203 34	End of C&G on N Side Top
"			376	203 78	G. Flow Line
			358	203 96	TC S. Side
			424	203 21	Gutter
6+22			245	203 69	Beg of Wall on N Side Top
7+	7.86	212 17	323	203 31	
7+00			608	206 09	Hayworth Ave
4+33.57			528	206 89	TC W end S.W.C.R.
"			594	206 23	G. Flow Line " " "
4+46.57			520	206 97	TC S " " "
"			578	206 37	Gutter " " "
7+35			462	205 55	End of Wall on N Side Top N. W. Cor. 46 Lt
			520	206 99	Gutter " " "
7+46.57			502	207 05	TC S side N.W. Cor
"			532	206 85	Gutter " " "
7+84.92			470	207 47	± Lot 50 + Hayworth Ave Finish Grade

Form 307 5M 11-35

PLEASE RETURN TO
LOS ANGELES COUNTY SURVEYOR
700 HALL OF RECORDS

NOTE: ANY ADDITIONS OR CHANGES ON THIS SHEET MUST BE MADE OR CIRCLED IN RED INK, WITH DATE AND NAME OF PERSON MAKING CHANGE

Do not extend notes this side of this line

STATION	B. S.	H. I.	F. S.	ELEV.	
					Foxworth Etc
			537	206 80	SS M -
			1350	-198 67	Inv.
			356	-198 61	Inv.

Form 307 5M 11-35

PLEASE RETURN TO
LOS ANGELES COUNTY SURVEYOR
700 HALL OF RECORDS

NOTE: ANY ADDITIONS OR CHANGES ON THIS SHEET MUST BE MADE OR CIRCLED IN RED INK, WITH DATE AND NAME OF PERSON MAKING CHANGE

Do not extend notes this side of this line

F. B. 706 PG. 120
Survey of
Survey by
Indexed
Job No. 638 Division No. 125
Notes Graphed
Date
Profile No.
X-Sec. No.
Plotted
Date
Checked
Date
Notes Red.
Date
Notes Chkd.
Date

STATION	B. S.	H. I.	F. S.	ELEV.	
					Bearing Base Line
		212.17			
			2?0	209.47	10' E of C/L of Int on E Rosecrans Ave
			260	209.57	TC " Side
			324	209.93	Gutter " "
			355	210.09	TC " "
			363	209.64	Gutter " "
			4?4	208.03	10' W of C/L of Int on E Laspalmas Ave
			?22	207.80	TC " " Side
			4??	207.39	Gutter " " 110' N of Int
			??	207.93	TC " E " " " "
			?5?	207.65	Gutter " " " " " "
			300	209.17	S.S.M.H. 267' N of C/L of Int on E Rosecrans Ave
			1093	201.34	Inv. 8" Stub N
			1101	201.16	Inv. 8" Stub S
					BM D-127 El. 207.234 FB.
BM. D-127			4?4	207.24	Rosecrans Ave & Sycamore Ave SE cor
					Wall Sign 7' S of Sycamore Ave

N: 205 + 7.25 + 67 = 209?
S: 202 + 7.22 + 67 = 1101

Notes Ck'd by	Survey of [illegible]
Map No.	W. O. 6343 Tape No. [illegible] St'd 62° F.
Office Work	Surveyed by WALLACE
Checked	Notes [illegible] Date
Date	Indexed [illegible]

F.B. 706 Pg. 121

5

SURVEY

SANTA [illegible] BLVD. LAT.

From Haywenhurst Dr. to Haynorth Ave.

[illegible] DIST.

J.M. 6343

Topog F.B. 706 Pgs. 111 to 120

Profile F.B. [illegible] Pgs. 121 to

Note- This Line of Storm Drain Shifted to Merton Ave - See Sheet (4A) of Plans of J.M. 6343

Wallace
Surveyed
Murray
Taped
Etzler

RECEIVED MAY 12 1937

PROGRESSED

BOOK INDEXED

MAP INDEXED

RECORD INDEXED

CARD INDEXED

RETURN TO
LOS ANGELES COUNTY SURVEYOR
700 HALL OF RECORDS

Note: Any Additions or Changes on This Sheet Must be Made or Circled in Red Ink With Date and Name of Person Making Change.

Do not extend notes this side of this line

FORM 247 10M 11-36

RETURN TO
LOS ANGELES COUNTY SURVEYOR
700 HALL OF RECORDS

Note: Any Additions or Changes on This Sheet Must be Made or Circled in **Red Ink** With Date and Name of Person Making Change.

Do not extend notes this side of this line

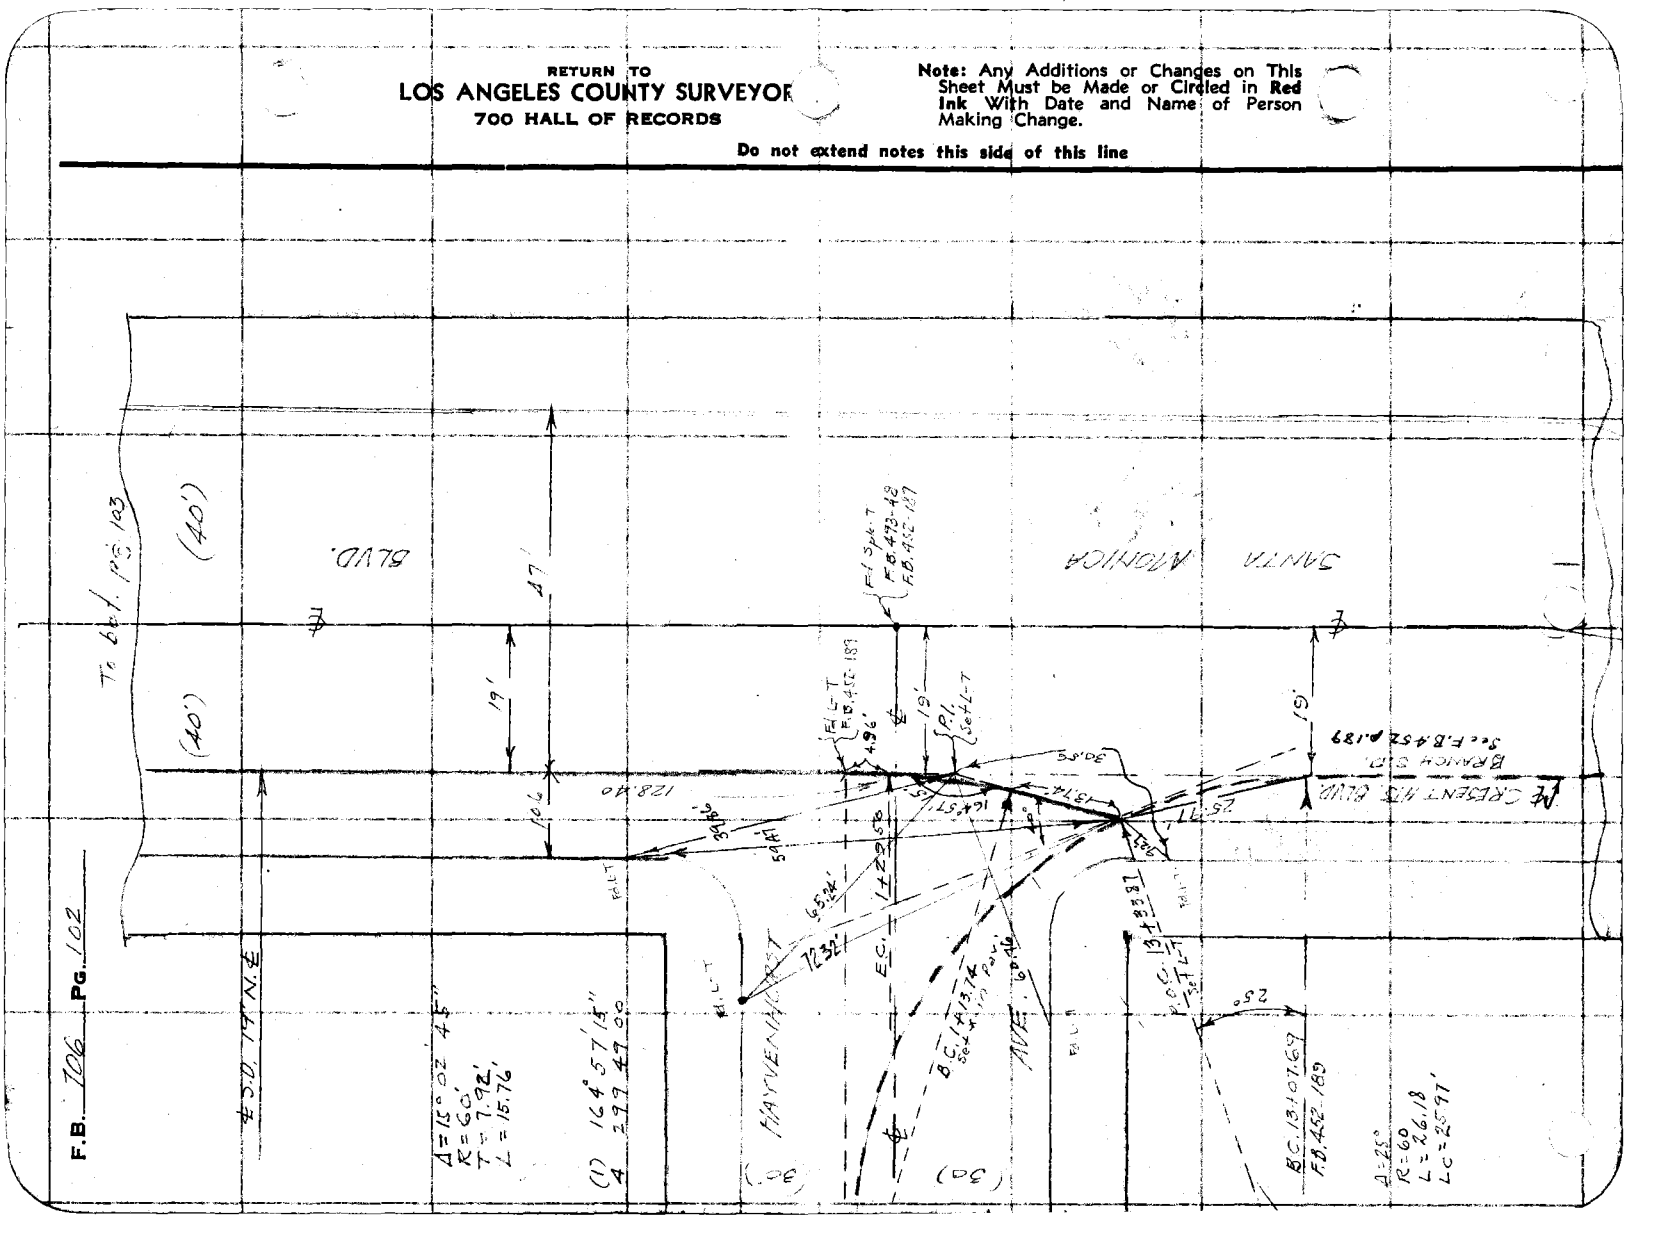

Notes Ck'd by	Survey of
Map No.	W. O. 6312 Tape No. St'd °F.
Office Work	Surveyed by
Checked	Notes Date
Date	Indexed

F.B. 701 PG. 103

Note: Any Additions or Changes on This Sheet Must be Made or Circled in Red Ink With Date and Name of Person Making Change

Do not extend notes this side of this line

RETURN TO
LOS ANGELES COUNTY SURVEYOR
700 HALL OF RECORDS

FORM 247 10M 11-35

F.B. 706 Pg. 104

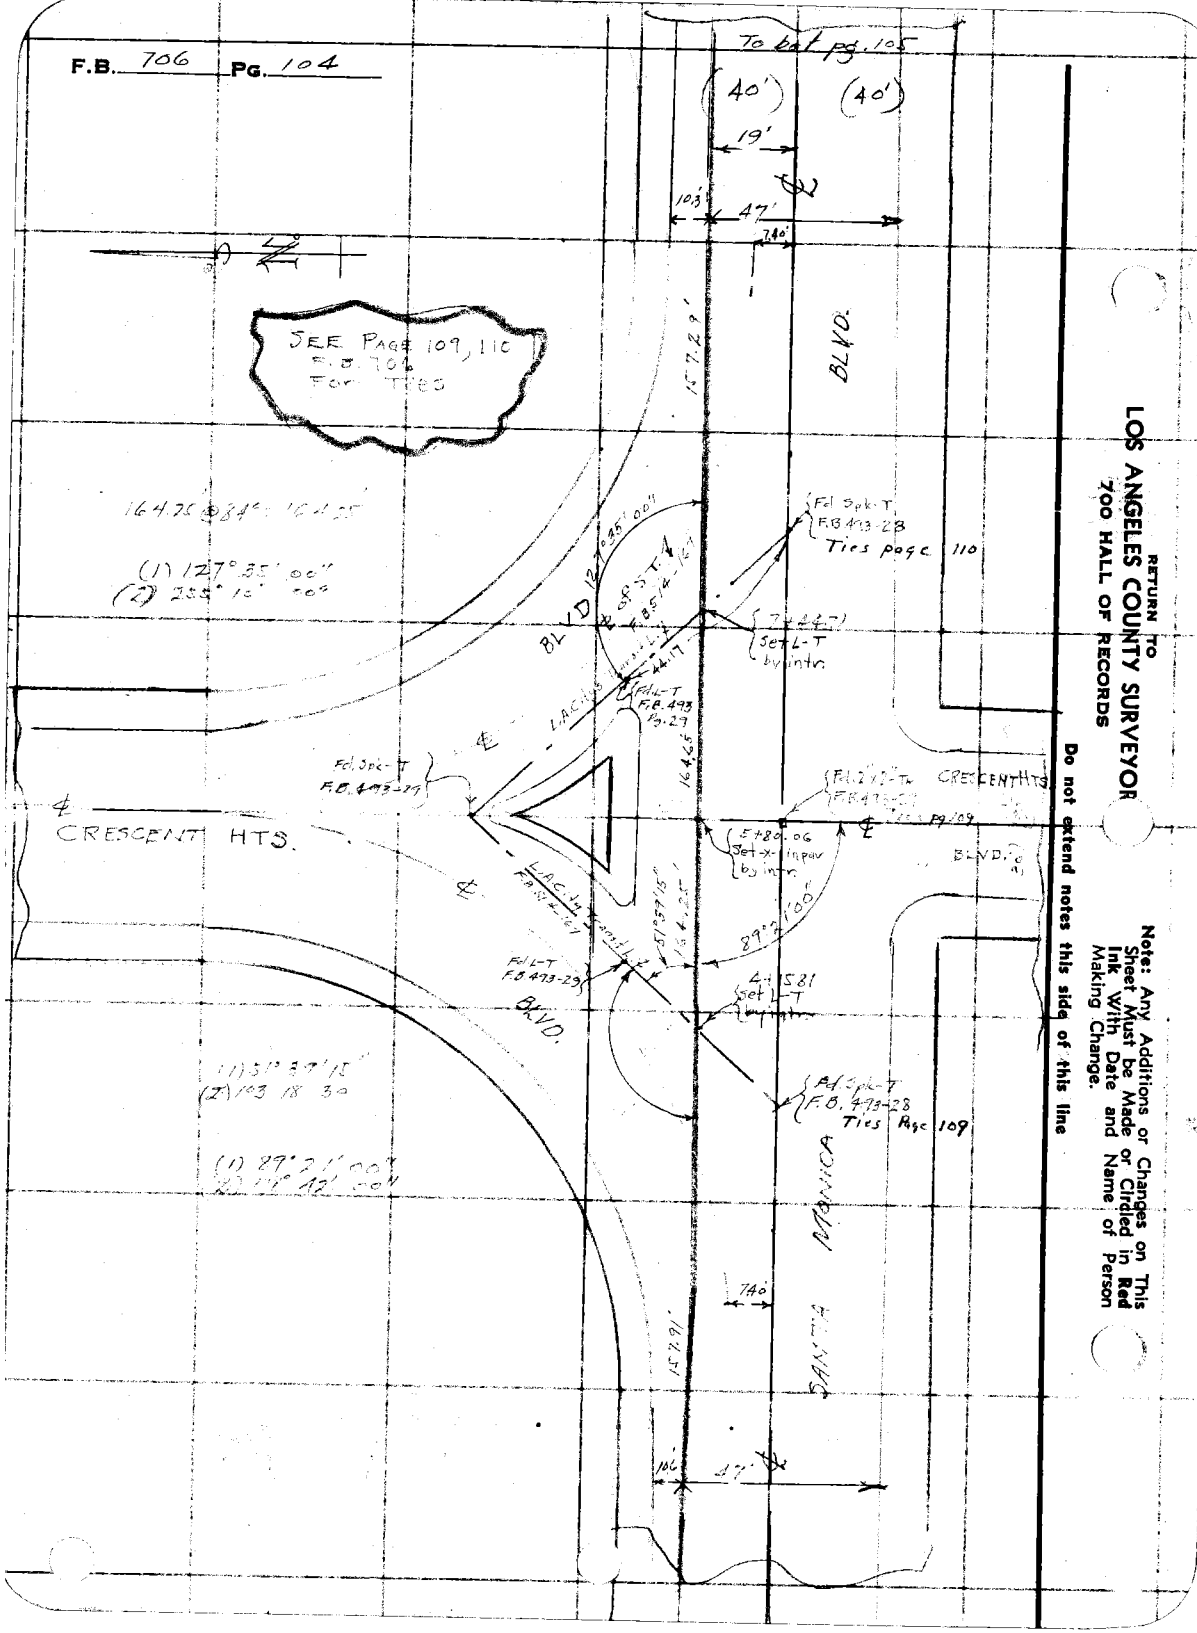

RETURN TO
LOS ANGELES COUNTY SURVEYOR
700 HALL OF RECORDS

Do not extend notes this side of this line

Note: Any Additions or Changes on This Sheet Must be Made or Circled in Red Ink With Date and Name of Person Making Change.

Notes Ck'd by	Survey of
Map No.	W. O. 6318 Tape No. 155 St'd 84 °F.
Office Work	Surveyed by Wallace
Checked	Notes V. L. Date May 1934
Date	Indexed C. Johnson

F.B. 711 Pg. 105

To bot. Pg. 106

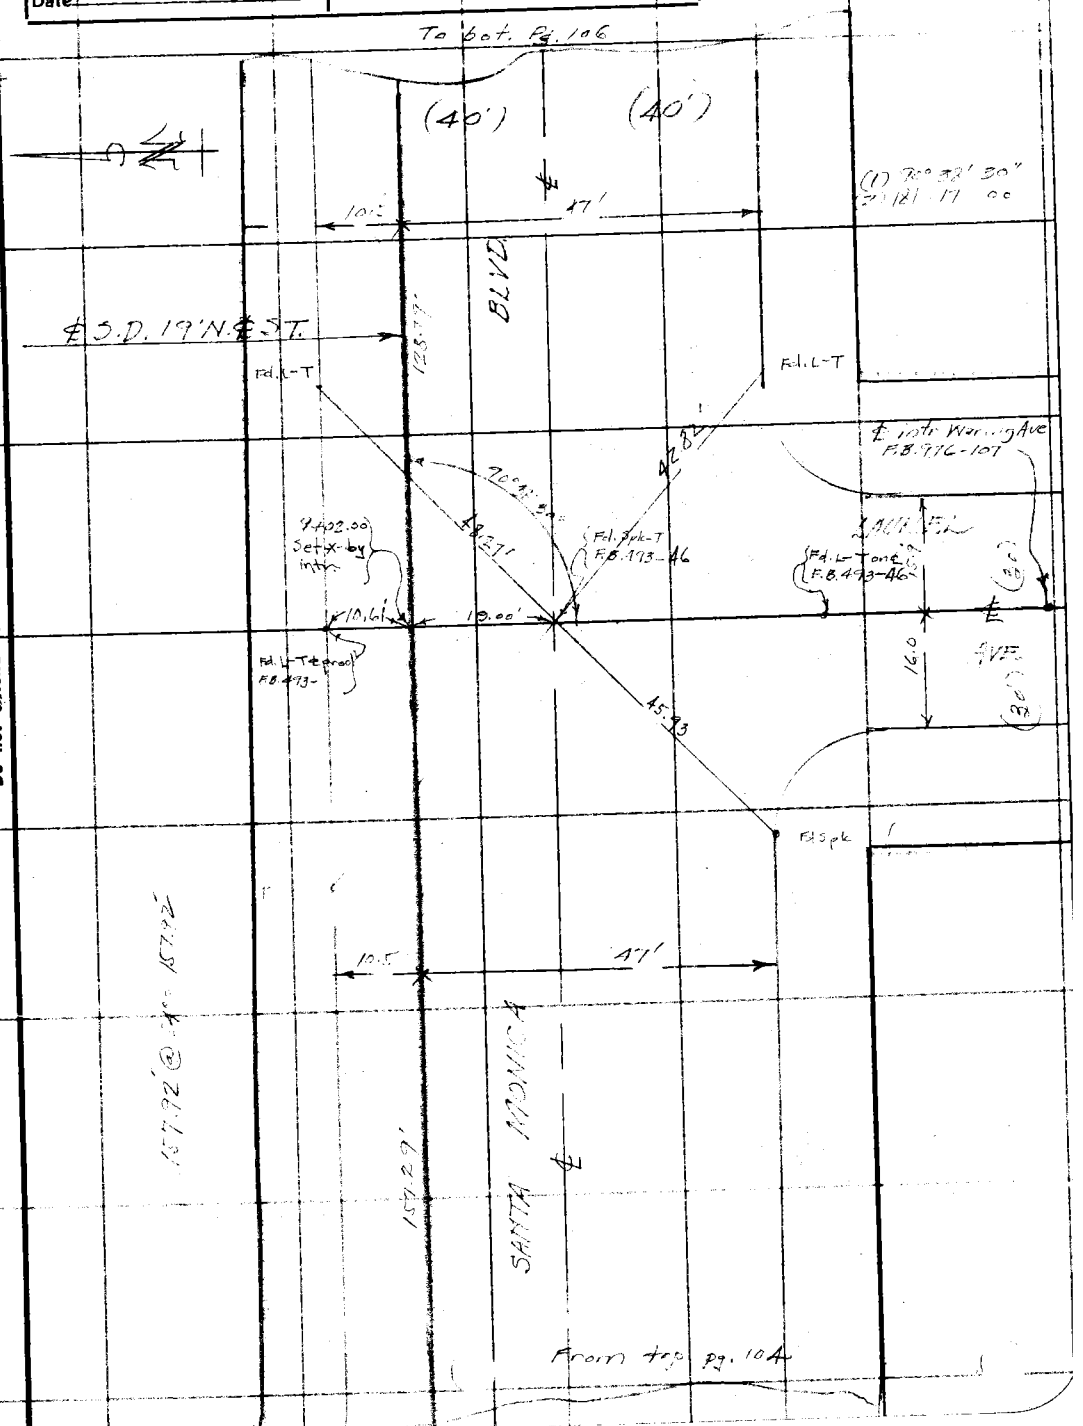

Note: Any Additions or Changes on This Sheet Must be Made or Circled in Red Ink With Date and Name of Person Making Change.

Do not extend notes this side of this line

RETURN TO
LOS ANGELES COUNTY SURVEYOR
700 HALL OF RECORDS

FORM 247 10M 11-35

F.B. 706 PG. 106

To bot pg. 107

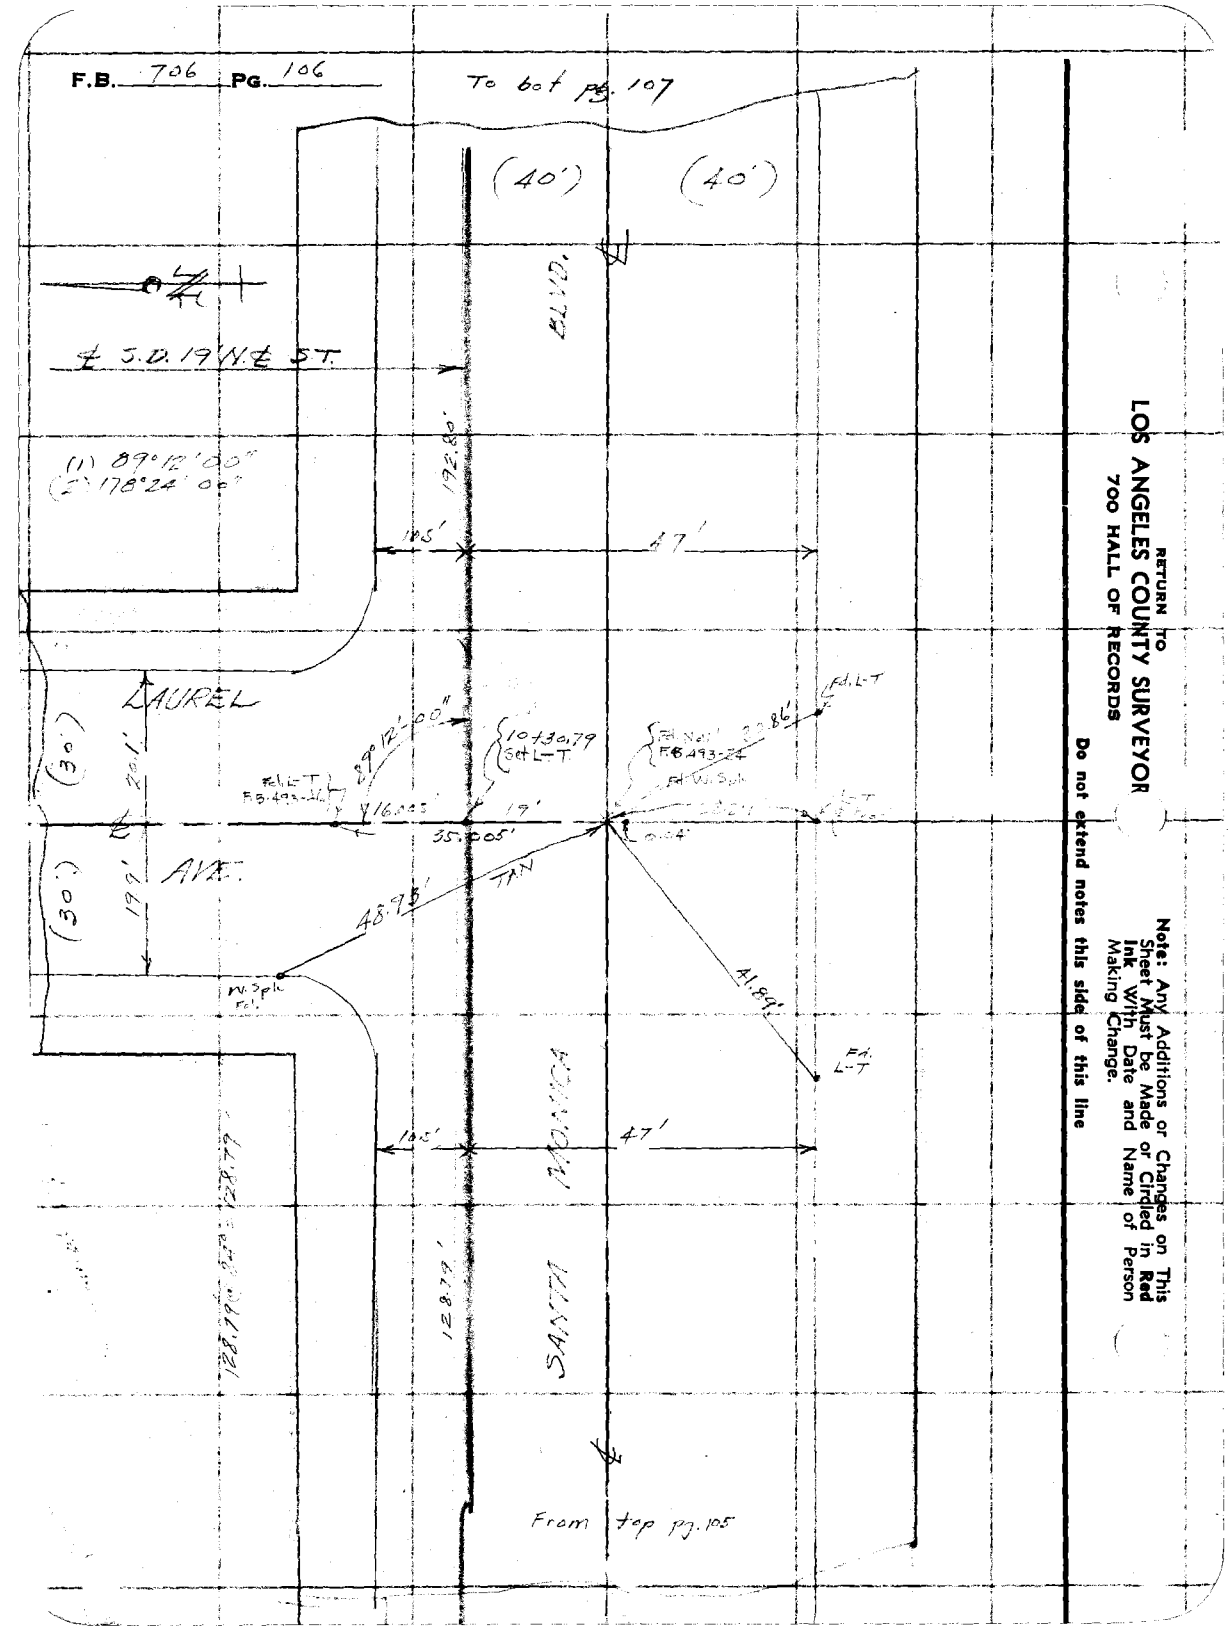

RETURN TO
LOS ANGELES COUNTY SURVEYOR
700 HALL OF RECORDS

Do not extend notes this side of this line

Note: Any Additions or Changes on This Sheet Must be Made or Circled in Red Ink With Date and Name of Person Making Change.

Notes Ck'd by	Survey of
Map No.	W. O. 2318 Tape No. 115 St'd 72 °F.
Office Work	Surveyed by Wallace
Checked	Notes N. Date May 1927
Date	Indexed C. Johnson


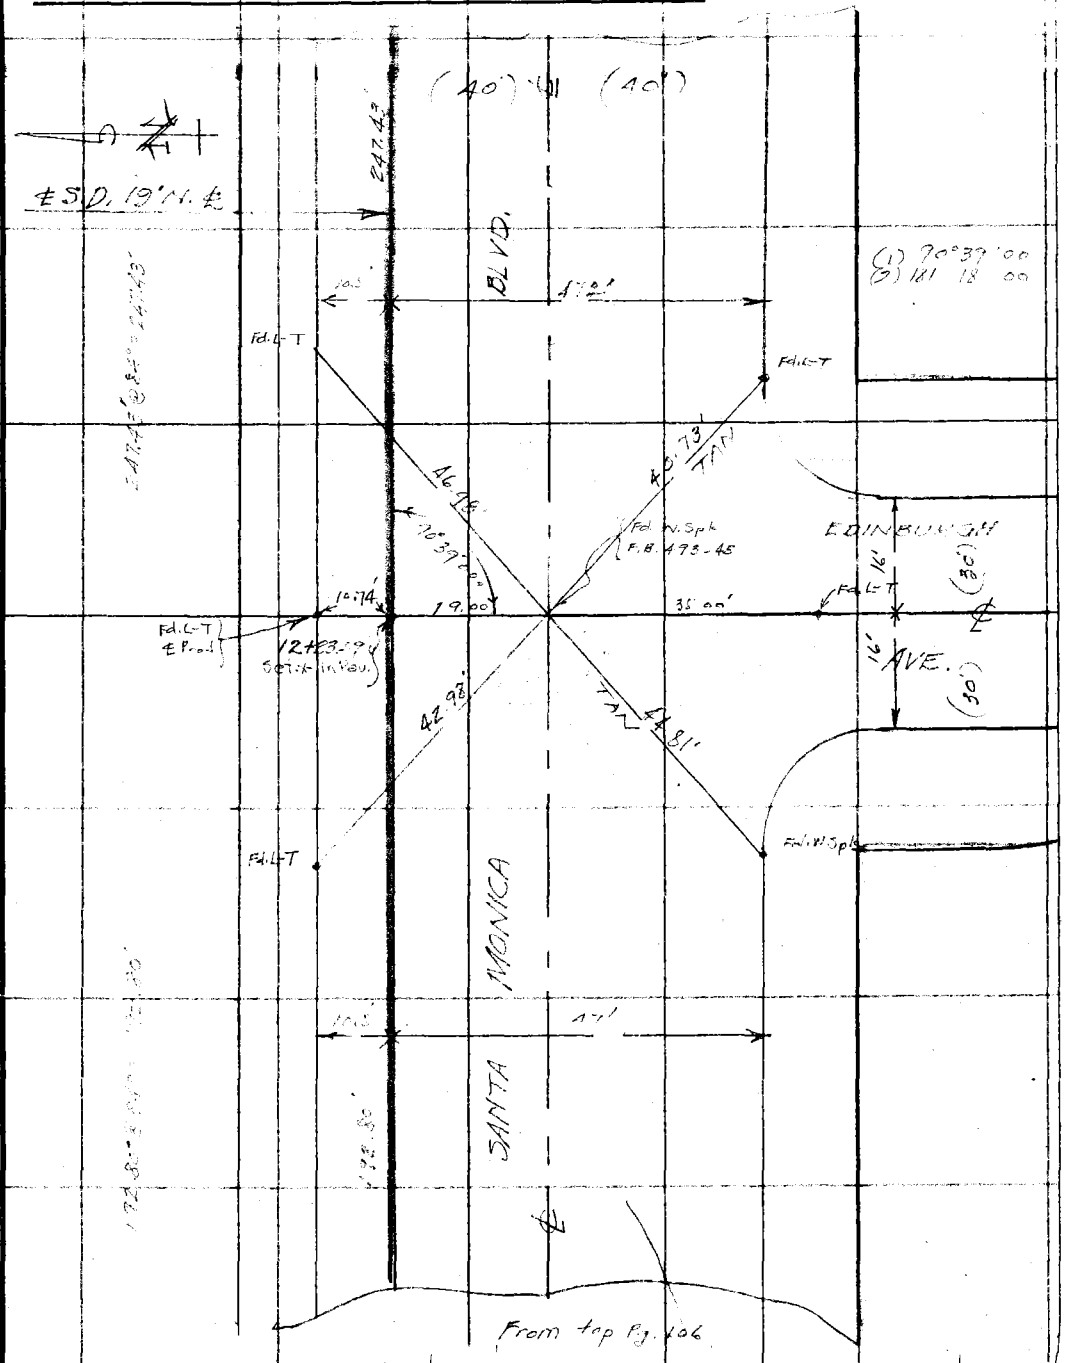

(1) 90°39'00"
(2) 141 18 00

Note: Any Additions or Changes on This Sheet Must be Made or Circled in Red Ink With Date and Name of Person Making Change

Do not extend notes this side of this line

RETURN TO
LOS ANGELES COUNTY SURVEYOR
700 HALL OF RECORDS

FORM 247 10M 11-35

F.B. 706 PG. 108

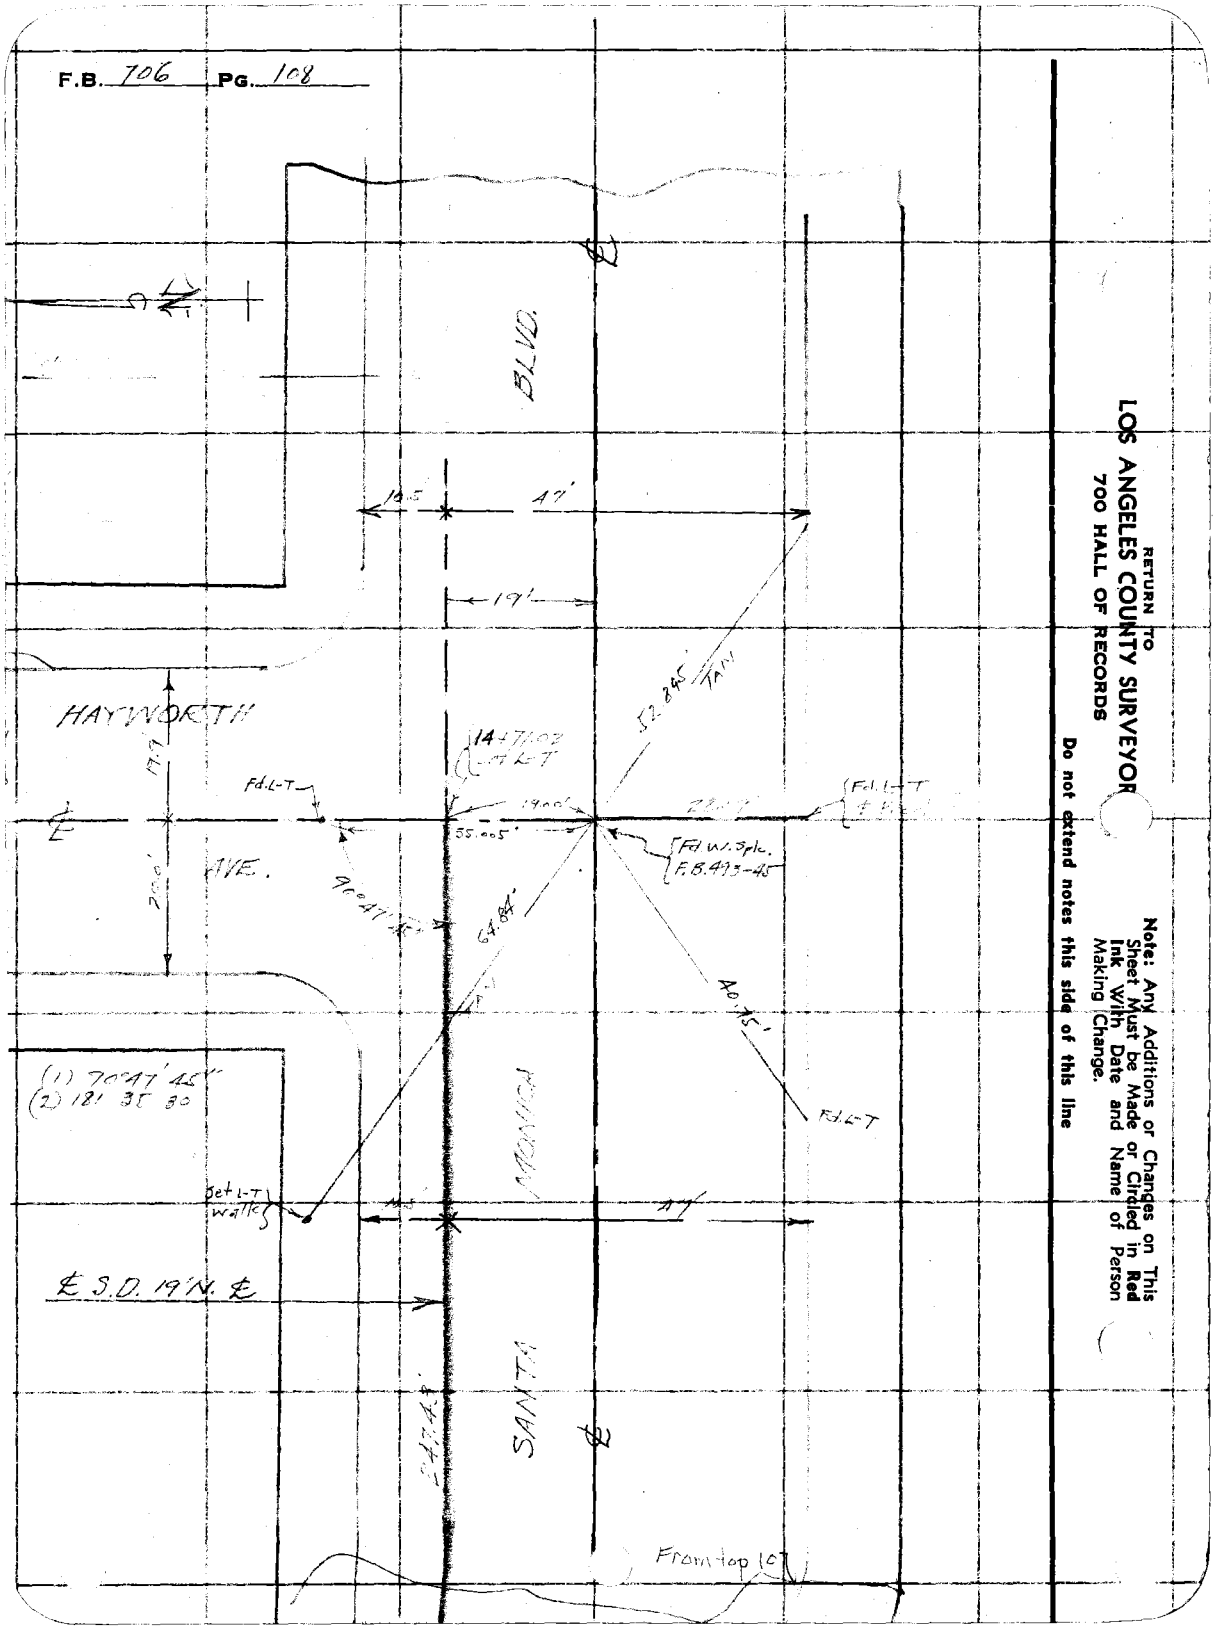

RETURN TO
LOS ANGELES COUNTY SURVEYOR
700 HALL OF RECORDS

Note: Any Additions or Changes on This Sheet Must be Made or Circled in Red Ink With Date and Name of Person Making Change.

Do not extend notes this side of this line

FORM 247 10M 11-38

RETURN TO
LOS ANGELES COUNTY SURVEYOR
700 HALL OF RECORDS

Note: Any Additions or Changes on This Sheet Must be Made or Circled in **Red Ink** With Date and Name of Person Making Change.

Do not extend notes this side of this line

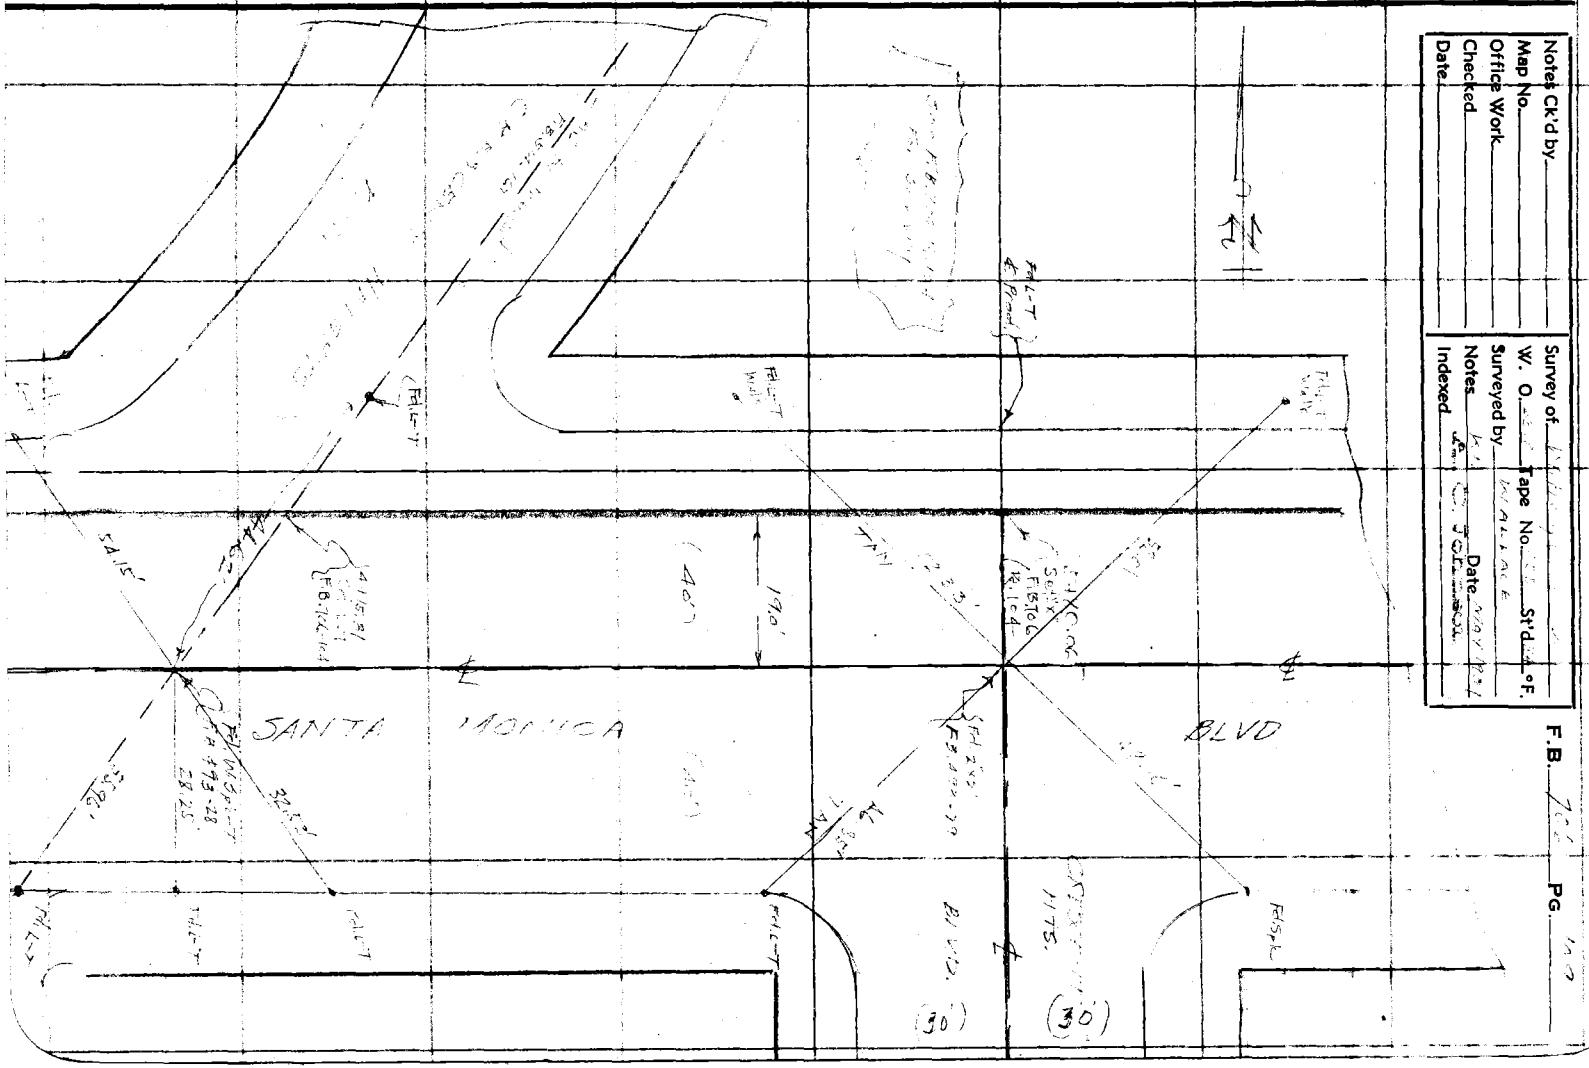
SANTA MONICA
BLVD
BLVD.
(40')
190'
SAME
SAME
SAME

F.B. 706 PG. 110

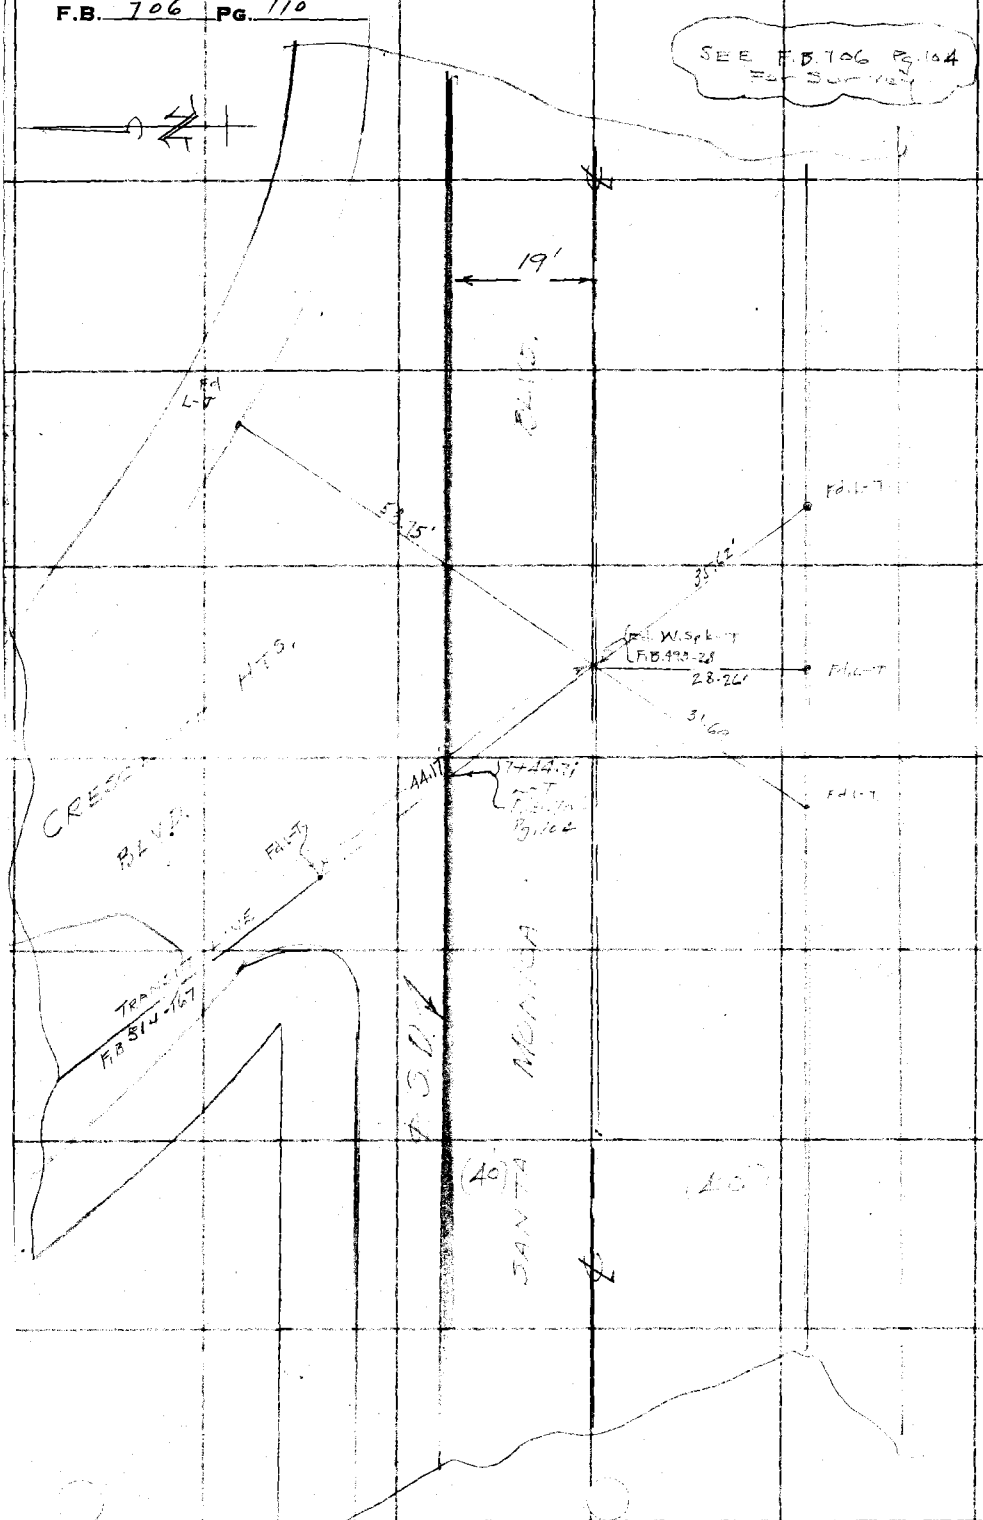

RETURN TO
LOS ANGELES COUNTY SURVEYOR
700 HALL OF RECORDS

Note: Any Additions or Changes on This Sheet Must be Made or Circled in Red Ink With Date and Name of Person Making Change.

Do not extend notes this side of this line

Notes Ck'd by	Survey of
Map No.	W. O. Tape No. St'd °F.
Office Work	Surveyed by
Checked	Notes Date
Date	Indexed

F.B. 706 PG. 111

(5)

TOPOGRAPHY

JAMES MONROE AVE & LAT.

WEST MONROE AVE

Note: Any Additions or Changes on This Sheet Must be Made in Red Ink With Date and Name of Person Making Change.

Do not extend notes this side of this line

RETURN TO
LOS ANGELES COUNTY SURVEYOR
700 HALL OF RECORDS

MAY 1 [illegible] 19[illegible]

RECEIVED	✓
PROGRESSED	✓ ✓
BOOK INDEXED	✓ ✓
MAP INDEXED	✓ ✓
RECORD INDEXED	✓
CARD INDEXED	✓ ✓

FORM 247 10M 11-38

RETURN TO
LOS ANGELES COUNTY SURVEYOR
700 HALL OF RECORDS

Note: Any Additions or Changes on This Sheet Must be Made or Circled in **Red Ink** With Date and Name of Person Making Change.

Do not extend notes this side of this line

F.B. 706 PG. 112

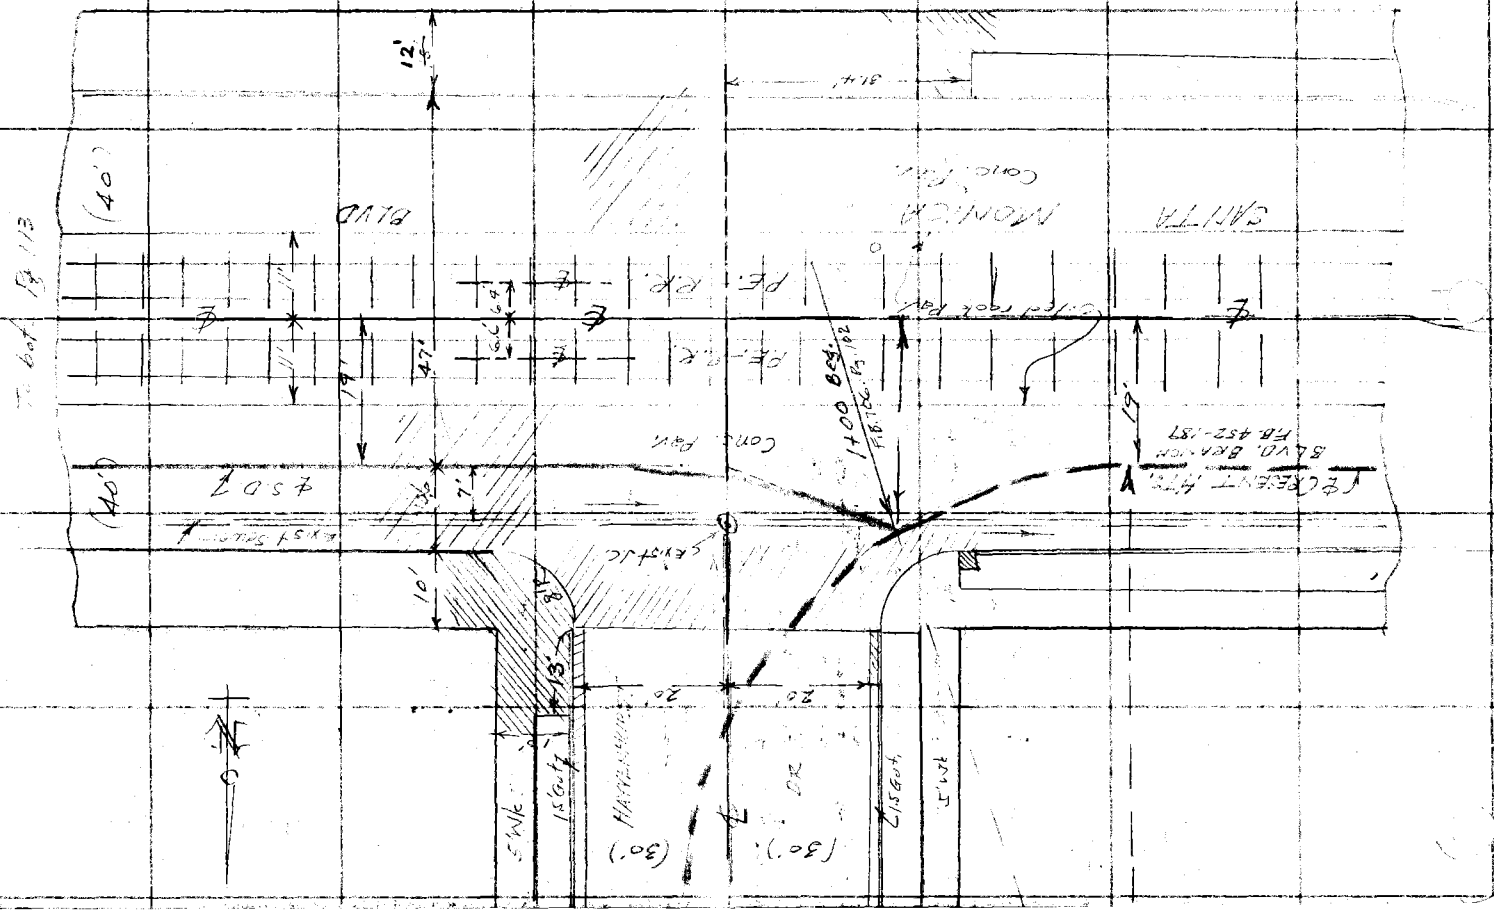

FORM 247 10M 11-35

RETURN TO
LOS ANGELES COUNTY SURVEYOR
700 HALL OF RECORDS

Note: Any Additions or Changes on This Sheet Must be Made or Circled in **Red Ink** With Date and Name of Person Making Change.

Do not extend notes this side of this line

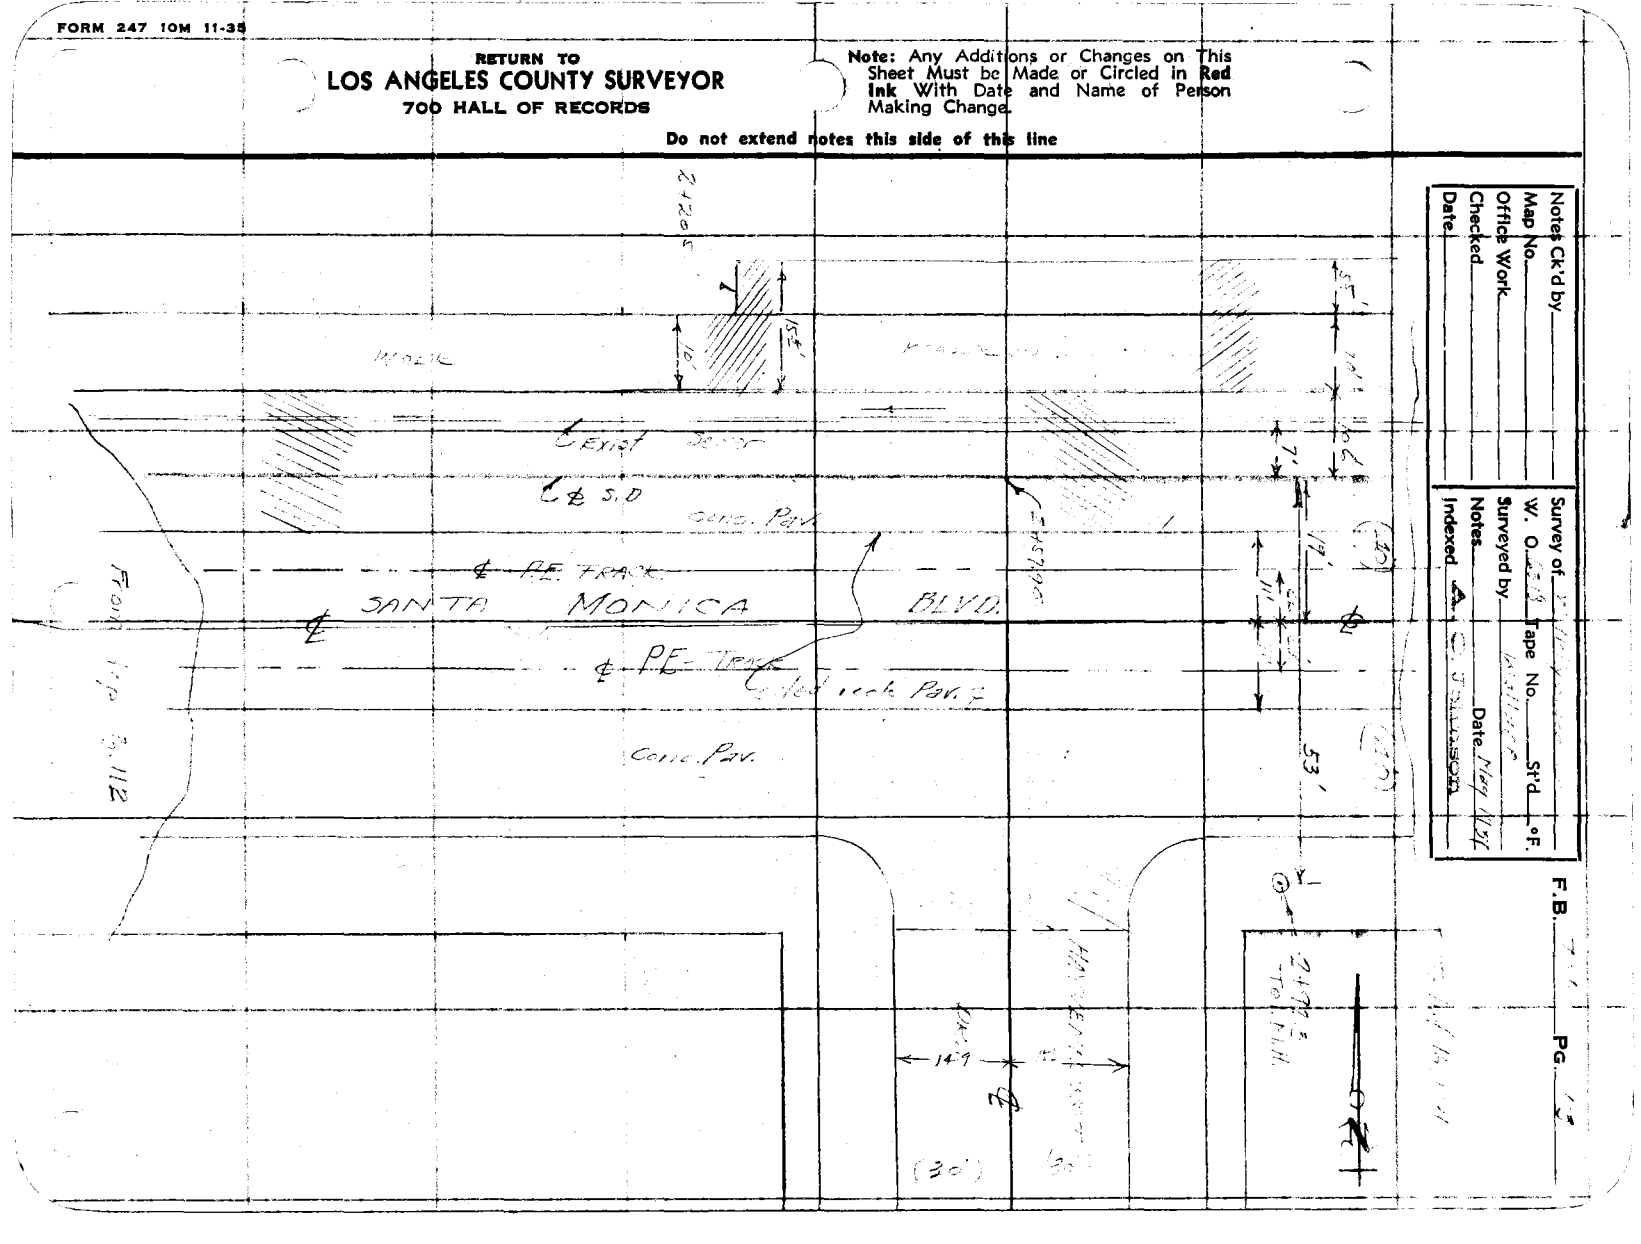

Notes Ck'd by
Map No.
Office Work
Checked
Date

Survey of
W. O. Tape No. St'd °F.
Surveyed by
Notes Date
Indexed

F.B. PG.

RETURN TO
LOS ANGELES COUNTY SURVEYOR
700 HALL OF RECORDS

Note: Any Additions or Changes on This Sheet Must be Made or Circled in **Red** Ink With Date and Name of Person Making Change.

Do not extend notes this side of this line

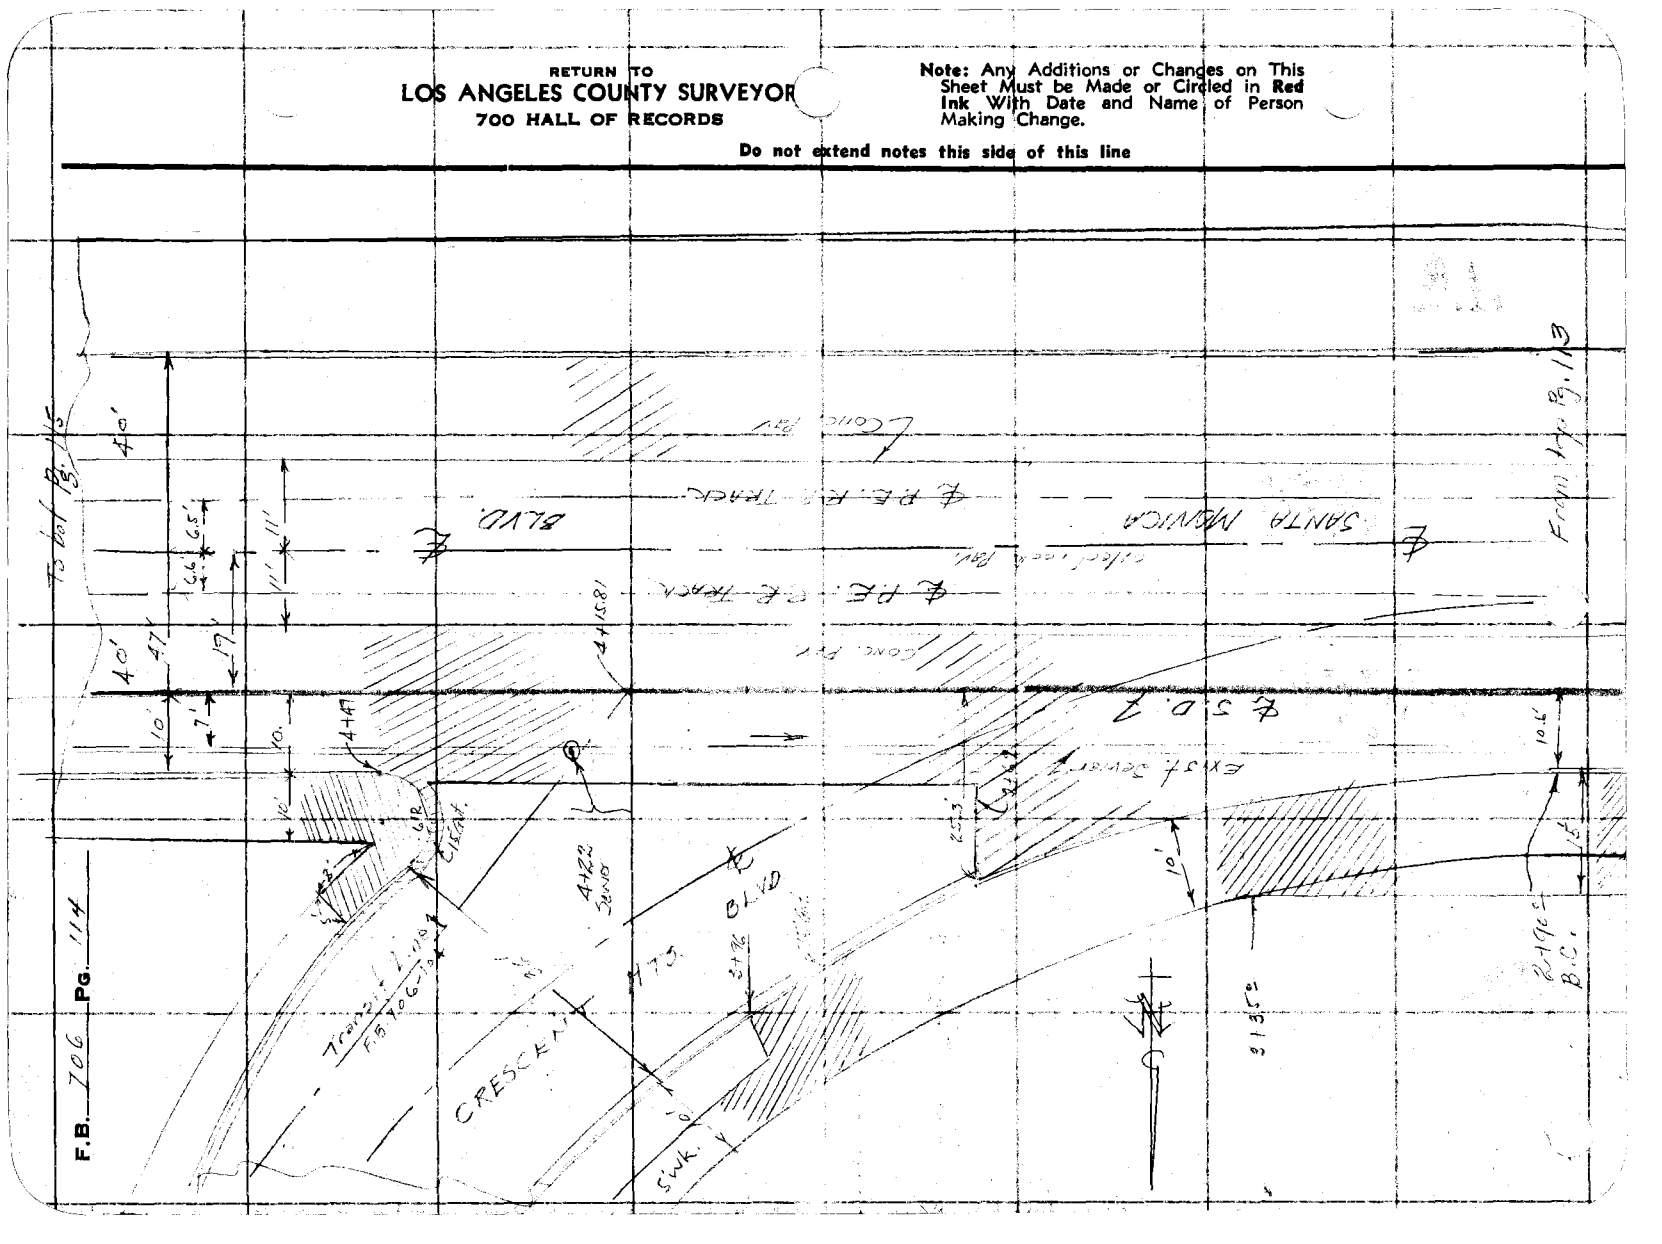

FORM 247 10M 11-35

RETURN TO
LOS ANGELES COUNTY SURVEYOR
700 HALL OF RECORDS

Note: Any Additions or Changes on This Sheet Must be Made or Circled in **Red Ink** With Date and Name of Person Making Change.

Do not extend notes this side of this line

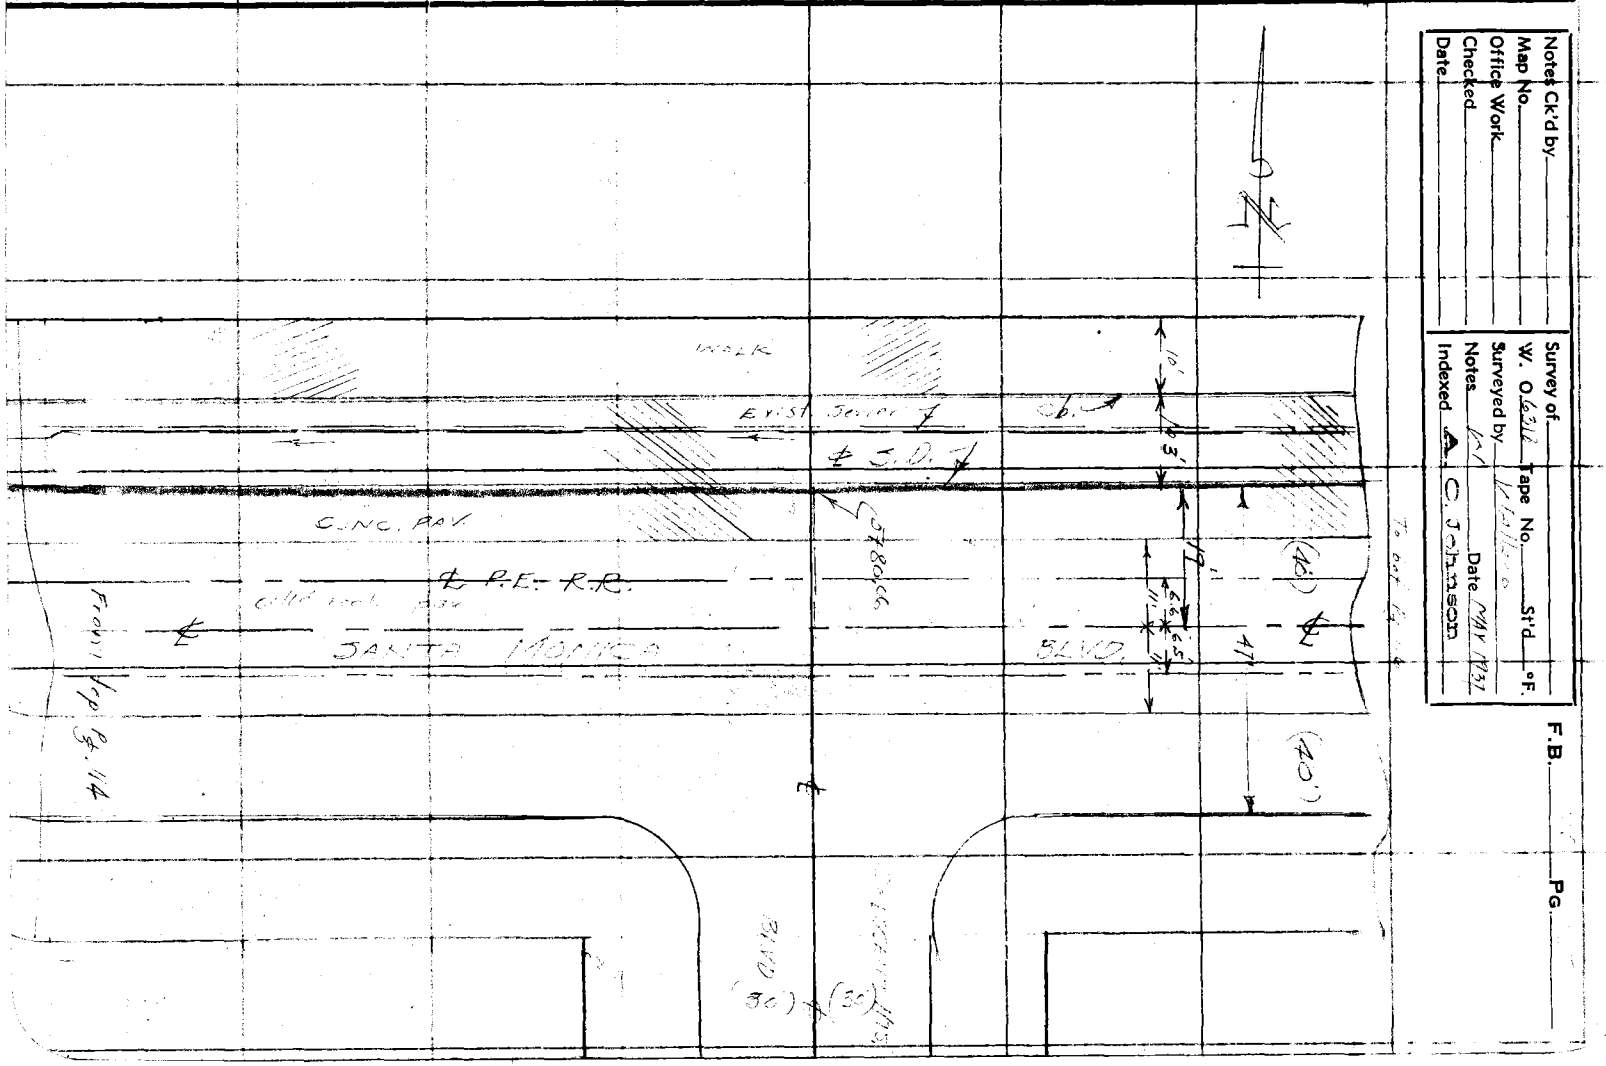

Notes Ck'd by
Map No.
Office Work
Checked
Date

Survey of
W. O. 6316 Tape No. St'd °F.
Surveyed by
Notes Date MAY 1931
Indexed C. Johnson

F.B. PG.

RETURN TO
LOS ANGELES COUNTY SURVEYOR
700 HALL OF RECORDS

Note: Any Additions or Changes on This Sheet Must be Made or Circled in **Red Ink** With Date and Name of Person Making Change.

Do not extend notes this side of this line

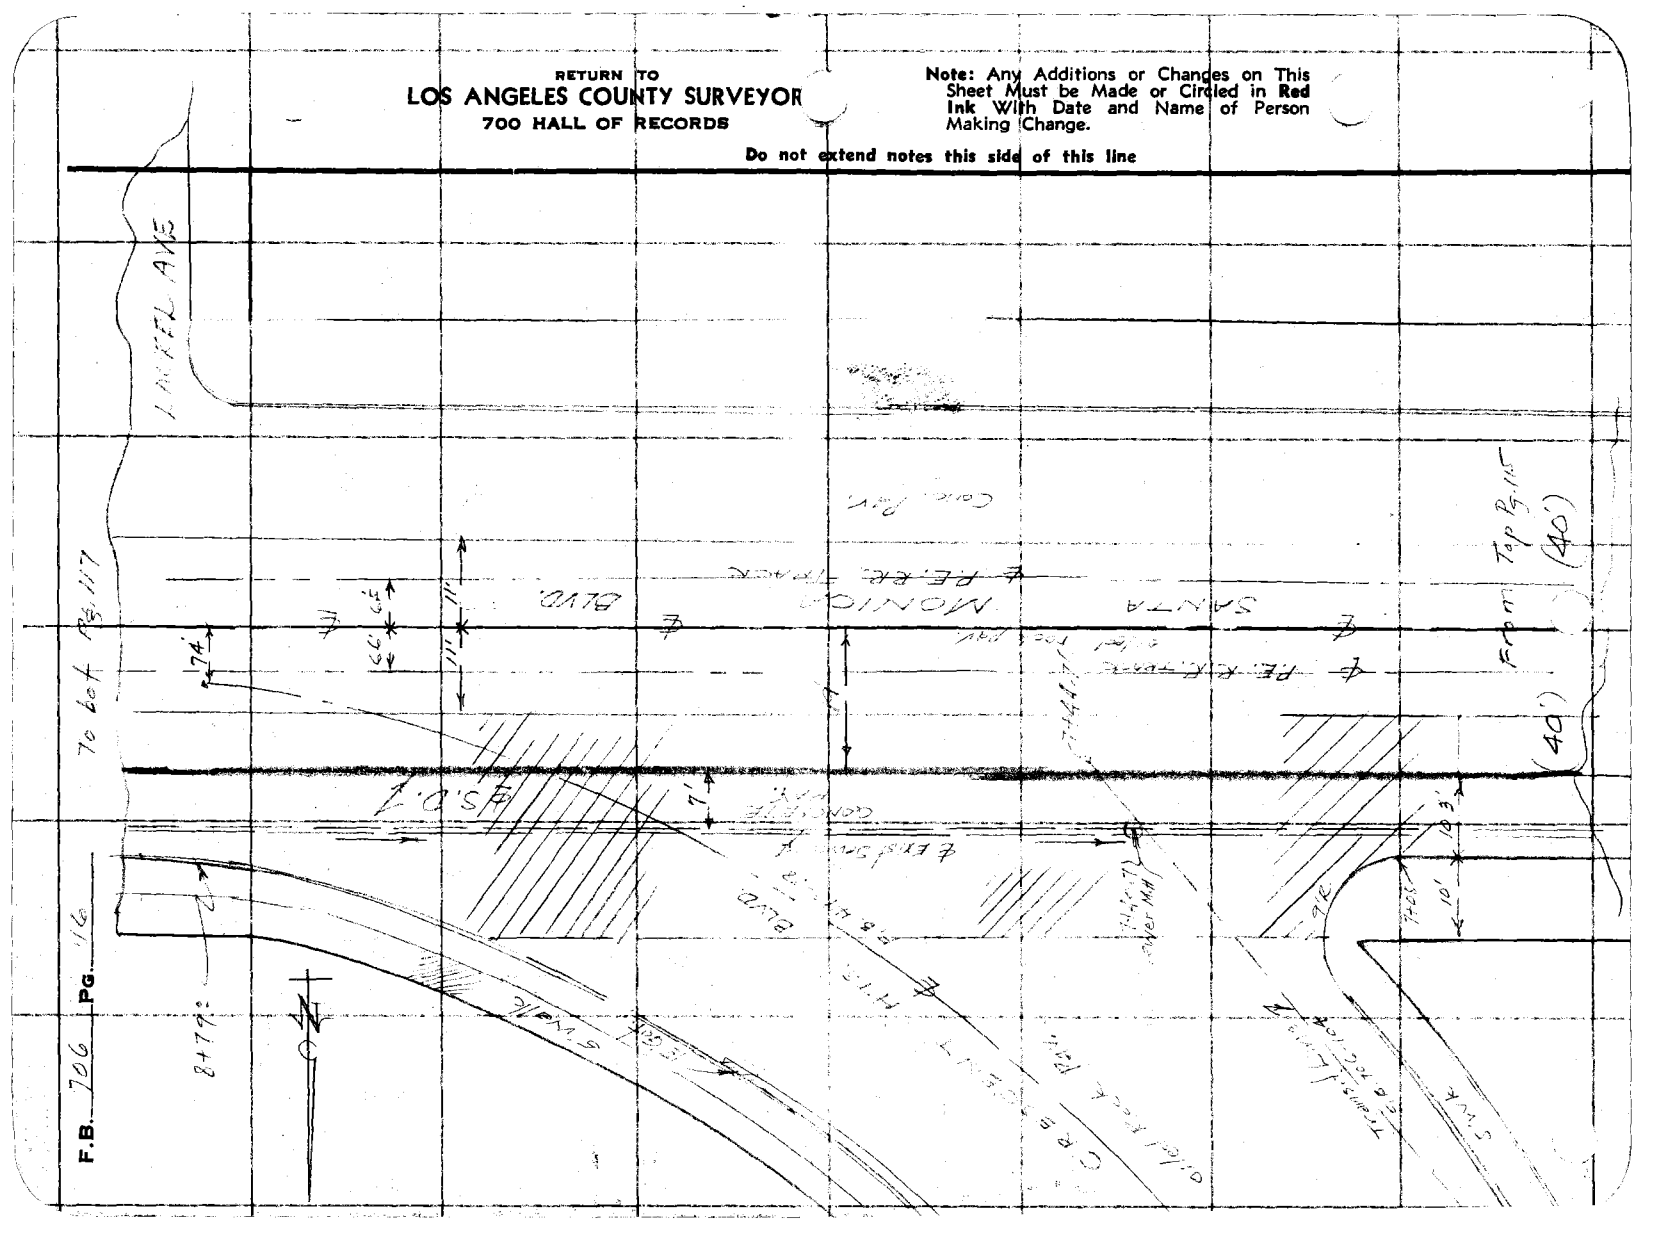

FORM 247 10M 11-35

RETURN TO
LOS ANGELES COUNTY SURVEYOR
700 HALL OF RECORDS

Note: Any Additions or Changes on This Sheet Must be Made or Circled in **Red Ink** With Date and Name of Person Making Change.

Do not extend notes this side of this line

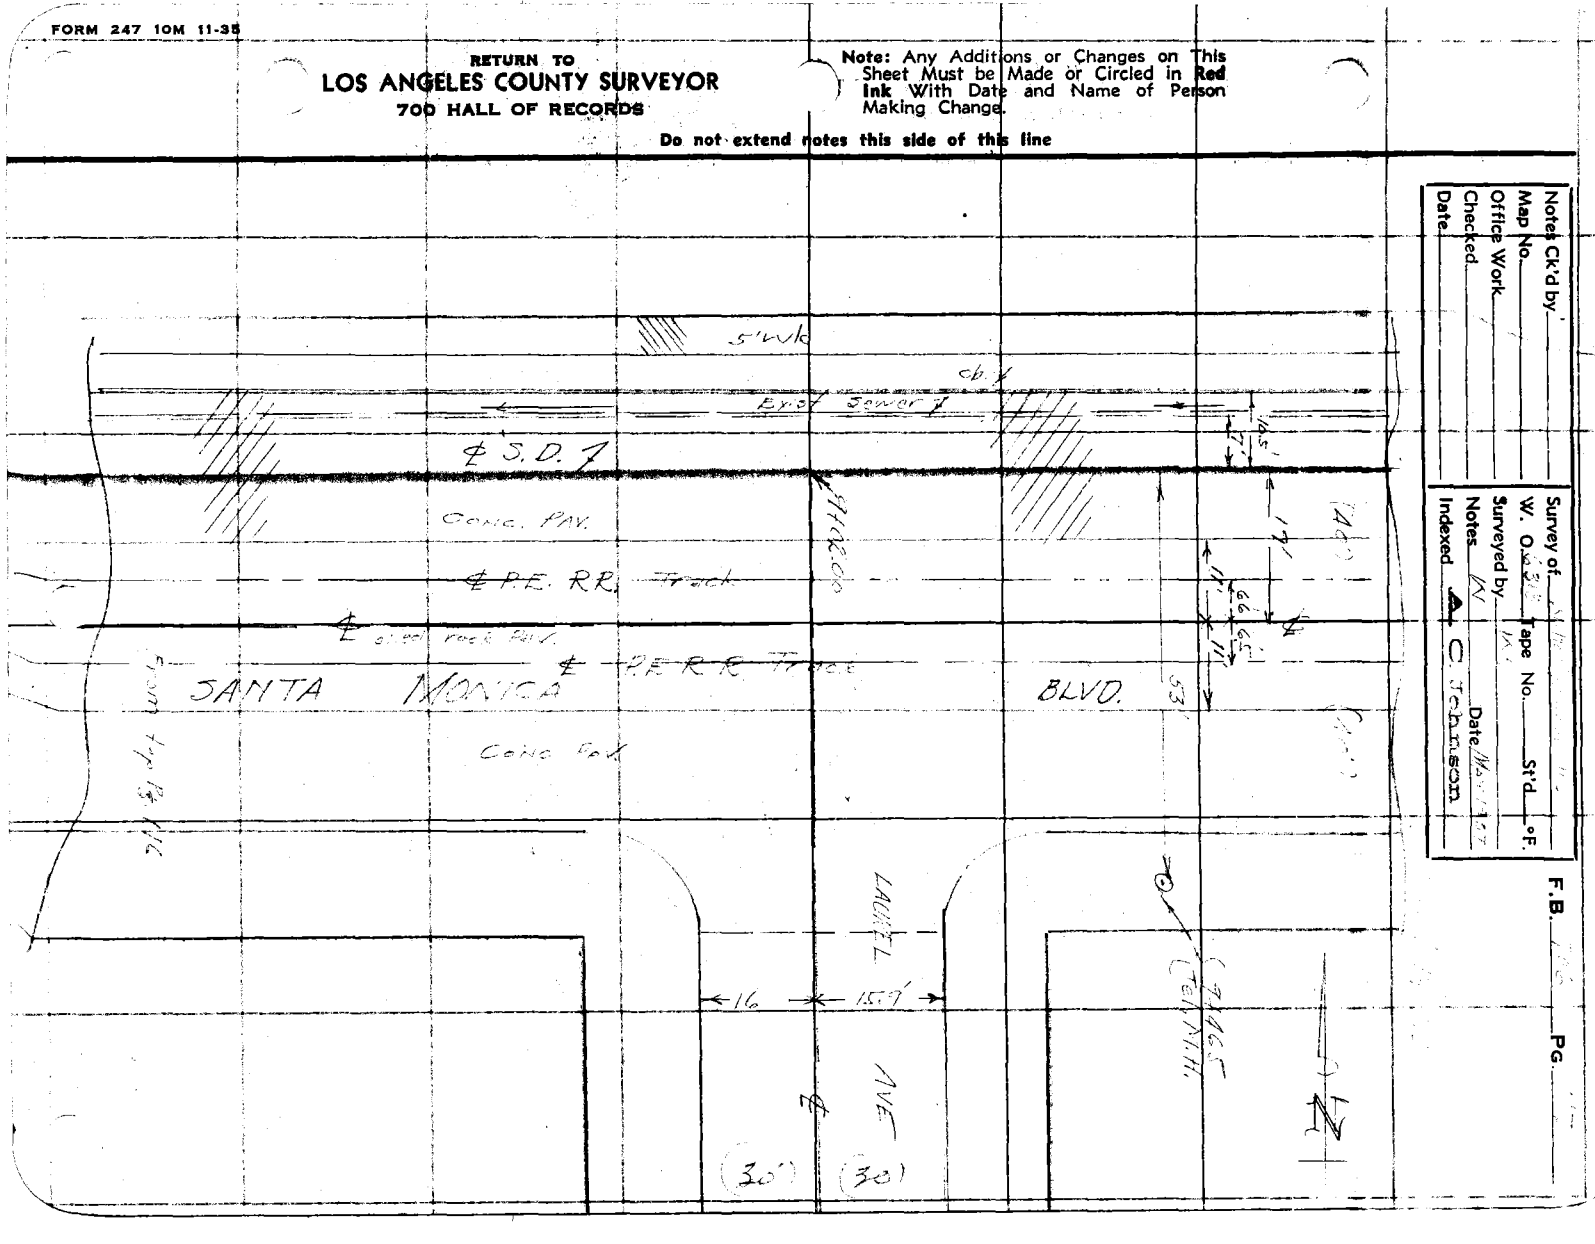

Notes Ck'd by
Map No.
Office Work
Checked
Date

Survey of
W. O. 22 Tape No. St'd °F.
Surveyed by
Notes Date
Indexed C. Johnson

F.B. PG.

F.B. 706 Pg. 118

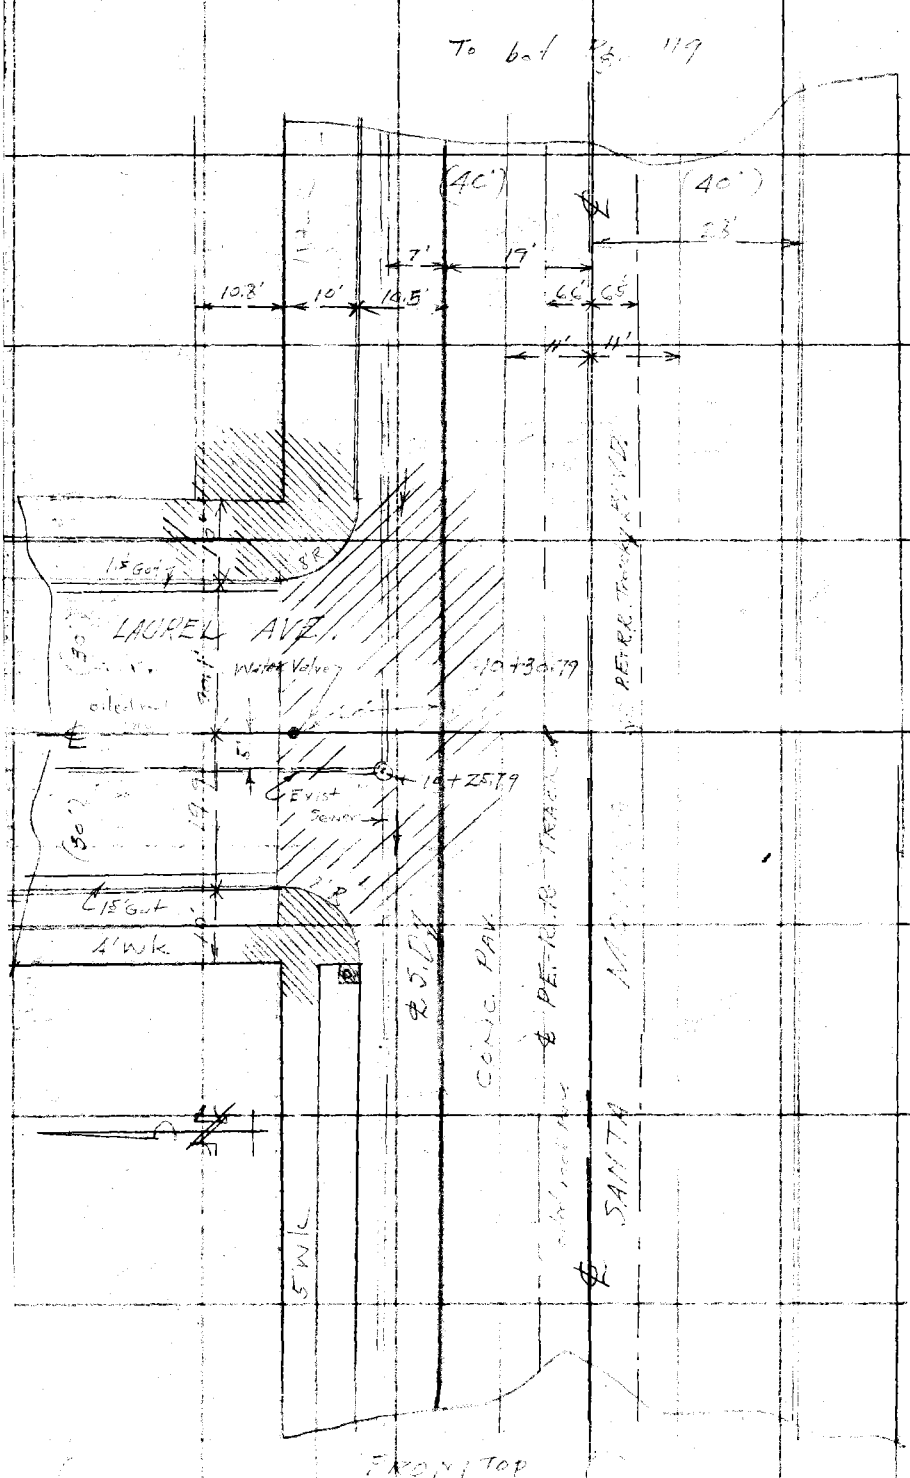

RETURN TO
LOS ANGELES COUNTY SURVEYOR
700 HALL OF RECORDS

Note: Any Additions or Changes on This Sheet Must be Made or Circled in Red Ink With Date and Name of Person Making Change.

Do not extend notes this side of this line

Notes Ck'd by	Survey of
Map No.	W. O. Tape No. St'd °F.
Office Work	Surveyed by
Checked	Notes Date
Date	Indexed

F.B. PG.

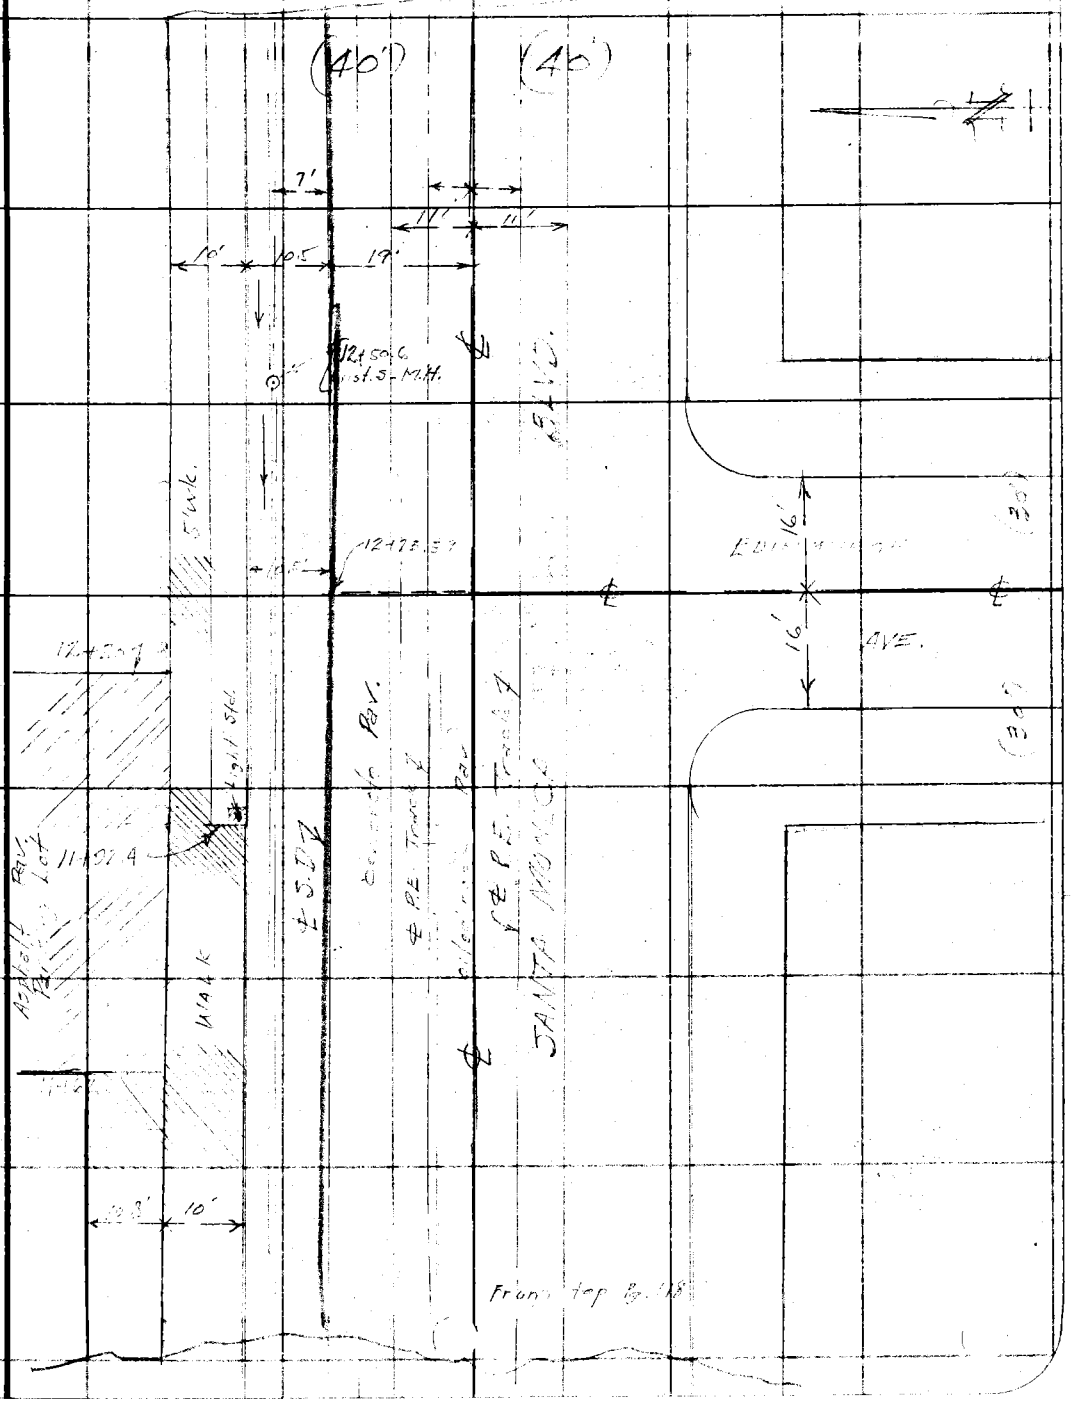

Note: Any Additions or Changes on This Sheet Must be Made or Circled in Red Ink With Date and Name of Person Making Change

Do not extend notes this side of this line

RETURN TO
LOS ANGELES COUNTY SURVEYOR
700 HALL OF RECORDS

FORM 247 10M 11-38

F.B. 706 PG. 120

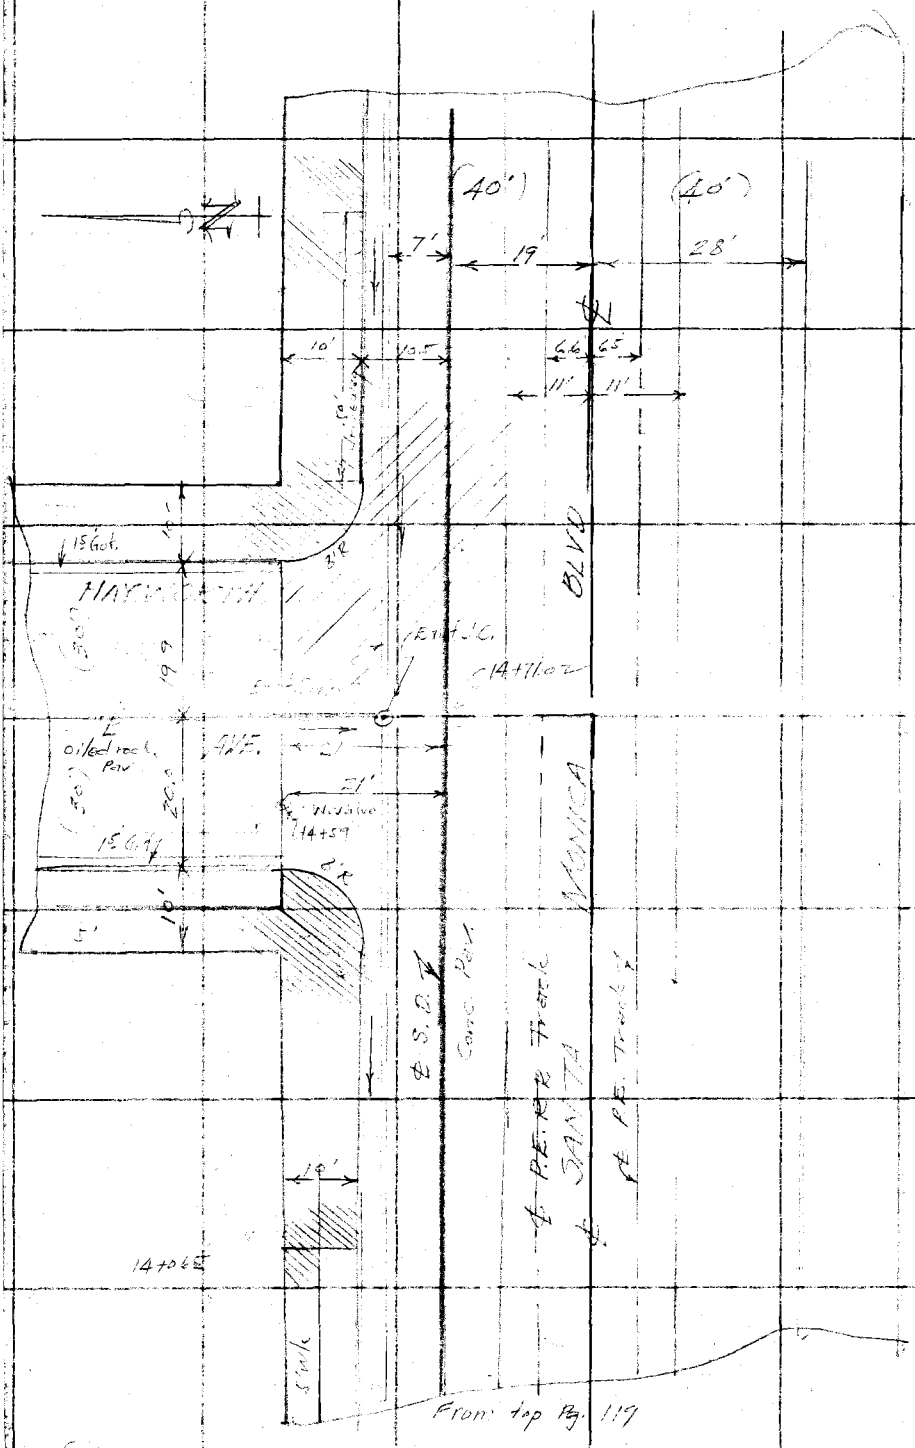

RETURN TO
LOS ANGELES COUNTY SURVEYOR
700 HALL OF RECORDS

Note: Any Additions or Changes on This Sheet Must be Made or Circled in Red Ink With Date and Name of Person Making Change.

Do not extend notes this side of this line

Profile No.	Notes Red.	Plotted	Job No. 6318	Division No.	F.B. 706 PG. 101
	Date	Date	Survey of W. Hollywood D.S.		
X-Sec. No.	Notes Chkd.	Checked	Survey by V. A. C. Johnson	Notes [illegible]	Date 5-3-41
	Date	Date	Map No.	Indexed	Date

NOTE: ANY ADDITIONS OR CHANGES ON THIS SHEET MUST BE MADE OR CIRCLED IN RED INK, WITH DATE AND NAME OF PERSON MAKING CHANGE

Do not extend notes this side of this line

PLEASE RETURN TO
LOS ANGELES COUNTY SURVEYOR
700 HALL OF RECORDS

Form 307 5M 11-35

STATION | B. S. | H. I. | F. S. | ELEV.

(5)

PROFILE

SANTA MONICA BLVD. ~~BRANCH~~ Lat

WEST HOLLYWOOD D.S.
J.N. 6318

& SURVEY F.B. 706 Pg. 101 to 110
Topog F.B. 706 Pg. 111 to 120

Wallace
Gregory
Murray
Tellez
Ethier

MAY 1

RECEIVED ..... ✓

PROGRESSED ..... ✓

BOOK INDEXED ..... ✓

MAP INDEXED ..... ✓

RECORD INDEXED ..... ✓

CARD INDEXED ..... ✓

REMARKS Infield + COM

4

Form 307 5M 11-35

PLEASE RETURN TO
LOS ANGELES COUNTY SURVEYOR
700 HALL OF RECORDS

NOTE: ANY ADDITIONS OR CHANGES ON THIS SHEET MUST BE MADE OR CIRCLED IN RED INK, WITH DATE AND NAME OF PERSON MAKING CHANGE

Do not extend notes this side of this line

F. B. 706 PG. 12 | Job No. 4815 | Division No. | Notes Red. | Plotted | Profile
Survey of | Date | No.
Survey by C. Johnson | Notes | Date | X-Sec.
Indexed | Date | Notes Chkd. | Checked | No.
Date | Date

STATION	B. S.	H. I.	F. S.	ELEV.	
					Hayvenhurst Dr N.
BM. D-12	6.02	281.58		275.56	C/L, D-26 El. 275.56 E 8, 582-23 Hayvenhurst Dr x Santa Monica Blvd NW Cor C/Spk 3' W/o ~ W end CR
			5.87	275.71	W end N, W, C &
			6.01		
			5.69		TC
			6.46		Gutter
POC L=30°E 15=2380 ON TANGENT PORTION			6.86		E C L
BC 1+13.74			5.73		E
EC 1+37.59			5.52		E
			6.00		E MH
			6.05		E
			6.65		TC
					Gutter
			6.70		Gutter
			5.85		TC N end N E CR
			6.21		Gutter
			5.72		TC E
			6.50		Gutter

Form 307 5M 11-35

PLEASE RETURN TO
LOS ANGELES COUNTY SURVEYOR
700 HALL OF RECORDS

NOTE: ANY ADDITIONS OR CHANGES ON THIS SHEET MUST BE MADE OR CIRCLED IN RED INK, WITH DATE AND NAME OF PERSON MAKING CHANGE

Do not extend notes this side of this line

STATION	B. S.	H. I.	F. S.	ELEV.		

Profile
No. X-Sec.
Notes Red Plotted Job No. Division No.
Date Date Survey of
Notes Chkd Checked Survey by Notes
Date Date Map No. Indexed Date Date
F. B. 716 PG. 17

Form 307 5M 11-35

PLEASE RETURN TO
LOS ANGELES COUNTY SURVEYOR
700 HALL OF RECORDS

NOTE: ANY ADDITIONS OR CHANGES ON THIS SHEET MUST BE MADE OR CIRCLED IN RED INK, WITH DATE AND NAME OF PERSON MAKING CHANGE

Do not extend notes this side of this line

F. B. 726 PG. 124 | Job No. 1318 | Division No. | Profile No. | X-Sec. No.

Survey of | Notes Red | Plotted
Survey by | Notes | Notes Chkd | Checked
Indexed | Date | Date | Date | Date

STATION	B. S.	H. I.	F. S.	ELEV.	Note Form
		✓	Grade		Elev. ft.
		281 58			
3+00			4.5	277	℄ SD
4+00			2.64		℄ SD
4+15.8			2.34		℄ Int S.D. & Crescent Hgts Blvd W. drive
TP	7.08	286 ✓	2.39		
4+15.8			7.10	279 17 ✓	℄ San Marino Blvd Elev.
			7.06	278 21 ✓	TC E Side
			8.00	278 27 ✓	Gutter "
4+22			7.01	279 26 ✓	SS MH
			16.52		Inv. 8" Outlet in
			16.43		Inv x" [illegible] E
4+15.8			7.15		Gutter " W
			3.95		50' N of N PL on E Crescent Hgts Blvd
			3.14		[illegible]
			3.95		[illegible]
			4.28		[illegible] No Ch.
			5.42		TC [illegible]
			3.91		Gutter [illegible]

W: 702, 280, 67, 16.52

E: 701, 876, 61, 16.43

Form 307 5M 11-35

PLEASE RETURN TO
LOS ANGELES COUNTY SURVEYOR
700 HALL OF RECORDS

NOTE: ANY ADDITIONS OR CHANGES ON THIS SHEET MUST BE MADE OR CIRCLED IN RED INK, WITH DATE AND NAME OF PERSON MAKING CHANGE

Do not extend notes this side of this line

Profile No. ____ X-Sec. No. ____

Notes Red. ____ Date ____ Notes Chkd. ____ Date ____

Plotted ____ Date ____ Checked ____ Date ____

Job No. ____ Survey of ____ Survey by ____ Map No. ____

Division No. ____ Notes ____ Date ____ Date ____

F. B. ____ Pg. ____

STATION	B. S.	H. I.	F. S.	ELEV.	
		28.0			
4+49			5.9	25	
"			6.5	279	
5+00			6.3	279	
TP		285	5.8	280	
	5.81	28.0	5.0	251	
			6.8	250	
				279	
				279	
				279	
			5.70	280	
				281	
			5.53	280	
			6.5	279	
			6.5	279	
			6.40	279	Brk

Form 307 5M 11-35

PLEASE RETURN TO
LOS ANGELES COUNTY SURVEYOR
700 HALL OF RECORDS

NOTE: ANY ADDITIONS OR CHANGES ON THIS SHEET MUST BE MADE OR CIRCLED IN RED INK, WITH DATE AND NAME OF PERSON MAKING CHANGE

Do not extend notes this side of this line

F. B. 706 PG. 126 | Job No. 6318 Division No. | Notes Red | Plotted | Profile No.
Survey of | Date | Date | X-Sec. No.
Survey by A. C. Johnson | Notes | Notes Chkd | Checked
Indexed | Date | Date | Date

STATION	B. S.	H. I.	F. S.	ELEV.	
					South Fork Sta 9
		✓			
		256 15			
			5 96		50' Sta 5 42 and 2 Crescent Hts Blvd
			3 21	42	70' W Sta 0
			9 25	63	Gutter
			9 11	73	70' E "
			9 00	83	Gutter " "
			5 76	37	70' S and 5 Sta 0
			6 53	60	Gutter " "
			5 72	41	70'
			6 37	74	Curb
					South Fork Sta 0 Blvd
5+00		✓	5 00	50	℄ SD
TP	7 20	289 02	4 31	281 82	
7+00			7 86	81	℄ SD
			Crescent Hts Blvd N		
7+05			7 21	67	70' W and N W C R
"			8 01	59	Gutter " "
			6 30	72	70' N
			6 53	49	Gutter "

Form 307 5M 11-35

PLEASE RETURN TO
LOS ANGELES COUNTY SURVEYOR
700 HALL OF RECORDS

NOTE: ANY ADDITIONS OR CHANGES ON THIS SHEET MUST BE MADE OR CIRCLED IN RED INK, WITH DATE AND NAME OF PERSON MAKING CHANGE

Do not extend notes this side of this line

STATION	B. S.	H. I.	F. S.	ELEV.	
		289.12			
7+45					
7+44.5					
8+00					
+79.2					
"					

Profile
No. X-Sec.
Notes Red Plotted Job No. Division No.
Date Date Survey of
Notes Chkd. Checked Survey by Notes
Date Date Map No. Indexed
Date Date
F. B. Pg.

Form 307 5M 11-35

PLEASE RETURN TO
LOS ANGELES COUNTY SURVEYOR
700 HALL OF RECORDS

NOTE: ANY ADDITIONS OR CHANGES ON THIS SHEET MUST BE MADE OR CIRCLED IN RED INK, WITH DATE AND NAME OF PERSON MAKING CHANGE

Do not extend notes this side of this line

F. B. 706 PG. 128 | Job No. 6315 Division No. | Notes Red. Date | Plotted Date | Profile No.
Survey of W. Pico Road Dist | Notes Date | Checked Date | X-Sec. No.
Survey by C. Johnson | Notes Chkd. Date | Indexed Date

STATION	B. S.	H. I.	F. S.	ELEV.	
					Santa Monica Blvd. Lat.
					Sand
					Level
					BM D-36 El 282.913 T3 S2 R34
BM-D-36	560	287 62	700	282 62	Santa Monica Blvd & Laurel Ave. S.W. Cor. 5' Spk S'W of W end C.H.
					Laurel Ave So.
			554	283 08	T.C. W end S w C.H.
			610	281 52	Gutter " " "
			500	281 87	T.C. " " "
			217	283 33	Gutter " " "
9+02			507	281 55	℄ Int SD & Laurel Ave
9+32			558	281 54	℄ Int Santa Monica & Laurel Ave
9+62					S. 5 M.H.
					W N E S W
					587 592 596 594
					1.5
			597	283 67	Gutter 25' " Laurel Ave
			582	281 32	Gutter 32' " " "
			709	281 43	56'5 " C.H. " " Laurel Ave
			700	282 62	T.C. W. Side
			633	279 29	Gutter " "

Form 307 5M 11-35

PLEASE RETURN TO
LOS ANGELES COUNTY SURVEYOR
700 HALL OF RECORDS

NOTE: ANY ADDITIONS OR CHANGES ON THIS SHEET MUST BE MADE OR CIRCLED IN RED INK, WITH DATE AND NAME OF PERSON MAKING CHANGE

Do not extend notes this side of this line

STATION	B. S.	H. I.	F. S.	ELEV.	
9+09.0			458	283 04	TC.
"			500	282 42	
				282 17	TC.
				281 71	
			504	282 58	TC.
				281 52	
			451	282 81	TC.
			500	283 12	
TP.		259	456	283	
10+02.8			531	283 50	TC.
"				282 97	
			512	283	TC.
				283 46	

Profile
No. ____ X-Sec. No. ____
Notes Red ____ Plotted ____ Job No. ____ Division No. ____
Date ____ Date ____ Survey of ____
Notes Chkd. ____ Checked ____ Survey by ____ Notes ____ Date ____
Date ____ Date ____ Map No. ____ Checked J. Johnson Date ____

F. B. ____ PG. ____

Form 307 5M 11-35

PLEASE RETURN TO
LOS ANGELES COUNTY SURVEYOR
700 HALL OF RECORDS

NOTE: ANY ADDITIONS OR CHANGES ON THIS SHEET MUST BE MADE OR CIRCLED IN RED INK, WITH DATE AND NAME OF PERSON MAKING CHANGE

Do not extend notes this side of this line

Profile No. ____ X-Sec. No. ____

F. B. 706 PG. 130 | Job No. 2315 | Division No. ____ | Notes Red. ____ Date ____ | Plotted ____ Date ____

Survey of ____ Notes ____ Date ____ | Notes Chkd. ____ Date ____ | Checked ____ Date ____

Survey by A. C. Johnson

Indexed ____

STATION	B. S.	H. I.	F. S.	ELEV.	
					Santa Monica Blvd.
					Avenue Sta.
		25° 11'			
10+35.74			589		33. N.C. ⊕ 7' N & S.D.
			1+13		Inv. 8" Inlet N
			1529		Inv. 8" Inlet E
			1534		W
10+30.22			580		Ave. & S.D.
"			576		Santa Monica Blvd.
"			600		7C S. Side
					Water & Sew. M. Manhole
					1' Gutter W. North & Laurel
			455		Brk 21'
			235		N. Rim & Laurel Ave.
			209		W. Side
			225		Curb
			230		5
			325		
10458.8			292		⊕ Curb NE Cor
"			524		Gutter

Form 307 5M 11-35

PLEASE RETURN TO
LOS ANGELES COUNTY SURVEYOR
700 HALL OF RECORDS

NOTE: ANY ADDITIONS OR CHANGES ON THIS SHEET MUST BE MADE OR CIRCLED IN RED INK, WITH DATE AND NAME OF PERSON MAKING CHANGE

Do not extend notes this side of this line

Profile No. ____ Notes Red. ____ Plotted ____ Job No. ____ Division No. ____
X-Sec. No. ____ Notes Chkd. ____ Date ____ Date ____ Survey of ____ Date ____
Date ____ Checked ____ Survey by ____ Notes ____
Date ____ Map No. ____ Traced ____ Date ____ Date ____

F. B. 706 PG. 21

STATION	B. S.	H. I.	F. S.	ELEV.	
		289 11		Laurel Ave. N.	
			5 10	284 11 - TC	
			5 52	233 29 + curb	
			5 39	250 72 + 2.00	
T.P.	6 38	290 28	5 21	283 90	
				Ellsworth Ave	
12700				284 32	
			6 28	8405	
			5 43	283 35	
			5 38	8400	
			5 31	283 40	
27235			5 10	284 41 + 1.00	
			5 80	284 45 + 2	
			5 [illegible]	283 [illegible]	
			5 [illegible]	283 [illegible]	
			5 22	282 [illegible]	
			5 20	281 87	
			5 [illegible]	281 22	
			5 70	281 58	
12712359			5 27	285 31	
"			5 29	284 29	

Form 307 5M 11-35

PLEASE RETURN TO
LOS ANGELES COUNTY SURVEYOR
700 HALL OF RECORDS

NOTE: ANY ADDITIONS OR CHANGES ON THIS SHEET MUST BE MADE OR CIRCLED IN RED INK, WITH DATE AND NAME OF PERSON MAKING CHANGE

Do not extend notes this side of this line

F. B. 106 PG. 132 | Job No. 2315 | Division No. | Profile No. | Notes Red. | Plotted | X-Sec. No.

Survey of [illegible] | Date | Date | Date

Survey by [illegible] | Notes [illegible] | Notes Chkd. | Checked

Indexed A. C. Johnson | Date | Date | Date

STATION	B. S.	H. I.	F. S.	ELEV.	Sight House Elev. 29
			Edison L. A.K.		
		290 28			
			592	284 36	TC Sand = E.C.R.
			565	283 60	Gutter " " "
			588	284 40	TC E " "
			650	283 78	Gutter " " "
			574	284 54	S.S. "
			13 96	275 32	Inv. & O.H. Pole
			14 88	275 40	Inv & Inlet E
TP	615	290 56	537	284 —	
			Edison Mon. Base		
3+00			574	284 92	" "
4+00			570	285 43	" "
TP	493	290 86	463	285 13	
			Hayhurst Ave N.		
14+43			473	286 13	TC W end N. Wall
"			545	285 41	" " " "
14+51			472	286 14	TC " " "
"			505	285 81	" " "

W
574
8.55
.67
9.22
.14

E
570
8.43
.67
9.10
.14

Form 307 5M 11-35

PLEASE RETURN TO
LOS ANGELES COUNTY SURVEYOR
700 HALL OF RECORDS

NOTE: ANY ADDITIONS OR CHANGES ON THIS SHEET MUST BE MADE OR CIRCLED IN RED INK, WITH DATE AND NAME OF PERSON MAKING CHANGE

Do not extend notes this side of this line

STATION	B. S.	H. I.	F. S.	ELEV.	
		290 S. ✓			Normandie Ave N.
14+00			4+72	285 74	± Int. [illegible] Normandie Ave
			5+09	285 [illegible]	55 V.C.
			14+25	276 [illegible]	Inv. [illegible]
			14+10	276 [illegible]	Inv. Inlet E
			14+1	276 [illegible]	Inv. Outlet W
[illegible]			[illegible]	286 61	W. [illegible]
			1+25	286 [illegible]	25' [illegible]
			[illegible]	286 32	70 [illegible]
			2+00	286 [illegible]	[illegible]
			2+02	286 [illegible]	[illegible]
			[illegible]	286 [illegible]	[illegible]
			[illegible]	286 [illegible]	[illegible]
			[illegible]	286 [illegible]	[illegible]
14+91			3+95	286 91	[illegible]
"			4+20	286 16	Sister
14+93			[illegible]	286 93	[illegible]
"			[illegible]	286 86	[illegible]
			4+22	286 64	± int. [illegible] Normandie Ave

Profile No.

Notes Red. Date Plotted Date Job No. 5311 Division No.

X-Sec. No. Notes Chkd. Date Checked Date Survey of Survey by [illegible] Notes Map No. Marked C. Johnson Date

F.B. 766 PG. 133

Form 307 5M 11-35

PLEASE RETURN TO
LOS ANGELES COUNTY SURVEYOR
700 HALL OF RECORDS

NOTE: ANY ADDITIONS OR CHANGES ON THIS SHEET MUST BE MADE OR CIRCLED IN RED INK, WITH DATE AND NAME OF PERSON MAKING CHANGE

Do not extend notes this side of this line

F. B. 706 Pg. 134 | Job No. [illegible] Division No. [illegible] Notes Red. ____ Plotted ____ Profile No. ____
Survey of ____ Date ____ Date ____ X-Sec. No. ____
Survey by ____ Notes ____ Notes Chkd. ____ Checked ____
Indexed C. Johnson Date ____ Date ____ Date ____

STATION	B. S.	H. I.	F. S.	ELEV.	
		290			
				285 85	
				286 79	
				285 65	
				286 17	
				285 56	
				284 90	
				283 68	
				284 08	
				283 49	
				284 22	
				283 90	
				284 60	
				286 01	
				284 35	
				286 11	
				284 88	
				287 40	
				286 43	

Form 307 5M 11-35

PLEASE RETURN TO
LOS ANGELES COUNTY SURVEYOR
700 HALL OF RECORDS

NOTE: ANY ADDITIONS OR CHANGES ON THIS SHEET MUST BE MADE OR CIRCLED IN RED INK, WITH DATE AND NAME OF PERSON MAKING CHANGE

Do not extend notes this side of this line

STATION	B. S.	H. I.	F. S.	ELEV.		
TP	3.81	287.30	5.37	285.49		
T.P	3.06	286.85	5.51	283.79		
					B.M. D-36 El. 282.01	F.B. 677-34
B.M. D-36			4.85	282.00	Stamped Brass Cap in Concrete Hdwl. S.W.	
					4 Ft. S. of W. end C.R.	
					Elevation is Mean Sea Level Datum of 1929	
					B.M. D-36 El. 282.01	F.B. 677-34
B.M. D-36	2.86	284.87		282.01	Same Station Shown Above	
					4 Ft. S. 8°30' W. of W end C.R.	
T.P	6.72	294.52	2.07	287.80	Elysian	
					1.15' N. E.	
			11.86	282.96	B.S.	N 334 342 842 1176 E 349
T.P	8.71	296.37	6.93	287.66		
T.P	9.24	301.57	4.54	292.33		
	1.44	293.44	3.57	291.00		

Profile No. ____ Notes Red. ____ Plotted ____ Job No. 23-1 Division No. ____
X-Sec. No. ____ Notes Chkd. ____ Checked ____ Survey of ____
Date ____ Date ____ Date ____
Date ____ Map No. ____ Survey by ____ Notes Indexed Johnson Date ____ Date ____

F.B. 706 PG. 135

Form 307 5M 11-35

PLEASE RETURN TO
LOS ANGELES COUNTY SURVEYOR
700 HALL OF RECORDS

NOTE: ANY ADDITIONS OR CHANGES ON THIS SHEET MUST BE MADE OR CIRCLED IN RED INK, WITH DATE AND NAME OF PERSON MAKING CHANGE

Do not extend notes this side of this line

F. B. 736 Pg. 136 | Job No. 6318 Division No. | Notes Red. | Plotted | Profile No.
Survey of | Date | Date | X-Sec. No.
Survey by C. Johnson | Notes Chkd. | Checked
Indexed | Notes | Date | Date

STATION	B. S.	H. I.	F. S.	ELEV.	

Notes Ck'd by	Survey of
Map No.	W. O. 6318 Tape No. St'd 84° F.
Office Work	Surveyed by
Checked	Notes Date May 1937
Date	Indexed A. C. Johnson

F.B. PG. 5

4. SURVEY
WILLOUGHBY - HAYWORTH AVE. LATERAL
WEST HOLLYWOOD U.S.
J.N. 6318

TOPOG F.B. 706 Pg. 147 to 156
PROFILE F.B. 706 Pg. 157 to

Note: Any Additions or Changes on This Sheet Must be Made or Circled in Red Ink With Date and Name of Person Making Change

Do not extend notes this side of this line

RETURN TO
LOS ANGELES COUNTY SURVEYOR
700 HALL OF RECORDS

RECEIVED	MAY 1	HLS
PROGRESSED	✓	✓
BOOK INDEXED	✓	✓
MAP INDEXED	✓	✓
RECORD INDEXED	✓	✓
CARD INDEXED	✓	✓

FORM 247 10M 11-36

F.B. 706 Pg. 138

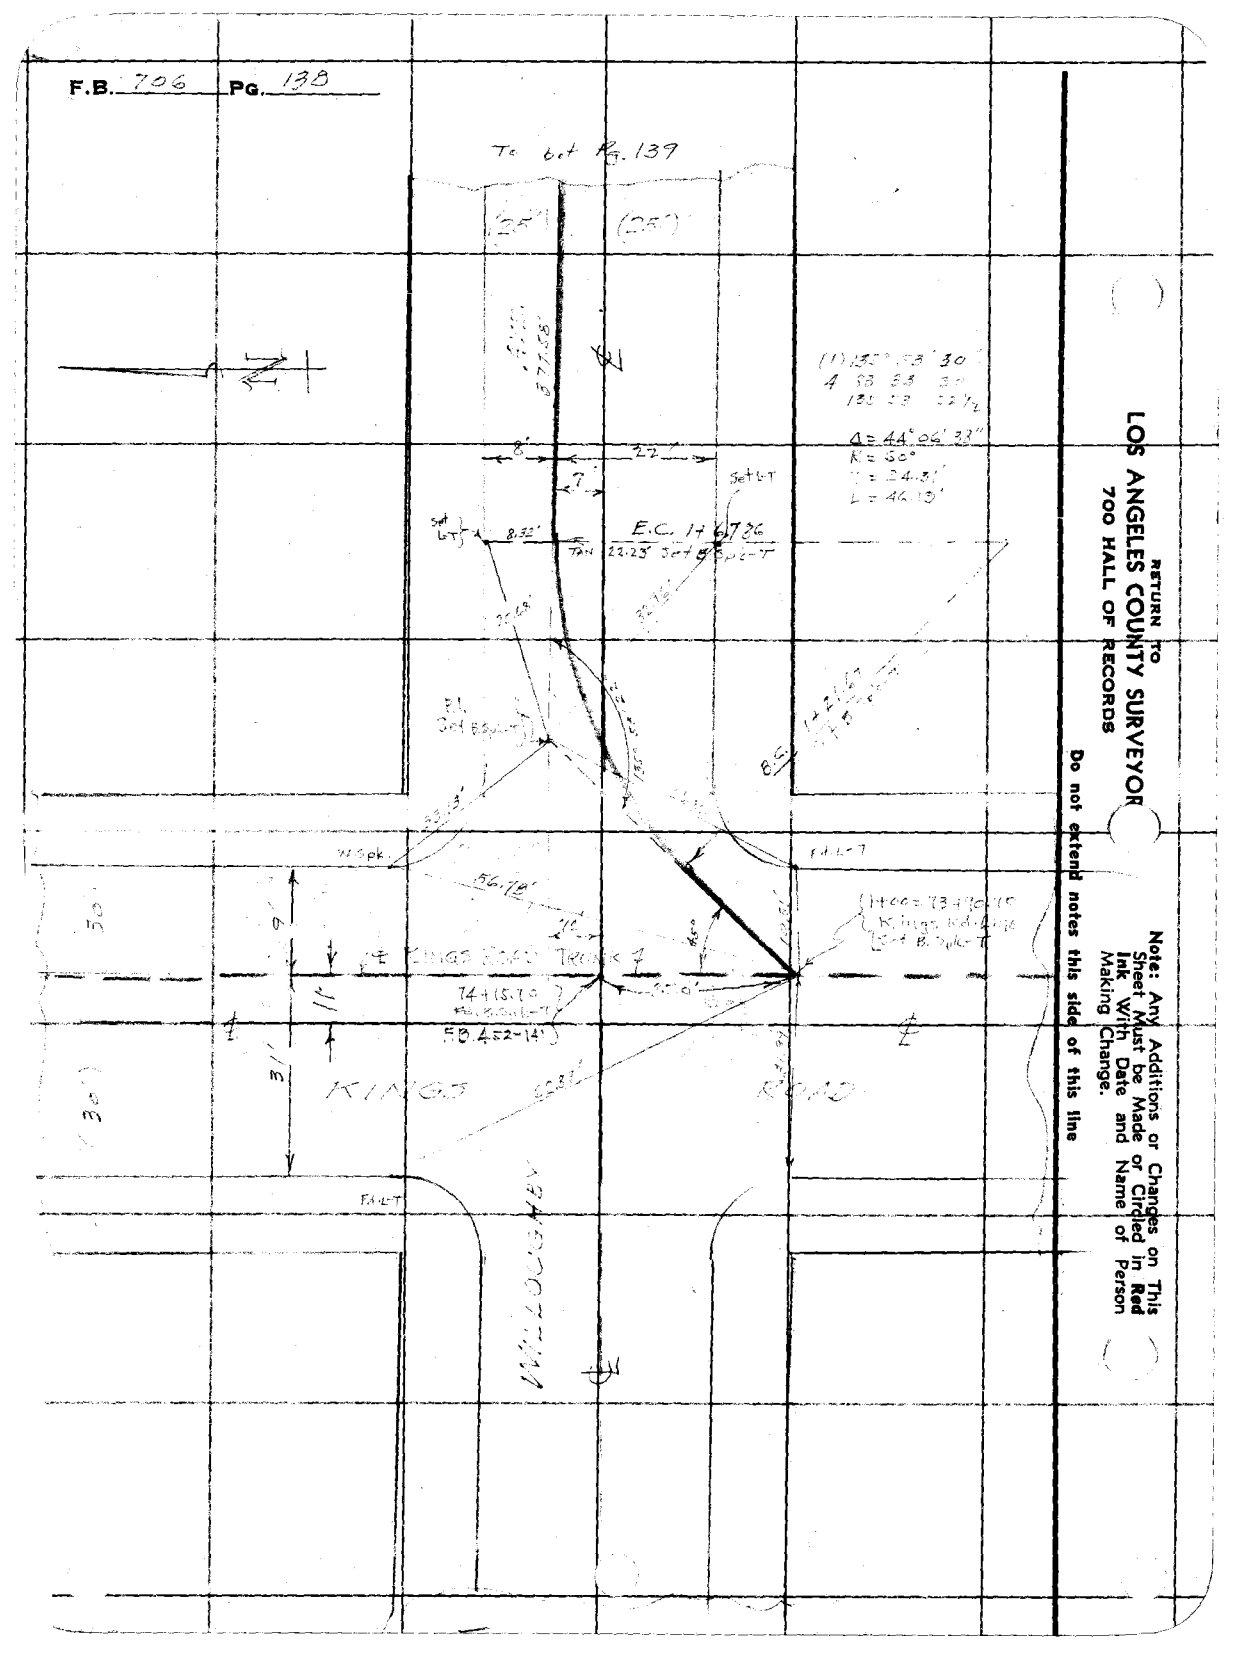

RETURN TO
LOS ANGELES COUNTY SURVEYOR
700 HALL OF RECORDS

Note: Any Additions or Changes on This Sheet Must be Made or Circled in Red Ink With Date and Name of Person Making Change.

Do not extend notes this side of this line

Notes Ck'd by	Survey of W. Hollywood
Map No.	W. O. 6318 Tape No. [illegible] St'd 62 °F.
Office Work	Surveyed by
Checked	Notes Date May 1927
Date	Indexed C. Johnson

F.B. [illegible] Pg. 124

Note: Any Additions or Changes on This Sheet Must be Made or Circled in Red Ink With Date and Name of Person Making Change.

Do not extend notes this side of this line

RETURN TO
LOS ANGELES COUNTY SURVEYOR
700 HALL OF RECORDS

FORM 247 10M 11-28

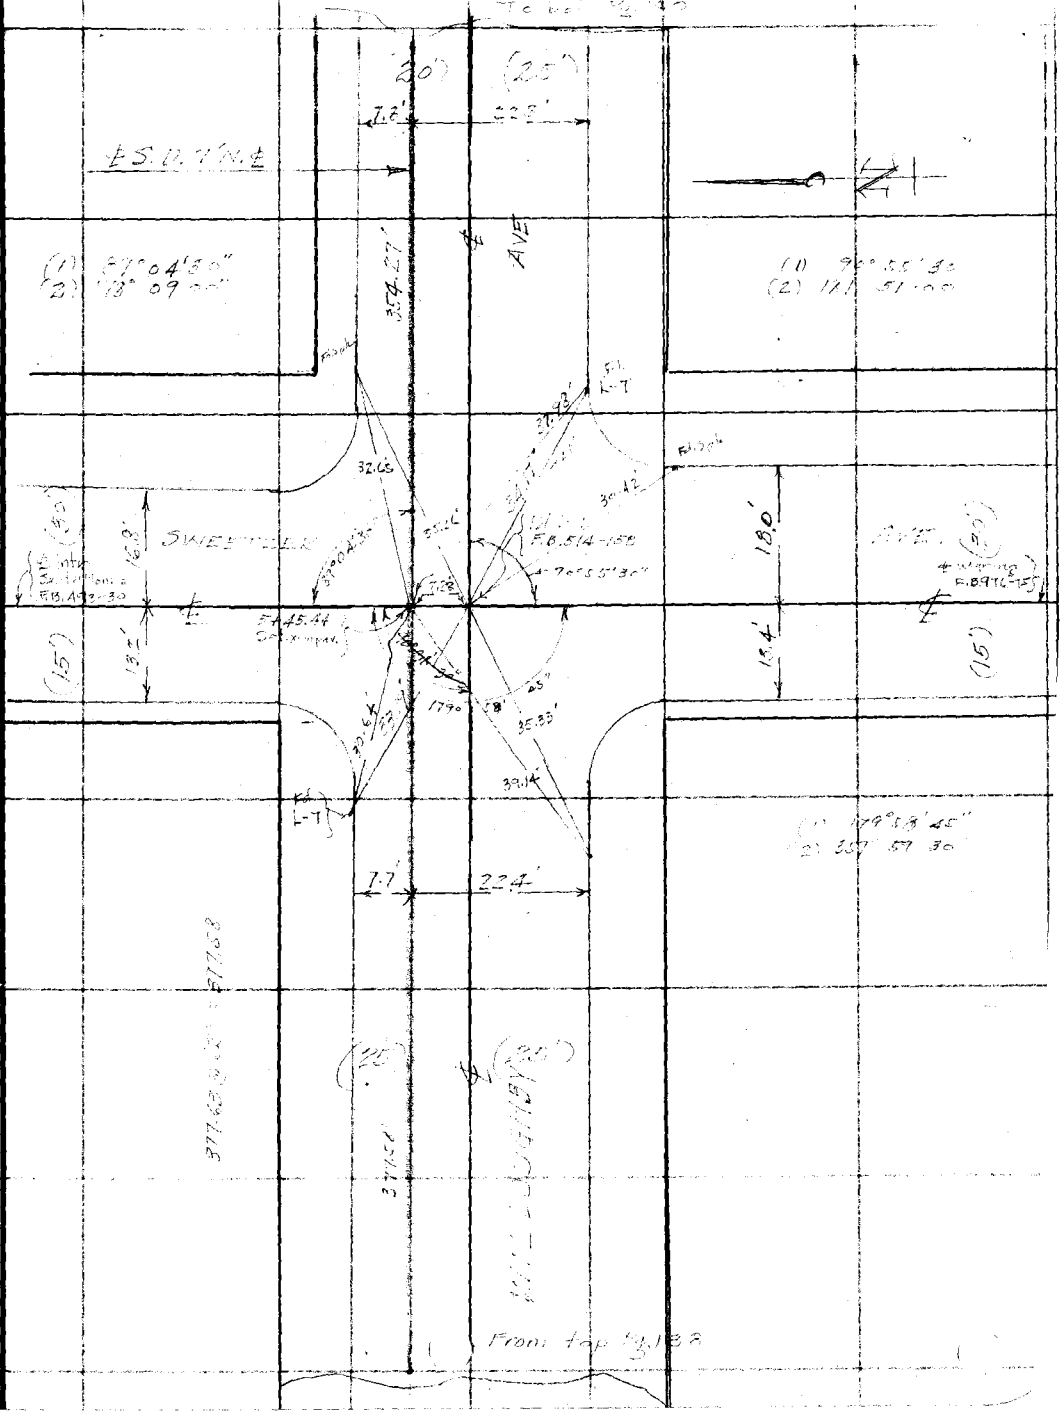

RETURN TO
LOS ANGELES COUNTY SURVEYOR
700 HALL OF RECORDS

Note: Any Additions or Changes on This Sheet Must be Made or Circled in **Red Ink** With Date and Name of Person Making Change.

Do not extend notes this side of this line

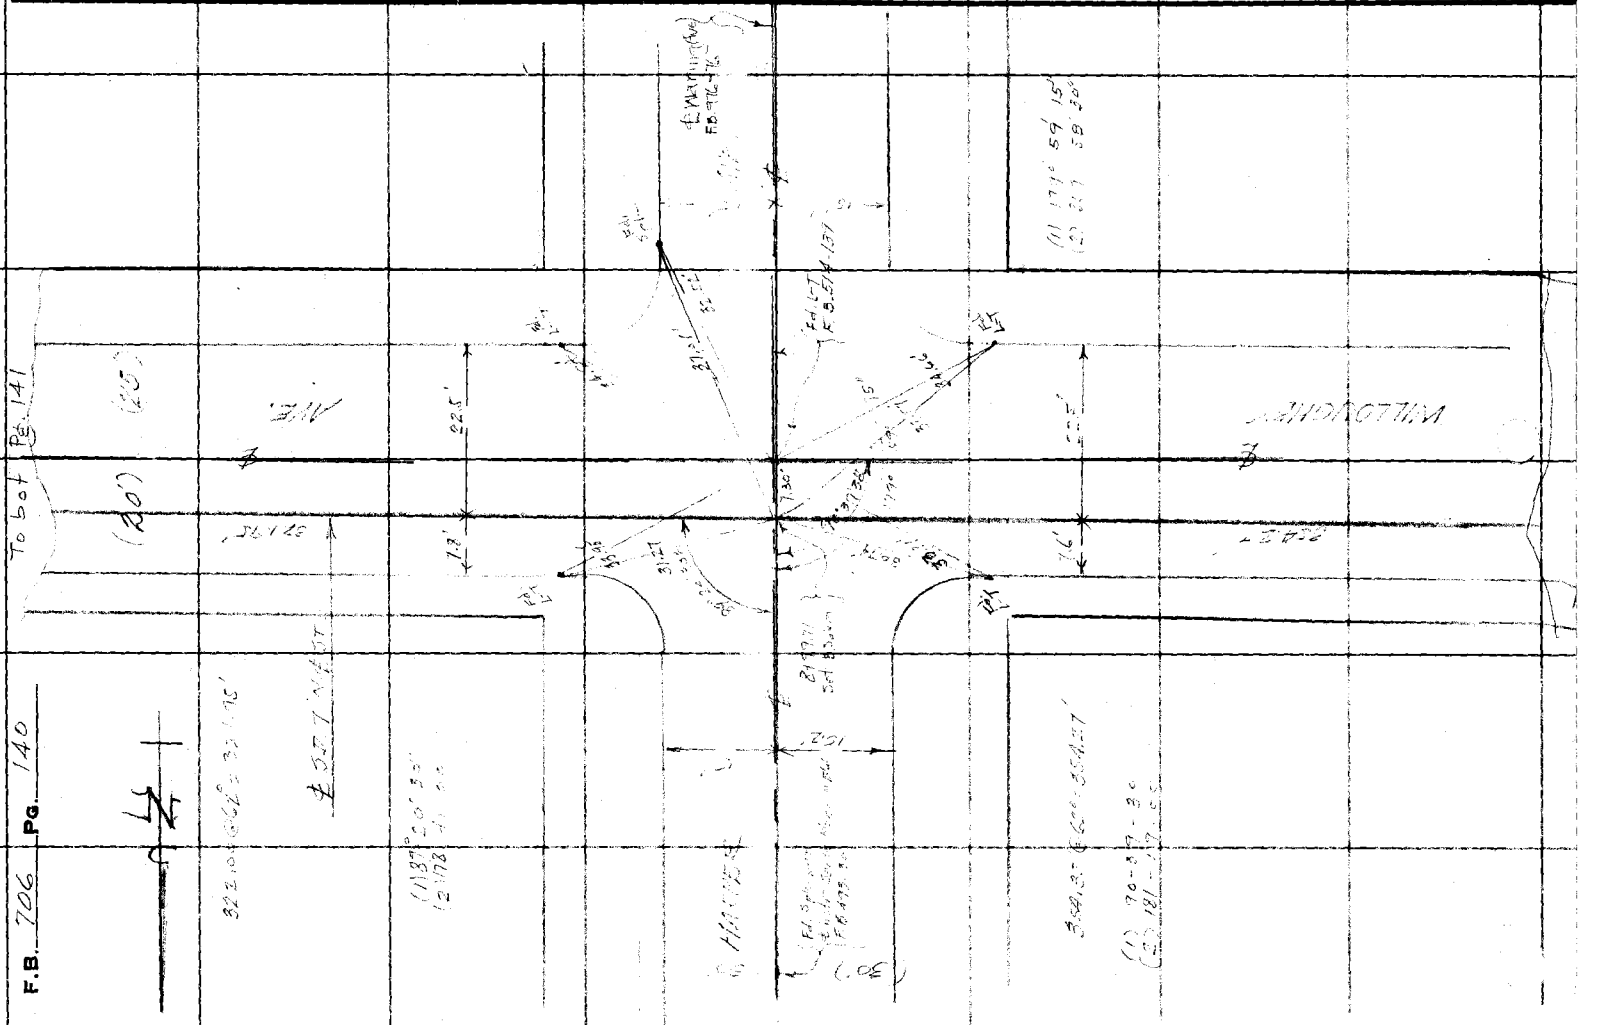

Notes Ck'd by	Survey of
Map No.	W. O. 4312 Tape No. 226 St'd 54 °F.
Office Work	Surveyed by
Checked	Notes Date
Date	Indexed A. C. Johnson

F.B. 1 Pg. 41

To bot Pg. 142

(20') (25') AVE.

337.00 N 64° E 391.76'

(1) 89° 31' 00"
(2) 178° 32' 00"

321.76'

(1) 179° 59' 15"
(2) 359° 58' 30"

78' 225'

Fd L-T

33.16'
33.16'
119° 59'
15° 30.75'
30.24'
33.45'

Fd. W.Spk

(30')

Fd. Pin & Mkd Cut in Box on E. Roseville Ave P.B. 193-20

E. Roseville Ave

E. Warning Ave P.B. 516-77

LA JOLLA AVE. N 12° 16' W 390.00' (390.17')

7.31'

Fd L-T P.B. 514-46

30.39'
33.39'
60°
34.70'
32.70'

BOT

Fd L-T

AVE.

27' 225'

(1) 90° 41' 00"
(2) 181° 22' 00"

E 5.0' 321.76' E 5'

321.76'

MILL COUNTY ST

Found top 6" IA o

Note: Any Additions or Changes on This Sheet Must be Made or Circled in Red Ink With Date and Name of Person Making Change.

Do not extend notes this side of this line

RETURN TO
LOS ANGELES COUNTY SURVEYOR
700 HALL OF RECORDS

FORM 247 10M 11-38

F.B. 706 Pg. 142

To be Pg. 143

322.00 @ 64° - 321.96

(20') (25')

℄ S.D. 7' N & S T

AVE

(1) 89° 19' 00"
(2) 175 38 00

(1) 179° 59' 00"
(2) 358 58 00

7.8 22.3'

Fd L&T

Fd. W. Spike

(Fd ⊙ on Mon. in
℄ Romaine Ave
F.B. 514-135

HAYVENHURST DR.

KILKEA DR.

15' 43.62'
Set L&T

Fd L&T
F.B. 514-140

Fd L&T

7.8 22.4

(1) 90° 41' 30"
(2) 89 23 00

WILLOUGHBY

(20') (25')

From Top Pg. 141

RETURN TO
LOS ANGELES COUNTY SURVEYOR
700 HALL OF RECORDS

Do not extend notes this side of this line

Note: Any Additions or Changes on This Sheet Must be Made or Circled in Red Ink With Date and Name of Person Making Change.

Notes Ck'd by	Survey of
Map No.	W. O. 6318 Tape No. 035 St'd 84 °F.
Office Work	Surveyed by
Checked	Notes Date Mar 1937
Date	Indexed A. C. Johnson

F.B. Pg.

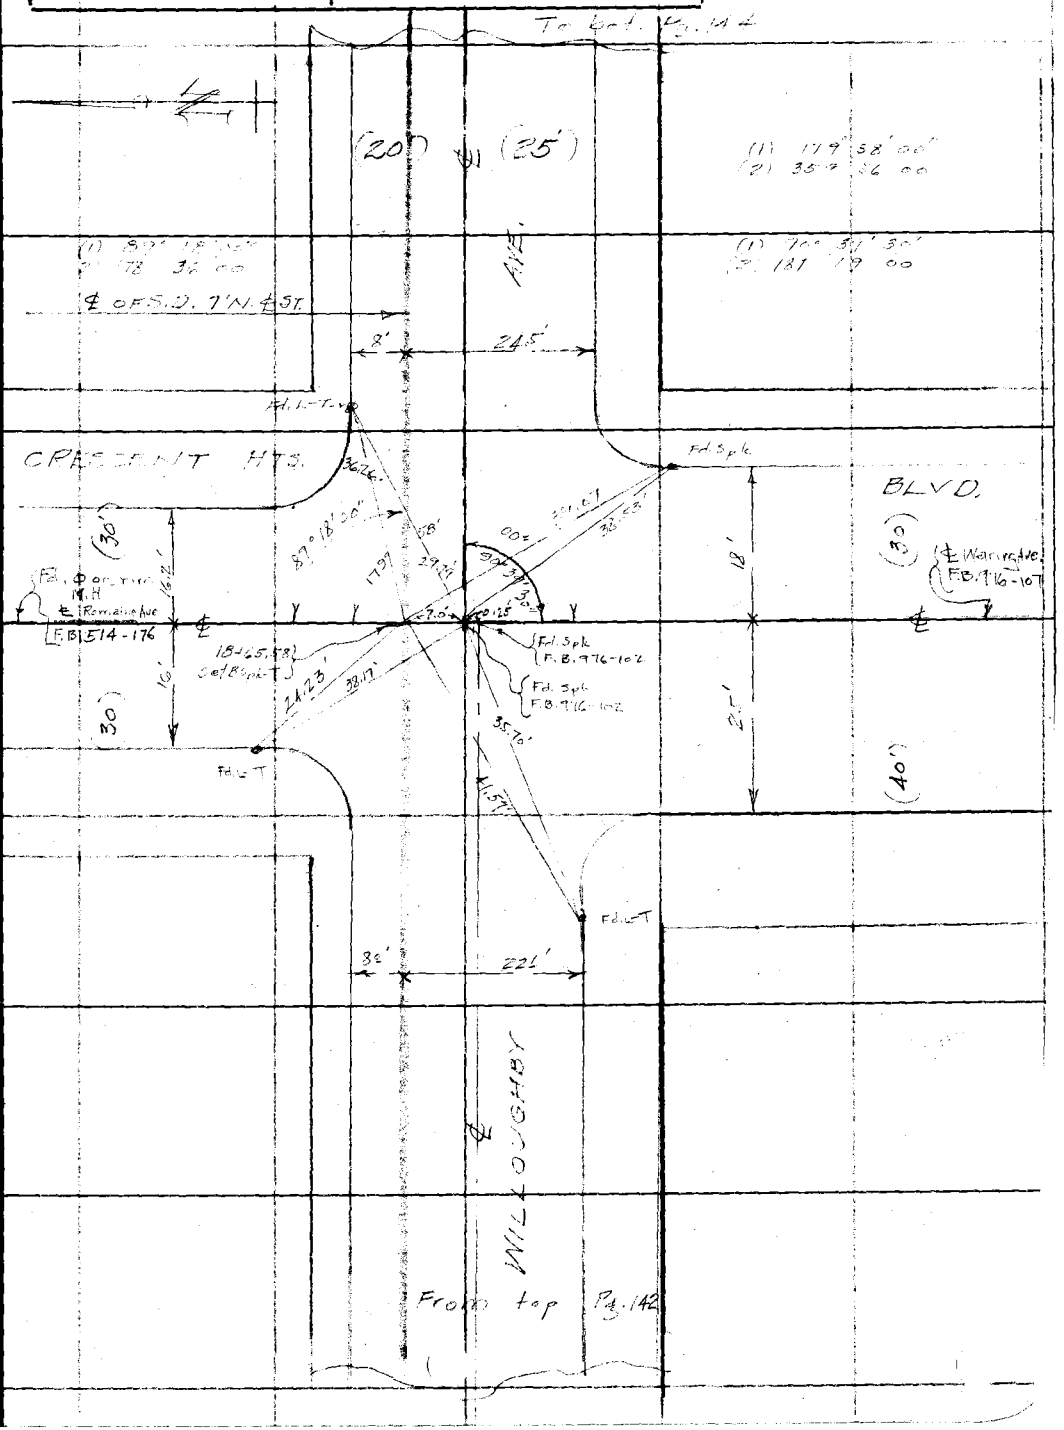

RETURN TO
LOS ANGELES COUNTY SURVEYOR
700 HALL OF RECORDS

Note: Any Additions or Changes on This Sheet Must be Made or Circled in Red Ink With Date and Name of Person Making Change.

Do not extend notes this side of this line

FORM 247 10M 11-35

F.B. 706 PG. 44

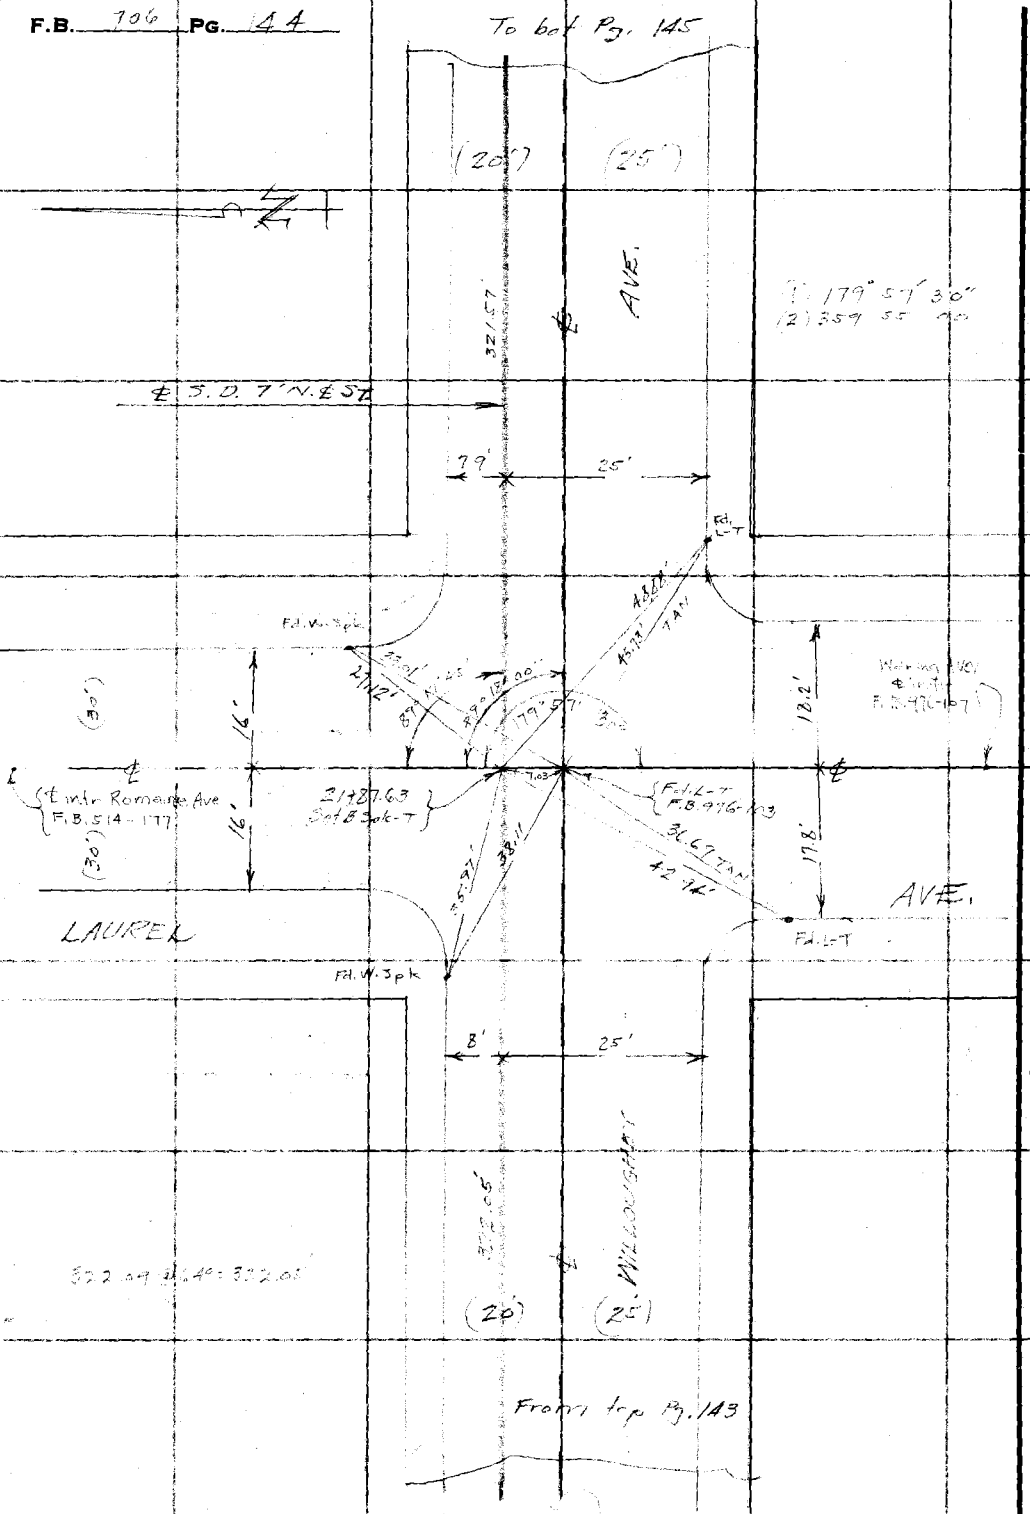

RETURN TO
LOS ANGELES COUNTY SURVEYOR
700 HALL OF RECORDS

Do not extend notes this side of this line

Note: Any Additions or Changes on This Sheet Must be Made or Circled in Red Ink With Date and Name of Person Making Change.

Notes Ck'd by	Survey of
Map No.	W. O. 6312 Tape No. 055 St'd 64 °F.
Office Work	Surveyed by
Checked	Notes Date Mar 1951
Date	Indexed C. Johnson

F.B. Pg.

To Cor 15, 146

(25')

(25')

S. L. INLET

5'

25'

FD L-T

FD L-T

16'

FD L-T

30.77

FD L-T

EDINBURGH

AVE.

8'

25'


From Cor 144

Note: Any Additions or Changes on This Sheet Must be Made or Circled in Red Ink With Date and Name of Person Making Change.

Do not extend notes this side of this line

RETURN TO
LOS ANGELES COUNTY SURVEYOR
700 HALL OF RECORDS

FORM 247 10M 11-35

RETURN TO
LOS ANGELES COUNTY SURVEYOR
700 HALL OF RECORDS

Note: Any Additions or Changes on This Sheet Must be Made or Circled in **Red Ink** With Date and Name of Person Making Change.

Do not extend notes this side of this line

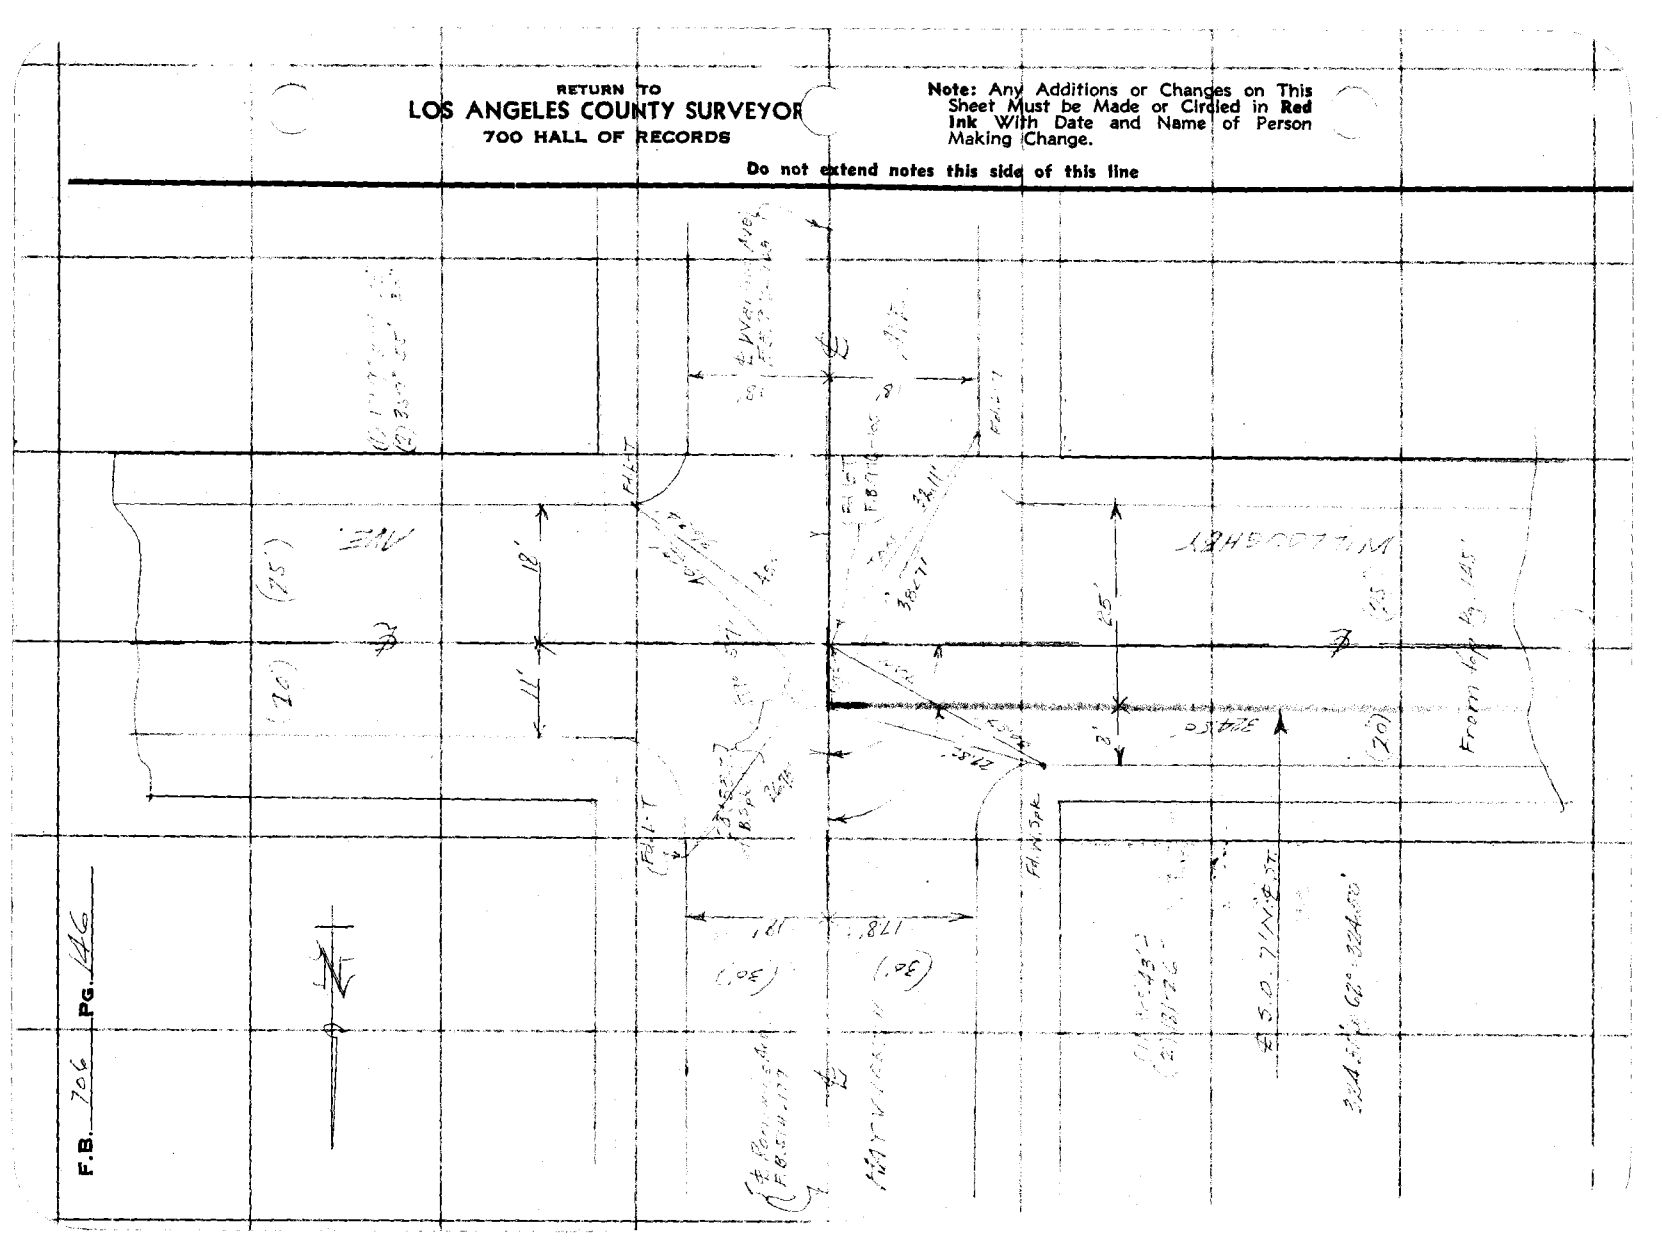

Notes Ck'd by	Survey of [illegible]
Map No.	W. O. 6318 Tape No. St'd °F.
Office Work	Surveyed by
Checked	Notes Date
Date	Indexed A. C. Johnson

F.B. [illegible] PG. [illegible]

5

TOPOGRAPHY

WILLOUGHBY - HAVENHURST AVE. [illegible]

WEST HOLLYWOOD QS.

JOB 6318

E SURVEY F.B. 706 Pg 137-146

R of Va F.B. 706 Pg. 157 ±

WALNUT
[illegible]
WONKAY
TALLY
ATWATER

Note: Any Additions or Changes on This Sheet Must be Made in Red Ink With Date and Name of Person Making Change.

Do not extend notes this side of this line

RETURN TO
LOS ANGELES COUNTY SURVEYOR
700 HALL OF RECORDS

RECEIVED	MAY 1	HLS
PROGRESSED	✓	✓
BOOK INDEXED	✓	✓
MAP INDEXED	✓	✓
RECORD INDEXED	✓	✓
CARD INDEXED	✓	✓

FORM 247 10M 11-38

F.B. 706 Pg. 148

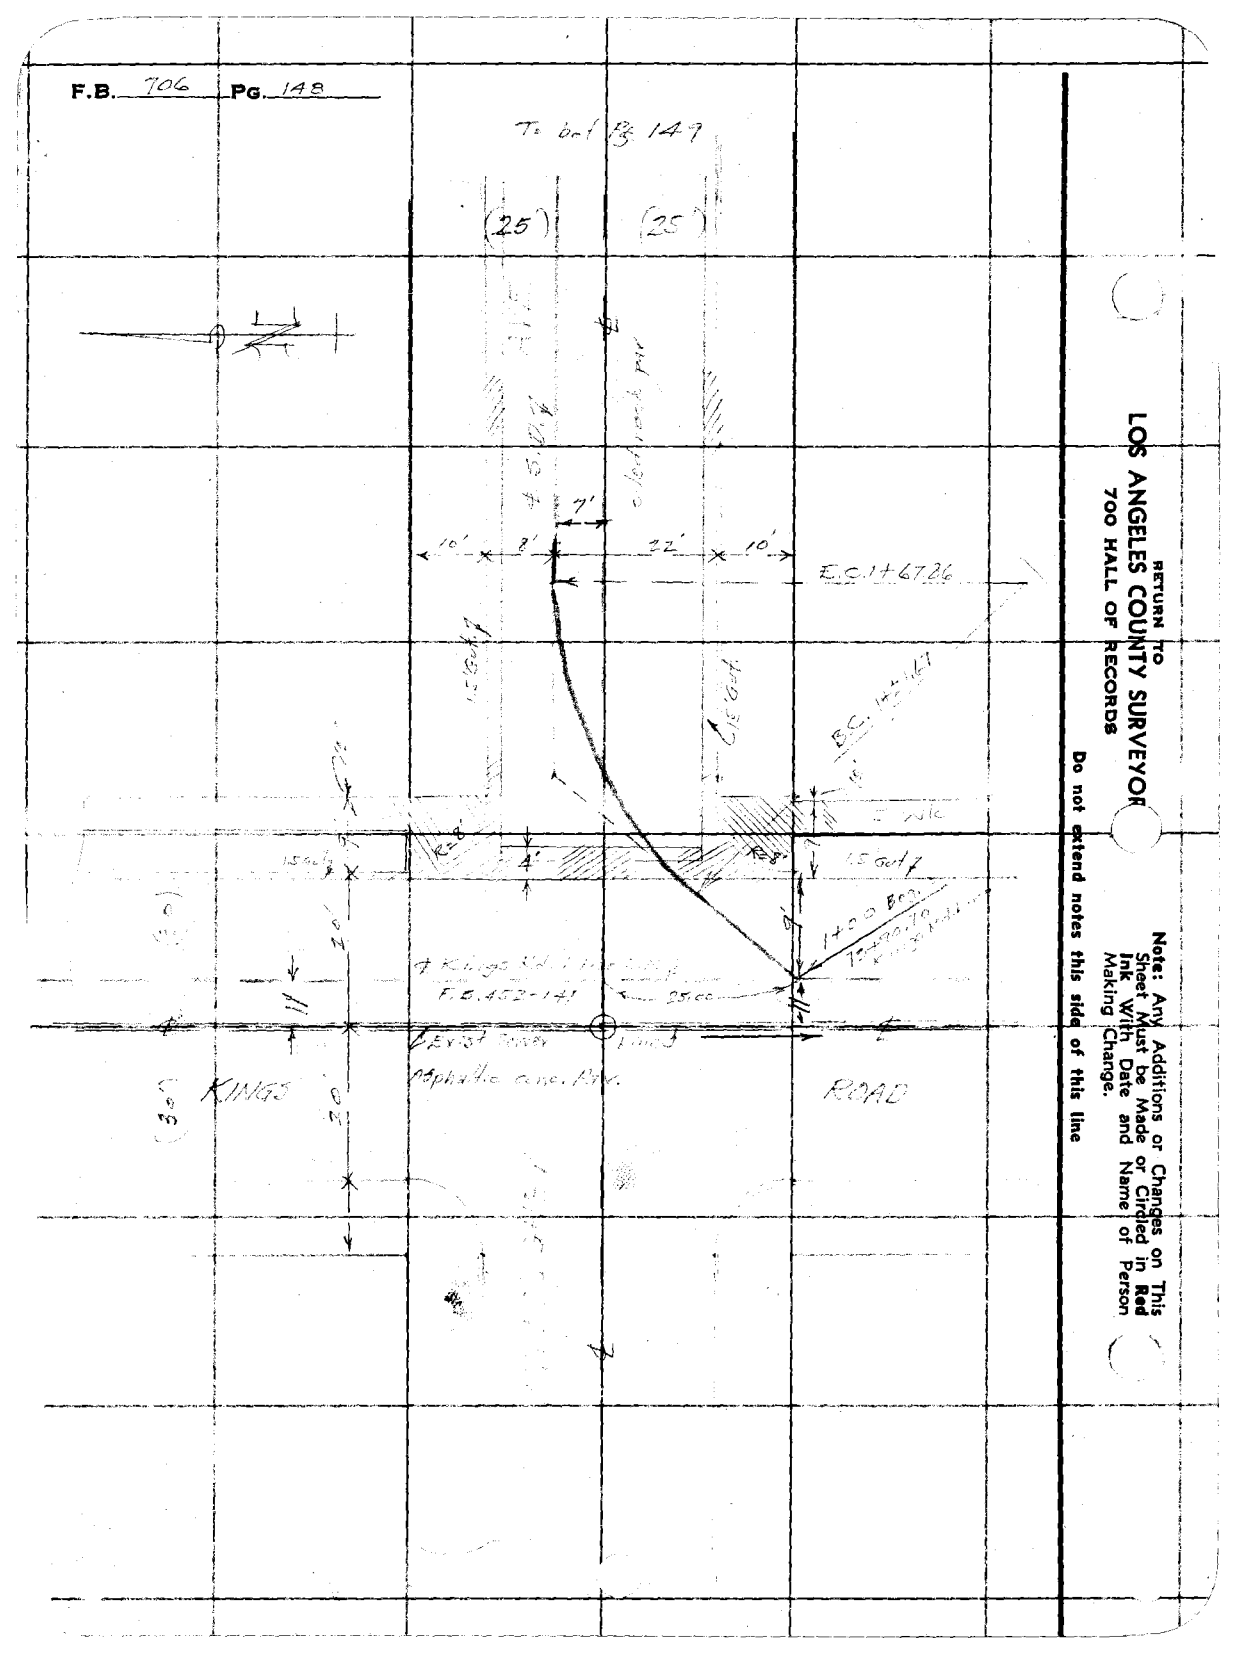

RETURN TO
LOS ANGELES COUNTY SURVEYOR
700 HALL OF RECORDS

Do not extend notes this side of this line

Note: Any Additions or Changes on This Sheet Must be Made or Circled in Red Ink With Date and Name of Person Making Change.

Notes Ck'd by	Survey of WILLOUGHBY
Map No.	W. O. 6312 Tape No. 00 St'd 67 °F.
Office Work	Surveyed by
Checked	Notes Date MAY 1927
Date	Indexed C Johnson

F.B. 5 PG. 119

RETURN TO
LOS ANGELES COUNTY SURVEYOR
700 HALL OF RECORDS

Note: Any Additions or Changes on This Sheet Must be Made or Circled in Red Ink With Date and Name of Person Making Change.

Do not extend notes this side of this line

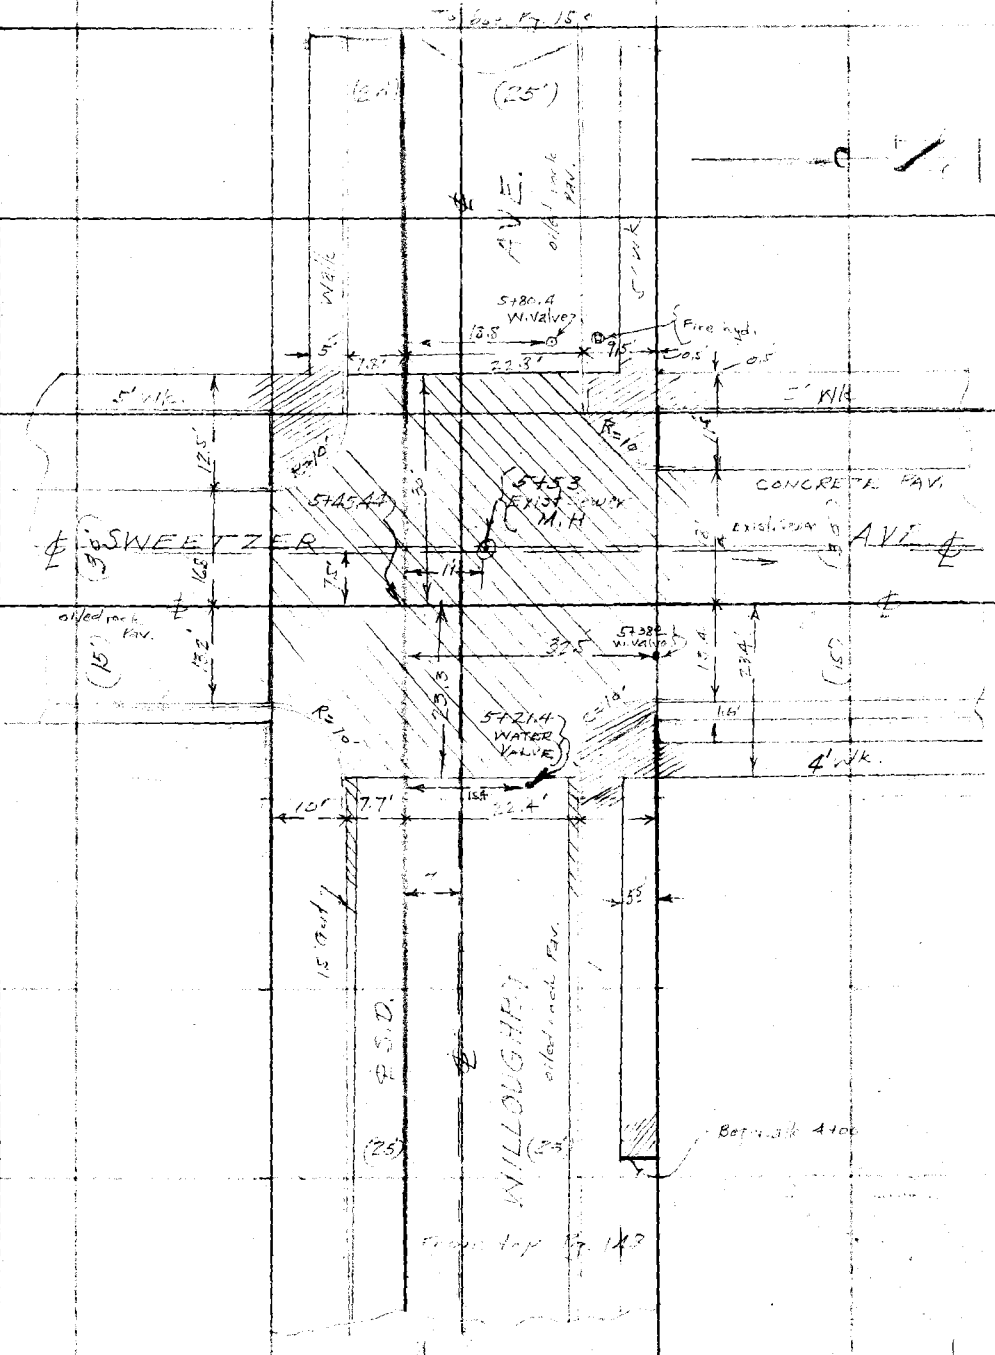

FORM 247 10M 11-33

RETURN TO
LOS ANGELES COUNTY SURVEYOR
700 HALL OF RECORDS

Note: Any Additions or Changes on This Sheet Must be Made or Circled in **Red** Ink With Date and Name of Person Making Change.

Do not extend notes this side of this line

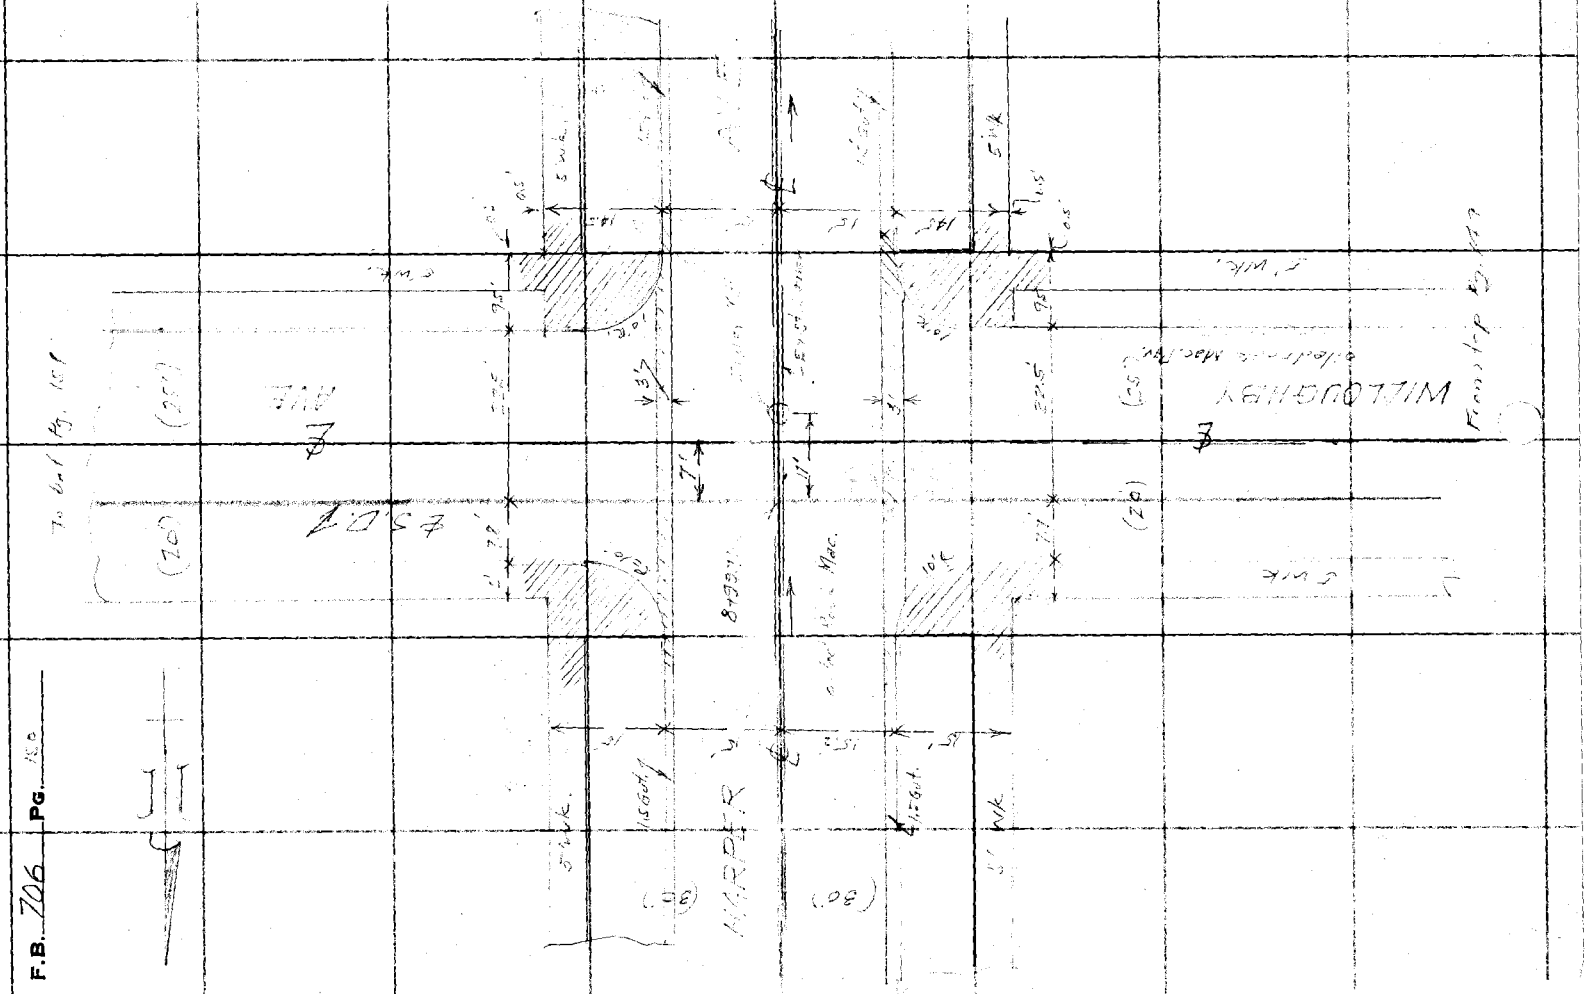
WILLOUGHBY

Notes Ck'd by	Survey of
Map No.	W. O. 6318 Tape No. St'd °F.
Office Work	Surveyed by
Checked	Notes Date
Date	Indexed C. Johnson

F.B. Pg.

Note: Any Additions or Changes on This Sheet Must be Made or Circled in Red Ink With Date and Name of Person Making Change.

Do not extend notes this side of this line

RETURN TO
LOS ANGELES COUNTY SURVEYOR
700 HALL OF RECORDS

FORM 247 10M 11-35

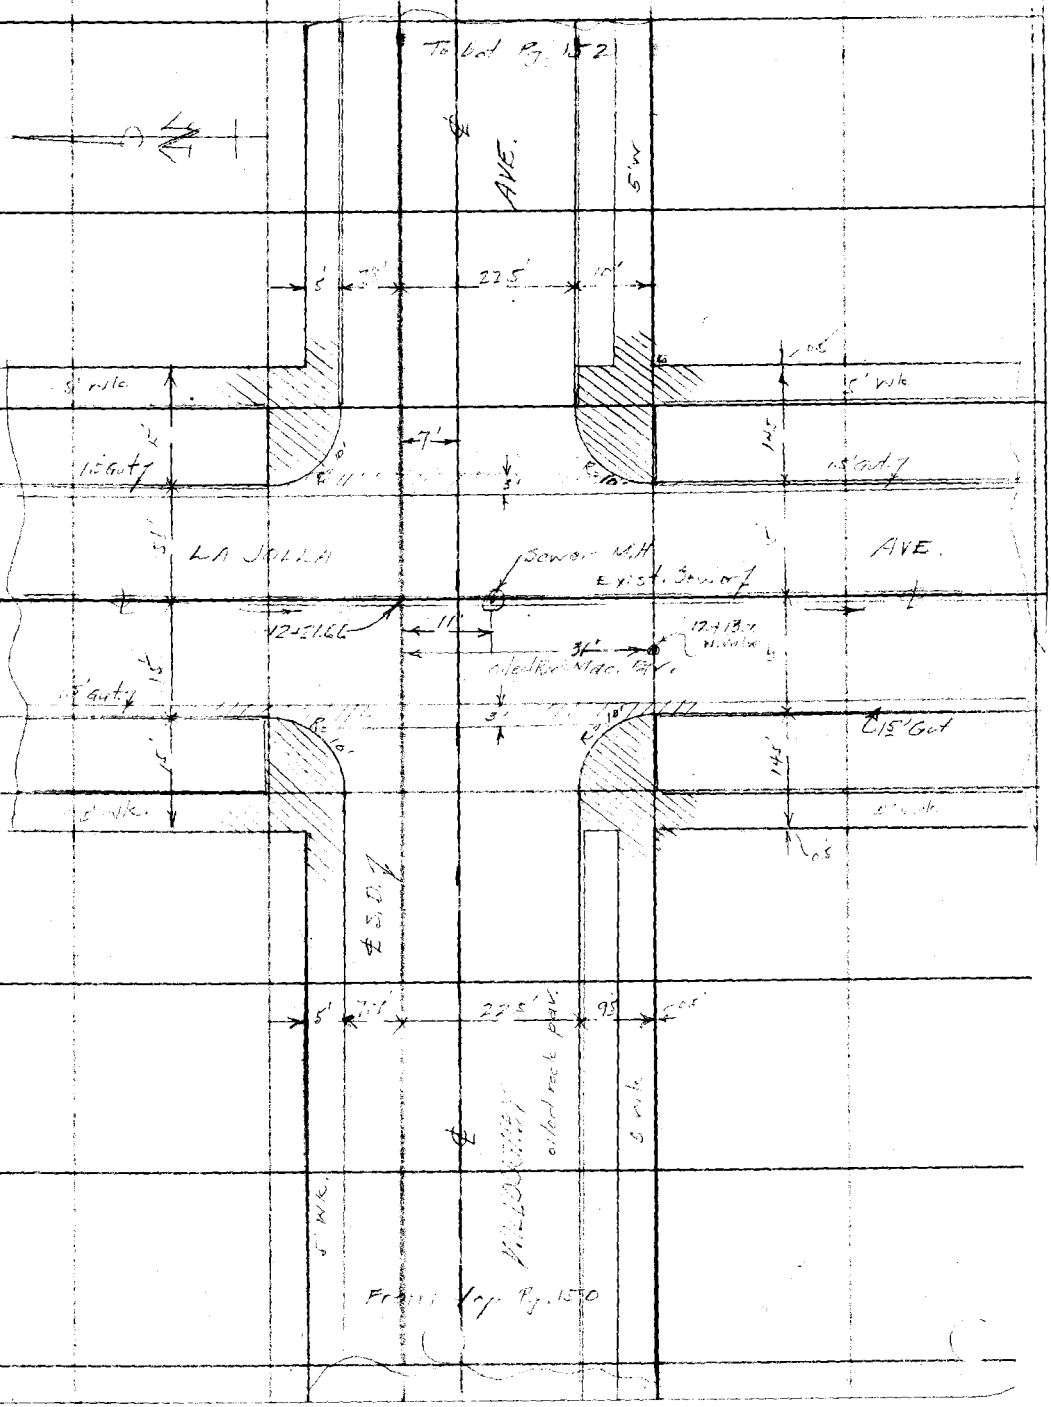

RETURN TO
LOS ANGELES COUNTY SURVEYOR
700 HALL OF RECORDS

Note: Any Additions or Changes on This Sheet Must be Made or Circled in **Red Ink** With Date and Name of Person Making Change.

Do not extend notes this side of this line

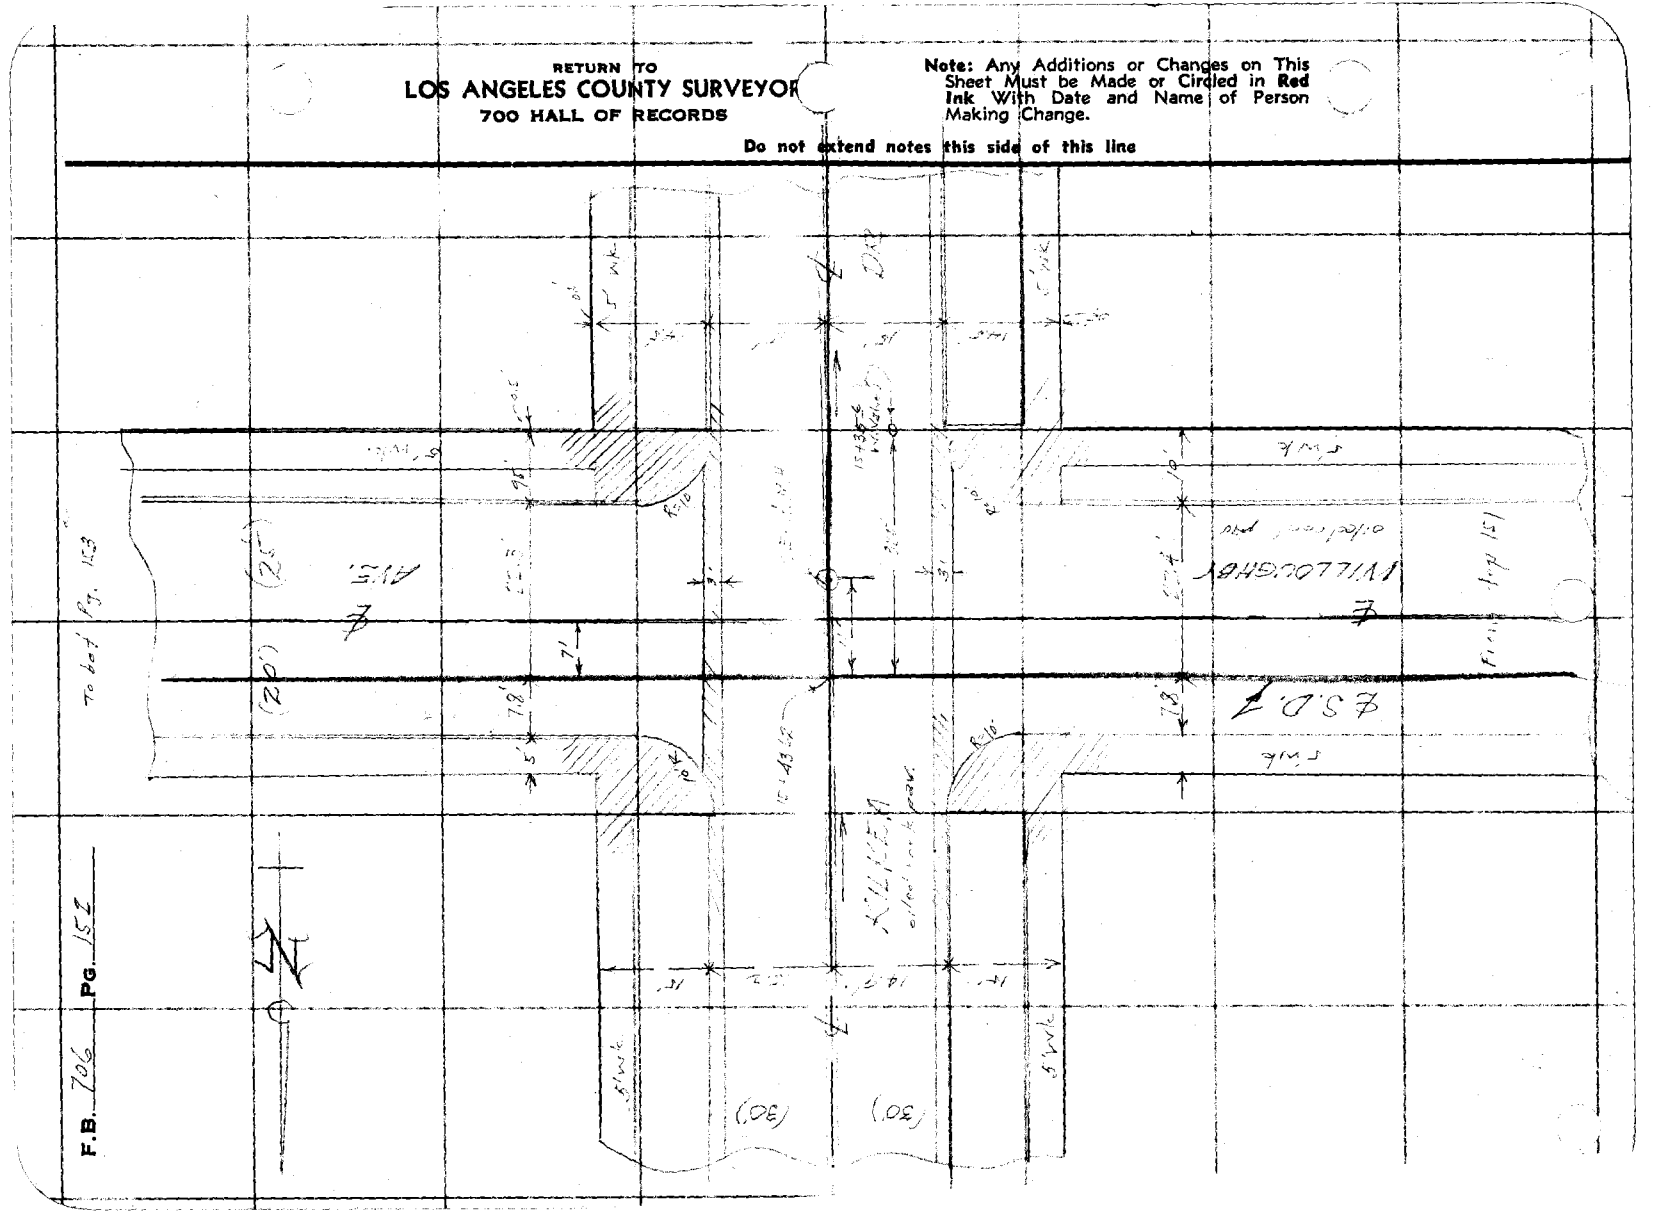

Notes Ck'd by		Survey of	F.B. Pg. 152
Map No.		W. O. 6318 Tape No.	St'd °F.
Office Work		Surveyed by	
Checked		Notes	Date May 1937
Date		Indexed	C. Johnson

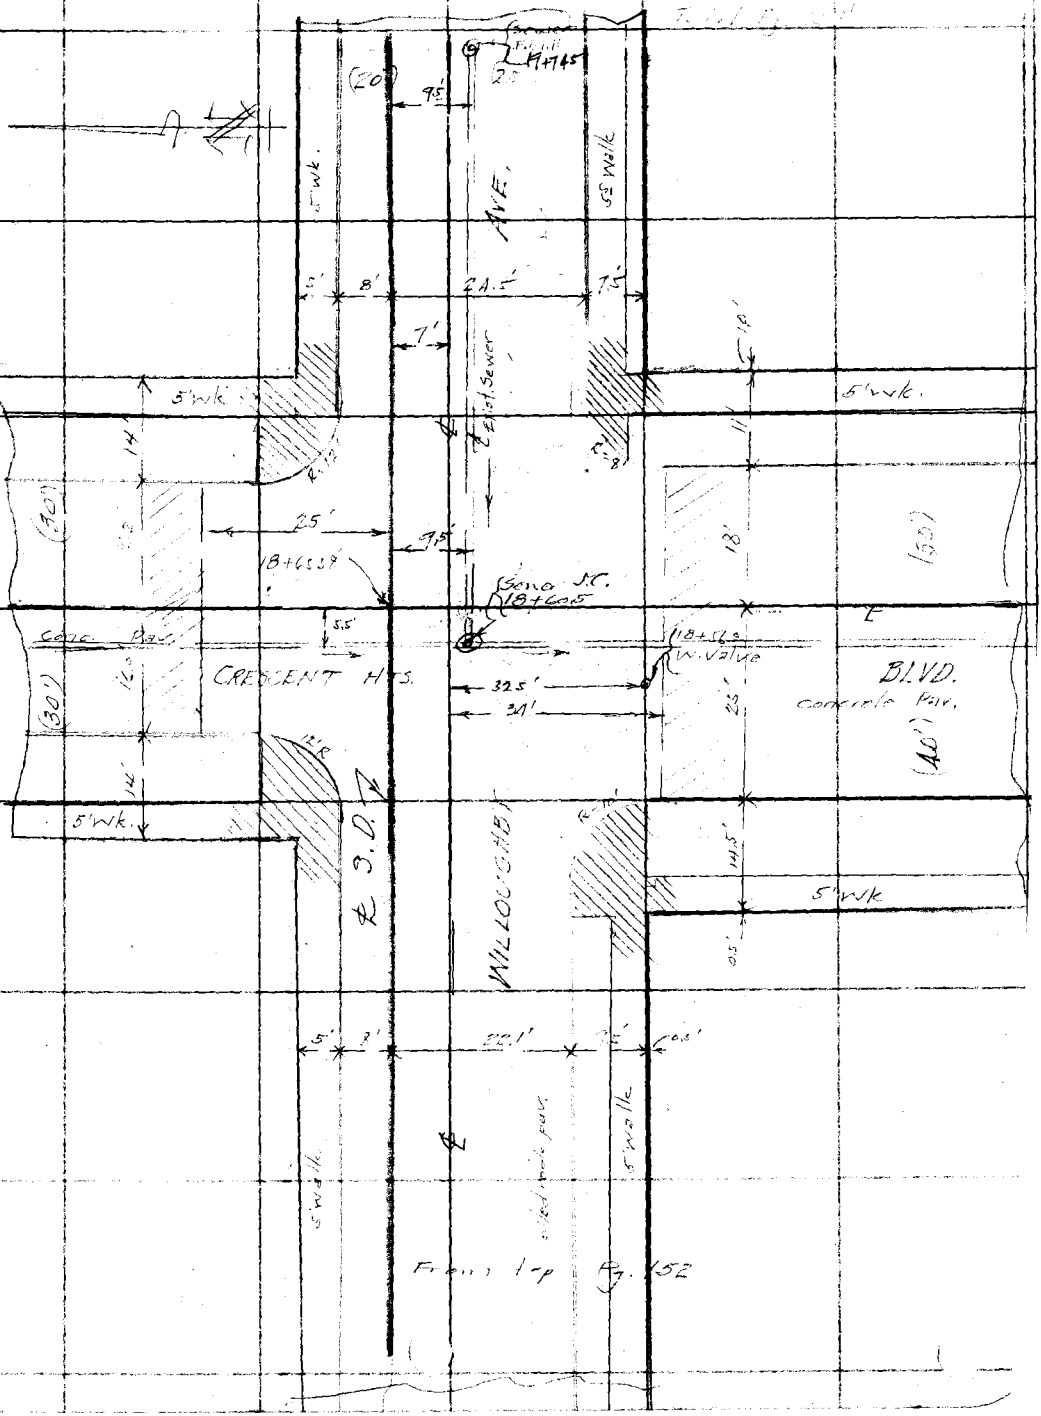

Note: Any Additions or Changes on This Sheet Must be Made or Circled in Red Ink With Date and Name of Person Making Change

Do not extend notes this side of this line

RETURN TO
LOS ANGELES COUNTY SURVEYOR
700 HALL OF RECORDS

FORM 247 10M 11-38

RETURN TO
LOS ANGELES COUNTY SURVEYOR
700 HALL OF RECORDS

Note: Any Additions or Changes on This Sheet Must be Made or Circled in **Red Ink** With Date and Name of Person Making Change.

Do not extend notes this side of this line

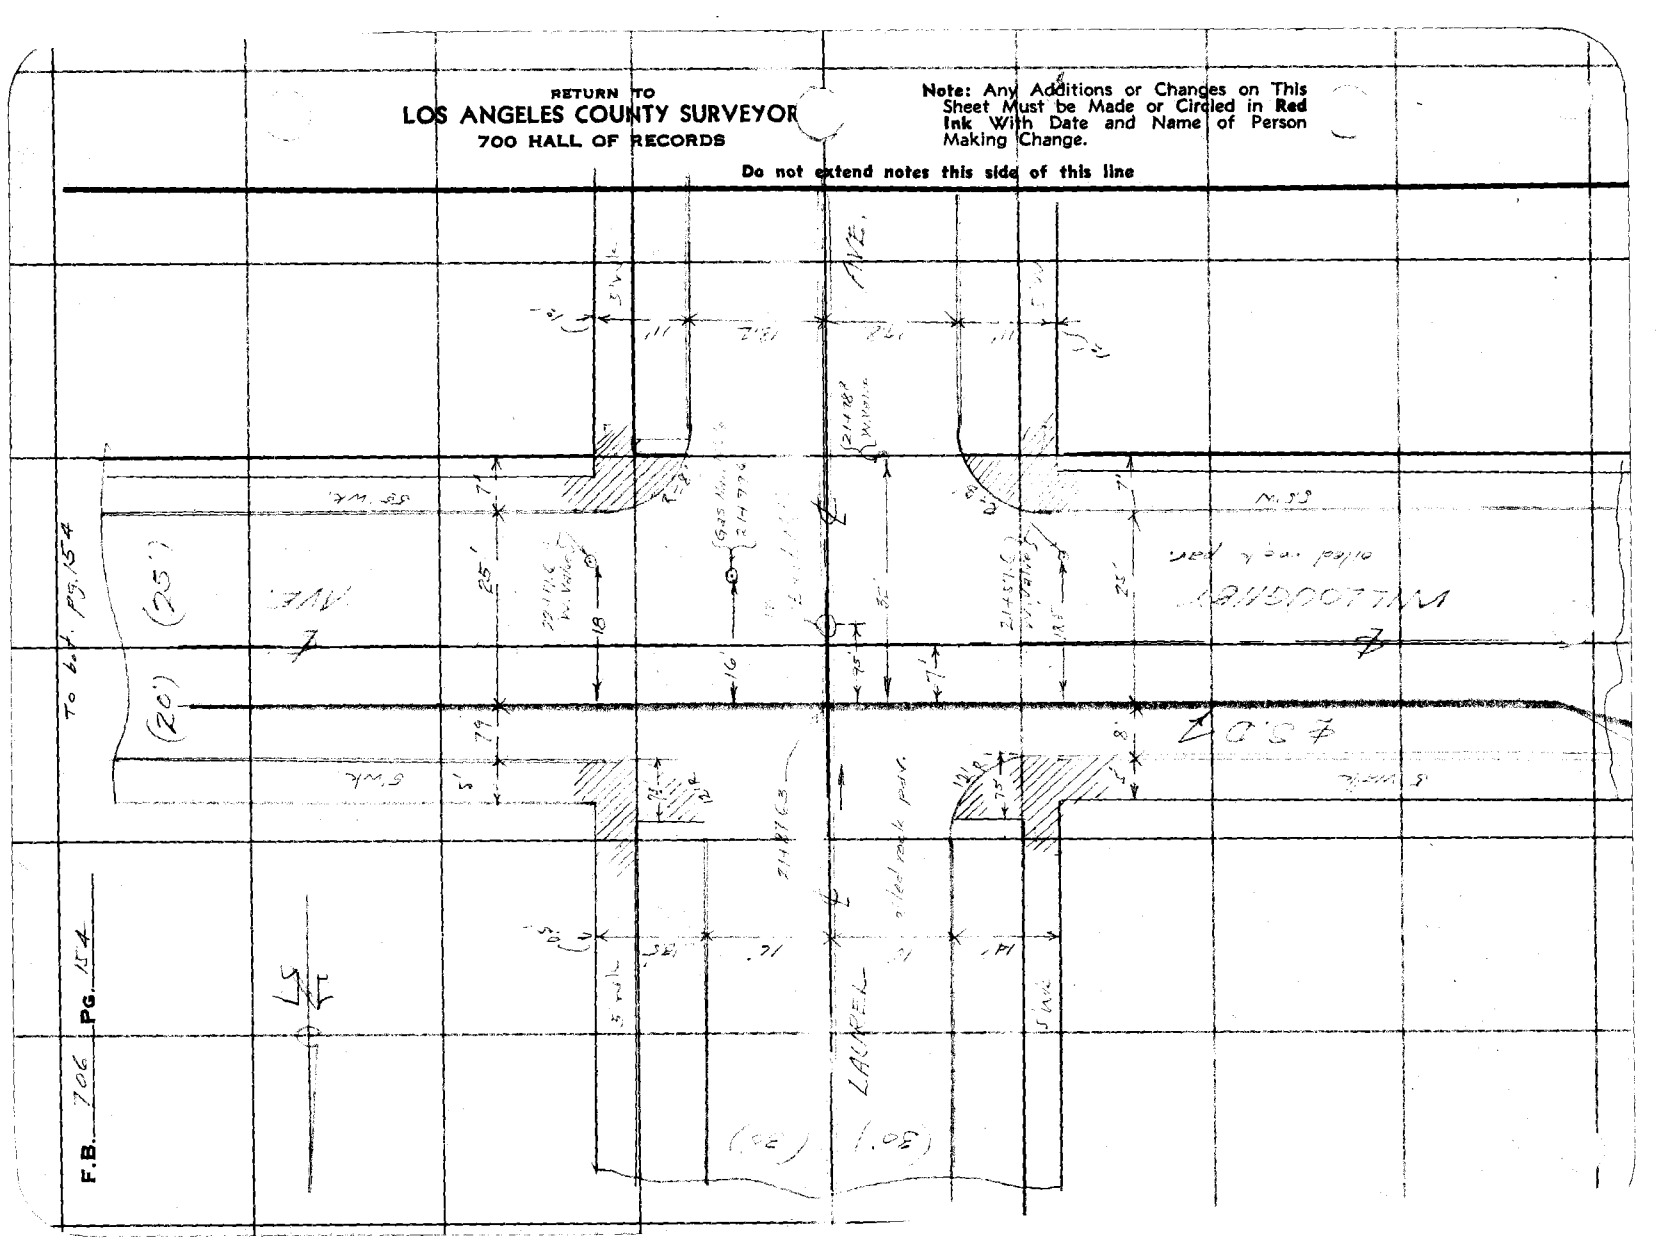

Notes Ck'd by	Survey of
Map No.	W. O. 6318 Tape No. St'd °F.
Office Work	Surveyed by
Checked	Notes Date May 1935
Date	Indexed C. Johnson

F.B. Pg.

Note: Any Additions or Changes on This Sheet Must be Made or Circled in Red Ink With Date and Name of Person Making Change.

Do not extend notes this side of this line

RETURN TO
LOS ANGELES COUNTY SURVEYOR
700 HALL OF RECORDS

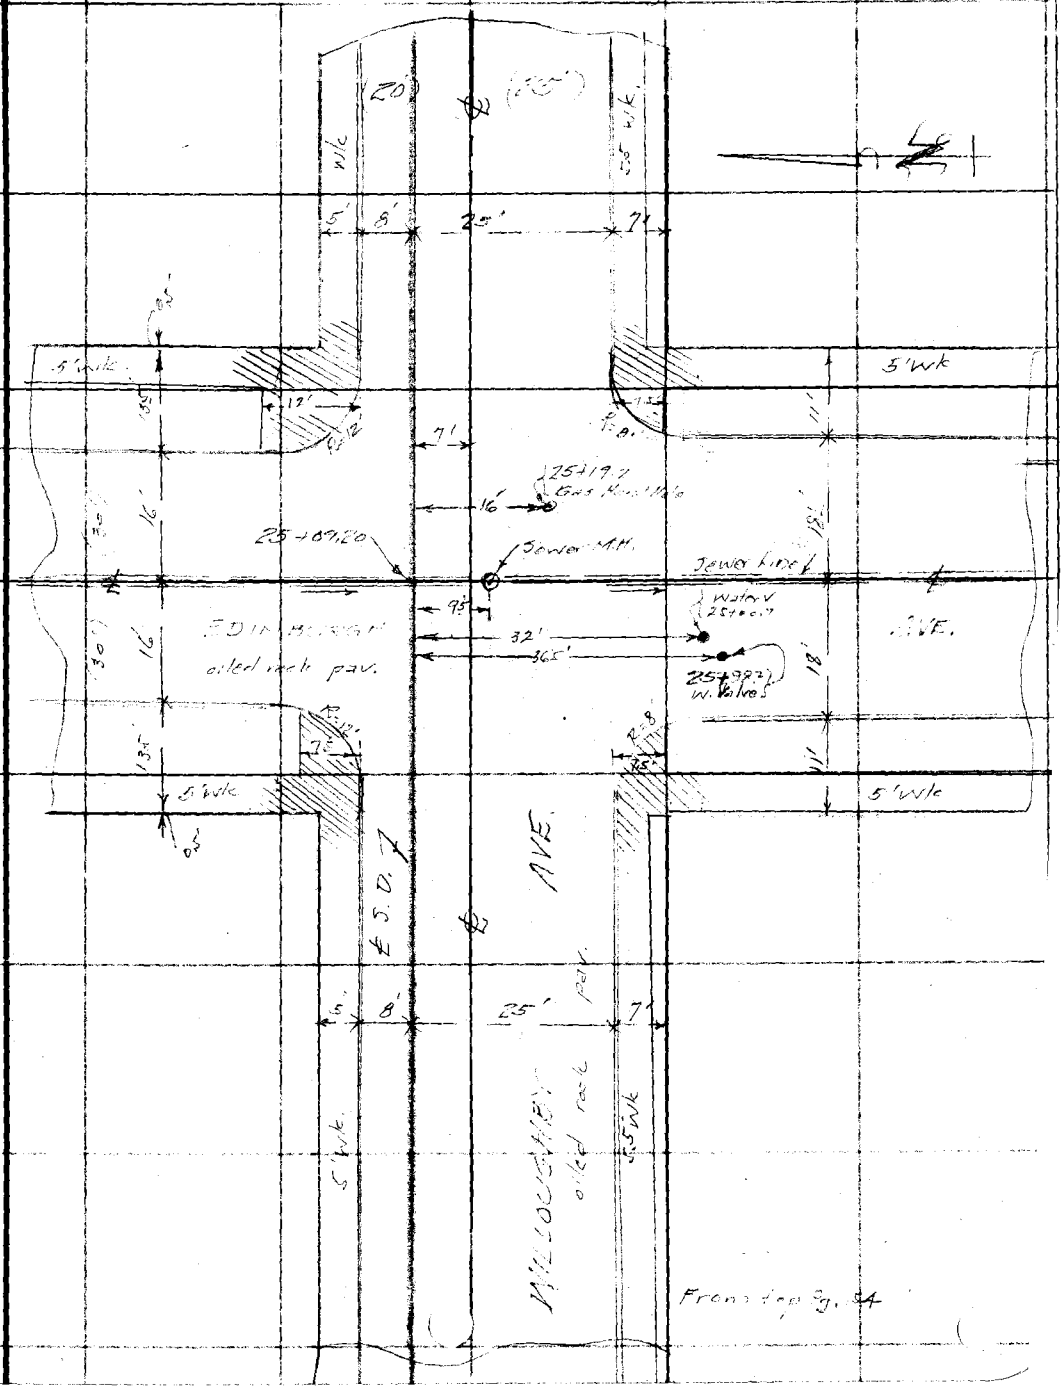

FORM 247 10M 11-35

RETURN TO
LOS ANGELES COUNTY SURVEYOR
700 HALL OF RECORDS

Note: Any Additions or Changes on This Sheet Must be Made or Circled in **Red Ink** With Date and Name of Person Making Change.

Do not extend notes this side of this line

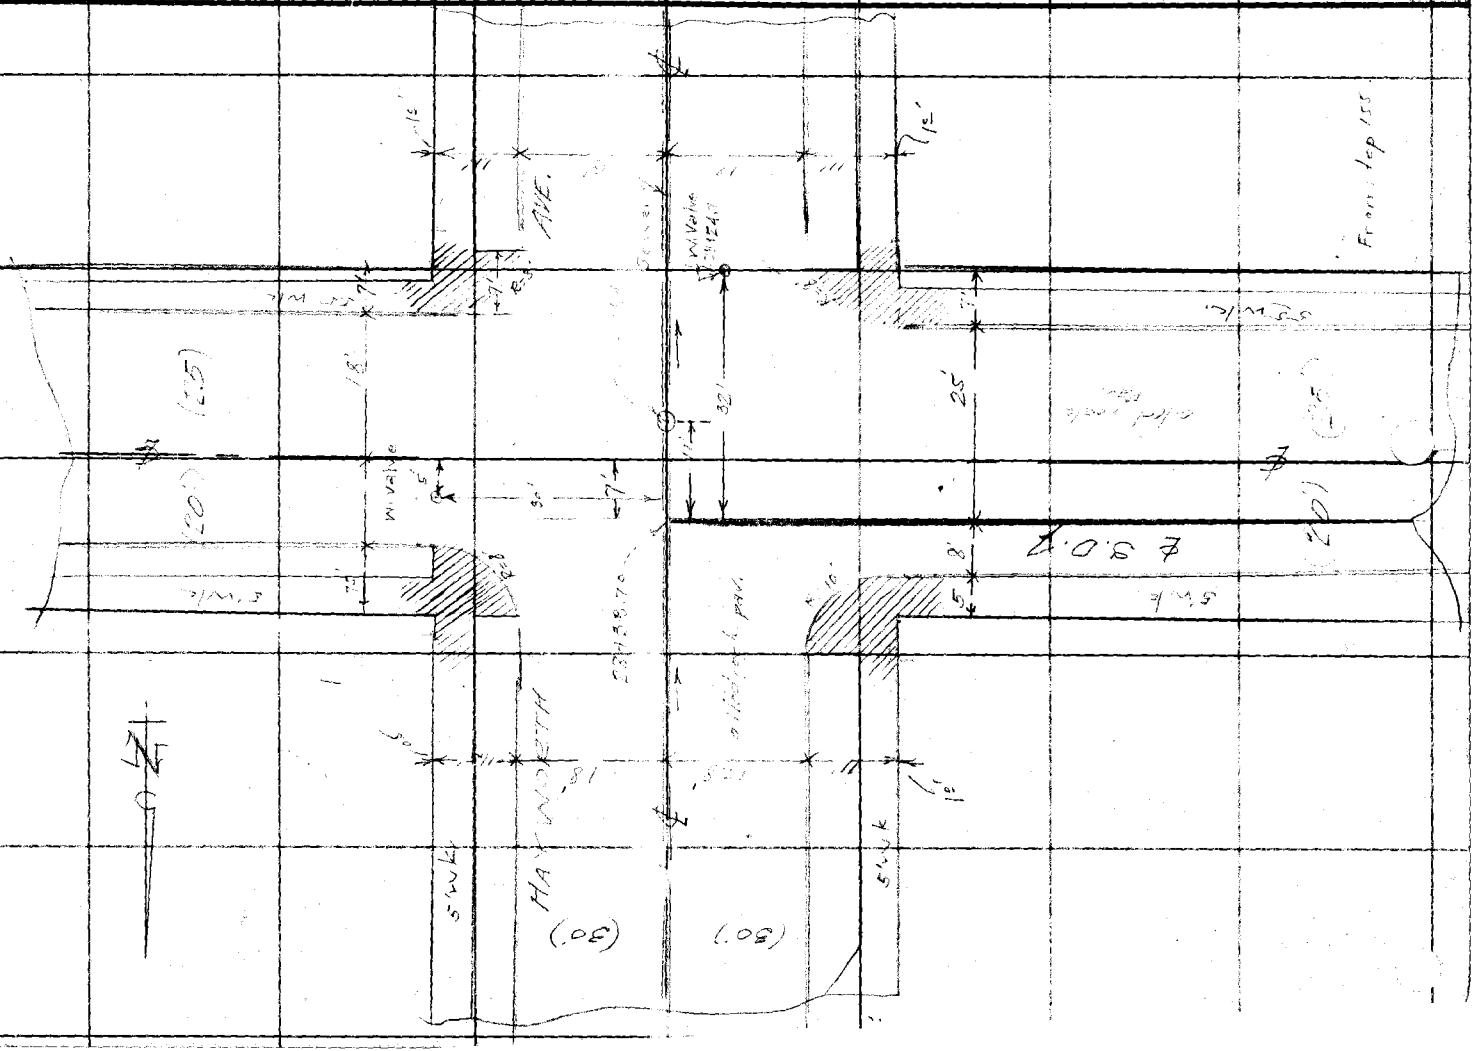

F. B. 706 PG. 157

Profile No. ____ X-Sec. No. ____

Notes Red. ____ Plotted ____ Job No. ____ Division No. ____
Date ____ Date ____ Survey of ____
Notes Chkd. ____ Checked ____ Survey by ____ Notes ____ Date ____
Date ____ Date ____ Map No. ____ Indexed ____ Date ____

PROFILE

WILLOUGHBY - HAYWORTH - WALLACE

West Hollywood D.S.

J.N. 6318

Topog F.B. 706 pg. 147 to 156

Wallace
Gregory
Tellez
Junior

NOTE: ANY ADDITIONS OR CHANGES ON THIS SHEET MUST BE MADE OR CIRCLED IN RED INK, WITH DATE AND NAME OF PERSON MAKING CHANGE

Do not extend notes this side of this line

PLEASE RETURN TO
LOS ANGELES COUNTY SURVEYOR
700 HALL OF RECORDS

Form 307 5M 11-35

STATION	B. S.	H. I.	F. S.	ELEV.

MAY 12 1937 HW

RECEIVED ✓ ✓
PROGRESSED ✓ ✓
BOOK INDEXED ✓ ✓
MAP INDEXED ✓ ✓
RECORD INDEXED ✓ ✓
CARD INDEXED ✓ ✓
PRODUCED in field & LCM
CHECKED LCM

Form 307 5M 11-35

PLEASE RETURN TO
LOS ANGELES COUNTY SURVEYOR
700 HALL OF RECORDS

NOTE: ANY ADDITIONS OR CHANGES ON THIS SHEET MUST BE MADE OR CIRCLED IN RED INK, WITH DATE AND NAME OF PERSON MAKING CHANGE

Do not extend notes this side of this line

F.B. 726 Pg. 158 | Job No. 6218 Division No. | Profile | Plotted | Notes Red. | No. | X-Sec. | No.
Survey of W. Hollywood Dist. | No. | Date | Date | Date | Date
Survey by M | Notes Grover | Notes Chkd. | Checked
Indexed A. C. Johnson | Date | Date | Date

STATION	B. S.	H. I.	F. S.	ELEV.	
			Kings Rd		Willoughby Ave
					BM D-33 El. 218.870 ✓
BM D-33	6.25	225.12 ✓		218.87	Willoughby Ave × Kings Rd
					L & T 5' S of Sand CR
POC [illegible]					
			6.38	218.73	℄ SD
			6.12	219.00	SS M — Tan 10ft Kings Rd × Willoughby Ave
			6.10	219.02	Tan Sand CR
			6.75	218.37	Gutter
			6.03	219.09	TC E
			6.34	218.78	Gutter
			5.76	219.36	TC N
			6.04	219.08	Gutter
			5.62	219.50	TC E
			5.82	219.30	Gutter
			6.70	218.42	Curb & Gutter ℄ SD Willoughby Ave
12.80					
1.80			6.10	219.02	℄ SD
+21.50					
23.30					
			1.89	222.23	Top Curb
23.06					
			1.34	222.78	Top Curb
24.40					
			1.81	222.31	℄ SD

Form 307 5M 11-35

PLEASE RETURN TO
LOS ANGELES COUNTY SURVEYOR
700 HALL OF RECORDS

NOTE: ANY ADDITIONS OR CHANGES ON THIS SHEET MUST BE MADE OR CIRCLED IN RED INK, WITH DATE AND NAME OF PERSON MAKING CHANGE

Do not extend notes this side of this line

STATION	B. S.	H. I.	F. S.	ELEV.		
			2 22			
			2 8.			
TA	7 75	230 62	2 2.5			
			6 8.0			
			6 02			

Form 307 5M 11-35

PLEASE RETURN TO
LOS ANGELES COUNTY SURVEYOR
700 HALL OF RECORDS

NOTE: ANY ADDITIONS OR CHANGES ON THIS SHEET MUST BE MADE OR CIRCLED IN RED INK, WITH DATE AND NAME OF PERSON MAKING CHANGE

Do not extend notes this side of this line

F. B. 720 PG. 140 | Job No. 6315 Division No. | Notes Red. | Plotted | Profile
Survey of [illegible] | Date | Date | No.
Survey by [illegible] | Notes [illegible] | Notes Chkd. | Checked | X-Sec.
Indexed A. C. Johnson | Date | Date | Date | No.

STATION	B. S.	H. I.	F. S.	ELEV.	
			Surface	220	
		230 62			
			7 52	223 10	T.C. E Side 100 S of ℄ SD
			5 21	212 62	Gutter " " "
			5 45	225 14	N radius Curb, Pt 10' N of ℄ SD on ℄ Sweetzer Ave
			2 10	228 52	10' N of ℄ SD on ℄ Sweetzer Ave.
			4 30	226 32	TC " "
			7 44	212 18	Gutter " "
			3 33	229 29	TC E Side
			3 59	226 73	Gutter "
T.P.	6 33	233 77	3 18	220 14	
			2 82	220 95	S.S. M.H. 20' N of ℄ SD on ℄ Sweetzer Ave.
			11 13	222 64	Inv. 8" Inlet N
			11 20	222 57	Inv. 8" Outlet S
T.P. 530	2 79	230 21	6 35	223 42	
			5 57	224 21	S.S. N.M. 11'S. of ℄ SD
			14 12	216 09	Inv. 8" Inlet N
			2 32	215 89	Inv. 8" Outlet S
			12 07	216 14	Inv. 8" Inlet N

N		N	
251		253	
765		770	
67		67	
1113		1120	

N	E	S	W
549	551	551	548
796		814	796
67		67	63
1212		1432	1407

Form 307 5M 11-35

PLEASE RETURN TO
LOS ANGELES COUNTY SURVEYOR
700 HALL OF RECORDS

NOTE: ANY ADDITIONS OR CHANGES ON THIS SHEET MUST BE MADE OR CIRCLED IN RED INK, WITH DATE AND NAME OF PERSON MAKING CHANGE

Do not extend notes this side of this line

STATION	B. S.	H. I.	F. S.	ELEV.		
		239 21		Universal Ave		
			557	224 64	Gutter	
+65.4			564	224 57		
			5 15	224		
+13.4			5 03	224 52		
			5 08	224 43	Curb	
+162.4			4 68	225 03		
			5 05	224		
+72.4			4 96	225 31		
			5 01	224 81	Gutter	
5+72.4			5 20	224	Sign of Comm. Parking	
6+00			4 08	225 53		Universal Ave
7+00			3 38	224 83		
			3 42	224 77		
			3 21	224 98		
			2 93	225		
			3 10	225		
			4 32	224 89		
TP	7 13	232 08	3 12	224 96		
			3 20	224	Z 55	

Profile

No. _____ Notes Red _____ Plotted _____ Job No. _____ Division No. _____

Date _____ Date _____ Survey of _____

X-Sec. _____ Notes Chkd. _____ Checked _____ Survey by _____ Notes _____

No. _____ Date _____ Date _____ Map No. _____ Date _____ Date _____

Surveyed Johnson

F. B. _____ PG. _____

Form 307 5M 11-35

PLEASE RETURN TO
LOS ANGELES COUNTY SURVEYOR
700 HALL OF RECORDS

NOTE: ANY ADDITIONS OR CHANGES ON THIS SHEET MUST BE MADE OR CIRCLED IN RED INK, WITH DATE AND NAME OF PERSON MAKING CHANGE

Do not extend notes this side of this line

F. B. 7[illegible] Pg. 62

Job No. [illegible] Division No. ____ Notes Red. ____ Plotted ____ Profile ____

Survey of ____ Date ____ Date ____ No. ____

Survey by A. C. Johnson Notes ____ Notes Chkd. ____ Checked ____ X-Sec. ____

Indexed ____ Date ____ Date ____ Date ____ No. ____

STATION	B. S.	H. I.	F. S.	ELEV.	
		↓	Hub	4.62	
		234.27			
3+74.7			5.42	228.85	TC W
"			5.91	228.36	outer
+34.7			5.44	228.83	TC
"			6.01	228.26	outer
+74.7			5.30	228.97	TC W CR
"			5.40	228.87	outer
+48.7			5.04	229.23	TC
"			5.49	228.78	outer
8+85			5.70	228.57	Top of bank SW
8+90.7			4.94	229.33	E int cb + Manhole 4"
"			5.02	229.25	Sewer W 5.52 in 52 in Sewer
			13.41	220.86	Inv 8" Inlet N
			13.54	220.73	Inv 8" Outlet S
			[illegible]	[illegible]	100' [illegible]
			[illegible]	[illegible]	TC W Curb
			7.34	226.93	Curb

N	E	S	W
502	501	502	502
785		785	
67		67	
1341		1354	

Form 307 5M 11-35

PLEASE RETURN TO
LOS ANGELES COUNTY SURVEYOR
700 HALL OF RECORDS

NOTE: ANY ADDITIONS OR CHANGES ON THIS SHEET MUST BE MADE OR CIRCLED IN RED INK, WITH DATE AND NAME OF PERSON MAKING CHANGE

Do not extend notes this side of this line

STATION	B. S.	H. I.	F. S.	ELEV.	
					Lemon Ave.

Form 307 5M 11-35

PLEASE RETURN TO
LOS ANGELES COUNTY SURVEYOR
700 HALL OF RECORDS

NOTE: ANY ADDITIONS OR CHANGES ON THIS SHEET MUST BE MADE OR CIRCLED IN RED INK, WITH DATE AND NAME OF PERSON MAKING CHANGE

Do not extend notes this side of this line

F. B. 706 Pg. 1-7 | Job No. 2318 Division No. | Notes Red. | Plotted | Profile No.
Survey of Wilsonby Haywood Acres | Date | Date | X-Sec. No.
Survey by A. L. Wood PLS | Notes Gregory | Notes Chkd. | Checked
Indexed A. C. Dickinson | Date | Date | Date

STATION	B. S.	H. I.	F. S.	ELEV.	Wilsonby Haywood Acres
		23.21			
7+14.7			6.75		TC.
"			7.28		Gutter
12+1.7			6.89		TC.
"			7.13		Gutter
			Wilson		
12+00			5.86		℄ S.D.
13+53			5.15		℄ Wilsonby Dr.
"			5.28		TC.
"			5.77		Gutter
"			4.74		TC.
"			5.10		Gutter
14+00			4.12		℄ S.D.
			Wilson		Ave.
11+96.7			2.96		TC.
"			3.40		Gutter
12+06.7			2.91		TC.
"			3.46		Gutter
11+96.7			2.10		TC.
"			2.67		Gutter

Form 307 5M 11-35

PLEASE RETURN TO
LOS ANGELES COUNTY SURVEYOR
700 HALL OF RECORDS

NOTE: ANY ADDITIONS OR CHANGES ON THIS SHEET MUST BE MADE OR CIRCLED IN RED INK, WITH DATE AND NAME OF PERSON MAKING CHANGE

Do not extend notes this side of this line

STATION	B. S.	H. I.	F. S.	ELEV.	
19+06.7					
"					
12+00					

Form 307 5M 11-35

PLEASE RETURN TO
LOS ANGELES COUNTY SURVEYOR
700 HALL OF RECORDS

NOTE: ANY ADDITIONS OR CHANGES ON THIS SHEET MUST BE MADE OR CIRCLED IN RED INK, WITH DATE AND NAME OF PERSON MAKING CHANGE

Do not extend notes this side of this line

F. B. 706 Pg. 166 | Job No. 631F | Division No. | Notes Red. | Plotted | Profile No.
Survey of Lakewood Estates | Date | Date | X-Sec. No.
Survey by A. C. Johnson | Notes Chkd. | Checked
Indexed | Notes | Date | Date | Date

STATION	B. S.	H. I.	F. S.	ELEV.	
					Lakewood Estates Tract 631F
		342.04			
					(?)
					Inl. 8" Inlet N
					Inl. 8" Outlet S
					TC N Side
					Gutter
					TC E
D-136.7					
"					
+26.7					TC
"					
-136.7					
+36.7					
+46.7					TC E
"					
					Conc. x Gutter + 0.0

N 76° E 220 | 220 | 215 | 62 | 100 | 161

Form 307 5M 11-35

PLEASE RETURN TO
LOS ANGELES COUNTY SURVEYOR
700 HALL OF RECORDS

NOTE: ANY ADDITIONS OR CHANGES ON THIS SHEET MUST BE MADE OR CIRCLED IN RED INK, WITH DATE AND NAME OF PERSON MAKING CHANGE

Do not extend notes this side of this line

Profile No.____ X-Sec. No.____ Notes Red.____ Plotted____ Job No.____ Division No.____ F. B. ____ Pg. ____

Date____ Date____ Survey of____

Notes Chkd.____ Checked____ Survey by____ Notes____ Date____

Date____ Date____ Map No.____ Indexed Johnson Date____

STATION	B. S.	H. I.	F. S.	ELEV.	
					Whittier Boulevard Ave Sta
					Whittier Blvd Ave
					Whittier Blvd

Form 307 5M 11-35

PLEASE RETURN TO
LOS ANGELES COUNTY SURVEYOR
700 HALL OF RECORDS

NOTE: ANY ADDITIONS OR CHANGES ON THIS SHEET MUST BE MADE OR CIRCLED IN RED INK, WITH DATE AND NAME OF PERSON MAKING CHANGE

Do not extend notes this side of this line

F. B. 736 PG. 45 | Job No. 58-5 | Division No. | Profile No. | X-Sec. No.

Survey of | Notes Red. | Date | Plotted | Date

Survey by C. Johnson | Notes | Date | Checked | Date

Indexed | Notes Chkd. | Date | Date

STATION	B. S.	H. I.	F. S.	ELEV.	
		✓			[illegible] Dr (Kilkea Dr)
		245.46 ✓			
T.P.	8.05	245.45	3.06	240.40 ✓	
			5.90	239.46	100' N of ℄ SD on ℄ Hayvenhurst (Kilkea Dr)
			6.20	239.25	T.C. W/, S/d.
			6.73	238.72	Gutter " "
			5.62	239.83	" E "
			6.14	239.31	Gutter " "
			1.27	244.18	SS MH 282.5'N of ℄ SD on ℄ Hayvenhurst (Kilkea Dr)
			9.34	236.11	Inv 8" Inlet N
			9.49	235.96	Inv 8" Outlet S
15+43.62			5.24	240.21	SS MH 1.5' S of ℄ SD on ℄ Kilkea Dr
			16.65	228.77	Inv 8" Inlet N
			16.83	228.62	Inv 8" Outlet S
			10.52	234.72	100' S of ℄ SD on ℄ Kilkea Dr
			10.67	234.75	T.C. W Side
			9.17	234.25	Gutter " "

N: 125, 742, 67 = 934 — S: 130, 754, 67 = 951 — N: 823, 778, 67 = 1668 — E: 825 — S: 824, 742, 67 = 1633 — W: 824

Form 307 5M 11-35

PLEASE RETURN TO
LOS ANGELES COUNTY SURVEYOR
700 HALL OF RECORDS

NOTE: ANY ADDITIONS OR CHANGES ON THIS SHEET MUST BE MADE OR CIRCLED IN RED INK, WITH DATE AND NAME OF PERSON MAKING CHANGE

Do not extend notes this side of this line

STATION	B. S.	H. I.	F. S.	ELEV.	
		245 45			
			10 61	234 84	
			11 00	234 45	
15+586			8 35	236 50	
"			9 [illegible]	236 28	
+686			8 47	236 98	
"			8 91	236 55	
+786			7 [illegible]	237 84	
"			8 12	237 33	
+886			7 70	237 75	
"			11 [illegible]	237 34	
15+958			5 40	237 00	
T.P.		243 72	5 94	237 78	
					BM D-38 El 236.587
BM D-38		243 63	6 90	236 [illegible]	
					Wilshire Blvd.
[illegible]			5 89	237 74	
17+0 [illegible]			5 0	235 22	
			5 22	235 41	

Profile
No. X-Sec.
Notes Red. Date
Notes Chkd. Date
Plotted Date
Checked Date
Job No. Division No.
Survey of
Survey by
Map No.
Notes
Indexed: Johnson Date
F. B. PG.

Form 307 5M 11-35

PLEASE RETURN TO
LOS ANGELES COUNTY SURVEYOR
700 HALL OF RECORDS

NOTE: ANY ADDITIONS OR CHANGES ON THIS SHEET MUST BE MADE OR CIRCLED IN RED INK, WITH DATE AND NAME OF PERSON MAKING CHANGE

Do not extend notes this side of this line

F. B. 706 Pg. 122 | Job No. 6218 Division No. | Notes Red. | Plotted | Profile
Survey of Willowcrest Dr. | Date | Date | No.
Survey by | Notes Clkd. | Checked | X-Sec.
Indexed by C. Johnson | Date | Date | No.

STATION	B. S.	H. I.	F. S.	ELEV.	
		✓	Willowcrest Dr.		
		243.03			
7+00			5.73	237.30	TC, S.S.Dr.
"			5.50	237.53	Gutter " "
"			4.80	238.23	TC " "
"			5.17	237.86	Gutter " "
8+00			4.38	238.65	± S.D.
BM D-39	6.34	244.33 ✓	5.64	238.69	BM. D-39 El 237.98 ✓ F.B. 682-37 Willowcrest Dr. & Crescent Hgts. Blvd. S.E. cor. Wh. Spk 2' S of Sandf. C.R.
			Crescent Hgts. Blvd.		
12+30.6			5.53	238.30	TC N curb S.W.C.R.
"			5.78	238.05	Gutter " " "
+40.6			5.39	238.44	TC. "
"			5.54	238.29	Gutter "
+137.6			4.47	239.36	TC. W. curb N.W.C.R.
"			4.53	239.30	Gutter " "
+149.6			4.30	239.53	TC. " "
"			4.57	239.26	Gutter " "

Form 307 5M 11-35

PLEASE RETURN TO
LOS ANGELES COUNTY SURVEYOR
700 HALL OF RECORDS

NOTE: ANY ADDITIONS OR CHANGES ON THIS SHEET MUST BE MADE OR CIRCLED IN RED INK, WITH DATE AND NAME OF PERSON MAKING CHANGE

Do not extend notes this side of this line

Profile No. ____ Notes Red. ____ Plotted ____ Job No. ____ Division No. ____
X-Sec. No. ____ Date ____ Date ____ Survey of ____
Notes Chkd. ____ Checked ____ Survey by ____ Notes ____
Date ____ Date ____ Map No. ____ Date ____ Date ____

F.B. ____ PG. ____

STATION	B. S.	H. I.	F. S.	ELEV.	
		244 3+			
5+50.5			5 52	239 31	
			11 85	232 45	
			11 99	232 3+	
18+25.5				237 69	
			5 93	238 40	
			7 93	236 60	
			7 47	236 5+	
			5 01	236 32	
			7 26	236 57	
			5 50	236 53	
			4 34	237 77	
			2 14	242 19	
			2 11	242 22	
			2 64	241 69	
			1 94	242 39	
			2 35	241 65	
	6 28	149 12	29	242 84	

Form 307 5M 11-35

PLEASE RETURN TO
LOS ANGELES COUNTY SURVEYOR
700 HALL OF RECORDS

NOTE: ANY ADDITIONS OR CHANGES ON THIS SHEET MUST BE MADE OR CIRCLED IN RED INK, WITH DATE AND NAME OF PERSON MAKING CHANGE

Do not extend notes this side of this line

F. B. 76 PG. 72 | Job No. 6318 Division No. | Profile No. | X-Sec. No.

Survey of | Notes Red. | Plotted

Survey by C. Johnson | Notes | Date | Notes Chkd. | Date | Checked | Date

Indexed | Date | Date

STATION	B. S.	H. I.	F. S.	ELEV.	Miscellaneous Remarks
					Blocked
		24?			
					SS MH 280' N of ℄ SD
					Inv 8" N of MH
					Inv 8" S of MH
I.P.	5 25				
18+23.6					TC
"					
+91.6					
"					
+93.6					
"					
+81.6					
"					
					Gutter ℄ SD
					Bot of Inv.

pin = Crossing Mark
5
214
615
67
896

"Flusher"
5
5 15
1074

Form 307 5M 11-35

PLEASE RETURN TO
LOS ANGELES COUNTY SURVEYOR
700 HALL OF RECORDS

NOTE: ANY ADDITIONS OR CHANGES ON THIS SHEET MUST BE MADE OR CIRCLED IN RED INK, WITH DATE AND NAME OF PERSON MAKING CHANGE

Do not extend notes this side of this line

Profile No. ____ X-Sec. No. ____ Notes Red. ____ Date ____ Notes Chkd. ____ Date ____ Plotted ____ Date ____ Checked ____ Date ____ Job No. ____ Survey of ____ Survey by ____ Map No. ____ Division No. ____ Noted ____ Indexed ____ Date ____ F.B. ____ Pg. 3

STATION	B. S.	H. I.	F. S.	ELEV.	Willoughby Hewitt Rd - 1"	
					Willowbrook Ave	
20+00			4.65	240 [illegible]	[illegible]	
"			4.75	240.[illegible]	[illegible]	
"			4.80	240.[illegible]	[illegible]	
"			4.84	240.[illegible]	[illegible]	
"			4.81	240.[illegible]	[illegible]	
"			5.00	239.[illegible]	[illegible]	
21+00			4.92	240.[illegible]	[illegible]	
					[illegible] 240.39±	[illegible]
[illegible]	6.24	246.39	4.71	240.68	[illegible]	[illegible]
					Laurel Ave	
21+616			5.74	240.[illegible]	[illegible]	
"			5.62	240.[illegible]	[illegible]	
+696			6.27	240.[illegible]	[illegible]	
"			6.81	239.[illegible]	[illegible]	
+796			5.01	241.[illegible]	[illegible]	
"			5.00	241.[illegible]	[illegible]	
+896			4.92	241.[illegible]	[illegible]	
"			5.20	241.[illegible]	[illegible]	

Form 307 5M 11-35

PLEASE RETURN TO
LOS ANGELES COUNTY SURVEYOR
700 HALL OF RECORDS

NOTE: ANY ADDITIONS OR CHANGES ON THIS SHEET MUST BE MADE OR CIRCLED IN RED INK, WITH DATE AND NAME OF PERSON MAKING CHANGE

Do not extend notes this side of this line

F. B. 756 Pg. 174 | Job No. 33 S | Division No. | Notes Red. | Plotted | Profile
Survey of | Date | Date | No.
Survey by A. C. Johnson | Notes | Notes Chkd. | Checked | X-Sec.
Indexed | Date | Date | Date | No.

STATION	B. S.	H. I.	F. S.	ELEV.	
					Side Street Work
		245.09 ✓			
21+57.2			4.80		℄ Int. C.W. & Laurel Ave
			5.08		S. J. C.
			15.79		Inv. 8" Inlet N
			16.06		Inv. 8" Inlet W
			6.22		Inv. 8" Outlet S
			3.18		Inv. 8" Drop N
			2.38		℄ Int. C.W. & Laurel Ave
			7.88		P.C. W. Side
			5.30		" "
			7.98		P.C. E "
			0.00		P.C. "
1+00	6.65	251.16 ✓	2.18	248.98	
			6.00		℄ Int. C.W. & Laurel Ave
			5.52		P.C. W. Side
			7.20		P.C. "
			1.02		P.C. E "
			1.63		S.S. N.W. 291' ℄ Int. C.W. & Laurel Ave
			9.15		Inv. 8" Inlet N
			4.59		Inv. 8" Inlet W

	W	S	Drop N
	5.98	5.52	5.04
	1.30	1.20	1.07
	.67	.67	.67
	0	0	.67
	7.95	7.39	7.45

	1.59	1.20
	7.22	7.26
	.67	.67
	7.48	7.59

Form 307 5M 11-35

PLEASE RETURN TO
LOS ANGELES COUNTY SURVEYOR
700 HALL OF RECORDS

NOTE: ANY ADDITIONS OR CHANGES ON THIS SHEET MUST BE MADE OR CIRCLED IN RED INK, WITH DATE AND NAME OF PERSON MAKING CHANGE

Do not extend notes this side of this line

STATION	B. S.	H. I.	F. S.	ELEV.	
		251.10			Wilson to Bayard Tr. to P
				Levels to	
TP	3.06	247.15	TP	244.09	
22+50			6.07	241.08	± Sta.
+05.6			6.79	244.36	TC.
"			7.41	243.74	Sta.
+13.6			6.38	244.77	TC.
"			7.15	244.03	Grav.
+03.6			5.65	244.53	TC.
"			6.22	244.96	Grav.
+15.6			5.50	245.68	TC.
"			6.05	245.13	Gutter
				Levels by Asc	
23+00			5.15	245.90	± SD.
23+51			4.55	246.50	± SD. Grade Elev
			5.32	245.73	TC. S. Old.
			5.78	245.27	Gutter
			4.91	246.14	TC. "
			5.15	245.90	Gutter
			4.72	246.33	± SD.

Profile No.
Notes Red. Plotted Job No. Division No.
Date Date Survey of
X-Sec. No.
Notes Chkd. Checked Survey by Notes Date
Date Date Map No. Traced Johnson Date
F. B. Vo PG.

Form 307 5M 11-35

PLEASE RETURN TO
LOS ANGELES COUNTY SURVEYOR
700 HALL OF RECORDS

NOTE: ANY ADDITIONS OR CHANGES ON THIS SHEET MUST BE MADE OR CIRCLED IN RED INK, WITH DATE AND NAME OF PERSON MAKING CHANGE

Do not extend notes this side of this line

F. B. 76 PG. 176 | Job No. 5825 | Division No. | Notes Red | Date | Plotted | Date | Profile No.

Survey of | Notes Chkd | Date | Checked | Date | X-Sec. No.

Survey by W. Gregory | Notes | Date

Indexed A. C. Johnson

STATION	B. S.	H. I.	F. S.	ELEV.	
					W. line of Tayman Ave.
					FB 682 p. 118
B.M. "D 147"					B.M. D 147 El. 241.05
					N. 1000.00 of E. Line
					N. 1000 15 W of N end
24483.2					
"					
491.2					
"					
481.2					
"					
93.2					
"					

Form 307 5M 11-35

PLEASE RETURN TO
LOS ANGELES COUNTY SURVEYOR
700 HALL OF RECORDS

NOTE: ANY ADDITIONS OR CHANGES ON THIS SHEET MUST BE MADE OR CIRCLED IN RED INK, WITH DATE AND NAME OF PERSON MAKING CHANGE

Do not extend notes this side of this line

STATION	B. S.	H. I.	F. S.	ELEV.		

Form 307 5M 11-35

PLEASE RETURN TO
LOS ANGELES COUNTY SURVEYOR
700 HALL OF RECORDS

NOTE: ANY ADDITIONS OR CHANGES ON THIS SHEET MUST BE MADE OR CIRCLED IN RED INK, WITH DATE AND NAME OF PERSON MAKING CHANGE

Do not extend notes this side of this line

F. B. 705 Pg. 128
Job No. 6218 Division No. Notes Red. Plotted Profile No.
Survey of Date Date X-Sec. No.
Survey by A. C. Jenkinson Notes Notes Chkd. Checked
Indexed Date Date Date

STATION	B. S.	H. I.	F. S.	ELEV.	
		253 30			
25+43.2			7 66	245 64	
"			7 2.	245 34	
+47.2			7 25	245 62	
"			5 13	245 17	
TP		253 20		245 13	
			3 54	245 31	
			4 2.	245 44	
				245 31	
			4 85	245 35	
			5	245 02	
			4 04	245 01	
			4 12	245	
			3 81	245 69	
SMDM	6 25	257 76	1 69	251 51	

Form 307 5M 11-35

PLEASE RETURN TO
LOS ANGELES COUNTY SURVEYOR
700 HALL OF RECORDS

NOTE: ANY ADDITIONS OR CHANGES ON THIS SHEET MUST BE MADE OR CIRCLED IN RED INK, WITH DATE AND NAME OF PERSON MAKING CHANGE

Do not extend notes this side of this line

STATION	B. S.	H. I.	F. S.	ELEV.	Witness, tie, monuments, etc.	
		257 76		Hayworth	Inc	
38+07.7			6 92	250 84	TC. W. of S.W. C.P.	
"			7 42	250 34	Gutter	
+15.7			6 90	250 86	TC	
"			7 47	250 29	Gutter	
+05.7			6 27	250 49	TC. W. of N.W. C.P.	
"			6 92	250 83	Gutter	
+15.7			6 33	251 43	TC	
"			6 90	250 86	Gutter	
25+33.72			6 76	251 00	B.M. on N.W. corner of Hydrant	Hyd
			4 15	253 61	15" C.M.P. on ℄ SD. on ℄	
			4 47	253 29	TC	
			3 13	252 63	Gutter	
			2 83	253 34	TC	
			2 83	253 34	Gutter	
			1 51	252 25	S.D. M.H. 2735' N of ℄	
			12 90	240 50	Inv 8" Inlet N	N 12 10.80 67 2790
			13 05	240 31	Inv 8 Outlet S	S 15 10.80 67 13 05
			13 07	240 29	Inv 8 Outlet to Sump	13.07
TC.	3 0	254 61	6 16	251 60		

Profile
No.
X-Sec.
No.
Notes Red
Date
Notes Chkd
Date
Plotted
Date
Checked
Date
Job No.
Survey of
Survey by
Map No.
Division No.
Notes
Date
F. B.
Pg.
Inked C. Johnson
Date

Form 307 5M 11-35

PLEASE RETURN TO
LOS ANGELES COUNTY SURVEYOR
700 HALL OF RECORDS

NOTE: ANY ADDITIONS OR CHANGES ON THIS SHEET MUST BE MADE OR CIRCLED IN RED INK, WITH DATE AND NAME OF PERSON MAKING CHANGE

Do not extend notes this side of this line

F. B. 706 PG. 181 | Job No. 2[illegible]5 | Division No. [illegible] | Notes Red [illegible] | Plotted [illegible] | Profile
Survey of [illegible] | Date [illegible] | No. [illegible]
Survey by [illegible] | Notes [illegible] | Notes Chkd. [illegible] | Checked [illegible] | X-Sec.
Indexed A. C. Johnson | Date [illegible] | Date [illegible] | No. [illegible]

STATION	B. S.	H. I.	F. S.	ELEV.	
28+33.70		584.61	Hac[illegible]		
			2.50	2[illegible]	582.11 - S.S. [illegible] 1125 of 2.52
			1.59	[illegible]	583.02 - Inv. 8" Inlet N
			1.53	[illegible]	583.08 - Inv. 8" Inlet E
			1.83	2[illegible]	582.78 - Inv. 8" Outlet S
			2.55	2[illegible]	[illegible] Cor. Concentric on W.E. Cor.
			2.17	2[illegible]	[illegible] TC N end N.C. [illegible]
			[illegible]	[illegible]	[illegible] Center
			2.[illegible]	[illegible]	[illegible] TC
			2.[illegible]	[illegible]	[illegible] Walk
			2.[illegible]	[illegible]	[illegible] TC. S end Curb
			3.[illegible]	[illegible]	[illegible] Center
			3.[illegible]	[illegible]	[illegible] " E "
			3.68	[illegible]	[illegible] " "
			3.[illegible]	[illegible]	[illegible] 100' F. of E. Int. of E. W. Survey Line
			2.58	[illegible]	[illegible] TC " Side
			[illegible].02	[illegible]	[illegible] Center
			[illegible]	[illegible]	[illegible] " (No Cor.)

	N	E	S	W
	346	350	354	350
	746	736	762	
	1	67	67	
	11.59 -	[illegible] -	11.83 -	

Form 307 5M 11-35

PLEASE RETURN TO
LOS ANGELES COUNTY SURVEYOR
700 HALL OF RECORDS

NOTE: ANY ADDITIONS OR CHANGES ON THIS SHEET MUST BE MADE OR CIRCLED IN RED INK, WITH DATE AND NAME OF PERSON MAKING CHANGE

Do not extend notes this side of this line

STATION	B. S.	H. I.	F. S.	ELEV.		
		254.5		Assume Elev		
TP	3.59	246.48	8.72	245.19		
BM 2-45				238.42	BM 2-45 E 238.482 Haywood Ave x Warring Ave W. Side	FB 582-42

Profile

No. _____ Notes Red. _____ Plotted _____ Job No. _____ Division No. _____

X-Sec. _____ Date _____ Date _____ Survey of _____

No. _____ Notes Chkd. _____ Checked _____ Survey by _____ Notes _____

Date _____ Date _____ Map No. _____ Indexed _____ Date _____

F. B. _____ PG. _____

F. B. 706 PG. 182 | Job No. 6318 | Division No. | Notes Red. | Plotted | Profile No.

Survey of W. L. Woody Co. | Date | Date | X-Sec. No.

Survey by [illegible] Notes Gregory | Notes Chkd. | Checked

Indexed A. C. Johnson | Date | Date | Date

STATION	B. S.	H. I.	F. S.	ELEV.

Form 307 5M 11-35

PLEASE RETURN TO
LOS ANGELES COUNTY SURVEYOR
700 HALL OF RECORDS

Do not extend notes this side of this line

NOTE: ANY ADDITIONS OR CHANGES ON THIS SHEET MUST BE MADE OR CIRCLED IN RED INK, WITH DATE AND NAME OF PERSON MAKING CHANGE

Notes Ck'd by	Survey of
Map No.	W. O. Tape No. St'd °F.
Office Work	Surveyed by
Checked	Notes Date
Date	Indexed A. C. Johnson

F.B. 706 Pg. 183

(5)

Lateral

Note: Any Additions or Changes on This Sheet Must be Made or Circled in Red Ink With Date and Name of Person Making Change.

Do not extend notes this side of this line

RETURN TO
LOS ANGELES COUNTY SURVEYOR
700 HALL OF RECORDS

RECEIVED MAY 12 1937 HS

PROGRESSED

INDEXED

FORM 247 10M 11-35

F.B. 706 Pg. 184

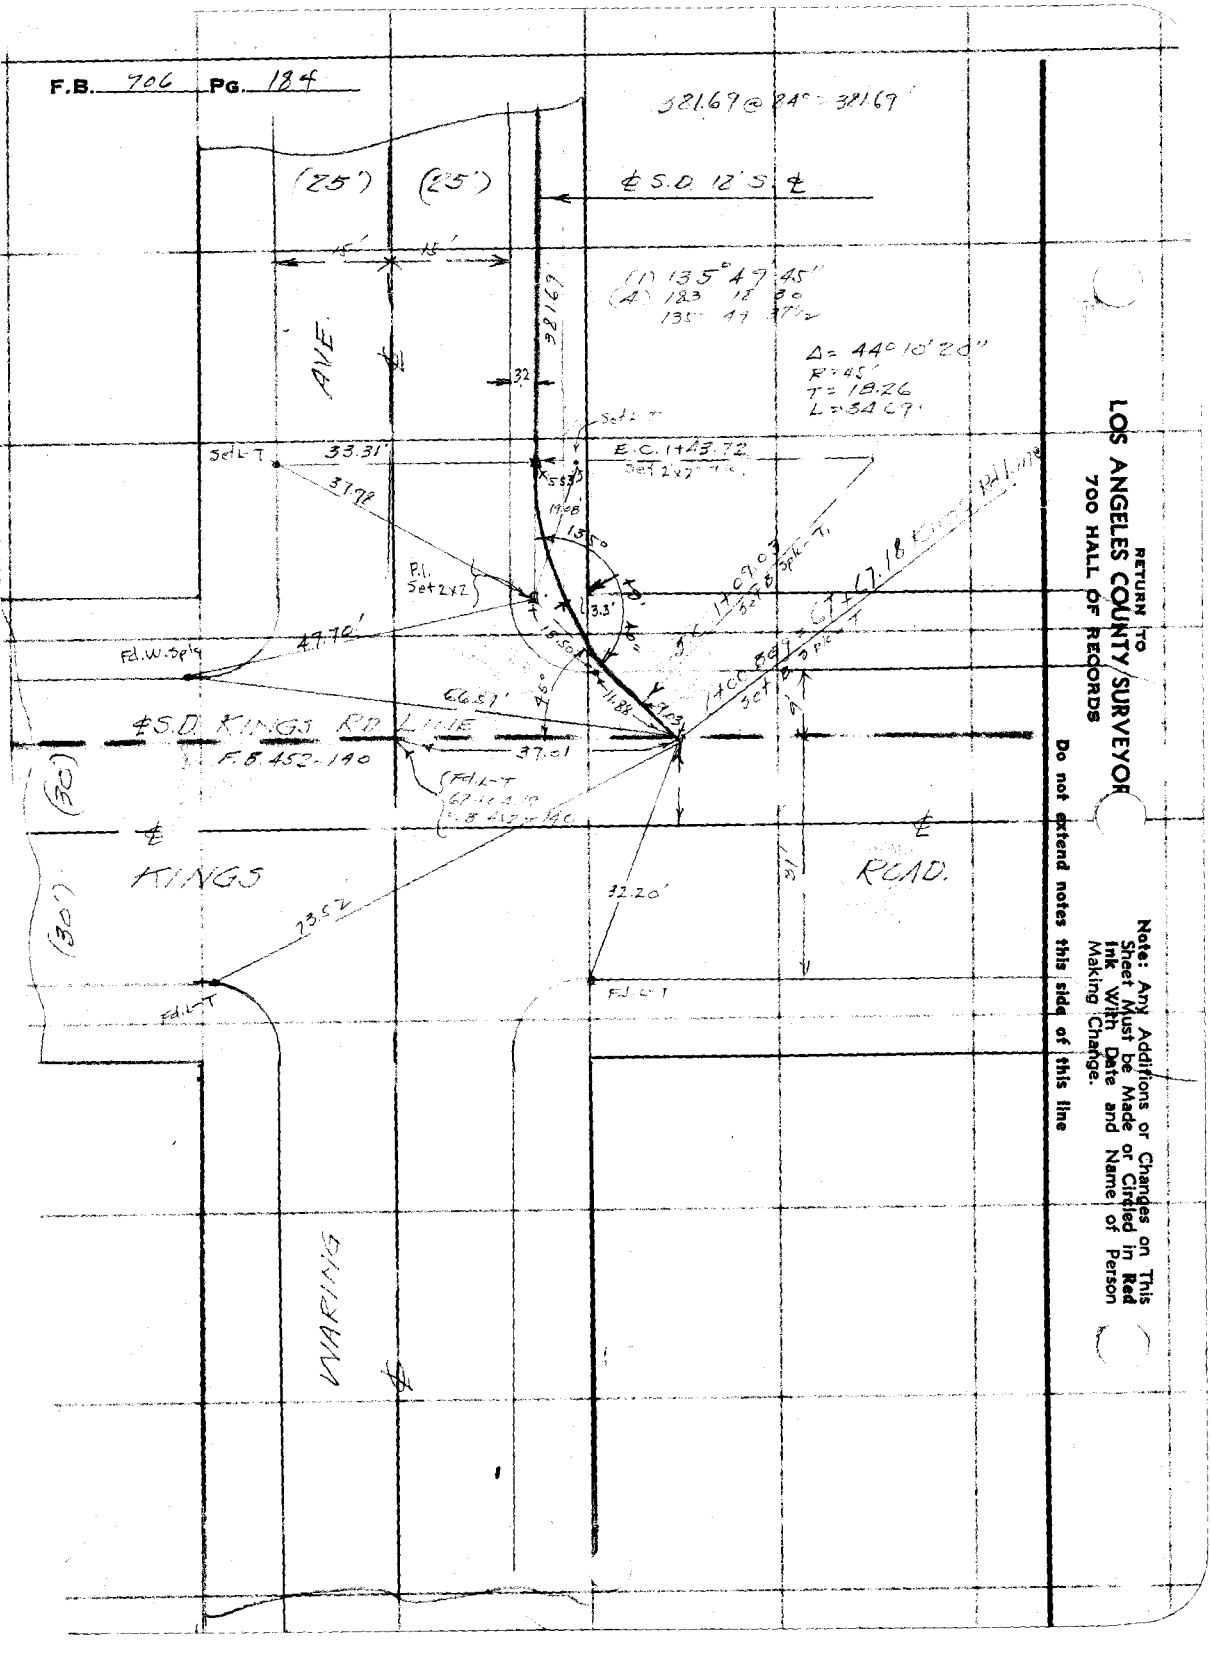
381.69 @ 24° = 381.69'
(25') (25')
℄ S.D. 12' S. ℄
15' 15'
AVE.
381.69'
32'
(1) 135° 47' 45"
(2) 183 18 30
135 47 37½
Δ = 44° 10' 20"
R = 45'
T = 18.26
L = 34.69'
Set L-T
33.31'
E.C. 1+43.72
Set 2x7" T.C.
31.98'
19.08'
15.50'
P.I. Set 2x2
13.3'
Fd. W. Spk
49.70'
66.57'
℄ S.D. KINGS RD LINE
F.B. 452-140
37.01'
(Fd L-T
60° 00' 00"
F.B. 452-140
(30')
KINGS
ROAD.
91'
32.20'
73.52'
Fd L-T
WARING
RETURN TO
LOS ANGELES COUNTY/SURVEYOR
700 HALL OF RECORDS
Do not extend notes this side of this line
Note: Any Additions or Changes on This Sheet Must be Made or Circled in Red Ink With Date and Name of Person Making Change.

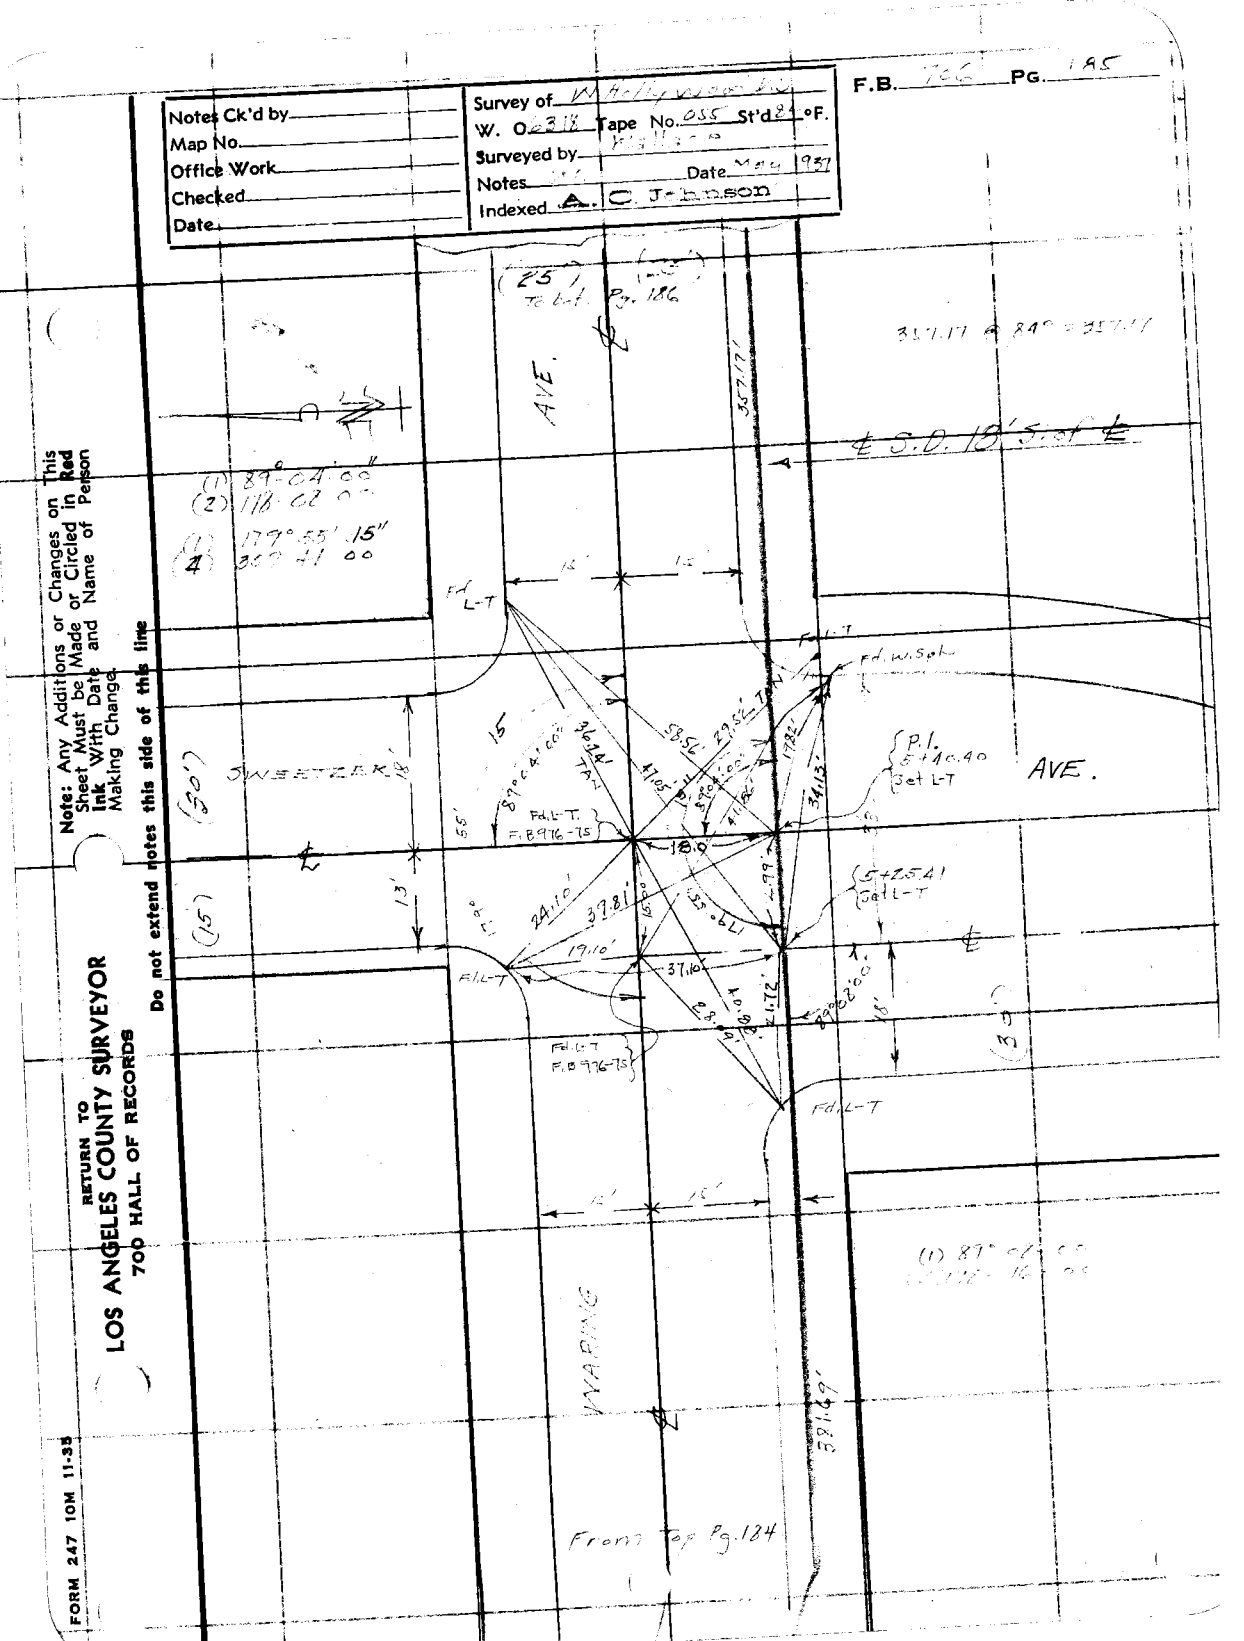
Notes Ck'd by
Map No.
Office Work
Checked
Date
W. O. 2318 Tape No. 055 St'd 82 °F.
Surveyed by
Notes
Date May 1937
Indexed A. C. Johnson
F.B. 766 PG. 185
Note: Any Additions or Changes on This Sheet Must be Made or Circled in Red Ink With Date and Name of Person Making Change
Do not extend notes this side of this line
RETURN TO
LOS ANGELES COUNTY SURVEYOR
700 HALL OF RECORDS
FORM 247 10M 11-35
AVE.
SWEETZER
AVE.
From Top Pg. 184
Fd L-T
Fd. W.Sph
P.I. 5+40.40
Set L-T
5+25.41
Set L-T
Fd L-T F.B. 976-75
(1) 89° 04' 00"
(2) 118 02 00
(3) 179° 55' 15"
(4) 359 41 00
(1) 87° 04' 00"
(2) 118 02 00
(3) 179° 55' 15"
(4) 359 41 00
(50')
(15)
15'
13'
18.0
24.10'
37.81'
19.10'
37.10'
41.05'
34.13'
29.55'
58.56'
89°04'00"
89°55'15"
89°06'00"
55°07'
L=72'
R=75'
T=39.99'
Δ=55°07'
36.44'
TAN
41.82'
R=100'
Δ=23°57'
L=41.82'
T=21.27'
357.17' @ 89° = 357.17'
℄ S.O. 18' S. of ℄
℄
℄

RETURN TO
LOS ANGELES COUNTY SURVEYOR
700 HALL OF RECORDS

Note: Any Additions or Changes on This Sheet Must be Made or Circled in **Red** Ink With Date and Name of Person Making Change.

Do not extend notes this side of this line

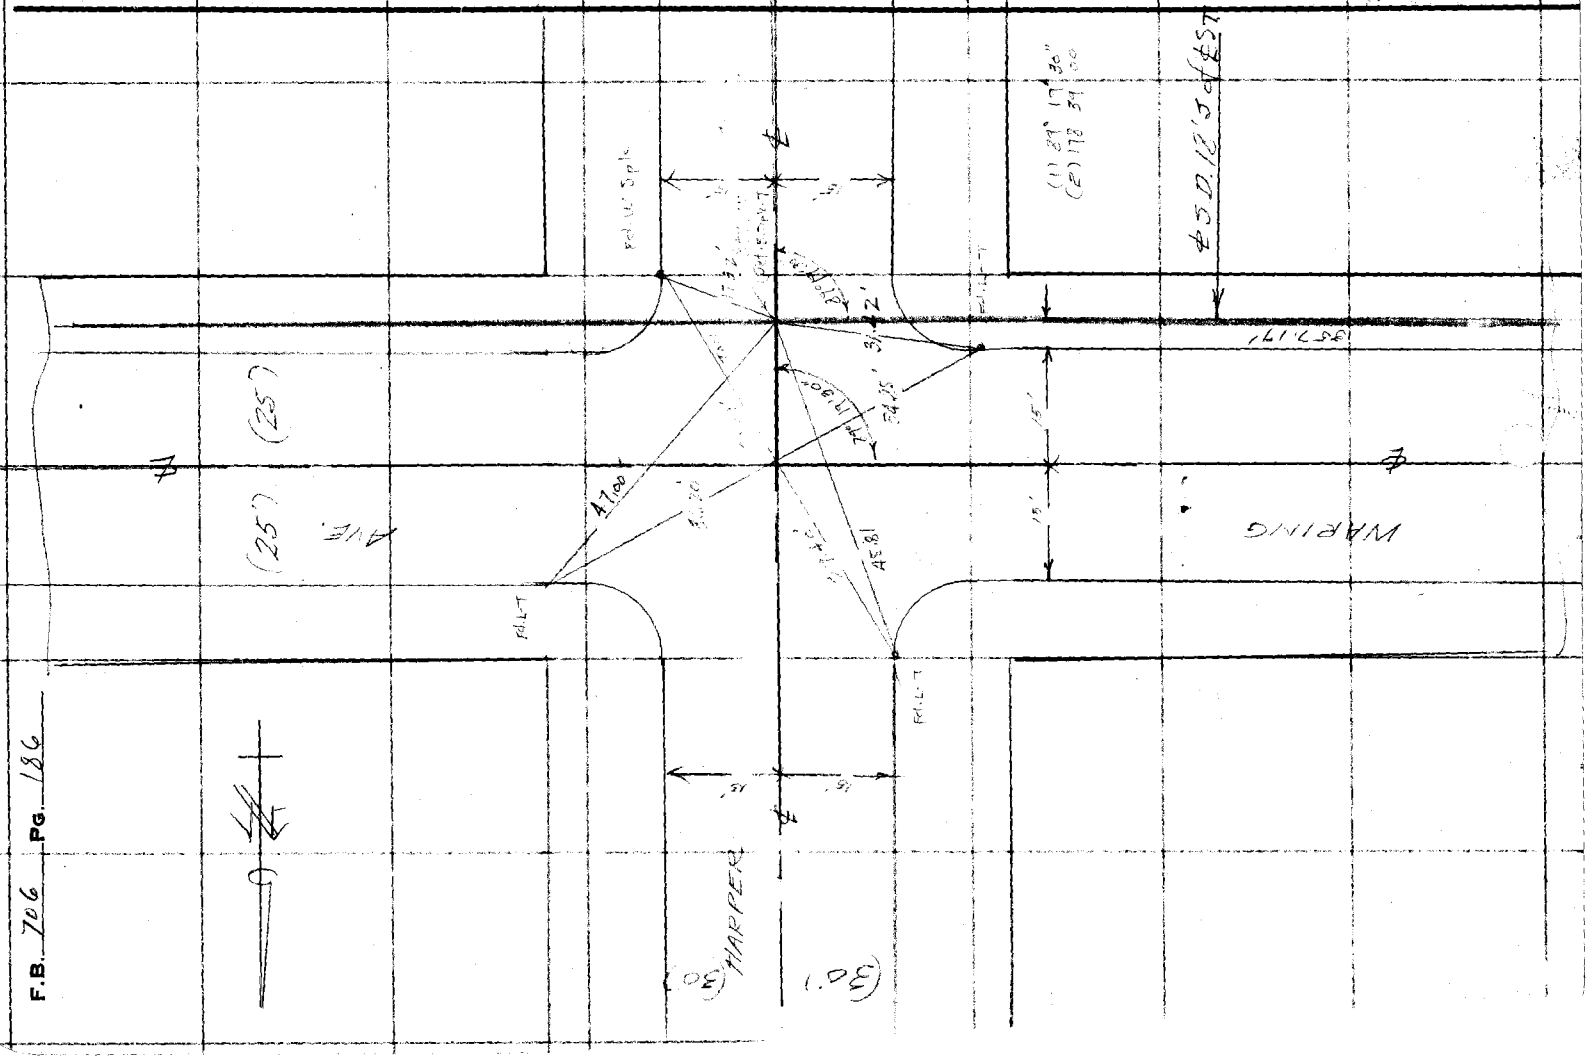

Notes Ck'd by	Survey of W. Holly and vic
Map No.	W. O. 232 Tape No. St'd °F.
Office Work	Surveyed by [illegible]
Checked	Notes VL Date May 1937
Date	Indexed A. C. Johnson











Note: Any Additions or Changes on This Sheet Must be Made in Red Ink With Date and Name of Person Making Change.

Do not extend notes this side of this line

RETURN TO
LOS ANGELES COUNTY SURVEYOR
700 HALL OF RECORDS

FORM 247 10M 11-35

RETURN TO
LOS ANGELES COUNTY SURVEYOR
700 HALL OF RECORDS

Note: Any Additions or Changes on This Sheet Must be Made or Circled in **Red** Ink With Date and Name of Person Making Change.

Do not extend notes this side of this line

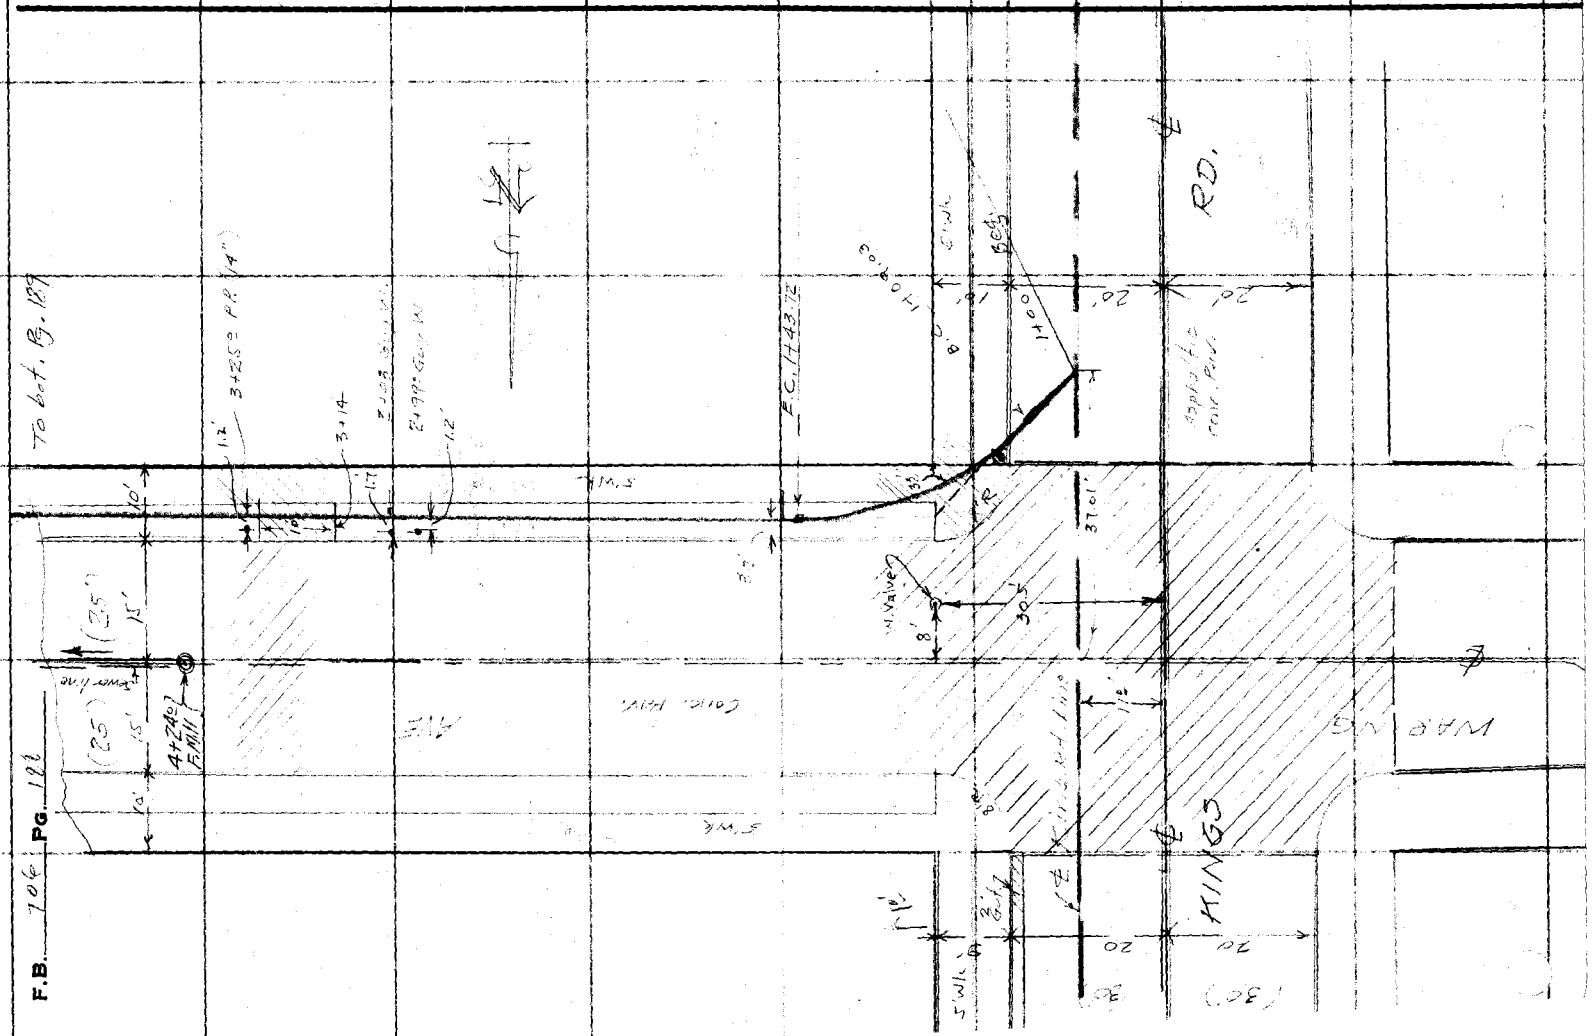

Notes Ck'd by	Survey of W. Hollywood D.S.
Map No.	W. O. 6318 Tape No. St'd °F.
Office Work	Surveyed by
Checked	Notes Date
Date	Indexed C. Johnson

F.B. 706 PG. 189

To bet. Pgs. 178

Note: Any Additions or Changes on This Sheet Must be Made or Circled in Red Ink With Date and Name of Person Making Change.

Do not extend notes this side of this line

RETURN TO
LOS ANGELES COUNTY SURVEYOR
700 HALL OF RECORDS

FORM 247 10M 11-38

From Pg. 188

RETURN TO
LOS ANGELES COUNTY SURVEYOR
700 HALL OF RECORDS

Note: Any Additions or Changes on This Sheet Must be Made or Circled in **Red Ink** With Date and Name of Person Making Change.

Do not extend notes this side of this line

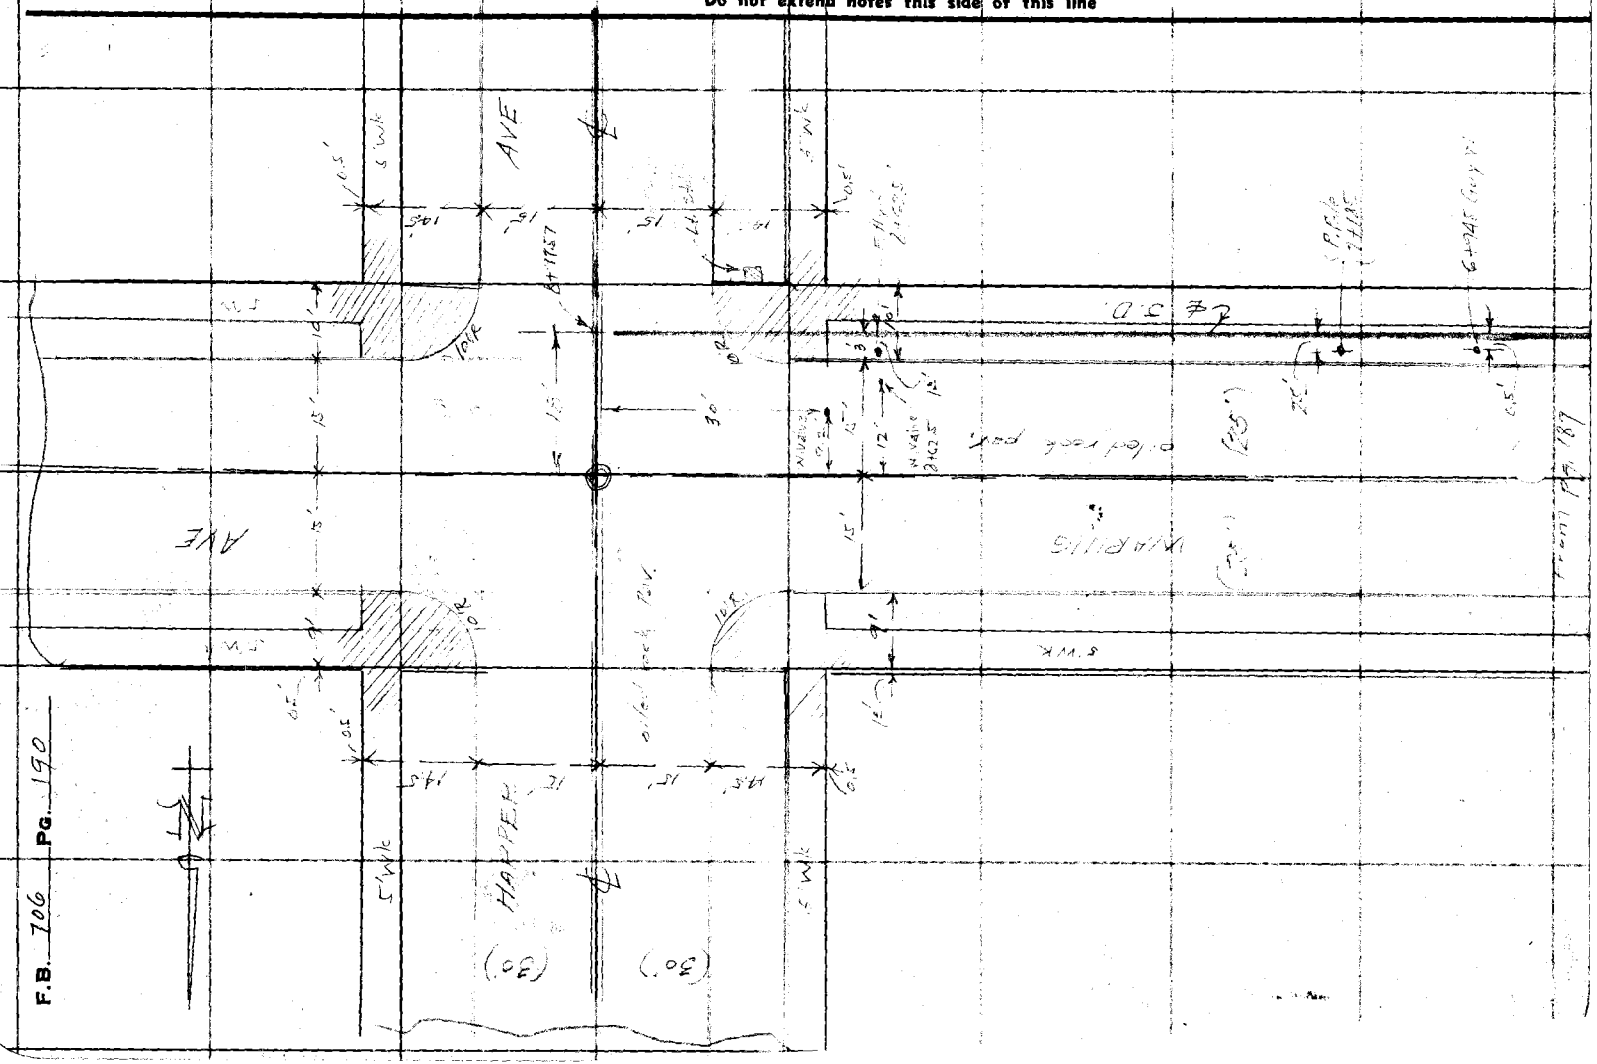
AVE
AVE
HARPER
S.W.K.
S.W.K.
S.W.K.
S.W.K.
S.W.K.
30'
15'
15'
15'
15'
15'
15'
12'
12'
14'
14'
14

Profile No. ____ X-Sec. No. ____

Notes Red. ____ Plotted ____ Job No. 311 Division No. ____
Date ____ Date ____ Survey of Hollywood Dist.
Notes Chkd. ____ Checked ____ Survey by W. A. C. Johnson Notes Date 5-11-37
Date ____ Date ____ Map No. ____ Indexed ____ Date ____

F. B. 706 PG. 191

PROFILE
WARING AVE. STA 0
WEST HOLLYWOOD DIST.
JN 6318

* Survey M.S. 106 Pgs. 183 & 186
Topog. M.S. 106 Pgs. 189 & 190

Plotted
Mylar
1" = 40'
1 line

MAY 12 1937 HLS

In field + L.C.M.

CHECKED LCM

NOTE: ANY ADDITIONS OR CHANGES ON THIS SHEET MUST BE MADE OR CIRCLED IN RED INK, WITH DATE AND NAME OF PERSON MAKING CHANGE

Do not extend notes this side of this line

PLEASE RETURN TO
LOS ANGELES COUNTY SURVEYOR
700 HALL OF RECORDS

STATION	B. S.	H. I.	F. S.	ELEV.

Form 307 5M 11-35

Form 307 SM 11-35

PLEASE RETURN TO
LOS ANGELES COUNTY SURVEYOR
700 HALL OF RECORDS

NOTE: ANY ADDITIONS OR CHANGES ON THIS SHEET MUST BE MADE OR CIRCLED IN RED INK, WITH DATE AND NAME OF PERSON MAKING CHANGE

Do not extend notes this side of this line

F. B. ___ PG. ___ | Job No. ___ Division No. ___ Profile ___
Survey of ___ No. ___ Notes Red ___ Plotted ___
Survey by ___ Date ___ Notes Chkd ___ Date ___
Indexed ___ Notes ___ Date ___ X-Sec. ___ No. ___ Checked ___ Date ___

STATION	B. S.	H. I.	F. S.	ELEV.	Waring Ave. Stud
				Assumed	
B.M. D-32	5.47			208.340	B.M. D-32 El. 208.340 FB. 682-30 Waring Av. & Kings Rd. S.S. Cor. Bl. Spk. 4' E. of E. end C.P.
1+00 = 67+60 Kings Rd. Line			6.36	207.85	℄ S.D.
			6.31	207.90	℄ S.D.
			5.80	208.41	℄ 4" Kings Rd. & Waring Ave.
			5.76	208.45	TC on ℄ S.D.
			6.30	207.91	[illegible]
			5.94	208.27	TC. Scmd. S.E.C.R.
			[illegible]	[illegible]	Gutter [illegible]
			[illegible]	[illegible]	TC [illegible]
			[illegible]	[illegible]	[illegible]
			6.21	208.01	TC N [illegible]
			5.90	208.32	Gutter [illegible]
			6.26	207.96	TC E
			[illegible]	[illegible]	[illegible]
14+25.22			5.30	208.92	℄ [illegible]
			5.21	209.01	TC [illegible]
			6.41	207.81	TC [illegible]
			5.95	208.27	Gutter

Form 307 5M 11-35

PLEASE RETURN TO
LOS ANGELES COUNTY SURVEYOR
700 HALL OF RECORDS

NOTE: ANY ADDITIONS OR CHANGES ON THIS SHEET MUST BE MADE OR CIRCLED IN RED INK, WITH DATE AND NAME OF PERSON MAKING CHANGE

Do not extend notes this side of this line

Profile No. ____ Notes Red ____ Plotted ____ Job No. ____ Division No. ____
X-Sec. No. ____ Date ____ Date ____ Survey of ____ F. B. ____ PG. ____
Notes Chkd ____ Checked ____ Survey by ____ Notes ____
Date ____ Date ____ Map No. ____ Indexed ____ Date ____ Johnson Date ____

3+00			4 9	208.9	± SD
			4 73	209 08	T. on
			4 90	208 91	T.C
			5 42	208 39	Gutter
			4 57	209 26	T.C
			5 04	208 79	Gutter
3+00			39	209.8	± S.D.
			3 80	210 01	T on
			4 02	209 75	T.C
			4 21	209 56	Gutter
			3 52	210 05	T on
			4 10	209 51	
7+00	7 51	216 80	6 42	209 38	
84 2			6 75	210 14	T on Curb =
4+00			6 2	210 6	± SD
			6 14	210 52	T on
			5 57	210 60	T
			5 52	210 64	Gutter

Form 307 5M 11-35

PLEASE RETURN TO
LOS ANGELES COUNTY SURVEYOR
700 HALL OF RECORDS

NOTE: ANY ADDITIONS OR CHANGES ON THIS SHEET MUST BE MADE OR CIRCLED IN RED INK, WITH DATE AND NAME OF PERSON MAKING CHANGE

Do not extend notes this side of this line

Profile No. ____ X-Sec. No. ____

Plotted ____ Notes Red ____ Notes Chkd ____ Checked ____

Division No. ____ Date ____ Date ____ Notes ____ Date ____ Date ____

Job No. 6318

F. B. 706 PG. 194

Survey of ____

Survey by A. C. Johnson

Indexed ____

STATION	B. S.	H. I.	F. S.	ELEV.	
		1	Hazel Ave		
		2.8'			
4+00			5??	210 90	- 5 min up Hill (Road)
			574	211 15	- TC " " CB.
			616	210 14	- Gutter " "
4+74			582	211 07	- SS MH Not ± SD. (Flushed)
			1064	208 25	- Bot of Inv?
					Swarthmore Ave
4+17			516	211 73	- Edge Pvmt. Inlet
			538	211 57	- TC N end SW CR
			562	211 35	- Gutter " " "
			513	211 76	- TC " " "
			550	211 3?	- Gutter " " "
			564	211 ??	- TC W " N end CR
			515	211 74	- Gutter " " "
			507	211 3?	- TC N " " "
			503	211 ??	- Gutter " " "
5+05			456	211 ??	- ℄ Int SD x Swarthmore Ave to S.
			535	211 ??	- 100' E CB on S Swarthmore Ave to S.

XI 584 − 582 = 2

15 − 561

Form 307 5M 11-35

PLEASE RETURN TO
LOS ANGELES COUNTY SURVEYOR
700 HALL OF RECORDS

NOTE: ANY ADDITIONS OR CHANGES ON THIS SHEET MUST BE MADE OR CIRCLED IN RED INK, WITH DATE AND NAME OF PERSON MAKING CHANGE

Do not extend notes this side of this line

Profile No. ____ X-Sec. No. ____ Notes Red. ____ Plotted ____ Job No. ____ Division No. ____ F.B. ____ PG. ____
Notes Ckd. ____ Date ____ Checked ____ Date ____ Survey of ____ Date ____ Survey by ____ Date ____ Map No. ____ Indexed ____ Date ____ Notes ____ Date ____

STATION	B. S.	H. I.	F. S.	ELEV.	Waring Arc	
		4.5 5'			Sweetser Arc 4	
			6 65	210 24	TC. N Store 100'0.5' E S.D.	
			7 03	209 5.	Gutter " " "	
			6 43	210 46	TC. E "	
			6 50	210 07	Gutter " "	
					(B.M D-31 El 212.041 F.S. 8.	
BM D-31	5.0	217 14	4 86	212 04	Waring Arc 4 & Sweetser Arc 5.5	
					Wm Spk 1.5 o.f. C.L.	
			10 04	207 10	55 4.7 309' S.D. on Sweetser Arc 4	
			19 67	197 47	Inv 8" Inlet V	10.03 5 10.67 10.5 903 6 10.75
			19 [illegible]	197 39	Inv 8" Inlet C	
					Sweetser Arc 4	
5'+0.5'			4 94	212 20	E Int S.D. Sweetser Arc 4	
			3 32	213 82	110' [illegible] S.D. on Sweetser Arc (Chan	
			3 16	213 96	TC " "	
			3 67	213 47	Gutter " "	
			3 18	213 96	TC " "	
			3 02	213 82	Gutter " "	

Form 307 5M 11-35

PLEASE RETURN TO
LOS ANGELES COUNTY SURVEYOR
700 HALL OF RECORDS

NOTE: ANY ADDITIONS OR CHANGES ON THIS SHEET MUST BE MADE OR CIRCLED IN RED INK, WITH DATE AND NAME OF PERSON MAKING CHANGE

Do not extend notes this side of this line

F.B. 706 PG. 19 | Job No. 6218 | Division No. | Profile No. | Plotted | Notes Red. | Date | Survey of | Date | Survey by C. Johnson | Notes | Checked | Notes Chkd. | Date | Indexed | Date | X-Sec. No. | Date

STATION	B. S.	H. I.	F. S.	ELEV.	Notes
					Station Ties
		1	Sunset Ave		
		217.14			
5+24			4 00		J.C. 18" N of ℄
			13 34		Inv 8" Inlet N
			13 40		Inv 8" Inlet S
			13 28		Inv 8" Inlet W
			5 09		T.C. S end Gutter
			5 [illegible]		Gutter
			[illegible]		T.C. E " "
			5 34		Gutter " " "
			4 64		T.C. N end Gutter
			5 03		Gutter " " "
			4 03		T.C. E " "
			5 15		Gutter " " "
			Hoover Ave		
			5 25		Gutter in ℄ Hoover Ave
			[illegible]		Edge Conc. Pav ℄ Hoover Ave
5+			2 5		Edge Conc. Walk ℄ SD
6+00			4 5		℄ SD

	N	E	S	W
	+95	500	4 07	494
	7.22		2 81	7 63
	67		6"	67
	13 24		13 94	13 28

Form 307 5M 11-35

PLEASE RETURN TO
LOS ANGELES COUNTY SURVEYOR
700 HALL OF RECORDS

NOTE: ANY ADDITIONS OR CHANGES ON THIS SHEET MUST BE MADE OR CIRCLED IN RED INK, WITH DATE AND NAME OF PERSON MAKING CHANGE

Do not extend notes this side of this line

Profile No. ____ X-Sec. No. ____

Notes Red. ____ Plotted ____ Job No. 42-16 Division No. ____
Date ____ Date ____ Survey of ____
Notes Ckkd. ____ Checked ____ Survey by ____ Notes ____ Date 5-6-37
Date ____ Date ____ Map No. ____ Traced ____ Date ____

F.B. 215 PG. 127

STATION	B. S.	H. I.	F. S.	ELEV.	
			472	212 72	T. W. [illegible]
			[illegible]	212 86	T.C. S Co.
			502	212 12	Gutter
			428	212 85	[illegible] Warning Fire (Ground)
			[illegible]	212 79	T.C. [illegible]
			[illegible]	212 4	Gutter
TP	5.35	219.50	[illegible]	214.15	
6+24			651	212 99	[illegible] Drwy on E SD
6+47			643	213 07	" " " "
7+00			[illegible]	213 8	E SD
			[illegible]	213 74	T. Wall
			[illegible]	213 64	T.C. S Co.
			[illegible]	213 21	[illegible]
			514	214 05	E Warning Fire (Ground)
			[illegible]	213 9	T.C. [illegible]
			[illegible]	213 42	[illegible]
			[illegible]	212 7	E SD
			459	212 91	T. Wall
			472	212 78	T.C. S Co
			514	214 36	Gutter

Form 307 5M 11-35

PLEASE RETURN TO
LOS ANGELES COUNTY SURVEYOR
700 HALL OF RECORDS

NOTE: ANY ADDITIONS OR CHANGES ON THIS SHEET MUST BE MADE OR CIRCLED IN RED INK, WITH DATE AND NAME OF PERSON MAKING CHANGE

Do not extend notes this side of this line

F. B. 718 Pg. 48 | Job No. 438 | Division No. | Notes Red. | Plotted | Profile No.
Survey of Hollywood Survey | Date | Date | X-Sec. No.
Survey by W. C. Johnson | Notes | Notes Chkd. | Checked
Indexed | Date | Date | Date

STATION	B. S.	H. I.	F. S.	ELEV.	Hollywood Ave
				212 Ave	
		219 50			
5+00			4 32	215 18	± Wilcox Ave (Found)
			2 45	218 05	TC N Co.
			4 86	214 64	Gutter " "
7+00	372	221 16	2 06	219 44	Harper Ave
8+			5 44	215 72	Edge Concrete with ± SD
			5 53	215 63	TC Wood SWCR.
			5 12	216 40	Gutter " "
			5 54	216 62	TC " "
			5 90	215 19	Gutter " "
			5 25	215 91	TC W " NWCR
			5 67	215 49	Gutter " "
			5 14	216 12	TC N "
			5 36	215 80	Gutter " " "
8+47.50			5 12	216 00	± ½" SD x Harper Ave
			7 27	213 89	" " " " " " "
			7 37	213 79	TC 11" Side
			7 82	213 34	Gutter " "
			7 26	213 90	TC E "
			7 65	213 51	Gutter " "

Form 307 5M 11-35

PLEASE RETURN TO
LOS ANGELES COUNTY SURVEYOR
700 HALL OF RECORDS

NOTE: ANY ADDITIONS OR CHANGES ON THIS SHEET MUST BE MADE OR CIRCLED IN RED INK, WITH DATE AND NAME OF PERSON MAKING CHANGE

Do not extend notes this side of this line

Profile No. ____ X-Sec. No. ____ Notes Red. ____ Date ____ Notes Chkd. ____ Date ____ Plotted ____ Date ____ Checked ____ Date ____ Job No. ____ Survey of ____ Survey by ____ Map No. ____ Division No. ____ Notes ____ Date ____ Indexed C. Johnson Date ____ F.B. ____ PG. ____

STATION	B. S.	H. I.	F. S.	ELEV.	
				Harper Ave	Harper Ave
			10.75	210 41	· S.S.M.H. 283'S of ℄ SD on ℄ Harper Ave
			20.29	200 87	· Inv Inlet N
			20.37	200 79	· Inv Outlet S
			4 96	216 20	· S.S.M.H 4'N of ℄ SD on ℄ Harper Ave
			12 95	208 21	· Inv 8" Inlet N
			12 95	208 18	· Inv 8" Outlet S
			5 31	215 85	· Gutter 21'N of ℄ SD on ℄ Harper Ave
			3 35	217 81	· 100' N of ℄ SD on ℄ Harper Ave
			3 51	217 66	· TC W Side
			3 59	217 27	· Gutter " "
			3 10	217 97	· TC E "
			3 60	217 53	· Gutter " "
			5 31	215 85	· TC S end SE ℄
			5 83	215 33	· Gutter " "
			5 08	216 08	· TC E "
			5 84	215 62	· Gutter " "

Form 307 5M 11-35

PLEASE RETURN TO
LOS ANGELES COUNTY SURVEYOR
700 HALL OF RECORDS

NOTE: ANY ADDITIONS OR CHANGES ON THIS SHEET MUST BE MADE OR CIRCLED IN RED INK, WITH DATE AND NAME OF PERSON MAKING CHANGE

Do not extend notes this side of this line

F. B. 720 Pg. 230 | Job No. 6318 Division No. | Notes Red. | Plotted | Profile
Survey of W. Torrance Blvd. | Date | Date | No.
Survey by A. C. Johnson | Notes | Notes Chkd. | Checked | X-Sec.
Indexed | Date | Date | Date | No.

STATION	B. S.	H. I.	F. S.	ELEV.	Hawthorne Ave
			Hawthorne Ave		
			4.72	216 44	
			5.15	216 01	
			4.87	216 29	
			5.22	216 94	
			4.14	217 02	150 E of ℄ of Hawthorne Ave.
			4.42	216 72	
			4.70	216 26	
			4.10	216 97	
			5.05	216 48	
BM. D-30.			5.34	211.82	BM D-30 Elev. 211.82 ✓ F.B. 682-29 Harbor Ave x Manhattan Pl. N. W. Cor Wr. Spk 1' W of N ext. Fc

Notes Ck'd by	Survey of Hollywood Sta
Map No.	W. O. 6818 Tape No. 655 St'd 24 °F.
Office Work	Surveyed by
Checked	Notes Date May 1937
Date	Indexed A. C. Johnson

F.B. PG.

(5)

SURVEY

MELROSE - LA BREA AVE. LATITUDE

WEST HOLLYWOOD U.S.

JN.6818

TOPOG. F.B. 706 - Pg. 213-to 224

PROFILE F.B. 706 Pg. 225-245

Wallace
Gregory T - Former T
Murray
Tellez
Ethier

RECEIVED Surveyor MAY 19 1937

PROGRESSED ✓ ✓

BOOK INDEXED ✓ ✓

MAP INDEXED ✓ ✓

RECORD INDEXED ✓ ✓

CARD INDEXED ✓

Note: Any Additions or Changes on This Sheet Must be Made or Circled in Red Ink With Date and Name of Person Making Change.

Do not extend notes this side of this line

RETURN TO
LOS ANGELES COUNTY SURVEYOR
708 HALL OF RECORDS

FORM 247 10M 11-35

F.B. 706 Pg. 202

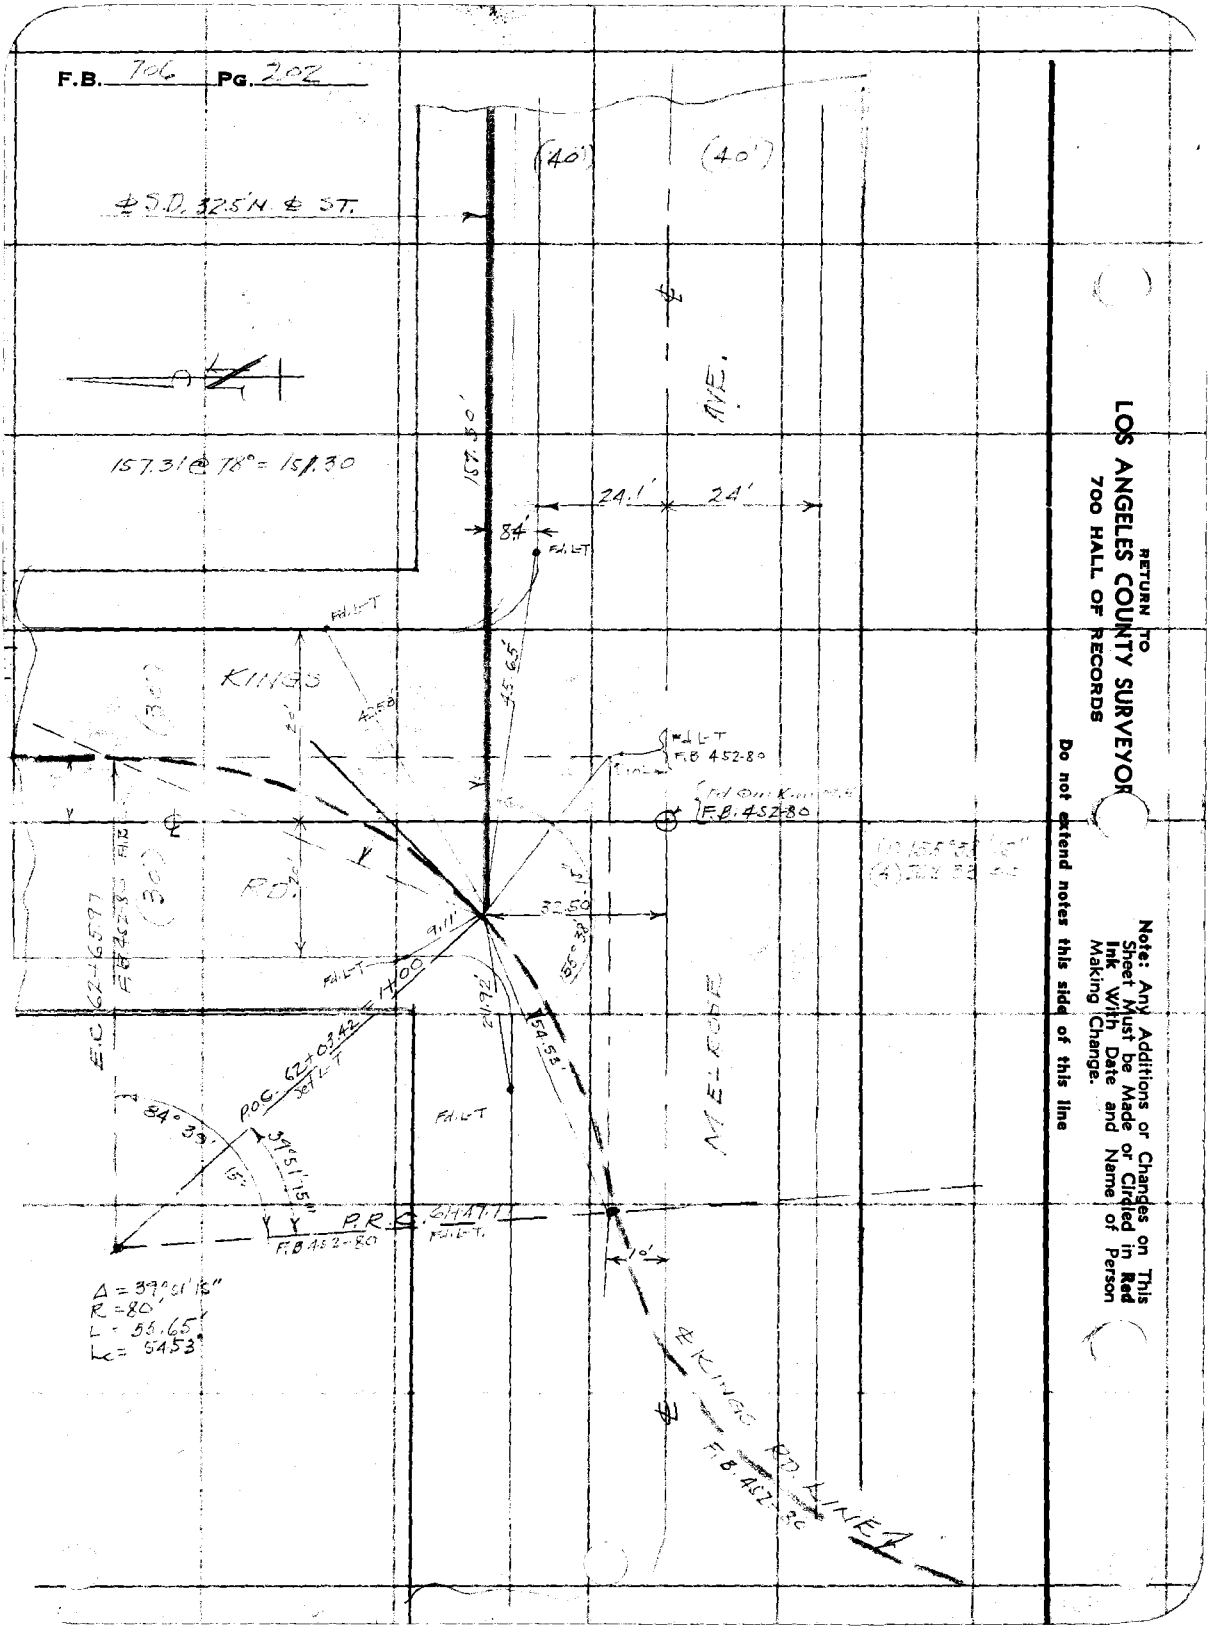

RETURN TO
LOS ANGELES COUNTY SURVEYOR
700 HALL OF RECORDS

Note: Any Additions or Changes on This Sheet Must be Made or Circled in Red Ink With Date and Name of Person Making Change.

Do not extend notes this side of this line

Notes Ck'd by	Survey of
Map No.	W. O. 6818 Tape No. 555 St'd. °F.
Office Work	Surveyed by
Checked	Notes Date
Date	Indexed A. C. Johnson

F.B. PG.

RETURN TO
LOS ANGELES COUNTY SURVEYOR
700 HALL OF RECORDS

Note: Any Additions or Changes on This Sheet Must be Made or Circled in Red Ink With Date and Name of Person Making Change

Do not extend notes this side of this line

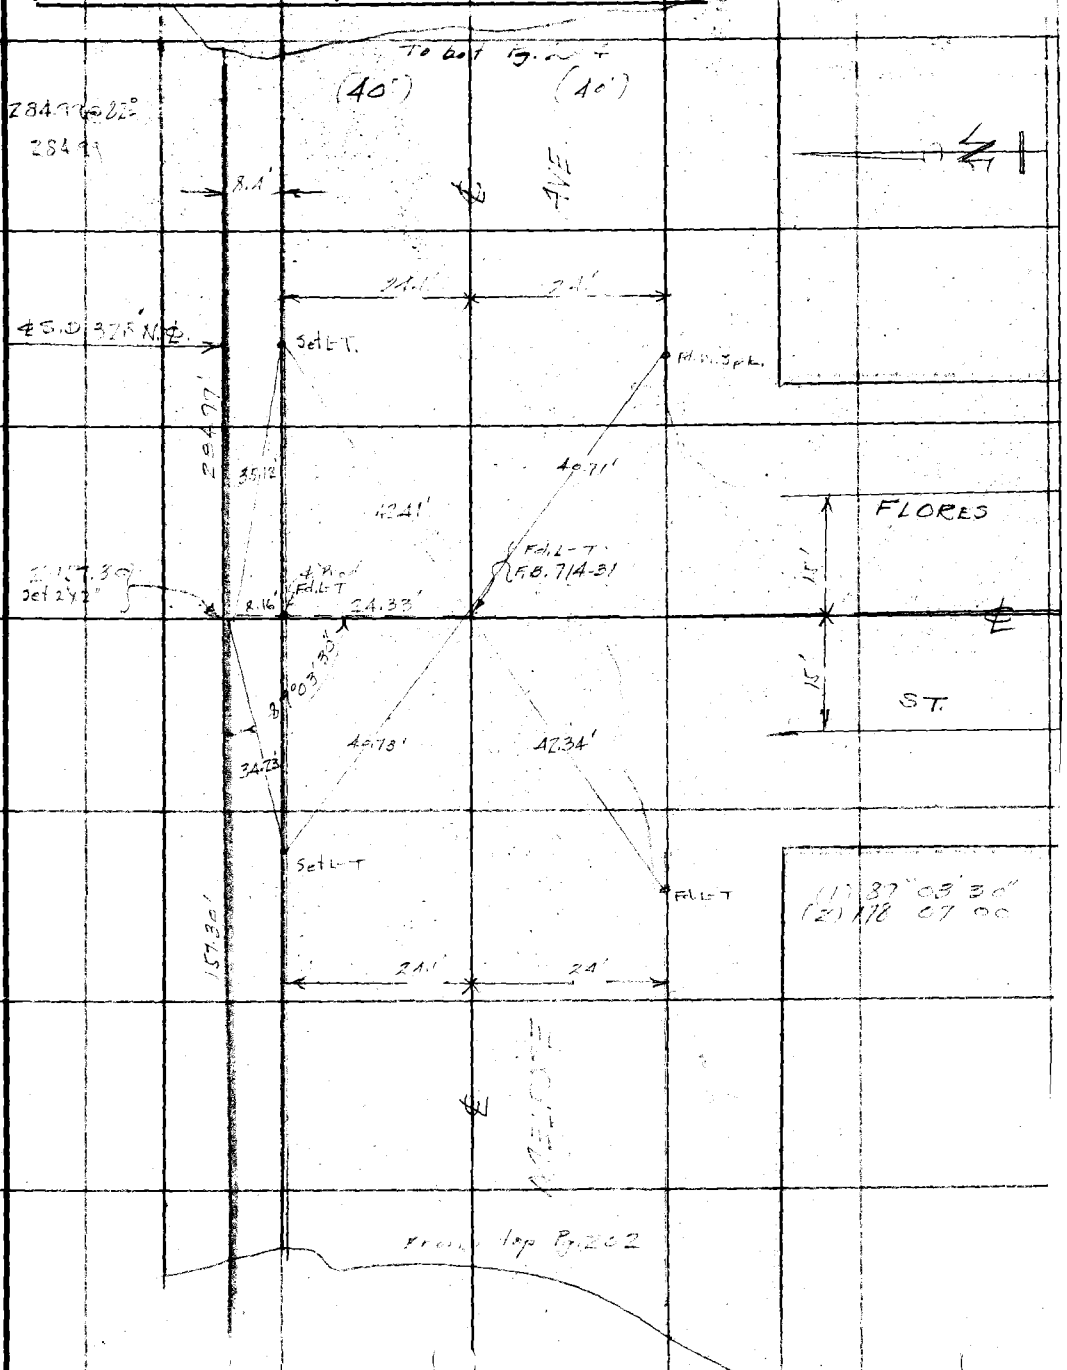

FORM 247 10M 11-38

F.B. 706 PG. 204

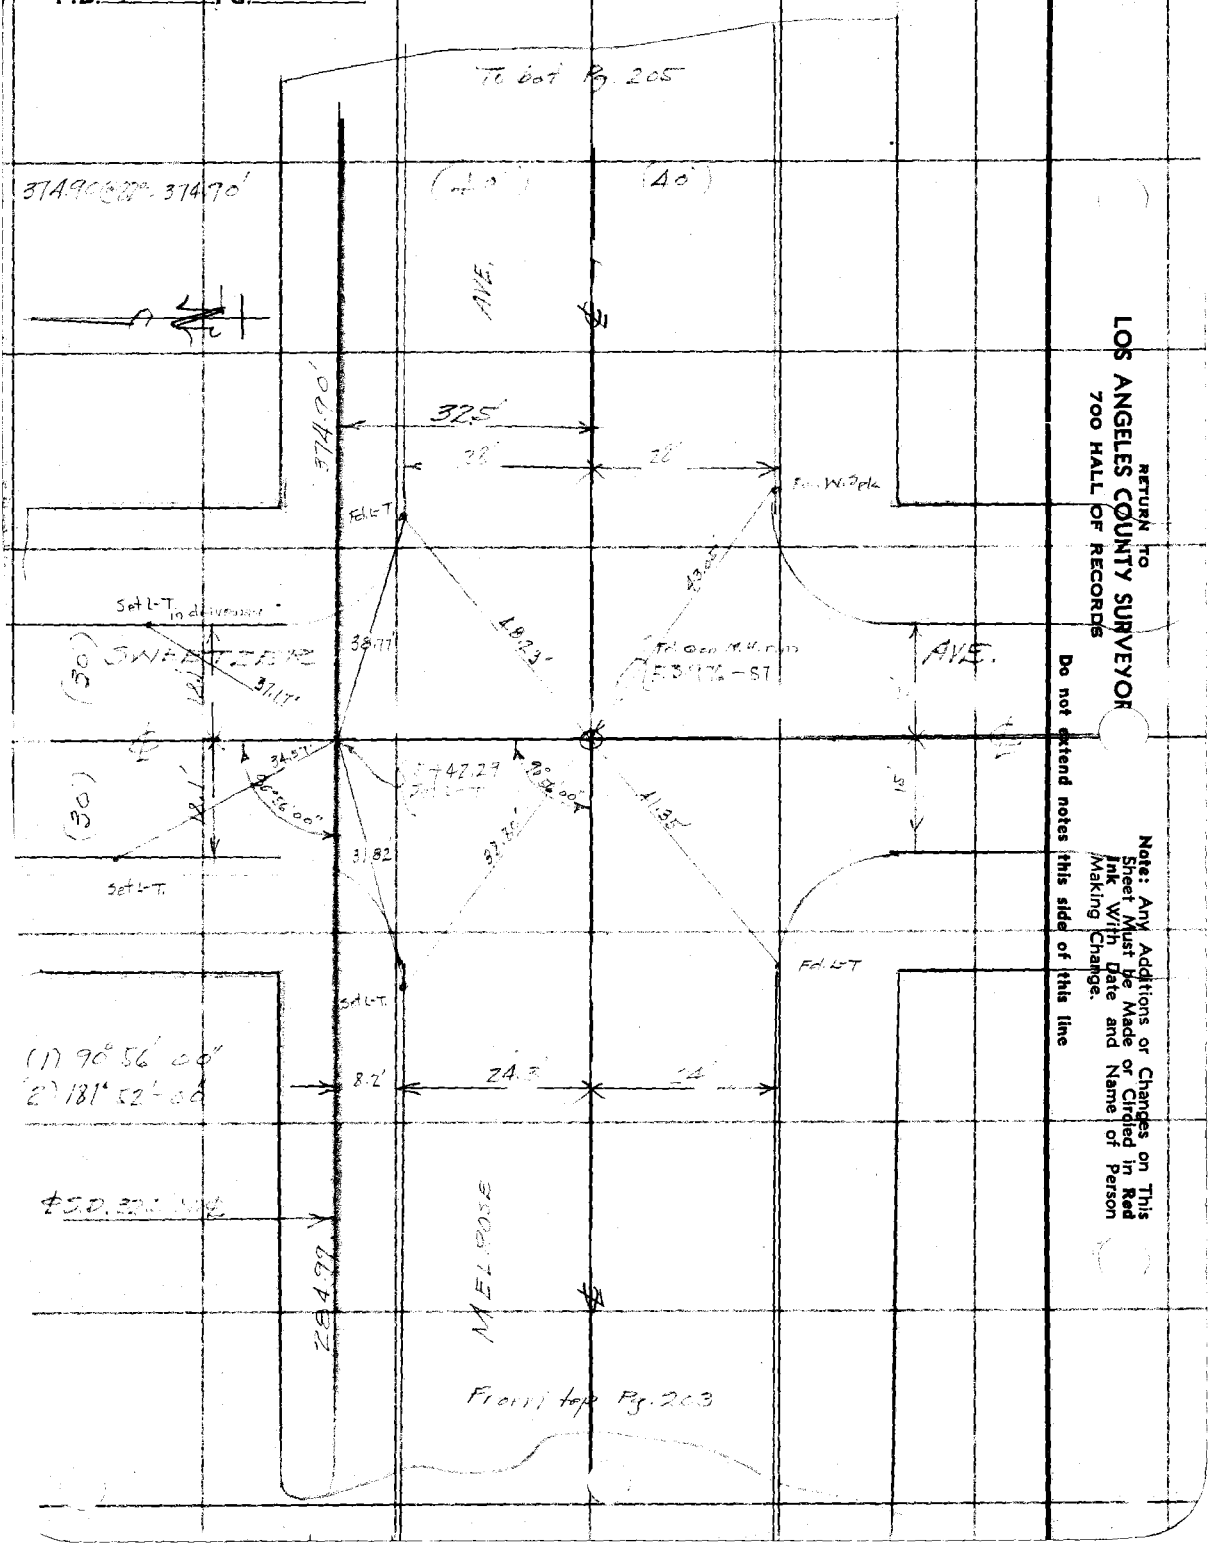

RETURN TO
LOS ANGELES COUNTY SURVEYOR
700 HALL OF RECORDS

Note: Any Additions or Changes on This Sheet Must be Made or Circled in Red Ink With Date and Name of Person Making Change.

Do not extend notes this side of this line

Notes Ck'd by	Survey of
Map No.	W. O. 6318 Tape No. [illegible] St'd °F.
Office Work	Surveyed by
Checked	Notes Date
Date	Indexed C. Johnson

F.B. Pg.

(40') (40')

AVE.

28' 78'

Fd. W.Sp's

AVE.

(F.B. 976-87)

Fd. L-T

Fd. L-T

23' 23'

32.50'

(1) 90°40'00"
(2) 180-20 00

Note: Any Additions or Changes on This Sheet Must be Made or Circled in Red Ink With Date and Name of Person Making Change

Do not extend notes this side of the line

RETURN TO
LOS ANGELES COUNTY SURVEYOR
7OO HALL OF RECORDS

FORM 247 10M 11-38

F.B. 706 Pg. 206

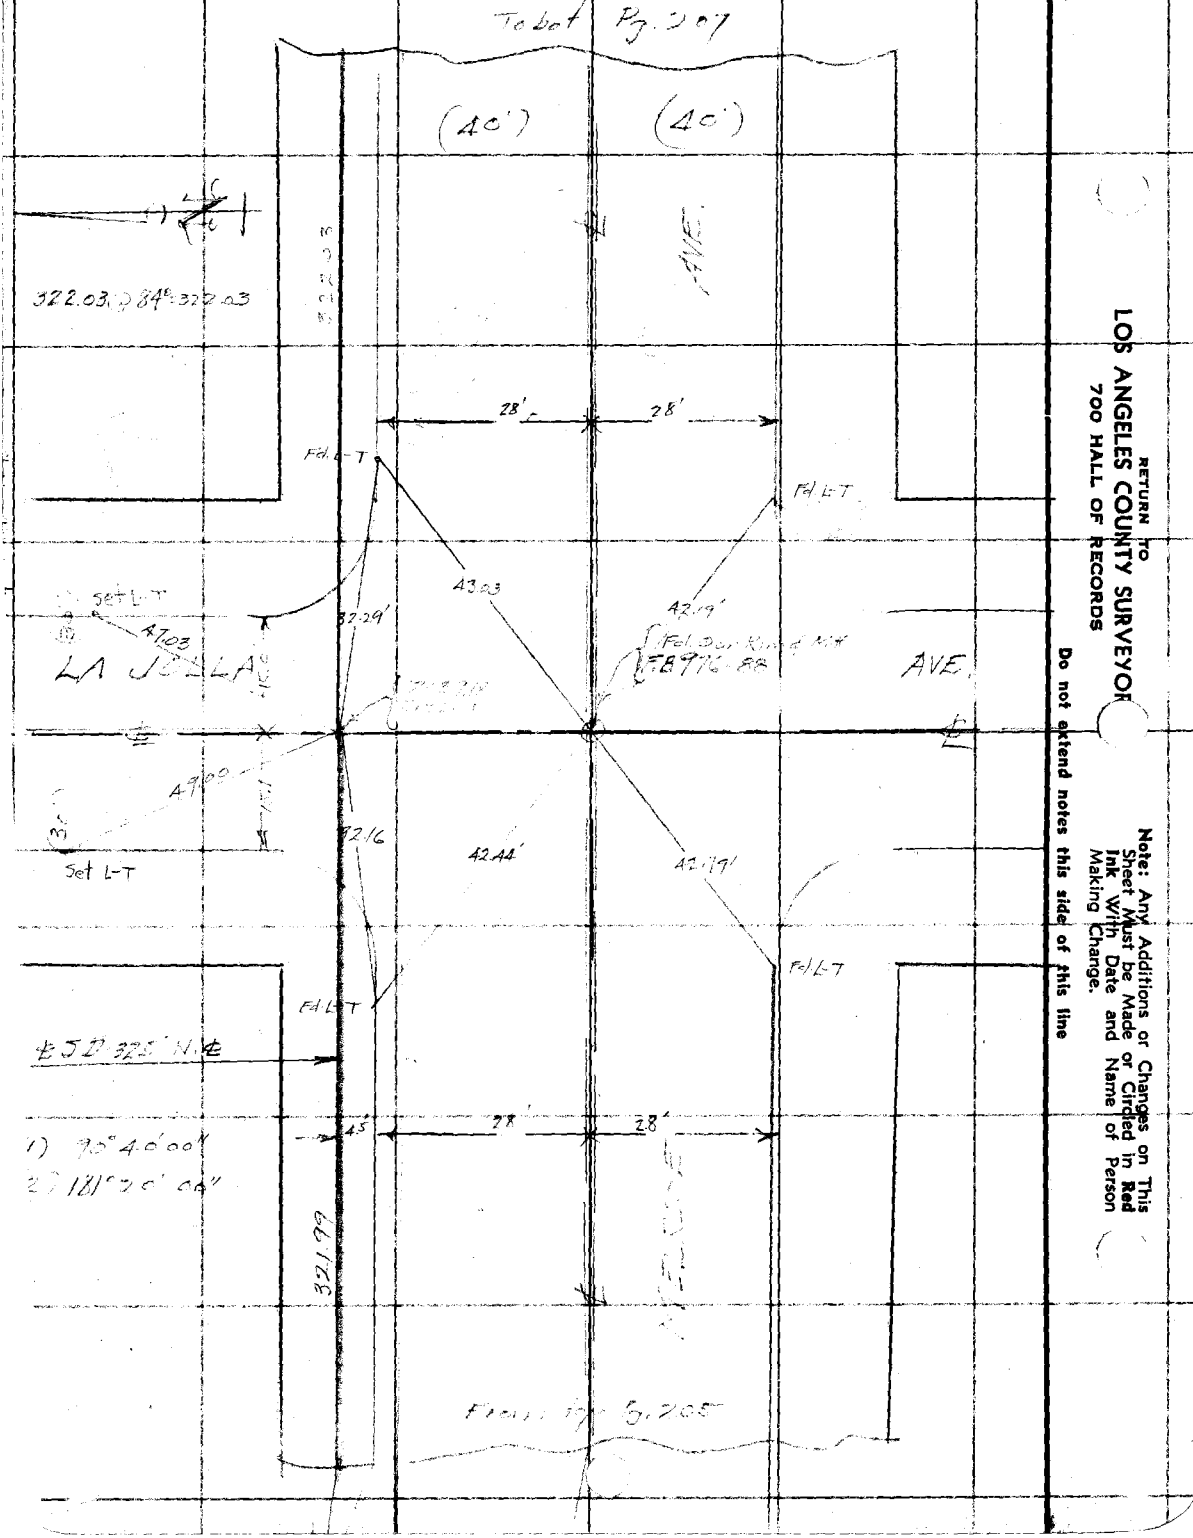

RETURN TO
LOS ANGELES COUNTY SURVEYOR
700 HALL OF RECORDS

Note: Any Additions or Changes on This Sheet Must be Made or Circled in Red Ink With Date and Name of Person Making Change.

Do not extend notes this side of this line

Notes Ck'd by	Survey of K.A. Kelly Wood & J.
Map No.	W. O. 6318 Tape No. 255 St'd 84° F.
Office Work	Surveyed by K.A. Kelly
Checked	Notes Date Nov 1927
Date	Indexed C. Johnson

F.B. 106 PG. 2

Note: Any Additions or Changes on This Sheet Must be Made or Circled in Red Ink With Date and Name of Person Making Change

Do not extend notes this side of this line

RETURN TO
LOS ANGELES COUNTY SURVEYOR
700 HALL OF RECORDS

FORM 247 10M 11-35

To Sht Pg 208

322.00 @ 28°
322.00'

522.00'

28' 28'

AVE.

℄ S.D.
325' N. ℄ ST.

127.7'

Fd
W.S.

KILKEA

15' 15'

15' 461.21'
15 ft
TX in Pal.

A1.50

N 25°

Fd. ⊙ on rim, of M.H.
F.B. 976-88

DR.

32.50'

15' 45.46

A3.12

A4.22

Fd
L.T.

522.03'

MELROSE

28' 28'

From Pg 206

RETURN TO
LOS ANGELES COUNTY SURVEYOR
700 HALL OF RECORDS

Note: Any Additions or Changes on This Sheet Must be Made or Circled in Red Ink With Date and Name of Person Making Change.

Do not extend notes this side of this line

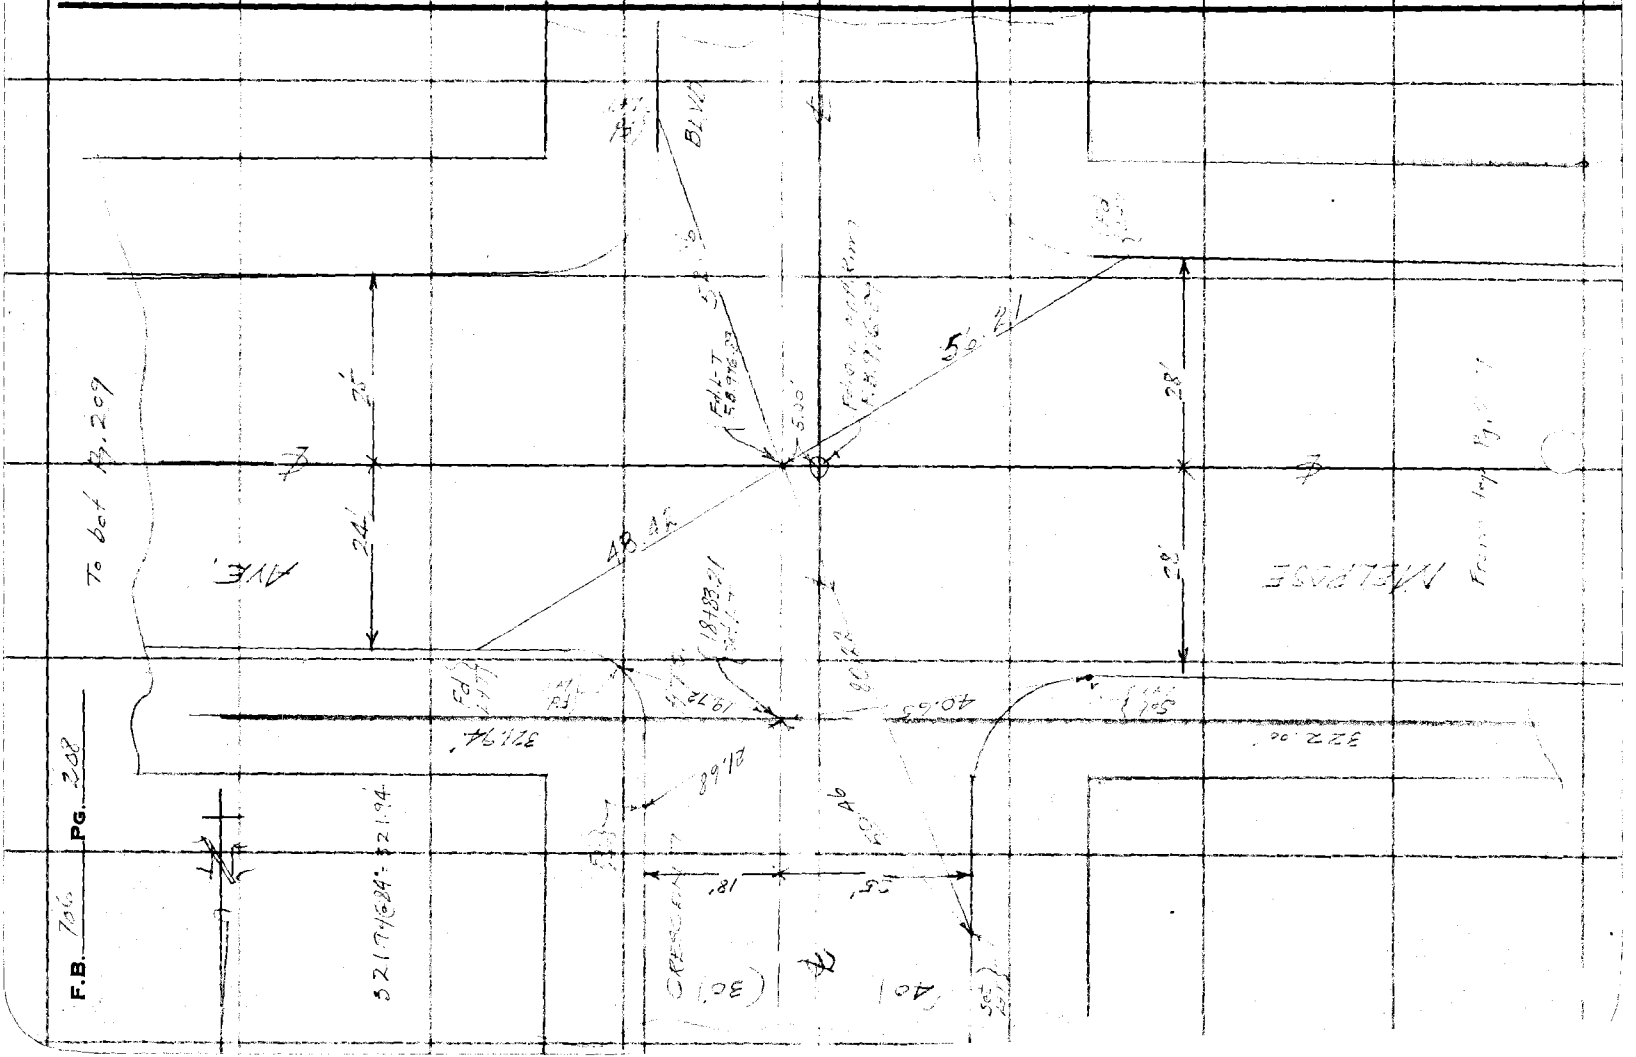

Notes Ck'd by	Survey of
Map No.	W. O. 6318 Tape No.	St'd °F.
Office Work	Surveyed by
Checked	Notes	Date
Date	Indexed	C. Johnson

F.B. Pg.

(to col. Pg. 210

(40') (40')

24' 25'

E 5.0328 N. & S.T.

AVE.

TIES F.B. 710 6-14


22+05.15 Set x in conc. 92.50'

Fd. o in rim of M.H. F.B. 916-85

AVE.

MELROSE

24' 25'

From top Pg. 208

Note: Any Additions or Changes on This Sheet Must be Made or Circled in Red Ink With Date and Name of Person Making Change.

Do not extend notes this side of this line

RETURN TO
LOS ANGELES COUNTY SURVEYOR
700 HALL OF RECORDS

FORM 247 10M 11-35

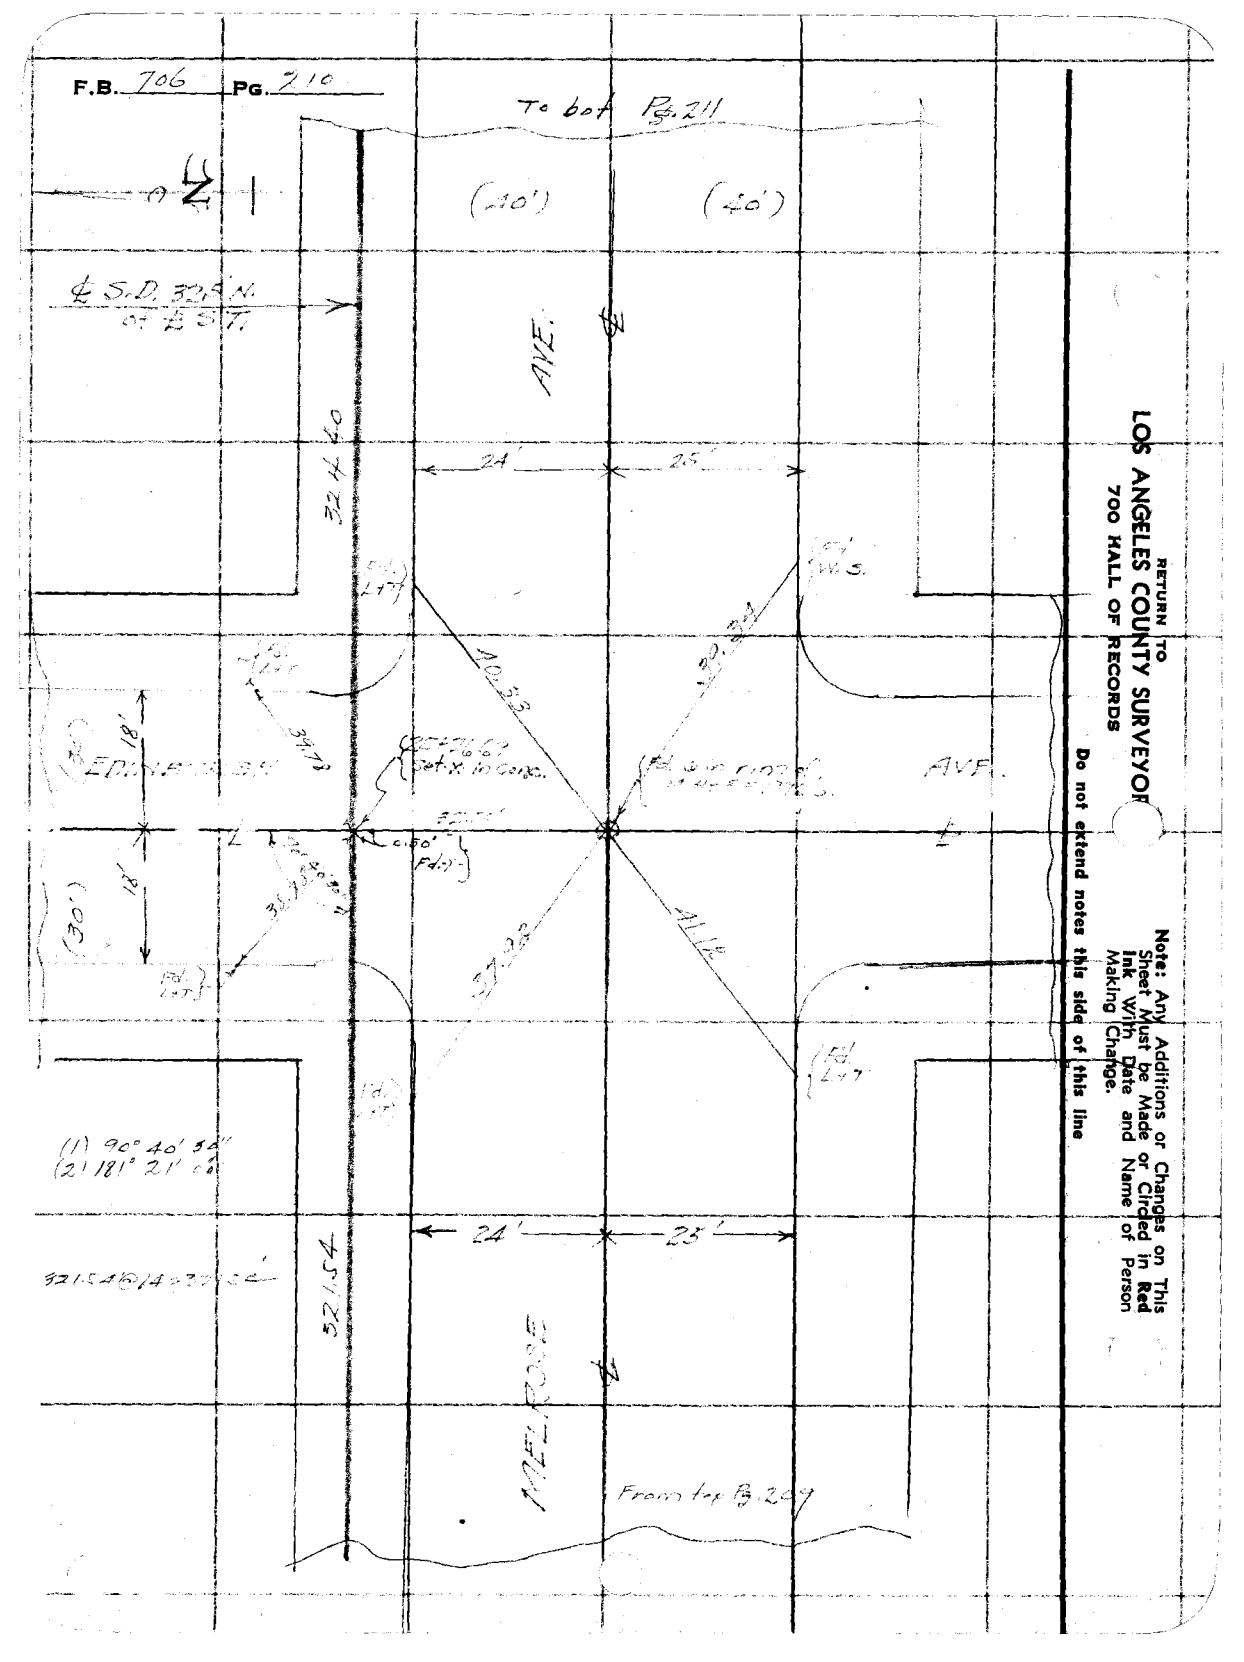
F.B. 706 Pg. 710
To bot Pg. 211
(20')
(40')
℄ S.D. 32.54 N. of ℄ St.
AVE.
24'
25'
32.40
10.33
39.21
18'
18'
(30')
AVE.
57.38
(1) 90° 40' 34"
(2) 181° 21' 00"
24'
25'
32.54
From top Pg. 209
RETURN TO
LOS ANGELES COUNTY SURVEYOR
700 HALL OF RECORDS
Note: Any Additions or Changes on This Sheet Must be Made or Circled in Red Ink With Date and Name of Person Making Change.
Do not extend notes this side of this line

Notes Ck'd by	Survey of W. Hollywood Lds
Map No.	W. O. 6318 Tape No. 855 St'd 24 °F.
Office Work	Surveyed by
Checked	Notes [illegible] Date June 1937
Date	Indexed A. C. Johnson

F.B. 706 PG.

Note: Any Additions or Changes on This Sheet Must be Made or Circled in Red Ink With Date and Name of Person Making Change.

Do not extend notes this side of this line

RETURN TO
LOS ANGELES COUNTY SURVEYOR
700 HALL OF RECORDS

FORM 247 10M 11-35

(40')

(40')

24'

25'

AVE

Fd. [illegible]

Set [illegible]

Fd. N.S.S.

HAWTHORNE

31.74

28.51.09

20.0

18'

32.50'

AVE.

Fd. [illegible] M.M. F.B. 976/110

N 28°41'00" E

41.55

20.05

38.15

41.37

Fd. [illegible]

℄ S.P. 325
N. ℄ 57.

(1) 90° 41' 00"
(2) 181 27 00

324.10

24'

25'

MELROSE

From top Pg. 710

RETURN TO
LOS ANGELES COUNTY SURVEYOR
700 HALL OF RECORDS

Note: Any Additions or Changes on This Sheet Must be Made or Circled in **Red Ink** With Date and Name of Person Making Change.

Do not extend notes this side of this line

F.B. 116 PG. 212

Notes Ck'd by	Survey of
Map No.	W. O. 6318 Tape No. St'd °F.
Office Work	Surveyed by
Checked	Notes Date
Date	Indexed C. Johnson

F.B. Pg. 213

(5)

TOPOG.

MAY. ROSE - LA JOLLA AVE. LATERAL

WEST HOLLYWOOD DIS.

J.N. 6318

& SURVEY F.B. 706 Pg. 201-2N

PROFILE F.B. 706 Pg. 225-245

Wallace
Flaherty
Murray
Taylor
Fuller

Note: Any Additions or Changes on This Sheet Must be Made or Circled in Red Ink With Date and Name of Person Making Change

Do not extend notes this side of this line

RETURN TO
LOS ANGELES COUNTY SURVEYOR
700 HALL OF RECORDS

RECEIVED Smelser MAY 19 1937

PROGRESSED ✓ ✓

BOOK INDEXED ✓ ✓

MAP INDEXED ✓ ✓

RECORD INDEXED ✓ ✓

CARD INDEXED ✓ ✓

FORM 247 10M 11-36

RETURN TO
LOS ANGELES COUNTY SURVEYOR
700 HALL OF RECORDS

Note: Any Additions or Changes on This Sheet Must be Made or Circled in **Red Ink** With Date and Name of Person Making Change.

Do not extend notes this side of this line

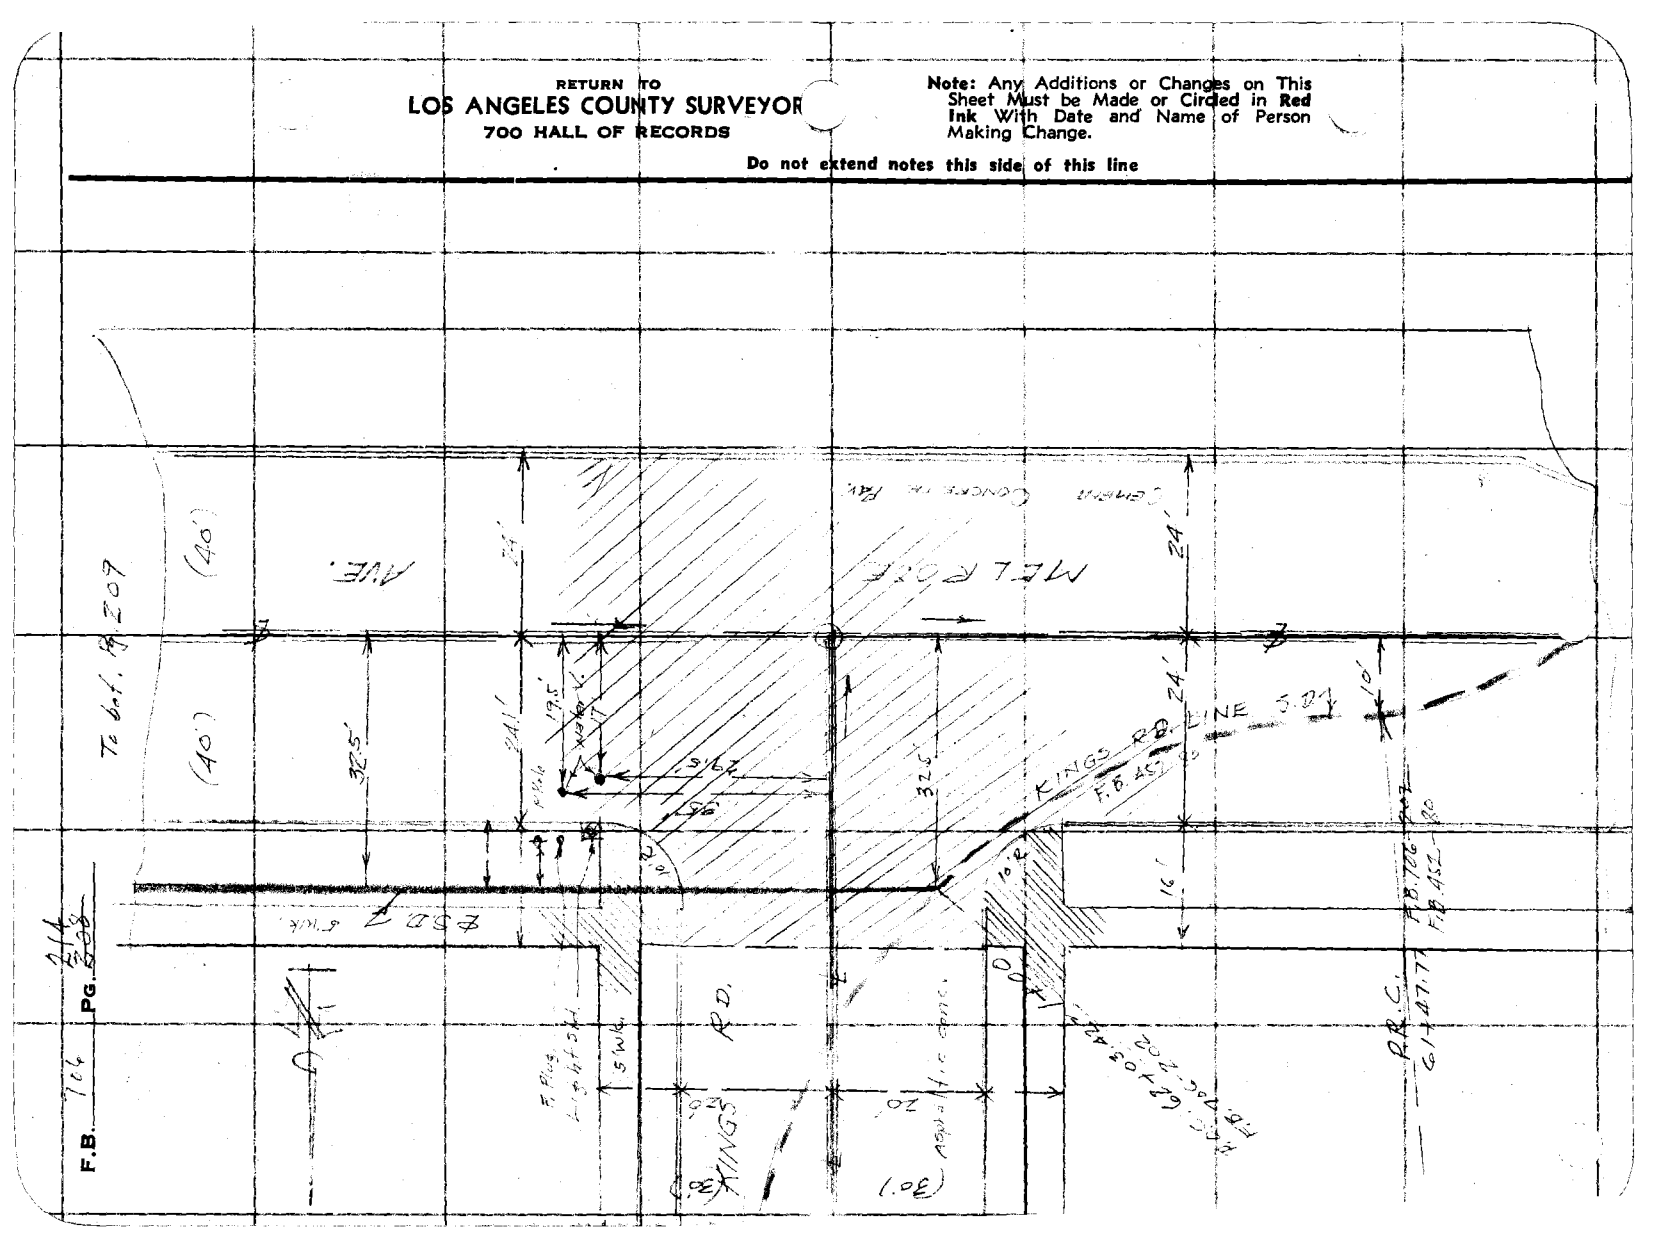

Notes Ck'd by	Survey of KM Hollywood D.S.
Map No.	W. O. 6318 Tape No. St'd °F.
Office Work	Surveyed by
Checked	Notes Date May 1937
Date	Indexed A. C. Johnson

F.B. 136 Pg. 215 207

To bk Pg. 210

(40') 325' (40')

Sewer M.H 3+26.5

AVE

16' 24.1' 24'



Exist. Sewer

Concrete

Pvmt

5' W.L.

2+57.30

32.5'

24.1' 24'

MELROSE

From top Pg. 208

Note: Any Additions or Changes on This Sheet Must be Made or Circled in Red Ink With Date and Name of Person Making Change

Do not extend notes this side of this line

RETURN TO
LOS ANGELES COUNTY SURVEYOR
700 HALL OF RECORDS

FORM 247 10M 11-35

RETURN TO
LOS ANGELES COUNTY SURVEYOR
700 HALL OF RECORDS

Note: Any Additions or Changes on This Sheet Must be Made or Circled in **Red Ink** With Date and Name of Person Making Change.

Do not extend notes this side of this line

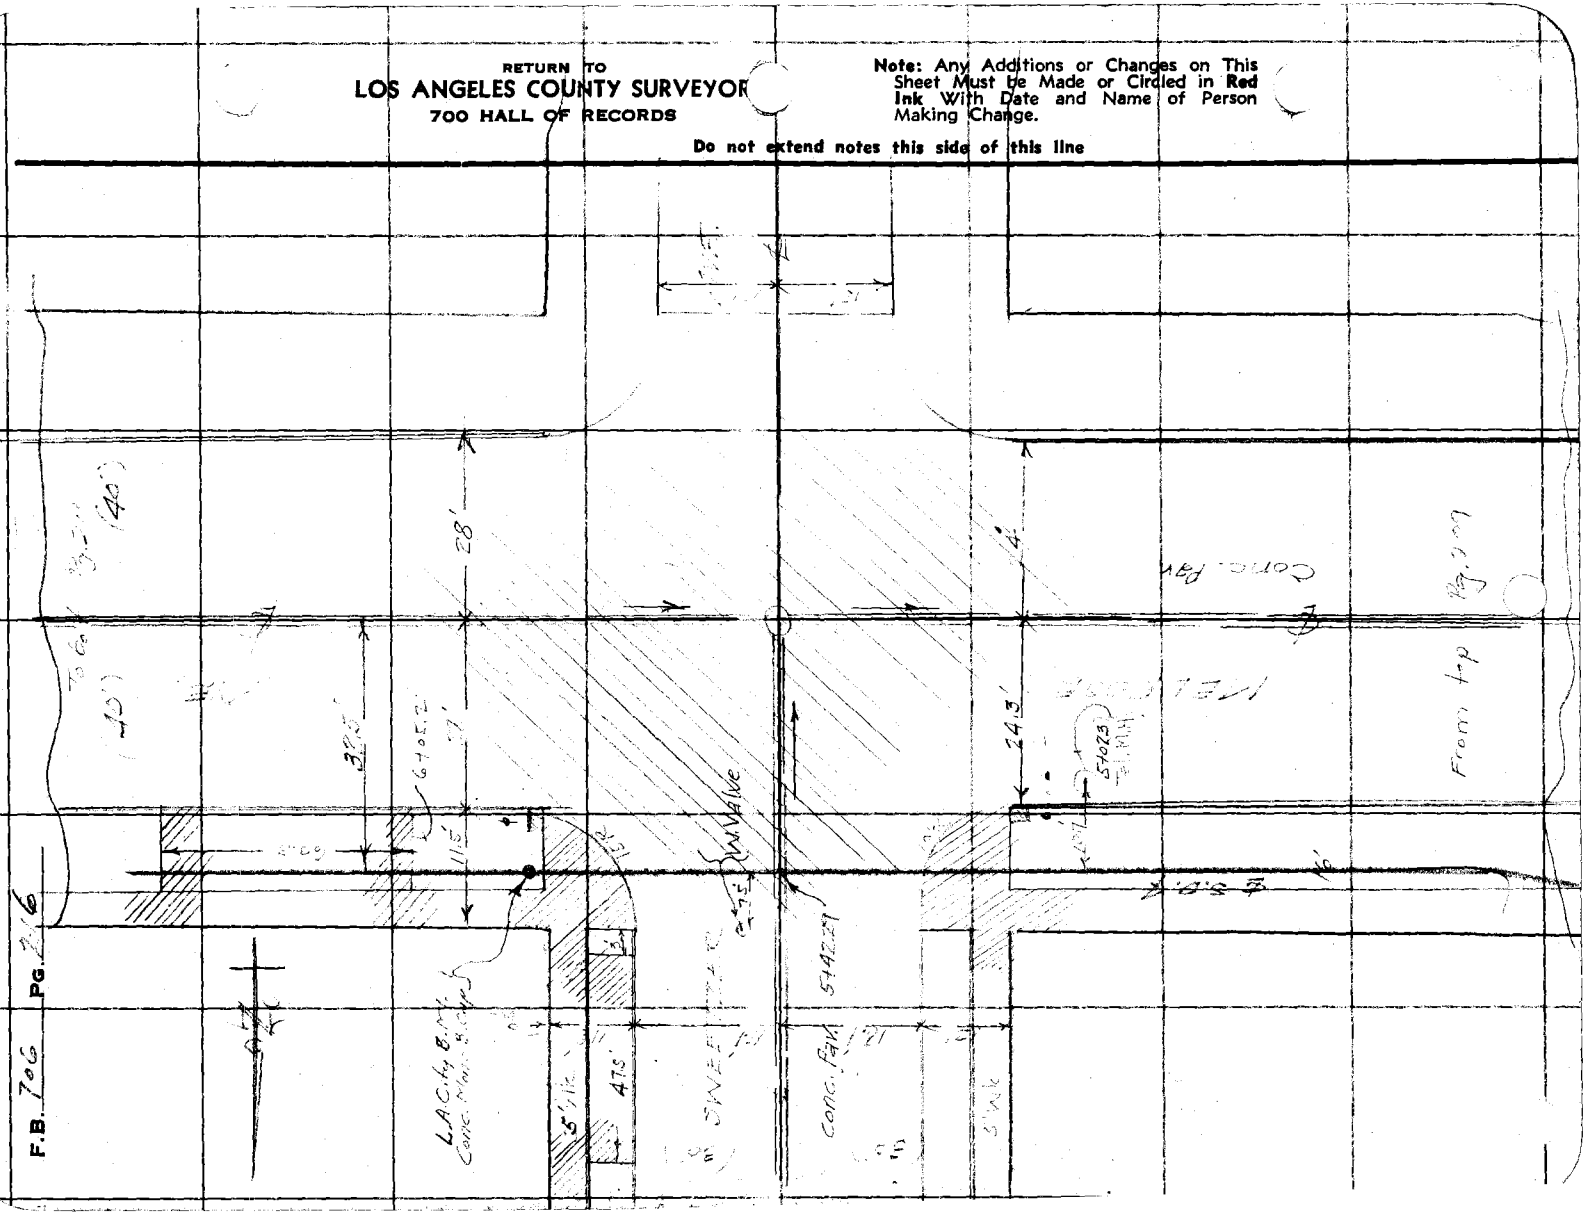



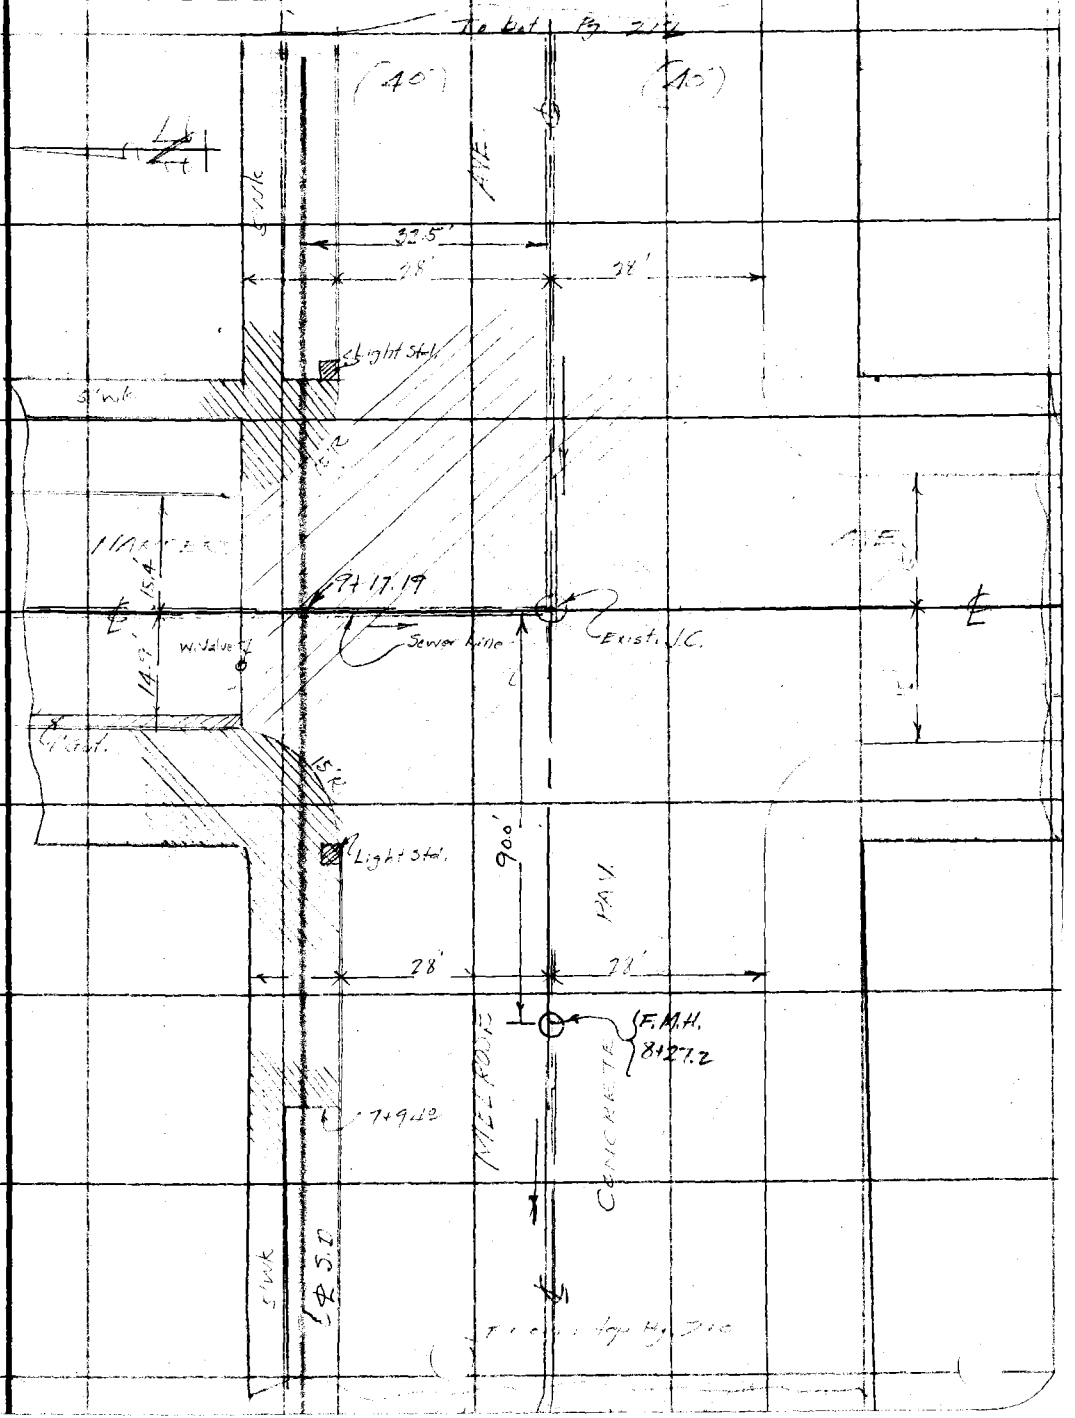

Note: Any Additions or Changes on This Sheet Must be Made or Circled in Red Ink With Date and Name of Person Making Change.

Do not extend notes this side of this line

RETURN TO
LOS ANGELES COUNTY SURVEYOR
7OO HALL OF RECORDS

FORM 247 10M 11-35

RETURN TO
LOS ANGELES COUNTY SURVEYOR
700 HALL OF RECORDS

Note: Any Additions or Changes on This Sheet Must be Made or Circled in **Red Ink** With Date and Name of Person Making Change.

Do not extend notes this side of this line

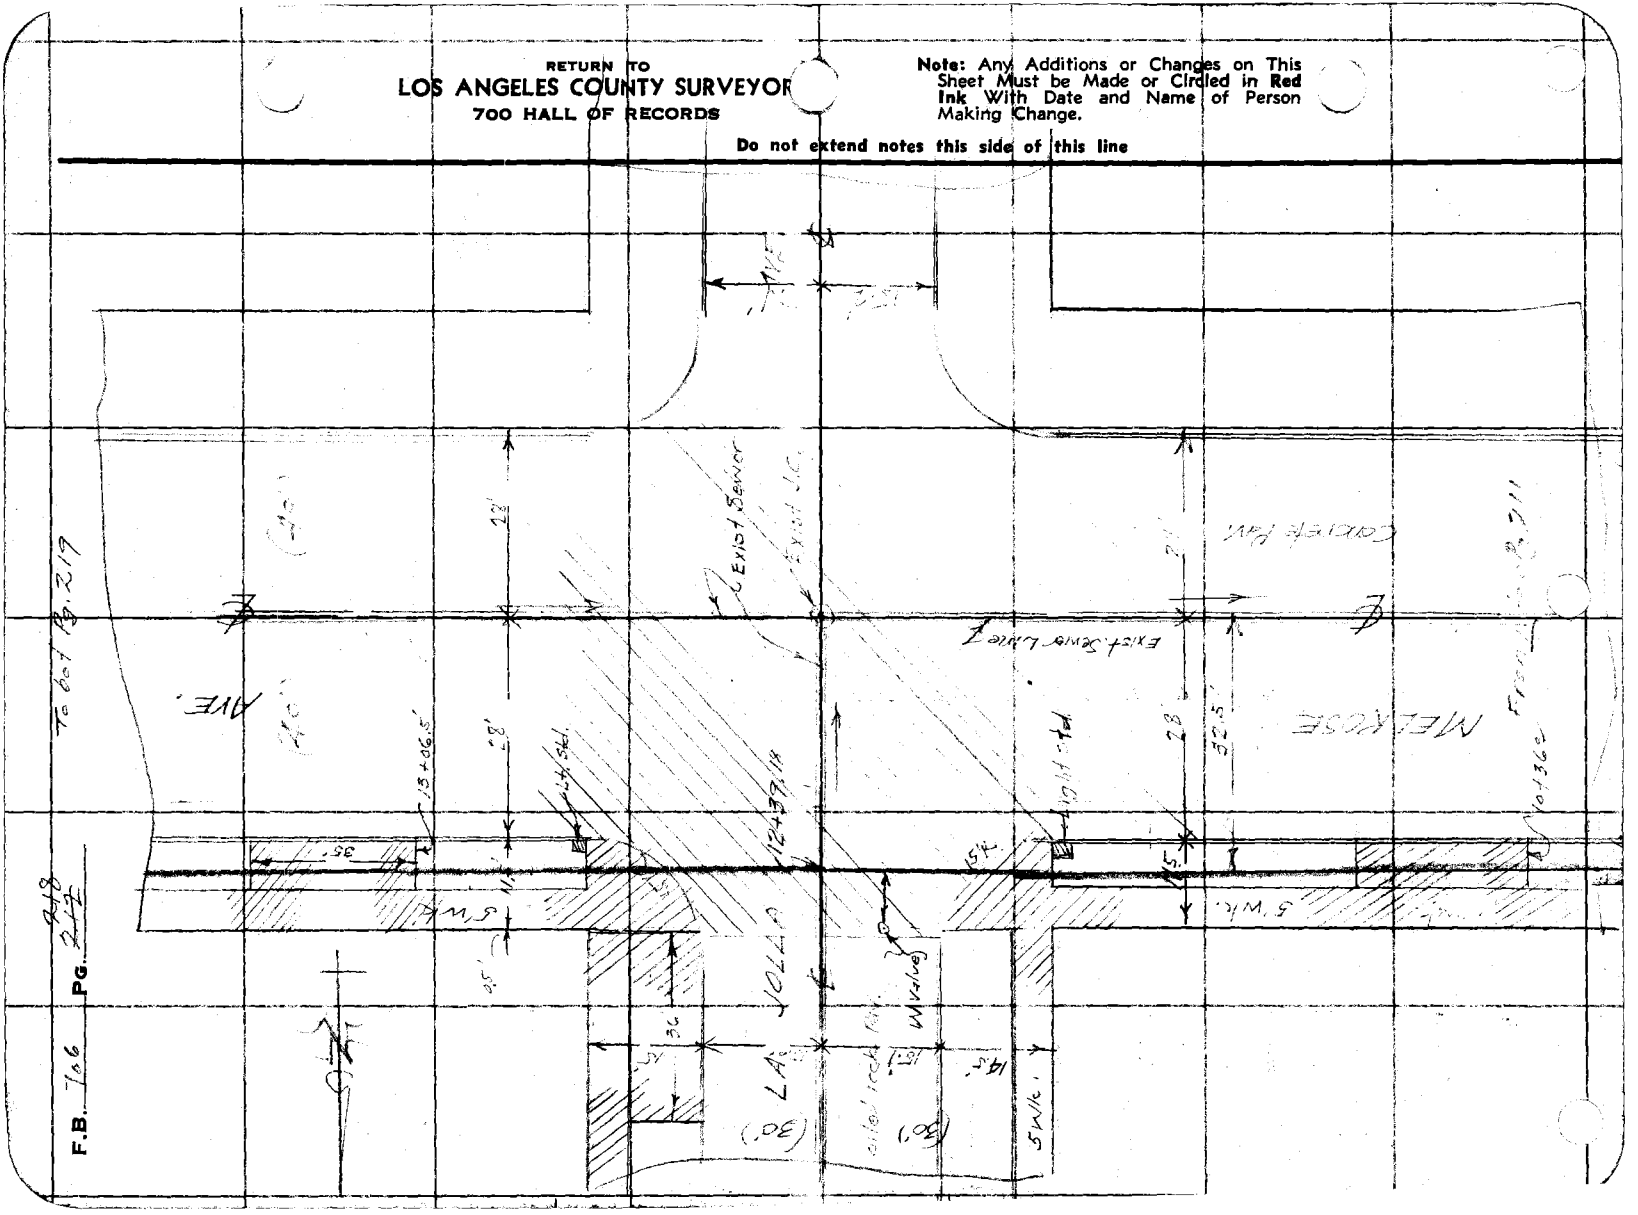

Notes Ck'd by	Survey of Hollywood
Map No.	W. O. 6318 Tape No. St'd °F.
Office Work	Surveyed by
Checked	Notes Date
Date	Indexed

F.B. Pg.

Note: Any Additions or Changes on This Sheet Must be Made or Circled in Red Ink With Date and Name of Person Making Change.

Do not extend notes this side of this line

RETURN TO
LOS ANGELES COUNTY SURVEYOR
700 HALL OF RECORDS

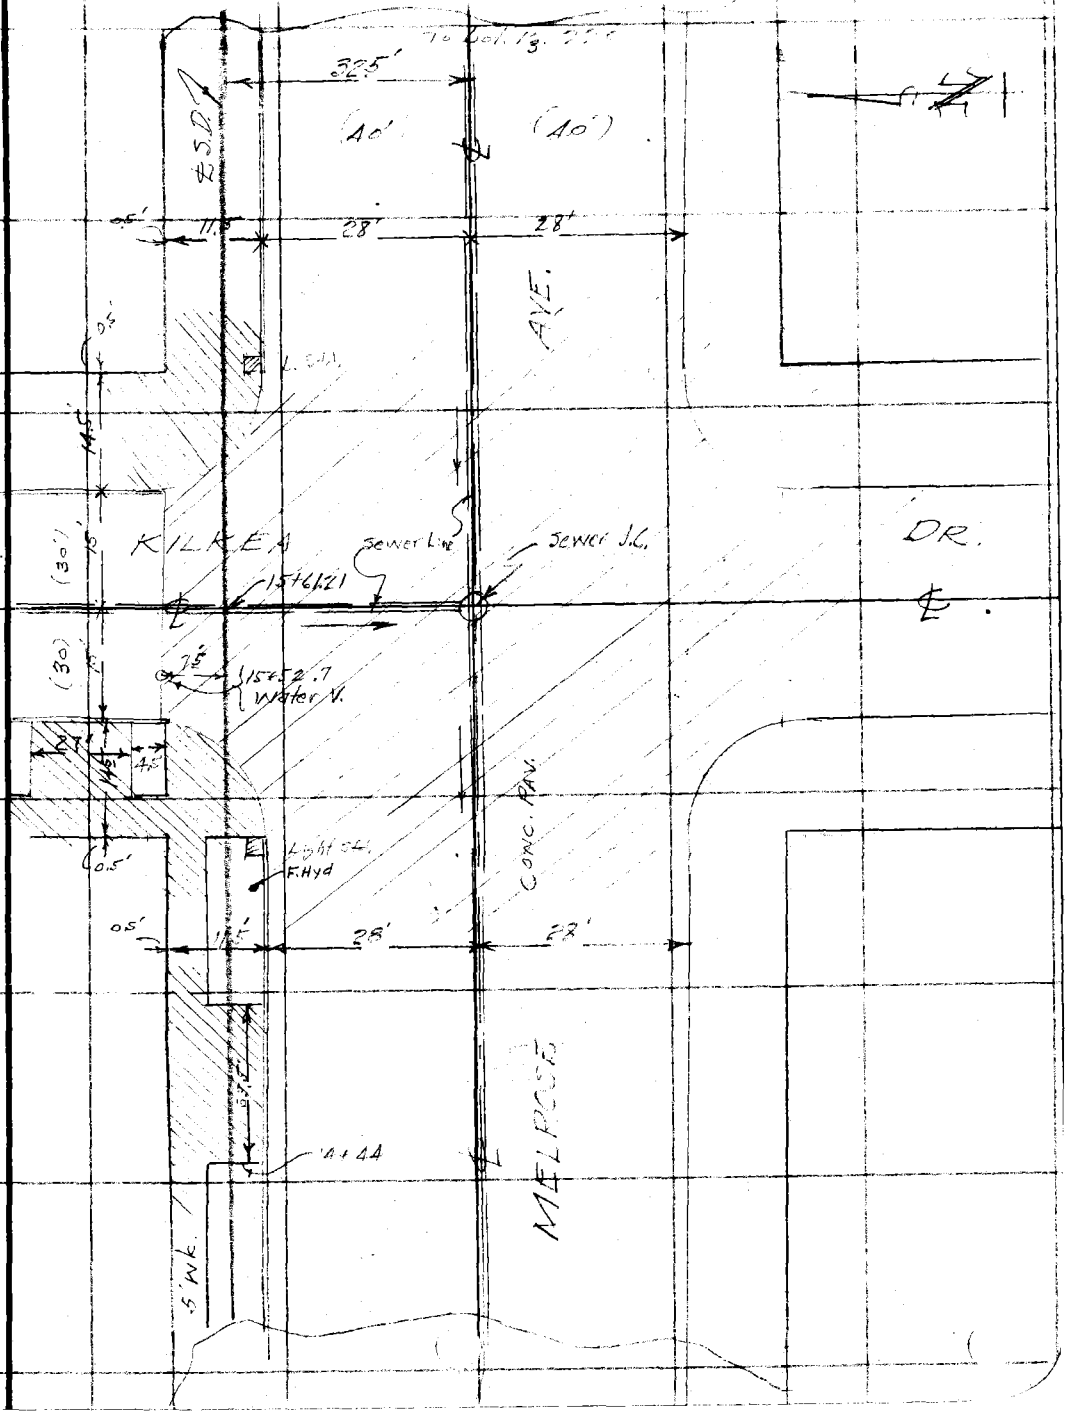

FORM 247 10M 11-38

RETURN TO
LOS ANGELES COUNTY SURVEYOR
700 HALL OF RECORDS

Note: Any Additions or Changes on This Sheet Must be Made or Circled in **Red Ink** With Date and Name of Person Making Change.

Do not extend notes this side of this line

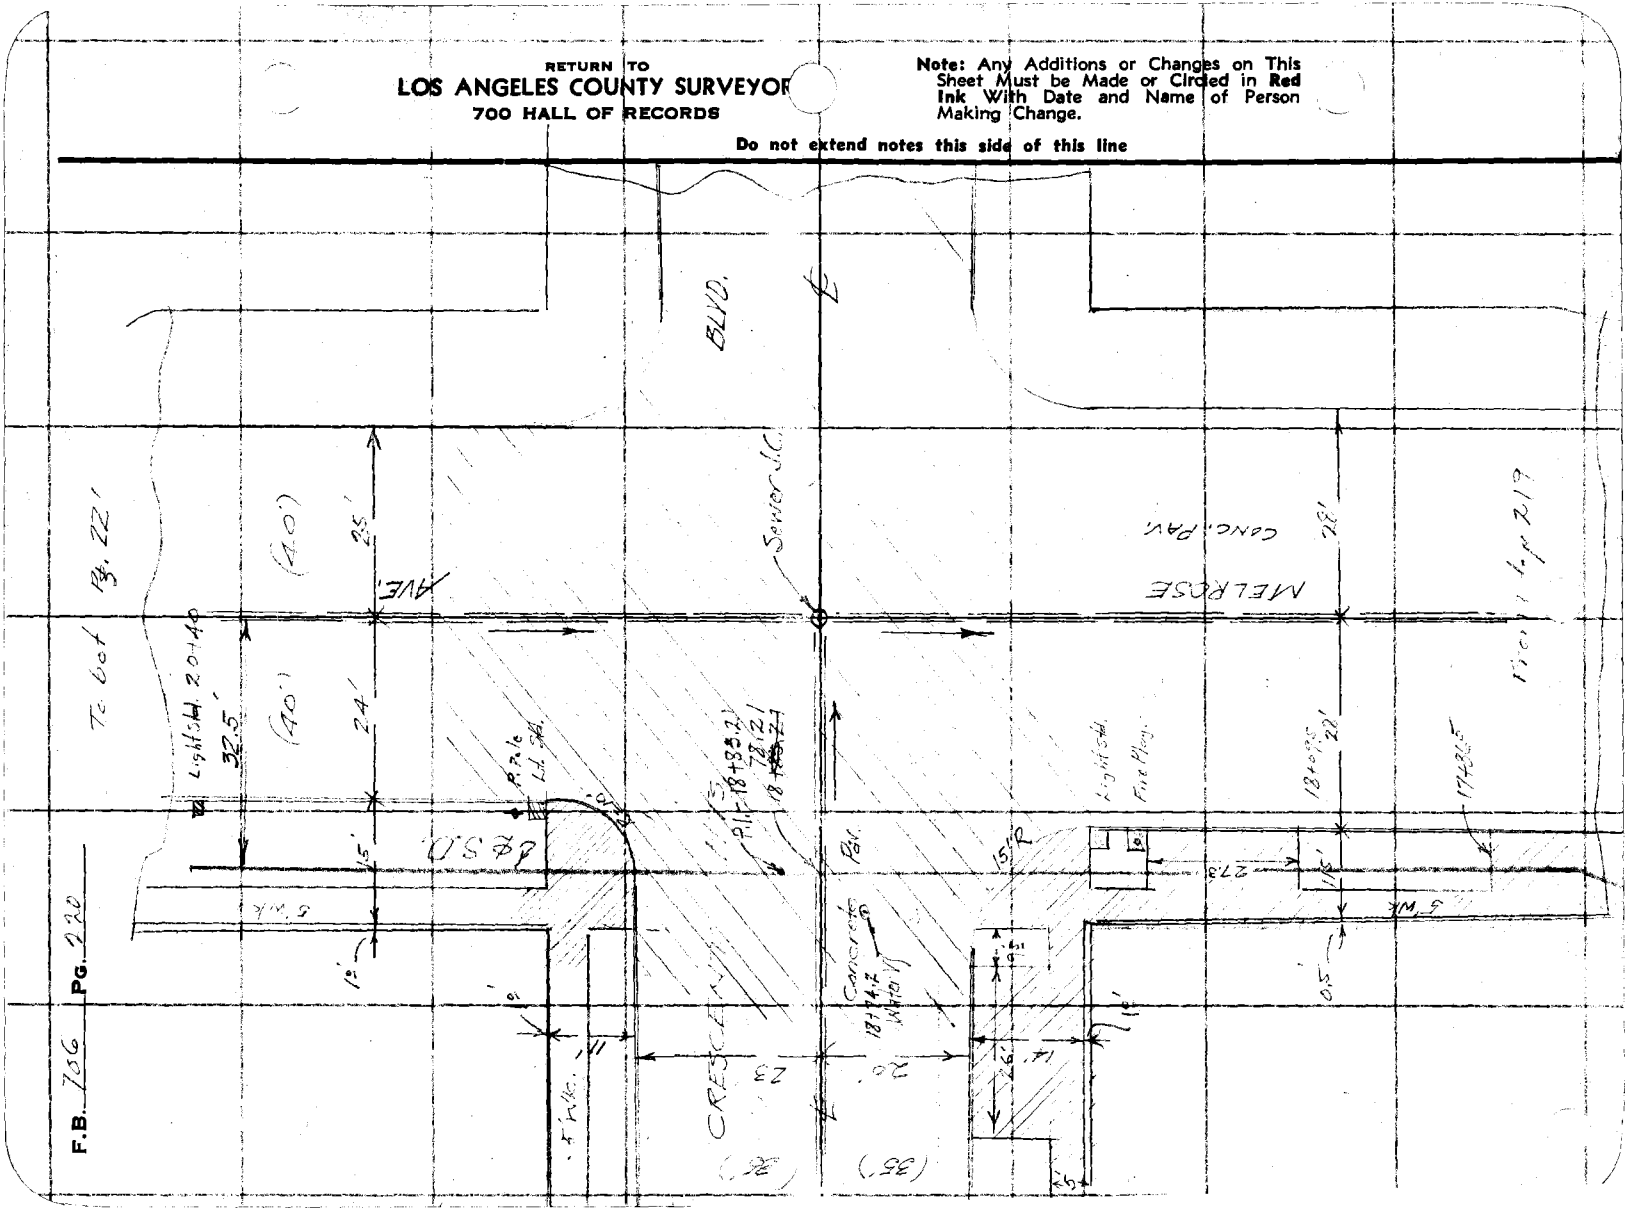

F.B. 756 Pg. 220

Notes Ck'd by	Survey of
Map No.	W. O. 6218 Tape No. St'd °F.
Office Work	Surveyed by
Checked	Notes Date
Date	Indexed C. Johnson

F.B. Pg.

Note: Any Additions or Changes on This Sheet Must be Made or Circled in Red Ink With Date and Name of Person Making Change.

Do not extend notes this side of this line

RETURN TO
LOS ANGELES COUNTY SURVEYOR
700 HALL OF RECORDS

FORM 247 10M 11-35

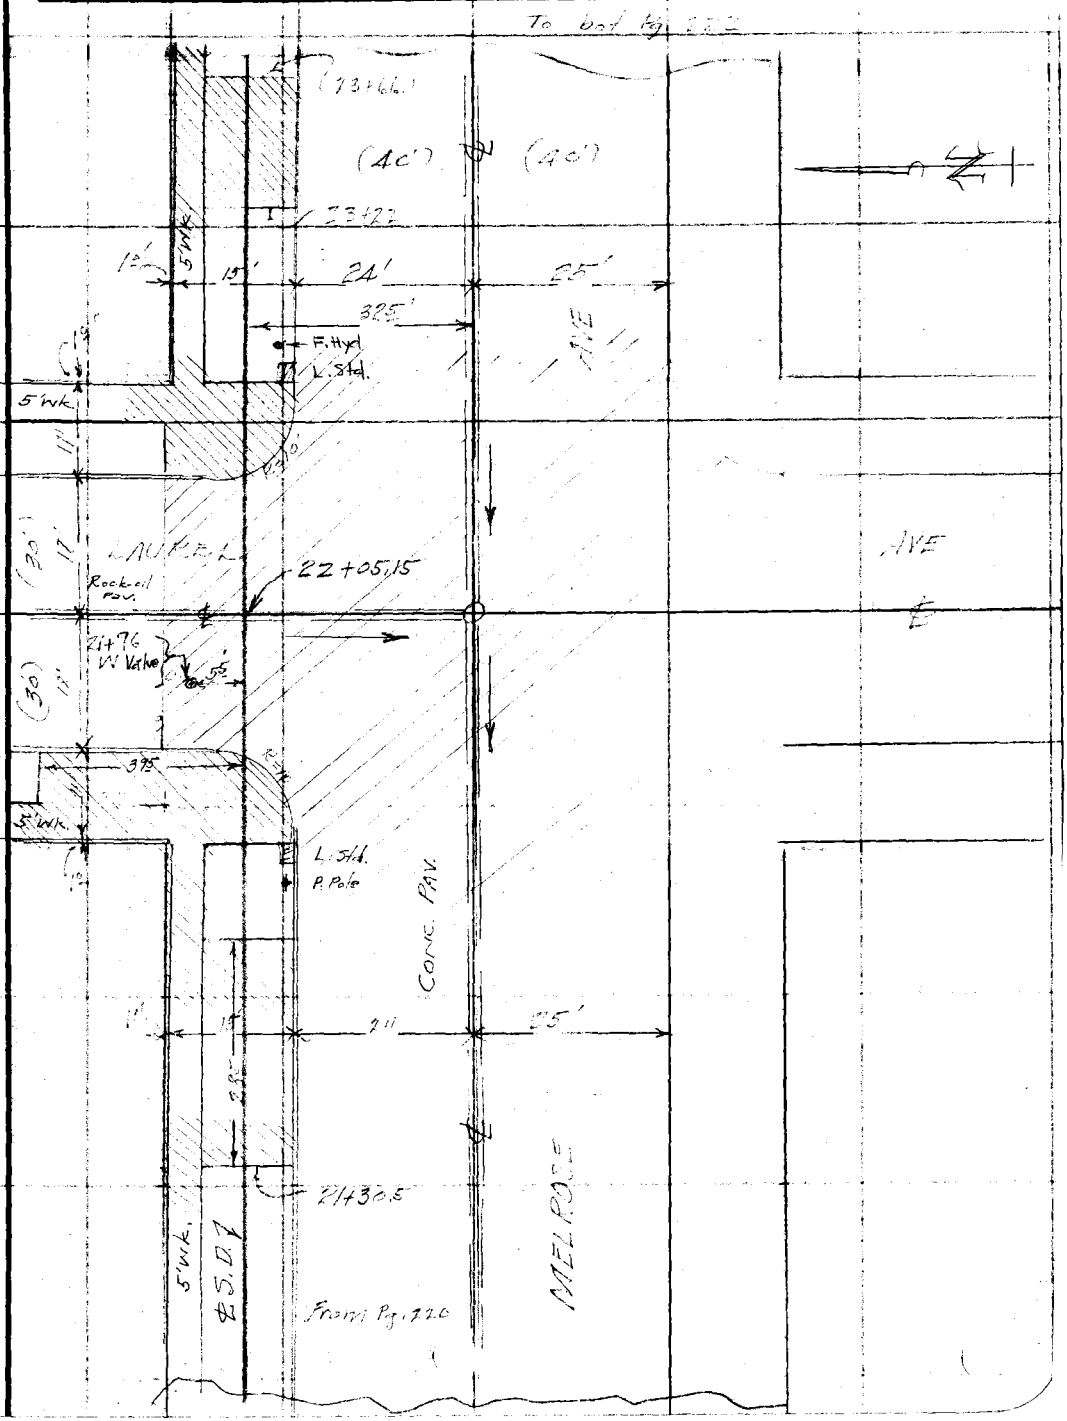

F.B. 706 PG. 222

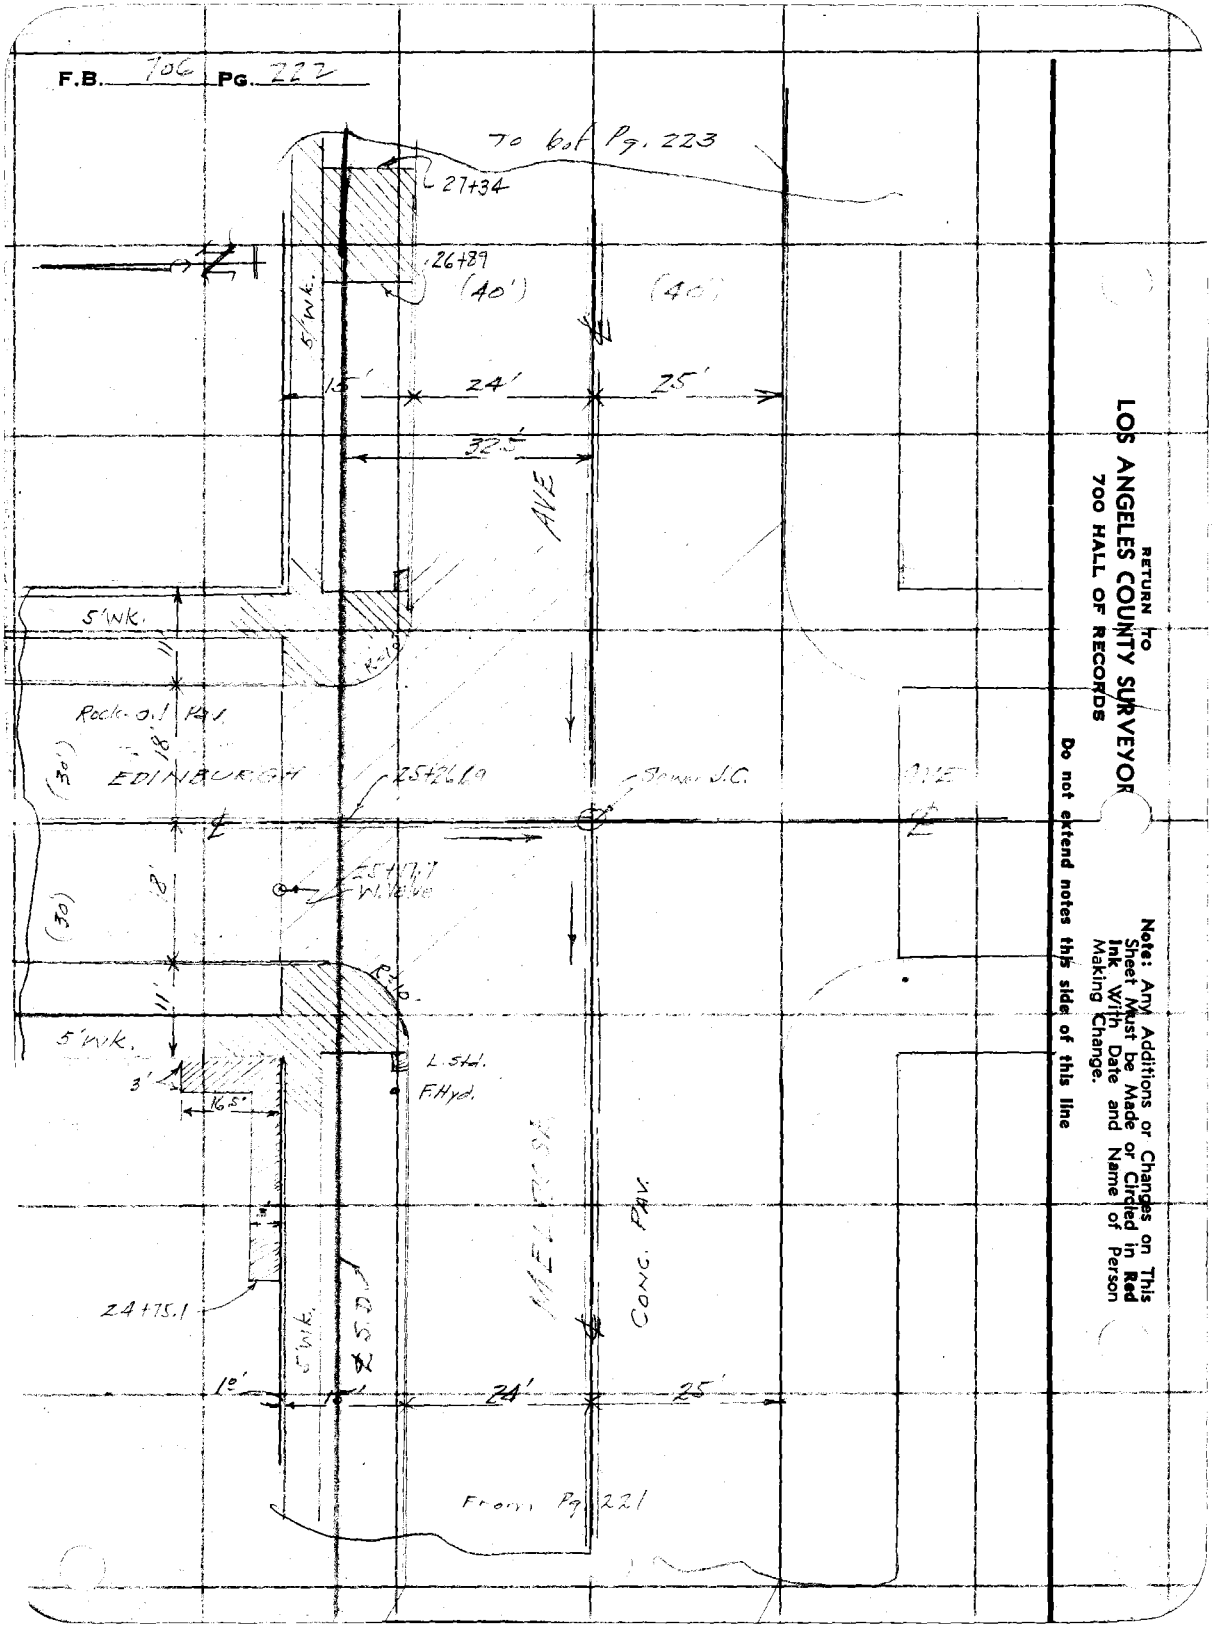

RETURN TO
LOS ANGELES COUNTY SURVEYOR
700 HALL OF RECORDS

Do not extend notes this side of this line

Note: Any Additions or Changes on This Sheet Must be Made or Circled in Red Ink With Date and Name of Person Making Change.

Notes Ck'd by	Survey of Various
Map No.	W. O. 6318 Tape No. St'd °F.
Office Work	Surveyed by W.I.
Checked	Notes Date June 1937
Date	Indexed C. Johnson

F.B. 726 PG. 15

Note: Any Additions or Changes on This Sheet Must be Made or Circled in Red Ink With Date and Name of Person Making Change.

Do not extend notes this side of this line

RETURN TO
LOS ANGELES COUNTY SURVEYOR
700 HALL OF RECORDS

5'Wk. (40') AVE. (40')

15' 15' 24'

1' 5'Wk. L. Std.

11' 18' HARVARD

Rock & Pav. 2845109 Sewer M.

30' 10' 28142 Widen 55'

5'Wk. 15' L. Std. F. Hyd.

32.5'

1' 15' 24' 28' Conc. Pav.

27479

5'Wk. From Pg 322

MELROSE AVE.

FORM 247 10M 11-35

RETURN TO
LOS ANGELES COUNTY SURVEYOR
700 HALL OF RECORDS

Note: Any Additions or Changes on This Sheet Must be Made or Circled in **Red Ink** With Date and Name of Person Making Change.

Do not extend notes this side of this line

F.B. 706 Pg. 224

Profile No. | Notes Red | Plotted | Job No. | Division No. | F. B. | PG.

X-Sec. No. | Notes Chkd | Checked | Survey by A. C. Johnson | Notes | Date

Date | Date | Map No. | Indexed | Date

NOTE: ANY ADDITIONS OR CHANGES ON THIS SHEET MUST BE MADE OR CIRCLED IN RED INK, WITH DATE AND NAME OF PERSON MAKING CHANGE

Do not extend notes this side of this line

PLEASE RETURN TO
LOS ANGELES COUNTY SURVEYOR
700 HALL OF RECORDS

Form 307 5M 11-35

STATION	B. S.	H. I.	F. S.	ELEV.

PROFILE

[illegible] LA JOLLA AV. CANAL

WEST HOLLYWOOD U.S.
JN. 6316

& Survey F.B. 706 P. 201 ~~206~~ 212
Topog I.B. 706 P. 213-224

(5)

Walters
Clegg
[illegible]
Tellez
Lima

RECEIVED Smelser MAY [illegible] 1957

PROGRESSED ✓ ✓

BOOK INDEXED ✓ ✓

MAP INDEXED ✓ ✓

~~RECORD INDEXED~~ ✓ ✓

CARD INDEXED ✓ ✓

REDUCED in field

CHECKED LCM

Form 307 5M 11-35

PLEASE RETURN TO
LOS ANGELES COUNTY SURVEYOR
700 HALL OF RECORDS

NOTE: ANY ADDITIONS OR CHANGES ON THIS SHEET MUST BE MADE OR CIRCLED IN RED INK, WITH DATE AND NAME OF PERSON MAKING CHANGE

Do not extend notes this side of this line

F. B. 72 Pg. 26 | Job No. 634 F | Division No. | Profile No. | X-Sec. No.

Survey of W. Hollywood 23

Survey by C. Johnson | Notes Gregory | Notes Red. | Plotted | Date | Notes Chkd. | Checked | Date

Indexed | Date | Date | Date

STATION	B. S.	H. I.	F. S.	ELEV.	Melrose Ave
					Kings Rd
BM D-49	7.16	206.67		199.51	BM D-49 El 199.51 F.B. 65-42 Melrose Ave & Kings Rd S.E. Cor. Wr. Spk 1' E of E end C.P.
			6.42	200.53	℄ 1st Melrose Ave & Kings Rd S.E. Cor. 55 ft. to 100 Kings Rd
POC 1700 Beg. = 617.00 ft. from Kings Rd Line			6.44	200.25	℄ SD.
			6.05	201.64	T.C. W on N W C.R.
			8.78	197.96	Curb " " " "
			5.44	201.74	T.C. N " " "
			6.42	201.07	Curb " " " "
			5.42	201.07	T.C. N " N E C.R.
			6.20	200.43	Curb " " " "
			5.55	201.11	T.C. E " " "
			6.26	200.43	Curb " " " "
					Melrose Ave
2400			5.22	201.45	Scribe Line on N ℄ 5.50
			5.00	201.69	℄ SD.
			5.30	201.39	T.C. N C.L.
			5.92	200.77	Curb " "
			4.98	201.71	T. Wall "

Form 307 5M 11-35

PLEASE RETURN TO
LOS ANGELES COUNTY SURVEYOR
700 HALL OF RECORDS

NOTE: ANY ADDITIONS OR CHANGES ON THIS SHEET MUST BE MADE OR CIRCLED IN RED INK, WITH DATE AND NAME OF PERSON MAKING CHANGE

Do not extend notes this side of this line

Profile No. X-Sec. No. Notes Red. Date Notes Chkd. Date Plotted Date Checked Date Job No. Survey of Survey by Map No. Division No. Date Date Notes Indexed C. Johnson Date F. B. PG. 77

STATION	B. S.	H. I.	F. S.	ELEV.	Notes
		210.20			Flores St.
24+50			+65	202.04	± Ctr. St. & Flores St.
			+04	201.65	T.C.
			566	201.03	Gutter
			4.14	201.92	T. Walk
25+00			+5	202.2	± S.D.
			+40	201.79	T.C. W. Cor. Pl.
			5.45	201.7	Gutter
			4.82	202.17	T. Walk
TP	6.31	208.20	4.79	201.94	
4+00			57	202.6	± S.D.
			597	202.33	T.C. W. Cor. Pl.
			664	201.66	Gutter
			5.72	202.58	T. Walk
5+00			53	203.0	± S.D.
			557	202.73	T.C.
			5.17	202.13	Gutter
			5.30	203.00	T. Walk
5+02.3			5.06	202.24	Tel. Pl. 102 S.D. ± S.D.
5+12.3			5.26	203.04	Edge Conc. Walk ± S.D.

Form 307 5M 11-35

PLEASE RETURN TO
LOS ANGELES COUNTY SURVEYOR
700 HALL OF RECORDS

NOTE: ANY ADDITIONS OR CHANGES ON THIS SHEET MUST BE MADE OR CIRCLED IN RED INK, WITH DATE AND NAME OF PERSON MAKING CHANGE

Do not extend notes this side of this line

F. B. 72-Pg. 228 | Job No. 6318 Division No. | Notes Red. Date | Plotted Date | Profile No.
Survey of | Date | Checked Date | X-Sec. No.
Survey by C. Johnson Notes | Notes Chkd. Date
Indexed | Date

STATION	B. S.	H. I.	F. S.	ELEV.	Melrose Ave Sta
		205 30			Sweet. & Ave
5+14.3			5+26	200 82	T.C. N end No. W Cor
"			6 11	200 12	Gutter " " " "
5+22.3			5+28	200 07	T.C. " " " "
"			5 94	200 36	Gutter " " " "
5+42 29			5 87	200 43	8 in S.D. & Sweetzer Ave
			6 00	200 30	Gutter 6' S.E. = SD on E Sweetzer
			5+65	200 65	SS. M.H. 10 E Melrose Ave
			1+90	198 37	1 Inv 8" Inlet N
			17 27	191 03	1 Inv. 8" Inlet E
			14 28	191 02	1 Inv 8" Drop N
			17 39	190 91	1 Inv 8" Outlet W
			6 21	202 69	T.C. N end Sidewalk
			6 32	201 58	Gutter " " " "
			5 97	201 23	T.C. S " " "
			6 12	201 65	Gutter " " " "
			6 02	201 28	T.C. S " Block
			6 63	201 67	Gutter " " " "
			5+14	201 46	T.C. E "
			5 21	201 90	Gutter "

N	E	N	W
5.63	5.64	5.63	5.64
10.63	11.08	2.98	11.08
67	67	67	67
10.93	17.72	14.26	17.39

Form 307 5M 11-35

PLEASE RETURN TO
LOS ANGELES COUNTY SURVEYOR
700 HALL OF RECORDS

NOTE: ANY ADDITIONS OR CHANGES ON THIS SHEET MUST BE MADE OR CIRCLED IN RED INK, WITH DATE AND NAME OF PERSON MAKING CHANGE

Do not extend notes this side of this line

STATION	B. S.	H. I.	F. S.	ELEV.	
		208 30		20 & 72nd Ave.	Kelvin Ave.
				204 35	
				204 38	
				203 88	
				204 28	
				203 93	
				207 13	
					See Warning Line Notes
5460.3				203 10	
"				202 56	
475.3				203 04	
"				202 42	
5792				203 21	
				203 01	
				203 14	
				202 45	
				203 37	
				203 30	
				203 55	

Profile
No. ____ X-Sec. ____ No. ____
Notes Red ____ Plotted ____ Job No. ____ Division No. ____
Date ____ Date ____ Survey of ____
Notes Chkd ____ Checked ____ Survey by ____ Notes ____ Date ____
Date ____ Date ____ Map No. ____ Inked D. Johnson Date ____
F. B. ____ PG. ____

Form 307 5M 11-35

PLEASE RETURN TO
LOS ANGELES COUNTY SURVEYOR
700 HALL OF RECORDS

NOTE: ANY ADDITIONS OR CHANGES ON THIS SHEET MUST BE MADE OR CIRCLED IN RED INK, WITH DATE AND NAME OF PERSON MAKING CHANGE

Do not extend notes this side of this line

F. B. 706 PG. 230 | Job No. 6318 | Division No. | Profile No. | X-Sec. No.

Survey of W. Florence Ave. | Notes Red. Survey | Plotted | Date | Checked | Date

Survey by A. C. Johnson | Notes Stations | Date | Notes Chkd. | Date

Indexed | Date

STATION	B. S.	H. I.	F. S.	ELEV.	
		✓	Melrose Ave		8+27.2 = F.M.H. 90.0' W. of ℄ Intn. Harper & Melrose Ave
		208.30 ✓			B.M. D-46 4.78 208.67 203.89' 9.85 5.02 14.87
					Top of F.M.H. 5.02' 203.65'
7+00	5.58	208.84	5.14	203.70	Bottom of channel 14.87' 193.80
7+00			5.3	203.5	± SD B.M. D-124 6.24 202.43 — Sweetzer & Melrose Ave. N. end S.E. Cor.
"			5.38	203.46	TC N CB. Pk
"			6.00	202.84	Gutter " "
"			5.16	203.68	Top of Walk
7+94			4.96	203.88	Back of Walk ± SD (Solid Walk)
8+00			4.80	204.04	± SD
"			4.75	203.87	TC N CB.
"			5.02	203.72	Gutter " "
					(B.M. D-45 E 203.391 FB, 88 p. 30
B.M. D-46	5.23	210.53	4.94	205.59	Melrose Ave & Fairfax Ave. S.E. Cor.
					Mh. Spk E 0.1' S 0.1' of CP
			Harper Ave.		
8+87.2			6.65	203.88	TC N end W side CP
"			7.01	203.52	Gutter " " " "
7+02.2			6.45	204.08	TC N " " " "
"			7.01	203.52	Gutter " " " "
9+			7.25	203.28	± SD

Form 307 5M 11-35

PLEASE RETURN TO
LOS ANGELES COUNTY SURVEYOR
700 HALL OF RECORDS

NOTE: ANY ADDITIONS OR CHANGES ON THIS SHEET MUST BE MADE OR CIRCLED IN RED INK, WITH DATE AND NAME OF PERSON MAKING CHANGE

Do not extend notes this side of this line

STATION	B. S.	H. I.	F. S.	ELEV.	Melrose Ave Lat.
		210 53		Melrose Ave	
4217			104	203 29	
			114	203 67	
			20	204 37	
			10	193	Inv 8" Inlet N
			20	193	Inv. 8" Inlet S
			17 27	193 56	Inv. 8" Inlet N Dry
			20 26	193 57	Inv 8" Outlet S
			3 35	203 45	
				202 85	
				202 93	
				202 92	
				203 52	
				208 59	
			4 37	203	
			4 35	206 43	
			4 05	210	W Side
			3 14	205	

	S	N
0+00	0+00	0
12+00	12+00	98
67	67	67
79+67	79+67	165
	10.17	

2.63

Profile No. ____ Notes Red ____ Plotted ____ Job No. ____ Division No. ____ F. B. ____ PG. 231

X-Sec. No. ____ Date ____ Date ____ Survey of ____

Notes Chkd. ____ Checked ____ Survey by ____ Notes ____

Date ____ Date ____ Map No. ____ Indexed J. Johnson Date ____ Date ____

Form 307 5M 11-35

PLEASE RETURN TO
LOS ANGELES COUNTY SURVEYOR
700 HALL OF RECORDS

NOTE: ANY ADDITIONS OR CHANGES ON THIS SHEET MUST BE MADE OR CIRCLED IN RED INK, WITH DATE AND NAME OF PERSON MAKING CHANGE

Do not extend notes this side of this line

F.B. 706 PG. 232 | Job No. 835 | Division No. | Notes Red. | Plotted | Profile No.
Survey of | Date | Date | X-Sec. No.
Survey by | Notes | Notes Chkd. | Checked
Indexed | Date | Date | Date

STATION	B. S.	H. I.	F. S.	ELEV.	Notes
		1.			E Harbor Ave
		210 83			
			452	205 31	TC E Side Jog N of Z SD
			496	205 87	Gutter " " " " " "
			0+00	206 37	SSMH N of Z SD, on E Harbor Ave
					3.42 3.46
					See Warring Ave Line Notes
+32.2			040	206 42	TC N end N Z SD
"			353	204 03	Gutter " " " "
+47.2			625	204 59	TC E " " "
"			648	204 84	Gutter " " " "
9+47			9	204 64	Edge Conc. walk Z SD Melrose Ave
10+00			55	205 3	Z SD
"			656	204 18	TC N Side "
"			665	204 28	Gutter " "
"			681	204 37	TC W of R
T.P.	523	210 76	530	205 53	
10+31			517	205 59	Edge Conc. Walk Z SD
10+			456	206 20	" " " "
11+55			47	205 1	Z SD

Form 307 5M 11-35

PLEASE RETURN TO
LOS ANGELES COUNTY SURVEYOR
700 HALL OF RECORDS

NOTE: ANY ADDITIONS OR CHANGES ON THIS SHEET MUST BE MADE OR CIRCLED IN RED INK, WITH DATE AND NAME OF PERSON MAKING CHANGE

Do not extend notes this side of this line

Profile No. X-Sec. No.

Notes Red. Date Plotted Job No. Division No.
Notes Chkd. Date Checked Survey of Date
Date Map No. Survey by Notes Indexed Johnson Date Date

F. B. Pg. 232

STATION	B. S.	H. I.	F. S.	ELEV.	
		210 76		Melrose Ave	
12+00			340	207 36	℄ SP.
12+10			335	207 41	Edge Conc. Walk ℄ SD.
T.P.	5.17	212.81	332	207 44	
				La Jolla Ave	
12+09.2			609	203 22	TC W end NW wing
"			676	204 55	Stop
12+11.2			545	207 26	TC
"			550	205 51	
12+30 ℄			555	204 93	℄ [illegible] & La Jolla Ave.
			[illegible]	206 51	Stop [illegible]
			[illegible]	208 24	55 [illegible] Melrose Ave & La Jolla Ave
			[illegible]	[illegible]	[illegible]
15 68		[illegible]	[illegible]	[illegible]	Inv 5' to b' ℄
15 95		[illegible]	[illegible]	[illegible]	Inv 10 Drop N.
15 57		[illegible]	[illegible]	206 46	Inv 8" Dr. W
[illegible]			[illegible]	206 40	[illegible]
[illegible]			[illegible]	205 86	[illegible]
[illegible]			[illegible]	206 48	[illegible]
[illegible]			[illegible]	205 85	Stop

	E	N	
[illegible]	[illegible]	9	
11 58	[illegible]	902	207
67	67	67	67
5 65	[illegible]	[illegible]	1 85

F. B. 706 PG. 34 | Job No. 535 | Division No. | Notes Red. | Plotted | Profile No.

Survey of | Date | Date | X-Sec. No.

Survey by | Notes | Notes Chkd. | Checked

Indexed | Date | Date | Date

Form 307 5M 11-35

PLEASE RETURN TO
LOS ANGELES COUNTY SURVEYOR
700 HALL OF RECORDS

NOTE: ANY ADDITIONS OR CHANGES ON THIS SHEET MUST BE MADE OR CIRCLED IN RED INK, WITH DATE AND NAME OF PERSON MAKING CHANGE

Do not extend notes this side of this line

STATION	B. S.	H. I.	F. S.	ELEV.

Form 307 5M 11-35

PLEASE RETURN TO
LOS ANGELES COUNTY SURVEYOR
700 HALL OF RECORDS

NOTE: ANY ADDITIONS OR CHANGES ON THIS SHEET MUST BE MADE OR CIRCLED IN RED INK, WITH DATE AND NAME OF PERSON MAKING CHANGE

Do not extend notes this side of this line

STATION	B. S.	H. I.	F. S.	ELEV.		
					Release from Co. Lab.	
					Release 4 ws	

Form 307 5M 11-35

PLEASE RETURN TO
LOS ANGELES COUNTY SURVEYOR
700 HALL OF RECORDS

NOTE: ANY ADDITIONS OR CHANGES ON THIS SHEET MUST BE MADE OR CIRCLED IN RED INK, WITH DATE AND NAME OF PERSON MAKING CHANGE

Do not extend notes this side of this line

F. B. No. 6318 Pg. 36 | Job No. 6318 | Division No. | Notes Red. | Plotted | Profile No.
Survey of VI | Date | Date | X-Sec. No.
Survey by C. Johnson | Notes | Notes Chkd. | Checked
Indexed | Date | Date | Date

STATION	B. S.	H. I.	F. S.	ELEV.	Kilkea Dr.
		217.0			
			6.61	210.40	T.C. W.E.C.R. N.W.C.
			7.22	209.79	gutter " "
			6.35	210.66	T.C. N.E.C.R. N.W.C
			6.85	210.15	gutter " " S?
			7.08	209.93	T.C. W.E.C.R. N.W.C.
			7.72	209.29	gutter
			7.01	210.00	T.C. E.C.R. S.W.C.
			7.72	209.29	gutter
15+61.21			6.76	210.25	INT. of S.D. & Kilkea
			6.85	210.16	gutter
			11.34	205.67	Top of DMH. & Kilkea dr. & Melrose Ave.
			18.47	198.52	→ 8" drop inlet N.
			18.41	198.60	8" inlet E
			18.54	198.47	8" outlet W
			8.30	208.71	℄ of Kilkea 100 S. of ℄ of Melrose
			8.30	208.71	T.C. W. side
			8.67	208.34	gutter
			8.06	208.95	T.C. E. side
			8.51	208.50	gutter

	S.	E.	W.
	6.45	6.45	6.47
	4.37	11.29	11.40
	.67	.67	.67
	18.49	18.41	18.54
	11.34		

Form 307 5M 11-35

PLEASE RETURN TO
LOS ANGELES COUNTY SURVEYOR
700 HALL OF RECORDS

NOTE: ANY ADDITIONS OR CHANGES ON THIS SHEET MUST BE MADE OR CIRCLED IN RED INK, WITH DATE AND NAME OF PERSON MAKING CHANGE

Do not extend notes this side of this line

Profile No. ____ X-Sec. No. ____ Notes Red. ____ Date ____ Notes Chkd. ____ Date ____ Map No. ____ Plotted ____ Date ____ Checked ____ Date ____ Survey of ____ Survey by ____ Job No. ____ Division No. ____ Date ____ Notes Indexed Johnson Date ____ F. B. ____ PG. ____

STATION	B. S.	H. I.	F. S.	ELEV.	
		217.3			Kilker Dr.
			5.74	210 27	T.C. S.E.C.R.S.E.C.
			7.34	209.67	gutter
			6.41	210.53	T.C. N.E.C.R.S.E.C.
			7.14	209.80	gutter
			5.07	211.94	2 Kilker 100' N. of Vernon Ln
			5.10	211.91	T.C. S.E.C.
			5.43	211.58	gutter
			5.30	211.71	T.C. W.S.C.
			5.14	211.87	gutter
			1.34	215.67	C.S.M.H. 273' N.E. J.D.
			10.40	206.61	8" inlet N.
			10.49	206.52	8" outlet S.
			5.11	211.13	T.C. N.E.C.R.A.P.C.
			5.70	210.54	gutter
			5.09	211.15	T.C. E.A.C.R.M.P.C.
			6.93	210.58	gutter
B.M.			6.95	210.56	B.M. D-44 W.S. 2' E.E.C.R.C.E.C. Elev. = 210.55
B.M.	7.13	217.58		210.45	B.M. D-44

N: 1.34, 8.39, .07 = 10.140

S: 1.35, 9.47, .67 = 10.49

Form 307 5M 11-35

PLEASE RETURN TO
LOS ANGELES COUNTY SURVEYOR
700 HALL OF RECORDS

NOTE: ANY ADDITIONS OR CHANGES ON THIS SHEET MUST BE MADE OR CIRCLED IN RED INK, WITH DATE AND NAME OF PERSON MAKING CHANGE

Do not extend notes this side of this line

F. B. 186 Pg. 238 | Job No. 6318 Division No. Whittwood D.S. | Notes Red. Date | Plotted Date | Profile No. | X-Sec. No.

Survey of W Notes E | Notes Chkd. Date | Checked Date

Survey by C. Johnson Date | Indexed Date

STATION	B. S.	H. I.	F. S.	ELEV.	Notice Ave. cut
		217.68			
16+00			6.28	211 40	= S.D. conc. walk
17+00			5.10	212 58	" " " "
+82.5			4.17	213 54	" " end. " " + Dr.
18+00			3.90	213 78	℄ S.D.
+			3.80	213 88	" " W.E. " Dr
+32.5			3.42	214 26	" " E.E. " "
+82.5			3.54	214 14	W/T ℄ S.L., + ℄ Cr. Ht's
T.P.	6.54	221.34	2.93	214 75	
					Cr. Heights
			7.22	214 12	T.C. W.E., C.B., S.W.C.
			7.80	213 54	gutter
			6.92	214 42	T.C. W.E., C.E., M.H., S
			7.51	213 83	gutter
			8.15	213 19	T.C. W.E., C.B., S.W.C.
			8.76	212 58	gutter
			8.20	213 14	T.C., S.C., P.J., M.H.
			8.82	212 69	gutter
			8.01	213 88	T.C., S.E., C.B., S.W.C.
			8.67	212 67	gutter

Form 307 5M 11-35

PLEASE RETURN TO
LOS ANGELES COUNTY SURVEYOR
700 HALL OF RECORDS

NOTE: ANY ADDITIONS OR CHANGES ON THIS SHEET MUST BE MADE OR CIRCLED IN RED INK, WITH DATE AND NAME OF PERSON MAKING CHANGE

Do not extend notes this side of this line

Profile No. ____ X-Sec. No. ____ Notes Red. ____ Date ____ Notes Chkd. ____ Date ____ Map No. ____ Plotted ____ Date ____ Checked ____ Date ____ Job No. ____ Survey of ____ Survey by ____ Division No. ____ Notes Indexed ____ Date ____ Checked ____ Date ____ F. B. ____ PG. ____

STATION	B. S.	H. I.	F. S.	ELEV.	Melrose Ave	
		221.31			[illegible] Hts. Blvd.	
			7.68	213.66	T.C. [illegible] S.E.C.	
			8.30	213 04	gutter	
			6.34	215 00	T.C. I.N.C. & N.E.C.	
			5.98	214 36	gutter	
			6.30	215 04	T.C. N.E.C. R.R. & S.E.C.	
			6.95	214 39	gutter	
			7.30	214 04	S.C. N.H. W/C of Melrose & Cr. Hts. Blvd	
			~~18.66~~	202.68	8" drop inlet N.	N 7.29, .67, 1699, 14.95 — E 7.30, 10.91, .67, 18.88 — W 11.03, .67, 18.03
			18.88	202 46	8" inlet E	
			19.03	202 31	8" outlet W	
			9.02	211. 92	100' S. of [illegible] Melrose	
			9.42	211 92	T.C. W.C.R.	
			10.0	211 24	gutter	
			9.23	211 41	T.C. S.C.R.	
			9.35	211 44	gutter	
			5.32	215 82	100' N. of INT Melrose	
			4.90	216 44	E.C. " "	
			5.60	215 74	gutter " "	

Form 307 5M 11-35

PLEASE RETURN TO
LOS ANGELES COUNTY SURVEYOR
700 HALL OF RECORDS

NOTE: ANY ADDITIONS OR CHANGES ON THIS SHEET MUST BE MADE OR CIRCLED IN RED INK, WITH DATE AND NAME OF PERSON MAKING CHANGE

Do not extend notes this side of this line

F.B. 706 Pg. 240 | Job No. 638 | Division No. | Notes Red. | Plotted | Profile
Survey of W. Hollywood D.S. | Date | Date | No.
Survey by W. C. Johnson | Notes | Notes Chkd. | Checked | X-Sec.
Indexed | Date | Date | Date | No.

STATION	B. S.	H. I.	F. S.	ELEV.	
		221.34			Melrose Ave
			5.83	215.51	Mk'd .100' N.E Melrose
			6.44	214.90	Cut. " " "
			1.56	219.78	Top M.H 281' N. & S.D.
			2.38	218.96	Inlet North
			8.52	212.82	outlet South
					Melrose Ave.
S.M.			7.60	213.74	B.M. D-93 W.S. = 5' E.F.C.R.S.E.C. Elev. = 213.746
	8.20	221.95		213.75	
1+00			8.65	213.30	" S.D.
2+00			5.4	216.4	" "
2+40			4.5	217.5	" "
+30			4.17	217.78	" " & E. E. Dr.
22+			3.83	218.13	" " & E.L. "
22+05.15				216.67	INT. & S.D. & E of Lowell Ave.
					S.S.M.H. E of Melrose N 3.81 E S N 3.64
					THIS M.H. Shown in Lowell Ave. S.D. Survey (T.S. RC-60)

M.H. to north - F.B 706 p. 62

63.35
N.E
9.22

Form 307 5M 11-35

PLEASE RETURN TO
LOS ANGELES COUNTY SURVEYOR
700 HALL OF RECORDS

NOTE: ANY ADDITIONS OR CHANGES ON THIS SHEET MUST BE MADE OR CIRCLED IN RED INK, WITH DATE AND NAME OF PERSON MAKING CHANGE

Do not extend notes this side of this line

STATION	B. S.	H. I.	F. S.	ELEV.	Melrose Ave	
		-21.92			Laurel Ave	
			5.70	216 25	℄ Laurel 100' S. of ℄ of Melrose	
			5.20	216 05	T.C. W. Side	
			6.25	215 70	gutter	
			5.60	216 55	T.C. E. Side	
			5.82	216 13	gutter	
			2.10	219 85	℄ Laurel 100' N. of ℄ of Melrose	
			1.82	219 13	T.C. E. Side	
			2.36	219 59	gutter	
			2.47	219 48	T.C. W. Side	
			2.75	219 00	gutter	
B.M. D-42	7.03	225.96	5.02	218.93	B.M. D-42 W.S. 9' E. of E.L.C.A.N.S. Elev. = 218.928	
					Melrose Ave	
23+00			5.9	220 1	℄ S.L.	
+22			5.60	220 36	" " & N.E. Curb Walk	
+66.5			5.00	220 96	" " E.L. " "	
24+00			4.5	221 5	" "	
25+00			2.9	223 1	" "	
+26.5			3.12	222 81	INT. ℄ S.D.R.E. of Ld Ave	

Profile
No.
X-Sec.
No.
Notes Red
Date
Notes Chkd.
Date
Plotted
Date
Checked
Date
Job No.
Survey of
Survey by
Map No.
Division No.
Notes
Date
Date
Date
F. B.
PG.

Form 307 5M 11-35

PLEASE RETURN TO
LOS ANGELES COUNTY SURVEYOR
700 HALL OF RECORDS

NOTE: ANY ADDITIONS OR CHANGES ON THIS SHEET MUST BE MADE OR CIRCLED IN RED INK, WITH DATE AND NAME OF PERSON MAKING CHANGE

Do not extend notes this side of this line

F. B. 706 PG. 242 | Job No. 6218 | Division No. D.5 | Profile No. | X-Sec. No.
Survey of W. Hollywood
Survey by C. Johnson | Notes Red | Date | Plotted | Date
Indexed | Notes Chkd | Date | Checked | Date

STATION	B. S.	H. I.	F. S.	ELEV.	MEMORANDA	P. C.
		222.96			Edinburgh Ave. EL. 222.326	
B.M.D-125	2578	230 ~~5.78~~ 904	3.13	227.32	B.M.D-125 { F.V.I.S. 3'E. of S.E. P.C.R. S.P.C. of Edinburgh Ave. & Melrose Ave.	
					(Page 59 N.G. Elev. Elev. of St. & obs. thereon in Survey of Edinburgh Ave. ST 18 F.B. 706 - Pg 79-1 & 84).	
					Edinburgh Ave.	
26+00			6.6	224.3	℄ S.D.	
+89			5.15	225.75	± Beg. curb. walk	
27+00			4.93	225.97	± S.D.	
+79			3.90	227.00	" Beg. curb. wk.	
					Melrose Ave.	
			3.48	227.45	W. end C.R. N.W. Cor	
			4.05	226.85	Gut. "	
			3.22	227.68	N " " "	
			3.82	227.08	Gut	
			4.82	226.08	W. end C.R. S.W. Cor	
			5.47	225.43	Gut " "	
			4.72	226.18	S. " " "	
			5.36	225.54	Gut	

Form 307 5M 11-35

PLEASE RETURN TO
LOS ANGELES COUNTY SURVEYOR
700 HALL OF RECORDS

NOTE: ANY ADDITIONS OR CHANGES ON THIS SHEET MUST BE MADE OR CIRCLED IN RED INK, WITH DATE AND NAME OF PERSON MAKING CHANGE

Do not extend notes this side of this line

STATION	B. S.	H. I.	F. S.	ELEV.		
		230 904 278				
			3.61	227.29		
			12,43.	218.47.	5" inlet rt	3.61 / 8.15 / .67 / 12.43 — E: 10.99 / 3.61 / .67 / 15.27. — W: 1.07 / 3.61 / .67 / 5.35
			15,27.	215,63.	5" " lft E.	
			15 37.	215,53	8" outlet W	
28+51.9			3.46	227 44		
			5.55	225 35		
			1.16	224 72	N.ob	
			6.67	224 33	N. Gut	
			[illegible]	225 46	E ob.	
			[illegible]	225 05	E. Gut	
			[illegible]	226.92	[illegible]	
			4.63	226 21	Gut	
			3.94	226 96	E "	
			[illegible]	226 27	Gut "	
			2.71	228 19	N. end CR	
			3.30	227 60	Gut "	
			2.66	228 24	E "	
			3.27	227 63	Gut "	

Profile No. ____ Notes Red. ____ Plotted ____ Job No. ____ Division No. ____
X-Sec. No. ____ Date ____ Date ____ Survey of ____
Notes Chkd. ____ Checked ____ Survey by ____ Notes ____ Date ____
Date ____ Date ____ Map No. ____ Indexed ____ Date ____
F. B. ____ PG. ____

Form 307 5M 11-35

PLEASE RETURN TO
LOS ANGELES COUNTY SURVEYOR
700 HALL OF RECORDS

NOTE: ANY ADDITIONS OR CHANGES ON THIS SHEET MUST BE MADE OR CIRCLED IN RED INK, WITH DATE AND NAME OF PERSON MAKING CHANGE

Do not extend notes this side of this line

F. B. 706 Pg 244 | Job No. 4318 | Division No. | Notes Red. | Plotted | Profile
Survey of W. Hollywood | Date | Date | No.
Survey by W | Notes W | Notes Chkd. | Checked | X-Sec.
Indexed C. Johnson | Date | Date | Date | No.

STATION	B. S.	H. I.	F. S.	ELEV.	Melrose Ave.	
		230 ~~904~~				
			233	226 57	℄ Melrose Ave 150' E. of ℄ Haywarth Ave	
			2[illegible]	[illegible] 10	S.cb. " "	" "
			2[illegible]	[illegible] 55	S.Gut. "	" "
			1[illegible]	[illegible] 10	N.cb. "	" "
			177	[illegible] 13	N.Gut. "	" "
Set B.M. "D150"	4.71	5[illegible]2.717	3 901	~~227.044~~ 227.003	B.M. D. 150 E.I. MELROSE AVE. & HAYWORTH AVE. B.Spk. 0.E. of E. end C.R. S.E. cor.	
			272	229 73	℄ Haywarth Ave. 100' N. of ℄ S.D.	
			296	229 75	E.cb. " "	" "
			346	229 25	E.Gut "	" "
			325	229 46	W.cb "	" "
			3[illegible]	229 06	W.Gut "	"

Form 307 5M 11-35

PLEASE RETURN TO
LOS ANGELES COUNTY SURVEYOR
700 HALL OF RECORDS

NOTE: ANY ADDITIONS OR CHANGES ON THIS SHEET MUST BE MADE OR CIRCLED IN RED INK, WITH DATE AND NAME OF PERSON MAKING CHANGE

Do not extend notes this side of this line

STATION	B. S.	H. I.	F. S.	ELEV.		
		230.113			MRL [illegible] Ave.	
			00'	232.70	Top of M.H. 294' N. & of S.D. [illegible]	
			706	225.64	inlet on N { 0.01, 8.38 }	{ 0.07, 8.47, .67 }
			92'	224.23	outlet on S. 9.06	
				227.00		
B.M. D150	2.535	230.538	2.73	227.77	B.M. D 150 L.L.	5.8706 Fg
			82'0	222.328	B.M. 228 L.L. Edinger [illegible] NW Cor. SE Cor.	222.326

Profile
No. X-Sec.
Notes Red. Plotted Job No. Division No.
Date Date Survey of
Notes Chkd. Checked Survey by Notes
Date Date Map No. Marked Johnson Date
F. B. Pg.

F. B. Pg.

Job No. Division No. Notes Red. Plotted Profile

Survey of Date Date No.

Survey by W. C. Johnson Notes Notes Chkd. Checked X-Sec.

Indexed Date Date Date No.

STATION	B. S.	H. I.	F. S.	ELEV.

Form 307 5M 11-35

PLEASE RETURN TO
LOS ANGELES COUNTY SURVEYOR
700 HALL OF RECORDS

Do not extend notes this side of this line

NOTE: ANY ADDITIONS OR CHANGES ON THIS SHEET MUST BE MADE OR CIRCLED IN RED INK, WITH DATE AND NAME OF PERSON MAKING CHANGE

Form 301 10M 3-34

PLEASE RETURN TO
LOS ANGELES COUNTY SURVEYOR
700 HALL OF RECORDS

NOTE: ANY ADDITIONS OR CHANGES ON THIS SHEET MUST BE MADE OR CIRCLED IN RED INK, WITH DATE AND NAME OF PERSON MAKING CHANGE

Do not extend notes this side of this line

Transit at	Sight on	Stadia Intercepts	Stadia Distance	Stadia Rod—	Horizontal Angle 0° to 360° Right	Horiz. Distance	+ Vertical Angle —	Elevation of Point	+ Back Sight	+ Difference — Elevation	Height of Instrument	+ Vertical Distance —	REMARKS Station	Left	Right
P1	PB				° ′		° ′		1						
					° ′		° ′		2						
					° ′		° ′		3						
Add'l Inform.

Notes Rod. _____ Platted _____ Job No. _____ Division No. _____ F.B. _____ PG. _____

Date _____ Date _____ Survey of _____

Notes Chkd. _____ Checked _____ Survey by _____ Notes

Date _____ Date _____ Map No. _____ Inform. C. Johnson Date _____

Form 301 10M 3-34

MAILED RETURN TO
LOS ANGELES COUNTY SURVEYOR
700 HALL OF RECORDS

NOTE: ANY ADDITIONS OR CHANGES ON THIS SHEET MUST BE MADE OR CIRCLED IN RED INK, WITH DATE AND NAME OF PERSON MAKING CHANGE

Direct attention to the sidelaps of this line

706

F.B. Pg.

Topography Description Legend:
Side Hill.....S.H.
Side of Draw.S.D.
Side of Ridge.S.R.
Head of Draw H.D.
Bottom Draw.B.D.
Bottom Wash B.W.
Top of Ridge.T.R.
Toe of Slope..T.S.

Intern. of Draws. V.D's
Break in Slope...Bk.S.
Steep Slope.....S.S.
Top of Cliff.....T.Cl.
Bottom of Cliff...B.Cl.
Top of Spur.....T.Sp.
Bottom Canyon..B.Cn.

Side of Canyon S.Cn.
Top of Bank...T.B.
Bottom of Bank..B.B.
Top of Cut.....T.C.
Bottom of Cut...B.C.
Top of Fill.....T.F.
Bottom of Fill..B.F.

Saddle .....Sa.
Swale .....Sw.
Flat .....Fl.
Stream .....Str.
Trail .....Tr.
Pavement .....Pvt.
Edge of Road E.Rd.

Traveled Rd. Tr. Rd.
Fence .....Fn.
Int. Fence
Ditch
Telephone
Power
Culvert

Oak-O. Pin-Pi. Sycamore Eucalyptus
Fir-Fr. Cedar-Ce.

Add'n'l Interm.