Notes Ck'd by
Map No.
Office Work
Checked
Date

Survey of
W. O. Tape No. St'd °F.
Surveyed by
Notes Date
Indexed

F.B. 709 PG.

Note: Any Additions or Changes on This Sheet Must Be Made or Circled in Red Ink With Date and Name of Person Making Change

LOS ANGELES COUNTY SURVEYOR
700 HALL OF RECORDS

FORM 247 10M 11-35

F.B. 709 Pg. Index

F.B. 709

Pages; Index, , 3 , 7 to 13 incl.,
, 15, , 17, , 19 to 45 incl., ,
47 to 73 incl., , 75 to 139 incl., ,
141 to 155 incl., , 157 to 167 incl.,
, 169 to 173 incl., , 175, ,
177 to 199 incl., , 201 to 209 incl.,
, 211 to 221 incl., , 223 to 248 incl.,
incl.,

RETURN TO
LOS ANGELES COUNTY SURVEYOR
700 HALL OF RECORDS

Do not extend notes this side of this line

Note: Any Additions or Changes on This Sheet Must be Made or Circled in Red Ink With Date and Name of Person Making Change.

Notes Ck'd by		Survey of OLIVE VIEW SANATORIUM	F.B. 709 PG. 3
Map No.		W. O. 8128 Tape No.	St'd °F.
Office Work		Surveyed by T. M. WALSH	
Checked		Notes T. M. WALSH Date 1936	
Date		Indexed A. C. Johnson 5-26-37	

Note: Any Additions or Changes on This Sheet Must be Made or Circled in Red Ink With Date and Name of Person Making Change.

Do not extend notes this side of this line

RETURN TO
LOS ANGELES COUNTY SURVEYOR
700 HALL OF RECORDS

OLIVE VIEW SANATORIUM UNDERGROUND

WATER LINES

J.N. 8128

APRIL TO NOV. 1936

NOTES TO BE USED IN CONJUNCTION WITH C.S.B 1201

Locations By
F. Greenwood & Party
&
R.L. Willey & Party

For Index (Field Maps)
See Plane Table Sheets
Nos. F147 to F163

Notes & Index Sheets
By Ted M. Walsh

For Final Index Maps
See C.S.B. 1201

SEE F.B. 710 FOR CONTINUATION OF NOTES

FORM 247 10M 11-35

RETURN TO
LOS ANGELES COUNTY SURVEYOR
700 HALL OF RECORDS

Note: Any Additions or Changes on This Sheet Must be Made or Circled in **Red Ink** With Date and Name of Person Making Change.

Do not extend notes this side of this line

F.B. 709 PG. 4

Notes Ck'd by	Survey of CLIVEVIEW SAN
Map No.	W. O. 8128 Tape No. St'd °F.
Office Work	Surveyed by T. M. WALSH
Checked	Notes WALSH Date APR. 36
Date	Indexed A. C. Johnson

F.B. 709 Pg. 7

WATER LINE

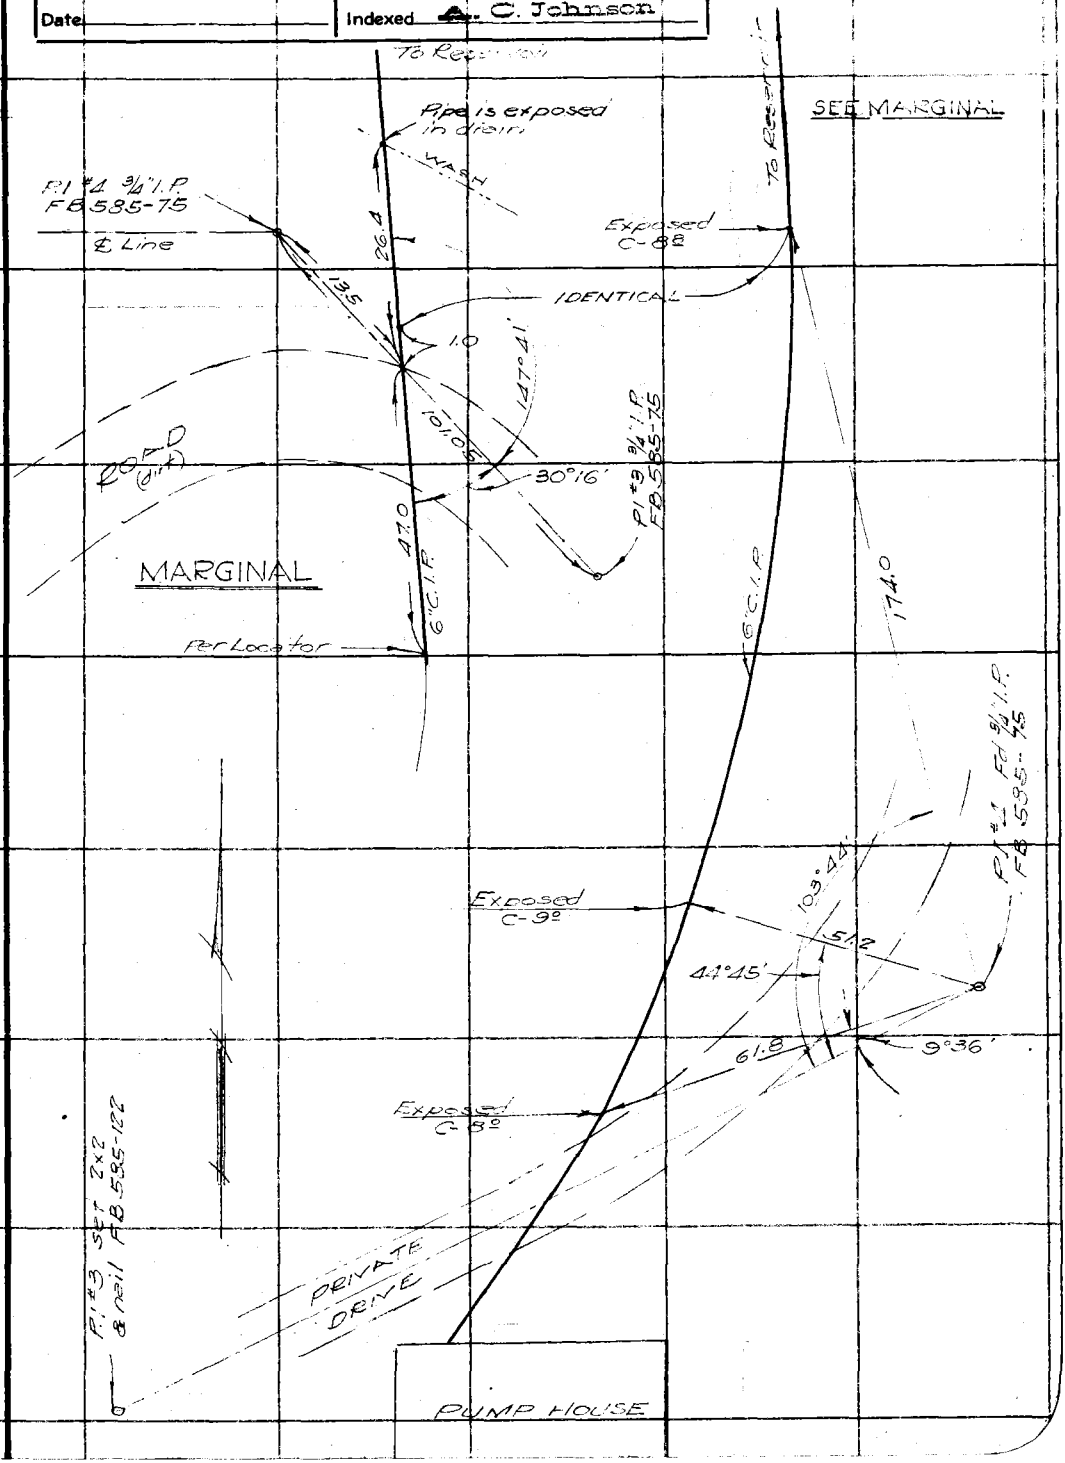

Note: Any Additions or Changes on This Sheet Must be Made or Circled in Red Ink With Date and Name of Person Making Change.

Do not extend notes this side of this line

RETURN TO
LOS ANGELES COUNTY SURVEYOR
700 HALL OF RECORDS

FORM 247 TOM 11-35

RETURN TO
LOS ANGELES COUNTY SURVEYOR
700 HALL OF RECORDS

Note: Any Additions or Changes on This Sheet Must be Made or Circled in **Red Ink** With Date and Name of Person Making Change.

Do not extend notes this side of this line

F.B. 709 PG. 8

RESERVOIR
OV 84

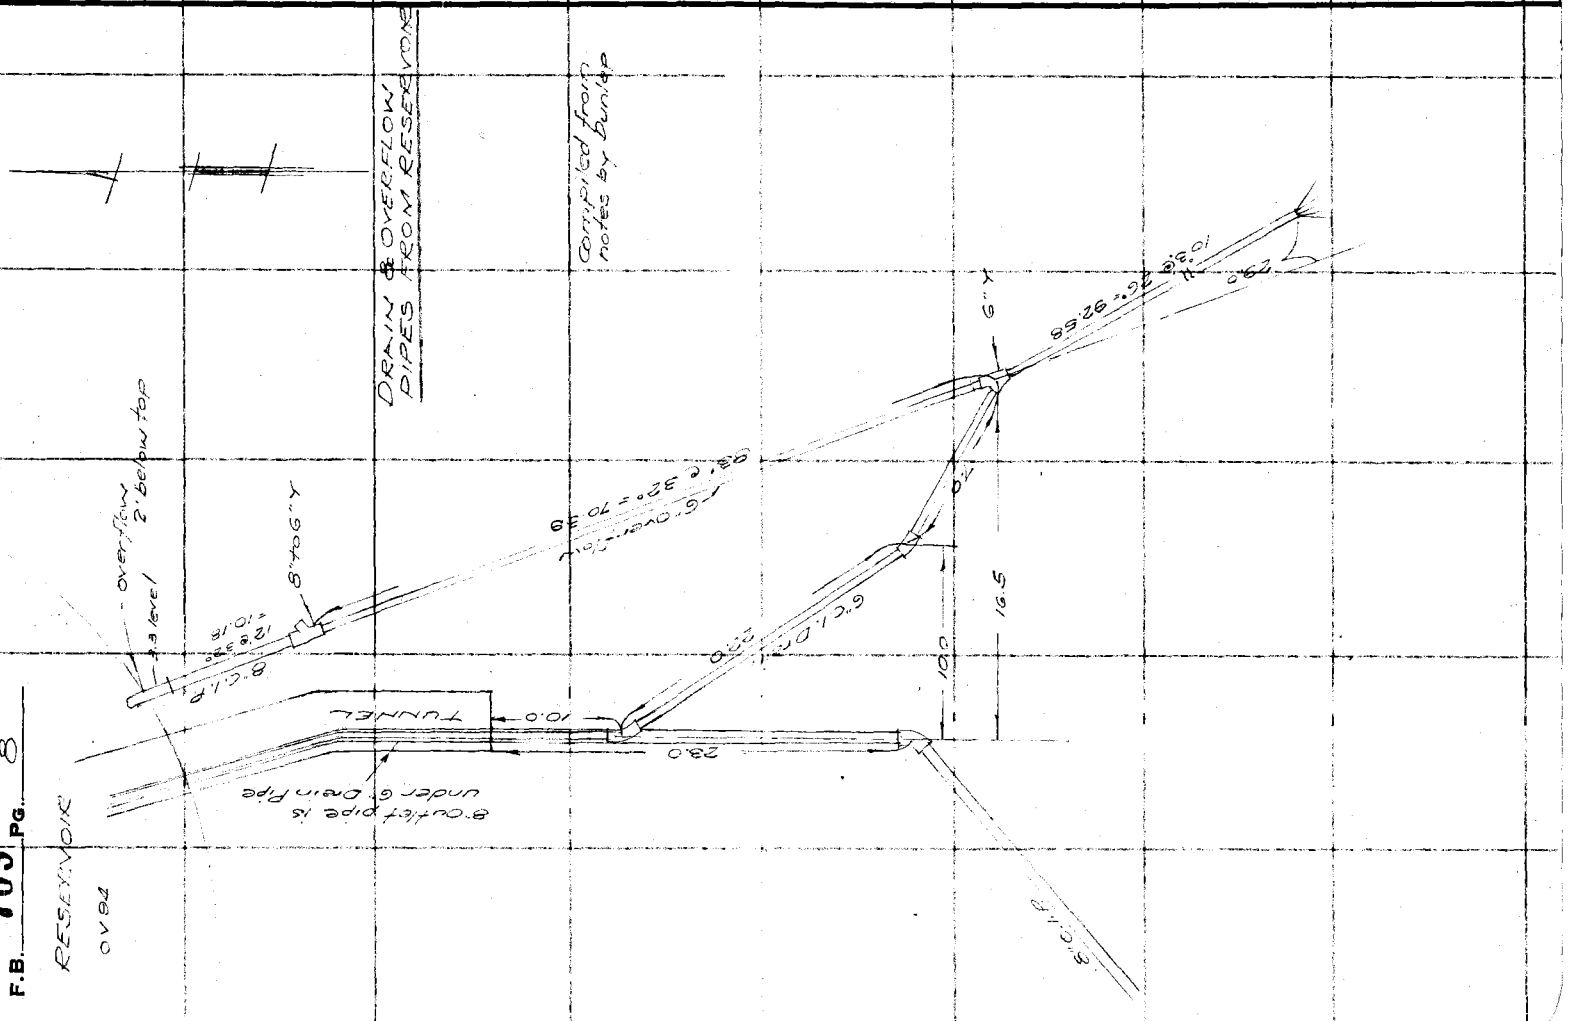

Notes Ck'd by	Survey of OLIVE VIEW SAN
Map No.	W. O. 8128 Tape No. UNDERGROUND St'd °F.
Office Work	Surveyed by T. WALSH
Checked	Notes WALSH Date 4-36
Date	Indexed A. C. Johnson

F.B. 709 PG. 9

WATER LINES

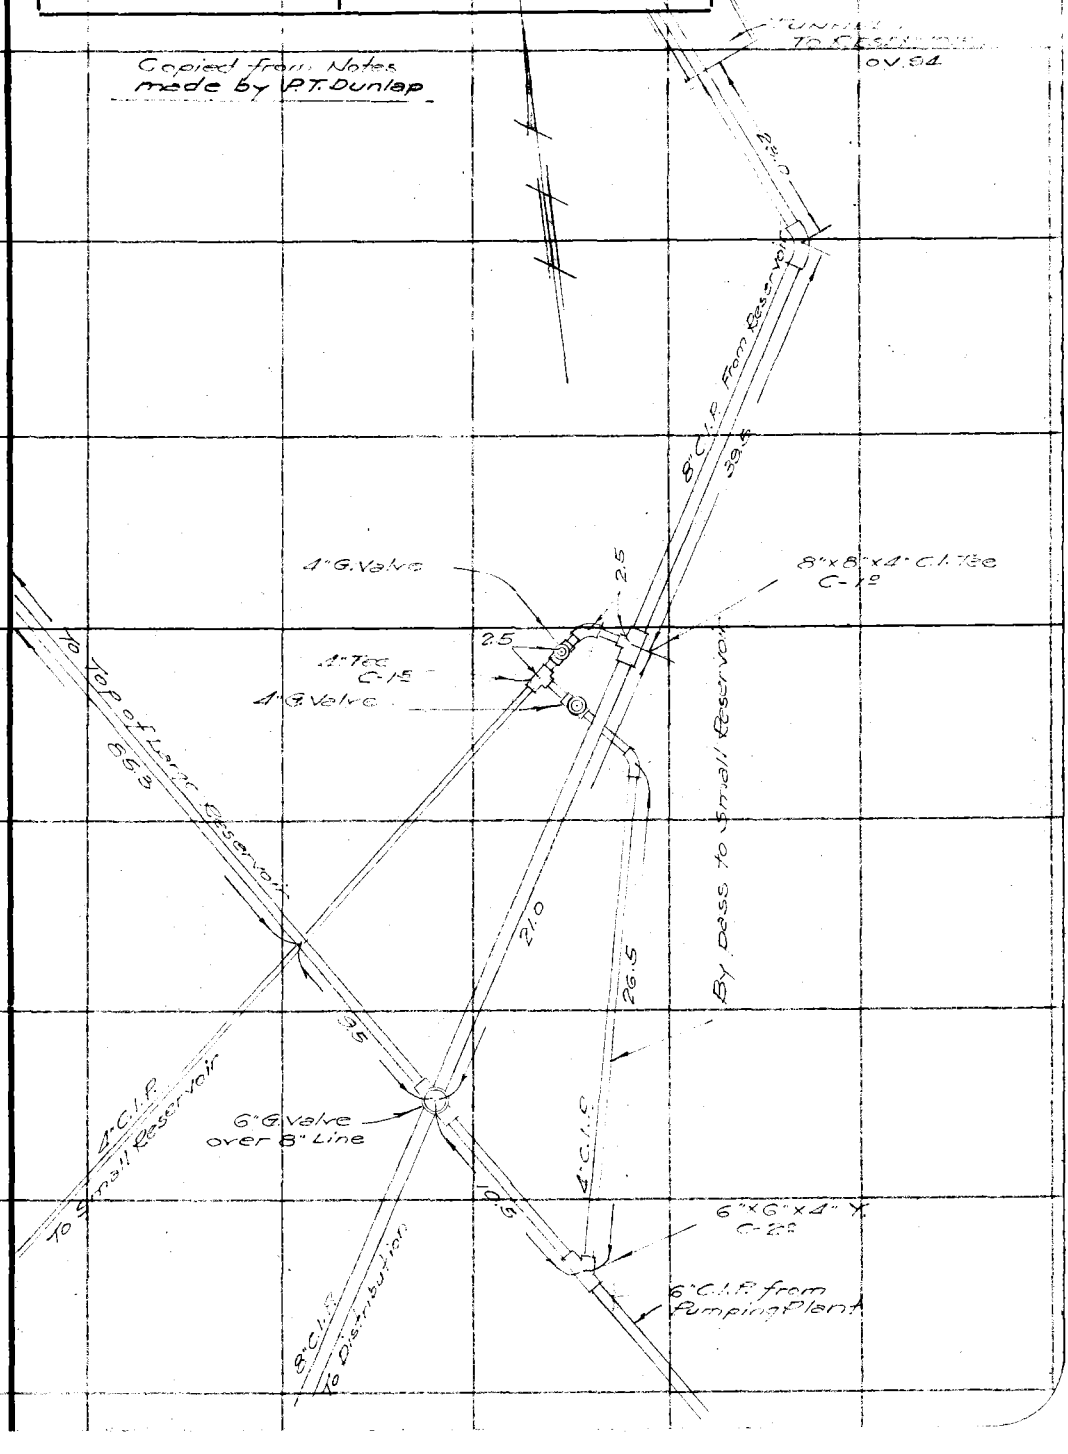

Note: Any Additions or Changes on This Sheet Must be Made or Circled in Red Ink With Date and Name of Person Making Change.

Do not extend notes this side of this line

RETURN TO
LOS ANGELES COUNTY SURVEYOR
700 HALL OF RECORDS

FORM 247 10M 11-35

F.B. 709 PG. 10

LOCATION BY DUNLAP
Copied from Dunlap notes

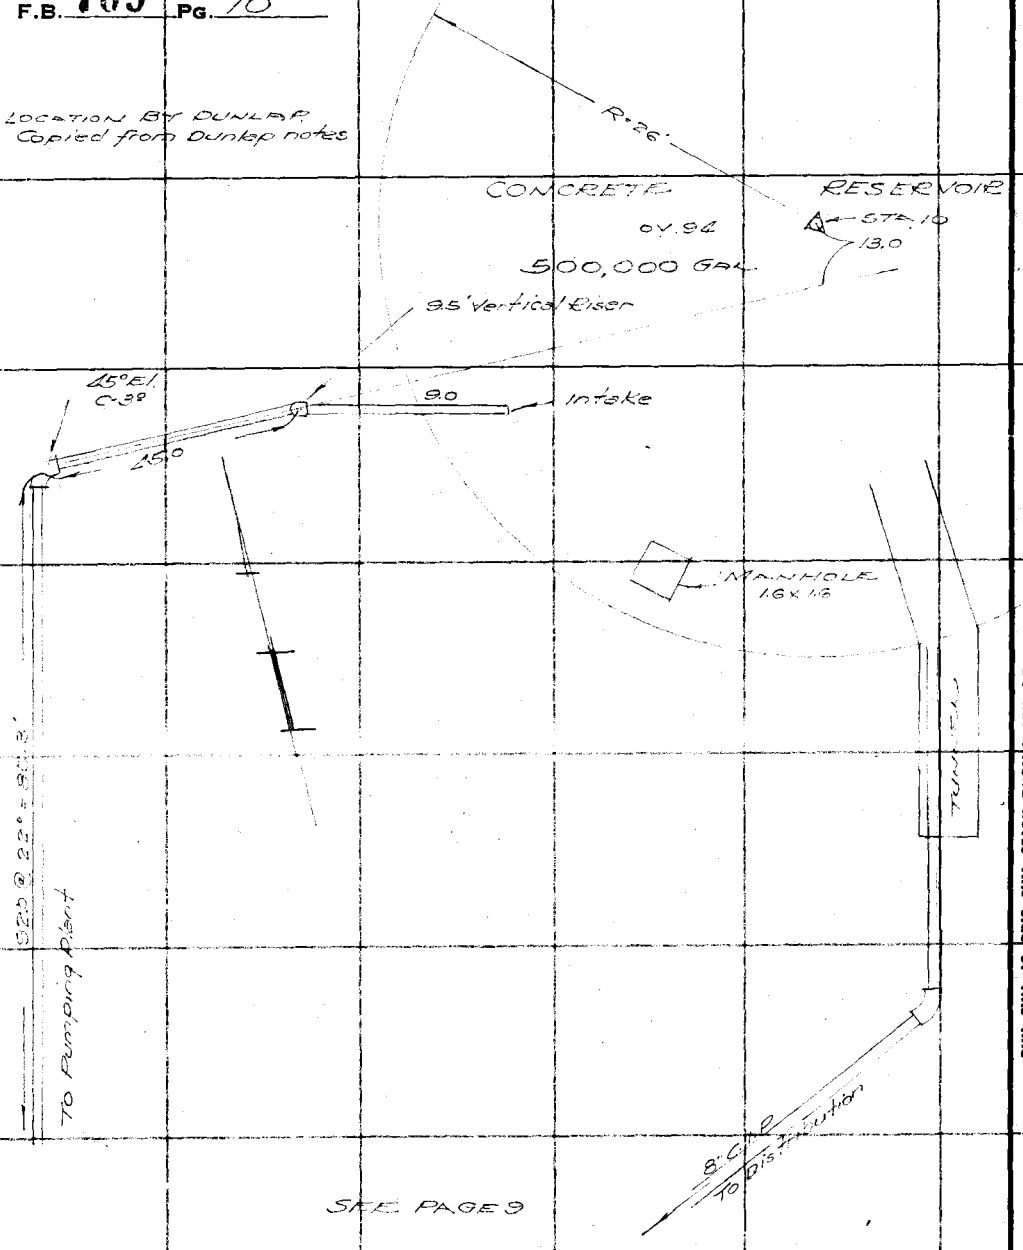

RETURN TO
LOS ANGELES COUNTY SURVEYOR
700 HALL OF RECORDS

Do not extend notes this side of this line

Note: Any Additions or Changes on This Sheet Must be Made or Circled in Red Ink With Date and Name of Person Making Change.

FORM 247 10M 11-38

RETURN TO
LOS ANGELES COUNTY SURVEYOR
700 HALL OF RECORDS

Note: Any Additions or Changes on This Sheet Must be Made or Circled in **Red Ink** With Date and Name of Person Making Change.

Do not extend notes this side of this line

Notes Ck'd by
Map No.
Office Work
Checked
Date

Survey of OLIVE VIEW SAN
W. O. 8xx Tape No. St'd °F.
Surveyed by TED WALSH
Notes WALSH Date 4-27-36
Indexed C. Johnson

F.B. 709 PG. 11

WATER LINES

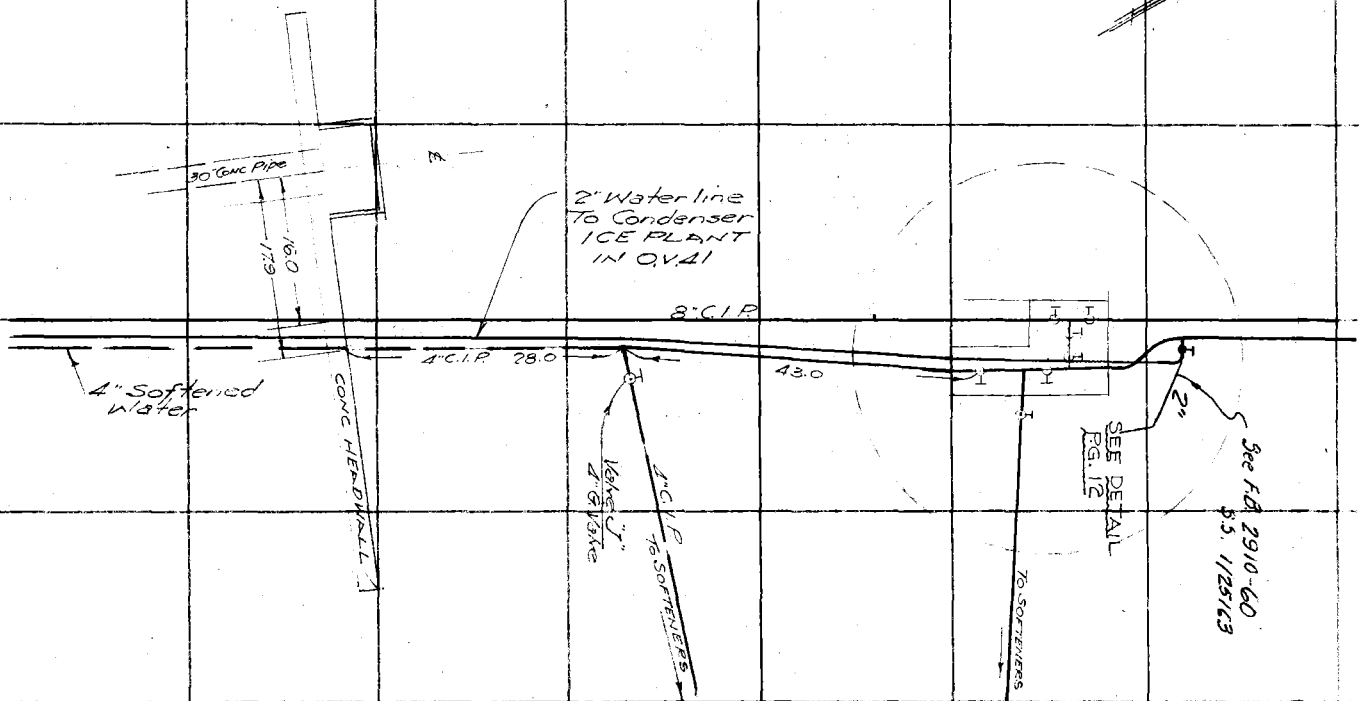

F.B. 709 PG. 12

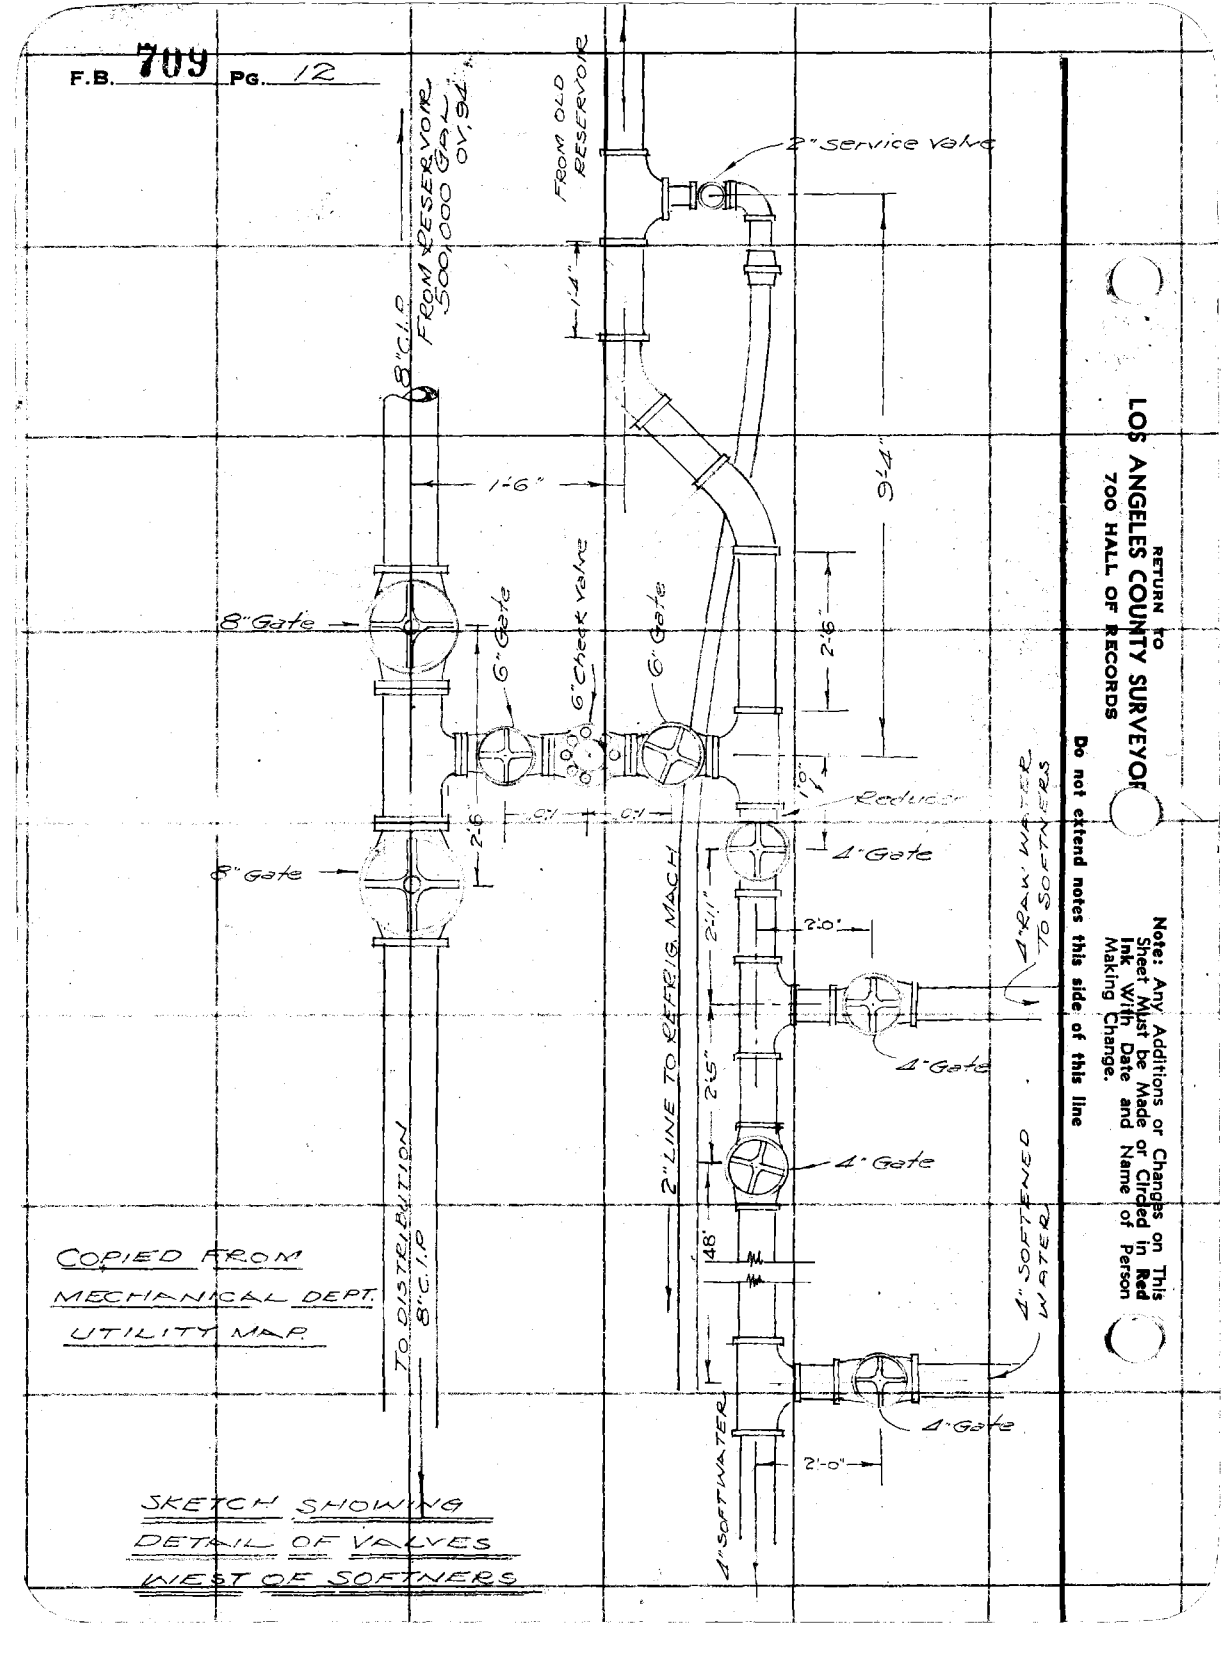

COPIED FROM MECHANICAL DEPT. UTILITY MAP.

SKETCH SHOWING DETAIL OF VALVES WEST OF SOFTNERS

RETURN TO
LOS ANGELES COUNTY SURVEYOR
700 HALL OF RECORDS

Note: Any Additions or Changes on This Sheet Must be Made or Circled in Red Ink With Date and Name of Person Making Change.

Do not extend notes this side of this line

Notes Ck'd by		Survey of OLIVE VIEW SANATORIUM	F.B. 709 Pg. 13
Map No.		W. O. 8128 Tape No.	St'd °F.
Office Work		Surveyed by I. M. WALSH	
Checked		Notes I. M. WALSH Date 4-13-26	SOFTENED WATER
Date		Indexed	

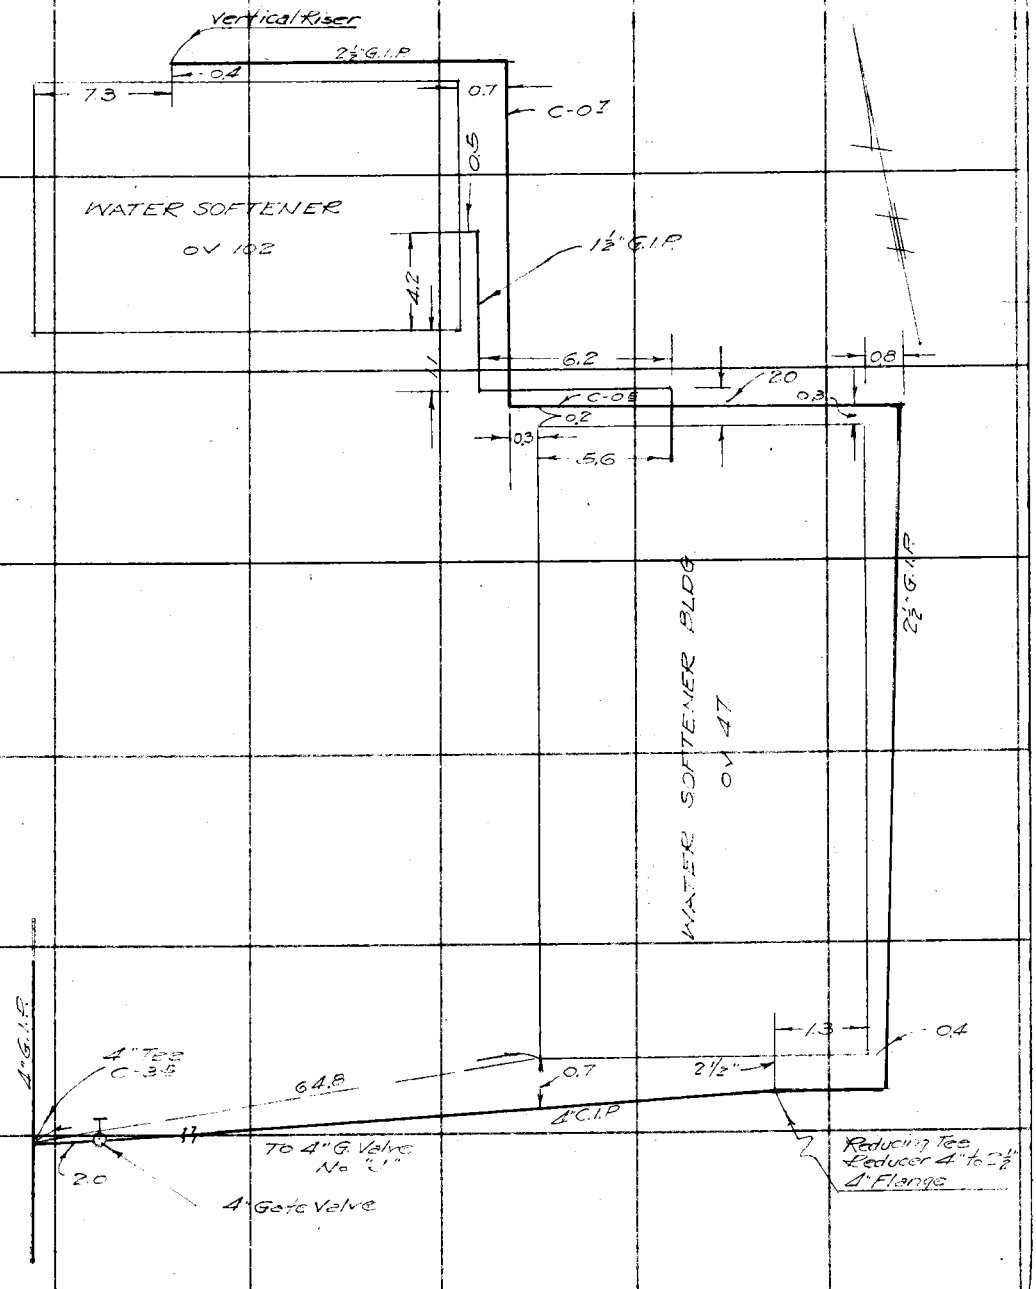

Note: Any Additions or Changes on This Sheet Must be Made or Circled in Red Ink With Date and Name of Person Making Change.

Do not extend notes this side of this line

RETURN TO
LOS ANGELES COUNTY SURVEYOR
700 HALL OF RECORDS

FORM 247 10M 11-38

RETURN TO
LOS ANGELES COUNTY SURVEYOR
700 HALL OF RECORDS

Note: Any Additions or Changes on This Sheet Must be Made or Circled in **Red Ink** With Date and Name of Person Making Change.

Do not extend notes this side of this line

F.B. 709 PG. 14

Notes Ck'd by	Survey of
Map No.	W. O. 8128 Tape No. St'd °F.
Office Work	Surveyed by I. M. WALSH
Checked	Notes I. M. WALSH Date 4-21-36
Date	Indexed A. C. Johnson

F.B. 719 Pg. 15

WATER LINES

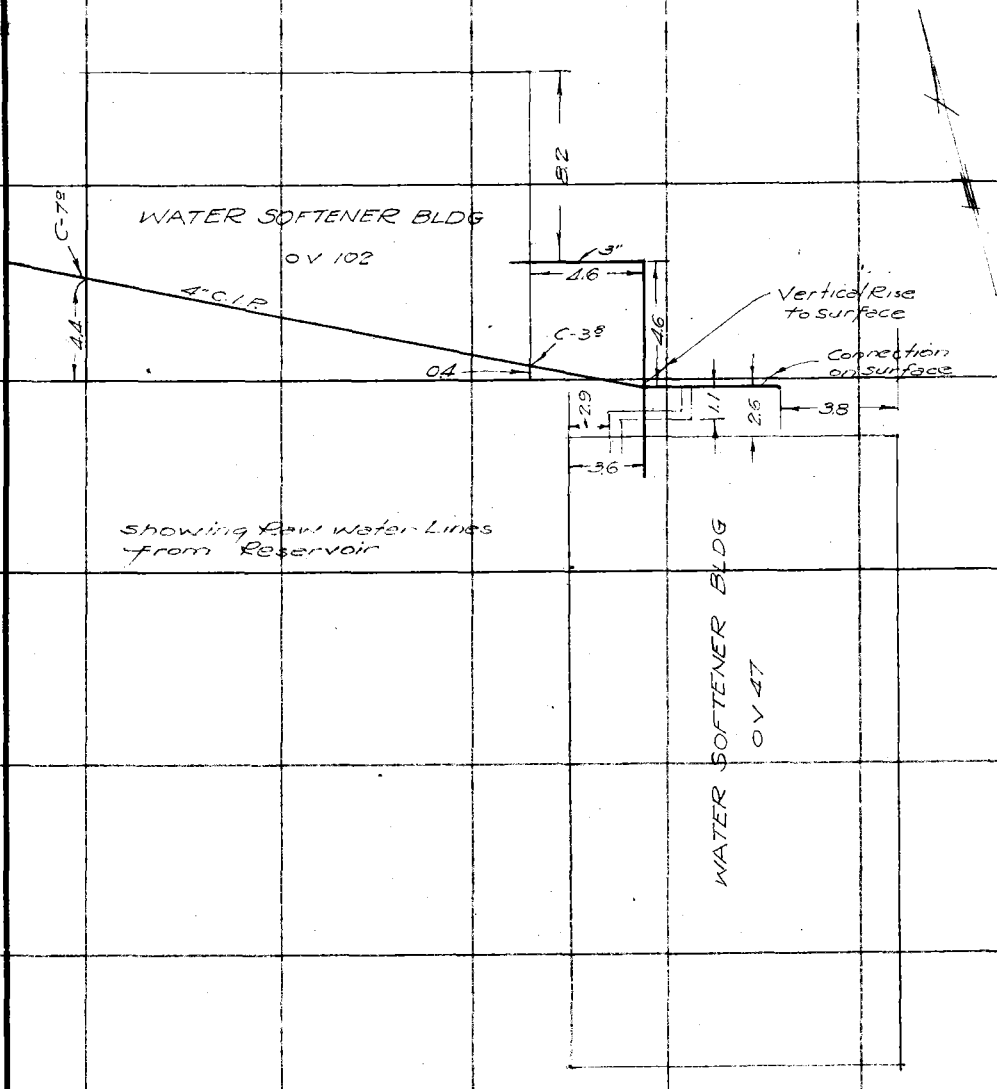

RETURN TO
LOS ANGELES COUNTY SURVEYOR
700 HALL OF RECORDS

Note: Any Additions or Changes on This Sheet Must be Made or Circled in Red Ink With Date and Name of Person Making Change.

Do not extend notes this side of this line

FORM 247 10M 11-35

RETURN TO
LOS ANGELES COUNTY SURVEYOR
700 HALL OF RECORDS

Note: Any Additions or Changes on This Sheet Must be Made or Circled in **Red Ink** With Date and Name of Person Making Change.

Do not extend notes this side of this line

F.B. 709 PG. 19

Map No.	W. O. 8178 Tape No. St'd °F.
Office Work	Surveyed by TED WALSH
Checked	Notes WALSH Date 5-56
Date	Indexed

F.B. 709 PG. 17

WATER LINES

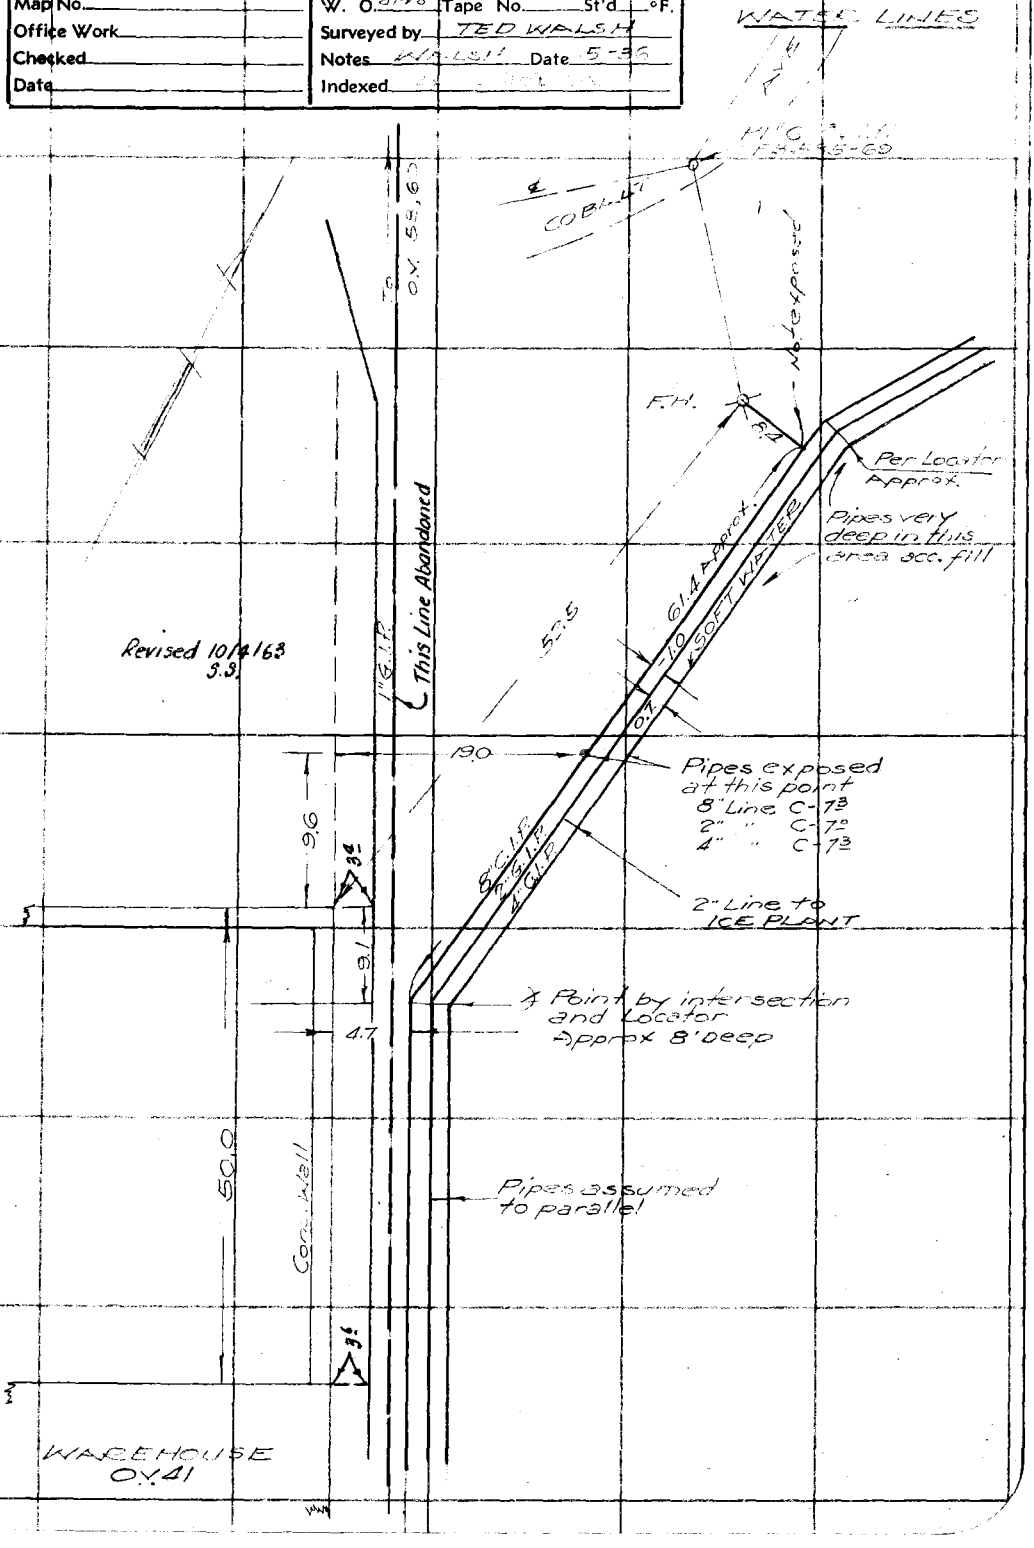

RETURN TO
LOS ANGELES COUNTY SURVEYOR
7DO HALL OF RECORDS

Note: Any Additions or Changes on This Sheet Must be Made or Circled in Red Ink With Date and Name of Person Making Change.

Do not extend notes this side of this line

FORM 247 10M 11-33

RETURN TO
LOS ANGELES COUNTY SURVEYOR
700 HALL OF RECORDS

Note: Any Additions or Changes on This Sheet Must be Made or Circled in **Red Ink** With Date and Name of Person Making Change.

Do not extend notes this side of this line

F.B. 709 PG. 18

Notes Ck'd by	Survey of OLIVEVIEW SAN. UNDERGROUND
Map No.	W. O. 8128 Tape No. St'd °F.
Office Work	Surveyed by T. WALSH
Checked	Notes T. WALSH Date 4-1936
Date	Indexed A. C. Johnson

F.B. 709 PG. 19

WATER LINES

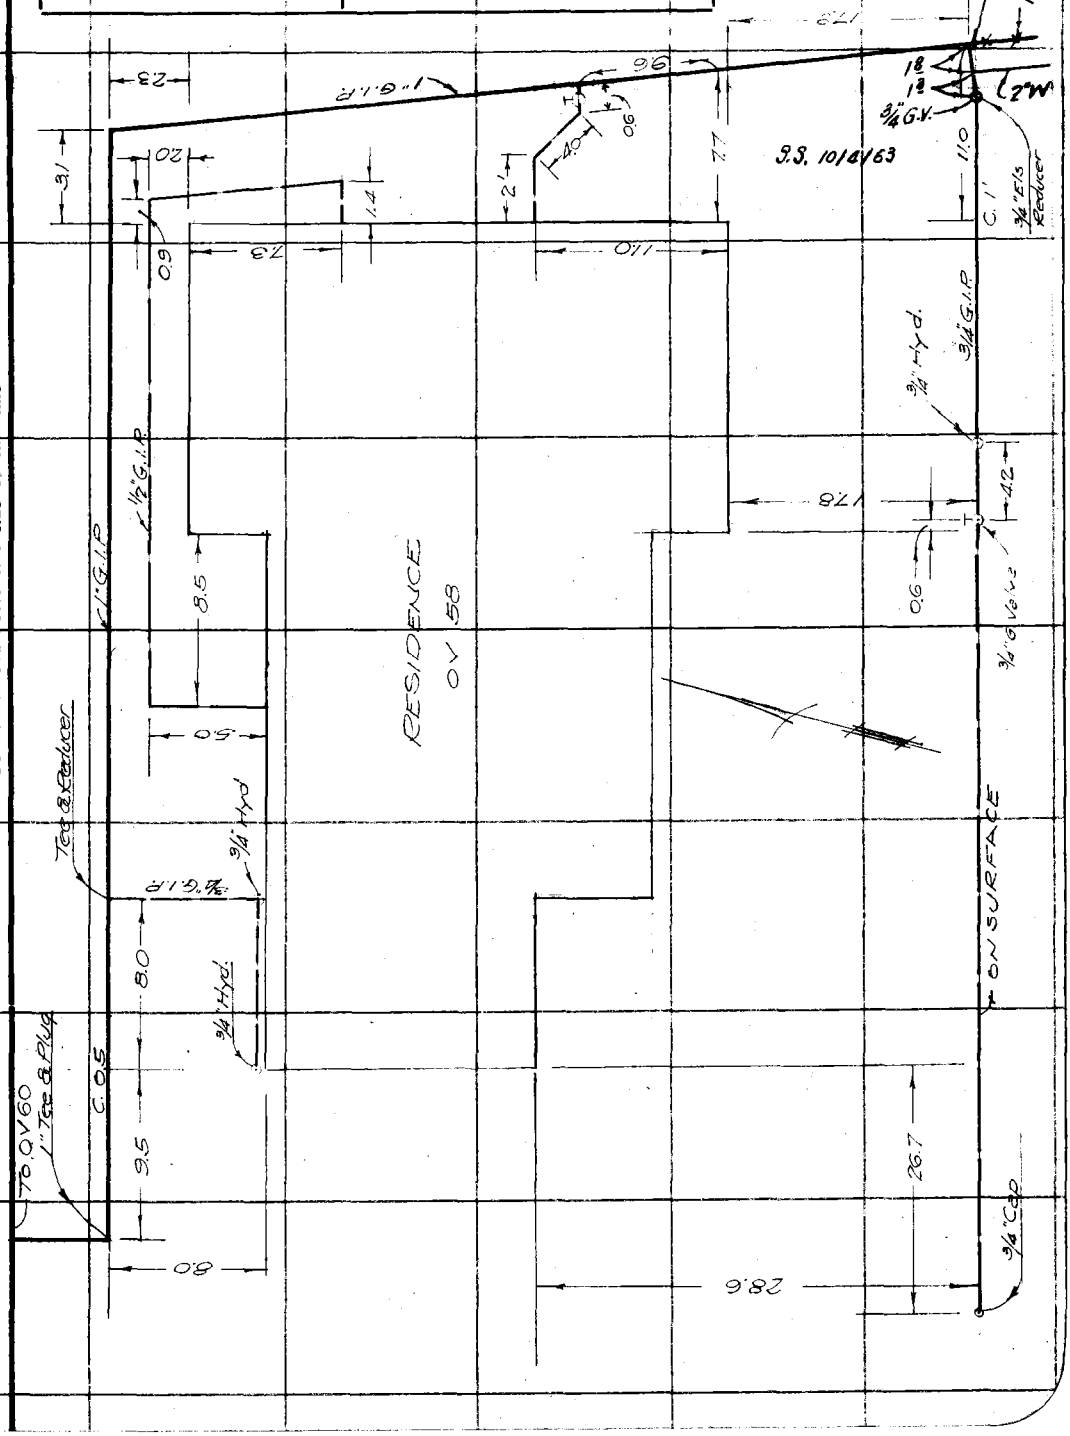

Note: Any Additions or Changes on This Sheet Must be Made or Circled in Red Ink With Date and Name of Person Making Change.

Do not extend notes this side of this line

RETURN TO
LOS ANGELES COUNTY SURVEYOR
700 HALL OF RECORDS

FORM 247 10M 11-38

RETURN TO
LOS ANGELES COUNTY SURVEYOR
700 HALL OF RECORDS

Note: Any Additions or Changes on This Sheet Must be Made or Circled in **Red Ink** With Date and Name of Person Making Change.

Do not extend notes this side of this line

F.B. 709 PG. 20

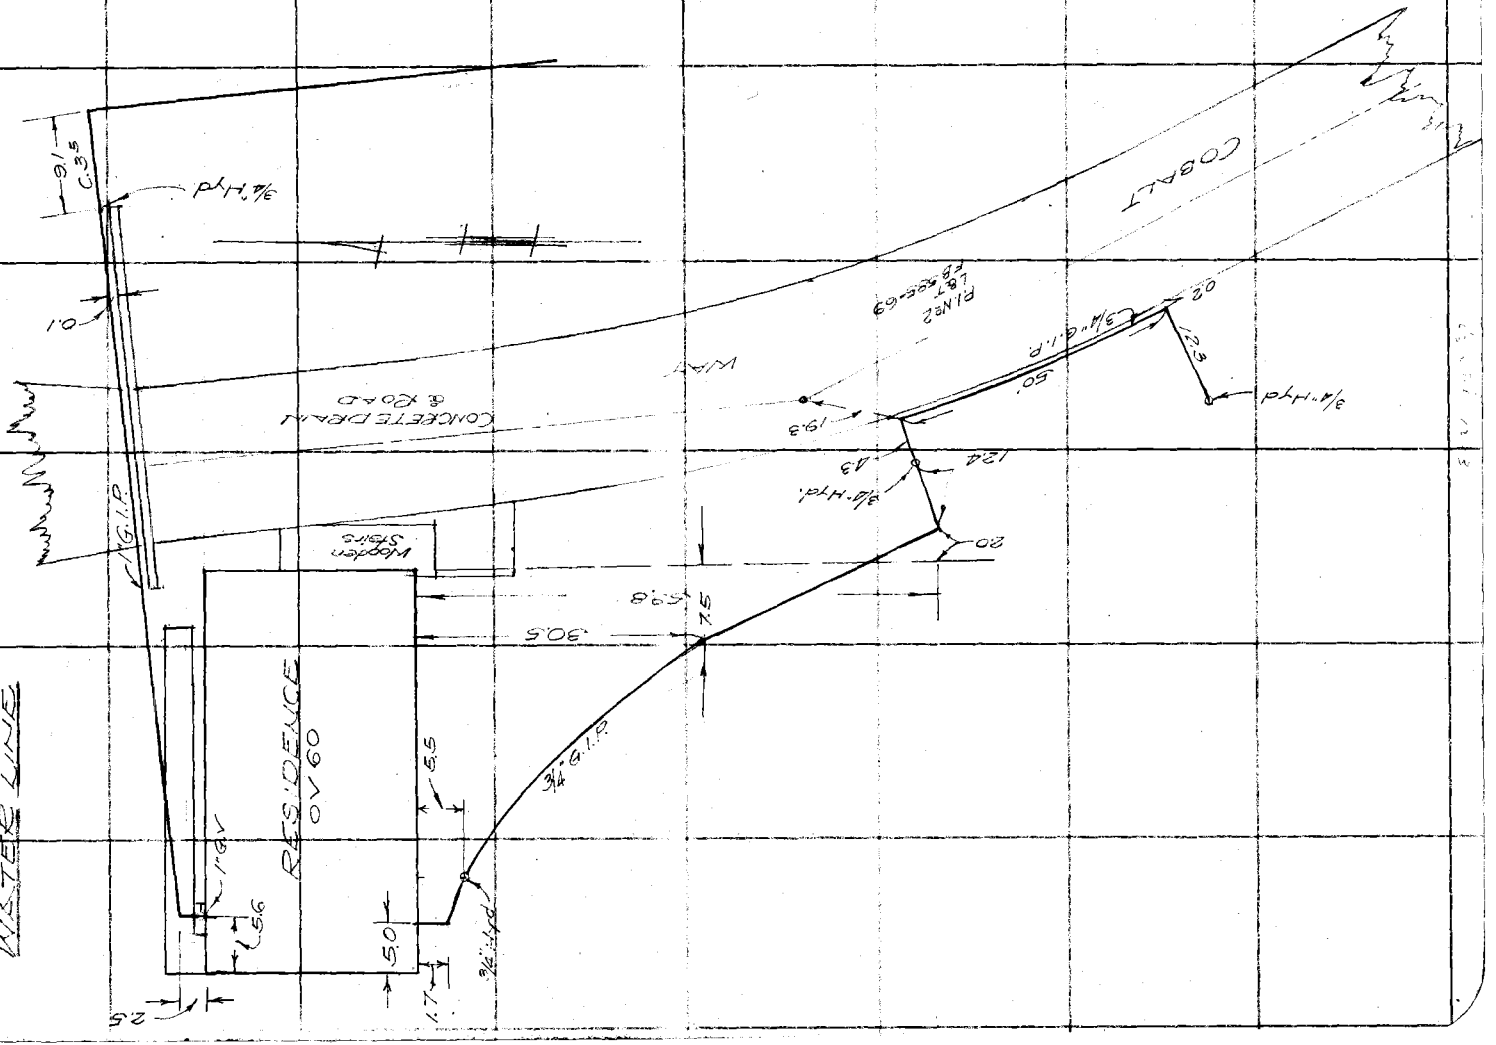

Notes Ck'd by	Survey of OLIVE VIEW SANATORIUM
Map No.	W. O. 8128 Tape No. St'd °F.
Office Work	Surveyed by T. M. WALSH
Checked	Notes T. M. WALSH Date 5-36
Date	Indexed [illegible]

F.B. 709 PG. 21

WATER LINES

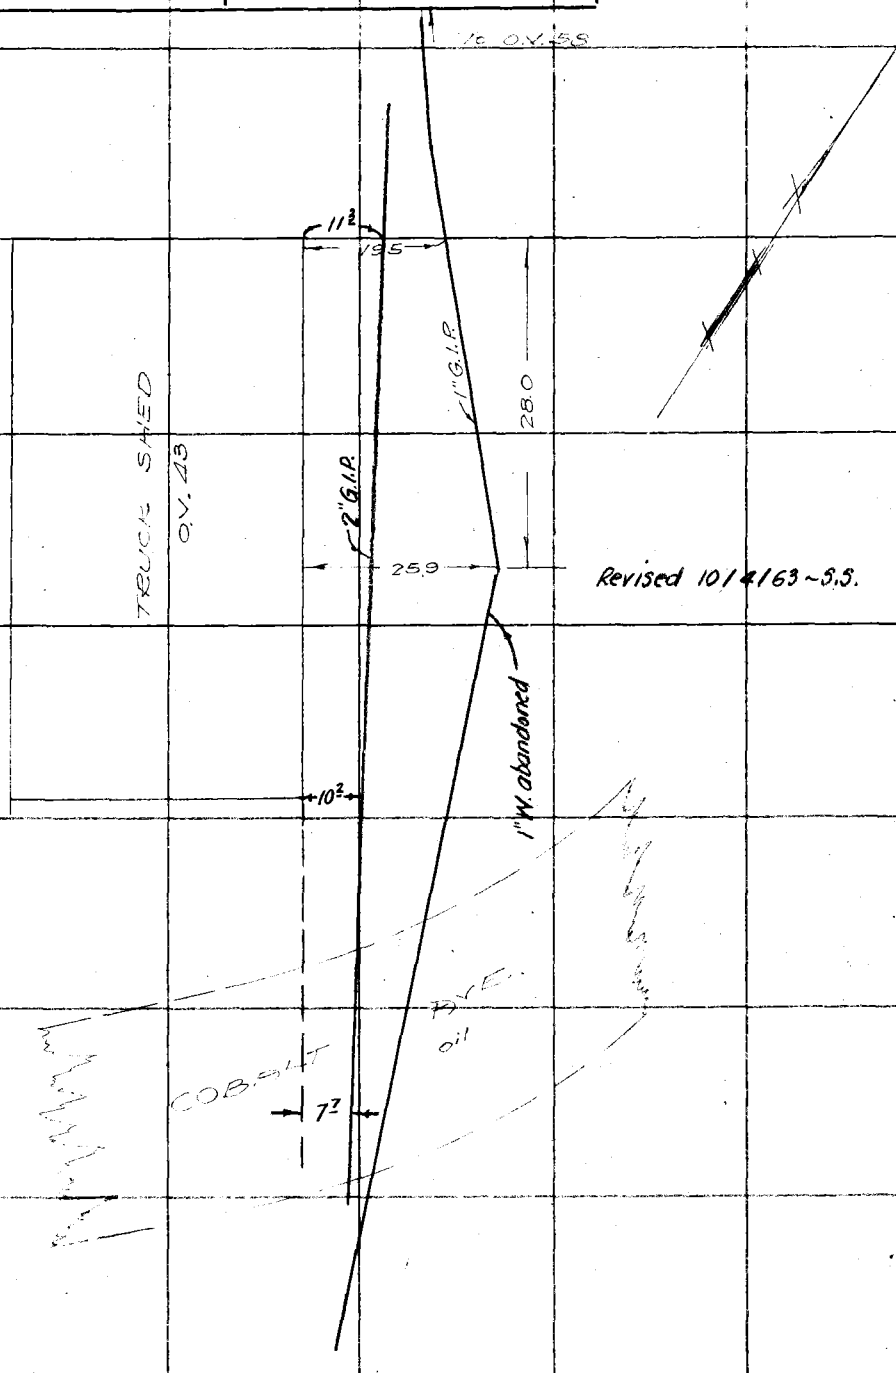

Note: Any Additions or Changes on This Sheet Must be Made or Circled in Red Ink With Date and Name of Person Making Change.

Do not extend notes this side of this line

RETURN TO
LOS ANGELES COUNTY SURVEYOR
700 HALL OF RECORDS

FORM 247 10M 11-38

RETURN TO
LOS ANGELES COUNTY SURVEYOR
700 HALL OF RECORDS

Note: Any Additions or Changes on This Sheet Must be Made or Circled in Red Ink With Date and Name of Person Making Change.

Do not extend notes this side of this line

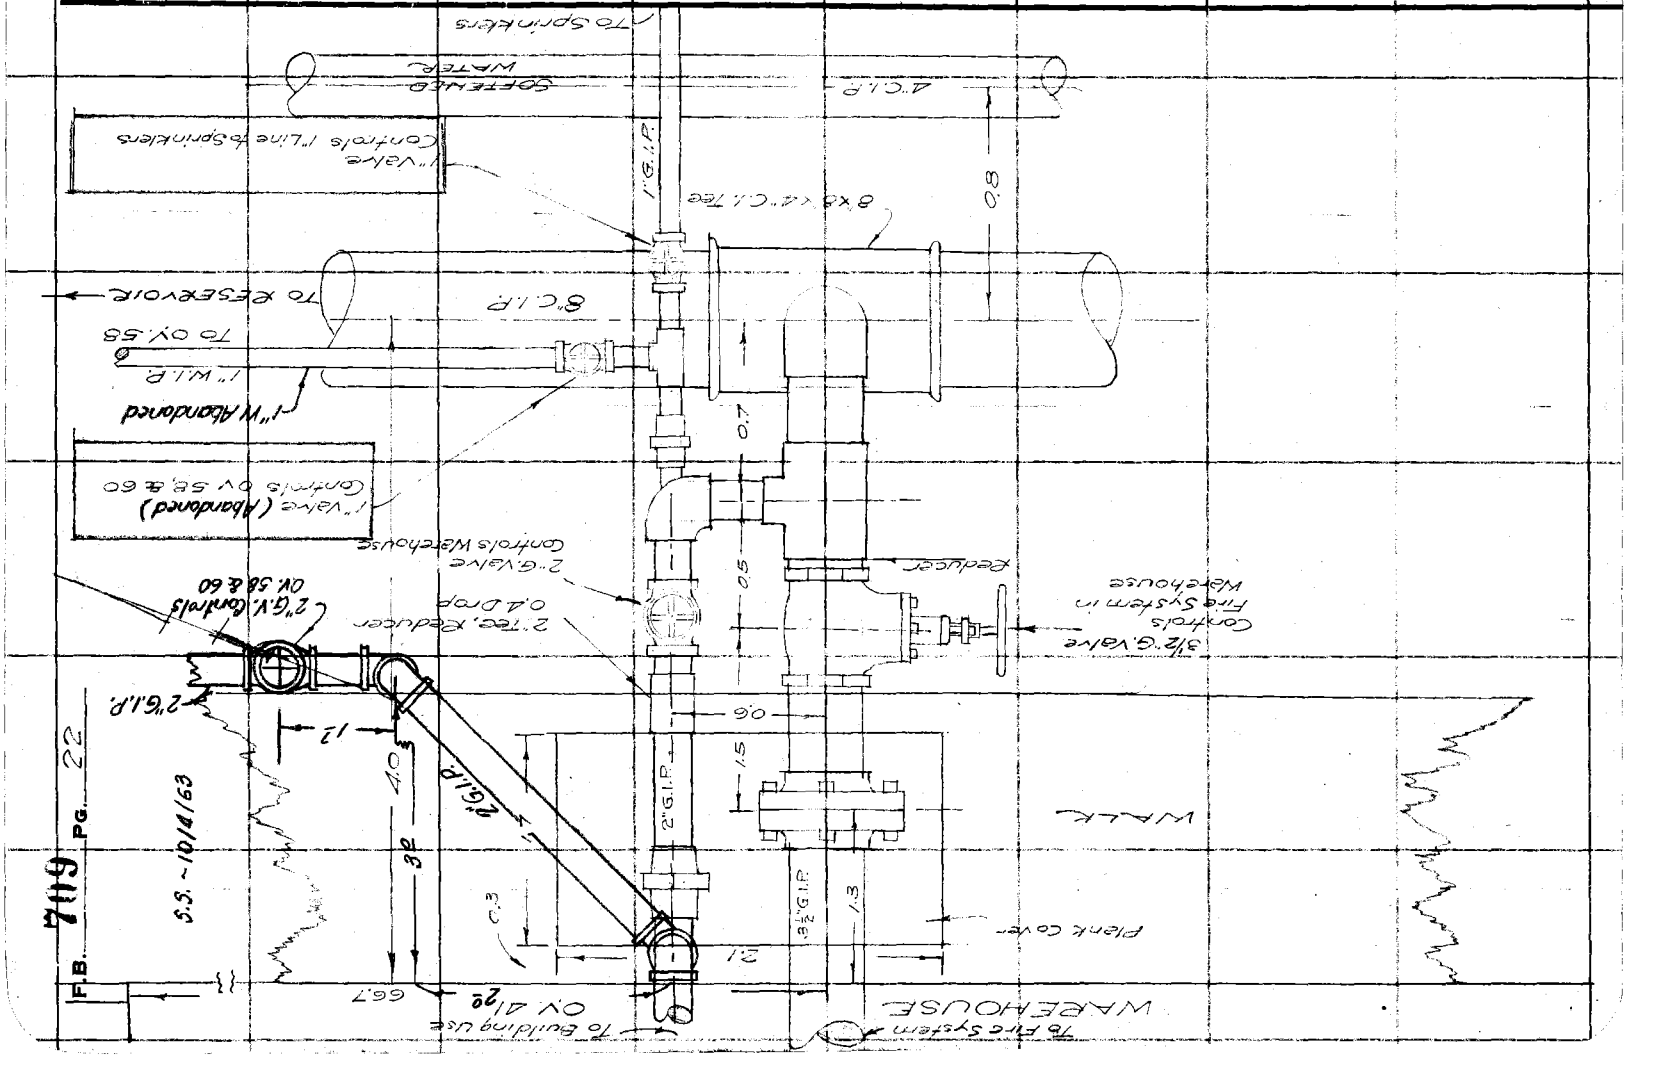

F.B. 719 PG. 22

S.S. ~ 10/4/63

FORM 247 10M 11-35

RETURN TO
LOS ANGELES COUNTY SURVEYOR
700 HALL OF RECORDS

Note: Any Additions or Changes on This Sheet Must be Made or Circled in **Red Ink** With Date and Name of Person Making Change.

Do not extend notes this side of this line

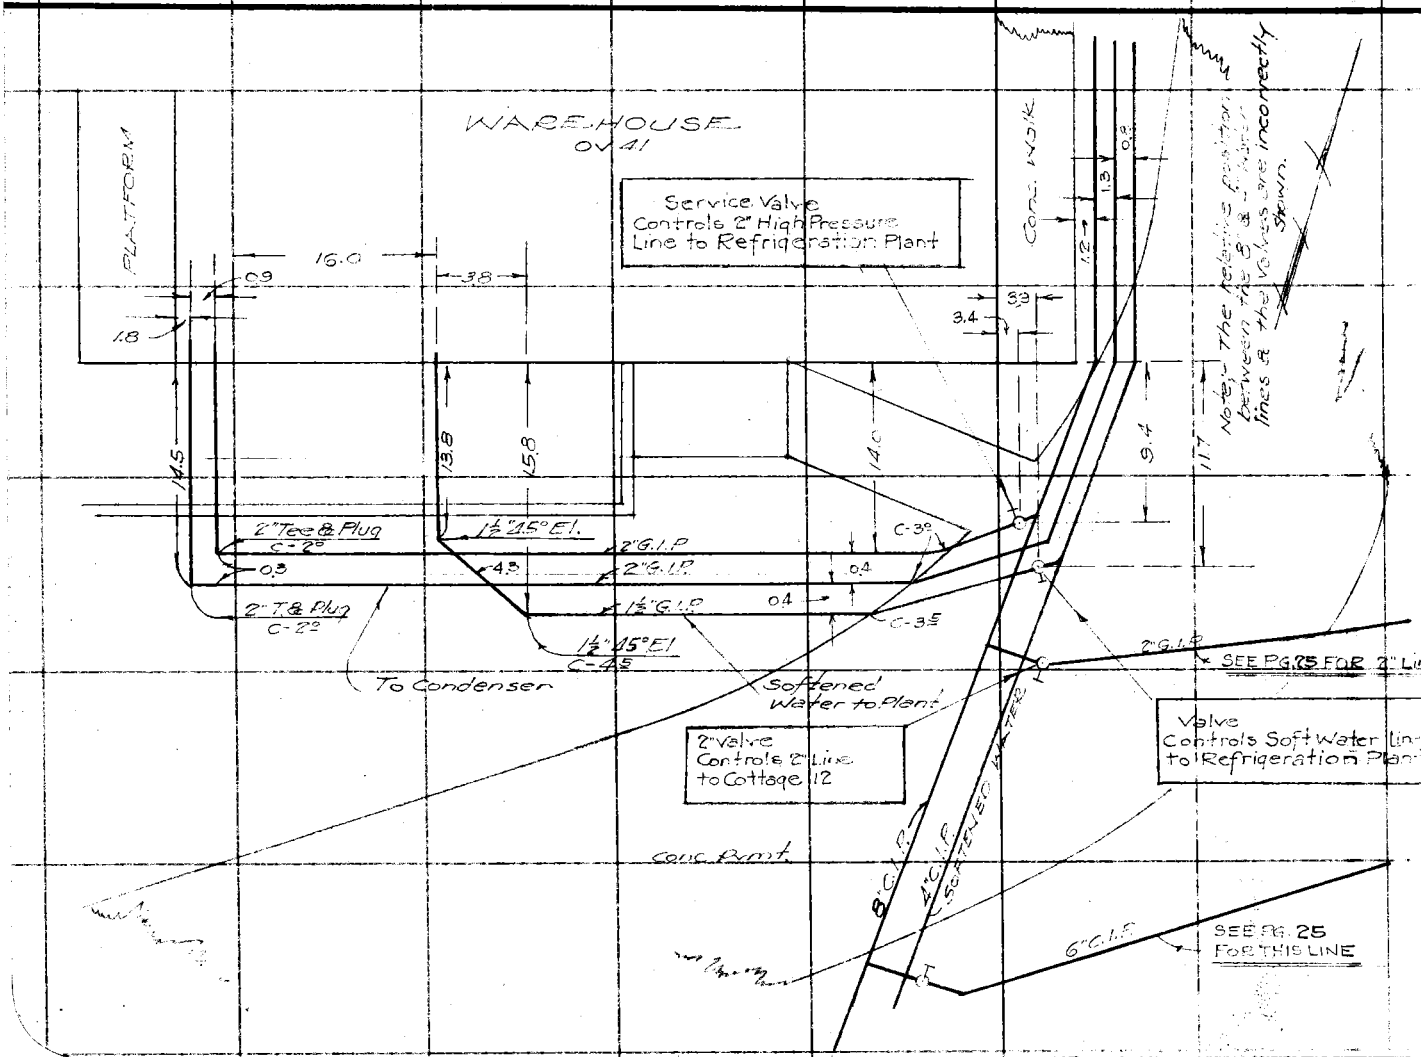

Notes Ck'd by
Map No.
Office Work
Checked
Date

Survey of OLIVE VIEW
W. O. 8148 Tape No. St'd °F.
Surveyed by TED M. WALSH Date 7-23-36
Notes
Indexed

F.B. 709 PG. 23

WATER LINES

RETURN TO
LOS ANGELES COUNTY SURVEYOR
700 HALL OF RECORDS

Note: Any Additions or Changes on This Sheet Must be Made or Circled in **Red** Ink With Date and Name of Person Making Change.

Do not extend notes this side of this line

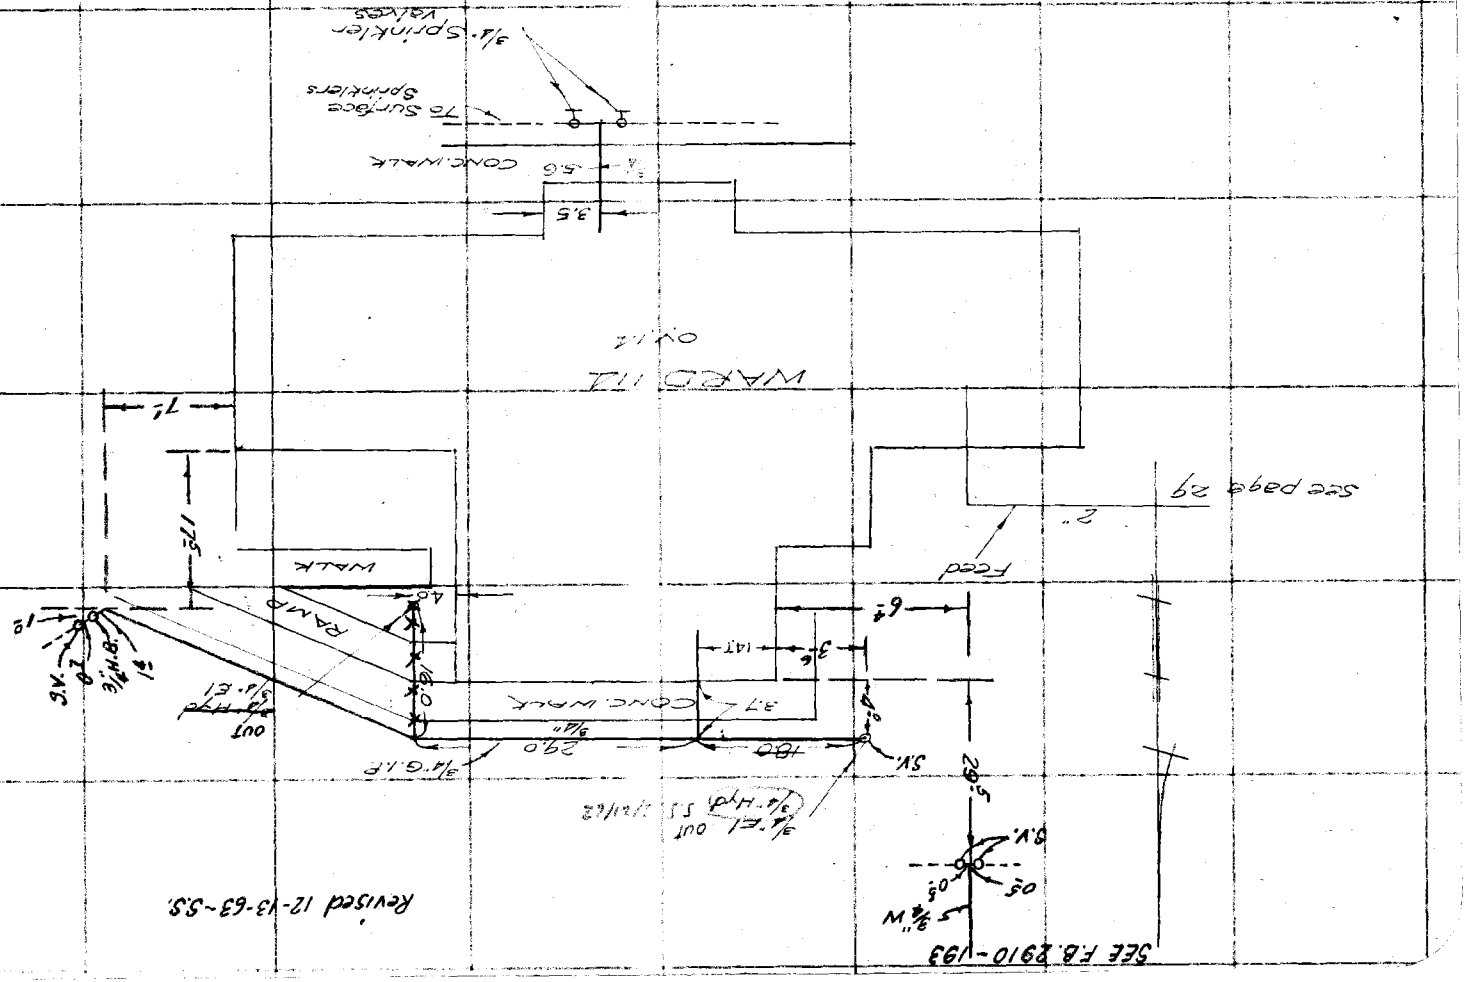

Revised 12-13-63-S.S.

F.B. 709 PG. 24

FORM 247 10M 11-38

RETURN TO
LOS ANGELES COUNTY SURVEYOR
700 HALL OF RECORDS

Note: Any Additions or Changes on This Sheet Must be Made or Circled in **Red Ink** With Date and Name of Person Making Change.

Do not extend notes this side of this line

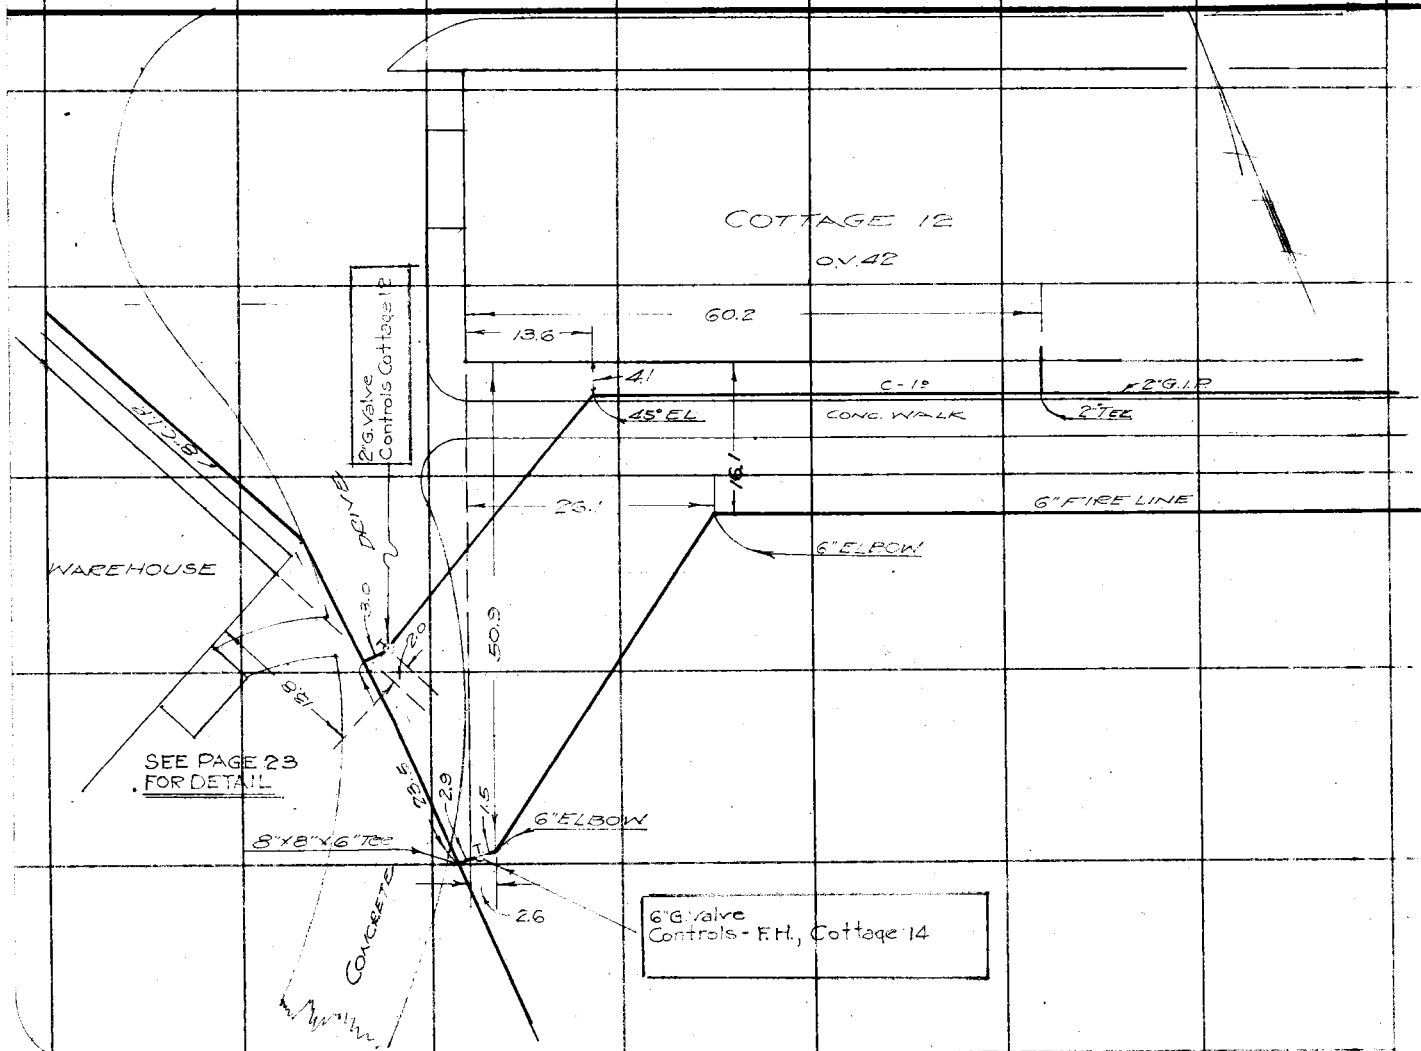

Notes Ck'd by
Map No.
Office Work
Checked
Date

Survey of W. O. 8128 Tape No.
Surveyed by T. M. WALSH St'd. °F.
Notes T. M. WALSH Date 4-19-38
Indexed

F.B. 709 PG. 25

RETURN TO
LOS ANGELES COUNTY SURVEYOR
700 HALL OF RECORDS

Note: Any Additions or Changes on This Sheet Must be Made or Circled in **Red Ink** With Date and Name of Person Making Change.

Do not extend notes this side of this line

F.B. 709 PG. 26

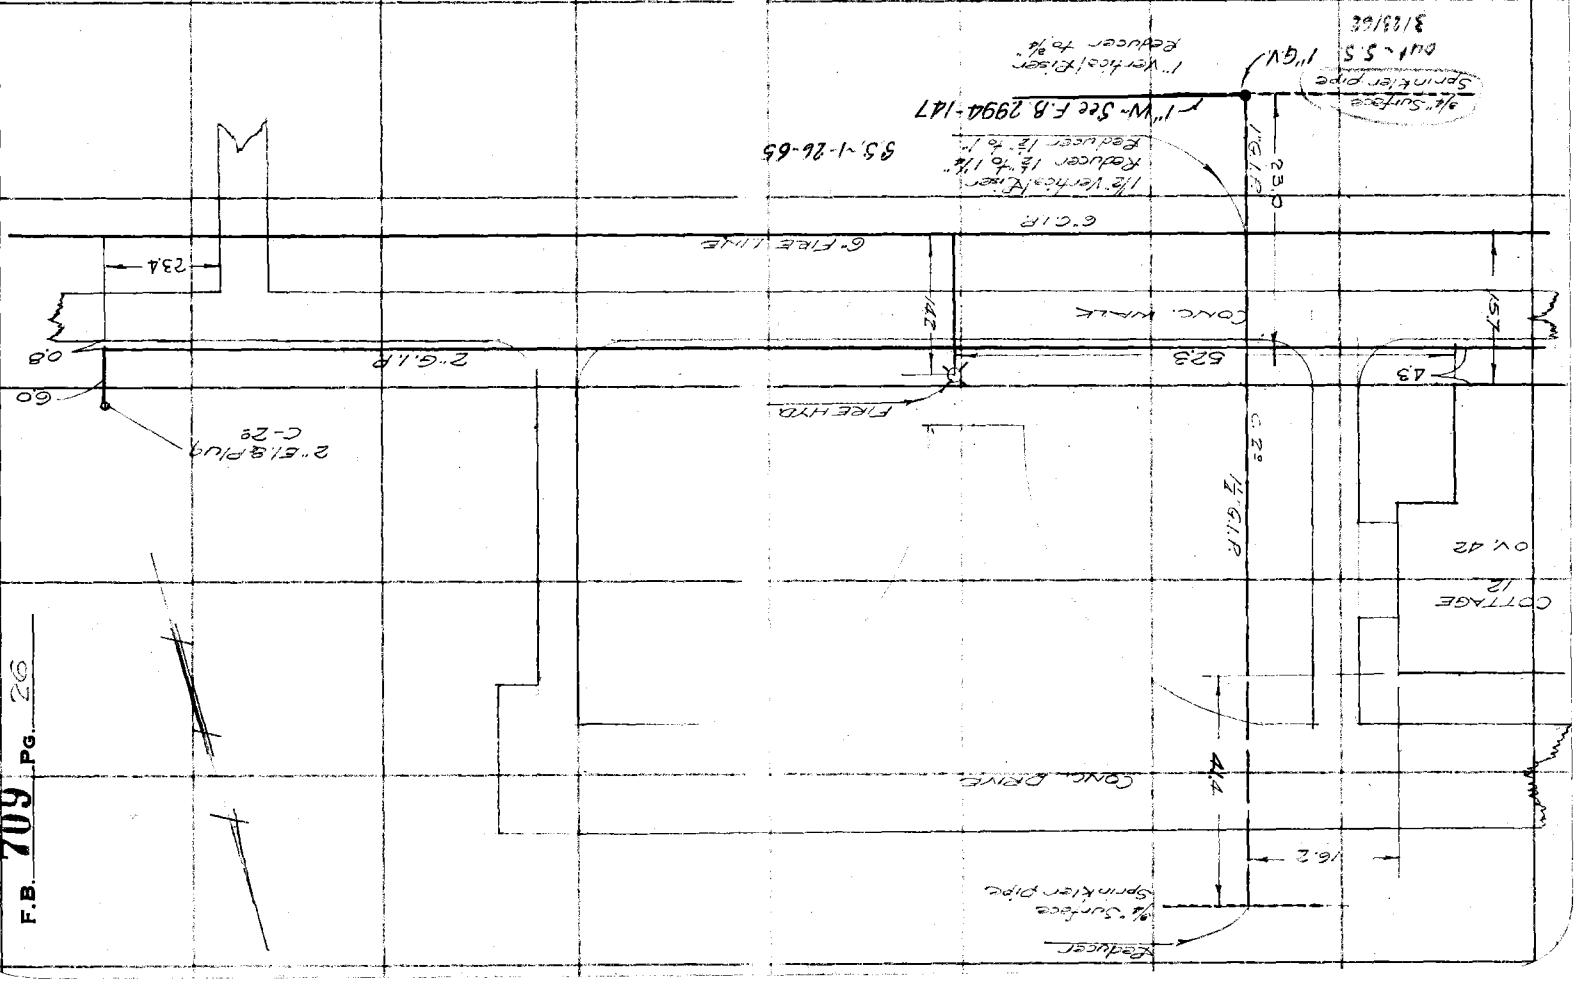

FORM 247 10M 11-35

RETURN TO
LOS ANGELES COUNTY SURVEYOR
700 HALL OF RECORDS

Note: Any Additions or Changes on This Sheet Must be Made or Circled in **Red Ink** With Date and Name of Person Making Change.

Do not extend notes this side of this line

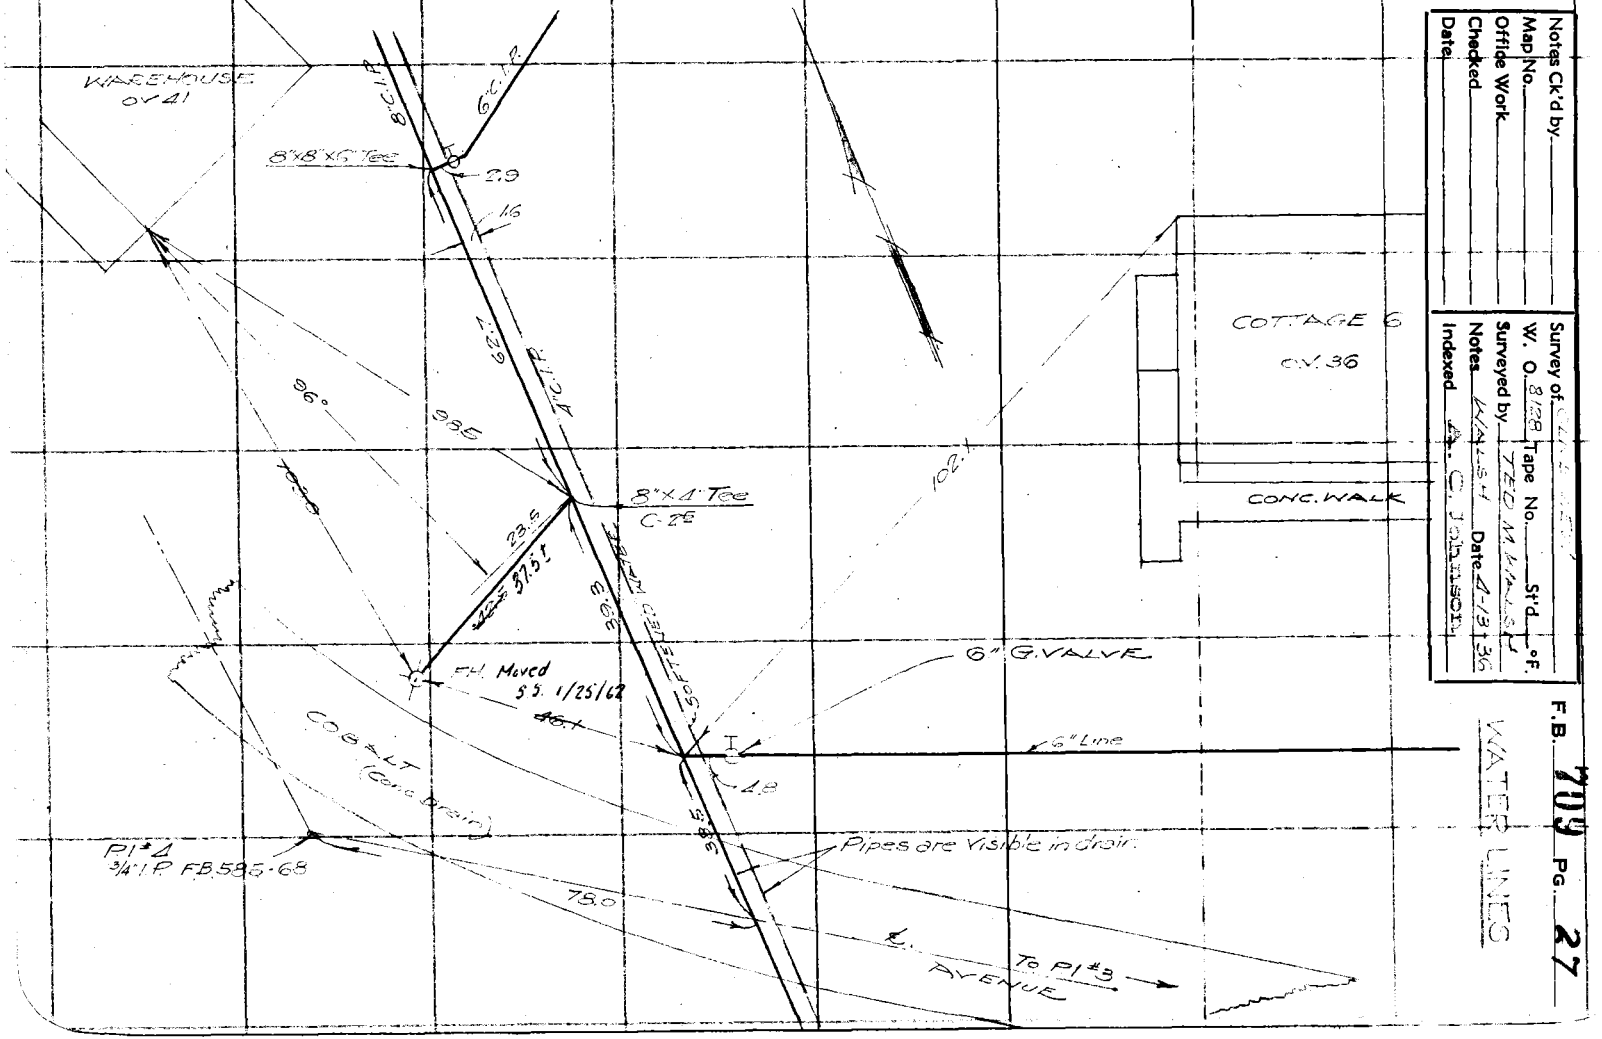

Notes Ck'd by _____
Map No. _____
Office Work _____
Checked _____
Date _____

Survey of WATER LINES
W. O. 8128 Tape No. _____ St'd. _____ °F.
Indexed _____

F.B. 709 Pg. 27

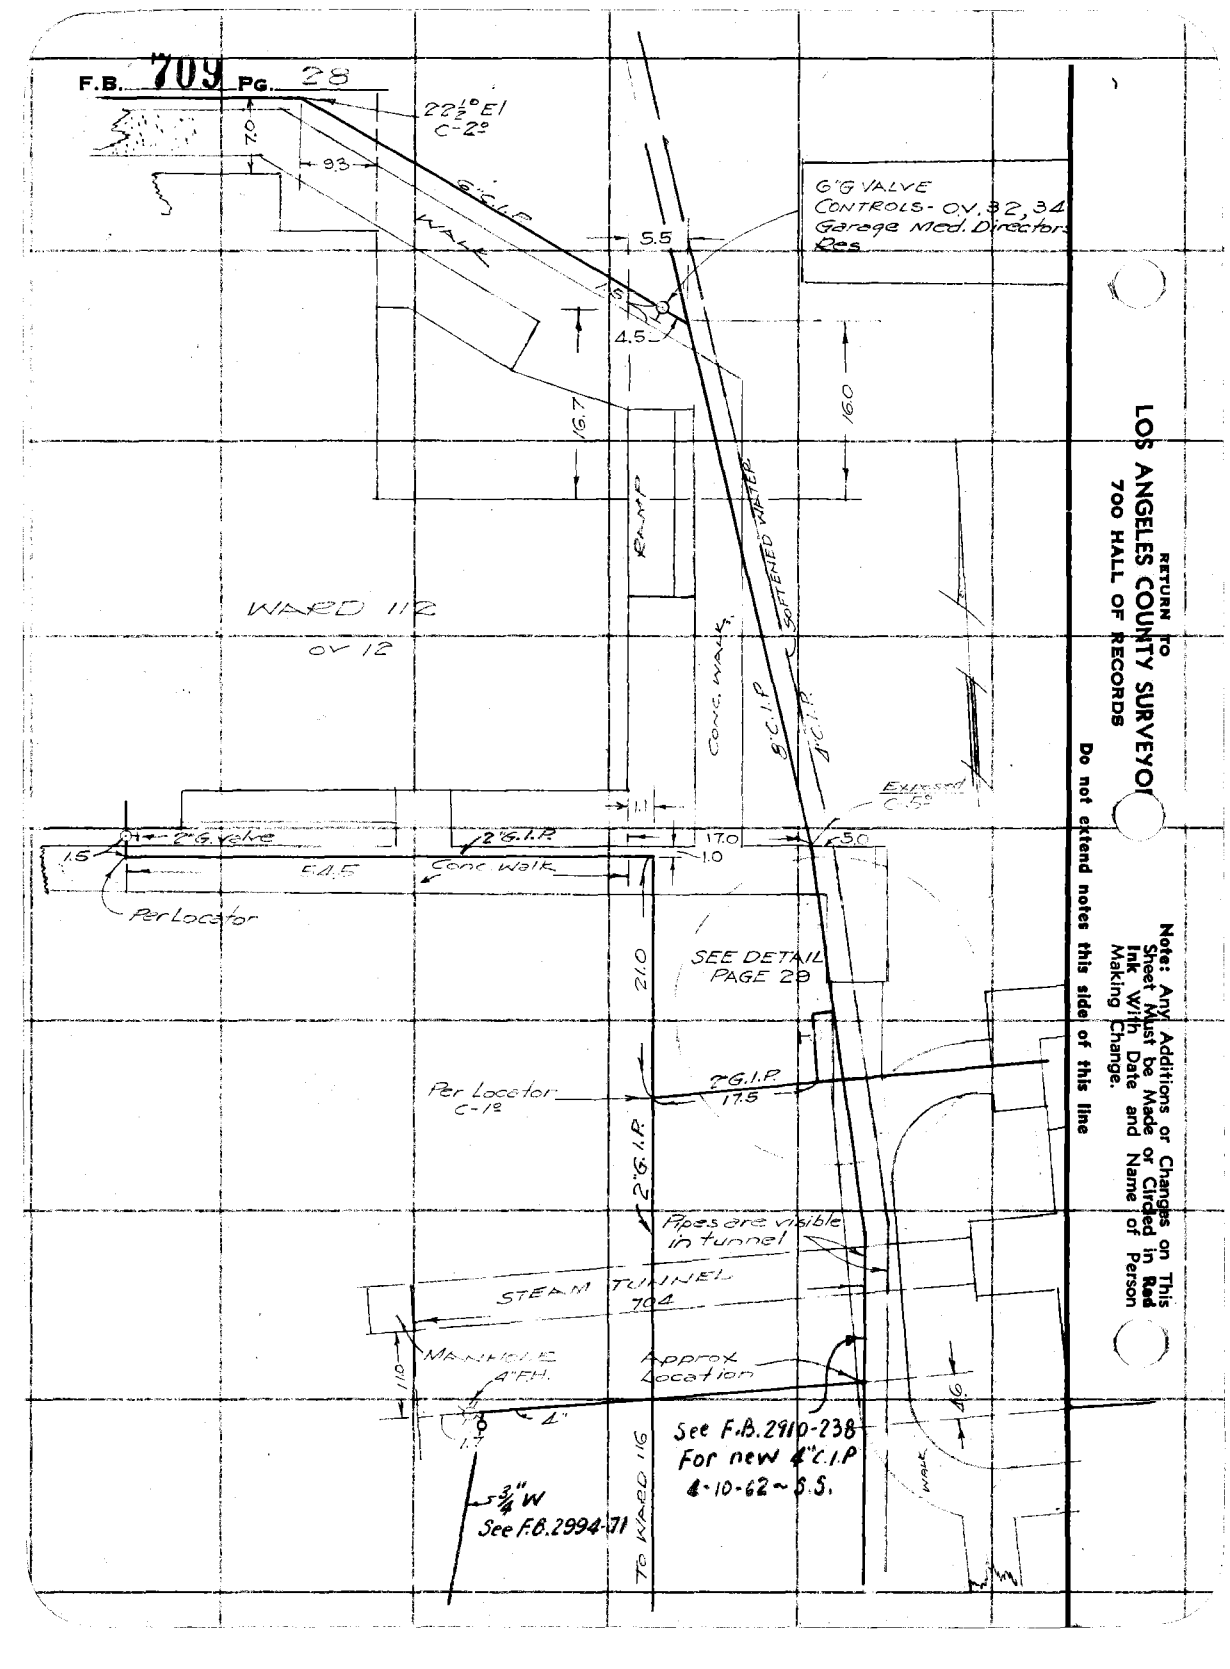

RETURN TO
LOS ANGELES COUNTY SURVEYOR
700 HALL OF RECORDS

Do not extend notes this side of this line

Note: Any Additions or Changes on This Sheet Must be Made or Circled in Red Ink With Date and Name of Person Making Change.

Notes Ck'd by	Survey of OLIVE VIEW SANATORIUM
Map No.	W. O. 8128 Tape No. St'd °F.
Office Work	Surveyed by T. M. WALSH
Checked	Notes T. M. WALSH Date 5-36
Date	Indexed

F.B. 709 PG. 29

WATER LINES

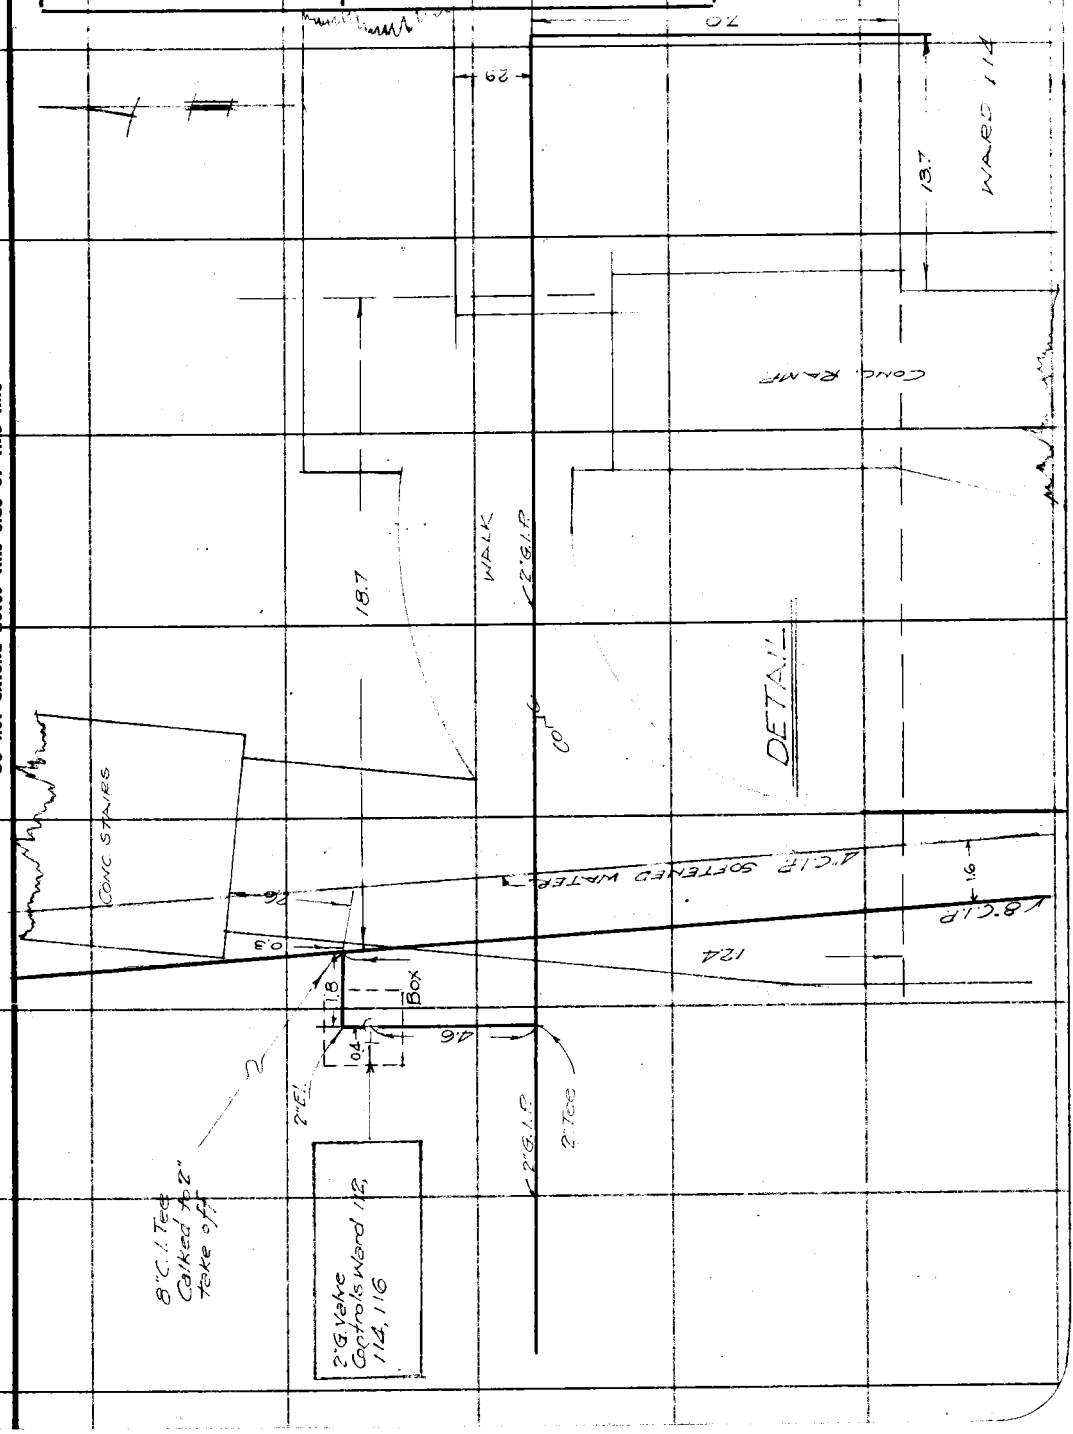

Note: Any Additions or Changes on This Sheet Must be Made or Circled in Red Ink With Date and Name of Person Making Change.

Do not extend notes this side of this line

RETURN TO
LOS ANGELES COUNTY SURVEYOR
700 HALL OF RECORDS

FORM 247 10M 11-35

F.B. 709 PG. 30

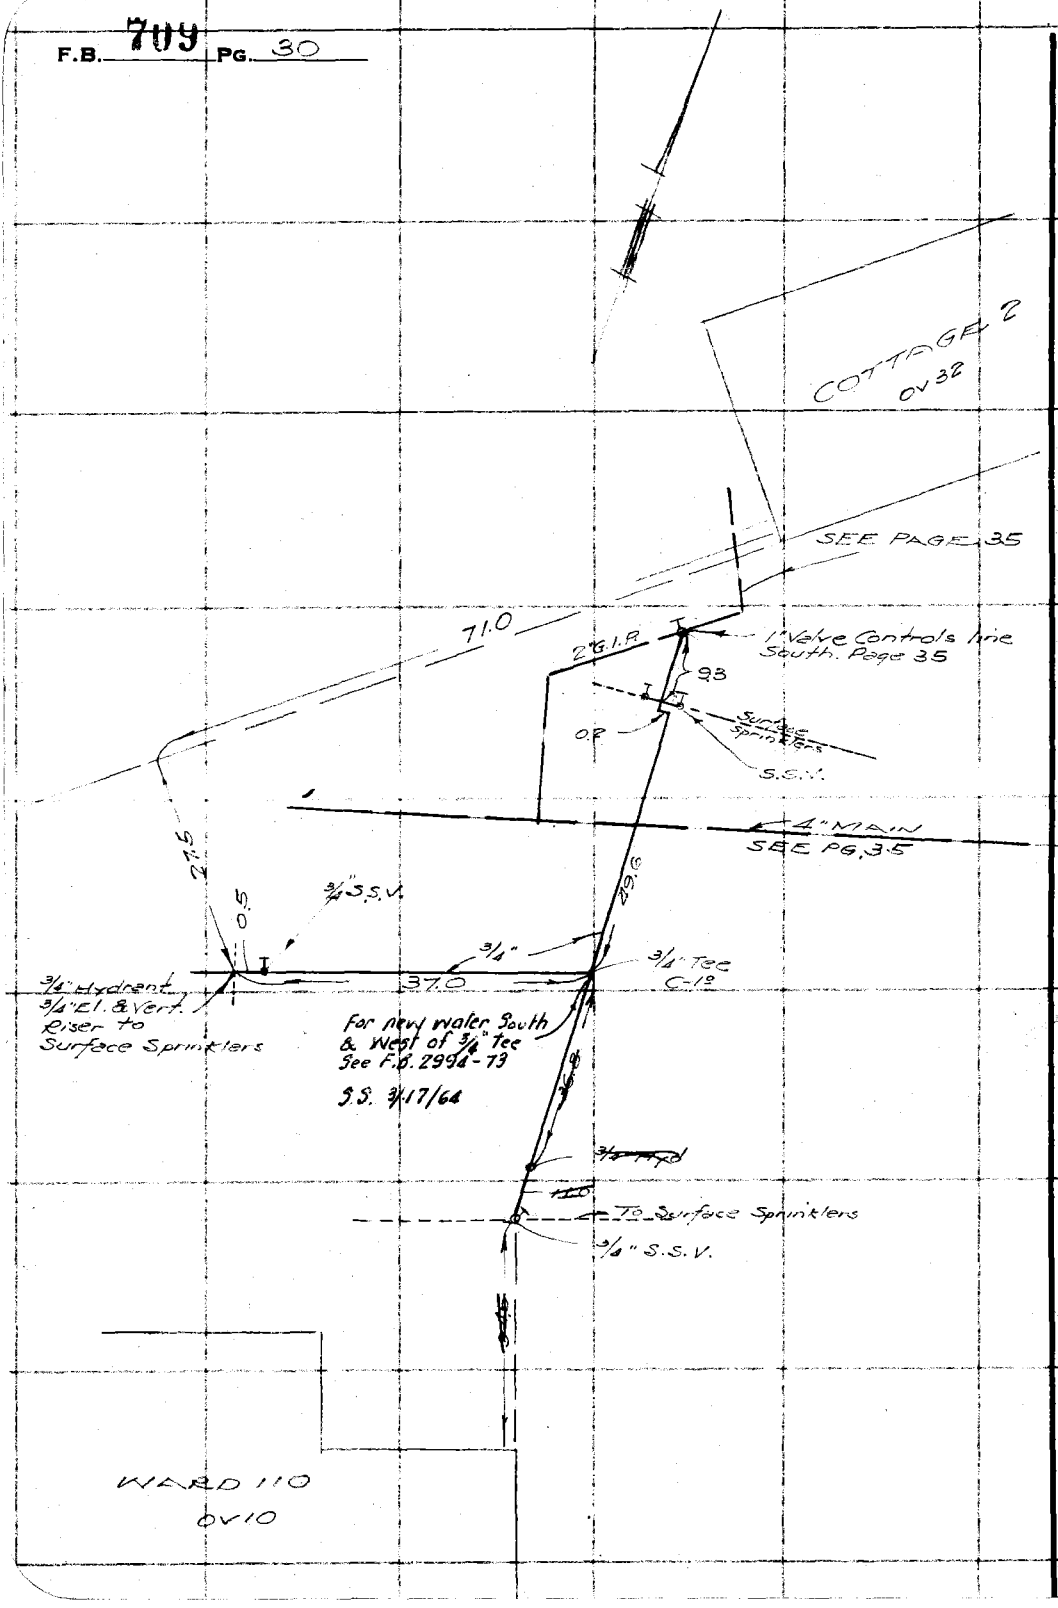

RETURN TO
LOS ANGELES COUNTY SURVEYOR
700 HALL OF RECORDS

Note: Any Additions or Changes on This Sheet Must be Made or Circled in Red Ink With Date and Name of Person Making Change.

Do not extend notes this side of this line

Notes Ck'd by	Survey of [illegible]
Map No.	W. O. 8128 Tape No. St'd °F.
Office Work	Surveyed by T. M. WALSH
Checked	Notes T. M. WALSH Date 6-36
Date	Indexed C. Johnson

F.B. 709 PG. 31

WATER LINE.

RETURN TO
LOS ANGELES COUNTY SURVEYOR
700 HALL OF RECORDS

Note: Any Additions or Changes on This Sheet Must be Made or Circled in Red Ink With Date and Name of Person Making Change

Do not extend notes this side of this line

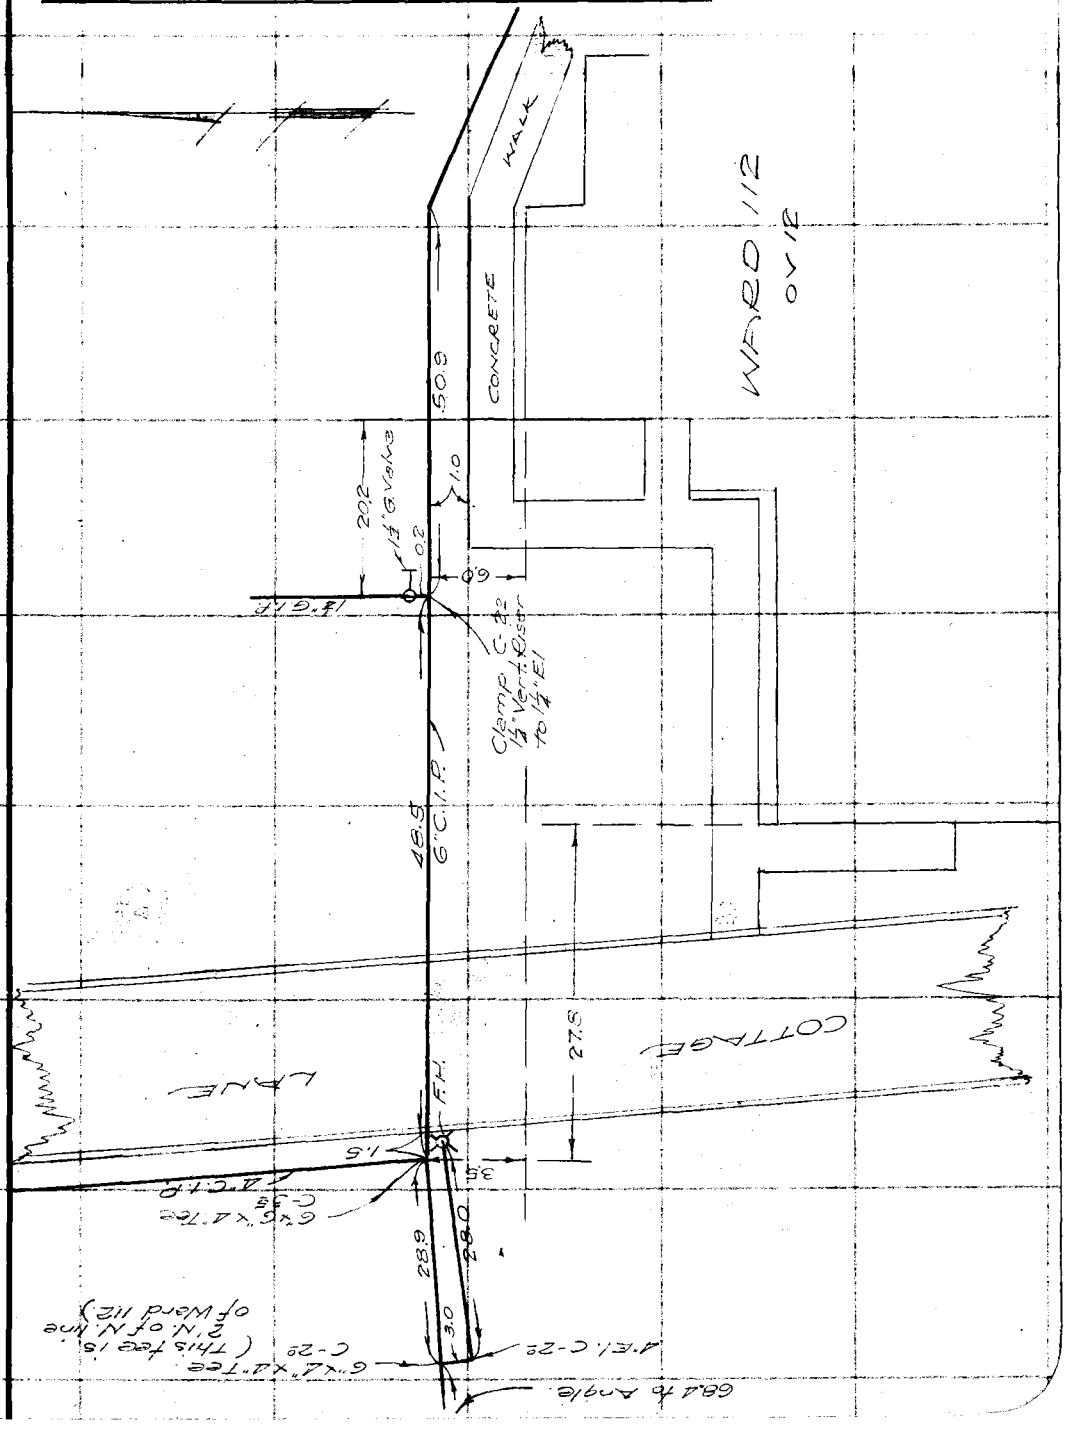

FORM 247 10M 11-35

RETURN TO
LOS ANGELES COUNTY SURVEYOR
700 HALL OF RECORDS

Note: Any Additions or Changes on This Sheet Must be Made or Circled in **Red Ink** With Date and Name of Person Making Change.

Do not extend notes this side of this line

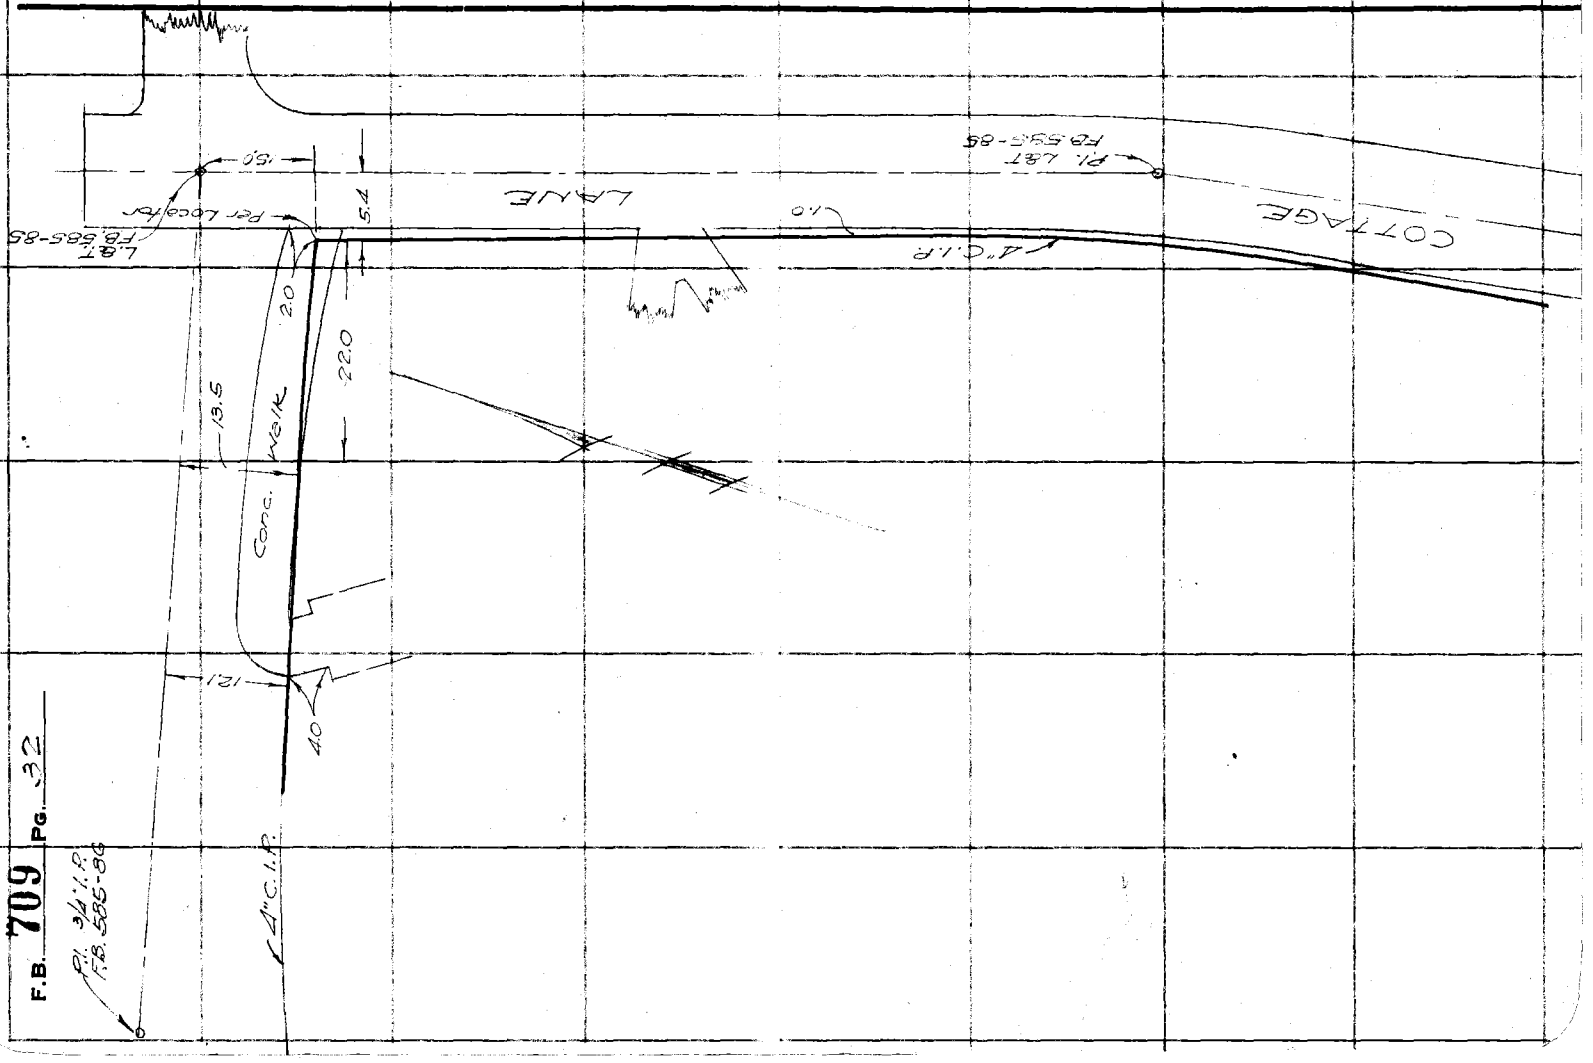

F.B. 709 PG. 32

Notes Ck'd by	Survey of OLIVE VIEW SANATORIUM
Map No.	W. O. 8128 Tape No. St'd °F.
Office Work	Surveyed by T. M. WALSH
Checked	Notes WALSH Date 5-9-36
Date	Indexed

F.B. 709 PG. 33

WATER LINES

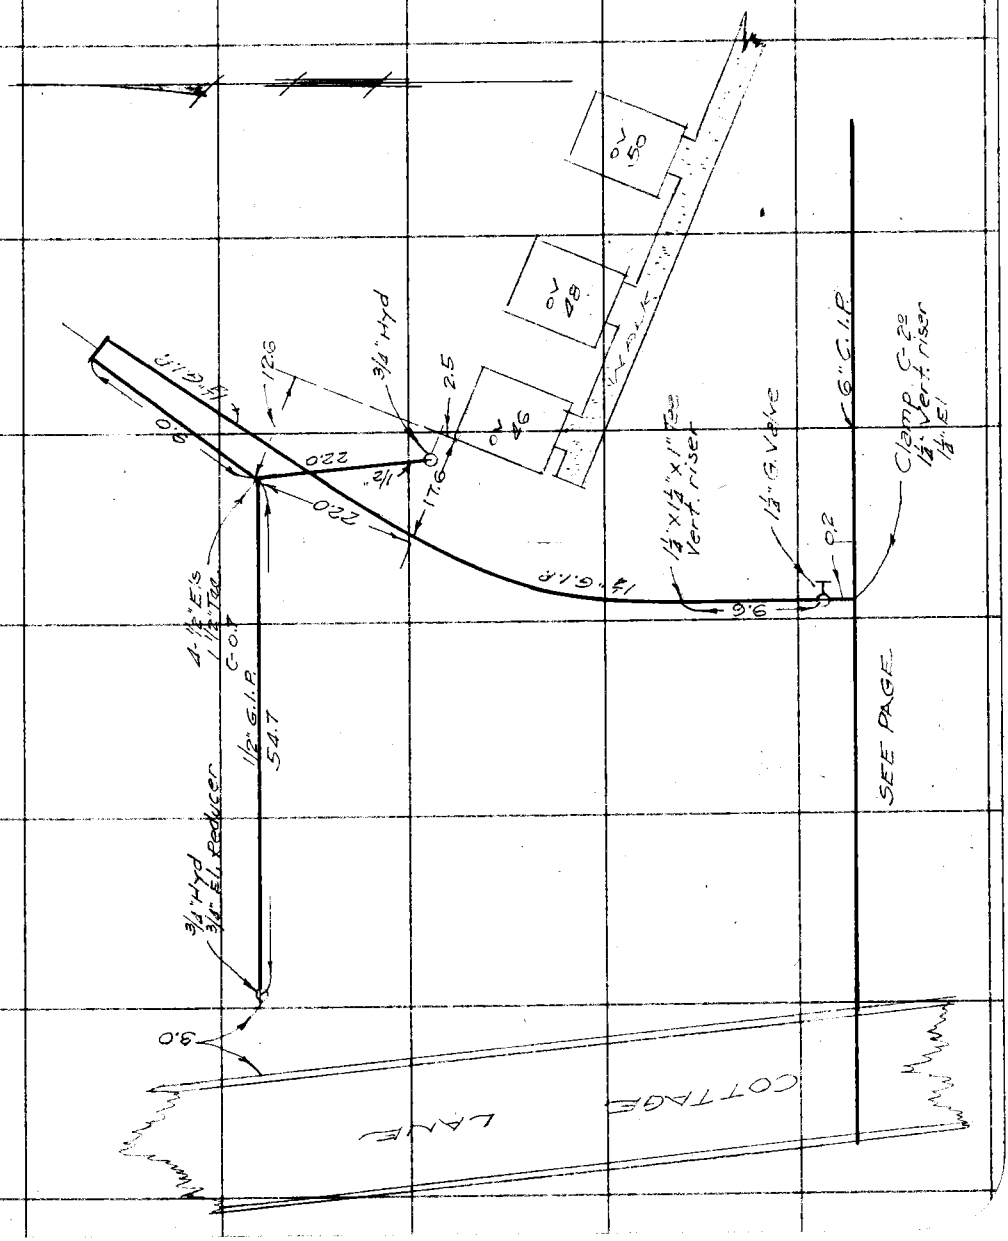

Note: Any Additions or Changes on This Sheet Must be Made or Circled in Red Ink With Date and Name of Person Making Change.

Do not extend notes this side of this line

RETURN TO
LOS ANGELES COUNTY SURVEYOR
700 HALL OF RECORDS

FORM 247 10M 11-35

F.B. 709 PG. 34

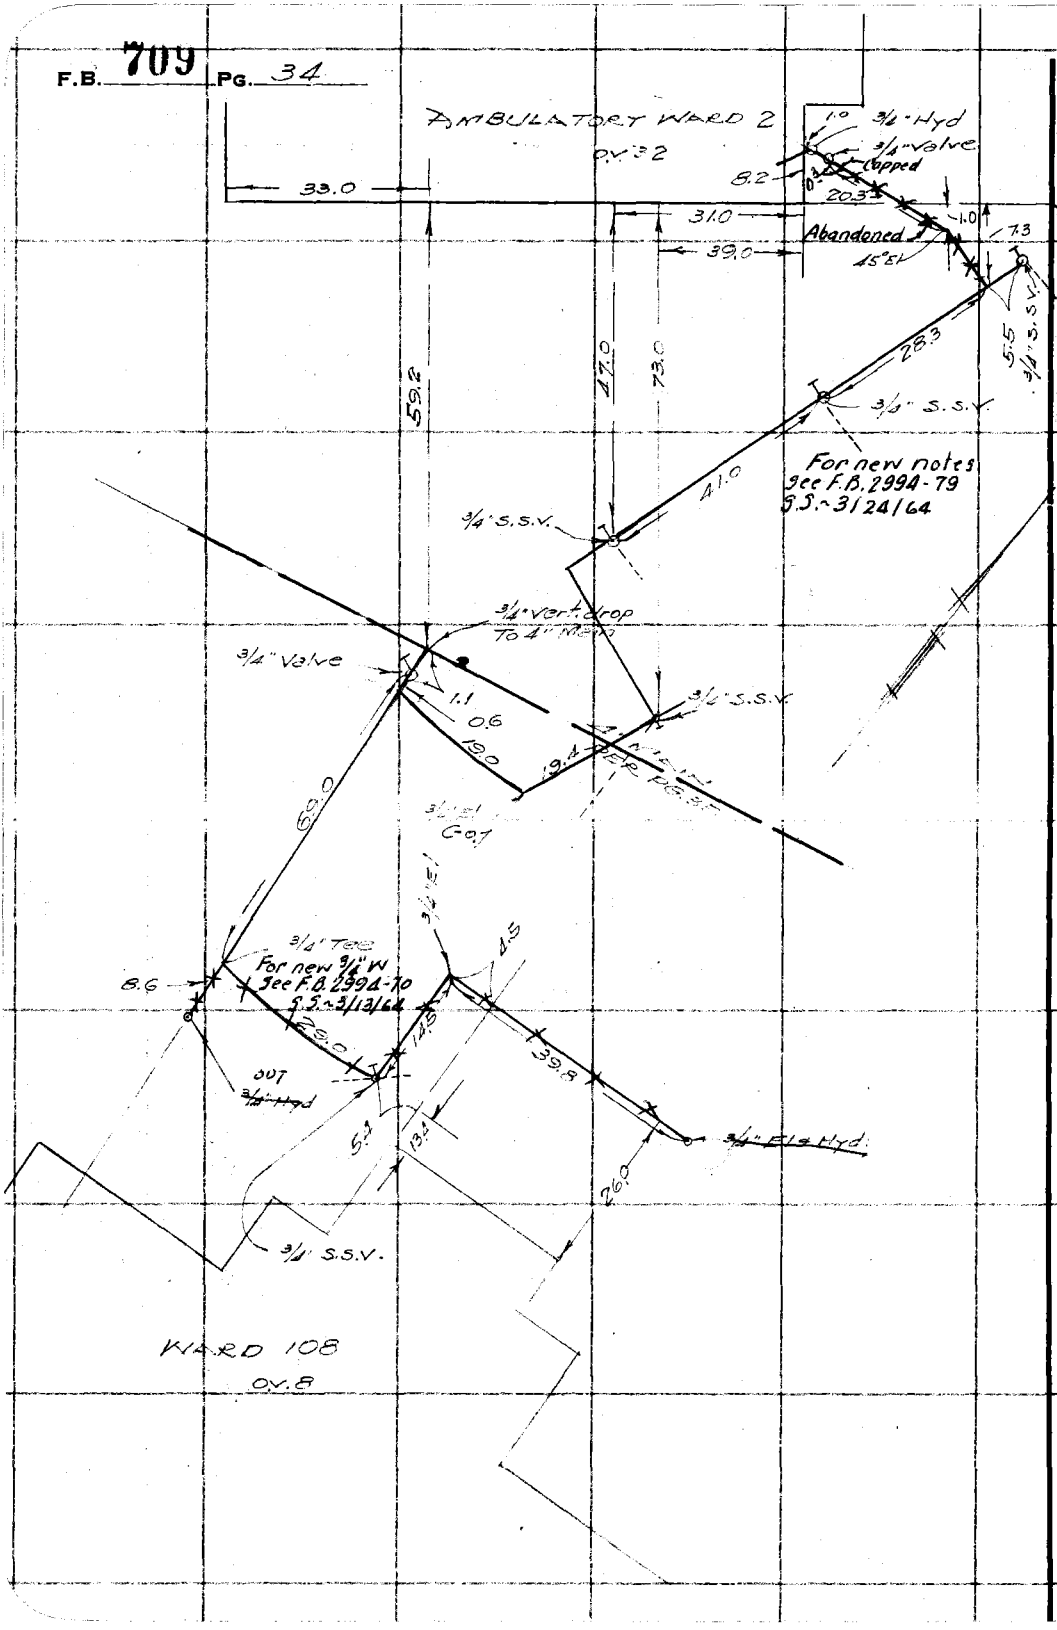

RETURN TO
LOS ANGELES COUNTY SURVEYOR
700 HALL OF RECORDS

Note: Any Additions or Changes on This Sheet Must be Made or Circled in Red Ink With Date and Name of Person Making Change.

Do not extend notes this side of this line

Notes Ck'd by	Survey of C.W.V. SANATORIUM
Map No.	W. O. 8128 Tape No. St'd °F.
Office Work	Surveyed by M. WALSH
Checked	Notes M. WALSH Date 7-14-36
Date	Indexed A. C. Johnson

F.B. 709 PG. 35

WATER LINES

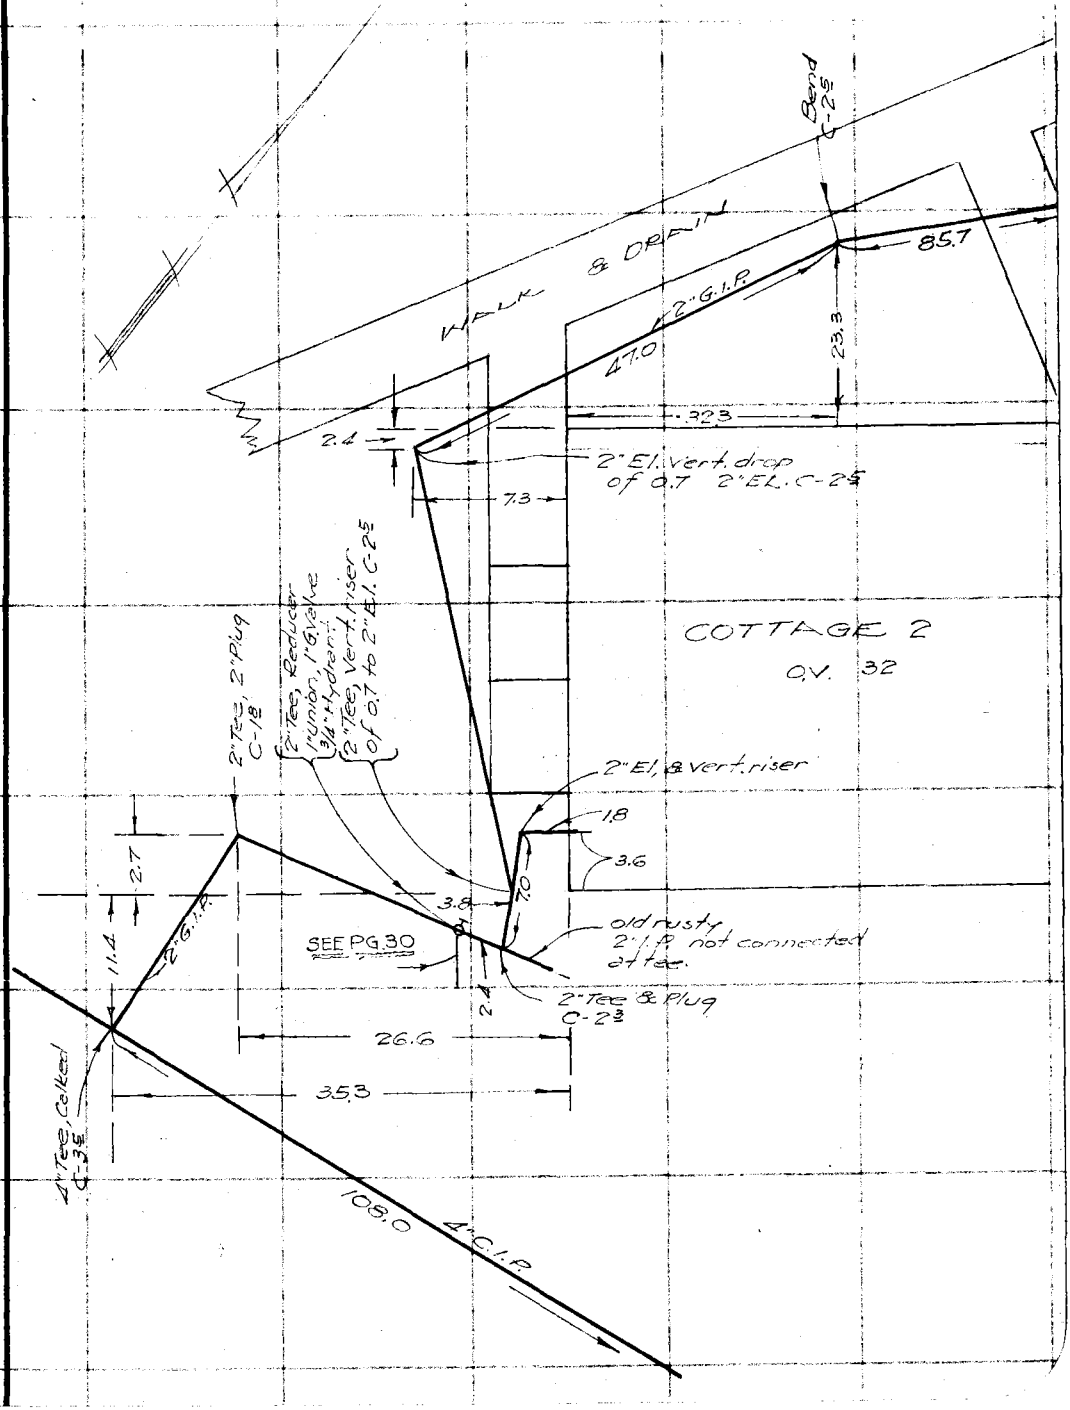

RETURN TO
LOS ANGELES COUNTY SURVEYOR
7dO HALL OF RECORDS

Note: Any Additions or Changes on This Sheet Must be Made or Circled in Red Ink With Date and Name of Person Making Change.

Do not extend notes this side of this line

FORM 247 10M 11-35

RETURN TO
LOS ANGELES COUNTY SURVEYOR
700 HALL OF RECORDS

Note: Any Additions or Changes on This Sheet Must be Made or Circled in **Red Ink** With Date and Name of Person Making Change.

Do not extend notes this side of this line

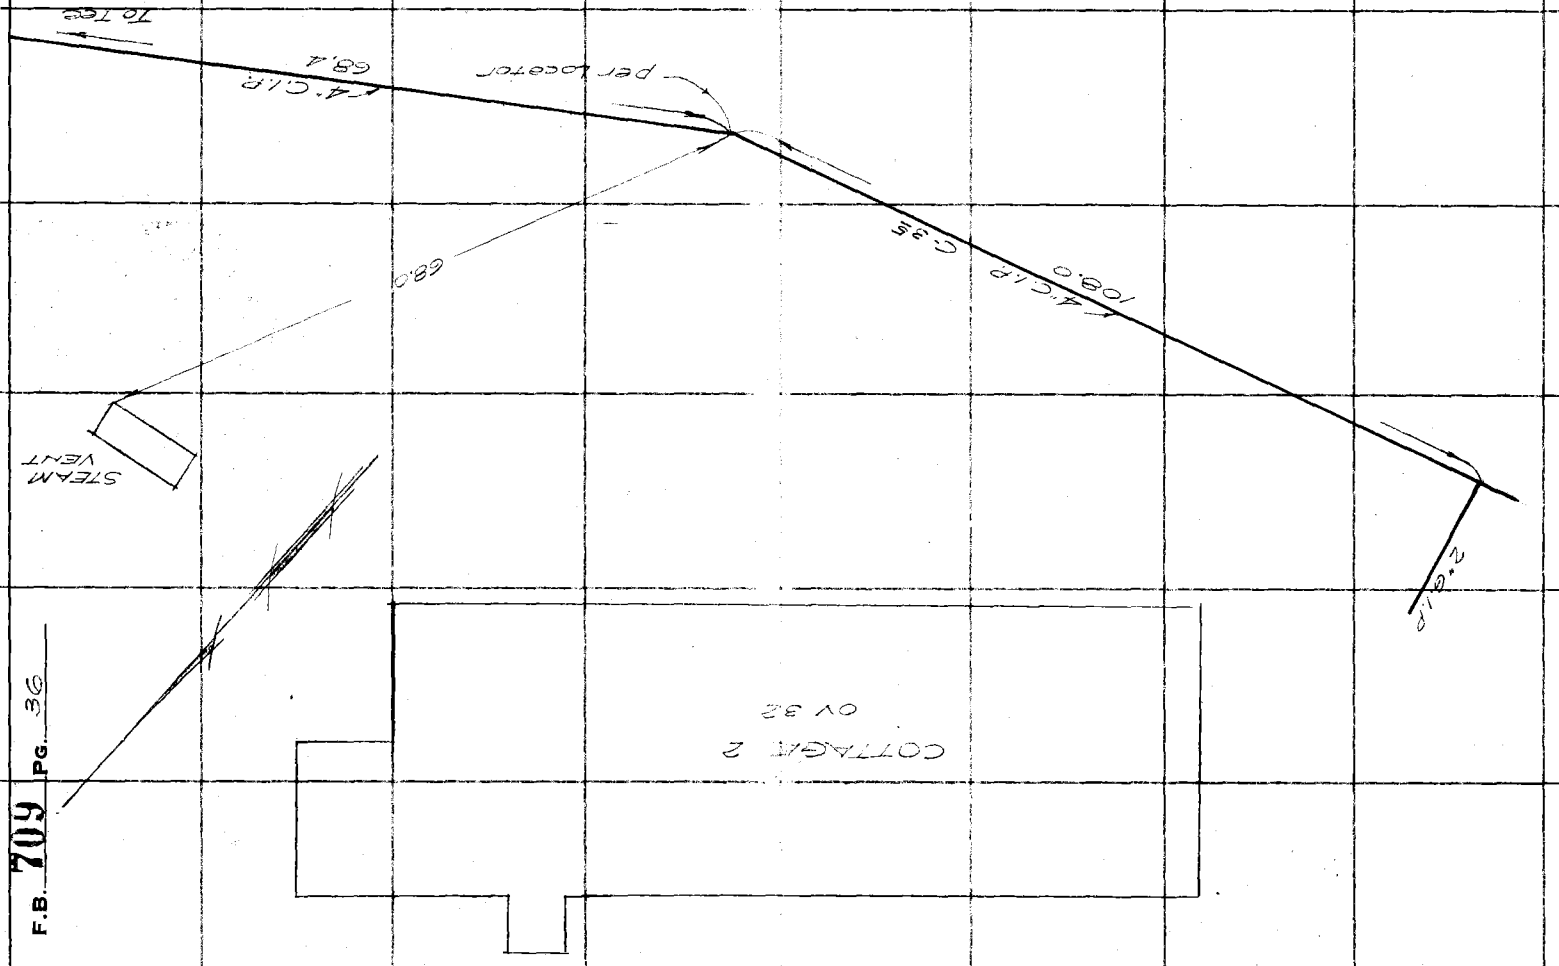

F.B. 709 PG. 36

Notes Ck'd by	Survey of OLIVE VIEW SANATORIUM
Map No.	W. O. Tape No. St'd °F.
Office Work	Surveyed by T. M. WALSH
Checked	Notes T. M. WALSH Date
Date	Indexed A. C. Johnson

F.B. 709 PG. 37

WATER LINES

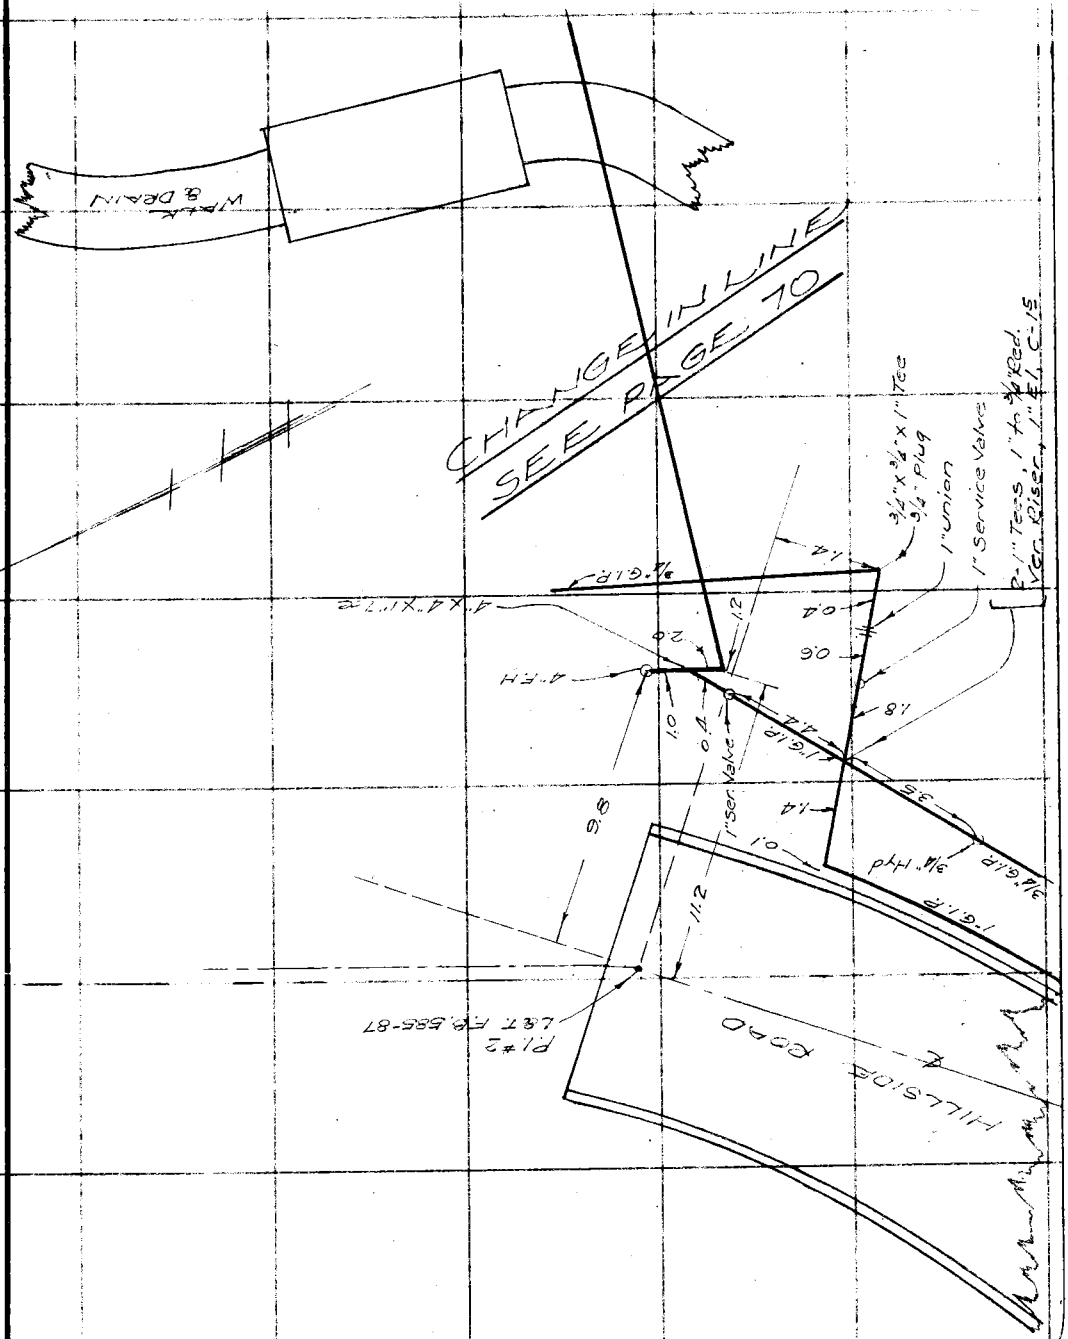

Note: Any Additions or Changes on This Sheet Must be Made or Circled in Red Ink With Date and Name of Person Making Change.

Do not extend notes this side of this line

RETURN TO
LOS ANGELES COUNTY SURVEYOR
700 HALL OF RECORDS

FORM 247 10M 11-35

RETURN TO
LOS ANGELES COUNTY SURVEYOR
700 HALL OF RECORDS

Note: Any Additions or Changes on This Sheet Must be Made or Circled in Red Ink With Date and Name of Person Making Change.

Do not extend notes this side of this line

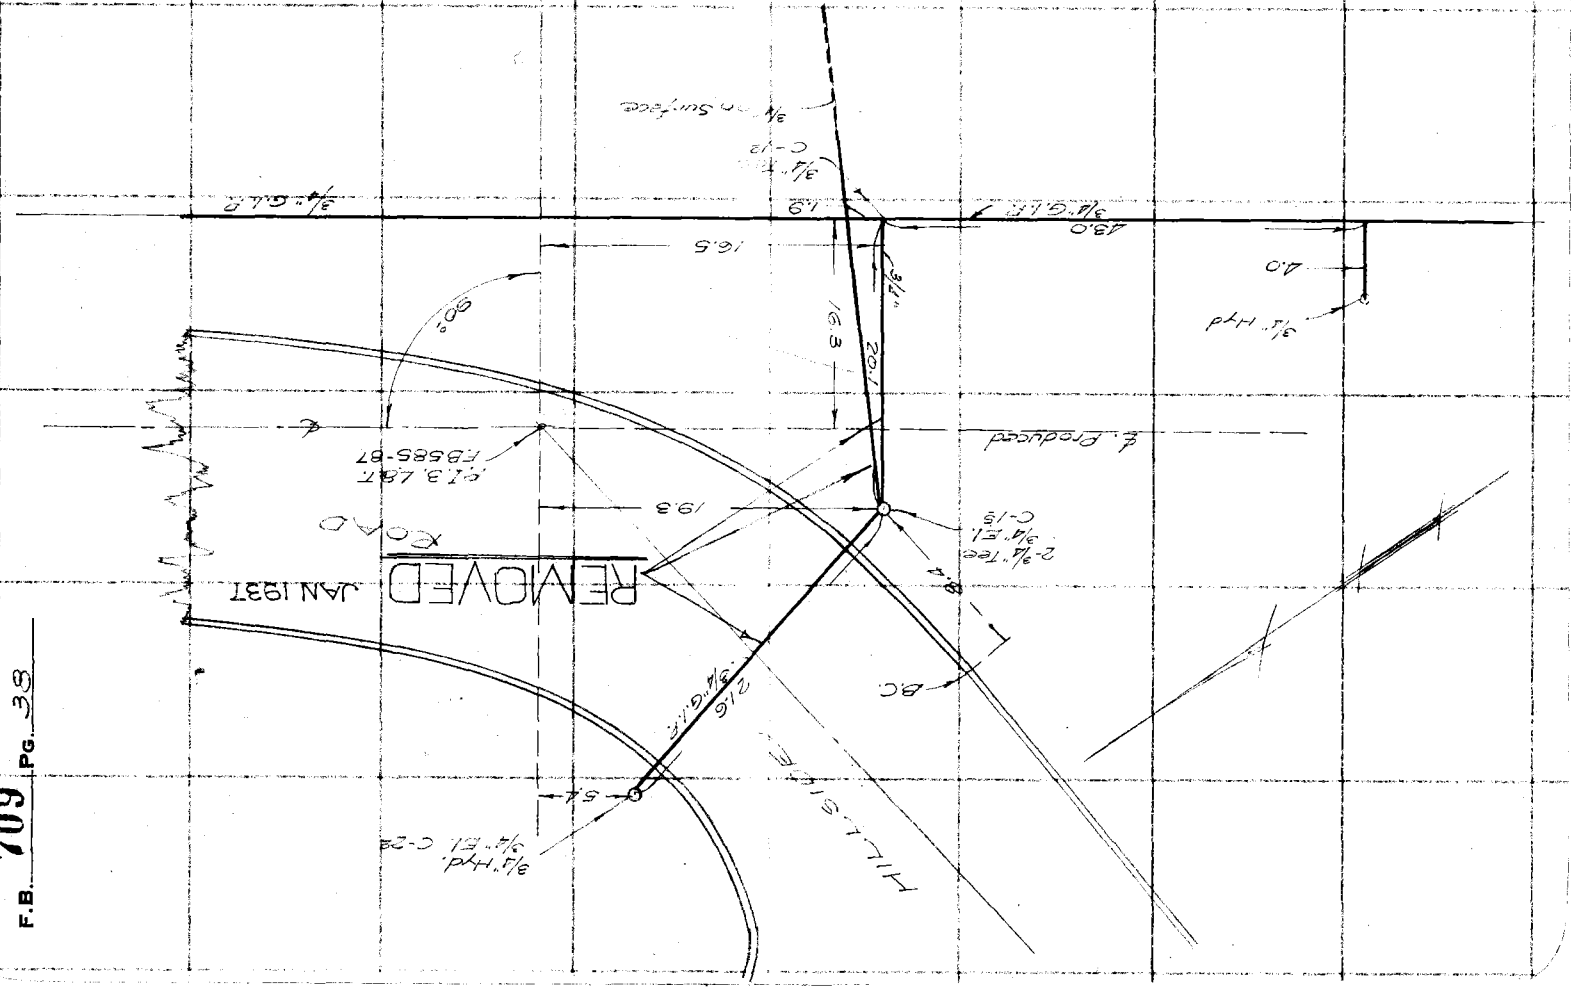

F.B. 709 PG. 38

Notes Ck'd by	Survey of
Map No.	W. O. 8128 Tape No. St'd °F.
Office Work	Surveyed by T. M. WALSH
Checked	Notes T. M. WALSH Date 8-4-36
Date	Indexed

F.B. 709 PG. 39

WATER LINES

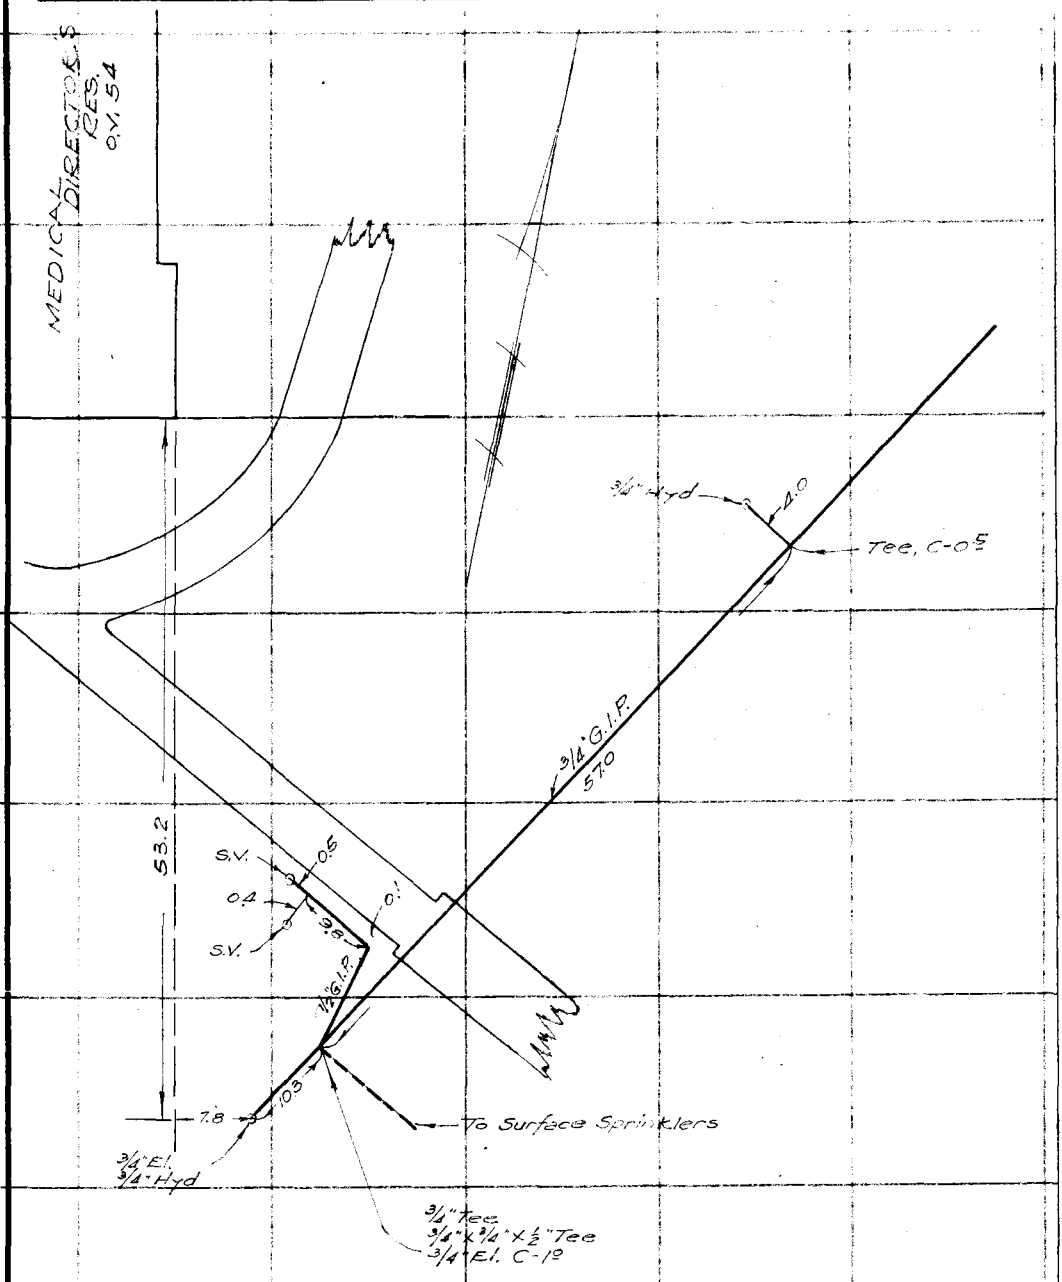

RETURN TO
LOS ANGELES COUNTY SURVEYOR
700 HALL OF RECORDS

Note: Any Additions or Changes on This Sheet Must be Made or Circled in Red Ink With Date and Name of Person Making Change

Do not extend notes this side of this line

FORM 247 10M 11-35

RETURN TO
LOS ANGELES COUNTY SURVEYOR
700 HALL OF RECORDS

Note: Any Additions or Changes on This Sheet Must be Made or Circled in **Red Ink** With Date and Name of Person Making Change.

Do not extend notes this side of this line

F.B. 709 PG. 40

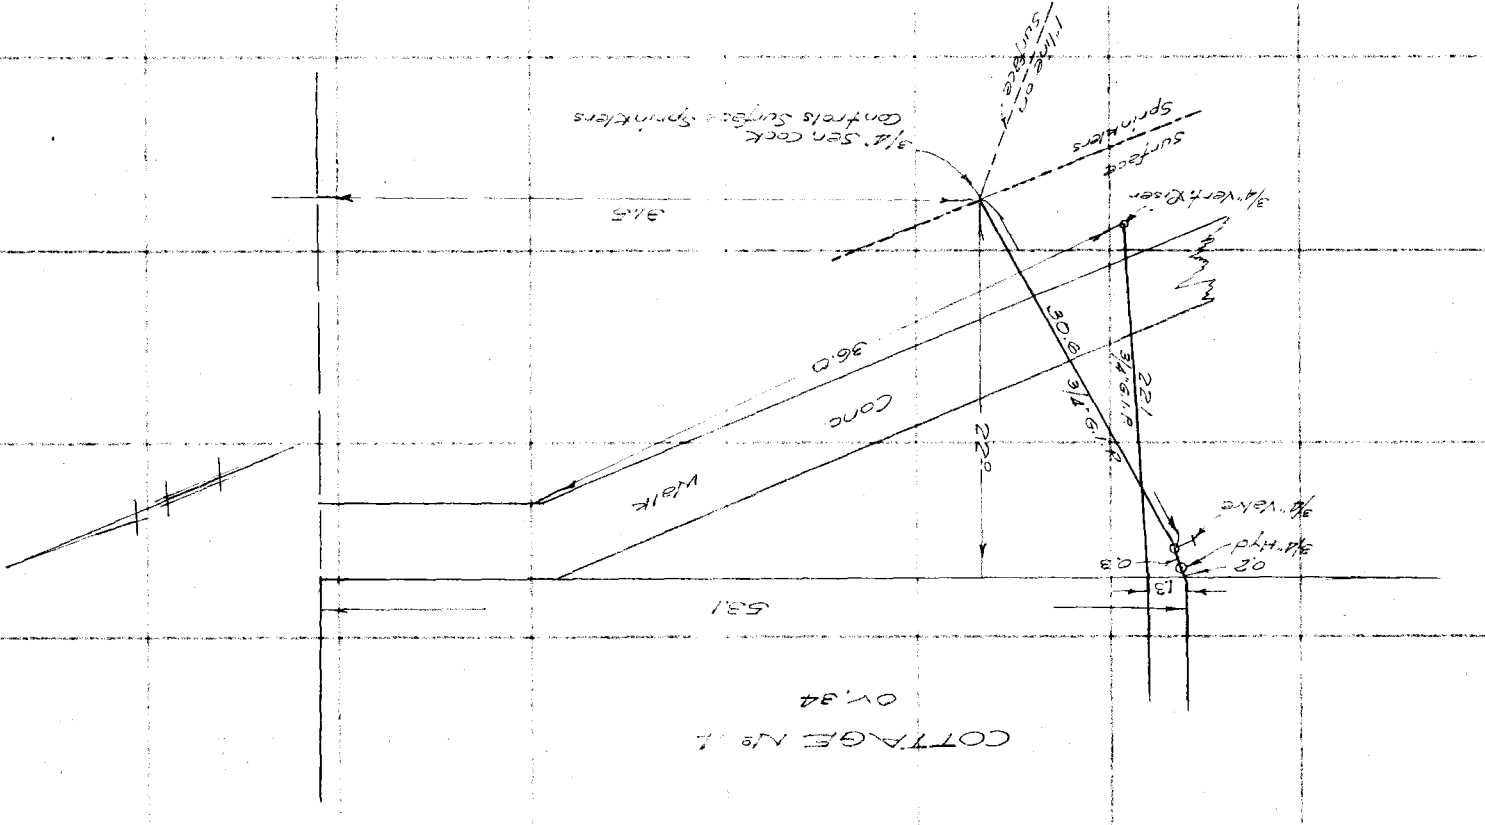

Notes Ck'd by	Survey of OLIVE VIEW SANATORIUM
Map No.	W. O. 8128 Tape No. Std °F.
Office Work	Surveyed by T. M. WALSH
Checked	Notes T. M. WALSH Date 6-1936
Date	Indexed C. Johnson

F.B. 709 PG. 41

WATER LINE

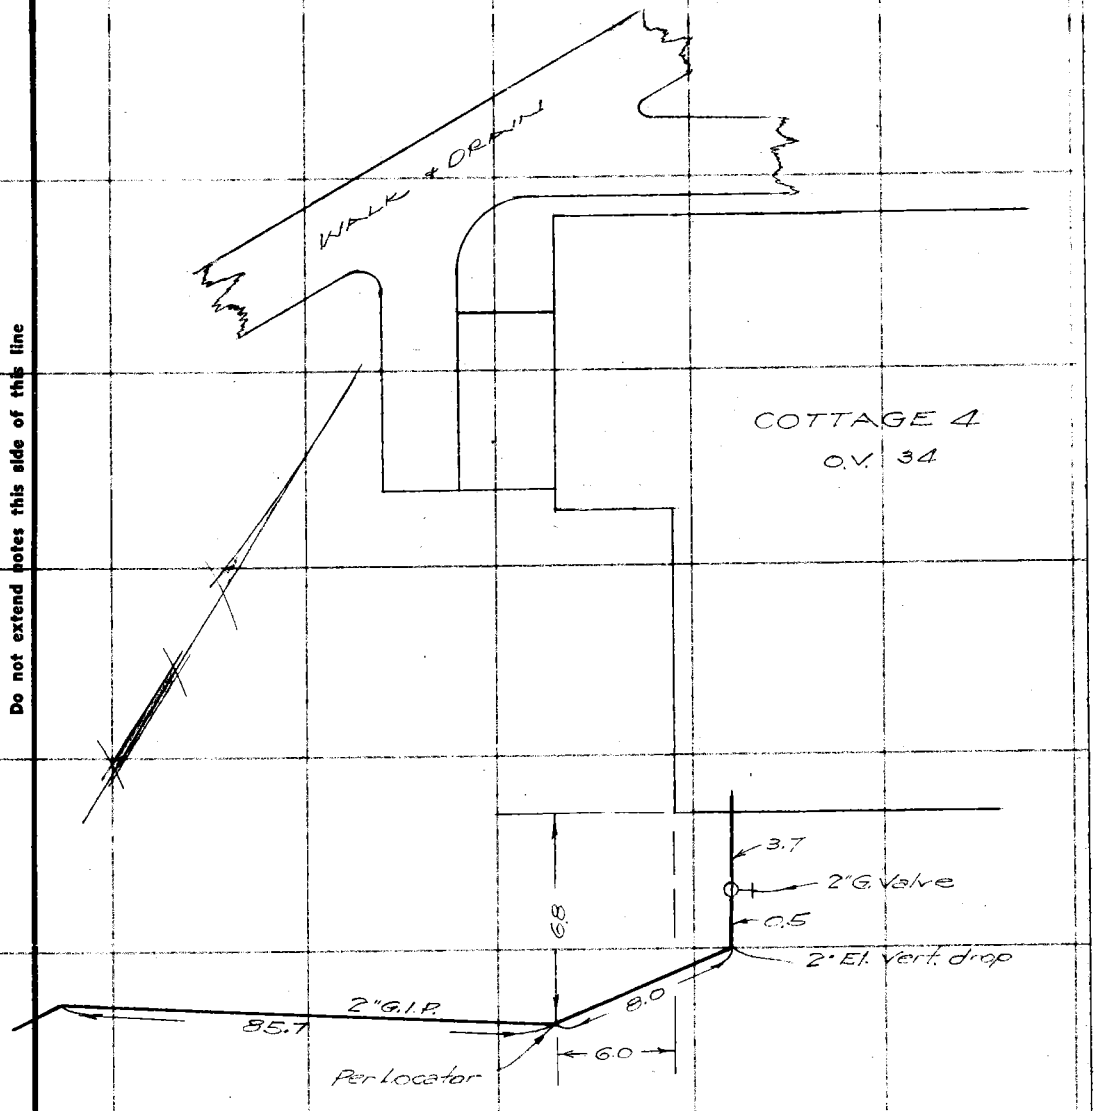

RETURN TO
LOS ANGELES COUNTY SURVEYOR
7do HALL OF RECORDS

Note: Any Additions or Changes on This Sheet Must be Made or Circled in Red Ink With Date and Name of Person Making Change

Do not extend notes this side of this line

FORM 247 10M 11-35

RETURN TO
LOS ANGELES COUNTY SURVEYOR
700 HALL OF RECORDS

Note: Any Additions or Changes on This Sheet Must be Made or Circled in **Red Ink** With Date and Name of Person Making Change.

Do not extend notes this side of this line

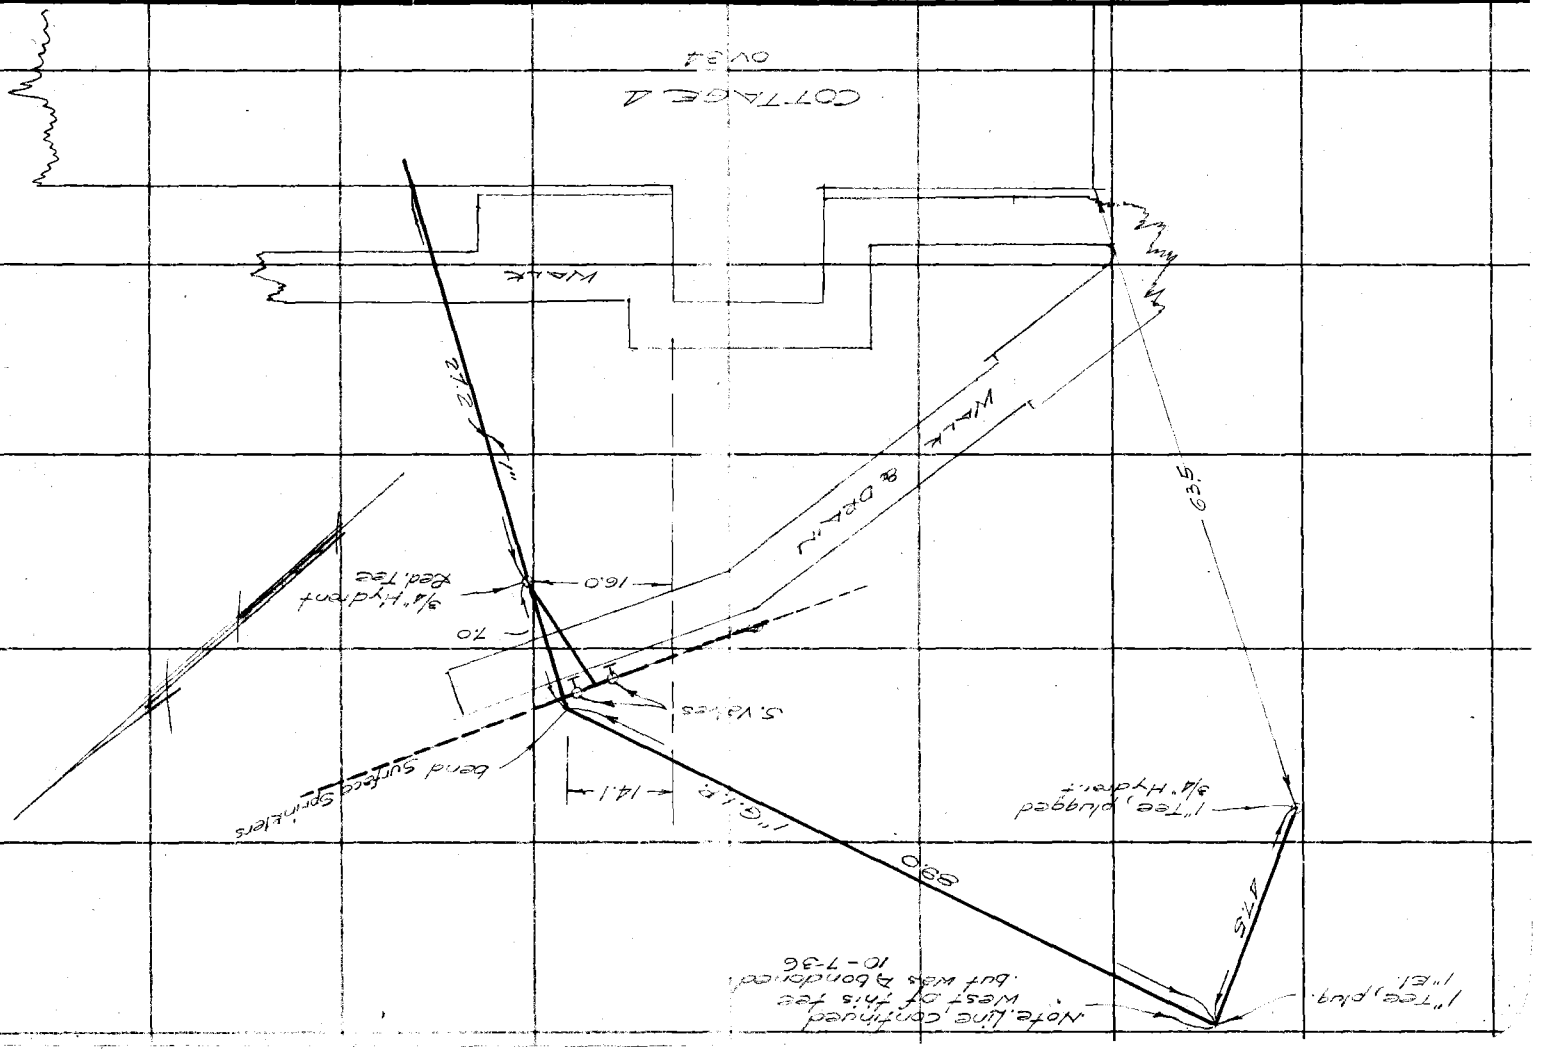

F.B. 709 PG. 42

Notes Ck'd by	Survey of OLIVE VIEW SANATORIUM
Map No.	W. O. 8128 Tape No. Std. °F.
Office Work	Surveyed by T. M. WALSH
Checked	Notes T. M. WALSH Date 5-15-36
Date	Indexed A. C. Johnson

F.B. 709 PG. 43

WATER LINES

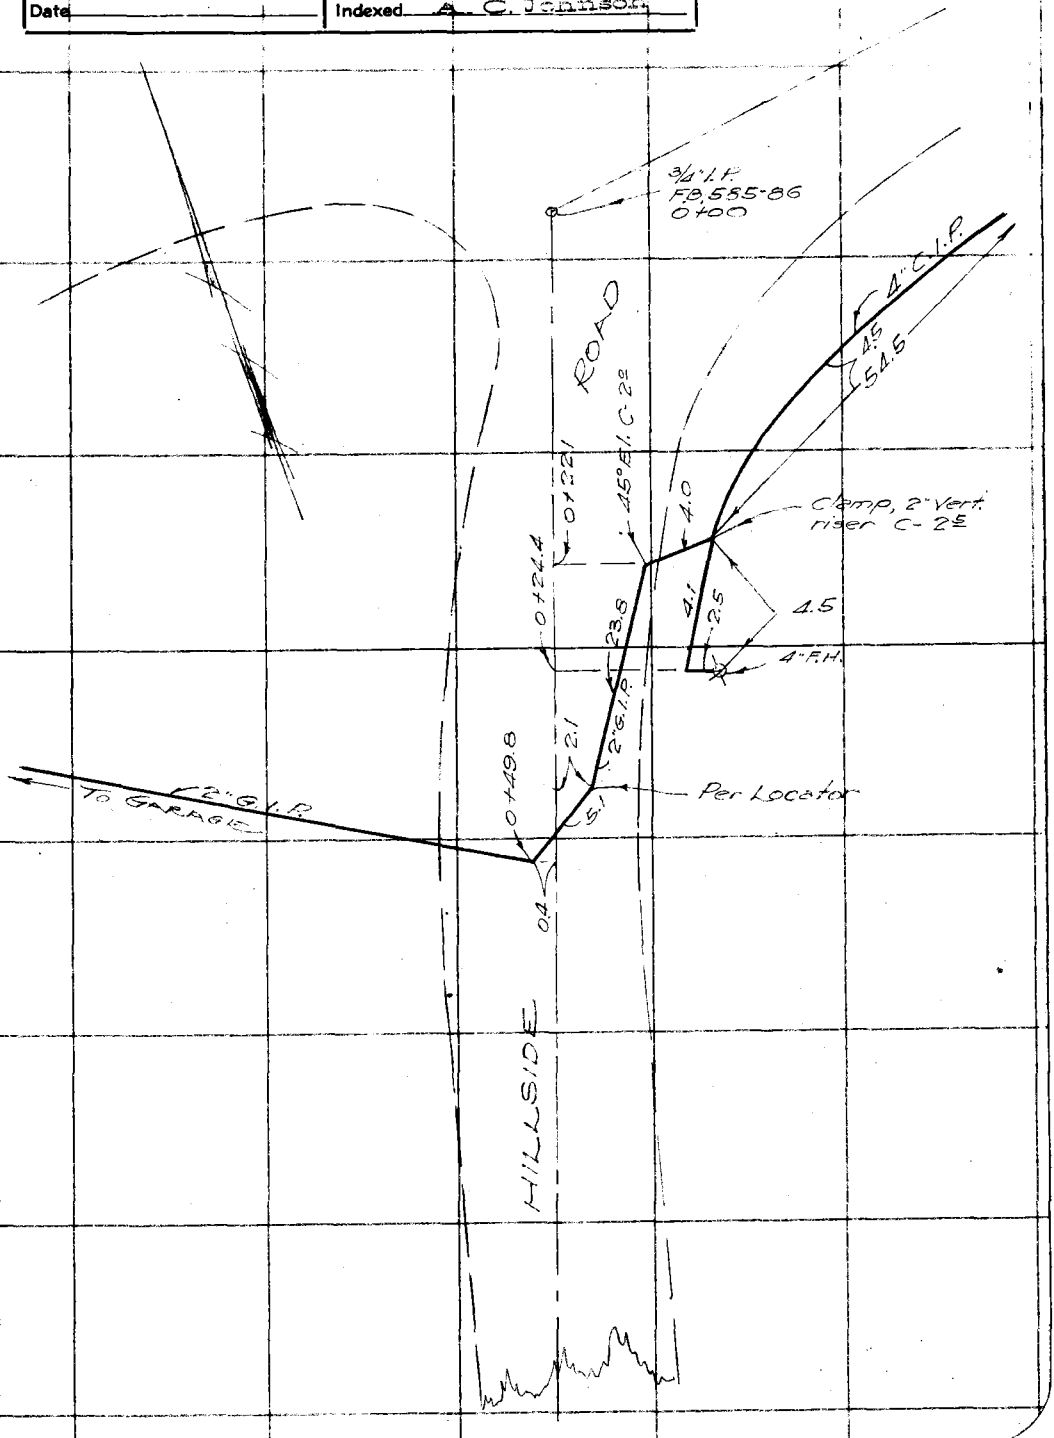

Note: Any Additions or Changes on This Sheet Must be Made or Circled in Red Ink With Date and Name of Person Making Change.

Do not extend notes this side of this line

RETURN TO
LOS ANGELES COUNTY SURVEYOR
700 HALL OF RECORDS

FORM 247 10M 11-35

RETURN TO
LOS ANGELES COUNTY SURVEYOR
700 HALL OF RECORDS

Note: Any Additions or Changes on This Sheet Must be Made or Circled in **Red Ink** With Date and Name of Person Making Change.

Do not extend notes this side of this line

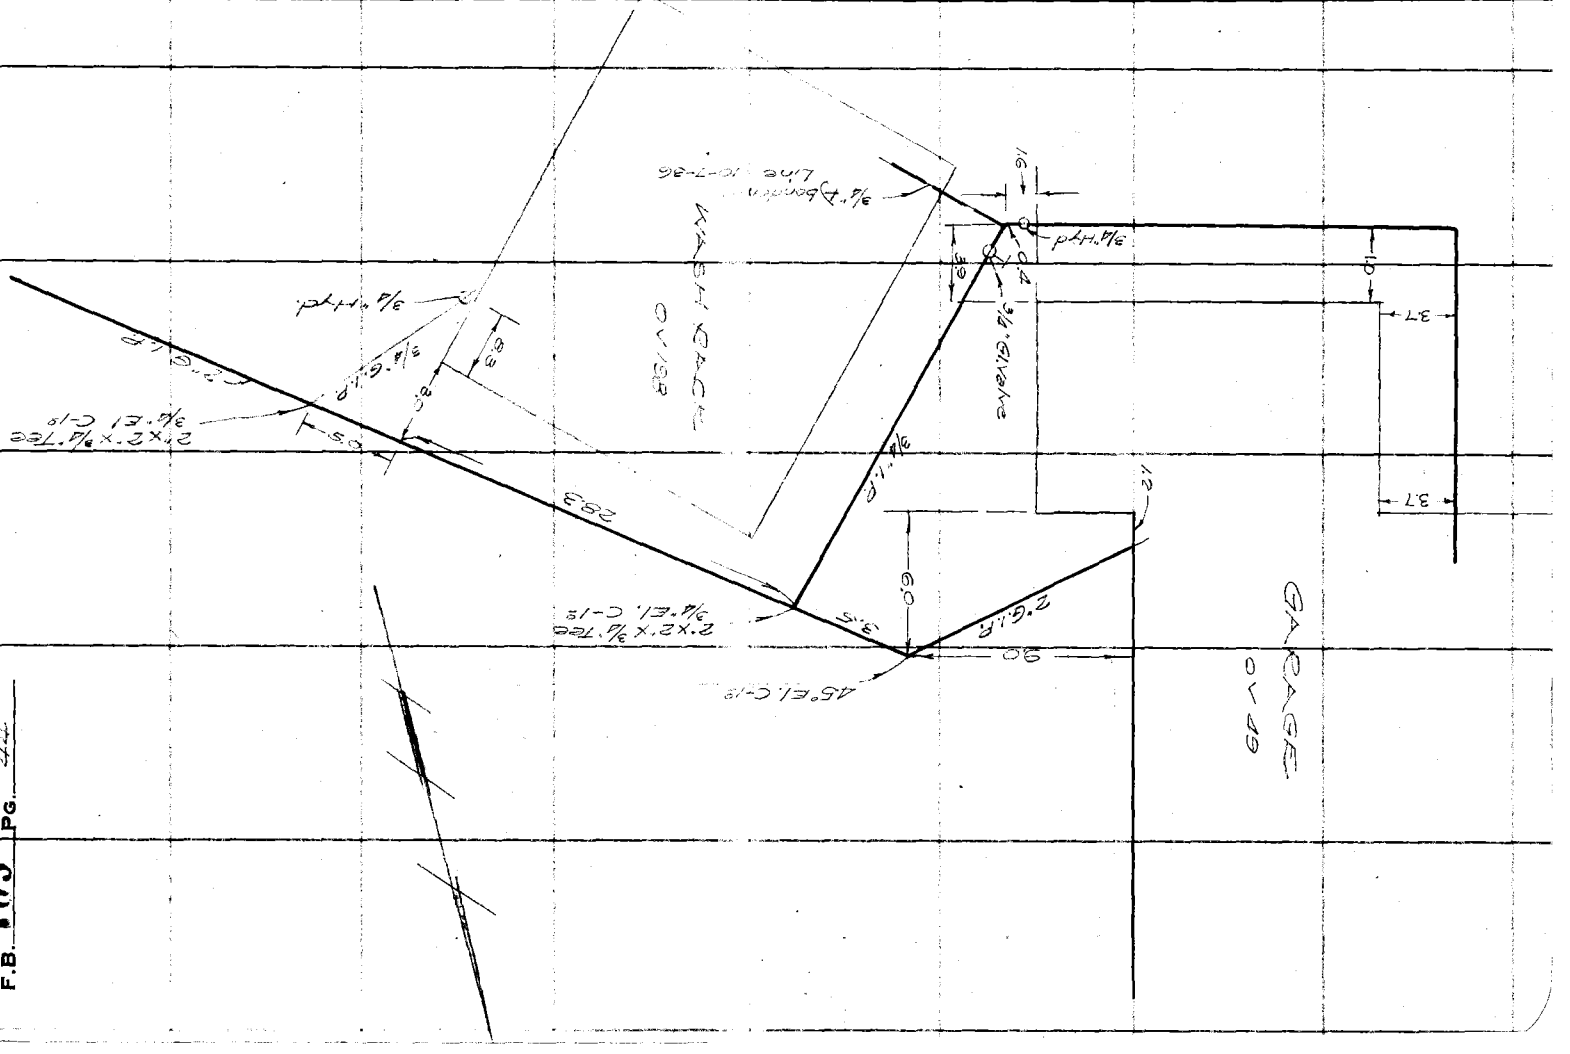


FORM 247 10M 11-38

RETURN TO
LOS ANGELES COUNTY SURVEYOR
700 HALL OF RECORDS

Note: Any Additions or Changes on This Sheet Must be Made or Circled in **Red Ink** With Date and Name of Person Making Change.

Do not extend notes this side of this line

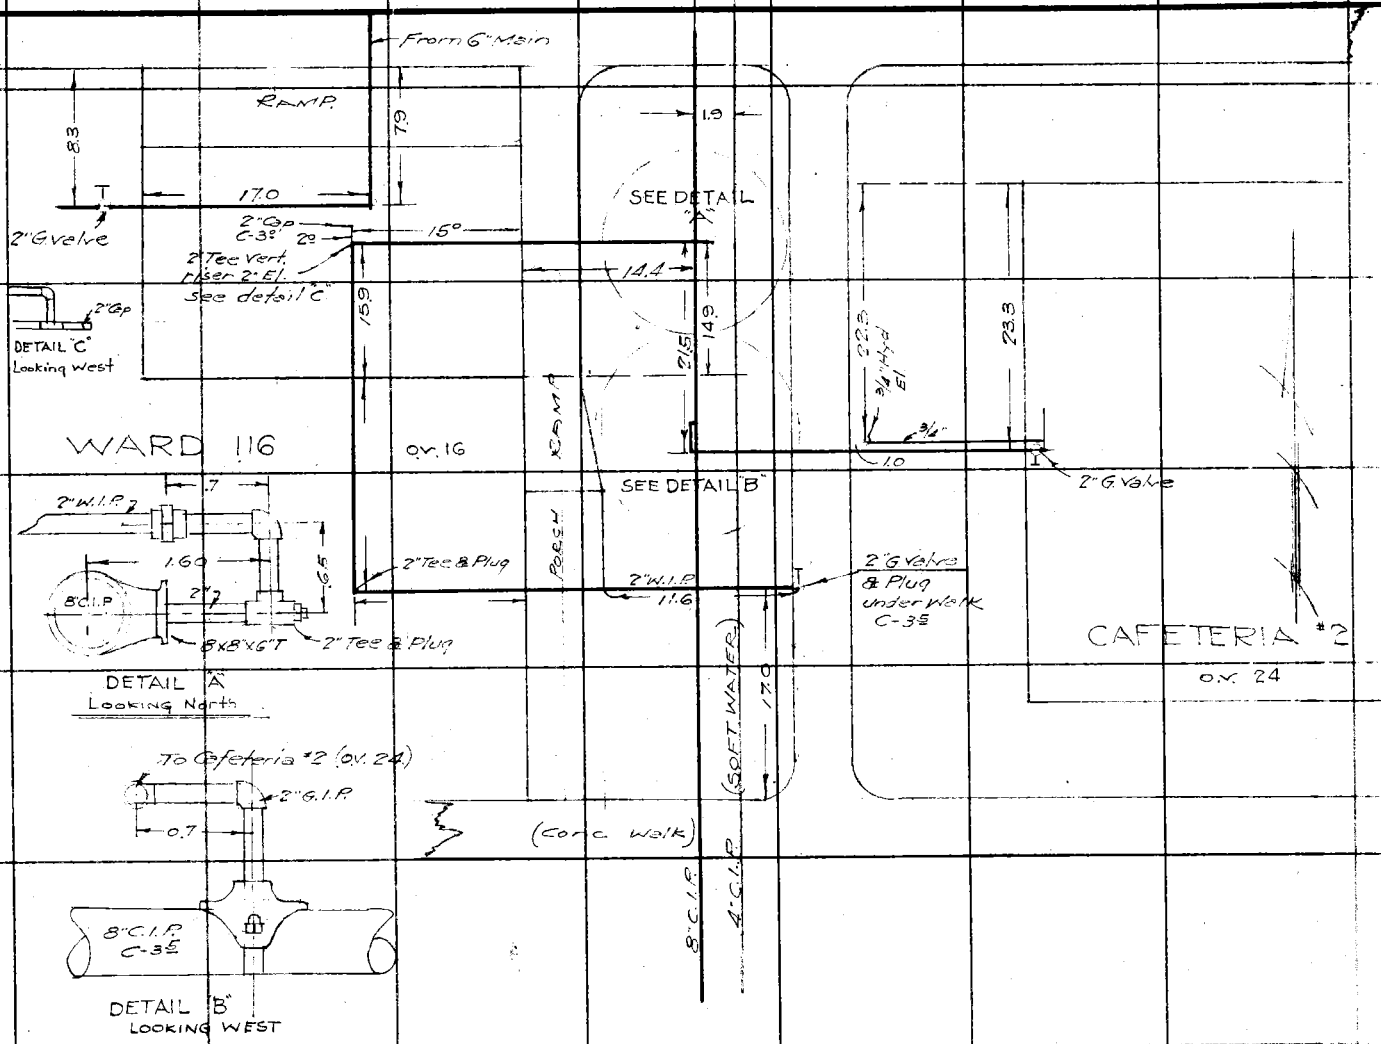

Notes Ck'd by _____
Map No. _____
Office Work _____
Checked _____
Date: _____

Survey of OLIVE VIEW
W. O. 8178 Tape No. _____ St'd. _____ °F.
Surveyed by TED WALSH Date 5-19-36
Notes _____
Indexed _____ C. Johnson

F.B. 709 PG. 45

WATER LINE

RETURN TO
LOS ANGELES COUNTY SURVEYOR
700 HALL OF RECORDS

Note: Any Additions or Changes on This Sheet Must be Made or Circled in **Red Ink** With Date and Name of Person Making Change.

Do not extend notes this side of this line

F.B. 709 PG. 46

Notes Ck'd by		Survey of OLIVE VIEW SANATORIUM	F.B. 709 PG. 47
Map No.		W. O. 8128 Tape No.	St'd °F.
Office Work		Surveyed by TED M. WALSH	
Checked		Notes WALSH Date 5-18-36	
Date		Indexed A. C. Johnson	

WATER LINES

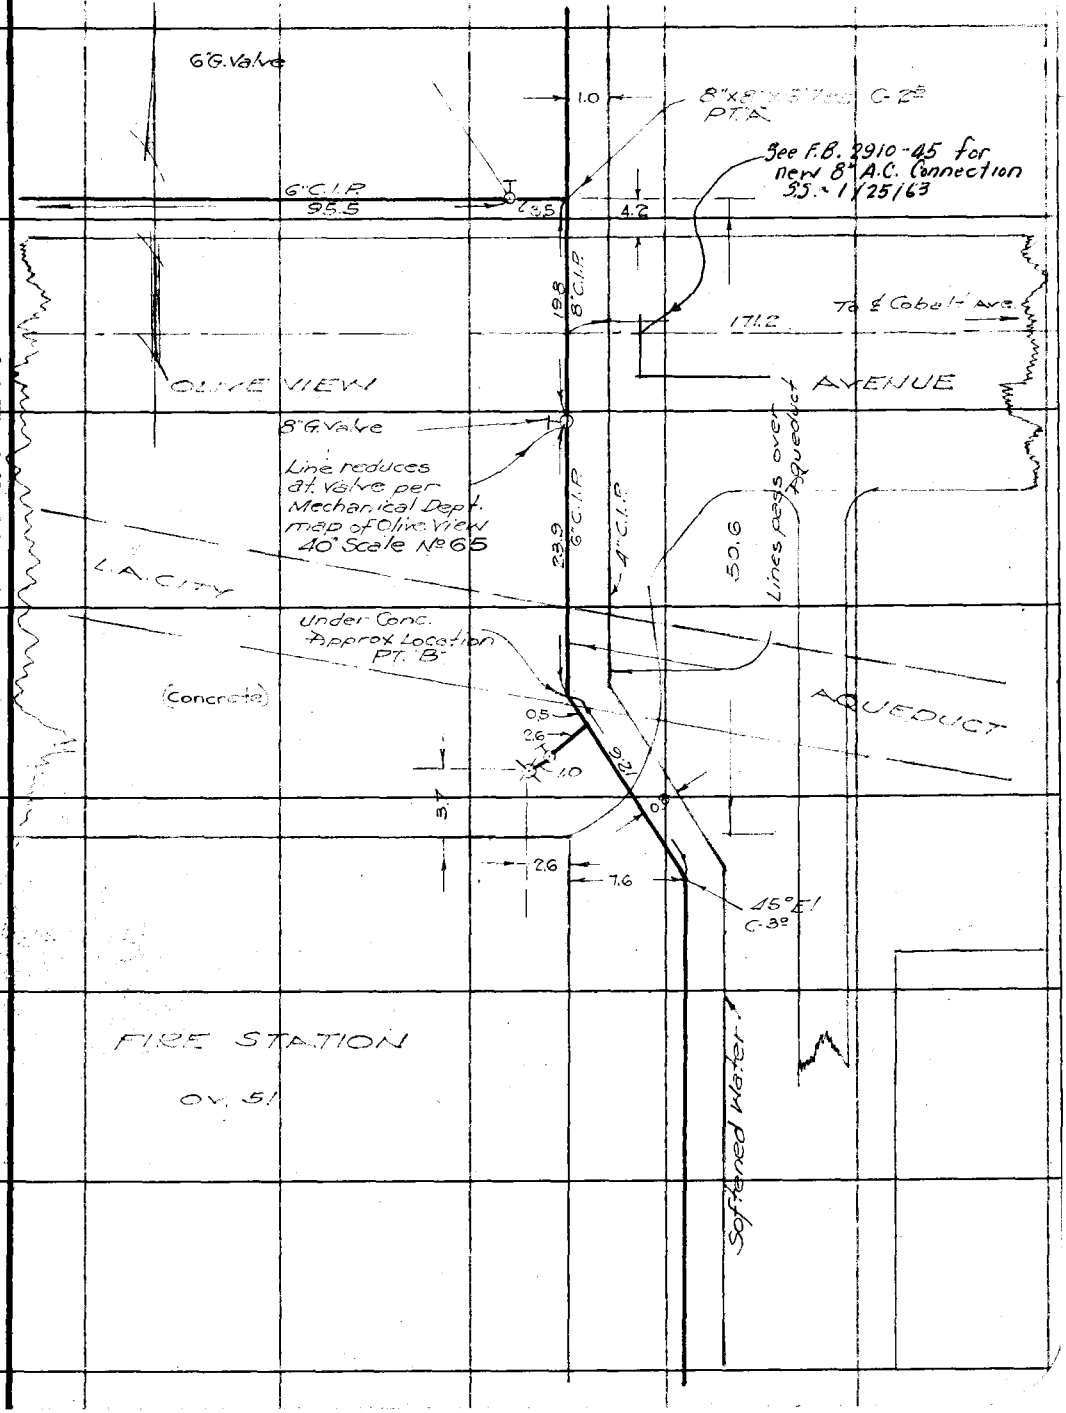

RETURN TO
LOS ANGELES COUNTY SURVEYOR
700 HALL OF RECORDS

Note: Any Additions or Changes on This Sheet Must be Made or Circled in Red Ink With Date and Name of Person Making Change.

Do not extend notes this side of this line

FORM 247 10M 11-35

RETURN TO
LOS ANGELES COUNTY SURVEYOR
700 HALL OF RECORDS

Note: Any Additions or Changes on This Sheet Must be Made or Circled in **Red Ink** With Date and Name of Person Making Change.

Do not extend notes this side of this line

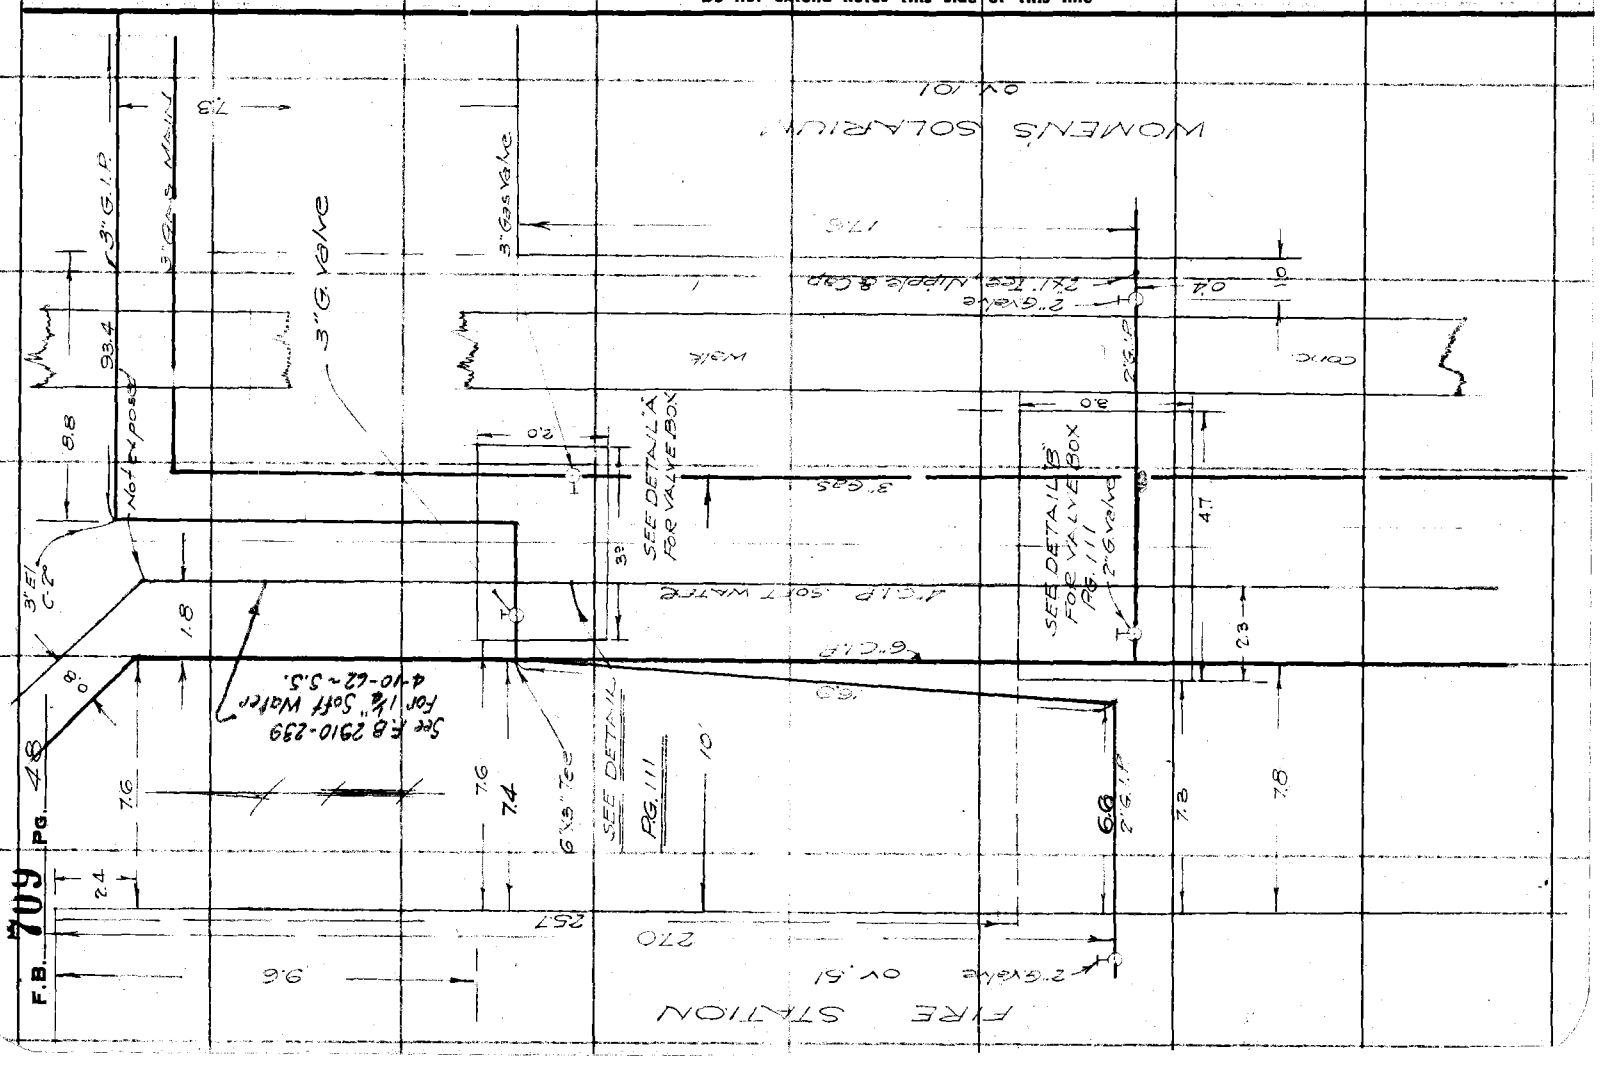

Notes Ck'd by	Survey of OLIVE VIEW SANATORIUM
Map No.	W. O. 81-28 Tape No. St'd °F.
Office Work	Surveyed by TED WALSH
Checked	Notes WALSH Date 5/20/36
Date	Indexed A. C. Johnson

F.B. 709 PG. 49

WATER LINES

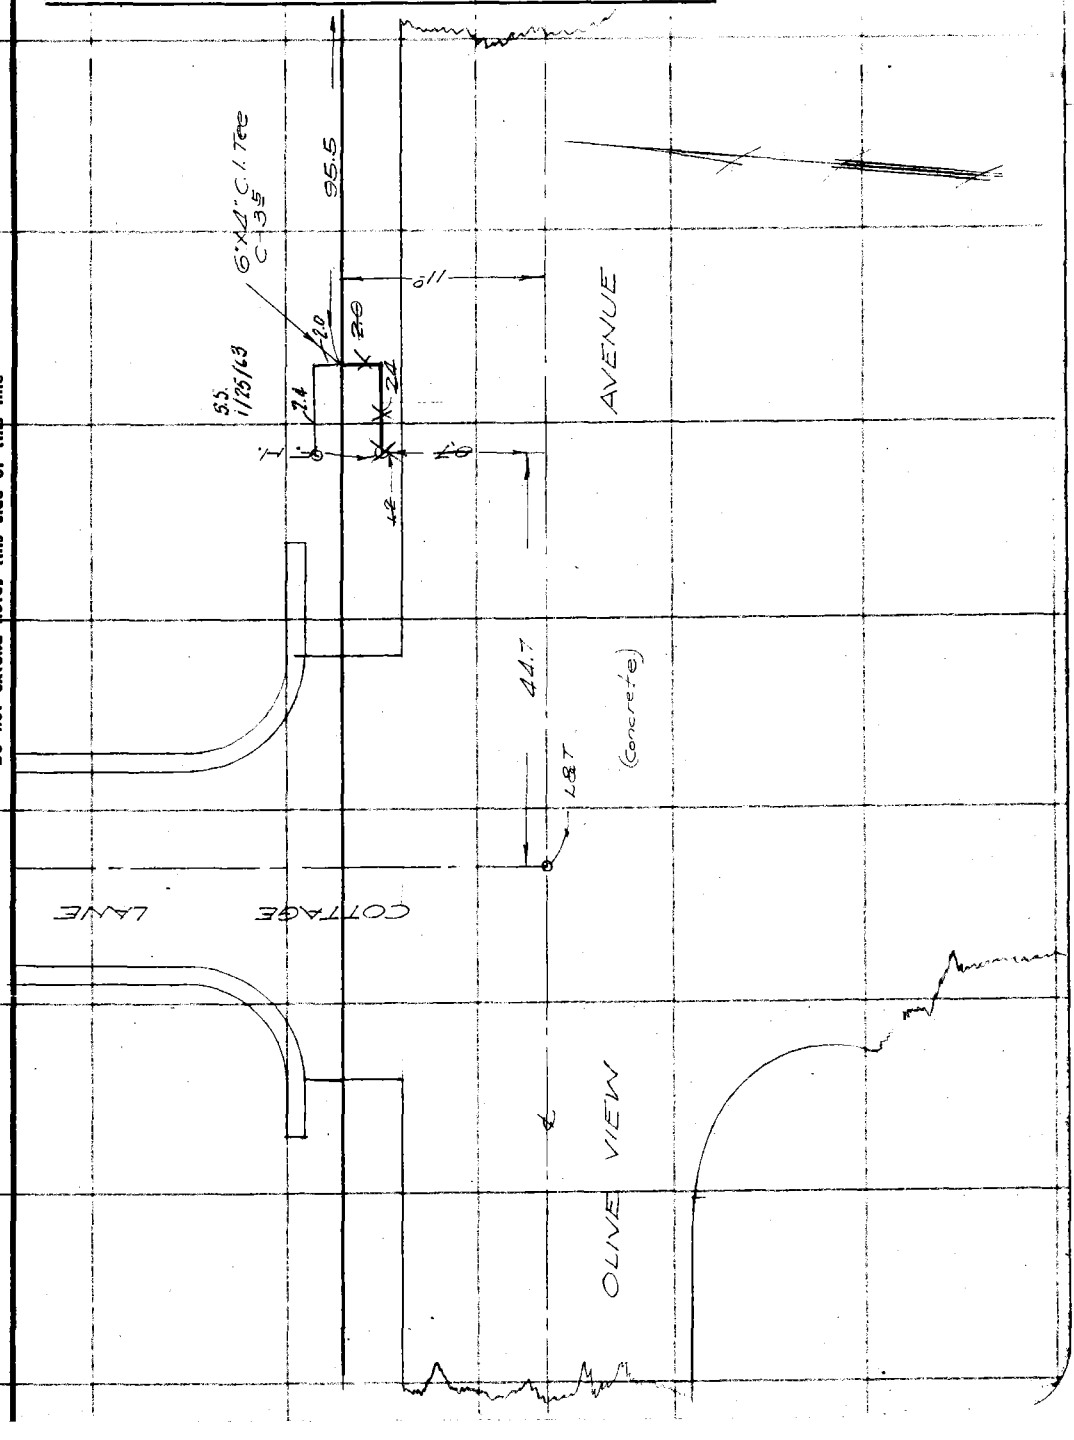

Note: Any Additions or Changes on This Sheet Must be Made or Circled in Red Ink With Date and Name of Person Making Change.

Do not extend notes this side of this line

RETURN TO
LOS ANGELES COUNTY SURVEYOR
700 HALL OF RECORDS

FORM 247 10M 11-35

RETURN TO
LOS ANGELES COUNTY SURVEYOR
700 HALL OF RECORDS

Note: Any Additions or Changes on This Sheet Must be Made or Circled in **Red Ink** With Date and Name of Person Making Change.

Do not extend notes this side of this line

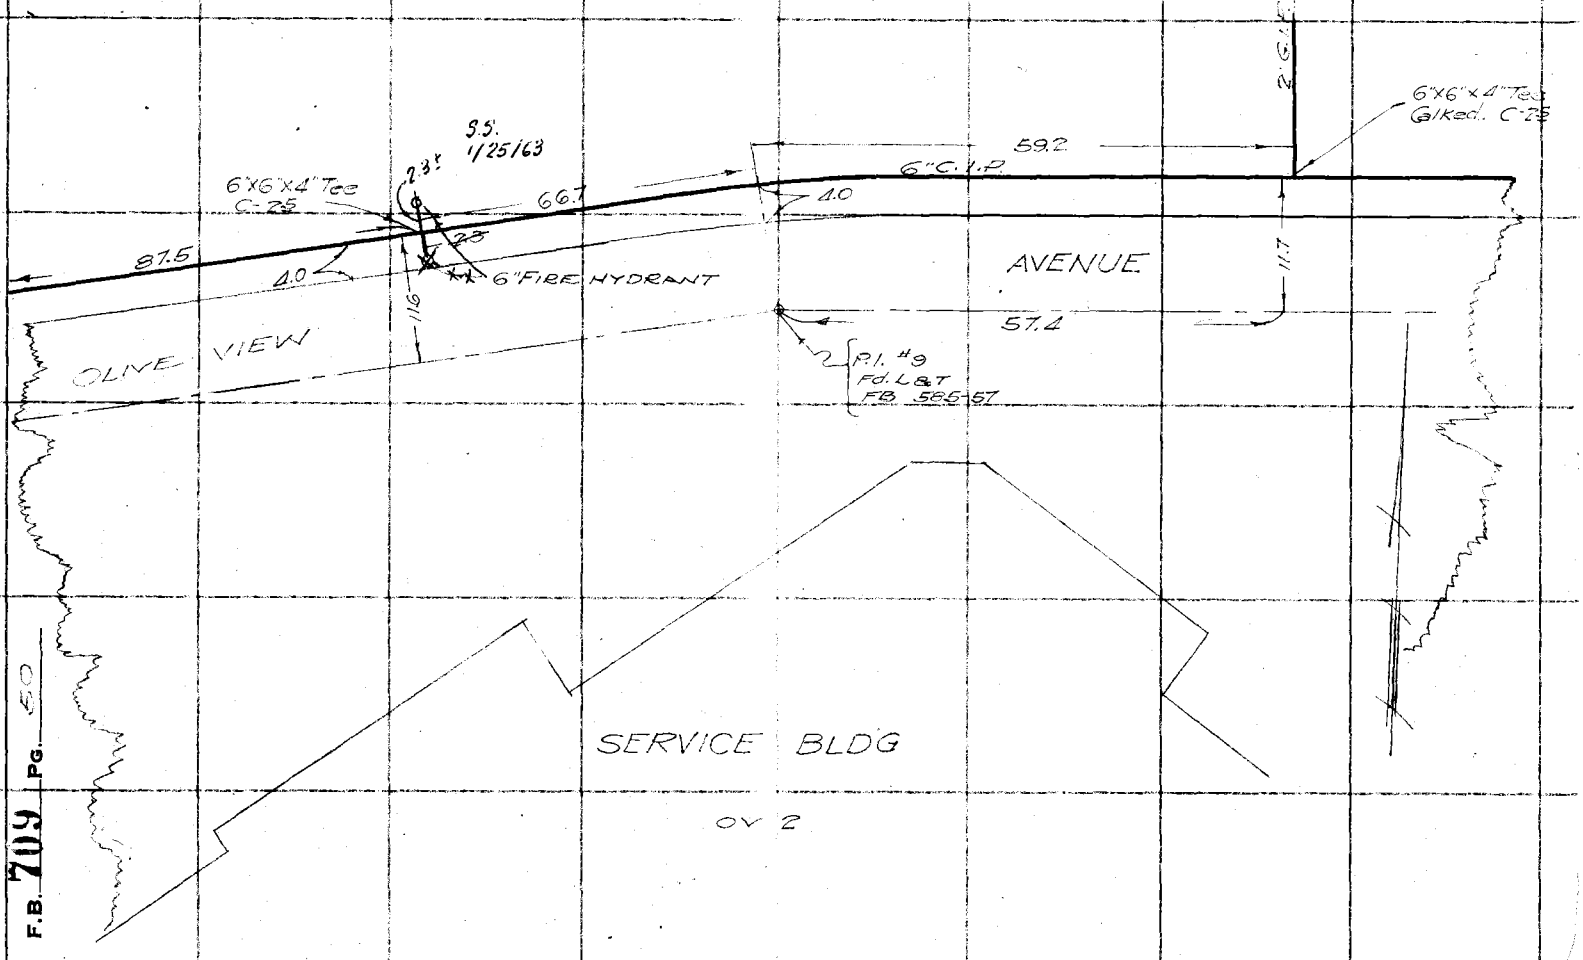

F.B. 709 PG. 30

Notes Ck'd by	Survey of OLIVE VIEW SANATORIUM
Map No.	W. O. 8148 Tape No. St'd °F.
Office Work	Surveyed by TED M. WALSH
Checked	Notes WALSH Date 5/21/36
Date	Indexed A. C. Johnson

F.B. 709 PG. 51

WATER LINES

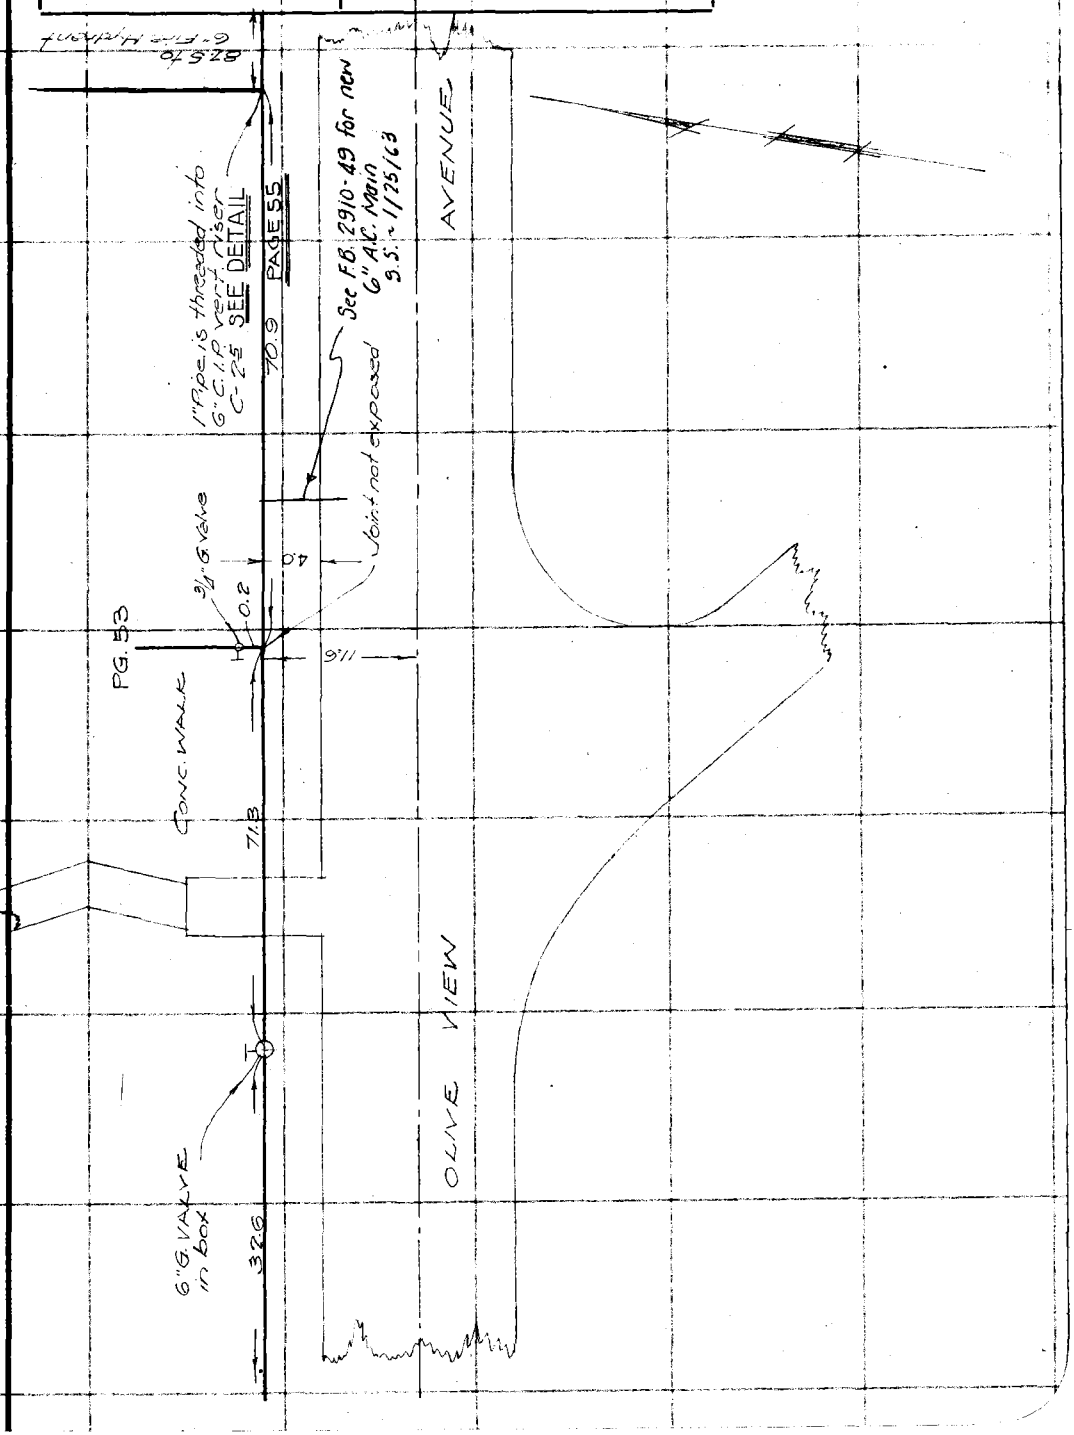

Note: Any Additions or Changes on This Sheet Must be Made or Circled in Red Ink With Date and Name of Person Making Change.

Do not extend notes this side of this line

RETURN TO
LOS ANGELES COUNTY SURVEYOR
700 HALL OF RECORDS

FORM 247 10M 11-35

RETURN TO
LOS ANGELES COUNTY SURVEYOR
700 HALL OF RECORDS

Note: Any Additions or Changes on This Sheet Must be Made or Circled in **Red** Ink With Date and Name of Person Making Change.

Do not extend notes this side of this line

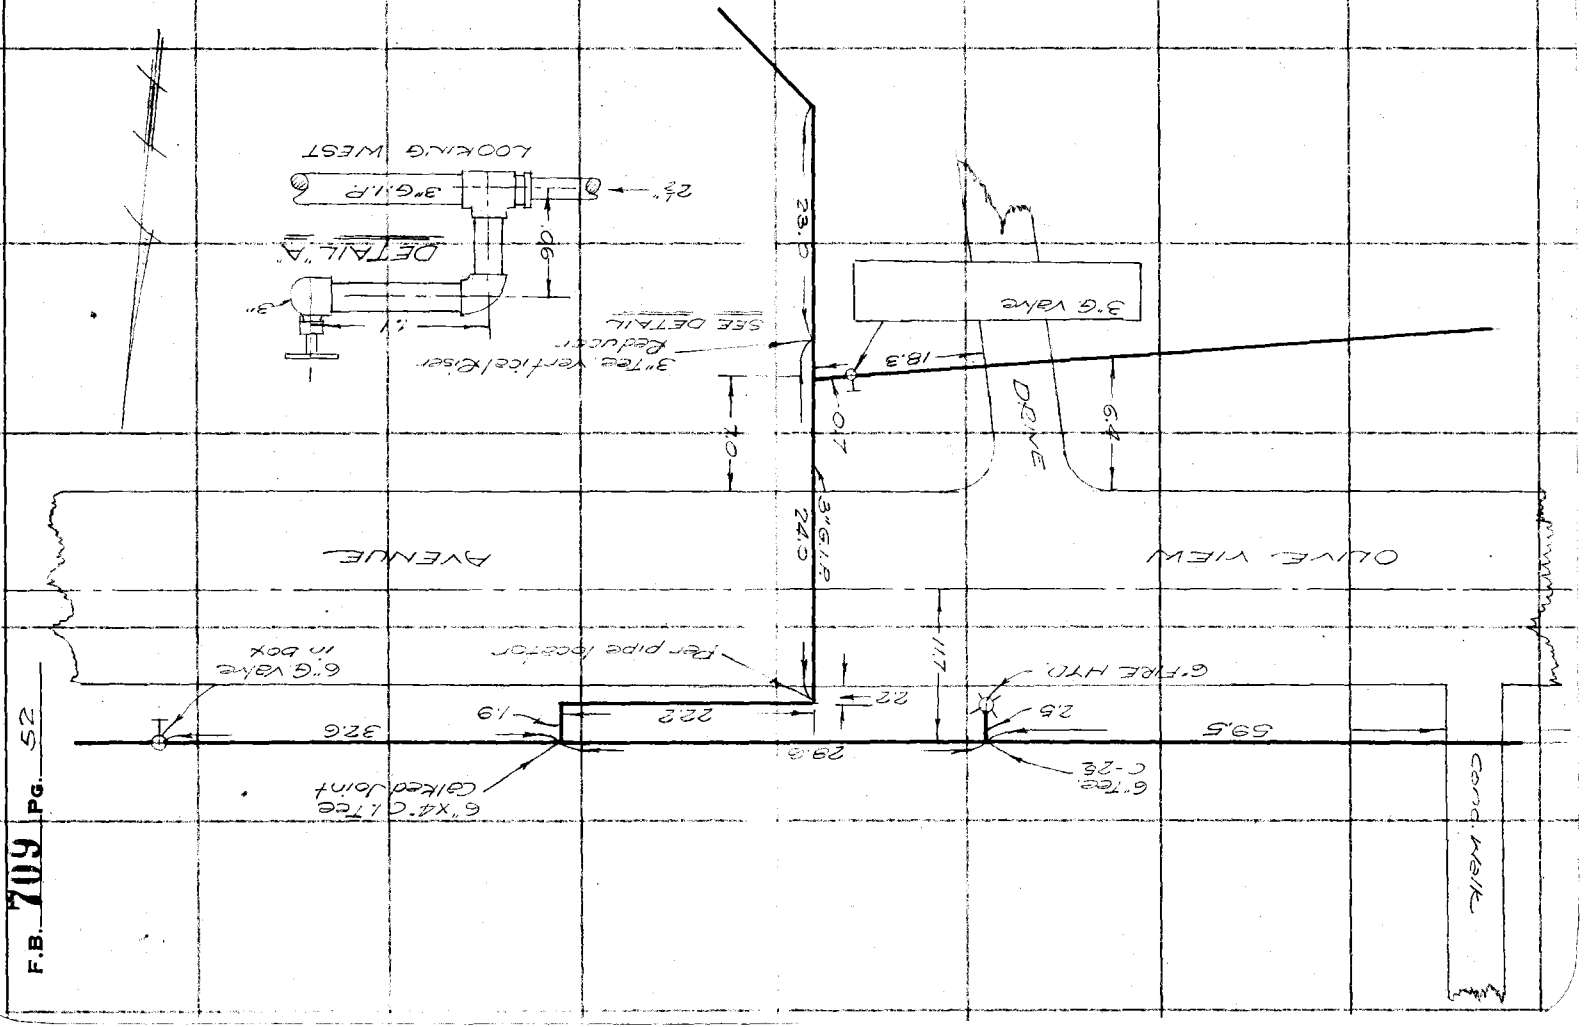

F.B. 709 PG. 52

Notes Ck'd by	Survey of OLIVE VIEW SANATORIUM
Map No.	W. O. 8128 Tape No. St'd °F.
Office Work	Surveyed by T. M. WALSH
Checked	Notes T. M. WALSH Date 7-36
Date	Indexed C. JOHNSON

F.B. 709 PG. 53

WATER LINE

Note: Any Additions or Changes on This Sheet Must be Made or Circled in Red Ink With Date and Name of Person Making Change.

Do not extend notes this side of this line

RETURN TO
LOS ANGELES COUNTY SURVEYOR
708 HALL OF RECORDS

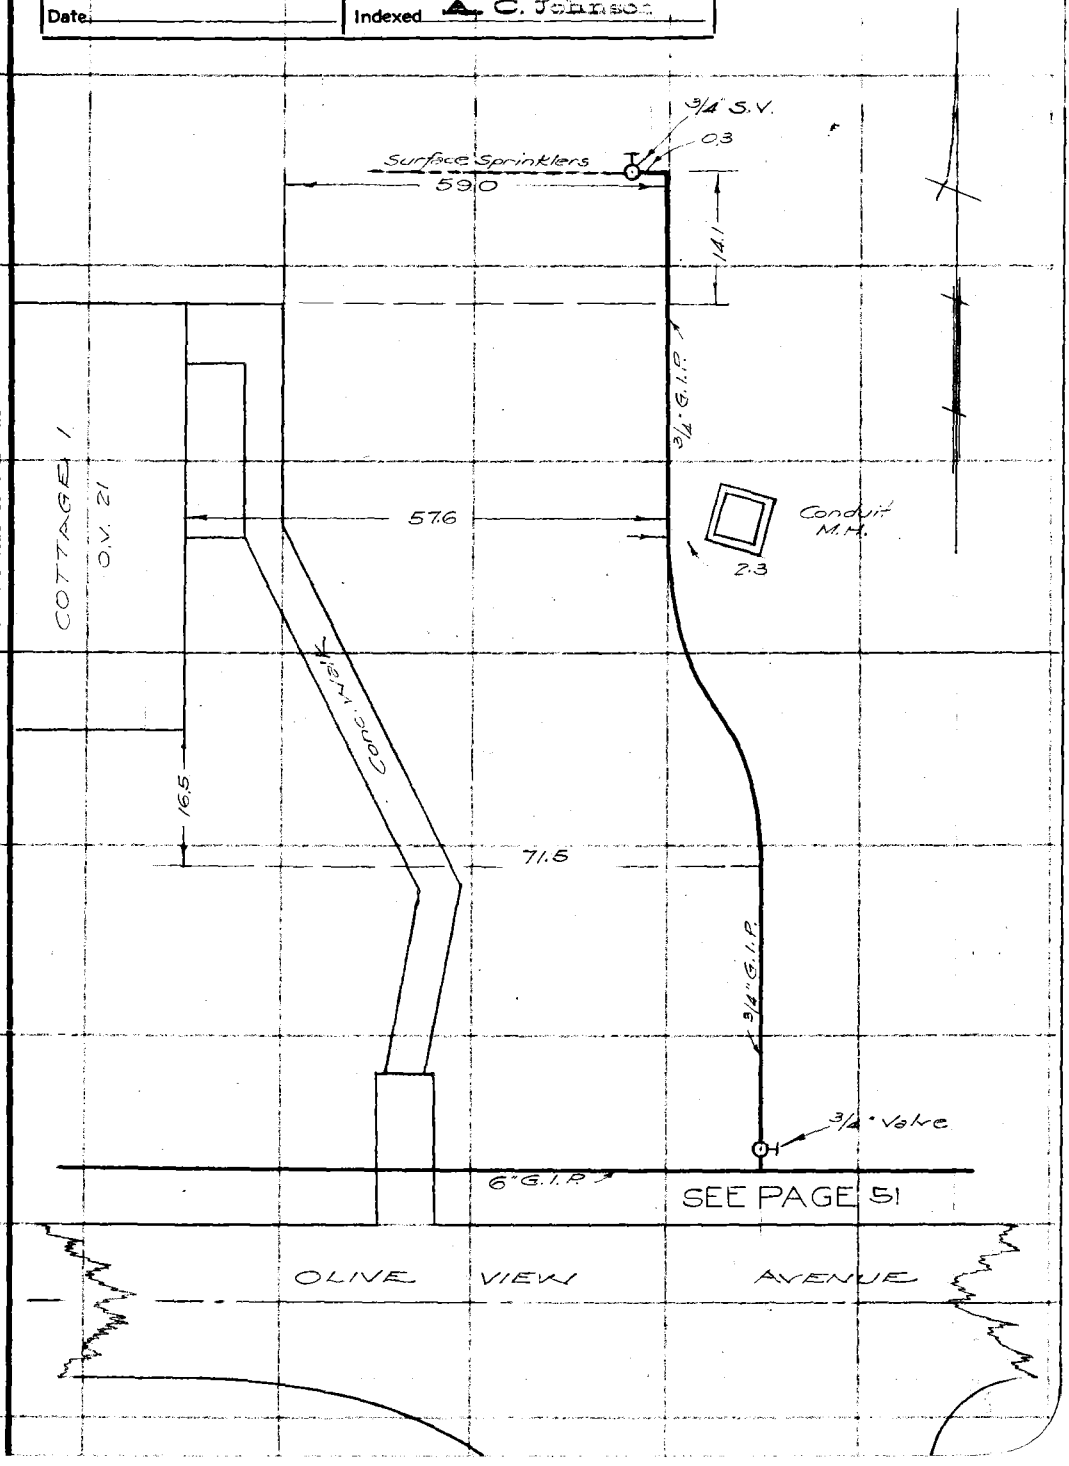

FORM 247 10M 11-38

RETURN TO
LOS ANGELES COUNTY SURVEYOR
700 HALL OF RECORDS

Note: Any Additions or Changes on This Sheet Must be Made or Circled in **Red Ink** With Date and Name of Person Making Change.

Do not extend notes this side of this line

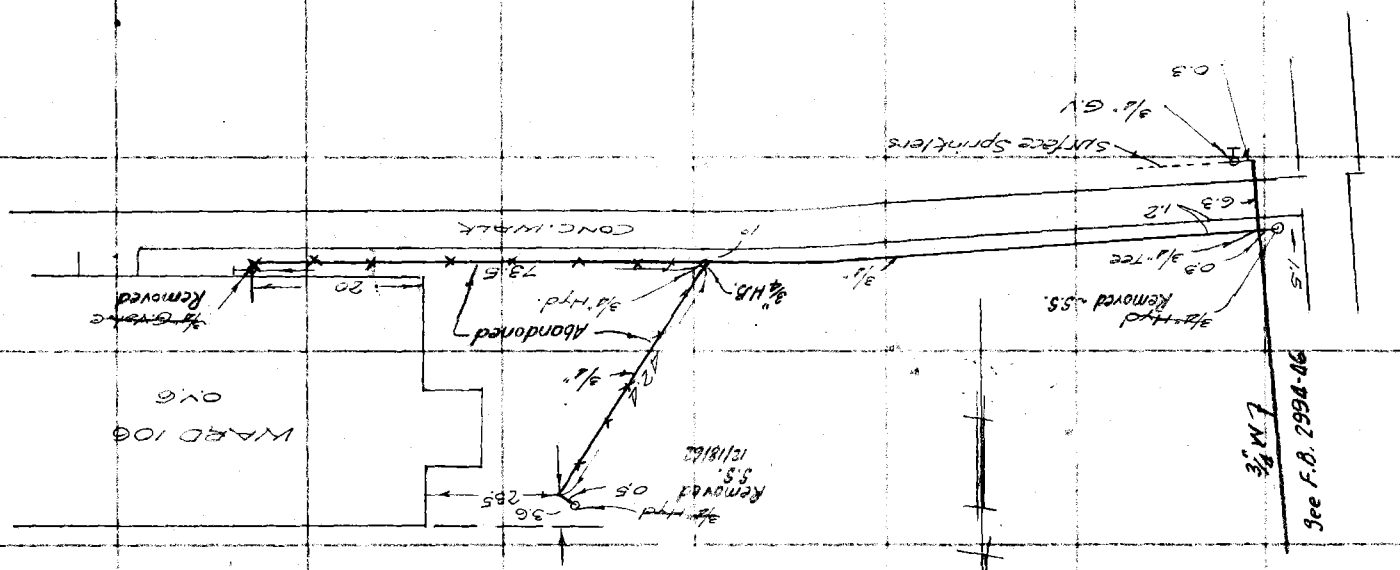

F.B. 704 PG. 54

Notes Ck'd by	Survey of OLIVE VIEW SANATORIUM
Map No.	W. O. 8128 Tape No. Std. °F.
Office Work	Surveyed by T. M. WALSH
Checked	Notes T. M. WALSH Date 5-21-36
Date	Indexed A. C. J.

F.B. 709 PG. 55

WATER LINES

To Medical Directors Residence

Approx. Angle Per Locator

WALK

11.5

6.22

& DRAIN

22.5

11.3

8.2

1"G.I.P.

To Surface Sprinklers & Hydrants

0.5

3/4"

0.7

1"G.I.P.

0.5

1"Service Valve

1.0

1"G.I.P.

Tapped

6"C.I.P.

VERTICAL SECTION

8.4

M= 0.3

CONDUIT MANHOLE

1.0

SEE DETAIL

6"C.I.P.

OLIVE VIEW AVENUE

Note: Any Additions or Changes on This Sheet Must be Made or Circled in Red Ink With Date and Name of Person Making Change.

Do not extend notes this side of this line

RETURN TO
LOS ANGELES COUNTY SURVEYOR
700 HALL OF RECORDS

FORM 247 10M 11-35

F.B. 709 PG. 56

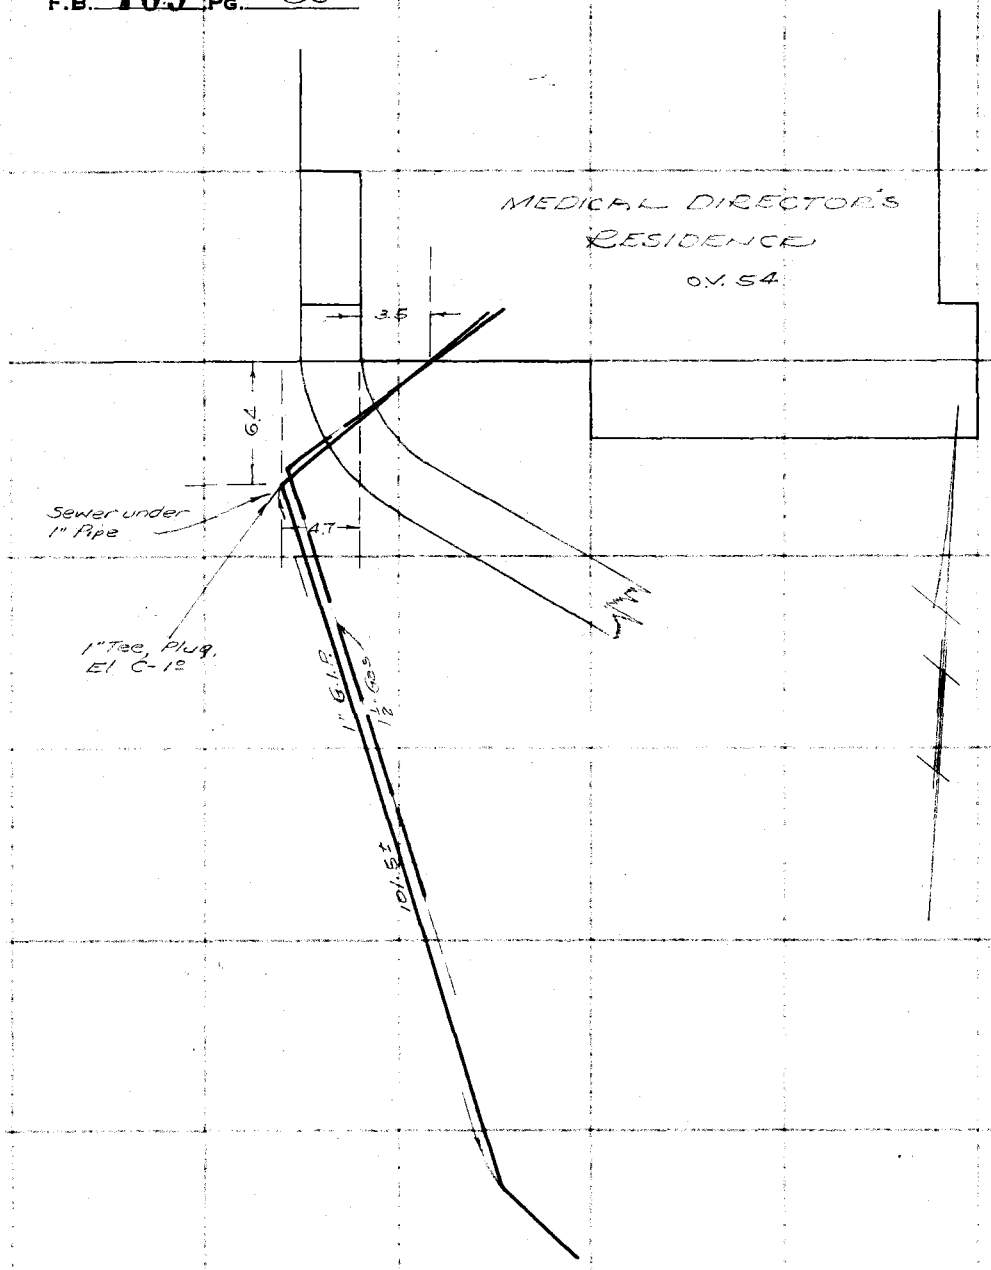

RETURN TO
LOS ANGELES COUNTY SURVEYOR
700 HALL OF RECORDS

Note: Any Additions or Changes on This Sheet Must be Made or Circled in Red Ink With Date and Name of Person Making Change.

Do not extend notes this side of this line

Notes Ck'd by	Survey of OLIVE VIEW SANATORIUM
Map No.	W. 08/28 Tape No. St'd °F.
Office Work	Surveyed by T. M. WALSH
Checked	Notes T. M. WALSH Date 12-36
Date	Indexed A. C. Johnson

F.B. 709 PG. 57

WATER LINE

COTTAGE 3
O.V. 23

COTTAGE 1
O.V. 21

13.1

3/4" Mvd

6.0

1.6

3/4" G.V.S.M.C.

WALK

24.1

1.6

7.4

0.4

3/4" S.V.

1.2

3/4" S.V.

1.4

0.6

OLIVE VIEW AVENUE

Note: Any Additions or Changes on This Sheet Must be Made or Circled in Red Ink With Date and Name of Person Making Change.

Do not extend notes this side of this line

RETURN TO
LOS ANGELES COUNTY SURVEYOR
7do HALL OF RECORDS

FORM 247 10M 11-36

F.B. 709 PG. 58

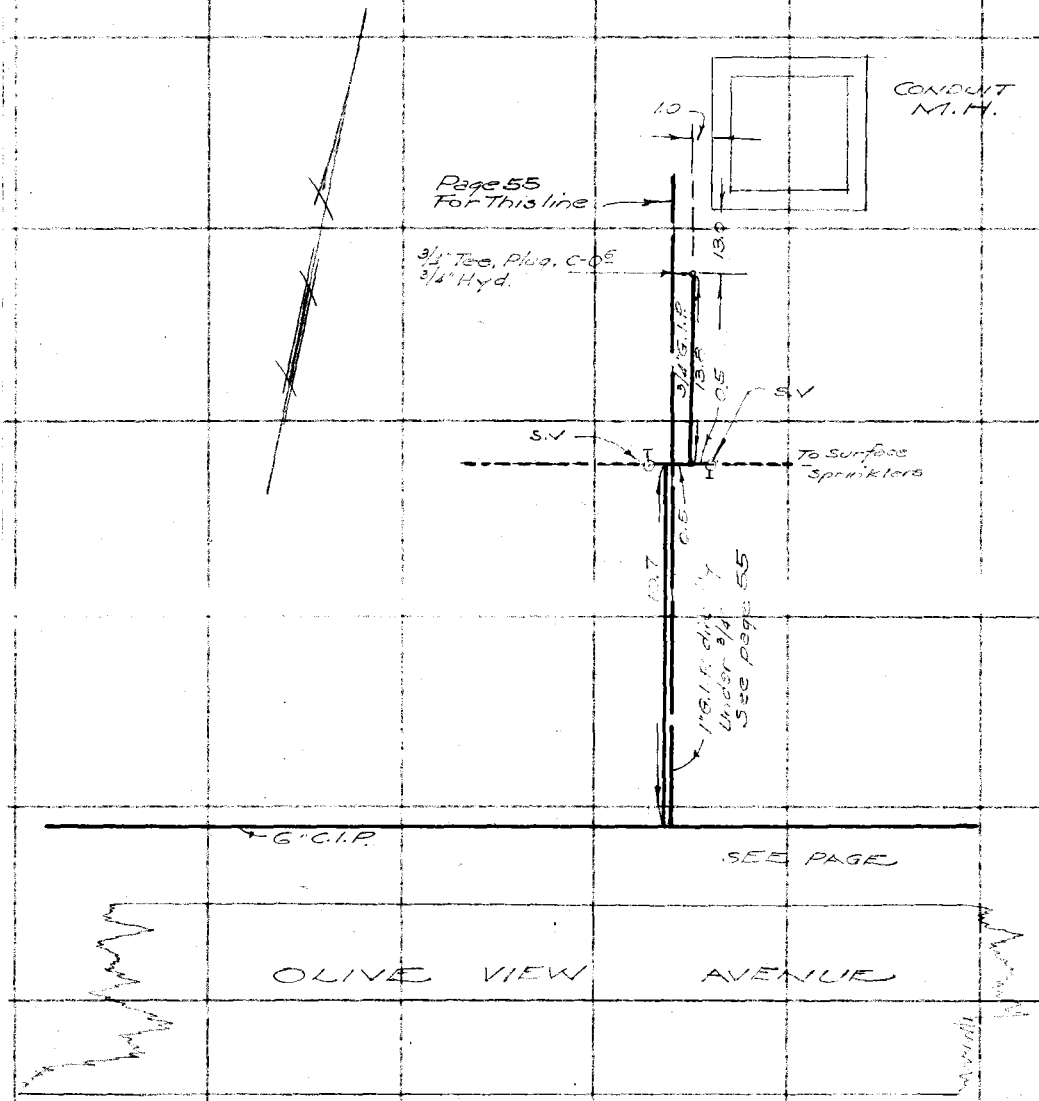

RETURN TO
LOS ANGELES COUNTY SURVEYOR
700 HALL OF RECORDS

Note: Any Additions or Changes on This Sheet Must be Made or Circled in Red Ink With Date and Name of Person Making Change.

Do not extend notes this side of this line

Notes Ck'd by	Survey of OLIVE VIEW SANATORIUM
Map No.	W. O. 8128 Tape No. — St'd — °F.
Office Work	Surveyed by T. M. WALSH
Checked	Notes T. M. WALSH Date 7-36
Date	Indexed A. C. Johnson


WATER LINES

Note: Any Additions or Changes on This Sheet Must be Made or Circled in Red Ink With Date and Name of Person Making Change.

Do not extend notes this side of this line

RETURN TO
LOS ANGELES COUNTY SURVEYOR
700 HALL OF RECORDS

FORM 247 10M 11-35

RETURN TO
LOS ANGELES COUNTY SURVEYOR
700 HALL OF RECORDS

Note: Any Additions or Changes on This Sheet Must be Made or Circled in **Red Ink** With Date and Name of Person Making Change.

Do not extend notes this side of this line

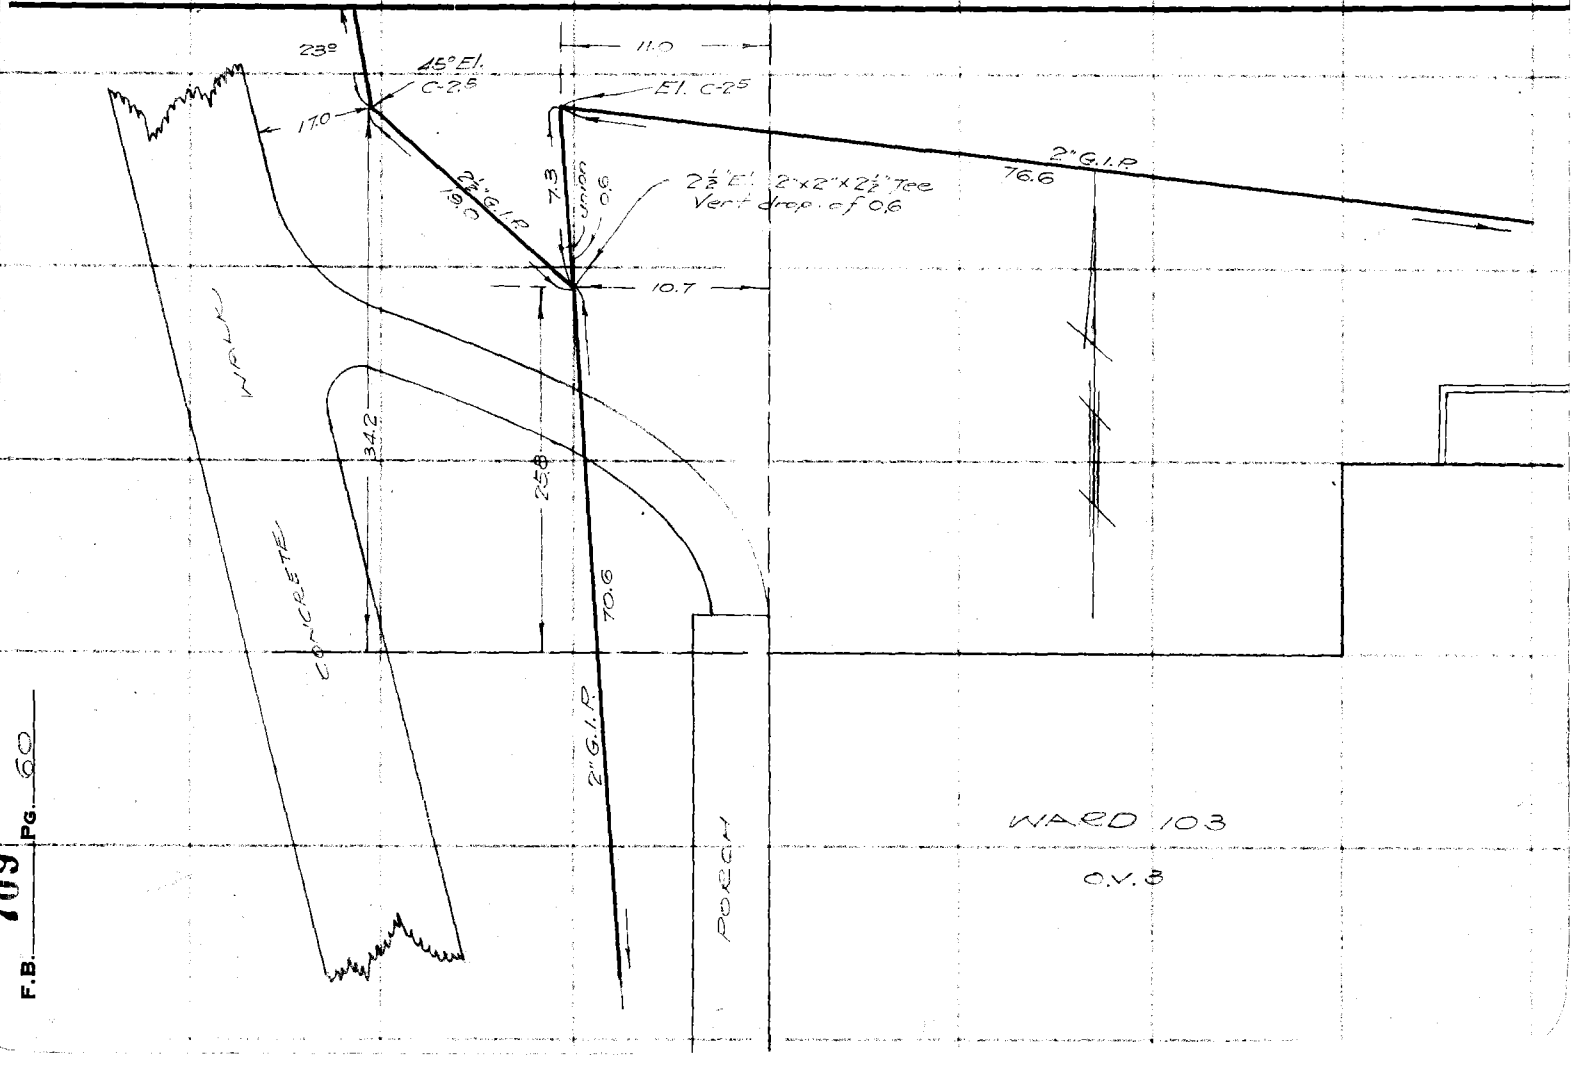

F.B. 709 PG. 60

Notes Ck'd by	Survey of OLIVE VIEW SANATORIUM
Map No.	W. O. 8128 Tape No. St'd °F.
Office Work	Surveyed by T. M. WALSH
Checked	Notes T. M. WALSH Date 6-36
Date	Indexed

F.B. 709 PG. 61

WATER LINES

Note: Any Additions or Changes on This Sheet Must be Made or Circled in Red Ink With Date and Name of Person Making Change.

Do not extend notes this side of this line

RETURN TO
LOS ANGELES COUNTY SURVEYOR
700 HALL OF RECORDS

FORM 247 10M 11-35

F.B. 709 PG. 62

RETURN TO
LOS ANGELES COUNTY SURVEYOR
700 HALL OF RECORDS

Note: Any Additions or Changes on This Sheet Must be Made or Circled in Red Ink With Date and Name of Person Making Change.

Do not extend notes this side of this line

FORM 247 10M 11-35

RETURN TO
LOS ANGELES COUNTY SURVEYOR
700 HALL OF RECORDS

Note: Any Additions or Changes on This Sheet Must be Made or Circled in **Red Ink** With Date and Name of Person Making Change.

Do not extend notes this side of this line

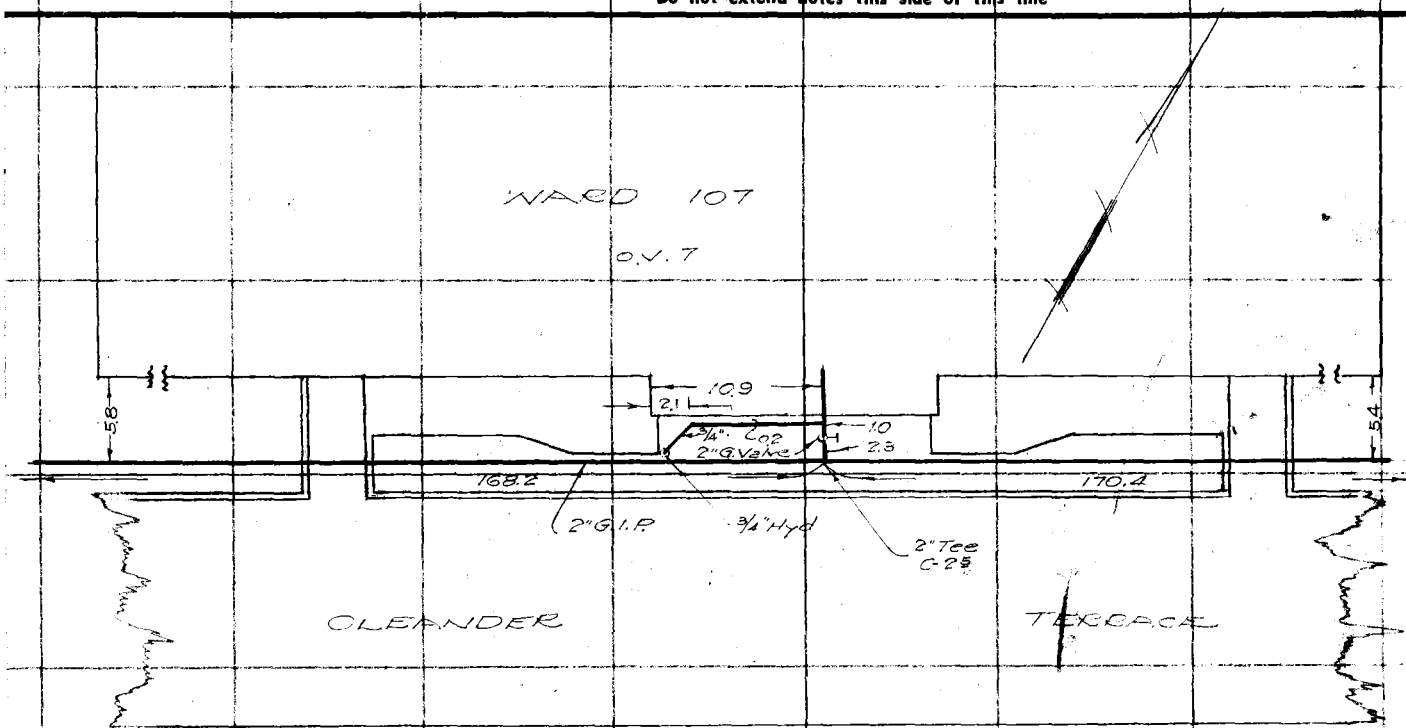

Notes Ck'd by
Map No.
Office Work
Checked
Date

W. O. 8128 Tape No. St'd °F.
Surveyed by T. M. WALSH
Notes T. M. WALSH Date 7-21-36
Indexed C. Johnson


WATER LINES

RETURN TO
LOS ANGELES COUNTY SURVEYOR
700 HALL OF RECORDS

Note: Any Additions or Changes on This Sheet Must be Made or Circled in **Red Ink** With Date and Name of Person Making Change.

Do not extend notes this side of this line

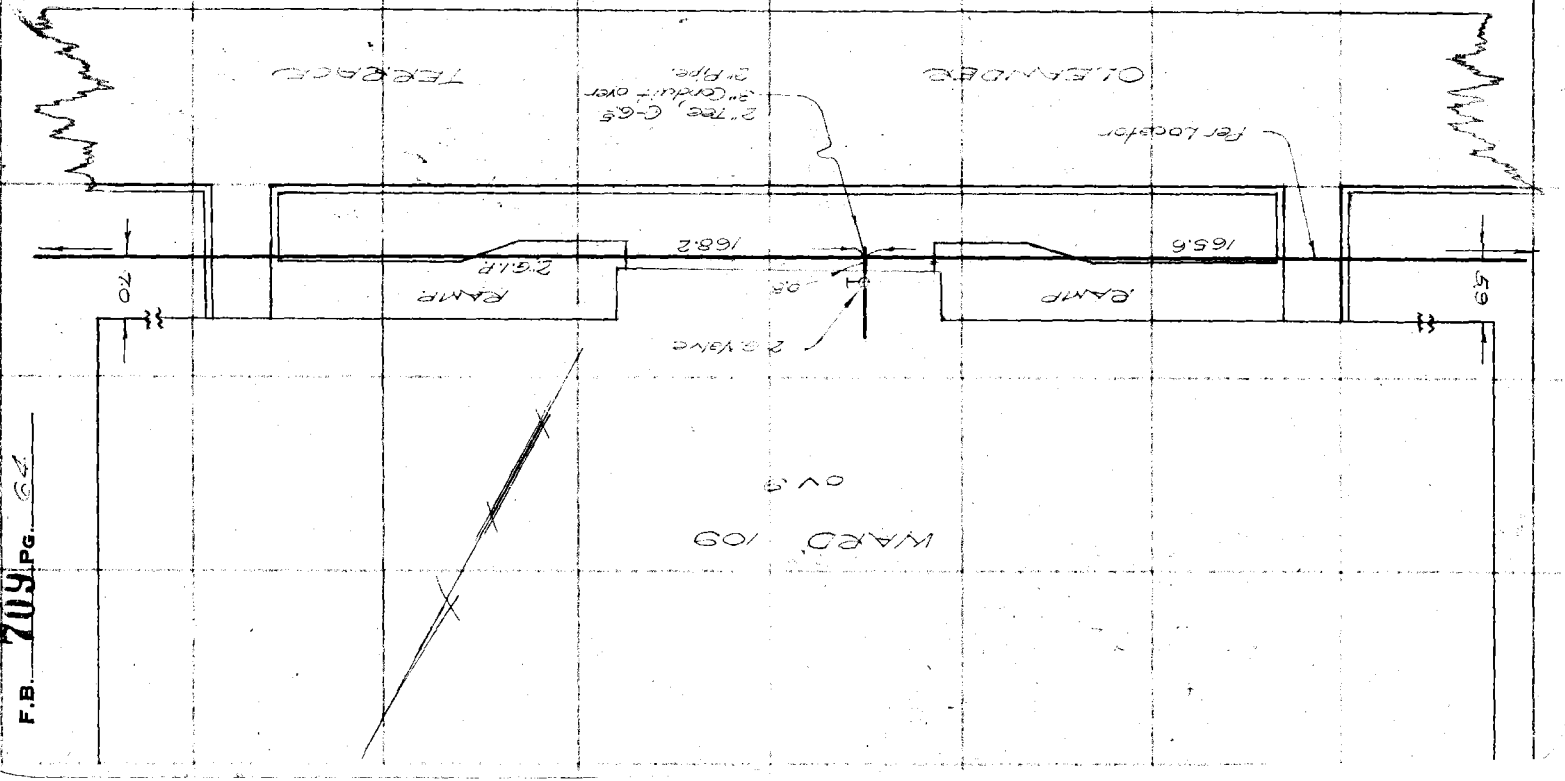

F.B. 709 PG. 64

FORM 247 10M 11-25

RETURN TO
LOS ANGELES COUNTY SURVEYOR
700 HALL OF RECORDS

Note: Any Additions or Changes on This Sheet Must be Made or Circled in **Red Ink** With Date and Name of Person Making Change.

Do not extend notes this side of this line

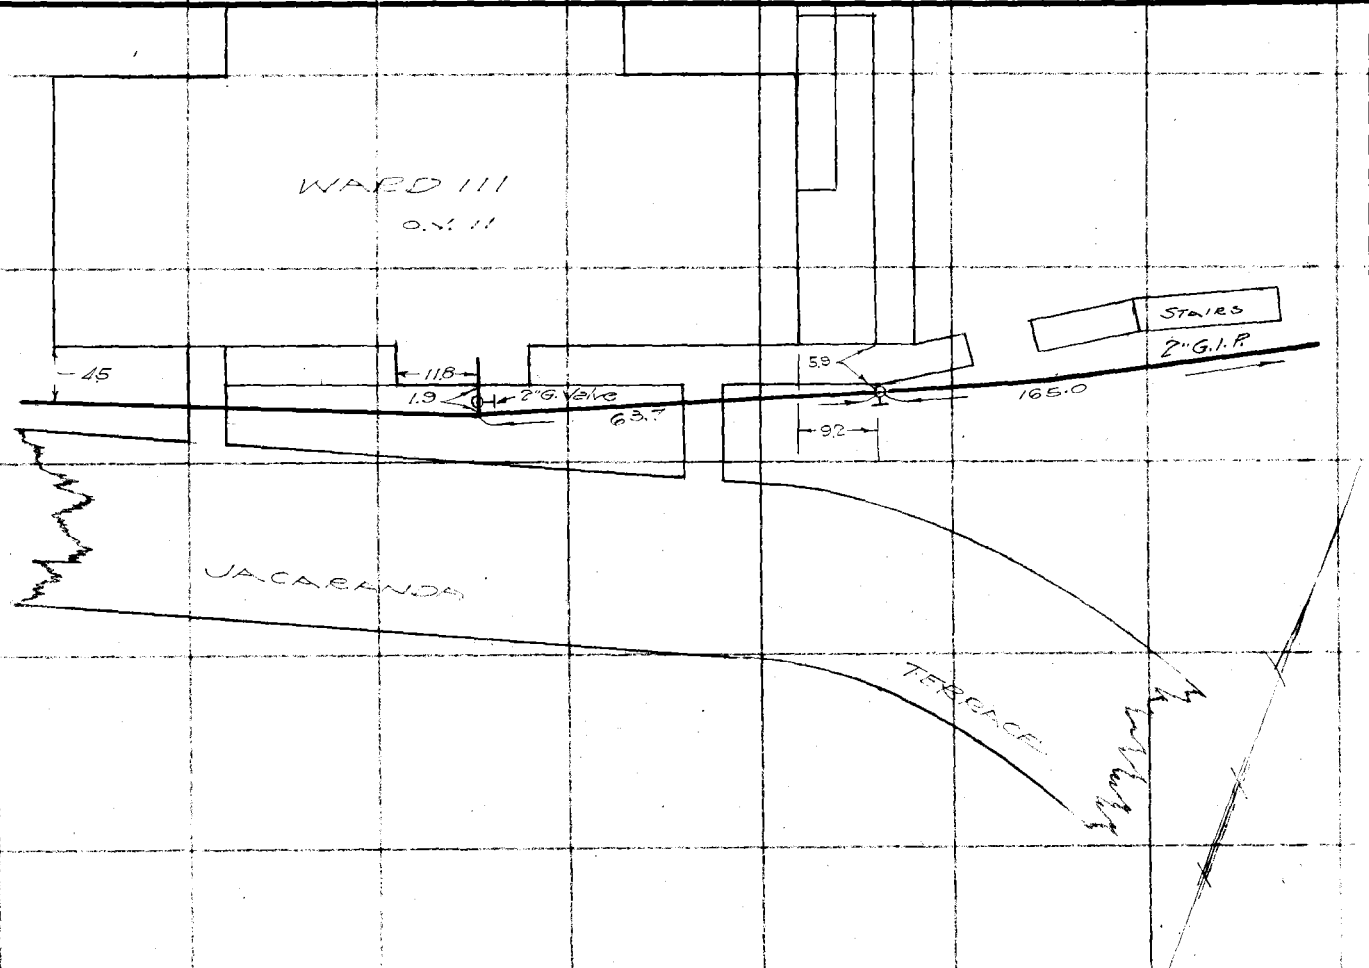

Notes Ck'd by
Map No.
Office Work
Checked
Date

W. O. 8128 Tape No. Std. °F.
Surveyed by T. M. WALSH
Notes T. M. WALSH Date 7-27-36
Indexed


RETURN TO
LOS ANGELES COUNTY SURVEYOR
700 HALL OF RECORDS

Note: Any Additions or Changes on This Sheet Must be Made or Circled in **Red Ink** With Date and Name of Person Making Change.

Do not extend notes this side of this line

F.B. 709 PG. 66

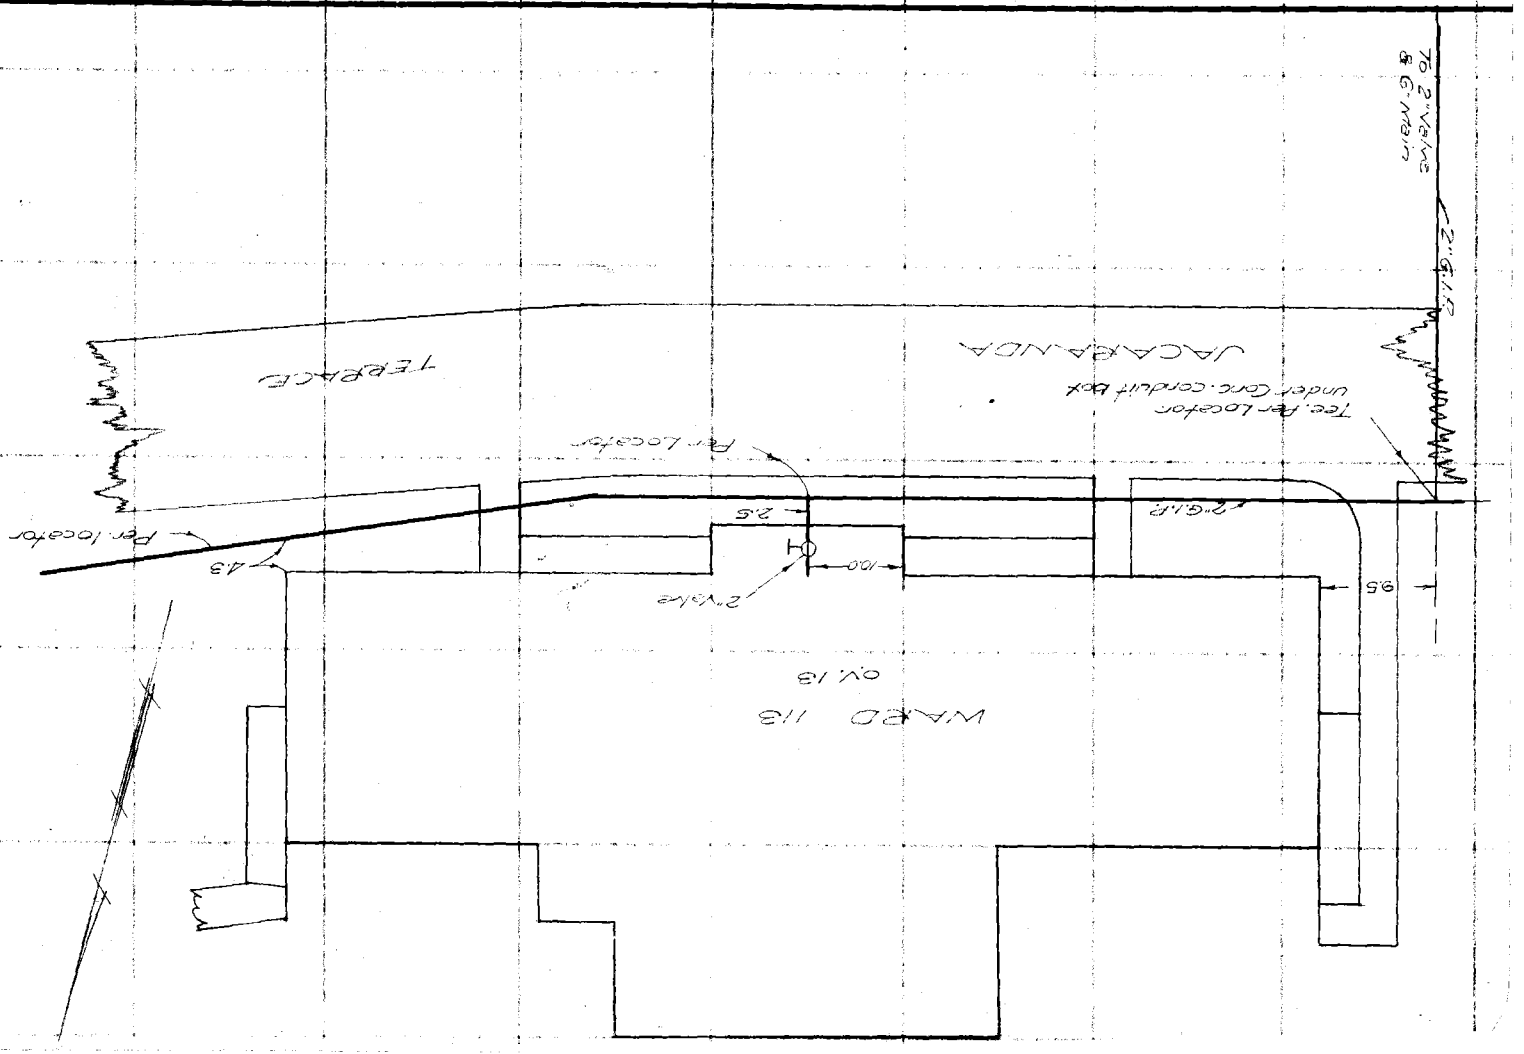

FORM 247 10M 11-35

RETURN TO
LOS ANGELES COUNTY SURVEYOR
700 HALL OF RECORDS

Note: Any Additions or Changes on This Sheet Must be Made or Circled in **Red Ink** With Date and Name of Person Making Change.

Do not extend notes this side of this line

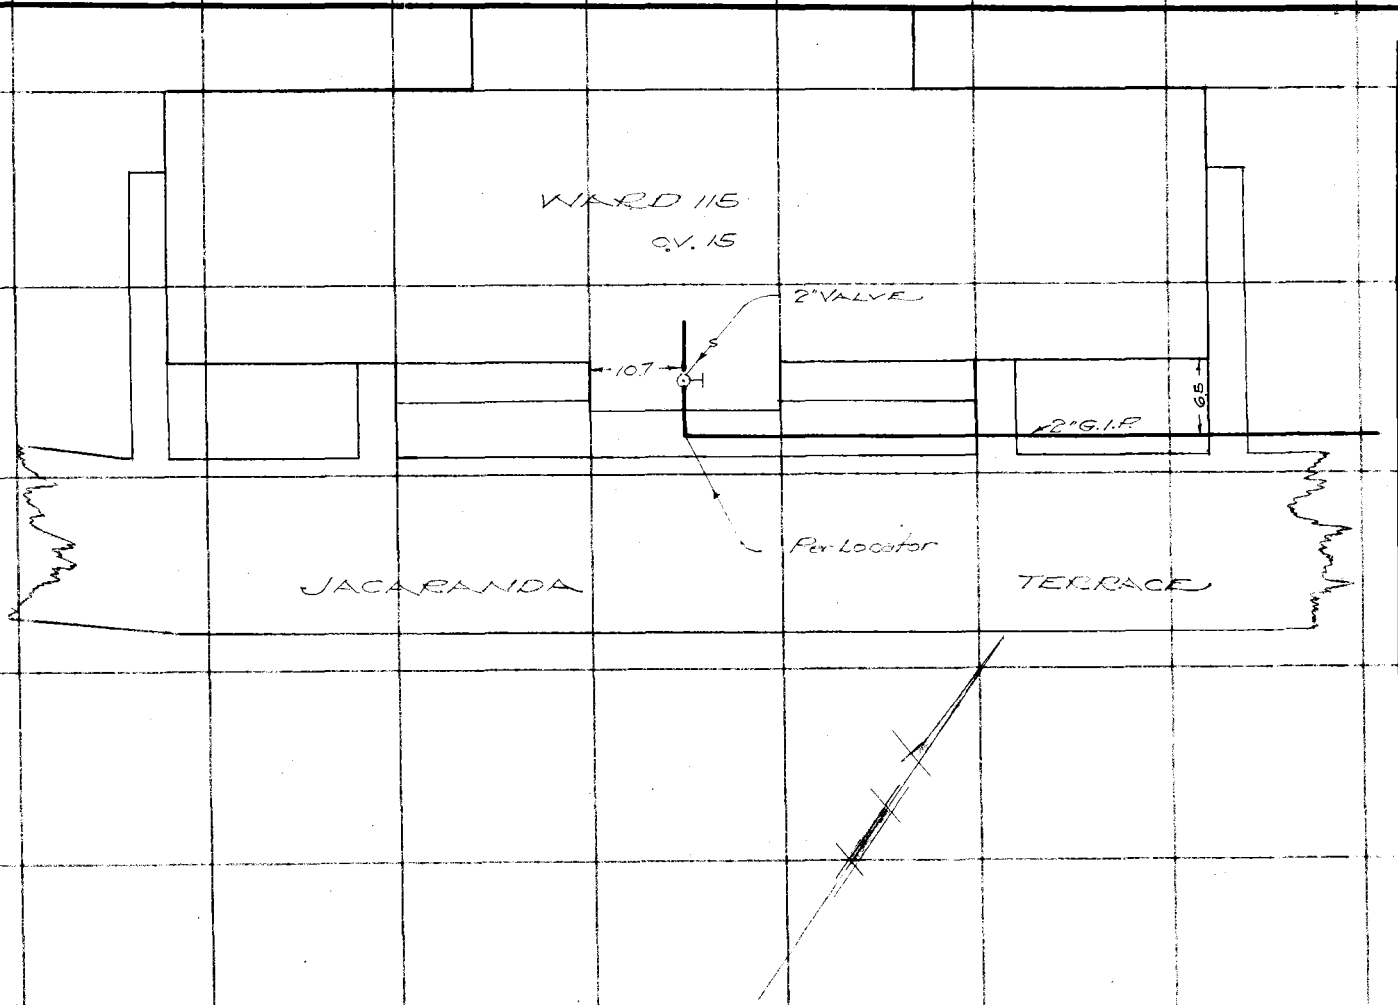

Notes Ck'd by
Map No.
Office Work
Checked
Date

W. O. 8128 Tape No. St'd °F.
Surveyed by T. M. WALSH Date 7-24-36
Notes T. M. WALSH
Indexed By C Johnson

F.B. 709 PG. 67

WATER LINES

RETURN TO
LOS ANGELES COUNTY SURVEYOR
700 HALL OF RECORDS

Note: Any Additions or Changes on This Sheet Must be Made or Circled in **Red Ink** With Date and Name of Person Making Change.

Do not extend notes this side of this line

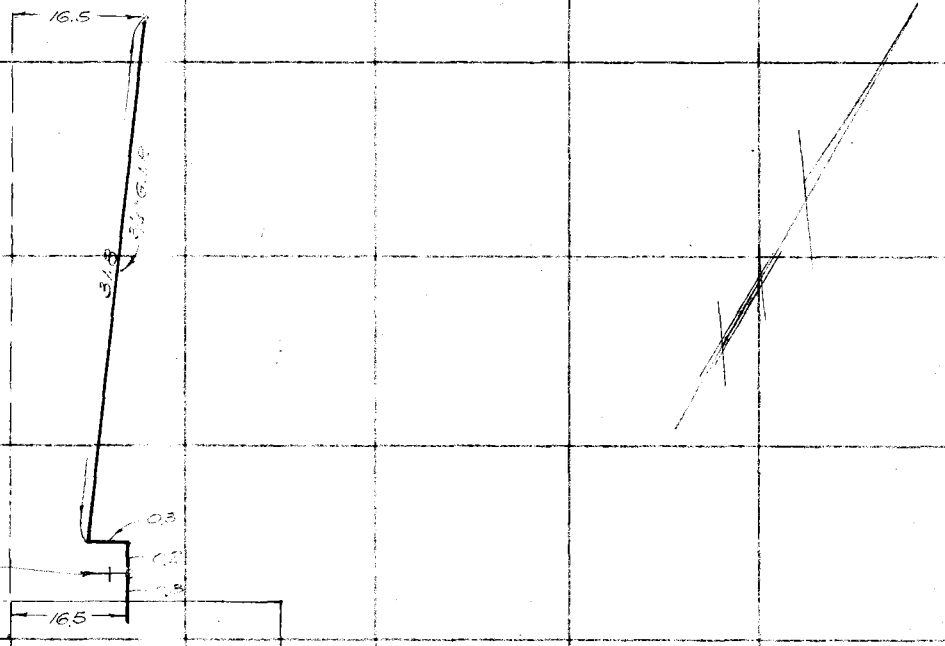

F.B. 709 PG. 68

WARD 105
O.V. 5

Notes Ck'd by	Survey of OLIVE VIEW SAN[illegible]
Map No.	W. O. 81-8 Tape No. St'd °F.
Office Work	Surveyed by TED M. WALSH
Checked	Notes WALSH Date 5-21-36
Date	Indexed

F.B. 709 PG. 69

WATER LINES

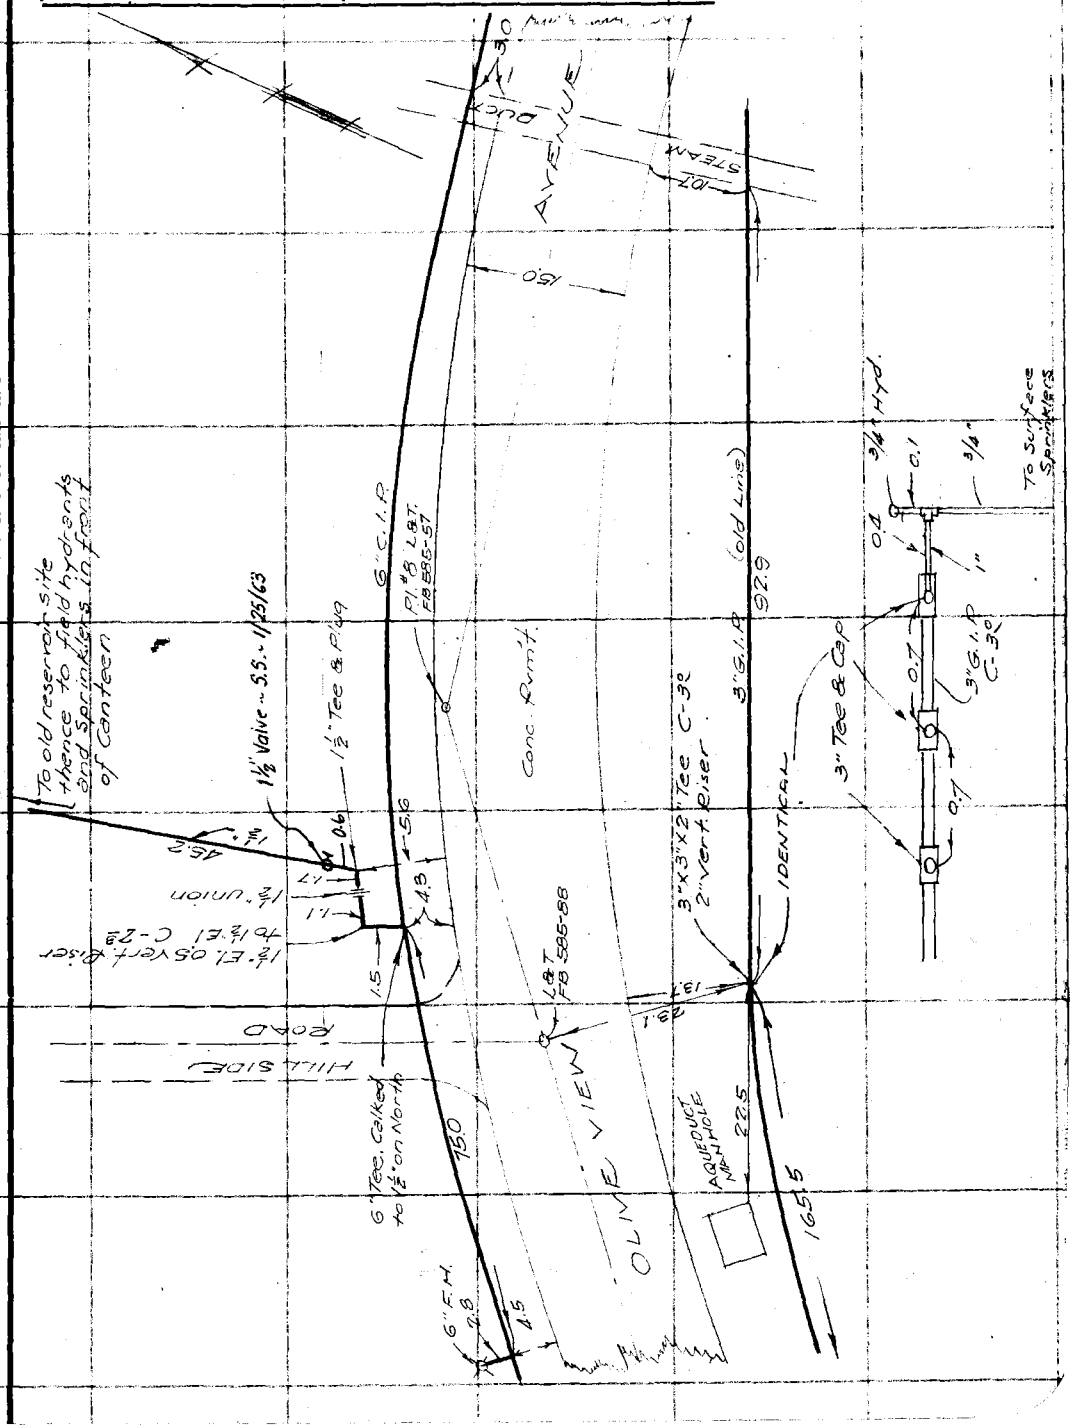

Note: Any Additions or Changes on This Sheet Must be Made or Circled in Red Ink With Date and Name of Person Making Change.

Do not extend notes this side of this line

RETURN TO
LOS ANGELES COUNTY SURVEYOR
700 HALL OF RECORDS

FORM 247 10M 11-35

F.B. 709 PG. 70

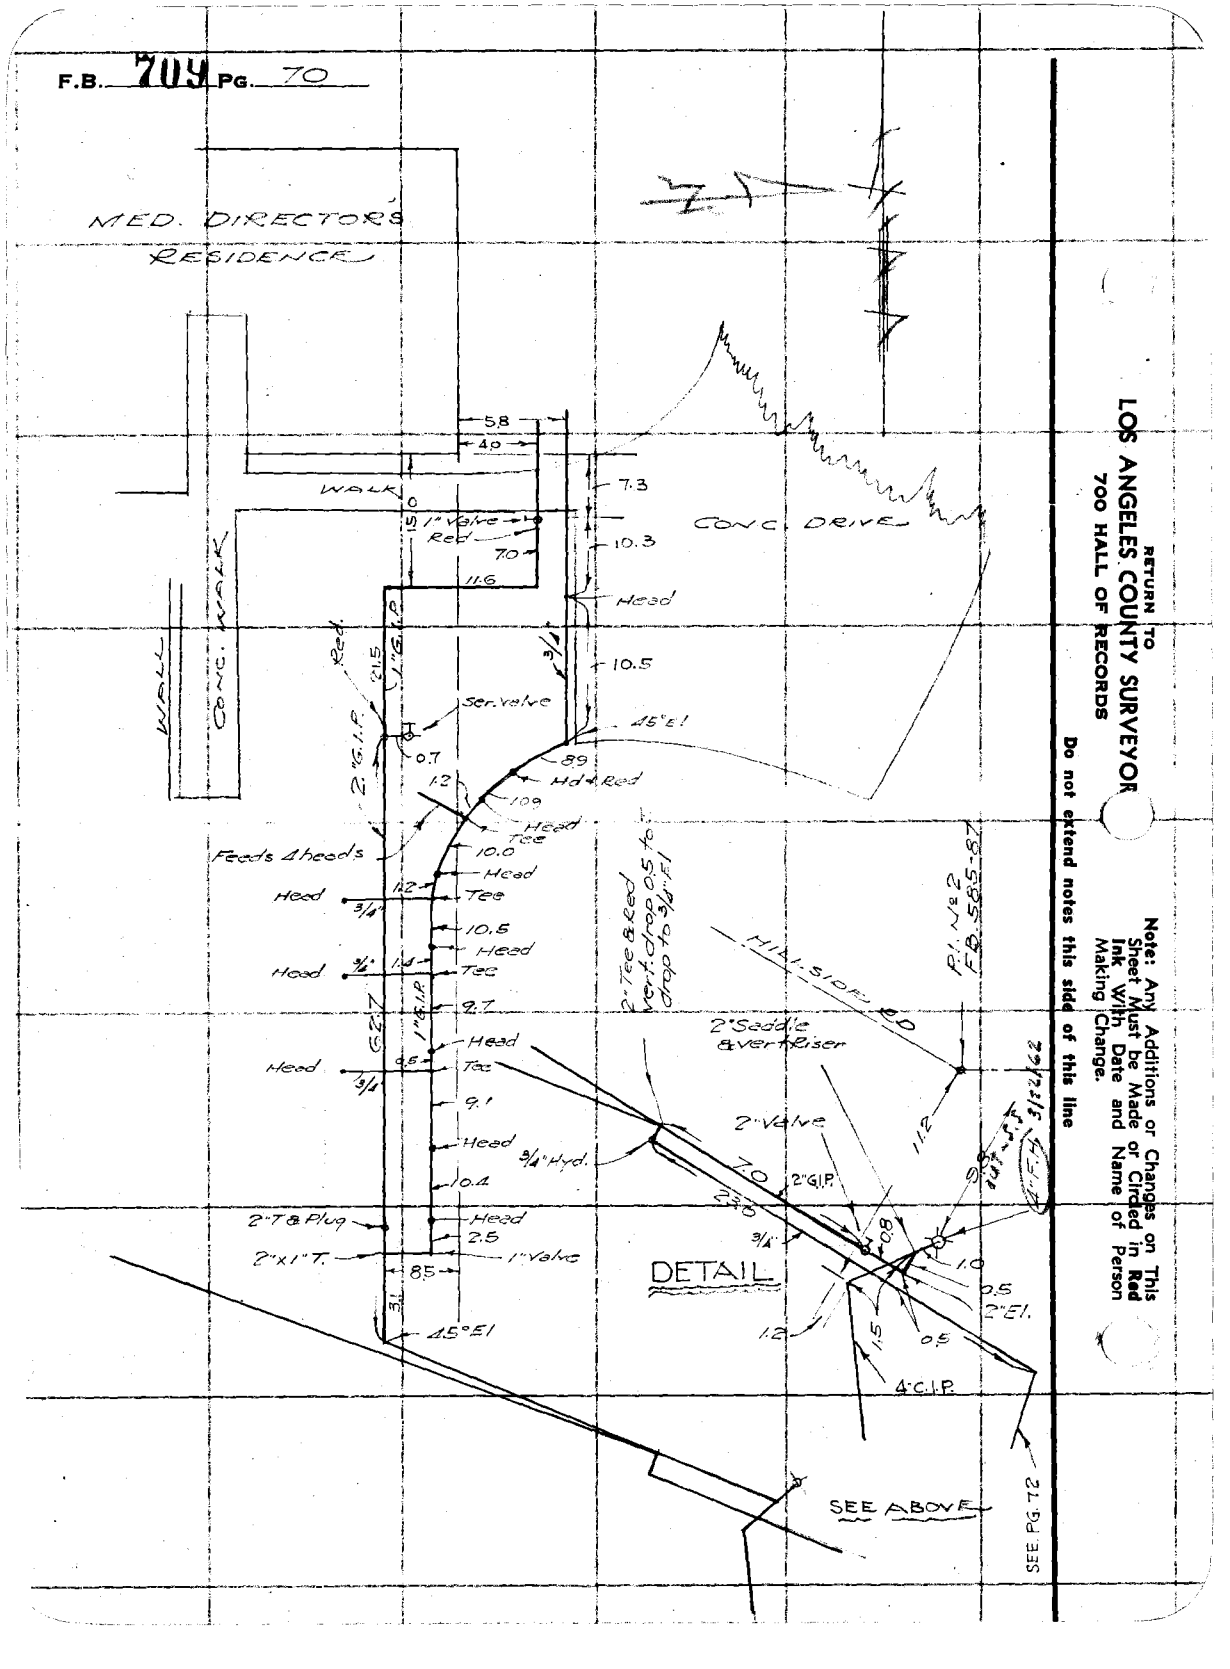

RETURN TO
LOS ANGELES COUNTY SURVEYOR
700 HALL OF RECORDS

Note: Any Additions or Changes on This Sheet Must be Made or Circled in Red Ink With Date and Name of Person Making Change.

Do not extend notes this side of this line

Notes Ck'd by	Survey of D.H.V. VIEW SANATORIUM
Map No.	W. 0.8128 Tape No. St'd °F.
Office Work	Surveyed by T. M. WALSH
Checked	Notes T. M. WALSH Date 7-36
Date	Indexed C. Johnson

F.B. 709 Pg. 71

WATER LINE

From old Reservoir site

74°00'

7.5

HILLSIDE ROAD

P.I. T
Fd 3/4" I.P.
FB 585-88

COTTAGE 1
O.V. 21

35.9

4.9

3/4" I.P. OUT

104.3

1½" G.I.P.

84.9

Abandoned to North

S.S. -12-11-63

3/4" I.P. OUT

"X" in pvmt
see FB 585-58

OLIVE VIEW

10.0

30.8

See F.B. 2994-46

3/4" I.P.

X in Pvmt

ALLEY

14.2

To lawn Sprinklers

SEE DETAIL

12.5

7.3

1½" El. & Red. Vert. Riser of 0.8 to 1½" El

WALK

0.1

0.5

CANTEEN
O.V. 86

1½" El. Reducer to 1"

1" Valve

DETAIL

CANTEEN
O.V. 86

ABONDONED
2-1½" lines

RETURN TO
LOS ANGELES COUNTY SURVEYOR
700 HALL OF RECORDS

Note: Any Additions or Changes on This Sheet Must be Made or Circled in Red Ink With Date and Name of Person Making Change

Do not extend notes this side of this line

FORM 247 10M 11-35

RETURN TO
LOS ANGELES COUNTY SURVEYOR
700 HALL OF RECORDS

Note: Any Additions or Changes on This Sheet Must be Made or Circled in **Red Ink** With Date and Name of Person Making Change.

Do not extend notes this side of this line

F.B. 709 PG. 72

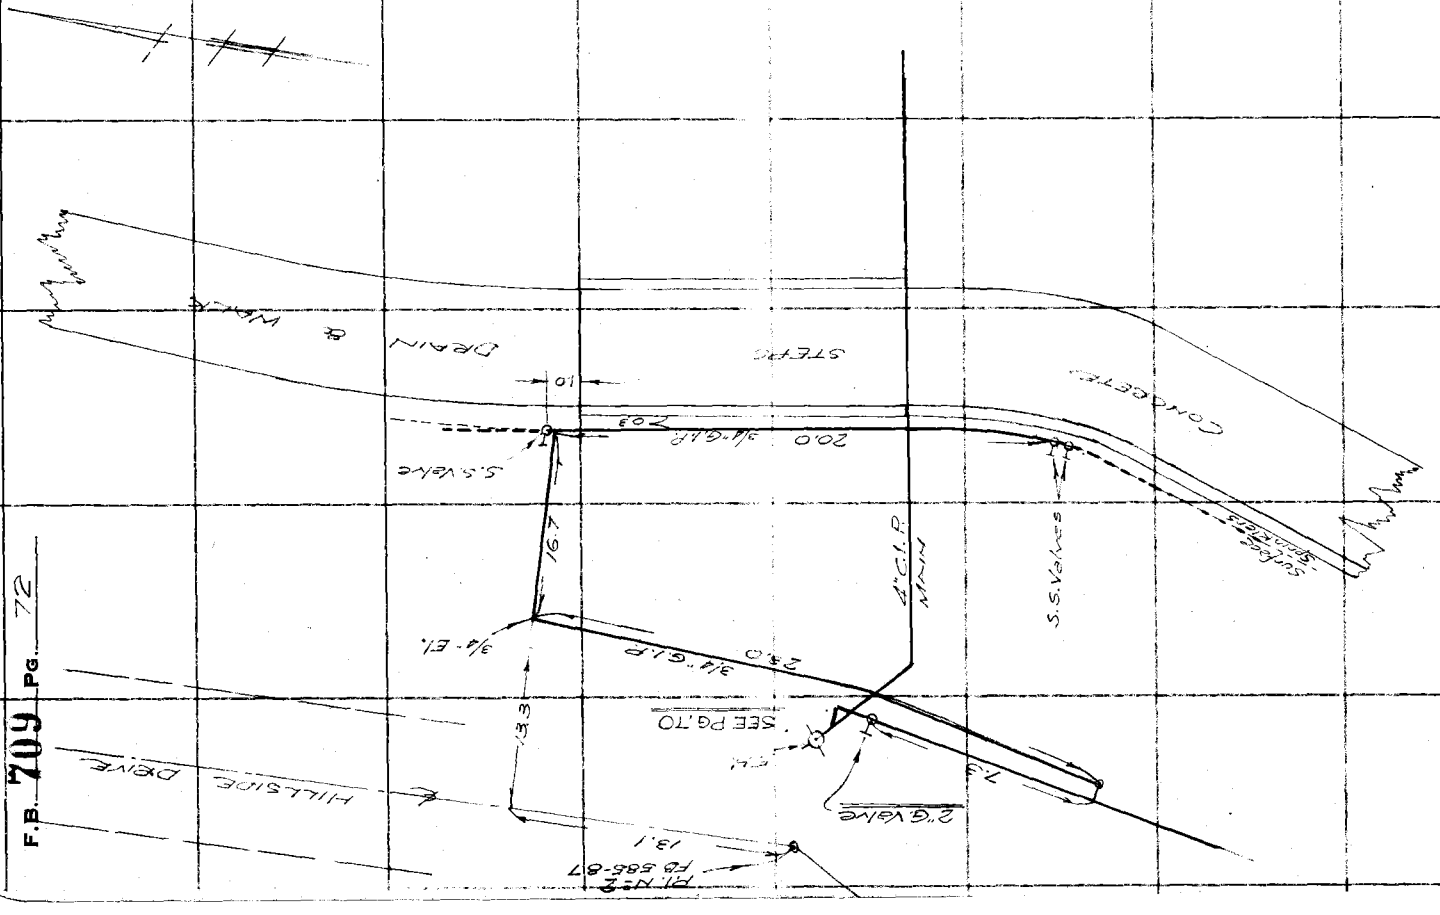

Notes Ck'd by	Survey of OLIVE VIEW SANATORIUM
Map No.	W. O. 8128 Tape No. Std
Office Work	Surveyed by T. M. WALSH
Checked	Notes T. M. WALSH Date T-17-36
Date	Indexed

F.B. 709 Pg. 73

WATER LINE

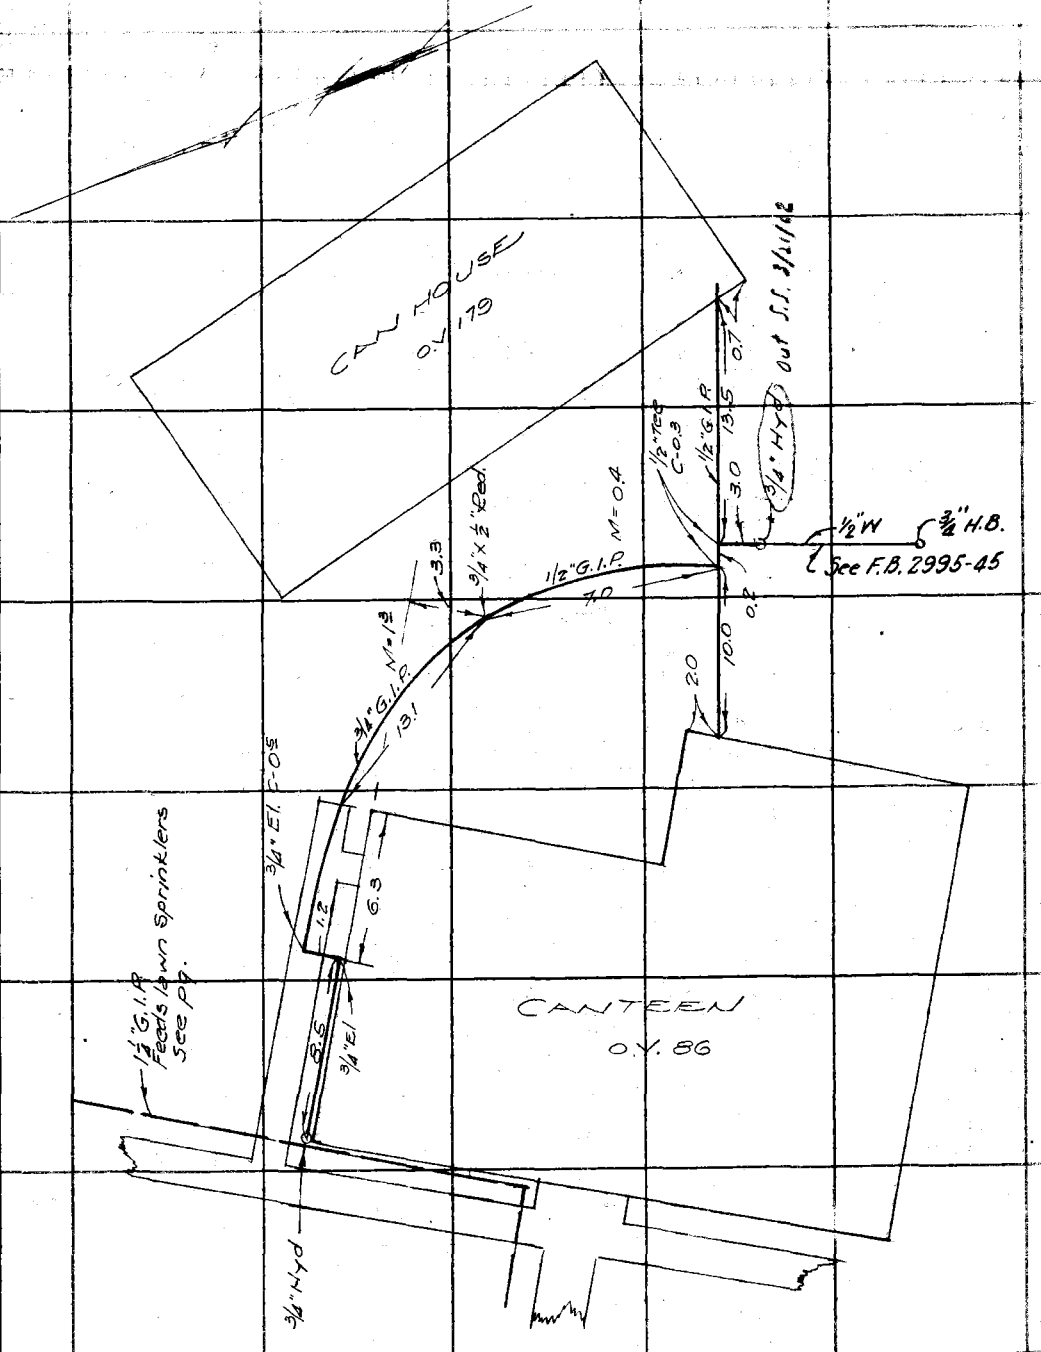

Note: ANY ADDITIONS OR CHANGES ON THIS SHEET MUST BE MADE OR CIRCLED IN Red Ink WITH DATE AND NAME OF PERSON MAKING CHANGE.

Do not extend notes this side of this line

RETURN TO
LOS ANGELES COUNTY SURVEYOR
700 HALL OF RECORDS

FORM 247 BM 2-34

RETURN TO

LOS ANGELES COUNTY SURVEYOR

700 HALL OF RECORDS

Note; ANY ADDITIONS OR CHANGES ON THIS SHEET MUST BE MADE OR CIRCLED IN **Red Ink** WITH DATE AND NAME OF PERSON MAKING CHANGE.

Do not extend notes this side of this line

F.B. 709 PG. 72

FORM 247 10M 11-35

RETURN TO
LOS ANGELES COUNTY SURVEYOR
700 HALL OF RECORDS

Note: Any Additions or Changes on This Sheet Must be Made or Circled in **Red Ink** With Date and Name of Person Making Change.

Do not extend notes this side of this line

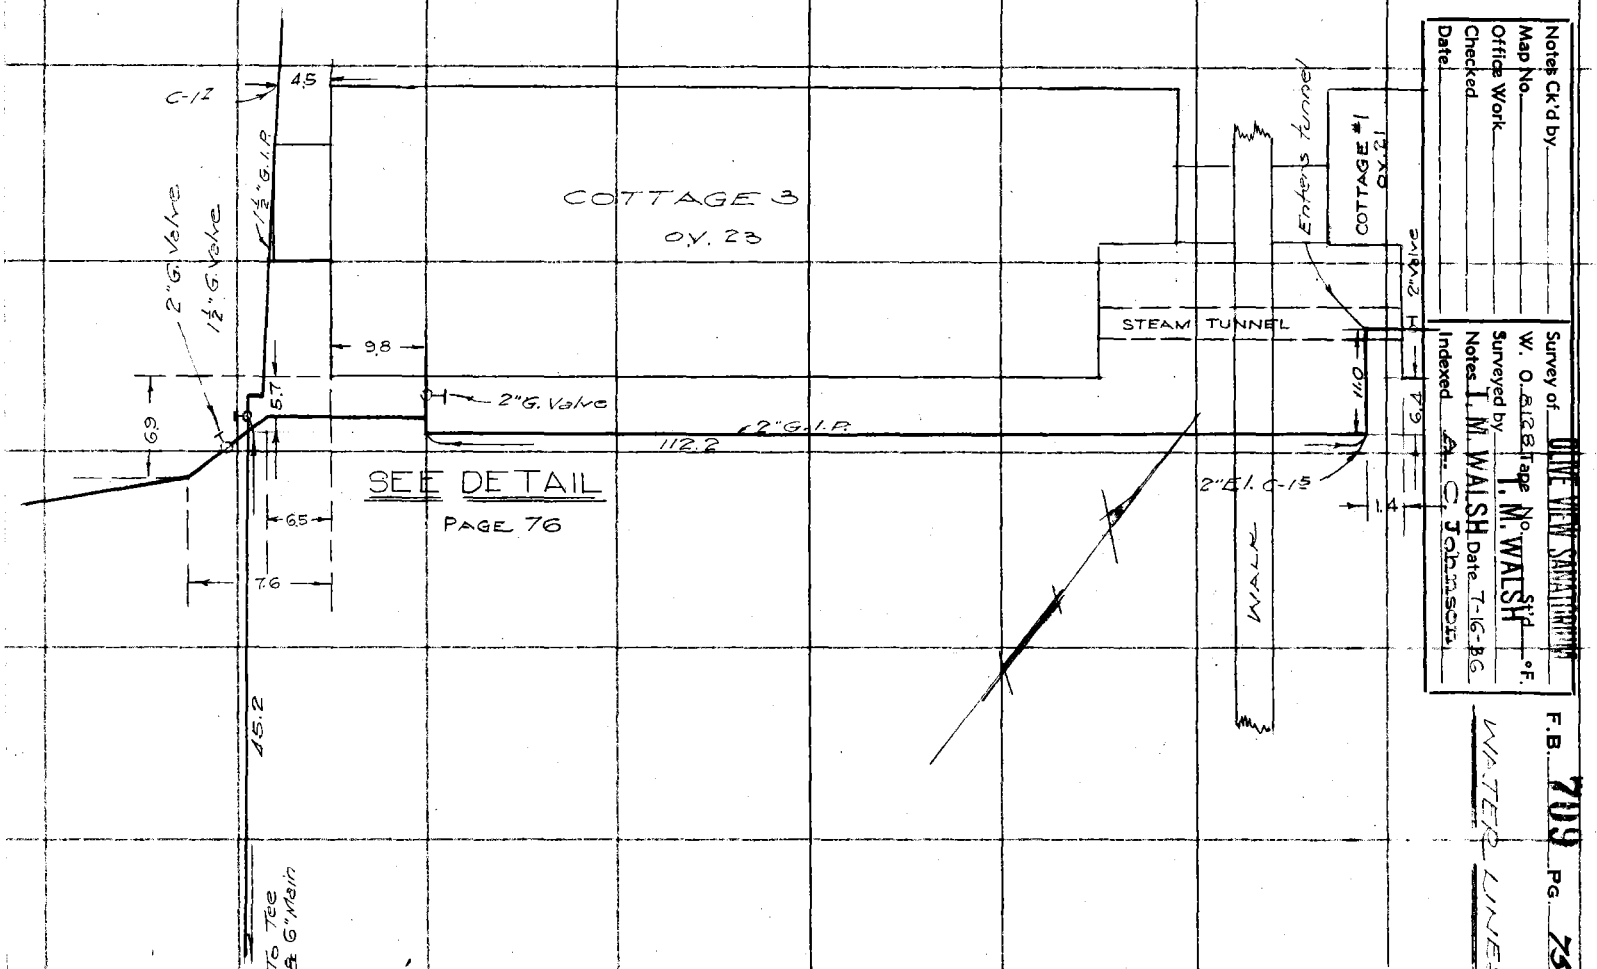

Notes Ck'd by
Map No.
Office Work
Checked
Date

Survey of OLIVE VIEW SANATORIUM
W. O. 8128 Tape No. St'd °F.
Surveyed by T. M. WALSH
Notes T. M. WALSH Date 7-16-36
Indexed A. C. Johnson

F.B. 709 PG. 75

WATER LINES

RETURN TO
LOS ANGELES COUNTY SURVEYOR
700 HALL OF RECORDS

Note: Any Additions or Changes on This Sheet Must be Made or Circled in Red Ink With Date and Name of Person Making Change.

Do not extend notes this side of this line

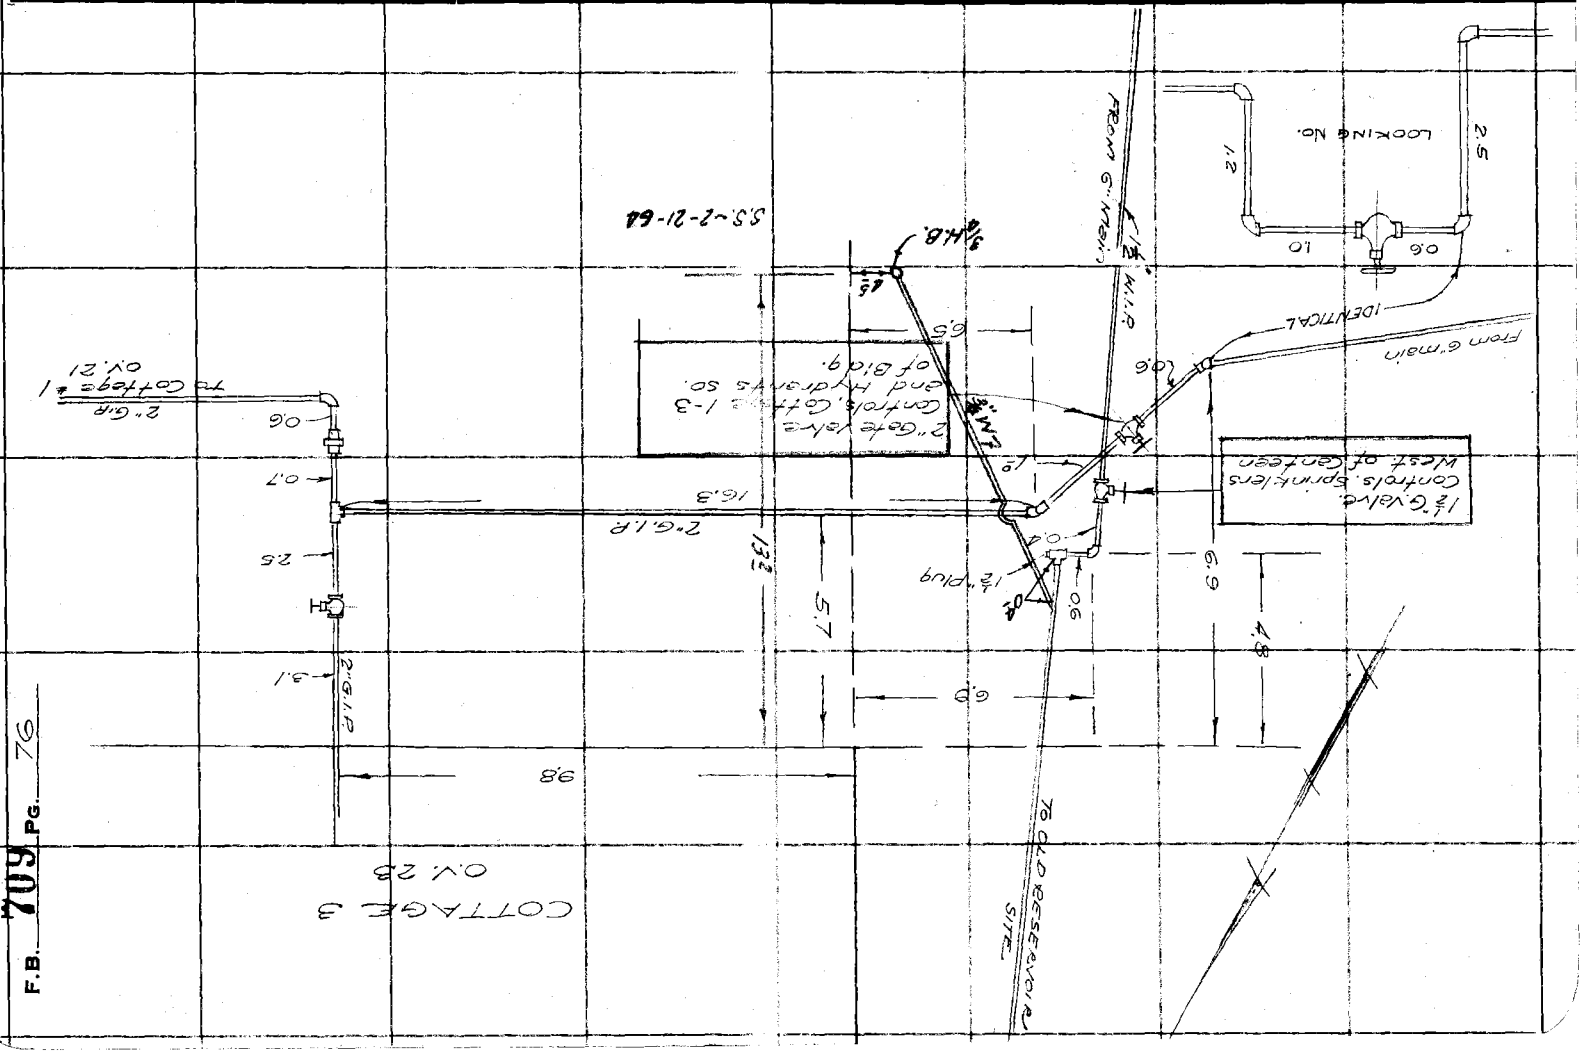

FORM 247 10M 11-35

RETURN TO
LOS ANGELES COUNTY SURVEYOR
700 HALL OF RECORDS

Note: Any Additions or Changes on This Sheet Must be Made or Circled in **Red Ink** With Date and Name of Person Making Change.

Do not extend notes this side of this line

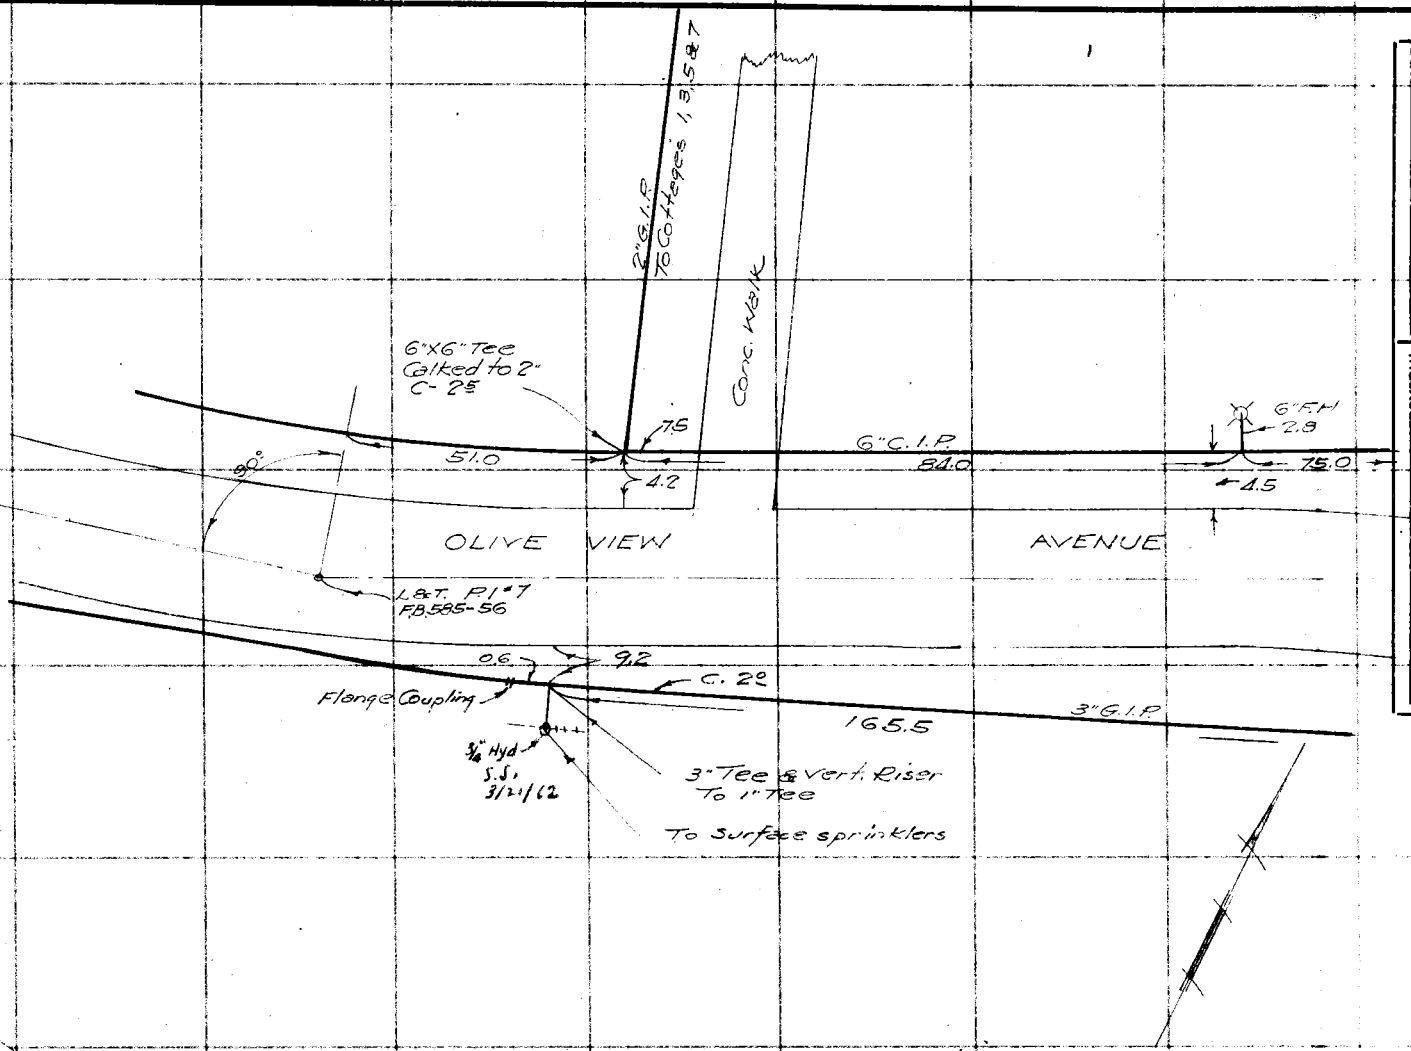

Notes Ck'd by
Map No.
Office Work
Checked
Date

Survey of OLIVE VIEW SANATORIUM
W. O. 8178 Tape No. St'd. °F.
Surveyed by TED M. WALSH
Notes WALSH Date
Indexed J.S.M.

F.B. 709 PG. 77

WM. ERIC LINARD

F.B. 709 PG. 78

RETURN TO
LOS ANGELES COUNTY SURVEYOR
700 HALL OF RECORDS

Do not extend notes this side of this line

Note: Any Additions or Changes on This Sheet Must be Made or Circled in Red Ink With Date and Name of Person Making Change.

FORM 247 IOM 11-38

RETURN TO
LOS ANGELES COUNTY SURVEYOR
700 HALL OF RECORDS

Note: Any Additions or Changes on This Sheet Must be Made or Circled in **Red Ink** With Date and Name of Person Making Change.

Do not extend notes this side of this line

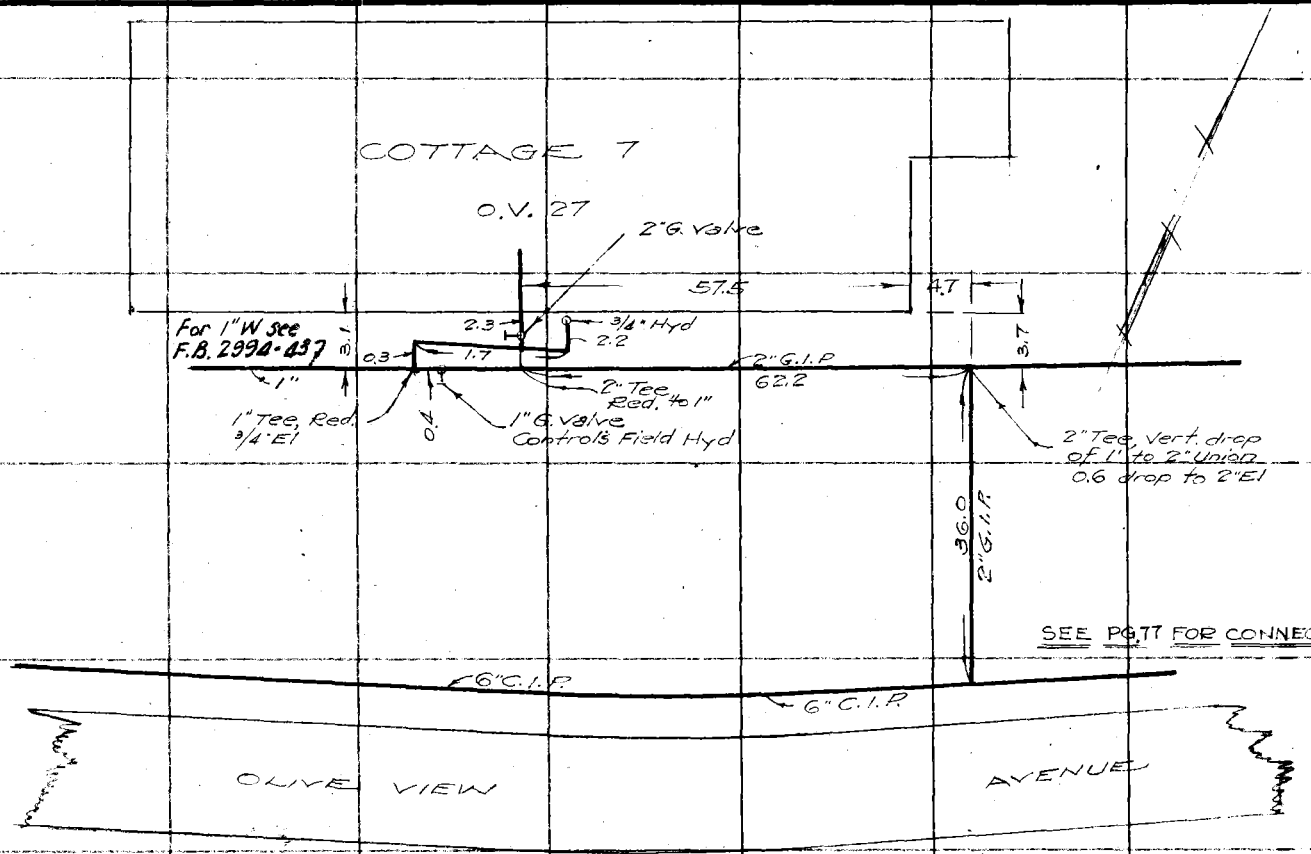

Notes Ck'd by _____ °F.
Map No. _____
Office Work _____
Checked _____
Date _____

Survey of OLIVE VIEW SANATORIUM
W. O. 8126 Tape No. _____
Surveyed by T. M. WALSH Ck'd _____
Notes T. M. WALSH Date 7-16-86
Indexed _____ Ck'd C. Johnson

F.B. 709 PG. 79

WATER LINES

RETURN TO
LOS ANGELES COUNTY SURVEYOR
700 HALL OF RECORDS

Note: Any Additions or Changes on This Sheet Must be Made or Circled in **Red Ink** With Date and Name of Person Making Change.

Do not extend notes this side of this line

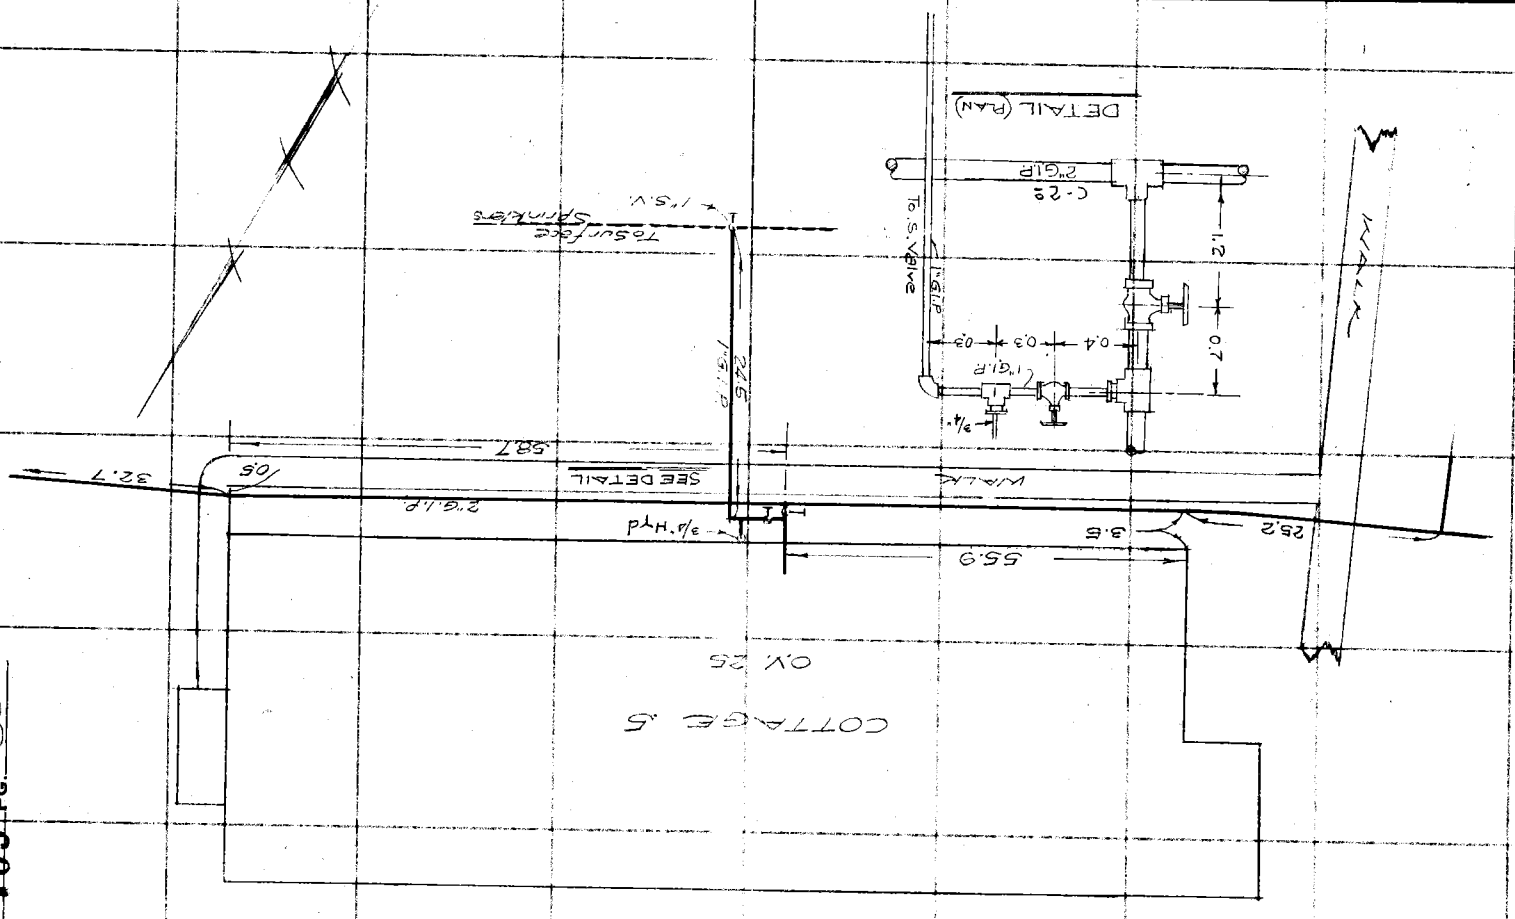

F.B. 709 PG. 80

FORM 247 10M 11-35

RETURN TO
LOS ANGELES COUNTY SURVEYOR
700 HALL OF RECORDS

Note: Any Additions or Changes on This Sheet Must be Made or Circled in **Red Ink** With Date and Name of Person Making Change.

Do not extend notes this side of this line

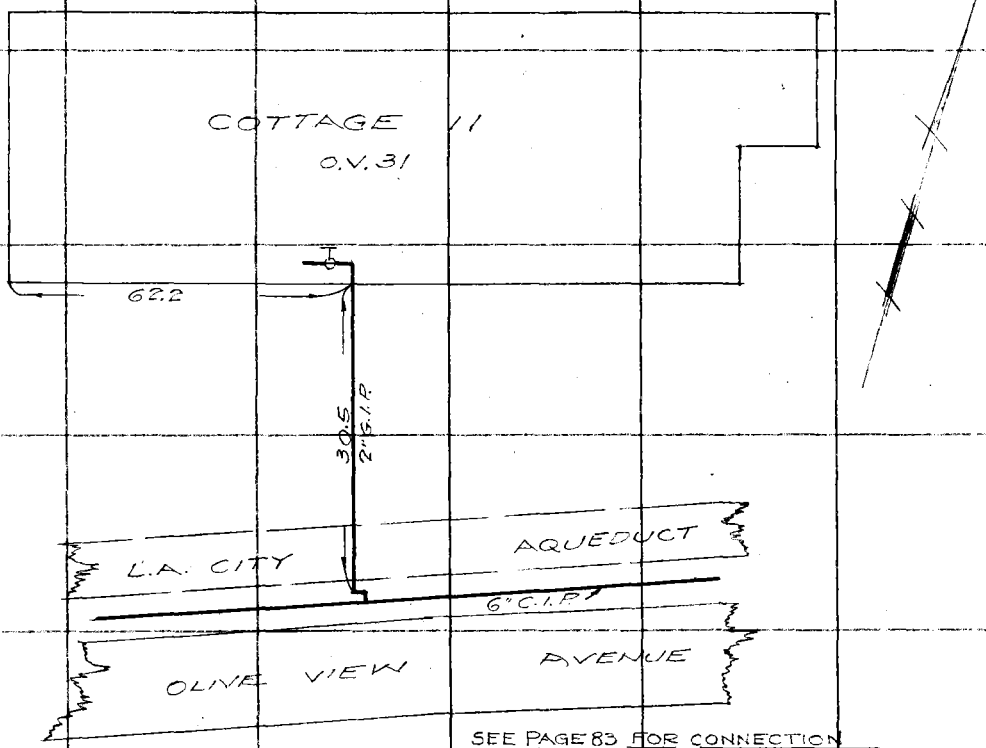

SEE PAGE 83 FOR CONNECTION

Notes Ck'd by
Map No.
Office Work
Checked
Date:

Survey of OLIVE VIEW SANATORIUM
W. O. 8128 Tape No. T. M. WALSH Sk'd °F.
Surveyed by T. M. WALSH Date 7-16-36
Notes
Indexed

F.B. 709 PG. 81

WATER LINES

F.B. 709 PG. 82

RETURN TO
LOS ANGELES COUNTY SURVEYOR
700 HALL OF RECORDS

Note: Any Additions or Changes on This Sheet Must be Made or Circled in Red Ink With Date and Name of Person Making Change.

Do not extend notes this side of this line

AVENUE

AQUEDUCT

SEE PG 78 FOR CONNECTION

16"C.I.P.

SEE PAGE 78 FOR 6" LINE

OLIVE VIEW

L.A. CO.

6"F.H.

COTTAGE 9
O.V. 20

55.4

3.8

2"E/
C-15

16.6

3.7

2"E/
C-22

5.2

22.0

Notes Ck'd by	Survey of OLIVE VIEW SANATORIUM
Map No.	W. O. 8/28 Tape No. St'd °F.
Office Work	Surveyed by TED M. WALSH
Checked	Notes WALSH Date 5-21-36
Date	Indexed A. C. Johnson

F.B. 709 PG. 83

WATER LINES

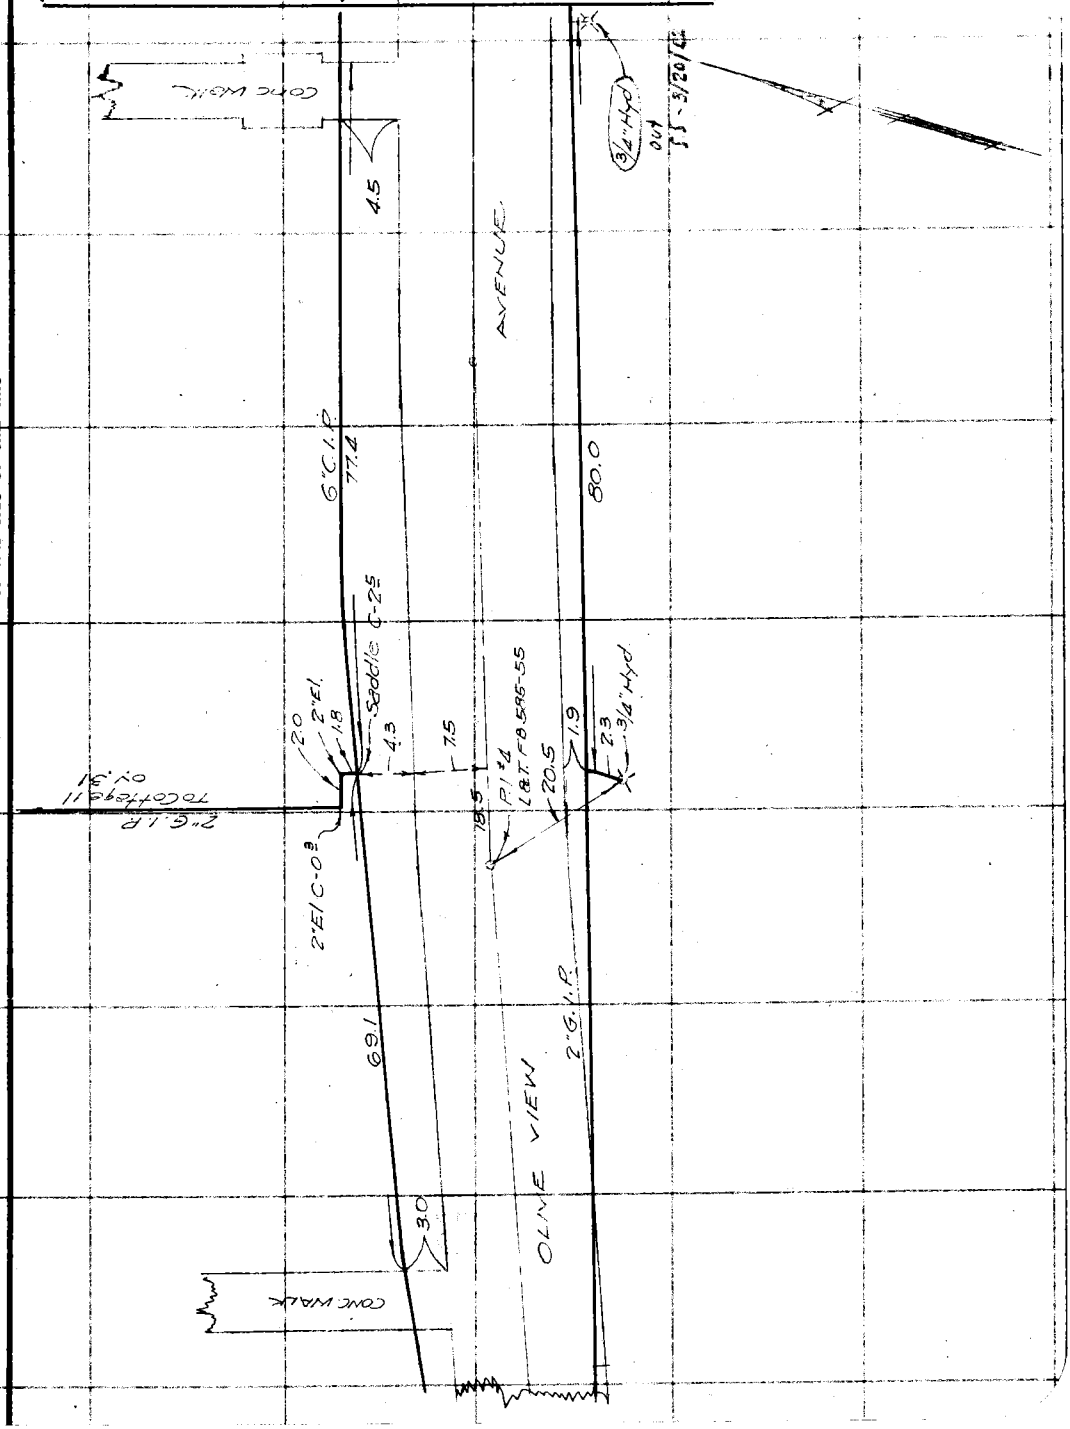

Note: Any Additions or Changes on This Sheet Must be Made or Circled in Red Ink With Date and Name of Person Making Change.

Do not extend notes this side of this line

RETURN TO
LOS ANGELES COUNTY SURVEYOR
700 HALL OF RECORDS

FORM 247 10M 11-35

RETURN TO
LOS ANGELES COUNTY SURVEYOR
700 HALL OF RECORDS

Note: Any Additions or Changes on This Sheet Must be Made or Circled in **Red Ink** With Date and Name of Person Making Change.

Do not extend notes this side of this line

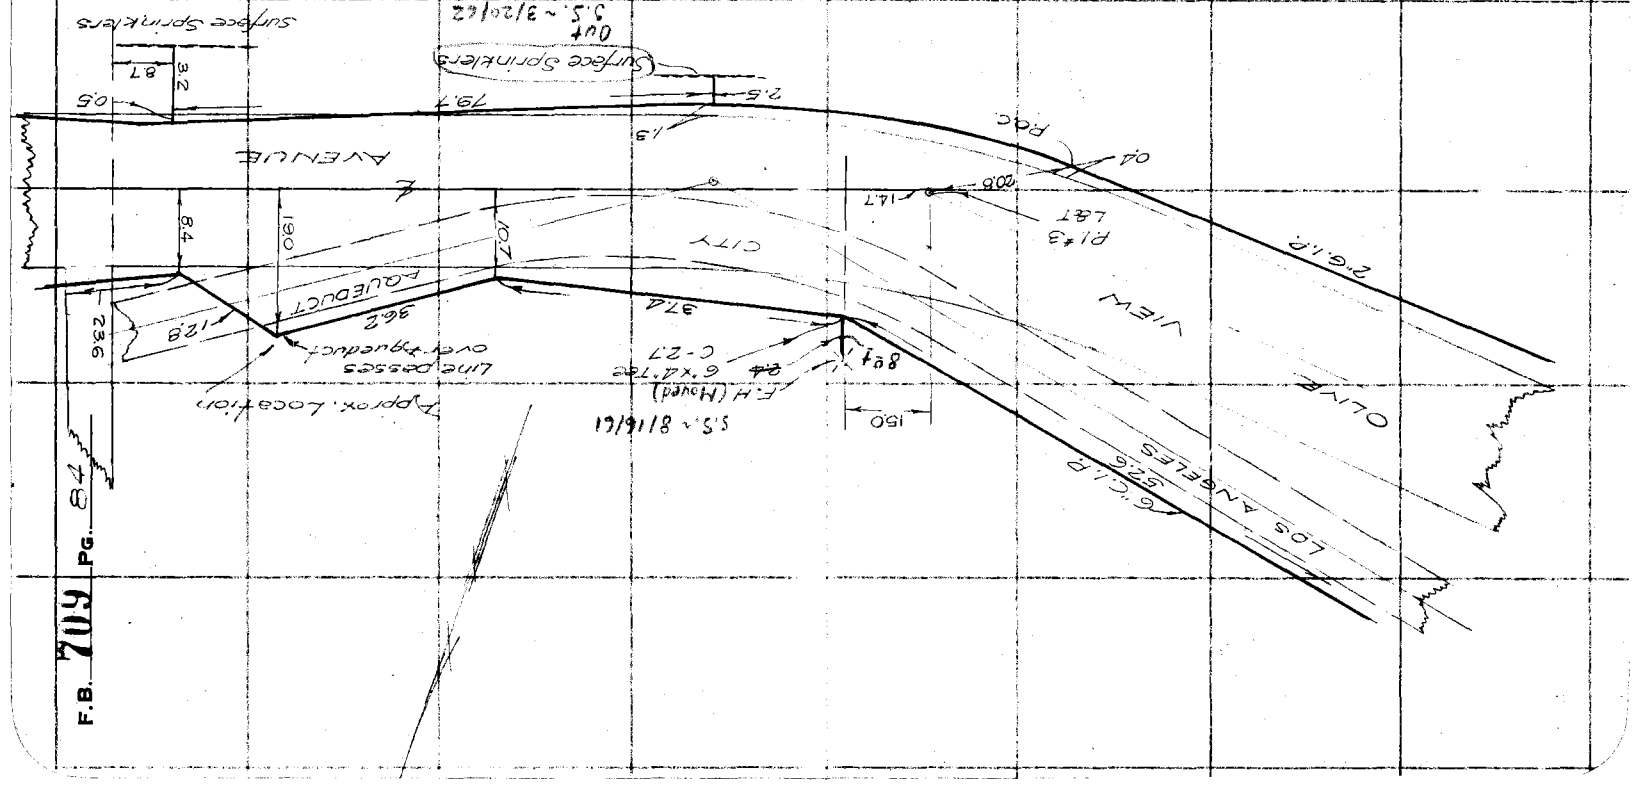

F.B. 709 Pg. 84

FORM 247 10M 11-33

RETURN TO
LOS ANGELES COUNTY SURVEYOR
700 HALL OF RECORDS

Note: Any Additions or Changes on This Sheet Must be Made or Circled in **Red Ink** With Date and Name of Person Making Change.

Do not extend notes this side of this line

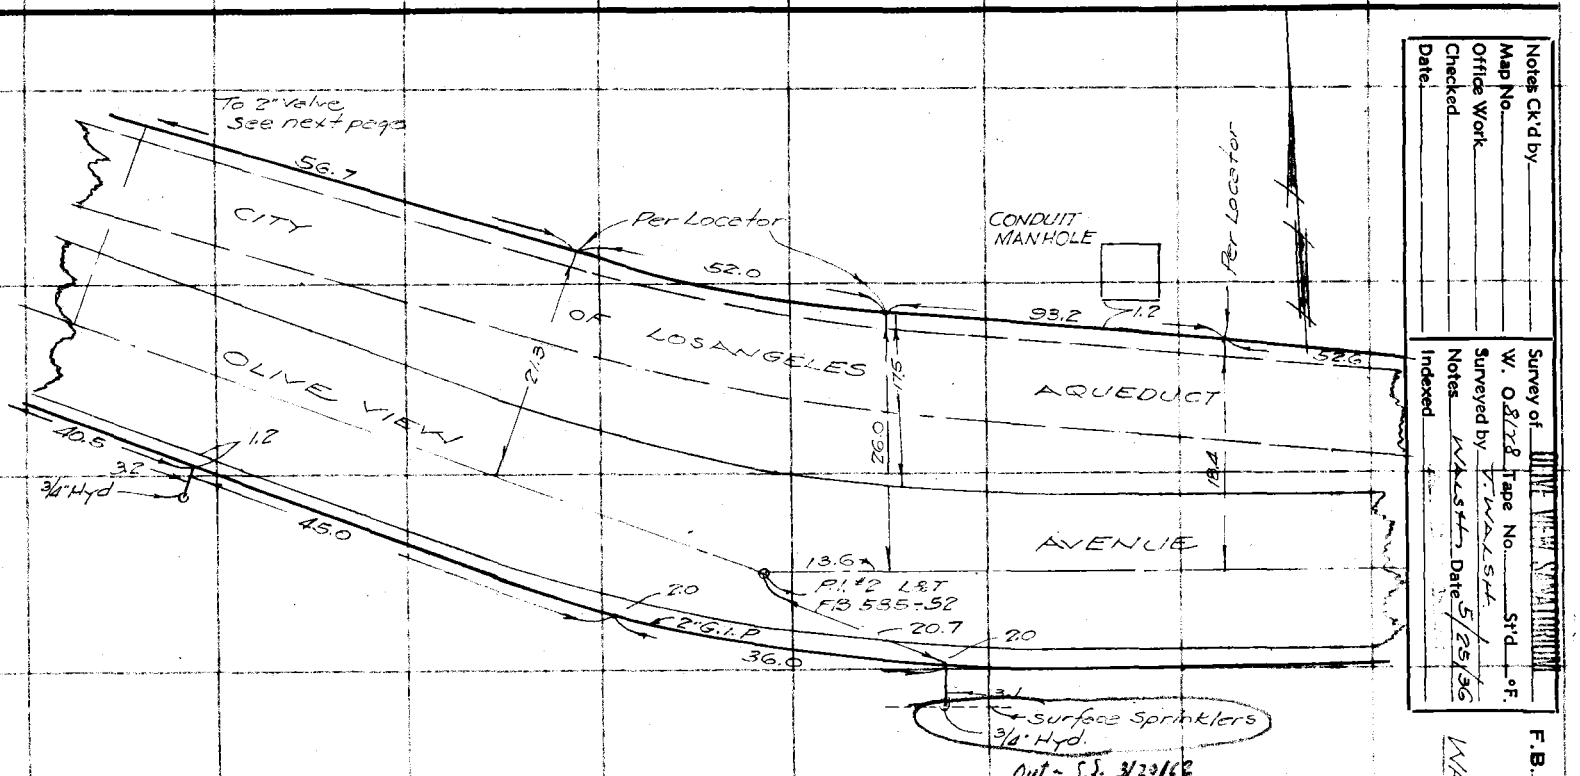

Notes Ck'd by _____
Map No. _____
Office Work _____
Checked _____
Date _____

Survey of OLIVE VIEW SANATORIUM
W. O. 8228 Tape No. _____ St'd _____ °F.
Surveyed by T. WALSH
Notes WATER LINES Date 5/25/36
Indexed

F.B. 709 Pg. 95

RETURN TO
LOS ANGELES COUNTY SURVEYOR
700 HALL OF RECORDS

Note: Any Additions or Changes on This Sheet Must be Made or Circled in **Red** Ink With Date and Name of Person Making Change.

Do not extend notes this side of this line

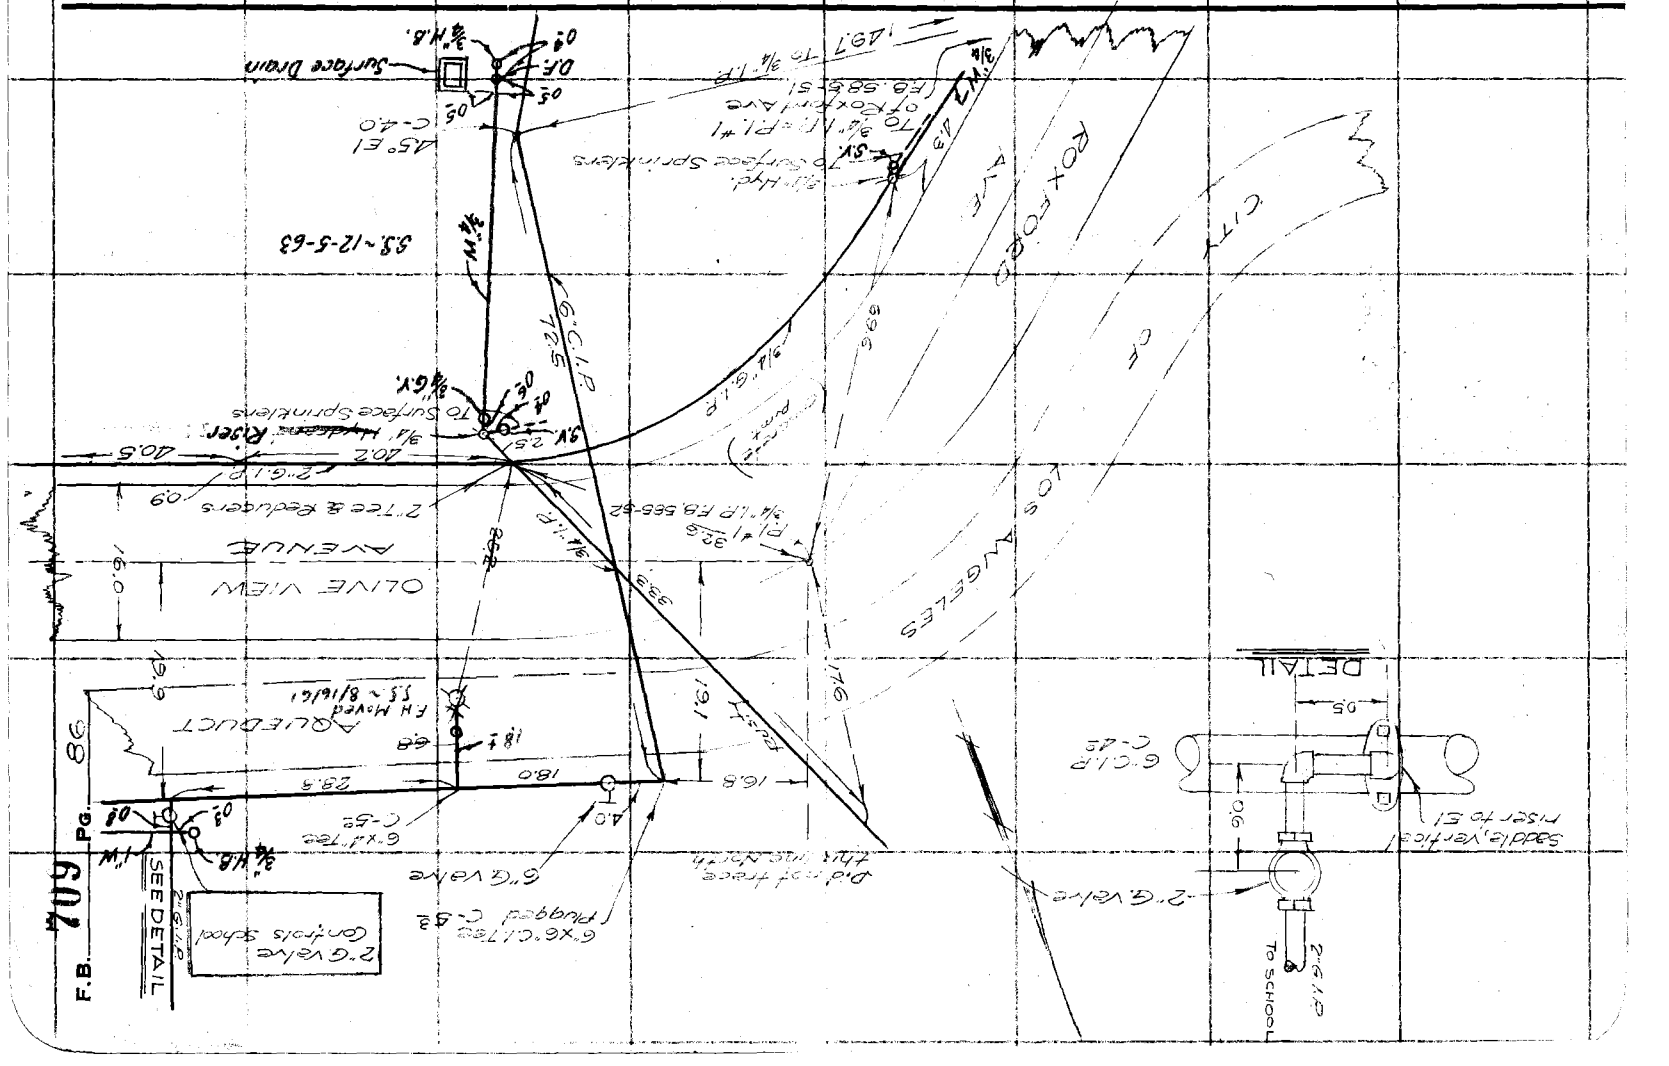

Notes Ck'd by	Survey of OLIVE VIEW SANATORIUM
Map No.	W. O. 8178 Tape No St'd OF.
Office Work	Surveyed by T. WALSH
Checked	Notes WALSH Date 5/26/36
Date	Indexed A. C. Johnson

F.B. 709 PG. 87

WATER LINES

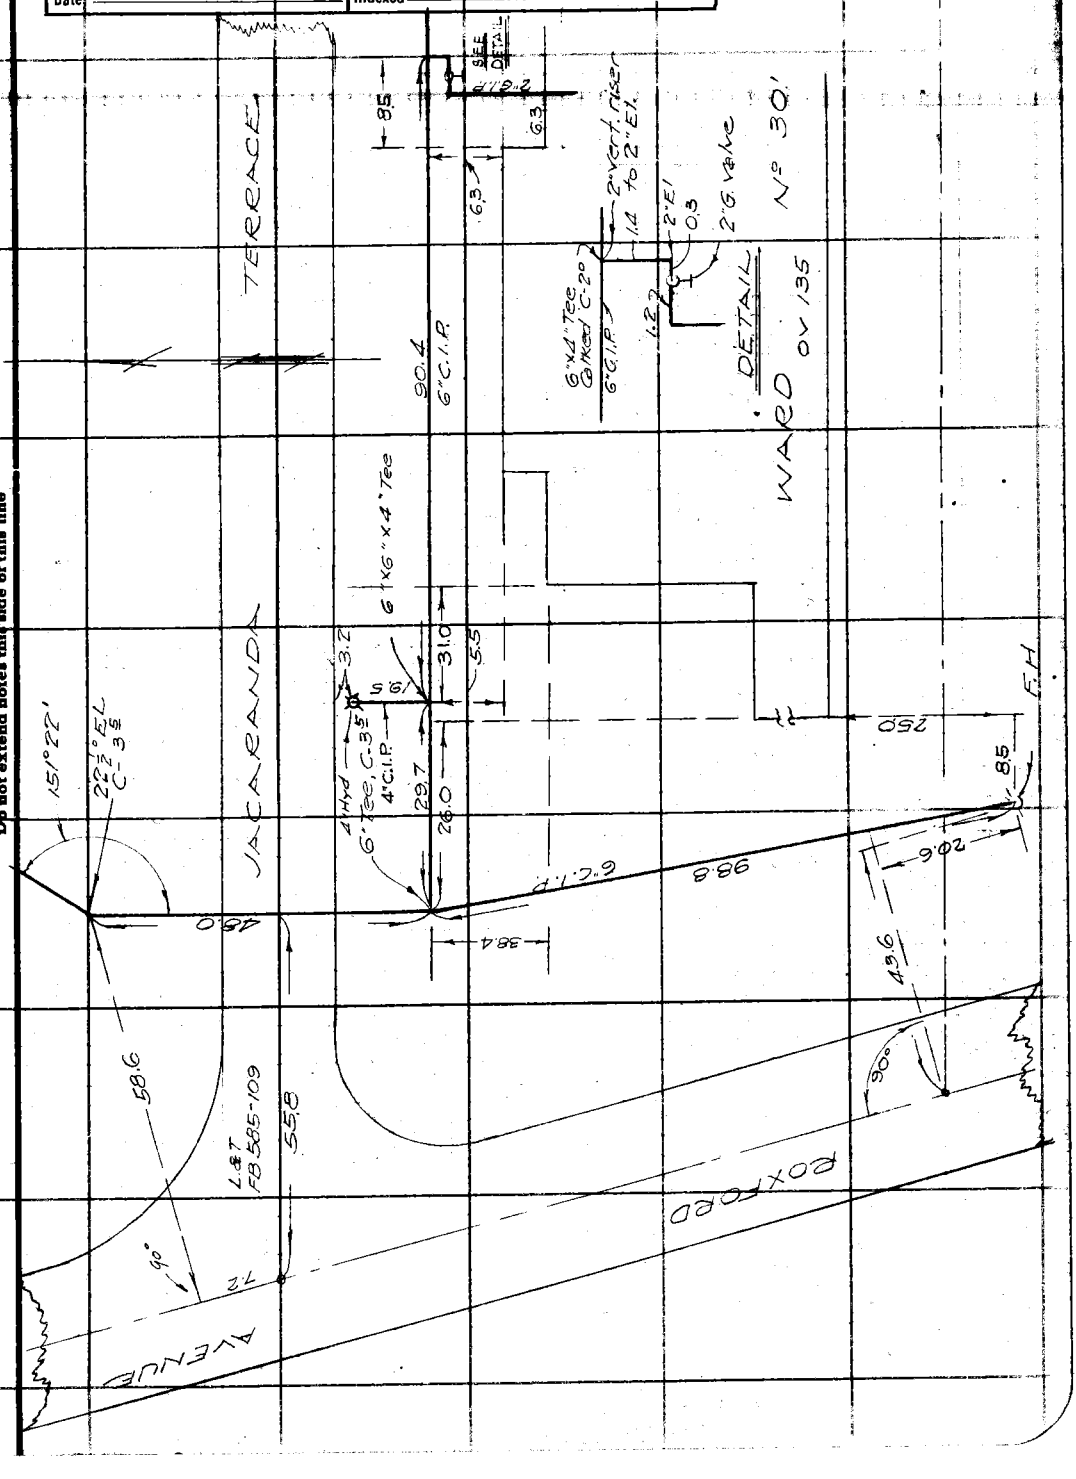

RETURN TO
LOS ANGELES COUNTY SURVEYOR
700 HALL OF RECORDS

Note: ANY ADDITIONS OR CHANGES ON THIS SHEET MUST BE MADE OR CIRCLED IN Red Ink WITH DATE AND NAME OF PERSON MAKING CHANGE.

Do not extend notes this side of this line

FORM 247 5M 2-34

RETURN TO
LOS ANGELES COUNTY SURVEYOR
700 HALL OF RECORDS

Note: ANY ADDITIONS OR CHANGES ON THIS SHEET MUST BE MADE OR CIRCLED IN **Red Ink** WITH DATE AND NAME OF PERSON MAKING CHANGE.

Do not extend notes this side of this line

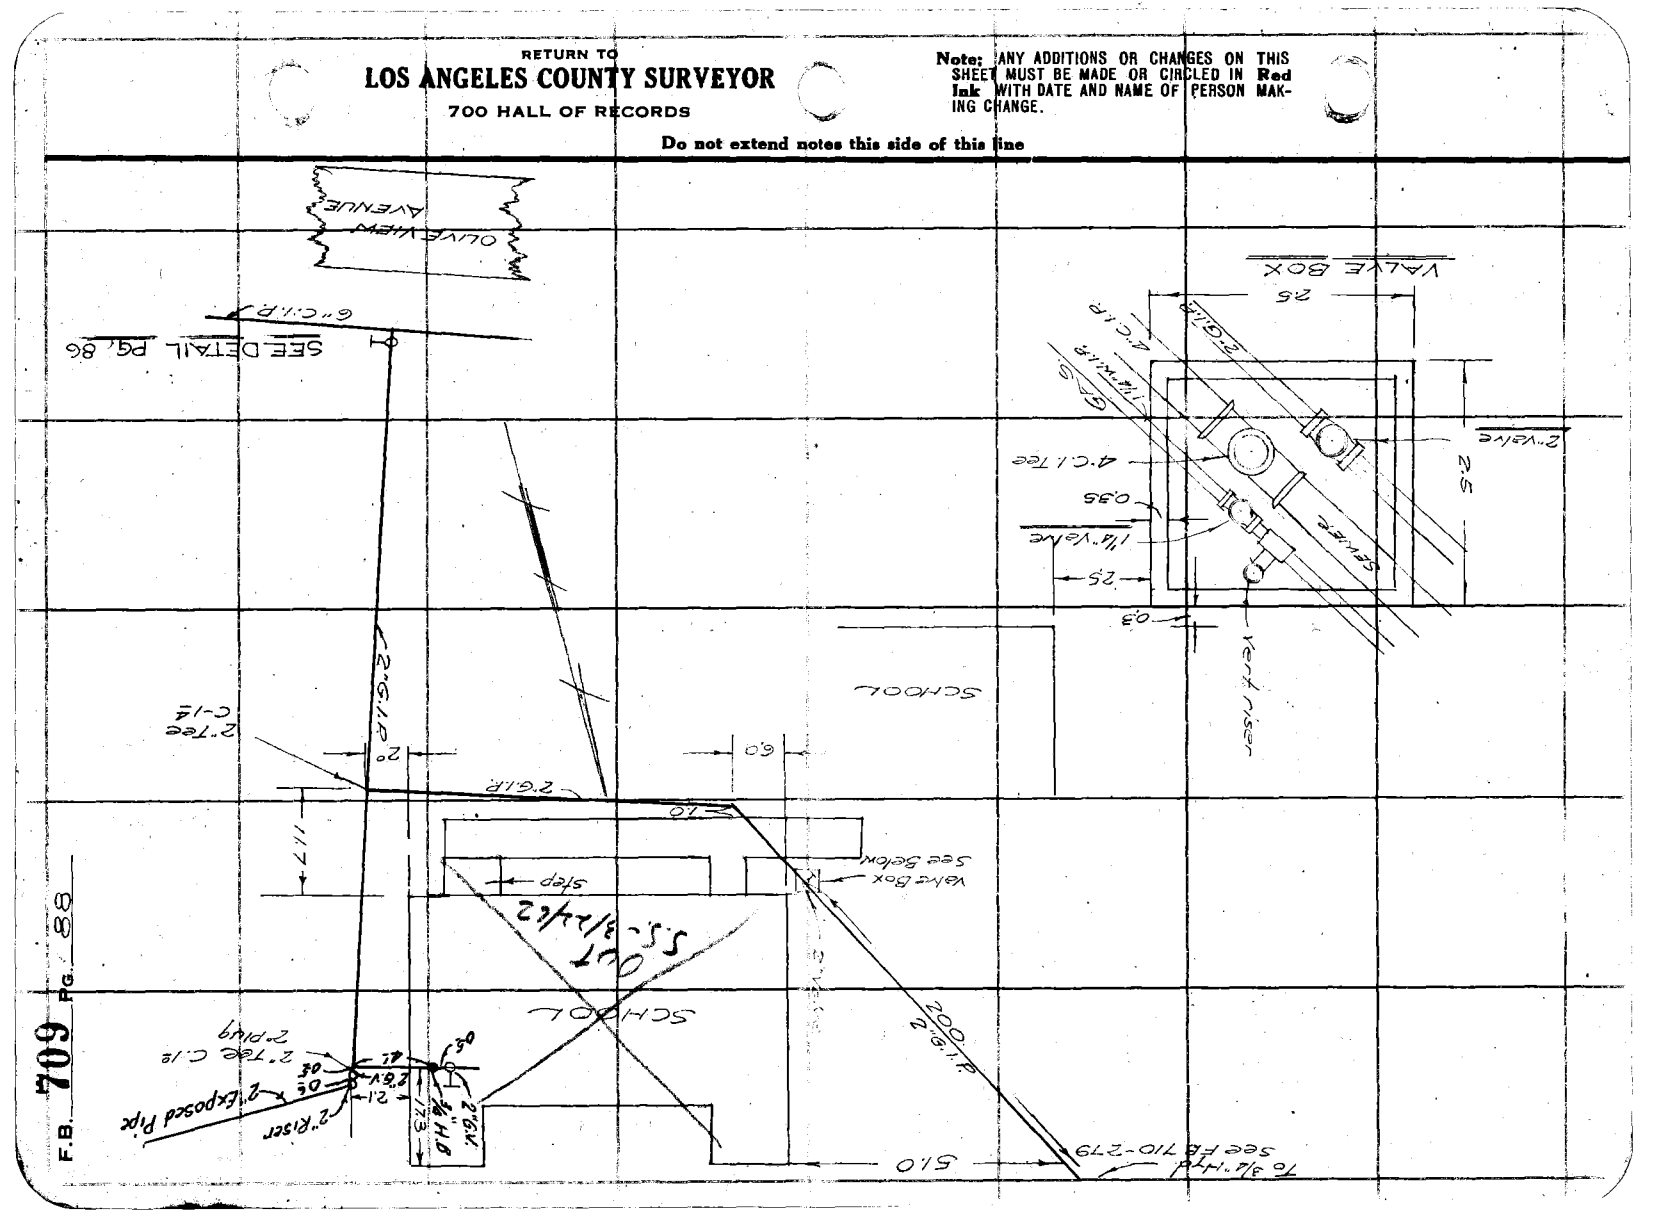

F.B. 709 PG. 88

Notes Ck'd by	Survey of OLIVE VIEW SANATORIUM	F.B. 709 Pg. 89
Map No.	W. O. 8128 Tape No. St'd °F.	WATER LINES
Office Work	Surveyed by T. WALSH	
Checked	Notes WALSH Date 5-27-36	
Date	Indexed	

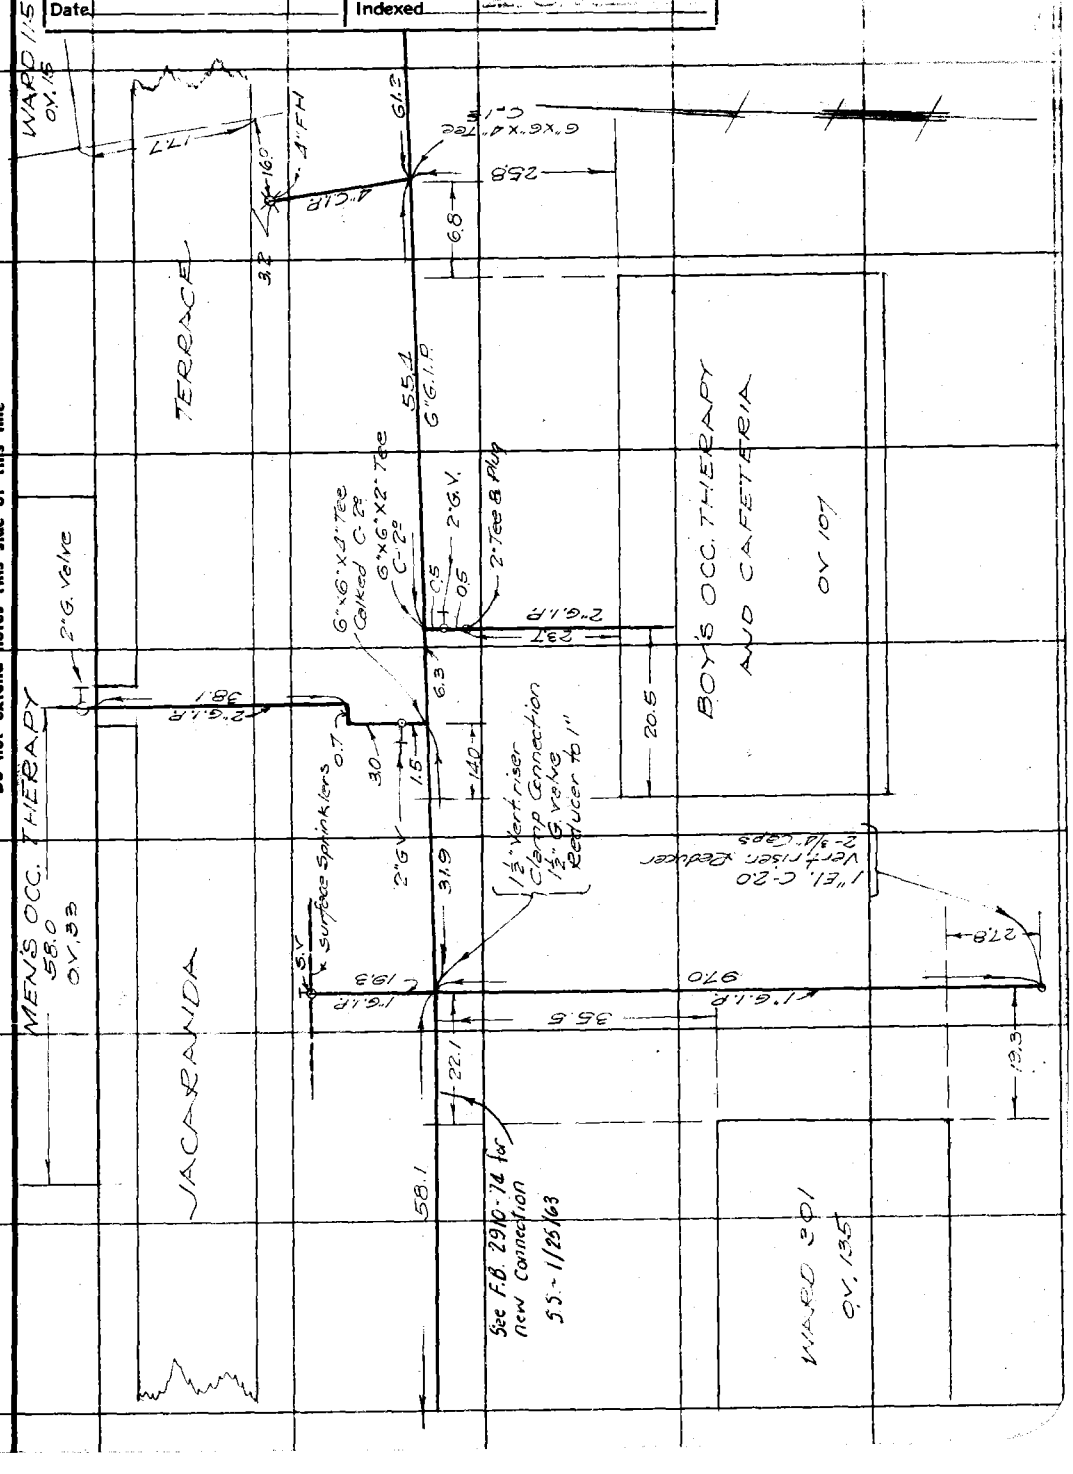

Note: Any Additions or Changes on This Sheet Must be Made or Circled in Red Ink With Date and Name of Person Making Change.

Do not extend notes this side of this line

RETURN TO
LOS ANGELES COUNTY SURVEYOR
700 HALL OF RECORDS

FORM 247 10M 11-35

RETURN TO
LOS ANGELES COUNTY SURVEYOR
700 HALL OF RECORDS

Note: Any Additions or Changes on This Sheet Must be Made or Circled in **Red Ink** With Date and Name of Person Making Change.

Do not extend notes this side of this line

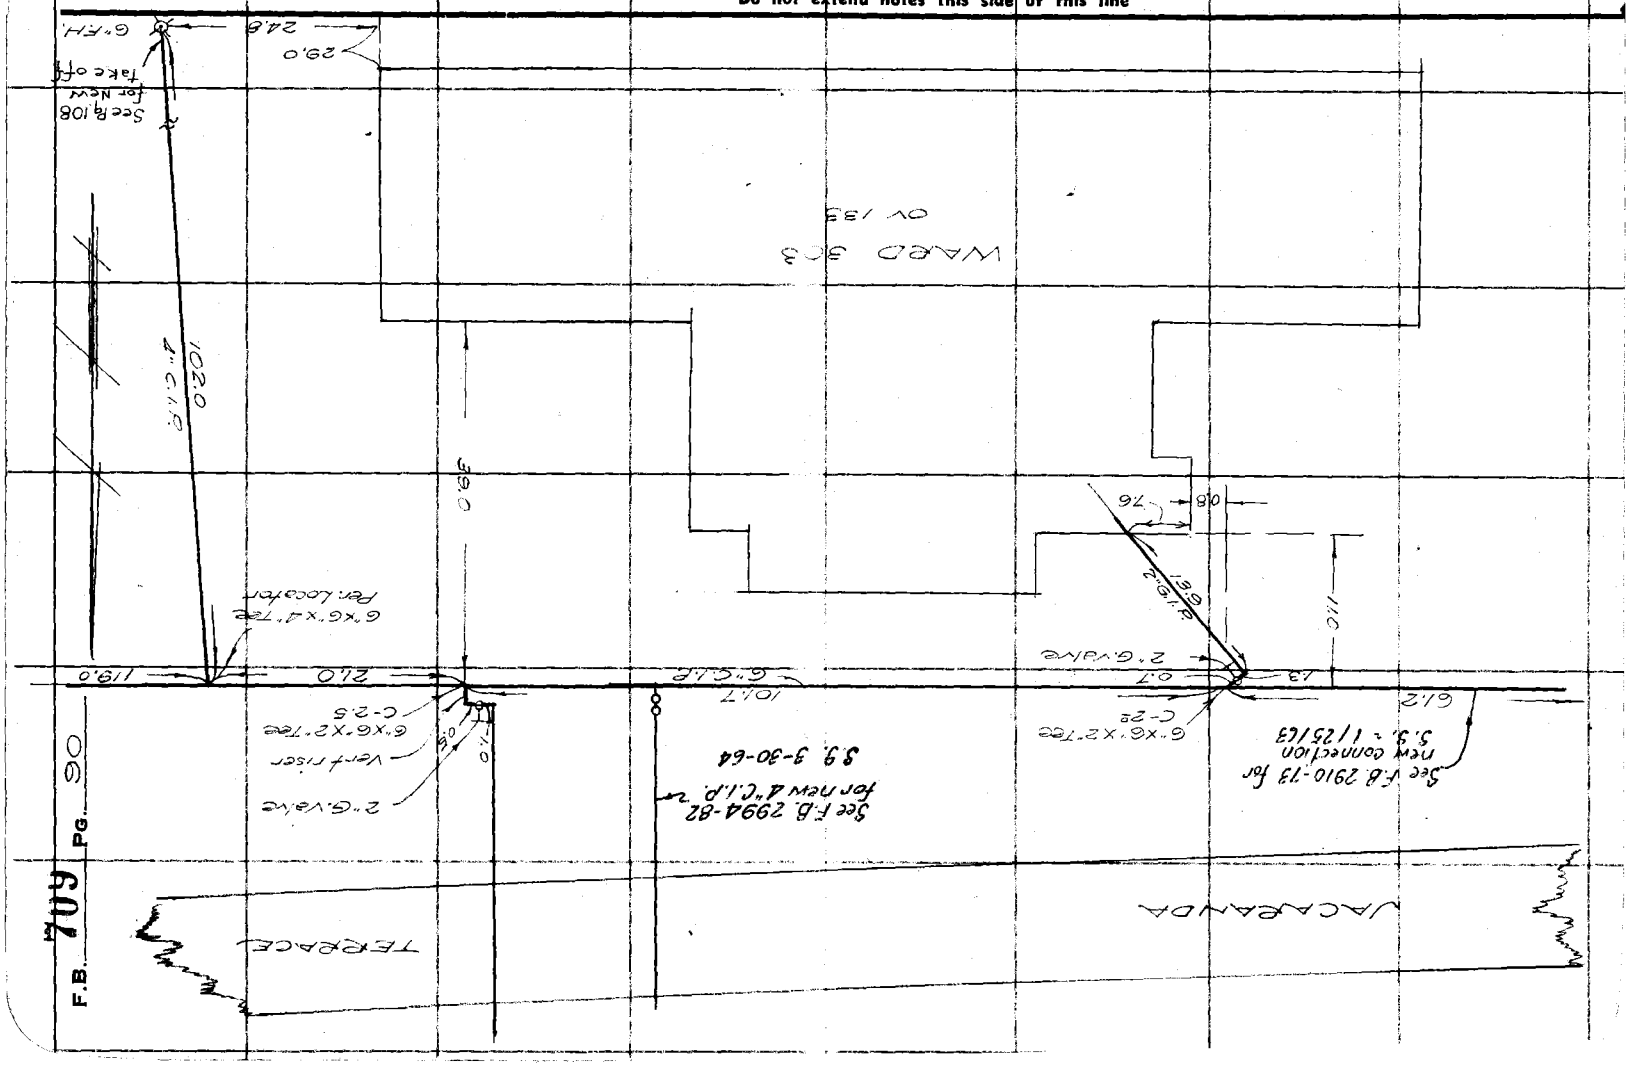

F.B. 709 PG. 90

Notes Ck'd by	Survey of OLIVE VIEW SANATORIUM
Map No.	W. O. 8128 Tape No. St'd °F.
Office Work	Surveyed by T. M. WALSH
Checked	Notes T. M. WALSH Date 5-28-36
Date	Indexed A. C. Johnson

F.B. 709 PG. 91

WATER LINE

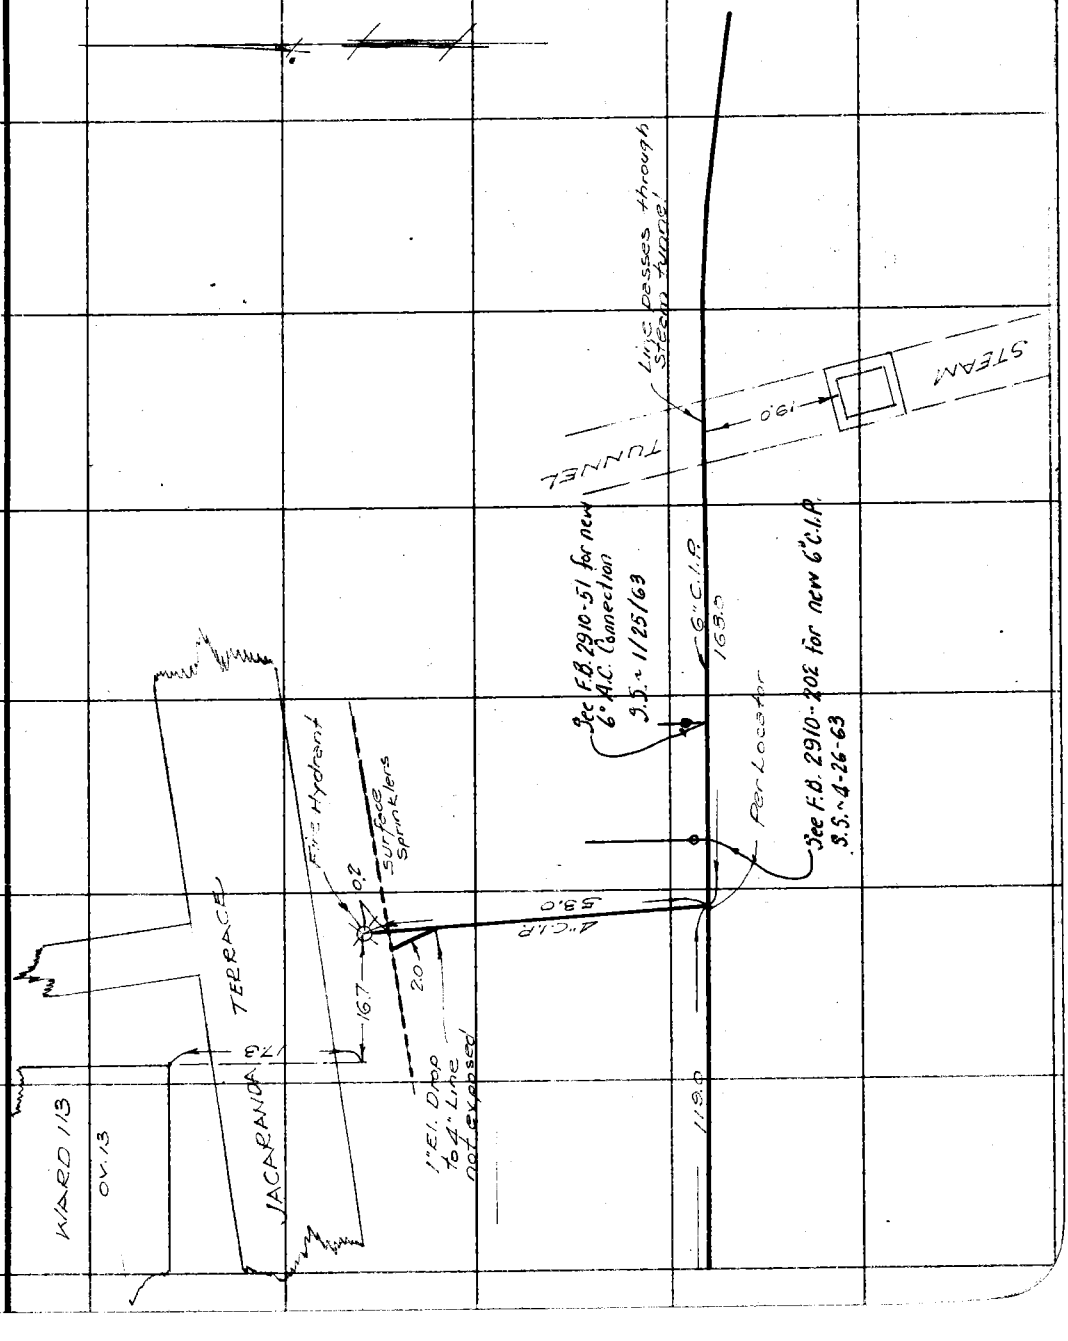

Note: Any Additions or Changes on This Sheet Must be Made or Circled in Red Ink With Date and Name of Person Making Change.

Do not extend notes this side of this line

RETURN TO
LOS ANGELES COUNTY SURVEYOR
700 HALL OF RECORDS

FORM 247 10M 11-35

RETURN TO
LOS ANGELES COUNTY SURVEYOR
700 HALL OF RECORDS

Note: Any Additions or Changes on This Sheet Must be Made or Circled in **Red Ink** With Date and Name of Person Making Change.

Do not extend notes this side of this line

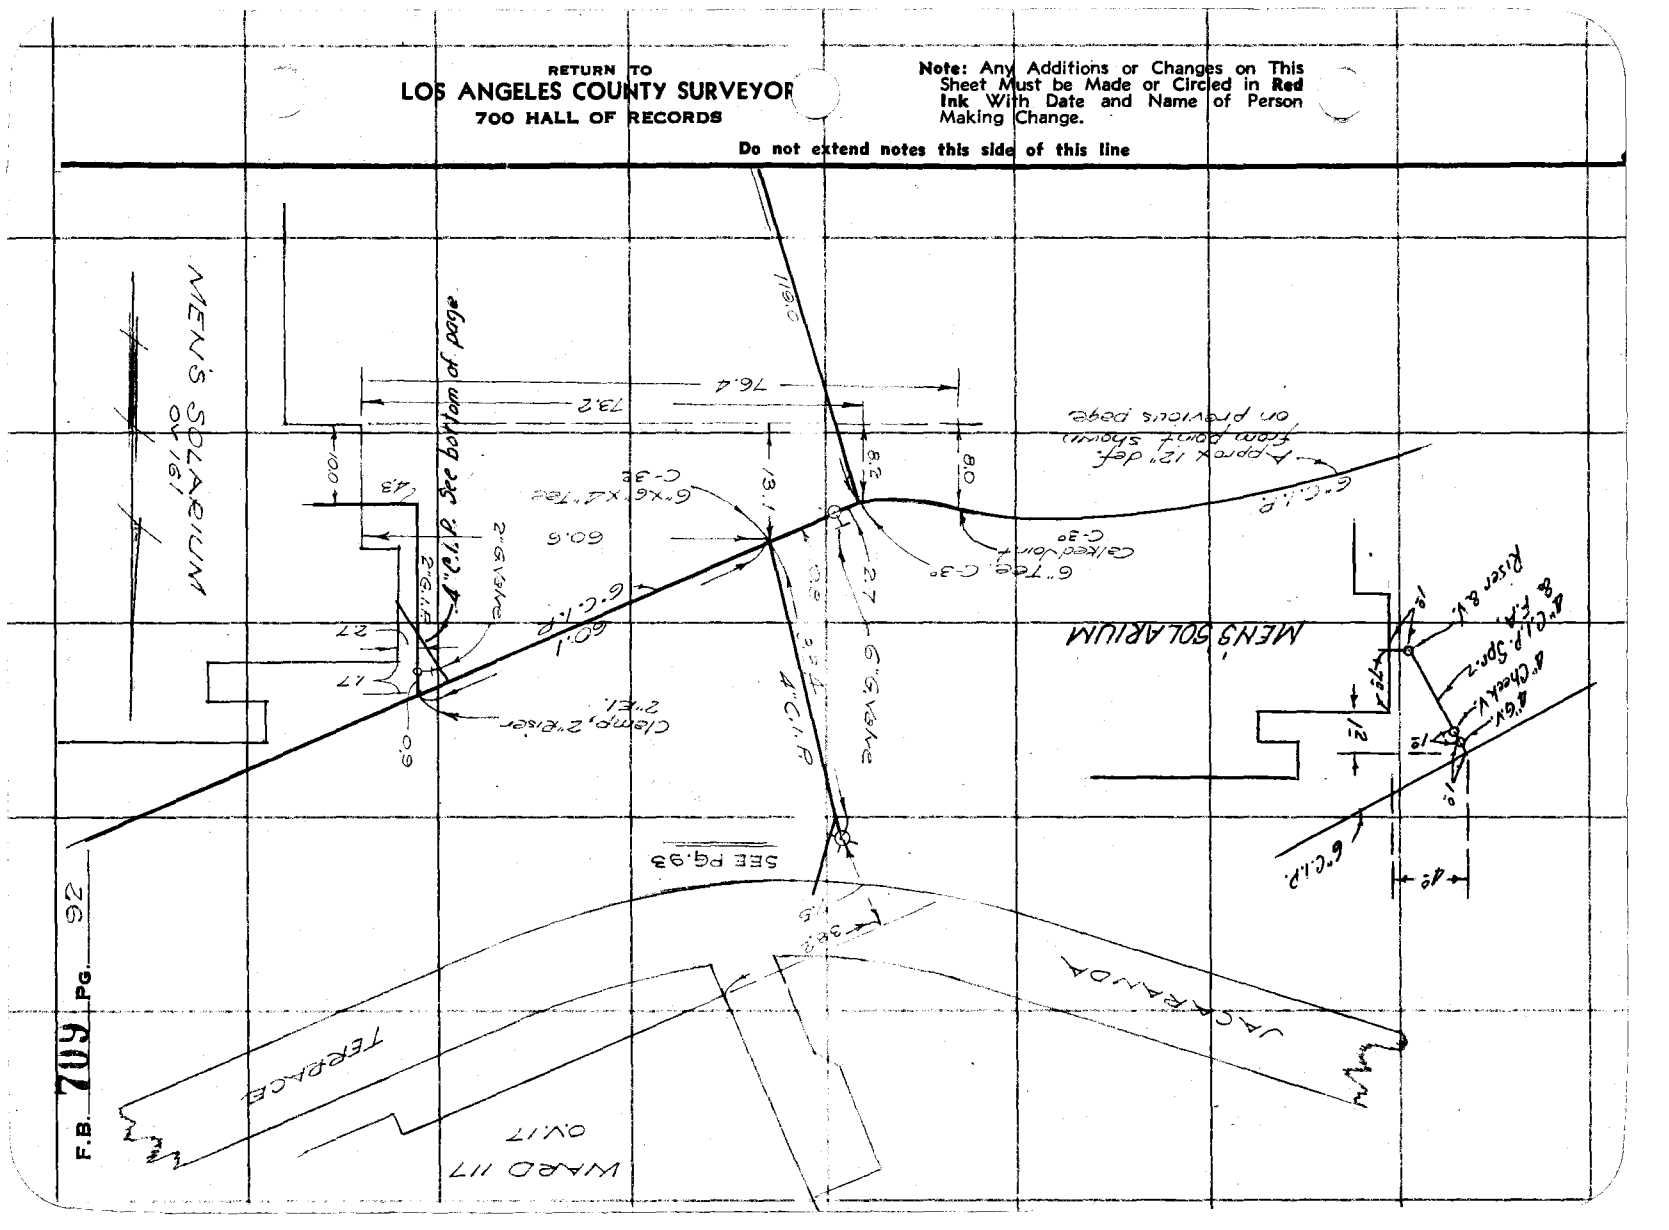

F.B. 709 PG. 92

Notes Ck'd by	Survey of CLIVE VIEW SANATORIUM
Map No.	W. O. 8128 Tape No. St'd °F.
Office Work	Surveyed by T. M. WALSH
Checked	Notes T. M. WALSH Date 6 - 1936
Date	Indexed

F.B. 709 PG. 93

WATER LINES

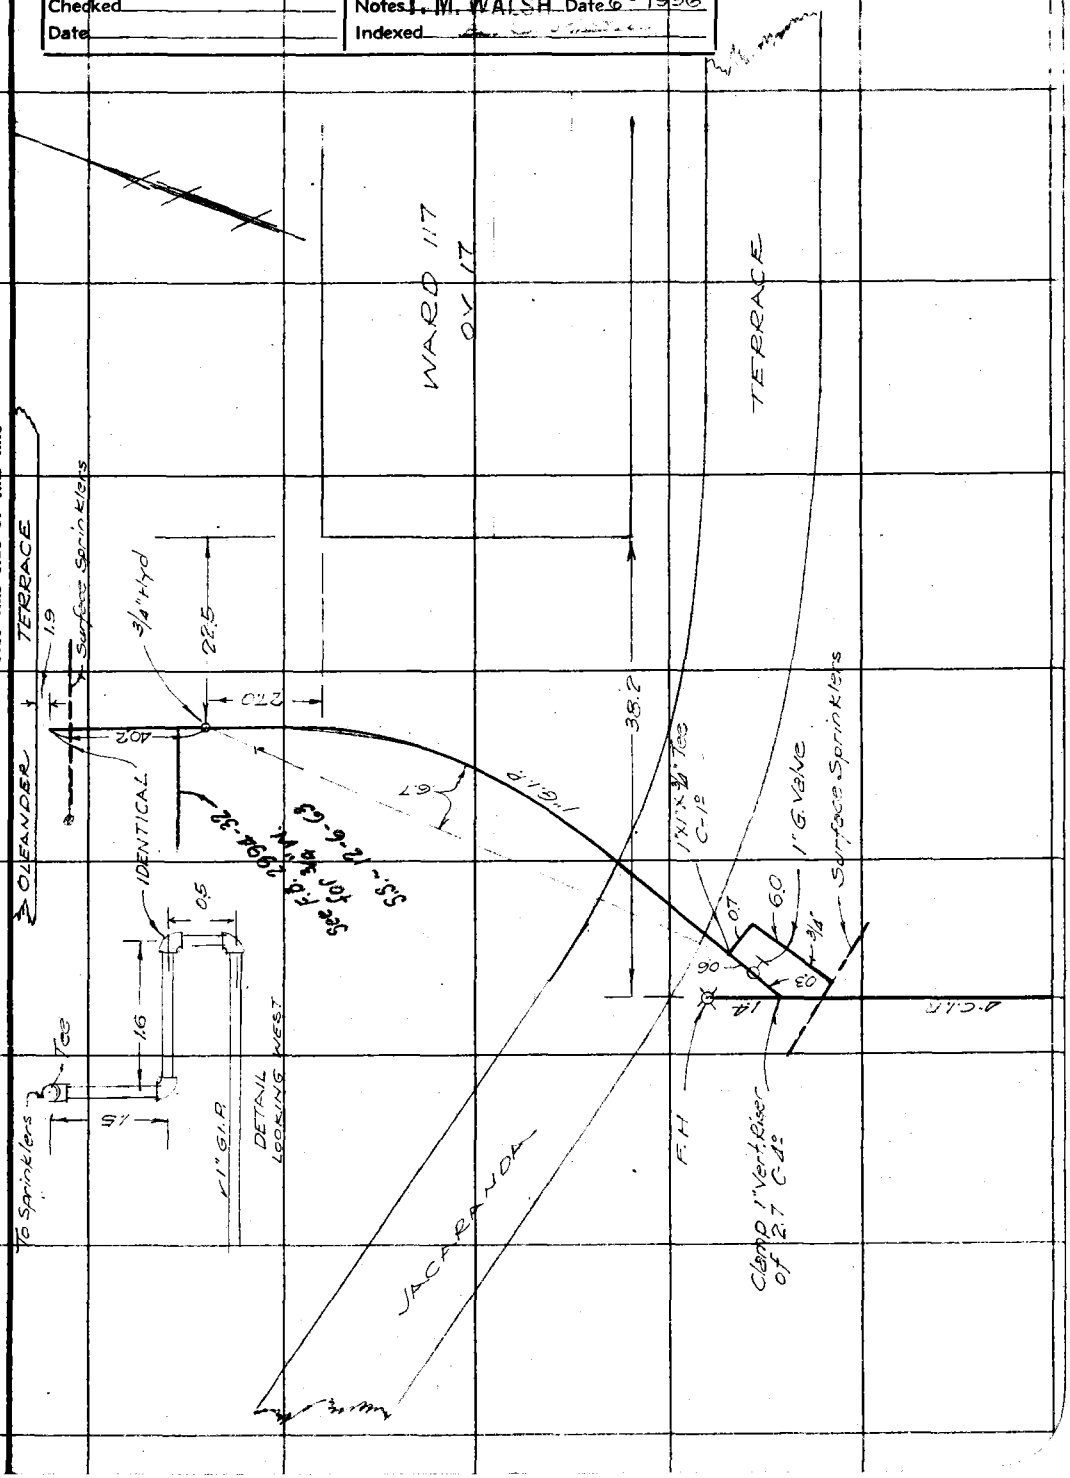

Note: Any Additions or Changes on This Sheet Must be Made or Circled in Red Ink With Date and Name of Person Making Change.

Do not extend notes this side of this line

RETURN TO
LOS ANGELES COUNTY SURVEYOR
700 HALL OF RECORDS

FORM 247 10M 11-35

RETURN TO
LOS ANGELES COUNTY SURVEYOR
700 HALL OF RECORDS

Note: Any Additions or Changes on This Sheet Must be Made or Circled in **Red Ink** With Date and Name of Person Making Change.

Do not extend notes this side of this line

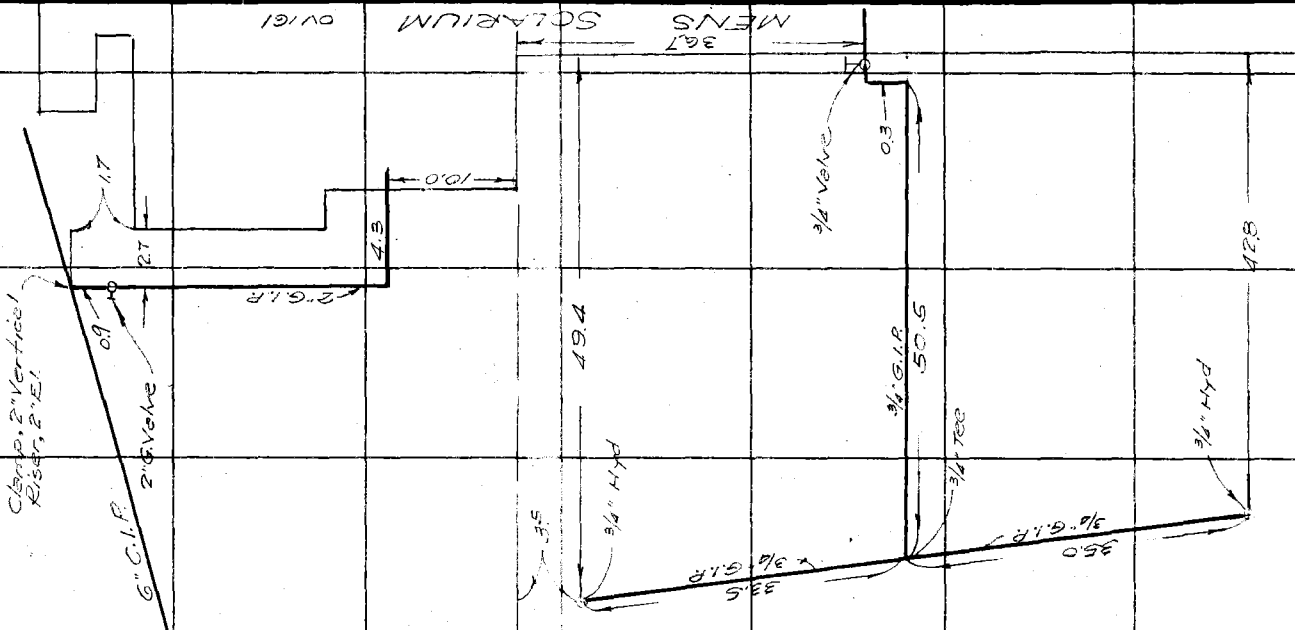

F.B. 709 Pg. 94

Notes Ck'd by	Survey of OLIVE VIEW SANATORIUM	F.B. 709 Pg. 95
Map No.	W. O. 8128 Tape No. St'd °F.	WATER LINES
Office Work	Surveyed by T. M. WALSH	
Checked	Notes T. M. WALSH Date 7-36	
Date	Indexed	

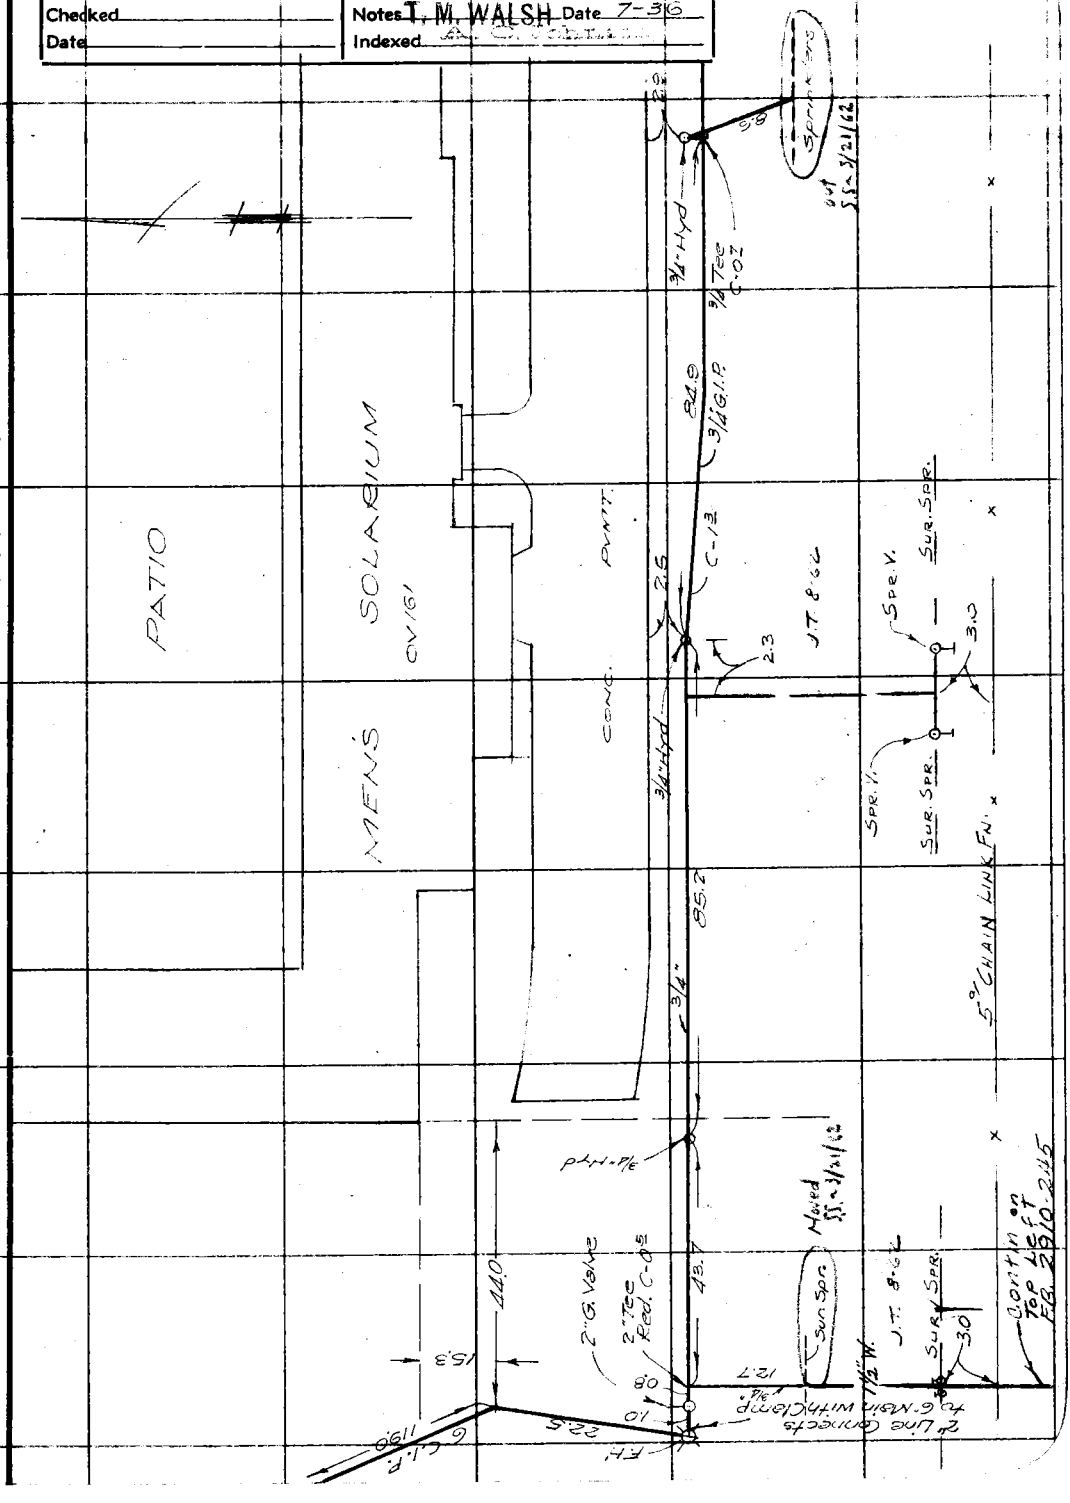

Note: Any Additions or Changes on This Sheet Must be Made or Circled in Red Ink With Date and Name of Person Making Change.

Do not extend notes this side of this line

RETURN TO
LOS ANGELES COUNTY SURVEYOR
700 HALL OF RECORDS

FORM 247 10M 11-35

RETURN TO
LOS ANGELES COUNTY SURVEYOR
700 HALL OF RECORDS

Note: Any Additions or Changes on This Sheet Must be Made or Circled in **Red Ink** With Date and Name of Person Making Change.

Do not extend notes this side of this line

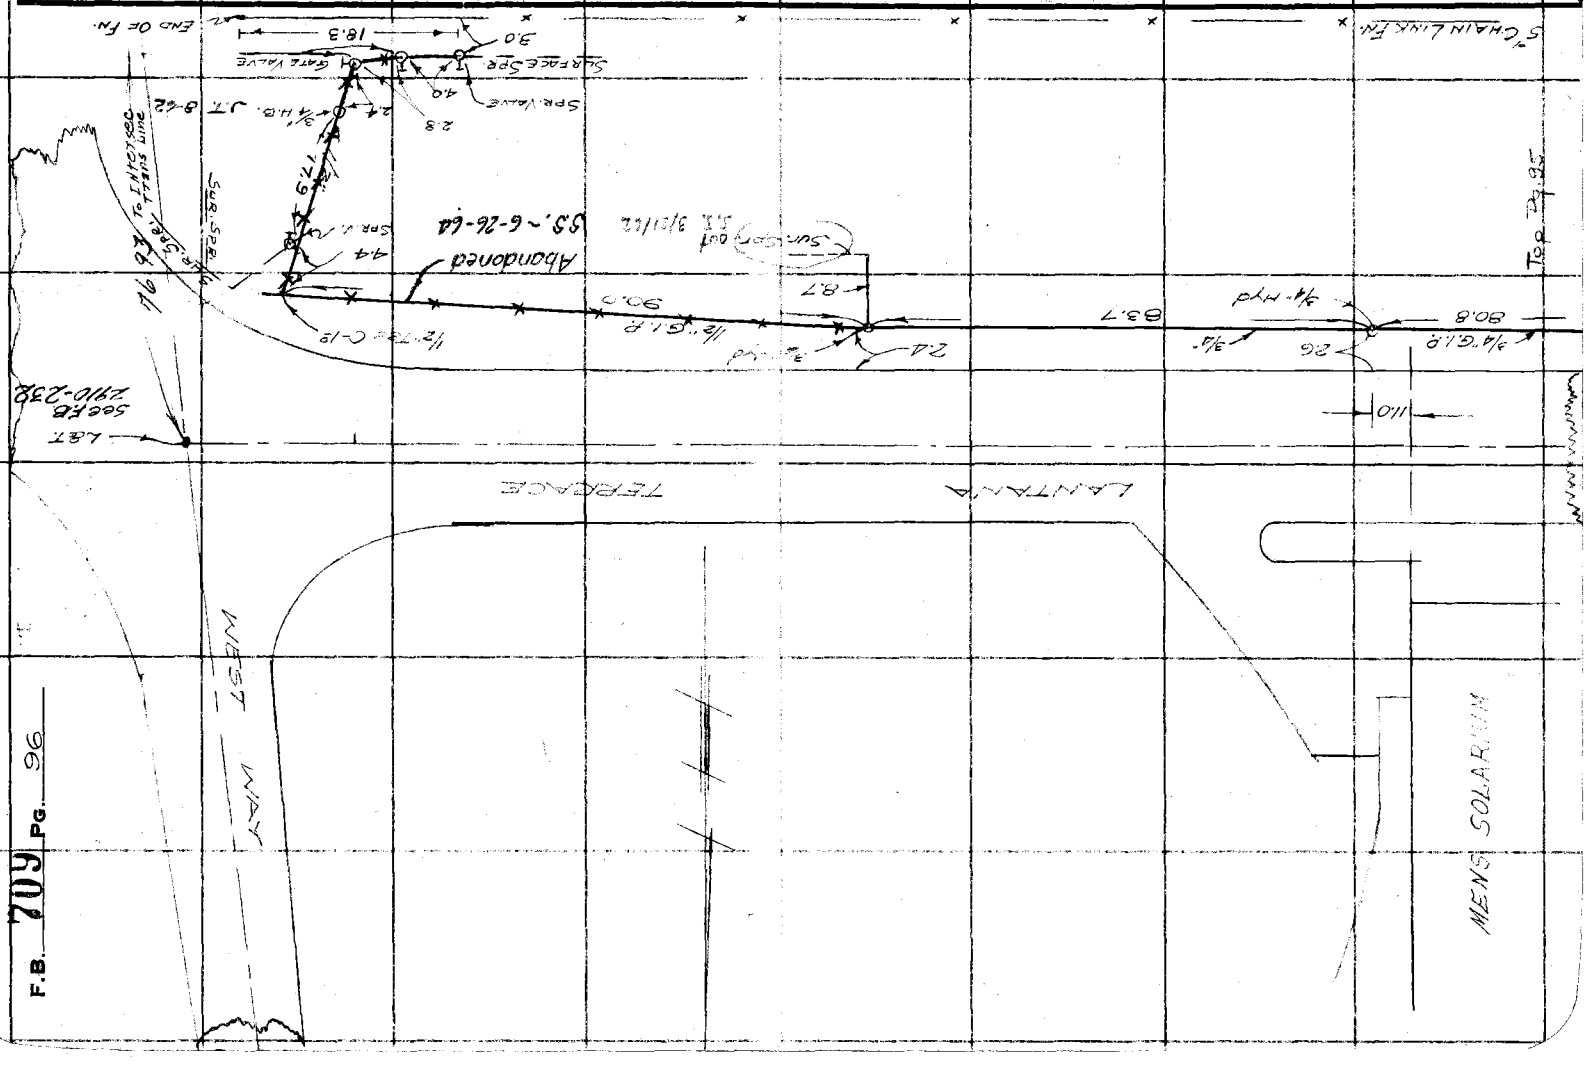

Notes Ck'd by	Survey of OLIVE VIEW SANATORIUM	F.B. 709 Pg. 97
Map No.	W. O. 8128 Tape No. St'd °F.	
Office Work	Surveyed by T. M. WALSH	WATER LINES
Checked	Notes T. M. WALSH Date 5-28-36	
Date	Indexed	

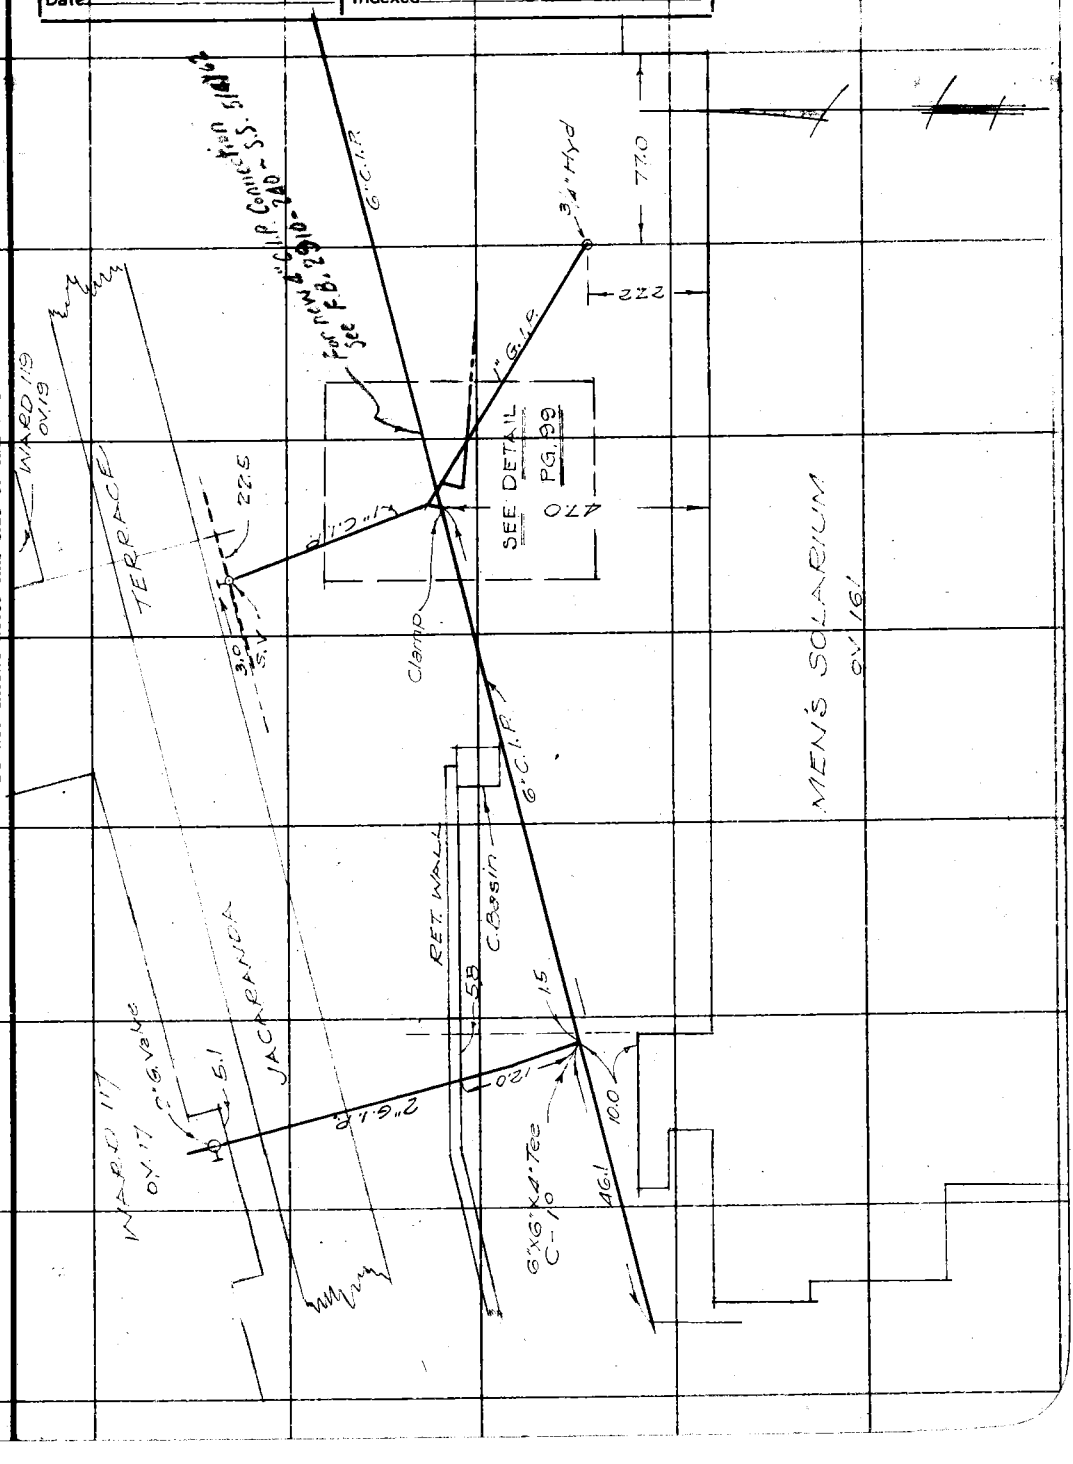

Note: Any Additions or Changes on This Sheet Must be Made or Circled in Red Ink With Date and Name of Person Making Change.

Do not extend notes this side of this line

RETURN TO
LOS ANGELES COUNTY SURVEYOR
700 HALL OF RECORDS

FORM 247 10M 11-35

RETURN TO
LOS ANGELES COUNTY SURVEYOR
700 HALL OF RECORDS

Note: Any Additions or Changes on This Sheet Must be Made or Circled in **Red Ink** With Date and Name of Person Making Change.

Do not extend notes this side of this line

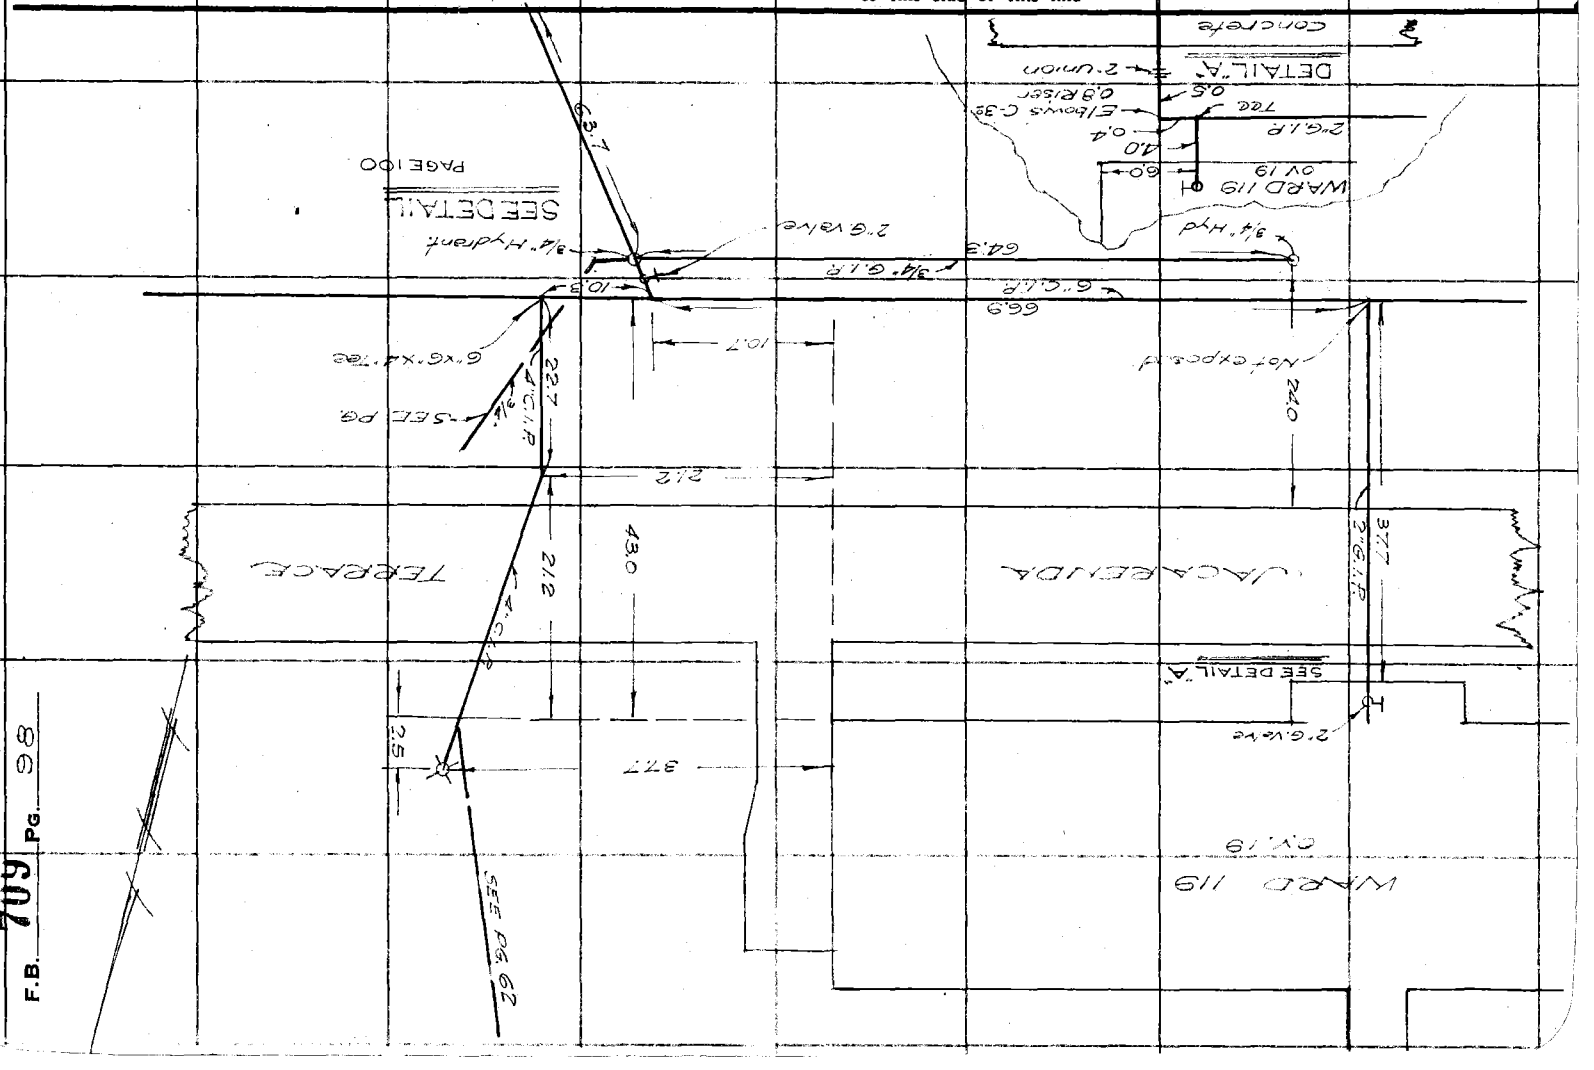

SEE DETAIL
PAGE 100

F.B. 709 PG. 98

Notes Ck'd by		Survey of OLIVE VIEW SANATORIUM	F.B. 709 PG. 99
Map No.		W. O. 5128 Tape No.	St'd °F.
Office Work		Surveyed by T. M. WALSH	
Checked		Notes T. M. WALSH Date 5-1936	
Date		Indexed	

WATER LINE

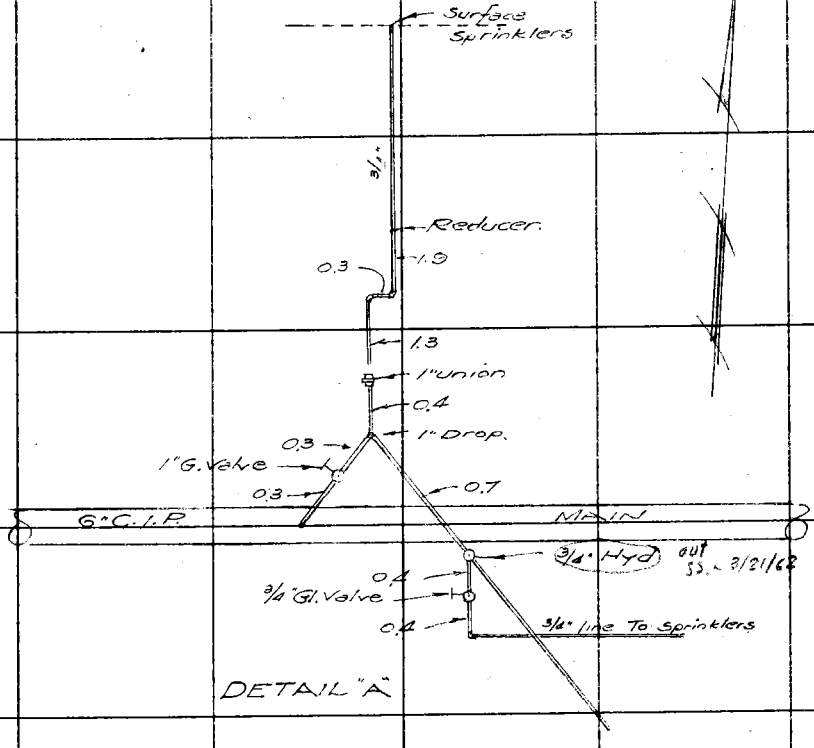

DETAIL "A"

Note: Any Additions or Changes on This Sheet Must be Made or Circled in Red Ink With Date and Name of Person Making Change.

Do not extend notes this side of this line

RETURN TO
LOS ANGELES COUNTY SURVEYOR
700 HALL OF RECORDS

FORM 247 10M 11-35

F.B. 709 Pg. 100

WARD 119

OV 19

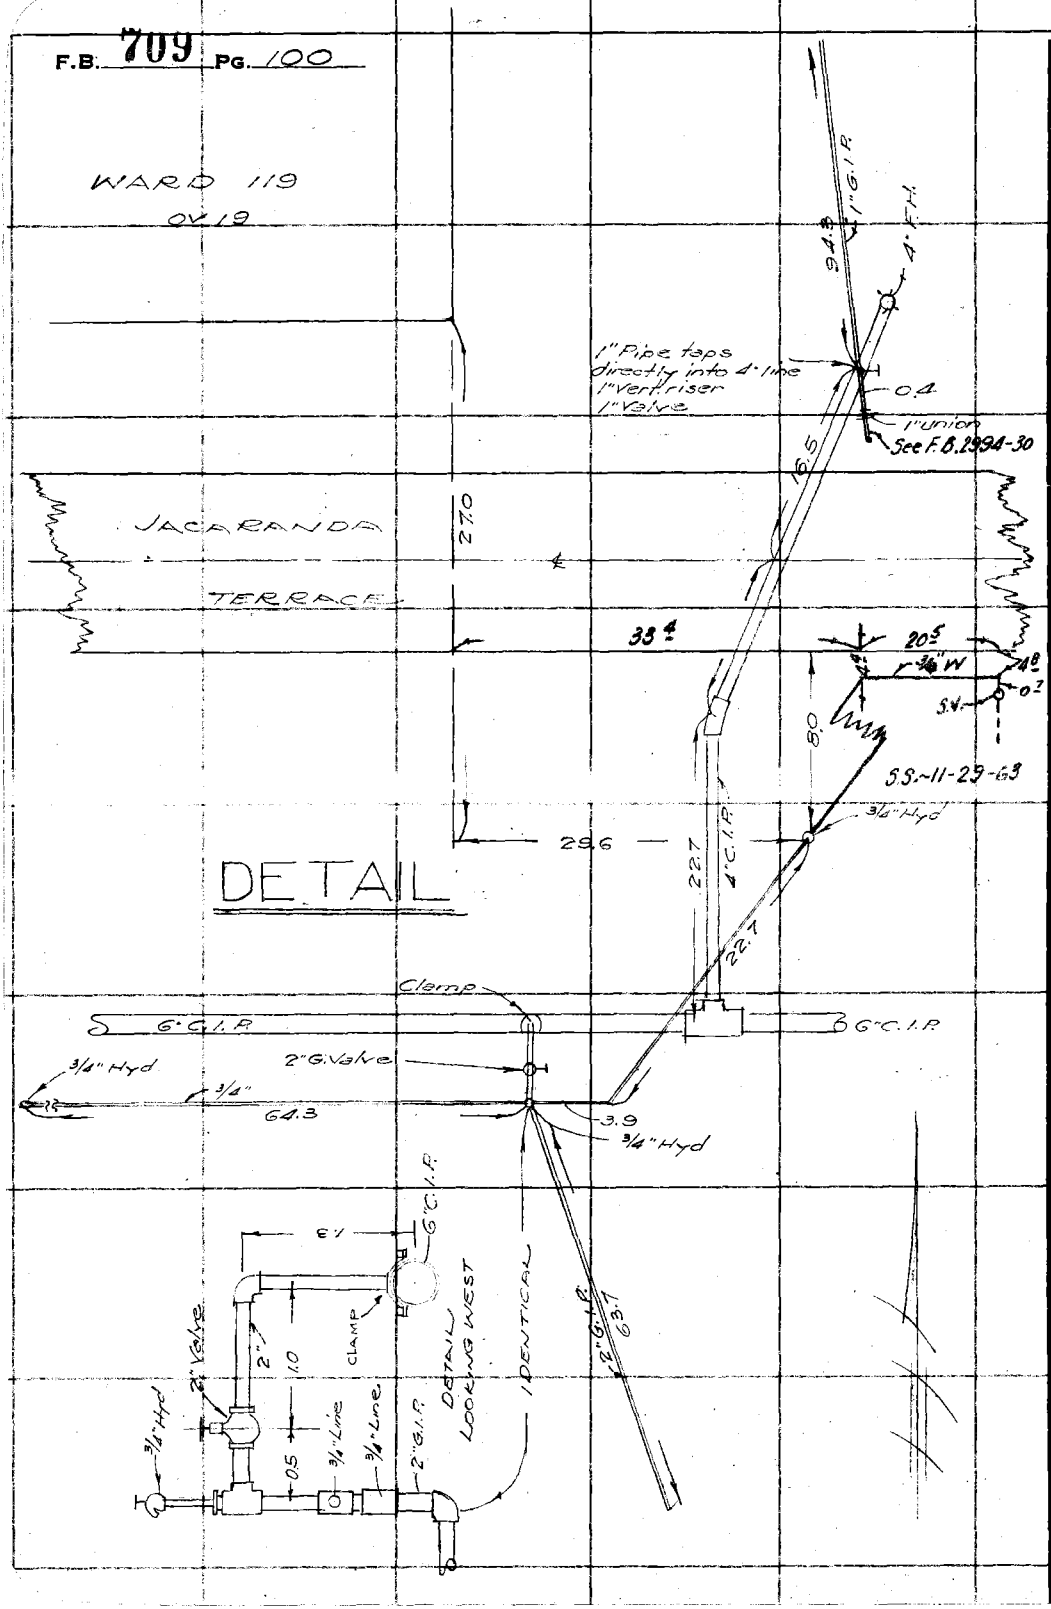

RETURN TO
LOS ANGELES COUNTY SURVEYOR
700 HALL OF RECORDS

Note: Any Additions or Changes on This Sheet Must be Made or Circled in Red Ink With Date and Name of Person Making Change.

Do not extend notes this side of this line

Notes Ck'd by	Survey of GLIVE VIEW SANATORIUM	F.B. 709 Pg. 101
Map No.	W. O. 81-8 Tape No. St'd °F.	WATER LINES
Office Work	Surveyed by T. WALSH	
Checked	Notes WALSH Date 8-3-36	
Date	Indexed	

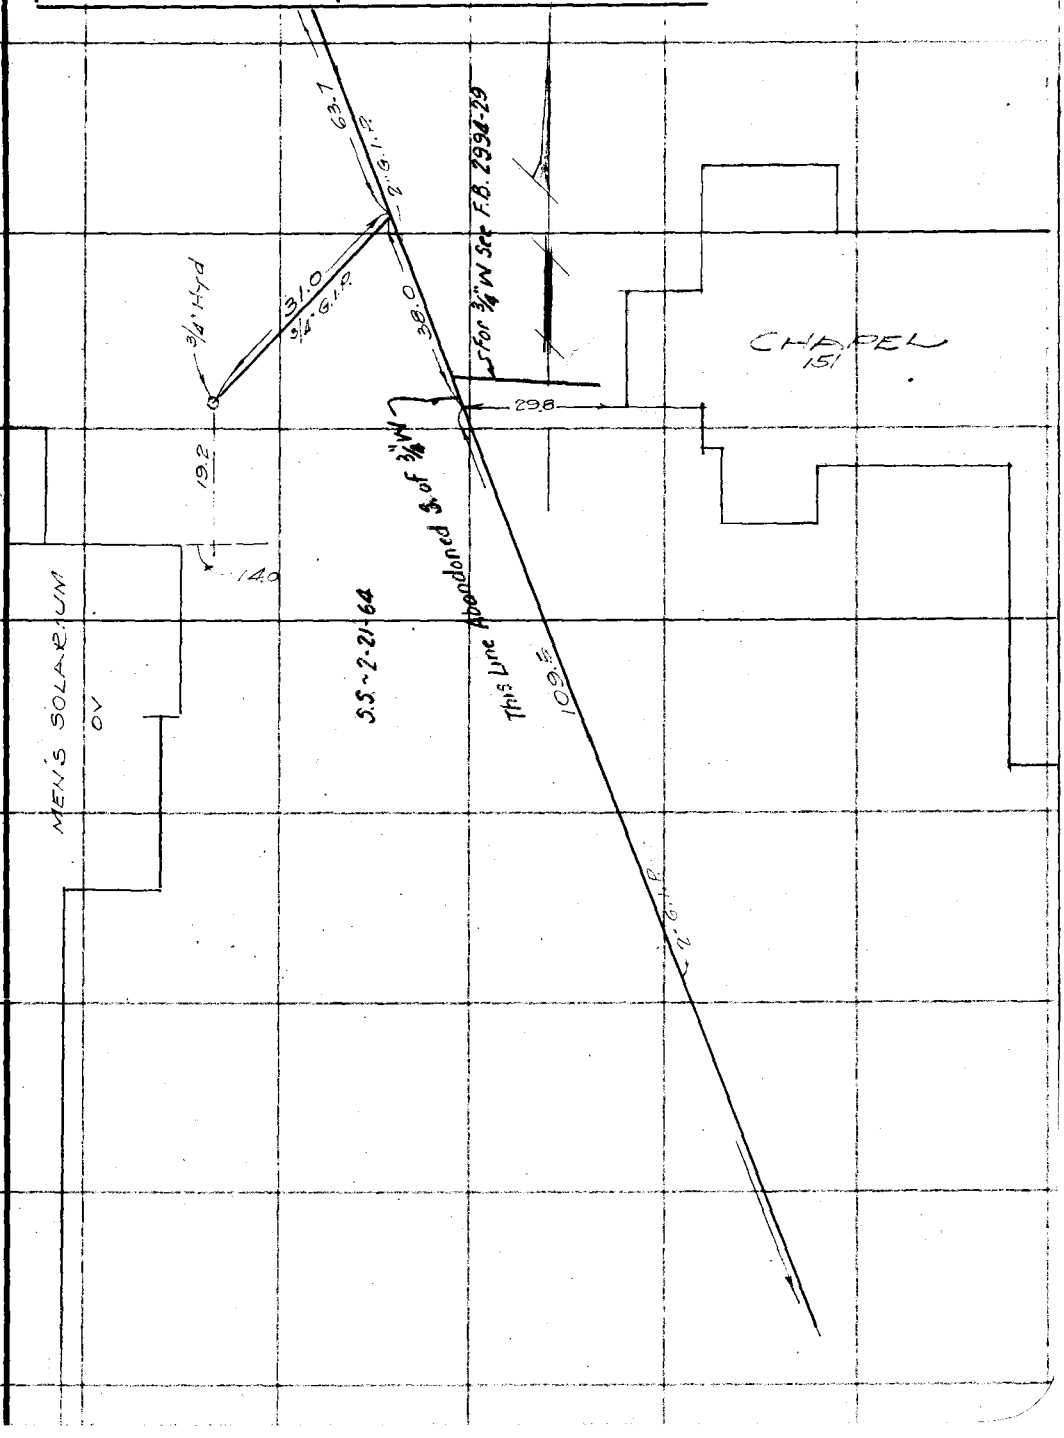

Note: Any Additions or Changes on This Sheet Must be Made or Circled in Red Ink With Date and Name of Person Making Change.

Do not extend notes this side of this line

RETURN TO
LOS ANGELES COUNTY SURVEYOR
700 HALL OF RECORDS

FORM 247 10M 11-35

RETURN TO
LOS ANGELES COUNTY SURVEYOR
700 HALL OF RECORDS

Note: Any Additions or Changes on This Sheet Must be Made or Circled in **Red Ink** With Date and Name of Person Making Change.

Do not extend notes this side of this line

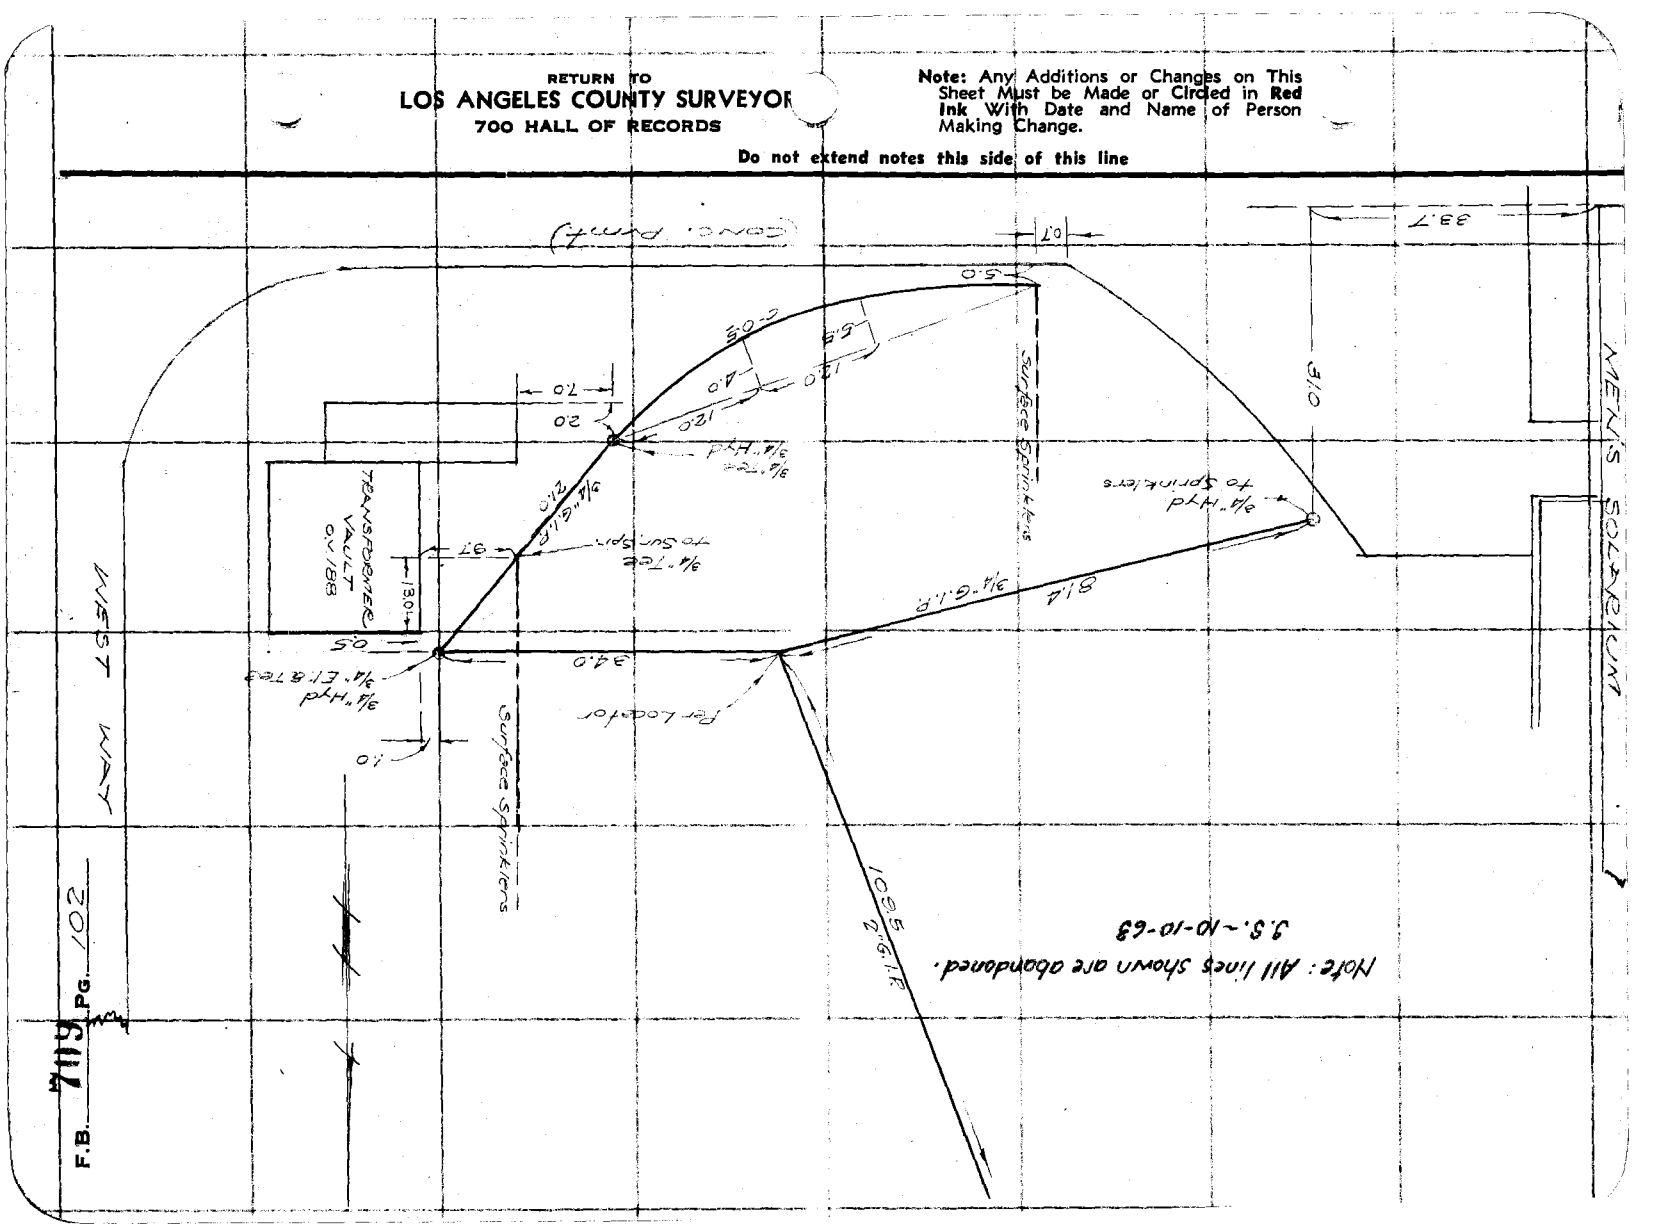


FORM 247 10M 11-35

RETURN TO
LOS ANGELES COUNTY SURVEYOR
700 HALL OF RECORDS

Note: Any Additions or Changes on This Sheet Must be Made or Circled in Red Ink With Date and Name of Person Making Change.

Do not extend notes this side of this line

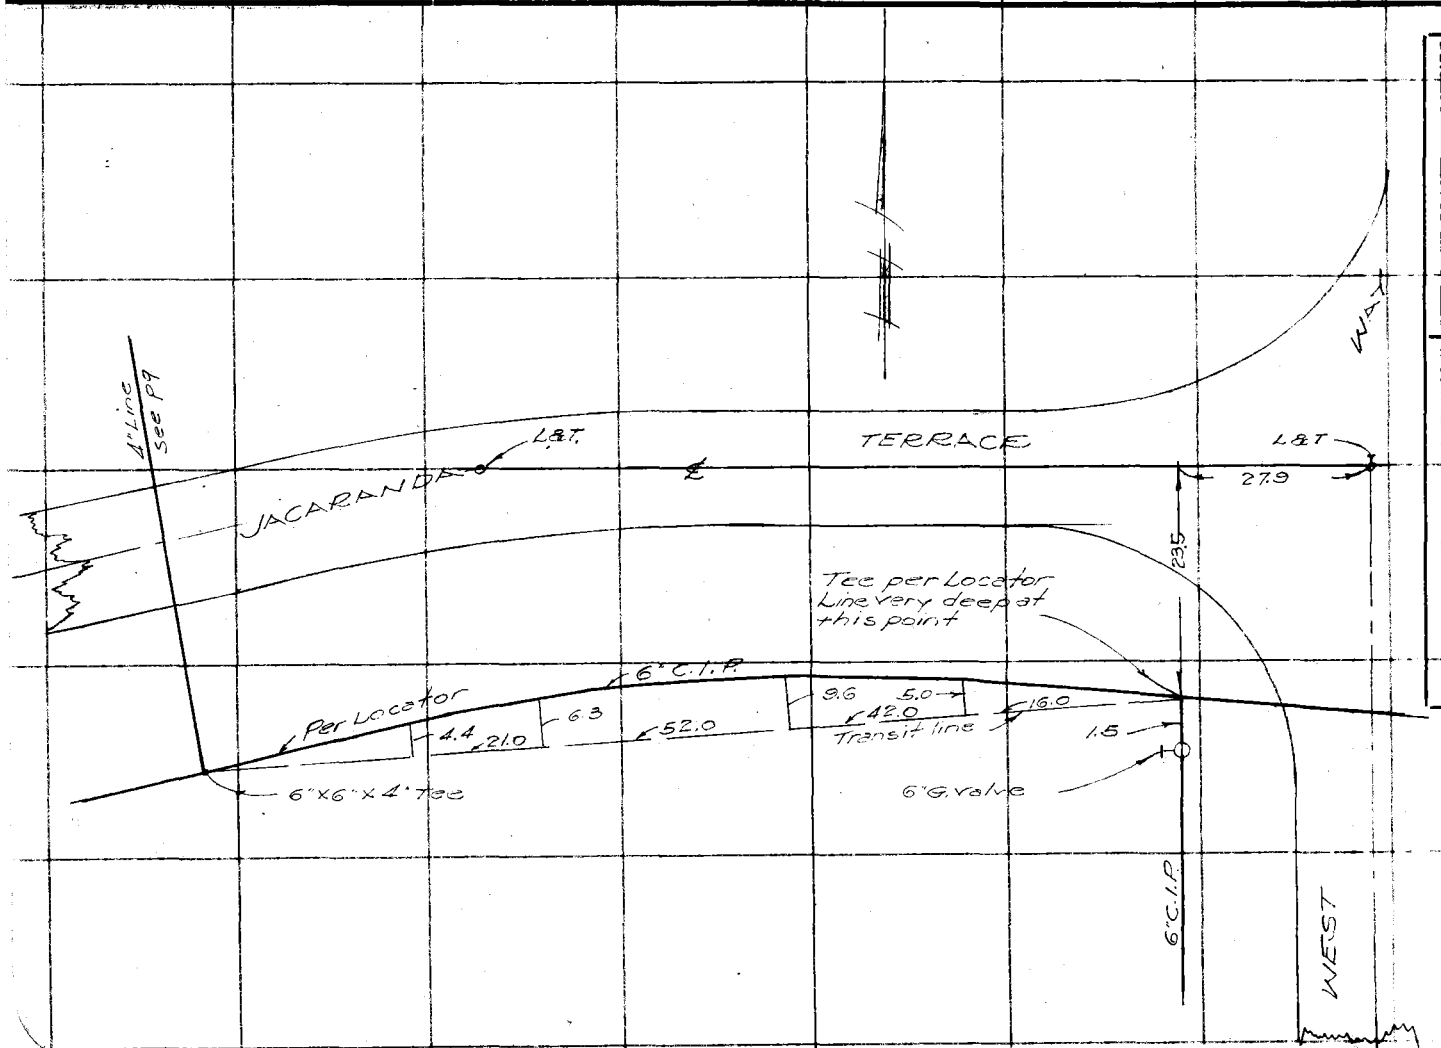

Notes Ck'd by
Map No.
Office Work
Checked
Date

W. O. 8128 Tape No. Std. °F.
Surveyed by TED WALSH Date 5-29-36
Notes WALSH
Indexed C. J.


WATER LINES

RETURN TO
LOS ANGELES COUNTY SURVEYOR
700 HALL OF RECORDS

Note: Any Additions or Changes on This Sheet Must be Made or Circled in **Red Ink** With Date and Name of Person Making Change.

Do not extend notes this side of this line

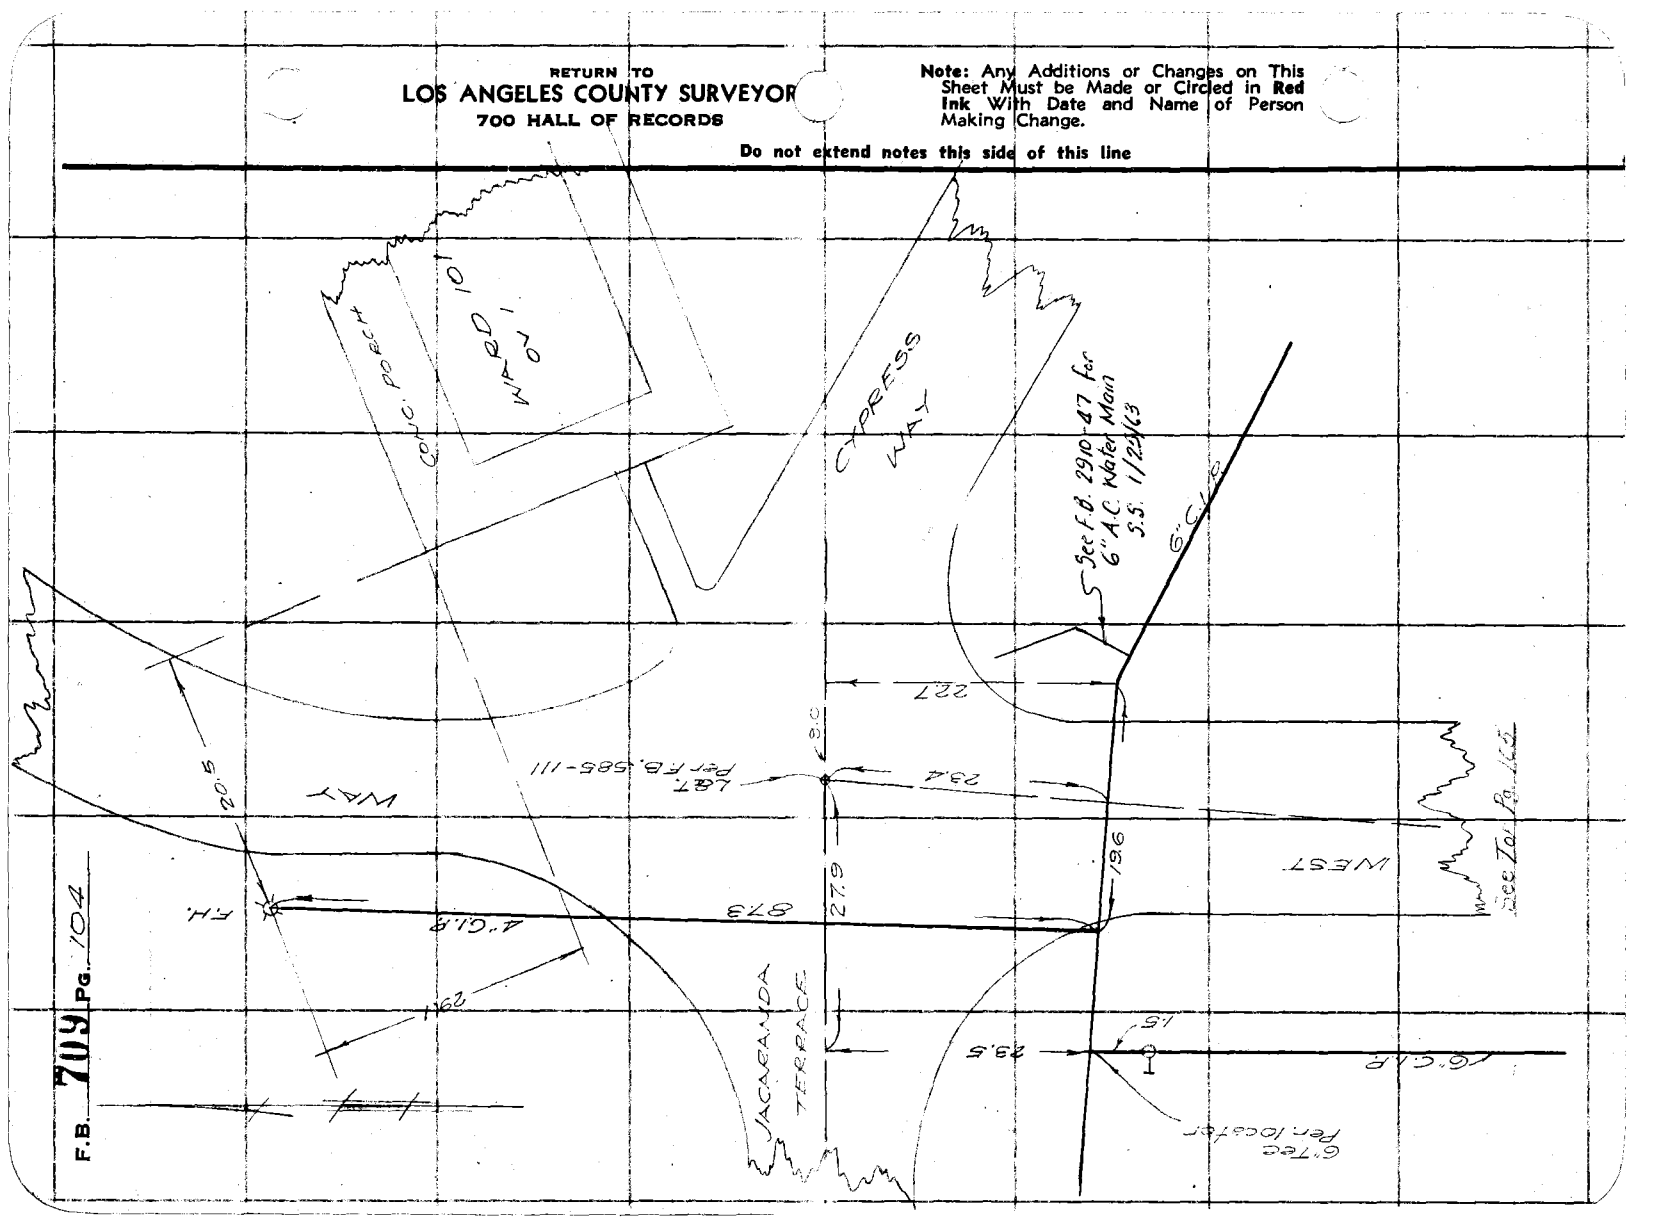

Notes Ck'd by	Survey of OLIVE VIEW SANATORIUM
Map No.	W. O. 2148 Tape No. St'd °F.
Office Work	Surveyed by T. WALSH
Checked	Notes WALSH Date 5-36
Date	Indexed

F.B. 709 PG. 105

Note: Any Additions or Changes on This Sheet Must be Made or Circled in Red Ink With Date and Name of Person Making Change.

Do not extend notes this side of this line

RETURN TO
LOS ANGELES COUNTY SURVEYOR
700 HALL OF RECORDS

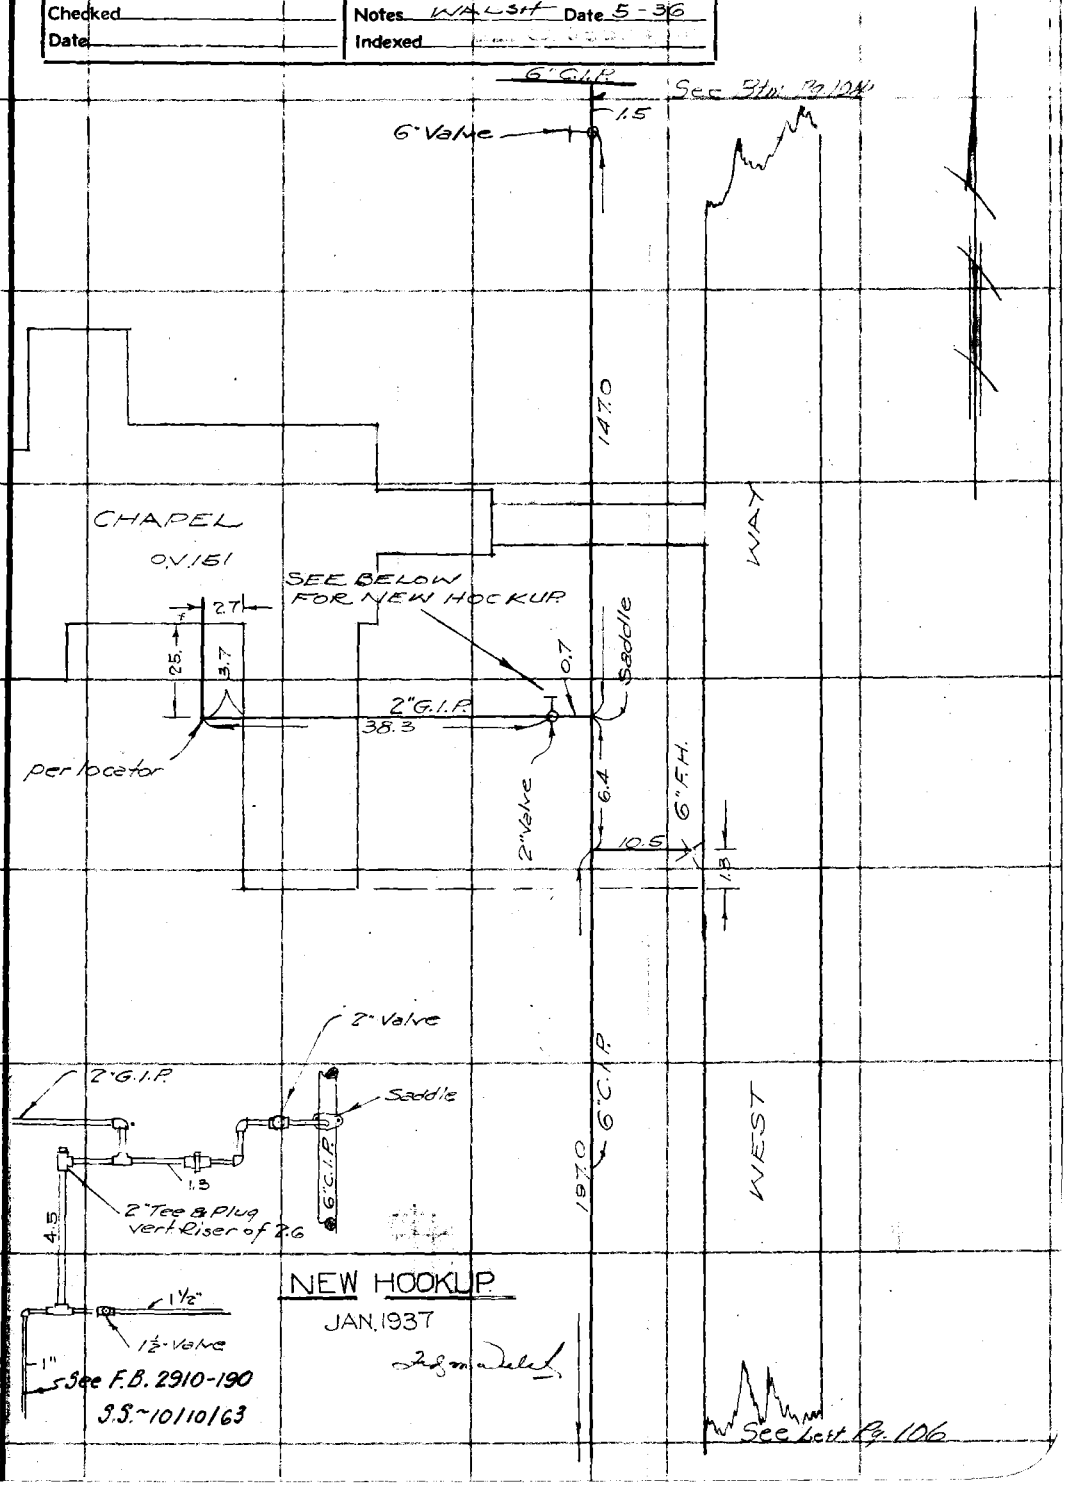

FORM 247 10M 11-35

F.B. 709 PG. 106

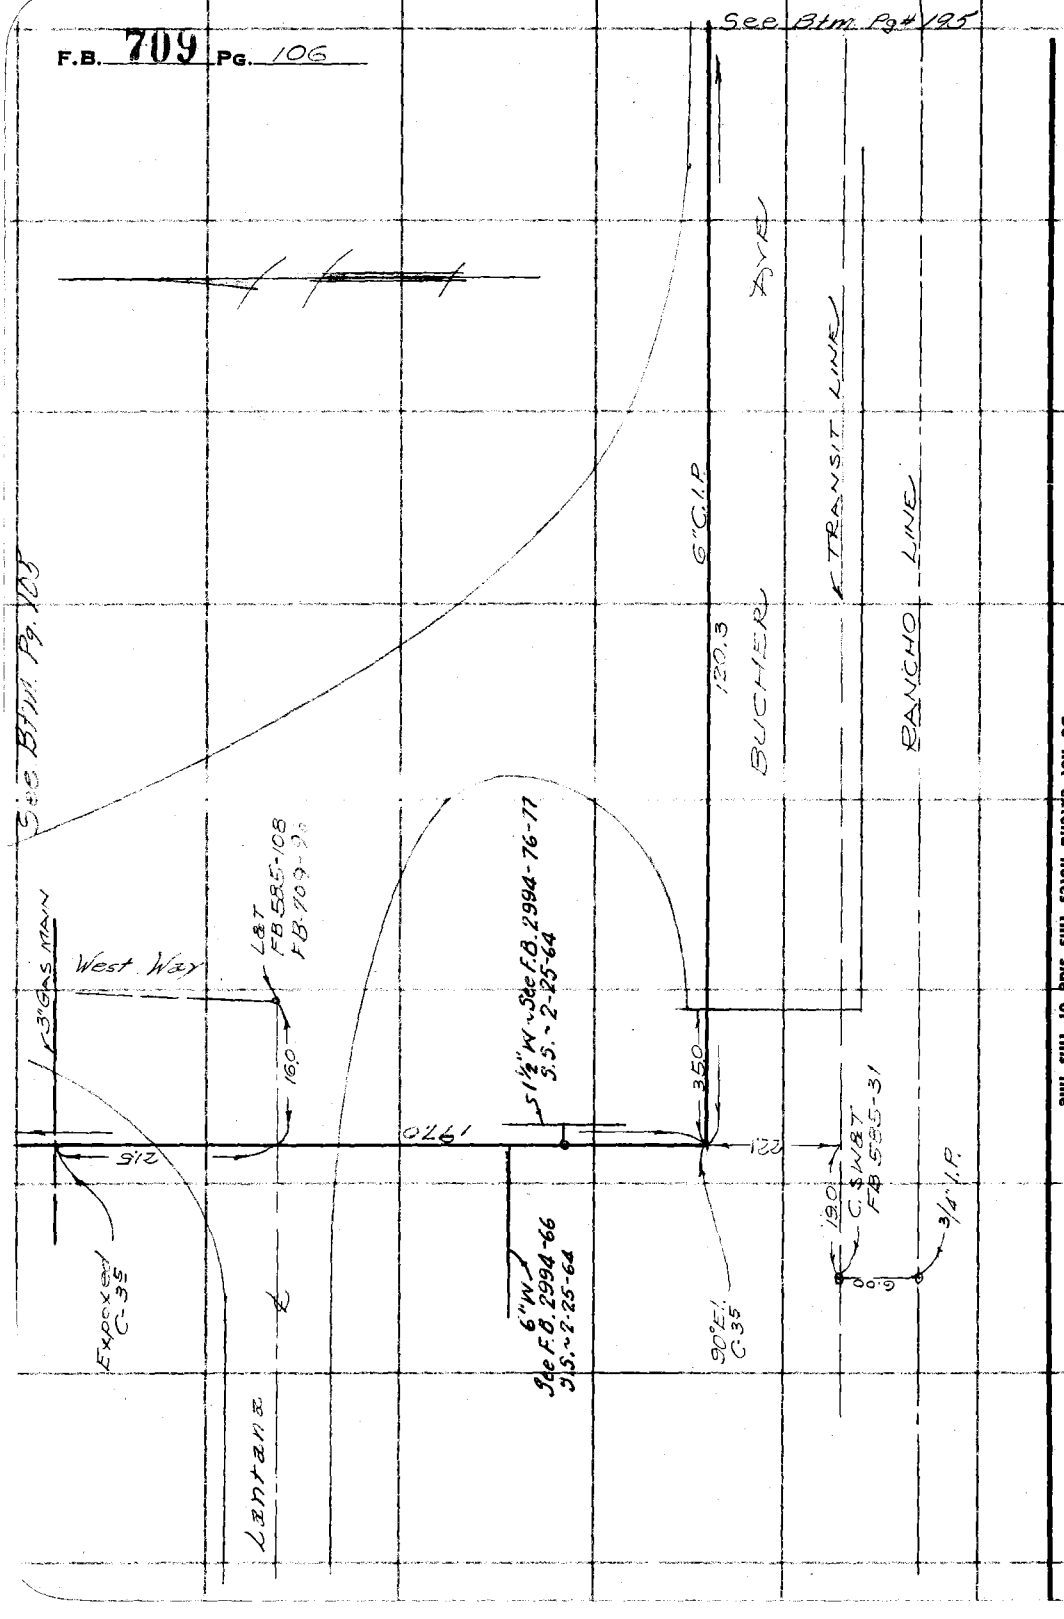

RETURN TO
LOS ANGELES COUNTY SURVEYOR
700 HALL OF RECORDS

Note: Any Additions or Changes on This Sheet Must be Made or Circled in Red Ink With Date and Name of Person Making Change.

Do not extend notes this side of this line

FORM 247 10M 11-33

RETURN TO
LOS ANGELES COUNTY SURVEYOR
700 HALL OF RECORDS

Note: Any Additions or Changes on This Sheet Must be Made or Circled in Red Ink With Date and Name of Person Making Change.

Do not extend notes this side of this line

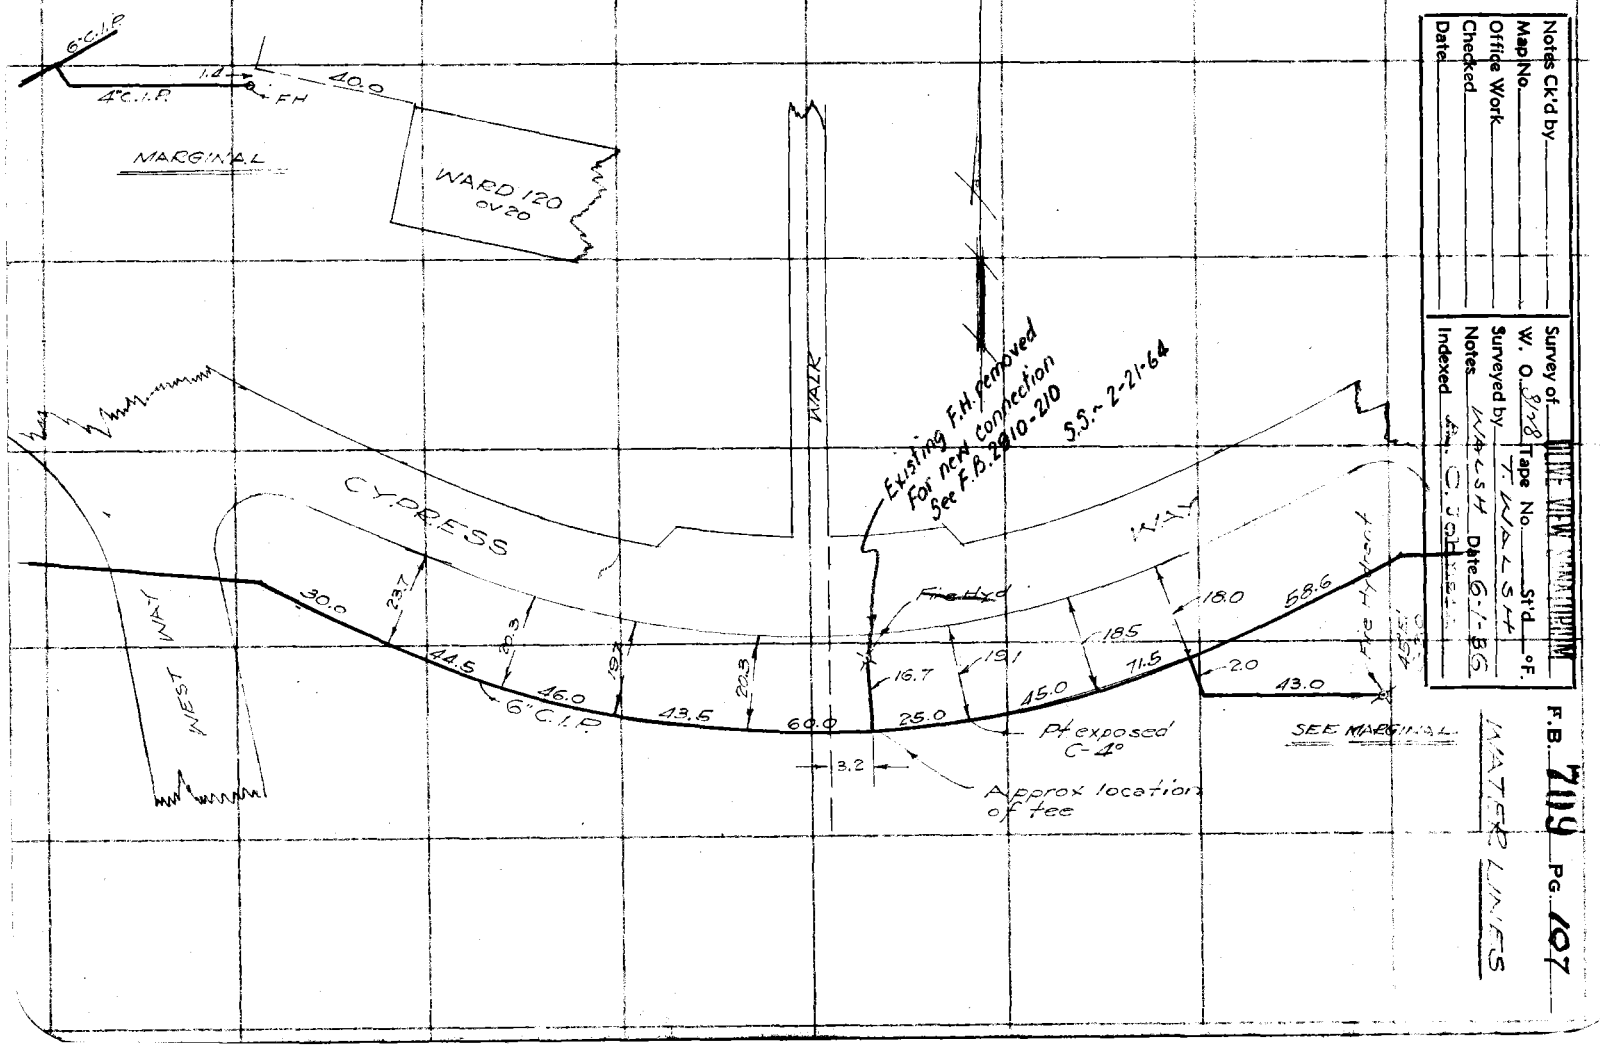

Notes Ck'd by _____
Map No. _____
Office Work _____
Checked _____
Date _____

W. O. 8128 Tape No. _____ St'd _____ °F.
Notes _____
Indexed _____


WATER LINES

F.B. 709 Pg. 108

Cont. on pg 112

INSTALLED MAY 1987

RETURN TO
LOS ANGELES COUNTY SURVEYOR
700 HALL OF RECORDS

Note: Any Additions or Changes on This Sheet Must be Made or Circled in Red Ink With Date and Name of Person Making Change.

Do not extend notes this side of this line

FORM 247 10M 11-55

RETURN TO
LOS ANGELES COUNTY SURVEYOR
700 HALL OF RECORDS

Note: Any Additions or Changes on This Sheet Must be Made or Circled in **Red Ink** With Date and Name of Person Making Change.

Do not extend notes this side of this line

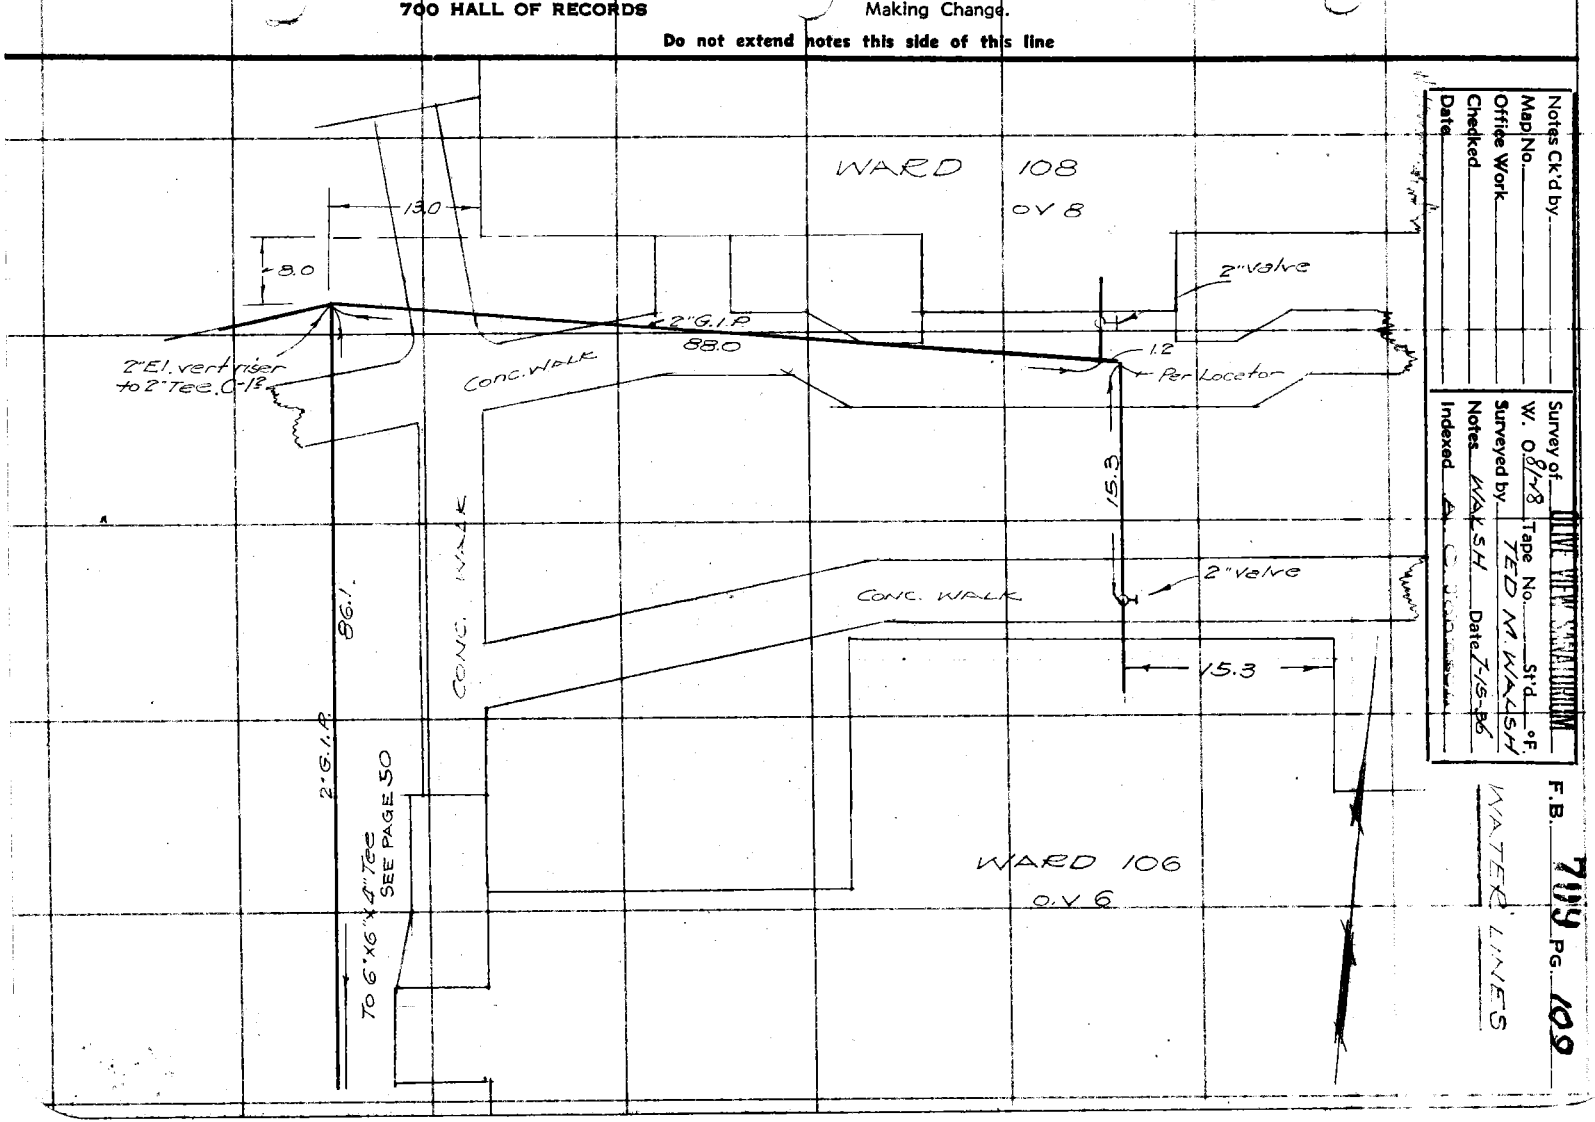

Notes Ck'd by _____
Map No. _____
Office Work _____
Checked _____
Date _____

Survey of OLIVE VIEW SANATORIUM
W. O. 8178 Tape No. _____ St'd. °F.
Notes WALSH
Indexed _____

F.B. 709 PG. 109

WATER LINES

F.B. 709 PG. 110

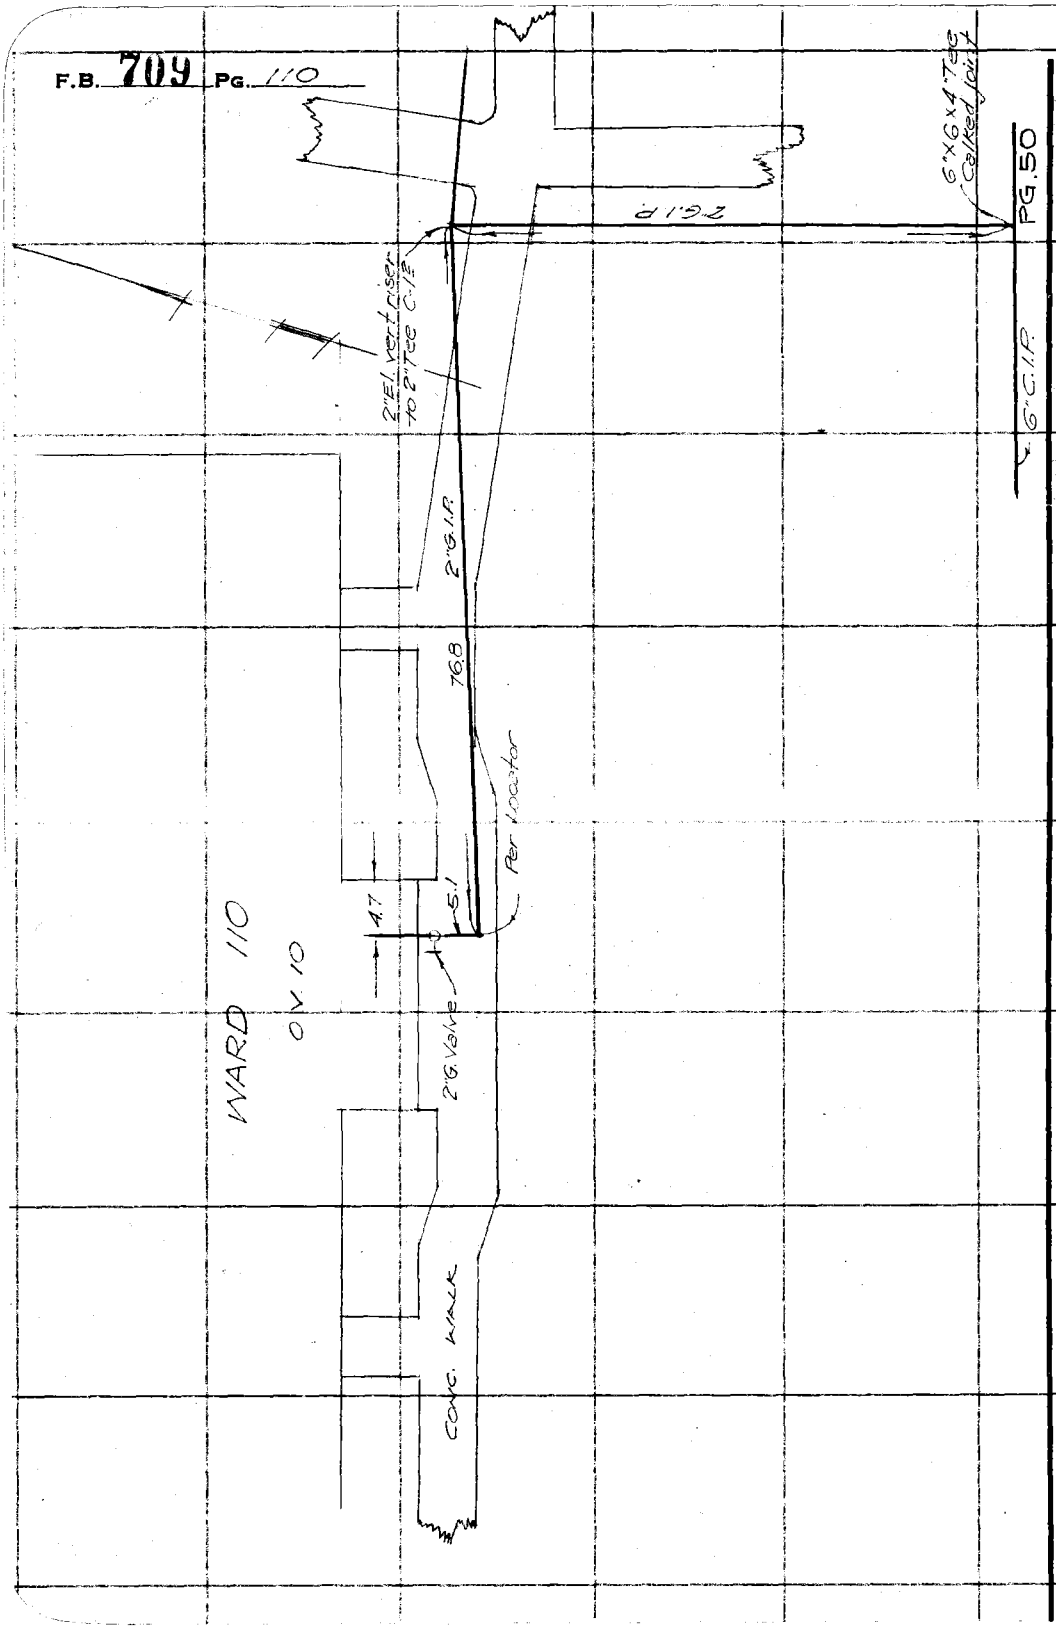

RETURN TO
LOS ANGELES COUNTY SURVEYOR
700 HALL OF RECORDS

Note: Any Additions or Changes on This Sheet Must be Made or Circled in Red Ink With Date and Name of Person Making Change.

Do not extend notes this side of this line

Notes Ck'd by	Survey of OLIVE VIEW SAN'
Map No.	W. O. 8178 Tape No. St'd °F.
Office Work	Surveyed by TED M. WALSH
Checked	Notes WALSH Date 5-19-36
Date	Indexed

F.B. 709 PG. 111

WATER LINES

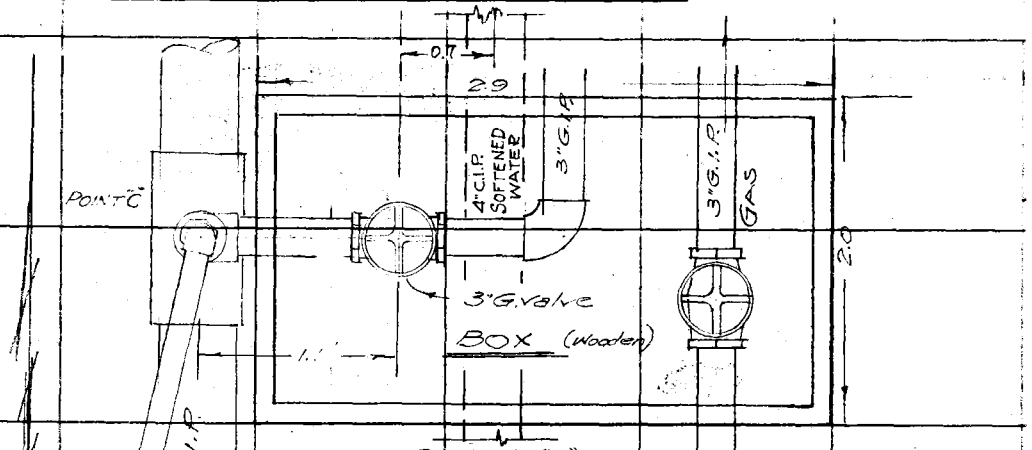

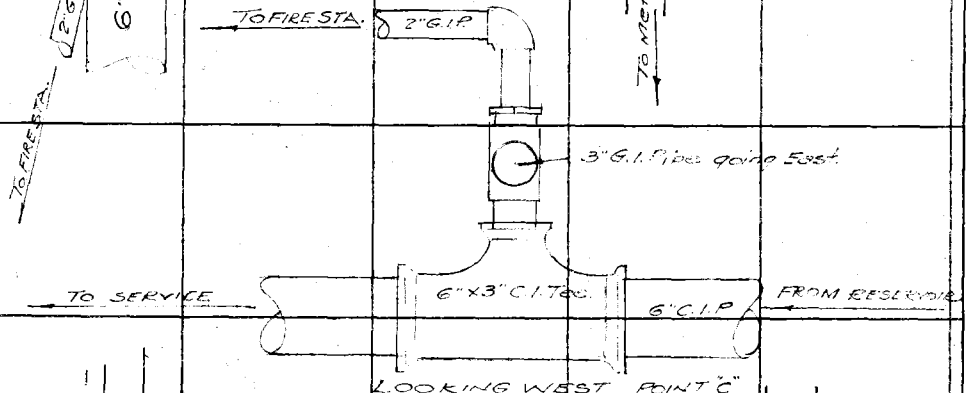

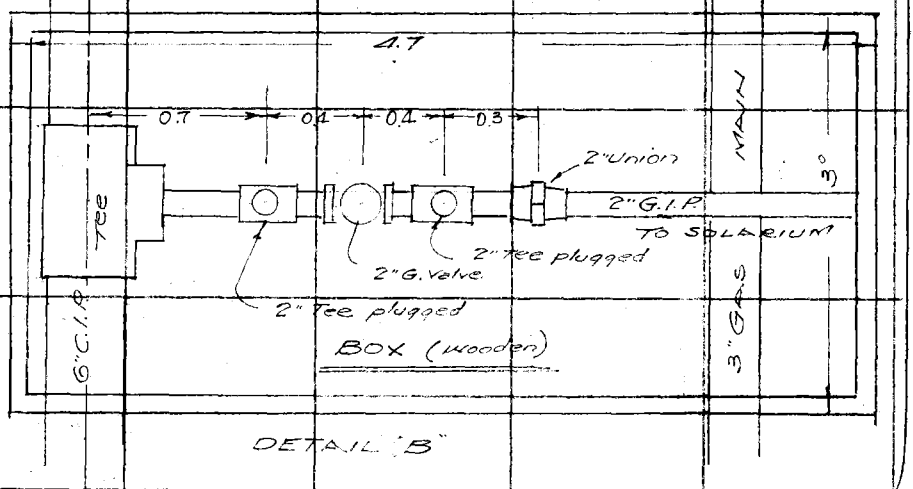

Note: Any Additions or Changes on This Sheet Must be Made or Circled in Red Ink With Date and Name of Person Making Change.

Do not extend notes this side of this line

RETURN TO
LOS ANGELES COUNTY SURVEYOR
700 HALL OF RECORDS

FORM 247 10M 11-35

RETURN TO
LOS ANGELES COUNTY SURVEYOR
700 HALL OF RECORDS

Note: Any Additions or Changes on This Sheet Must be Made or Circled in **Red Ink** With Date and Name of Person Making Change.

Do not extend notes this side of this line

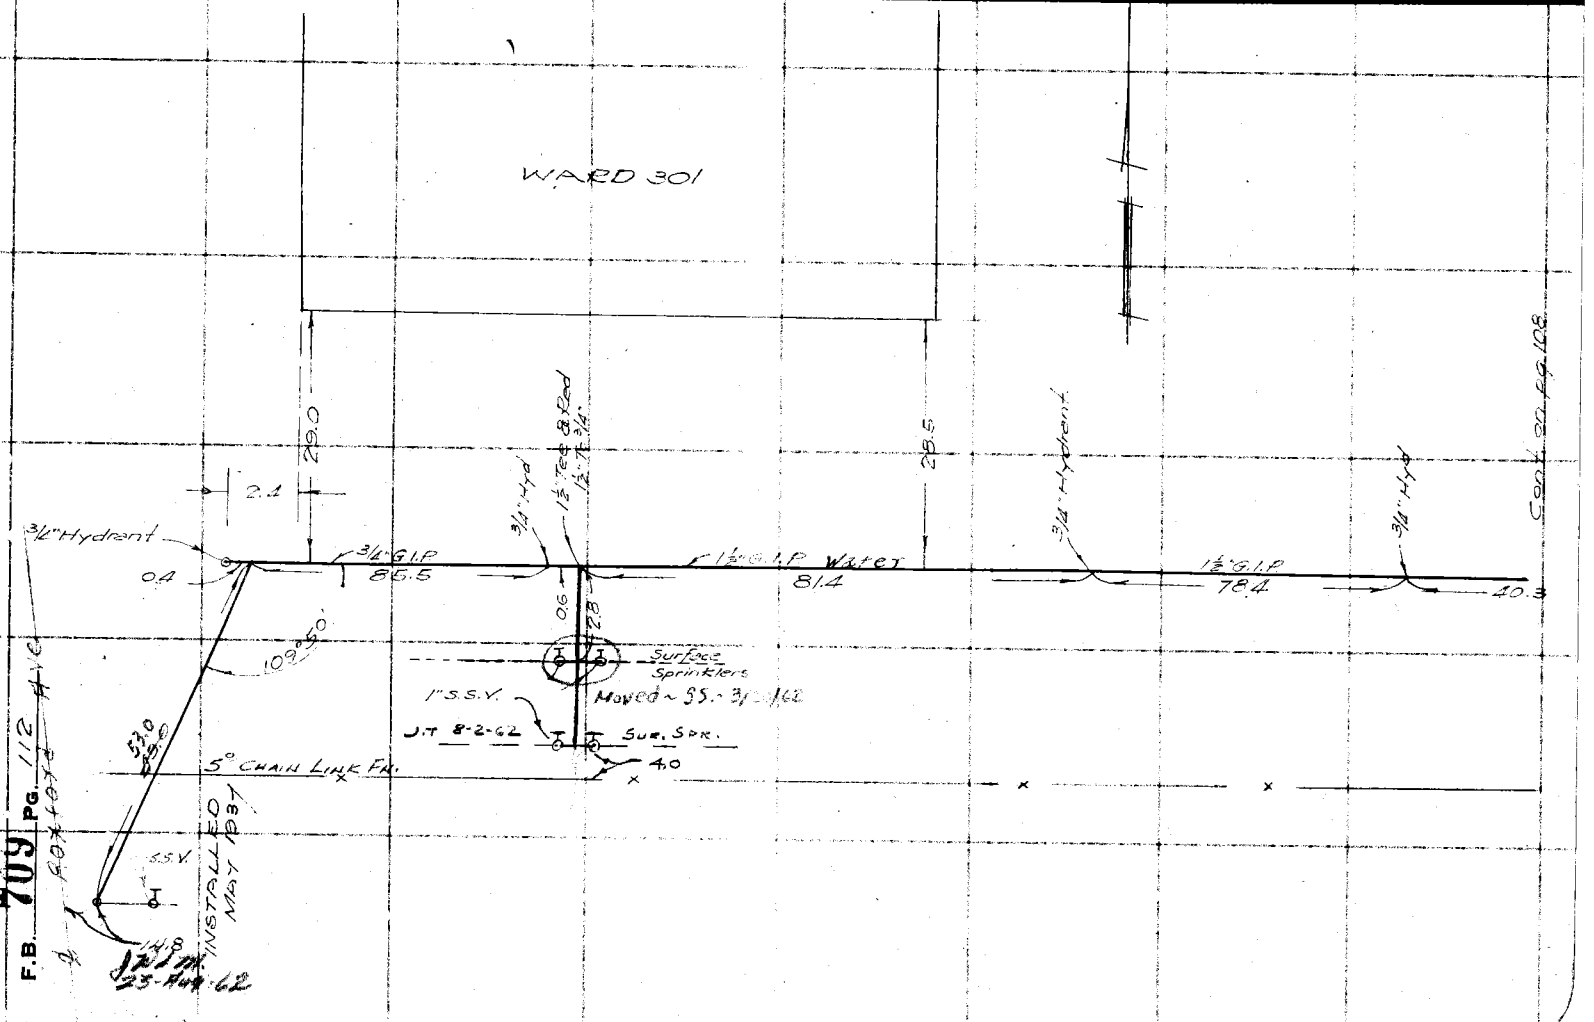

Notes Ck'd by	Survey of OLIVEVIEW SAN
Map No.	W. O. 8H8 Tape No. St'd °F.
Office Work	Surveyed by TED M. WALSH
Checked	Notes WALSH Date 6-36
Date	Indexed A. C. Johnson

F.B. 709 Pg. 113

WATER LINES

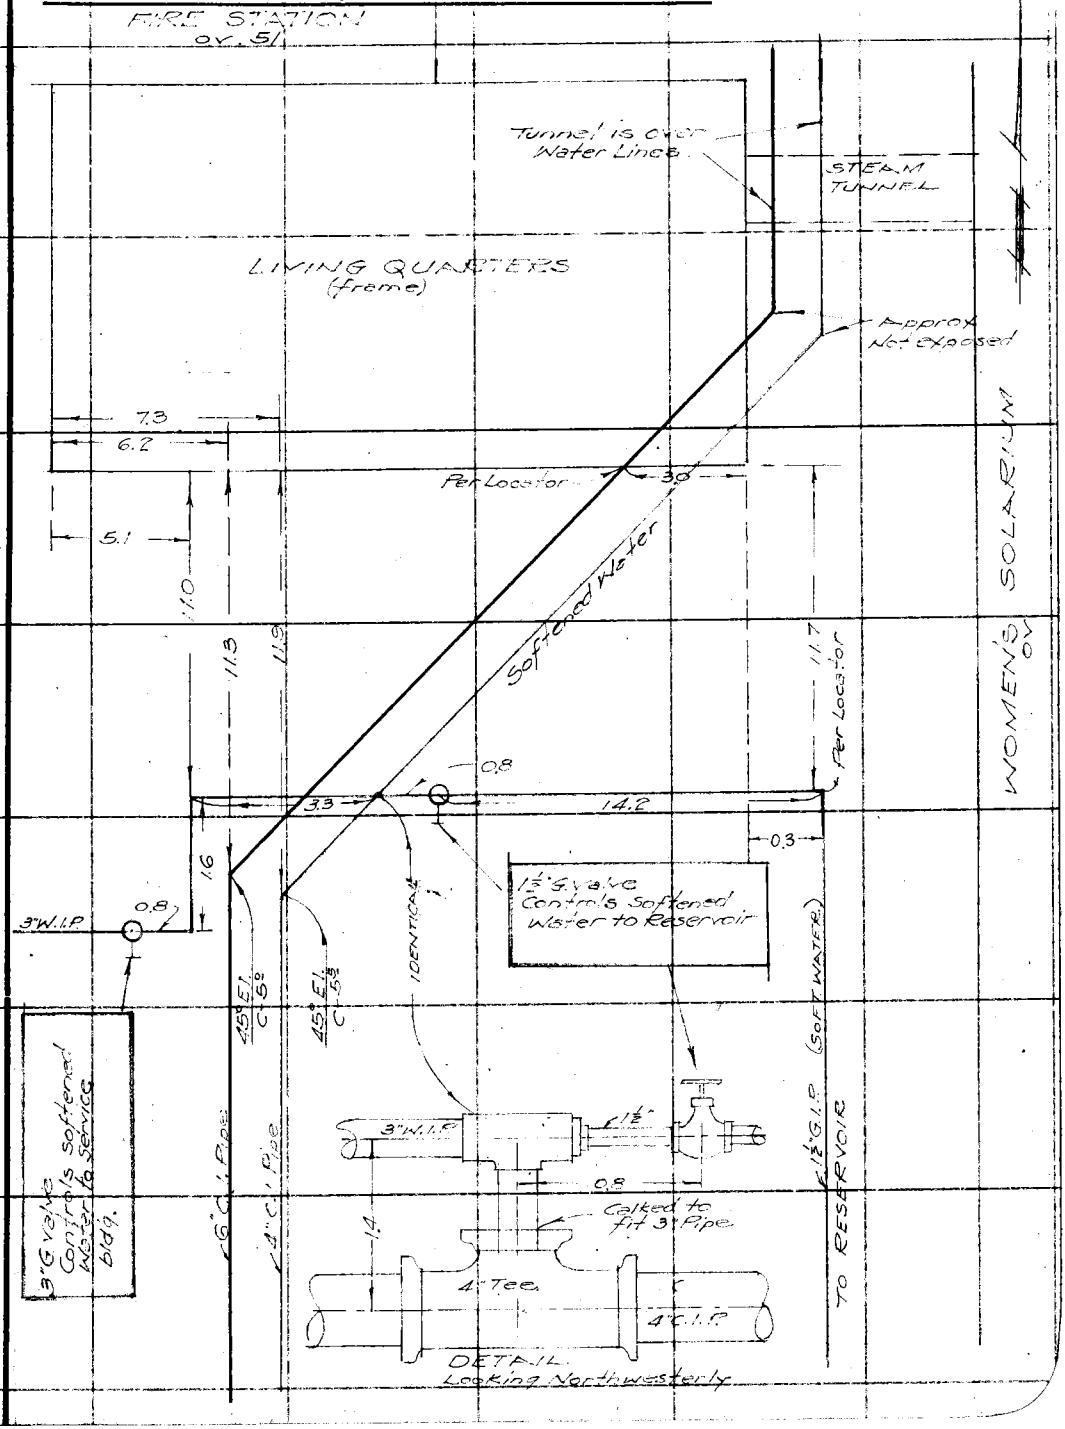

Note: Any Additions or Changes on This Sheet Must be Made or Circled in Red Ink With Date and Name of Person Making Change.

Do not extend notes this side of this line

RETURN TO
LOS ANGELES COUNTY SURVEYOR
700 HALL OF RECORDS

FORM 247 10M 11-35

F.B. 709 PG. 114

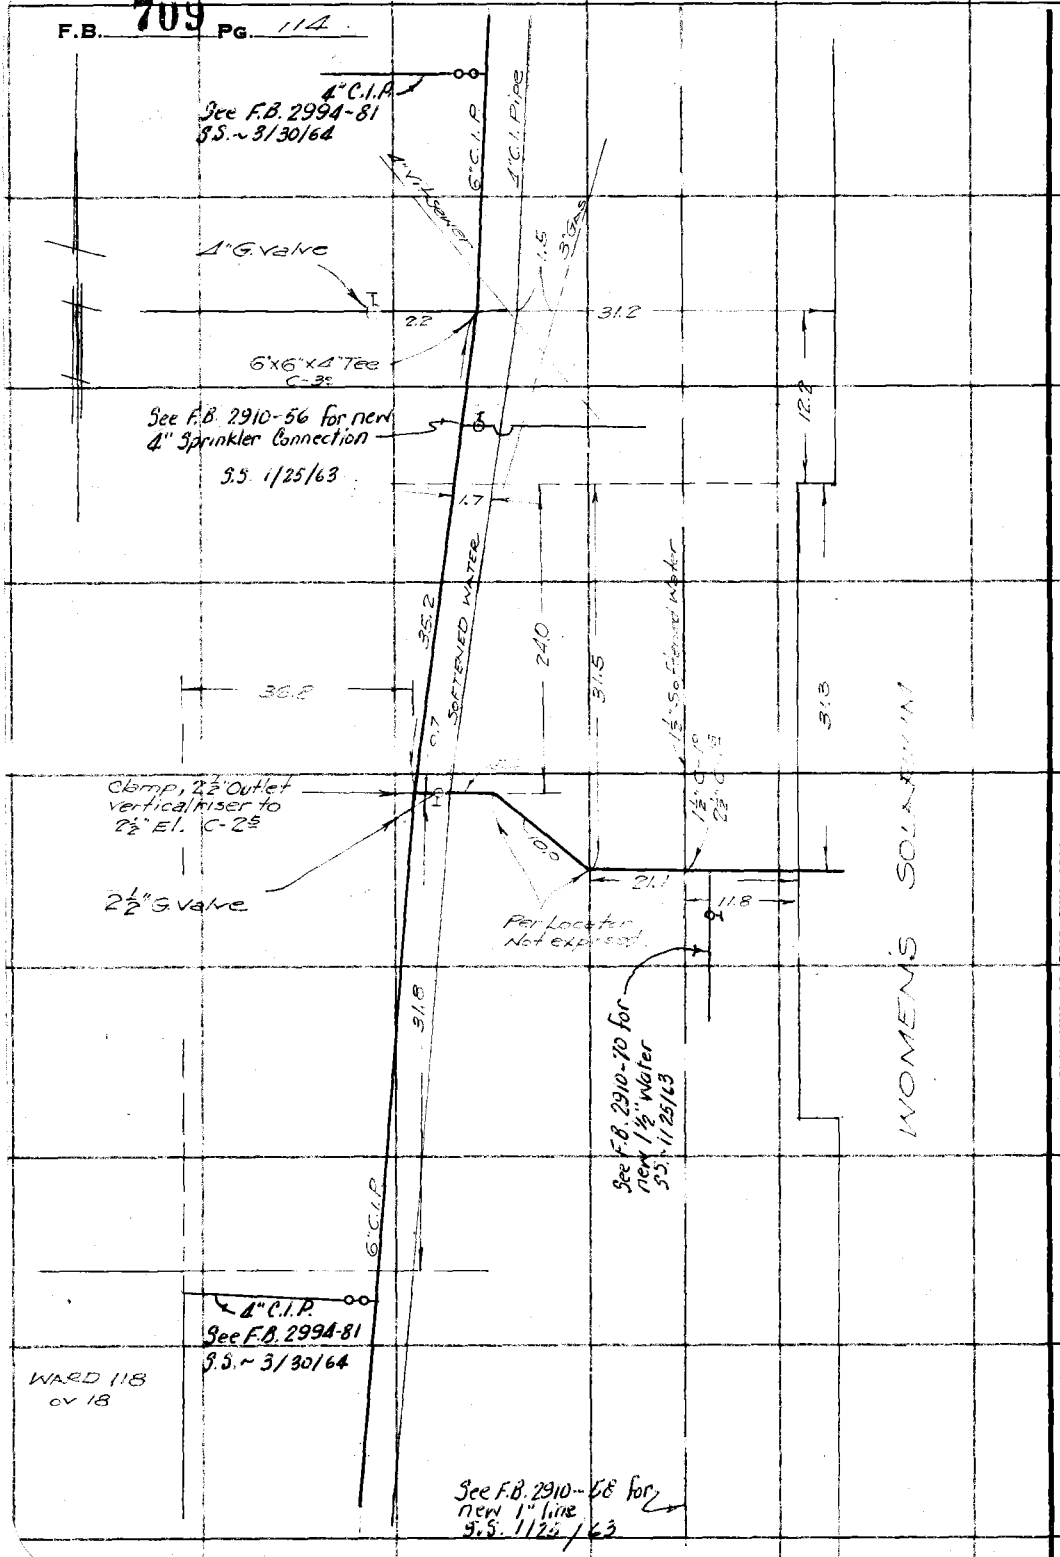

RETURN TO
LOS ANGELES COUNTY SURVEYOR
700 HALL OF RECORDS

Do not extend notes this side of this line

Note: Any Additions or Changes on This Sheet Must be Made or Circled in Red Ink With Date and Name of Person Making Change.

FORM 247 10M 11-35

RETURN TO
LOS ANGELES COUNTY SURVEYOR
7DO HALL OF RECORDS

Note: Any Additions or Changes on This Sheet Must be Made or Circled in **Red Ink** With Date and Name of Person Making Change.

Do not extend notes this side of this line

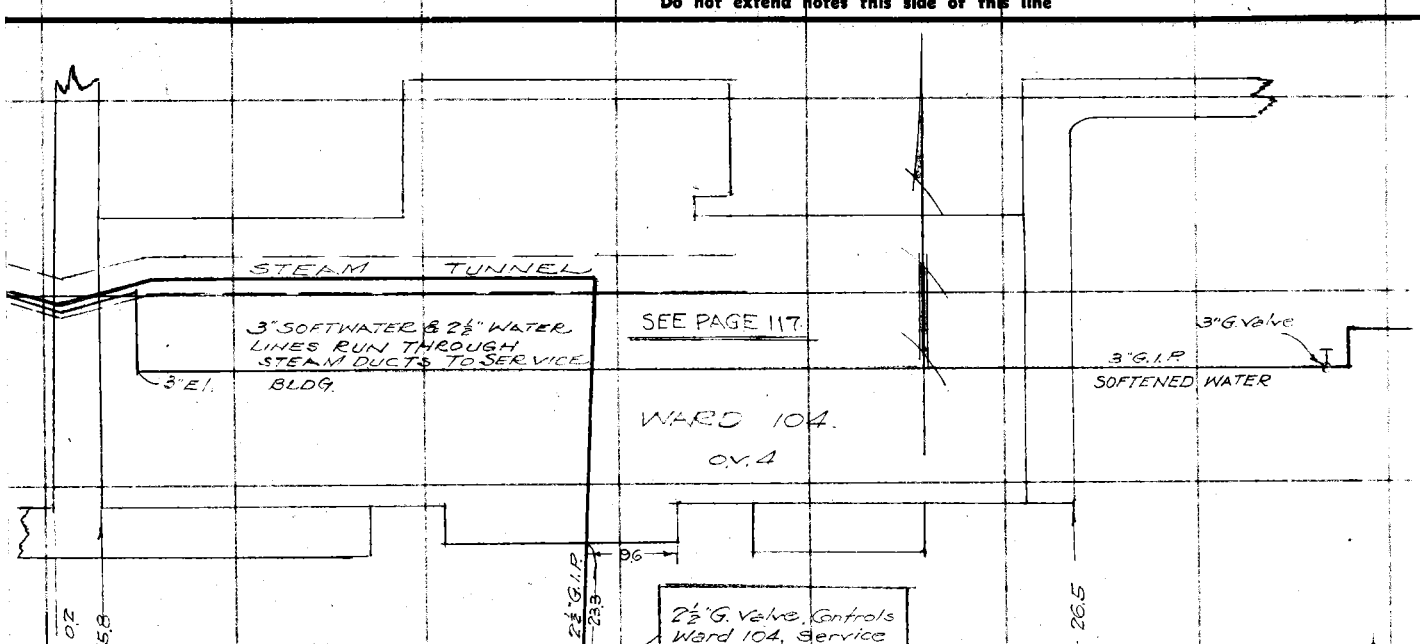

Notes Ck'd by
Map No.
Offide Work
Checked
Date

Survey of WATER LINES
W. O. 8178 Tape No. St'd. °F.
Surveyed by TED M. WALSH
Notes WALSH Date 6-10-46
Indexed

F.B. 209 PG. 115

RETURN TO
LOS ANGELES COUNTY SURVEYOR
700 HALL OF RECORDS

Note: Any Additions or Changes on This Sheet Must be Made or Circled in **Red Ink** With Date and Name of Person Making Change.

Do not extend notes this side of this line

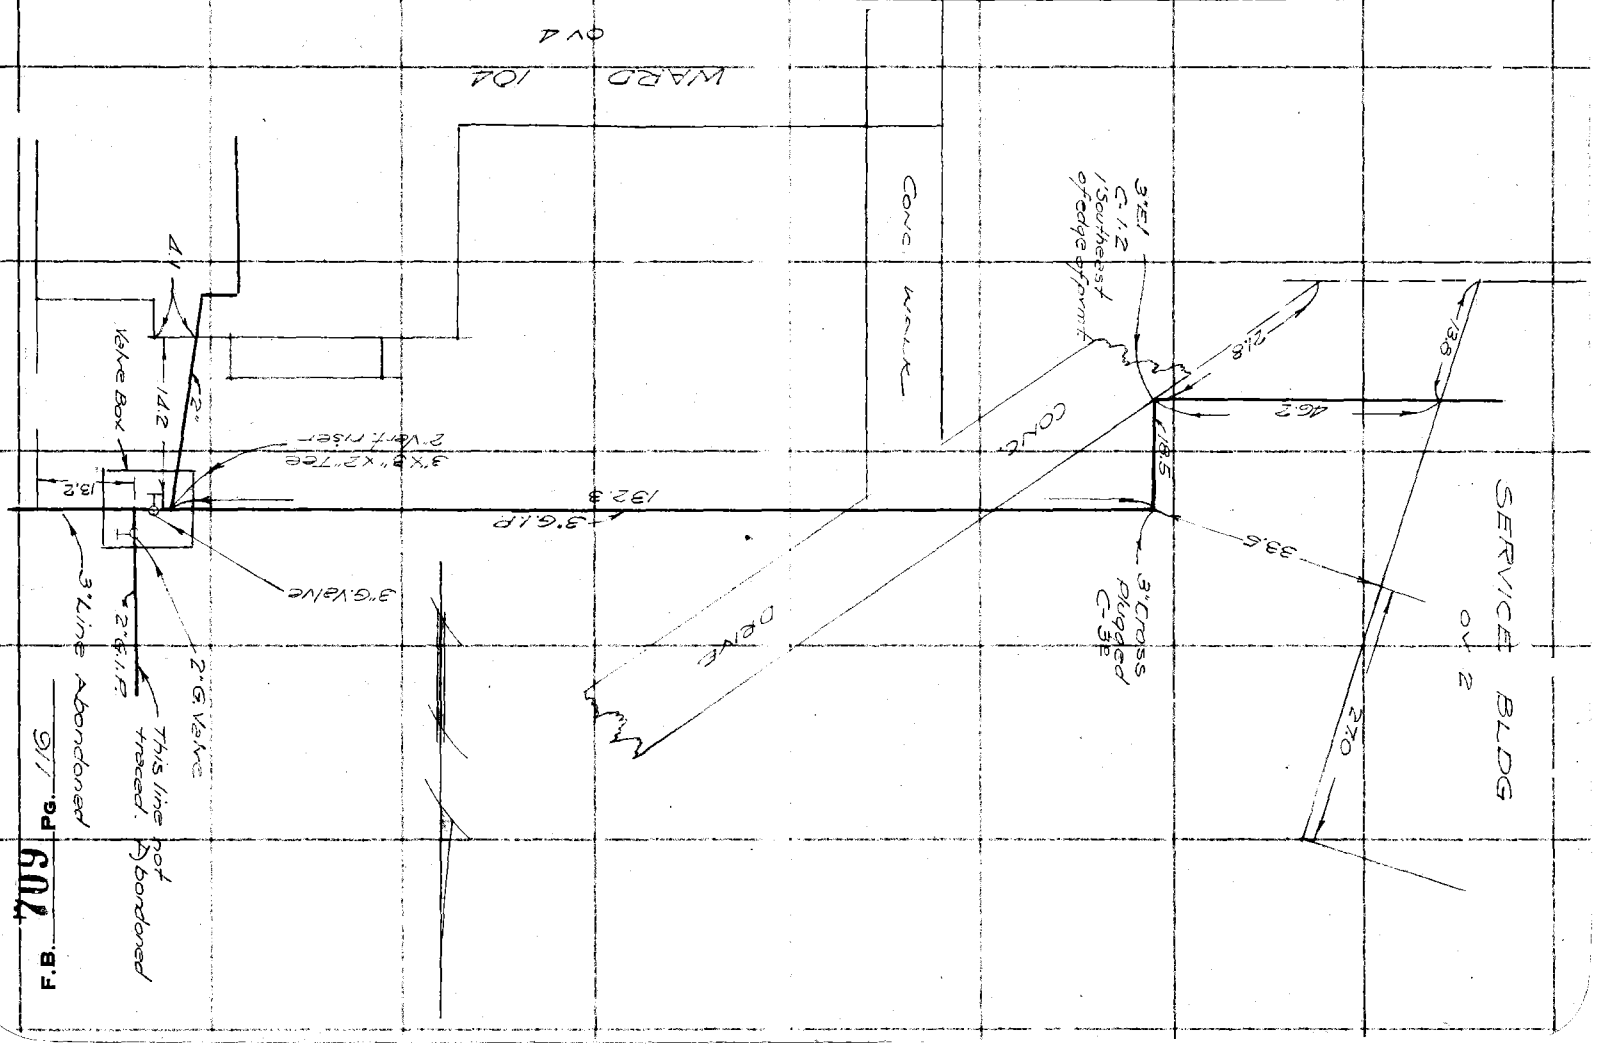


FORM 247 10M 11-35

RETURN TO
LOS ANGELES COUNTY SURVEYOR
700 HALL OF RECORDS

Note: Any Additions or Changes on This Sheet Must be Made or Circled in Red Ink With Date and Name of Person Making Change.

Do not extend notes this side of this line

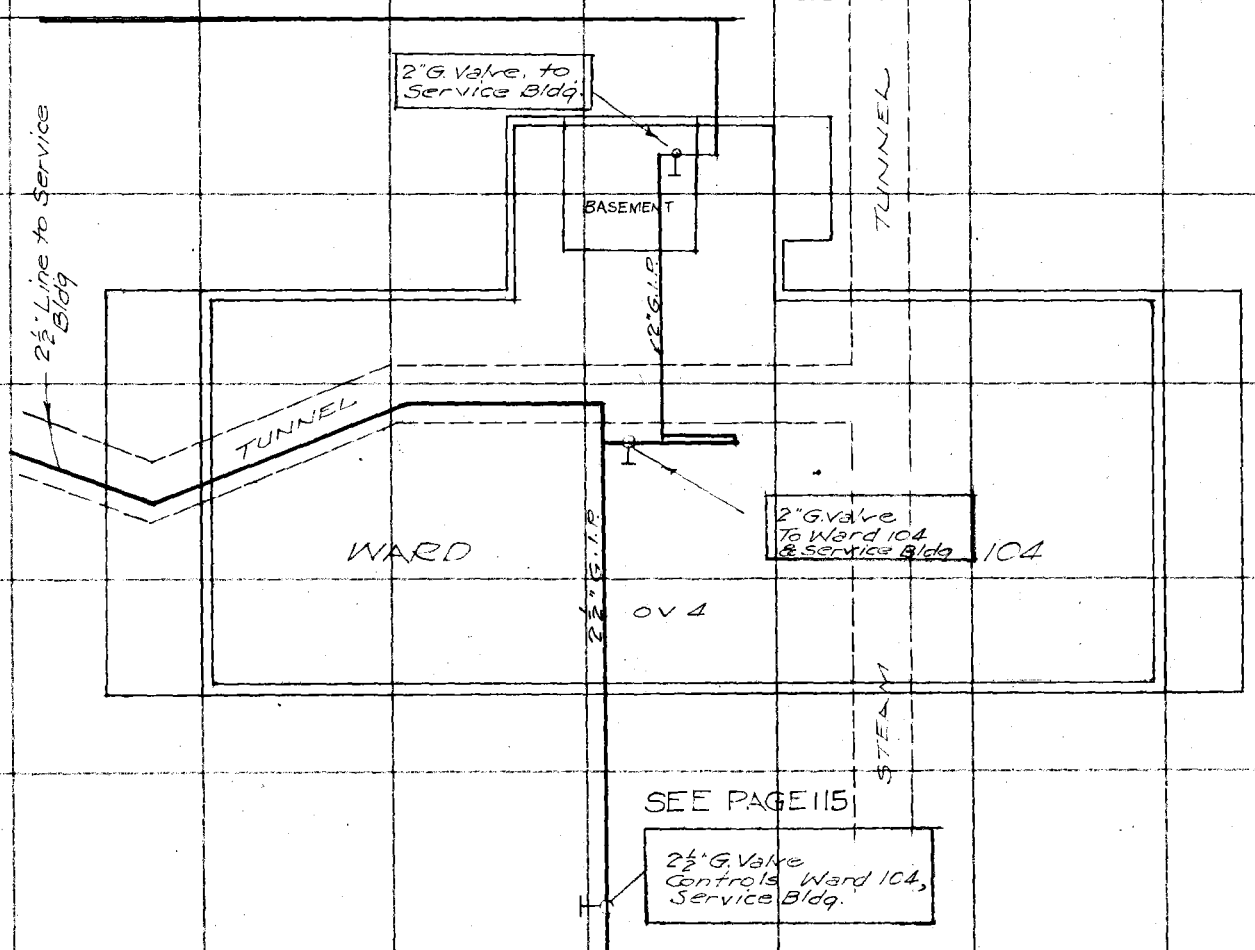

Notes Ck'd by
Map No.
Office Work
Checked
Date

Survey of OLIVE VIEW SANITORIUM
W. O. 8128 Tape No. St'd °F.
Surveyed by T. M. WALSH Date 12-23-36
Notes T. M. WALSH
Indexed


WATER LINES

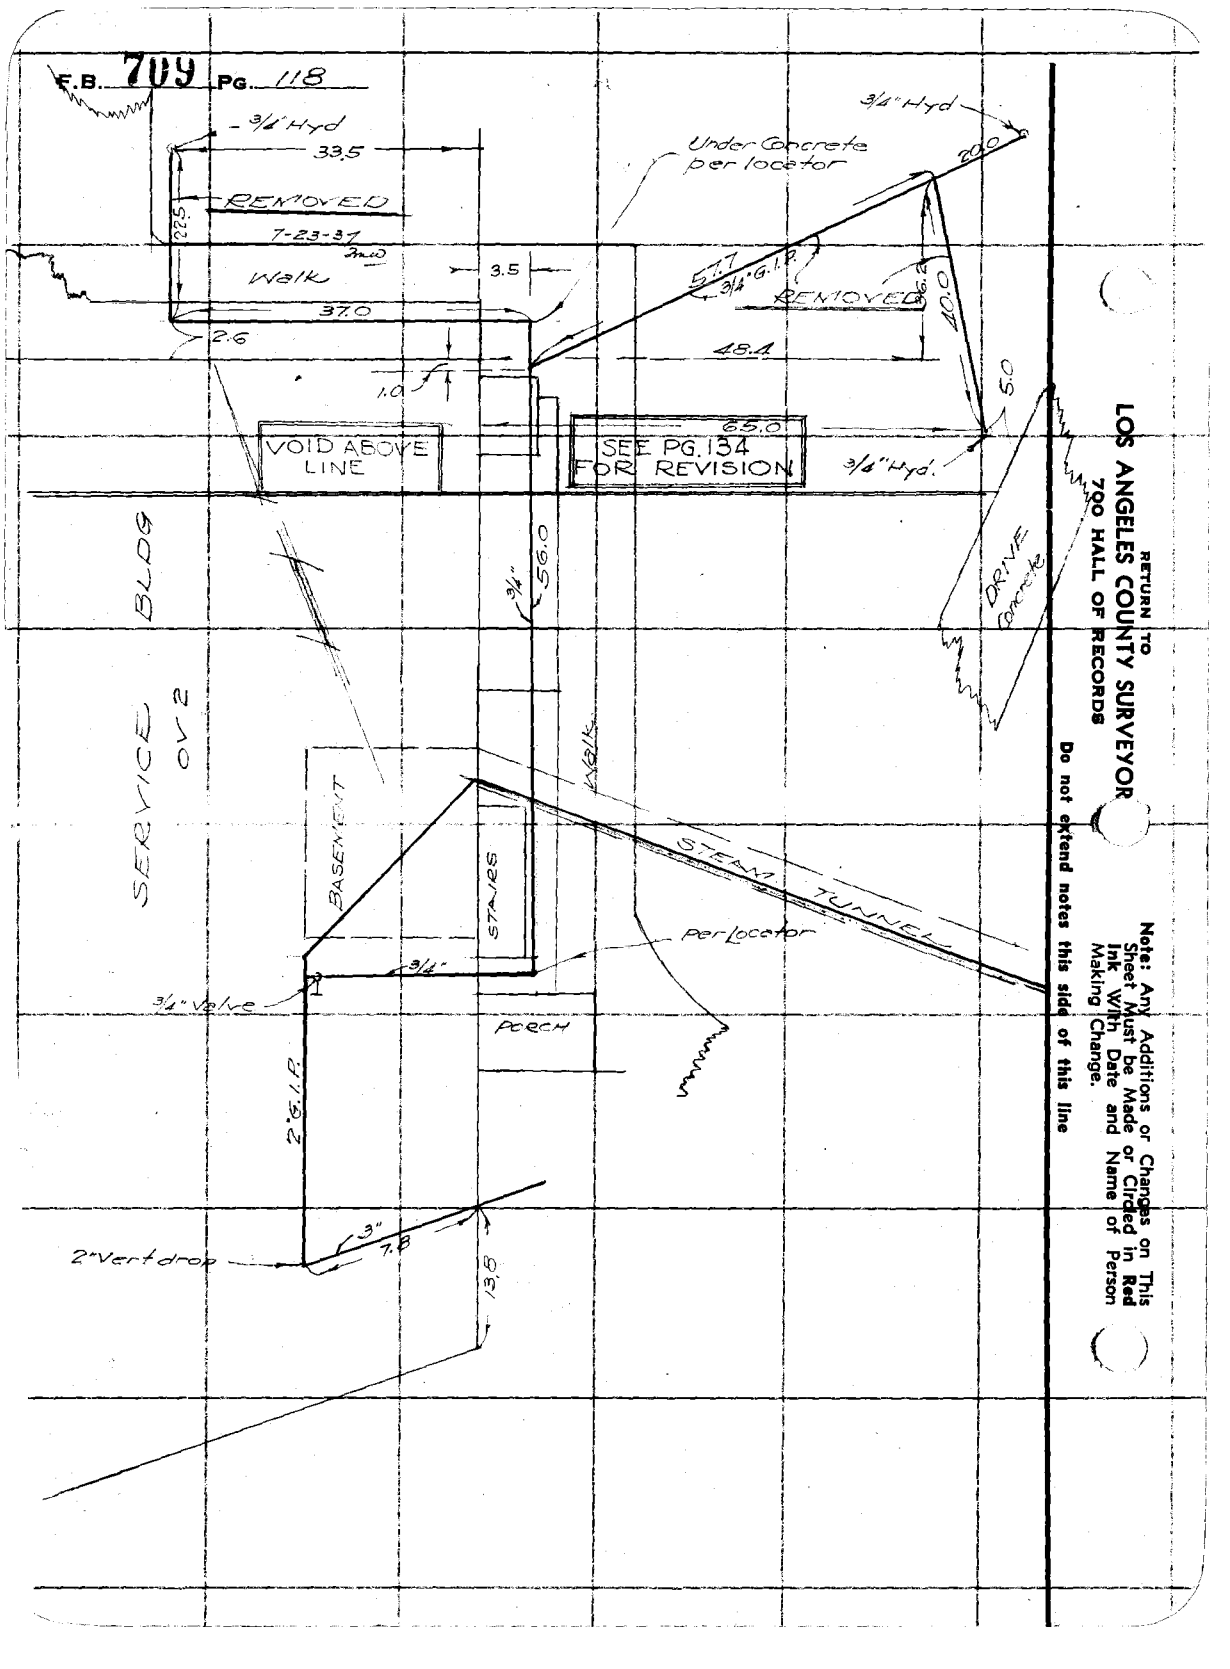
F.B. 709 PG. 118
3/4" Hyd
33.5
REMOVED
22.5
7-23-37
Walk
3.5
37.0
2.6
1.0
VOID ABOVE LINE
SEE PG. 134 FOR REVISION
65.0
3/4" Hyd.
3/4" Hyd
Under Concrete per locator
20.0
5.7
3/4" G.I.P.
REMOVED
6.4
40.0
48.4
5.0
DRIVE Concrete
3/4"
56.0
BLDG
SERVICE
OV 2
BASEMENT
STAIRS
WALK
STEAM TUNNEL
per Locator
3/4"
3/4" Valve
PORCH
2"G.I.P.
2" Vert drop
3"
7.8
13.5
RETURN TO
LOS ANGELES COUNTY SURVEYOR
Do not extend notes this side of this line
Note: Any Additions or Changes on This Sheet Must be Made or Circled in Red Ink With Date and Name of Person Making Change.

FORM 247 10M 11-35

RETURN TO
LOS ANGELES COUNTY SURVEYOR
700 HALL OF RECORDS

Note: Any Additions or Changes on This Sheet Must be Made or Circled in Red Ink With Date and Name of Person Making Change.

Do not extend notes this side of this line

WARD 104

OV 4

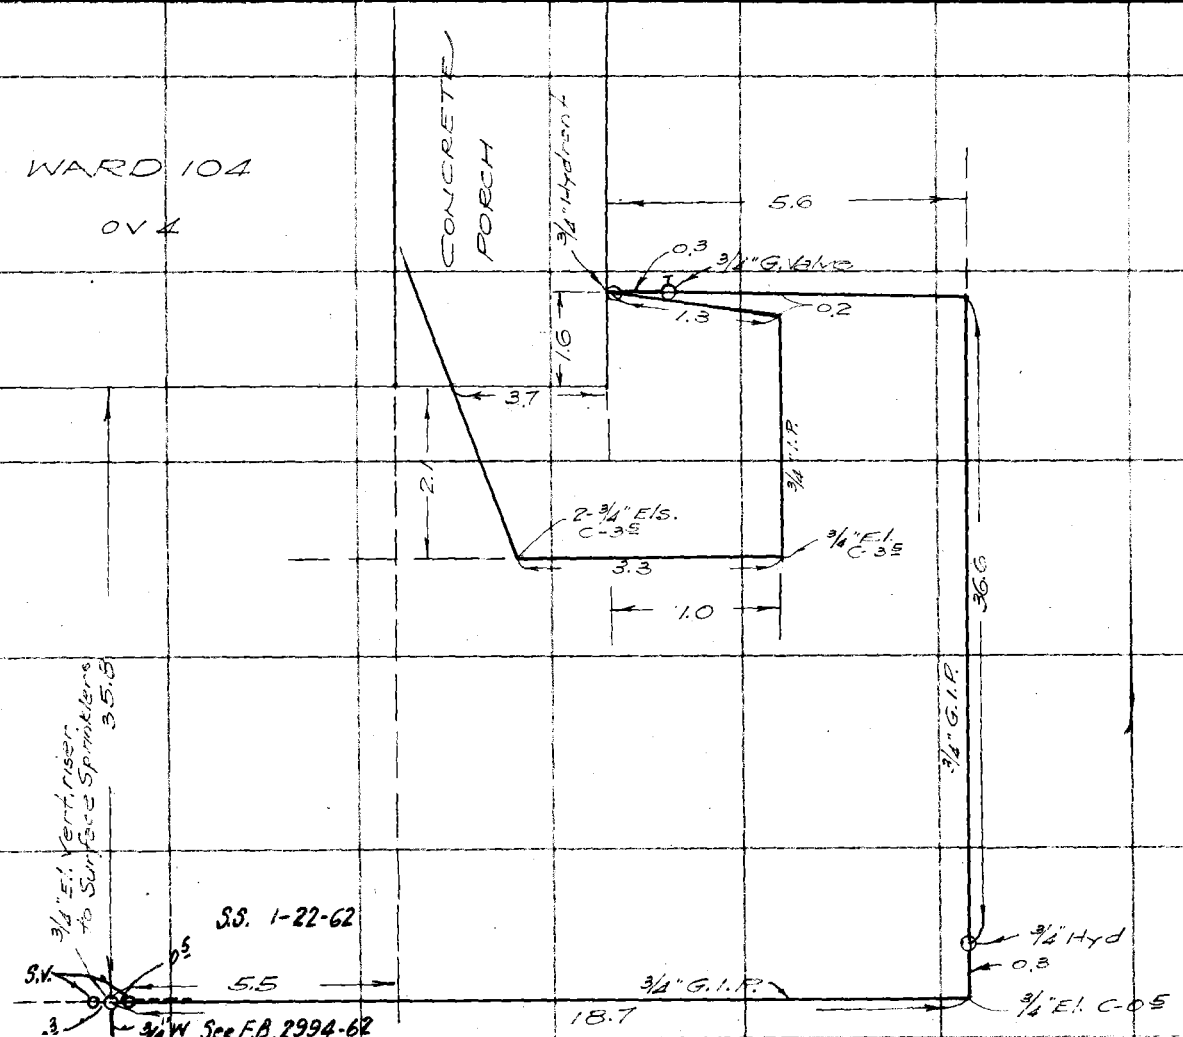

Notes Ck'd by
Map No.
Office Work
Checked
Date

W. O. 8128 Tape No. Sk'd °F.
Surveyed by T. M. WALSH Date 8-36
Notes T. M. WALSH Date 8-36
Indexed [illegible]

F.B. 709 PG. 119

WATER LINES

RETURN TO
LOS ANGELES COUNTY SURVEYOR
700 HALL OF RECORDS

Note: Any Additions or Changes on This Sheet Must be Made or Circled in **Red Ink** With Date and Name of Person Making Change.

Do not extend notes this side of this line

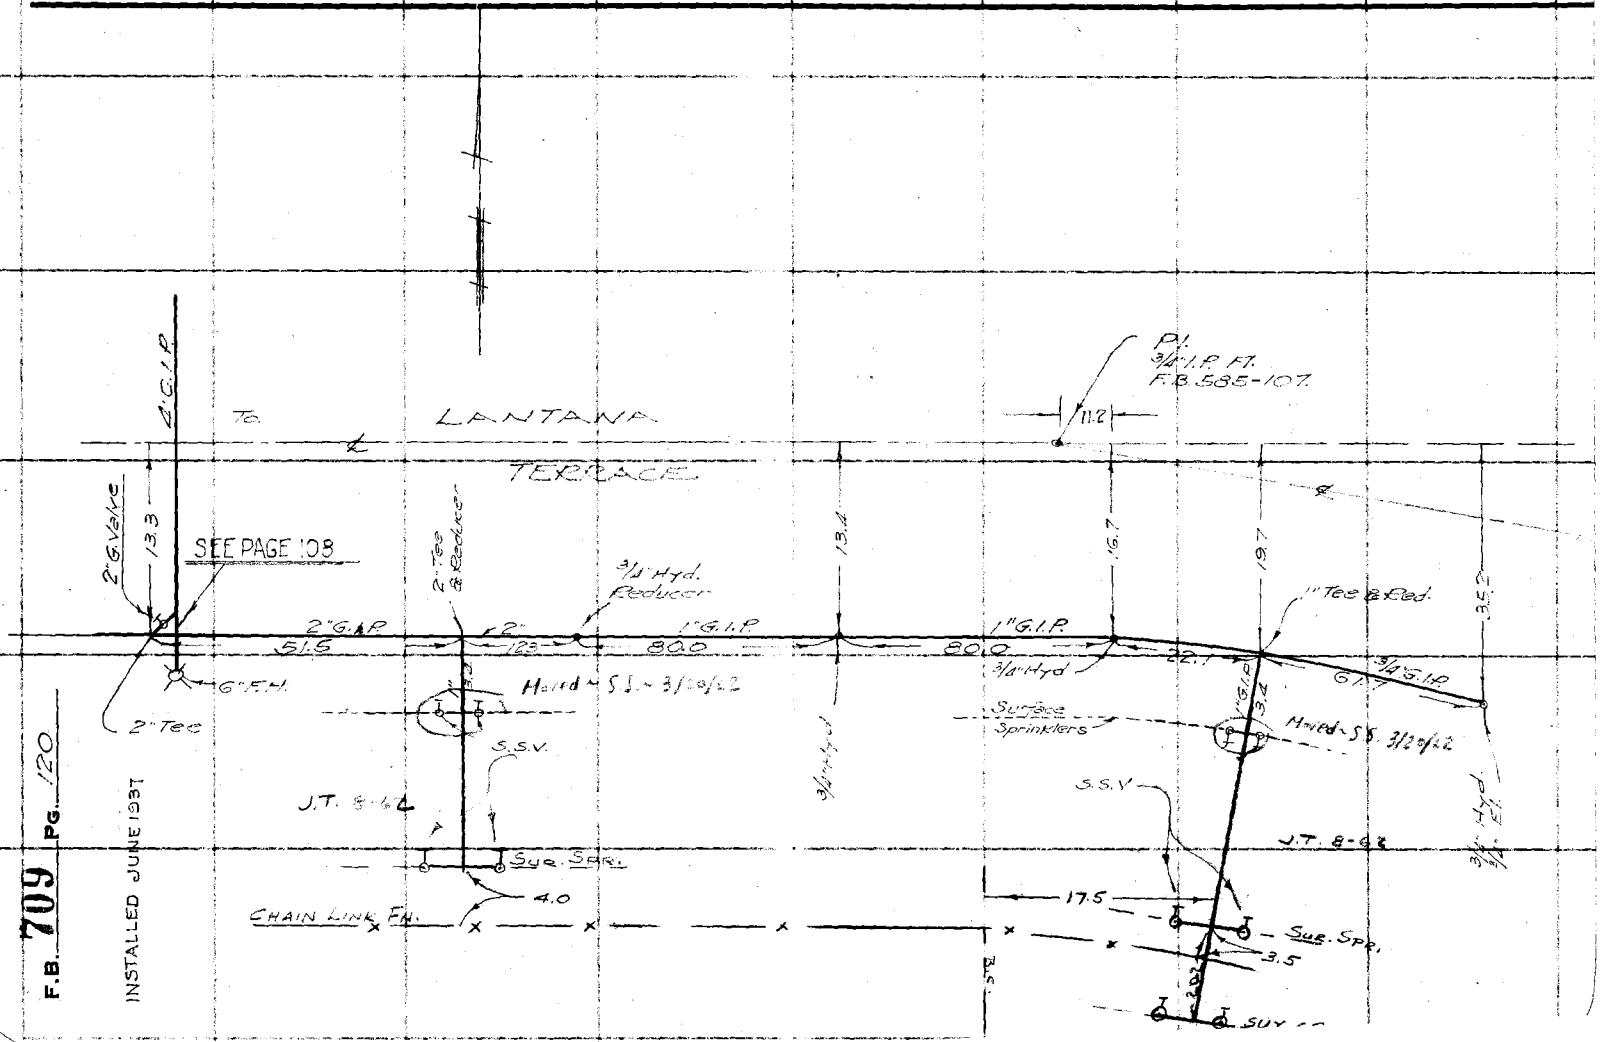

F.B. 709 Pg. 120

INSTALLED JUNE 1937

FORM 247 10M 11-38

RETURN TO
LOS ANGELES COUNTY SURVEYOR
700 HALL OF RECORDS

Note: Any Additions or Changes on This Sheet Must be Made or Circled in **Red Ink** With Date and Name of Person Making Change.

Do not extend notes this side of this line

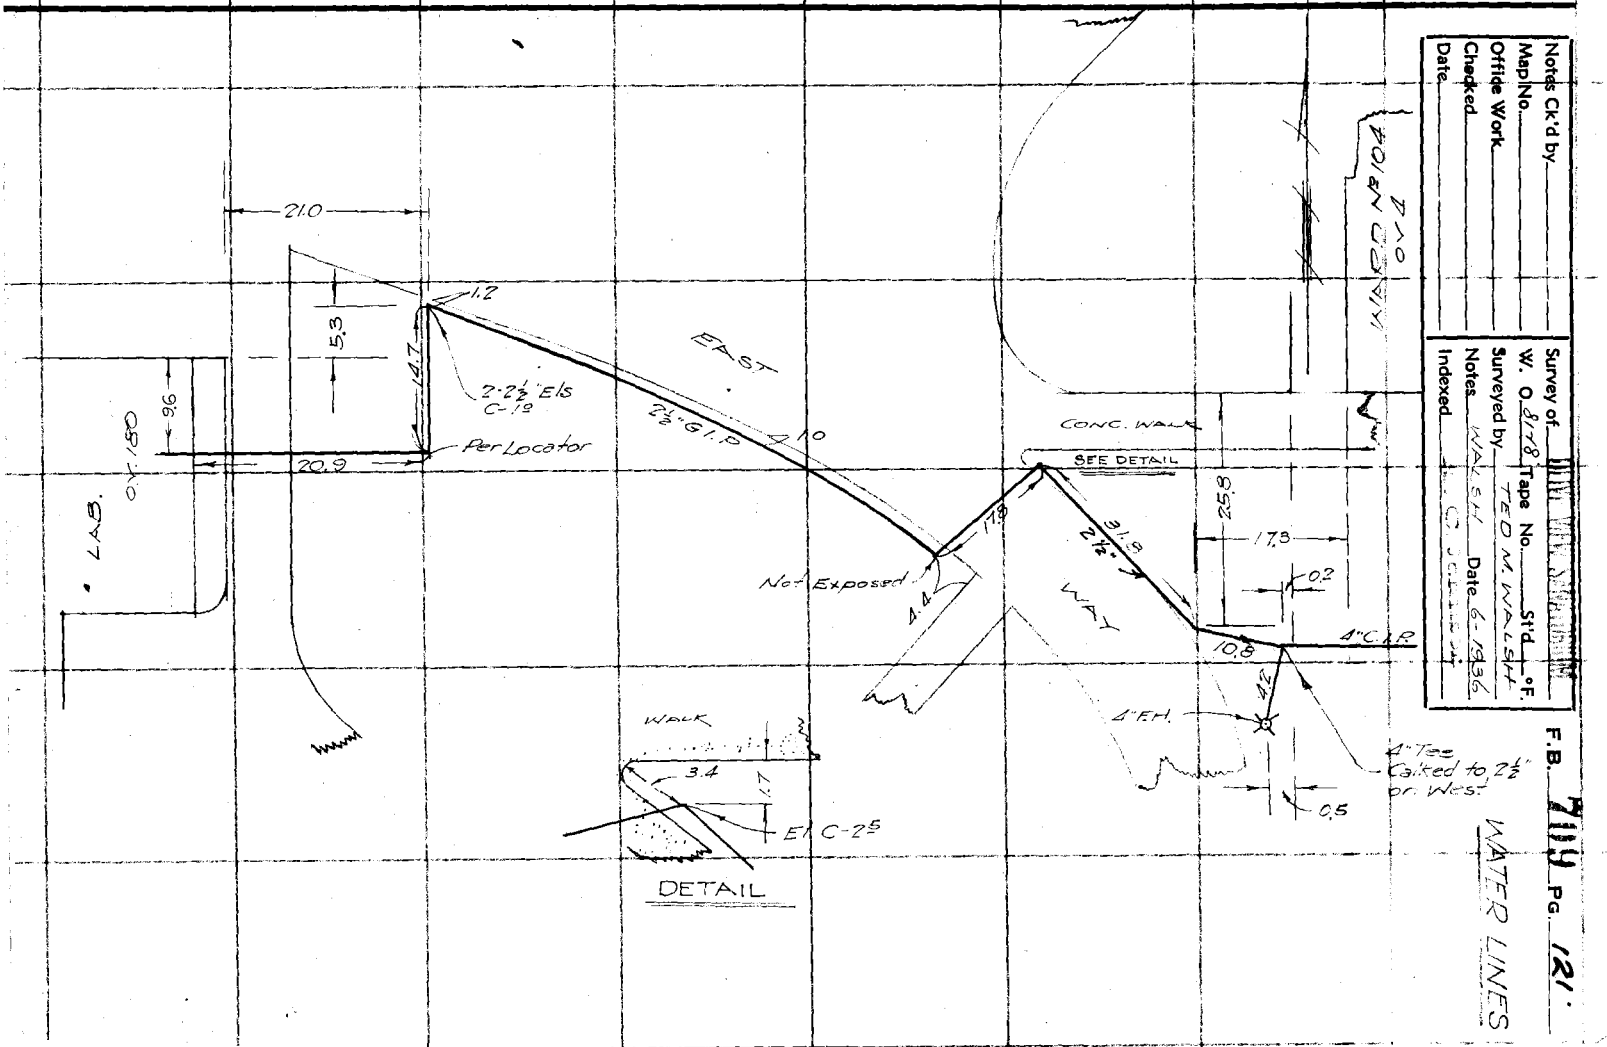

Notes Ck'd by
Map No.
Office Work
Checked
Date

Survey of W. O. 8178 Tape No. St'd. °F.
Surveyed by TED M WALSH Date 6-1936
Notes WALSH
Indexed


WATER LINES

F.B. 709 Pg. 122

RETURN TO
LOS ANGELES COUNTY SURVEYOR
700 HALL OF RECORDS

Note: Any Additions or Changes on This Sheet Must be Made or Circled in Red Ink With Date and Name of Person Making Change.

Do not extend notes this side of this line

FORM 247 10M 11-35

RETURN TO
LOS ANGELES COUNTY SURVEYOR
700 HALL OF RECORDS

Note: Any Additions or Changes on This Sheet Must be Made or Circled in **Red Ink** With Date and Name of Person Making Change.

Do not extend notes this side of this line

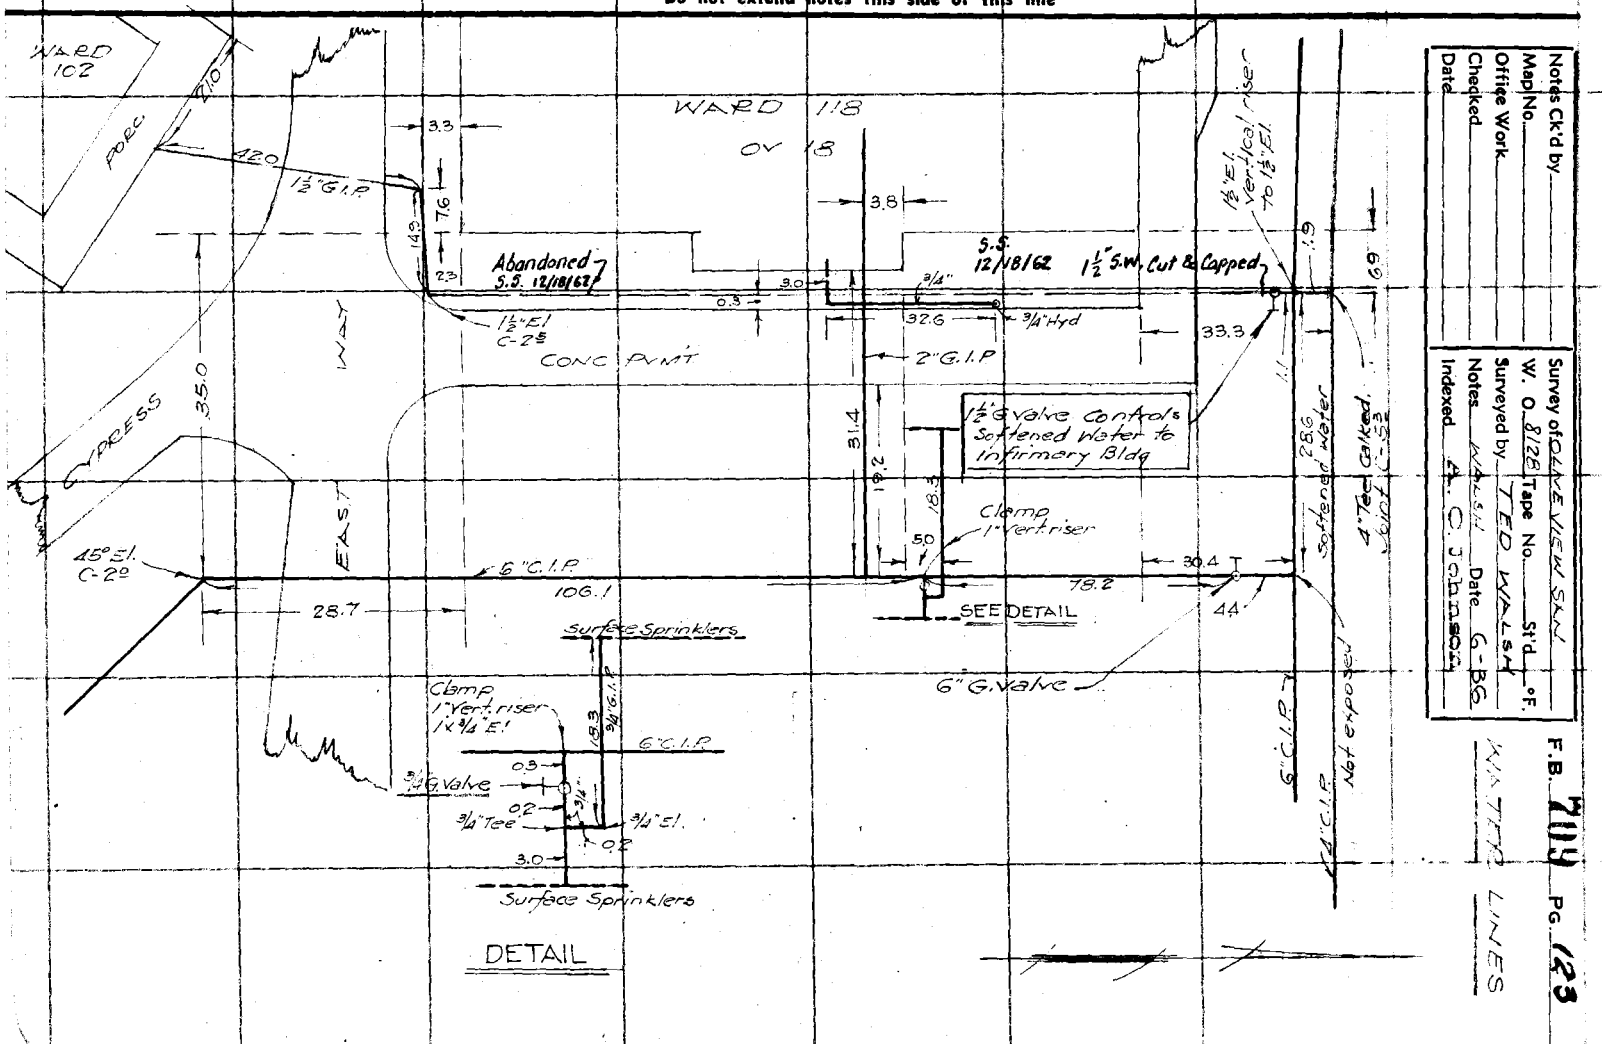

Notes Ck'd by
Map No.
Office Work
Checked
Date

Survey of OLIVE VIEW SAN
W. O. 8128 Tape No. St'd. °F.
Surveyed by TED WALSH
Notes WALSH Date 6-26
Indexed A. C. Johnson

WATER LINES


F.B. 709 PG. 124

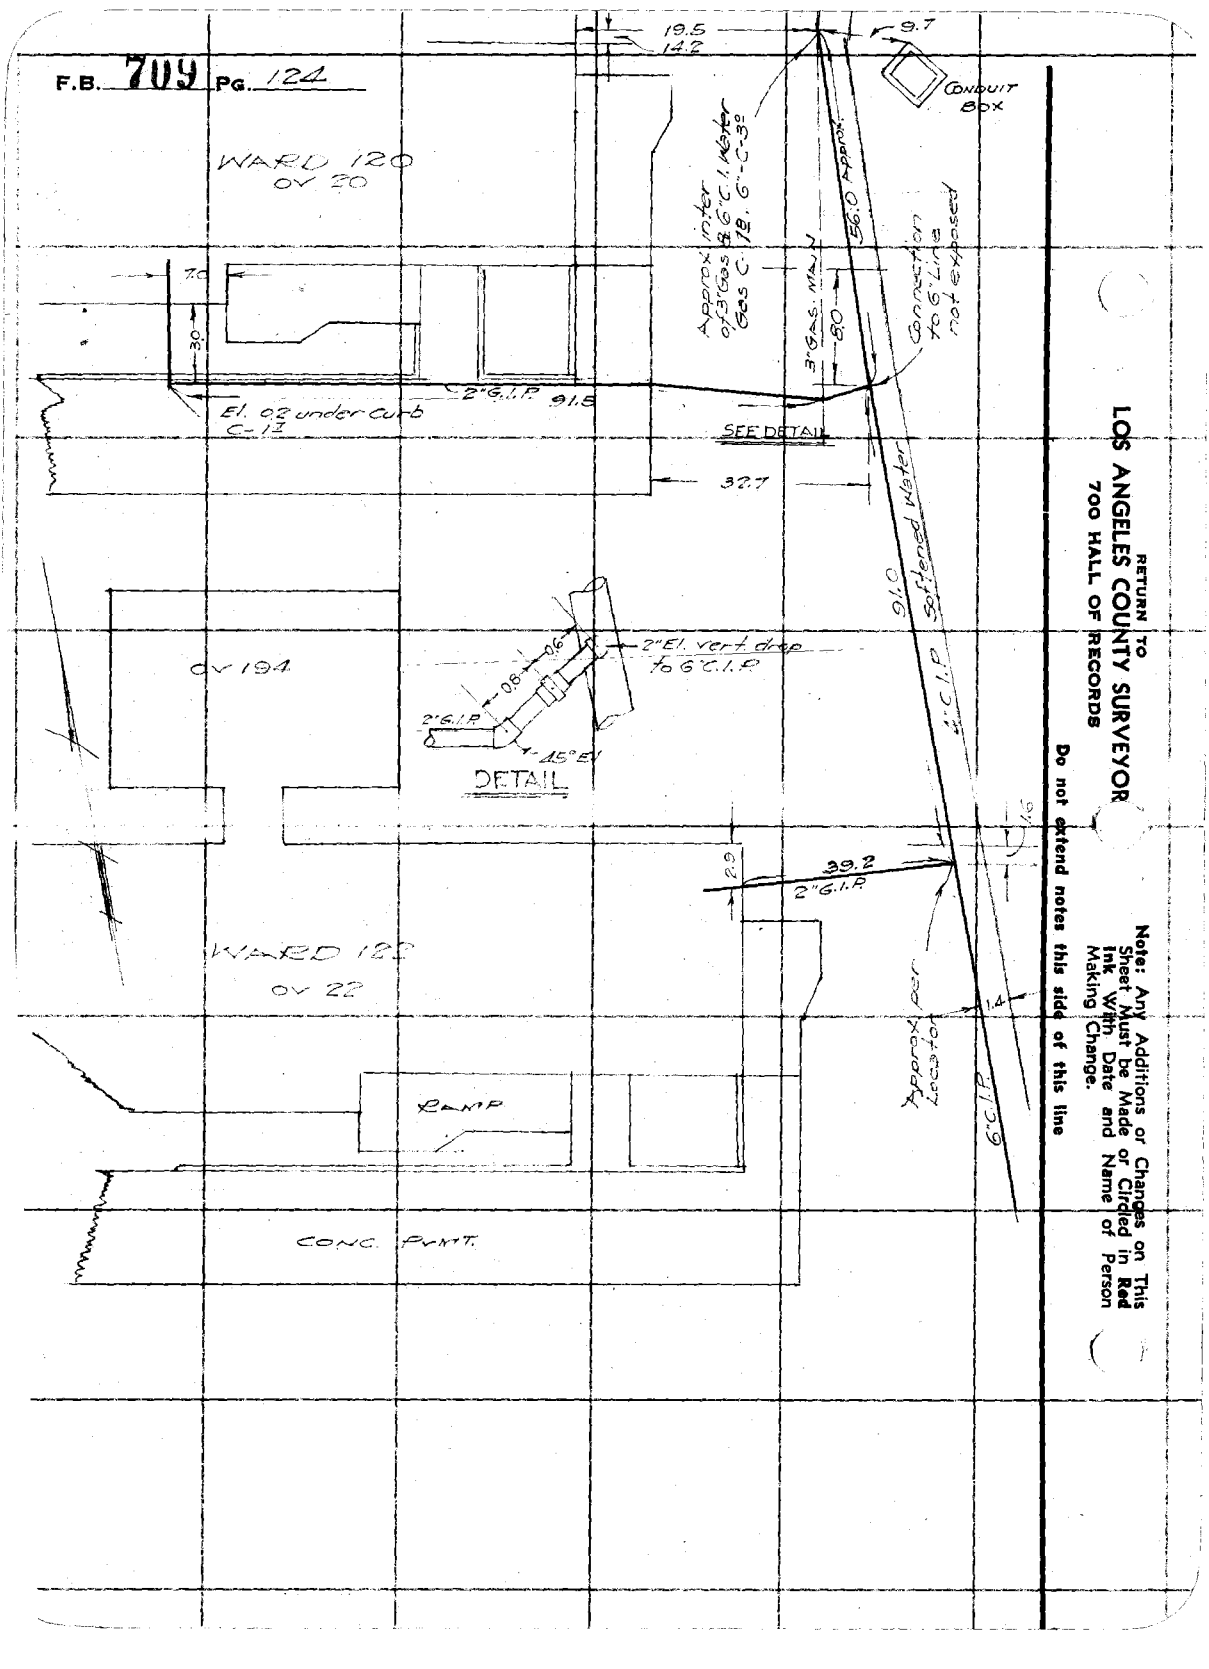

RETURN TO
LOS ANGELES COUNTY SURVEYOR
700 HALL OF RECORDS

Do not extend notes this side of this line

Note: Any Additions or Changes on This Sheet Must be Made or Circled in Red Ink With Date and Name of Person Making Change.

FORM 247 10M 11-35

RETURN TO
LOS ANGELES COUNTY SURVEYOR
700 HALL OF RECORDS

Note: Any Additions or Changes on This Sheet Must be Made or Circled in **Red Ink** With Date and Name of Person Making Change.

Do not extend notes this side of this line

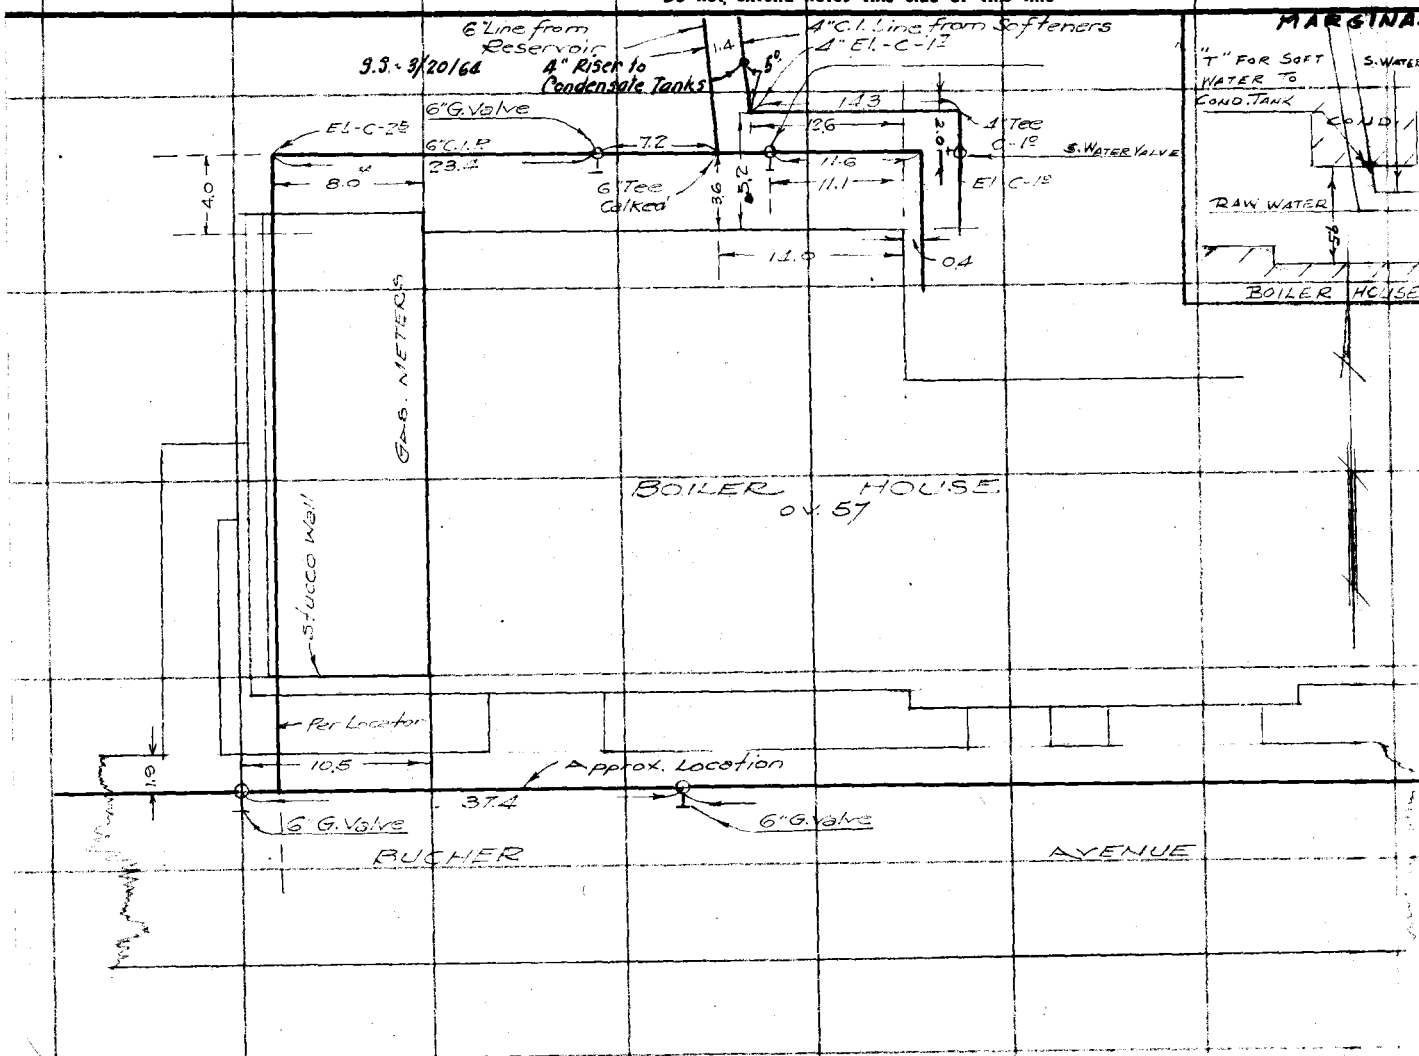

Notes Ck'd by
Map No.
Office Work
Checked
Date

Survey of OLIVE VIEW SANATORIUM
W. O. 8148 Tape No. St'd °F.
Surveyed by TED M. WALSH
Notes WALSH Date 6-1936
Indexed

F.B. 709 PG. 125

WATER LINES

F.B. 709 PG. 126

RETURN TO
LOS ANGELES COUNTY SURVEYOR
700 HALL OF RECORDS

Note: Any Additions or Changes on This Sheet Must be Made or Circled in Red Ink With Date and Name of Person Making Change.

Do not extend notes this side of this line.

Notes Ck'd by	Survey of OLIVE VIEW SANATORIUM	F.B. 709 Pg. 127
Map No.	W. O. 8148 Tape No. St'd °F.	WATER LINES
Office Work	Surveyed by TED WALSH	
Checked	Notes WALSH Date June 1936	
Date	Indexed A. C. Johnson	

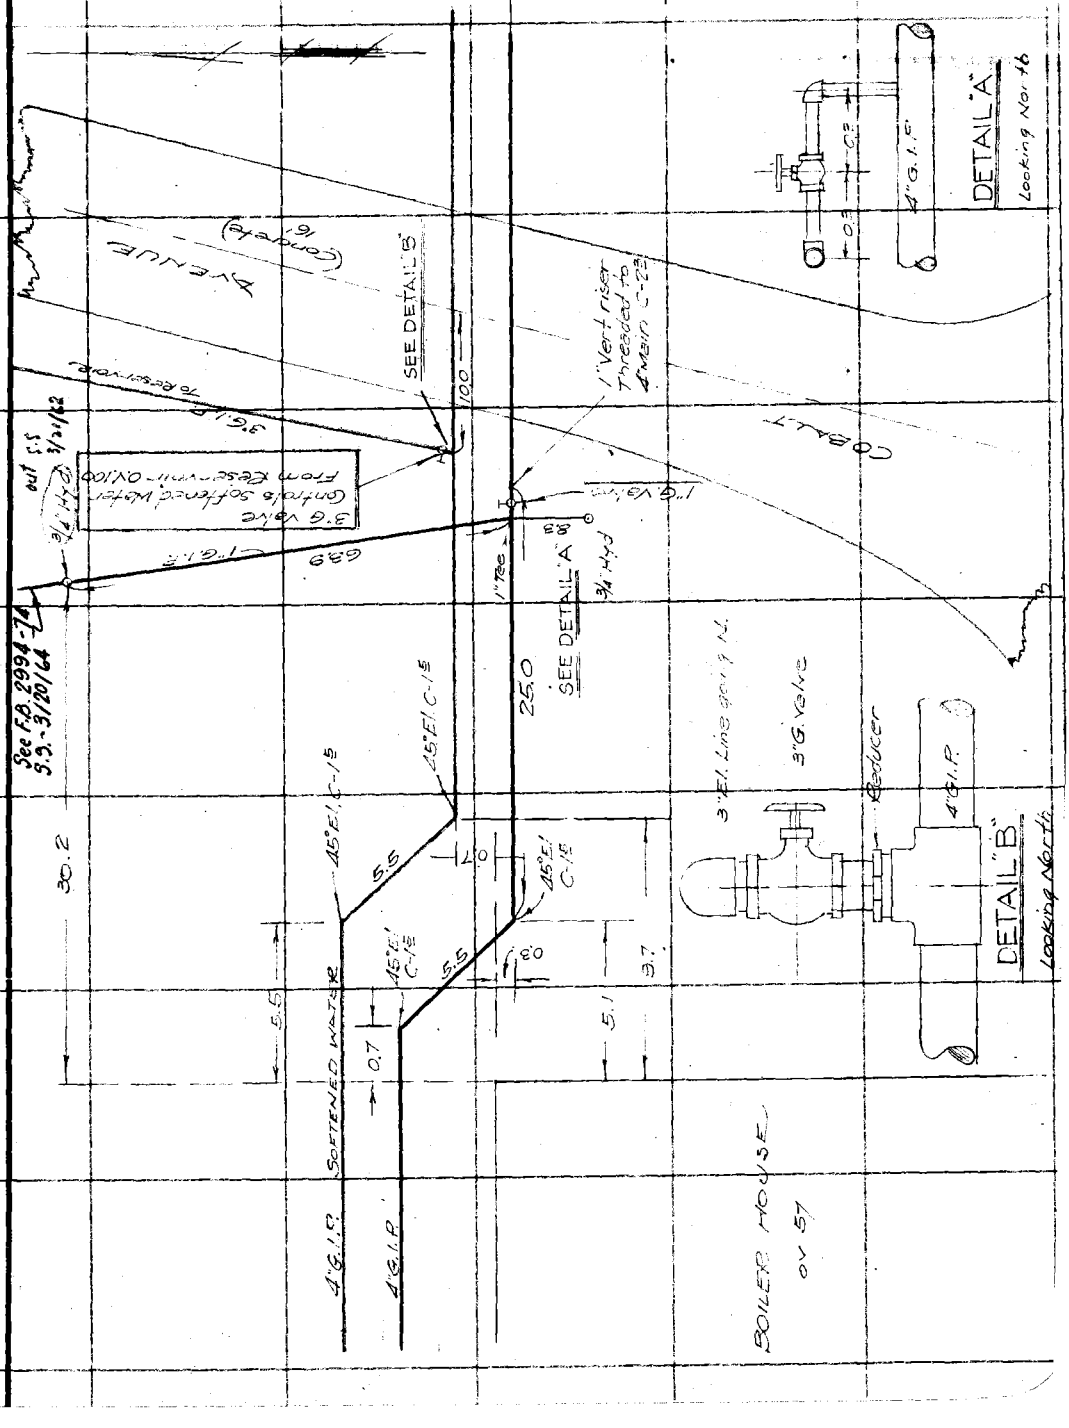

Note: Any Additions or Changes on This Sheet Must be Made or Circled in Red Ink With Date and Name of Person Making Change.

Do not extend notes this side of this line

RETURN TO
LOS ANGELES COUNTY SURVEYOR
700 HALL OF RECORDS

FORM 247 10M 11-35

F.B. 709 Pg. 128

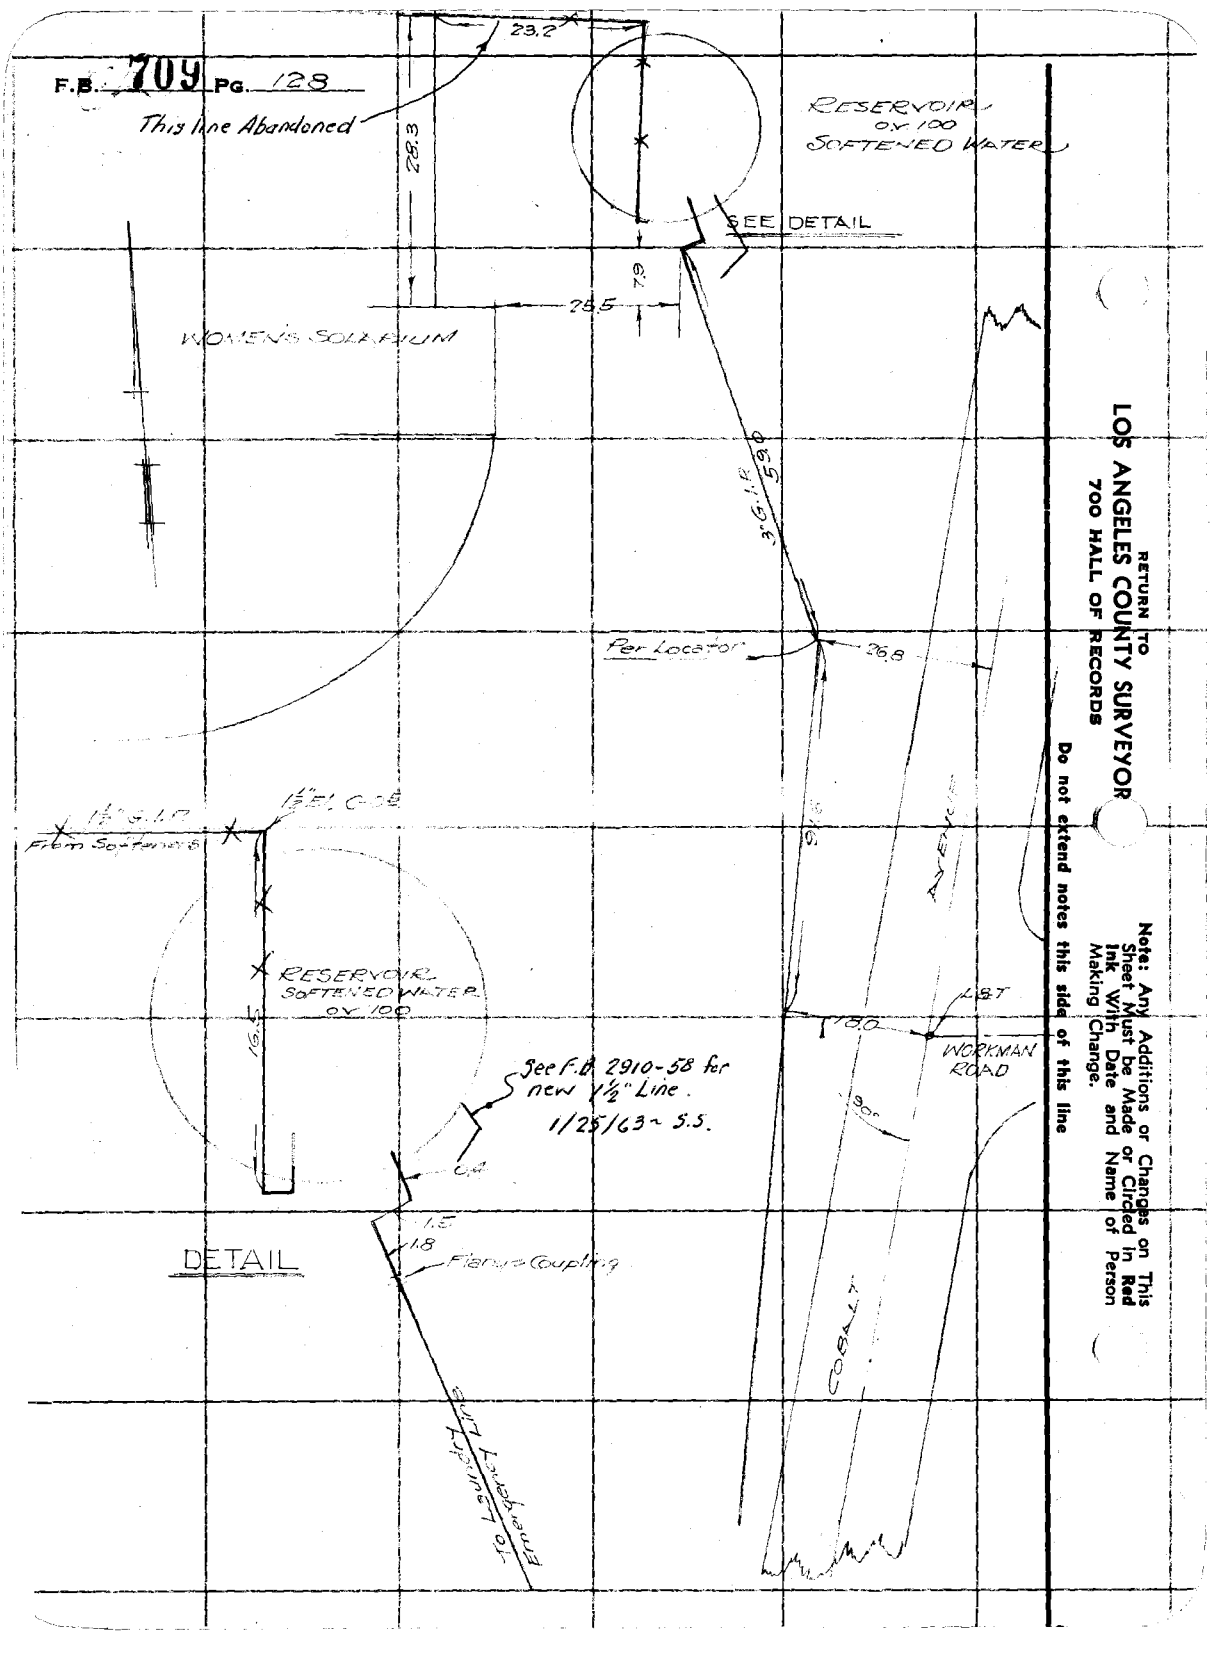

RETURN TO
LOS ANGELES COUNTY SURVEYOR
700 HALL OF RECORDS

Note: Any Additions or Changes on This Sheet Must be Made or Circled in Red Ink With Date and Name of Person Making Change.

Do not extend notes this side of this line

Notes Ck'd by	Survey of OLIVE VIEW SANATORIUM	F.B. 709	Pg. 129
Map No.	W. O. 8178 Tape No.	St'd °F.	
Office Work	Surveyed by J. WALSH		
Checked	Notes T. WALSH Date June 36		
Date	Indexed C. JOBES		

WATER LINES

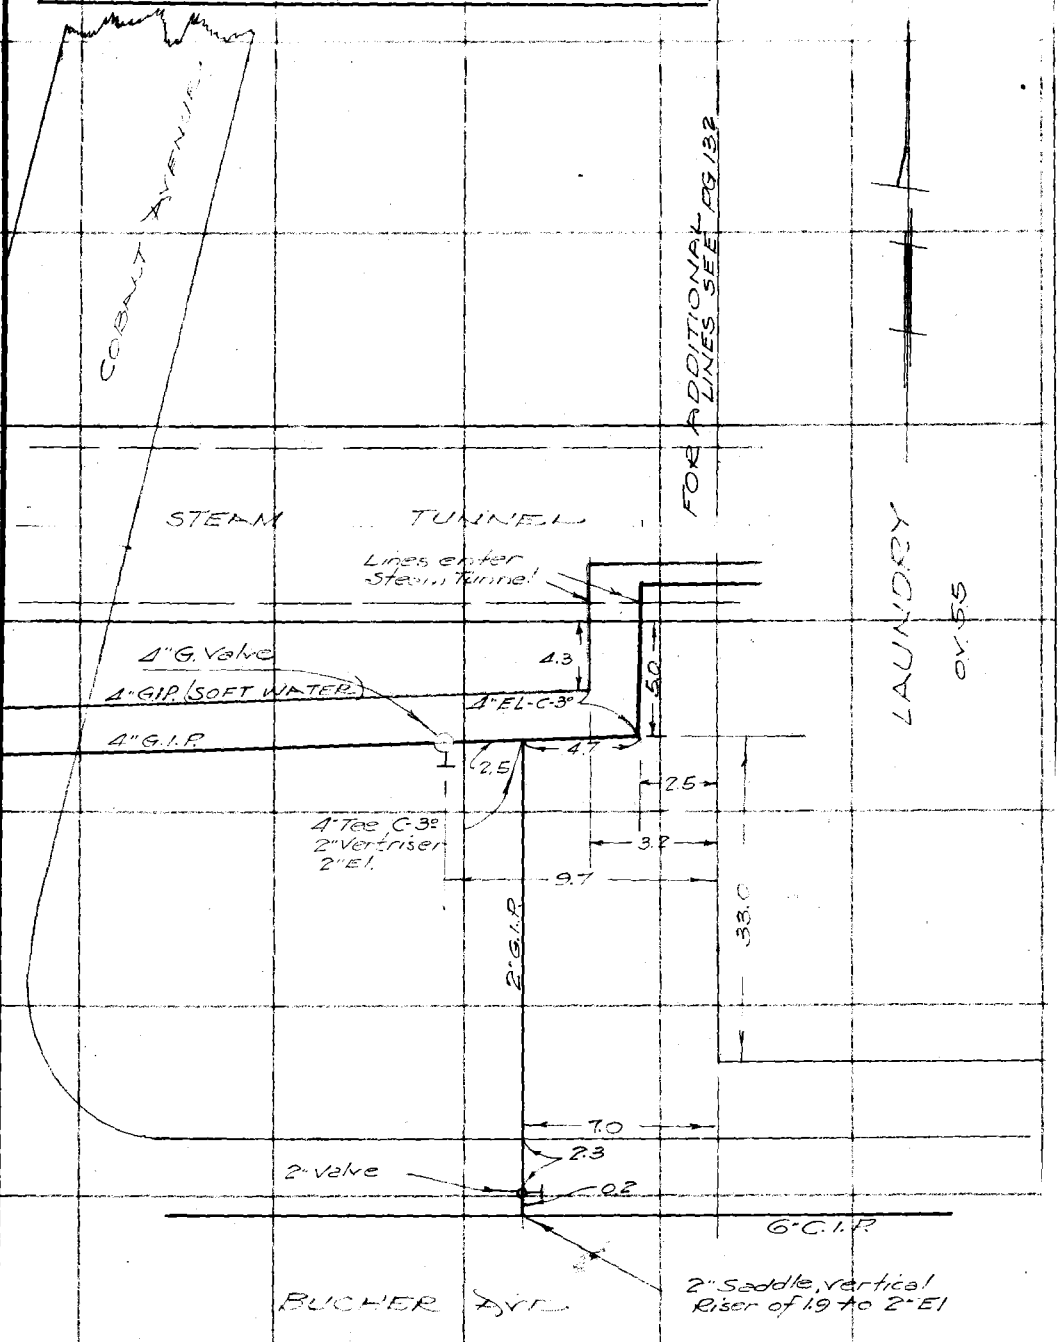

Note: Any Additions or Changes on This Sheet Must be Made or Circled in Red Ink With Date and Name of Person Making Change.

Do not extend notes this side of this line

RETURN TO
LOS ANGELES COUNTY SURVEYOR
700 HALL OF RECORDS

FORM 247 10M 11-35

F.B. 709 Pg. 130

JAN 29, 1937

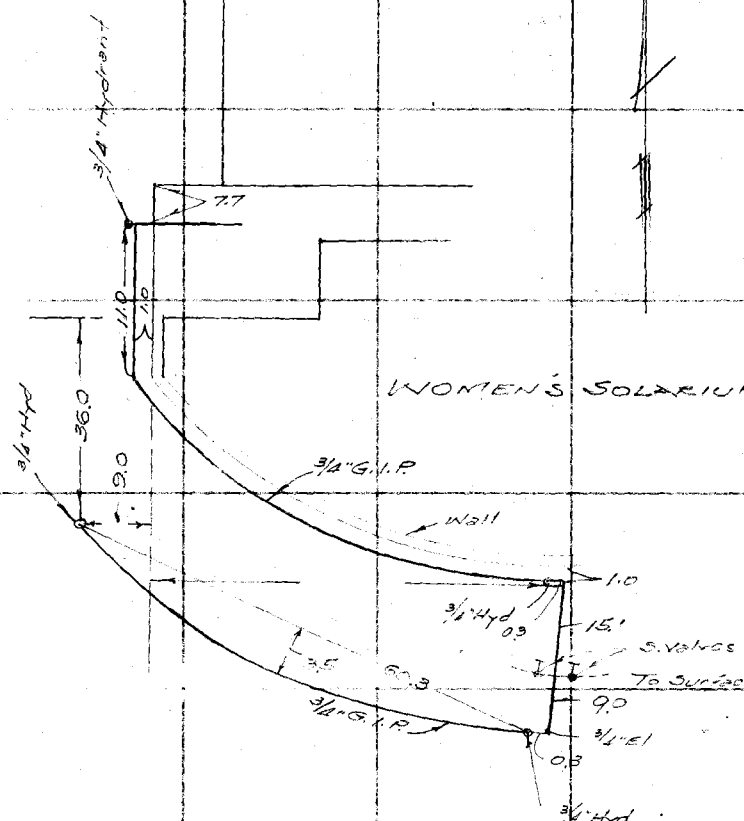

RETURN TO
LOS ANGELES COUNTY SURVEYOR
700 HALL OF RECORDS

Do not extend notes this side of this line

Note: Any Additions or Changes on This Sheet Must be Made or Circled in Red Ink With Date and Name of Person Making Change.

Notes Ck'd by	Survey of OLIVE VIEW SANATORIUM
Map No.	W. O. 8128 Tape No. St'd °F.
Office Work	Surveyed by T. M. WALSH
Checked	Notes T. M. WALSH Date 7-36
Date	Indexed A. C. Johnson

F.B. 709 PG. 131

WATER LINES

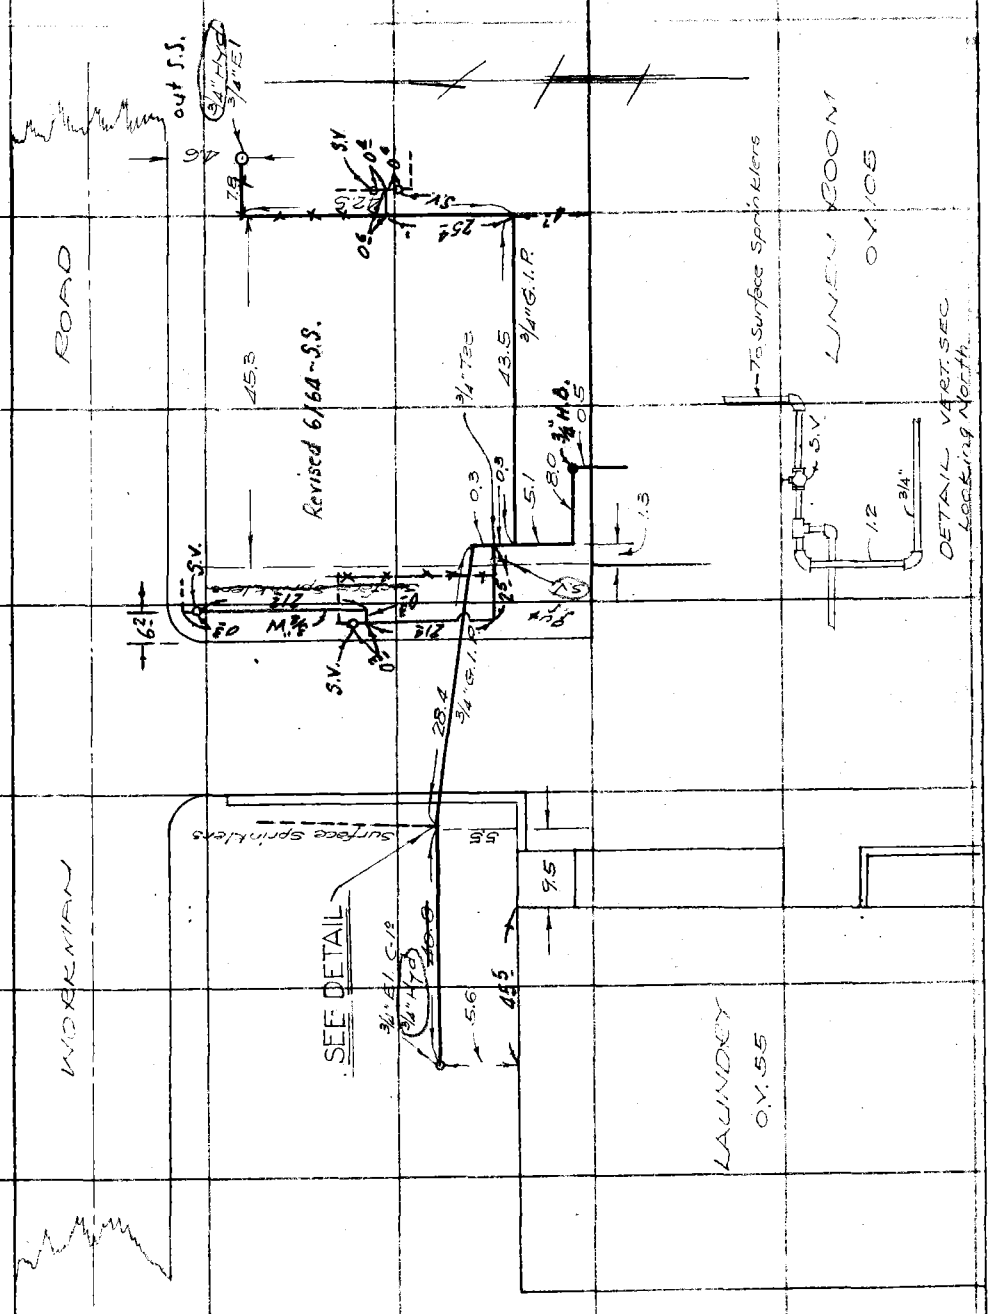

Note: Any Additions or Changes on This Sheet Must be Made or Circled in Red Ink With Date and Name of Person Making Change.

Do not extend notes this side of this line

RETURN TO
LOS ANGELES COUNTY SURVEYOR
700 HALL OF RECORDS

FORM 247 10M 11-35

F.B. 709 PG. 132

RETURN TO
LOS ANGELES COUNTY SURVEYOR
700 HALL OF RECORDS

Note: Any Additions or Changes on This Sheet Must be Made or Circled in Red Ink With Date and Name of Person Making Change.

Do not extend notes this side of this line

FORM 247 10M 11-38

RETURN TO
LOS ANGELES COUNTY SURVEYOR
700 HALL OF RECORDS

Note: Any Additions or Changes on This Sheet Must be Made or Circled in **Red Ink** With Date and Name of Person Making Change.

Do not extend notes this side of this line

Notes Ck'd by
Map No.
Office Work
Checked
Date

Survey of OLIVE VIEW SANATORIUM
W. O. 8128 Tape No. T. M. WALSH °F.
Surveyed by T. M. WALSH Date 7-36
Notes
Indexed


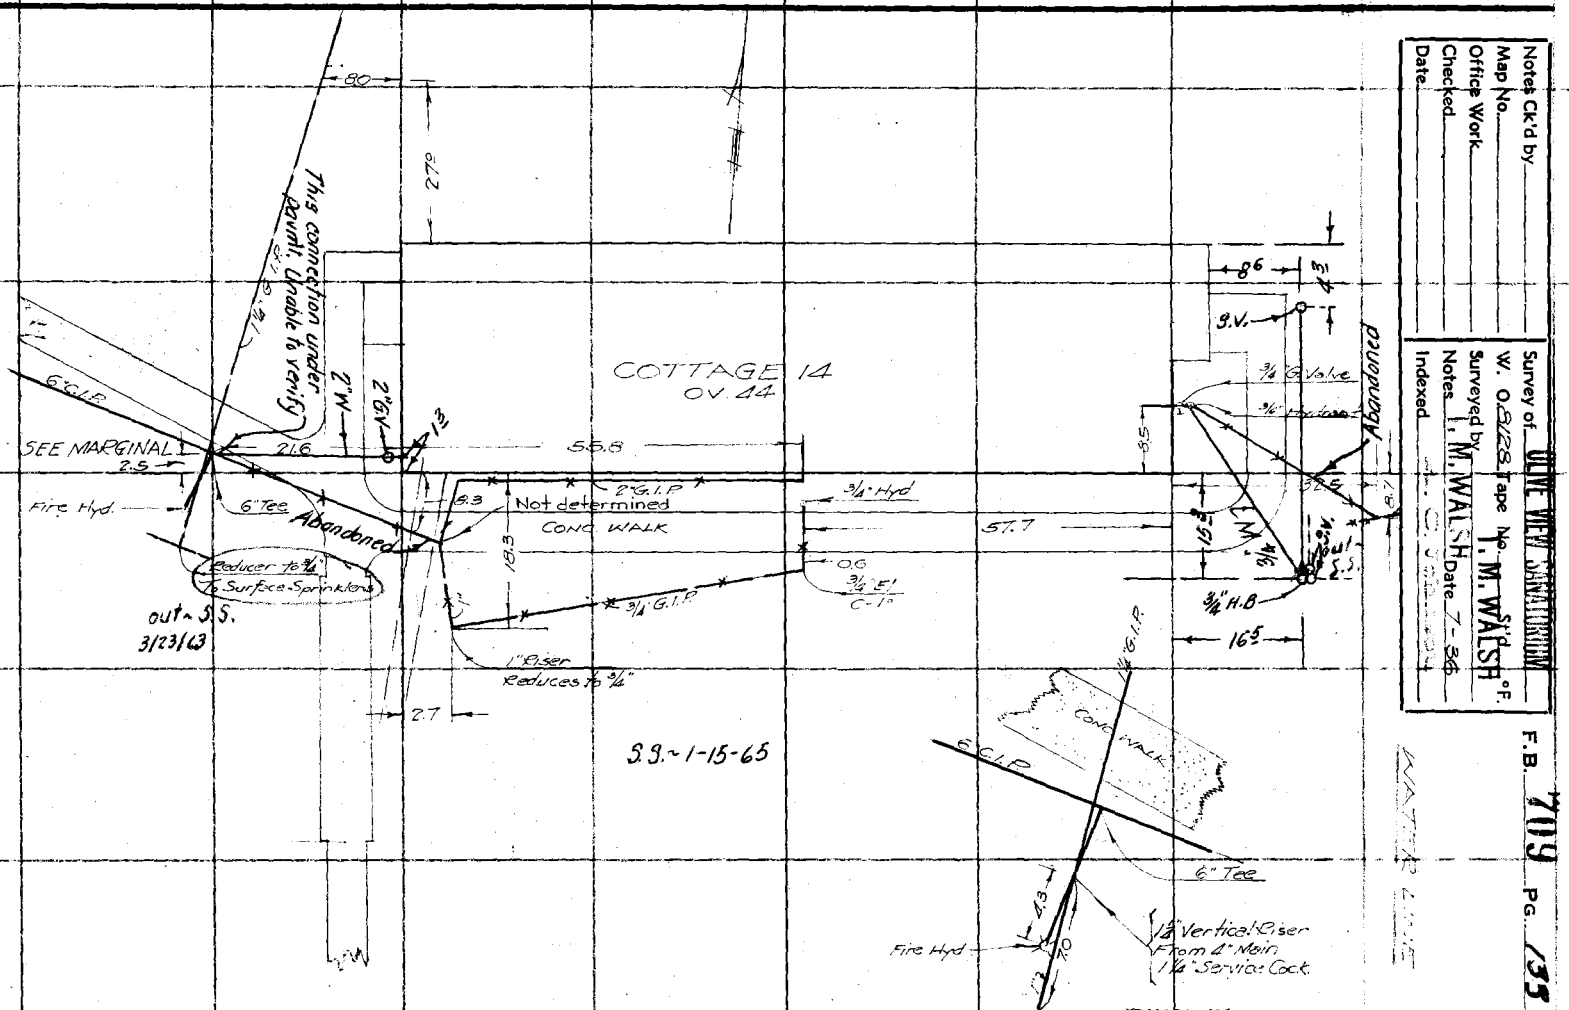

RETURN TO
LOS ANGELES COUNTY SURVEYOR
700 HALL OF RECORDS

Note: Any Additions or Changes on This Sheet Must be Made or Circled in **Red Ink** With Date and Name of Person Making Change.

Do not extend notes this side of this line

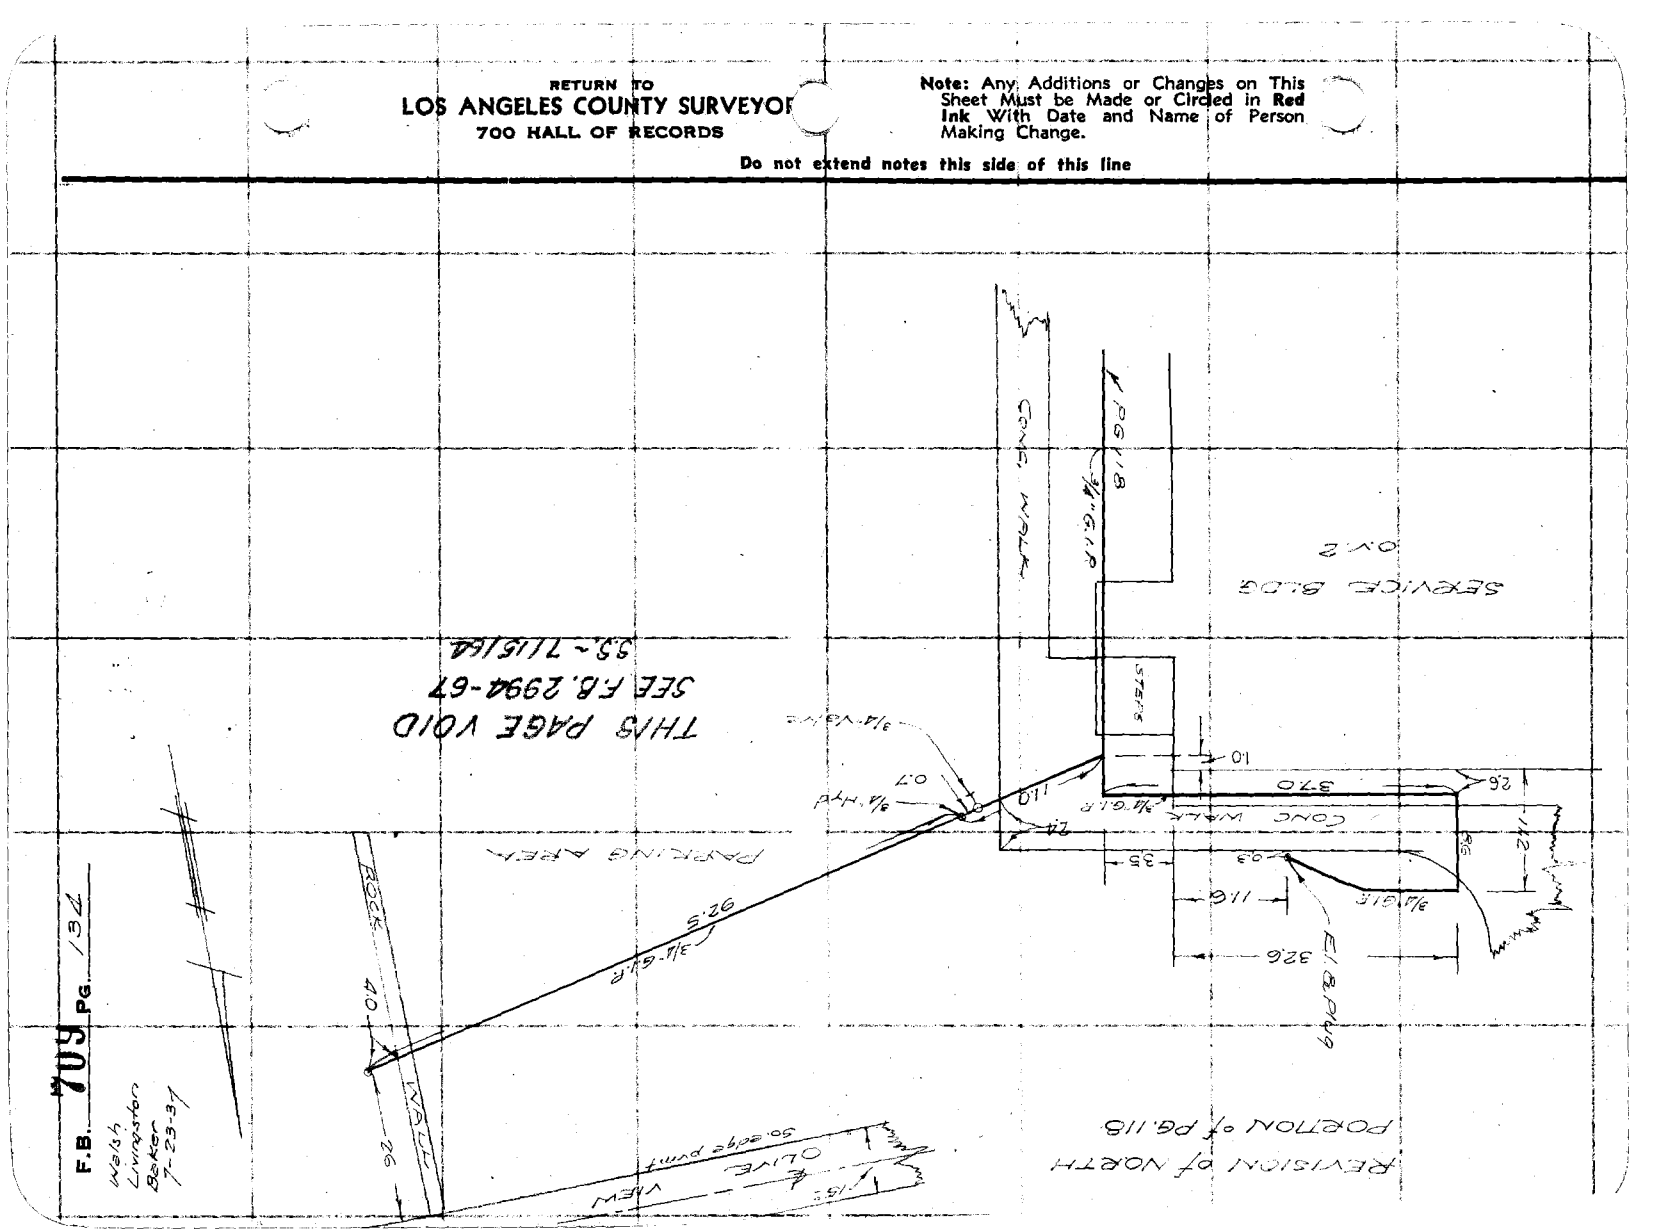

Notes Ck'd by	Survey of OLIVE VIEW SANATORIUM	F.B. 709 Pg. 135
Map No.	W. O. 8128 Tape No. St'd °F.	WATER LINES
Office Work	Surveyed by T. M. WALSH	
Checked	Notes T. M. WALSH Date 7-36	
Date	Indexed A. C. Johnson	

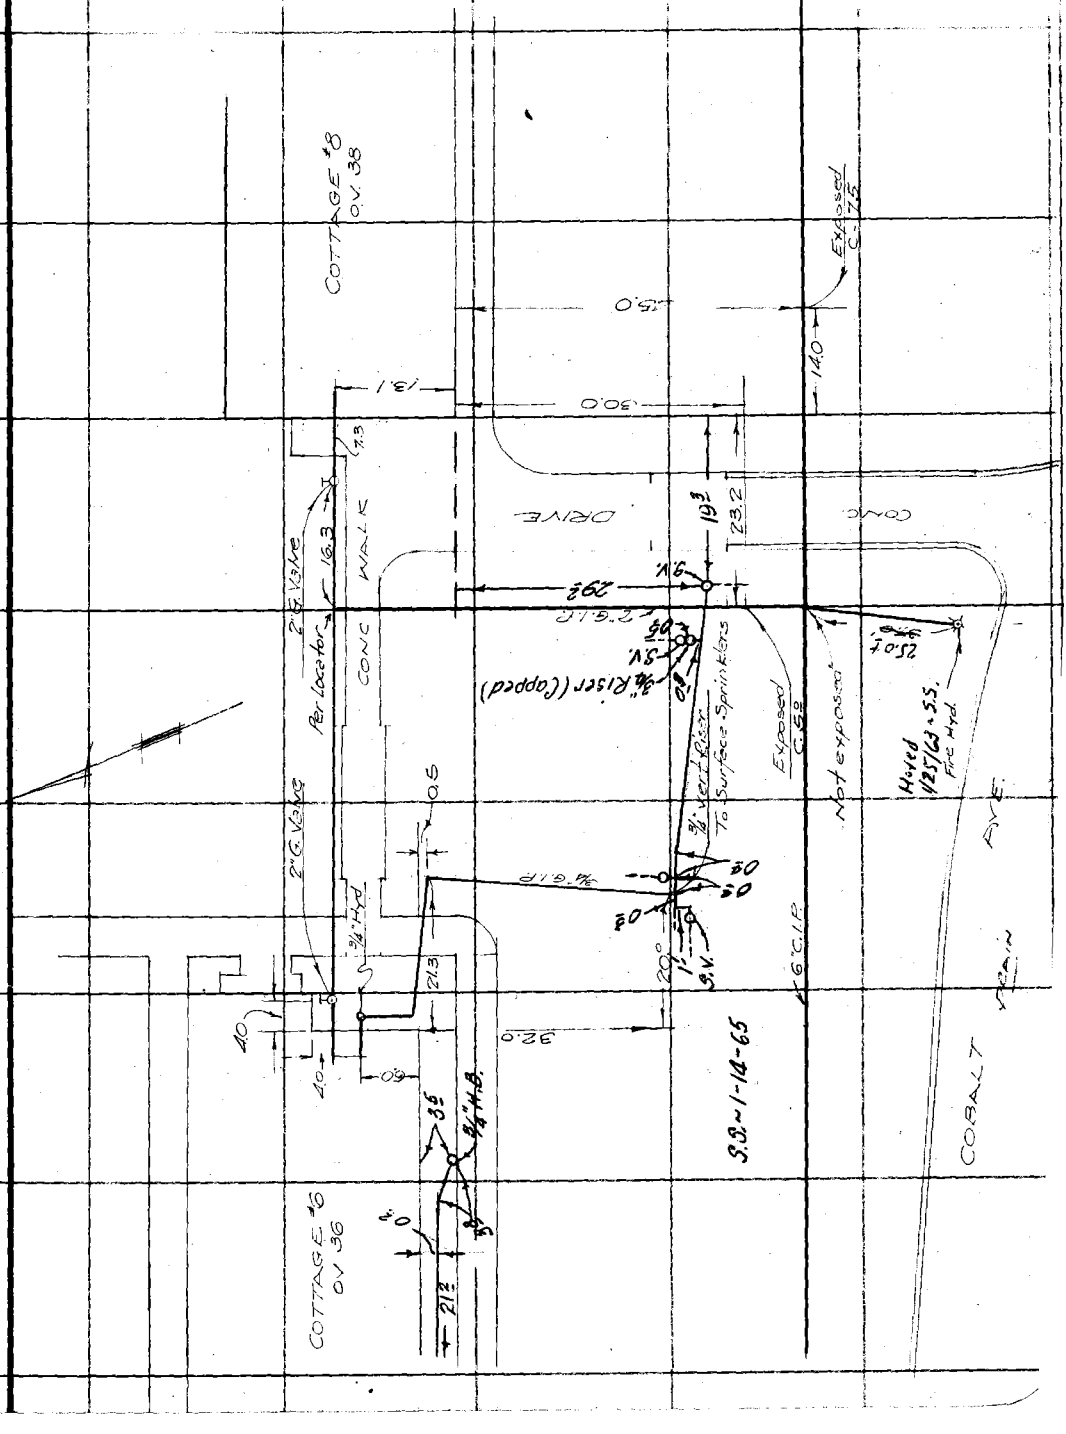

Note: Any Additions or Changes on This Sheet Must be Made or Circled in Red Ink With Date and Name of Person Making Change.

Do not extend notes this side of this line

RETURN TO
LOS ANGELES COUNTY SURVEYOR
700 HALL OF RECORDS

FORM 247 10M 11-35

RETURN TO
LOS ANGELES COUNTY SURVEYOR
700 HALL OF RECORDS

Note: Any Additions or Changes on This Sheet Must be Made or Circled in **Red Ink** With Date and Name of Person Making Change.

Do not extend notes this side of this line

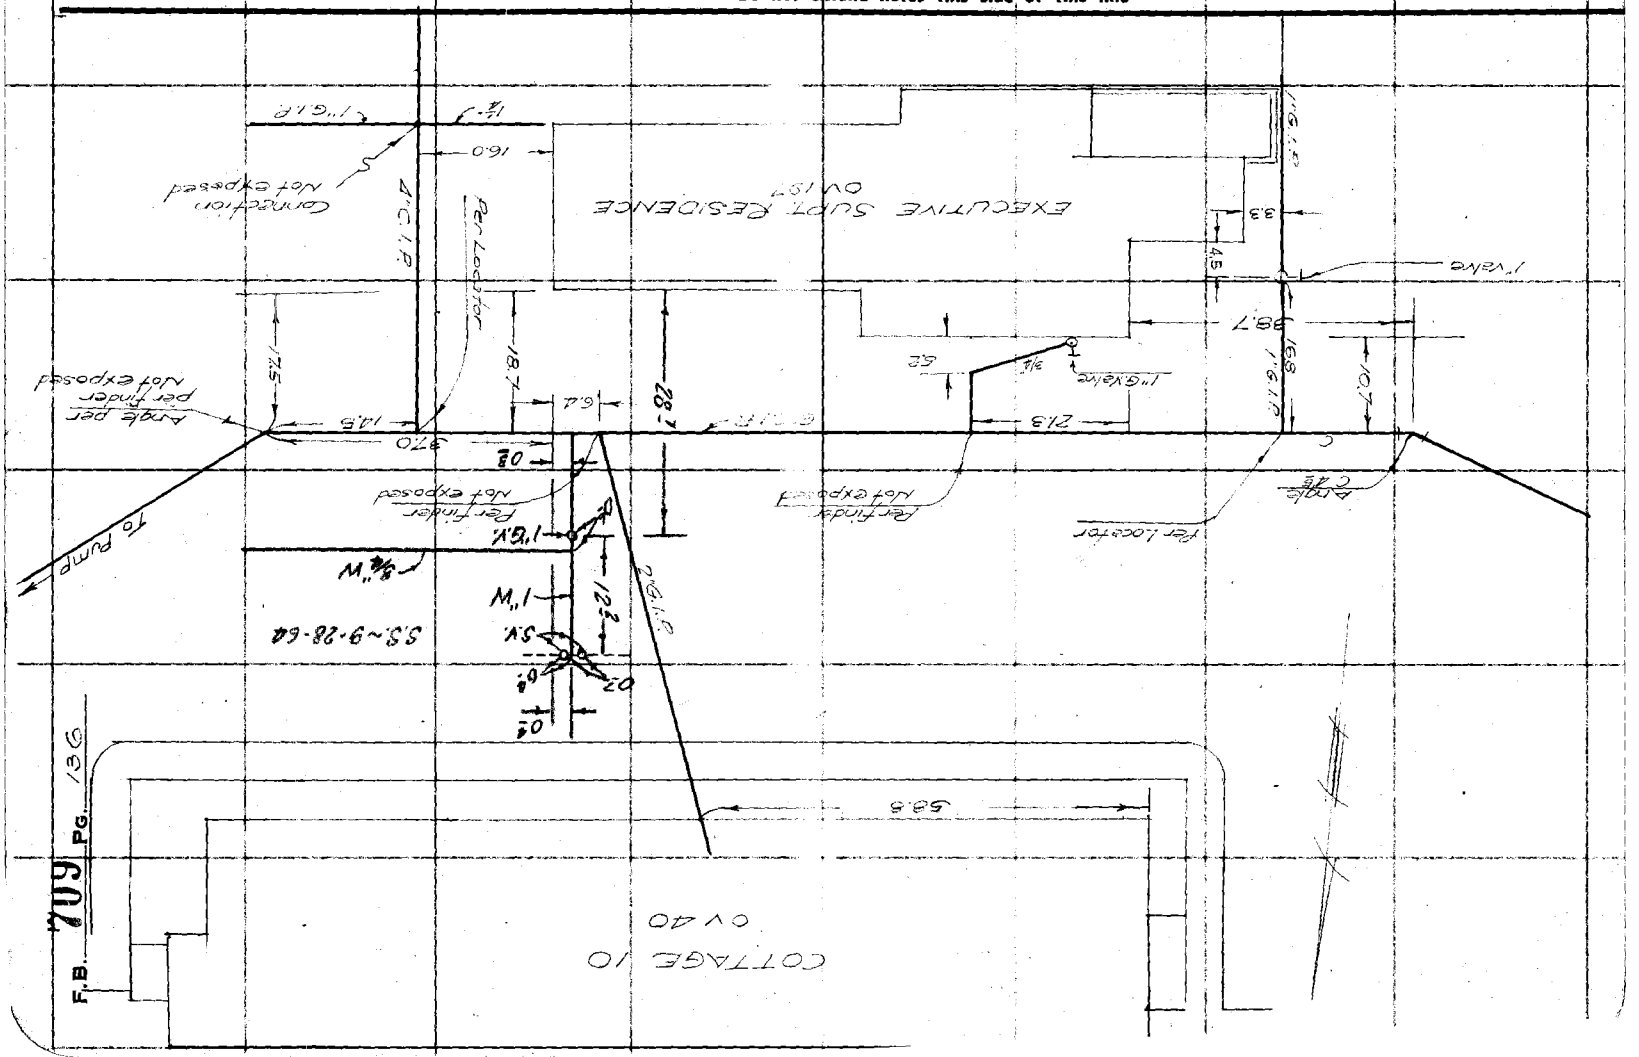

F.B. 709 PG. 136

FORM 247 10M 11-35

RETURN TO
LOS ANGELES COUNTY SURVEYOR
700 HALL OF RECORDS

Note: Any Additions or Changes on This Sheet Must be Made or Circled in **Red Ink** With Date and Name of Person Making Change.

Do not extend notes this side of this line

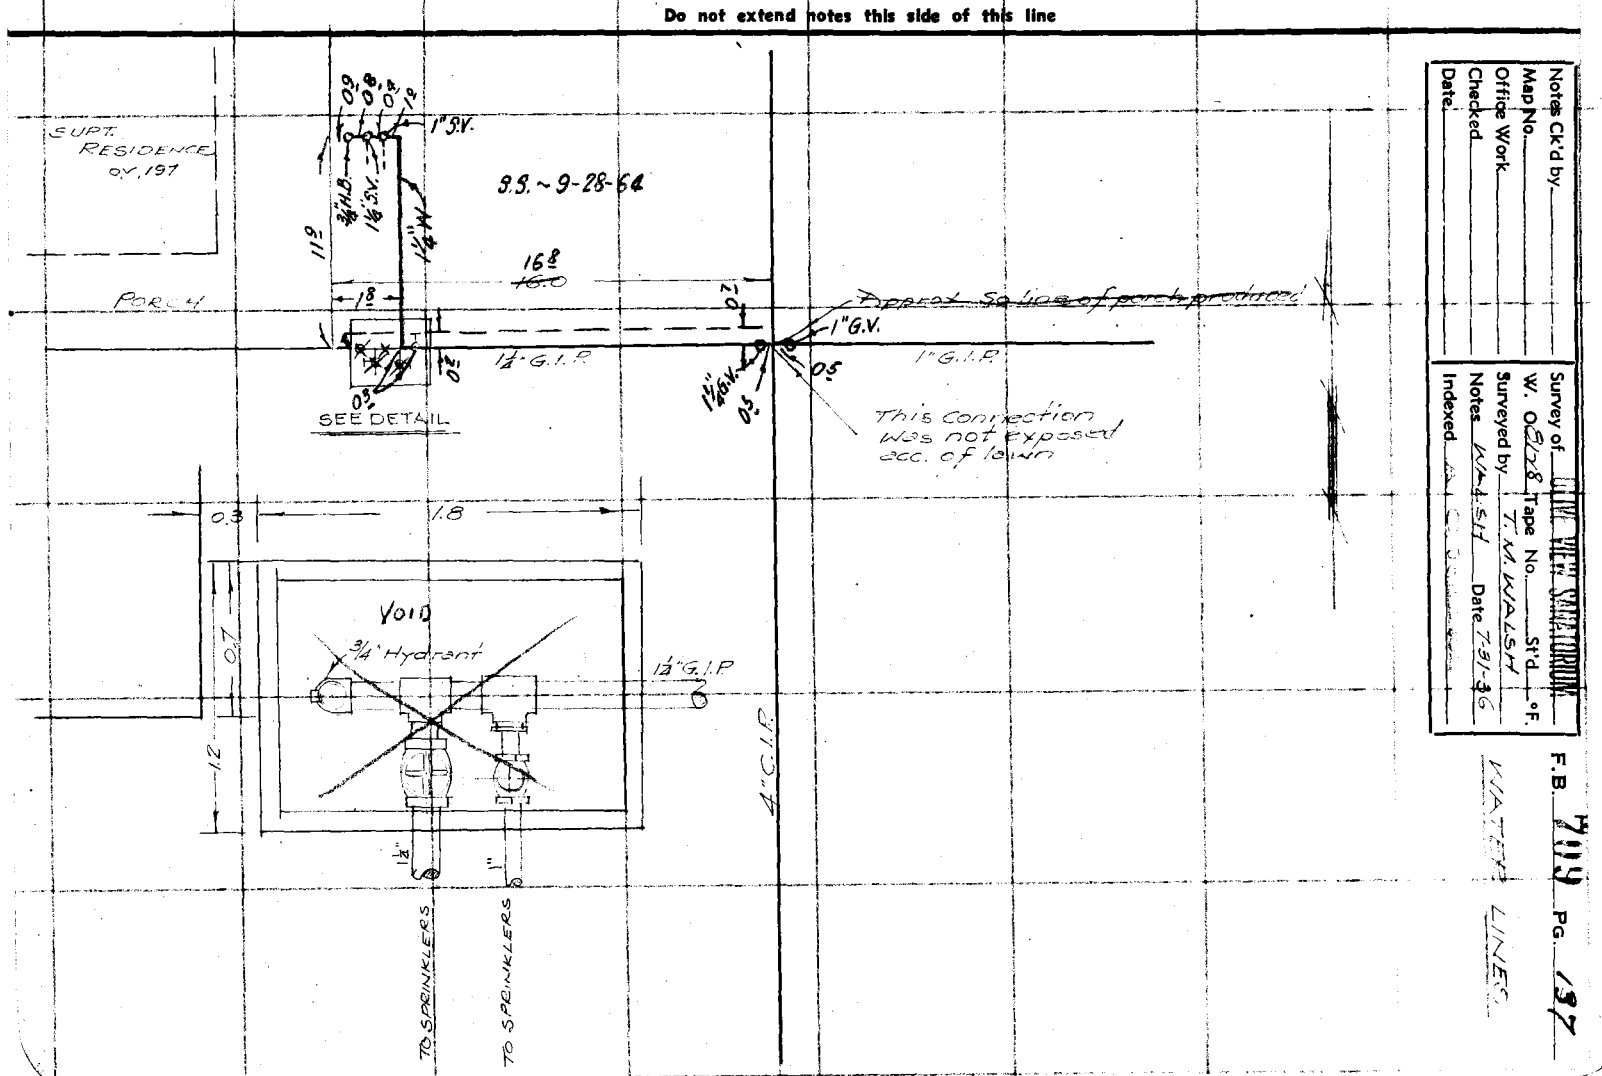

Notes Ck'd by
Map No.
Office Work
Checked
Date

Survey of OLIVE VIEW SANATORIUM
W. O. 8128 Tape No. St'd. °F.
Surveyed by T. M. WALSH Date 7-31-36
Notes WATER LINES
Indexed


RETURN TO
LOS ANGELES COUNTY SURVEYOR
700 HALL OF RECORDS

Note: Any Additions or Changes on This Sheet Must be Made or Circled in **Red** Ink With Date and Name of Person Making Change.

Do not extend notes this side of this line

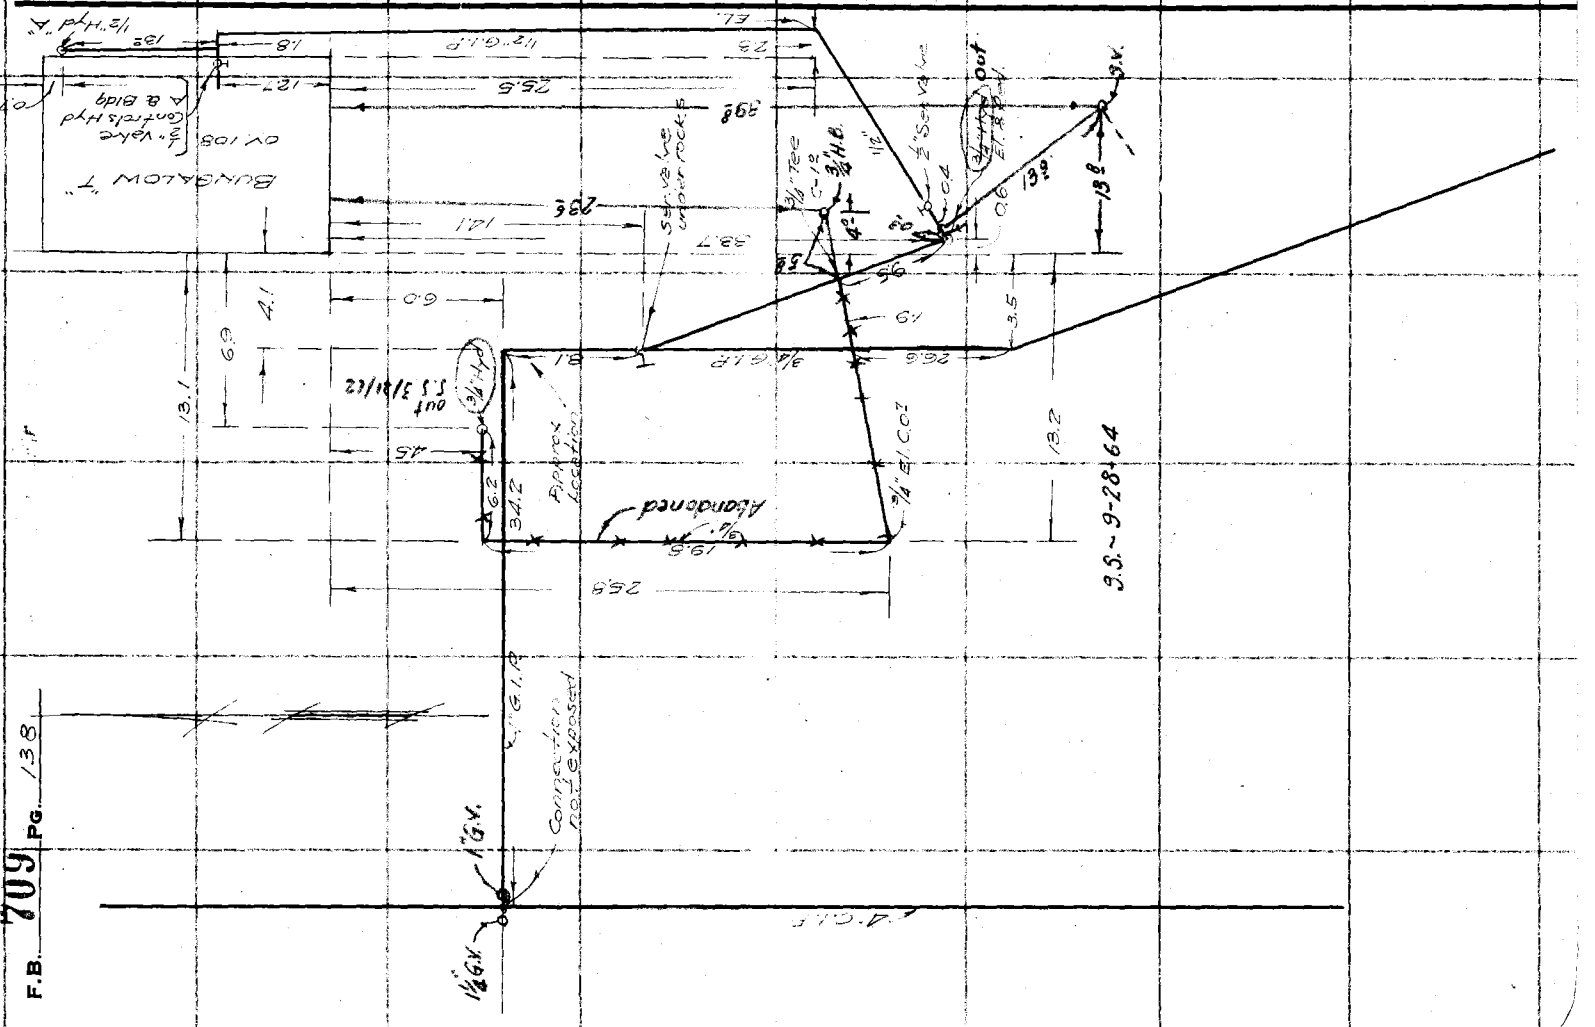

Notes Ck'd by	Survey of OLIVE VIEW SANATORIUM	F.B. 709 Pg. 139
Map No.	W. O. 8148 Tape No. St'd °F.	
Office Work	Surveyed by TEO M. WALSH	WATER LINES
Checked	Notes WALSH Date 7-31-36	
Date	Indexed A. C. Johns	

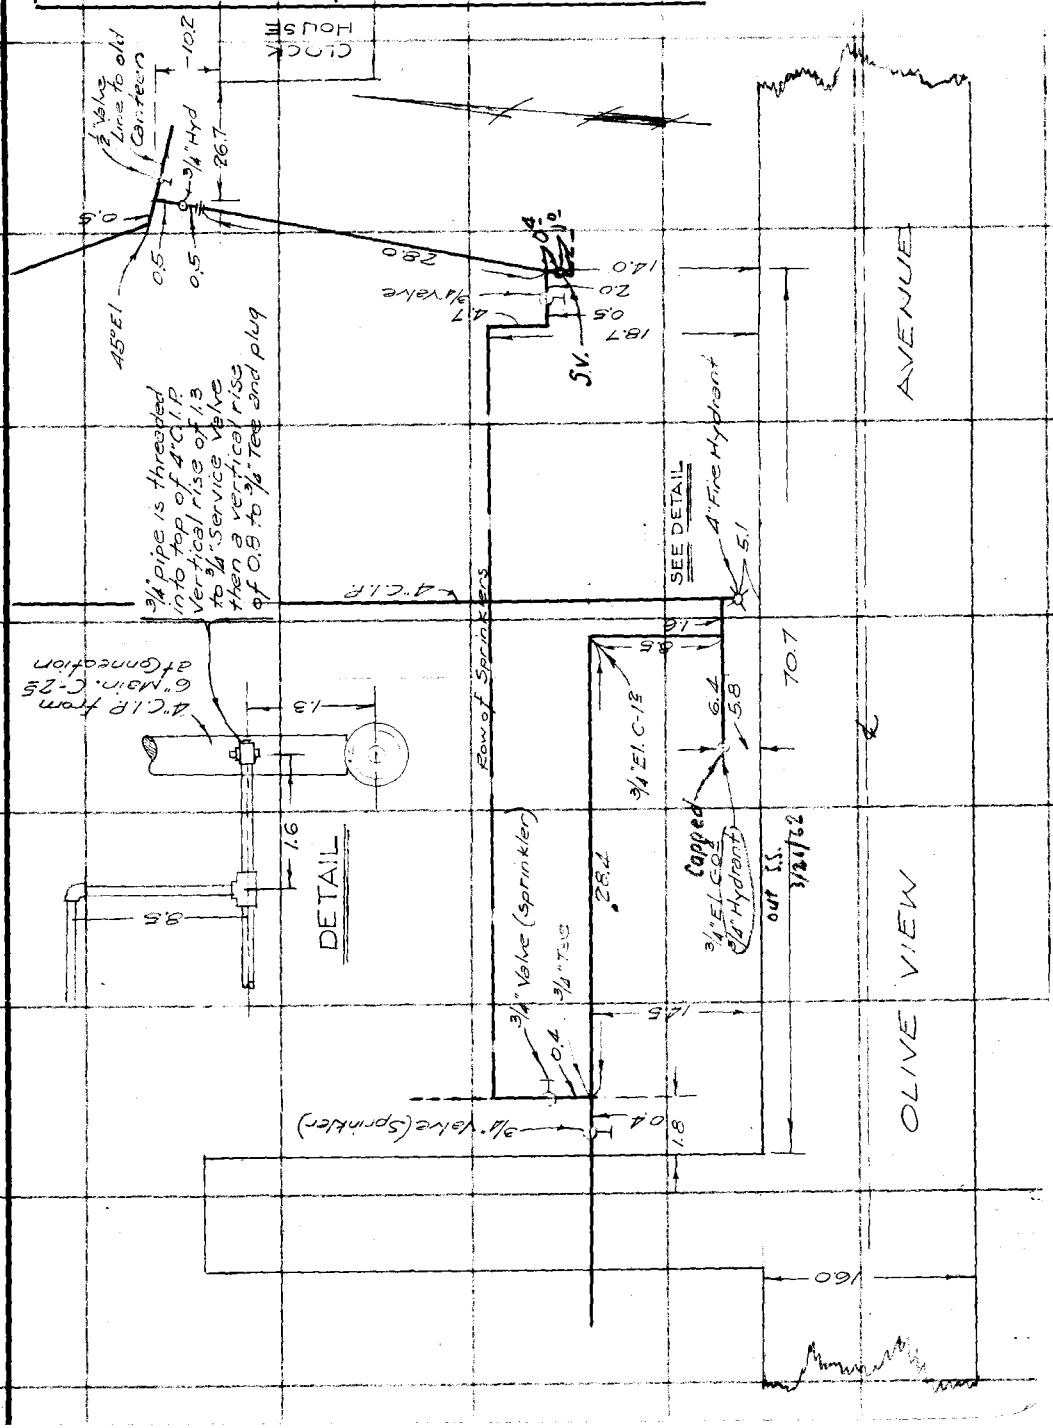

Note: Any Additions or Changes on This Sheet Must be Made or Circled in Red Ink With Date and Name of Person Making Change.

Do not extend notes this side of this line

RETURN TO
LOS ANGELES COUNTY SURVEYOR
700 HALL OF RECORDS

FORM 247 10M 11-35

RETURN TO
LOS ANGELES COUNTY SURVEYOR
700 HALL OF RECORDS

Note: Any Additions or Changes on This Sheet Must be Made or Circled in **Red Ink** With Date and Name of Person Making Change.

Do not extend notes this side of this line

F.B. 709 Pg. 140

Notes Ck'd by	Survey of OLIVE VIEW SANATORIUM	F.B. 709 PG. 141
Map No.	W. O. 8148 Tape No. St'd °F.	WATER LINES
Office Work	Surveyed by TED WALSH	
Checked	Notes WALSH Date 7/31/36	
Date	Indexed A. C. [illegible]	

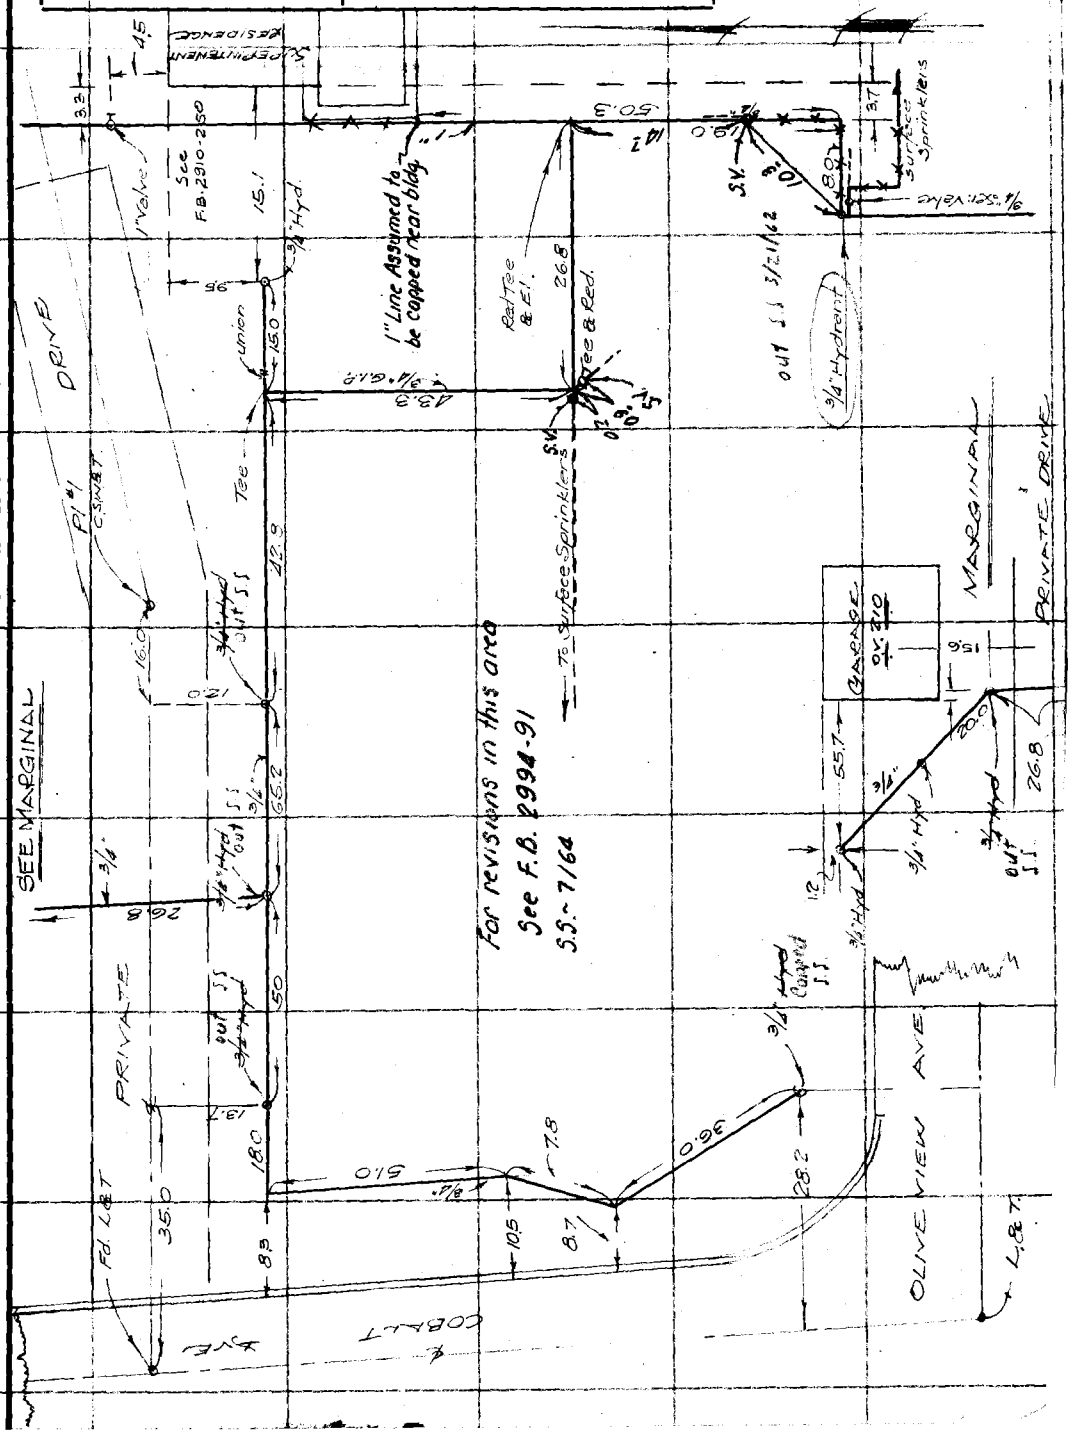

Note: Any Additions or Changes on This Sheet Must be Made or Circled in Red Ink With Date and Name of Person Making Change.

Do not extend notes this side of this line

RETURN TO
LOS ANGELES COUNTY SURVEYOR
700 HALL OF RECORDS

FORM 247 10M 11-35

F.B. 709 Pg. 142

12

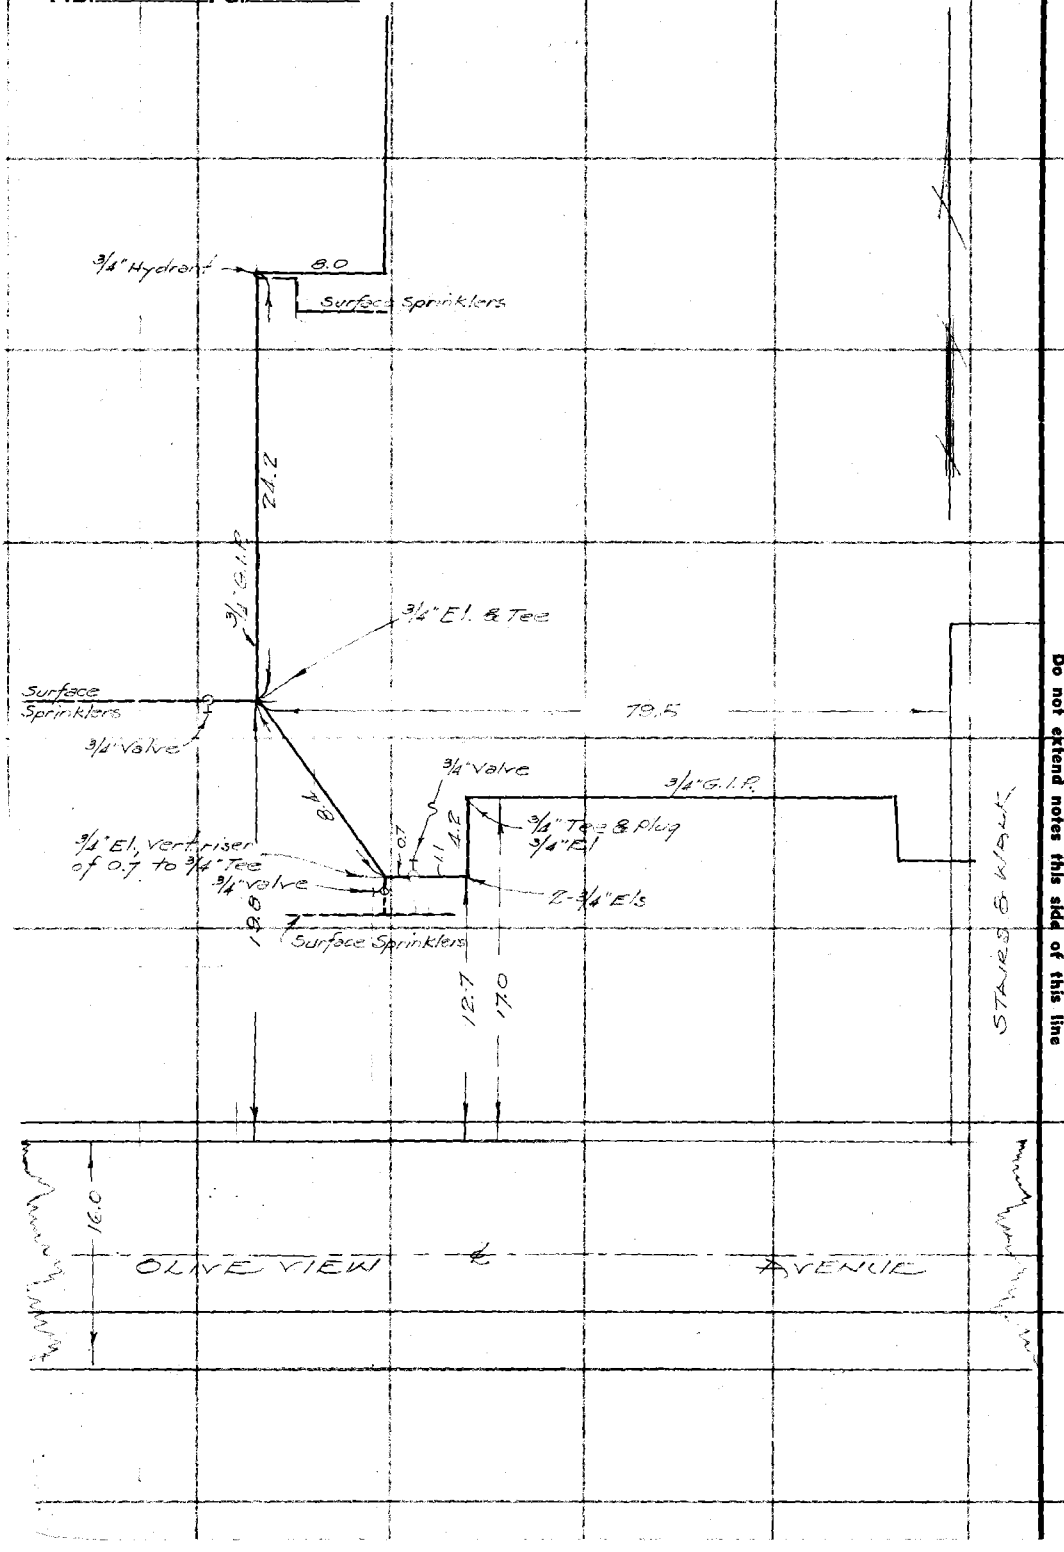

RETURN TO
LOS ANGELES COUNTY SURVEYOR
700 HALL OF RECORDS

Note: Any Additions or Changes on This Sheet Must be Made or Circled in Red Ink With Date and Name of Person Making Change.

Do not extend notes this side of this line

FORM 247 10M 11-35

RETURN TO
LOS ANGELES COUNTY SURVEYOR
700 HALL OF RECORDS

Note: Any Additions or Changes on This Sheet Must be Made or Circled in **Red Ink** With Date and Name of Person Making Change.

Do not extend notes this side of this line

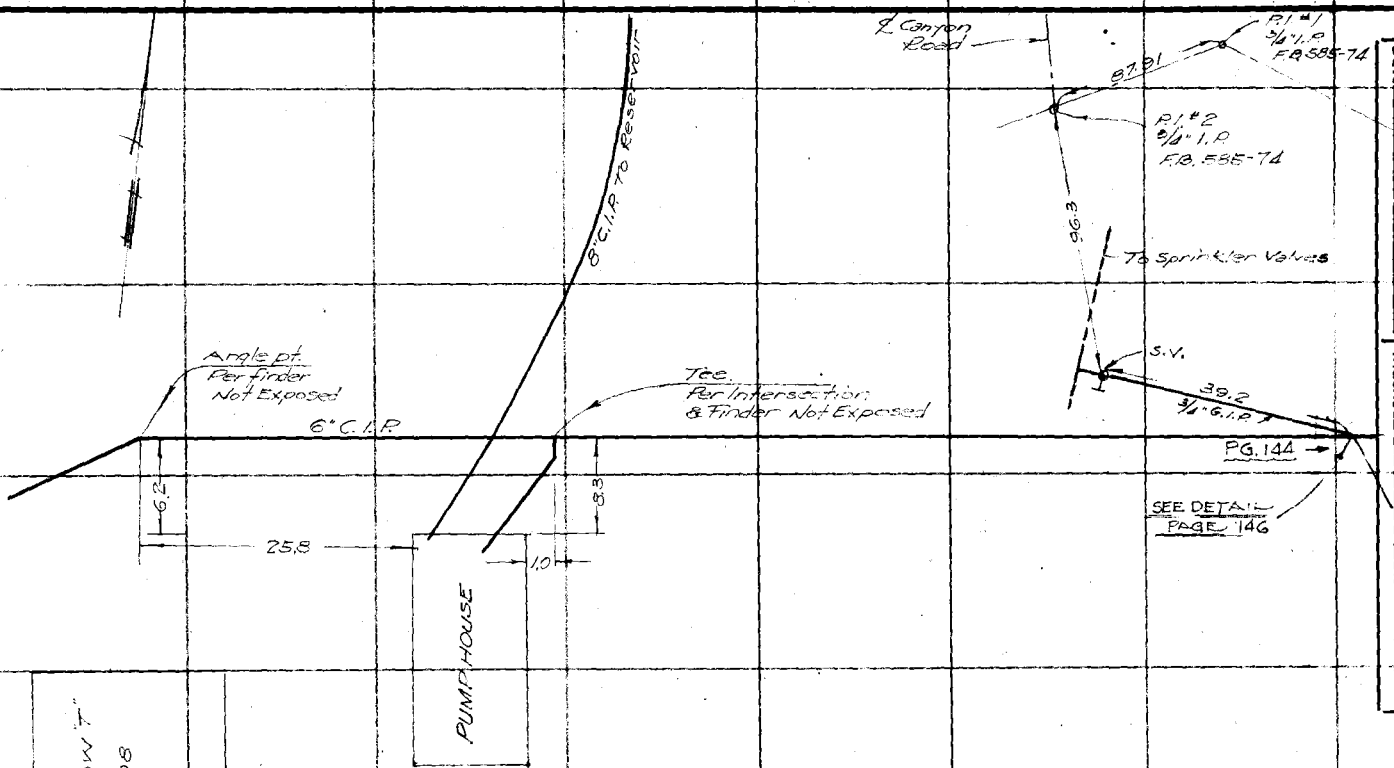

Notes Ck'd by
Map No.
Office Work
Checked
Date

Survey of OLIVE VIEW SANATORIUM
W. O. 8128 Tract No.
Surveyed by T. M. WALSH St'd °F.
Notes T. M. WALSH Date 8-36
Indexed A. C. Johnson


WATER LINES

RETURN TO
LOS ANGELES COUNTY SURVEYOR
700 HALL OF RECORDS

Note: Any Additions or Changes on This Sheet Must be Made or Circled in **Red Ink** With Date and Name of Person Making Change.

Do not extend notes this side of this line

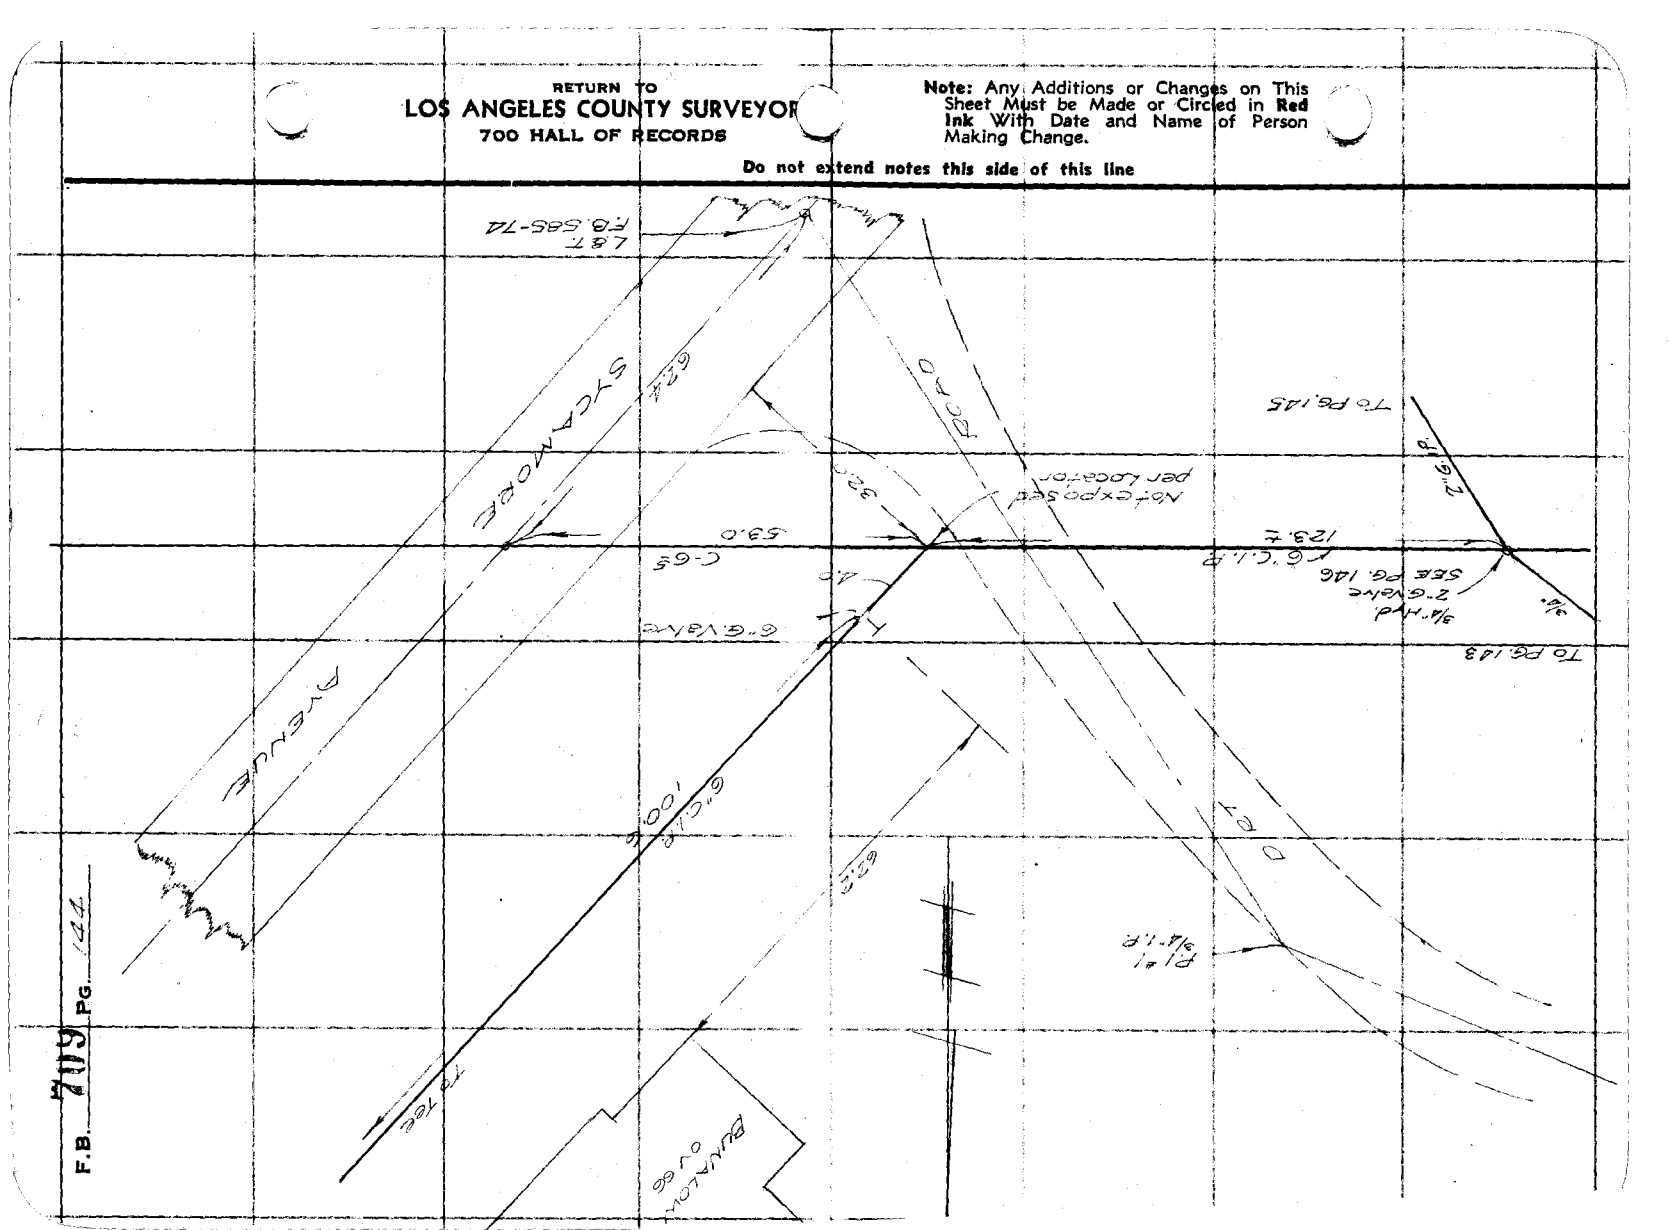

FORM 247 10M 11-35

RETURN TO
LOS ANGELES COUNTY SURVEYOR
700 HALL OF RECORDS

Note: Any Additions or Changes on This Sheet Must be Made or Circled in **Red** Ink With Date and Name of Person Making Change.

Do not extend notes this side of this line

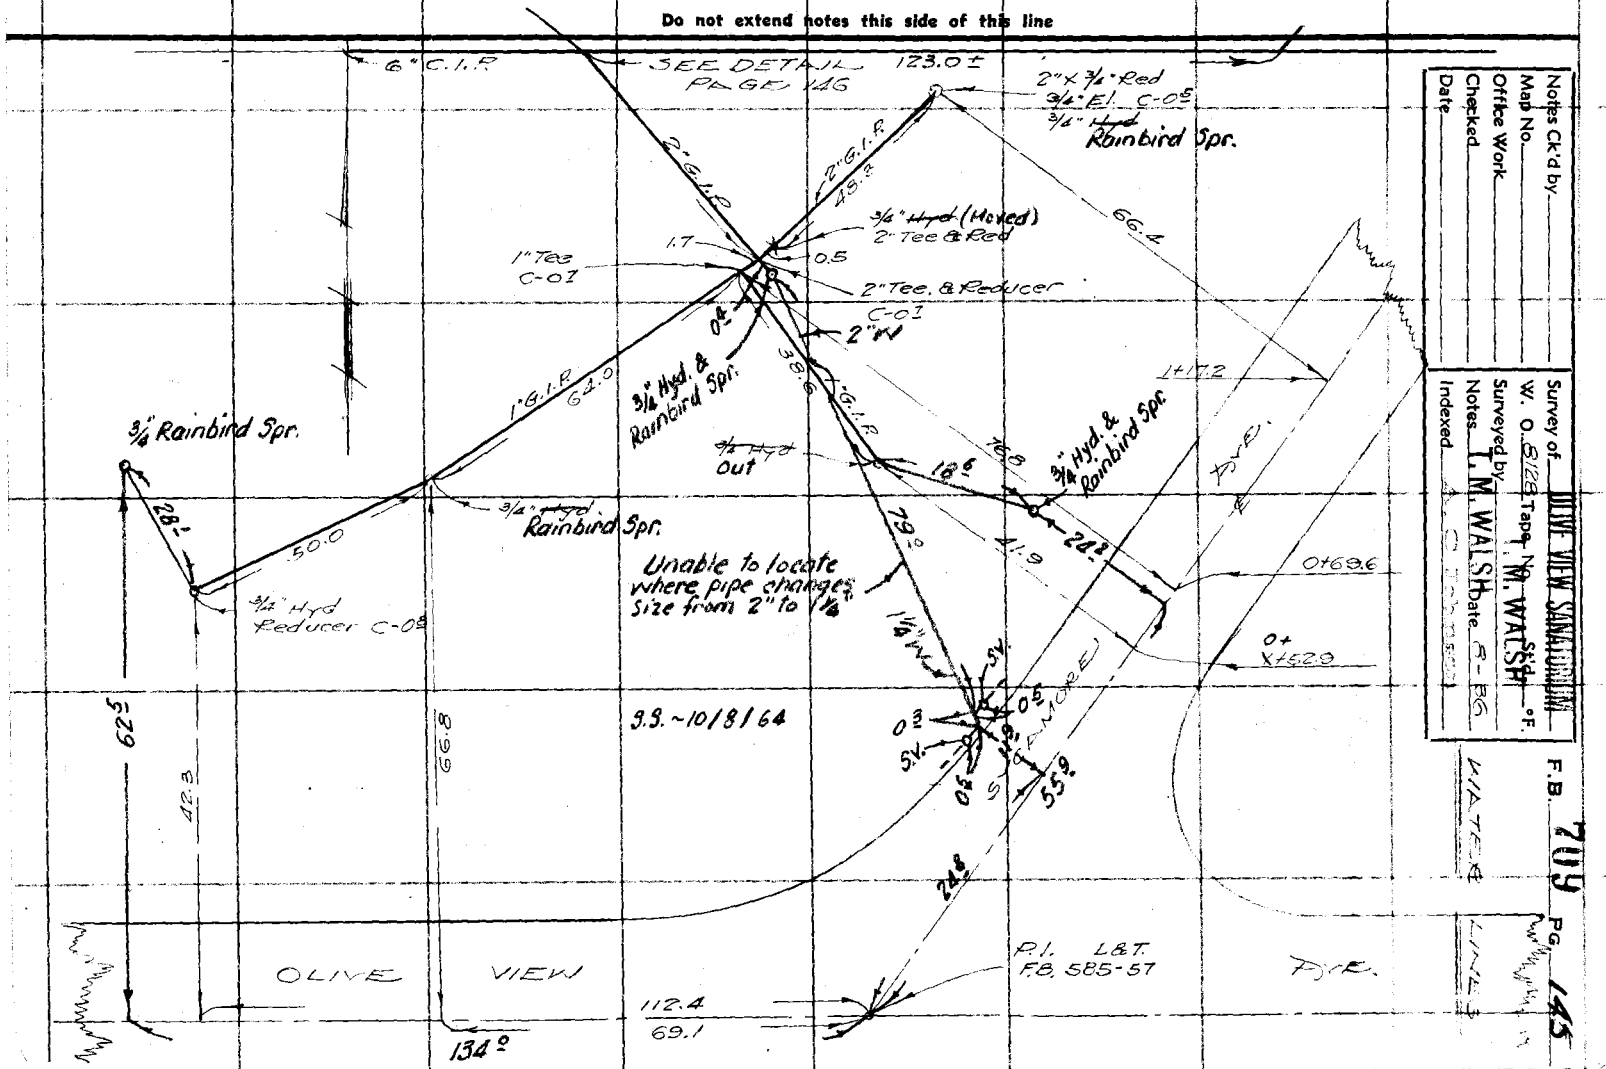

Notes Ck'd by
Map No.
Office Work
Checked
Date

Survey of OLIVE VIEW SANITARIUM
W. O. 8128 Tape No. M. WALSH °F.
Surveyed by T. M. WALSH Date 8-86
Notes T. M. WALSH
Indexed

F.B. 709 PG. 145

RETURN TO
LOS ANGELES COUNTY SURVEYOR
700 HALL OF RECORDS

Note: Any Additions or Changes on This Sheet Must be Made or Circled in **Red Ink** With Date and Name of Person Making Change.

Do not extend notes this side of this line

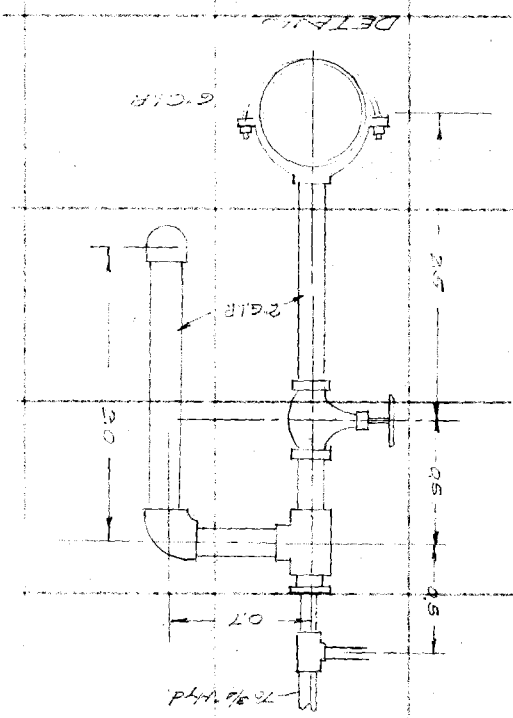

F.B. 709 Pg. 146

FORM 247 10M 11-35

RETURN TO
LOS ANGELES COUNTY SURVEYOR
700 HALL OF RECORDS

Note: Any Additions or Changes on This Sheet Must be Made or Circled in **Red Ink** With Date and Name of Person Making Change.

Do not extend notes this side of this line

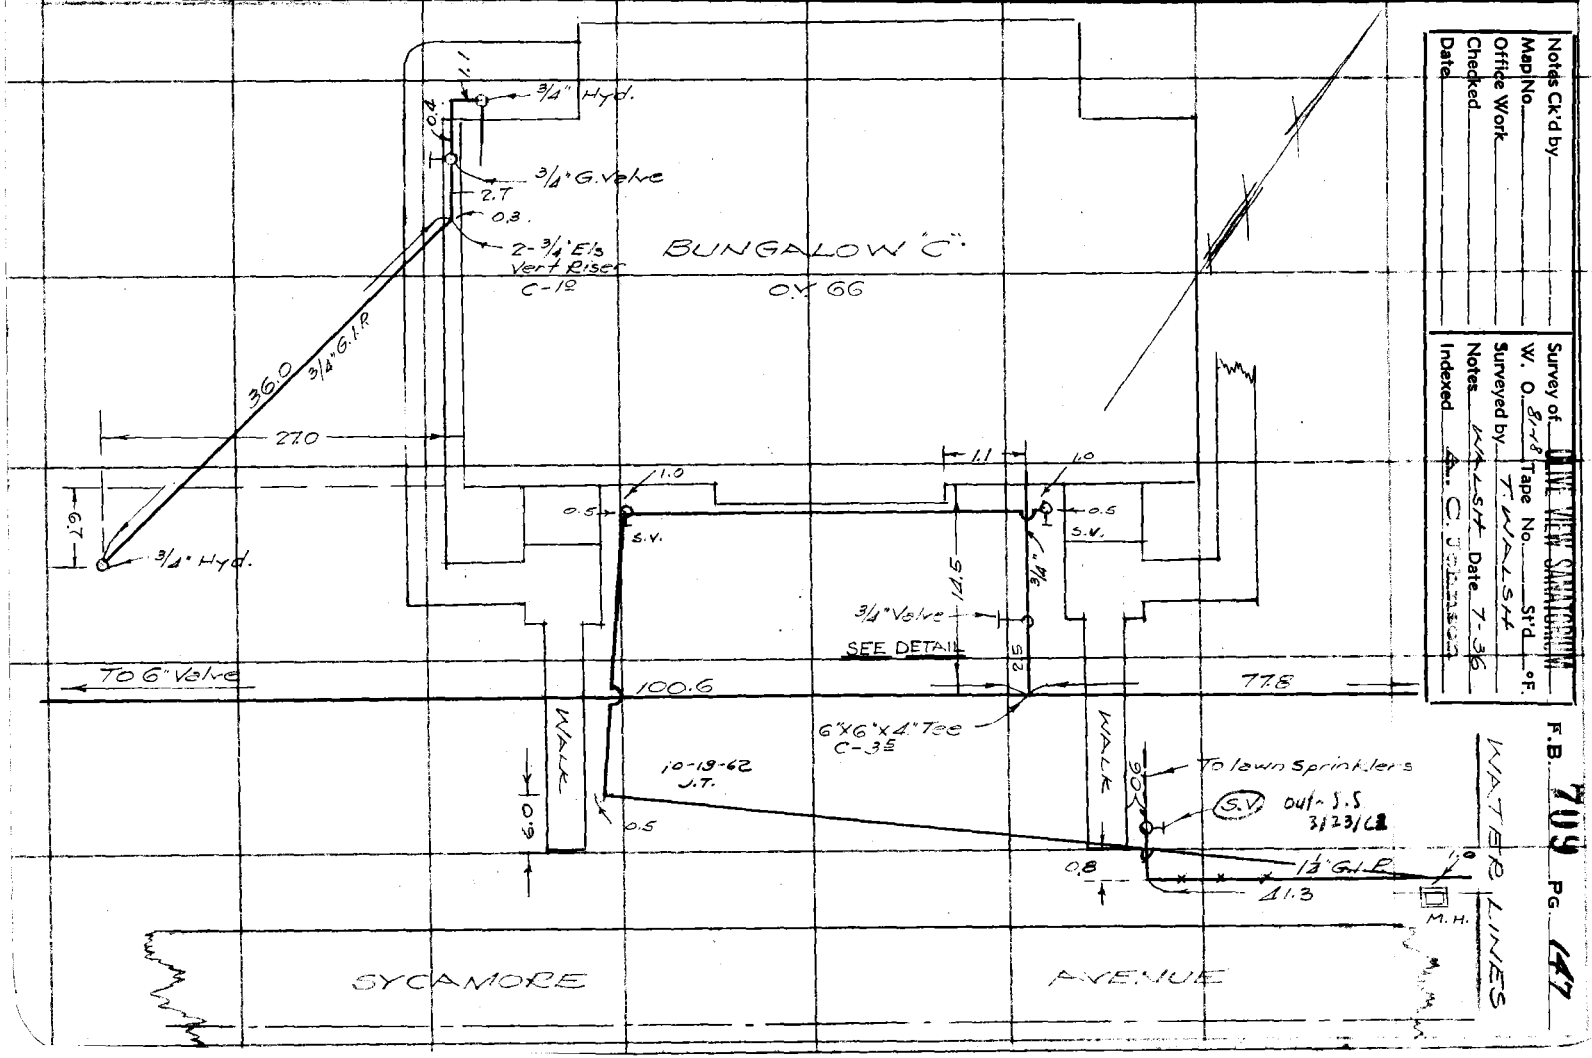

Notes Ck'd by
Map No.
Office Work
Checked
Date

Survey of LIVE VIEW SANITARIUM
W. O. St'd Tape No. St'd °F.
Surveyed by T. WALSH Date 7-36
Notes
Indexed A. C. JOHNSON

F.B. 709 PG. 147

WATER LINES

RETURN TO
LOS ANGELES COUNTY SURVEYOR
700 HALL OF RECORDS

Note: Any Additions or Changes on This Sheet Must be Made or Circled in **Red Ink** With Date and Name of Person Making Change.

Do not extend notes this side of this line

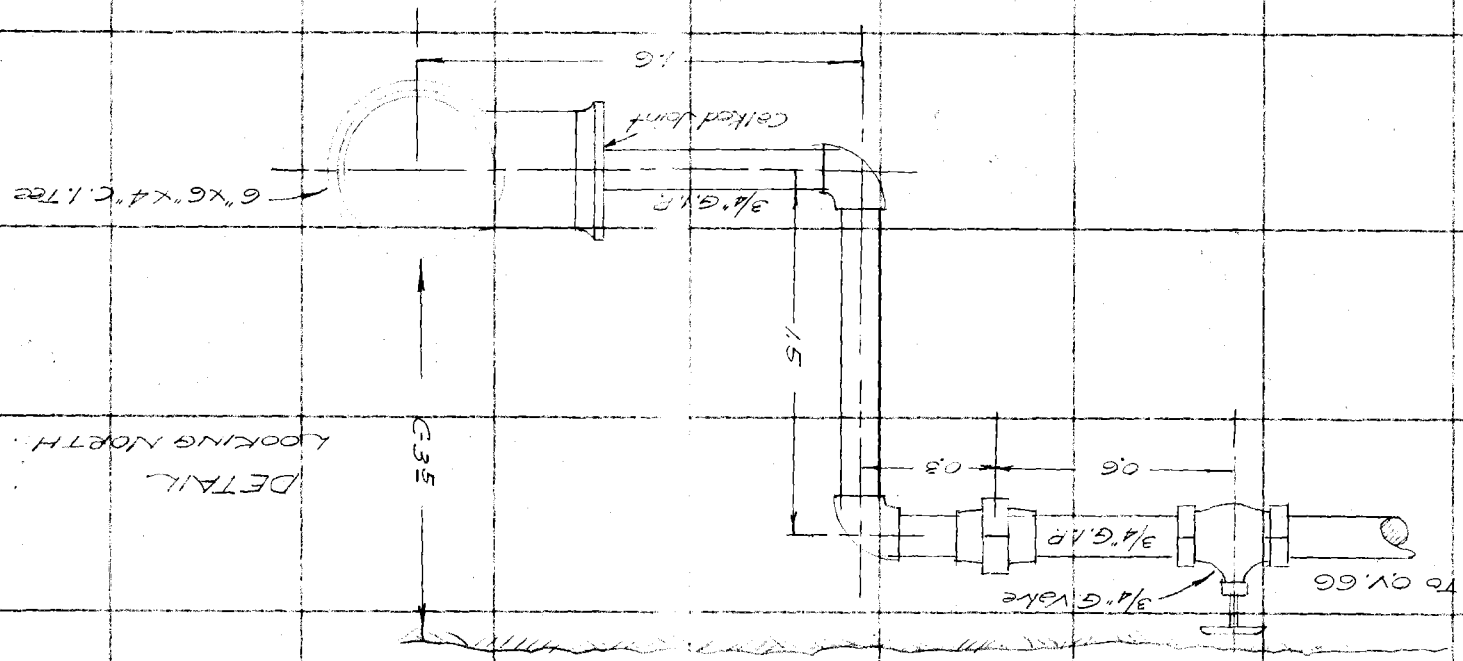

F.B. 709 PG. 148

FORM 247 10M 11-38

RETURN TO
LOS ANGELES COUNTY SURVEYOR
700 HALL OF RECORDS

Note: Any Additions or Changes on This Sheet Must be Made or Circled in Red Ink With Date and Name of Person Making Change

Do not extend notes this side of this line

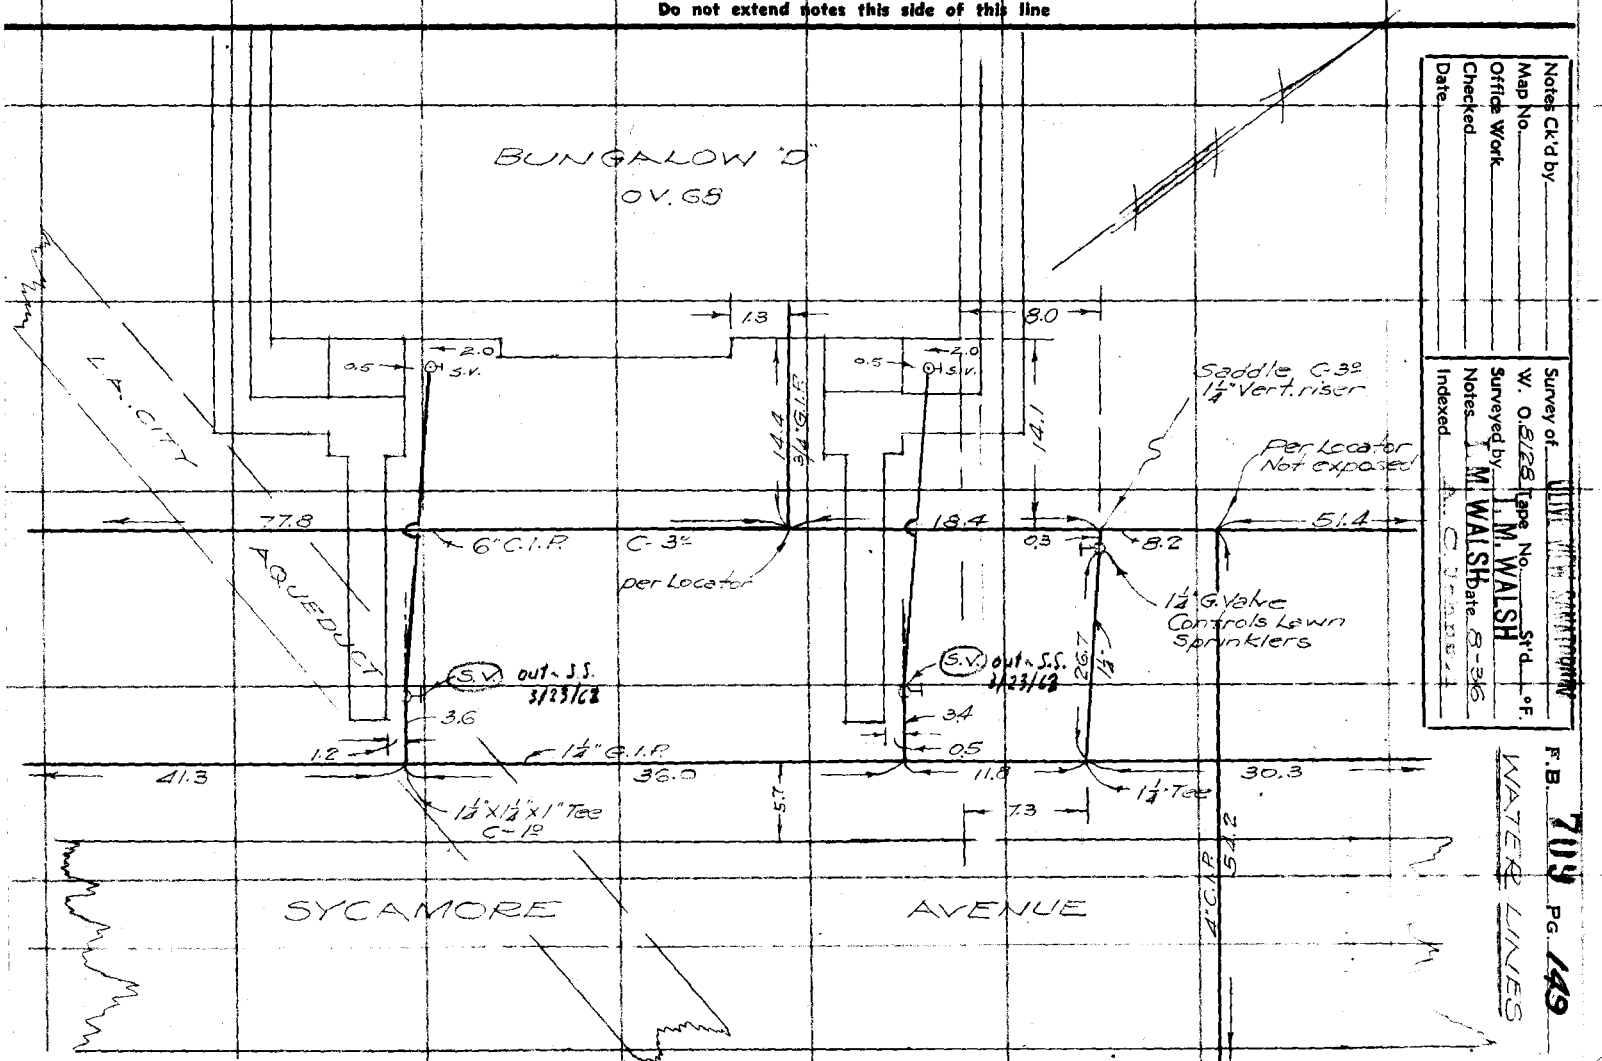

Notes Ck'd by
Map No.
Office Work
Checked
Date

Survey of ULIVE [illegible]
W. O. 8428 Tape No. Std. °F.
Surveyed by J. M. WALSH
Notes J. M. WALSH Date 8-3-62
Indexed [illegible]

F.B. 709 PG. 149

WATER LINES

RETURN TO
LOS ANGELES COUNTY SURVEYOR
700 HALL OF RECORDS

Note: Any Additions or Changes on This Sheet Must be Made or Circled in **Red Ink** With Date and Name of Person Making Change.

Do not extend notes this side of this line

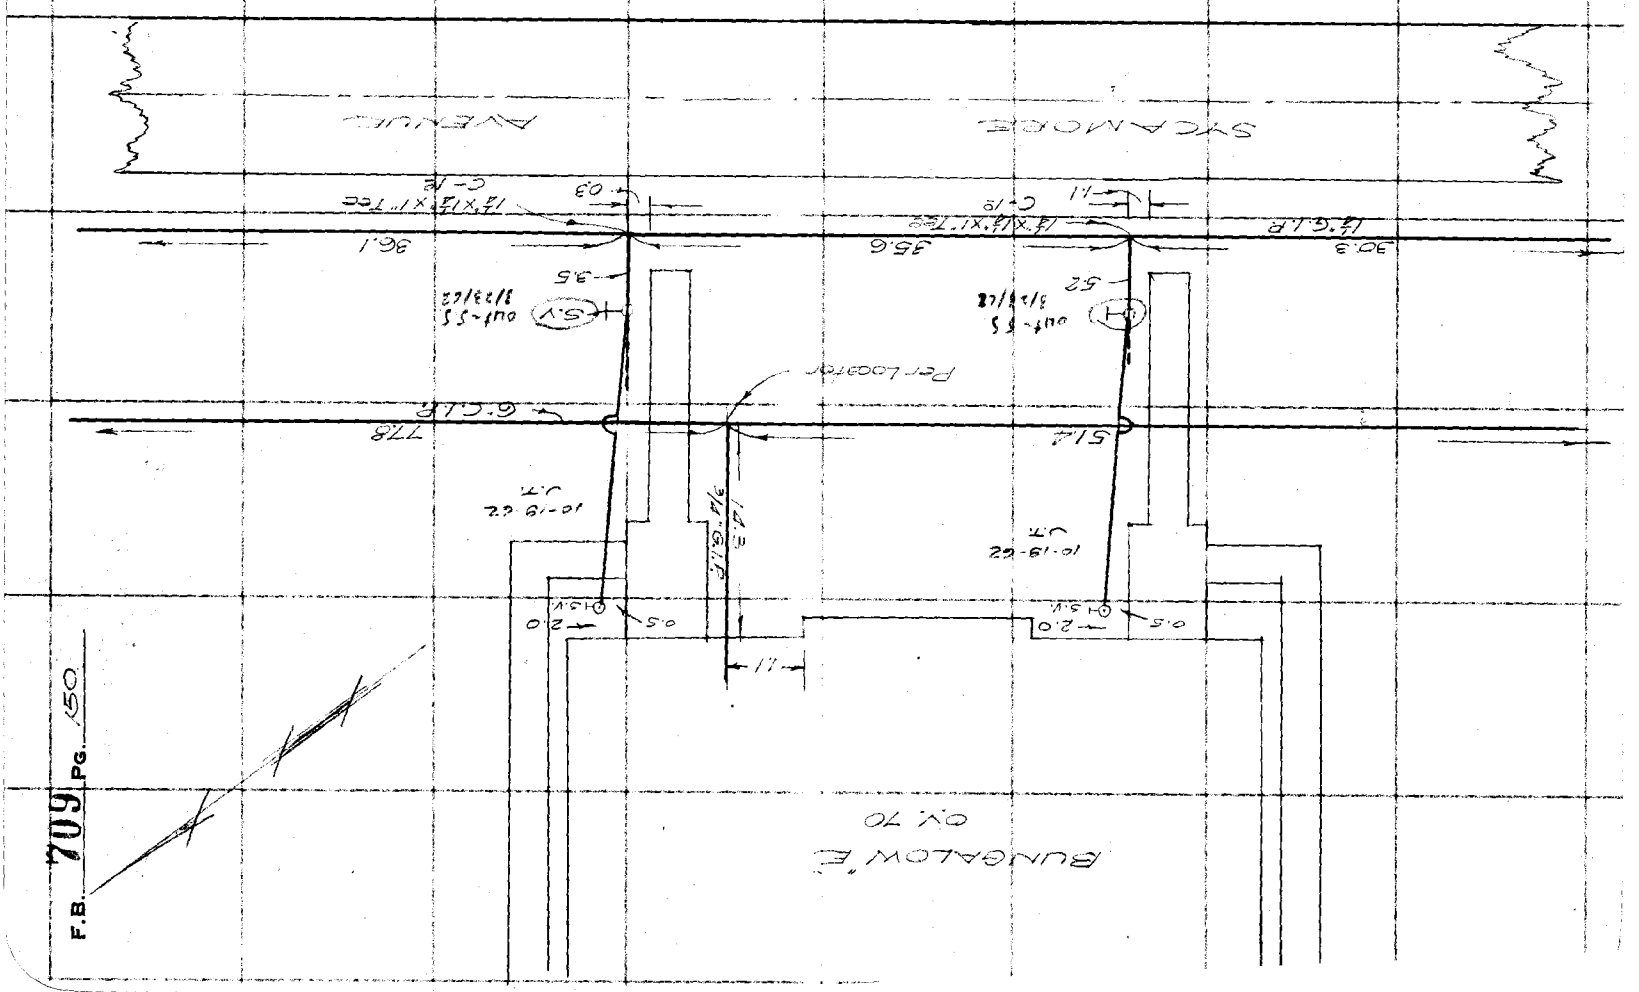

F.B. 709 PG. 150

FORM 247 10M 11-35

RETURN TO
LOS ANGELES COUNTY SURVEYOR
700 HALL OF RECORDS

Note: Any Additions or Changes on This Sheet Must be Made or Circled in **Red Ink** With Date and Name of Person Making Change.

Do not extend notes this side of this line

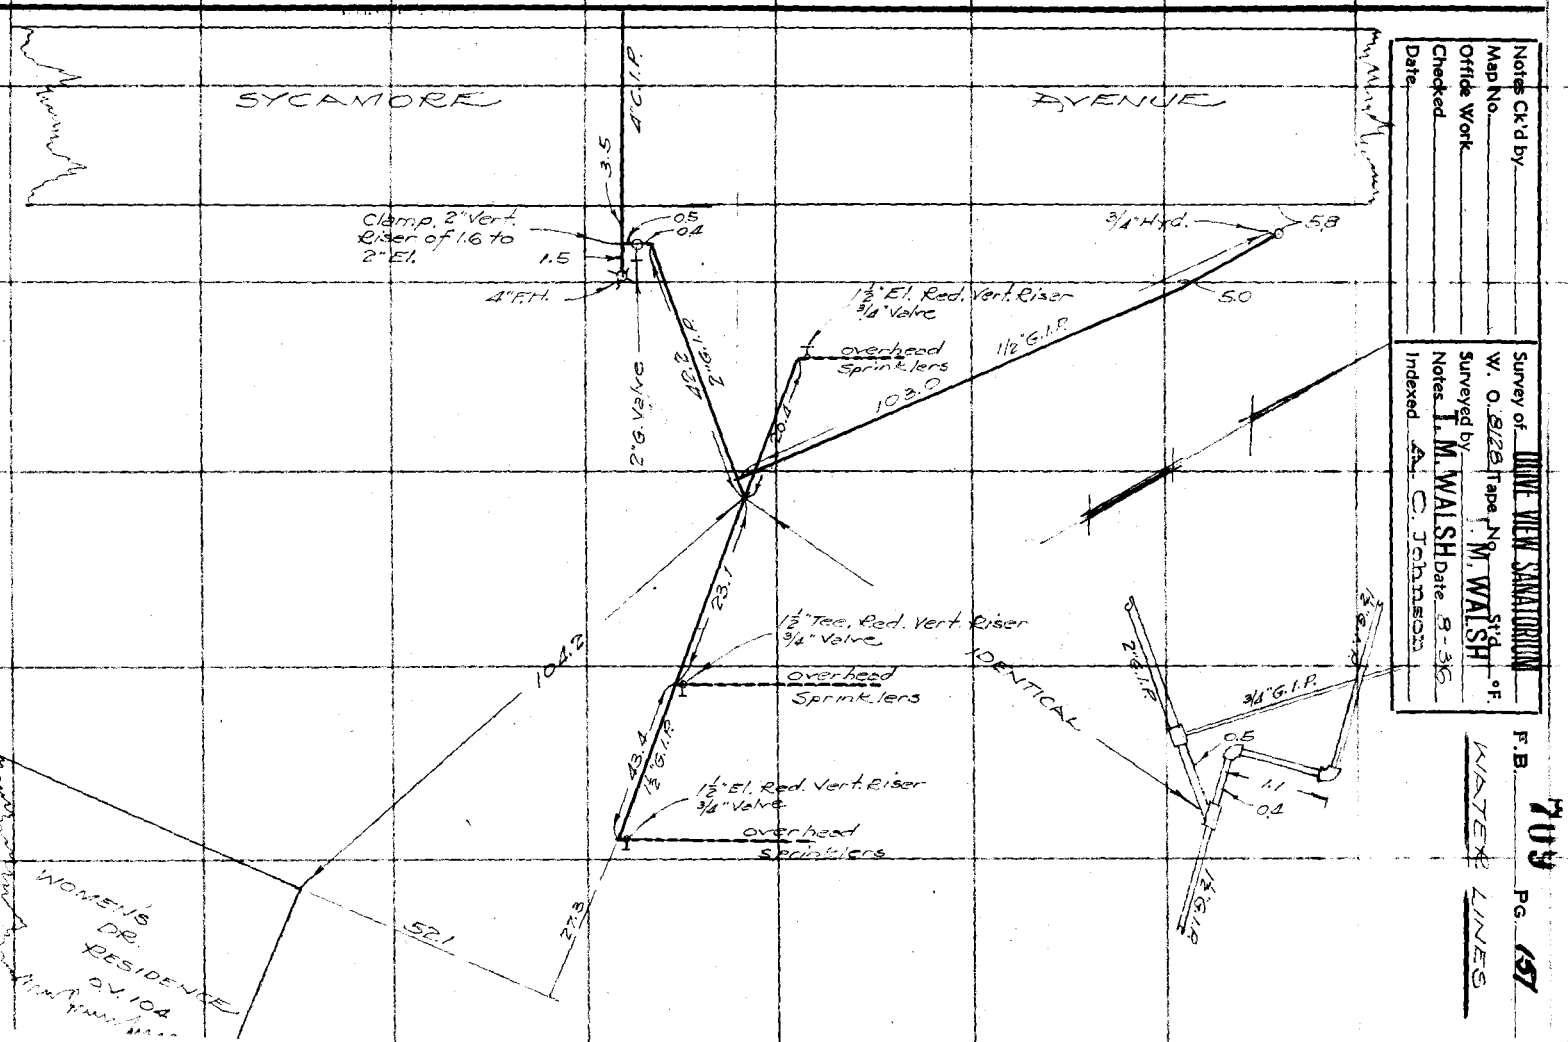

Notes Ck'd by
Map No.
Office Work
Checked
Date

Survey of OLIVE VIEW SANATORIUM
W. O. 8128 Tape No. T. M. WALSH Sk'd T. M. WALSH D.F.
Surveyed by T. M. WALSH
Notes T. M. WALSH Date 9-36
Indexed A. C. Johnson


WATER LINES

RETURN TO
LOS ANGELES COUNTY SURVEYOR
700 HALL OF RECORDS

Note: Any Additions or Changes on This Sheet Must be Made or Circled in Red Ink With Date and Name of Person Making Change.

Do not extend notes this side of this line

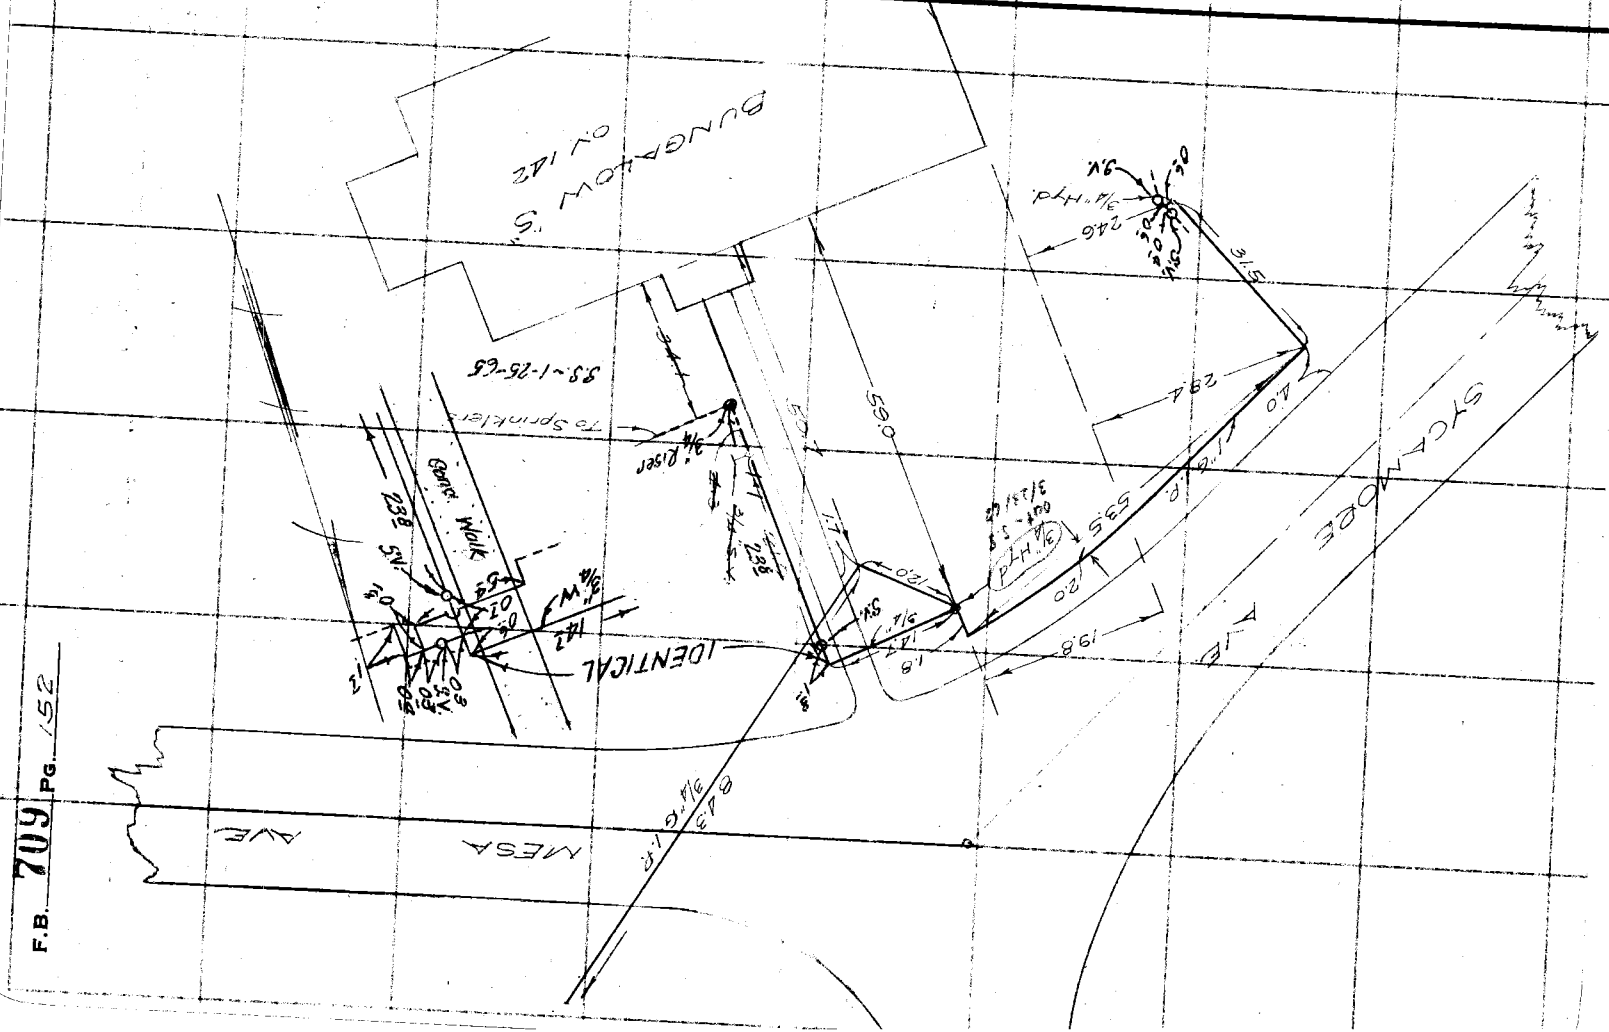

F.B. 709 PG. 152

FORM 247 10M 11-38

RETURN TO
LOS ANGELES COUNTY SURVEYOR
700 HALL OF RECORDS

Note: Any Additions or Changes on This Sheet Must be Made or Circled in Red Ink With Date and Name of Person Making Change

Do not extend notes this side of this line

Notes Ck'd by
Map No.
Office Work
Checked
Date

Survey of DRIVE VIEW SANATORIUM
W. O. 8123 Tape No. T. M. WALSH °F.
Surveyed by T. M. WALSH Date 5-36
Notes T. M. WALSH
Indexed

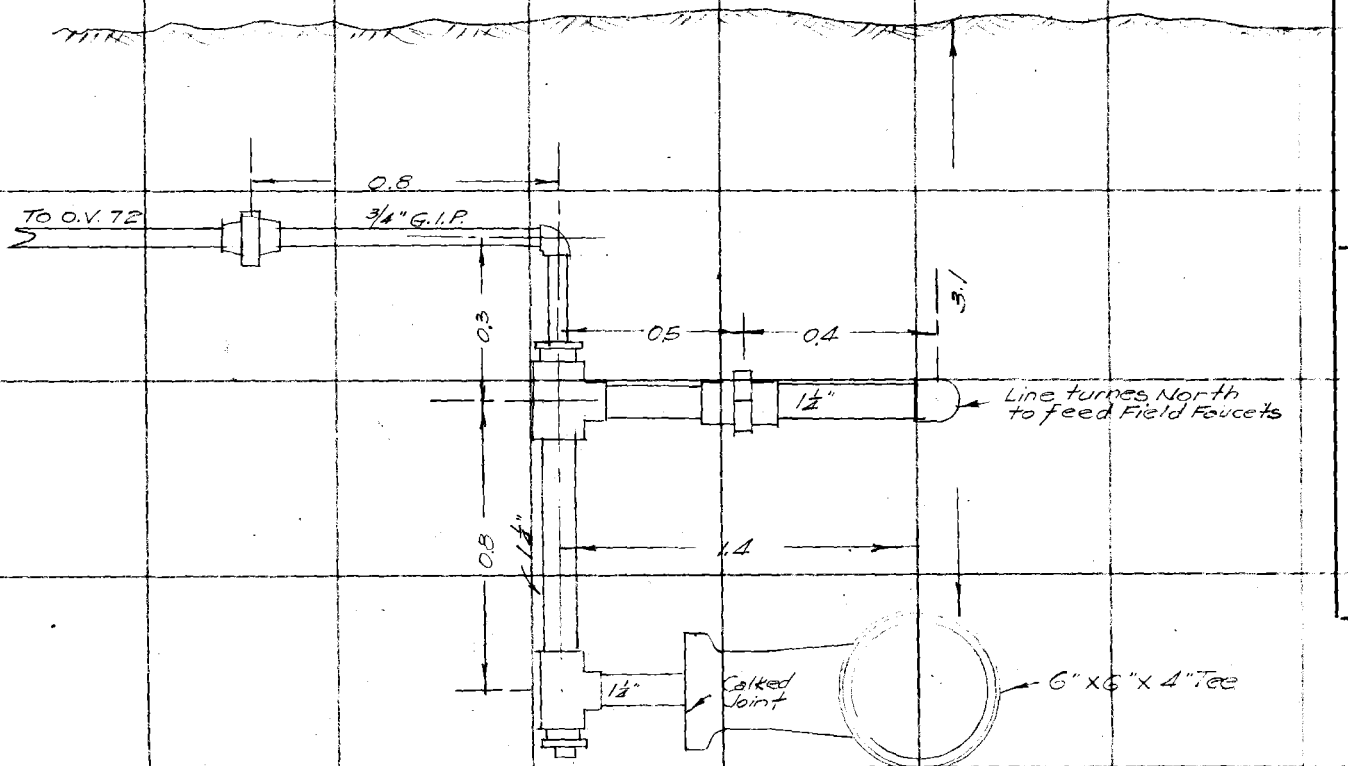

DETAIL
LOOKING NORTH

F.B. 7034 PG. 153

WATER LINES

RETURN TO
LOS ANGELES COUNTY SURVEYOR
700 HALL OF RECORDS

Note: Any Additions or Changes on This Sheet Must be Made or Circled in **Red Ink** With Date and Name of Person Making Change.

Do not extend notes this side of this line

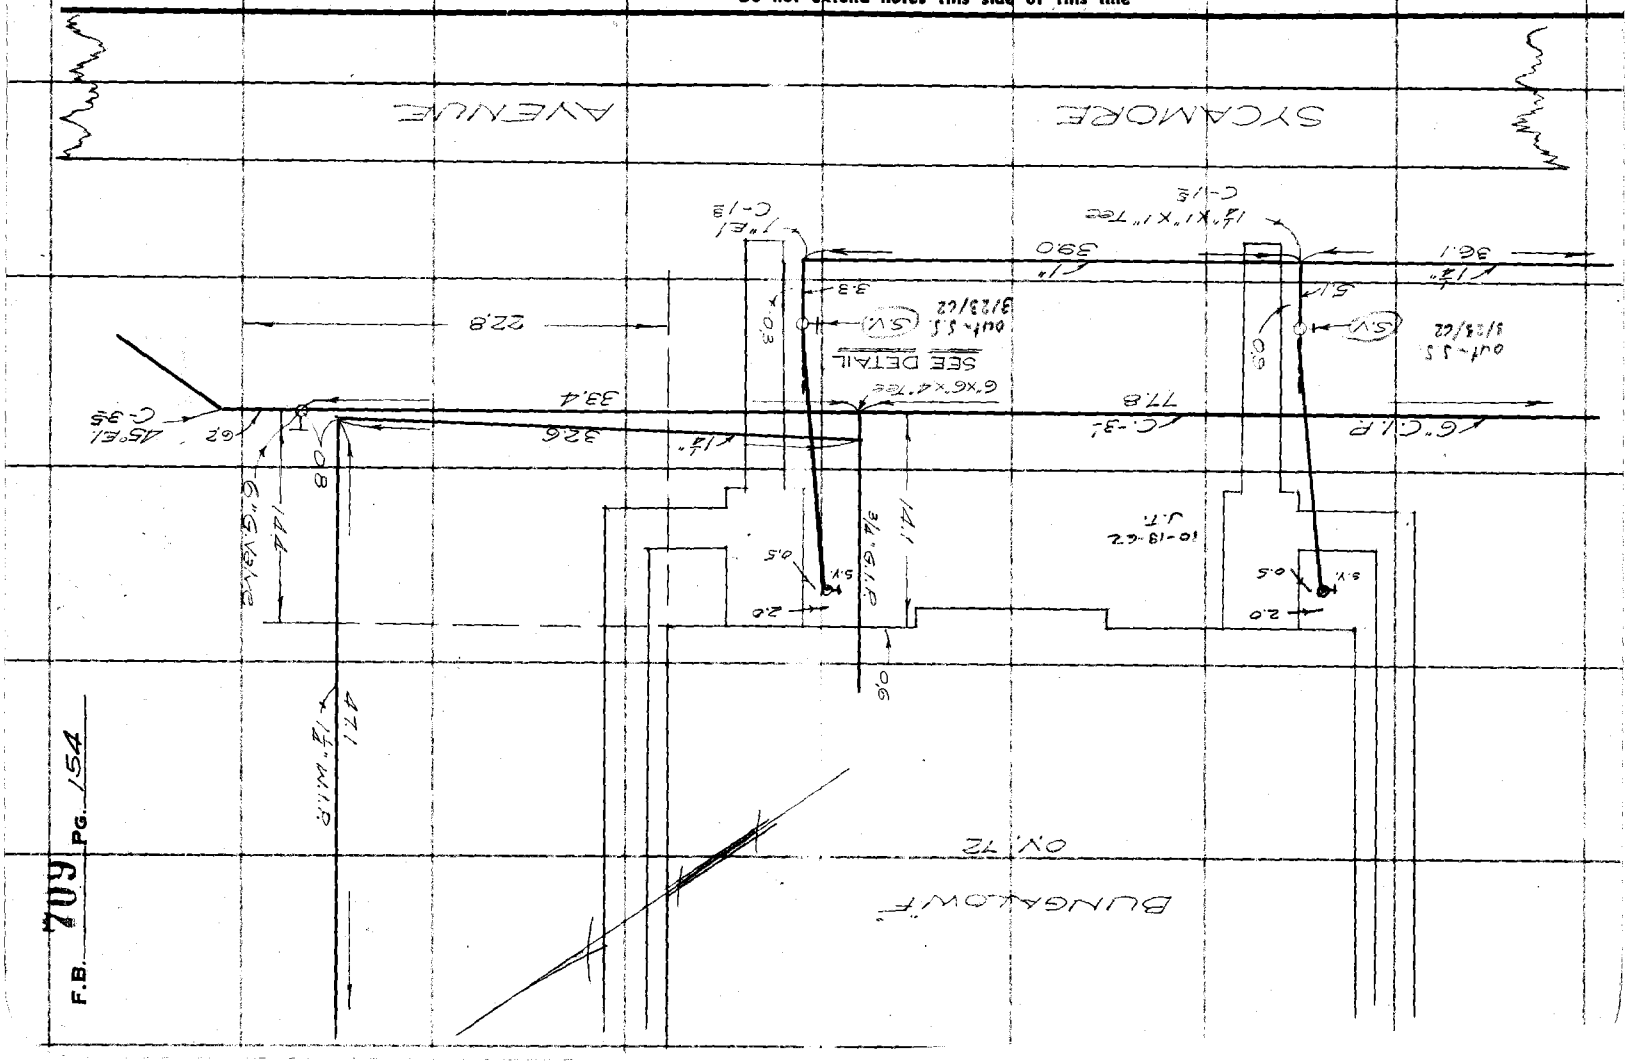

F.B. 709 PG. 154

FORM 247 10M 11-35

RETURN TO
LOS ANGELES COUNTY SURVEYOR
700 HALL OF RECORDS

Note: Any Additions or Changes on This Sheet Must be Made or Circled in **Red Ink** With Date and Name of Person Making Change.

Do not extend notes this side of this line

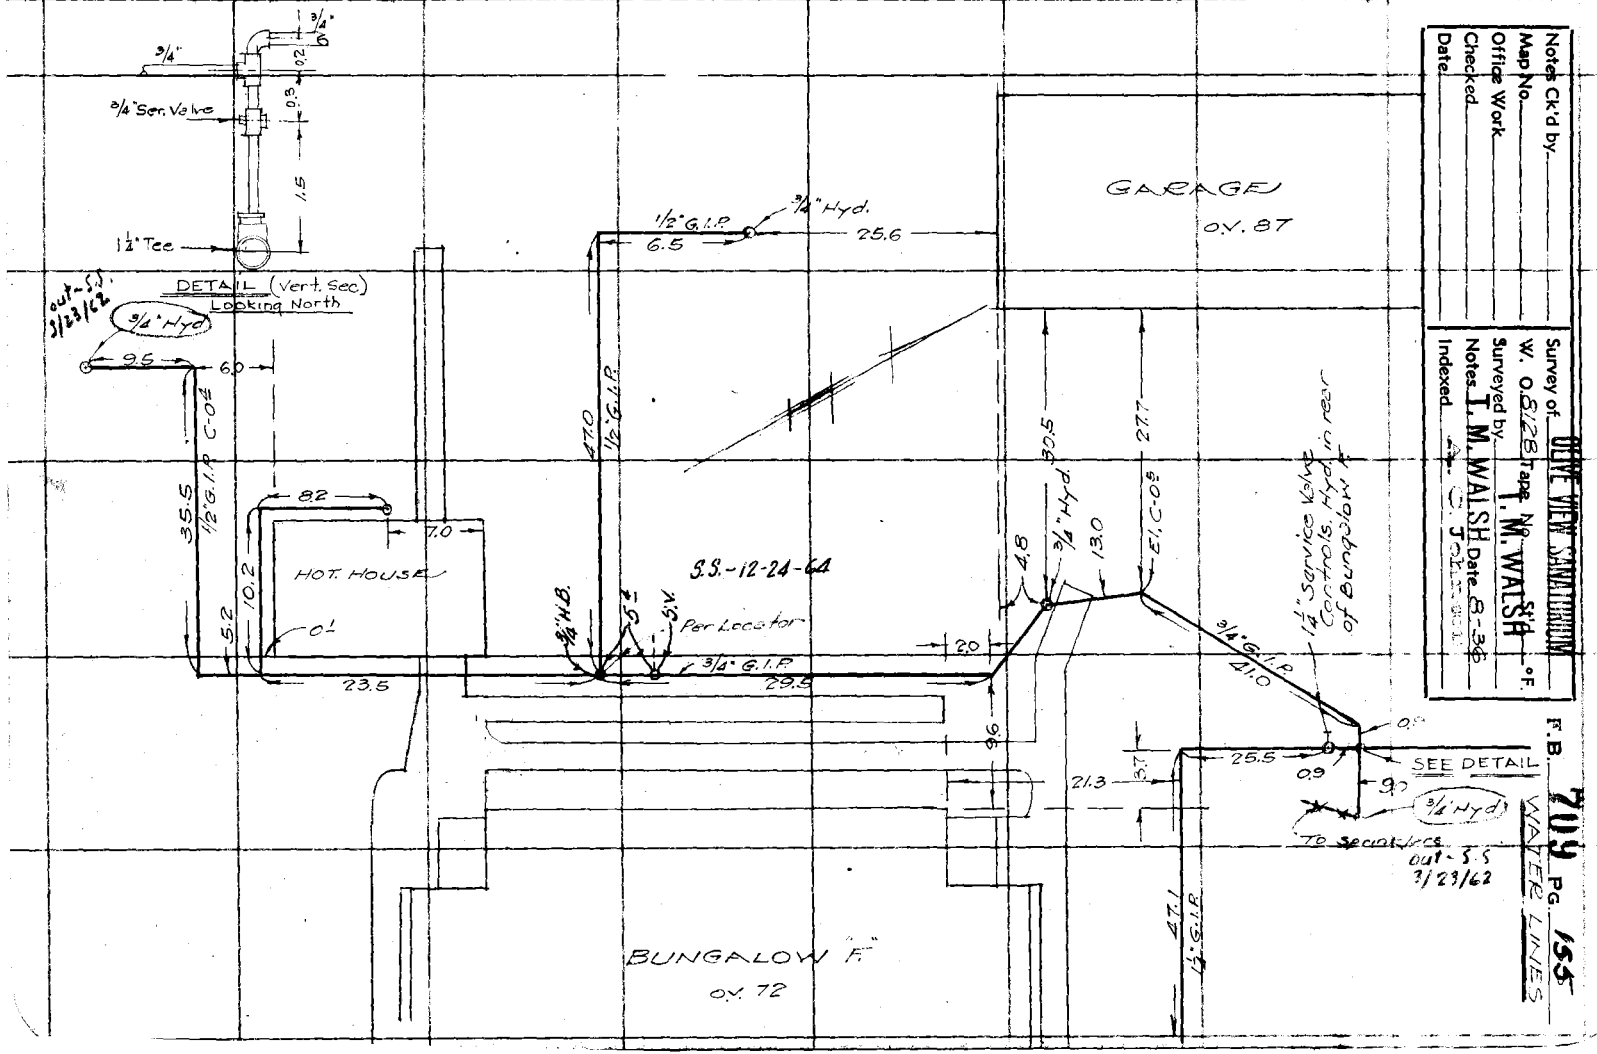

Notes Ck'd by
Map No.
Office Work
Checked
Date

Survey of OLIVE VIEW SANATORIUM
W. O. 8128 Tape No. T. M. WALSH °F.
Surveyed by T. M. WALSH Date 8-36
Notes
Indexed

F.B. 709 PG. 155 WATER LINES

RETURN TO
LOS ANGELES COUNTY SURVEYOR
700 HALL OF RECORDS

Note: Any Additions or Changes on This Sheet Must be Made or Circled in **Red Ink** With Date and Name of Person Making Change.

Do not extend notes this side of this line

F.B. 709 PG. 156

FORM 247 10M 11-35

RETURN TO
LOS ANGELES COUNTY SURVEYOR
700 HALL OF RECORDS

Note: Any Additions or Changes on This Sheet Must be Made or Circled in Red Ink With Date and Name of Person Making Change.

Do not extend notes this side of this line

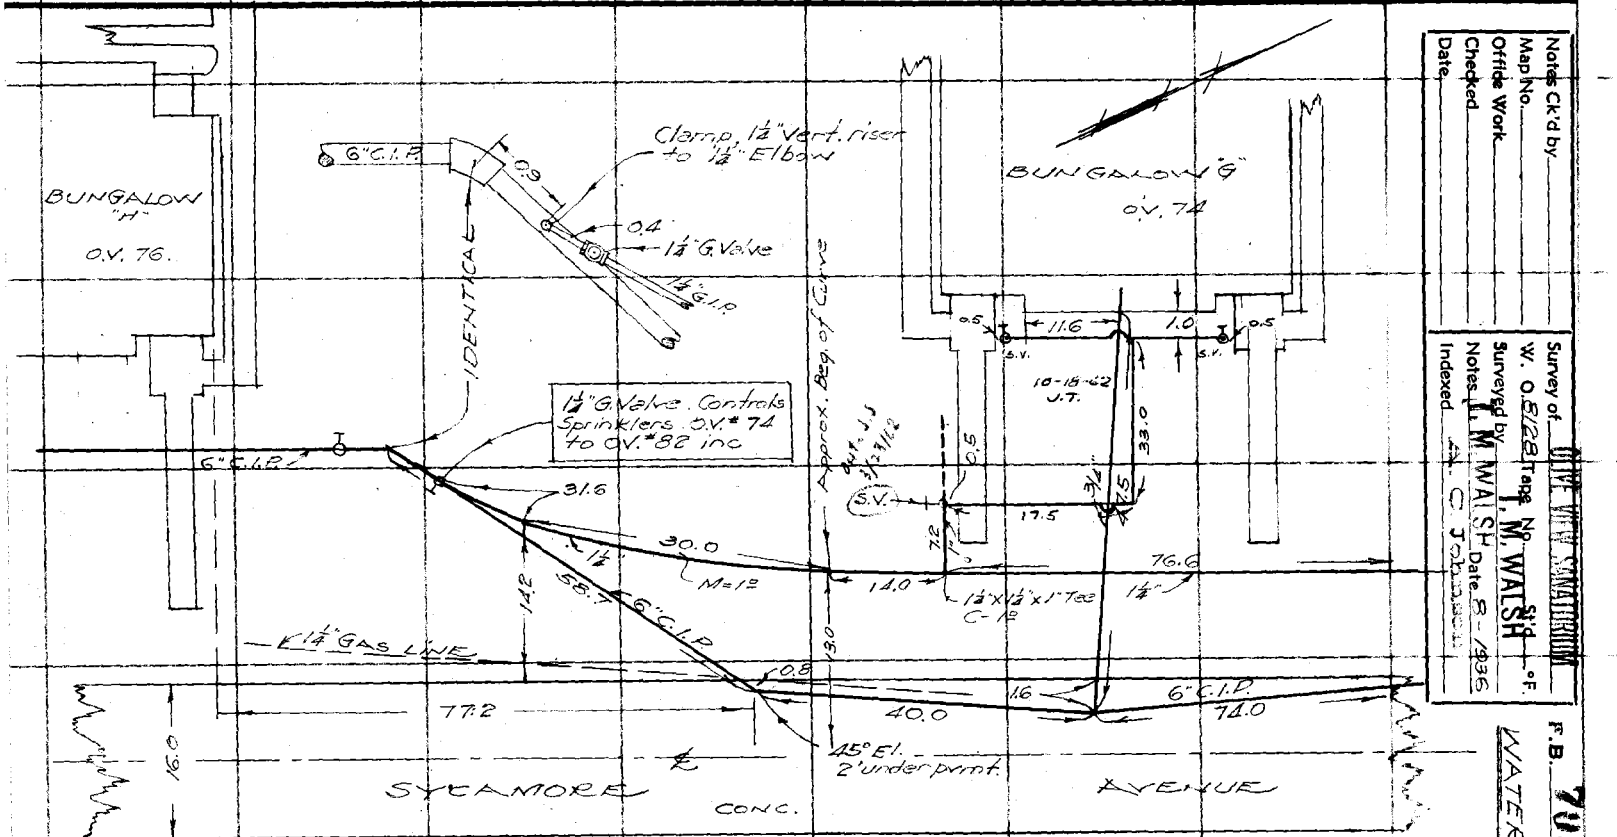

Notes Ck'd by
Map No.
Offside Work
Checked
Date

Survey of OLIVE VIEW SANATORIUM
W. O. 8728 Trans. No.
Surveyed by T. M. WALSH Date 8-1936
Notes T. M. WALSH Date
Indexed C. C. Johnson

F.B. 709 PG. 157

WATER LINES

RETURN TO
LOS ANGELES COUNTY SURVEYOR
700 HALL OF RECORDS

Do not extend notes this side of this line

Note: Any Additions or Changes on This Sheet Must be Made or Circled in Red Ink With Date and Name of Person Making Change.

FORM 247 10M 11-35

RETURN TO
LOS ANGELES COUNTY SURVEYOR
700 HALL OF RECORDS

Note: Any Additions or Changes on This Sheet Must be Made or Circled in **Red Ink** With Date and Name of Person Making Change.

Do not extend notes this side of this line

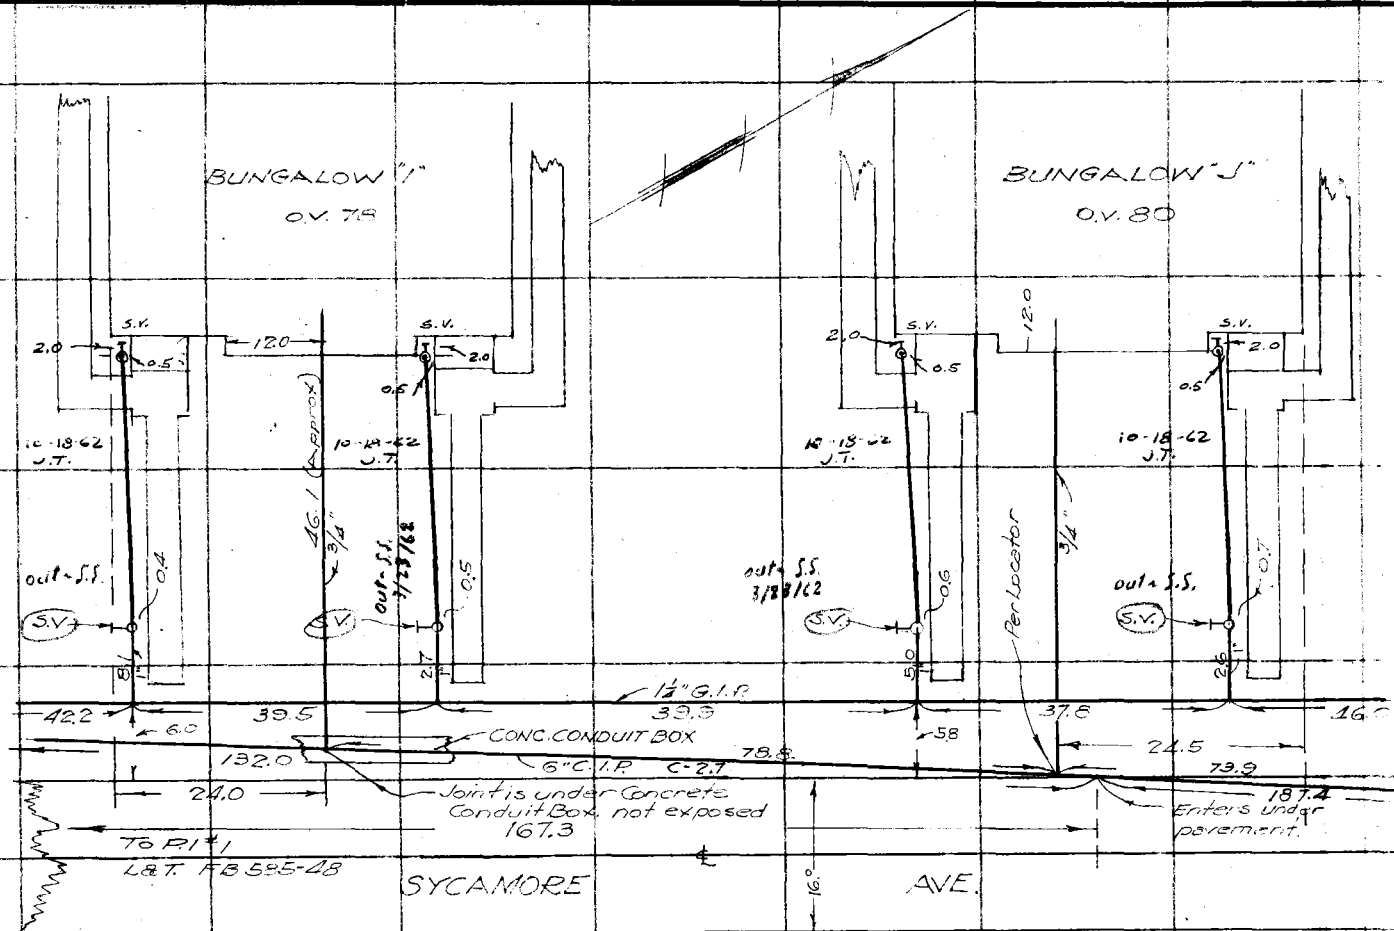

Notes Ck'd by
Map No.
Office Work
Checked
Date

Survey of
W. O. 8128 Tape No. St'd °F.
Surveyed by T. M. WALSH
Notes T. M. WALSH Date 8-36
Indexed

F.B. 709 PG. 159

WATER LINES

RETURN TO
LOS ANGELES COUNTY SURVEYOR
700 HALL OF RECORDS

Note: Any Additions or Changes on This Sheet Must be Made or Circled in **Red Ink** With Date and Name of Person Making Change.

Do not extend notes this side of this line

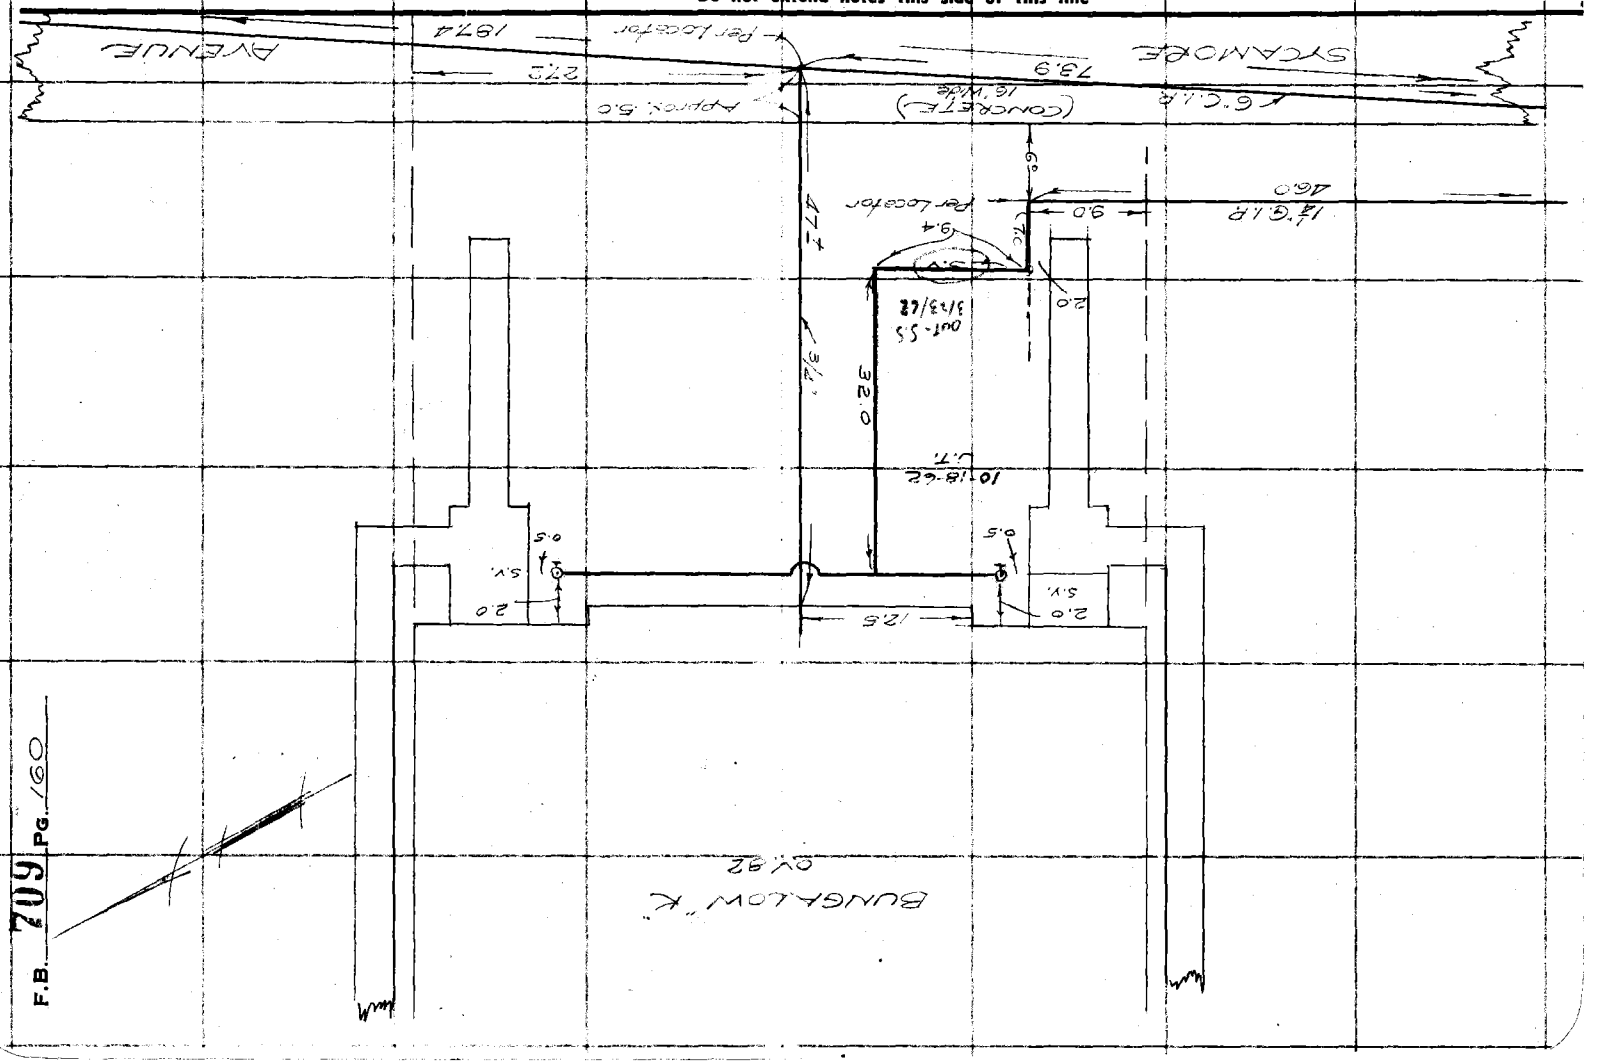

F.B. 709 PG. 160

FORM 247 10M 11-35

RETURN TO
LOS ANGELES COUNTY SURVEYOR
700 HALL OF RECORDS

Note: Any Additions or Changes on This Sheet Must be Made or Circled in **Red Ink** With Date and Name of Person Making Change.

Do not extend notes this side of this line

Notes Ck'd by
Map No.
Office Work
Checked
Date

Survey of OLIVE VIEW SANITARIUM
W. O. 8128 Tape No. Std. °F.
Surveyed by T. M. WALSH
Notes T. M. WALSH Date 6-38
Indexed A. C. Johnson

F.B. 709 PG. 161

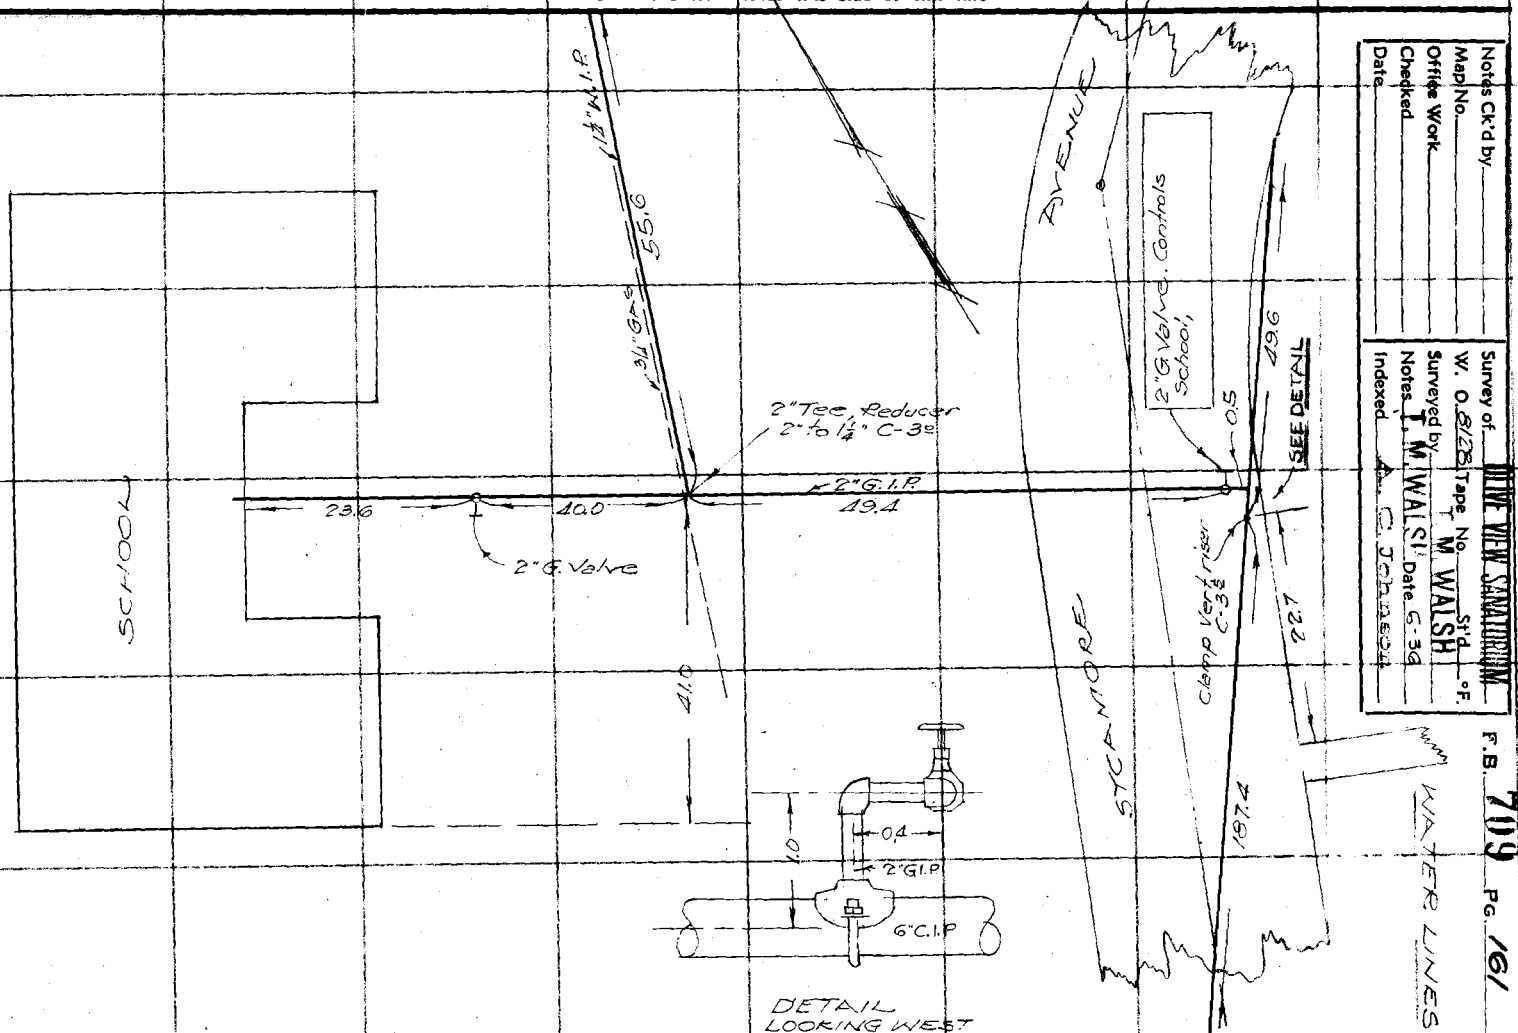

F.B. 709 PG. 162

RETURN TO
LOS ANGELES COUNTY SURVEYOR
700 HALL OF RECORDS
Do not extend notes this side of this line
Note: Any Additions or Changes on This Sheet Must be Made or Circled in Red Ink With Date and Name of Person Making Change.
S.S.-12-28-64
6"C.I.P.
237.3
97.0
3"G.I.P.
0.5
6"Calked to 3"
C-2.5
3.3
6"G.V.
45°El
C-2.5
7.5
0+25.7
1.9
5.1
1.8
4.1
6"F.H.
8.1
0+20.6
4"C.I.P.
2"G.Valve Controls O.V. 143, 144, 145.
6"x6"x4" Tee
C-2.5 under
E. edge of pvmt.
16.7
2"G.I.P.
Saddle, 2" Vert. riser to 2" El.
SEE DETAIL
2"x2"x1" Tee
C-1.5
6.0
40.1
1"G.I.P.
39.2
1"G. Valve
1.0
1.3
16.0
AVENUE
P.I.#2 L&T
FB 585-48
0+00
6"C.I.P.
49.6
O.V. 145
BUNGALOW "C"
82.0
2"G.I.P.
SYCAMORE
0.4 2" Tee to 2" El.
9.0
0.4
1.1
0.4
6"C.I.P.
0.4
0.5
1"G.I.P.
2"G.I.P.
To Bungalows "P" "Q" "R"
DETAIL
LOOKING WEST

Notes Ck'd by	Survey of
Map No.	W. O. 8123 Tape No. St'd °F.
Office Work	Surveyed by T. M. WALSH
Checked	Notes T. M. WALSH Date 7-36
Date	Indexed

F.B. 709 PG. 163

WATER LINE

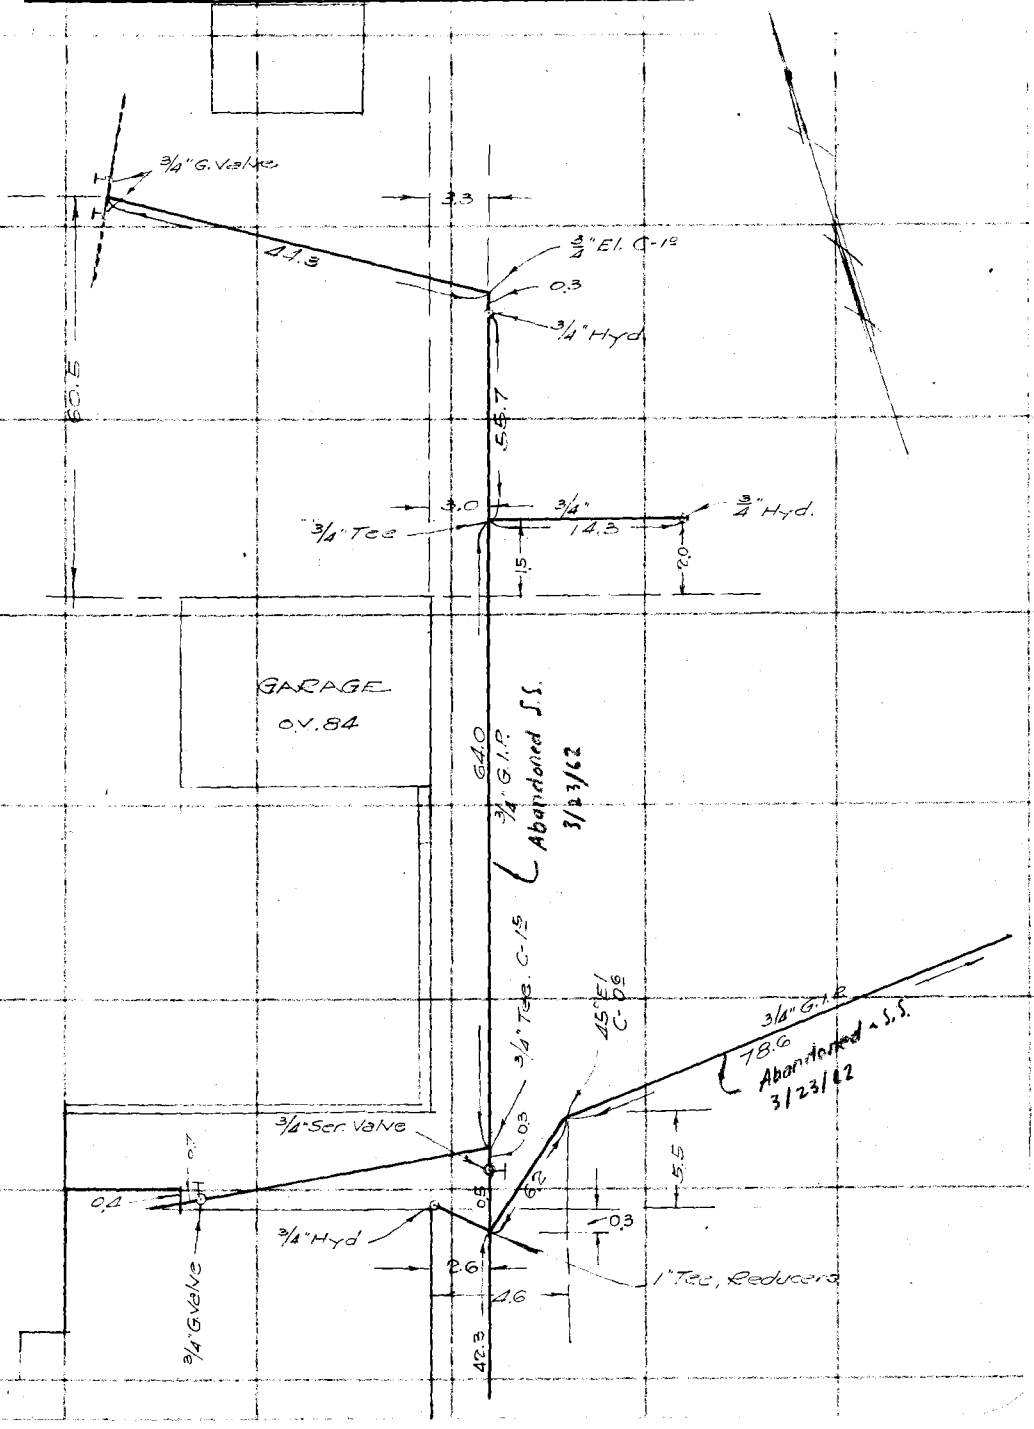

Note: Any Additions or Changes on This Sheet Must be Made or Circled in Red Ink With Date and Name of Person Making Change

Do not extend notes this side of this line

RETURN TO
LOS ANGELES COUNTY SURVEYOR
700 HALL OF RECORDS

FORM 247 10M 11-35

RETURN TO
LOS ANGELES COUNTY SURVEYOR
700 HALL OF RECORDS

Note: Any Additions or Changes on This Sheet Must be Made or Circled in **Red Ink** With Date and Name of Person Making Change.

Do not extend notes this side of this line

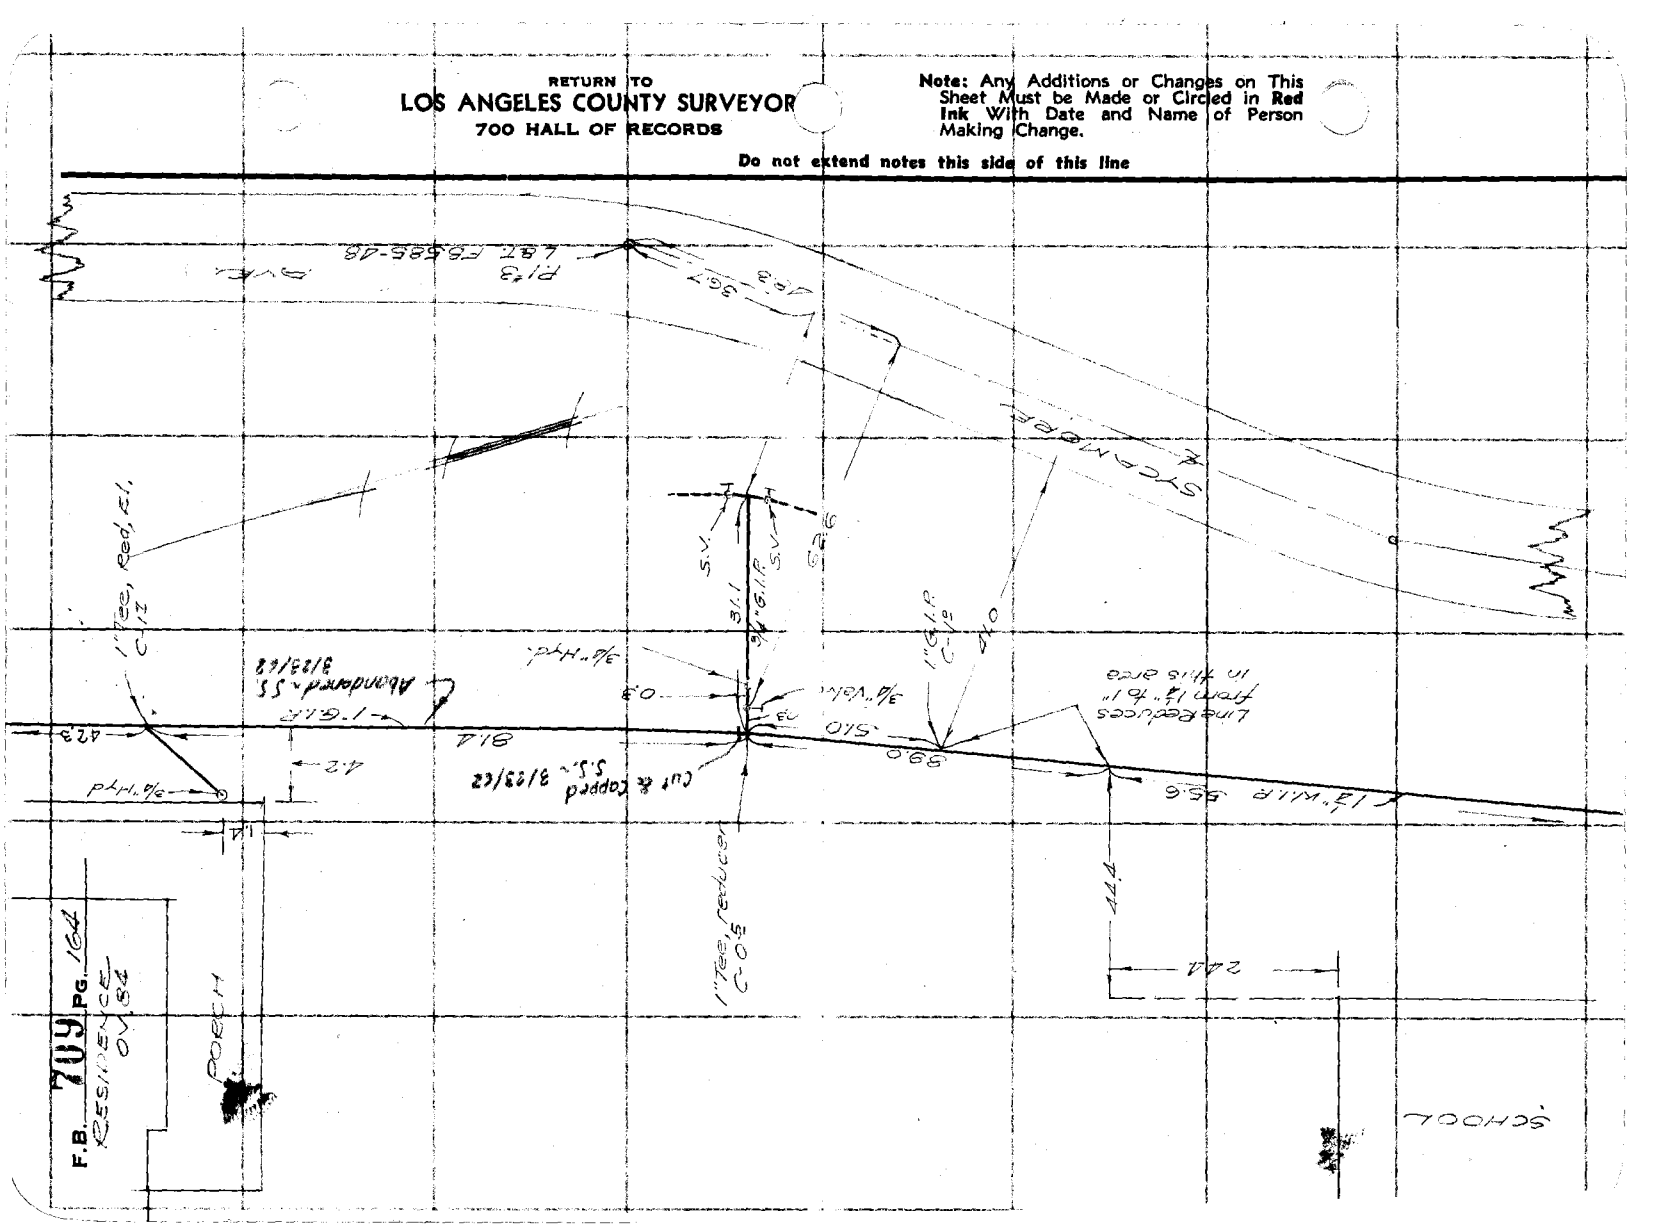

Map No.	W. O. 5128 Tape No. St'd °F.
Office Work	Surveyed by T. M. WALSH
Checked	Notes T. M. WALSH Date 12-16
Date	Indexed A. C. Johnson

F.B. 709 PG. 165

WATER LINE

Note: Any Additions or Changes on This Sheet Must be Made or Circled in Red Ink With Date and Name of Person Making Change

Do not extend notes this side of this line

RETURN TO
LOS ANGELES COUNTY SURVEYOR
700 HALL OF RECORDS

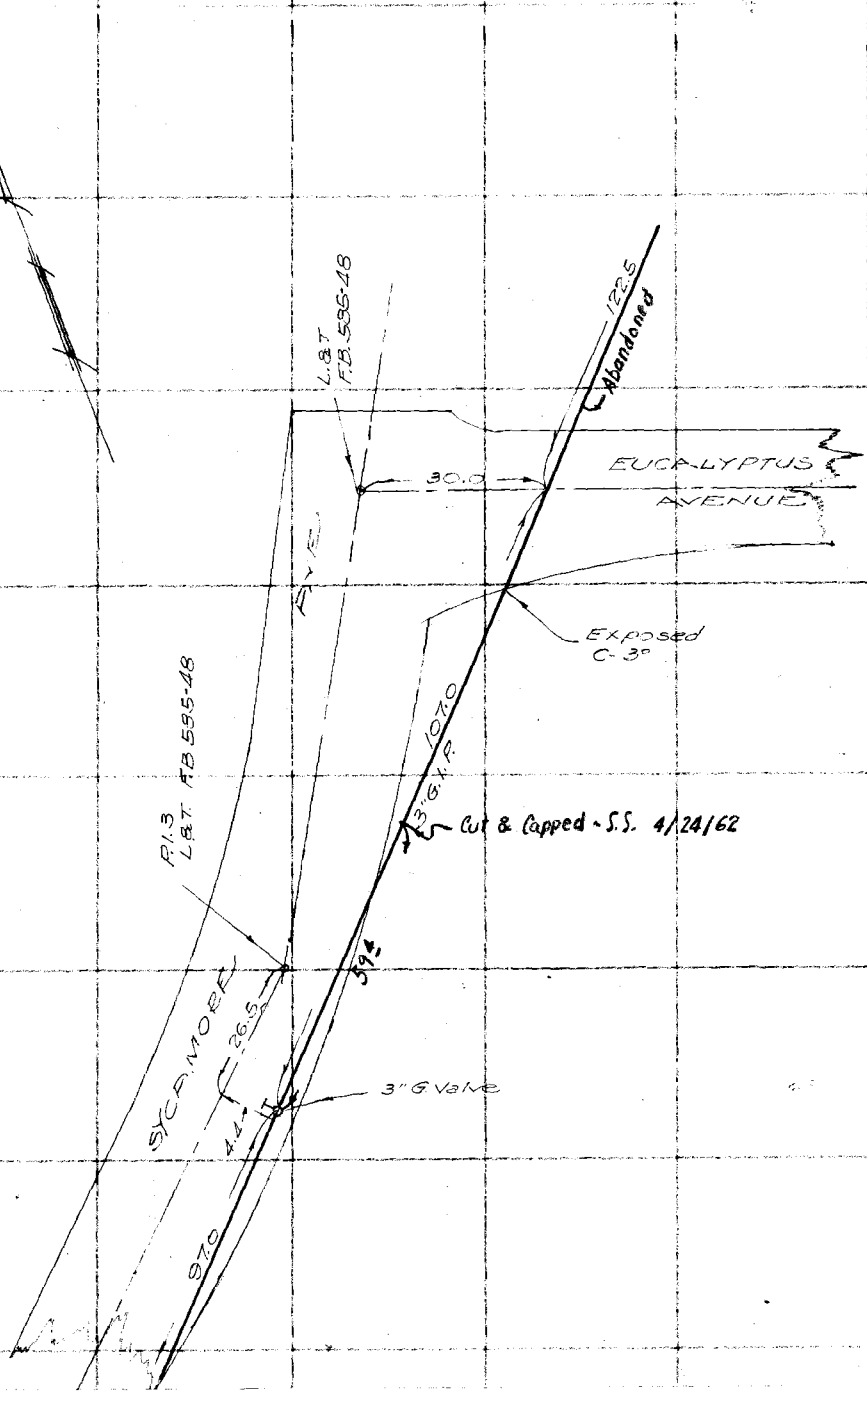

FORM 247 10M 11-38

F.B. 709 PG. 166

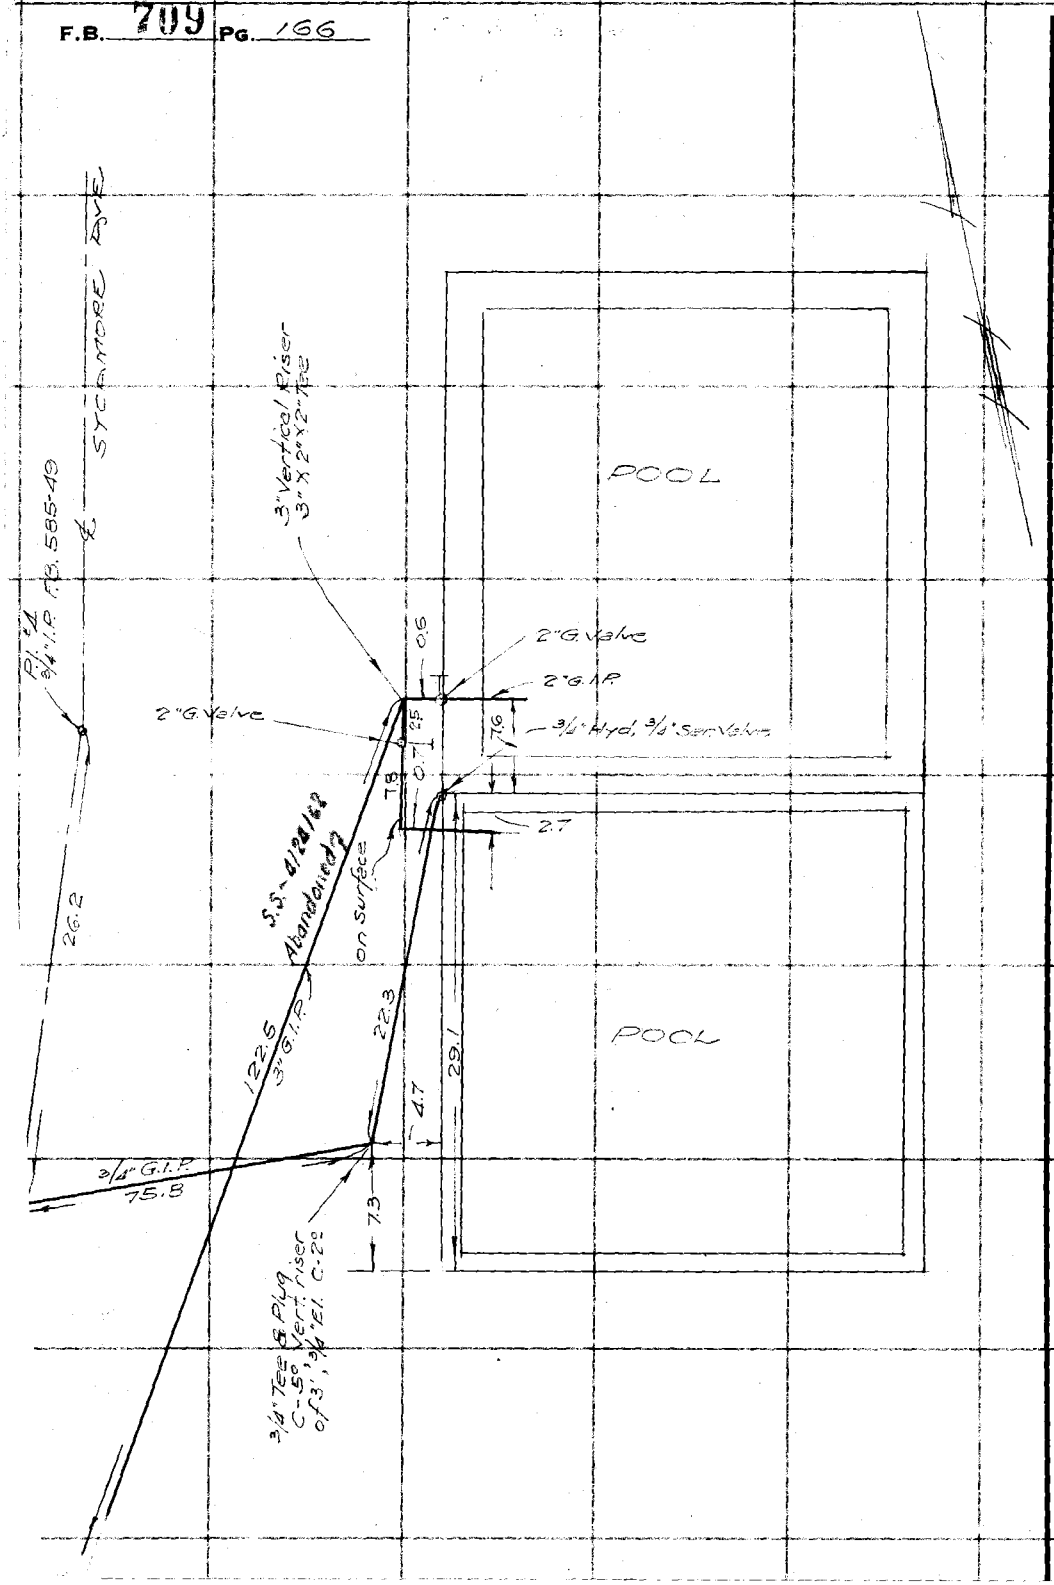

RETURN TO
LOS ANGELES COUNTY SURVEYOR
700 HALL OF RECORDS

Note: Any Additions or Changes on This Sheet Must be Made or Circled in Red Ink With Date and Name of Person Making Change.

Do not extend notes this side of this line

Notes Ck'd by	Survey of OLIVE VIEW SANATORIUM
Map No.	W. O. 8/28 Tape No. St'd °F.
Office Work	Surveyed by T. M. WALSH
Checked	Notes T. M. WALSH Date 6-36
Date	Indexed

F.B. 709 PG. 167

WATER LINES

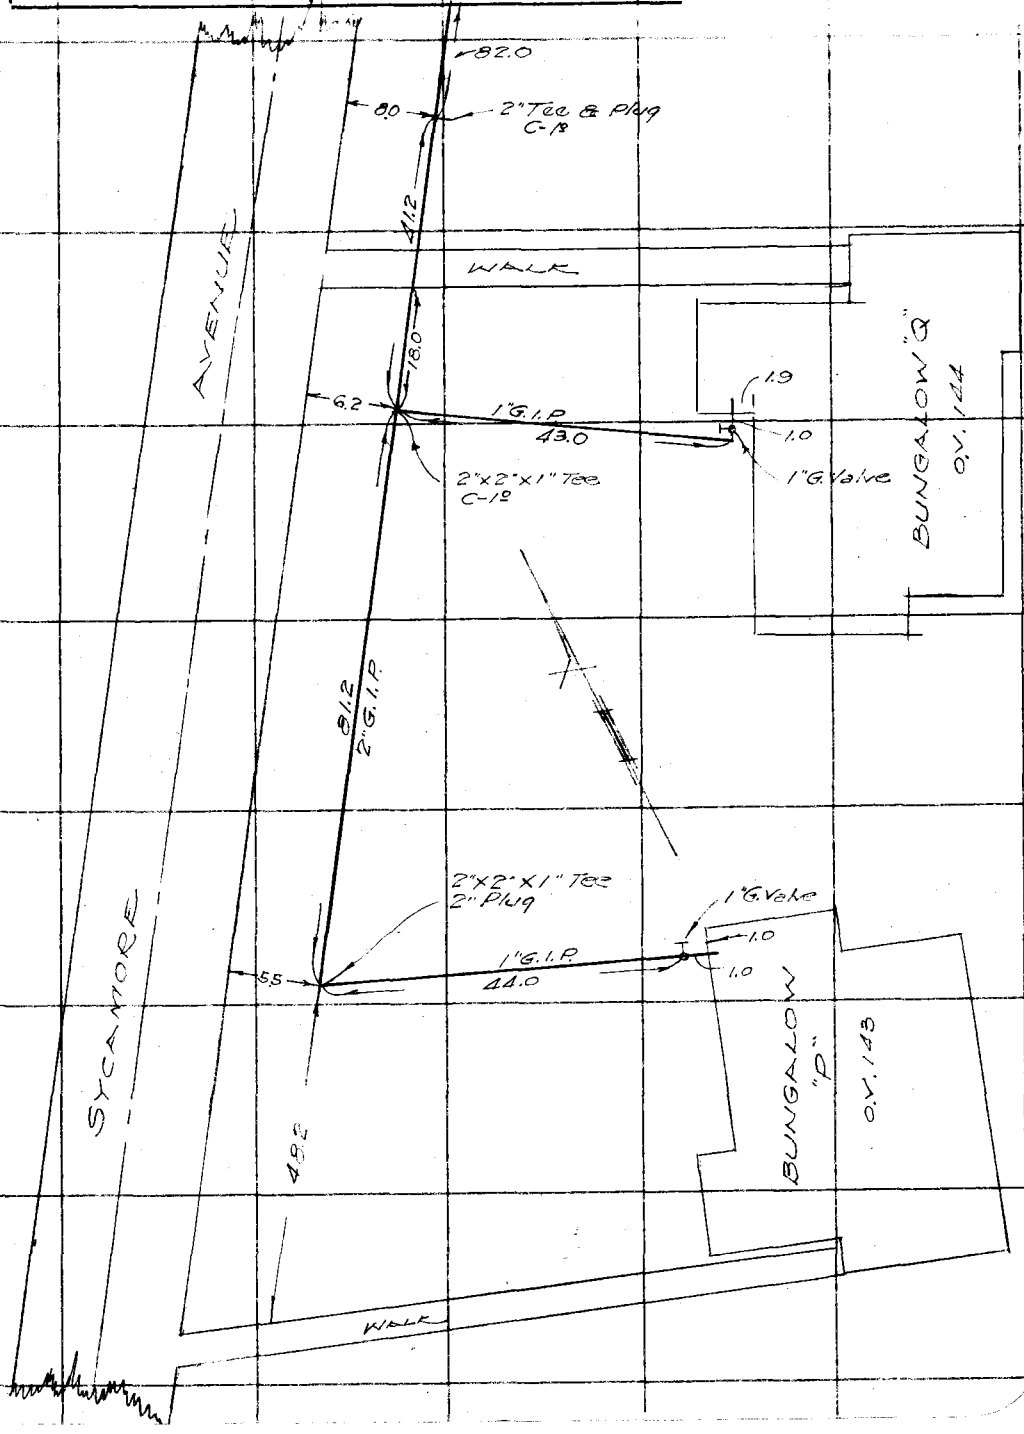

RETURN TO
LOS ANGELES COUNTY SURVEYOR
700 HALL OF RECORDS

Note: Any Additions or Changes on This Sheet Must be Made or Circled in Red Ink With Date and Name of Person Making Change

Do not extend notes this side of this line

FORM 247 10M 11-35

RETURN TO
LOS ANGELES COUNTY SURVEYOR
700 HALL OF RECORDS

Note: Any Additions or Changes on This Sheet Must be Made or Circled in **Red Ink** With Date and Name of Person Making Change.

Do not extend notes this side of this line

F.B. 709 PG. 168

Notes Ck'd by	Survey of OLIVE VIEW SANATORIUM
Map No.	W. O. 8128 Tape No. St'd °F.
Office Work	Surveyed by T. M. WALSH
Checked	Notes T. M. WALSH Date 7-36
Date	Indexed A. C. Johnson

F.B. 719 PG. 169

Note: Any Additions or Changes on This Sheet Must be Made or Circled in Red Ink With Date and Name of Person Making Change

Do not extend notes this side of this line

RETURN TO
LOS ANGELES COUNTY SURVEYOR
700 HALL OF RECORDS

FORM 247 10M 11-35

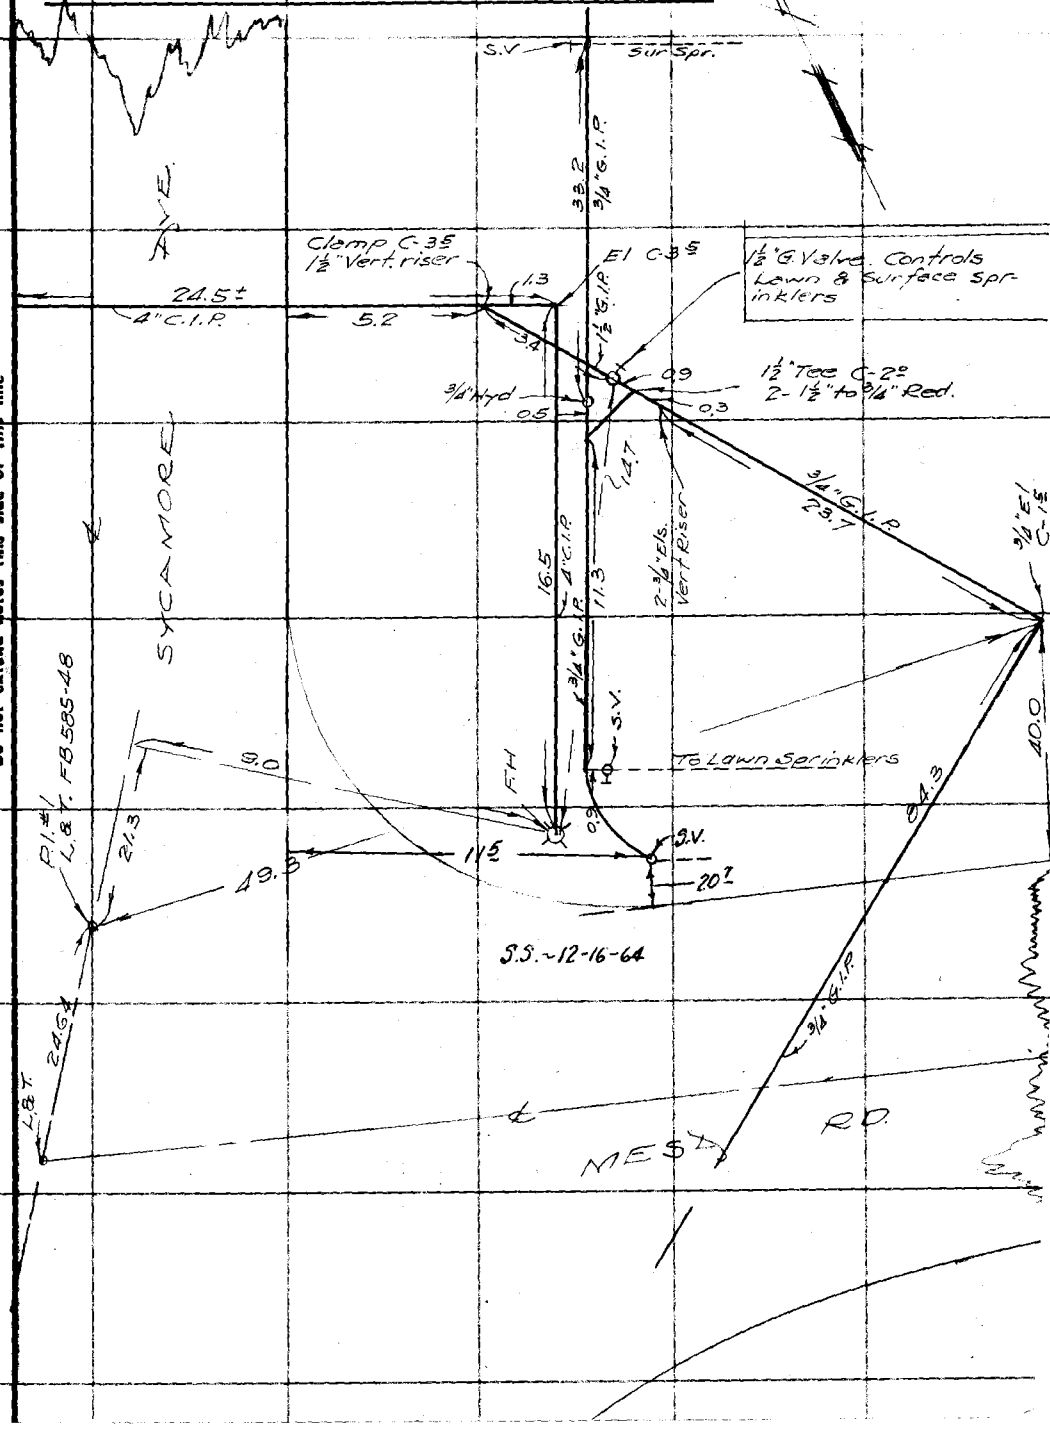

RETURN TO
LOS ANGELES COUNTY SURVEYOR
700 HALL OF RECORDS

Note: Any Additions or Changes on This Sheet Must be Made or Circled in **Red Ink** With Date and Name of Person Making Change.

Do not extend notes this side of this line

F.B. 709 Pg. 170

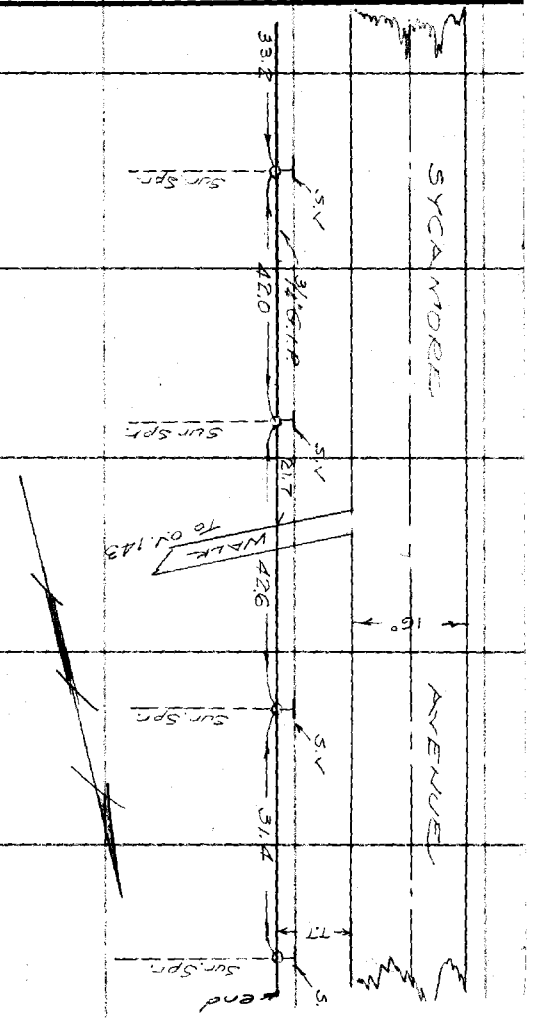

FORM 247 10M 11-35

RETURN TO
LOS ANGELES COUNTY SURVEYOR
700 HALL OF RECORDS

Note: Any Additions or Changes on This Sheet Must be Made or Circled in **Red Ink** With Date and Name of Person Making Change.

Do not extend notes this side of this line

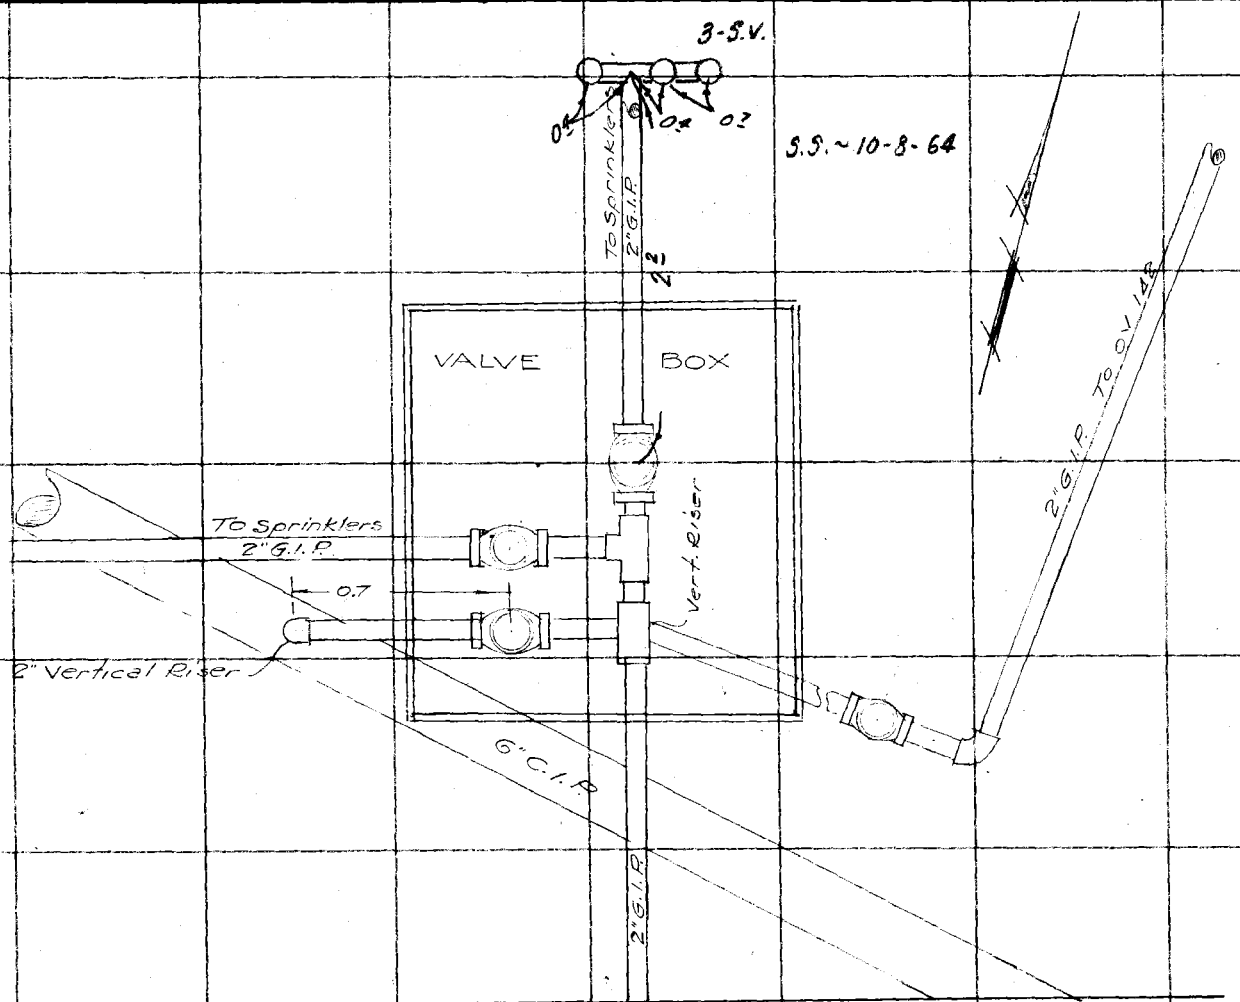

Notes Ck'd by _____
Map No. _____
Office Work _____
Checked _____
Date _____

Survey of LIVE VIEW SANATORIUM
W. O. 8128 Dept. T. M. WALSH D.F.
Surveyed by T. M. WALSH Date 4-23-36
Notes _____
Indexed _____

F.B. 719 Pg. 171

WATER LINES

RETURN TO
LOS ANGELES COUNTY SURVEYOR
700 HALL OF RECORDS

Note: Any Additions or Changes on This Sheet Must be Made or Circled in **Red** Ink With Date and Name of Person Making Change.

Do not extend notes this side of this line

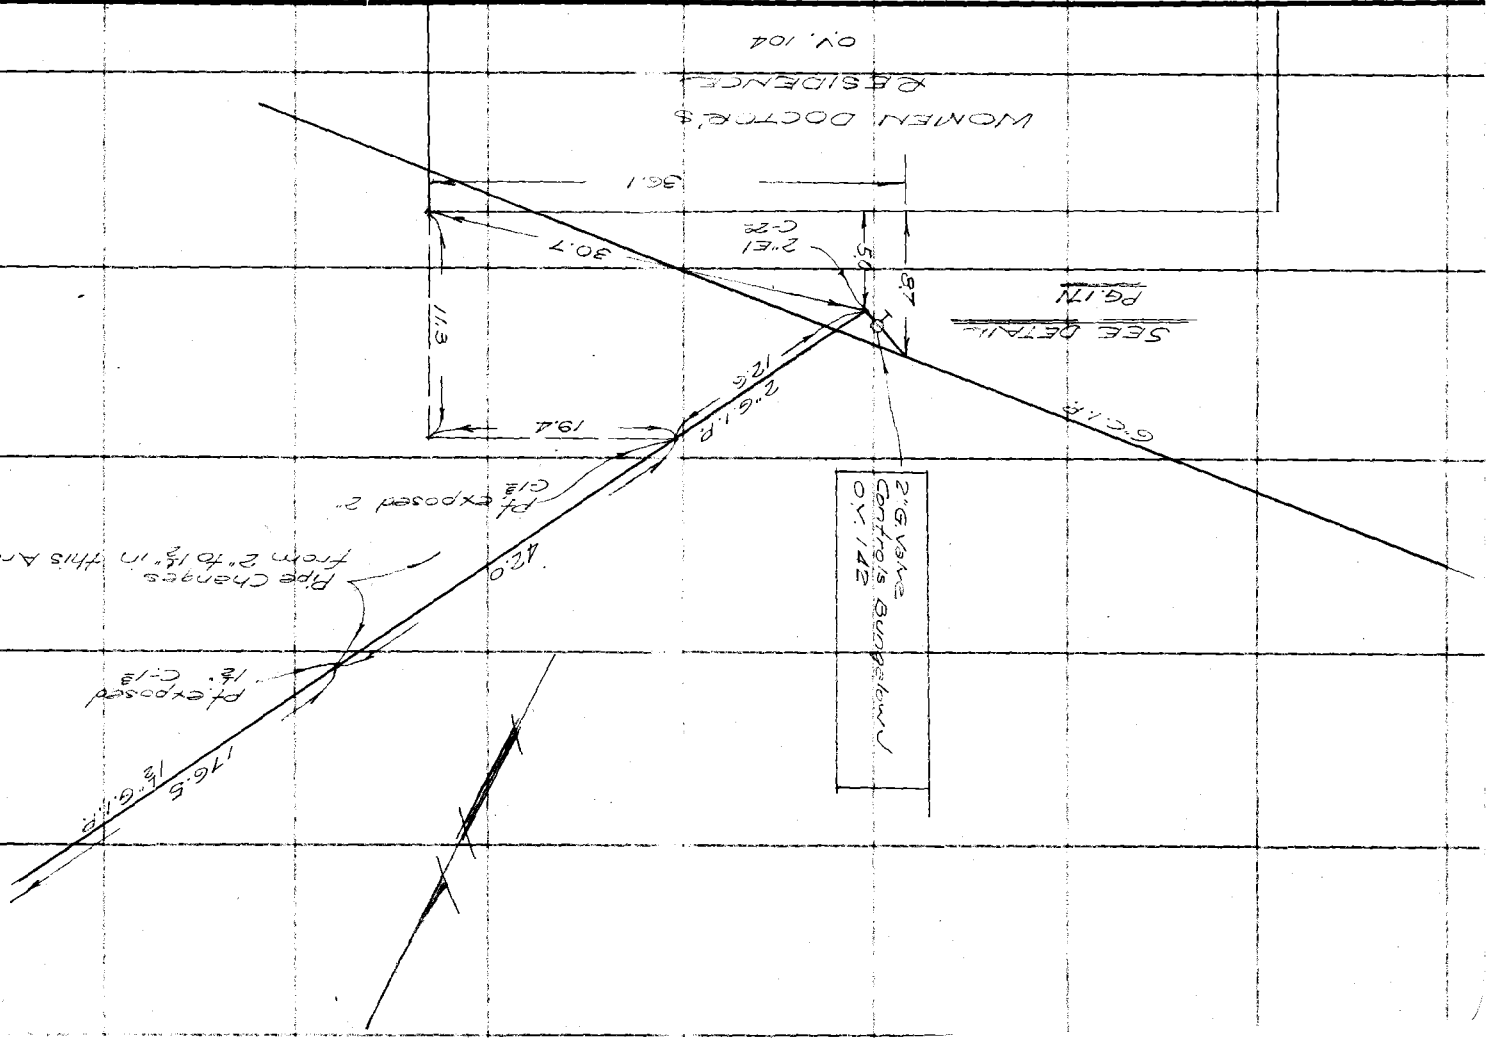

F.B. 709 PG. 172

FORM 247 10M 11-35

RETURN TO
LOS ANGELES COUNTY SURVEYOR
700 HALL OF RECORDS

Note: Any Additions or Changes on This Sheet Must be Made or Circled in Red Ink With Date and Name of Person Making Change.

Do not extend notes this side of this line

Notes Ck'd by
Map No.
Office Work
Checked
Date

Survey of OLIVE VIEW SANATORIUM
W. O. 528 Tape No. St'd. °F.
Surveyed by T. M. WALSH Date 8-3-37
Notes T. M. WALSH
Indexed

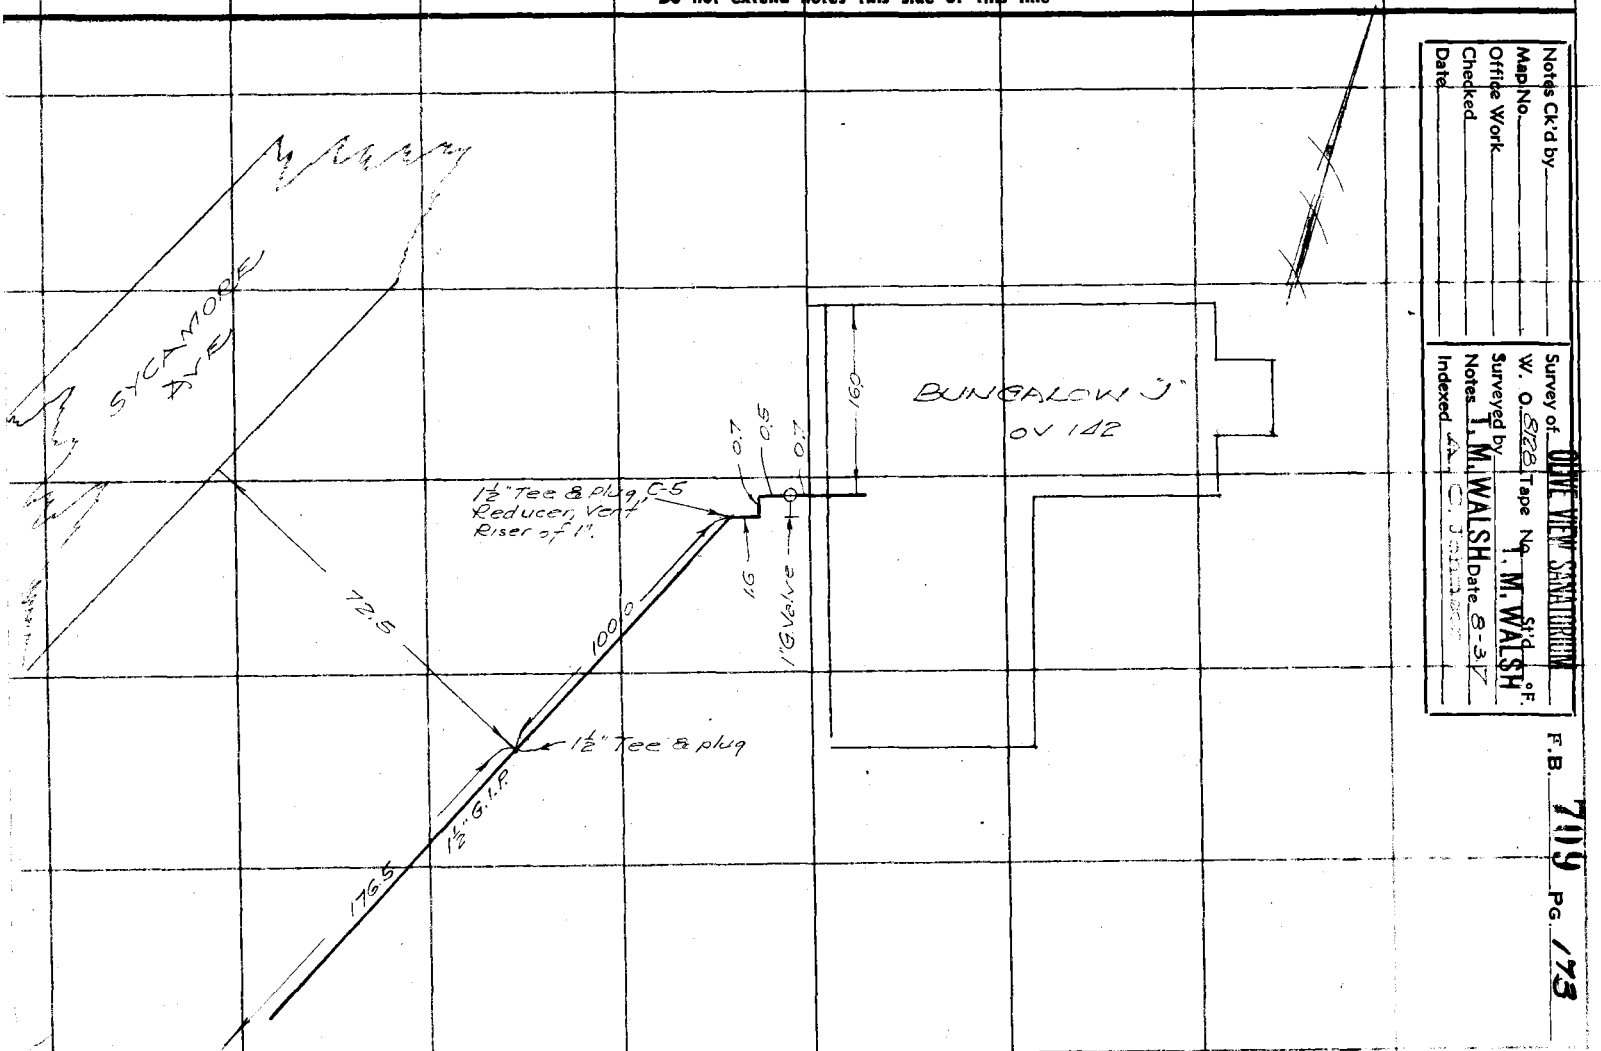

F.B. 709 PG. 173

RETURN TO
LOS ANGELES COUNTY SURVEYOR
700 HALL OF RECORDS

Note: Any Additions or Changes on This Sheet Must be Made or Circled in **Red Ink** With Date and Name of Person Making Change.

Do not extend notes this side of this line

F.B. 709 PG. 174

Notes Ck'd by	Survey of
Map No.	W. O. 8128 Tape No. St'd °F.
Office Work	Surveyed by T. M. WALSH
Checked	Notes T. M. WALSH Date 8-36
Date	Indexed

F.B. 709 PG. 175

WATER LINES

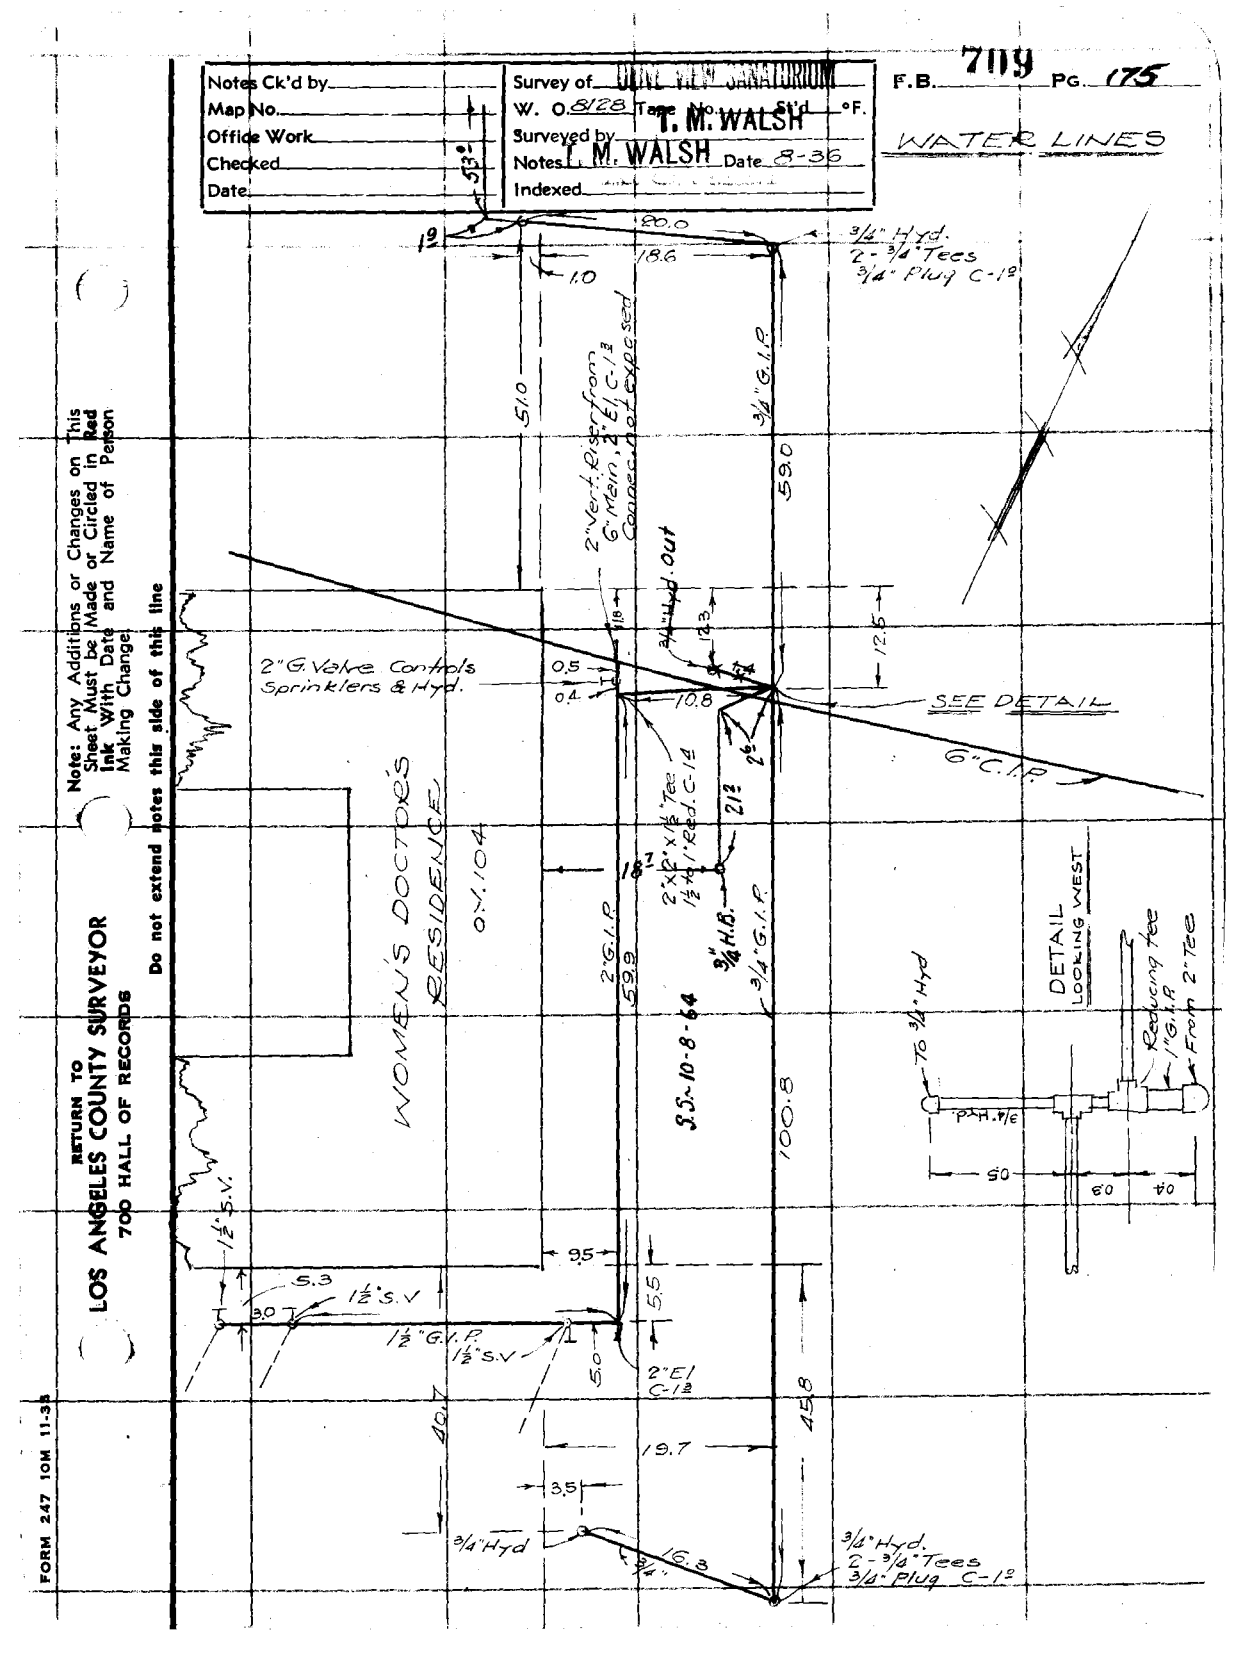

Note: Any Additions or Changes on This Sheet Must be Made or Circled in Red Ink With Date and Name of Person Making Change

Do not extend notes this side of this line

RETURN TO
LOS ANGELES COUNTY SURVEYOR
700 HALL OF RECORDS

FORM 247 10M 11-38

RETURN TO
LOS ANGELES COUNTY SURVEYOR
700 HALL OF RECORDS

Note: Any Additions or Changes on This Sheet Must be Made or Circled in **Red Ink** With Date and Name of Person Making Change.

Do not extend notes this side of this line

F.B. 709 PG. 178

Notes Ck'd by	Survey of O.V. UNDERGROUND UTILITIES
Map No.	W. O. 8120 Tape No. St'd °F.
Office Work	Surveyed by TWALSH
Checked	Notes WALSH Date 4-10-36
Date	Indexed A. C. Johnson

F.B. 7119 PG. 177

WATER LINE

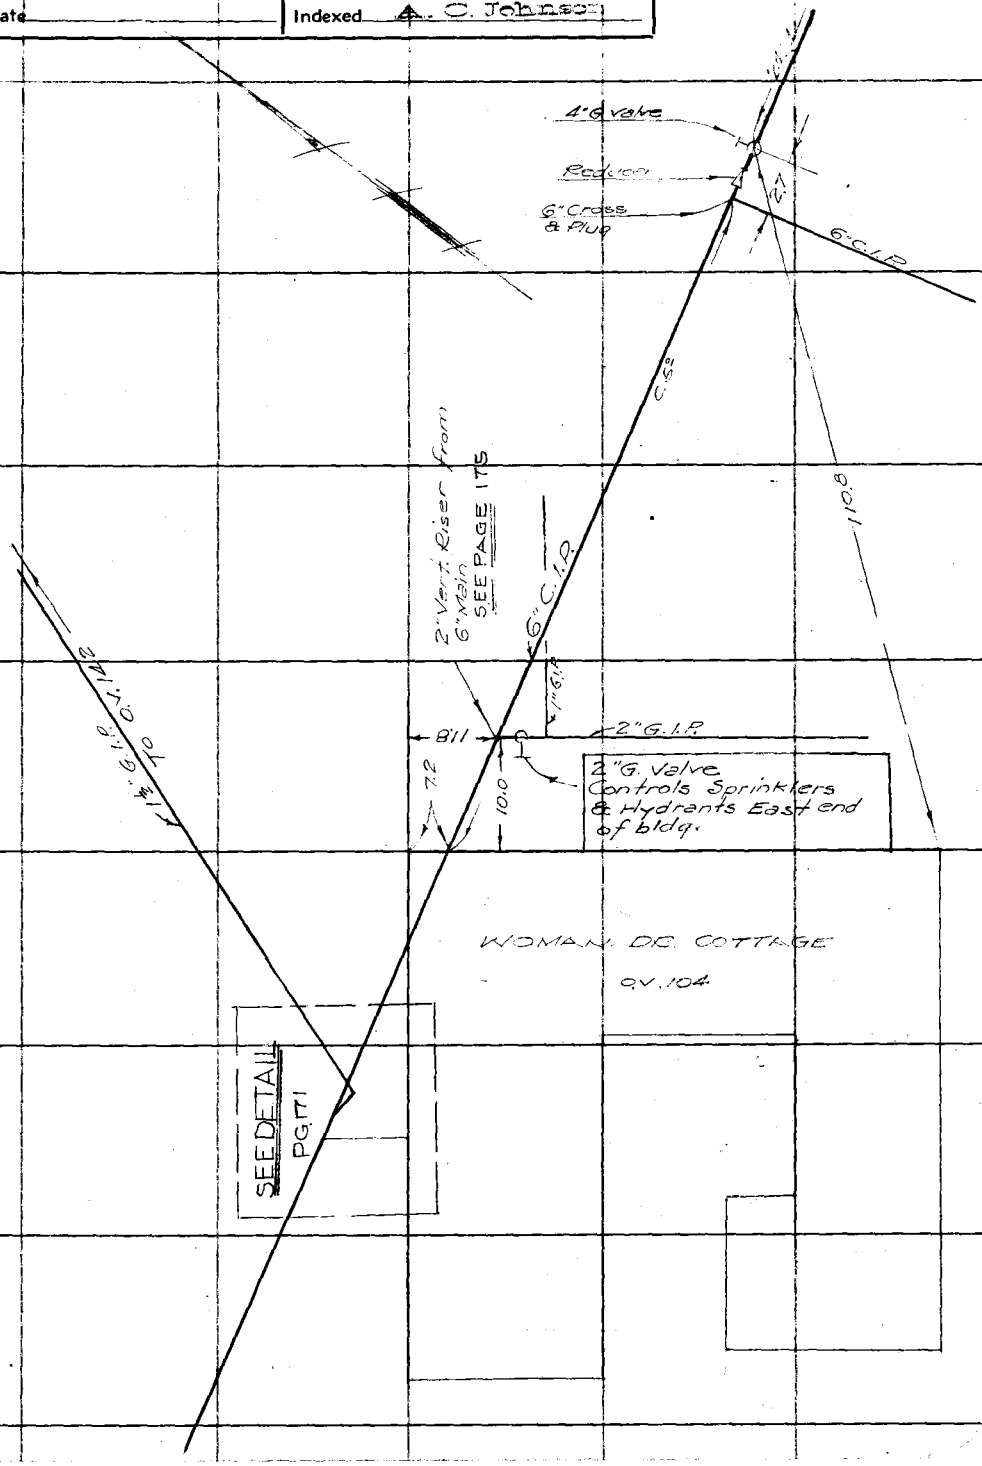

Note: Any Additions or Changes on This Sheet Must be Made or Circled in Red Ink With Date and Name of Person Making Change.

Do not extend notes this side of this line

RETURN TO
LOS ANGELES COUNTY SURVEYOR
700 HALL OF RECORDS

FORM 247 10M 11-35

RETURN TO
LOS ANGELES COUNTY SURVEYOR
700 HALL OF RECORDS

Note: Any Additions or Changes on This Sheet Must be Made or Circled in **Red Ink** With Date and Name of Person Making Change.

Do not extend notes this side of this line

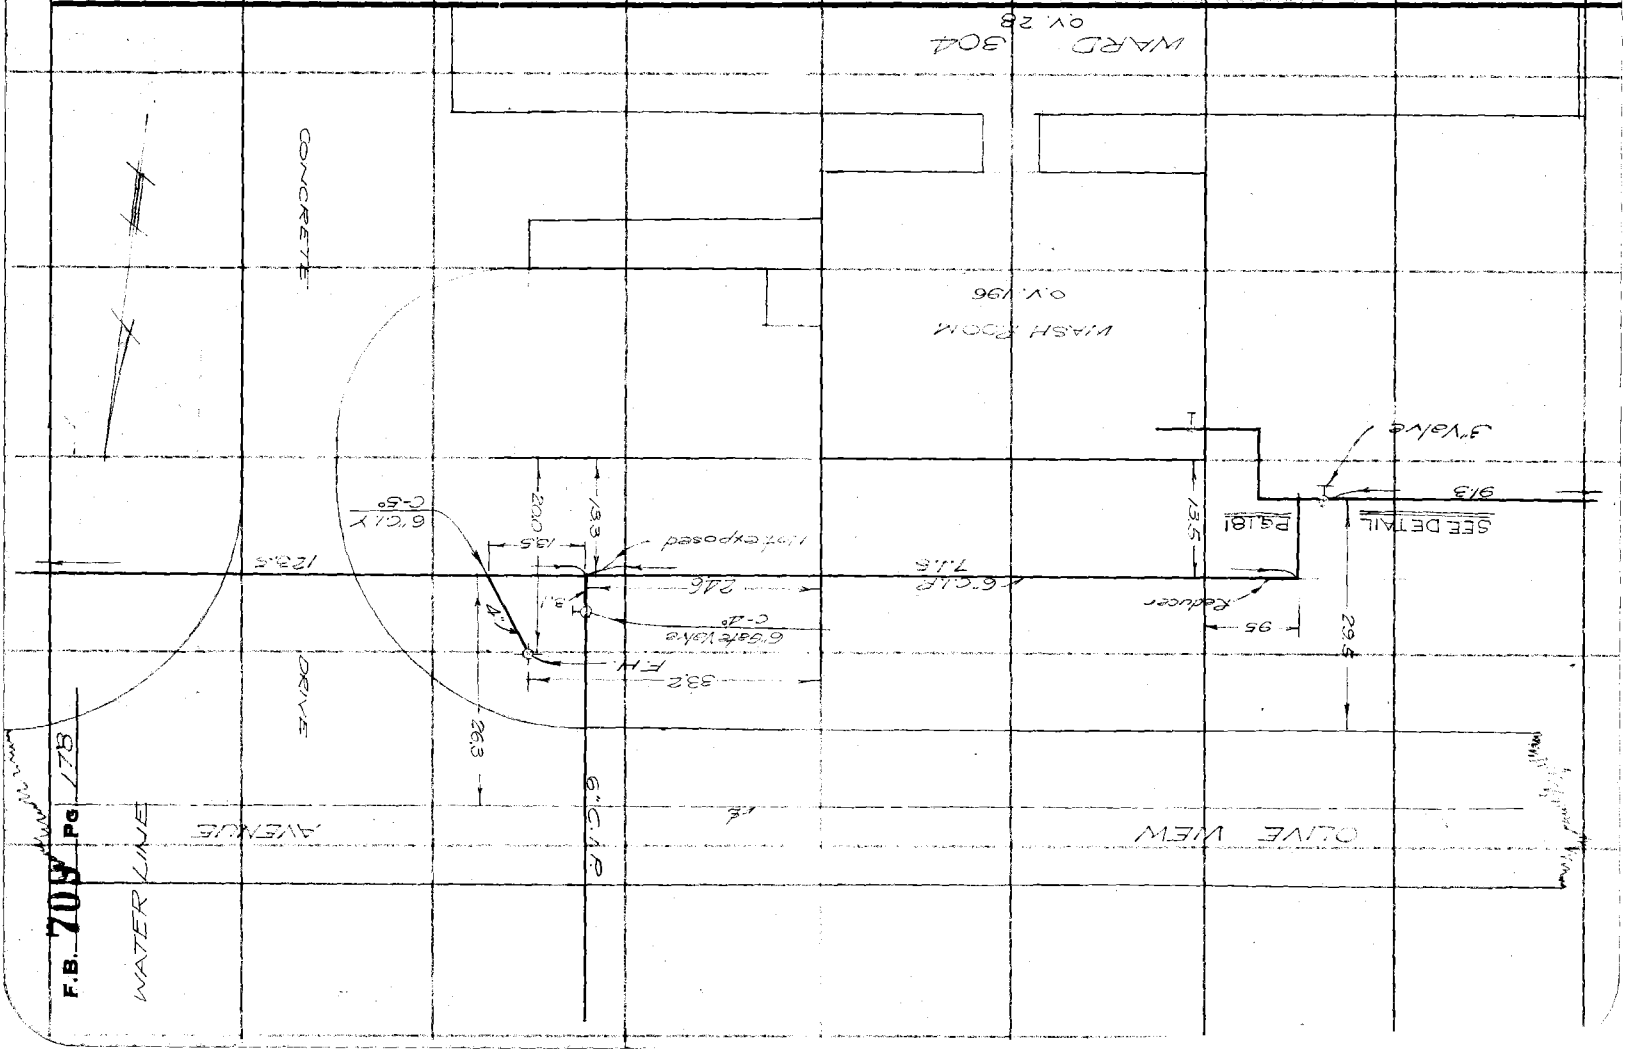

Notes Ck'd by	Survey of OLIVE VIEW SANATORIUM
Map No.	W. O. 8128 Tape No. St'd °F.
Office Work	Surveyed by T. M. WALSH
Checked	Notes T. M. WALSH Date 8-36
Date	Indexed

F.B. 709 PG. 179

WATER LINE

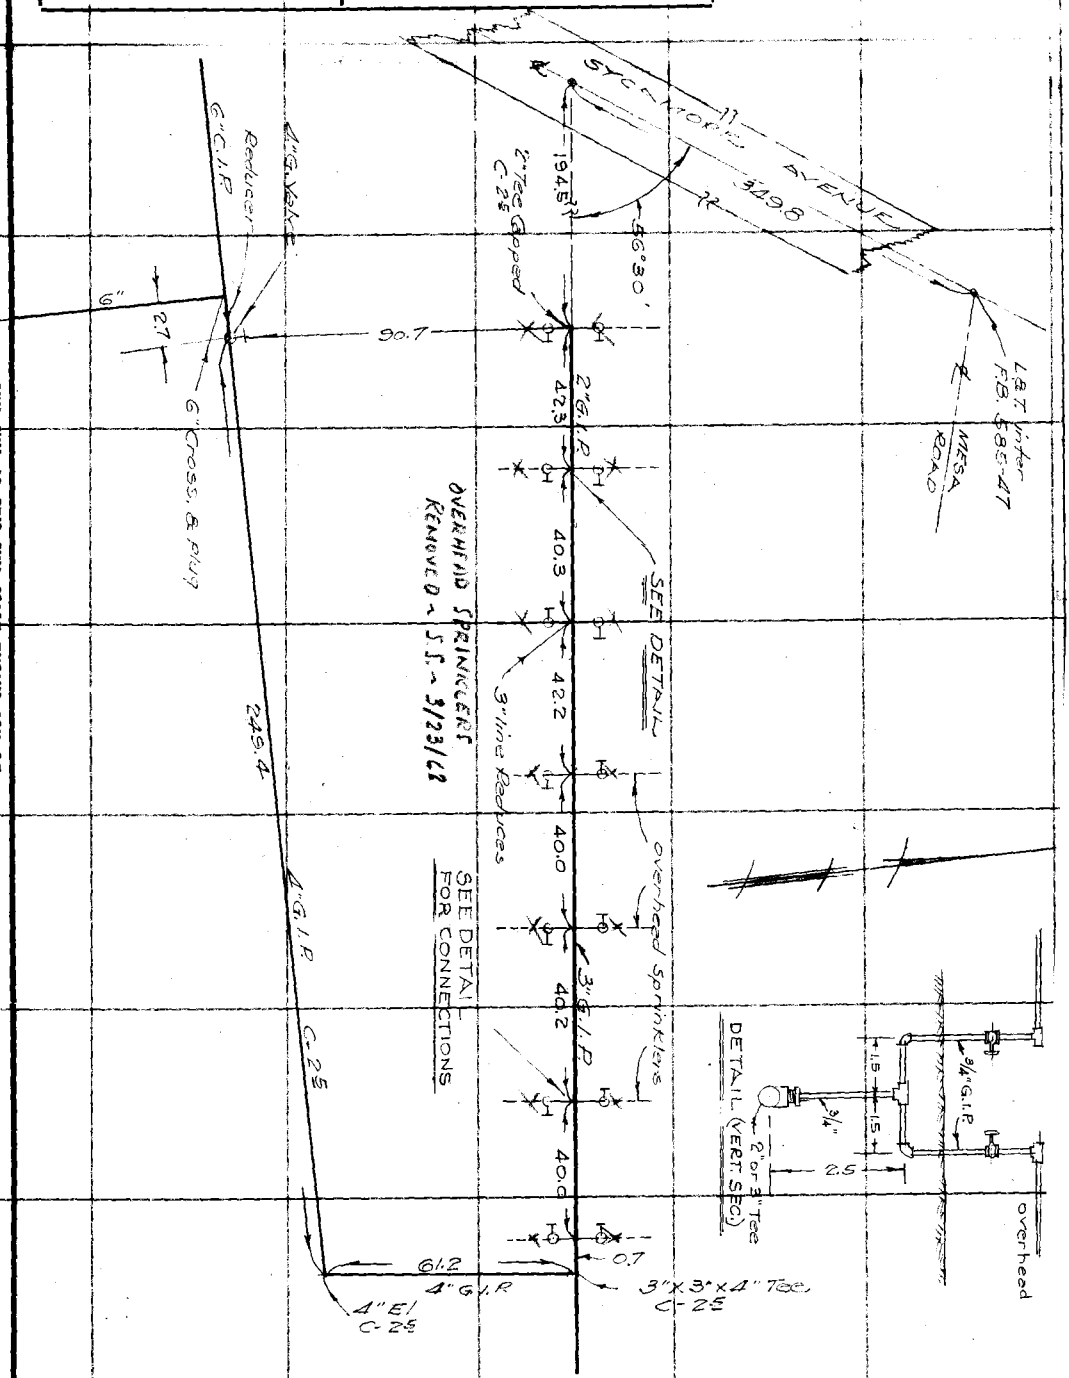

Note: Any Additions or Changes on This Sheet Must be Made or Circled in Red Ink With Date and Name of Person Making Change

Do not extend notes this side of this line

RETURN TO
LOS ANGELES COUNTY SURVEYOR
700 HALL OF RECORDS

FORM 247 10M 11-35

F.B. 709 PG. 180

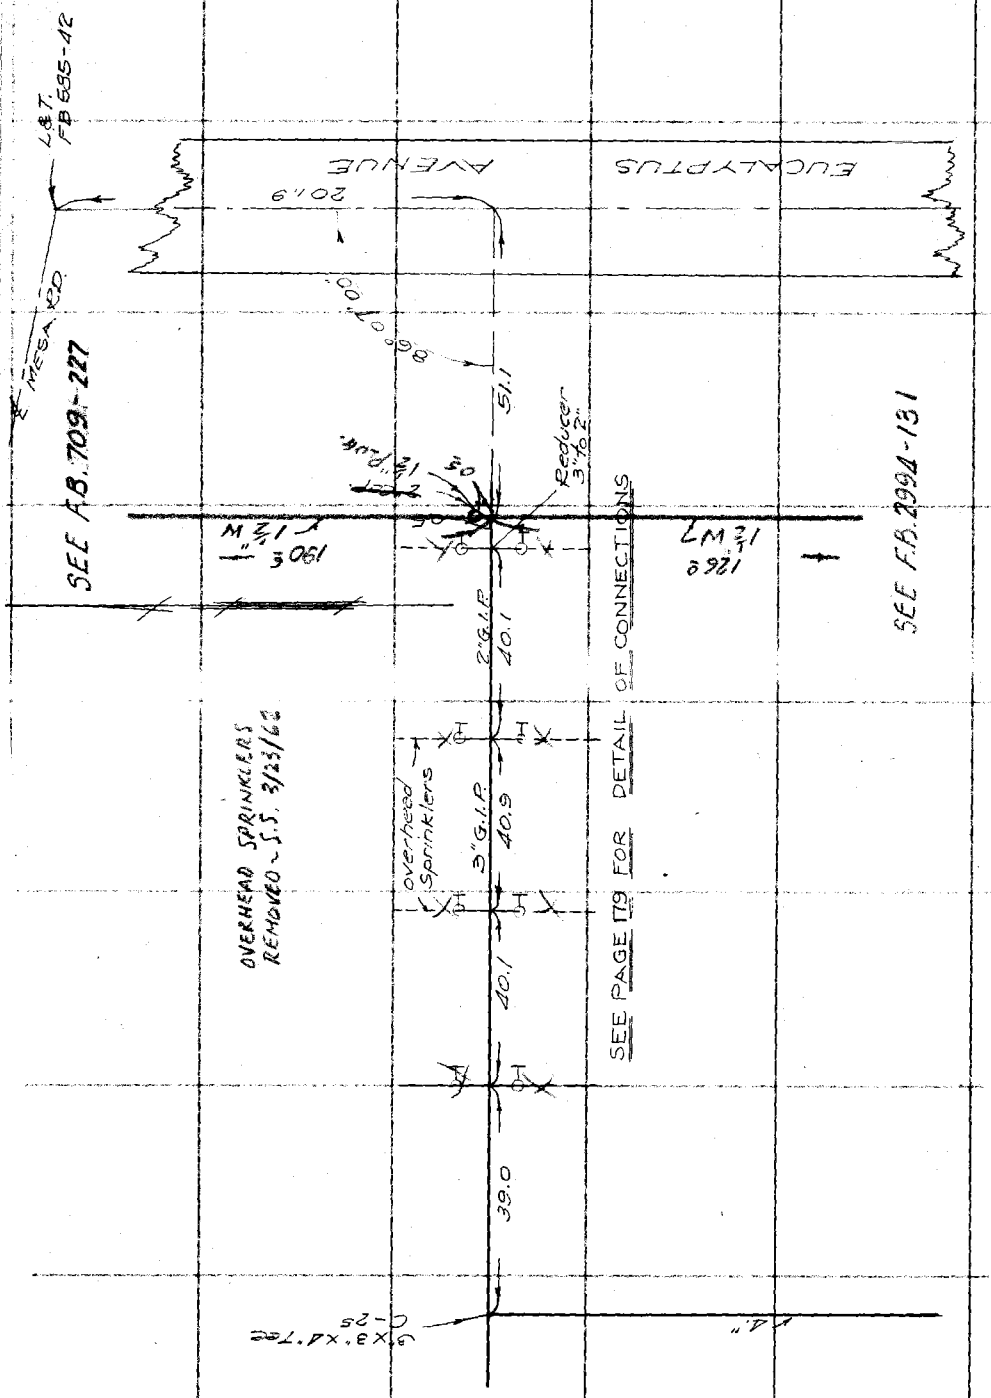

RETURN TO
LOS ANGELES COUNTY SURVEYOR
700 HALL OF RECORDS

Note: Any Additions or Changes on This Sheet Must be Made or Circled in Red Ink With Date and Name of Person Making Change.

Do not extend notes this side of this line

Notes Ck'd by	Survey of OLIVE VIEW SANATORIUM
Map No.	W. O. 8148 Tape No. St'd °F.
Office Work	Surveyed by TED WALSH
Checked	Notes WALSH Date 6-15-36
Date	Indexed A. C. Johnson

F.B. 709 Pg. 181

WATER LINES

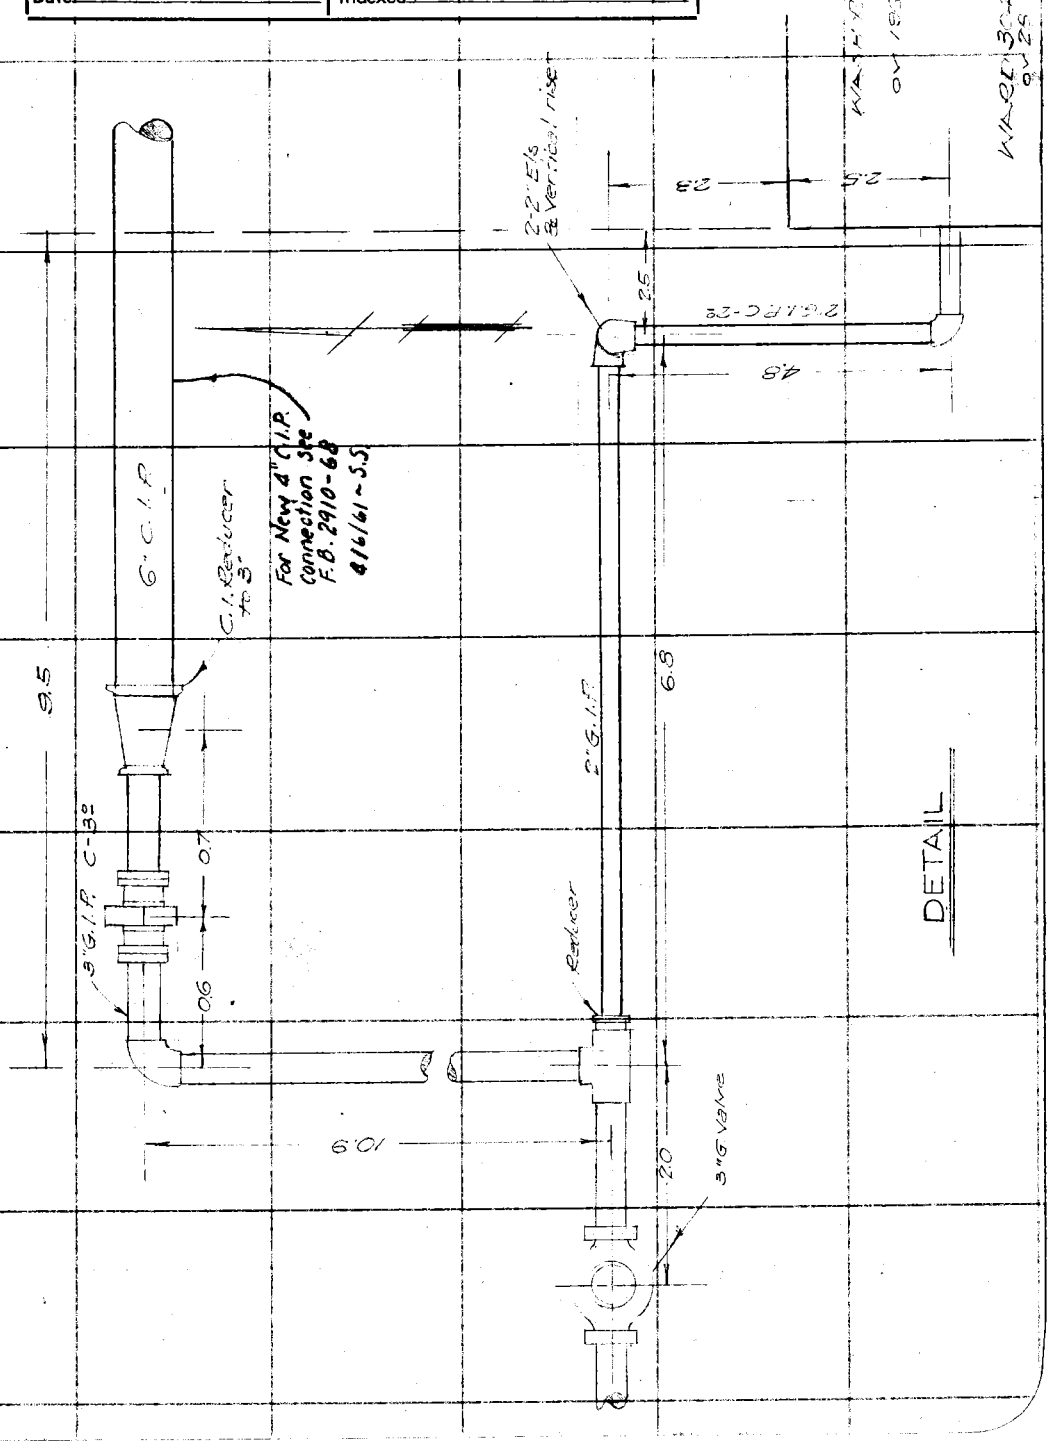

Note: Any Additions or Changes on This Sheet Must be Made or Circled in Red Ink With Date and Name of Person Making Change.

Do not extend notes this side of this line

RETURN TO
LOS ANGELES COUNTY SURVEYOR
700 HALL OF RECORDS

FORM 247 10M 11-35

F.B. 709 PG. 182

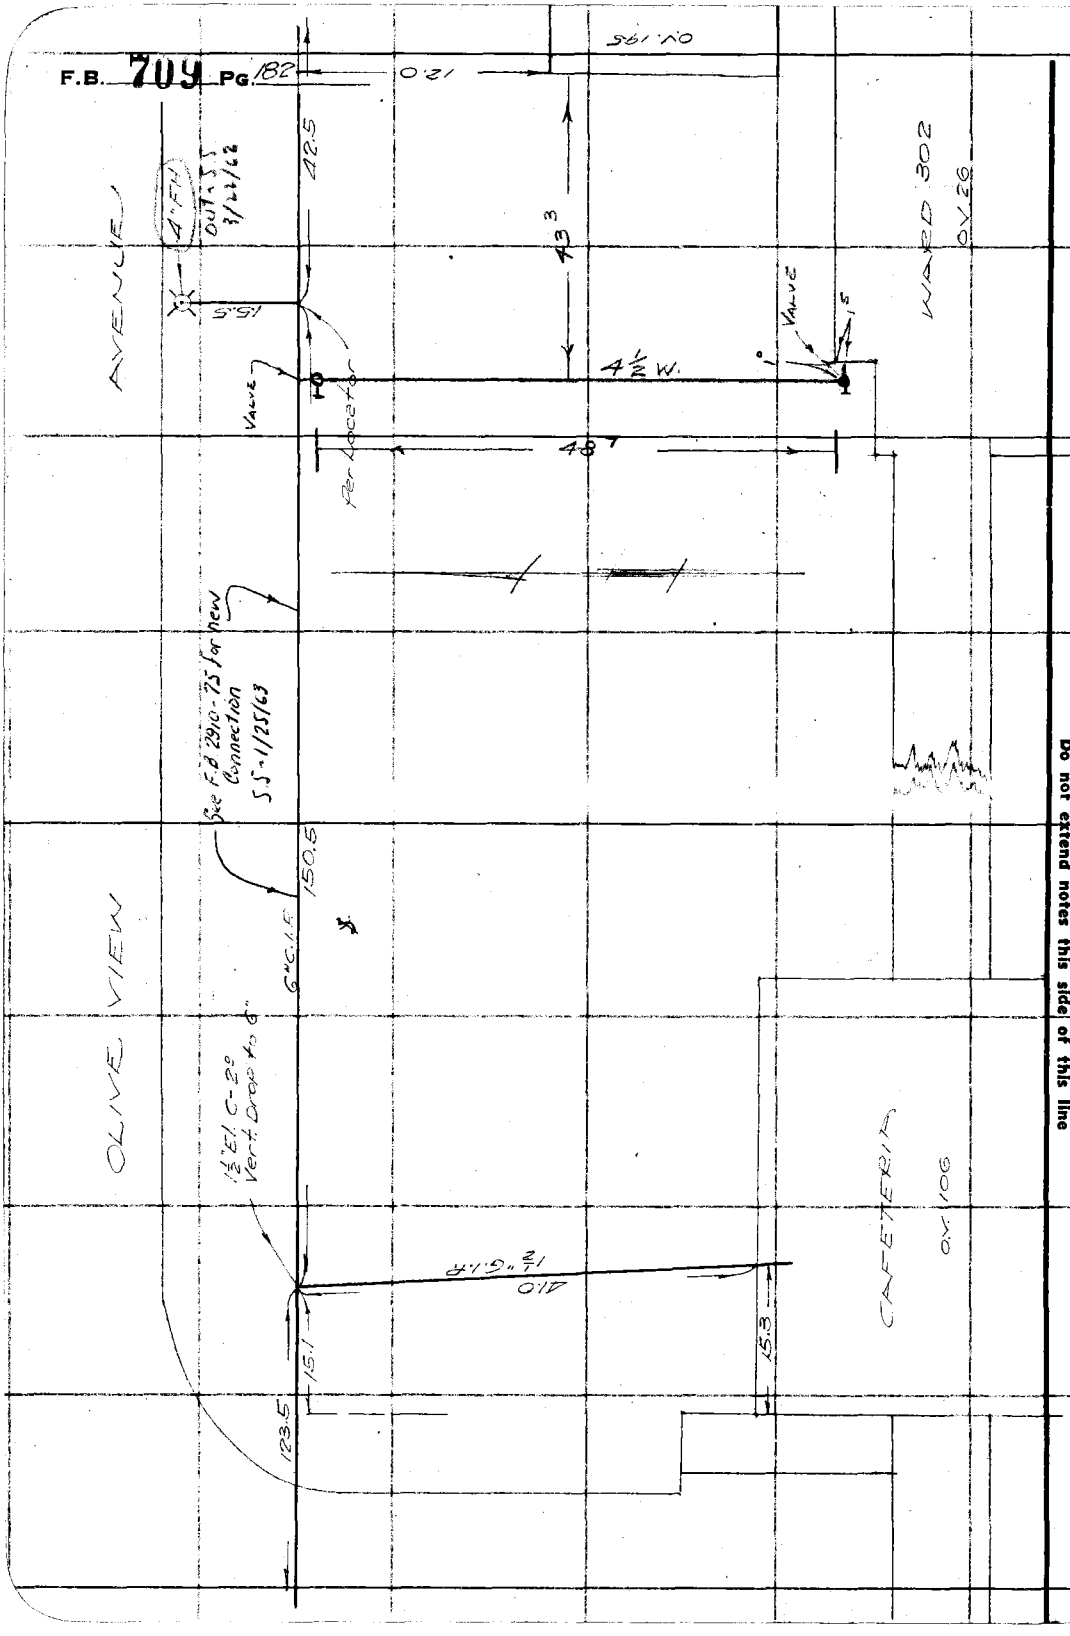

RETURN TO
LOS ANGELES COUNTY SURVEYOR
700 HALL OF RECORDS

Note: Any Additions or Changes on This Sheet Must be Made or Circled in Red Ink With Date and Name of Person Making Change.

Do not extend notes this side of this line

FORM 247 10M 11-35

RETURN TO
LOS ANGELES COUNTY SURVEYOR
700 HALL OF RECORDS

Note: Any Additions or Changes on This Sheet Must be Made or Circled in **Red Ink** With Date and Name of Person Making Change.

Do not extend notes this side of this line

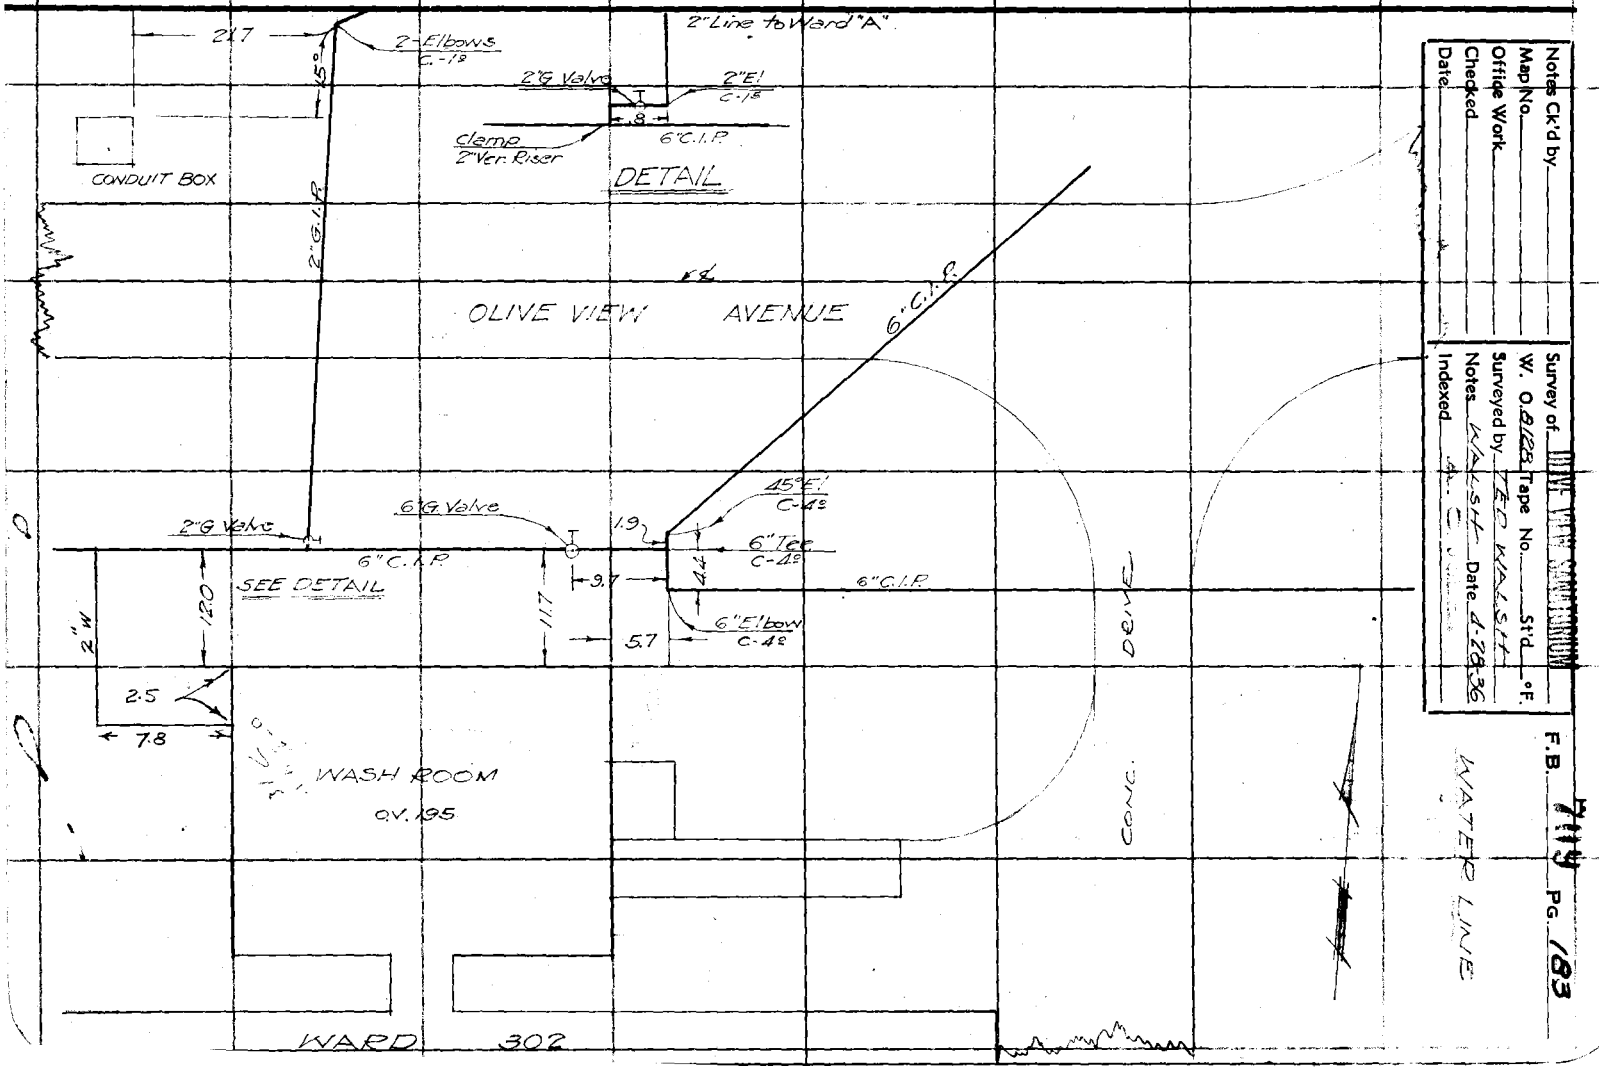

Notes Ck'd by
Map No.
Office Work
Checked
Date

W. O. 8128 Tape No. Std. °F.
Surveyed by T.E.C. WALSH Date 4-28-36
Notes WALSH
Indexed


RETURN TO
LOS ANGELES COUNTY SURVEYOR
700 HALL OF RECORDS

Note: Any Additions or Changes on This Sheet Must be Made or Circled in **Red** Ink With Date and Name of Person Making Change.

Do not extend notes this side of this line

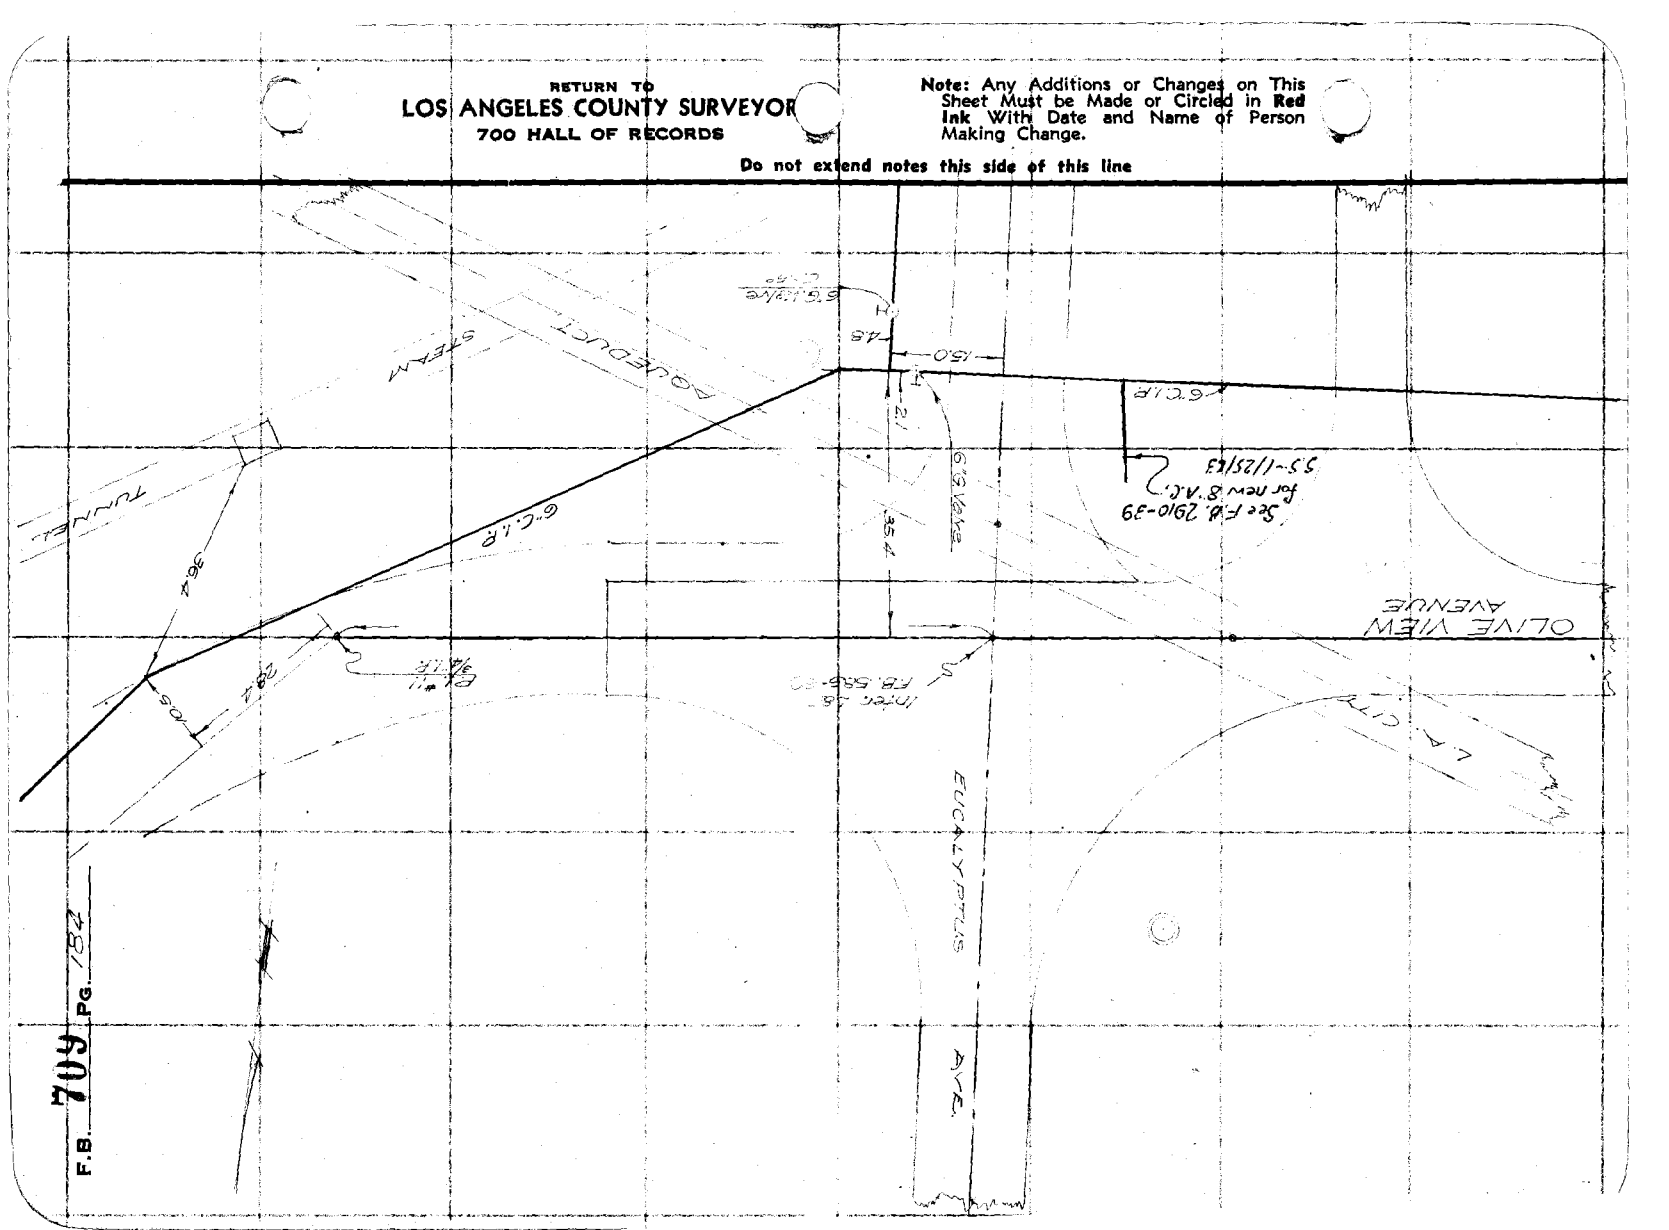

F.B. 709 PG. 184

Notes Ck'd by	Survey of OLIVE VIEW SAN
Map No.	W. O. 8148 Tape No. St'd °F.
Office Work	Surveyed by TED M. WALSH
Checked	Notes WALSH Date 4-28-36
Date	Indexed A. C.

F.B. 709 Pg. 185

WATER LINES

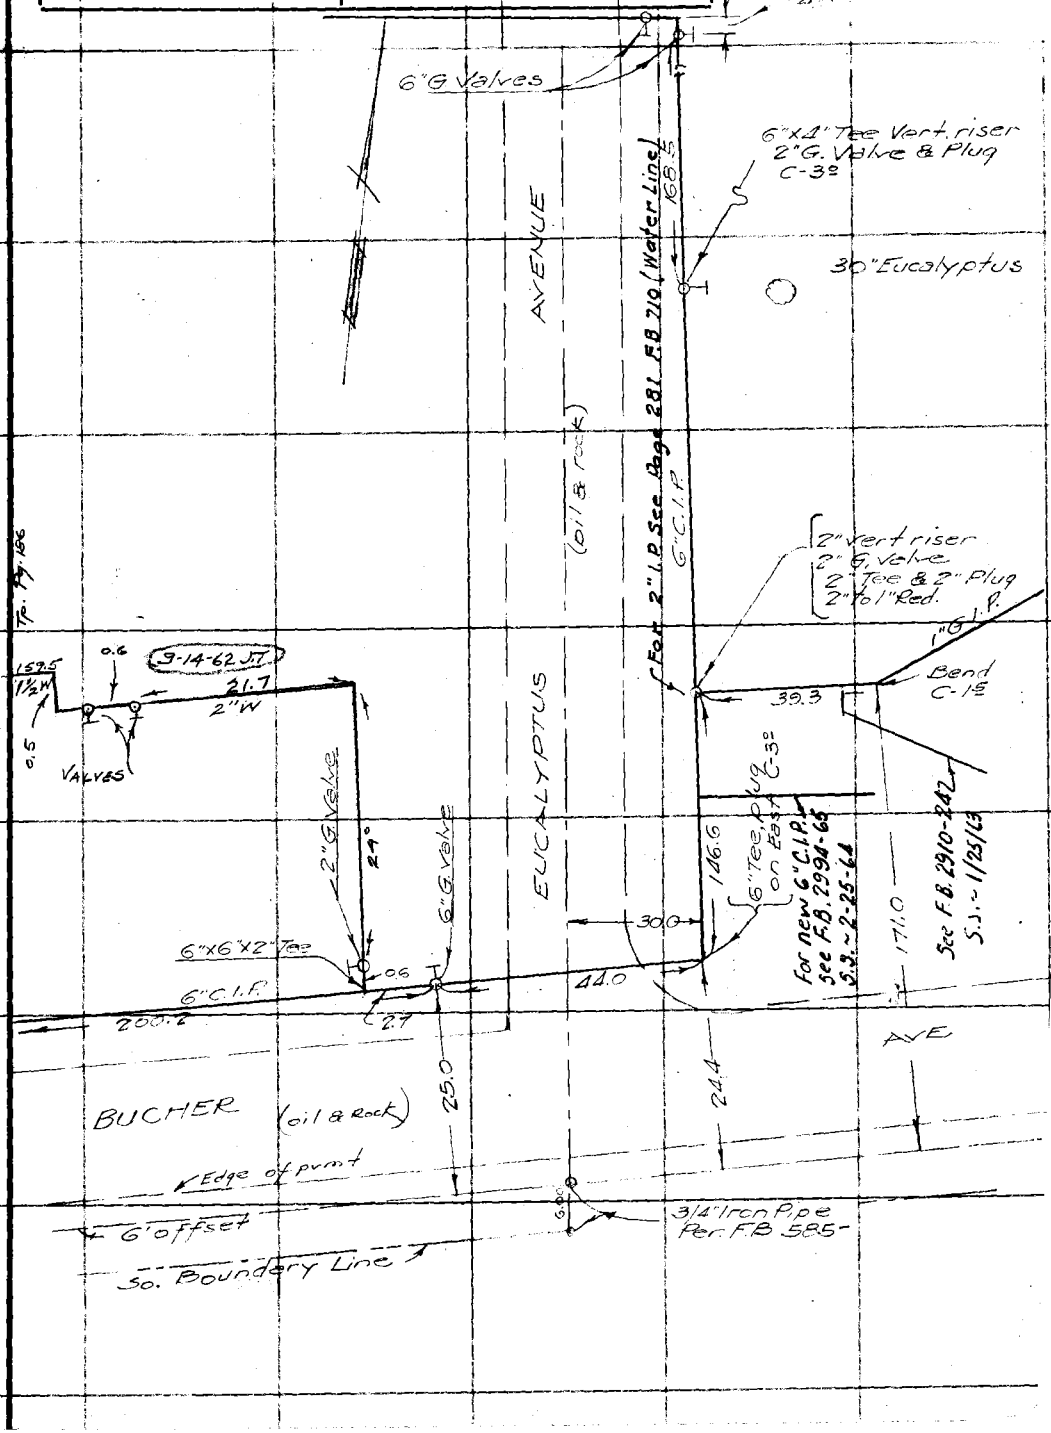

Tp. Pg. 186

Note: Any Additions or Changes on This Sheet Must be Made or Circled in Red Ink With Date and Name of Person Making Change.

Do not extend notes this side of this line

RETURN TO
LOS ANGELES COUNTY SURVEYOR
700 HALL OF RECORDS

FORM 247 10M 11-65

RETURN TO
LOS ANGELES COUNTY SURVEYOR
700 HALL OF RECORDS

Note: Any Additions or Changes on This Sheet Must be Made or Circled in Red Ink With Date and Name of Person Making Change.

Do not extend notes this side of this line

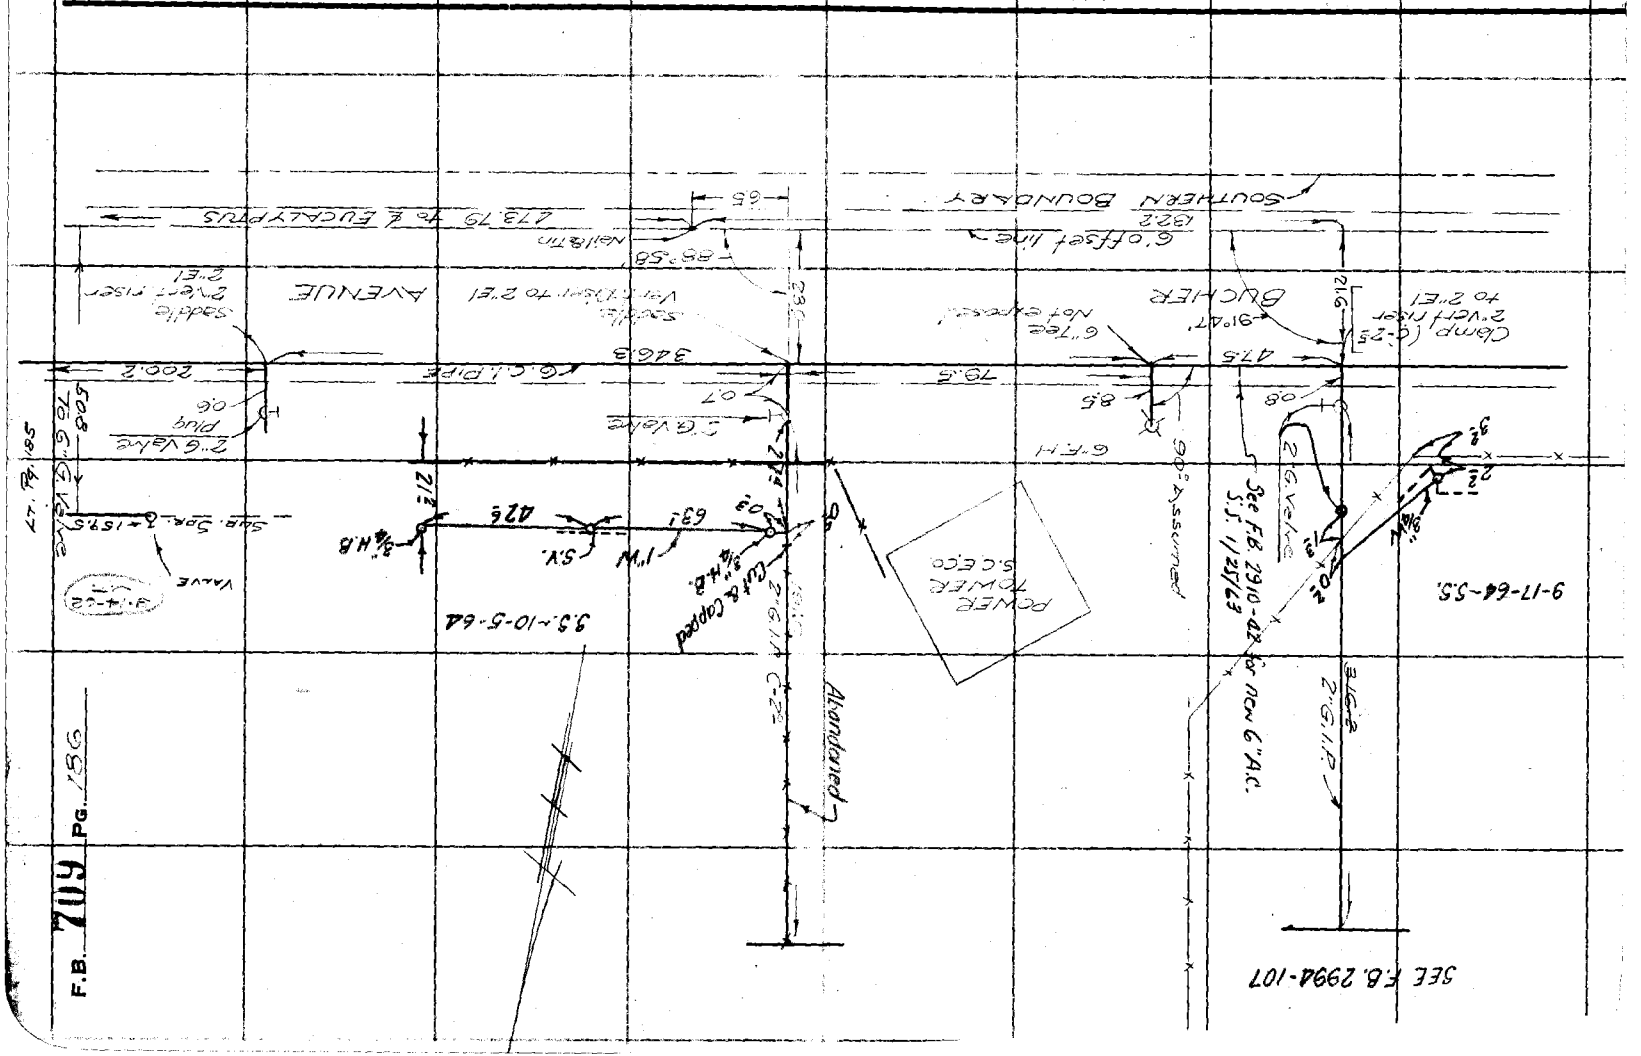

F.B. 709 PG. 186

Notes Ck'd by	Survey of OLIVE VIEW SAN.
Map No.	W. O. 8148 Tape No. St'd °F.
Office Work	Surveyed by TED WALSH
Checked	Notes WALSH Date 7-21-36
Date	Indexed

F.B. 709 PG. 187

WATER LINES

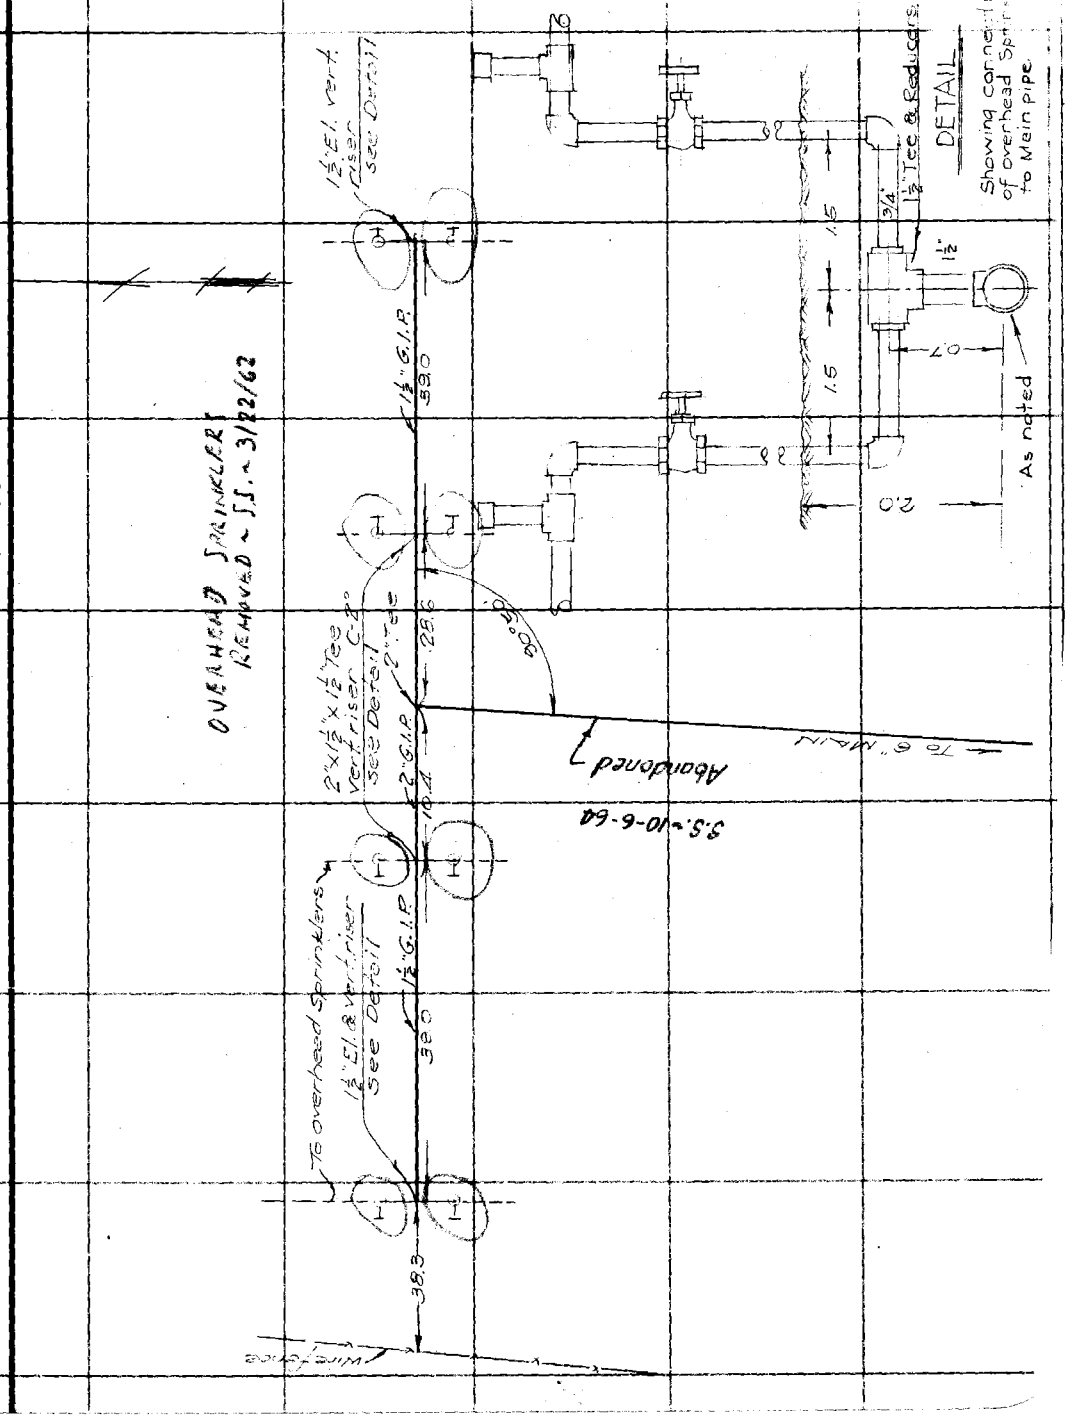

Note: Any Additions or Changes on This Sheet Must be Made or Circled in Red Ink With Date and Name of Person Making Change.

Do not extend notes this side of this line

RETURN TO
LOS ANGELES COUNTY SURVEYOR
700 HALL OF RECORDS

FORM 247 10M 11-38

RETURN TO
LOS ANGELES COUNTY SURVEYOR
700 HALL OF RECORDS

Note: Any Additions or Changes on This Sheet Must be Made or Circled in **Red Ink** With Date and Name of Person Making Change.

Do not extend notes this side of this line

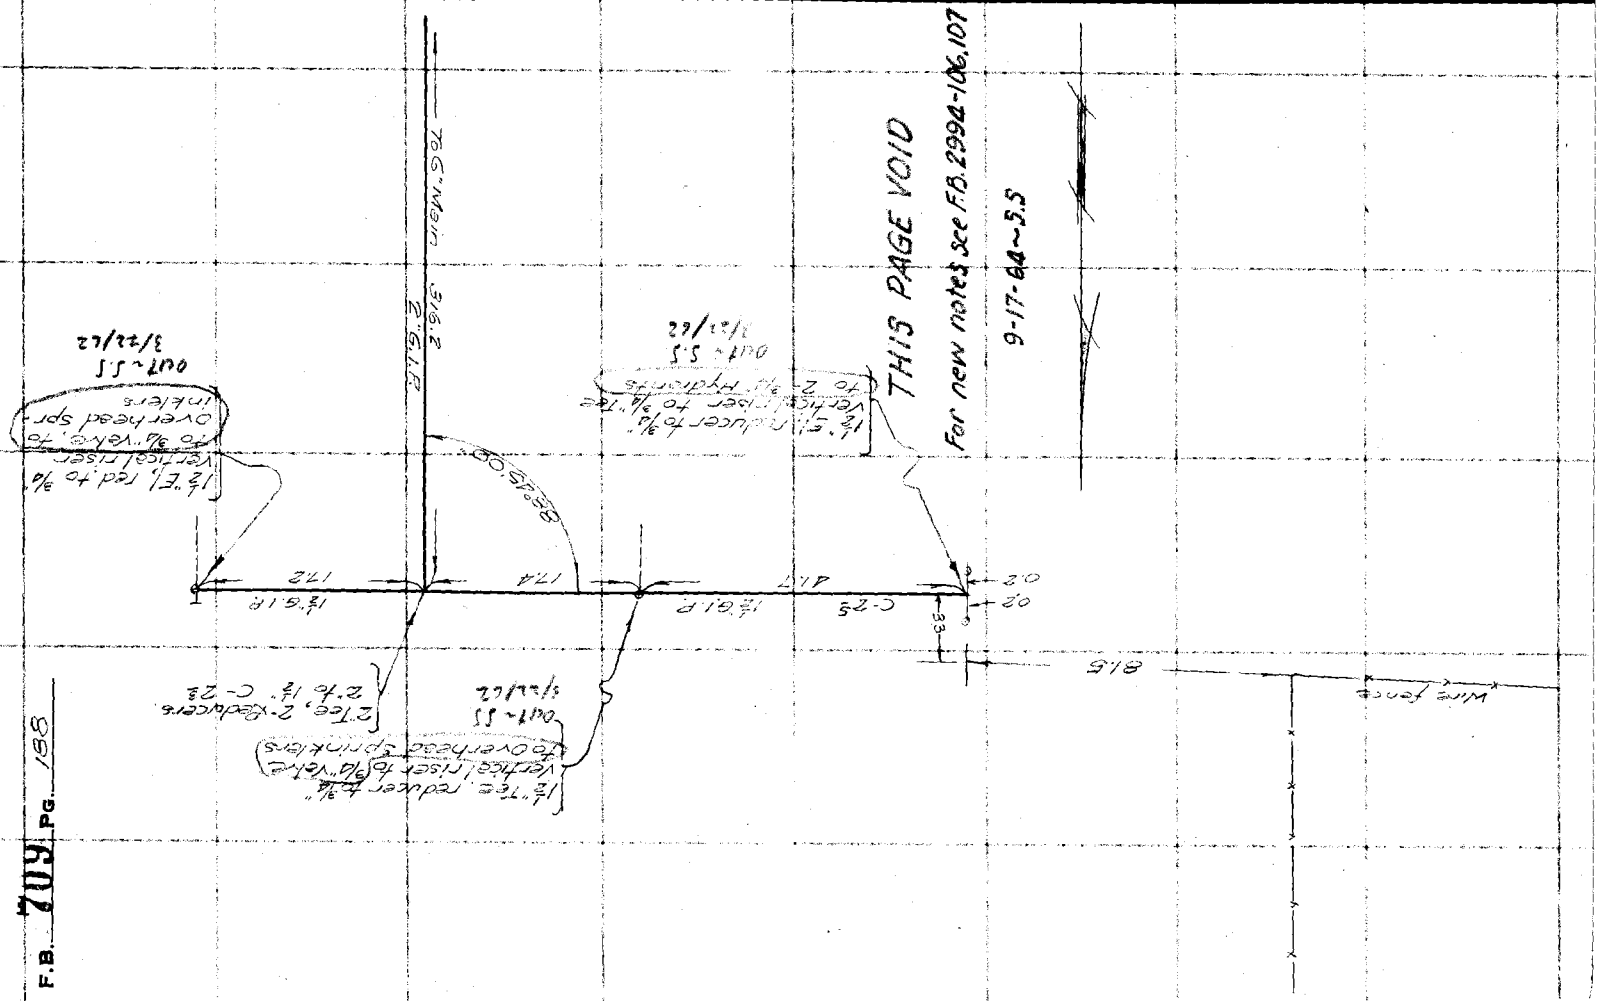

F.B. 709 Pg. 188

FORM 247 10M 11-38

RETURN TO
LOS ANGELES COUNTY SURVEYOR
700 HALL OF RECORDS

Note: Any Additions or Changes on This Sheet Must be Made or Circled in **Red Ink** With Date and Name of Person Making Change.

Do not extend notes this side of this line

Notes Ck'd by
Map No.
Office Work
Checked
Date

Surveyed by
Notes
Indexed

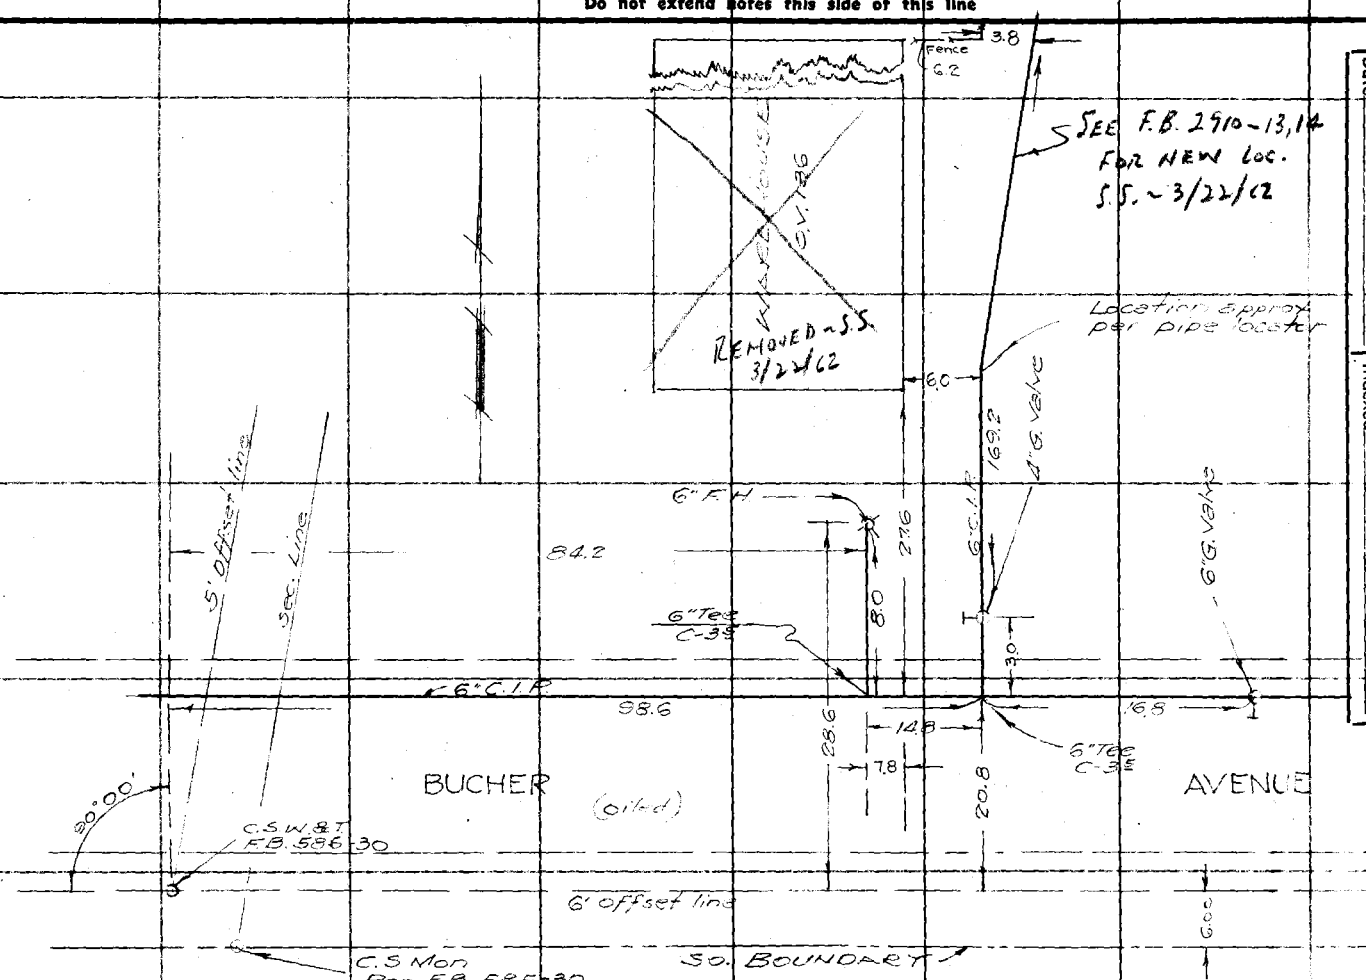


F.B. 709 PG. 190

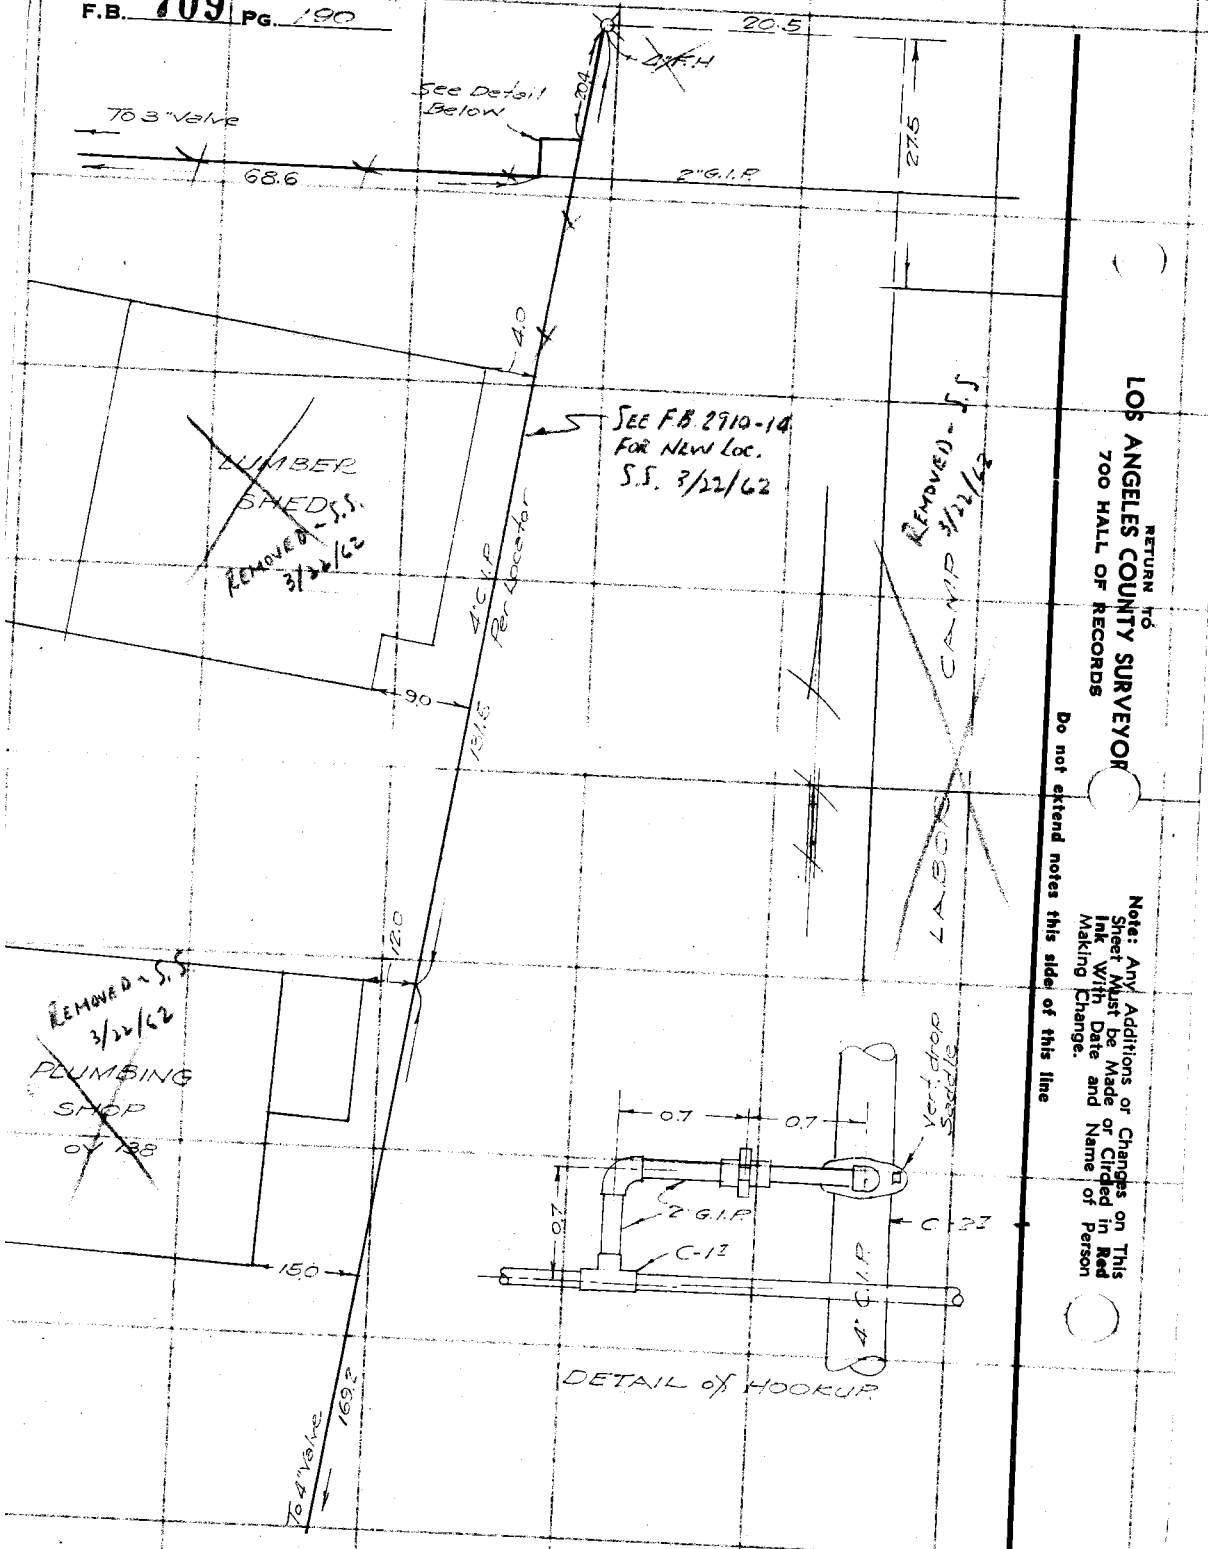

RETURN TO
LOS ANGELES COUNTY SURVEYOR
700 HALL OF RECORDS

Note: Any Additions or Changes on This Sheet Must be Made in Red Ink With Date and Name of Person Making Change.

Do not extend notes this side of this line

Notes Ck'd by	Survey of OLIVEVIEW SAN
Map No.	W. O. 8148 Tape No. St'd °F.
Office Work	Surveyed by TED M. WALSH
Checked	Notes WALSH Date 5-36
Date	Indexed A. C. Johnson

F.B. 709 PG. 191

WATER LINES

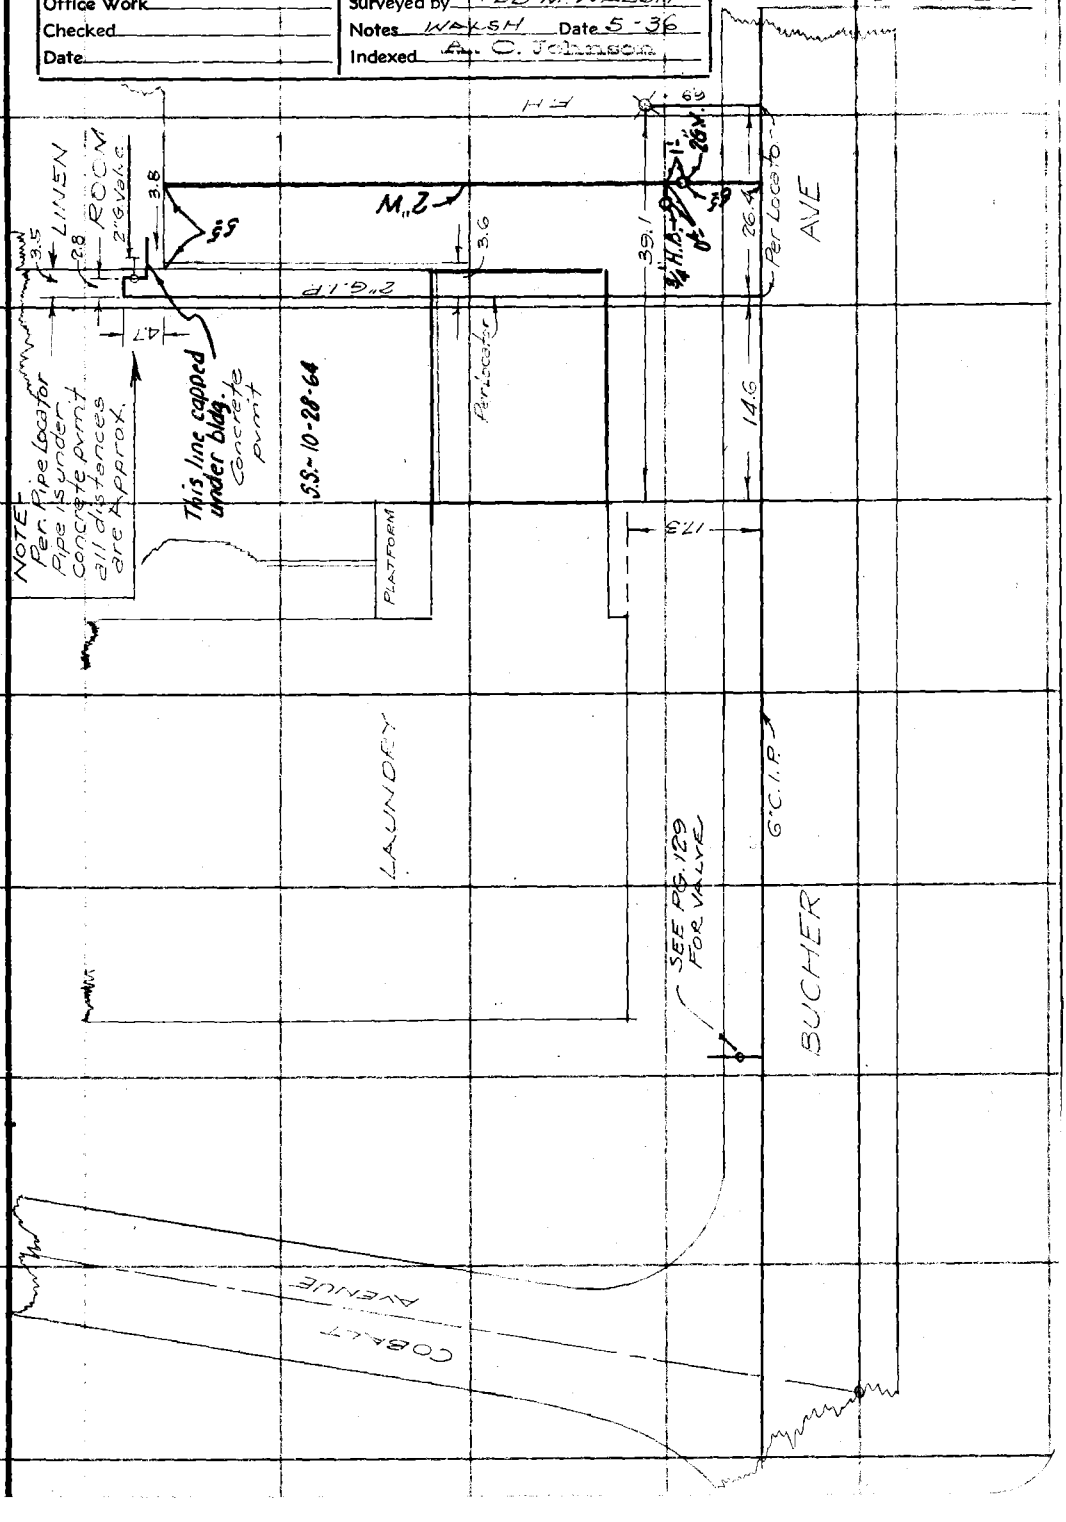

Note: Any Additions or Changes on This Sheet Must be Made or Circled in Red Ink With Date and Name of Person Making Change.

Do not extend notes this side of this line

RETURN TO
LOS ANGELES COUNTY SURVEYOR
700 HALL OF RECORDS

FORM 247 10M 11-35

F.B. 709 PG. 192

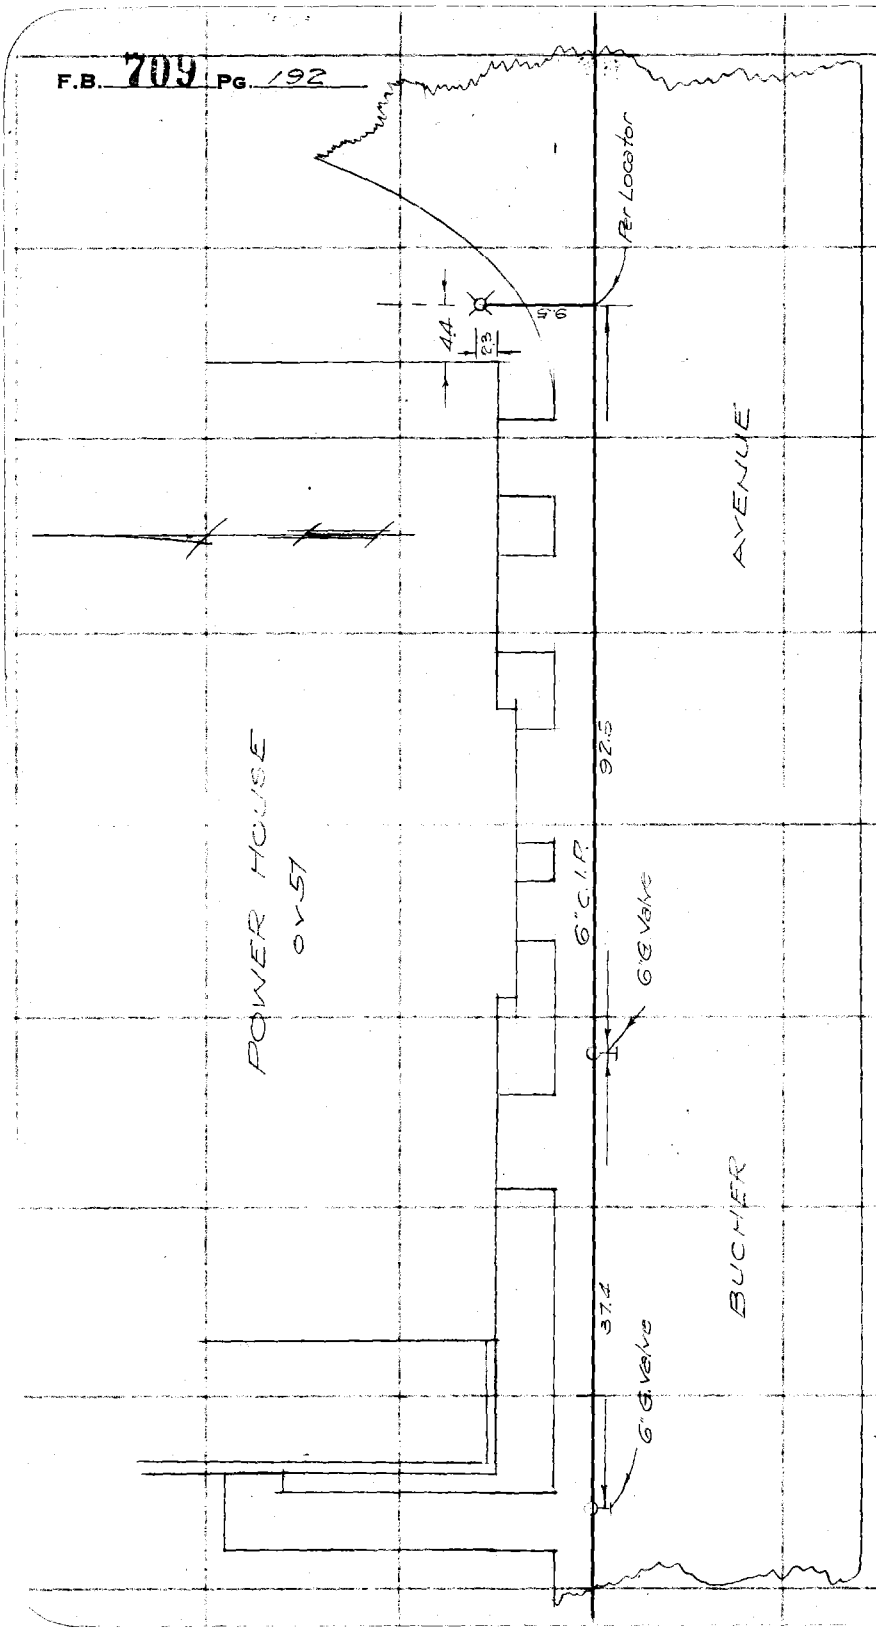

RETURN TO
LOS ANGELES COUNTY SURVEYOR
700 HALL OF RECORDS

Note: Any Additions or Changes on This Sheet Must be Made or Circled in Red Ink With Date and Name of Person Making Change.

Do not extend notes this side of this line

Notes Ck'd by	Survey of OLIVE VIEW SANATORIUM
Map No.	W. O. 8128 Tape No. St'd °F.
Office Work	Surveyed by T. M. WALSH
Checked	Notes T. M. WALSH Date 9-36
Date	Indexed A. C. Johnson

F.B. 709 PG. 193

WATER LINES

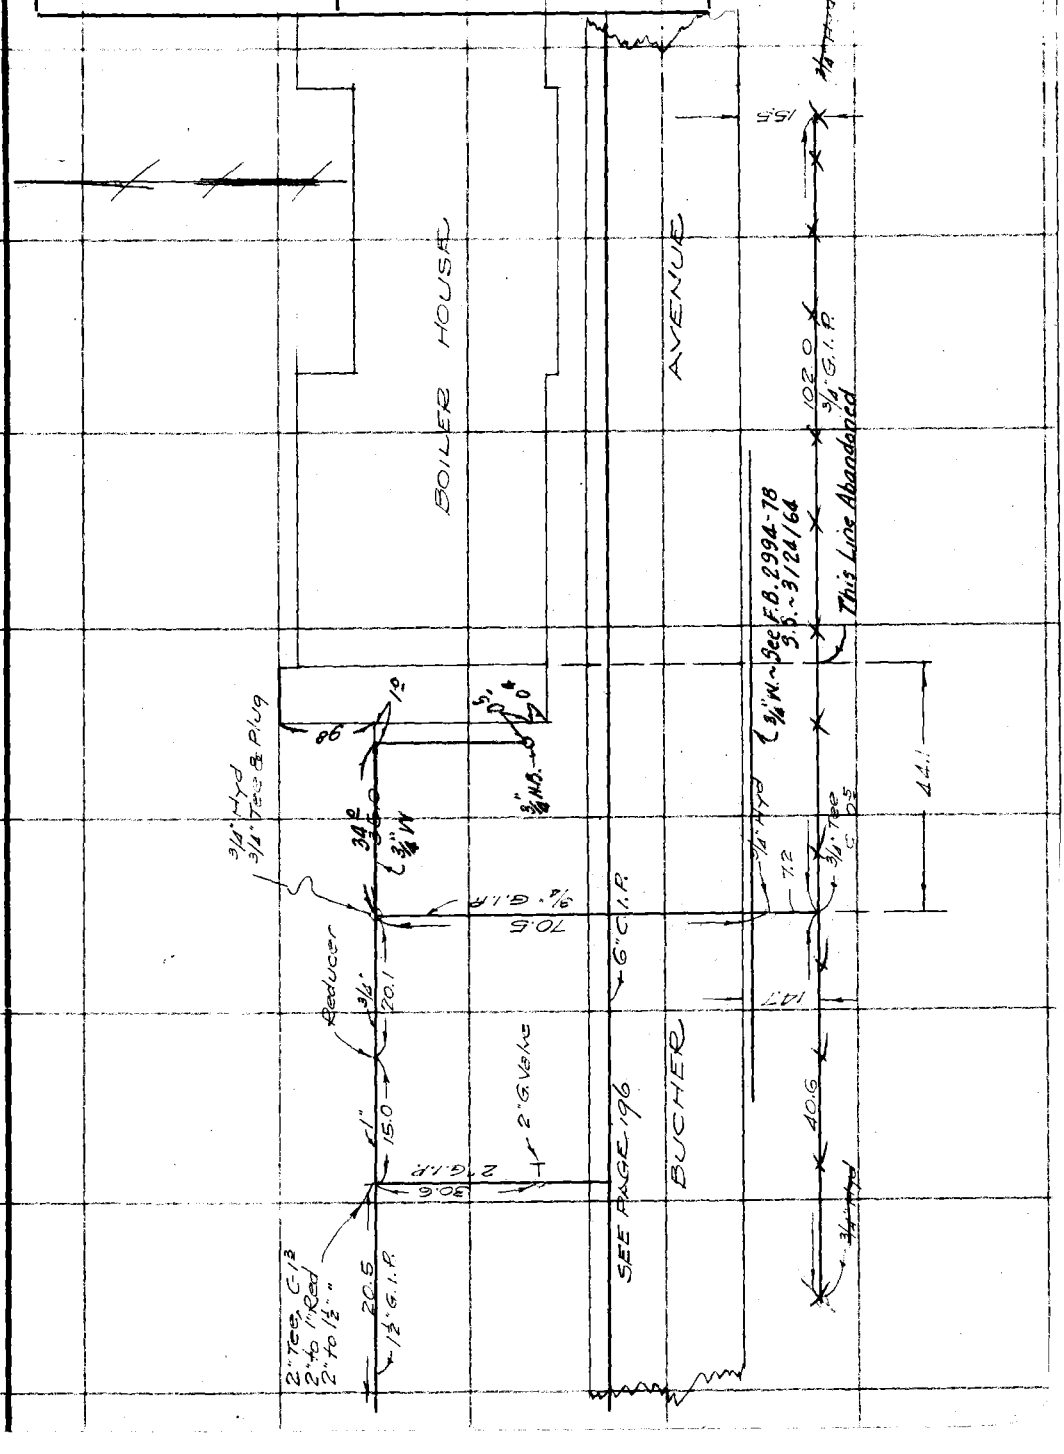

Note: Any Additions or Changes on This Sheet Must be Made or Circled in Red Ink With Date and Name of Person Making Change

Do not extend notes this side of this line

RETURN TO
LOS ANGELES COUNTY SURVEYOR
700 HALL OF RECORDS

FORM 247 10M 11-35

F.B. 709 Pg. 194

RETURN TO
LOS ANGELES COUNTY SURVEYOR
700 HALL OF RECORDS

Note: Any Additions or Changes on This Sheet Must be Made or Circled in Red Ink with Date and Name of Person Making Change.

Do not extend notes this side of this line

Map No.	W. O. 8128 Tape No. St'd °F.
Checked	Notes WALSH Date 6-1936
Date	Indexed A. C. Johnson

F.B. 709 PG. 195

WATER LINES

Note: Any Additions or Changes on This Sheet Must be Made or Circled in Red Ink With Date and Name of Person Making Change

Do not extend notes this side of this line

RETURN TO
LOS ANGELES COUNTY SURVEYOR
700 HALL OF RECORDS

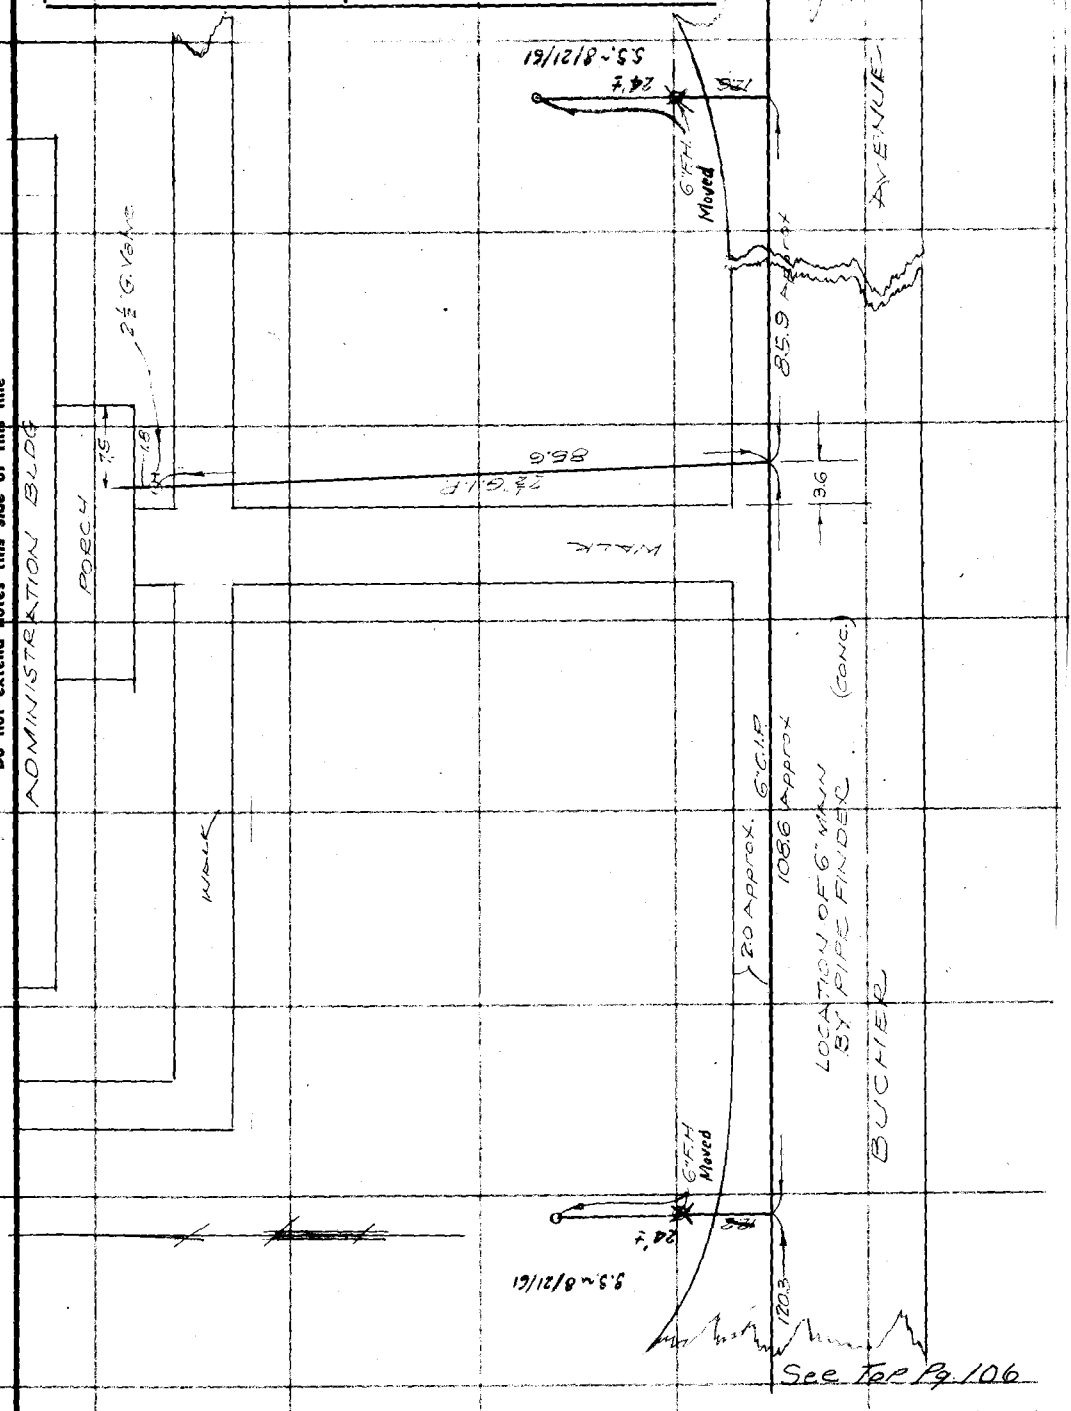

See Top Pg. 106

FORM 247 10M 11-35

RETURN TO
LOS ANGELES COUNTY SURVEYOR
700 HALL OF RECORDS

Note: Any Additions or Changes on This Sheet Must be Made or Circled in **Red Ink** With Date and Name of Person Making Change.

Do not extend notes this side of this line

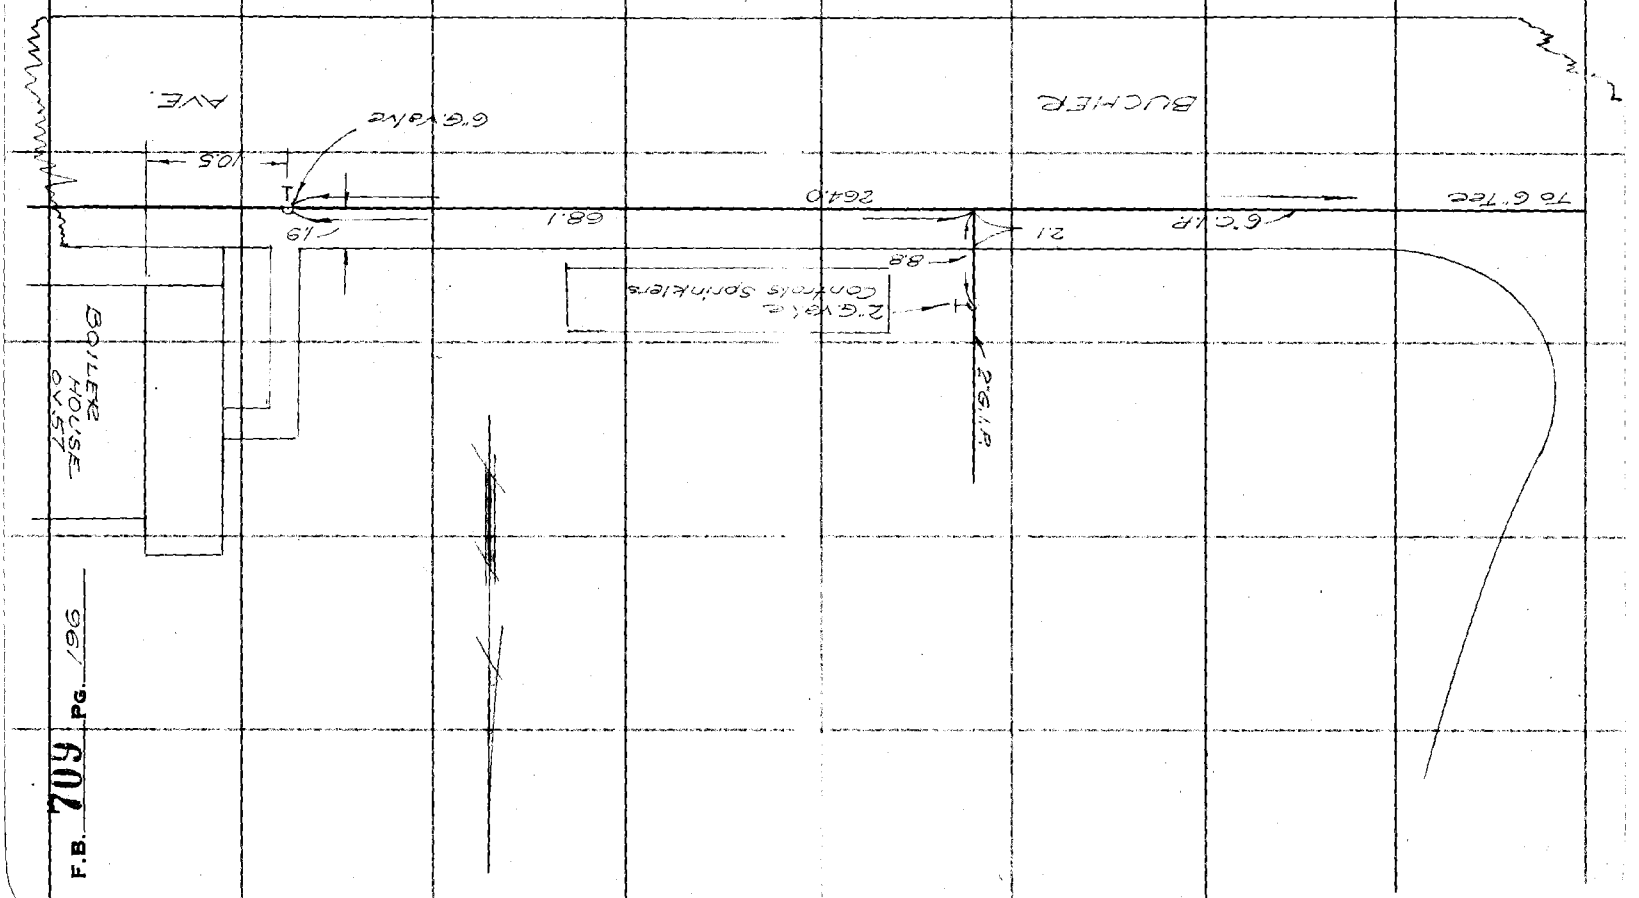

F.B. 709 PG. 196

FORM 247 10M 11-35

RETURN TO
LOS ANGELES COUNTY SURVEYOR
700 HALL OF RECORDS

Note: Any Additions or Changes on This Sheet Must be Made or Circled in **Red Ink** With Date and Name of Person Making Change.

Do not extend notes this side of this line

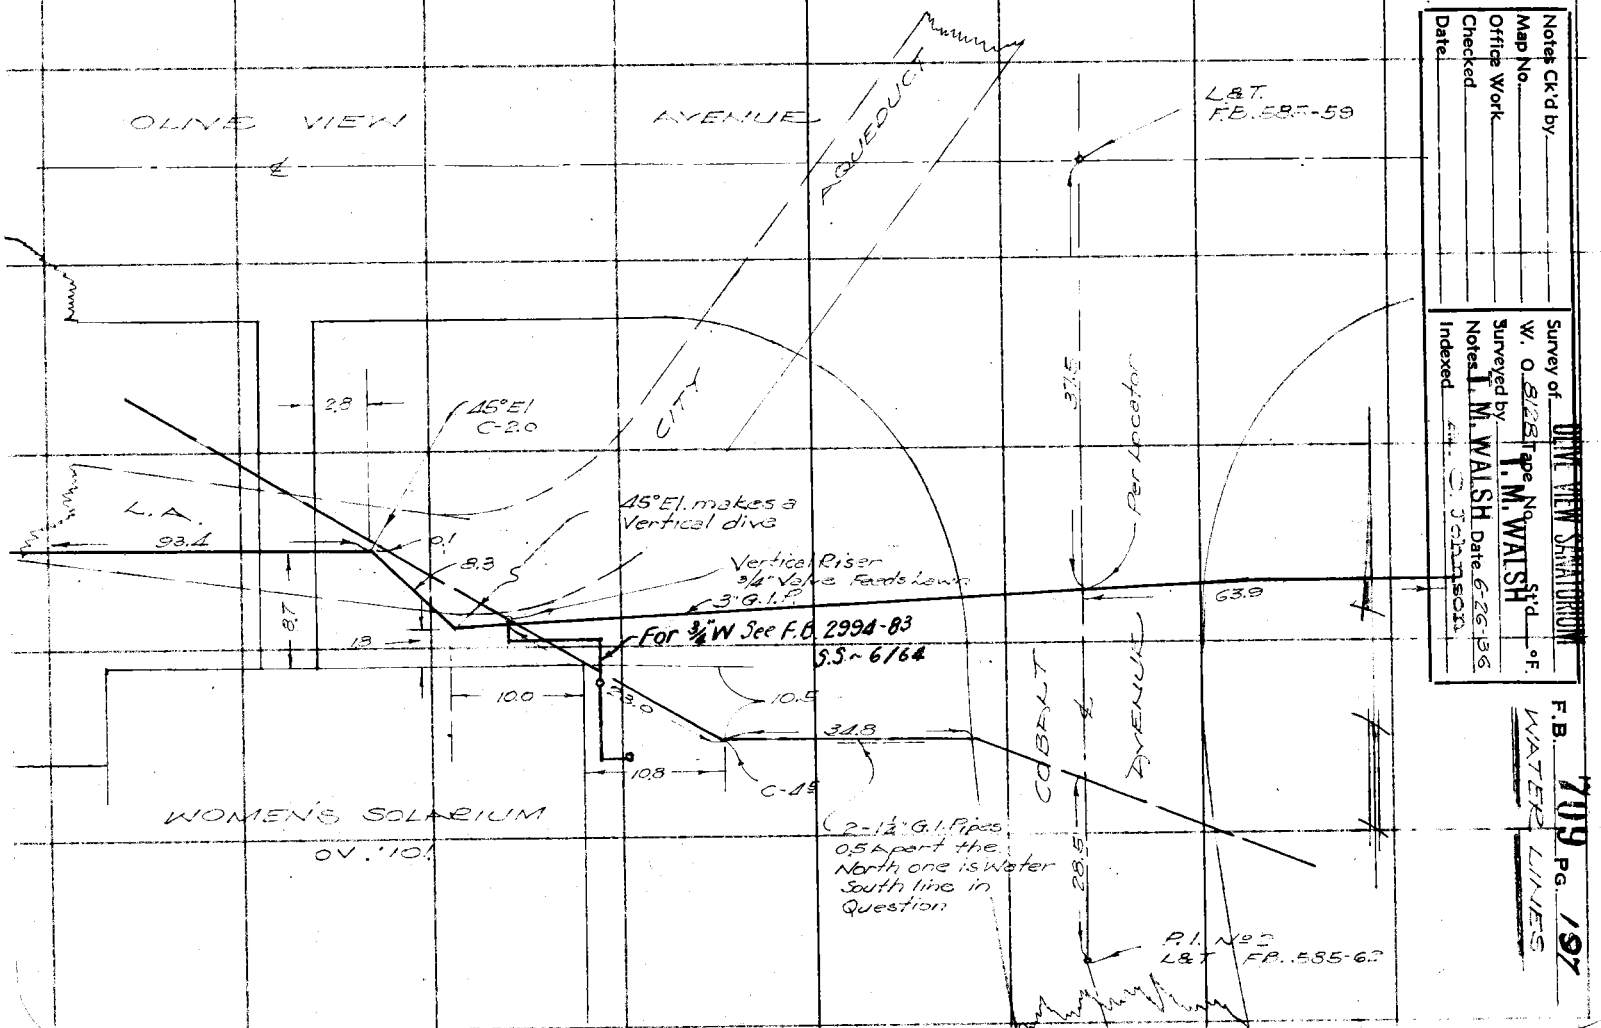

Notes Ck'd by
Map No.
Office Work
Checked
Date

Survey of OLIVE VIEW SANATORIUM
W. O. 8125 Tape No. °F.
Surveyed by T. M. WALSH Ck'd
Notes T. M. WALSH Date 6-26-36
Indexed C. Johnson

F.B. 709 PG. 197
WATER LINES

RETURN TO
LOS ANGELES COUNTY SURVEYOR
700 HALL OF RECORDS

Note: Any Additions or Changes on This Sheet Must be Made or Circled in **Red Ink** With Date and Name of Person Making Change.

Do not extend notes this side of this line

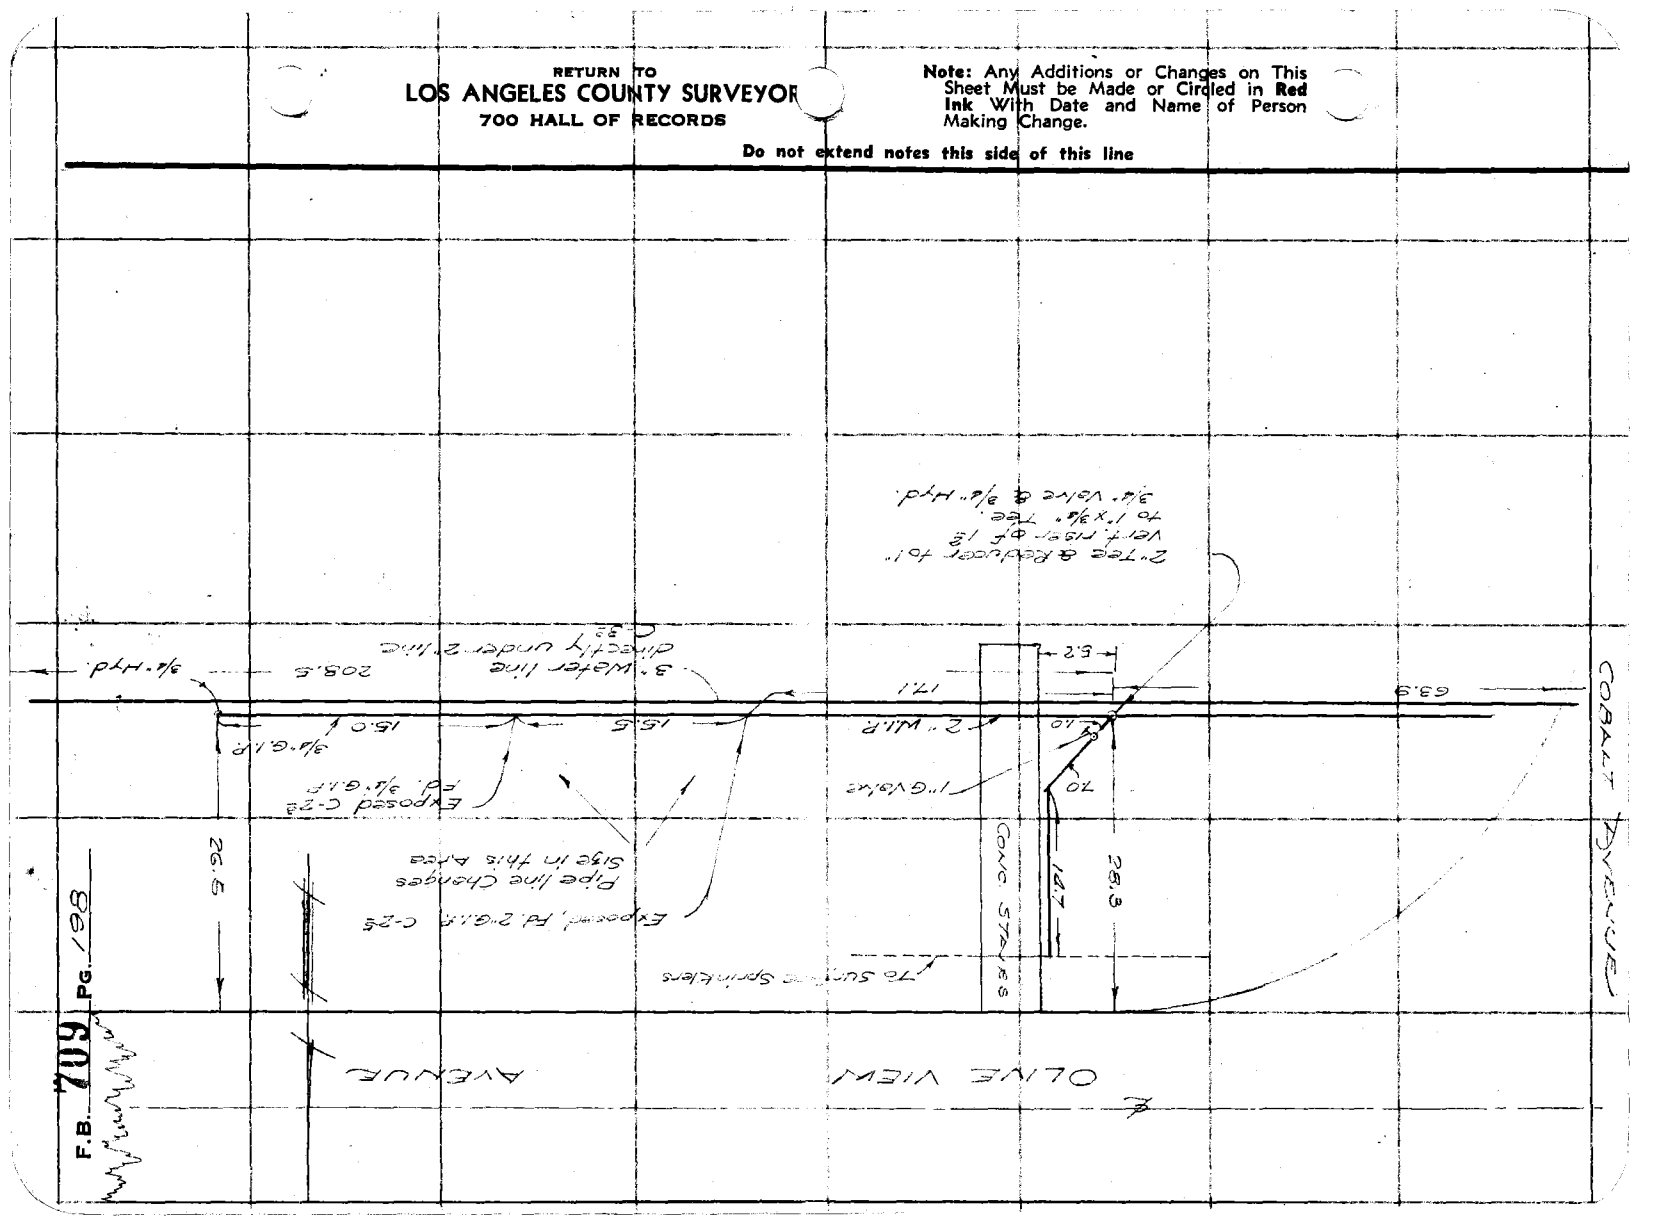

Notes Ck'd by	Survey of OLIVE VIEW SANATORIUM	F.B. 709 PG. 199
Map No.	W. O. 8128 Tape No. St'd. °F.	
Office Work	Surveyed by T. M. WALSH	
Checked	Notes T. M. WALSH Date 6-1936	
Date	Indexed A. C. Johnson	

WATER LINES

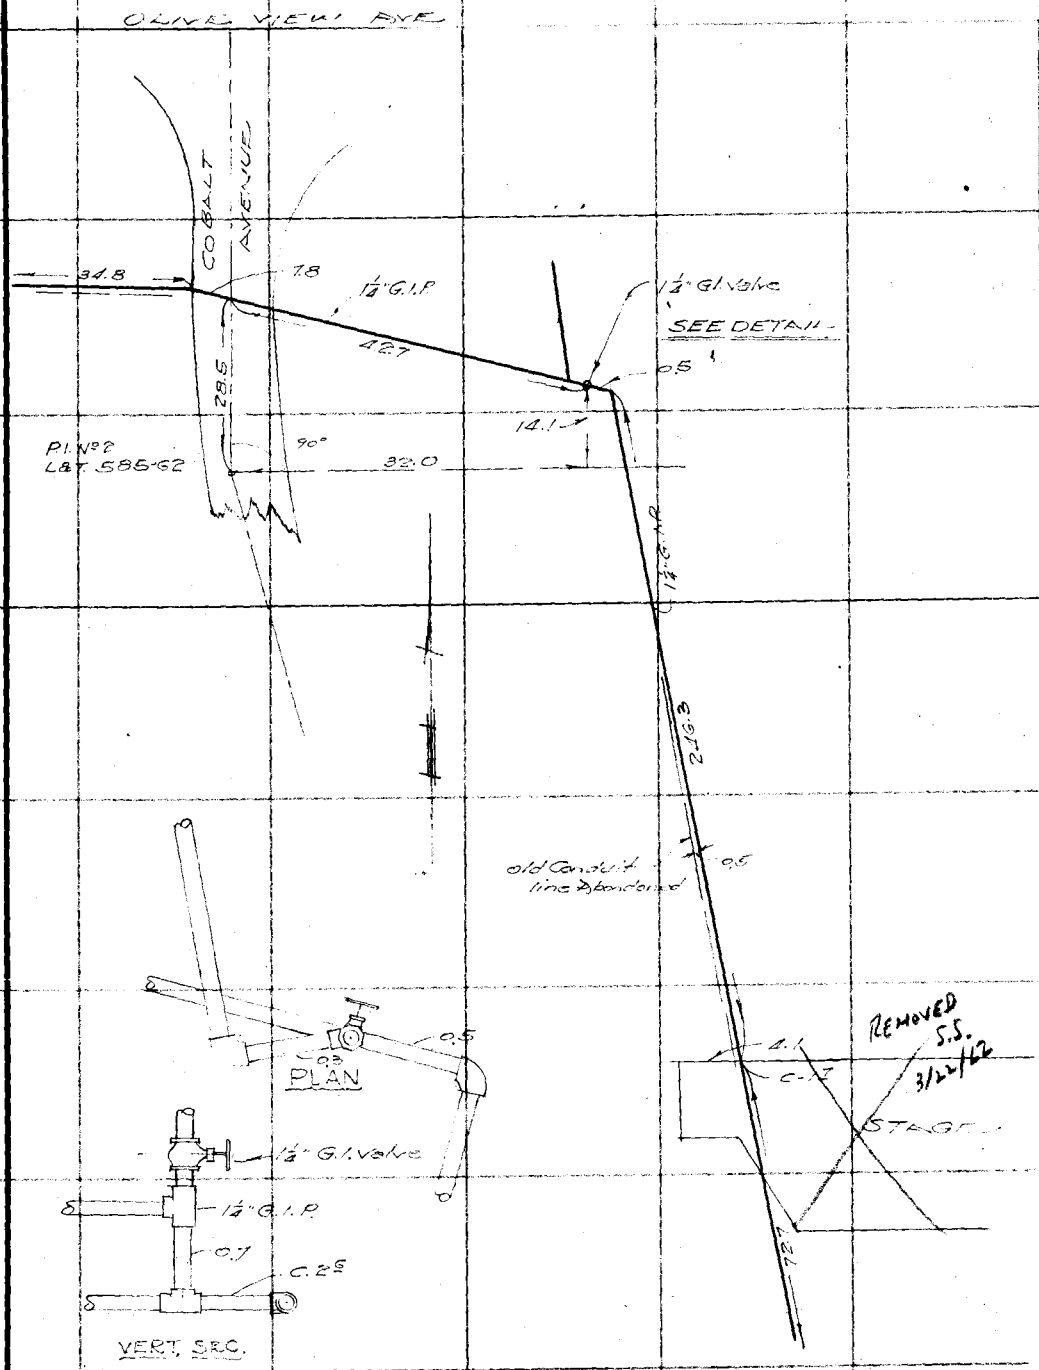

Note: Any Additions or Changes on This Sheet Must be Made or Circled in Red Ink With Date and Name of Person Making Change.

Do not extend notes this side of this line

RETURN TO
LOS ANGELES COUNTY SURVEYOR
700 HALL OF RECORDS

FORM 247 10M 11-35

RETURN TO
LOS ANGELES COUNTY SURVEYOR
700 HALL OF RECORDS

Note: Any Additions or Changes on This Sheet Must be Made or Circled in **Red Ink** With Date and Name of Person Making Change.

Do not extend notes this side of this line

F.B. 709 PG. 200

Notes Ck'd by	Survey of OLIVE VIEW SANATORIUM
Map No.	W. O. 8148 Tape No. St'd °F.
Office Work	Surveyed by TED M. WALSH
Checked	Notes WALSH Date 6-16-36
Date	Indexed A. C. Johnson

F.B. 709 PG. 201

WATER LINE

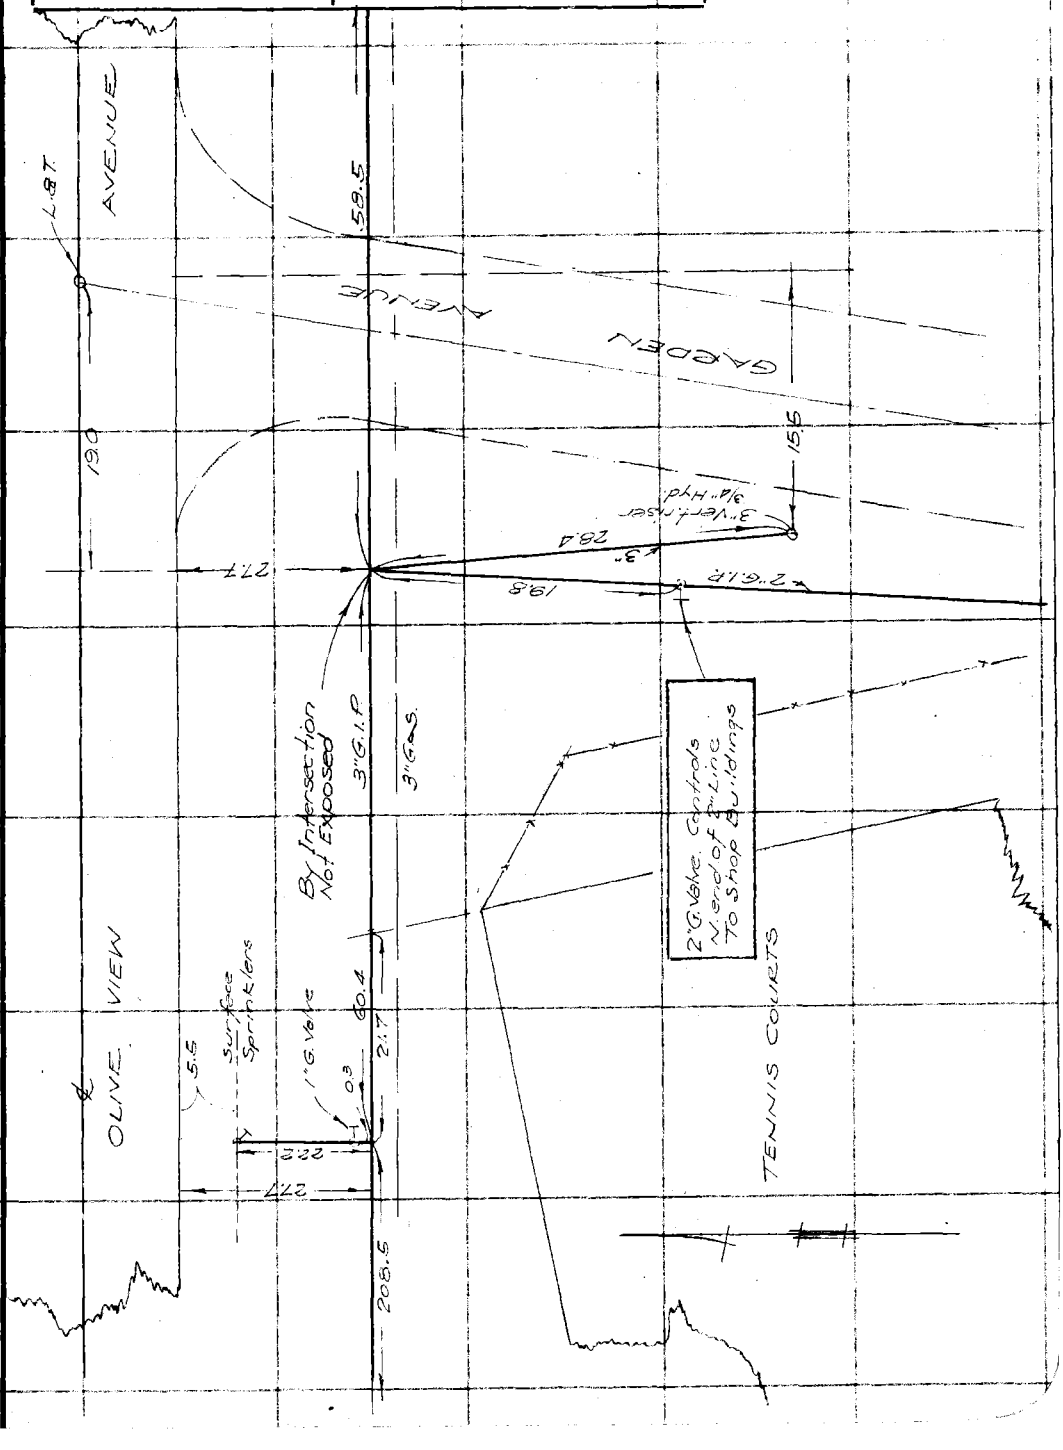

Note: Any Additions or Changes on This Sheet Must be Made or Circled in Red Ink With Date and Name of Person Making Change.

Do not extend notes this side of this line

RETURN TO
LOS ANGELES COUNTY SURVEYOR
700 HALL OF RECORDS

FORM 247 10M 11-35

RETURN TO
LOS ANGELES COUNTY SURVEYOR
700 HALL OF RECORDS

Note: Any Additions or Changes on This Sheet Must be Made or Circled in **Red Ink** With Date and Name of Person Making Change.

Do not extend notes this side of this line

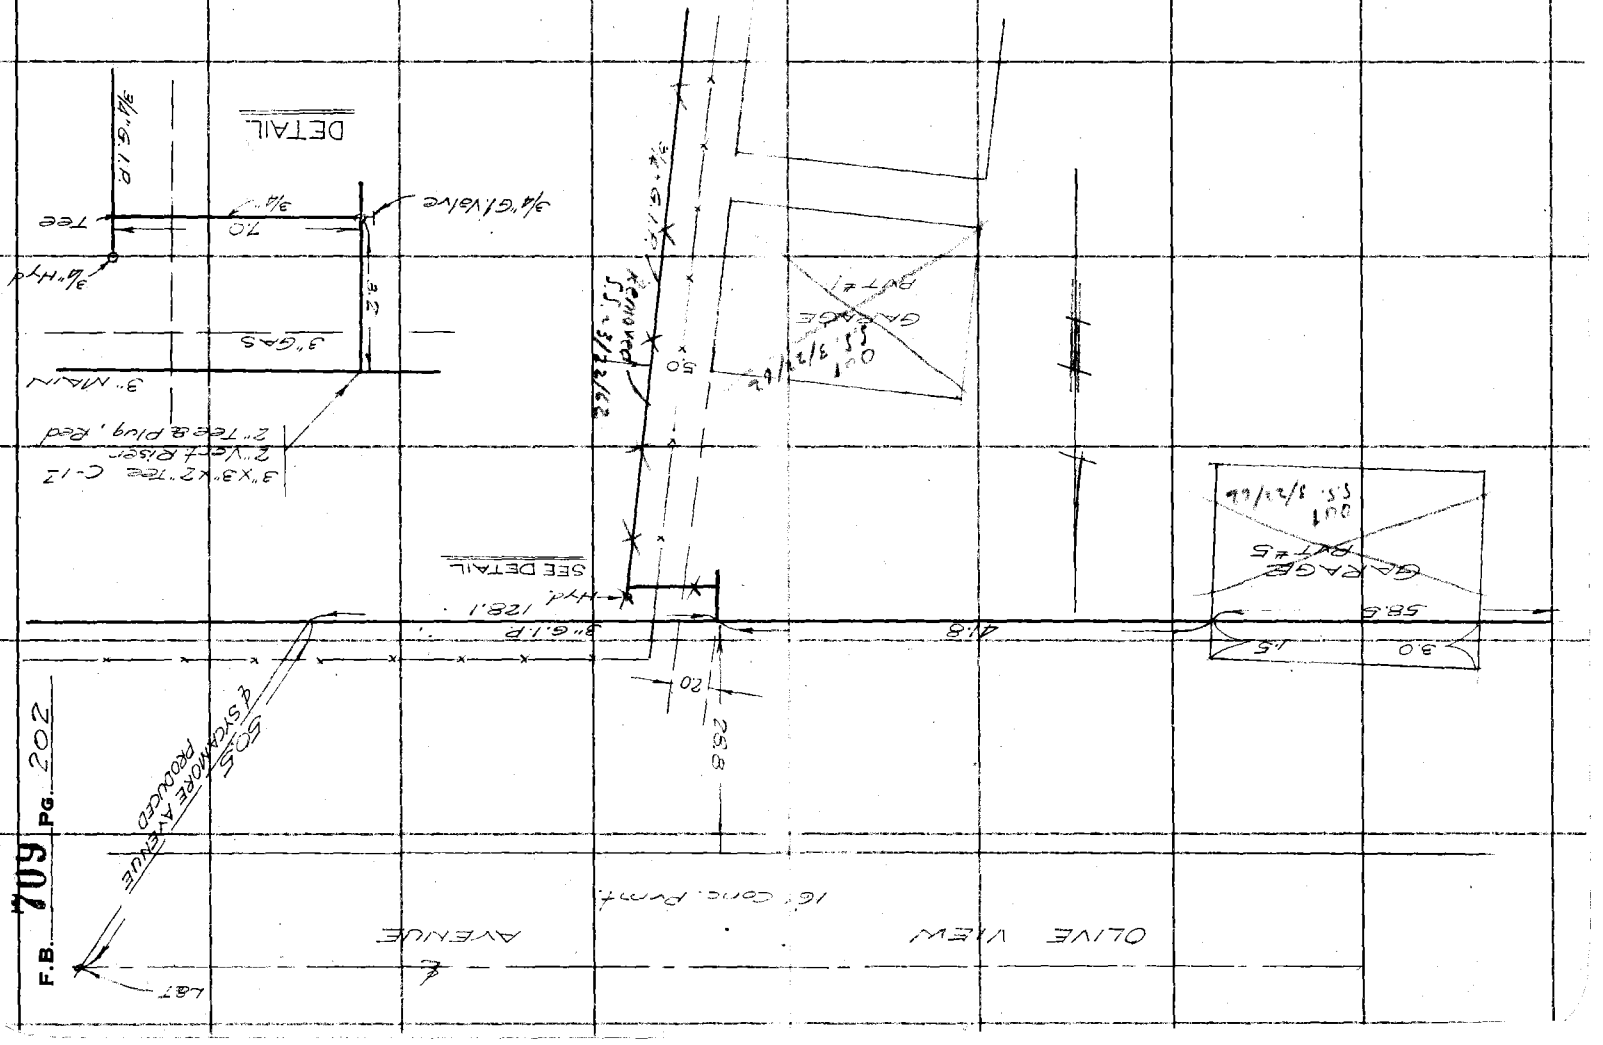

F.B. 709 PG. 202

Notes Ck'd by	Survey of OLIVE VIEW SANATORIUM
Map No.	W. O. 8178 Tape No. St'd °F.
Office Work	Surveyed by TED. WALSH
Checked	Notes WALSH Date 6-24-36
Date	Indexed C. Johnson

F.B. 709 PG. 203

WATER LINES

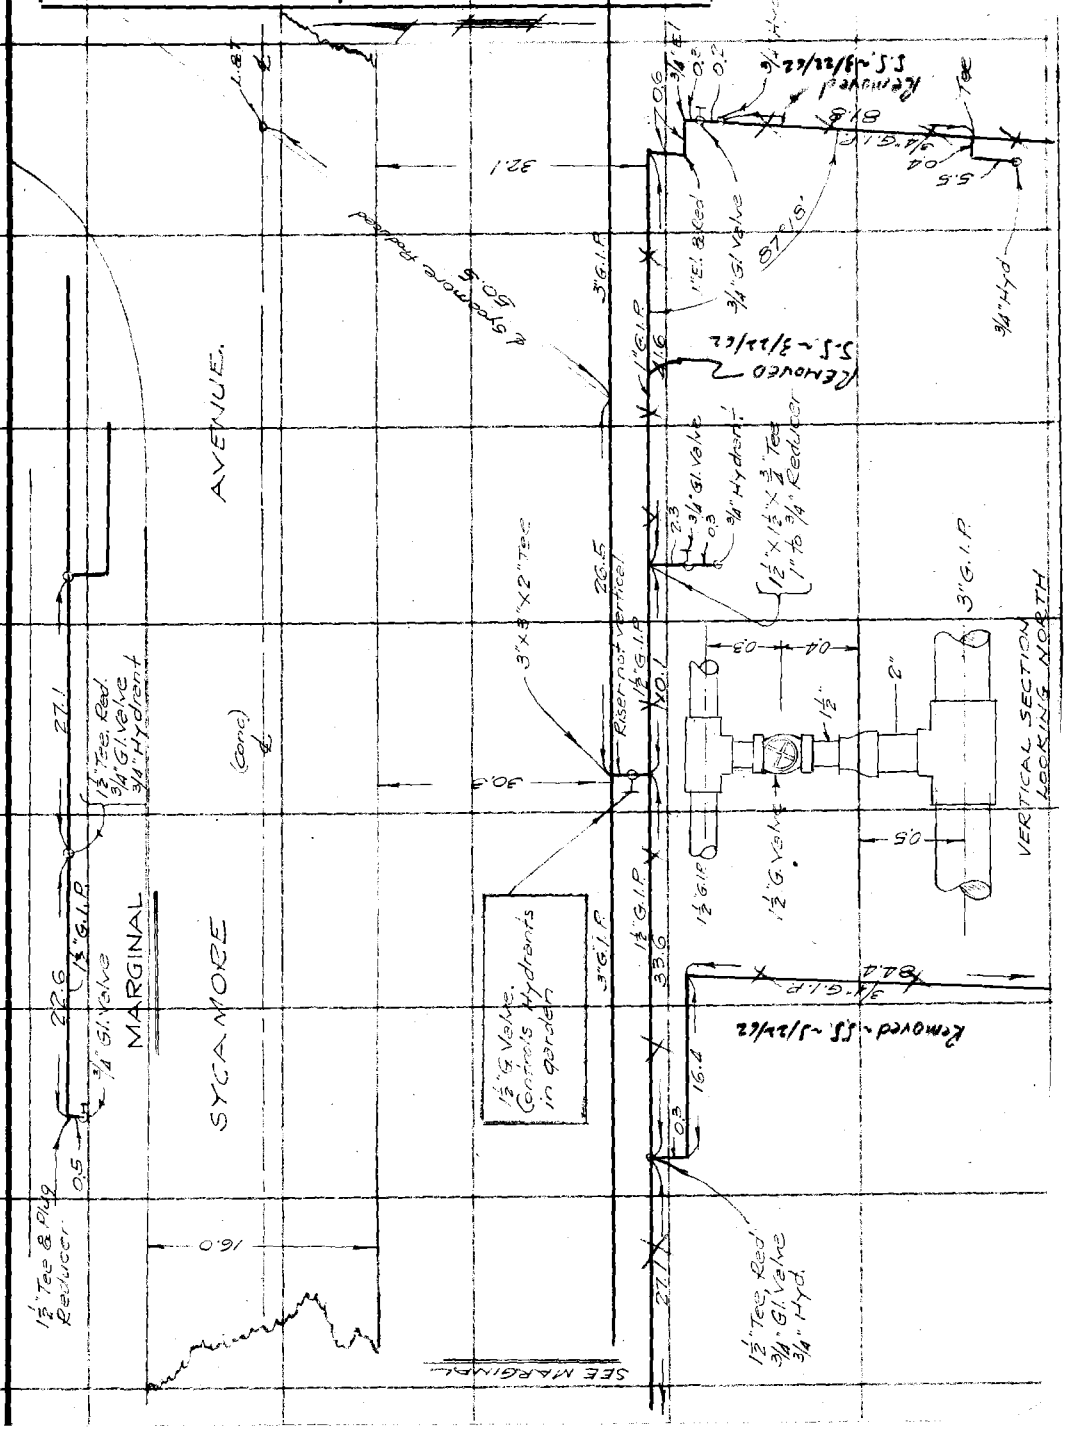

Note: Any Additions or Changes on This Sheet Must be Made or Circled in Red Ink With Date and Name of Person Making Change.

Do not extend notes this side of this line

RETURN TO
LOS ANGELES COUNTY SURVEYOR
700 HALL OF RECORDS

FORM 247 10M 11-35

RETURN TO
LOS ANGELES COUNTY SURVEYOR
700 HALL OF RECORDS

Note: Any Additions or Changes on This Sheet Must be Made or Circled in **Red Ink** With Date and Name of Person Making Change.

Do not extend notes this side of this line

F.B. 709 Pg. 204

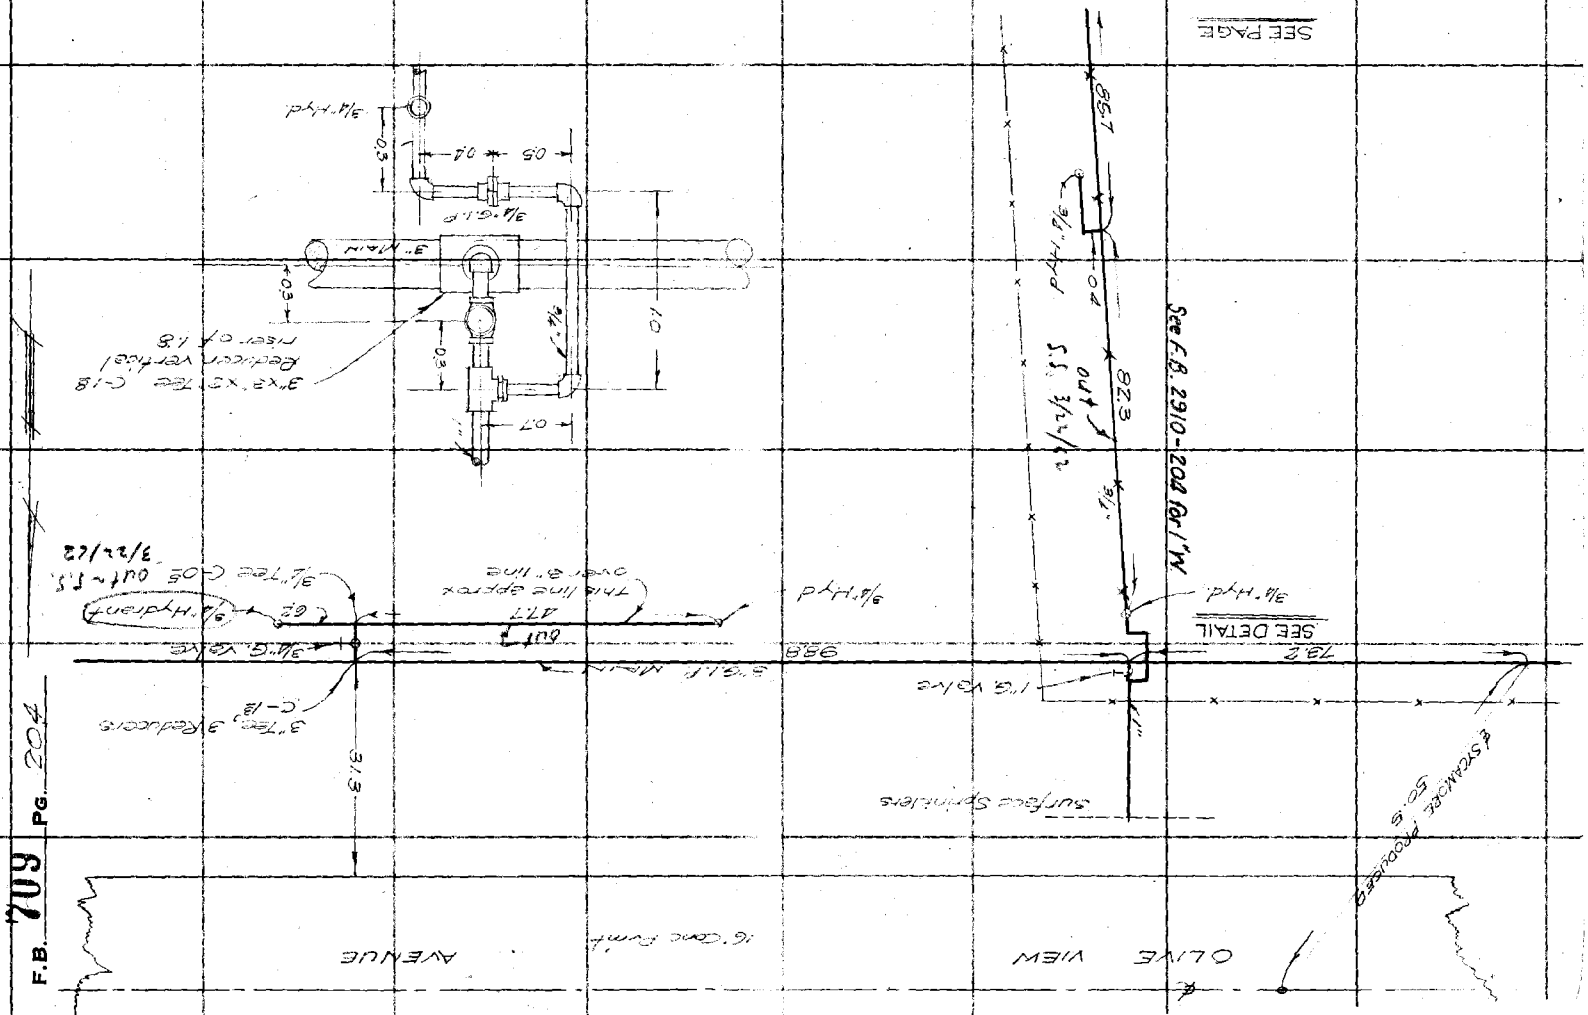

Notes Ck'd by	Survey of OLIVE VIEW SANATORIUM
Map No.	W. O. 8148 Tape No. St'd °F.
Office Work	Surveyed by TED M. WALSH
Checked	Notes WALSH Date 6-25-36
Date	Indexed J. Johnson

F.B. 719 PG. 205

WATER LINES

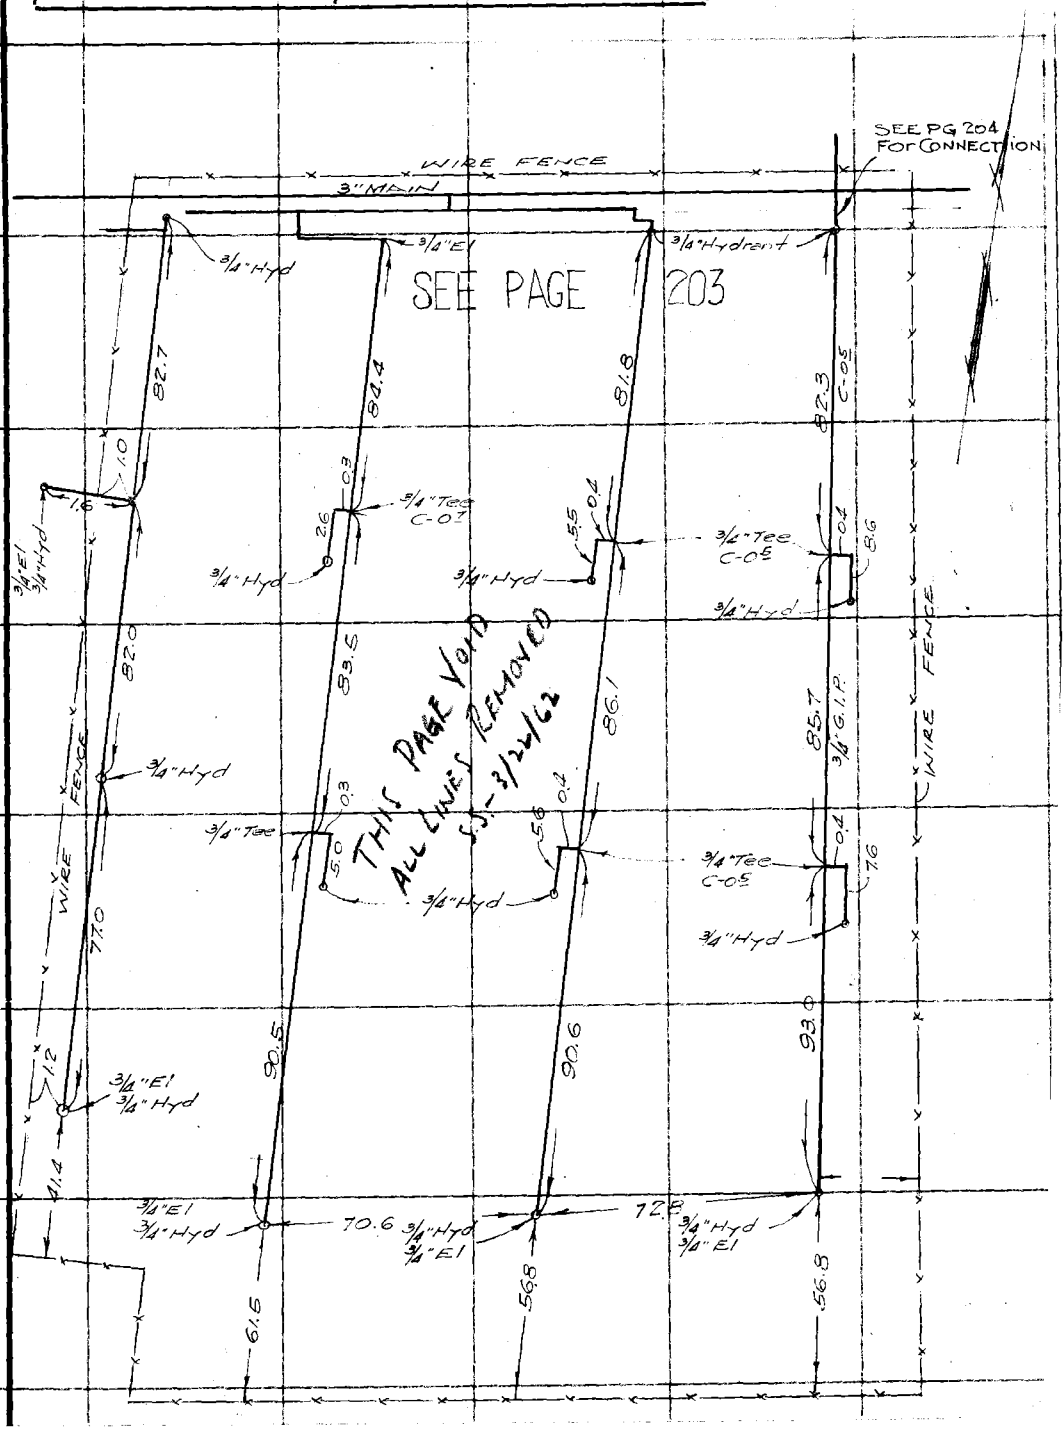

Note: Any Additions or Changes on This Sheet Must be Made or Circled in Red Ink With Date and Name of Person Making Change.

Do not extend notes this side of this line

RETURN TO
LOS ANGELES COUNTY SURVEYOR
700 HALL OF RECORDS

FORM 247 10M 11-35

F.B. 709 Pg. 206

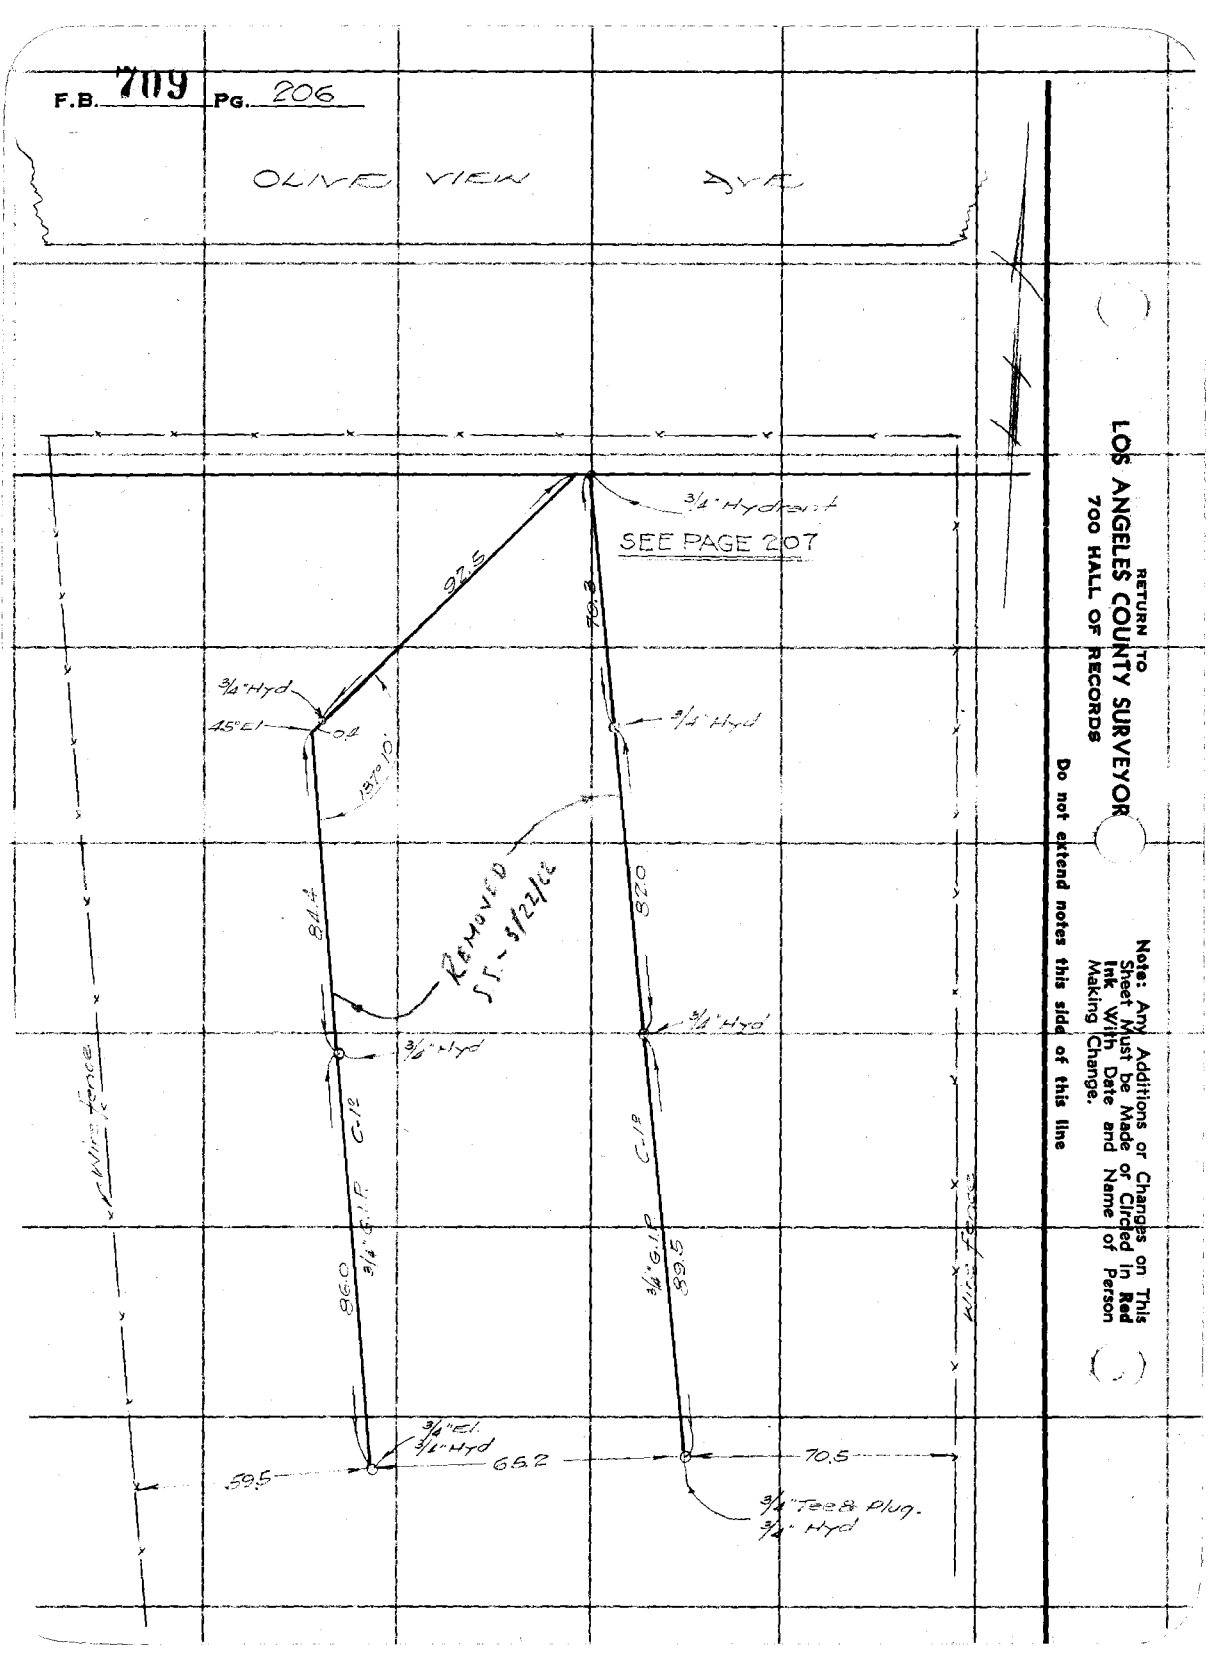

RETURN TO
LOS ANGELES COUNTY SURVEYOR
700 HALL OF RECORDS

Note: Any Additions or Changes on This Sheet Must be Made or Circled in Red Ink With Date and Name of Person Making Change.

Do not extend notes this side of this line

Notes Ck'd by	Survey of OLIVE VIEW SANATORIUM	F.B. 709 Pg. 207
Map No.	W. O. 8128 Tape No. St'd °F.	
Office Work	Surveyed by TED M. WALSH	
Checked	Notes WALSH Date 6-15-36	
Date	Indexed A. C. Johnson	

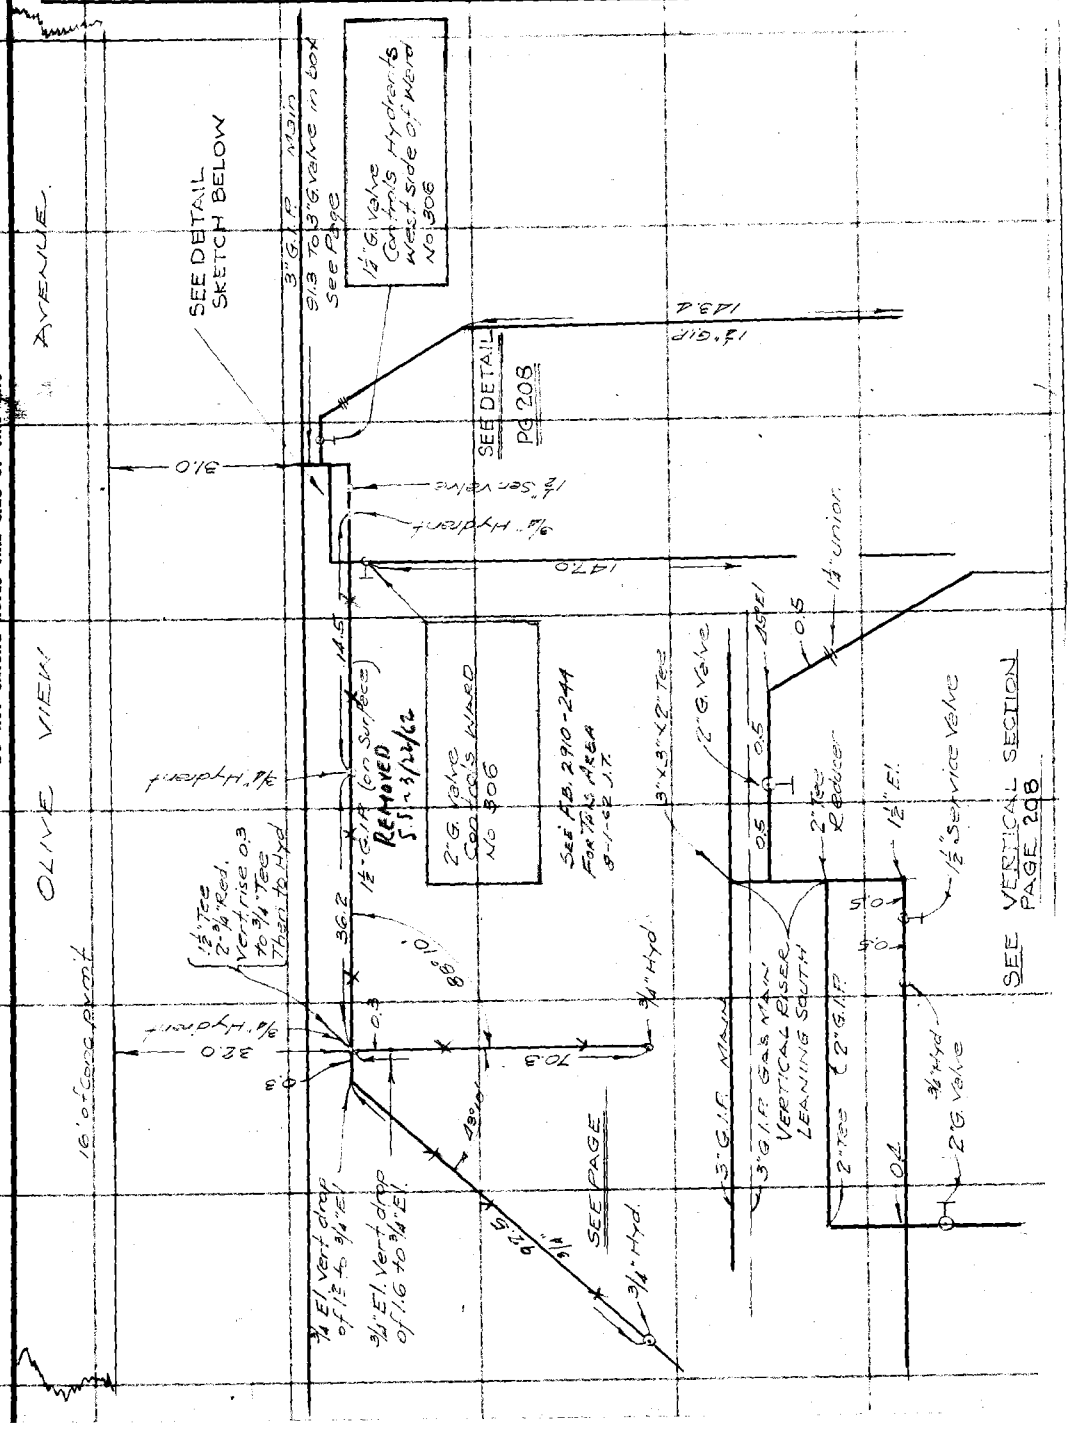

Note: Any Additions or Changes on This Sheet Must be Made or Circled in Red Ink With Date and Name of Person Making Change.

Do not extend notes this side of this line

RETURN TO
LOS ANGELES COUNTY SURVEYOR
700 HALL OF RECORDS

FORM 247 10M 11-35

RETURN TO
LOS ANGELES COUNTY SURVEYOR
700 HALL OF RECORDS

Note: Any Additions or Changes on This Sheet Must be Made or Circled in **Red Ink** With Date and Name of Person Making Change.

Do not extend notes this side of this line

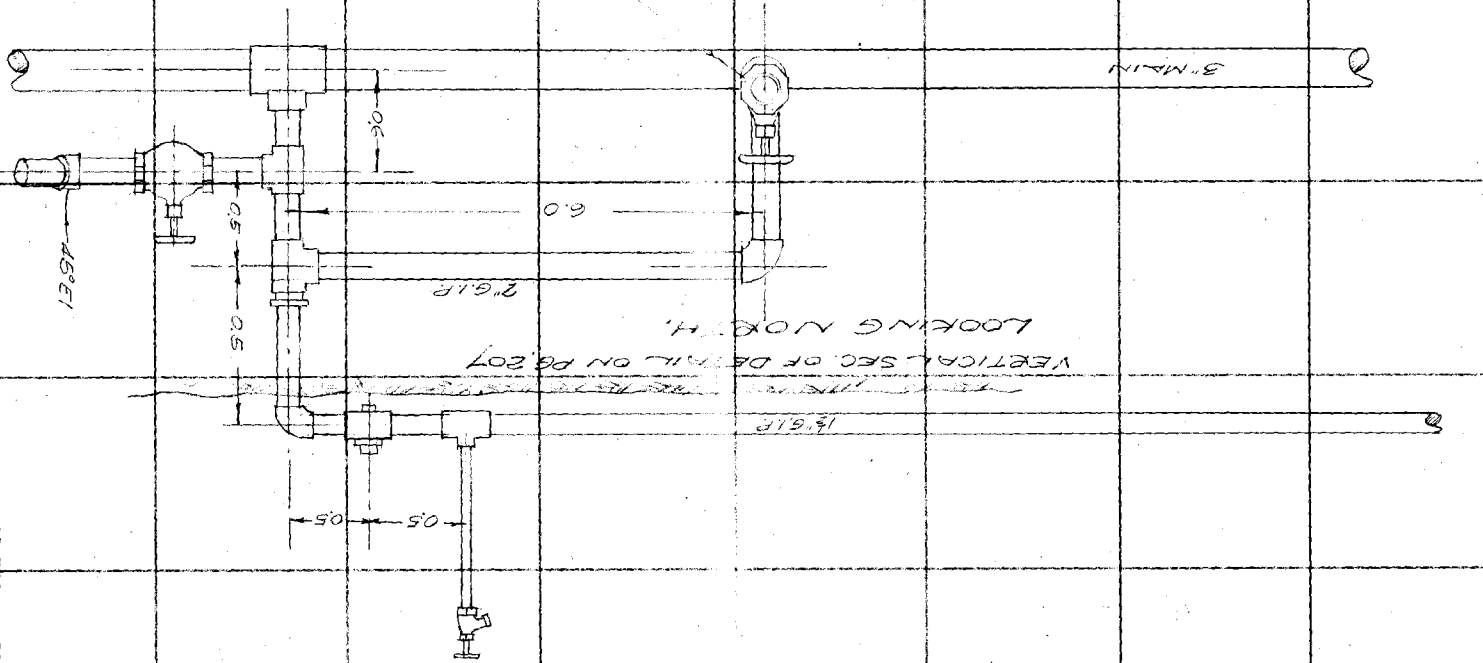

F.B. 709 PG. 208

Notes Ck'd by	Survey of OLIVE VIEW SANATORIUM	F.B. 709 Pg. 209
Map No.	W. O. 8128 Tape No. St'd °F.	WATER LINES
Office Work	Surveyed by T. M. WALSH	
Checked	Notes T. M. WALSH Date 7-6-36	
Date	Indexed [illegible]	

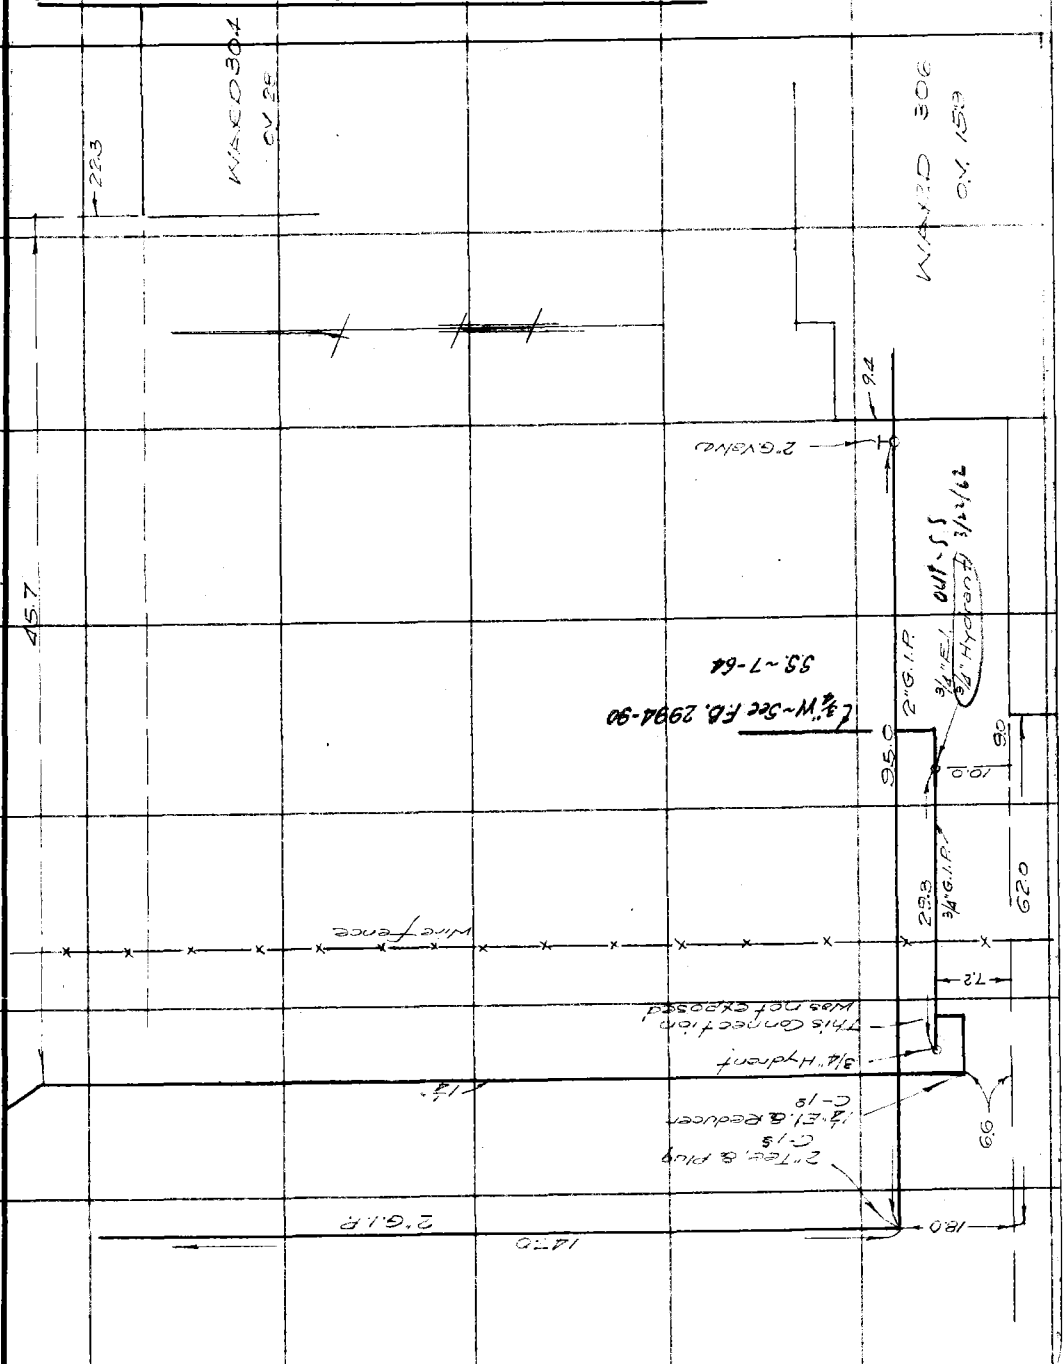

Note: Any Additions or Changes on This Sheet Must be Made or Circled in Red Ink With Date and Name of Person Making Change.

Do not extend notes this side of this line

RETURN TO
LOS ANGELES COUNTY SURVEYOR
700 HALL OF RECORDS

FORM 247 10M 11-35

RETURN TO
LOS ANGELES COUNTY SURVEYOR
700 HALL OF RECORDS

Note: Any Additions or Changes on This Sheet Must be Made or Circled in **Red Ink** With Date and Name of Person Making Change.

Do not extend notes this side of this line

F.B. 709 Pg. 210

Notes Ck'd by	Survey of OLIVE VIEW SANATORIUM
Map No.	W. O. 8148 Tape No. St'd °F.
Office Work	Surveyed by T. WALSH
Checked	Notes WALSH Date 7-1936
Date	Indexed A. C. Johnson

F.B. 709 PG. 211

WATER LINES

Note: Any Additions or Changes on This Sheet Must be Made or Circled in Red Ink With Date and Name of Person Making Change.

Do not extend notes this side of this line

RETURN TO
LOS ANGELES COUNTY SURVEYOR
700 HALL OF RECORDS

FORM 247 10M 11-35

RETURN TO
LOS ANGELES COUNTY SURVEYOR
700 HALL OF RECORDS

Note: Any Additions or Changes on This Sheet Must be Made or Circled in **Red** Ink With Date and Name of Person Making Change.

Do not extend notes this side of this line

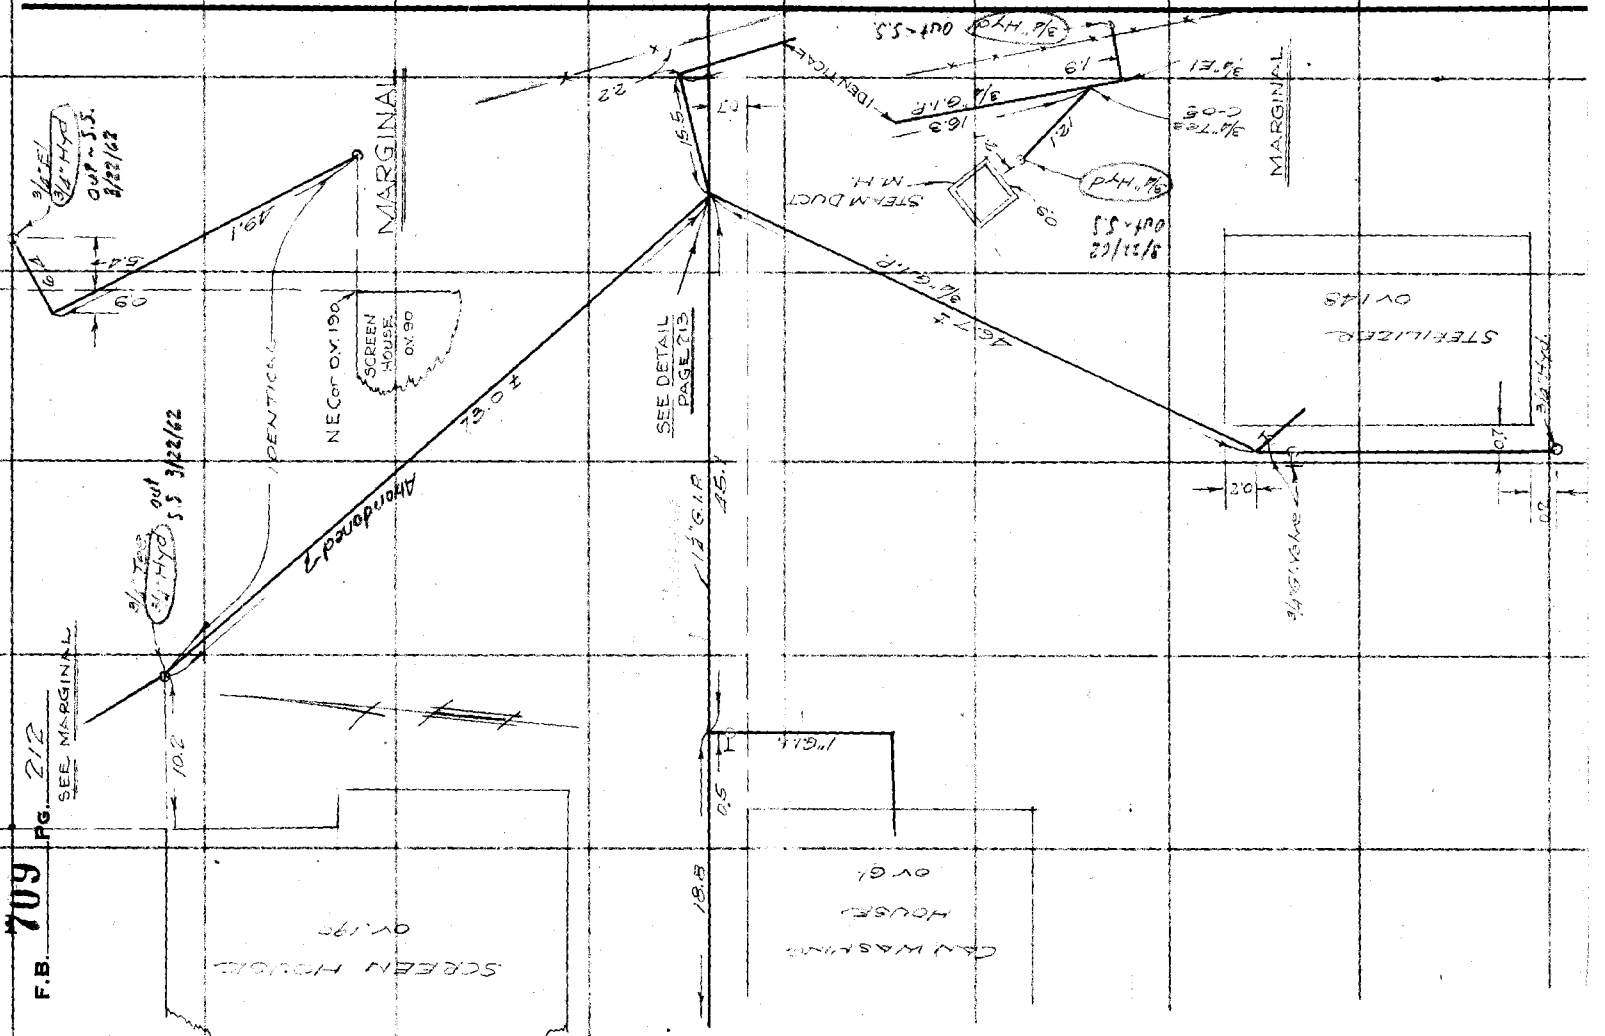

F.B. 709 PG. 212
SEE MARGINAL

Notes Ck'd by	Survey of OLIVE VIEW SANATORIUM
Map No.	W. O. 8178 Tape No. St'd °F.
Office Work	Surveyed by TED. WALSH
Checked	Notes WALSH Date 6-29-36
Date	Indexed A. C. Johnson

F.B. 709 PG. 213

WATER LINES

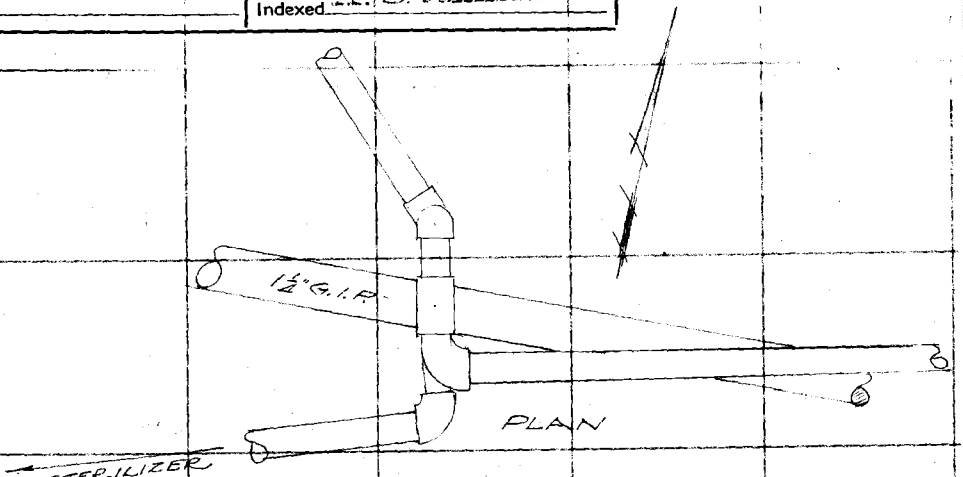

DETAIL

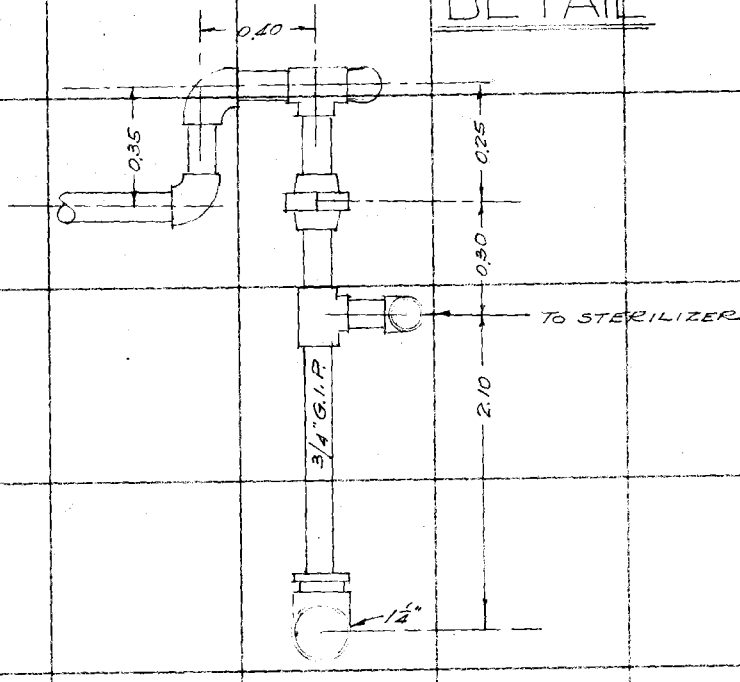

VERTICAL SEC.
LOOKING EAST

Note: Any Additions or Changes on This Sheet Must be Made or Circled in Red Ink With Date and Name of Person Making Change.

Do not extend notes this side of this line

RETURN TO
LOS ANGELES COUNTY SURVEYOR
700 HALL OF RECORDS

FORM 247 10M 11-35

RETURN TO
LOS ANGELES COUNTY SURVEYOR
700 HALL OF RECORDS

Note: Any Additions or Changes on This Sheet Must be Made or Circled in **Red** Ink With Date and Name of Person Making Change.

Do not extend notes this side of this line

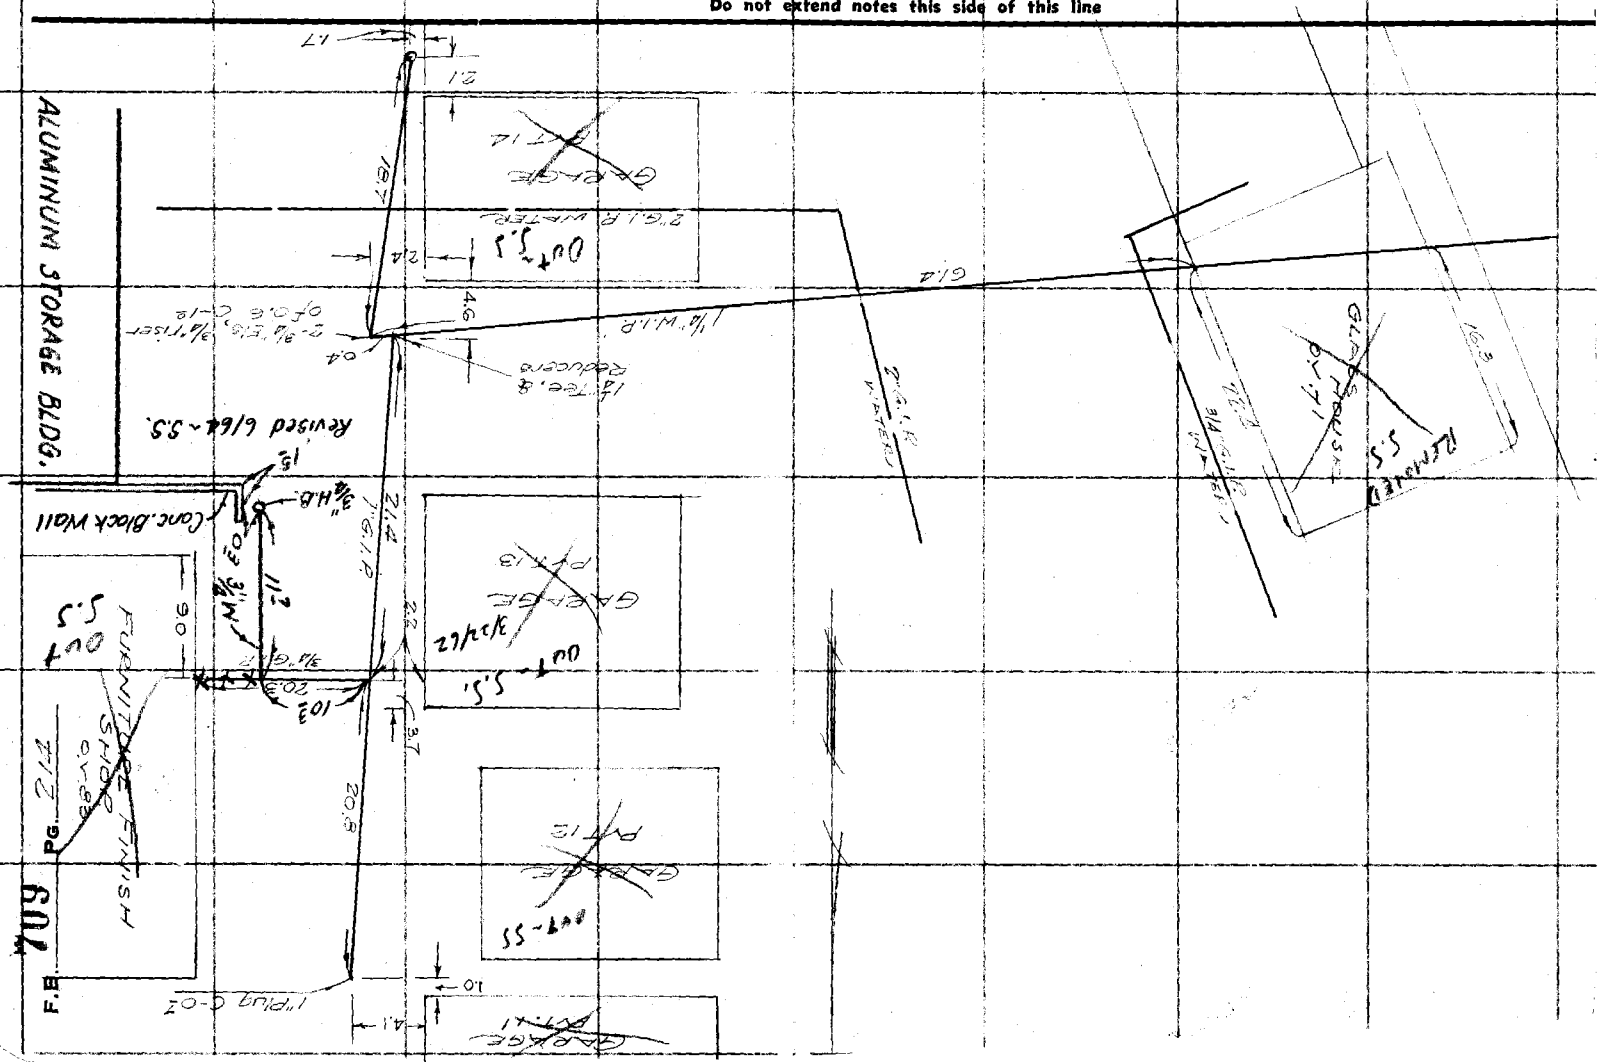

Notes Ck'd by	Survey of OLIVE VIEW SANATORIUM
Map No.	W. O. 8178 Tape No. St'd °F.
Office Work	Surveyed by TENN. WALSH
Checked	Notes WALSH Date 6-19-50
Date	Indexed A. C. Johnson

F.B. 709 PG. 215

WATER LINES

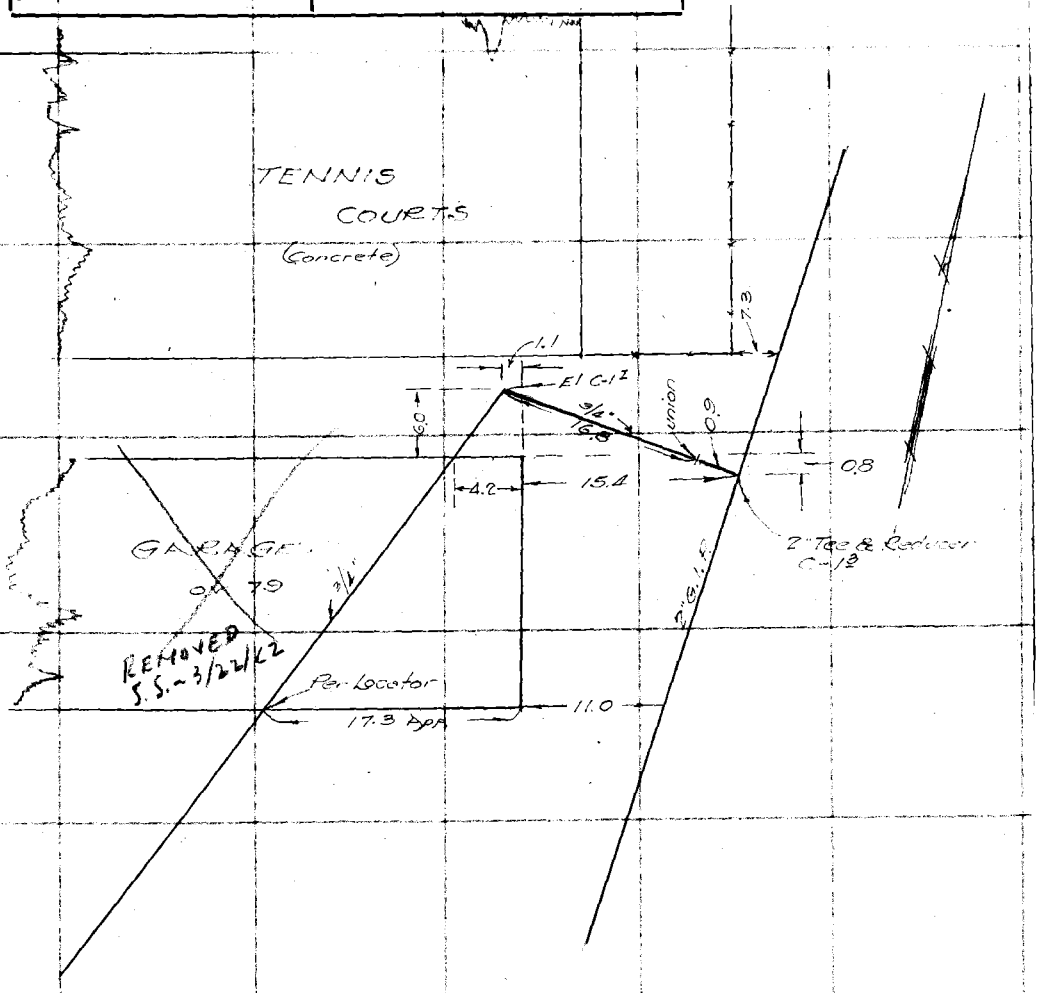

Note: Any Additions or Changes on This Sheet Must be Made or Circled in Red Ink With Date and Name of Person Making Change.

Do not extend notes this side of this line

RETURN TO
LOS ANGELES COUNTY SURVEYOR
7do HALL OF RECORDS

FORM 247 10M 11-35

RETURN TO
LOS ANGELES COUNTY SURVEYOR
700 HALL OF RECORDS

Note: Any Additions or Changes on This Sheet Must be Made or Circled in Red Ink With Date and Name of Person Making Change.

Do not extend notes this side of this line

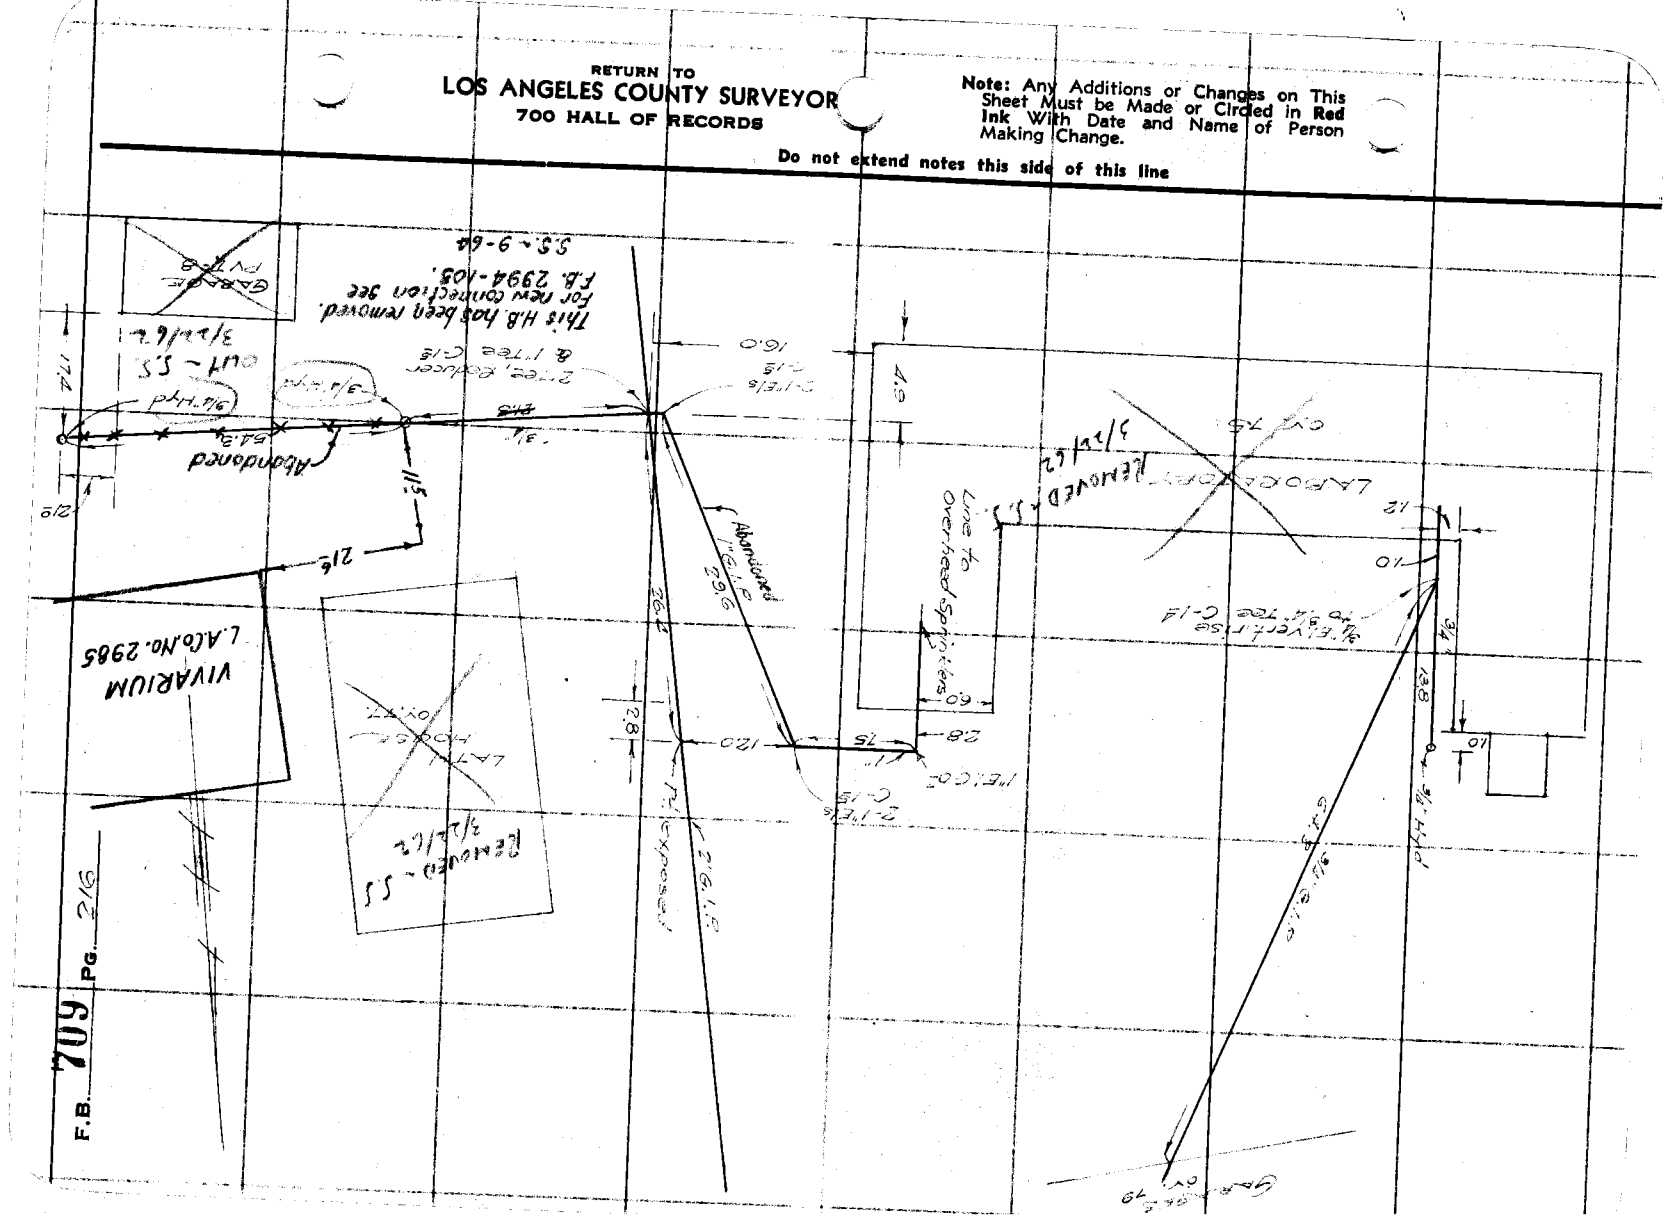

Notes Ck'd by	Survey of OLIVE VIEW SANATORIUM
Map No.	W. O. 8148 Tape No. St'd °F.
Office Work	Surveyed by
Checked	Notes Date
Date	Indexed

F.B. 709 PG. 217

WATER LINES

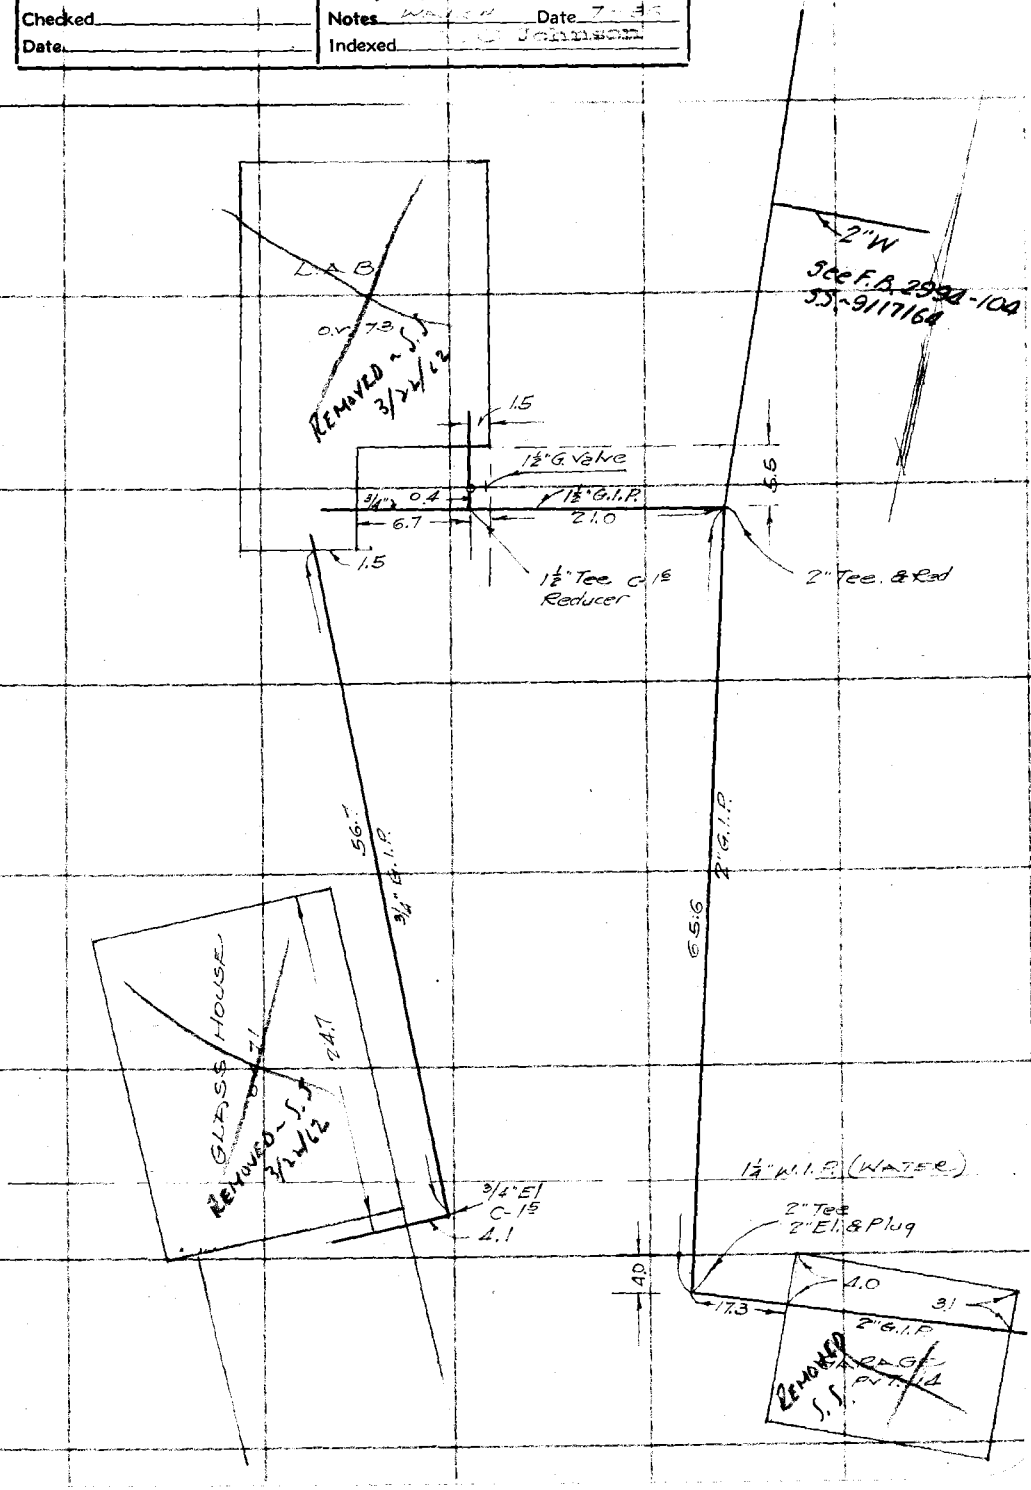

Note: Any Additions or Changes on This Sheet Must be Made or Circled in Red Ink With Date and Name of Person Making Change.

Do not extend notes this side of this line

RETURN TO
LOS ANGELES COUNTY SURVEYOR
7do HALL OF RECORDS

FORM 247 10M 11-35

F.B. 709 PG. 218

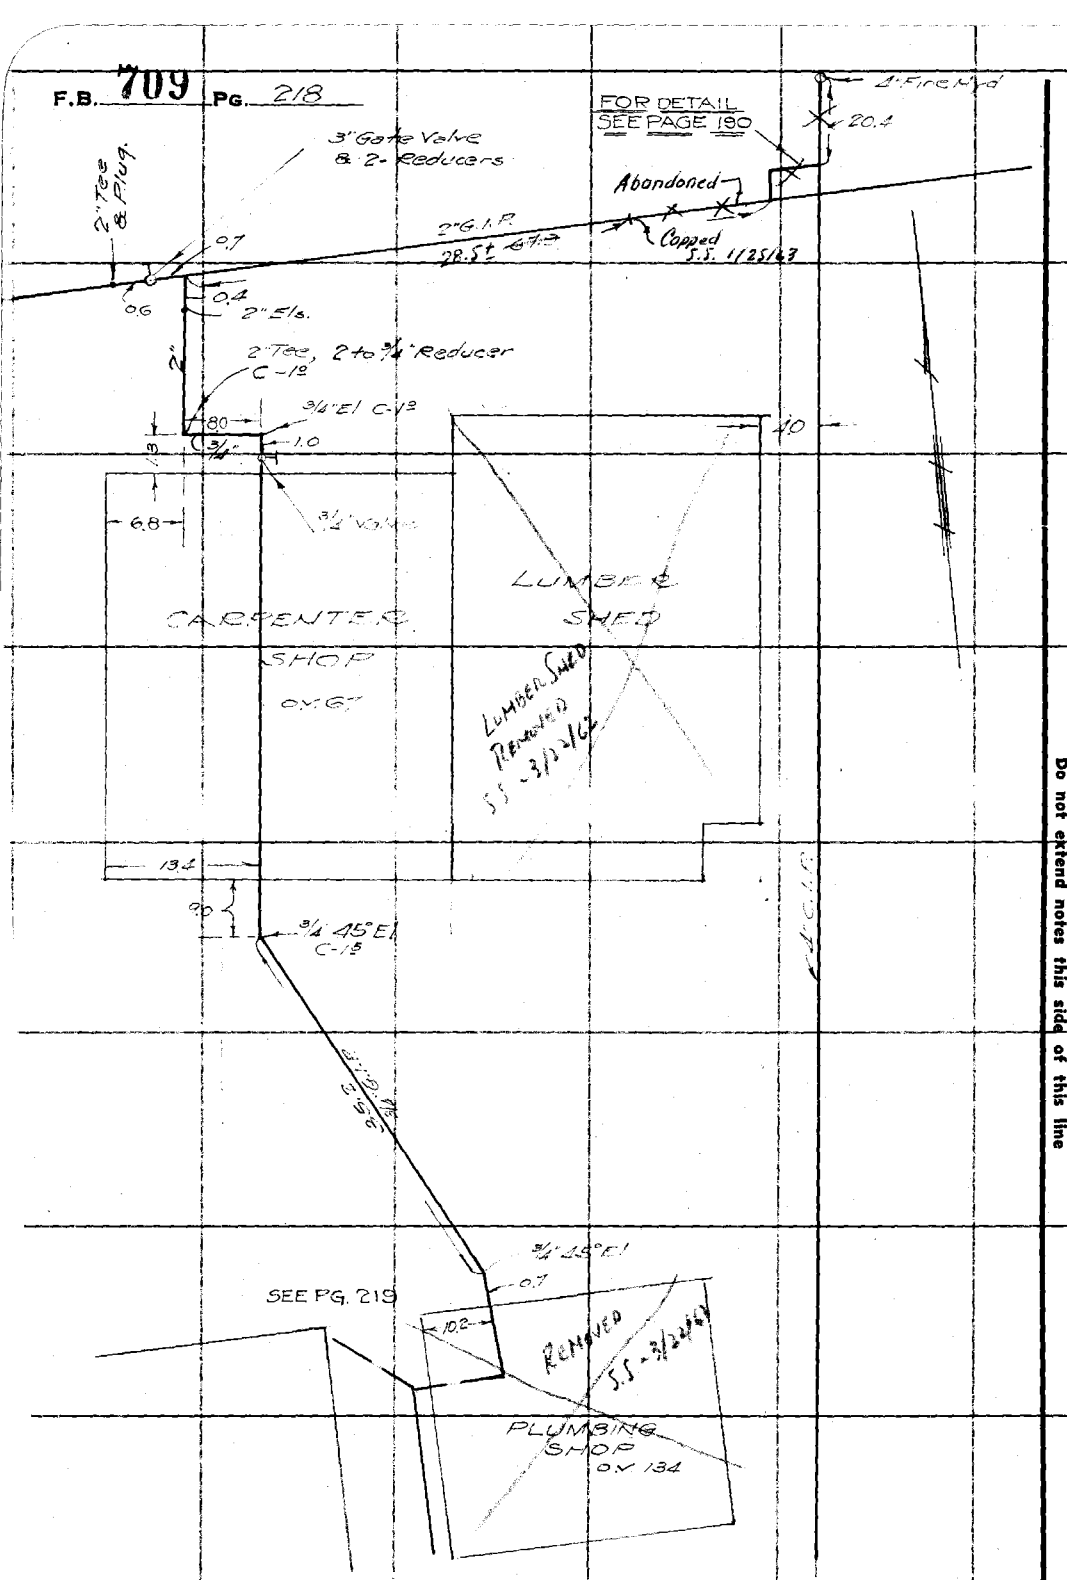

RETURN TO
LOS ANGELES COUNTY SURVEYOR
700 HALL OF RECORDS

Note: Any Additions or Changes on This Sheet Must be Made or Circled in Red Ink With Date and Name of Person Making Change.

Do not extend notes this side of this line

FORM 247 10M 11-35

RETURN TO
LOS ANGELES COUNTY SURVEYOR
700 HALL OF RECORDS

Note: Any Additions or Changes on This Sheet Must be Made or Circled in **Red Ink** With Date and Name of Person Making Change.

Do not extend notes this side of this line

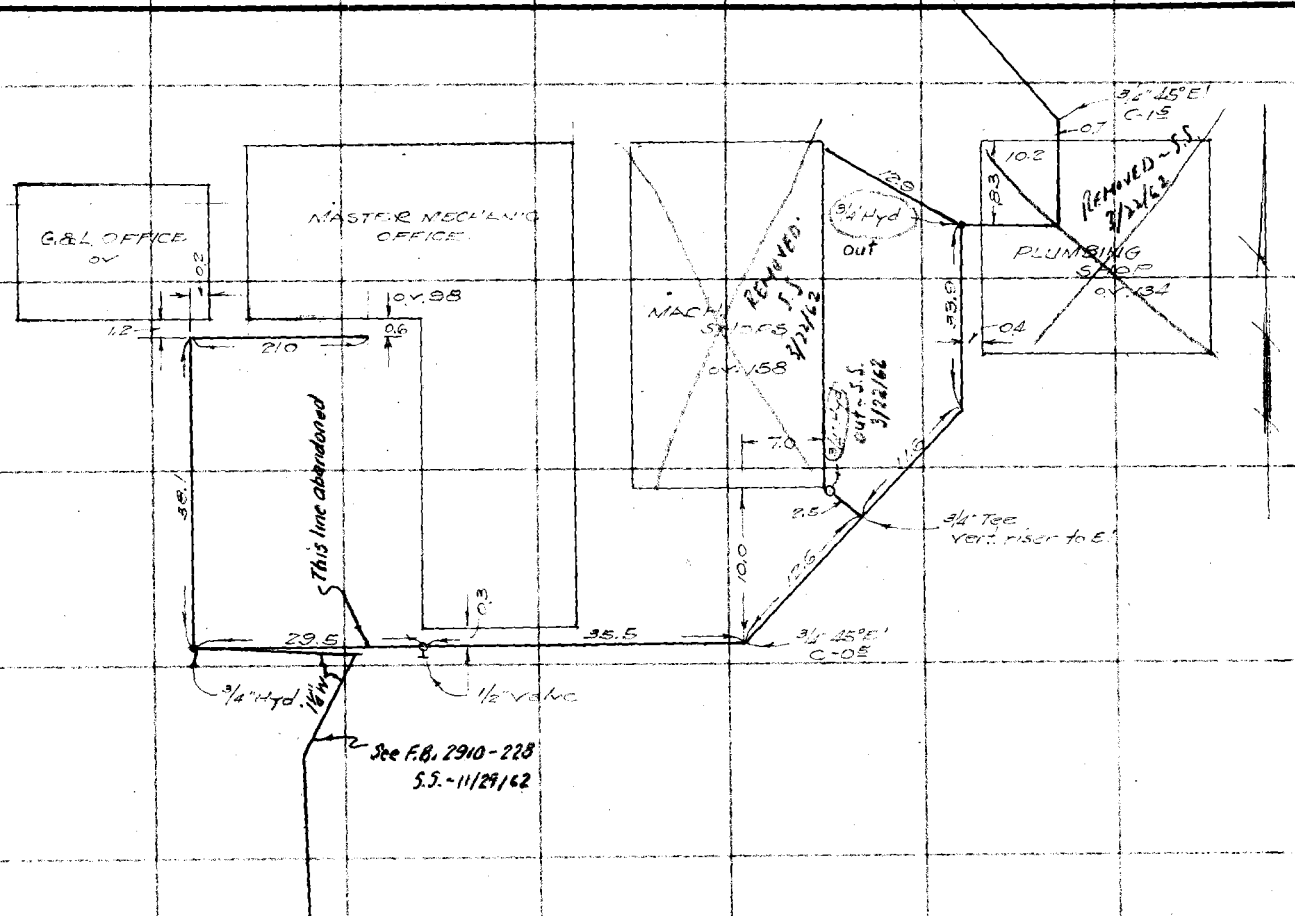

Notes Ck'd by
Map No.
Office Work
Checked
Date

Survey of DRIVE VIEW SANATORIUM
W. O. 8748 Tape No. St'd °F.
Surveyed by [illegible] Date 7-13-62
Notes
Indexed [illegible]

F.B. 709 PG. 219

[illegible] LINES

F.B. 709 Pg. 220

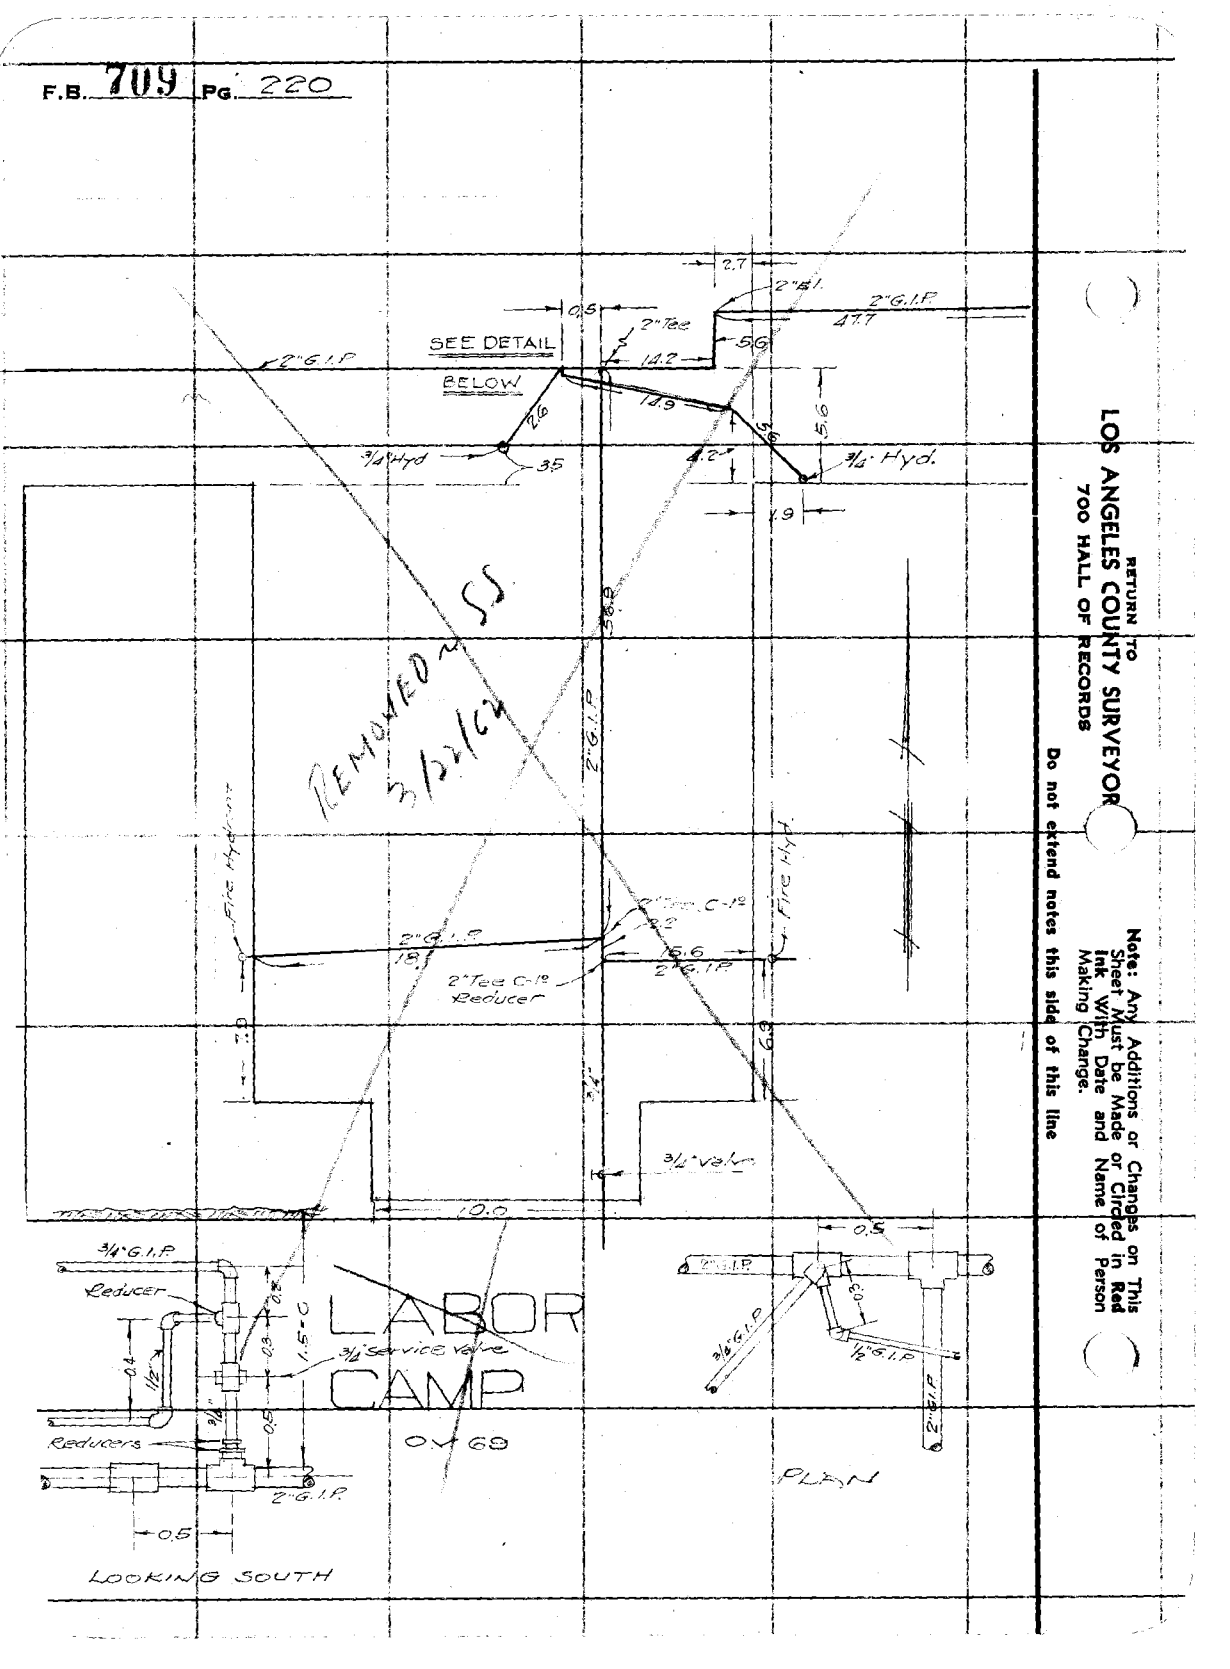

RETURN TO
LOS ANGELES COUNTY SURVEYOR
700 HALL OF RECORDS

Note: Any Additions or Changes on This Sheet Must be Made or Circled in Red Ink With Date and Name of Person Making Change.

Do not extend notes this side of this line

Notes Ck'd by	Survey of OLIVE VIEW SANATORIUM
Map No.	W. O. 8128 Tape No. St'd °F.
Office Work	Surveyed by TED M. WALSH
Checked	Notes WALSH Date 7-1-36
Date	Indexed A. C. Johnson

F.B. 709 PG. 221

WATER LINE

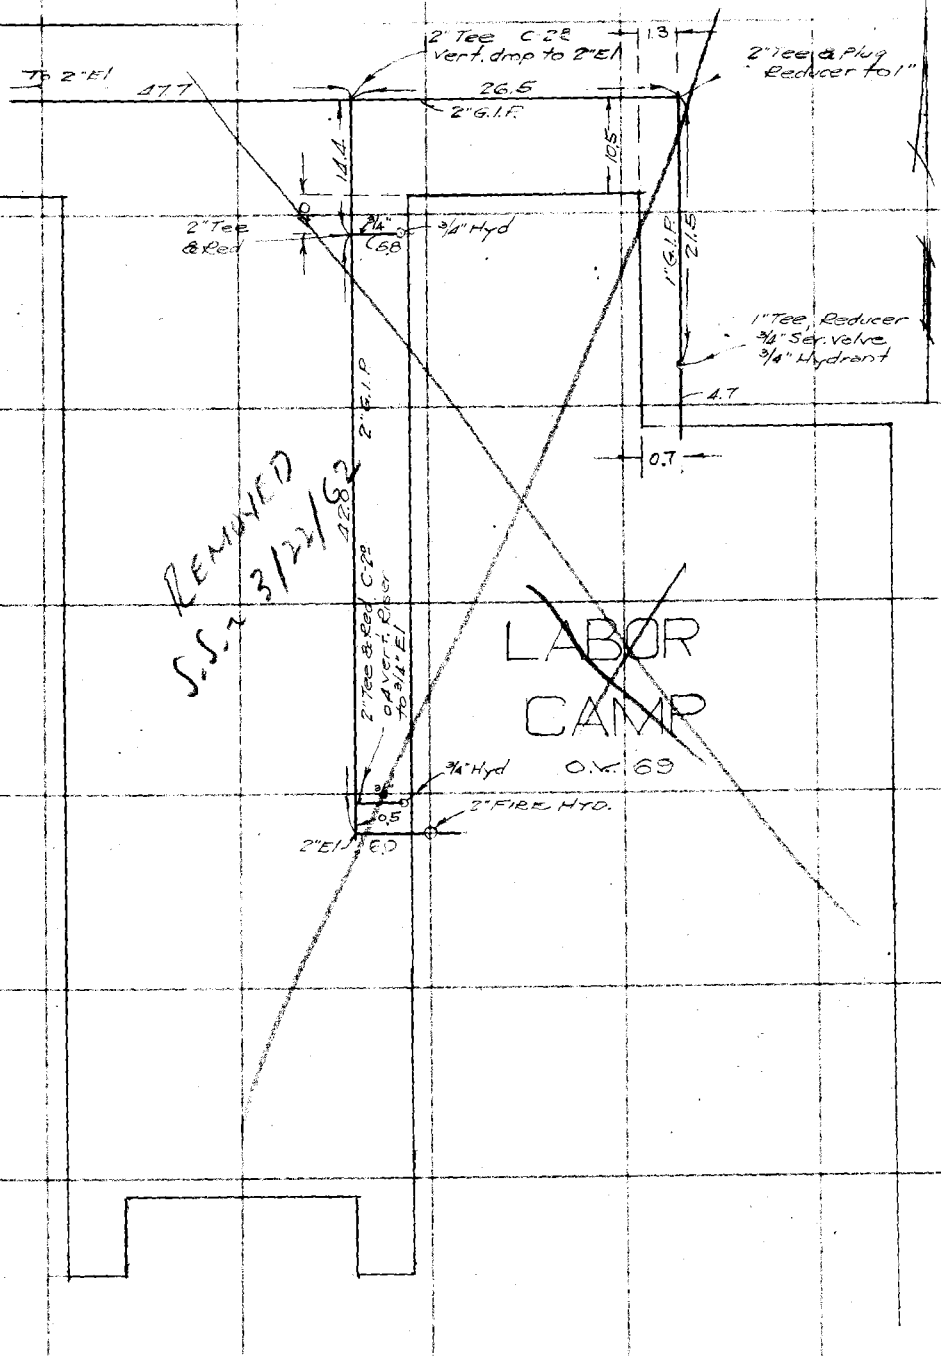

Note: Any Additions or Changes on This Sheet Must be Made or Circled in Red Ink With Date and Name of Person Making Change.

Do not extend notes this side of this line

RETURN TO
LOS ANGELES COUNTY SURVEYOR
700 HALL OF RECORDS

FORM 247 10M 11-35

RETURN TO
LOS ANGELES COUNTY SURVEYOR
700 HALL OF RECORDS

Note: Any Additions or Changes on This Sheet Must be Made or Circled in Red Ink With Date and Name of Person Making Change.

Do not extend notes this side of this line

F.B. 709 Pg. 222

Notes Ck'd by	Survey of OLIVE VIEW SANATORIUM
Map No.	W. O. 8128 Tape No. St'd °F.
Office Work	Surveyed by TEO. WALSH
Checked	Notes WALSH Date 4-27-36
Date	Indexed A. C. Johns

F.B. 709 Pg. 223

WATER LINES

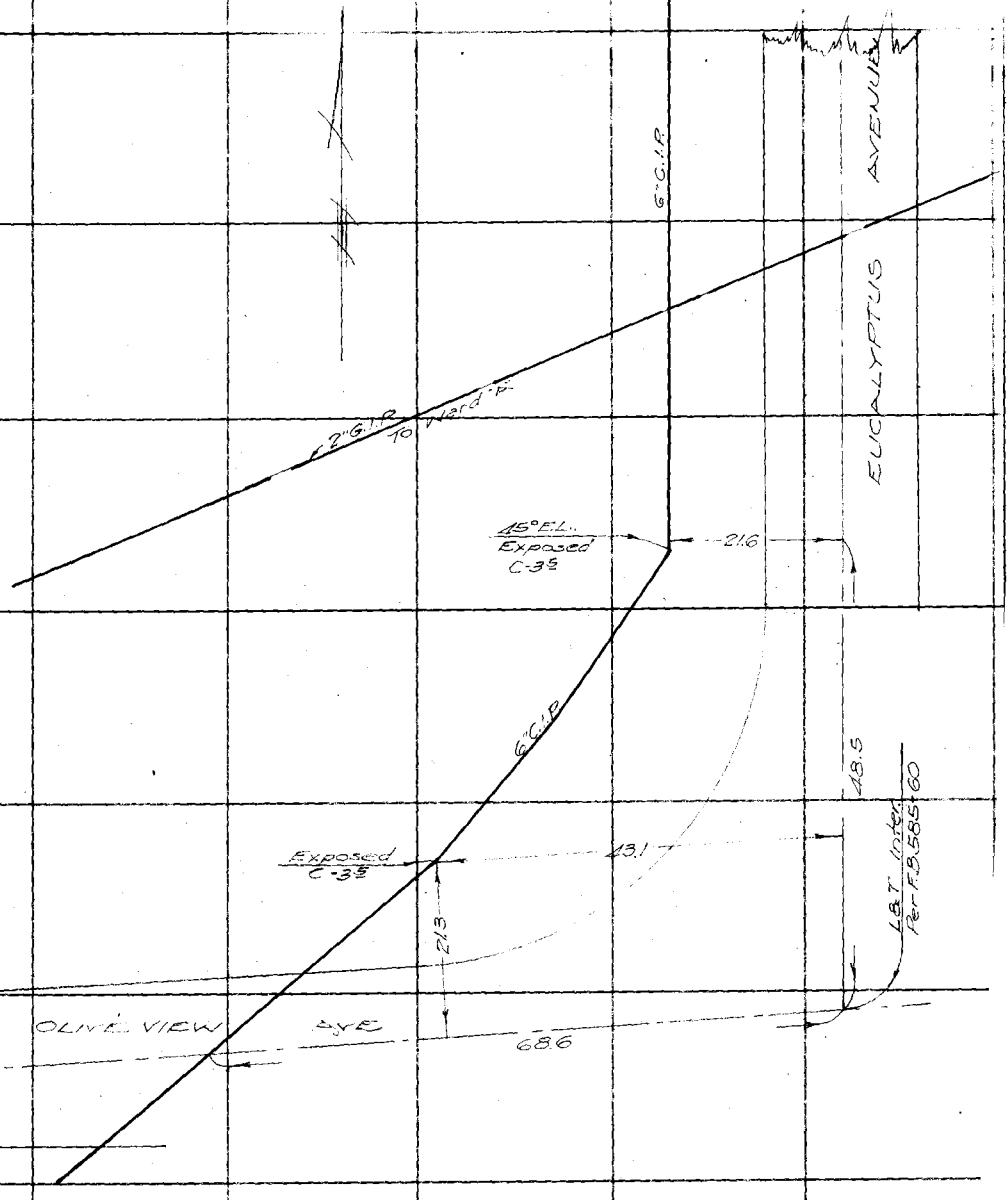

Note: Any Additions or Changes on This Sheet Must be Made or Circled in Red Ink With Date and Name of Person Making Change.

Do not extend notes this side of this line

RETURN TO
LOS ANGELES COUNTY SURVEYOR
700 HALL OF RECORDS

FORM 247 10M 11-35

RETURN TO
LOS ANGELES COUNTY SURVEYOR
700 HALL OF RECORDS

Note: Any Additions or Changes on This Sheet Must be Made or Circled in **Red Ink** With Date and Name of Person Making Change.

Do not extend notes this side of this line

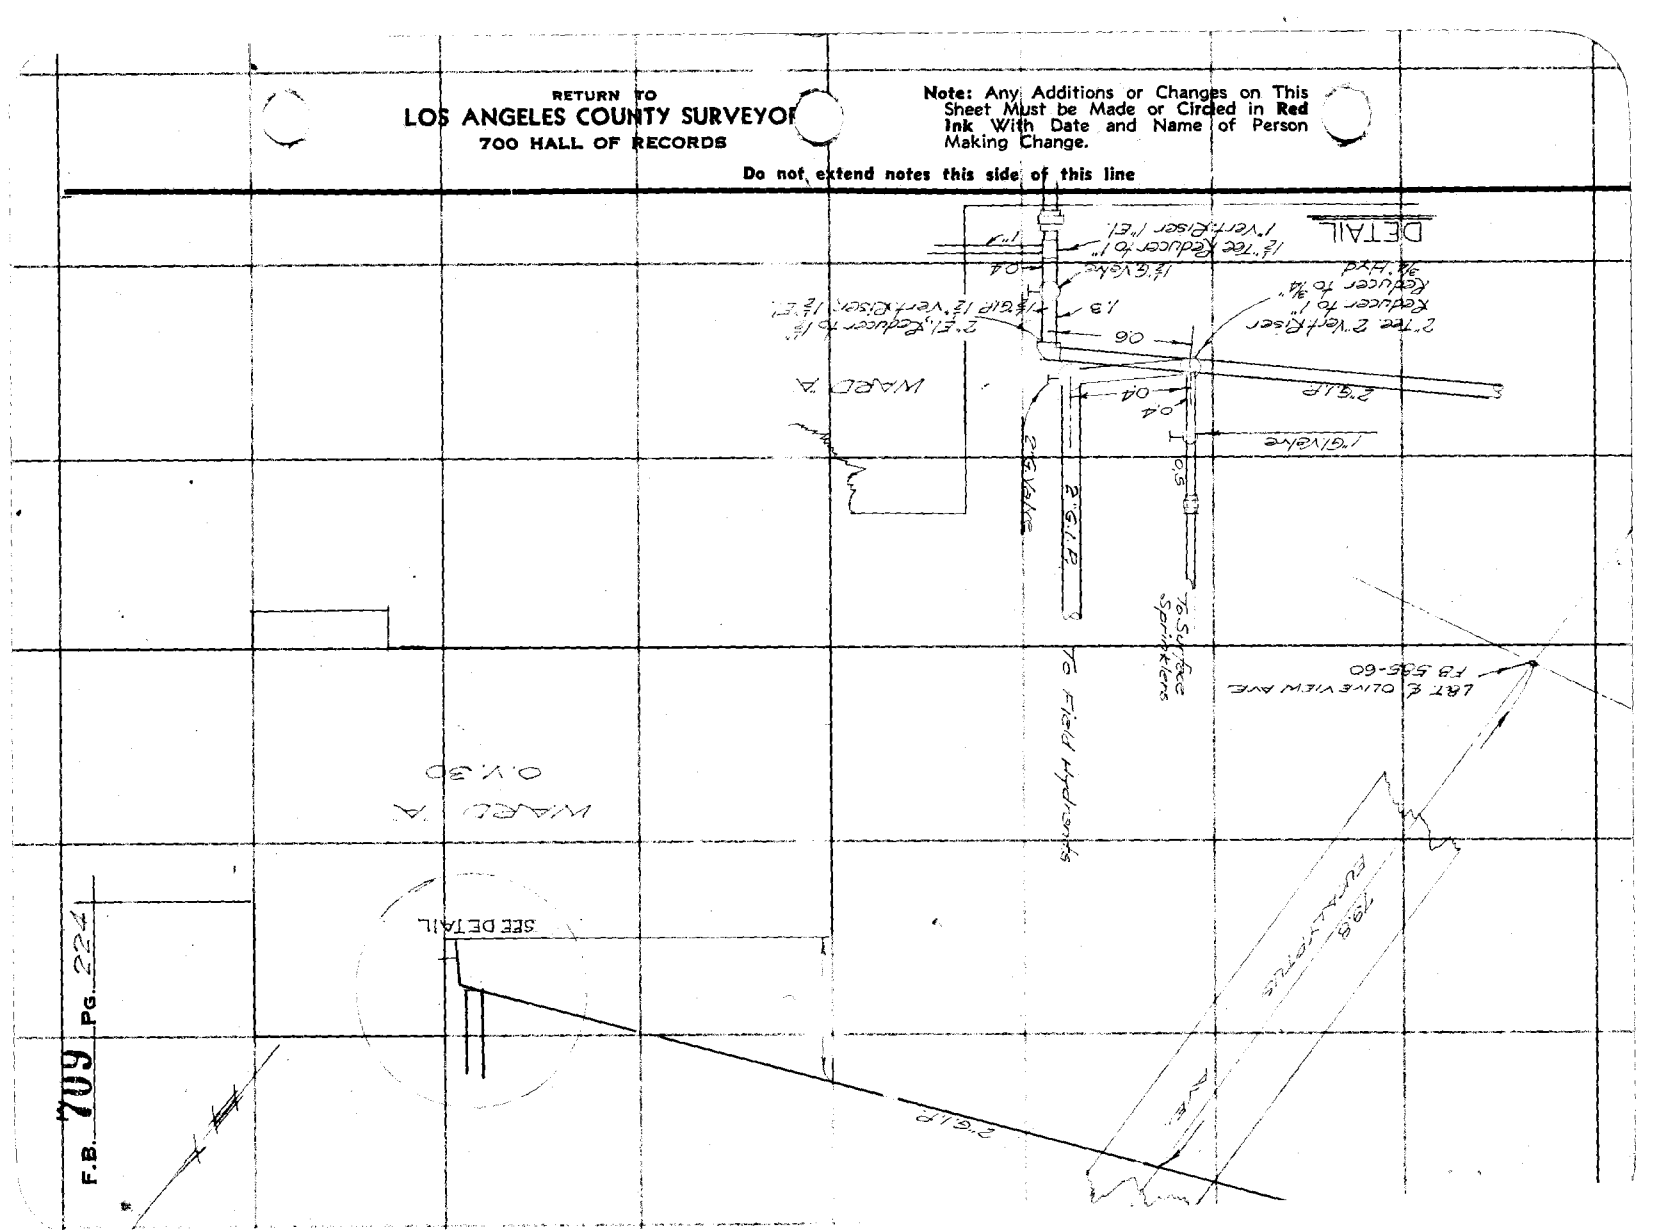

F.B. 709 PG. 224

Notes Ck'd by	Survey of OLIVE VIEW SANATORIUM
Map No.	W. O. 8125 Tape No. St'd °F.
Office Work	Surveyed by T. M. WALSH
Checked	Notes T. M. WALSH Date 8-14-36
Date	Indexed A. C. Johnson

F.B. 709 PG. 225

WATER LINES

Note: Any Additions or Changes on This Sheet Must be Made or Circled in Red Ink With Date and Name of Person Making Change.

Do not extend notes this side of this line

RETURN TO
LOS ANGELES COUNTY SURVEYOR
700 HALL OF RECORDS

FORM 247 10M 11-35

RETURN TO
LOS ANGELES COUNTY SURVEYOR
700 HALL OF RECORDS

Note: Any Additions or Changes on This Sheet Must be Made or Circled in **Red Ink** With Date and Name of Person Making Change.

Do not extend notes this side of this line

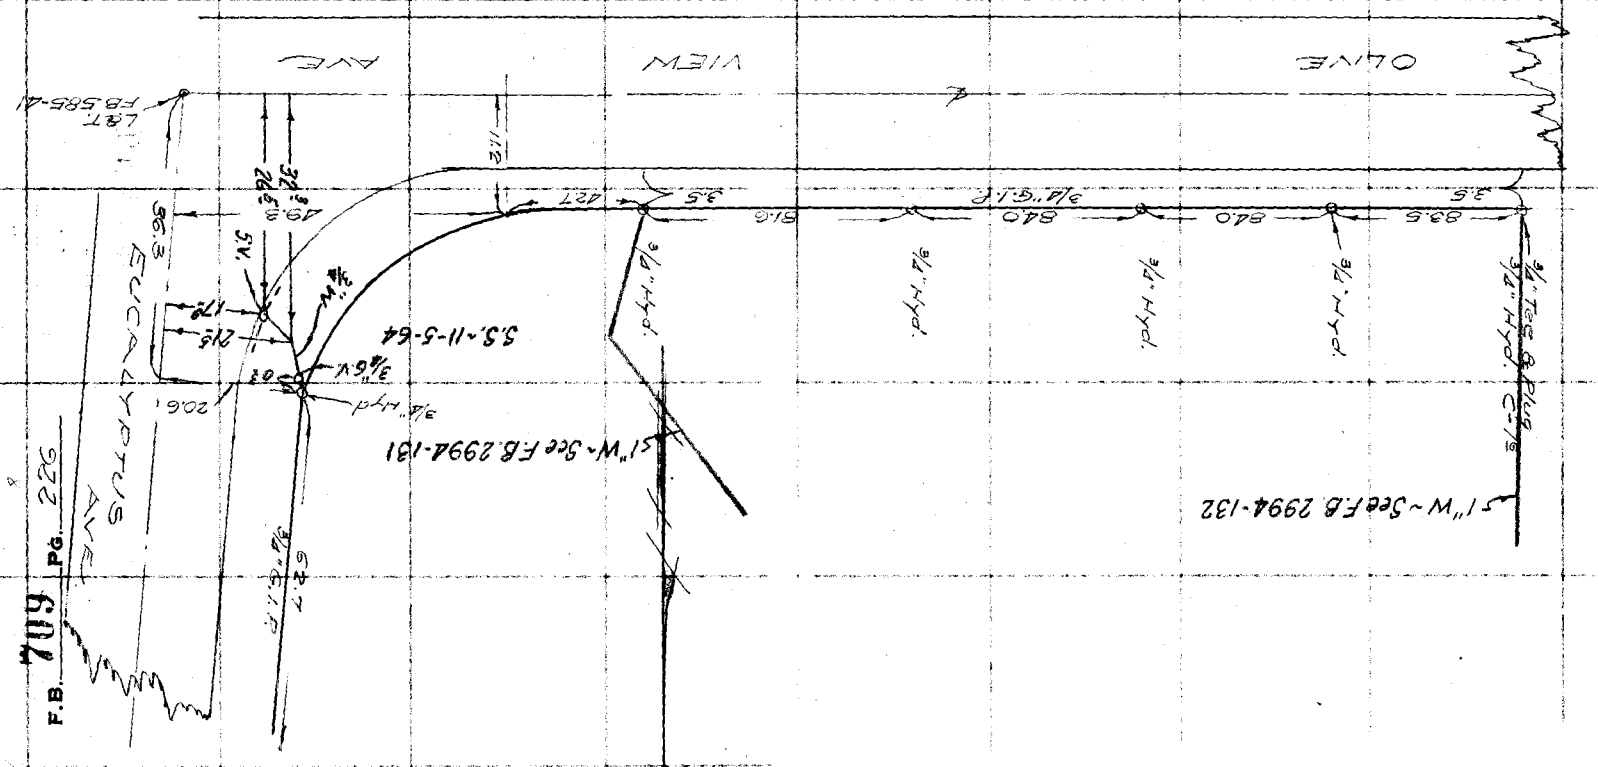

F.B. 709 PG. 226

Notes Ck'd by	Survey of OLIVE VIEW SANATORIUM
Map No.	W. O. 8128 Tape No. St'd °F.
Office Work	Surveyed by T. M. WALSH
Checked	Notes T. M. WALSH Date 8-14-36
Date	Indexed A. C. Johnson

F.B. 709 PG. 227

WATER LINES

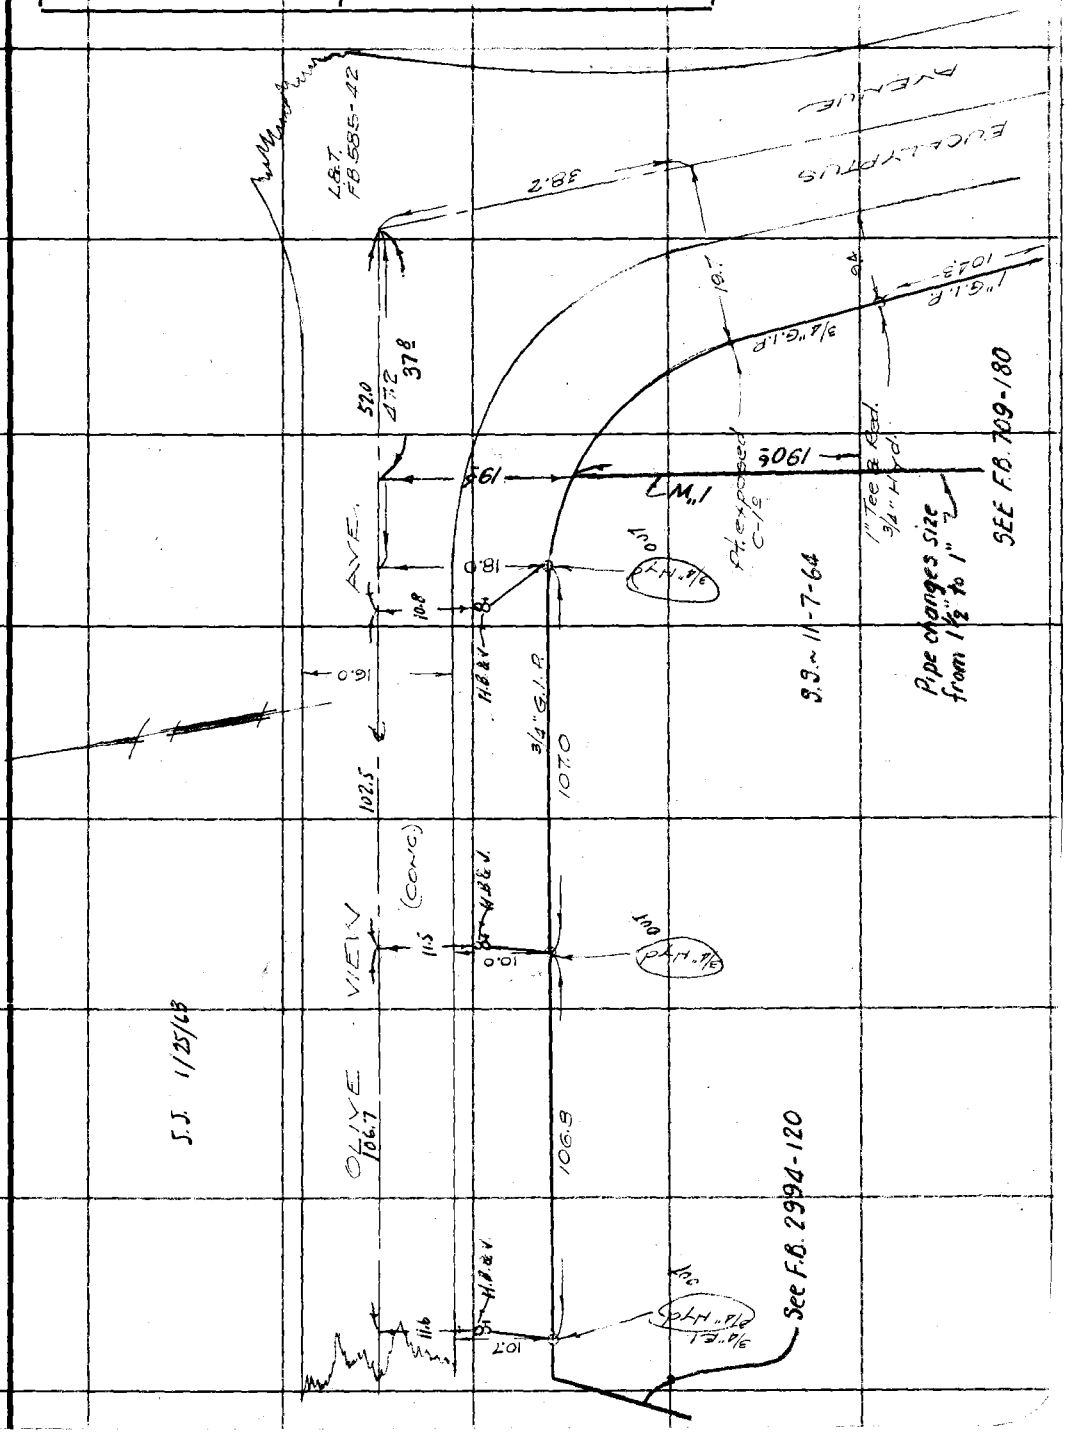

Note: Any Additions or Changes on This Sheet Must be Made or Circled in Red Ink With Date and Name of Person Making Change.

Do not extend notes this side of this line

RETURN TO
LOS ANGELES COUNTY SURVEYOR
700 HALL OF RECORDS

FORM 247 10M 11-35

RETURN TO
LOS ANGELES COUNTY SURVEYOR
700 HALL OF RECORDS

Note: Any Additions or Changes on This Sheet Must be Made or Circled in **Red Ink** With Date and Name of Person Making Change.

Do not extend notes this side of this line

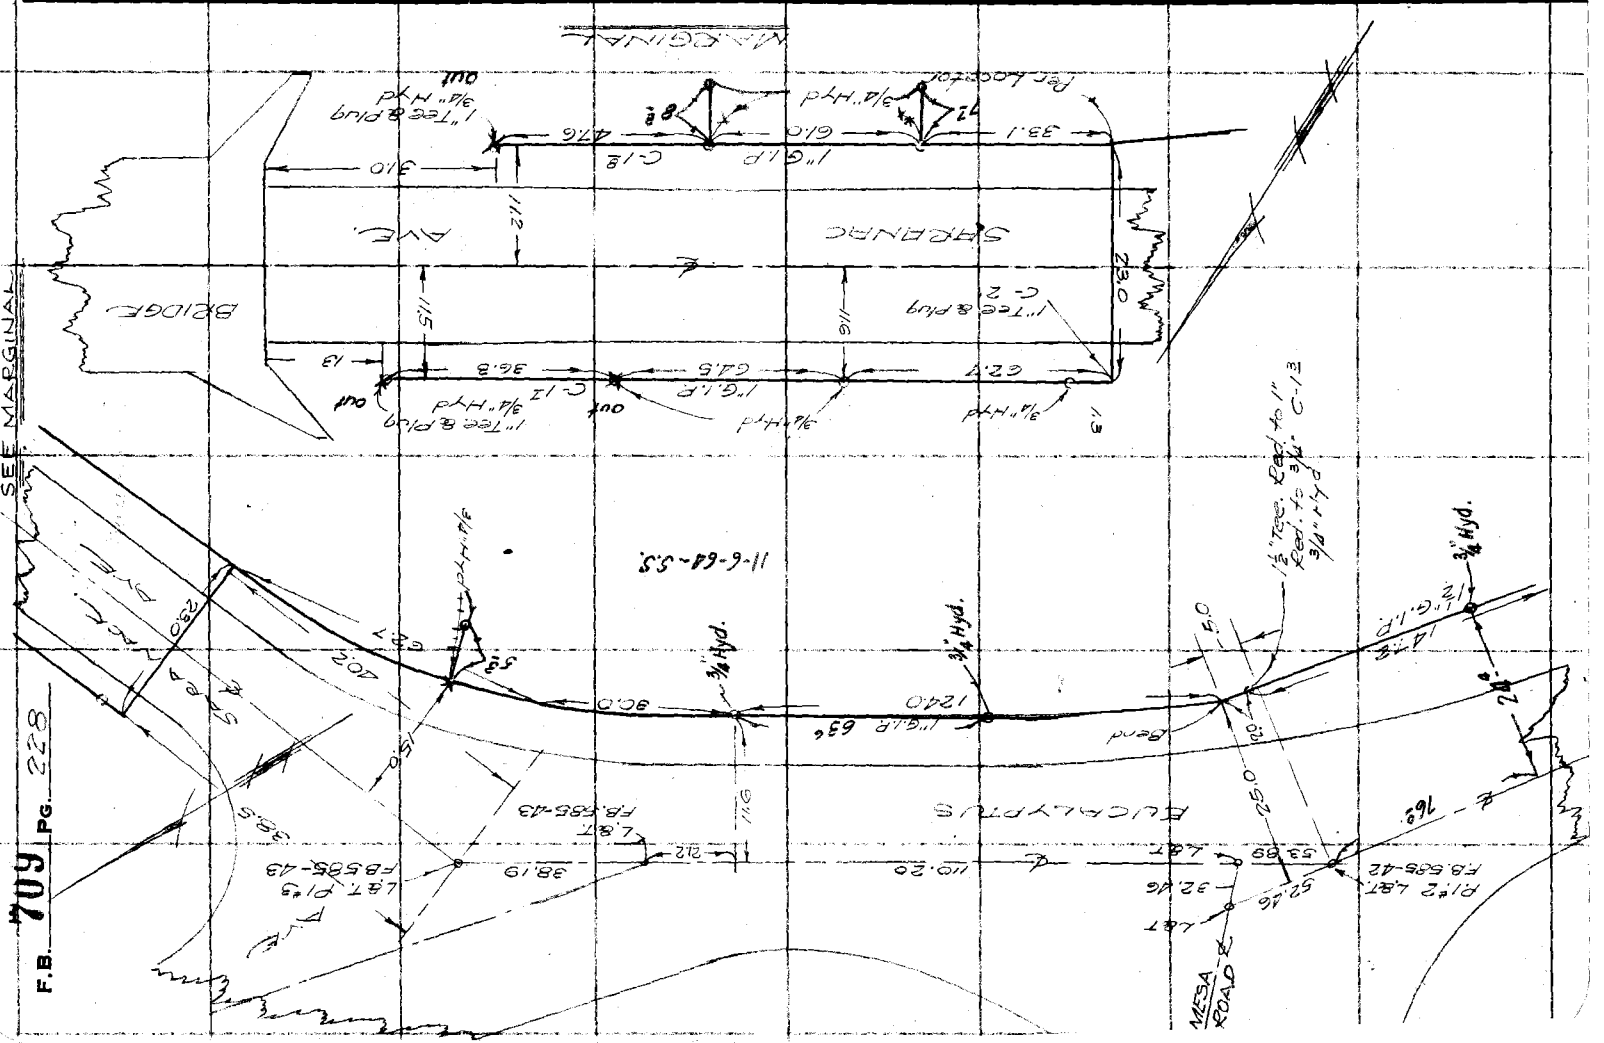

FORM 247 10M 11-38

RETURN TO
LOS ANGELES COUNTY SURVEYOR
700 HALL OF RECORDS

Note: Any Additions or Changes on This Sheet Must be Made or Circled in Red Ink With Date and Name of Person Making Change.

Do not extend notes this side of this line

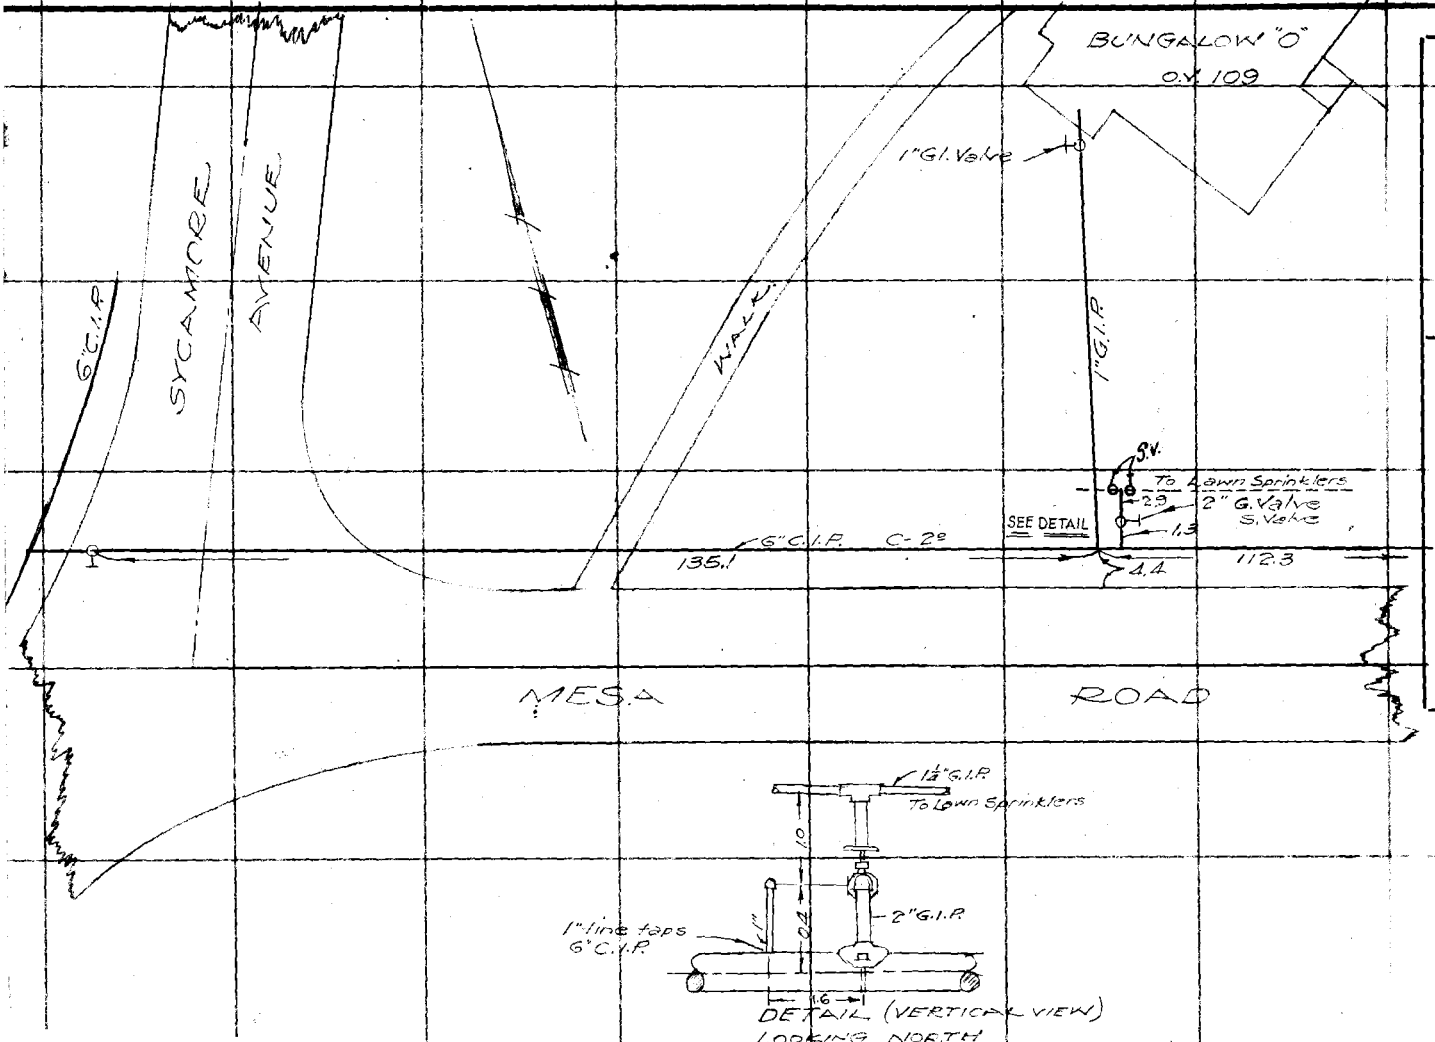

Notes Ck'd by
Map No.
Office Work
Checked
Date

W. O. 8228 Tape No. T. M. WALSH P.F.
Surveyed by T. M. WALSH Date 6-11-36
Notes
Indexed A. C. Johnson

F.B. 709 Pg. 229

WATER LINES

RETURN TO
LOS ANGELES COUNTY SURVEYOR
700 HALL OF RECORDS

Note: Any Additions or Changes on This Sheet Must be Made or Circled in **Red** Ink With Date and Name of Person Making Change.

Do not extend notes this side of this line

F.B. 709 PG. 230

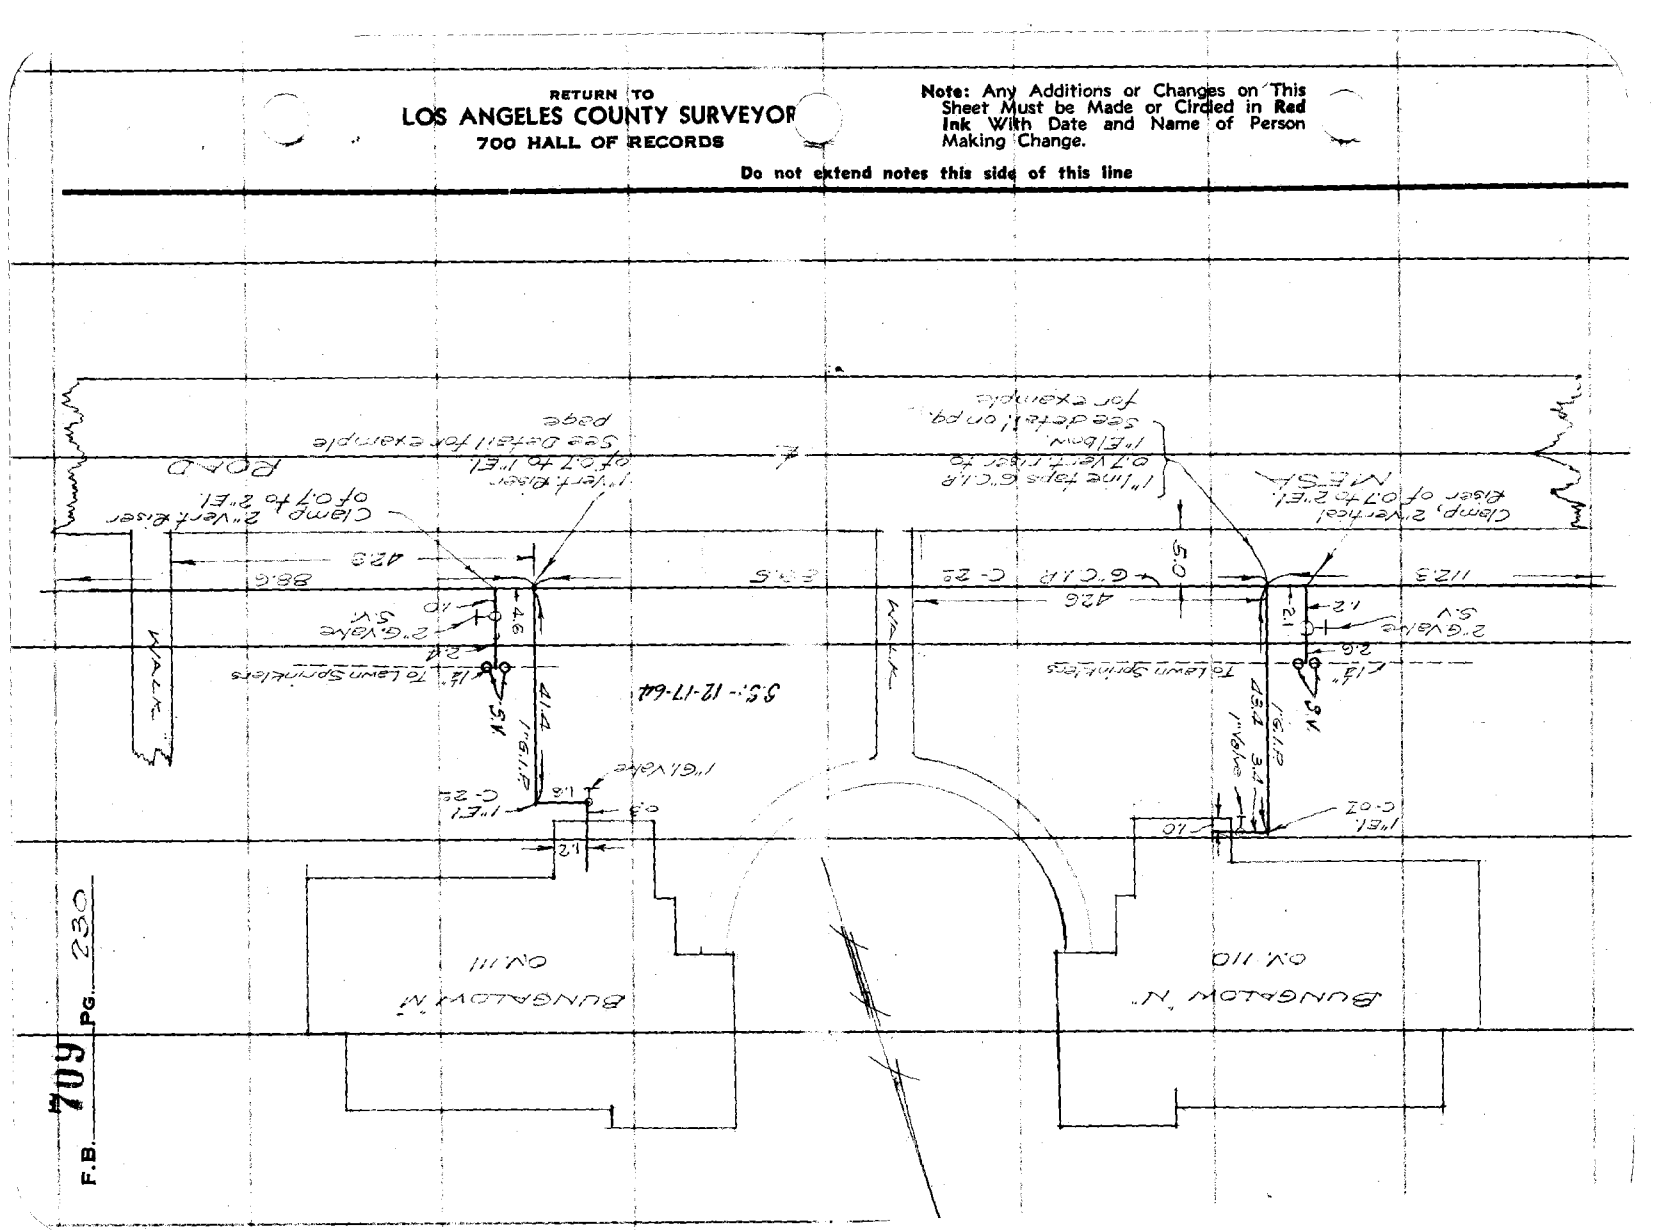

FORM 247 10M 11-35

RETURN TO
LOS ANGELES COUNTY SURVEYOR
700 HALL OF RECORDS

Note: Any Additions or Changes on This Sheet Must be Made or Circled in **Red Ink** With Date and Name of Person Making Change.

Do not extend notes this side of this line

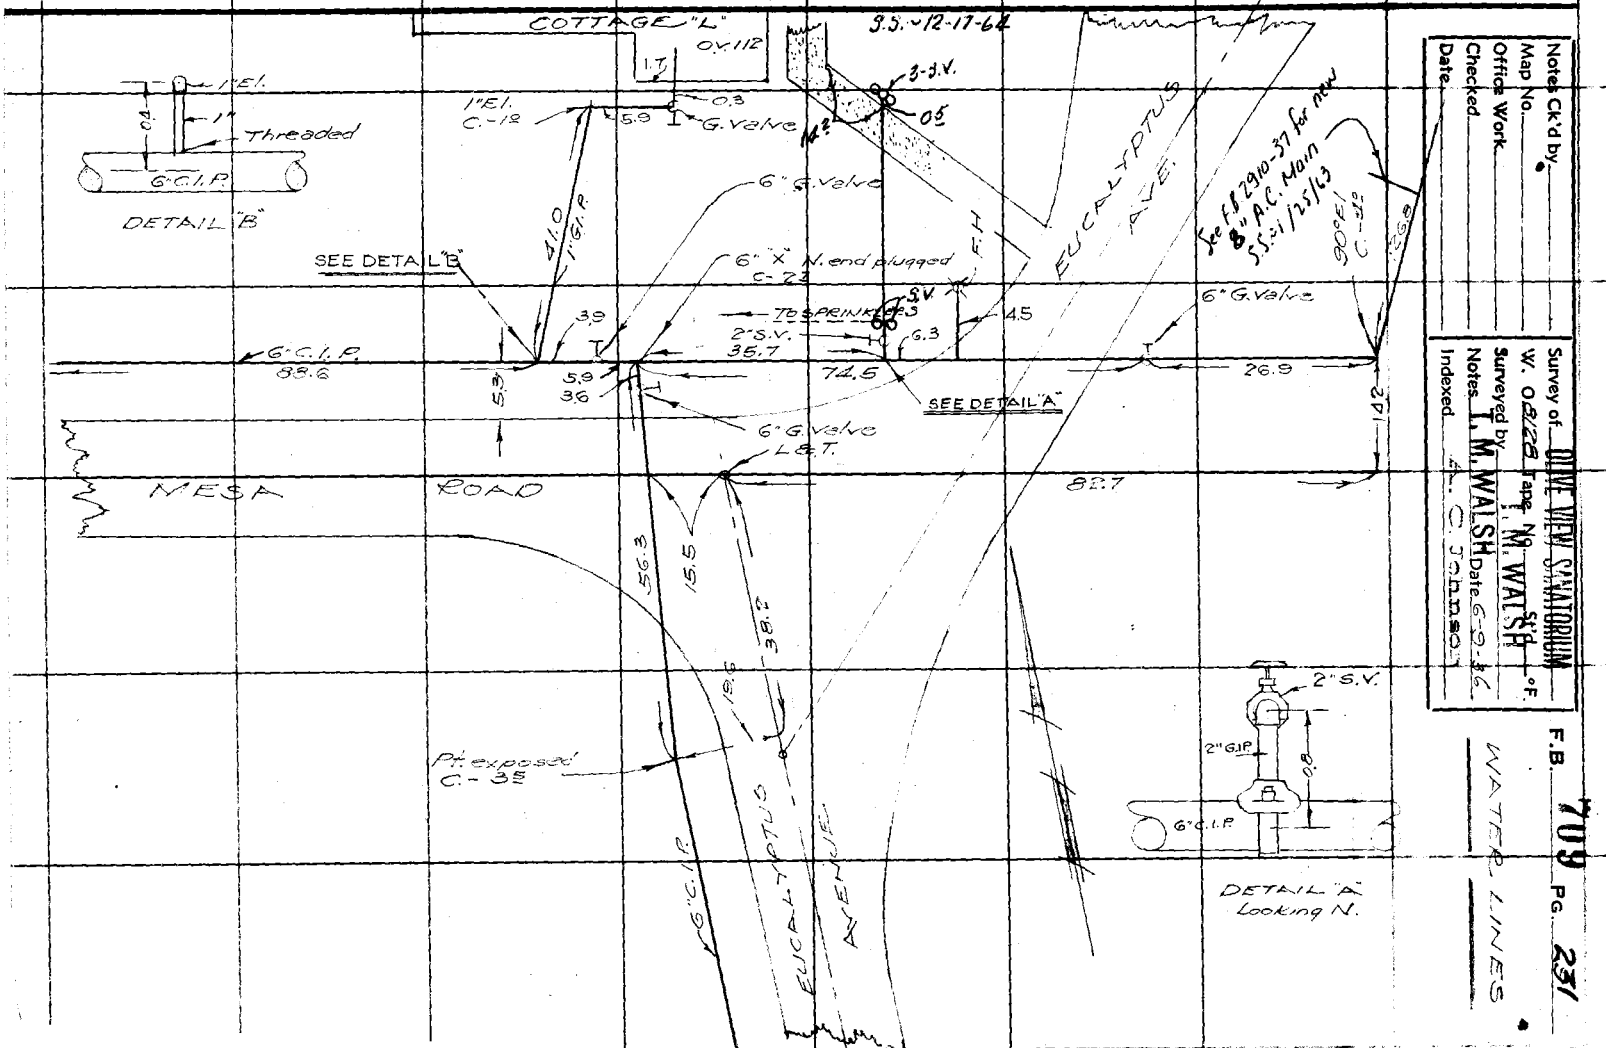

See F.B. 2910-37 for new 8" A.C. Main S.S.:1/25/63

3.S. - 12-17-62

Notes Ck'd by
Map No.
Office Work
Checked
Date

Survey of OLIVE VIEW SANATORIUM
W. O. 8228 Page No. °F.
Surveyed by T. M. WALSH Date 6-9-36
Notes T. M. WALSH
Indexed A. C. Johnson

F.B. 709 Pg. 231

WATER LINES

RETURN TO
LOS ANGELES COUNTY SURVEYOR
700 HALL OF RECORDS

Note: Any Additions or Changes on This Sheet Must be Made or Circled in **Red** Ink With Date and Name of Person Making Change.

Do not extend notes this side of this line

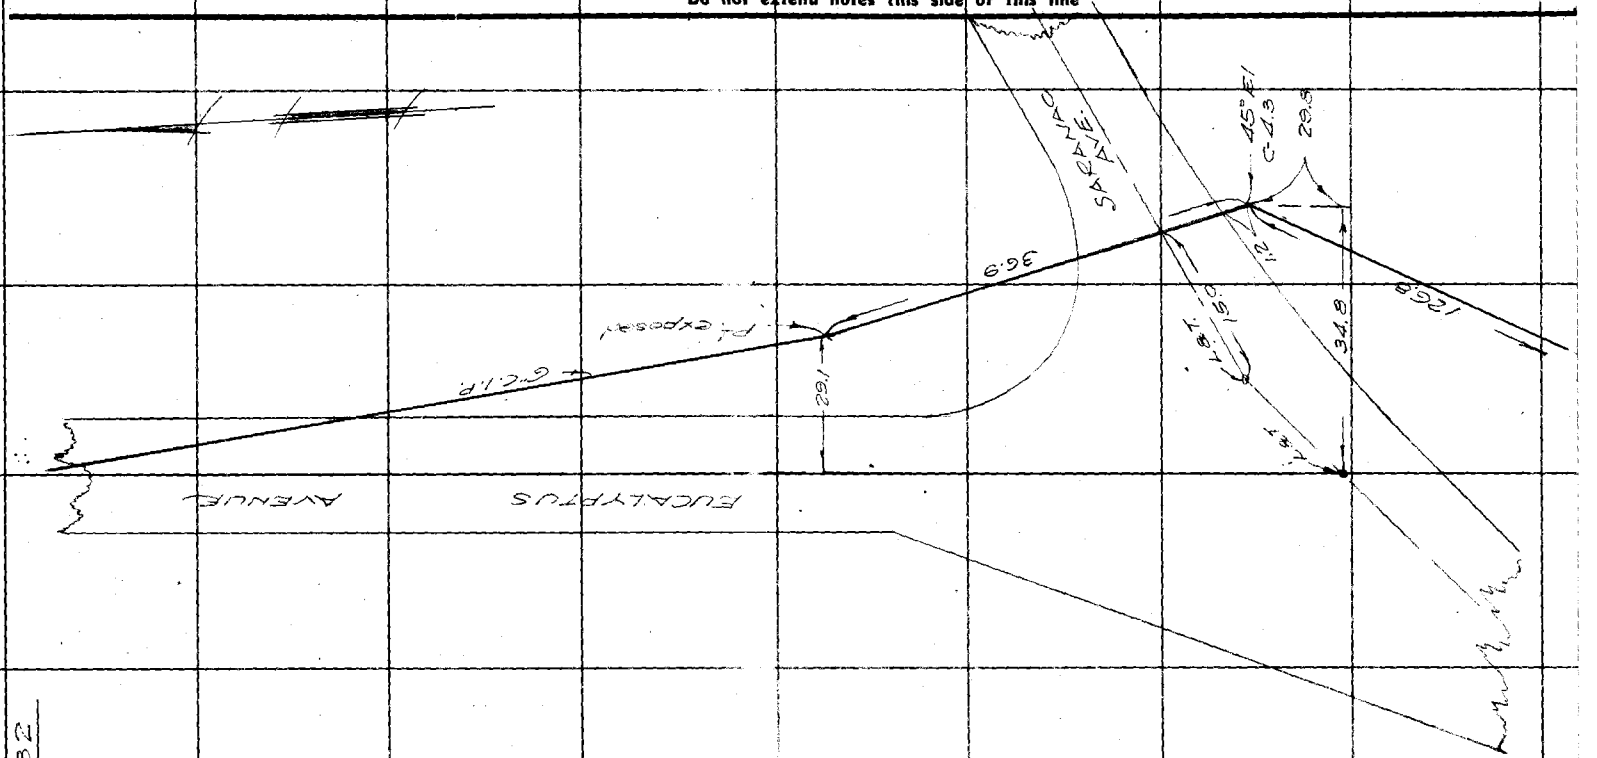

F.B. 709 PG. 232

FORM 247 10M 11-35

RETURN TO
LOS ANGELES COUNTY SURVEYOR
700 HALL OF RECORDS

Note: Any Additions or Changes on This Sheet Must be Made or Circled in **Red Ink** With Date and Name of Person Making Change.

Do not extend notes this side of this line

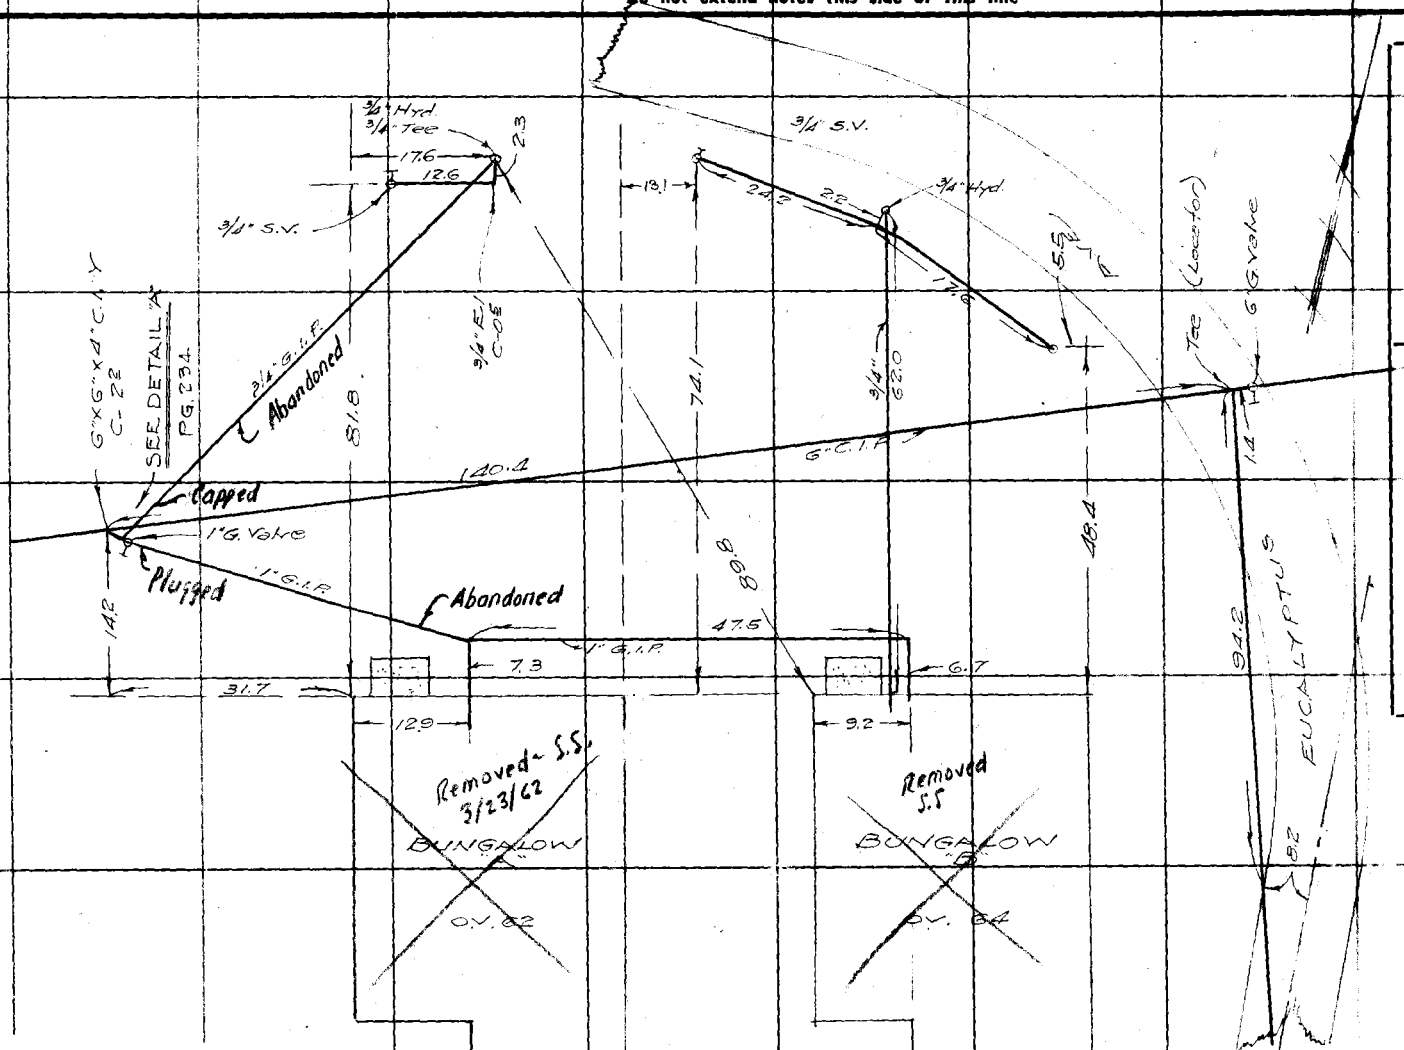

Notes Ck'd by
Map No.
Office Work
Checked
Date

W. O. 8728 Tape No. T. M. WALSH °F.
Surveyed by T. M. WALSH Date 3-10-62
Notes T. M. WALSH
Indexed C. Johnson

F.B. 7019 PG. 233

F.B. 709 PG. 234

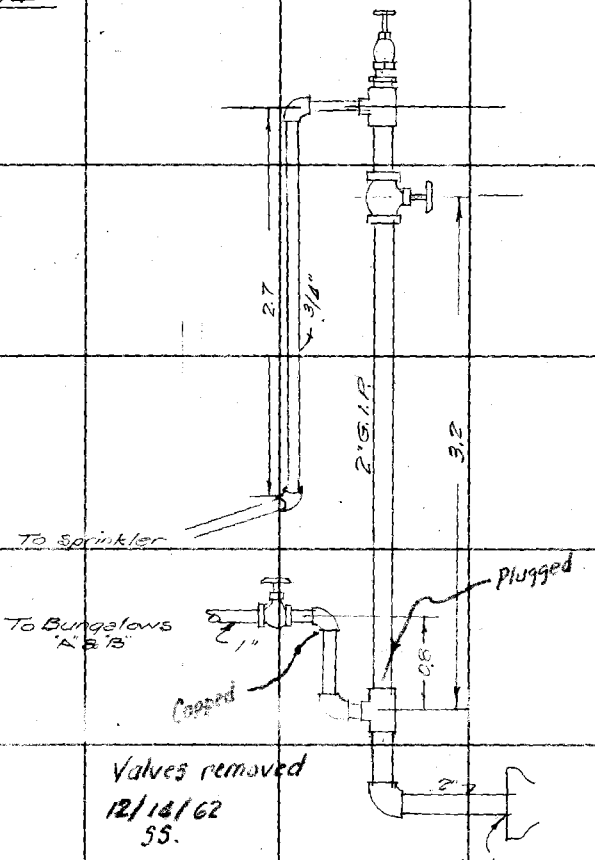

Valves removed
12/18/62
SS.

DETAIL "A"

LOOKING SOUTH.

RETURN TO
LOS ANGELES COUNTY SURVEYOR
700 HALL OF RECORDS

Note: Any Additions or Changes on This Sheet Must be Made or Circled in Red Ink With Date and Name of Person Making Change.

Do not extend notes this side of this line

FORM 247 10M 11-35

RETURN TO
LOS ANGELES COUNTY SURVEYOR
700 HALL OF RECORDS

Note: Any Additions or Changes on This Sheet Must be Made or Circled in **Red Ink** With Date and Name of Person Making Change.

Do not extend notes this side of this line

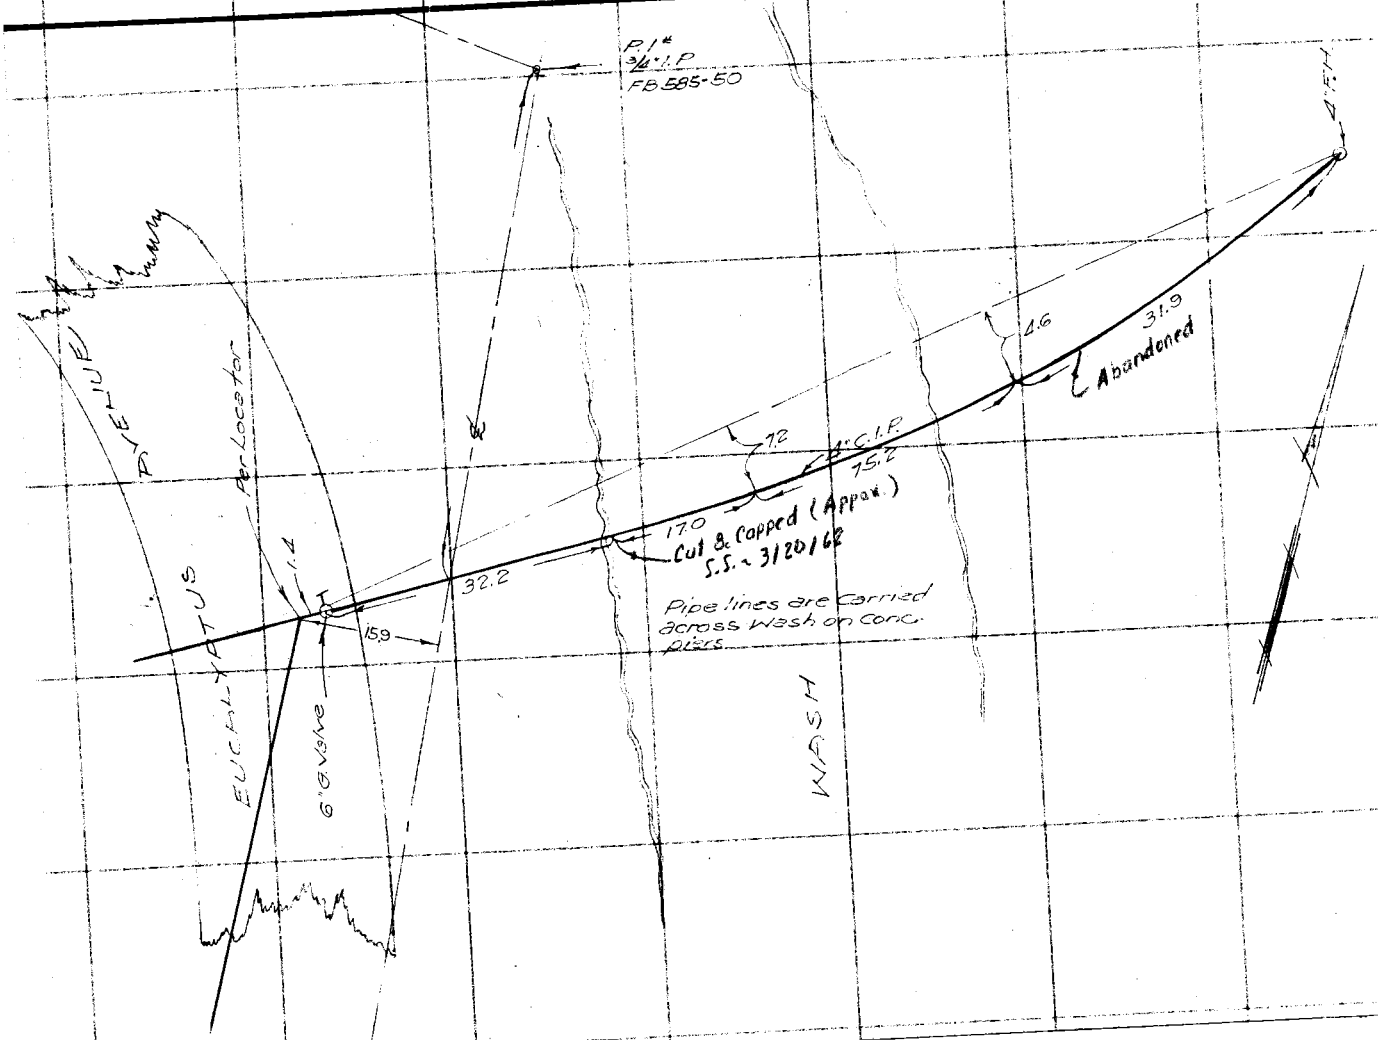

Notes Ck'd by _____
Map No. _____
Office Work _____
Checked _____
Date _____

W. O. 8228 Tape No. F. M. WALSH
Surveyed by F. M. WALSH Date 6/20/36
Notes F. M. WALSH
Indexed C. Johnson

F.B. 709 PG. 235

RETURN TO
LOS ANGELES COUNTY SURVEYOR
700 HALL OF RECORDS

Note: Any Additions or Changes on This Sheet Must be Made or Circled in **Red Ink** With Date and Name of Person Making Change.

Do not extend notes this side of this line

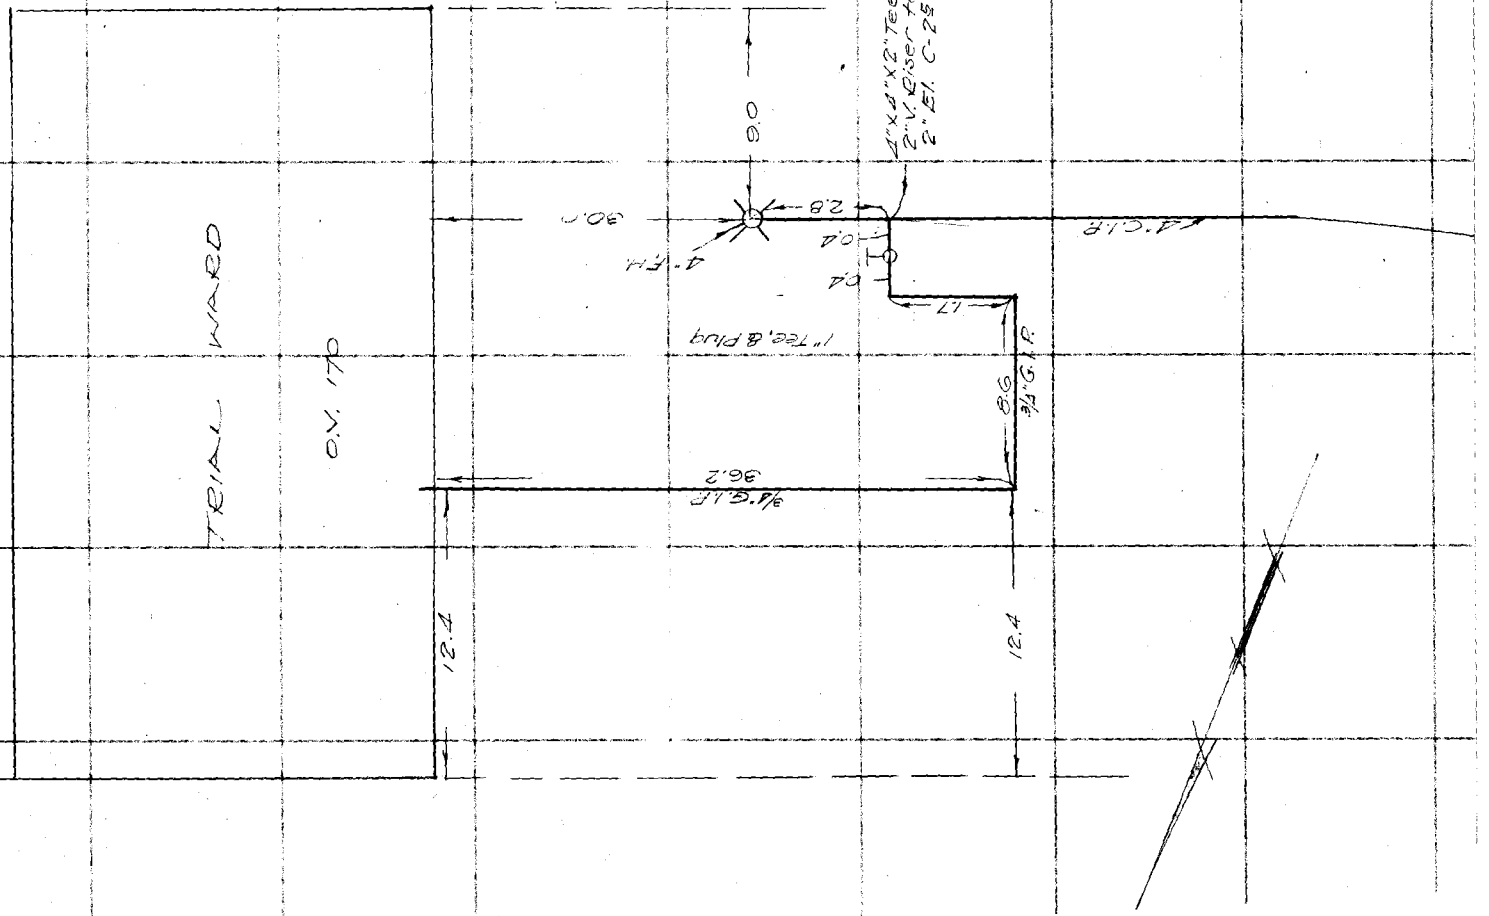

F.B. 709 PG. 236

Notes Ck'd by	Survey of OLIVE VIEW SANATORIUM
Map No.	W. O. 8128 Tape No. St'd °F.
Office Work	Surveyed by J. WALSH
Checked	Notes WALSH Date 4-29-36
Date	Indexed C. Johnson

F.B. 709 PG. 237

WATER LINES

RETURN TO
LOS ANGELES COUNTY SURVEYOR
700 HALL OF RECORDS

Note: Any Additions or Changes on This Sheet Must be Made or Circled in Red Ink With Date and Name of Person Making Change.

Do not extend notes this side of this line

FORM 247 10M 11-35

F.B. 709 Pg. 236

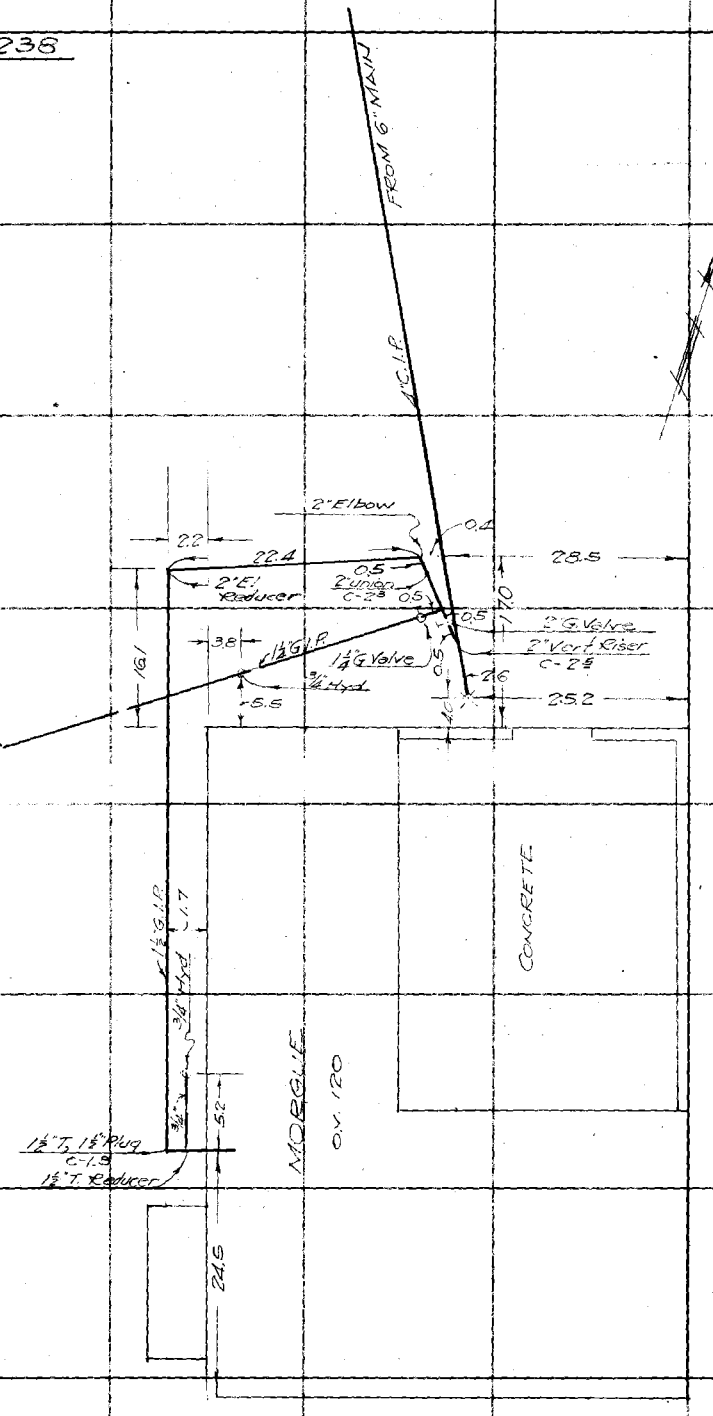

RETURN to
LOS ANGELES COUNTY SURVEYOR
700 HALL OF RECORDS

Note: Any Additions or Changes on This Sheet Must be Made or Circled in Red Ink With Date and Name of Person Making Change.

Do not extend notes this side of this line

Notes Ck'd by	Survey of OLIVE VIEW SANITORIUM
Map No.	W. O. 8128 Tape No. Sht. of.
Office Work	Surveyed by T. M. WALSH
Checked	Notes T. M. WALSH Date 4-29-36
Date	Indexed C. C. Johnson

F.B. 709 Pg. 239

WATER LINE

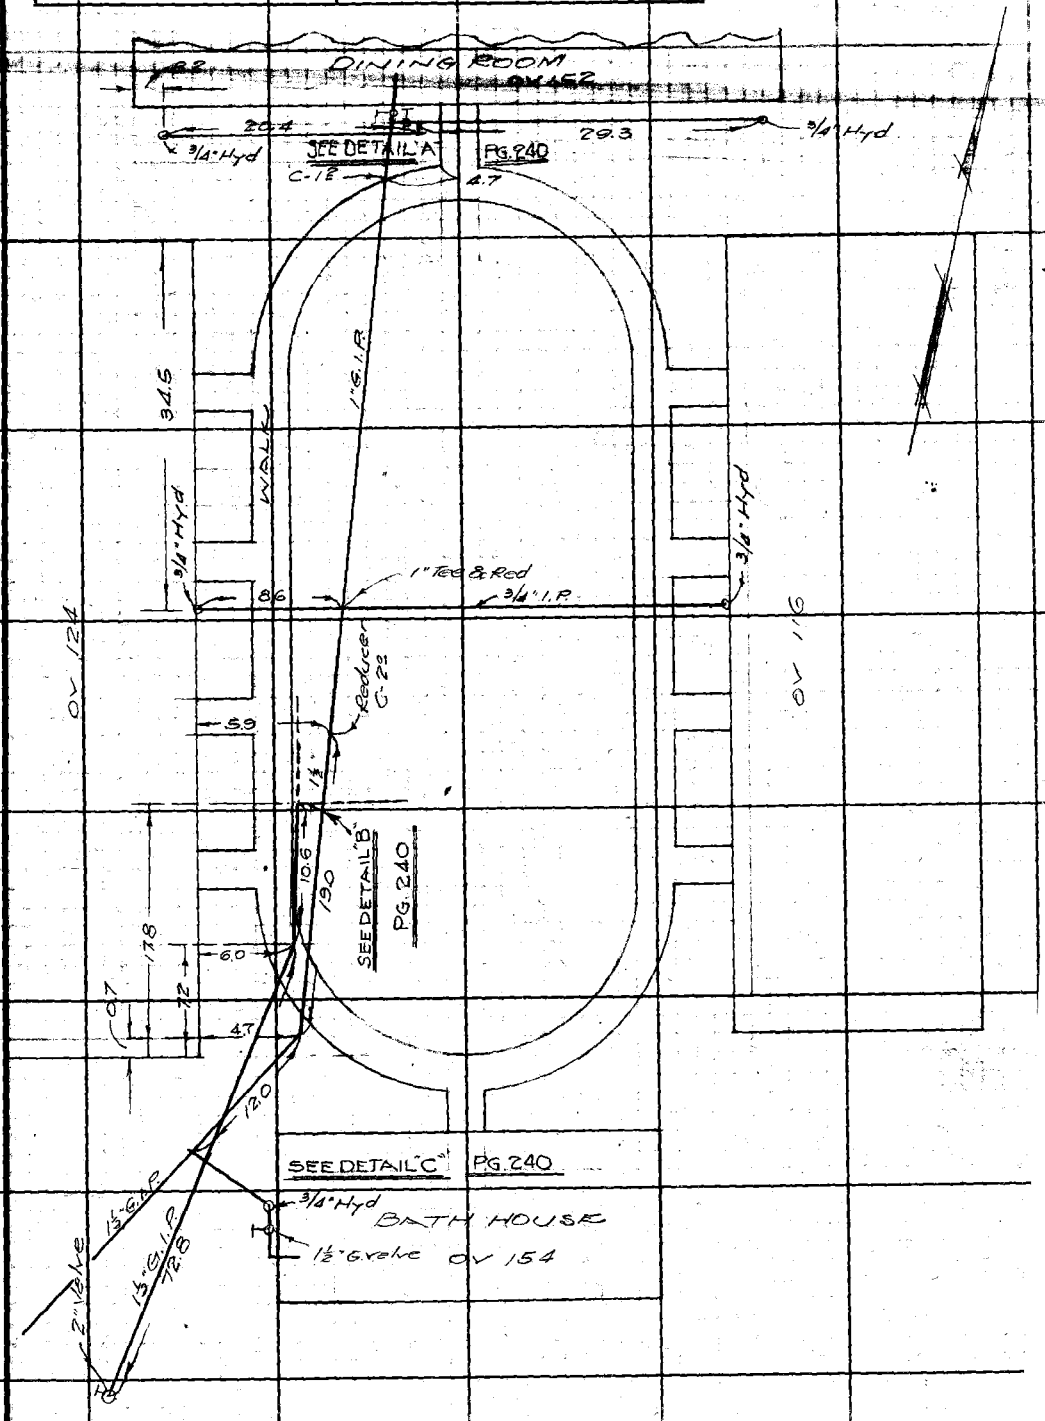

Note: ANY ADDITIONS OR CHANGES ON THIS SHEET MUST BE MADE OR CIRCLED IN Red Ink WITH DATE AND NAME OF PERSON MAKING CHANGE.

Do not extend notes this side of this line

RETURN TO
LOS ANGELES COUNTY SURVEYOR
700 HALL OF RECORDS

FORM 247 5M 2-34

F.B. 709 Pg. 240

RETURN TO
LOS ANGELES COUNTY SURVEYOR
700 HALL OF RECORDS
Do not extend notes this side of this line

Note: ANY ADDITIONS OR CHANGES ON THIS SHEET MUST BE MADE OR CIRCLED IN Red Ink WITH DATE AND NAME OF PERSON MAKING CHANGE.

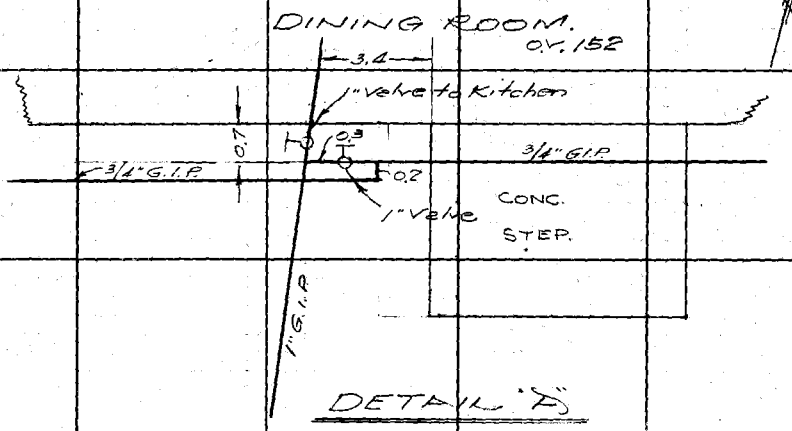


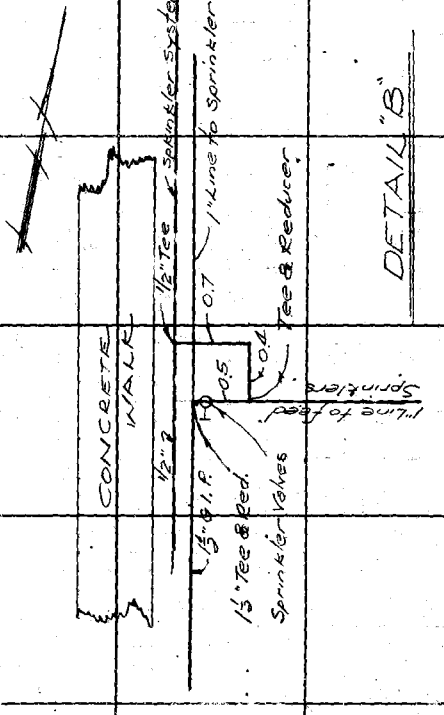

DETAIL "B"

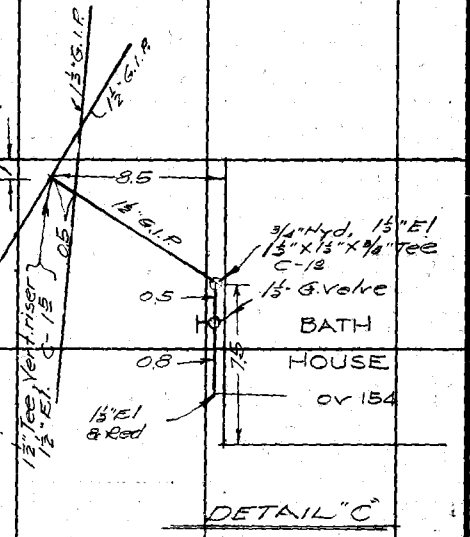

DETAIL "C"

FORM 247 10M 11-38

RETURN TO
LOS ANGELES COUNTY SURVEYOR
700 HALL OF RECORDS

Note: Any Additions or Changes on This Sheet Must be Made or Circled in **Red Ink** With Date and Name of Person Making Change.

Do not extend notes this side of this line

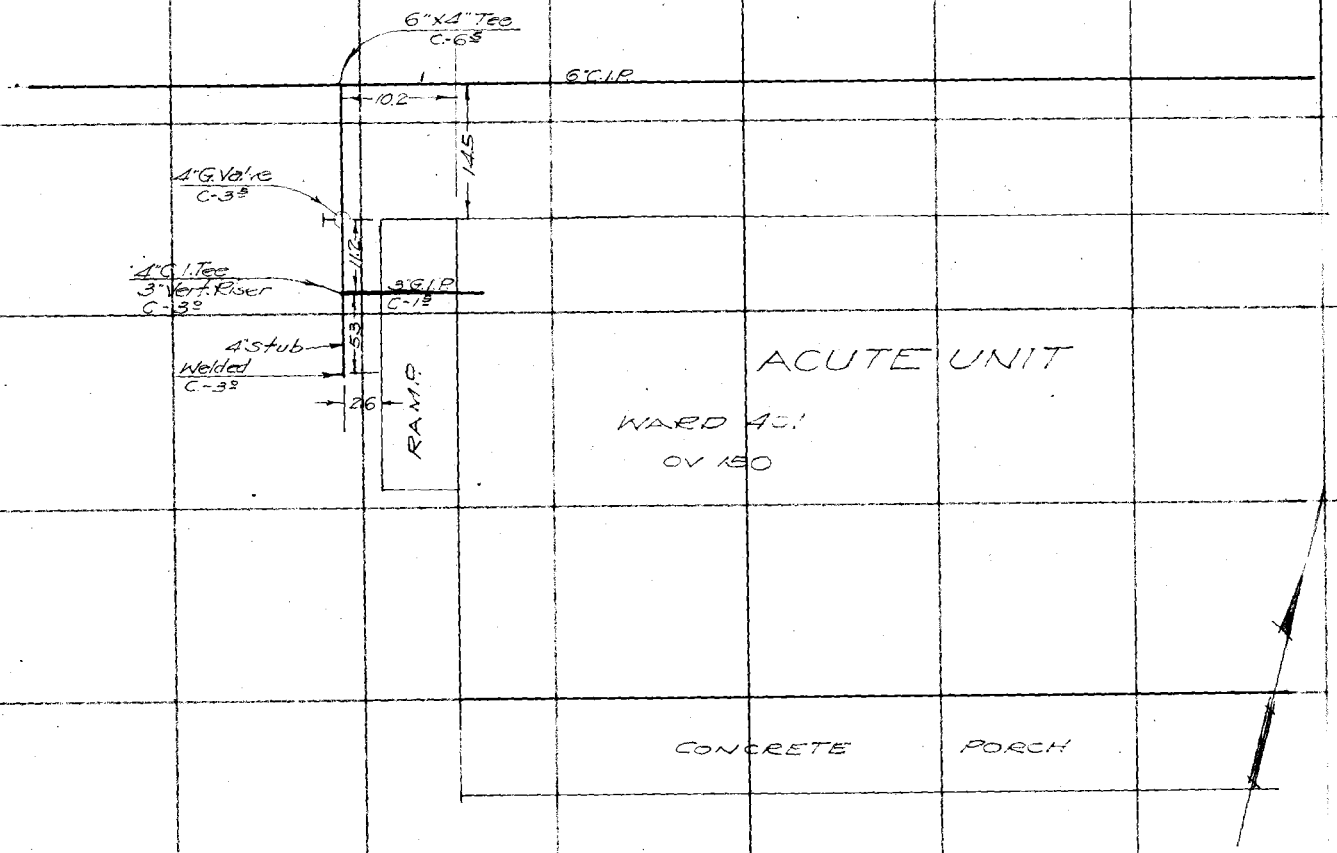

Notes Ck'd by _____
Map No. _____
Office Work _____
Checked _____
Date _____

W. O. 8129 Tape No. _____ Std. _____ °F.
Surveyed by TED WALSH
Notes WALSH Date 4-30-36
Indexed _____

F.B. 709 PG. 24

F.B. 709 Pg. 242

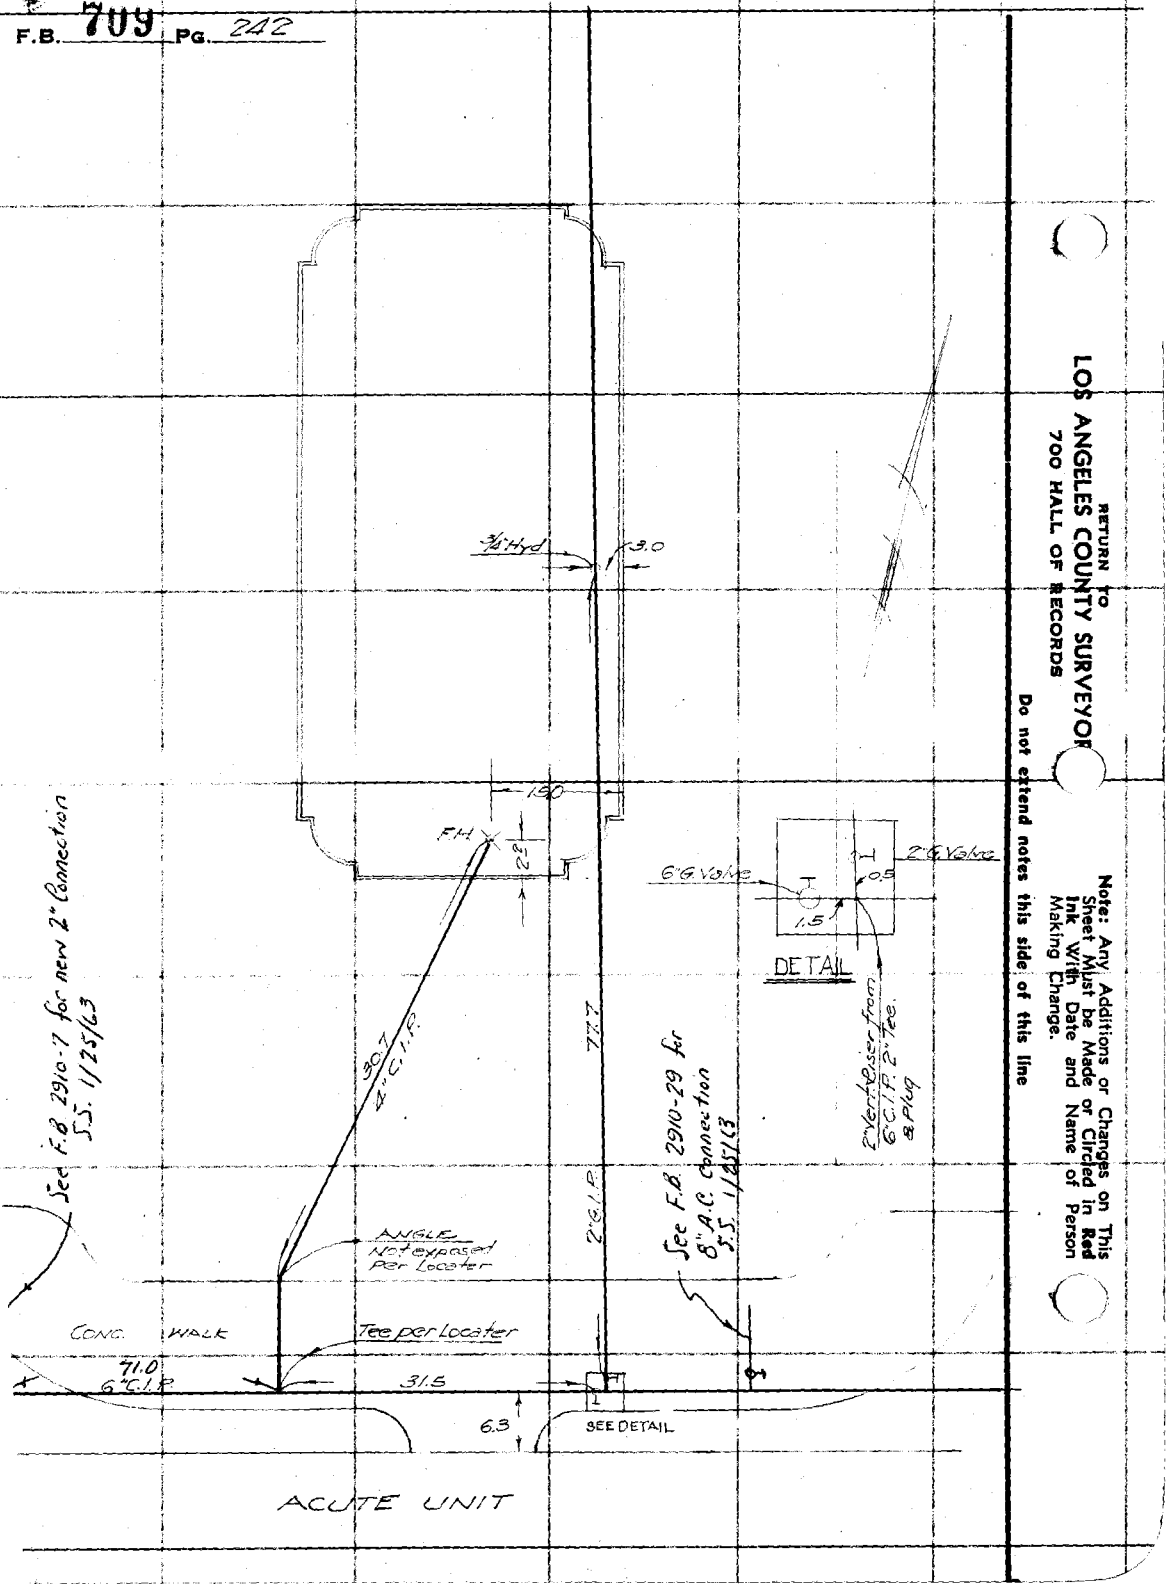

RETURN TO
LOS ANGELES COUNTY SURVEYOR
700 HALL OF RECORDS

Do not extend notes this side of this line

Note: Any Additions or Changes on This Sheet Must be Made or Circled in Red Ink With Date and Name of Person Making Change.

FORM 247 10M 11-35

RETURN TO
LOS ANGELES COUNTY SURVEYOR
700 HALL OF RECORDS

Note: Any Additions or Changes on This Sheet Must be Made or Circled in **Red Ink** With Date and Name of Person Making Change.

Do not extend notes this side of this line

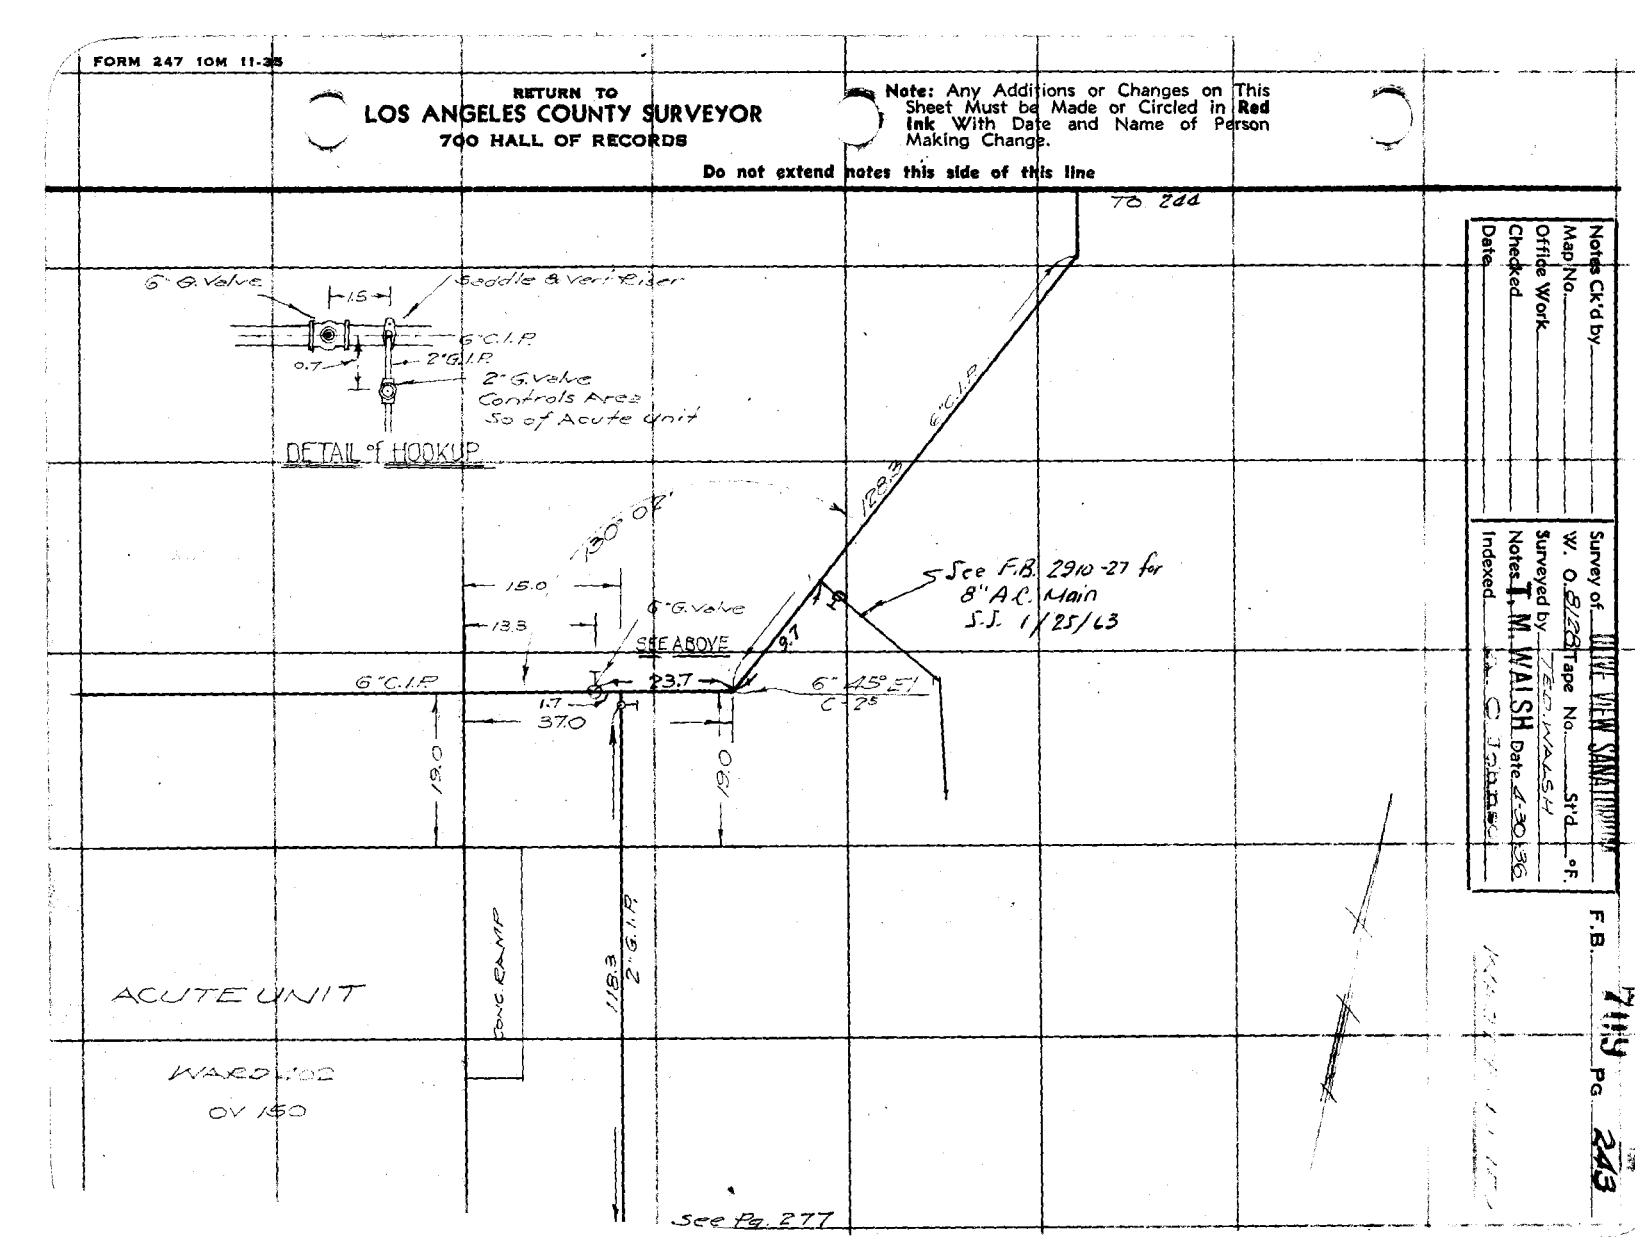

Notes Ck'd by
Map No.
Office Work
Checked
Date

W. O. 8229 Tape No. St'd °F.
Surveyed by TED WALSH Date 4-30-63
Notes T. M. WALSH
Indexed


RETURN TO
LOS ANGELES COUNTY SURVEYOR
700 HALL OF RECORDS

Note: Any Additions or Changes on This Sheet Must be Made or Circled in **Red Ink** With Date and Name of Person Making Change.

Do not extend notes this side of this line

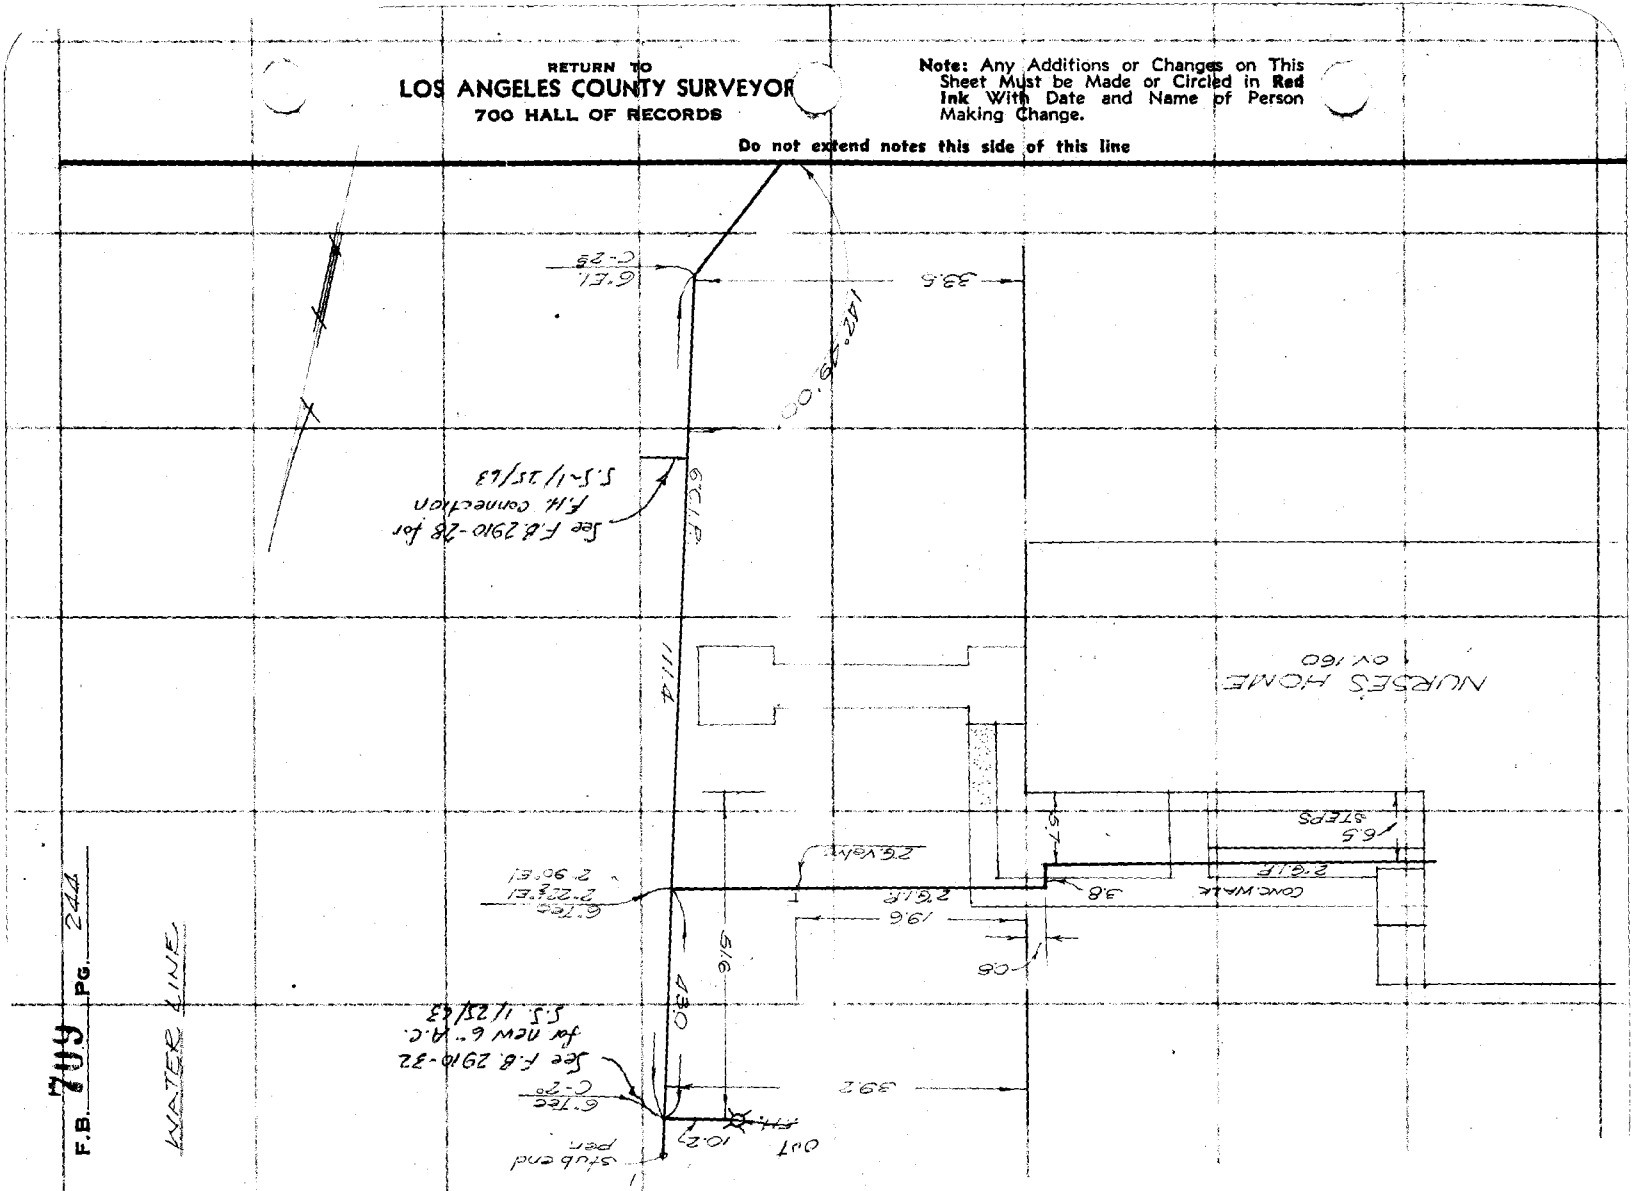


WATER LINE

FORM 247 10M 11-38

RETURN TO
LOS ANGELES COUNTY SURVEYOR
700 HALL OF RECORDS

Note: Any Additions or Changes on This Sheet Must be Made or Circled in **Red Ink** With Date and Name of Person Making Change.

Do not extend notes this side of this line

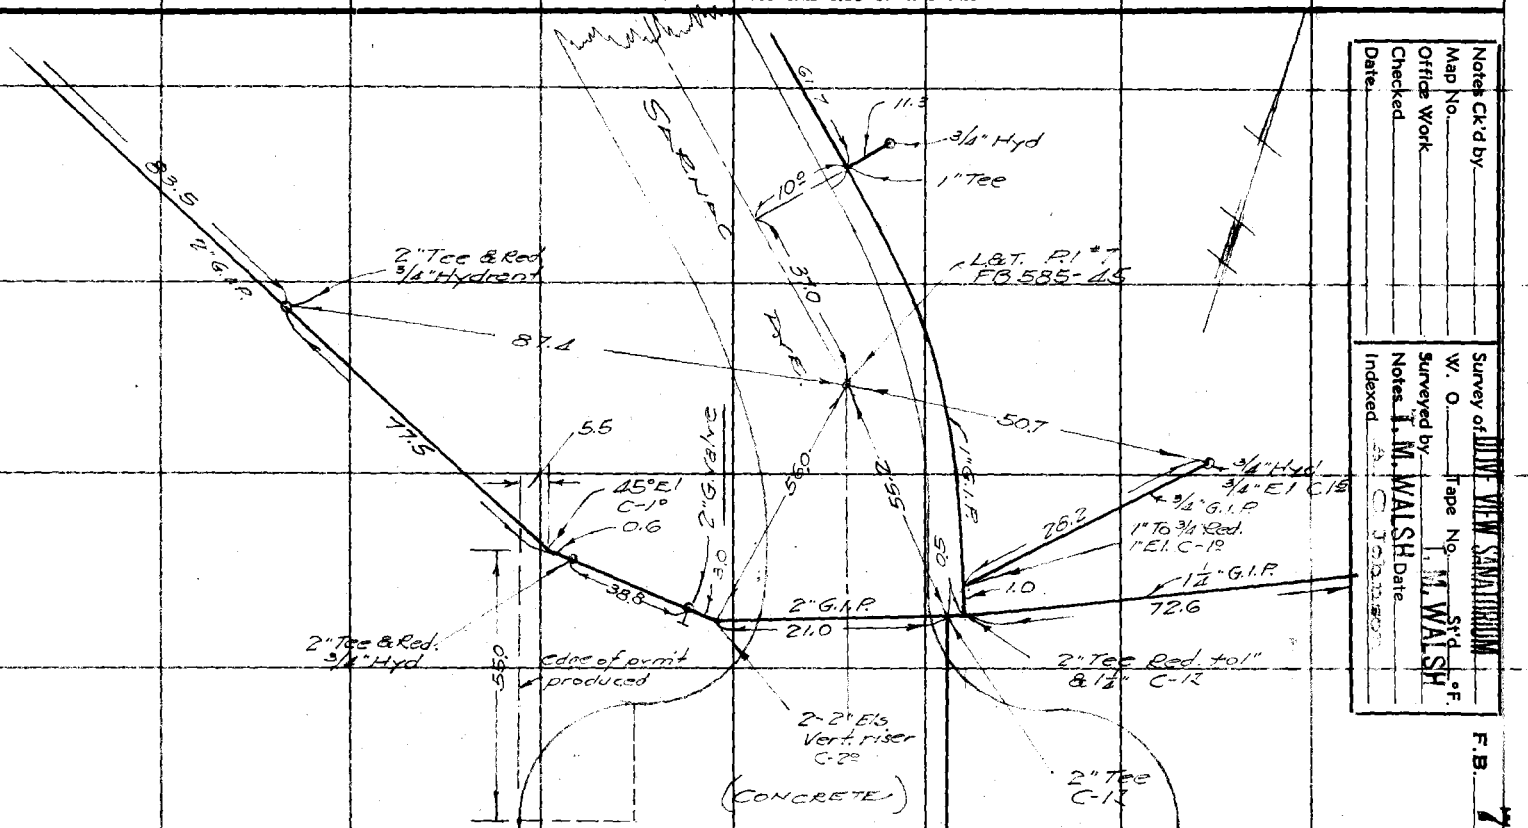

Notes Ck'd by
Map No.
Office Work
Checked
Date

Survey of OLIVE VIEW SANATORIUM
W. O. Tape No. St'd. °F.
Surveyed by L. M. WALSH Date
Notes L. M. WALSH
Indexed

F.B. 709 PG. 245

RETURN TO
LOS ANGELES COUNTY SURVEYOR
700 HALL OF RECORDS

Note: Any Additions or Changes on This Sheet Must be Made or Circled in **Red Ink** With Date and Name of Person Making Change.

Do not extend notes this side of this line

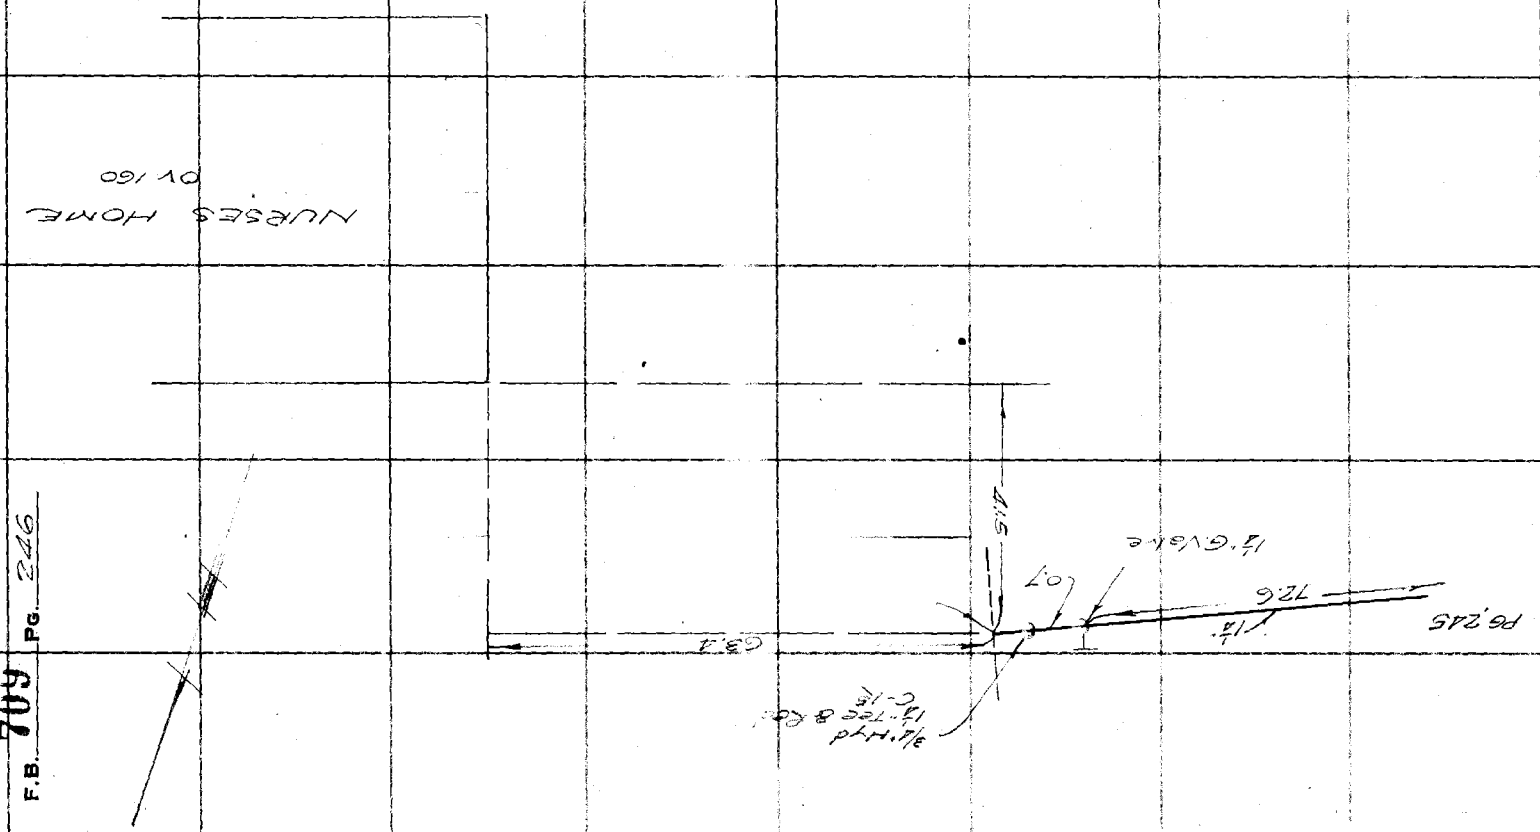

FORM 247 10M 11-35

RETURN TO
LOS ANGELES COUNTY SURVEYOR
700 HALL OF RECORDS

Note: Any Additions or Changes on This Sheet Must be Made or Circled in **Red Ink** With Date and Name of Person Making Change.

Do not extend notes this side of this line

Notes Ck'd by
Map No.
Office Work
Checked
Date

Survey of OLIVE VIEW
W. O.
Surveyed by T. M. WALSH
Notes T. M. WALSH Date
Indexed

F.B. 709 PG. 247

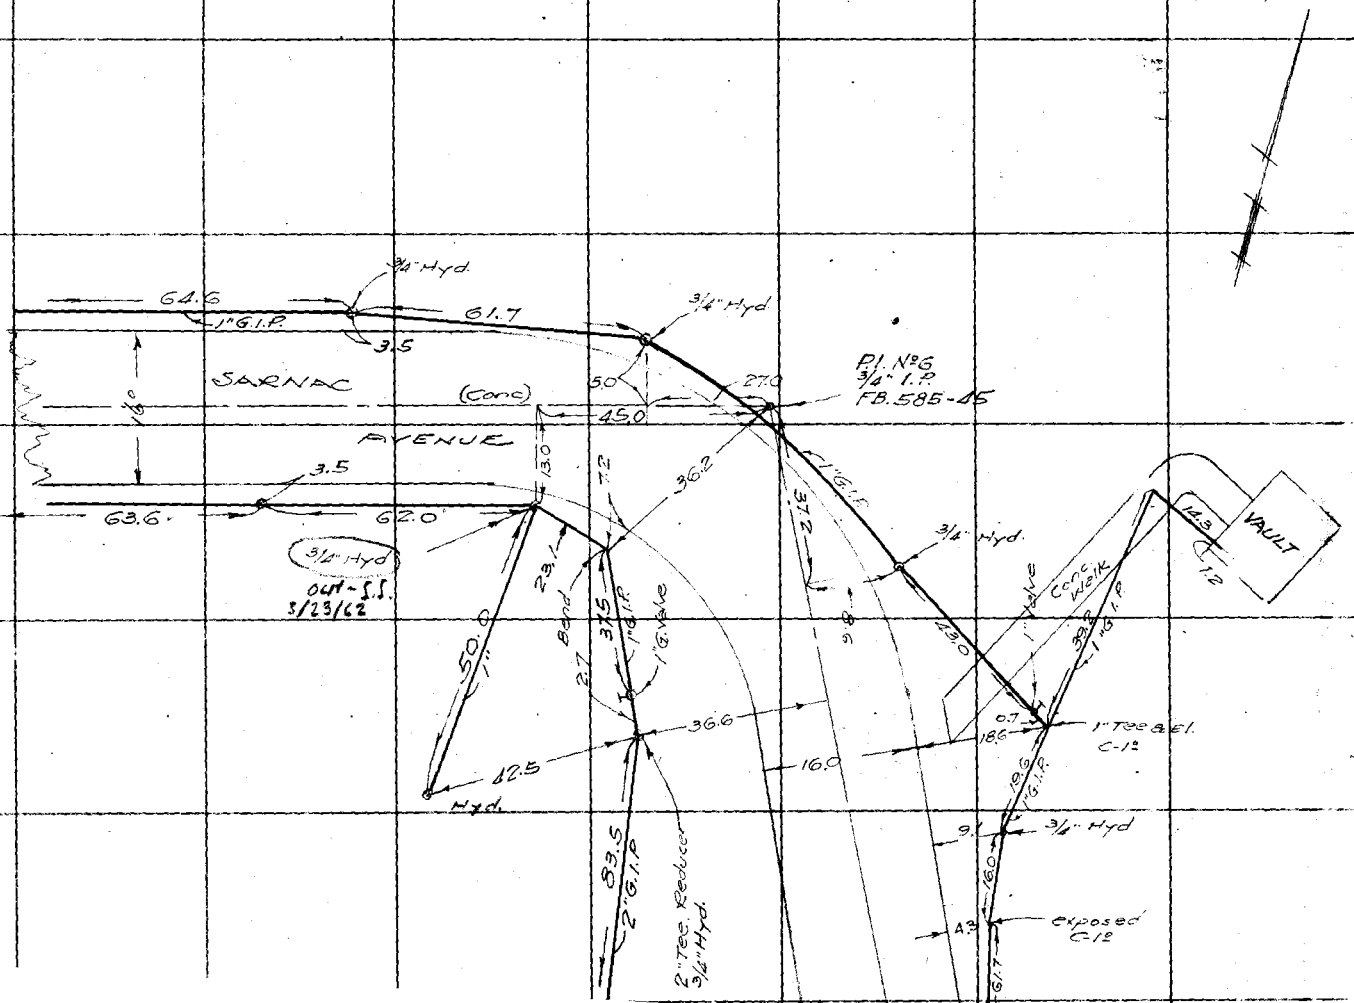

RETURN TO
LOS ANGELES COUNTY SURVEYOR
700 HALL OF RECORDS

Note: Any Additions or Changes on This Sheet Must be Made or Circled in Red Ink With Date and Name of Person Making Change.

Do not extend notes this side of this line

709

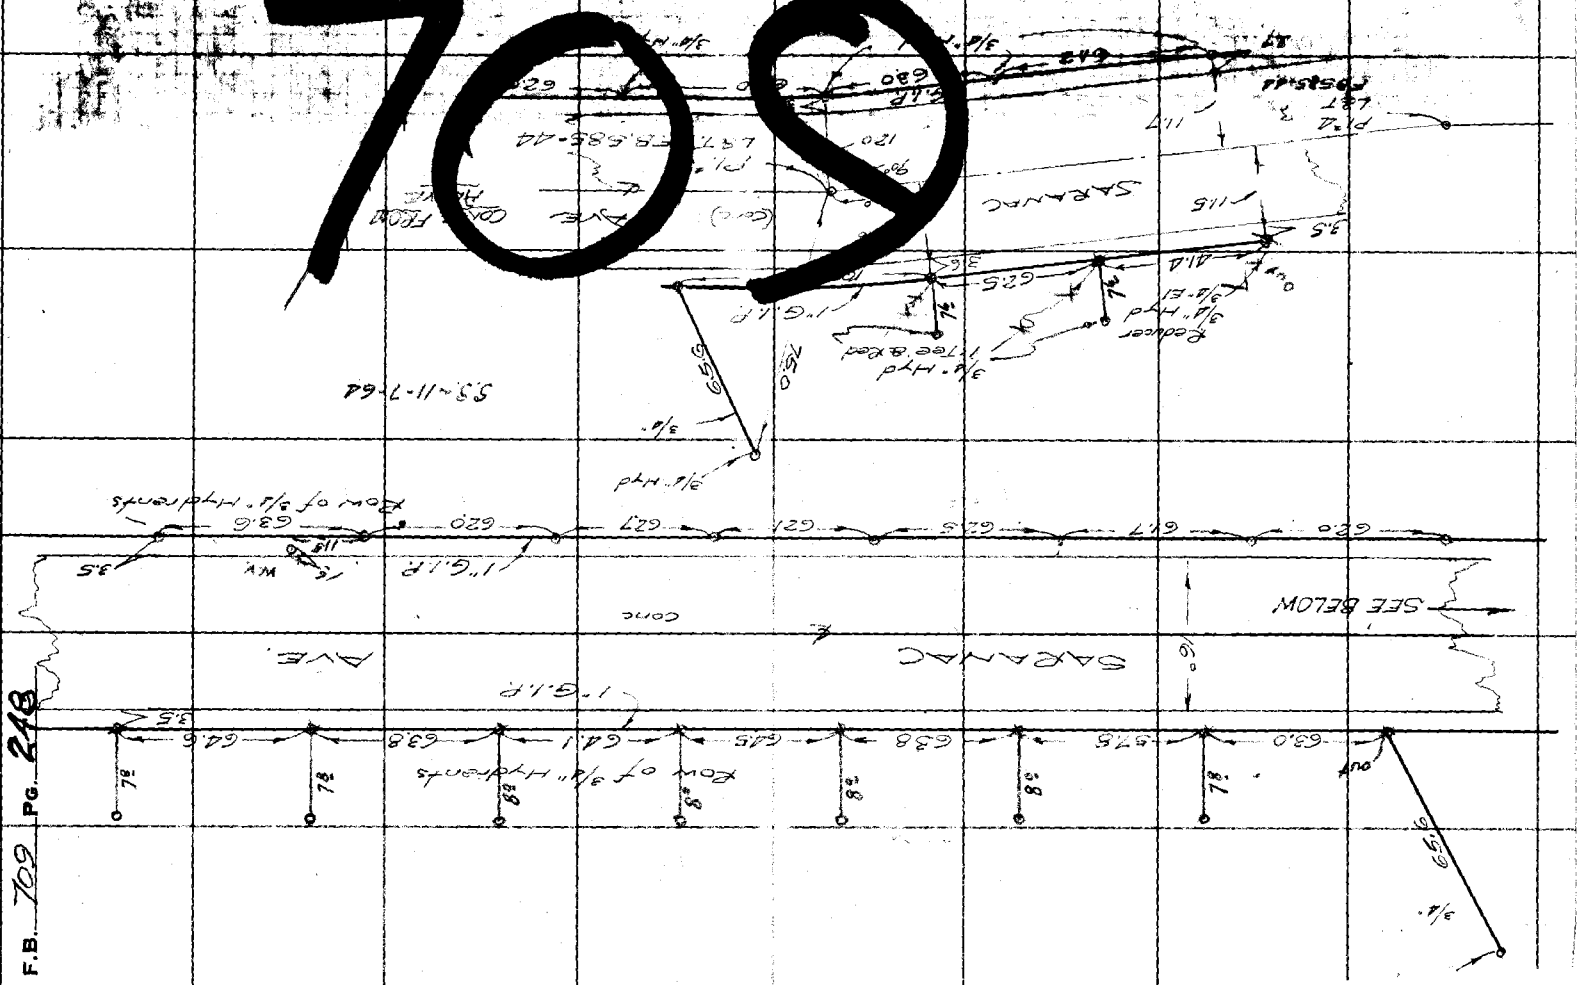

F.B. 709 PG. 248