Notes Ck'd by	Survey of
Map No.	W. O. Tape No. St'd °F.
Office Work	Surveyed by
Checked	Notes Date
Date	Indexed

F.B. Pg. 2

Note: Any Additions or Changes on This Sheet Must be Made or Circled in Red Ink With Date and Name of Person Making Change.

Do not extend notes this side of this line

RETURN TO
LOS ANGELES COUNTY SURVEYOR
700 HALL OF RECORDS

710

FORM 247 10M 11-35

F.B. 710 PG. Index

F.B. 710

PAGES: Index,

249 to 267 incl., , 269 to 280 incl.,

RETURN TO
LOS ANGELES COUNTY SURVEYOR
700 HALL OF RECORDS

Do not extend notes this side of this line

Note: Any Additions or Changes on This Sheet Must be Made or Circled in Red Ink With Date and Name of Person Making Change.

Notes Ck'd by		Survey of	
Map No.		W. O.	Tape No. St'd °F.
Office Work		Surveyed by	
Checked		Notes	Date
Date		Indexed	5-26-37

F.B. 714 PG. 249

Note: Any Additions or Changes on This Sheet Must be Made or Circled in Red Ink With Date and Name of Person Making Change.

Do not extend notes this side of this line

RETURN TO
LOS ANGELES COUNTY SURVEYOR
700 HALL OF RECORDS

OLIVE VIEW SANATORIUN
UNDERGROUND
WATER LINES

JN 8128

APRIL TO NOV. 1936

NOTES TO BE USED IN CONJUNCTION WITH C.S.B-1201

For Index (Field Maps)
See Plane Table Sheets
Nos. F147 to F163

For Final Index Maps
See C.S.B. 1201

Locations By
F. Greenwood & Party
R. L. Willey & Party

Notes & Index Sheets By Ted Walsh

SEE F.B. 709
FOR PAGES 1 to 248

FORM 247 10M 11-36

F.B. 710 PG. 250

LEGEND WATER LINES

C-	Depth under surface
G.V.	Gate Valve
G.L.V.	Globe Valve
—o—	Hydrant
	Fire Hydrant
	Valve
S.S.V.	Surface Sprinkler Valve (Line on Surface)
S.V.	Sprinkler Valve (Lines under ground with heads)
----------	Surface Sprinklers
— — — — —	1" Pipe or under
————	Water Mains over 1"
G.I.P.	Galvanized Iron Pipe
W.I.P.	Wrought Iron Pipe
C.I.P.	Cast Iron Pipe
--•---	Sprinkler head

RETURN TO
LOS ANGELES COUNTY SURVEYOR
700 HALL OF RECORDS

Note: Any Additions or Changes on This Sheet Must be Made or Circled in Red Ink With Date and Name of Person Making Change.

Do not extend notes this side of this line

Notes Ck'd by	Survey of CLINE VETS SANITARIUM
Map No.	W. O. 8128 Tape No. St'd °F.
Office Work	Surveyed by T. M. WALSH
Checked	Notes T. M. WALSH Date 9-21-36
Date	Indexed

F.B. 710 PG. 251

WATER LINE

Note: Any Additions or Changes on This Sheet Must be Made or Circled in Red Ink With Date and Name of Person Making Change.

Do not extend notes this side of this line

RETURN TO
LOS ANGELES COUNTY SURVEYOR
700 HALL OF RECORDS

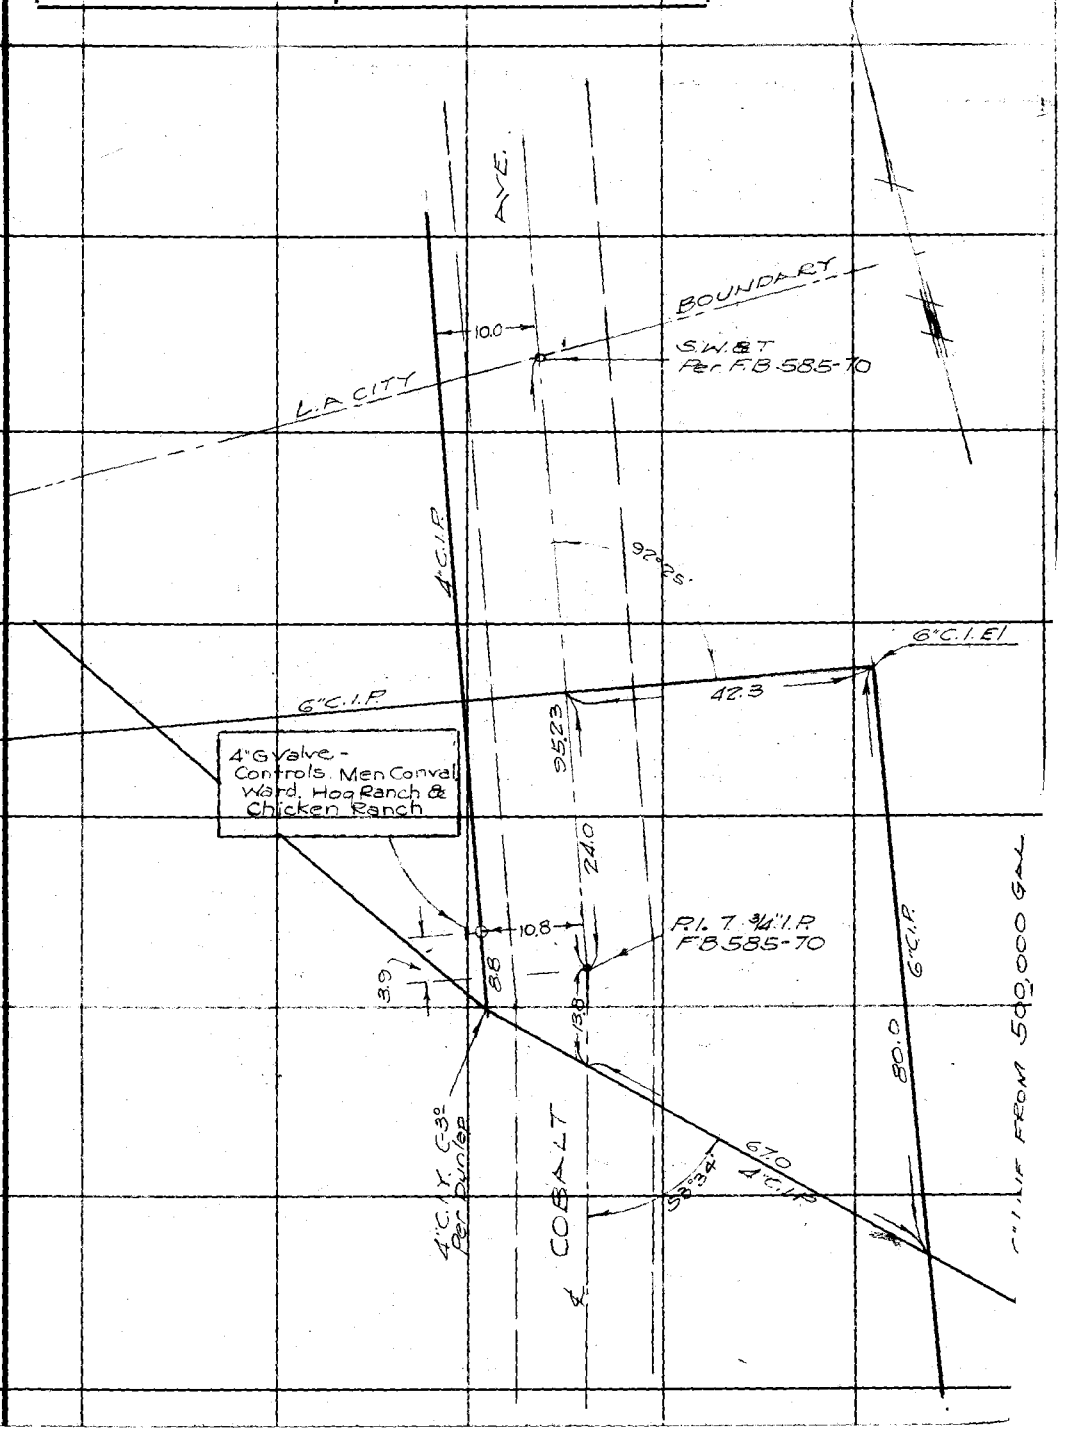

FORM 247 10M 11-35

RETURN TO
LOS ANGELES COUNTY SURVEYOR
700 HALL OF RECORDS

Note: Any Additions or Changes on This Sheet Must be Made or Circled in **Red Ink** With Date and Name of Person Making Change.

Do not extend notes this side of this line

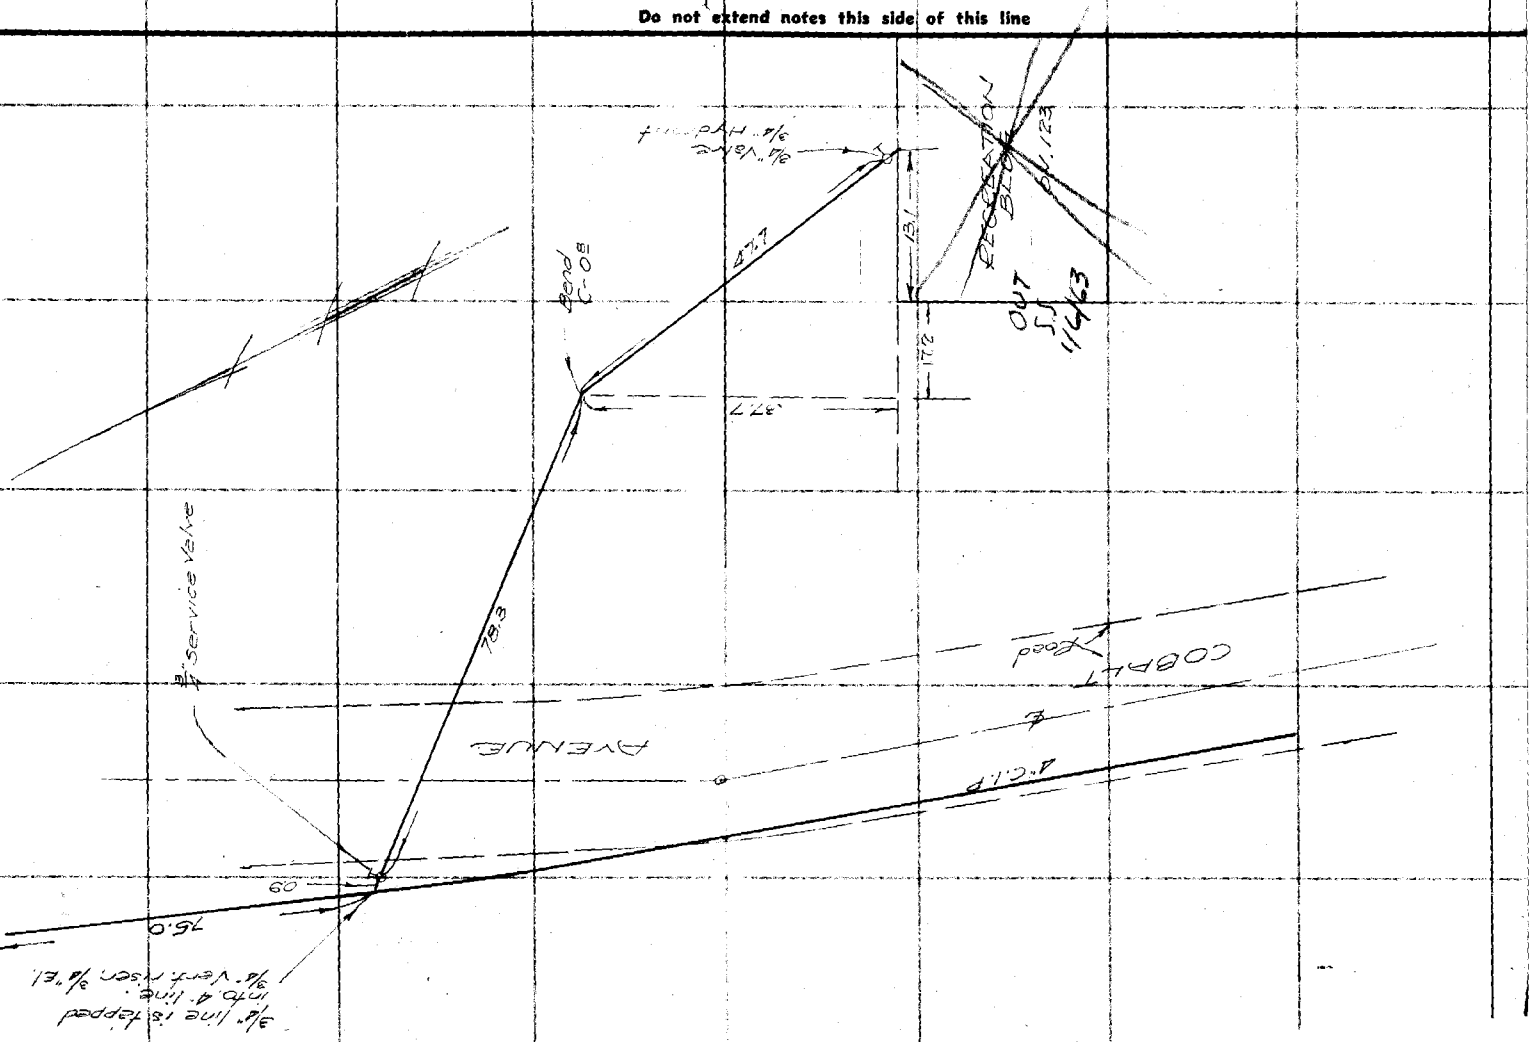

F.B. 710 PG. 252

FORM 247 10M 11-38

RETURN TO
LOS ANGELES COUNTY SURVEYOR
700 HALL OF RECORDS

Note: Any Additions or Changes on This Sheet Must be Made or Circled in **Red Ink** With Date and Name of Person Making Change.

Do not extend notes this side of this line

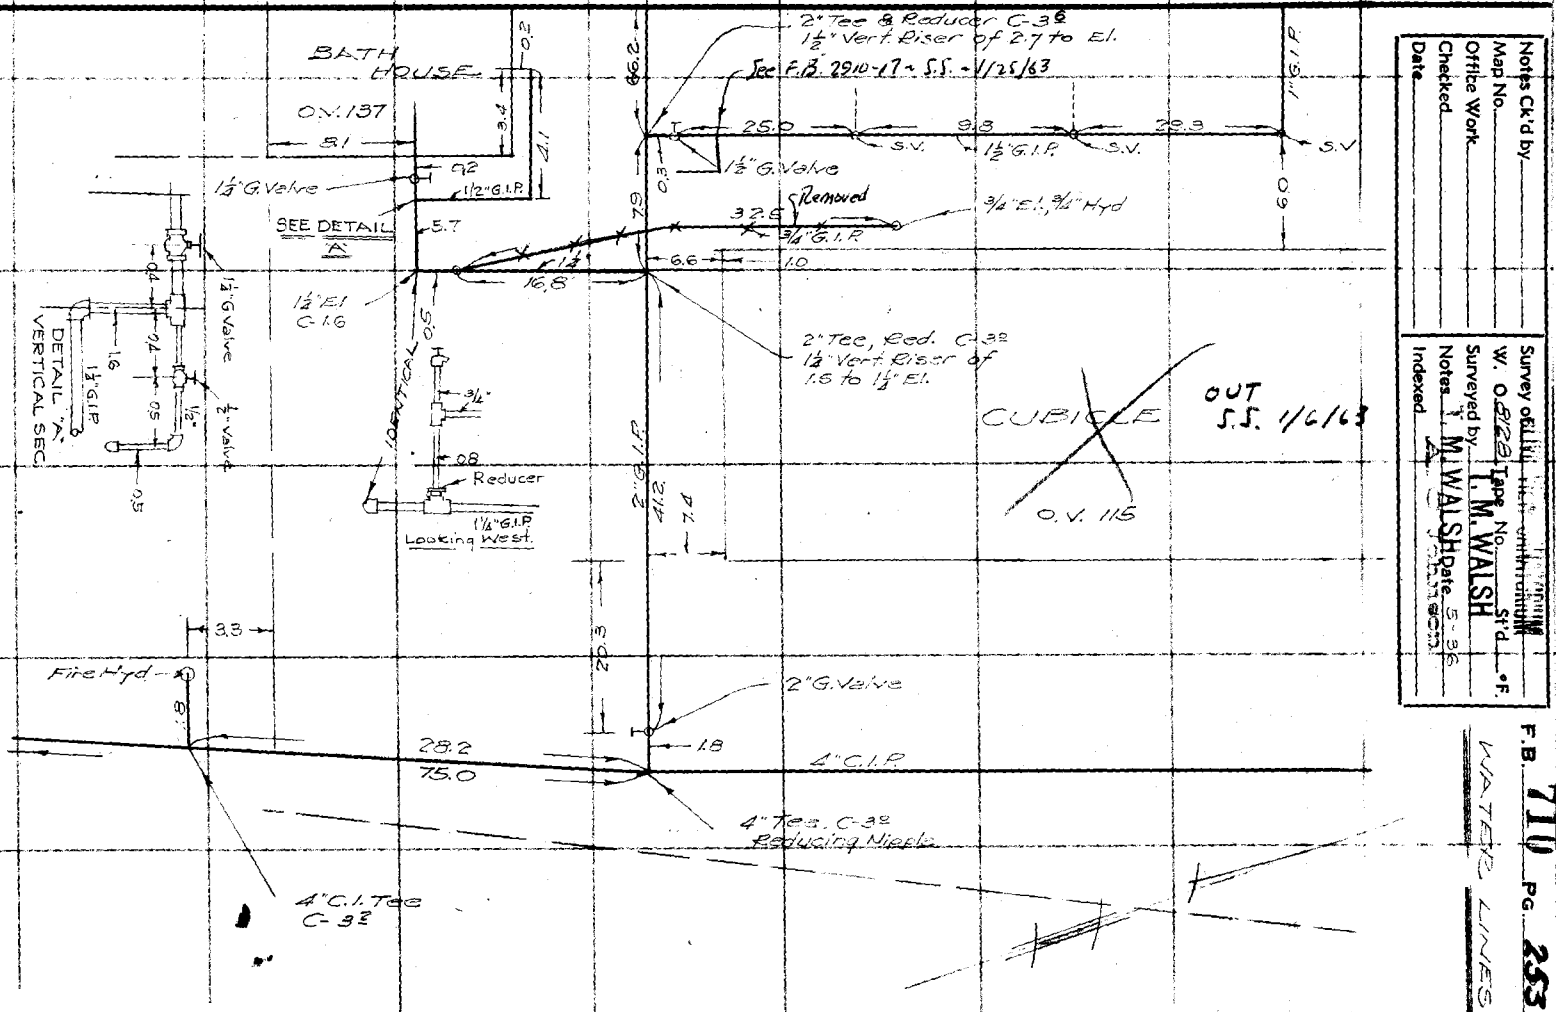

Notes Ck'd by
Map No.
Office Work
Checked
Date

Survey of
W. O.
Surveyed by
Notes
Indexed

Tape No.
St'd
Date 5-36

F.B. 710 PG. 253

WATER LINES

RETURN TO
LOS ANGELES COUNTY SURVEYOR
700 HALL OF RECORDS

Note: Any Additions or Changes on This Sheet Must be Made or Circled in **Red** Ink With Date and Name of Person Making Change.

Do not extend notes this side of this line

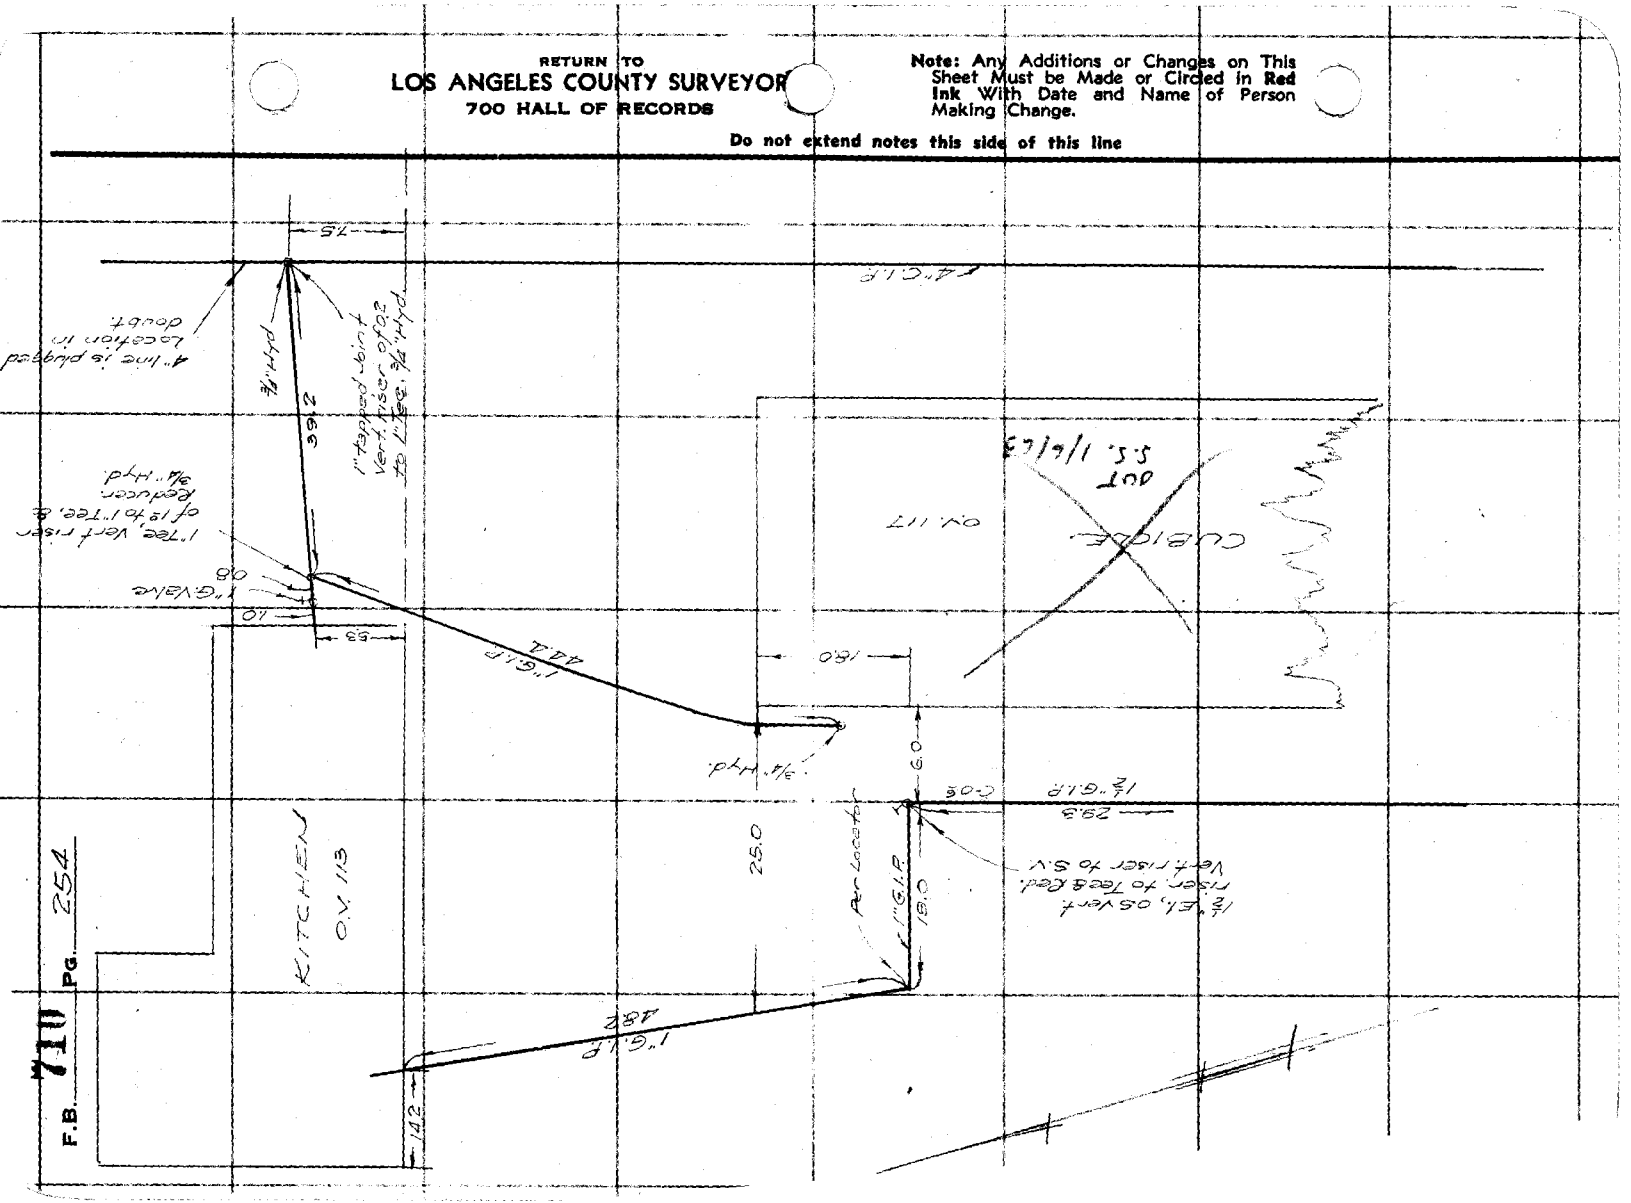

Notes Ck'd by	Survey of
Map No.	W. O. 8128 Tape No. St'd °F.
Office Work	Surveyed by T. M. WALSH
Checked	Notes T. M. WALSH Date 8-20-36
Date	Indexed A. C. Johnson

F.B. 710 PG. 255

WATER LINES

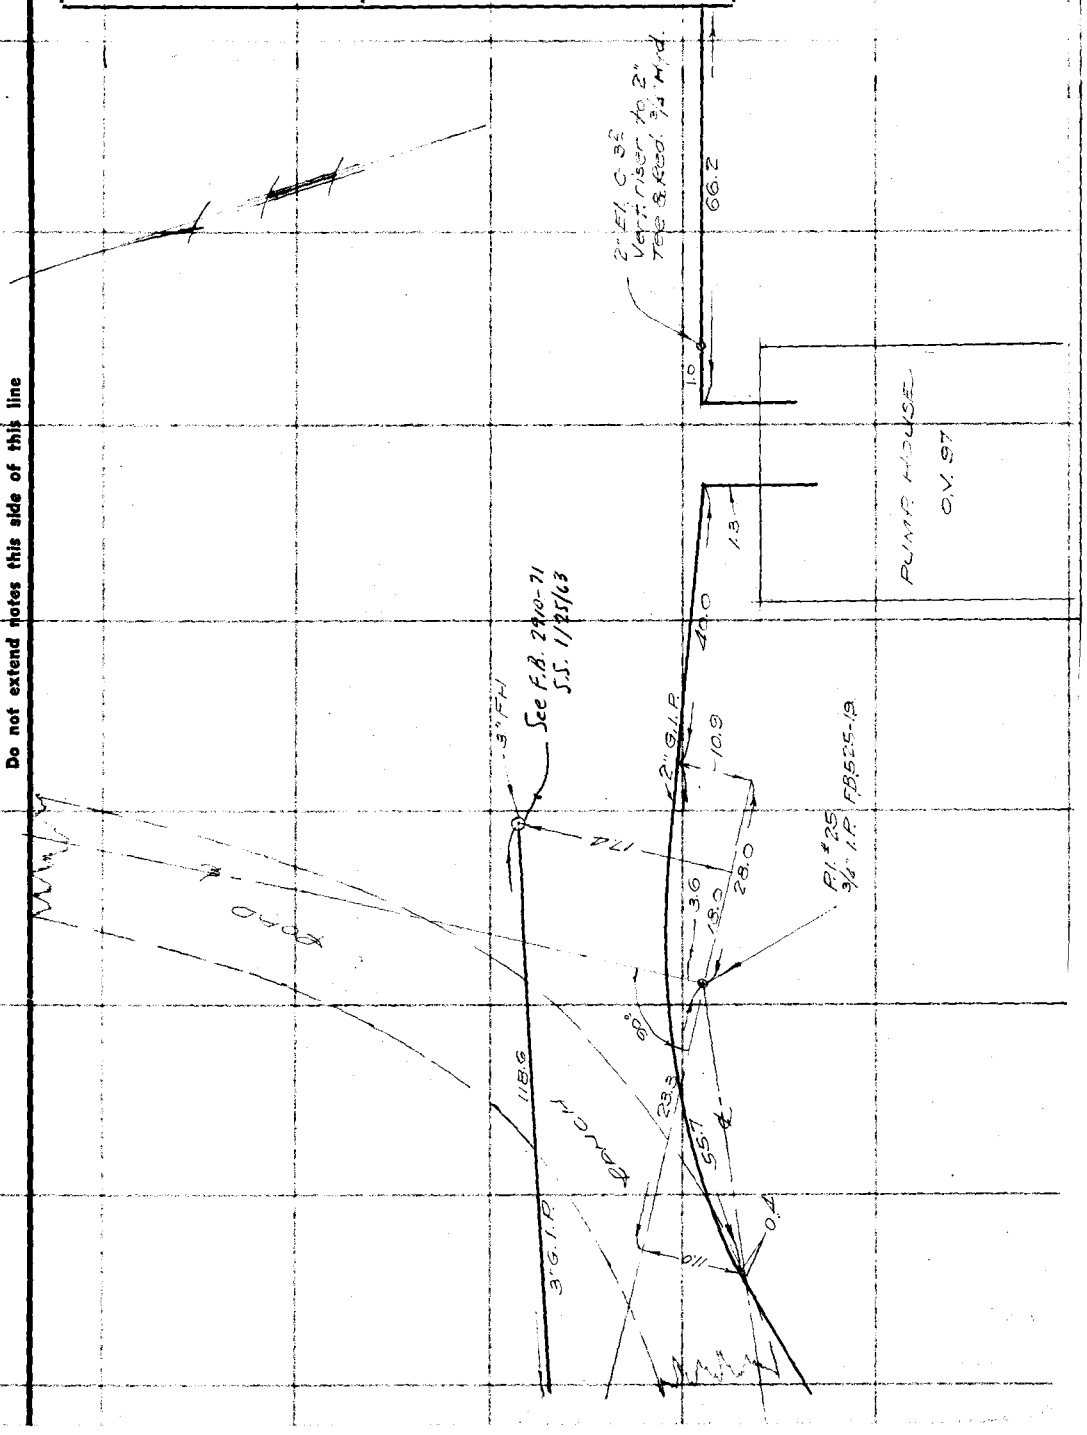

RETURN TO
LOS ANGELES COUNTY SURVEYOR
700 HALL OF RECORDS

Note: Any Additions or Changes on This Sheet Must be Made or Circled in Red Ink With Date and Name of Person Making Change

Do not extend notes this side of this line

FORM 247 10M 11-35

RETURN TO
LOS ANGELES COUNTY SURVEYOR
700 HALL OF RECORDS

Note: Any Additions or Changes on This Sheet Must be Made or Circled in Red Ink With Date and Name of Person Making Change.

Do not extend notes this side of this line

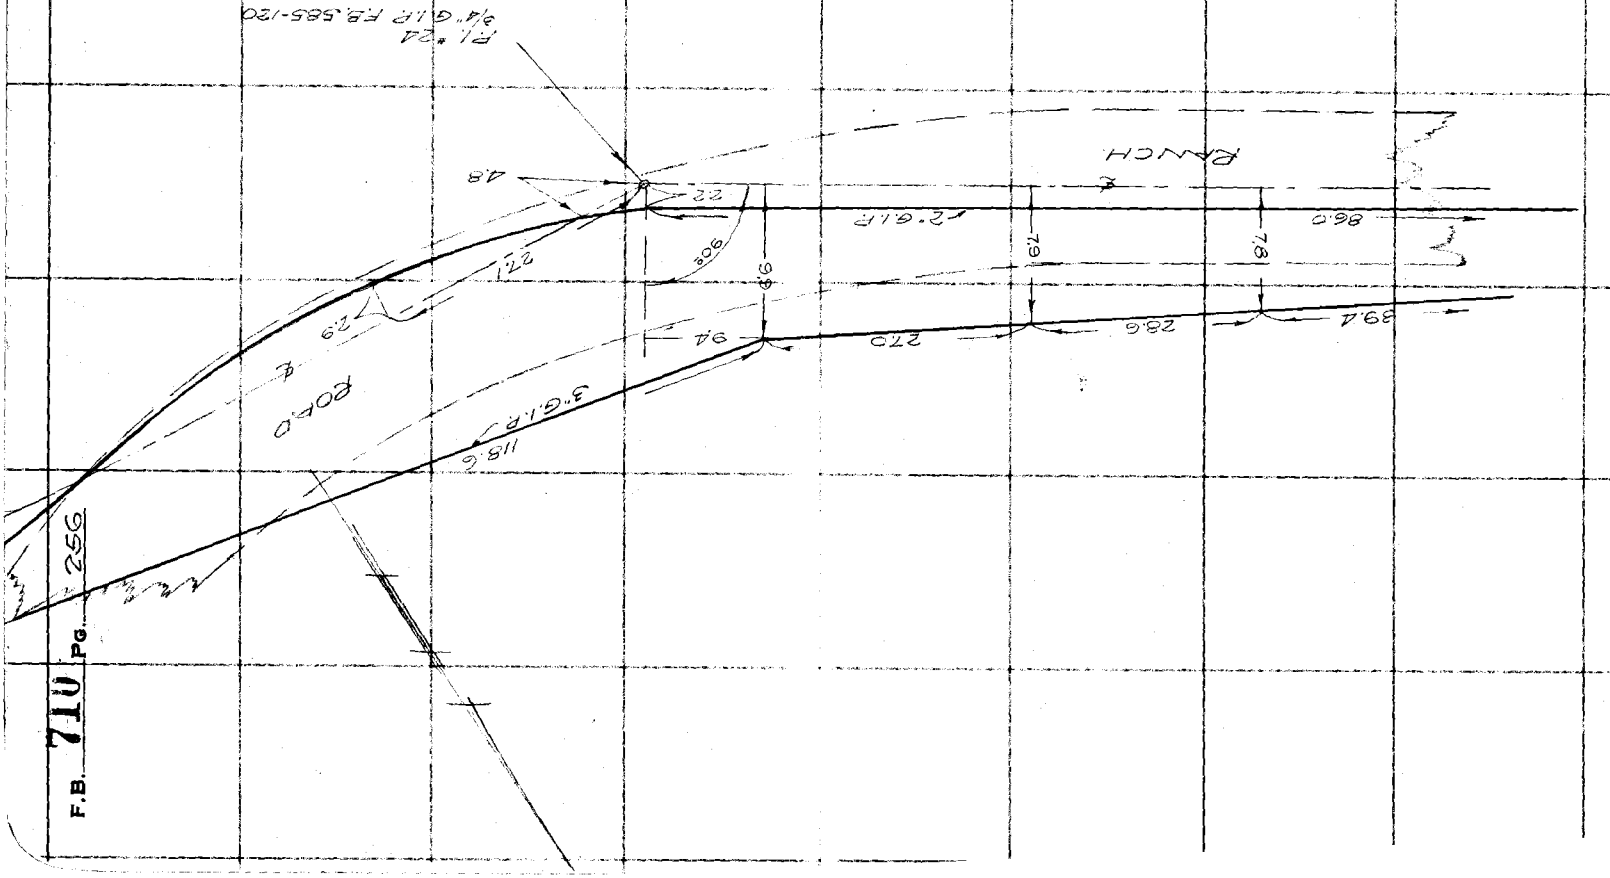

F.B. 710 Pg. 256

FORM 247 10M 11-38

RETURN TO
LOS ANGELES COUNTY SURVEYOR
700 HALL OF RECORDS

Note: Any Additions or Changes on This Sheet Must be Made or Circled in **Red Ink** With Date and Name of Person Making Change.

Do not extend notes this side of this line

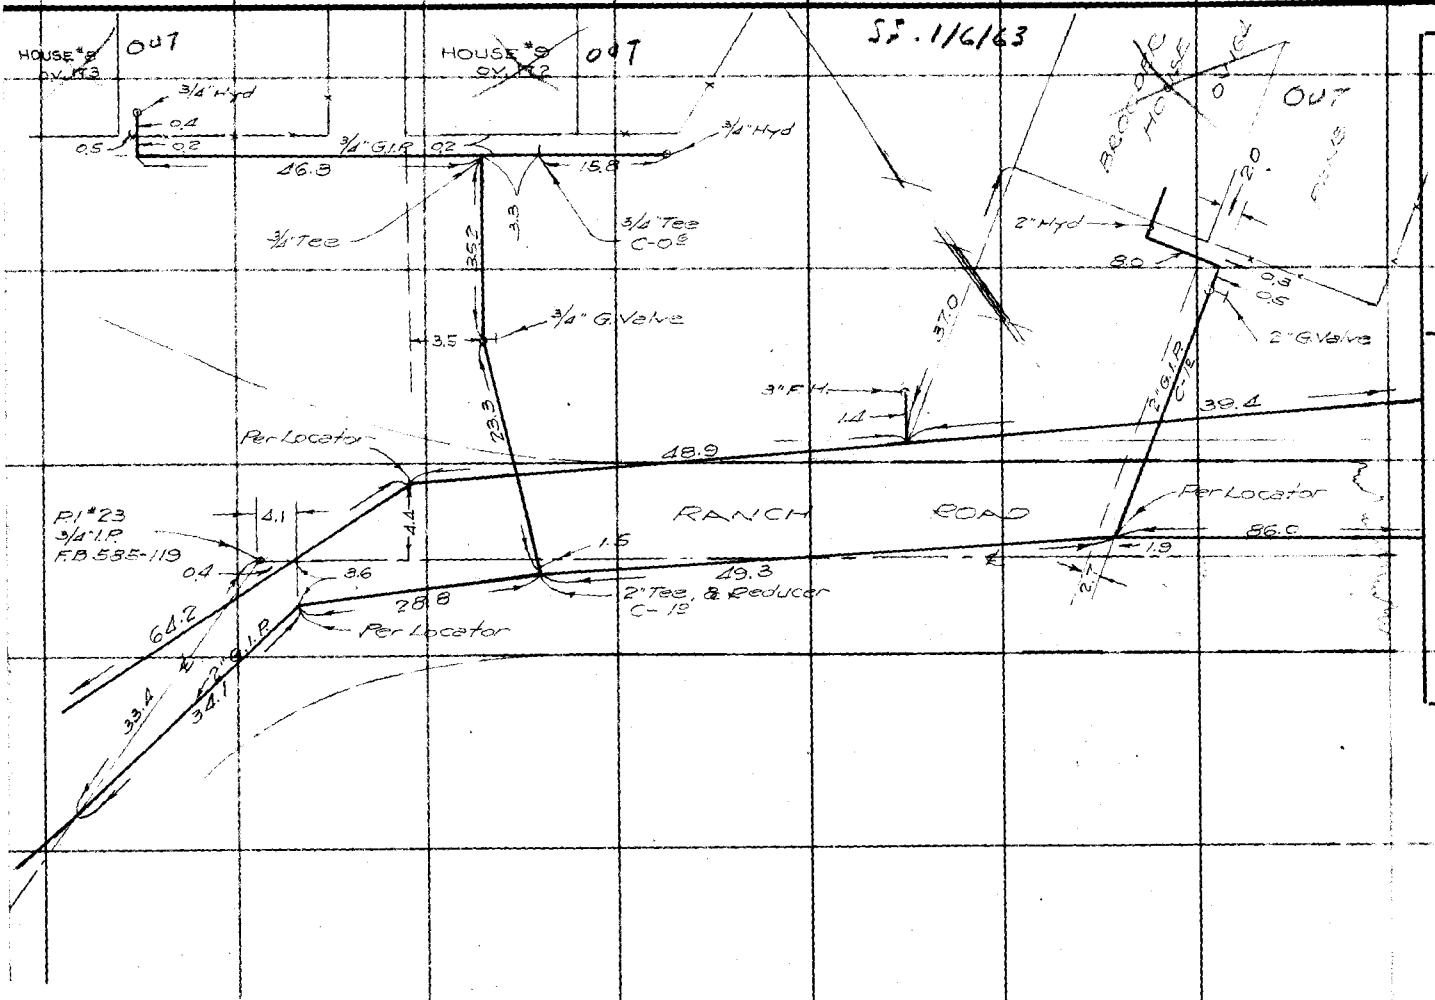

Notes Ck'd by
Map No.
Office Work
Checked
Date

Survey of CLIVE VIEW SANATORIUM
W. O. 8223 Tape No. M. WALSH St'd °F.
Surveyed by M. WALSH Date 6-24-36
Notes
Indexed

WATER LINES

F.B. 711 Pg. 267

RETURN TO
LOS ANGELES COUNTY SURVEYOR
700 HALL OF RECORDS

Note: Any Additions or Changes on This Sheet Must be Made or Circled in **Red Ink** With Date and Name of Person Making Change.

Do not extend notes this side of this line

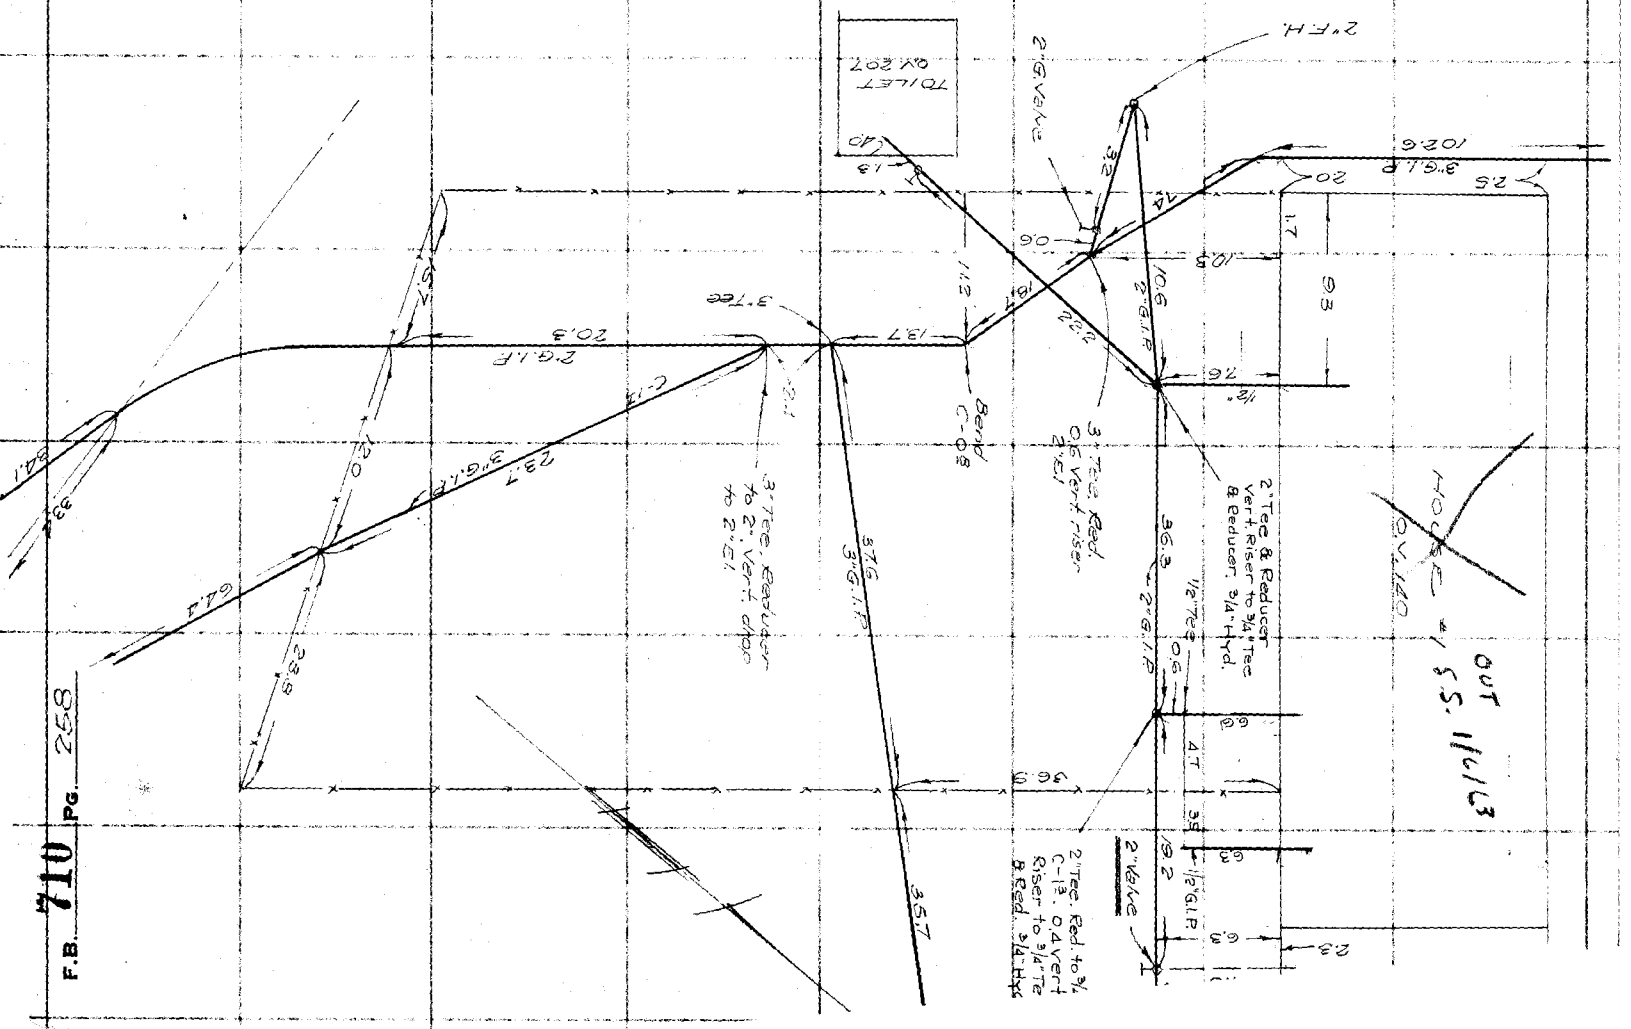

F.B. 710 PG. 258

Notes Ck'd by	Survey of [illegible] SANATORIUM
Map No.	W. O. 8128 Tape No. St'd °F.
Office Work	Surveyed by T. M. WALSH
Checked	Notes T. M. WALSH Date 8-26-36
Date	Indexed A. C. Johnson

F.B. 710 PG. 259

WATER LINE

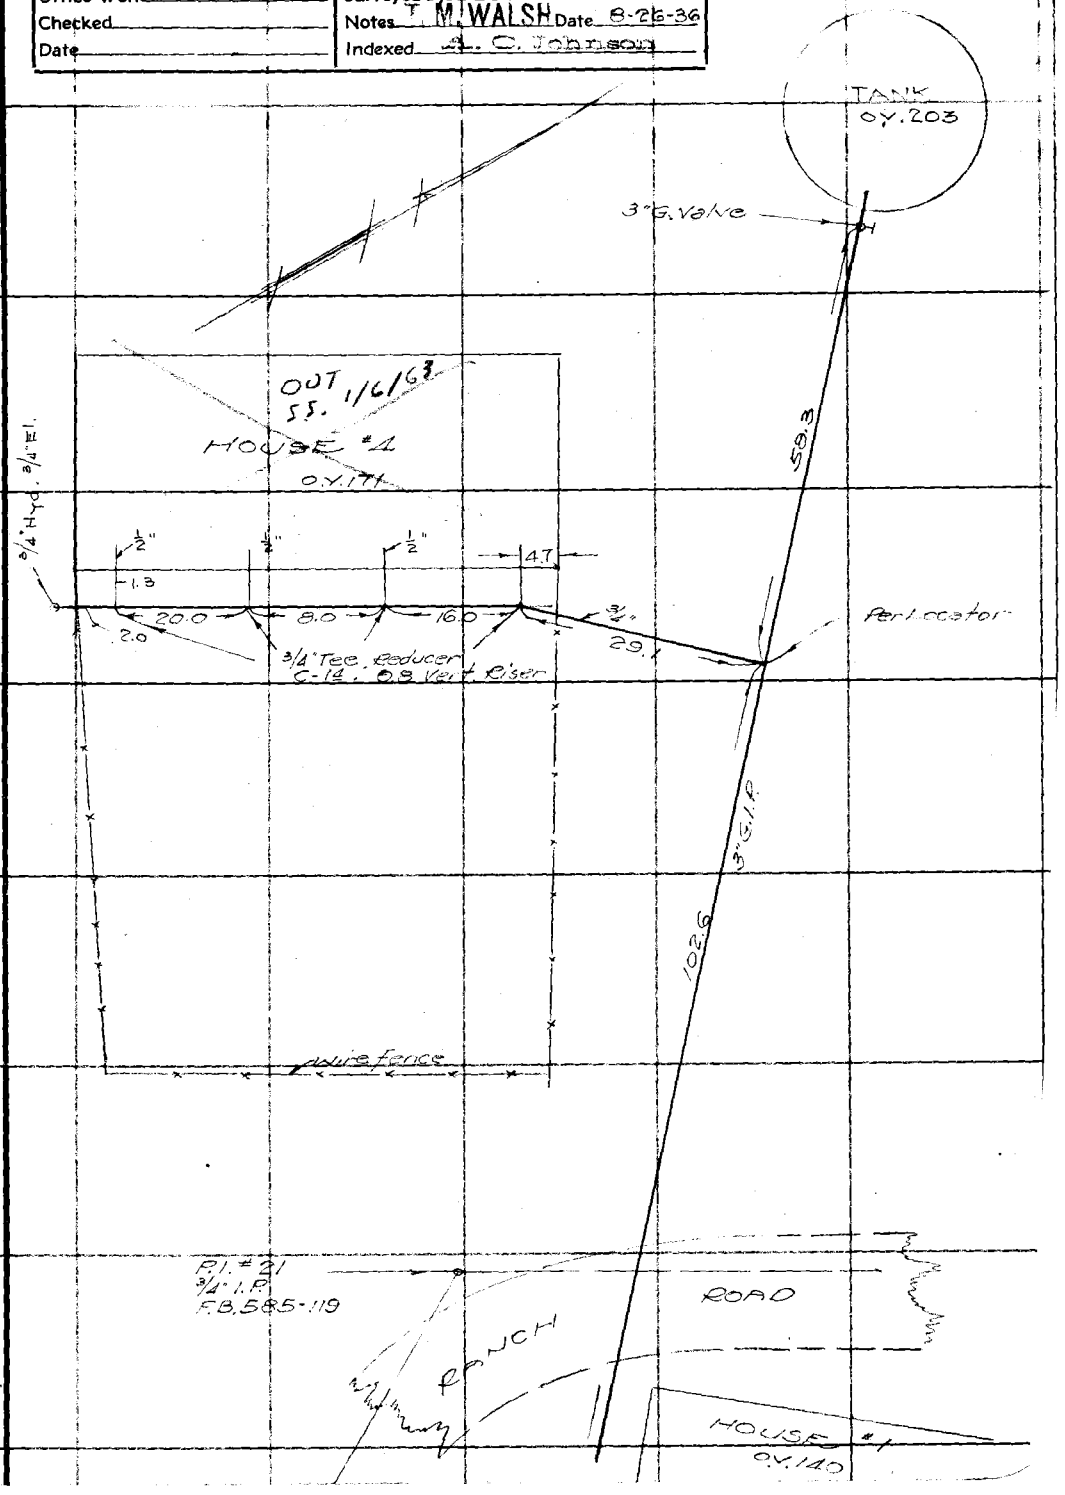

Note: Any Additions or Changes on This Sheet Must be Made or Circled in Red Ink With Date and Name of Person Making Change.

Do not extend notes this side of this line

RETURN TO
LOS ANGELES COUNTY SURVEYOR
700 HALL OF RECORDS

FORM 247 10M 11-35

RETURN TO
LOS ANGELES COUNTY SURVEYOR
700 HALL OF RECORDS

Note: Any Additions or Changes on This Sheet Must be Made or Circled in **Red Ink** With Date and Name of Person Making Change.

Do not extend notes this side of this line

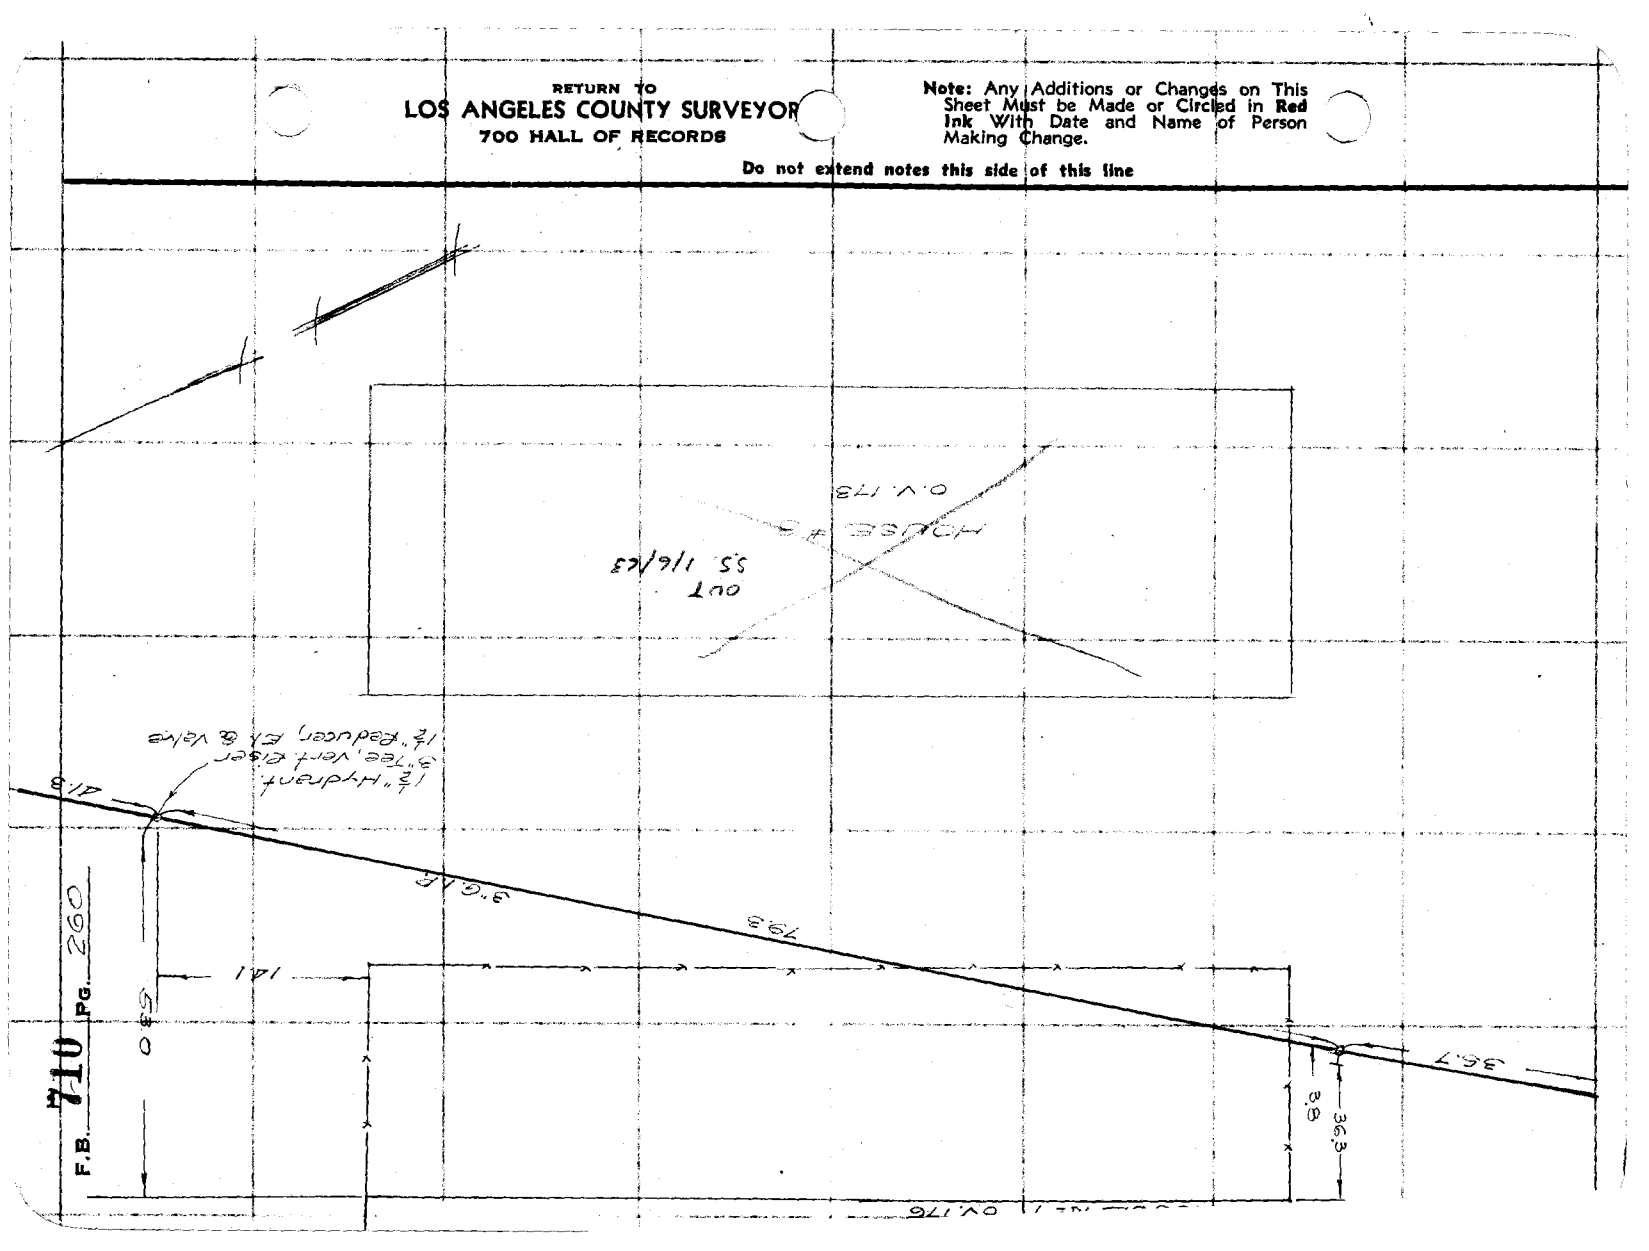

Notes Ck'd by	Survey of [illegible] SANATORIUM
Map No.	W. O. 8128 Tape No. St'd °F.
Office Work	Surveyed by M. WALSH
Checked	Notes T. M. WALSH Date 8-26-36
Date	Indexed A. C. Johnson

F.B. 710 PG. 261

WATER LINE

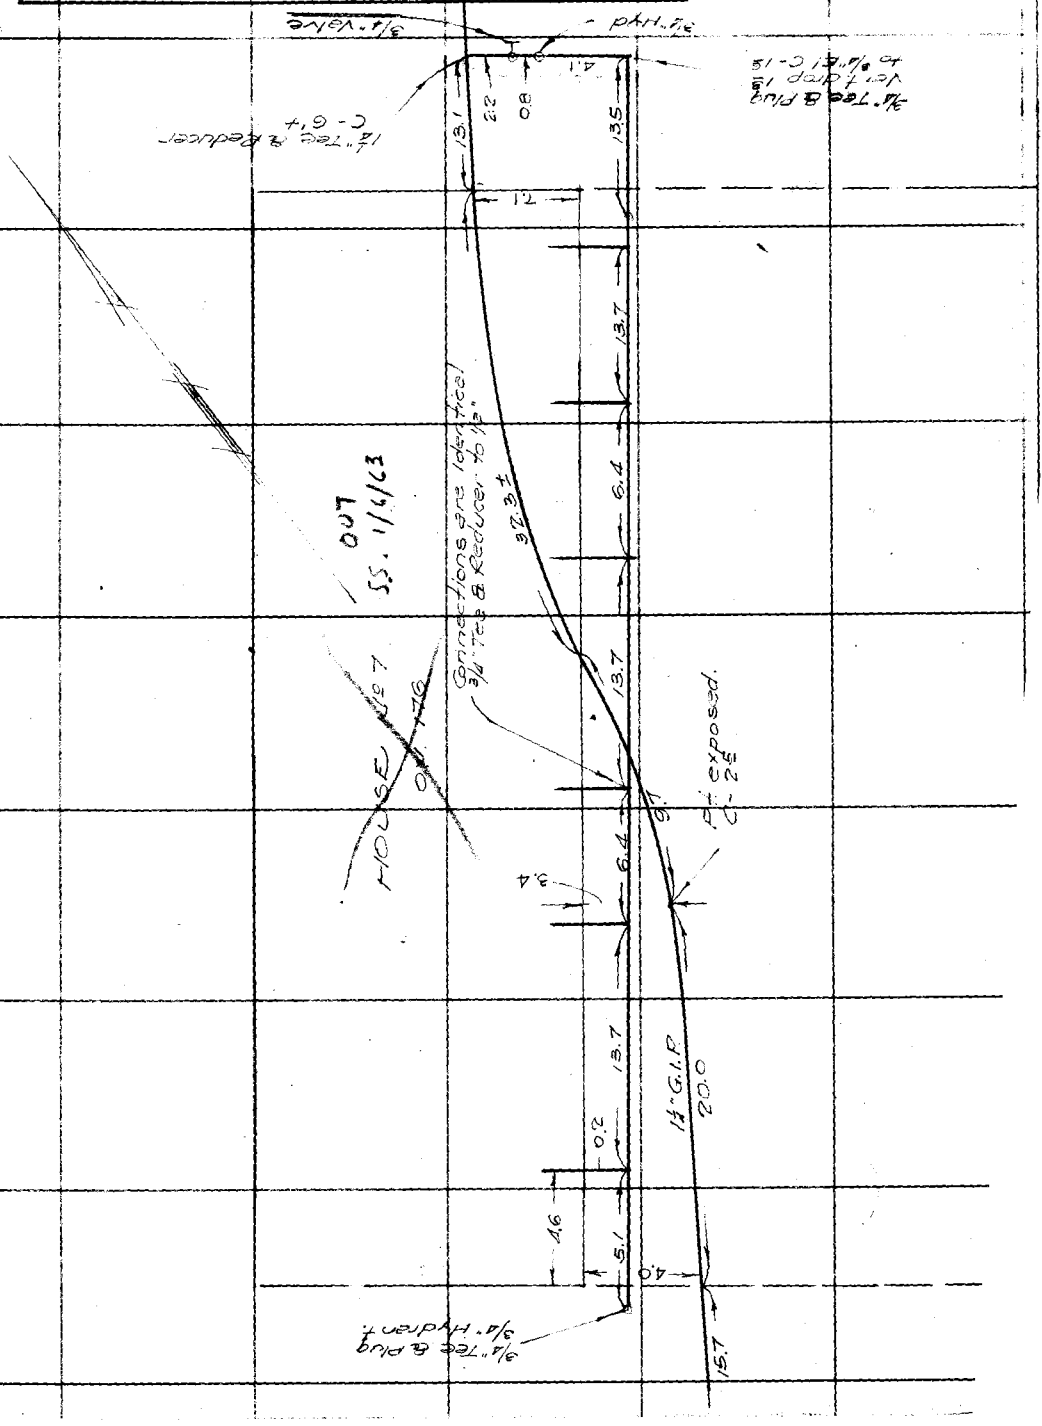

Note: Any Additions or Changes on This Sheet Must be Made or Circled in Red Ink With Date and Name of Person Making Change.

Do not extend notes this side of this line

RETURN TO
LOS ANGELES COUNTY SURVEYOR
700 HALL OF RECORDS

FORM 247 10M 11-35

RETURN TO
LOS ANGELES COUNTY SURVEYOR
700 HALL OF RECORDS

Note: Any Additions or Changes on This Sheet Must be Made or Circled in **Red Ink** With Date and Name of Person Making Change.

Do not extend notes this side of this line

F.B. 710 PG. 262

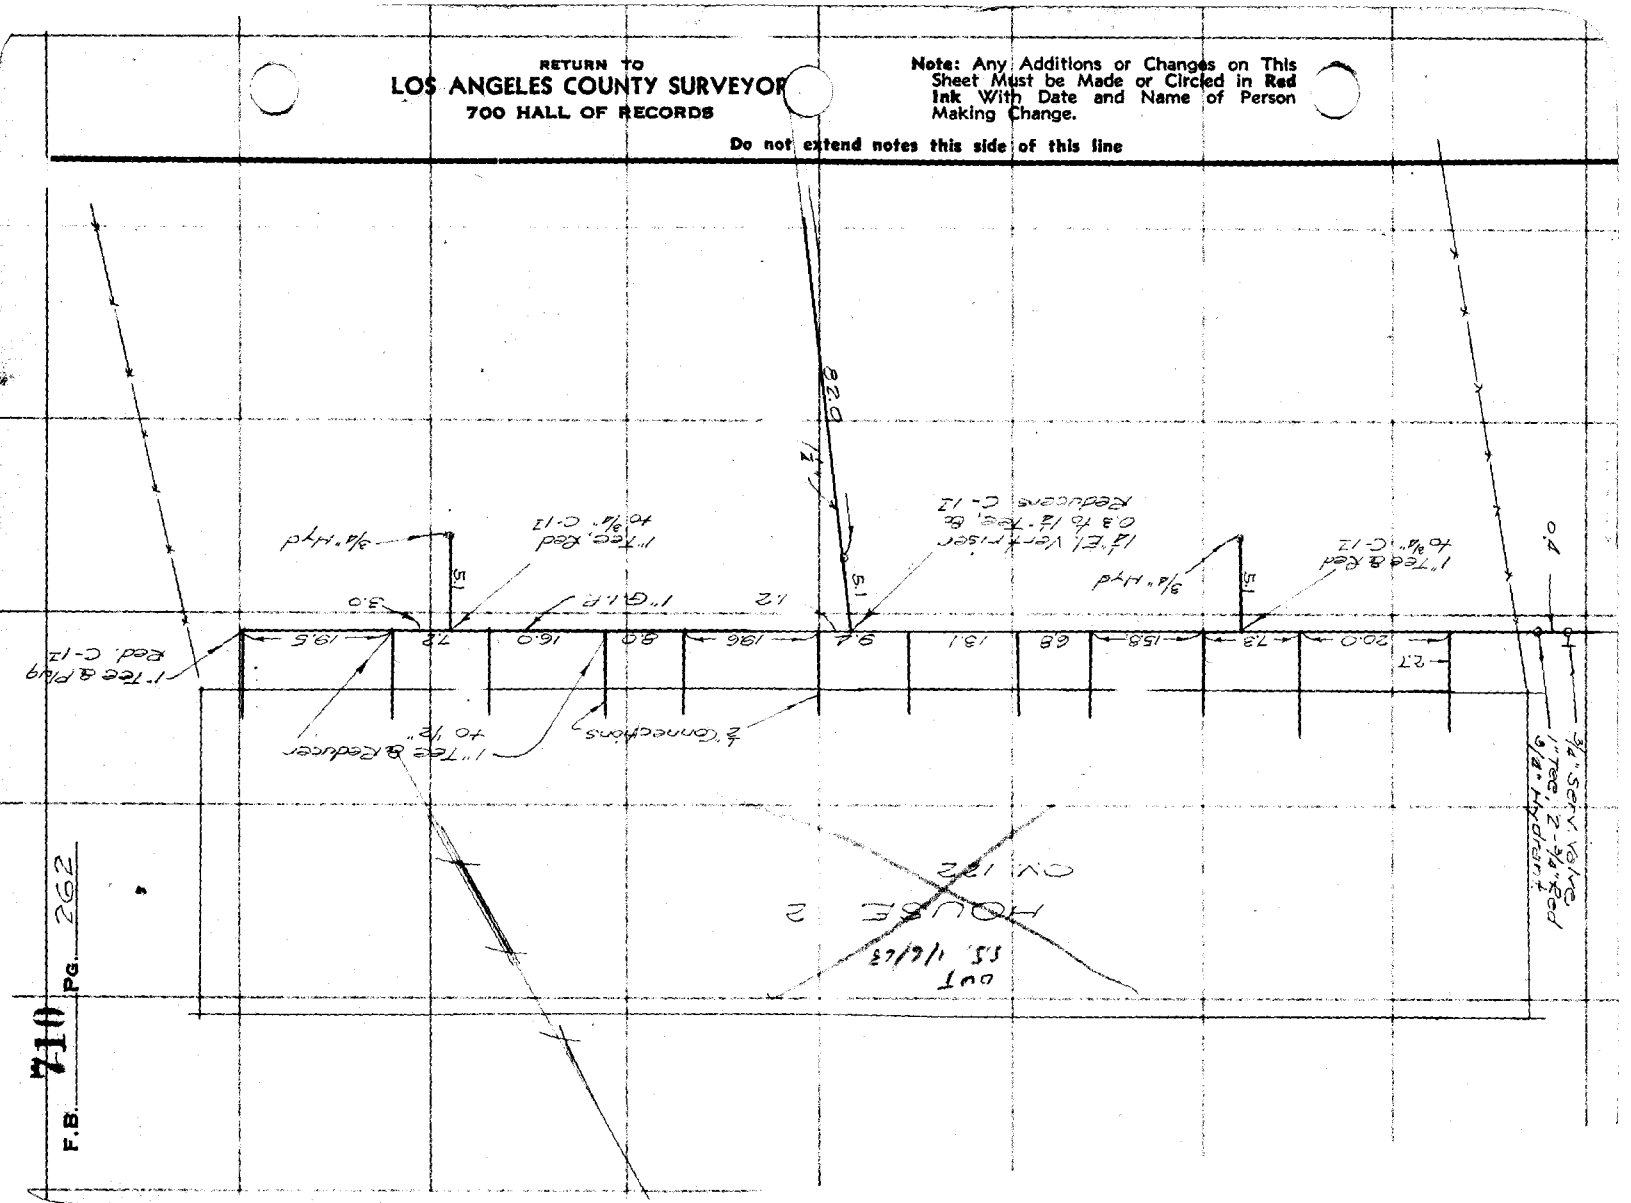

FORM 247 10M 11-35

RETURN TO
LOS ANGELES COUNTY SURVEYOR
700 HALL OF RECORDS

Note: Any Additions or Changes on This Sheet Must be Made or Circled in **Red Ink** With Date and Name of Person Making Change.

Do not extend notes this side of this line

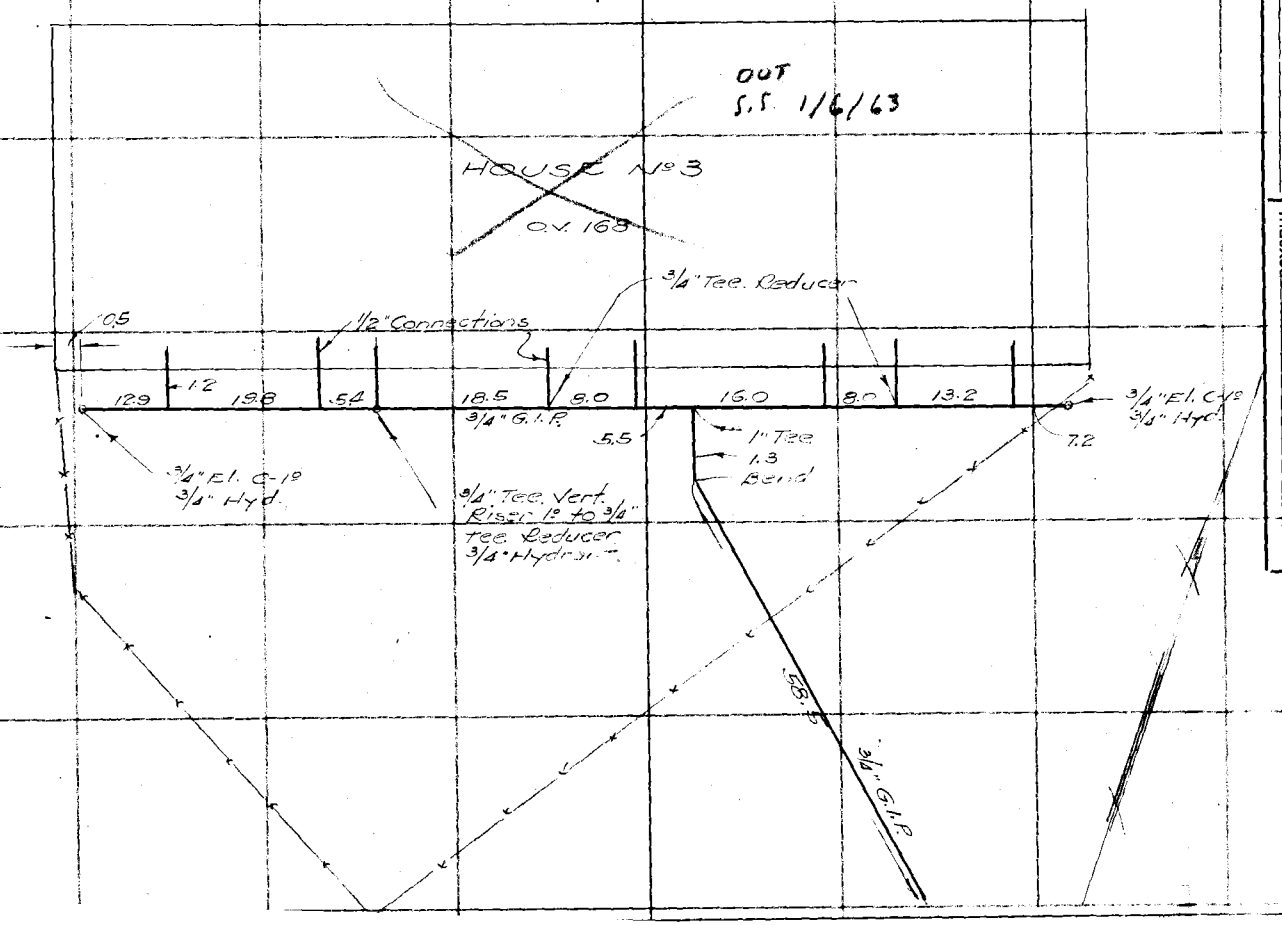

Notes Ck'd by _____ °F.
Map No. _____
Office Work _____
Checked _____
Date _____

Survey of W. O. 8/28 Type M. WALSH
Surveyed by M. WALSH Date 8-27-36
Notes
Indexed A. C. Johnson

F.B. 710 PG. 263

WATER LINES

RETURN TO
LOS ANGELES COUNTY SURVEYOR
700 HALL OF RECORDS

Note: Any Additions or Changes on This Sheet Must be Made or Circled in **Red** Ink With Date and Name of Person Making Change.

Do not extend notes this side of this line

F.B. 710 PG. 264

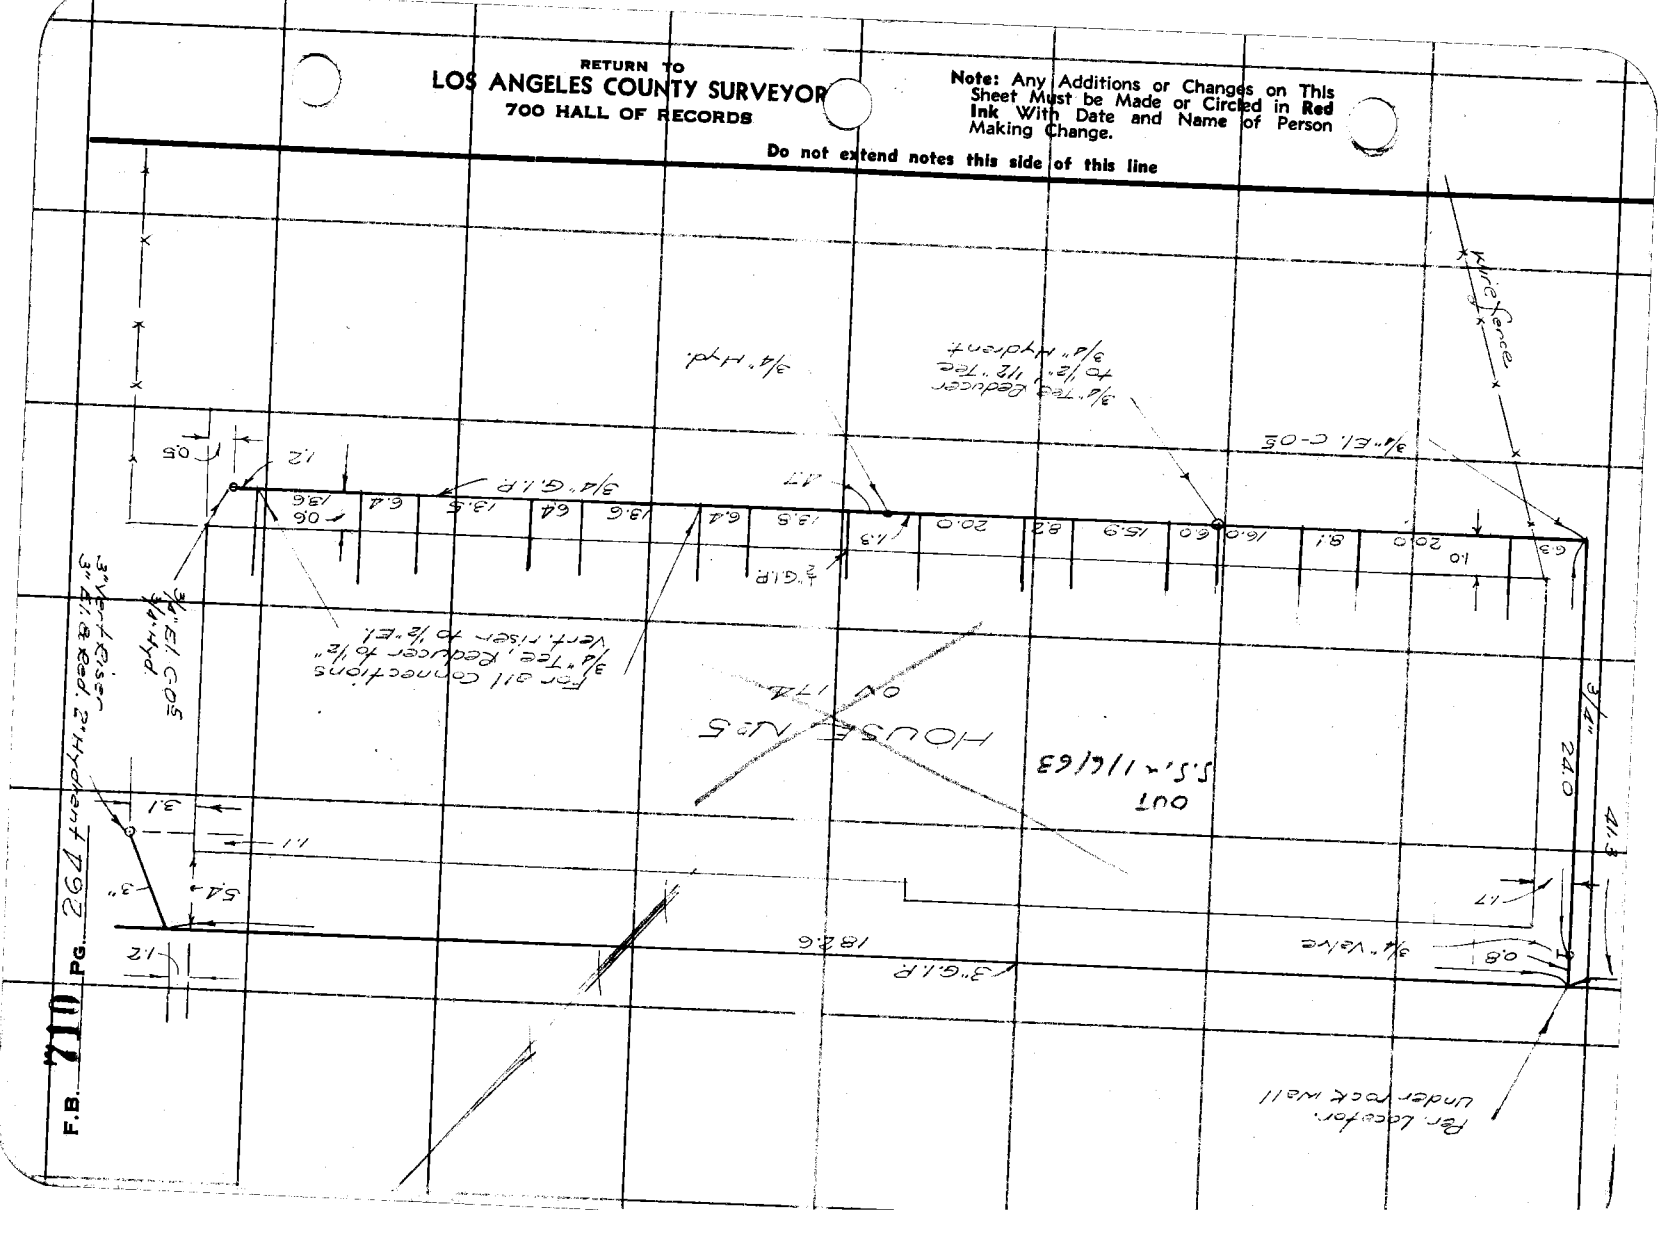

Notes Ck'd by	Survey of
Map No.	W. O. 8128 Tape No. St'd °F.
Office Work	Surveyed by T. M. WALSH
Checked	Notes T. M. WALSH Date 8-36
Date	Indexed A. C. Johnson

F.B. 710 PG. 265

WATER LINES

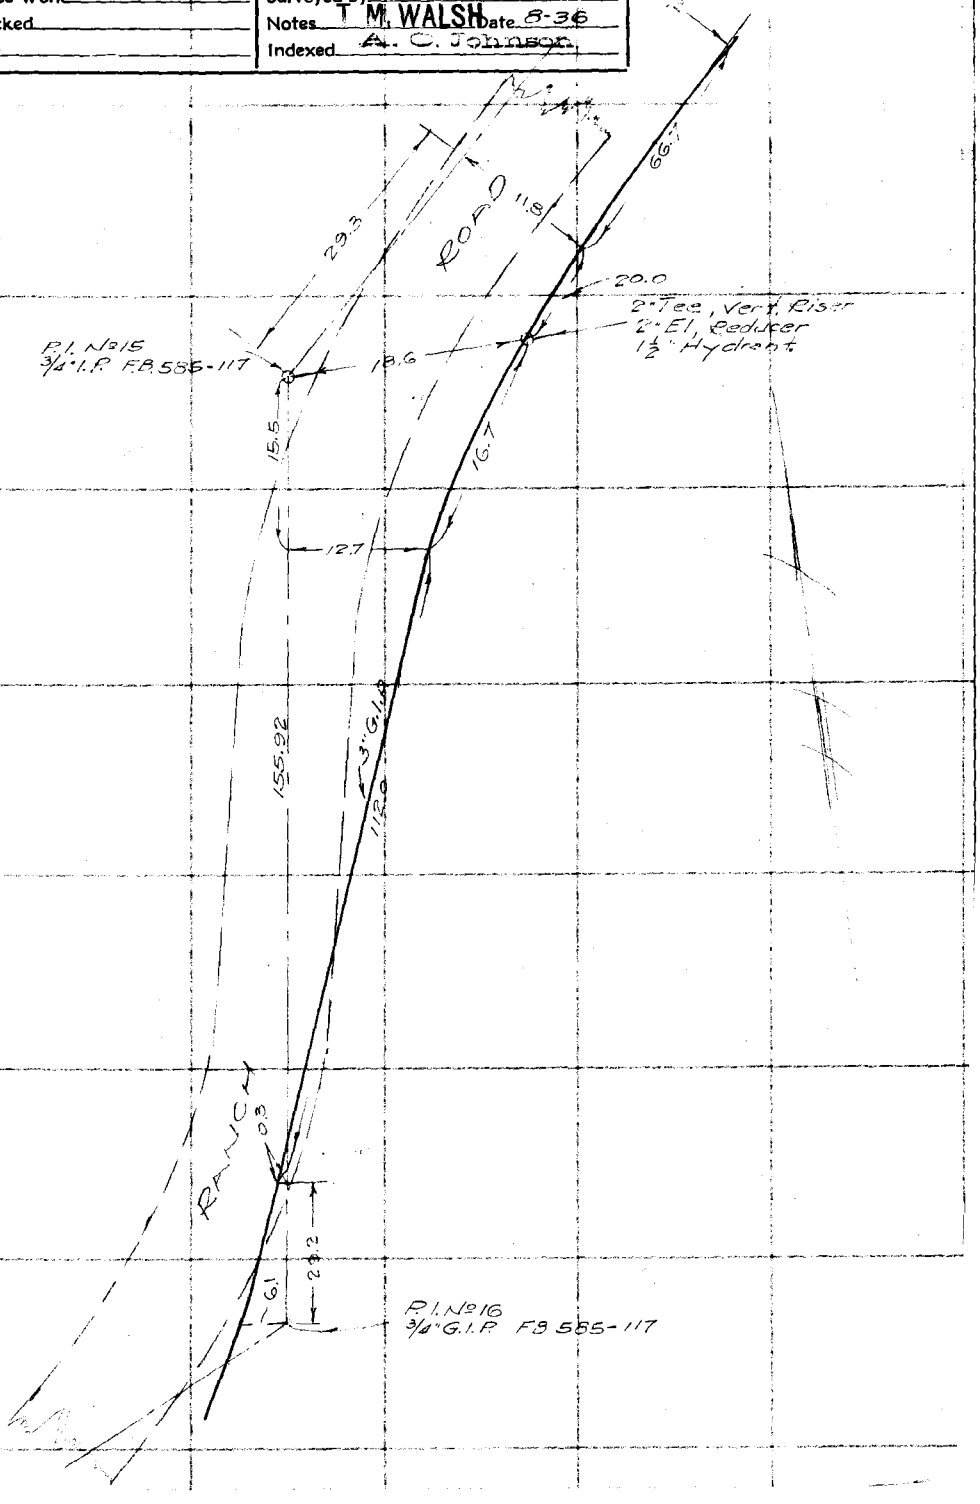

RETURN TO
LOS ANGELES COUNTY SURVEYOR
700 HALL OF RECORDS

Note: Any Additions or Changes on This Sheet Must be Made or Circled in Red Ink With Date and Name of Person Making Change.

Do not extend notes this side of this line

FORM 247 10M 11-38

RETURN TO
LOS ANGELES COUNTY SURVEYOR
700 HALL OF RECORDS

Note: Any Additions or Changes on This Sheet Must be Made or Circled in **Red** Ink With Date and Name of Person Making Change.

Do not extend notes this side of this line

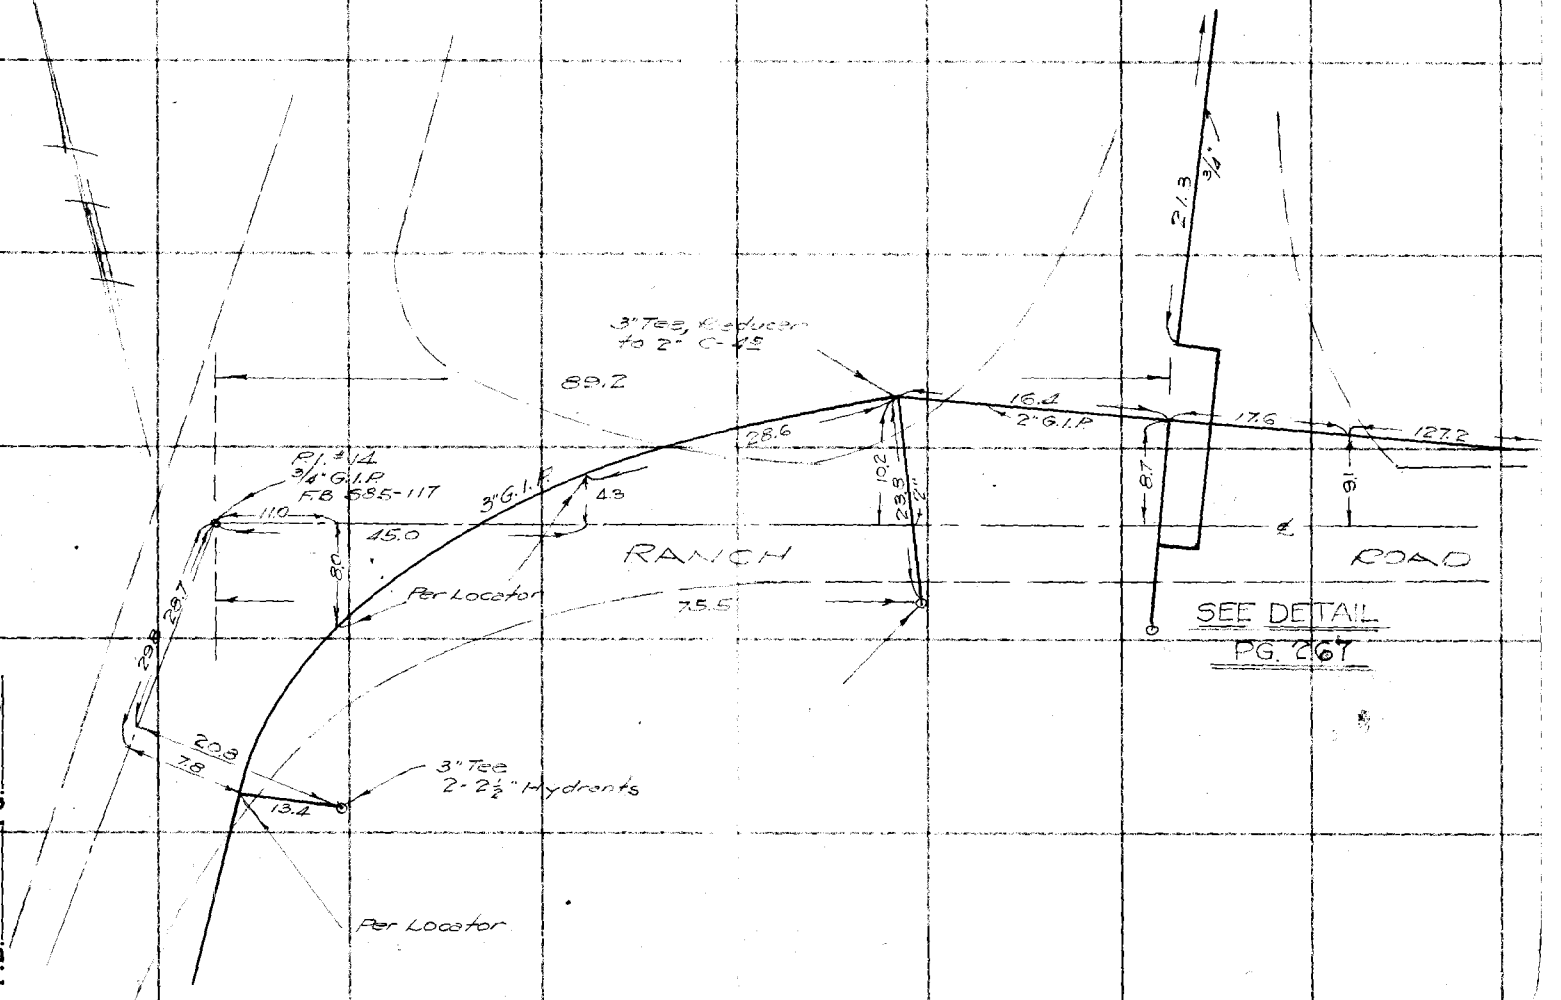

F.B. 710 PG. 266

Notes Ck'd by	Survey of OLIVE VIEW SANATORIUM
Map No.	W. O. 8128 Tape No. St'd °F.
Office Work	Surveyed by T. M. WALSH
Checked	Notes T. M. WALSH Date 8-28-36
Date	Indexed A. C. Johnson

F.B. 710 Pg. 267

WATER LINES

Note: Any Additions or Changes on This Sheet Must be Made or Circled in Red Ink With Date and Name of Person Making Change.

Do not extend notes this side of this line

RETURN TO
LOS ANGELES COUNTY SURVEYOR
700 HALL OF RECORDS

FORM 247 10M 11-35

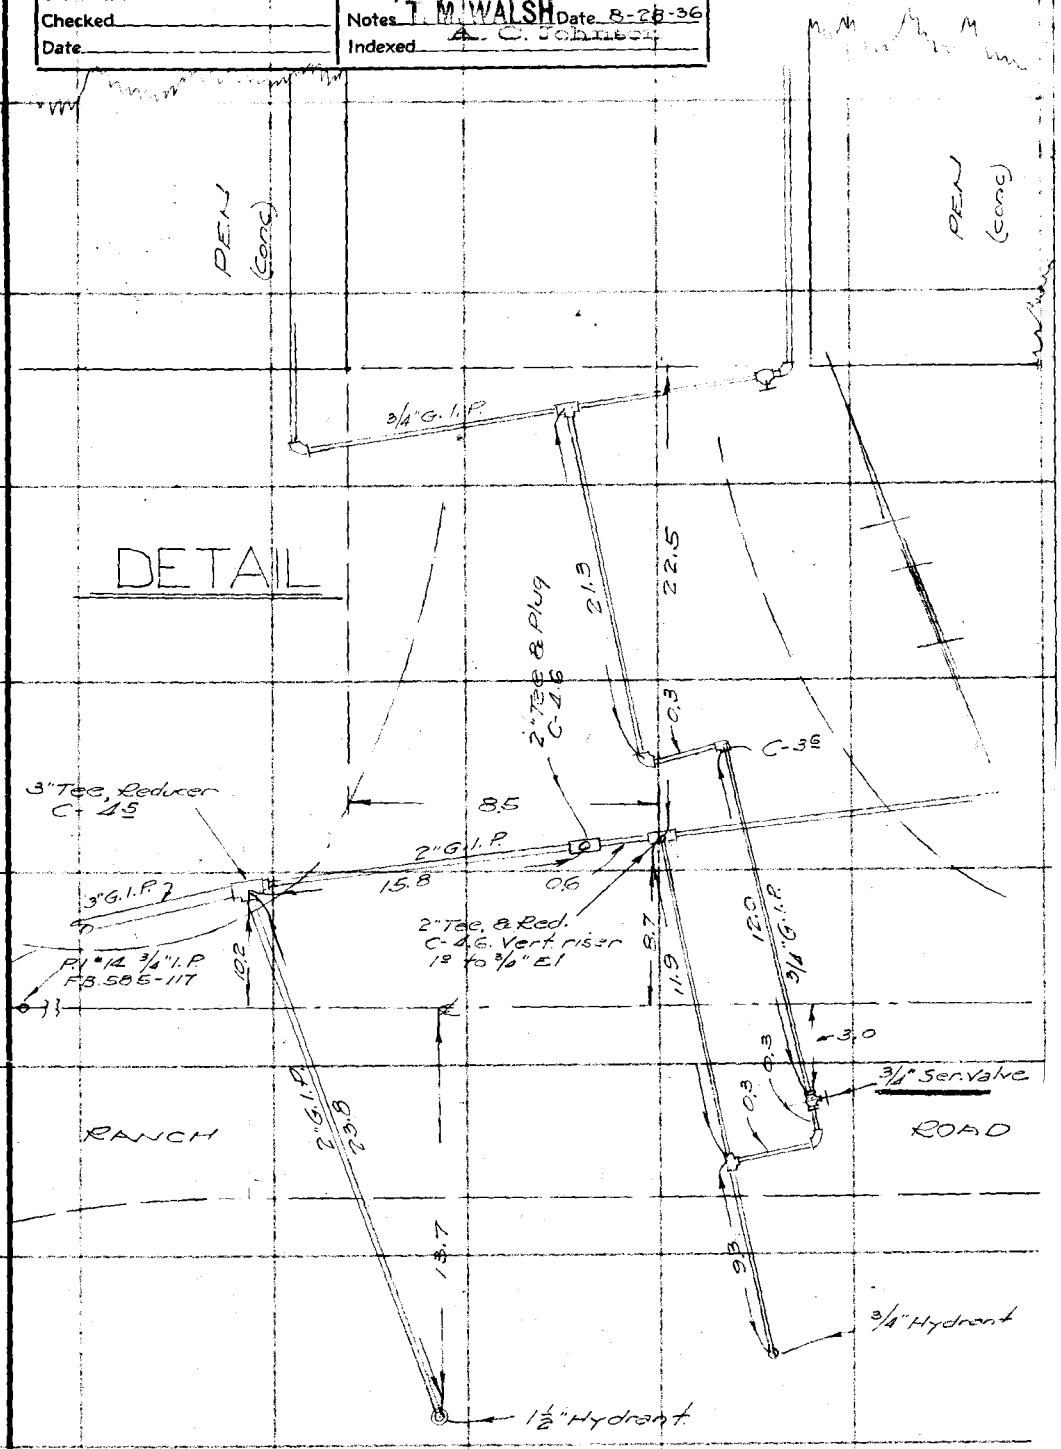

F.B. 710 PG. 268

RETURN TO
LOS ANGELES COUNTY SURVEYOR
700 HALL OF RECORDS

Note: Any Additions or Changes on This Sheet Must be Made or Circled in Red Ink With Date and Name of Person Making Change.

Do not extend notes this side of this line

Notes Ck'd by	Survey of [illegible]
Map No.	W. O. 8128 Tape No. St'd °F.
Office Work	Surveyed by T. M. WALSH
Checked	Notes T. M. WALSH Date 8-37
Date	Indexed A. C. Johnson

F.B. 710 PG. 269

WATER LINES

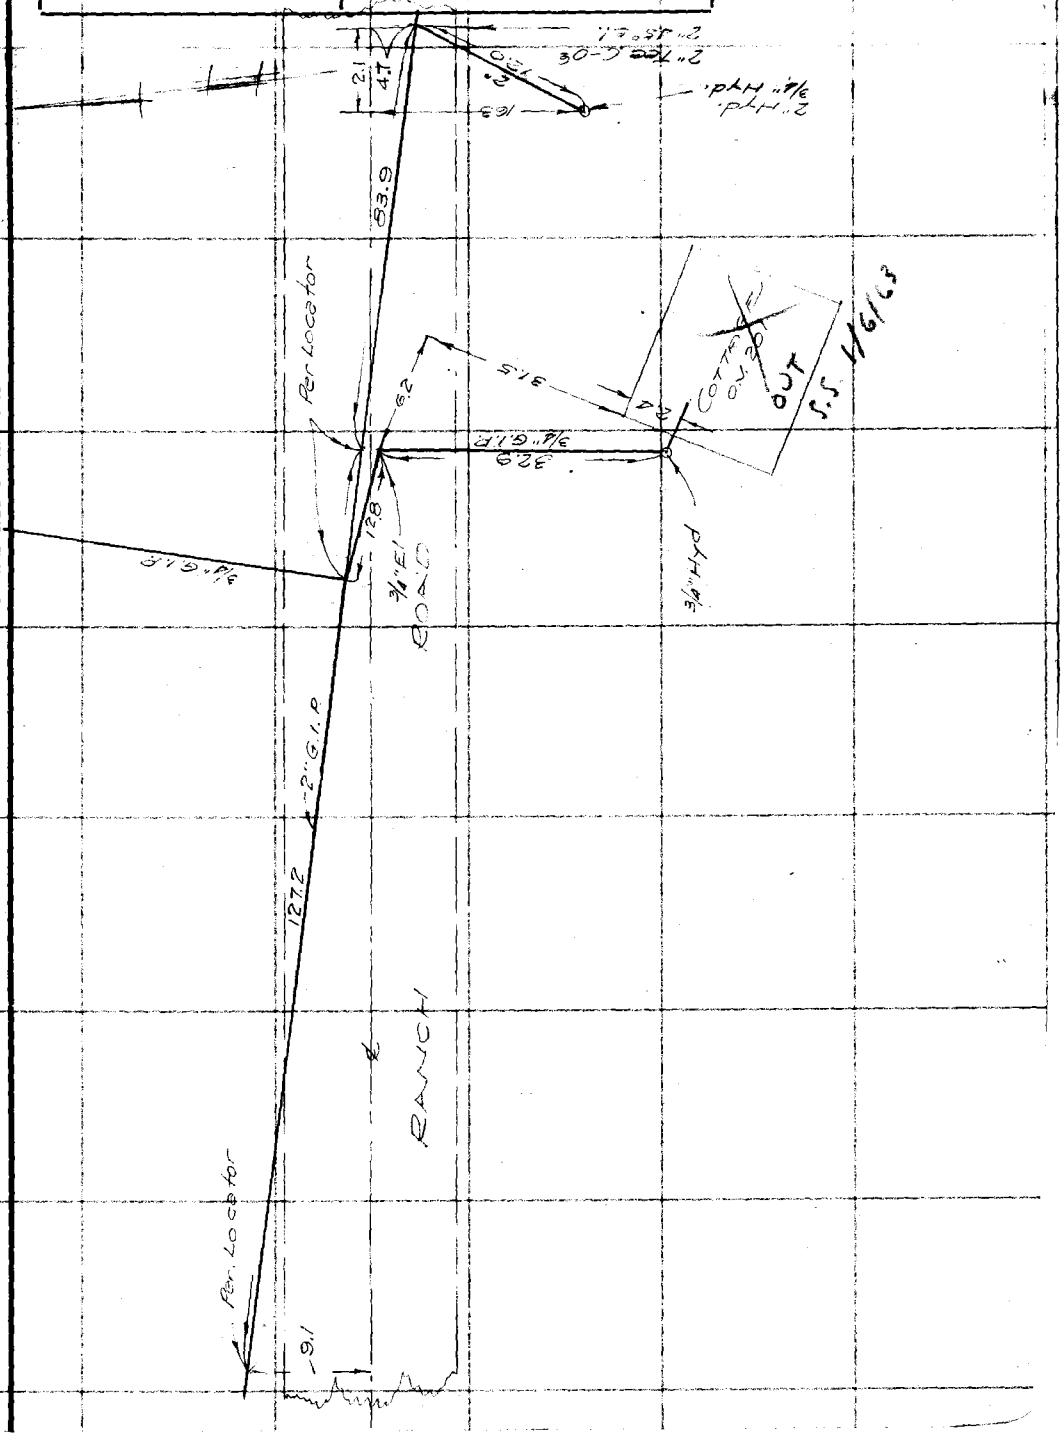

RETURN TO
LOS ANGELES COUNTY SURVEYOR
700 HALL OF RECORDS

Note: Any Additions or Changes on This Sheet Must be Made or Circled in Red Ink With Date and Name of Person Making Change

Do not extend notes this side of this line

FORM 347 10M 11-38

RETURN TO
LOS ANGELES COUNTY SURVEYOR
700 HALL OF RECORDS

Note: Any Additions or Changes on This Sheet Must be Made or Circled in **Red** Ink With Date and Name of Person Making Change.

Do not extend notes this side of this line

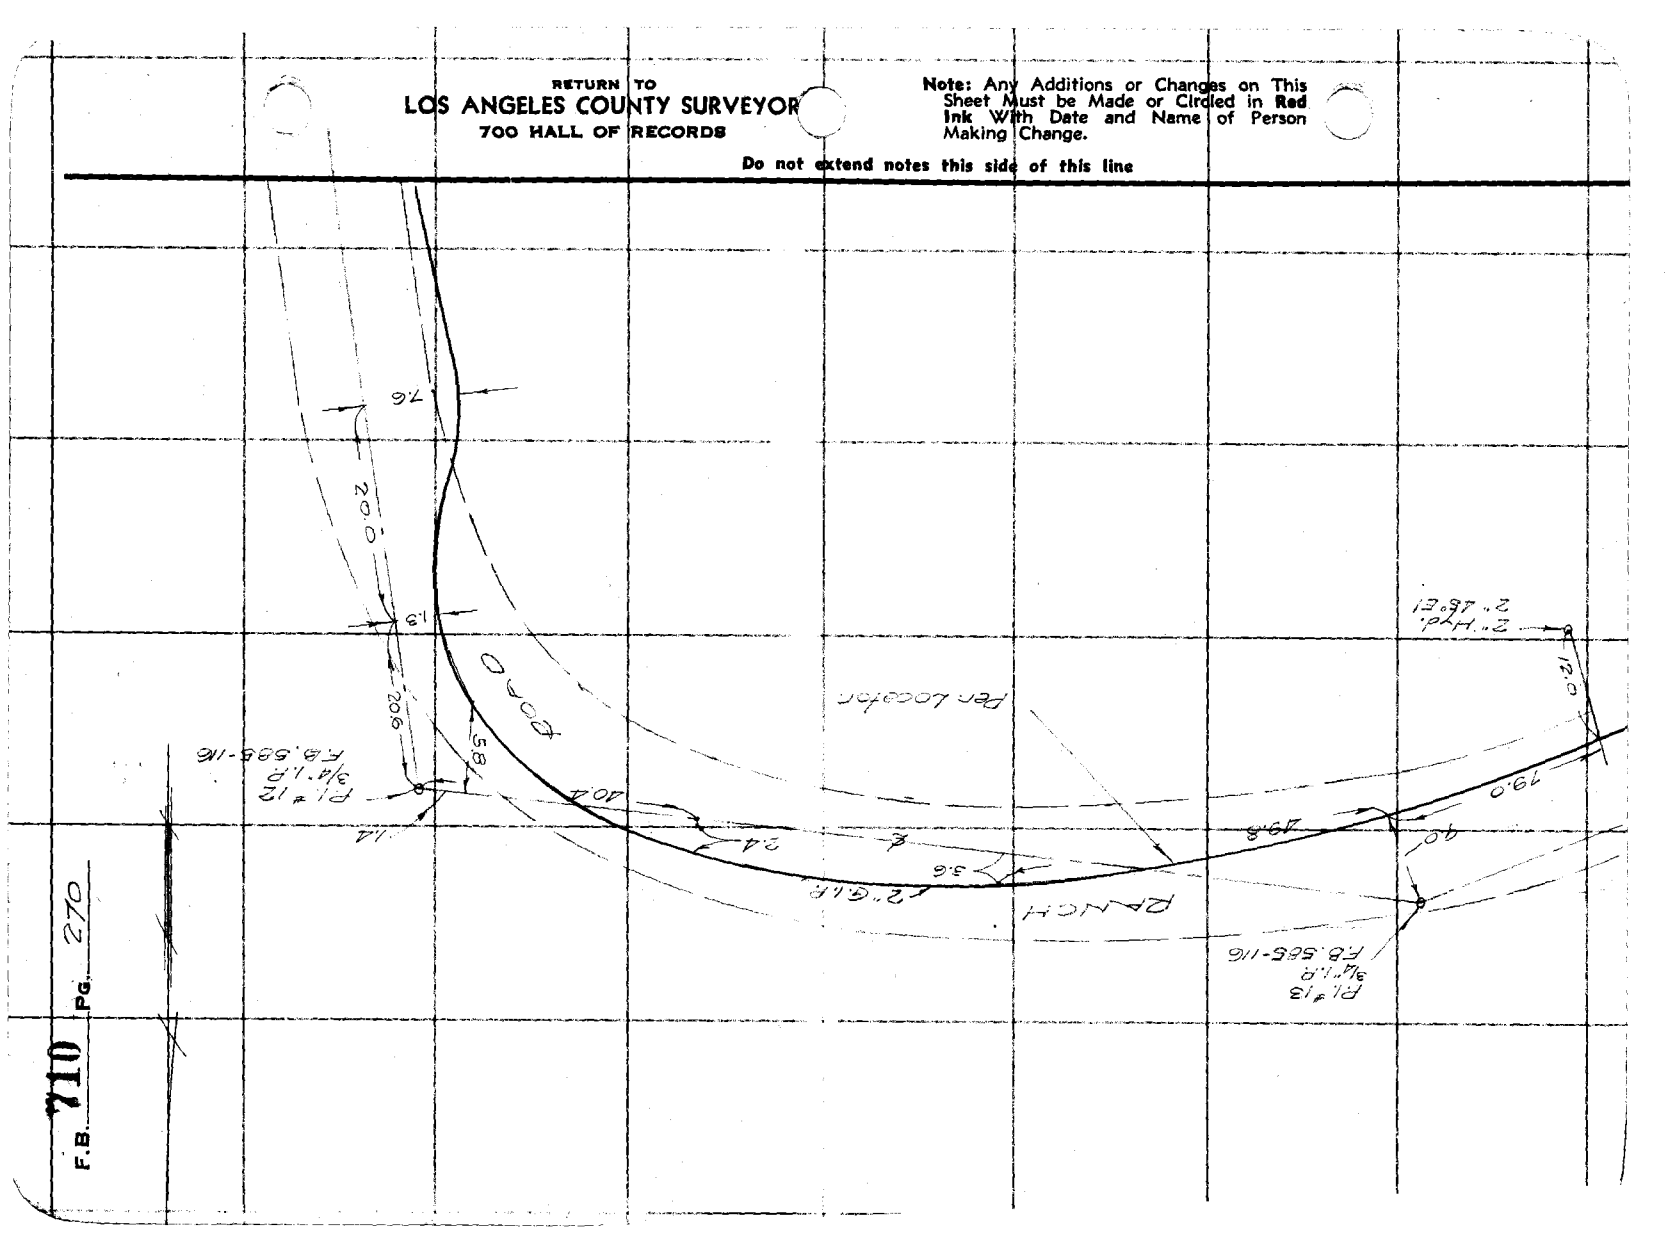

F.B. 710 PG. 270

Notes Ck'd by	Survey of
Map No.	W. O. 8128 Tape No. St'd °F.
Office Work	Surveyed by M. WALSH
Checked	Notes M. WALSH Date 8-31-36
Date	Indexed A. C. Johnson

F.B. 710 PG. 271

WATER LINE

RETURN TO
LOS ANGELES COUNTY SURVEYOR
700 HALL OF RECORDS

Note: Any Additions or Changes on This Sheet Must be Made or Circled in Red Ink With Date and Name of Person Making Change.

Do not extend notes this side of this line

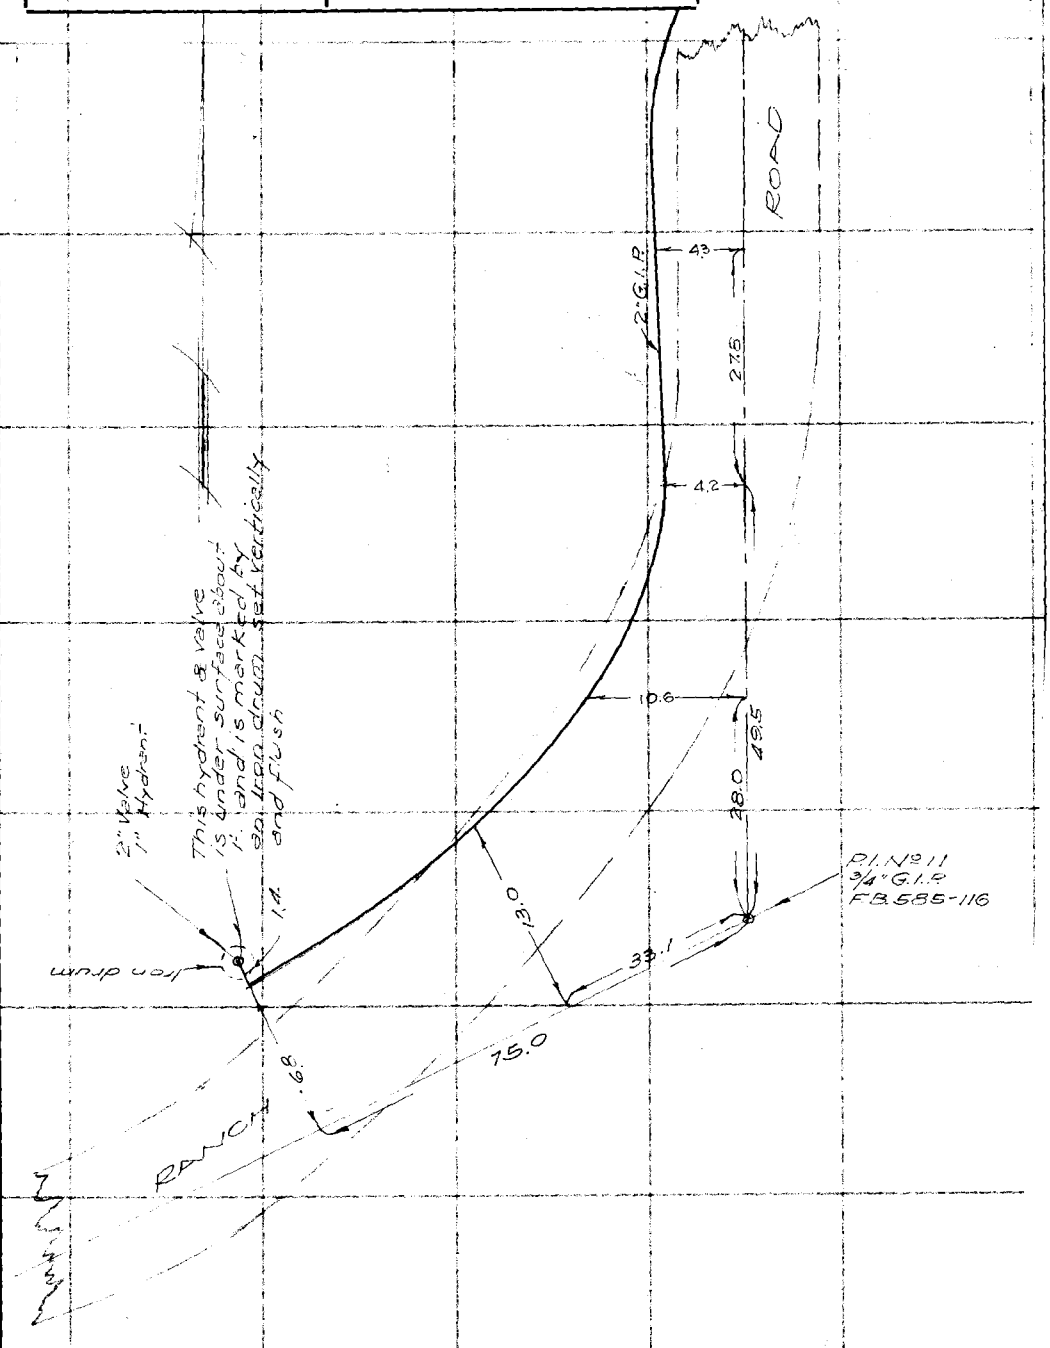

FORM 247 10M 11-35

F.B. 710 Pg. 272

RETURN TO
LOS ANGELES COUNTY SURVEYOR
700 HALL OF RECORDS

Note: Any Additions or Changes on This Sheet Must be Made or Circled in Red Ink With Date and Name of Person Making Change.

Do not extend notes this side of this line

FORM 247 10M 11-35

RETURN TO
LOS ANGELES COUNTY SURVEYOR
700 HALL OF RECORDS

Note: Any Additions or Changes on This Sheet Must be Made or Circled in **Red Ink** With Date and Name of Person Making Change

Do not extend notes this side of this line

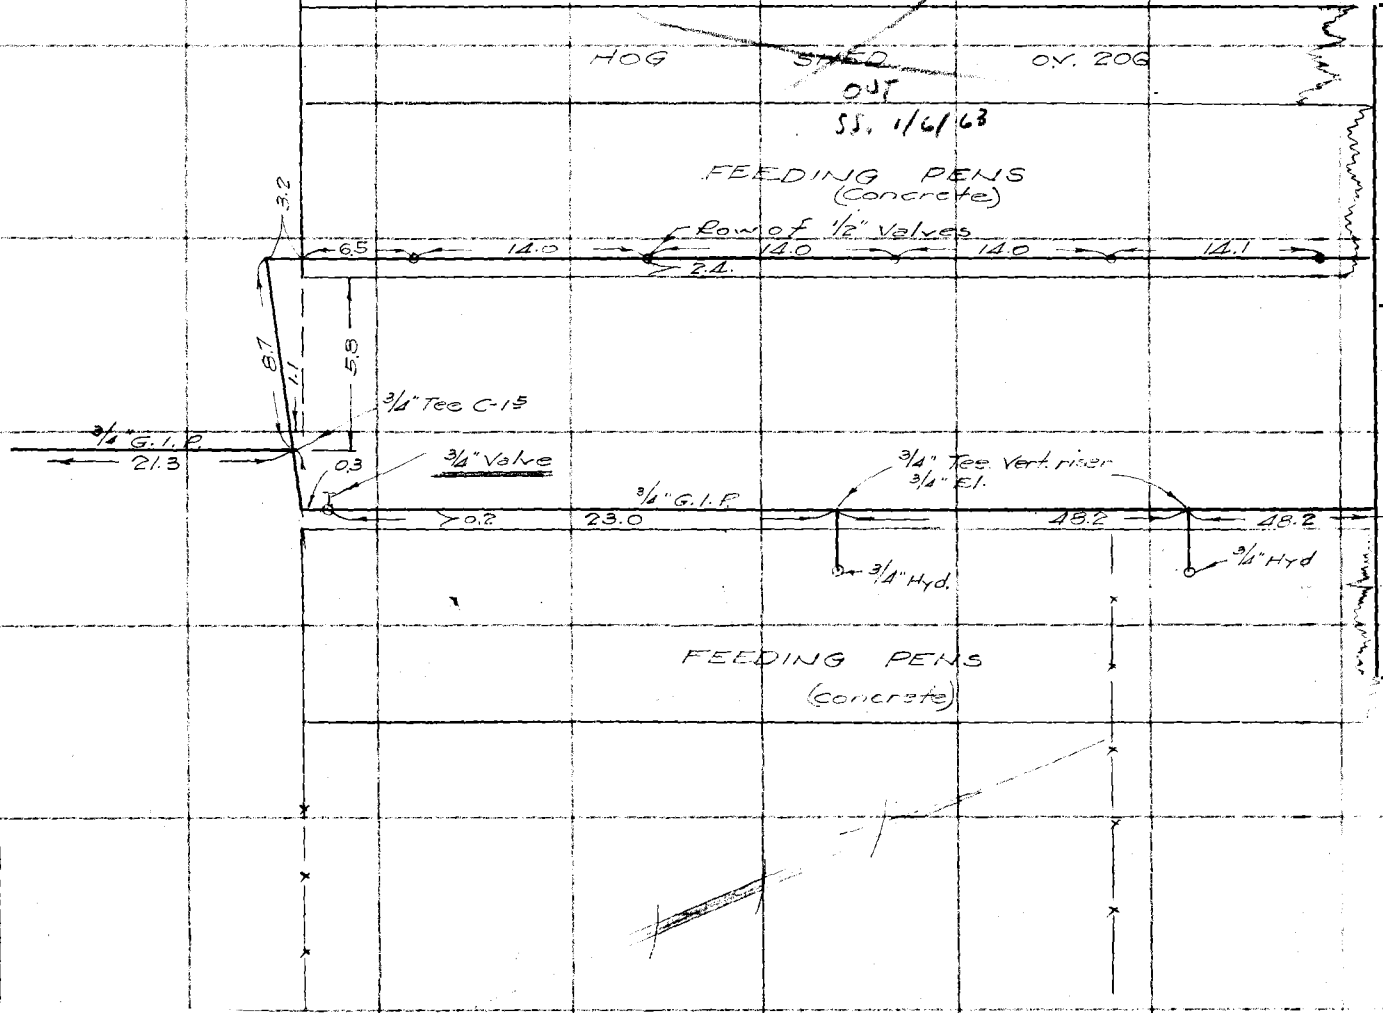

Notes Ck'd by _____
Map No. _____
Offsite Work _____
Checked _____
Date _____

Survey of W. O. 5128 Tag No. _____ Std. _____ °F.
Surveyed by M. WALSH Date 9-2-36
Notes _____
Indexed A. C. Johnson

F.B. 711 PG. 273

WATER LINE

F.B. 710 PG. 274

RETURN TO
LOS ANGELES COUNTY SURVEYOR
700 HALL OF RECORDS

Note: Any Additions or Changes on This Sheet Must be Made or Circled in Red Ink With Date and Name of Person Making Change.

Do not extend notes this side of this line

HOG SHED
OV 206
OUT

S.S 1/6/63

Notes Ck'd by	Survey of OLIVE VIEW SANATORIUM	F.B. 710 Pg. 275
Map No.	W. O. 8128 Tape No. St'd °F.	WATER LINES
Office Work	Surveyed by T. M. WALSH	
Checked	Notes M. WALSH Date 9-2-36	
Date	Indexed A. C. Johnson	

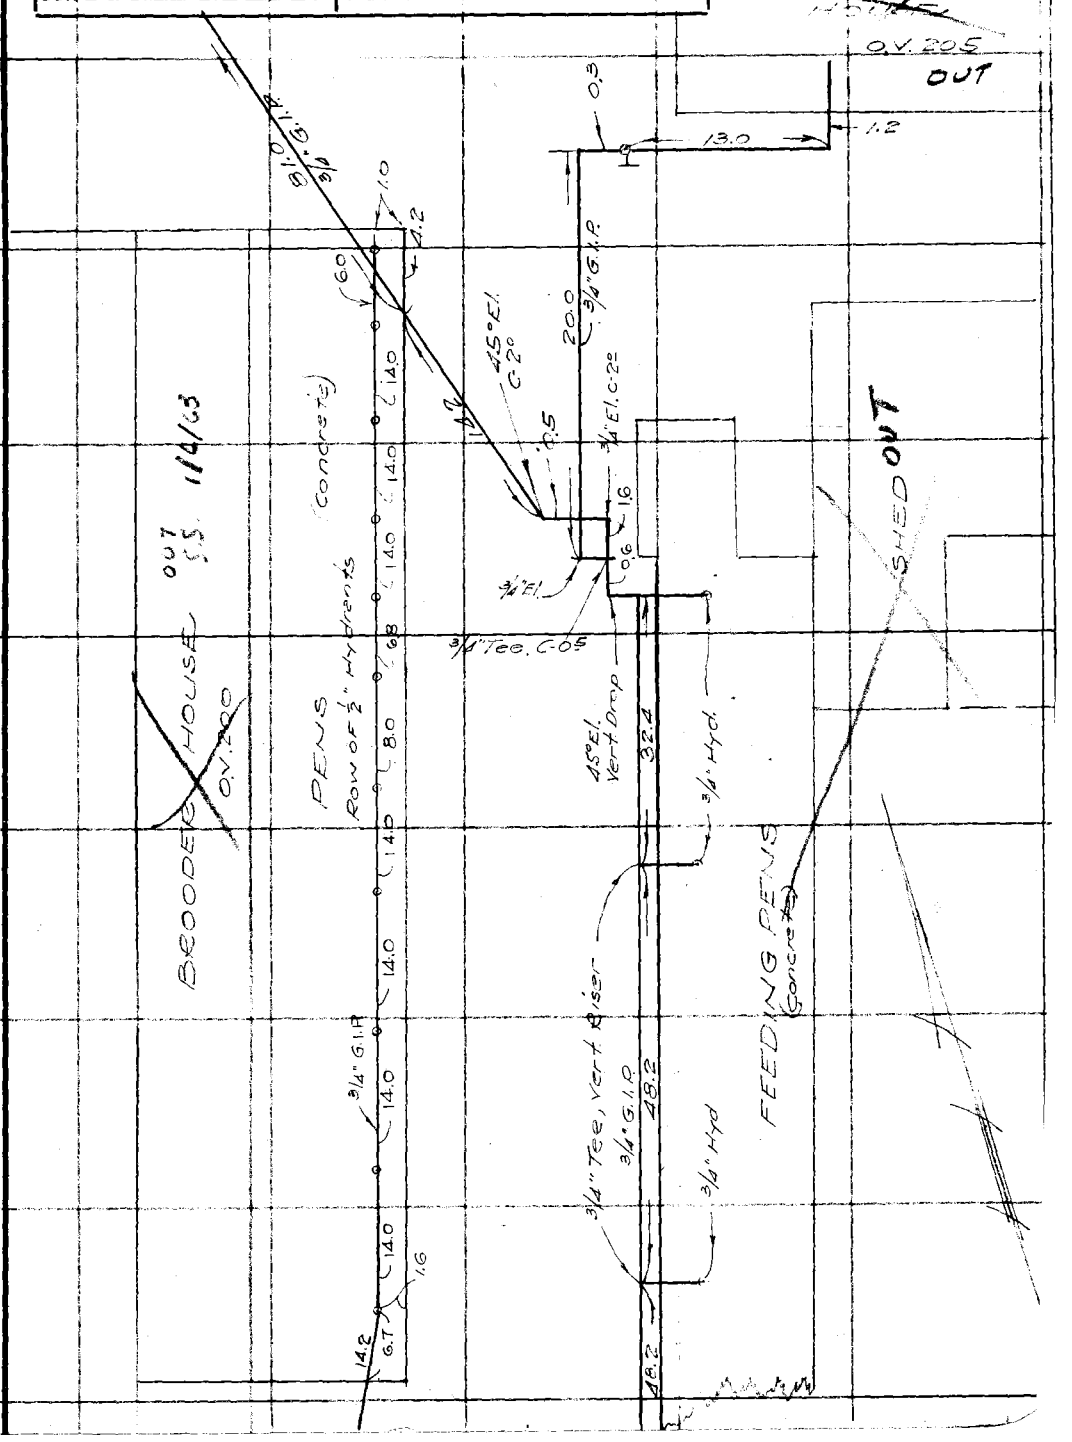

Note: Any Additions or Changes on This Sheet Must be Made or Circled in Red Ink With Date and Name of Person Making Change.

Do not extend notes this side of this line

RETURN TO
LOS ANGELES COUNTY SURVEYOR
700 HALL OF RECORDS

FORM 247 10M 11-35

RETURN TO
LOS ANGELES COUNTY SURVEYOR
700 HALL OF RECORDS

Note: Any Additions or Changes on This Sheet Must be Made or Circled in **Red** Ink With Date and Name of Person Making Change.

Do not extend notes this side of this line

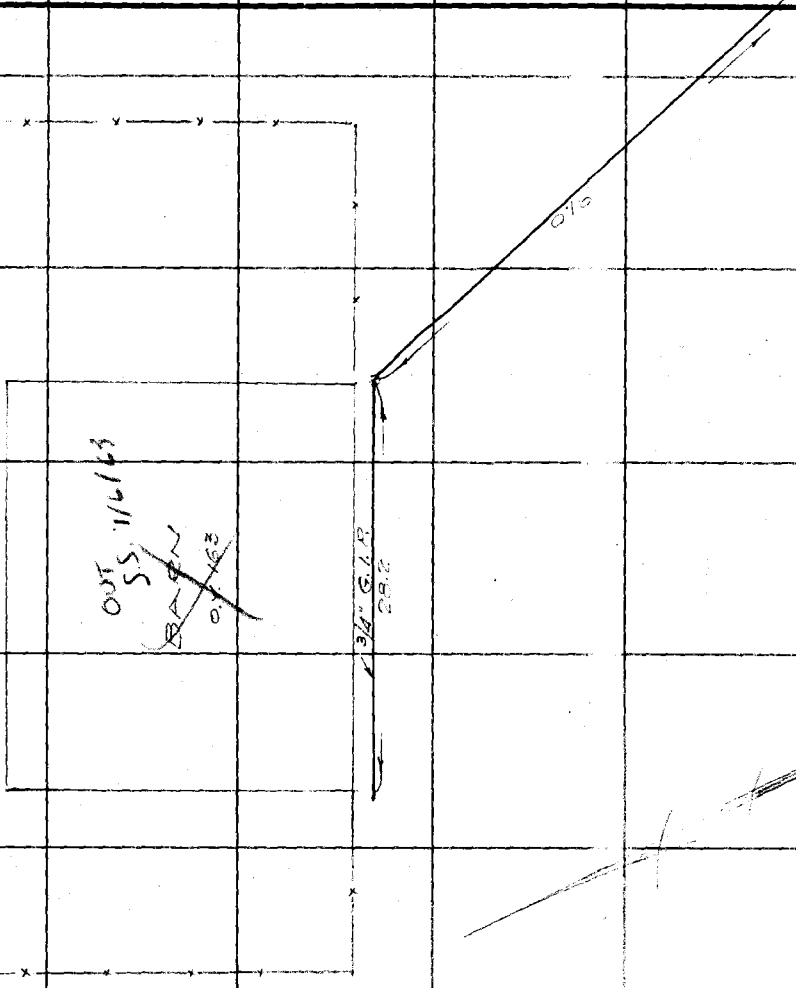

F.B. 710 PG. 276

Notes Ck'd by	Survey of OLIVE VIEW SANATORIUM	F.B. 710 Pg. 277
Map No.	W. O. 8128 Tape No. St'd °F.	
Office Work	Surveyed by T. M. WALSH	
Checked	Notes T. M. WALSH Date 7-16-37	
Date	Indexed A. C. Johnson 8-26-37	

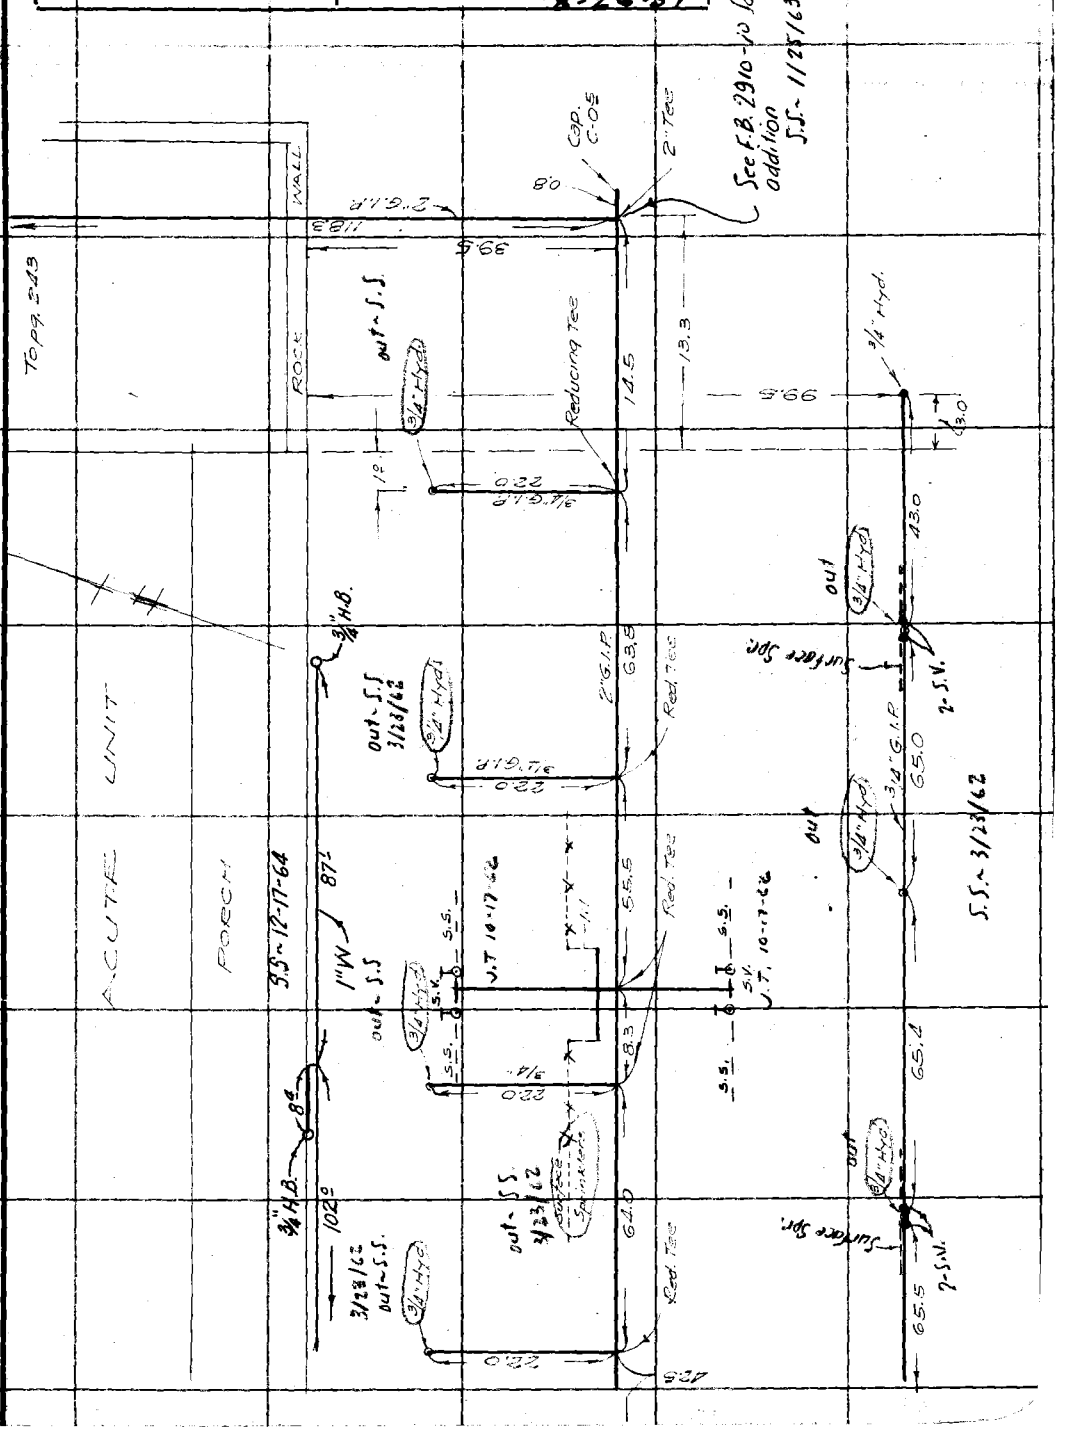

Note: Any Additions or Changes on This Sheet Must be Made or Circled in Red Ink With Date and Name of Person Making Change.

Do not extend notes this side of this line

RETURN TO
LOS ANGELES COUNTY SURVEYOR
700 HALL OF RECORDS

FORM 247 10M 11-38

RETURN TO
LOS ANGELES COUNTY SURVEYOR
700 HALL OF RECORDS

Note: Any Additions or Changes on This Sheet Must be Made or Circled in **Red Ink** With Date and Name of Person Making Change.

Do not extend notes this side of this line

F.B. 711 PG. 278

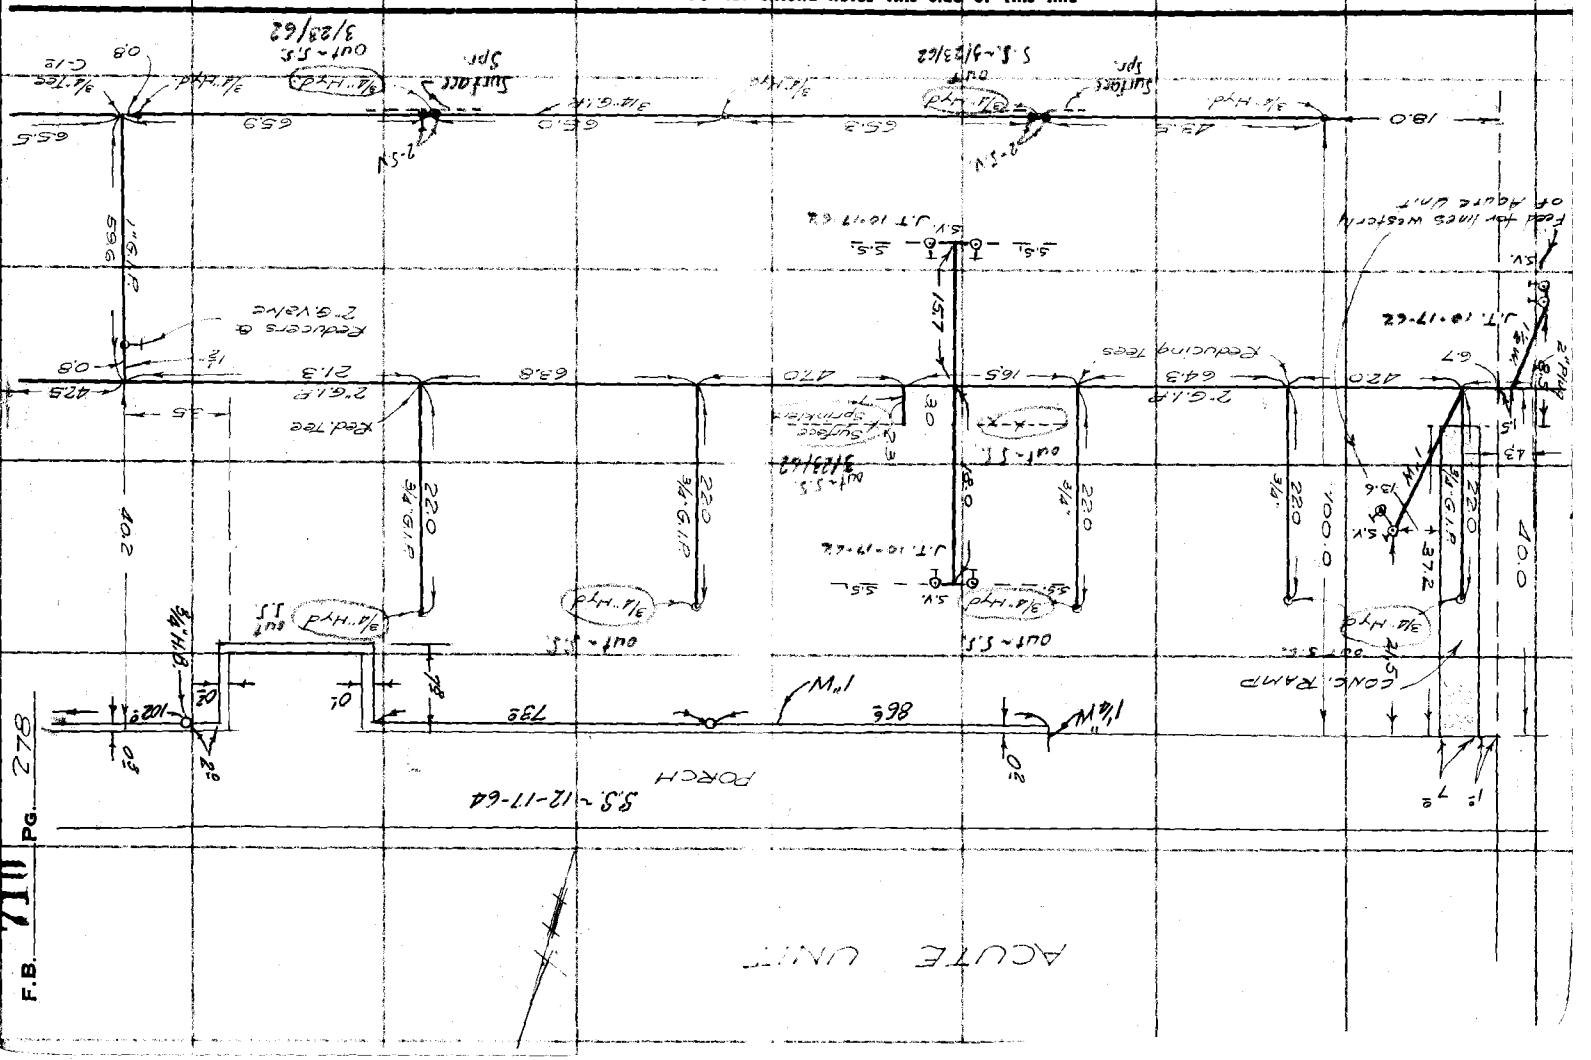

Notes Ck'd by	Survey of OLIVE VIEW SAN
Map No.	W. O. 8128 Tape No. St'd °F.
Office Work	Surveyed by TED WALSH
Checked	Notes WALSH Date July 1937
Date	Indexed [illegible] 8-26-37

F.B. 710 PG. 279

WATER

See page 280

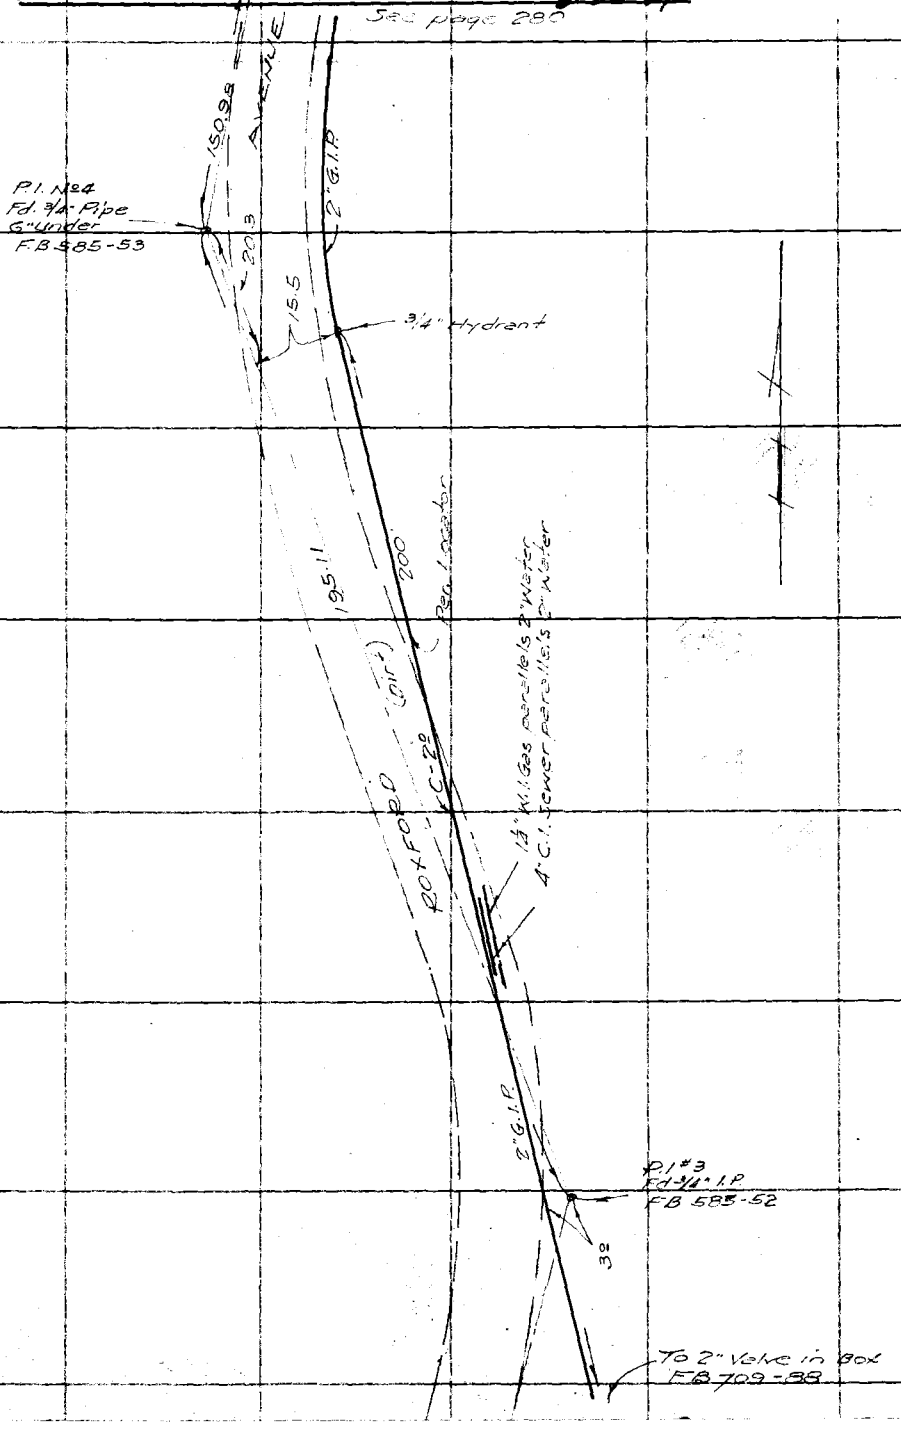

Note: Any Additions or Changes on This Sheet Must be Made or Circled in Red Ink With Date and Name of Person Making Change.

Do not extend notes this side of this line

RETURN TO
LOS ANGELES COUNTY SURVEYOR
700 HALL OF RECORDS

FORM 247 10M 11-38

F.B. 710 Pg. 280

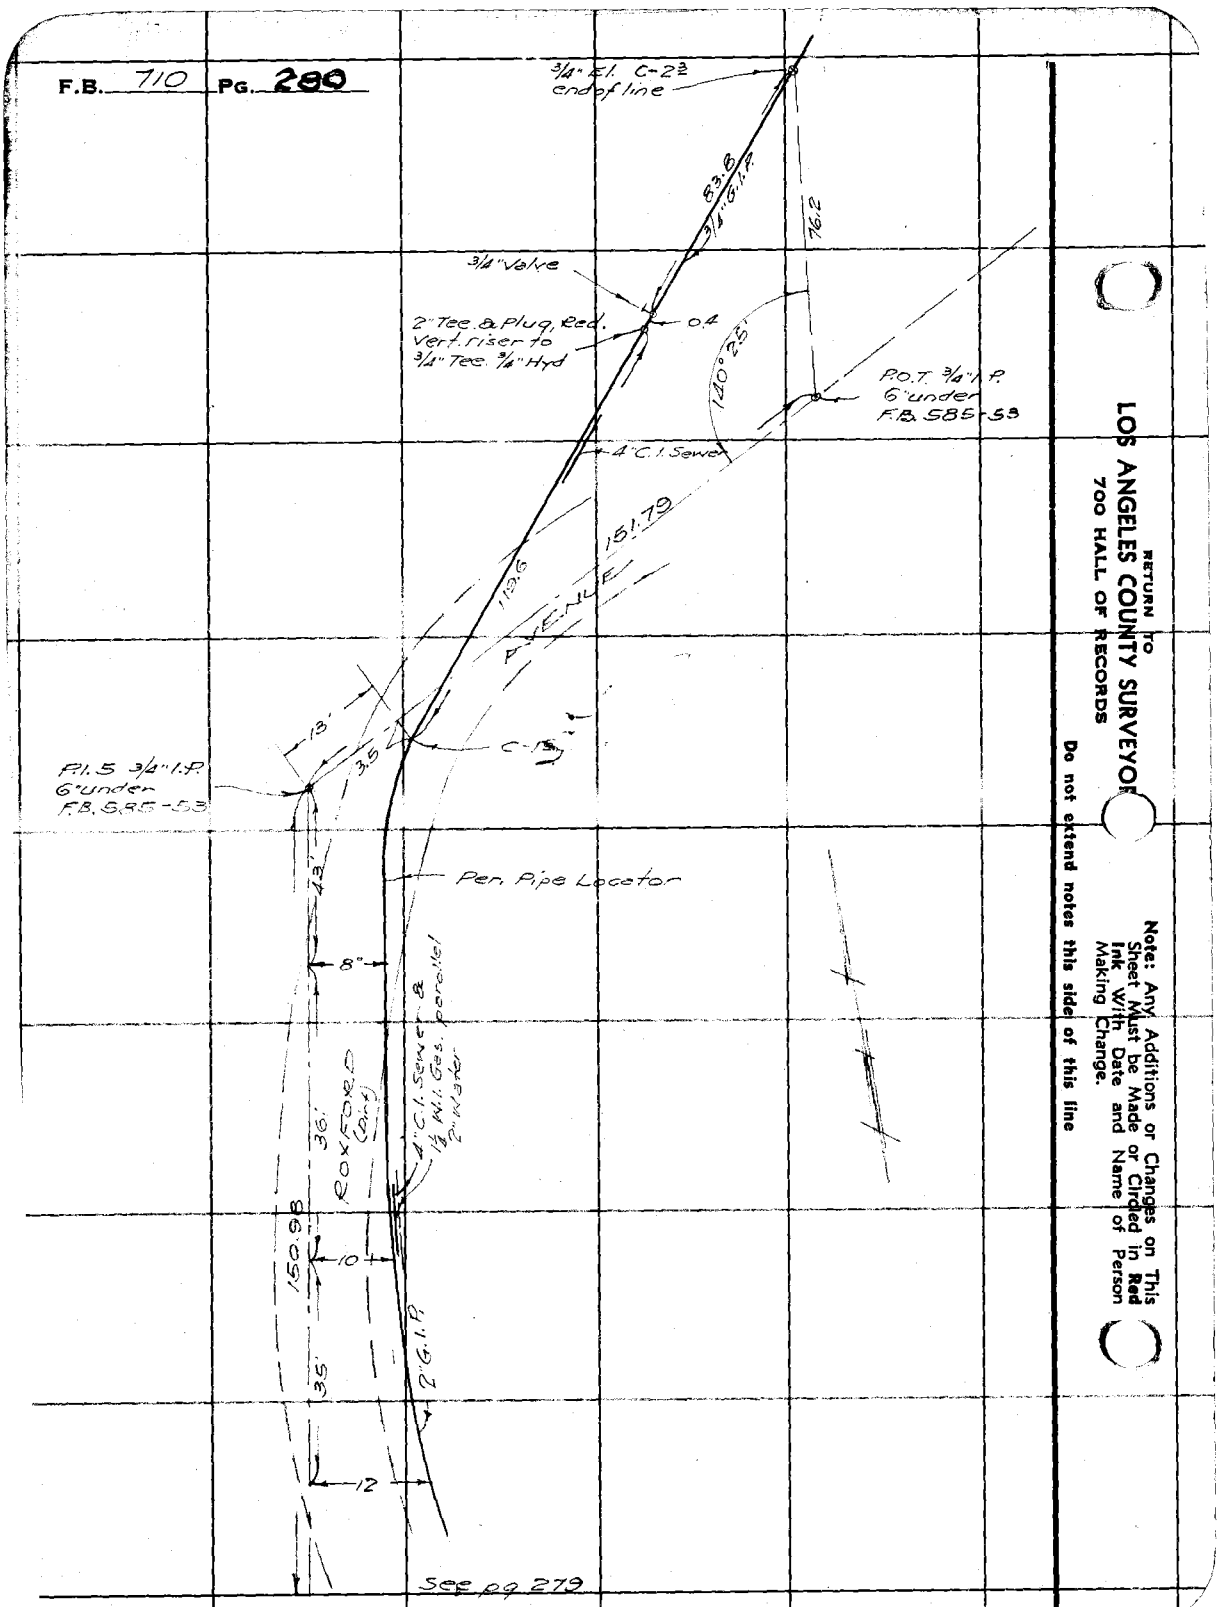

RETURN TO
LOS ANGELES COUNTY SURVEYOR
700 HALL OF RECORDS

Note: Any Additions or Changes on This Sheet Must be Made or Circled in Red Ink With Date and Name of Person Making Change.

Do not extend notes this side of this line

Notes Ck'd by		Survey of Surveyors Station	F.B. 710 Pg. 281
Map No.		W. O. 8101 Tape No.	Std °F
Office Work		Surveyed by R C Bowers	
Checked		Notes	Date 3-26-48
Date		Indexed	

Additional Pipe Line
along Eucalyptus Ave
between Bucher Ave
&
Olive View Ave

Note: Any Additions or Changes on This Sheet Must be Made or Circled in Red Ink With Date and Name of Person Making Change.

Do not extend notes this side of this line.

RETURN TO
LOS ANGELES COUNTY SURVEYOR
700 HALL OF RECORDS

FORM 247 5M 12-40

F.B. 710 PG. 282

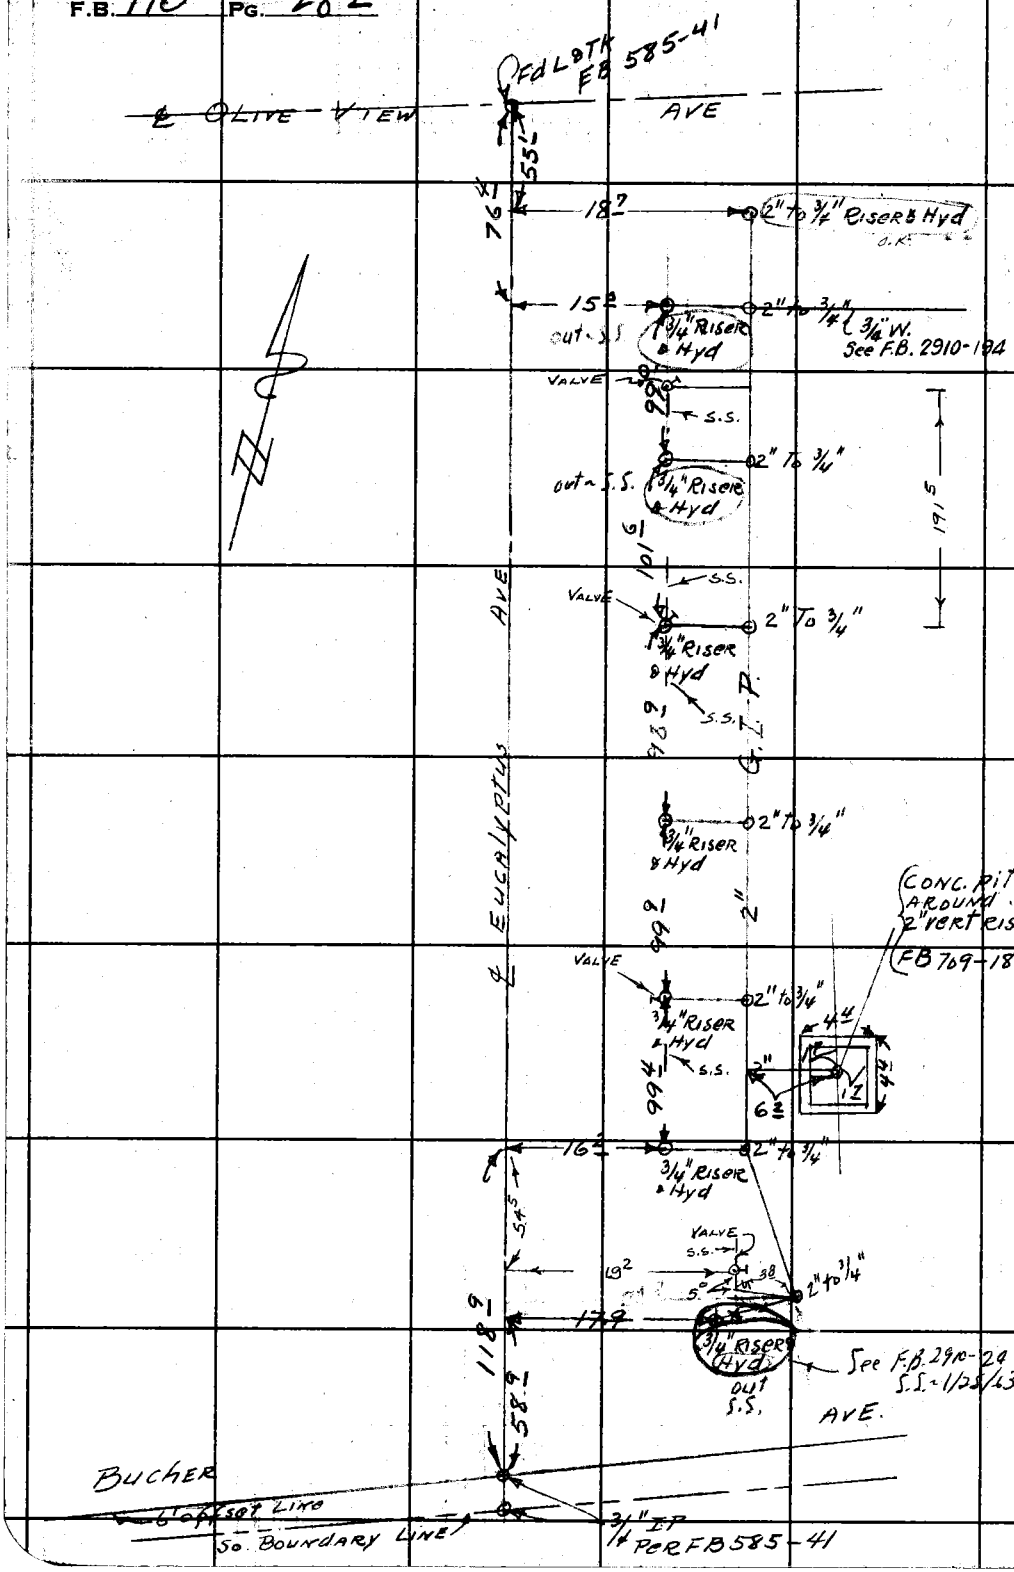

RETURN TO
LOS ANGELES COUNTY SURVEYOR
700 HALL OF RECORDS

Do not extend notes this side of this line.

Note: Any Additions or Changes on This Sheet Must be Made or Circled in Red Ink With Date and Name of Person Making Change.

Form 307 5M 11-35

PLEASE RETURN TO
LOS ANGELES COUNTY SURVEYOR
700 HALL OF RECORDS

NOTE: ANY ADDITIONS OR CHANGES ON THIS SHEET MUST BE MADE OR CIRCLED IN RED INK, WITH DATE AND NAME OF PERSON MAKING CHANGE

Do not extend notes this side of this line

STATION	B. S.	H. I.	F. S.	ELEV.		

Profile No.
X-Sec. No.
Notes Red. Date
Plotted Date
Job No. Survey of
Division No.
Notes Chkd. Date
Checked Date
Survey by
Map No.
Notes Indexed
Date
Date
Date

F. B. 710 PG. 263

Form 307 5M 11-35

PLEASE RETURN TO
LOS ANGELES COUNTY SURVEYOR
700 HALL OF RECORDS

NOTE: ANY ADDITIONS OR CHANGES ON THIS SHEET MUST BE MADE OR CIRCLED IN RED INK, WITH DATE AND NAME OF PERSON MAKING CHANGE

Do not extend notes this side of this line

710

STATION	B. S.	[redacted]		ELEV	
BM#				153 [illegible]	
	1 51	154 99	0[illegible]	154 [illegible]	
	11 83	16[illegible] 01	[illegible]9	16[illegible]	
	11 52	175 94	0 76	175 [illegible]	
	10 44	185 62	0 52	18[illegible] 10	
	11 74	196 84	0 82	196 [illegible]	
	11 59	207 61	1 74	205 87	
	11 73	217 60	0 71	216 89	
P#14	11 41	228 30	3 51	2[illegible] 79	[illegible]

RETURN CIRCUIT BETWEEN T.P. (TOP OF DAM) & BM#14

				8[illegible] 31	Top of Dam
	0 63	80 94	8 60	7[illegible] 34	
	1 46	73 80	3 71	7[illegible] 09	
	1 09	71 18	10 50	[illegible] 6[illegible]	
	2 39	63 07	6 80	56 27	
BM#14	10 36	66 63	8 34	5[illegible] 29	

Profile No. ___ X-Sec. No. ___
Plotted ___ Date ___ Checked ___ Date ___
Notes Chkd. ___ Date ___
Division No. ___ Notes WALSH Date 9-15-36
Job No. ___
Survey of ___
Survey by TED WALSH
Indexed ___

B 710 PG. 284