Notes Ck'd by	Survey of
Map No.	W. O. 8128 Tape No. St'd °F.
Office Work	Surveyed by T. M. WALSH
Checked	Notes T. M. WALSH Date
Date	Indexed

F.B. PG.

Note: Any Additions or Changes on This Sheet Must be Made or Circled in Red Ink With Date and Name of Person Making Change.

Do not extend notes this side of this line.

RETURN TO
LOS ANGELES COUNTY SURVEYOR
700 HALL OF RECORDS

7 1 2

FORM 247 10M 11-35

F.B. 712 PG. Index

F.B. 712

PAGES: Index, , 5 to 7 incl.,
9, , 11 to 17 incl., , 19 to 41 incl.,
, 43 to 89 incl., , 91 to 95 incl.,
, 97 to 104 incl.,
111 to 145 incl., , 147 to 149 incl.,
, 151 to 171 incl., , 173 to 185
incl., , 187 to 189 incl.,

RETURN TO
LOS ANGELES COUNTY SURVEYOR
700 HALL OF RECORDS

Do not extend notes this side of this line

Note: Any Additions or Changes on This Sheet Must be Made or Circled in Red Ink With Date and Name of Person Making Change.

Notes Ck'd by	Survey of OLIVE VIEW SANATORIUM	F.B. 7-2	Pg. 5
Map No.	W. O. 8128 Tape No.	St'd °F.	
Office Work	Surveyed by T. M. WALSH		
Checked	Notes T. M. WALSH Date 1936		
Date	Indexed A. C. Johnson 5-26-37		

Note: Any Additions or Changes on This Sheet Must be Made or Circled in Red Ink With Date and Name of Person Making Change.

Do not extend notes this side of this line

RETURN TO
LOS ANGELES COUNTY SURVEYOR
700 HALL OF RECORDS

OLIVE VIEW SANATORIUM
UNDERGROUND
GAS & STEAM LINES

JN° 8128

APRIL TO NOV. 1936

NOTES TO BE USED IN CONJUNCTION WITH C.S.B.-1202

For Index (Field Maps)
See Plane Table Sheets
NO. F1164 to F1180

Locations By
F. Greenwood & Party
R.L. Willey & Party

Notes & Index Sheets
By Ted Walsh

FORM 247 10M 11-35

F.B. 712 PG. 7

LEGEND

————	Water Mains over 1"
- - - - - -	1" pipe or under
----------	Surface Sprinklers (lines on surface)
G.I.P.	Galvanized Iron pipe
W.I.P.	Wrough Iron Pipe
C.I.P.	Cast Iron Pipe
S.V.	Sprinkler Valve
S.S.V	Surface Sprinkler Valve
G.V.	Gate Valve
Gl.V.	Globe Valve
C -	Depth of line under Surface
—o—	Hydrant
	Fire Hydrant
	Valve
-•- -	Sprinkler Head

RETURN TO
LOS ANGELES COUNTY SURVEYOR
700 HALL OF RECORDS

Note: Any Additions or Changes on This Sheet Must be Made or Circled In Red Ink With Date and Name of Person Making Change.

Do not extend notes this side of this line

Map No.	W. O. 8128 Tape No. St'd °F.
Office Work	Surveyed by T. M. WALSH
Checked	Notes T. M. WALSH Date 1936
Date	Indexed A. C. Johnson

F.B. 712 PG. 7

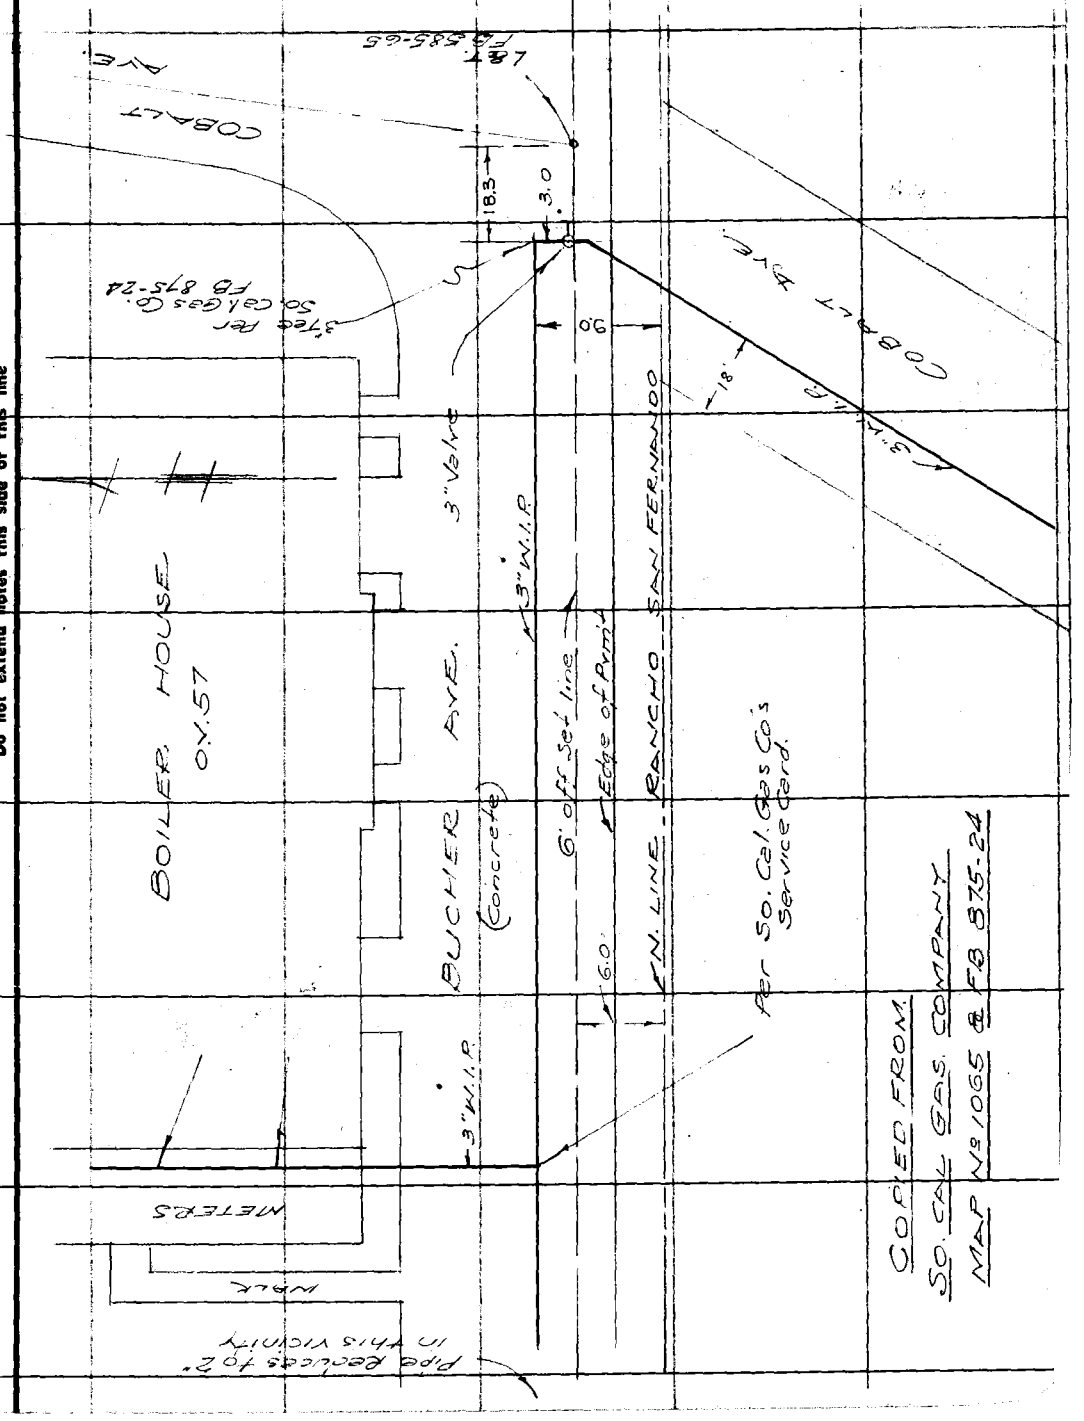

Note: Any Additions or Changes on This Sheet Must be Made or Circled in Red Ink With Date and Name of Person Making Change.

Do not extend notes this side of this line

RETURN TO
LOS ANGELES COUNTY SURVEYOR
700 HALL OF RECORDS

FORM 247 10M 11-35

RETURN TO
LOS ANGELES COUNTY SURVEYOR
700 HALL OF RECORDS

Note: Any Additions or Changes on This Sheet Must be Made or Circled in **Red Ink** With Date and Name of Person Making Change.

Do not extend notes this side of this line

F.B. 712 PG. 8

FORM 247 10M 11-35

RETURN TO
LOS ANGELES COUNTY SURVEYOR
700 HALL OF RECORDS

Note: Any Additions or Changes on This Sheet Must be Made or Circled in Red Ink With Date and Name of Person Making Change.

Do not extend notes this side of this line

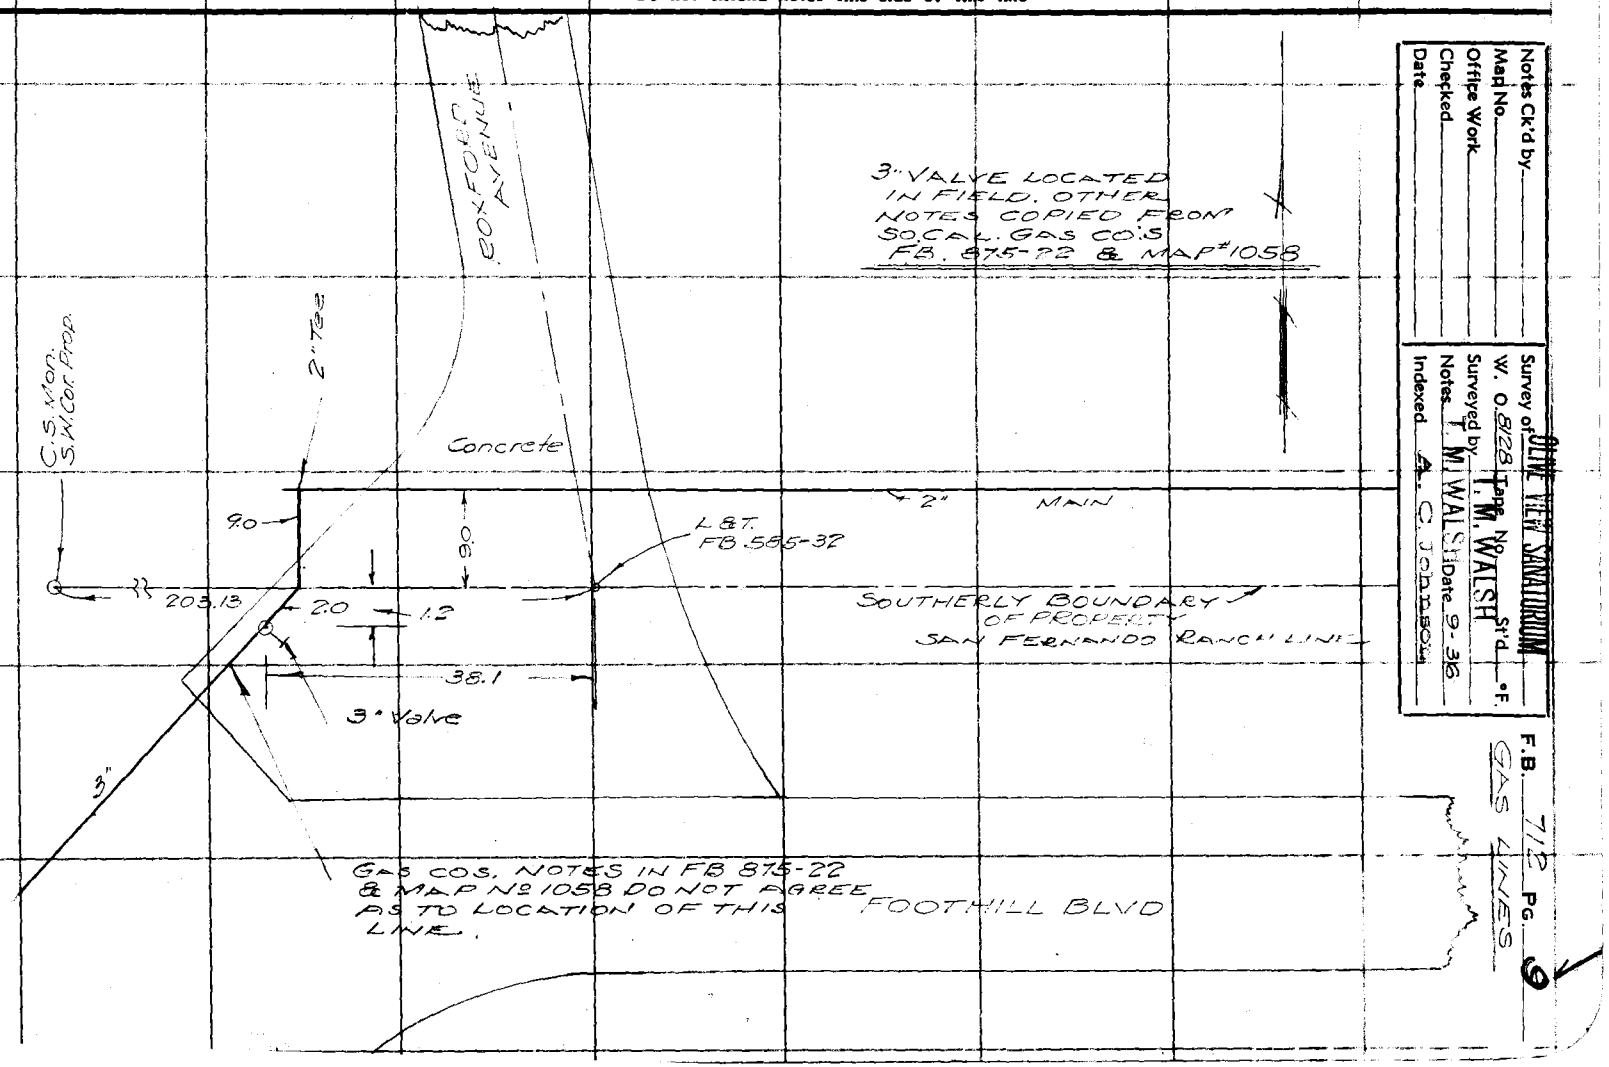

Notes Ck'd by
Map No.
Office Work
Checked
Date

Survey of OLIVE VIEW SANATORIUM
W. O. 8128 Topo No. St'd °F.
Surveyed by T. M. WALSH Date 9-36
Notes T. M. WALSH
Indexed A. C. Johnson

F.B. 712 Pg. 9
GAS LINES

RETURN TO
LOS ANGELES COUNTY SURVEYOR
700 HALL OF RECORDS

Note: Any Additions or Changes on This Sheet Must be Made or Circled in **Red Ink** With Date and Name of Person Making Change.

Do not extend notes this side of this line

F.B. 712 Pg. 10

Notes Ck'd by	Survey of OLIVE VIEW SAN UNDERGROUND
Map No.	W. O. 5128 Tape No. St'd °F.
Office Work	Surveyed by T. WALSH
Checked	Notes WALSH Date 7/29/36
Date	Indexed A. C. Johnson

F.B. 712 PG. 11

GAS LINES

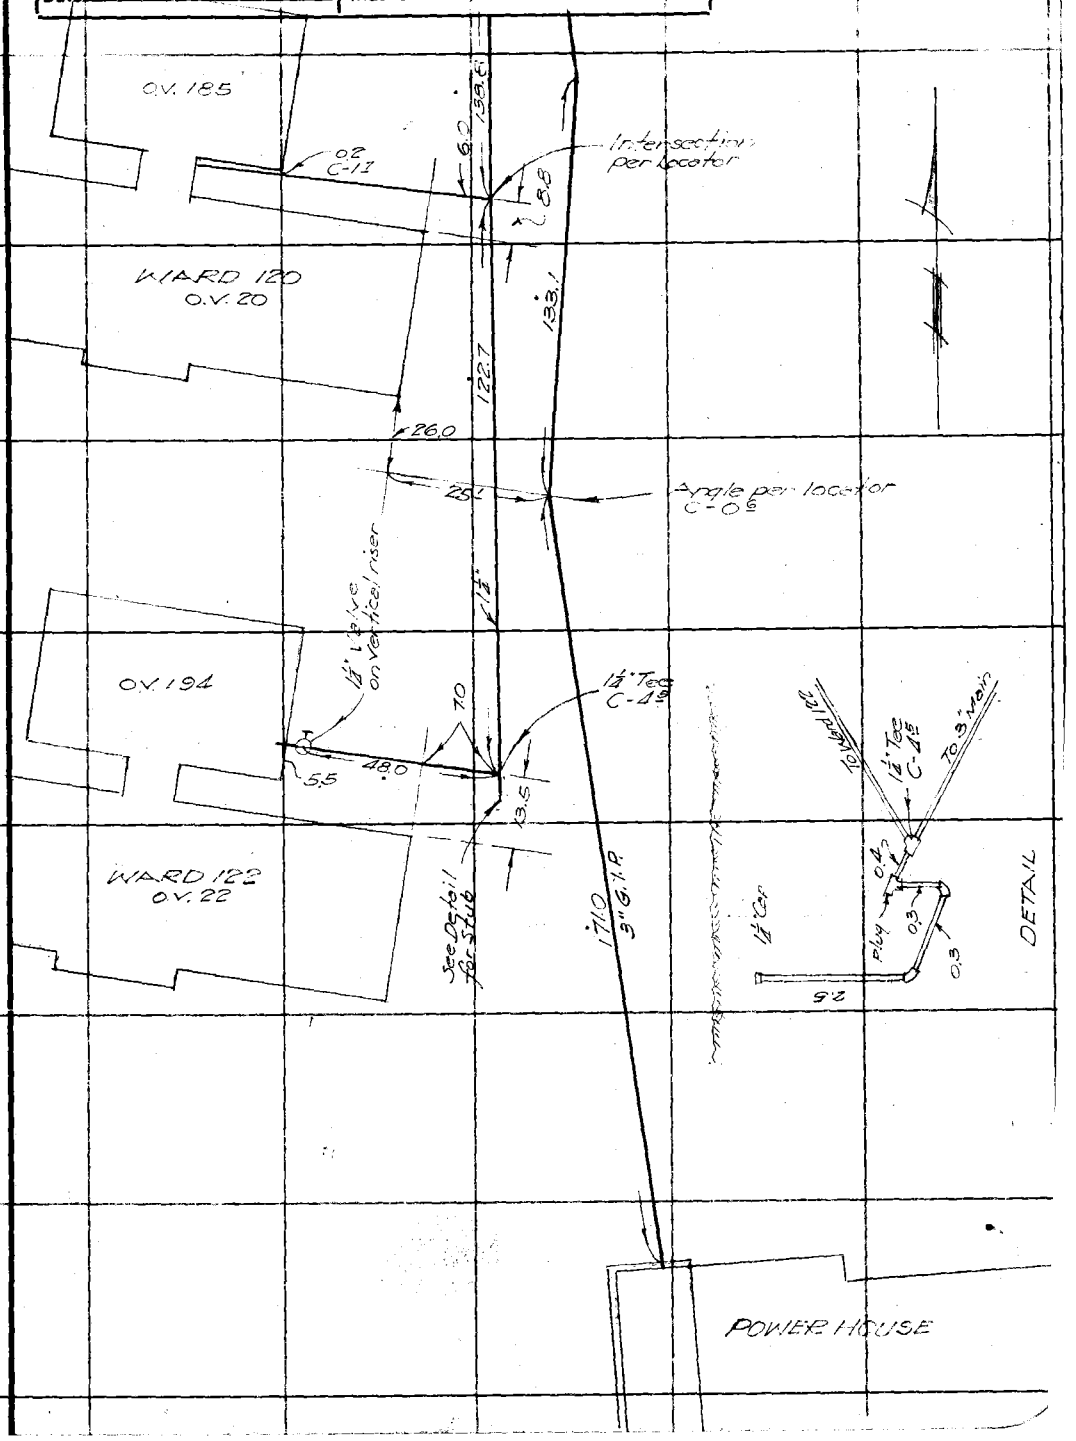

Note: Any Additions or Changes on This Sheet Must be Made or Circled in Red Ink With Date and Name of Person Making Change.

Do not extend notes this side of this line

RETURN TO
LOS ANGELES COUNTY SURVEYOR
700 HALL OF RECORDS

FORM 247 10M 11-35

F.B. 712 Pg. 12

GAS LINES

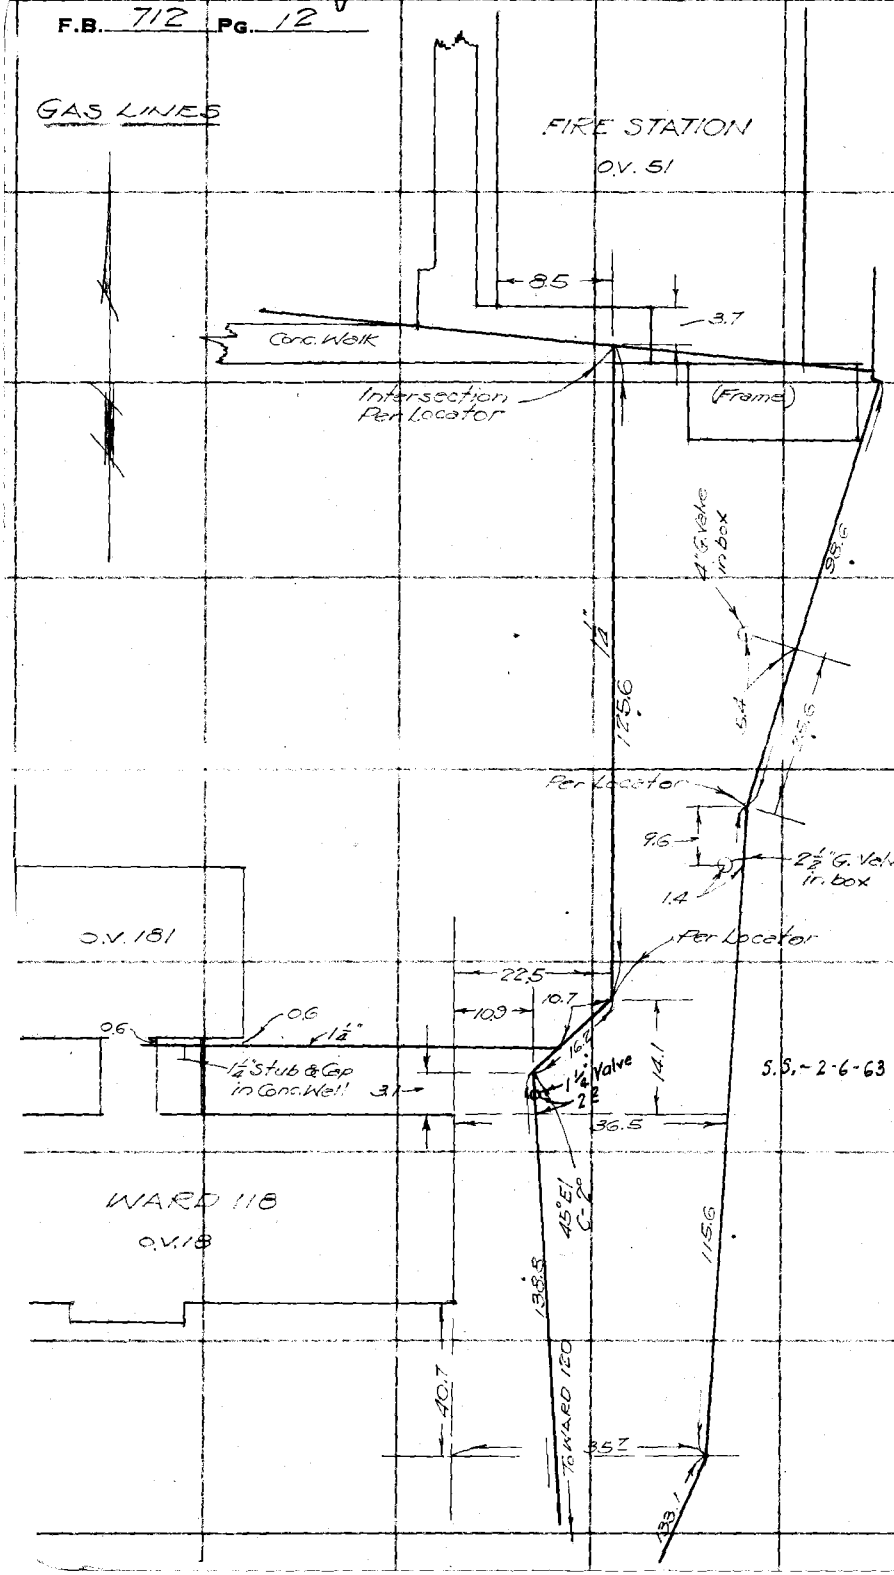

RETURN TO
LOS ANGELES COUNTY SURVEYOR
700 HALL OF RECORDS

Note: Any Additions or Changes on This Sheet Must be Made or Circled in Red Ink With Date and Name of Person Making Change.

Do not extend notes this side of this line

Notes Ck'd by	Survey of OLIVE VIEW SAN
Map No.	W. O. 8178 Tape No. St'd °F.
Office Work	Surveyed by T. WH. I. SH.
Checked	Notes WH. I. SH. Date 7-9-36
Date	Indexed A. C. Johnson

F.B. 712 Pg. 13

GAS LINES

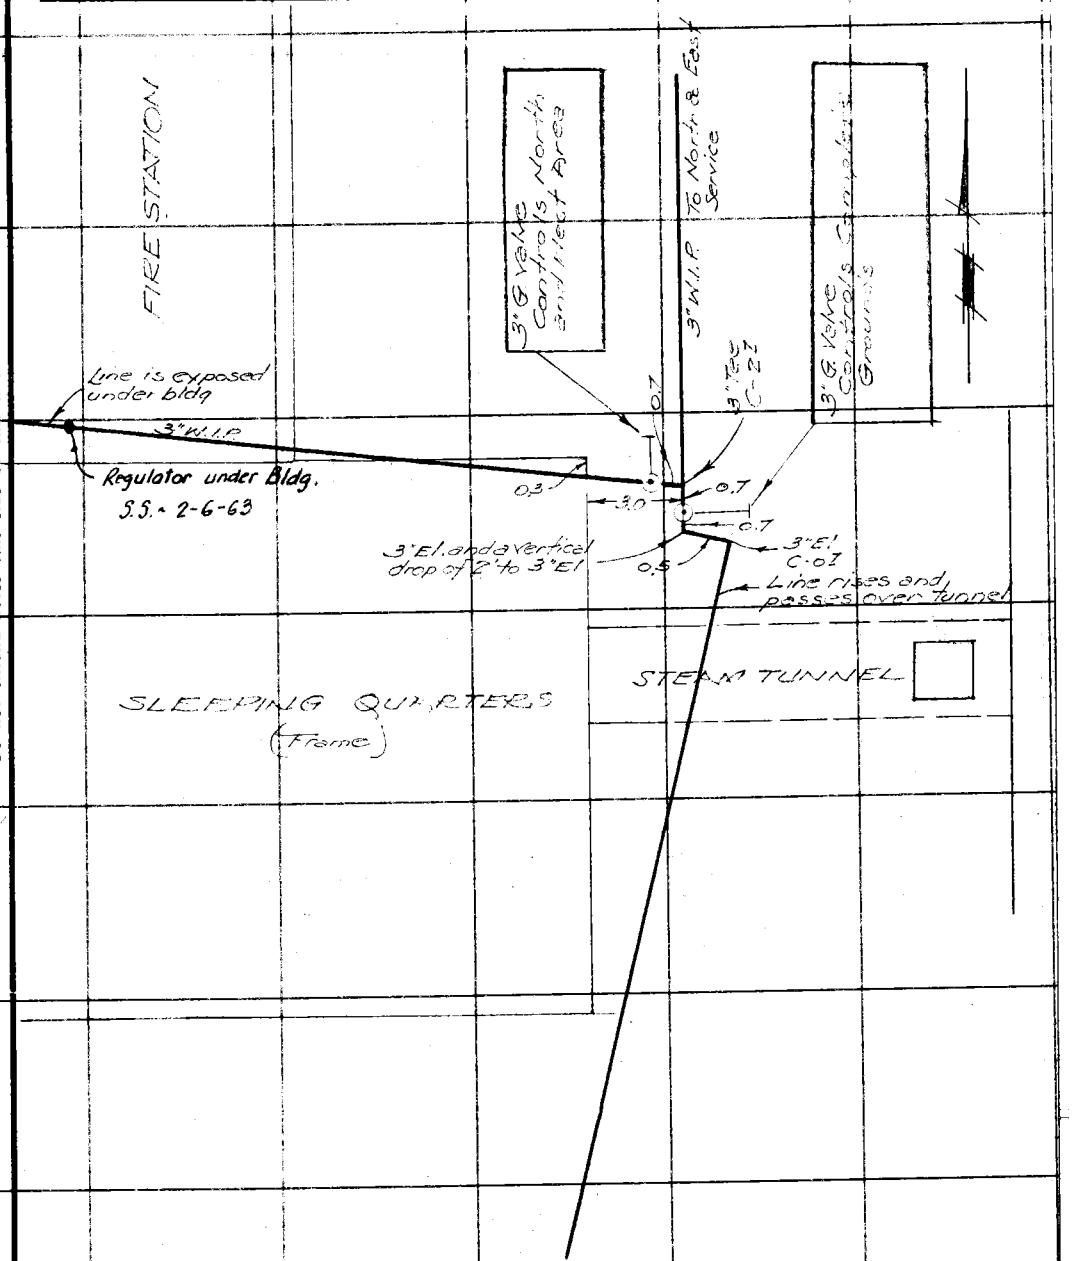

Note: Any Additions or Changes on This Sheet Must be Made or Circled in Red Ink With Date and Name of Person Making Change.

Do not extend notes this side of this line

RETURN TO
LOS ANGELES COUNTY SURVEYOR
7do HALL OF RECORDS

FORM 247 10M 11-35

RETURN TO
LOS ANGELES COUNTY SURVEYOR
700 HALL OF RECORDS

Note: Any Additions or Changes on This Sheet Must be Made or Circled in **Red Ink** With Date and Name of Person Making Change.

Do not extend notes this side of this line

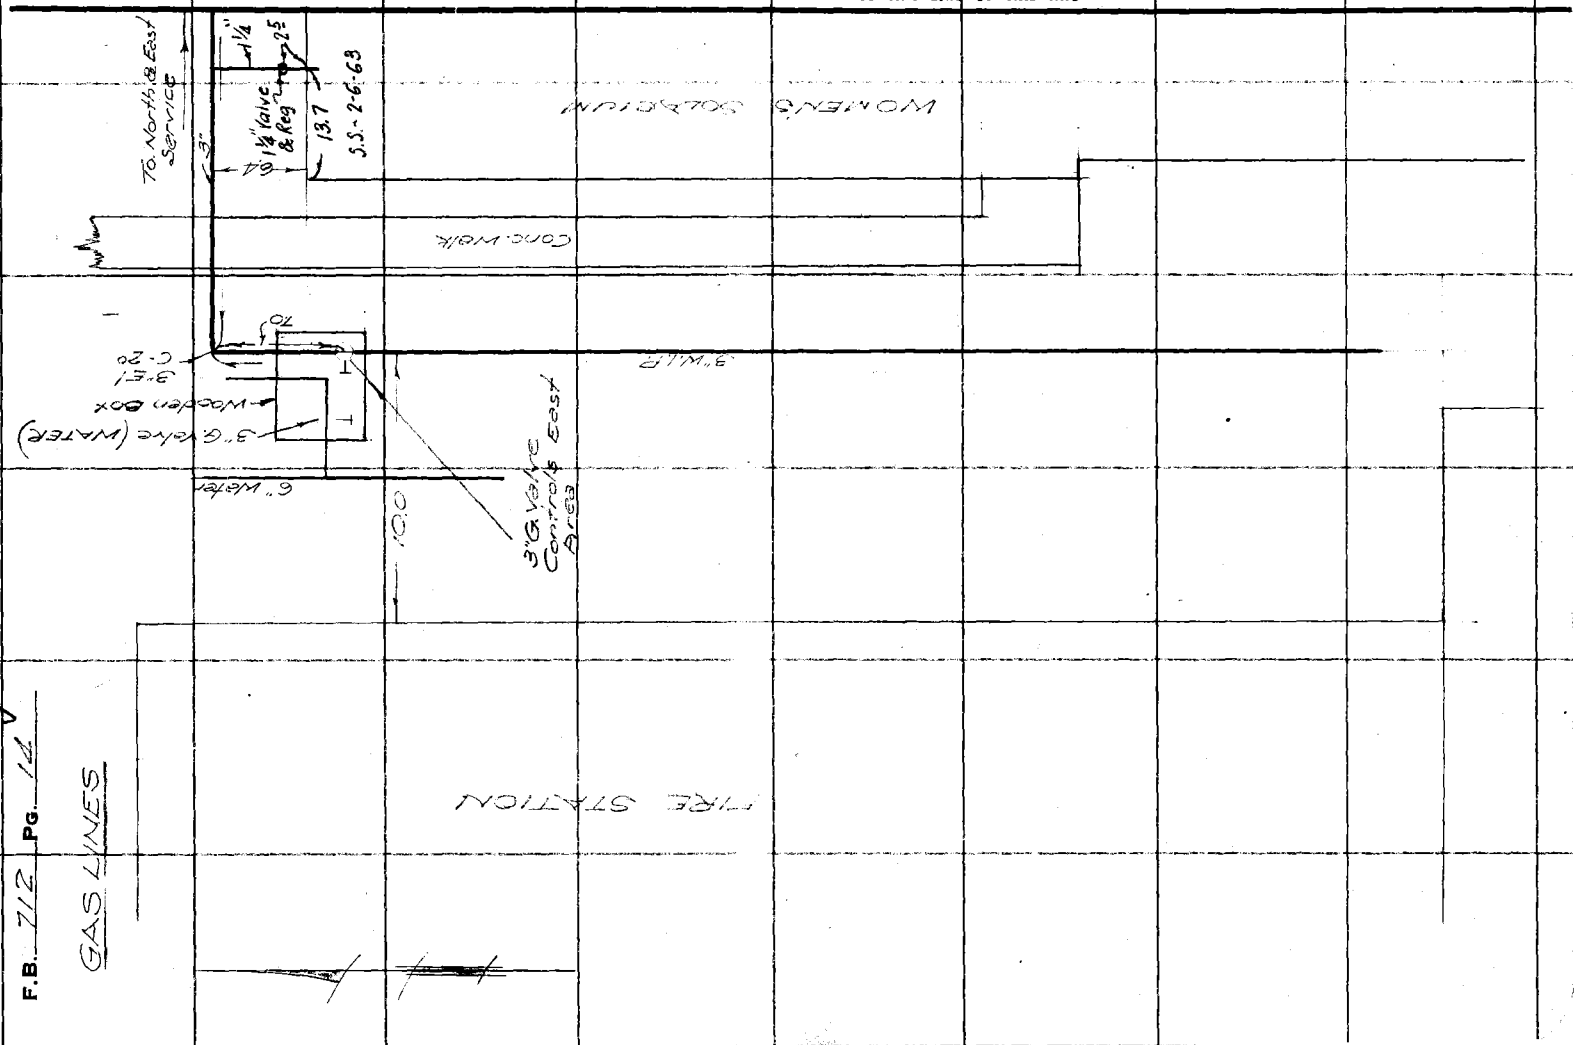


GAS LINES

FORM 247 10M 11-35

RETURN TO
LOS ANGELES COUNTY SURVEYOR
700 HALL OF RECORDS

Note: Any Additions or Changes on This Sheet Must be Made or Circled in Red Ink With Date and Name of Person Making Change.

Do not extend notes this side of this line

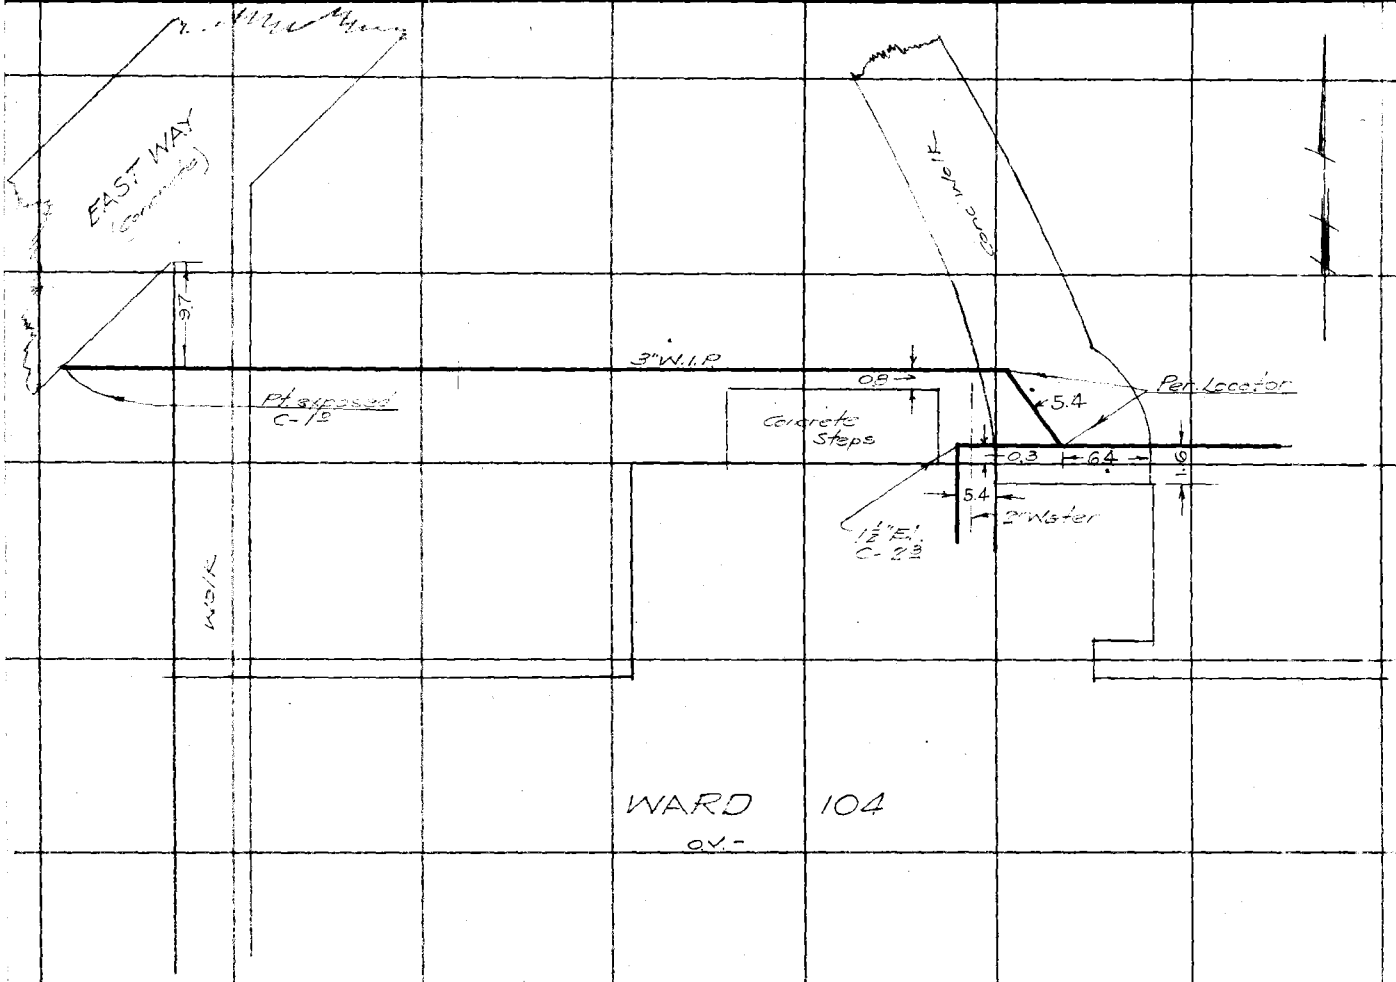

Notes Ck'd by
Map No.
Office Work
Checked
Date

Survey of OLIVE VIEW SAN
W. O. 8178 Tape No. St'd. °F.
Surveyed by TOM WALSH
Notes WALSH Date 7-26-36
Indexed A. C. Johnson

F.B. 712 PG. 5

GAS LINES

RETURN TO
LOS ANGELES COUNTY SURVEYOR
700 HALL OF RECORDS

Note: Any Additions or Changes on This Sheet Must be Made or Circled in **Red** Ink With Date and Name of Person Making Change.

Do not extend notes this side of this line

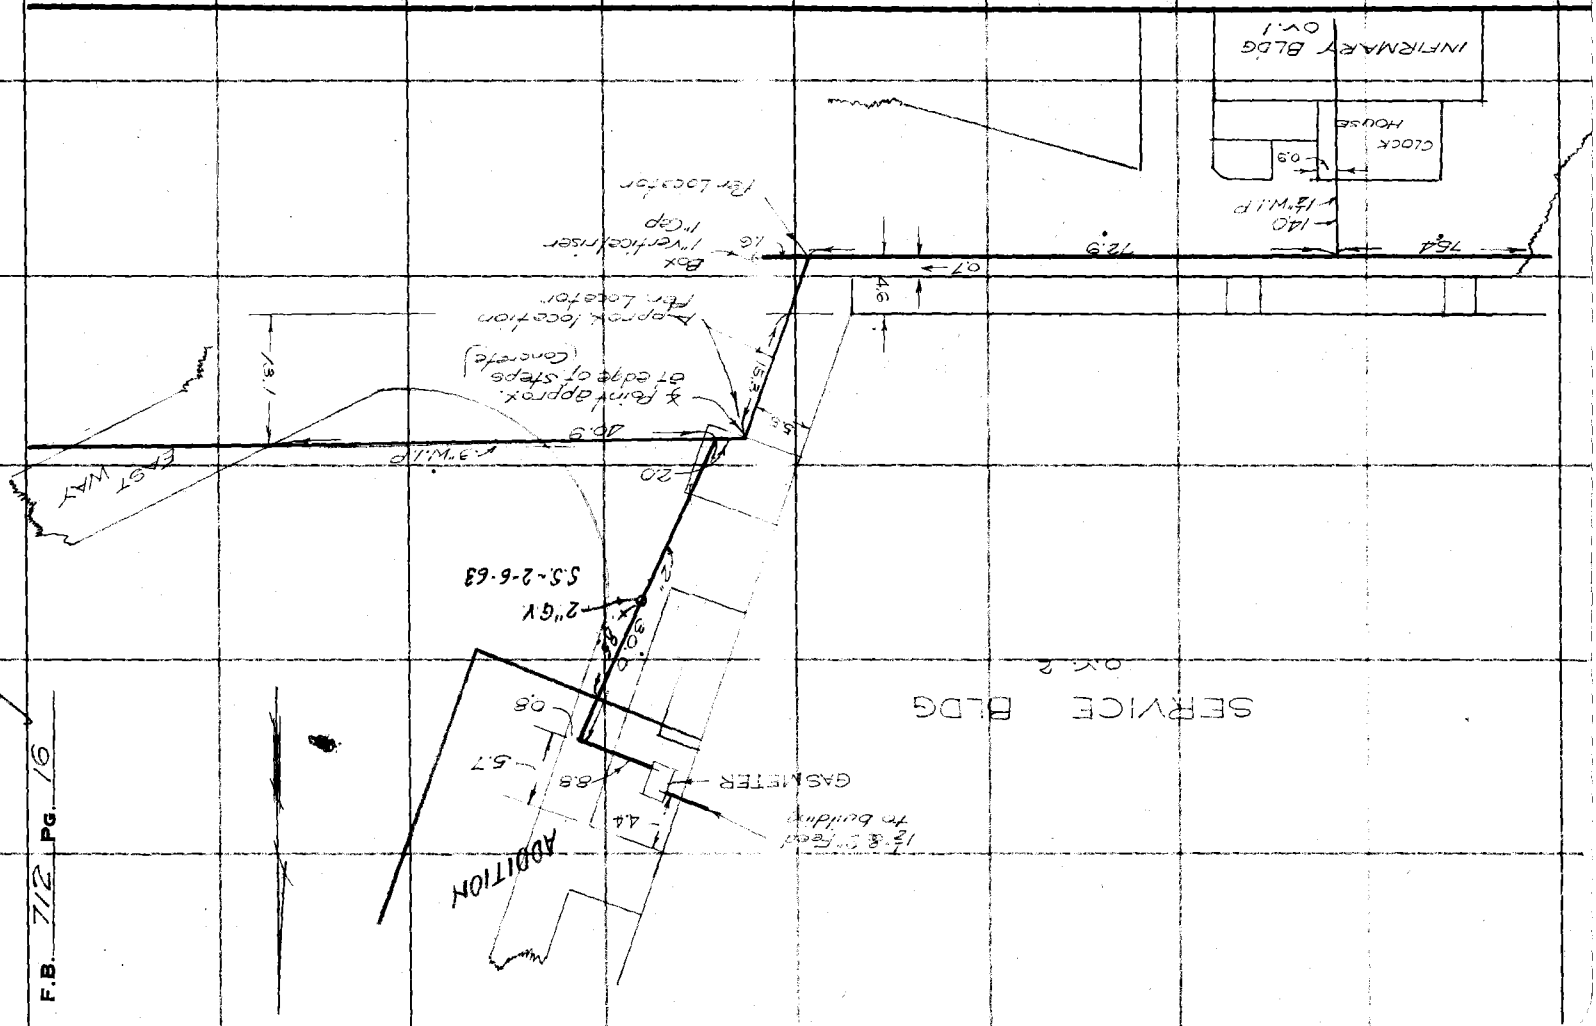

Notes Ck'd by	Survey of OLIVE VIEW SAN
Map No.	W. O. 8128 Tape No. St'd °F.
Office Work	Surveyed by T.M. WALSH
Checked	Notes WALSH Date 7-10-36
Date	Indexed A. C. Johnson

F.B. 712 PG. 17

GAS LINES

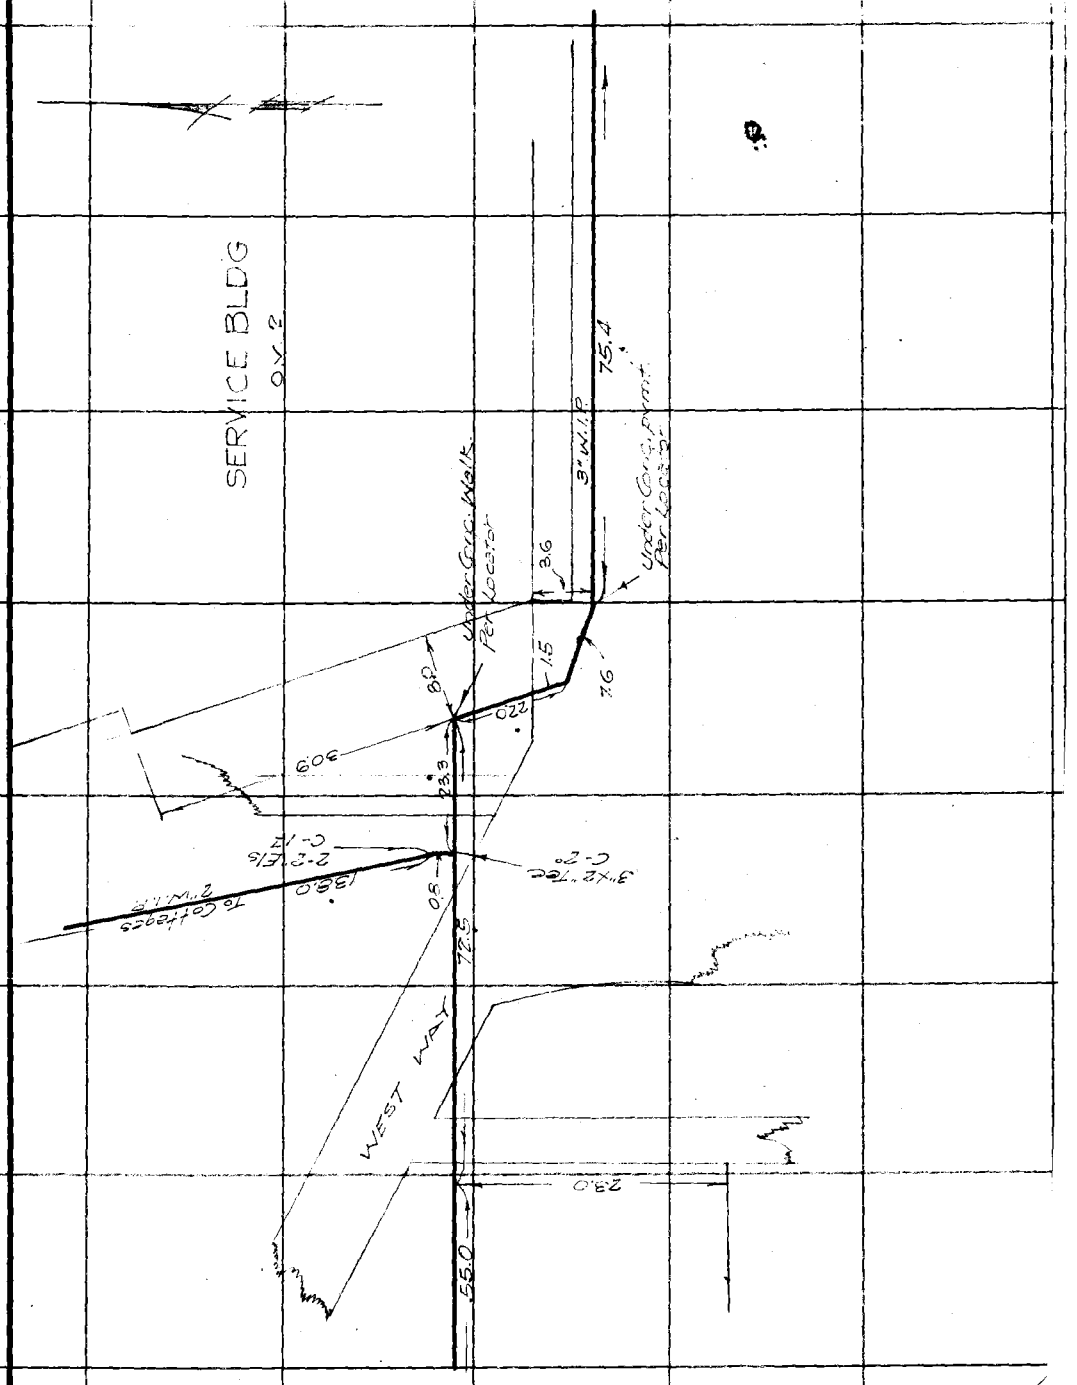

Note: Any Additions or Changes on This Sheet Must be Made or Circled in Red Ink With Date and Name of Person Making Change.

Do not extend notes this side of this line

RETURN TO
LOS ANGELES COUNTY SURVEYOR
700 HALL OF RECORDS

FORM 247 10M 11-35

RETURN TO
LOS ANGELES COUNTY SURVEYOR
700 HALL OF RECORDS

Note: Any Additions or Changes on This Sheet Must be Made or Circled in Red Ink With Date and Name of Person Making Change.

Do not extend notes this side of this line

F.B. 712 Pg. 18

Notes Ck'd by	Survey of GLEN VIEW SAN	F.B. 712 PG. 19
Map No.	W. O. 8148 Tape No. St'd °F.	
Office Work	Surveyed by T. M. WALSH	GAS LINES
Checked	Notes WALSH Date 7-16-36	
Date	Indexed A. C. Johnson	

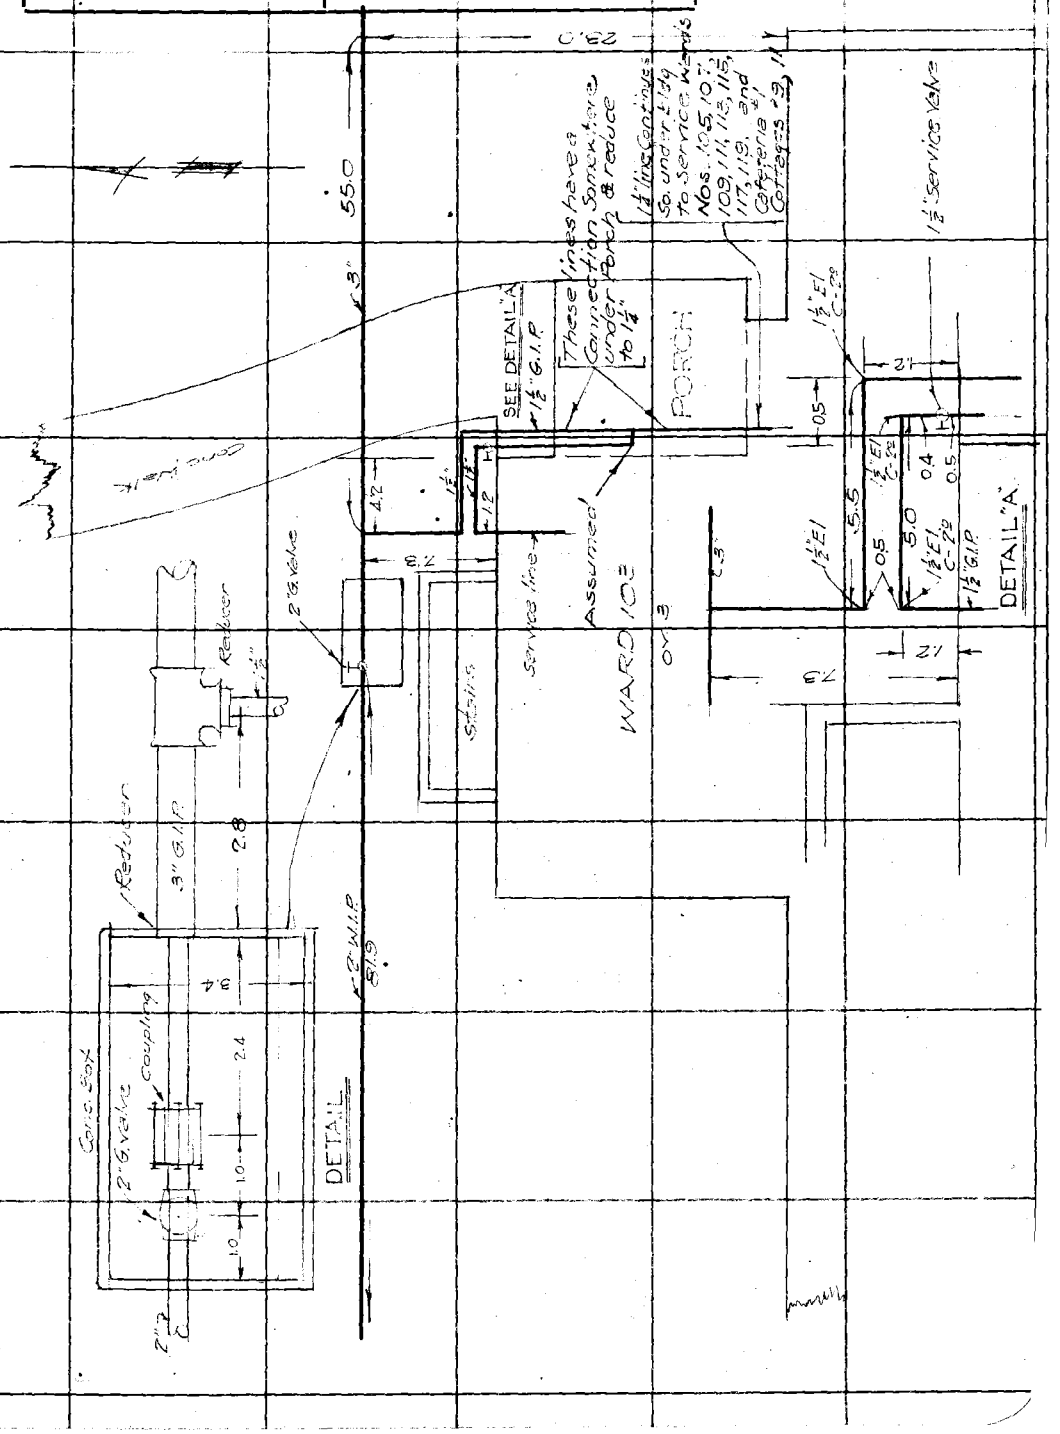

Note: Any Additions or Changes on This Sheet Must be Made or Circled in Red Ink With Date and Name of Person Making Change.

Do not extend notes this side of this line

RETURN TO
LOS ANGELES COUNTY SURVEYOR
700 HALL OF RECORDS

FORM 247 10M 11-35

RETURN TO
LOS ANGELES COUNTY SURVEYOR
700 HALL OF RECORDS

Note: Any Additions or Changes on This Sheet Must be Made or Circled in Red Ink With Date and Name of Person Making Change.

Do not extend notes this side of this line

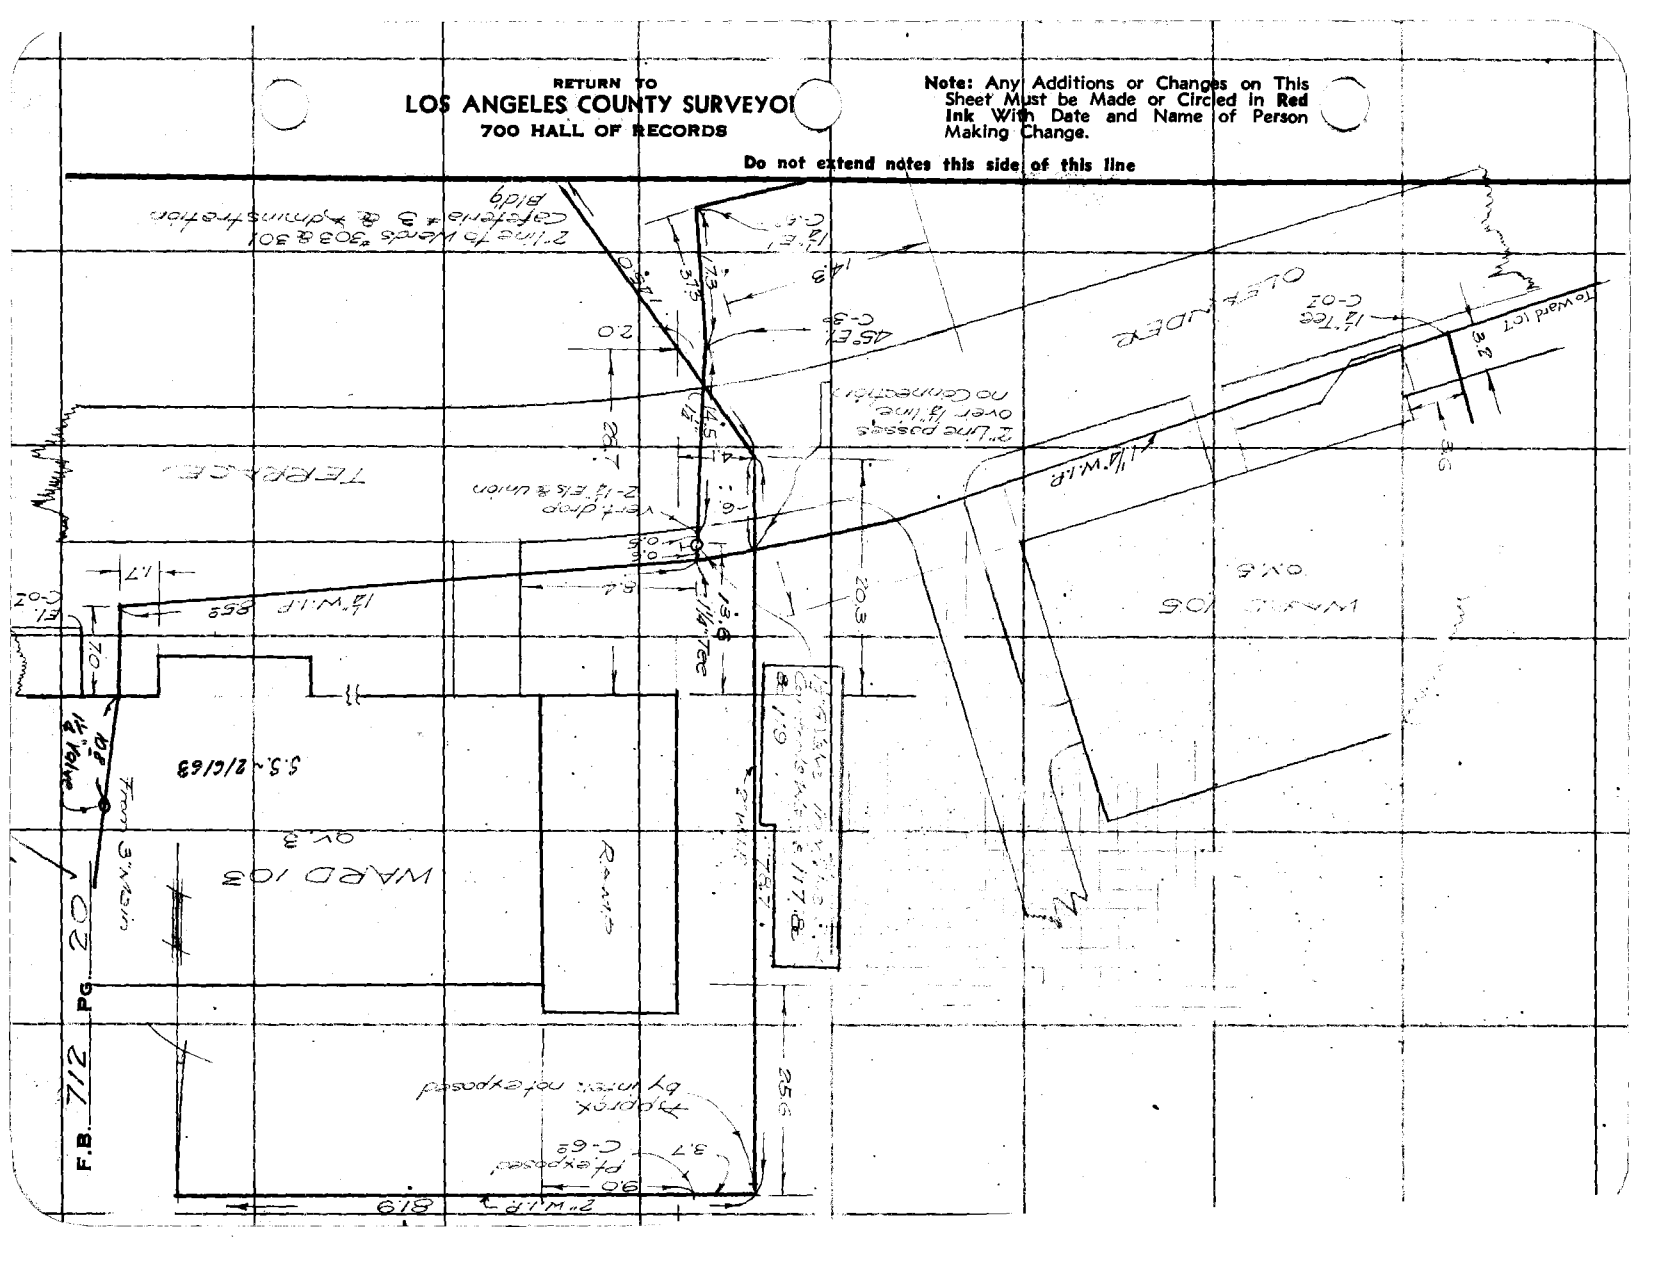

Notes Ck'd by	Survey of OLIVE VIEW [illegible]	F.B. 712 Pg. 21 ✓
Map No.	W. O. 81-V8 Tape No. St'd °F.	GAS LINES
Office Work	Surveyed by T. WALSH	
Checked	Notes WALSH Date [illegible]	
Date	Indexed A. C. Johnson	

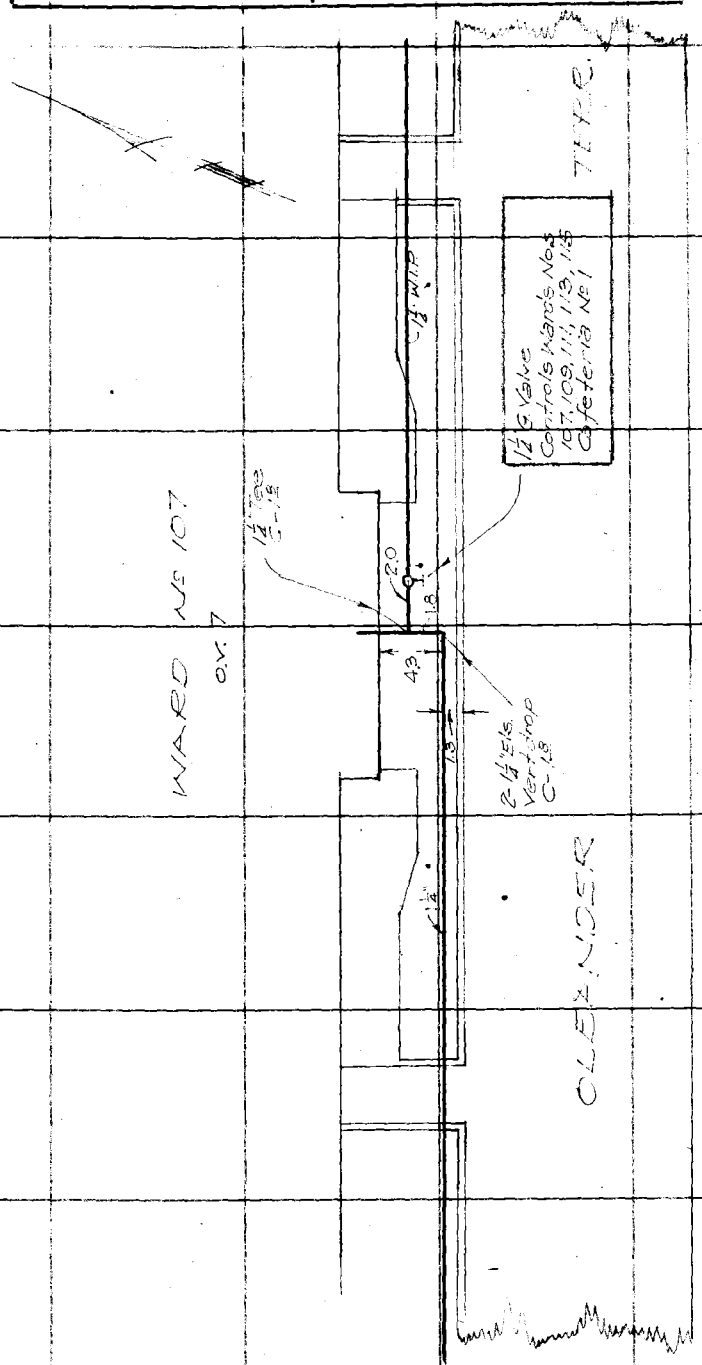

Note: Any Additions or Changes on This Sheet Must be Made or Circled in Red Ink With Date and Name of Person Making Change.

Do not extend notes this side of this line

RETURN TO
LOS ANGELES COUNTY SURVEYOR
700 HALL OF RECORDS

FORM 247 10M 11-35

RETURN TO
LOS ANGELES COUNTY SURVEYOR
700 HALL OF RECORDS

Note: Any Additions or Changes on This Sheet Must be Made or Circled in **Red Ink** With Date and Name of Person Making Change.

Do not extend notes this side of this line

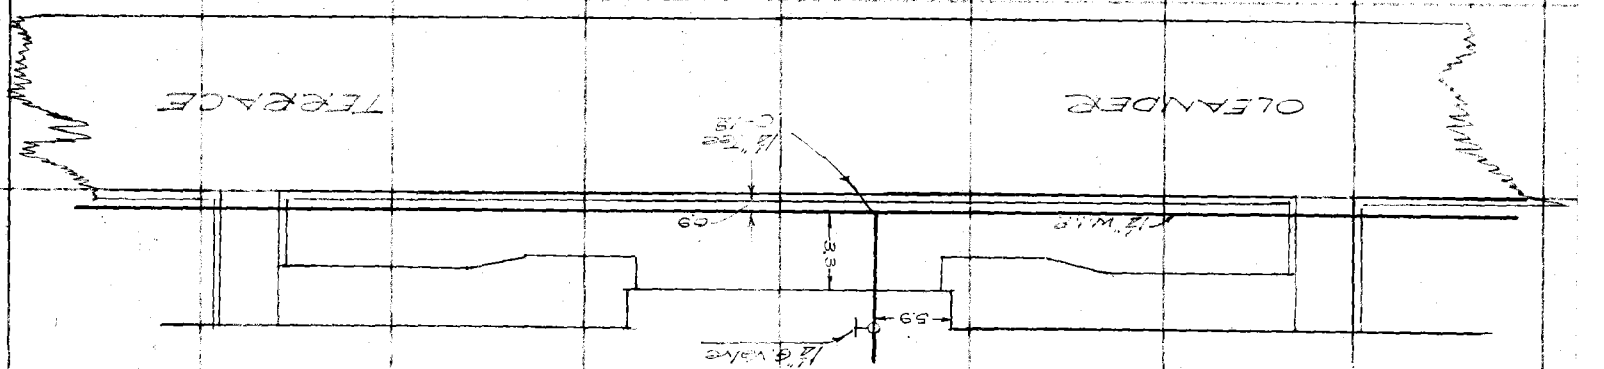

F.B. 712 PG. 22

Notes Ck'd by	Survey of OLIVE VIEW SAN	F.B. 712 PG. 23
Map No.	W. O. 8178 Tape No. St'd °F.	
Office Work	Surveyed by TED M WALSH	GAS LINES
Checked	Notes WALSH Date 7-27-36	
Date	Indexed A. C. Johnson	

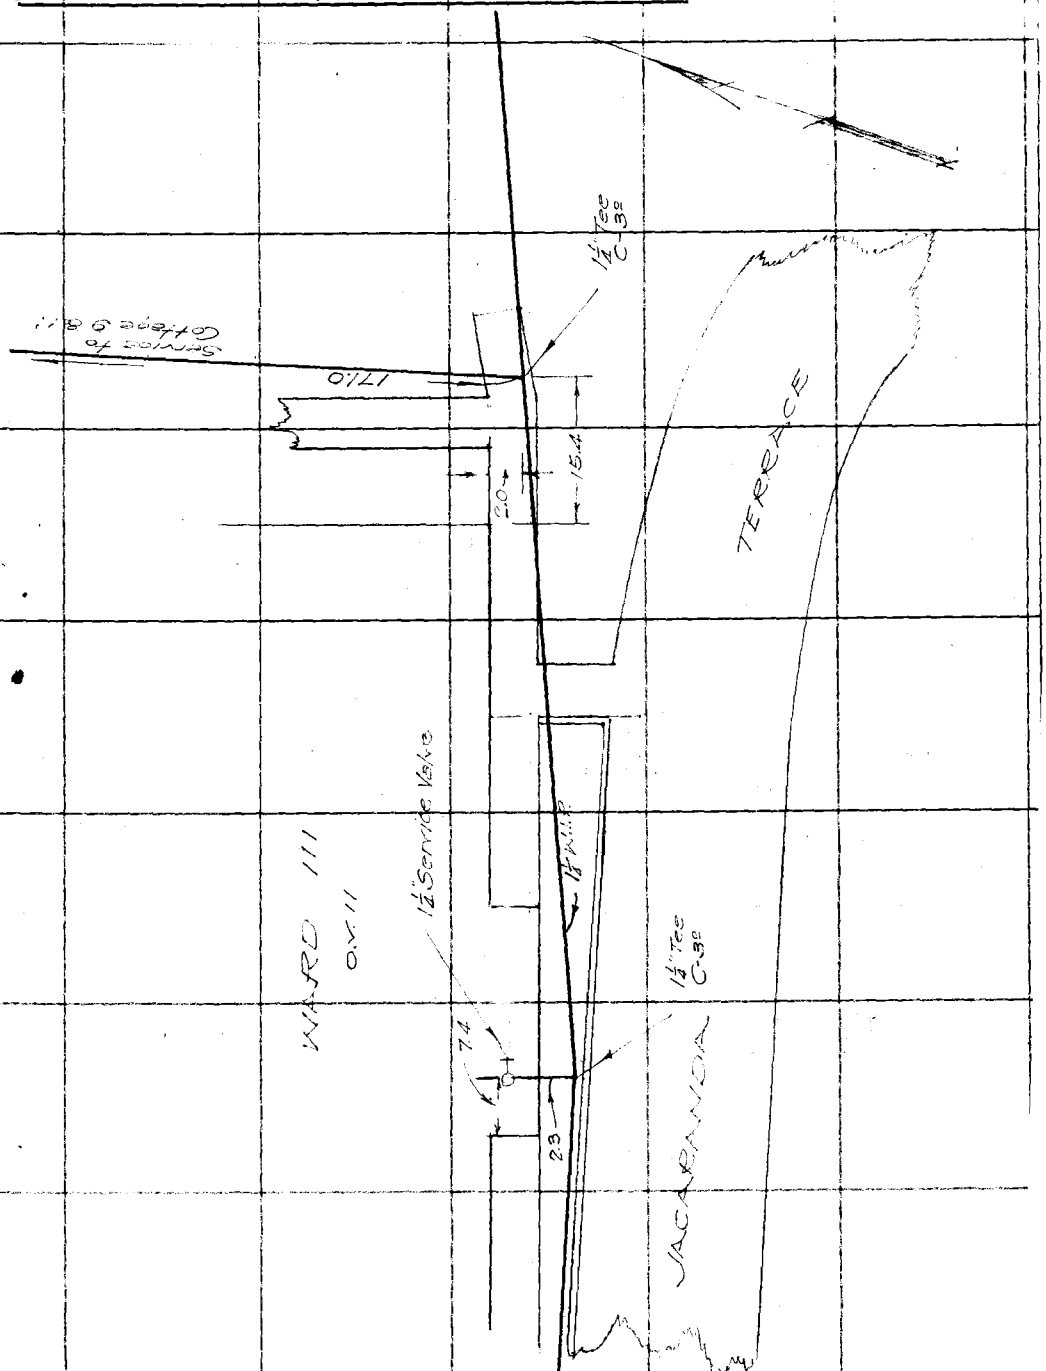

Note: Any Additions or Changes on This Sheet Must be Made or Circled in Red Ink With Date and Name of Person Making Change.

Do not extend notes this side of this line

RETURN TO
LOS ANGELES COUNTY SURVEYOR
700 HALL OF RECORDS

FORM 247 10M 11-35

RETURN TO
LOS ANGELES COUNTY SURVEYOR
700 HALL OF RECORDS

Note: Any Additions or Changes on This Sheet Must be Made or Circled in **Red Ink** With Date and Name of Person Making Change.

Do not extend notes this side of this line

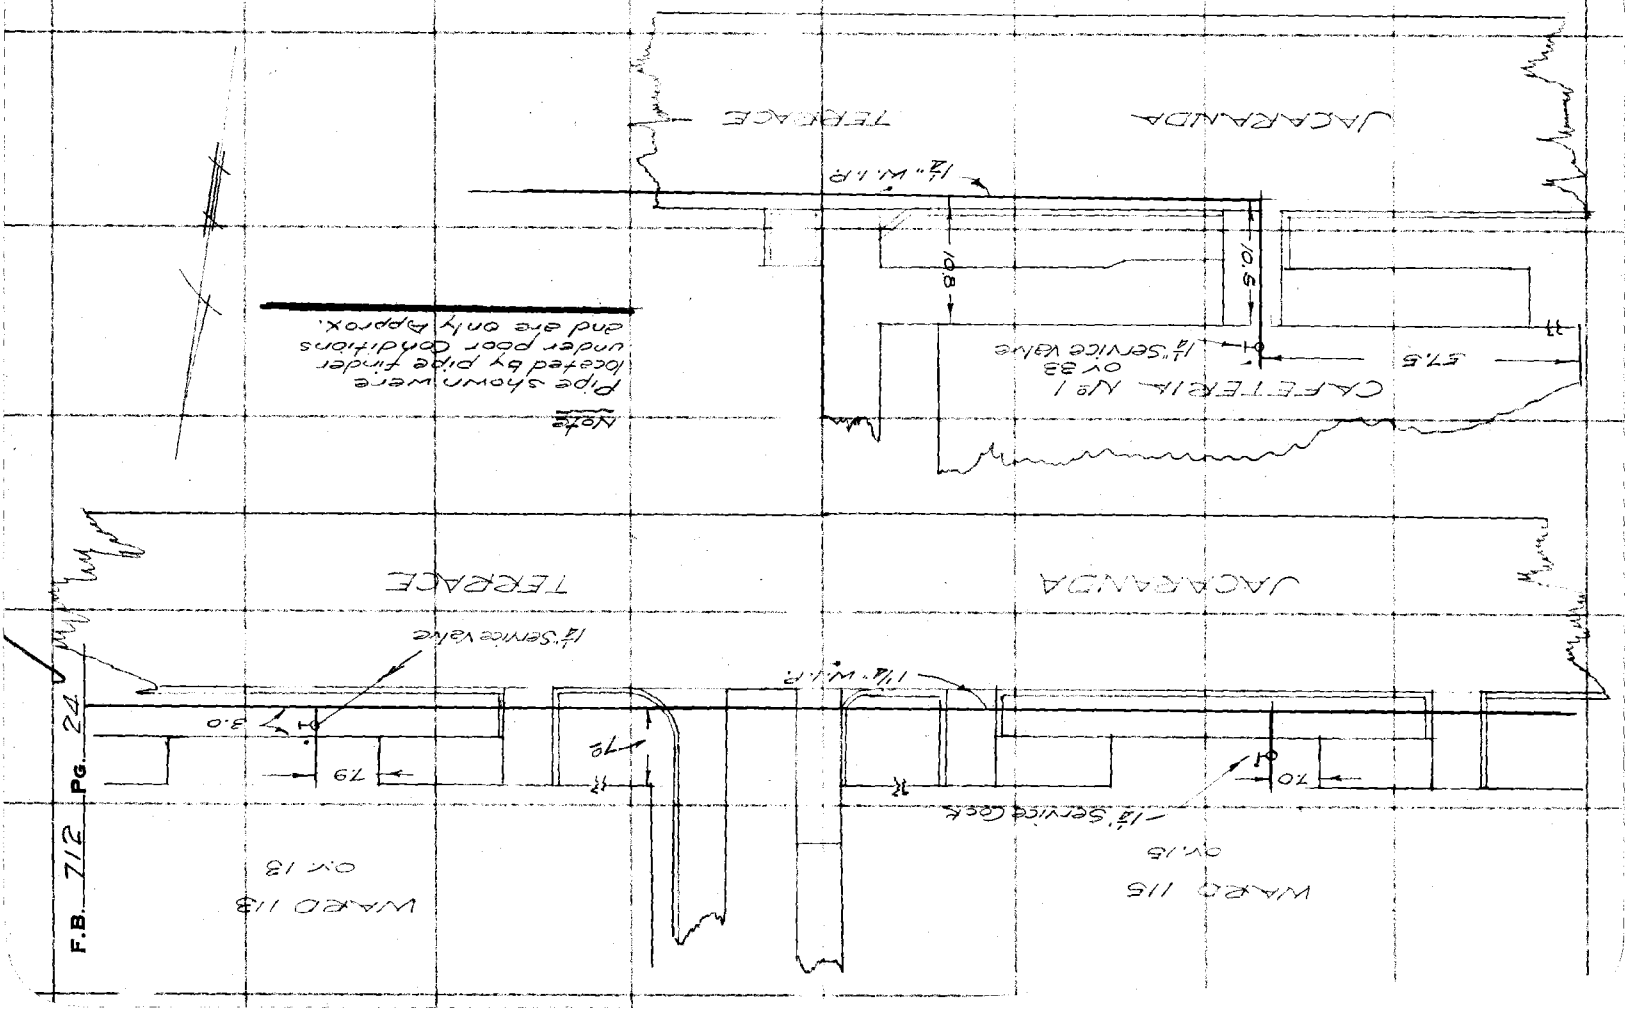

F.B. 712 PG. 24

FORM 247 10M 11-38

RETURN TO
LOS ANGELES COUNTY SURVEYOR
700 HALL OF RECORDS

Note: Any Additions or Changes on This Sheet Must be Made or Circled in **Red Ink** With Date and Name of Person Making Change.

Do not extend notes this side of this line

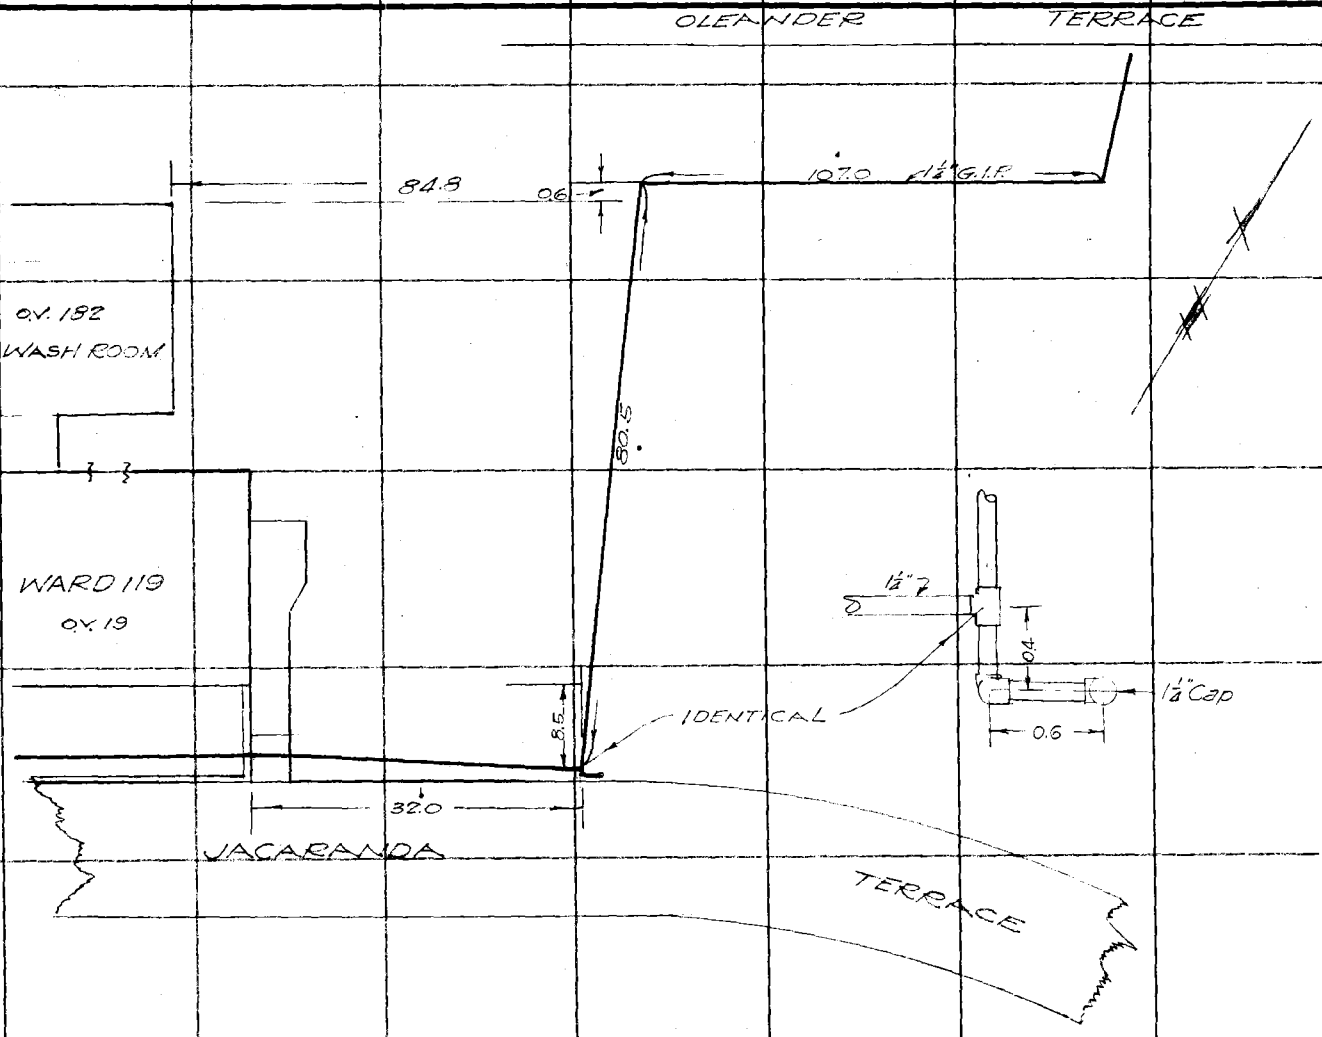

Notes Ck'd by
Map No.
Office Work
Checked
Date

Survey of OLIVE VIEW SAN
W. O. 8118 Tape No. Std. °F.
Surveyed by TED. M WALSH
Notes WALSH Date 7-28-36
Indexed A. C. Johnson

F.B. 712 Pg. 25

GAS LINES

RETURN TO
LOS ANGELES COUNTY SURVEYOR
700 HALL OF RECORDS

Note: Any Additions or Changes on This Sheet Must be Made or Circled in **Red Ink** With Date and Name of Person Making Change.

Do not extend notes this side of this line

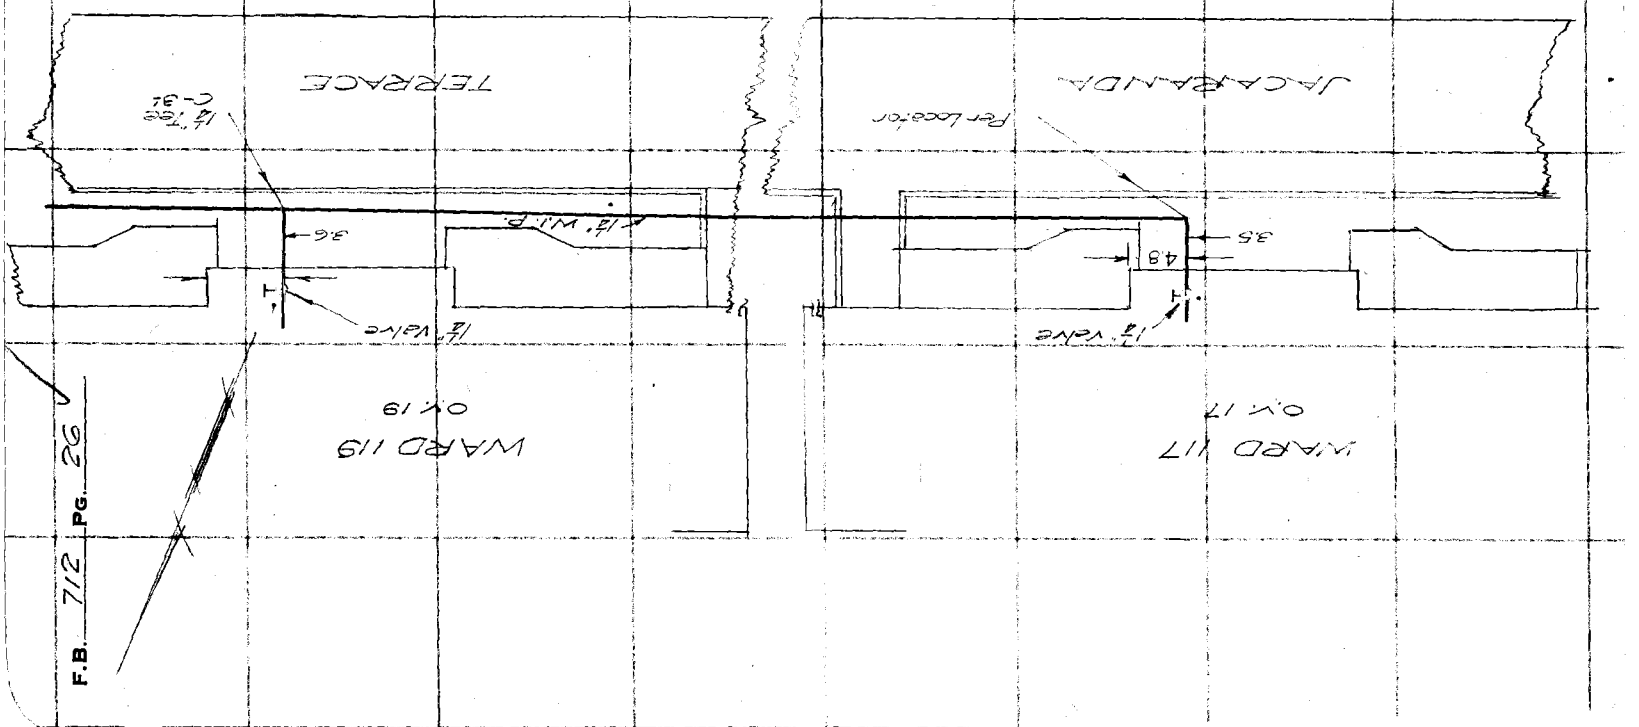

F.B. 712 PG. 26

Notes Ck'd by	Survey of OLIVE VIEW SAN.
Map No.	W. O. 8178 Tape No. St'd °F.
Office Work	Surveyed by TED M. WALSH
Checked	Notes WALSH Date 7-29-36
Date	Indexed A. C. Schiess

F.B. 712 PG. 27

GAS LINES

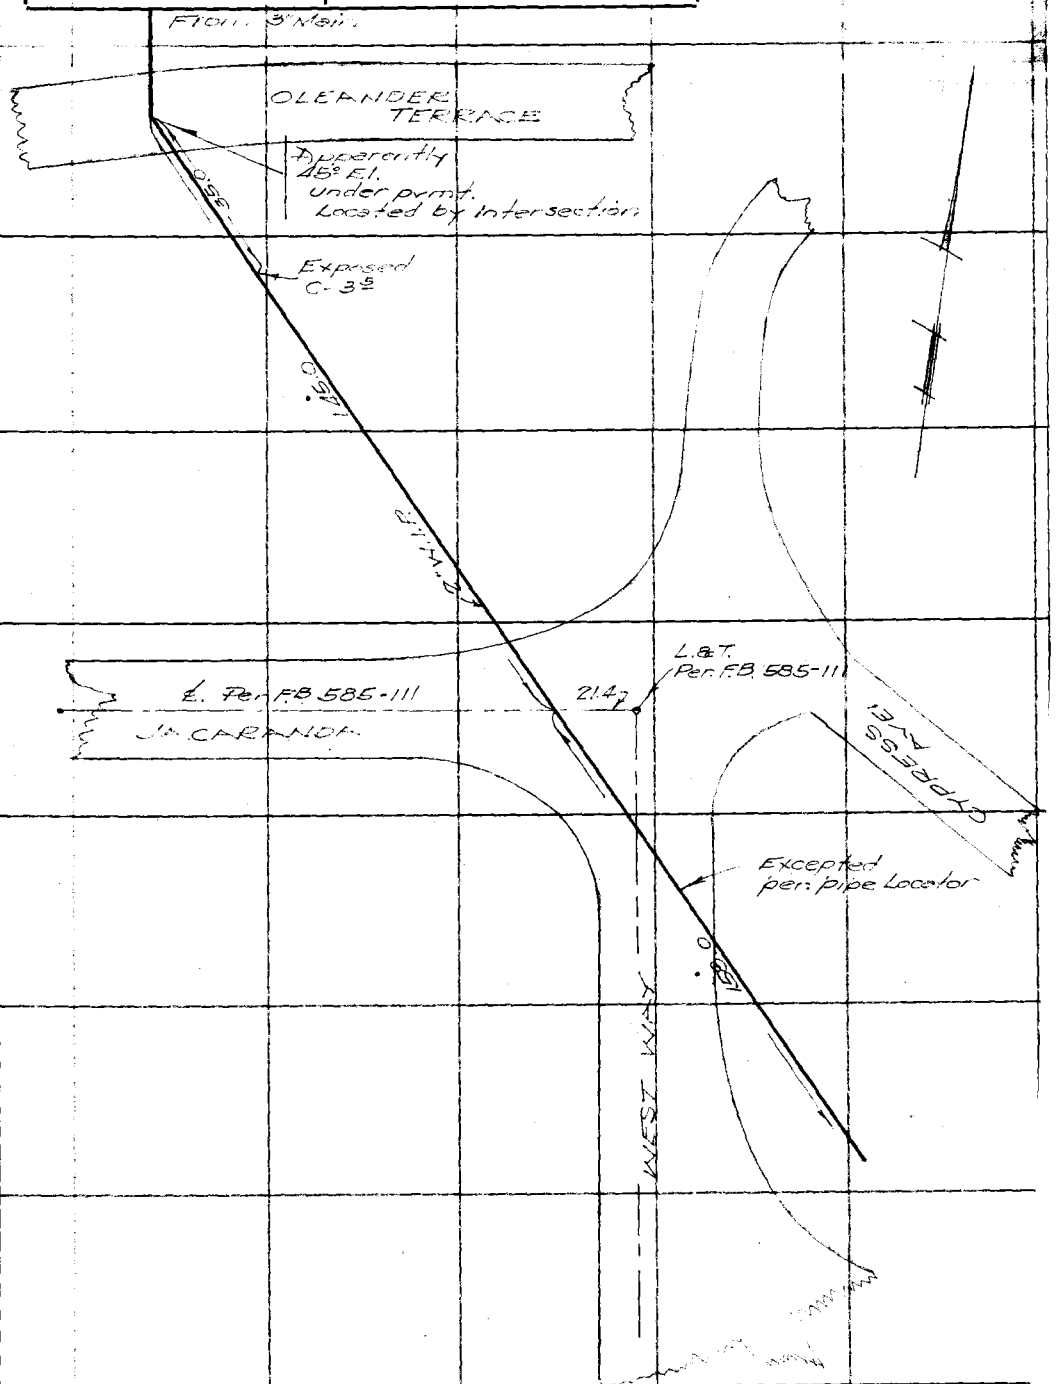

Note: Any Additions or Changes on This Sheet Must be Made or Circled in Red Ink With Date and Name of Person Making Change.

Do not extend notes this side of this line

RETURN TO
LOS ANGELES COUNTY SURVEYOR
700 HALL OF RECORDS

FORM 247 10M 11-36

F.B. 712 Pg. 28

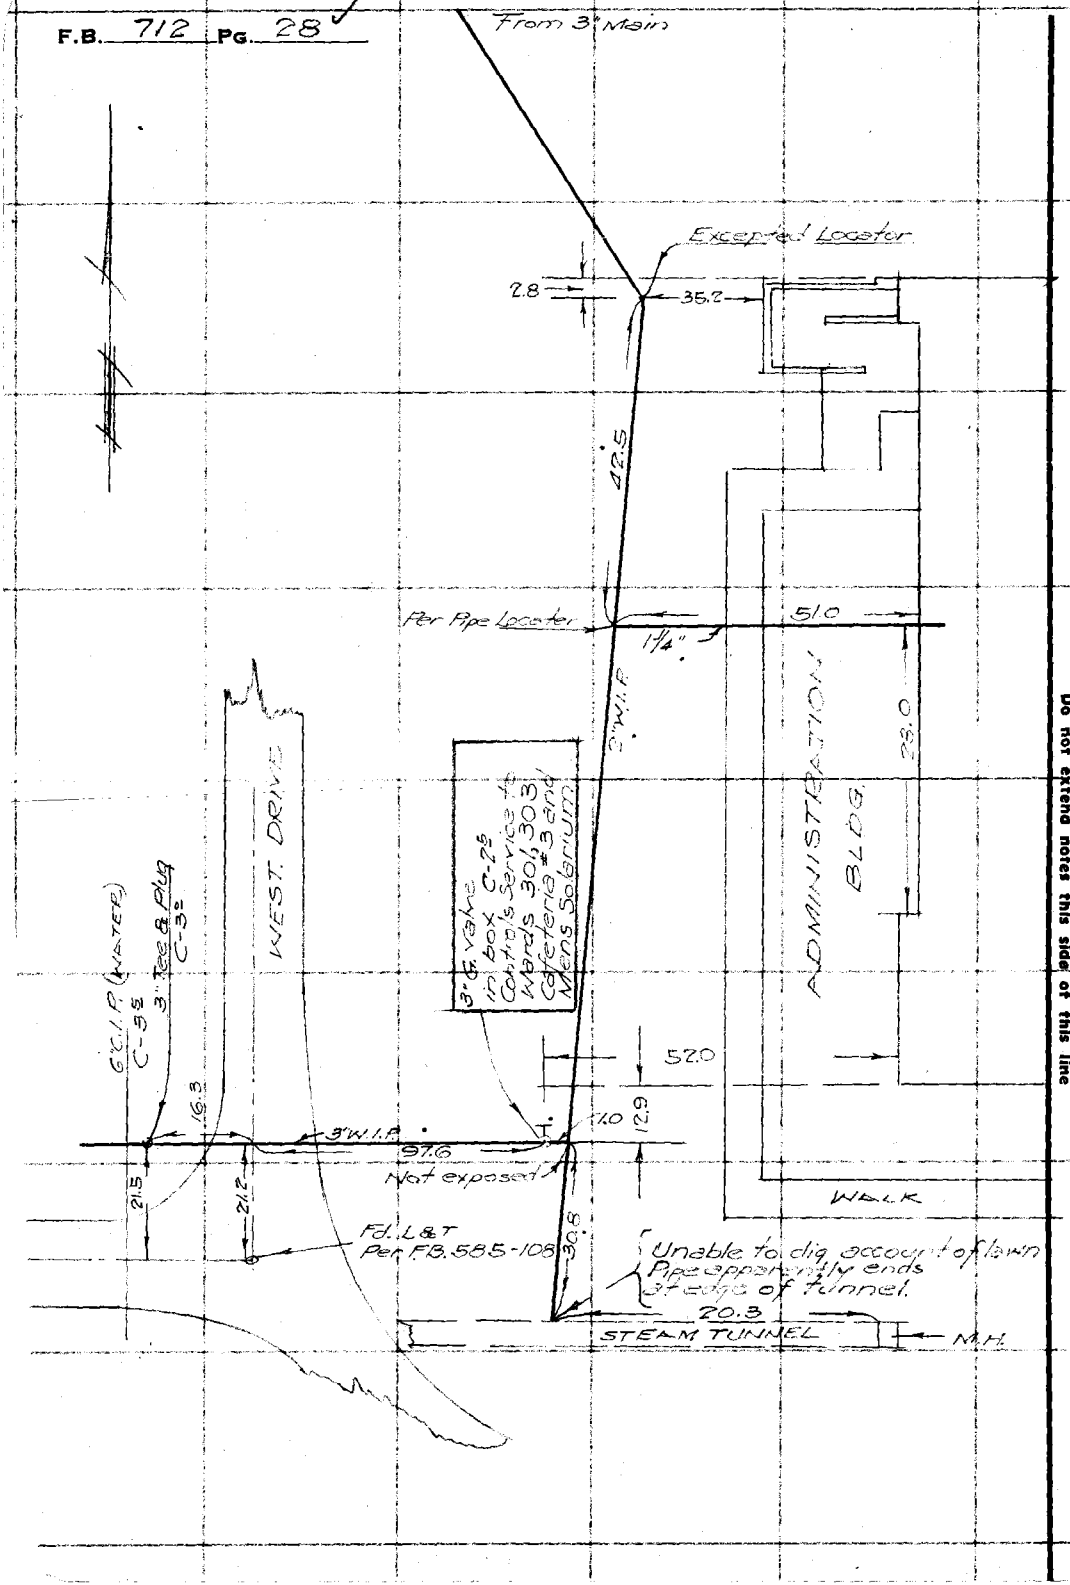

RETURN TO
LOS ANGELES COUNTY SURVEYOR
700 HALL OF RECORDS

Do not extend notes this side of this line

Note: Any Additions or Changes on This Sheet Must be Made or Circled in Red Ink With Date and Name of Person Making Change.

FORM 247 10M 11-35

RETURN TO
LOS ANGELES COUNTY SURVEYOR
700 HALL OF RECORDS

Note: Any Additions or Changes on This Sheet Must be Made or Circled in Red Ink With Date and Name of Person Making Change.

Do not extend notes this side of this line

Notes Ck'd by
Map No.
Office Work
Checked
Date

Survey of OLIVE VIEW SAN
W. O. 8178 Tape No. St'd. °F.
Surveyed by TED M WALSH
Notes WALSH Date 7-30-36
Indexed C. C. Johnson

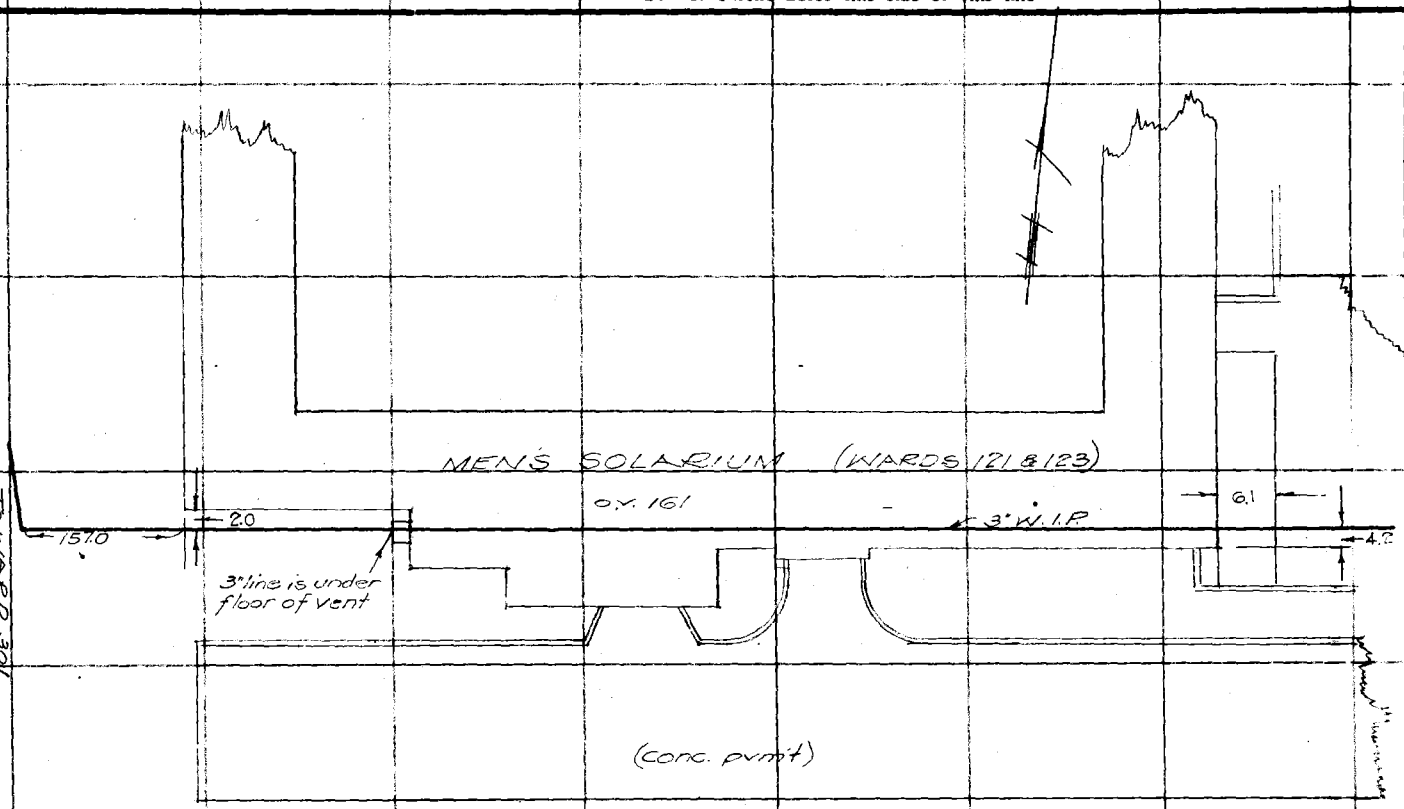

F.B. 712 PG. 29

GAS LINES

F.B. 712 Pg. 30

RETURN TO
LOS ANGELES COUNTY SURVEYOR
700 HALL OF RECORDS

Note: Any Additions or Changes on This Sheet Must be Made or Circled in Red Ink With Date and Name of Person Making Change.

Do not extend notes this side of this line

Notes Ck'd by	Survey of OLIVEVIEW SAN	F.B. 712 Pg. 31
Map No.	W. O. 8148 Tape No. St'd °F.	GAS LINES
Office Work	Surveyed by TED. WALSH	
Checked	Notes WALSH Date 7-17-36	
Date	Indexed A. C. Johnson	

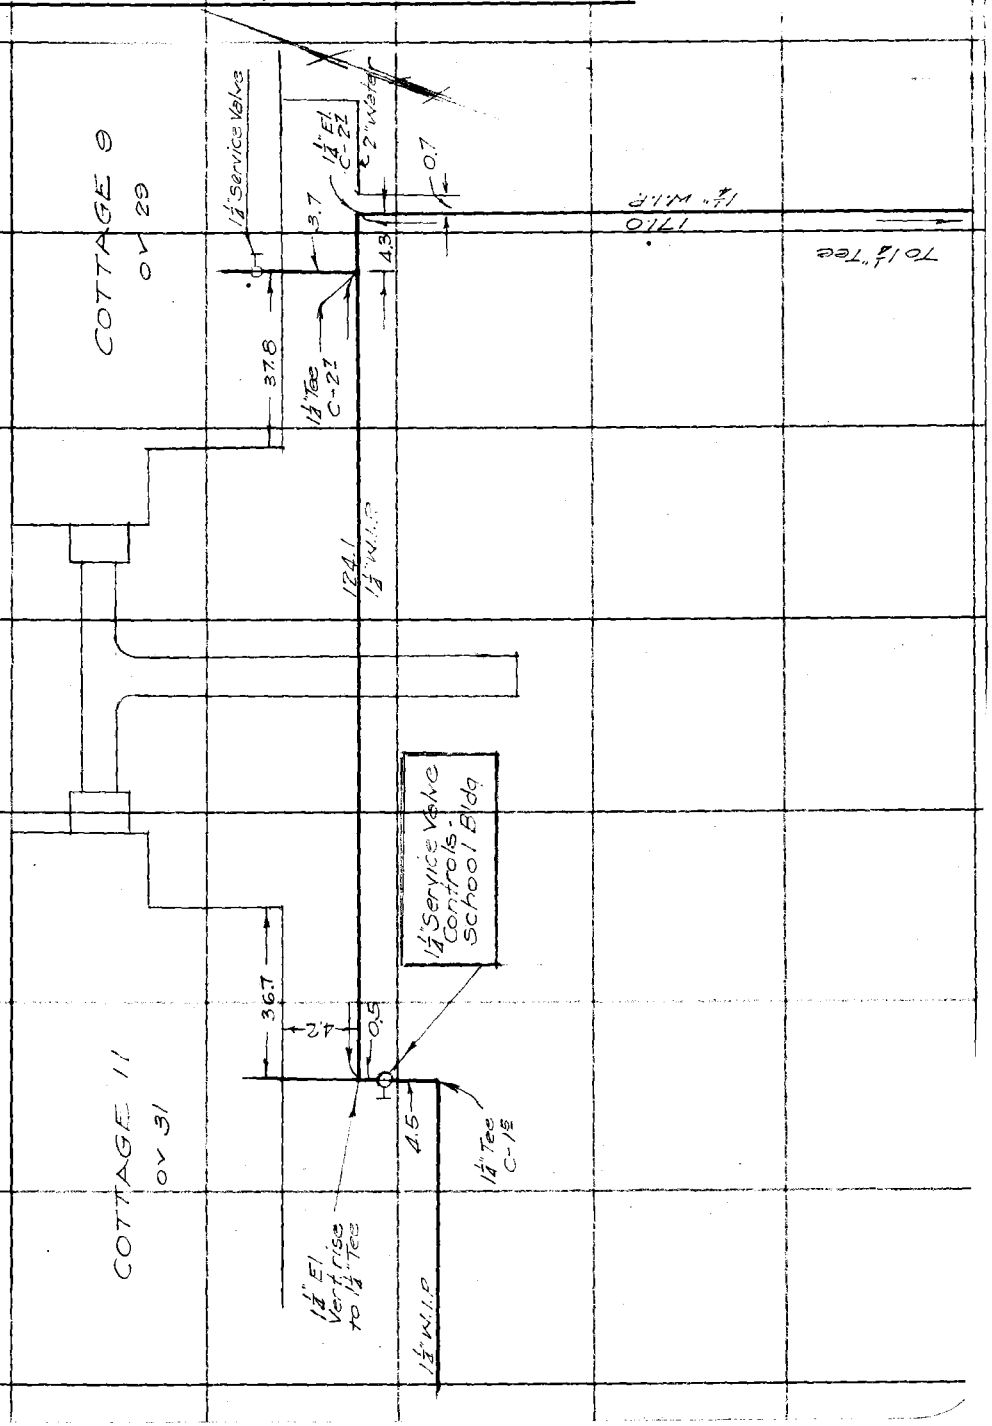

Note: Any Additions or Changes on This Sheet Must be Made or Circled in Red Ink With Date and Name of Person Making Change.

Do not extend notes this side of this line

RETURN TO
LOS ANGELES COUNTY SURVEYOR
700 HALL OF RECORDS

FORM 247 10M 11-35

F.B. 712 Pg. 32

RETURN TO
LOS ANGELES COUNTY SURVEYOR
700 HALL OF RECORDS

Note: Any Additions or Changes on This Sheet Must be Made or Circled in Red Ink With Date and Name of Person Making Change.

Do not extend notes this side of this line

Notes Ck'd by	Survey of OLIVE VIEW SAN	F.B. 712 PG. 33
Map No.	W. O. 8148 Tape No. St'd °F.	
Office Work	Surveyed by TED M. WALSH	GAS LINES
Checked	Notes WALSH Date 8-5-86	
Date	Indexed A. C. Johnson	

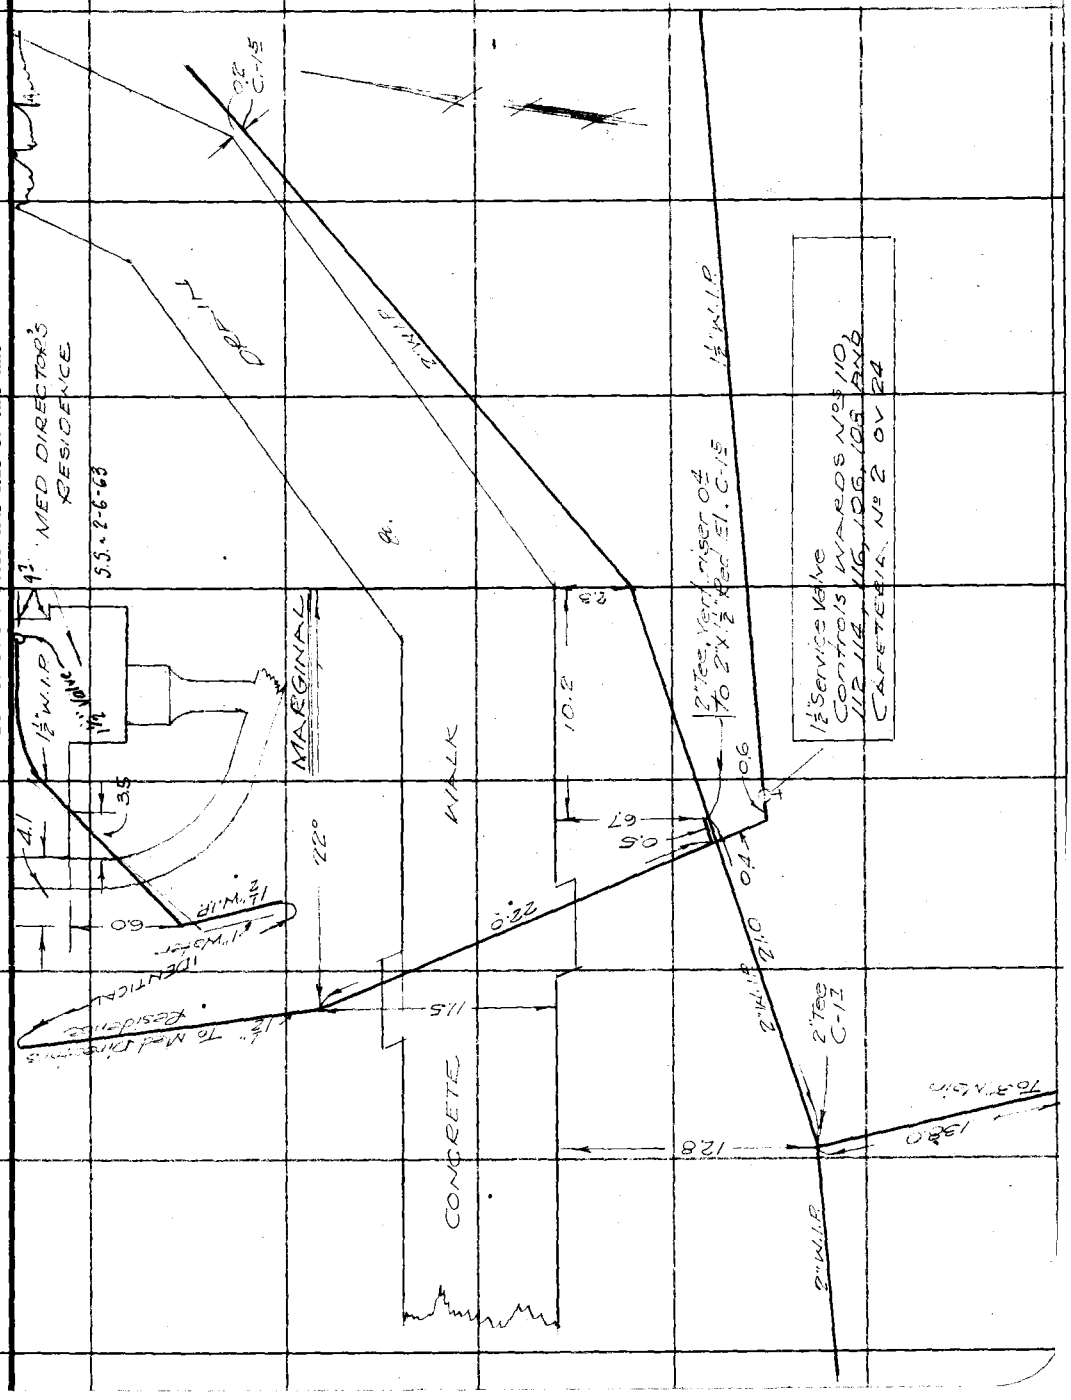

Note: Any Additions or Changes on This Sheet Must be Made or Circled in Red Ink With Date and Name of Person Making Change.

Do not extend notes this side of this line

RETURN TO
LOS ANGELES COUNTY SURVEYOR
700 HALL OF RECORDS

FORM 247 10M 11-35

F.B. 712 PG. 34

RETURN TO
LOS ANGELES COUNTY SURVEYOR
700 HALL OF RECORDS

Note: Any Additions or Changes on This Sheet Must be Made or Circled in Red Ink With Date and Name of Person Making Change.

Do not extend notes this side of this line

Notes Ck'd by	Survey of OLIVE VIEW SAN
Map No.	W. O. 8148 Tape No. St'd °F.
Office Work	Surveyed by TED M. WALSH
Checked	Notes WALSH Date 8-12-36
Date	Indexed [illegible]

F.B. 712 PG. 35

GAS LINES

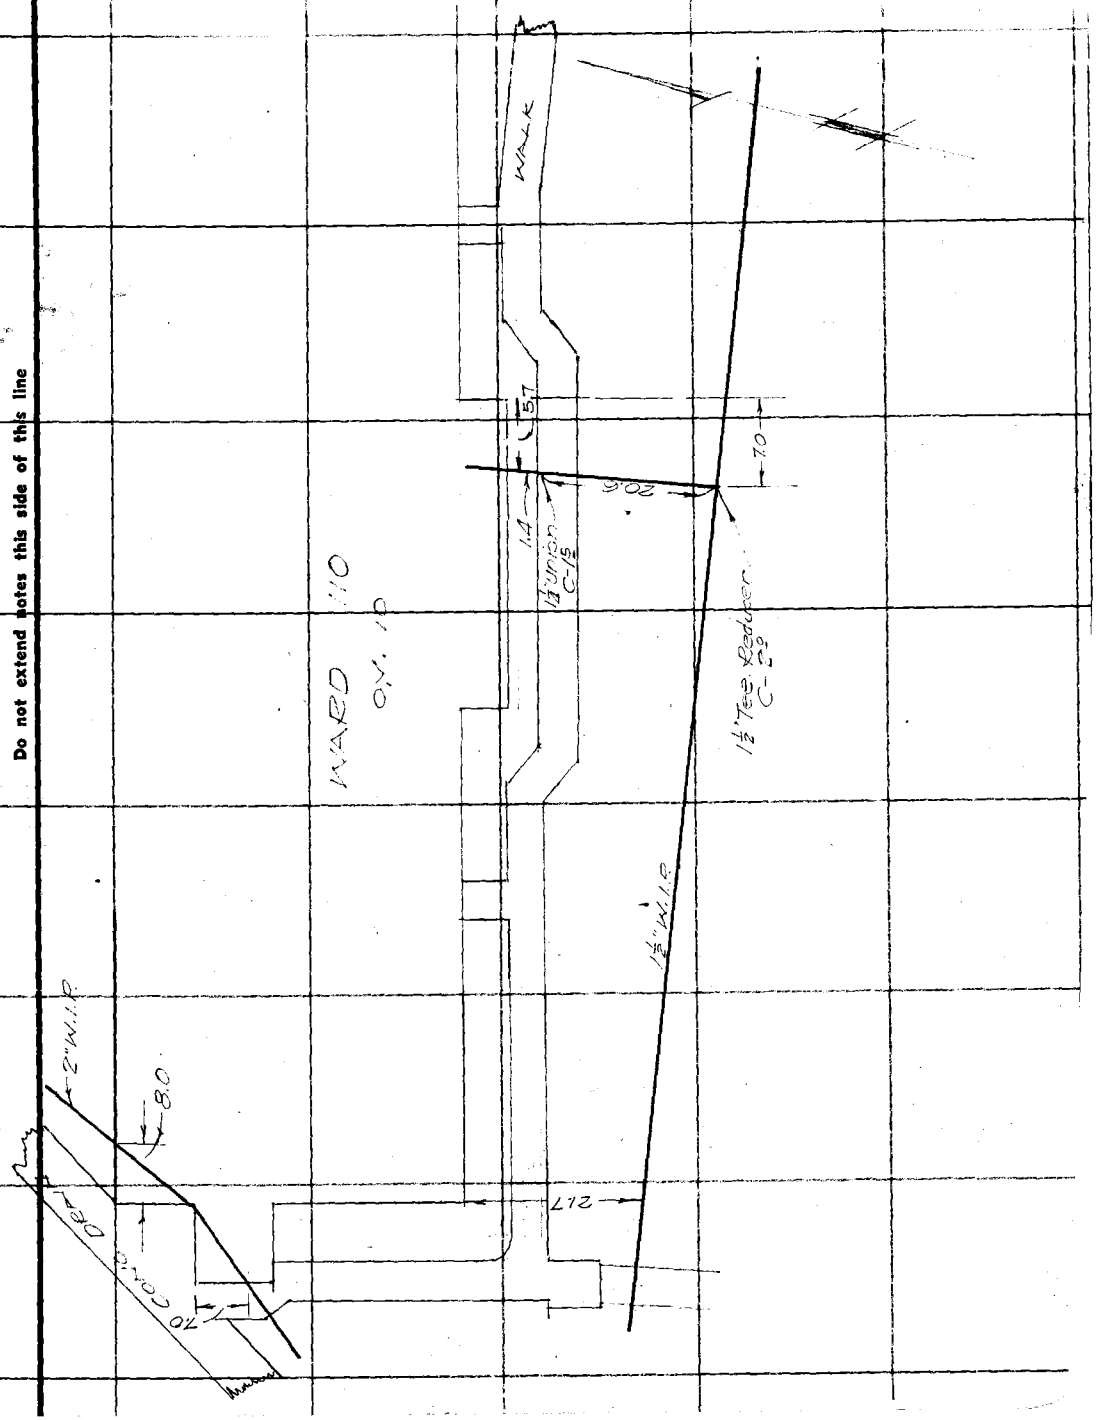

Note: Any Additions or Changes on This Sheet Must be Made or Circled in Red Ink With Date and Name of Person Making Change.

Do not extend notes this side of this line

RETURN TO
LOS ANGELES COUNTY SURVEYOR
700 HALL OF RECORDS

FORM 247 10M 11-35

RETURN TO
LOS ANGELES COUNTY SURVEYOR
700 HALL OF RECORDS

Note: Any Additions or Changes on This Sheet Must be Made or Circled in **Red Ink** With Date and Name of Person Making Change.

Do not extend notes this side of this line

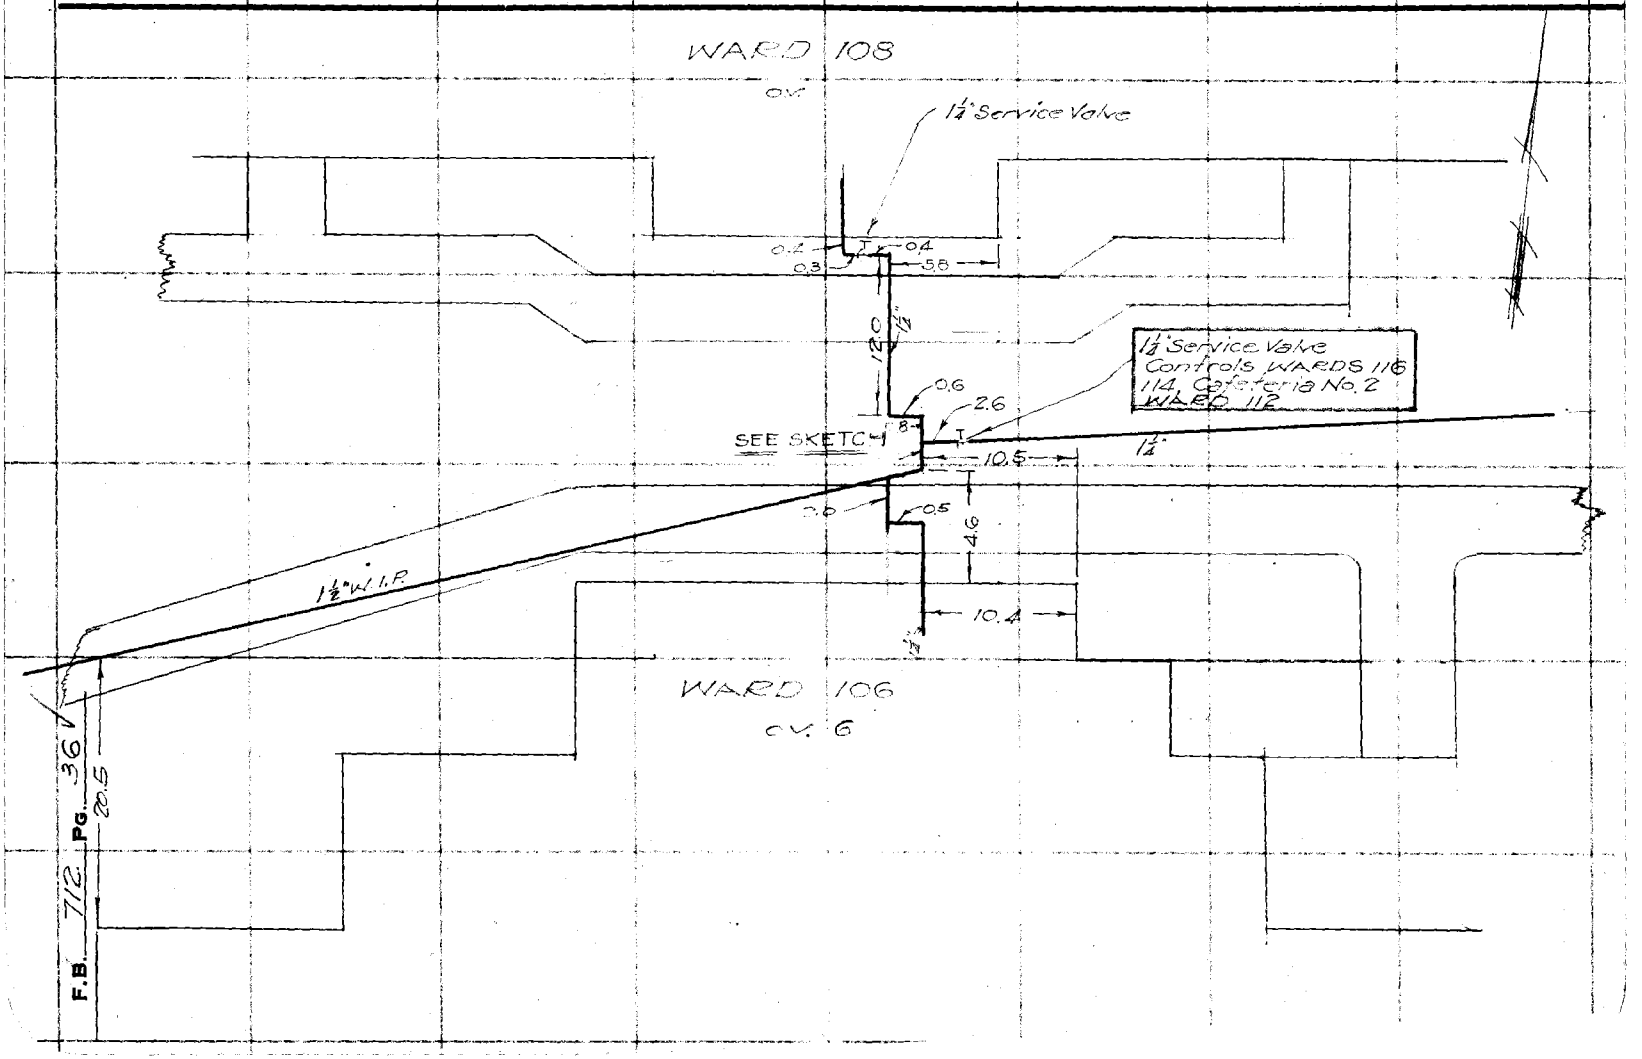

Notes Ck'd by	Survey of OLIVE VIEW SAN
Map No.	W. O. 8178 Tape No. St'd °F.
Office Work	Surveyed by T. WALSH
Checked	Notes WALSH Date 8-14-36
Date	Indexed A. C. Johnson

F.B. 712 PG. 37

GAS LINES

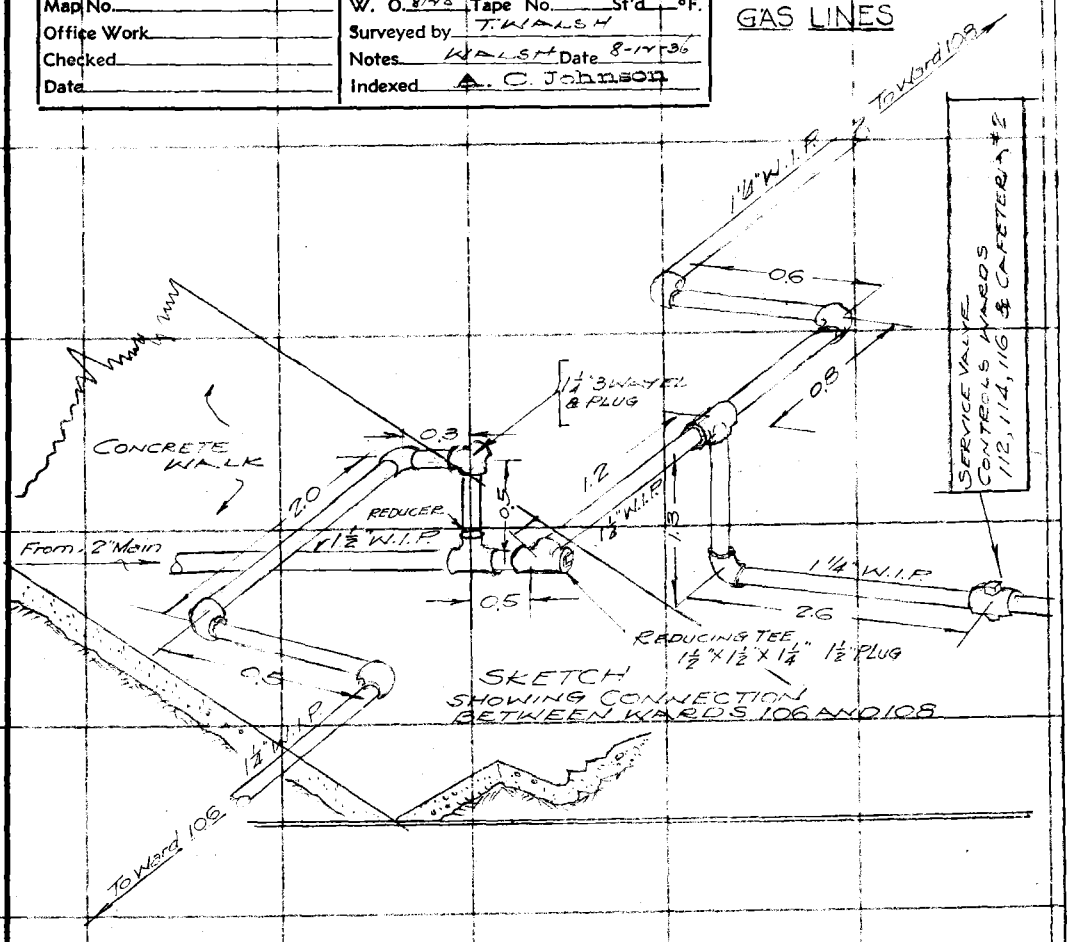

Note: Any Additions or Changes on This Sheet Must be Made or Circled in Red Ink With Date and Name of Person Making Change.

Do not extend notes this side of this line

RETURN TO
LOS ANGELES COUNTY SURVEYOR
700 HALL OF RECORDS

FORM 247 10M 11-35

RETURN TO
LOS ANGELES COUNTY SURVEYOR
700 HALL OF RECORDS

Note: Any Additions or Changes on This Sheet Must be Made or Circled in **Red** Ink With Date and Name of Person Making Change.

Do not extend notes this side of this line

F.B. 712 PG. 38

Map No.	W. O. 8148 Tape No. St'd °F.
Office Work	Surveyed by TED WALSH
Checked	Notes WALSH Date 7-14-36
Date	Indexed A. C. Johnson

F.B. PG. 39

GAS LINES

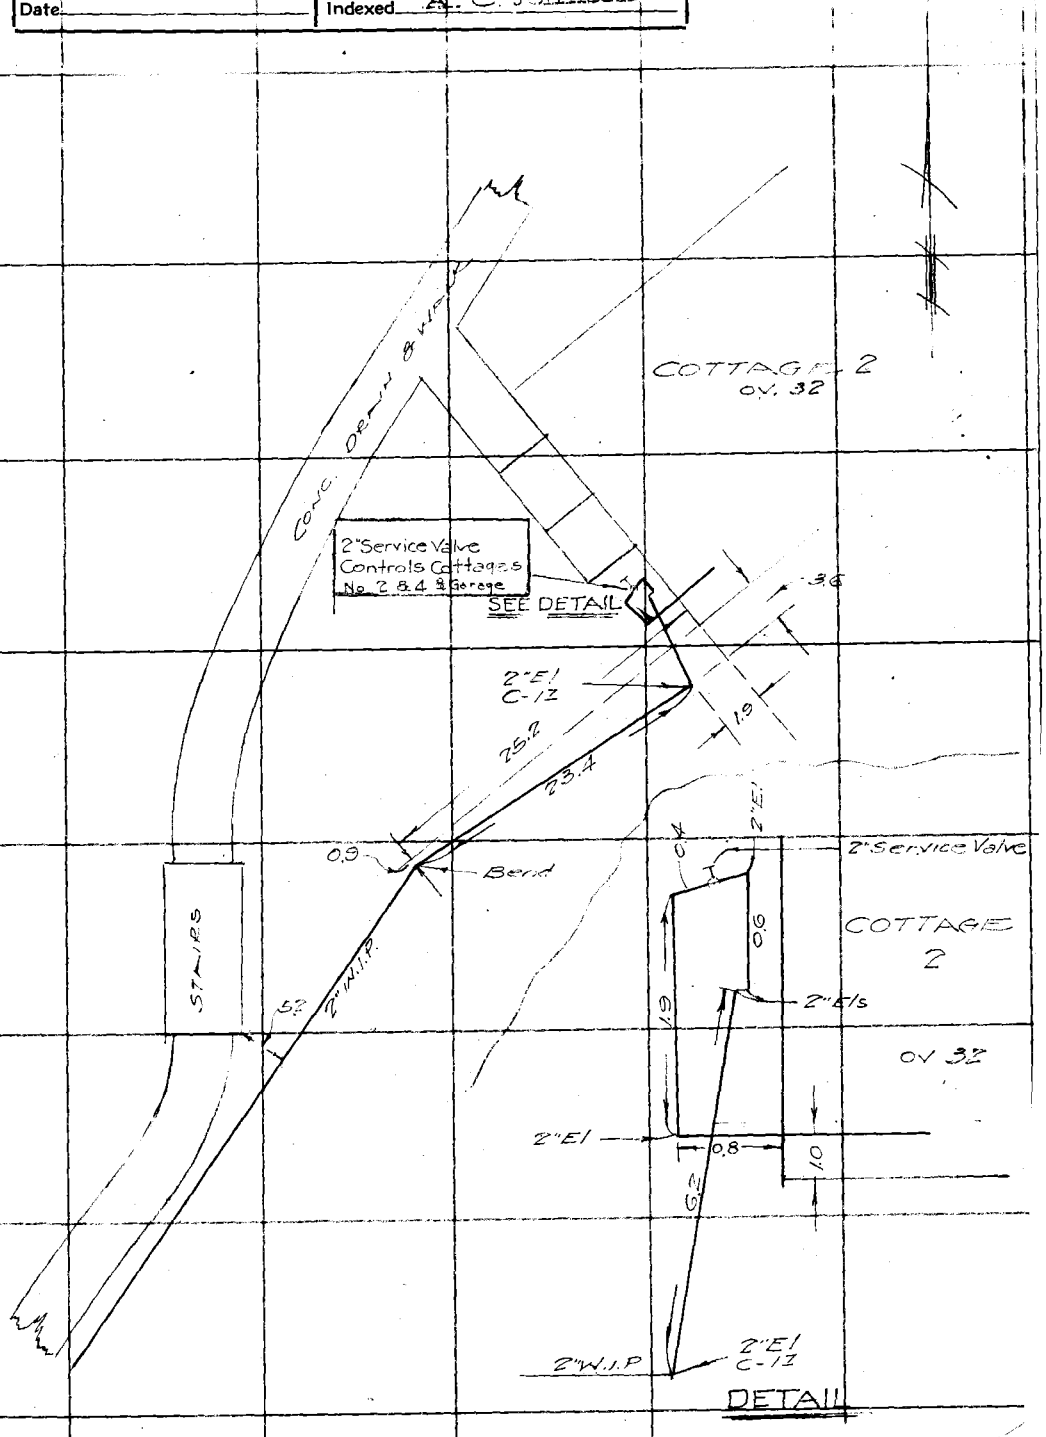

Note: Any Additions or Changes on This Sheet Must be Made or Circled in Red Ink With Date and Name of Person Making Change.

Do not extend notes this side of this line

RETURN TO
LOS ANGELES COUNTY SURVEYOR
700 HALL OF RECORDS

FORM 247 10M 11-35

RETURN TO
LOS ANGELES COUNTY SURVEYOR
700 HALL OF RECORDS

Note: Any Additions or Changes on This Sheet Must be Made or Circled in **Red Ink** With Date and Name of Person Making Change.

Do not extend notes this side of this line

F.B. 712 Pg. 40

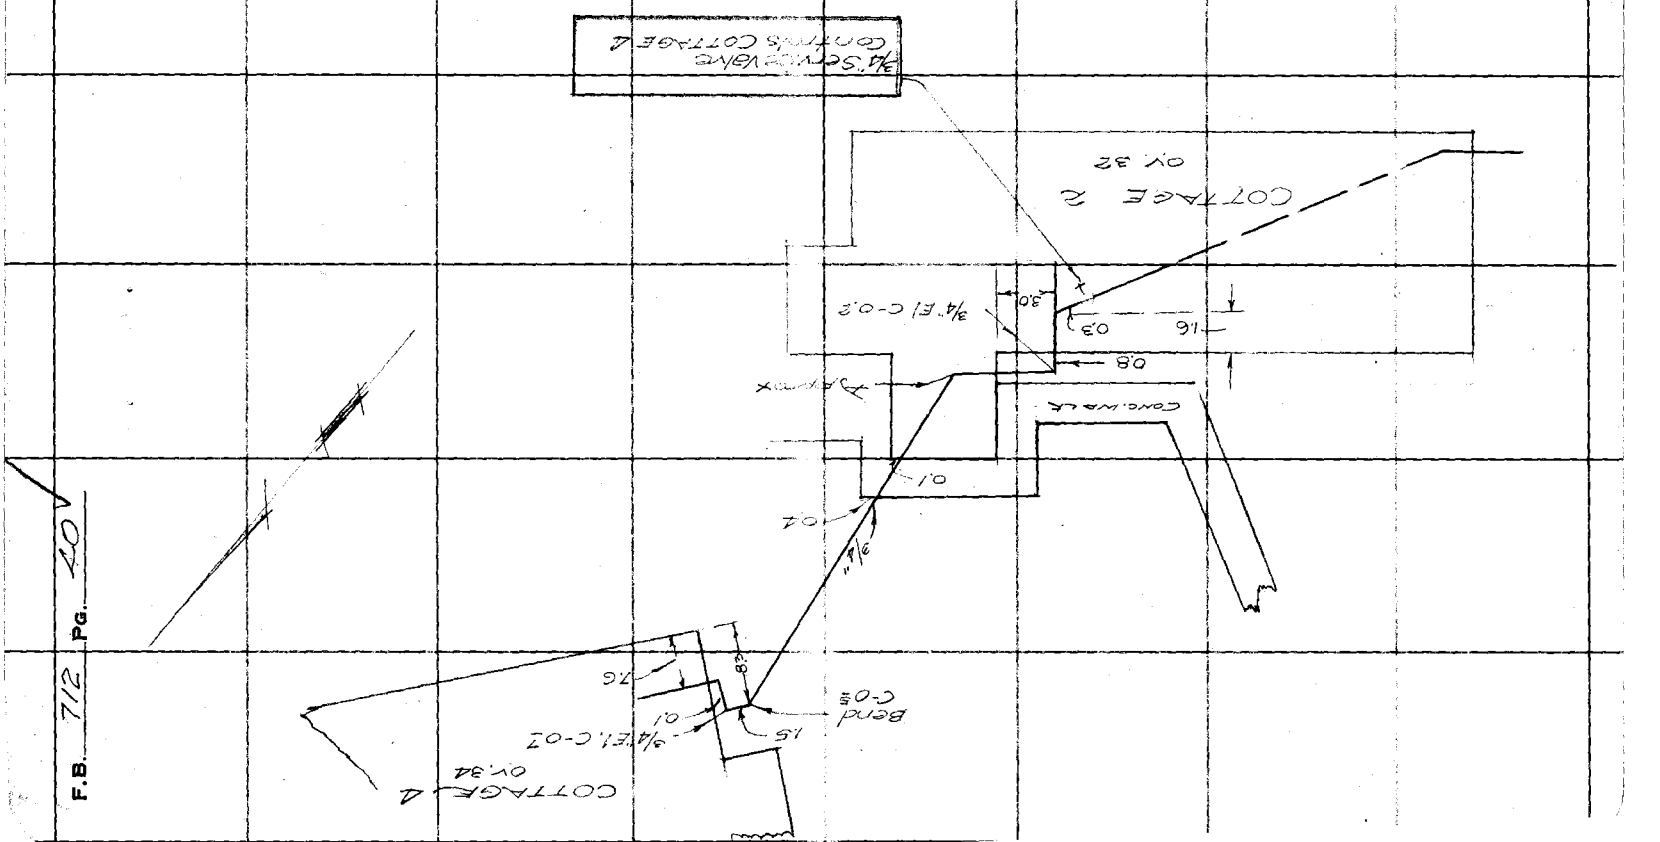

FORM 247 10M 11-35

RETURN TO
LOS ANGELES COUNTY SURVEYOR
700 HALL OF RECORDS

Note: Any Additions or Changes on This Sheet Must be Made or Circled in **Red Ink** With Date and Name of Person Making Change.

Do not extend notes this side of this line

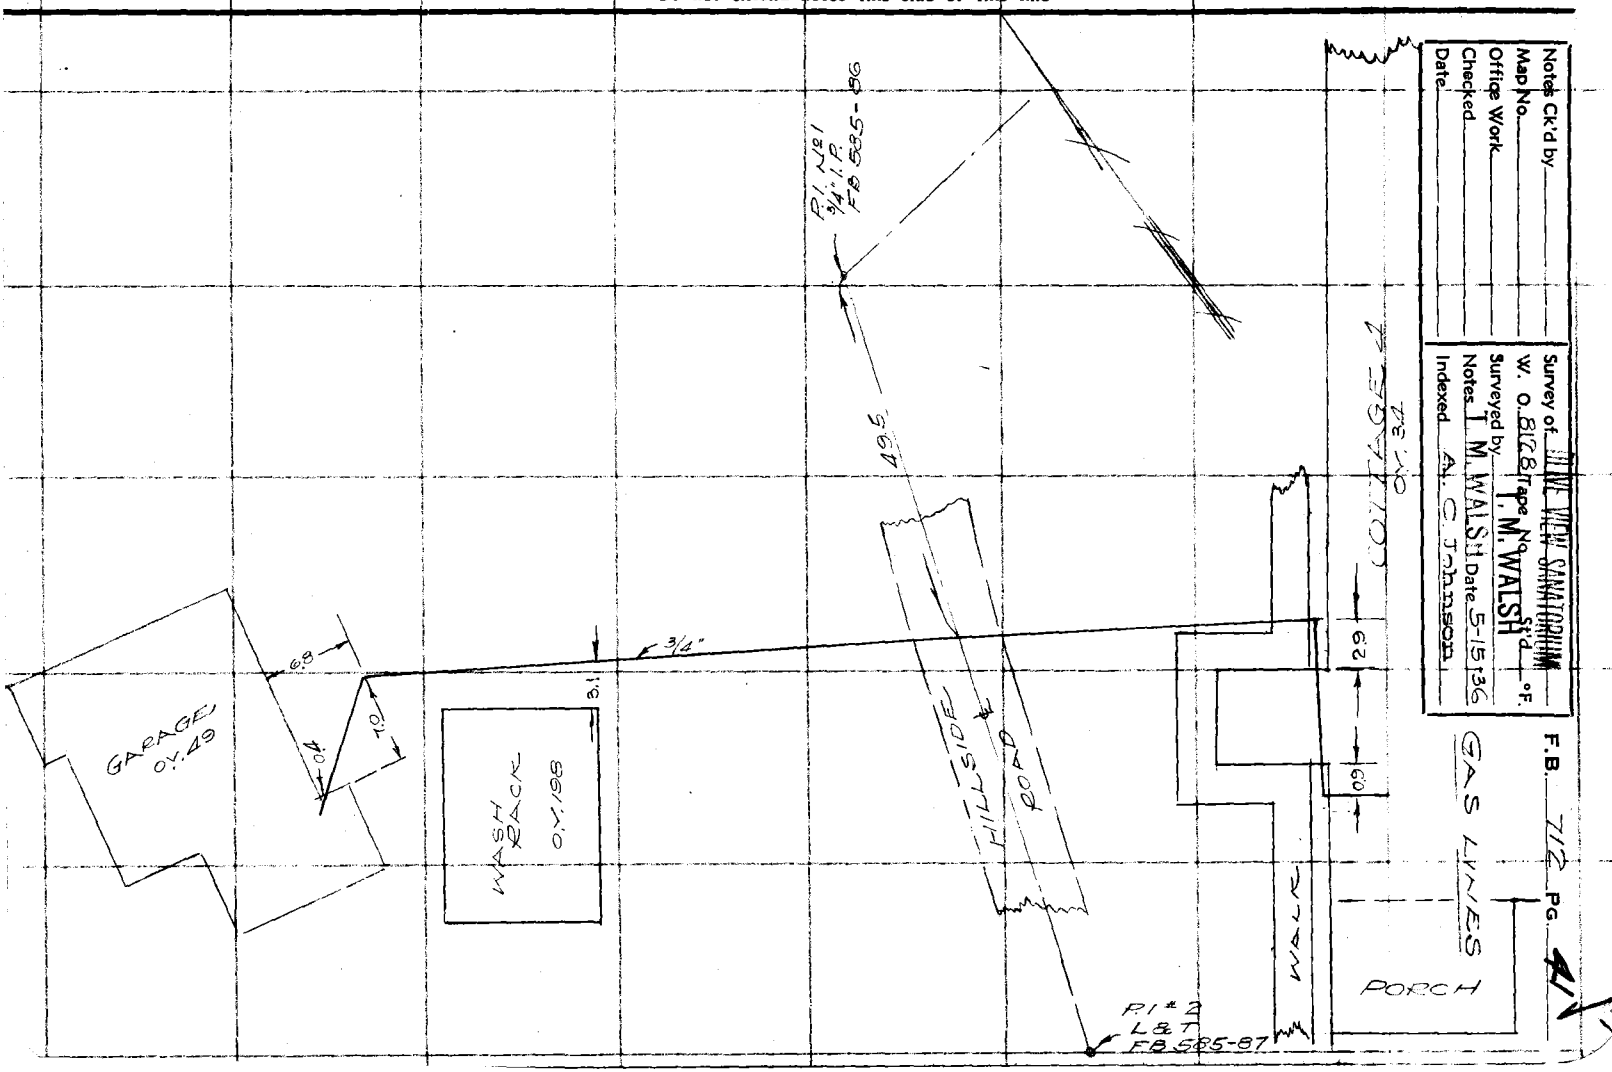

Notes Ck'd by _____
Map No. _____
Office Work _____
Checked _____
Date _____

W. O. 8128 Tape No. T. M. WALSH 2nd °F.
Surveyed by T. M. WALSH Date 5-15-36
Notes _____
Indexed A. C. Johnson

F.B. 712 PG. 41

RETURN TO
LOS ANGELES COUNTY SURVEYOR
700 HALL OF RECORDS

Note: Any Additions or Changes on This Sheet Must be Made or Circled in **Red Ink** With Date and Name of Person Making Change.

Do not extend notes this side of this line

F.B. 7/2 Pg. 42

Notes Ck'd by	Survey of	F.B. 712 Pg. 43
Map No.	W. O. 8128 Tape No. St'd °F.	
Office Work	Surveyed by T. M. WALSH	
Checked	Notes WAL Date 7-37	
Date	Indexed A. C. Johnson	

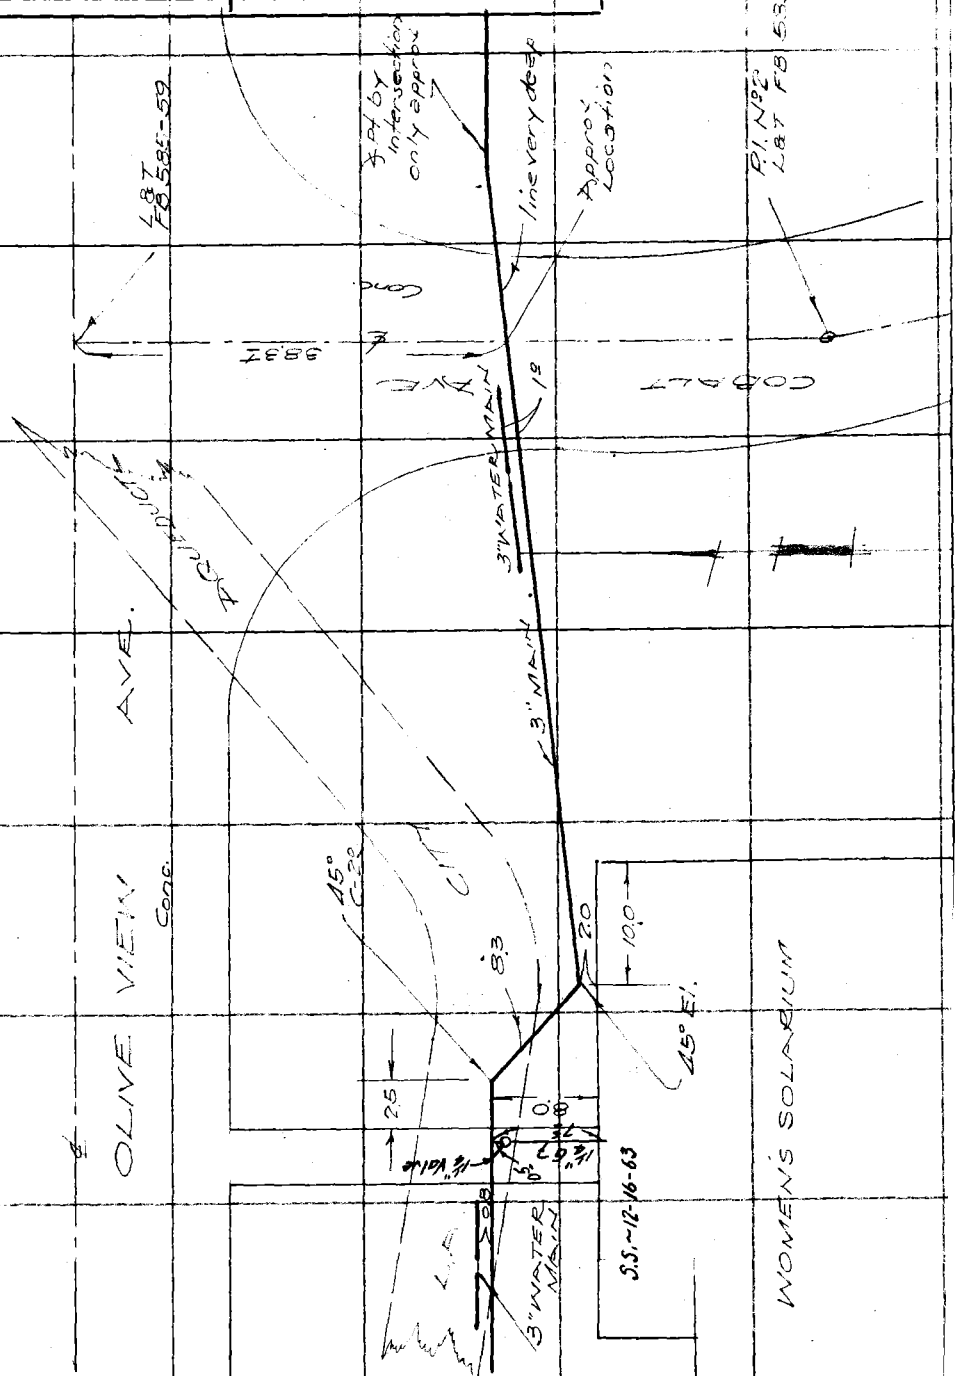

Note: Any Additions or Changes on This Sheet Must be Made or Circled in Red Ink With Date and Name of Person Making Change.

Do not extend notes this side of this line

RETURN TO
LOS ANGELES COUNTY SURVEYOR
700 HALL OF RECORDS

FORM 247 10M 11-35

F.B. 712 Pg. 44 ✓

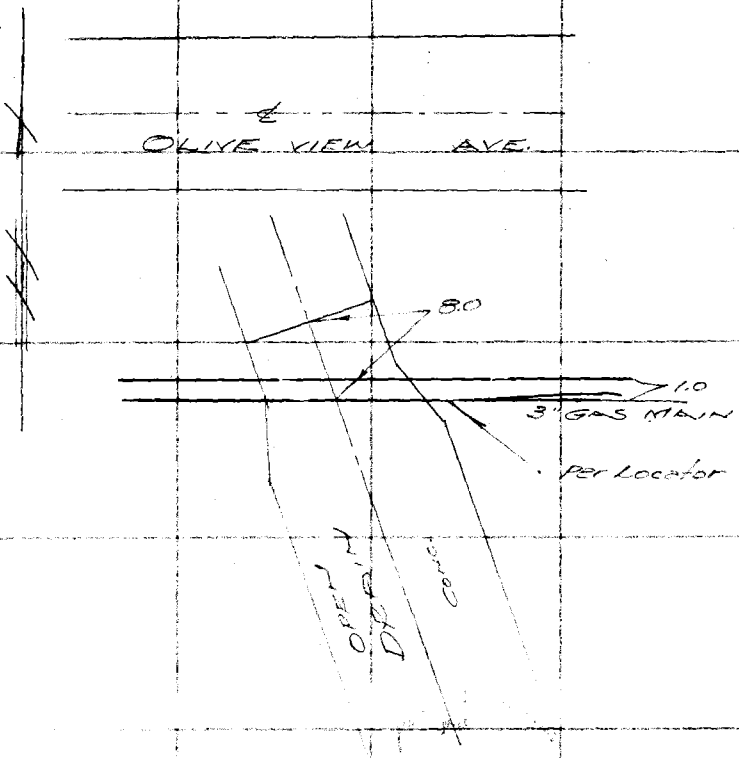

RETURN TO
LOS ANGELES COUNTY SURVEYOR
700 HALL OF RECORDS

Note: Any Additions or Changes on This Sheet Must be Made or Circled in Red Ink With Date and Name of Person Making Change.

Do not extend notes this side of this line

FORM 247 10M 11-35

RETURN TO
LOS ANGELES COUNTY SURVEYOR
700 HALL OF RECORDS

Note: Any Additions or Changes on This Sheet Must be Made or Circled in **Red Ink** With Date and Name of Person Making Change.

Do not extend notes this side of this line

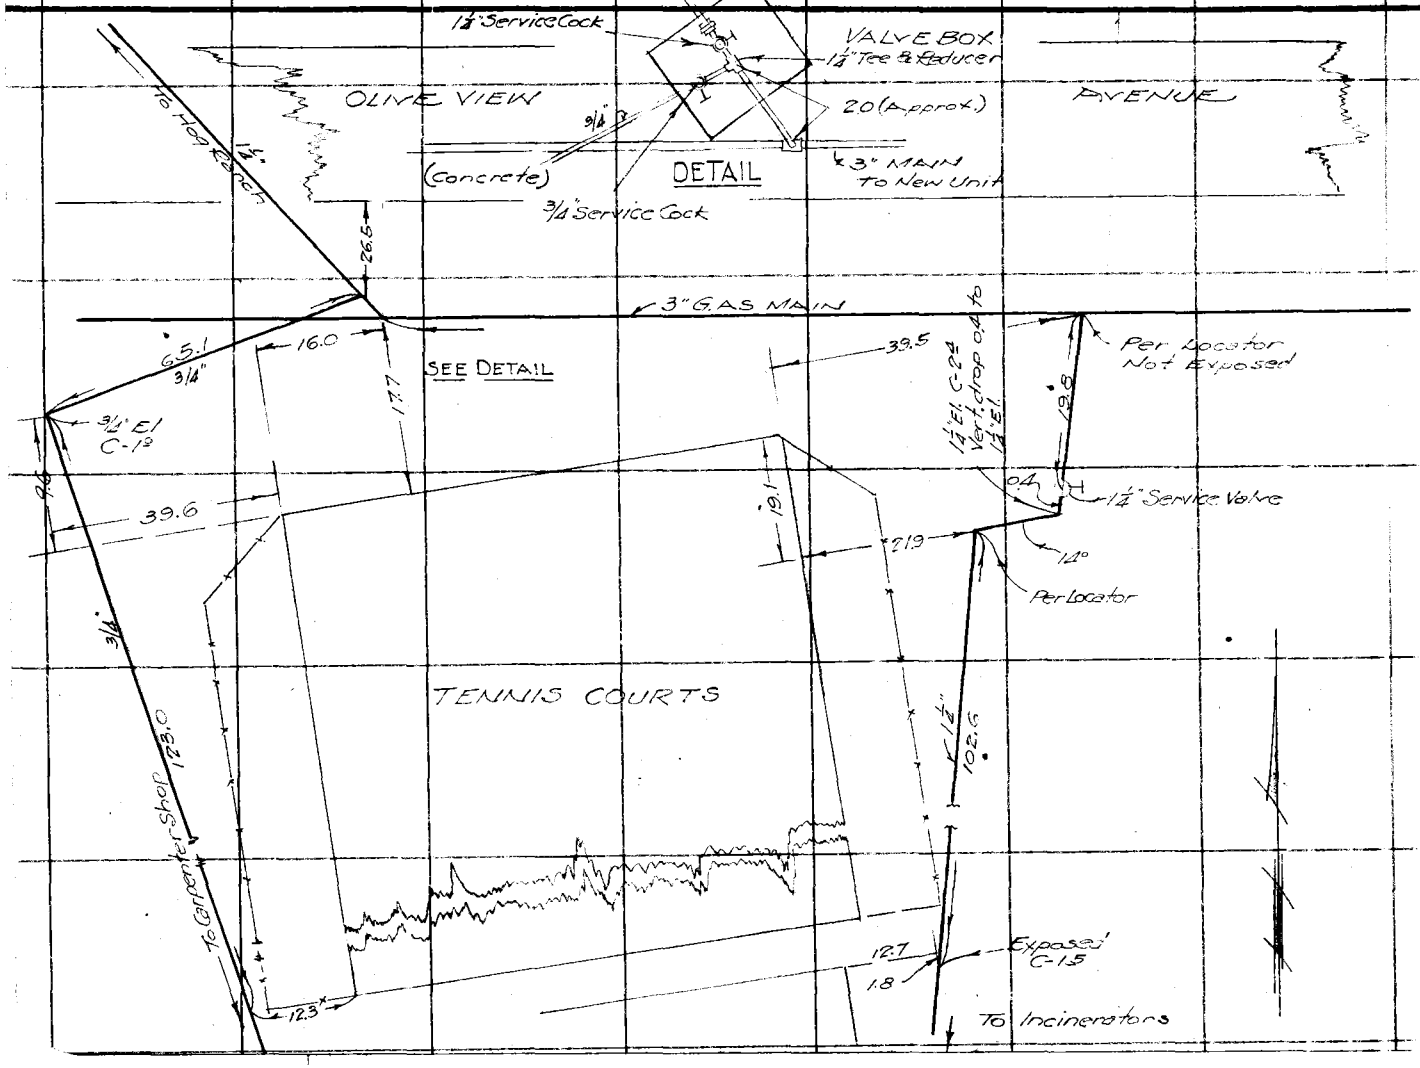

Notes Ck'd by
Map No.
Office Work
Checked
Date

Survey of OLIVE VIEW SAN
W. O. 8178 Tape No. St'd °F.
Surveyed by T. WALSH
Notes WALSH Date 7-3-36
Indexed A. C. Johnson

F.B. 712 Pg. 45

GAS LINES

RETURN TO
LOS ANGELES COUNTY SURVEYOR
700 HALL OF RECORDS

Note: Any Additions or Changes on This Sheet Must be Made or Circled in **Red Ink** With Date and Name of Person Making Change.

Do not extend notes this side of this line

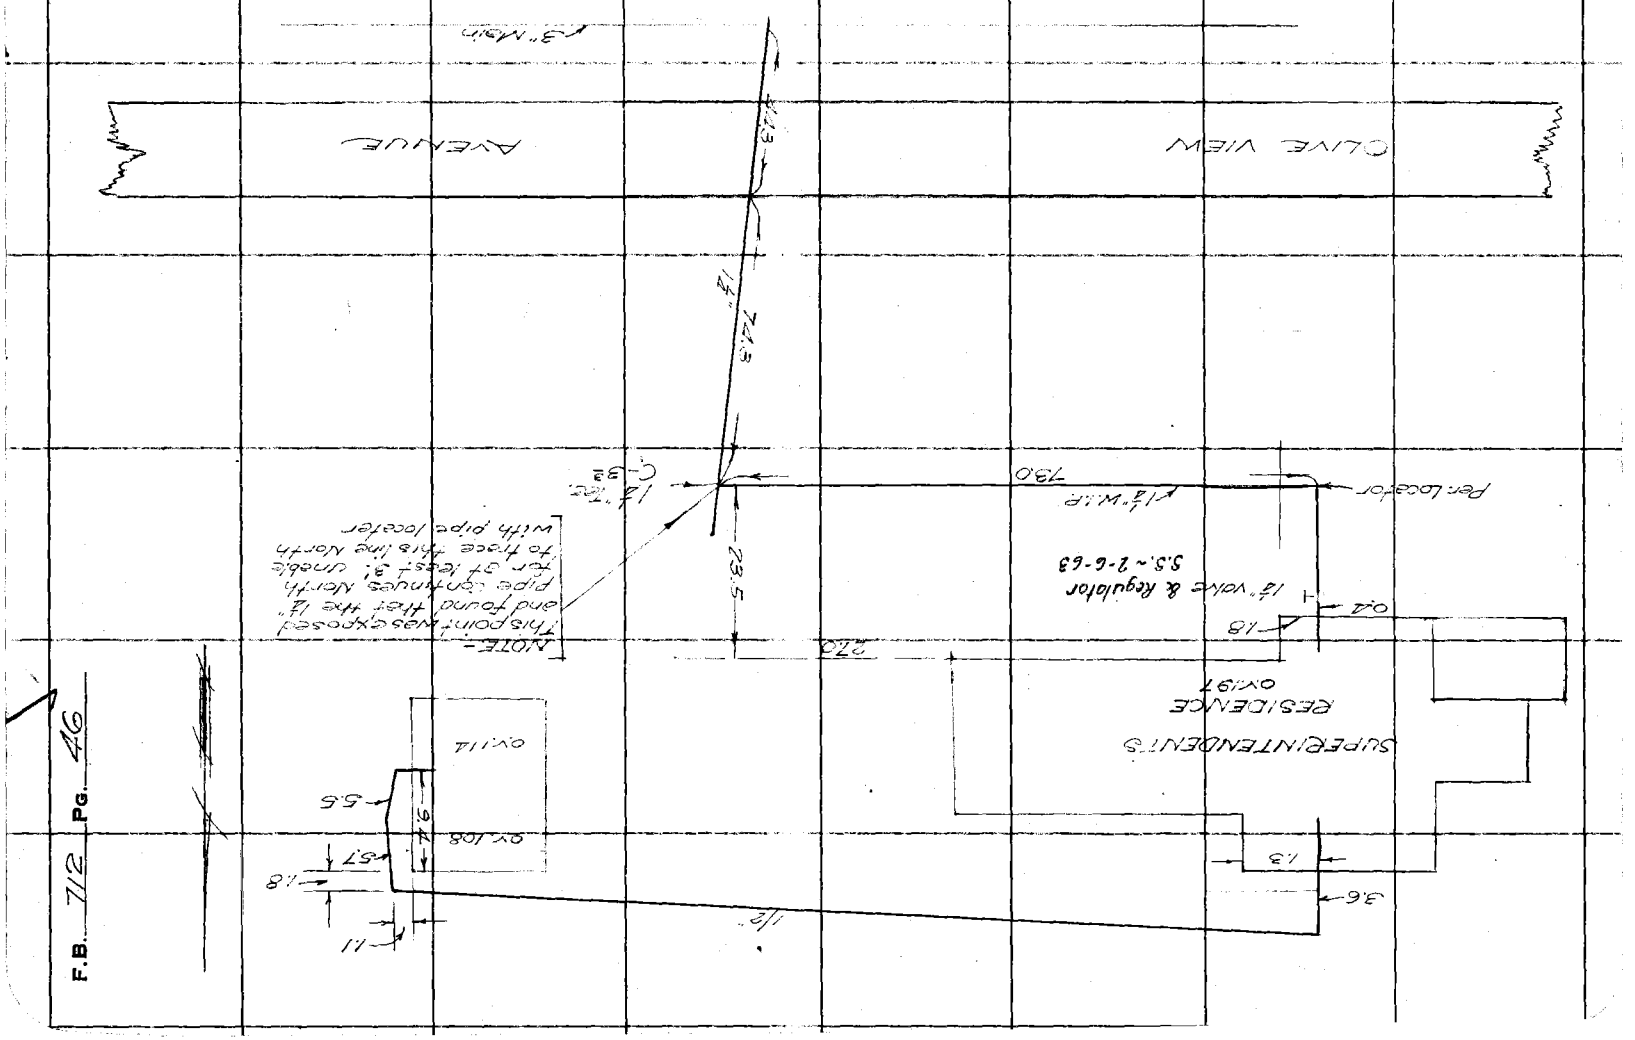

F.B. 712 PG. 46

Notes Ck'd by	Survey of OLIVE VIEW SAN
Map No.	W. O. 8125 Tape No. St'd °F.
Office Work	Surveyed by TWIGG
Checked	Notes WALSH Date 7-3-36
Date	Indexed A. C. Johnson

F.B. 718 PG. 47 V

RETURN TO
LOS ANGELES COUNTY SURVEYOR
720 HALL OF RECORDS

Note: Any Additions or Changes on This Sheet Must be Made or Circled in Red Ink With Date and Name of Person Making Change.

Do not extend notes this side of this line

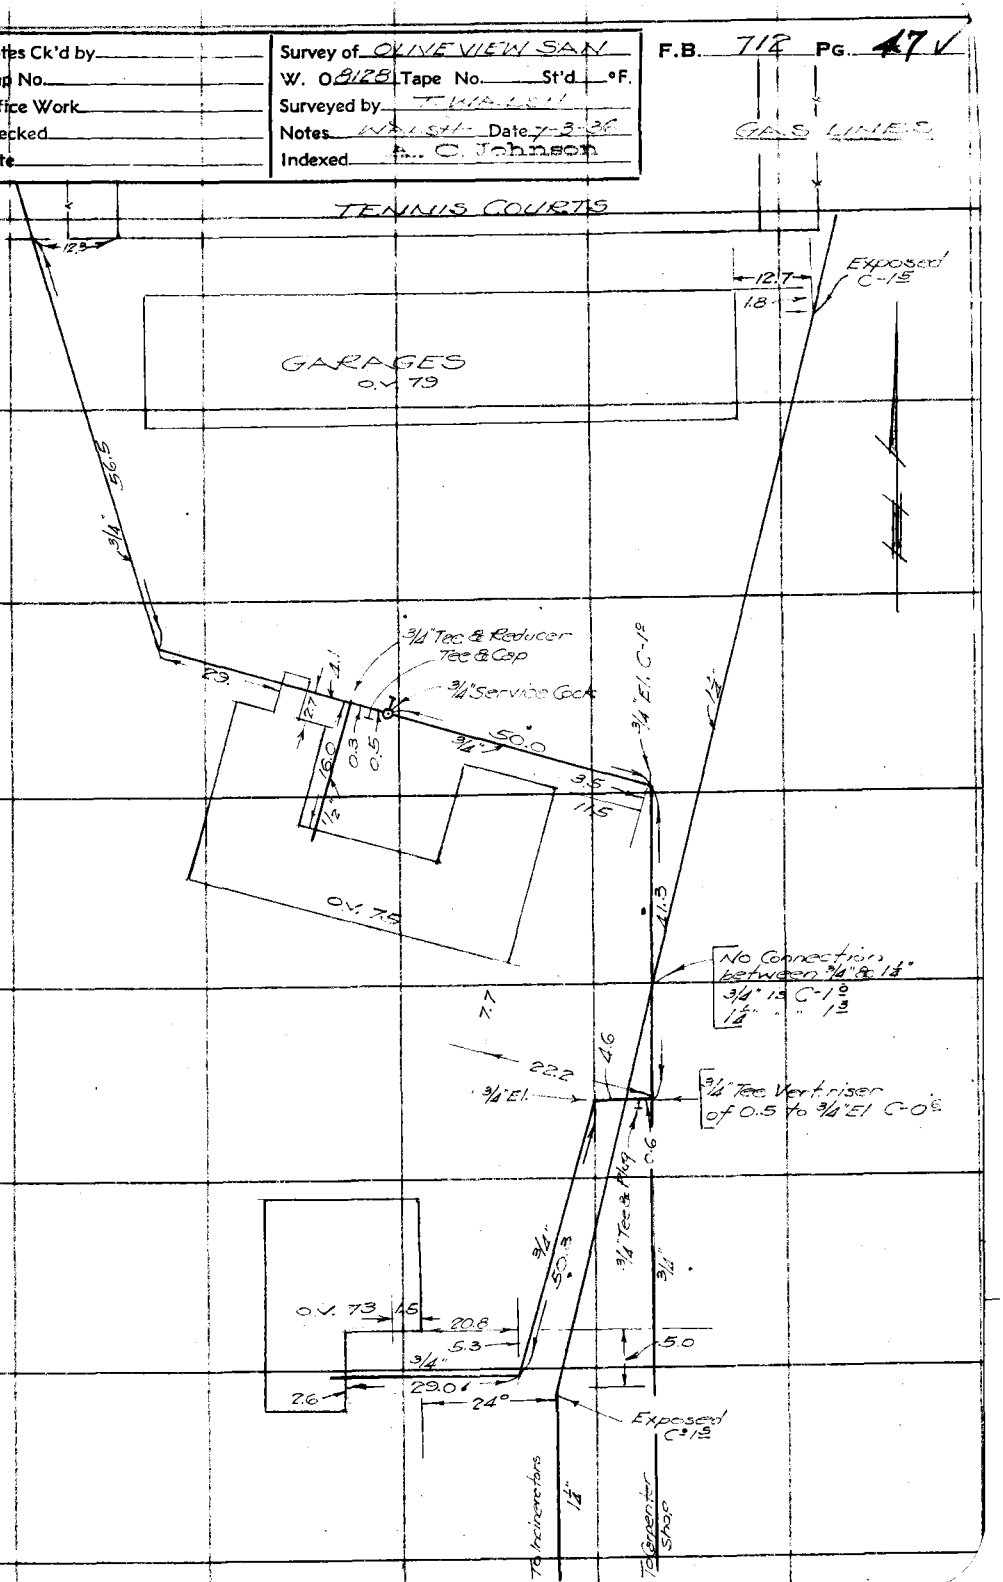

FORM 247 10M 11-35

RETURN TO
LOS ANGELES COUNTY SURVEYOR
700 HALL OF RECORDS

Note: Any Additions or Changes on This Sheet Must be Made or Circled in **Red** Ink With Date and Name of Person Making Change.

Do not extend notes this side of this line

F.B. 712 PG. 48

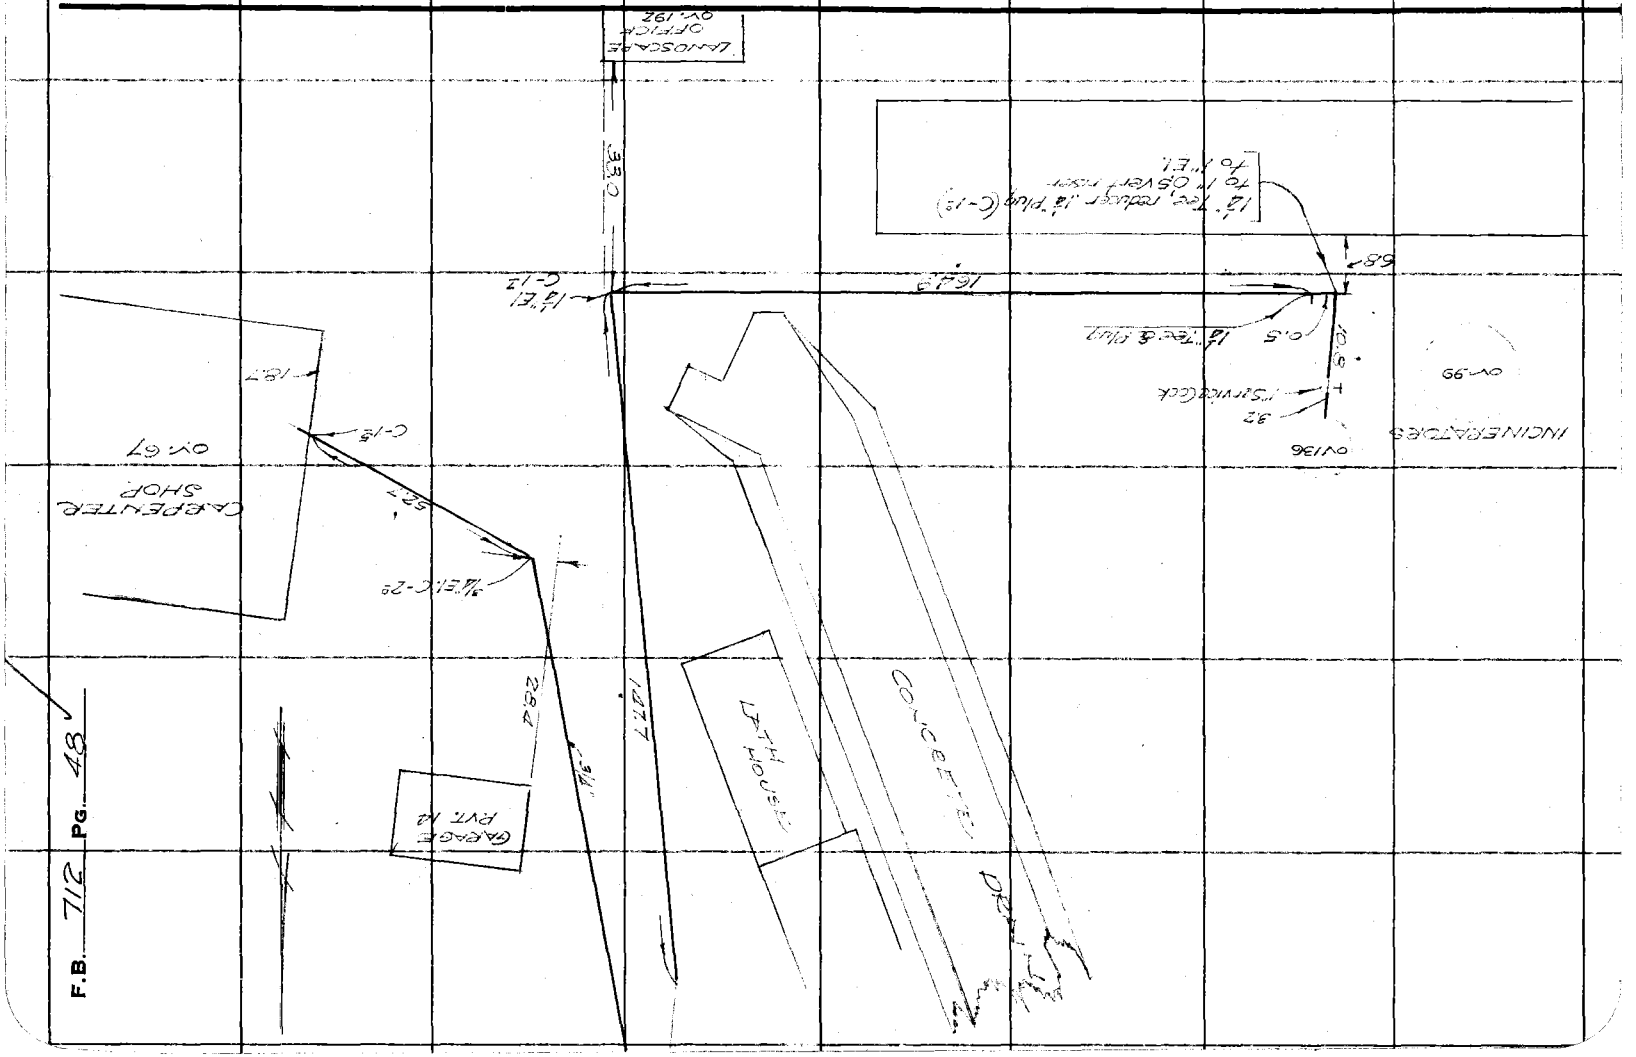

Notes Ck'd by	Survey of OLIVE VIEW SANATORIUM
Map No.	W. O. 8178 Tape No. St'd °F.
Office Work	Surveyed by T. WALSH
Checked	Notes WALSH Date 8-5-36
Date	Indexed A. C. Johnson

F.B. 712 PG. 49

GAS LINES

Note: Any Additions or Changes on This Sheet Must be Made or Circled in Red Ink With Date and Name of Person Making Change.

Do not extend notes this side of this line

RETURN TO
LOS ANGELES COUNTY SURVEYOR
700 HALL OF RECORDS

OLIVE VIEW AVE.

1¼" Service Valve

1¼" Tee & P.

1¼" Service Valve controls Line up Sycamore & Old Labor Camp

1¼" El C-1²

3" Water

3" Gas

Abandoned

New 1¼" Gas See F.B. 2910-182

3" Tee & Reducer Vertical riser of C.C to 1¼" El.

STEAM TUNNEL

MANHOLE

S.S. - 2/6/63

New line in Bldg.

1¼" Tee, C-1²

Abandoned

1¼" Service Valve

1¼" Tee & Plug

1" Service Valve

1¼" El & Rod Vert. riser

1" El. C-0⁵

1¼" El & Reducer C-1²

FORM 247 10M 11-35

RETURN TO
LOS ANGELES COUNTY SURVEYOR
700 HALL OF RECORDS

Note: Any Additions or Changes on This Sheet Must be Made or Circled in **Red Ink** With Date and Name of Person Making Change.

Do not extend notes this side of this line

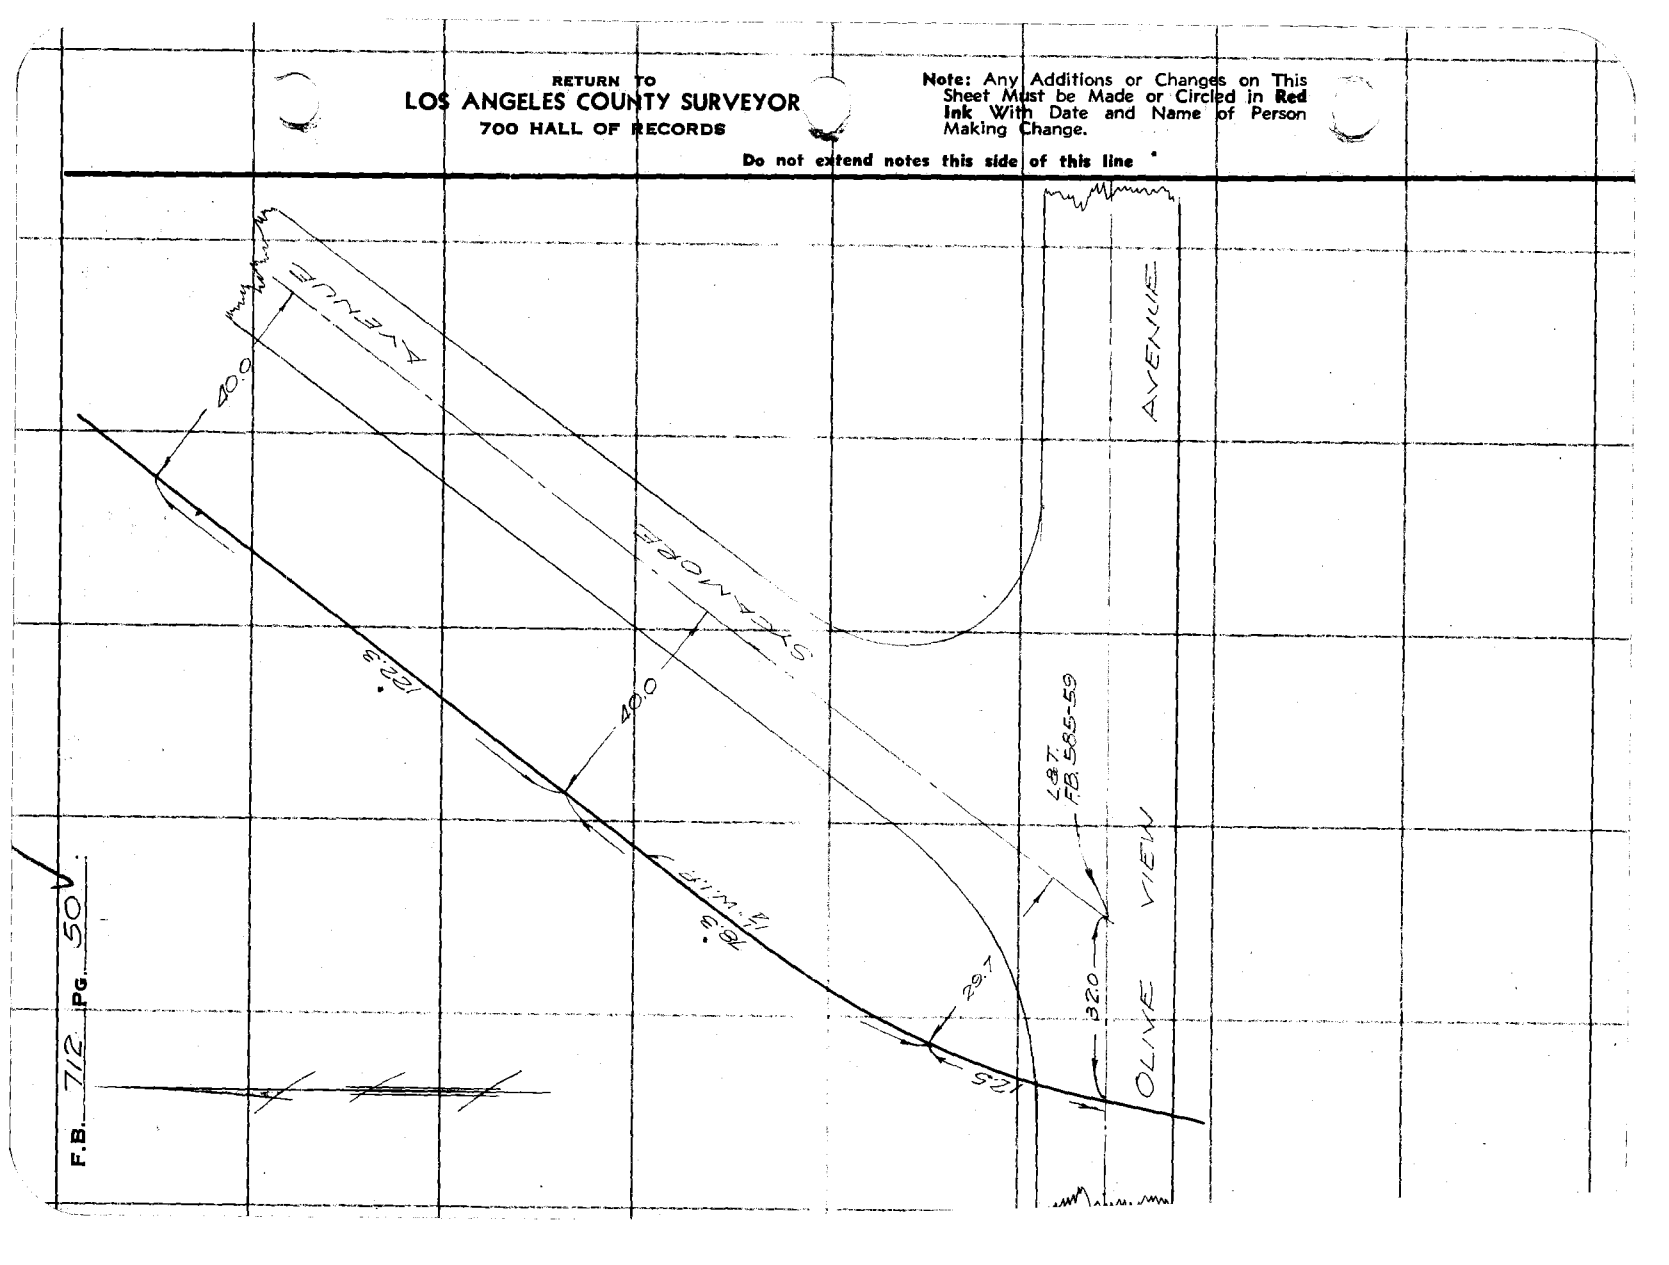

F.B. 712 PG. 50

Notes Ck'd by	Survey of OLIVE VIEW SANATORIUM
Map No.	W. O. 8128 Tape No. St'd °F.
Office Work	Surveyed by T. M. WALSH
Checked	Notes T. M. WALSH Date 9-36
Date	Indexed A. C. Johnson

F.B. 712 Pg. 51

GAS LINES

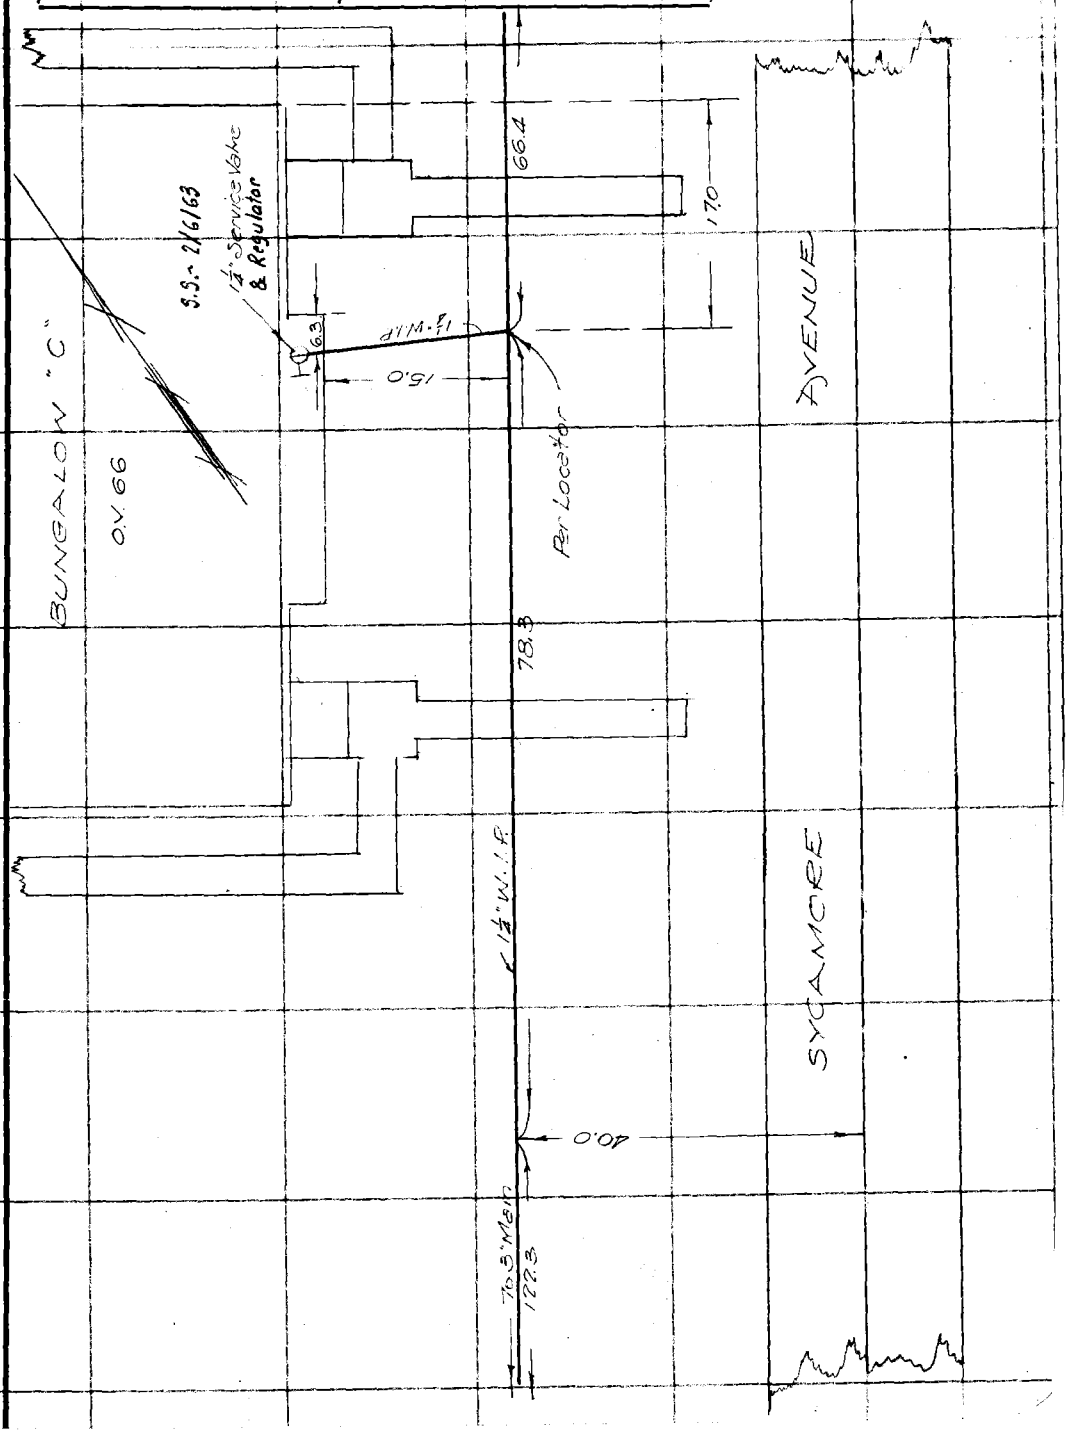

Note: Any Additions or Changes on This Sheet Must be Made or Circled in Red Ink With Date and Name of Person Making Change.

Do not extend notes this side of this line

RETURN TO
LOS ANGELES COUNTY SURVEYOR
700 HALL OF RECORDS

FORM 247 10M 11-35

RETURN TO
LOS ANGELES COUNTY SURVEYOR
700 HALL OF RECORDS

Note: Any Additions or Changes on This Sheet Must be Made or Circled in **Red Ink** With Date and Name of Person Making Change.

Do not extend notes this side of this line

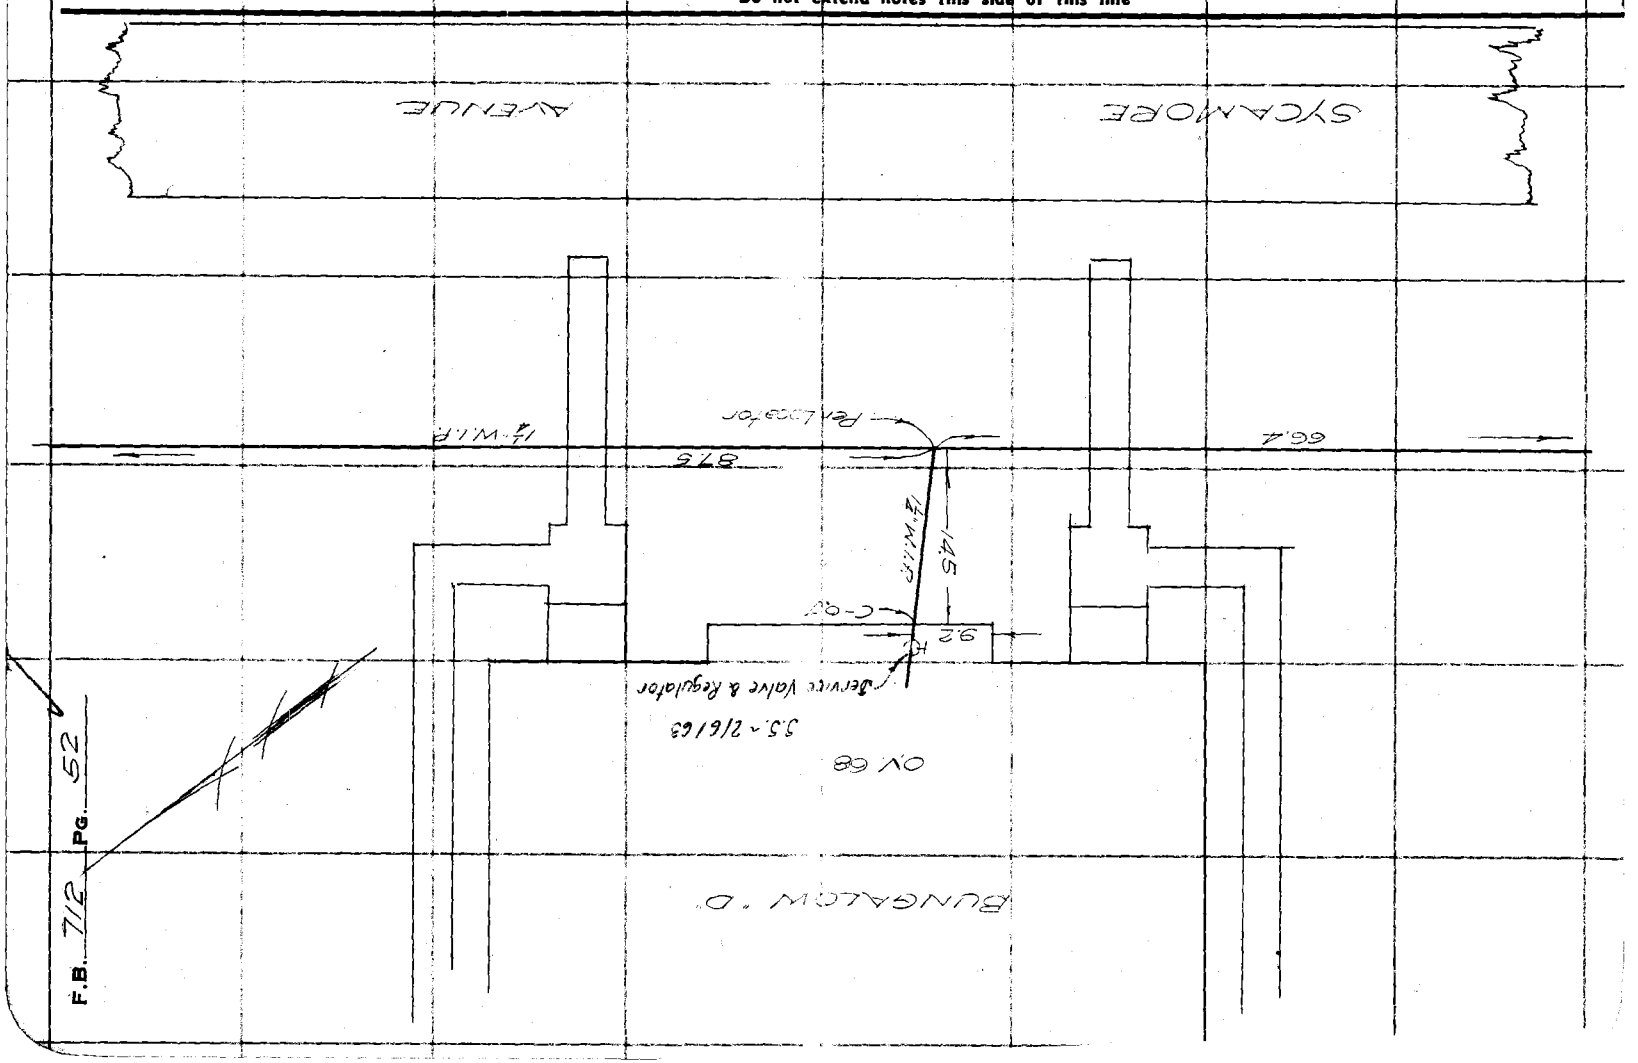

F.B. 712 PG. 52

FORM 247 10M 11-38

RETURN TO
LOS ANGELES COUNTY SURVEYOR
700 HALL OF RECORDS

Note: Any Additions or Changes on This Sheet Must be Made or Circled in Red Ink With Date and Name of Person Making Change.

Do not extend notes this side of this line

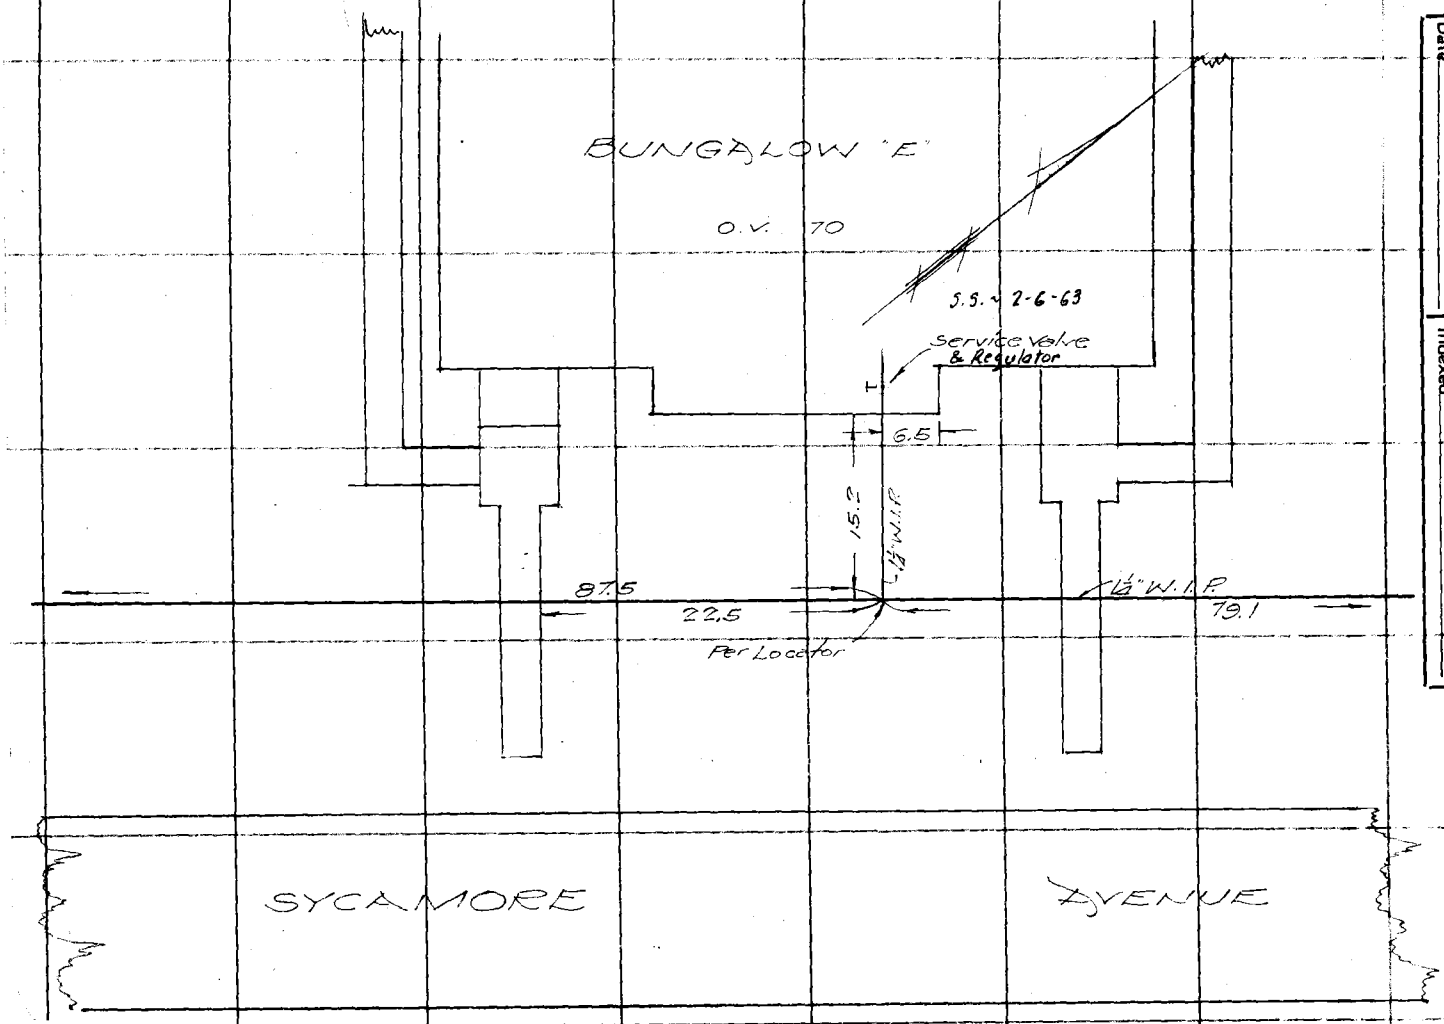

Notes Ck'd by
Map No.
Office Work
Checked
Date

Survey of W. O. 8128
Surveyed by T. M. WALSH St'd. °F.
Notes T. M. WALSH Date 9-36
Indexed A. C. Johnson

F.B. 712 Pg. 53

GAS LINES

RETURN TO
LOS ANGELES COUNTY SURVEYOR
700 HALL OF RECORDS

Note: Any Additions or Changes on This Sheet Must be Made or Circled in **Red Ink** With Date and Name of Person Making Change.

Do not extend notes this side of this line

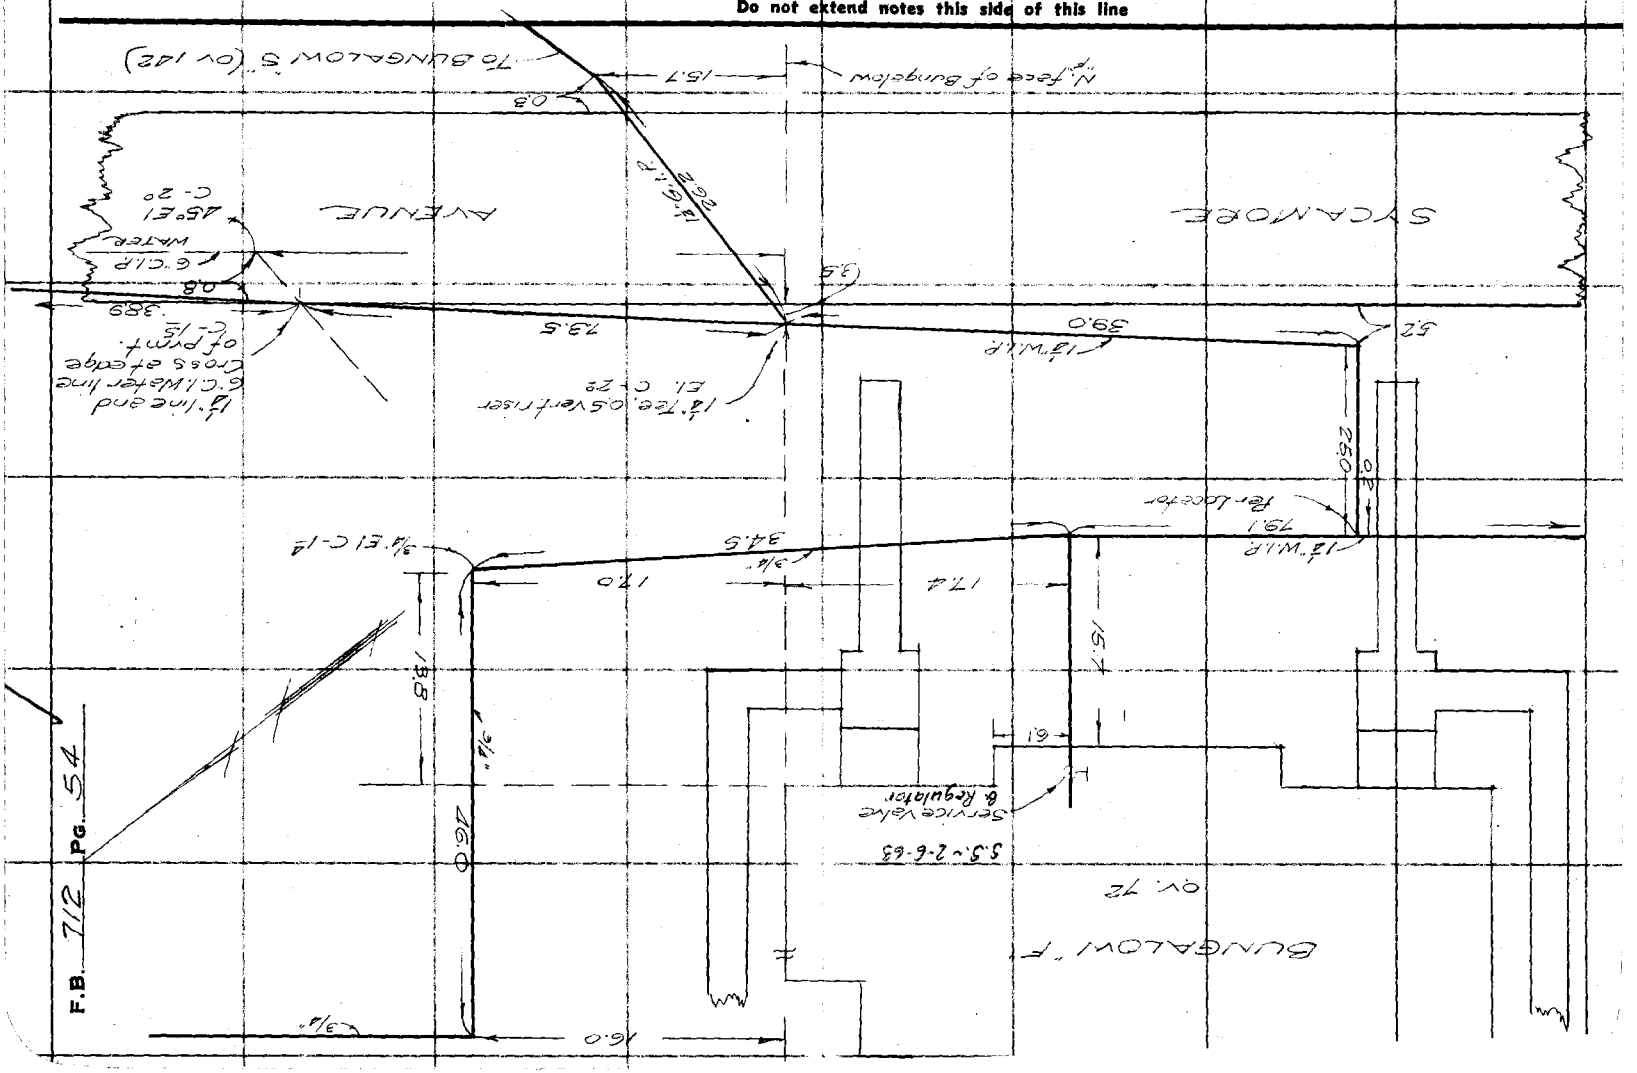

F.B. 712 PG. 54

Notes Ck'd by	Survey of
Map No.	W. O. 8128 Tape No. St'd °F.
Office Work	Surveyed by T. M. WALSH
Checked	Notes T. M. WALSH Date 8-316
Date	Indexed C. Johnson

F.B. 712 Pg. 56

GAS LINES

Note: Any Additions or Changes on This Sheet Must be Made or Circled in Red Ink With Date and Name of Person Making Change.

Do not extend notes this side of this line

RETURN TO
LOS ANGELES COUNTY SURVEYOR
700 HALL OF RECORDS

FORM 247 10M 11-35

AVENUE

SYCAMORE

BUNGALOW'S
O.V. 142

155

VENT

1½" Service Valve
& Regulator

S.S. - 2/16/63

105.6

1½"

0.3

For Locator

26.4

RETURN TO
LOS ANGELES COUNTY SURVEYOR
700 HALL OF RECORDS

Note: Any Additions or Changes on This Sheet Must be Made or Circled in **Red Ink** With Date and Name of Person Making Change.

Do not extend notes this side of this line

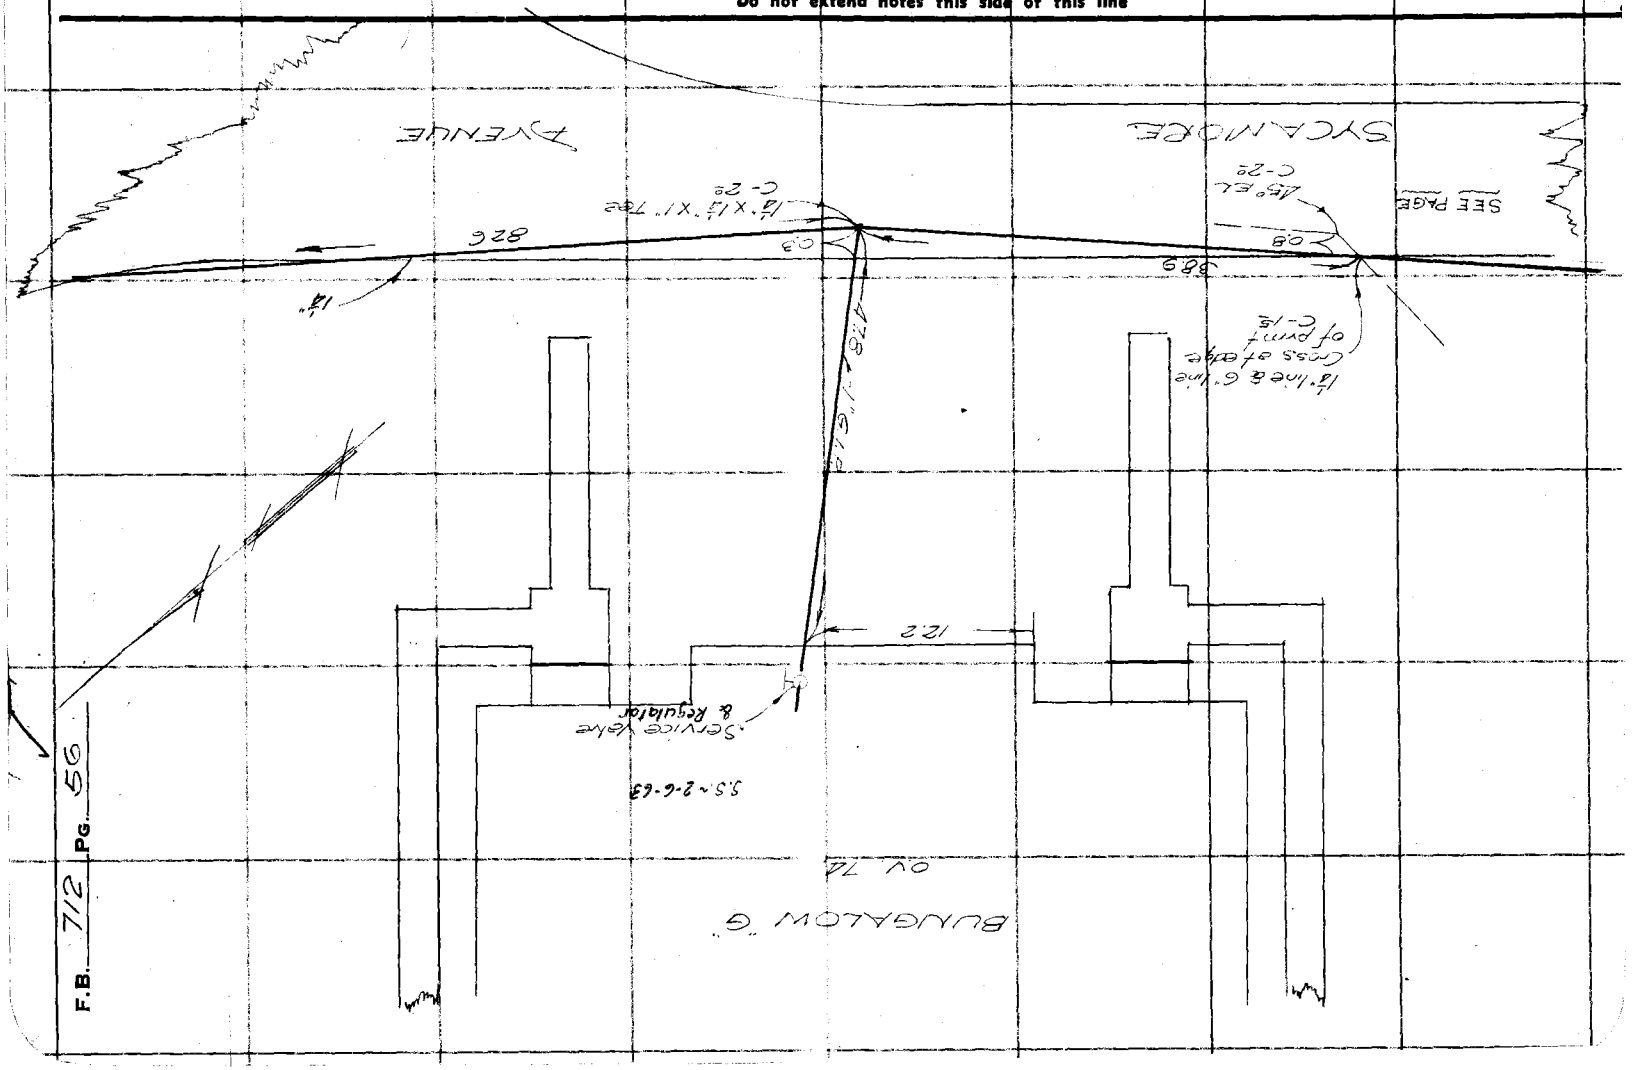

F.B. 712 PG. 56

FORM 247 10M 11-38

RETURN TO
LOS ANGELES COUNTY SURVEYOR
700 HALL OF RECORDS

Note: Any Additions or Changes on This Sheet Must be Made or Circled in Red Ink With Date and Name of Person Making Change.

Do not extend notes this side of this line

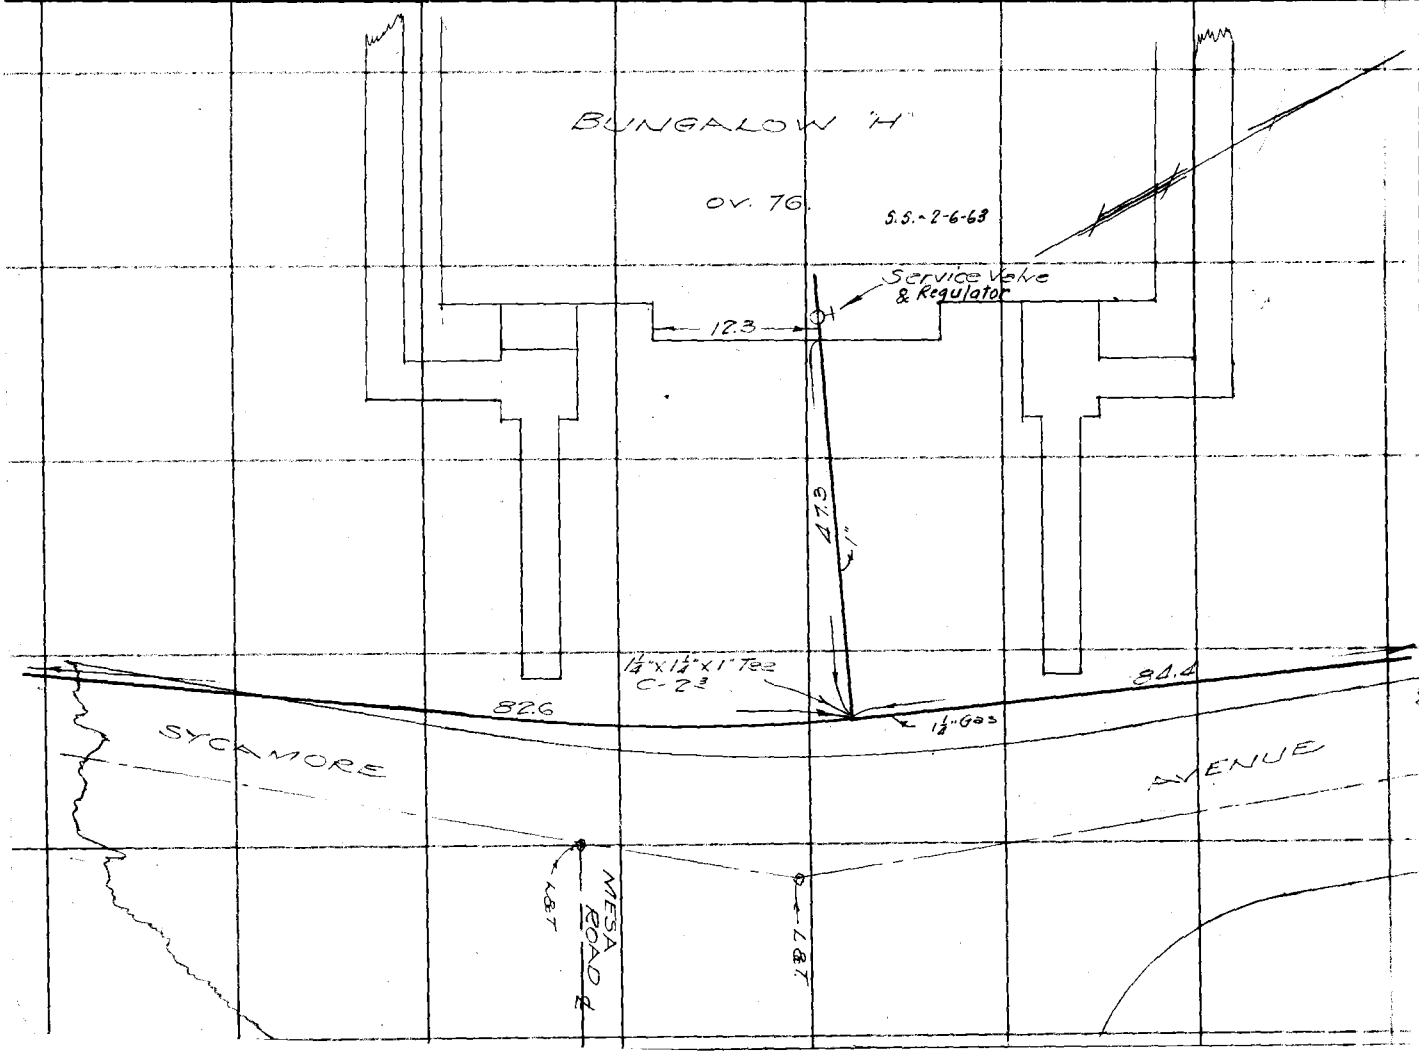

Notes Ck'd by
Map No.
Office Work
Checked
Date

Survey of OLIVE VIEW SANATORIUM
W. O. 8128 Tape No. T. M. WALSH Std. °F.
Surveyed by T. M. WALSH Date 5-36
Notes T. M. WALSH
Indexed A. C. Johnson

F.B. 712 PG. 57

RETURN TO
LOS ANGELES COUNTY SURVEYOR
700 HALL OF RECORDS

Note: Any Additions or Changes on This Sheet Must be Made or Circled in **Red Ink** With Date and Name of Person Making Change.

Do not extend notes this side of this line

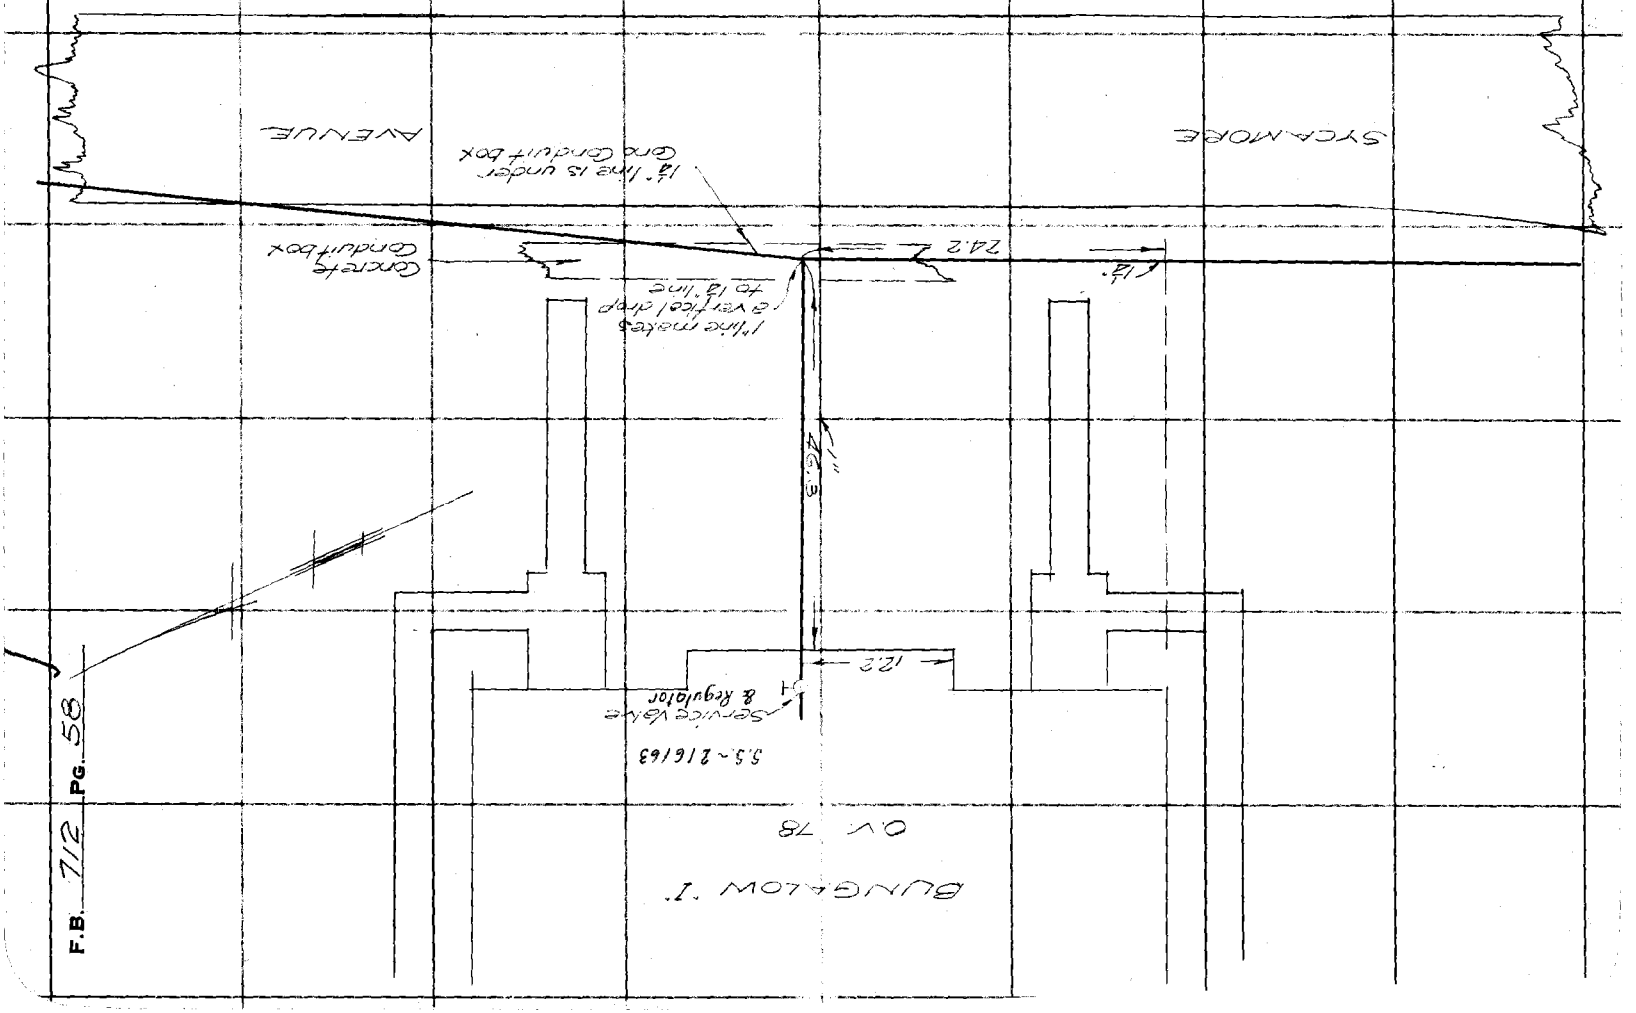

F.B. 712 PG. 58

FORM 247 10M 11-35

RETURN TO
LOS ANGELES COUNTY SURVEYOR
700 HALL OF RECORDS

Note: Any Additions or Changes on This Sheet Must be Made or Circled in **Red Ink** With Date and Name of Person Making Change.

Do not extend notes this side of this line

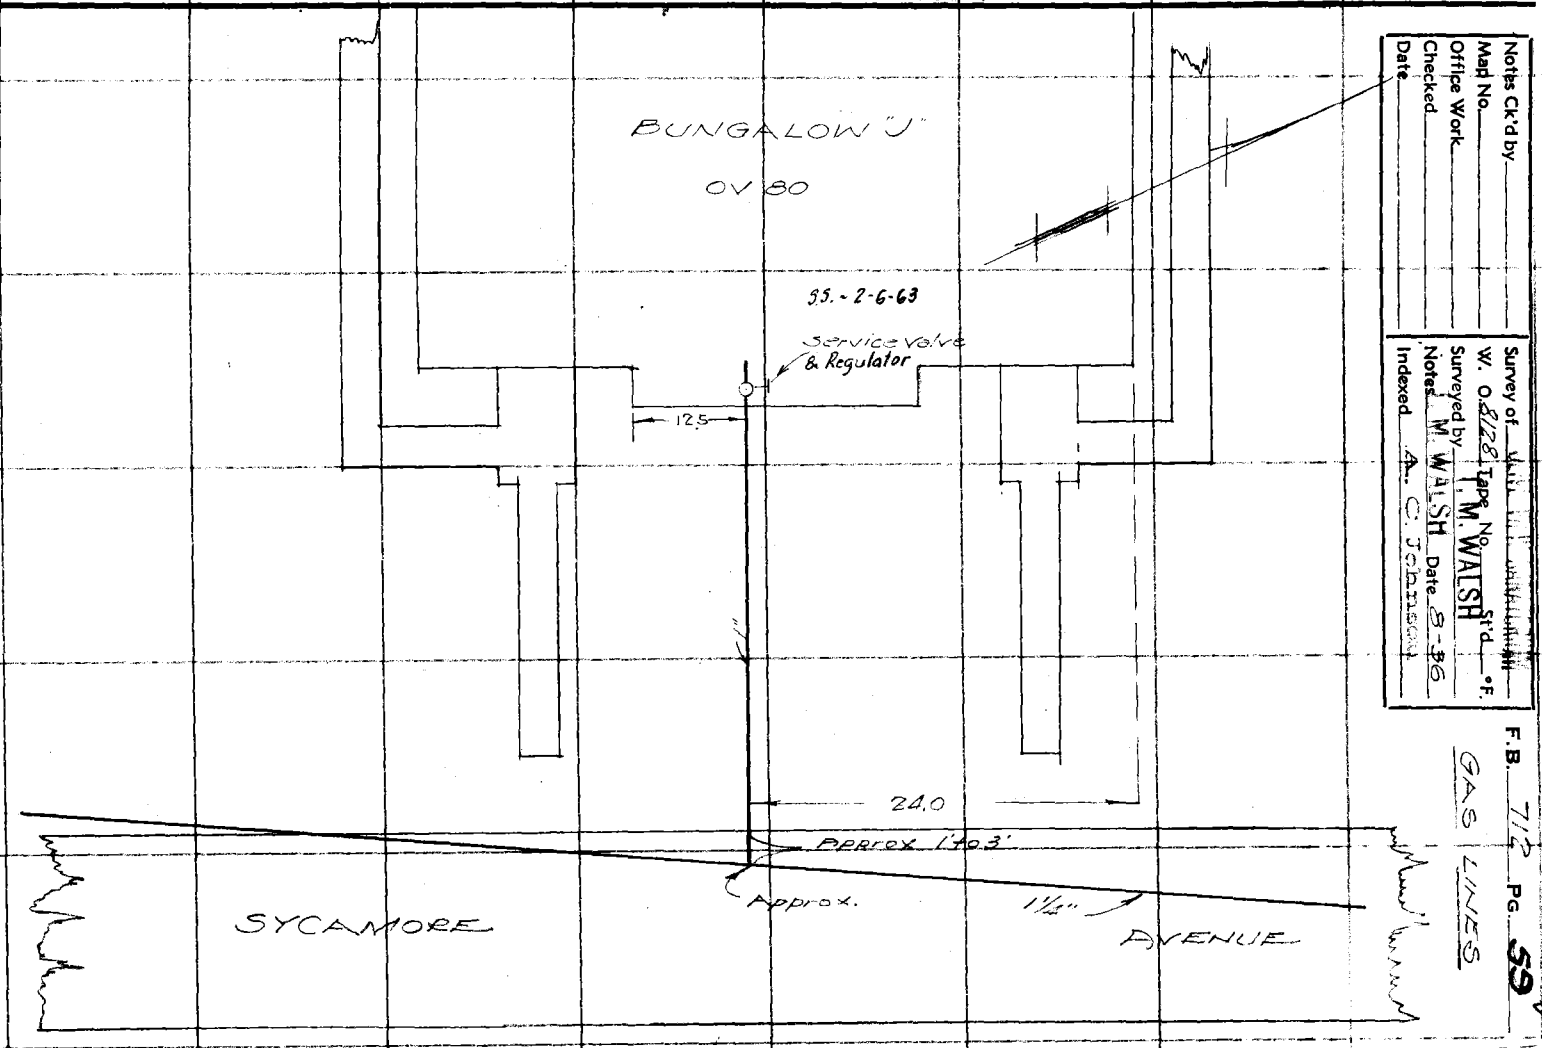

Notes Ck'd by
Map No.
Office Work
Checked
Date

Survey of W. O. 8128 Tape No.
Surveyed by T. M. WALSH Std'd °F.
Notes M. WALSH Date 8-86
Indexed A. C. Johnson

F.B. 7/2 Pg. 59

GAS LINES

F.B. 712 PG. 60 ✓

RETURN TO
LOS ANGELES COUNTY SURVEYOR
700 HALL OF RECORDS

Note: Any Additions or Changes on This Sheet Must be Made or Circled in Red Ink With Date and Name of Person Making Change.

Do not extend notes this side of this line

Notes Ck'd by	Survey of
Map No.	W. O. 8128 Tape No. St'd °F.
Office Work	Surveyed by T. M. WALSH
Checked	Notes T. M. WALSH Date 9-36
Date	Indexed A. C. Johnson

F.B. 712 PG. 61

GAS LINES

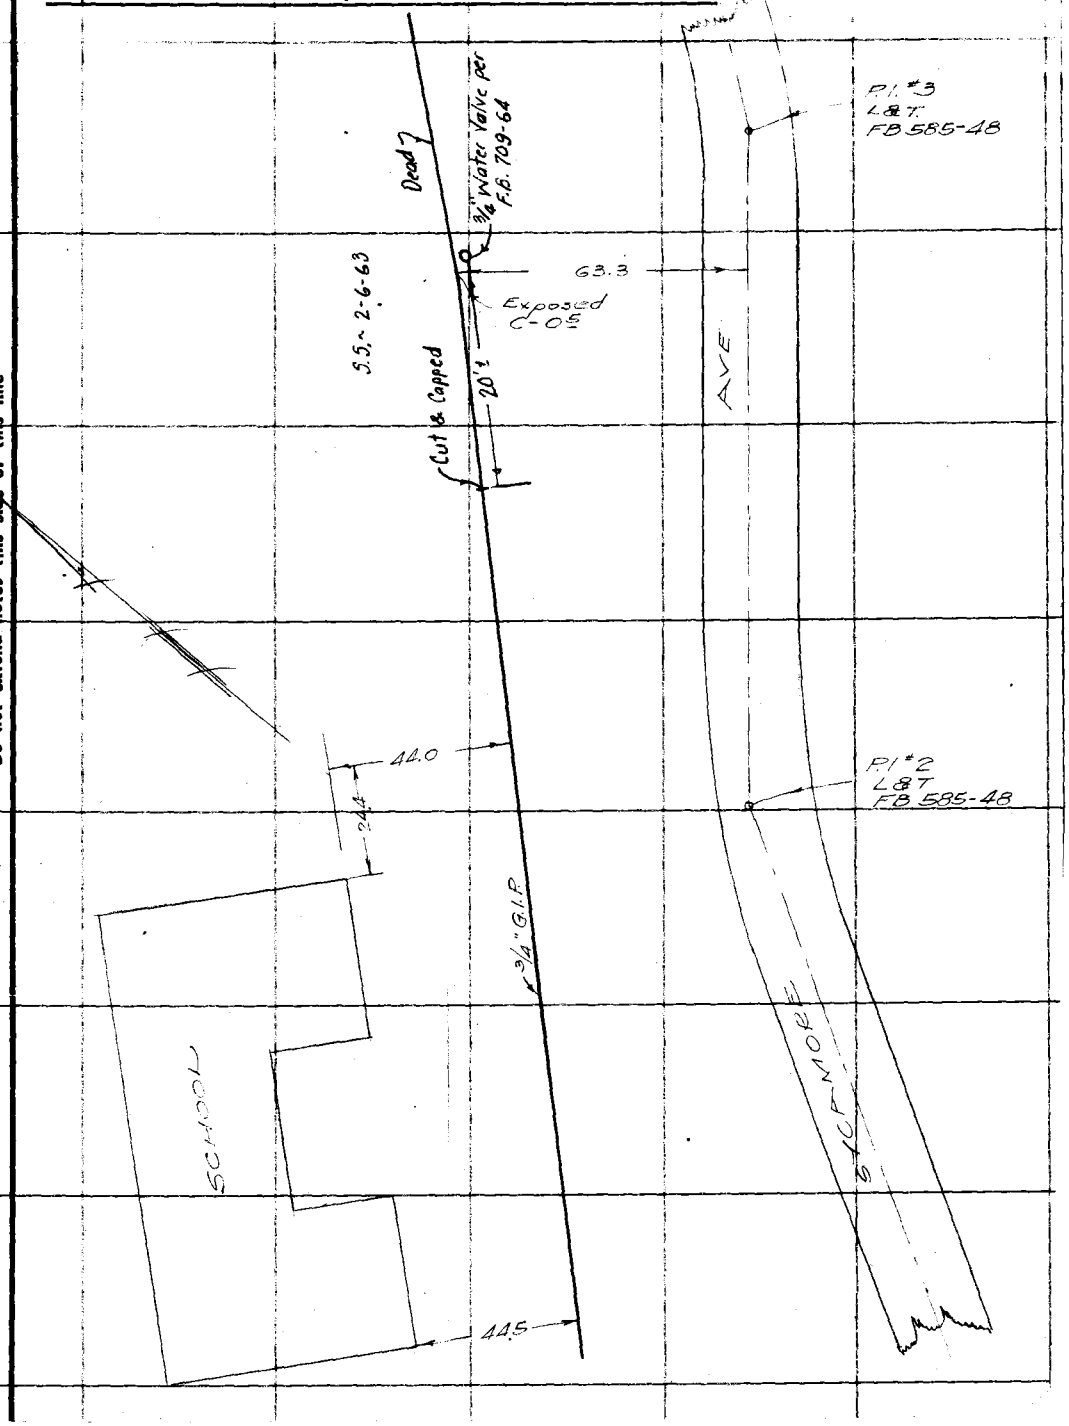

Note: Any Additions or Changes on This Sheet Must be Made or Circled in Red Ink With Date and Name of Person Making Change.

Do not extend notes this side of this line

RETURN TO
LOS ANGELES COUNTY SURVEYOR
700 HALL OF RECORDS

FORM 247 10M 11-35

RETURN TO
LOS ANGELES COUNTY SURVEYOR
700 HALL OF RECORDS

Note: Any Additions or Changes on This Sheet Must be Made or Circled in **Red** Ink With Date and Name of Person Making Change.

Do not extend notes this side of this line

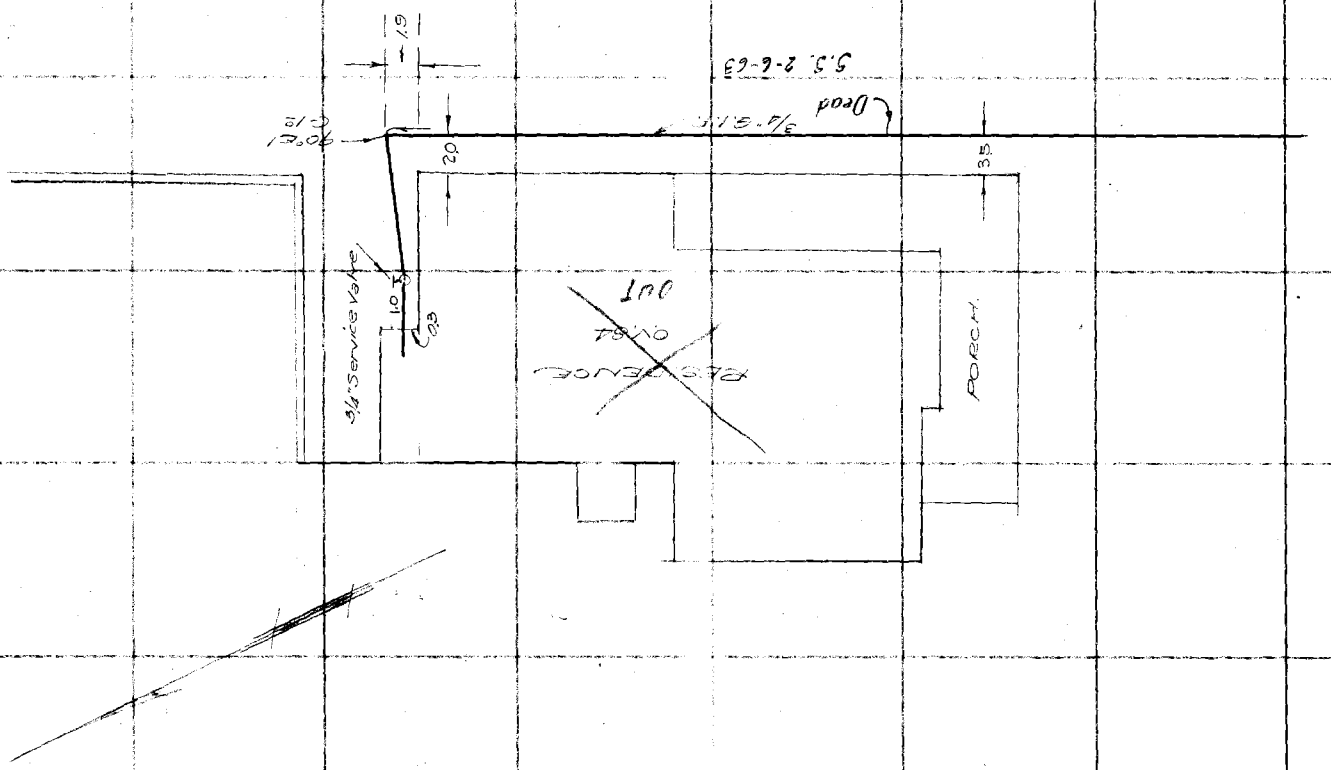

F.B. 712 PG. 62

FORM 247 10M 11-35

RETURN TO
LOS ANGELES COUNTY SURVEYOR
700 HALL OF RECORDS

Note: Any Additions or Changes on This Sheet Must be Made or Circled in Red Ink With Date and Name of Person Making Change.

Do not extend notes this side of this line

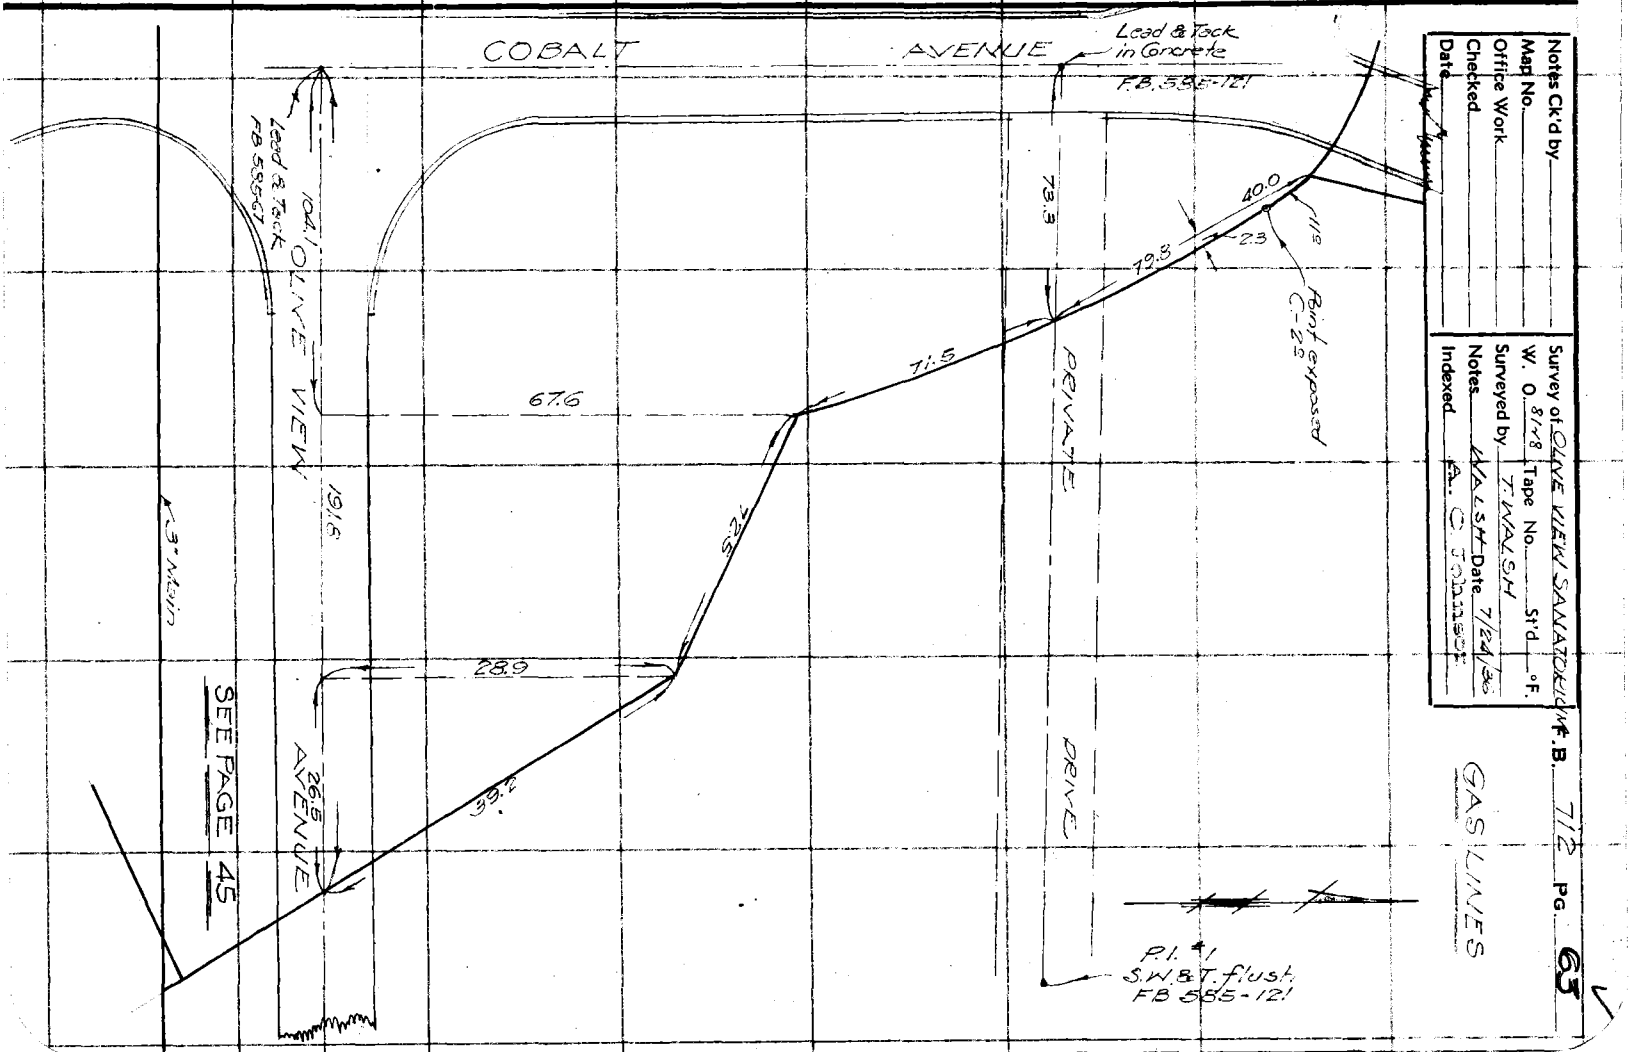

Notes Ck'd by
Map No.
Office Work
Checked
Date

Survey of OLIVE VIEW SANATORIUM F.B. 772 PG. 63
W. O. 8148 Tape No. St'd °F.
Surveyed by T. WALSH
Notes WALSH Date 7/24/36
Indexed A. C. Johnson

GAS LINES

RETURN TO
LOS ANGELES COUNTY SURVEYOR
700 HALL OF RECORDS

Note: Any Additions or Changes on This Sheet Must be Made or Circled in **Red Ink** With Date and Name of Person Making Change.

Do not extend notes this side of this line

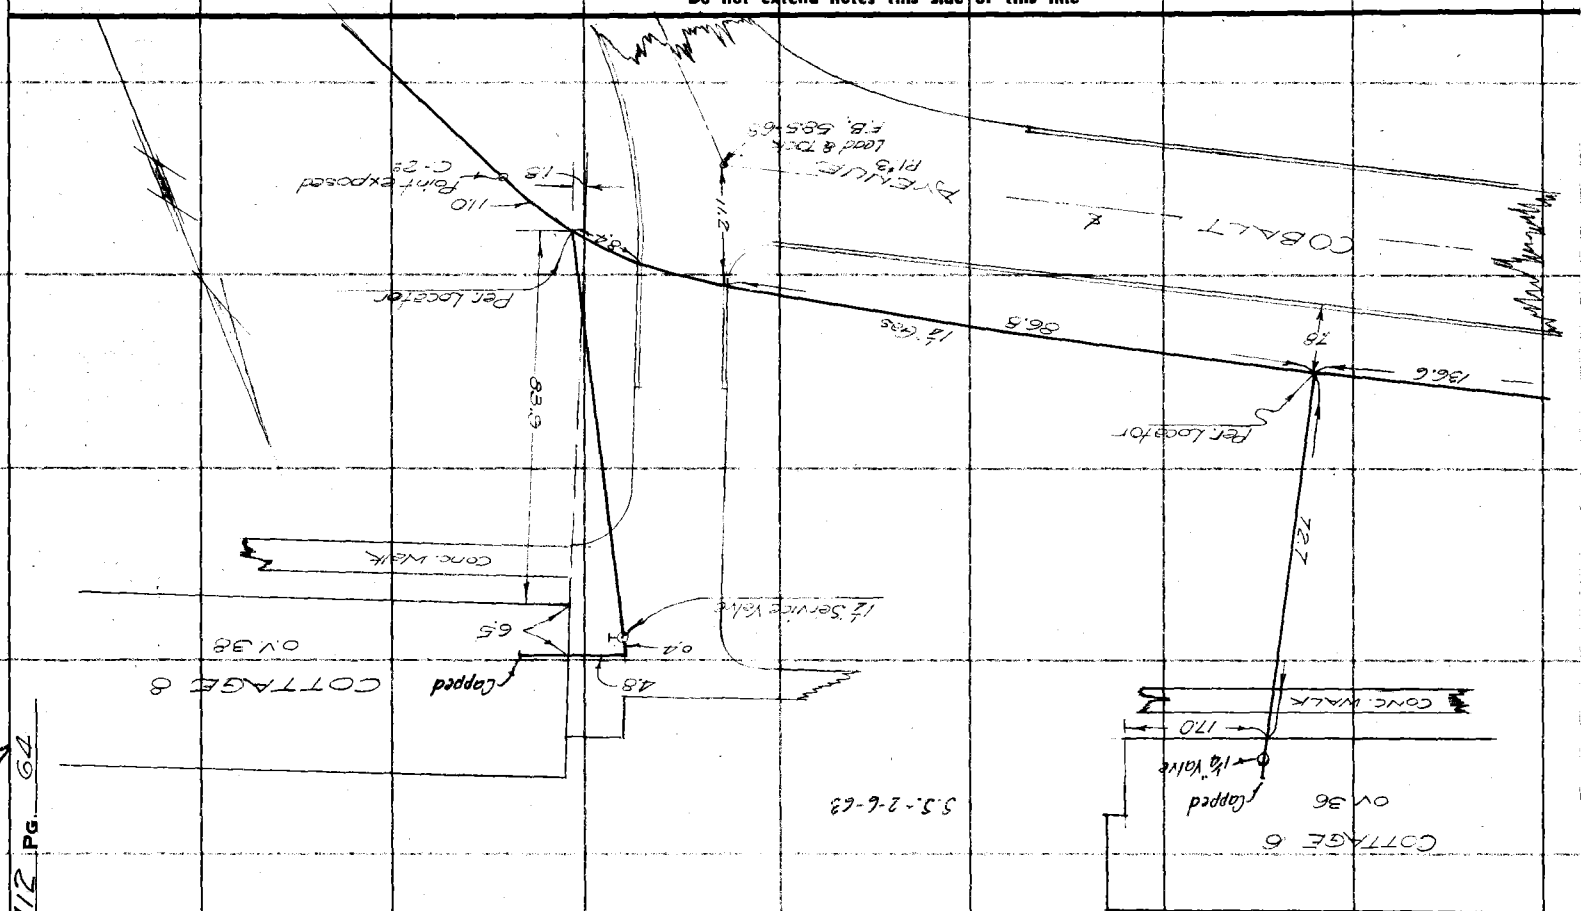

F.B. 712 PG. 64

Notes Ck'd by	Survey of OLIVEVIEW SANATORIUM
Map No.	W. O. 81-8 Tape No. St'd °F.
Office Work	Surveyed by T. WALSH
Checked	Notes WALSH Date 7-22-36
Date	Indexed A. C. Johnson

F.B. 712 PG. 65

GAS LINES

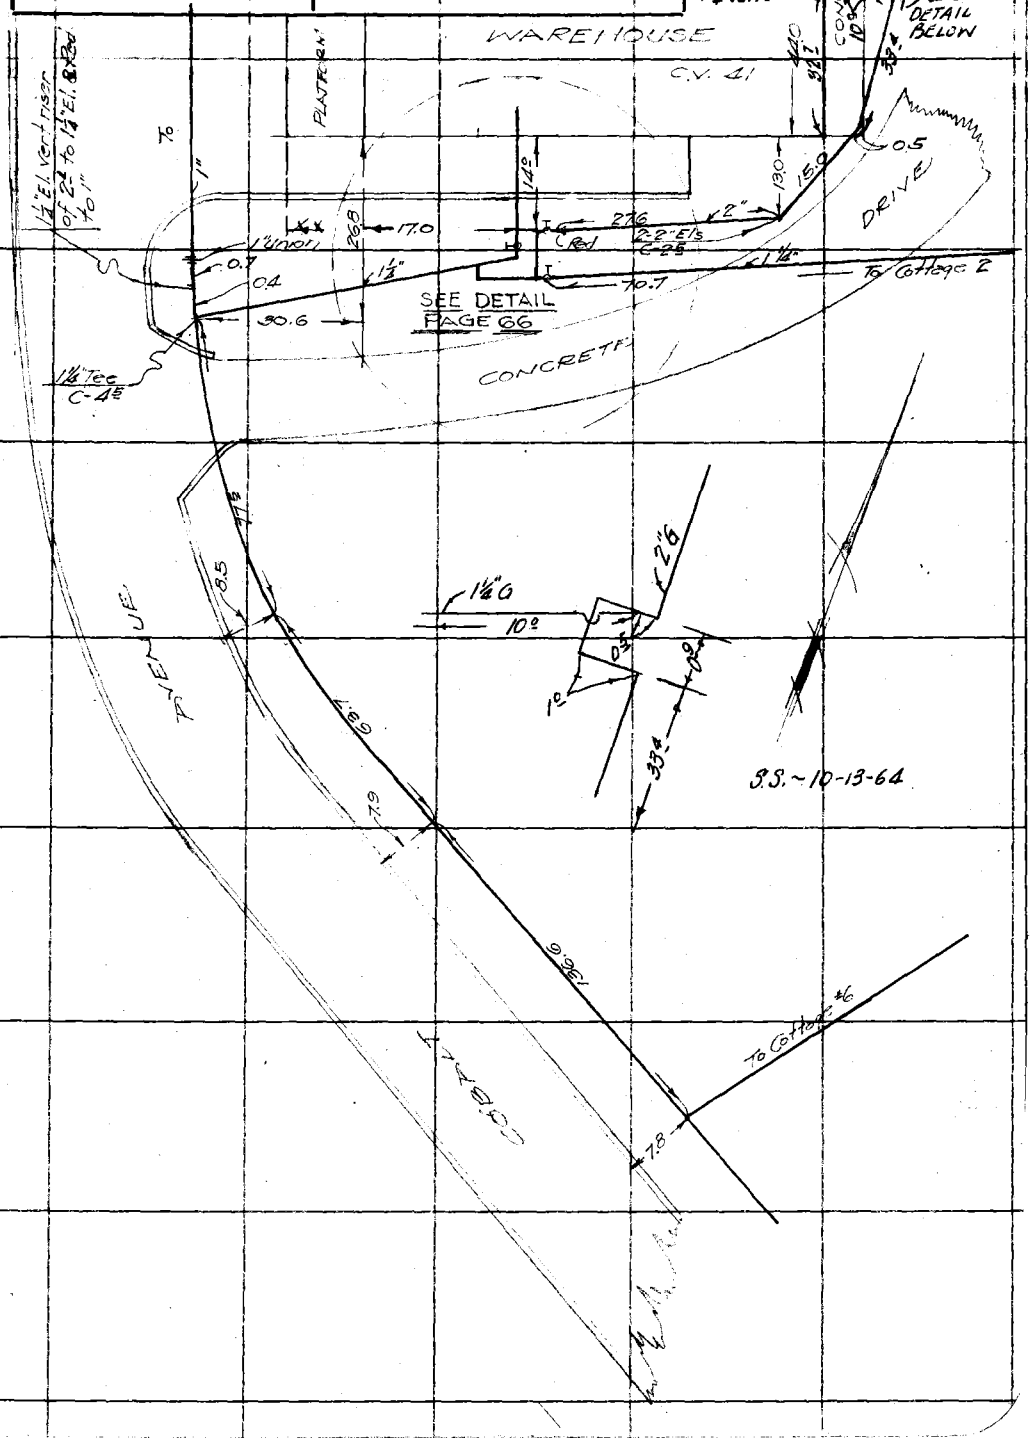

Note: Any Additions or Changes on This Sheet Must be Made or Circled in Red Ink With Date and Name of Person Making Change.

Do not extend notes this side of this line

RETURN TO
LOS ANGELES COUNTY SURVEYOR
700 HALL OF RECORDS

FORM 247 10M 11-35

RETURN TO
LOS ANGELES COUNTY SURVEYOR
700 HALL OF RECORDS

Note: Any Additions or Changes on This Sheet Must be Made or Circled in **Red Ink** With Date and Name of Person Making Change.

Do not extend notes this side of this line

F.B. 7/2 Pg. 66

GAS LINES

DETAIL SECTION

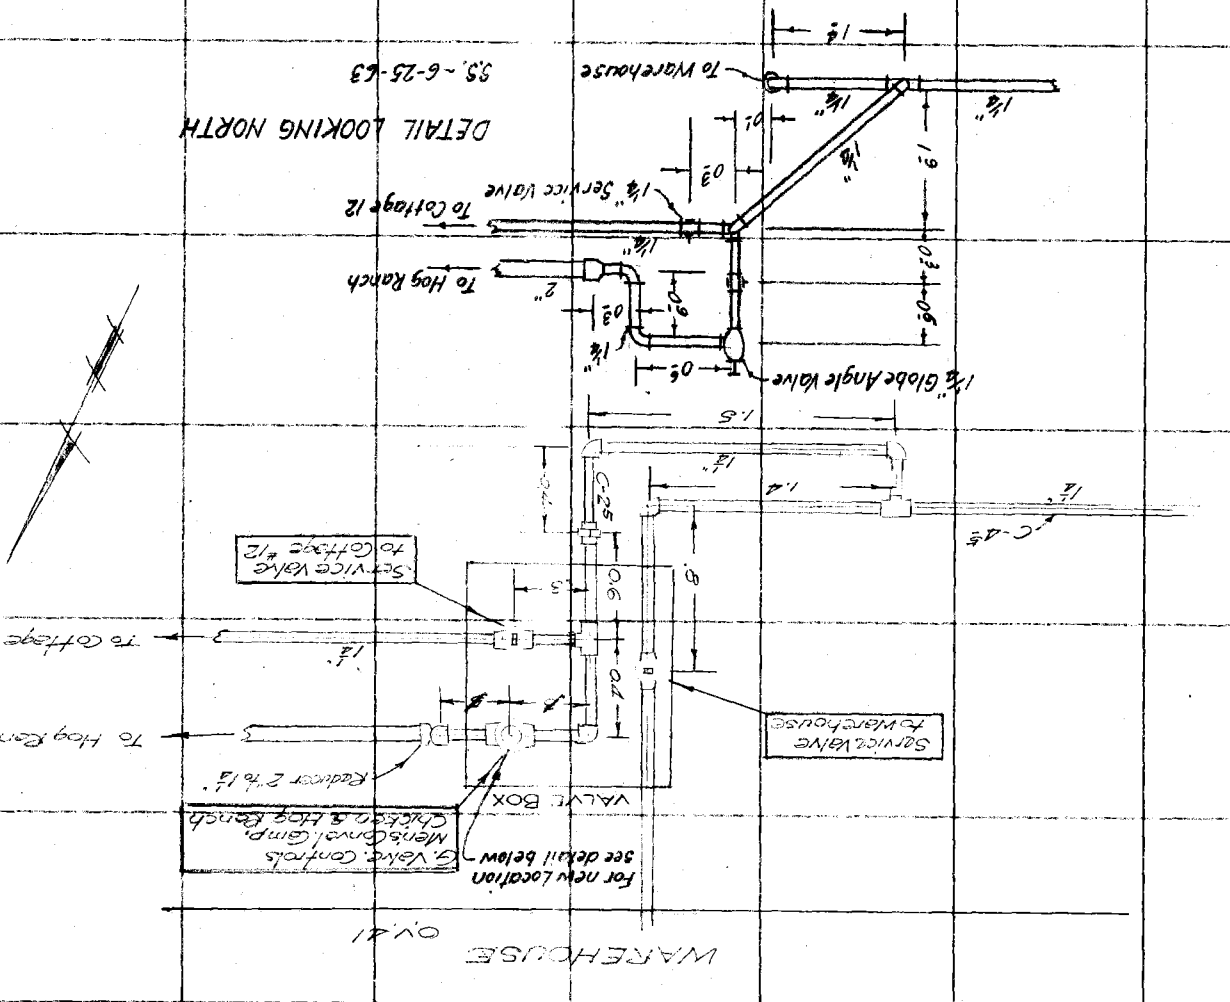

Notes Ck'd by	Survey of OLIVE VIEW SANATORIUM
Map No.	W. O. 8128 Tape No. St'd °F.
Office Work	Surveyed by T. M. WALSH
Checked	Notes T. M. WALSH Date 12-3-63
Date	Indexed A. C. JOHNSON

F.B. 712 PG. 67

GAS LINES

Note: Any Additions or Changes on This Sheet Must be Made or Circled in Red Ink With Date and Name of Person Making Change.

Do not extend notes this side of this line

RETURN TO
LOS ANGELES COUNTY SURVEYOR
700 HALL OF RECORDS

FORM 247 10M 11-38

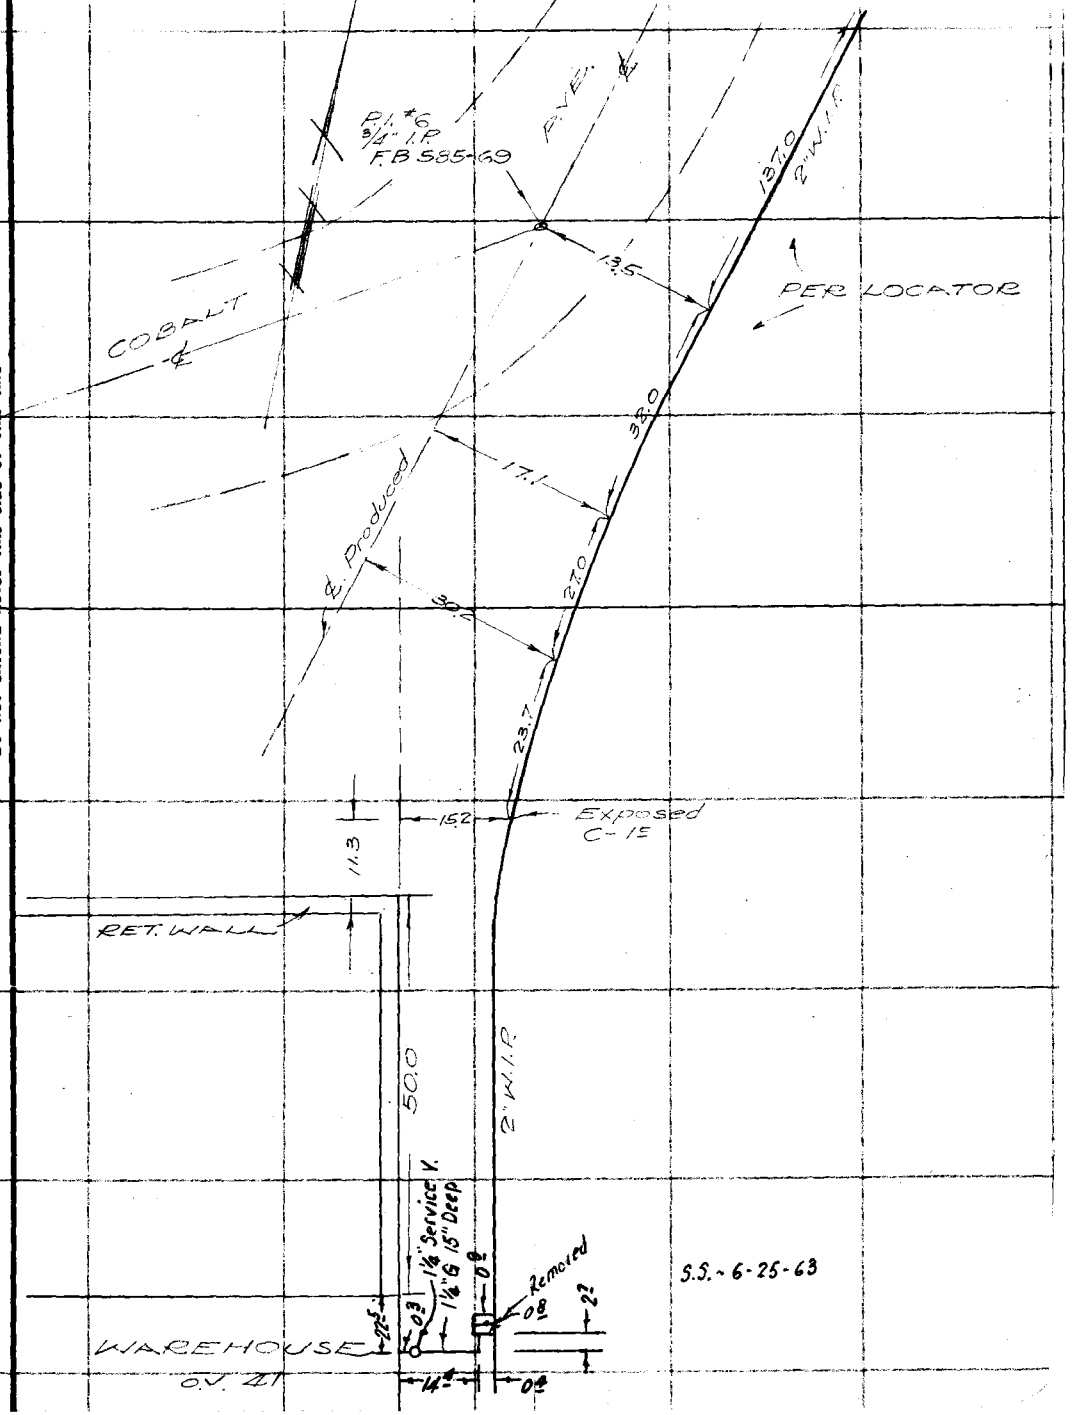

RETURN TO
LOS ANGELES COUNTY SURVEYOR
700 HALL OF RECORDS

Note: Any Additions or Changes on This Sheet Must be Made or Circled in **Red Ink** With Date and Name of Person Making Change.

Do not extend notes this side of this line

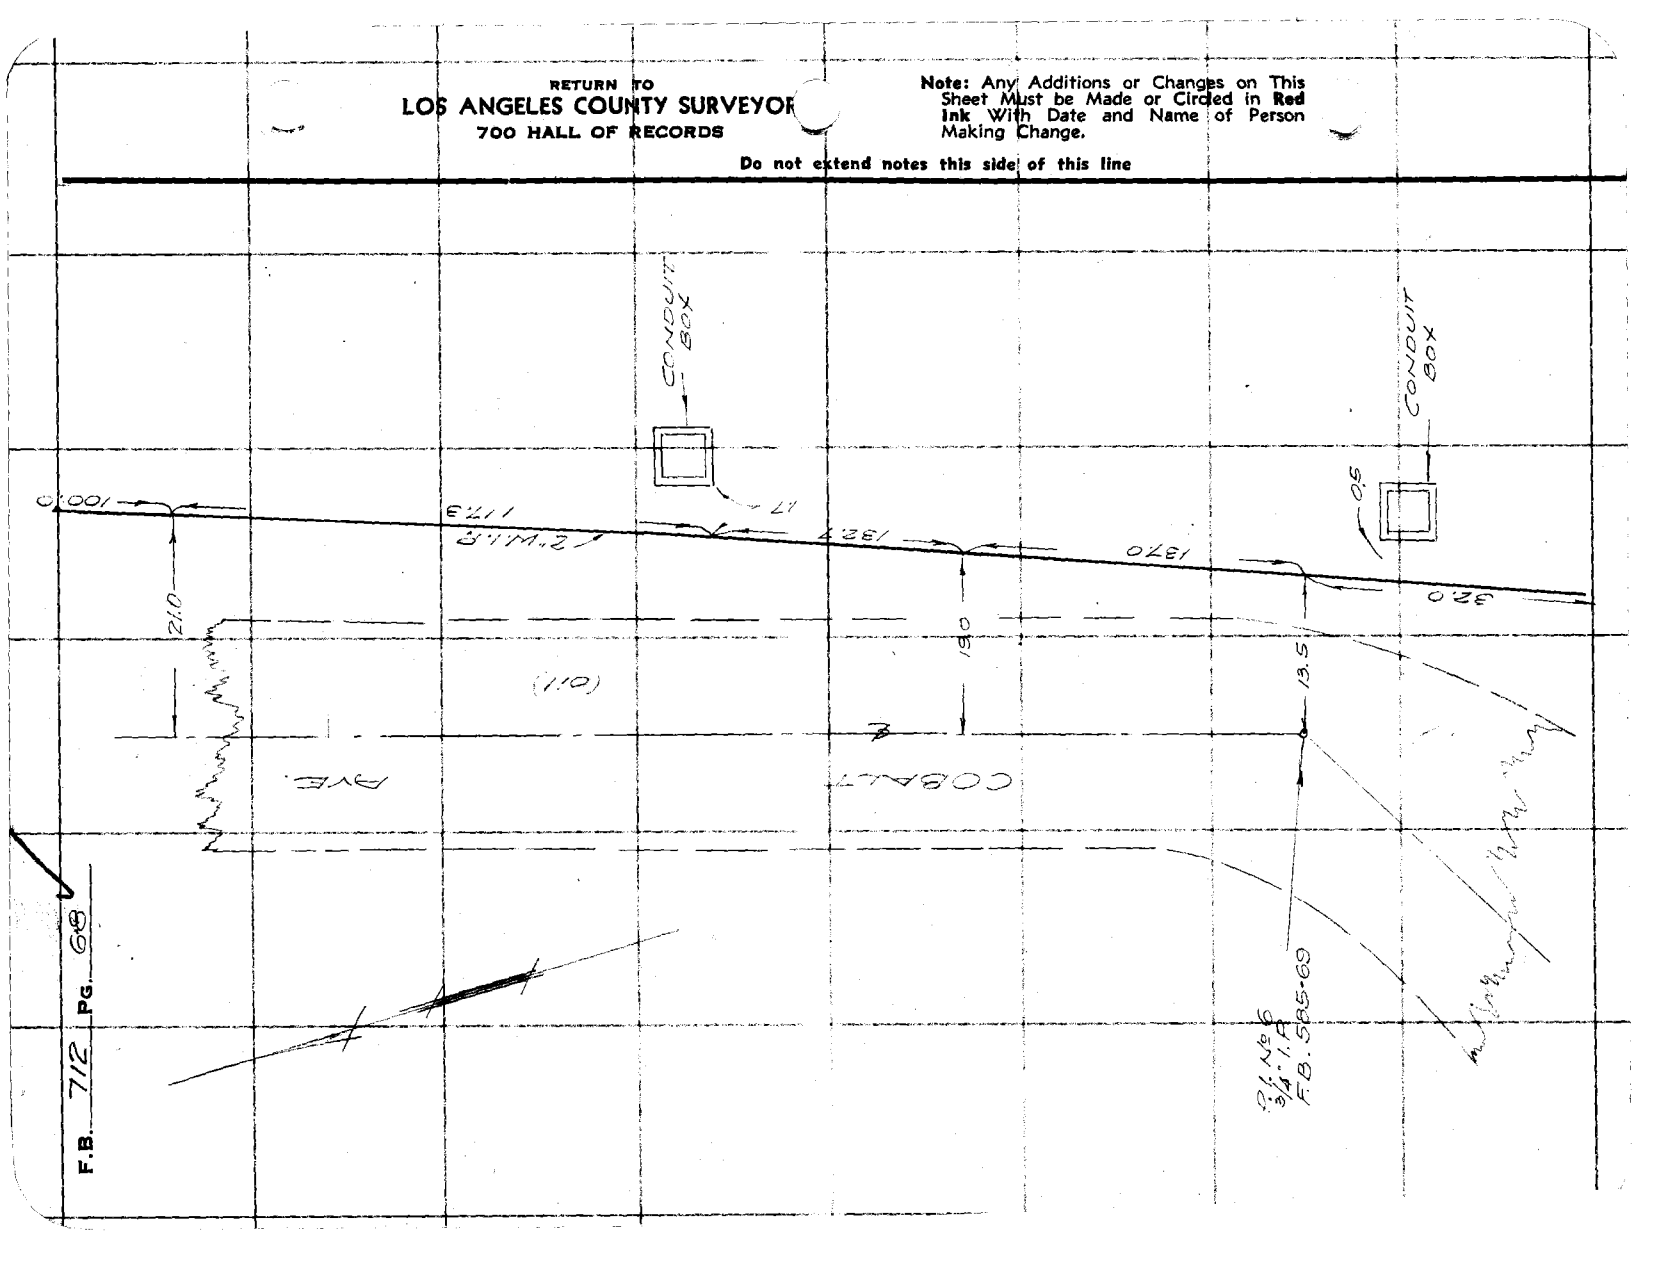

Notes Ck'd by	Survey of [illegible]	F.B. 712 PG. 69
Map No.	W. O. 8128 Tape No. St'd °F.	GAS LINES
Office Work	Surveyed by T. M. WALSH	
Checked	Notes T. M. WALSH Date 9-36	
Date	Indexed A. C. Johnson	

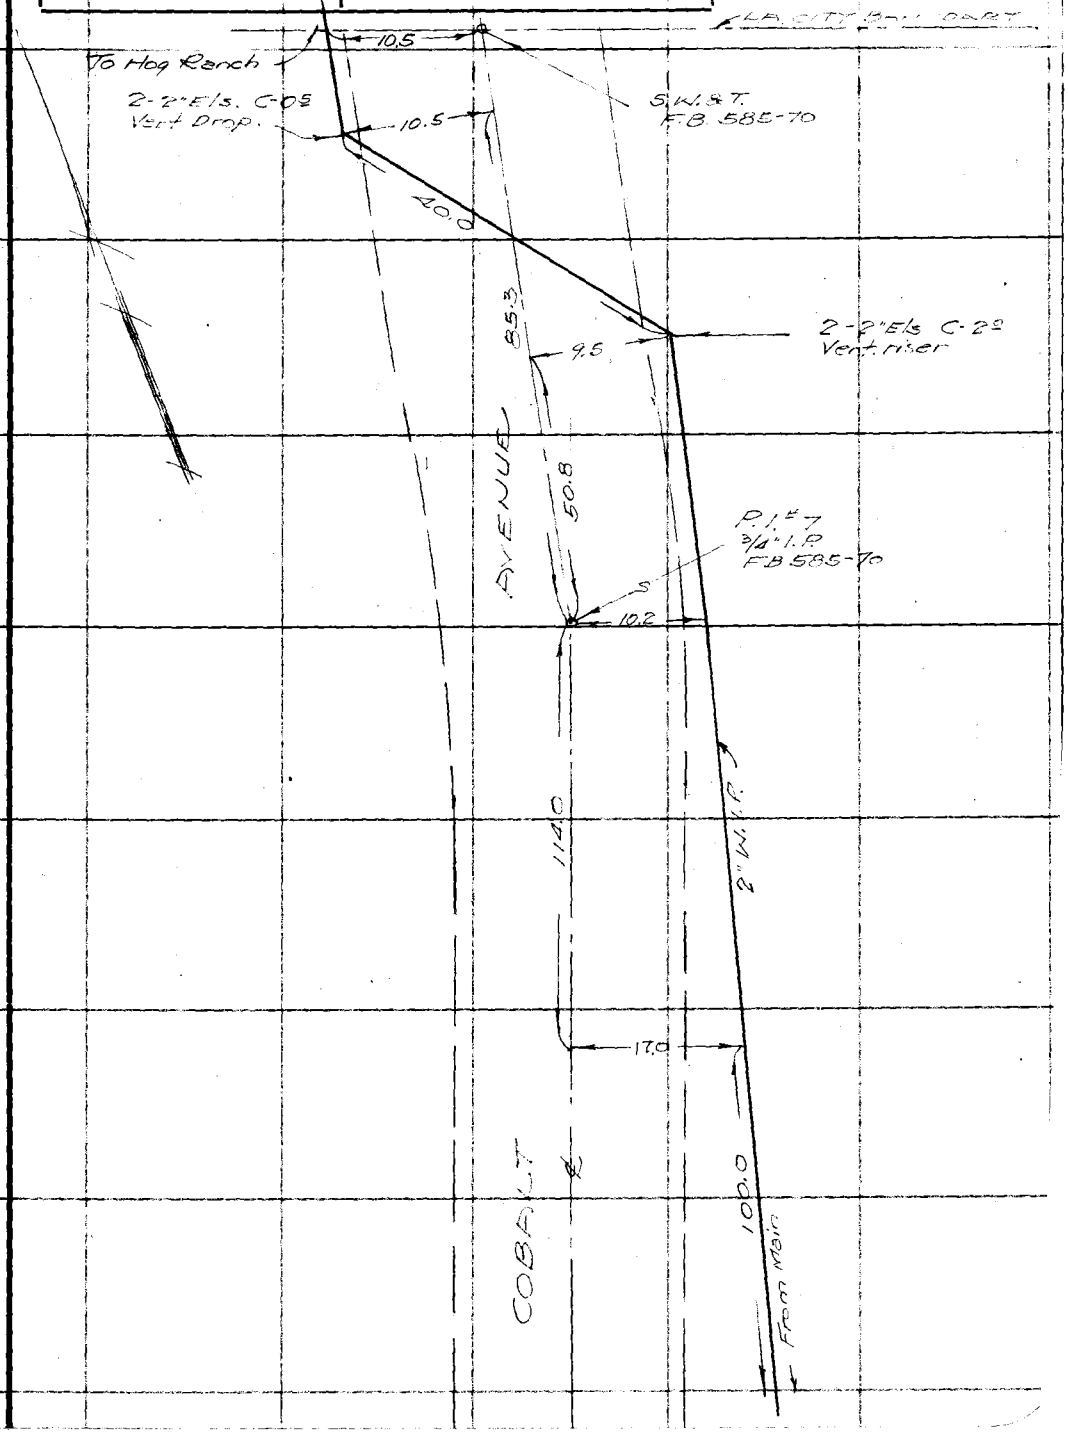

Note: Any Additions or Changes on This Sheet Must be Made or Circled in Red Ink With Date and Name of Person Making Change.

Do not extend notes this side of this line

RETURN TO
LOS ANGELES COUNTY SURVEYOR
700 HALL OF RECORDS

FORM 247 10M 11-35

RETURN TO
LOS ANGELES COUNTY SURVEYOR
700 HALL OF RECORDS

Note: Any Additions or Changes on This Sheet Must be Made or Circled in **Red Ink** With Date and Name of Person Making Change.

Do not extend notes this side of this line

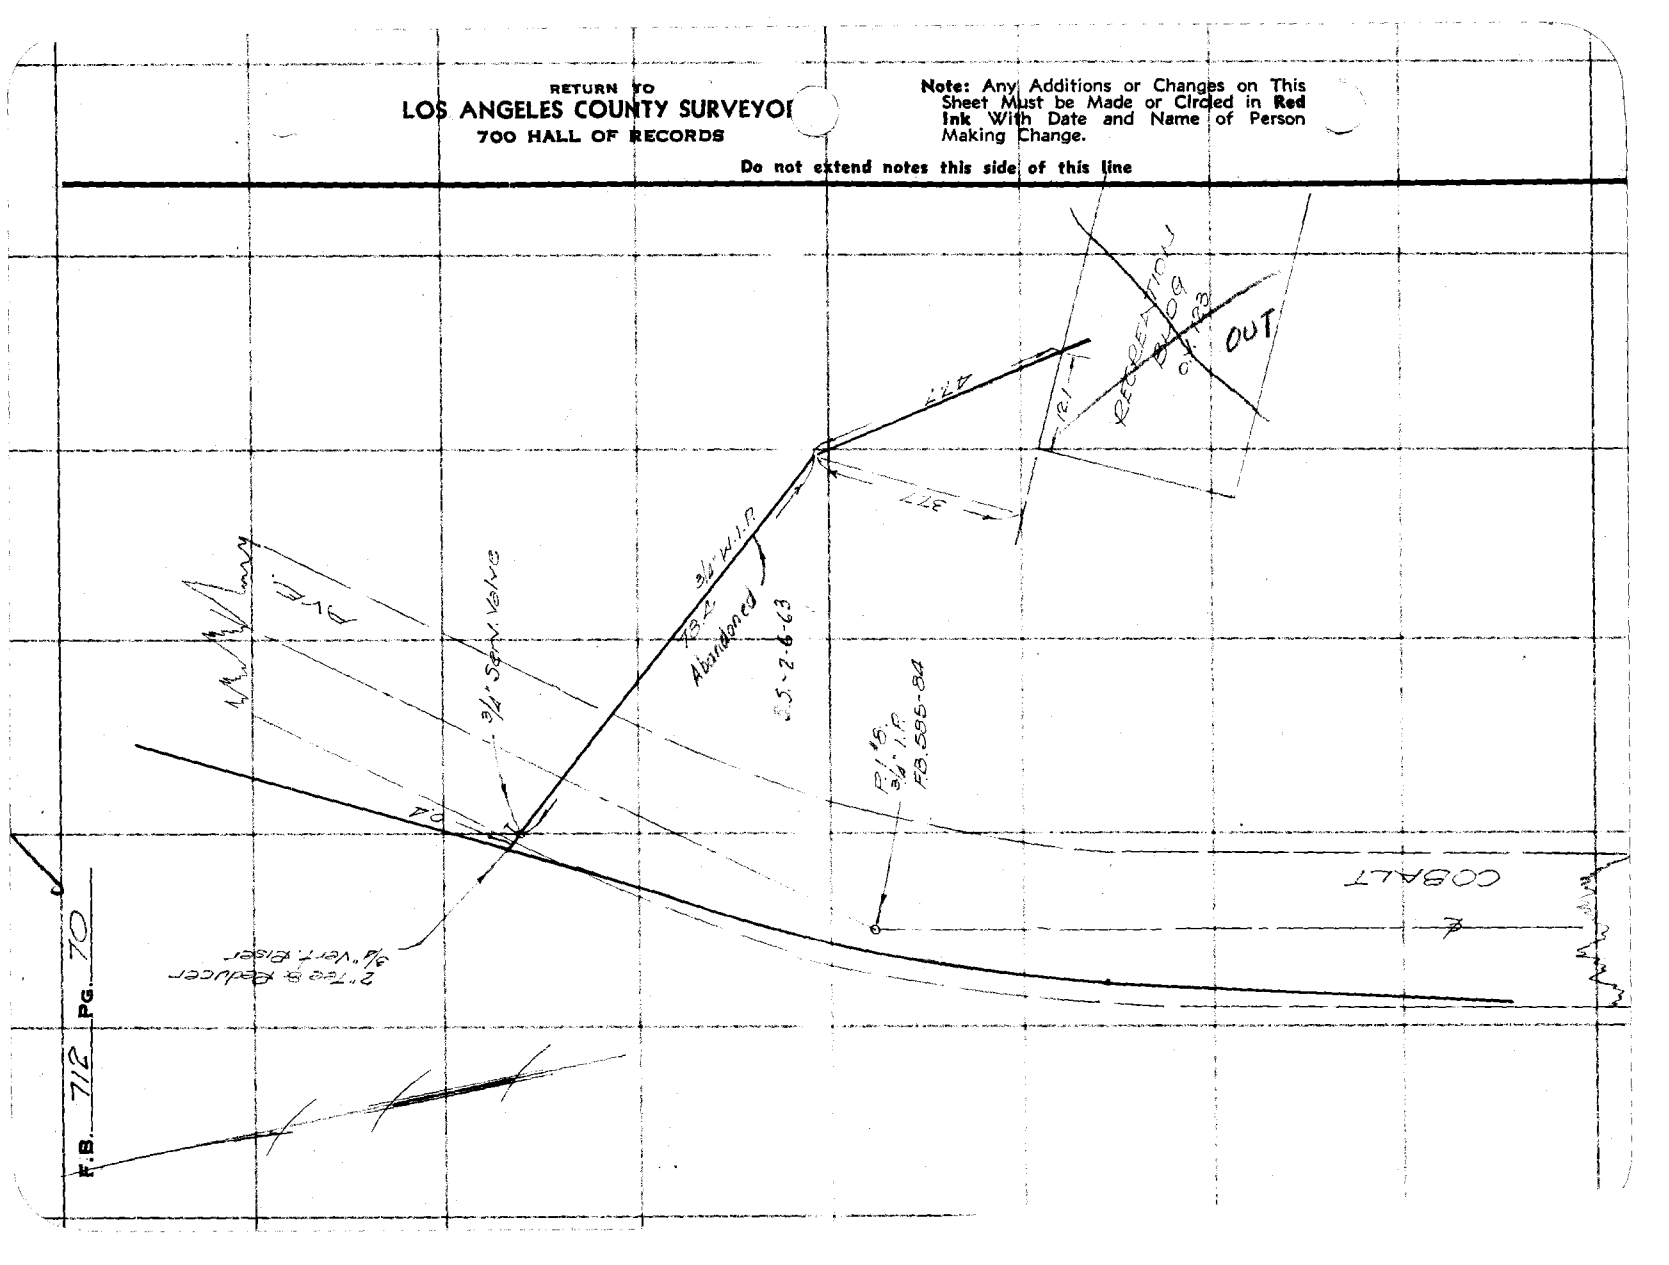

F.B. 712 PG. 70

FORM 247 10M 11-35

RETURN TO
LOS ANGELES COUNTY SURVEYOR
700 HALL OF RECORDS

Note: Any Additions or Changes on This Sheet Must be Made or Circled in Red Ink With Date and Name of Person Making Change.

Do not extend notes this side of this line

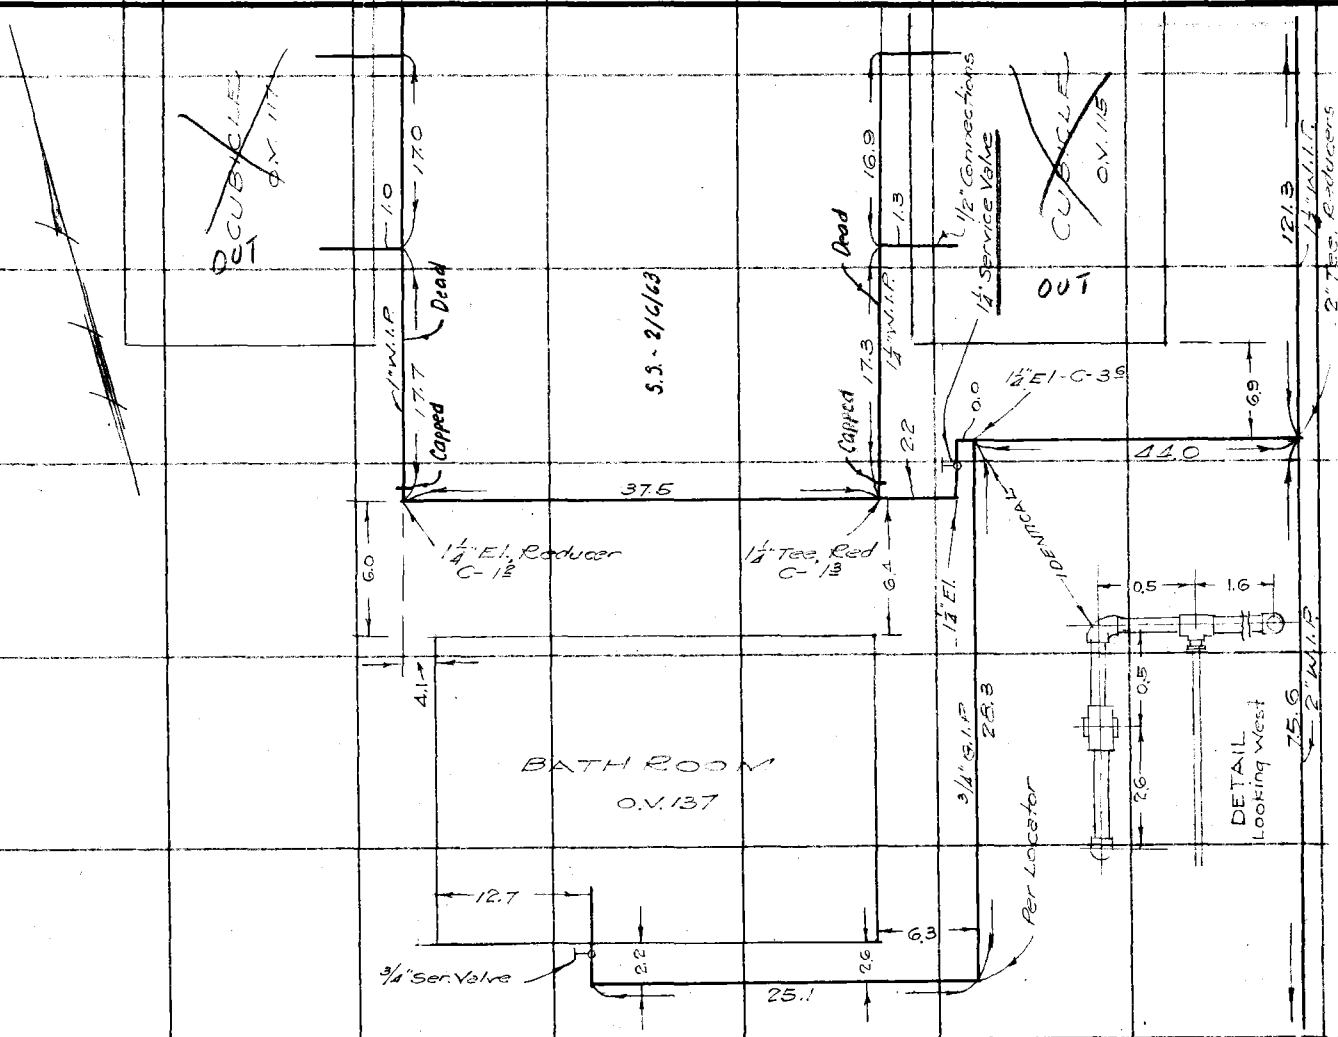

Notes Ck'd by _____
Map No. _____
Office Work _____
Checked _____
Date _____

Survey of W. O. 8128 Tape No. F. M. WALSH
Surveyed by F. M. WALSH Date 8-26
Notes _____
Indexed A. C. John

F.B. 712 Pg. 71

RETURN TO
LOS ANGELES COUNTY SURVEYOR
700 HALL OF RECORDS

Note: Any Additions or Changes on This Sheet Must be Made or Circled in Red Ink With Date and Name of Person Making Change.

Do not extend notes this side of this line

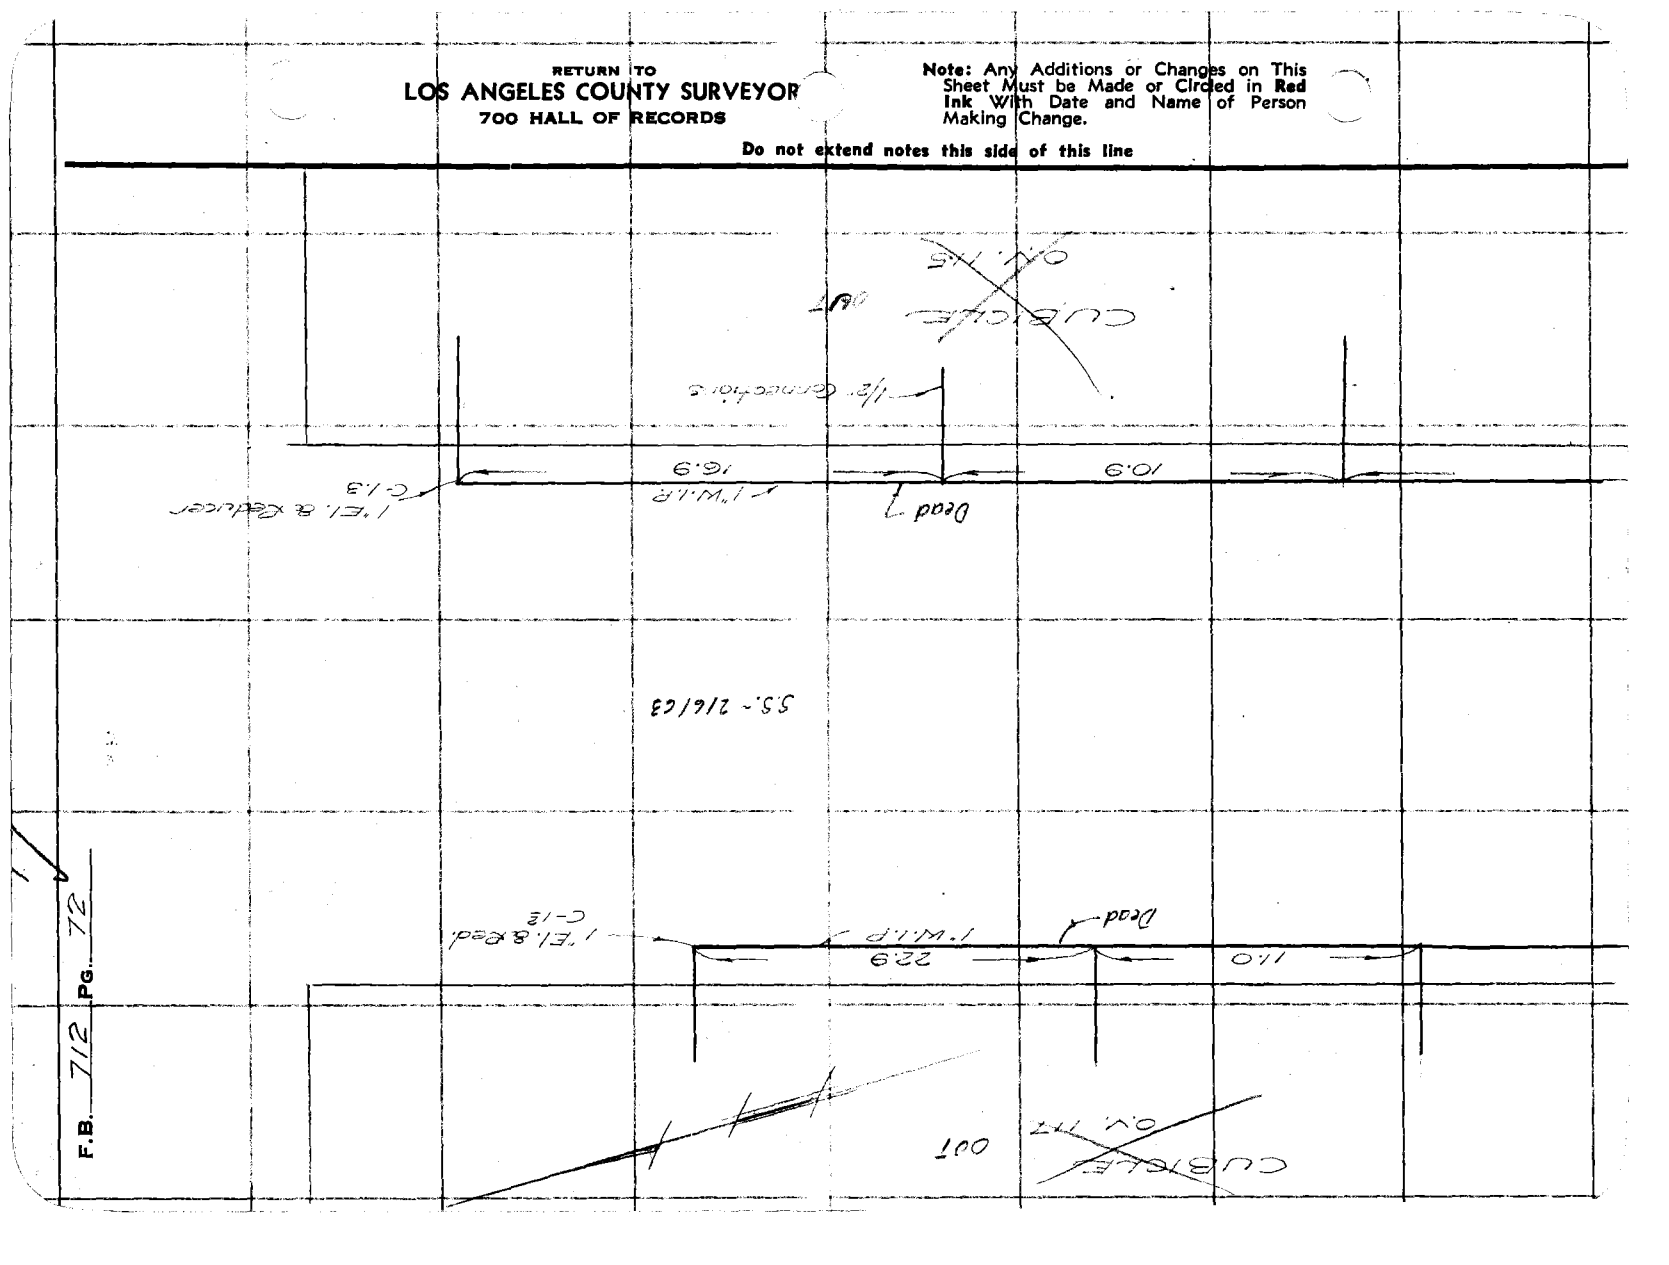

F.B. 712 Pg. 72

Notes Ck'd by	Survey of
Map No.	W. O. 8128 Tape No. St'd °F.
Office Work	Surveyed by T. M. WALSH
Checked	Notes T. M. WALSH Date 8-19-36
Date	Indexed A. C. Johnson

F.B. 712 PG. 73

GAS LINE

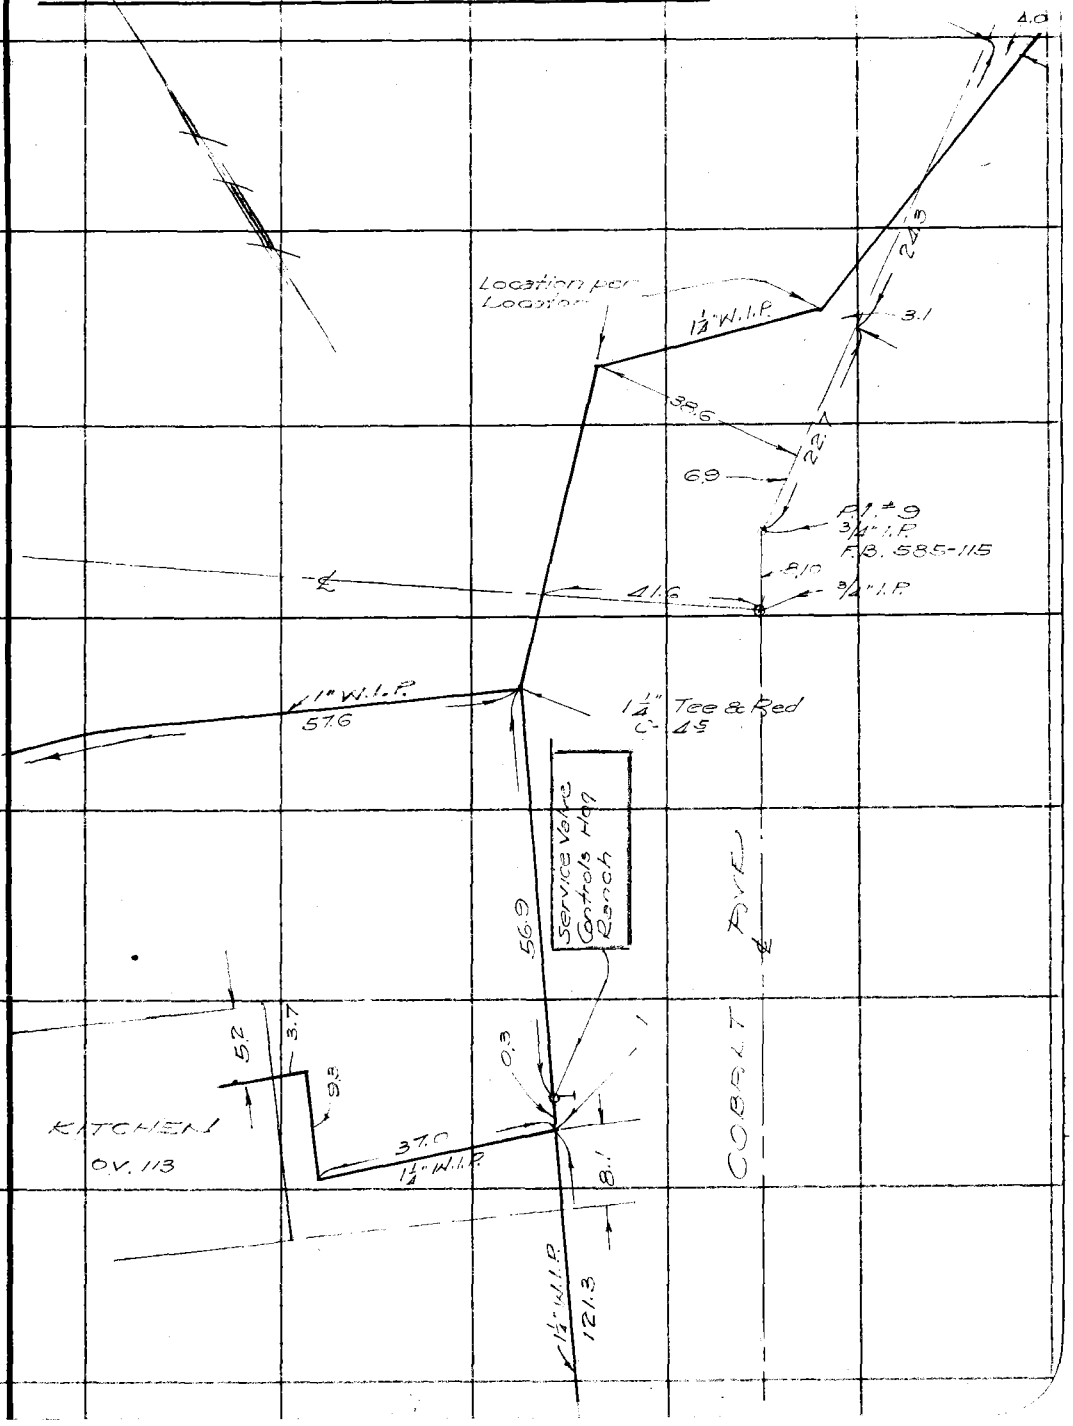

Note: Any Additions or Changes on This Sheet Must be Made or Circled in Red Ink With Date and Name of Person Making Change.

Do not extend notes this side of this line

RETURN TO
LOS ANGELES COUNTY SURVEYOR
700 HALL OF RECORDS

FORM 247 10M 11-35

RETURN TO
LOS ANGELES COUNTY SURVEYOR
700 HALL OF RECORDS

Note: Any Additions or Changes on This Sheet Must be Made or Circled in **Red Ink** With Date and Name of Person Making Change.

Do not extend notes this side of this line

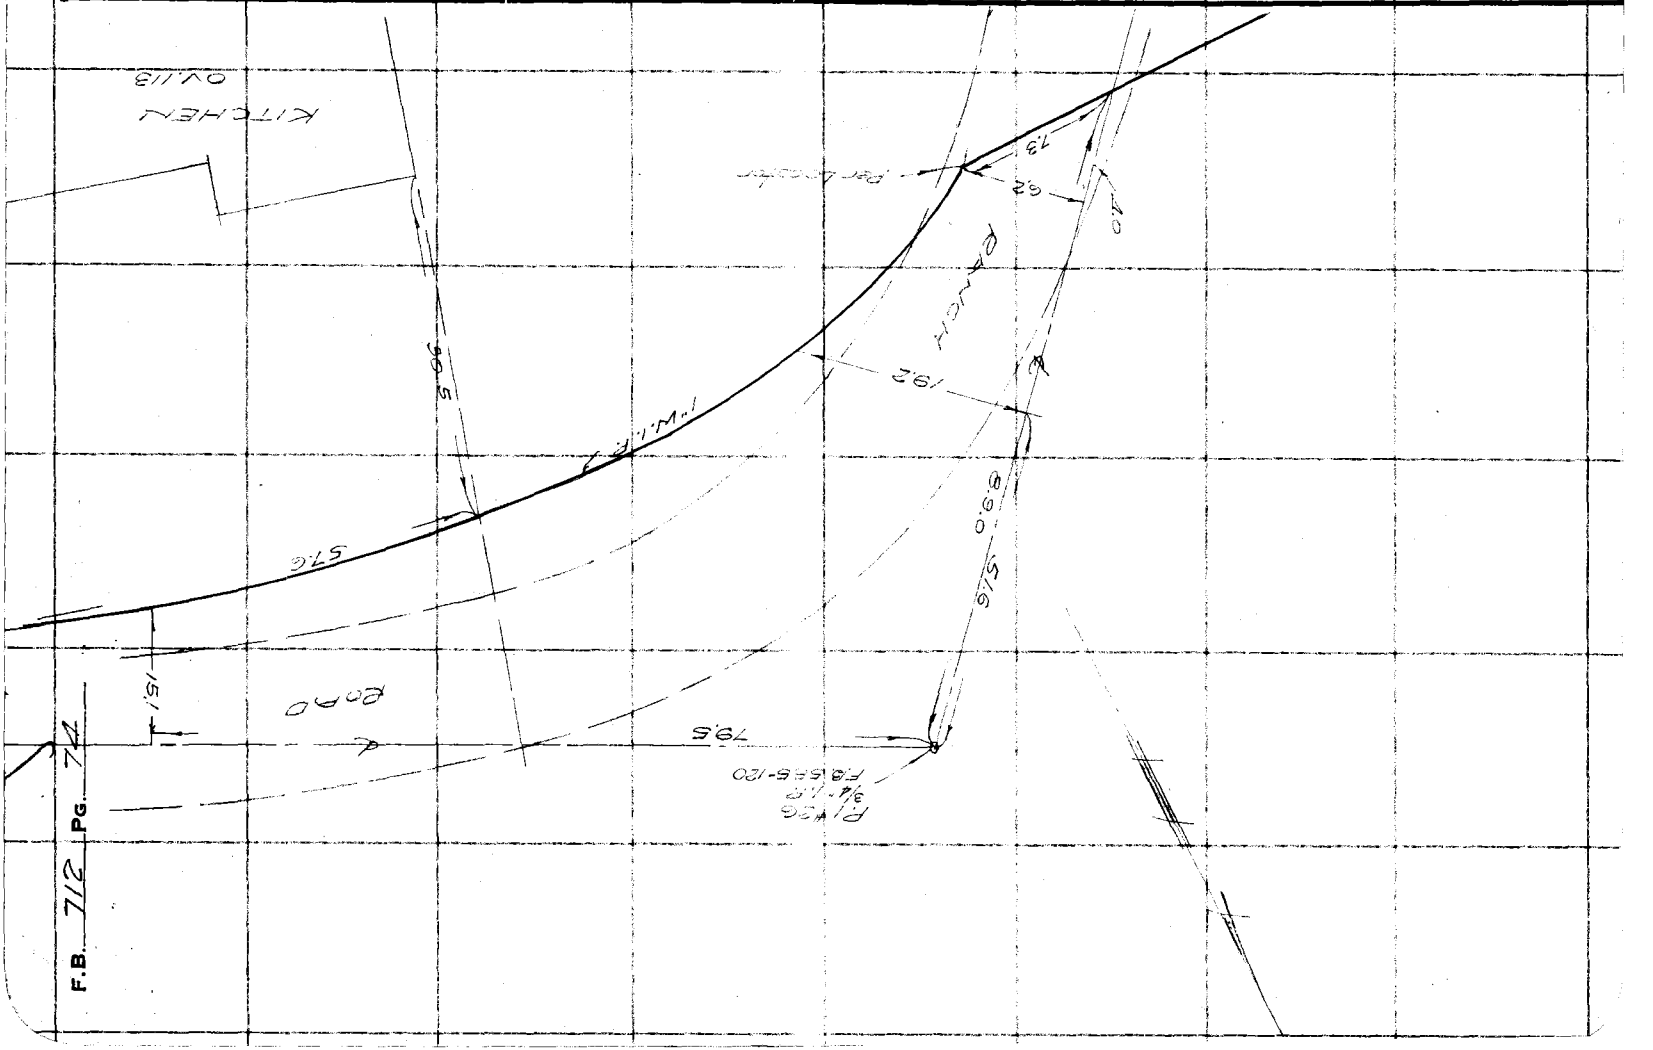

FORM 247 10M 11-35

RETURN TO
LOS ANGELES COUNTY SURVEYOR
700 HALL OF RECORDS

Note: Any Additions or Changes on This Sheet Must be Made or Circled in **Red Ink** With Date and Name of Person Making Change.

Do not extend notes this side of this line

Notes Ck'd by
Map No.
Office Work
Checked
Date

Survey of DUNE VIEW CHICKEN RANCH
W. O. 8128 Tape No. Std. °F.
Surveyed by T. M. WALSH Date 8-19-36
Notes T. M. WALSH
Indexed R. C. Johnson

F.B. 712 Pg. 73

GAS LINE

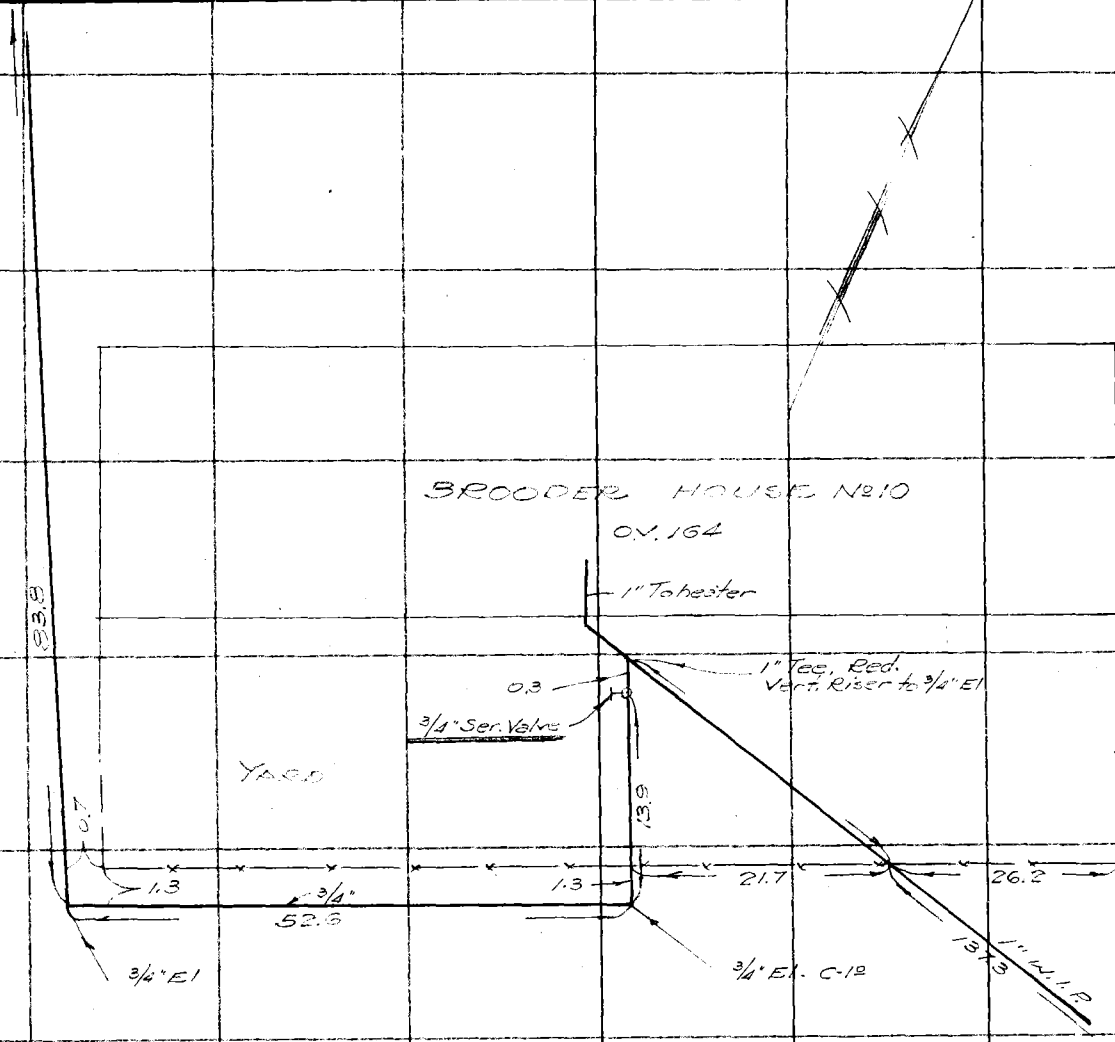

RETURN TO
LOS ANGELES COUNTY SURVEYOR
700 HALL OF RECORDS

Note: Any Additions or Changes on This Sheet Must be Made or Circled in **Red Ink** With Date and Name of Person Making Change.

Do not extend notes this side of this line

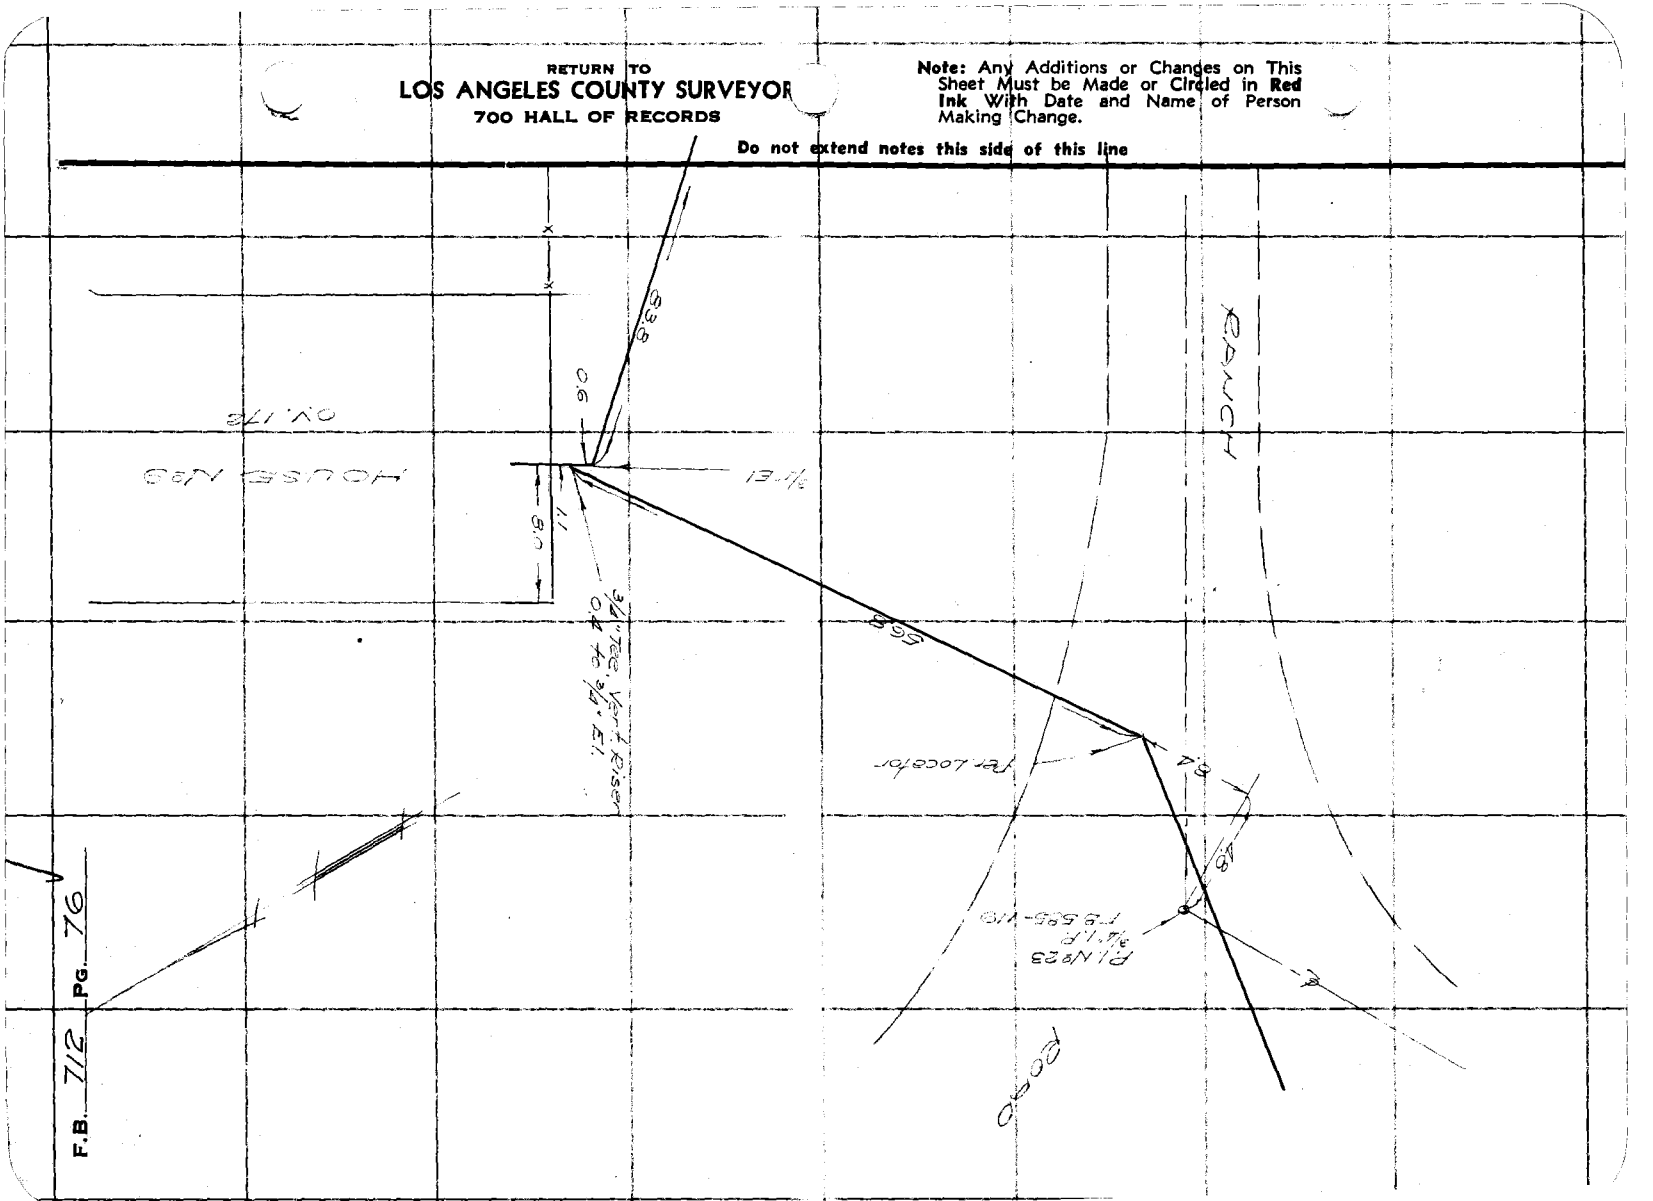

Notes Ck'd by	Survey of [illegible] VIEW SANITARIUM	F.B. 712 Pg. 77
Map No.	W. O. 8128 Tape No.	St'd °F.
Office Work	Surveyed by T. M. WALSH	GAS LINE
Checked	Notes T. M. WALSH Date 8-20-36	
Date	Indexed A. C. Johnson	

RETURN TO
LOS ANGELES COUNTY SURVEYOR
700 HALL OF RECORDS

Note: Any Additions or Changes on This Sheet Must be Made or Circled in Red Ink With Date and Name of Person Making Change.

Do not extend notes this side of this line

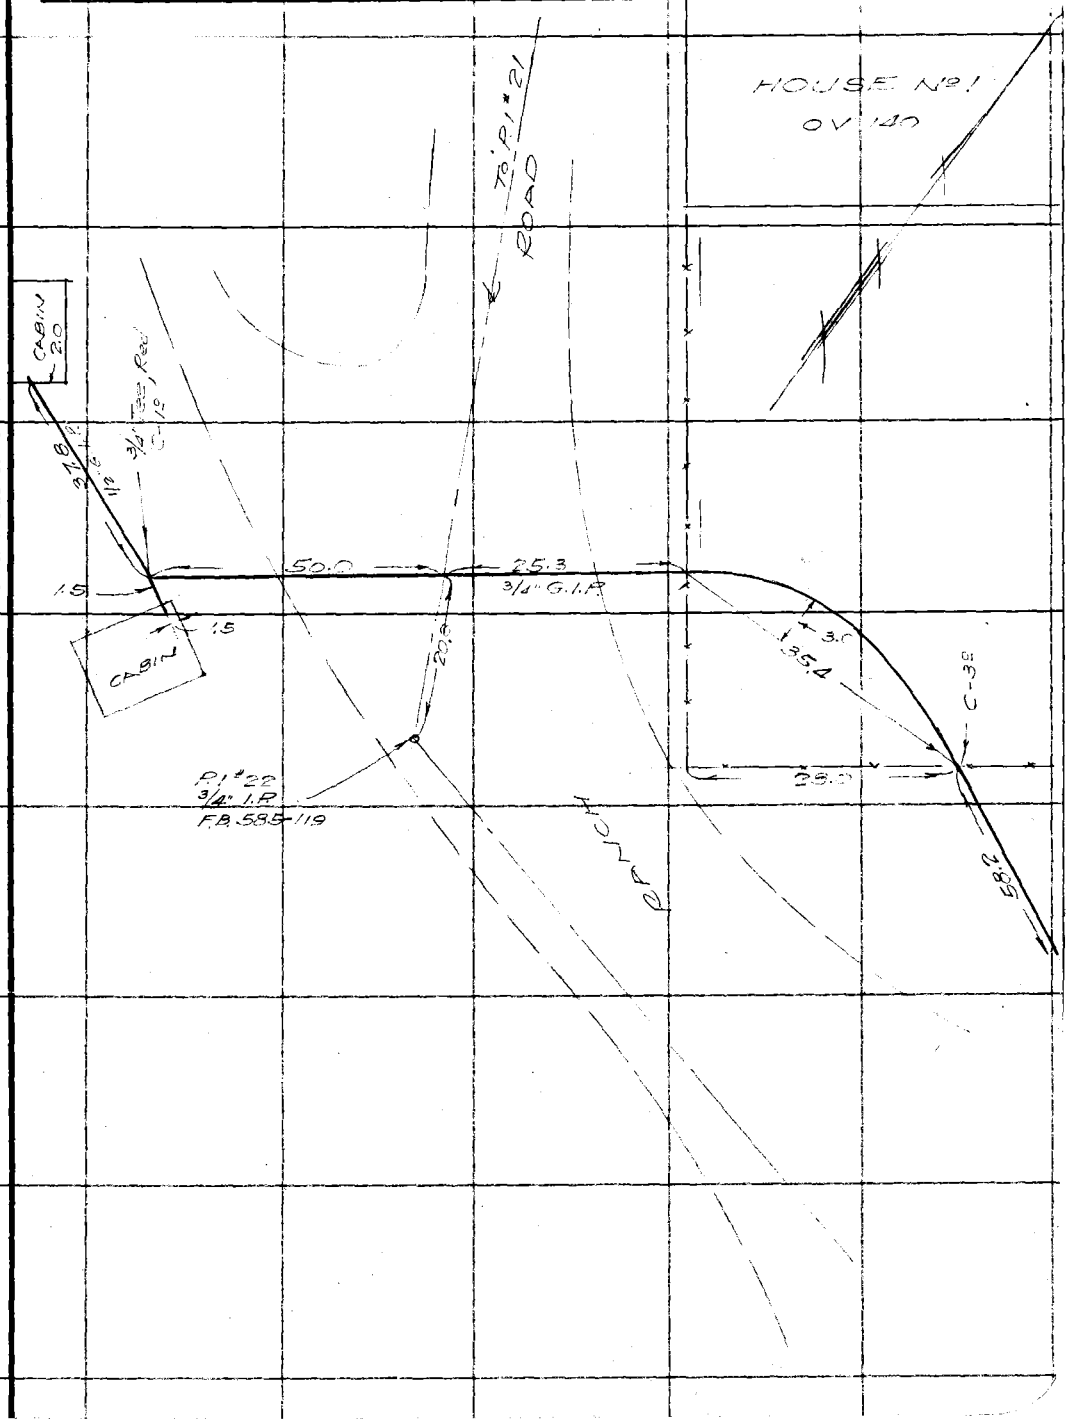

FORM 247 10M 11-35

RETURN TO
LOS ANGELES COUNTY SURVEYOR
700 HALL OF RECORDS

Note: Any Additions or Changes on This Sheet Must be Made or Circled in **Red Ink** With Date and Name of Person Making Change.

Do not extend notes this side of this line

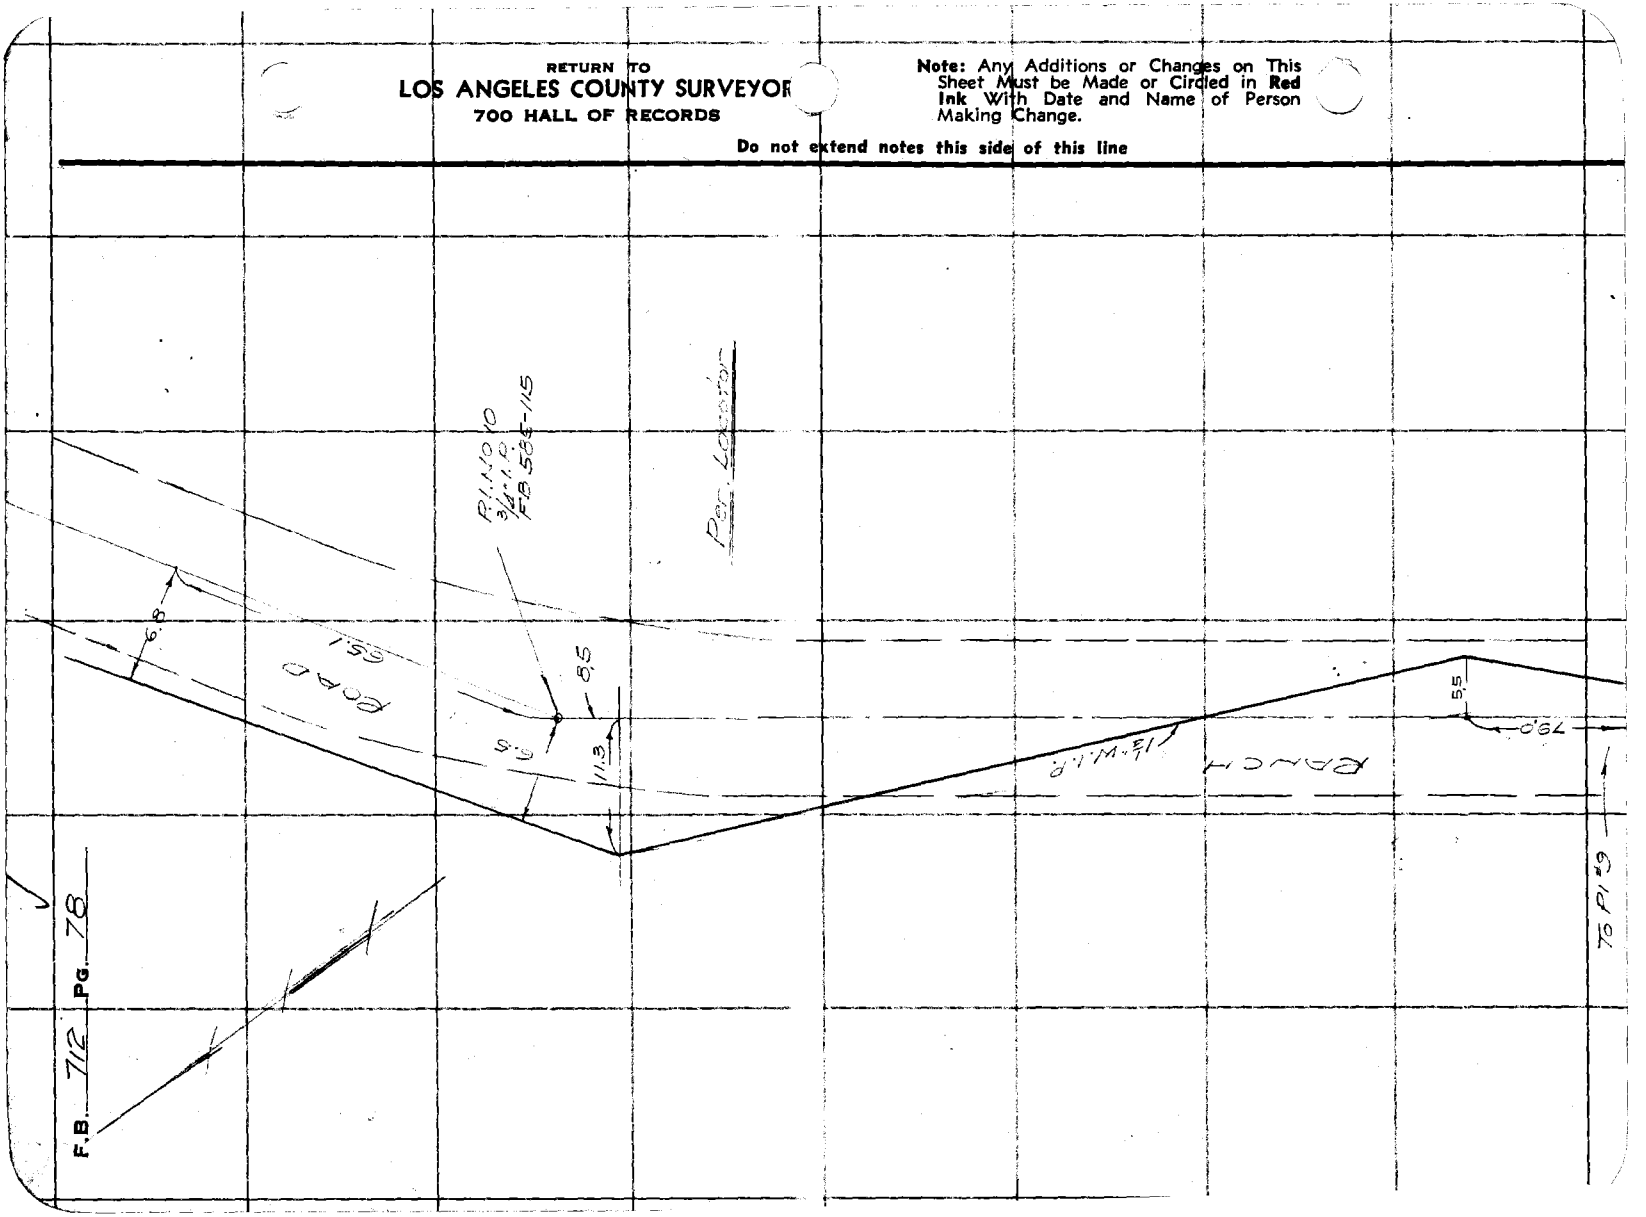

Notes Ck'd by	Survey of [illegible]
Map No.	W. O. 8128 Tape No. St'd. °F.
Office Work	Surveyed by T. M. WALSH
Checked	Notes T. M. WALSH Date 8-26-36
Date	Indexed A. C. Johnson

F.B. 712 PG. 79

GAS LINES

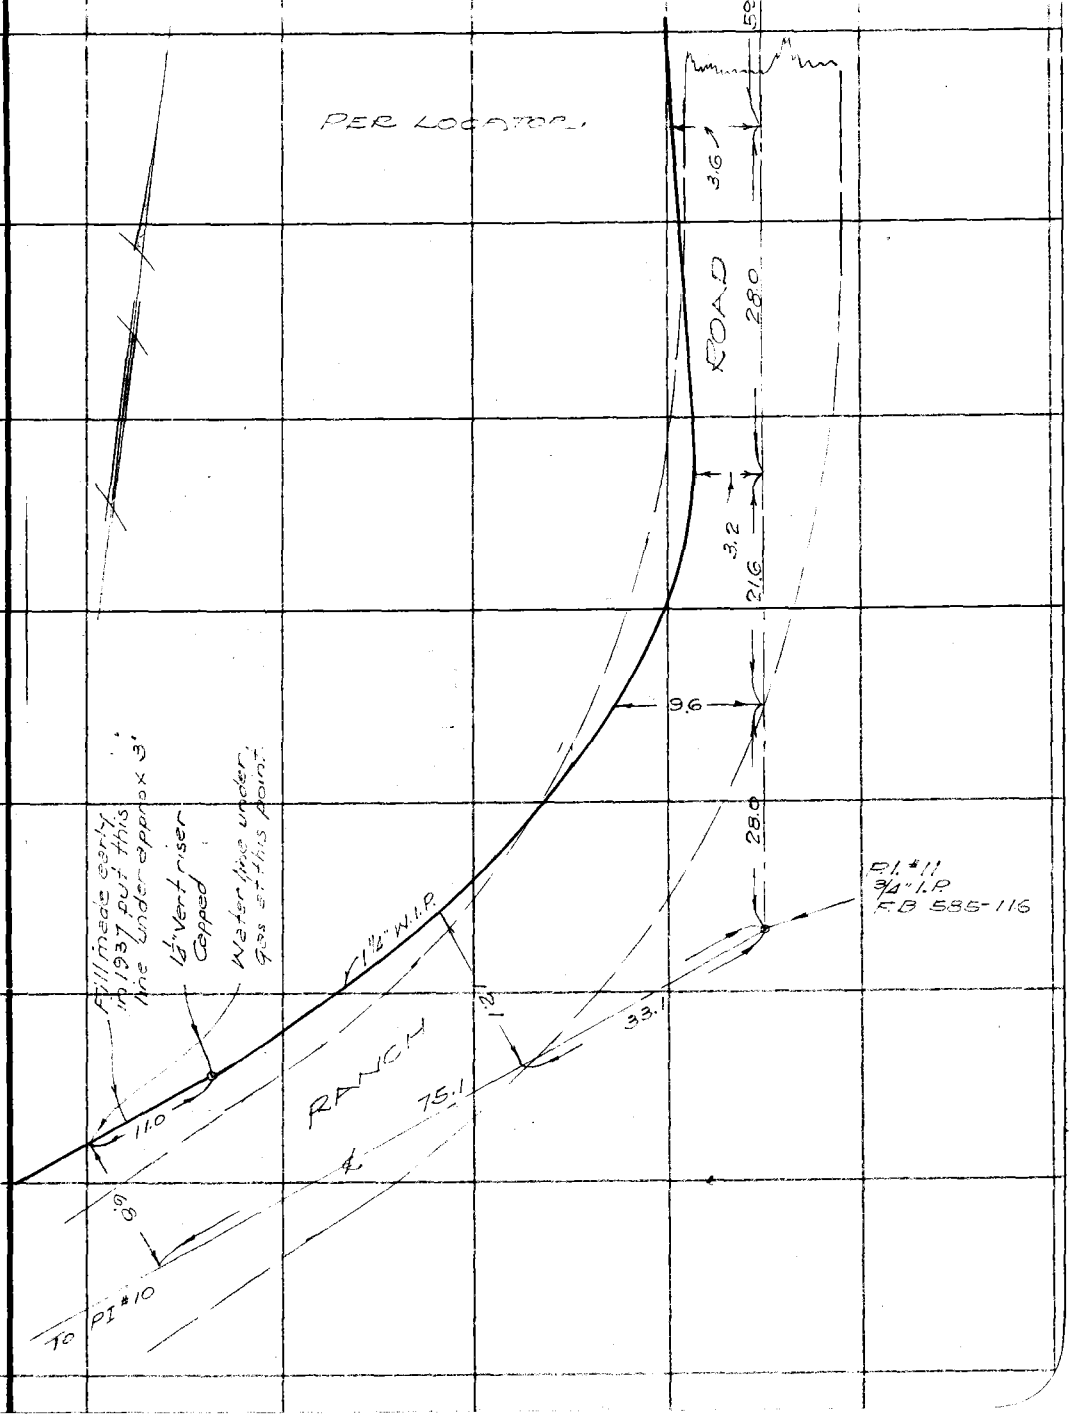

Note: Any Additions or Changes on This Sheet Must be Made or Circled in Red Ink With Date and Name of Person Making Change.

Do not extend notes this side of this line

RETURN TO
LOS ANGELES COUNTY SURVEYOR
700 HALL OF RECORDS

FORM 247 10M 11-35

RETURN TO
LOS ANGELES COUNTY SURVEYOR
700 HALL OF RECORDS

Note: Any Additions or Changes on This Sheet Must be Made or Circled in **Red Ink** With Date and Name of Person Making Change.

Do not extend notes this side of this line

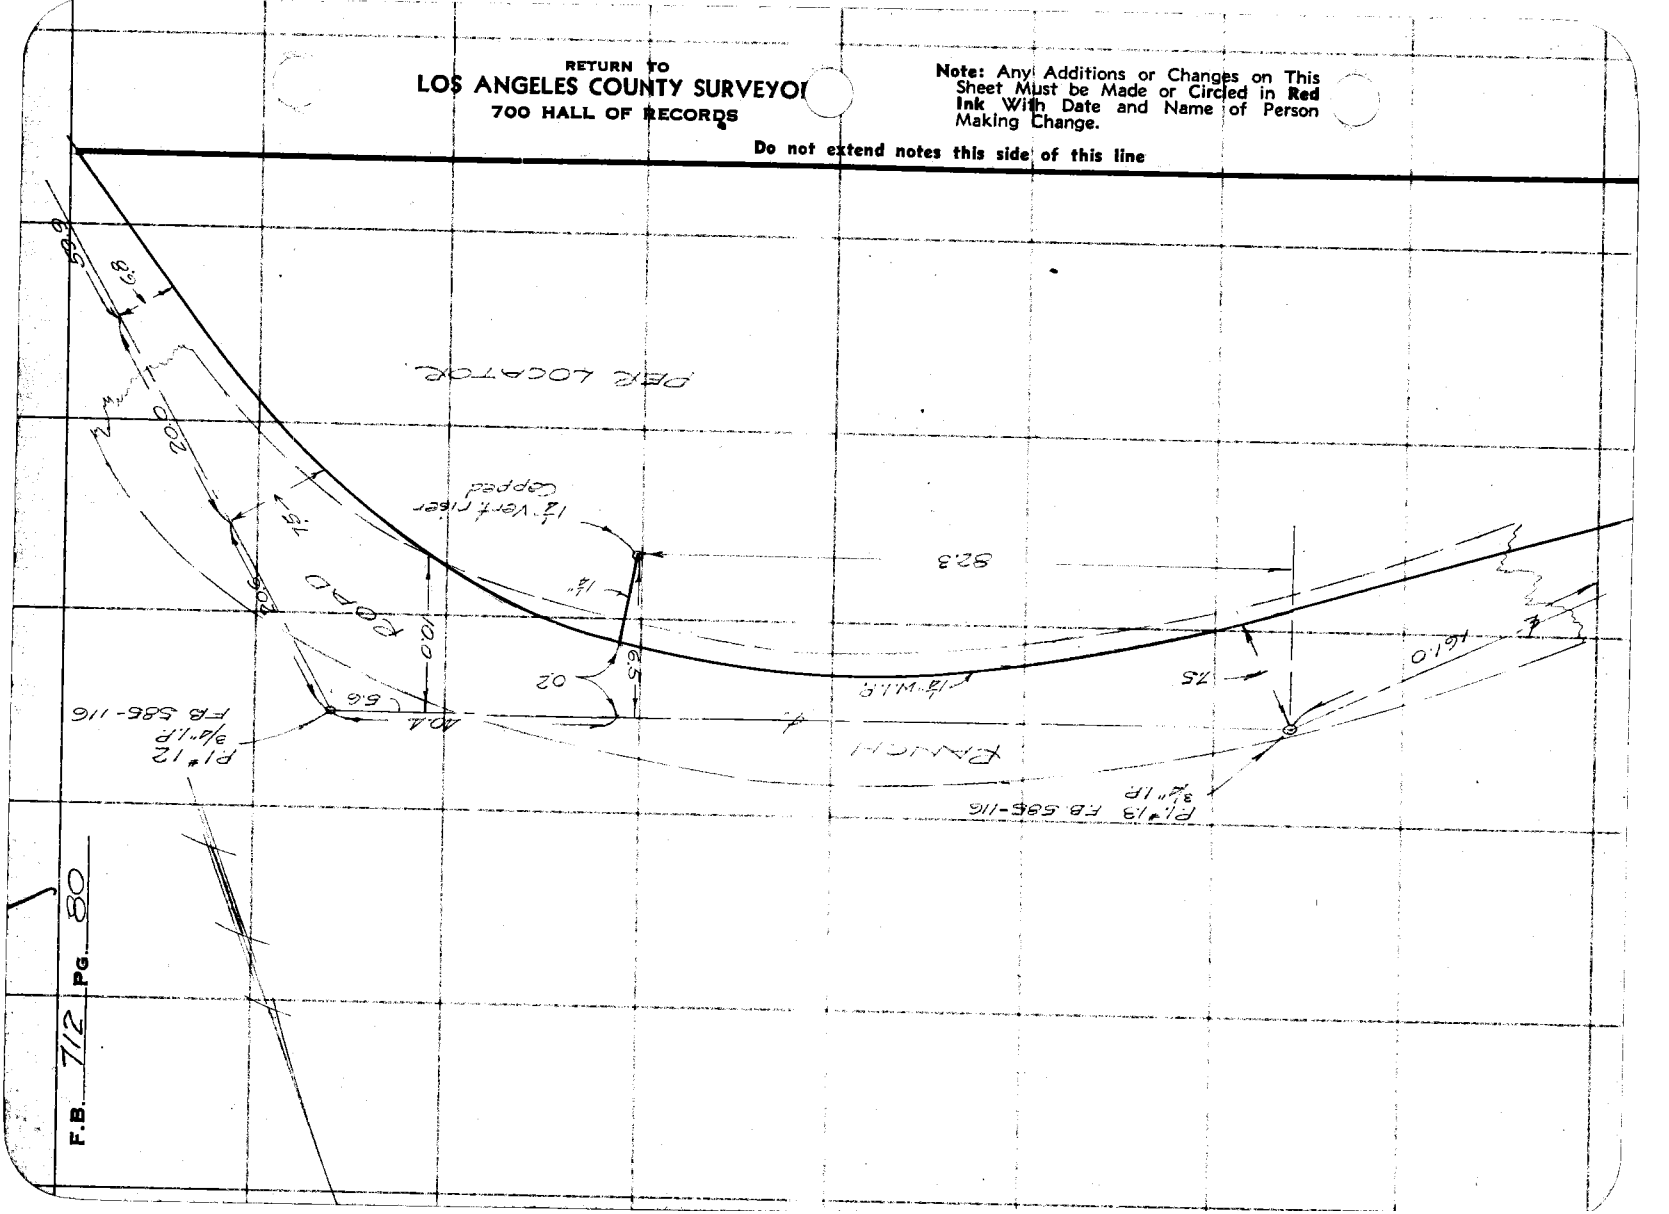

F.B. 712 PG. 80

FORM 247 10M 11-35

RETURN TO
LOS ANGELES COUNTY SURVEYOR
700 HALL OF RECORDS

Note: Any Additions or Changes on This Sheet Must be Made or Circled in **Red Ink** With Date and Name of Person Making Change.

Do not extend notes this side of this line

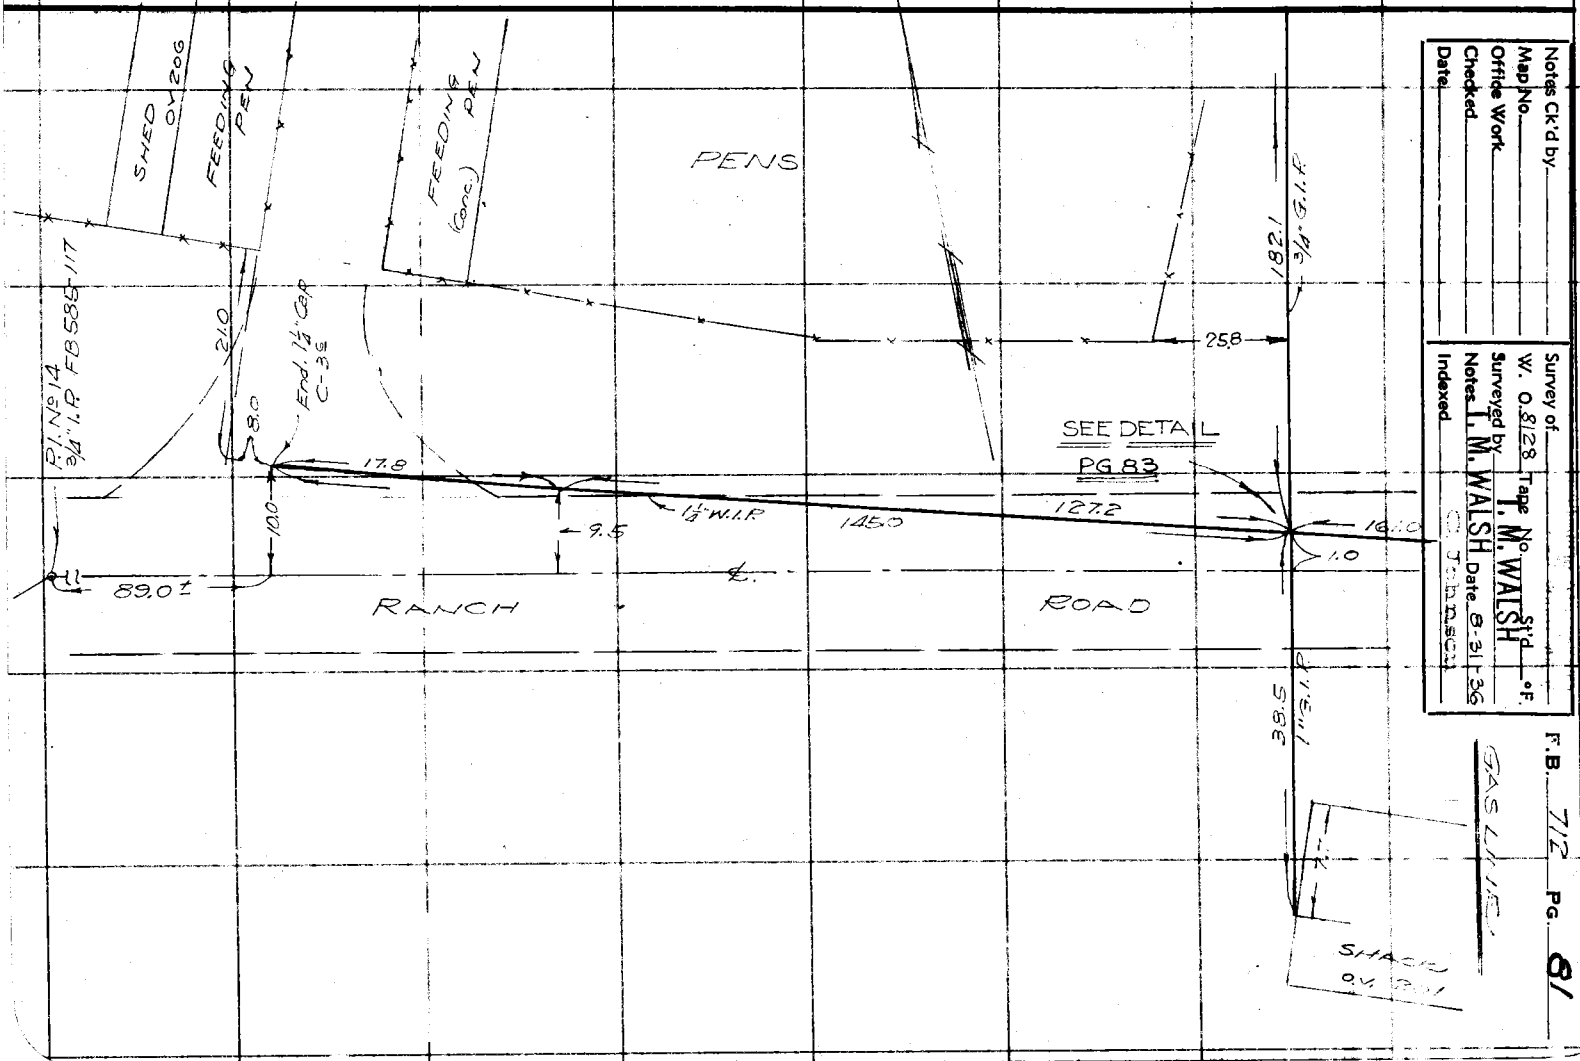

Notes Ck'd by
Map No.
Offide Work
Checked
Date

Survey of
W. O. 8128 Tape No.
Surveyed by I. M. WALSH St'd °F.
Notes I. M. WALSH Date 8-31-36
Indexed C. Johnson

F. B. 712 PG. 81

F.B. 712 PG. 82

RETURN TO
LOS ANGELES COUNTY SURVEYOR
700 HALL OF RECORDS

Note: Any Additions or Changes on This Sheet Must be Made or Circled in Red Ink With Date and Name of Person Making Change.

Do not extend notes this side of this line

Notes Ck'd by	Survey of OLIVE VIEW SANATORIUM	F.B. 712	Pg. 85
Map No.	W. O. 8128 Tape No.	St'd °F.	
Office Work	Surveyed by T. M. WALSH		
Checked	Notes T. M. WALSH Date 8-28-36		
Date	Indexed L. C. Johnson		

GAS LINE

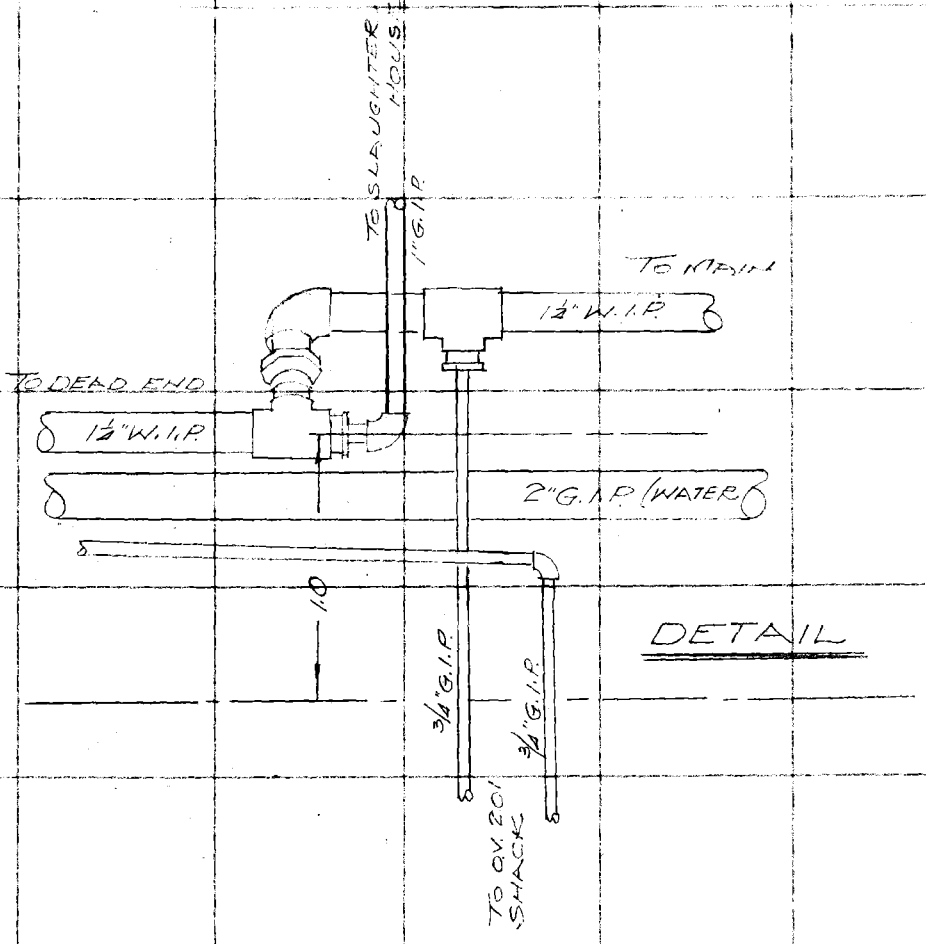

DETAIL

Note: Any Additions or Changes on This Sheet Must be Made or Circled in Red Ink With Date and Name of Person Making Change.

Do not extend notes this side of this line

RETURN TO
LOS ANGELES COUNTY SURVEYOR
700 HALL OF RECORDS

FORM 247 10M 11-35

RETURN TO
LOS ANGELES COUNTY SURVEYOR
700 HALL OF RECORDS

Note: Any Additions or Changes on This Sheet Must be Made or Circled in **Red Ink** With Date and Name of Person Making Change.

Do not extend notes this side of this line

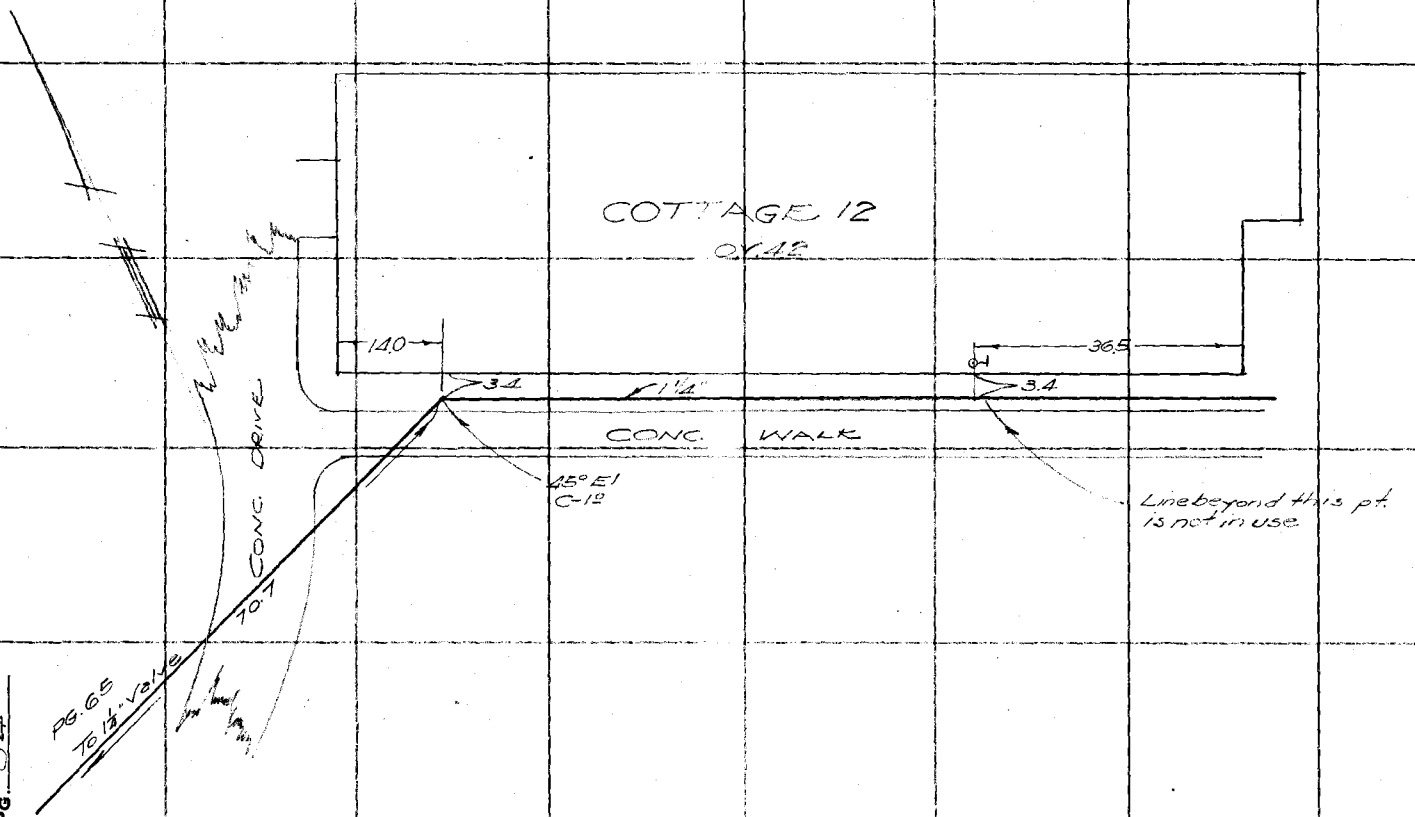

F.B. 712 PG. 84

Notes Ck'd by	Survey of [illegible] SANATORIUM	F.B. 712 Pg. 85
Map No.	W. O. 8128 Tape No. St'd °F.	GAS LINES.
Office Work	Surveyed by T. M. WALSH	
Checked	Notes T. M. WALSH Date 9-36	
Date	Indexed A. C. Johnson	

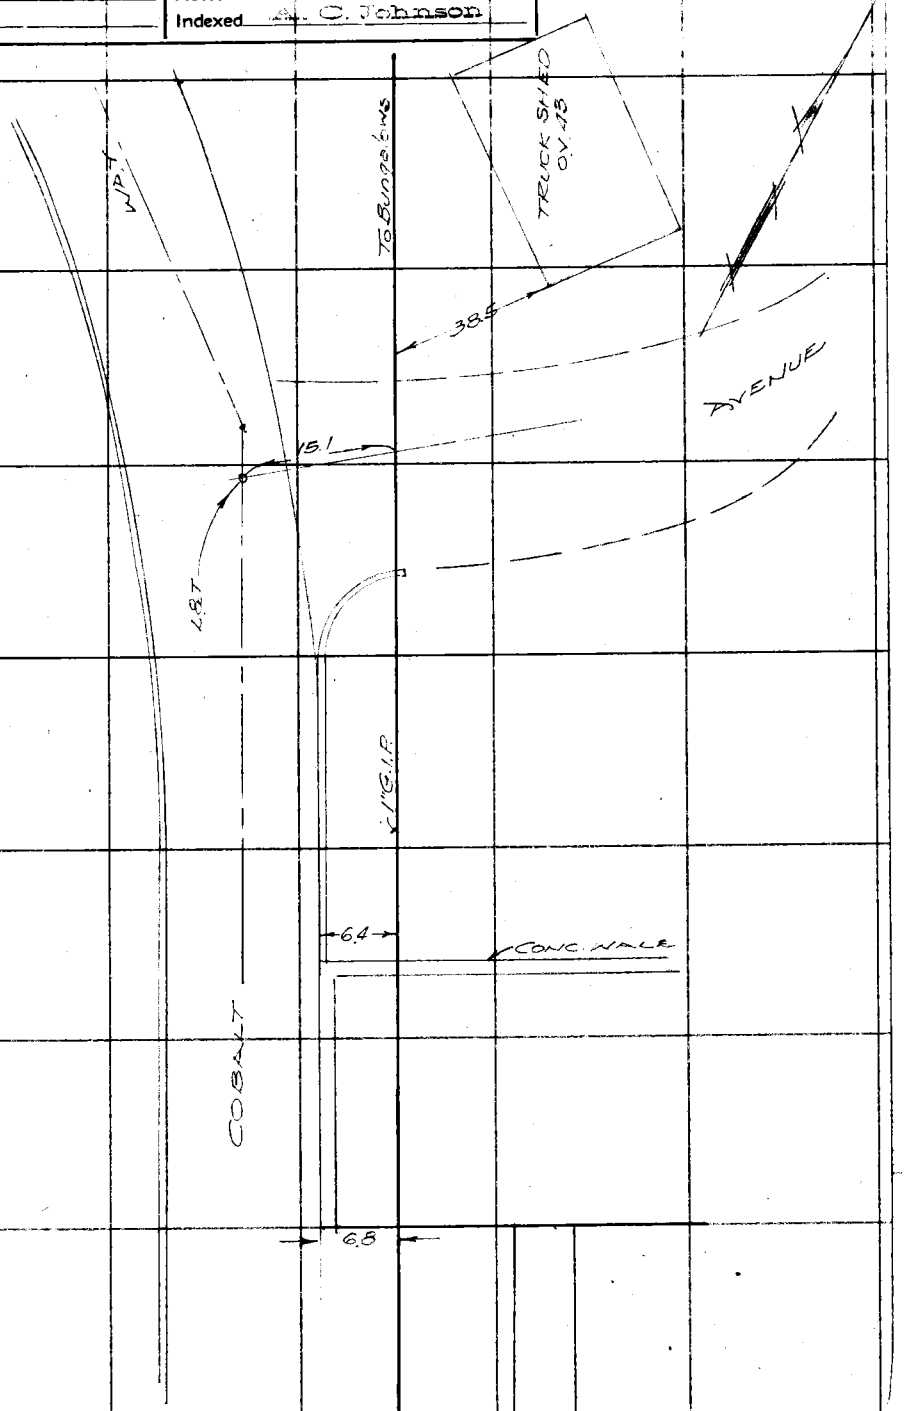

Note: Any Additions or Changes on This Sheet Must be Made or Circled in Red Ink With Date and Name of Person Making Change.

Do not extend notes this side of this line

RETURN TO
LOS ANGELES COUNTY SURVEYOR
700 HALL OF RECORDS

FORM 247 10M 11-38

RETURN TO
LOS ANGELES COUNTY SURVEYOR
700 HALL OF RECORDS

Note: Any Additions or Changes on This Sheet Must be Made or Circled in **Red** Ink With Date and Name of Person Making Change.

Do not extend notes this side of this line

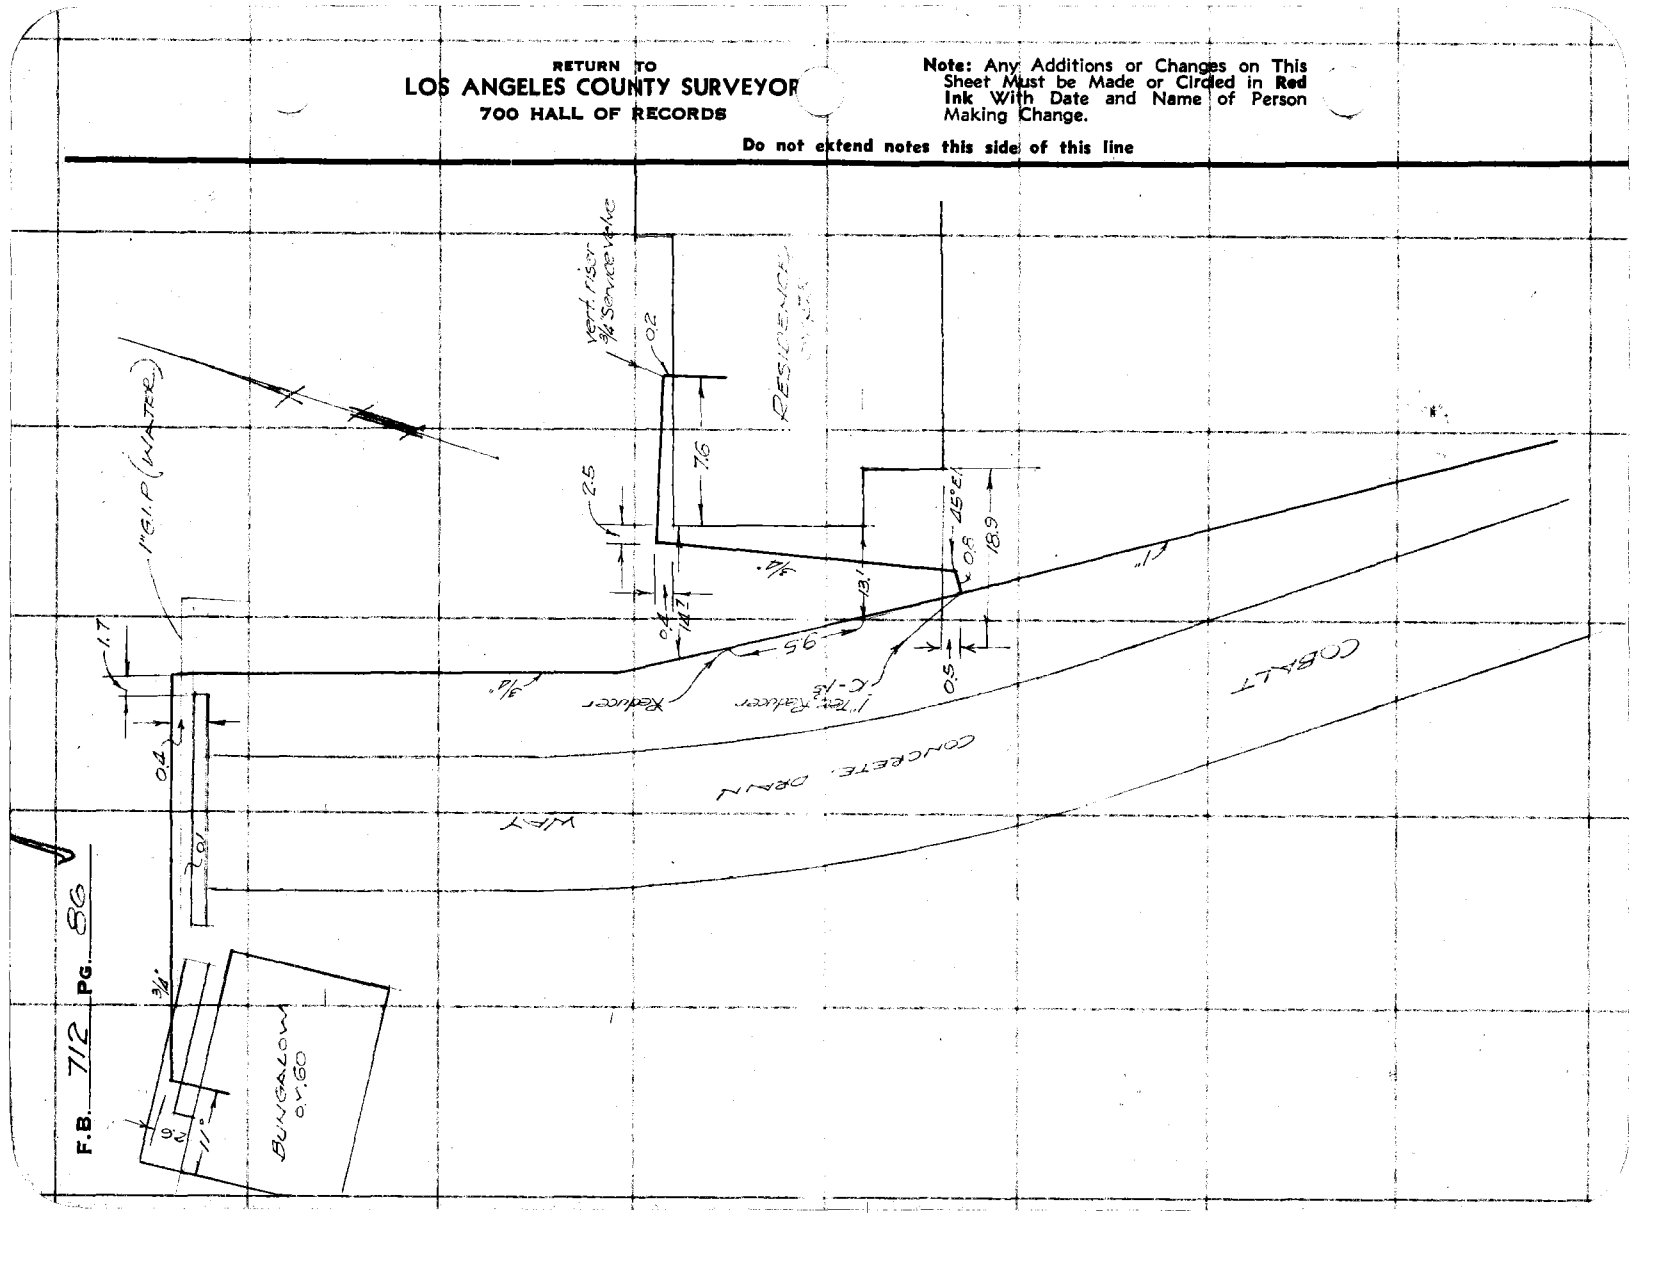

Notes Ck'd by	Survey of	F.B. 712 PG. 87
Map No.	W. O. 8128 Tape No. St'd °F.	
Office Work	Surveyed by T. M. WALSH	GAS LINES
Checked	Notes Date 9-36	
Date	Indexed T. M. Wilkinson	

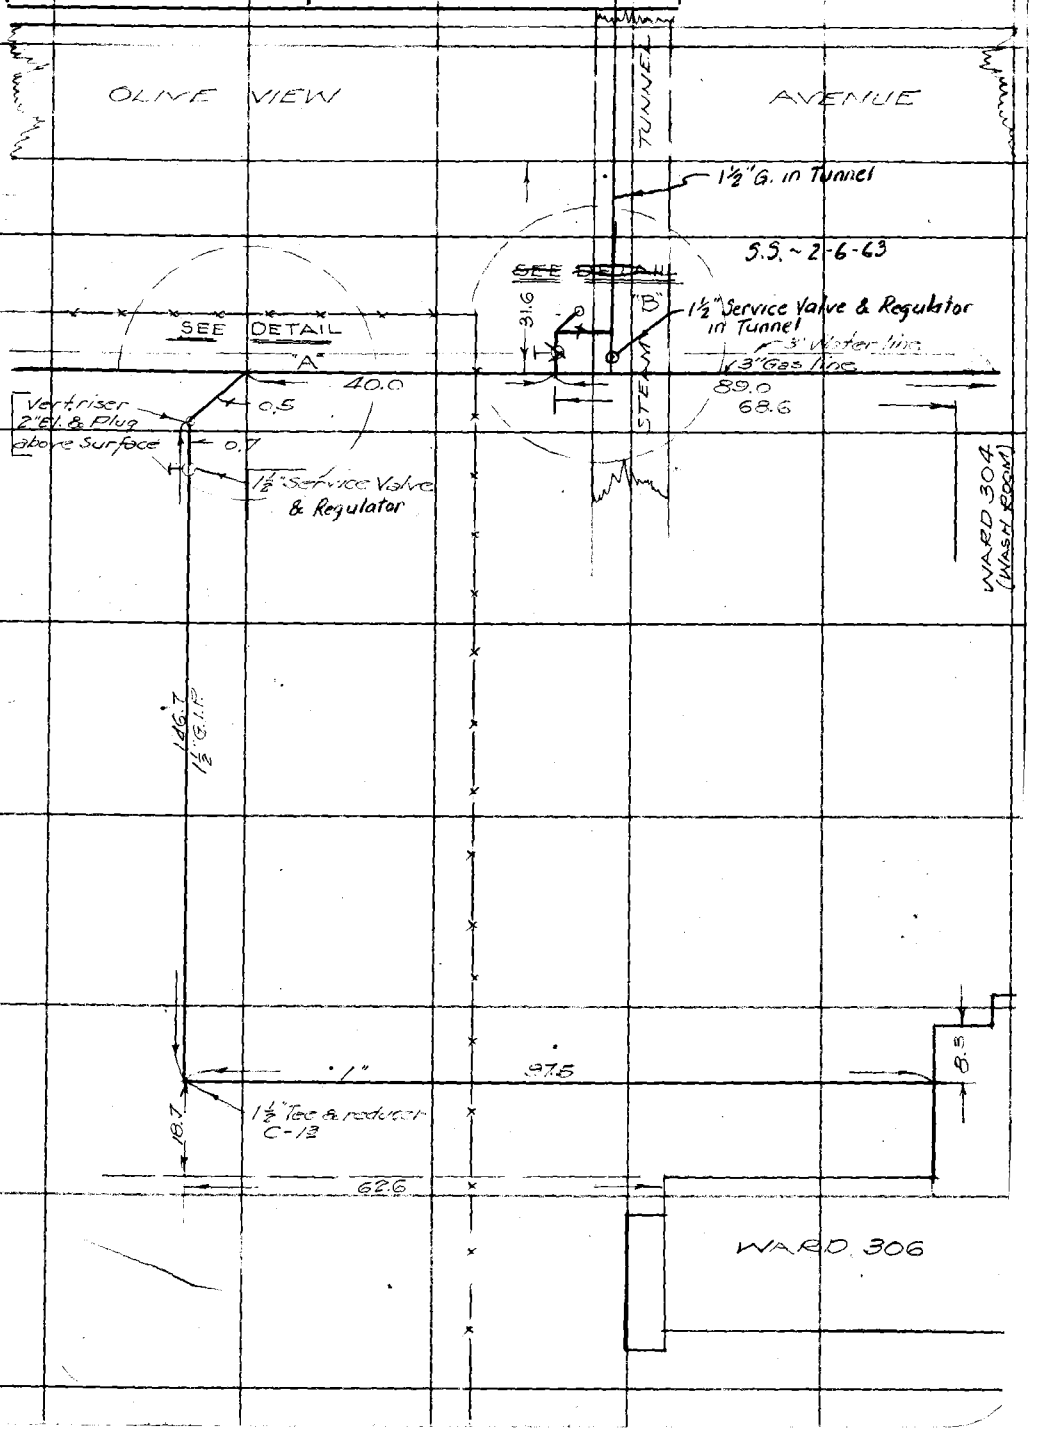

Note: Any Additions or Changes on This Sheet Must be Made or Circled in Red Ink With Date and Name of Person Making Change.

Do not extend notes this side of this line

RETURN TO
LOS ANGELES COUNTY SURVEYOR
700 HALL OF RECORDS

FORM 247 10M 11-38

F.B. 712 PG. 88

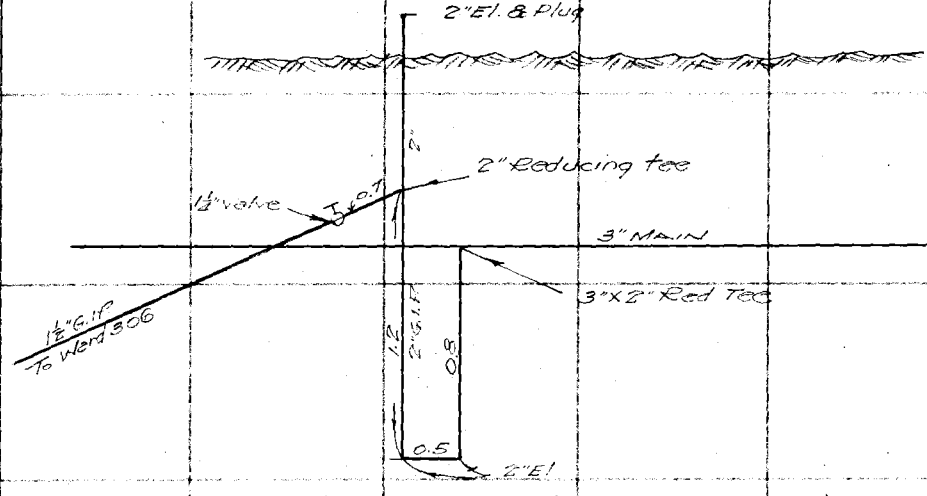

DETAIL "A" (LOOKING NORTH)

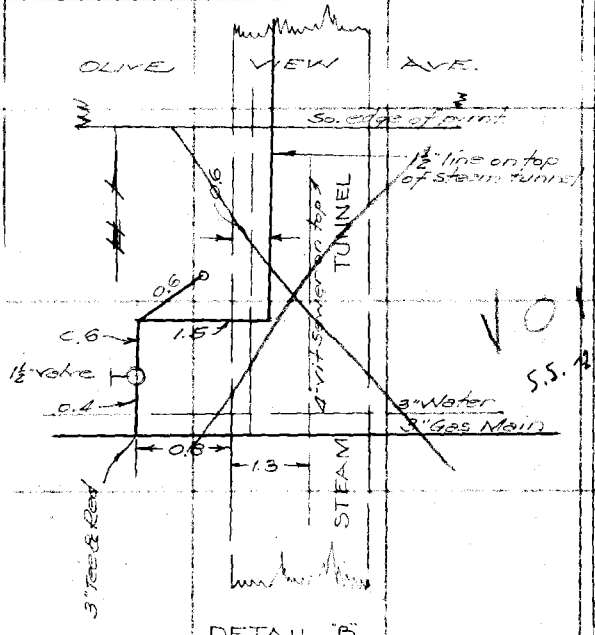

DETAIL "B"

VOID
S.S. 12/6/63

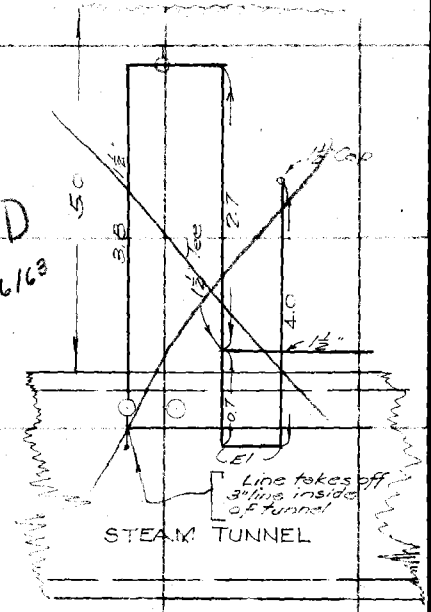

DETAIL "B" (LOOKING WEST)

RETURN TO
LOS ANGELES COUNTY SURVEYOR
700 HALL OF RECORDS

Note: Any Additions or Changes on This Sheet Must be Made or Circled in Red Ink With Date and Name of Person Making Change.

Do not extend notes this side of this line

Notes Ck'd by	Survey of OLIVE VIEW SAN	F.B. 712 Pg. 89
Map No.	W. O. 81-18 Tape No. St'd °F.	
Office Work	Surveyed by T. WALSH	
Checked	Notes WALSH Date 7-7-86	GAS LINES
Date	Indexed A. C. Johnson	

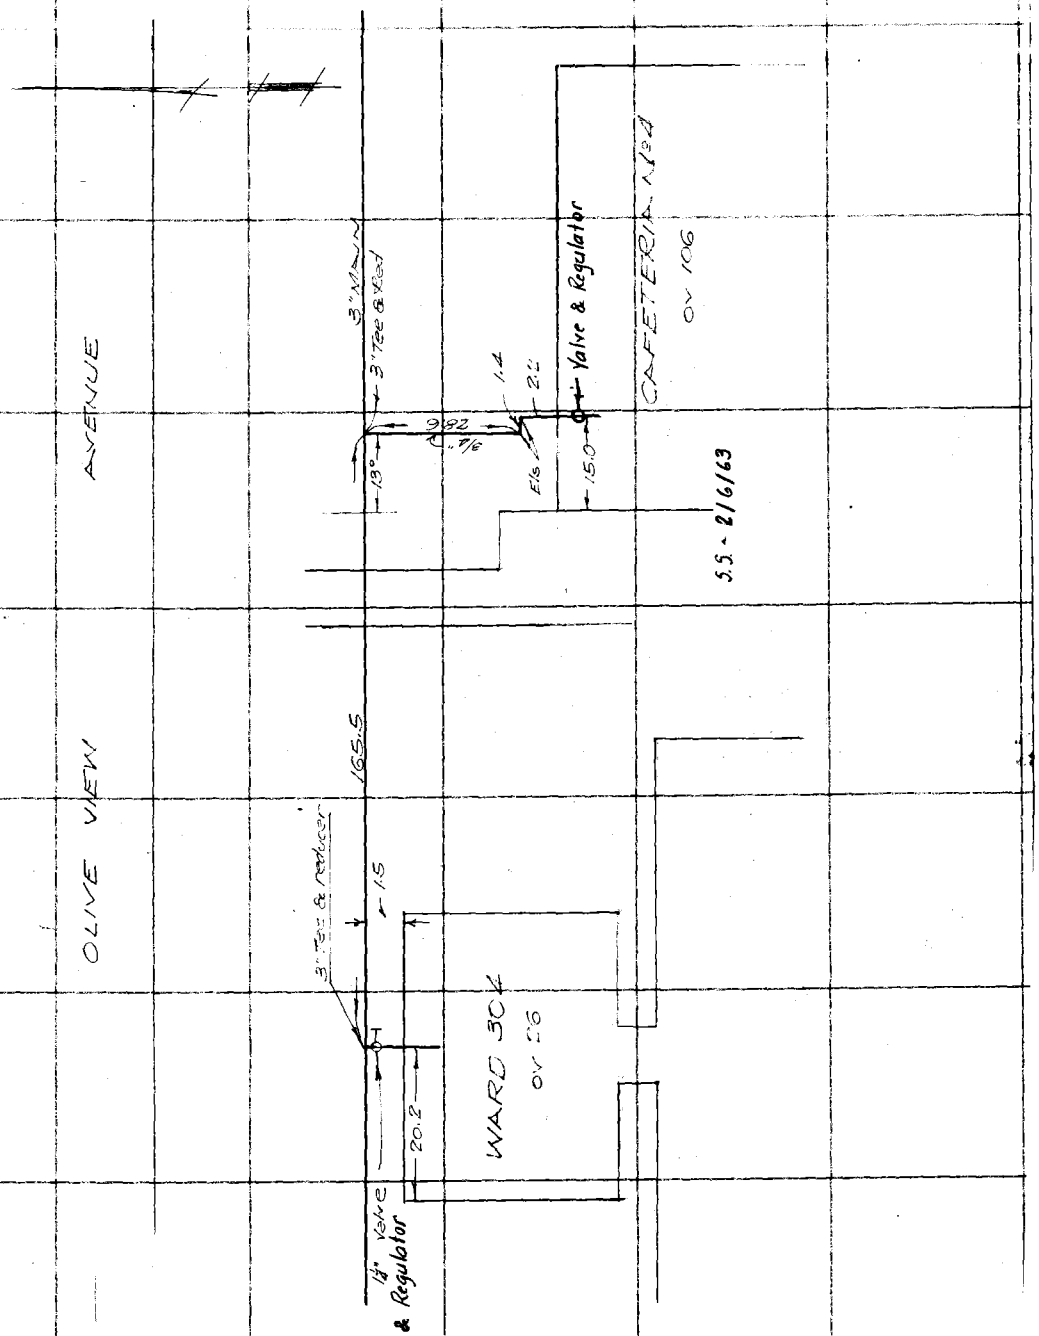

Note: Any Additions or Changes on This Sheet Must be Made or Circled in Red Ink With Date and Name of Person Making Change.

Do not extend notes this side of this line

RETURN TO
LOS ANGELES COUNTY SURVEYOR
700 HALL OF RECORDS

FORM 247 10M 11-35

RETURN TO
LOS ANGELES COUNTY SURVEYOR
700 HALL OF RECORDS

Note: Any Additions or Changes on This Sheet Must be Made or Circled in **Red Ink** With Date and Name of Person Making Change.

Do not extend notes this side of this line

F.B. 712 PG. 90

Notes Ck'd by	Survey of OLIVE VIEW SANATORIUM
Map No.	W. O. 81-18 Tape No. St'd °F.
Office Work	Surveyed by TED M. WALSH
Checked	Notes WALSH Date 4-24-36
Date	Indexed A. C. Johnson

F.B. 712 PG. 91

GAS LINES

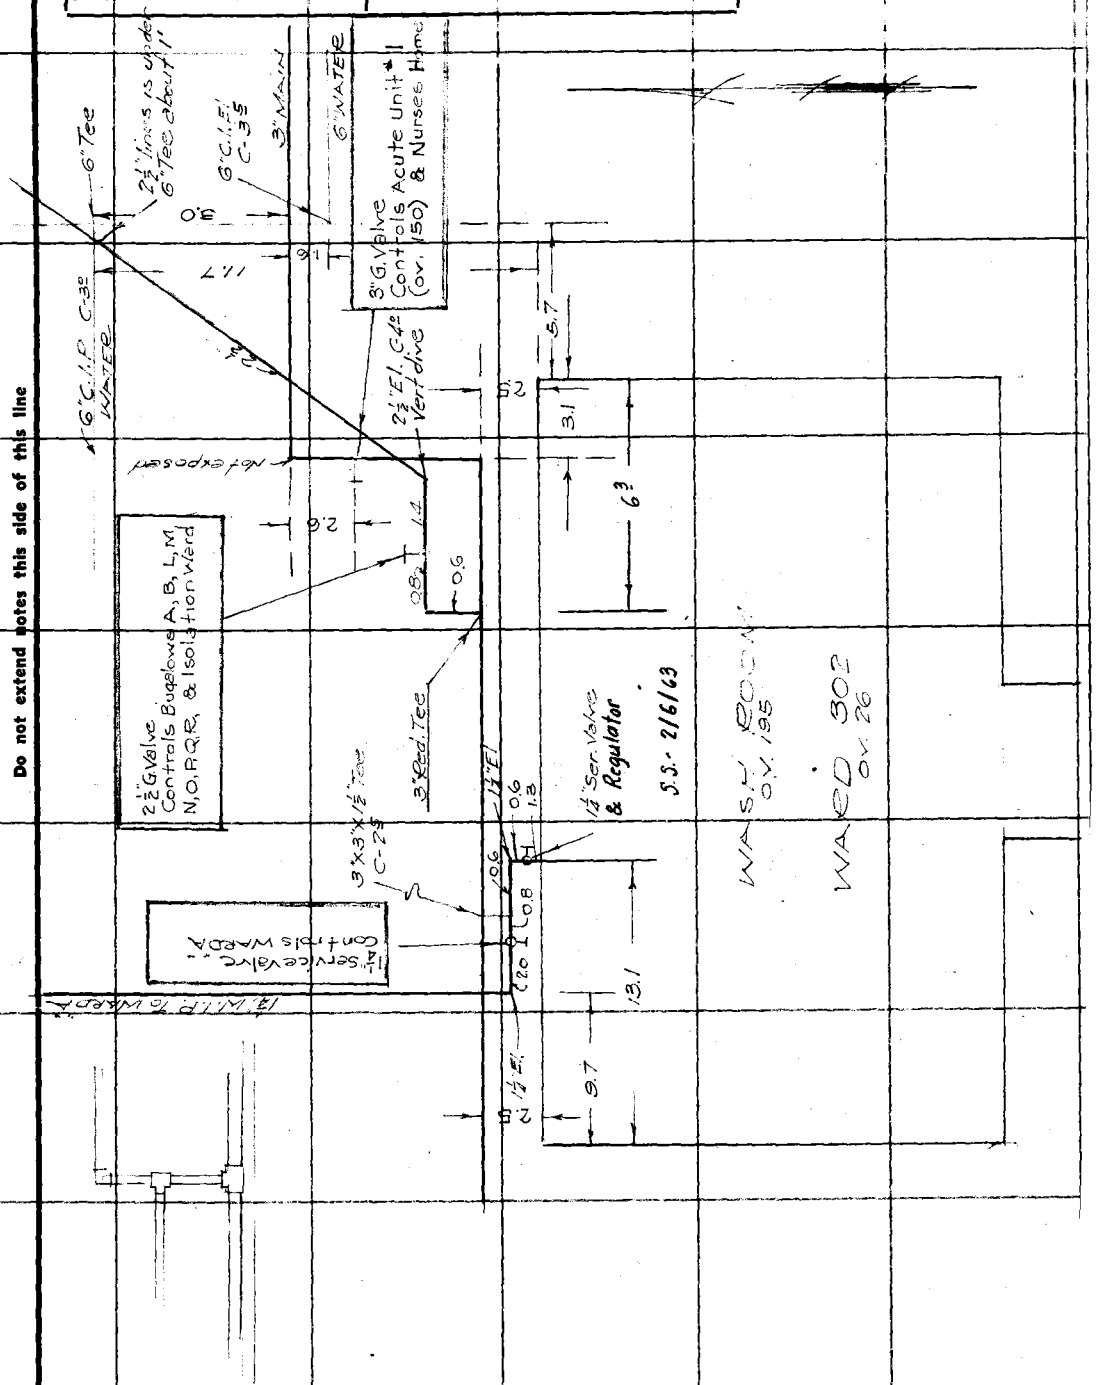

Note: Any Additions or Changes on This Sheet Must be Made or Circled in Red Ink With Date and Name of Person Making Change.

Do not extend notes this side of this line

RETURN TO
LOS ANGELES COUNTY SURVEYOR
700 HALL OF RECORDS

FORM 247 10M 11-33

F.B. 712 Pg. 92

RETURN TO
LOS ANGELES COUNTY SURVEYOR
700 HALL OF RECORDS

Note: Any Additions or Changes on This Sheet Must be Made or Circled in Red Ink With Date and Name of Person Making Change.

Do not extend notes this side of this line

Notes Ck'd by	Survey of OLIVE VIEW S.M.
Map No.	W. O. 814 Tape No. St'd °F.
Office Work	Surveyed by T.M. WALSH
Checked	Notes KA-LSH Date 4-27-36
Date	Indexed A. C. Johnson

F.B. 712 PG. 93

GAS LINES

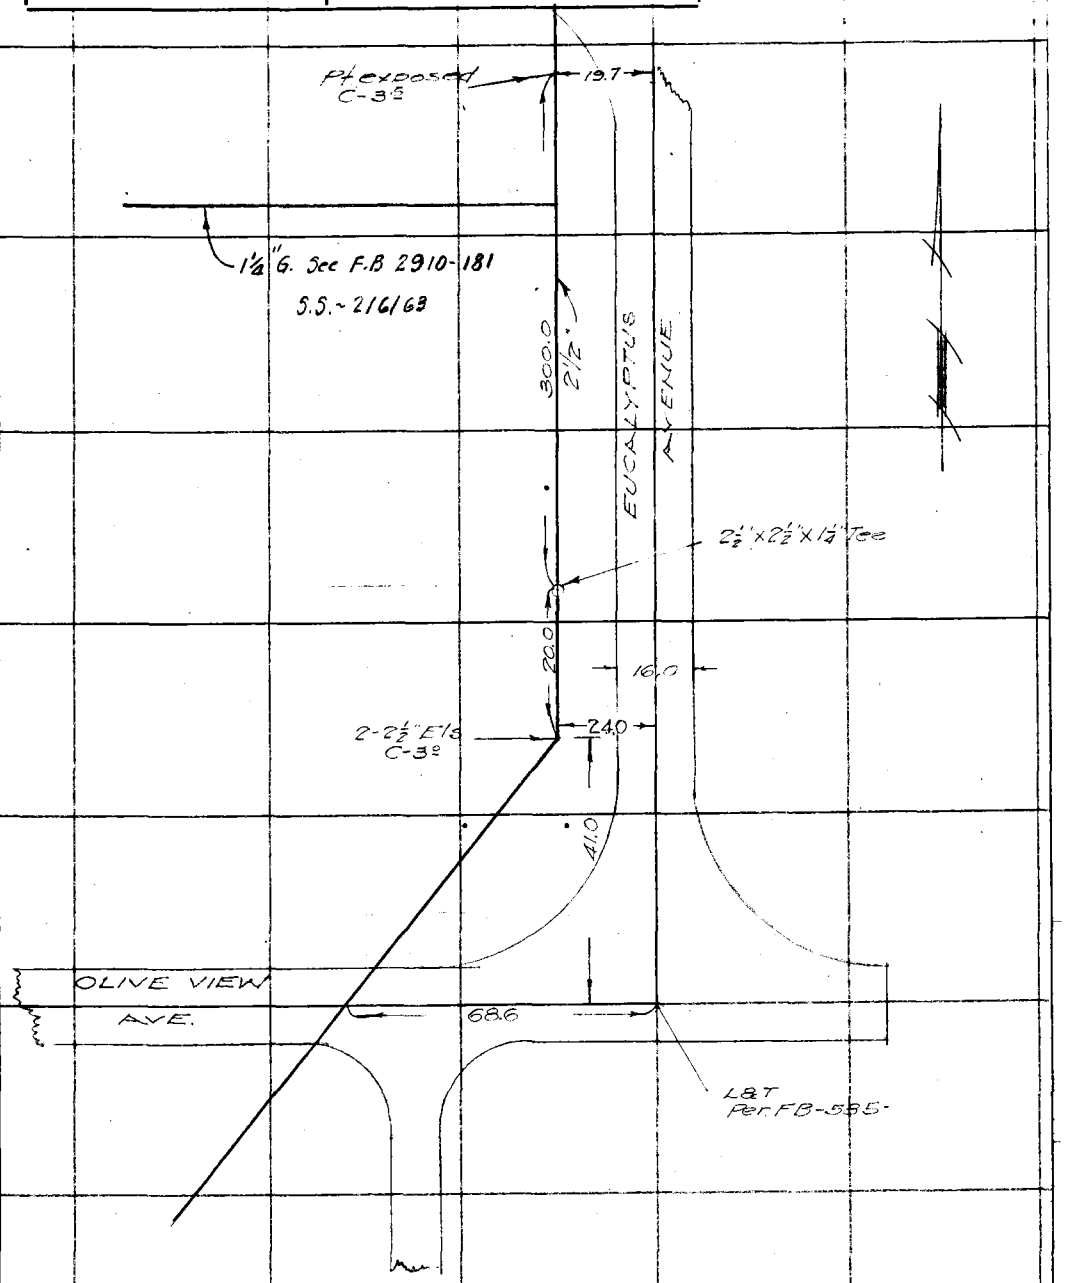

Note: Any Additions or Changes on This Sheet Must be Made in Red Ink With Date and Name of Person Making Change.

Do not extend notes this side of this line

RETURN TO
LOS ANGELES COUNTY SURVEYOR
700 HALL OF RECORDS

FORM 247 10M 11-38

RETURN TO
LOS ANGELES COUNTY SURVEYOR
700 HALL OF RECORDS

Note: Any Additions or Changes on This Sheet Must be Made or Circled in **Red Ink** With Date and Name of Person Making Change.

Do not extend notes this side of this line

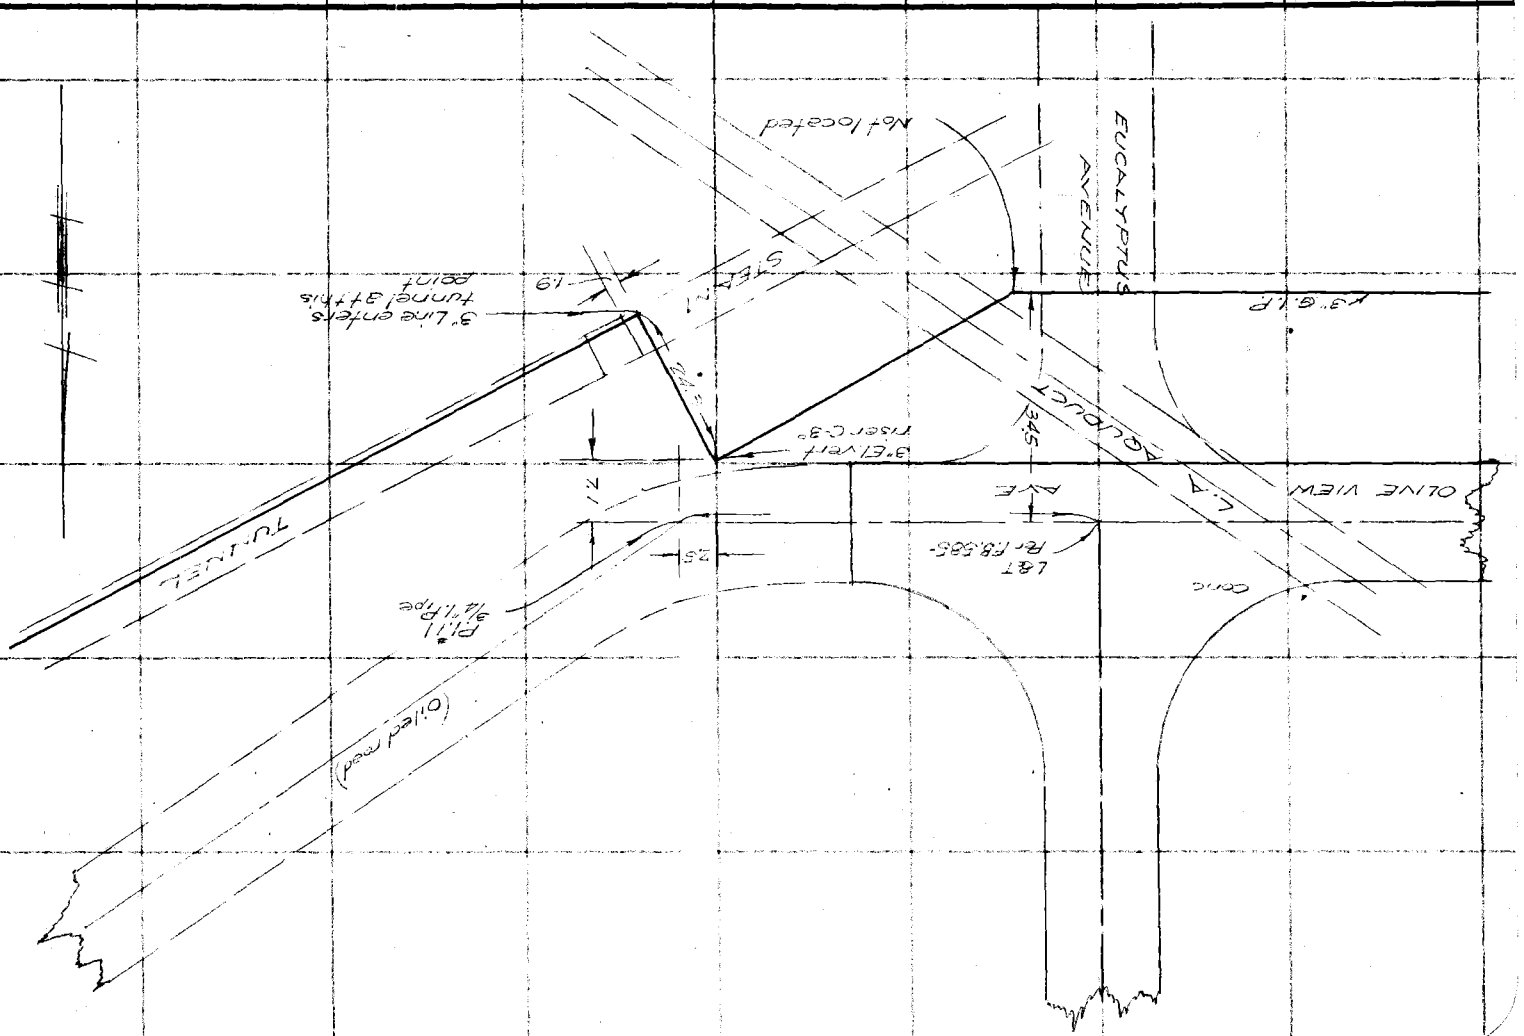

F.B. 712 PG. 94

Notes Ck'd by	Survey of OLIVE VIEW SAN
Map No.	W. O. 8178 Tape No. St'd °F.
Office Work	Surveyed by TED M. WALSH
Checked	Notes WALSH Date 7-28-36
Date	Indexed A. C. Johnson

F.B. T-2 Pg. 95

GAS LINES

SEE MARGINAL

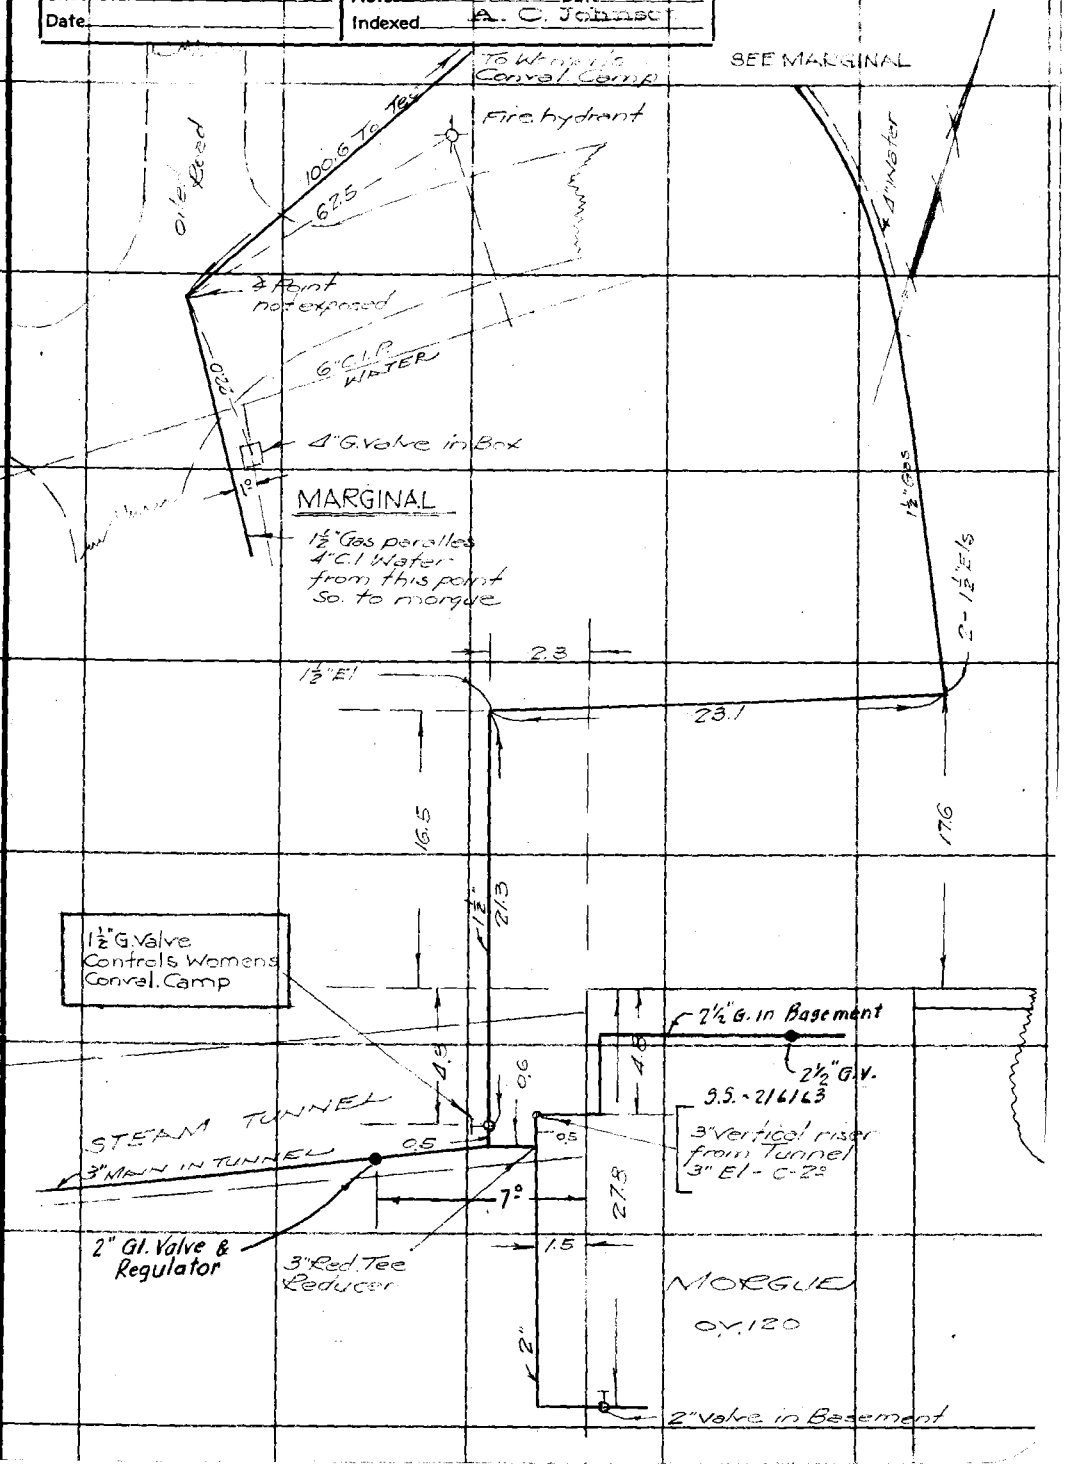

Note: Any Additions or Changes on This Sheet Must be Made or Circled in Red Ink With Date and Name of Person Making Change.

Do not extend notes this side of this line

RETURN TO
LOS ANGELES COUNTY SURVEYOR
700 HALL OF RECORDS

FORM 247 10M 11-35

RETURN TO
LOS ANGELES COUNTY SURVEYOR
700 HALL OF RECORDS

Note: Any Additions or Changes on This Sheet Must be Made or Circled in **Red Ink** With Date and Name of Person Making Change.

Do not extend notes this side of this line

F.B. 712 Pg. 96

Notes Ck'd by	Survey of OLIVE VIEW SAN
Map No.	W. O. 8178 Tape No. St'd °F.
Office Work	Surveyed by TED WALSH
Checked	Notes WALSH Date 7-27-36
Date	Indexed C. Johnson

F.B. 712 PG. 97

GAS LINES

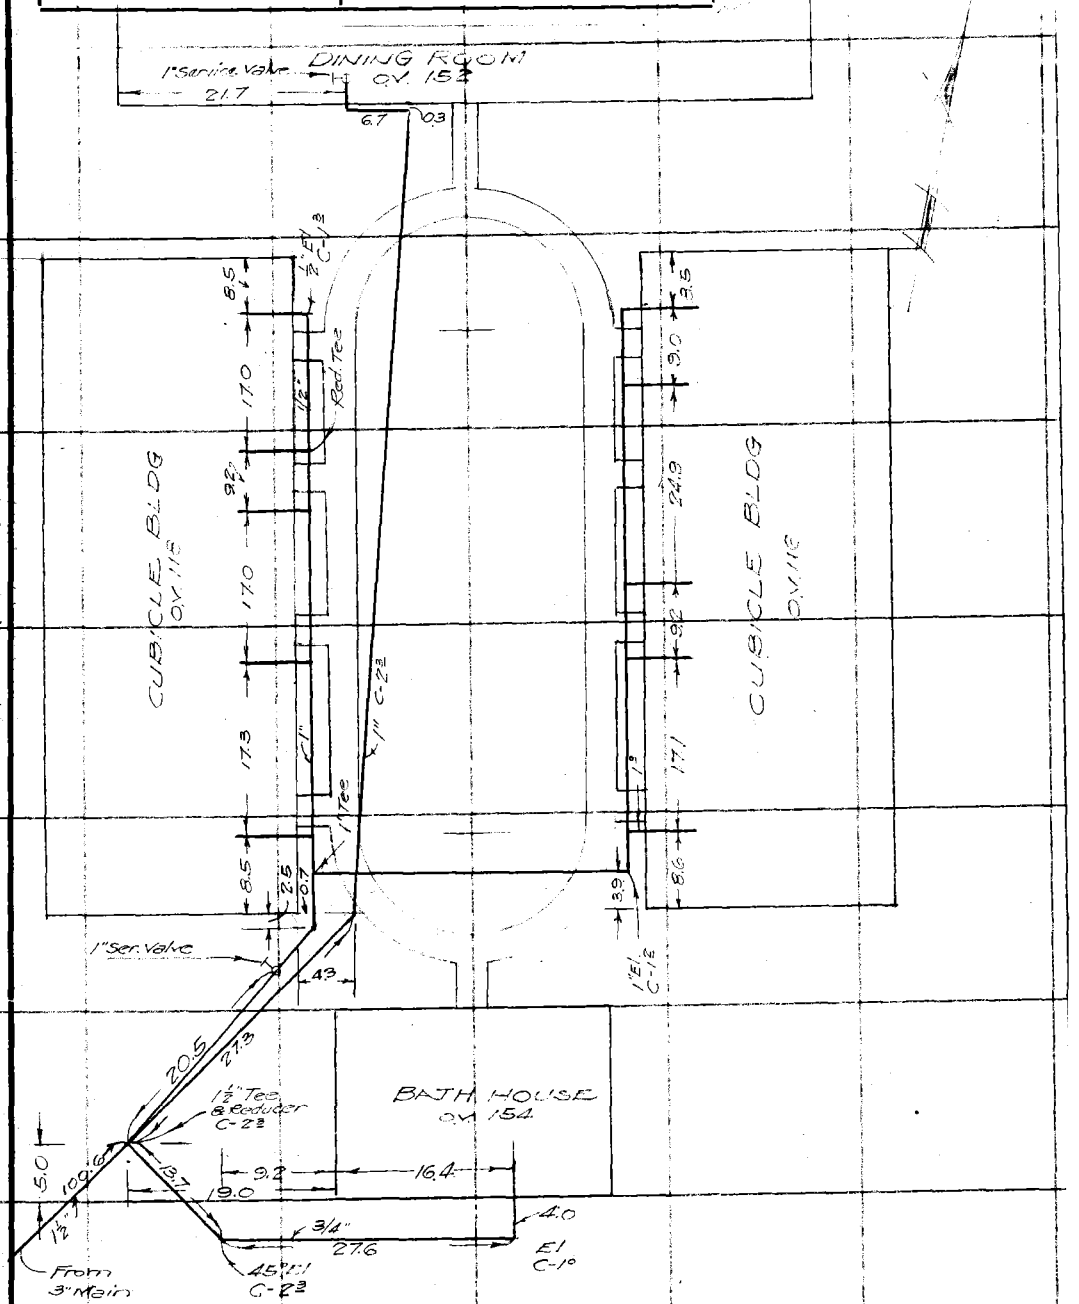

Note: Any Additions or Changes on This Sheet Must be Made or Circled in Red Ink With Date and Name of Person Making Change.

Do not extend notes this side of this line

RETURN TO
LOS ANGELES COUNTY SURVEYOR
700 HALL OF RECORDS

FORM 247 10M 11-35

RETURN TO
LOS ANGELES COUNTY SURVEYOR
700 HALL OF RECORDS

Note: Any Additions or Changes on This Sheet Must be Made or Circled in **Red Ink** With Date and Name of Person Making Change.

Do not extend notes this side of this line

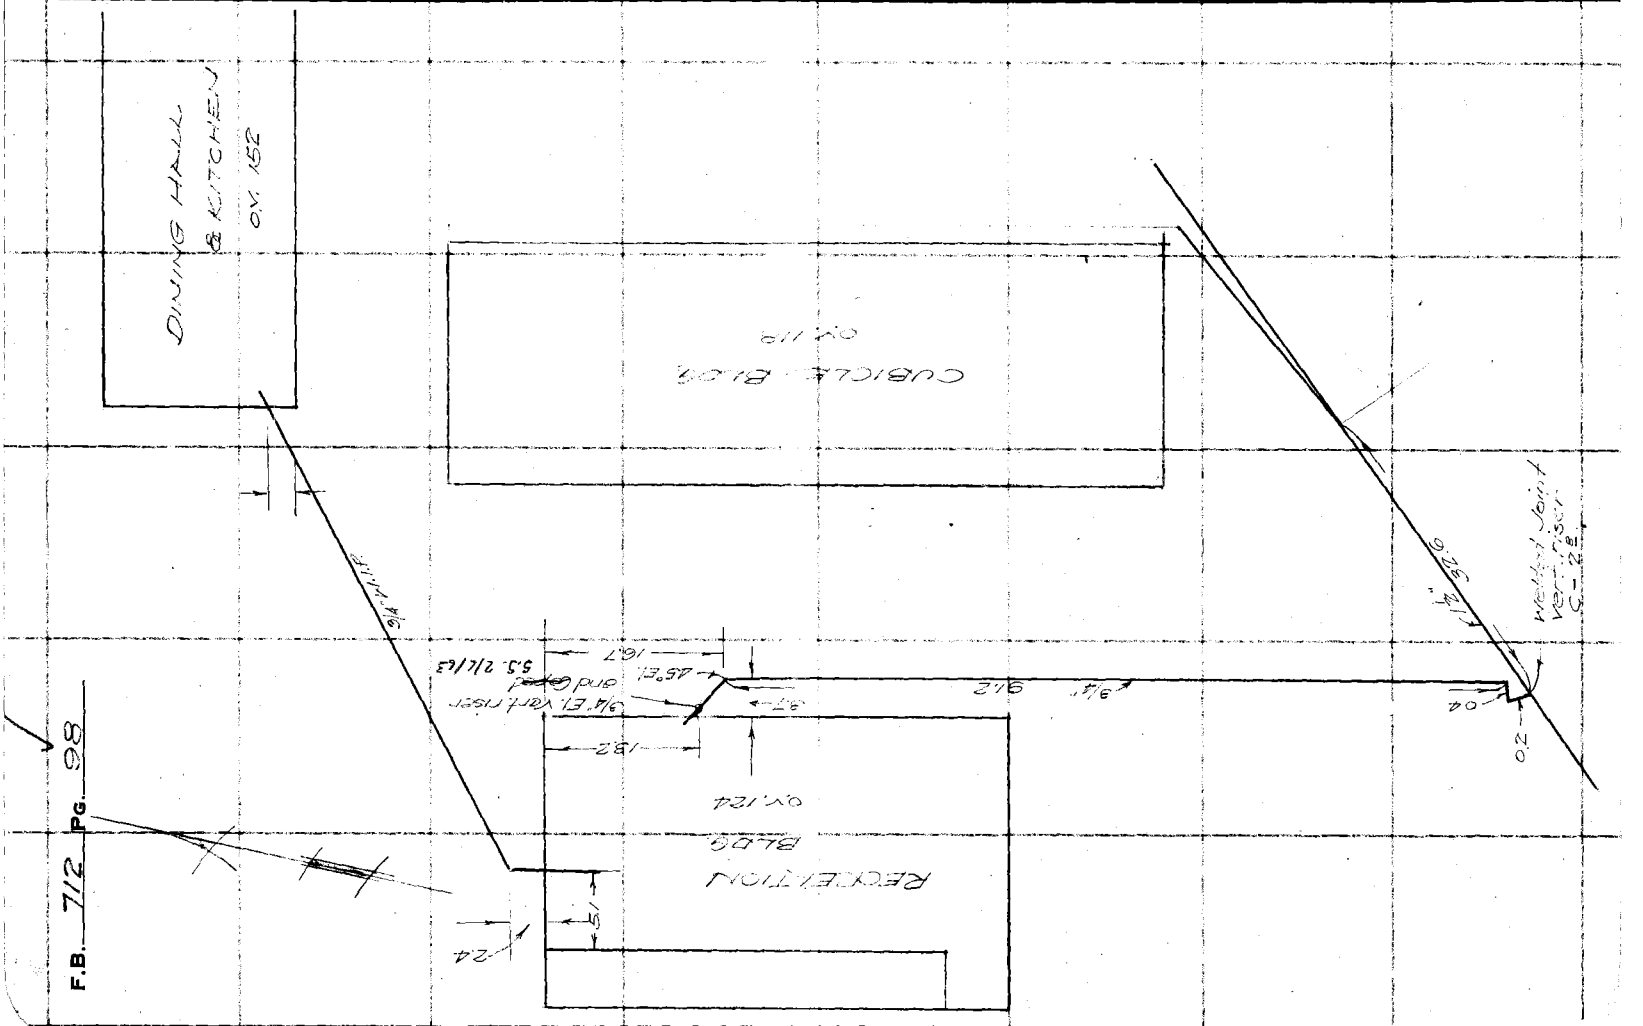

Notes Ck'd by	Survey of OLIVE VIEW SAN	F.B. 712 Pg. 99
Map No.	W. O. 8148 Tape No. St'd °F.	GAS LINES
Office Work	Surveyed by TED WALSH	
Checked	Notes WALSH Date 8-7-36	
Date	Indexed A. C. Johnson	

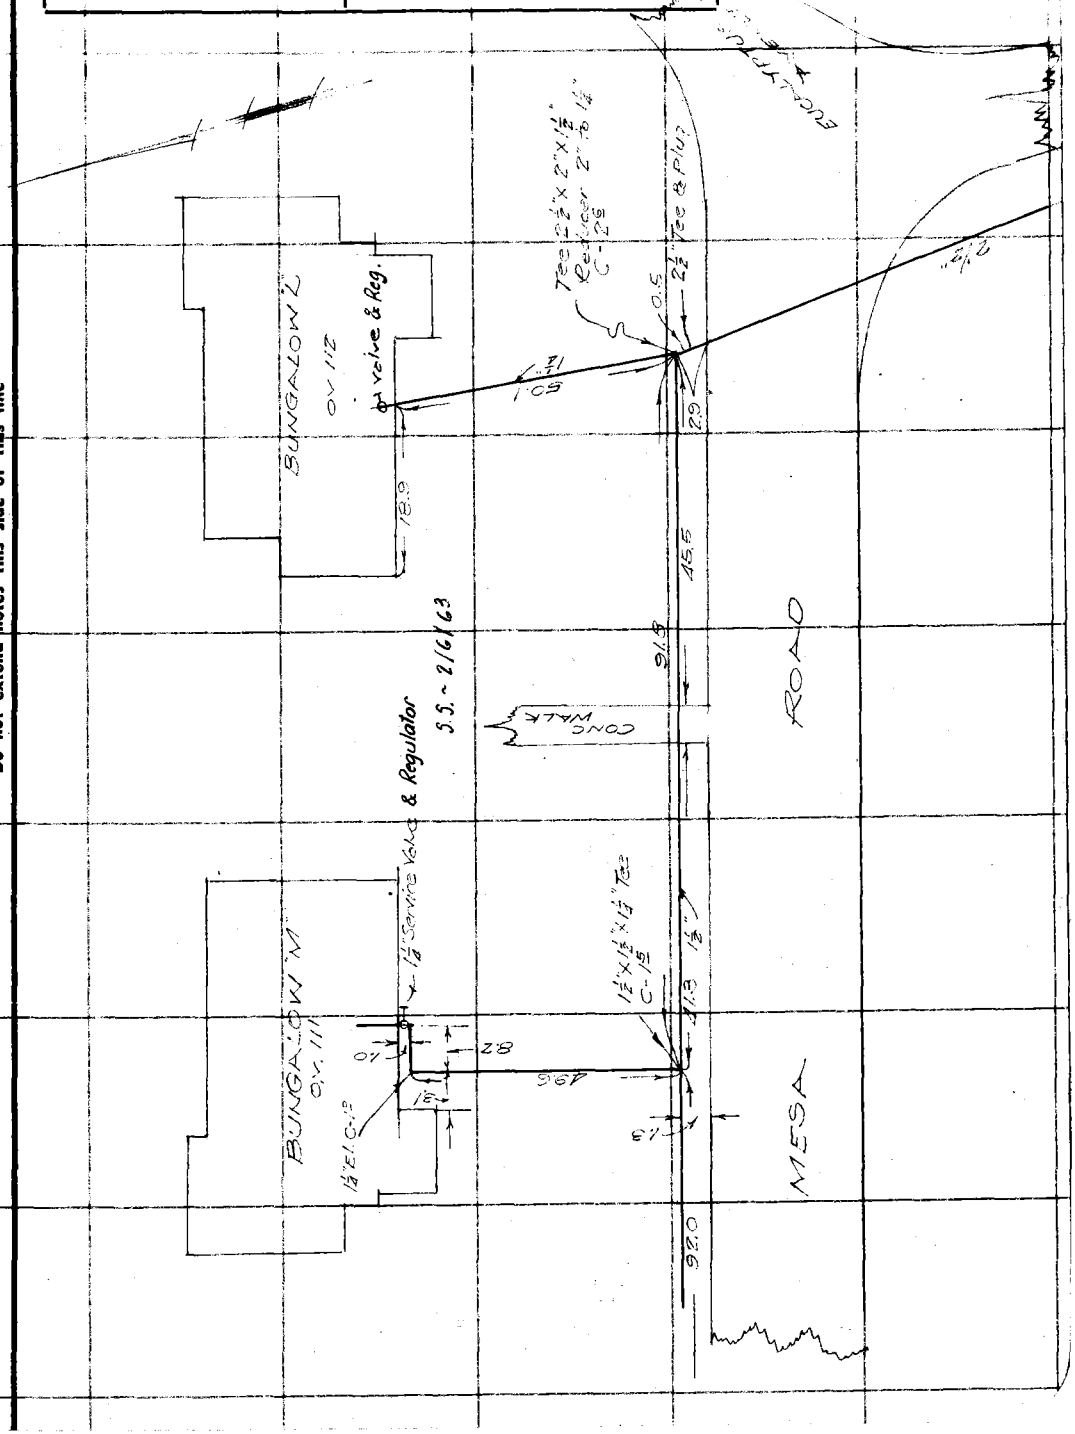

Note: Any Additions or Changes on This Sheet Must be Made or Circled in Red Ink With Date and Name of Person Making Change.

Do not extend notes this side of this line

RETURN TO
LOS ANGELES COUNTY SURVEYOR
700 HALL OF RECORDS

FORM 247 10M 11-35

RETURN TO
LOS ANGELES COUNTY SURVEYOR
700 HALL OF RECORDS

Note: Any Additions or Changes on This Sheet Must be Made or Circled in **Red Ink** With Date and Name of Person Making Change.

Do not extend notes this side of this line

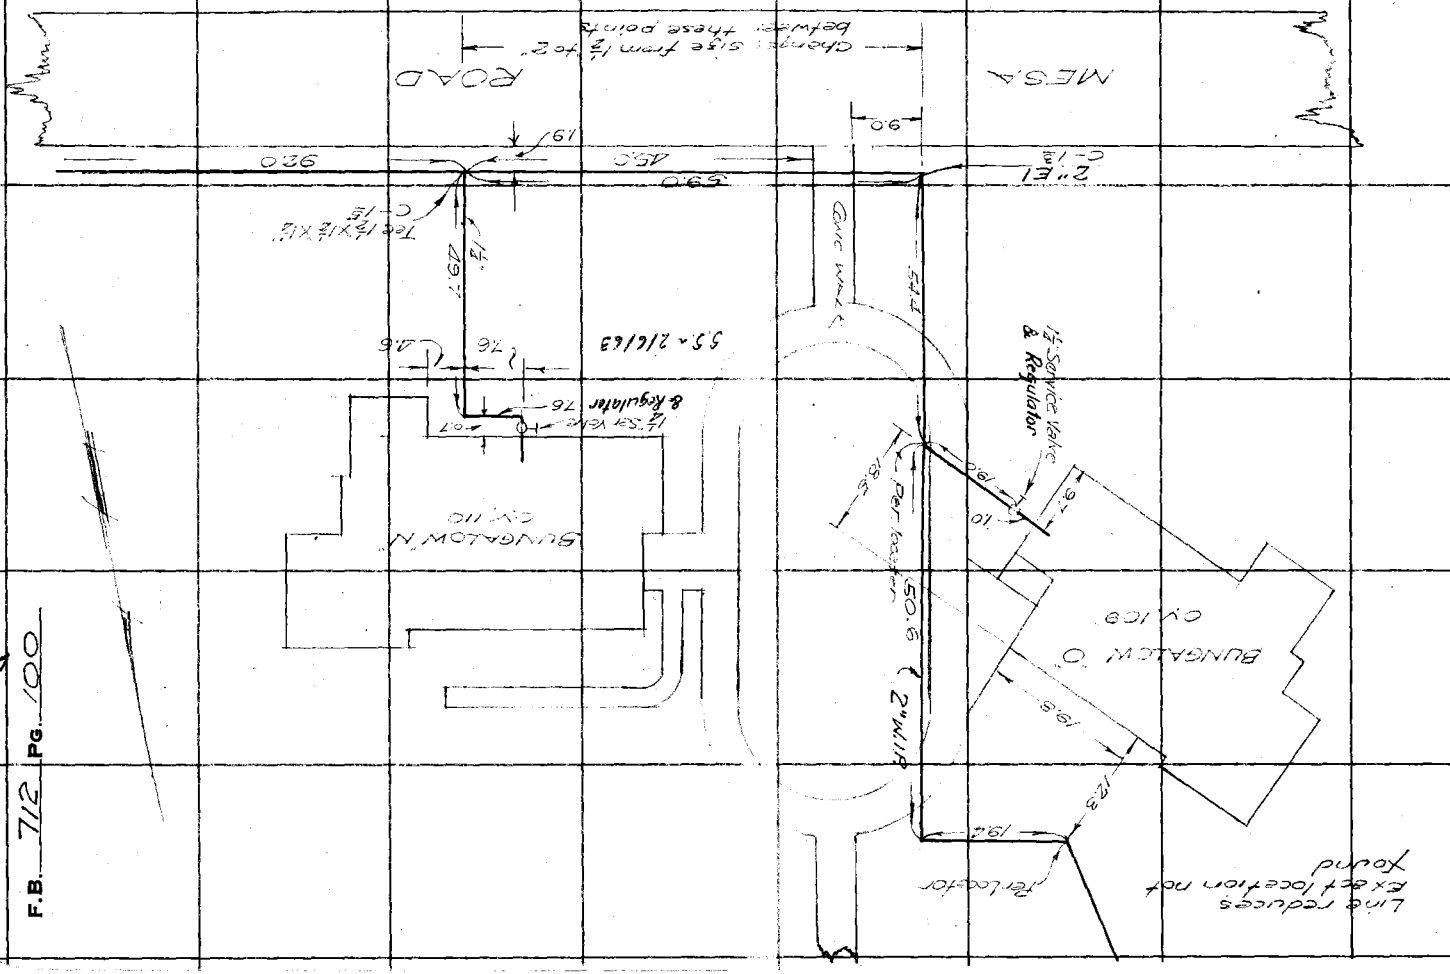

F.B. 712 PG. 100

FORM 247 10M 11-35

RETURN TO
LOS ANGELES COUNTY SURVEYOR
700 HALL OF RECORDS

Note: Any Additions or Changes on This Sheet Must be Made or Circled in **Red Ink** With Date and Name of Person Making Change.

Do not extend notes this side of this line

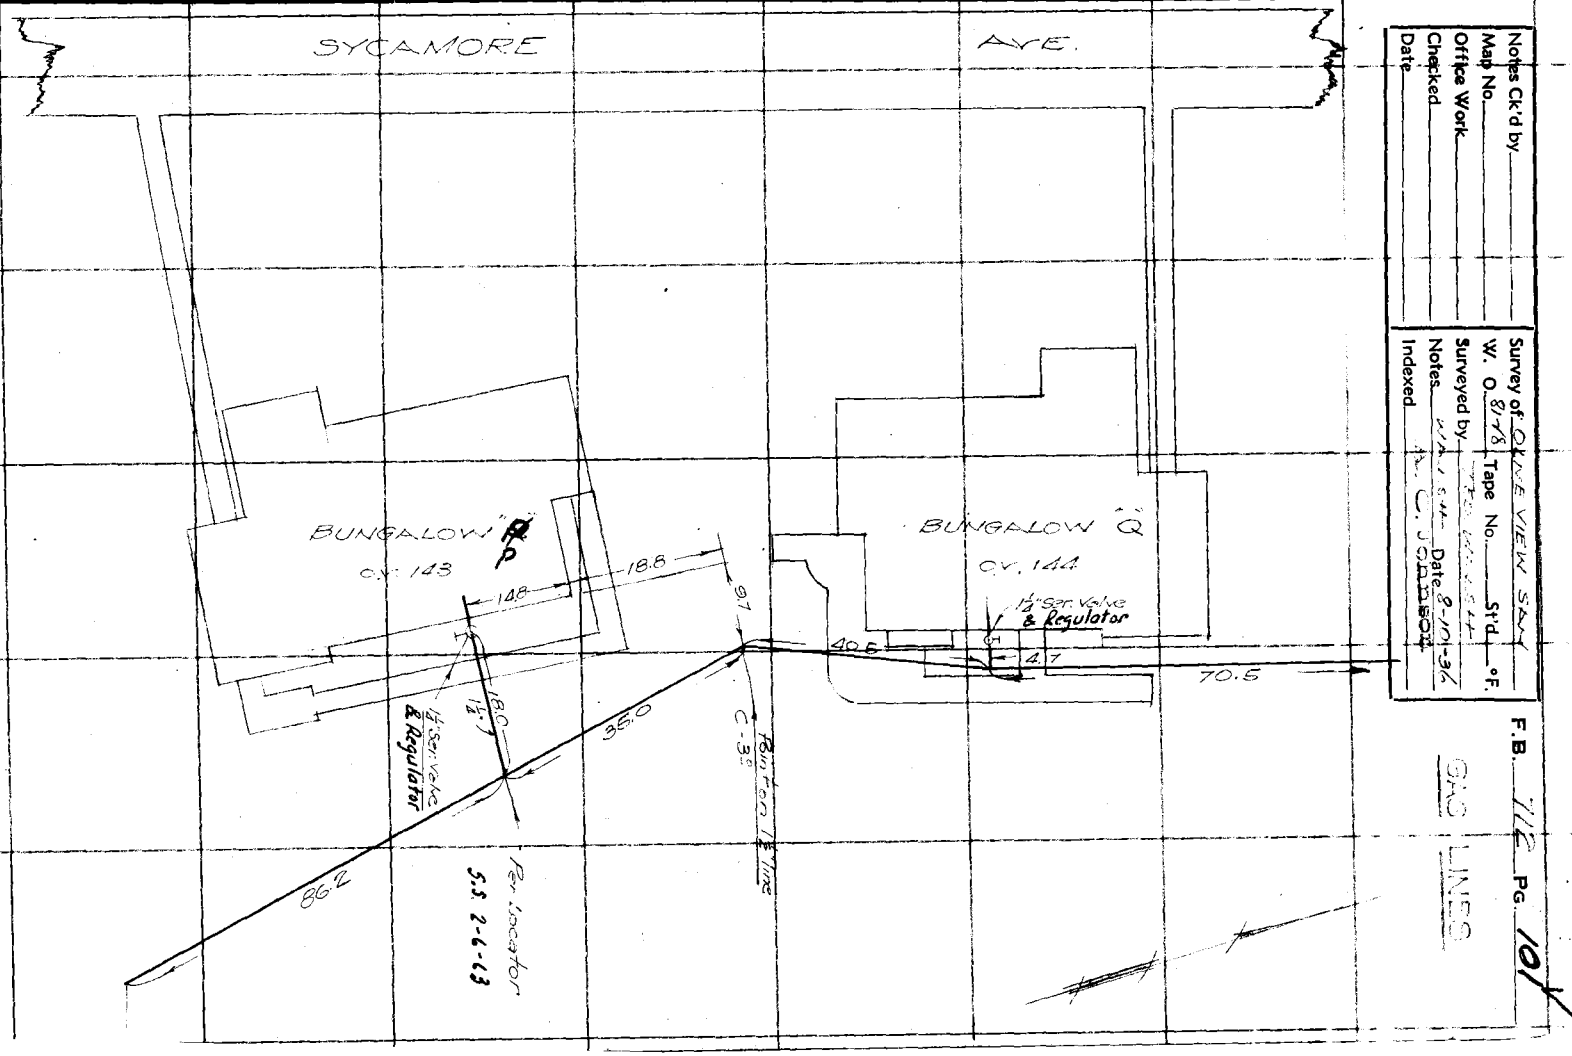

Notes Ck'd by
Map No.
Office Work
Checked
Date

W. O. 81-78 Tape No. Std. °F.
Surveyed by
Notes Date 8-10-36
Indexed


GAS LINES

RETURN TO
LOS ANGELES COUNTY SURVEYOR
700 HALL OF RECORDS

Note: Any Additions or Changes on This Sheet Must be Made or Circled in **Red Ink** With Date and Name of Person Making Change.

Do not extend notes this side of this line

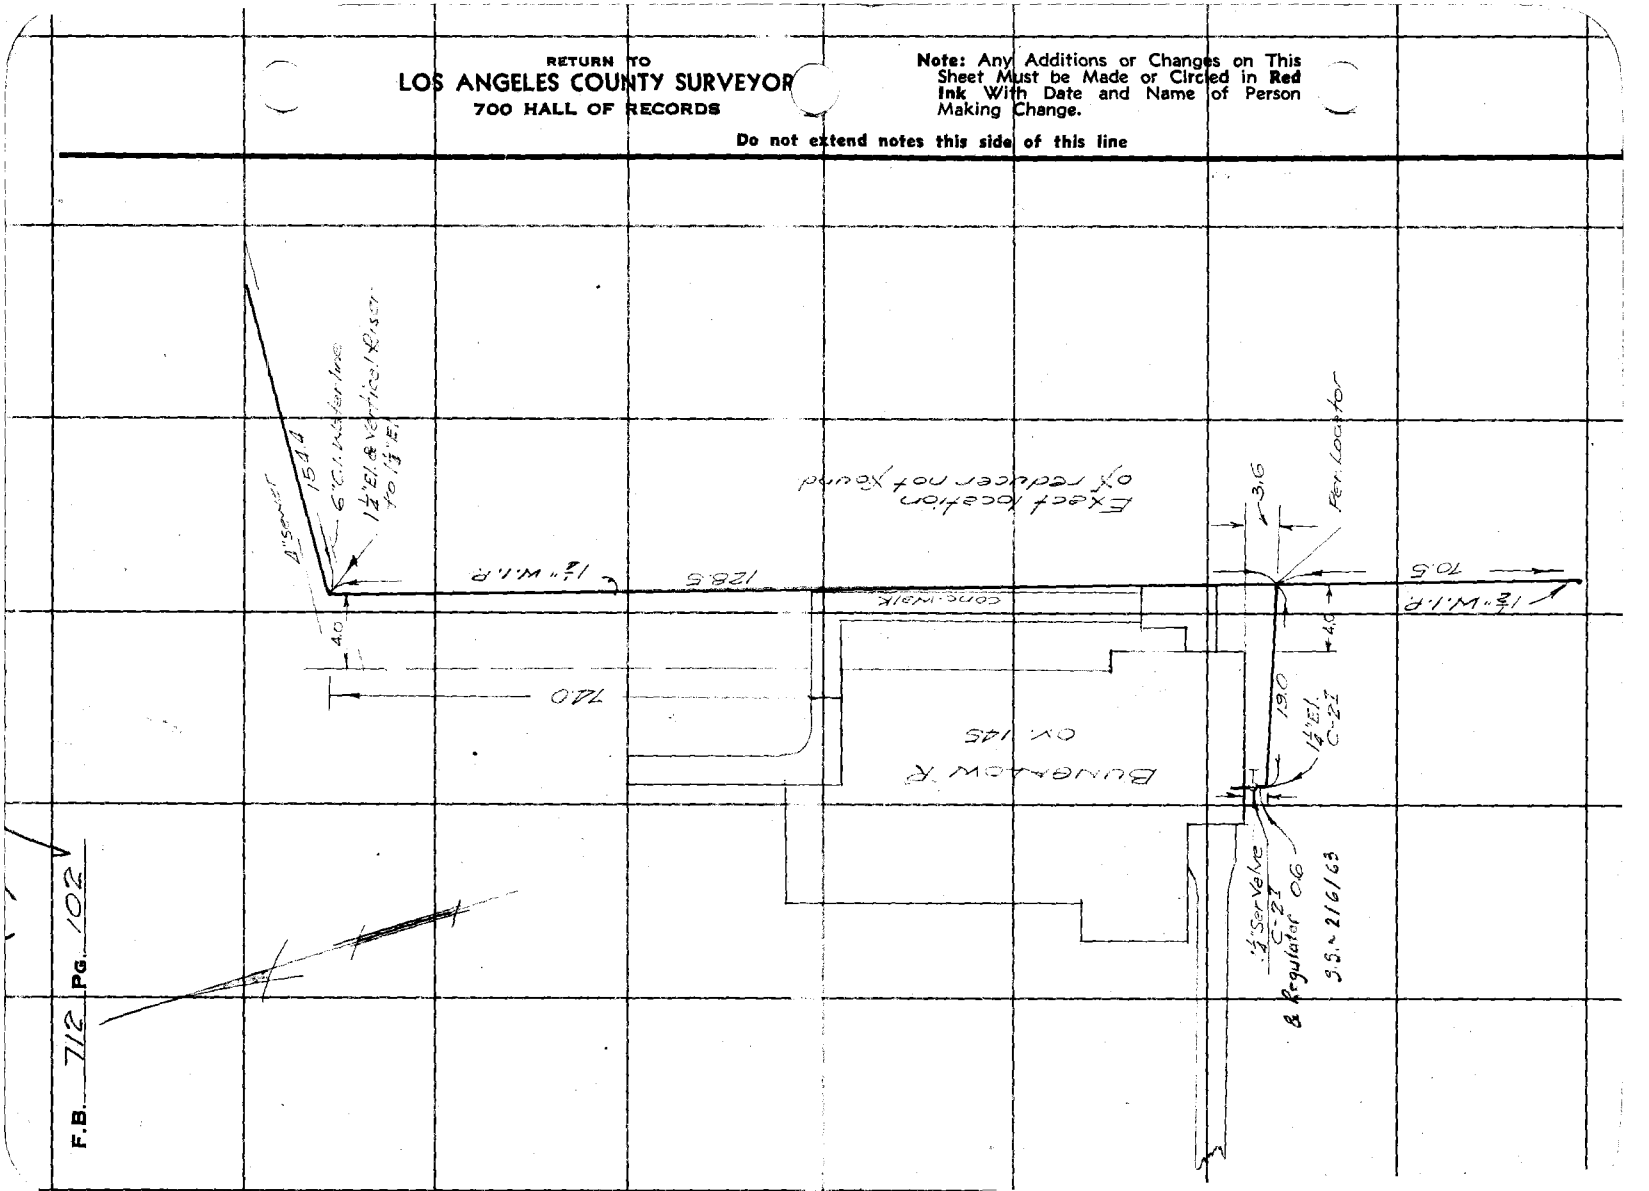

F.B. 712 PG. 102

FORM 247 10M 11-38

RETURN TO
LOS ANGELES COUNTY SURVEYOR
700 HALL OF RECORDS

Note: Any Additions or Changes on This Sheet Must be Made or Circled in **Red Ink** With Date and Name of Person Making Change.

Do not extend notes this side of this line

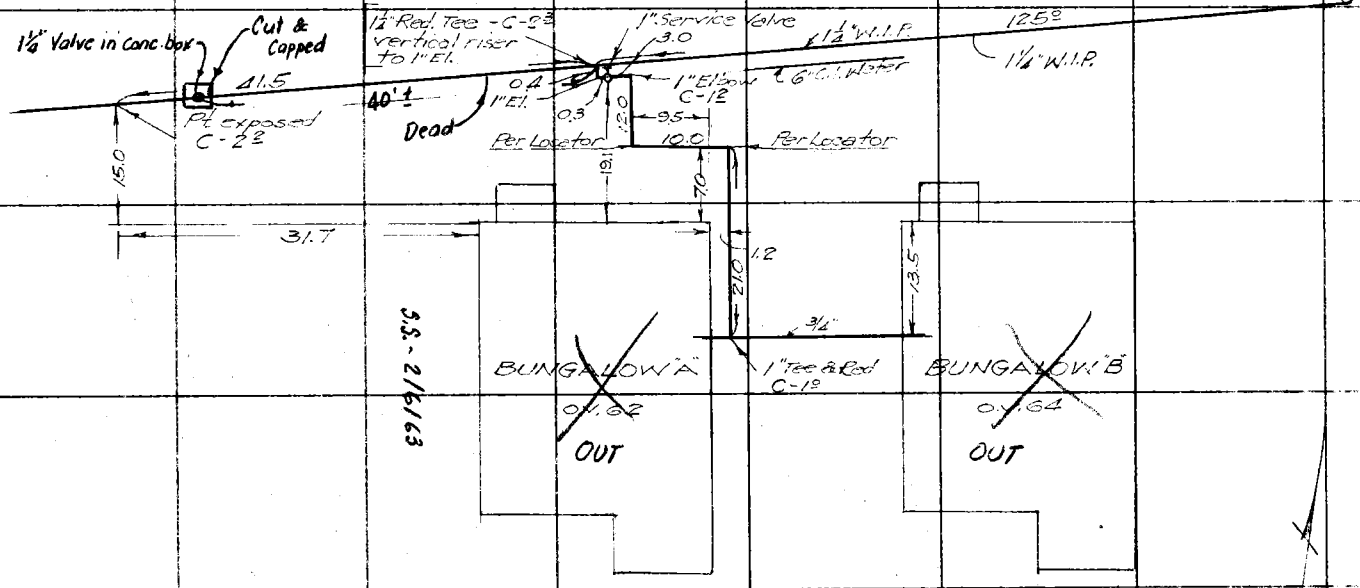

Notes Ck'd by _____
Map No. _____
Office Work _____
Checked _____
Date _____

Survey of CLARE VIEW SAN.
W. O. 8147-8 Tape No. _____ St'd _____ °F.
Surveyed by TED WALSH
Notes _____ Date 8-1-36
Indexed _____ C. Johnson

F.B. 712 PG. 103

GAS LINES

F.B. 712 Pg. 104

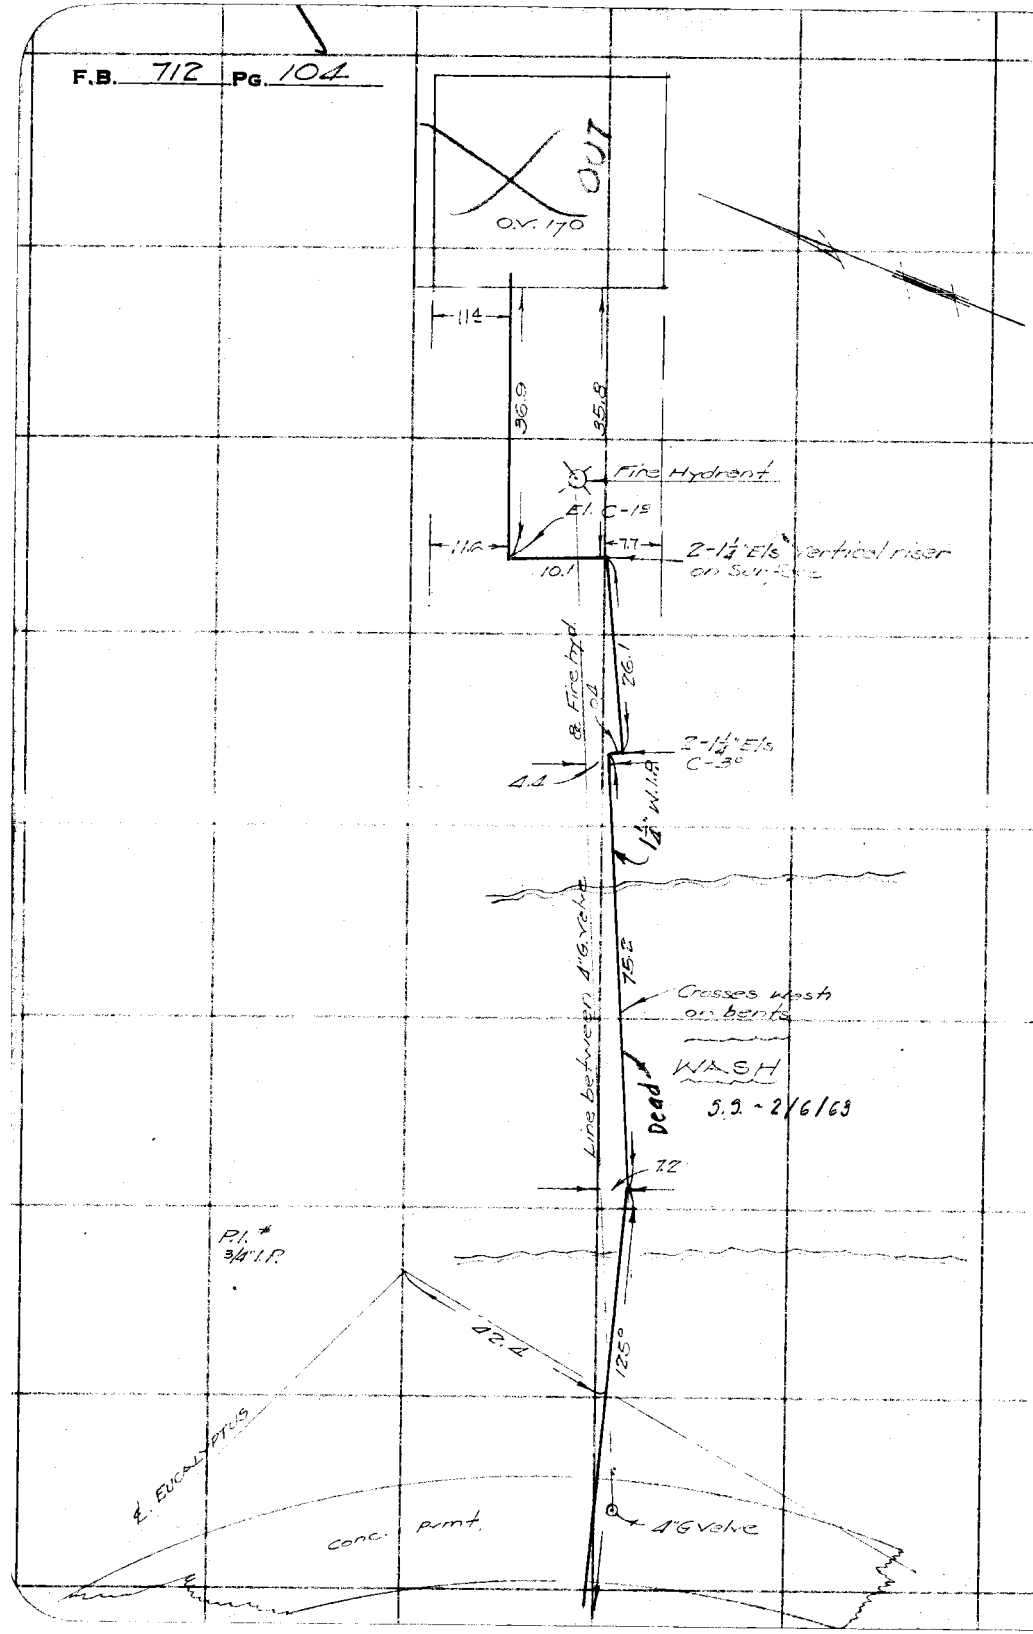

RETURN TO
LOS ANGELES COUNTY SURVEYOR
700 HALL OF RECORDS

Note: Any Additions or Changes on This Sheet Must be Made or Circled in Red Ink With Date and Name of Person Making Change.

Do not extend notes this side of this line

Notes Ck'd by	Survey of OLIVE VIEW SANATORIUM	F.B. 712 Pg. 105
Map No.	W. O. Tape No. St'd °F.	
Office Work	Surveyed by T. M. WALSH	
Checked	Notes T. M. WALSH Date	
Date	Indexed A. C. Johnson 5-26-37	

Note: Any Additions or Changes on This Sheet Must be Made or Circled in Red Ink With Date and Name of Person Making Change.

Do not extend notes this side of this line

RETURN TO
LOS ANGELES COUNTY SURVEYOR
700 HALL OF RECORDS

FORM 247 10M 11-35

RETURN TO
LOS ANGELES COUNTY SURVEYOR
700 HALL OF RECORDS

Note: Any Additions or Changes on This Sheet Must be Made or Circled in **Red Ink** With Date and Name of Person Making Change.

Do not extend notes this side of this line

F.B. 712 PG. 106

Notes Ck'd by	Survey of
Map No.	W. O. Tape No. St'd °F.
Offide Work	Surveyed by M. WALSH
Checked	Notes M. WALSH Date
Date	Indexed K. C. Johnson

F.B. 712 PG. 107

Note: Any Additions or Changes on This Sheet Must be Made or Circled in Red Ink With Date and Name of Person Making Change.

Do not extend notes this side of this line

RETURN TO
LOS ANGELES COUNTY SURVEYOR
700 HALL OF RECORDS

FORM 247 10M 11-38

RETURN TO
LOS ANGELES COUNTY SURVEYOR
700 HALL OF RECORDS

Note: Any Additions or Changes on This Sheet Must be Made or Circled in **Red Ink** With Date and Name of Person Making Change.

Do not extend notes this side of this line

F.B. 712 PG. 108

FORM 247 10M 11-35

RETURN TO
LOS ANGELES COUNTY SURVEYOR
700 HALL OF RECORDS

Note: Any Additions or Changes on This Sheet Must be Made or Circled in **Red Ink** With Date and Name of Person Making Change.

Do not extend notes this side of this line

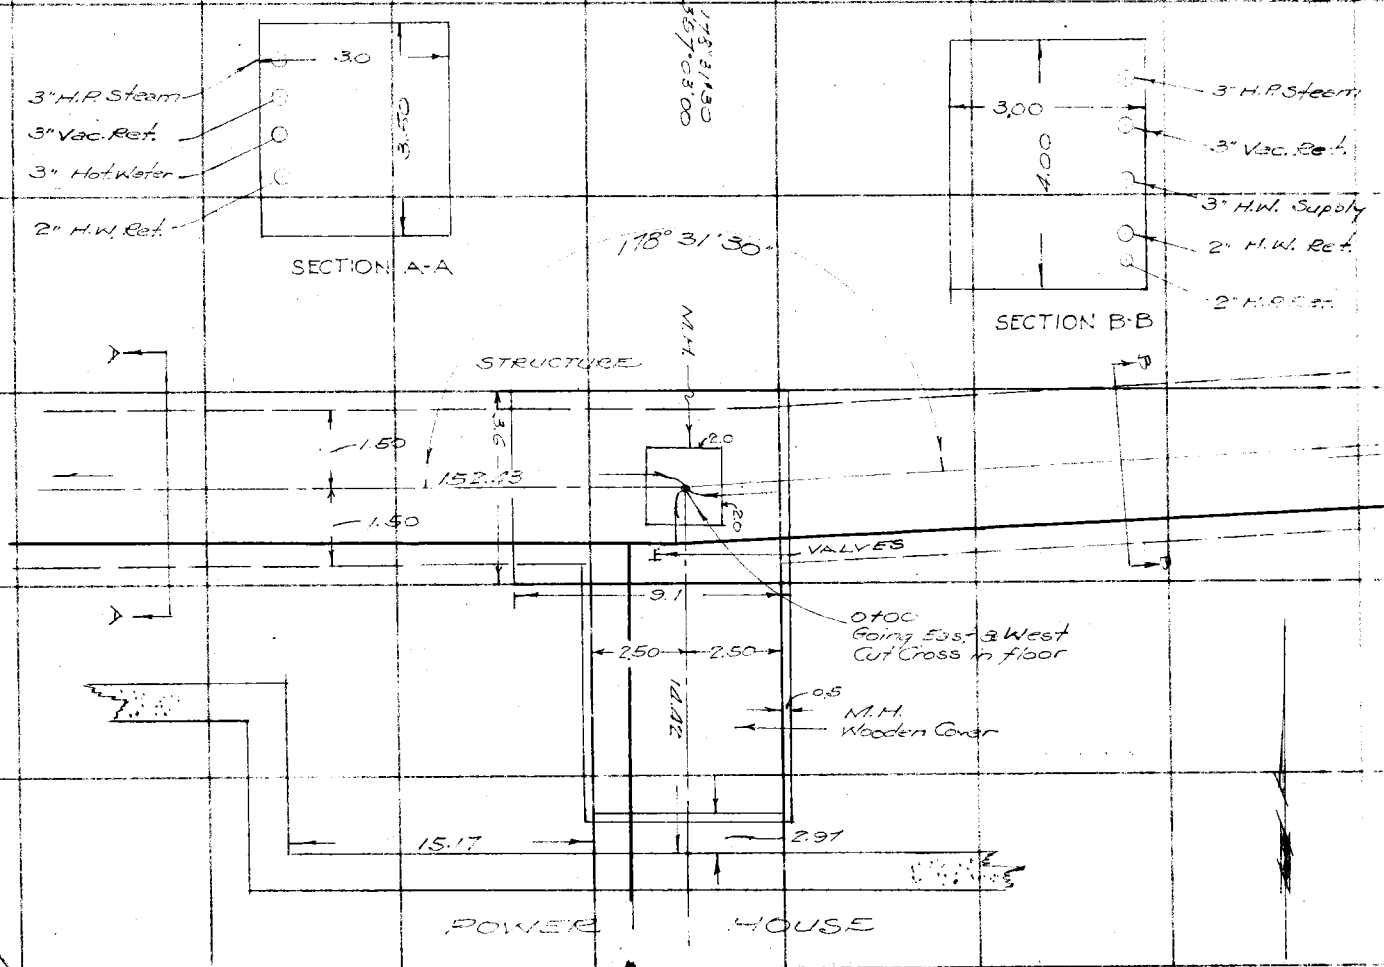

Notes Ck'd by _____
Map No. _____
Office Work _____
Checked _____
Date _____

Surveyed by [illegible] Date 9-3-36
Notes. [illegible]
Indexed [illegible] 5-26-37

F.B. 712 PG. 111

STEAM TUNNELS

F.B. 712 PG. 112

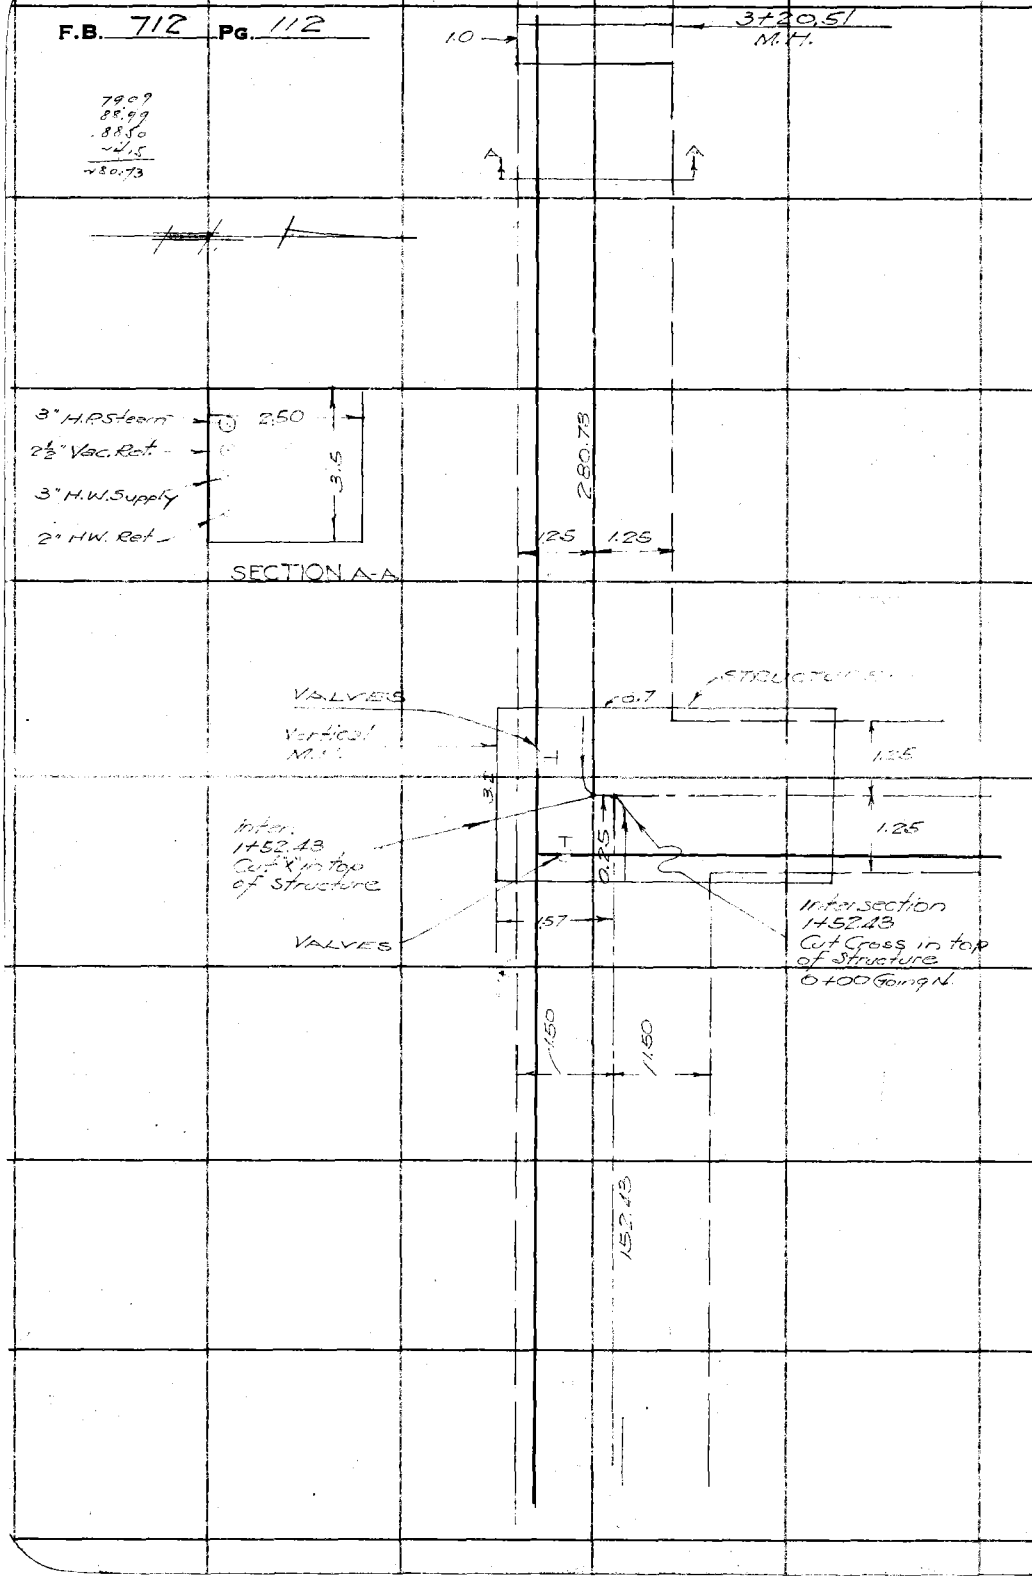

RETURN TO
LOS ANGELES COUNTY SURVEYOR
700 HALL OF RECORDS

Note: Any Additions or Changes on This Sheet Must be Made or Circled in Red Ink With Date and Name of Person Making Change.

Do not extend notes this side of this line

Notes Ck'd by	Survey of OLIVE VIEW SAN'L
Map No.	W. O. 8148 Tape No. St'd °F.
Office Work	Surveyed by T. WALSH
Checked	Notes WALSH Date 9-3-36
Date	Indexed

F.B. 712 PG. 113

STEAM TUNNELS

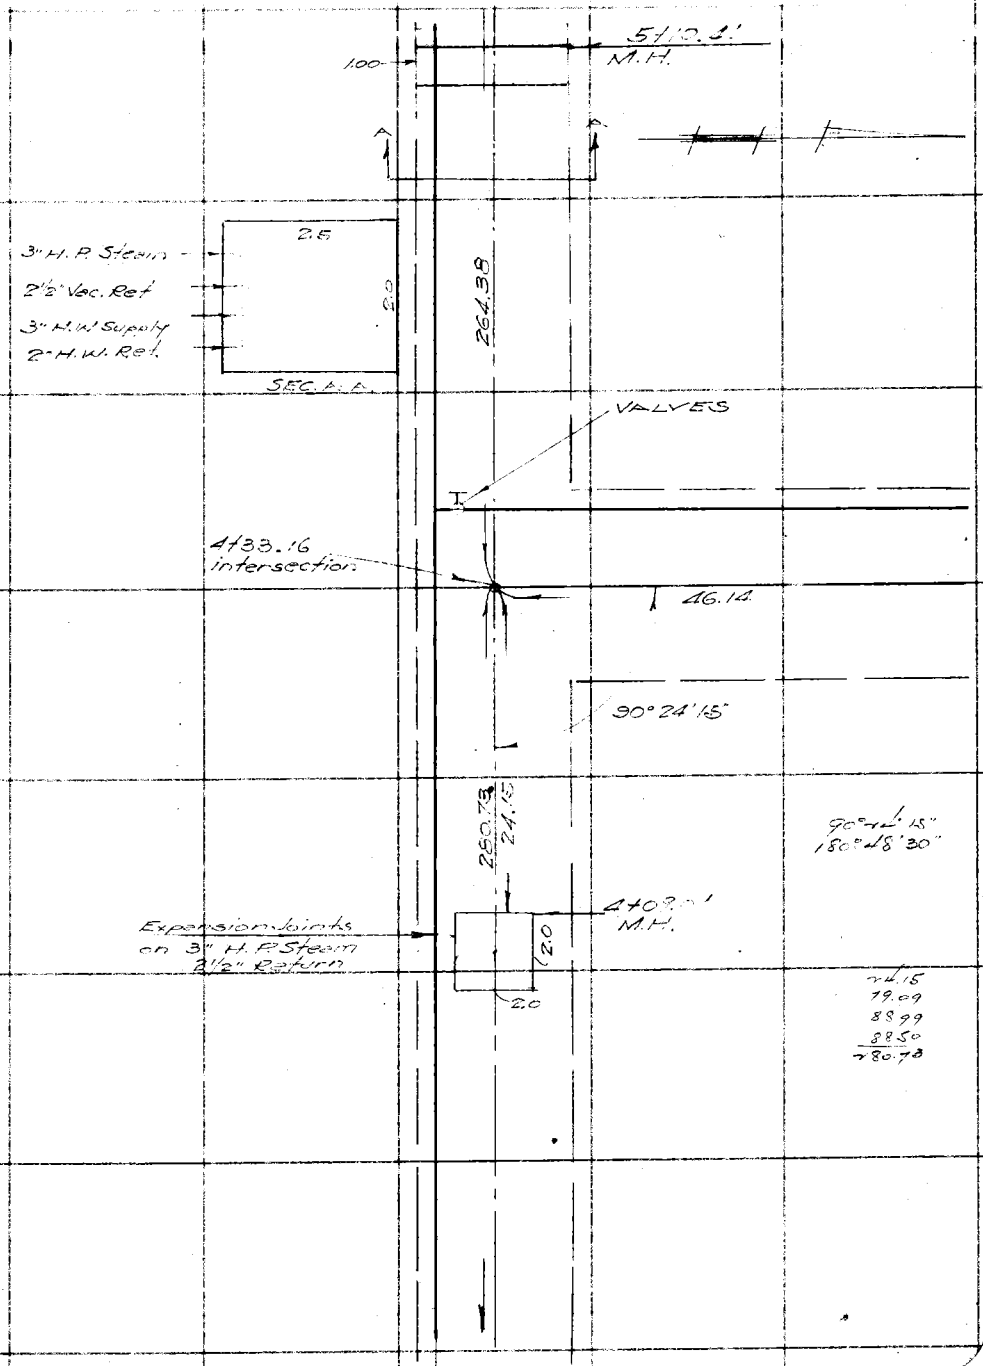

Note: Any Additions or Changes on This Sheet Must be Made or Circled in Red Ink With Date and Name of Person Making Change.

Do not extend notes this side of this line

RETURN TO
LOS ANGELES COUNTY SURVEYOR
700 HALL OF RECORDS

FORM 247 10M 11-35

F.B. 712 PG. 114

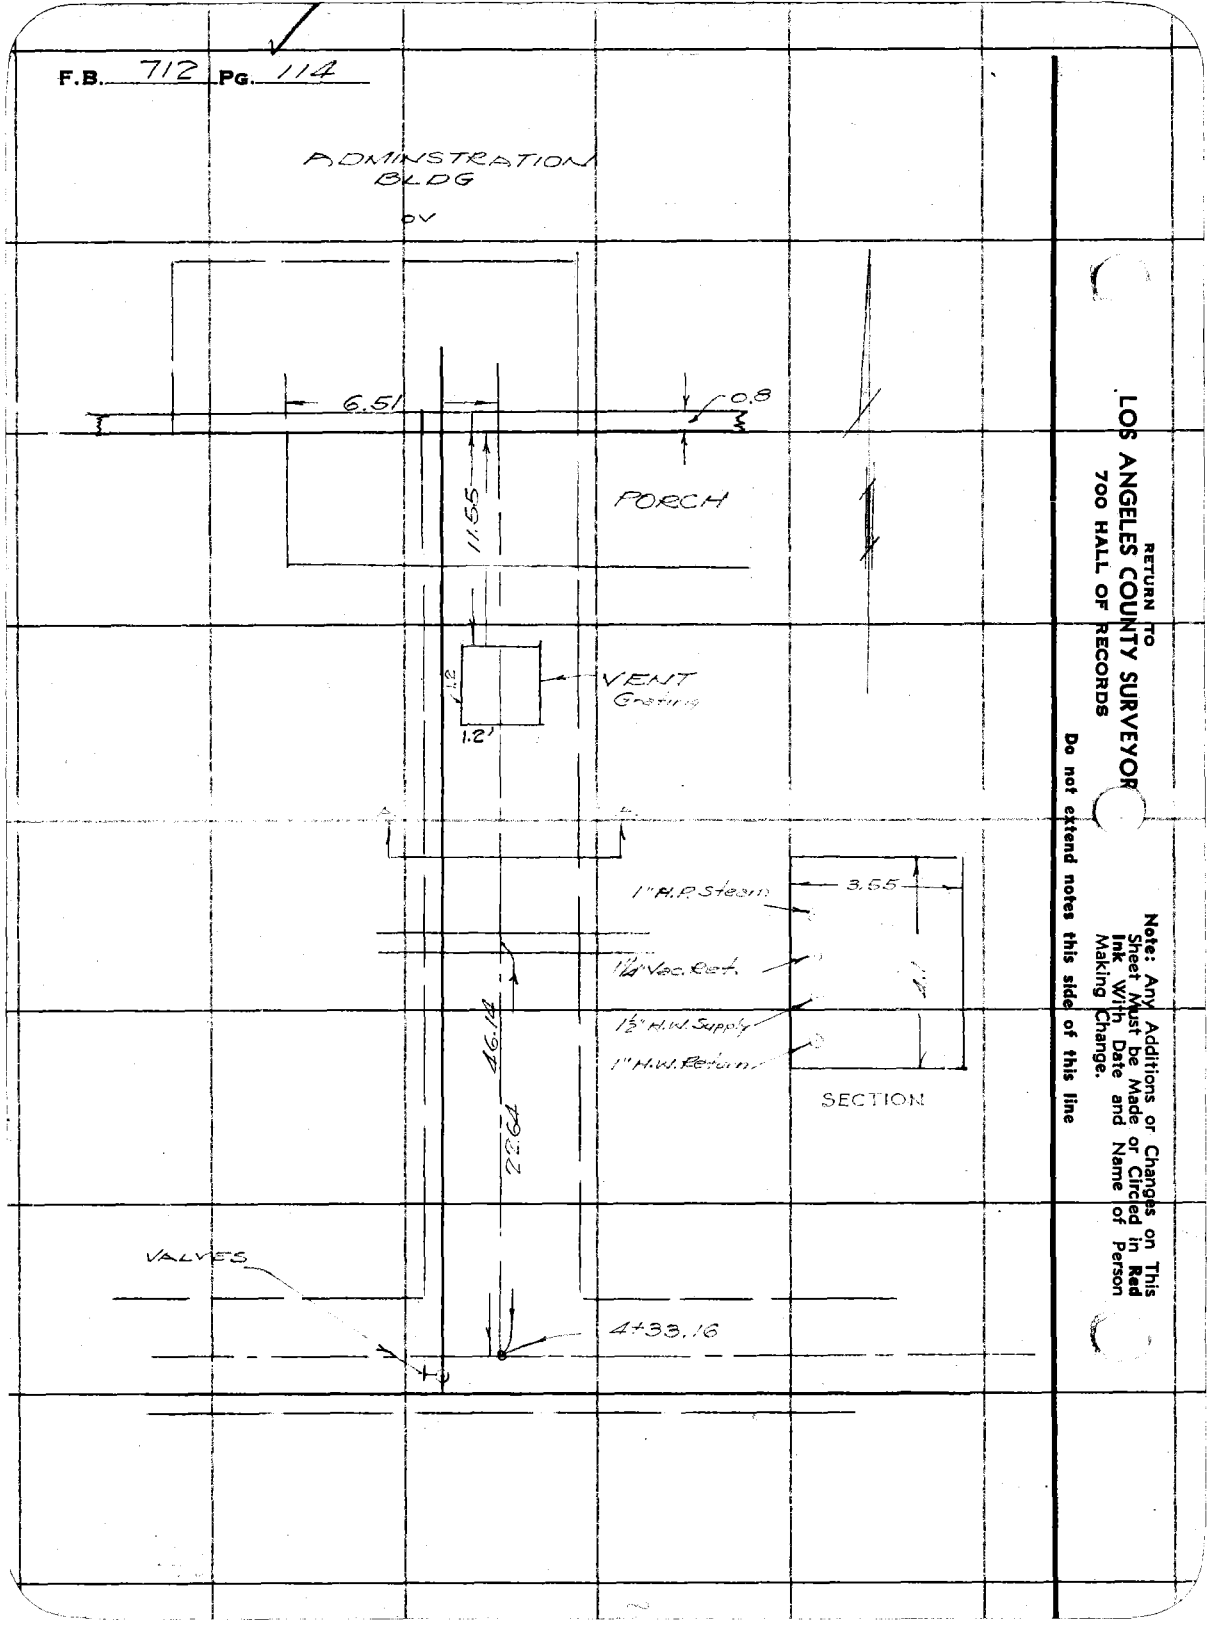

RETURN TO
LOS ANGELES COUNTY SURVEYOR
700 HALL OF RECORDS

Do not extend notes this side of this line

Note: Any Additions or Changes on This Sheet Must be Made or Circled in Red Ink With Date and Name of Person Making Change.

Notes Ck'd by	Survey of OLIVE VIEW SANATORIUM	F.B. 712 PG. 115
Map No.	W. O. 8148 Tape No. St'd °F.	STEAM TUNNELS
Office Work	Surveyed by TTOWALSH	
Checked	Notes WALSH Date 9-24-36	
Date	Indexed A. C. Johnson	

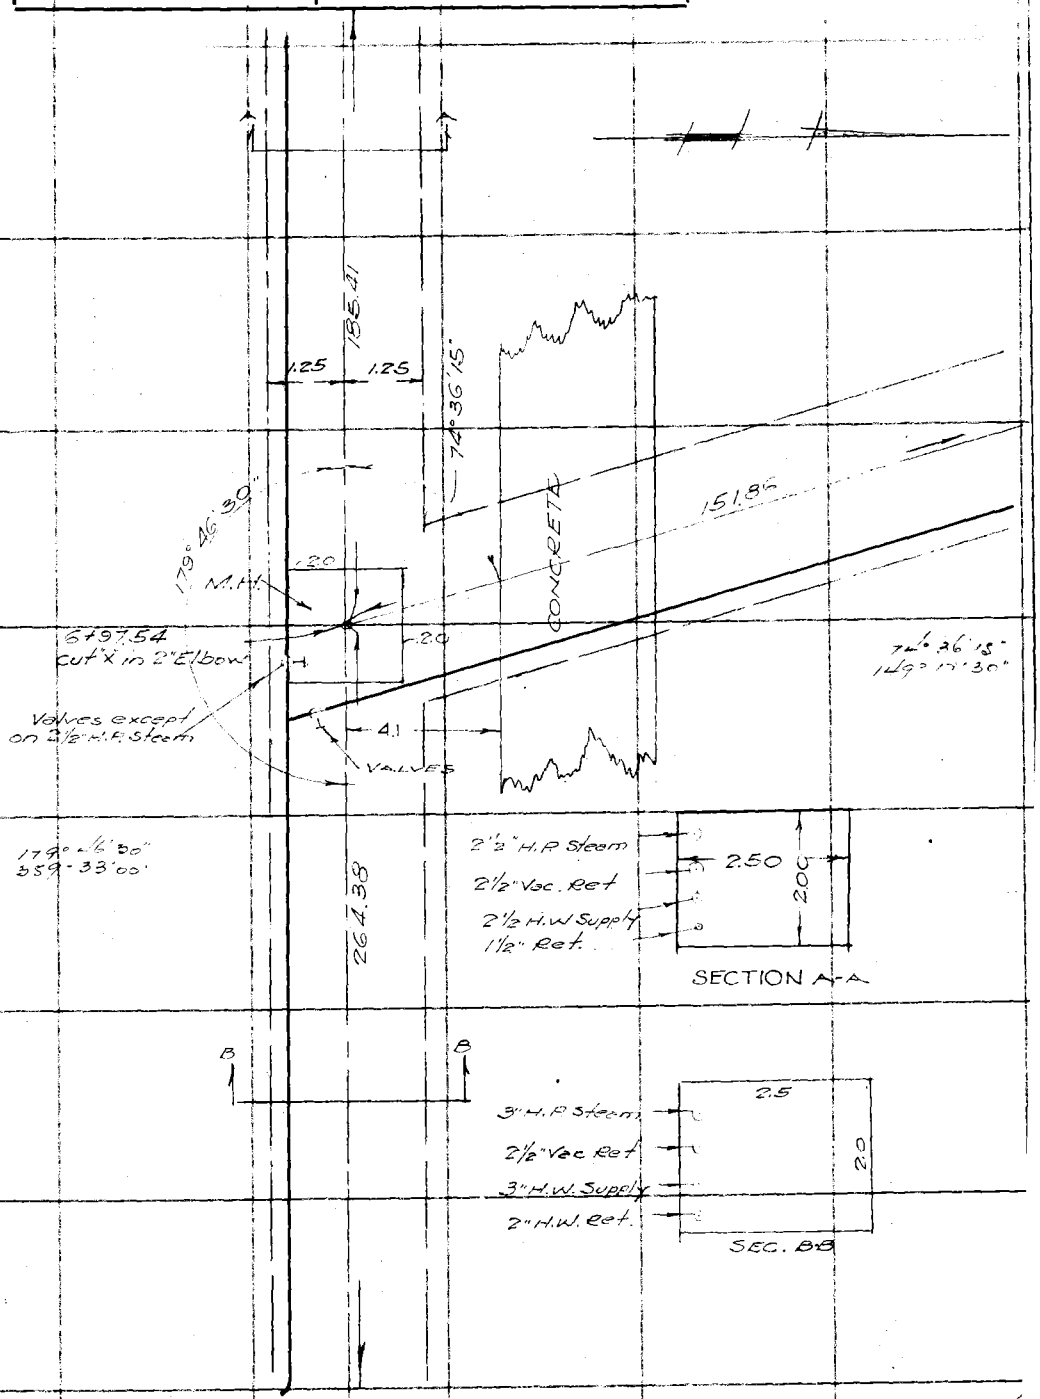

Note: Any Additions or Changes on This Sheet Must be Made or Circled in Red Ink With Date and Name of Person Making Change.

Do not extend notes this side of this line

RETURN TO
LOS ANGELES COUNTY SURVEYOR
700 HALL OF RECORDS

FORM 247 10M 11-35

F.B. 712 PG. 116

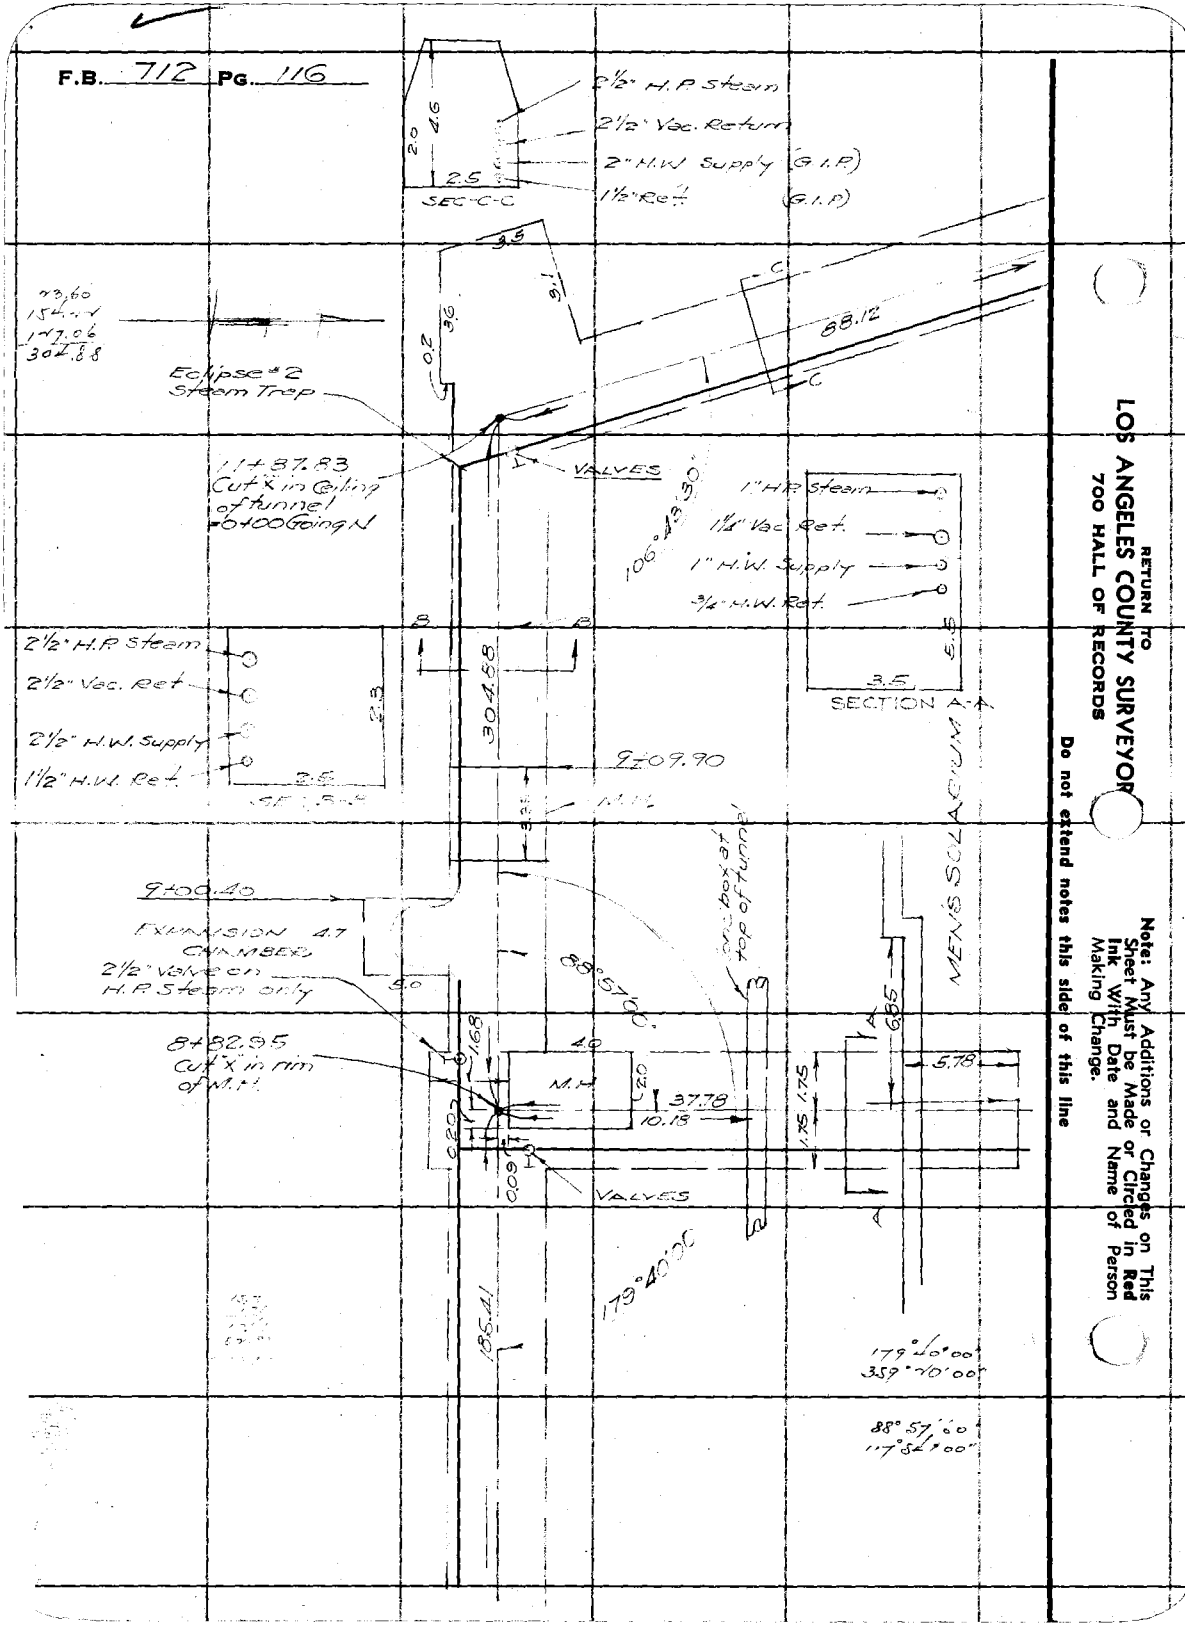

RETURN TO
LOS ANGELES COUNTY SURVEYOR
700 HALL OF RECORDS

Note: Any Additions or Changes on This Sheet Must be Made or Circled in Red Ink With Date and Name of Person Making Change.

Do not extend notes this side of this line

Notes Ck'd by	Survey of OLIVE VIEW SANATORIUM
Map No.	W. O. 8148 Tape No. St'd °F.
Office Work	Surveyed by TED WALSH
Checked	Notes WALSH Date 9-2-36
Date	Indexed

F.B. 712 PG. 117

STEAM TUNNELS

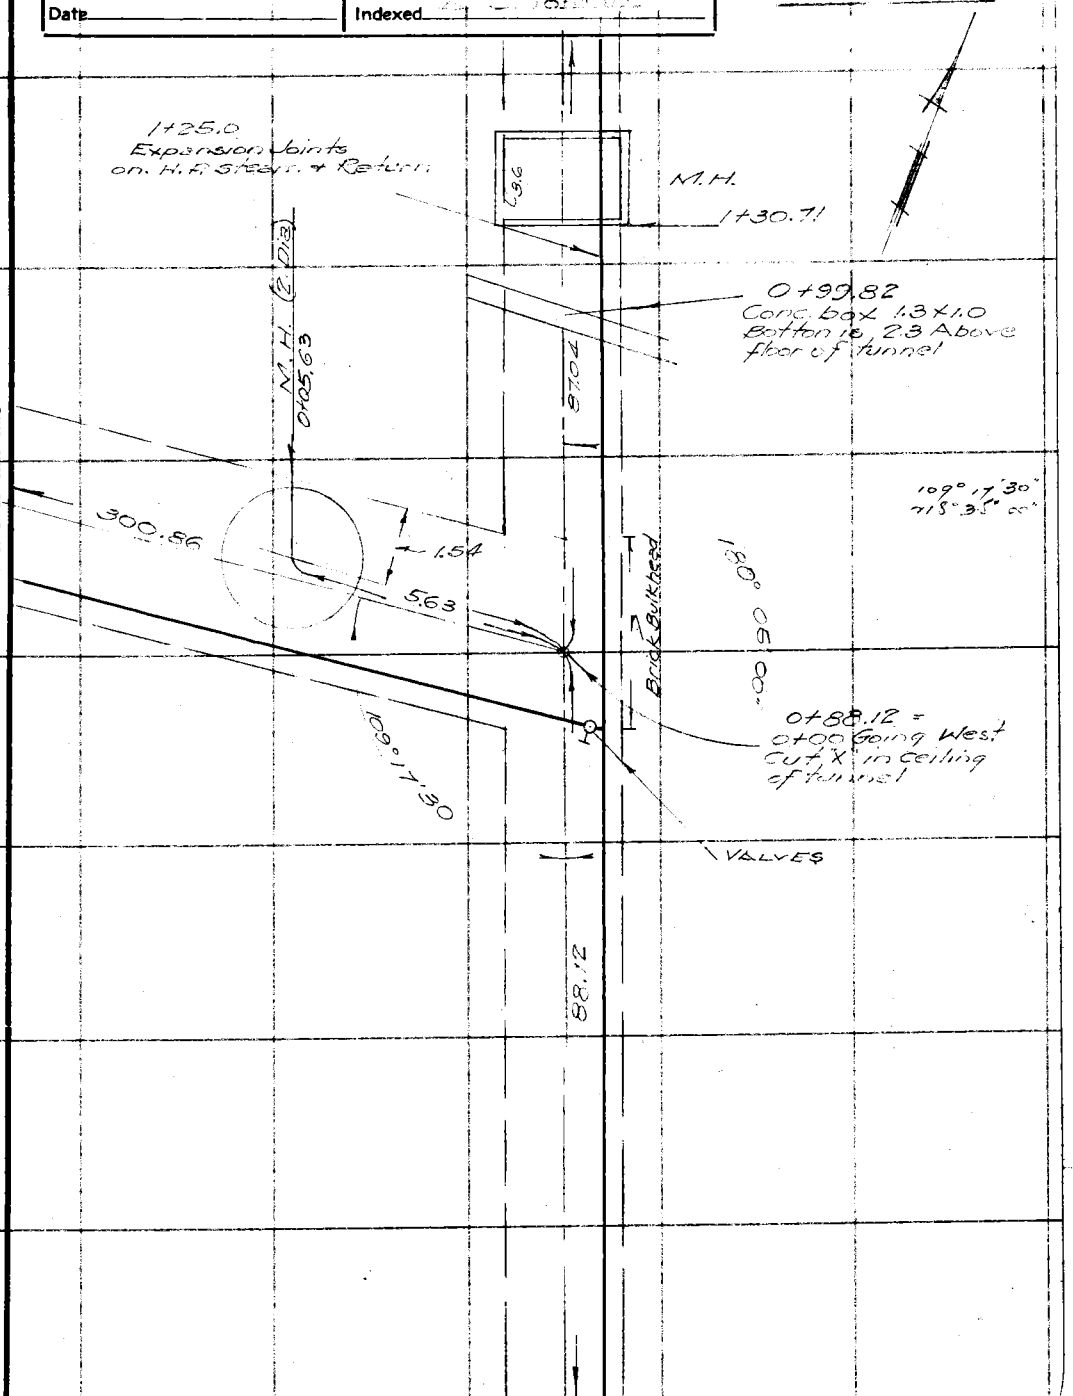

Note: Any Additions or Changes on This Sheet Must be Made or Circled in Red Ink With Date and Name of Person Making Change.

Do not extend notes this side of this line

RETURN TO
LOS ANGELES COUNTY SURVEYOR
700 HALL OF RECORDS

FORM 247 10M 11-35

F.B. 712 PG. 118

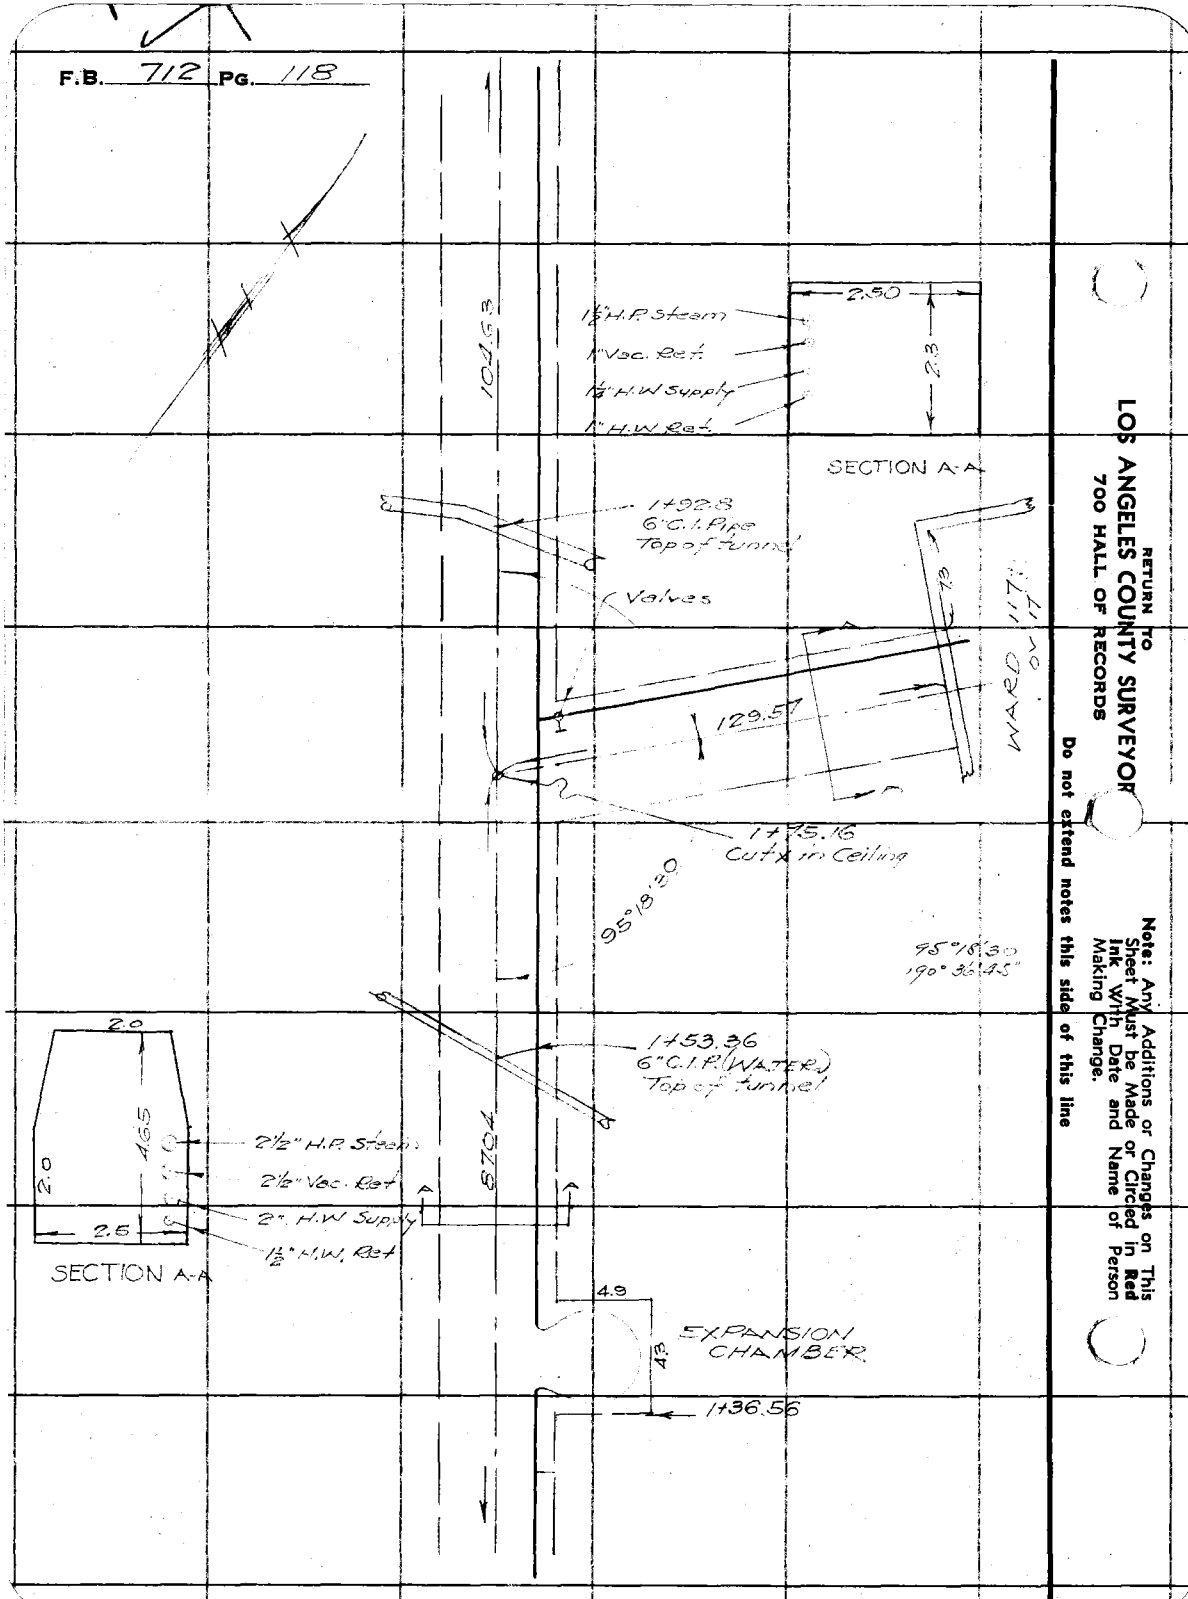

RETURN TO
LOS ANGELES COUNTY SURVEYOR
700 HALL OF RECORDS

Do not extend notes this side of this line

Note: Any Additions or Changes on This Sheet Must be Made or Circled in Red Ink With Date and Name of Person Making Change.

Notes Ck'd by	Survey of OLIVE VIEW SAN.	F.B. 712 PG. 119
Map No.	W. O. 8148 Tape No. St'd °F.	
Office Work	Surveyed by T. Wa[illegible]	STEAM TUNNELS
Checked	Notes WALSH Date 9-4-36	
Date	Indexed [illegible] C. Johnson	

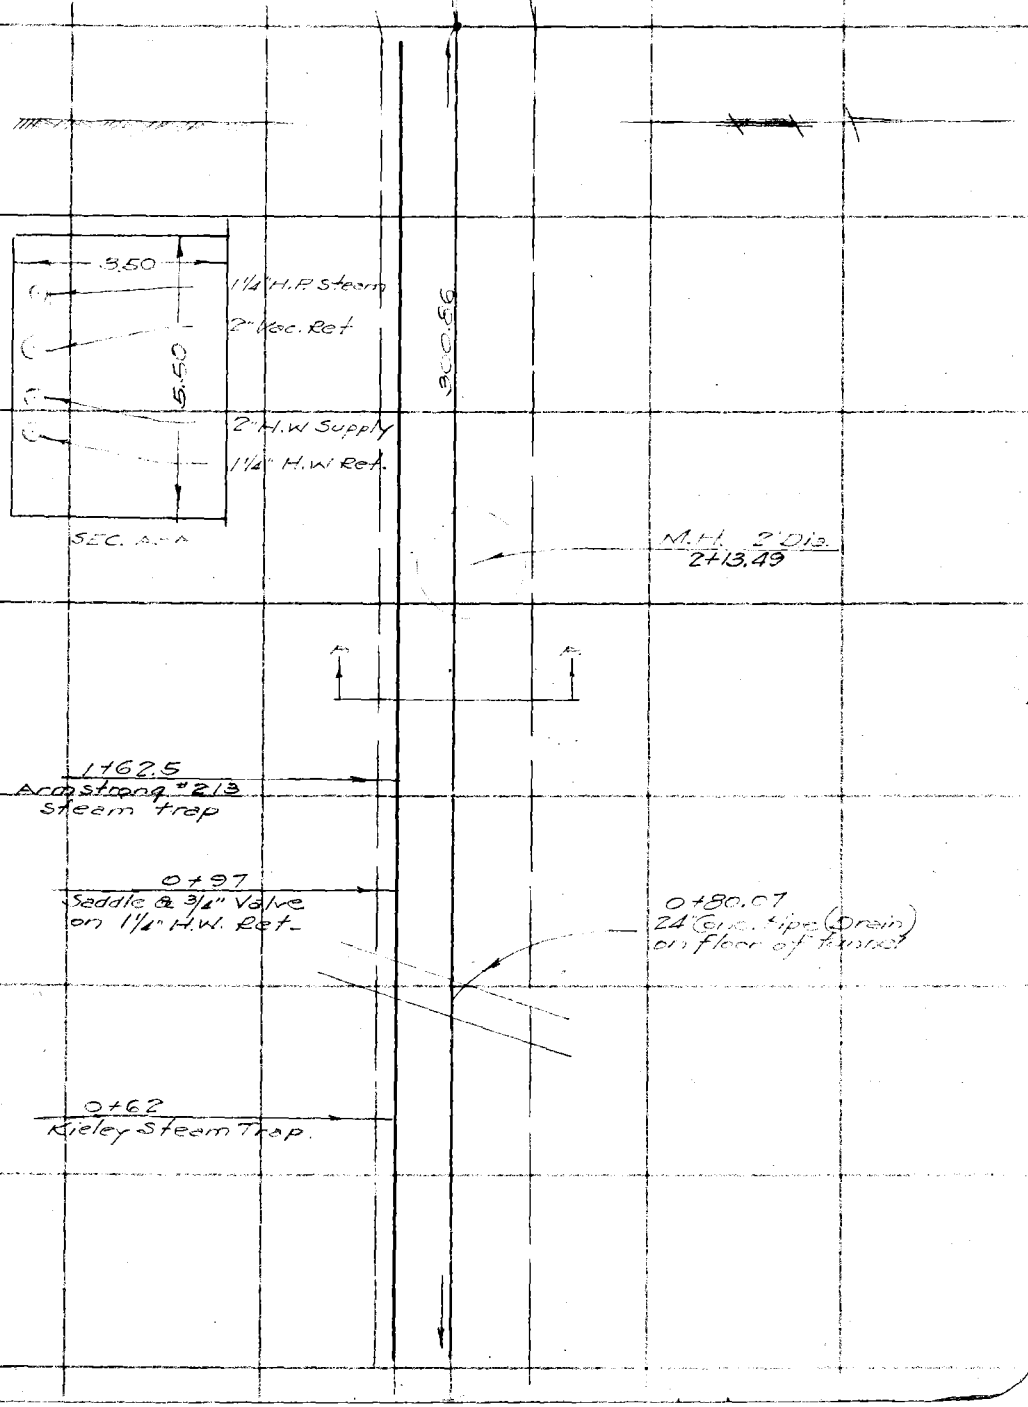

Note: Any Additions or Changes on This Sheet Must be Made or Circled in Red Ink With Date and Name of Person Making Change.

Do not extend notes this side of this line

RETURN TO
LOS ANGELES COUNTY SURVEYOR
700 HALL OF RECORDS

FORM 247 10M 11-38

F.B. 712 Pg. 120

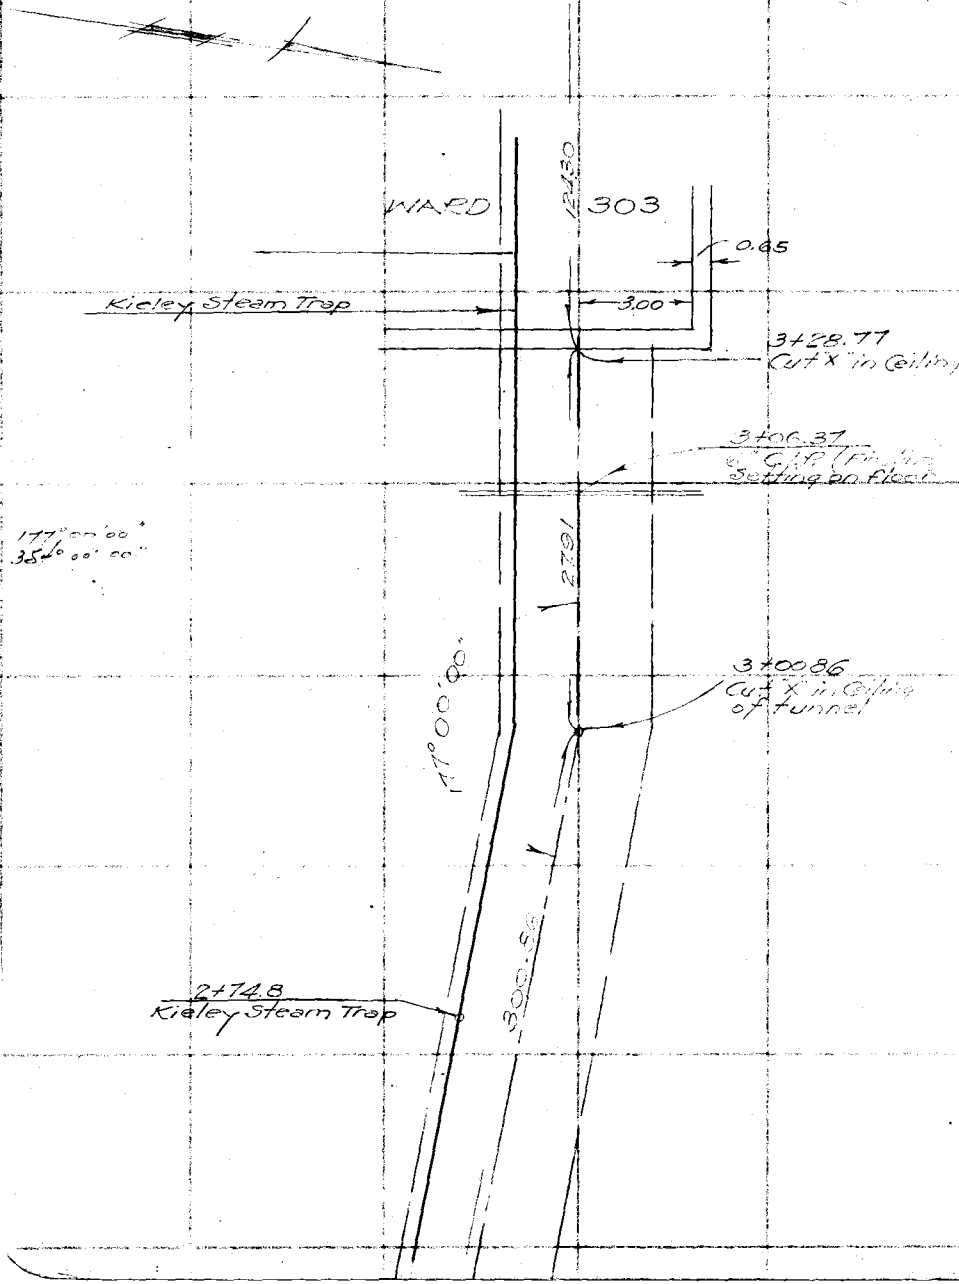

RETURN TO
LOS ANGELES COUNTY SURVEYOR
700 HALL OF RECORDS

Note: Any Additions or Changes on This Sheet Must be Made or Circled in Red Ink With Date and Name of Person Making Change.

Do not extend notes this side of this line

Notes Ck'd by	Survey of
Map No.	W. O. 8128 Tape No. St'd °F.
Office Work	Surveyed by T. M. WALSH
Checked	Notes T. M. WALSH Date 9-18-36
Date	Indexed A. C. Johnson

F.B. 712 PG. 121

STEAM DUCTS

Note: Any Additions or Changes on This Sheet Must be Made or Circled in Red Ink With Date and Name of Person Making Change.

Do not extend notes this side of this line

RETURN TO
LOS ANGELES COUNTY SURVEYOR
700 HALL OF RECORDS

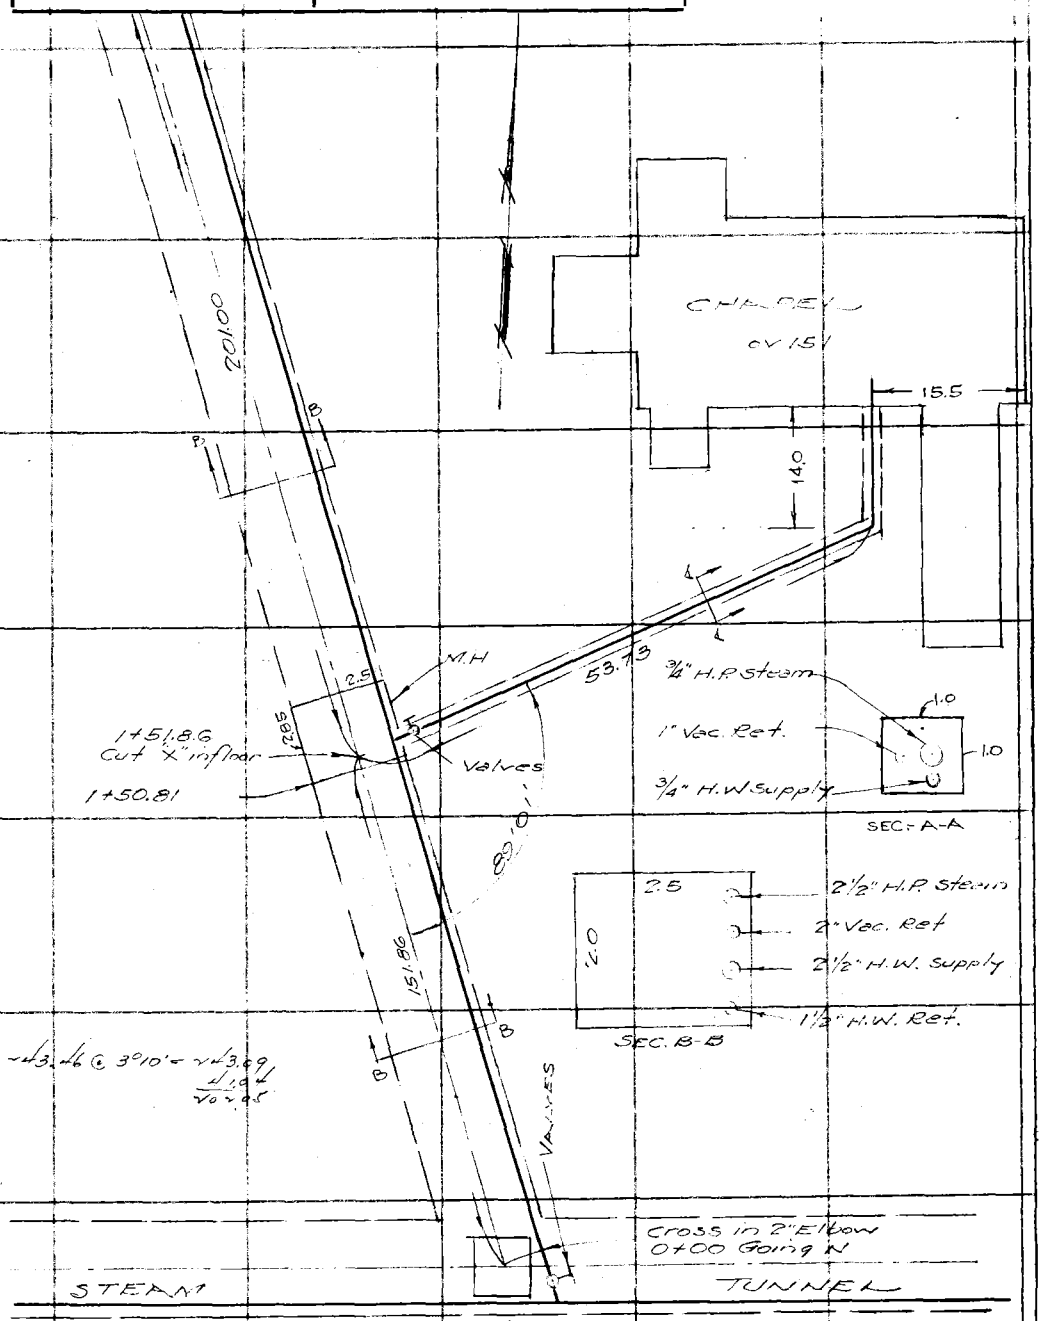

FORM 247 10M 11-35

RETURN TO
LOS ANGELES COUNTY SURVEYOR
700 HALL OF RECORDS

Note: Any Additions or Changes on This Sheet Must be Made or Circled in **Red Ink** With Date and Name of Person Making Change.

Do not extend notes this side of this line

F.B. 712 PG. 122

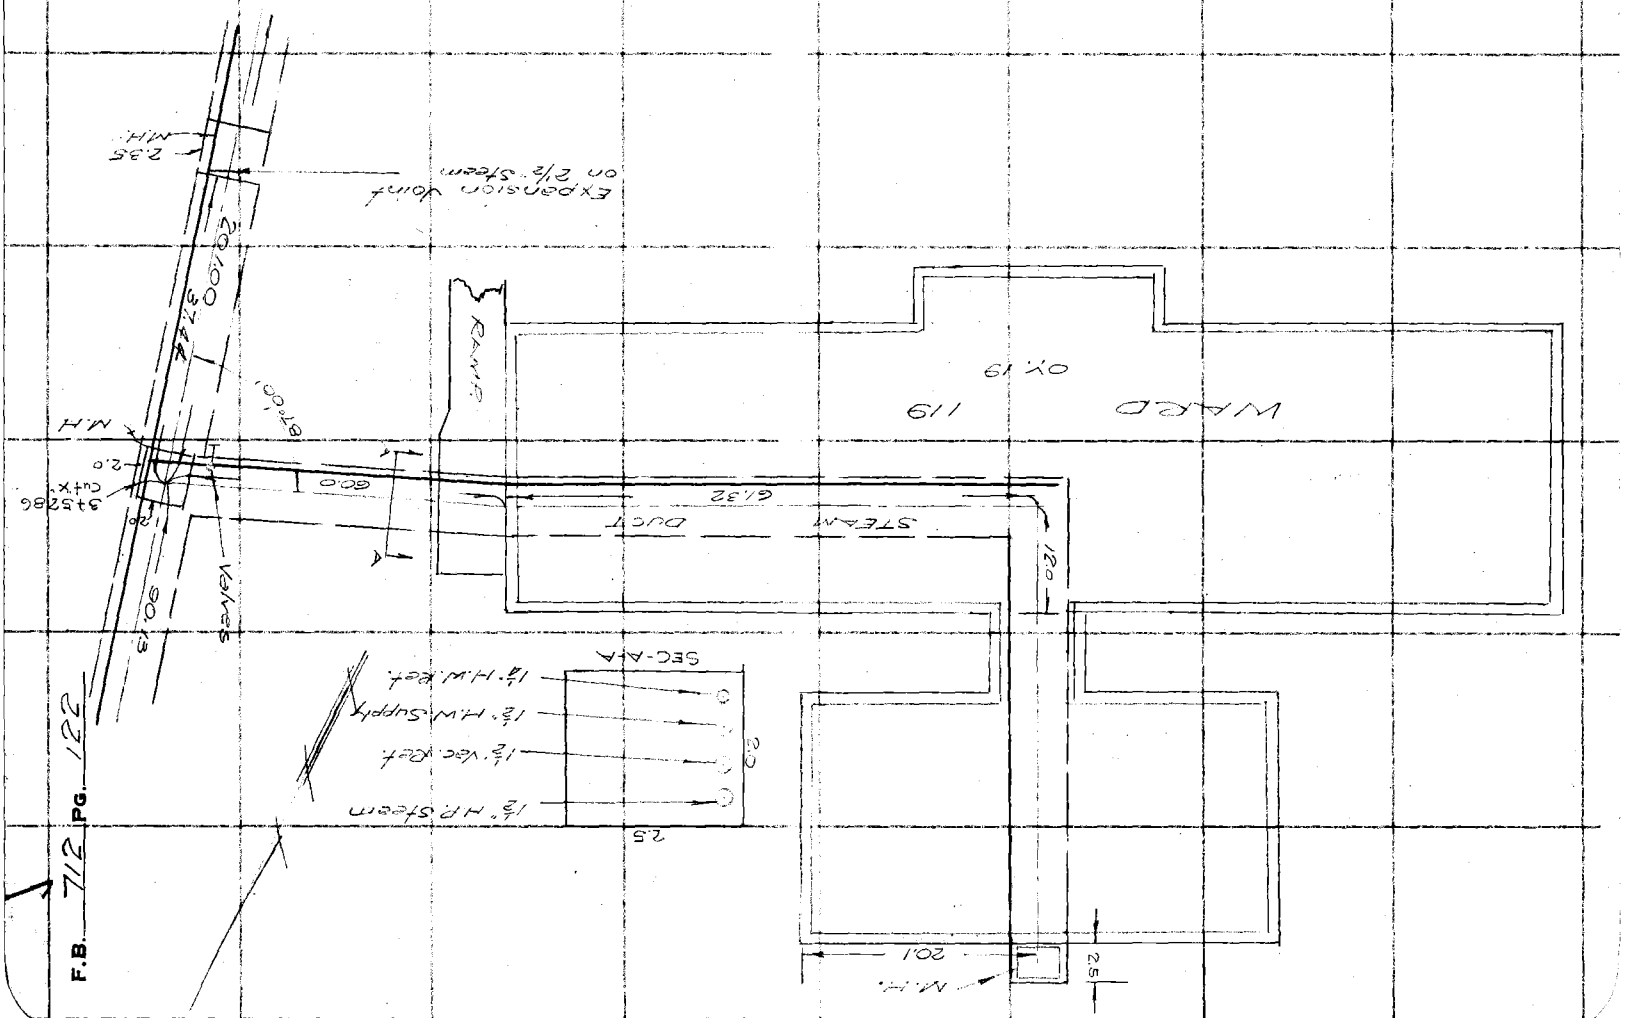

FORM 247 10M 11-35

RETURN TO
LOS ANGELES COUNTY SURVEYOR
700 HALL OF RECORDS

Note: Any Additions or Changes on This Sheet Must be Made or Circled in **Red Ink** With Date and Name of Person Making Change.

Do not extend notes this side of this line

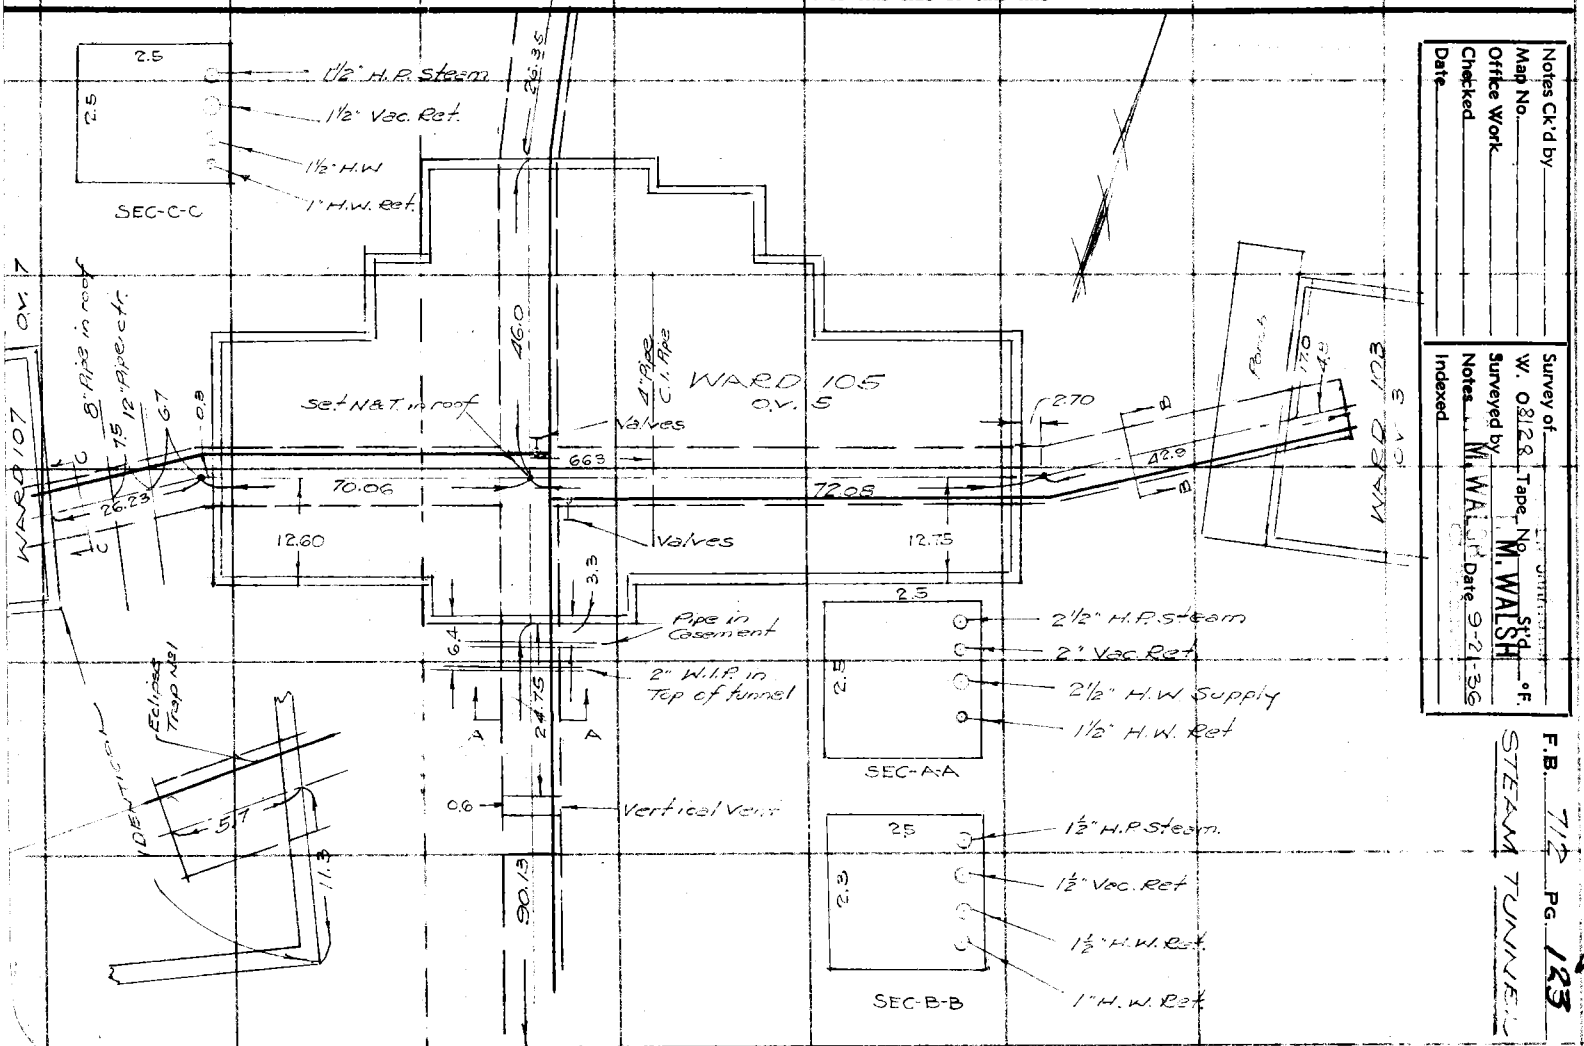

Notes Ck'd by
Map No.
Office Work
Checked
Date

Survey of W. O. 8128 Tape No.
Surveyed by M. WALSH Std'd °F.
Notes
Indexed

F.B. 712 PG. 123

STEAM TUNNEL

RETURN TO
LOS ANGELES COUNTY SURVEYOR
700 HALL OF RECORDS

Note: Any Additions or Changes on This Sheet Must be Made or Circled in **Red Ink** With Date and Name of Person Making Change.

Do not extend notes this side of this line

F.B. 712 PG. 124

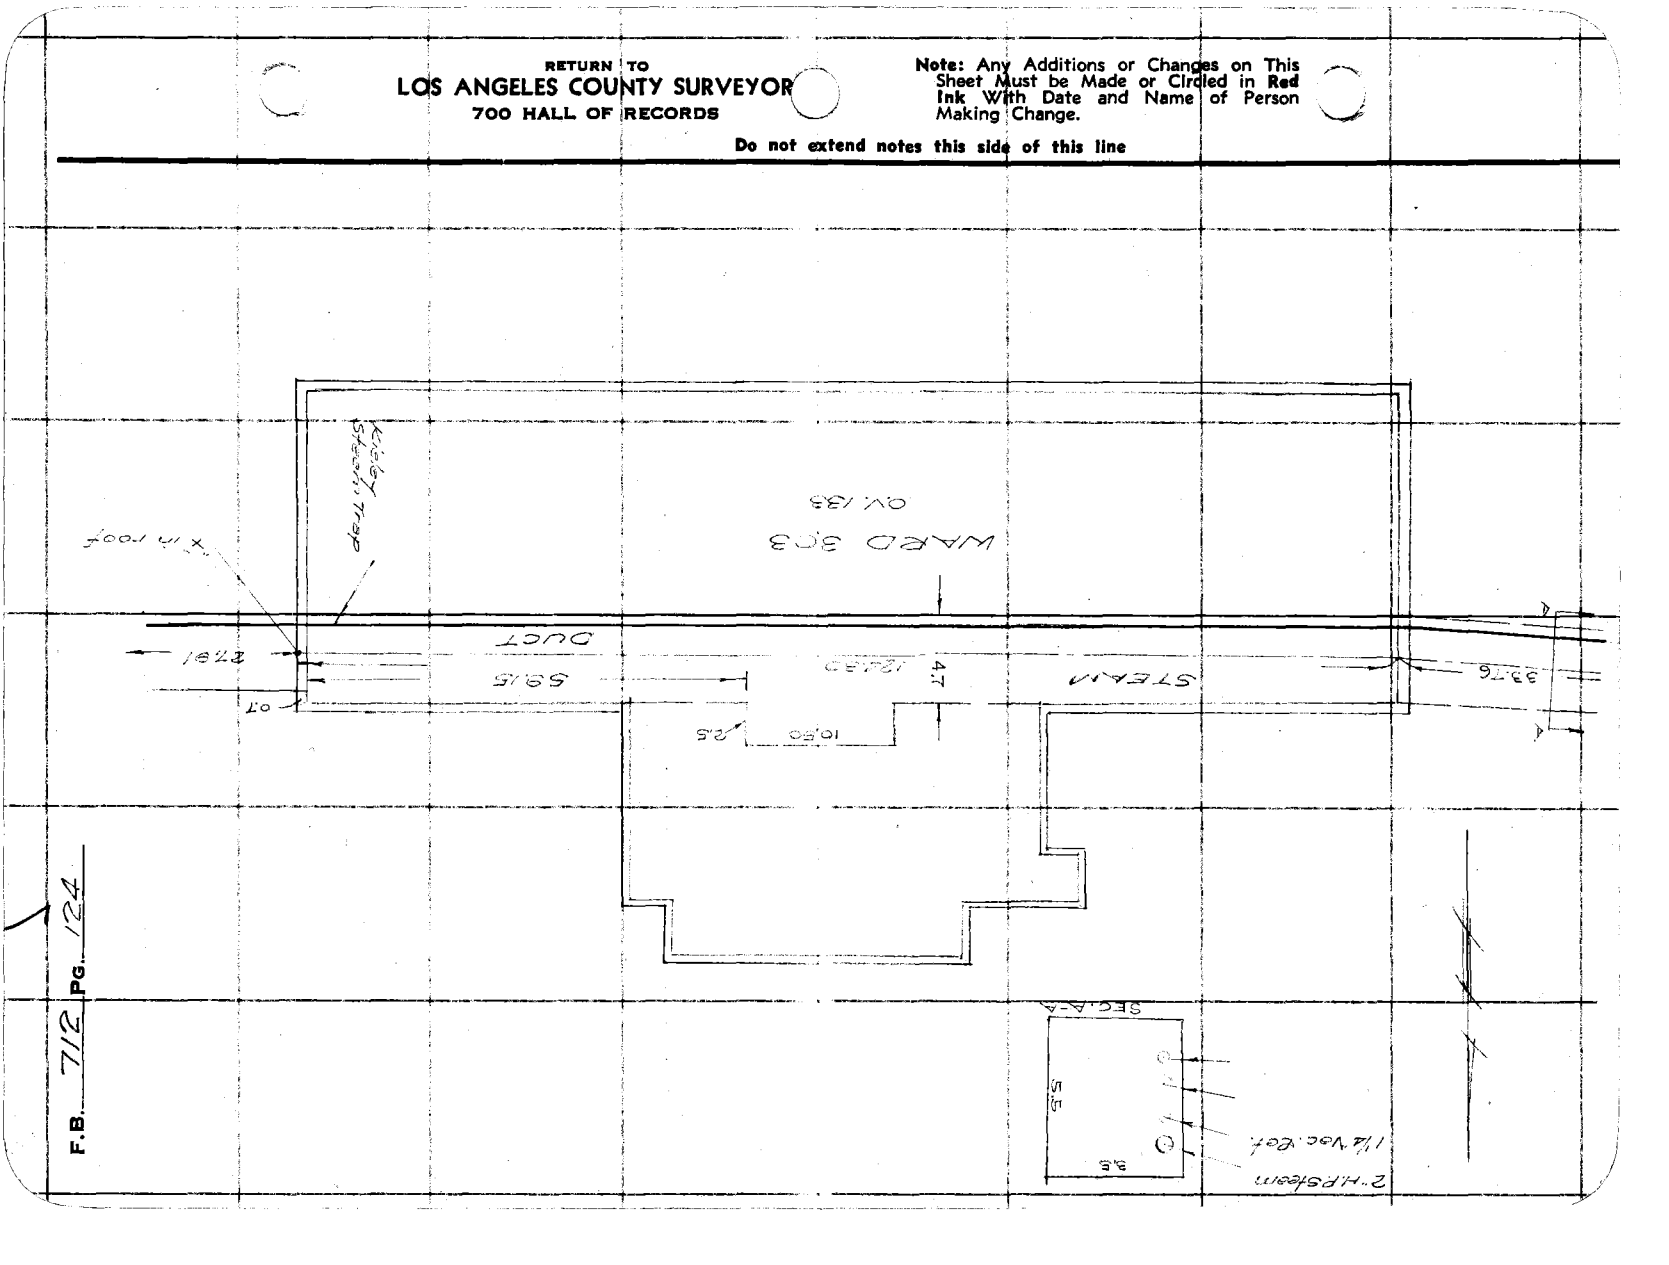

Notes Ck'd by	Survey of
Map No.	W. O. 8128 Tape No. St'd °F.
Office Work	Surveyed by T. M. WALSH
Checked	Notes T. M. WALSH Date 9-22-36
Date	Indexed A. C. Johnson

F.B. 712 PG. 125

STEAM TUNNEL

COTTAGE 1

COTTAGE 3

OV. 21

OV. 23

1+26.30 "X" in floor

Eclipse #1 Steam Trap

10.8

25.75

5.7

1+20.55

1+15.80

8" V.I.P. Pipe also 2" G.I.P.

Eclipse #1 Steam Trap.

0+89.05 Change in Depth of tunnel

A A

2.5

1.1 VENT

0+77.95

6" C.I. Water line

0+77.11

OLIVE VIEW AVE.

0+47.25

+3" Water line

2.5

2" H.P. Steam

1½" Vac. Ret.

2" H.W. Supply

1¼" " Ret.

2.3

B B

SEC-A-A

L.A. CITY

0+29.35

AQUEDUCT

8.5

0+28.55 Change Depth of tunnel

0+26.35

1.1 VENT

2.5

2.5

A A

26.35

0+00

14.75

4.3

2" H.P. Steam

1½" Vac. Ret.

2" H.W. Supply

1¼" " Ret.

SEC-B-B

WARD 105

OV 5

Note: Any Additions or Changes on This Sheet Must be Made or Circled in Red Ink With Date and Name of Person Making Change.

Do not extend notes this side of this line

RETURN TO
LOS ANGELES COUNTY SURVEYOR
700 HALL OF RECORDS

FORM 247 10M 11-36

RETURN TO
LOS ANGELES COUNTY SURVEYOR
700 HALL OF RECORDS

Note: Any Additions or Changes on This Sheet Must be Made or Circled in **Red Ink** With Date and Name of Person Making Change.

Do not extend notes this side of this line

F.B. 712 PG. 126

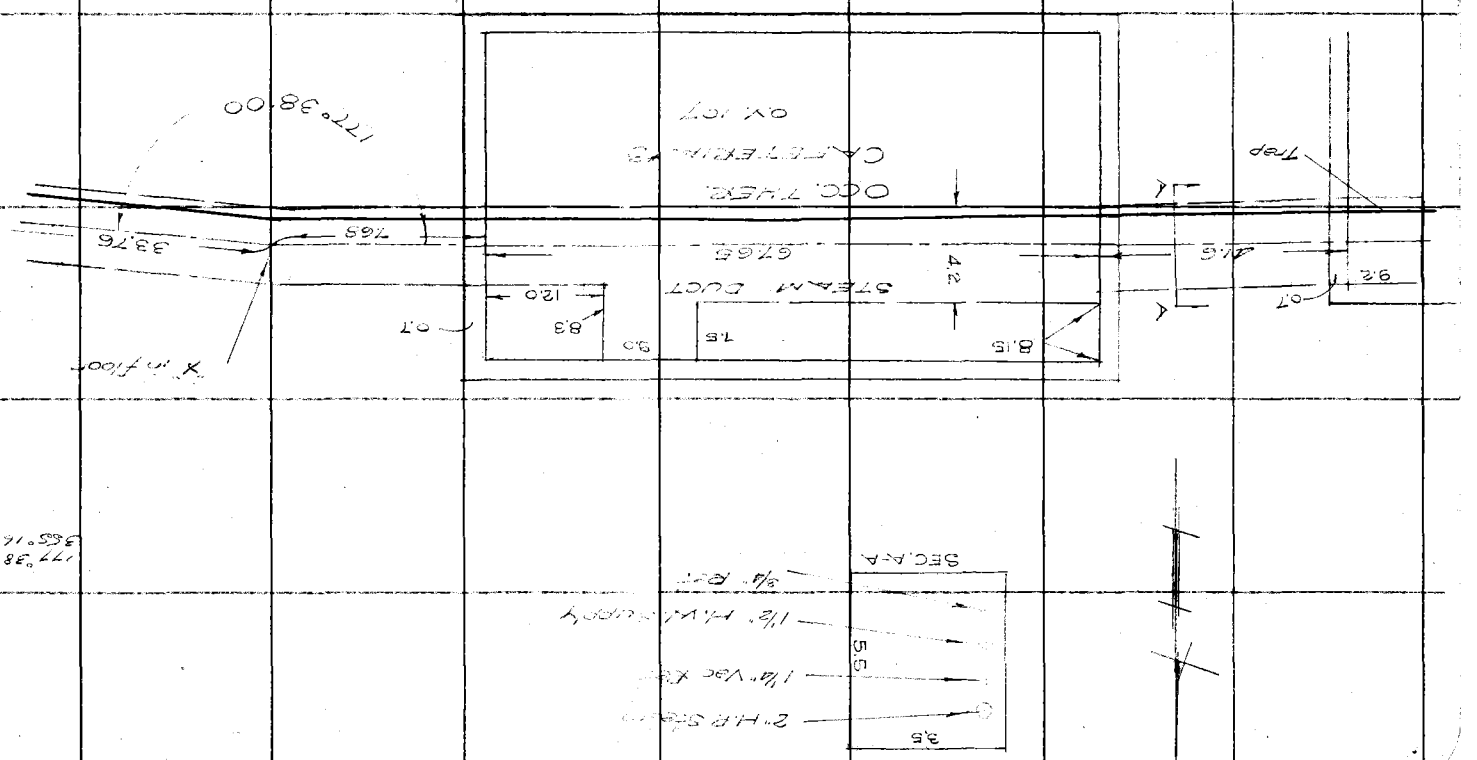

Notes Ck'd by	Survey of OLIVE VIEW SANATORIUM
Map No.	W. O. 8128 Tape No. St'd °F.
Office Work	Surveyed by M. WALSH
Checked	Notes M. WALSH Date 9-17-36
Date	Indexed A. C. Johnson

F.B. 712 PG. 127

STEAM DUCTS

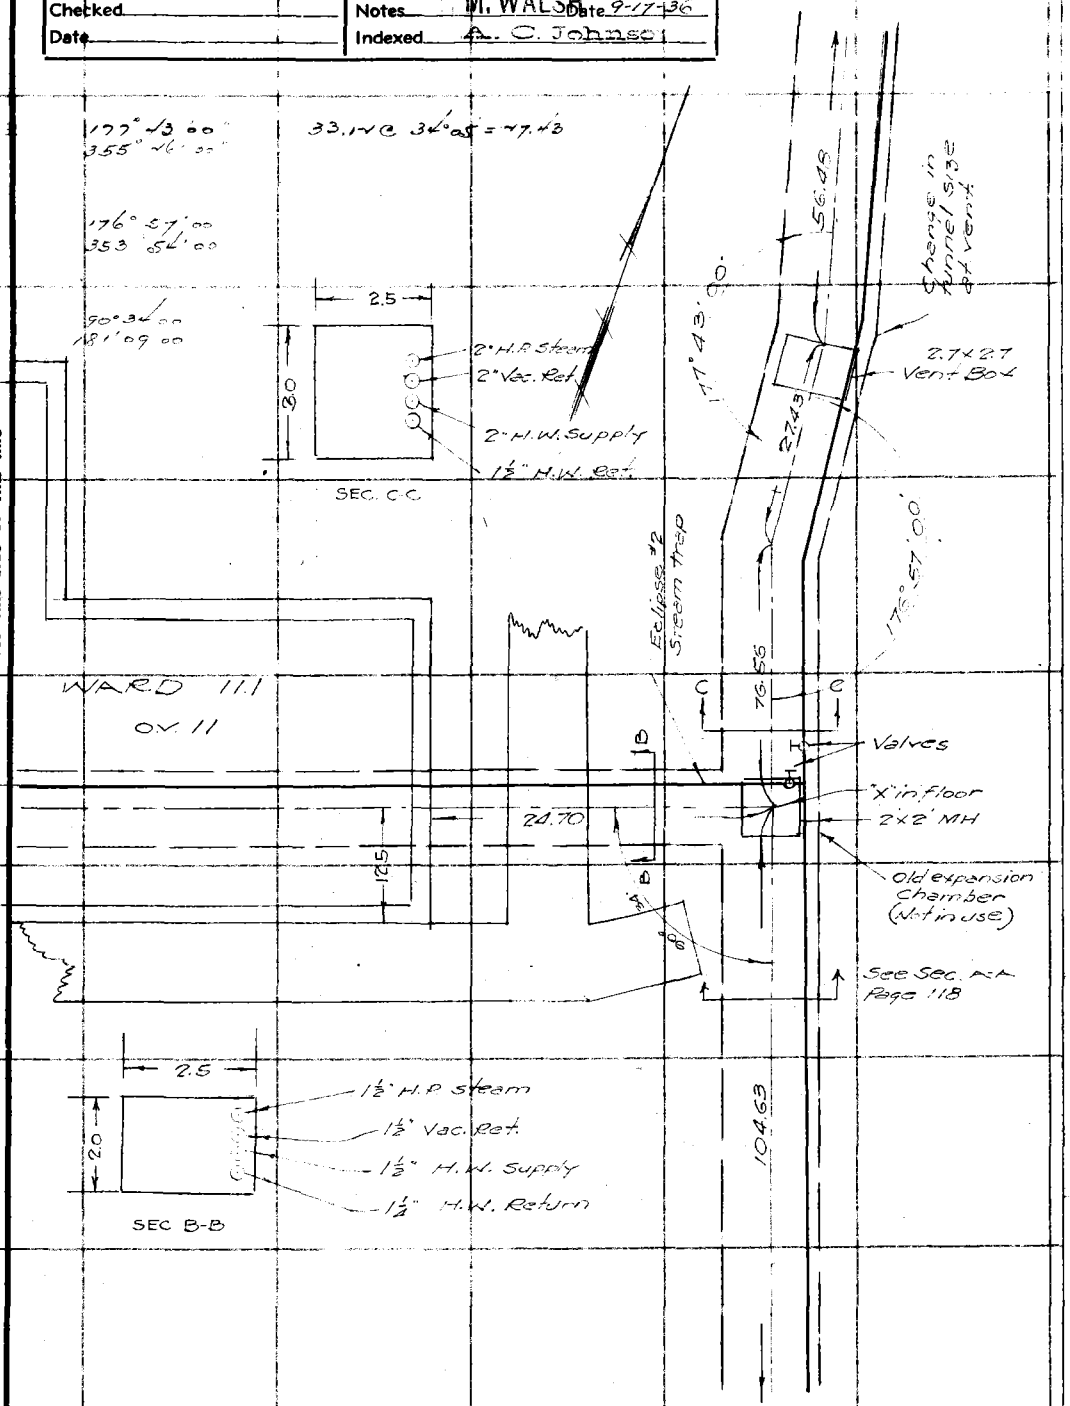

Note: Any Additions or Changes on This Sheet Must be Made or Circled in Red Ink With Date and Name of Person Making Change.

Do not extend notes this side of this line

RETURN TO
LOS ANGELES COUNTY SURVEYOR
700 HALL OF RECORDS

FORM 247 10M 11-35

F.B. 712 PG. 128

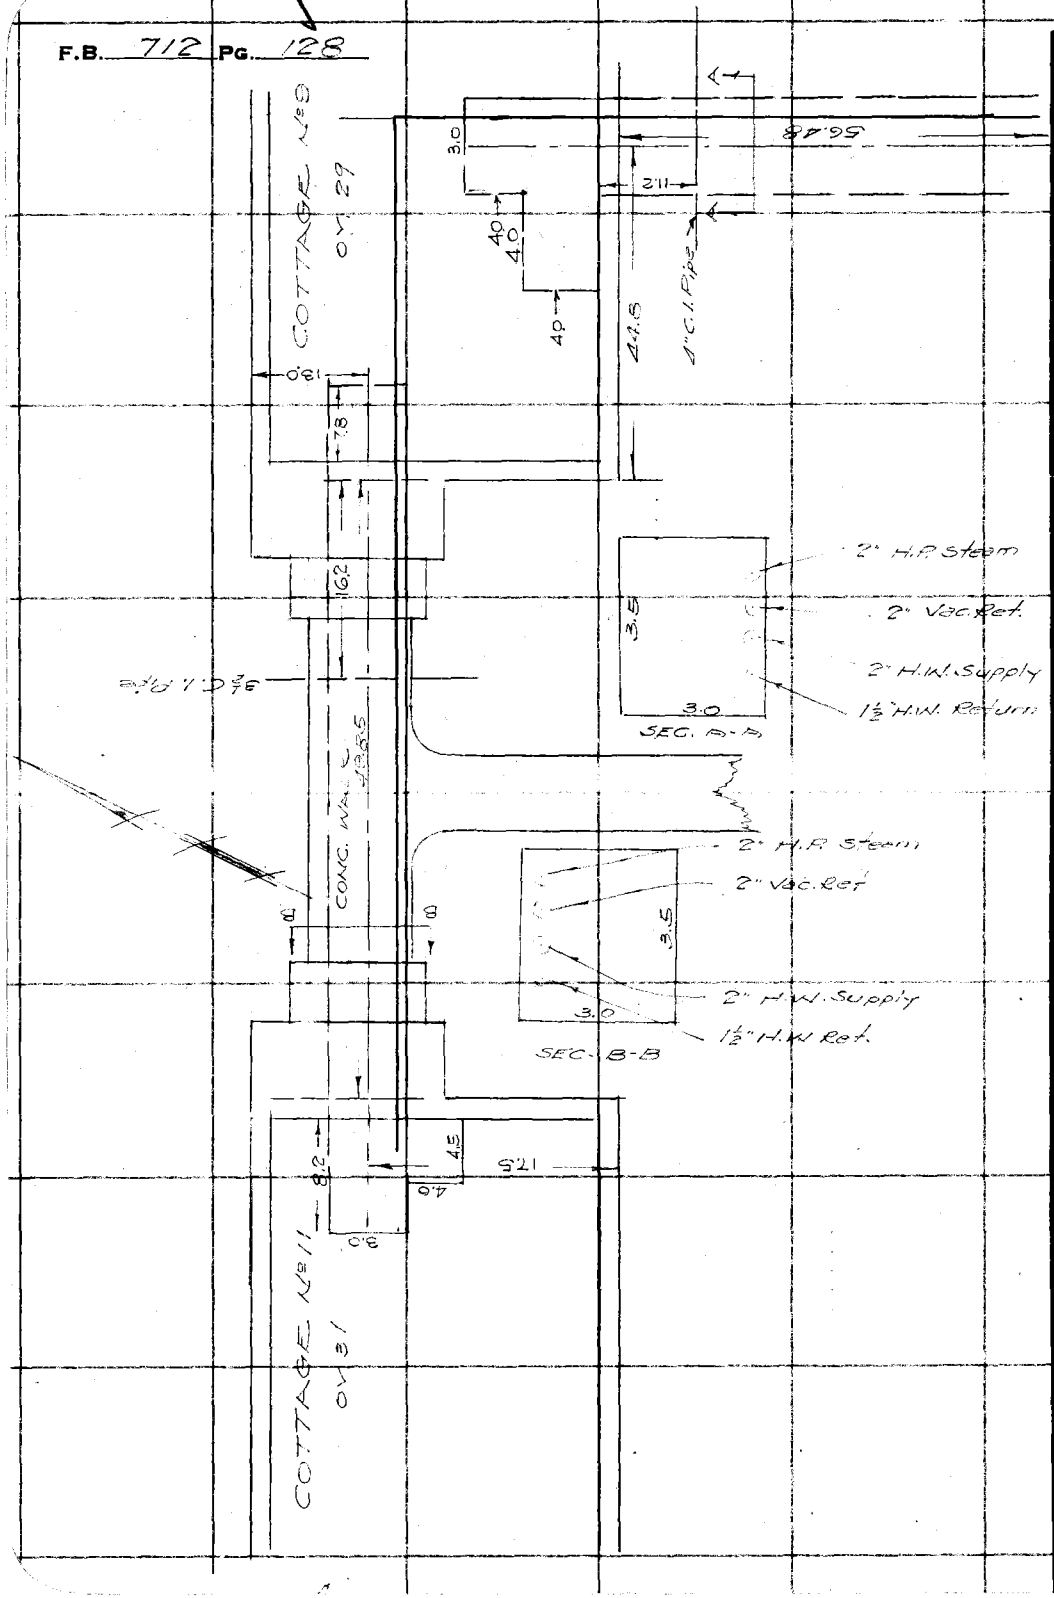

RETURN TO
LOS ANGELES COUNTY SURVEYOR
700 HALL OF RECORDS

Note: Any Additions or Changes on This Sheet Must be Made or Circled in Red Ink With Date and Name of Person Making Change.

Do not extend notes this side of this line

FORM 247 10M 11-35

RETURN TO
LOS ANGELES COUNTY SURVEYOR
700 HALL OF RECORDS

Note: Any Additions or Changes on This Sheet Must be Made or Circled in **Red Ink** With Date and Name of Person Making Change.

Do not extend notes this side of this line

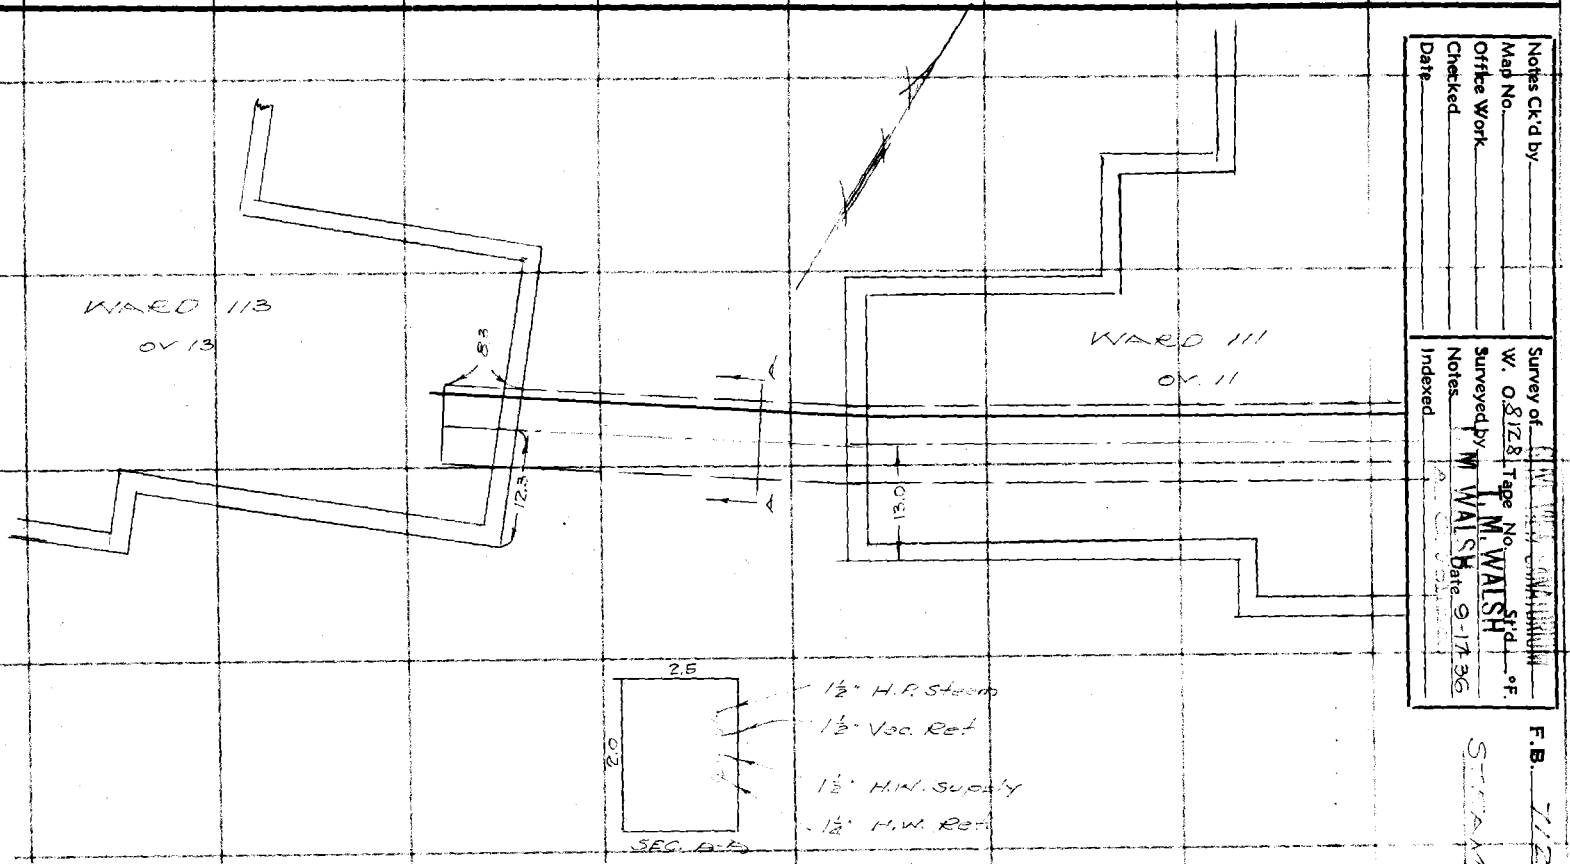

Notes Ck'd by _____
Map No. _____
Office Work _____
Checked _____
Date _____

Survey of W. O. 8128 Tape No. _____ Std. _____ °F.
Surveyed by M. M. WALSH Date 9-17-36
Notes _____
Indexed _____

F.B. 212 PG. 129

STEAM DUCTS

RETURN TO
LOS ANGELES COUNTY SURVEYOR
700 HALL OF RECORDS

Note: Any Additions or Changes on This Sheet Must be Made or Circled in **Red Ink** With Date and Name of Person Making Change.

Do not extend notes this side of this line

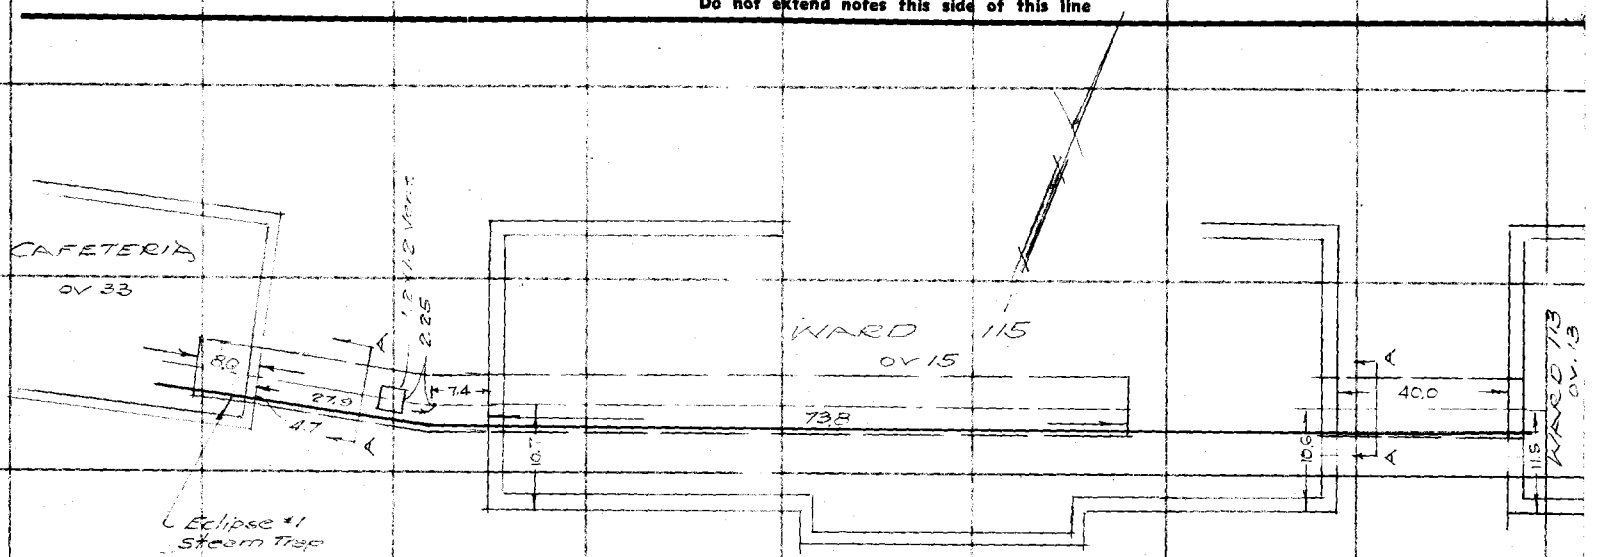

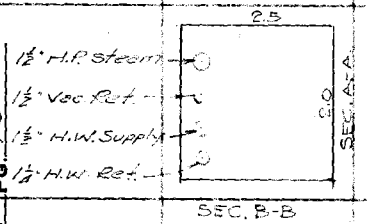

F.B. 712 PG. 130

FORM 247 10M 11-38

RETURN TO
LOS ANGELES COUNTY SURVEYOR
700 HALL OF RECORDS

Note: Any Additions or Changes on This Sheet Must be Made or Circled in **Red Ink** With Date and Name of Person Making Change.

Do not extend notes this side of this line

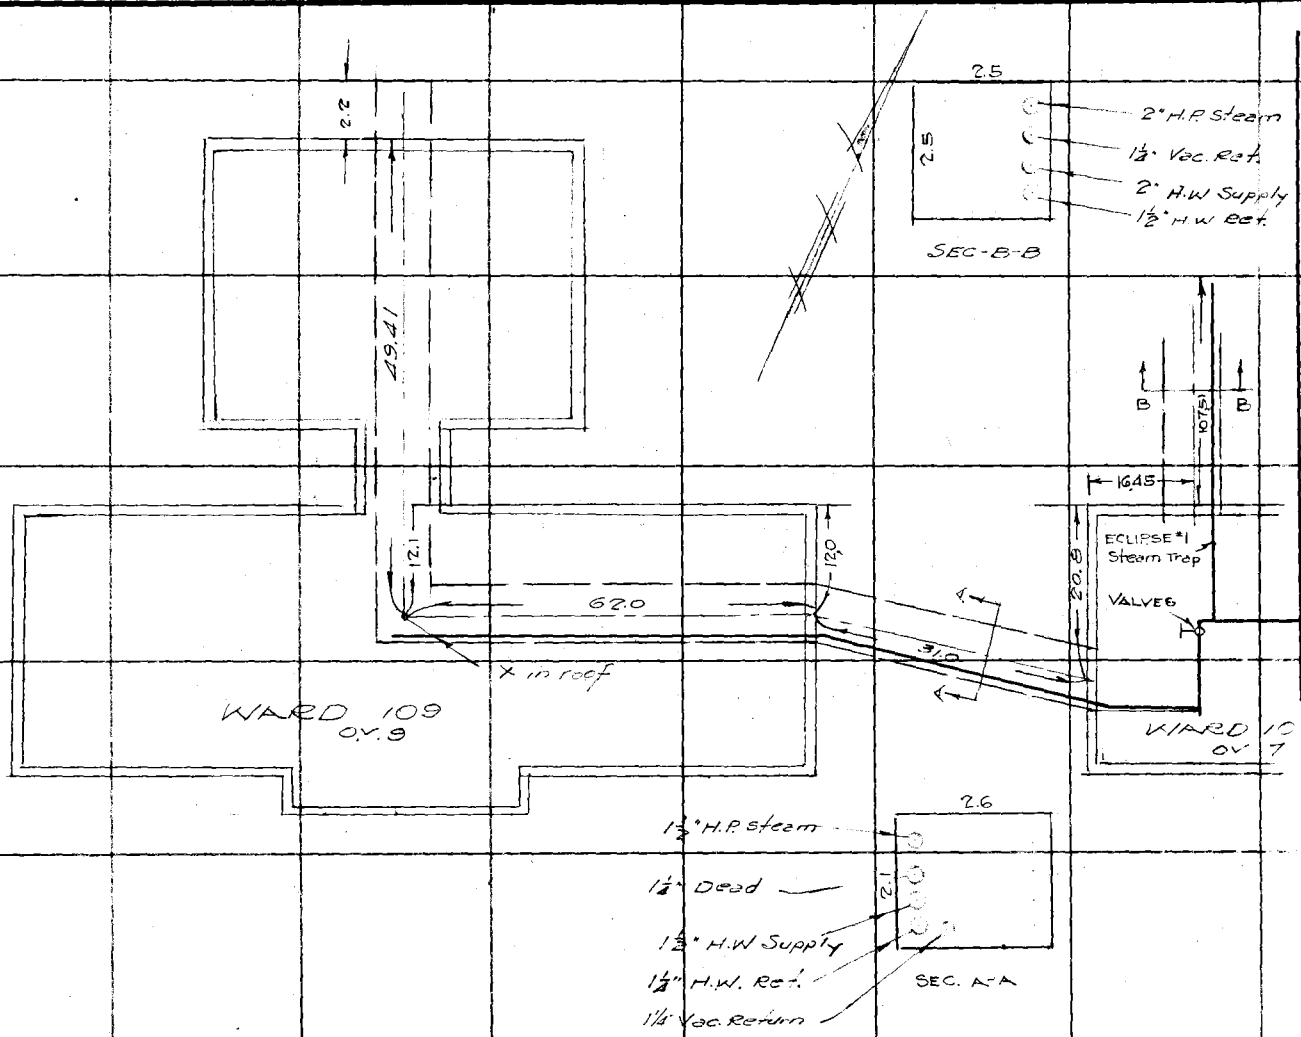

Notes Ck'd by _____
Map No. _____
Office Work _____
Checked _____
Date _____

Survey of W. O. 8128
Surveyed by T. M. WALSH
Notes T. M. WALSH Date 9-21-36
Indexed A. C. Johnes

Tape No. _____ St'd _____ °F.

F.B. 712 Pg. 137

STEAM TUNNEL

F.B. 712 Pg. 132

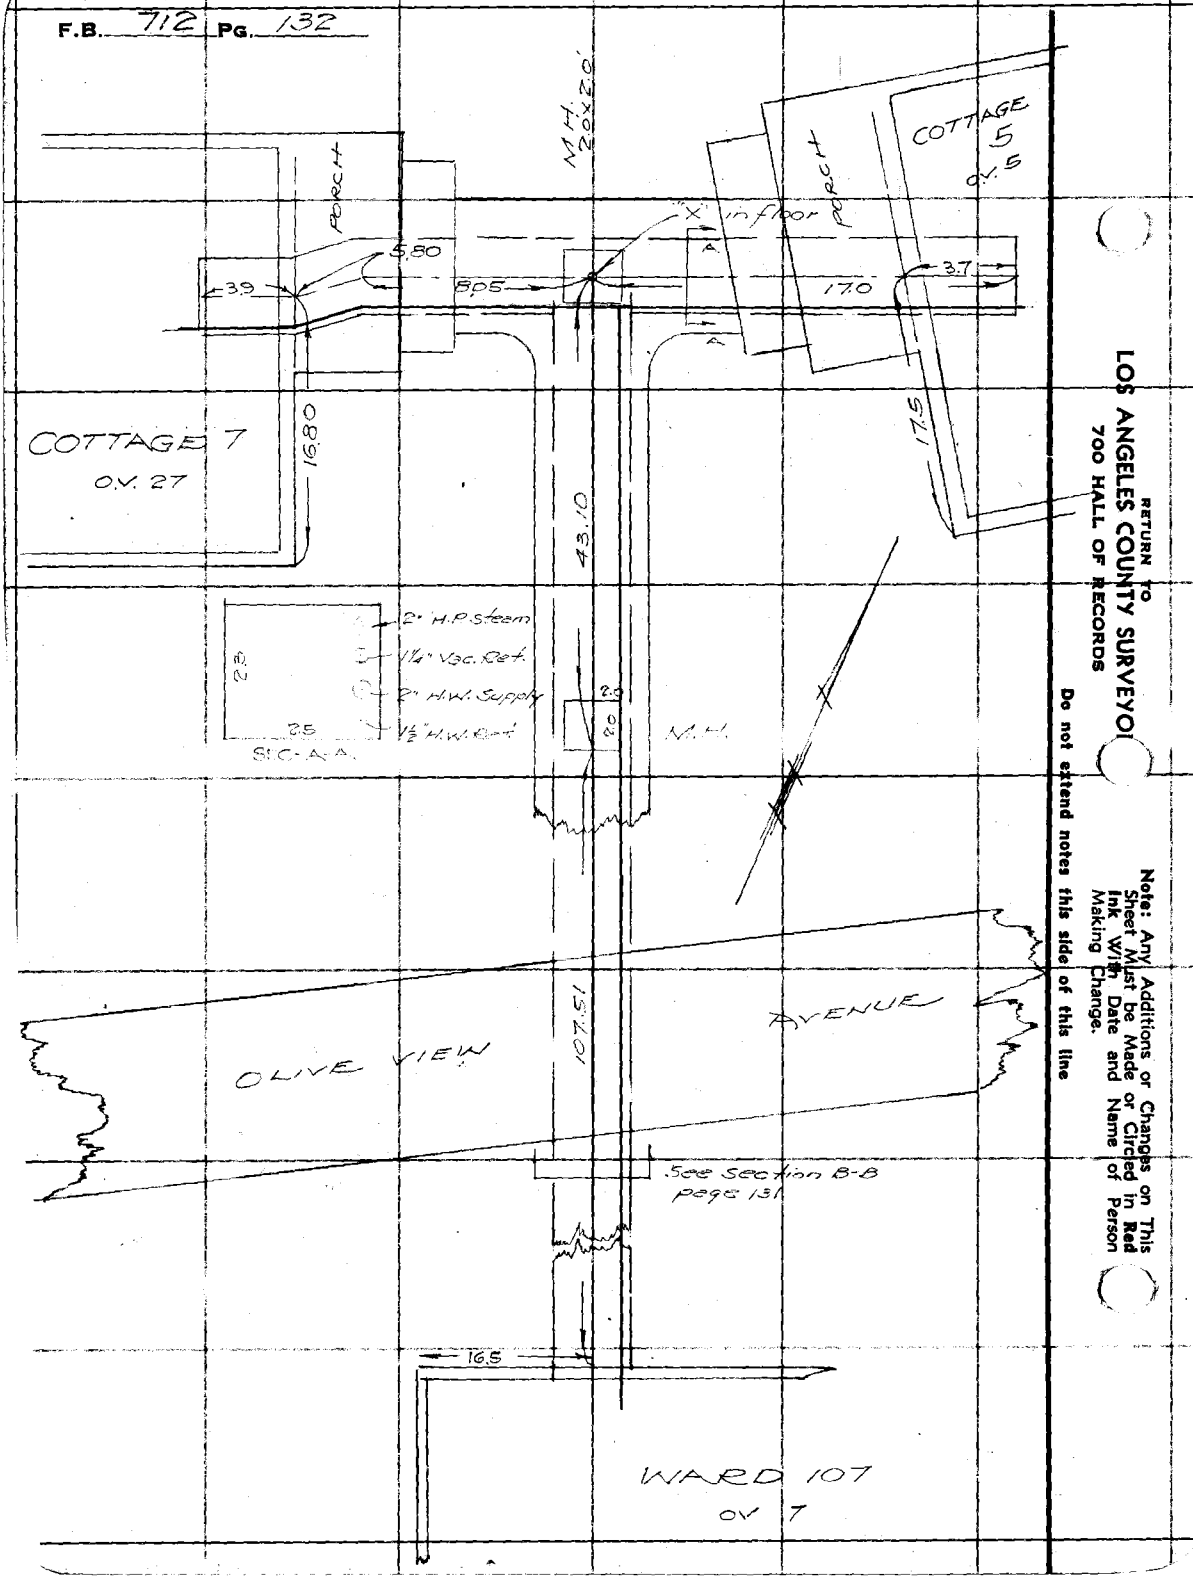

RETURN TO
LOS ANGELES COUNTY SURVEYOR
700 HALL OF RECORDS

Note: Any Additions or Changes on This Sheet Must be Made or Circled in Red Ink With Date and Name of Person Making Change.

Do not extend notes this side of this line

Notes Ck'd by	Survey of
Map No.	W. O. 8128 Tape No. St'd °F.
Office Work	Surveyed by T. M. WALSH
Checked	Notes Walsh Date 9-22-31
Date	Indexed A. C. Jones

F.B. 712 Pg. 133

STEAM TUNNEL

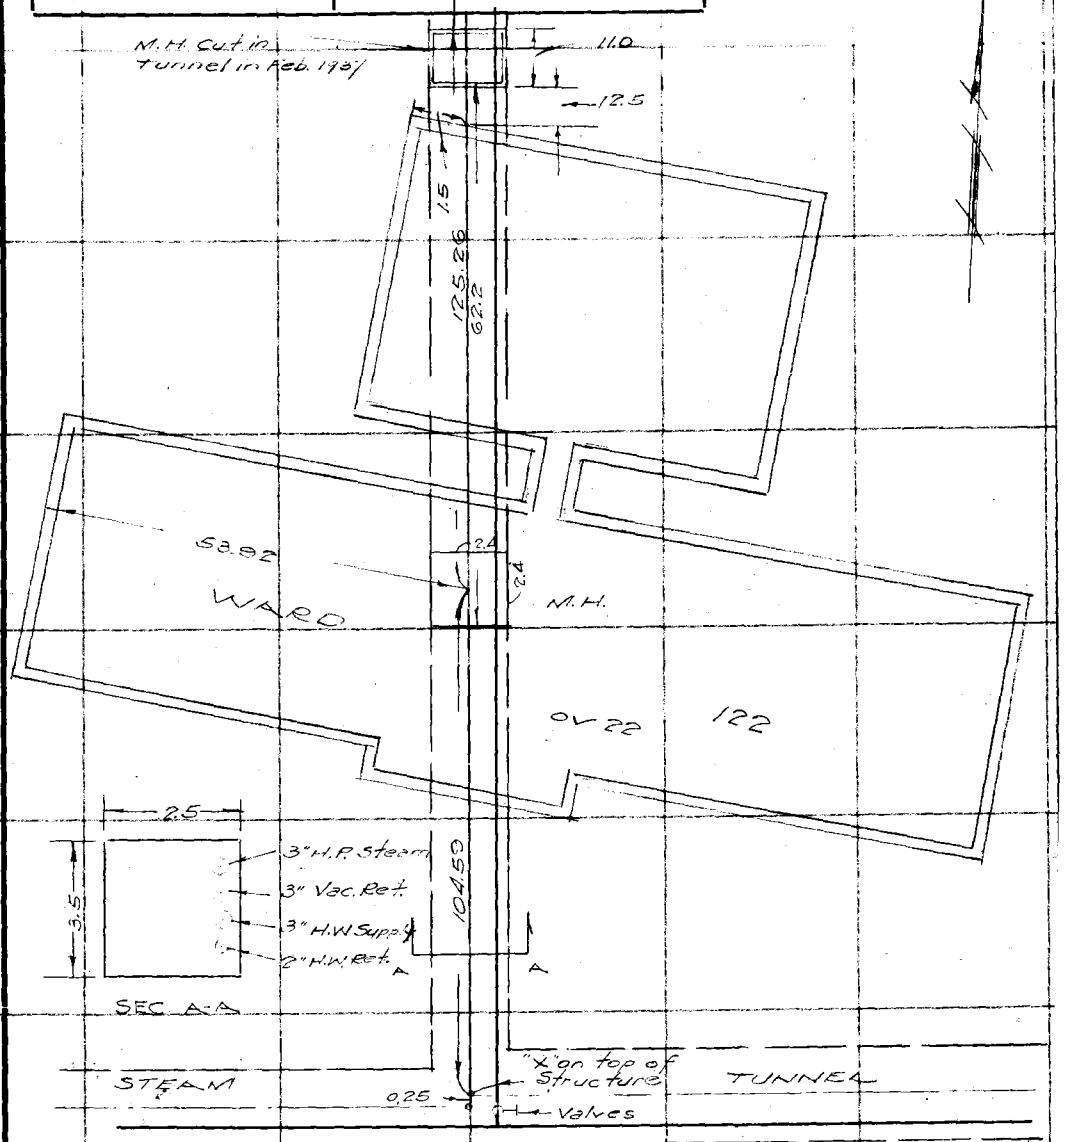

Note: Any Additions or Changes on This Sheet Must be Made or Circled in Red Ink With Date and Name of Person Making Change

Do not extend notes this side of this line

RETURN TO
LOS ANGELES COUNTY SURVEYOR
700 HALL OF RECORDS

FORM 247 10M 11-35

F.B. 712 Pg. 134

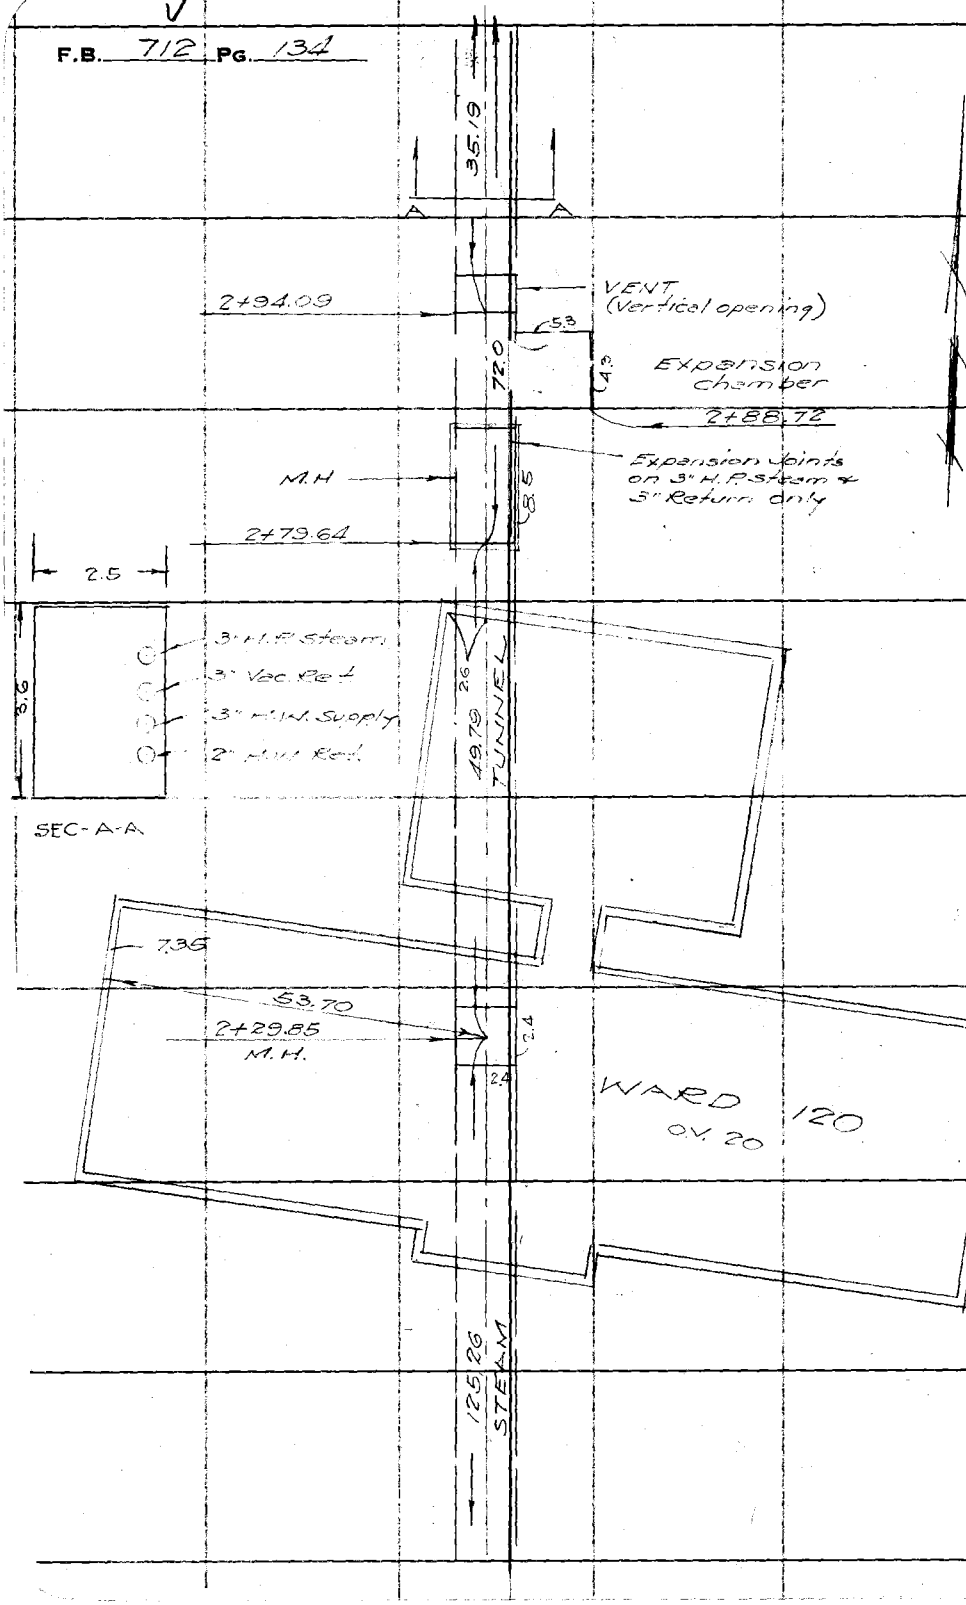

RETURN TO
LOS ANGELES COUNTY SURVEYOR
700 HALL OF RECORDS

Do not extend notes this side of this line

Note: Any Additions or Changes on This Sheet Must be Made or Circled in Red Ink With Date and Name of Person Making Change.

Notes Ck'd by	Survey of OLIVE VIEW SANATORIUM
Map No.	W. O. 8128 Tape No. St'd °F.
Office Work	Surveyed by T. M. WALSH
Checked	Notes M. WALSH Date 9-23-36
Date	Indexed A. C. Johnson

F.B. 712 PG. 135

STEAM TUNNELS

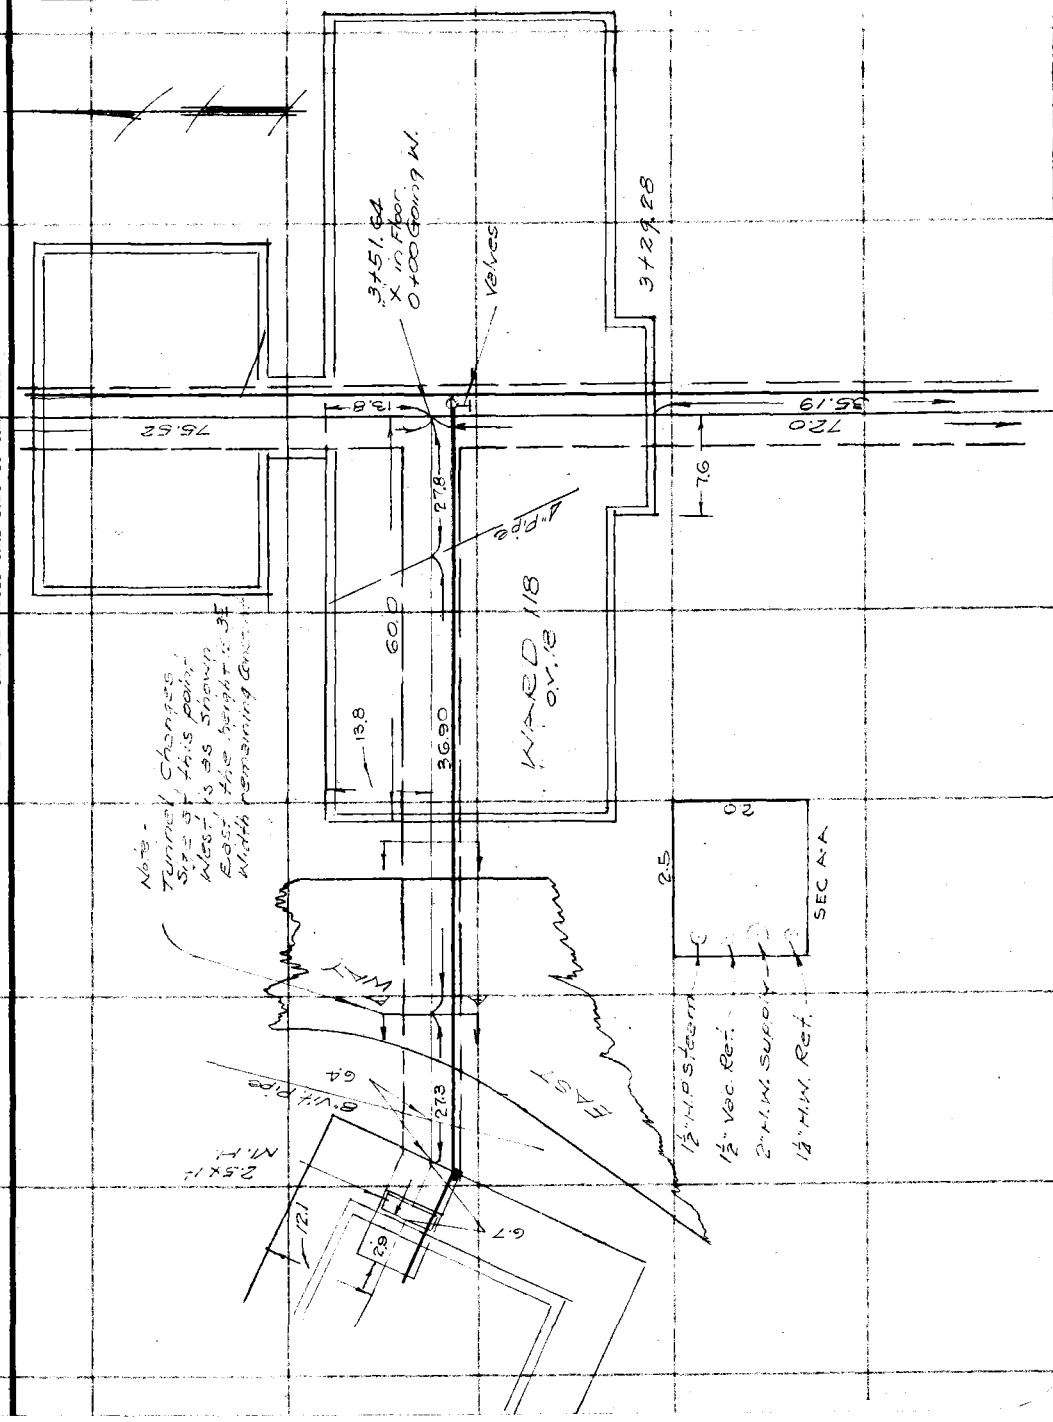

Note: Any Additions or Changes on This Sheet Must be Made or Circled in Red Ink With Date and Name of Person Making Change.

Do not extend notes this side of this line

RETURN TO
LOS ANGELES COUNTY SURVEYOR
700 HALL OF RECORDS

FORM 247 10M 11-35

RETURN TO
LOS ANGELES COUNTY SURVEYOR
700 HALL OF RECORDS

Note: Any Additions or Changes on This Sheet Must be Made or Circled in **Red Ink** With Date and Name of Person Making Change.

Do not extend notes this side of this line

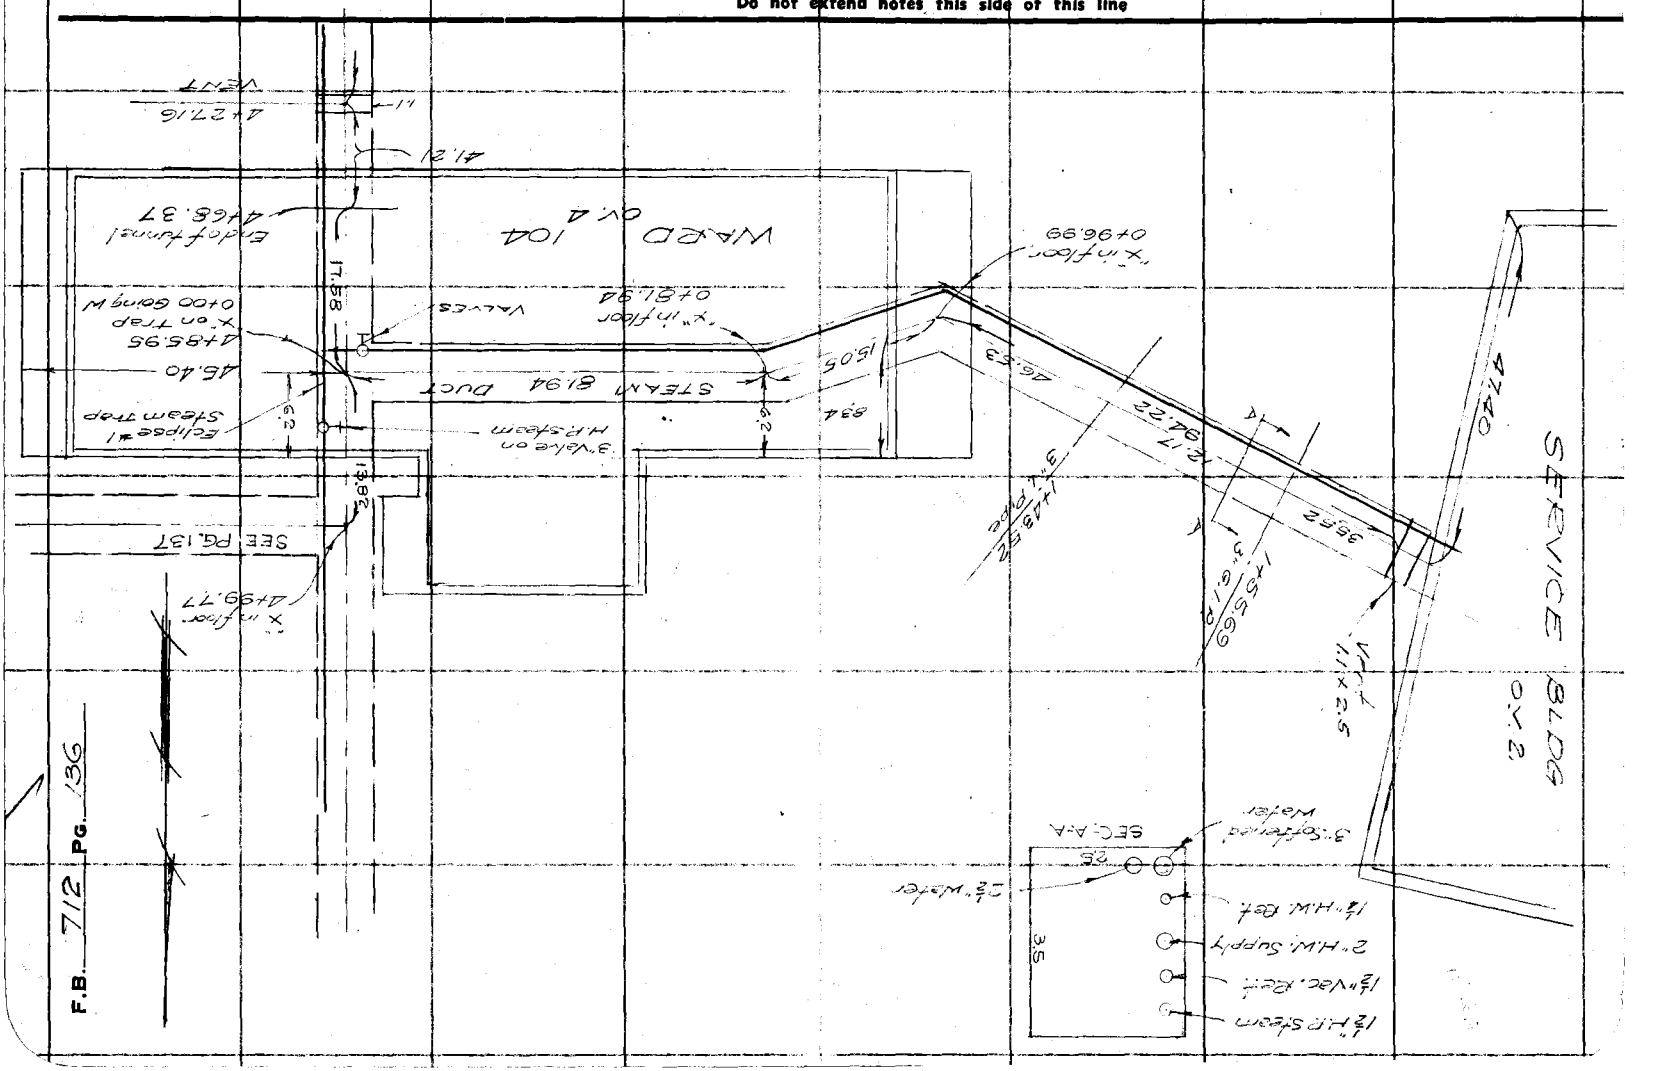

Notes Ck'd by	Survey of OLIVE VIEW SANATORIUM	F.B. 712 Pg. 137
Map No.	W. O. 8128 Tape No. St'd °F.	STEAM TUNNEL
Office Work	Surveyed by T. M. WALSH	
Checked	Notes T. M. WALSH Date 9-24-36	
Date	Indexed A. C. Johnson	

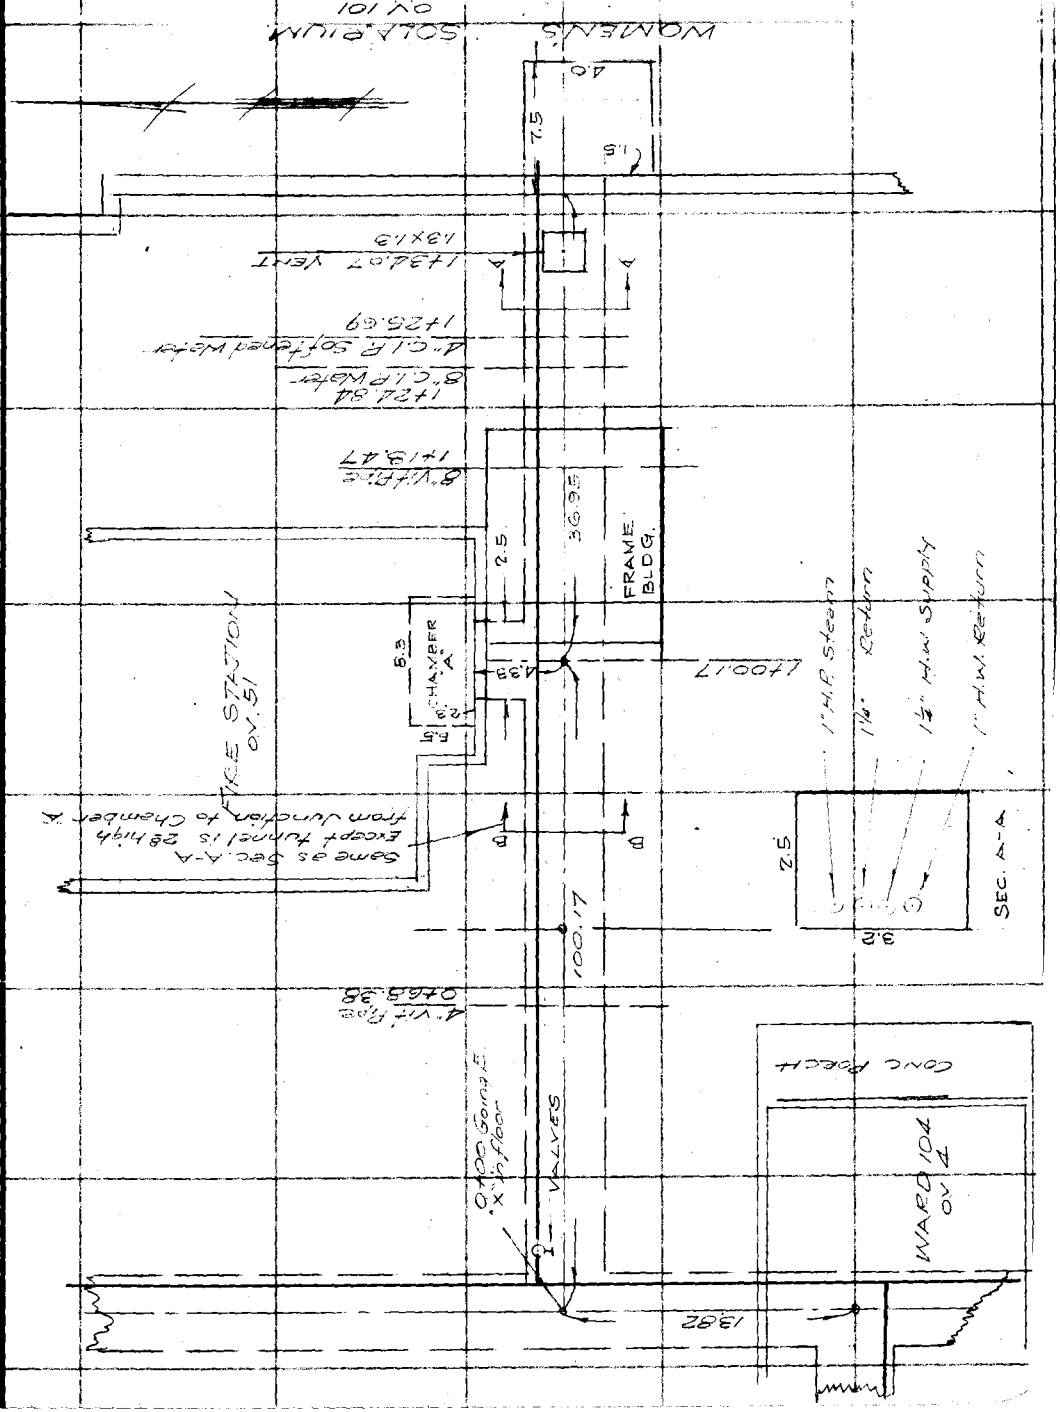

Note: Any Additions or Changes on This Sheet Must be Made or Circled in Red Ink With Date and Name of Person Making Change.

Do not extend notes this side of this line

RETURN TO
LOS ANGELES COUNTY SURVEYOR
700 HALL OF RECORDS

FORM 247 10M 11-35

F.B. 712 Pg. 138

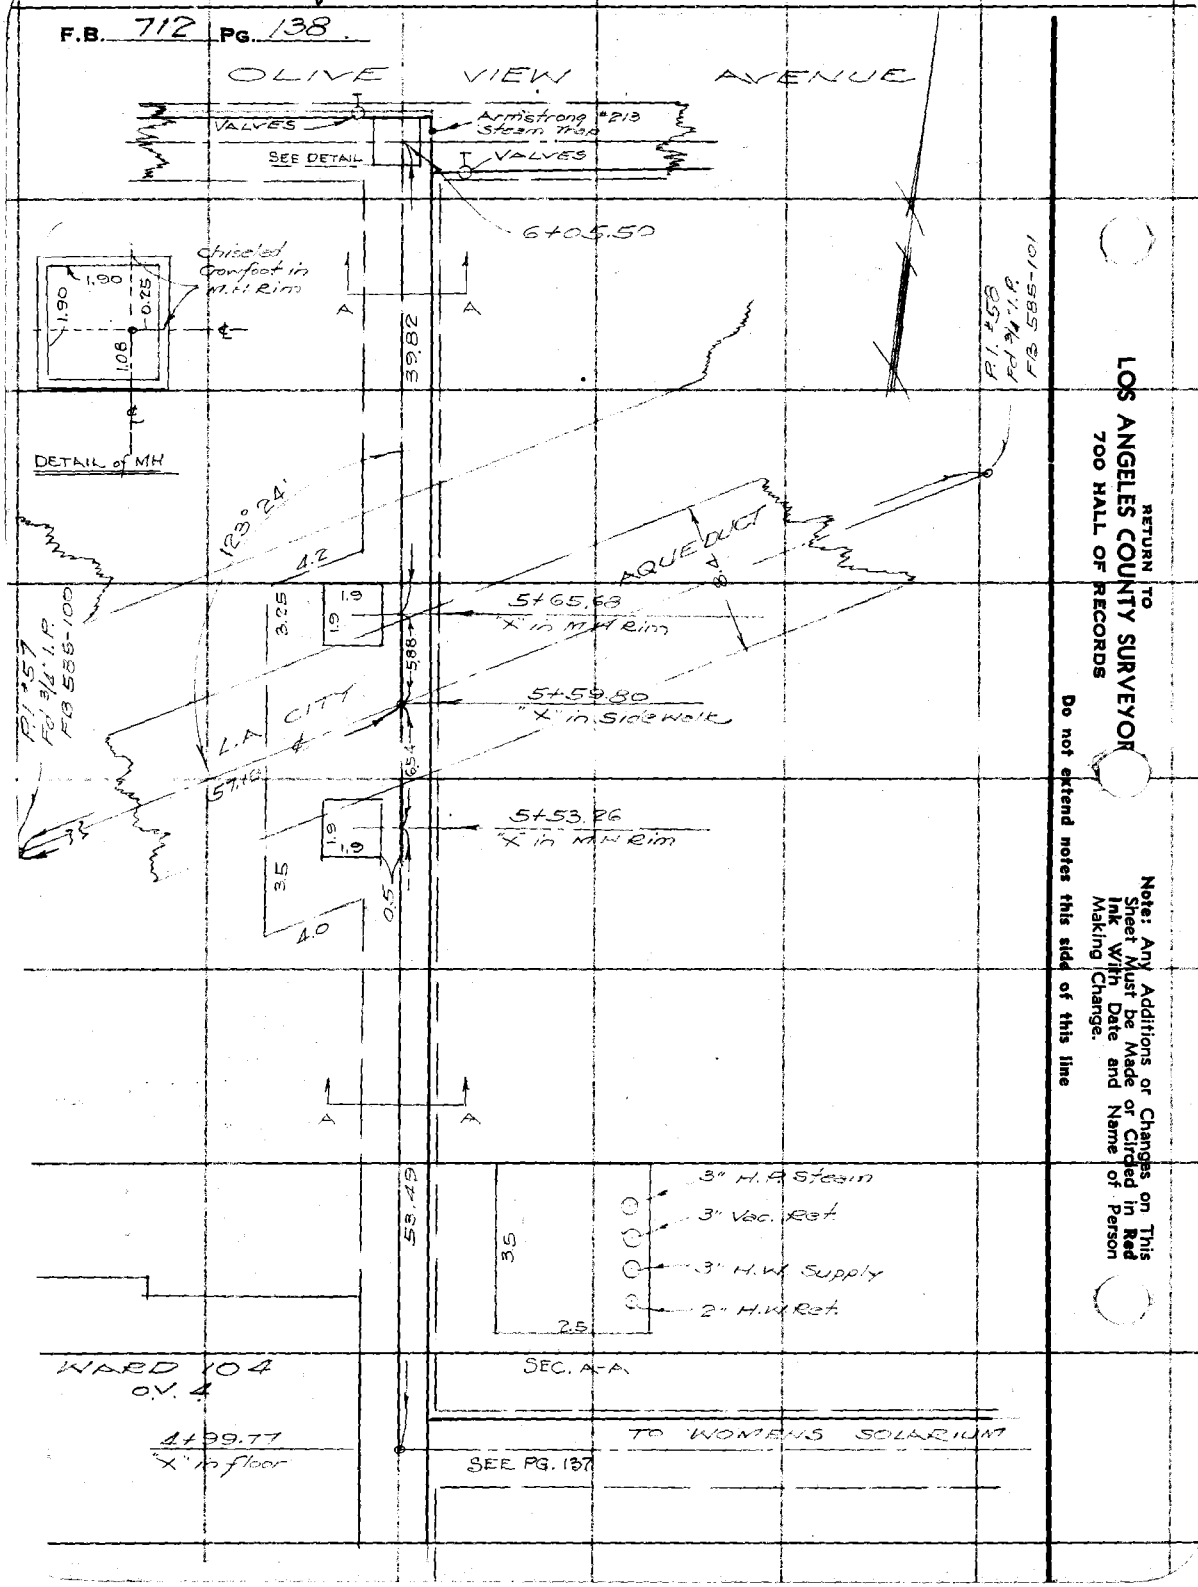

RETURN TO
LOS ANGELES COUNTY SURVEYOR
700 HALL OF RECORDS

Note: Any Additions or Changes on This Sheet Must be Made or Circled in Red Ink With Date and Name of Person Making Change.

Do not extend notes this side of this line

FORM 247 10M 11-38

RETURN TO
LOS ANGELES COUNTY SURVEYOR
700 HALL OF RECORDS

Note: Any Additions or Changes on This Sheet Must be Made or Circled in **Red Ink** With Date and Name of Person Making Change.

Do not extend notes this side of this line

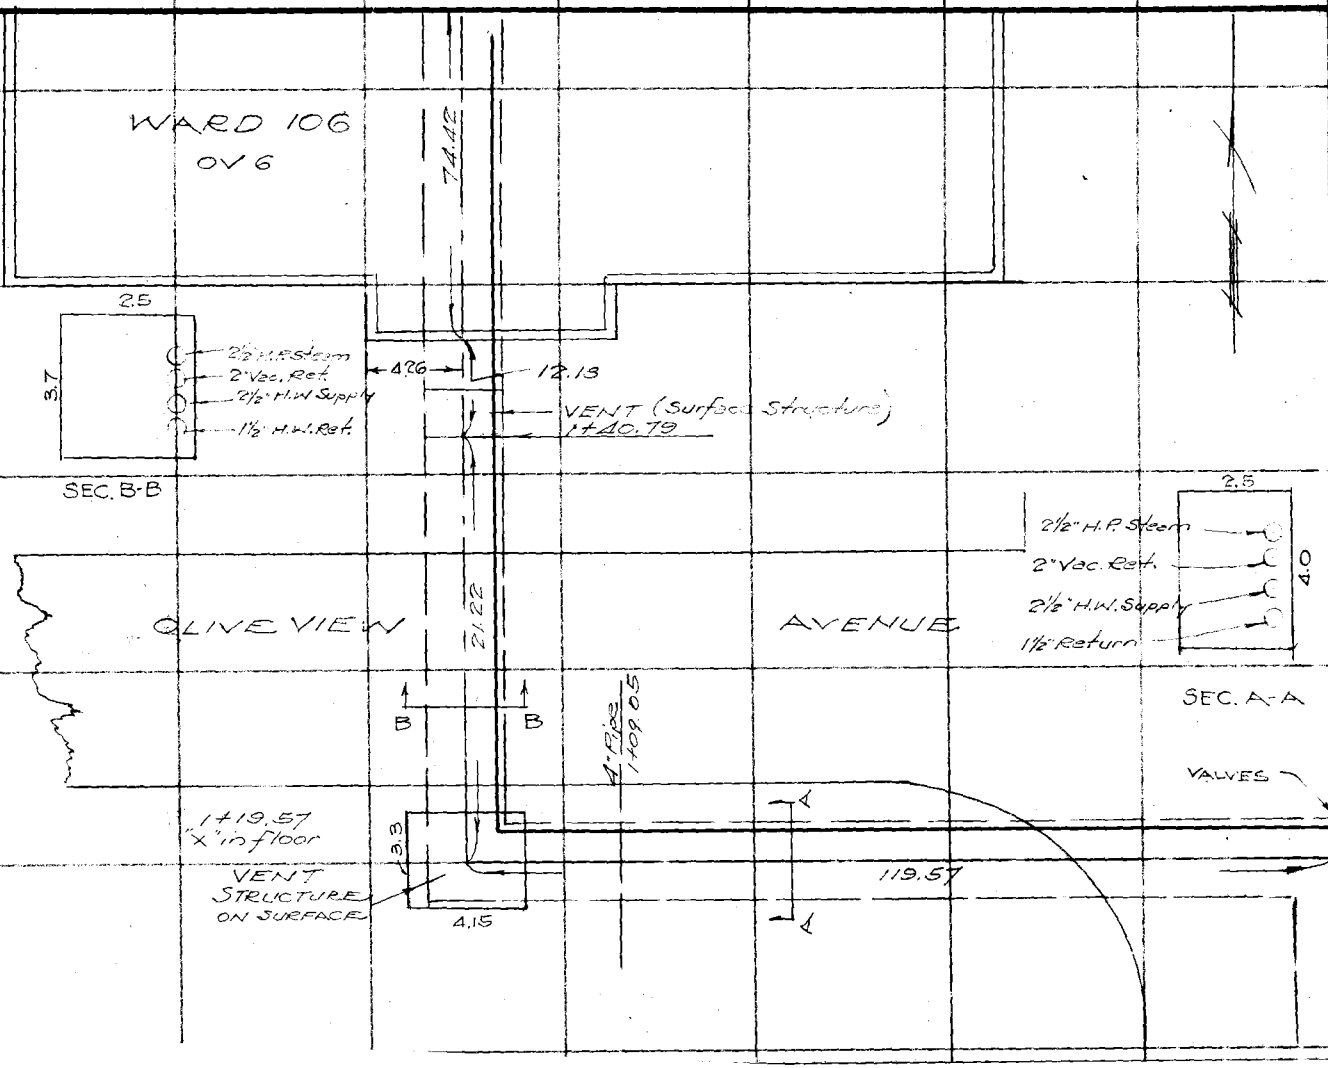

Notes Ck'd by _____
Map No. _____
Offide Work _____
Checked _____
Date _____

Survey of _____
W. O. 8128 Tape No. _____ Std'd _____ °F.
Surveyed by J. M. WALSH
Notes J. M. WALSH Date 9-3rd-38
Indexed A. C. Jacobsen

F.B. 712 PG. 199

STEAM TUNNEL

RETURN TO
LOS ANGELES COUNTY SURVEYOR
700 HALL OF RECORDS

Note: Any Additions or Changes on This Sheet Must be Made or Circled in **Red Ink** With Date and Name of Person Making Change.

Do not extend notes this side of this line

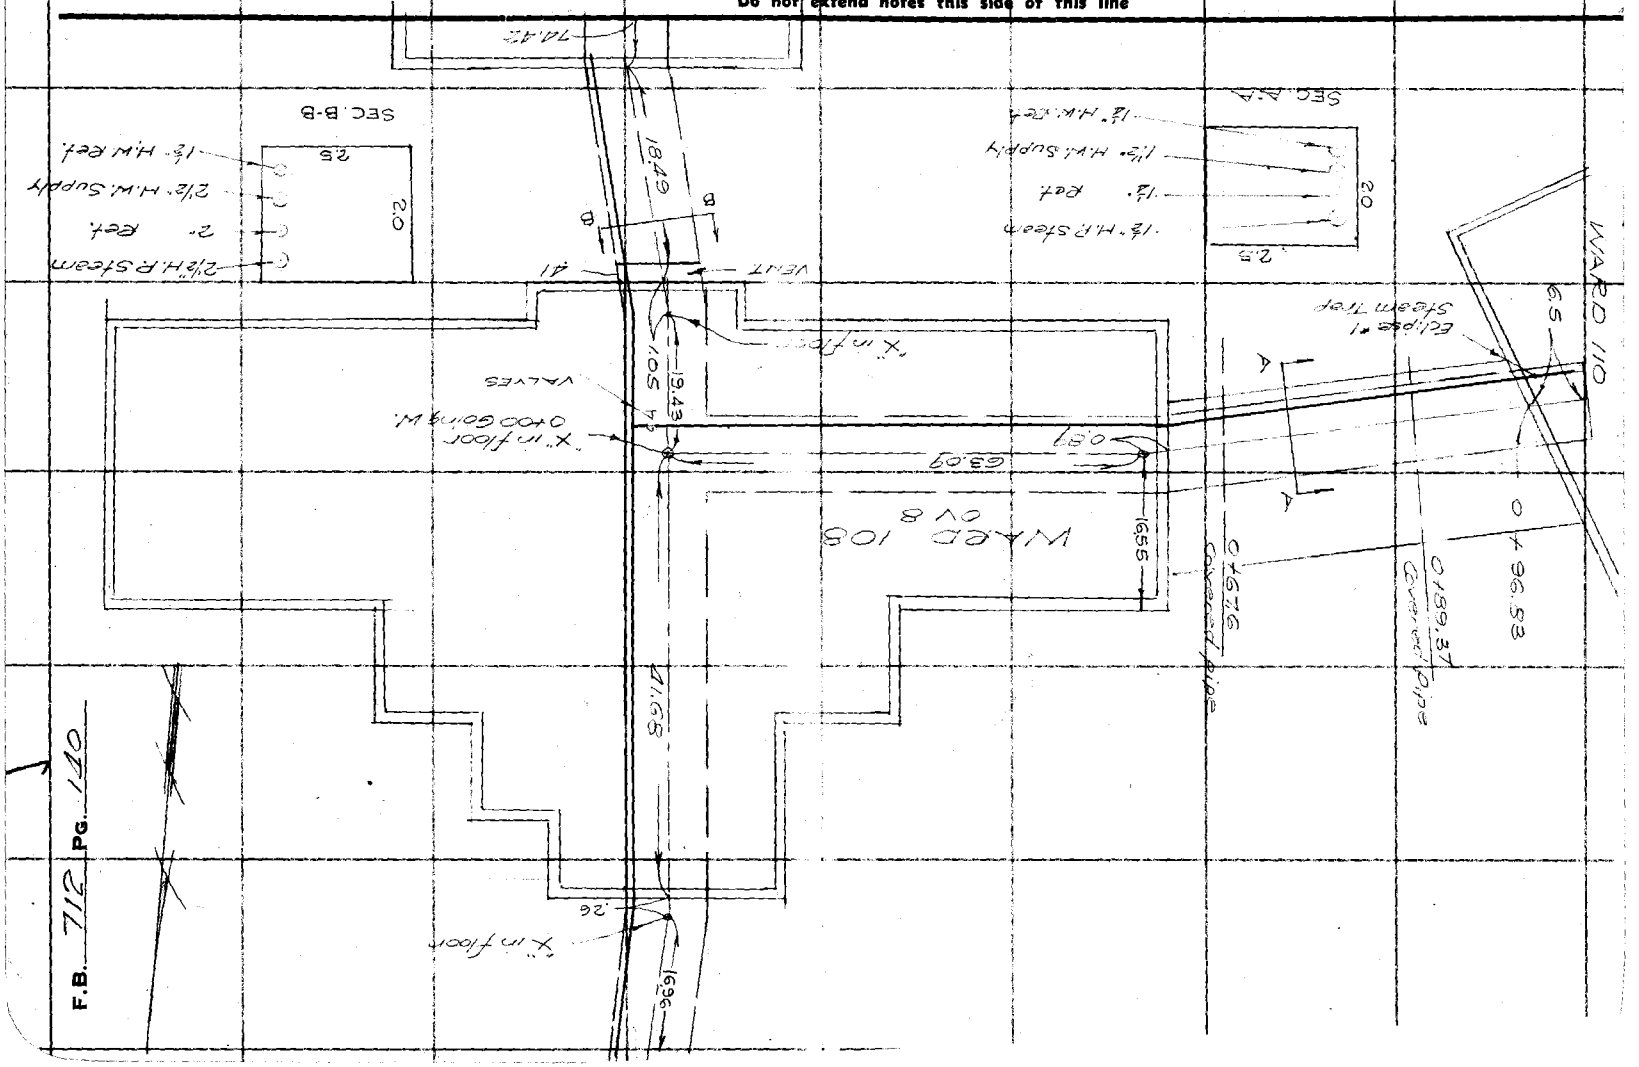

F.B. 712 PG. 140

FORM 247 10M 11-35

RETURN TO
LOS ANGELES COUNTY SURVEYOR
700 HALL OF RECORDS

Note: Any Additions or Changes on This Sheet Must be Made or Circled in Red Ink With Date and Name of Person Making Change.

Do not extend notes this side of this line

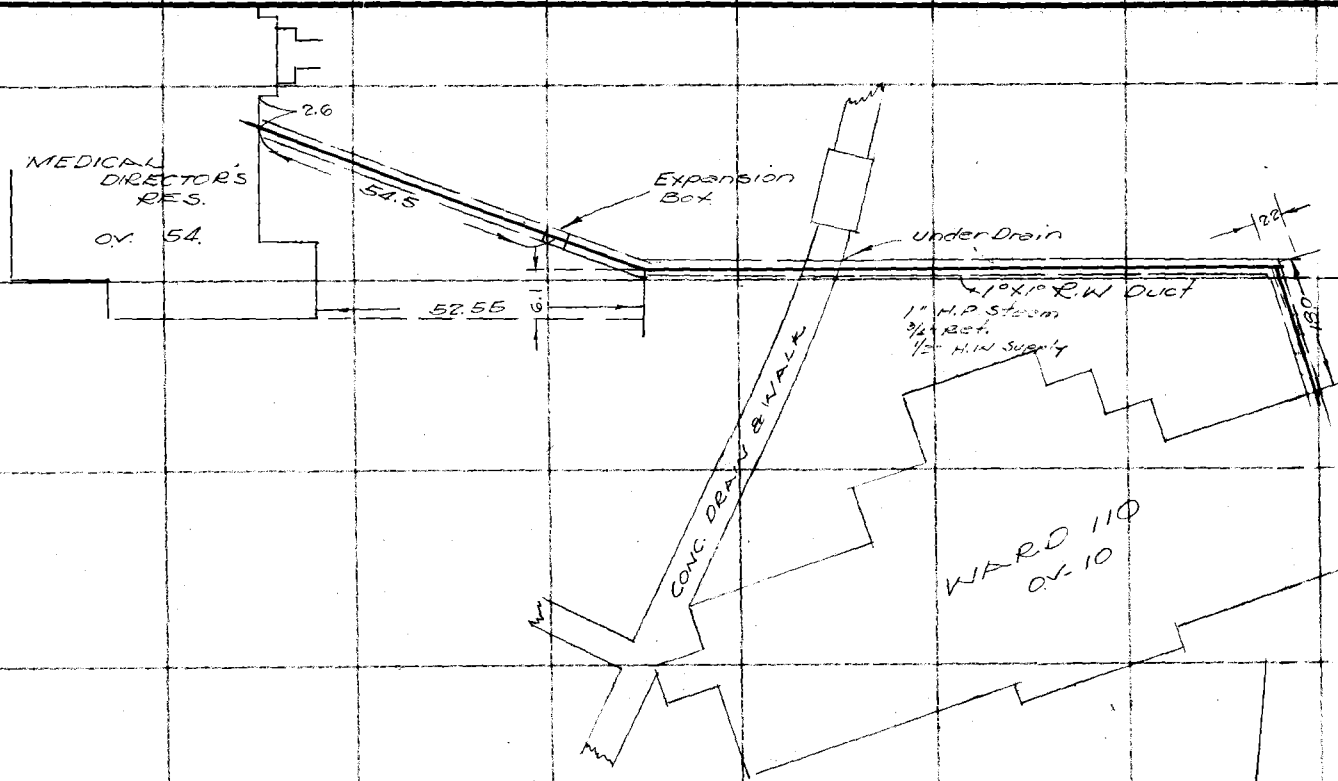

Notes Ck'd by
Map No.
Office Work
Checked
Date

Survey of W. O. & 128 Tape No. S'd °F.
Surveyed by T. M. WALSH Date 9-36
Notes T. M. WALSH
Indexed

F.B. 712 PG. 141

STEAM DUCT

RETURN TO
LOS ANGELES COUNTY SURVEYOR
700 HALL OF RECORDS

Note: Any Additions or Changes on This Sheet Must be Made or Circled in **Red Ink** With Date and Name of Person Making Change.

Do not extend notes this side of this line

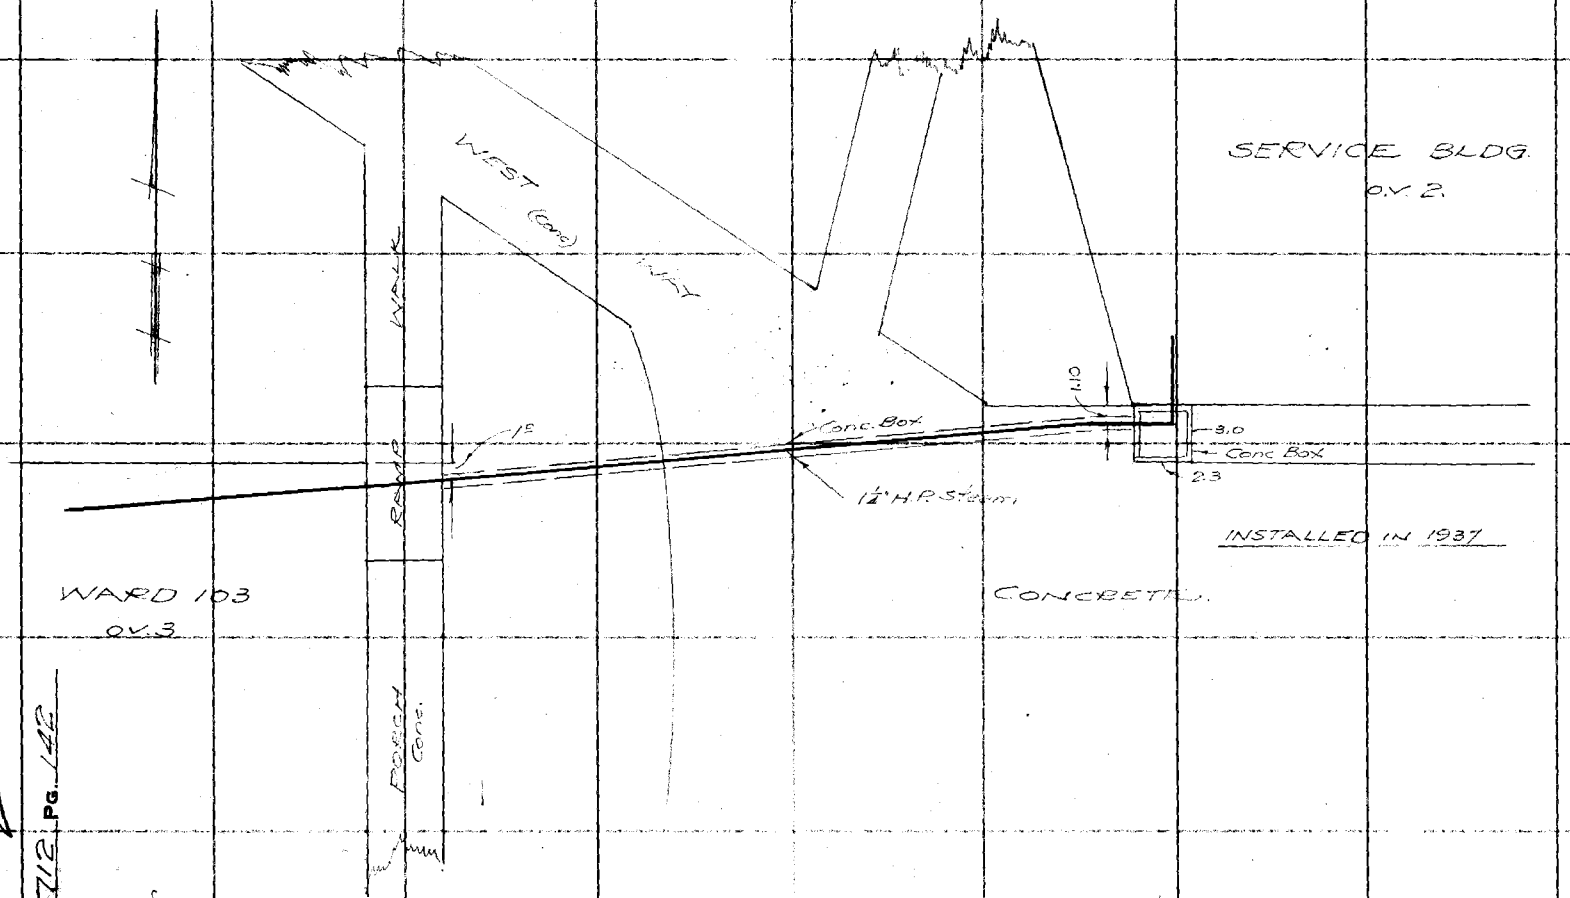

F.B. 712 Pg. 142

Walsh
Livingston
Baker

Notes Ck'd by	Survey of
Map No.	W. O. 8128 Tape No. St'd °F.
Office Work	Surveyed by T. M. WALSH
Checked	Notes T. M. WALSH Date 9-30-36
Data	Indexed

F.B. 712 PG. 143

STELLA TUNNELS

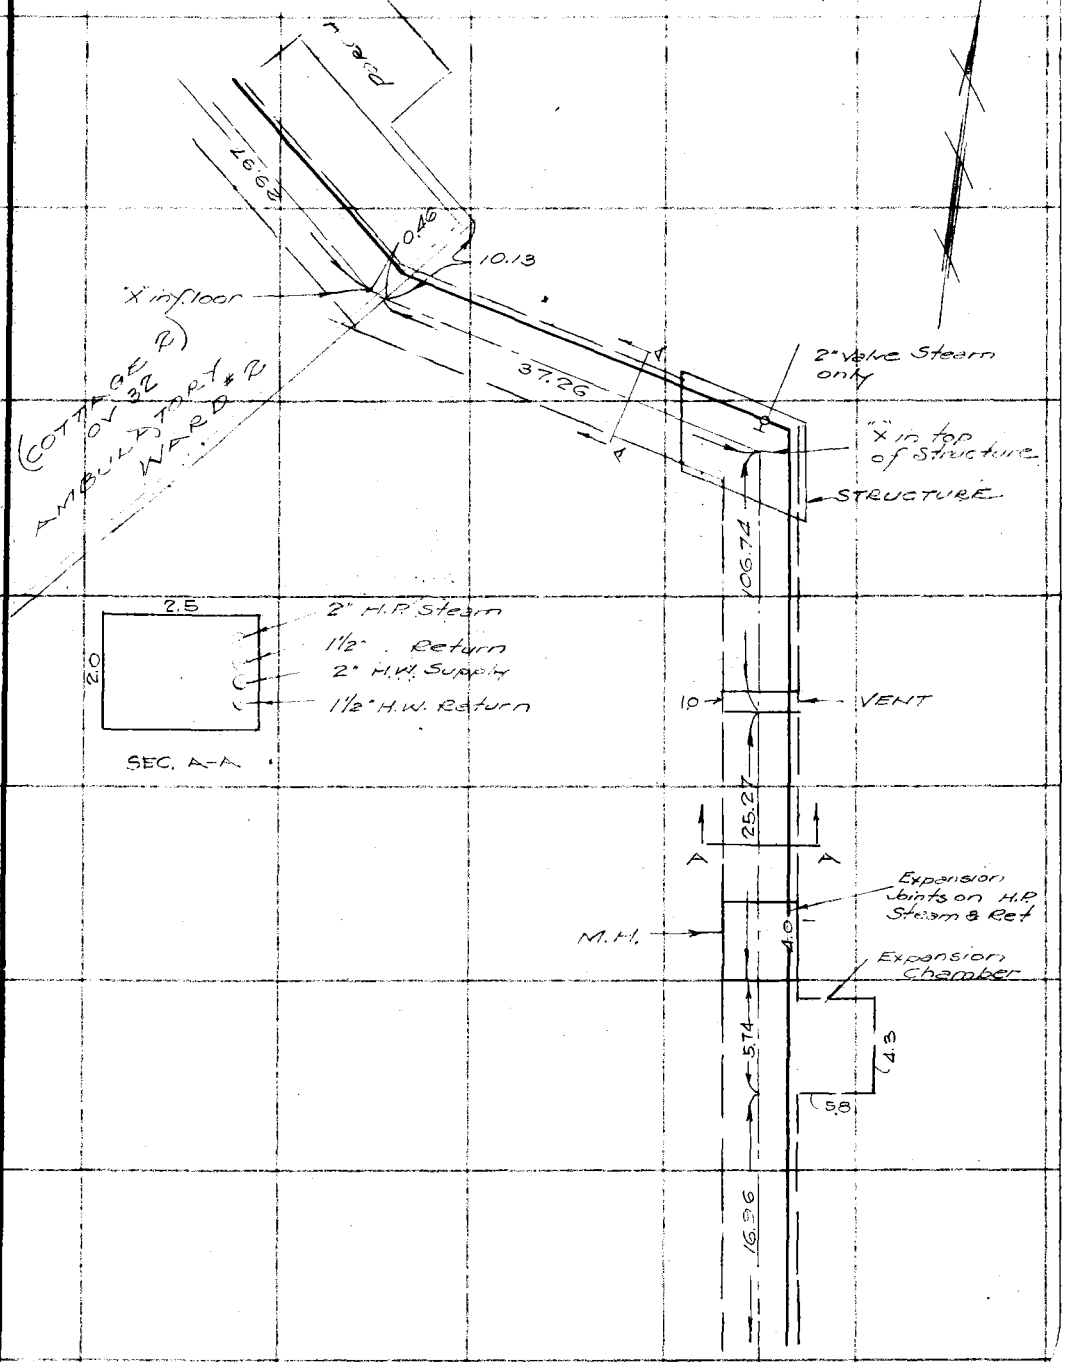

RETURN TO
LOS ANGELES COUNTY SURVEYOR
700 HALL OF RECORDS

Note: Any Additions or Changes on This Sheet Must be Made or Circled in Red Ink With Date and Name of Person Making Change.

Do not extend notes this side of this line

FORM 247 10M 11-35

RETURN TO
LOS ANGELES COUNTY SURVEYOR
700 HALL OF RECORDS

Note: Any Additions or Changes on This Sheet Must be Made or Circled in **Red** Ink With Date and Name of Person Making Change.

Do not extend notes this side of this line

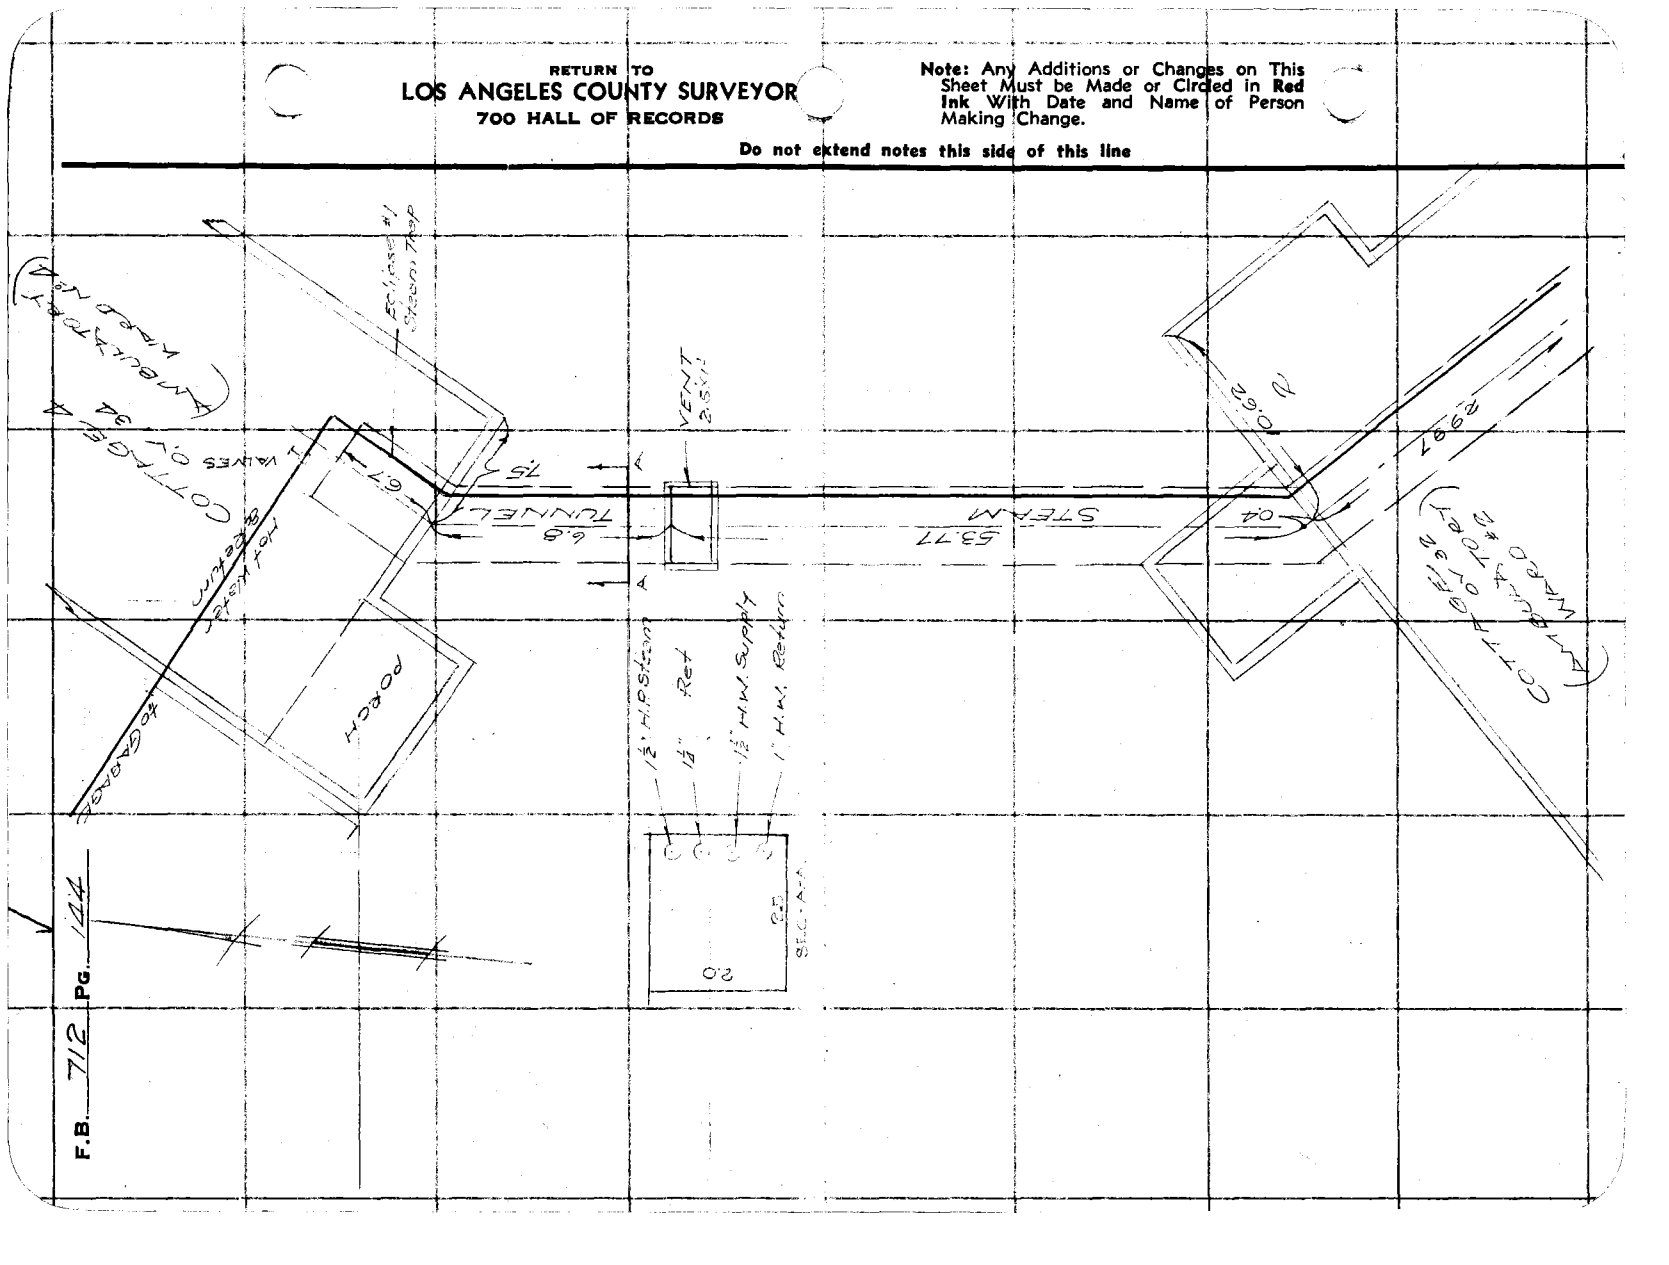

Notes Ck'd by	Survey of OLIVE VIEW SANATORIUM
Map No.	W. 0.8128 Tape No. St'd °F.
Office Work	Surveyed by M. WALSH
Checked	Notes T. M. WALSH Date 5-15-36
Date	Indexed

F.B. 712 Pg. 145

HOT WATER

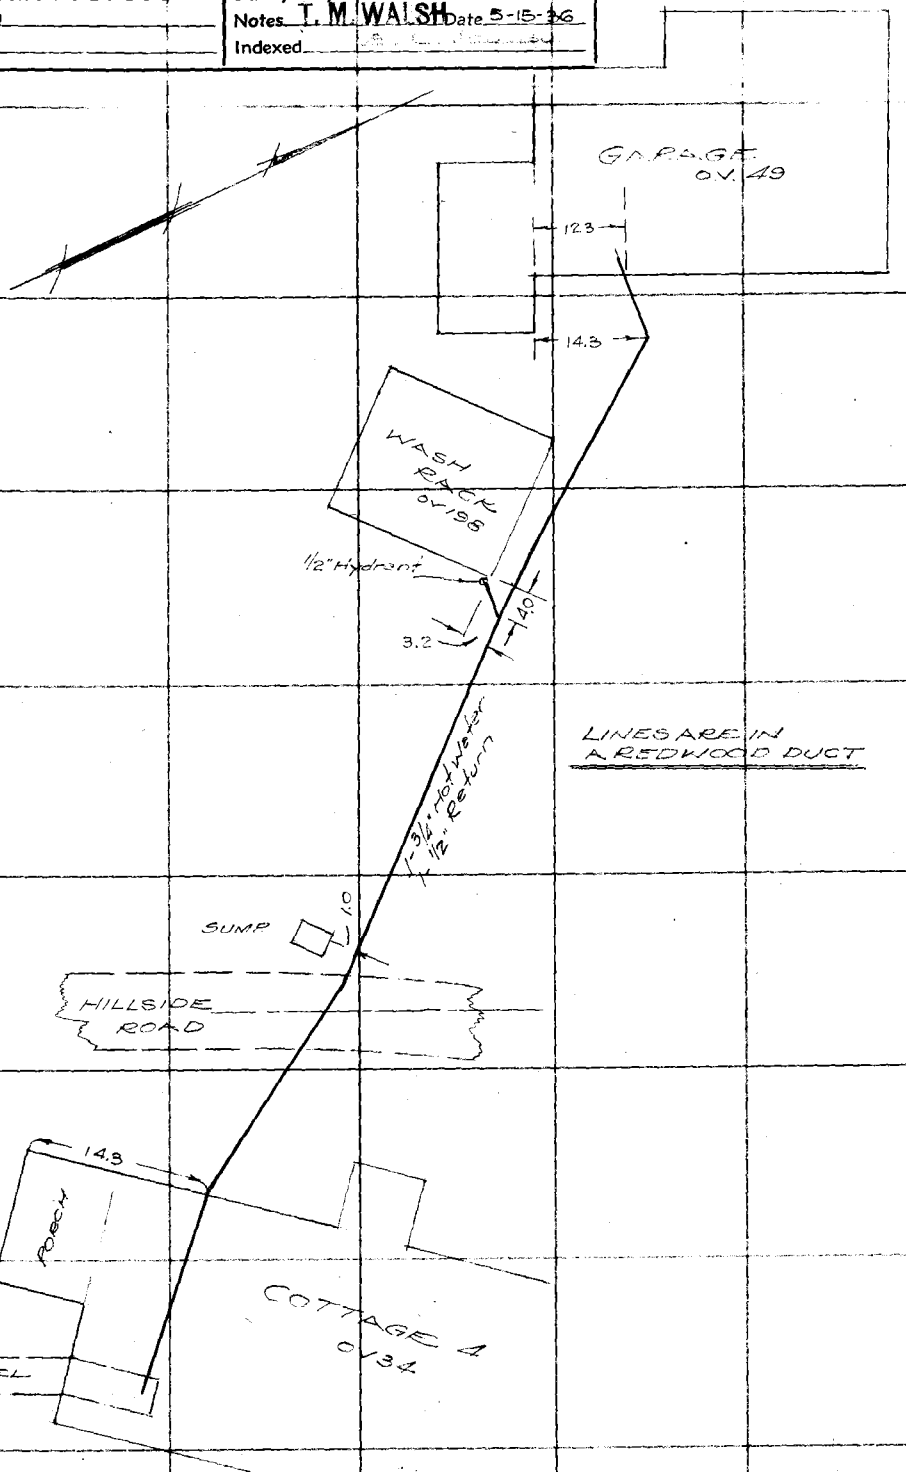

Note: Any Additions or Changes on This Sheet Must be Made or Circled in Red Ink With Date and Name of Person Making Change.

Do not extend notes this side of this line

RETURN TO
LOS ANGELES COUNTY SURVEYOR
700 HALL OF RECORDS

FORM 247 10M 11-35

RETURN TO
LOS ANGELES COUNTY SURVEYOR
700 HALL OF RECORDS

Note: Any Additions or Changes on This Sheet Must be Made or Circled in **Red Ink** With Date and Name of Person Making Change.

Do not extend notes this side of this line

F.B. 712 PG. 146

Notes Ck'd by	Survey of [illegible]
Map No.	W. O. 8128 Tape No. St'd °F.
Office Work	Surveyed by T. M. WALSH
Checked	Notes T. M. WALSH Date 9-24-36
Date	Indexed A. C. Johnson

F.B. 712 PG. 147

STEAM TUNNELS

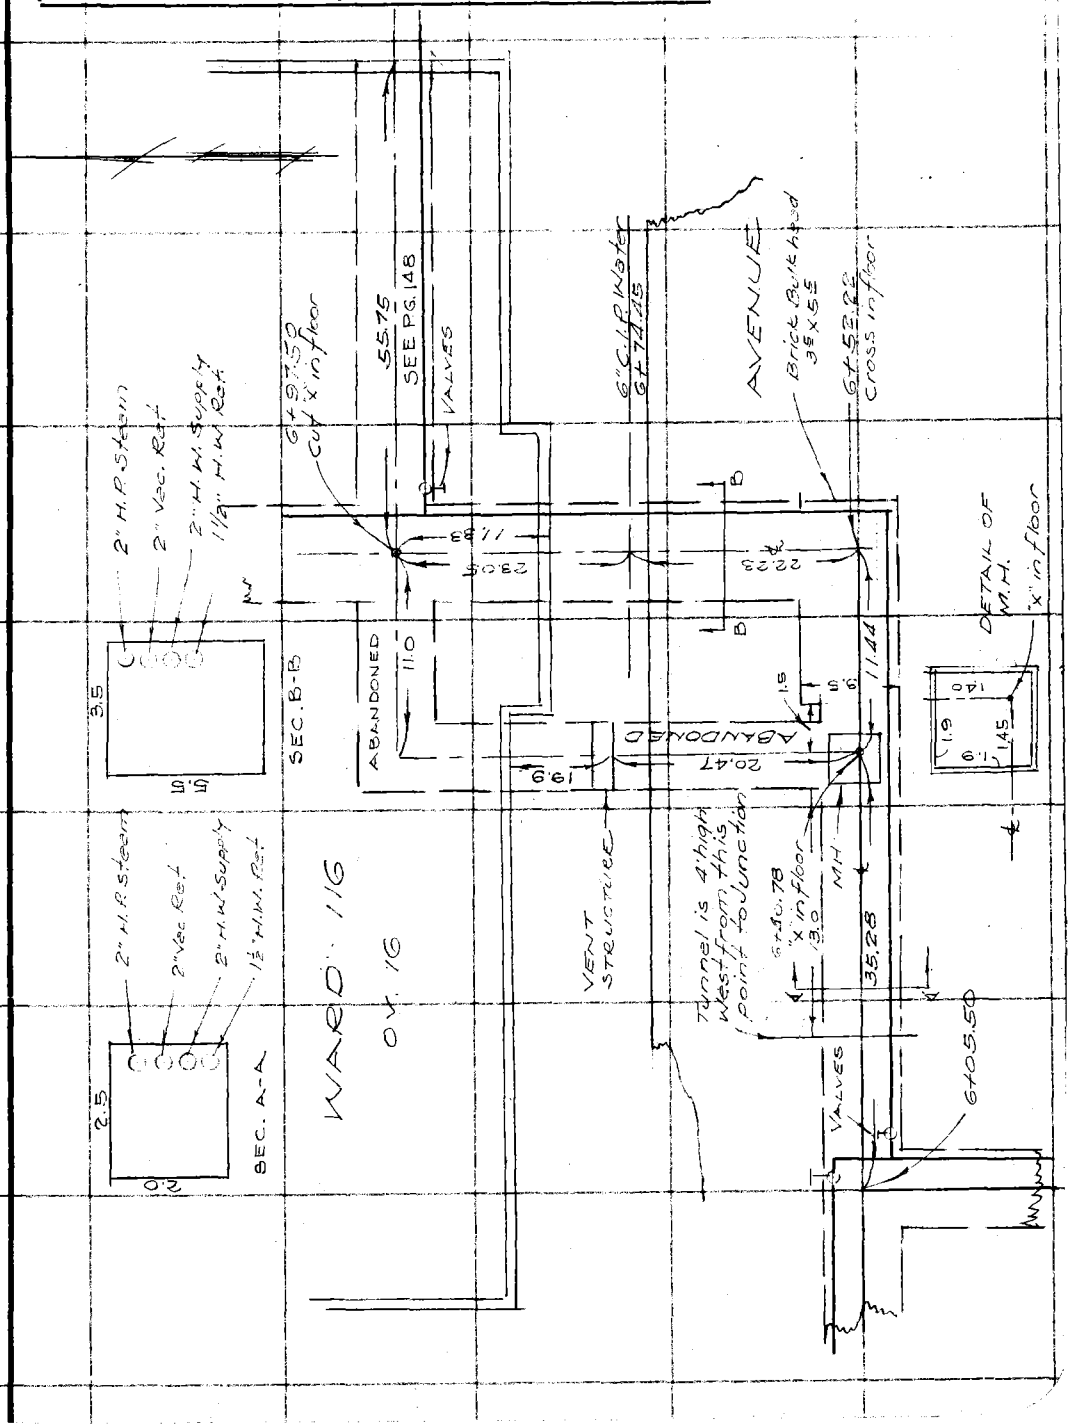

Note: Any Additions or Changes on This Sheet Must be Made or Circled in Red Ink With Date and Name of Person Making Change.

Do not extend notes this side of this line

RETURN TO
LOS ANGELES COUNTY SURVEYOR
700 HALL OF RECORDS

FORM 247 10M 11-35

RETURN TO
LOS ANGELES COUNTY SURVEYOR
700 HALL OF RECORDS

Note: Any Additions or Changes on This Sheet Must be Made or Circled in **Red Ink** With Date and Name of Person Making Change.

Do not extend notes this side of this line

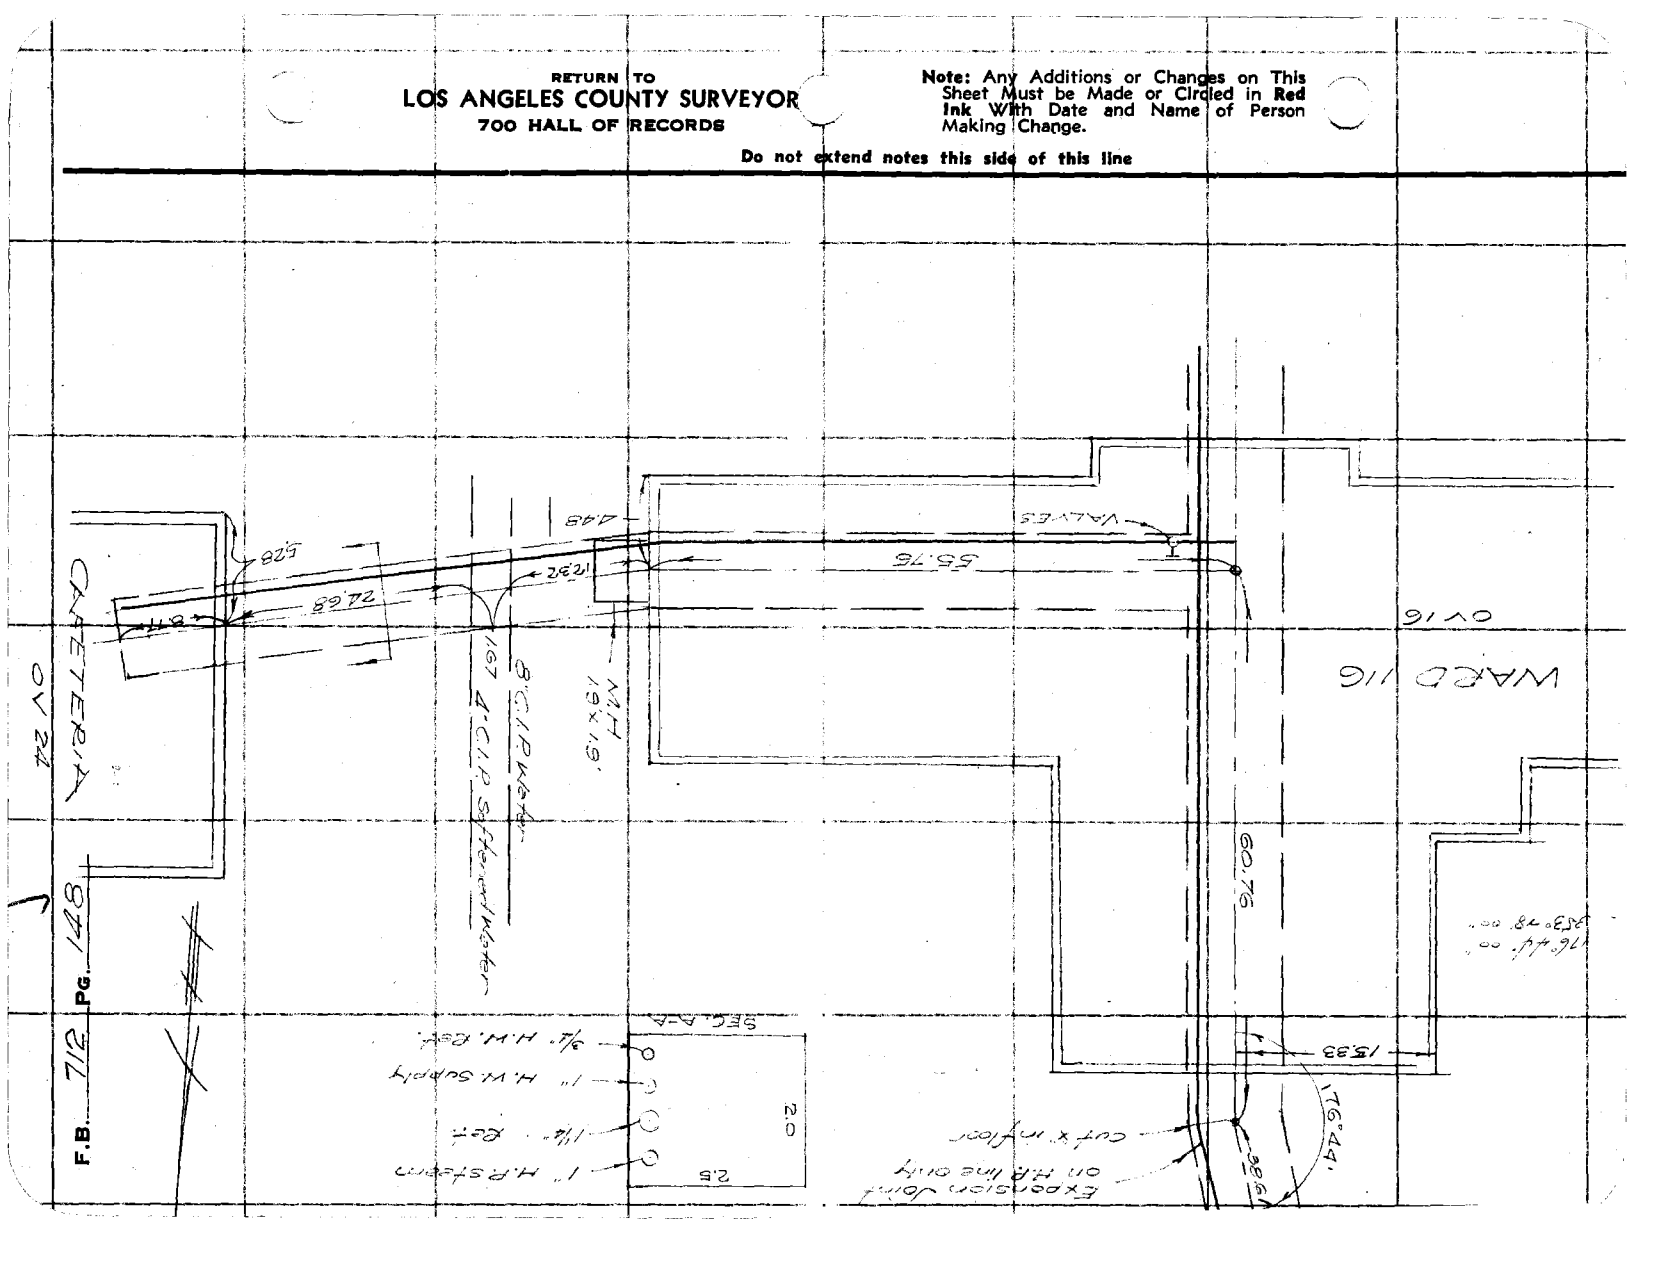

Notes Ck'd by	Survey of
Map No.	W. O. 8128 Tape No. St'd °F.
Office Work	Surveyed by T. M. WALSH
Checked	Notes T. M. WALSH Date 9-36
Date	Indexed

F.B. 712 PG. 149

STEAM TUNNELS

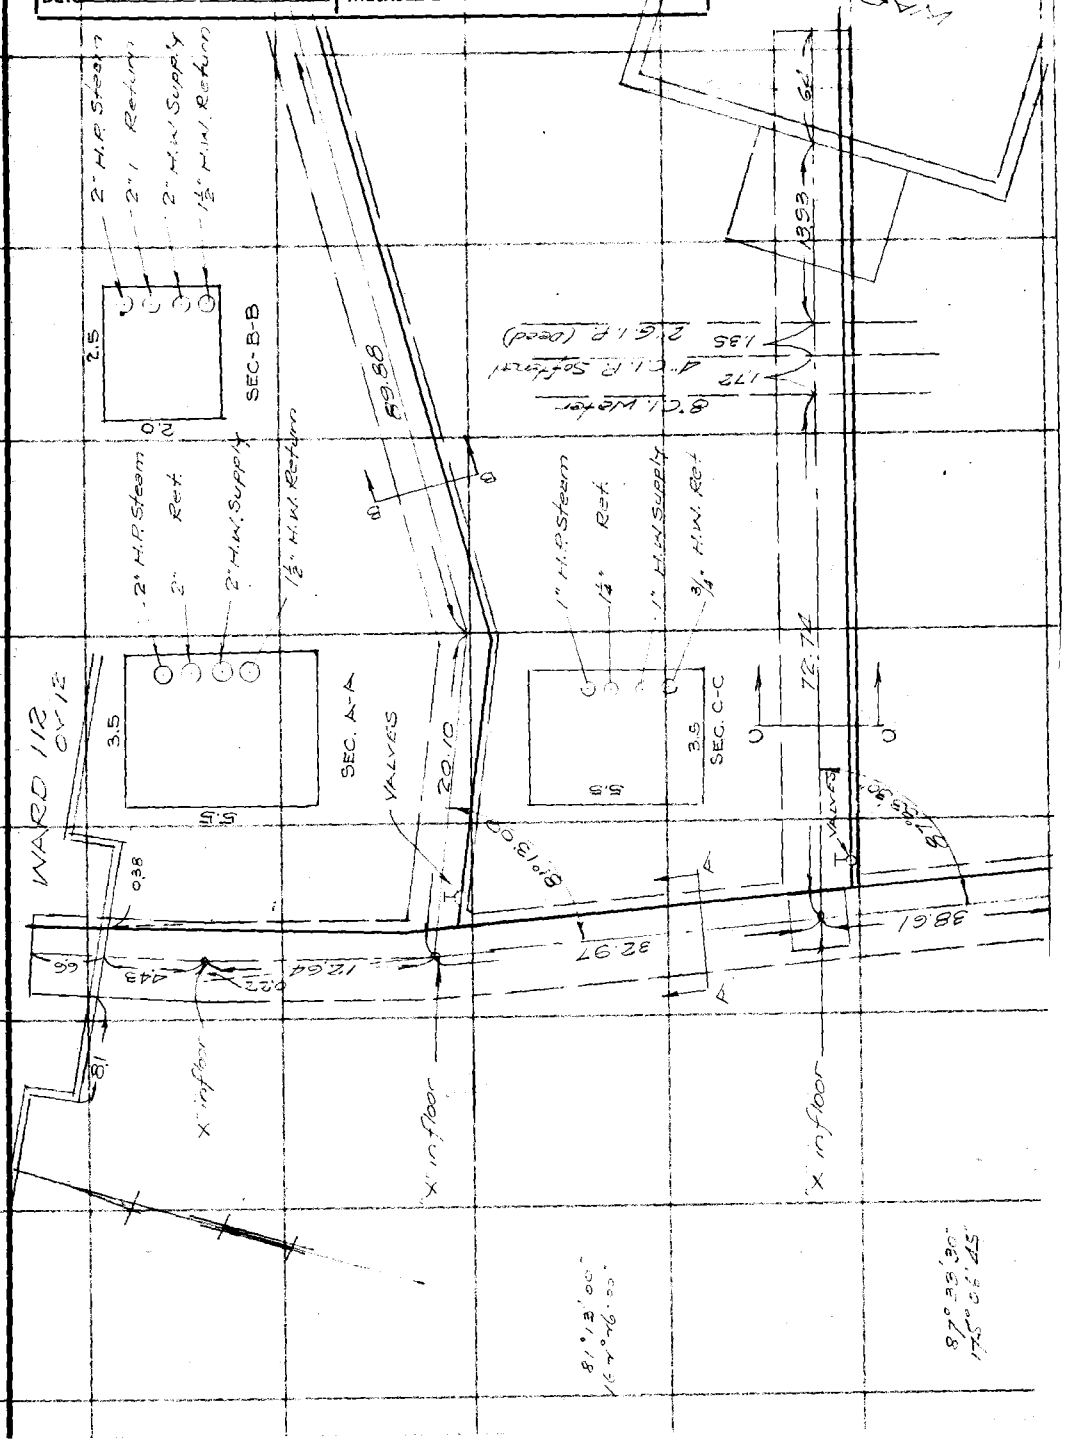

Note: Any Additions or Changes on This Sheet Must be Made or Circled in Red Ink With Date and Name of Person Making Change.

Do not extend notes this side of this line

RETURN TO
LOS ANGELES COUNTY SURVEYOR
700 HALL OF RECORDS

FORM 247 10M 11-35

RETURN TO
LOS ANGELES COUNTY SURVEYOR
700 HALL OF RECORDS

Note: Any Additions or Changes on This Sheet Must be Made or Circled in **Red Ink** With Date and Name of Person Making Change.

Do not extend notes this side of this line

F.B. 712 PG. 150

FORM 247 5M 2-34

RETURN TO

LOS ANGELES COUNTY SURVEYOR

700 HALL OF RECORDS

Note: ANY ADDITIONS OR CHANGES ON THIS SHEET MUST BE MADE OR CIRCLED IN Red Ink WITH DATE AND NAME OF PERSON MAKING CHANGE.

Do not extend notes this side of this line

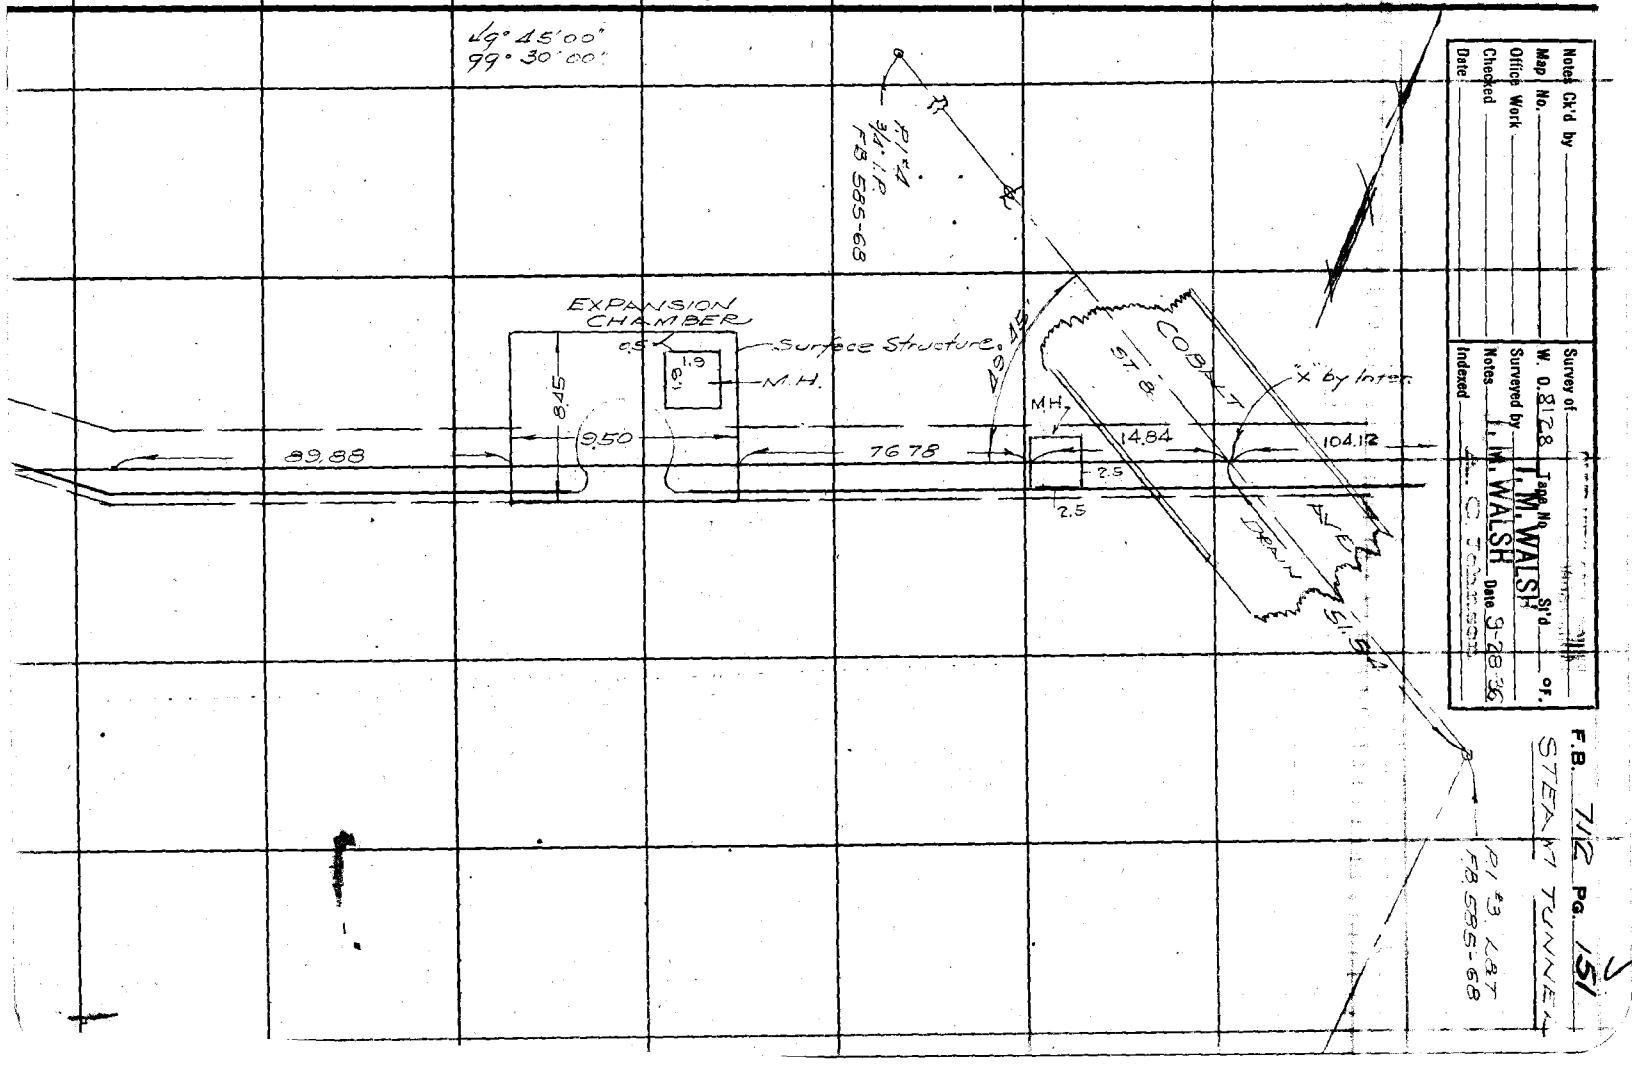

Notes Ck'd by _____

Map No. _____

Office Work _____

Checked _____

Date _____

Survey of _____

W. O. 8128 Page No. _____

Surveyed by T. M. WALSH Sk'd _____ of _____

Notes T. M. WALSH Date 3-28-36

Indexed _____ Ck. _____

F.B. 712 Pg. 151

STEAM TUNNEL

RETURN TO

LOS ANGELES COUNTY SURVEYOR

700 HALL OF RECORDS

Note: ANY ADDITIONS OR CHANGES ON THIS SHEET MUST BE MADE OR CIRCLED IN **Red Ink** WITH DATE AND NAME OF PERSON MAKING CHANGE.

Do not extend notes this side of this line

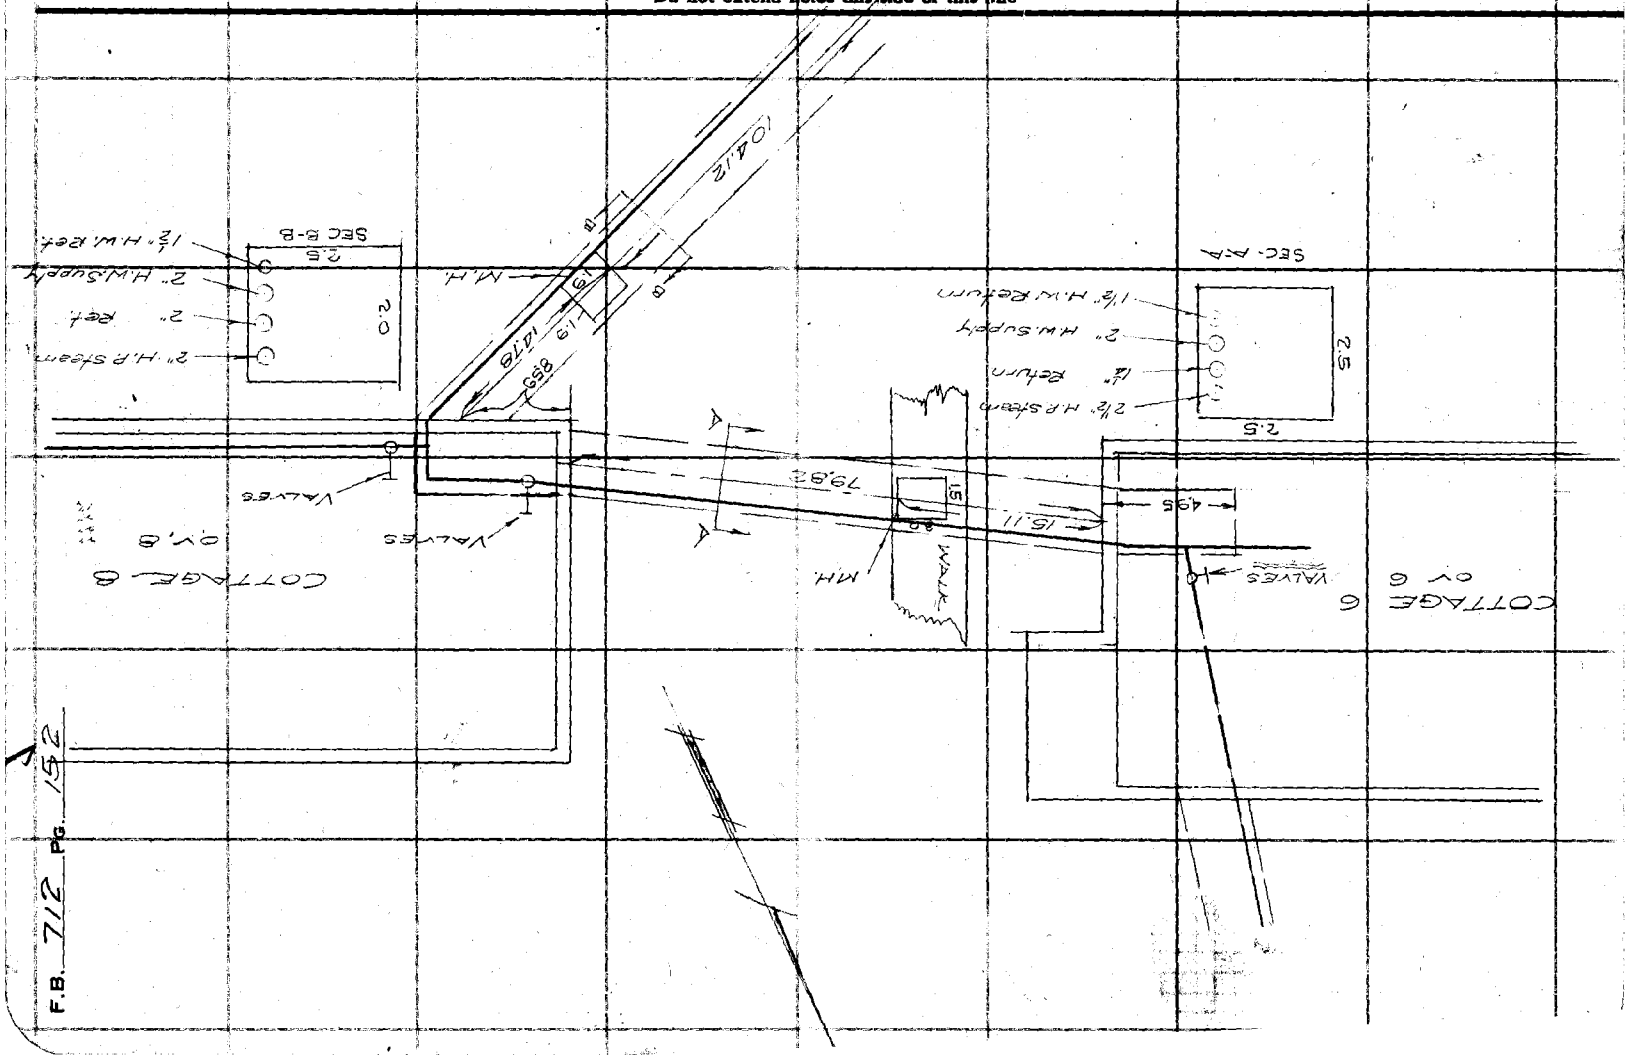

F.B. 712 PG. 152

FORM 247 5M 2-34

RETURN TO
LOS ANGELES COUNTY SURVEYOR
700 HALL OF RECORDS

Note: ANY ADDITIONS OR CHANGES ON THIS SHEET MUST BE MADE OR CIRCLED IN Red Ink WITH DATE AND NAME OF PERSON MAKING CHANGE.

Do not extend notes this side of this line

Notes Ck'd by
Map No.
Office Work
Checked
Date

Survey of
W. O. 8128 Topo M. WALSH 8/34 or.
Surveyed by T. M. WALSH Date 9-36
Notes
Indexed
Checked C. JOHNSON


STEAM TUNNELS

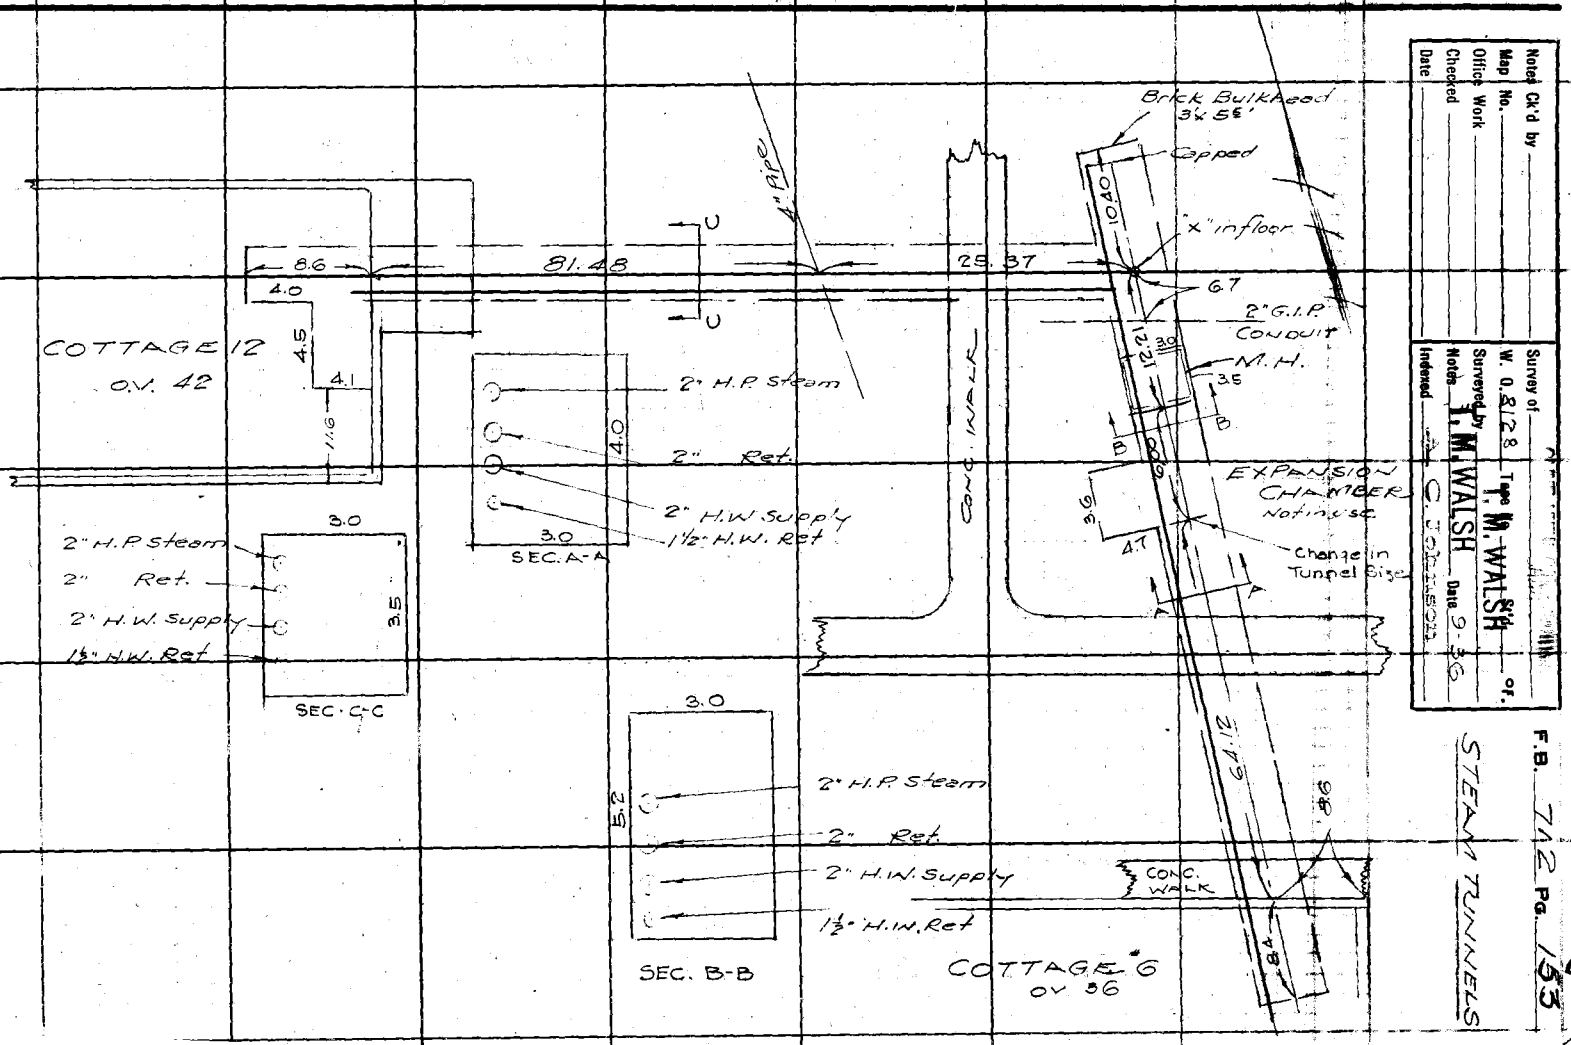

RETURN TO
LOS ANGELES COUNTY SURVEYOR
700 HALL OF RECORDS

Note: ANY ADDITIONS OR CHANGES ON THIS SHEET MUST BE MADE OR CIRCLED IN **Red Ink** WITH DATE AND NAME OF PERSON MAKING CHANGE.

Do not extend notes this side of this line

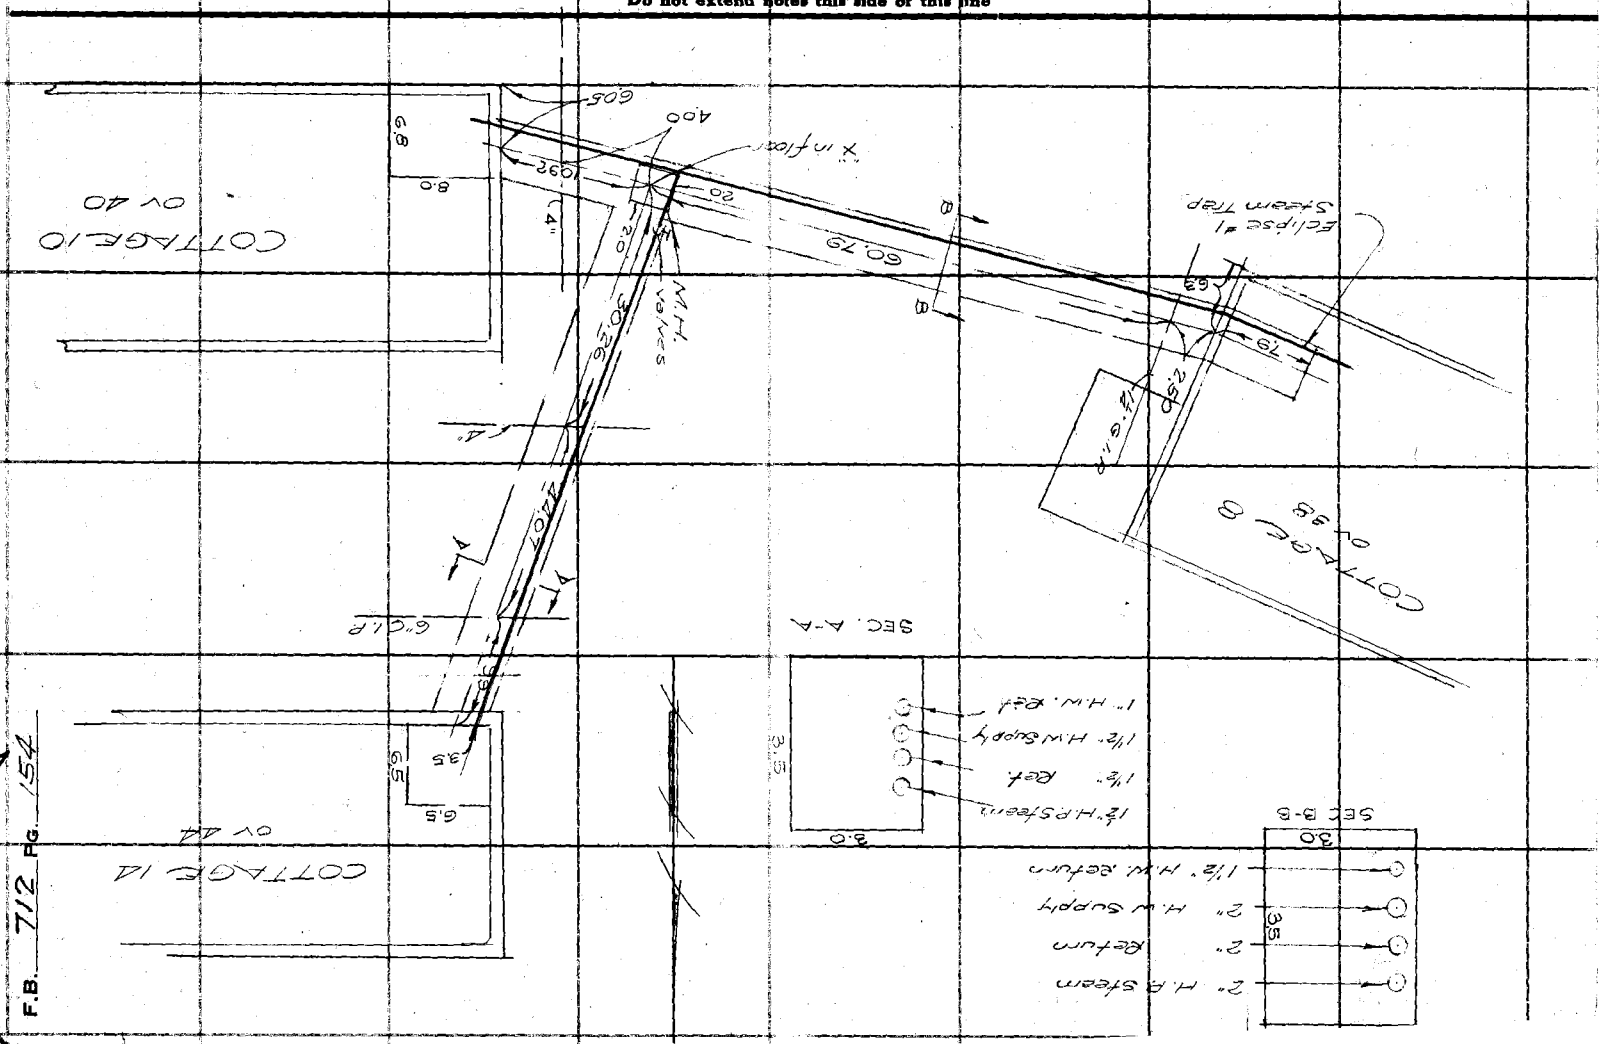

F.B. 712 PG. 154

Notes Ck'd by	Survey of OLIVE VIEW SAN
Map No.	W. O. 81-8 Tape No. St'd °F.
Office Work	Surveyed by TED WALSH
Checked	Notes WALSH Date 9-19-36
Date	Indexed

F.B. 712 Pg. 155

STEAM TUNNEL

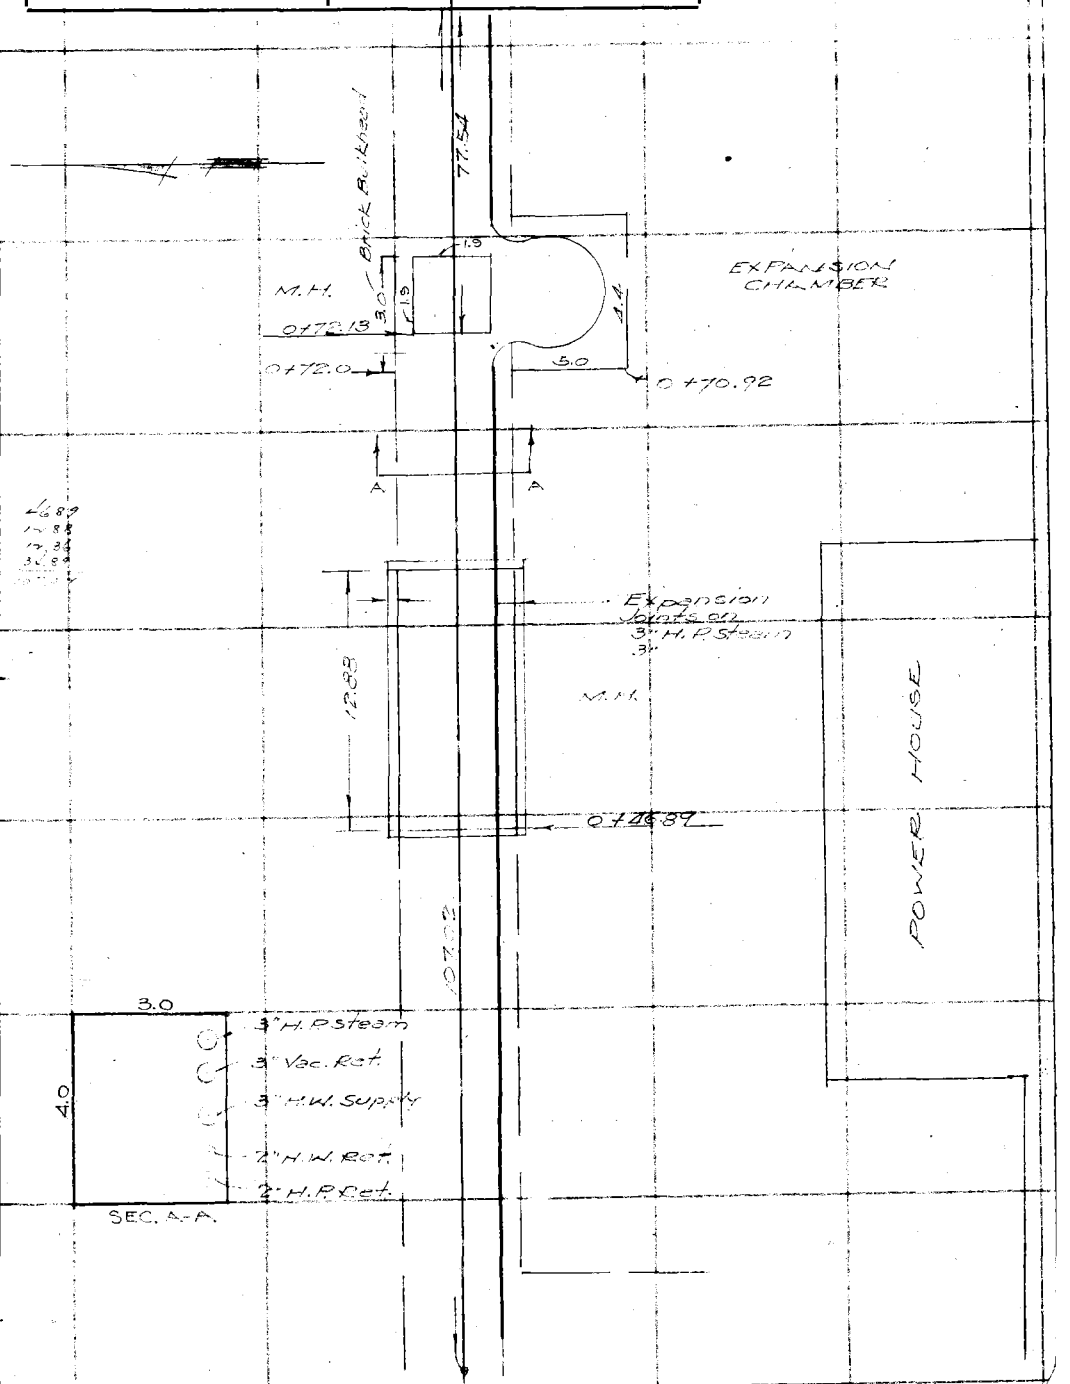

Note: Any Additions or Changes on This Sheet Must be Made or Circled in Red Ink With Date and Name of Person Making Change.

Do not extend notes this side of this line

RETURN TO
LOS ANGELES COUNTY SURVEYOR
700 HALL OF RECORDS

FORM 247 10M 11-35

RETURN TO
LOS ANGELES COUNTY SURVEYOR
700 HALL OF RECORDS

Note: Any Additions or Changes on This Sheet Must be Made or Circled in **Red Ink** With Date and Name of Person Making Change.

Do not extend notes this side of this line

F.B. 712 PG. 156

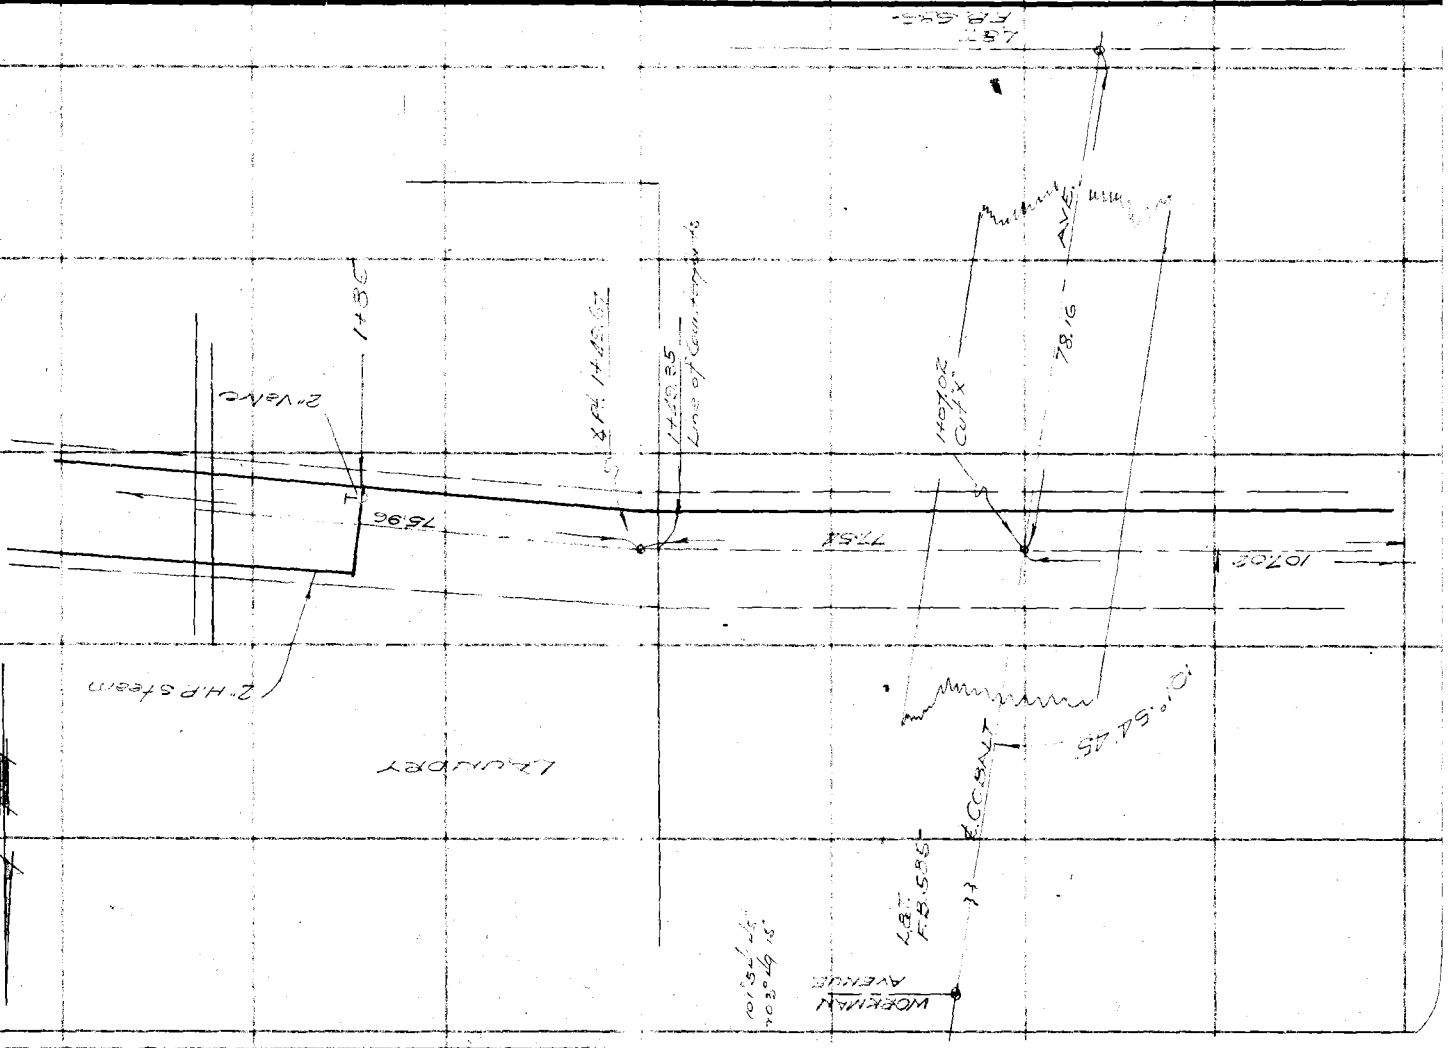

Notes Ck'd by	Survey of OLIVE VIEW SAN
Map No.	W. O. 81-18 Tape No. St'd. °F.
Office Work	Surveyed by TED WALSH
Checked	Notes WALSH Date 9-8-36
Date	Indexed A. O. Johnson

F.B. 712 PG. 157

STEAM TUNNELS

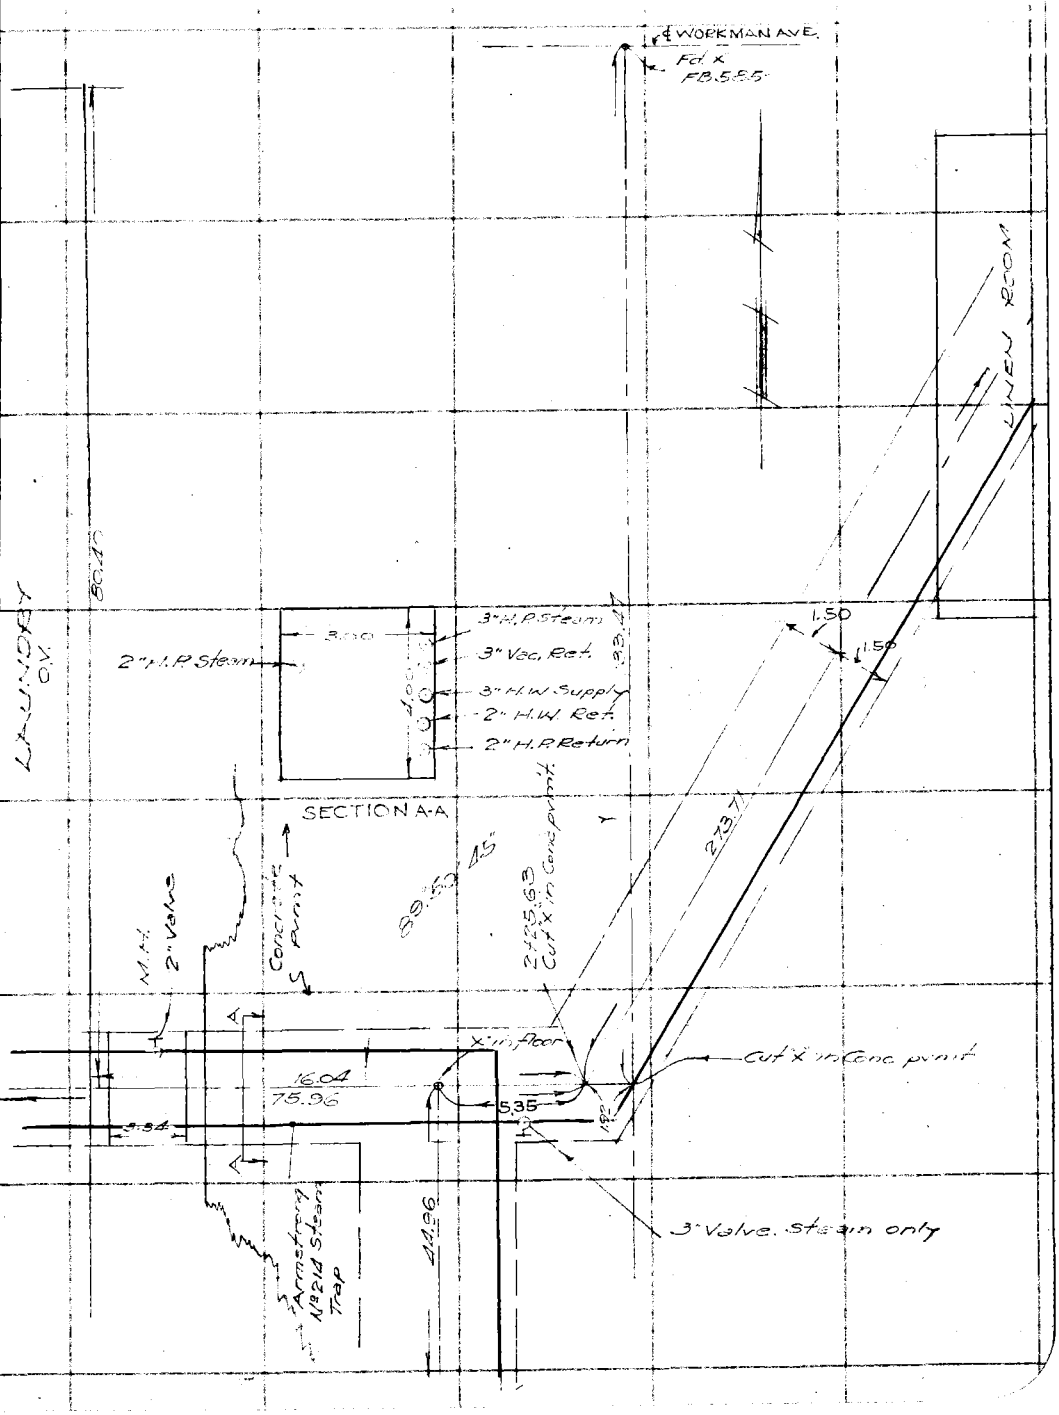

Note: Any Additions or Changes on This Sheet Must be Made or Circled in Red Ink With Date and Name of Person Making Change.

Do not extend notes this side of this line

RETURN TO
LOS ANGELES COUNTY SURVEYOR
700 HALL OF RECORDS

FORM 247 10M 11-35

F.B. 712 PG. 158

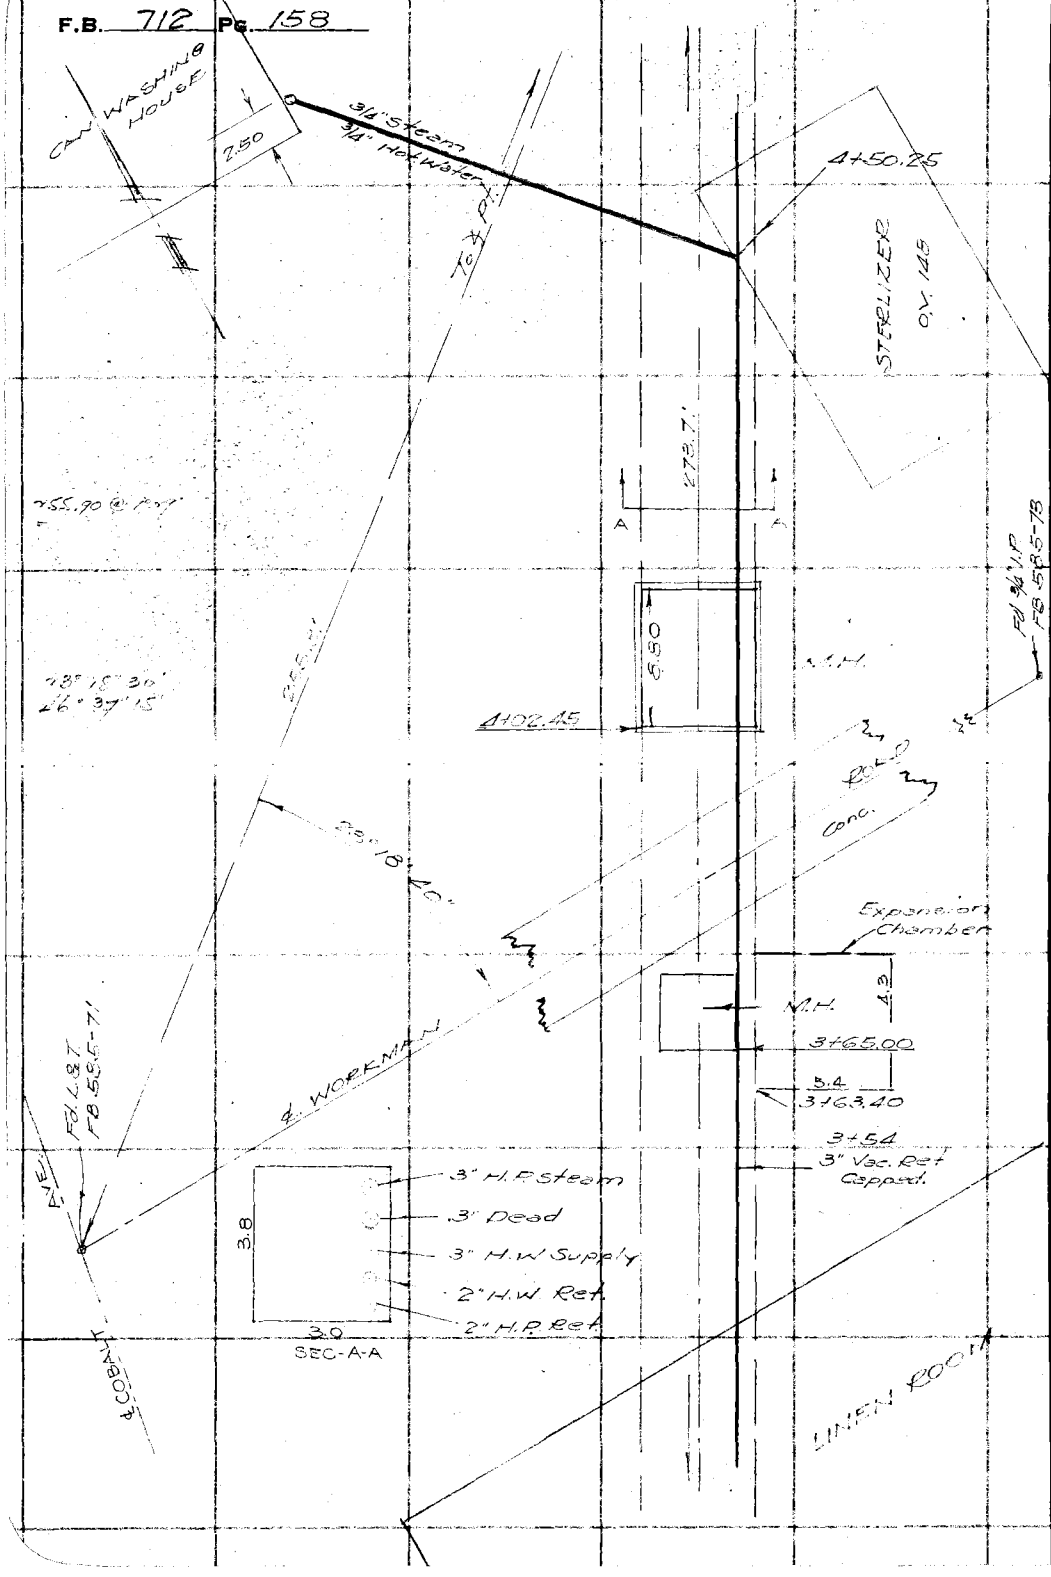

RETURN TO
LOS ANGELES COUNTY SURVEYOR
700 HALL OF RECORDS

Note: Any Additions or Changes on This Sheet Must be Made or Circled in Red Ink With Date and Name of Person Making Change.

Do not extend notes this side of this line

Notes Ck'd by	Survey of OLIVE VIEW SAN
Map No.	W. O. 81-18 Tape No. St'd °F.
Office Work	Surveyed by TED WALSH
Checked	Notes WALSH Date 9-8-36
Date	Indexed By C. Johnson

F.B. 712 PG. 159

STEAM TUNNELS

Note: Any Additions or Changes on This Sheet Must be Made in Red Ink With Date and Name of Person Making Change.

Do not extend notes this side of this line

RETURN TO
LOS ANGELES COUNTY SURVEYOR
700 HALL OF RECORDS

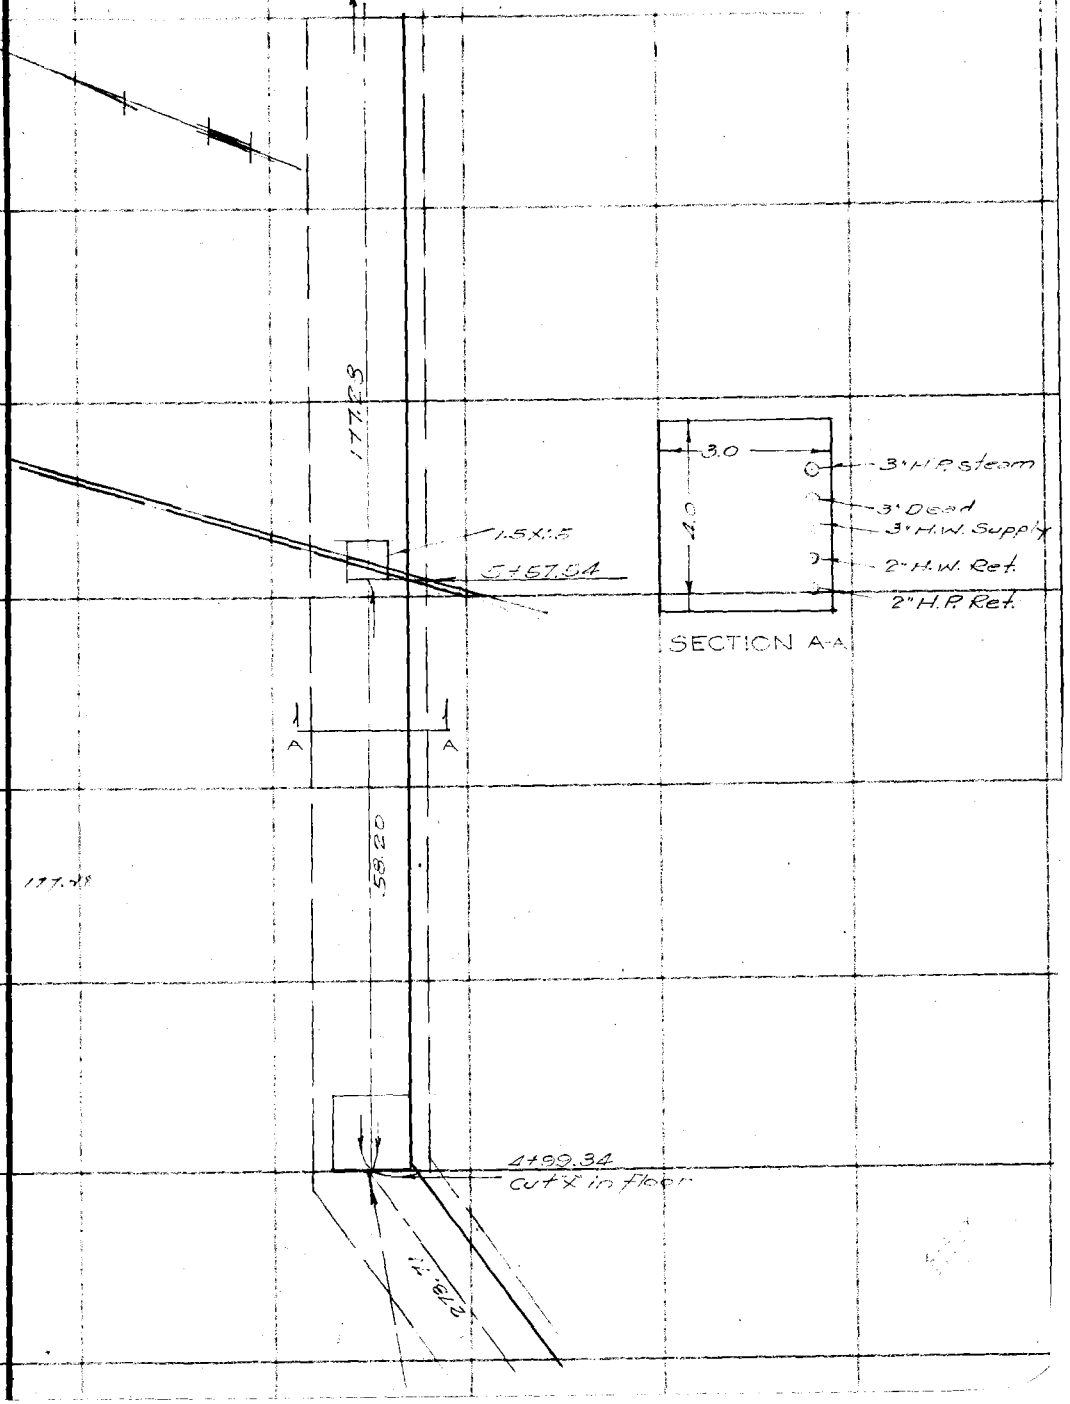

FORM 247 10M 11-35

F.B. 712 PG. 160

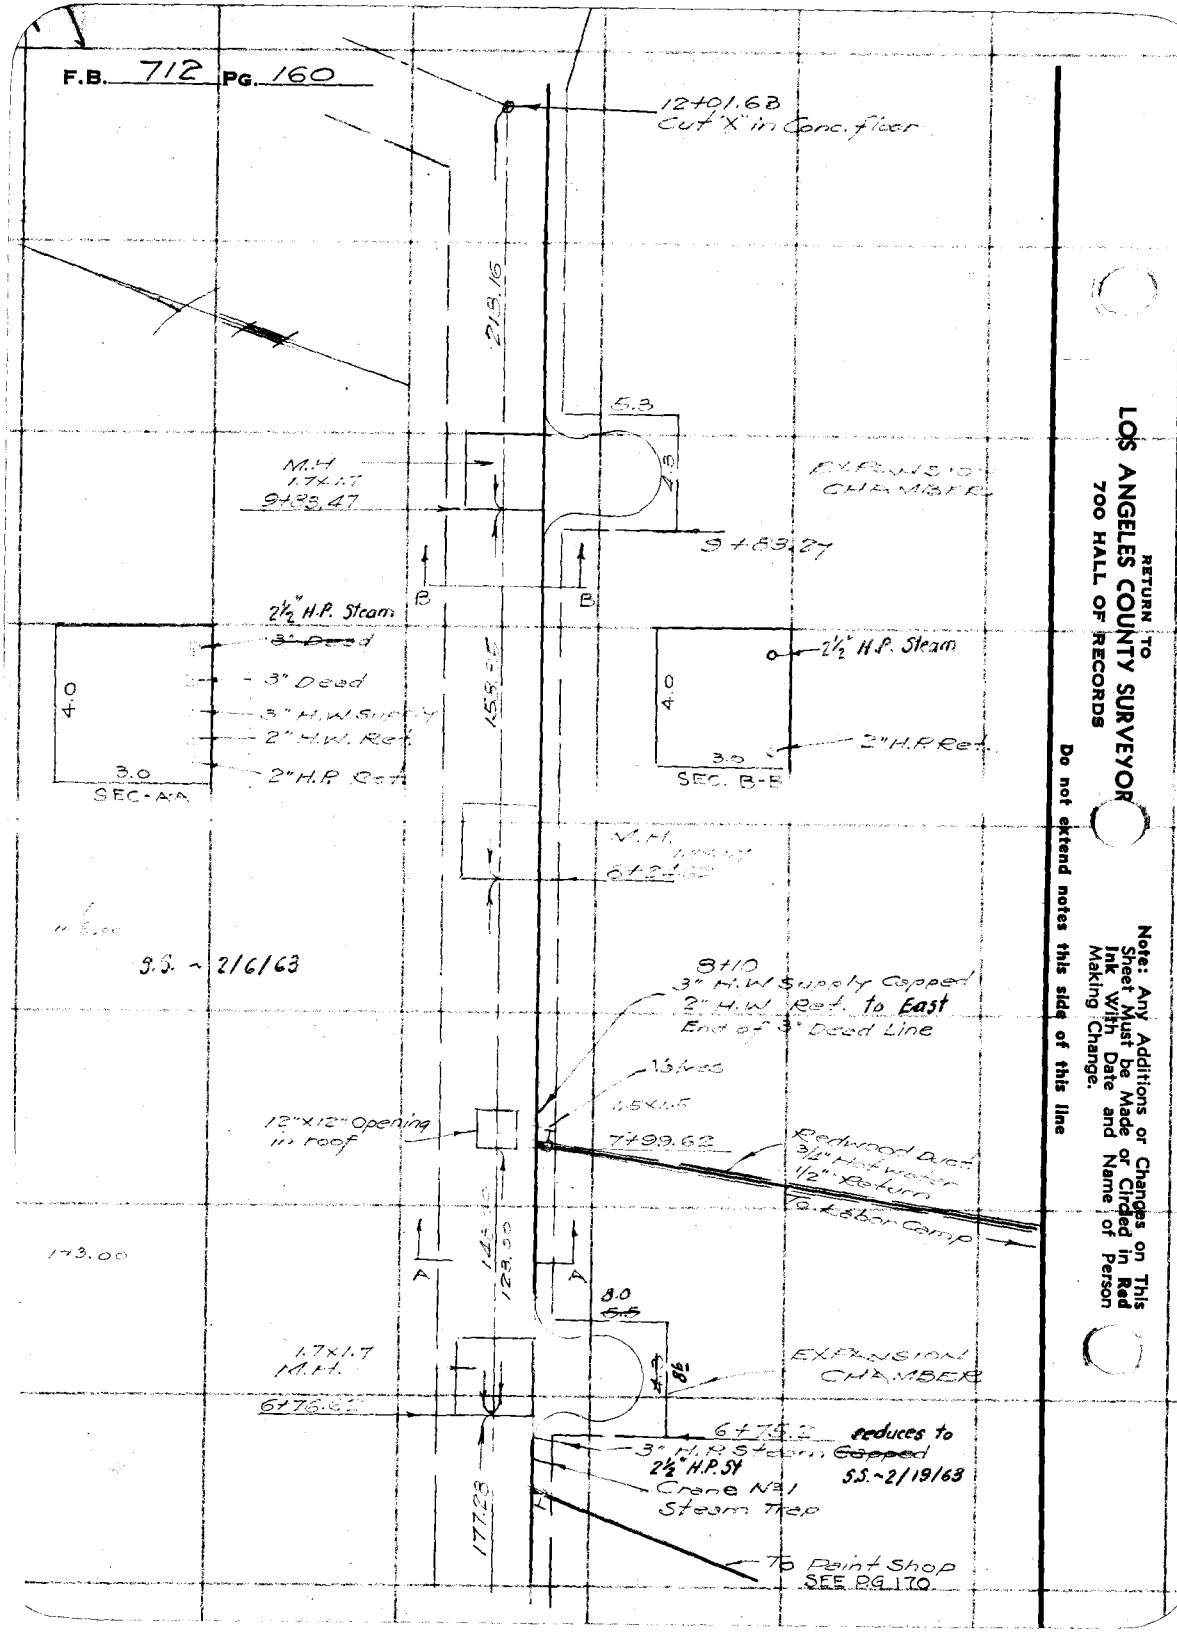

RETURN TO
LOS ANGELES COUNTY SURVEYOR
700 HALL OF RECORDS

Note: Any Additions or Changes on This Sheet Must be Made or Circled in Red Ink With Date and Name of Person Making Change.

Do not extend notes this side of this line

Notes Ck'd by	Survey of OLIVE VIEW SAN
Map No.	W. O. 8128 Tape No. St'd °F.
Office Work	Surveyed by TED WALSH
Checked	Notes WALSH Date 9-10-36
Date	Indexed A. C. Johns

F.B. 712 PG. 161

STEAM TUNNEL

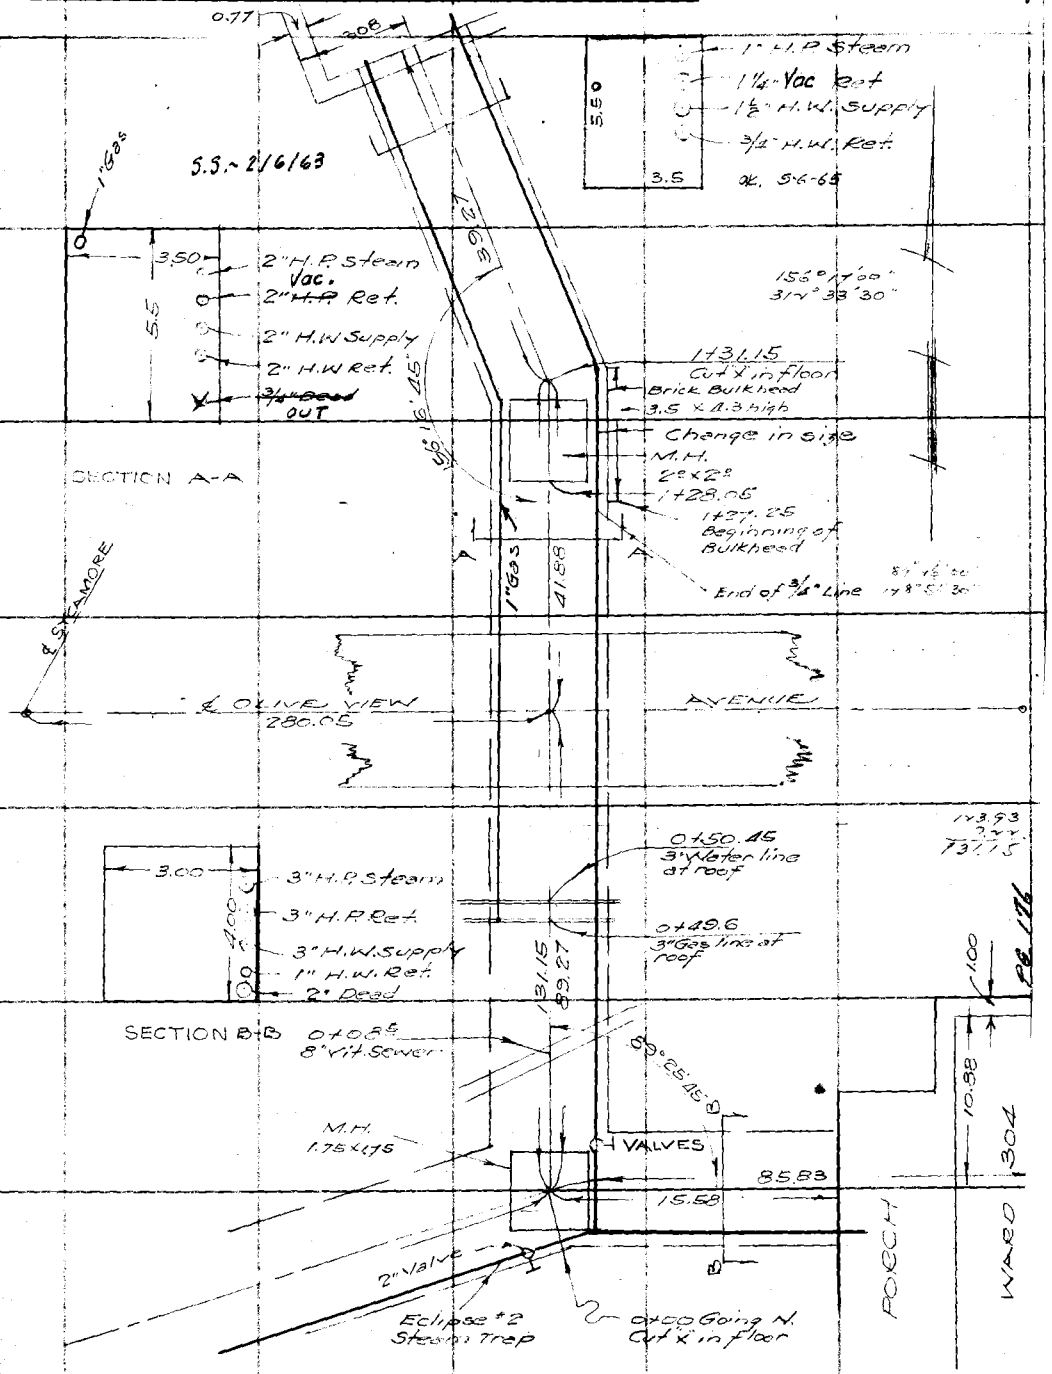

Note: Any Additions or Changes on This Sheet Must be Made or Circled in Red Ink With Date and Name of Person Making Change.

Do not extend notes this side of this line

RETURN TO
LOS ANGELES COUNTY SURVEYOR
700 HALL OF RECORDS

FORM 247 10M 11-35

RETURN TO
LOS ANGELES COUNTY SURVEYOR
700 HALL OF RECORDS

Note: Any Additions or Changes on This Sheet Must be Made or Circled in **Red Ink** With Date and Name of Person Making Change.

Do not extend notes this side of this line

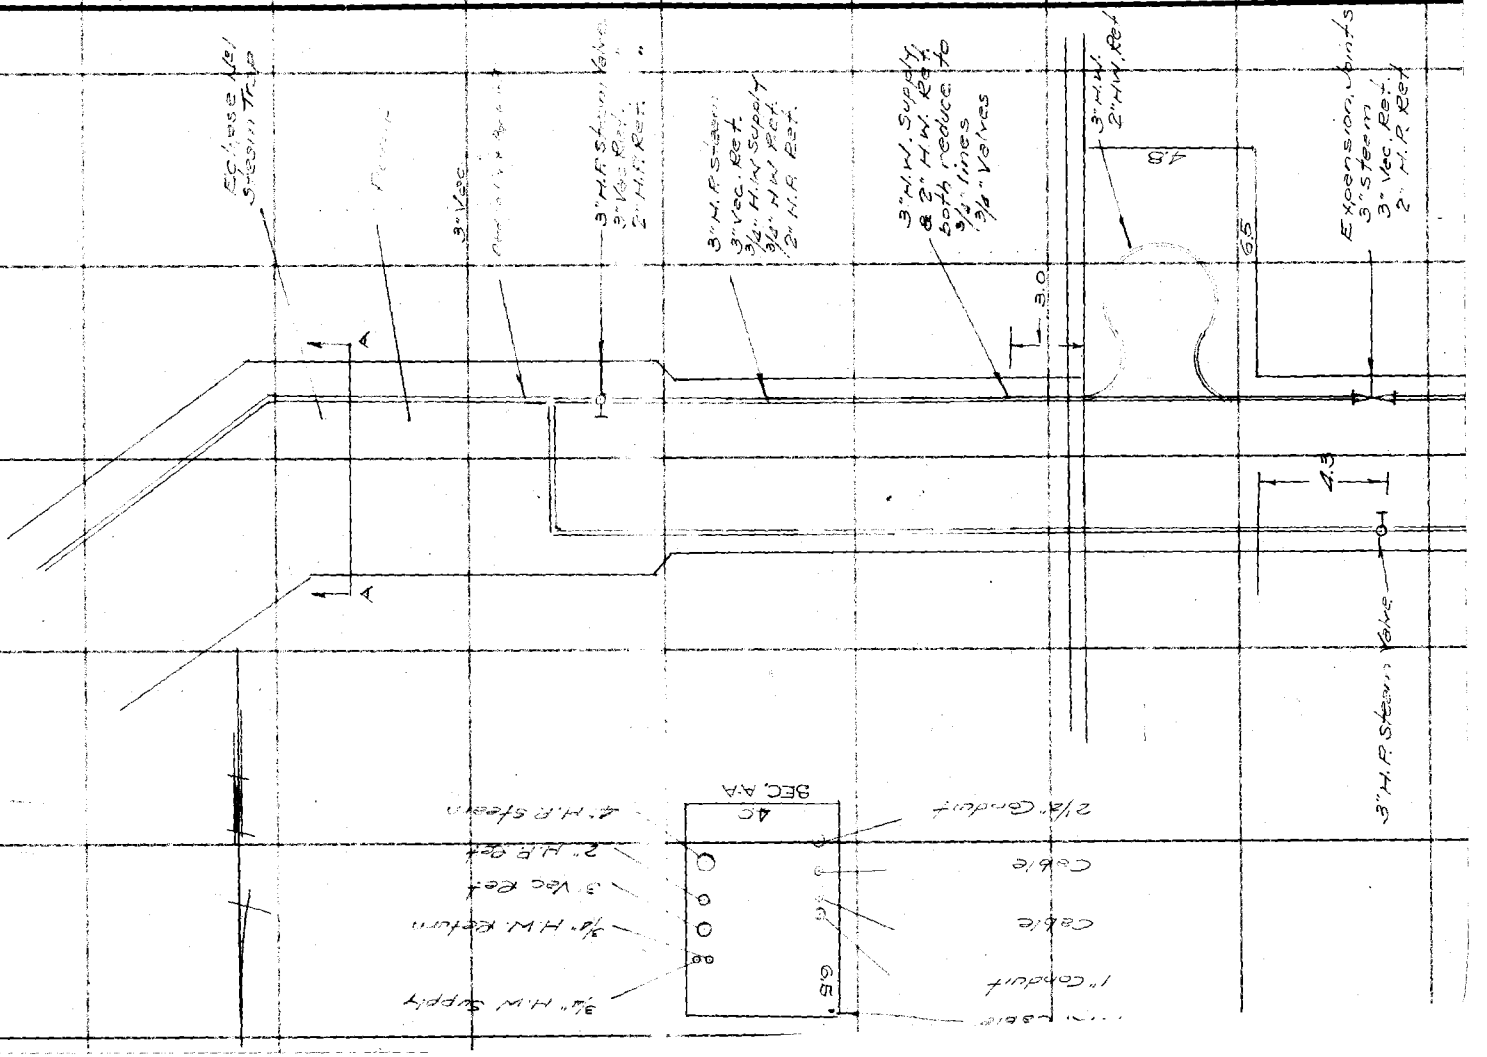

F.B. 7/2 PG. 162

Notes Ck'd by	Survey of OLIVE VIEW SANATORIUM
Map No.	W. O. 8128 Tape No. St'd °F.
Office Work	Surveyed by T. M. WALSH
Checked	Notes T. M. WALSH Date 12-2-36
Date	Indexed A. C. Johnson

F.B. 712 PG. 163

HOT WATER

Note: Any Additions or Changes on This Sheet Must be Made in Red Ink or Circled in Red With Date and Name of Person Making Change.

Do not extend notes this side of this line

RETURN TO
LOS ANGELES COUNTY SURVEYOR
700 HALL OF RECORDS

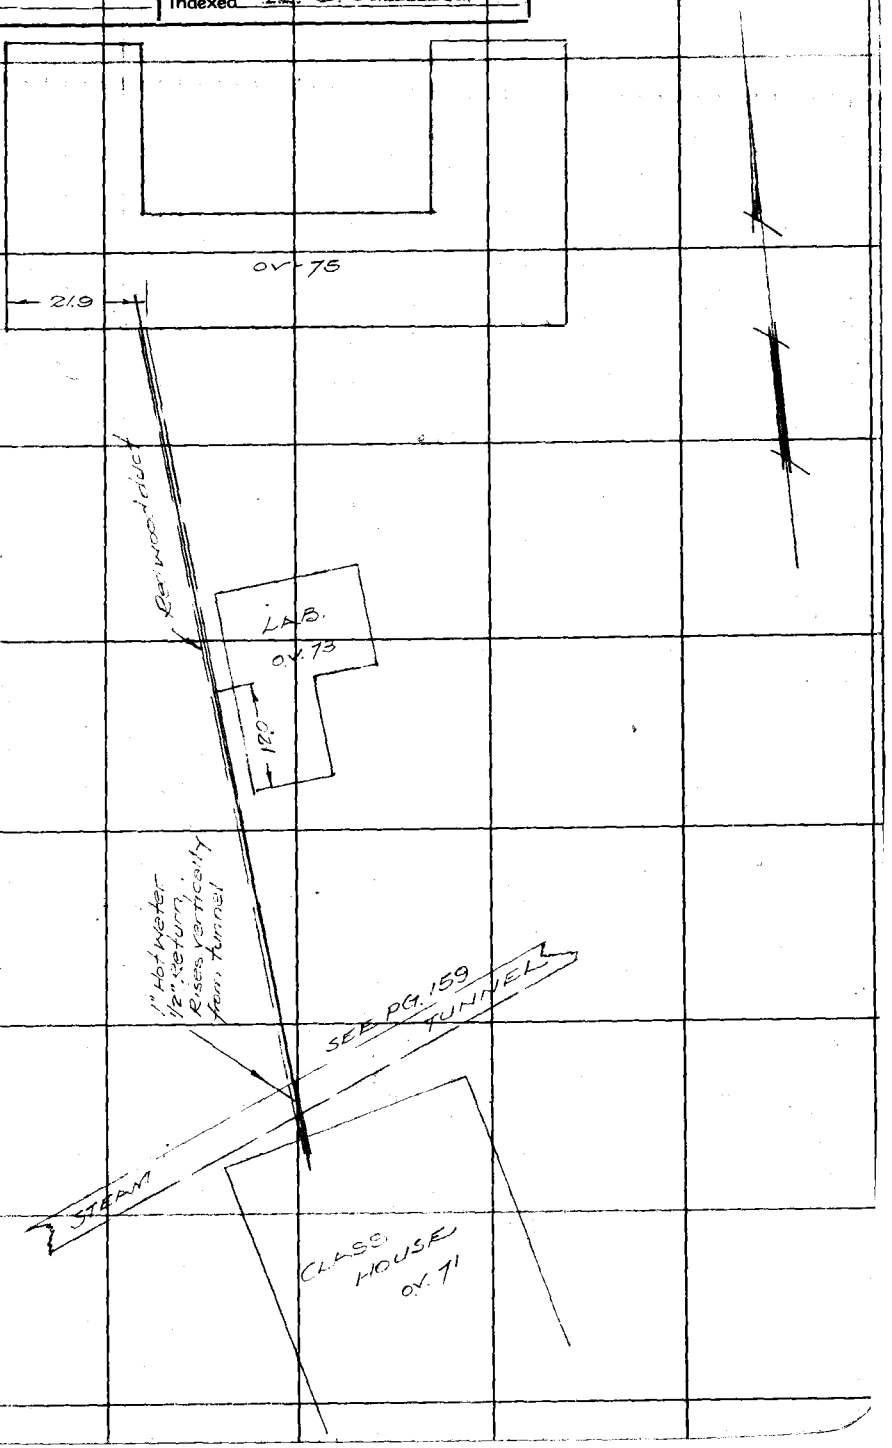

FORM 247 10M 11-35

F.B. 712 PG. 164

HOT WATER

RETURN TO
LOS ANGELES COUNTY SURVEYOR
700 HALL OF RECORDS

Note: Any Additions or Changes on This Sheet Must be Made or Circled in Red Ink With Date and Name of Person Making Change.

Do not extend notes this side of this line

Notes Ck'd by	Survey of [illegible]
Map No.	W. O. 8128 Tape No. St'd °F.
Office Work	Surveyed by T. M. WALSH
Checked	Notes T. M. WALSH Date 9-10-36
Date	Indexed A. C. Johnson

F.B. 712 PG. 165

STEAM TUNNEL

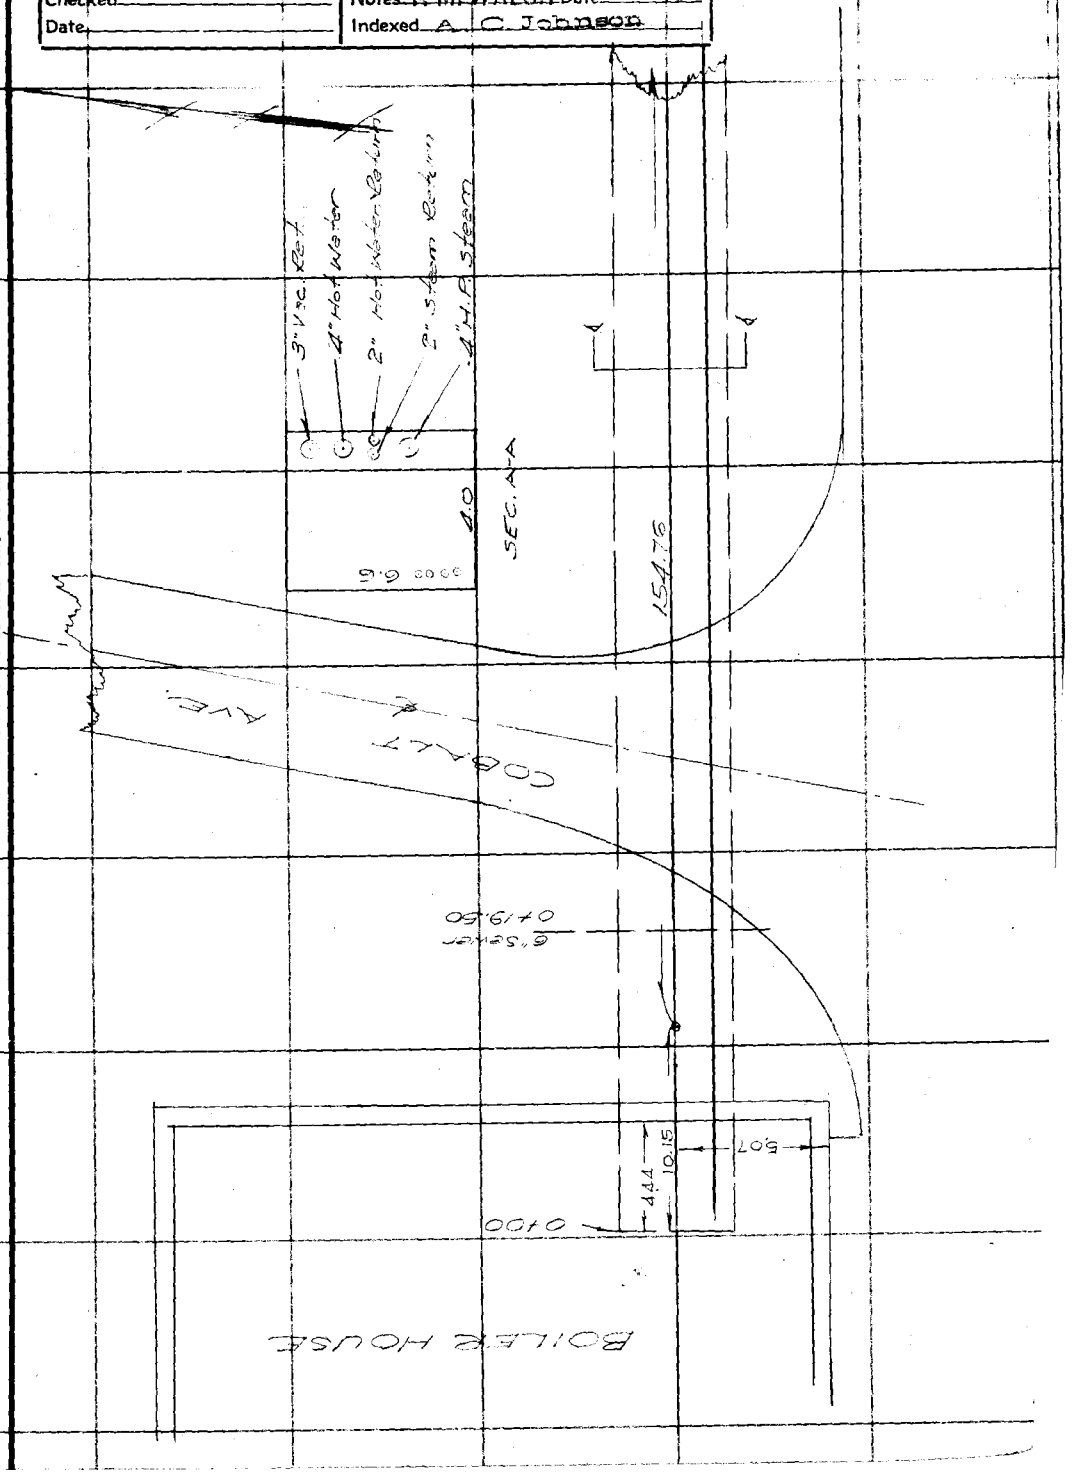

Note: Any Additions or Changes on This Sheet Must be Made or Circled in Red Ink With Date and Name of Person Making Change.

Do not extend notes this side of this line

RETURN TO
LOS ANGELES COUNTY SURVEYOR
700 HALL OF RECORDS

FORM 247 10M 11-35

RETURN TO
LOS ANGELES COUNTY SURVEYOR
700 HALL OF RECORDS

Note: Any Additions or Changes on This Sheet Must be Made or Circled in **Red** Ink With Date and Name of Person Making Change.

Do not extend notes this side of this line

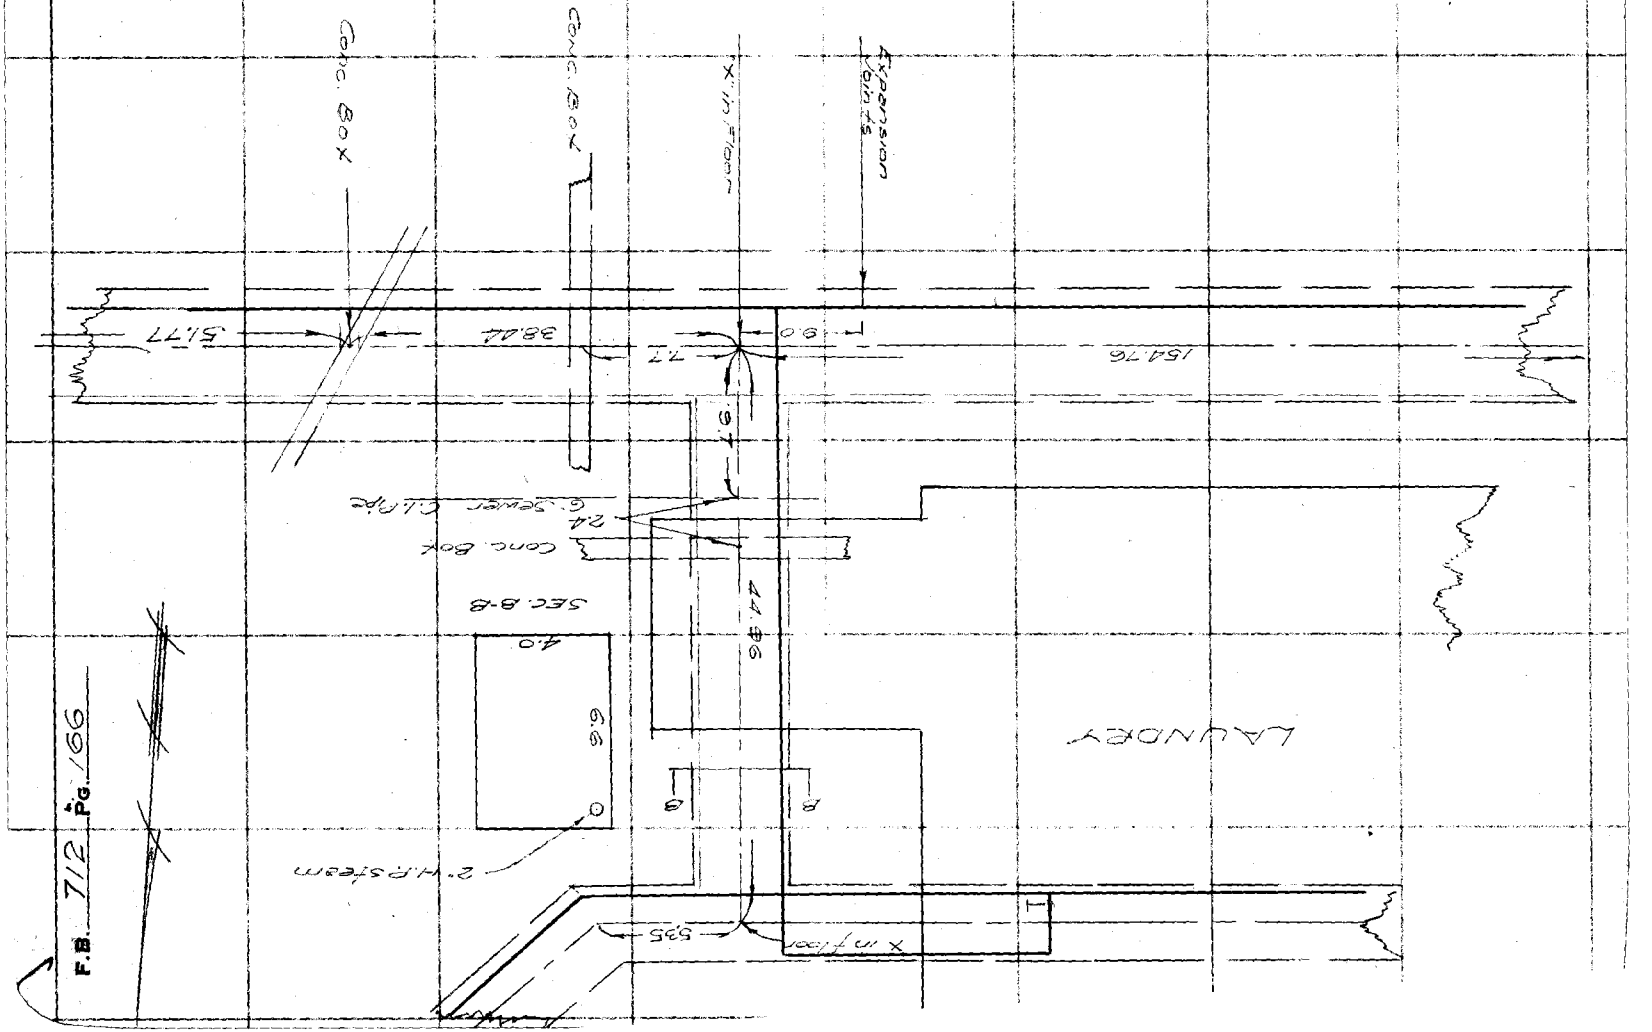

FORM 247 10M 11-35

RETURN TO
LOS ANGELES COUNTY SURVEYOR
700 HALL OF RECORDS

Note: Any Additions or Changes on This Sheet Must be Made or Circled in **Red Ink** With Date and Name of Person Making Change.

Do not extend notes this side of this line

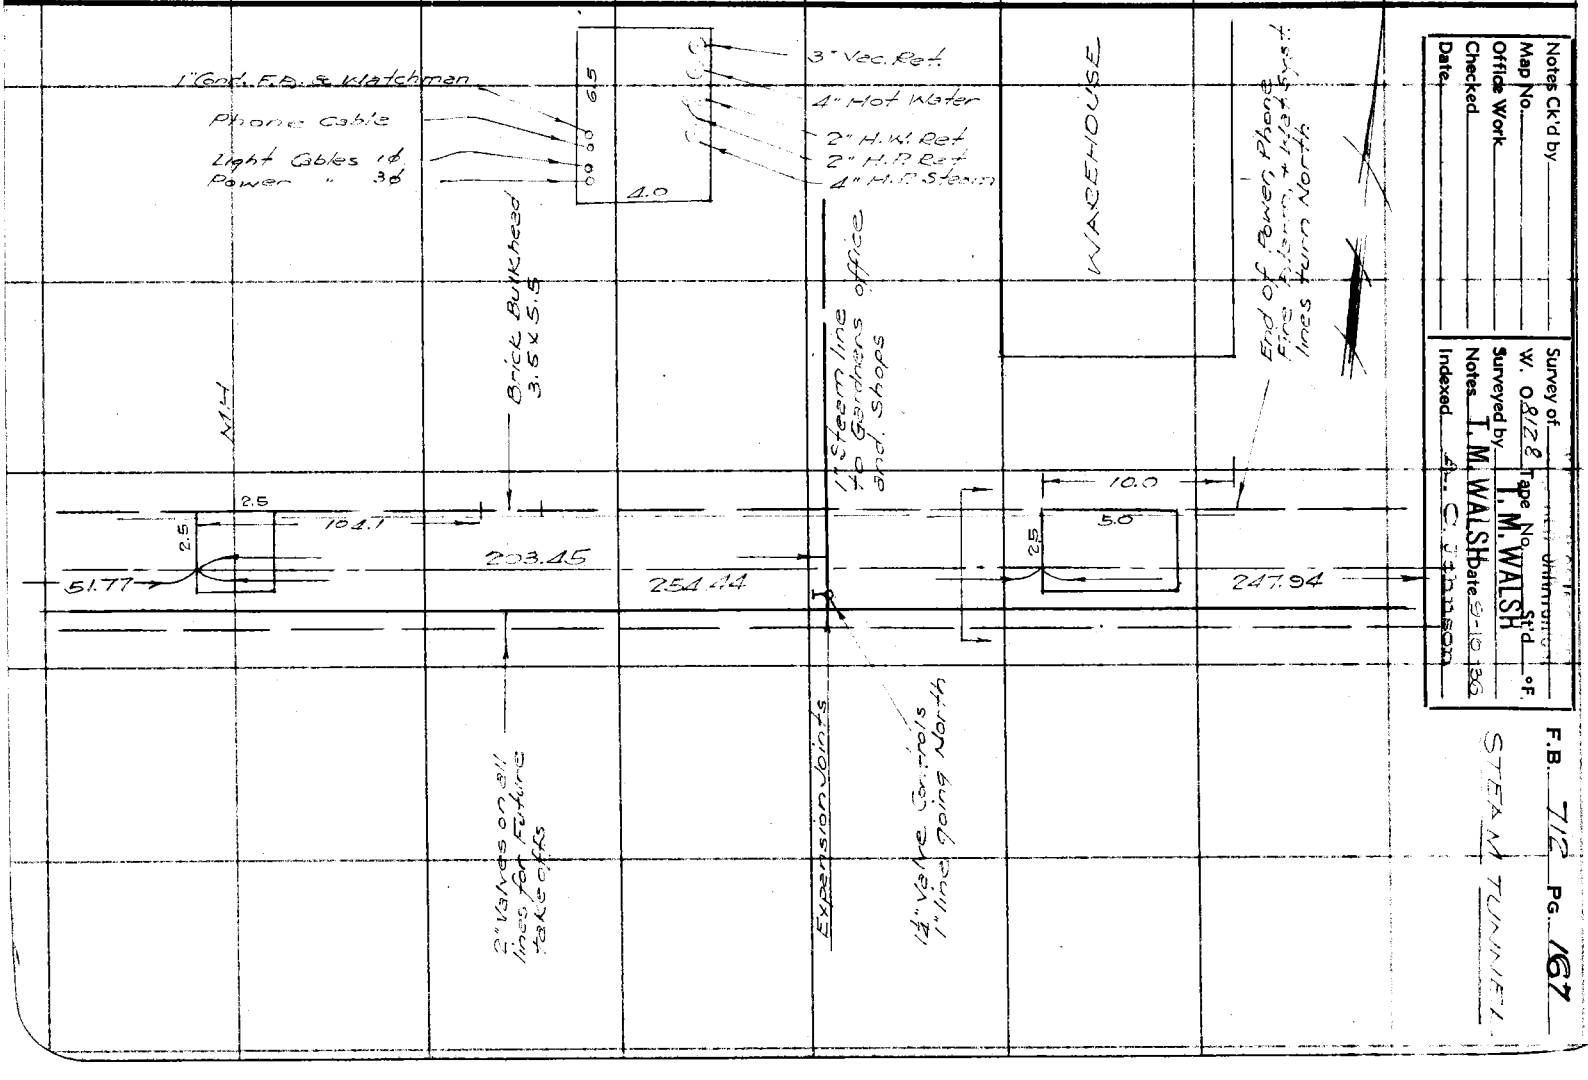

Notes Ck'd by
Map No.
Office Work
Checked
Date

Survey of W. O. 8128 Tape No. Std'd °F.
Surveyed by T. M. WALSH Date 9-10-36
Notes T. M. WALSH

F.B. 712 PG. 167

STEAM TUNNEL

RETURN TO
LOS ANGELES COUNTY SURVEYOR
700 HALL OF RECORDS

Note: Any Additions or Changes on This Sheet Must be Made or Circled in **Red Ink** With Date and Name of Person Making Change.

Do not extend notes this side of this line

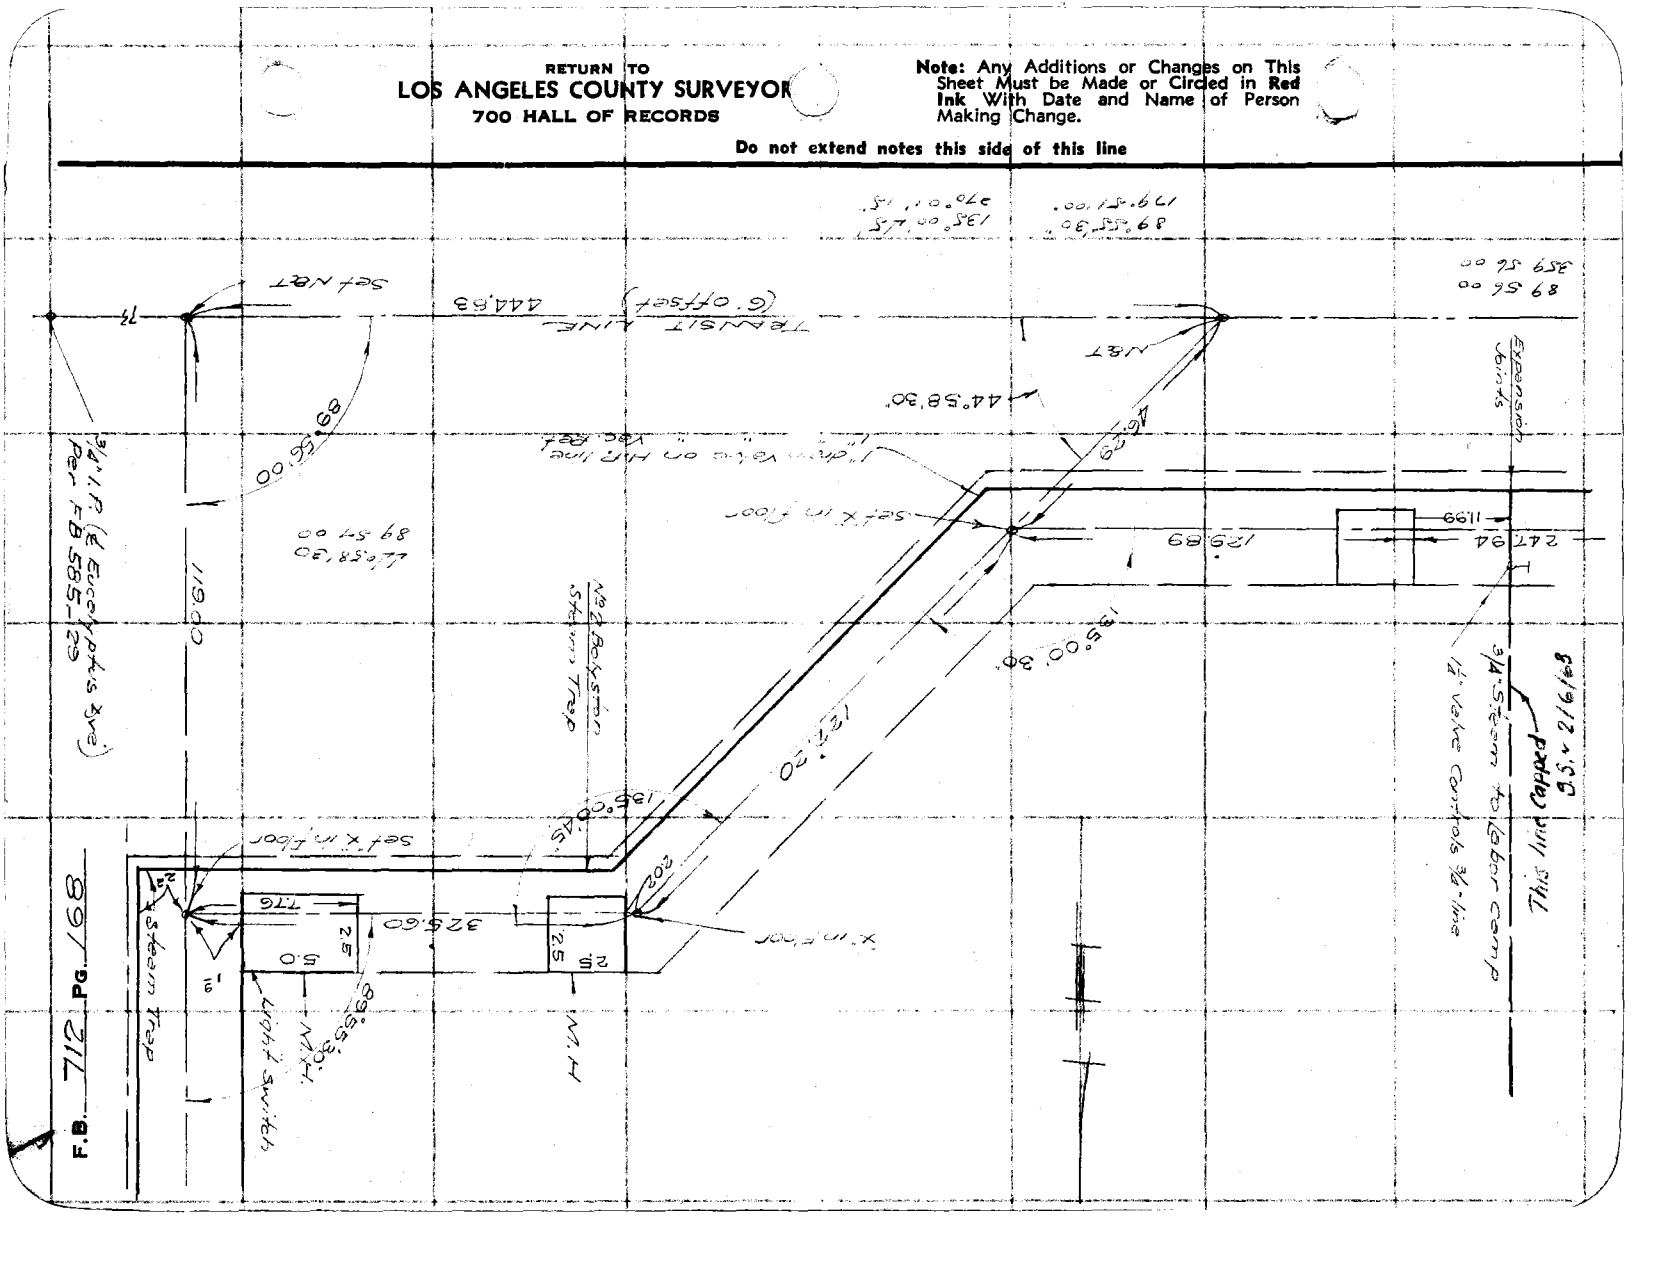

Notes Ck'd by	Survey of
Map No.	W. O. 8128 Tape No. St'd °F.
Office Work	Surveyed by T. M. WALSH
Checked	Notes T. M. WALSH Date 12-3-[illegible]
Date	Indexed

F.B. 712 PG. 169

STEAM LINE
SECONDARY

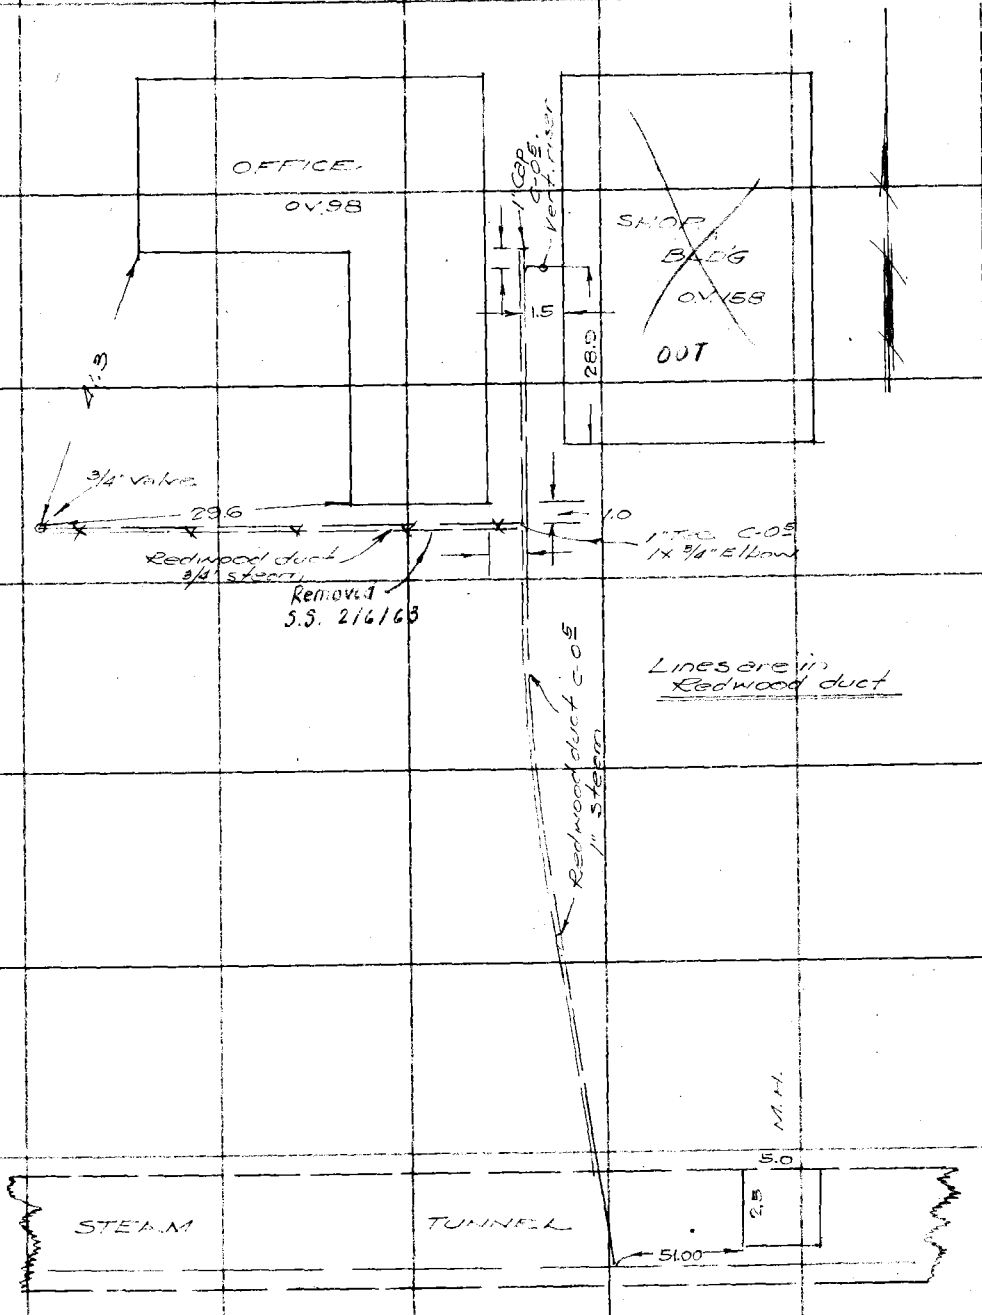

Note: Any Additions or Changes on This Sheet Must be Made or Circled in Red Ink With Date and Name of Person Making Change.

Do not extend notes this side of this line

RETURN TO
LOS ANGELES COUNTY SURVEYOR
700 HALL OF RECORDS

FORM 247 10M 11-38

F.B. 712 PG. 170

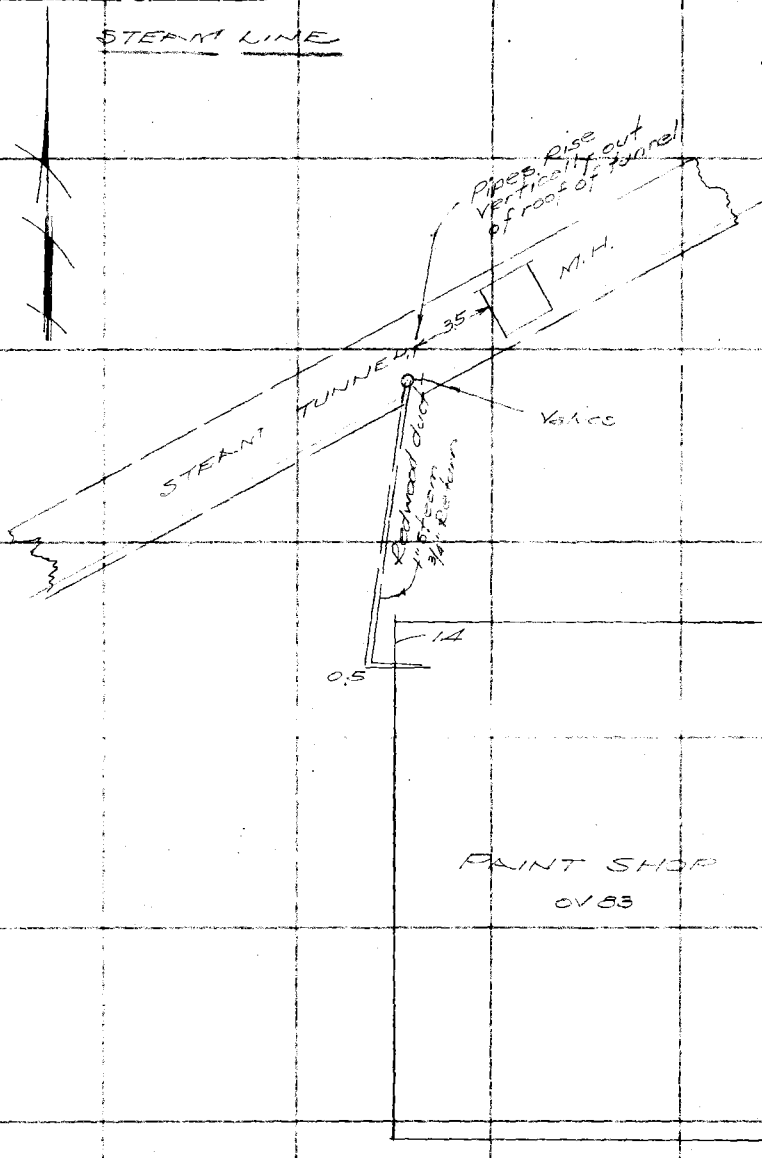

RETURN TO
LOS ANGELES COUNTY SURVEYOR
700 HALL OF RECORDS

Note: Any Additions or Changes on This Sheet Must be Made or Circled in Red Ink With Date and Name of Person Making Change.

Do not extend notes this side of this line

Notes Ck'd by	Survey of OLIVE VIEW SANATORIUM	F.B. 712 PG. 171
Map No.	W. O. 8128 Tape No. St'd °F.	HOT WATER
Office Work	Surveyed by T. M. WALSH	STEAM LINE
Checked	Notes T. M. WALSH Date 9-36	SECONDARY
Date	Indexed A. C. Johnson	

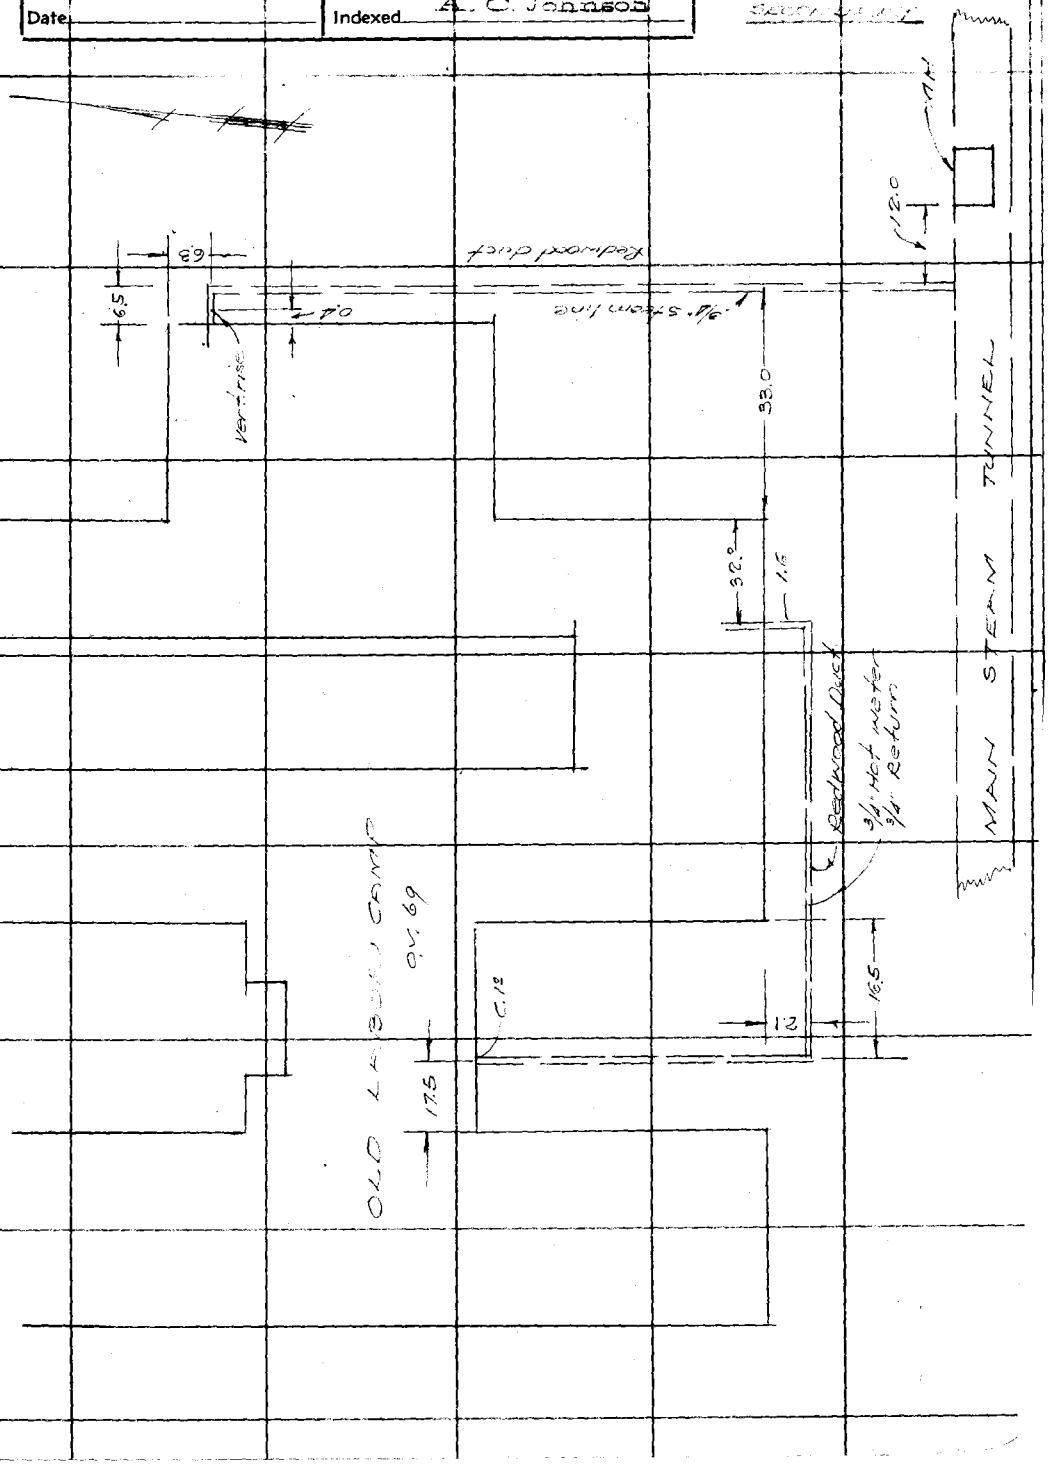

Note: Any Additions or Changes on This Sheet Must be Made or Circled in Red Ink With Date and Name of Person Making Change.

Do not extend notes this side of this line

RETURN TO
LOS ANGELES COUNTY SURVEYOR
700 HALL OF RECORDS

FORM 247 10M 11-35

RETURN TO
LOS ANGELES COUNTY SURVEYOR
700 HALL OF RECORDS

Note: Any Additions or Changes on This Sheet Must be Made or Circled in **Red Ink** With Date and Name of Person Making Change.

Do not extend notes this side of this line

F.B. 712 PG. 172

Notes Ck'd by	Survey of OLIVE VIEW SANATORIUM
Map No.	W. O. 8128 Tape No. St'd °F.
Office Work	Surveyed by T. M. WALSH
Checked	Notes T. M. WALSH Date 9-15-36
Date	Indexed A. C. Johnson

F.B. 712 PG. 173

STEAM TUNNEL

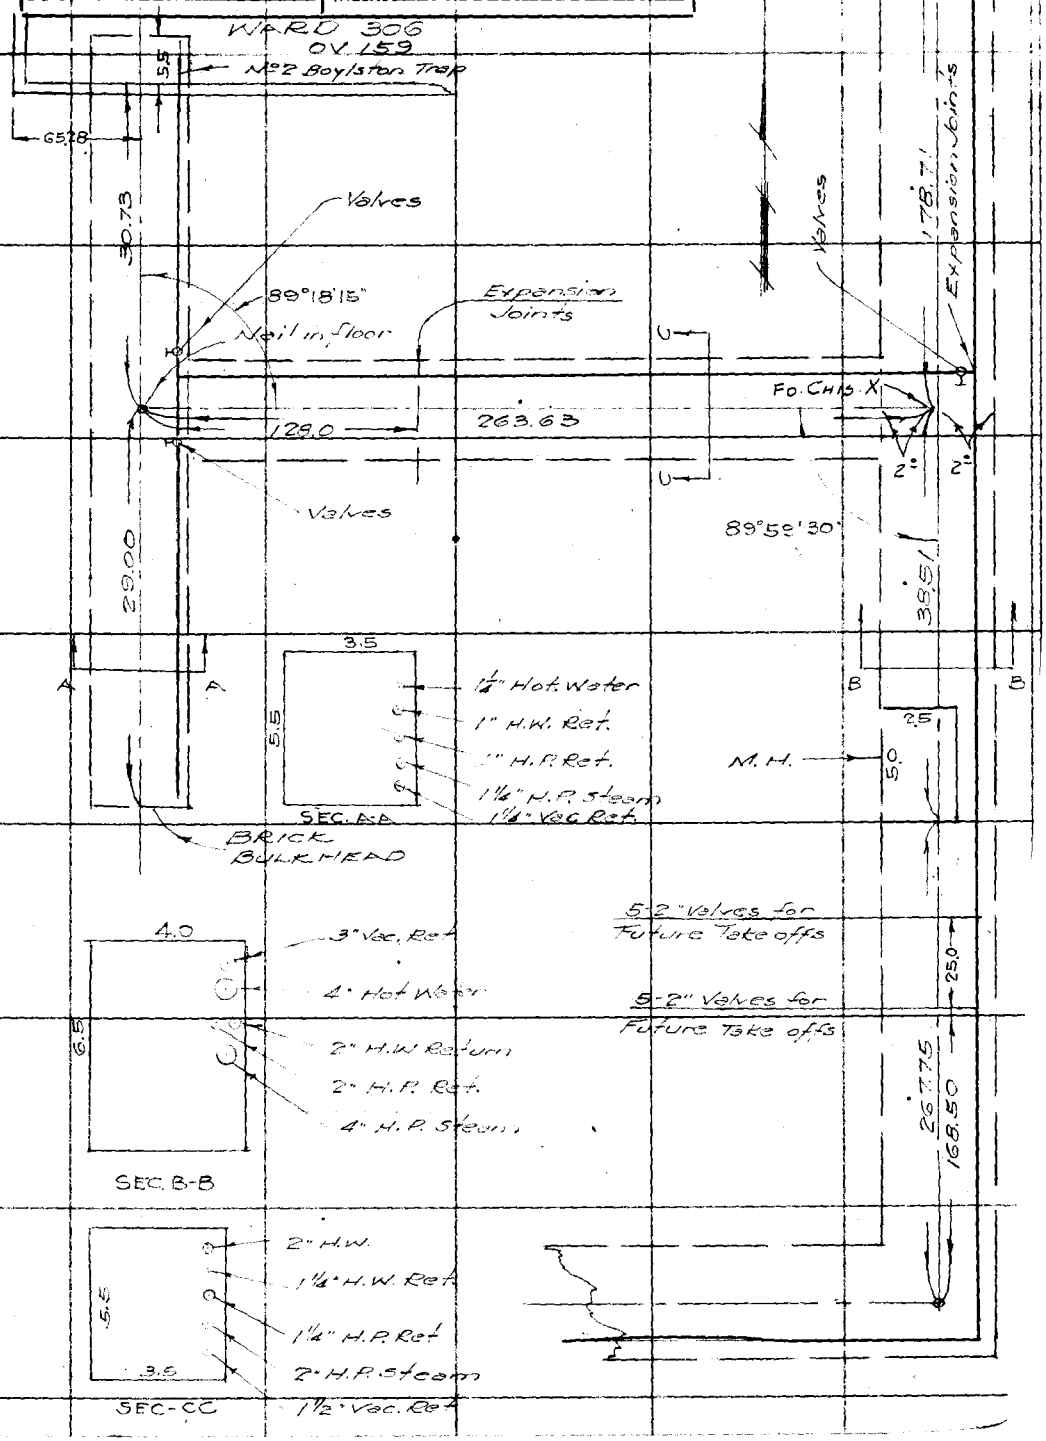

Note: Any Additions or Changes on This Sheet Must be Made or Circled in Red Ink With Date and Name of Person Making Change.

Do not extend notes this side of this line

RETURN TO
LOS ANGELES COUNTY SURVEYOR
700 HALL OF RECORDS

FORM 247 10M 11-35

RETURN TO
LOS ANGELES COUNTY SURVEYOR
700 HALL OF RECORDS

Note: Any Additions or Changes on This Sheet Must be Made or Circled in **Red** Ink With Date and Name of Person Making Change.

Do not extend notes this side of this line

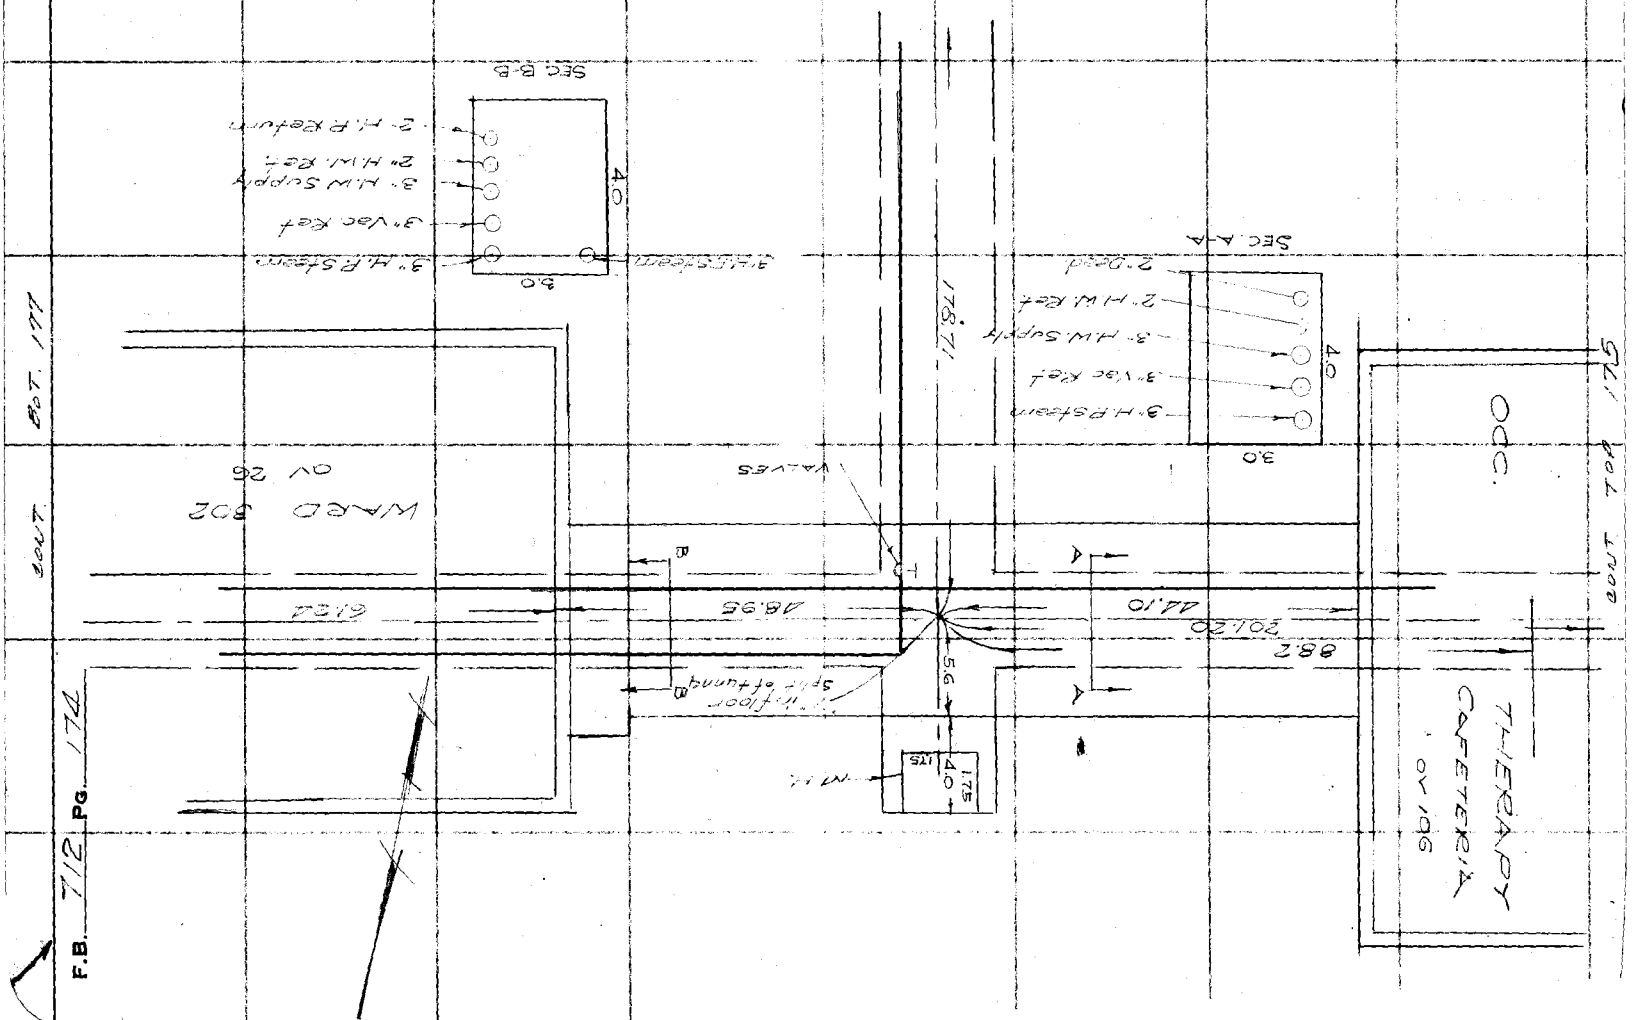

FORM 247 10M 11-38

RETURN TO
LOS ANGELES COUNTY SURVEYOR
700 HALL OF RECORDS

Note: Any Additions or Changes on This Sheet Must be Made or Circled in **Red Ink** With Date and Name of Person Making Change.

Do not extend notes this side of this line

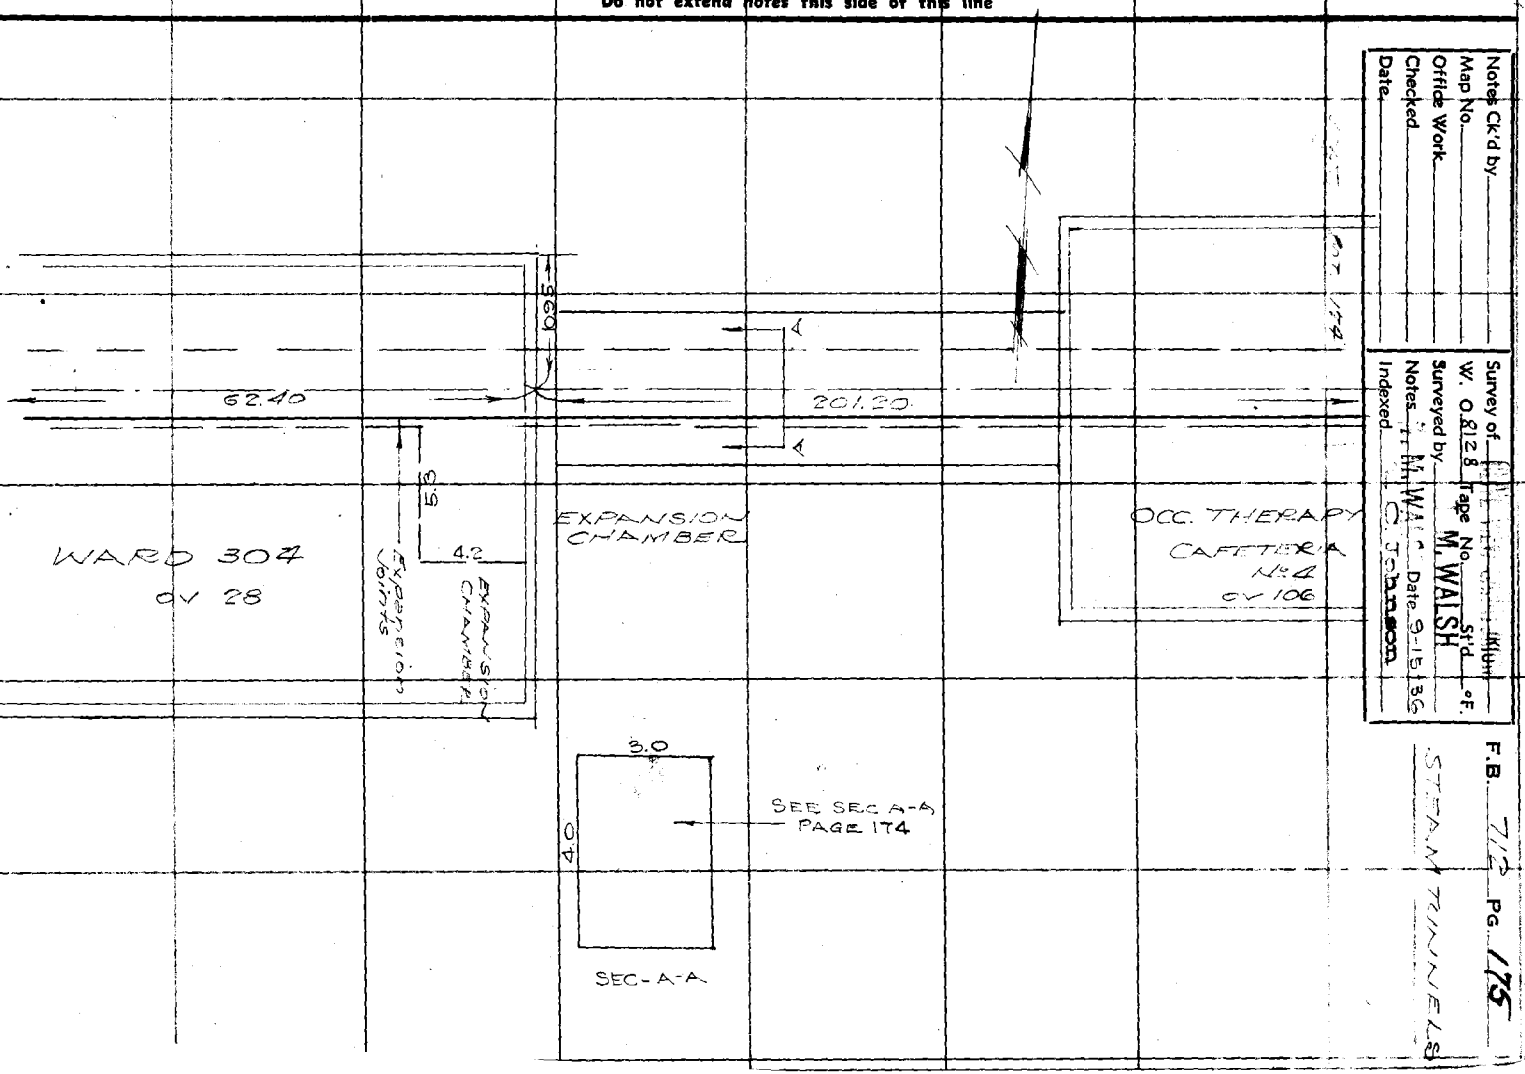

Notes Ck'd by
Map No.
Office Work
Checked
Date

Survey of W. O. 8128
Surveyed by
Notes
Indexed

Tape No. M. WALSH Std. °F.
M. Walsh Date 9-15-36
C. Johnson

F.B. 712 PG. 175

STEAM TUNNELS

RETURN TO
LOS ANGELES COUNTY SURVEYOR
700 HALL OF RECORDS

Note: Any Additions or Changes on This Sheet Must be Made or Circled in **Red** Ink With Date and Name of Person Making Change.

Do not extend notes this side of this line

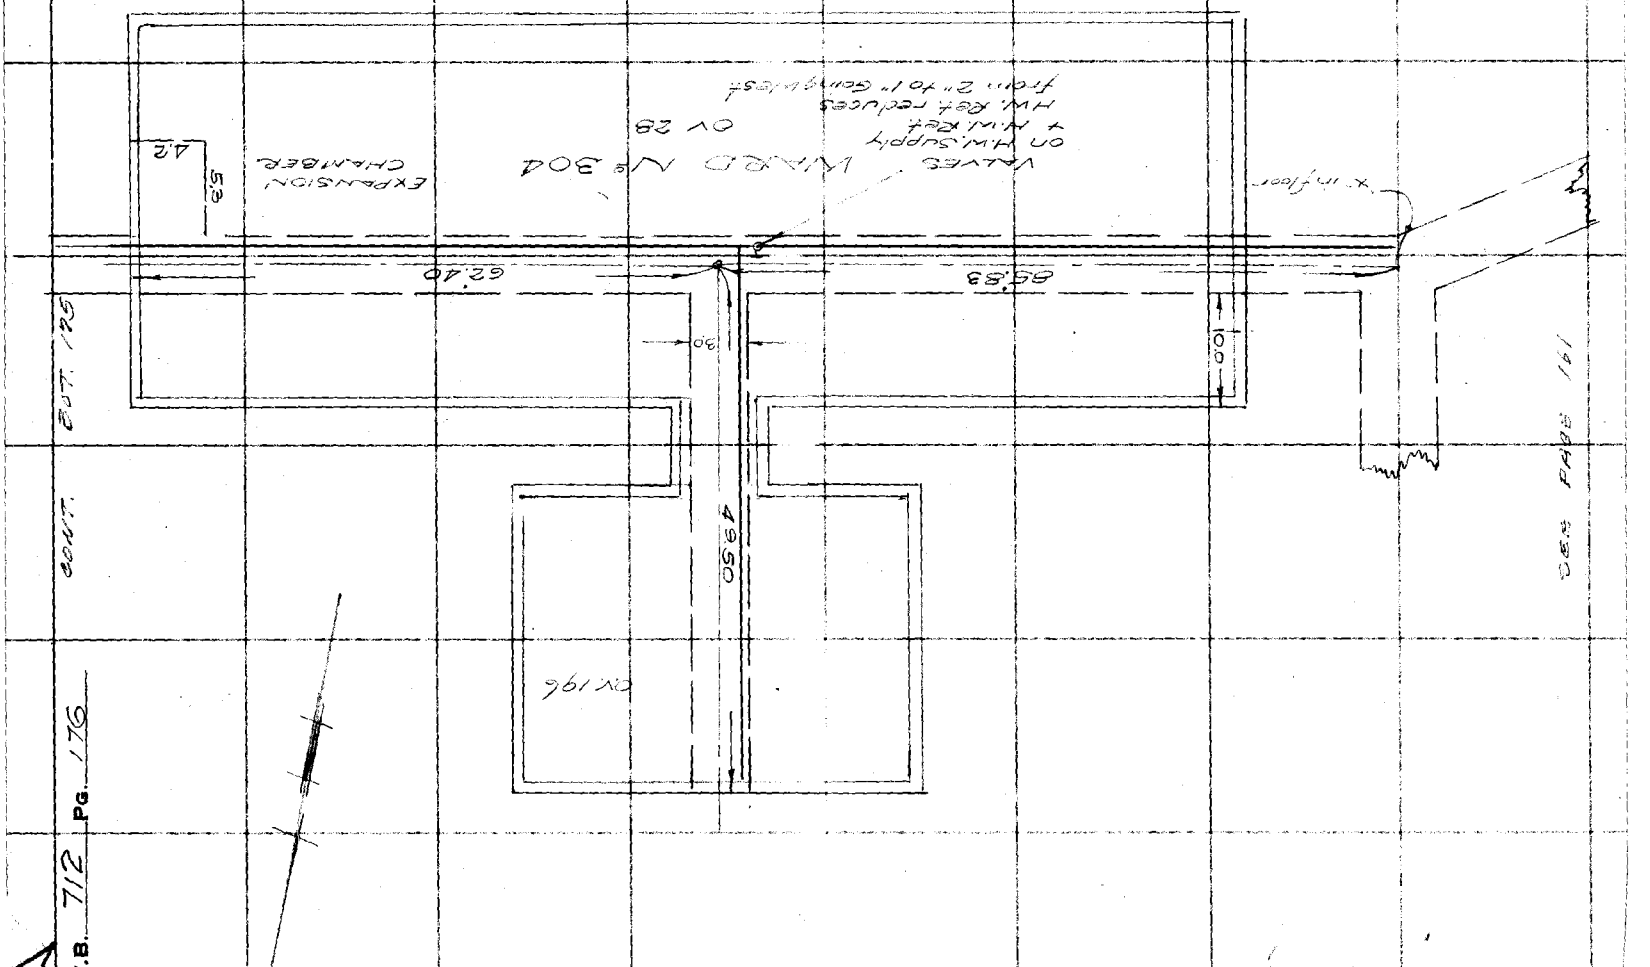

Notes Ck'd by	Survey of
Map No.	W. O. 8128 Tape No. Std °F.
Office Work	Surveyed by T. M. WALSH
Checked	Notes T. M. WALSH Date 9-15-36
Date	Indexed A. C. Johnson

F.B. 712 PG. 177

STEEL TUNNEL

CONT. EST. 178

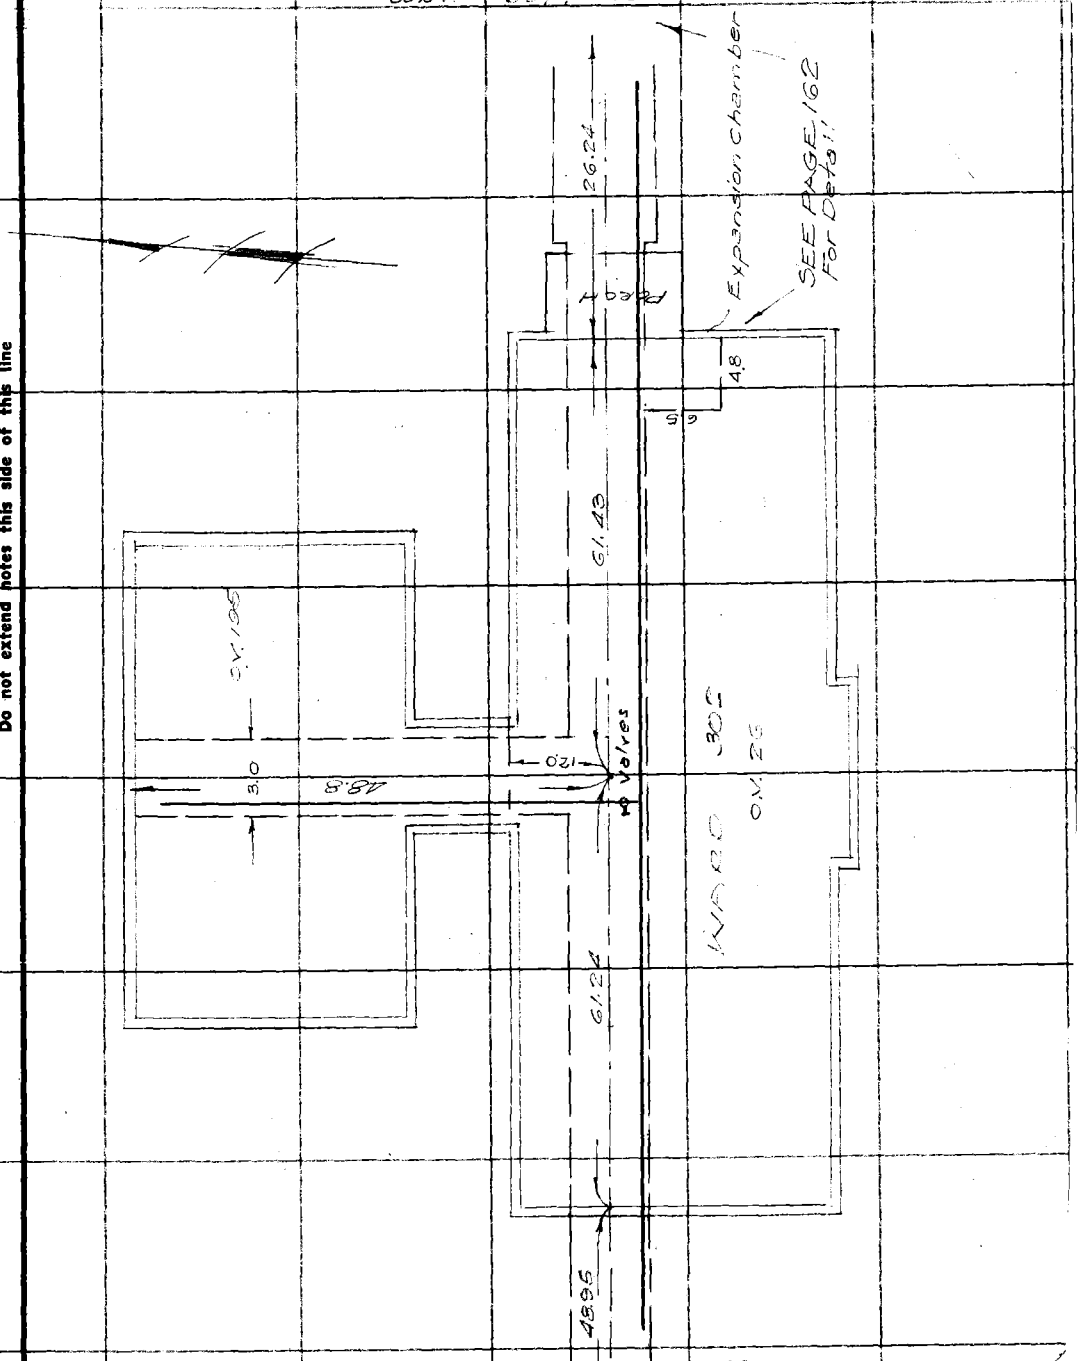

Note: Any Additions or Changes on This Sheet Must be Made in Red Ink or Circled in Red With Date and Name of Person Making Change.

Do not extend notes this side of this line

RETURN TO
LOS ANGELES COUNTY SURVEYOR
700 HALL OF RECORDS

FORM 247 10M 11-35

RETURN TO
LOS ANGELES COUNTY SURVEYOR
700 HALL OF RECORDS

Note: Any Additions or Changes on This Sheet Must be Made or Circled in **Red Ink** With Date and Name of Person Making Change.

Do not extend notes this side of this line

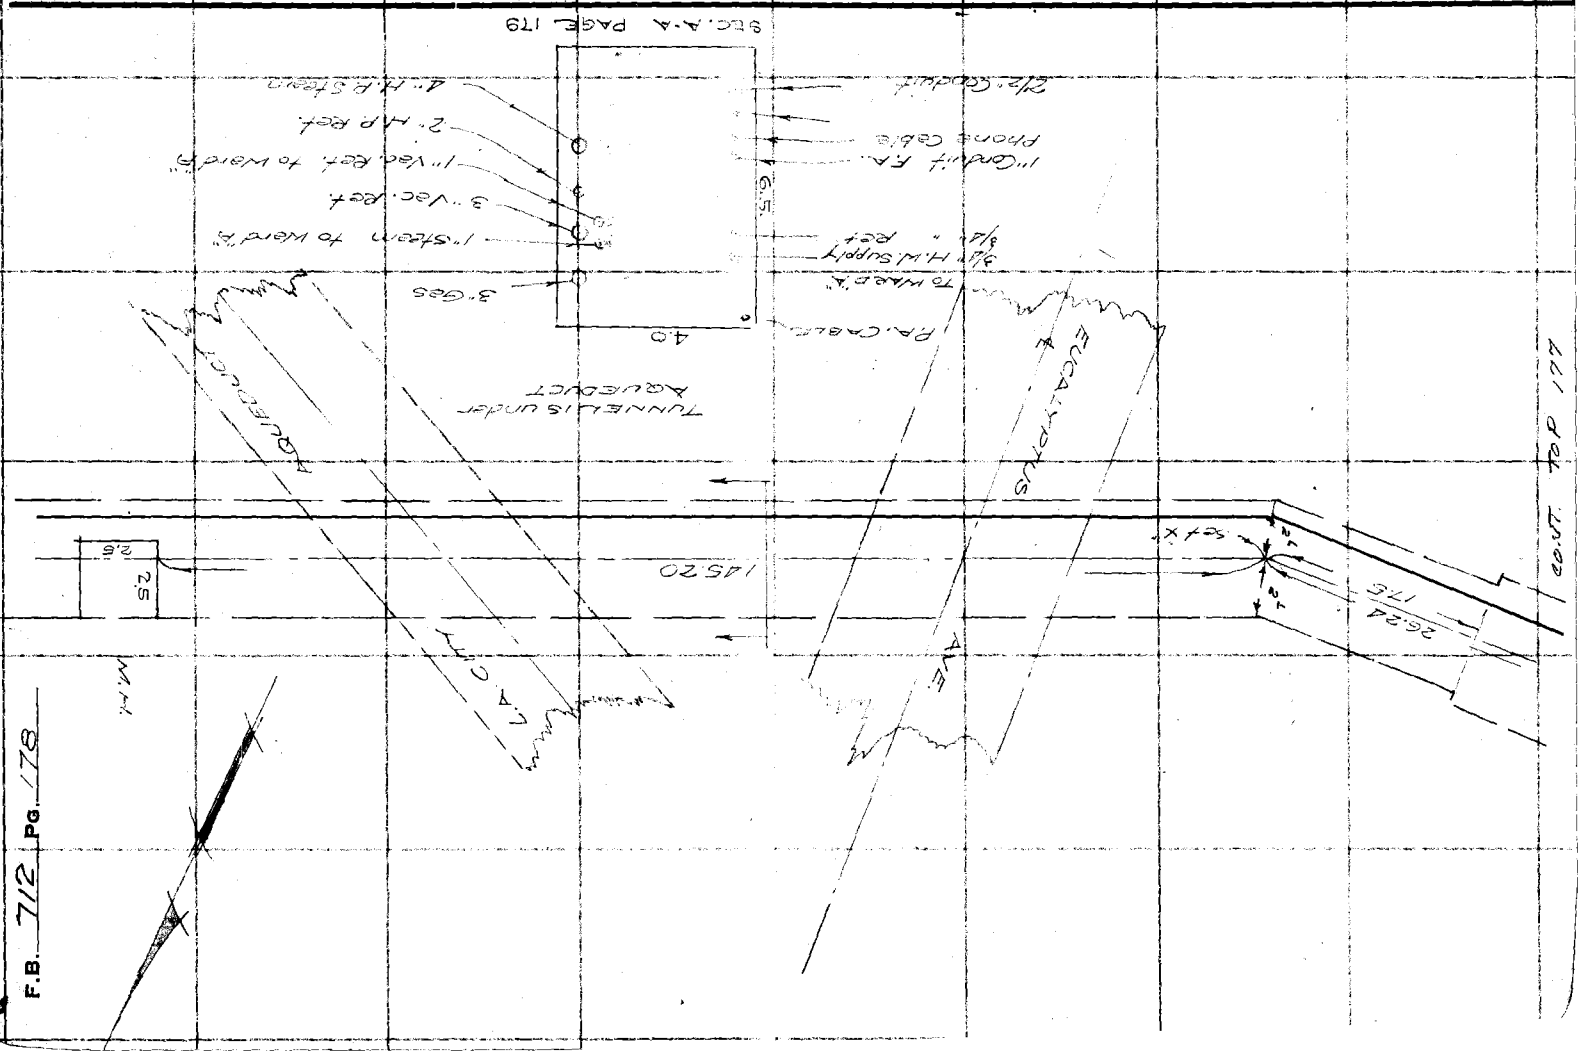

Notes Ck'd by	Survey of
Map No.	W. O. 8128 Tape No. St'd °F.
Office Work	Surveyed by T. M. WALSH
Checked	Notes T. M. WALSH Date 9-15-36
Date	Indexed A. C. Johnson

F.B. 712 PG. 179

STEAM TUNNELS

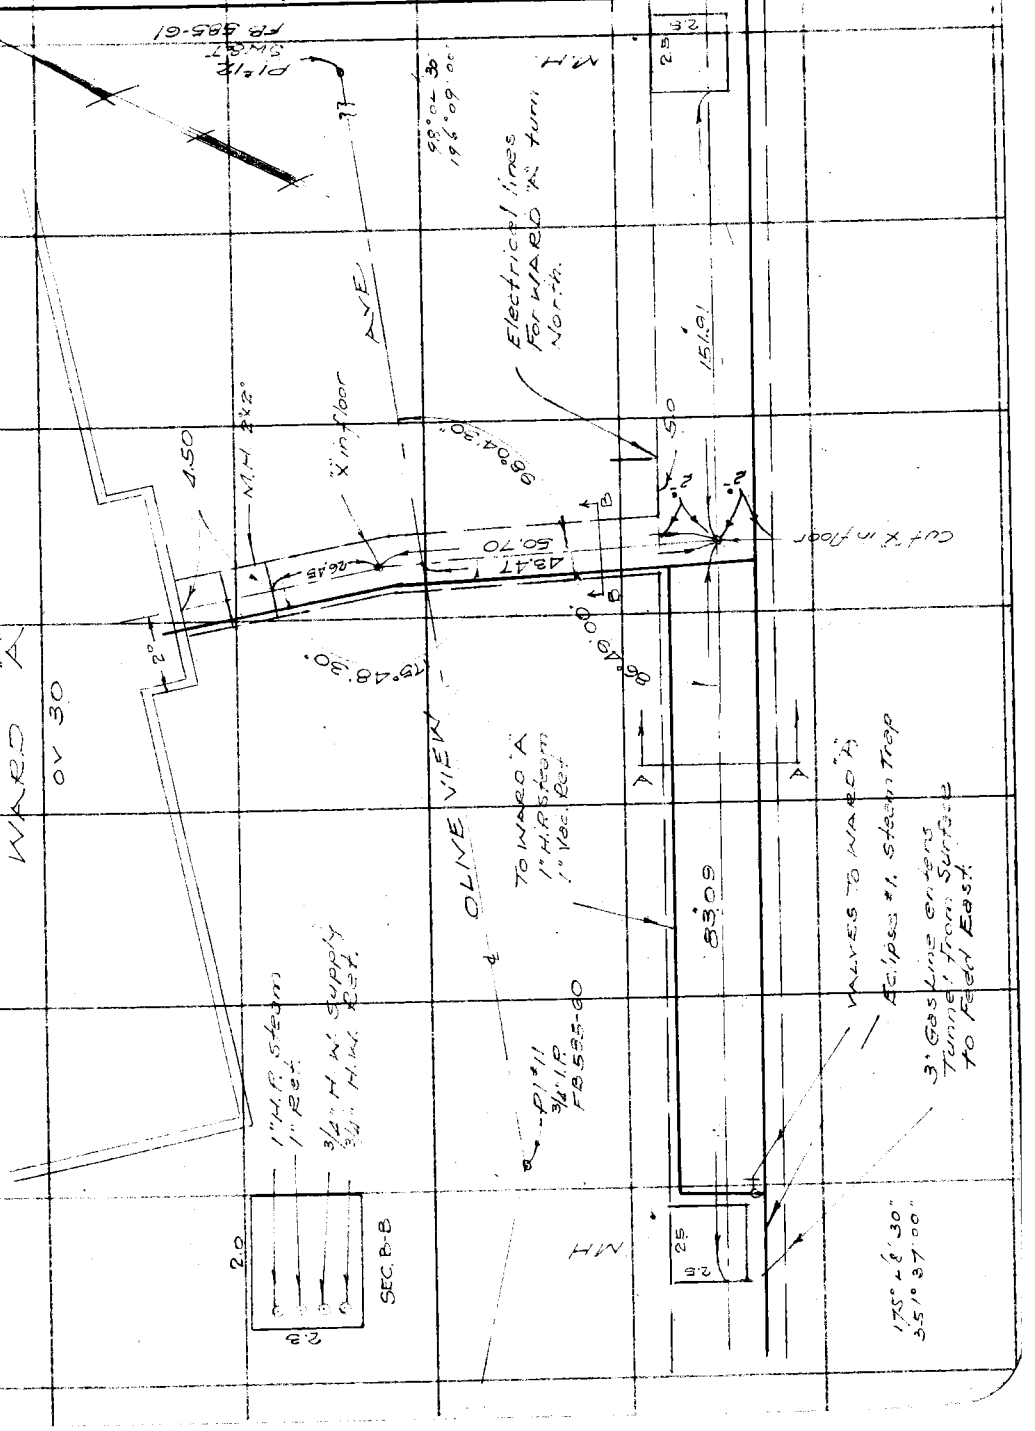

Note: Any Additions or Changes on This Sheet Must be Made or Circled in Red Ink With Date and Name of Person Making Change.

Do not extend notes this side of this line

RETURN TO
LOS ANGELES COUNTY SURVEYOR
700 HALL OF RECORDS

FORM 247 10M 11-35

RETURN TO
LOS ANGELES COUNTY SURVEYOR
700 HALL OF RECORDS

Note: Any Additions or Changes on This Sheet Must be Made or Circled in **Red Ink** With Date and Name of Person Making Change.

Do not extend notes this side of this line

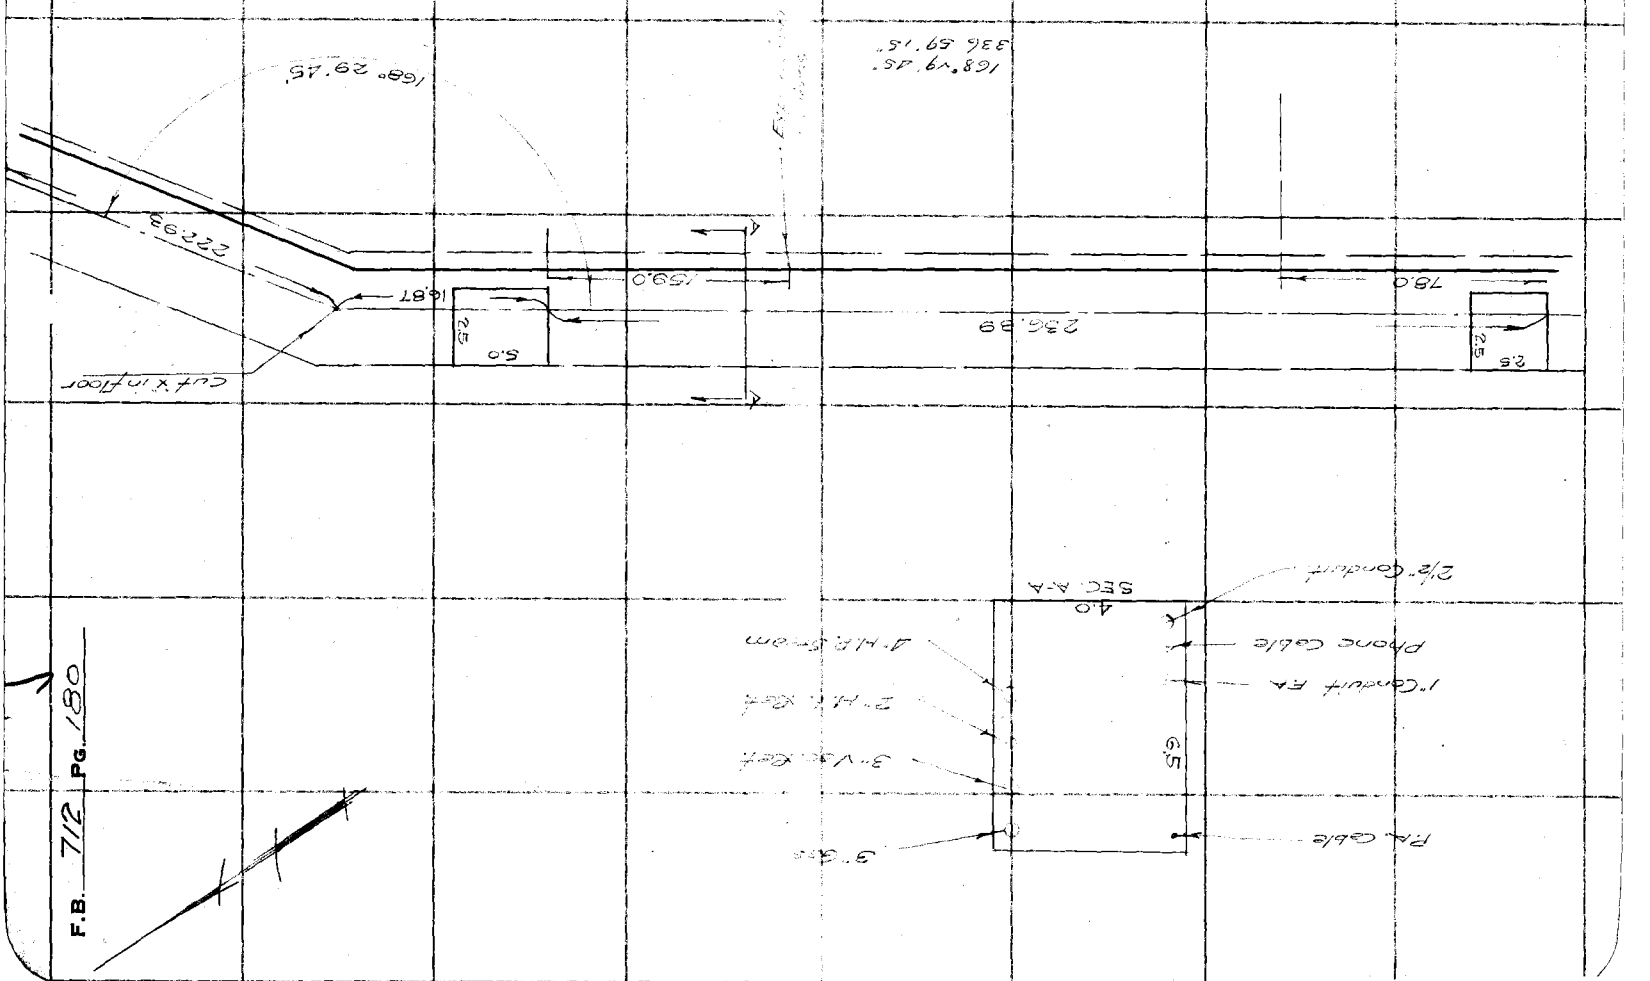

F.B. 712 Pg. 180

Notes Ck'd by	Survey of	F.B. 712 Pg. 181
Map No.	W. O. 8128 Tape No. St'd °F.	STEAM TUNNELS
Office Work	Surveyed by T. M. WALSH	
Checked	Notes T. M. WALSH Date 9-15-36	
Date	Indexed A. C. Johnson	

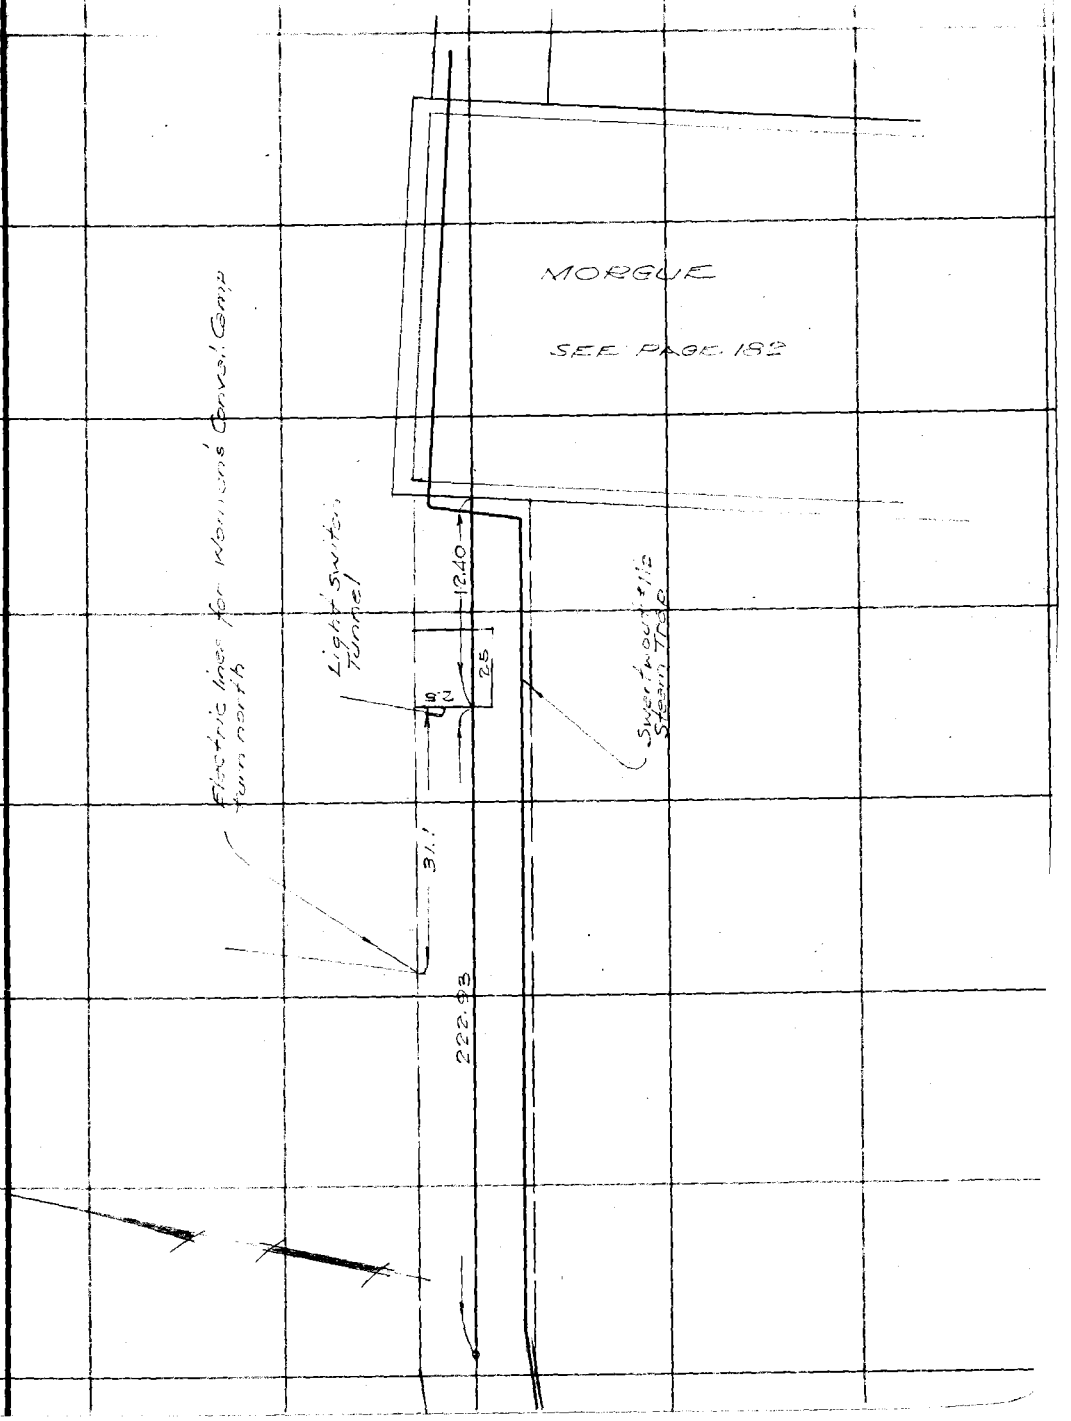

RETURN TO
LOS ANGELES COUNTY SURVEYOR
700 HALL OF RECORDS

Note: Any Additions or Changes on This Sheet Must be Made or Circled in Red Ink With Date and Name of Person Making Change.

Do not extend notes this side of this line

FORM 247 10M 11-35

RETURN TO
LOS ANGELES COUNTY SURVEYOR
700 HALL OF RECORDS

Note: Any Additions or Changes on This Sheet Must be Made or Circled in **Red Ink** With Date and Name of Person Making Change.

Do not extend notes this side of this line

F.B. 712 Pg. 182

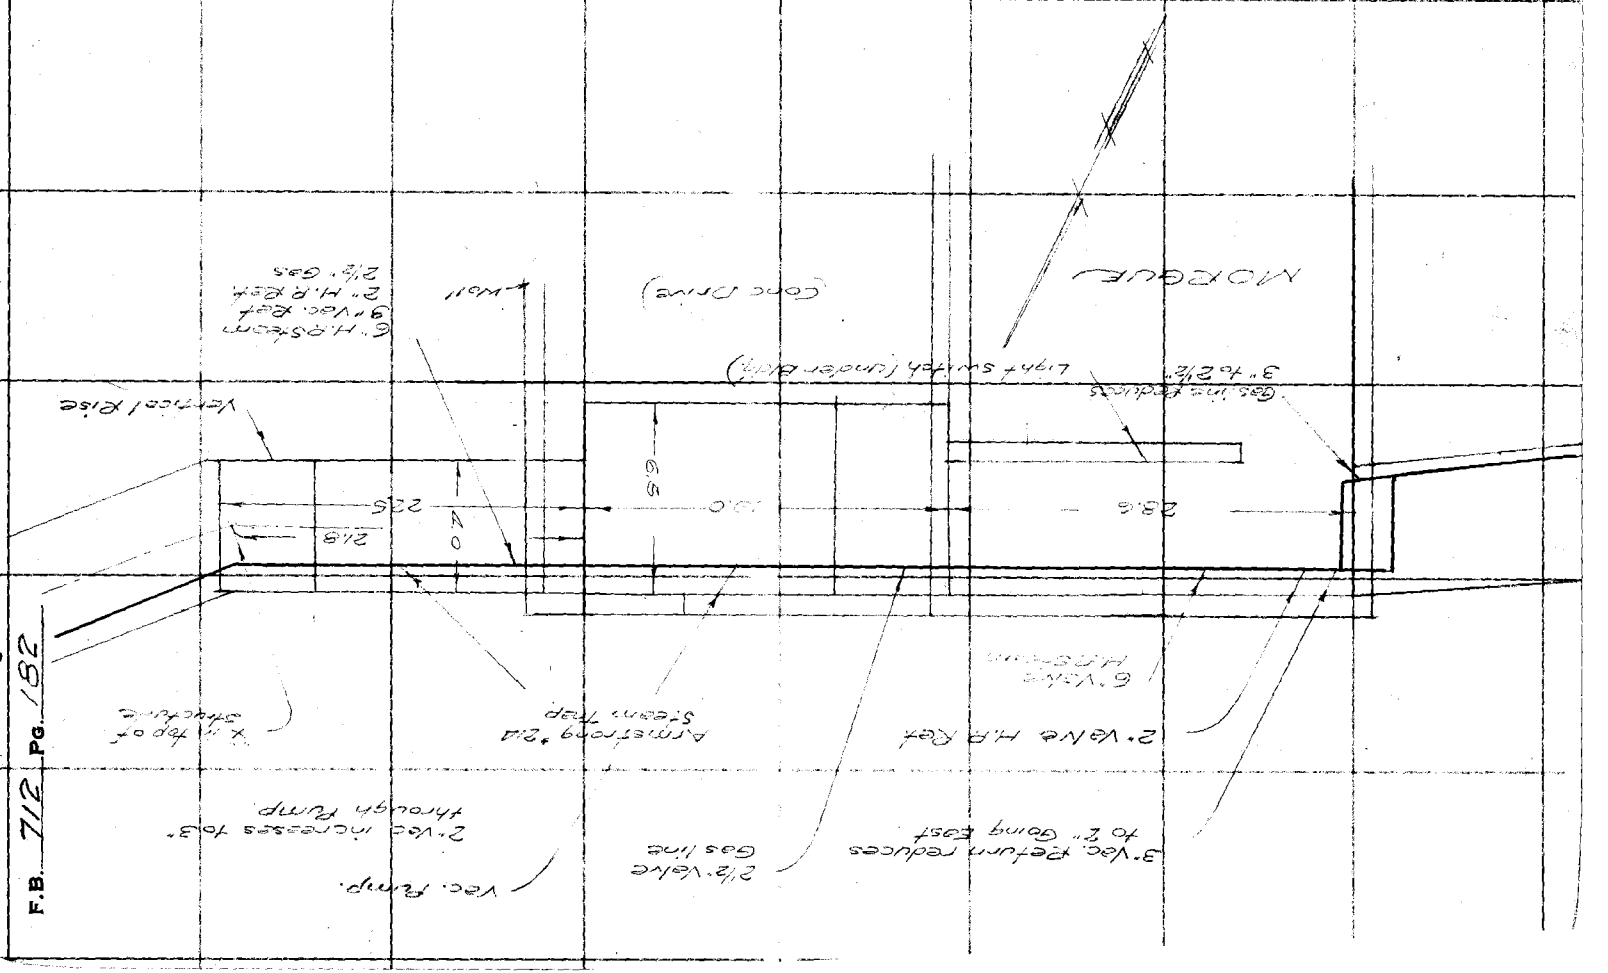

Notes Ck'd by		Survey of	
Map No.		W. O. 8128	Tape No. St'd °F.
Offlbe Work		Surveyed by	M. WALSH
Chetked		Notes	M. WALSH Date 1-12-37
Date		Indexed	A. C. Johnson

F.B. 712 PG. 183

STEAM TUNNEL

Note: Any Additions or Changes on This Sheet Must be Made or Circled in Red Ink With Date and Name of Person Making Change.

Do not extend notes this side of this line

RETURN TO
LOS ANGELES COUNTY SURVEYOR
700 HALL OF RECORDS

FORM 247 10M 11-35

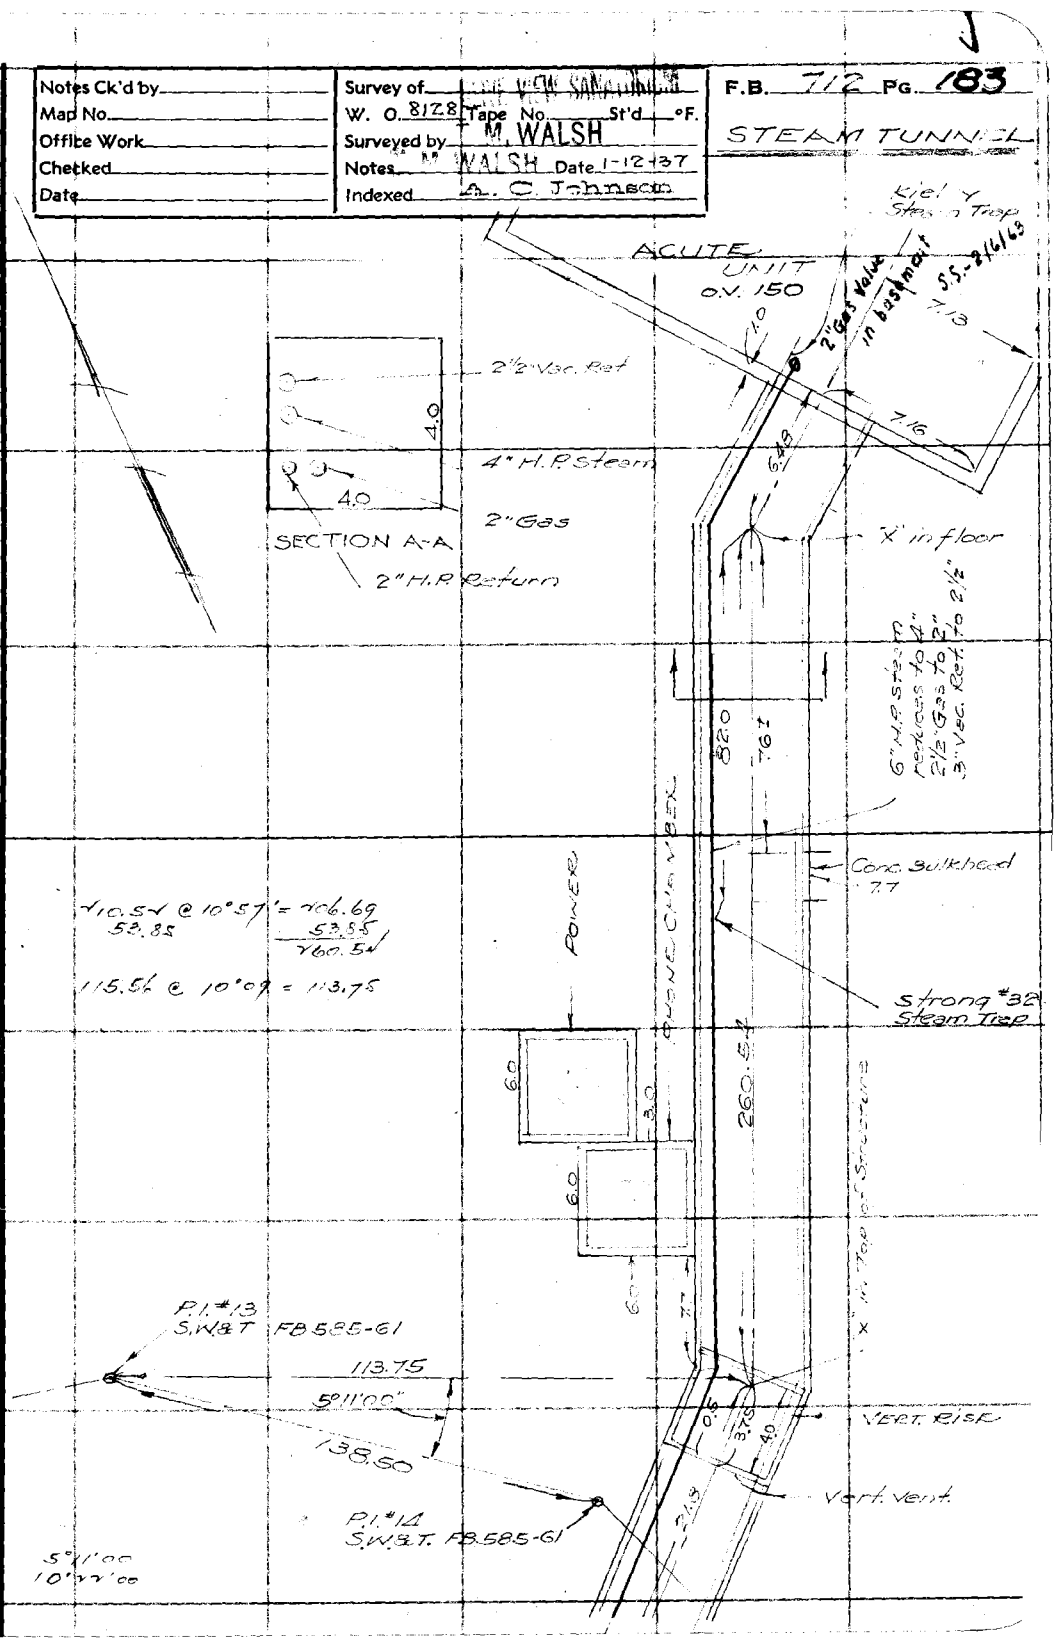

RETURN TO
LOS ANGELES COUNTY SURVEYOR
700 HALL OF RECORDS

Note: Any Additions or Changes on This Sheet Must be Made or Circled in **Red Ink** With Date and Name of Person Making Change.

. Do not extend notes this side of this line

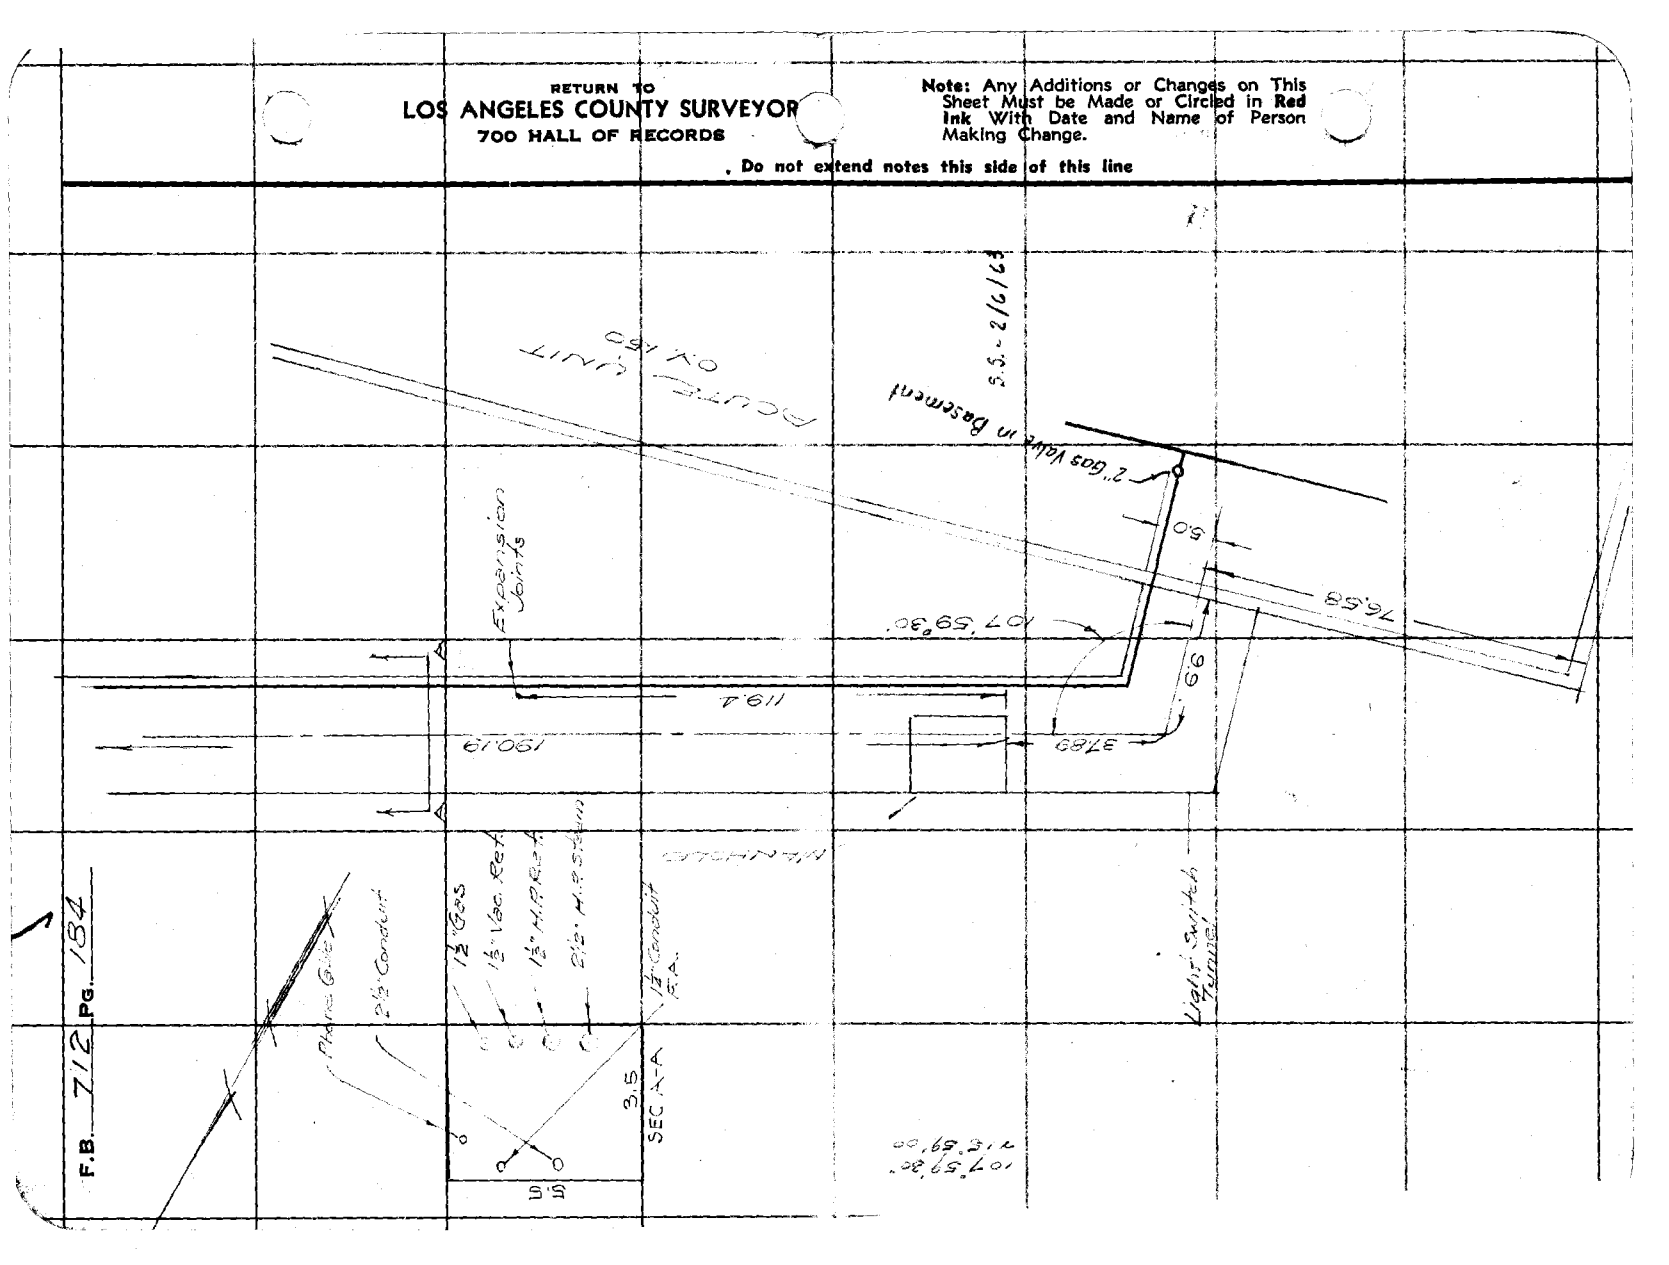

FORM 247 10M 11-35

RETURN TO
LOS ANGELES COUNTY SURVEYOR
700 HALL OF RECORDS

Note: Any Additions or Changes on This Sheet Must be Made or Circled in Red Ink With Date and Name of Person Making Change.

Do not extend notes this side of this line

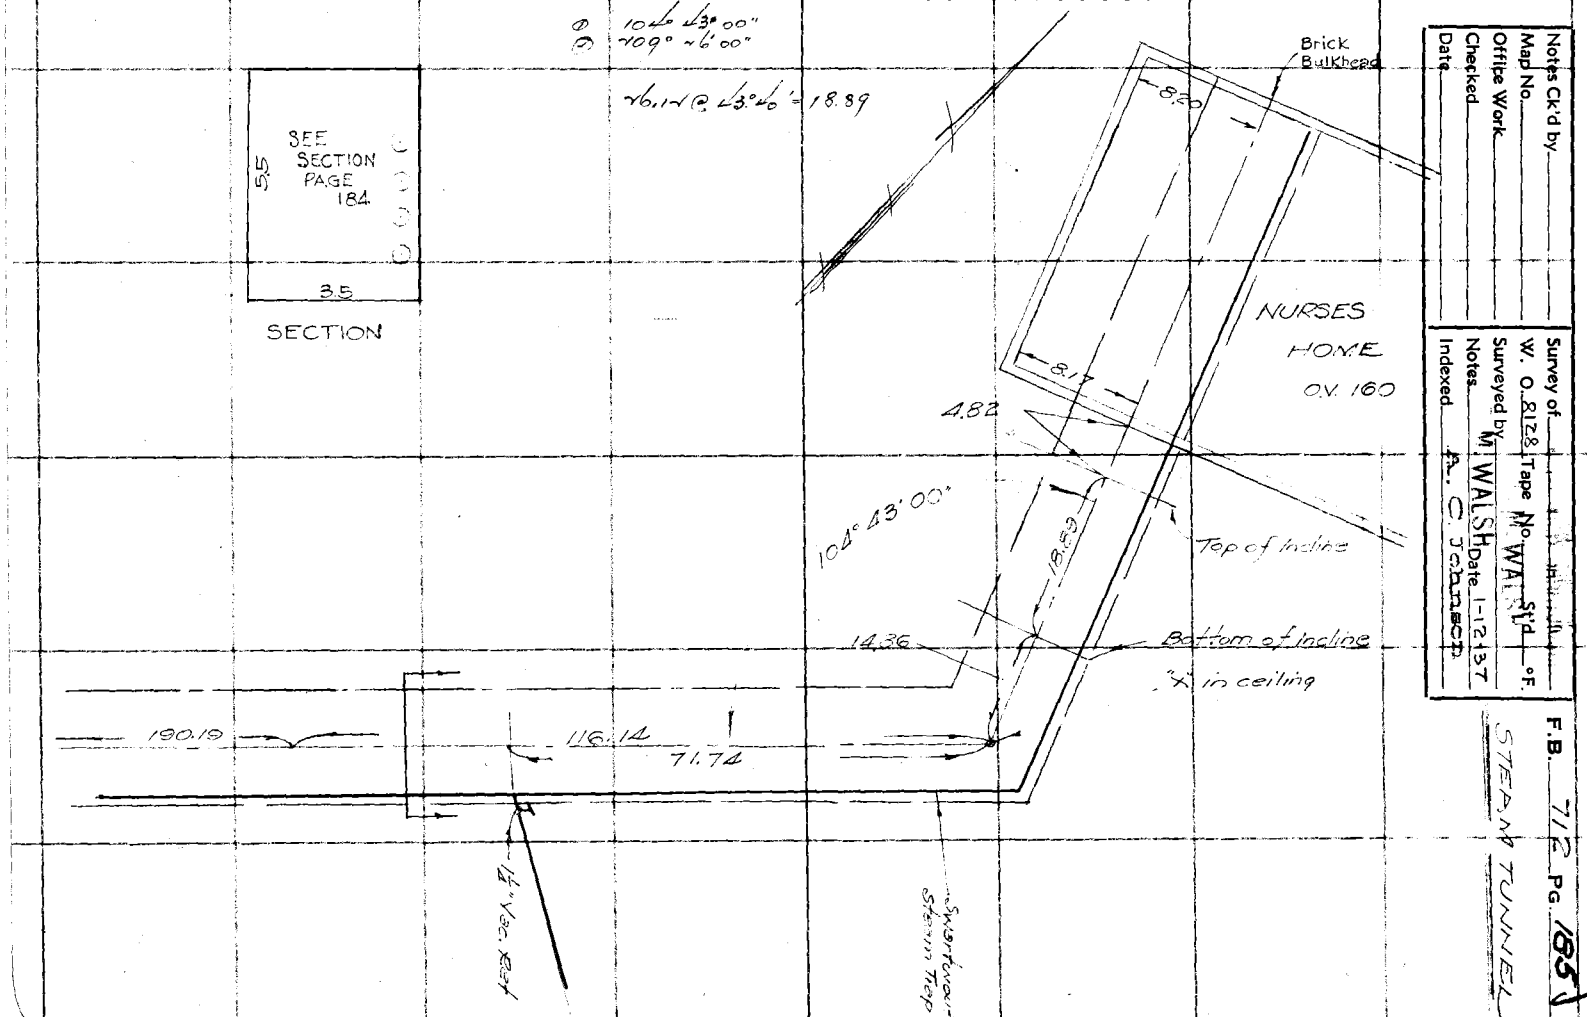

Notes Ck'd by
Map No.
Office Work
Checked
Date

Survey of W. O. 8128 Tape No. M. WALSH Std. °F.
Surveyed by M. WALSH Date 1-12-37
Notes
Indexed R. C. Johnson

F.B. 712 PG. 185

STEAM TUNNEL

RETURN TO
LOS ANGELES COUNTY SURVEYOR
700 HALL OF RECORDS

Note: Any Additions or Changes on This Sheet Must be Made or Circled in **Red Ink** With Date and Name of Person Making Change.

Do not extend notes this side of this line

F.B. 712 Pg. 196

FORM 247 10M 11-35

RETURN TO
LOS ANGELES COUNTY SURVEYOR
700 HALL OF RECORDS

Note: Any Additions or Changes on This Sheet Must be Made or Circled in **Red Ink** With Date and Name of Person Making Change.

Do not extend notes this side of this line

Notes Ck'd by
Map No.
Office Work
Checked
Date

Survey of OLIVE VIEW SAN.
W. O. 8128 Tape No. St'd. °F.
Surveyed by TED M. WALSH
Notes WALSH Date 7-20-37
Indexed C. Johnson

F.B. PG. 87

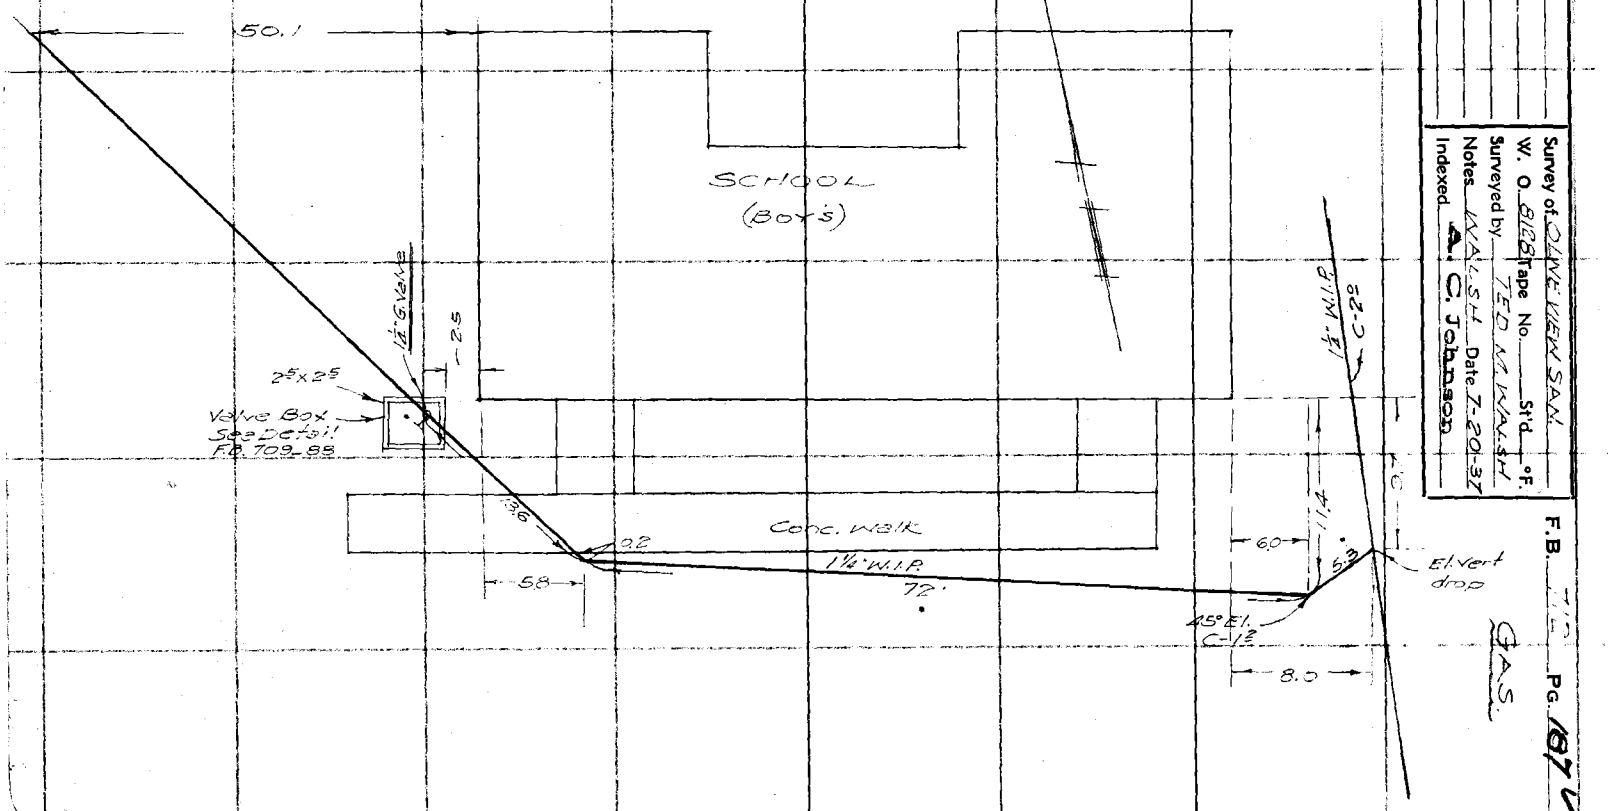

RETURN TO
LOS ANGELES COUNTY SURVEYOR
700 HALL OF RECORDS

Note: Any Additions or Changes on This Sheet Must be Made or Circled in **Red Ink** With Date and Name of Person Making Change.

Do not extend notes this side of this line

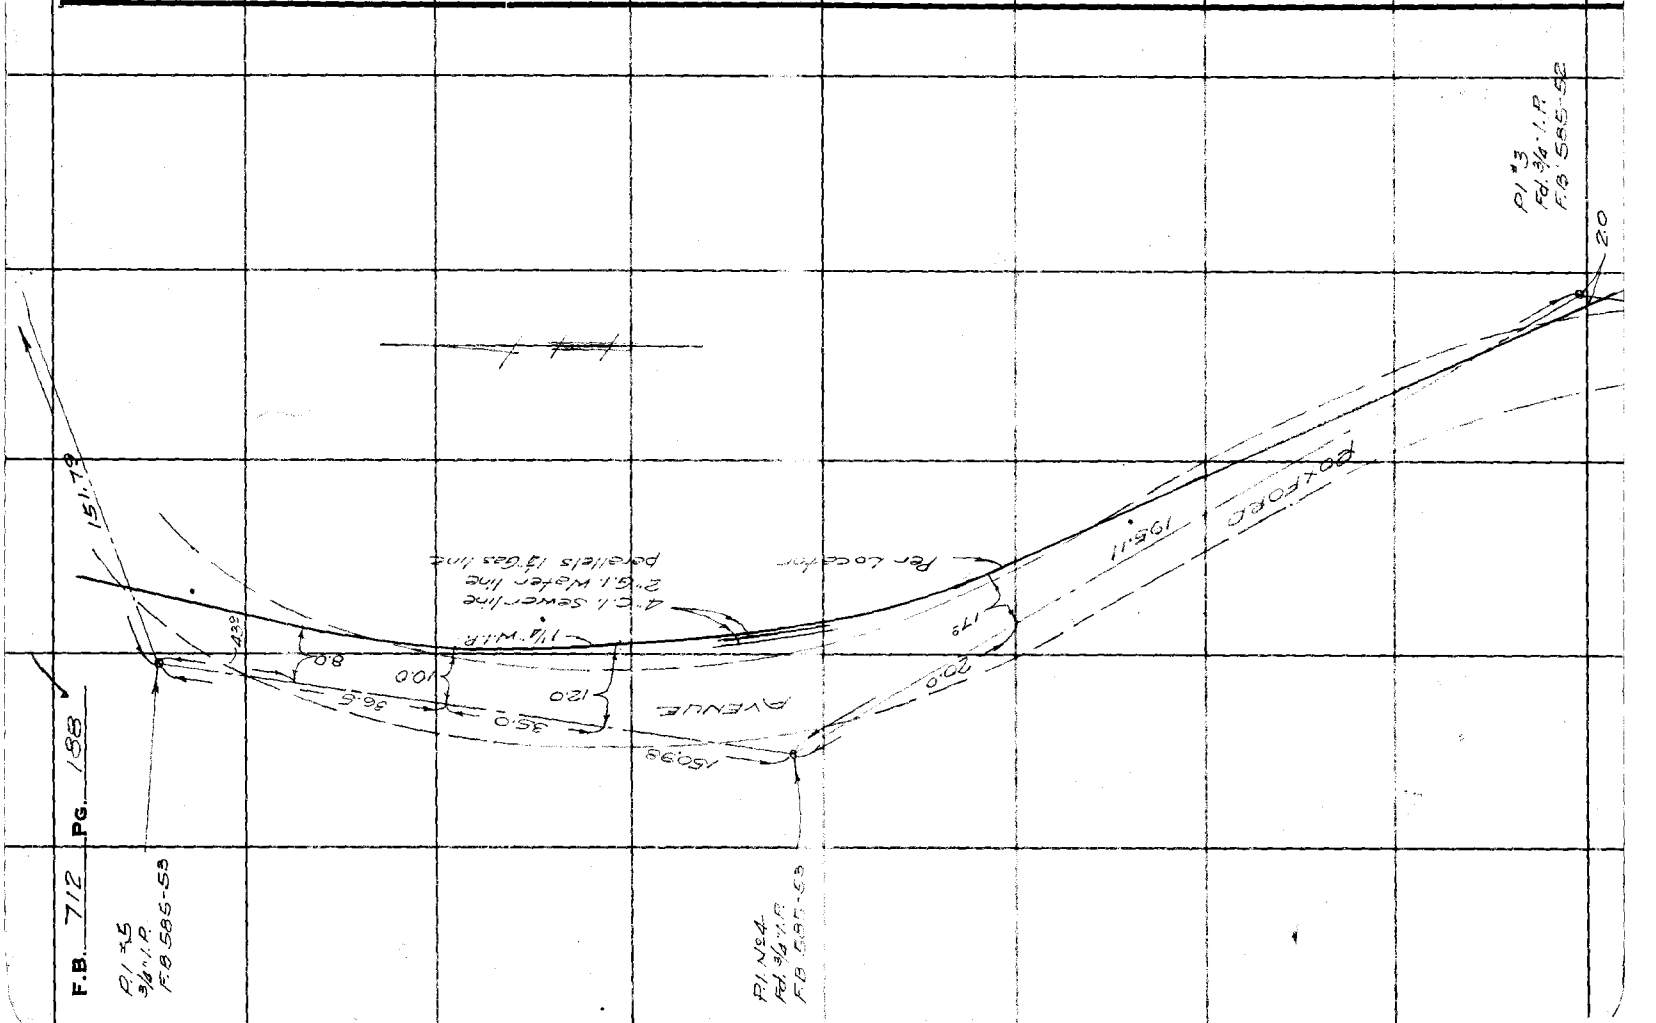

F.B. 712 Pg. 188

Notes Ck'd by	Survey of OLIVE VIEW SANATORIUM
Map No.	W. O. 8128 Tape No. St'd °F.
Office Work	Surveyed by TED M. WALSH
Checked	Notes WALSH Date 7-21-37
Date	Indexed A. C. Johnson

F.B. 712 Pg. 189

GAS

Note: Any Additions or Changes on This Sheet Must be Made or Circled in Red Ink With Date and Name of Person Making Change.

Do not extend notes this side of this line

RETURN TO
LOS ANGELES COUNTY SURVEYOR
7do HALL OF RECORDS

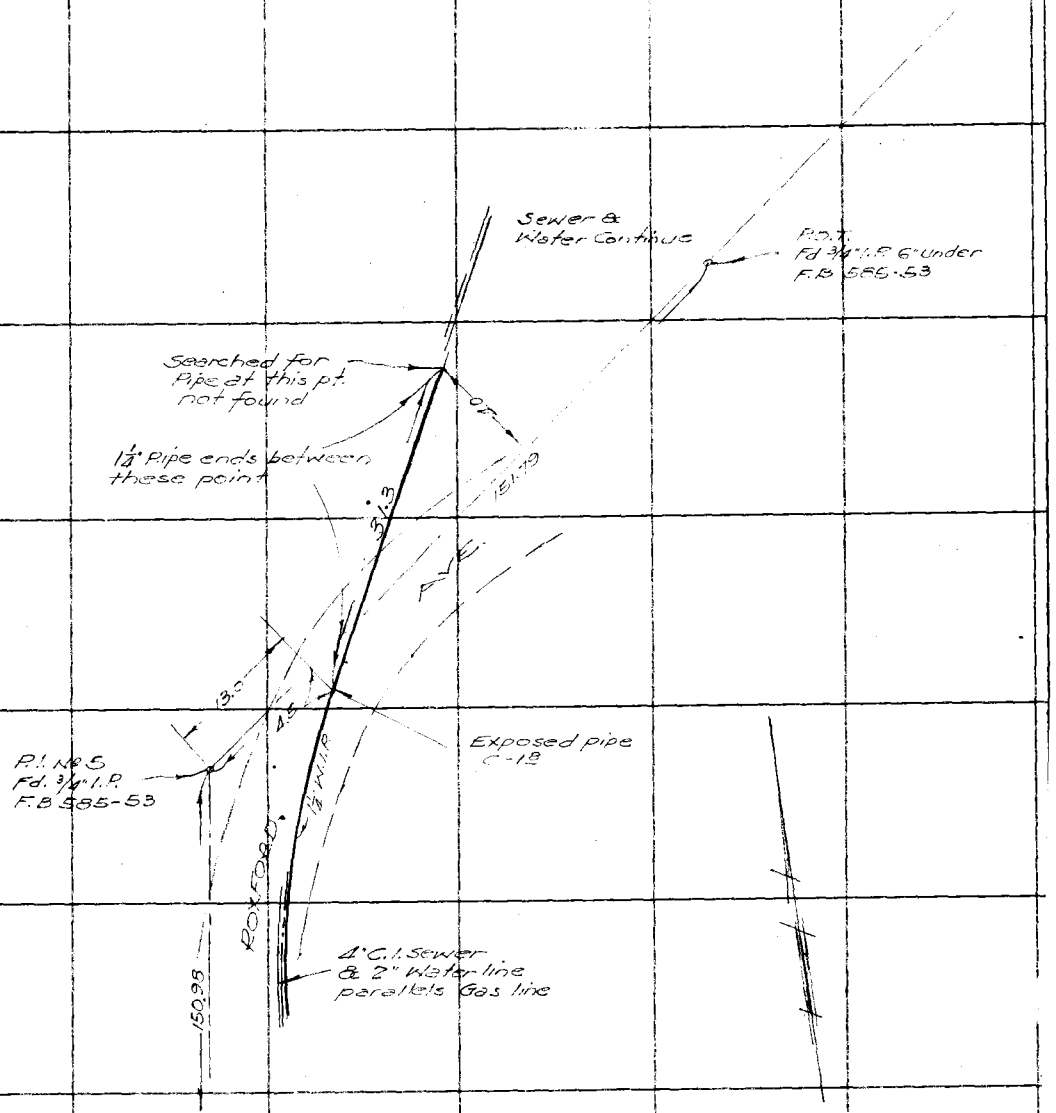

FORM 247 10M 11-35

RETURN TO
LOS ANGELES COUNTY SURVEYOR
700 HALL OF RECORDS

Note: Any Additions or Changes on This Sheet Must be Made or Circled in **Red Ink** With Date and Name of Person Making Change.

Do not extend notes this side of this line

F.B. 712 PG. 190

Notes Ck'd by	Survey of OLIVE VIEW HOSPITAL
Map No.	JN 0022.08 Tape 191 Std. 84 °F
Office Work	Surveyed by J. TERRANOVA
Checked	Notes J.T. Date 8-25-64
Date	Indexed E. J. GALLI Aug 27 '64

F. B. 712 PG. 191

OLIVE VIEW HOSPITAL

STEAM TUNNEL LOCATION & TIE TO OLIVE VIEW AVE.

J.N. 0022.08
AUG. 1964

REF.
F.B. 585-60
F.B. 712-161, 178, 178
F.B. 2994-6, 7

PARTY
J. TERRANOVA
J. MOORE
J. PIKE
V. HUCKABY

Note: Any Additions or Changes on This Sheet Must be Made or Circled in Red Ink With Date and Name of Person Making Change.

Do not extend this side of this line.

PLEASE RETURN TO
LOS ANGELES COUNTY ENGINEER
403 LOS ANGELES COUNTY ENGINEERING BLDG.

76F309S CE # 310 3-61

PLEASE RETURN TO
LOS ANGELES COUNTY ENGINEER
403 LOS ANGELES COUNTY ENGINEERING BLDG.

Note: Any Additions or Changes on This Sheet Must be Made or Circled in Red Ink With Date and Name of Person Making Change.

Do not extend this side of this line.

F.B. 712 PG. 192

Notes Ck'd by	Survey of OLIVE VIEW HOSPITAL
Map No. 2-83	JN 0022.08 Tape 191 Std 84 °F
Office Work	Surveyed by J. TERRANOVA
Checked	Notes J.T. Date 8-25-64
Date	Indexed J. GALLI

F. B. 712 PG. 193

OLIVE VIEW HOSPITAL

ELEVATIONS ON TUNNEL FLOOR, CEILING, & SURFACE ELEV.

J.N. 0022.08
AUG 1964

REF:
F.B. 712-192

PARTY
J. TERRANOVA
J. MOORE
J. RIKE
V. HUCKABY

Note: Any Additions or Changes on this Sheet Must be Made or Circled in Red Ink With Date and Name of Person Making Change.

Do not extend this side of this line.

PLEASE RETURN TO
LOS ANGELES COUNTY ENGINEER
403 LOS ANGELES COUNTY ENGINEERING BLDG.

76F3095 CE # 310 3-61

PLEASE RETURN TO
LOS ANGELES COUNTY ENGINEER
403 LOS ANGELES COUNTY ENGINEERING BLDG.

Note: Any Additions or Changes on This Sheet Must be Made or Circled in Red Ink With Date and Name of Person Making Change.

Do not extend this side of this line.

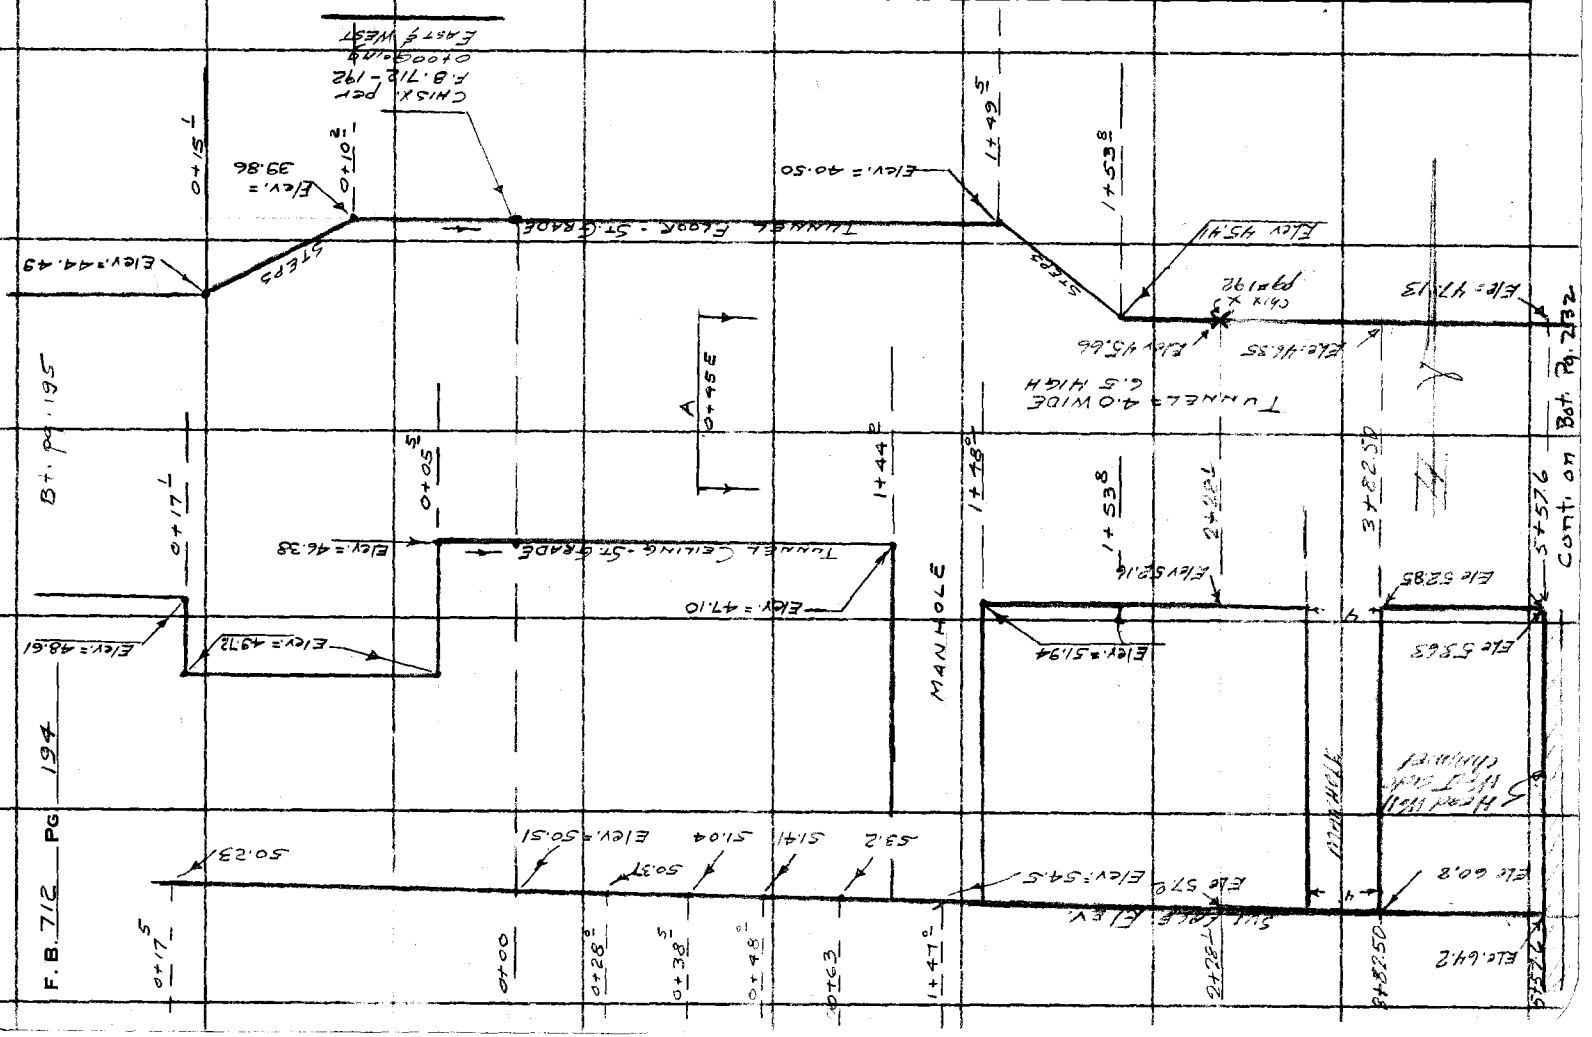

76F309S CE # 310 3-61

PLEASE RETURN TO
LOS ANGELES COUNTY ENGINEER
403 LOS ANGELES COUNTY ENGINEERING BLDG.

Note: Any Additions or Changes on This Sheet Must be Made or Circled in Red Ink With Date and Name of Person Making Change.

Do not extend this side of this line.

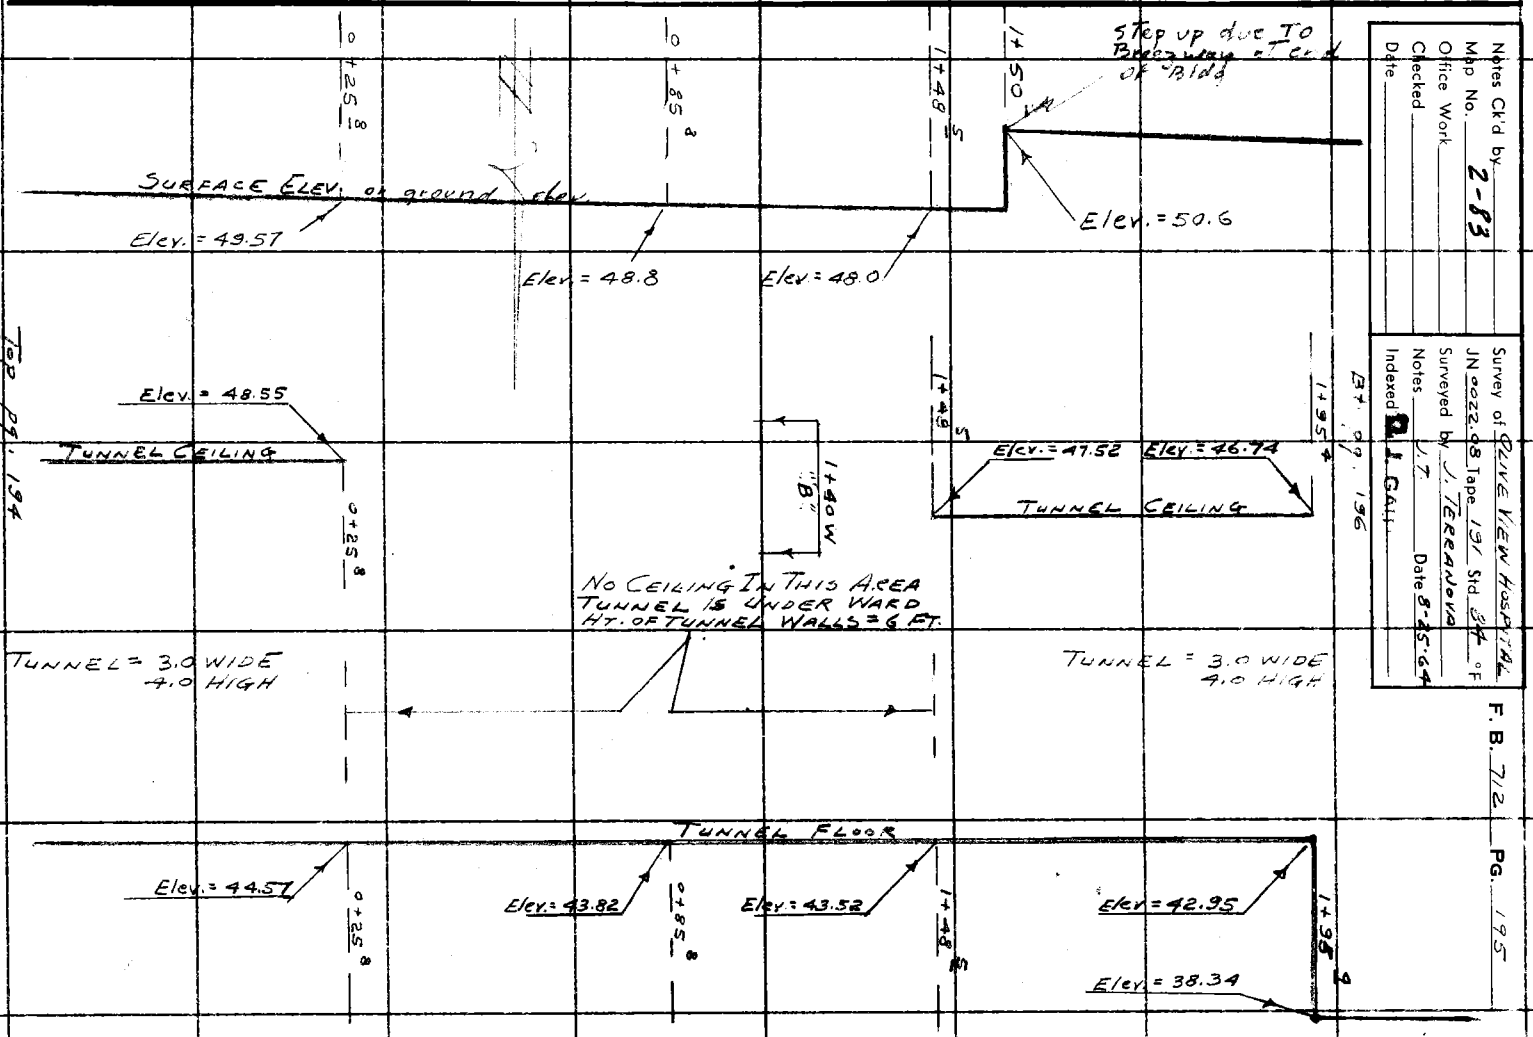

Notes Ck'd by 2-83
Map No.
Office Work
Checked
Date

Survey of Olive View Hospital
JN 00222.08 Tape 191 Std. 34 °F
Surveyed by J. Terranova
Notes
J.T. Date 8-25-64
Indexed P.L. Gall

F.B. 712 PG. 195

PLEASE RETURN TO
LOS ANGELES COUNTY ENGINEER
403 LOS ANGELES COUNTY ENGINEERING BLDG.

Note: Any Additions or Changes on This Sheet Must be Made or Circled in Red Ink With Date and Name of Person Making Change.

Do not extend this side of this line.

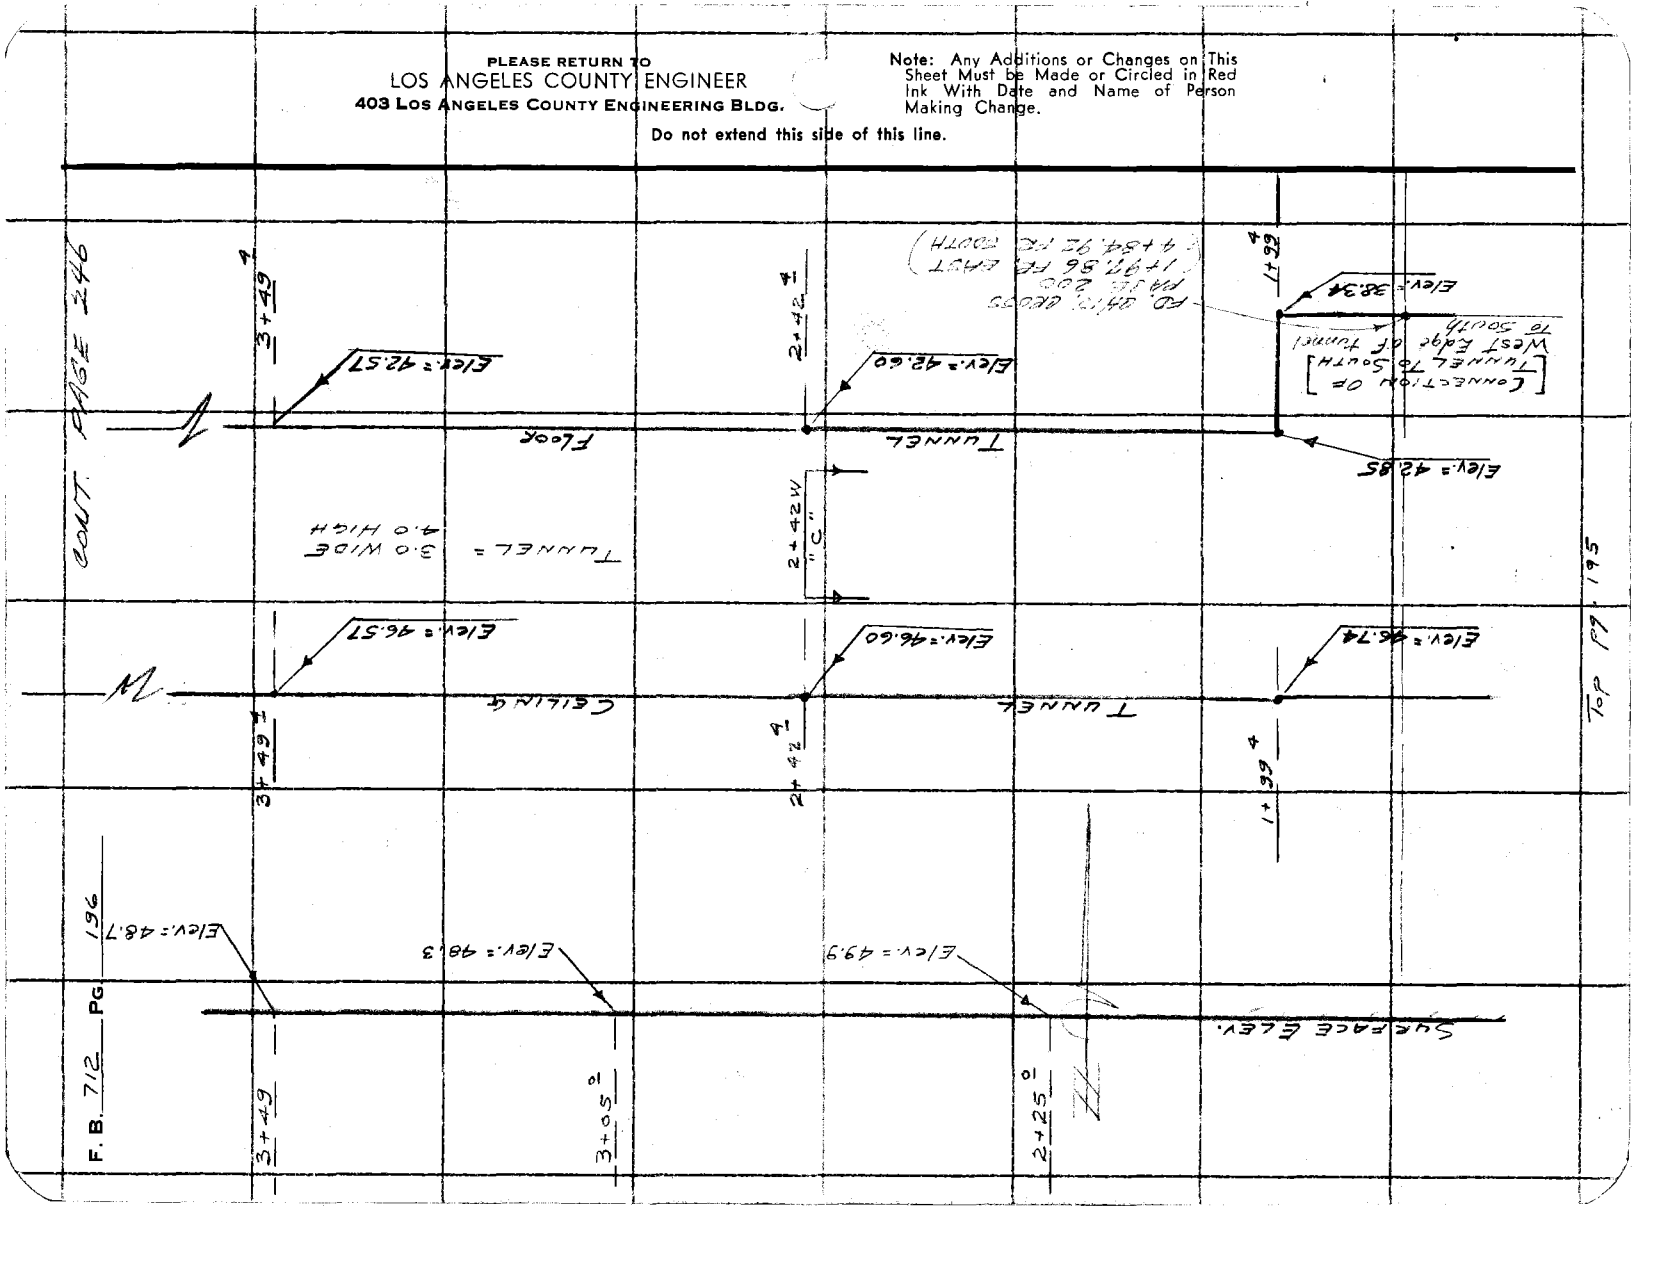

Notes Ck'd by	Survey of OLIVE VIEW HOSPITAL
Map No. 2-83	JN 0022.98 Tape Std °F
Office Work	Surveyed by J. TERRANOVA
Checked	Notes J.T. Date 8-25-64
Date	Indexed R. J. GALLI

F. B. 712 PG. 197

OLIVE VIEW HOSPITAL

UTILITY PIPE SECTIONS IN STEAM TUNNEL

J.N. 0022.08
AUG. 1964

REF:
F.B. 712 - 194, 195, 196

PARTY
J. TERRANOVA
J. MOORE
J. PIKE
V. HUCKABY

Note: Any Additions or Changes on This Sheet Must Be Made or Circled in Red Ink With Date and Name of Person Making Change.

Do not extend this side of this line.

PLEASE RETURN TO
LOS ANGELES COUNTY ENGINEER
403 Los Angeles County Engineering Bldg.

76F3095 CE # 310 3-61

F. B. 712 PG. 198

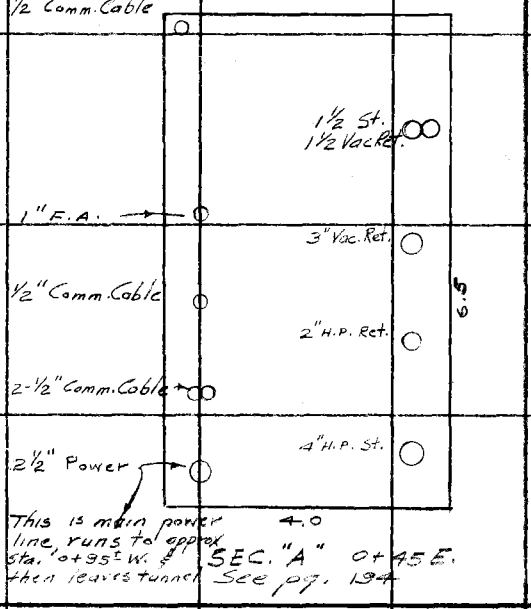


SEC. "A" 0+45 E.
See pg. 194

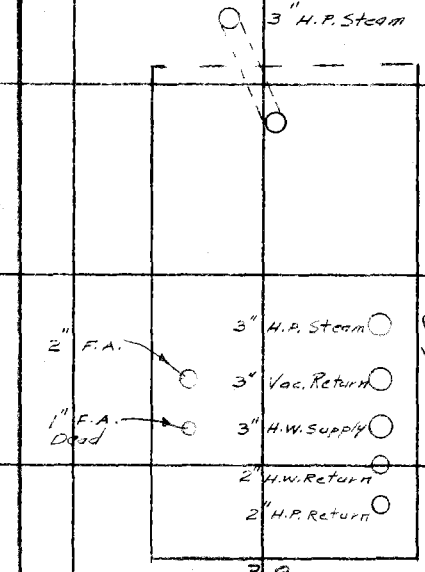

SEC. "B" 1+40 W
See pg. 195

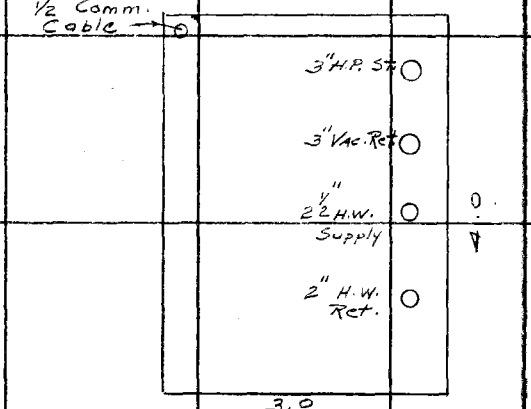

SEC. "C" 2+42 W.
See pg. 196

PLEASE RETURN TO
LOS ANGELES COUNTY ENGINEER
403 Los Angeles County Engineering Bldg.

Do not extend this side of this line.

Note: Any Additions or Changes on This Sheet Must be Made or Circled in Red Ink With Date and Name of Person Making Change.

Notes Ck'd by	Survey of OLIVE VIEW HOSPITAL
Map No. 2-83	JN 0022.08 Tape 191 Std. 84 °F
Office Work	Surveyed by J. TERRANOVA
Checked	Notes J.T. Date
Date	Indexed E. J. GALLI SEP 2 '64

F. B. 712 PG. 177

Note: Any Additions or Changes on This Sheet Must be Made or Circled in Red Ink, With Date and Name of Person Making Change.

Do not extend this side of this line.

PLEASE RETURN TO
LOS ANGELES COUNTY ENGINEER
403 Los Angeles County Engineering Bldg.

OLIVE VIEW HOSPITAL

J.N. 0022.08
AUG. 1964

CONTINUATION OF STEAM TUNNEL LOCATION, WITH TIES TO OLIVE VIEW AVE. & 6 FT. OFFSET LINE ON BUCHER AVE.

REF.

F.B. 585 - 29, 41, 60
F.B. 712 - 173, 174, 168
F.B. 2994 - 6, 7

PARTY

J. TERRANOVA
J. MOORE
J. KIKE
V. HUCKABY

76F309S CE # 310 3-61

F. B. 712 Pg. 200

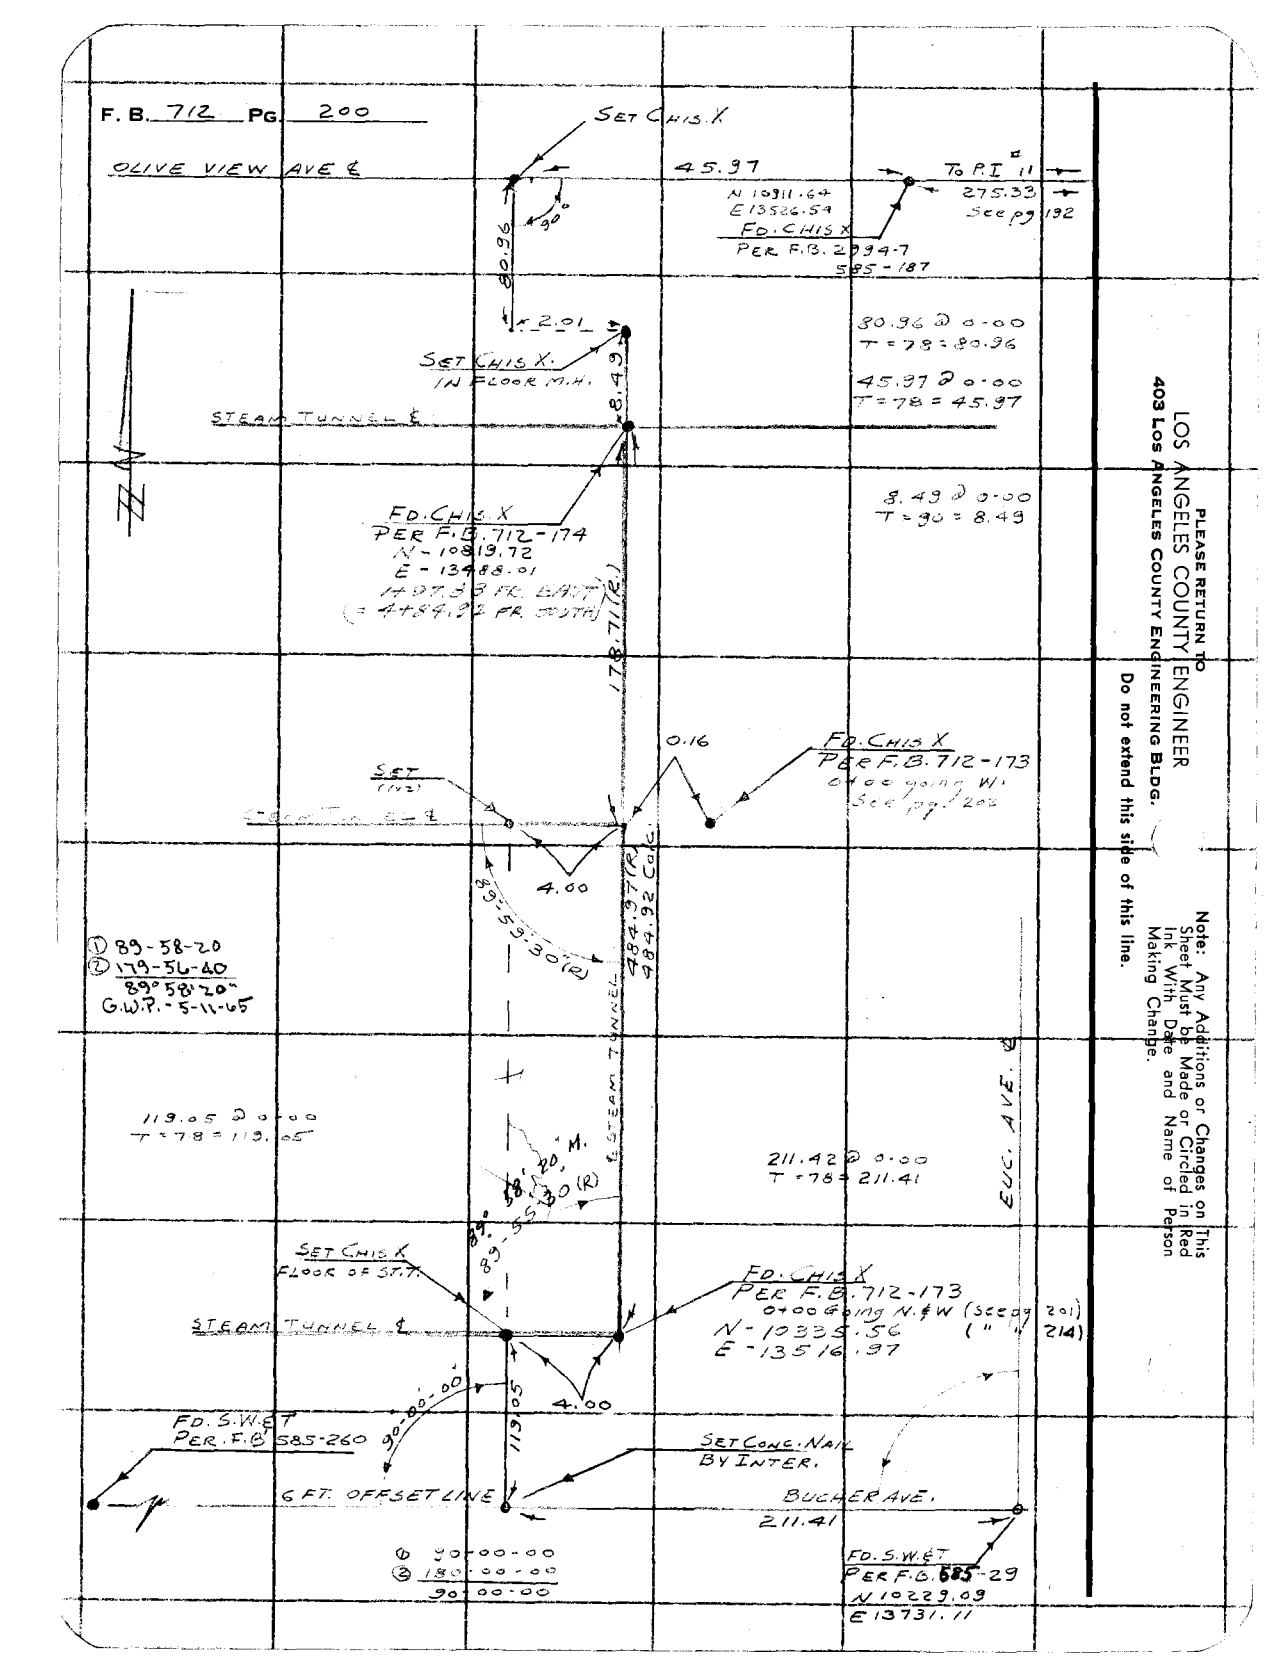

PLEASE RETURN TO
LOS ANGELES COUNTY ENGINEER
403 Los Angeles County Engineering Bldg.

Do not extend this side of this line.

Note: Any Additions or Changes on This Sheet Must be Made or Circled in Red Ink With Date and Name of Person Making Change.

Notes Ck'd by	Survey of OLIVEVIEW HOSPITAL
Map No. 2-83	JN 0022.08 Tape ____ Std ____ °F
Office Work	Surveyed by J. TERRANOVA
Checked	Notes J.T. Date 8-28-64
Date	Indexed [illegible] GALLI

F. B. 712 PG. 201

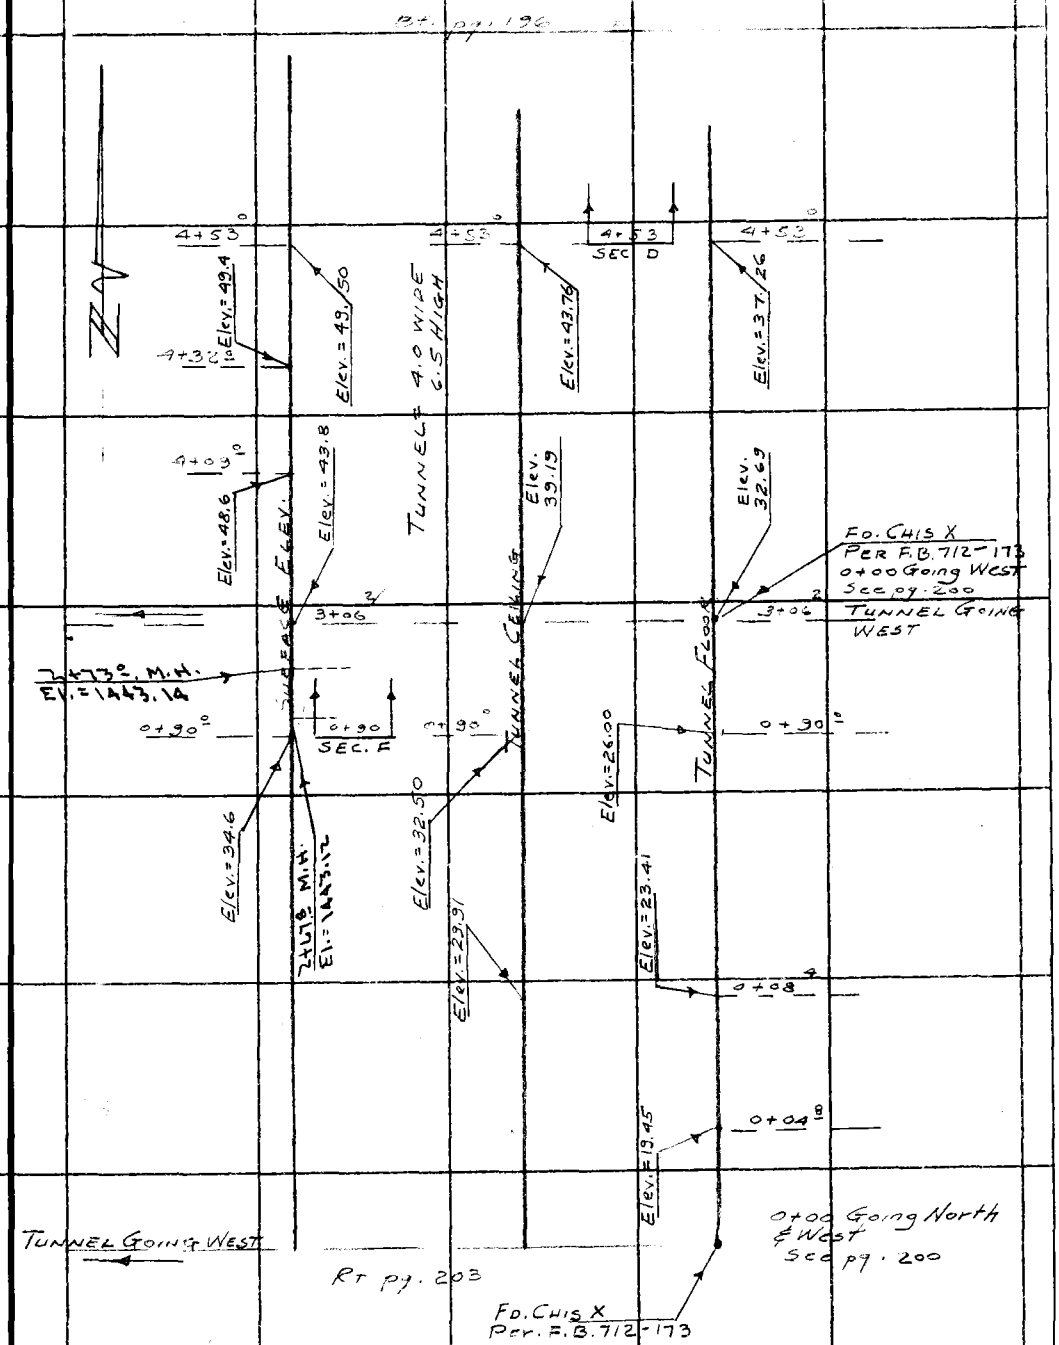

Note: Any Additions or Changes on This Sheet Must be Made or Circled in Red Ink With Date and Name of Person Making Change.

Do not extend this side of this line.

PLEASE RETURN TO
LOS ANGELES COUNTY ENGINEER
403 LOS ANGELES COUNTY ENGINEERING BLDG.

76F309S CE # 310 3-61

F. B. 712 PG 202

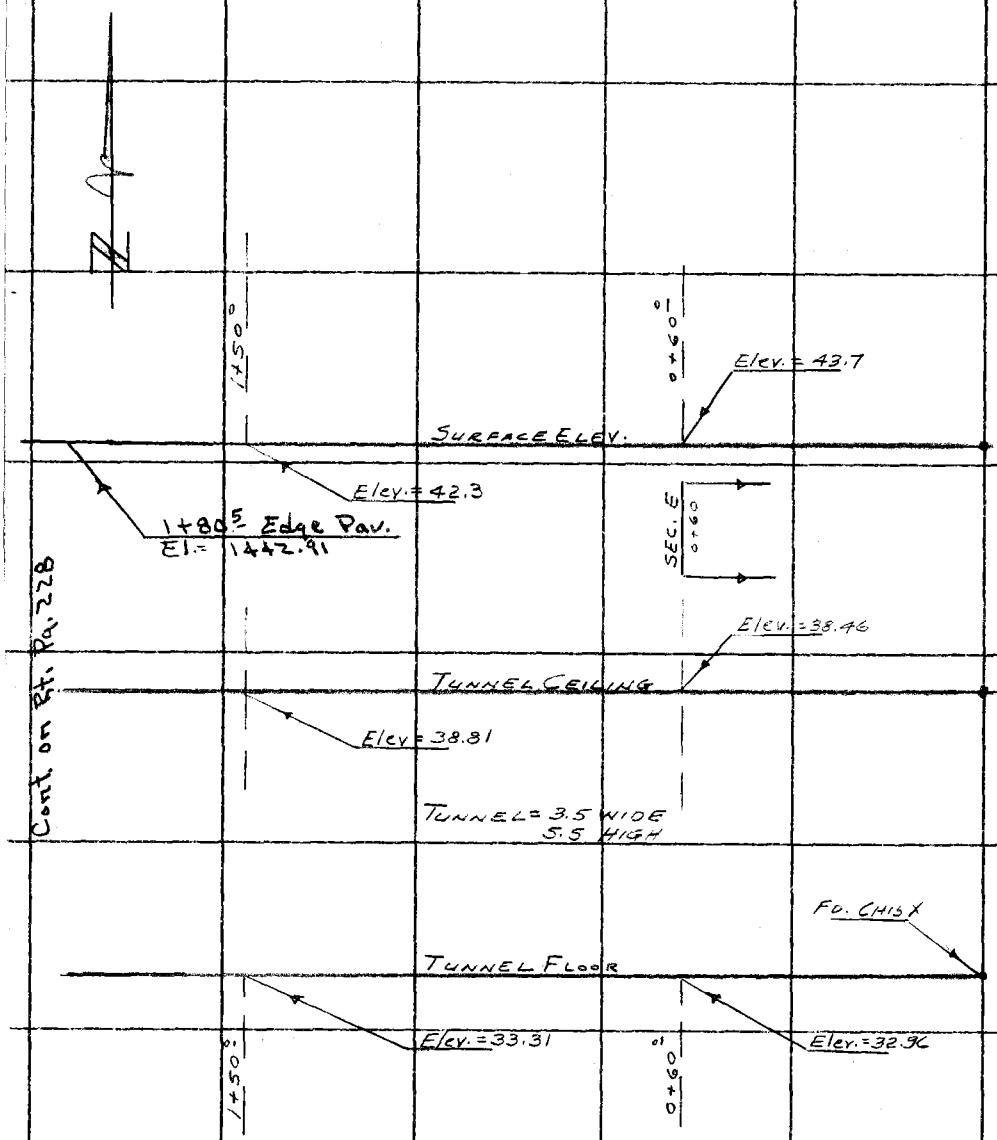

Cont. on Rt. Pg. 228

MID PG. 201

PLEASE RETURN TO
LOS ANGELES COUNTY ENGINEER
403 LOS ANGELES COUNTY ENGINEERING BLDG.

Do not extend this side of this line.

Note: Any Additions or Changes on This Sheet Must be Made or Circled in Red Ink With Date and Name of Person Making Change.

Notes Ck'd by	Survey of OLIVE VIEW HOSPITAL
Map No. 2-83	JN 0022.08 Tape Std °F
Checked	Notes J.T. Date 8-28-64
Date	Indexed

F. B. 712 PG. 203

Note: Any Additions or Changes on This Sheet Must be Made or Circled in Red Ink With Date and Name of Person Making Change.

Do not extend this side of this line.

PLEASE RETURN TO
LOS ANGELES COUNTY ENGINEER
403 LOS ANGELES COUNTY ENGINEERING BLDG.

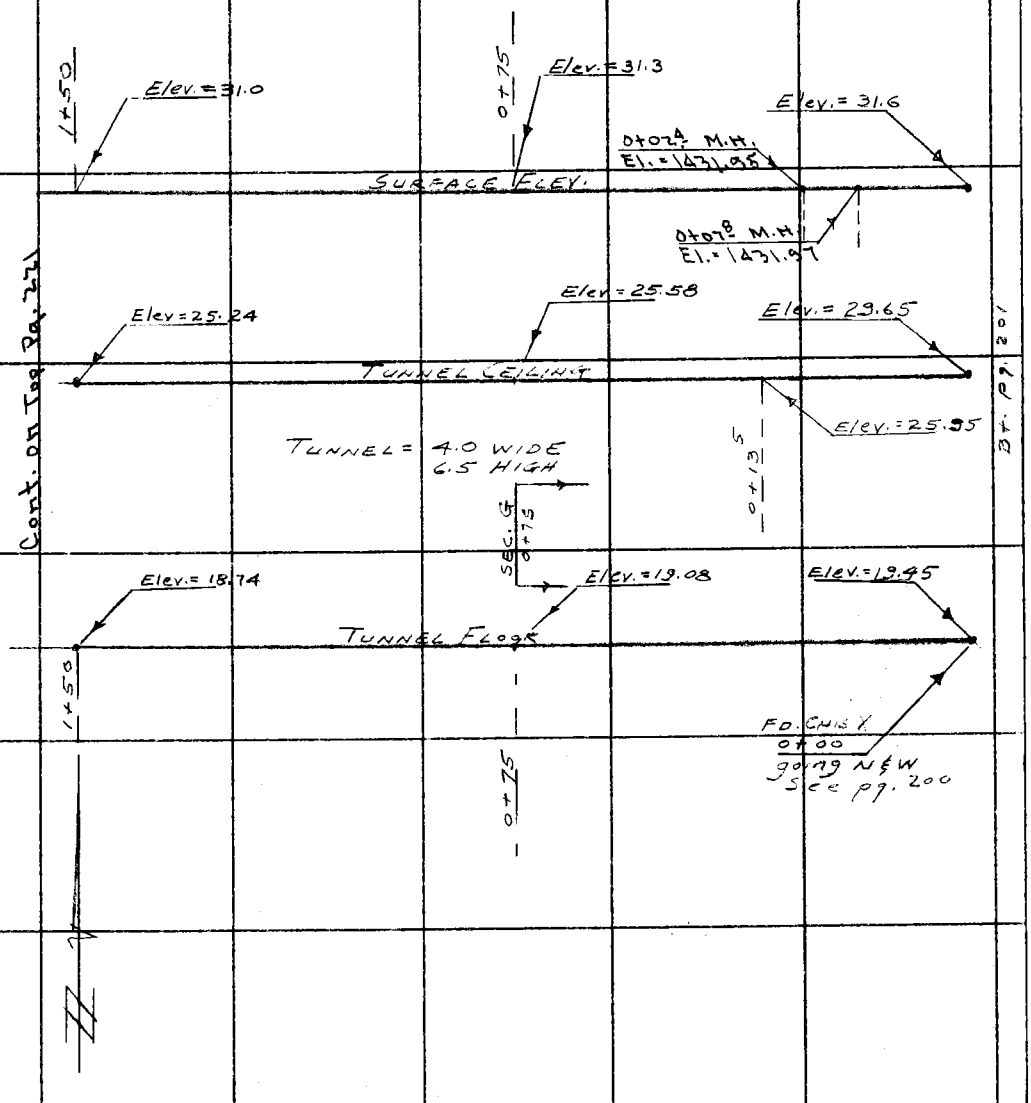

76F3095 CE # 310 3-61

PLEASE RETURN TO
LOS ANGELES COUNTY ENGINEER
403 LOS ANGELES COUNTY ENGINEERING BLDG.

Note: Any Additions or Changes on This Sheet Must be Made or Circled in Red Ink With Date and Name of Person Making Change.

Do not extend this side of this line.

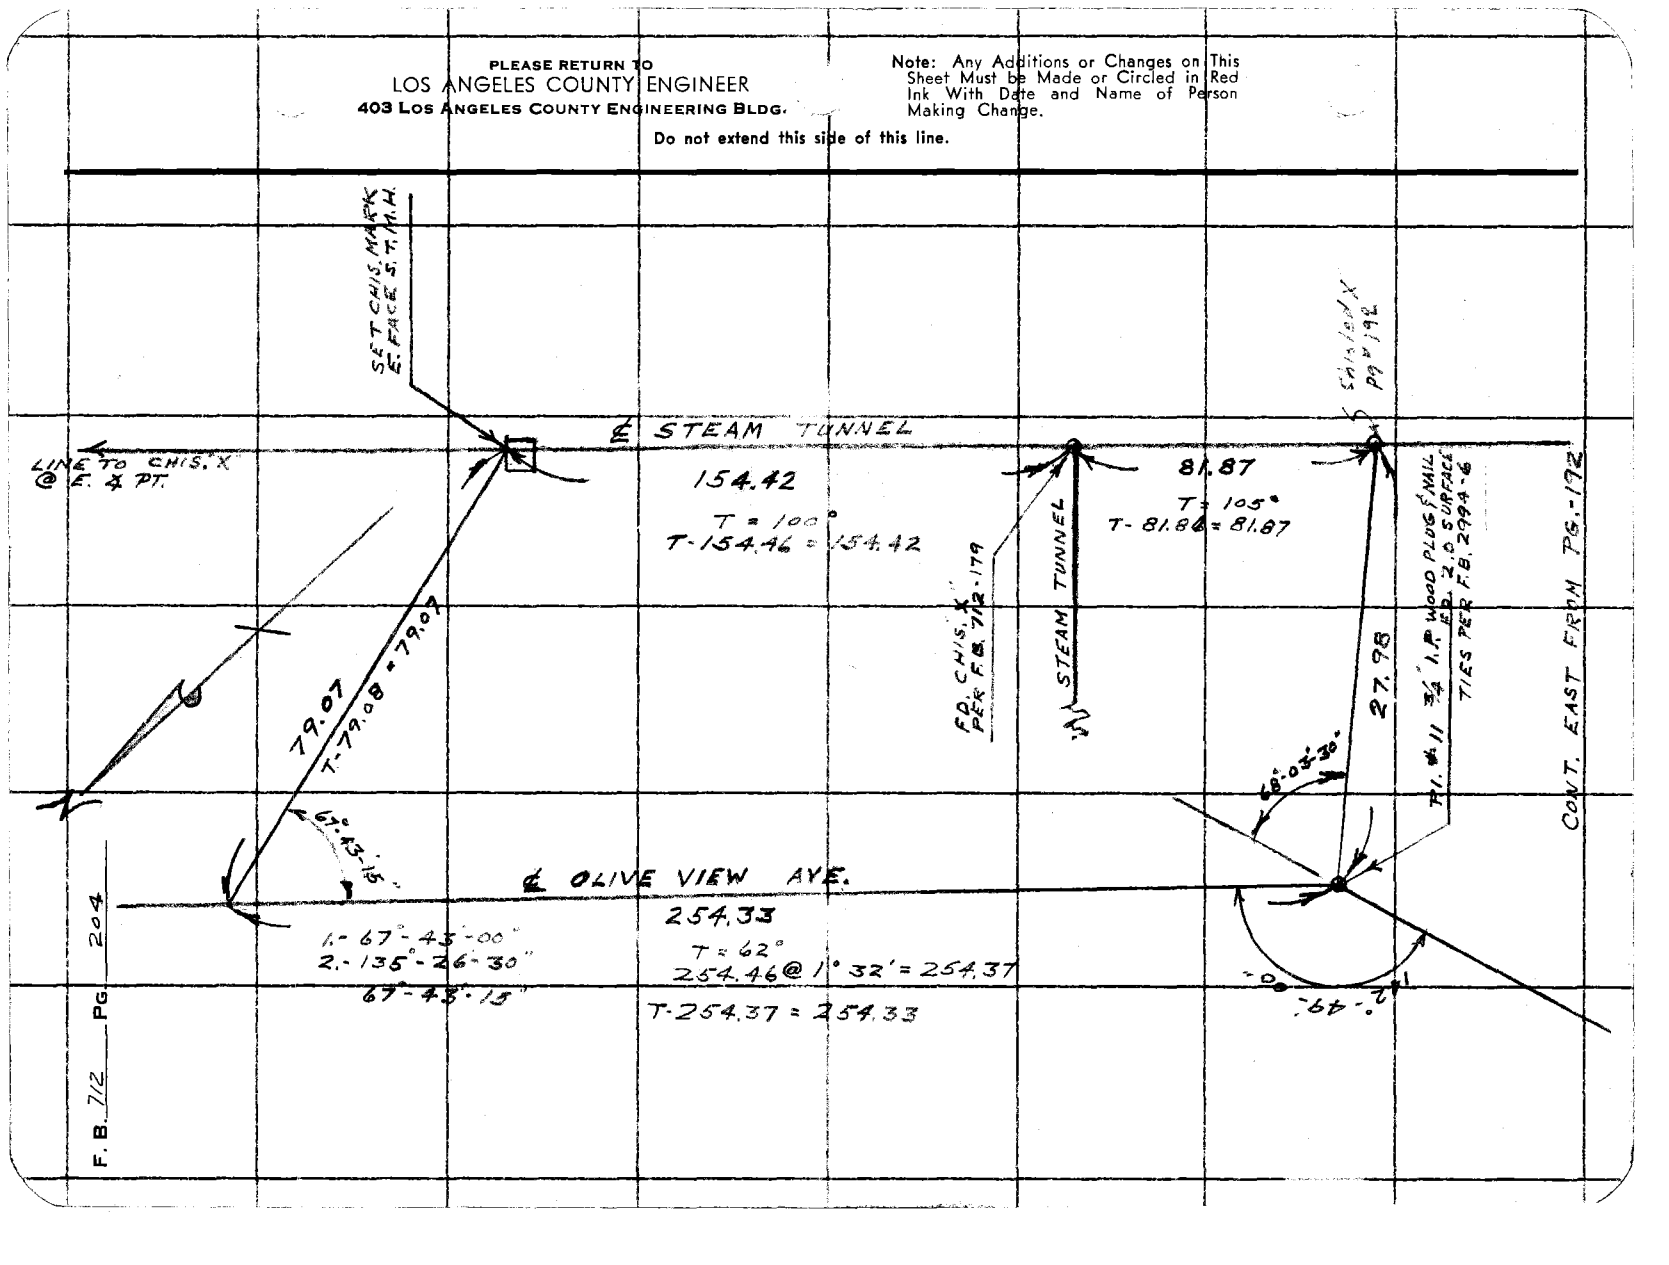

Notes Ck'd by	Survey of OLIVE VIEW HOSPITAL
Map No. 2-83	JN 0022.08 Tape Std °F
Office Work	Surveyed by J. TERRANOVA
Checked	Notes Date 8-27-64
Date	Indexed E. J. GALL

F. B. 712 PG. 205

OLIVE VIEW HOSPITAL

J. N. 0022.08
AUG 1964

UTILITY PIPE SECTIONS
IN STEAM TUNNEL

REF:
F.B. 712 - 173,

PARTY
J. TERRANOVA
J. MOORE
J. EAKE
V. HOCKABY

PLEASE RETURN TO
LOS ANGELES COUNTY ENGINEER
403 LOS ANGELES COUNTY ENGINEERING BLDG.

Note: Any Additions or Changes on This Sheet Must Be Made or Circled in Red Ink With Date and Name of Person Making Change.

Do not extend this side of this line.

76F309S CE # 310 3-61

F. B. 712 PG. 206

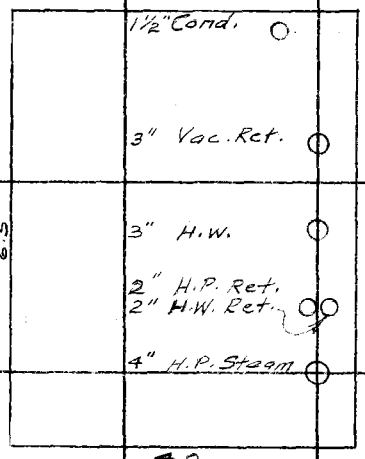

SEC. "D"
2+53
pg. 201

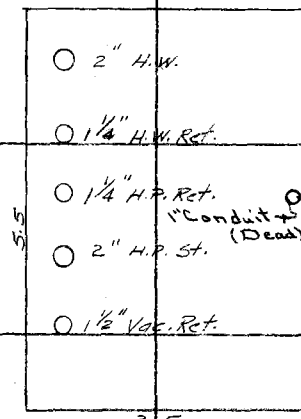

SEC. "E"
0+60
pg. 202

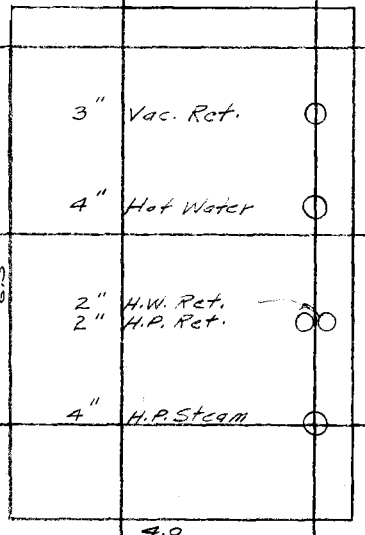

SEC. "F"
0+90
pg. 201

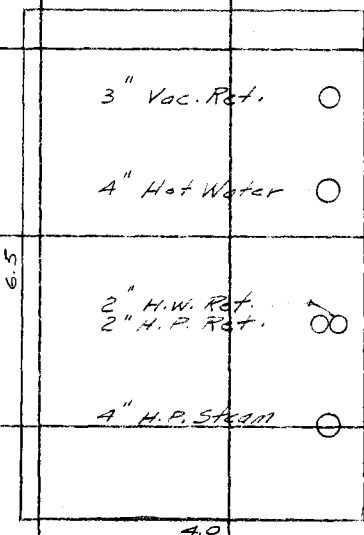

SEC. "G"
0+75
pg. 202

PLEASE RETURN TO
LOS ANGELES COUNTY ENGINEER
403 Los Angeles County Engineering Bldg.

Do not extend this side of this line.

Note: Any Additions or Changes on This Sheet Must be Made or Circled in Red Ink With Date and Name of Person Making Change.

F. B. 712 Pg. 207

Profile No. | Notes Red. | Plotted | Job No 2022.08 | Division No.
Date | Date | Survey of OLIVE VIEW HOSPITAL
X-Sec. No. | Notes Chkd. | Checked | Survey by | Notes | Date 9-11-64
Date | Date | Map No. | Indexed C. J. GALE | Date SEP 14 '64

OLIVE VIEW HOSPITAL

TRANSFER ELEV.'S B.M. # 9

F.B. 585 PG. 13

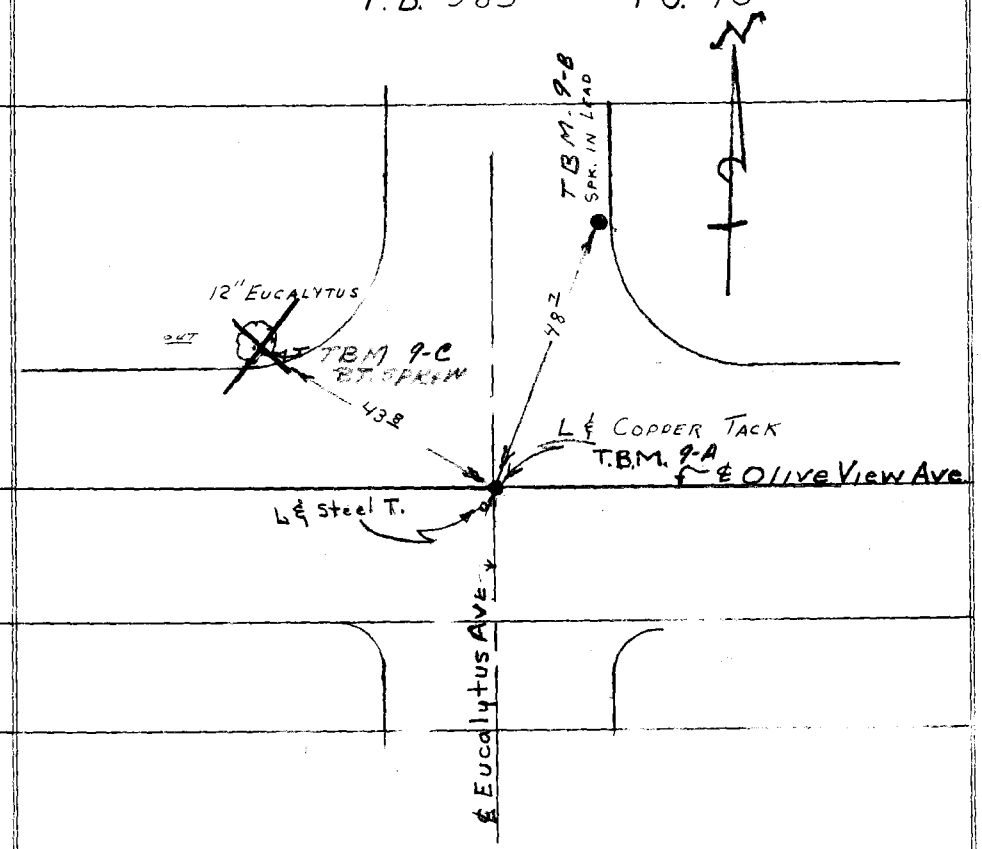

NOTE: ANY ADDITIONS OR CHANGES ON THIS SHEET MUST BE MADE OR CIRCLED IN RED INK, WITH DATE AND NAME OF PERSON MAKING CHANGE.

Do not extend notes this side of this line.

PLEASE RETURN TO
LOS ANGELES COUNTY SURVEYOR
726 Los Angeles County Engineering Bldg.

STATION	B. B.	H. I.	F. S.	ELEV.

76L298 S & E #307 9-54

76L298 S & E #307 9-54

PLEASE RETURN TO
LOS ANGELES COUNTY SURVEYOR
726 LOS ANGELES COUNTY ENGINEERING BLDG.

NOTE: ANY ADDITIONS OR CHANGES ON THIS SHEET MUST BE MADE OR CIRCLED IN RED INK, WITH DATE AND NAME OF PERSON MAKING CHANGE.

Do not extend notes this side of this line.

STATION	B. S.	H. I.	F. S.	ELEV.	
B.M. #9	6.730			1450.325	F.B. 585 Pg. 13 - B.M. #9 Eucalyptus & Olive View Ave. S.W. Corner at the N.E. Cor. of Porch at East End of Bldg. Chiseled Square on West Edge of Conc. Pvmt. Ward No. 302
		1457.055			
T.B.M. 9-A	2.573		2.507	1454.548	L & Copper Tack at Inter. Olive View & Eucalytus. Ave.
T.B.M. 9-B		1457.121	0.808	1456.313	Bt. Spk. in Lead in Pavement @ N.E. Cor. Euc. Ave. 48.2 N. of ℄ Olive View Ave. & 7.8 E. ℄ Euc. Ave.
T.B.M. 9-C	0.763	1457.076	0.224	1456.852	Bt. Spk. & W. in 12" Euc. Tree 42.0 W. of ℄ Euc. Ave. & 12.7 N. of Olive View Ave.
B.M. #9	0.211	1457.063	6.739	1450.324	B.M. #9 See Above for Description

F. B. 712 Pg. 208 Job No. 002208 Division No. Notes Red. Plotted Profile
Survey of Olive View Hosp. Date 9-11-64 Date No. X-Sec.
Survey by J.M.S. Moore Notes Notes Chkd. Checked
Indexed Date Date Date No.

Notes Ck'd by		Survey of OLIVE VIEW HOSPITAL	F. B. 712 PG. 204
Map No.		JN 8167.01 Tape Std °F	
Office Work		Surveyed by J. TERRAZAS	
Checked		Notes Date 5-6-65	
Date		Indexed C. J. GALLI MAY 7	

BENCH LEVEL TIE BETWEEN
COUNTY ENG. B.M. #10 & L.A. CITY
DEPT. OF WATER & POWER B.M. # 24,
WITH ELEV. ON TOP OF MACLAY
HIGHLINE AQUEDUCT AT POINTS
SHOWN ON INDEX PAGE

J.N. 8167.01

MAY 1965

OLIVE VIEW HOSPITAL

REF: F.B. 585-13
DEPT. W. & P.
MACLAY HIGHLINE
DRAWING NO. D 2269-15,16
F.B. 712 - 179, 204

PARTY
J. TERRAZAS
C. GALLI
V. HACKBY
G. MASUDA

Note: Any Additions or Changes on This Sheet Must be Made or Circled in Red Ink With Date and Name of Person Making Change.

Do not extend this side of this line.

PLEASE RETURN TO
LOS ANGELES COUNTY ENGINEER
403 LOS ANGELES COUNTY ENGINEERING BLDG.

76F3095 CE #310 6-62

PLEASE RETURN TO
LOS ANGELES COUNTY ENGINEER
403 LOS ANGELES COUNTY ENGINEERING BLDG.

Note: Any Additions or Changes on This Sheet Must be Made or Circled in Red Ink With Date and Name of Person Making Change.

Do not extend this side of this line.

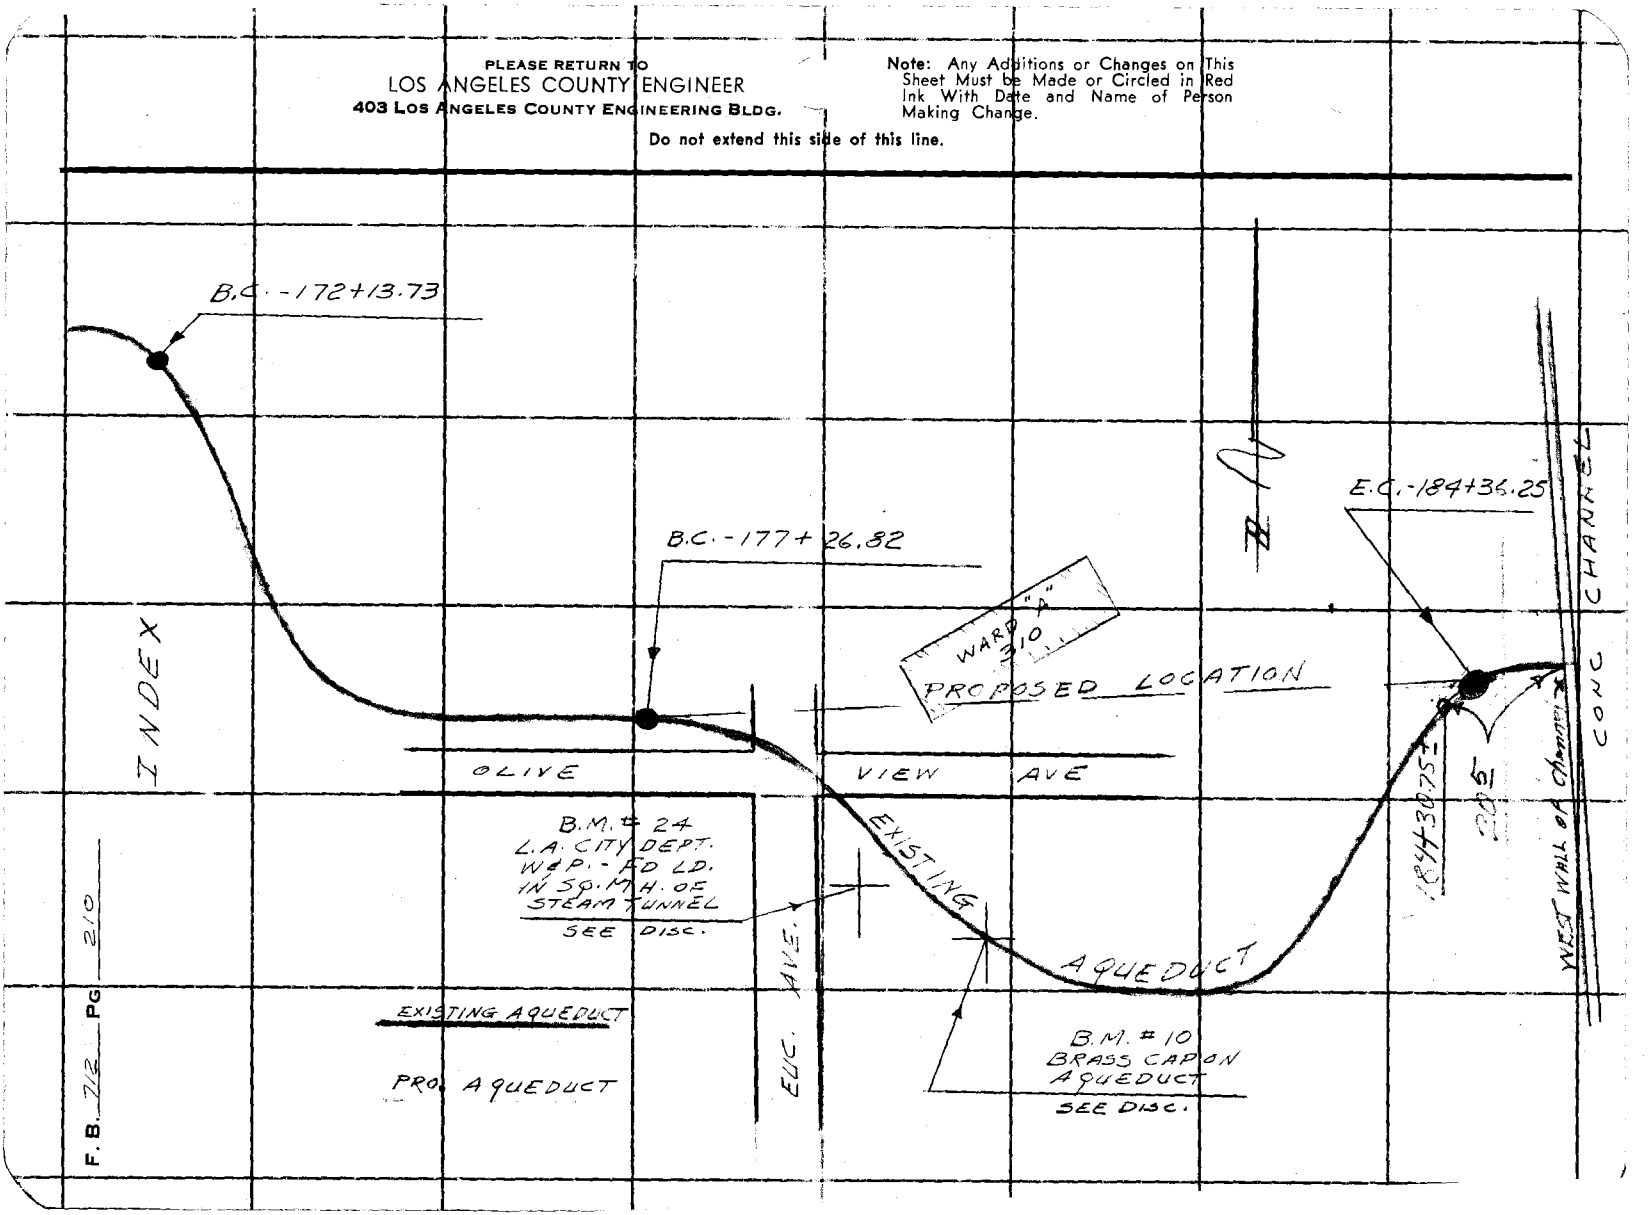

76L298 S & E #307 9-54

PLEASE RETURN TO
LOS ANGELES COUNTY SURVEYOR
726 Los Angeles County Engineering Bldg.

NOTE: ANY ADDITIONS OR CHANGES ON THIS SHEET MUST BE MADE OR CIRCLED IN RED INK, WITH DATE AND NAME OF PERSON MAKING CHANGE.

Do not extend notes this side of this line.

STATION	B. S.	H. I.	F. S.	ELEV.		
T.P.						
B.M. #10				1453.02		
T.P.	7.42	1452.59				
B.M. #24			7.61	1444.98		
T.P.	4.24	1450.98				
B.M. #23			3.41	1447.57		
Sta.	4.53	1450.31				
T.P.			4.53	1445.78		
T.P.	3.12	1445.05				
T.P.	3.24	1447.29	1.21	1443.84		
T.P.	2.64	1447.79	2.14	1445.15		
B.C. 172+13.42			5.69	1443.10	C.M. Aqueduct	
T.P.	5.80	1459.90	3.00	1456.90		
B.C. 177+26.82			3.23	1453.57	B.C. 177+26.82 Elev. = 1453.57 Top Conc. Invert City Aqueduct	
T.P.	4.64	1460.24	4.18	1455.72		
T.P.	6.12	1462.12	4.39	1456.02		
T.P.	7.06	1463.22	5.84	1456.60		
E.C. 184+36.25			4.47	1457.19	E.C. 184+36.25 Elev. = 1457.19 Top of Conc.-Profile Invert Conc. shield over AQUEDUCT	
T.P.	4.53	1462.40	2.32	1458.24		
B.M. = 9	7.16	1462.21	7.38	1455.34	B.M. #10 See Disc. Above	Rod Shot 184+30.75
T.P.	3.35	1461.50	4.06	1458.15	184+30.75± Rod Shot Given on & Point of conc. shield over Aqueduct	EL = 1452.20 EL = 1453.15 Aqueduct
184+30.75±			4.30	1457.20		

Profile Notes Rod Plotted Job No. 8161-01 Division No.
No. Date Date Survey of OLIVE VIEW [illegible]
X-Sec. Notes Chkd. Checked Survey by J.T. Notes C.V. Date 5-6-65
No. Date Date Map No. Indexed E. J. GALLI Date
F. B. 712 Pg. 111

76L298 S & E #307 9-54

PLEASE RETURN TO

LOS ANGELES COUNTY SURVEYOR

726 LOS ANGELES COUNTY ENGINEERING BLDG.

NOTE: ANY ADDITIONS OR CHANGES ON THIS SHEET MUST BE MADE OR CIRCLED IN RED INK, WITH DATE AND NAME OF PERSON MAKING CHANGE.

Do not extend notes this side of this line.

STATION	B. S.	H. I.	F. S.	ELEV.		
		461.50			184+30.75±	
184+30.75±			8.35	1453.15	Elev. 1453.15 Top Conc. los Angeles City Aqueduct 4.05 Below ℄ PT in 10M shield over aqueduct	
T.P.	4.28	461.62	4.17	1457.33	BMTE SEE DISC page # 213	
BM #10			6.58	[illegible]		

F. B. 712 PG. 212

Job No. 816701 Division No. Notes Red. Plotted Profile

Survey of OLIVE VIEW HOSPITAL Date Date No.

Survey by J.T. Notes C.Y. Notes Chkd. Checked X-Sec.

Indexed [illegible] Date 5-6-65 Date Date No.

Notes Ck'd by		Survey of Olive View Hosp.	F. B. 712 PG. 213
Map No. 2-83		JN 8154.01 Tape 47 Std 24 °F	
Office Work		Surveyed by Petri	
Checked		Notes Petri Date 5-7-65	
Date		Indexed C. J. GALLI MAY 1 8 65	

J.N. 8154.01

Olive View Hospital
Central Heating & A.C. Plant - Steam Tunnels

5-7-65

Revision of Steam Tunnel Locations Per F.B. 712, Including Pipe Sections; & Surface, Tunnel Floor & Tunnel Ceiling Profiles.

See Pg's 226 & 233 For Index

Petri
Goble
Guizado
Beaudry

Note: Any Additions or Changes on This Sheet Must be Made or Circled in Red Ink With Date and Name of Person Making Change.

Do not extend this side of this line.

PLEASE RETURN TO
LOS ANGELES COUNTY ENGINEER
403 Los Angeles County Engineering Bldg.

76F3095 CE # 310 3-61

See Pg. 226 For Index

F. B. 712 PG. 214

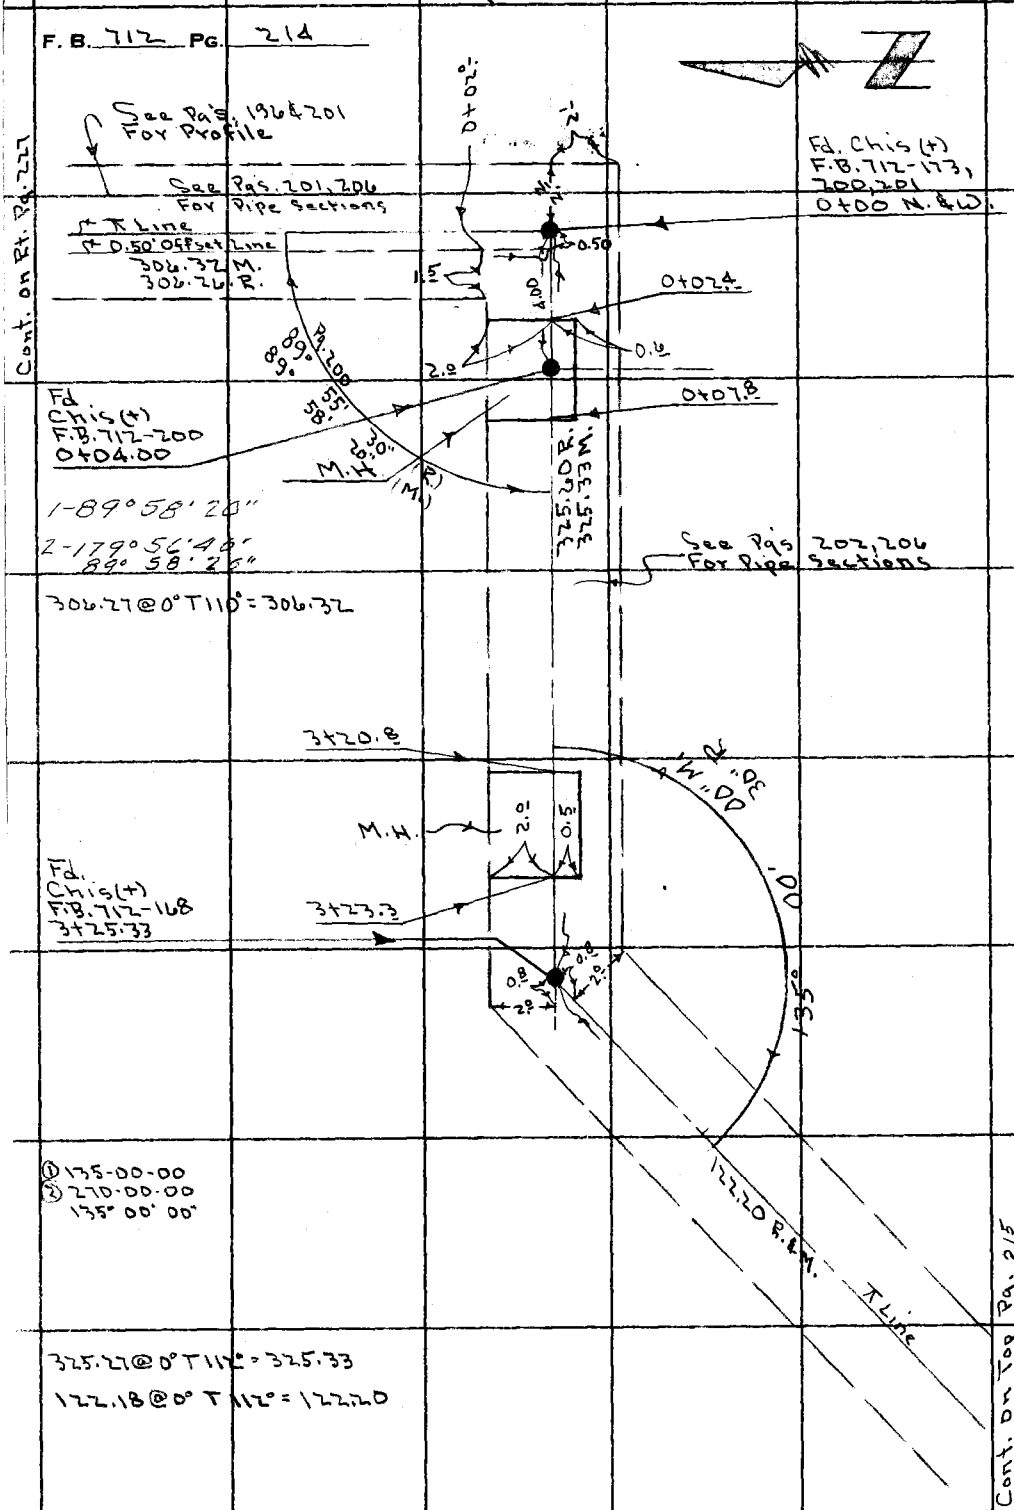

Cont. on Rt. Pg. 227

Cont. on Top Pg. 215

PLEASE RETURN TO
LOS ANGELES COUNTY ENGINEER
403 LOS ANGELES COUNTY ENGINEERING BLDG.
Do not extend this side of this line.

Note: Any Additions or Changes on This Sheet Must be Made or Circled in Red Ink With Date and Name of Person Making Change.

Notes Ck'd by	Survey of Olive View. Hosp.
Map No. 2-83	JN 8154.01 Tape 67 Std 84 °F
Office Work	Surveyed by Petri
Checked	Notes Petri Date 5-7-65
Date	Indexed C. J. GALLI

F. B. 712 PG. 215

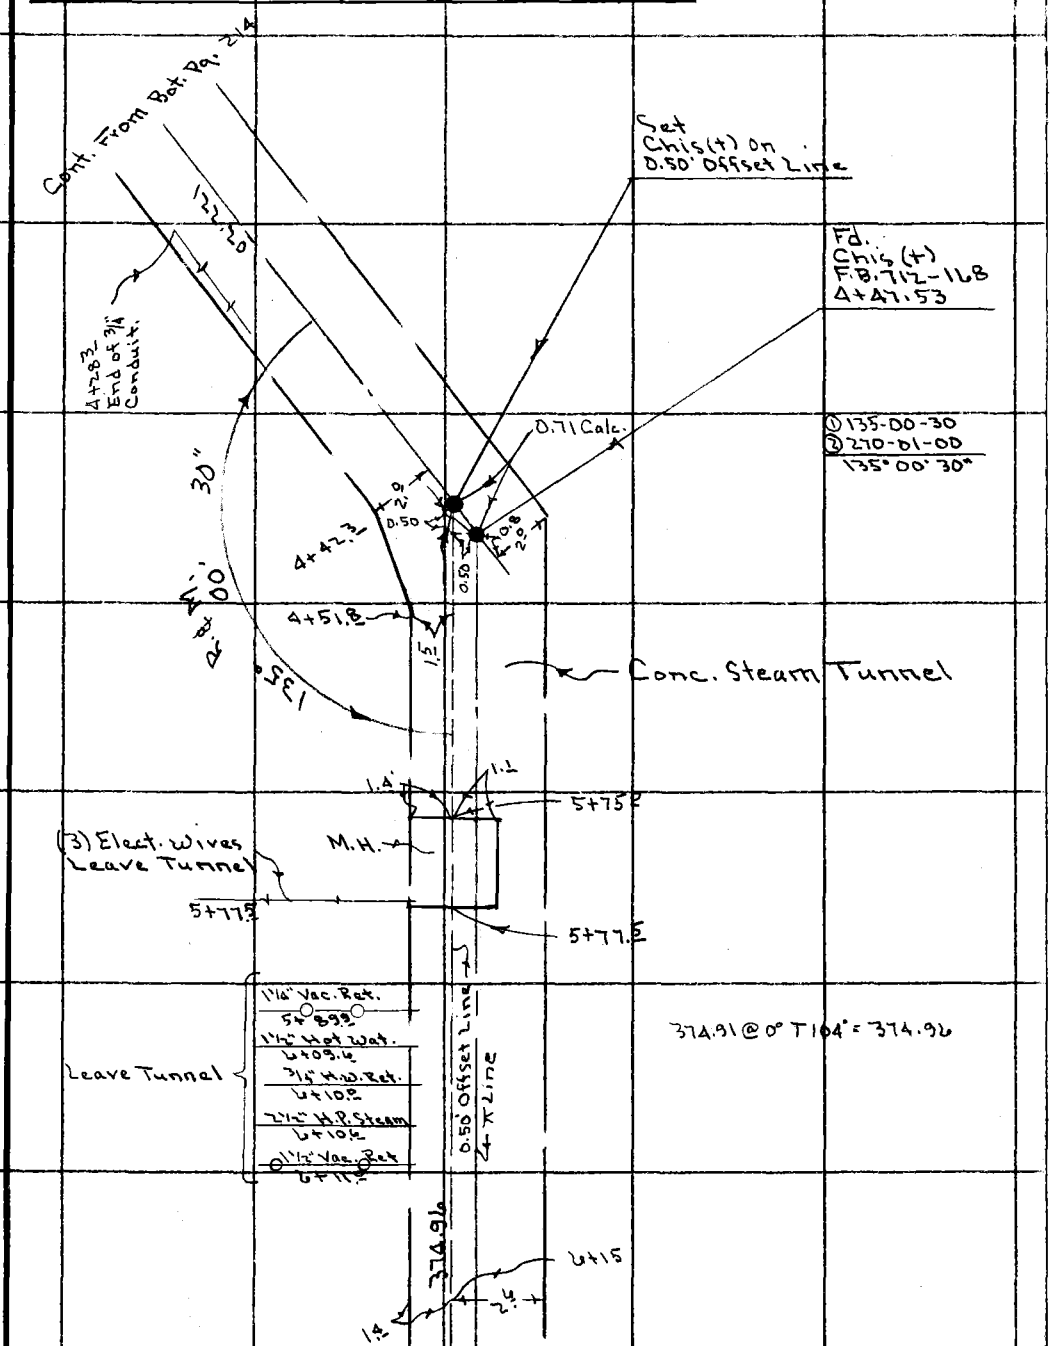

Cont. on Top Pg. 216

Note: Any Additions or Changes on This Sheet Must be Made or Circled in Red Ink With Date and Name of Person Making Change.

PLEASE RETURN TO
LOS ANGELES COUNTY ENGINEER
403 LOS ANGELES COUNTY ENGINEERING BLDG.

Do not extend this side of this line.

76F309S CE # 310 3-61

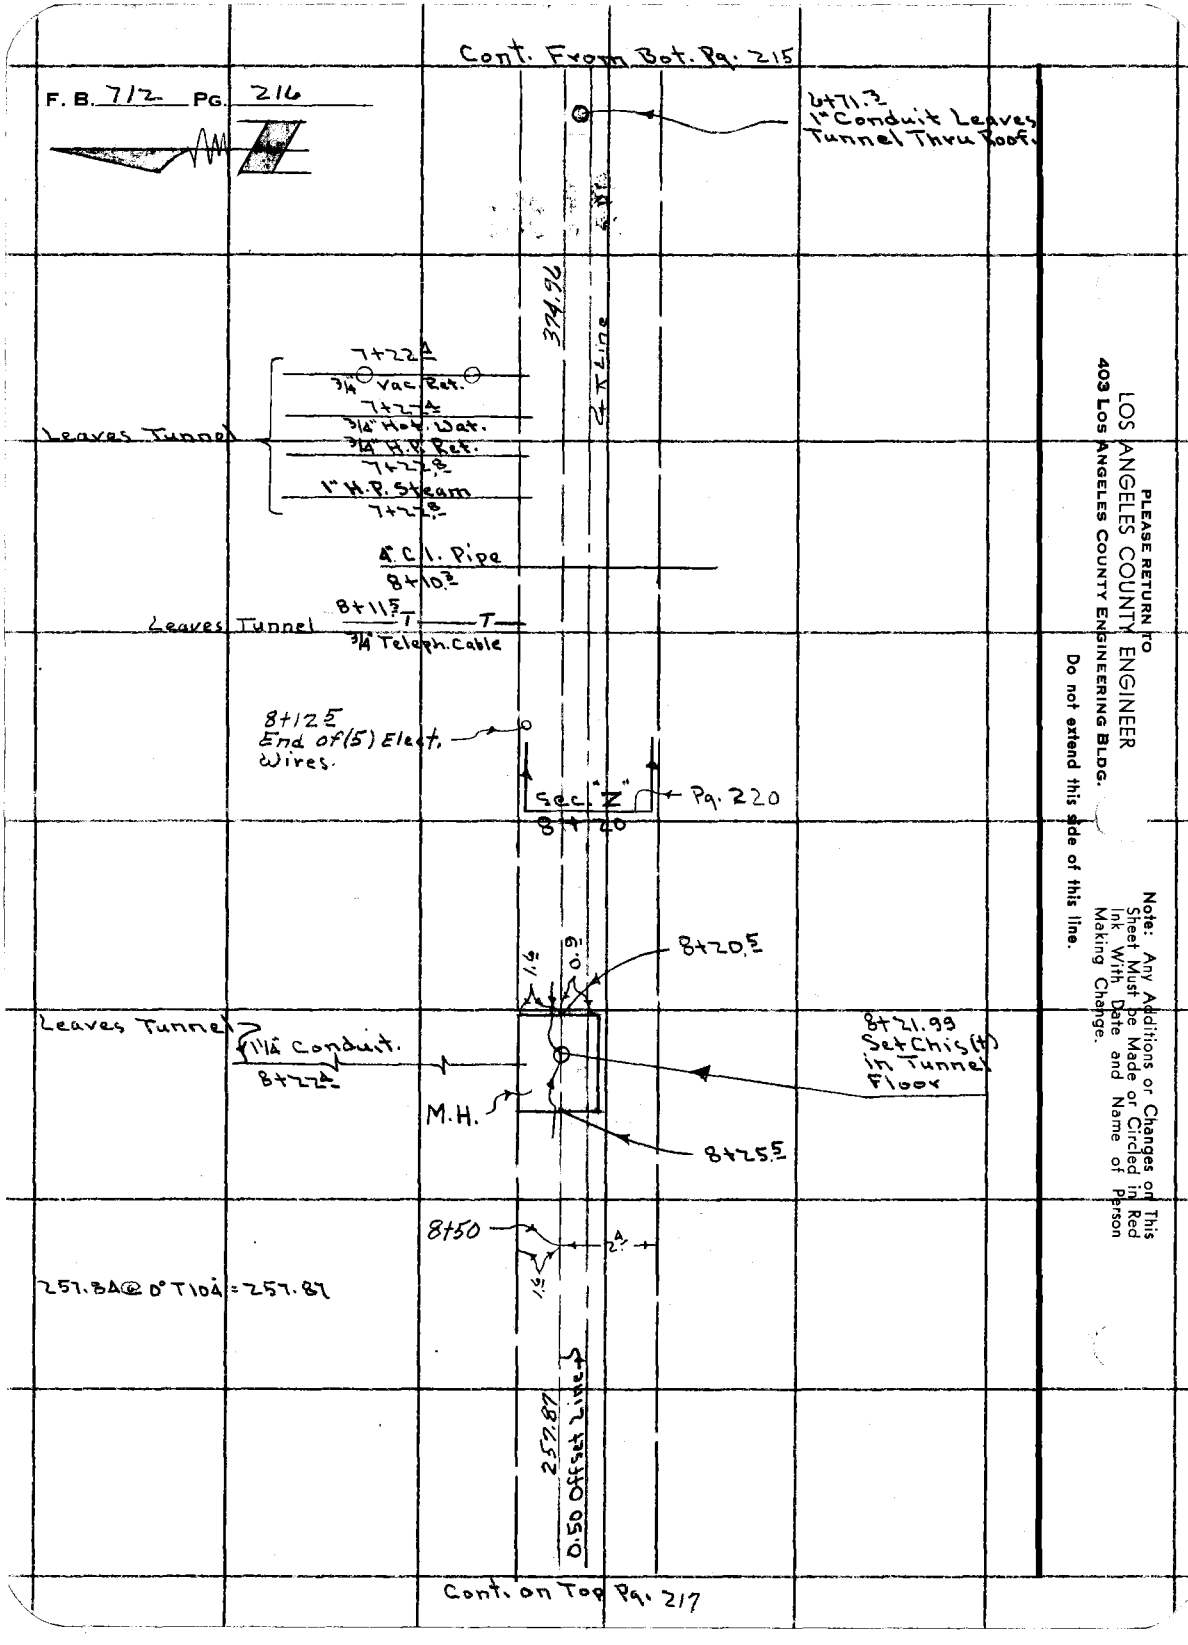

PLEASE RETURN TO
LOS ANGELES COUNTY ENGINEER
403 LOS ANGELES COUNTY ENGINEERING BLDG.

Do not extend this side of this line.

Note: Any Additions or Changes on This Sheet Must be Made or Circled in Red Ink With Date and Name of Person Making Change.

Notes Ck'd by	Survey of Olive View Hosp.	F. B. 712 PG. 217
Map No. 2-83	JN 8154.01 Tape 67 Std 84 °F	
Office Work	Surveyed by Petri	
Checked	Notes Petri Date 5-11-65	
Date	Indexed	

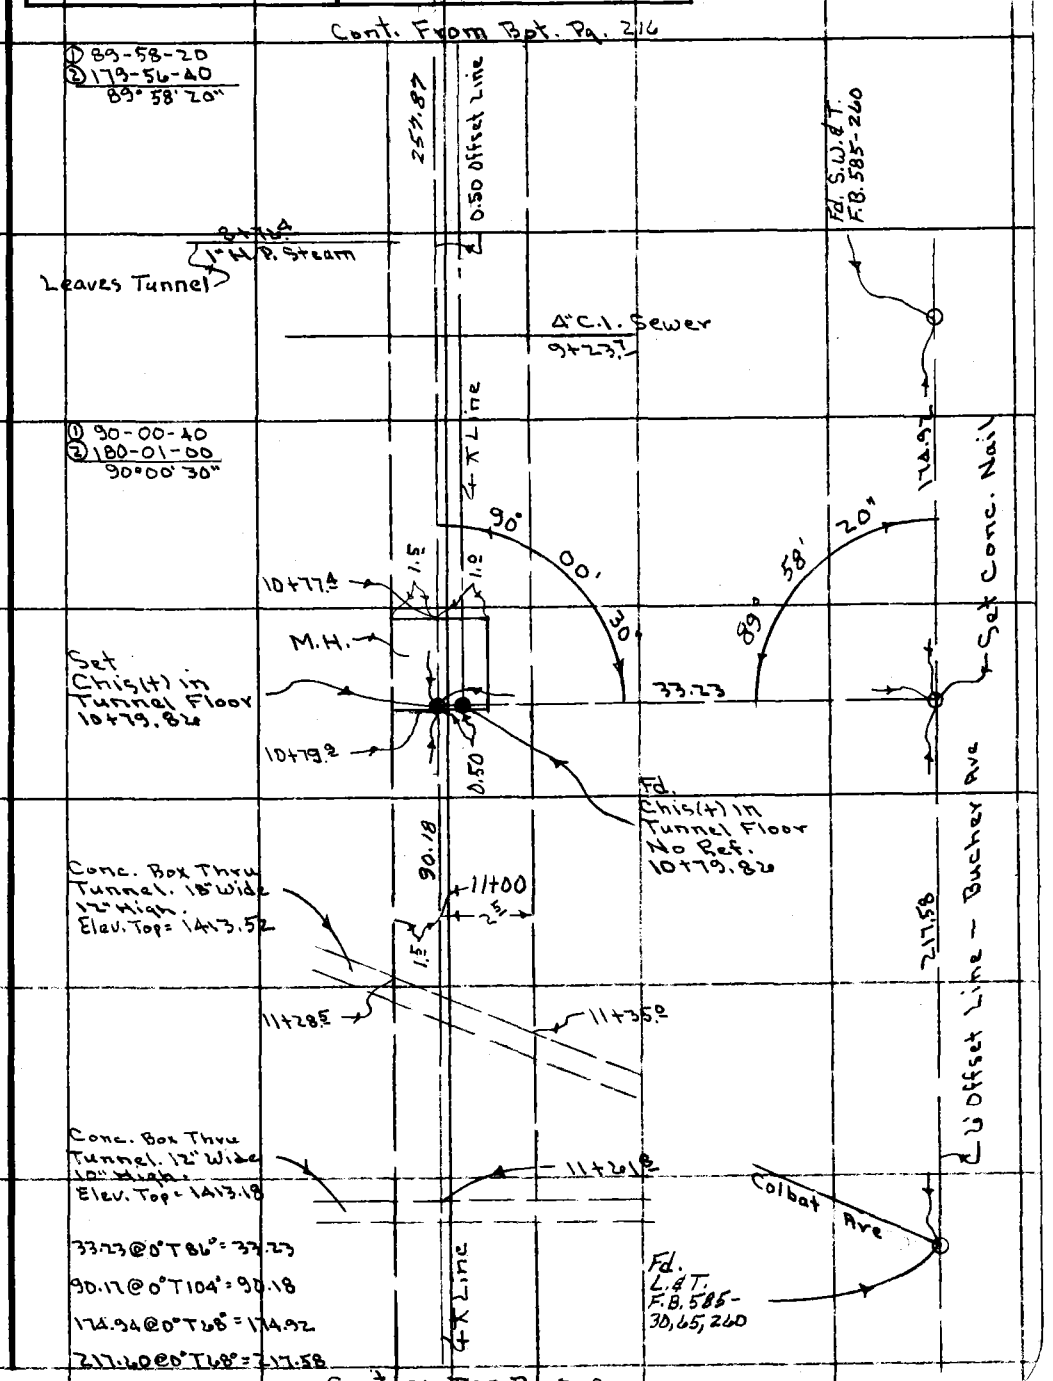

Note: Any Additions or Changes on This Sheet Must be Made or Circled in Red Ink With Date and Name of Person Making Change.

PLEASE RETURN TO
LOS ANGELES COUNTY ENGINEER
700 LOS ANGELES COUNTY ENGINEERING BLDG.
Do not extend this side of this line.

76F309S S&E #247 11-58

Cont. From Bot. Pg. 217

F. B. 712 Pg. 218

67.69@0°T68=67.68

46.65@0°T68=46.65

44.64 T=68°=44.64

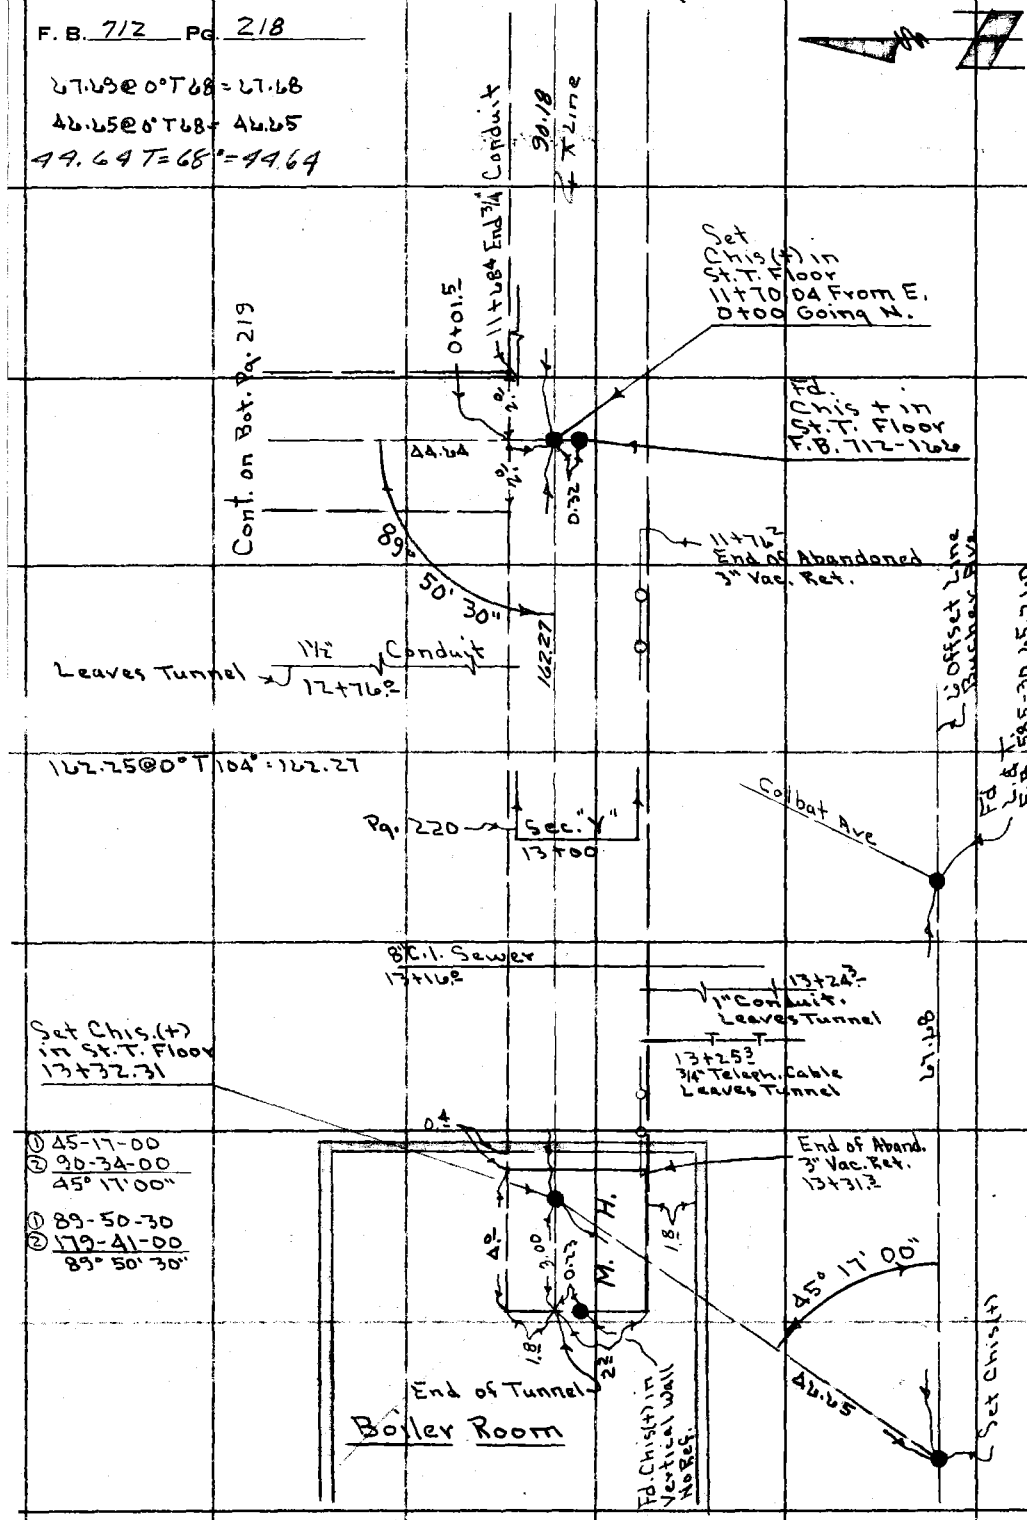

PLEASE RETURN TO
LOS ANGELES COUNTY ENGINEER
700 Los Angeles County Engineering Bldg.

Do not extend this side of this line.

Note: Any Additions or Changes on This Sheet Must be Made or Circled in Red Ink With Date and Name of Person Making Change.

Notes Ck'd by	Survey of Olive View Hosp.	F. B. 712 PG. 219
Map No. 2-83	JN 8154.01 Tape 67 Std 84 °F	
Office Work	Surveyed by Petr.	
Checked	Notes Petr. Date 5-12-65	
Date	Indexed C. J. GALLI	

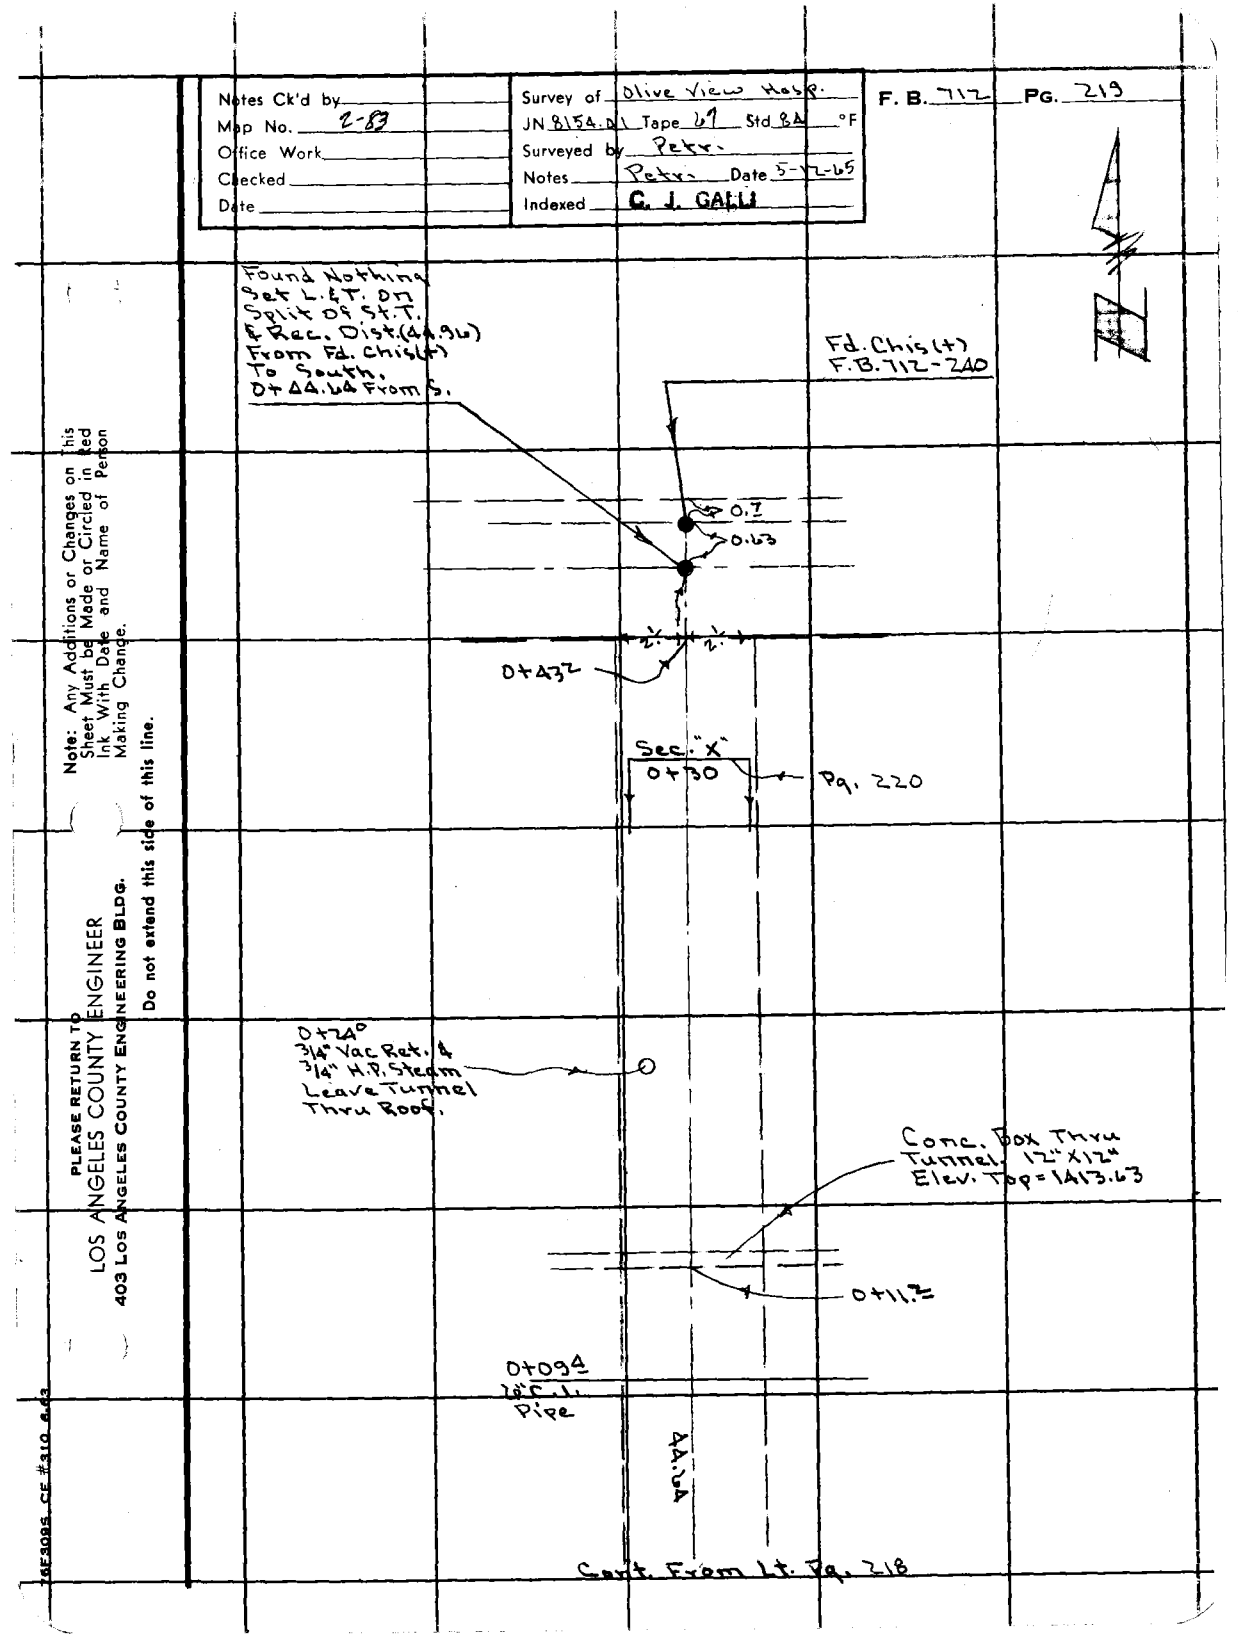

Note: Any Additions or Changes on This Sheet Must be Made or Circled in Red Ink With Date and Name of Person Making Change.

PLEASE RETURN TO
LOS ANGELES COUNTY ENGINEER
403 LOS ANGELES COUNTY ENGINEERING BLDG.

Do not extend this side of this line.

76F3095 CE #310 6-63

F. B. 712 PG. 220

Sec. "Z" (H-H)
8+20
Pg. 216

3¼" Conduit
3" Vac. Ret.
4" Hot Water
1" Conduit
2" H.W. Ret.
2" H.P. Ret.
¾ Teleph. Cable
(2) Elect. Wires
(5) Elect. Wires
4" H.P. Steam
Δ.P.

Sec. "Y" (J-J)
13+00
Pg. 218

3" Vac. Ret. (Abandoned) See Pg. 218
4" Hot Water
1" Conduit
¾ Teleph. Cable
2" H.W. Ret.
(2) Elect. Wires
4" H.P. Steam
Δ.P.

Sec. "X" (K-K)
0+30
Pg. 219

¾" Vac. Ret.
¾" H.P. Steam
3" Vac. Ret.
2½" H.P. Ret.
1" Conduit
(5) Elect. Wires
Δ.P.

Sec. "W" (F-F)
0+20
Pg. 227

1½" Hot. Wat.
1" Conduit
1" Hot Wat. Ret.
2" H.P. Steam
1¼" Vac. Ret.
Δ.P.

PLEASE RETURN TO
LOS ANGELES COUNTY ENGINEER
403 Los Angeles County Engineering Bldg.

Do not extend this side of this line.

Note: Any Additions or Changes on This Sheet Must Be Made or Circled in Red Ink With Date and Name of Person Making Change.

Notes Ck'd by	Survey of Olive View Hosp.	F. B. 712 Pg. 221
Map No. 2-83	JN 8154.01 Tape Std °F	
Office Work	Surveyed by Petri	
Checked	Notes Petri Date 5-13-65	
Date	Indexed C. J. GALLI	

Cont. From Lt. Pg. 203

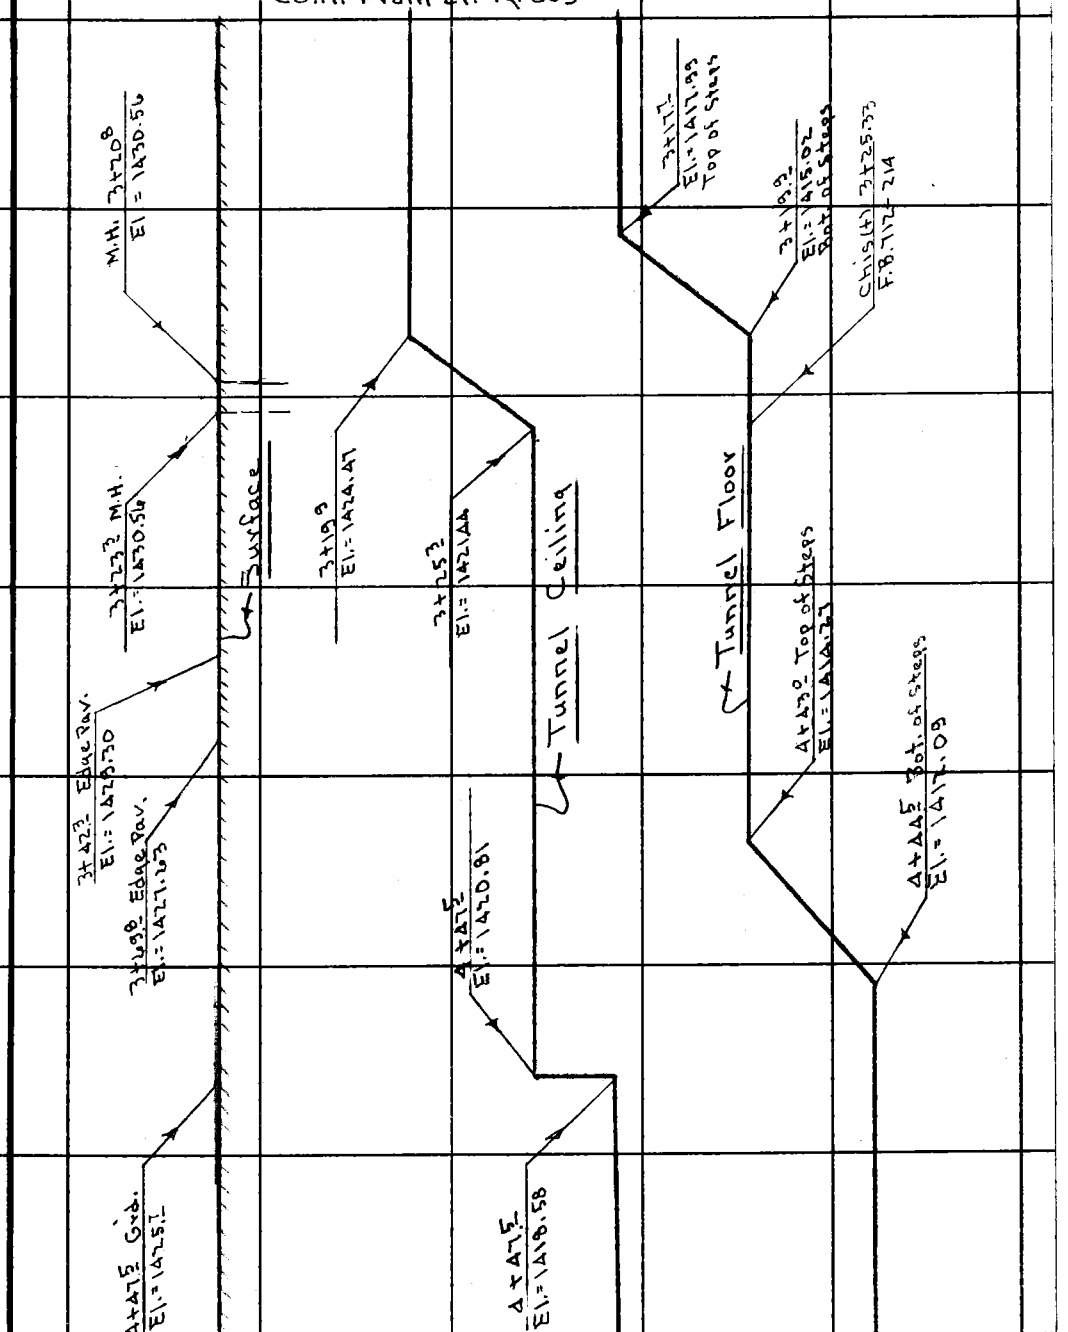

Cont. on Top Pg. 222

Note: Any Additions or Changes on This Sheet Must be Made or Circled in Red Ink With Date and Name of Person Making Change.

PLEASE RETURN TO
LOS ANGELES COUNTY ENGINEER
403 LOS ANGELES COUNTY ENGINEERING BLDG.

Do not extend this side of this line.

76F3095 CE #310 6-63

F. B. 712 PG. 222

Cont. From Bot. Pg. 221

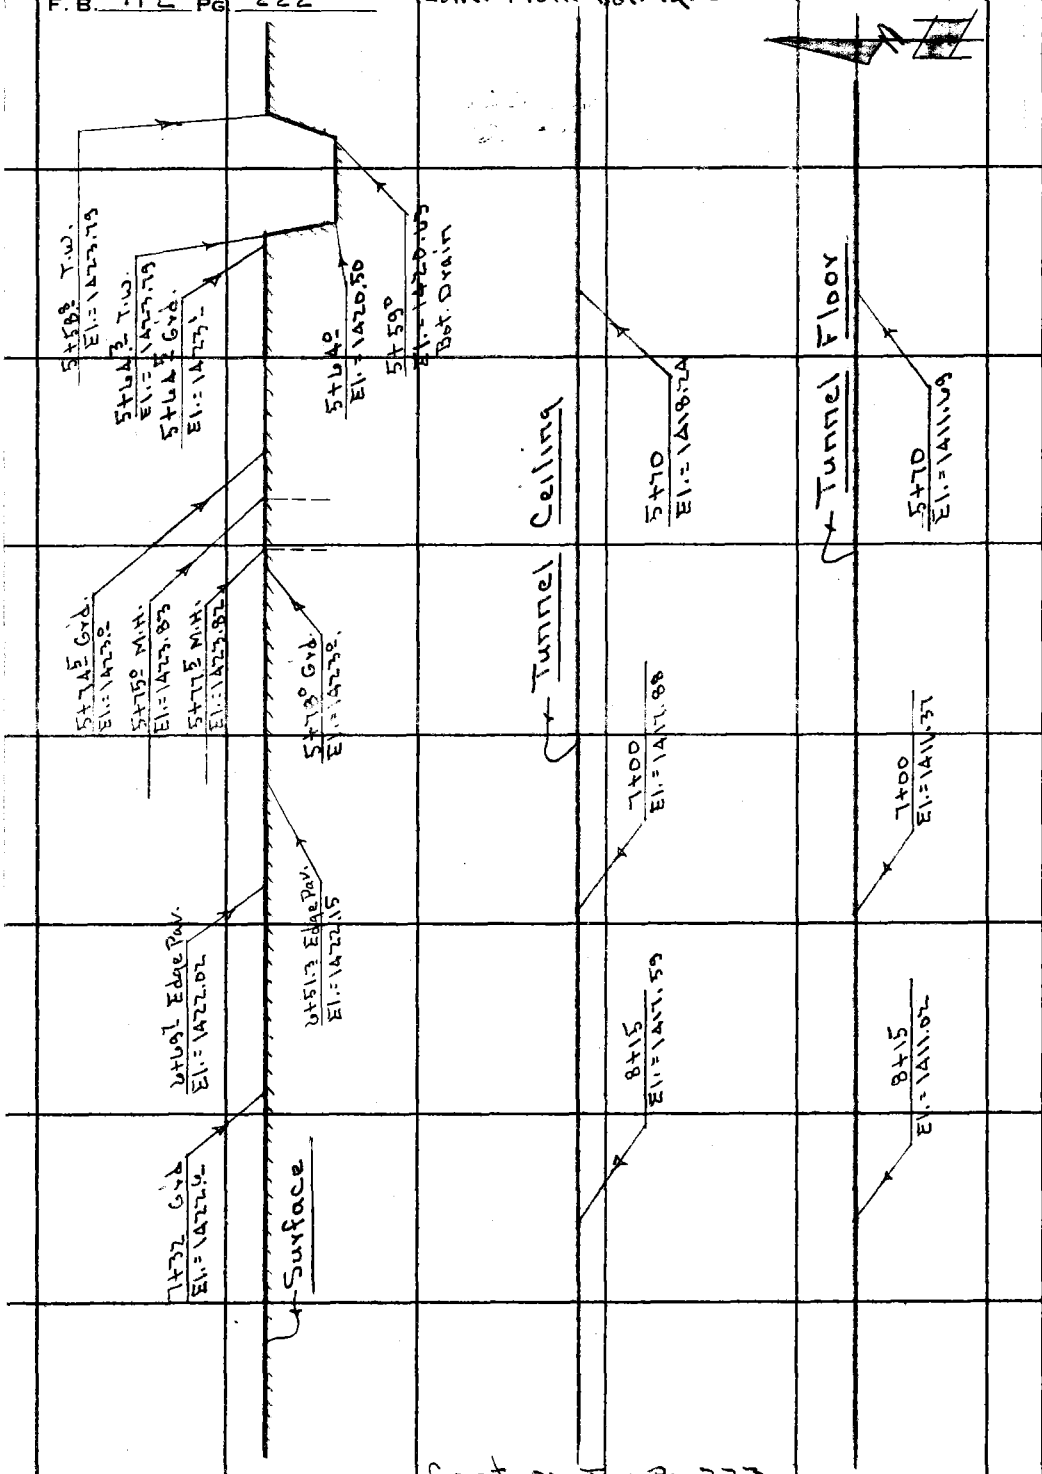

Cont. on Top Pg. 223

PLEASE RETURN TO
LOS ANGELES COUNTY ENGINEER
403 LOS ANGELES COUNTY ENGINEERING BLDG.

Do not extend this side of this line.

Note: Any Additions or Changes on This Sheet Must be Made or Circled in Red Ink With Date and Name of Person Making Change.

Notes Ck'd by	Survey of Olive View Hosp	F. B. 712 PG. 223
Map No. 2-83	JN 8154.01 Tape Std °F	
Office Work	Surveyed by Petri	
Checked	Notes Petri Date 5-13-65	
Date	Indexed C. J. GALLI	

Cont. From Bot. Pg. 222

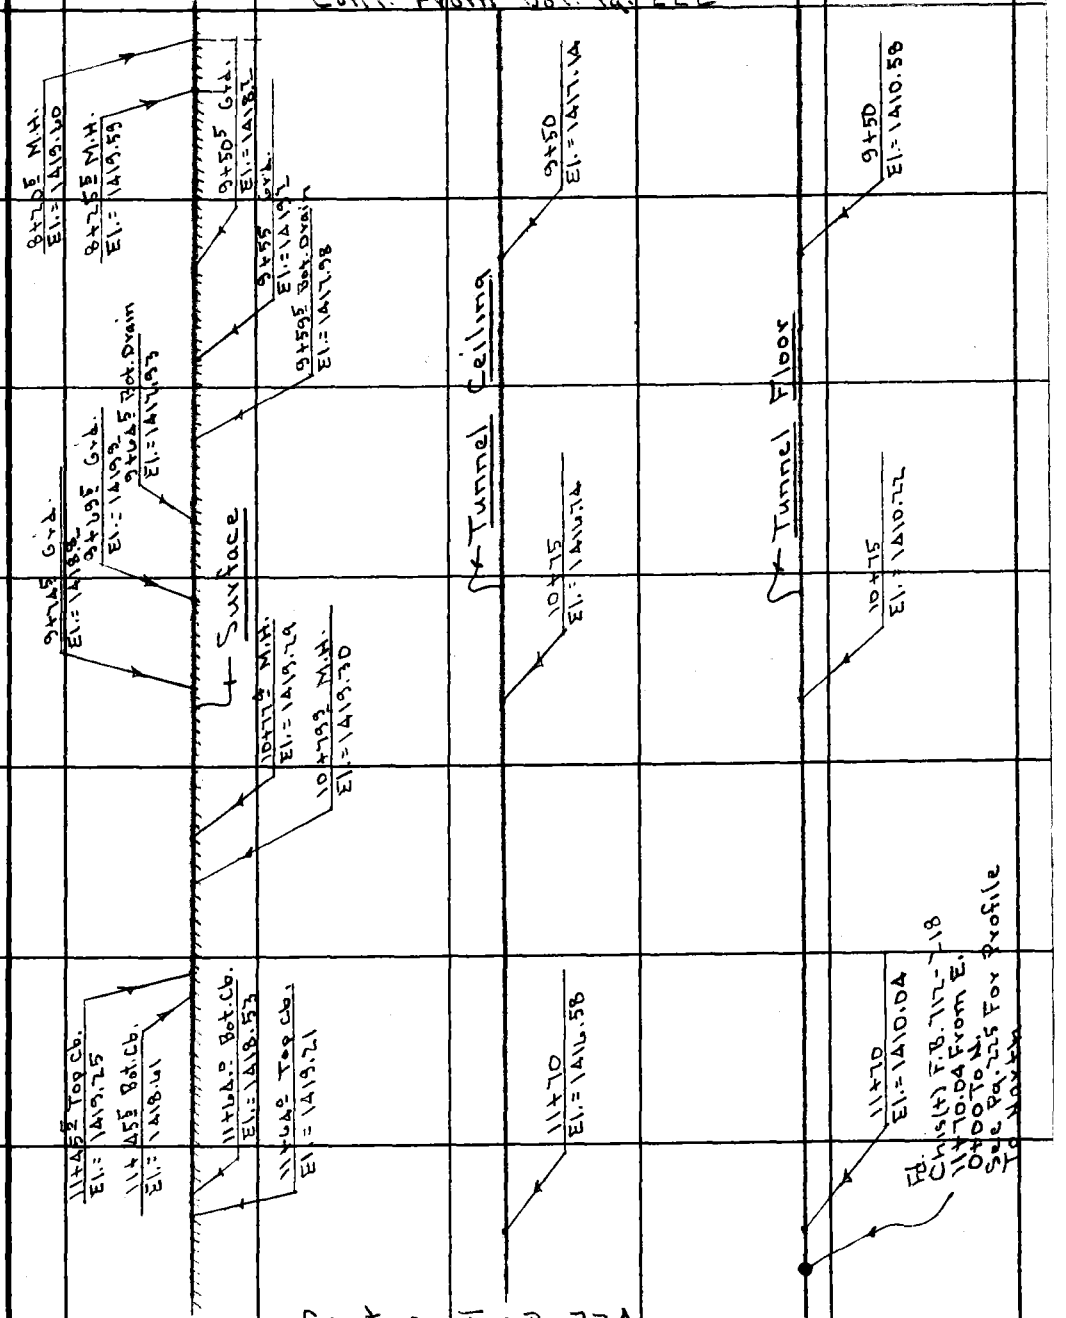

Cont. on Top Pg. 224

Note: Any Additions or Changes on This Sheet Must be Made or Circled in Red Ink With Date and Name of Person Making Change.

PLEASE RETURN TO
LOS ANGELES COUNTY ENGINEER
403 LOS ANGELES COUNTY ENGINEERING BLDG.

Do not extend this side of this line.

76F309S CE #310 6-63

PLEASE RETURN TO
LOS ANGELES COUNTY ENGINEER
403 LOS ANGELES COUNTY ENGINEERING BLDG.

Note: Any Additions or Changes on This Sheet Must be Made or Circled in Red Ink With Date and Name of Person Making Change.

Do not extend this side of this line.

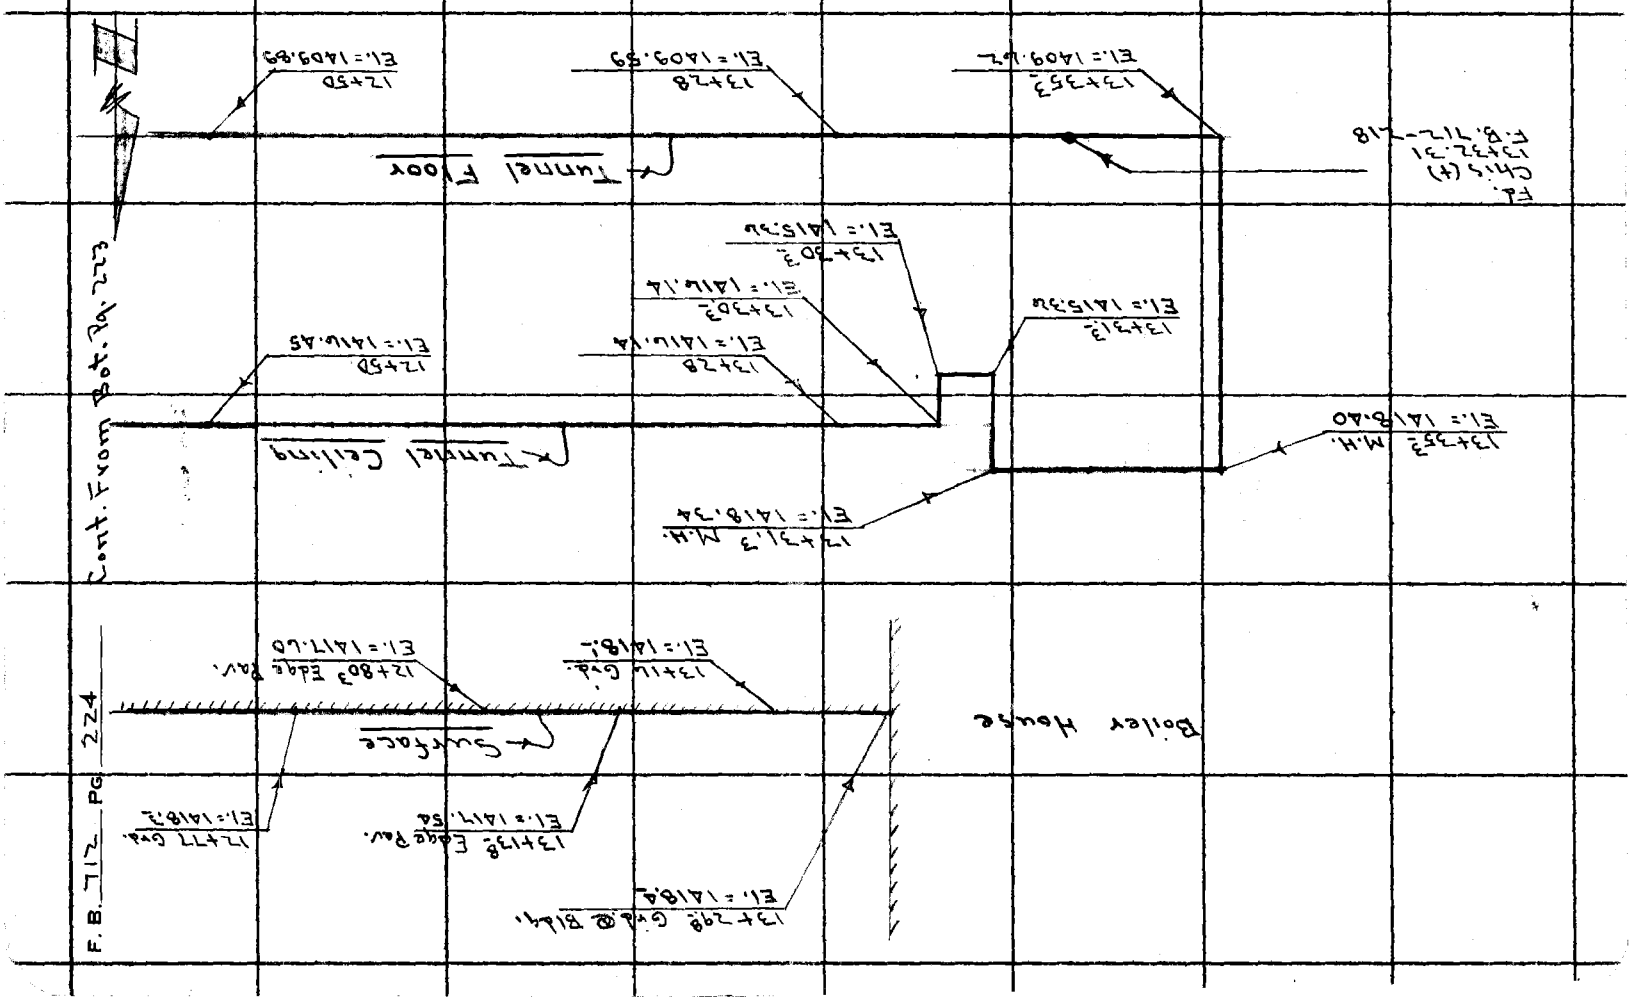

F. B. 712 PG. 224

Notes Ck'd by	Survey of Olive View Hosp.	F. B. 712 PG. 225
Map No. 2-83	JN 8154.01 Tape ____ Std ____ °F	
Office Work	Surveyed by Petr.	
Checked	Notes Petr. Date 5-13-63	
Date	Indexed C. J. GALLI	

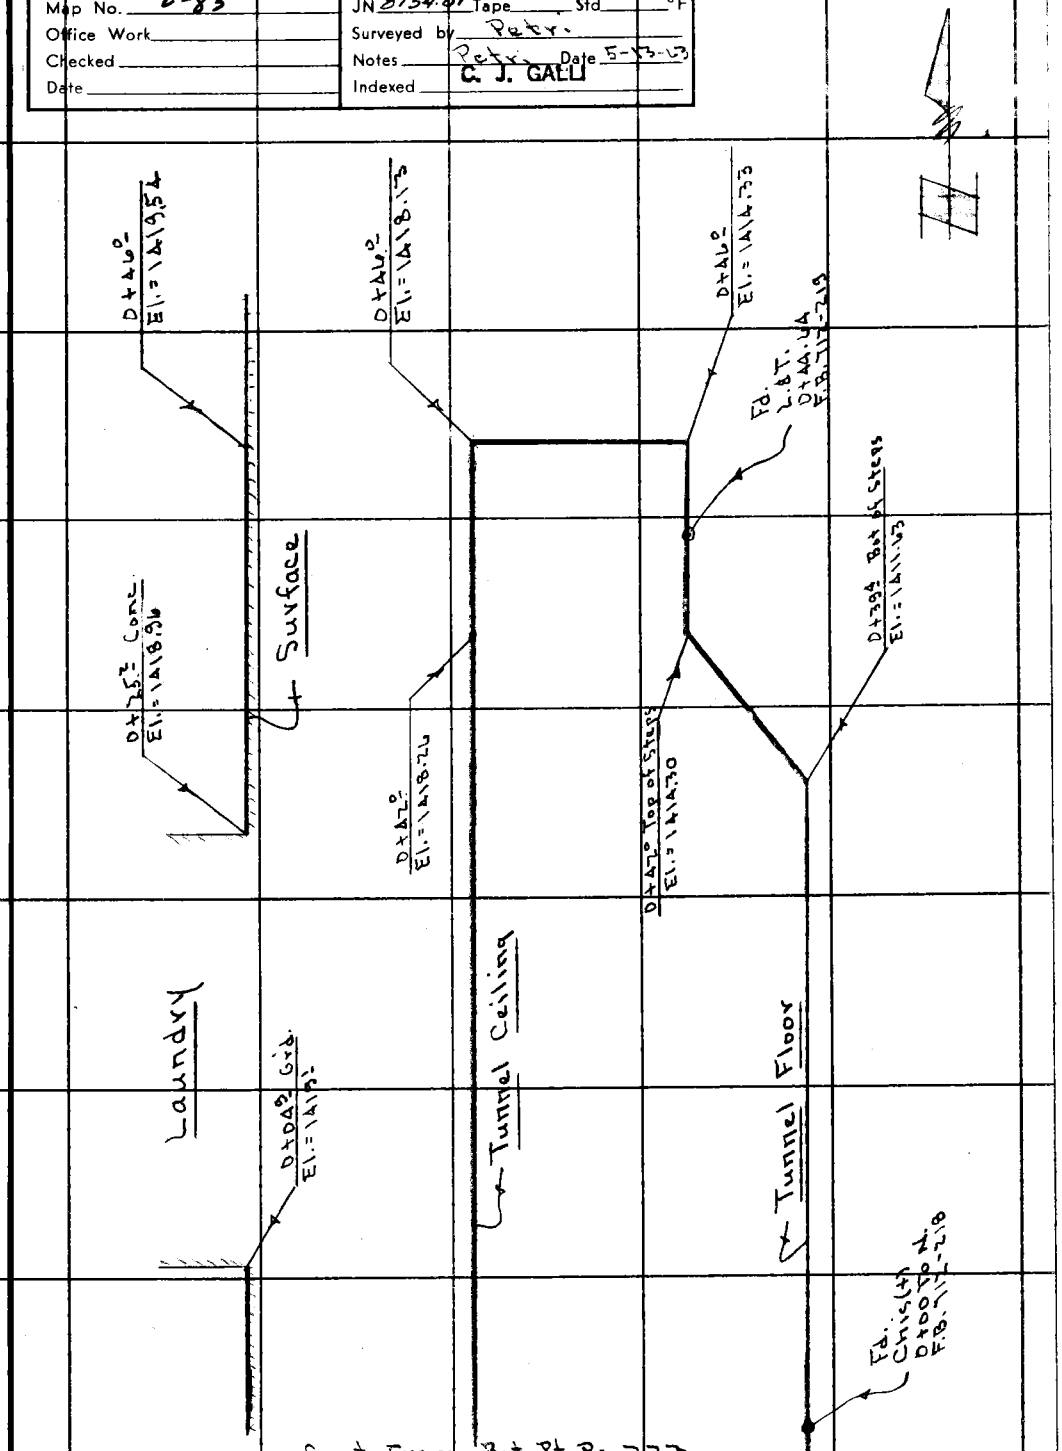

Cont. From Bot. Pt. Pg. 223

Note: Any Additions or Changes on This Sheet Must be Made or Circled in Red Ink With Date and Name of Person Making Change.

PLEASE RETURN TO
LOS ANGELES COUNTY ENGINEER
403 LOS ANGELES COUNTY ENGINEERING BLDG.
Do not extend this side of this line.

76F309S CE #310 6-63

PLEASE RETURN TO
LOS ANGELES COUNTY ENGINEER
403 LOS ANGELES COUNTY ENGINEERING BLDG.

Do not extend this side of this line.

Note: Any Additions or Changes on This Sheet Must be Made or Circled in Red Ink With Date and Name of Person Making Change.

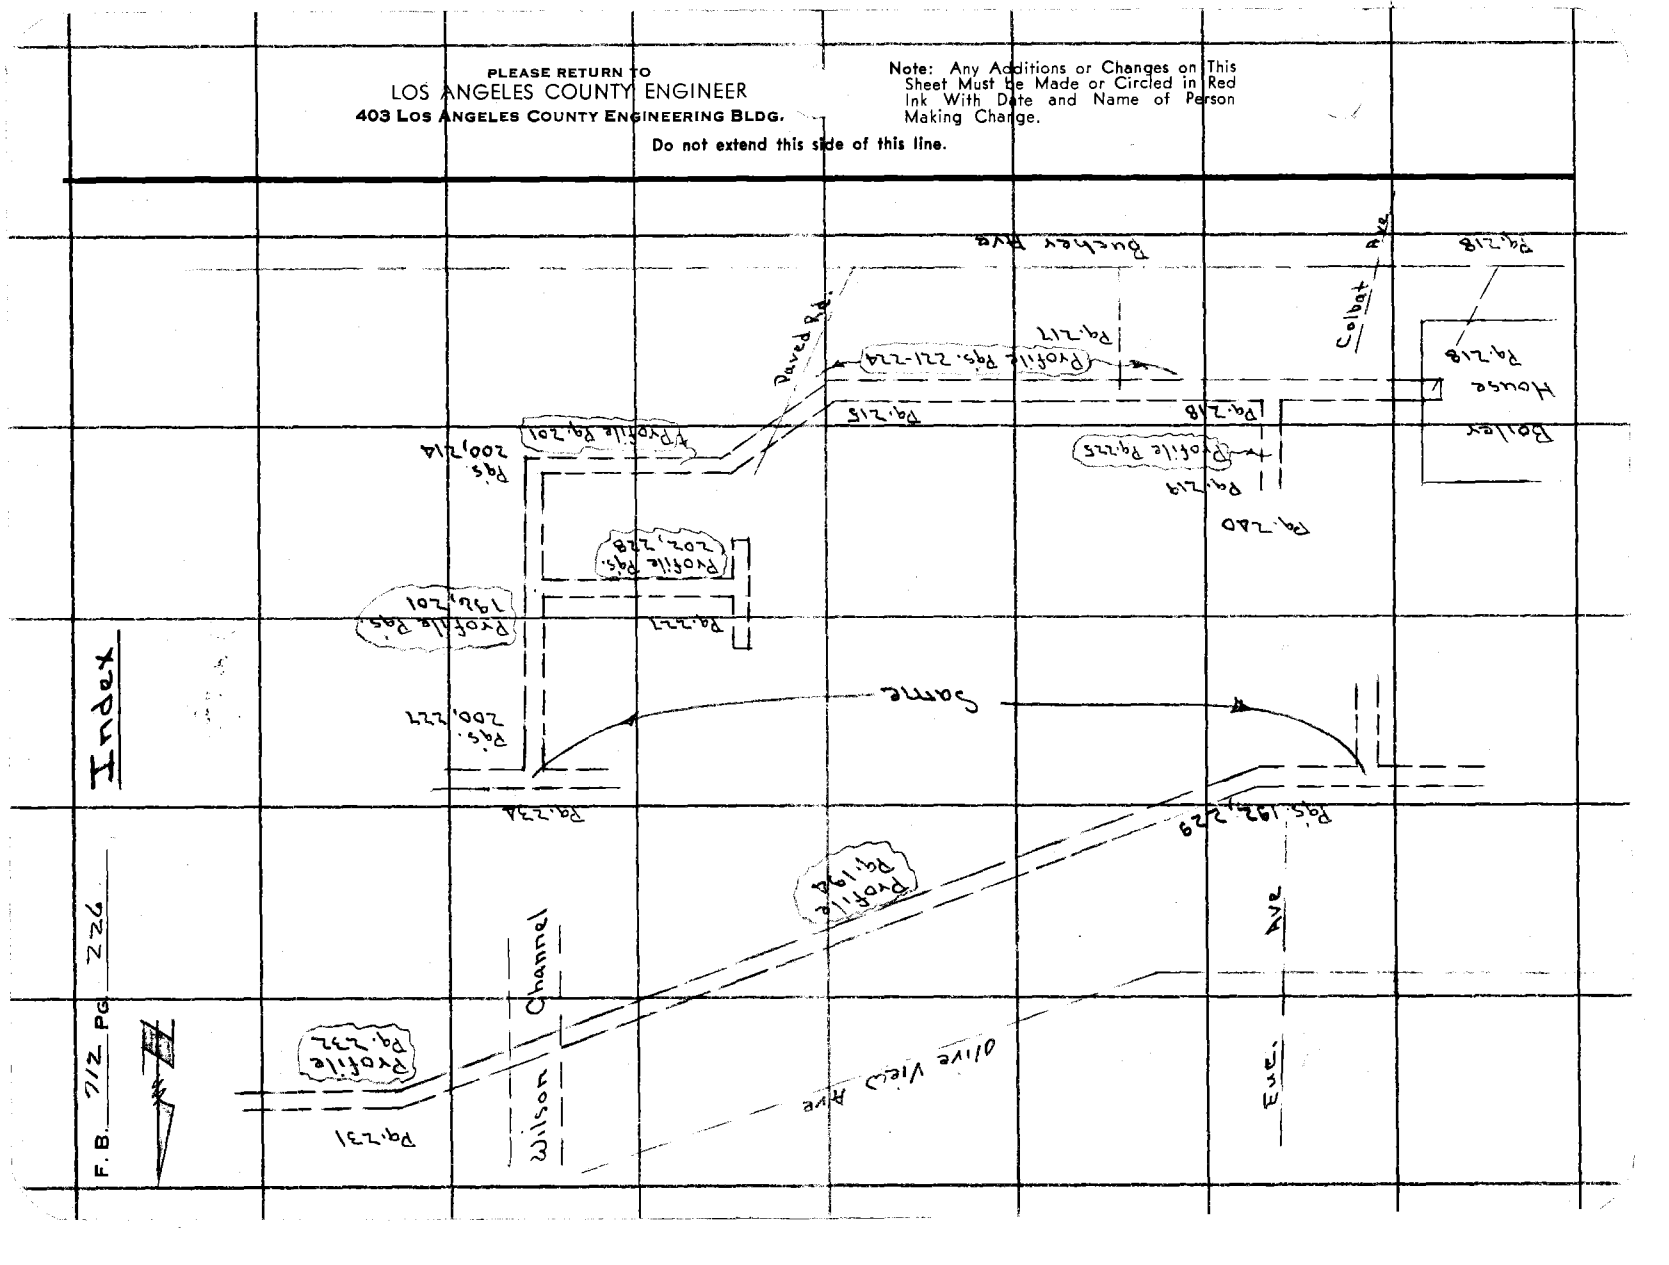

Notes Ck'd by	Survey of Olive View Hosp.	F. B. 712 PG. 227
Map No. 2-83	JN 8154.01 Tape 67 Std 84 °F	
Office Work	Surveyed by Petri	
Checked	Notes Petri Date 5-14-65	
Date	Indexed C. J. GALLI	

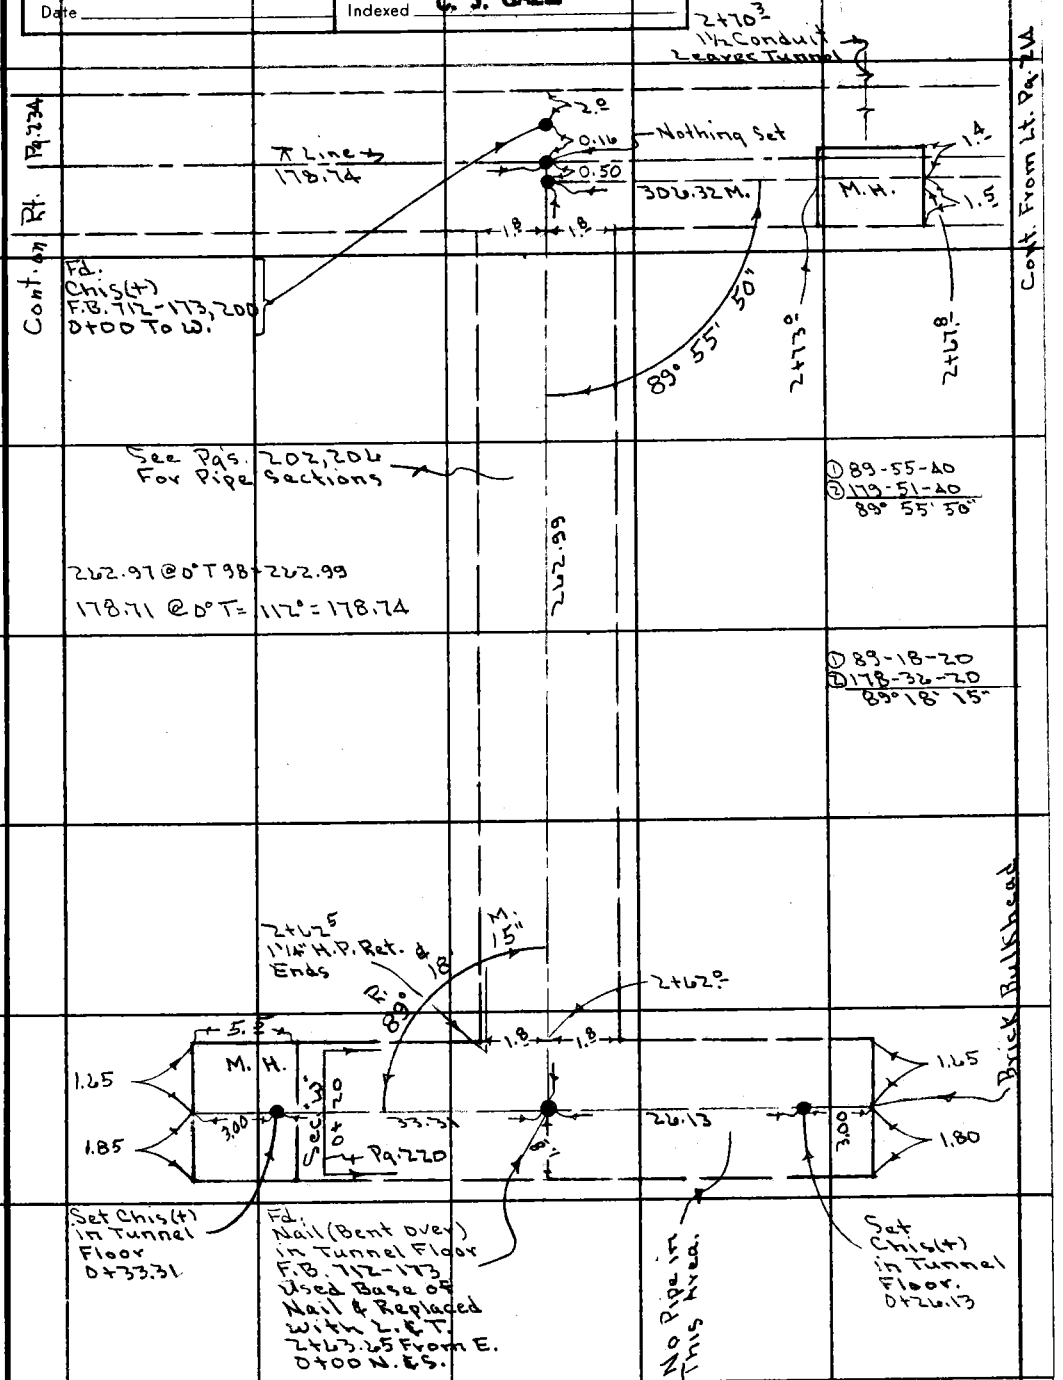

Note: Any Additions or Changes on This Sheet Must be Made or Circled in Red Ink With Date and Name of Person Making Change.

PLEASE RETURN TO
LOS ANGELES COUNTY ENGINEER
403 LOS ANGELES COUNTY ENGINEERING BLDG.

Do not extend this side of this line.

76F309S CE #310 6-63

F. B. 712 PG 228

PLEASE RETURN TO
LOS ANGELES COUNTY ENGINEER
403 Los Angeles County Engineering Bldg.

Do not extend this side of this line.

Note: Any Additions or Changes on This Sheet Must be Made or Circled in Red Ink With Date and Name of Person Making Change.

Notes Ck'd by	Survey of Olive View Hosp.	F. B. 712 PG. 229
Map No. 2-83	JN 8154.01 Tape 67 Std 84 °F	
Office Work	Surveyed by Petri	
Checked	Notes Petri Date 5-15-65	
Date	Indexed C. J. GALLI	

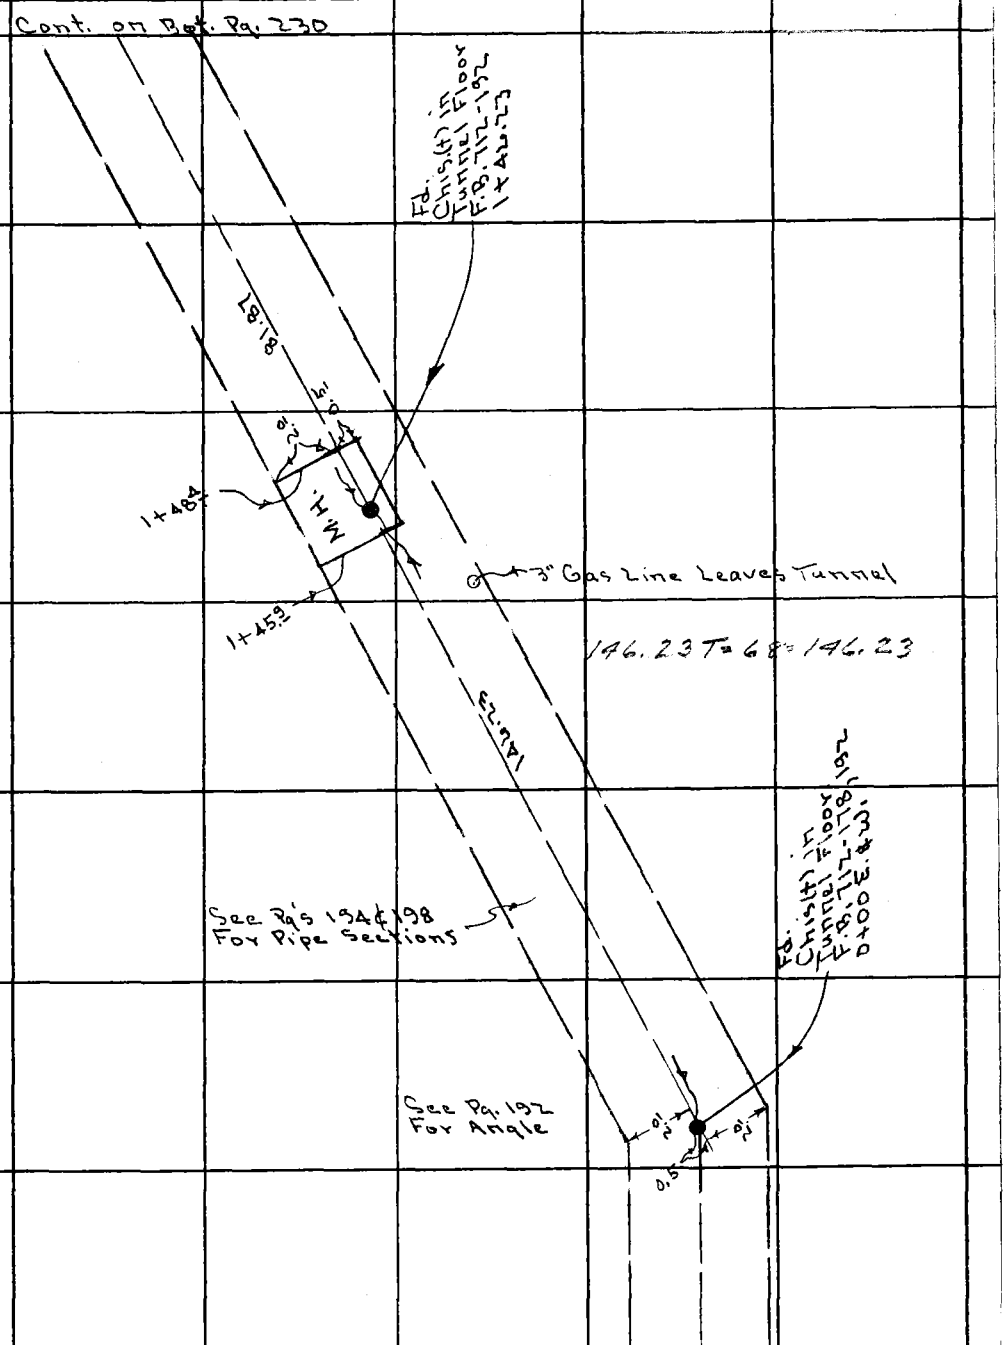

Note: Any Additions or Changes on This Sheet Must be Made or Circled in Red Ink With Date and Name of Person Making Change.

PLEASE RETURN TO
LOS ANGELES COUNTY ENGINEER
403 LOS ANGELES COUNTY ENGINEERING BLDG.

Do not extend this side of this line.

76F309S CE #310 6-63

Cont. on Bot. Pg. 231

F. B. 712 PG. 230

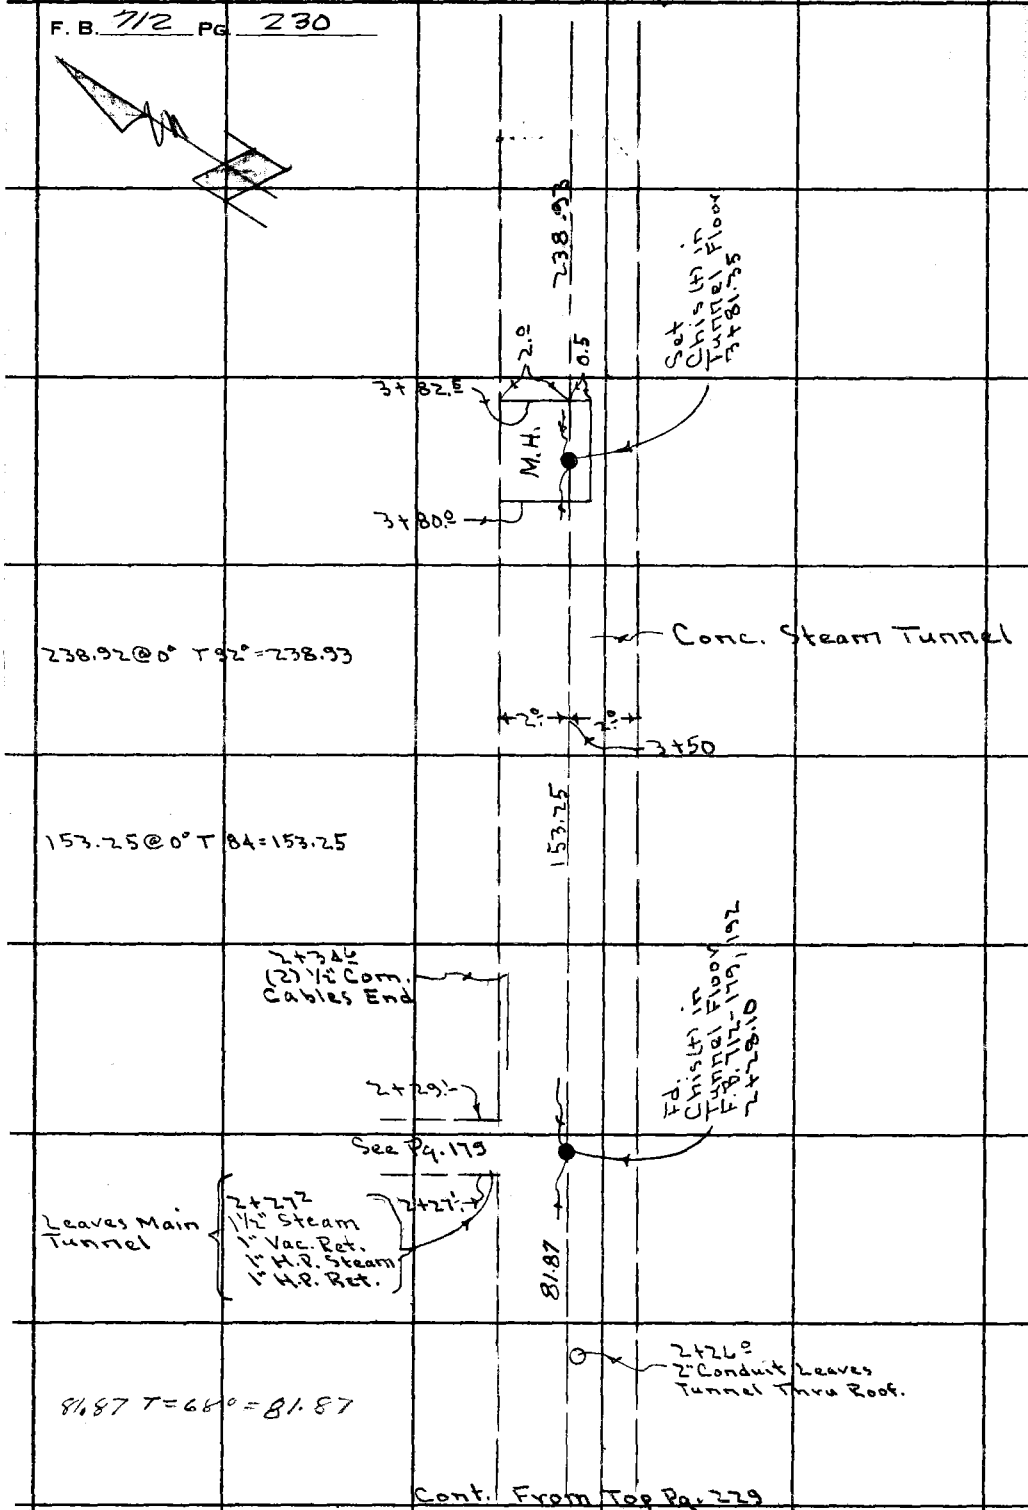

Cont. From Top Pg. 229

PLEASE RETURN TO
LOS ANGELES COUNTY ENGINEER
403 LOS ANGELES COUNTY ENGINEERING BLDG.
Do not extend this side of this line.

Note: Any Additions or Changes on This Sheet Must be Made or Circled in Red Ink With Date and Name of Person Making Change.

Notes Ck'd by	Survey of Olive View Hosp.	F. B. 712 Pg. 231
Map No. 2-83	JN 8154.01 Tape 67 Std 84 °F	
Office Work	Surveyed by Petri	
Checked	Notes Petri Date 5-15-65	
Date	Indexed [illegible]	

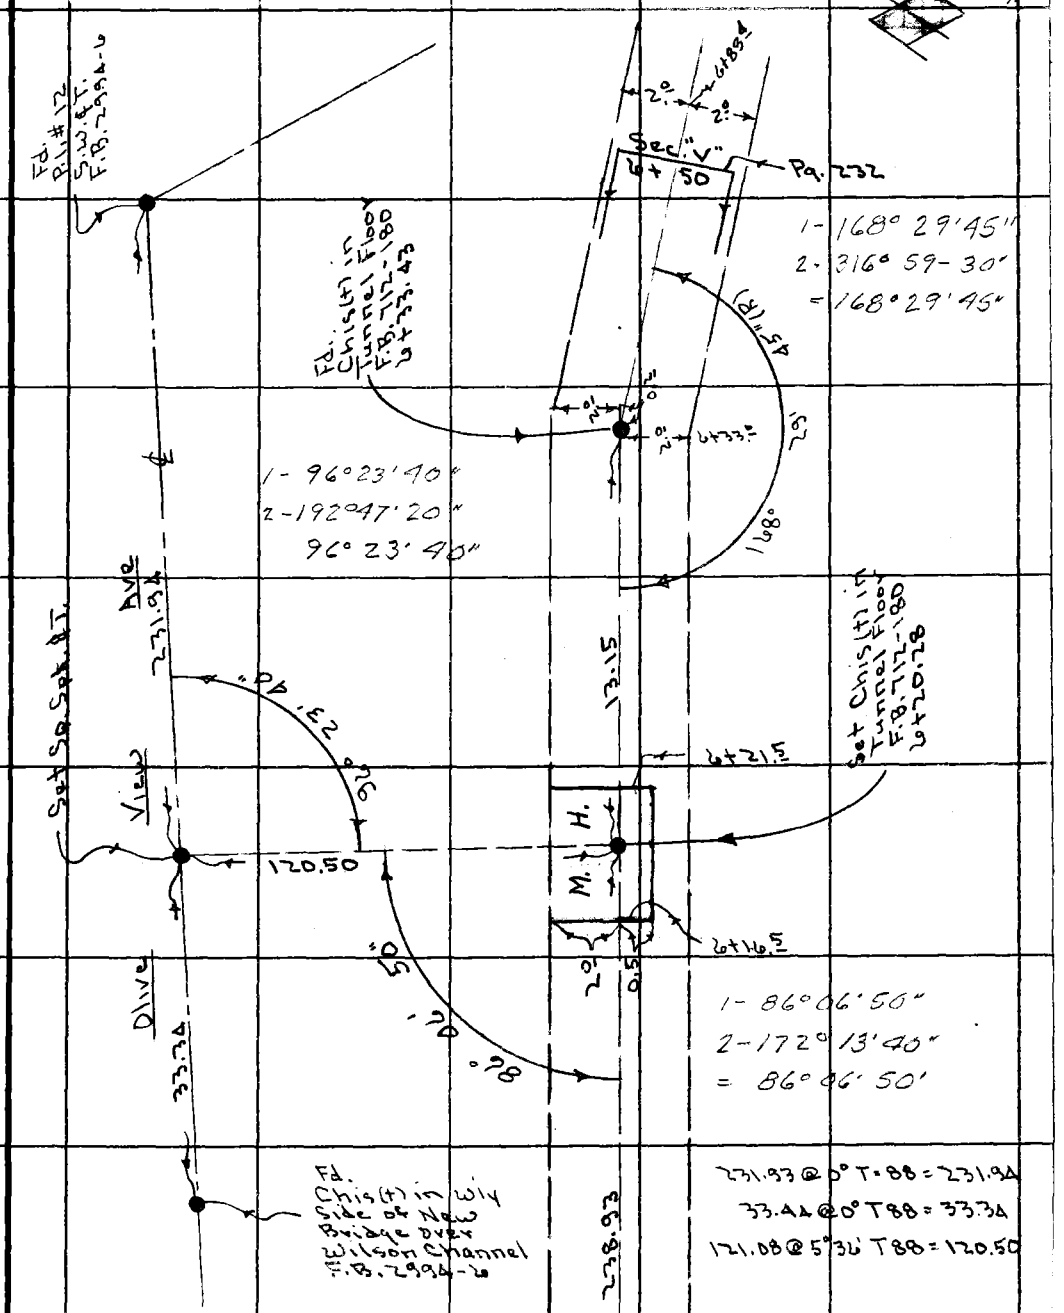

Cont. From Top Pg. 230

Note: Any Additions or Changes on This Sheet Must be Made or Circled in Red Ink With Date and Name of Person Making Change.

PLEASE RETURN TO
LOS ANGELES COUNTY ENGINEER
403 LOS ANGELES COUNTY ENGINEERING BLDG.
Do not extend this side of this line.

76F309S CE #310 6-63

PLEASE RETURN TO
LOS ANGELES COUNTY ENGINEER
403 LOS ANGELES COUNTY ENGINEERING BLDG.

Note: Any Additions or Changes on This Sheet Must Be Made or Circled in Red Ink With Date and Name of Person Making Change.

Do not extend this side of this line.

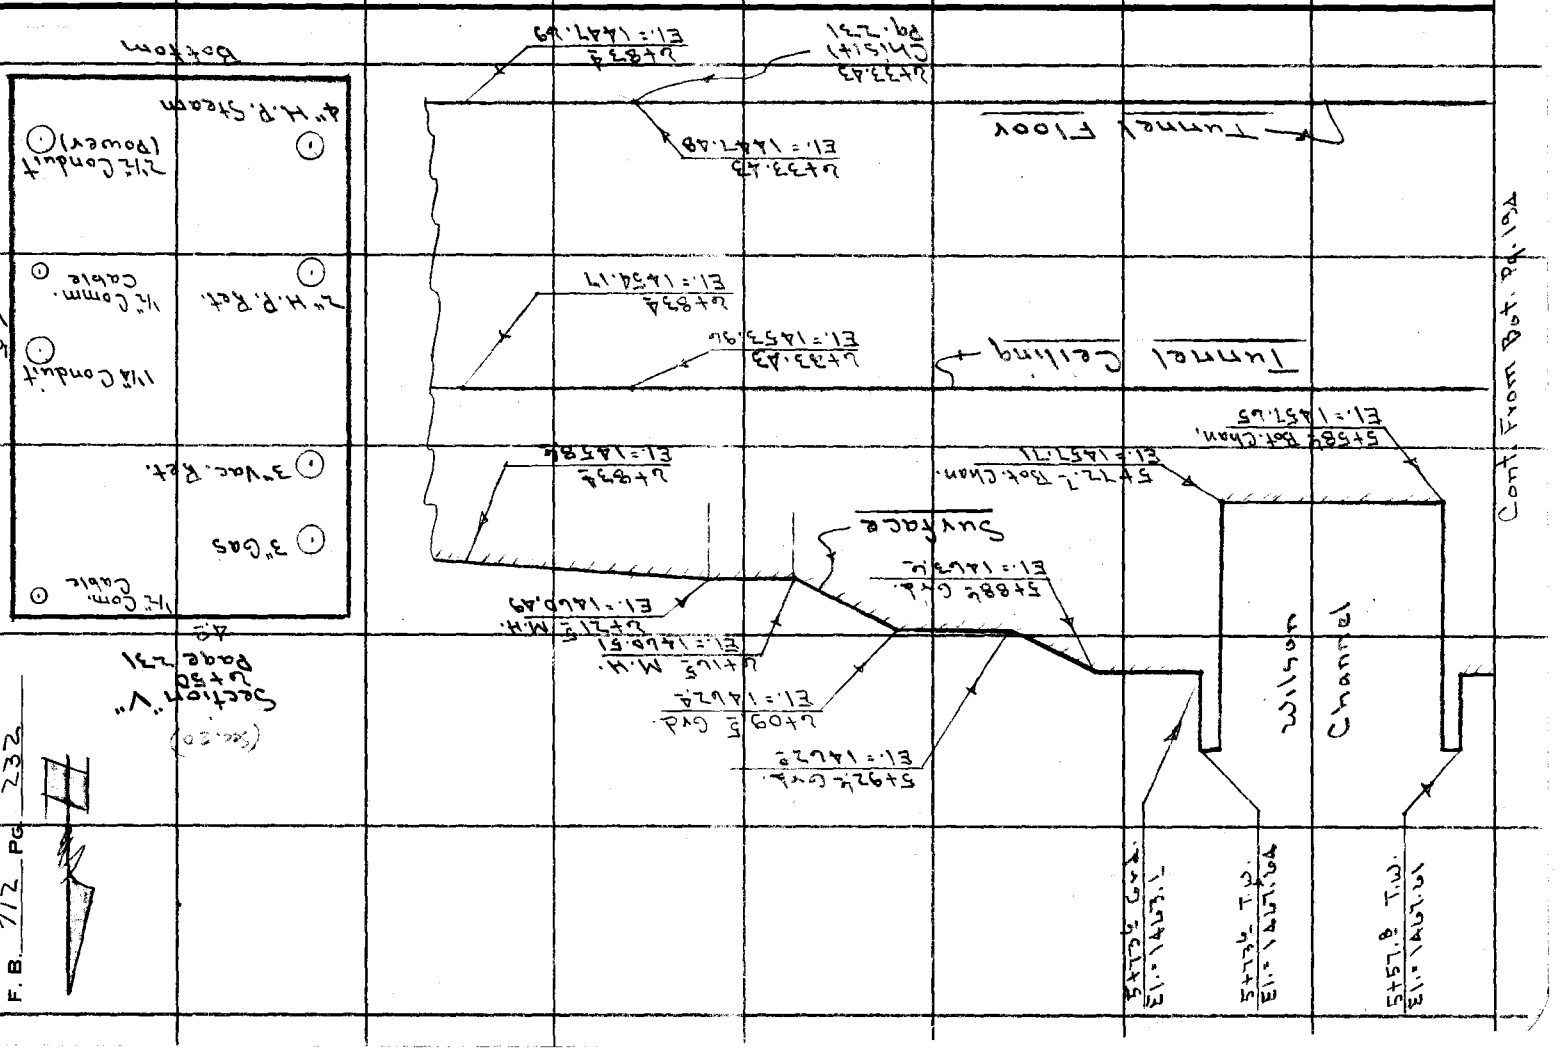

76F309S CE #310 6-63

PLEASE RETURN TO
LOS ANGELES COUNTY ENGINEER
403 LOS ANGELES COUNTY ENGINEERING BLDG.

Note: Any Additions or Changes on This Sheet Must be Made or Circled in Red Ink With Date and Name of Person Making Change.

Do not extend this side of this line.

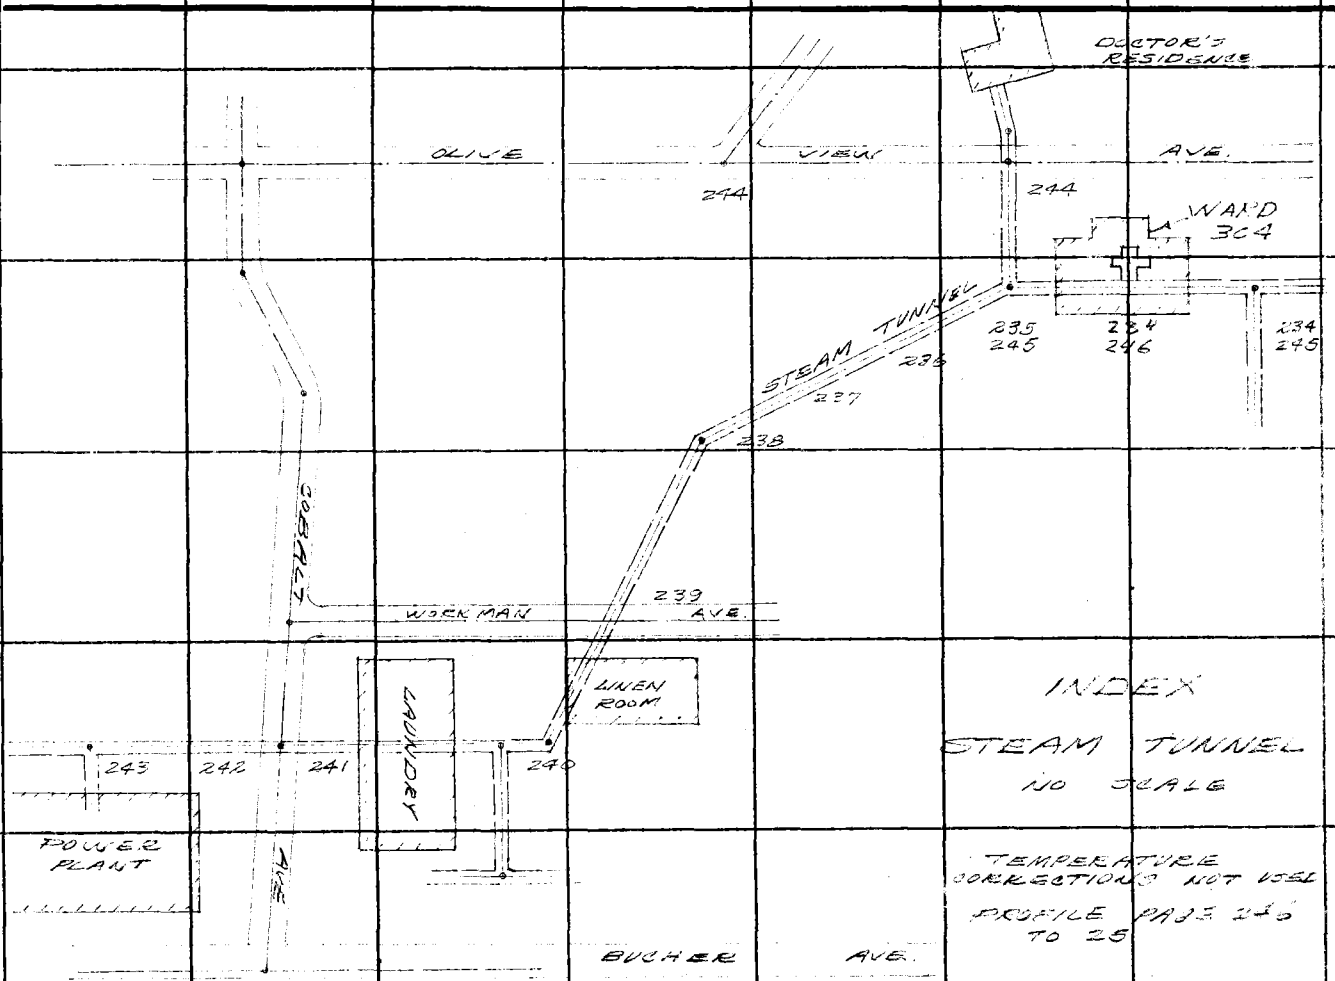

Notes Ck'd by
Map No. 2-83
Office Work
Checked
Date

Survey of OLIVE VIEW HOSPITAL
JN 815A.W Tape Std. °F
Surveyed by
Notes Date
Indexed C. J. GALLIN 7 0 '63

F. B. PG. 233

PLEASE RETURN TO
LOS ANGELES COUNTY ENGINEER
403 LOS ANGELES COUNTY ENGINEERING BLDG.

Note: Any Additions or Changes on This Sheet Must be Made or Circled in Red Ink With Date and Name of Person Making Change.

Do not extend this side of this line.

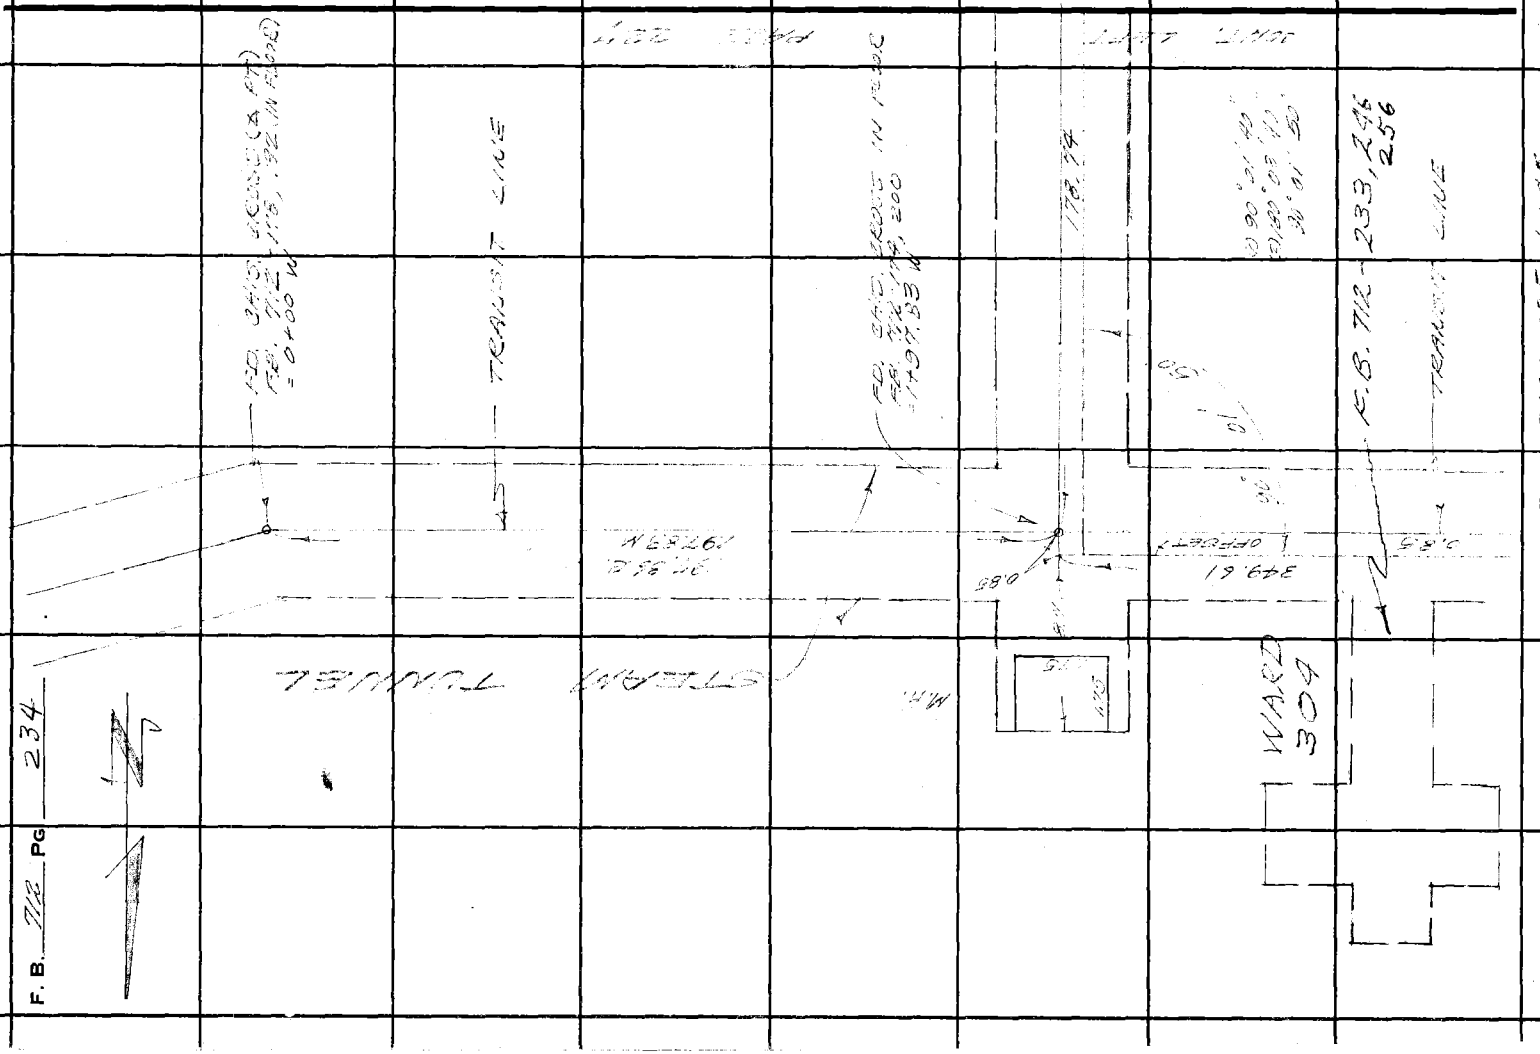

Notes Ck'd by	Survey of [illegible]
Map No. 2-83	JN [illegible] Tape ____ Std ____ °F
Office Work	Surveyed by [illegible]
Checked	Notes [illegible] Date [illegible]
Date	Indexed C. J. GALLI

F. B. [illegible] PG. 235

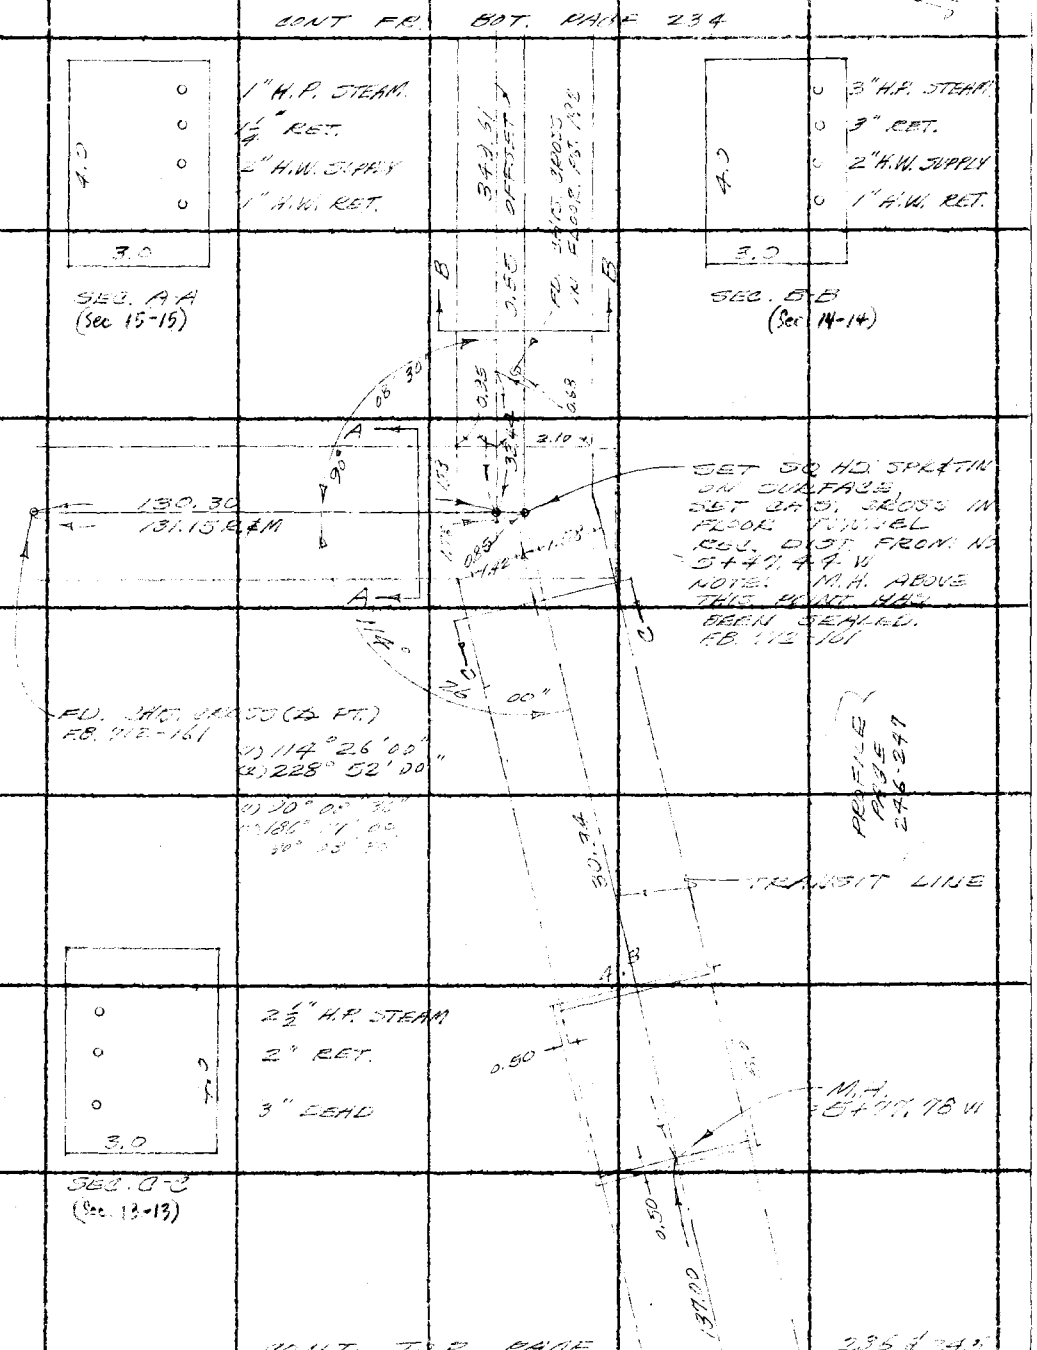

Note: Any Additions or Changes on This Sheet Must be Made or Circled in Red Ink With Date and Name of Person Making Change.

PLEASE RETURN TO
LOS ANGELES COUNTY ENGINEER
403 LOS ANGELES COUNTY ENGINEERING BLDG.

Do not extend this side of this line.

76F309S CE #310 6-63

F. B. 712 PG. 236

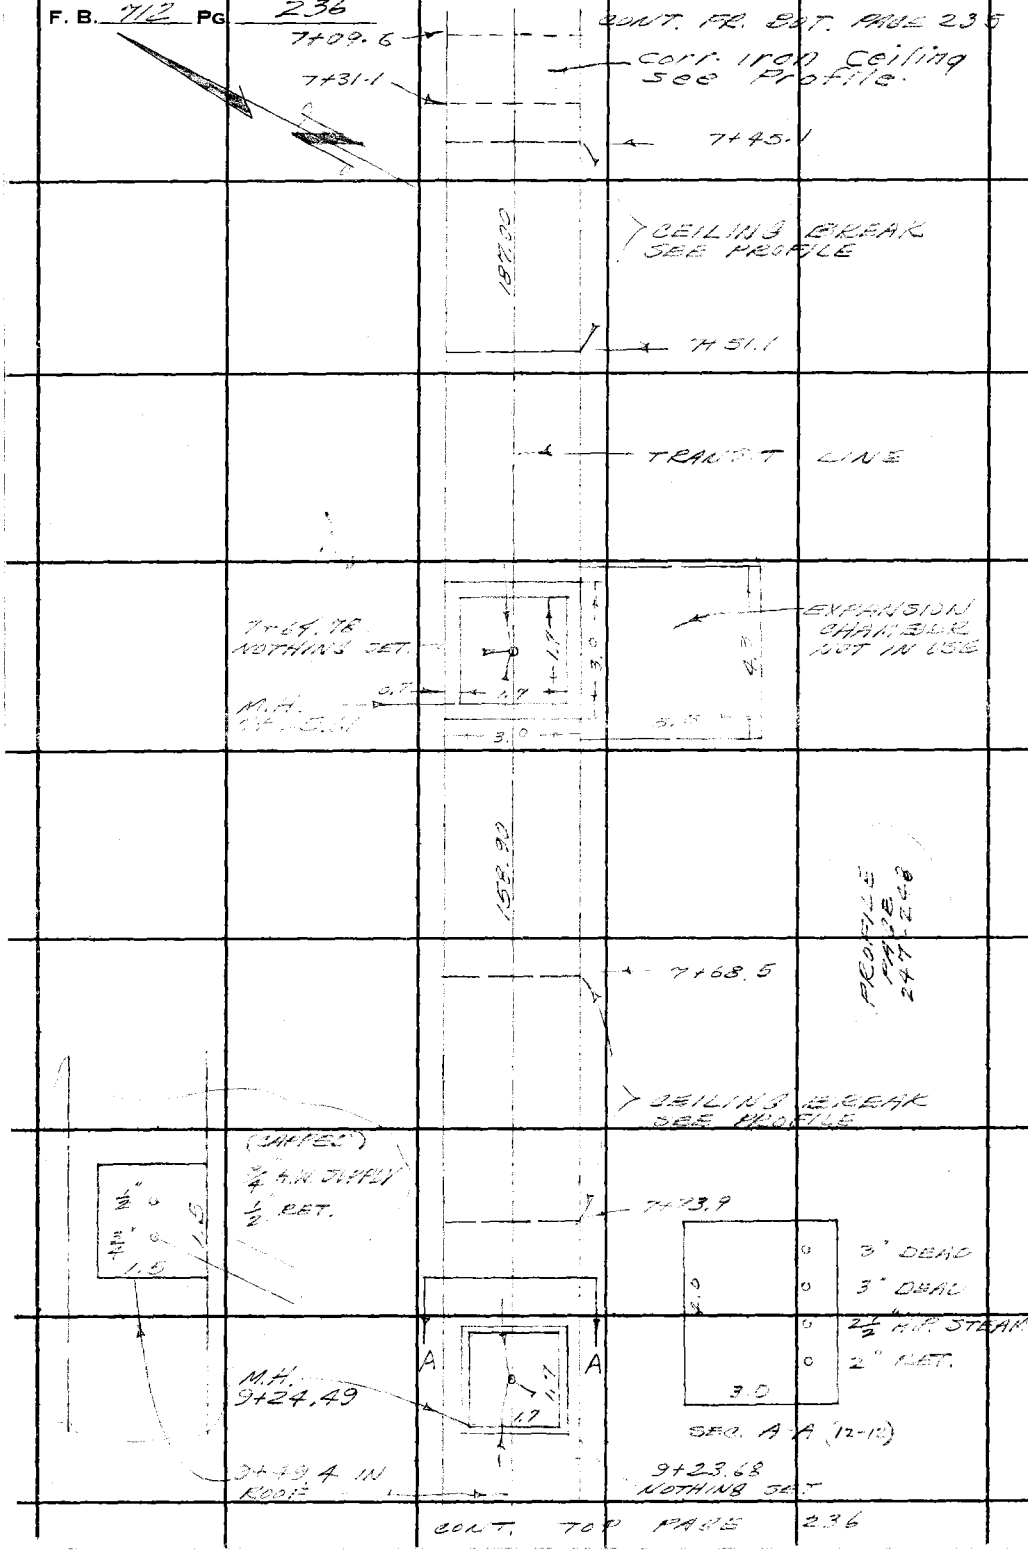

PLEASE RETURN TO
LOS ANGELES COUNTY ENGINEER
403 LOS ANGELES COUNTY ENGINEERING BLDG.

Do not extend this side of this line.

Note: Any Additions or Changes on This Sheet Must be Made or Circled in Red Ink With Date and Name of Person Making Change.

Notes Ck'd by	Survey of [illegible]
Map No. 2-83	JN [illegible] Tape ____ Std ____ °F
Office Work	Surveyed by [illegible]
Checked	Notes [illegible] Date [illegible]
Date	Indexed C. J. GALLI

F. B. [illegible] PG. 237

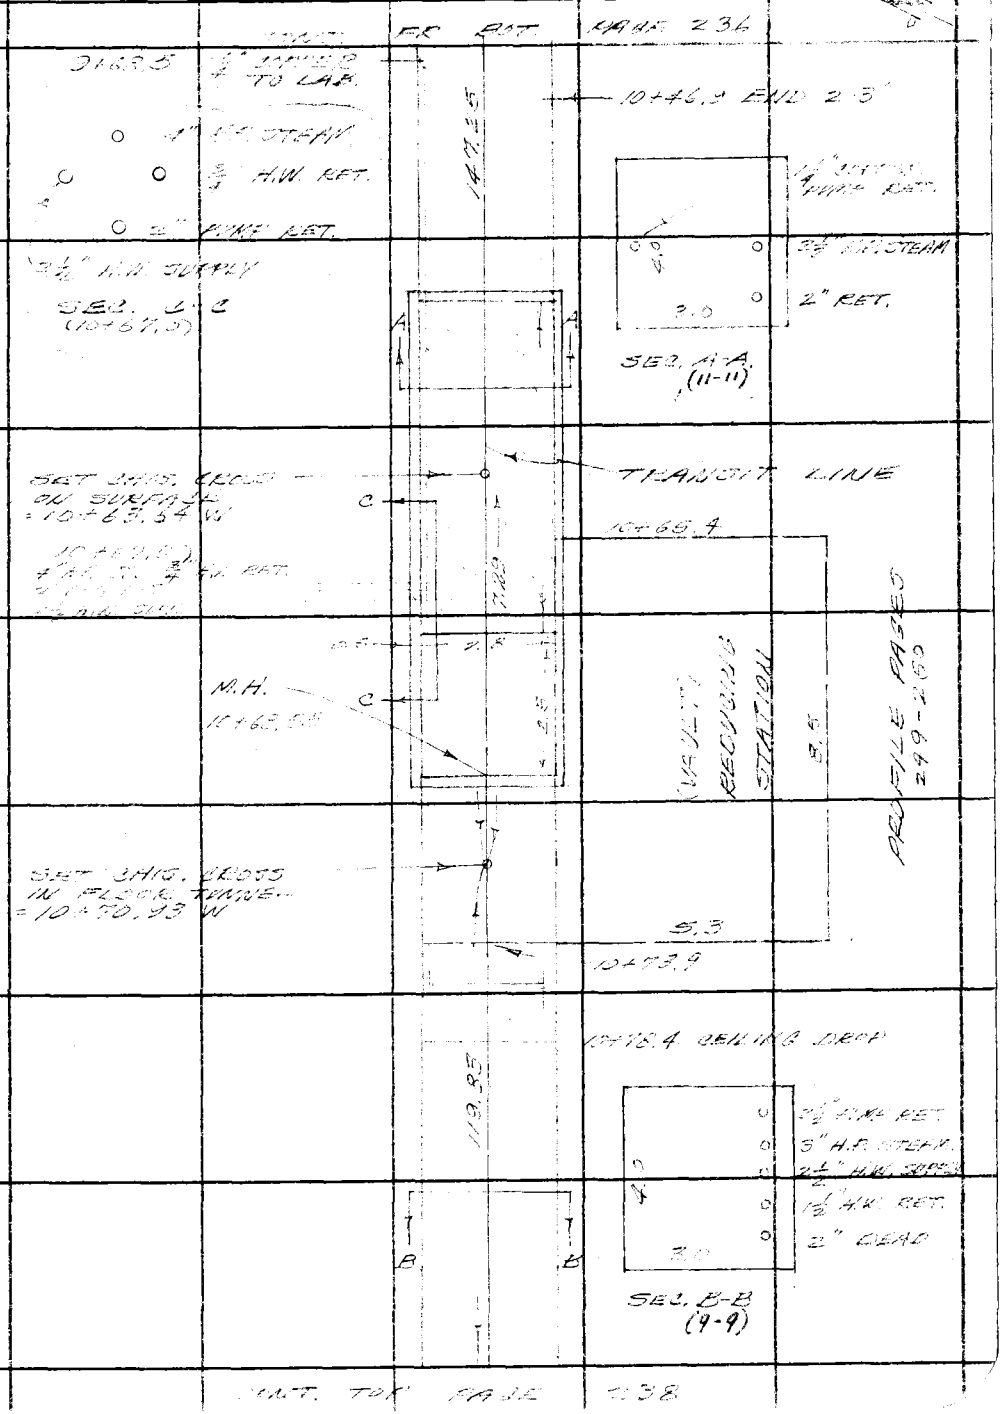

Note: Any Additions or Changes on This Sheet Must be Made or Circled in Red Ink With Date and Name of Person Making Change.

PLEASE RETURN TO
LOS ANGELES COUNTY ENGINEER
403 LOS ANGELES COUNTY ENGINEERING BLDG.

Do not extend this side of this line.

76F3095 CE #310 6-63

PLEASE RETURN TO
LOS ANGELES COUNTY ENGINEER
403 LOS ANGELES COUNTY ENGINEERING BLDG.

Do not extend this side of this line.

Note: Any Additions or Changes on This Sheet Must be Made or Circled in Red Ink With Date and Name of Person Making Change.

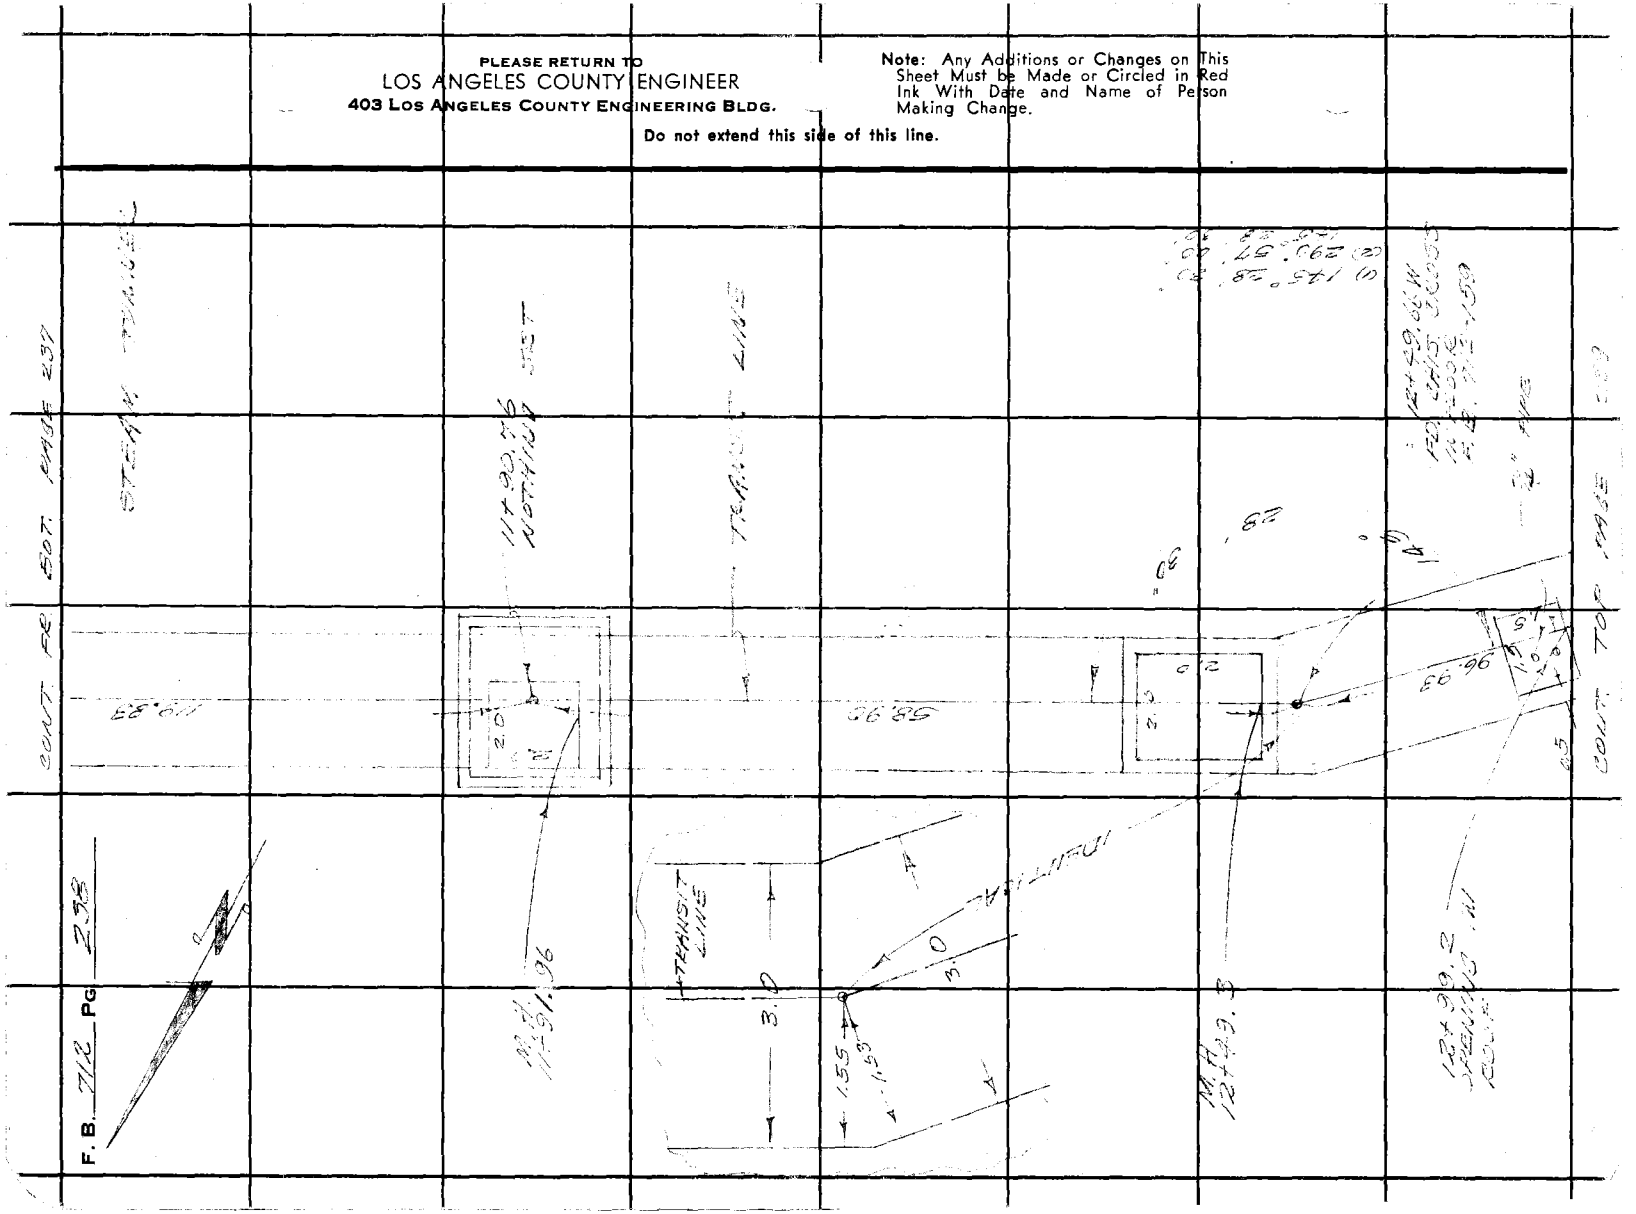

Notes Ck'd by	Survey of [illegible]
Map No. 2-83	JN #154.01 Tape ____ Std ____ °F
Office Work	Surveyed by M. [illegible]
Checked	Notes [illegible] Date [illegible]
Date	Indexed C. J. GALLI

F. B. [illegible] PG. 239

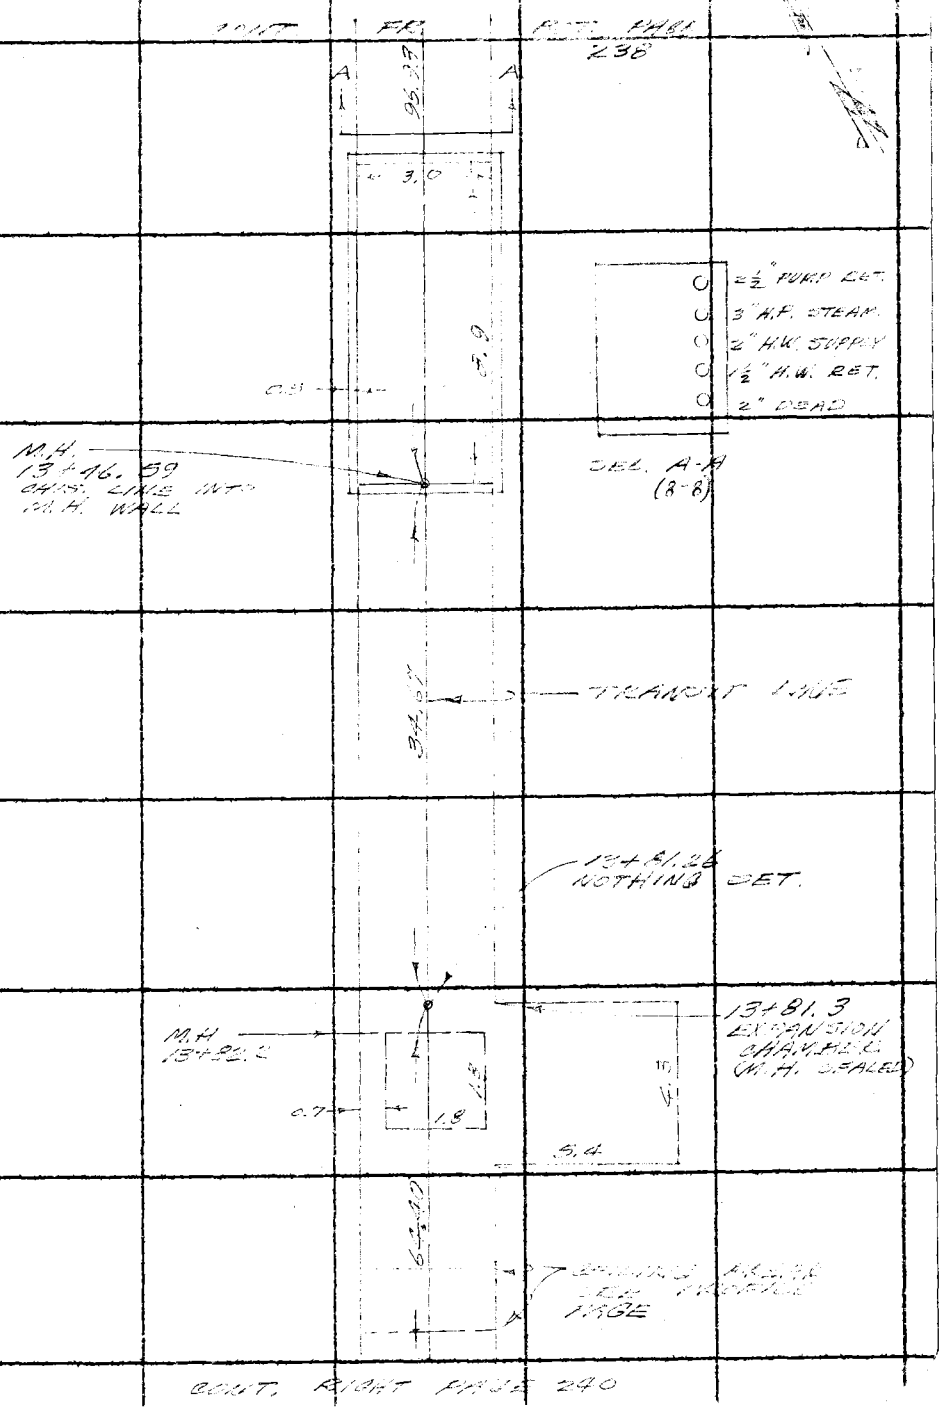

CONT. RIGHT PAGE 240

Note: Any Additions or Changes on This Sheet Must be Made or Circled in Red Ink With Date and Name of Person Making Change.

PLEASE RETURN TO
LOS ANGELES COUNTY ENGINEER
403 LOS ANGELES COUNTY ENGINEERING BLDG.

Do not extend this side of this line.

76F309S CE #310 6-63

F. B. 712 PG 240 CONT. FR. BOT. PAGE 239

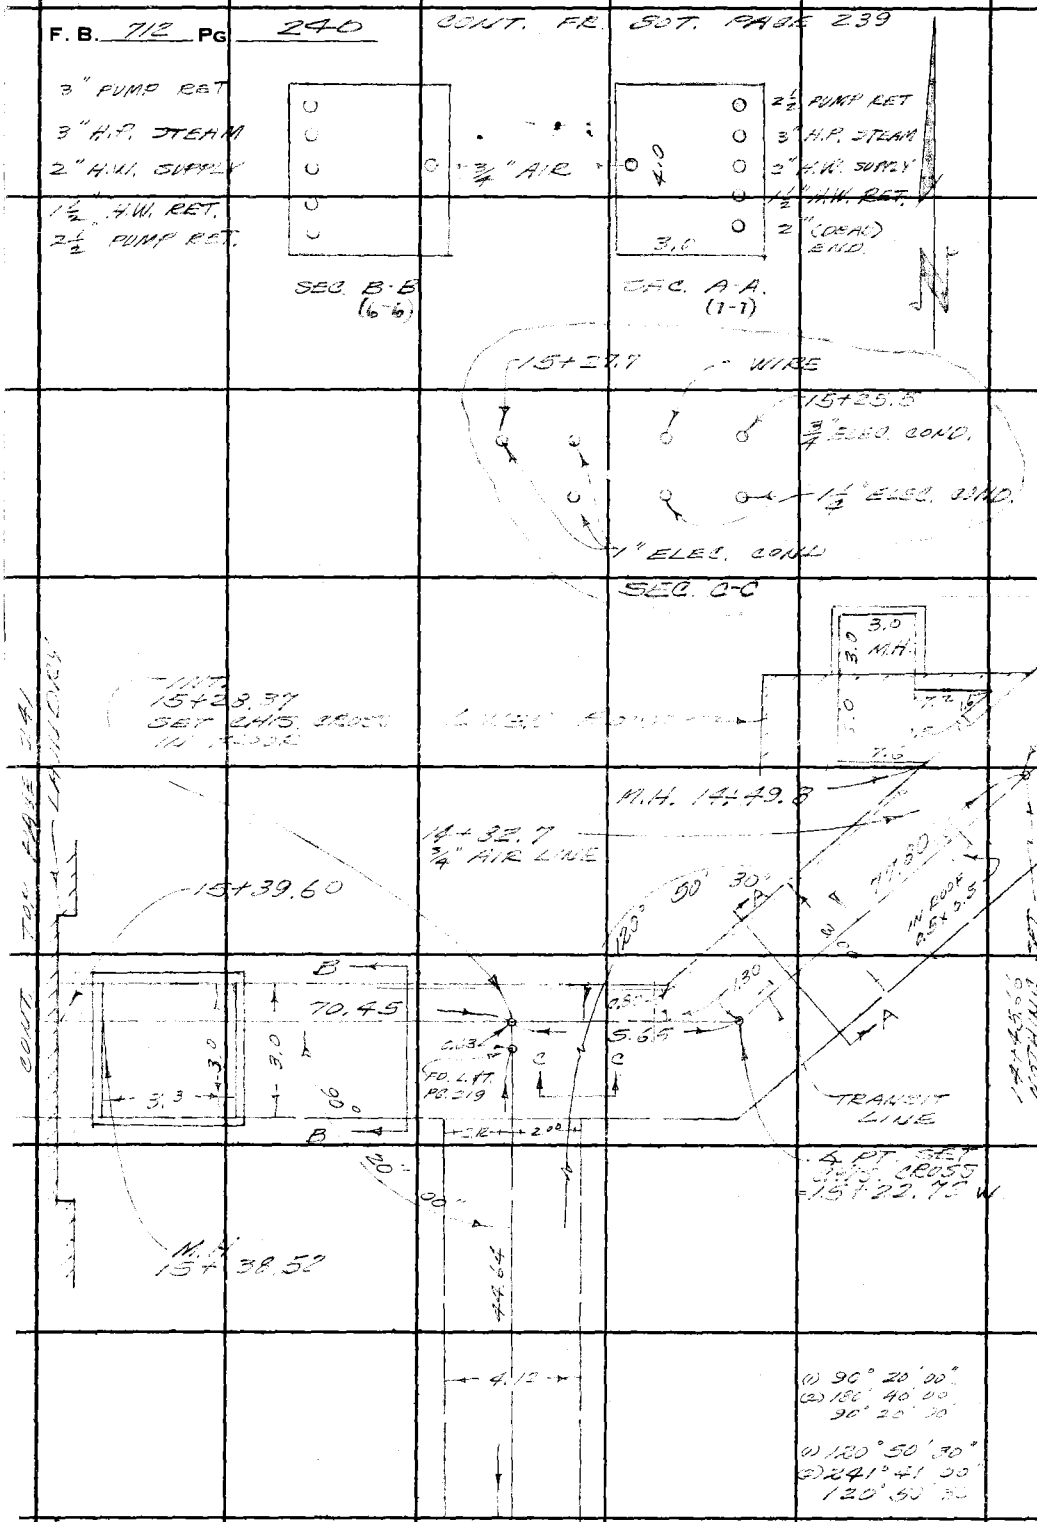

PLEASE RETURN TO
LOS ANGELES COUNTY ENGINEER
403 LOS ANGELES COUNTY ENGINEERING BLDG.

Do not extend this side of this line.

Note: Any Additions or Changes on This Sheet Must be Made or Circled in Red Ink With Date and Name of Person Making Change.

Notes Ck'd by	Survey of [illegible]
Map No. 2-83	JN [illegible] Tape ____ Std ____ °F
Office Work	Surveyed by [illegible]
Checked	Notes [illegible] Date [illegible]
Date	Indexed C. J. GALLI

F. B. [illegible] PG. 241

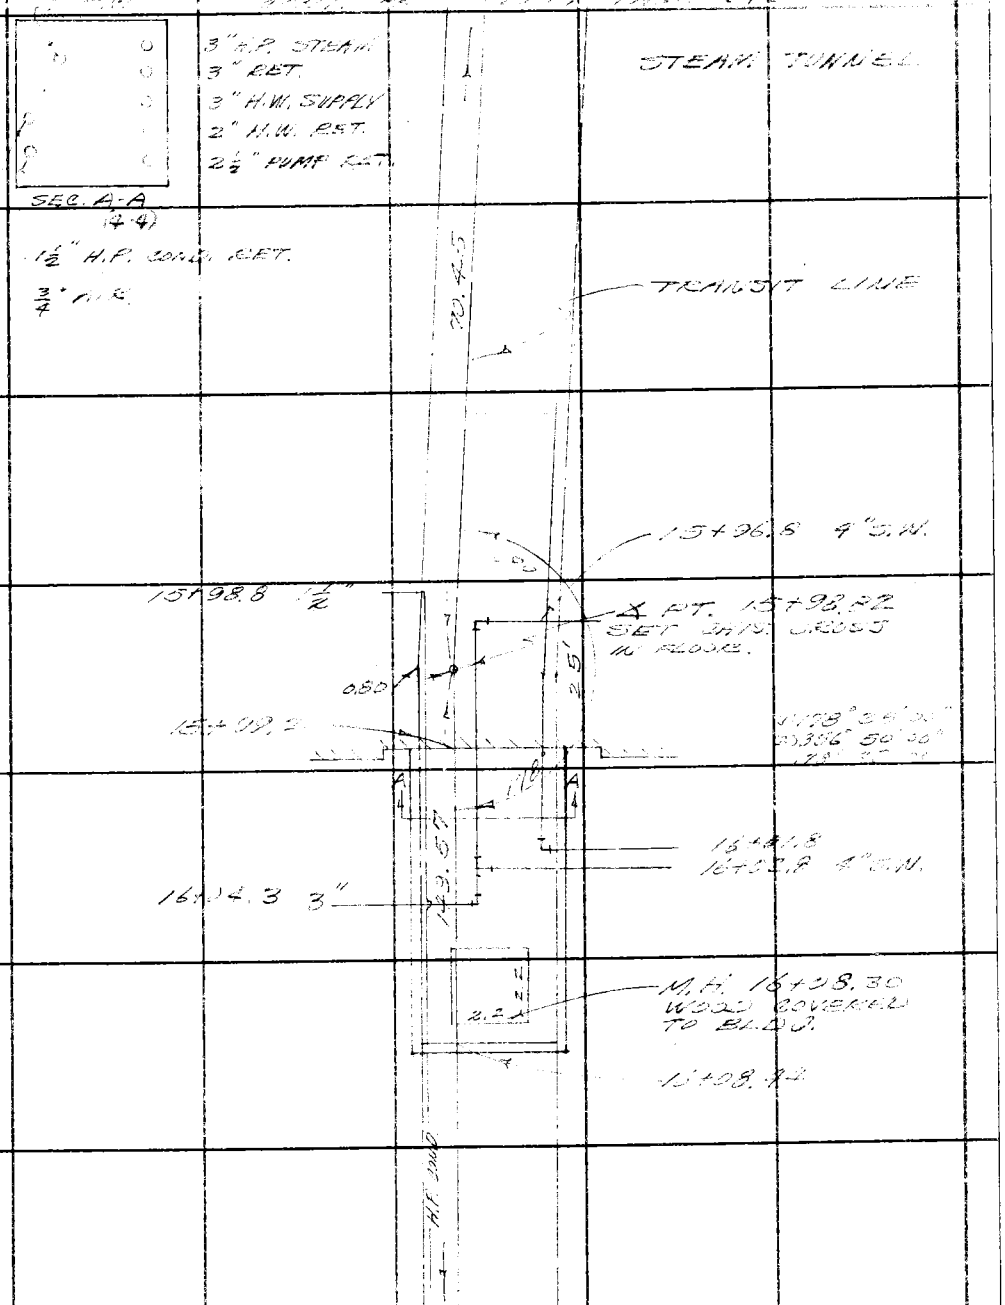

CONT. TO PAGE 242

Note: Any Additions or Changes on This Sheet Must be Made or Circled in Red Ink With Date and Name of Person Making Change.

PLEASE RETURN TO
LOS ANGELES COUNTY ENGINEER
403 LOS ANGELES COUNTY ENGINEERING BLDG.
Do not extend this side of this line.

76F309S CE #310 6-63

PLEASE RETURN TO
LOS ANGELES COUNTY ENGINEER
403 LOS ANGELES COUNTY ENGINEERING BLDG.

Note: Any Additions or Changes on This Sheet Must be Made or Circled in Red Ink With Date and Name of Person Making Change.

Do not extend this side of this line.

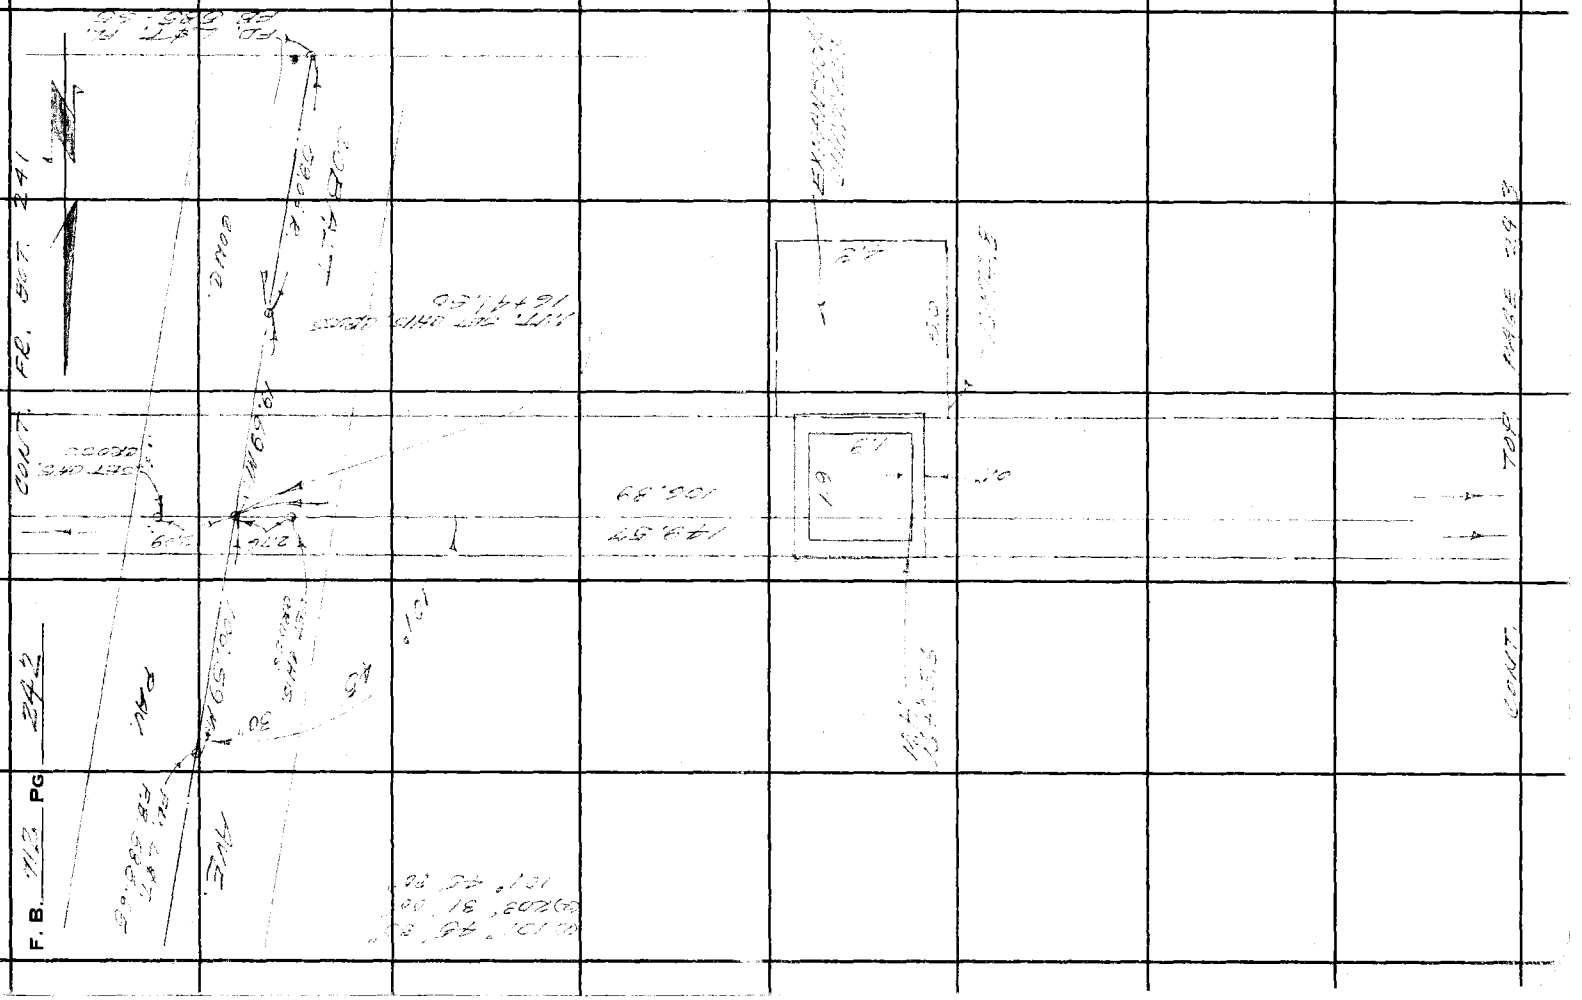

Notes Ck'd by		Survey of	
Map No.	2-83	JN	Tape Std °F
Office Work		Surveyed by	
Checked		Notes	Date
Date		Indexed	C. L. GAULT

F. B. 412 PG. 243

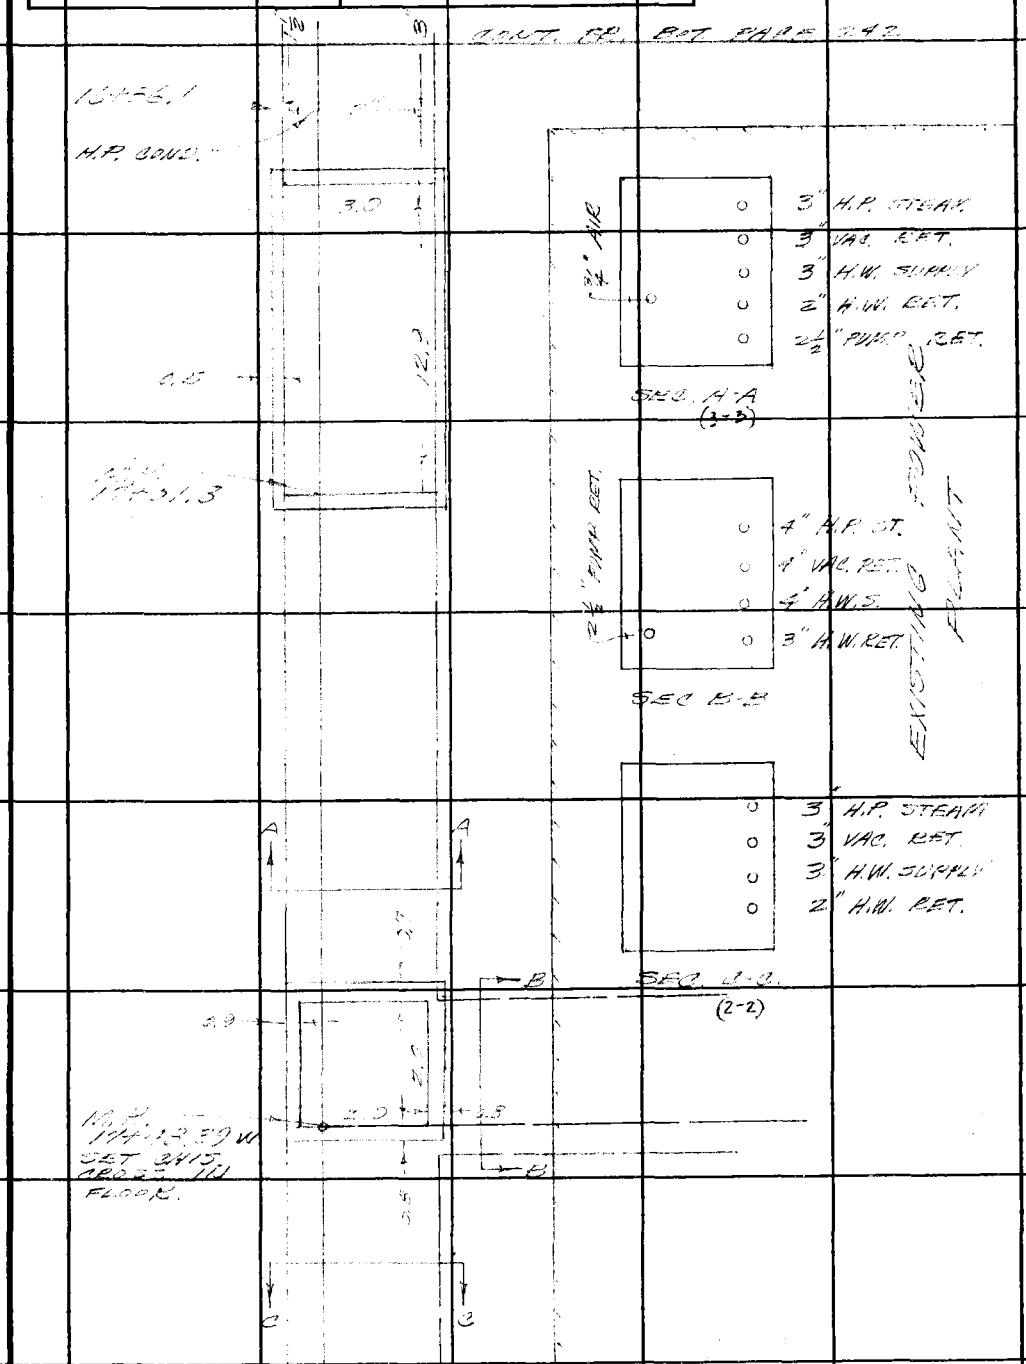

Note: Any Additions or Changes on this Sheet Must be Made or Circled in Red Ink With Date and Name of Person Making Change.

Do not extend this side of this line.

PLEASE RETURN TO
LOS ANGELES COUNTY ENGINEER
403 Los Angeles County Engineering Bldg.

76F3095 CE #310 8-83

F. B. 712 PG 244

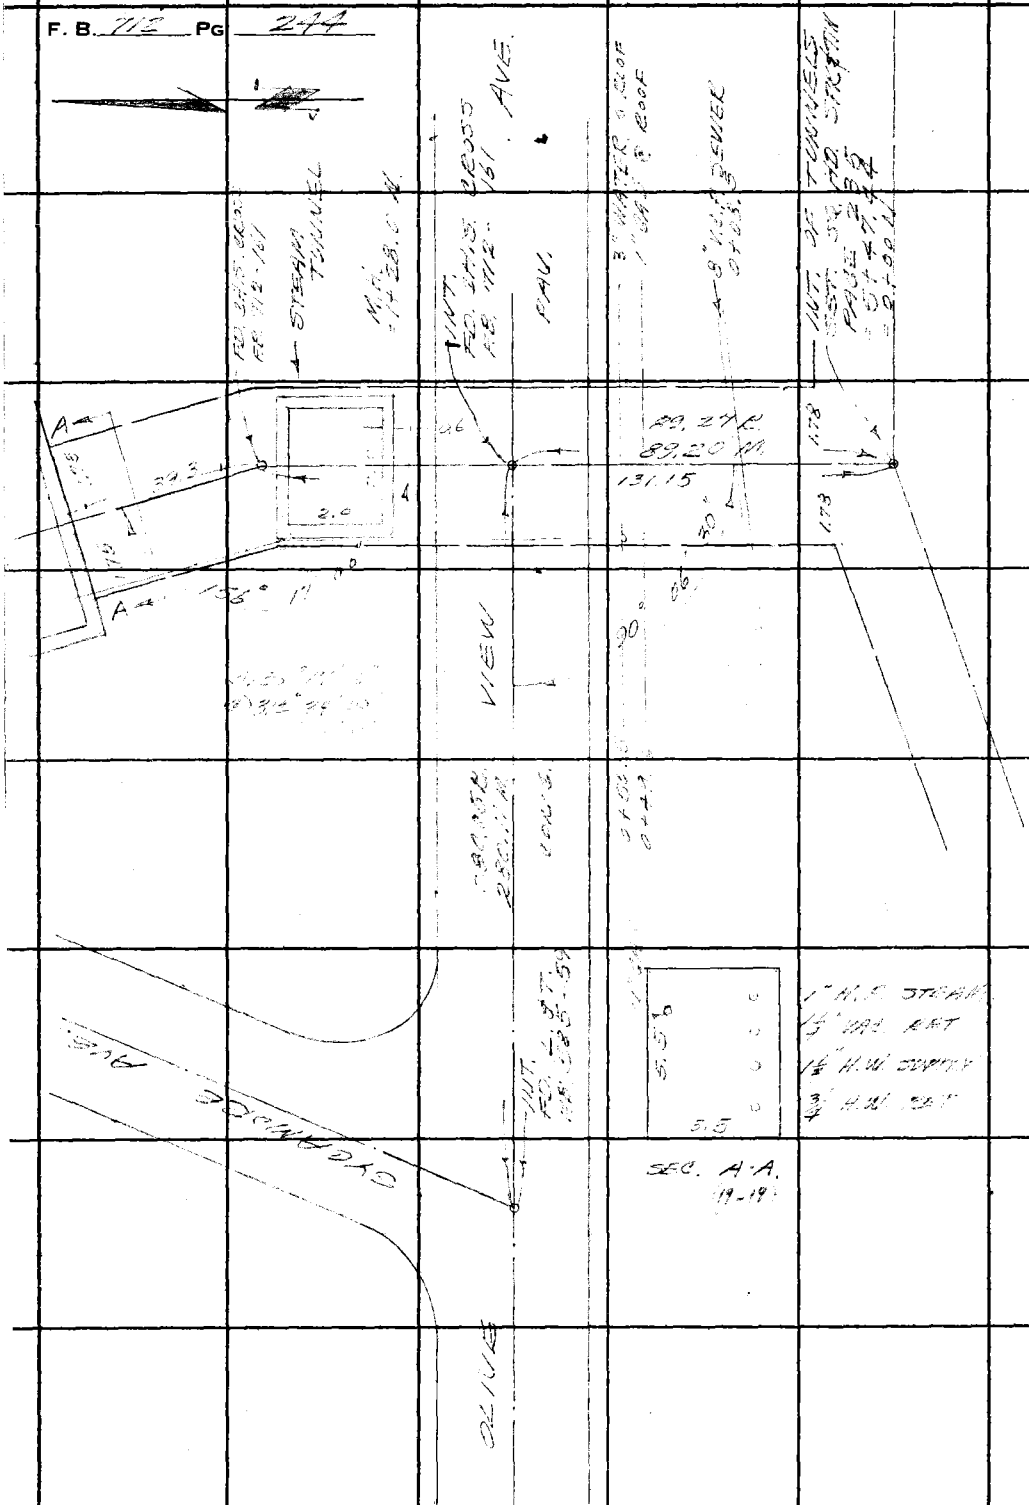

PLEASE RETURN TO
LOS ANGELES COUNTY ENGINEER
403 LOS ANGELES COUNTY ENGINEERING BLDG.

Do not extend this side of this line.

Note: Any Additions or Changes on This Sheet Must be Made or Circled in Red Ink With Date and Name of Person Making Change.

Notes Ck'd by	Survey of OLIVE VIEW HOSPITAL
Map No. 2-83	JN 8/59, 61 Tape Std °F
Office Work	Surveyed by M. SOTELO
Checked	Notes SOTELO Date 2-1983
Date	Indexed C. J. GALLI

F. B. 712 PG. 245

Note: Any Additions or Changes on This Sheet Must be Made or Circled in Red Ink With Date and Name of Person Making Change.

PLEASE RETURN TO
LOS ANGELES COUNTY ENGINEER
403 Los Angeles County Engineering Bldg.

Do not extend this side of this line.

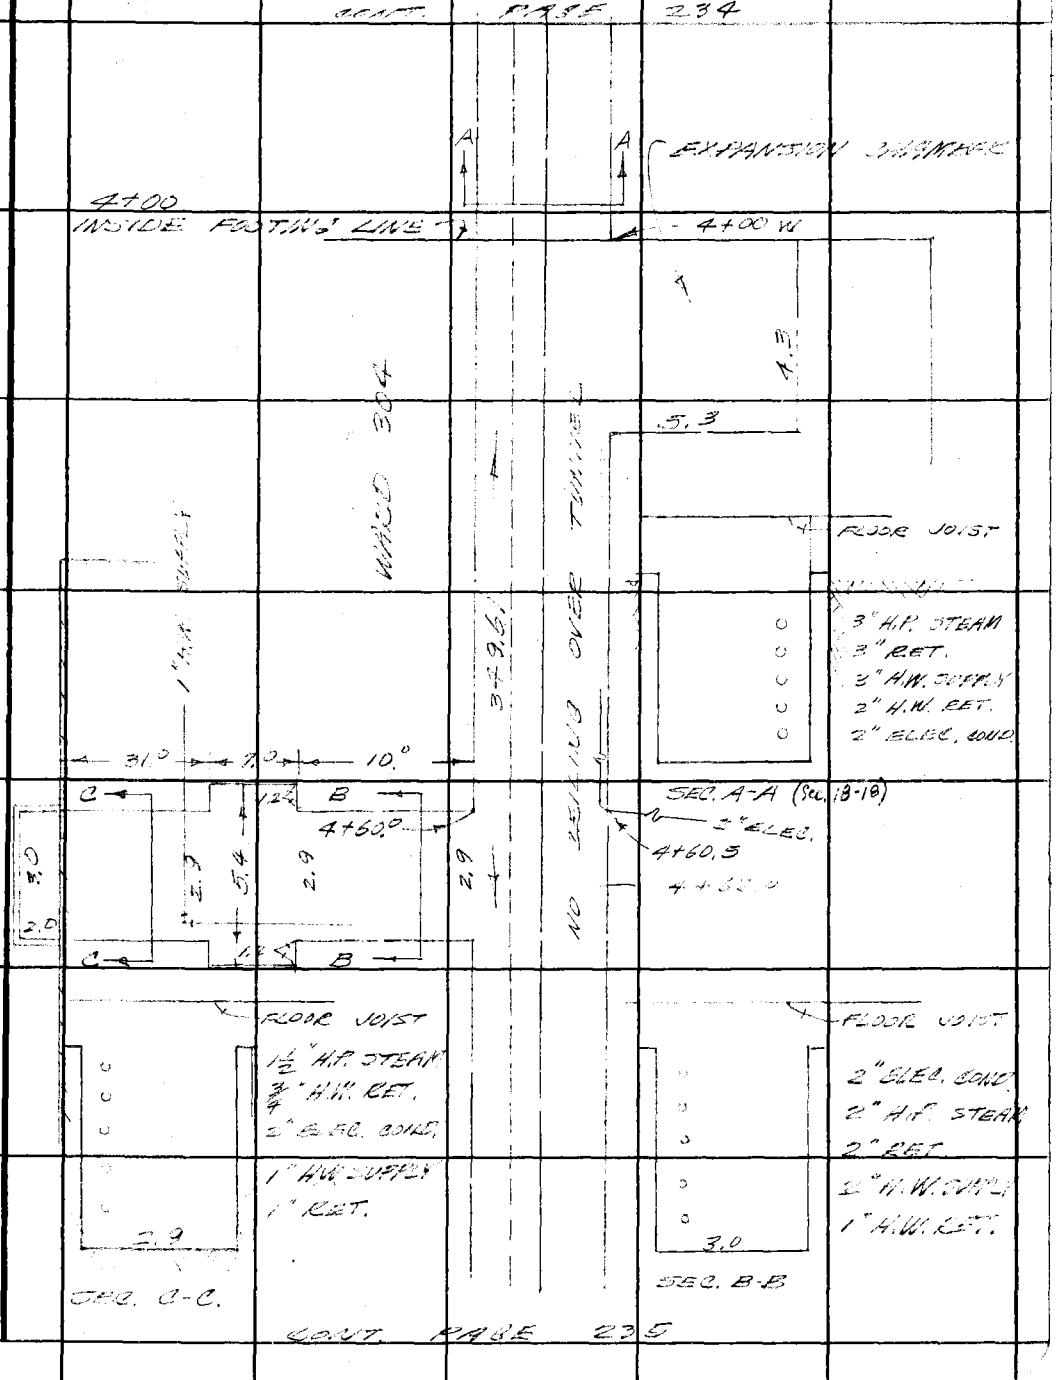

76F3095 CE #310 8-83

F. B. 712 PG. 246

CONT. TOP PAGE 196

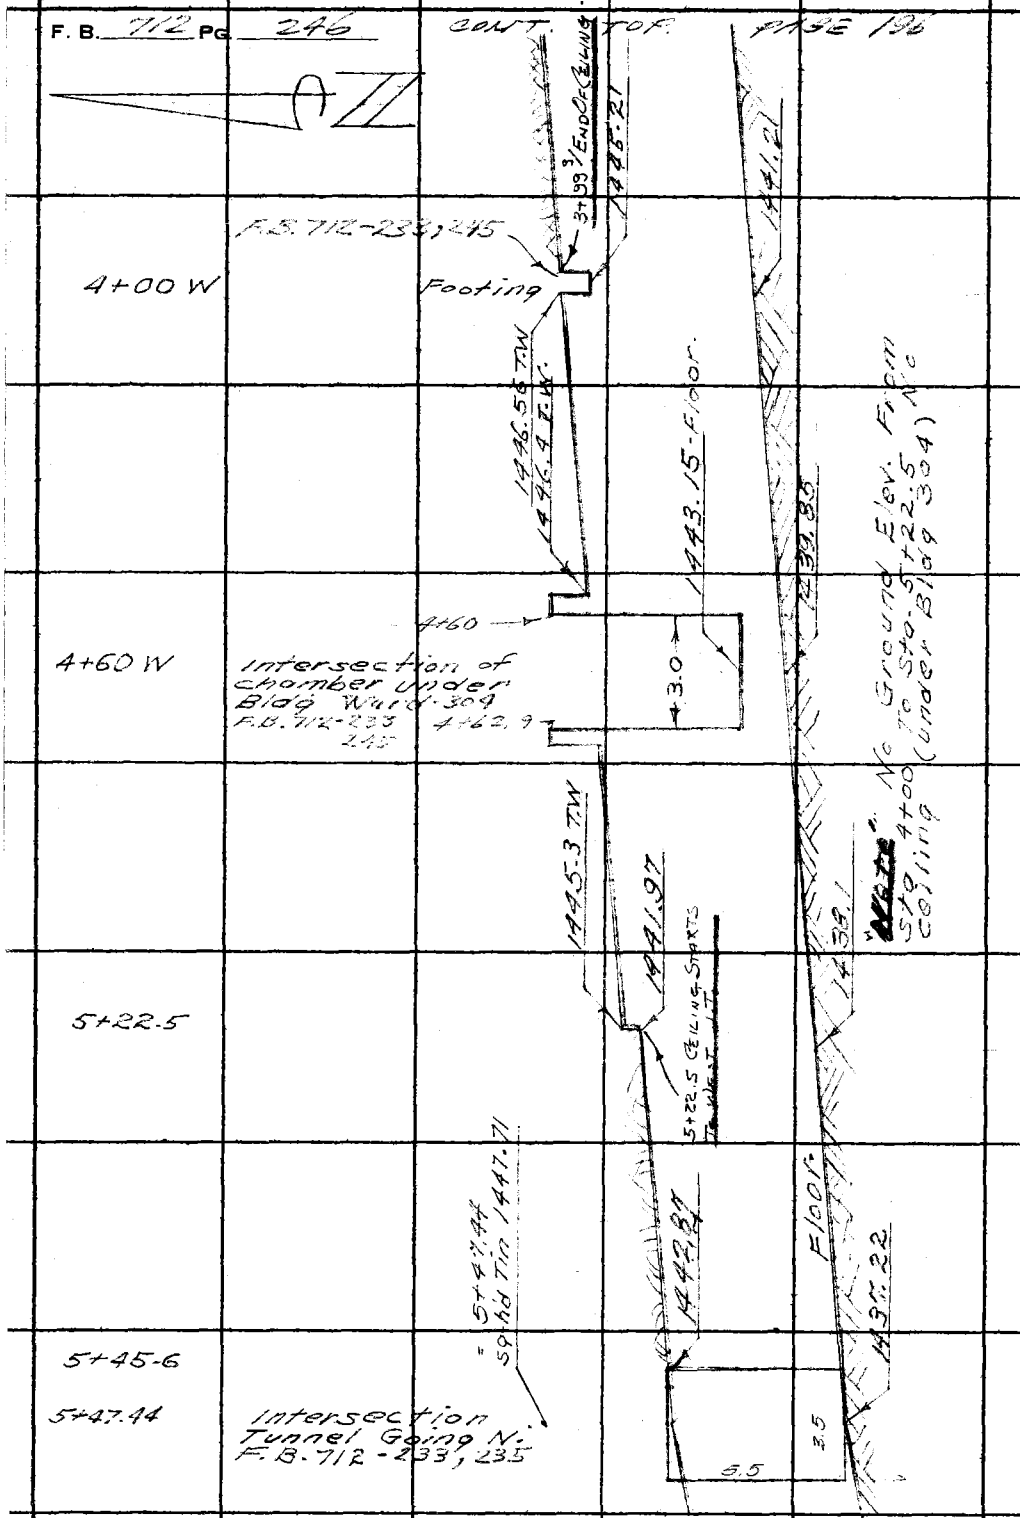

CONT. TOP PAGE 297

PLEASE RETURN TO
LOS ANGELES COUNTY ENGINEER
403 LOS ANGELES COUNTY ENGINEERING BLDG.

Do not extend this side of this line.

Note: Any Additions or Changes on This Sheet Must be Made or Circled in Red Ink With Date and Name of Person Making Change.

Notes Ck'd by	Survey of OLIVE VIEW HOSPITAL
Map No. 2-83	JN 8154.01 Tape Std. °F
Office Work	Surveyed by M. SOTKO
Checked	Notes I.V. BOWLES Date 11-7-83
Date	Indexed C. J. GALLI

F. B. 712 PG. 247

CONT. FE PAGE 246

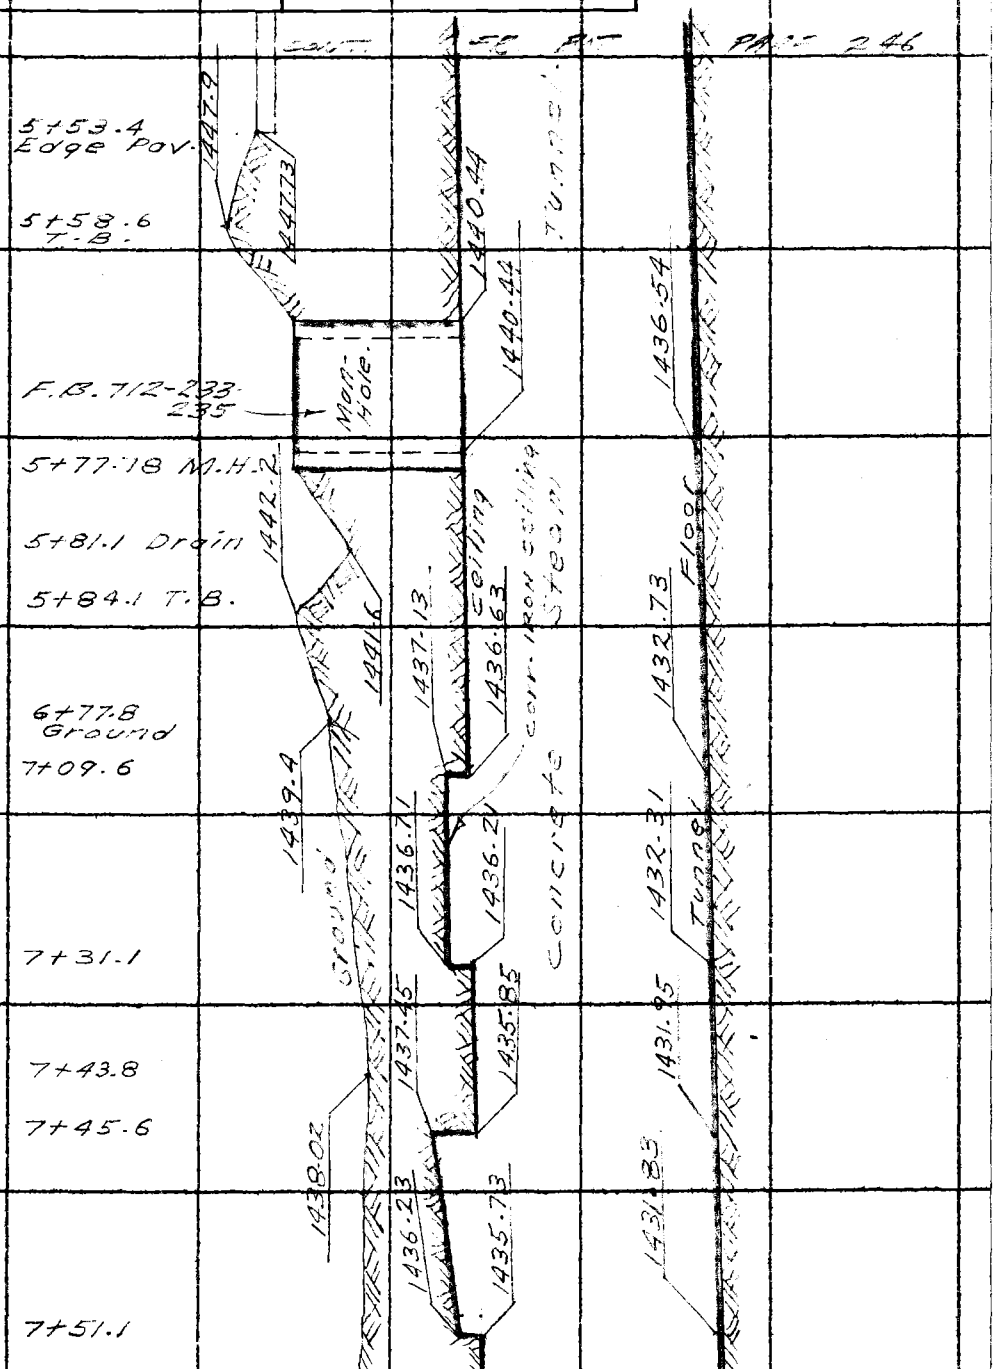

CONT. TOP PAGE 248

Note: Any Additions or Changes on This Sheet Must be Made or Circled in Red Ink With Date and Name of Person Making Change.

PLEASE RETURN TO
LOS ANGELES COUNTY ENGINEER
403 LOS ANGELES COUNTY ENGINEERING BLDG.
Do not extend this side of this line.

76F309S CE #310 6-63

F. B. 712 PG 248

CONT. FR. EOT. PAGE 247

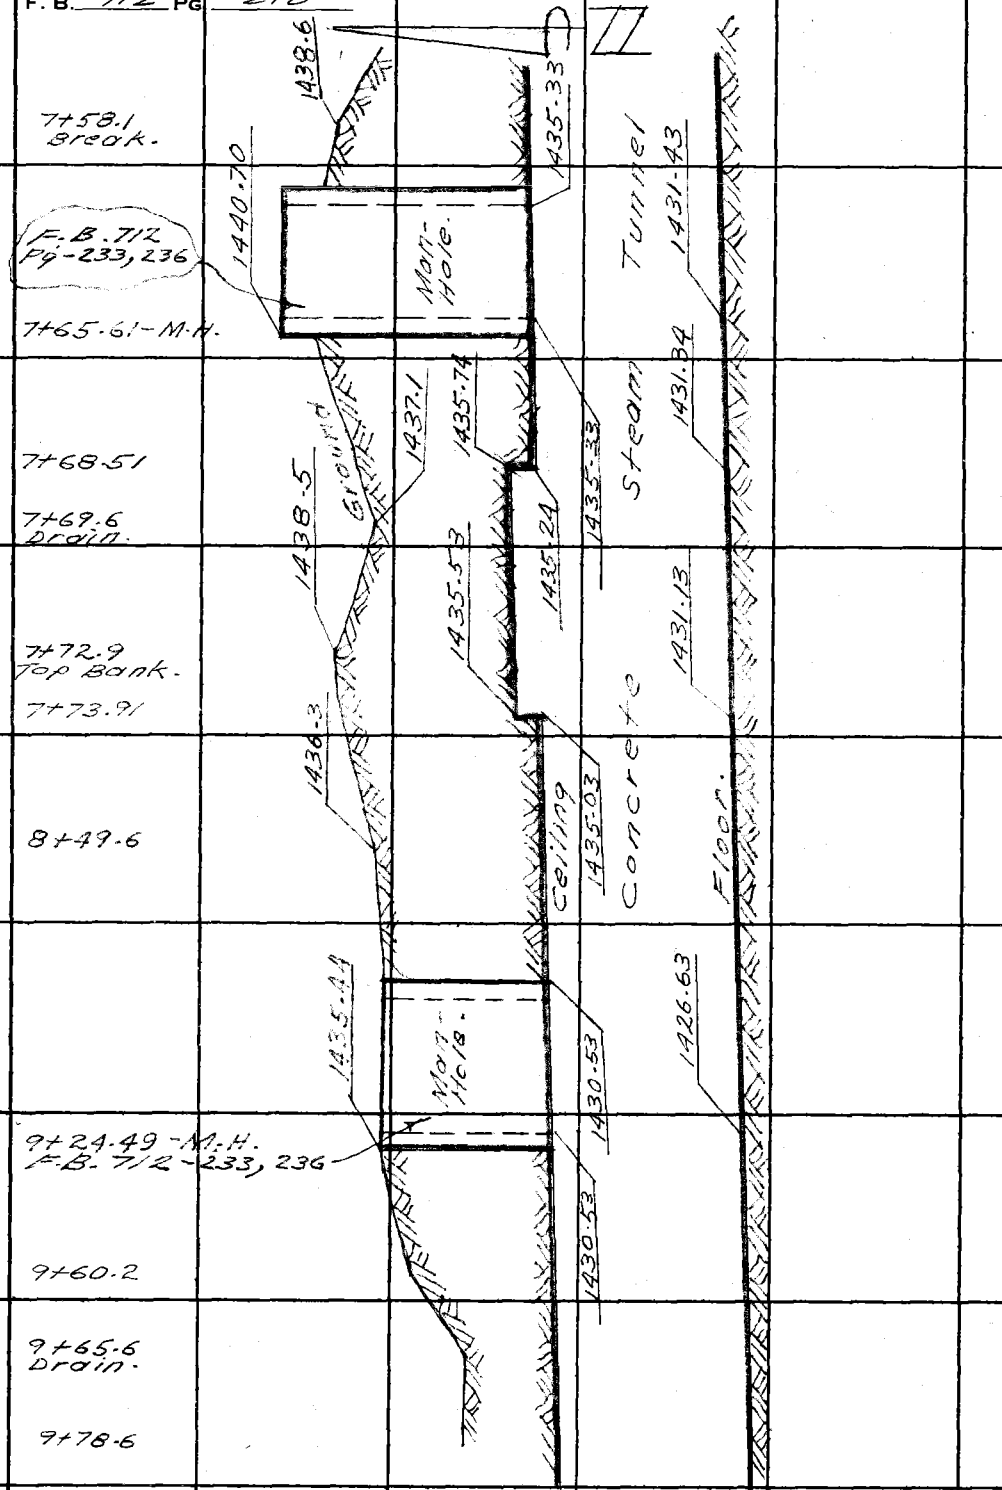

CONT. TOP PAGE 249

PLEASE RETURN TO
LOS ANGELES COUNTY ENGINEER
403 Los Angeles County Engineering Bldg.

Do not extend this side of this line.

Note: Any Additions or Changes on This Sheet Must be Made or Circled in Red Ink With Date and Name of Person Making Change.

Notes Ck'd by	Survey of OLIVE VIEW HOSP.
Map No. 2-83	JN 8154.01 Tape ____ Std ____ °F
Office Work	Surveyed by M. SOTRO
Checked	Notes I.J. BOWLES Date 5-17-65
Date	Indexed

F. B. 712 PG. 249

CONT. FR. BOT. PAGE 248

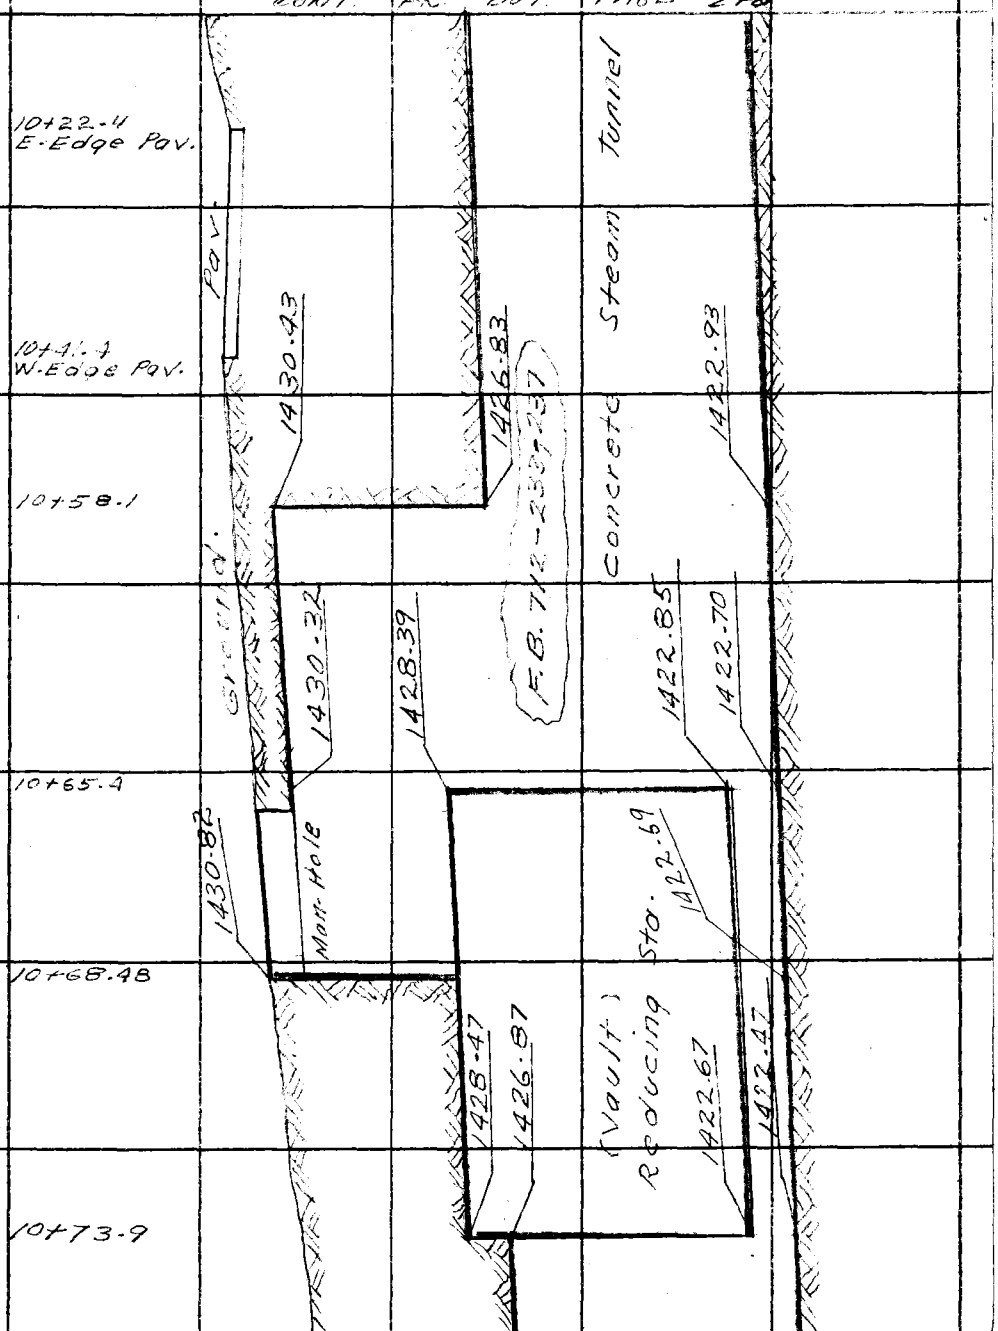

CONT TOP PAGE 250

Note: Any Additions or Changes on This Sheet Must be Made or Circled in Red Ink With Date and Name of Person Making Change.

PLEASE RETURN TO
LOS ANGELES COUNTY ENGINEER
403 LOS ANGELES COUNTY ENGINEERING BLDG.

Do not extend this side of this line.

76F309S CE #310 6-63

F. B. 712 PG 250

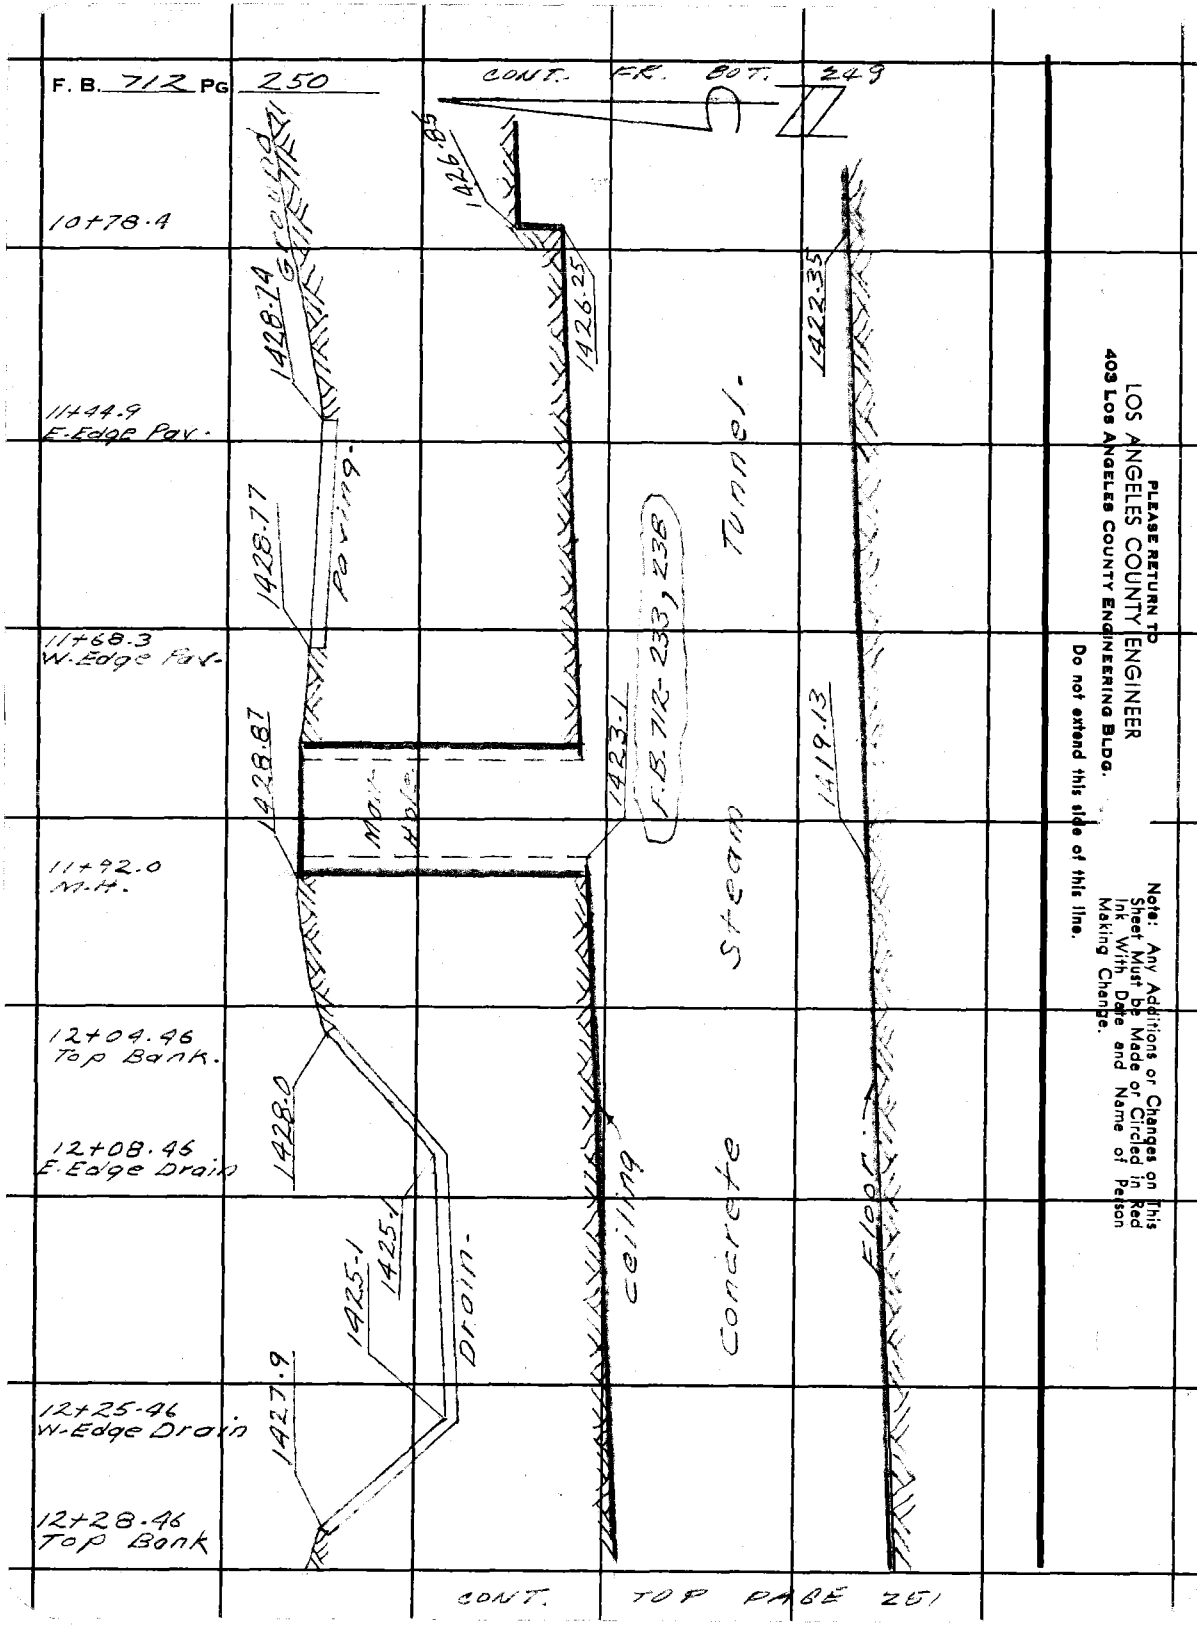

PLEASE RETURN TO
LOS ANGELES COUNTY ENGINEER
403 LOS ANGELES COUNTY ENGINEERING BLDG.

Do not extend this side of this line.

Note: Any Additions or Changes on This Sheet Must be Made or Circled in Red Ink With Date and Name of Person Making Change.

76F3095 CE #310 6-63

PLEASE RETURN TO
LOS ANGELES COUNTY ENGINEER
403 LOS ANGELES COUNTY ENGINEERING BLDG.

Note: Any Additions or Changes on This Sheet Must be Made or Circled in Red Ink With Date and Name of Person Making Change.

Do not extend this side of this line.

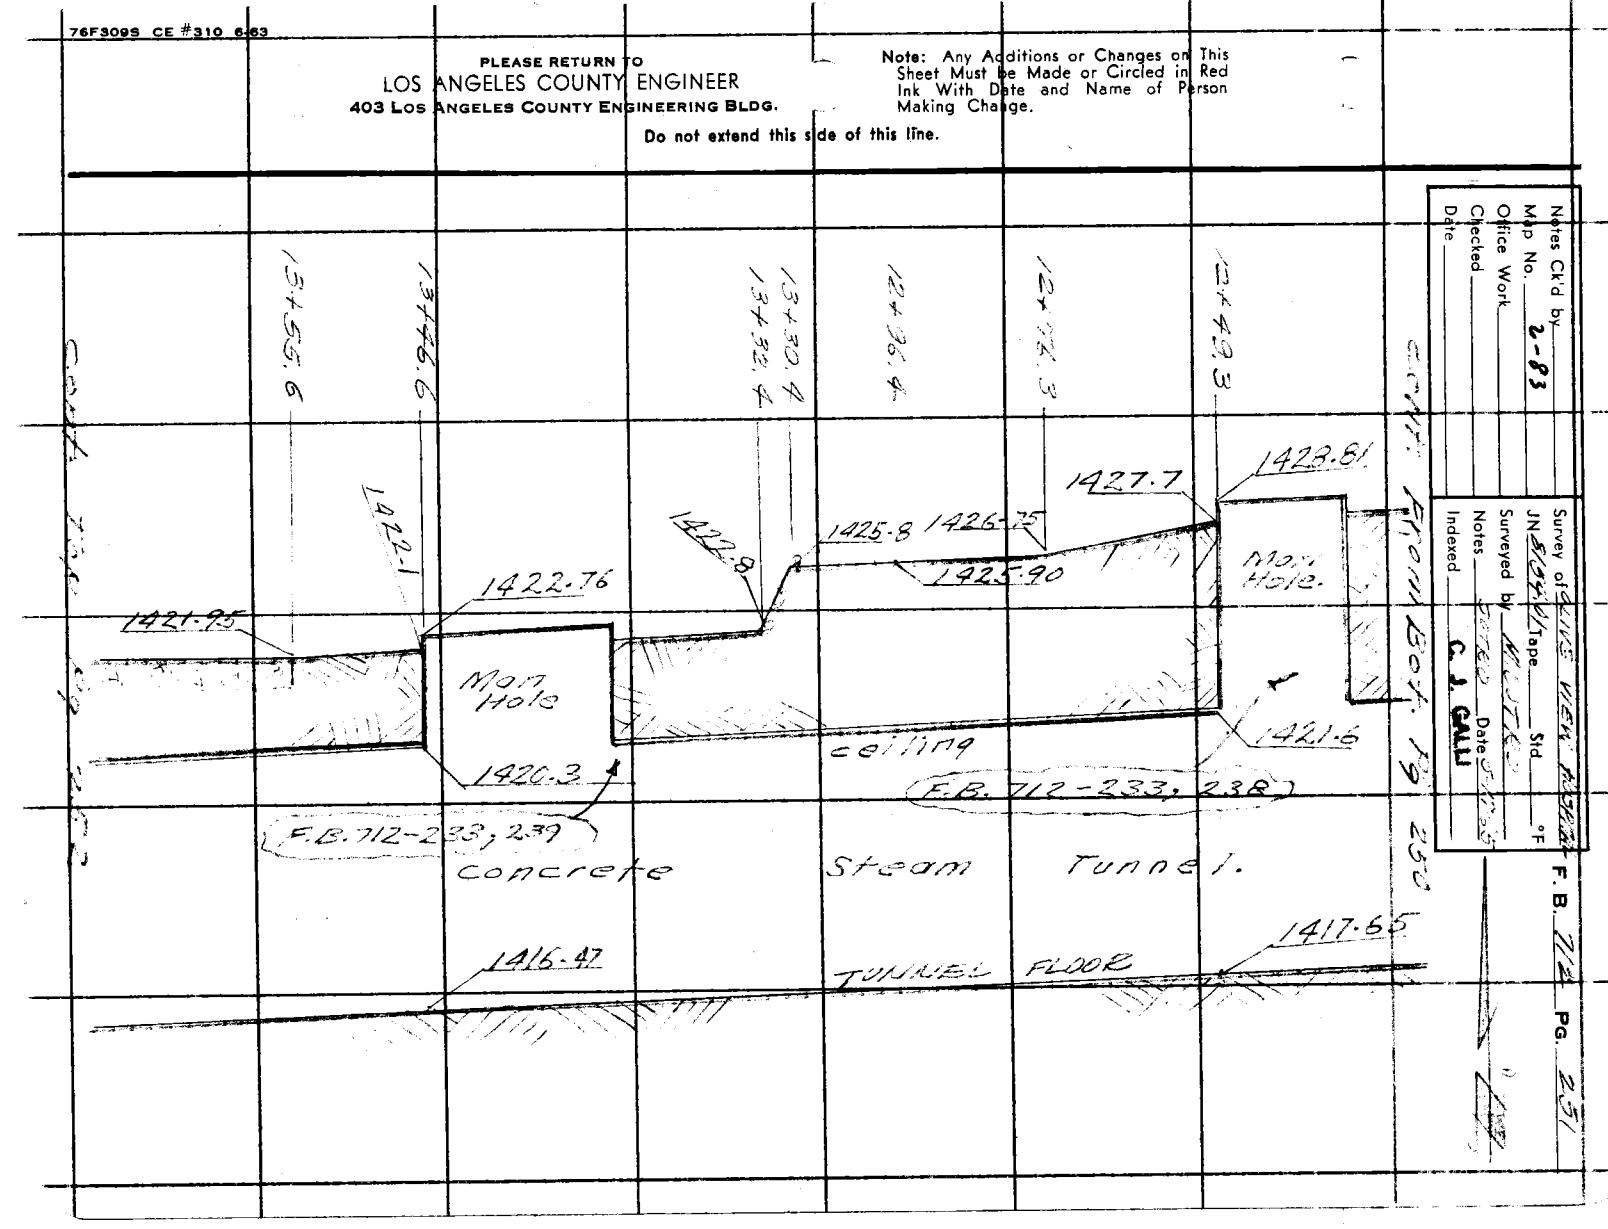

Notes Ck'd by
Map No. 2-83
Office Work
Checked
Date

JN Tape Std °F
Surveyed by
Notes Date
Indexed C. J. GALL


PLEASE RETURN TO
LOS ANGELES COUNTY ENGINEER
403 LOS ANGELES COUNTY ENGINEERING BLDG.

Do not extend this side of this line.

Note: Any Additions or Changes on This Sheet Must be Made or Circled in Red Ink With Date and Name of Person Making Change.

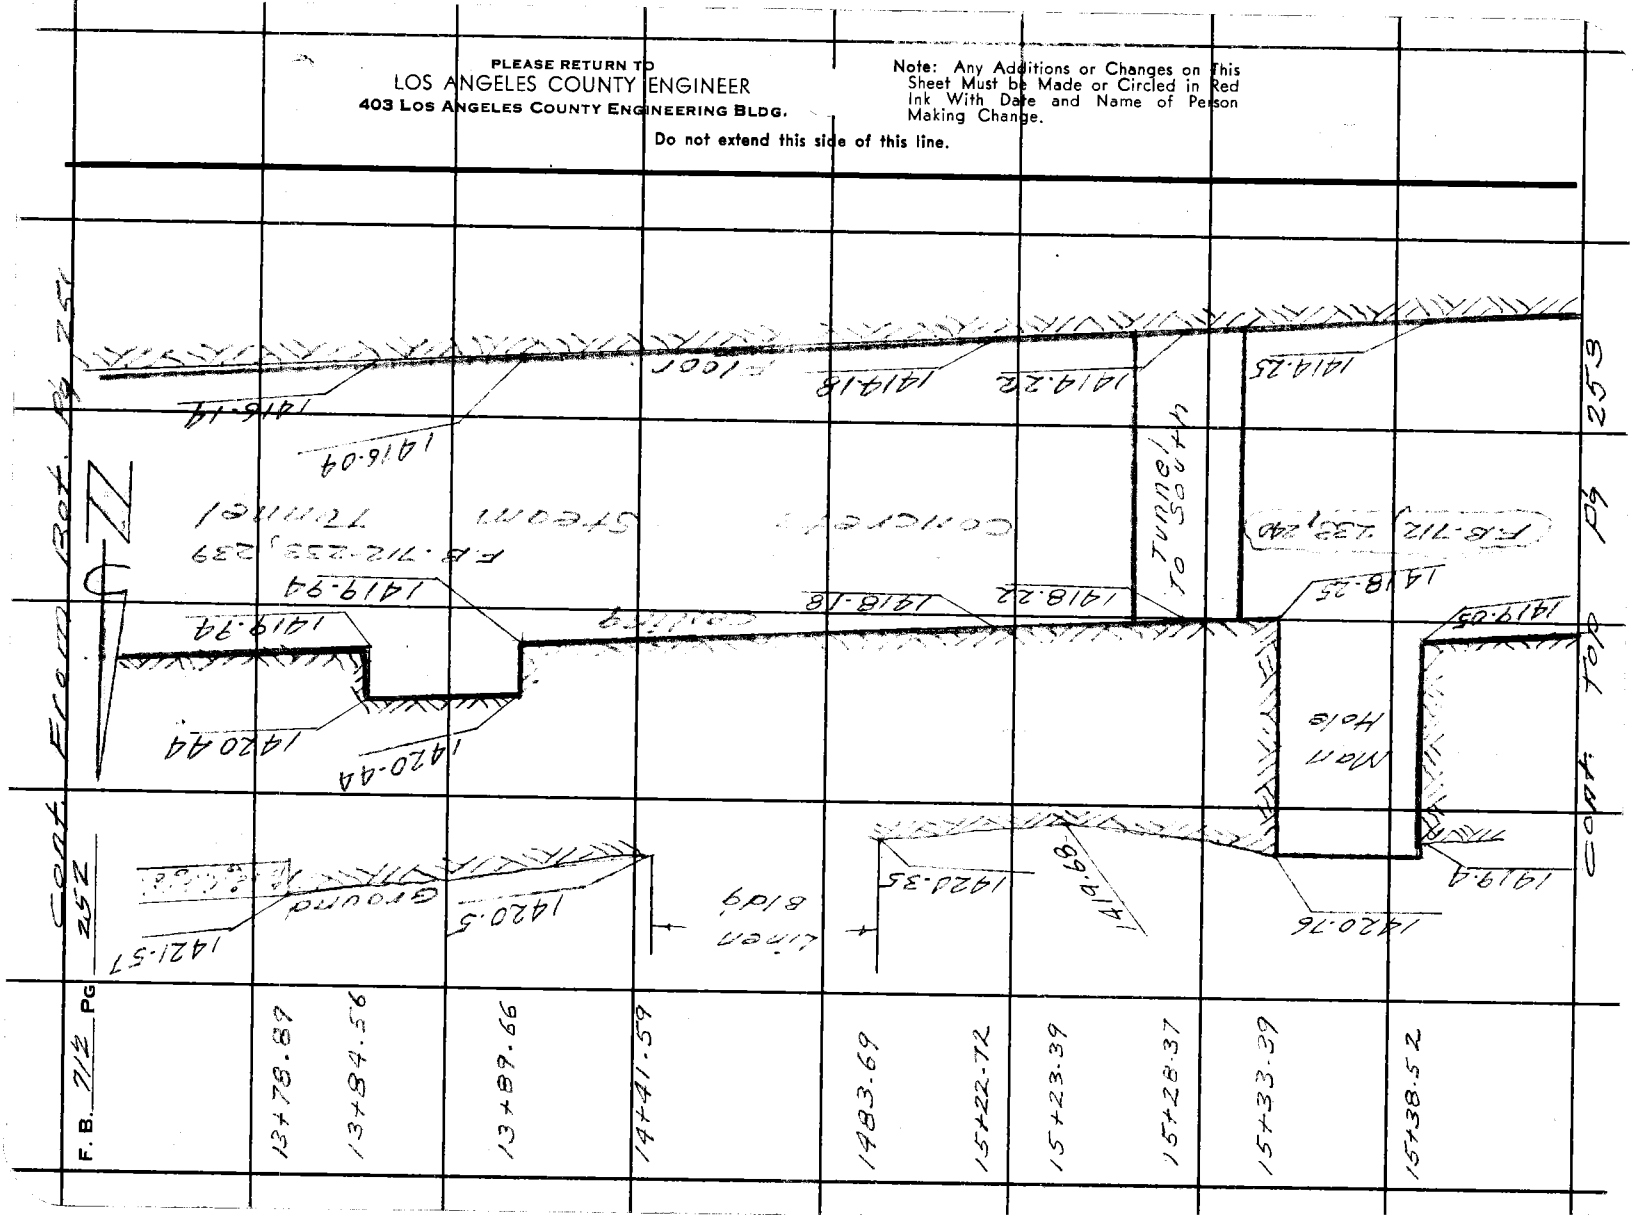

76F309S CE #310 6-63

PLEASE RETURN TO
LOS ANGELES COUNTY ENGINEER
403 LOS ANGELES COUNTY ENGINEERING BLDG.

Note: Any Additions or Changes on This Sheet Must be Made or Circled in Red Ink With Date and Name of Person Making Change.

Do not extend this side of this line.

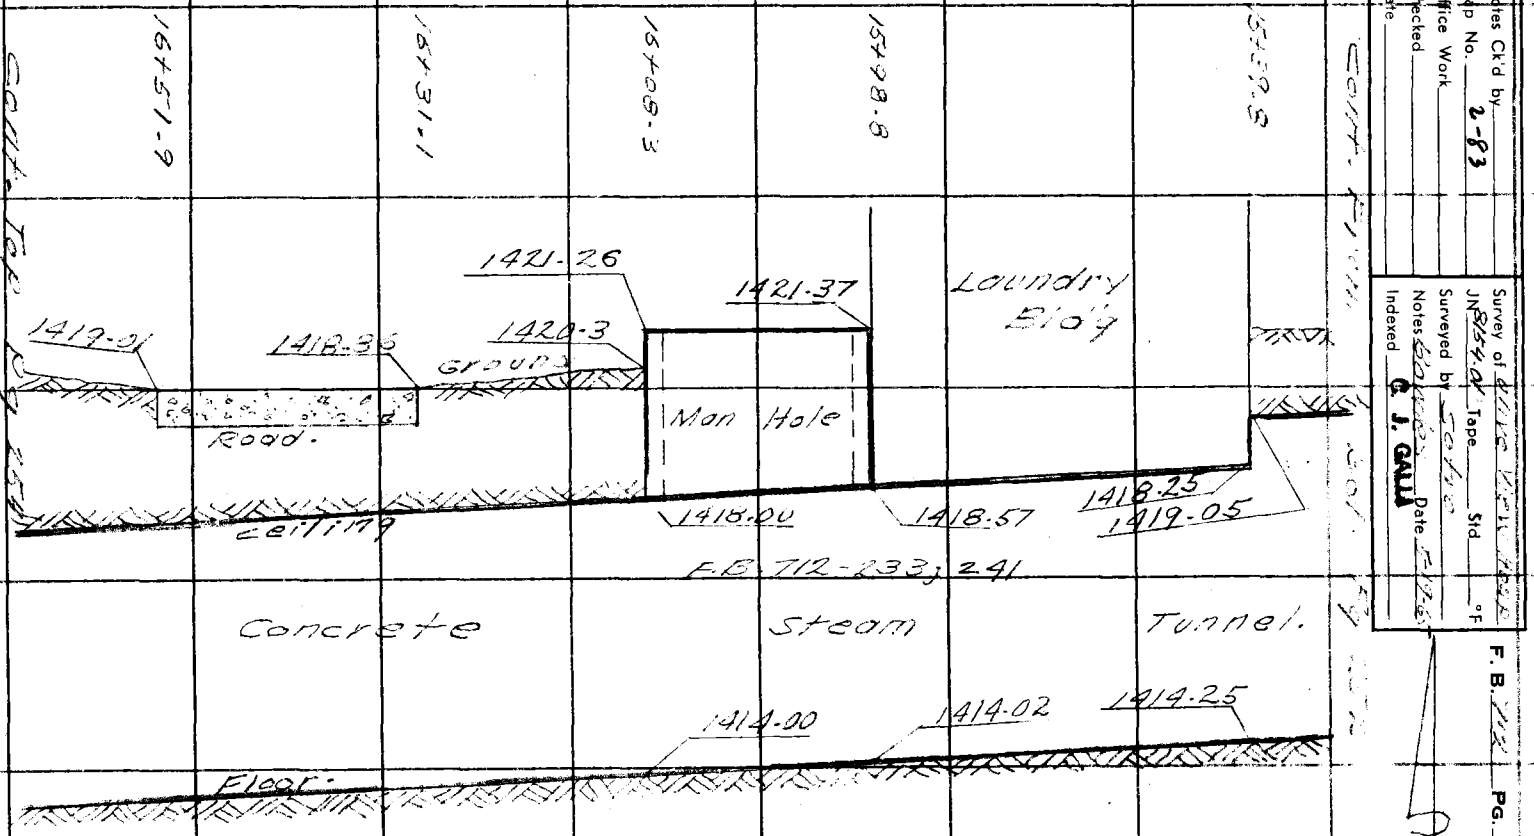

Notes Ck'd by
Map No. 2-83
Office Work
Checked
Date

Survey of
JN 8594 Tape Std °F
Surveyed by
Notes
Indexed C. J. GALL Date

F. B. PG.

PLEASE RETURN TO
LOS ANGELES COUNTY ENGINEER
403 LOS ANGELES COUNTY ENGINEERING BLDG.

Note: Any Additions or Changes on This Sheet Must be Made or Circled in Red Ink With Date and Name of Person Making Change.

Do not extend this side of this line.

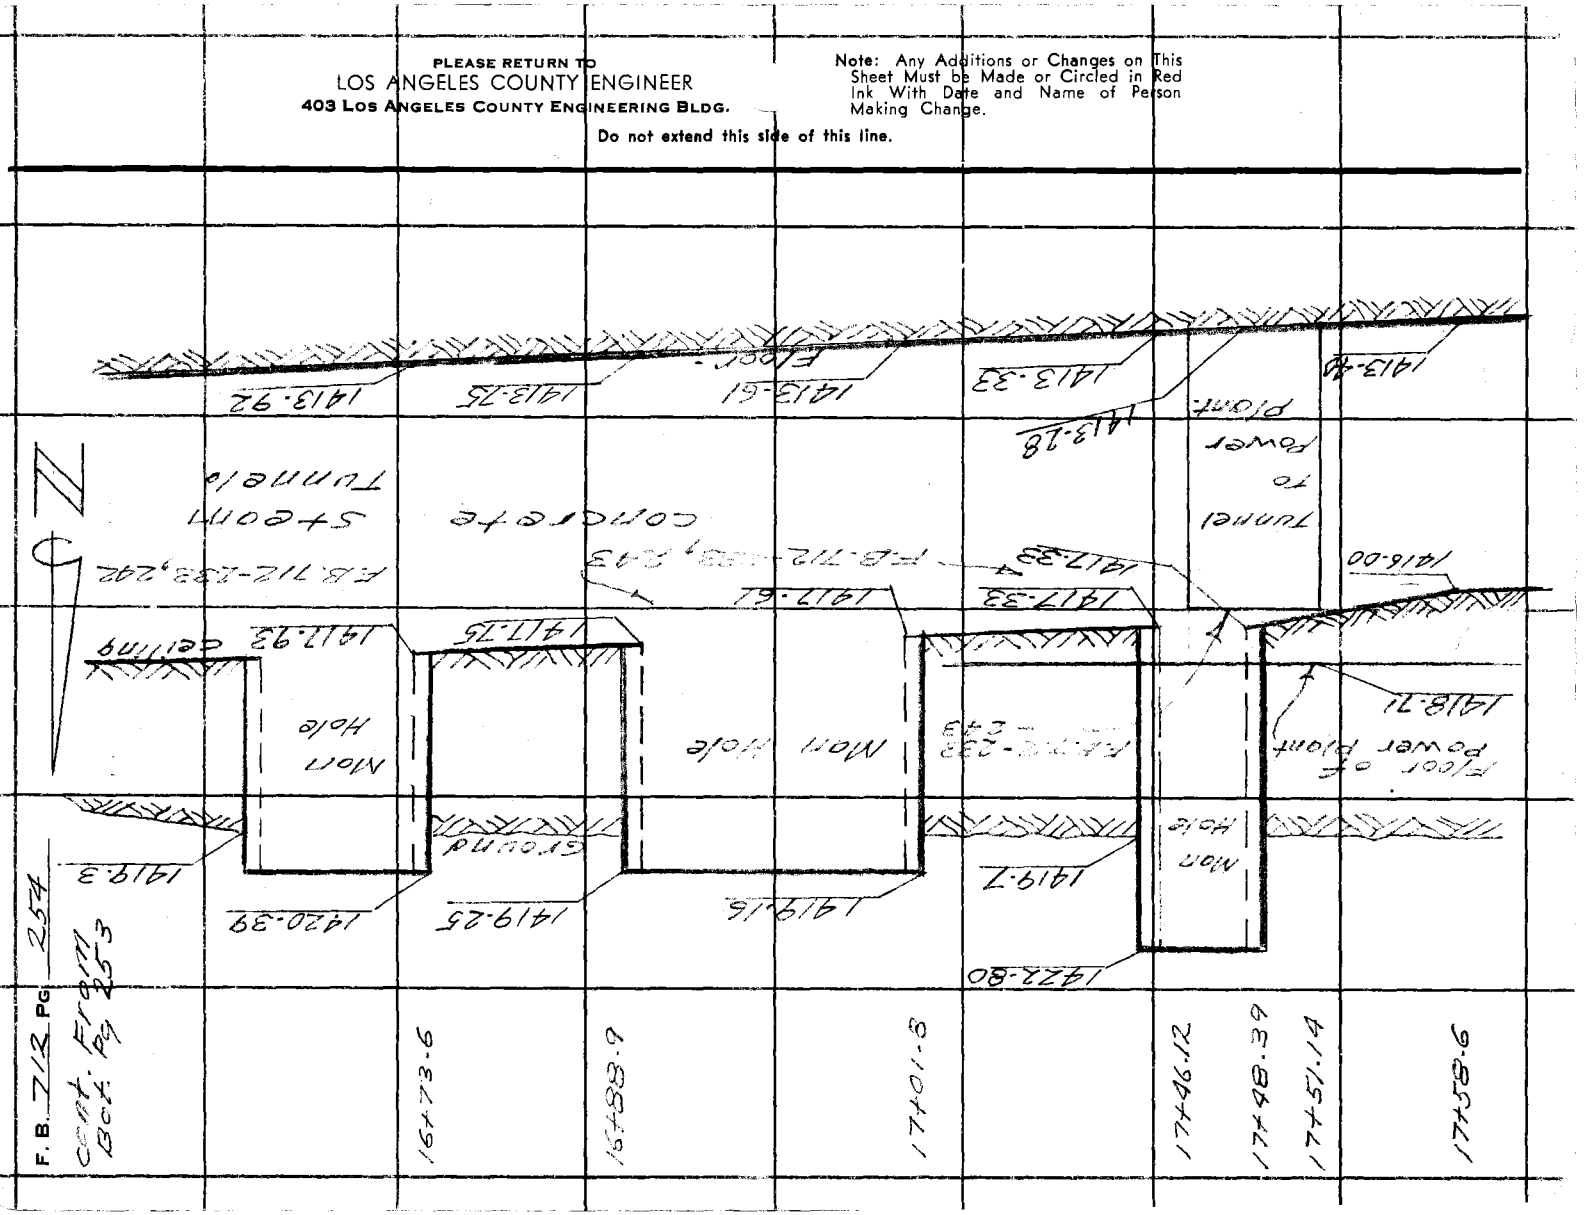

Notes Ck'd by	Survey of Olive View Hosp
Map No. 2-83	JN B154.00 Tape Std °F
Office Work	Surveyed by Sotre
Checked	Notes Bowles Date 5-19-65
Date	Indexed C. J. GALLI

F. B. 11 PG. 255

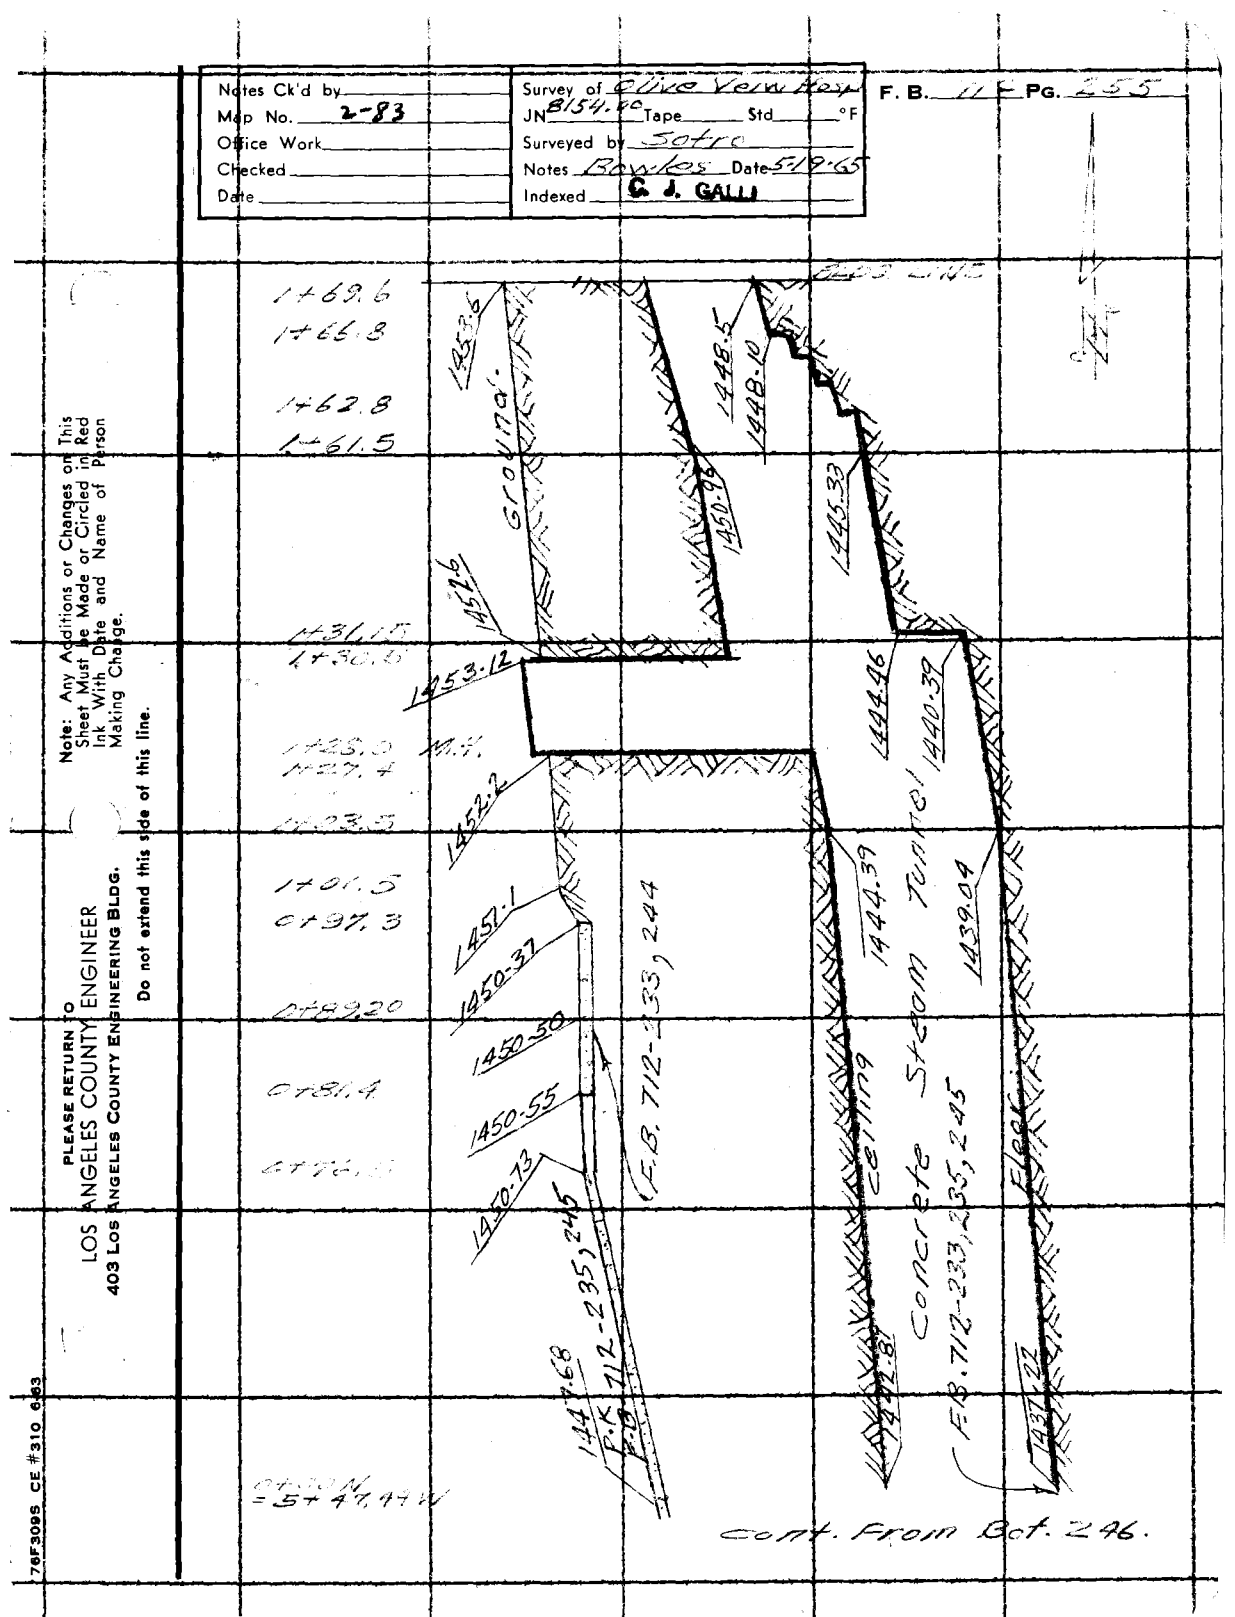

Note: Any Additions or Changes on This Sheet Must Be Made or Circled in Red Ink With Date and Name of Person Making Change.

Do not extend this side of this line.

PLEASE RETURN TO
LOS ANGELES COUNTY ENGINEER
403 Los Angeles County Engineering Bldg.

76F3095 CE #310 6-63

F. B. 712 PG 256

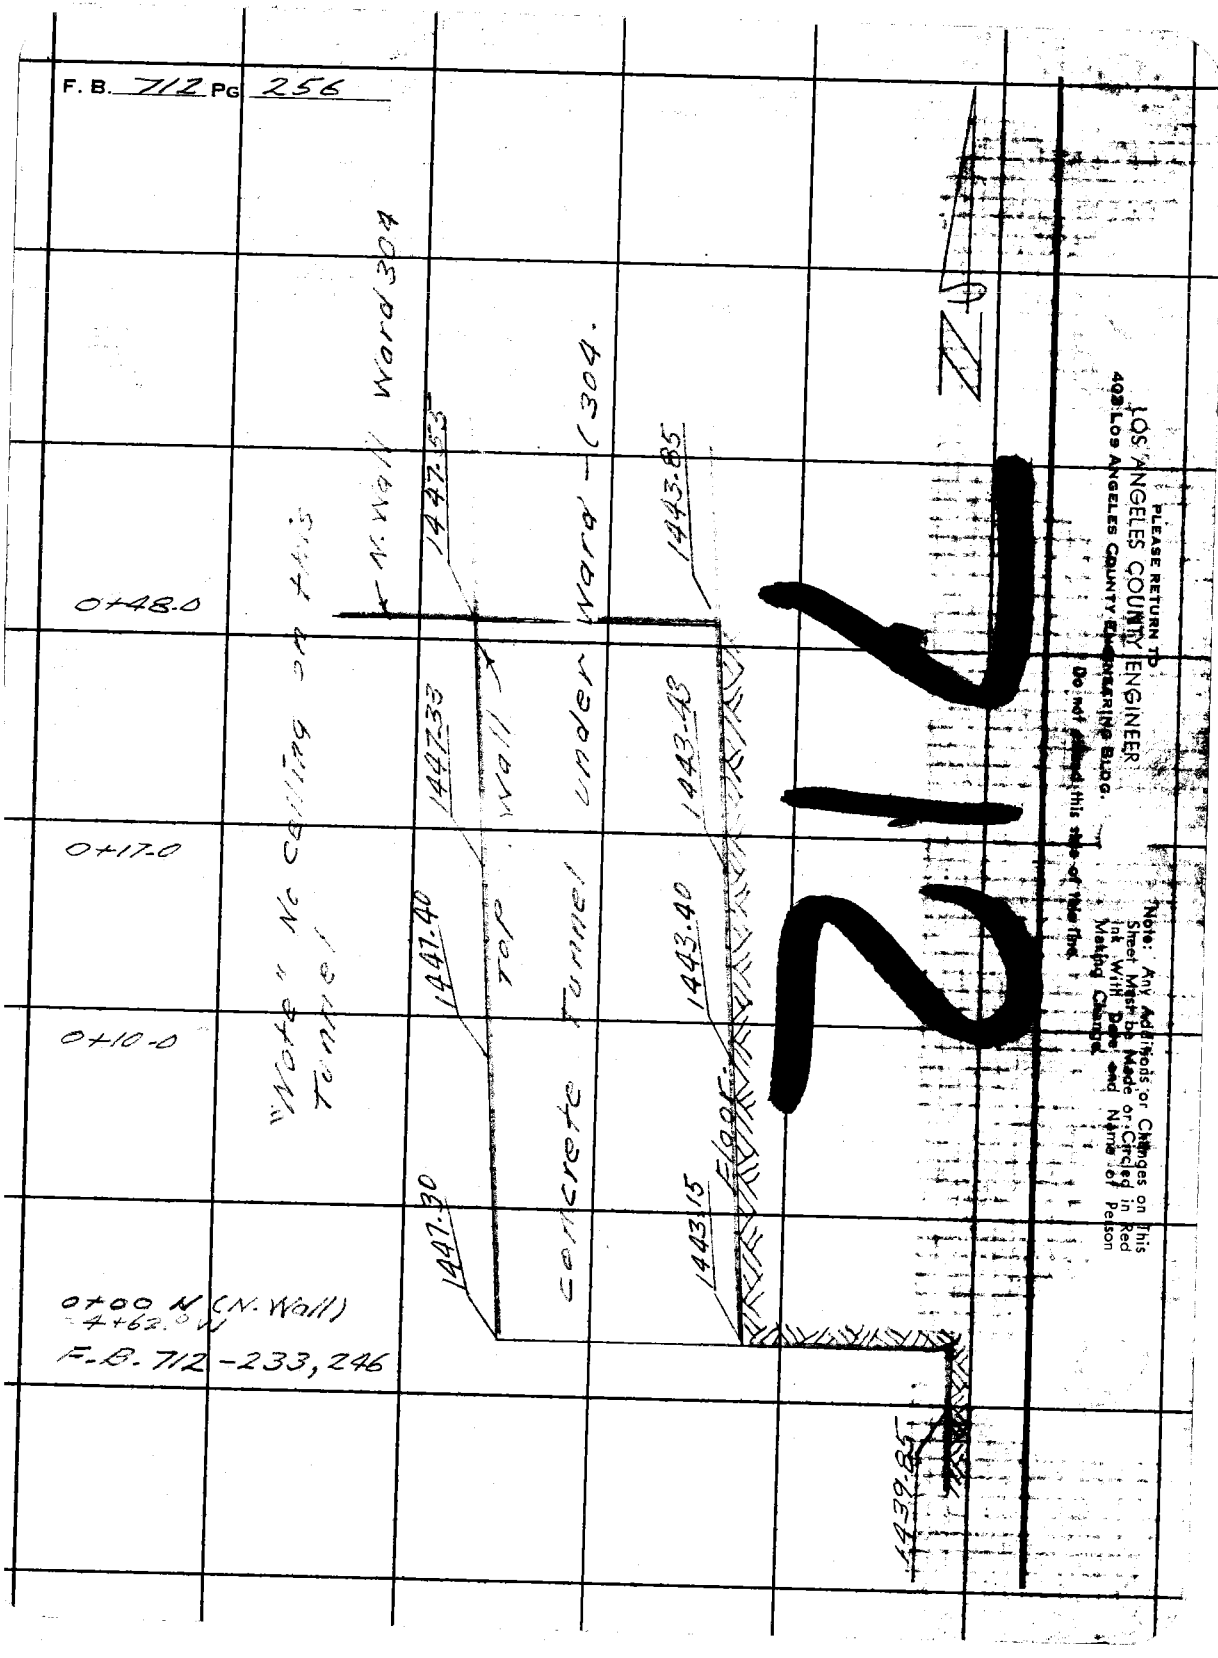

PLEASE RETURN TO
LOS ANGELES COUNTY ENGINEER
403 LOS ANGELES COUNTY ENGINEERING BLDG.
Do not [illegible] this side of this line.
Note: Any Additions or Changes on This Sheet Must be Made or Circled in Red Ink With Date and Name of Person Making Change.