Profile No. | Notes Red. | Plotted | Job No. 8128 | Division No. | F. B. 713 Pg. 305

No. | Date | Checked | Date | Survey of OLIVE VIEW SANATORIUM

Survey by T. WALSH | Notes T. WALSH | Date 7-26-1937

Map No. | Indexed | Date 5-3-38

NOTE: ANY ADDITIONS OR CHANGES ON THIS SHEET MUST BE MADE OR CIRCLED IN RED INK, WITH DATE AND NAME OF PERSON MAKING CHANGE

PLEASE RETURN TO LOS ANGELES COUNTY SURVEYOR 700 ... BLDG. LOS ANGELES

Form 307 5M 10-37

STATION | B. S. | H. I. | F. S. | ELEV.

OLIVE VIEW SANATORIUM

UNDERGROUND

SEWERS

N. 81

JULY 1937 to FEB. 1938

T. M. Walsh
F. S. Livingston
H. Baker
R. Murray

F. B. 713 Pg. 306 | Job No. 8128 Division No. | Notes Red. | Plotted | Profile

Survey of OLIVE VIEW SANATORIUM Date | Date | No.

Survey by T. WALSH Notes T.M.IN | Notes Chkd. | Checked | X-Sec.

Indexed | Date | Date | Date | No.

LEGEND.

Vit. ----- Vitrified Pipe
C.I.P. ------ Cast Iron Pipe
W.I.P. ---- Wrought Iron Pipe
J.C. ----- Junction chamber
M.H ----- Manhole
M.D.U.M. ---- Mechanical Dept. Utility Map
C-O° ----- Covered (depth below surface)

STATION	B.S.	H.I.	F.S.	ELEV.

Form 307 5M 10-37

PLEASE RETURN TO
LOS ANGELES COUNTY SURVEYOR
700 HALL OF RECORDS

Do not extend notes this side of this line

NOTE: ANY ADDITIONS OR CHANGES ON THIS SHEET MUST BE MADE OR CIRCLED IN RED INK, WITH DATE AND NAME OF PERSON MAKING CHANGE

Form 307 5M 11-35

PLEASE RETURN TO
LOS ANGELES COUNTY SURVEYOR
700 HALL OF RECORDS

NOTE: ANY ADDITIONS OR CHANGES ON THIS SHEET MUST BE MADE OR CIRCLED IN RED INK, WITH DATE AND NAME OF PERSON MAKING CHANGE

Do not extend notes this side of this line

Profile No. _____ X-Sec. No. _____ Notes Red _____ Date _____ Notes Chkd. Martin Date 8-8-39 Plotted Martin Date August '39 Checked _____ Date _____ Job No. 8108 Division No. _____ Survey of OLIVE VIEW SANITORIUM Survey by INVALLEY Notes INVALLEY Date 7-26-39 Map No. _____ Indexed _____ Date _____ F.B. 713 PG. 307

STATION	B. S.	H. I.	F. S.	ELEV.
B.M. No 3 W. Spk S.E. Cor. Boiler House F.B. 585-5	5.60	1420.48	5.91	1418.88 B.M. #3
			12.11	1418.57 Rim
				1412.37 F.L.

(over)

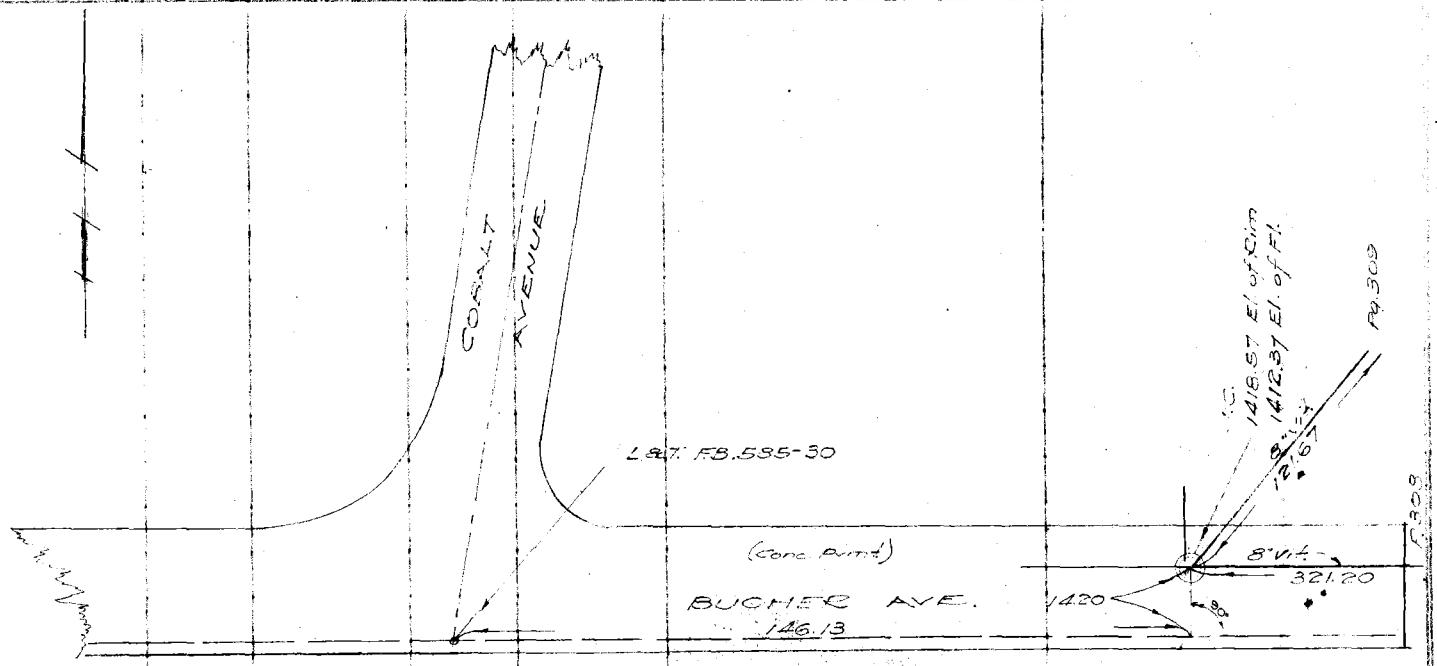

Form 307 5M 11-35

PLEASE RETURN TO
LOS ANGELES COUNTY SURVEYOR
700 HALL OF RECORDS

NOTE: ANY ADDITIONS OR CHANGES ON THIS SHEET MUST BE MADE OR CIRCLED IN RED INK, WITH DATE AND NAME OF PERSON MAKING CHANGE

Do not extend notes this side of this line

F. B. 713 Pg. 308 | Job No. 818 | Division No. | Notes Red. | Plotted Martin | Profile No.
Survey of OLIVE VIEW SANATORIUM | Date 7-26-37 | Date Aug. 1939 | X-Sec. No.
Survey by TED WALSH | Notes WALSH | Notes Chkd. Martin | Checked
Indexed | Date | Date 8-8-39 | Date

STATION	B. S.	H. I.	F. S.	ELEV.
		142.48	(cont from previous page)	
			5.34	1419.14 El. Rim
			10.34	1414.14 F.L.
			3.57	142.91
676		142.67	3.97	1418.70 El. Rim
			11.88	1415.79 F.L.
			0.03	142.64

For new 4" C.I.P
See F.B. 2910-159
S.S. 2/16/63

TP #4
"X" on Fire Hyd
F.B. 585-5

S.M.H
1423.70 El. Rim
1415.79 El. F.L.

8" V.C. Pipe

321.20 — 330.40 — 176.37 — To P. 326

S.M.H.
1419.14 El. Rim
1414.14 El. F.L.

BUCHER AVE.

13.90

℄ Transit Line

RANCHO LINE

Pg. 7

Profile	Notes Red.	Plotted Martin	Job No. 8/2	Division No.	F. B. 713 PG. 309
No.	Date	Date Aug. 1939	Survey of OLIVE VIEW SANATORIUM		
X-Sec.	Notes Chkd.	Checked	Survey by TED. WALSH	Notes WALSH	Date 7-26-37
No.	Date	Date	Map No.	Indexed	Date

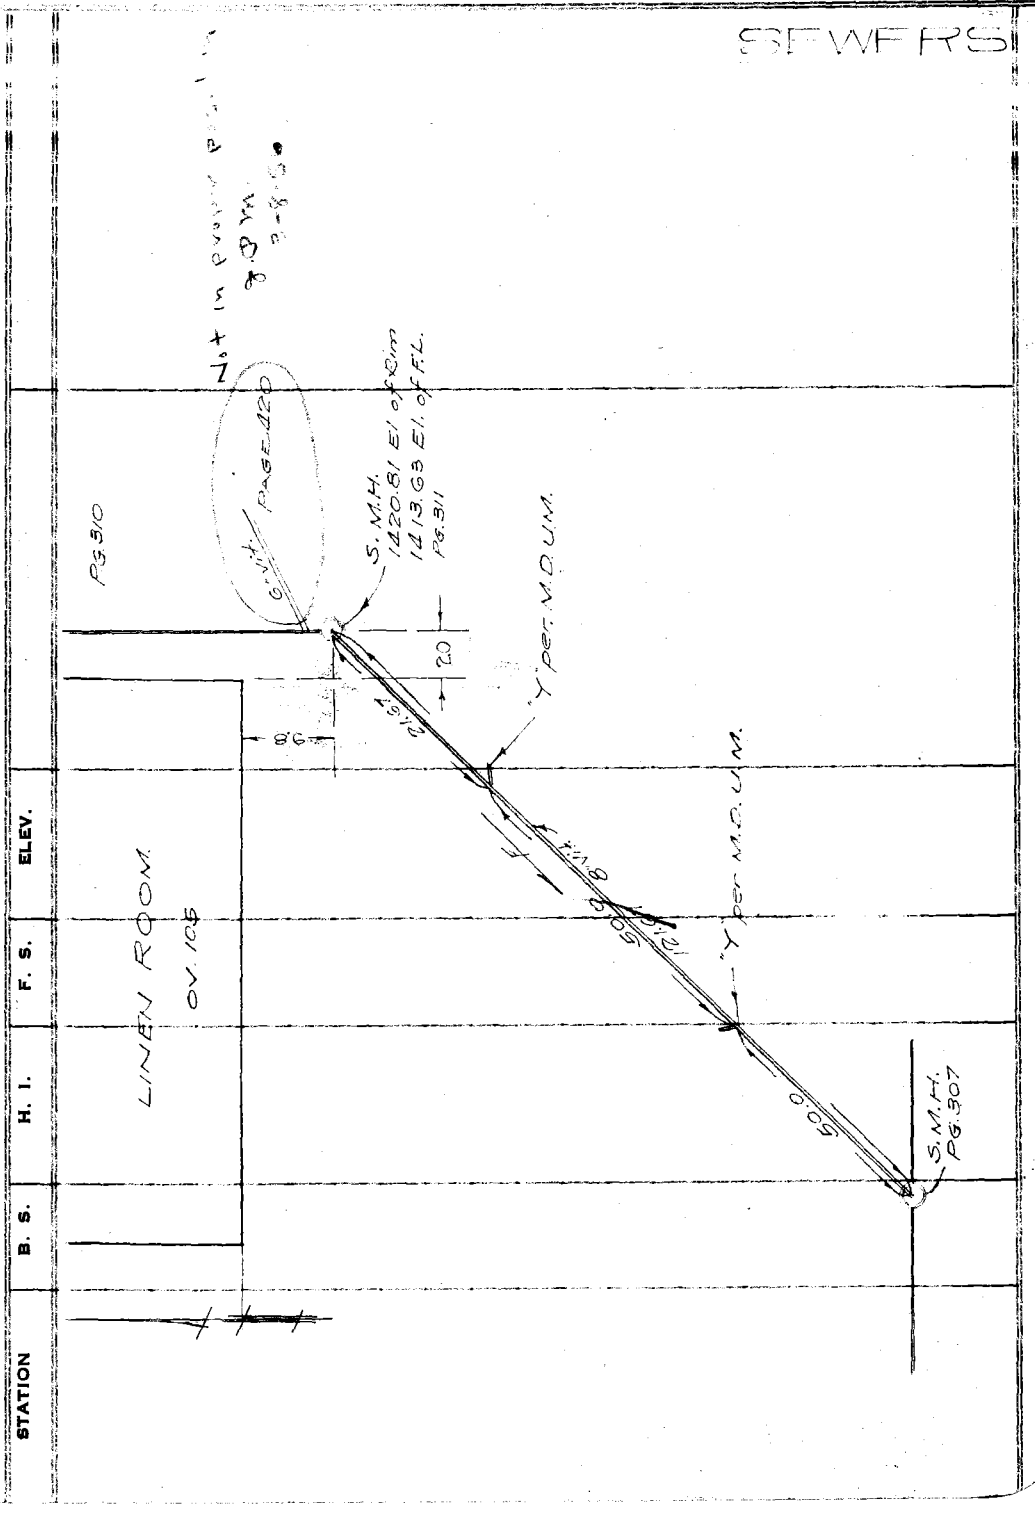

NOTE: ANY ADDITIONS OR CHANGES ON THIS SHEET MUST BE MADE OR CIRCLED IN RED INK, WITH DATE AND NAME OF PERSON MAKING CHANGE

Do not extend notes this side of this line

PLEASE RETURN TO
LOS ANGELES COUNTY SURVEYOR
700 HALL OF RECORDS

Form 307 5M 11-35

F. B. 713 Pg 310 ✓ | Job No. 8148 | Division No. | Notes Red. | Plotted Martin | Profile
Survey of OLIVE VIEW SANATORIUM | Date 7-26-37 | Date Aug. 1939 | No.
Survey by TED. WALSH | Notes WALSH | Notes Chkd. Martin | Checked | X-Sec.
Indexed | Date | Date 8-8-39 | Date | No.

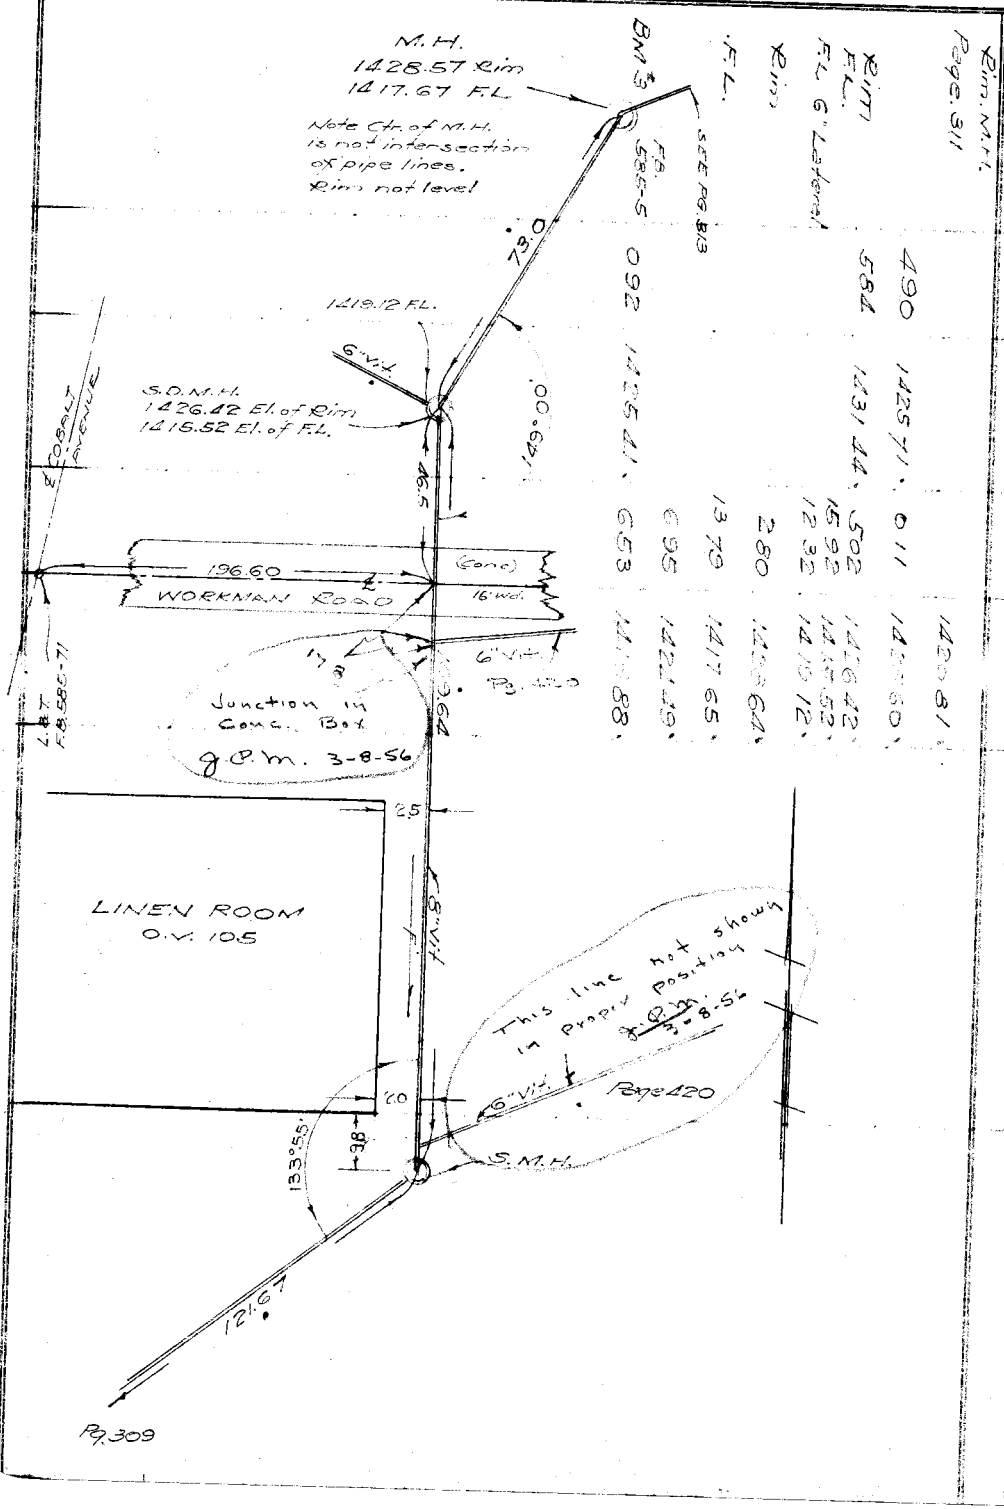

STATION	B. S.	H. I.	F. S.	ELEV.
Rim. M.H. Page. 311				1420.81
Rim	490	1425.71	0.11	1425.60
F.L.	584	1431.44	5.02	1426.42
F.L. 6" Lateral			15.92	1415.52
Rim			12.32	1419.12
F.L.			2.80	1428.64
			13.79	1417.65
			6.95	1424.49
	092	1425.41	6.53	1418.88

Form 307 5M 11-35

PLEASE RETURN TO
LOS ANGELES COUNTY SURVEYOR
700 HALL OF RECORDS

Do not extend notes this side of this line

NOTE: ANY ADDITIONS OR CHANGES ON THIS SHEET MUST BE MADE OR CIRCLED IN RED INK, WITH DATE AND NAME OF PERSON MAKING CHANGE

Form 307 5M 11-35

PLEASE RETURN TO
LOS ANGELES COUNTY SURVEYOR
700 HALL OF RECORDS

NOTE: ANY ADDITIONS OR CHANGES ON THIS SHEET MUST BE MADE OR CIRCLED IN RED INK, WITH DATE AND NAME OF PERSON MAKING CHANGE

Do not extend notes this side of this line

Profile No. ____ X-Sec. No. ____ Notes Red. ____ Date ____ Notes Chkd. Martin Date 8-8-39 Plotted Martin Date Aug. 1939 Checked ____ Date ____

Job No. 8128 Division No. ____ Survey of OLIVE VIEW SANATORIUM Survey by TED KNELL Notes KNELL Date 7-26-39 Map No. ____ Indexed ____ Date ____

F.B. 713 Pg. 31

STATION	B. S.	H. I.	F. S.	ELEV.
B.M. No 3 Wire Spk S.E. Cor Boiler House FB 585-5	5455	142433		1418875
			352	142081 Rim
			1070	141363 F.L.
			340	142093
	4735	142566	835	141731 Pt on 4" C.I.P. (Top of pipe)
			504	142062
B.M. No 3	621	142683	796	1418875

PAGE 309

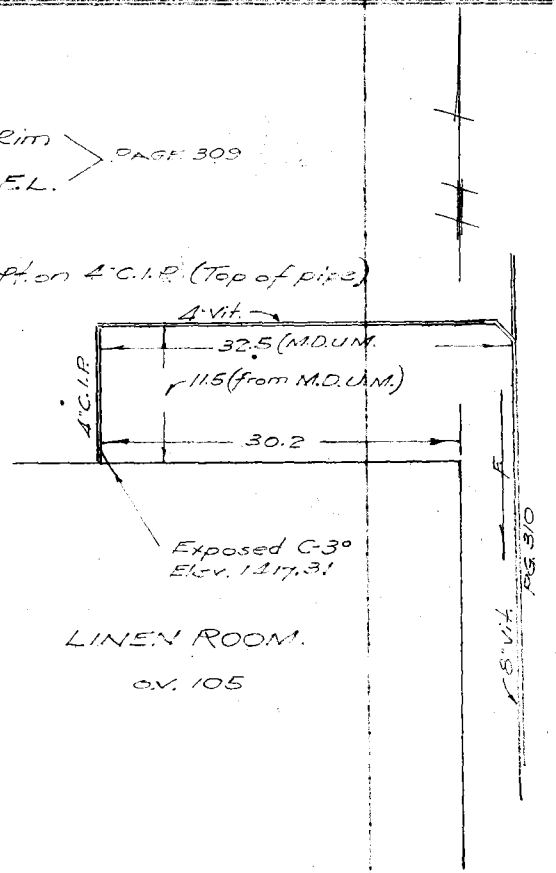

SEWERS

F. B. 713 PG. 312 | Job No. 8128 | Division No. | Notes Red. | Plotted Martin | Profile

Survey of OLIVE VIEW SANATORIUM | Date | Date Aug. 1939 | No.

Survey by T.M. WALSH Notes T. WALSH | Notes Chkd. | Checked | X-Sec.

Indexed | Date Nov. 22-37 | Date | Date | No.

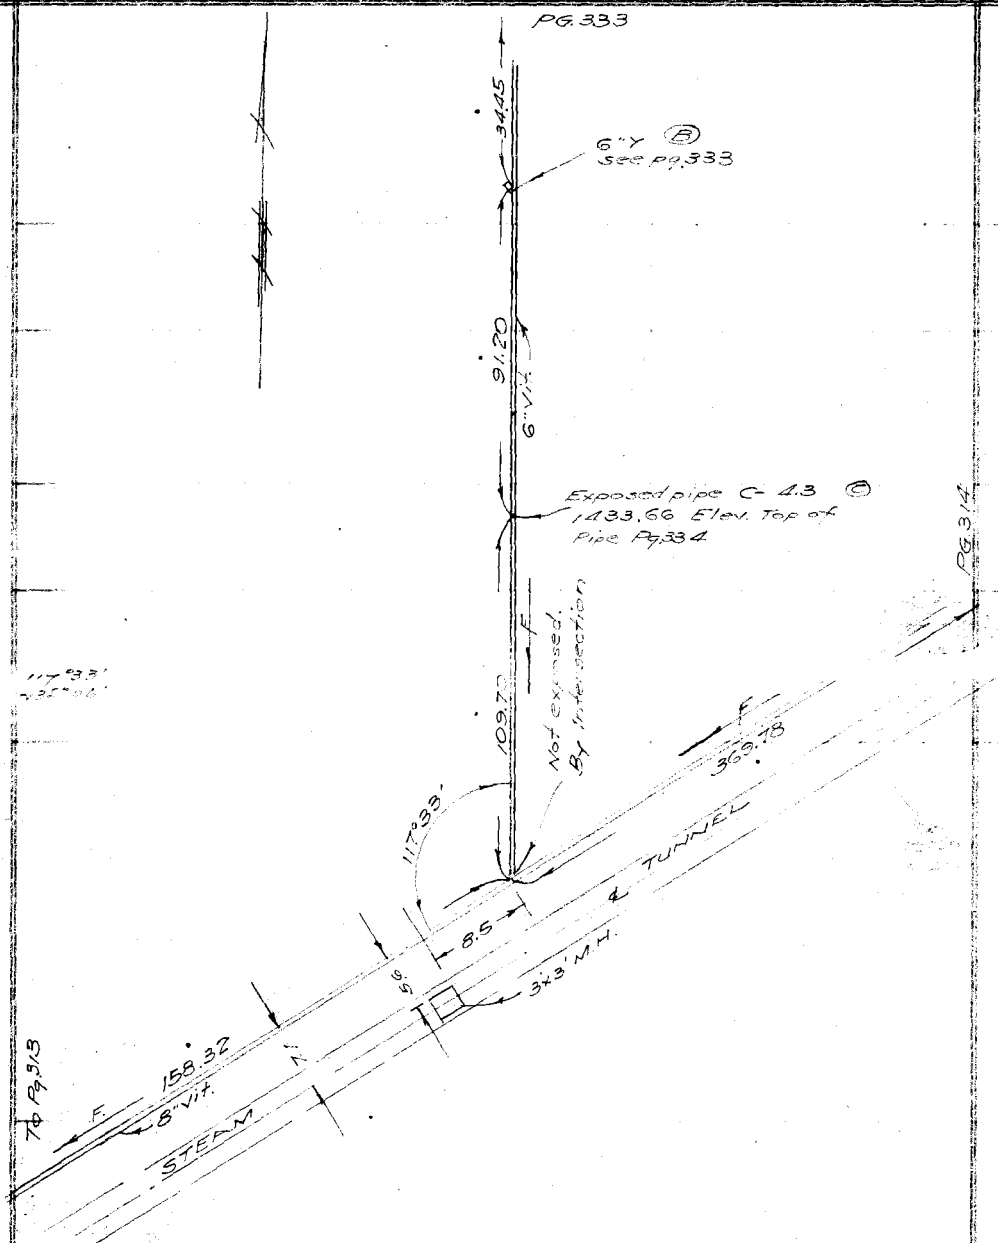

STATION | B. S. | H. I. | F. S. | ELEV.

Form 307 SM 11-35

PLEASE RETURN TO
LOS ANGELES COUNTY SURVEYOR
700 HALL OF RECORDS

Do not extend notes this side of this line

NOTE: ANY ADDITIONS OR CHANGES ON THIS SHEET MUST BE MADE OR CIRCLED IN RED INK, WITH DATE AND NAME OF PERSON MAKING CHANGE

Profile	Notes Red.	Plotted Martin	Job No. 8128	Division No.	F. B. 713 Pg. 313
No.	Date	Date Aug. 1939	Survey of OLIVE VIEW SANATORIUM		
X-Sec.	Notes Chkd.	Checked	Survey by T. WALSH	Notes WALSH	Date Nov. 23-37
No.	Date	Date	Map No.	Indexed	Date

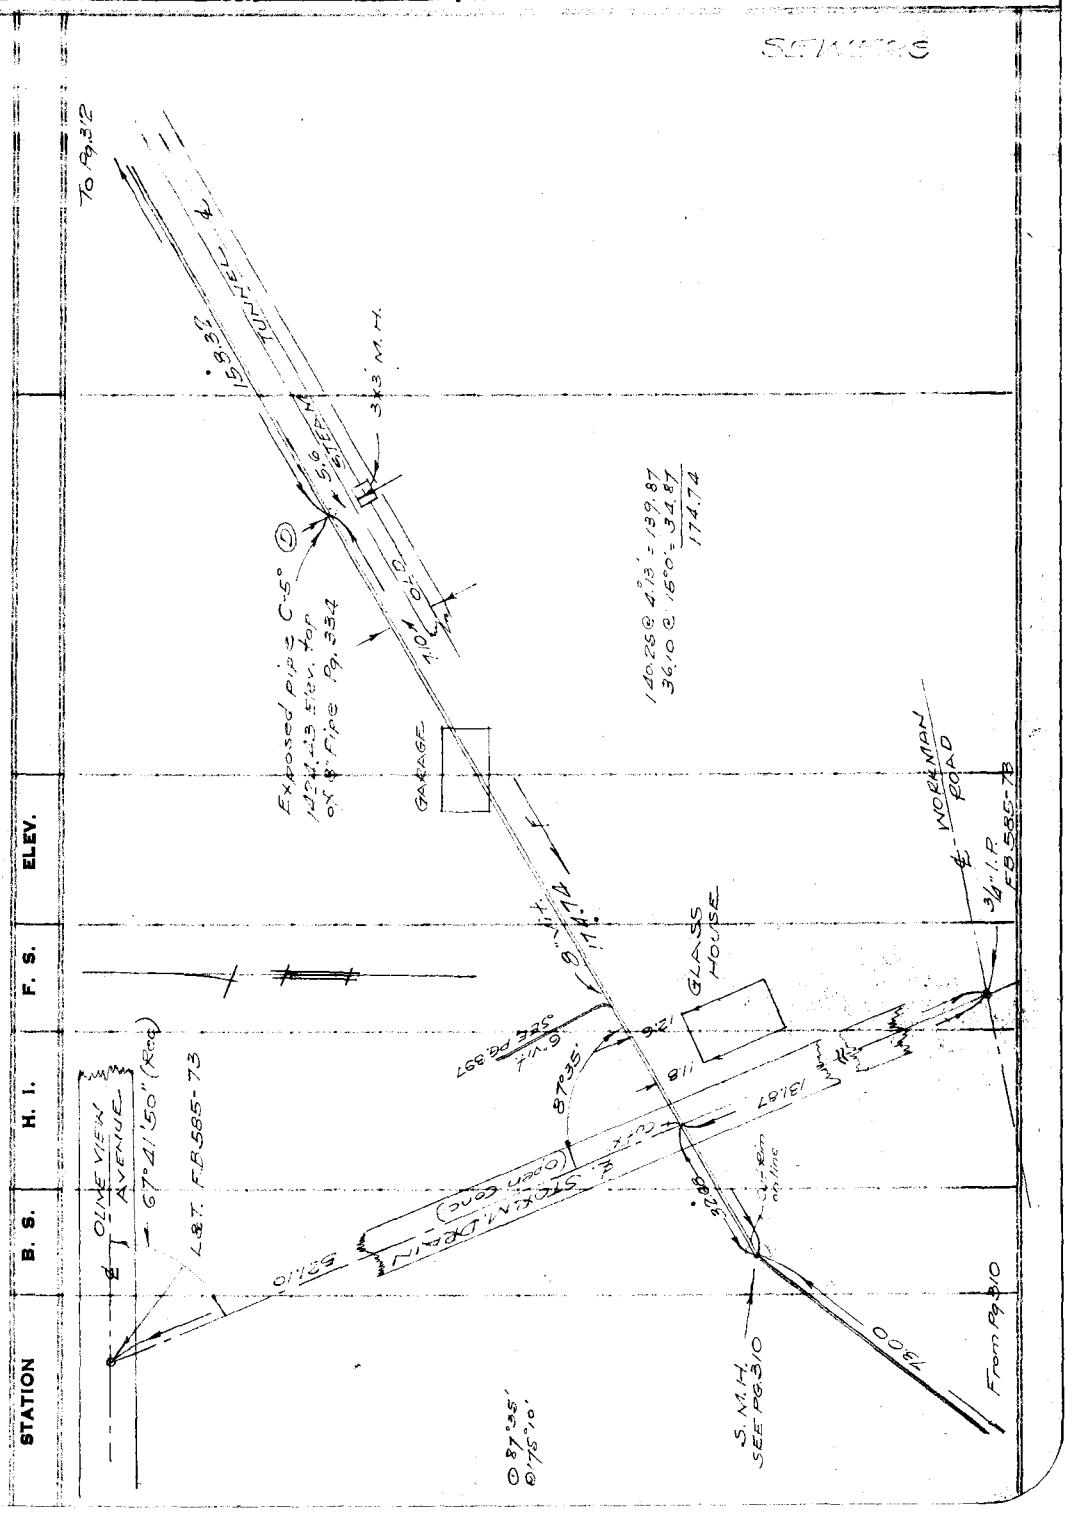

Form 307 5M 11-35

PLEASE RETURN TO
LOS ANGELES COUNTY SURVEYOR
700 HALL OF RECORDS

NOTE: ANY ADDITIONS OR CHANGES ON THIS SHEET MUST BE MADE OR CIRCLED IN RED INK, WITH DATE AND NAME OF PERSON MAKING CHANGE

Do not extend notes this side of this line

Form 307 5M 11-35

PLEASE RETURN TO
LOS ANGELES COUNTY SURVEYOR
700 HALL OF RECORDS

NOTE: ANY ADDITIONS OR CHANGES ON THIS SHEET MUST BE MADE OR CIRCLED IN RED INK, WITH DATE AND NAME OF PERSON MAKING CHANGE

Do not extend notes this side of this line

STATION	B. S.	H. I.	F. S.	ELEV.
B.M. No 9				
"□" N.E. COR. WARD 302. F.B. 585-13				[illegible] 32
Rim of J.C.	8.84	1459.16	8.14	[illegible]
F.L. of J.C.			12.99	[illegible] 17
T.P.			6.95	[illegible] 21
Pt on 8" Pipe T.P. L.&T. & Olive View Ave & Sycamore F.B. 585-16	3.33	1455.54	13.25	[illegible]
			6.25	[illegible] 29

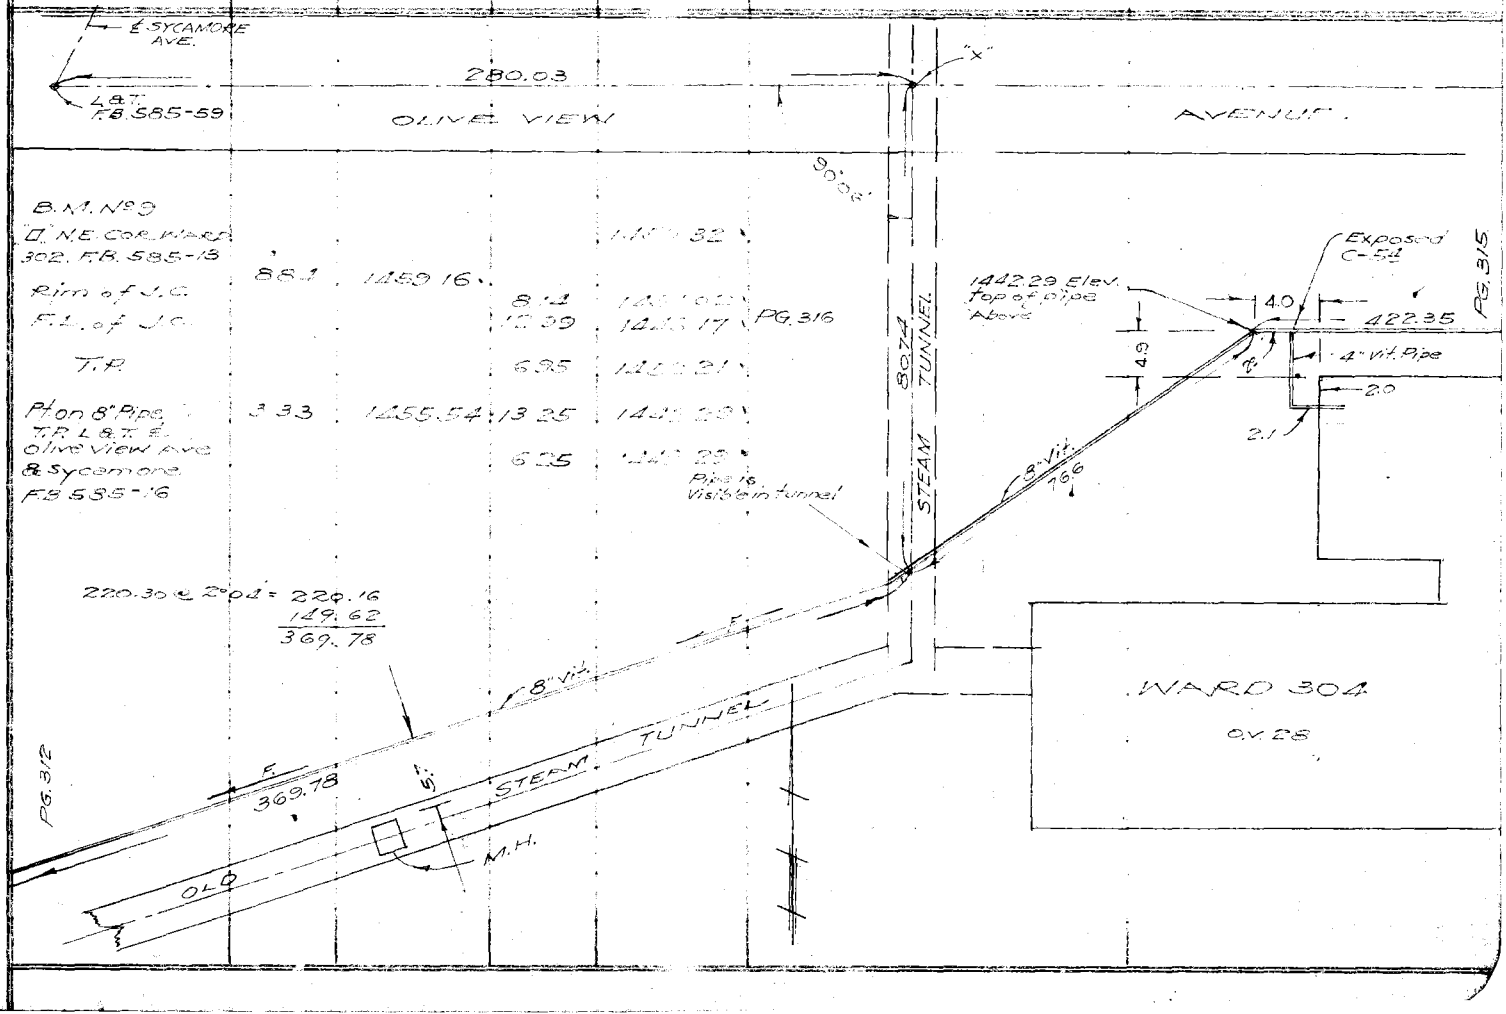

F.B. 713 PG. 314 Job No. 8128 Division No. Notes Red. Plotted Martin Profile
Survey of OLIVE VIEW SANATORIUM Date 7-28-37 Date Aug. 1939 No.
Survey by TED WALSH Notes WALSH Notes Chkd. Martin Checked X-Sec.
Indexed Date Date 8-8-39 Date No.

Form 307 5M 11-35

PLEASE RETURN TO
LOS ANGELES COUNTY SURVEYOR
700 HALL OF RECORDS

NOTE: ANY ADDITIONS OR CHANGES ON THIS SHEET MUST BE MADE OR CIRCLED IN RED INK, WITH DATE AND NAME OF PERSON MAKING CHANGE

Do not extend notes this side of this line

STATION	B. S.	H. I.	F. S.	ELEV.

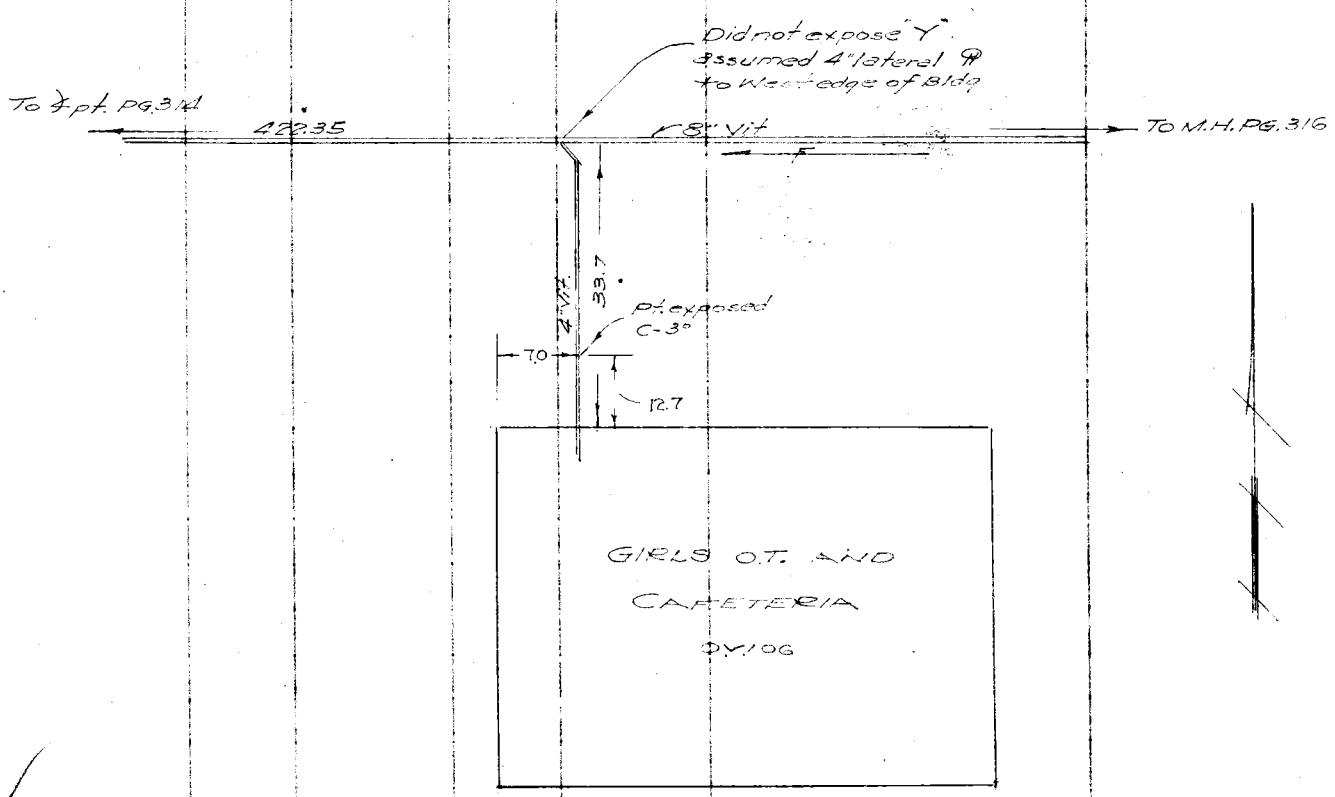

Profile No. ____ X-Sec. No. ____

Notes Red. ____ Date ____ Notes Chkd. ____ Date ____

Plotted Martin Date Aug. 1939 Checked ____ Date ____ Map No. ____

Job No. 848 Division No. ____ Survey of [illegible] Survey by TED WALSH Notes WALSH Date 8-5-1937 Indexed ____ Date ____

F. B. 713 PG. 315

Form 307 5M 11-35

PLEASE RETURN TO
LOS ANGELES COUNTY SURVEYOR
700 HALL OF RECORDS

NOTE: ANY ADDITIONS OR CHANGES ON THIS SHEET MUST BE MADE OR CIRCLED IN RED INK, WITH DATE AND NAME OF PERSON MAKING CHANGE

Do not extend notes this side of this line

STATION	B. S.	H. I.	F. S.	ELEV.
BM No 9 "B" NE. Cor. of Ward "A" F.B. 585-13	1111	1461.43		1450.32
C.I.Y.			7.38	1454.05
4" Vit Y			3.48	1457.95
BM No 9 Above			1111	1450.32

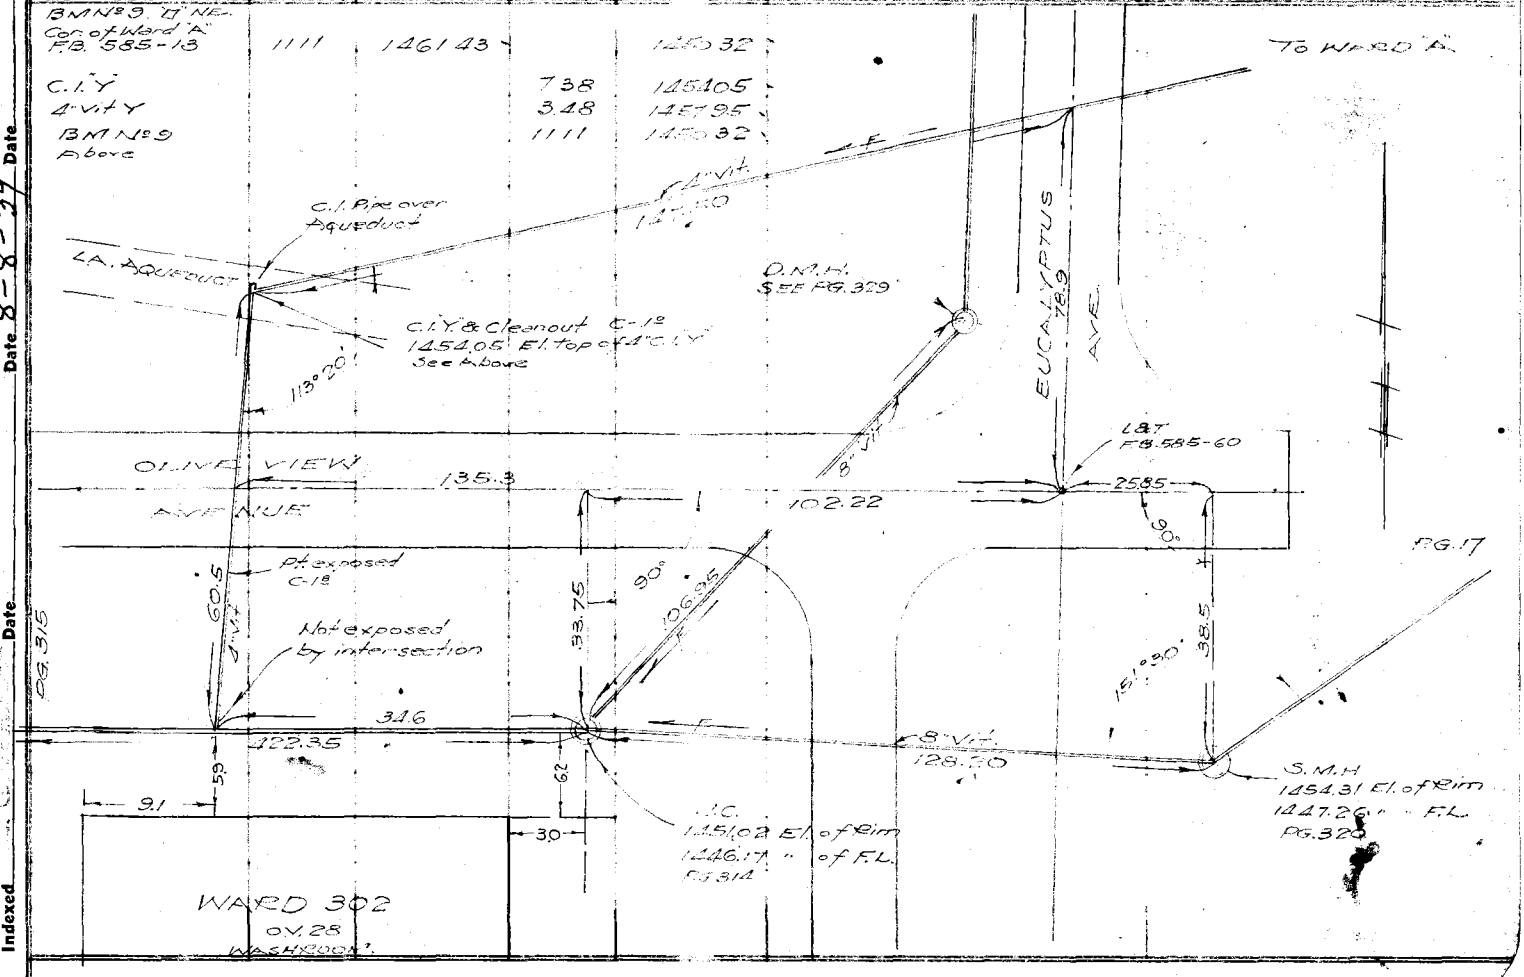

F. B. 713 PG 316 Job No. 8128 Division No. Notes Red. Plotted Martin Profile
Survey of OLIVE VIEW SANATORIUM Date 7-29-37 Date Aug. 1939 No.
Survey by TED WALSH Notes WALSH Notes Chkd Martin Checked X-Sec.
Indexed Date Date 8-8-39 Date No.

Profile	Notes Red.	Plotted Martin	Job No. 8128	Division No.	F. B. 713	PG 317
No.	Date	Date Aug. 1939	Survey of OLIVE VIEW SANITARIUM			
X-Sec.	Notes Chkd.	Checked	Survey by TED WALSH	Notes WALSH	Date 7-29-37	
No.	Date	Date	Map No.	Indexed	Date	

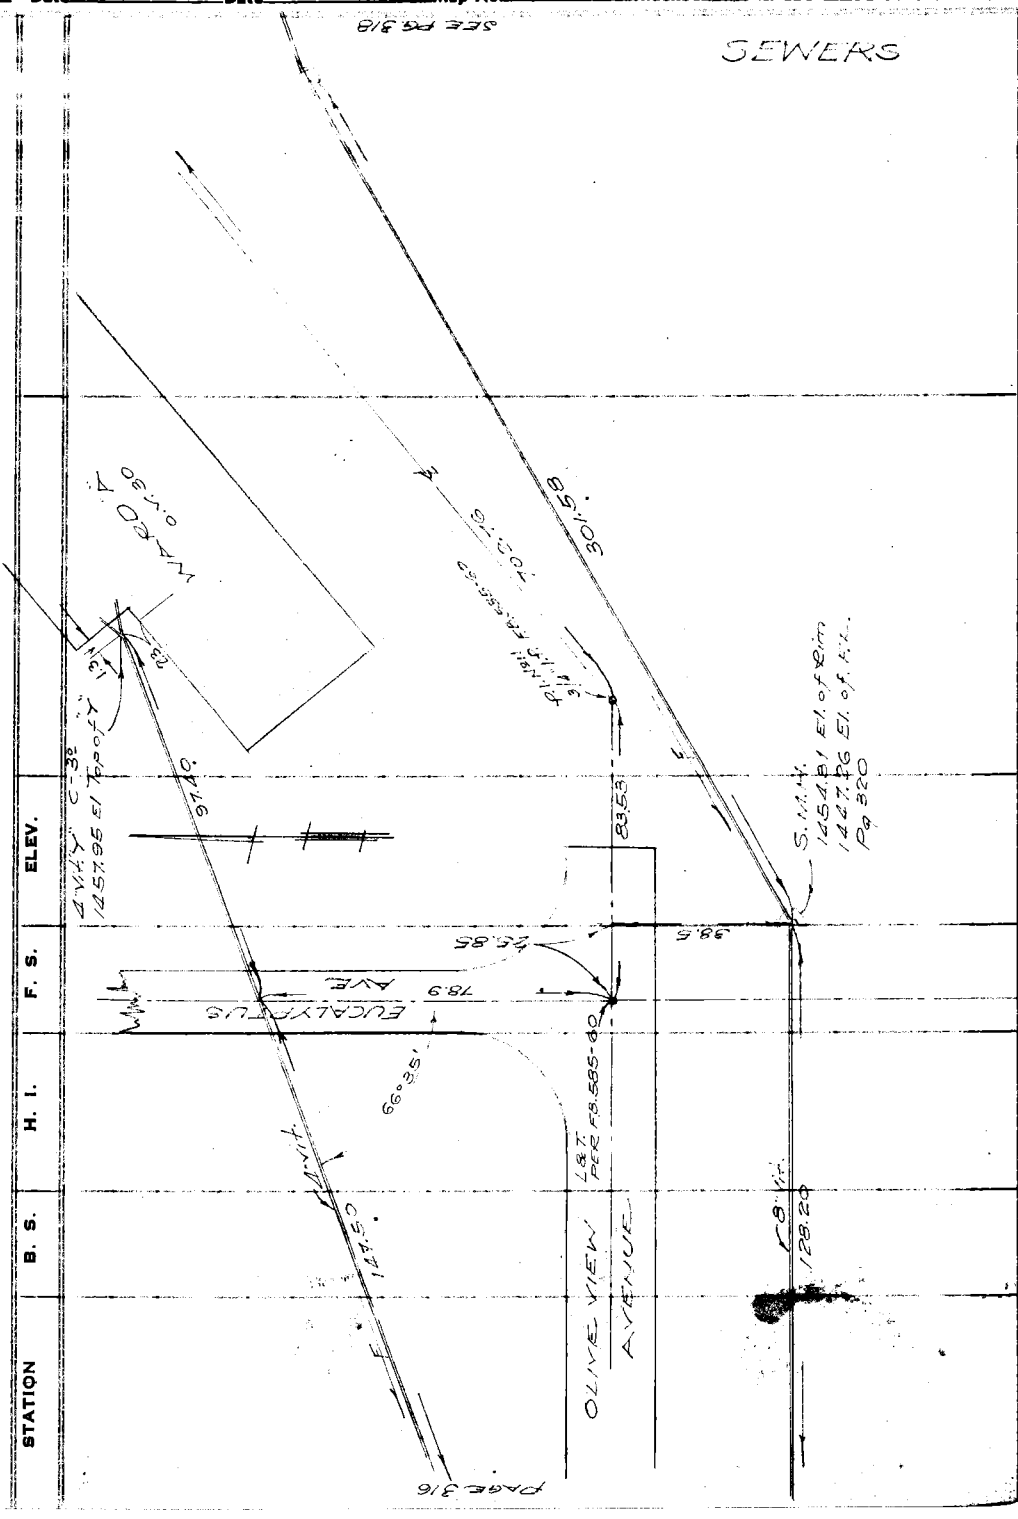

NOTE: ANY ADDITIONS OR CHANGES ON THIS SHEET MUST BE MADE OR CIRCLED IN RED INK, WITH DATE AND NAME OF PERSON MAKING CHANGE

Do not extend notes this side of this line

PLEASE RETURN TO
LOS ANGELES COUNTY SURVEYOR
700 HALL OF RECORDS

Form 307 5M 11-35

Form 307 5M 11-35

PLEASE RETURN TO
LOS ANGELES COUNTY SURVEYOR
700 HALL OF RECORDS

NOTE: ANY ADDITIONS OR CHANGES ON THIS SHEET MUST BE MADE OR CIRCLED IN RED INK, WITH DATE AND NAME OF PERSON MAKING CHANGE

Do not extend notes this side of this line

B. 718 Pg 318 | Job No. 8128 | Division No. | Notes Red. | Plotted Martin | Profile No.
Survey of OLIVE VIEW SANATORIUM | Date | Date July 29, 37 | Date Aug. 1939 | X-Sec. No.
Survey by TED KVALSH | Notes KVALSH | Notes Chkd. | Checked
Indexed | Date | Date | Date

STATION	B. S.	H. I.	F. S.	ELEV.

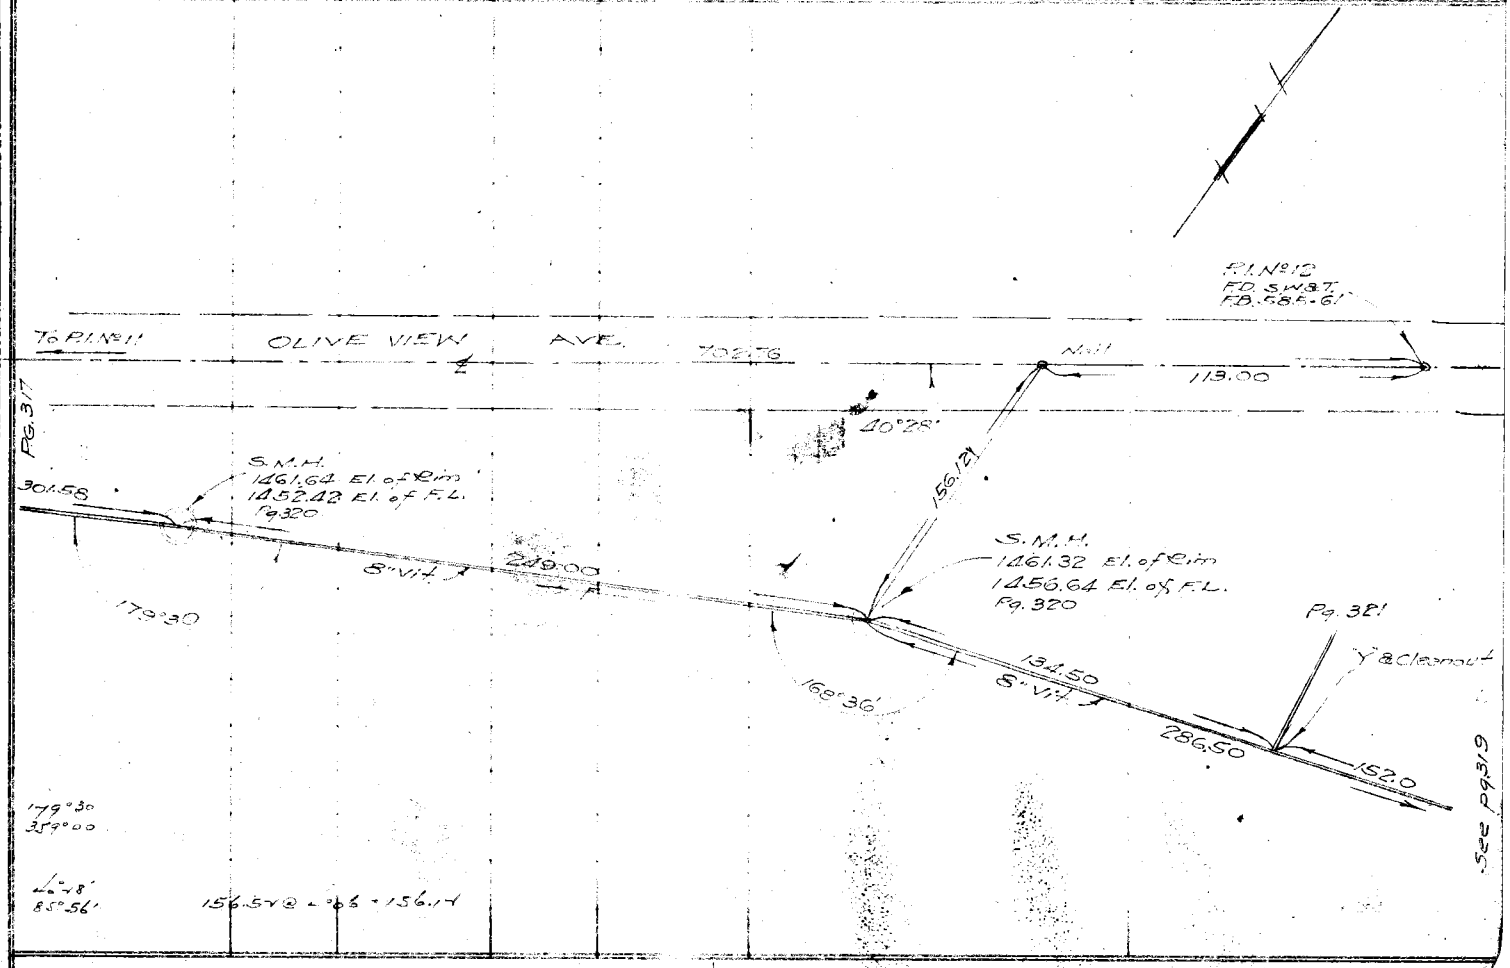

Form 307 5M 11-35

PLEASE RETURN TO
LOS ANGELES COUNTY SURVEYOR
700 HALL OF RECORDS

NOTE: ANY ADDITIONS OR CHANGES ON THIS SHEET MUST BE MADE OR CIRCLED IN RED INK, WITH DATE AND NAME OF PERSON MAKING CHANGE

Do not extend notes this side of this line




No. _____ Date _____ Date _____ Map No. _____ Indexed _____ Date _____

STATION	B. S.	H. I.	F. S.	ELEV.

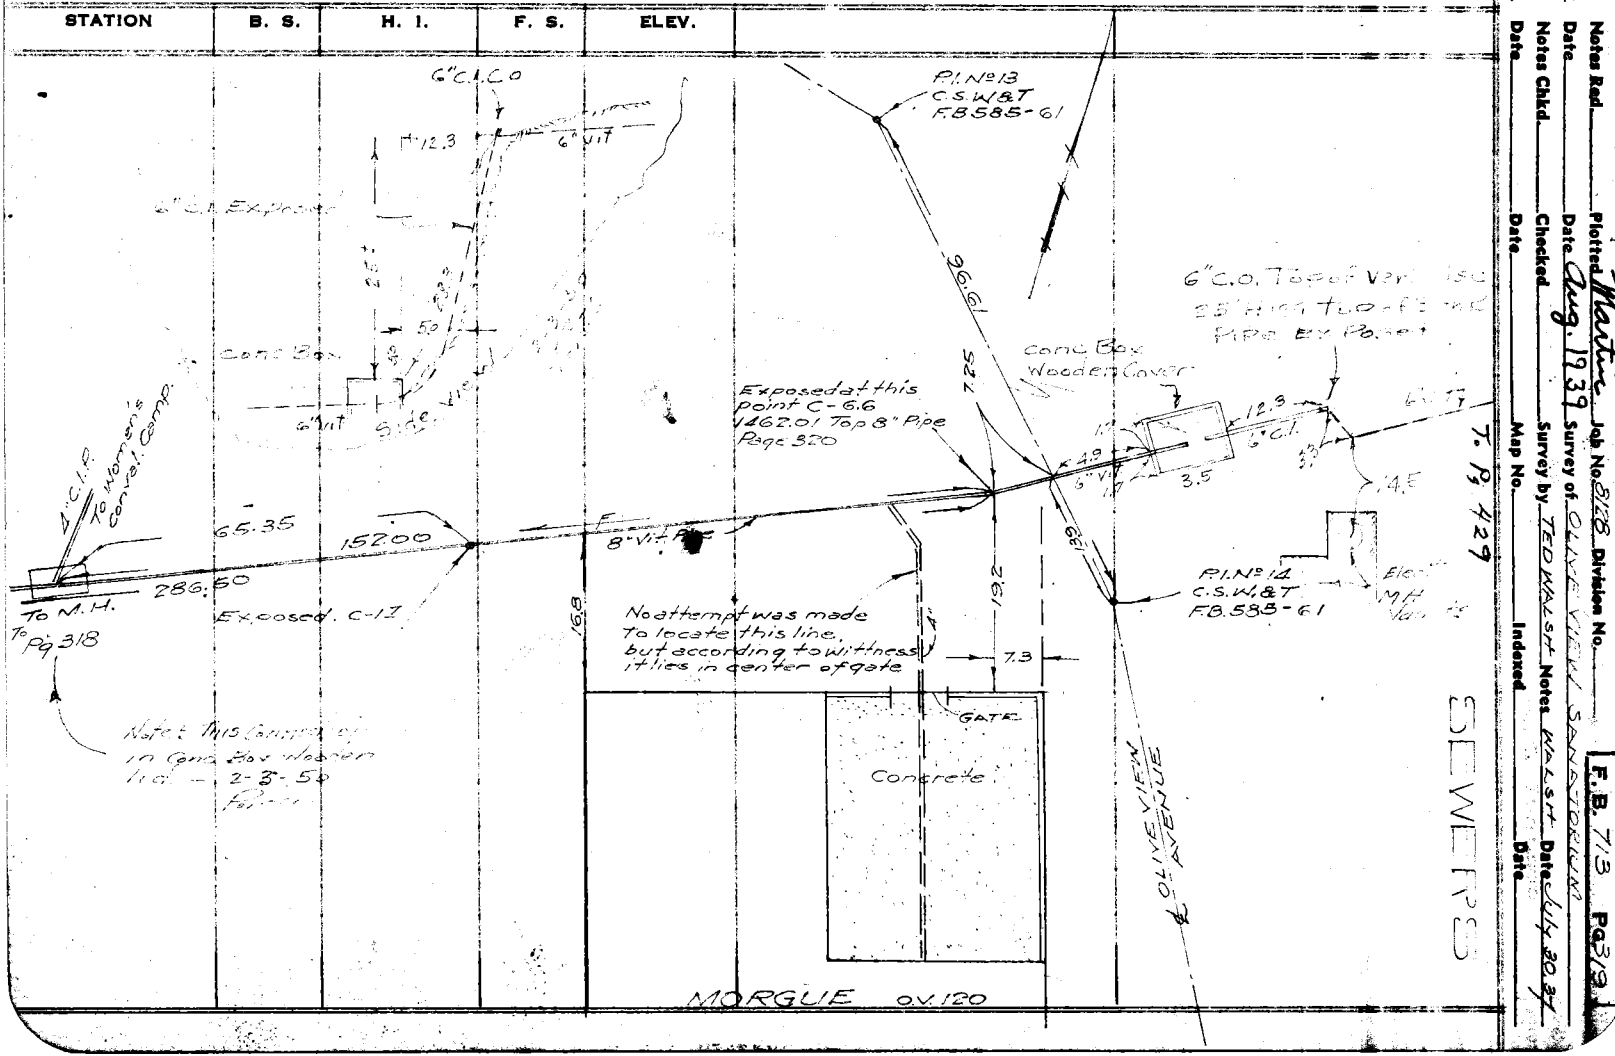

Form 307 5M 11-35

PLEASE RETURN TO
LOS ANGELES COUNTY SURVEYOR
700 HALL OF RECORDS

NOTE: ANY ADDITIONS OR CHANGES ON THIS SHEET MUST BE MADE OR CIRCLED IN RED INK, WITH DATE AND NAME OF PERSON MAKING CHANGE

Do not extend notes this side of this line

F.B. 713 PG 320 | Job No. 8128 Division No. | Notes Red | Plotted | Profile No.
Survey of OLIVE VIEW SANATORIUM | Date July 30, 37 | Date | X-Sec. No.
Survey by TED WALSH | Notes WALSH | Notes Chkd Martin | Checked
Indexed | Date | Date 8-8-39 | Date

STATION	B. S.	H. I.	F. S.	ELEV.	
BM #9				1450 32	"D" N.E. Cor. of WARD 302 F.B. 585-13
	12 22	1462 54			
Rim of M.H.			8 23	1454 31	
F.L.		705	15 28	1447 26	
Rim of M.H.			0 90	1461 64	
F.L.		922	10 12	1452 42	
Rim of M.H.			1 22	1461 32	T.P.
F.L.		168	590	1455 64	
	476	1466 08			
Top of 8" Y.			656	1459 52	A.C. inter. of 4" lateral from Women's Conval Camp
T.P.			160	1464 48	C. Spk by morgue
	9435	1473 915			
Top of 8" Pipe			1190	1462 01	19' No. of Morgue bldg.
P.I. No 12			0.235	1473 68	C.S.W.&T. OLIVE VIEW AVE.
Top 4" C.I.P.	389	1477 57	1104	1466 53	So. of Olive View Ave
			1235	1476 335	
Top of 4" Y	9445	1485 78	839	1477 39	"Y" from Bath House
Top of 4" Y			787	1477 91	"Y" Rear of Bath House
Top of 4" Y			784	1477 94	"Y" S.E. Cor O.V. 118
Top of 4" Y			612	1479 66	"Y" So of Kitchen
			Cont'd on pg 322		

Form 307 5M 11-35

PLEASE RETURN TO
LOS ANGELES COUNTY SURVEYOR
700 HALL OF RECORDS

NOTE: ANY ADDITIONS OR CHANGES ON THIS SHEET MUST BE MADE OR CIRCLED IN RED INK, WITH DATE AND NAME OF PERSON MAKING CHANGE

Do not extend notes this side of this line

STATION	B. S.	H. I.	F. S.	ELEV.

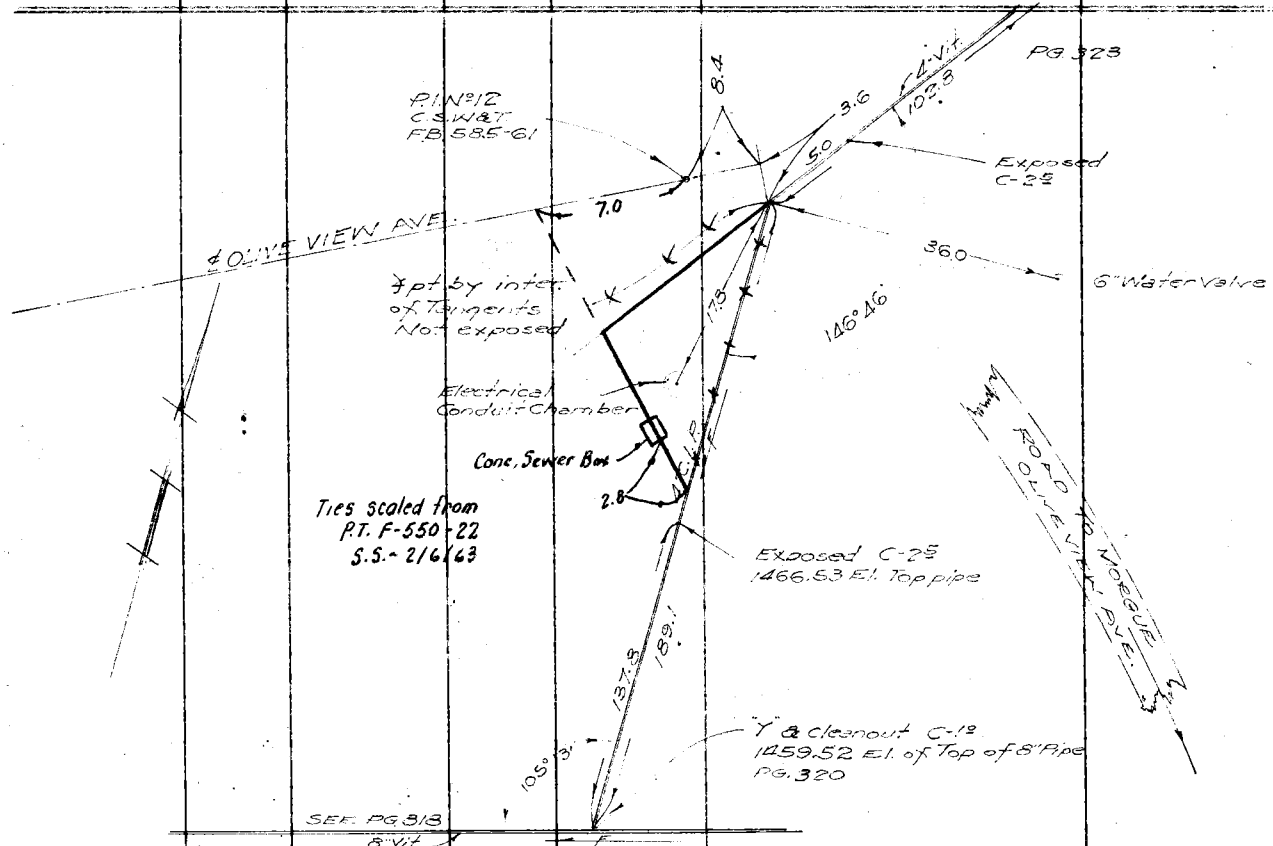

Profile
No.
X-Sec.
No.

Notes Red. Plotted Martin Job No. 8128 Division No.
Date Date Aug. 1939 Survey of OLIVE VIEW SANATORIUM
Notes Chkd. Checked Survey by TED WALSH Notes WALSH Date 8-2-37
Date Date Map No. Indexed Date

F. B. 713 PG. 32

Form 307 5M 11-35

PLEASE RETURN TO
LOS ANGELES COUNTY SURVEYOR
700 HALL OF RECORDS

NOTE: ANY ADDITIONS OR CHANGES ON THIS SHEET MUST BE MADE OR CIRCLED IN RED INK, WITH DATE AND NAME OF PERSON MAKING CHANGE

Do not extend notes this side of this line

STATION	B. S.	H. I.	F. S.	ELEV.		
		1485 78			Cont. from pg. 320	
			4 19	1481 59		
	2 215	1483 805				
			10 12	1473 685		
	0 495	1474 18				
			9 695	1464 485		
	1 78	1466 265				
			9 525	1456 74		
	3 535	1460 275				
B.M. No 10			5 225	1455 05	250' S.E. of Inter. & Olive View Ave. & Eucalyptus City B.M. on Aqueduct Structure F.B. 585-13.	

F. B. 713 Pg. 322 Job No. 8128 Division No. Notes Red. Plotted Profile No.
Survey of OLIVE VIEW SANATORIUM Date Date X-Sec.
Survey by T. WALSH Notes WALSH Notes Chkd Martin Checked No.
Indexed Date Date 8-8-39 Date

Profile No.	Notes Red.	Plotted Martin	Job No. 8125	Division No.	F. B. 713 Pg. 323
	Date	Date Aug. 1939	Survey of OLIVE VIEW SANATORIUM		
X-Sec. No.	Notes Chkd.	Checked	Survey by WALSH	Notes WALSH	Date 8-3-37
	Date	Date	Map No.	Indexed	Date

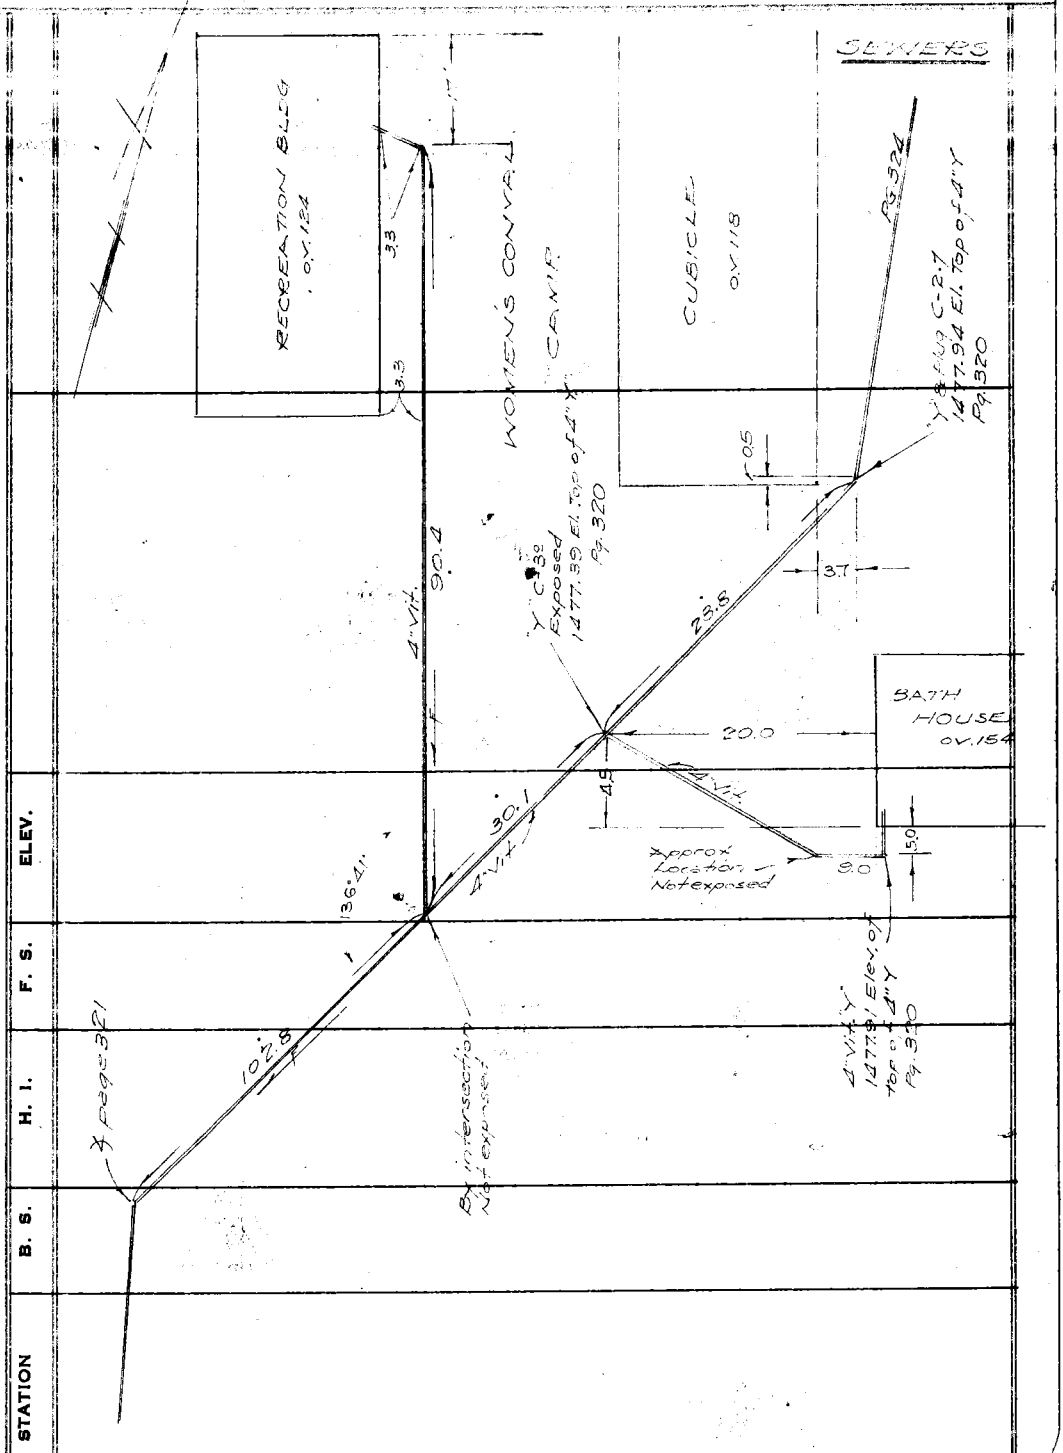

NOTE: ANY ADDITIONS OR CHANGES ON THIS SHEET MUST BE MADE OR CIRCLED IN RED INK, WITH DATE AND NAME OF PERSON MAKING CHANGE

Do not extend notes this side of this line

PLEASE RETURN TO
LOS ANGELES COUNTY SURVEYOR
700 HALL OF RECORDS

Form 307 5M 11-35

Form 307 5M 11-35

PLEASE RETURN TO
LOS ANGELES COUNTY SURVEYOR
700 HALL OF RECORDS

NOTE: ANY ADDITIONS OR CHANGES ON THIS SHEET MUST BE MADE OR CIRCLED IN RED INK, WITH DATE AND NAME OF PERSON MAKING CHANGE

Do not extend notes this side of this line

F. B. 713 Pg 324 | Job No. 818 | Division No. | Notes Red. | Plotted Martin | Profile No.
Survey of OLIVE VIEW SANATORIUM | Date 8-3-37 | Date Aug. 1939 | X-Sec. No.
Survey by TED WALSH | Notes WALSH | Notes Chkd. | Checked
Indexed | Date | Date | Date

STATION	B. S.	H. I.	F. S.	ELEV.

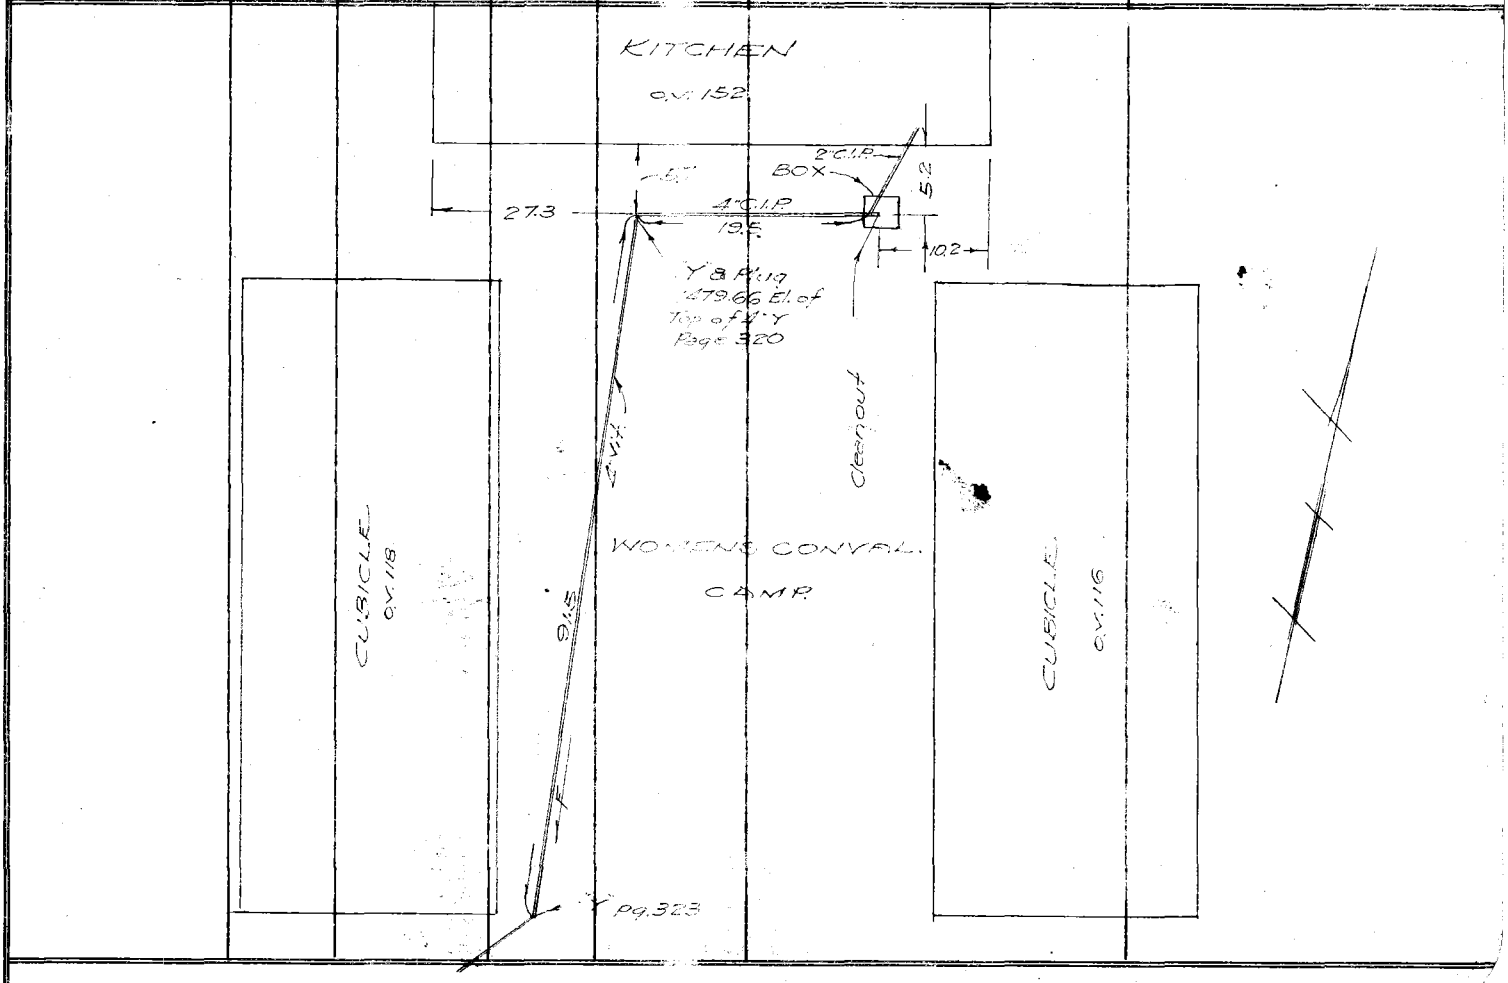

Pro[illegible] No. ____ Notes Red. ____ Plotted Martin Job No. 8/28 Division No. ____ F. B. 713 PG 325

Date ____ Date Aug. 1939 Survey of OLIVE VIEW SANATORIUM

X-Sec. No. ____ Notes Chkd. ____ Checked ____ Survey by T. WALSH Notes WALSH Date OCT. 18 1937

Date ____ Date ____ Map No. ____ Indexed ____ Date ____

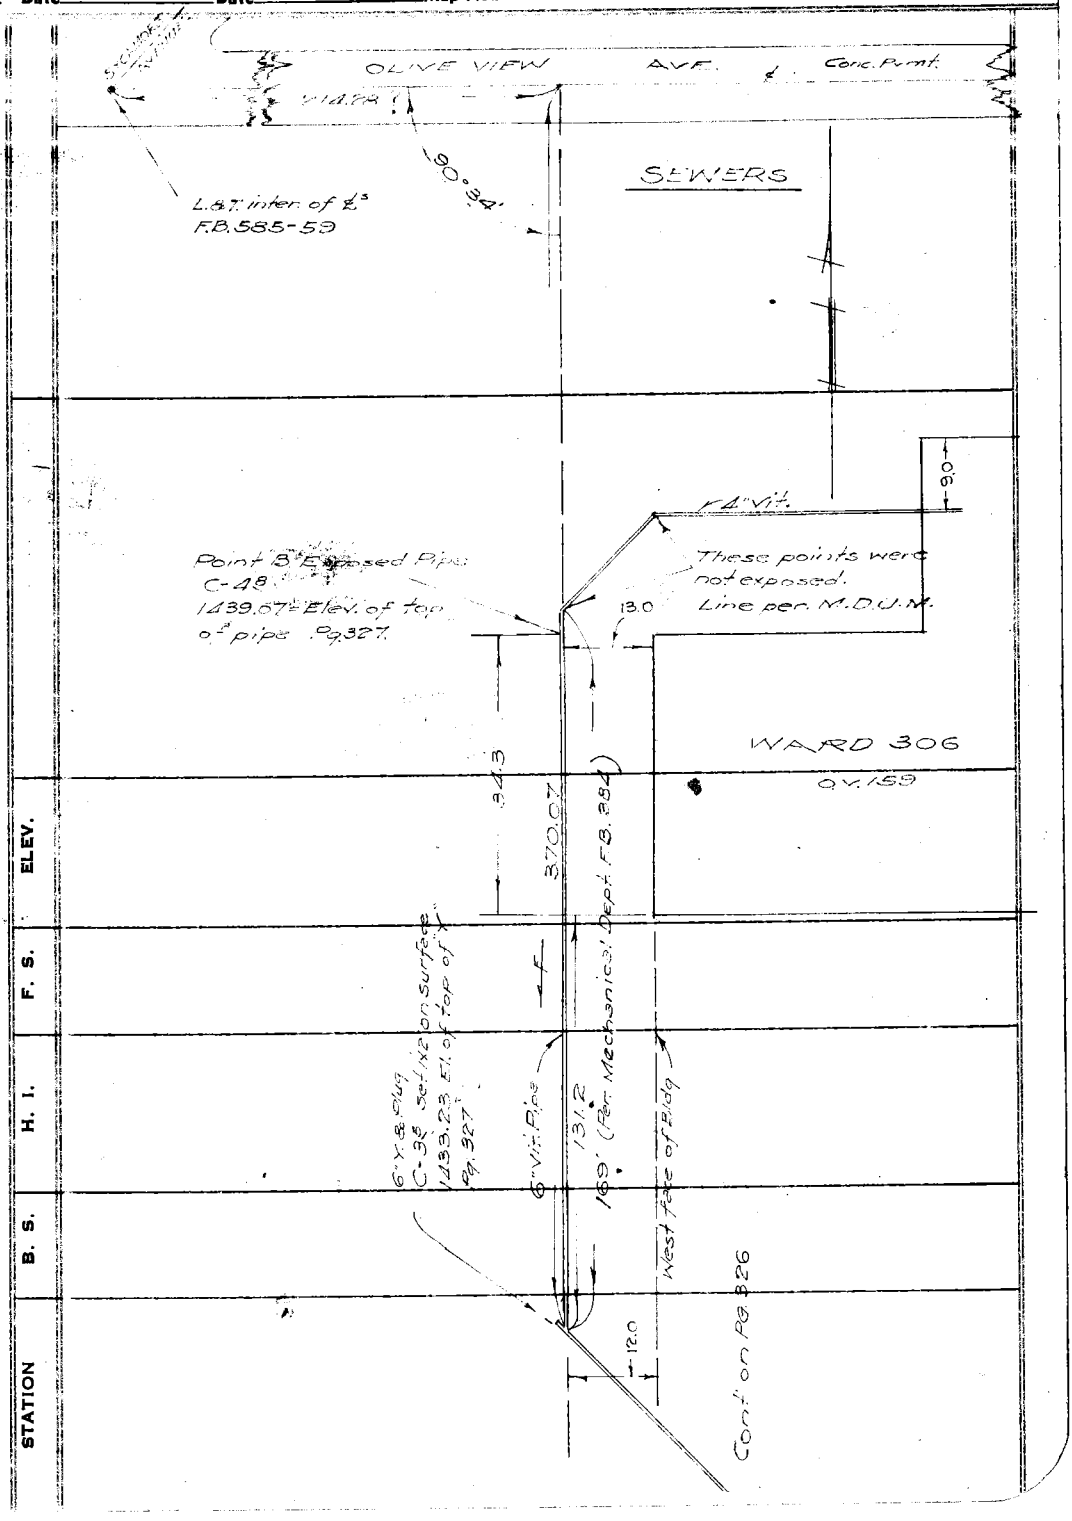

NOTE: ANY ADDITIONS OR CHANGES ON THIS SHEET MUST BE MADE OR CIRCLED IN RED INK, WITH DATE AND NAME OF PERSON MAKING CHANGE

Do not extend notes this side of this line

PLEASE RETURN TO
LOS ANGELES COUNTY SURVEYOR
700 HALL OF RECORDS

Form 307 5M 11-35

F. B. 713 PG 326 | Job No. 8128 | Division No. | Notes Red. | Plotted Martin | Profile

Survey of OLIVE VIEW SANATORIUM | Date | Date Aug. 1939 | No.

Survey by T. WALSH | Notes T. WALSH | Notes Chkd. | Checked | X-Sec.

Indexed | Date | Date | Date | No.

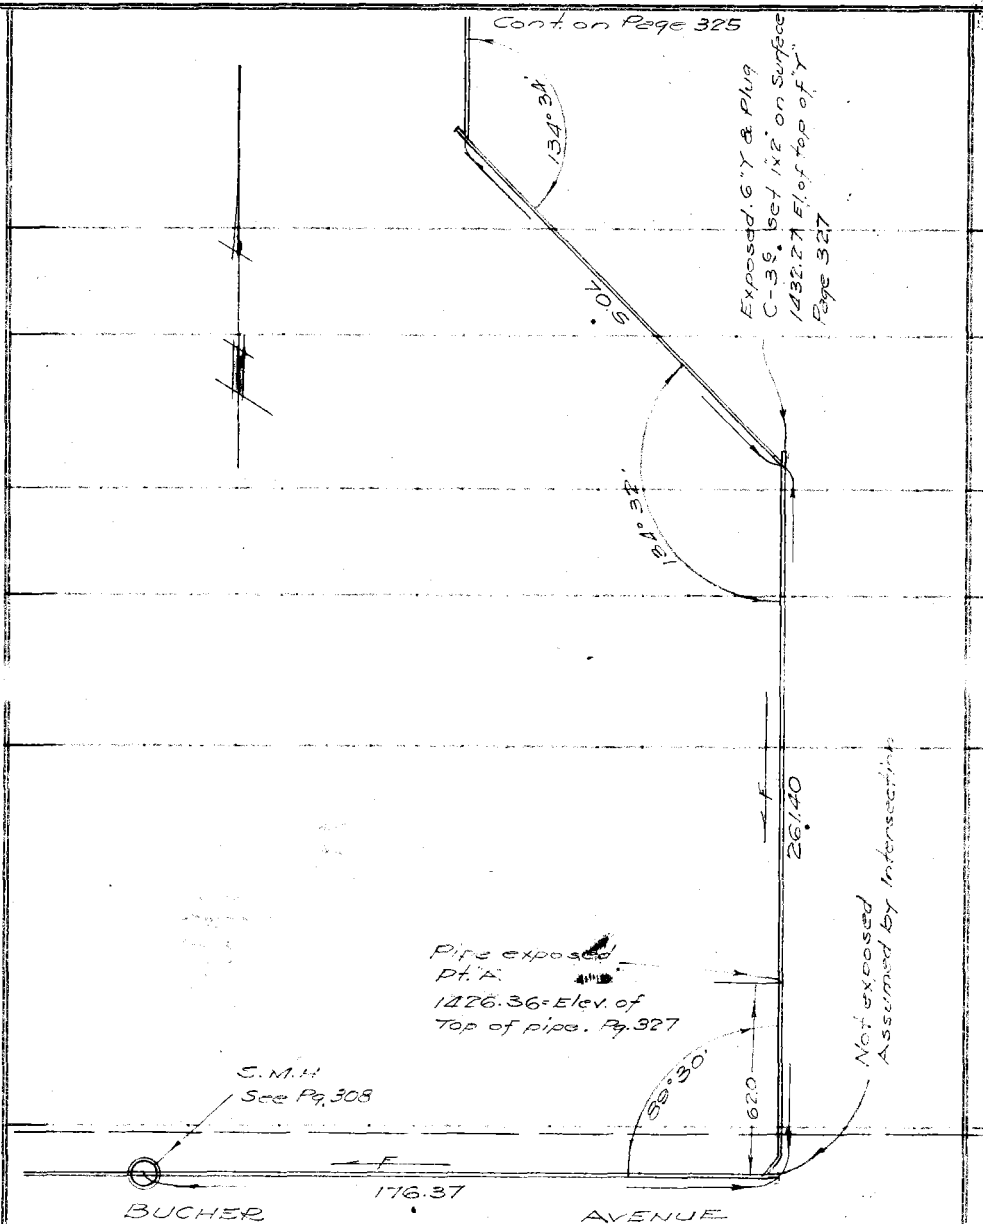

STATION | B. S. | H. I. | F. S. | ELEV.

Form 307 5M 11-35

PLEASE RETURN TO
LOS ANGELES COUNTY SURVEYOR
700 HALL OF RECORDS

Do not extend notes this side of this line

NOTE: ANY ADDITIONS OR CHANGES ON THIS SHEET MUST BE MADE OR CIRCLED IN RED INK, WITH DATE AND NAME OF PERSON MAKING CHANGE

Form 307 5M 11-35

PLEASE RETURN TO
LOS ANGELES COUNTY SURVEYOR
700 HALL OF RECORDS

NOTE: ANY ADDITIONS OR CHANGES ON THIS SHEET MUST BE MADE OR CIRCLED IN RED INK, WITH DATE AND NAME OF PERSON MAKING CHANGE

Do not extend notes this side of this line

STATION	B. S.	H. I.	F. S.	ELEV.		
T.P. #4.				1427 64	T.P. No 4. X on Fire Hydrant	Bucher Ave. 22'± W. of Edison power Tower #W[illegible] F.B. 585-5.
	7.93	1435 57				
Rim of M.H.			11 87	1423 70	M.H Shown on Rt. of pg 308	
Point "A"			9 21	1426 36	Page 326	
T.P.			0.89	1434 63		
	7 97	1442 [illegible]5				
6" Y			10 38	1432 27	Pg. 326	
6" Y			9 42	1433 23	Pg. 325	
T.P.			0 29	1442 36		
	7 64	1450 00	0 48	1449 52		F.B 585-16
T.P.	6 27	1455 79	6 50	1449 29	T.P. L&T. inter. Olive View Ave & Sycamore	
T.P.				1449 29	See Above.	
	5 33	1454 62				
			9 36	1445 26		
	4 15	1449 41				
Point "B"			10 34	1439 07	PG. 325	
			1 52	1447 89		
	7 18	1455 07				
T.P.			5 78	1449 29	See Above	

SEWERS

Profile No. ____ Notes Red. ____ Plotted ____ Job No. 8128 Division No. ____ F.B. 713 PG 327
Date ____ Date ____ Survey of CLIVE VIEW SANATORIUM
X-Sec. No. ____ Notes Chkd Martin Checked ____ Survey by T. WALSH Notes WALSH Date OCT. 19 1937
Date 8-8-39 Date ____ Map No. ____ Indexed ____ Date ____

F. B. 713 PG328 | Job No. | Division No. | Notes Red. | Plotted | Profile No.

Survey of | Date | Date

Survey by | Notes | Notes Chkd. | Checked | X-Sec. No.

Indexed L. C. Peterson | Date | Date | Date

STATION	B. S.	H. I.	F. S.	ELEV.

Form 307 5M 11-35

PLEASE RETURN TO
LOS ANGELES COUNTY SURVEYOR
700 HALL OF RECORDS

Do not extend notes this side of this line

NOTE: ANY ADDITIONS OR CHANGES ON THIS SHEET MUST BE MADE OR CIRCLED IN RED INK, WITH DATE AND NAME OF PERSON MAKING CHANGE

Profile No.	Notes Red.	Plotted Martin	Job No. 8128 Division No.	F.B. 713 PG. 329
	Date	Date Aug. 1939	Survey of OLIVEVIEW SANATORIUM	
X-Sec. No.	Notes Chkd.	Checked	Survey by T. WALSH Notes WALSH Date 10-20-37	
	Date	Date	Map No. Indexed A. C. Johnson Date	

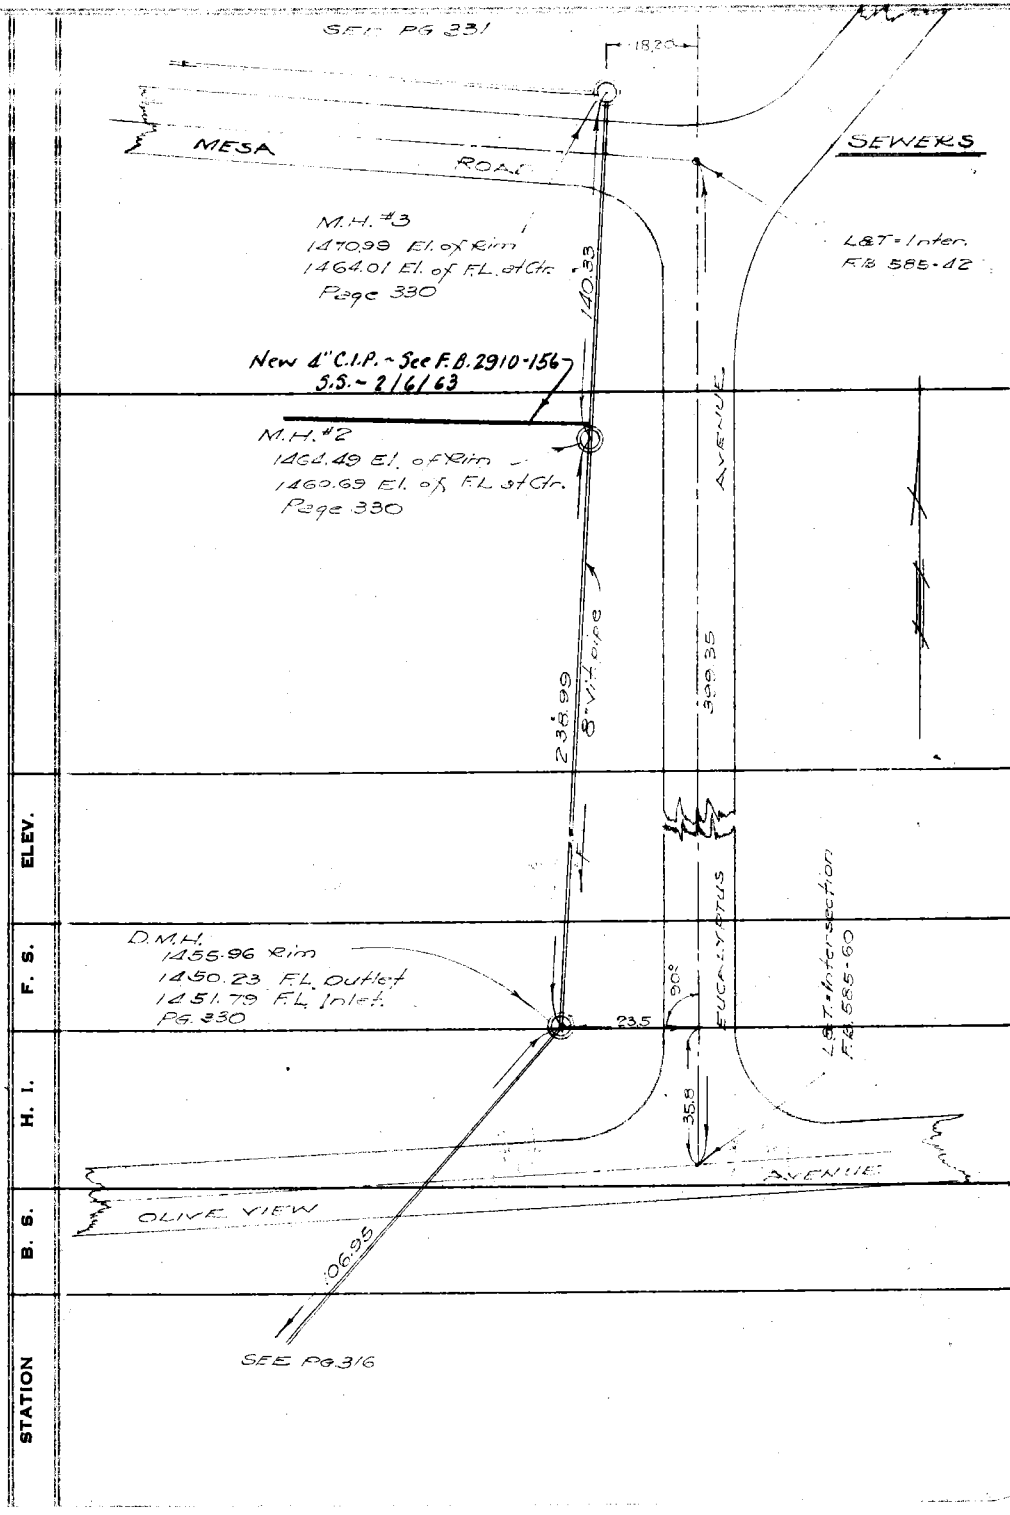

NOTE: ANY ADDITIONS OR CHANGES ON THIS SHEET MUST BE MADE OR CIRCLED IN RED INK, WITH DATE AND NAME OF PERSON MAKING CHANGE

Do not extend notes this side of this line

PLEASE RETURN TO
LOS ANGELES COUNTY SURVEYOR
700 HALL OF RECORDS

Form 307 5M 11-35

Form 307 5M 11-35

PLEASE RETURN TO
LOS ANGELES COUNTY SURVEYOR
700 HALL OF RECORDS

NOTE: ANY ADDITIONS OR CHANGES ON THIS SHEET MUST BE MADE OR CIRCLED IN RED INK, WITH DATE AND NAME OF PERSON MAKING CHANGE

Do not extend notes this side of this line

F. B. Pg. 330 | Job No. 9128 | Division No. | Notes Red. | Plotted | Profile No.
Survey of OLIVE VIEW SANATORIUM | Date | Date | X-Sec. No.
Survey by T. WALSH | Notes WALSH | Notes Chkd. Martin | Checked
Indexed | Date 10-20-37 | Date 8-8-39 | Date

STATION	B. S.	H. I.	F. S.	ELEV.		
BM. No 9				1458.33'	BM. No 9 Eucalyptus & Olive View Ave., at S.W. Cor.	
	9.85	1460.18'			at the N.E. Corner of porch at east end of	
					bldg. Ward 302. Chiseled square on West	
					edge of Conc. pvmt. F.B. 595-18	
D. M.H. #1			4.22	1455.96	Rim	
			9.95	1450.23'	Invert of Outlet	
			8.39	1451.79	" " Inlet	
T.P.			0.28	1459.90		
	9.78	1469.68'				
M.H. #2			5.19	1464.49	Rim	
			8.99	1460.69'	F.L. at Ctr.	
T.P.			0.36	1469.32'		
	6.16	1475.48'				
M.H. #3			4.49	1470.99'	Rim	
			11.47	1463.01	F.L. at Ctr.	
B.M. S-1			0.85	1474.63'	BM S-1 - Eucalyptus & Mesa. N.W. Corner "X" on	
	0.85	1475.48'			bolt head of F.H.	
			6.16	1469.32'		
	0.13	1469.45	10.79	1458.66'		
	1.90	1460.56'				
BM #9			10.23	1458.33	See Above	

PAGE 329

Profile No.	Notes Red.	Plotted Martin	Job No. 8128	Division No.	F. B. 713 PG 331
	Date	Date Aug. 1939	Survey of OLIVE VIEW SANATORIUM		
X-Sec. No.	Notes Chkd.	Checked	Survey by T. WALSH	Notes T. WALSH	Date OCT. 21, 37
	Date	Date	Map No.	Indexed A. C. John	Date

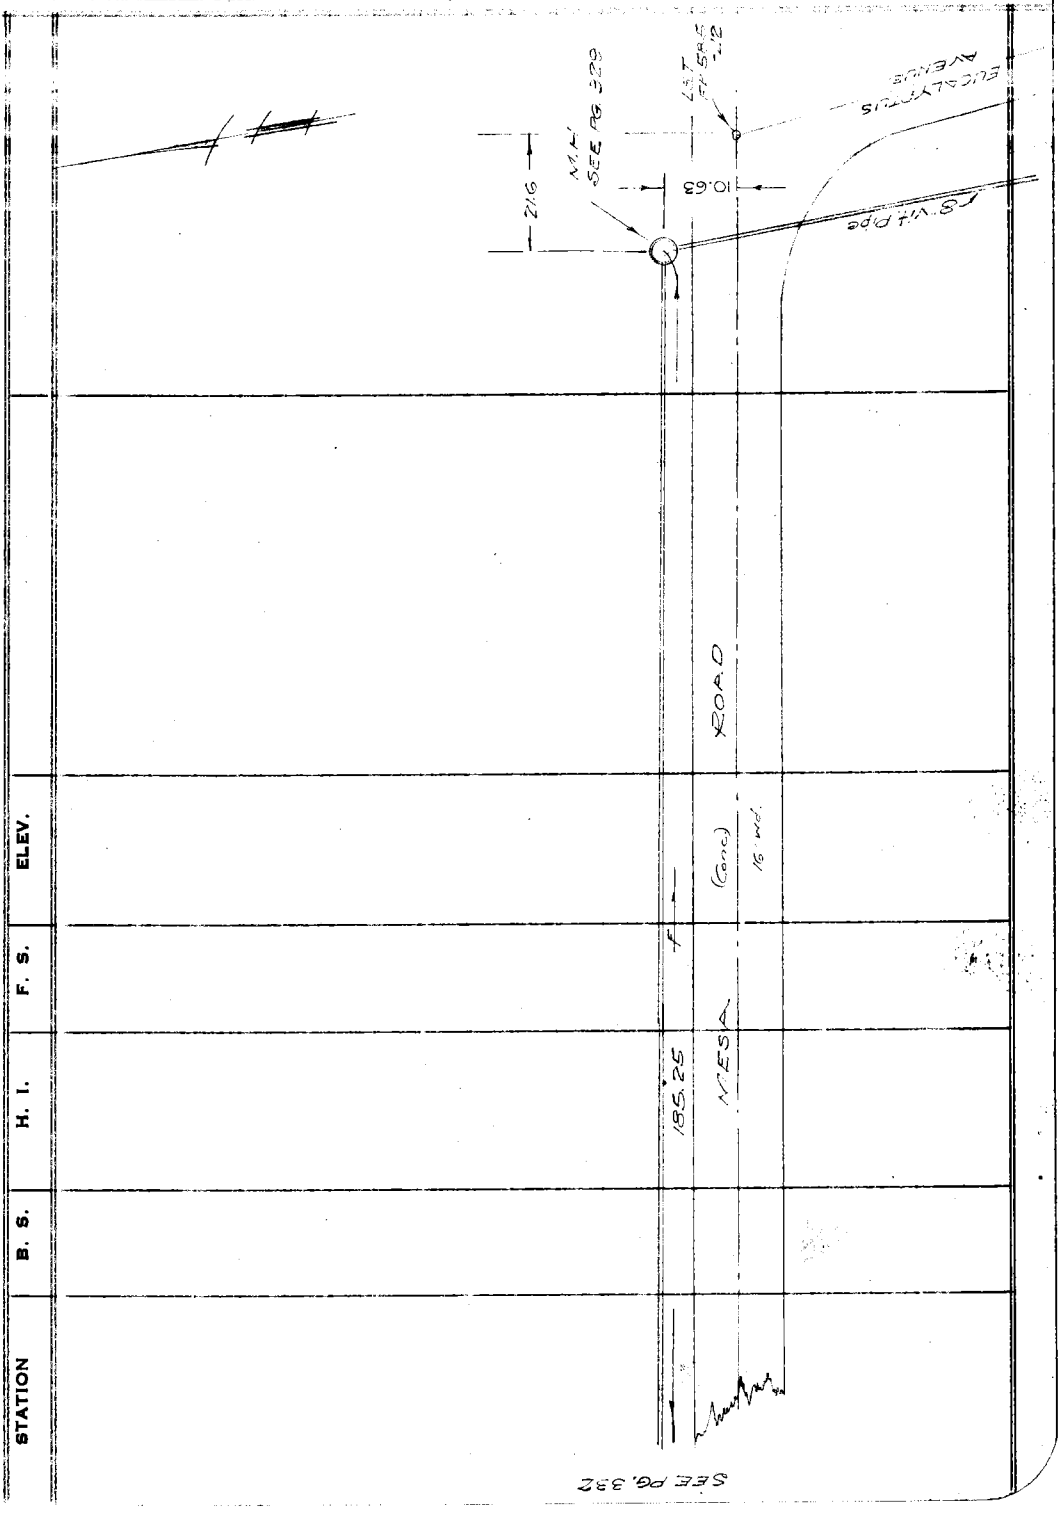

NOTE: ANY ADDITIONS OR CHANGES ON THIS SHEET MUST BE MADE OR CIRCLED IN RED INK, WITH DATE AND NAME OF PERSON MAKING CHANGE

Do not extend notes this side of this line

PLEASE RETURN TO
LOS ANGELES COUNTY SURVEYOR
700 HALL OF RECORDS

Form 307 5M 11-35

F. B. 713 PG 332 | Job No. 8128 | Division No. | Notes Red. | Plotted Martin | Profile

Survey of OLIVE VIEW SANATORIUM | Date | Date Aug. 1939 | No.

Survey by T. WALSH | Notes T. WALSH | Notes Chkd. Martin | Checked | X-Sec.

Indexed A. C. Johnson | Date 10-21-37 | Date 8-8-39 | Date | No.

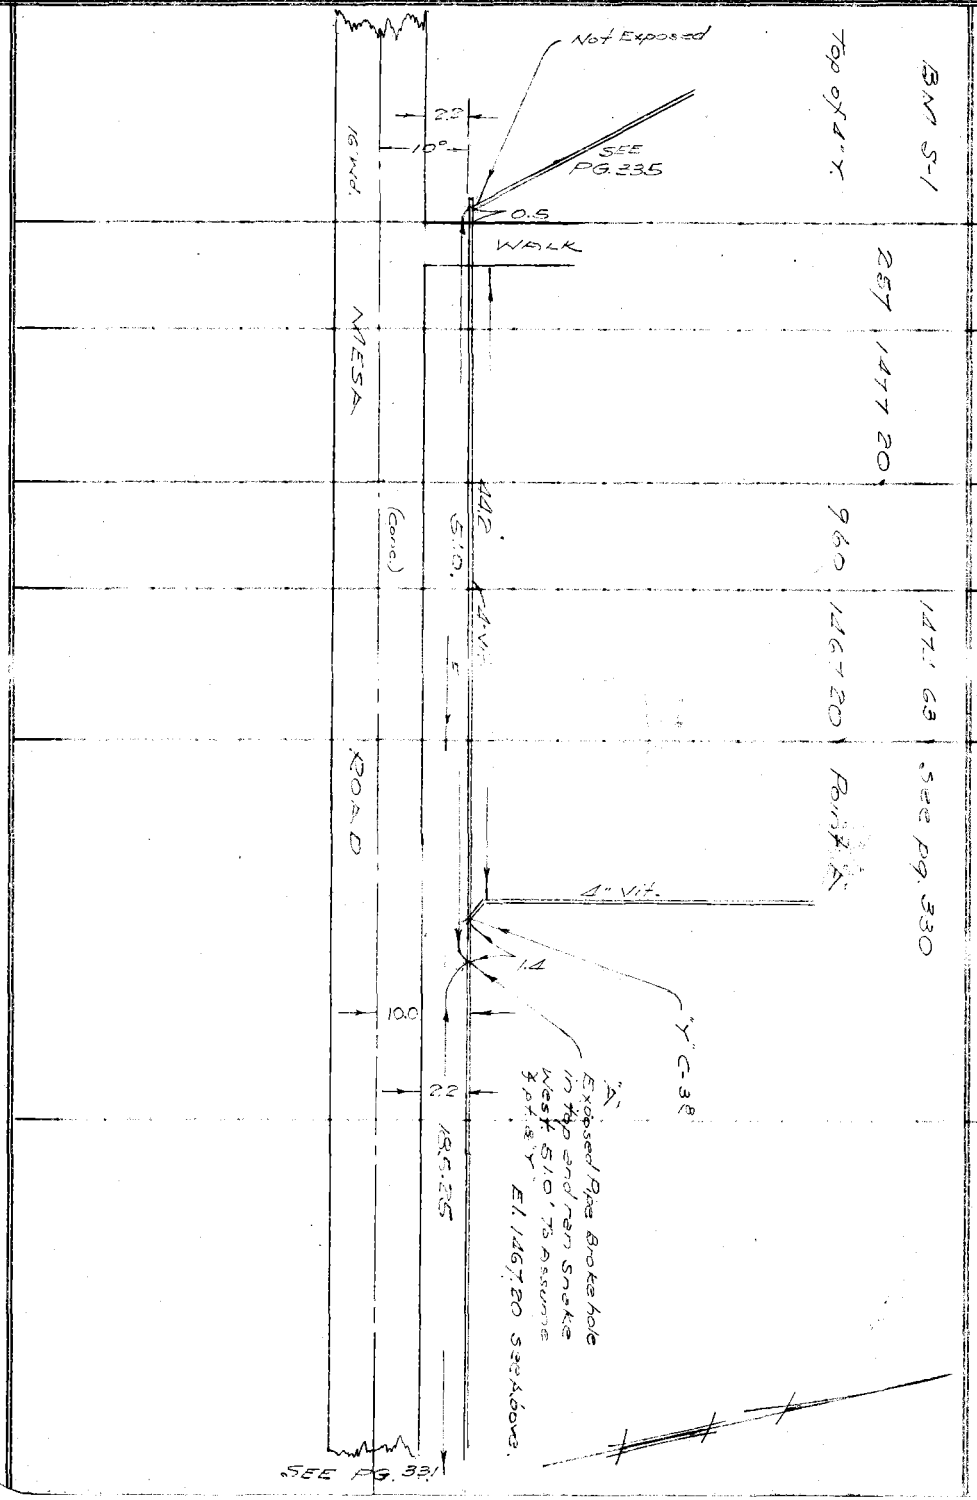

Form 307 5M 11-35

PLEASE RETURN TO
LOS ANGELES COUNTY SURVEYOR
700 HALL OF RECORDS

Do not extend notes this side of this line

NOTE: ANY ADDITIONS OR CHANGES ON THIS SHEET MUST BE MADE OR CIRCLED IN RED INK, WITH DATE AND NAME OF PERSON MAKING CHANGE

Profile	Notes Red.	Plotted Martin	Job No. 8128	Division No.	F. B. 713 PG. 333
No.	Date	Date Aug. 1939	Survey of OLIVE VIEW SANATORIUM		
X-Sec.	Notes Chkd.	Checked	Survey by T. WALSH	Notes WALSH	Date 11-22-37
No.	Date	Date	Map No.	Indexed	Date

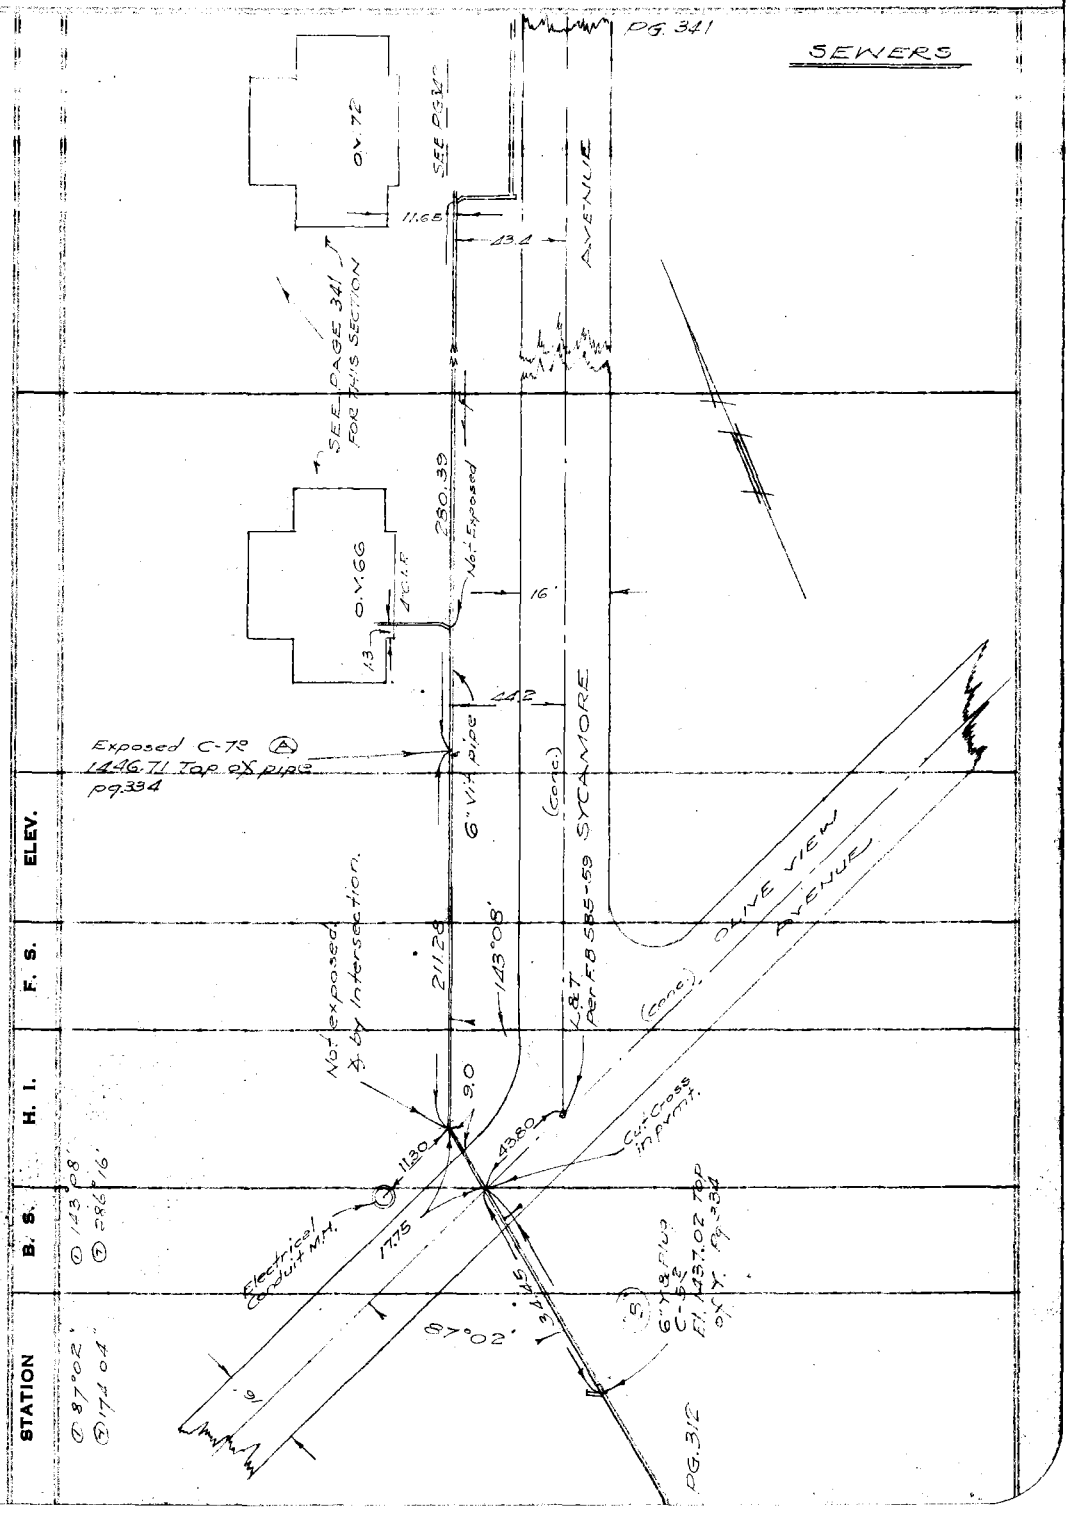

NOTE: ANY ADDITIONS OR CHANGES ON THIS SHEET MUST BE MADE OR CIRCLED IN RED INK, WITH DATE AND NAME OF PERSON MAKING CHANGE

Do not extend notes this side of this line

PLEASE RETURN TO
LOS ANGELES COUNTY SURVEYOR
700 HALL OF RECORDS

Form 307 5M 11-35

Form 307 5M 11-35

PLEASE RETURN TO
LOS ANGELES COUNTY SURVEYOR
700 HALL OF RECORDS

NOTE: ANY ADDITIONS OR CHANGES ON THIS SHEET MUST BE MADE OR CIRCLED IN RED INK, WITH DATE AND NAME OF PERSON MAKING CHANGE

Do not extend notes this side of this line

STATION	B. S.	H. I.	F. S.	ELEV.		
T.P.				1449 29	T.P. L&T. Inter. Olive View Ave. & Sycamore	
	642	1455 71			Ave F.B 585-16	
Top of 6" Pipe			900	1446 71	Top of 6" Pipe pg. 333 (A)	
T.P.			1125	1444 46		
	136	1445 82				
Top of 6" Y.			880	1437 02	Pt. exposed pg. 333 (B)	
Top of Pipe			1216	1433 66	Pt. exposed pg. 312 (C)	
T.P.			1123	1434 59		
	218	1436 77				
Top of Pipe			1234	1424 43	Pt. exposed. pg. 313 (D)	
			646	1430 31		
	566	1435 97				
			732	1428 65		
	242	1431 07				
			684	1424 23		
	145	1425 68				
BM #3			679	1418 89	FB 585-5	1418.88 1418.89 .01

F. B. 713 Pg. 334 Job No. 8178 Division No. Notes Red. Plotted Profile No.
Survey of OLIVE VIEW SANATORIUM Date Date X-Sec. No.
Survey by T. WALSH Notes T.M.W. Notes Chkd Martin Checked
Indexed Date Nov. 24-37 Date 8-8-39 Date

Profile No.	Notes Red.	Plotted Martin	Job No. 8128	Division No.	F. B. 713 PG. 335
	Date	Date Aug. 1939	Survey of OLIVE VIEW SANATORIUM		
X-Sec. No.	Notes Chkd.	Checked	Survey by T. WALSH	Notes T.M.W	Date Nov. 24 37
	Date	Date	Map No.	Indexed	Date

NOTE: ANY ADDITIONS OR CHANGES ON THIS SHEET MUST BE MADE OR CIRCLED IN RED INK, WITH DATE AND NAME OF PERSON MAKING CHANGE

Do not extend notes this side of this line

PLEASE RETURN TO
LOS ANGELES COUNTY SURVEYOR
700 HALL OF RECORDS

Form 307 5M 11-35

STATION | B. S. | H. I. | F. S. | ELEV.

PG. 336

BUNGALOW "R" O.V. 143

25°

24.8

This point not Exposed By Intersection

Point "B" Exposed this point. C. 24 El. 1071.08 Top of Pipe Pg. 339

BUNGALOW "O" O.V. 109

26

19°55'

Not Exposed. Assumed ± pt. at "Y" Cut "X" in Conc Walk over point

Concrete

101°10'

202°32'

167°55'

335°50'

PG. 332

MESA ROAD

F. B. 713 Pg 336 | Job No. 8128 | Division No. | Notes Red. | Plotted Martin | Profile

Survey of OLIVE VIEW SANATORIUM | Date | Date Aug. 1939 | No.

Survey by T.WALSH | Notes T.M.W. | Notes Chkd. | Checked | X-Sec.

Indexed | Date Nov. 24 1937 | Date | Date | No.

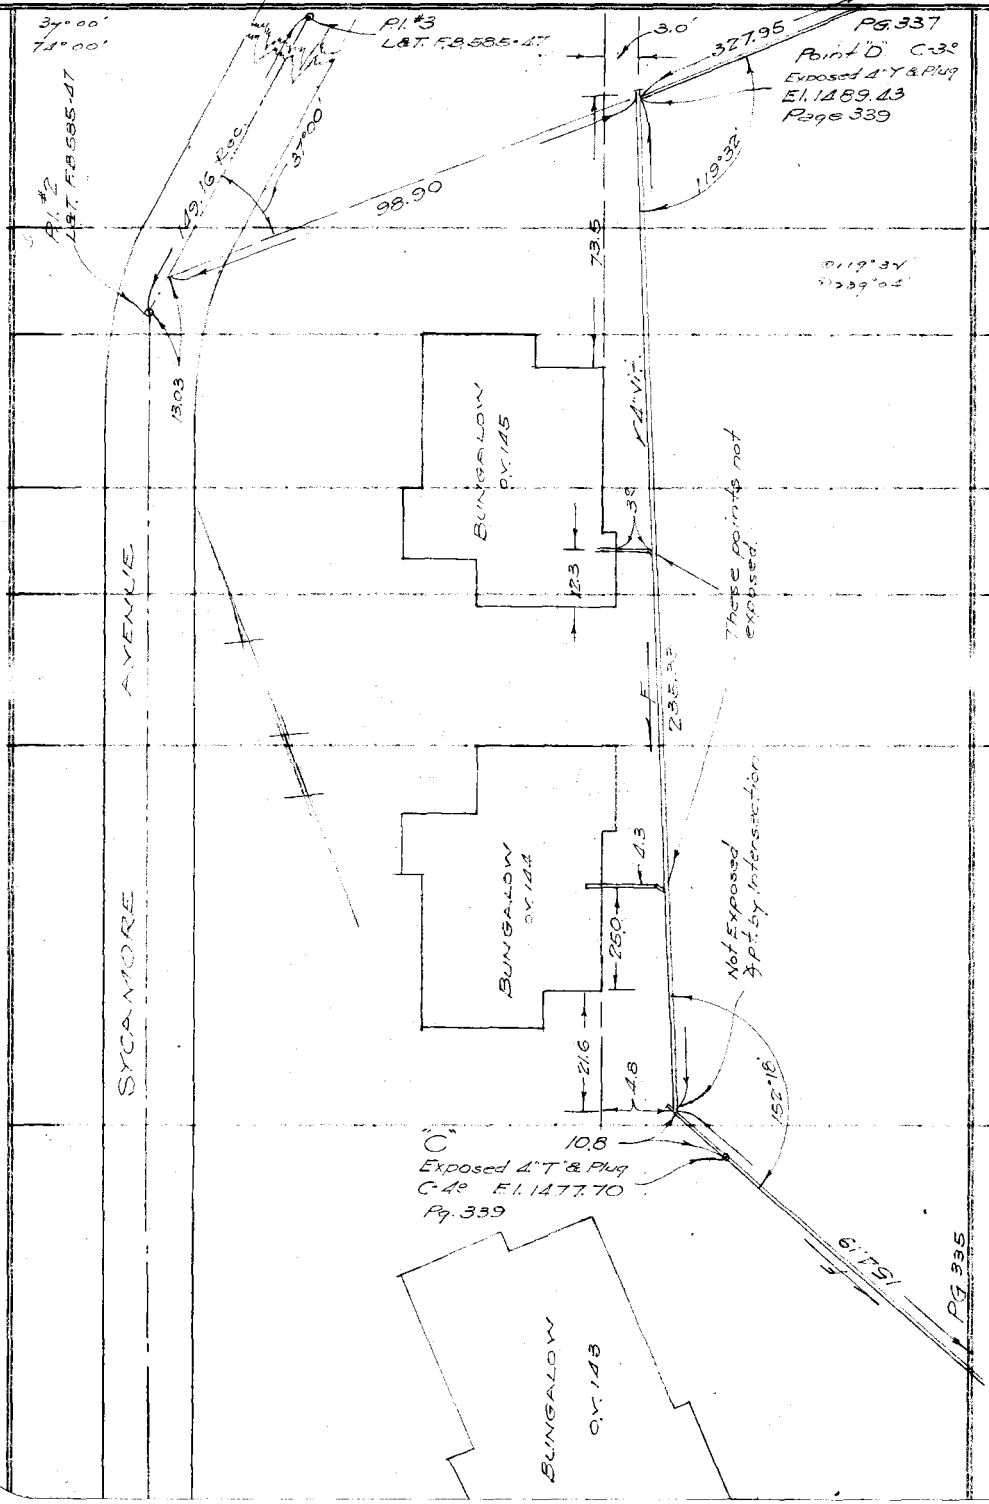

STATION | B. S. | H. I. | F. S. | ELEV.

Form 307 5M 11-35

PLEASE RETURN TO
LOS ANGELES COUNTY SURVEYOR
700 HALL OF RECORDS

Do not extend notes this side of this line

NOTE: ANY ADDITIONS OR CHANGES ON THIS SHEET MUST BE MADE OR CIRCLED IN RED INK, WITH DATE AND NAME OF PERSON MAKING CHANGE

Profile No.	Notes Red.	Plotted Martin	Job No. 8108	Division No.	F. B. 713 Pg. 337
	Date	Date Aug. 1939	Survey of OLIVE VIEW SANATORIUM		
X-Sec. No.	Notes Chkd.	Checked	Survey by T. WALSH	Notes T.M.W.	Date Nov. 29, 37
	Date	Date	Map No.	Indexed A. C. [illegible]	Date

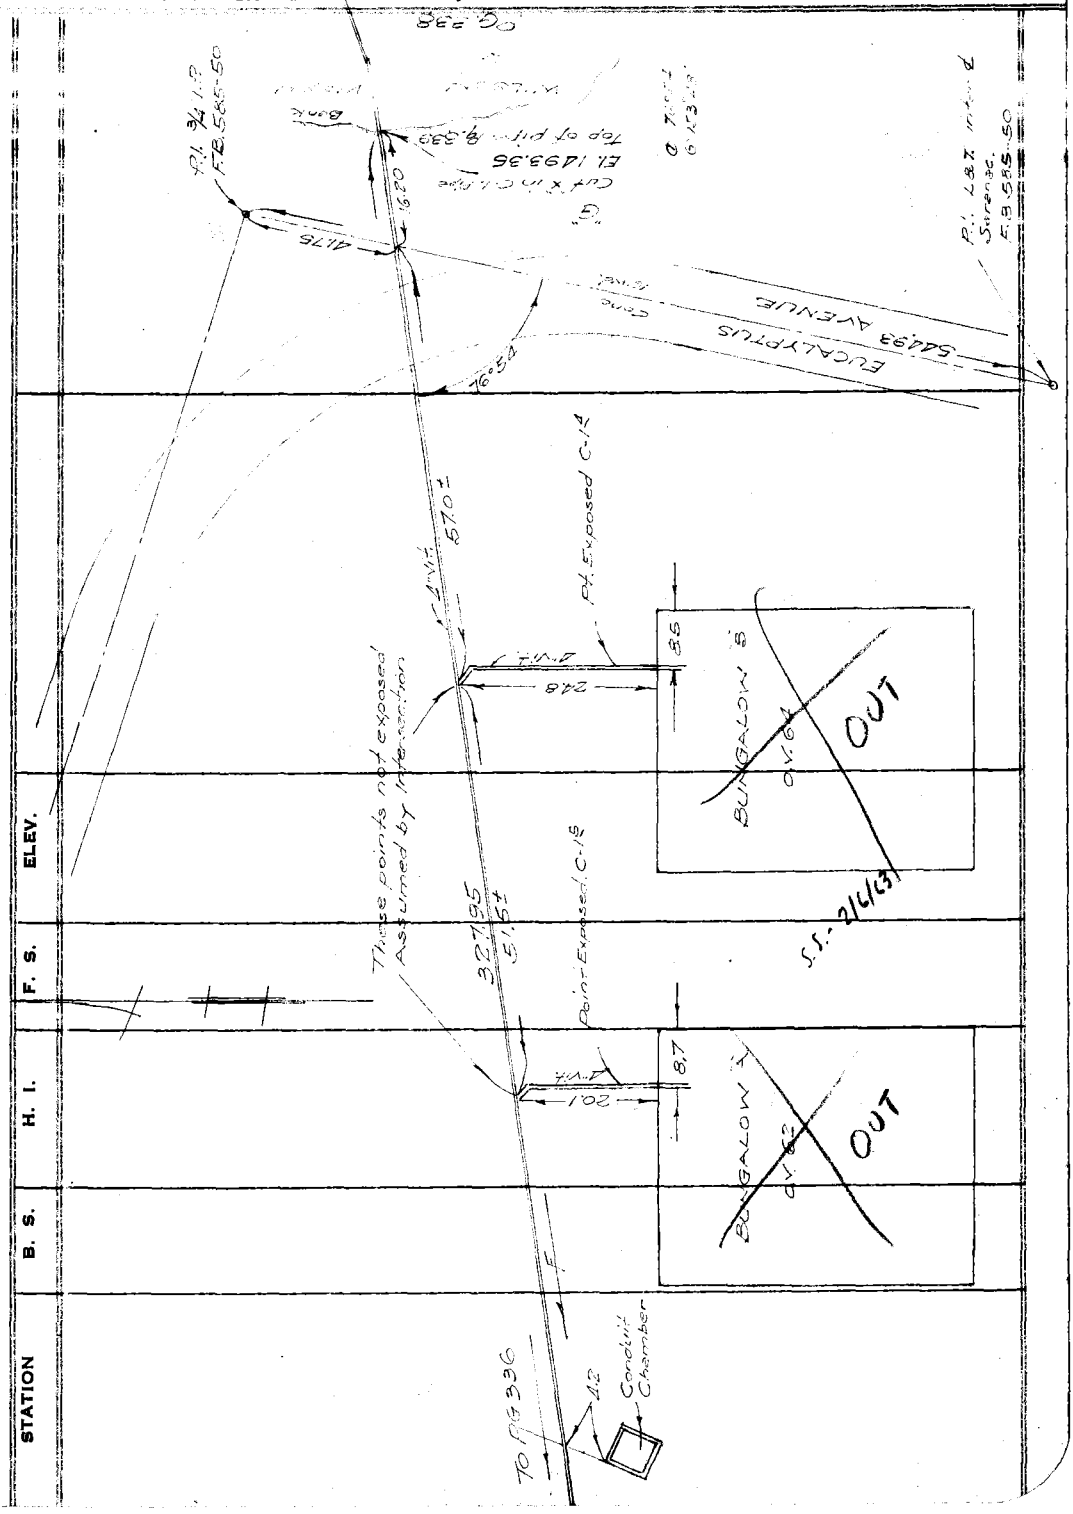

NOTE: ANY ADDITIONS OR CHANGES ON THIS SHEET MUST BE MADE OR CIRCLED IN RED INK, WITH DATE AND NAME OF PERSON MAKING CHANGE

Do not extend notes this side of this line

PLEASE RETURN TO
LOS ANGELES COUNTY SURVEYOR
700 HALL OF RECORDS

Form 307 5M 11-35

Form 307 5M 11-35

PLEASE RETURN TO
LOS ANGELES COUNTY SURVEYOR
700 HALL OF RECORDS

NOTE: ANY ADDITIONS OR CHANGES ON THIS SHEET MUST BE MADE OR CIRCLED IN RED INK, WITH DATE AND NAME OF PERSON MAKING CHANGE

Do not extend notes this side of this line

F. B. 713 PG. 338 | Job No. 8128 | Division No. | Notes Red. | Plotted Martin | Profile No.
Survey of OLIVE VIEW SANATORIUM | Date Nov. 29-37 | Date Aug. 1939 | X-Sec. No.
Survey by T. WALSH | Notes T.M.W. | Notes Chkd. | Checked
Indexed | Date | Date | Date

STATION	B. S.	H. I.	F. S.	ELEV.

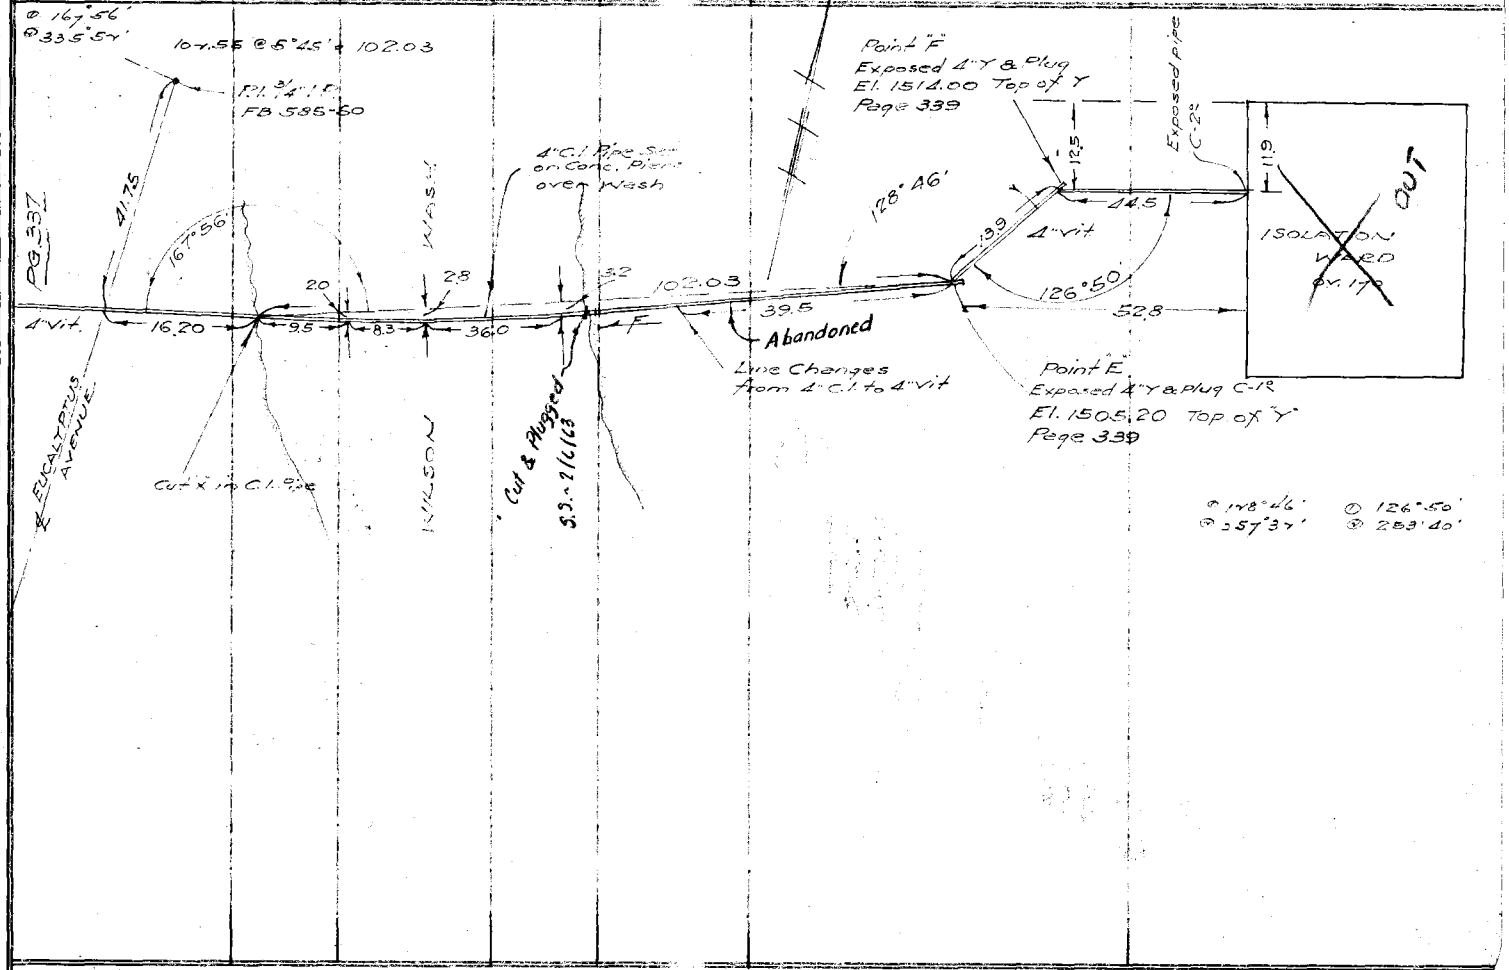

Form 307 5M 11-35

PLEASE RETURN TO
LOS ANGELES COUNTY SURVEYOR
700 HALL OF RECORDS

NOTE: ANY ADDITIONS OR CHANGES ON THIS SHEET MUST BE MADE OR CIRCLED IN RED INK, WITH DATE AND NAME OF PERSON MAKING CHANGE

Do not extend notes this side of this line

STATION	B. S.	H. I.	F. S.	ELEV.		
BM S-1				1474 63	"X" on F.H. N.W. Cor Eucalyptus & Mesa. PG. 330	
	2 63	1477 26				
			4 98	1472 28		
	5 95	1478 23	2 95	1475 28		
Top 4" Pipe	8 10	1483 38	12 30	1471 08	"B" See page 335	
Top 4" Pipe			5 68	1477 70	"C" See page 336	
T.P.			0 29	1483 09		
	11 57	1494 66				
Top 4" Y			5 23	1489 43	"D" See page 336	
T.P.			0 42	1494 24		
	6 05	1500 29				
BM S-2			1 99	1498 30	BM S-2	C.S.W.&T. in E. Side of 60" Eucalyptus. 20' SO. of Road 100'± N.W. of O.V. 62. Road is continuation of Eucalyptus North of Mesa Road.
	3 26	1501 56				
Top of 4" C.I.P.			8 21	1493 35	"G" See pg. 337	
			1 57	1499 99		
	11 66	1511 65				
Top of 4" Y			6 45	1505 20	"E" Page 338	
			2 54	1509 11		
	11 10	1520 21				
Top of 4" Y			6 21	1514 00	"F" Page 338	
			3 12	1517 09		

Profile No. ____ Notes Red. ____ Plotted ____ Job No. 8148 Division No. ____ F. B. 713 PG. 339
X-Sec. No. ____ Date ____ Date ____ Survey of OLIVE VIEW SANATORIUM
Notes Chkd. Martin Checked ____ Survey by TWALSH Notes T.M.W. Date Nov. 29, 37
Date 8-8-39 Date ____ Map No. ____ Indexed ____ Date ____

Form 307 5M 11-35

PLEASE RETURN TO
LOS ANGELES COUNTY SURVEYOR
700 HALL OF RECORDS

NOTE: ANY ADDITIONS OR CHANGES ON THIS SHEET MUST BE MADE OR CIRCLED IN RED INK, WITH DATE AND NAME OF PERSON MAKING CHANGE

Do not extend notes this side of this line

F. B. 713 Pg. 340 | Job No. 8178 | Division No. | Notes Red. | Plotted | Profile No.

Survey of OLIVE VIEW SANATORIUM | Date | X-Sec. No.

Survey by T. WALSH | Notes T.M.W. | Notes Chkd. Martin | Checked

Indexed | Date Nov. 29-37 | Date 8-8-39 | Date

STATION	B. S.	H. I.	F. S.	ELEV.		
				1507.09		
	1.68	1518.77	11.35	1507.42		
	0.42	1507.84				
			11.11	1496.73		
	0.20	1496.93				
			11.00	1485.93		
	0.21	1486.14				
BM S-1			11.51	1474.63	PG. 939	

Profile No.	Notes Red.	Plotted Martin	Job No. 8128	Division No.	F. B. 713 PG 341
	Date	Date Aug. 1939	Survey of OLIVE VIEW SANATORIUM		
X-Sec. No.	Notes Chkd.	Checked	Survey by T. WALSH	Notes T.M.W	Date 12-2-37
	Date	Date	Map No.	Indexed A. C. Johnson	Date

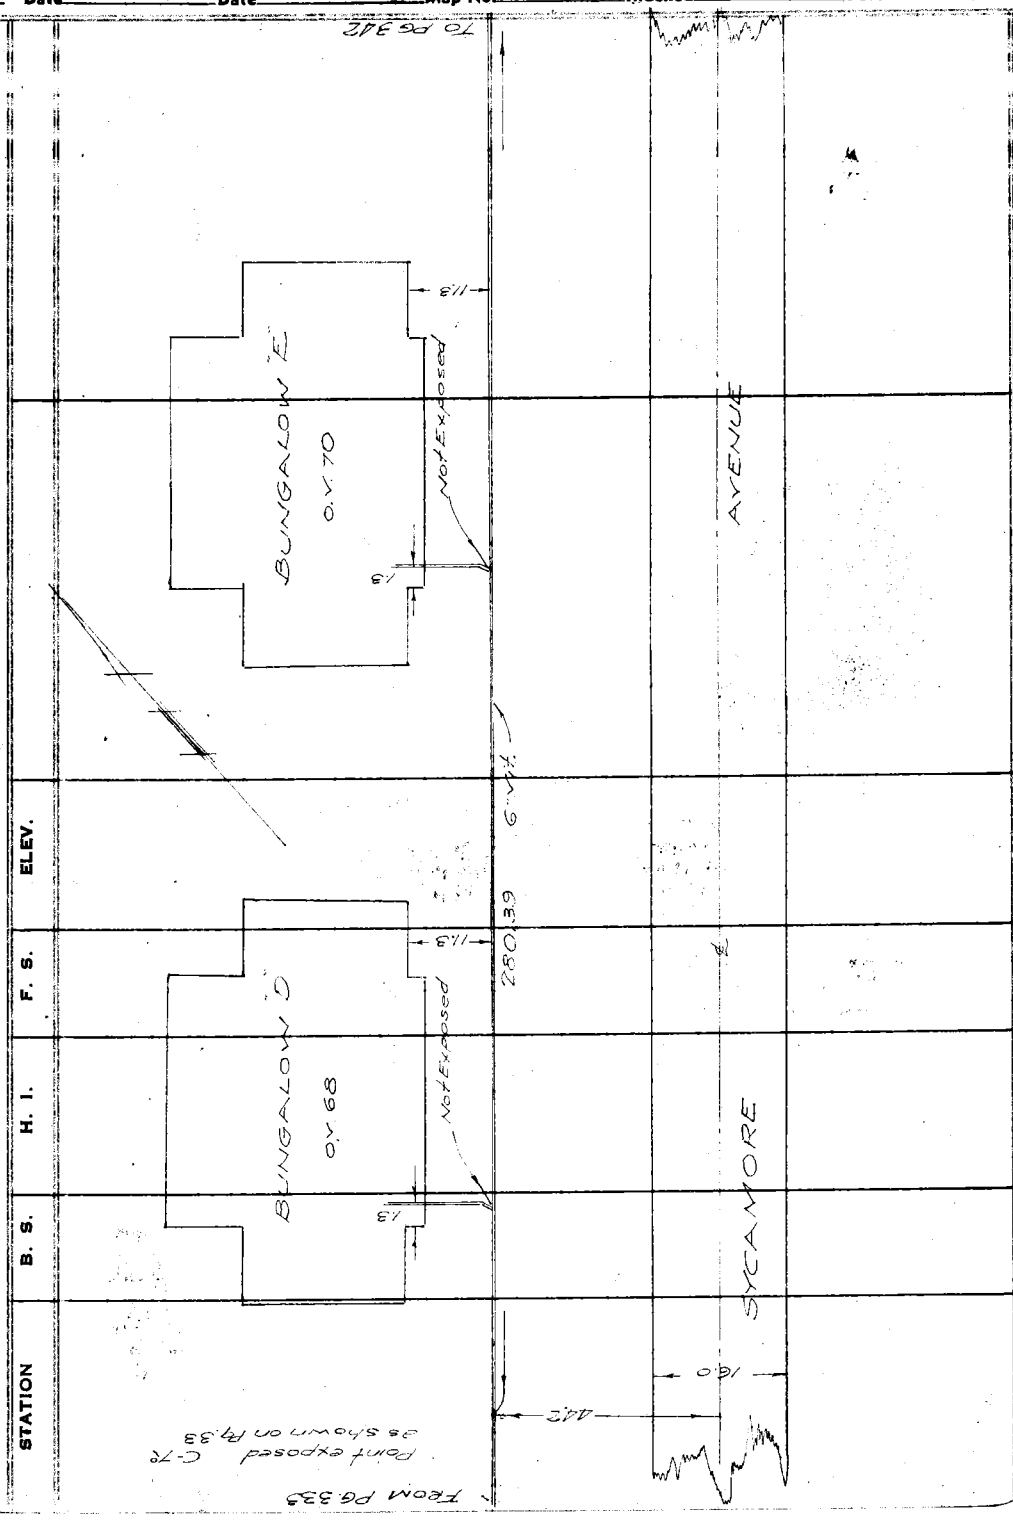

NOTE: ANY ADDITIONS OR CHANGES ON THIS SHEET MUST BE MADE OR CIRCLED IN RED INK, WITH DATE AND NAME OF PERSON MAKING CHANGE

Do not extend notes this side of this line

PLEASE RETURN TO
LOS ANGELES COUNTY SURVEYOR
700 HALL OF RECORDS

Form 307 5M 11-35

F.B. 713 PG. 342 | Job No. | Division No. | Notes Red. | Plotted Martin | Profile

Survey of OLIVE VIEW SANATORIUM | Date | Date Aug. 1939 | No.

Survey by T. WALSH | Notes T.M.W. | Notes Chkd. | Checked | X-Sec.

Indexed | Date DEC. 2. 37 | Date | Date | No.

Form 307 5M 11-35

PLEASE RETURN TO
LOS ANGELES COUNTY SURVEYOR
700 HALL OF RECORDS

NOTE: ANY ADDITIONS OR CHANGES ON THIS SHEET MUST BE MADE OR CIRCLED IN RED INK, WITH DATE AND NAME OF PERSON MAKING CHANGE

Do not extend notes this side of this line

STATION | B. S. | H. I. | F. S. | ELEV.

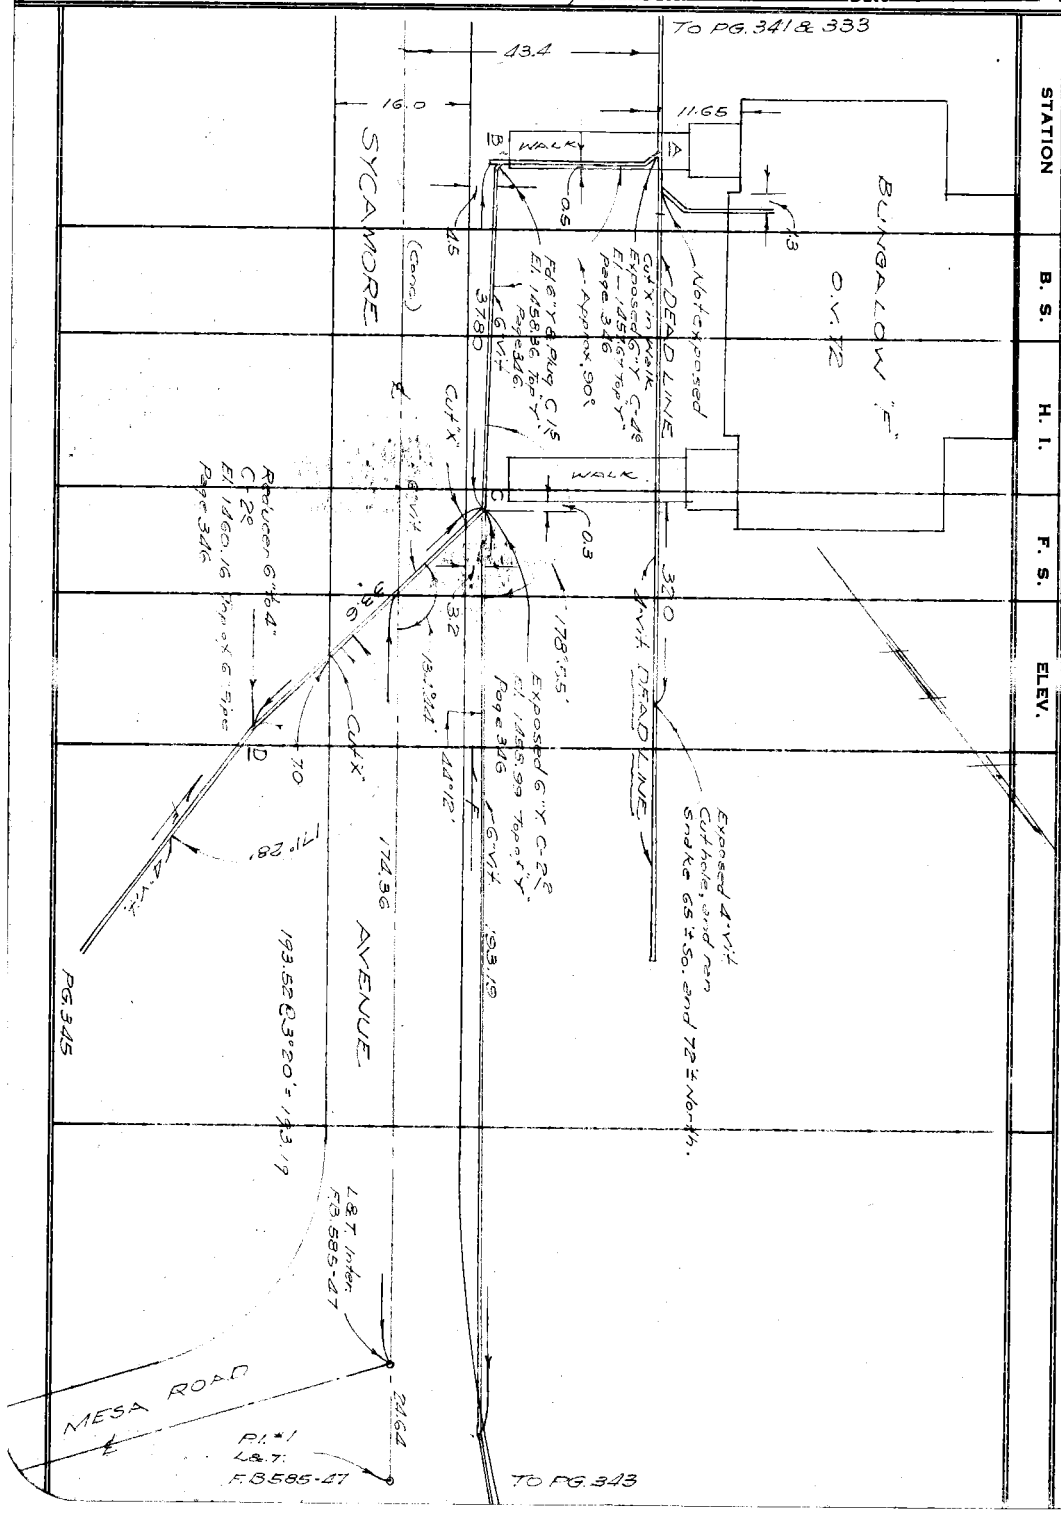

Profile	Notes Red.	Plotted Martin	Job No. 8148	Division No.	F. B. 713	Pg. 343
No.	Date	Date Aug. 1939	Survey of OLIVE VIEW SANATORIUM			
X-Sec.	Notes Chkd.	Checked	Survey by T. WALSH	Notes T.M.W.	Date DEC. 1 37	
No.	Date	Date	Map No.	Indexed	Date	

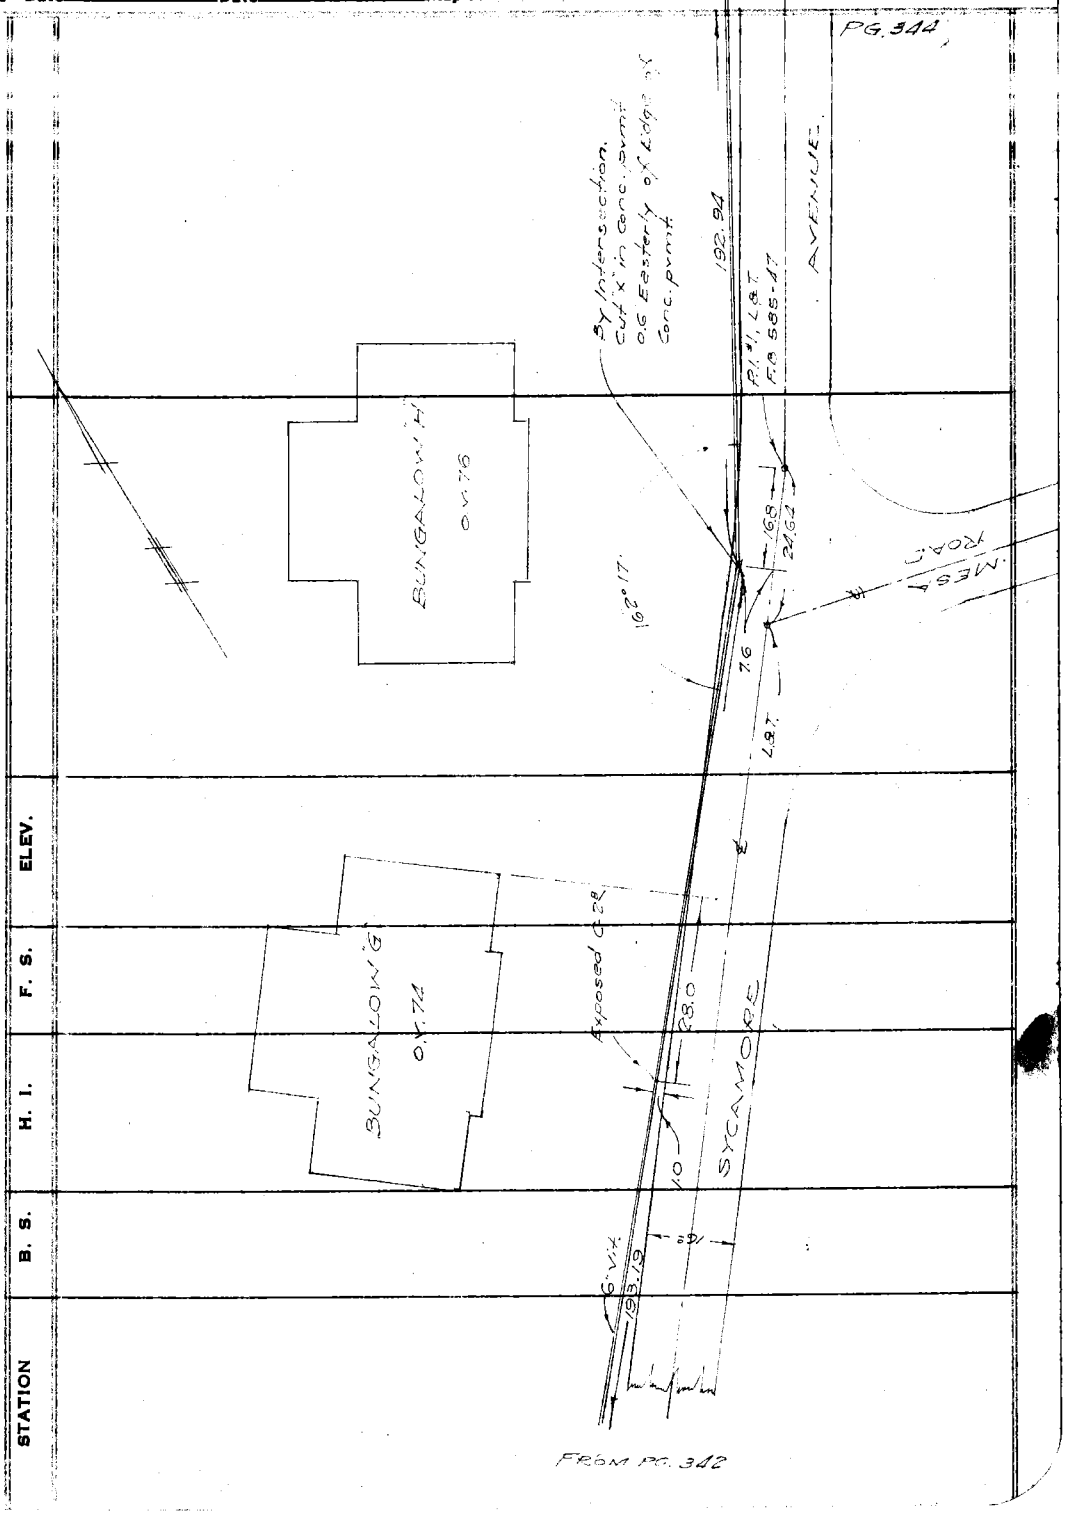

Form 307 5M 11-35

PLEASE RETURN TO
LOS ANGELES COUNTY SURVEYOR
700 HALL OF RECORDS

NOTE: ANY ADDITIONS OR CHANGES ON THIS SHEET MUST BE MADE OR CIRCLED IN RED INK, WITH DATE AND NAME OF PERSON MAKING CHANGE

Do not extend notes this side of this line

F. B. 713 PG. 344 | Job No. | Division No. | Notes Red. | Plotted Martin | Profile
Survey of OLIVE VIEW SANATORIUM | Date | Date Aug. 1939 | No.
Survey by T. WALSH | Notes T.M.W | Notes Chkd. | Checked | X-Sec.
Indexed | Date DEC. 1, 1937 | Date | Date | No.

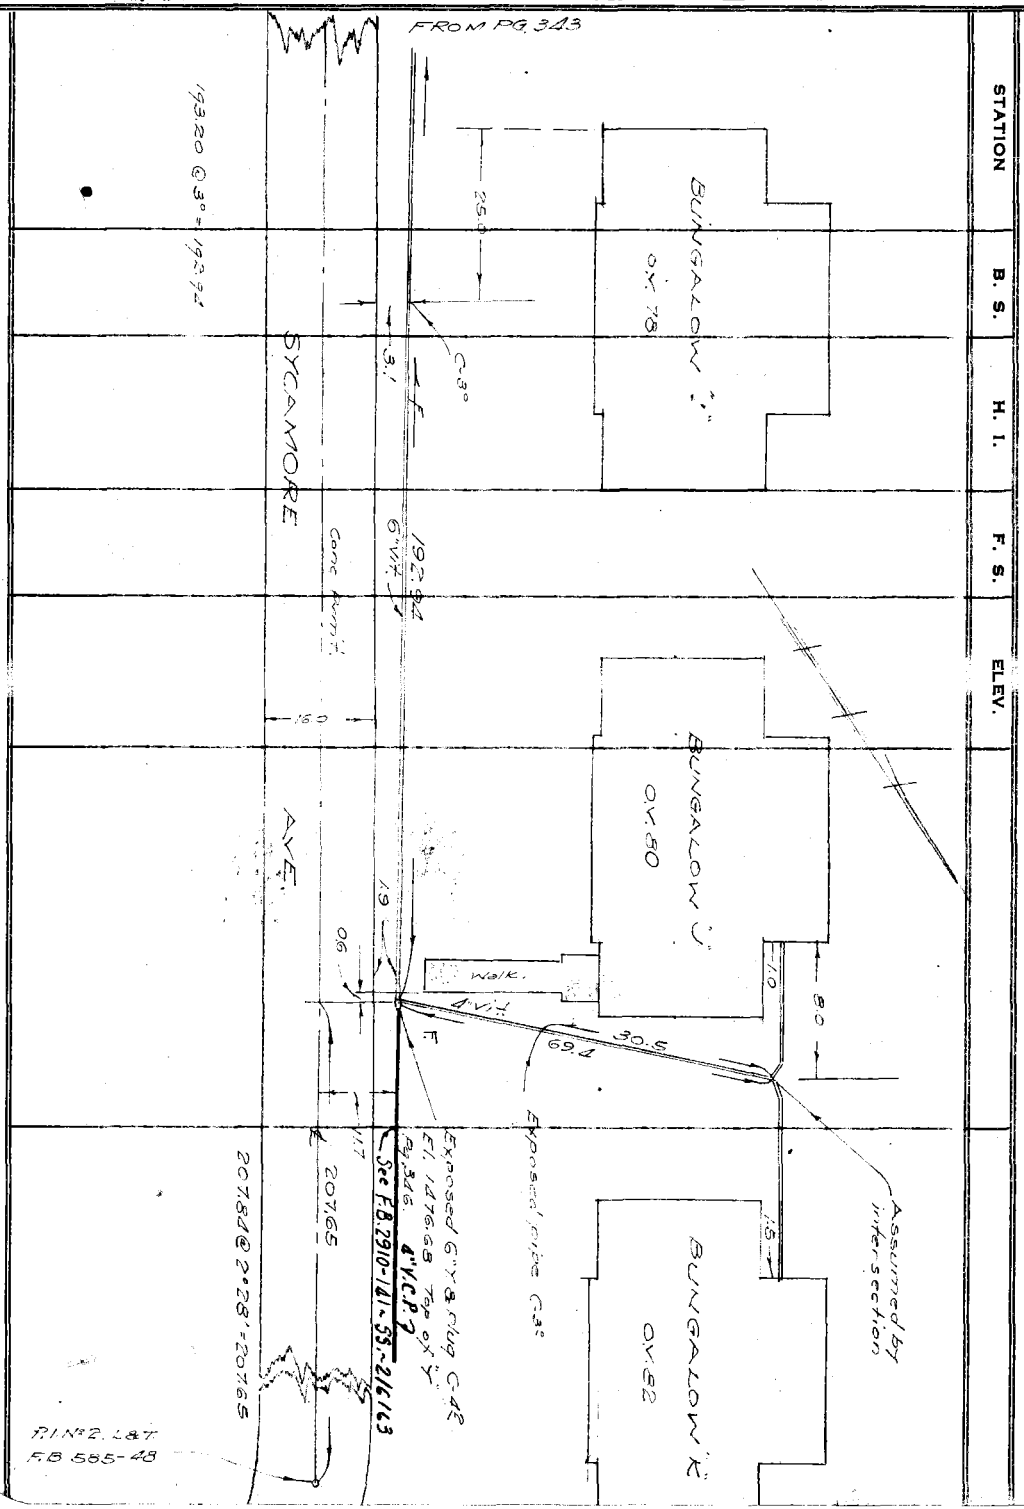

STATION | B. S. | H. I. | F. S. | ELEV.

Form 307 5M 11-35

PLEASE RETURN TO
LOS ANGELES COUNTY SURVEYOR
700 HALL OF RECORDS

Do not extend notes this side of this line

NOTE: ANY ADDITIONS OR CHANGES ON THIS SHEET MUST BE MADE OR CIRCLED IN RED INK, WITH DATE AND NAME OF PERSON MAKING CHANGE

Profile No. | Notes Red. | Plotted Martin | Job No. 3178 | Division No. | F. B. 713 PG. 345 V

X-Sec. No. | Date | Date Aug. 1939 | Survey of OLIVE VIEW SANATORIUM

Notes Chkd. | Checked | Survey by T. WALSH Notes T.M.W. Date 12-1-37

Date | Date | Map No. | Indexed C. Johnson Date

NOTE: ANY ADDITIONS OR CHANGES ON THIS SHEET MUST BE MADE OR CIRCLED IN RED INK, WITH DATE AND NAME OF PERSON MAKING CHANGE

Do not extend notes this side of this line

PLEASE RETURN TO
LOS ANGELES COUNTY SURVEYOR
700 HALL OF RECORDS

Form 307 SM 11-35

STATION	B. S.	H. I.	F. S.	ELEV.

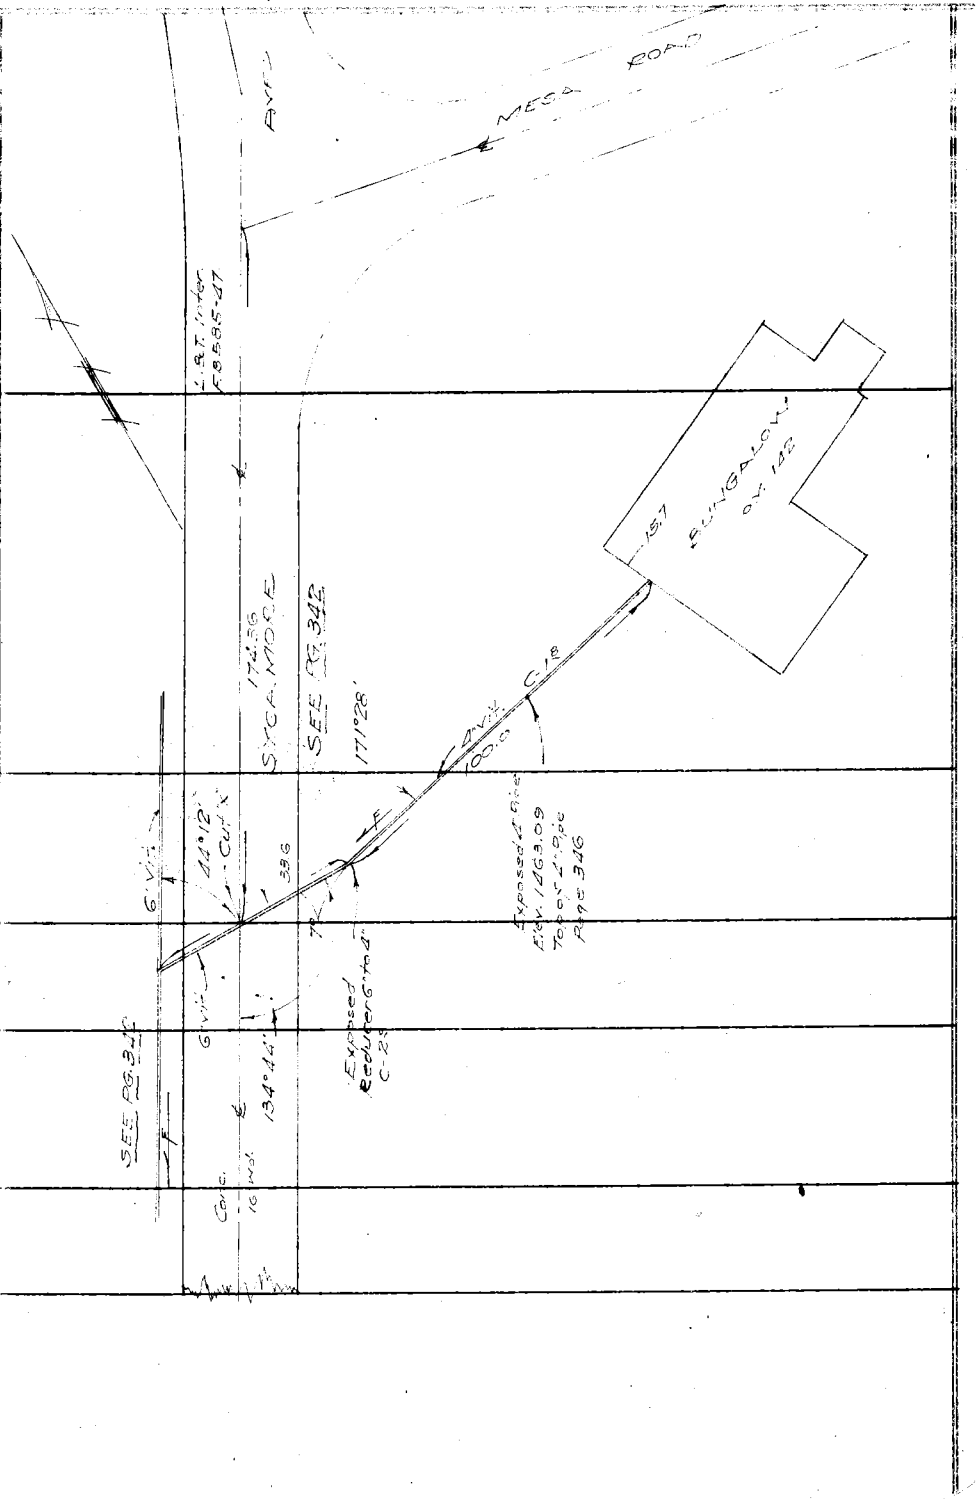

Form 307 5M 11-35

PLEASE RETURN TO
LOS ANGELES COUNTY SURVEYOR
700 HALL OF RECORDS

NOTE: ANY ADDITIONS OR CHANGES ON THIS SHEET MUST BE MADE OR CIRCLED IN RED INK, WITH DATE AND NAME OF PERSON MAKING CHANGE

Do not extend notes this side of this line

F. B. 713 Pg 346 | Job No. 818 | Division No. | Notes Rod. | Plotted | Profile No.
Survey of OLIVE VIEW SANATORIUM | Date | Date | X-Sec. No.
Survey by TINALSH | Notes T.M.W. | Notes Ckkd. Martin | Checked
Indexed | Date DEC. 2, 1937 | Date 8-8-39 | Date

STATION	B. S.	H. I.	F. S.	ELEV.		
T.P.				1449 29	L&T Inter. ℄ of Olive View Ave & Sycamore Ave.	F.B. 585-16
	691	1456 20	076	1455 44		
Top of 6" Y	1115	1466 59	892	1457 67	"A" Page 342	
Top of 6" Y			823	1458 36	B Page 342	
Top of 6" Y			760	1458 99	C Page 342	
Top of 6" Pipe			643	1460 16	D Page 342	
Top of 4" " of Reducer			3.50	1463 09	E Page 345	
T.P.			015	1466 44		
	11.09	1477 53				
			0.97	1476 56		
	792	1484 48				
Top of 6" Y			780	1476 68	"F" Page 342	
			041	1480 07		
	1172	1495 79				
			228	1493 51		
	591	1499 42				
B.M. 5-2			112	1498 30	See page 339	

Form 307 5M 10-37

PLEASE RETURN TO
LOS ANGELES COUNTY SURVEYOR
700 HALL OF RECORDS

NOTE: ANY ADDITIONS OR CHANGES ON THIS SHEET MUST BE MADE OR CIRCLED IN RED INK, WITH DATE AND NAME OF PERSON MAKING CHANGE

Do not extend notes this side of this line

STATION	B. S.	H. I.	F. S.	ELEV.		

Profile No. ____ Notes Red. ____ Plotted ____ Job No. ____ Division No. ____

X-Sec. No. ____ Date ____ Date ____ Survey of ____

Notes Chkd. ____ Checked ____ Survey by ____ Notes ____ Date ____

Date ____ Date ____ Map No. ____ Indexed ____ Date ____

F. B. 713 Pg. 351

F. B. 713 PG. 352 | Job No. 8128 | Division No. | Notes Red. | Plotted Martin | Profile

Survey of OLIVE VIEW SANATORIUM | Date | Date Aug. 1939 | No.

Survey by TED WALSH | Notes WALSH | Notes Chkd. | Checked | X-Sec.

Indexed | Date DEC. 2, 1937 | Date | Date | No.

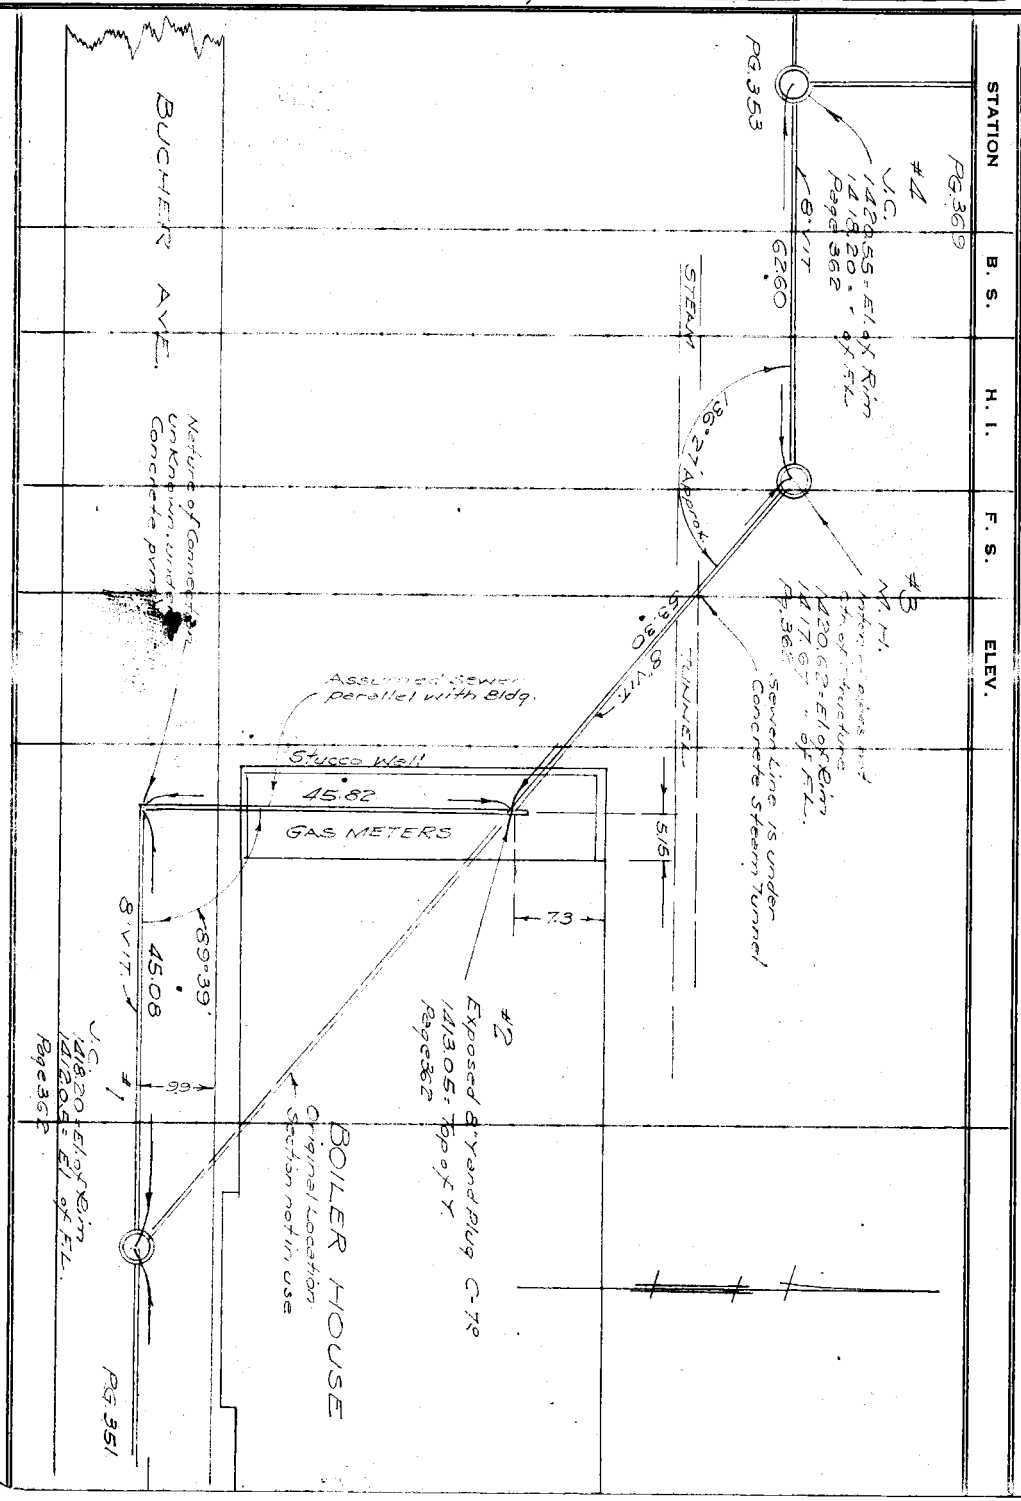

Form 307 5M 10-37

PLEASE RETURN TO
LOS ANGELES COUNTY SURVEYOR
700 HALL OF RECORDS

NOTE: ANY ADDITIONS OR CHANGES ON THIS SHEET MUST BE MADE OR CIRCLED IN RED INK, WITH DATE AND NAME OF PERSON MAKING CHANGE

Do not extend notes this side of this line

Profile	Notes Red.	Plotted Martin	Job No. 8128 Division No.	F. B. 713 PG. 353
No.	Date	Date Aug. 1939	Survey of OLIVE VIEW SANATORIUM	
X-Sec.	Notes Chkd.	Checked	Survey by TED WALSH Notes T.M.W.	Date DEC. 13, 37
No.	Date	Date	Map No. Indexed	Date

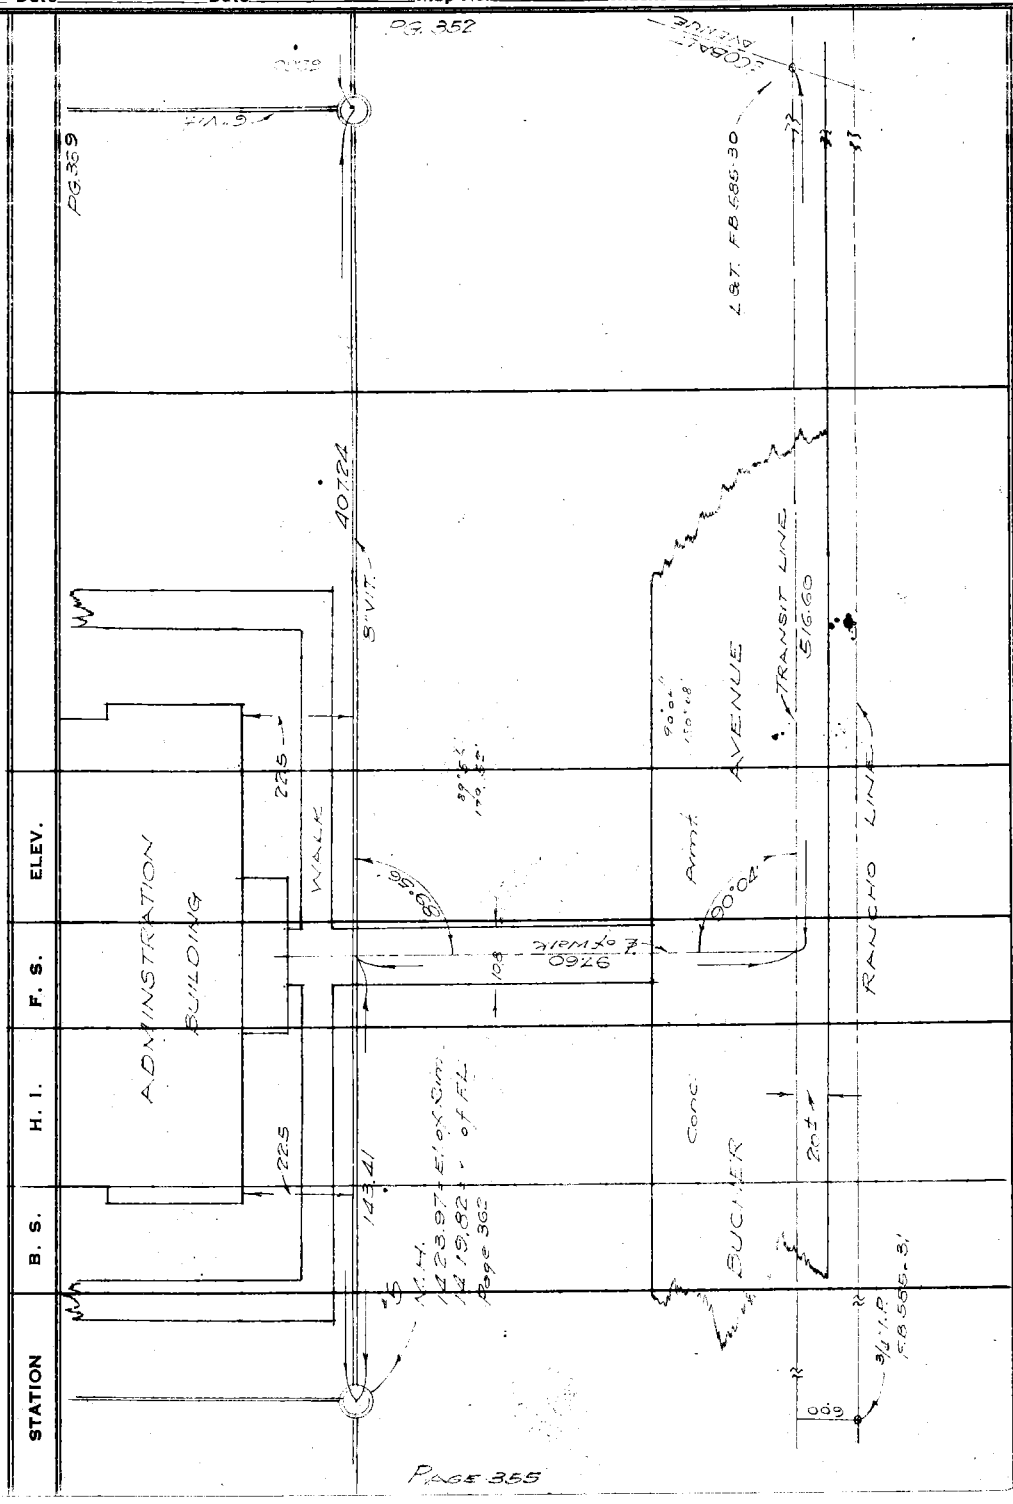

PAGE 355

NOTE: ANY ADDITIONS OR CHANGES ON THIS SHEET MUST BE MADE OR CIRCLED IN RED INK, WITH DATE AND NAME OF PERSON MAKING CHANGE

Do not extend notes this side of this line

PLEASE RETURN TO
LOS ANGELES COUNTY SURVEYOR
700 HALL OF RECORDS

Form 307 5M 10-37

F. B. 713 PG. 354 ✓ | Job No. 8128 | Division No. | Notes Red. | Plotted Martin | Profile

Survey of OLIVE VIEW SANATORIUM | Date DEC. 14, 37 | Date Aug. 1939 | No.

Survey by T. M. WALSH | Notes WALSH | Notes Chkd. | Checked | X-Sec.

Indexed [illegible] | Date | Date | Date | No.

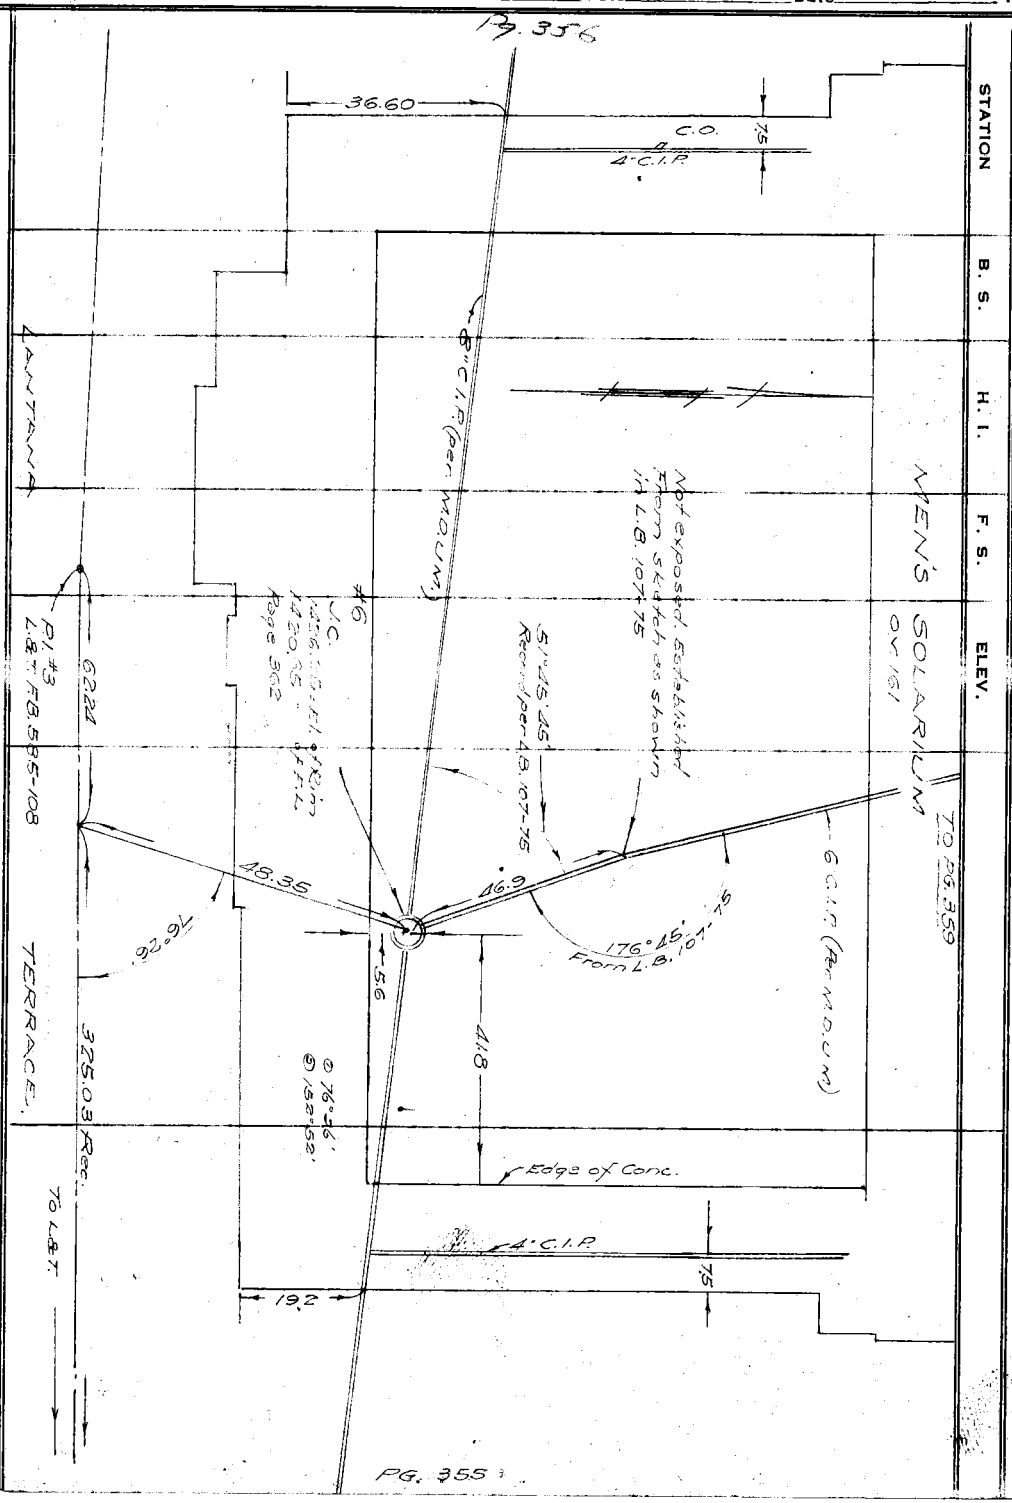

Form 307 5M 10-37

PLEASE RETURN TO
LOS ANGELES COUNTY SURVEYOR
700 HALL OF RECORDS

NOTE: ANY ADDITIONS OR CHANGES ON THIS SHEET MUST BE MADE OR CIRCLED IN RED INK, WITH DATE AND NAME OF PERSON MAKING CHANGE

Do not extend notes this side of this line

Form 307 5M 10-37

PLEASE RETURN TO
LOS ANGELES COUNTY SURVEYOR
700 HALL OF RECORDS

NOTE: ANY ADDITIONS OR CHANGES ON THIS SHEET MUST BE MADE OR CIRCLED IN RED INK, WITH DATE AND NAME OF PERSON MAKING CHANGE

Do not extend notes this side of this line

STATION	B. S.	H. I.	F. S.	ELEV.

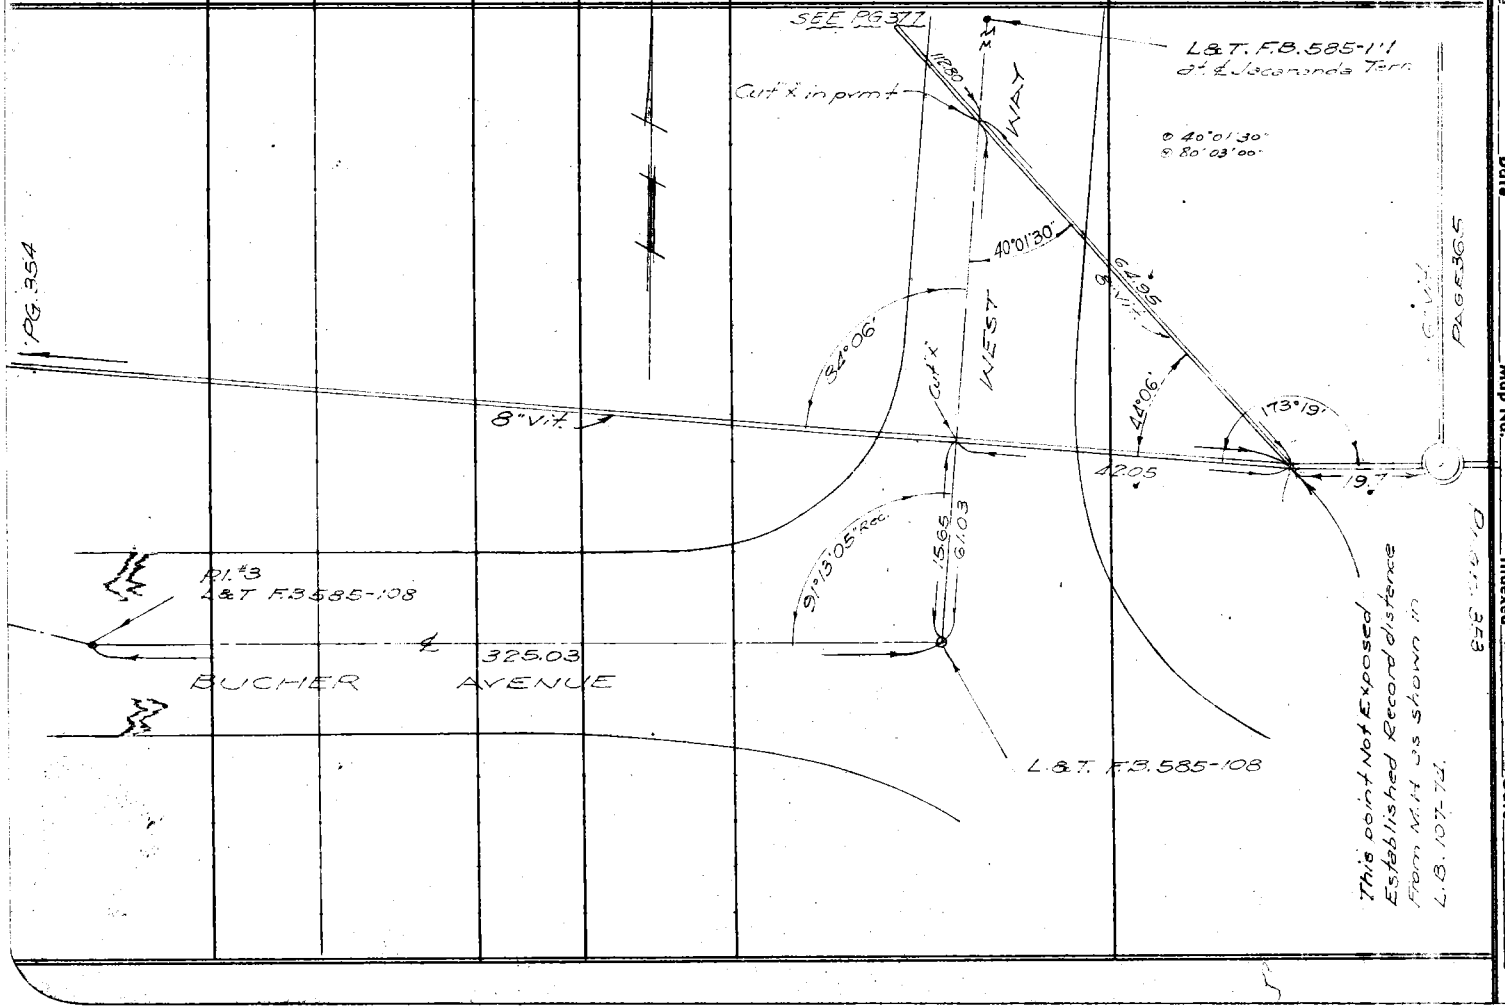

Profile

No. _____ Notes Red. _____ Plotted Martin Job No. 8128 Division No. _____ F. B. 743 PG. 355

Date _____ Date Aug. 1939 Survey of OLIVE VIEW SANITORIUM

X-Sec. _____ Notes Chkd. _____ Checked _____ Survey by T.W. WRIGHT Notes T.W. Date 12-14-37

No. _____ Date _____ Date _____ Map No. _____ Indexed _____ Date _____

F. B. 713 PG. 356 | Job No. 8128 | Division No. | Notes Red. | Plotted Martin | Profile

Survey of OLIVE VIEW SANATORIUM | Date DEC. 14, 37 | Date Aug. 1939 | No.

Survey by TED WALSH | Notes T.M.W | Notes Chkd. | Checked | X-Sec.

Indexed | Date | Date | Date | No.

Form 307 5M 10-37

PLEASE RETURN TO
LOS ANGELES COUNTY SURVEYOR
700 HALL OF RECORDS

NOTE: ANY ADDITIONS OR CHANGES ON THIS SHEET MUST BE MADE OR CIRCLED IN RED INK, WITH DATE AND NAME OF PERSON MAKING CHANGE

Do not extend notes this side of this line

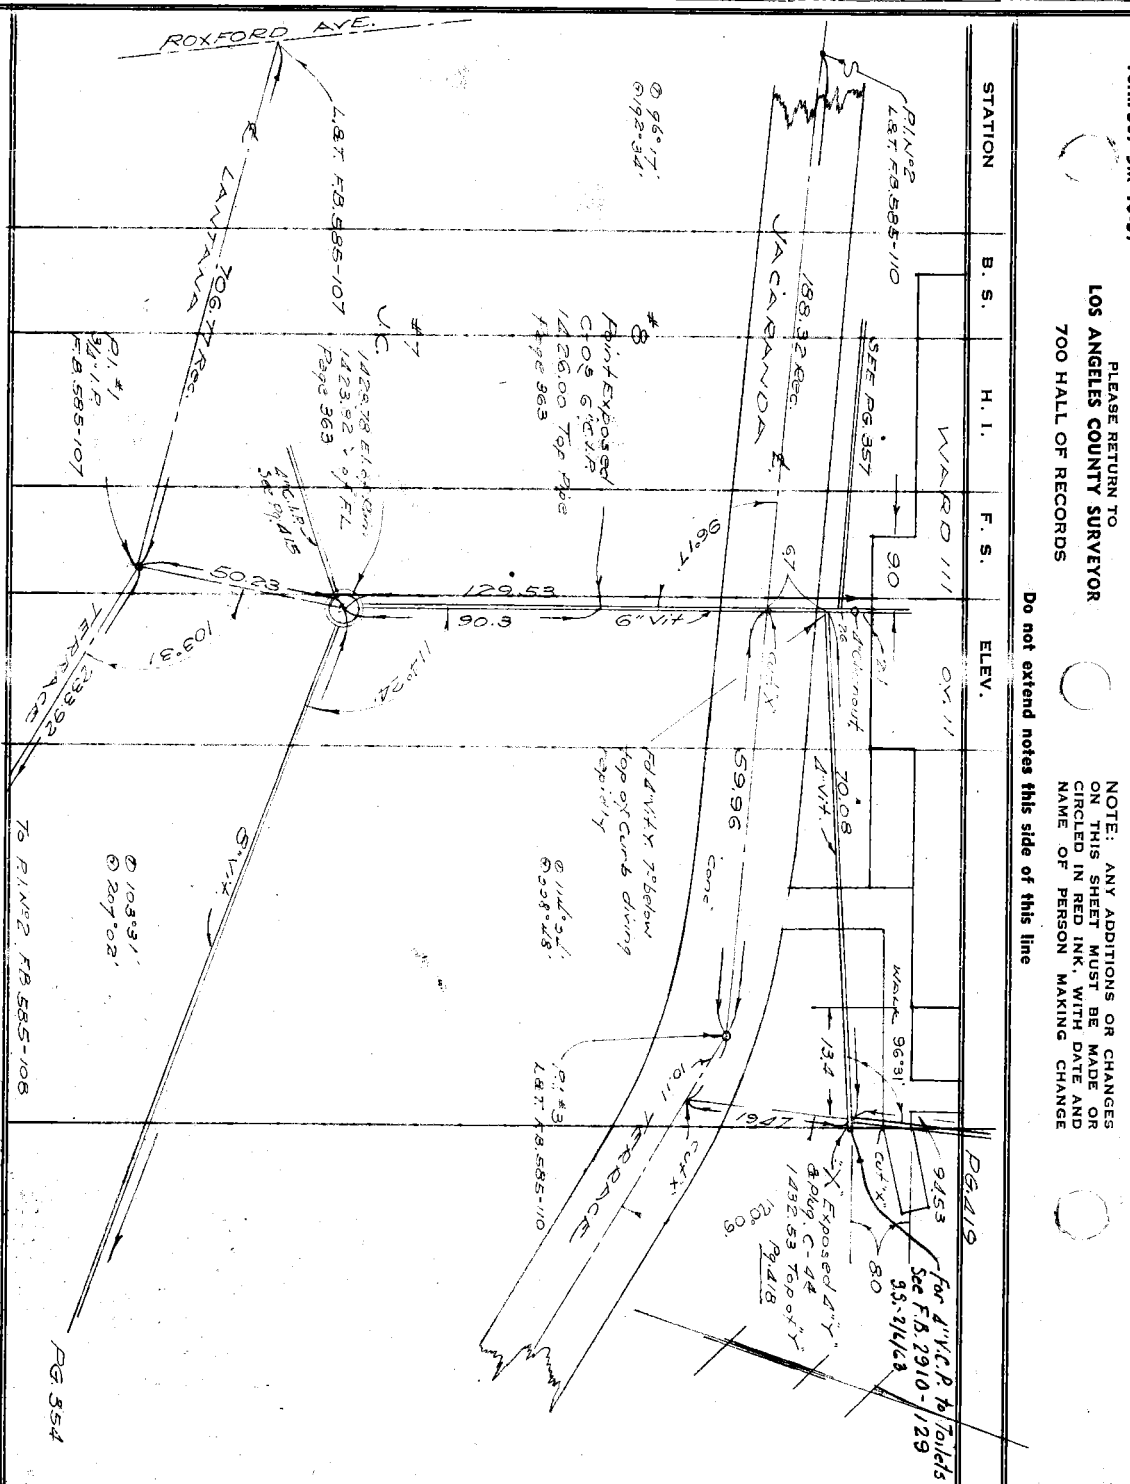

Profile No.	Notes Red.	Plotted Martin	Job No. 8128	Division No.	F. B. 713 Pg. 357 ✓
	Date	Date Aug. 1939	Survey of OLIVE VIEW SANATORIUM		
X-Sec. No.	Notes Chkd.	Checked	Survey by T.M. WALSH	Notes T.M.W.	Date DEC. 16, 37
	Date	Date	Map No.	Indexed A. C. Johnson	Date

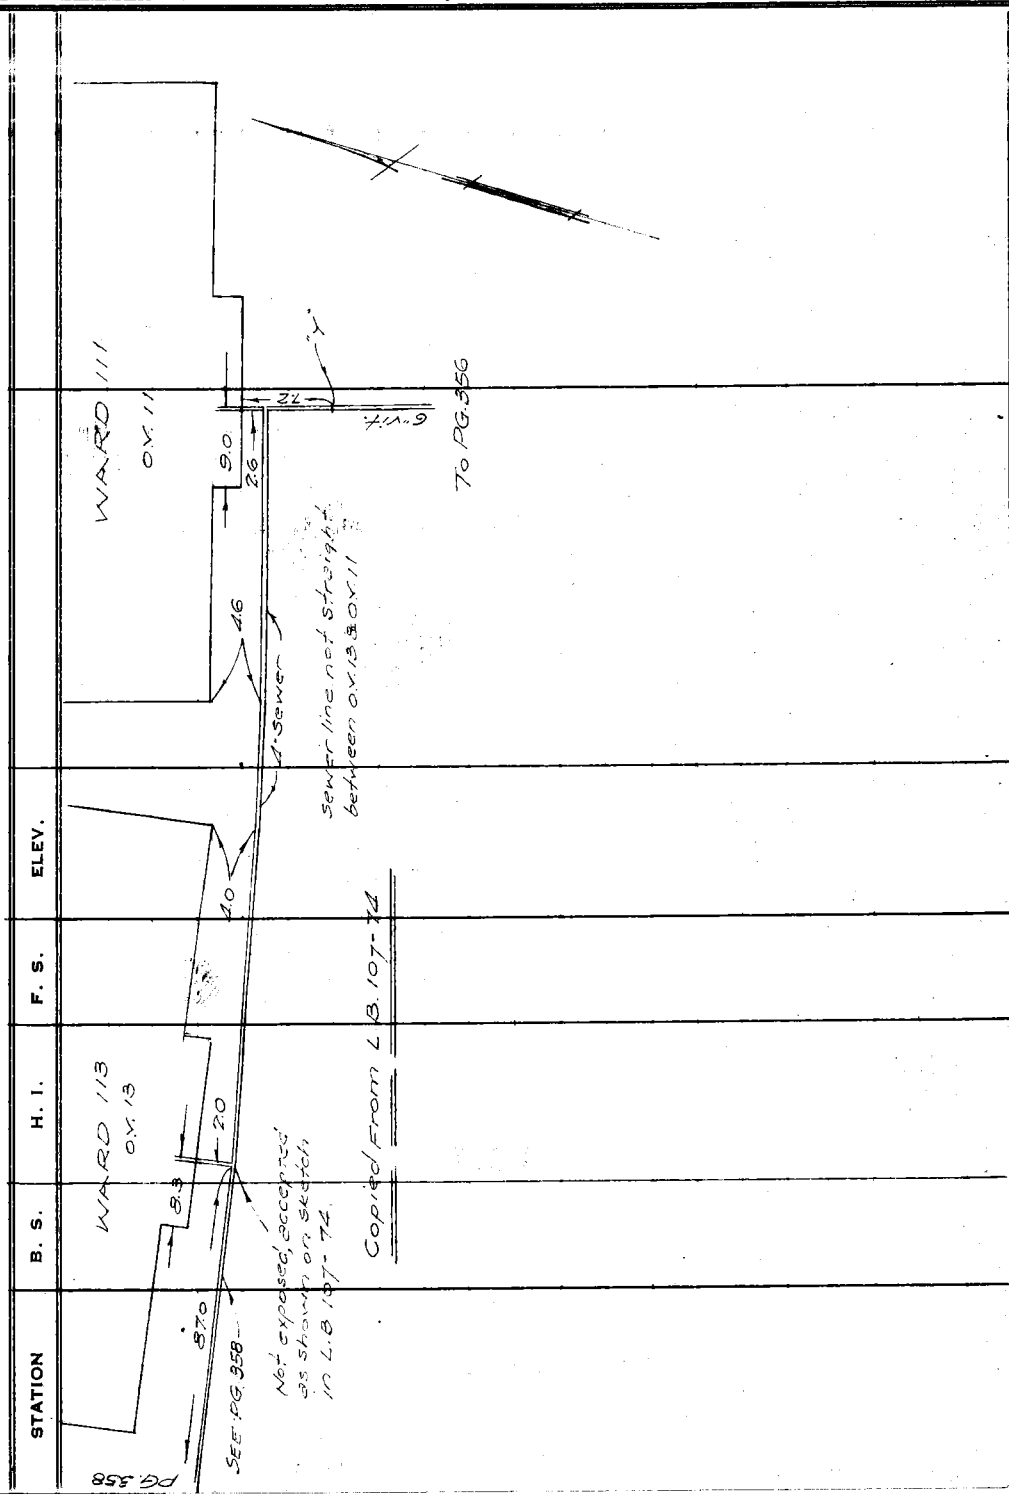

NOTE: ANY ADDITIONS OR CHANGES ON THIS SHEET MUST BE MADE OR CIRCLED IN RED INK, WITH DATE AND NAME OF PERSON MAKING CHANGE

Do not extend notes this side of this line

PLEASE RETURN TO
LOS ANGELES COUNTY SURVEYOR
700 HALL OF RECORDS

Form 307 5M 10-37

Form 307 5M 10-37

PLEASE RETURN TO
LOS ANGELES COUNTY SURVEYOR
700 HALL OF RECORDS

NOTE: ANY ADDITIONS OR CHANGES ON THIS SHEET MUST BE MADE OR CIRCLED IN RED INK, WITH DATE AND NAME OF PERSON MAKING CHANGE

Do not extend notes this side of this line

F. B. 713 PG 358 | Job No. 818 | Division No. | Notes Red. | Plotted Martin | Profile
Survey of OLIVE VIEW SANATORIUM | Date | Date | Date Aug. 1939 | No.
Survey by T. WALSH | Notes T.M.W. | Notes Chkd. | Checked | X-Sec.
Indexed | Date 12-16-38 | Date | Date | No.

STATION	B. S.	H. I.	F. S.	ELEV.	
					WARD 115 OV 15
					WARD 113 OV 13
					7.3
					17.5
					4" C.I.P.
					11.90
					6" Vit 110.8
					16.0
					87.0
					2.0 SEE PG 357
					4.5
					18.0
					Pt. not exposed
					6" Vit
					0.3
					6.0
					22.1
					223.25 Rec. JACARANDA
					10' Pvmt.
					TERRACE
					Cont. Below
					Point "X" Exposed C-4" 1' So. of N. Edge of Pvmt.
					P.I. No. 1 L&T. FB 586-109
					"A" Exposed C-38 Under Conc. Conduit Box 1433.82 El. top of Pipe
					P.I. No. 2 L&T. FB 585-110
Rim of MH #7	Page 356			1428.78	
Top of 4" Pipe	11.74	1440.52	6.70	1433.82	Pt. "A"
					MEN'S O.T. BLDG. & CAFETERIA OV 33
					6.3
					6" Vit
					Exposed ELBOW 1.5' Below Pvmt.
					112.50
					Point "X"
					13.5
					5.2
					6" Vit. 10' Pvmt.
					JACARANDA TER.
					Cont. From Above

Profile No.	Notes Red.	Plotted Martin	Job No. 8178	Division No.	F. B. 713 PG. 359 ✓
	Date	Date Aug. 1939	Survey of OLIVE VIEW SANATORIUM		
X-Sec. No.	Notes Chkd.	Checked	Survey by TED WALSH	Notes T.M.W.	Date Dec. 14, 37
	Date	Date	Map No.	Indexed A. C. Johnson	Date

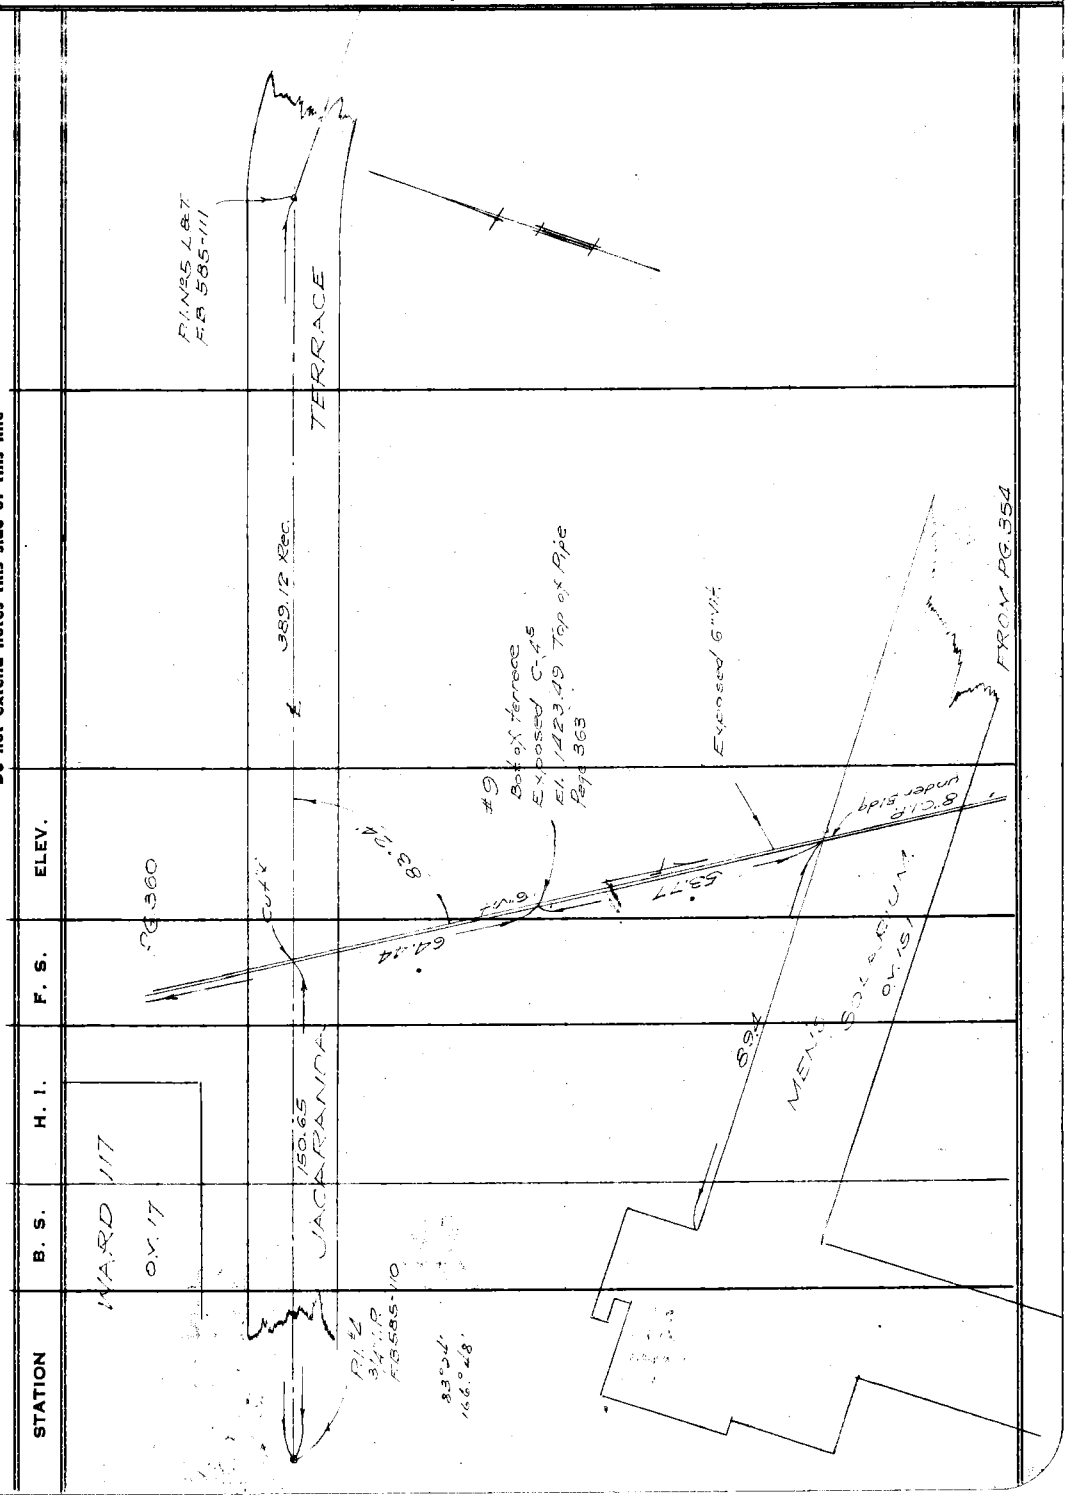

NOTE: ANY ADDITIONS OR CHANGES ON THIS SHEET MUST BE MADE OR CIRCLED IN RED INK, WITH DATE AND NAME OF PERSON MAKING CHANGE

Do not extend notes this side of this line

PLEASE RETURN TO
LOS ANGELES COUNTY SURVEYOR
700 HALL OF RECORDS

Form 307 5M 10-37

F. B. 713 PG 360 ✓ Job No. 8148 Division No. _____ Notes Red. _____ Plotted Martin Profile

Survey of OLIVE VIEW SANATORIUM. Date _____ Date Aug. 1939 No. _____

Survey by T. WALSH Notes T.M.W. Notes Chkd. _____ Checked _____ X-Sec.

Indexed A. C. Johnson Date Dec. 14, 1937 Date _____ Date _____ No. _____

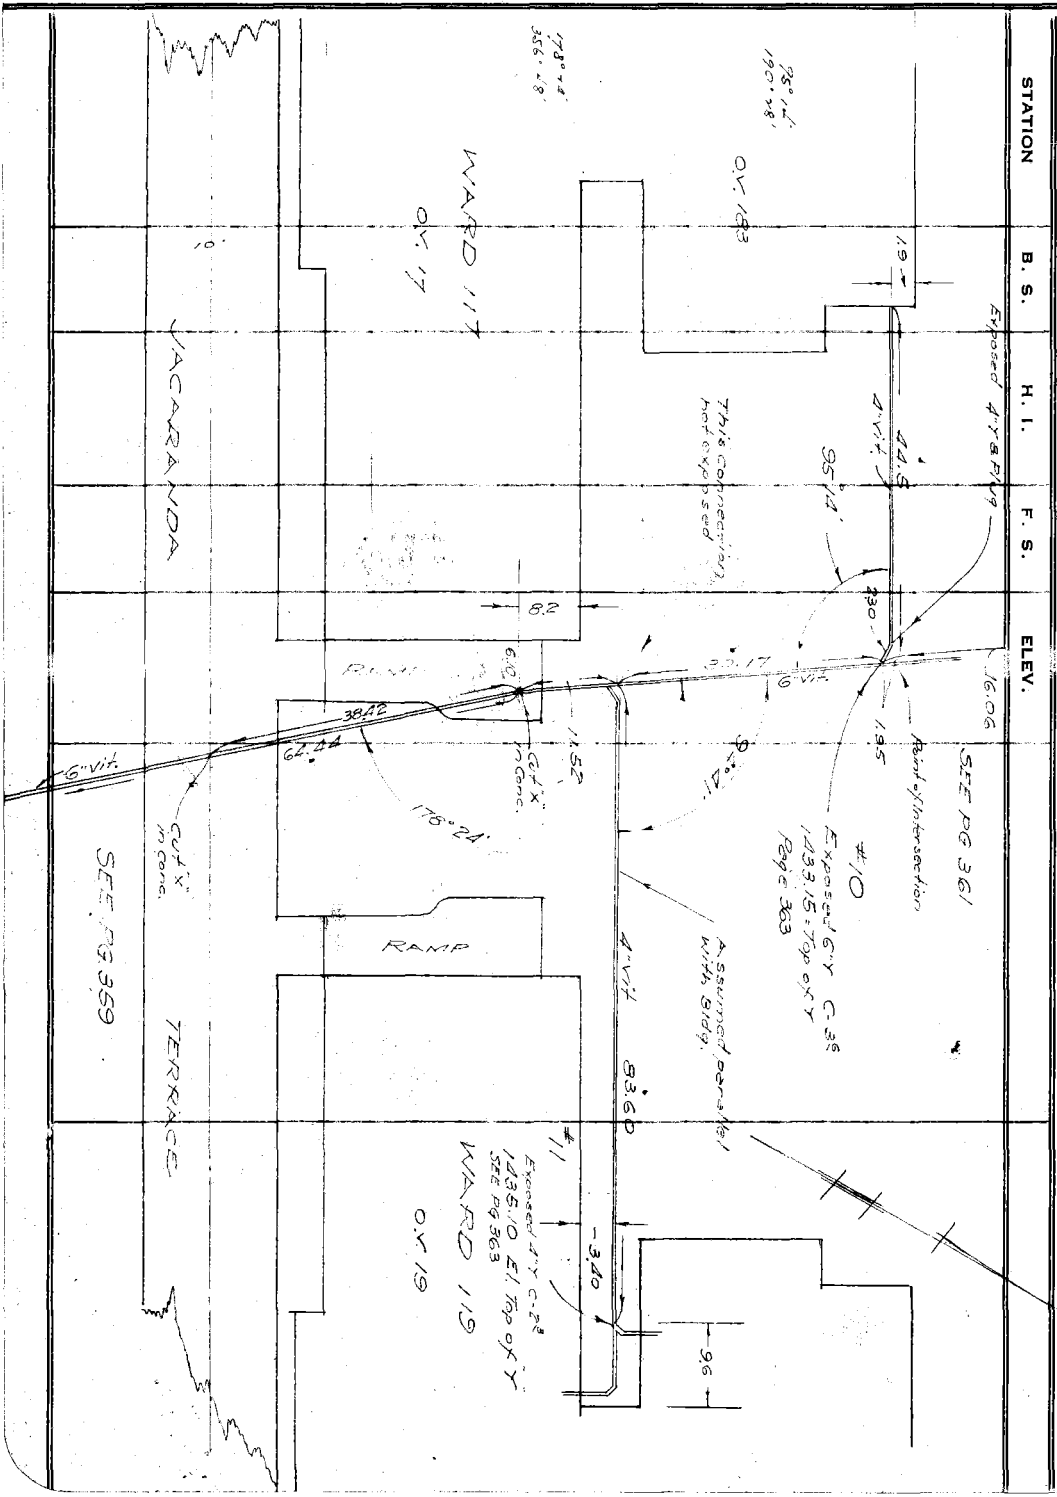

Form 307 5M 10-37

PLEASE RETURN TO
LOS ANGELES COUNTY SURVEYOR
700 HALL OF RECORDS

Do not extend notes this side of this line

NOTE: ANY ADDITIONS OR CHANGES ON THIS SHEET MUST BE MADE OR CIRCLED IN RED INK, WITH DATE AND NAME OF PERSON MAKING CHANGE

Profile No.	Notes Red.	Plotted Martin	Job No. 8148	Division No.	F. B. 713 PG. 361
	Date	Date Aug. 1939	Survey of OLIVE VIEW SANATORIUM		
X-Sec. No.	Notes Chkd.	Checked	Survey by T. WALSH	Notes T.M.W.	Date Dec. 17, 1937
	Date	Date	Map No.	Indexed A. C. Johnson	Date

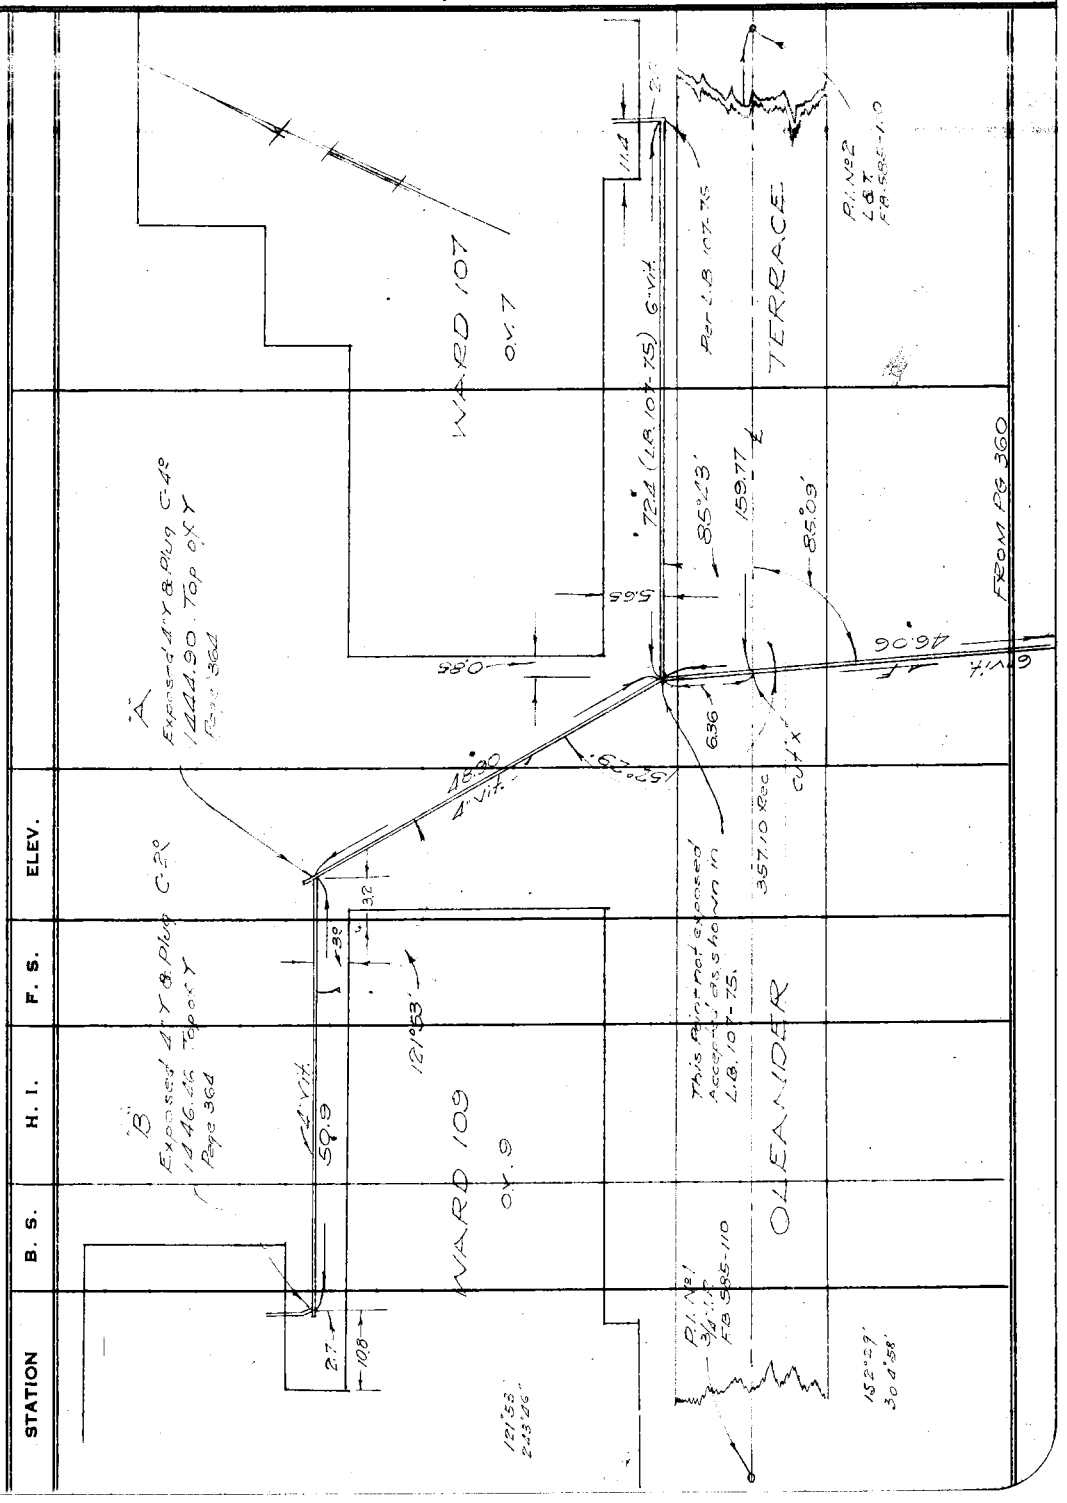

NOTE: ANY ADDITIONS OR CHANGES ON THIS SHEET MUST BE MADE OR CIRCLED IN RED INK, WITH DATE AND NAME OF PERSON MAKING CHANGE

Do not extend notes this side of this line

PLEASE RETURN TO
LOS ANGELES COUNTY SURVEYOR
700 HALL OF RECORDS

Form 307 5M 10-37

Form 307 5M 10-37

PLEASE RETURN TO
LOS ANGELES COUNTY SURVEYOR
700 HALL OF RECORDS

NOTE: ANY ADDITIONS OR CHANGES ON THIS SHEET MUST BE MADE OR CIRCLED IN RED INK, WITH DATE AND NAME OF PERSON MAKING CHANGE

Do not extend notes this side of this line

STATION	B. S.	H. I.	F. S.	ELEV.		
T.P. #2				1423 40	Bucher Ave & East Way N.W. Cor. "X" in F.H.	
	0.64	1424 04			F.B. 585-5.	
#1			5 84	1418 20	Rim of M.H.	Page 352
			11 99	1412 05	F.L.	✓
T.P.			3 34	1420 70		
	4 50	1425 20				
#2			12 15	1413 05	Top of 8" Y.	Page. 352
#3			4 38	1420 82	Rim of M.H.	✓
✓			7 53	1417 67	F.L.	✓
#4			4 65	1420 55	Rim of M.H	✓
✓			7 00	1418 20	F.L.	✓
			0 69	1422 51		
	5 74	1430 25				
			6 85	1423 40		
	5 41	1428 81				
#5			4 84	1423 97	Rim of M.H.	Page 353
✓			8 99	1419 82	F.L.	✓
			2 29	1426 52		
	5 14	1431 66				
#6			5 41	1426 25	Rim of M.H	Page 354
✓			11 01	1420 65	F.L. (Approx)	✓

F.B. 713 Pg 362 Job No. 8178 Division No. Notes Red. Plotted Profile
Survey of OLIVE VIEW SANATORIUM Date Date No.
Survey by T. WALSH Notes T.W. Notes Chkd. Martin Checked X-Sec.
Indexed A. C. [illegible] Date Date 8-8-39 Date No.

Form 307 5M 11-35

PLEASE RETURN TO
LOS ANGELES COUNTY SURVEYOR
700 HALL OF RECORDS

NOTE: ANY ADDITIONS OR CHANGES ON THIS SHEET MUST BE MADE OR CIRCLED IN RED INK, WITH DATE AND NAME OF PERSON MAKING CHANGE

Do not extend notes this side of this line

STATION	B. S.	H. I.	F. S.	ELEV.		
		1431 66			From pg 362	
			4 07	1427 59		
	4 57	1432 16				
#7			3 38	1428 78	Rim of M.H	Page 356
"			8 34	1423 82	F.L. (Approx)	✓
#8			6 16	1426 00	Top of Pipe	✓
			0 59	1431 57		
	6 79	1438 36				
#9			14 87	1423 49	Top of Pipe	Page 359
			0 905	1437 455		
	12 04	1449 495				
#10			16 34	1433 15	Top of "Y"	Page 360
11			14 39	1435 10	Top of 4" Y	✓
BM # S-3			1 44	1448 055	BM S-3 Oleander Terrace. 4' W.& 12' S. of S.[illegible] Ward 105 (O.V. 5) L&T in pvmt = P.I #2	
	11 815	1459 870				
BM #12			2 255	1457 615	BM #12 Opposite East end of Cottage No 5. South Side Olive View Ave. L&N. in N.E. [illegible] Aqueduct M.H. Approx 45' W. of P.I #3 Olive View Ave. El. 1457.615 • FE 58[illegible]-17	

Profile No. ____ Notes Red. ____ Plotted ____ Job No. 8/78 Division No. ____ F. B. 7/3 PG 363

X-Sec. No. ____ Date ____ Date ____ Survey of [illegible] VIEW SANATORIUM

Notes Chkd Martin Checked ____ Survey by T. WALSH Notes T.M.W. Date DEC. 15, 37

Date 8-8-39 Date ____ Map No. ____ Indexed [illegible] Date ____

Form 307 5M 11-35

PLEASE RETURN TO
LOS ANGELES COUNTY SURVEYOR
700 HALL OF RECORDS

NOTE: ANY ADDITIONS OR CHANGES ON THIS SHEET MUST BE MADE OR CIRCLED IN RED INK, WITH DATE AND NAME OF PERSON MAKING CHANGE

Do not extend notes this side of this line

F. B. 713 Pg 364 | Job No. | Division No. | Notes Red. | Plotted | Profile No.
Survey of OLIVE VIEW SANATORIUM | Date | Date | X-Sec. No.
Survey by T. NICOLSEN | Notes T. NICOLSEN | Notes Chkd. Martin | Checked | Date
Indexed | Date DEC 17, 37 | Date 8-8-39 | Date

STATION	B. S.	H. I.	F. S.	ELEV.		
BM S-3				1445.055	PAGE 363	
	516	1453.215				
PT "A"			832	1442.190	Top of 4" Y	Page 361
			676	1446.46	Top of 4" Y	✓
BM S-3			516	1445.055	Alone	

Profile	Notes Red.	Plotted Martin	Job No. 8/18	Division No.	F. B. 713	PG 365
No.	Date	Date Aug. 1939	Survey of [illegible] VIEW SANATORIUM			
X-Sec.	Notes Chkd.	Checked	Survey by T. WALSH	Notes T.M.W.	Date 12-28-37	
No.	Date	Date	Map No.	Indexed [illegible]	Date	

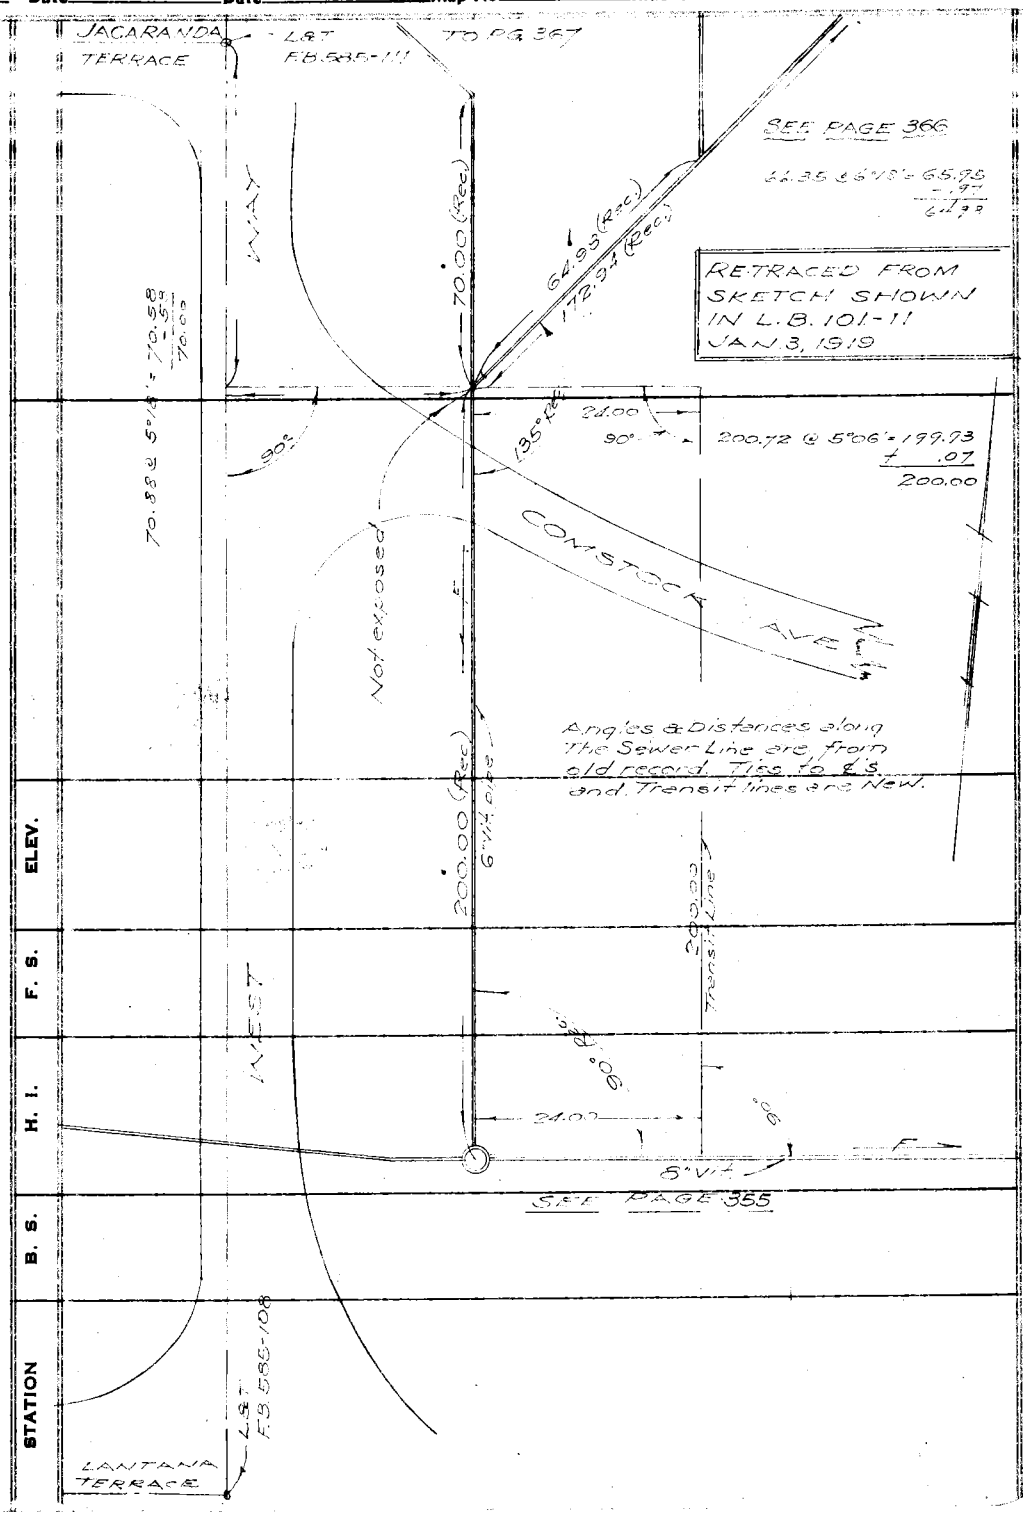

NOTE: ANY ADDITIONS OR CHANGES ON THIS SHEET MUST BE MADE OR CIRCLED IN RED INK, WITH DATE AND NAME OF PERSON MAKING CHANGE

Do not extend notes this side of this line

PLEASE RETURN TO
LOS ANGELES COUNTY SURVEYOR
700 HALL OF RECORDS

Form 307 5M 11-35

F. B. 713 Pg 366 | Job No. | Division No. | Notes Red. | Plotted Martin | Profile
Survey of OLIVE VIEW SANATORIUM | Date | Date Aug. 1939 | No.
Survey by T. WALSH Notes T.M.W | Notes Chkd. | Checked | X-Sec.
Indexed | Date DEC. 28. 1937 | Date | Date | No.

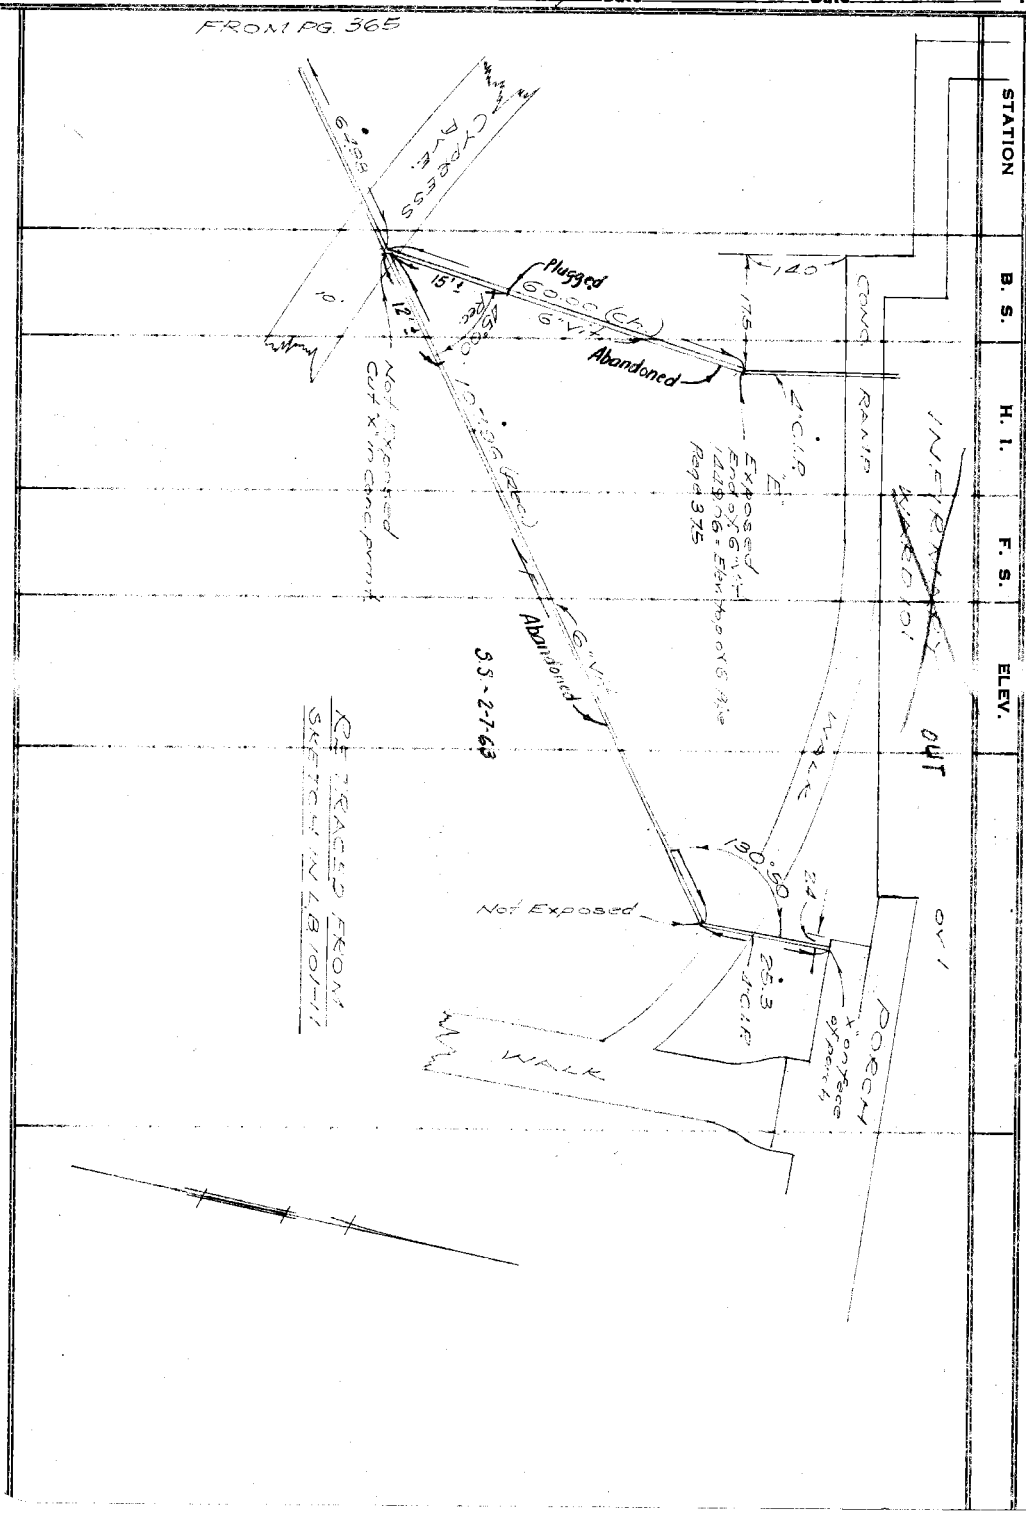

Form 307 5M 11-35

PLEASE RETURN TO
LOS ANGELES COUNTY SURVEYOR
700 HALL OF RECORDS

Do not extend notes this side of this line

NOTE: ANY ADDITIONS OR CHANGES ON THIS SHEET MUST BE MADE OR CIRCLED IN RED INK, WITH DATE AND NAME OF PERSON MAKING CHANGE

STATION | B. S. | H. I. | F. S. | ELEV.

Profile	Notes Red.	Plotted *Martin*	Job No. *848*	Division No.	F. B. *713* Pg *367* ✓
No.	Date	Date *Aug. 1939*	Survey of *OLIVE VIEW SANATORIUM*		
X-Sec.	Notes Chkd.	Checked	Survey by *T. WALSH*	Notes *T.M.W.*	Date *DEC. 29. 37*
No.	Date	Date	Map No.	Indexed	Date

NOTE: ANY ADDITIONS OR CHANGES ON THIS SHEET MUST BE MADE OR CIRCLED IN RED INK, WITH DATE AND NAME OF PERSON MAKING CHANGE

Do not extend notes this side of this line

PLEASE RETURN TO
LOS ANGELES COUNTY SURVEYOR
700 HALL OF RECORDS

STATION	B. S.	H. I.	F. S.	ELEV.

Form 307 5M 11-35

Form 307 5M 11-35

PLEASE RETURN TO
LOS ANGELES COUNTY SURVEYOR
700 HALL OF RECORDS

NOTE: ANY ADDITIONS OR CHANGES ON THIS SHEET MUST BE MADE OR CIRCLED IN RED INK, WITH DATE AND NAME OF PERSON MAKING CHANGE

Do not extend notes this side of this line

F. B. 713 Pg. 368 V | Job No. 8178 | Division No. | Notes Red. | Plotted Martin | Profile
Survey of OLIVE VIEW SANATORIUM | Date | Date Aug. 1939 | No. | X-Sec.
Survey by T.M.WALSH | Notes T.M.W. | Notes Chkd. | Checked | No.
Indexed | Date DEC 29 1937 | Date | Date

STATION	B. S.	H. I.	F. S.	ELEV.

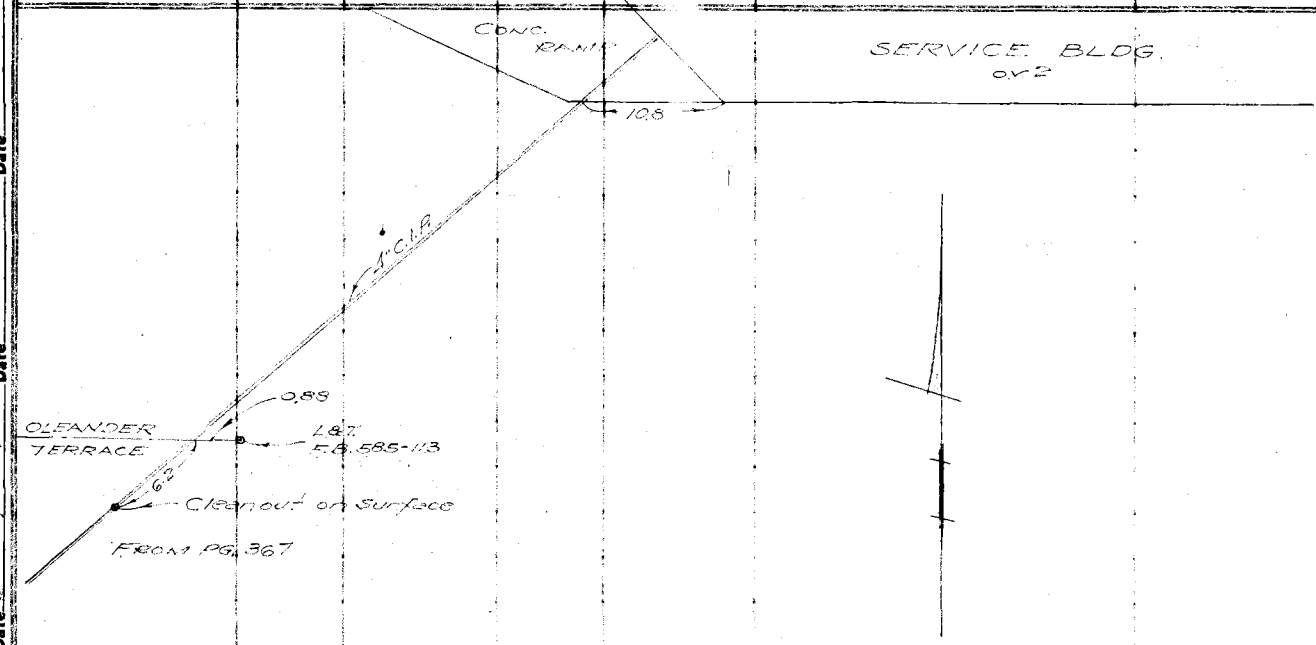

Profile	Notes Red.	Plotted Martin	Job No.	Division No.	F. B. 713 PG. 369
No.	Date	Date Aug. 1939	Survey of OLIVE VIEW SANATORIUM		
X-Sec.	Notes Chkd.	Checked	Survey by T. WALSH	Notes T.M.W.	Date DEC. 31, 1937
No.	Date	Date	Map No.	Indexed	Date

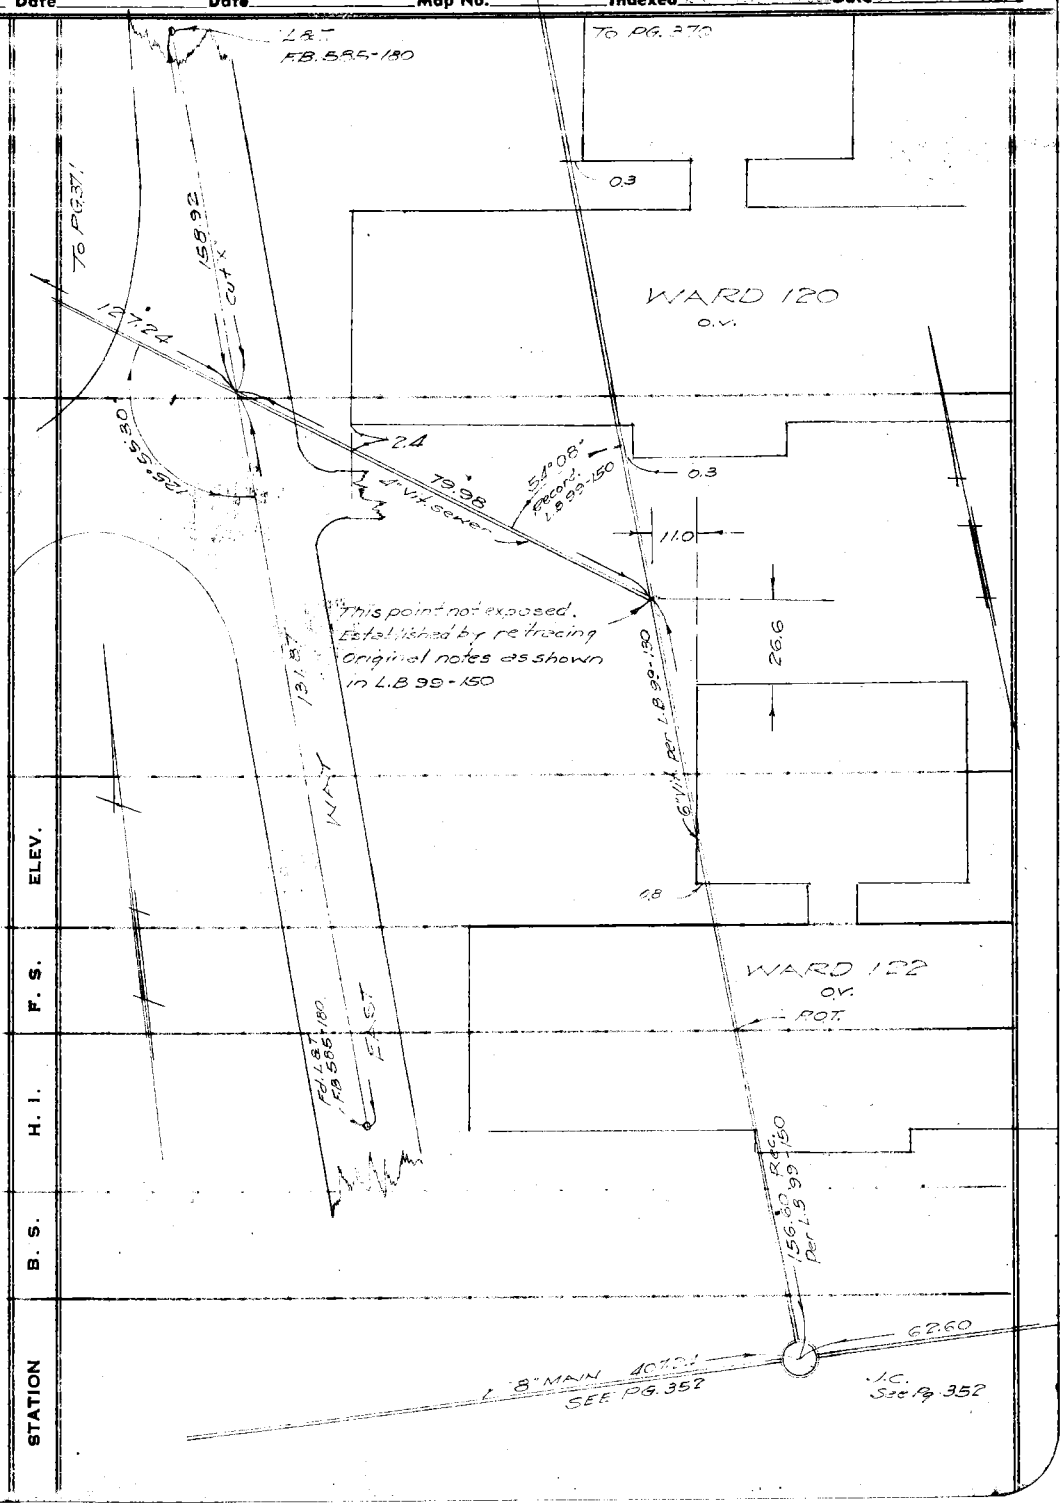

NOTE: ANY ADDITIONS OR CHANGES ON THIS SHEET MUST BE MADE OR CIRCLED IN RED INK, WITH DATE AND NAME OF PERSON MAKING CHANGE

Do not extend notes this side of this line

PLEASE RETURN TO
LOS ANGELES COUNTY SURVEYOR
700 HALL OF RECORDS

Form 307 5M 10-37

F. B. 713 PG 370 | Job No. | Division No. | Notes Red. | Plotted Martin | Profile

Survey of OLIVE VIEW SANATORIUM | Date | Date Aug. 1939 | No.

Survey by T. WALSH | Notes T.M.W. | Notes Chkd. | Checked | X-Sec.

Indexed | Date DEC. 31 1937 | Date | Date | No.

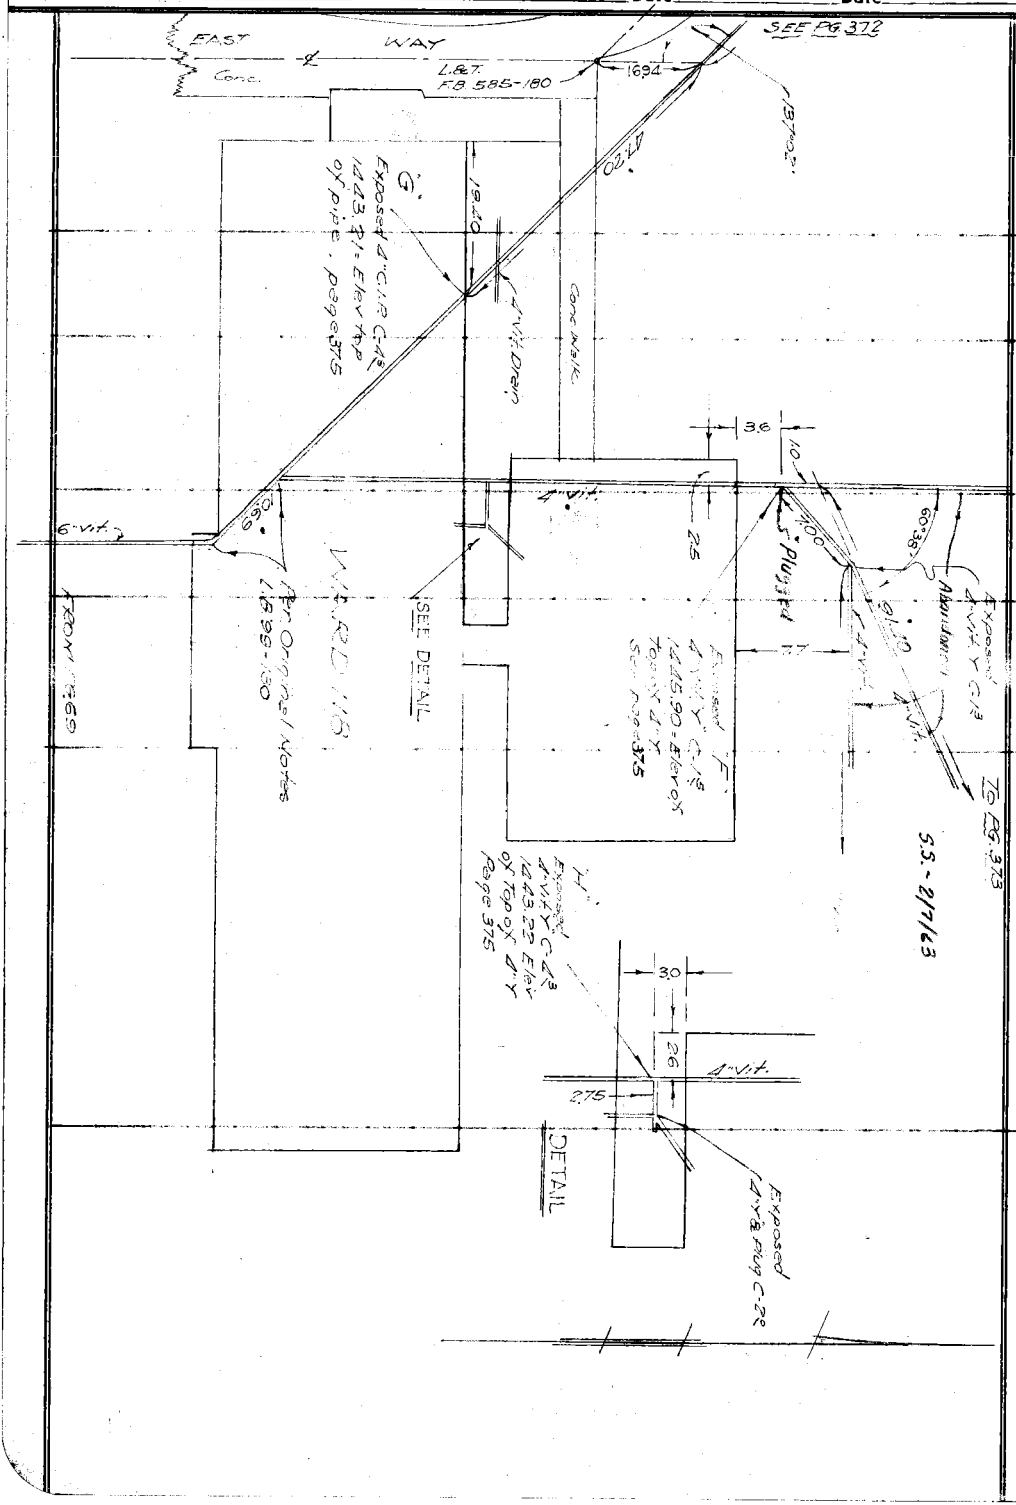

STATION | B. S. | H. I. | F. S. | ELEV.

Form 307 5M 10-37

PLEASE RETURN TO
LOS ANGELES COUNTY SURVEYOR
700 HALL OF RECORDS

Do not extend notes this side of this line

NOTE: ANY ADDITIONS OR CHANGES ON THIS SHEET MUST BE MADE OR CIRCLED IN RED INK, WITH DATE AND NAME OF PERSON MAKING CHANGE

Form 307 SM 10-37

PLEASE RETURN TO
LOS ANGELES COUNTY SURVEYOR
700 HALL OF RECORDS

NOTE: ANY ADDITIONS OR CHANGES ON THIS SHEET MUST BE MADE OR CIRCLED IN RED INK, WITH DATE AND NAME OF PERSON MAKING CHANGE

Do not extend notes this side of this line

STATION	B. S.	H. I.	F. S.	ELEV.

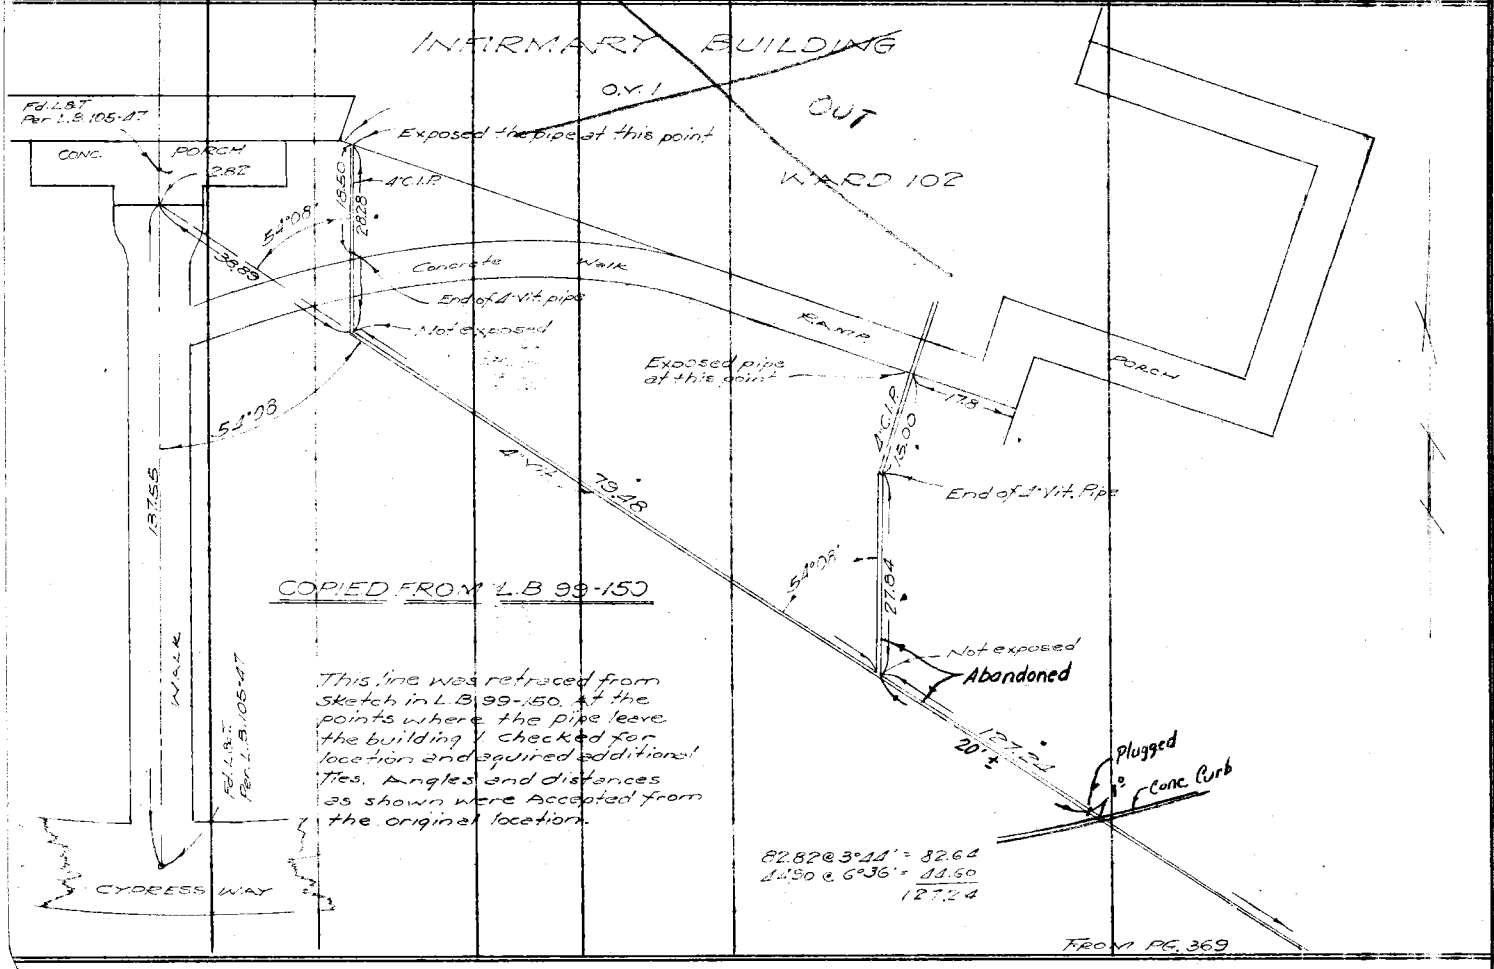

Profile

Notes Red. ____ Plotted Martin Job No. ____ Division No. ____

No. ____ Date ____ Date Aug. 1939 Survey of OLIVE VIEW SANATORIUM

X-Sec. ____ Notes Chkd. ____ Checked ____ Survey by T. WALSH Notes T. WALSH Date DEC 30 1937

No. ____ Date ____ Date ____ Map No. ____ Indexed ____ Date ____

F. B. 73 PG. 371

F. B 713 PG 372 ✓ | Job No. | Division No. | Notes Red. | Plotted Martin | Profile

Survey of OLIVE VIEW SANATORIUM | Date | Date Aug. 1939 | No.

Survey by TED WALSH | Notes T.M.W. | Notes Chkd. | Checked | X-Sec.

Indexed | Date JAN. 4, 1938 | Date | Date | No.

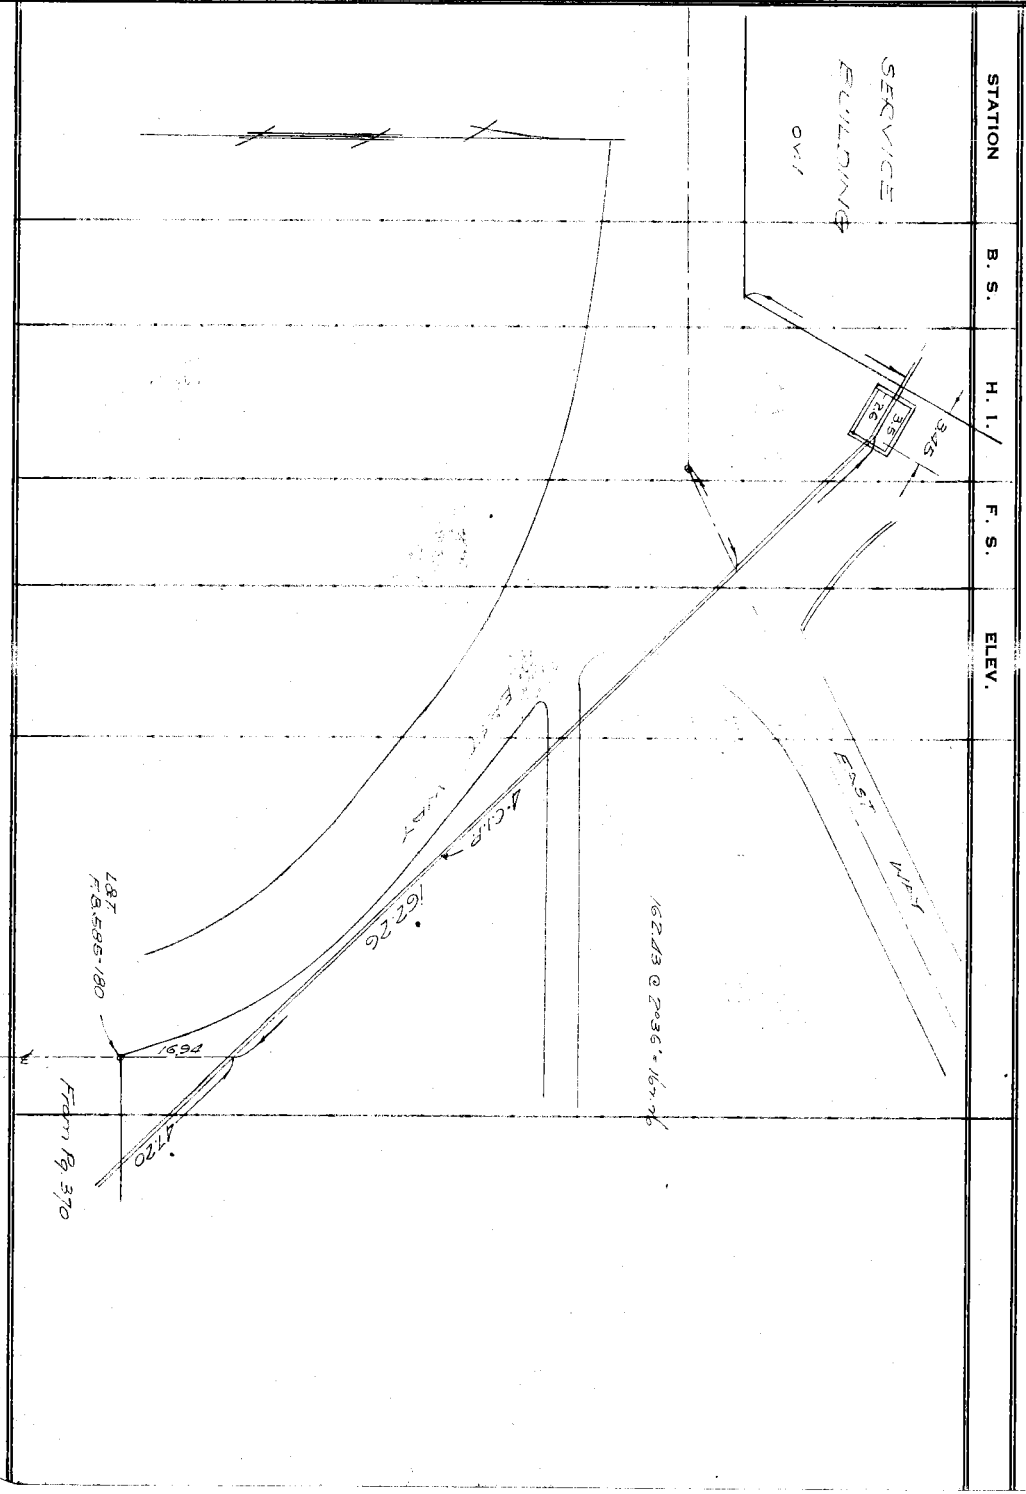

STATION | B. S. | H. I. | F. S. | ELEV.

Form 307 5M 10-37

PLEASE RETURN TO
LOS ANGELES COUNTY SURVEYOR
700 HALL OF RECORDS

Do not extend notes this side of this line

NOTE: ANY ADDITIONS OR CHANGES ON THIS SHEET MUST BE MADE OR CIRCLED IN RED INK, WITH DATE AND NAME OF PERSON MAKING CHANGE

Profile No. ____ X-Sec. No. ____

Notes Red. ____ Date ____ Notes Chkd. ____ Date ____

Plotted Martin Date Aug. 1939 Checked ____ Date ____

Job No. 818 Division No. ____ Survey of OLIVE VIEW SANITARIUM

Survey by TMW Notes TMW Map No. ____

Date DEC. 31, 1937 Indexed ____ Date ____

F. B. 713 PG. 373

NOTE: ANY ADDITIONS OR CHANGES ON THIS SHEET MUST BE MADE OR CIRCLED IN RED INK, WITH DATE AND NAME OF PERSON MAKING CHANGE

Do not extend notes this side of this line

PLEASE RETURN TO
LOS ANGELES COUNTY SURVEYOR
700 HALL OF RECORDS

Form 307 5M 10-37

STATION | B. S. | H. I. | F. S. | ELEV.

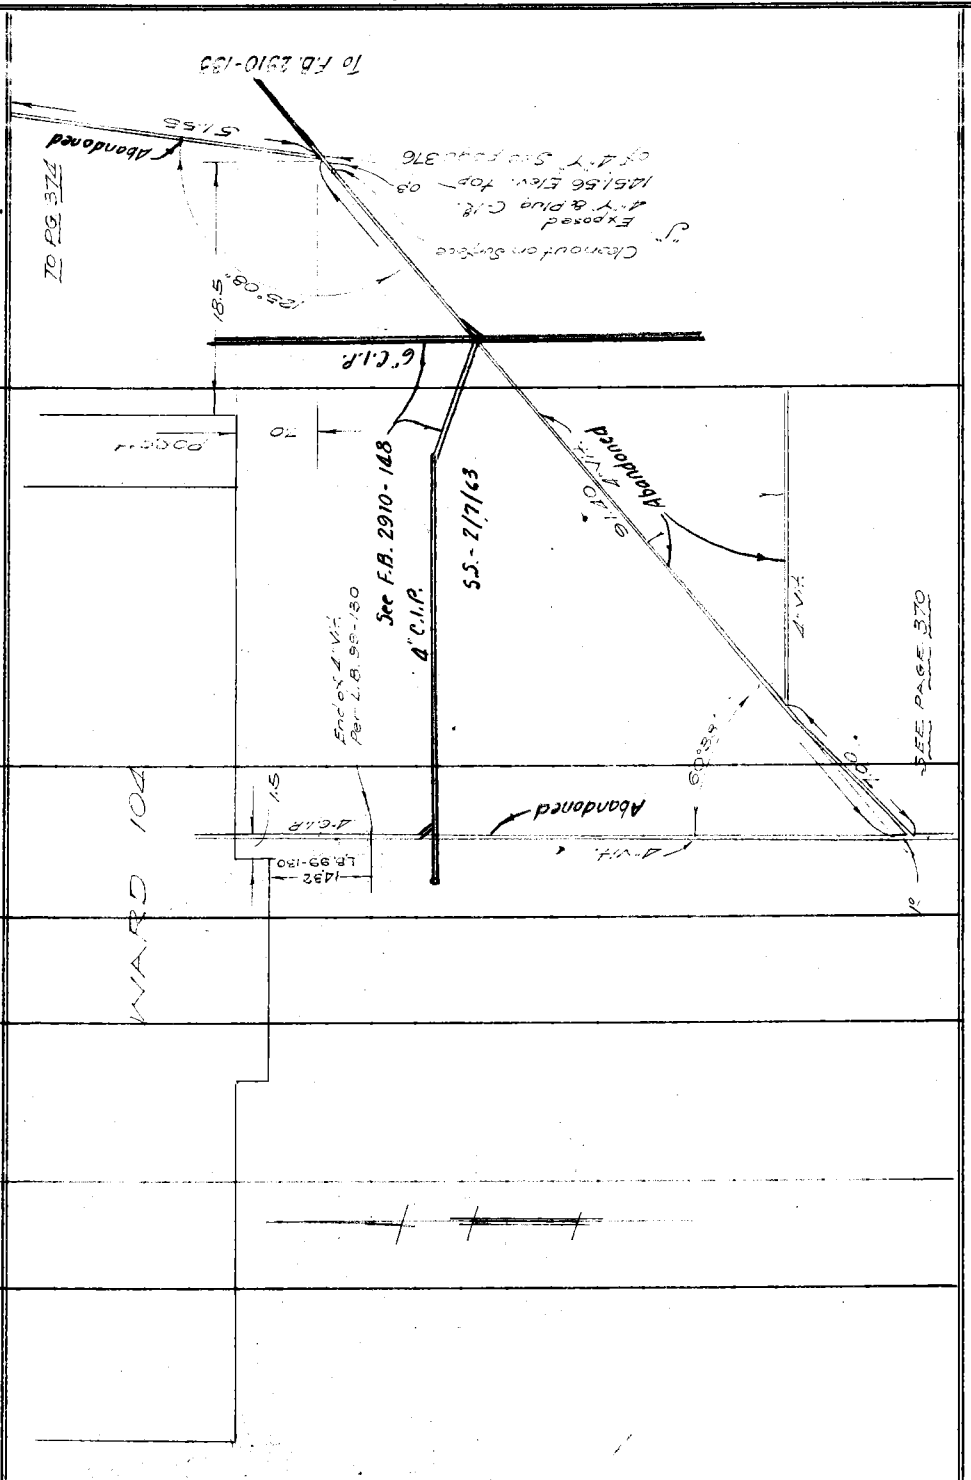

F. B. 713 PG 374 V | Job No. 8/28 | Division No. | Notes Red. | Plotted Martin | Profile

Survey of OLIVE VIEW SANATORIUM | Date | Date Aug. 1939 | No.

Survey by T. WALSH | Notes T. M. W | Notes Chkd. | Checked | X-Sec.

Indexed | Date JAN. 19, 1938 | Date | Date | No.

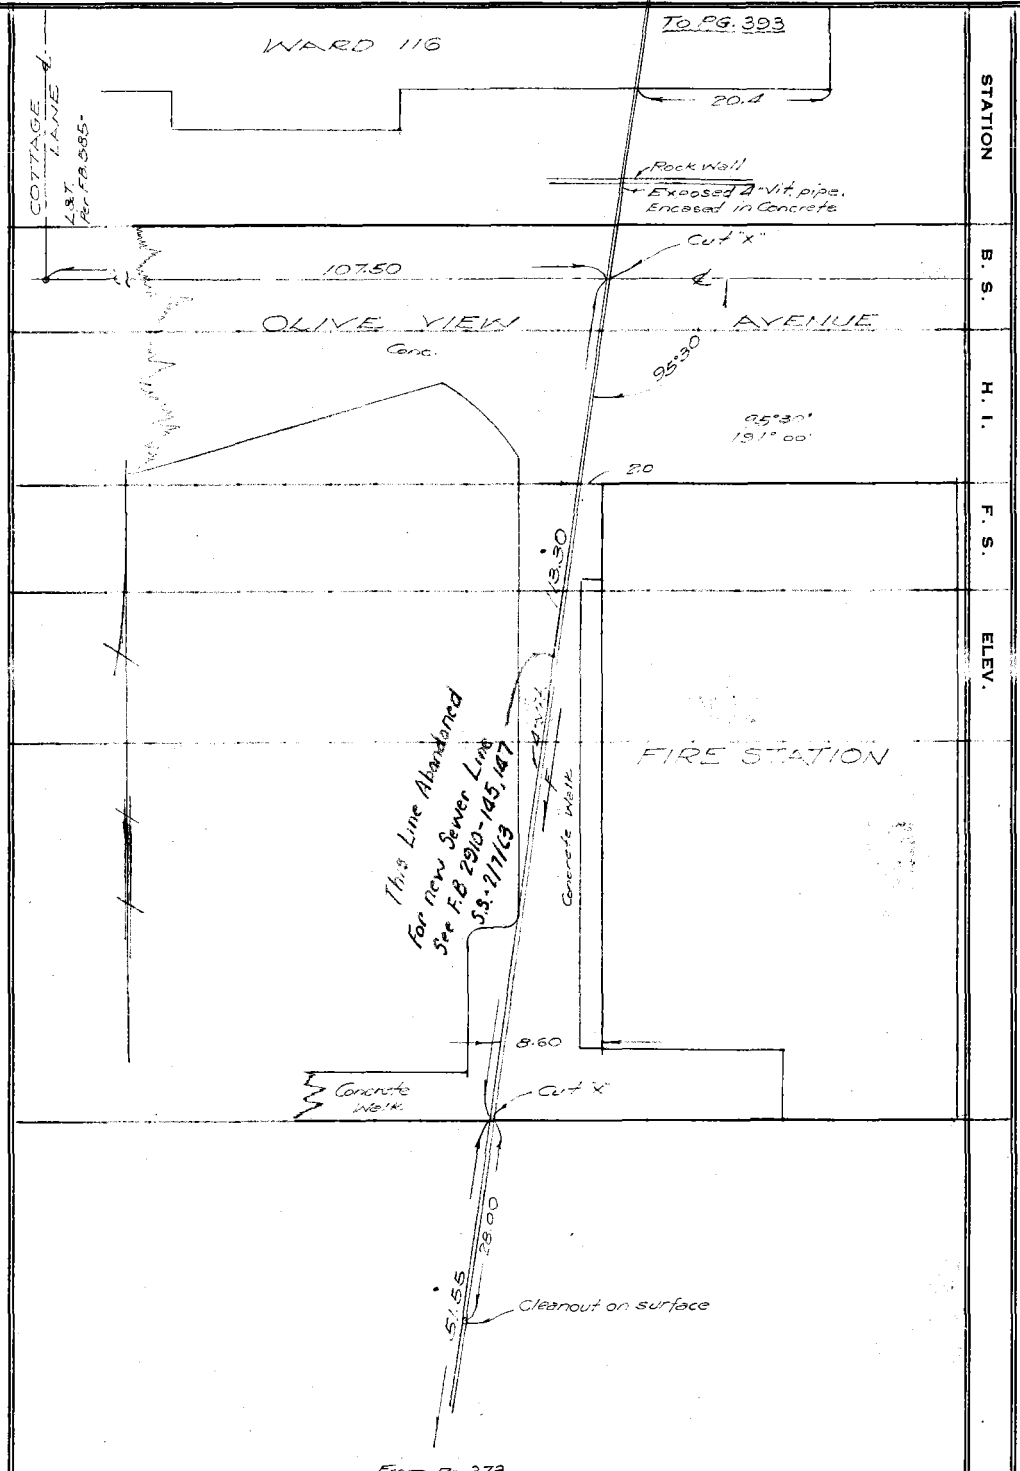

STATION | B. S. | H. I. | F. S. | ELEV.

Form 307 5M 10-37

PLEASE RETURN TO
LOS ANGELES COUNTY SURVEYOR
700 HALL OF RECORDS

Do not extend notes this side of this line

NOTE: ANY ADDITIONS OR CHANGES ON THIS SHEET MUST BE MADE OR CIRCLED IN RED INK, WITH DATE AND NAME OF PERSON MAKING CHANGE

Form 307 5M 10-37

PLEASE RETURN TO
LOS ANGELES COUNTY SURVEYOR
700 HALL OF RECORDS

NOTE: ANY ADDITIONS OR CHANGES ON THIS SHEET MUST BE MADE OR CIRCLED IN RED INK, WITH DATE AND NAME OF PERSON MAKING CHANGE

Do not extend notes this side of this line

STATION	B. S.	H. I.	F. S.	ELEV.		
BM #11				1456 63	BM No 11 Cross in top of stairs to basement	
	5 40	1462 03			N. Side of Ward 103 F.B. 585-16	
			6 63	1455 40		
	2 26	1457 66				
Point "A"			9 75	1447 91	Top of 4" Vit.	Page 367
Point "B"			14 96	1442 70	Top of 4" Vit.	✓
Point "C"			15 66	1442 00	Top of 4" Vit. Y	✓
Point "D"			14 91	1442 75	Top of 4" C.I.P. where 4" C.I.P. joins 4" Vit. at Point "C"	Page 367
			8 58	1449 08		
	2 69	1451 77	1 76	1450 01		
	9 00	1459 01				
Point "E"			9 95	1449 06	Top of 6" Vit	Page 366
BM S-3A			1 42	1457 59	BM S-3A L.S.T. ℄ of Infirmary Bldg. on So. porch 3' North of top of Steps.	
	1 49	1459 08				
			8 89	1450 19		
	1 99	1452 18				
Point "F"			6 28	1445 90	Top of 4" Y	Page 370
Point "G"			8 97	1443 21	Top of 4" C.I.P.	Page 370
Point "H"			8 96	1443 22	Top of 4" Y	Page 370
			1 36	1450 82		
	7 13	1457 95				

Profile No. ____ Notes Red. ____ Plotted ____ Job No. 8178 Division No. ____ F.B. 713 Pg. 375
X-Sec. No. ____ Date ____ Date ____ Survey of OLIVE VIEW SANATORIUM
Notes Chkd. Martin Checked ____ Survey by T. WALSH Notes T.M.W. Date DEC 31, 1937
Date 8-8-39 Date ____ Map No. ____ Indexed ____ Date ____

Form 307 5M 10-37

PLEASE RETURN TO
LOS ANGELES COUNTY SURVEYOR
700 HALL OF RECORDS

NOTE: ANY ADDITIONS OR CHANGES ON THIS SHEET MUST BE MADE OR CIRCLED IN RED INK, WITH DATE AND NAME OF PERSON MAKING CHANGE

Do not extend notes this side of this line

STATION	B. S.	H. I.	F. S.	ELEV.		
		1457 95				
Point "J"			6 39	1451 56	Top of 4" Y	Page 373
			1 52	1456 43		
	5 60	1462 03				
T.P.			5 43	1456 60	T.P. L.&T. Inter. ℄ Olive View Ave & Cottage Lane	
					F.B 585-16	1456.595

F. B. 713 Pg. 376 Job No. 8148 Division No. Notes Red. Plotted Profile
Survey of OLIVE VIEW SANATORIUM Date Date No.
Survey by T. WALSH Notes T.M.W Notes Chkd. Martin Checked X-Sec.
Indexed Date DEC. 31, 1937 Date 8-8-39 Date No.

Profile No.	Notes Red.	Plotted Martin	Job No. 8148	Division No.	F. B. 713 Pg. 377
	Date	Date Aug. 1939	Survey of OLIVE VIEW SANATORIUM		
X-Sec. No.	Notes Chkd.	Checked	Survey by T. WALSH	Notes T.M.W.	Date JAN. 6, 1938
	Date	Date	Map No.	Indexed C. Johnson	Date

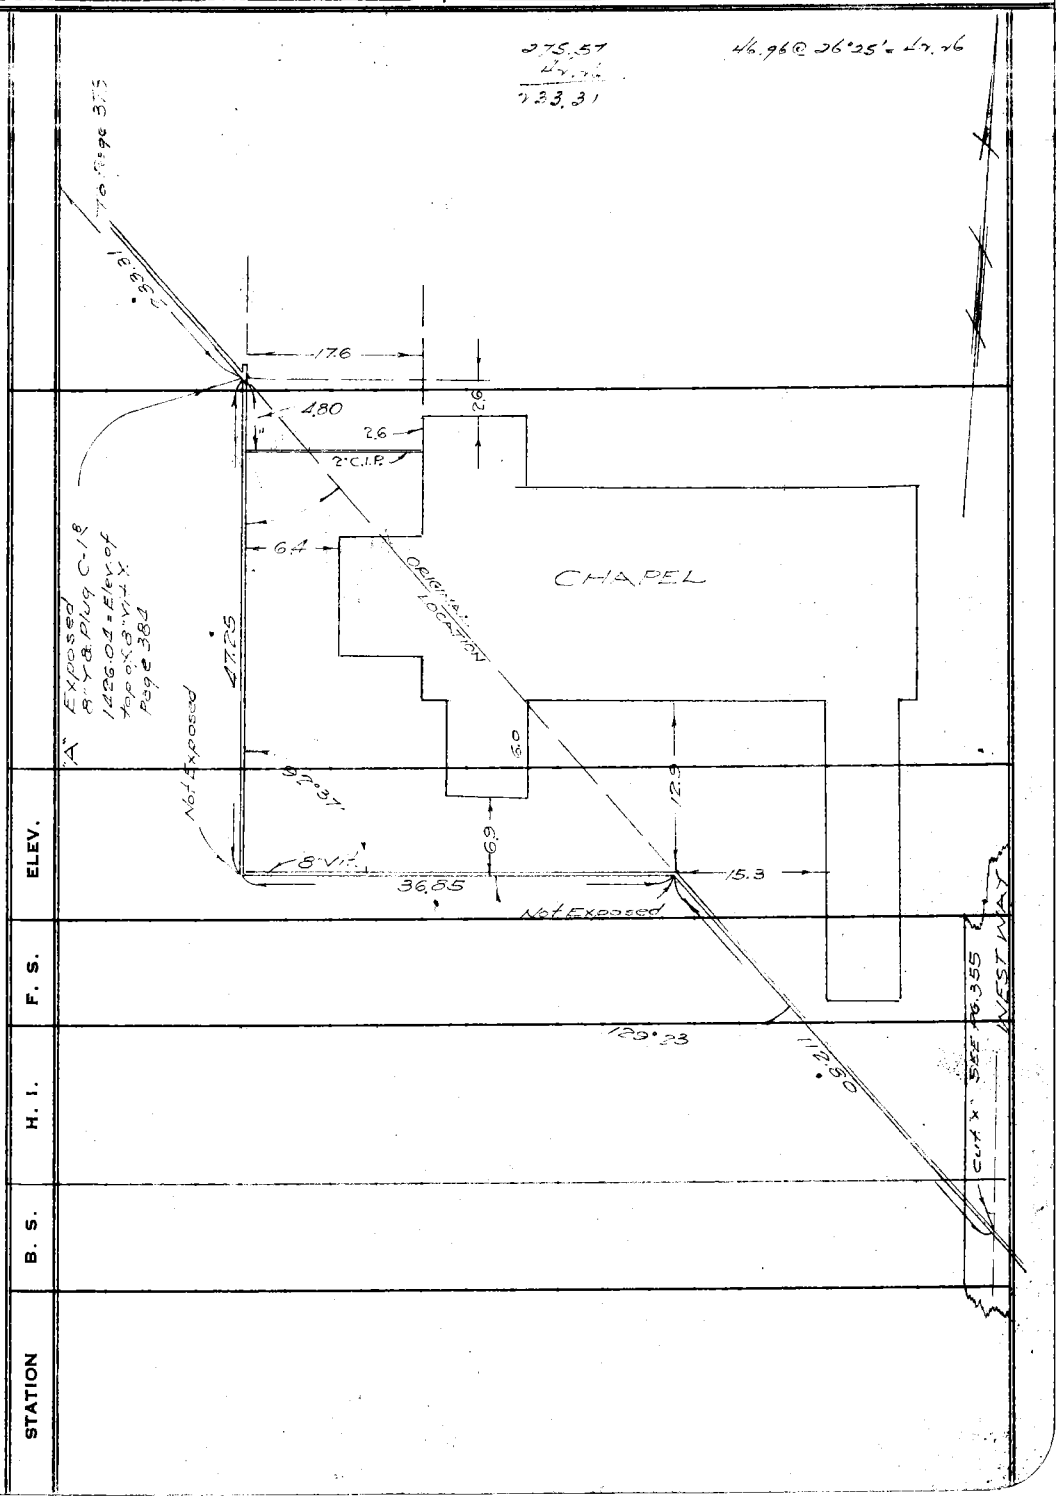

NOTE: ANY ADDITIONS OR CHANGES ON THIS SHEET MUST BE MADE OR CIRCLED IN RED INK, WITH DATE AND NAME OF PERSON MAKING CHANGE

Do not extend notes this side of this line

PLEASE RETURN TO
LOS ANGELES COUNTY SURVEYOR
700 HALL OF RECORDS

Form 307 5M 10-37

F. B. 713 PG378 ✓ | Job No. 8178 | Division No. | Notes Red. | Plotted Martin | Profile

Survey of OLIVE VIEW SANATORIUM | Date | Date Aug. 1939 | No.

Survey by TED. WALSH | Notes T.M.W. | Notes Chkd. | Checked | X-Sec.

Indexed | Date JAN. 6 1938 | Date | Date | No.

Form 307 5M 10-37

PLEASE RETURN TO
LOS ANGELES COUNTY SURVEYOR
700 HALL OF RECORDS

NOTE: ANY ADDITIONS OR CHANGES ON THIS SHEET MUST BE MADE OR CIRCLED IN RED INK, WITH DATE AND NAME OF PERSON MAKING CHANGE

Do not extend notes this side of this line

STATION | B. S. | H. I. | F. S. | ELEV.

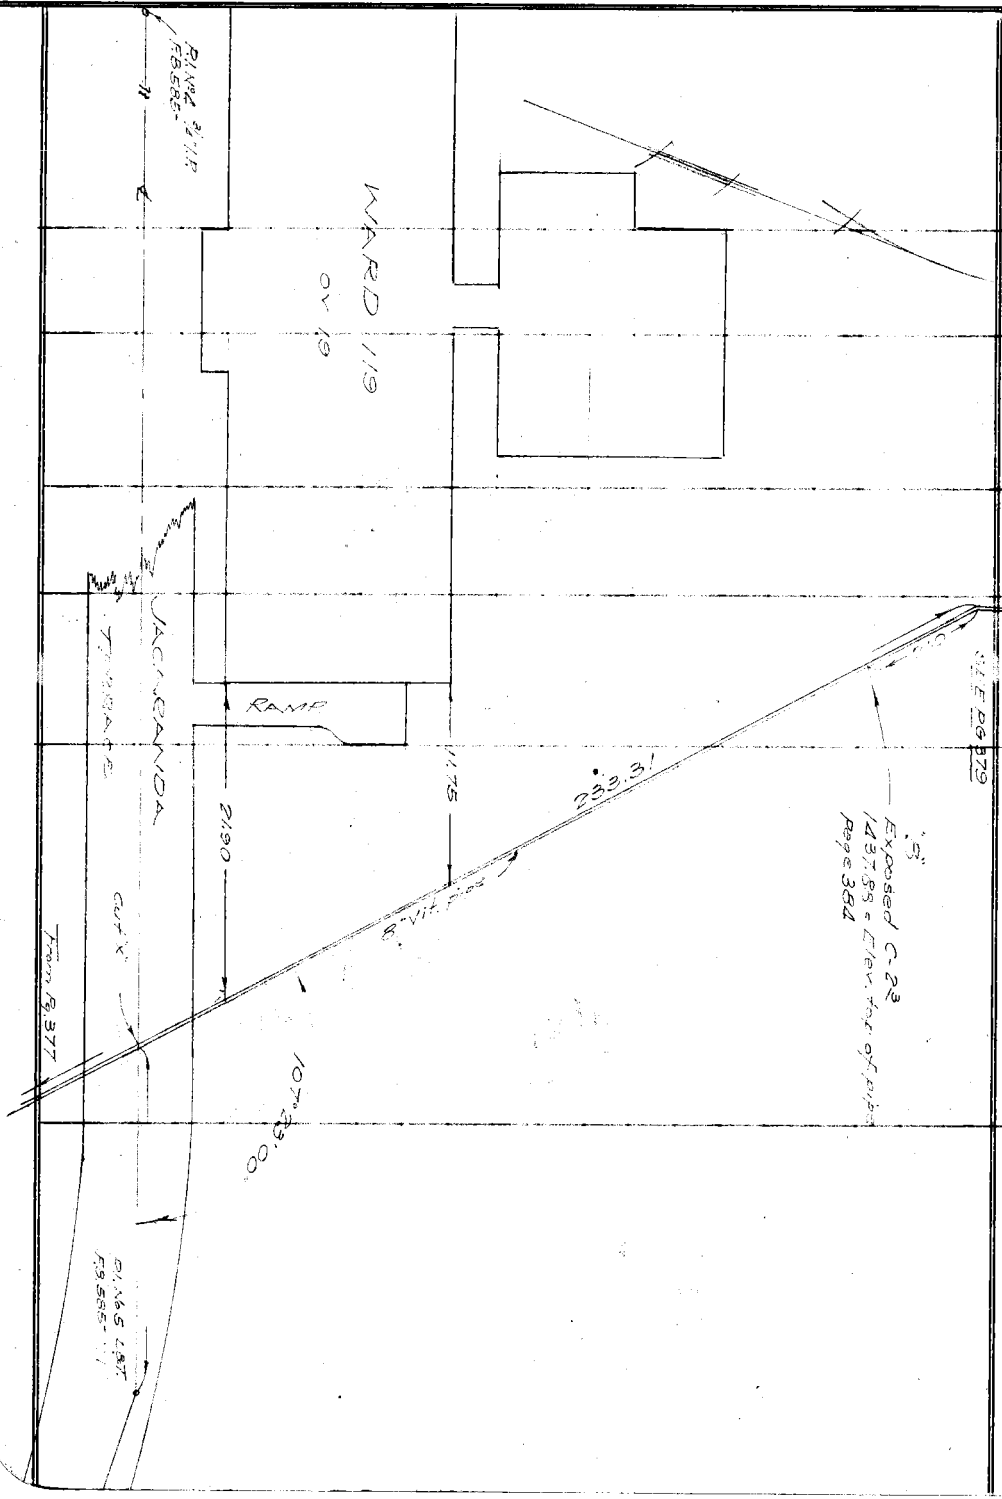

Profile No.	Notes Red.	Plotted Martin	Job No. 8148	Division No.
	Date	Date Aug. 1939	Survey of OLIVE VIEW SANATORIUM	
X-Sec. No.	Notes Chkd.	Checked	Survey by T. WALSH	Notes T.M.W. Date JAN. 5 1938
	Date	Date	Map No.	Indexed Date

F. B. 713 PG. 379

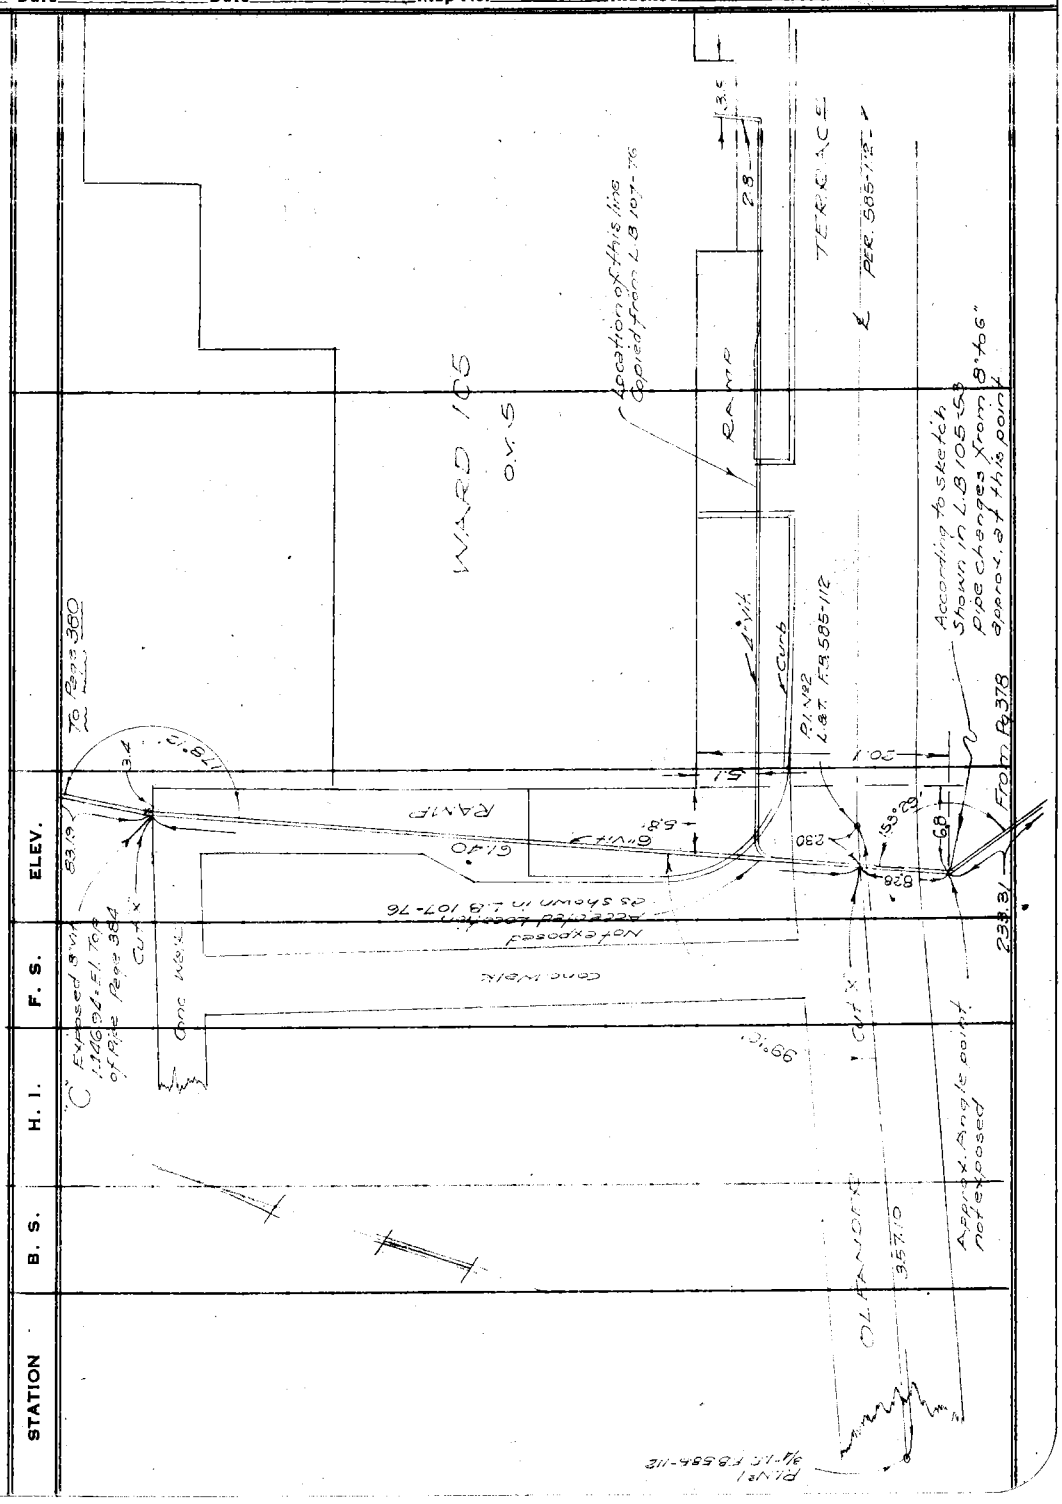

NOTE: ANY ADDITIONS OR CHANGES ON THIS SHEET MUST BE MADE OR CIRCLED IN RED INK, WITH DATE AND NAME OF PERSON MAKING CHANGE

Do not extend notes this side of this line

PLEASE RETURN TO
LOS ANGELES COUNTY SURVEYOR
700 HALL OF RECORDS

Form 307 5M 10-37

Form 307 5M 10-37

PLEASE RETURN TO
LOS ANGELES COUNTY SURVEYOR
700 HALL OF RECORDS

NOTE: ANY ADDITIONS OR CHANGES ON THIS SHEET MUST BE MADE OR CIRCLED IN RED INK, WITH DATE AND NAME OF PERSON MAKING CHANGE

Do not extend notes this side of this line

F.B. 713 Pg 380 | Job No. 8178 | Division No. | Notes Red. | Plotted Martin | Profile
Survey of OLIVE VIEW SANATORIUM | Date | Date Aug. 1939 | No.
Survey by T. M. KIALSH | Notes T. KIALSH | Notes Chkd. | Checked | X-Sec.
Indexed | Date JAN. 6 1938 | Date | Date | No.

STATION	B. S.	H. I.	F. S.	ELEV.

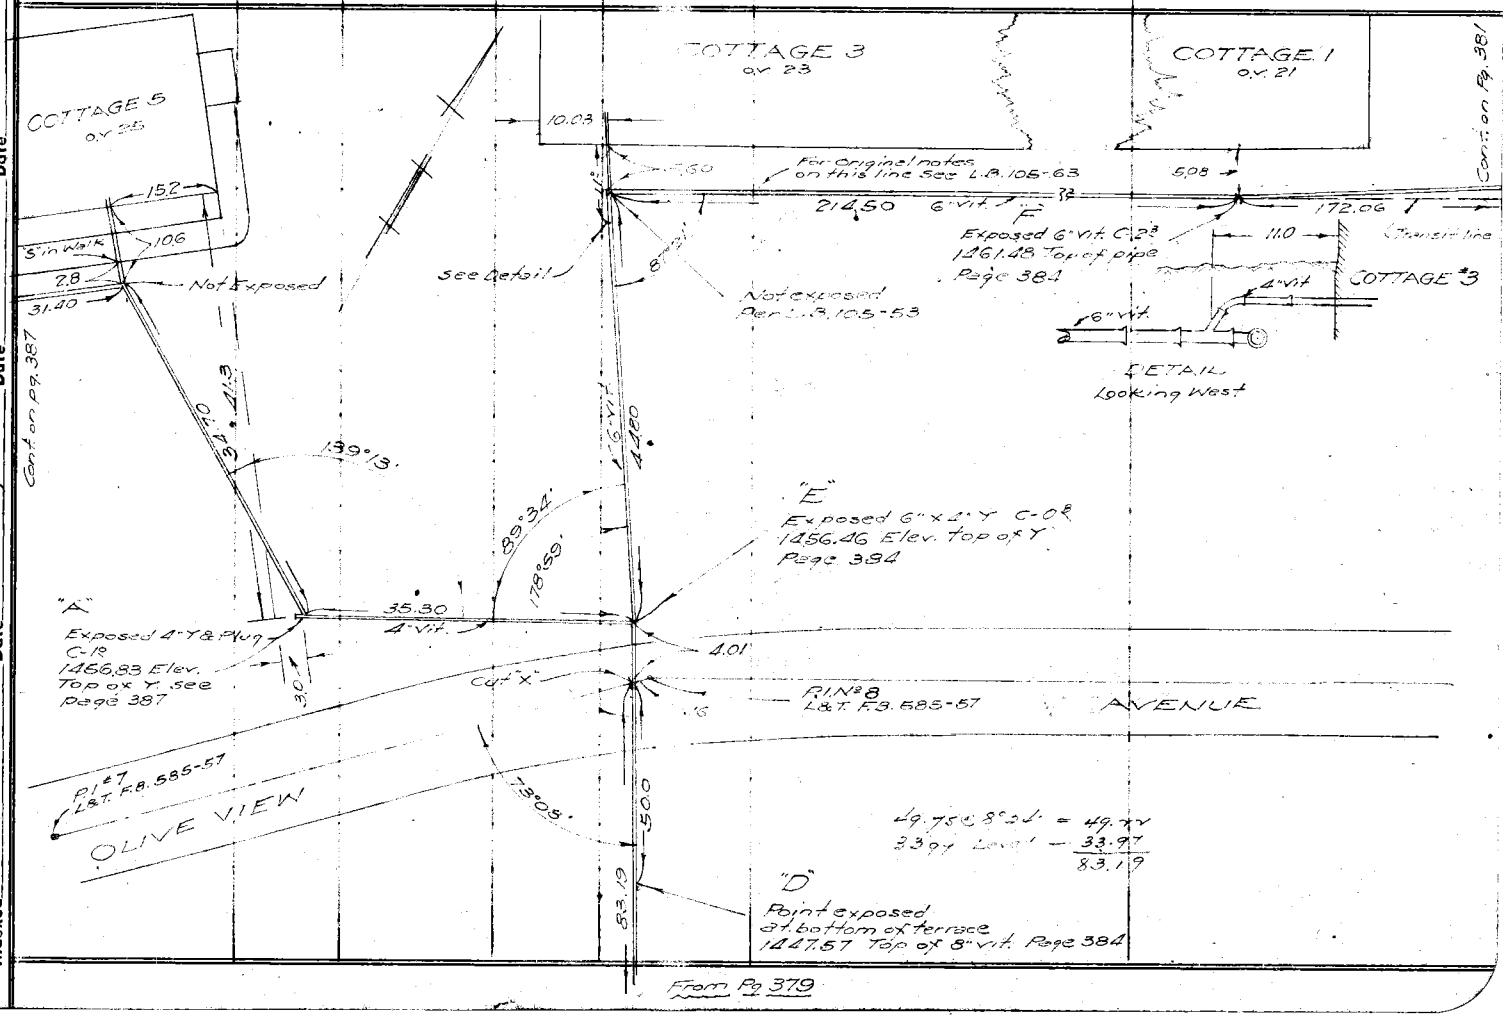

From Pg 379

Profile	Notes Red.	Plotted Martin	Job No. 8178	Division No.	F. B. 713 PG. 381 ✓
No.	Date	Date Aug. 1939	Survey of OLIVE VIEW SANATORIUM		
X-Sec.	Notes Chkd.	Checked	Survey by T. WALSH	Notes T.M.W.	Date JAN 4, 1938
No.	Date	Date	Map No.	Indexed A. [illegible]	Date

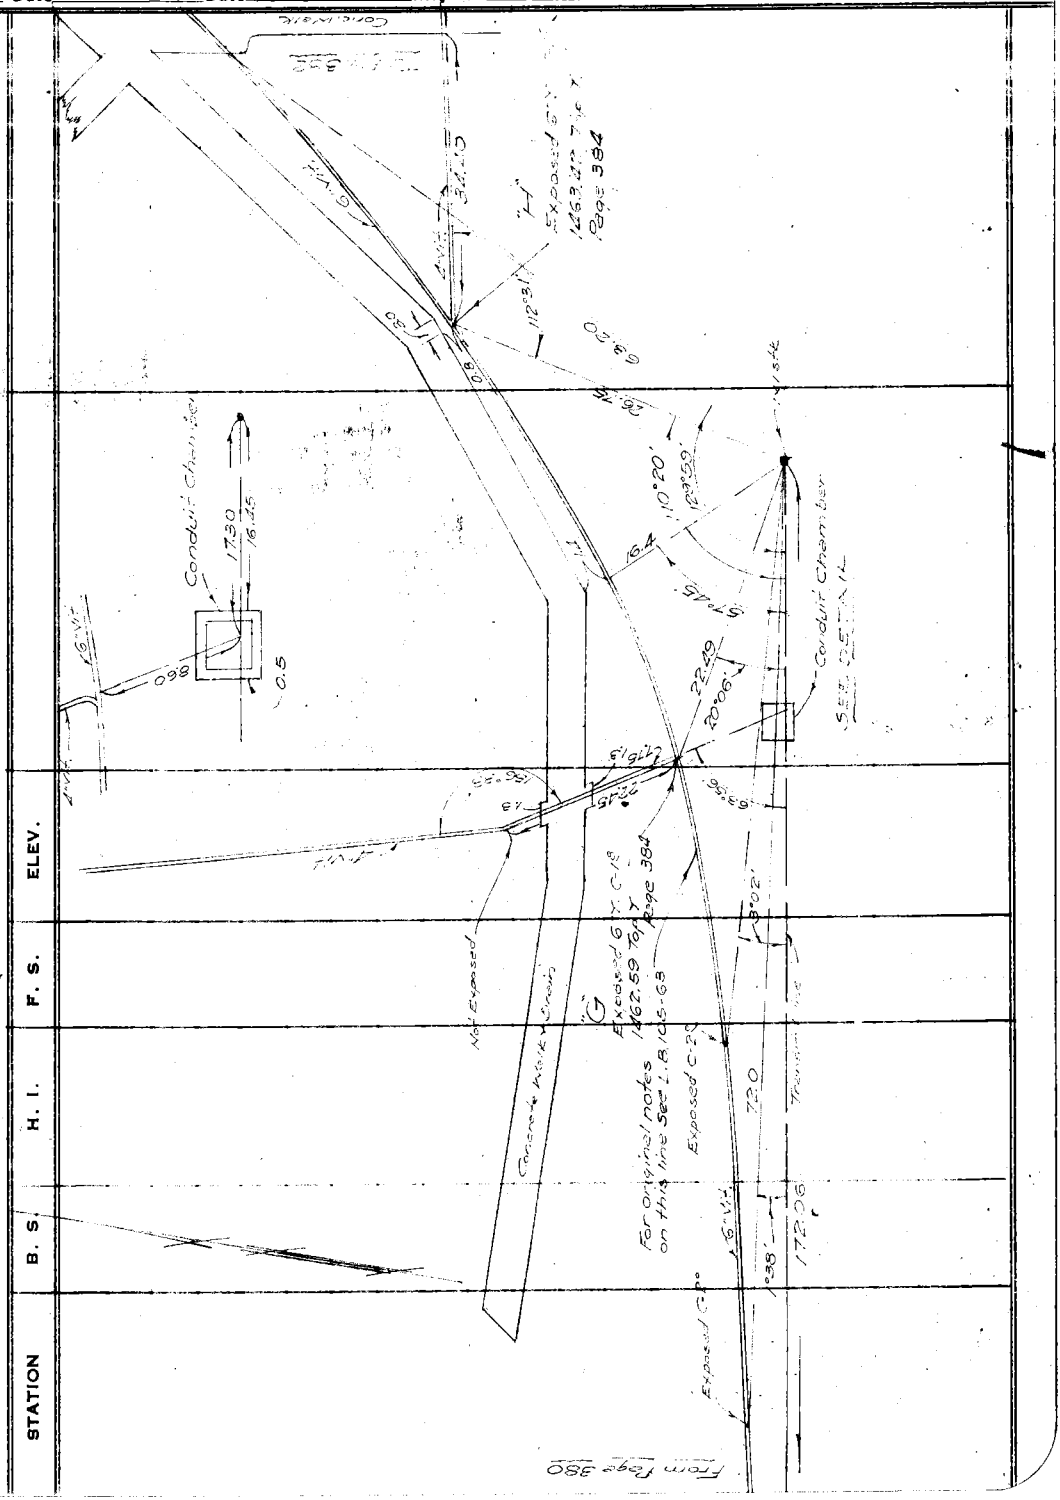

NOTE: ANY ADDITIONS OR CHANGES ON THIS SHEET MUST BE MADE OR CIRCLED IN RED INK, WITH DATE AND NAME OF PERSON MAKING CHANGE

Do not extend notes this side of this line

PLEASE RETURN TO
LOS ANGELES COUNTY SURVEYOR
700 HALL OF RECORDS

Form 307 5M 10-37

F. B. 713 Pg 382 | Job No. 8178 | Division No. | Notes Red. | Plotted Martin | Profile

Survey of OLIVE VIEW SANATORIUM | Date | Date Aug. 1939 | No.

Survey by I. WALSH | Notes T.M.W. | Notes Chkd. | Checked | X-Sec.

Indexed | Date JAN 4, 1938 | Date | Date | No.

Form 307 5M 10-37

PLEASE RETURN TO
LOS ANGELES COUNTY SURVEYOR
700 HALL OF RECORDS

Do not extend notes this side of this line

NOTE: ANY ADDITIONS OR CHANGES ON THIS SHEET MUST BE MADE OR CIRCLED IN RED INK, WITH DATE AND NAME OF PERSON MAKING CHANGE

STATION | B. S. | H. I. | F. S. | ELEV.

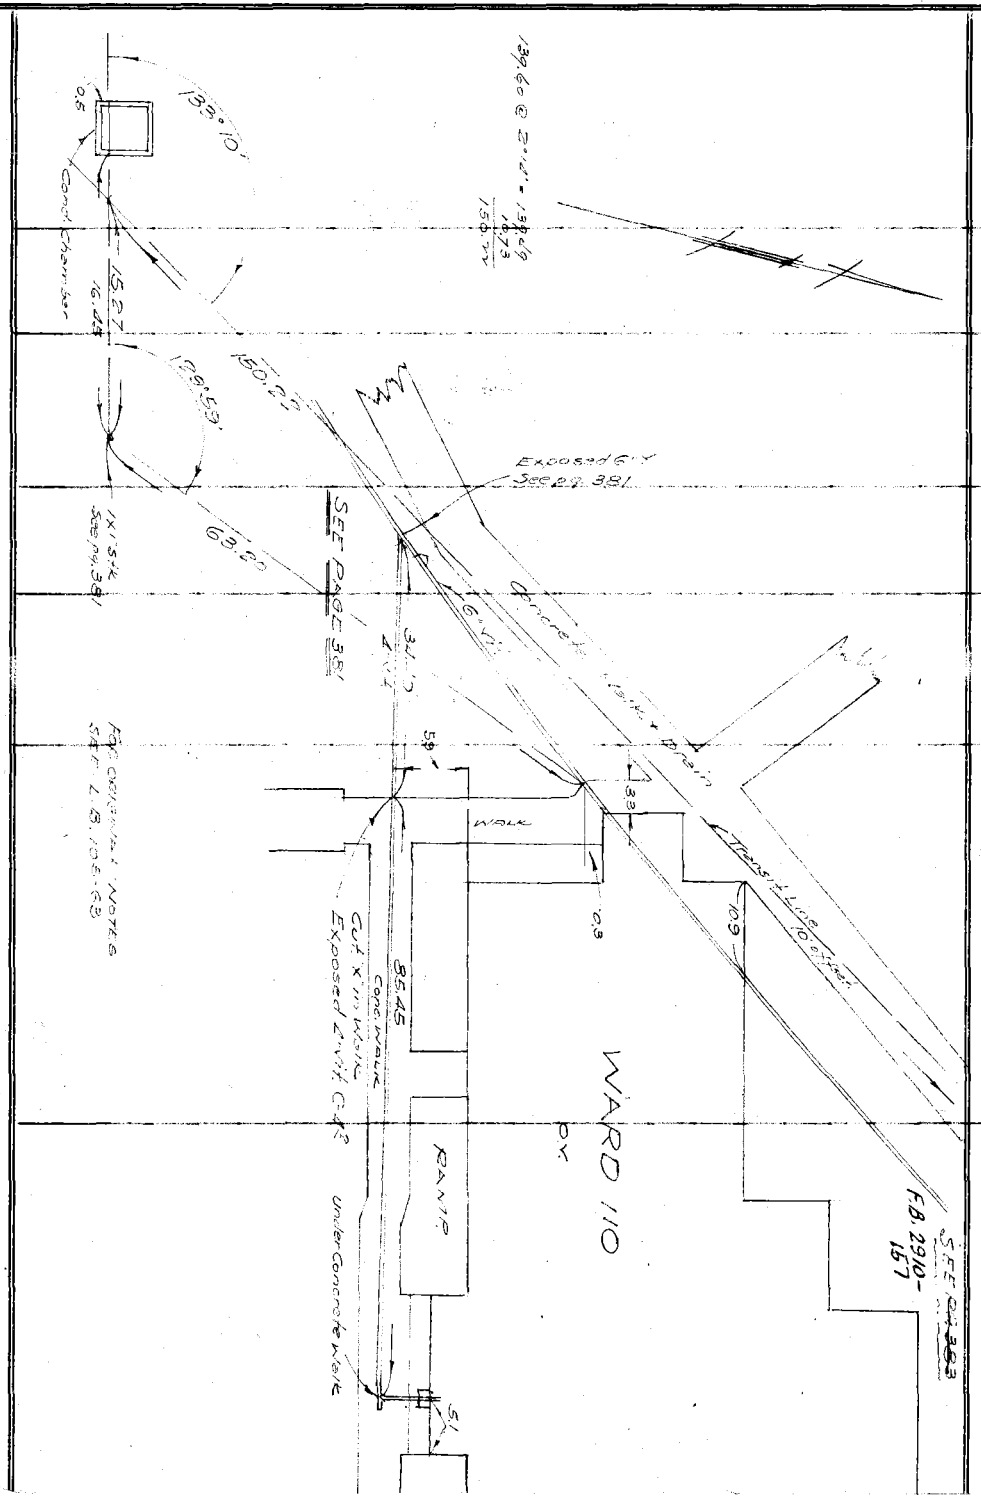

Form 307 5M 10-37

PLEASE RETURN TO
LOS ANGELES COUNTY SURVEYOR
700 HALL OF RECORDS

NOTE: ANY ADDITIONS OR CHANGES ON THIS SHEET MUST BE MADE OR CIRCLED IN RED INK, WITH DATE AND NAME OF PERSON MAKING CHANGE

Do not extend notes this side of this line

STATION	B. S.	H. I.	F. S.	ELEV.

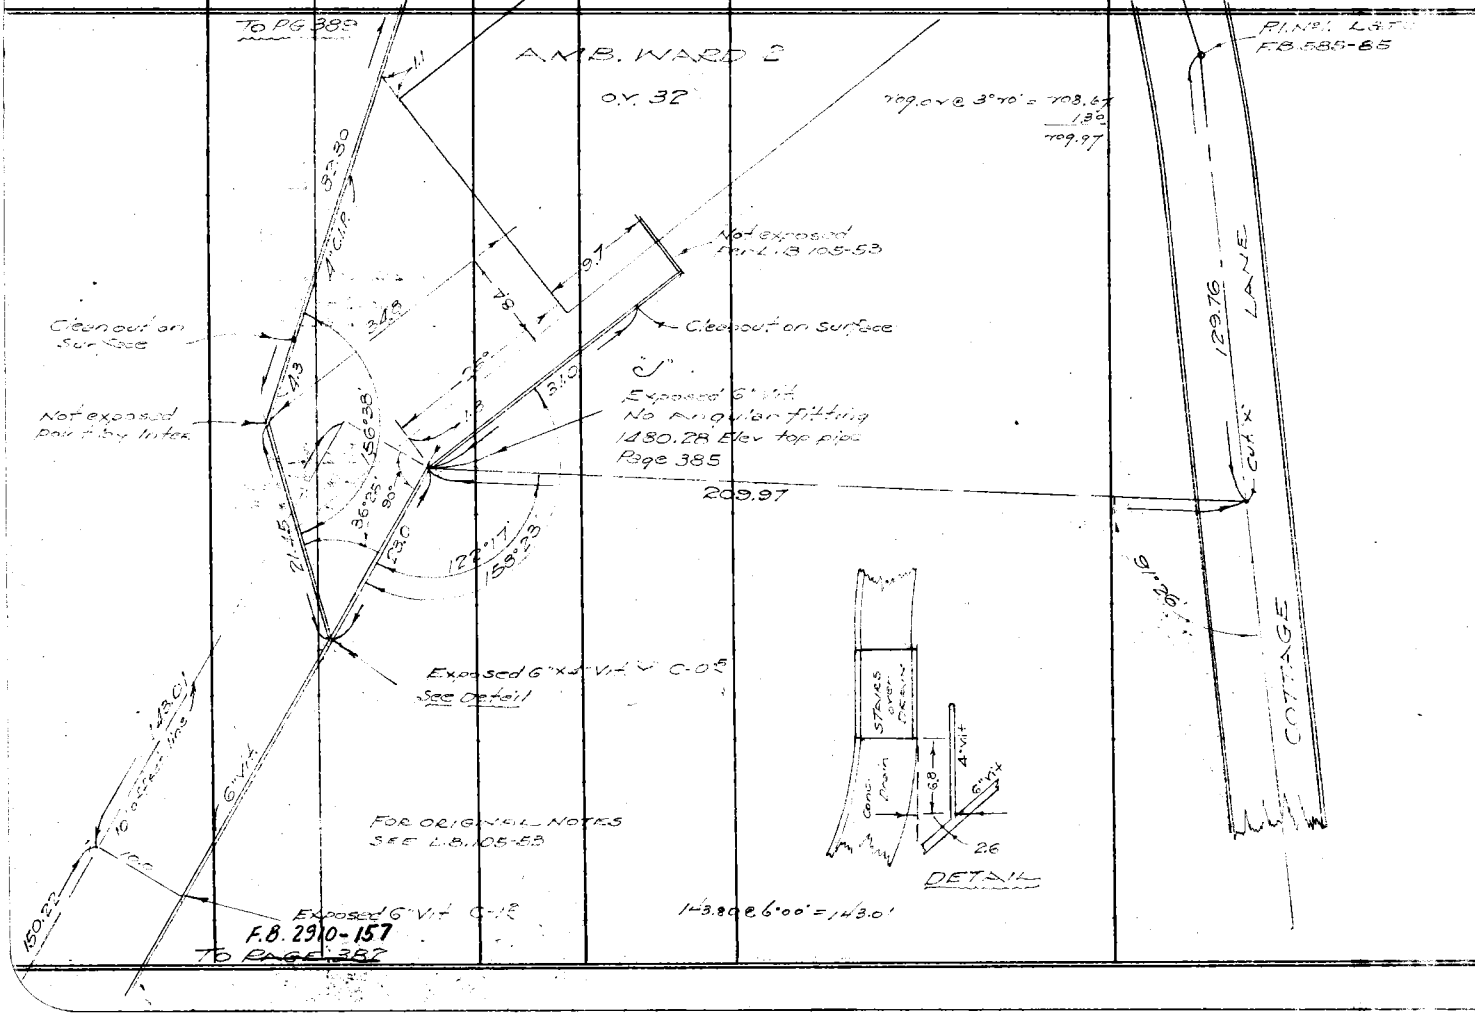

Profile No. ____ Notes Red. ____ Plotted Martin Job No. 8178 Division No. ____ F. B. 713 PG. 383

X-Sec. No. ____ Date ____ Date Aug. 1939 Survey of [illegible] Notes [illegible] Date JAN 14 1938

Notes Chkd. ____ Checked ____ Survey by [illegible] Date ____

Date ____ Date ____ Map No. ____ Indexed [illegible] Date ____

Form 307 5M 10-37

PLEASE RETURN TO
LOS ANGELES COUNTY SURVEYOR
700 HALL OF RECORDS

NOTE: ANY ADDITIONS OR CHANGES ON THIS SHEET MUST BE MADE OR CIRCLED IN RED INK, WITH DATE AND NAME OF PERSON MAKING CHANGE

Job No. ____ Division No. ____ Notes Red. ____ Plotted ____ Profile
Survey of ____ Notes ____ Date ____ Notes Chkd. Martin Date 8-8-39 Checked ____ Date ____ X-Sec. No.
Survey by ____ Date ____
Indexed ____

F.B. 713 PG 384

Do not extend notes this side of this line

STATION	B. S.	H. I.	F. S.	ELEV.		
T.P. #2				1423.40	Bucher Ave Approx. 40' E. of E. face of Administration Bldg 6'N. of N. edge of pvmt	F.B. 585-5
	756	1430 96	313	1423 83		
"A"	1098	1438 81	1277	1426 04	Top of 8" Vit. Y	Page 377
			080	1430 01		
"B"	519	1443 20	532	1437 68	Top of 8" Vit.	Page 378
			049	1443 71		
"C"	1207	1451 78	784	1443 94	Top of 8" Vit.	Page 379
"D"			721	1447 57	Top of 8" Vit.	Page 380
			051	1451 27		
	827	1462 54				
T.P.			5.21	1457 33	L.&T. = F.1"B. Olive View Ave	
"E"			608	1456 46	Top of 6" Vit. Y	Page 380
			492	1457 62		
	588	1463.50	327	1460 23		
"F"	842	1468 65	717	1461 48	Top of 6" Vit.	Page 380
"G"			606	1462 59	Top of 6" Y	Page 381
"H"			523	1463 42	Top of 6" Y	do
			1.11	1467 54		
	506	1472 60	022	1472 38		
	1170	1484 08	036	1483 72		

PG 385

Form 307 5M 10-37

PLEASE RETURN TO
LOS ANGELES COUNTY SURVEYOR
700 HALL OF RECORDS

NOTE: ANY ADDITIONS OR CHANGES ON THIS SHEET MUST BE MADE OR CIRCLED IN RED INK, WITH DATE AND NAME OF PERSON MAKING CHANGE

Do not extend notes this side of this line

STATION	B. S.	H. I.	F. S.	ELEV.		
				1483 72		
"J"	5 56	1489 28	9 00	1480 28	Top of 6" Vit.	Page 383
BM S-4			5 00	1484 28	BM S-4 40' West Amb. Ward 2. (OV. 32)	
	5 56	1489 84	0 28	1489 56	Chiseled "□" in top of steps.	
	4 08	1493 64				
BM #.14			10 32	1483 32	Cobalt Ave. 70'± So. of So. face of Warehouse	
					Chiseled □ in E. Curb.	F.B 585-18

Profile Notes Red. Plotted Job No. 8148 Division No. F. B. 713 PG. 385
No. Date Date Survey of [illegible] SANATORIUM
X-Sec. Notes Chkd. Martin Checked Survey by T. WELSH Notes T.N.W. Date Jan 6, 1938
No. Date 8-8-39 Date Map No. Indexed A. C. [illegible] Date

F. B. 713 PG. 386 | Job No. | Division No. | Notes Red. | Plotted | Profile

Survey of | Date | Date | No.

Survey by | Notes | Notes Chkd. | Checked | X-Sec.

Indexed | Date | Date | Date | No.

STATION	B. S.	H. I.	F. S.	ELEV.	

Form 307 SM 10-37

PLEASE RETURN TO
LOS ANGELES COUNTY SURVEYOR
700 HALL OF RECORDS

Do not extend notes this side of this line

NOTE: ANY ADDITIONS OR CHANGES ON THIS SHEET MUST BE MADE OR CIRCLED IN RED INK, WITH DATE AND NAME OF PERSON MAKING CHANGE

Form 307 5M 10-37

PLEASE RETURN TO
LOS ANGELES COUNTY SURVEYOR
700 HALL OF RECORDS

NOTE: ANY ADDITIONS OR CHANGES ON THIS SHEET MUST BE MADE OR CIRCLED IN RED INK, WITH DATE AND NAME OF PERSON MAKING CHANGE

Do not extend notes this side of this line

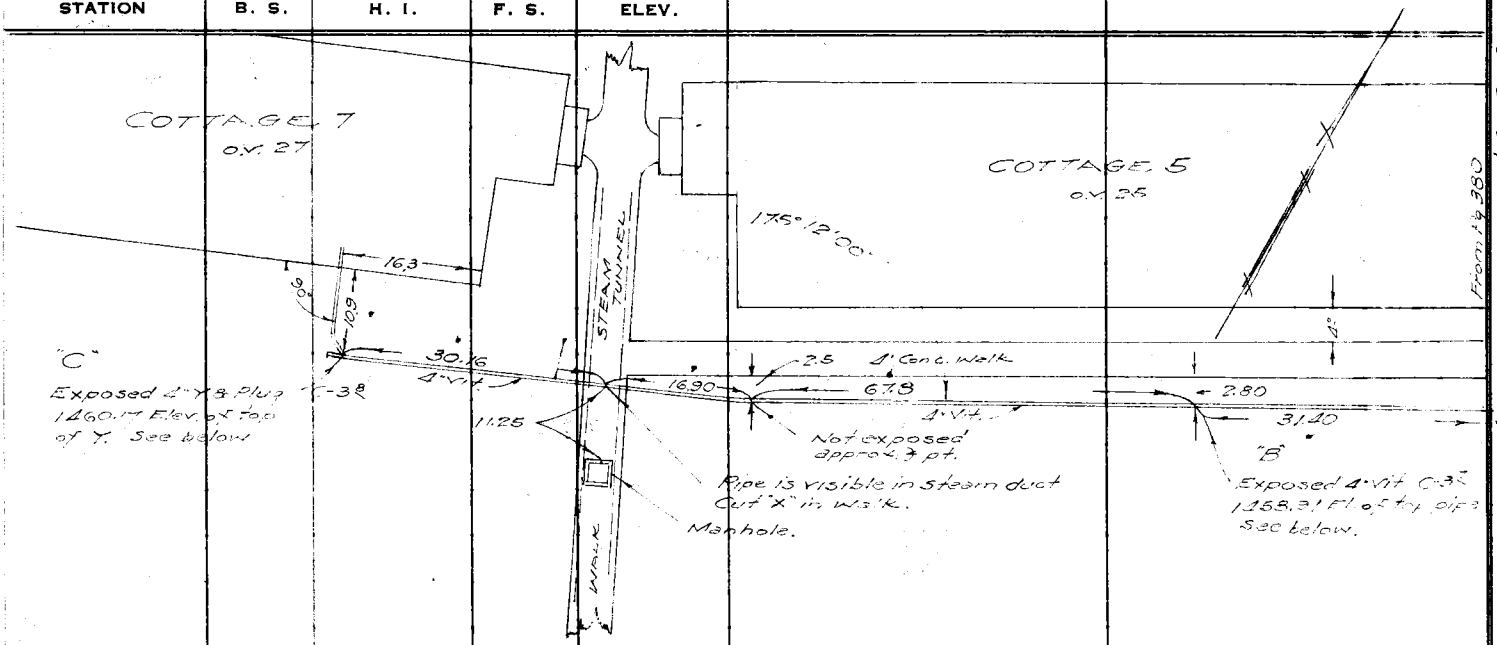

STATION	B. S.	H. I.	F. S.	ELEV.		
BM No 12				1457 62	BM.	BM. No 12 Opposite E. end of Cottage 5 (O.V. 25) L.& N. in N.E. Corner of M.H. on L.A. Aqueduct S. side of Olive View Ave. F.B. 585-17
	10 46	1468 08				
"A"			11 25	1456 83	Top of 4" Y Page 380	
"B"			9 17	1458 91	Top of 4" Pipe ✓ 387	
"C"			7 91	1460 17	Top of 4" Y ✓ 387	
BM #12			10 46	1457 62	See Above	

Profile No. ____ Notes Red. ____ Plotted Martin Job No. 8148 Division No. ____ F. B. 713 Pg. 387
Date ____ Date Aug. 1939 Survey of OLIVE VIEW SANATORIUM
X-Sec. No. ____ Notes Chkd. Martin Checked ____ Survey by TED MANNISH Notes TMW Date JAN. 14 1938
Date 8-8-39 Date ____ Map No. ____ Indexed ____ Date ____

F. B. 713 PG 358 | Job No. | Division No. | Notes Red. | Plotted | Profile

Survey of | Date | Date | No.

Survey by | Notes | Notes Chkd. | Checked | X-Sec.

Indexed | Date | Date | Date | No.

Form 307 5M 10-37

PLEASE RETURN TO
LOS ANGELES COUNTY SURVEYOR
700 HALL OF RECORDS

NOTE: ANY ADDITIONS OR CHANGES ON THIS SHEET MUST BE MADE OR CIRCLED IN RED INK, WITH DATE AND NAME OF PERSON MAKING CHANGE

Do not extend notes this side of this line

STATION	B. S.	H. I.	F. S.	ELEV.

Form 307 5M 10-37

PLEASE RETURN TO
LOS ANGELES COUNTY SURVEYOR
700 HALL OF RECORDS

NOTE: ANY ADDITIONS OR CHANGES ON THIS SHEET MUST BE MADE OR CIRCLED IN RED INK, WITH DATE AND NAME OF PERSON MAKING CHANGE

Do not extend notes this side of this line

STATION	B. S.	H. I.	F. S.	ELEV.

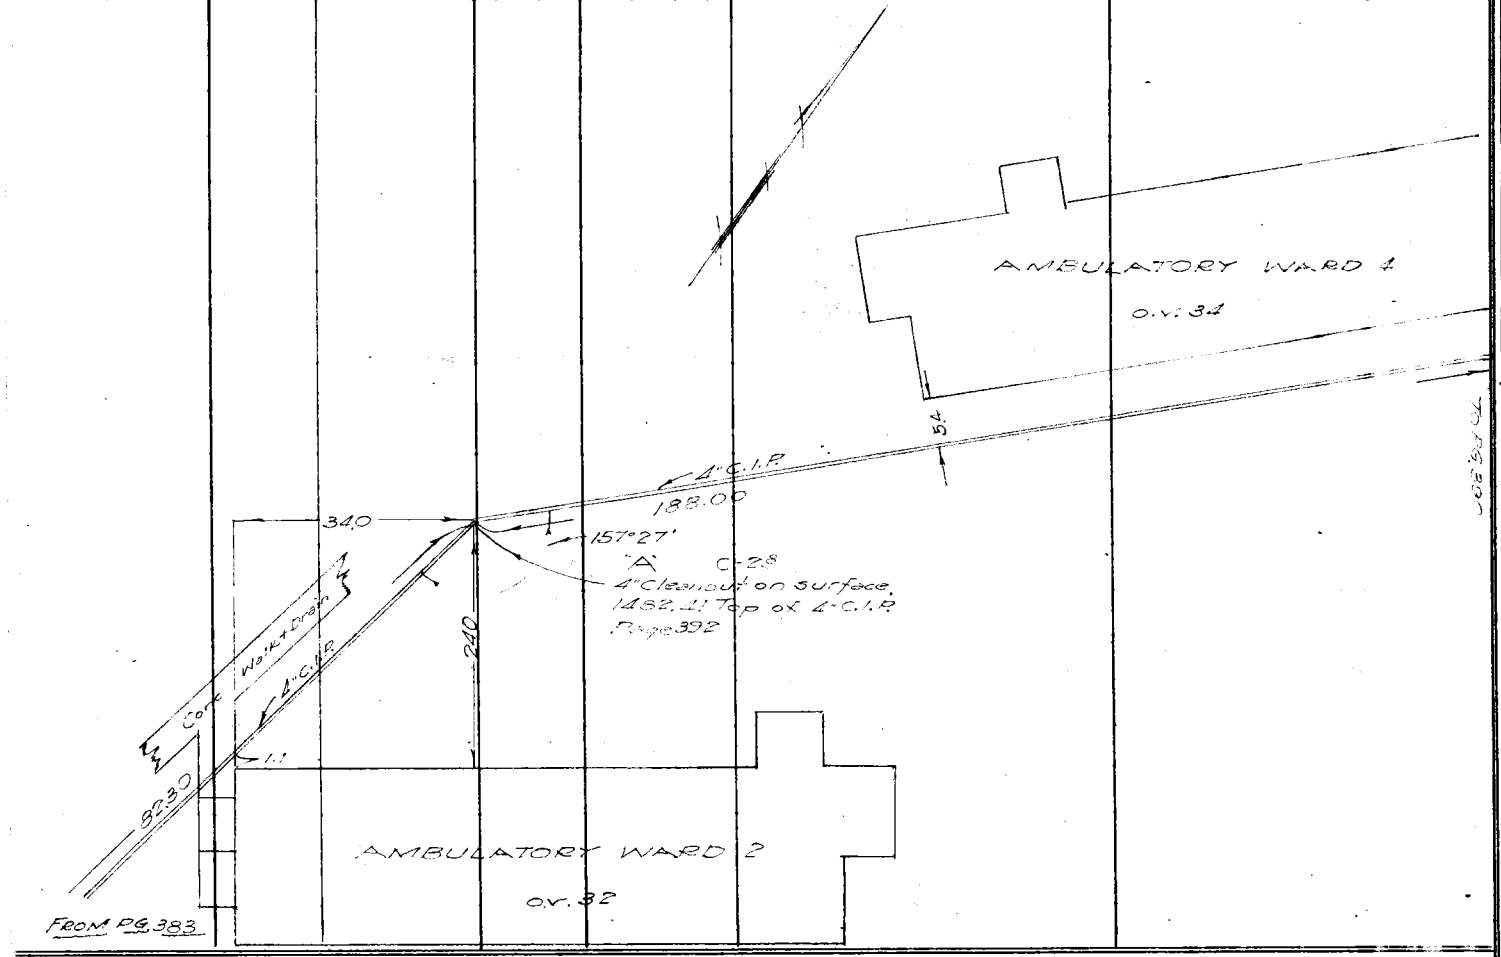

Profile

No. _____ Notes Red. _____ Plotted Martin

No. _____ Date _____ Date Aug. 1934 Job No. 8128 Division No. _____

X-Sec. _____ Notes Chkd. _____ Checked _____ Survey of OLIVE VIEW SANATORIUM

No. _____ Date _____ Date _____ Survey by T. WALSH Notes T.MAY Date JAN. 14, 1933

Map No. _____ Indexed _____ Date _____

F. B. 713 PG. 389

F. B. 713 PG 390 | Job No. 8178 | Division No. | Notes Red. | Plotted Martin | Profile

Survey of OLIVE VIEW SANATORIUM | Date | Date Aug. 1939 | No.

Survey by T. WALSH | Notes T.M.W | Notes Chkd. | Checked | X-Sec.

Indexed | Date | Date | Date | No.

Form 307 5M 10-37

PLEASE RETURN TO
LOS ANGELES COUNTY SURVEYOR
700 HALL OF RECORDS

Do not extend notes this side of this line

NOTE: ANY ADDITIONS OR CHANGES ON THIS SHEET MUST BE MADE OR CIRCLED IN RED INK, WITH DATE AND NAME OF PERSON MAKING CHANGE

STATION | B. S. | H. I. | F. S. | ELEV.

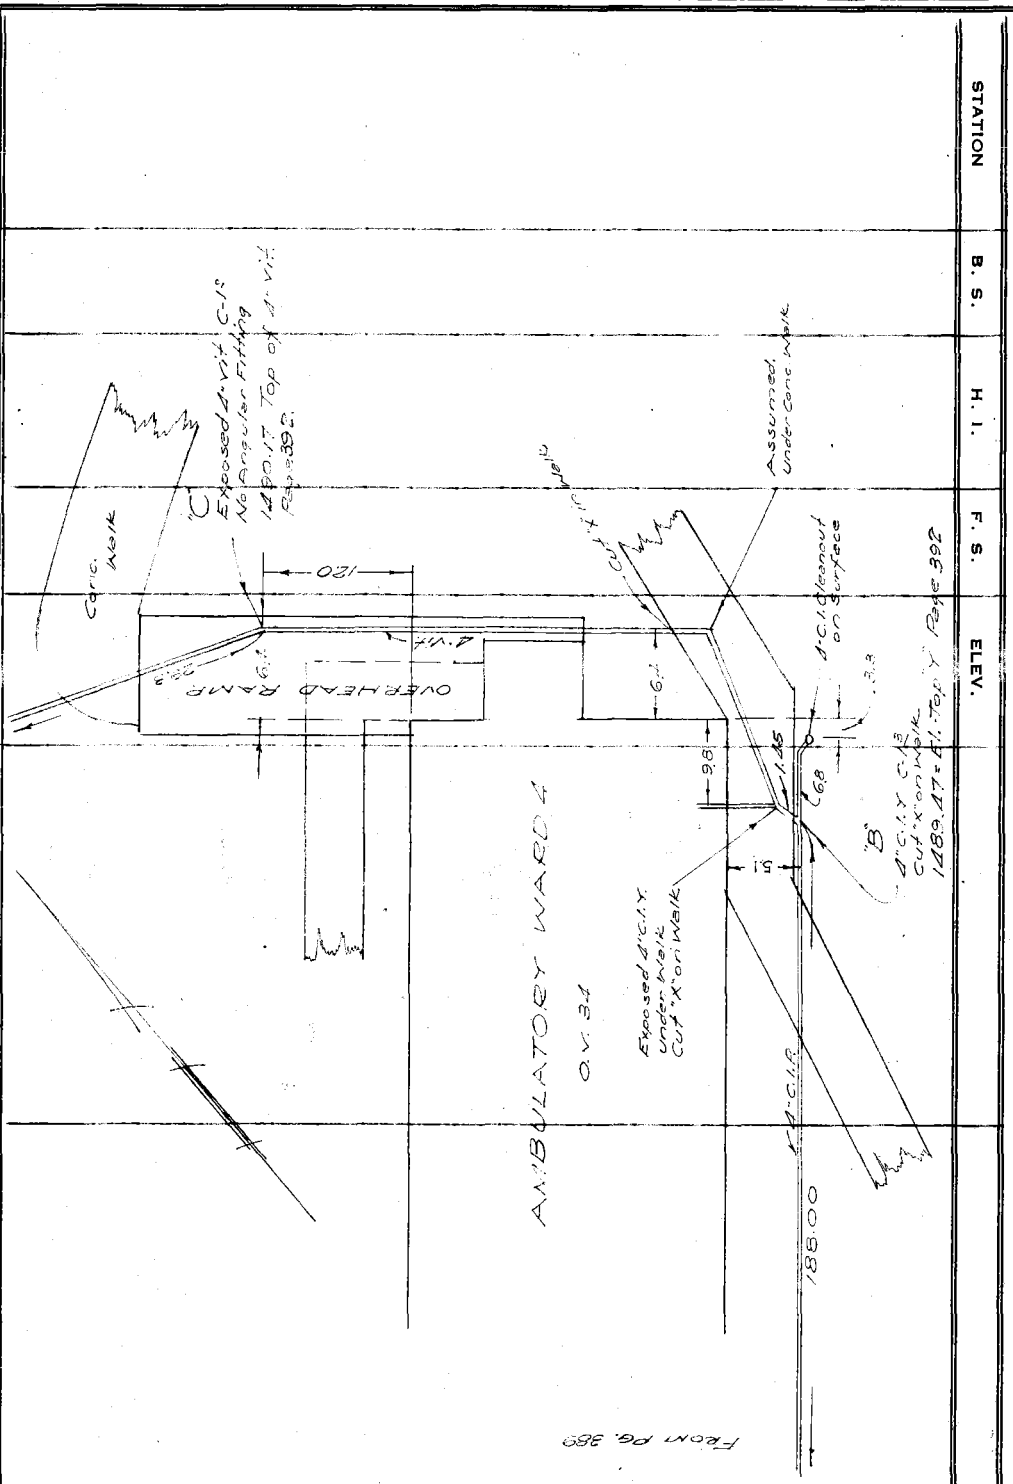

F. B. 713 Pg. 391

Division No. 8178 Job No. Martin Platted

Survey of OLIVE VIEW SANATORIUM Date Aug. 1939 Date

Notes T.M.M. Survey by T. WALSH Checked Date JAN. 17, 1938

Indexed Map No. Date

Notes Red. Date

Profile No.

X-Sec. No.

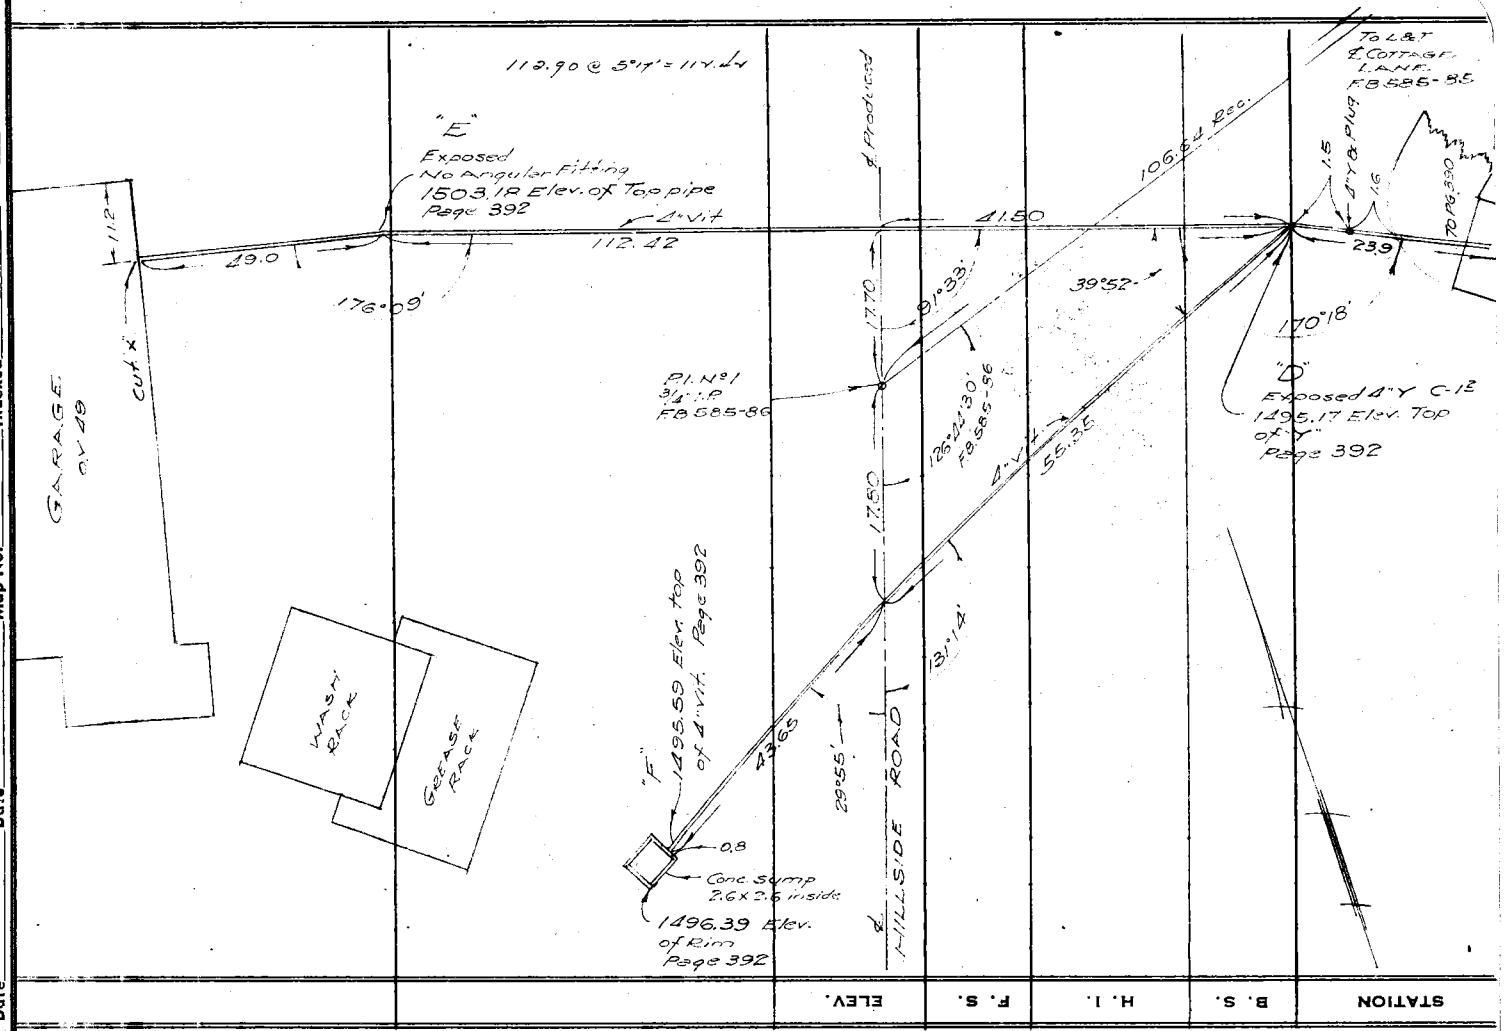

STATION	B. S.	H. I.	F. S.	ELEV.

Do not extend notes this side of this line

PLEASE RETURN TO
LOS ANGELES COUNTY SURVEYOR
700 HALL OF RECORDS

NOTE: ANY ADDITIONS OR CHANGES ON THIS SHEET MUST BE MADE OR CIRCLED IN RED INK, WITH DATE AND NAME OF PERSON MAKING CHANGE

Form 307 SM 10-37

Form 307 SM 10-37

PLEASE RETURN TO
LOS ANGELES COUNTY SURVEYOR
700 HALL OF RECORDS

NOTE: ANY ADDITIONS OR CHANGES ON THIS SHEET MUST BE MADE OR CIRCLED IN RED INK, WITH DATE AND NAME OF PERSON MAKING CHANGE

Do not extend notes this side of this line

F. B. 713 Pg 392 | Job No. | Division | Notes Red. | Plotted | Profile
Survey of OLIVE VIEW SANATORIUM | Date | No.
Survey by T. WALSH | Notes T.M.W. | Notes Chkd. Martin | Checked | X-Sec.
Indexed | Date JAN. 17 1938 | Date 8-8-39 | Date | No.

STATION	B. S.	H. I.	F. S.	ELEV.		
					40' West of Amb. ward. No 2	
BM S-1				1484 28	BM. S-1 "J" in top of Conc. Stairs	PG. 385
	10 33	1494 61				
"A"			12 20	1482 41	Top of 4" C.I.P.	Page 389
			0 25	1491 36		
	11 55	1505 91				
"F"			10 32	1495.59	Top of 4" Vit. Pipe	Page 391
			9 52	1496 39	Top of Sump.	✓
"E"			2 73	1503 18	Top of 4" Vit. Pipe	Page 391
"D"			10 74	1495 17	Top of 4" Vit. "Y"	Page 391
			10 92	1494 99		
	0 92	1495 91				
"C"			5 20	1490 71	Top of 4" Vit. Pipe	Page 390
"B"			6 44	1489 47	Top 4" C.I.Y.	✓
			9 74	1486 17		
	3 64	1489 81				
BM #14			6 49	1483 32	BM #14	Page 385

Profile No. _____ Notes Red. _____ Plotted Martin Job No. 818 Division No. _____ F. B. 713 PG. 393

X-Sec. No. _____ Notes Chkd. _____ Checked _____ Survey by T.M. WALSH Notes T.M.W Date JAN 18 1938

Date _____ Date Aug. 1939 Survey of OLIVE VIEW SANATORIUM

Date _____ Date _____ Map No. _____ Indexed _____ Date _____

NOTE: ANY ADDITIONS OR CHANGES ON THIS SHEET MUST BE MADE OR CIRCLED IN RED INK, WITH DATE AND NAME OF PERSON MAKING CHANGE

Do not extend notes this side of this line

PLEASE RETURN TO
LOS ANGELES COUNTY SURVEYOR
700 HALL OF RECORDS

Form 307 5M 10-37

STATION | B. S. | H. I. | F. S. | ELEV.

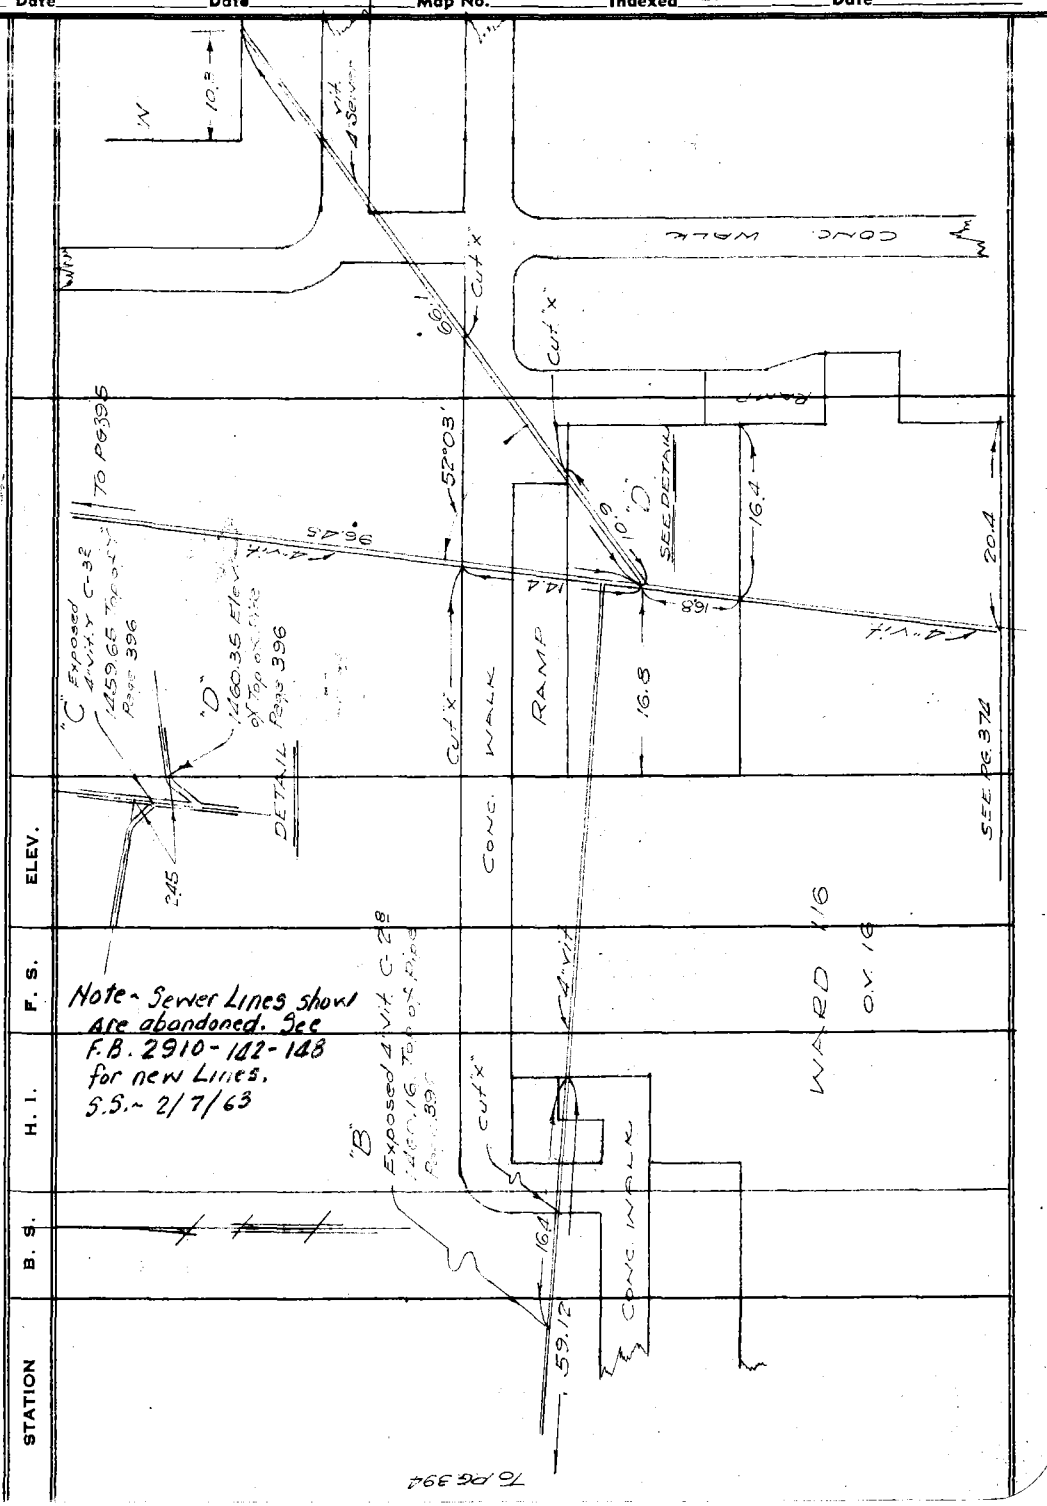

Note - Sewer Lines shown Are abandoned. See F.B. 2910-182-188 for new Lines. S.S. - 2/7/63

F. B. 713 PG 394 | Job No. 8128 | Division No. | Notes Red. | Plotted Martin | Profile
Survey of OLIVE VIEW SANATORIUM | Date | Date Aug. 1939 | No.
Survey by T. M. WALSH | Notes T. M. W. | Notes Chkd. | Checked | X-Sec.
Indexed | Date JAN. 18, 1938 | Date | Date | No.

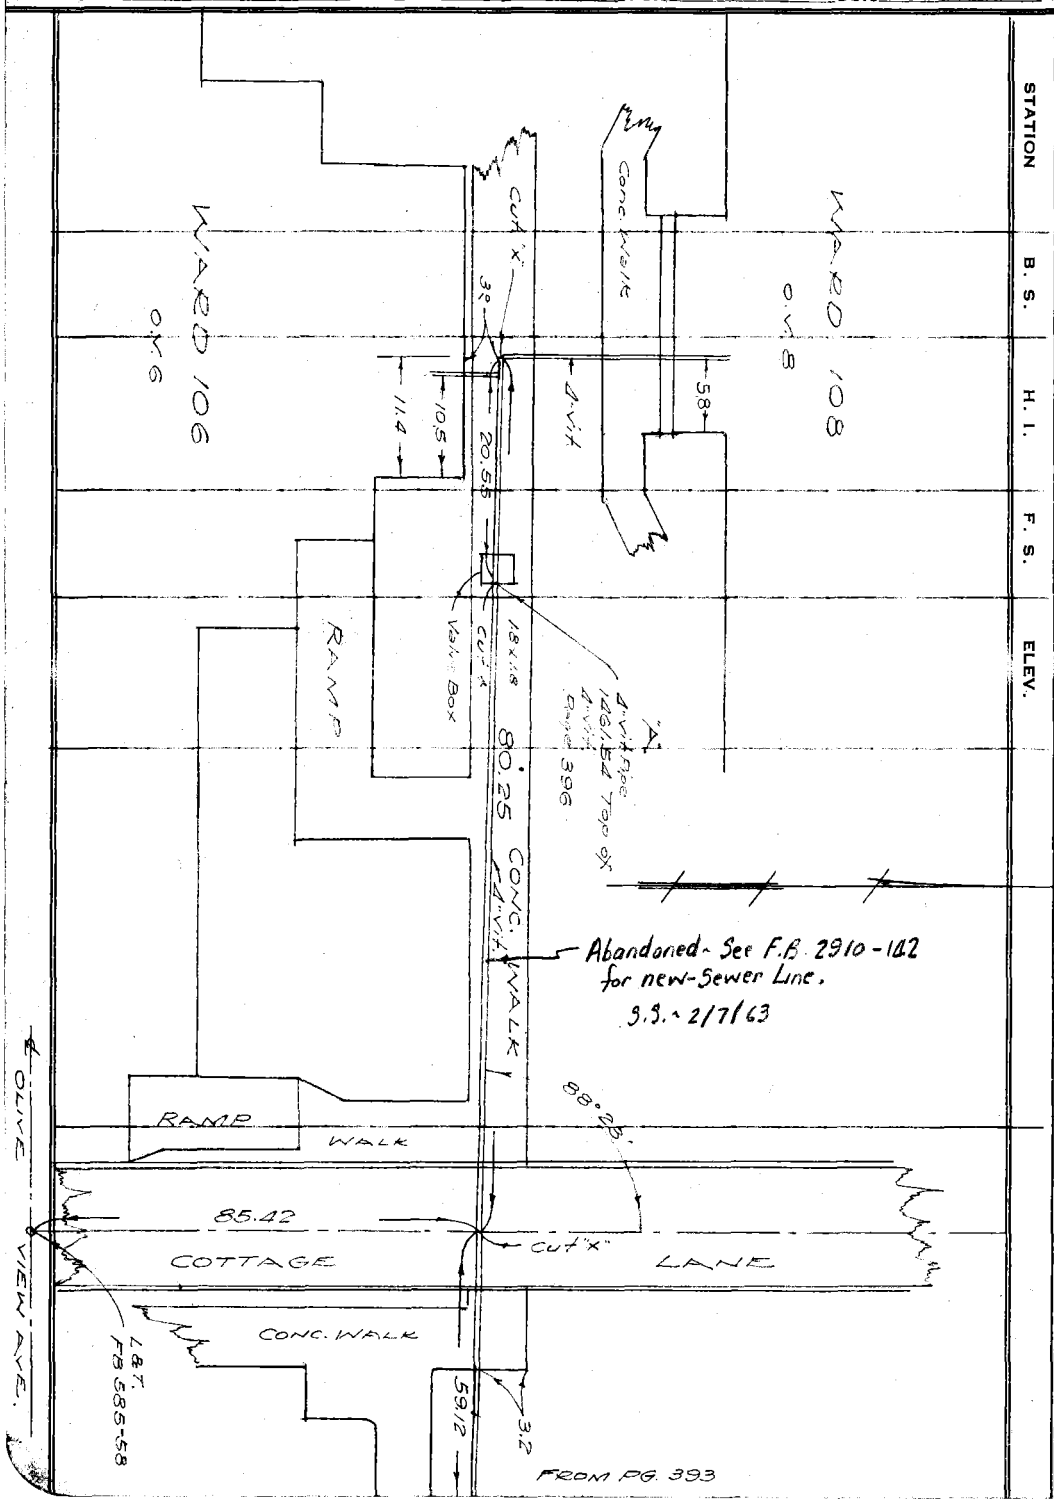

Form 307 5M 10-37

PLEASE RETURN TO
LOS ANGELES COUNTY SURVEYOR
700 HALL OF RECORDS

NOTE: ANY ADDITIONS OR CHANGES ON THIS SHEET MUST BE MADE OR CIRCLED IN RED INK, WITH DATE AND NAME OF PERSON MAKING CHANGE

Do not extend notes this side of this line

Profile No.	Notes Red.	Plotted Martin	Job No. 8178	Division No.
	Date	Date Aug. 1939	Survey of OLIVEVIEW SANATORIUM	
X-Sec. No.	Notes Chkd.	Checked	Survey by T. M. WALSH	Notes T. M. W. Date JAN. 18 1938
	Date	Date	Map No.	Indexed Date

F. B. 713 PG. 395

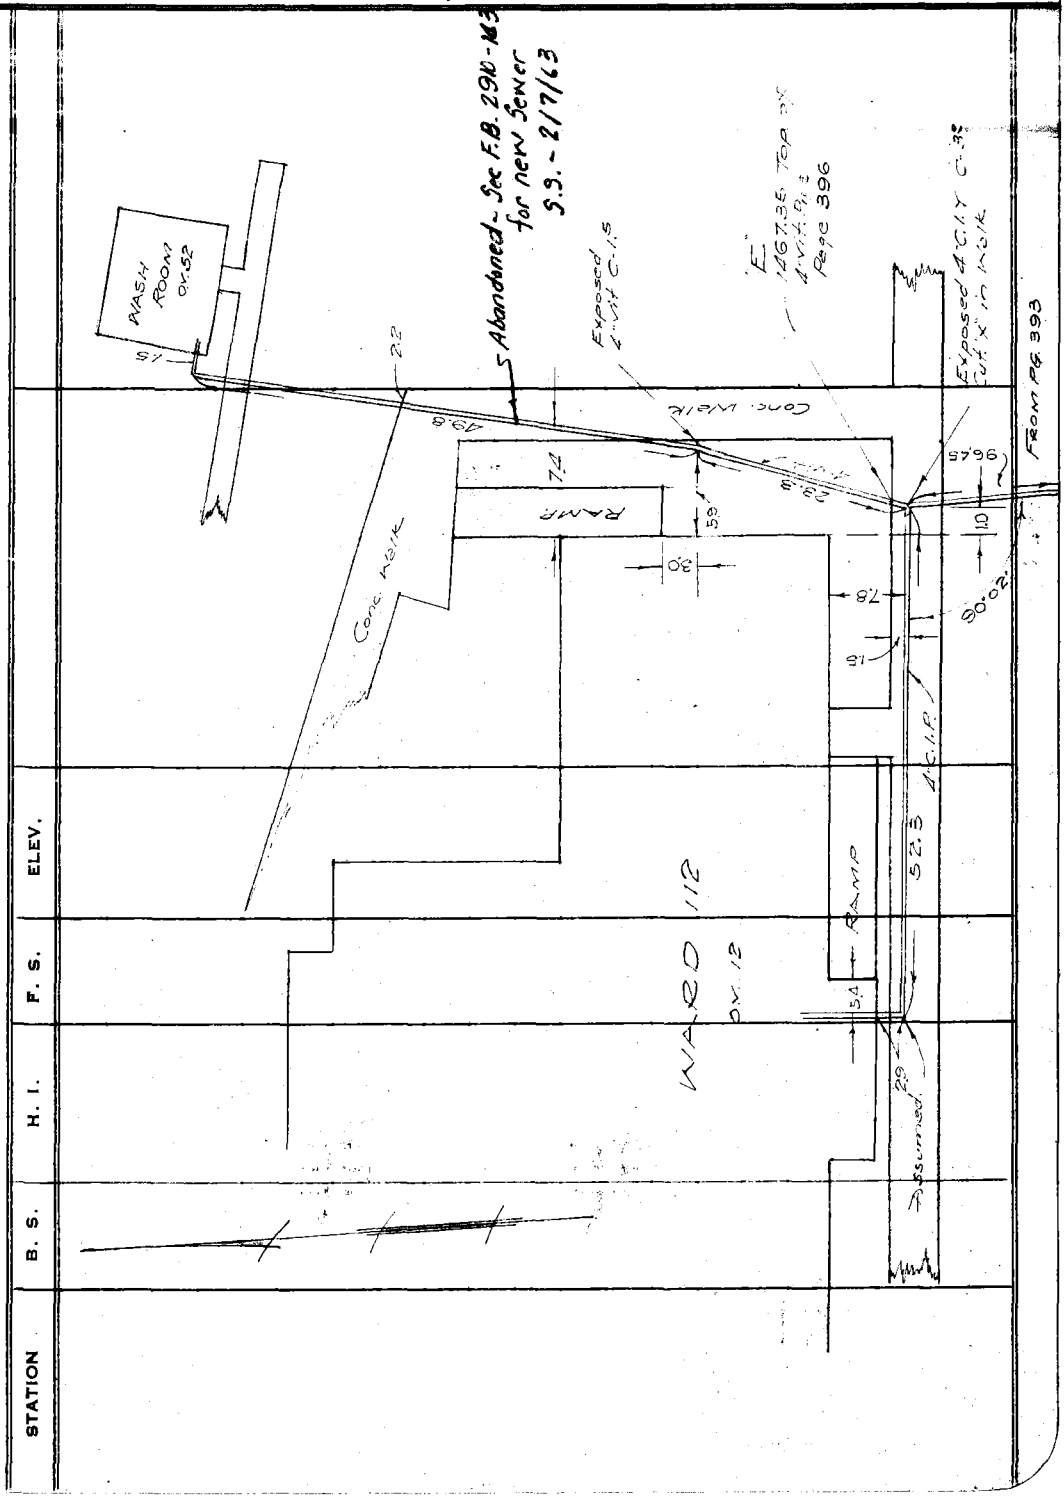

NOTE: ANY ADDITIONS OR CHANGES ON THIS SHEET MUST BE MADE OR CIRCLED IN RED INK, WITH DATE AND NAME OF PERSON MAKING CHANGE

Do not extend notes this side of this line

PLEASE RETURN TO
LOS ANGELES COUNTY SURVEYOR
700 HALL OF RECORDS

Form 307 5M 10-37

Form 307 5M 10-37

PLEASE RETURN TO
LOS ANGELES COUNTY SURVEYOR
700 HALL OF RECORDS

NOTE: ANY ADDITIONS OR CHANGES ON THIS SHEET MUST BE MADE OR CIRCLED IN RED INK, WITH DATE AND NAME OF PERSON MAKING CHANGE

Do not extend notes this side of this line

STATION	B. S.	H. I.	F. S.	ELEV.		
T.P.				1456 60	T.P. L&T. Inter. ℄ Olive View Ave & Cottage Lane, F.B. 585-16	
	11 71	1468 31				
"A"			6 77	1461 54	Top of 4" Vit. pipe in Valve Box	Page 394
			4 98	1463 33		
"B"	8 17	1471 50	11 34	1460 16	Top of 4" Vit. pipe	Page 393
"C"			11 85	1459 65	Top of 4" Vit. Y	✓
"D"			11 15	1460 35	Top of 4" Pipe	✓
"E"			4 15	1467 35	Top of 4" Vit. pipe	Page 395
			1 09	1470 41		
	11 10	1481 51	1 22	1480 29		
	6 16	1486 45				
BM #14			3 13	1482 32	BM No 14	Page 385

F. B. 713 PG 396 Job No. 81-8 Division No. Notes Red. Plotted Profile
Survey of OLIVE VIEW SANATORIUM Date Date No.
Survey by T. M. WALSH Notes T. M. W. Notes Chkd. Martin Checked X-Sec.
Indexed Date JAN. 18, 1938 Date 8-8-39 Date No.

Profile No. | Notes Red. | Plotted Martin | Job No. | Division No. | F. B. 713 Pg. 397
X-Sec. No. | Notes Chkd. | Checked | Survey by T.N. WALSH | Notes T.N. | Date JAN. 27, 38
Date | Date | Map No. | Indexed | Date

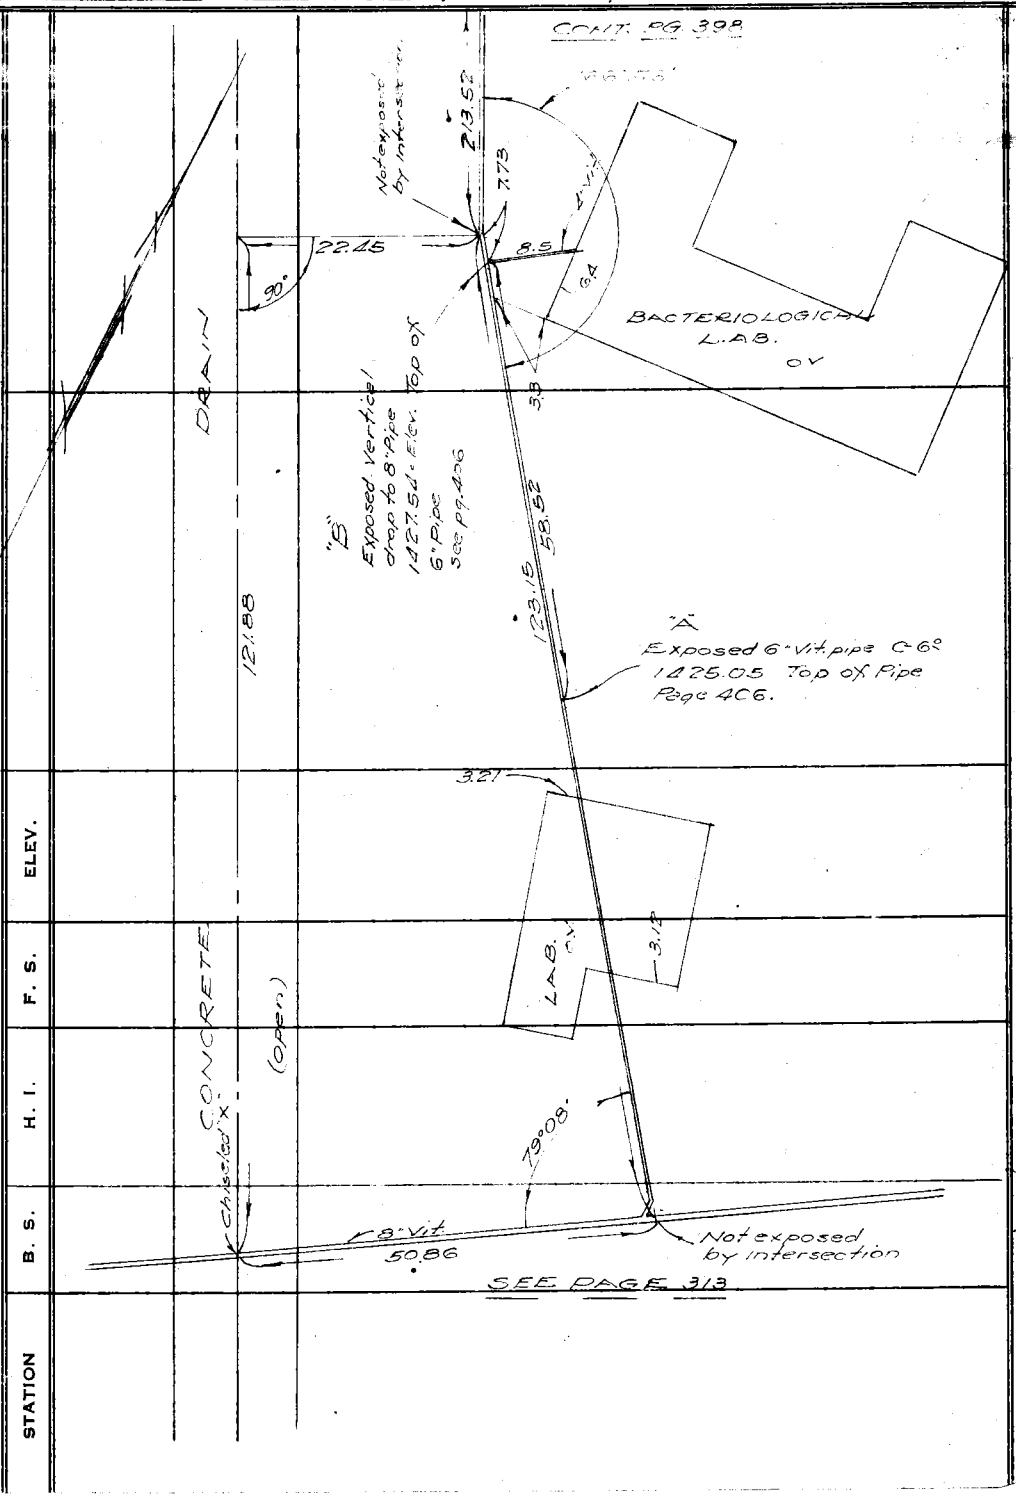

NOTE: ANY ADDITIONS OR CHANGES ON THIS SHEET MUST BE MADE OR CIRCLED IN RED INK, WITH DATE AND NAME OF PERSON MAKING CHANGE

Do not extend notes this side of this line

PLEASE RETURN TO
LOS ANGELES COUNTY SURVEYOR
700 HALL OF RECORDS

Form 307 5M 10-37

F. B. 713 Pg. 398 ✓ Job No. 8178 Division No. _____ Notes Red. _____ Plotted ✓ Martin Profile

Survey of OLIVE VIEW SAN. Date _____ Date Aug. 1939 No. _____

Survey by T. WALSH Notes T. WALSH Notes Chkd. _____ Checked _____ X-Sec.

Indexed _____ Date JAN. 27, 1938 Date _____ Date _____ No. _____

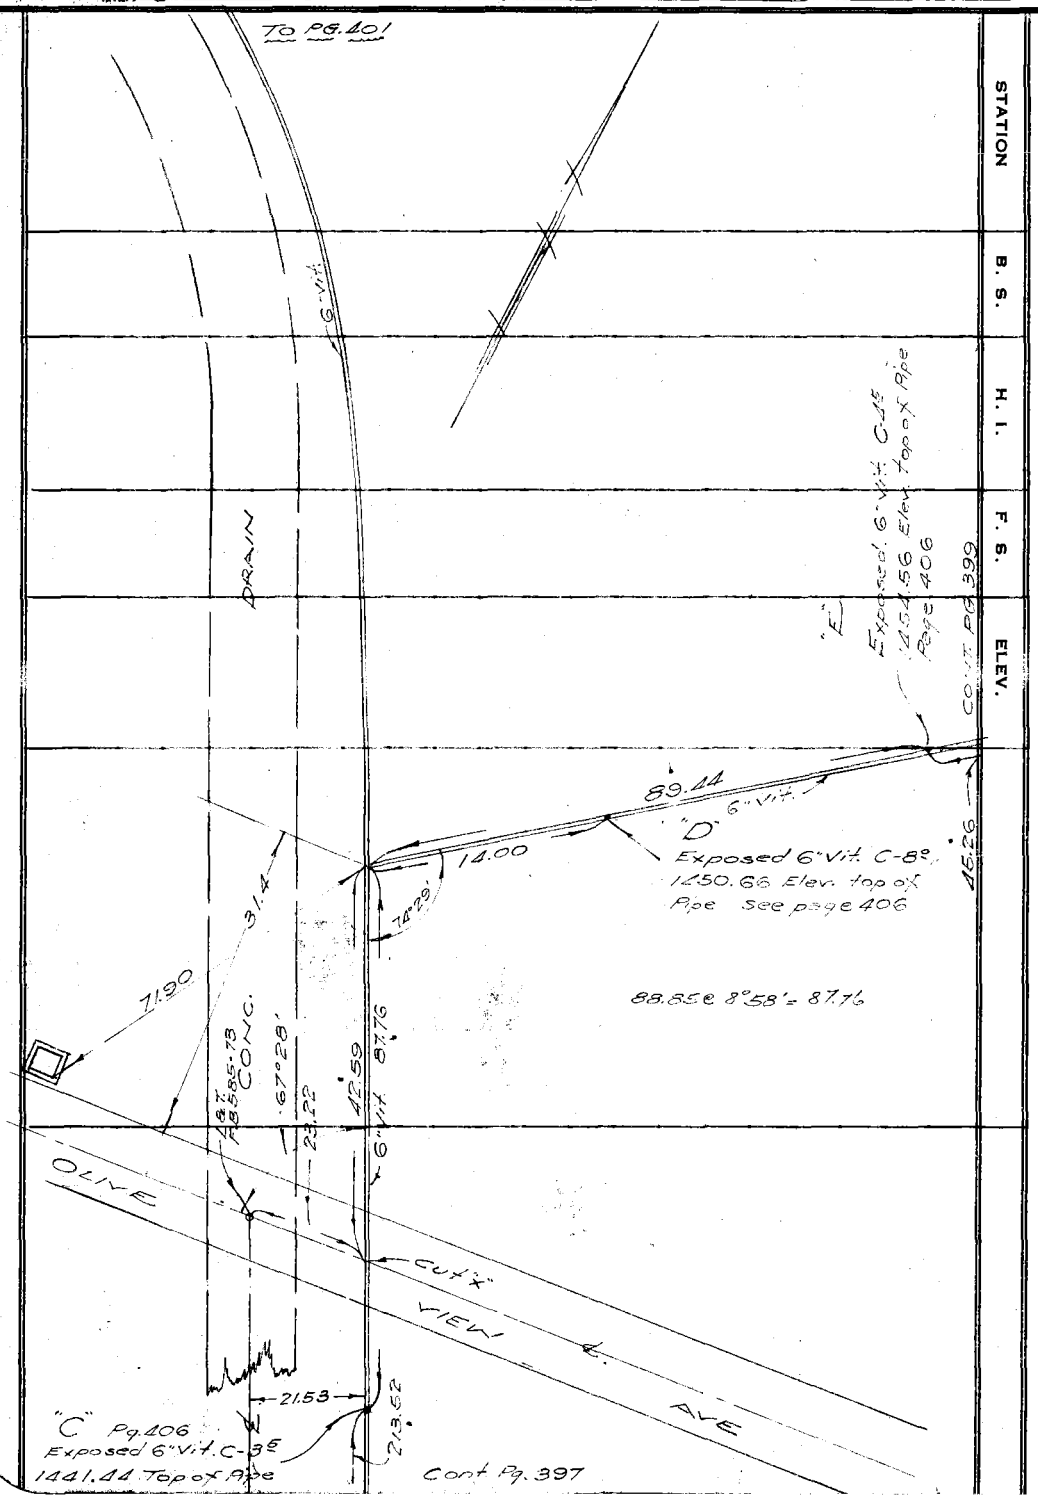

STATION | B. S. | H. I. | F. S. | ELEV.

Form 307 5M 10-37

PLEASE RETURN TO
LOS ANGELES COUNTY SURVEYOR
700 HALL OF RECORDS

Do not extend notes this side of this line

NOTE: ANY ADDITIONS OR CHANGES ON THIS SHEET MUST BE MADE OR CIRCLED IN RED INK, WITH DATE AND NAME OF PERSON MAKING CHANGE

Form 307 5M 10-37

PLEASE RETURN TO
LOS ANGELES COUNTY SURVEYOR
700 HALL OF RECORDS

NOTE: ANY ADDITIONS OR CHANGES ON THIS SHEET MUST BE MADE OR CIRCLED IN RED INK, WITH DATE AND NAME OF PERSON MAKING CHANGE

Do not extend notes this side of this line

STATION	B. S.	H. I.	F. S.	ELEV.		

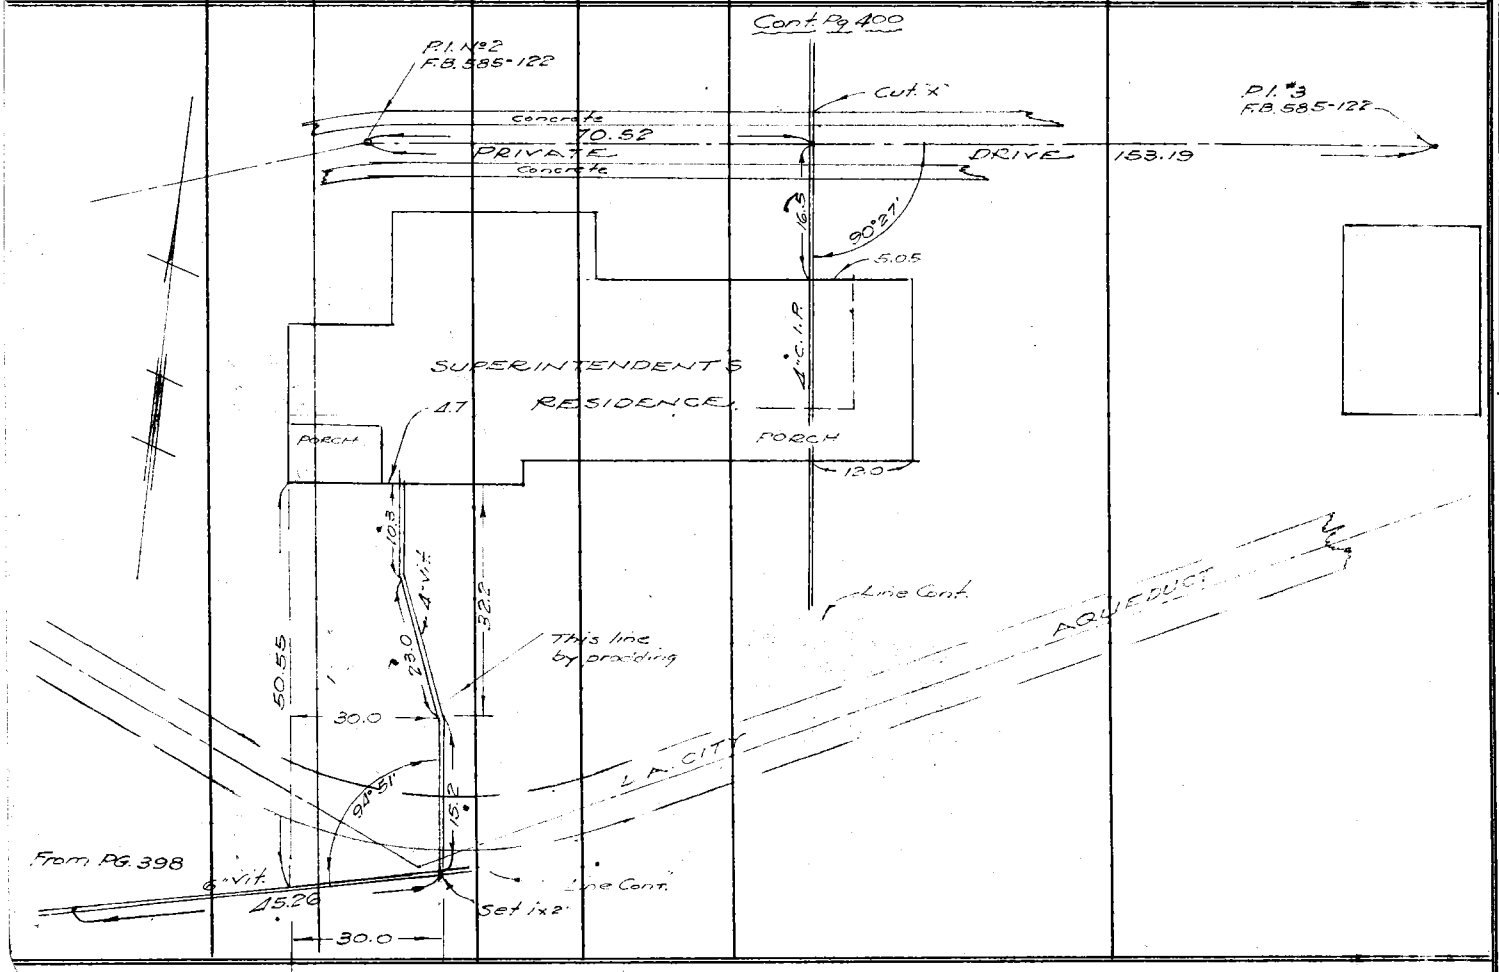

Profile

No. _____ Notes Red. _____ Plotted Aug. 1937 Job No. _____ Division No. _____ F.B. 715 Pg. 399

X-Sec. _____ Notes Chkd. _____ Checked _____ Survey of _____

No. _____ Date _____ Date _____ Survey by _____ Notes _____ Date _____

Date _____ Map No. _____ Indexed _____ Date _____

F. B. 713 Pg 100 | Job No. 8178 | Division No. | Notes Red. | Plotted Martin | Profile

Survey of OLIVE VIEW SANATORIUM | Date | Date Aug. 1939 | No.

Survey by T.M. WALSH | Notes T.M.W. | Notes Chkd. | Checked | X-Sec.

Indexed | Date | Date | Date | No.

Form 307 5M 10-37

PLEASE RETURN TO
LOS ANGELES COUNTY SURVEYOR
700 HALL OF RECORDS

Do not extend notes this side of this line

NOTE: ANY ADDITIONS OR CHANGES ON THIS SHEET MUST BE MADE OR CIRCLED IN RED INK, WITH DATE AND NAME OF PERSON MAKING CHANGE

STATION | B. S. | H. I. | F. S. | ELEV.

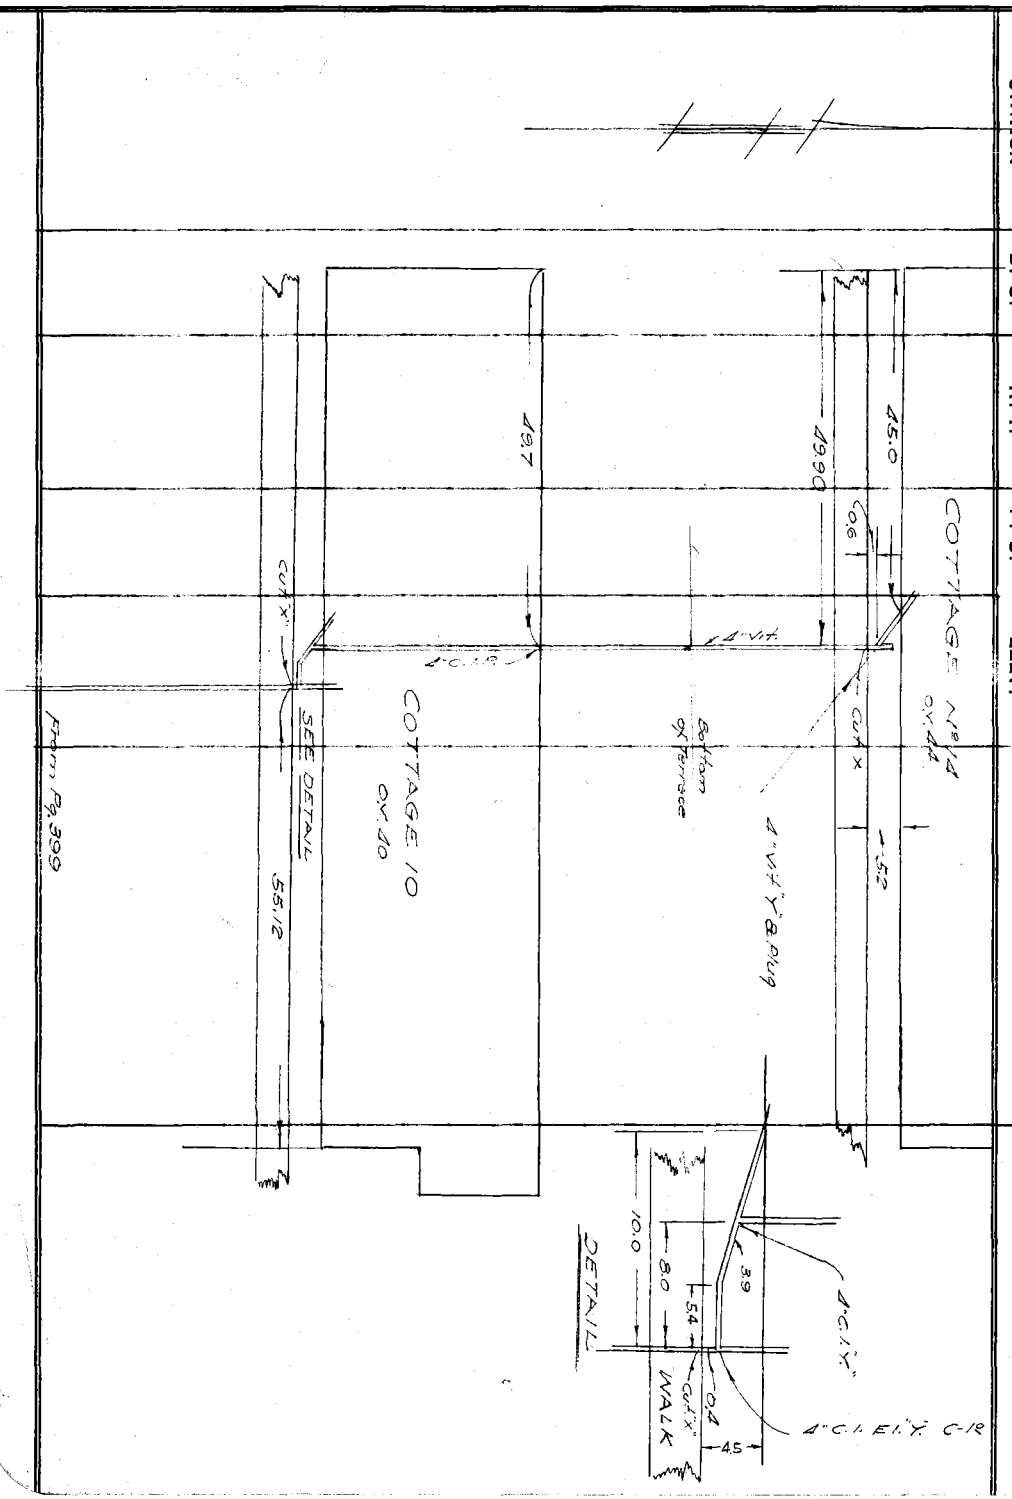

Profile No.	Notes Red.	Plotted Martin	Job No. 81-18	Division No.	F. B. 713 PG. 401
	Date	Date Aug. 1939	Survey of OLIVE VIEW SANATORIUM		
X-Sec. No.	Notes Chkd.	Checked	Survey by T. WALSH	Notes T.M.W.	Date JAN. 21, 1938
	Date	Date	Map No.	Indexed	Date

NOTE: ANY ADDITIONS OR CHANGES ON THIS SHEET MUST BE MADE OR CIRCLED IN RED INK, WITH DATE AND NAME OF PERSON MAKING CHANGE

Do not extend notes this side of this line

PLEASE RETURN TO
LOS ANGELES COUNTY SURVEYOR
700 HALL OF RECORDS

Form 307 5M 10-37

STATION	B. S.	H. I.	F. S.	ELEV.

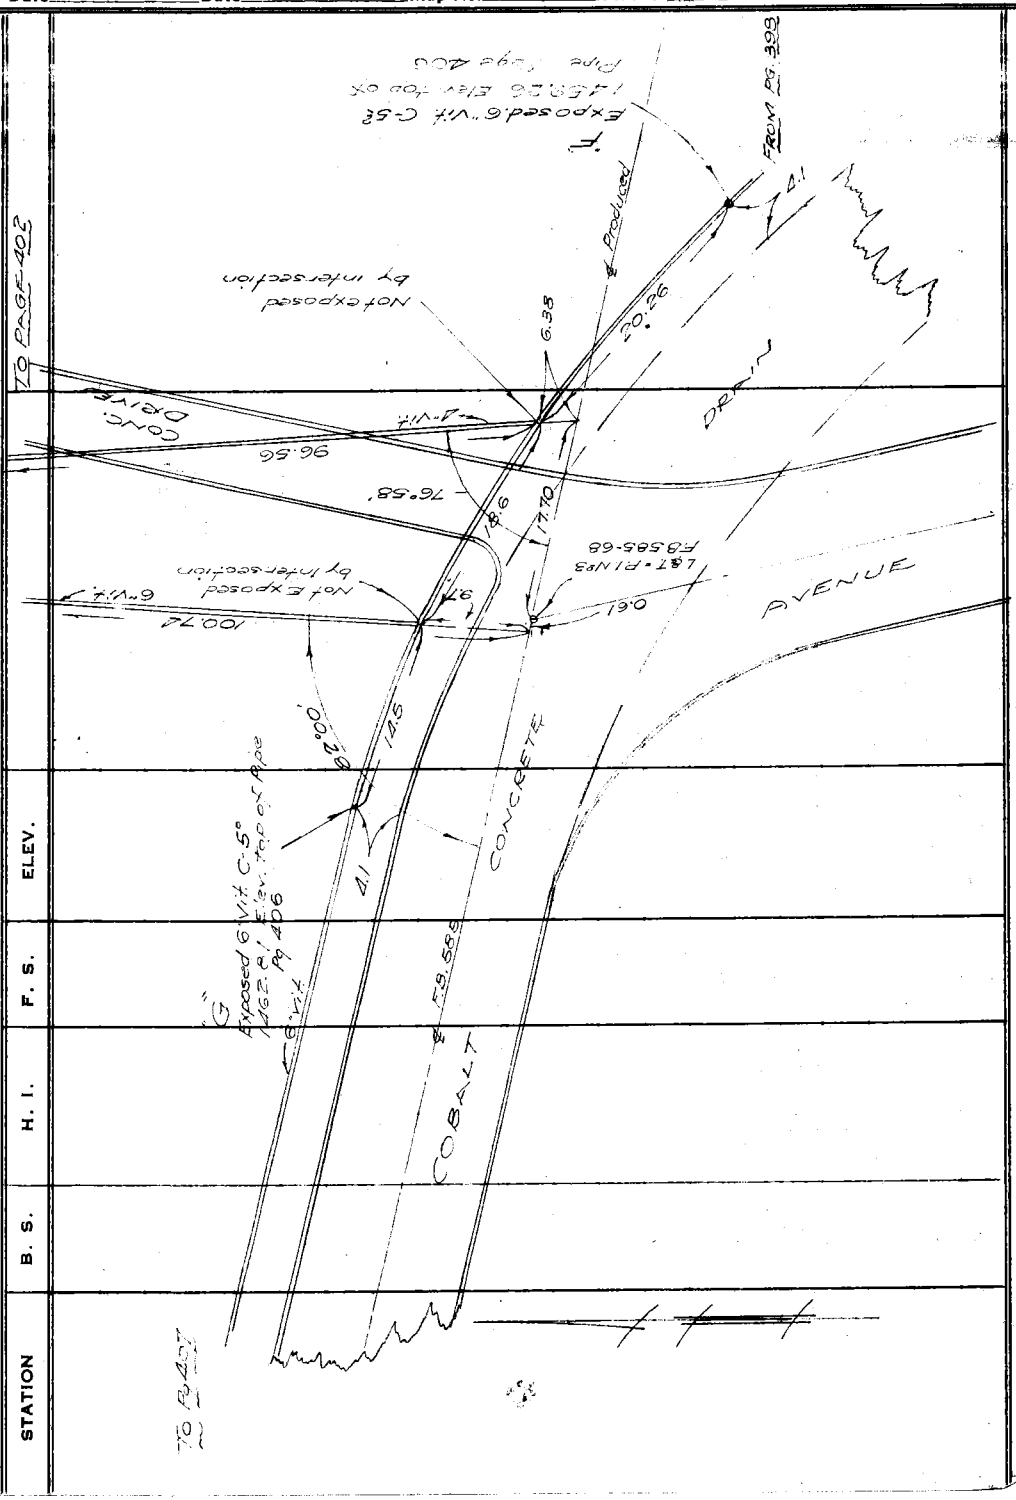

F. B. 713 PG 402 | Job No. 8128 | Division No. | Notes Red. | Plotted Martin | Profile

Survey of OLIVE VIEW SANATORIUM | Date | Date Aug. 1939 | No.

Survey by T. WALSH | Notes WALSH | Notes Chkd. | Checked | X-Sec.

Indexed | Date | Date | Date | No.

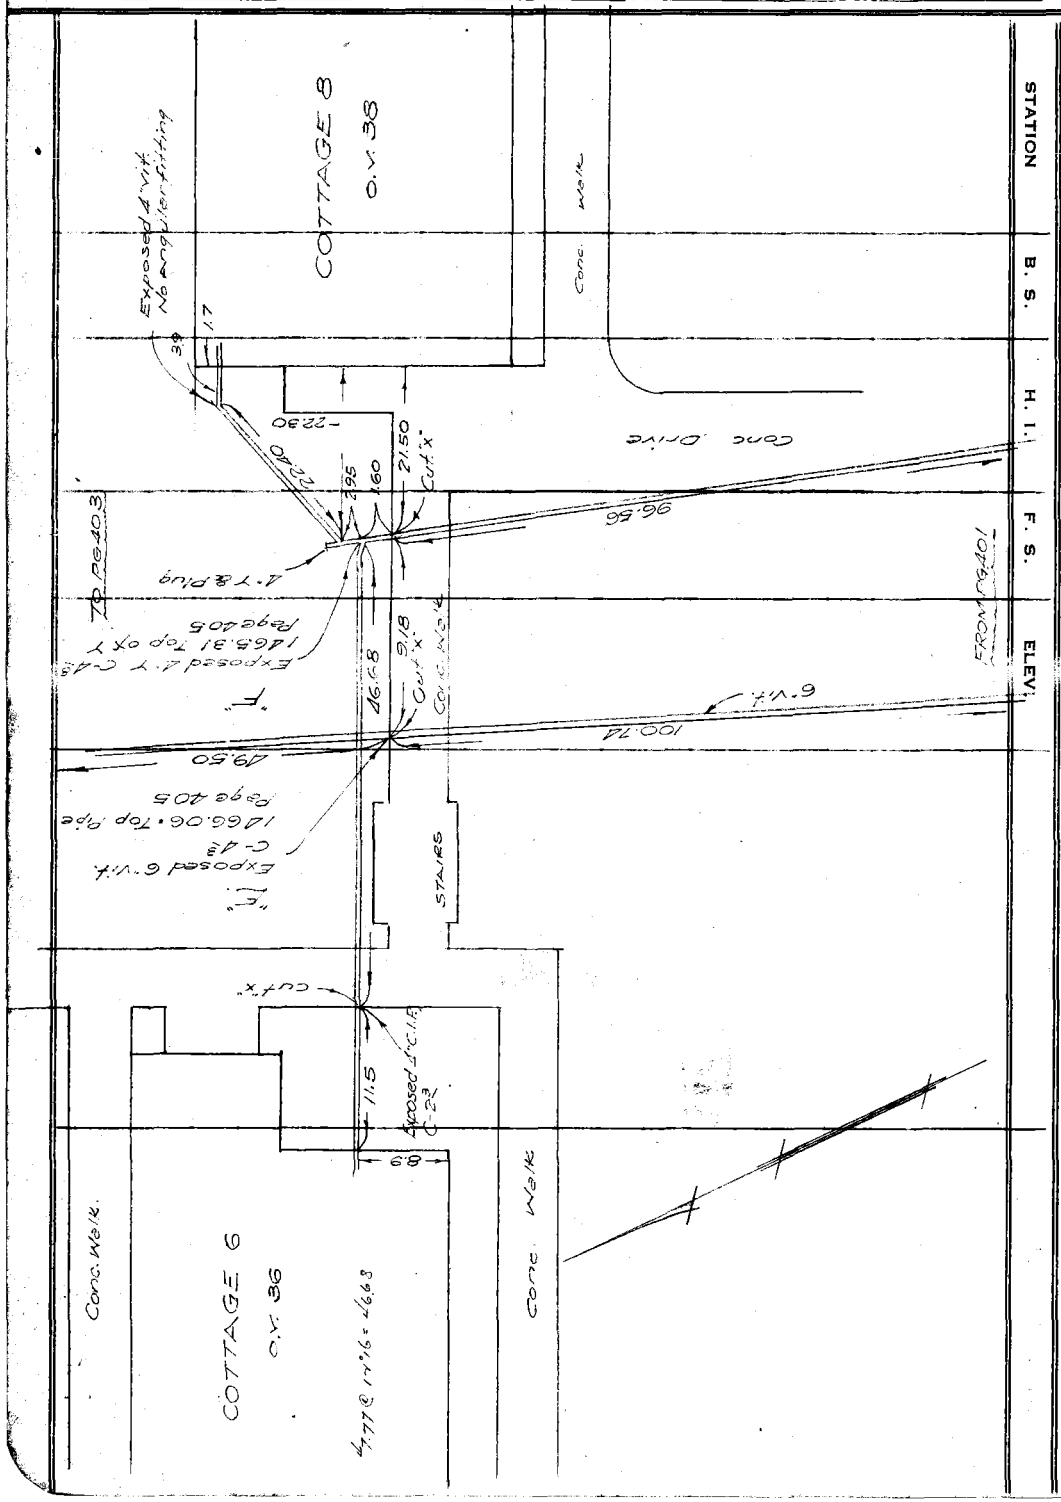

Form 307 5M 10-37

PLEASE RETURN TO
LOS ANGELES COUNTY SURVEYOR
700 HALL OF RECORDS

Do not extend notes this side of this line

NOTE: ANY ADDITIONS OR CHANGES ON THIS SHEET MUST BE MADE OR CIRCLED IN RED INK, WITH DATE AND NAME OF PERSON MAKING CHANGE

Profile	Notes Red.	Plotted Martin	Job No. 8178	Division No.	F. B. 713 PG. 403
No.	Date	Date Aug. 1939	Survey of OLIVE VIEW SANATORIUM		
X-Sec.	Notes Chkd.	Checked	Survey by TEO WALSH	Notes T.W.	Date 1-20-38
No.	Date	Date	Map No.	Indexed	Date

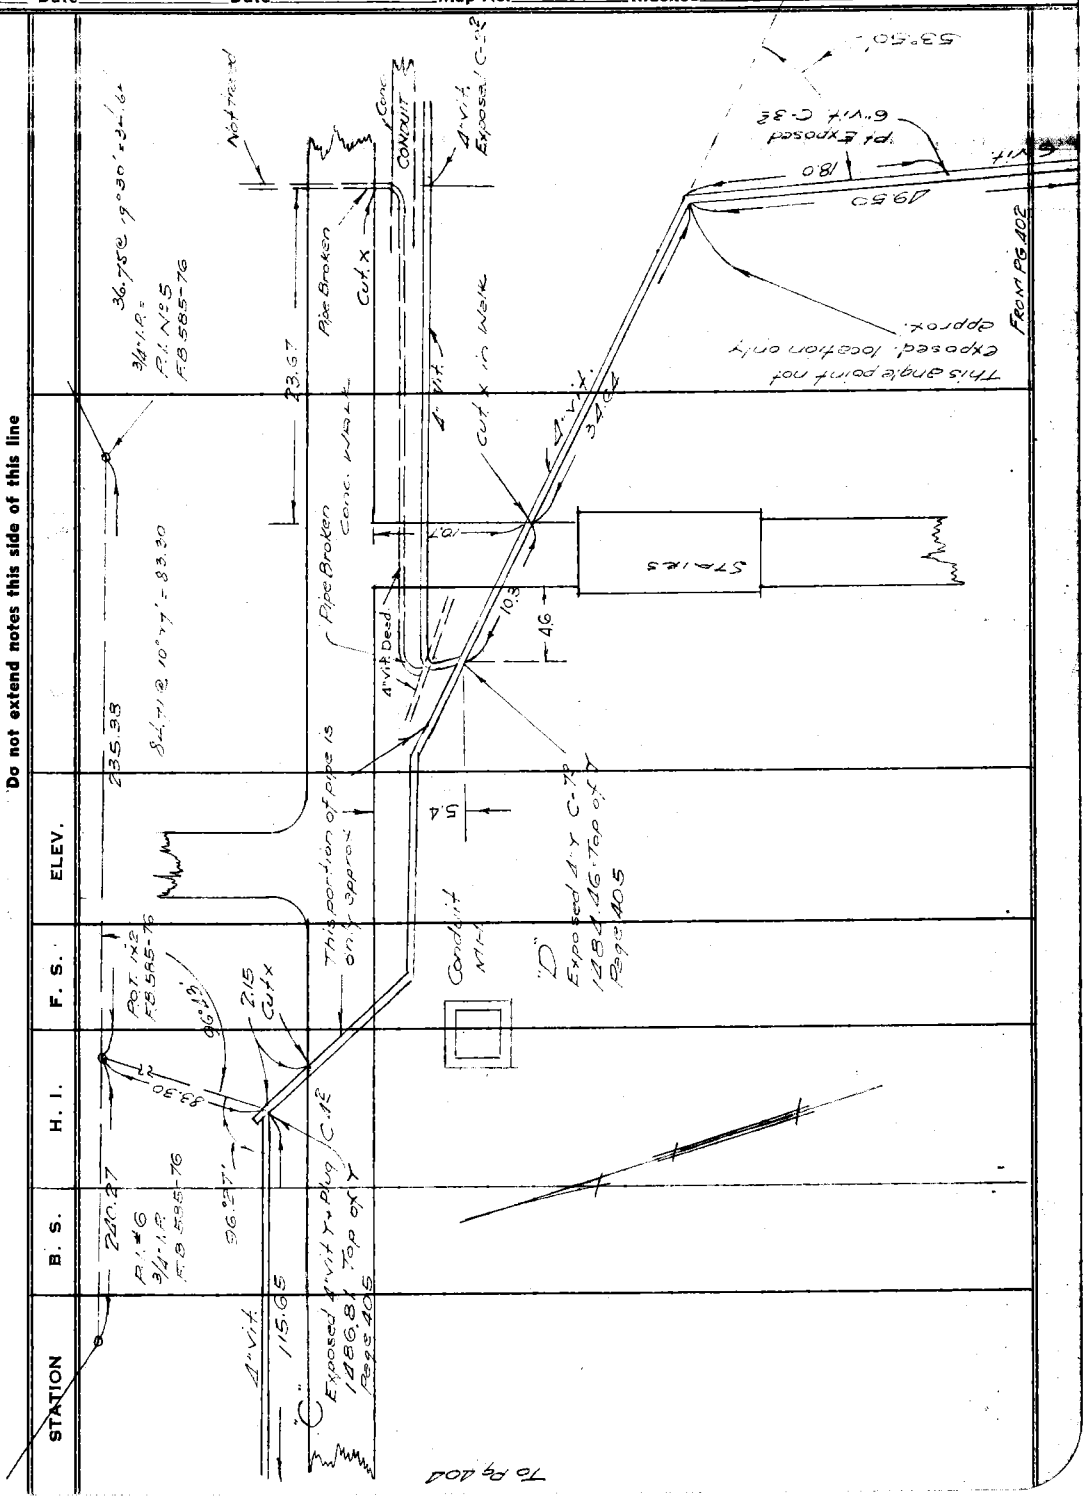

Form 307 5M 10-37

PLEASE RETURN TO
LOS ANGELES COUNTY SURVEYOR
700 HALL OF RECORDS

NOTE: ANY ADDITIONS OR CHANGES ON THIS SHEET MUST BE MADE OR CIRCLED IN RED INK, WITH DATE AND NAME OF PERSON MAKING CHANGE

Do not extend notes this side of this line

F. B. 713 PG 404 | Job No. 8178 | Division No. | Notes Red. | Plotted Martin | Profile

Survey of OLIVE VIEW SANATORIUM | Date | Date Aug. 1939 | No.

Survey by T. WALSH | Notes T.W. | Notes Chkd. | Checked | X-Sec.

Indexed | Date JAN 20, 1938 | Date | Date | No.

Form 307 5M 10-37

PLEASE RETURN TO
LOS ANGELES COUNTY SURVEYOR
700 HALL OF RECORDS

Do not extend notes this side of this line

NOTE: ANY ADDITIONS OR CHANGES ON THIS SHEET MUST BE MADE OR CIRCLED IN RED INK, WITH DATE AND NAME OF PERSON MAKING CHANGE

STATION	B. S.	H. I.	F. S.	ELEV.

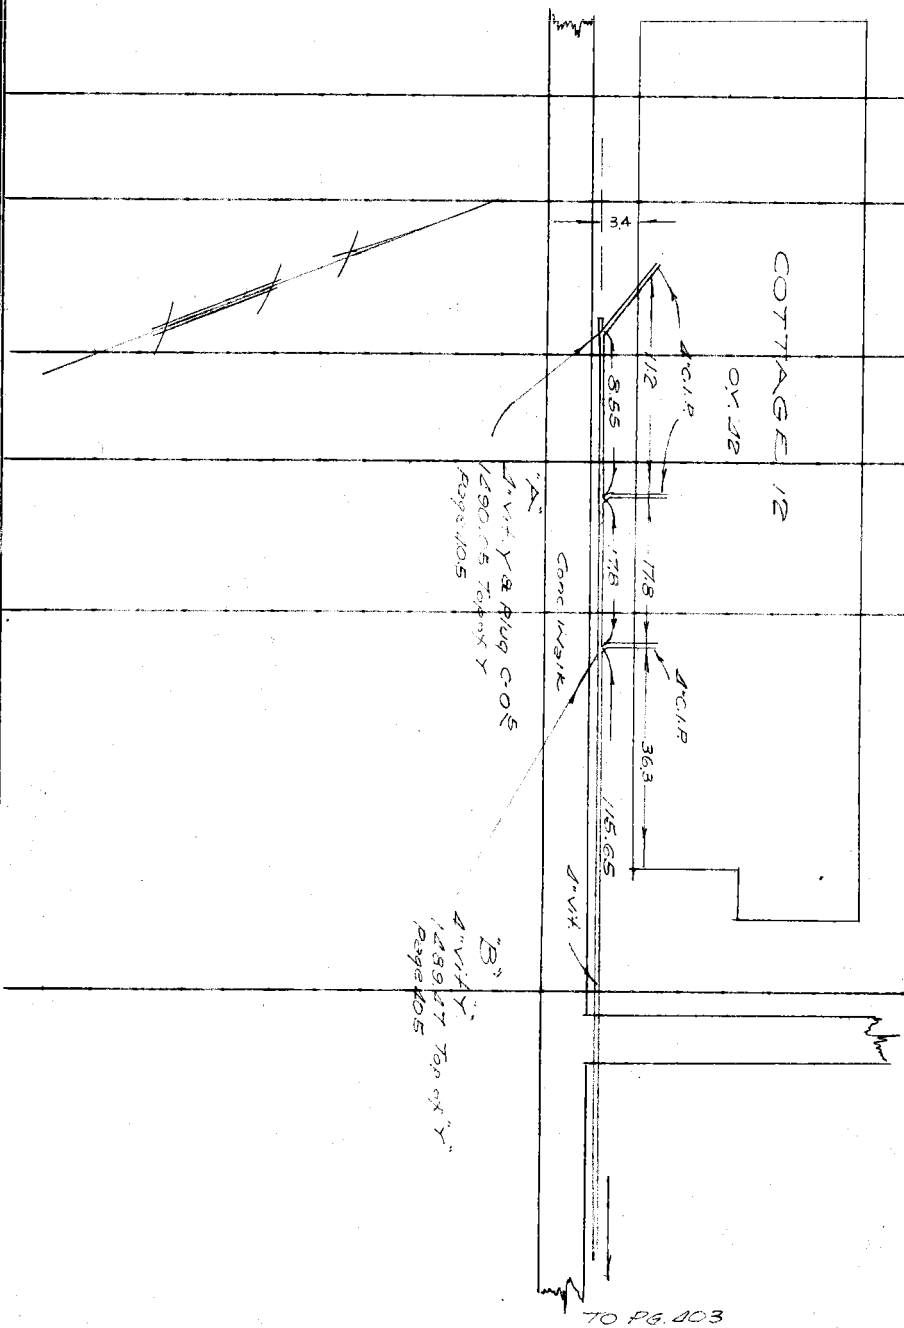

TO PG. 403

Form 307 5M 10-37

PLEASE RETURN TO
LOS ANGELES COUNTY SURVEYOR
700 HALL OF RECORDS

NOTE: ANY ADDITIONS OR CHANGES ON THIS SHEET MUST BE MADE OR CIRCLED IN RED INK, WITH DATE AND NAME OF PERSON MAKING CHANGE

Do not extend notes this side of this line

STATION	B. S.	H. I.	F. S.	ELEV.		
BM # 14				1483 32	BM #14. Cobalt Ave 70'± So. of So. face of	
	11 61	1494 93			Warehouse Chiseled "□" in East Curb F.B. 585-18	
"A"			4 88	1490 05	Top of 4" Y & Plug	Page 404
"B"			5 46	1489 47	Top of 4" Y	do
			2 675	1492 255		
	2 81	1495 065				
"C"			8 25	1486 81	Top of 4" Y & Plug	Page 403
BM "S-5"			3 625	1491 44	B.M. # S-5	Cut "X" on S.E. Corner Steam Tunnel M.H. 110' E. of E. end of Cottage 12 (O.V. 42)
	4 40	1495 84				
"D"			11 38	1484 46	Top of 4" Y	Page 403
BM "S-5"			4 40	1491 44	See Above	
	1 73	1493 17				
			11 645	1481 525		
	3 66	1485 185				
			11 715	1473 47		
	0 20	1473 67				
"E"			7 61	1466 06	Top 6" Vit. Pipe	Page 402
"F"			8 36	1465 31	Top 4" Y	do
			7 85	1465 82		
T.P.	0 24	1466 06	10 75	1455 31	T.P. L.&T. inter. ℄ Cobalt & Olive View. Ave. F.B. 585-16	

Profile No. ____ Notes Red. ____ Plotted ____ Job No. 5178 Division No. ____ F.B. 713 PG. 405

X-Sec. No. ____ Date ____ Date ____ Survey of OLIVE VIEW SANATORIUM

Notes Chkd. Martin Checked ____ Survey by T. WALSH Notes TMW Date JAN 26 38

Date 8-8-39 Date ____ Map No. ____ Indexed A. C. [illegible] Date ____

Form 307 5M 10-37

PLEASE RETURN TO
LOS ANGELES COUNTY SURVEYOR
700 HALL OF RECORDS

NOTE: ANY ADDITIONS OR CHANGES ON THIS SHEET MUST BE MADE OR CIRCLED IN RED INK, WITH DATE AND NAME OF PERSON MAKING CHANGE

F. B. 713 Pg. 406 | Job No. 8148 Division No. | Profile
Survey of OLIVE VIEW SANATORIUM Date | Plotted
Survey by T. WALSH Notes T.N.I.M. Notes Chkd. Martin Checked | X-Sec. No.
Indexed Date JAN. 27. 1938 Date 8-8-39 Date

Do not extend notes this side of this line

STATION	B. S.	H. I.	F. S.	ELEV.		
BM #3				1418 875		BM #3, Wire Spk. SE. Cor. Boiler House F.B. 585-5
	805	1426 925	1085	1425 84		
"A"	10 10	1435 94	1089	1425 05	Top of 6" Pipe	Pg. 397
"B"			8 40	1427 54	Top 6" Pipe at Junction	Pg. 397
			0 145	1435 795		
"C"	1199	1447 785	634	1441 44	Top of 6" Pipe	Page 398
			1 15	1446 635		
	1132	1457 955	264	1455 315		
	754	1462 855				
"D"			1219	1450 66	Top of 6" Pipe	Page 398
"E"			8 29	1453 56	do	do
T.P.			1 75	1461 105		
	708	1468 185				
"F"			8 92	1459 26	Top of 6" Pipe	Page 401
"G"			537	1462 81	"	do
			072	1467 465		
	10 945	1478 41	061	1477 80		
	739	1485 19				
BM #4			1 87	1483 32	See pg. 405	

Profile No.	Notes Red.	Plotted Martin	Job No. 8123 Division No.	F. B. 713 PG. 407
	Date	Date Aug. 1939	Survey of OLIVE VIEW SANATORIUM	
X-Sec. No.	Notes Chkd.	Checked	Survey by TED WALSH Notes T.M.W.	Date JAN. 31, 1938
	Date	Date	Map No. Indexed	Date

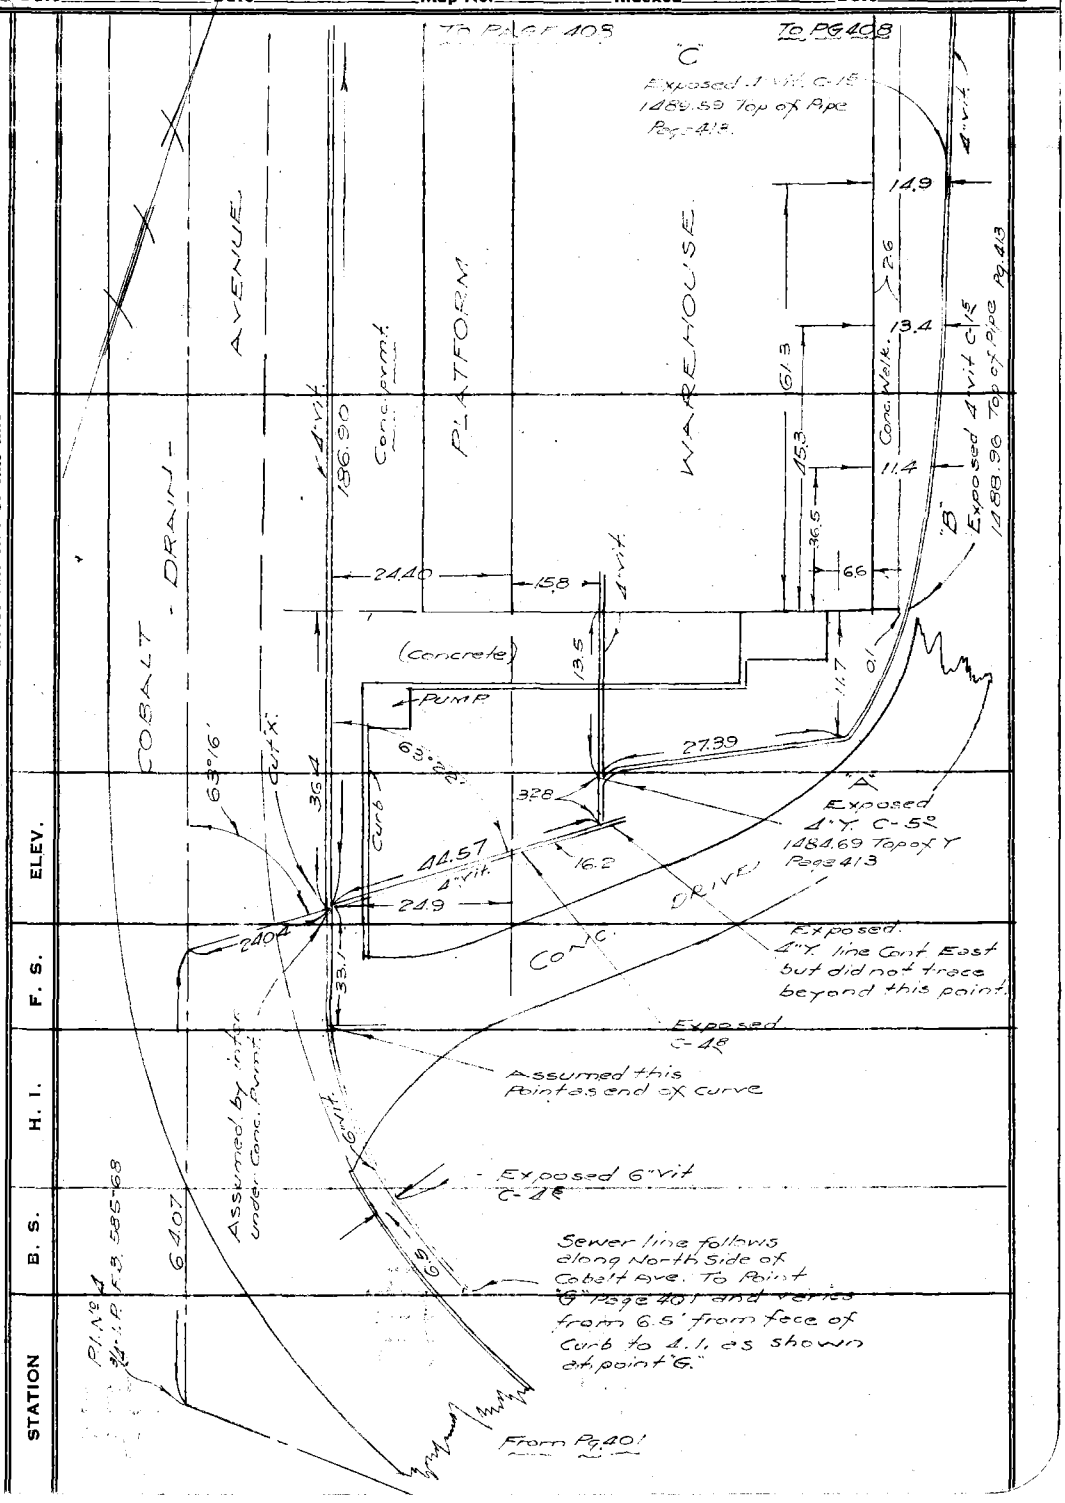

NOTE: ANY ADDITIONS OR CHANGES ON THIS SHEET MUST BE MADE OR CIRCLED IN RED INK, WITH DATE AND NAME OF PERSON MAKING CHANGE

Do not extend notes this side of this line

PLEASE RETURN TO
LOS ANGELES COUNTY SURVEYOR
700 HALL OF RECORDS

Form 307 SM 10-37

F. B. 713 PG 408 | Job No. 8148 | Division No. | Notes Red. | Plotted Martin | Profile

Survey of OLIVE VIEW SANATORIUM | Date | Date Aug. 1939 | No.

Survey by T. WALSH | Notes T. M. W. | Notes Chkd. | Checked | X-Sec.

Indexed | Date Feb. 2, 1938 | Date | Date | No.

Form 307 5M 10-37

PLEASE RETURN TO
LOS ANGELES COUNTY SURVEYOR
700 HALL OF RECORDS

Do not extend notes this side of this line

NOTE: ANY ADDITIONS OR CHANGES ON THIS SHEET MUST BE MADE OR CIRCLED IN RED INK, WITH DATE AND NAME OF PERSON MAKING CHANGE

STATION | B. S. | H. I. | F. S. | ELEV.

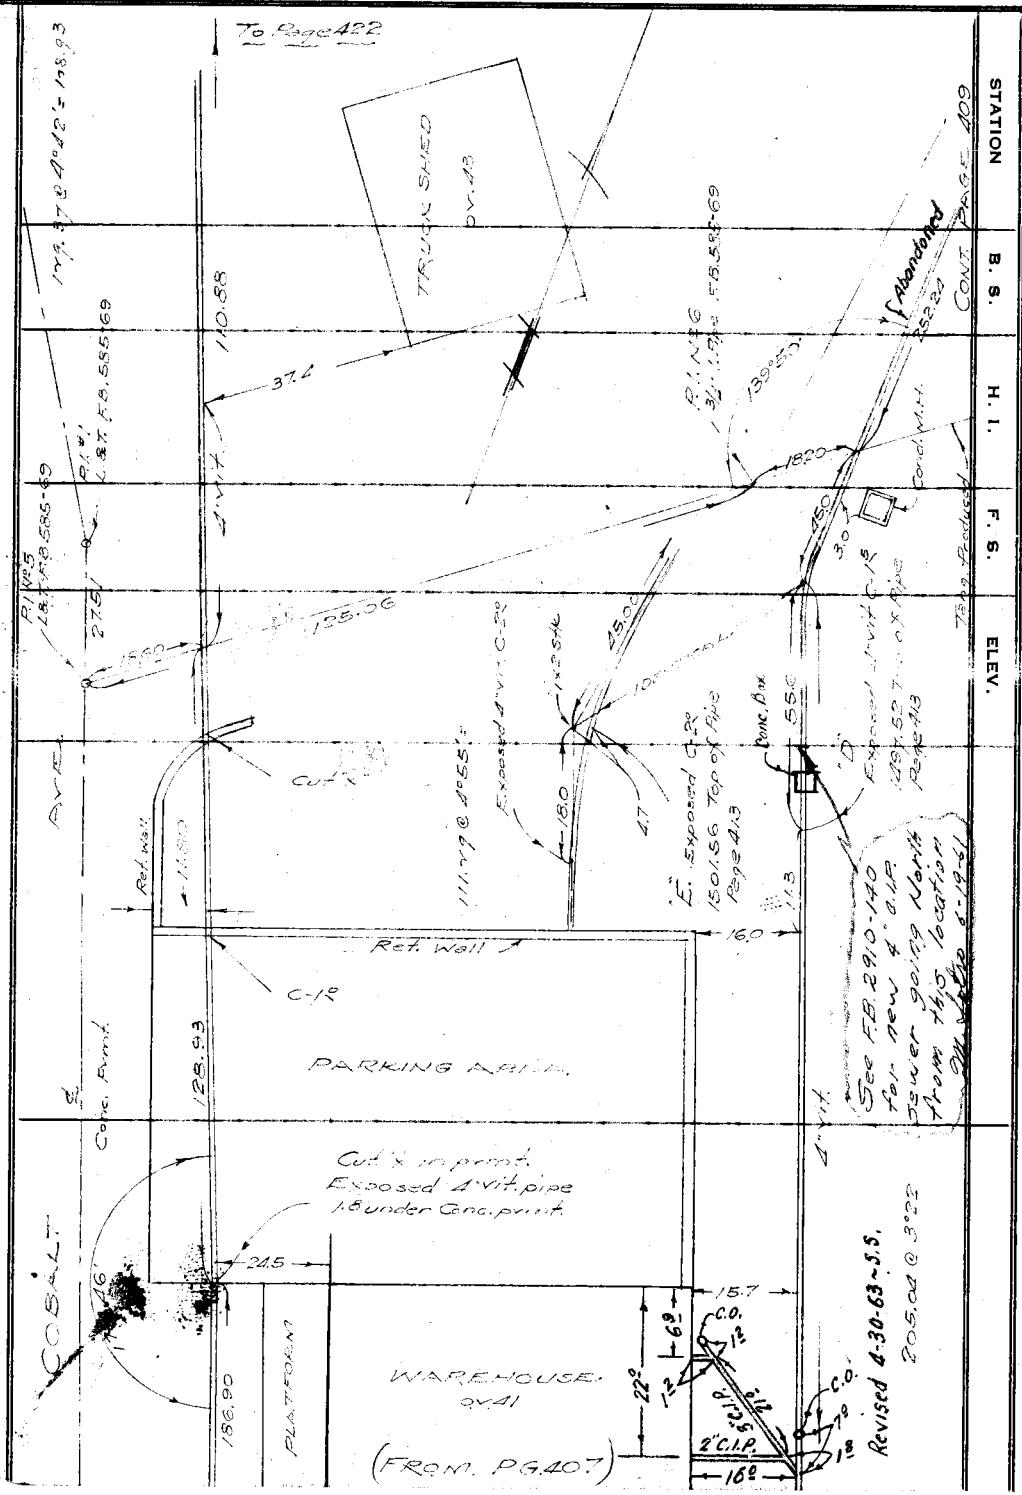

Form 307 5M 10-37

PLEASE RETURN TO
LOS ANGELES COUNTY SURVEYOR
700 HALL OF RECORDS

NOTE: ANY ADDITIONS OR CHANGES ON THIS SHEET MUST BE MADE OR CIRCLED IN RED INK, WITH DATE AND NAME OF PERSON MAKING CHANGE

Do not extend notes this side of this line

Profile	Notes Red.	Plotted Martin	Job No. 508	Division No.	F. B. 713 PG. 409
No.	Date	Date Aug. 1937	Survey of		
X-Sec.	Notes Chkd.	Checked	Survey by	Notes	Date FEB. 3, 1938
No.	Date	Date	Map No.	Indexed	Date

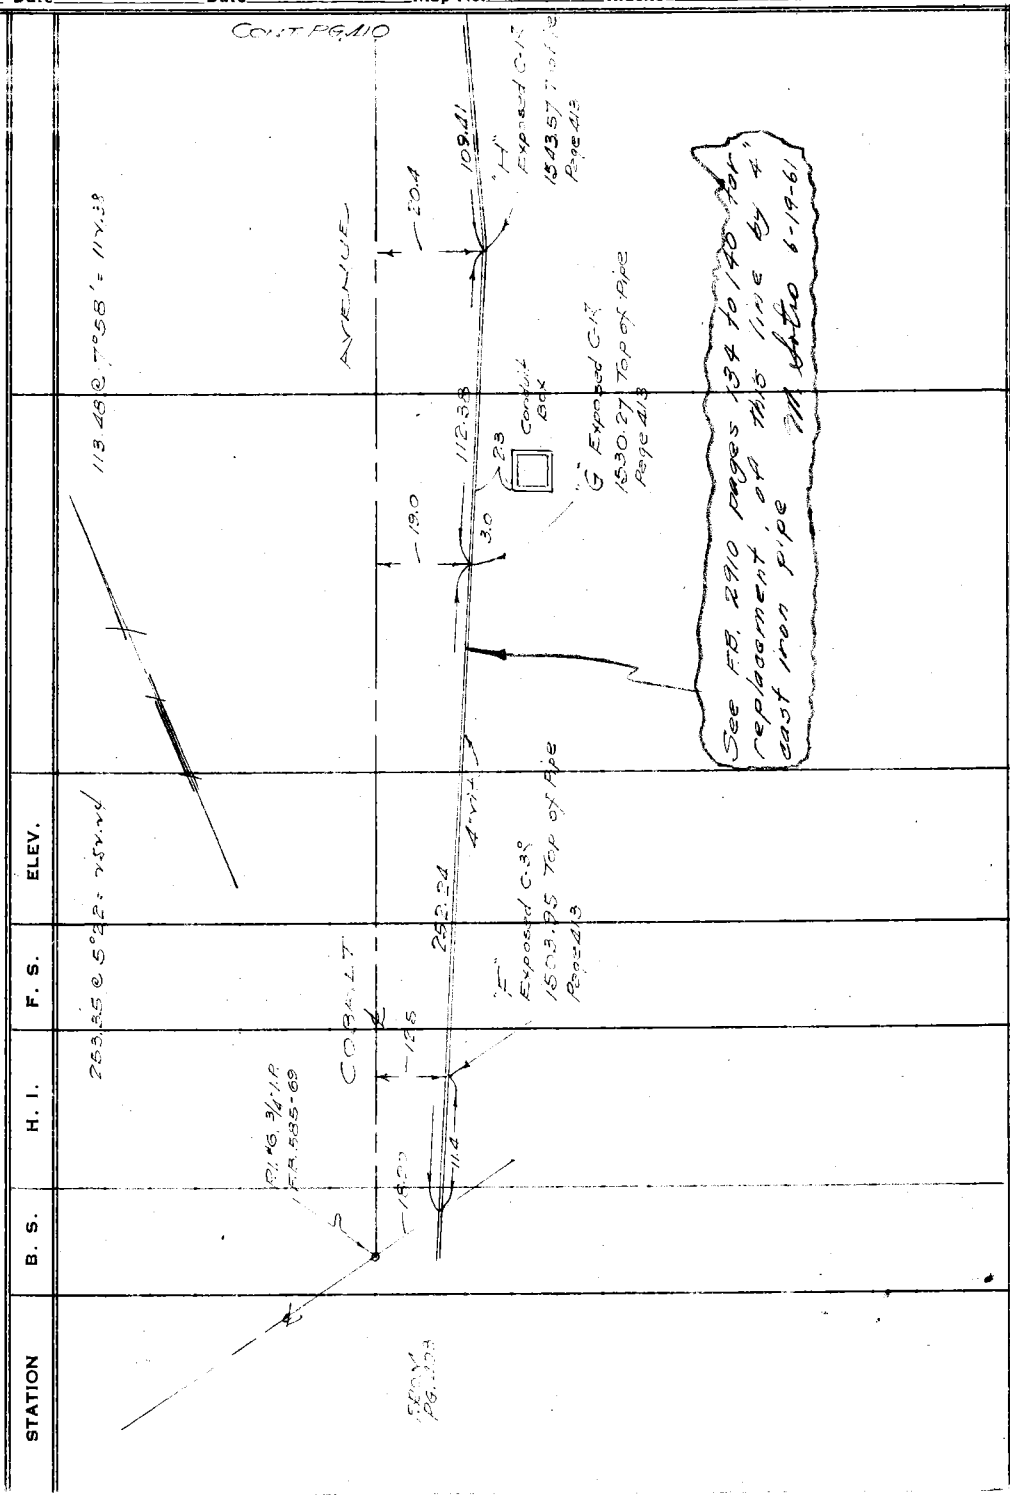

F. B. 713 Pg 410 ✓ | Job No. 8148 | Division No. | Notes Red. | Plotted Martin | Profile

Survey of OLIVE VIEW SANATORIUM | Date | Date Aug. 1939 | No.

Survey by T. WALSH | Notes T.M.W. | Notes Chkd. | Checked | X-Sec.

Indexed | Date Feb. 3, 1938 | Date | Date | No.

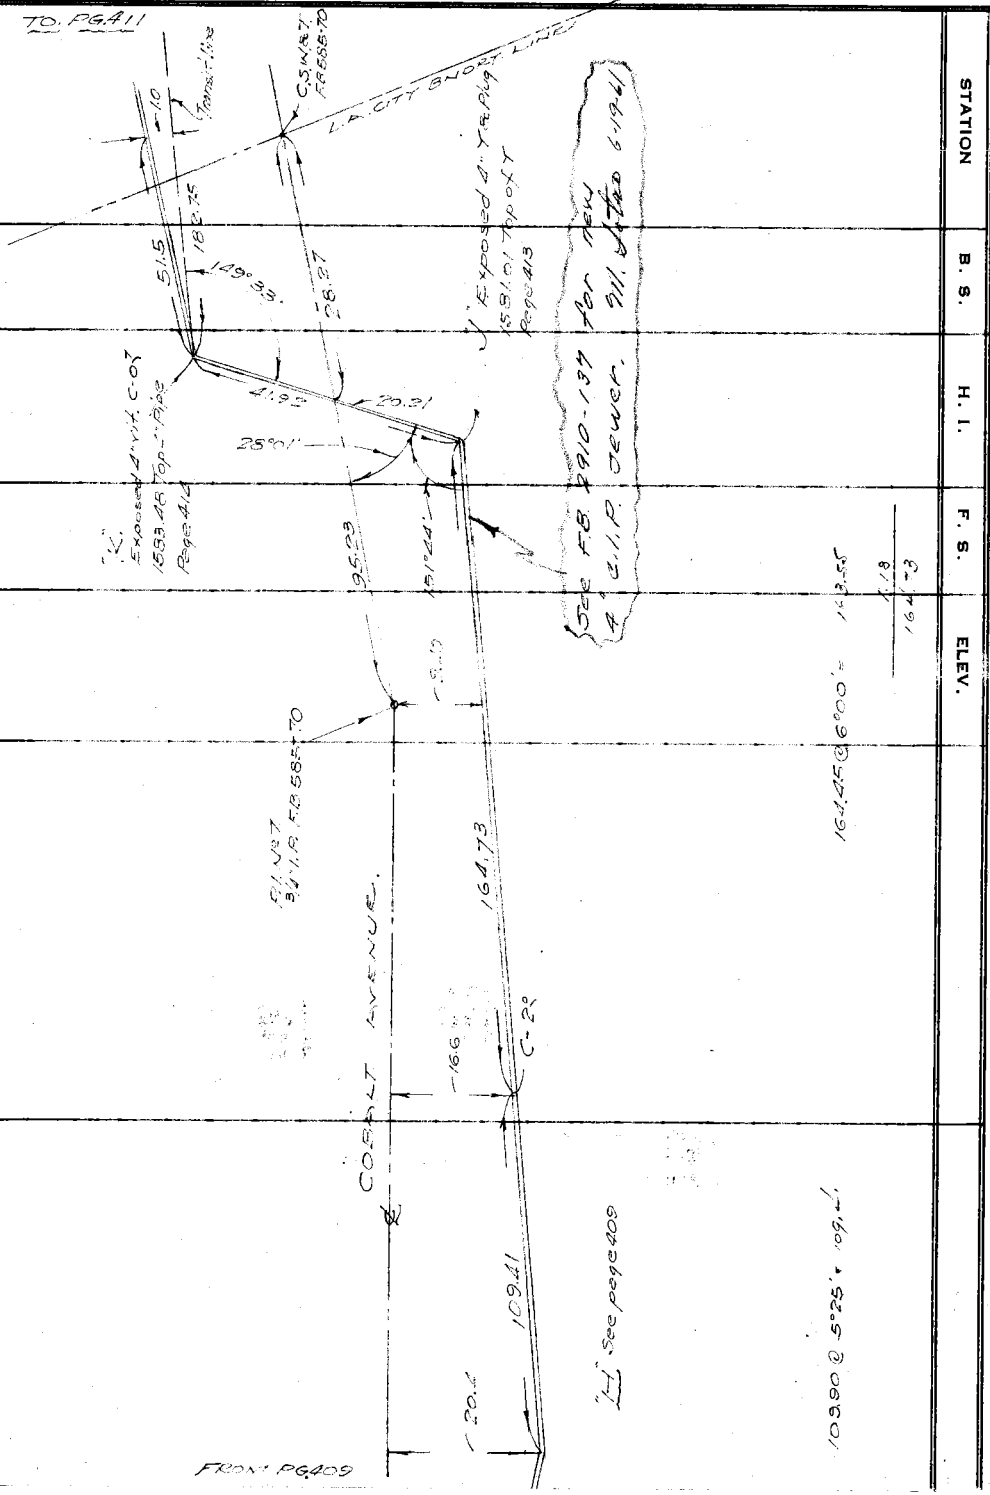

Form 307 5M 10-37

PLEASE RETURN TO
LOS ANGELES COUNTY SURVEYOR
700 HALL OF RECORDS

Do not extend notes this side of this line

NOTE: ANY ADDITIONS OR CHANGES ON THIS SHEET MUST BE MADE OR CIRCLED IN RED INK. WITH DATE AND NAME OF PERSON MAKING CHANGE

Profile	Notes Red.	Plotted Martin	Job No. 8/78	Division No.	F. B. 713 PG. 411
No.	Date	Date Aug. 1939	Survey of OLIVE VIEW SAN. TERRAIN		
X-Sec.	Notes Chkd.	Checked	Survey by T. WALSH	Notes F.M.W.	Date FEB. 4, 1938
No.	Date	Date	Map No.	Indexed A. C. [illegible]	Date

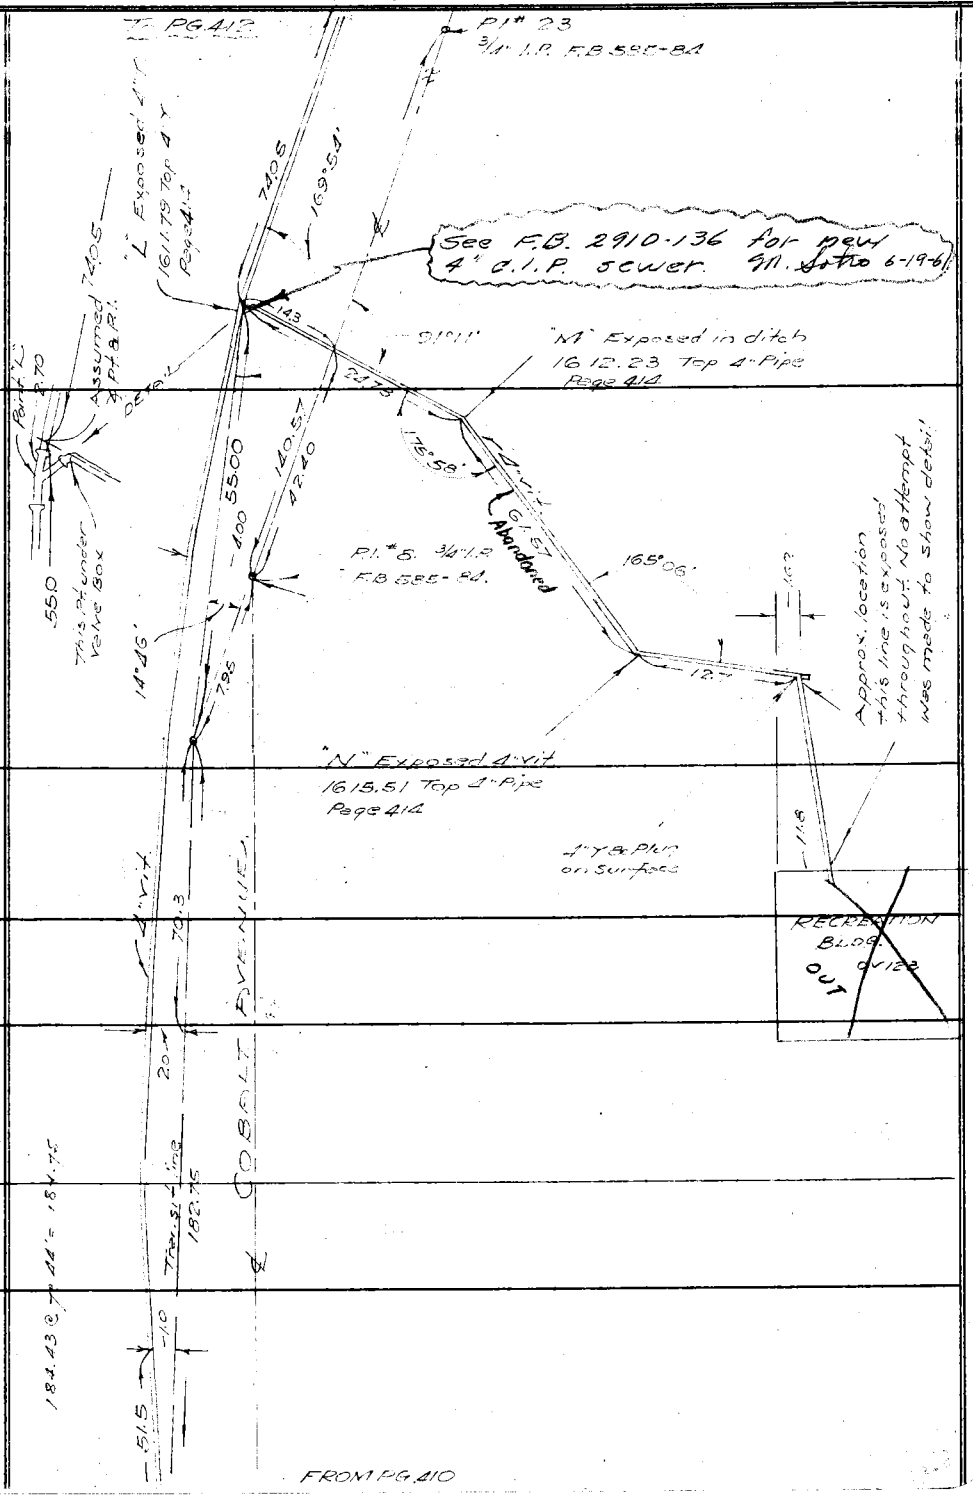

NOTE: ANY ADDITIONS OR CHANGES ON THIS SHEET MUST BE MADE OR CIRCLED IN RED INK, WITH DATE AND NAME OF PERSON MAKING CHANGE

Do not extend notes this side of this line

PLEASE RETURN TO
LOS ANGELES COUNTY SURVEYOR
700 HALL OF RECORDS

Form 307 5M 10-37

F. B. 713 PG 412 | Job No. 8178 | Division No. | Notes Red. | Plotted Martin | Profile

Survey of CLIVE VIEW SANATORIUM | Date | Date Aug. 1939 | No.

Survey by T. WALSH | Notes T. WALSH | Notes Chkd. | Checked | X-Sec.

Indexed | Date FEB. 4 1938 | Date | Date | No.

Form 307 SM 10-37

PLEASE RETURN TO
LOS ANGELES COUNTY SURVEYOR
700 HALL OF RECORDS

NOTE: ANY ADDITIONS OR CHANGES ON THIS SHEET MUST BE MADE OR CIRCLED IN RED INK, WITH DATE AND NAME OF PERSON MAKING CHANGE

Do not extend notes this side of this line

STATION	B. S.	H. I.	F. S.	ELEV.

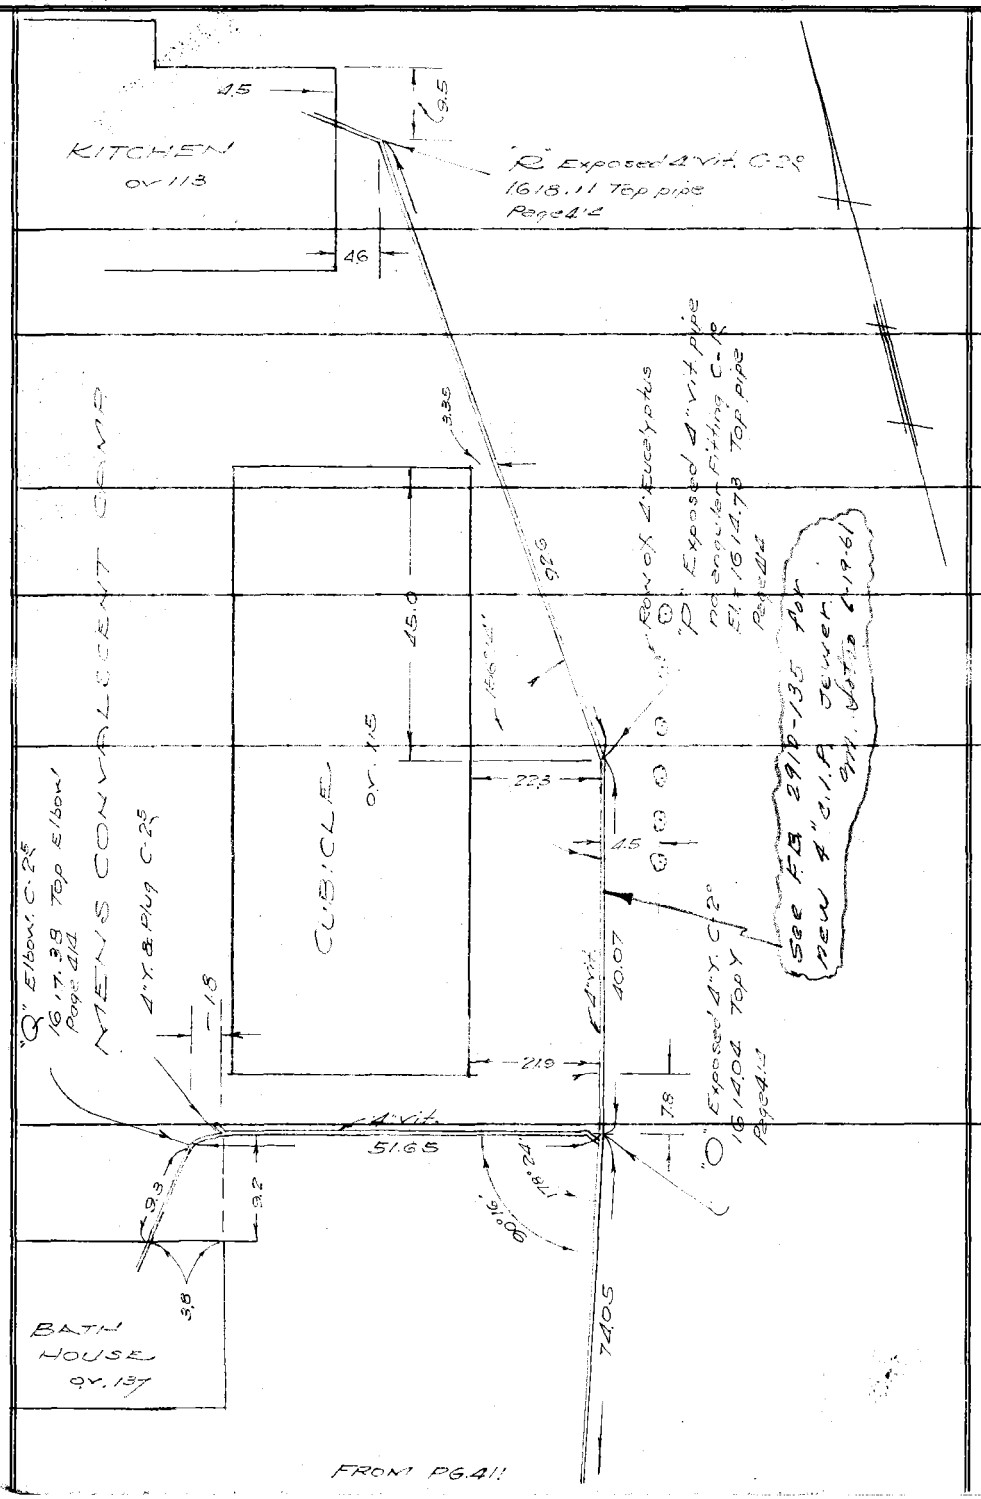

Form 307 5M 10-37

PLEASE RETURN TO
LOS ANGELES COUNTY SURVEYOR
700 HALL OF RECORDS

NOTE: ANY ADDITIONS OR CHANGES ON THIS SHEET MUST BE MADE OR CIRCLED IN RED INK, WITH DATE AND NAME OF PERSON MAKING CHANGE

Do not extend notes this side of this line

STATION	B. S.	H. I.	F. S.	ELEV.		
BM #14				1483.32	SEE PG. 105	F.B 585-16
"A"	11 465	1494 785	10 09	1484 69	Top 4" Y (vit.)	Page 407
"B"			5 82	1488 96	Top 4" vit. Pipe	✓
"C"			5 19	1489 59	do	✓
			0 270	1491 515		
	10 89	1505 405	0.075	1505 330		
"D"	10 535	1515 865	18 34	1497 52	Top 4" vit Pipe	Page 408
"E"			14 30	1501 56	do	✓
"F"			11 91	1503 95	do	Page 409
BM# S-6			9 785	1506 08	Cobalt Ave. S.W. of Softners "X" in bolt on F.H.	
			0 455	1515 41		
	11 125	1526 535	0 155	1526 38		
"G"	12 285	1538 665	8 39	1530 27	Top 4" vit Pipe	Page 409
			0 32	1538 345		
"H"	11 66	1550 005	6 43	1543 57		
			0 245	1549 760		
	12 11	1561 87	0 475	1561 395		
	6 32	1567 715	5 045	1562 67		
	10 51	1573 18	0 355	1572 825		
"J"	11 215	1584 04	3 03	1581 01	on Top 4" vit. pipe	Page 410
			0 13	1583 91		

Profile No. ____ Notes Red. ____ Plotted ____ Job No. 8 in 8 Division No. ____ F.B. 713 PG. 413
Date ____ Date ____ Survey of [illegible]
X-Sec. No. ____ Notes Chkd. Martin Checked ____ Survey by T. Walsh Notes T. Walsh Date ____
Date 8-8-39 Date ____ Map No. ____ Indexed R. C. Johnson Date ____

Form 307 5M 10-37

PLEASE RETURN TO
LOS ANGELES COUNTY SURVEYOR
700 HALL OF RECORDS

NOTE: ANY ADDITIONS OR CHANGES ON THIS SHEET MUST BE MADE OR CIRCLED IN RED INK, WITH DATE AND NAME OF PERSON MAKING CHANGE

Do not extend notes this side of this line

STATION	B. S.	H. I.	F. S.	ELEV.		
				1583 91	Cont. pg 413.	
"K"	9 555	1593 465	9 98	1583 48	Top 4" Pipe	Page 410
			0 765	1592 70		
	10 415	1603 115	0 300	1602 815		
	11 50	1614 315	1 49	1612 825		
"L"	7 935	1620 76	8 97	1611 79	Top 4" Vit. Y	Page 411
"M"			8 53	1612 23	Top 4" Vit. Pipe	do
"N"			5 25	1615 51	do	do
"O"			6 72	1614 04	Top 4" Vit. Y.	Page 412
"P"			6 03	1614 73		
"Q"			3 38	1617 38	Top 4" Vit. El.	Page 412
			2 785	1617 975		
	7 22	1625 195				
"R"			7 08	1618 11	Top 4" Vit. Pipe	Page 412
T.P.			7 22	1617 975	T.P. Men's Convel. Camp. "X" on F.H. 45' E. & 3' So. of S.E. Cor. Bldg. (O.V. #137) F.B. 585-18	
					1617.975 = Elev.	

F. B. 713 PG 414 Job No. 8148 Division No. Notes Red. Plotted Profile
Survey of OLIVE VIEW SANATORIUM Date Date No.
Survey by T. M. WALSH Notes T. M. W. Notes Chkd. Martin Checked X-Sec.
Indexed A. C. Johnson Date Date 8-8-39 Date No.

Profile No.	Notes Red.	Plotted Martin	Job No. 8778 Division No.	F. B. 713 PG. 415
	Date	Date Aug. 1939	Survey of OLIVE VIEW SANATORIUM	
X-Sec. No.	Notes Chkd.	Checked	Survey by T. WALSH Notes T.M.W.	Date Feb. 14, 1938
	Date	Date	Map No. Indexed	Date

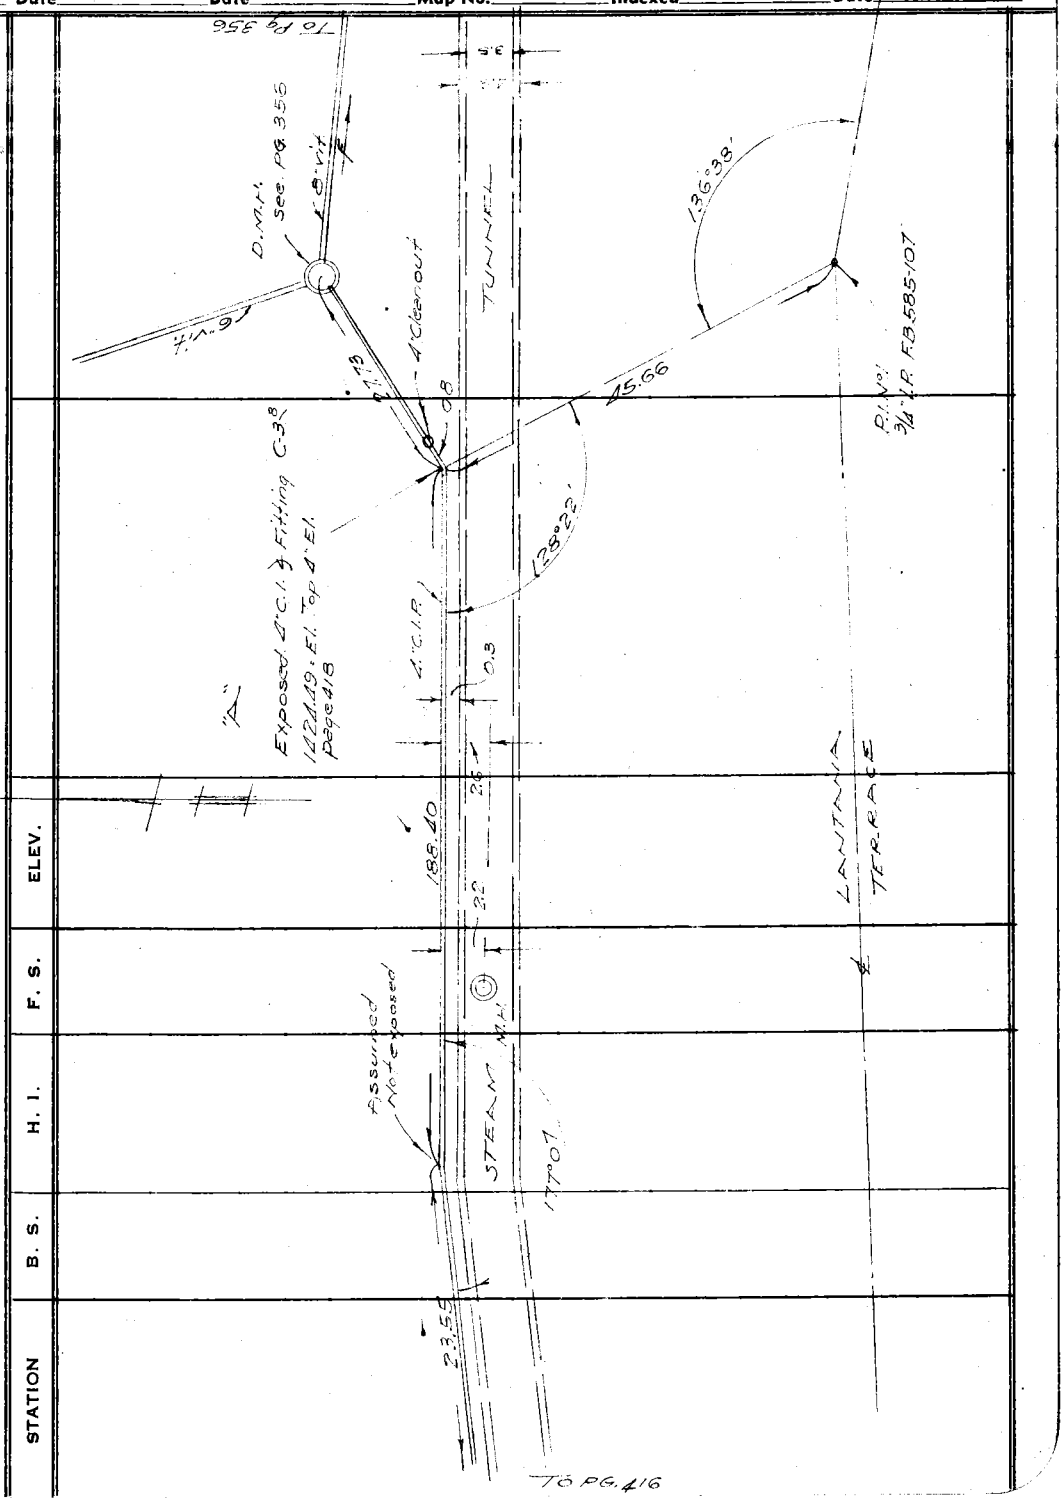

STATION	B. S.	H. I.	F. S.	ELEV.

Do not extend notes this side of this line

NOTE: ANY ADDITIONS OR CHANGES ON THIS SHEET MUST BE MADE OR CIRCLED IN RED INK, WITH DATE AND NAME OF PERSON MAKING CHANGE

PLEASE RETURN TO
LOS ANGELES COUNTY SURVEYOR
700 HALL OF RECORDS

Form 307 5M 10-37

F. B. 713 PG 416 ✓ | Job No. 8178 | Division No. | Notes Red. | Plotted Martin | Profile

Survey of OLIVE VIEW SANATORIUM | Date | Date Aug. 1939 | No.

Survey by T. WALSH | Notes T.M.W | Notes Chkd. | Checked | X-Sec.

Indexed | Date Feb. 14 1938 | Date | Date | No.

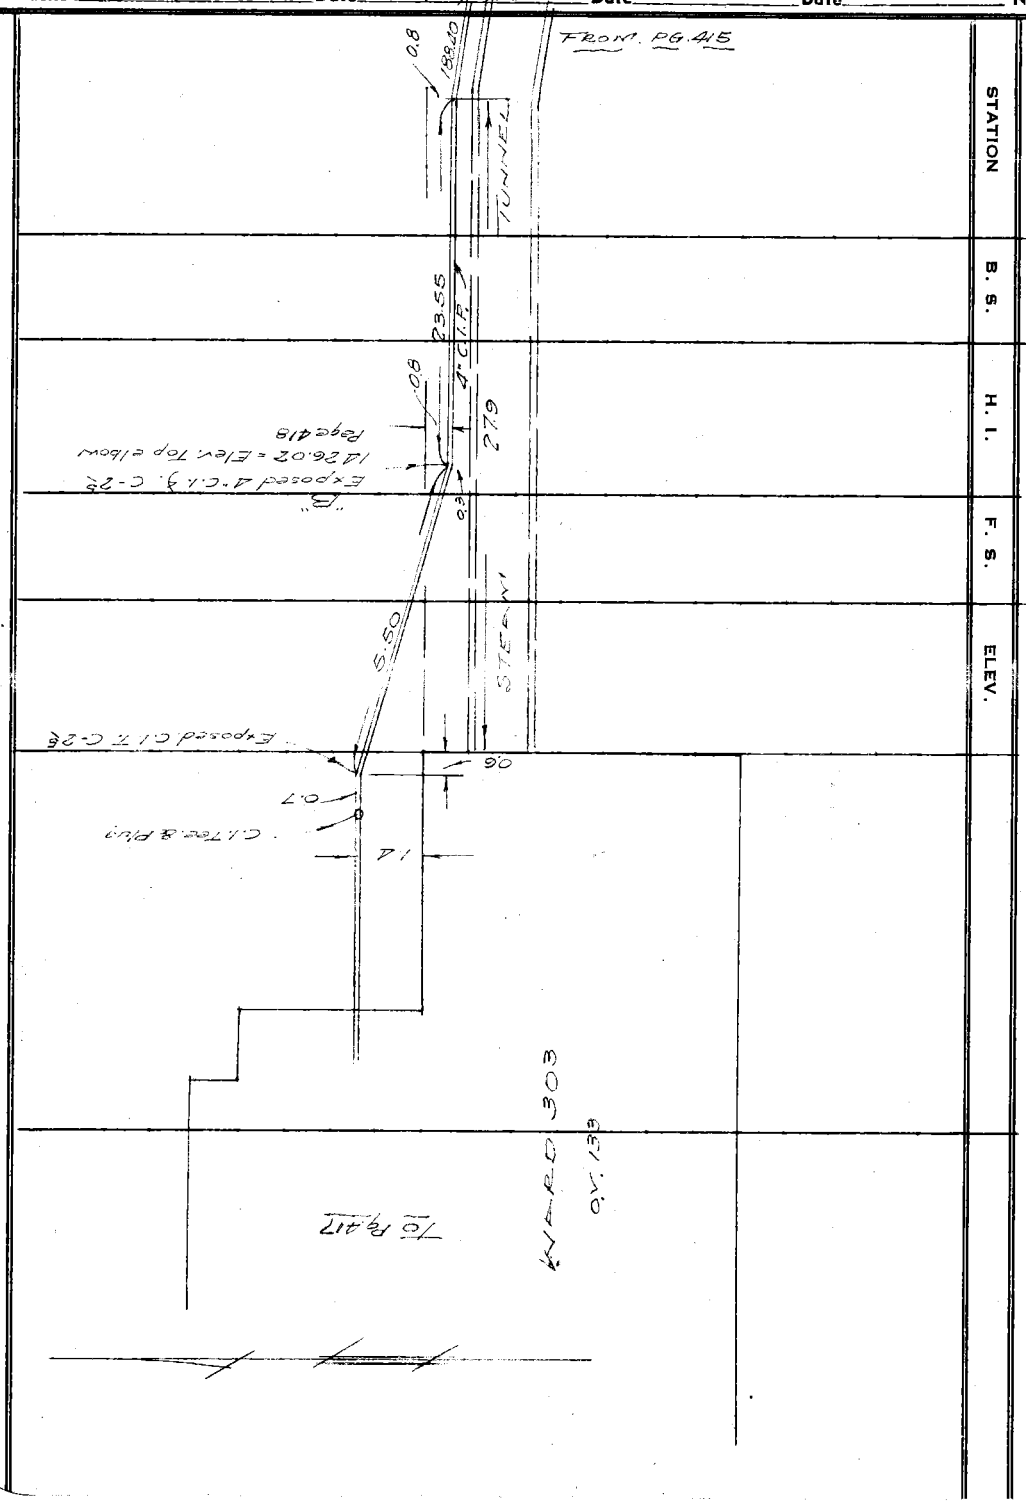

Form 307 5M 10-37

PLEASE RETURN TO
LOS ANGELES COUNTY SURVEYOR
700 HALL OF RECORDS

Do not extend notes this side of this line

NOTE: ANY ADDITIONS OR CHANGES ON THIS SHEET MUST BE MADE OR CIRCLED IN RED INK, WITH DATE AND NAME OF PERSON MAKING CHANGE

Profile	Notes Red.	Plotted Martin	Job No. 8148	Division No.	F. B. 713 PG. 417
No.	Date	Date Aug. 1939	Survey of [illegible]		
X-Sec.	Notes Chkd.	Checked	Survey by T. WALSH	Notes T.M.W.	Date Feb. 14. 1938
No.	Date	Date	Map No.	Indexed [illegible]	Date

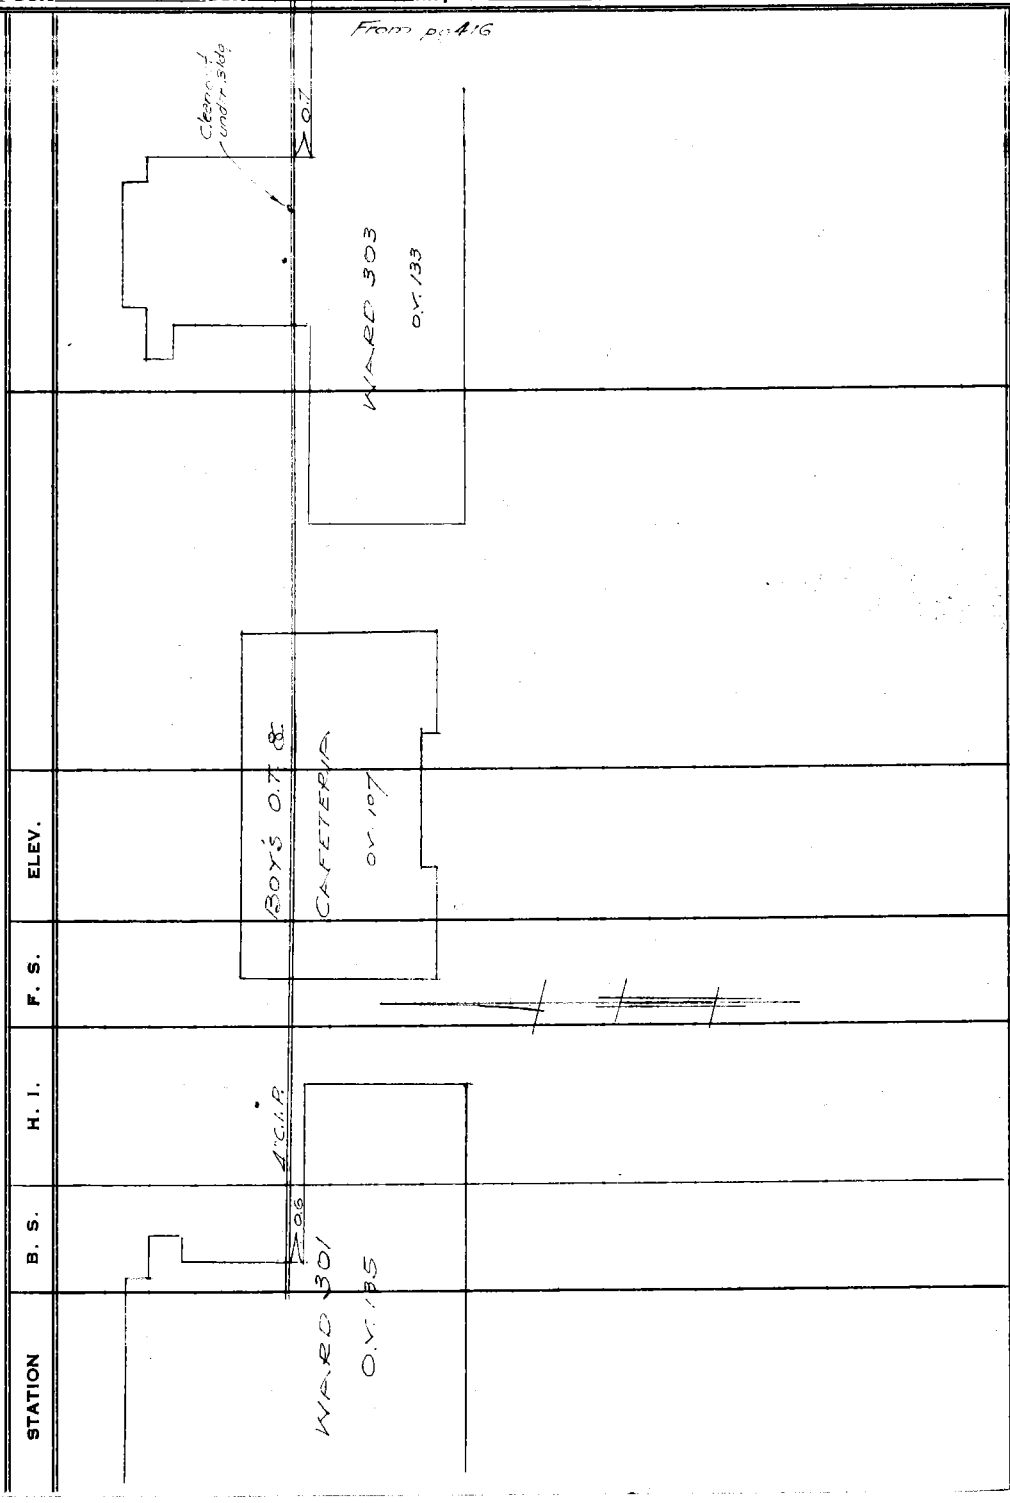

NOTE: ANY ADDITIONS OR CHANGES ON THIS SHEET MUST BE MADE OR CIRCLED IN RED INK, WITH DATE AND NAME OF PERSON MAKING CHANGE

Do not extend notes this side of this line

PLEASE RETURN TO
LOS ANGELES COUNTY SURVEYOR
700 HALL OF RECORDS

Form 307 5M 10-37

Form 307 5M 10-37

PLEASE RETURN TO
LOS ANGELES COUNTY SURVEYOR
700 HALL OF RECORDS

NOTE: ANY ADDITIONS OR CHANGES ON THIS SHEET MUST BE MADE OR CIRCLED IN RED INK, WITH DATE AND NAME OF PERSON MAKING CHANGE

Do not extend notes this side of this line

STATION	B. S.	H. I.	F. S.	ELEV.		
BM S-3				1448 05	See pg. 363	
	337	1451 42				
			11 73	1439 69		
	261	1442 30	5 21	1437 09		
Point "X"	485	1441 94	9 41	1432 53	Top 4" Y.	Page 356
" "Y"			7 42	1434 52	Top 4" Pipe	Page 419
			11 88	1430 06		
Point "A"	274	1432 80	8 31	1424 49	Top 4" C.I. Elbow.	Page 415
" "B"			6 78	1426 02	" 4" C.I. "	Page 416
Rim of M.H			4 02	1428 78	See page 356 + Pg. 365	

F. B. 713 Pg 418 Job No. 8178 Division No. Notes Red. Plotted Profile
Survey of OLIVE VIEW SANATORIUM Date Date No.
Survey by T. WALSH Notes T. M. W. Notes Chkd. Martin Checked X-Sec.
Indexed A. C. [illegible] Date Feb. 15, 1938. Date 8-8-39 Date No.

Form 307 5M 10-37

PLEASE RETURN TO
LOS ANGELES COUNTY SURVEYOR
700 HALL OF RECORDS

NOTE: ANY ADDITIONS OR CHANGES ON THIS SHEET MUST BE MADE OR CIRCLED IN RED INK, WITH DATE AND NAME OF PERSON MAKING CHANGE

Do not extend notes this side of this line

STATION	B. S.	H. I.	F. S.	ELEV.

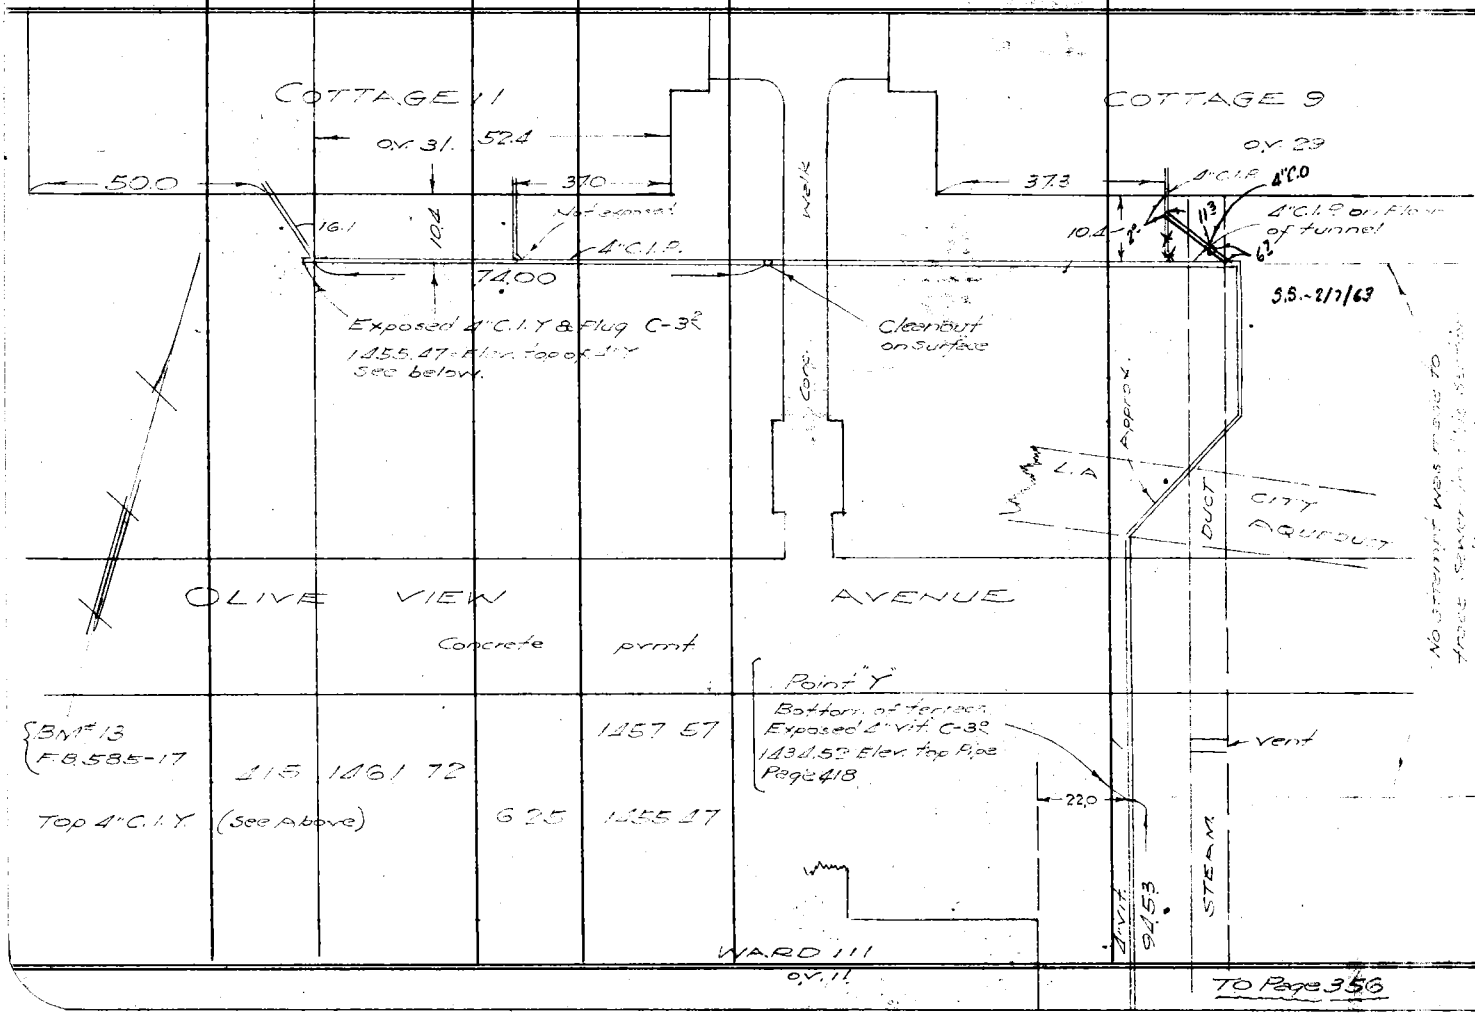

Profile No. ____ Notes Red. ____ Plotted Martin Job No. 8/78 Division No. ____ F.B. 713 PG. 419

X-Sec. No. ____ Date ____ Date Aug. 1939 Survey of OLIVE VIEW SANATORIUM

Notes Chkd. ____ Checked ____ Survey by T. WALSH Notes T.M.W. Date FEB 17, 1938

Date ____ Date ____ Map No. ____ Indexed A. C. Jelson Date ____

F. B. 713 PG. 420 | Job No. 8128 | Division No. | Notes Red. | Plotted Martin | Profile

Survey of OLIVE VIEW SANATORIUM | Date / | Date Aug. 1939 | No.

Survey by T. WALSH | Notes T. M. W. | Notes Chkd. | Checked | X-Sec.

Indexed | Date Feb. 2, 1938 | Date | Date | No.

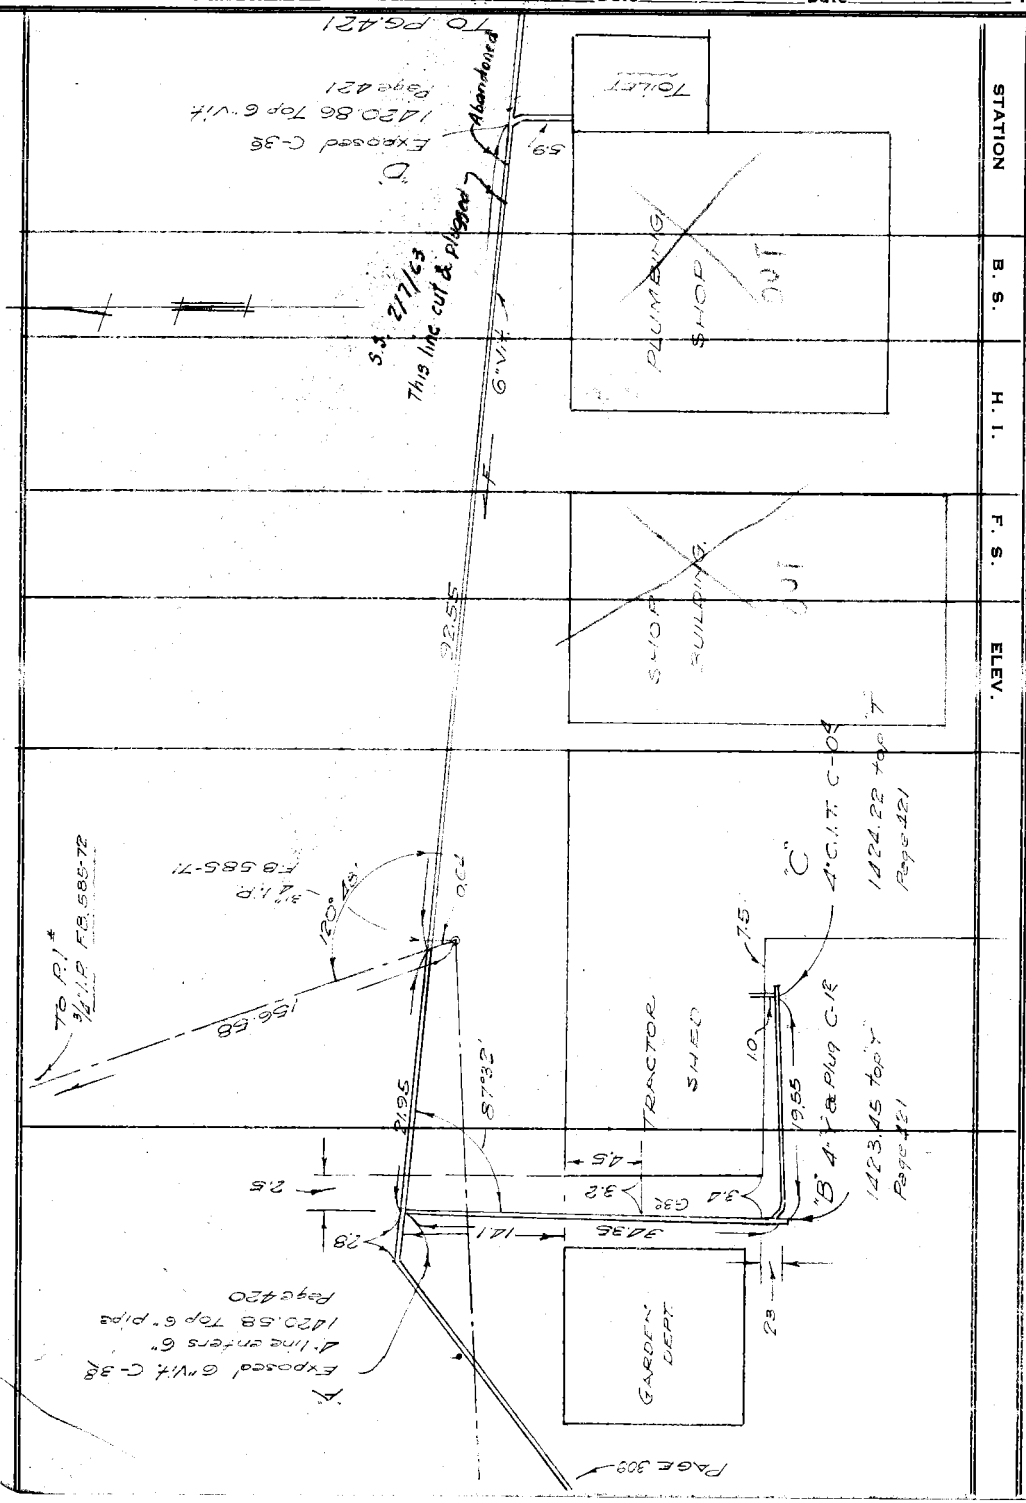

Form 307 5M 10-37

PLEASE RETURN TO
LOS ANGELES COUNTY SURVEYOR
700 HALL OF RECORDS

Do not extend notes this side of this line

NOTE: ANY ADDITIONS OR CHANGES ON THIS SHEET MUST BE MADE OR CIRCLED IN RED INK, WITH DATE AND NAME OF PERSON MAKING CHANGE

Form 307 5M 10-37

PLEASE RETURN TO
LOS ANGELES COUNTY SURVEYOR
700 HALL OF RECORDS

NOTE: ANY ADDITIONS OR CHANGES ON THIS SHEET MUST BE MADE OR CIRCLED IN RED INK, WITH DATE AND NAME OF PERSON MAKING CHANGE

Do not extend notes this side of this line

STATION	B. S.	H. I.	F. S.	ELEV.		
					~~OLD LABOR CAMP~~ OUT	
					6.5	
					18.9	
					2" W.I.P.	
					"E" Exposed 4" Vit. "Y" C-3.5 1423.44 Top 4" Pipe See below	
					36.7	
					4" Vit	
					7.1	
					Abandoned S.S. - 2/7/63	
					1.1	
BM#3				1418 87	Nail in lead. S.E. Cor. Boiler house F.B. 585-5	
	6 21	1425 08	3 78	1421 30		
"A"	8 44	1429 74	9 16	1420 58	Top of 6" Vit pipe	Page 420
"B"			6 29	1423 45	" " 4" " Y	"
"C"			5 52	1424 22	" " 4" C.I. T	"
"D"			8 88	1420 86	" " 6" Vit	"
			2 36	1427 38		
"E"	1 37	1428 75	5 31	1423 44	Top of 4" Pipe	Above
T.P#3			6 65	1422 10	"X" in Fire plug. 500' E. of Power house F.B. 585-5	

FROM PG 420

Profile No. ____ Notes Red. ____ Plotted Martin Job No. 8128 Division No. ____ F.B. 713 PG. 421

X-Sec. No. ____ Date ____ Date Aug. 1939 Survey of OLD LABOR CAMP

Notes Chkd. Martin Checked ____ Survey by T. WALSH Notes T.M.W. Date 2-8-38

Date 8-8-39 Date ____ Map No. ____ Indexed A. C. Johnson Date ____

F. B. 713 Pg 422 | Job No. 818 | Division No. | Notes Red. | Plotted Martin | Profile

Survey of OLIVE VIEW SANATORIUM | Date | Date Aug. 1939 | No.

Survey by T. WALSH | Notes T. WALSH | Notes Chkd. | Checked | X-Sec.

Indexed A. C. Johnson | Date FEB. 1, 1938 | Date | Date | No.

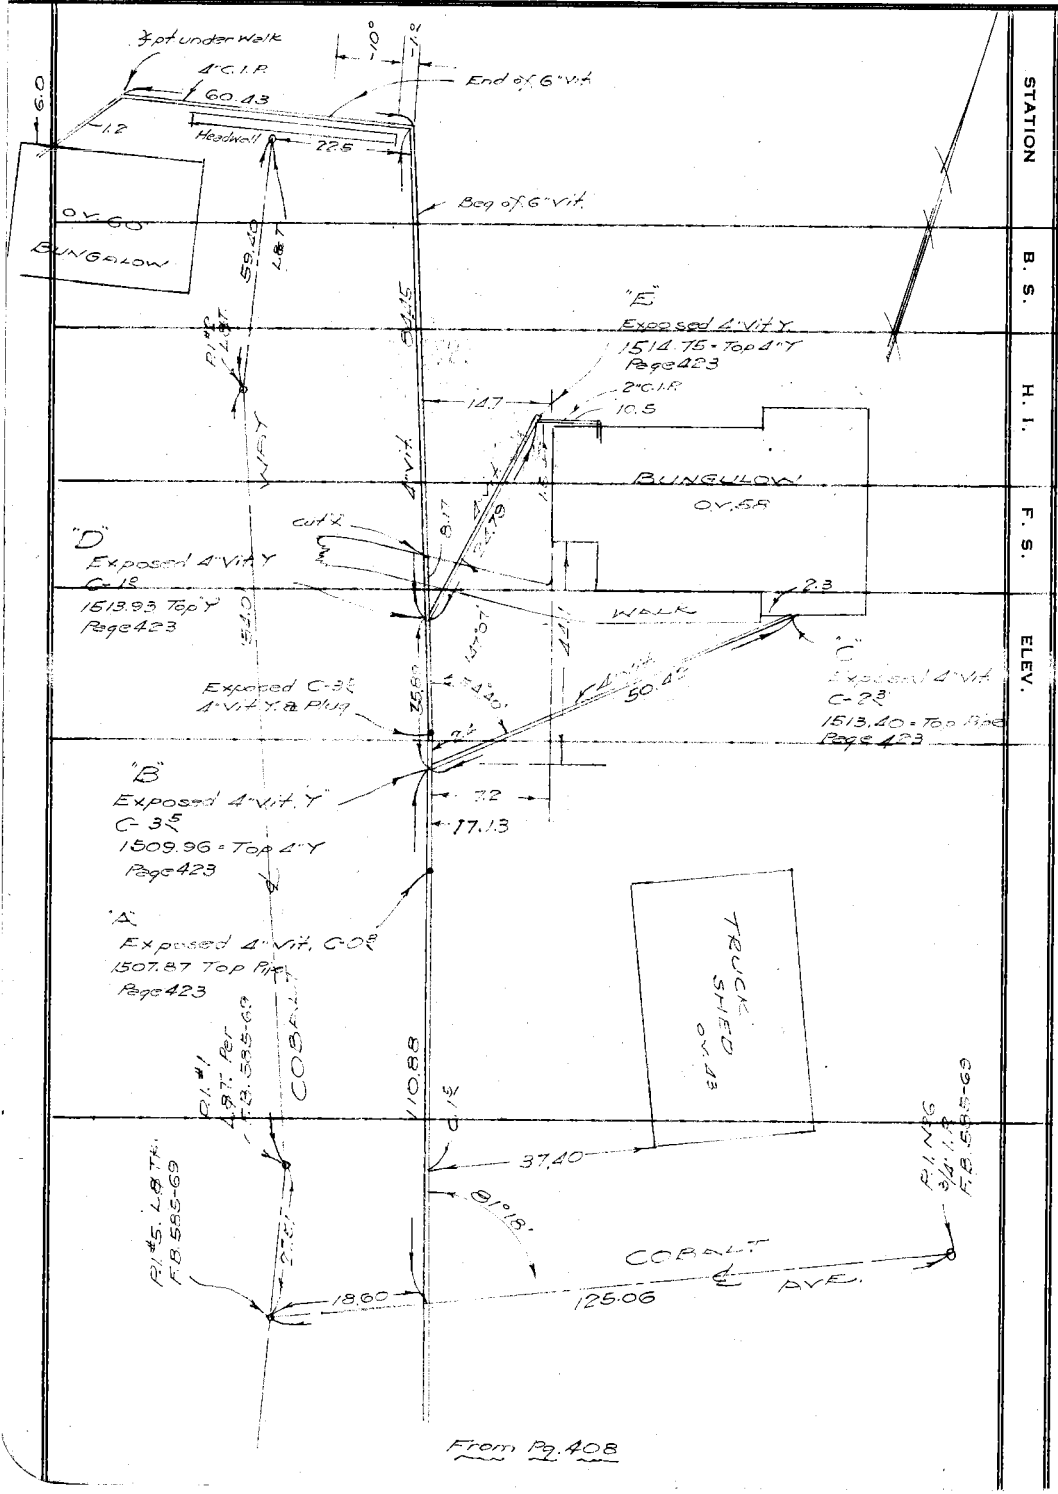

Form 307 5M 10-37

PLEASE RETURN TO
LOS ANGELES COUNTY SURVEYOR
700 HALL OF RECORDS

Do not extend notes this side of this line

NOTE: ANY ADDITIONS OR CHANGES ON THIS SHEET MUST BE MADE OR CIRCLED IN RED INK, WITH DATE AND NAME OF PERSON MAKING CHANGE

Form 307 5M 10-37

PLEASE RETURN TO
LOS ANGELES COUNTY SURVEYOR
700 HALL OF RECORDS

NOTE: ANY ADDITIONS OR CHANGES ON THIS SHEET MUST BE MADE OR CIRCLED IN RED INK, WITH DATE AND NAME OF PERSON MAKING CHANGE

Do not extend notes this side of this line

STATION	B. S.	H. I.	F. S.	ELEV.		
BM # S-6				1506 08	Cobalt Ave. S.W. of Softners "X" in bolt of Fire hydrant	See Page 413
"A"	11 44	1517 52	9 65	1507 87	Top of 4" vit.	Page 422
"B"			7 56	1509 96	" " " "Y"	"
"C"			4 12	1513 40	" " 4" vit.	"
"D"			3 59	1513 93	" " 4" vit. "Y"	"
"E"			2 77	1514 75	" " 4" "	"
BM # S-6			11 44	1506 08	See Above	

Profile No. ____ Notes Red. ____ Plotted ____ Job No. 8/78 Division No. ____ F. B. 713 PG. 423

X-Sec. No. ____ Date ____ Date ____ Survey of OLIVE VIEW SANATORIAL

Notes Chkd. Martin Checked ____ Survey by T. M. WALSH Notes T.M.W. Date Feb. 1, 1938

Date 8-8-39 Date ____ Map No. ____ Indexed A. C. [illegible] Date ____

F. B. 713 PG 424 | Job No. _____ Division No. _____ Notes Red. _____ Plotted _____ Profile

Survey of _____ Date _____ Date _____ No. _____

Survey by _____ Notes _____ Notes Chkd. _____ Checked _____ X-Sec.

Indexed C. Johansen Date _____ Date _____ Date _____ No. _____

Form 307 5M 10-37

PLEASE RETURN TO
LOS ANGELES COUNTY SURVEYOR
700 HALL OF RECORDS

NOTE: ANY ADDITIONS OR CHANGES ON THIS SHEET MUST BE MADE OR CIRCLED IN RED INK, WITH DATE AND NAME OF PERSON MAKING CHANGE

Do not extend notes this side of this line

STATION	B. S.	H. I.	F. S.	ELEV.	

Profile	Notes Red.	Plotted	Job No. 8148	Division No.	F. B. 713	Pg. 425
No.	Date	Date	Survey of OLIVE VIEW SANATORIUM			
X-Sec.	Notes Chkd.	Checked	Survey by T. WALSH	Notes T.M.W.	Date 2-15-37	
No.	Date	Date	Map No.	Indexed	Date	

DRAINAGE

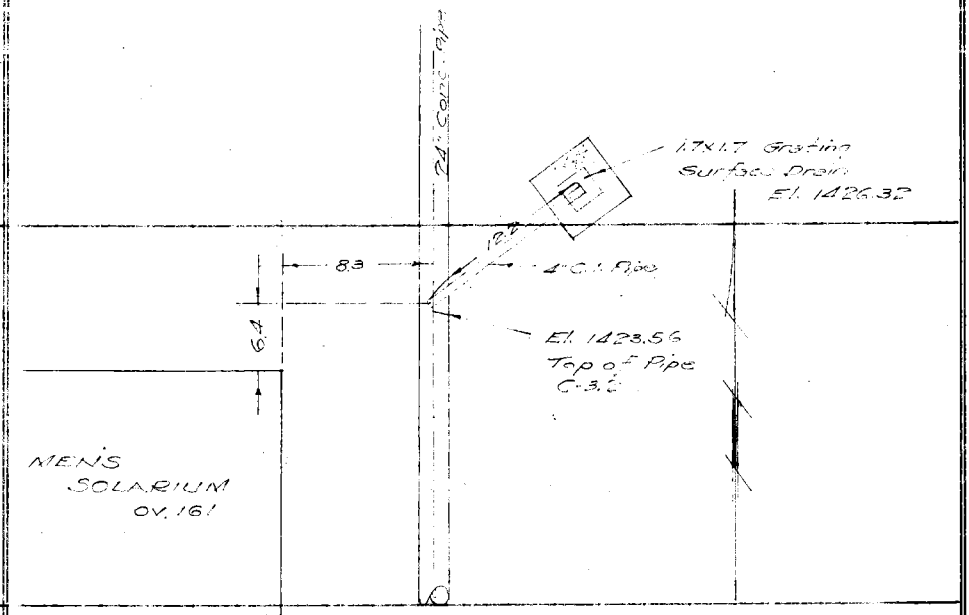

STATION	B. S.	H. I.	F. S.	ELEV.
T.D. #2 "X" in top of F.H. F8 585-5	8.53	14/31 93		14/23 40
Top of 24" Pipe			8 37	14/23 56
Grating			5 61	14/26 32

NOTE: ANY ADDITIONS OR CHANGES ON THIS SHEET MUST BE MADE OR CIRCLED IN RED INK, WITH DATE AND NAME OF PERSON MAKING CHANGE

Do not extend notes this side of this line

PLEASE RETURN TO
LOS ANGELES COUNTY SURVEYOR
700 HALL OF RECORDS

Form 307 5M 11-35

F. B. 13 PG. 126 | Job No. | Division No. | Notes Red. | Plotted | Profile No.

Survey of | Date | Date

Survey by | Notes | Notes Chkd. | Checked | X-Sec. No.

Indexed | Date | Date | Date

STATION	B. S.	H. I.	F. S.	ELEV.

Form 307 5M 11-35

PLEASE RETURN TO
LOS ANGELES COUNTY SURVEYOR
700 HALL OF RECORDS

Do not extend notes this side of this line

NOTE: ANY ADDITIONS OR CHANGES ON THIS SHEET MUST BE MADE OR CIRCLED IN RED INK, WITH DATE AND NAME OF PERSON MAKING CHANGE

Notes Ck'd by	Survey of [illegible] UNDERGROUND	F.B. [illegible] Pg. [illegible]
Map No.	W. O. 81-8 Tape No. St'd °F.	
Office Work	Surveyed by T. WALSH	DRAINAGE
Checked	Notes T. WALSH Date 6-19-36	
Date	Indexed A. C. Johnson 2-6-50	

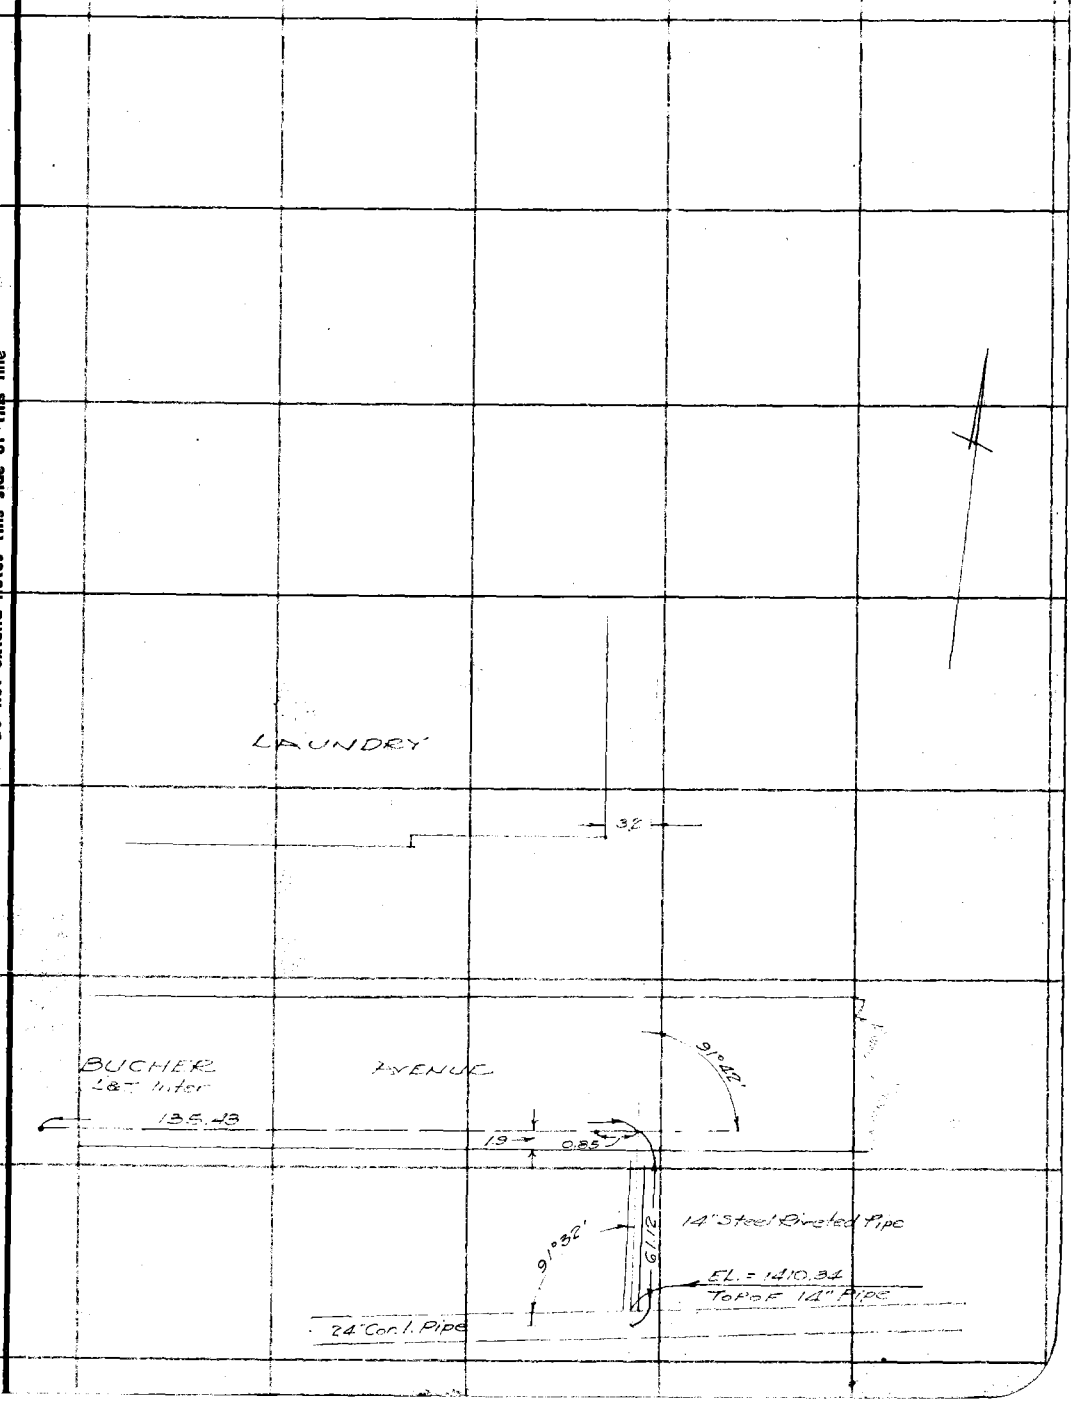

Note: Any Additions or Changes on This Sheet Must be Made or Circled in Red Ink With Date and Name of Person Making Change.

Do not extend notes this side of this line

RETURN TO
LOS ANGELES COUNTY SURVEYOR
700 HALL OF RECORDS

FORM 247 10M 11-35

RETURN TO
LOS ANGELES COUNTY SURVEYOR
700 HALL OF RECORDS

Note: Any Additions or Changes on This Sheet Must be Made or Circled in **Red** Ink With Date and Name of Person Making Change.

Do not extend notes this side of this line

F.B. 123 Pg. 128

FORM 307 10M 10-46

PLEASE RETURN TO
LOS ANGELES COUNTY SURVEYOR
700 HALL OF RECORDS

NOTE: ANY ADDITIONS OR CHANGES ON THIS SHEET MUST BE MADE OR CIRCLED IN RED INK, WITH DATE AND NAME OF PERSON MAKING CHANGE.

Do not extend notes this side of this line.

STATION	B. S.	H. I.	F. S.	ELEV.		Cont Bot next Page 430
71.59 @ 0°	7.59				Note large patch in Pav. Witness says this is 4 pt which broke 7 years Prev. [illegible] was made to expose [illegible] depth under Pav. 11+ Distance shown [illegible] determined by pushing [illegible]	
139.12 @ 8°53	= 137.15					
139.22 @ 9°08	[illegible]					
46.11 @ 0°	255.15					

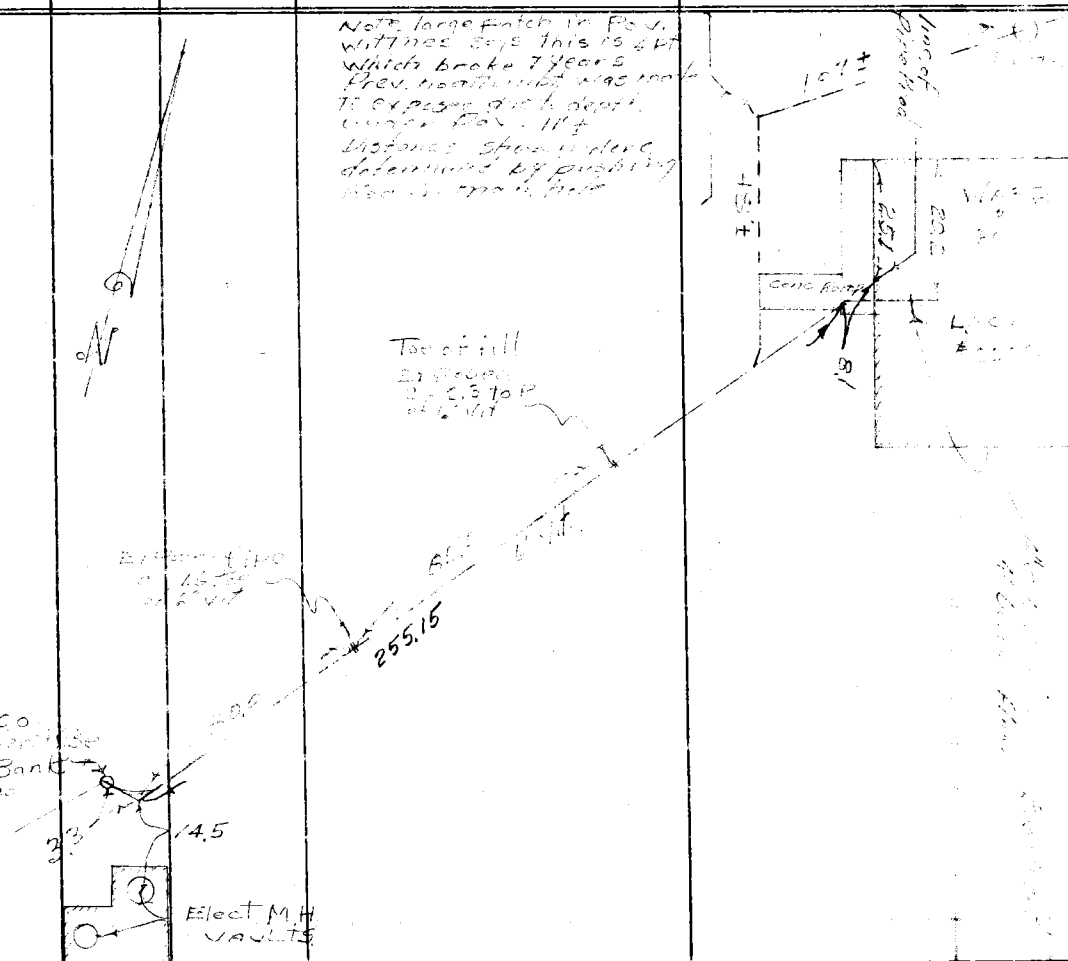

Cont from top Page 319

Profile No. X-Sec. No. Notes Red Date Plotted R.E.D. Date 2-6-50 Job No. 5150 Division No. Survey of [illegible] Notes Chkd. Checked L.D. Date 2-8-50 Survey by [illegible] Date 2-1-50 Map No. P.T.54 Indexed C. Johnson Date 2-7-50

F.B. 712 PG 439

F.B. 713 PG. 430 | Job No. 8128 | Division No. | Notes Red. | Plotted R.E.S. | Profile

Survey of Oliveview Sun | Date | Date 2-6-50 | No.

Survey by Porter | Notes Porter | Notes Chkd. | Checked L.D. | X-Sec.

Indexed A. C. Johnson | Date | Date | Date 2-8-50 | No.

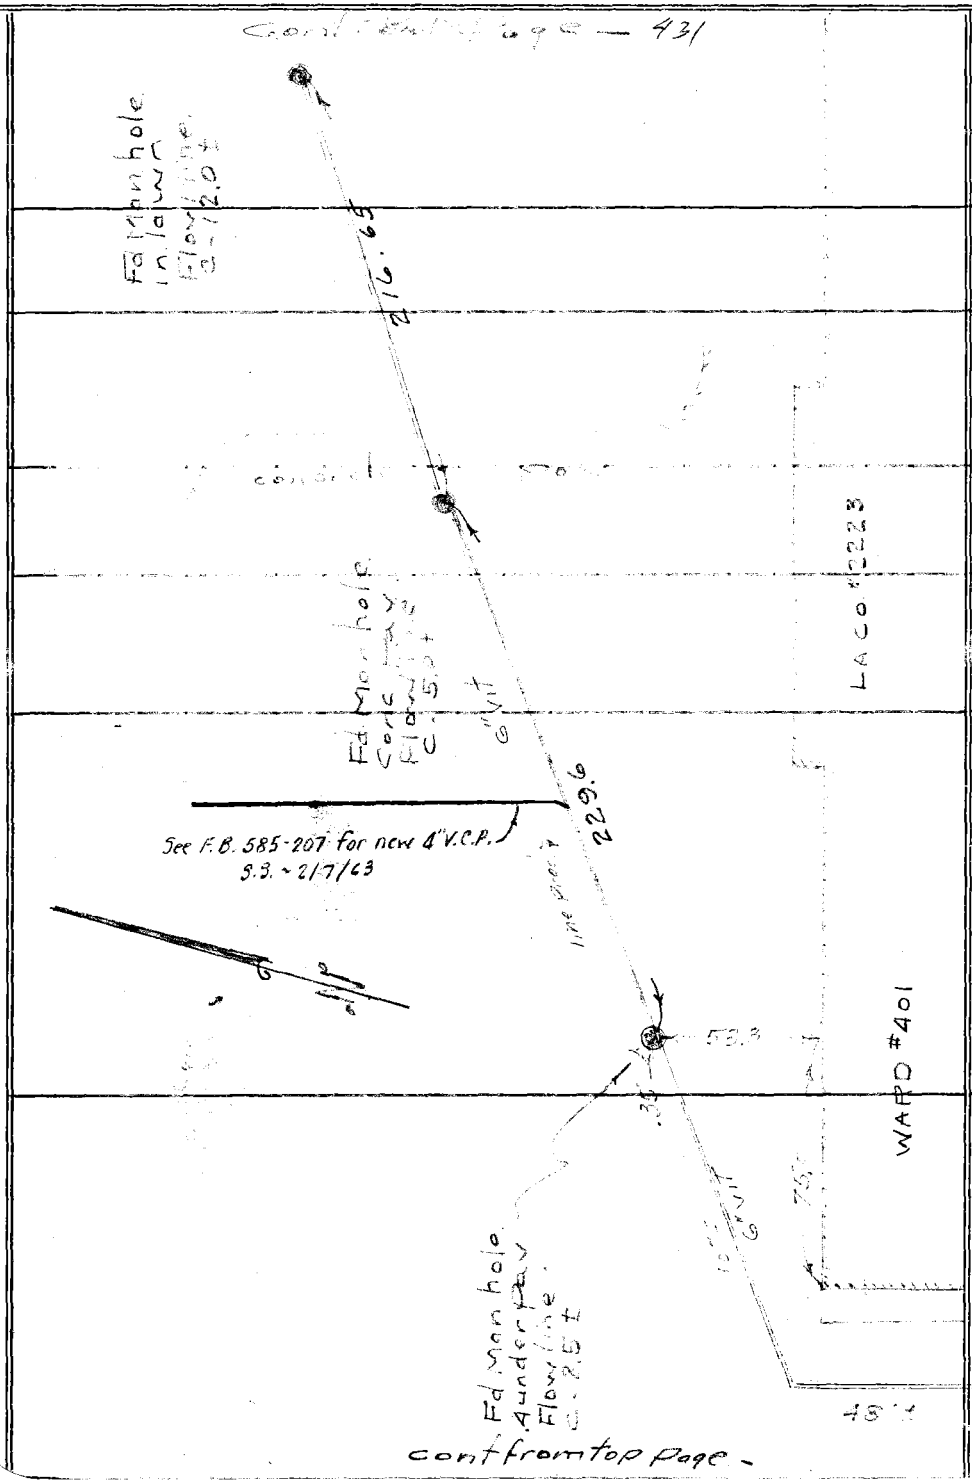

STATION	B.S.	H.I.	F.S.	ELEV.

FORM 307 10M 10-46

PLEASE RETURN TO
LOS ANGELES COUNTY SURVEYOR
700 HALL OF RECORDS

NOTE: ANY ADDITIONS OR CHANGES ON THIS SHEET MUST BE MADE OR CIRCLED IN RED INK, WITH DATE AND NAME OF PERSON MAKING CHANGE.

Do not extend notes this side of this line.

Olive View Sanatorium
J.N. 8101

DATUM – MEAN SEA LEVEL

Elevations shown hereon are based on the 1928 U.S.C.&G.S. adjustment of U.S.C.&G.S. BM "P-53" (U.S.2202) and U.S.G.S. BM "R.S. 10 – 1924" (U.S.951)

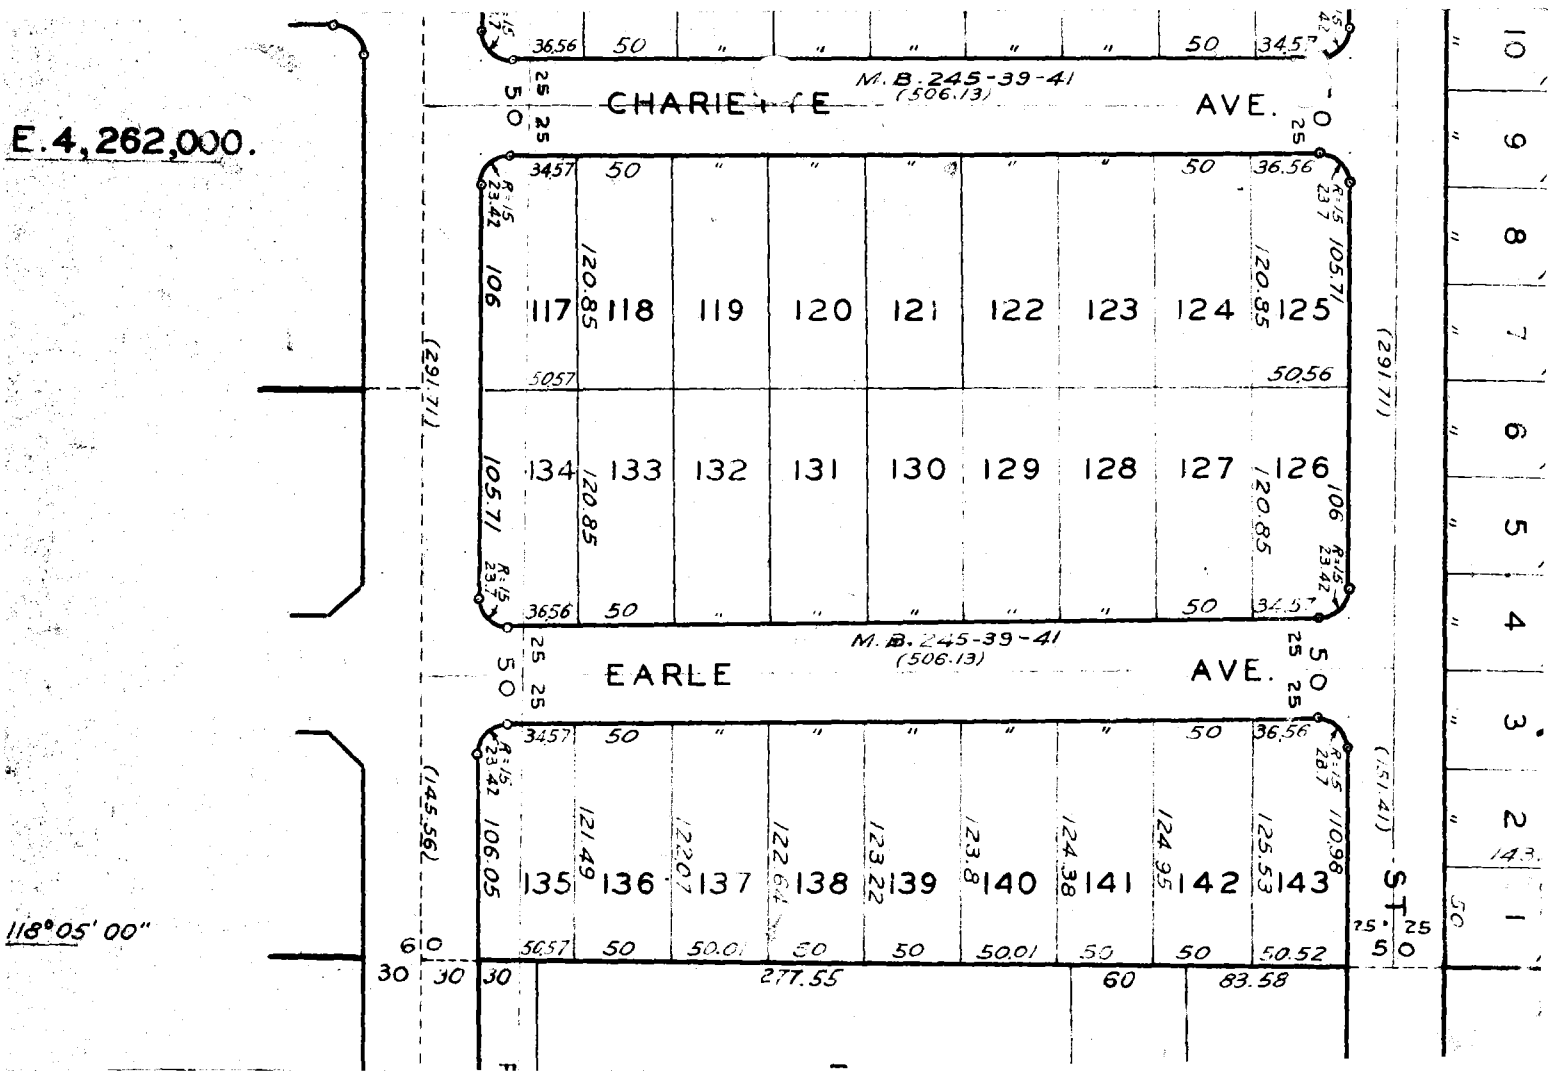
E.4,262,000.
118°05' 00"
CHARIETTE AVE.
EARLE AVE.
M.B. 245-39-41
(506.13)
117
118
119
120
121
122
123
124
125
134
133
132
131
130
129
128
127
126
135
136
137
138
139
140
141
142
143
(291.71)
(145.56)
(151.41)
277.55
83.58
ST.

Profile No. _____ Notes Red. _____ Plotted R.B.C. Job No. [illegible] Division No. _____

F.B. 713 Pg. 431

Date _____ Date 2-6-[illegible] Survey of [illegible]

X-Sec. No. _____ Notes Chkd. _____ Checked L.D. Survey by [illegible] Notes [illegible] Date 2-[illegible]-50

Date _____ Date 2-8-50 Map No. P.T. 54 A. C. Johnson Indexed _____ Date _____

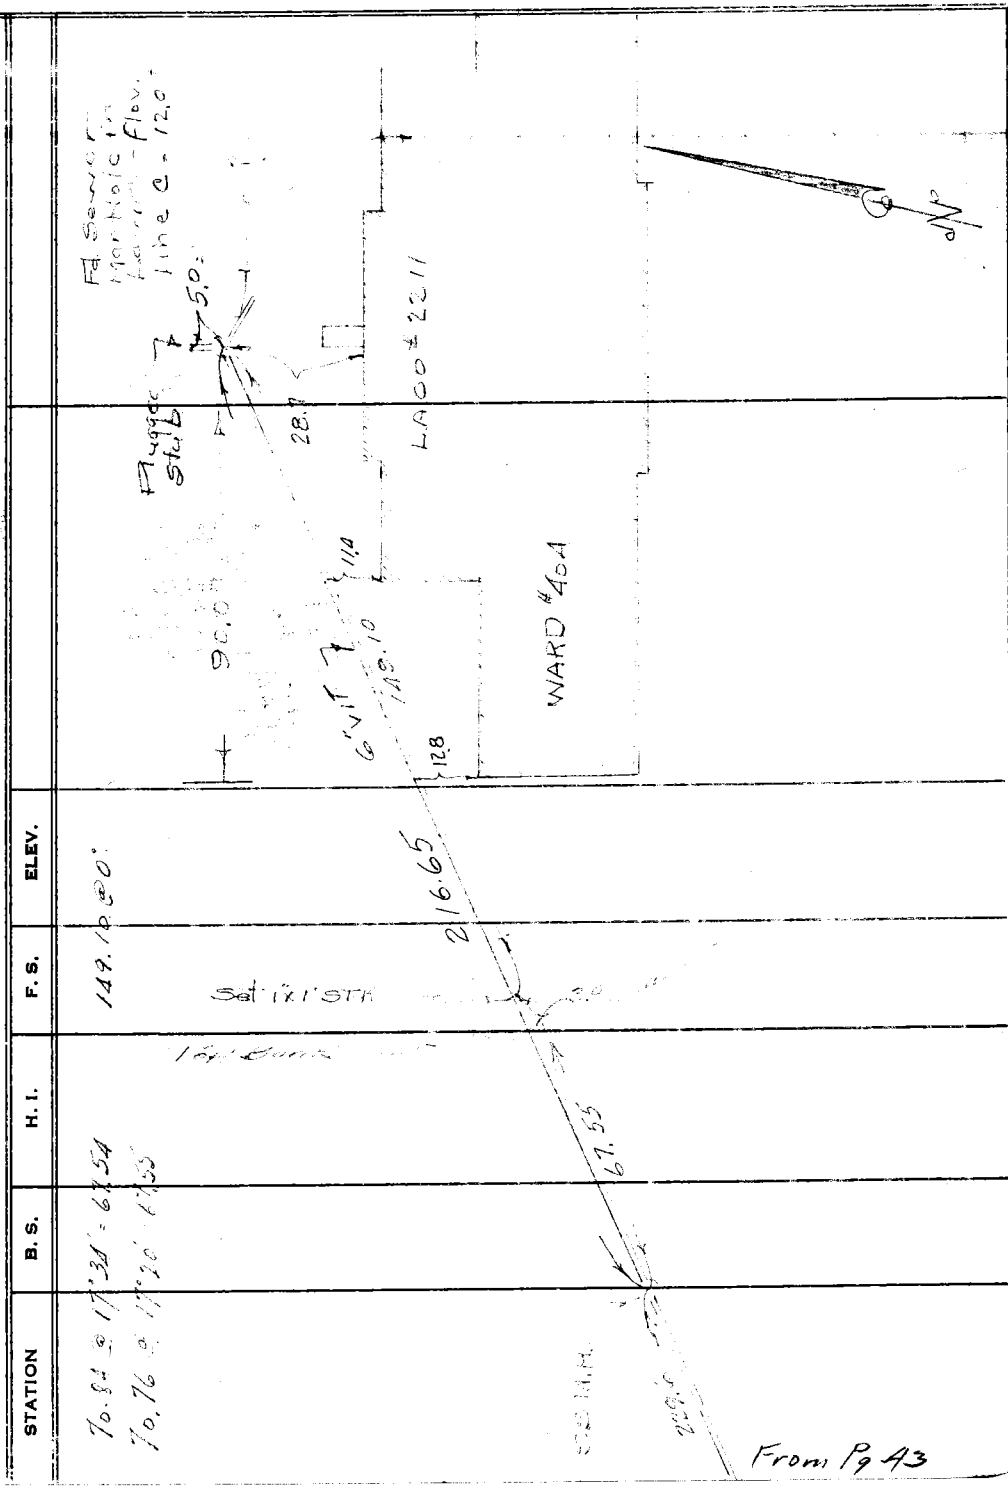

STATION	B.S.	H.I.	F.S.	ELEV.
70.84 @ 17°34' = 67.54				
70.76 @ 17°20' = 67.55				

From Pg 43

NOTE: ANY ADDITIONS OR CHANGES ON THIS SHEET MUST BE MADE OR CIRCLED IN RED INK, WITH DATE AND NAME OF PERSON MAKING CHANGE.

PLEASE RETURN TO
LOS ANGELES COUNTY SURVEYOR
700 HALL OF RECORDS

Do not extend notes this side of this line.

FORM 307 10M 10-46

F.B. 713 PG. 432

Job No. _____ Division No. _____ Notes Red. _____ Plotted _____ Profile

Survey of _____ Date _____ Date _____ No. _____

Survey by _____ Notes _____ Notes Chkd. _____ Checked _____ X-Sec.

Indexed _____ Date _____ Date _____ Date _____ No. _____

FORM 307 10M 10-46

PLEASE RETURN TO
LOS ANGELES COUNTY SURVEYOR
700 HALL OF RECORDS

NOTE: ANY ADDITIONS OR CHANGES ON THIS SHEET MUST BE MADE OR CIRCLED IN RED INK, WITH DATE AND NAME OF PERSON MAKING CHANGE.

Do not extend notes this side of this line.

STATION	B. S.	H. I.	F. S.	ELEV.	

Notes Ck'd by KRN	Survey of Olive View Sanatorium
Map No.	W. O. 8101 Tape No. St'd °F
Office Work	Surveyed by R C Bowers
Checked	Notes RCB Date 10-10-52
Date	Indexed A. C. Johnson 10-20-52

F. B. 719 Pg. 433

Points for Topog Map of Area for Pharmacy & Flammable Liquid Storage Bldg.

Note: Any Additions or Changes on This Sheet Must be Made or Circled in Red Ink With Date and Name of Person Making Change.

Do not extend notes this side of this line.

RETURN TO
LOS ANGELES COUNTY SURVEYOR
700 HALL OF RECORDS

FORM 247 SM 11-46

F. B. 713 Pg. 434

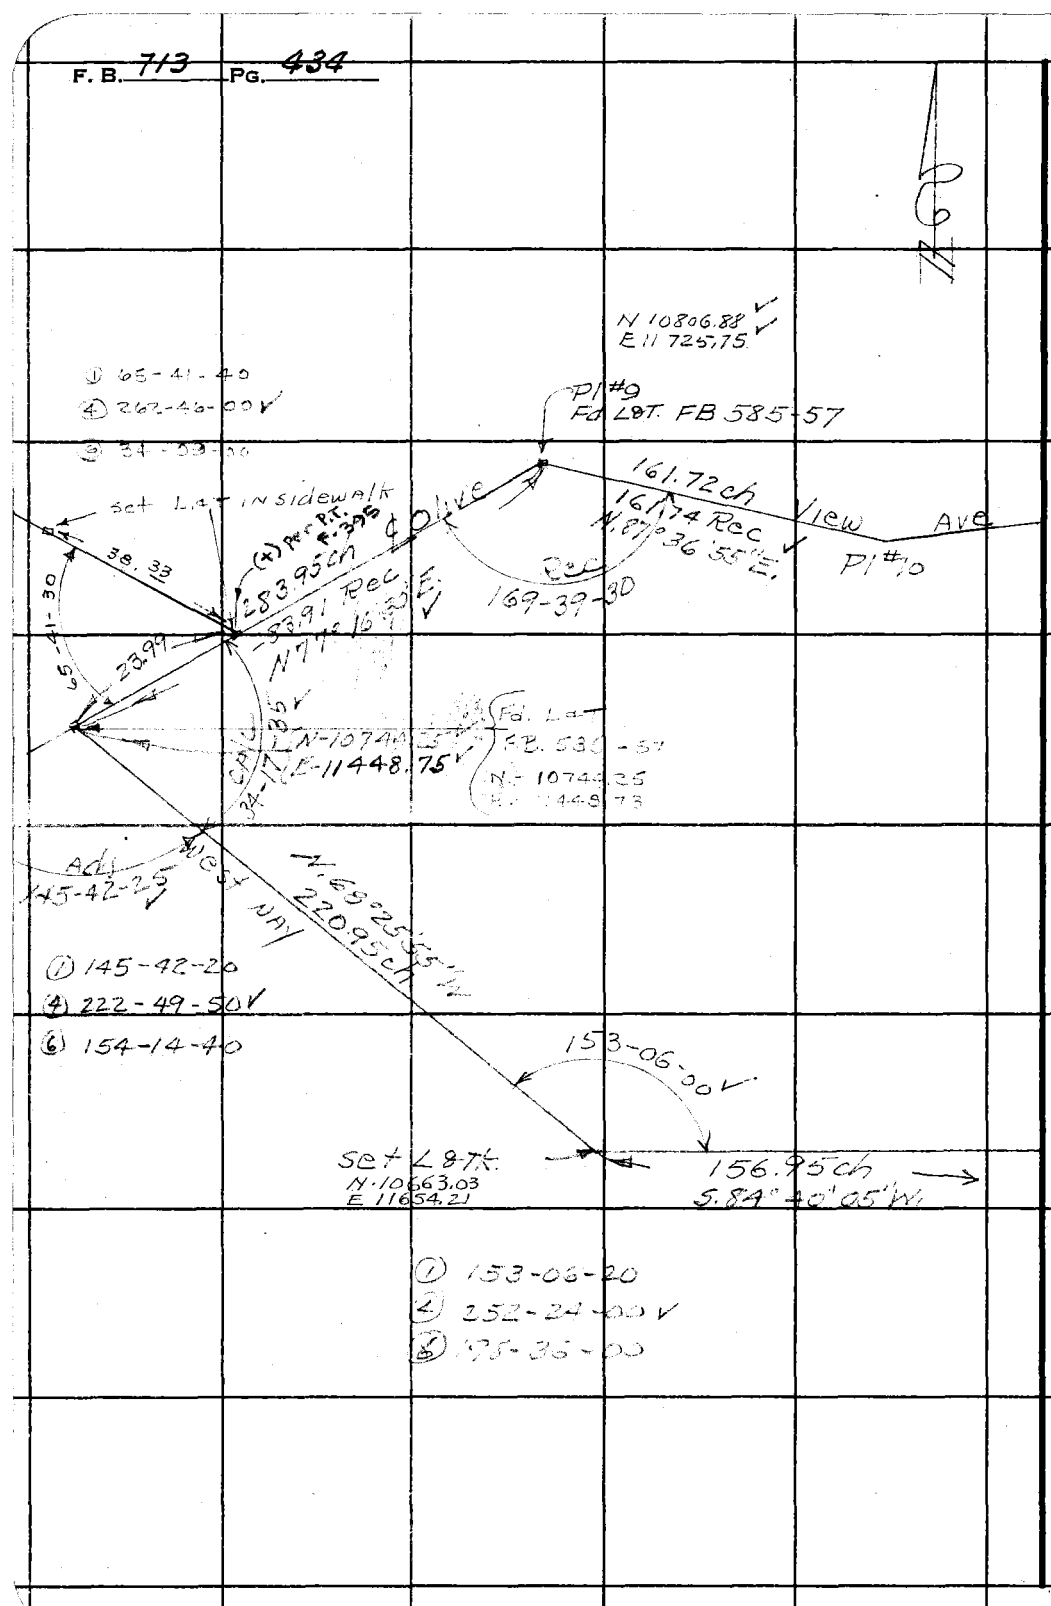

RETURN TO
LOS ANGELES COUNTY SURVEYOR
700 HALL OF RECORDS

Do not extend notes this side of this line.

Note: Any Additions or Changes on This Sheet Must be Made or Circled in Red Ink With Date and Name of Person Making Change.

Notes Ck'd by KRMc
Map No.
Office Work
Checked
Date

Survey of Olive View Sanatorium
W. O. 810 Tape No. St'd °F
Surveyed by R.C. Bowers
Notes R.C.B. Date 10-10-52
Indexed C. Johnson

F. B. 715 Pg. 435

RETURN TO
LOS ANGELES COUNTY SURVEYOR
700 HALL OF RECORDS

Note: Any Additions or Changes on This Sheet Must be Made or Circled in Red Ink With Date and Name of Person Making Change.

Do not extend notes this side of this line.

FORM 247 SM 11-46

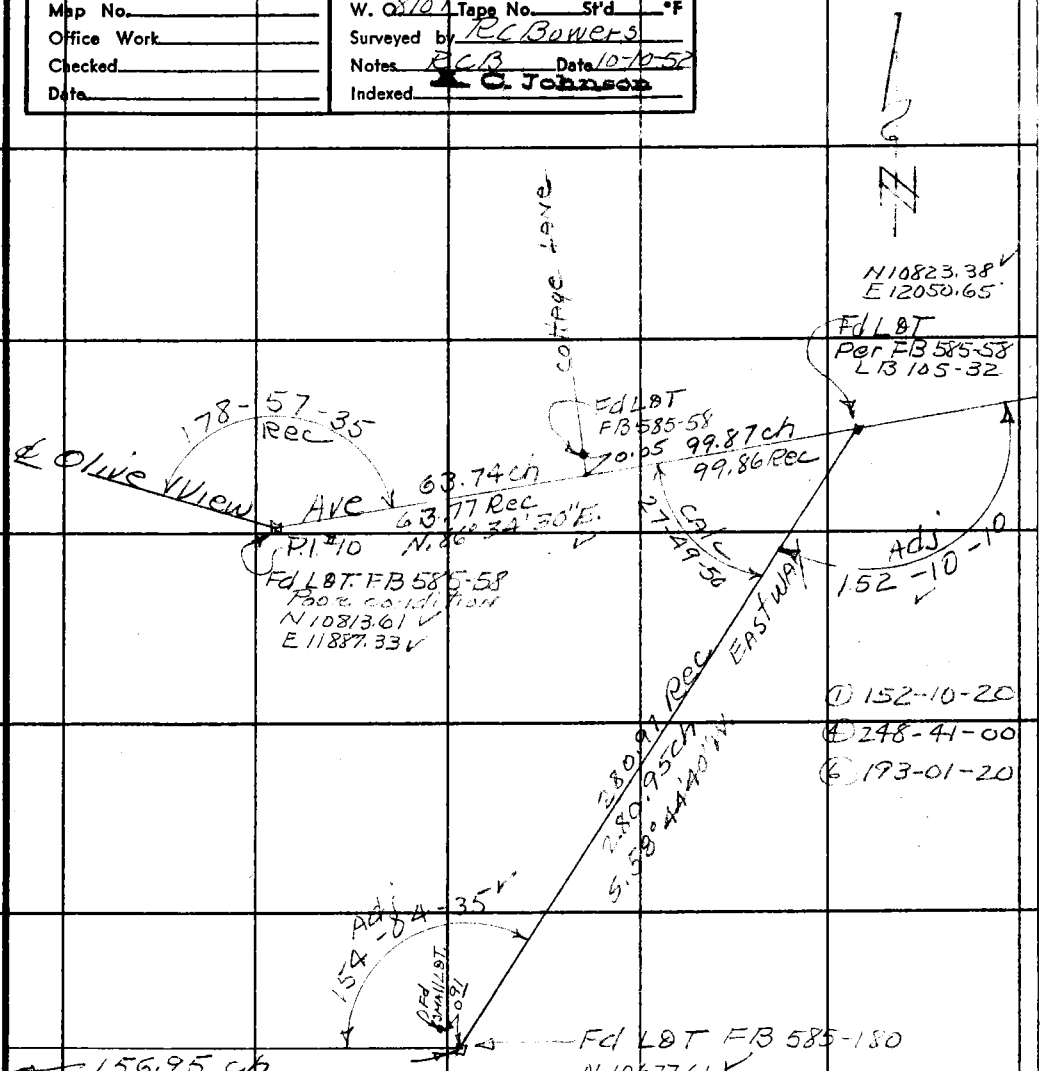

RETURN TO
LOS ANGELES COUNTY SURVEYOR
700 HALL OF RECORDS

Note: Any Additions or Changes on This Sheet Must Be Made or Circled in Red Ink With Date and Name of Person Making Change.

Do not extend notes this side of this line.

F. B. 713 PG. 436

Profile No. ____ X-Sec. No. ____

Notes Red. ____ Date ____ Plotted ____ Date ____ Job No. 8101 Division No. ____

Notes Chkd. ____ Date ____ Checked ____ Date ____ Survey of Olive View Sanatorium

Survey by R.C. Bowers Notes Menne Date 10-10-52

Map No. ____ Indexed C. Johnson Date ____

F.B. 713 PG. 437

LEVELS

for

PHARMACY and FLAMMABLE LIQUID STORAGE BLDG.

R.C. Bowers
J.P. Menne
L.C. Love
R.C. Wilson

STATION	B.S.	H.I.	F.S.	ELEV.

NOTE: ANY ADDITIONS OR CHANGES ON THIS SHEET MUST BE MADE OR CIRCLED IN RED INK, WITH DATE AND NAME OF PERSON MAKING CHANGE.

Do not extend notes this side of this line.

PLEASE RETURN TO
LOS ANGELES COUNTY SURVEYOR
700 HALL OF RECORDS

FORM 307 5M 1-46

FORM 307 5M 1-46

PLEASE RETURN TO
LOS ANGELES COUNTY SURVEYOR
700 HALL OF RECORDS

NOTE: ANY ADDITIONS OR CHANGES ON THIS SHEET MUST BE MADE OR CIRCLED IN RED INK, WITH DATE AND NAME OF PERSON MAKING CHANGE.

Do not extend notes this side of this line.

F.B. 713 Pg. 438 | Job No. 8101 Division No. | Notes Red. | Plotted | Profile
Survey of Olive View Sanatorium | Date | No. | X-Sec.
Survey by R. C. Baxters Notes Memo | Notes Chkd. H.N.F.D. | Checked
Indexed A. C. Johnson Date | Date 10-21-53 | Date | No.

STATION	B. S.	H. I.	F. S.	ELEV.	
				1456 630	B.M. # 11 Cross in top of steps No. side
	S 327	1461 957	S 238	1456 719	of bldg. Ward 103 - F.B 585 Pg. 16
	3 957	1460 676	S 471	1455 205	
	S 349	1460 554	S 400	1455 154	
	4 387	1459 541	2 408	1457 133	Cut square on top of wall 31' East of S.E. cor.
	2 839	1459 972	4 496	1455 476	of Service Bldg. OV-2.
	4 998	1460 474	S 271	1455 203	
	S 549	1460 752	4 033	1456 719	
	S 302	1462 021	S 391	1456 630	B.M. # 11 Same as above.

Notes Ck'd by	Survey of Olive View
Map No.	W. O. 8101 Tape No. 0136 St'd. 68 °F
Office Work	Surveyed by J. P. Mains
Checked	Notes J P M Date 10-2-53
Date	Indexed A. C. Johnson 10-5-53

F. B. 712 Pg. 439

Note: Any Additions or Changes on This Sheet Must be Made or Circled in Red Ink With Date and Name of Person Making Change.

Do not extend notes this side of this line.

RETURN TO
LOS ANGELES COUNTY SURVEYOR
726 LOS ANGELES COUNTY
ENGINEERING BLDG.

OFFSETS

from

L. A. AQUEDUCT

To

SERVICE BUILDING O.V.-2

Between

P.I. 55 & P.I. 56

76F3095 247 2-51

F. B. 713 PG. 440

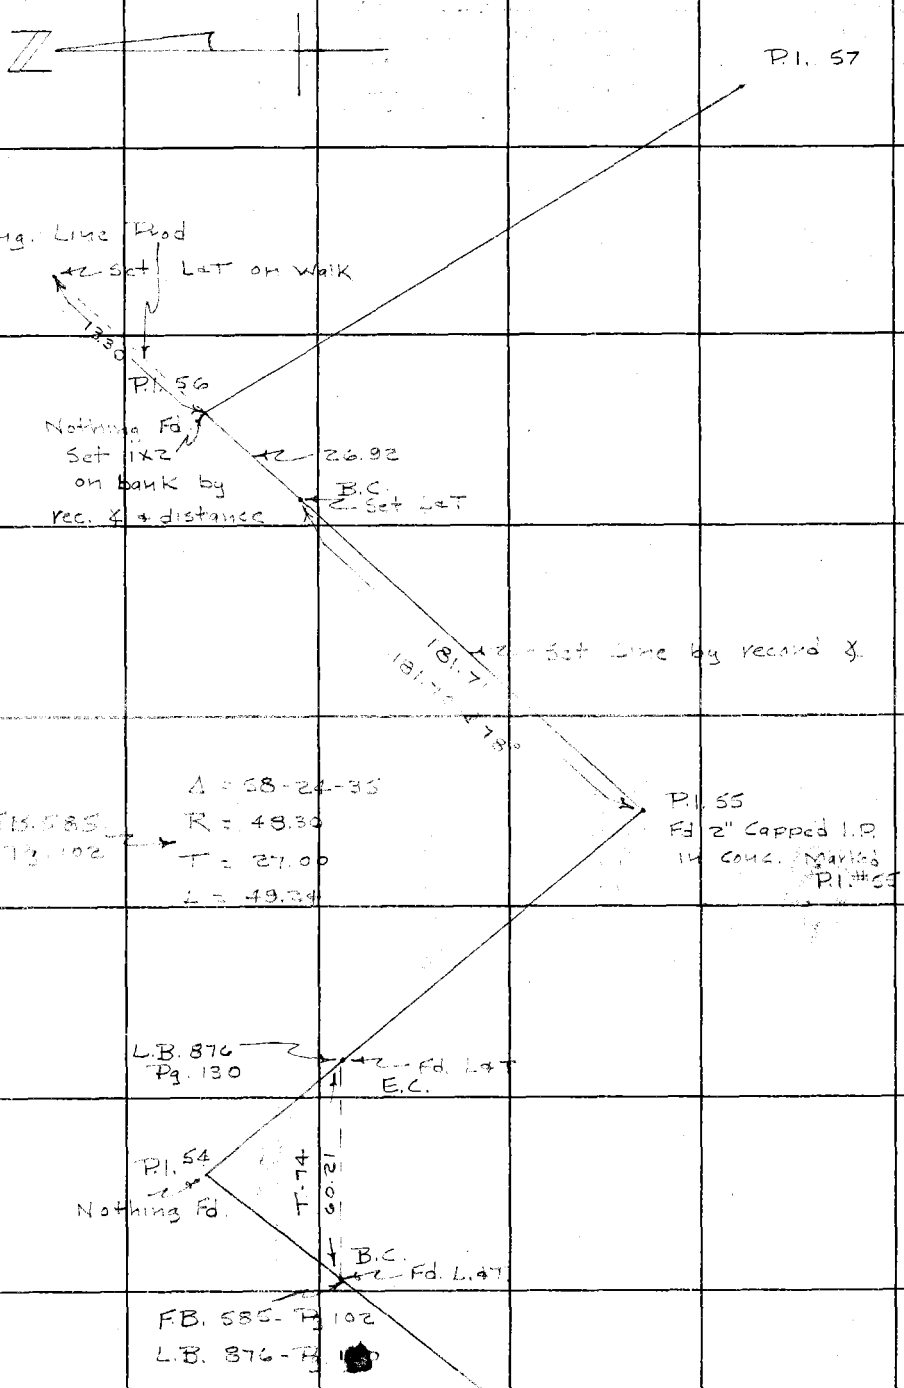

RETURN TO
LOS ANGELES COUNTY SURVEYOR
726 LOS ANGELES COUNTY
ENGINEERING BLDG.

Do not extend notes this side of this line.

Note: Any Additions or Changes on This Sheet Must be Made or Circled in Red Ink With Date and Name of Person Making Change.

Notes Ck'd by	Survey of Olive View
Map No.	W. O. 8101 Tape No. 0126 St'd. 68 °F
Office Work	Surveyed by J. P. Mc[illegible]
Checked	Notes J. P. M. Date 10-7-53
Date	Indexed A. C. Johnson

F. B. 713 PG. 441

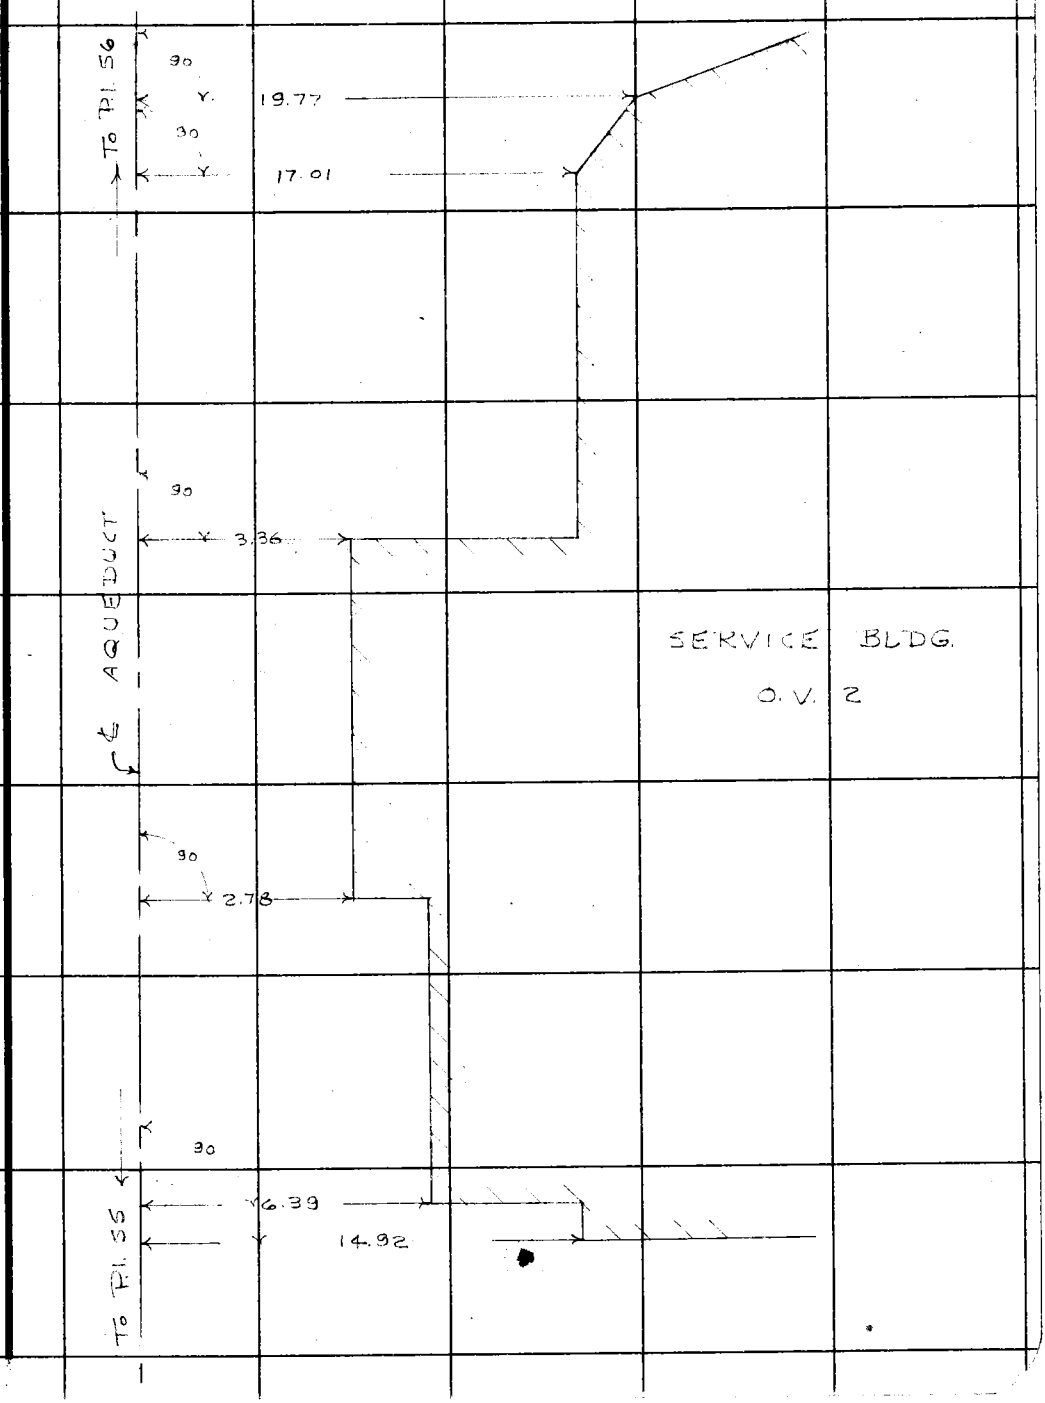

Note: Any Additions or Changes on This Sheet Must be Made or Circled in Red Ink With Date and Name of Person Making Change.

Do not extend notes this side of this line.

RETURN TO
LOS ANGELES COUNTY SURVEYOR
726 LOS ANGELES COUNTY
ENGINEERING BLDG.

76F309S 247 2-51

RETURN TO
LOS ANGELES COUNTY SURVEYOR
726 LOS ANGELES COUNTY
ENGINEERING BLDG.

Note: Any Additions or Changes on This Sheet Must be Made or Circled in Red Ink With Date and Name of Person Making Change.

Do not extend notes this side of this line.

F. B. 713 PG. 442

76L298 307 8-53

PLEASE RETURN TO
LOS ANGELES COUNTY SURVEYOR
726 LOS ANGELES COUNTY ENGINEERING BLDG.

NOTE: ANY ADDITIONS OR CHANGES ON THIS SHEET MUST BE MADE OR CIRCLED IN RED INK, WITH DATE AND NAME OF PERSON MAKING CHANGE.

Do not extend notes this side of this line.

STATION	B. S.	H. I.	F. S.	ELEV.		
			J.N.	# 8162.02 (Nov. 1954)		HELLSTROM CURTIS GUIZADO DEANE
	OLIVE VIEW SANITORIUM - SERVICE BLDG. ADDTN.					
	{See pg. 444 For Plan Of Addition}					
BM #11				1456.63	BM #11 El. 1456.630	Cross in top of Stops
	5.19	1461.82			No. Side of Bldg. Ward 103	FB 585-16 also F.B. 713-438
T.P.			6.18	1455.64	T.P.	
	4.31	1459.95				
			0.05	1459.90	Top of Existing Floor E. sd. Exist Service Bldg.	
T.B.M. For Contractor			0.05	1459.90	{T.B.M. - Set [illegible] In E. sd. of Service Bldg - [illegible] Conc. Stps.	
TBM			2.81	1457.14	TBM El. 1457.133	F.B. 713-438 Cut □
					On Top of Wall 31' East of S.E. Cor. Service Bldg. - D.V. 2	

Profile Notes Red. ____ Plotted ____ Job No. 8162.02 Division No. 10 F. B. 713 PG. 443
No. ____ Date ____ Date ____ Survey of [illegible] Service Bldg.
X-Sec. Notes Chkd. [illegible] Checked ____ Survey by Hellstrom Notes A.S.C. Date 11-10-54
No. ____ Date 11-54 Date ____ Map No. ____ Indexed Johnson Date 11-15-54

F.B. 773 Pg. 444 Job No. 8162.02 Division No. _____ Notes Red. _____ Plotted _____ Profile

Survey of OLIVE VIEW SANIT. - SERVICE BLDG Date _____ Date _____

Survey by Hellstrom Notes A.N.H Notes Chkd. _____ Checked _____

Indexed C. Johnson Date _____ Date _____ Date _____

NEW ADDITION TO SERVICE BLDG. - Nov. 1954
SKETCH SHOWING FOUNDATION and PILES
And Offset Stakes To Same
⊙ Red Dot = 1x2 N&T
Set 1x2 and Nail For Cntr. of Piles.
{See Pg. 443 For ELEVS.}

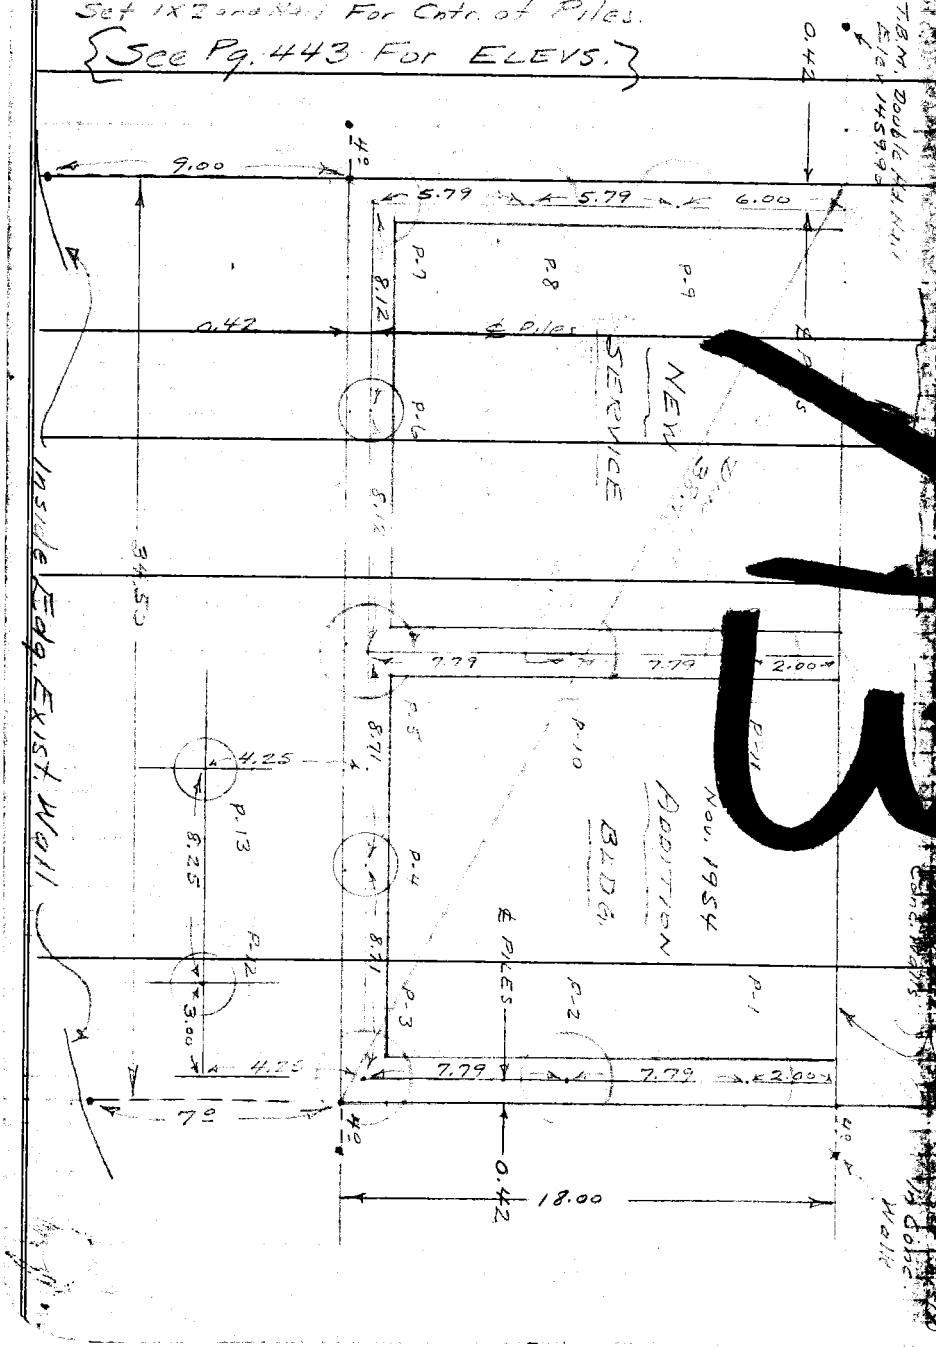

FOL298 307 8-53
PLEASE RETURN TO
LOS ANGELES COUNTY SURVEYOR
726 LOS ANGELES COUNTY ENGINEERING BLDG.
Do not extend notes this side of this line.
NOTE: ANY ADDITIONS OR CHANGES ON THIS SHEET MUST BE MADE OR COPIED IN RED INK, WITH DATE AND NAME OF PERSON MAKING CHANGE.