FORM 247 10M 11-55

RETURN TO
LOS ANGELES COUNTY SURVEYOR
700 HALL OF RECORDS

Note: Any Additions or Changes on This Sheet Must be Made or Circled in Red Ink With Date and Name of Person Making Change.

Do not extend notes this side of this line

715

Notes Ck'd by
Misc. No.
Office Work
Check as
Date

Survey of
W. O.
Surveyed by
Notes
Indexed

Tape No. St'd °F.
Date

F.B.

PG.

F.B. 715 PG. Index

Pages: 1 to 191

201 to 258.

RETURN TO
LOS ANGELES COUNTY SURVEYOR
700 HALL OF RECORDS

Note: Any Additions or Changes on This Sheet Must be Made or Circled in Red Ink With Date and Name of Person Making Change.

Do not extend notes this side of this line

Notes Ck'd by L.A.		Survey of Peck Rd	F.B. 715 Pg. 7
Map No. C.S. 8-135/-13		W. O. 7052 Tape No. 042 St'd 99 °F.	
Office Work d. D. Price.		Surveyed by Evans	
Checked		Notes FT Date 1931-1938	
Date		Indexed	

SURVEY OF PECK RD.

(DIV. 1)

FROM

SIPHON RD.

TO

POMONA BLVD.

AND

(DIV. II)

FROM

POMONA BLVD.

TO

SAN BERNARDINO RD.

(DIV. II CONTINUED IN F.B. 746)

M. F. EVANS - DEP.
F. H. BLANCHARD - "
L. H. FENNER - "
H. M. SMITH - "
[illegible] WILLIS - "
D. S. ELLIS - RC.
H. M. SMITH - RC.
E. CLINITE - RC.

Note: Any Additions or Changes on This Sheet Must be Made or Circled in Red Ink With Date and Name of Person Making Change.

Do not extend notes this side of this line

RETURN TO
LOS ANGELES COUNTY SURVEYOR
700 HALL OF RECORDS

FORM 247 10M 11-38

RETURN TO
LOS ANGELES COUNTY SURVEYOR
700 HALL OF RECORDS

Note: Any Additions or Changes on This Sheet Must be Made or Circled in Red Ink With Date and Name of Person Making Change.

Do not extend notes this side of this line

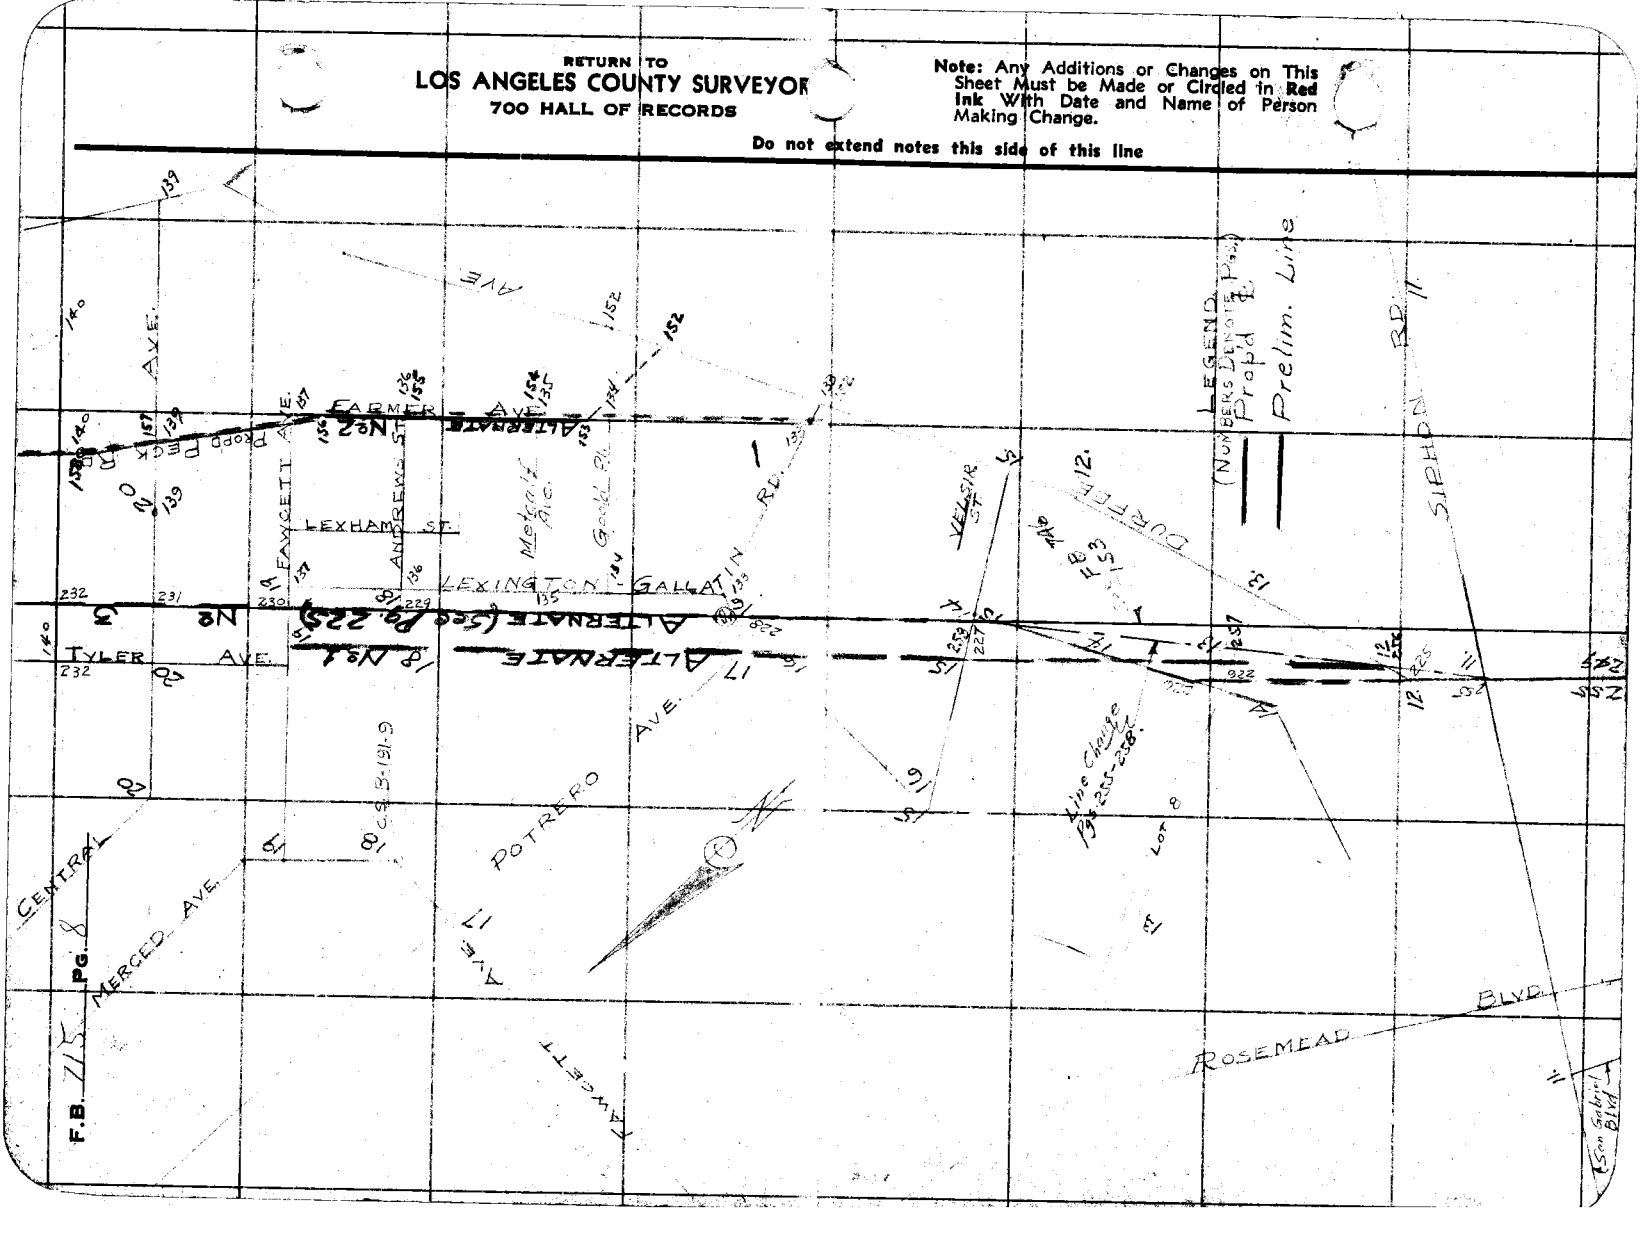

Notes Ck'd by	Survey of Peck Rd.
Map No. C.S. B-1351-1-5.	W. O. 7052 Tape No. 043 St'd 84° F.
Office Work J. D. Price	Surveyed by Evans
Checked	Notes 14 Date 7-29-37
Date	Indexed

F.B. 315 Pg. 9

Note: Any Additions or Changes on This Sheet Must be Made or Circled in Red Ink With Date and Name of Person Making Change.

Do not extend notes this side of this line

RETURN TO
LOS ANGELES COUNTY SURVEYOR
700 HALL OF RECORDS

FORM 247 10M 11-35

F.B. 715 · Pg. 10

CONTINUED F.B. 746

RETURN TO
LOS ANGELES COUNTY SURVEYOR
700 HALL OF RECORDS

Do not extend notes this side of this line

Note: Any Additions or Changes on This Sheet Must be Made or Circled in Red Ink With Date and Name of Person Making Change.

P. E. R. R.

SAN BERNARDINO RD.

MEDINA ST.

PECK RD.

LEE LANE

STEWART

VALLEY

S. P. R. R.

SITKA ST.

BLVD.

PECK RD.

DIV. No 2.

DIV. PECK No 1.

AVE.

MEEKER RD.

AMADOR ST.

MILDRED AVE.

(POMONA) BLVD.

LANSDALE ST.

TYLER ST.

BODGER ST.

PROVO

MEEKER RD.

VIEW RD.

GARVEY BLVD.

MERLE ST.

DEE ST.

MUSGROVE AVE

MEEKER AVE

MAGNOLIA ST.

TYLER ST.

W.S. 37, A-3

Notes Ck'd by S. A. P.	Survey of PECK RD.
Map No. C.S. B-1351-1	W. O. 7052 Tape No. 026 St'd 84° F.
Office Work J. D. Price	Surveyed by EVANS
Checked Aug	Notes HE Date 6-14-37
Date Aug '39	Indexed 7-19-37

F.B. 71 Pg. 11

(76-51-45
307.28-4.5
76°-51'-41¼"

To R.S. Pg. 12

(16-21-15
5° 22' 15"
103°-07'-18¾"

PRELIMINARY SURVEY
FOR
ALTERNATE No. 1
PECK RD.
Pgs. 11-25
See pg. 151 for ALT. No. 2
See Pgs. 225-238 for ALT. No. 3.

FOR PROPOSED CENTER LINE OF PECK ROAD SEE R.25

DURFEE AVE.

Note: Any Additions or Changes on This Sheet Must be Made or Circled in Red Ink With Date and Name of Person Making Change

Do not extend plates this side of this line

RETURN TO
LOS ANGELES COUNTY SURVEYOR
700 HALL OF RECORDS

Fd. Nail & Shr. with L.T. tags
Elev. 252.54

103°-07'-29"

Fd. Nail & Small Tin P.P. #491301E

6.86

Set L&T conc. Pump Island

76°-51'-40"

85°-08' 0.00 going N Fd. L&T pcr
F.B. 172-7
F.B. 299-12

RD.

26.43

Set SW & T P.P. #128720E.

51.43

SIPHON

Fd. L&T conc. porch

SAN GABRIEL BLVD.

Fd. SW & T F.B. 541-257

FORM 247 10M 11-38

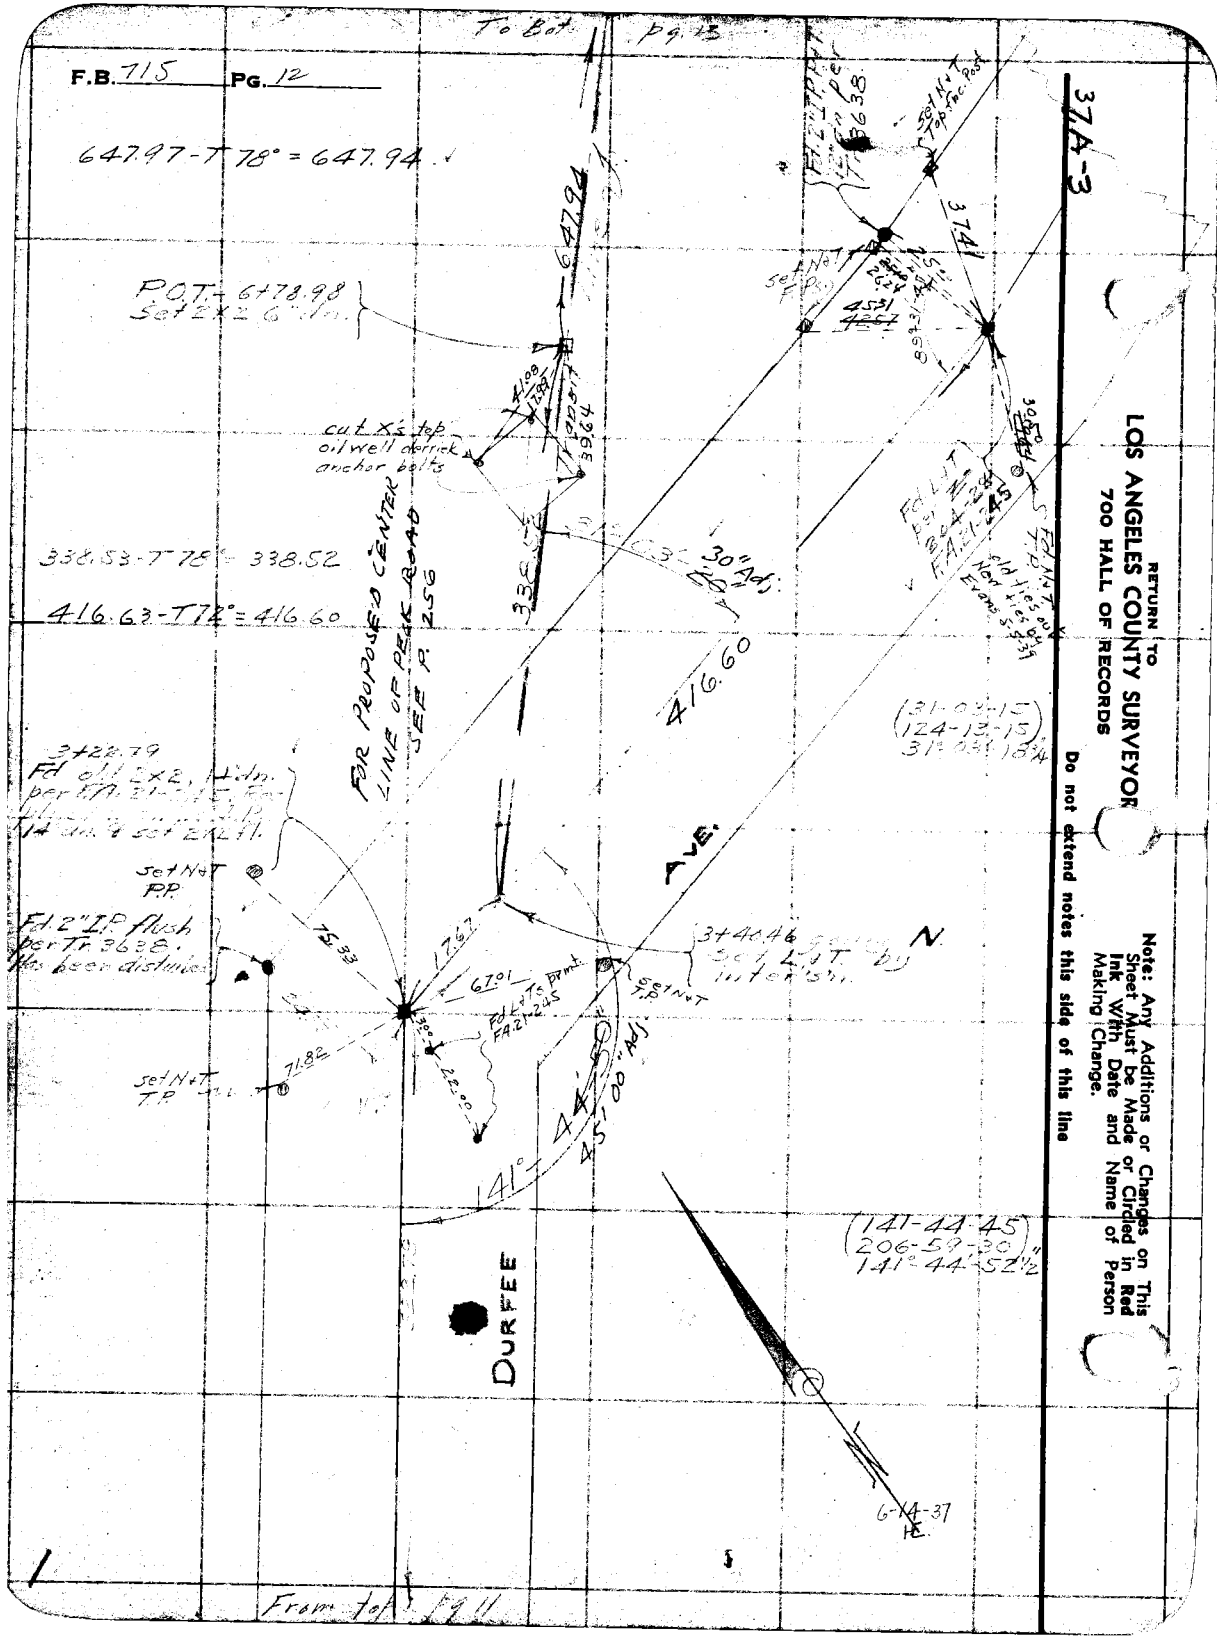
F.B. 715 PG. 12
To Bot. Pg. 13
647.97-T 78° = 647.94
POT- 647.98
Set 2"x 2' Iron
cut X's top oil well derrick anchor bolts
338.53-T 78° = 338.52
416.63-T 78° = 416.60
FOR PROPOSED CENTER LINE OF PEAK ROAD SEE P. 256
3422.79
Fd Oil Pipe, Hdn. per ETR. 21-15
Set 2" I.P. & Set Nail
Set N+T P.P.
Fd. 2" I.P. flush per Tr. 3698. Has been disturbed
Set N+T T.P.
71.82
17.67
67.01
Pd. L+T's prmt. FA 21-245
Set N+T T.P.
3740.46
Set L+T. in Hor'tal.
N
AVE.
DURFEE
141° 44' 45"
(141-44-45)
(206-59-30)
141°-44-52½"
6-14-37
HE
From Top Pg 11
3741
Set N+T Top Fac. Post
Fd. 2" I.P. flush
Set N+T P.P.
4531
4567
89°31'
30.00
Fd. L+T Pd. L+T's FA 21-245
Old Hies on Line Not Evans's
(31-03-15)
(124-13-15)
31°-03'-15"
Note: Any Additions or Changes on This Sheet Must be Made or Circled in Red Ink With Date and Name of Person Making Change.
Do not extend notes this side of this line
RETURN TO
LOS ANGELES COUNTY SURVEYOR
700 HALL OF RECORDS
37A-3

Notes Ck'd by	Survey of PECK RD.
Map No. C.S.B-1351-1	W. O. 7052 Tape No. 226 St'd 64°F.
Office Work J. D. Price	Surveyed by EVANS
Checked CAR	Notes	Date 6-15-37
Date Aug. 139	Indexed

F.B. 114 Pg. 12

37-A-2

From pg. 11

754.37-T 78°= 754.34

LOT 9.

FOR PROPOSED CENTER LINE OF PECK ROAD SEE P. 257

N.W. cor. Lot 9. Fd. 1/2" I.P. 6" dp. per Tr. 3638

S.W. cor. Lot 9 Fd. 2" I.P. 3" dp. per Tr. 3638

754.34

10" Adj.

65°-54'-05"

F-5741.

Fd. 1/2" I.P. 3" dp. per Tr. 3638

P.O.T.-16+43.32 Set 2x2 10" dp. by Miller's Co.

LOT 8.

LOT 7.

316.40

316.41-T 78°= 316.40

638.34

(60)

S.E. cor. Lot 7 Fd. 2" I.P. cor. 3 stks. ctr. 14" dn. per Tr. 3638

Meas. 60 c° (643.3 Rec.) 2622

28.87

Set Nail & Tag in Pav't.

Set Nail & Tag

Set Nail & Tag fnc.

20.56

F.C.T.-13+26.42 Set 2x2 10" dn.

638.85-T 32°= 638.84

DURFEE AVE.

Fd. 2" I.P. pt. 18" dn. per Tag Rec. pg. 1

(65-54-00) (263.26-15) 65°-54'-03¾"

(335-53-15) (335-52-45) 83°-58-1¼"

From top pg. 12

RETURN TO
LOS ANGELES COUNTY SURVEYOR
700 HALL OF RECORDS

Note: Any Additions or Changes on This Sheet Must Be Made or Circled In Red Ink With Date and Name of Person Making Change.

Do not extend notes this side of this line

FORM 247 10M 11-36

F.B. 715 PG. 14

(17-50-15)
71-21-30
17°-50-22½"

To 17 side

Fd 2" IP 9" high per T.M. 3638

Rec 50.00
49.97 Calc

17°50'-25" Adj.

NE Cor Lot 9 Making

784.70 - T78° = 784.67

P.O.T. = 23492.95
Set 2x2 by Inters.

528.28 T68° = 528.22

set N&T top Inc. Post

P.O.T. - 23497.66
Set 2x2, 12" down

6' IS 37 E

20.81

set N&T F.P.

33.86

set N&T top E.P.

195.30 - T78° = 195.29

SE. cor. Lot
Fd. 1½ I.P., 1.5' dn.

5.0' 1x2

LOT 10

LOT 9

784.57

784.57

784.57

From top pg 13

RETURN TO
LOS ANGELES COUNTY SURVEYOR
700 HALL OF RECORDS

Note: Any Additions or Changes on This Sheet Must be Made or Circled in Red Ink with Date and Name of Person Making Change.

Do not extend notes this side of this line

37 4-2

Notes Ck'd by	Survey of PECK ROAD
Map No. C.S. B-1361-1	W. O. 7058 Tape No. 2 St'd 84°F.
Office Work J.D. Rice	Surveyed by EVANS
Checked OAR	Notes HE Date 10-16-39
Date Aug. '39	Indexed

F.B. 714 Pg. 10

263.75-T78°=263.74

37 B-2

(73°-58' / 29°-52')

73°-58'-00"]

Set 1X2

Fnd. Nail per Tract 3638 C.S. B134

W'ly line Lot 3, Blk K, M.R. 43-43

BLK. K. M.R. 43-43

To E'ly line Pg. 16

93.27-T7.9°=93.27

P.O.T.-33+77.62 Set 2x2-12" in.

FOR PROPOSED CENTER LINE OF PECK ROAD SEE P. 258

P.O.T.-34+60.87 Set 2x2-8" in. & New Ties Pg. 168

Set N&T Top P.P.

10.92

491°-6'-E 262.74

Set N&T 12" in.

Line 1

Fd. 4" I.P. 3 Ft. high. C.S. 8124

2"I.P. 3" high per Top Prec. Page

266.24

5.24

5.00

Set

0.24

794.67

Trans. Pt.

83.27

Pt. on Line

PL. per Pg. 14

3°-59'-00"

LOT 9

TR. 3638

1304.09-T72=1303.99

1303.99

Set 1X2

Fd. 1½" I.P. & C.C. 4" high

Marked

GENERAL LAND OFFICE SURVEY

PENALTY $250 FOR REMOVAL

R. F. G.

A.P. 3

AP 39 / AP 40

LMG / FLG

1920

115' Walk

Set N&T

16.00

Fd. 2" I.P. Pnt. 8" high in C.C. 8124. See Tr. 3638

43.36

46.58

Set L&T at the Pnt. of

Set N&T T.P.

DURFEE AVE.

Note: Any Additions or Changes on This Sheet Must be Made or Circled in Red Ink With Date and Name of Person Making Change

Do not extend Notes this side of this line

RETURN TO LOS ANGELES COUNTY SURVEYOR 700 HALL OF RECORDS

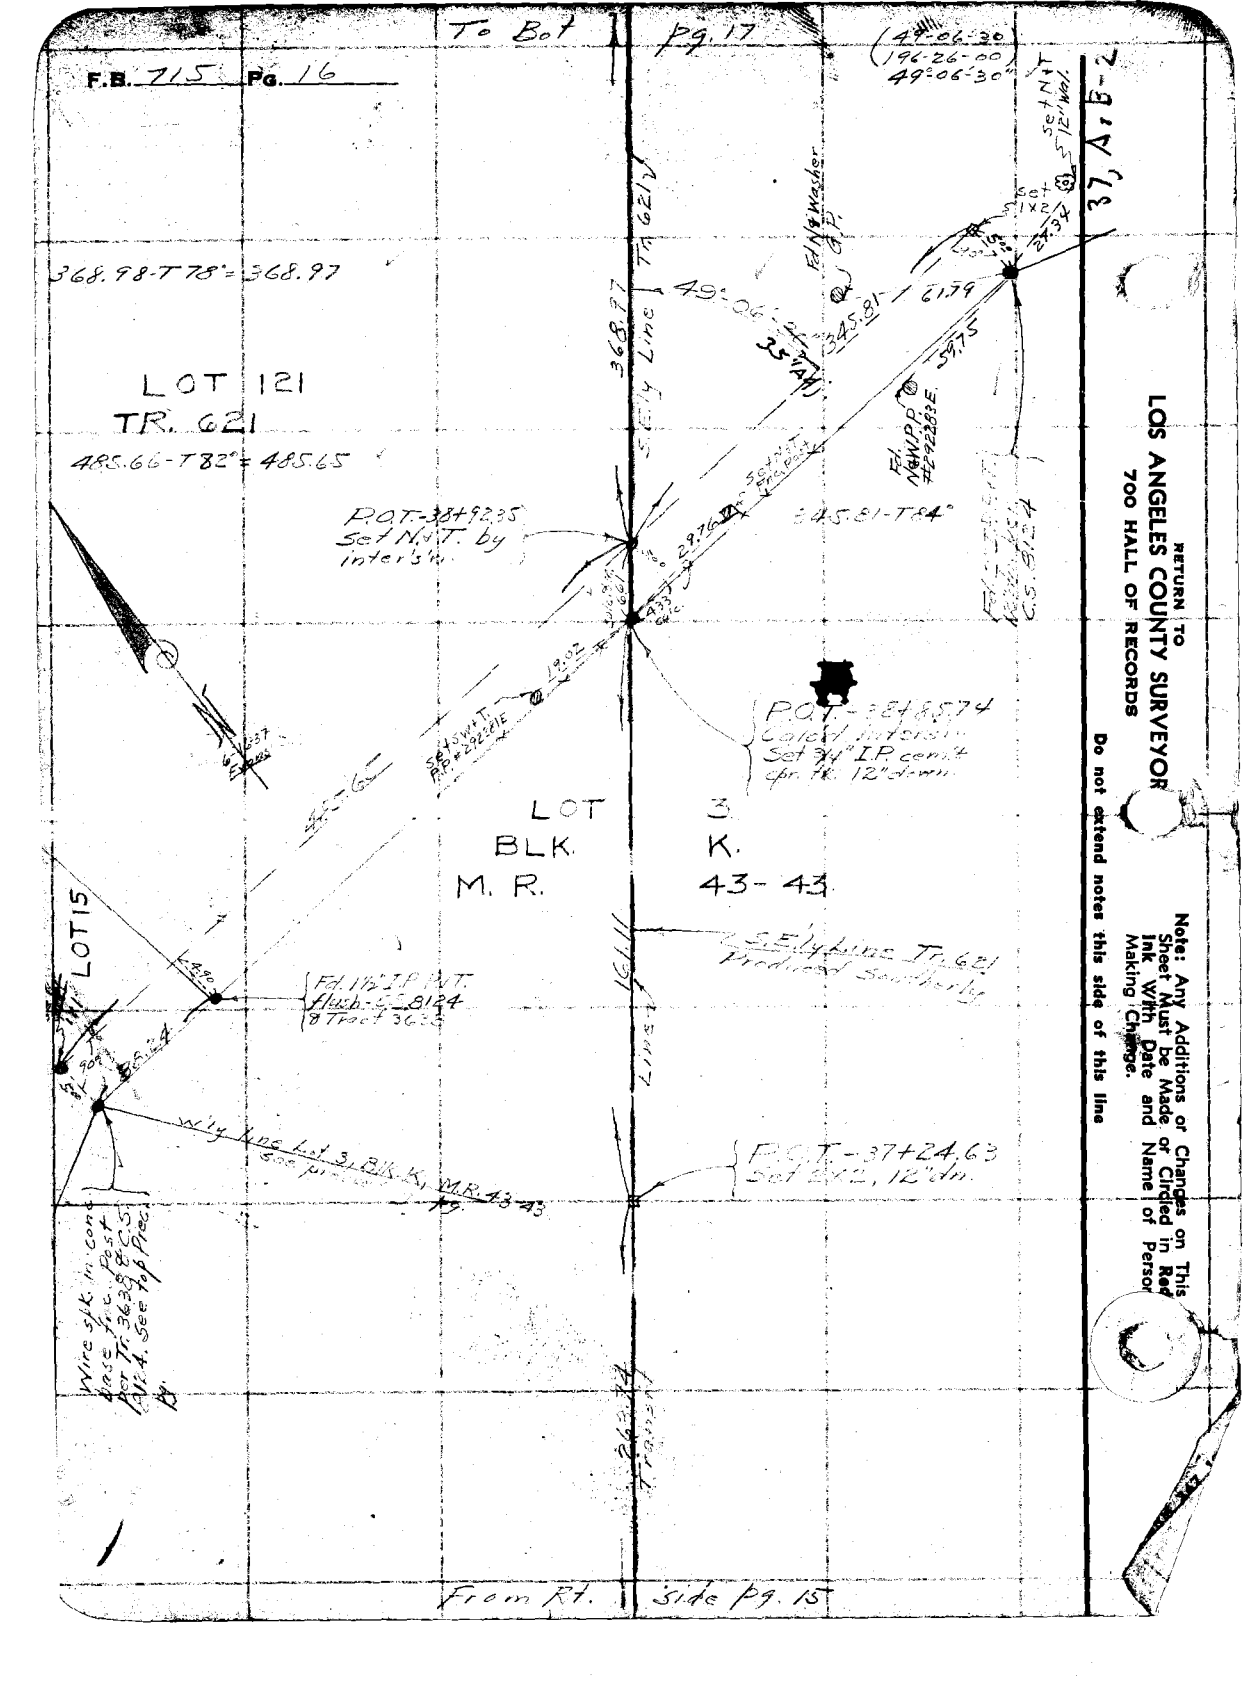
To Bof
pg. 17
F.B. 715 Pg. 16
(48°-06'-20" 196.26-00 49°-06'-30")
Set N+T 5/8" iron
Fd 1/2" Washer
368.98-T78°=368.97
LOT 121
TR. 621
485.66-T82°=485.65
368.77
S'ely Line Tr 621
49°-06'-
345.81 - 61.79
Fd N+W.P.
#2222E
59.75
345.81-T84°
P.O.T.-38+49.35
Set N+T by
inter's'n.
Set N+T
P.O.T.-38+48.74
Calcd. Intersn.
Set 3/4" I.P. cen'd
in fk. 12"d-mm.
LOT
BLK.
M. R.
3
K.
43-43
LOT 15
Fd 1½" I.P. N.T.
Flush-C.-8124
& Tract 36.38
S'ly Line Tr. 621
Produced Southerly
W'ly Line Lot 3, BLK. K, M.R. 43-43
P.O.T.-37+24.63
Set 2x2, 12"d-m.
Wire fnc. in conc.
base fr. E. Post
for Tr. 3638 & C.S.
Vol. 4, See Top Fnce.
From Rt. Side Pg. 15
RETURN TO
LOS ANGELES COUNTY SURVEYOR
700 HALL OF RECORDS
Do not extend notes this side of this line
Note: Any Additions or Changes on This Sheet Must be Made or Circled in Red Ink With Date and Name of Person Making Change.

FORM 247 10M 11-35

RETURN TO
LOS ANGELES COUNTY SURVEYOR
700 HALL OF RECORDS

Note: Any Additions or Changes on This Sheet Must be Made or Circled in Red Ink With Date and Name of Person Making Change.

Do not extend notes this side of this line

37, B-2

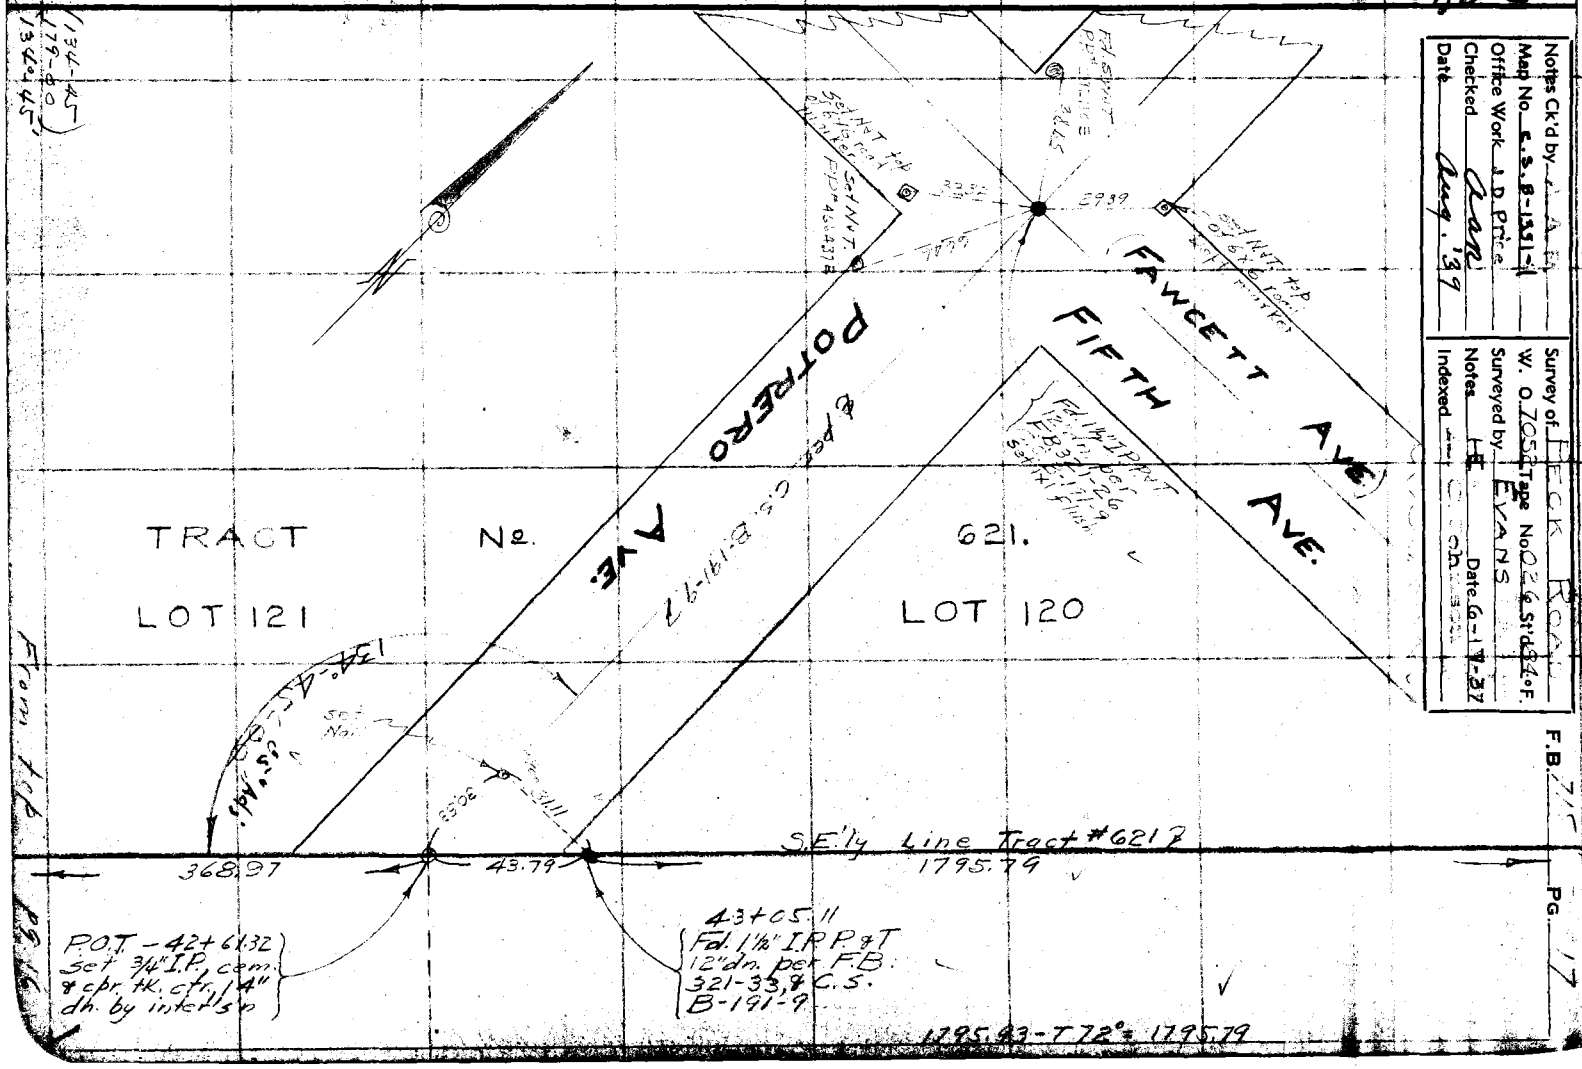

Notes Ck'd by A. E.
Map No. E.S.B-1351-1
Office Work J.D. Price
Checked Aug.
Date Aug. '37

Survey of BECK RCH
W. O. 7053 Tape No. 2 & Std. 84 o F.
Surveyed by EVANS
Notes HE
Indexed Date 6-17-37

F.B. 717
PG. 17

RETURN TO
LOS ANGELES COUNTY SURVEYOR
700 HALL OF RECORDS

Note: Any Additions or Changes on This Sheet Must be Made or Circled in Red Ink With Date and Name of Person Making Change.

W.S. 37, B-2

Do not extend notes this side of this line

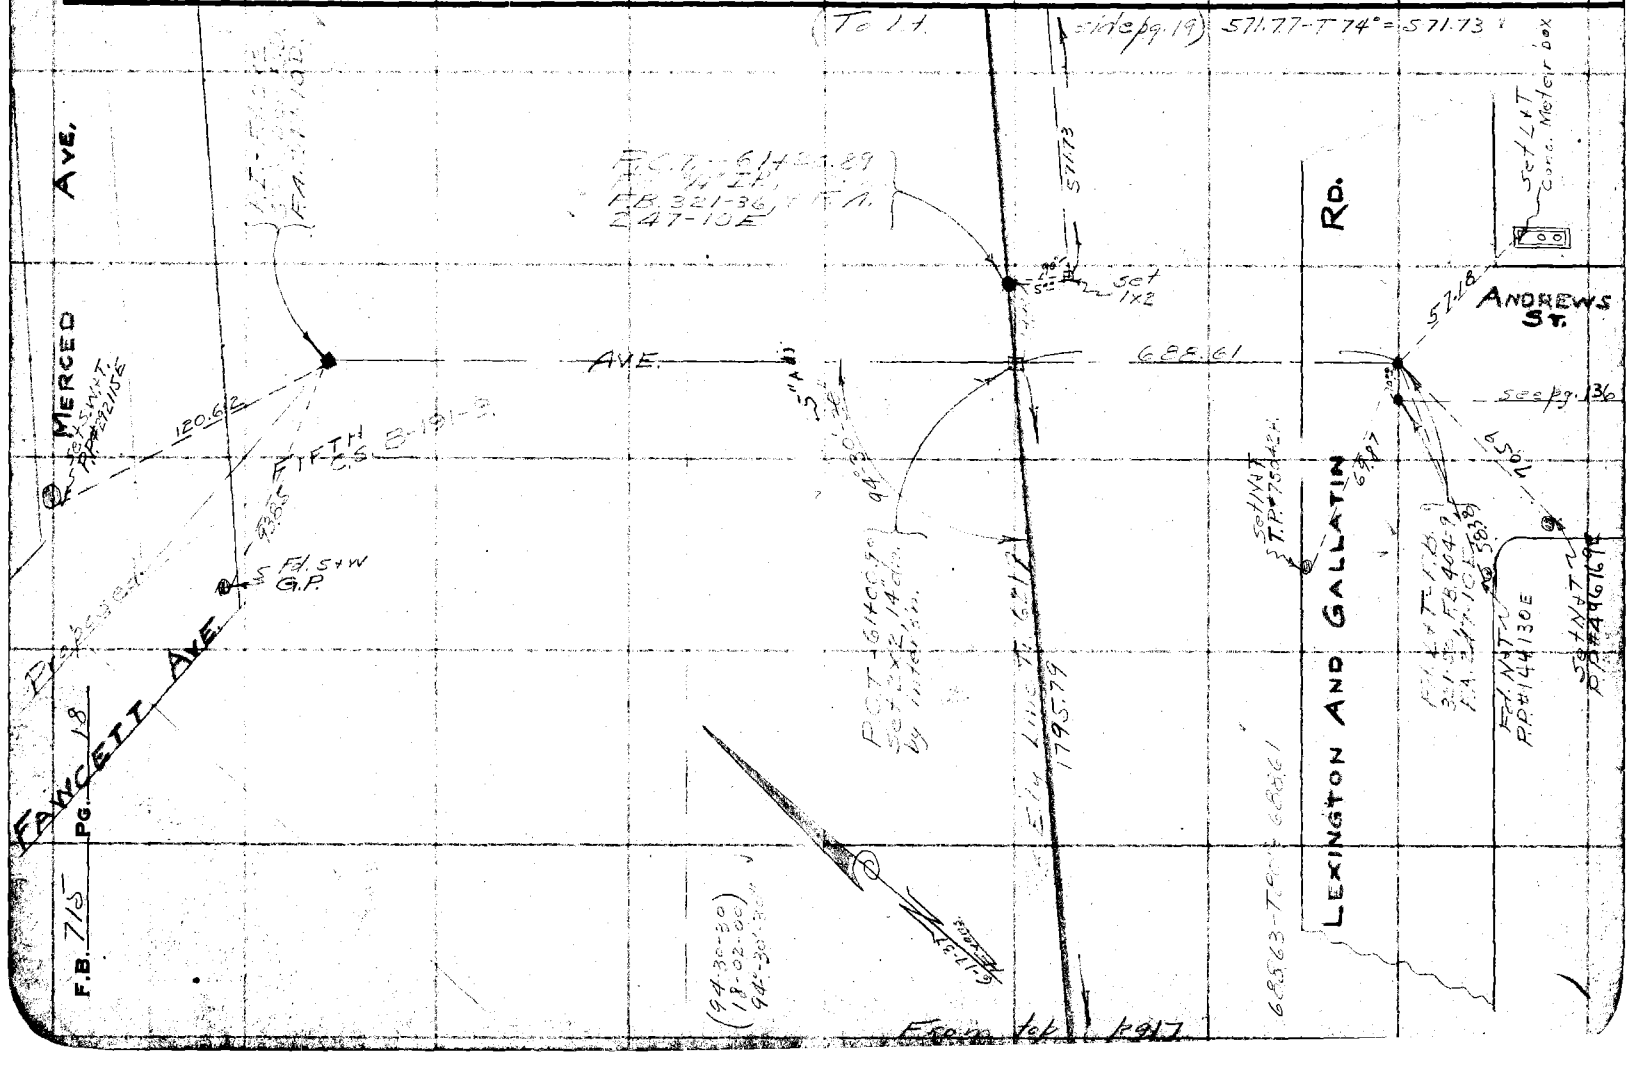

Notes Ck'd by		Survey of FECK RD.	F.B. 215 Pg. 10
Map No. C.S.B-1351-1		W. O. 7052 Tape No. 026 St'd & F.	
Office Work J.D. Price.		Surveyed by EVANS	
Checked		Notes HF Date 6-11-31	
Date Aug. '39		Indexed	

37 B-2








































Note: Any Additions or Changes on This Sheet Must be Made or Circled in Red Ink With Date and Name of Person Making Change.

Do not extend notes this side of this line

RETURN TO LOS ANGELES COUNTY SURVEYOR 700 HALL OF RECORDS

FORM 247.10M 11-35

RETURN TO
LOS ANGELES COUNTY SURVEYOR
700 HALL OF RECORDS

Note: Any Additions or Changes on This Sheet Must be Made or Circled in **Red** Ink With Date and Name of Person Making Change.

Do not extend notes this side of this line

W.S. 37, B-2

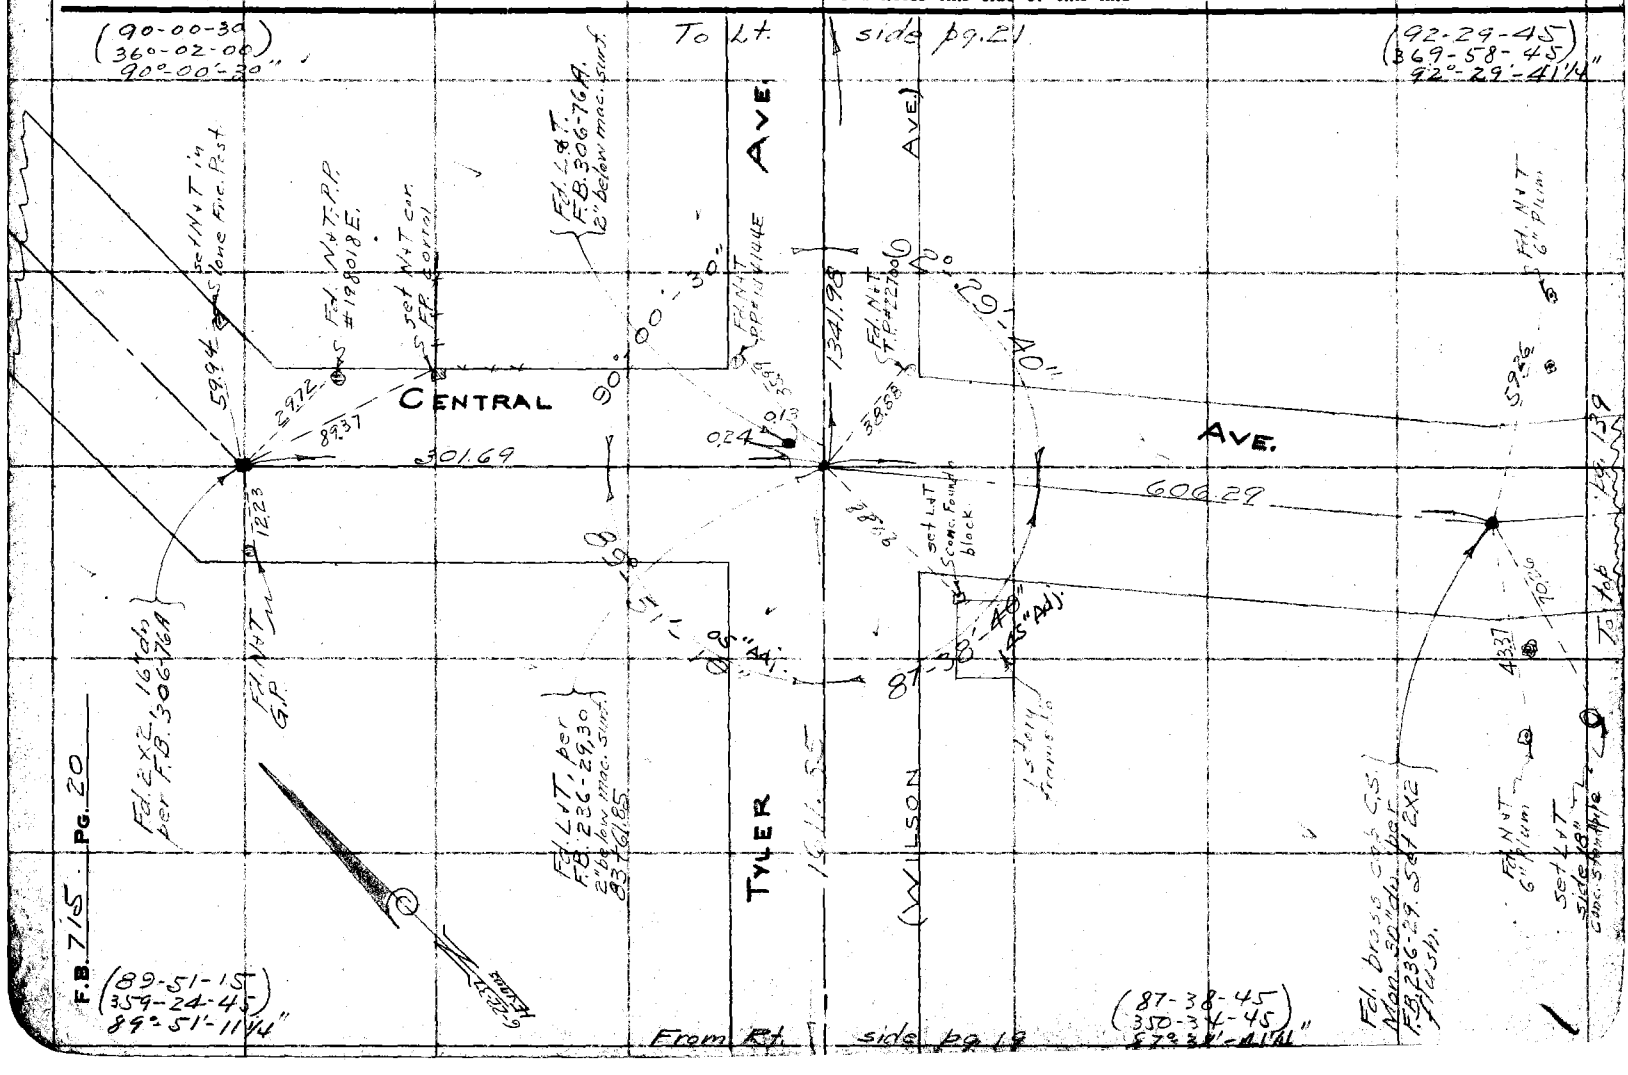

Notes Ck'd by	Survey of PECK RD.
Map No. S.S. B-135[illegible]-1	W. O. 7054 Tape No. 026 St'd 84°F.
Office Work J.D. Price	Surveyed by EVANS
Checked Aak	Notes HE Date 6-28-37
Date Aug. '37.	Indexed C. Jones

F.B. 115 PG. 21

37 B-2

Note: Any Additions or Changes on This Sheet Must be Made in Red Ink With Date and Name of Person Making Change.

Do not extend notes this side of this line

RETURN TO
LOS ANGELES COUNTY SURVEYOR
700 HALL OF RECORDS

FORM 247 10M 11-35

Fd X in pvmt, 2" below macadam Surf per L.S. 14-31, and F.B. 236-30 & 32

Fd N+T P.P. #144150E

Fd. L & T. 2.00 low mac. surf. This point set several years ago by Adams & Ellis of El Monte according to Mr. Payzant of their office. Supposed to be Rec. Dist. Frah. Inter'sn North, but surveyer used wrong L & T.

Fr. N+T col. fnc. post 1.00

3.16 3

3.27 4

0.17

0.03

TYLER AVE.

1341.98

265.96

From R.L. Side Pg 20

To Ben. Ap. 22

8.50 4

57.35

Set N+T TP L.A.# 22692 T

(WILSON AVE)

Set N+T TP #102772 H

Set boat spk. in lead, 2" below mac. Surf. by inter'sn. 97+03.83

(89-54-30 359-58-00 89°59'30")

SLACK RD.

Fd. 1" I.P. P.U.T. 6" dp. per L.S. 14-31 See F.B. 236-33

Fd. 2×2 8 ft. Flush. No Ref. Replaced with 3/4" I.P. per Pg. 141

25.00

30.00

34.89

0.10

Set N+T 14' wal.

Set N+T

See pg. 141

RETURN TO
LOS ANGELES COUNTY SURVEY
700 HALL OF RECORDS

Note: Any Additions or Changes on Th Sheet Must be Made or Circled in R Ink With Date and Name of Pers Making Change.

Do not extend notes this side of this line

37, B-1

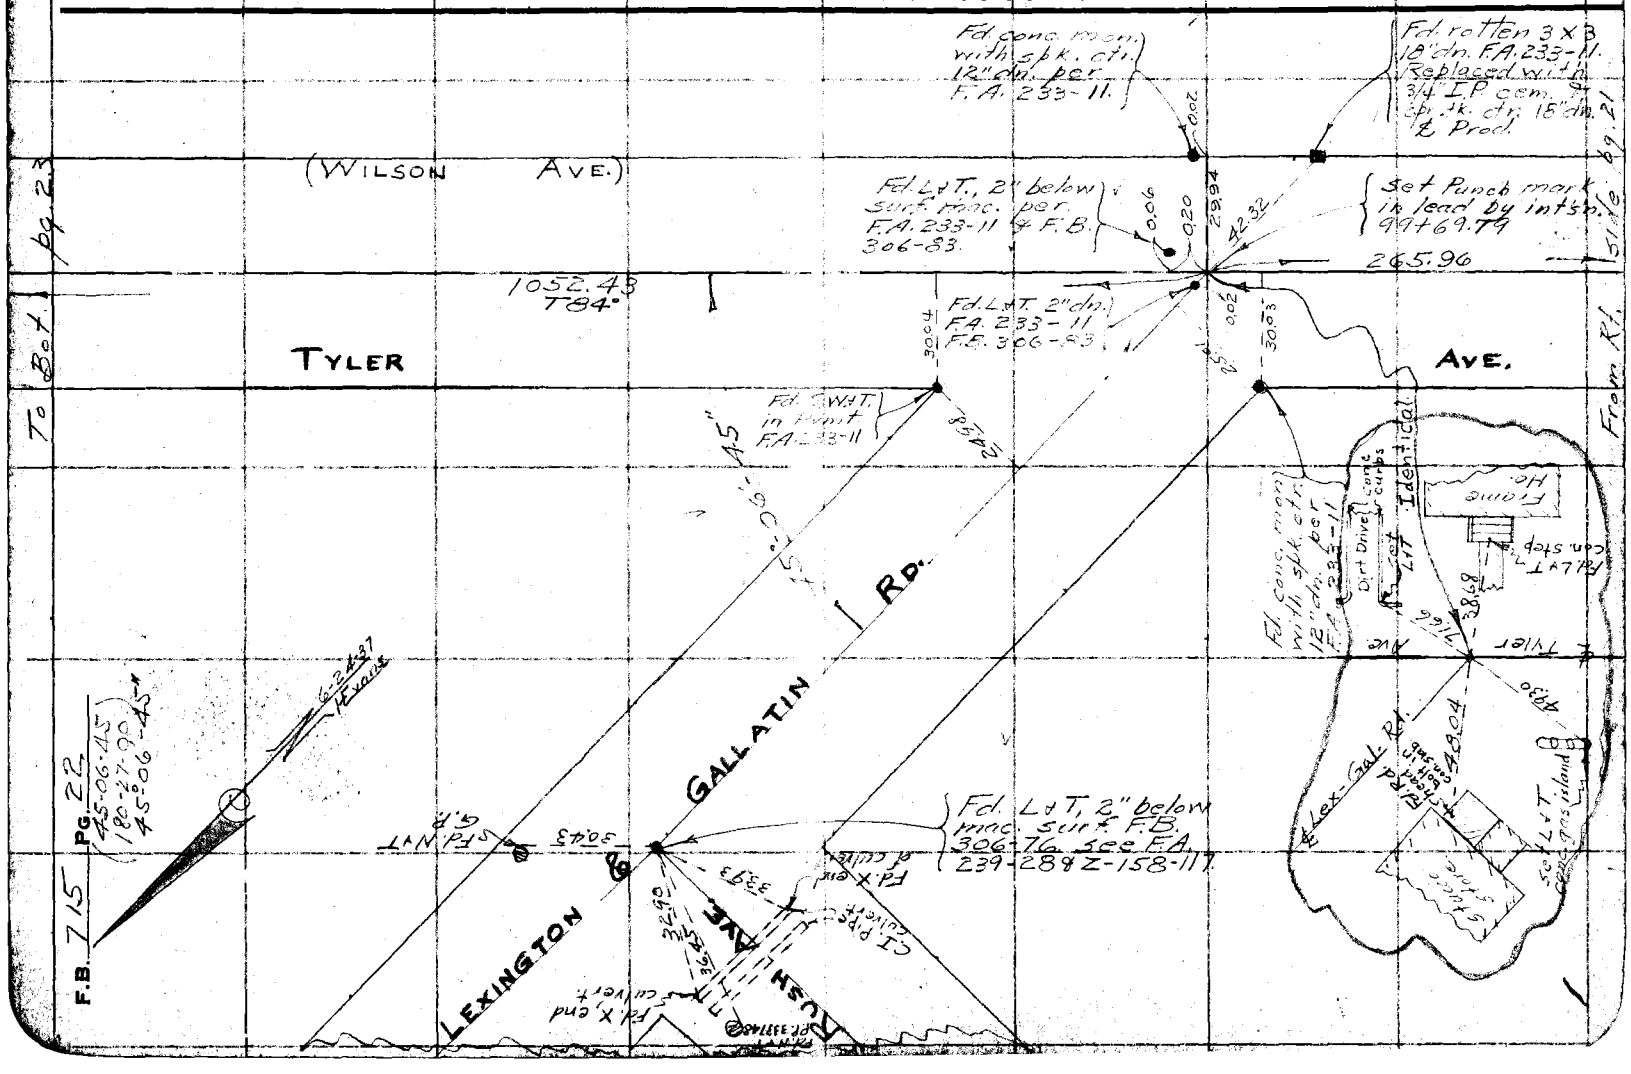

Notes Ck'd by	Survey of PECK RD.
Map No. C.S. B-1351-1	W. O. 7052 Tape No. 026 St'd 84° F.
Office Work J.D. Price	Surveyed by EVANS
Checked AAR	Notes HE Date 6-25-37
Date Aug. 39	Indexed by C. Johnson

F.B. 715 Pg. 23
(89-59-15
359-57-15
57° 57' 18 3/4"

37 B+C-2

To Bot. pg. 21

WILSON AVE.

TYLER

DURFEE

THIENES AVE

See pg. 143

From Top pg. 22.

1320.07

1052.43

Fd. S.W.T. F.B. 1306-93 F.A. 233-10

Set N/T S.T.P. 440 o.s.T.

Set P.K. by 111 feet S.E. 118422.42

Fd. L & T per F.B. 1306-99 & 1581-121

Fd. L & T in conc. parking space, per F.A. 233-10

Set Prod. set 3/4" I.P. cem'd Cor. Tk. ctr. Ex. dg.

Set L & T Gas meter box

Fd. L & T Conc. Block 2' high

Fd. L & T No Ref.

Set L & T Conc. Driveway

Fd. S.O.W. 36" Pine

RETURN TO
LOS ANGELES COUNTY SURVEYOR
700 HALL OF RECORDS

Note: Any Additions or Changes on This Sheet Must be Made or Circled in Red Ink With Date and Name of Person Making Change

Do not extend notes this side of this line

FORM 247 10M 11-38

37, B-1
C-2

RETURN TO
LOS ANGELES COUNTY SURVEYOR
700 HALL OF RECORDS

Note: Any Additions or Changes on This Sheet Must be Made or Circled in Red Ink With Date and Name of Person Making Change.

Do not extend notes this side of this line

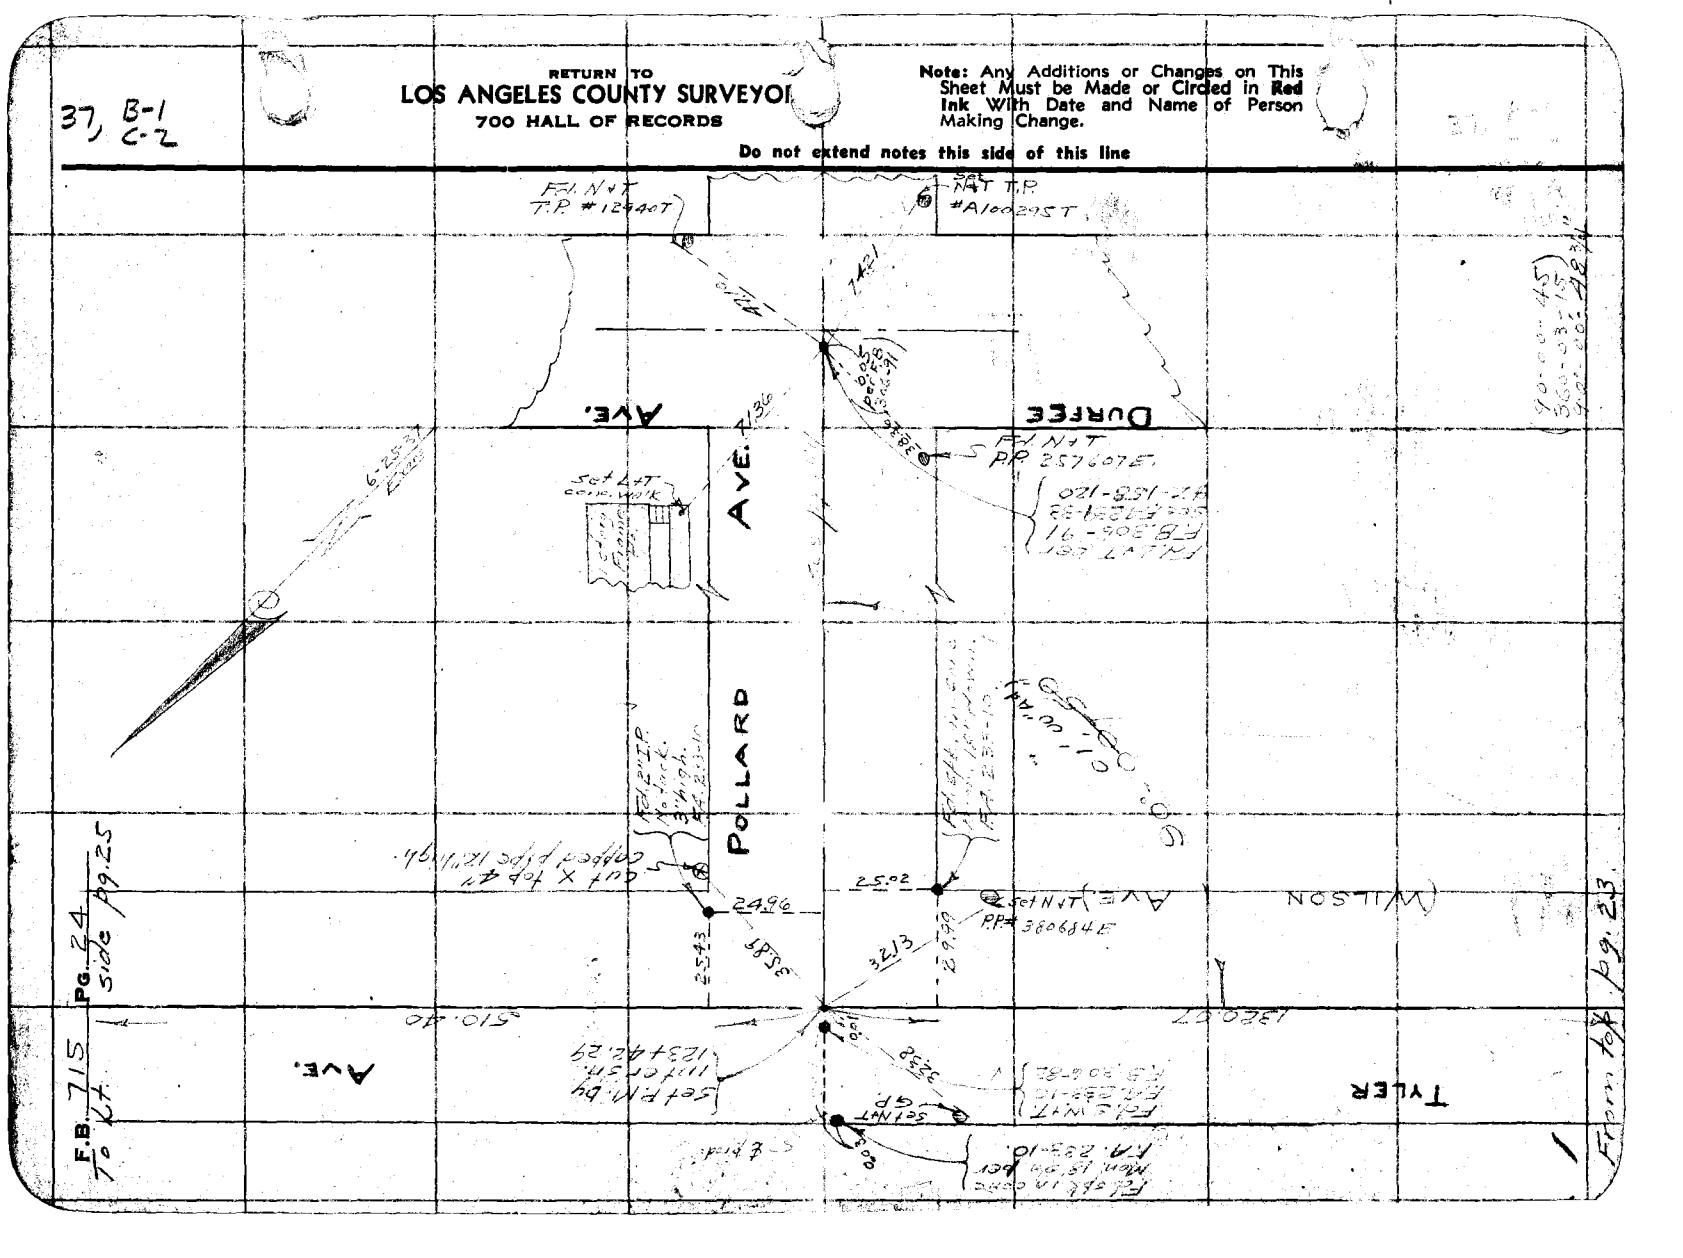
POLLARD
AVE.
DURFEE
AVE.
AVE.
TYLER
WILSON
AVE.
Set NAT T.P. #A100295T
Fd. NAT T.P. #1294oT
Fd. NAT T.P. 2576075
Set NAT GP

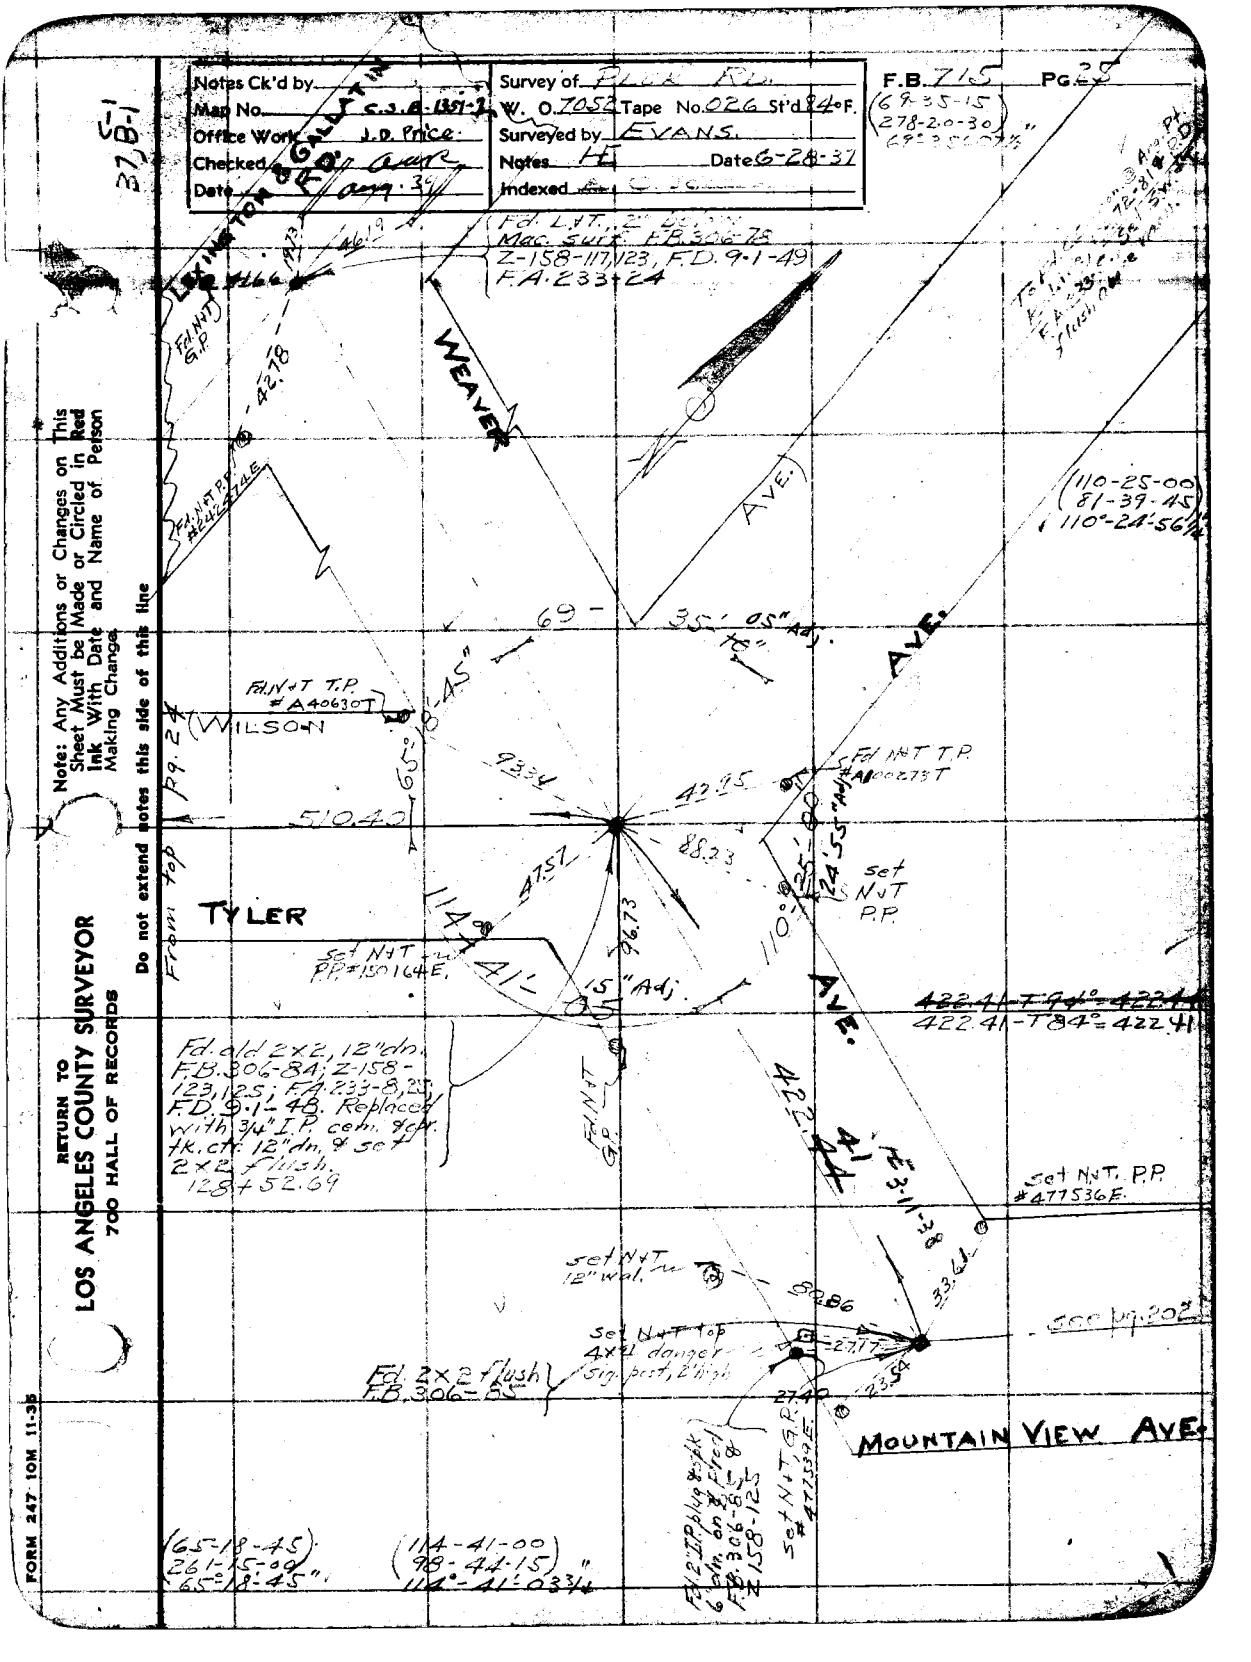
Notes Ck'd by
Map No. C.S.B. 1351-2
Office Work J.D. Price
Checked
Date
W. O. 7052 Tape No. 026 St'd 34°F.
Surveyed by EVANS.
Notes HI Date 6-28-37
Indexed
F.B. 715 PG. 25
(69-35-15)
(278-20-30)
69°-35-05"
Fd. L.H.T., 2" Dia.
Mac. Swift F.B. 306-78
Z-158-117,123, F.D. 9-1-49
F.A. 233+24
WEAVER
AVE.
Fd. NAIL & T. P.
#A40630T
WILSON
TYLER
Set NAIL & T. P.
#A40627T
Set NAIL P.P.
#150164E.
Fd. old 2"x2", 12" dn.
F.B. 306-84; Z-158-123, 125; F.A. 233-8, 25
F.D. 9-1-48. Replaced with 3/4" I.P. cem. & P.K. nail, 12" dn. & set 2"x2" flush.
128+52.69
422.41-T 84°=422.41
Set NAIL P.P.
#477536E.
Set NAIL 12" Wal.
Set NAIL top 4"x4" dangerous sign post, 2' high
Fd. 2"x2" flush
F.B. 306-85
MOUNTAIN VIEW AVE.
Fd. 2" I.P. & tack
6 cm. dn. & L.S.
F.B. 306-85
Z-158-123
Set NAIL & T. P.
#477536E.
(65-18-45)
(26-15-00)
65°-18-45"
(114-41-00)
(98-44-15)
114°-41-03¾"
Note: Any Additions or Changes on This Sheet Must be Made or Circled in Red Ink With Date and Name of Person Making Change
Do not extend notes this side of this line
RETURN TO
LOS ANGELES COUNTY SURVEYOR
700 HALL OF RECORDS
FORM 247 10M 11-35
37 B-1
5-1

RETURN TO
LOS ANGELES COUNTY SURVEYOR
700 HALL OF RECORDS

Note: Any Additions or Changes on This Sheet Must be Made or Circled in **Red Ink** With Date and Name of Person Making Change.

Do not extend notes this side of this line

F.B. 715 PG. 26

Notes Ck'd by	Survey of
Map No. C.S.B-1351-2	W. O. 7666 Tape No. St'd °F.
Office Work J.D. Price	Surveyed by H.F. EVANS
Checked	Notes F.B. 4 Date 6-14-37
Date Aug. '39	Indexed 7-10-37

F.B. 779 Pg. 27

[See F.B. 737-15 for 1938 Survey]

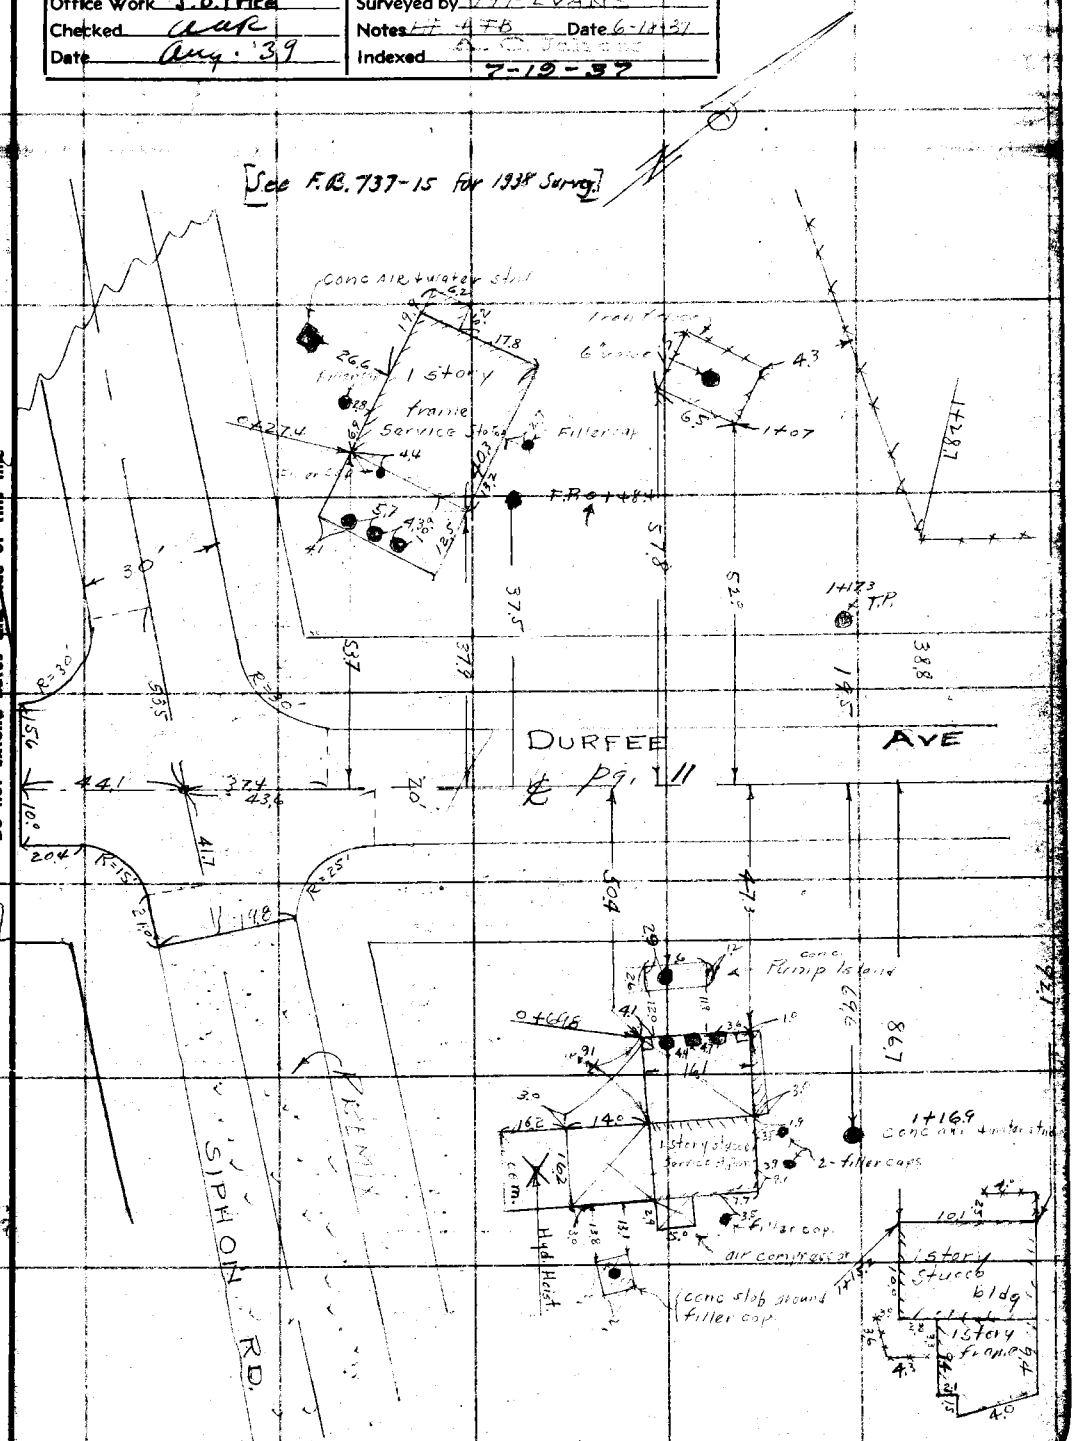

Note: Any Additions or Changes on This Sheet Must be Made or Circled in Red Ink With Date and Name of Person Making Change

Do not extend notes this side of this line

RETURN TO
LOS ANGELES COUNTY SURVEYOR
700 HALL OF RECORDS

M 347 10M 11-38

RETURN TO
LOS ANGELES COUNTY SURVEYOR
700 HALL OF RECORDS

Note: Any Additions or Changes on This Sheet Must be Made or Circled in **Red Ink** With Date and Name of Person Making Change.

Do not extend notes this side of this line

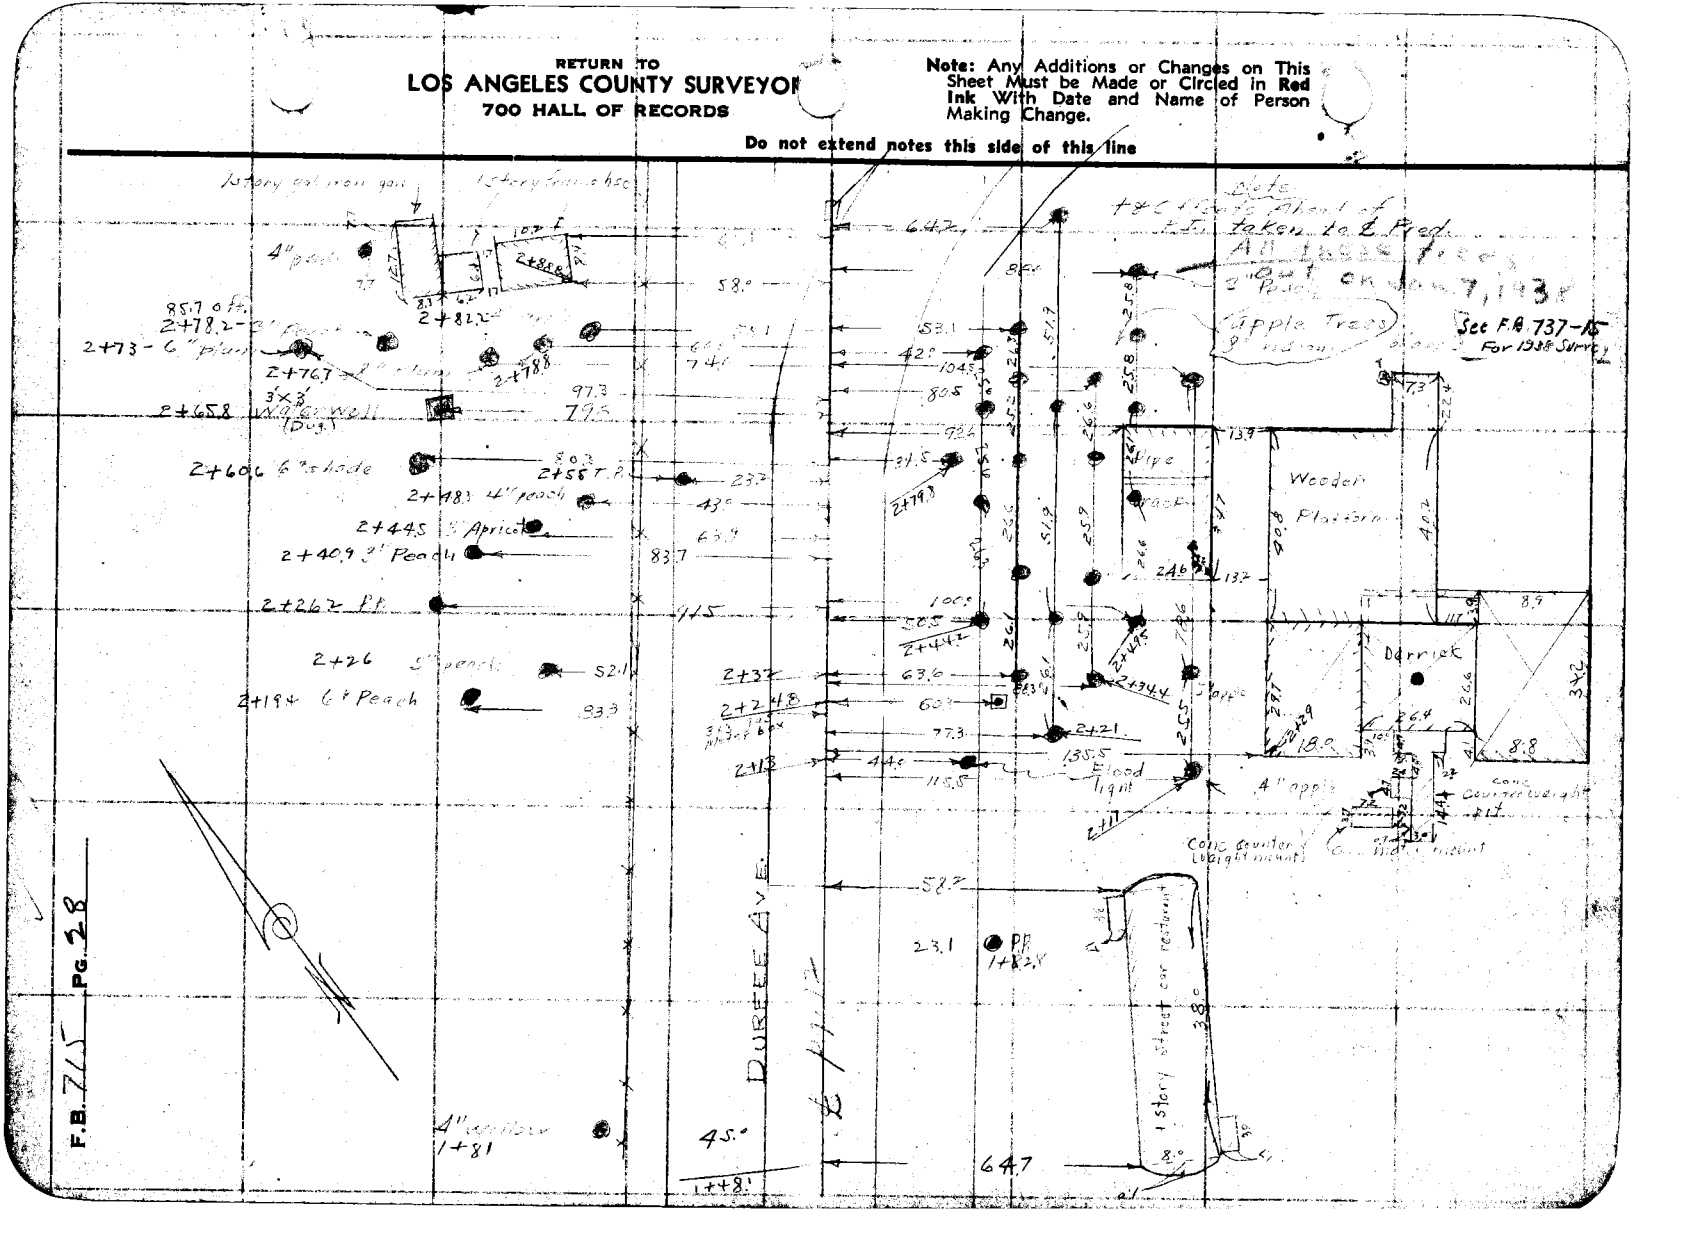

Notes Ck'd by	Survey of FLOOD CO.
Map No. C.S. B-135-2	W. O. 2004 Tape No. St'd °F.
Office Work J. D. Price	Surveyed by H. F. EVANS
Checked Aug	Notes Blanchard Date 6-18-37
Date Aug. '39	Indexed A. C. Jensen

F.B. 115 Pg. 29

RETURN TO
LOS ANGELES COUNTY SURVEYOR
708 HALL OF RECORDS

Note: Any Additions or Changes on This Sheet Must be Made or Circled in Red Ink With Date and Name of Person Making Change

Do not extend notes this side of this line

FORM 247 10M 11-38

[See F.B. 737 Pg. 15 for 1938 Survey]

F.B. 715 Pg. 30

RETURN TO
LOS ANGELES COUNTY SURVEYOR
700 HALL OF RECORDS

Note: Any Additions or Changes on This Sheet Must be Made or Circled in Red Ink With Date and Name of Person Making Change.

Do not extend notes this side of this line

Toilet
50.8
53.9
7+33.5
11 Willows
6.4.6
P.P. 7+25.3
134.8
Line
Pg. 13
All identical distance
144.6
Willow
116°
82.8
6+98 v-ln
6+90.7
6+93
5'x5' Palm tree
6+90.1
168.7
Trail
6+64 P.P.
411
6+51 -ll-
125.2
4'x4' Concrete piers
26.5
26.5
oil well & tierack
10.3
5.2
5.4
P.P.
6+55
6+25
11.8
60.0
41.6
10.0
1 story galvanized bldg
16.1
8.6

Notes Ck'd by	Survey of
Map No. C.S.B-1351-1	W. O. 7054 Tape No. 226 St'd 27 F.
Office Work J. D. Price	Surveyed by E. Yates
Checked Gap	Notes HE Date 6-24-37
Date Aug. '39	Indexed A. C. Jones

F.B. 715 Pg. 31

Note: Any Additions or Changes on This Sheet Must be Made or Circled in Red Ink With Date and Name of Person Making Change.

Do not extend notes this side of this line

RETURN TO
LOS ANGELES COUNTY SURVEYOR
700 HALL OF RECORDS

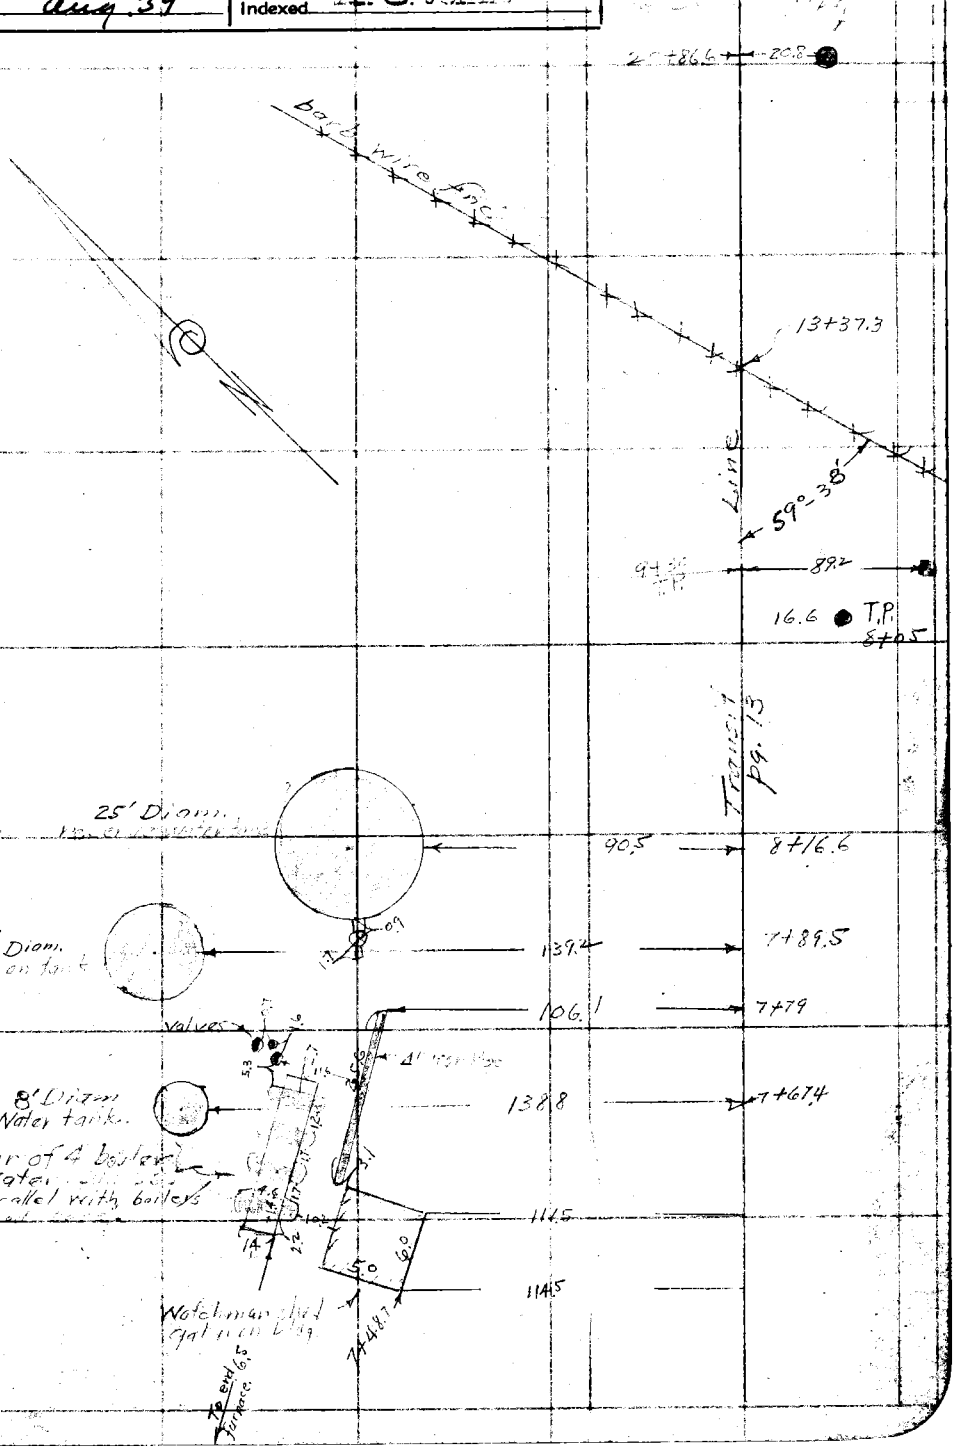

FORM 247 10M 11-38

F.B. 715 PG. 32

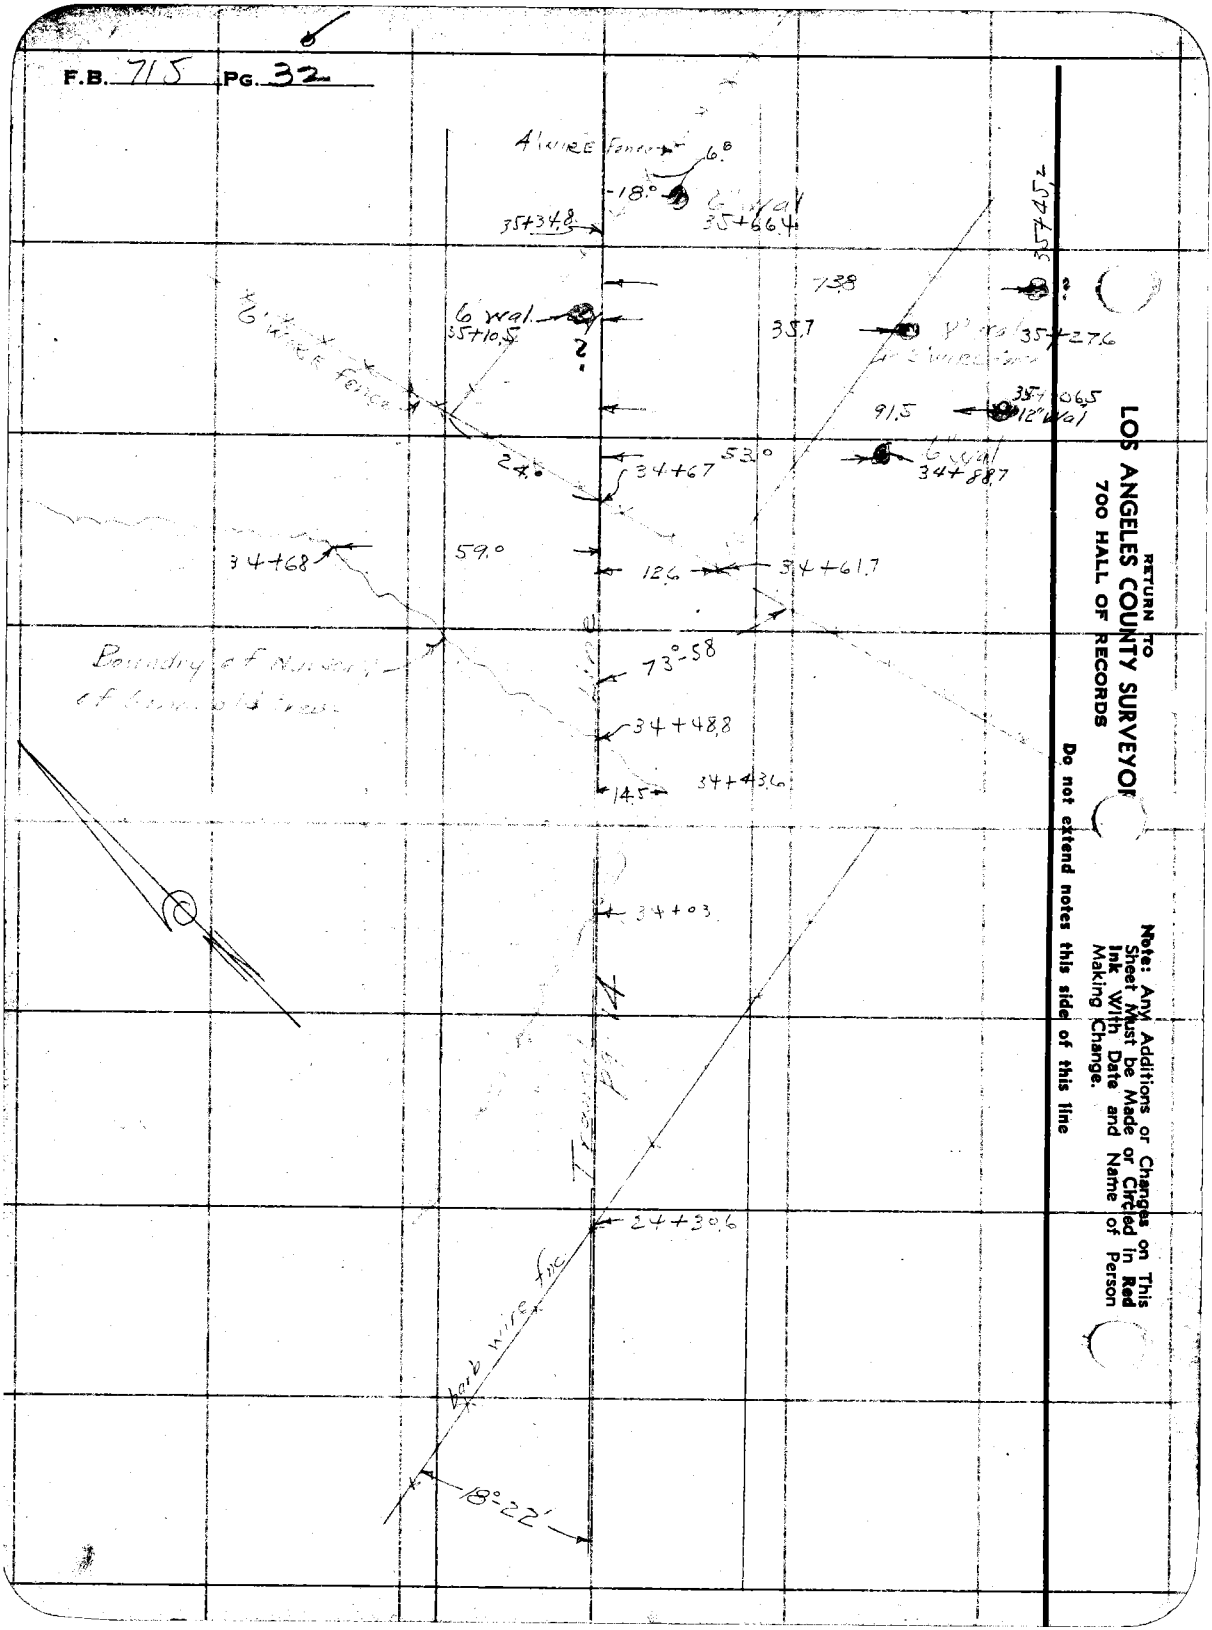

RETURN TO
LOS ANGELES COUNTY SURVEYOR
700 HALL OF RECORDS

Note: Any Additions or Changes on This Sheet Must be Made or Circled in Red Ink With Date and Name of Person Making Change.

Do not extend notes this side of this line

Notes Ck'd by	Survey of Peck Rd
Map No. C.S. B-13815-2	W. O. 7056 Tape No. St'd °F.
Office Work J. D. Price	Surveyed by H.E. Evans
Checked Aug	Notes HE 478 Date 6-21-37
Date Aug. '39	Indexed

F.B. 715 Pg. 32

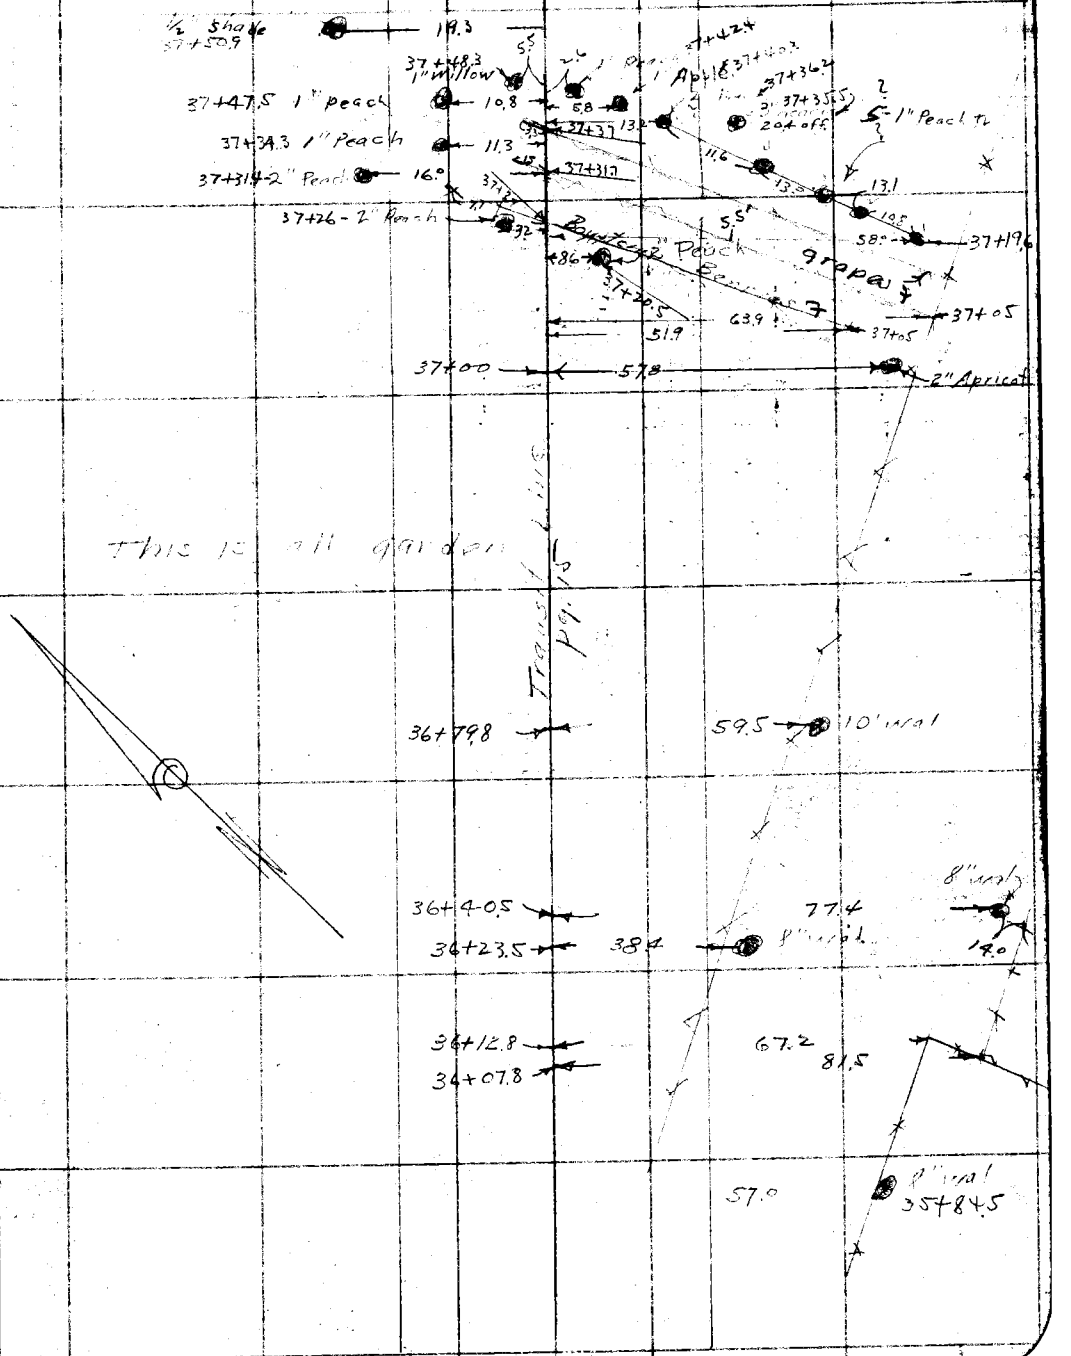

RETURN TO
LOS ANGELES COUNTY SURVEYOR
700 HALL OF RECORDS

Note: Any Additions or Changes on This Sheet Must be Made or Circled in Red Ink With Date and Name of Person Making Change.

Do not extend notes this side of this line

FORM 247 10M 11-35

RETURN TO
LOS ANGELES COUNTY SURVEYOR
700 HALL OF RECORDS

Note: Any Additions or Changes on This Sheet Must be Made or Circled in **Red** Ink With Date and Name of Person Making Change.

Do not extend notes this side of this line

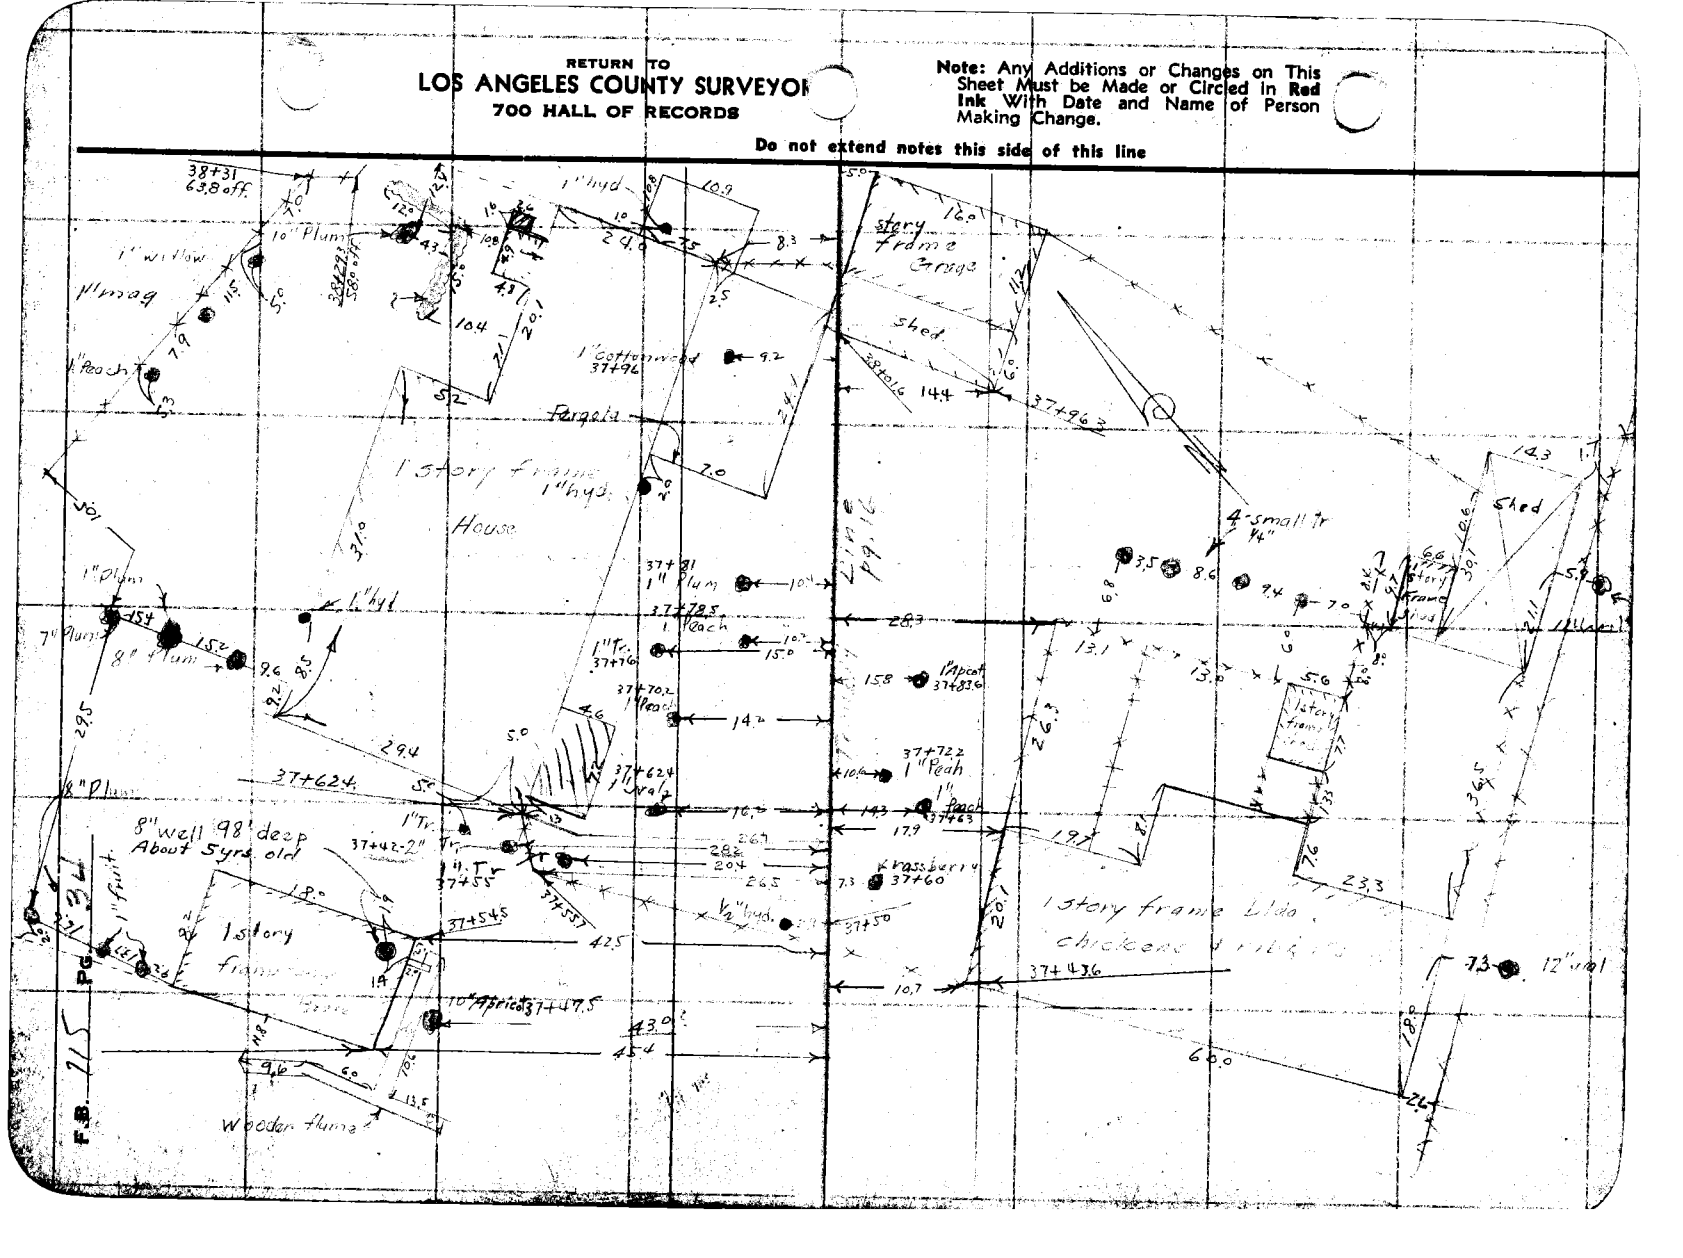

Notes Ck'd by	Survey of Peck Rd
Map No. C.S. B-1351-7	W. 0.205 Tape No. St'd °F.
Office Work J. D. Price.	Surveyed by H.F. EVANS
Checked aar	Notes HE-478 Date 6-22-37
Date Aug. '39	Indexed A. C. Johnson

F.B. 715 PG. 35

Note: Any Additions or Changes on This Sheet Must be Made or Circled in Red Ink With Date and Name of Person Making Change.

Do not extend notes this side of this line

RETURN TO
LOS ANGELES COUNTY SURVEYOR
700 HALL OF RECORDS

FORM 2.47 10M 11-38

RETURN TO
LOS ANGELES COUNTY SURVEYOR
700 HALL OF RECORDS

Note: Any Additions or Changes on This Sheet Must be Made or Circled in Red Ink With Date and Name of Person Making Change.

Do not extend notes this side of this line

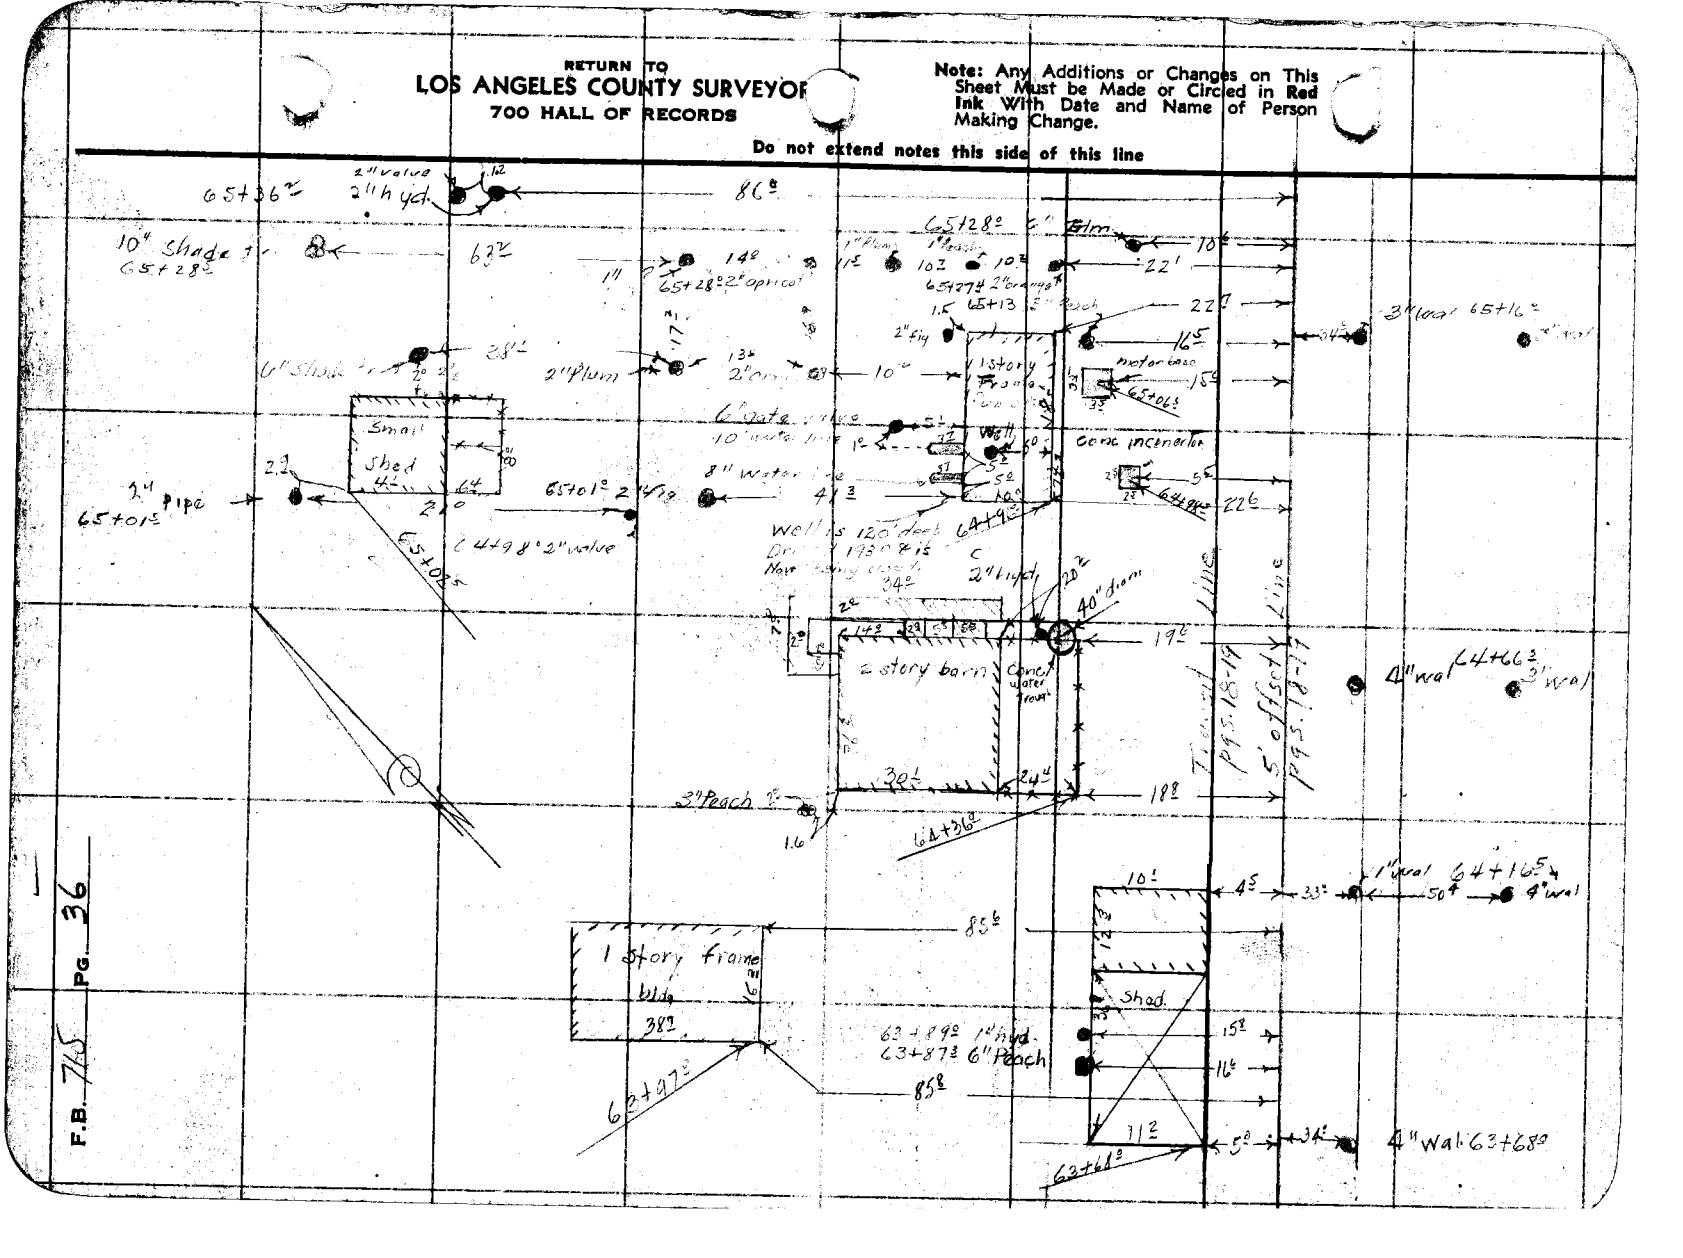

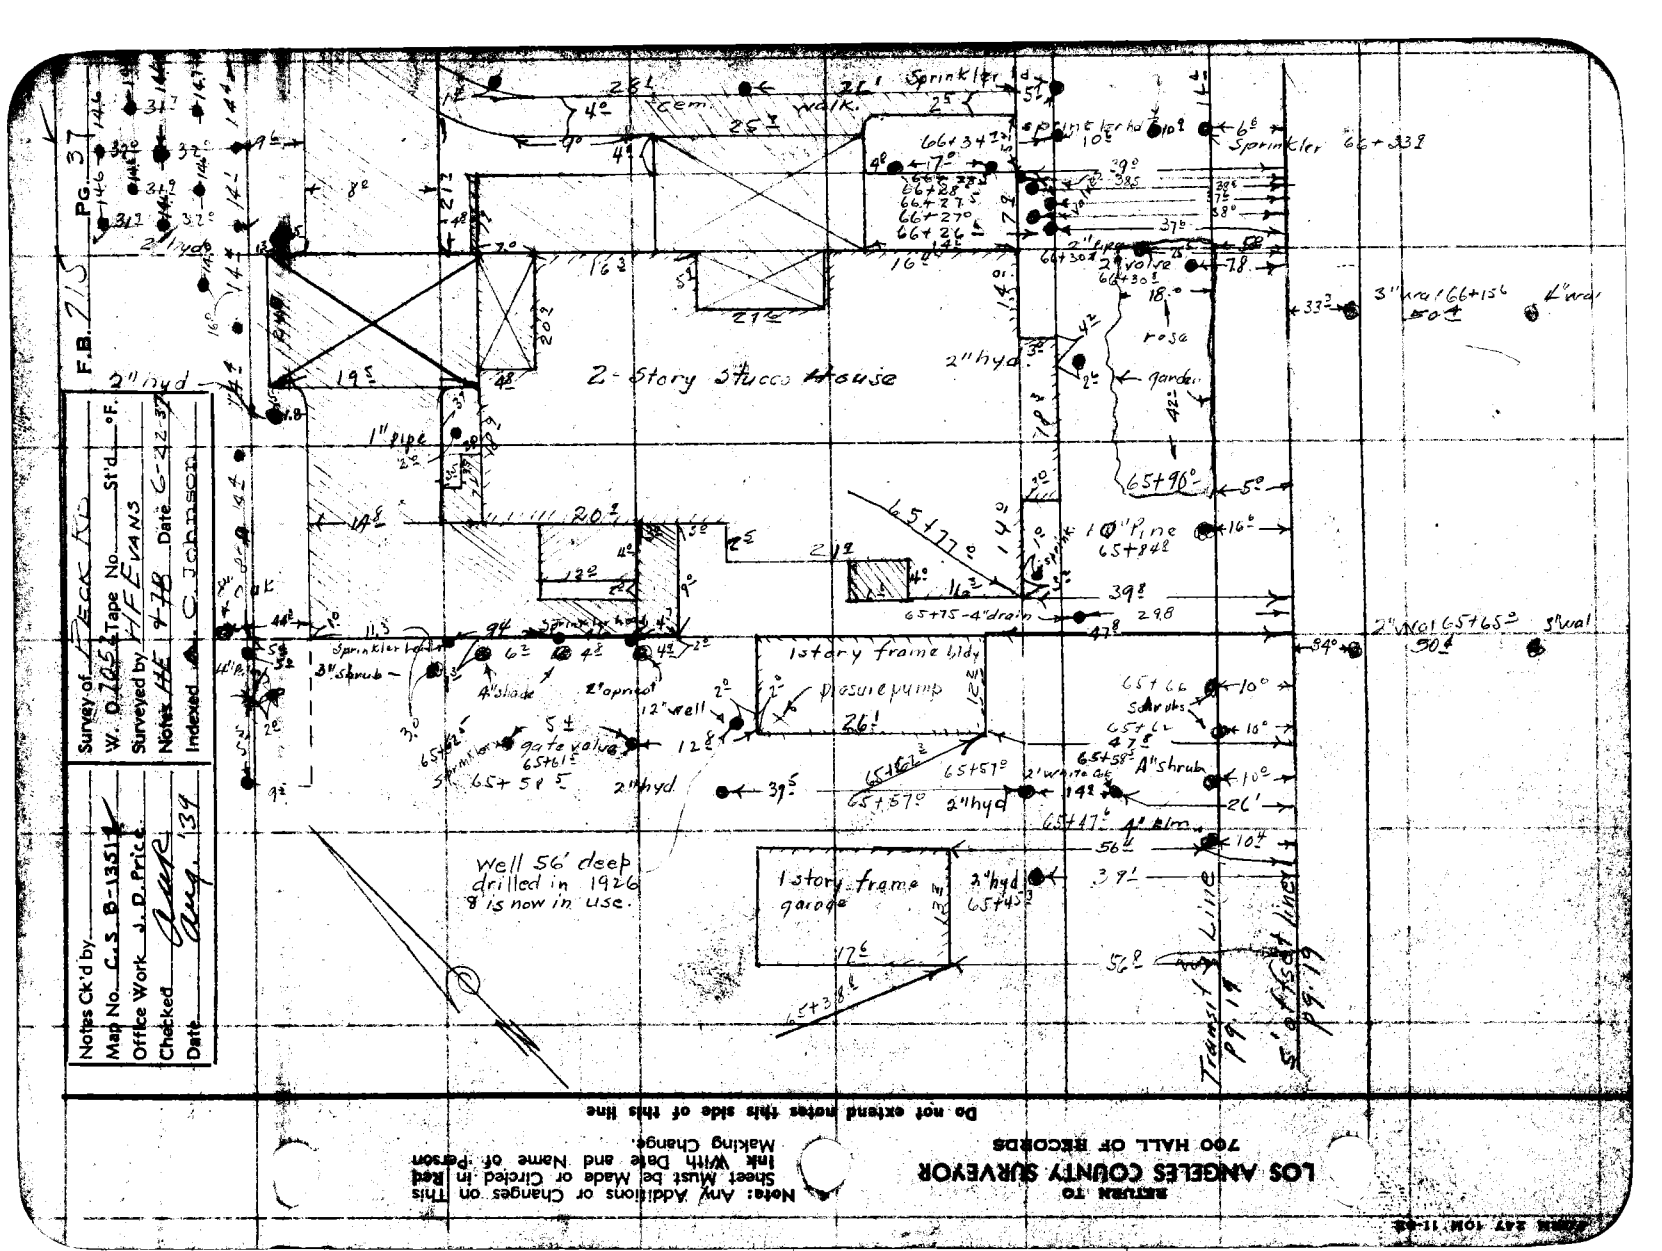
F.B. 215
PG. 37
Survey of Beck Rd
W.O. 7065 Tape No. Std. °F.
Surveyed by H.F. Evans
Notes HE 4-78 Date 6-12-37
Indexed by C. Johnson
Notes Ck'd by
Map No. C.S. B-1351
Office Work J.D. Price
Checked Guy
Date Aug. 134
2-Story Stucco House
1-Story frame bldg
pleasure pump
1-Story frame garage
Well 56' deep drilled in 1926 is now in use.
2" hyd
gate valve
Sprinkler
Sprinkler head
3" shrub
4" slash
2" apricot
12" well
rose garden
10" Pine
65+96
65+77
65+75 - 4" drain
65+66
65+62
65+58
65+57
65+47
65+45
65+38
66+34
66+28
66+27.5
66+27
66+26
66+30
66+33
66+15.6
Transit Line
Pg. 19
Pg. 18
LOS ANGELES COUNTY SURVEYOR
700 HALL OF RECORDS
RETURN TO
Note: Any Additions or Changes on This Sheet Must be Made or Circled in Red Ink With Date and Name of Person Making Change.
Do not extend notes this side of this line

RETURN TO
LOS ANGELES COUNTY SURVEYOR
700 HALL OF RECORDS

Note: Any Additions or Changes on This Sheet Must be Made or Circled in Red Ink With Date and Name of Person Making Change.

Do not extend notes this side of this line

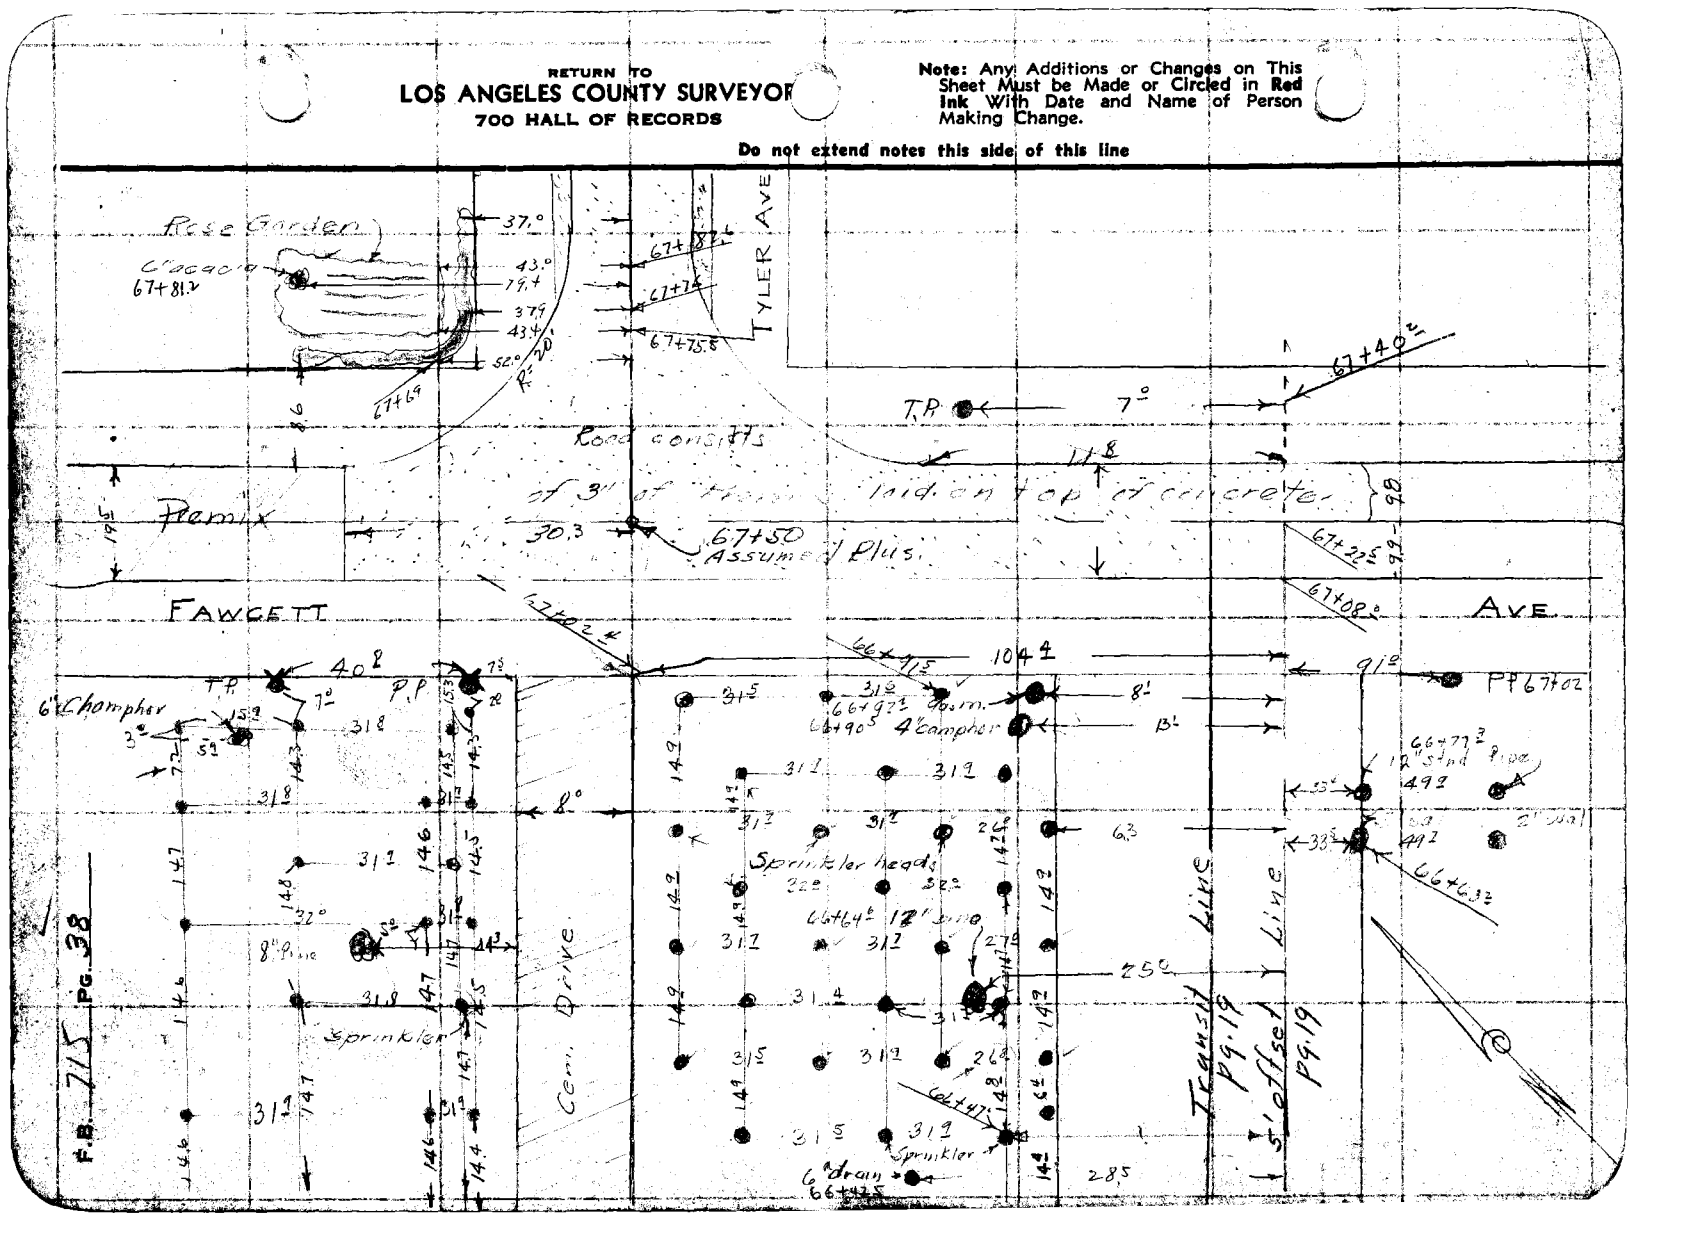

Notes Ck'd by	Survey of FERN PL
Map No. C.S. B-1351	W. O. 7052 Tape No. St'd °F.
Office Work J. D. Price	Surveyed by H F EVANS
Checked Aug	Notes H & TB Date 6-29-37
Date Aug. '37	Indexed A. C. Cook

F.B. 715 Pg. 39

Note: Any Additions or Changes on This Sheet Must be Made or Circled in Red Ink With Date and Name of Person Making Change.

Do not extend notes this side of this line

RETURN TO
LOS ANGELES COUNTY SURVEYOR
700 HALL OF RECORDS

FORM 247 10M 11-35

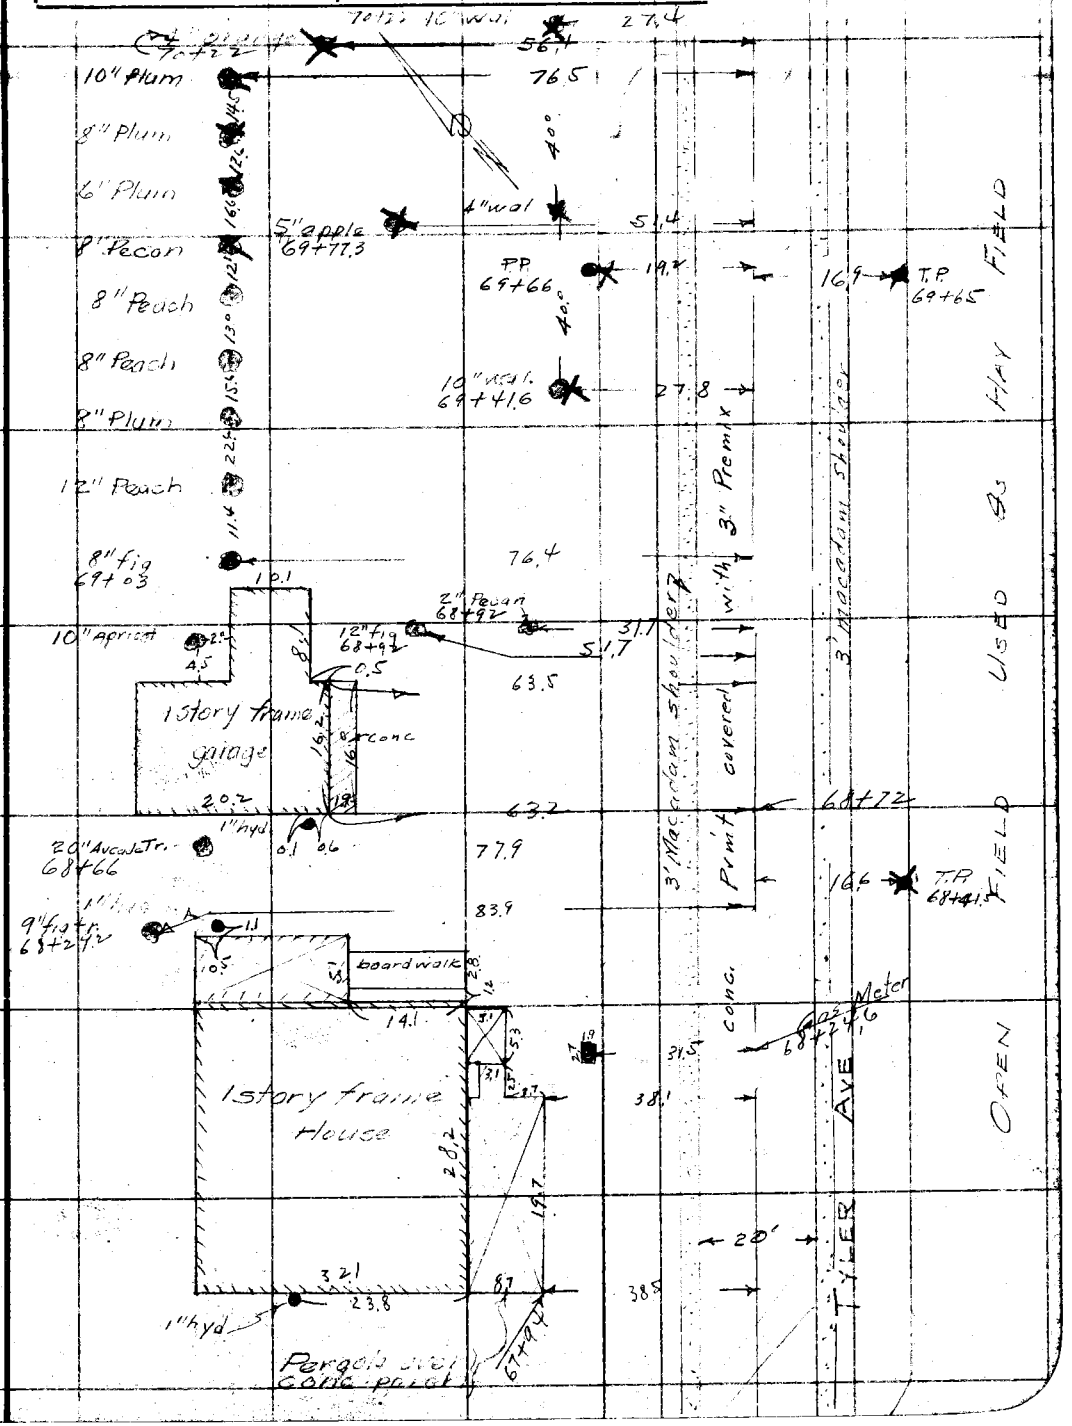

F.B. 715 PG. 40

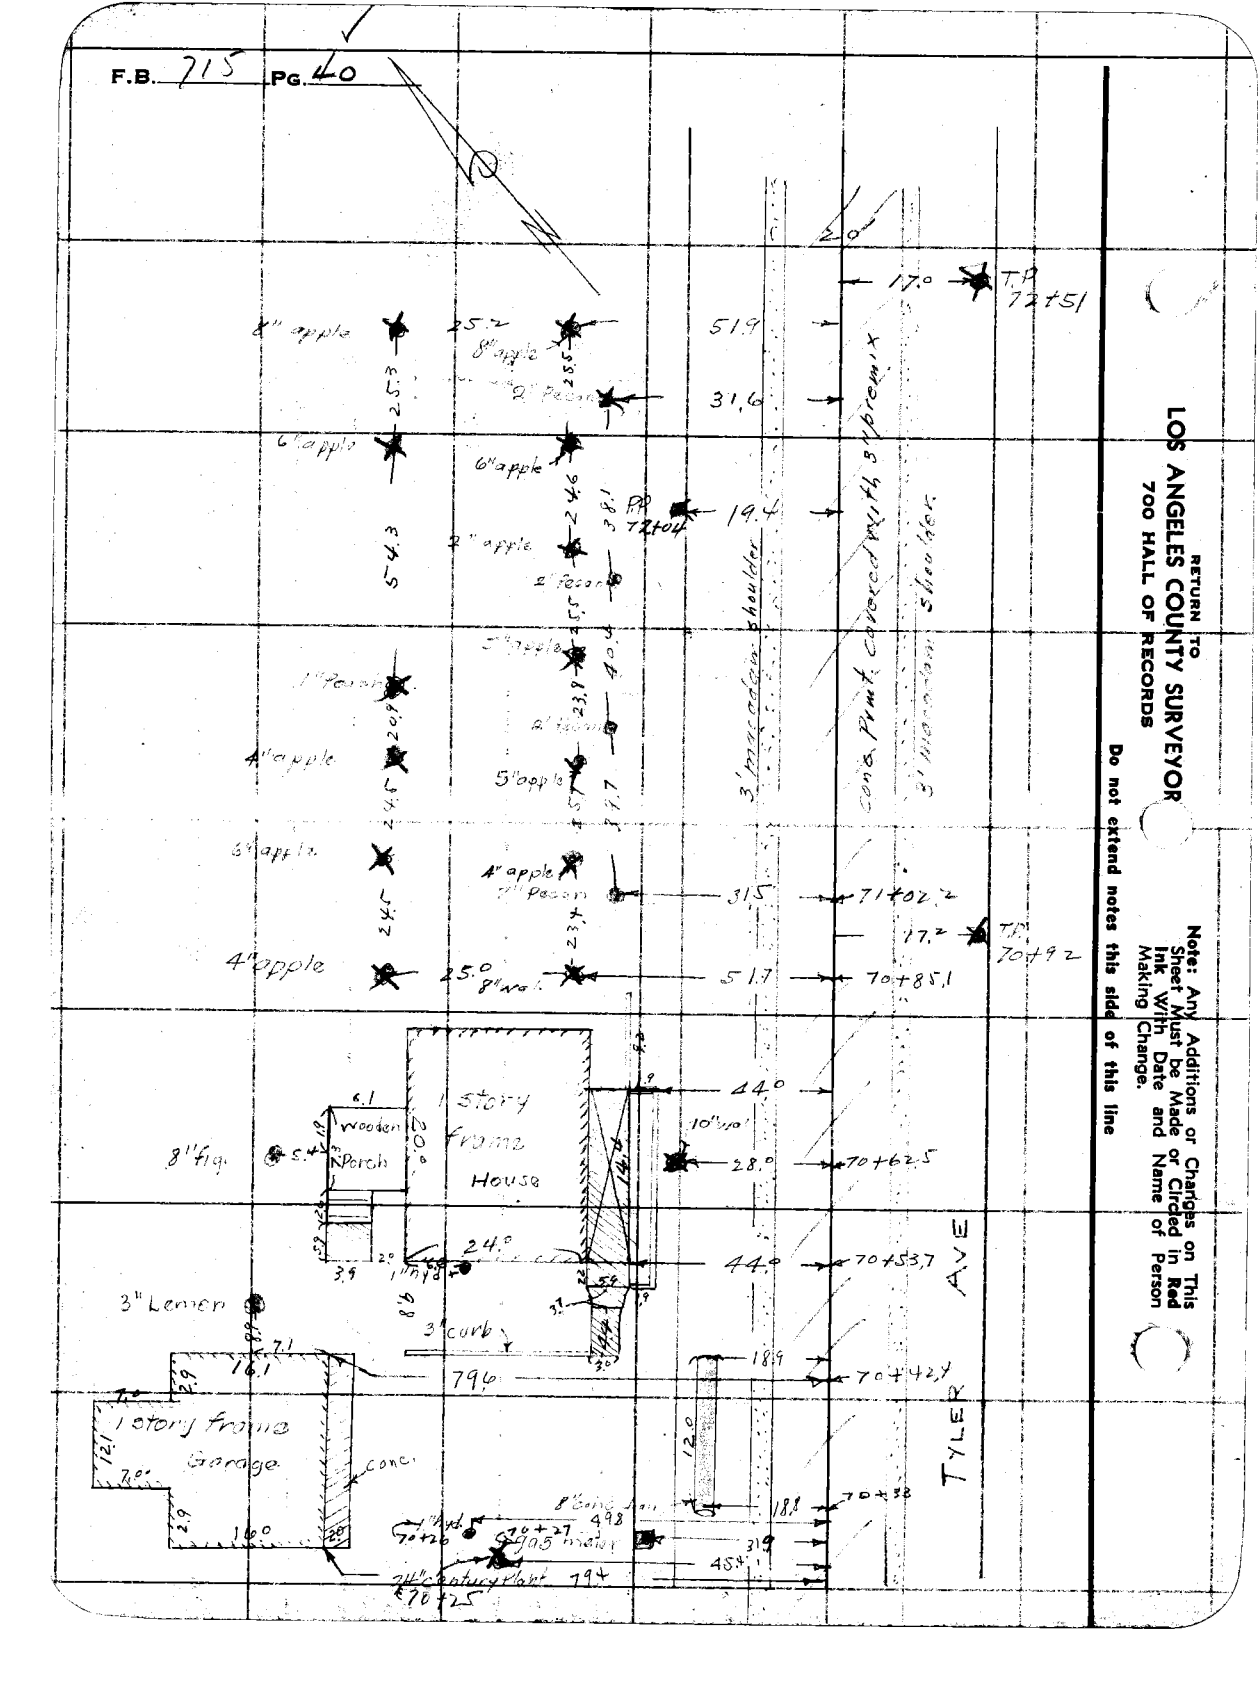
RETURN TO
LOS ANGELES COUNTY SURVEYOR
700 HALL OF RECORDS
Note: Any Additions or Changes on This Sheet Must be Made or Circled in Red Ink With Date and Name of Person Making Change.
Do not extend notes this side of this line
17.0
TP 72+51
8" apple
25.2
8" apple
25.5
2" Pecan
51.9
31.6
6" apple
6" apple
2.5.3
2.4.6
3.8.1
PP 72+04
19.4
2" apple
2" Pecan
5.4.3
4.5.1
5" apple
1" Pecan
4" apple
5" apple
2.0.9
2.4.6
2.3.6
4.0.4
2.1.7
6" apple
4" apple
11" Pecan
2.3.4
31.5
71+02.2
17.2
TP 70+92
4" apple
25.0
8" Walnut
51.7
70+85.1
1 Story Frame House
Wooden Porch
8" fig
44.0
10" Pine
28.0
70+62.5
24.0
44.0
70+53.7
3" Lemon
3" curb
18.9
79.6
70+42.4
1 story frame Garage
conc
8" Concrete Curb
18.8
70+38
70+26
70+27
49.8
Gas meter
31.9
45.4
70+25
79.4
TYLER AVE

Notes Ck'd by
Map No. C.S.B-136[illegible]
Office Work J.D. Price
Checked A.A.C.
Date Aug '39

Survey of JECK RD
W. O. 7052 Tape No. St'd °F.
Surveyed by H.F. EVANS
Notes H 178 Date 6-29-37
Indexed A. C. Johns

F.B. [illegible] Pg. 41

Note: Any Additions or Changes on This Sheet Must be Made or Circled in Red Ink With Date and Name of Person Making Change.

Do not extend notes this side of this line

RETURN TO
LOS ANGELES COUNTY SURVEYOR
700 HALL OF RECORDS

FORM 247 10M 11-38

71+38.8
12" Steel Pipe
37.3
10" [illegible]
53.9
P.P. 72+42
19.5
23.8
78.3
12" apricot
8" apple
24.0
8" apple stump
10" apple
24.8
24.7
10" apple
8" apple
25.8
25.4
8" apple
10" apple
24.8
34.7
6" apple
8" apple
24.6
25.3
8" apple
8" apple
24.7
25.2
8" apple
53.2
72+83.3
25.1
8" apple 72+60
77.2
3' Shoulder (Macadam)
Conc Pvmt covered w/1-1/4" Premix
3' Shoulder (Macadam)
20'
17.0
T.P. 74+11
TYLER AVE

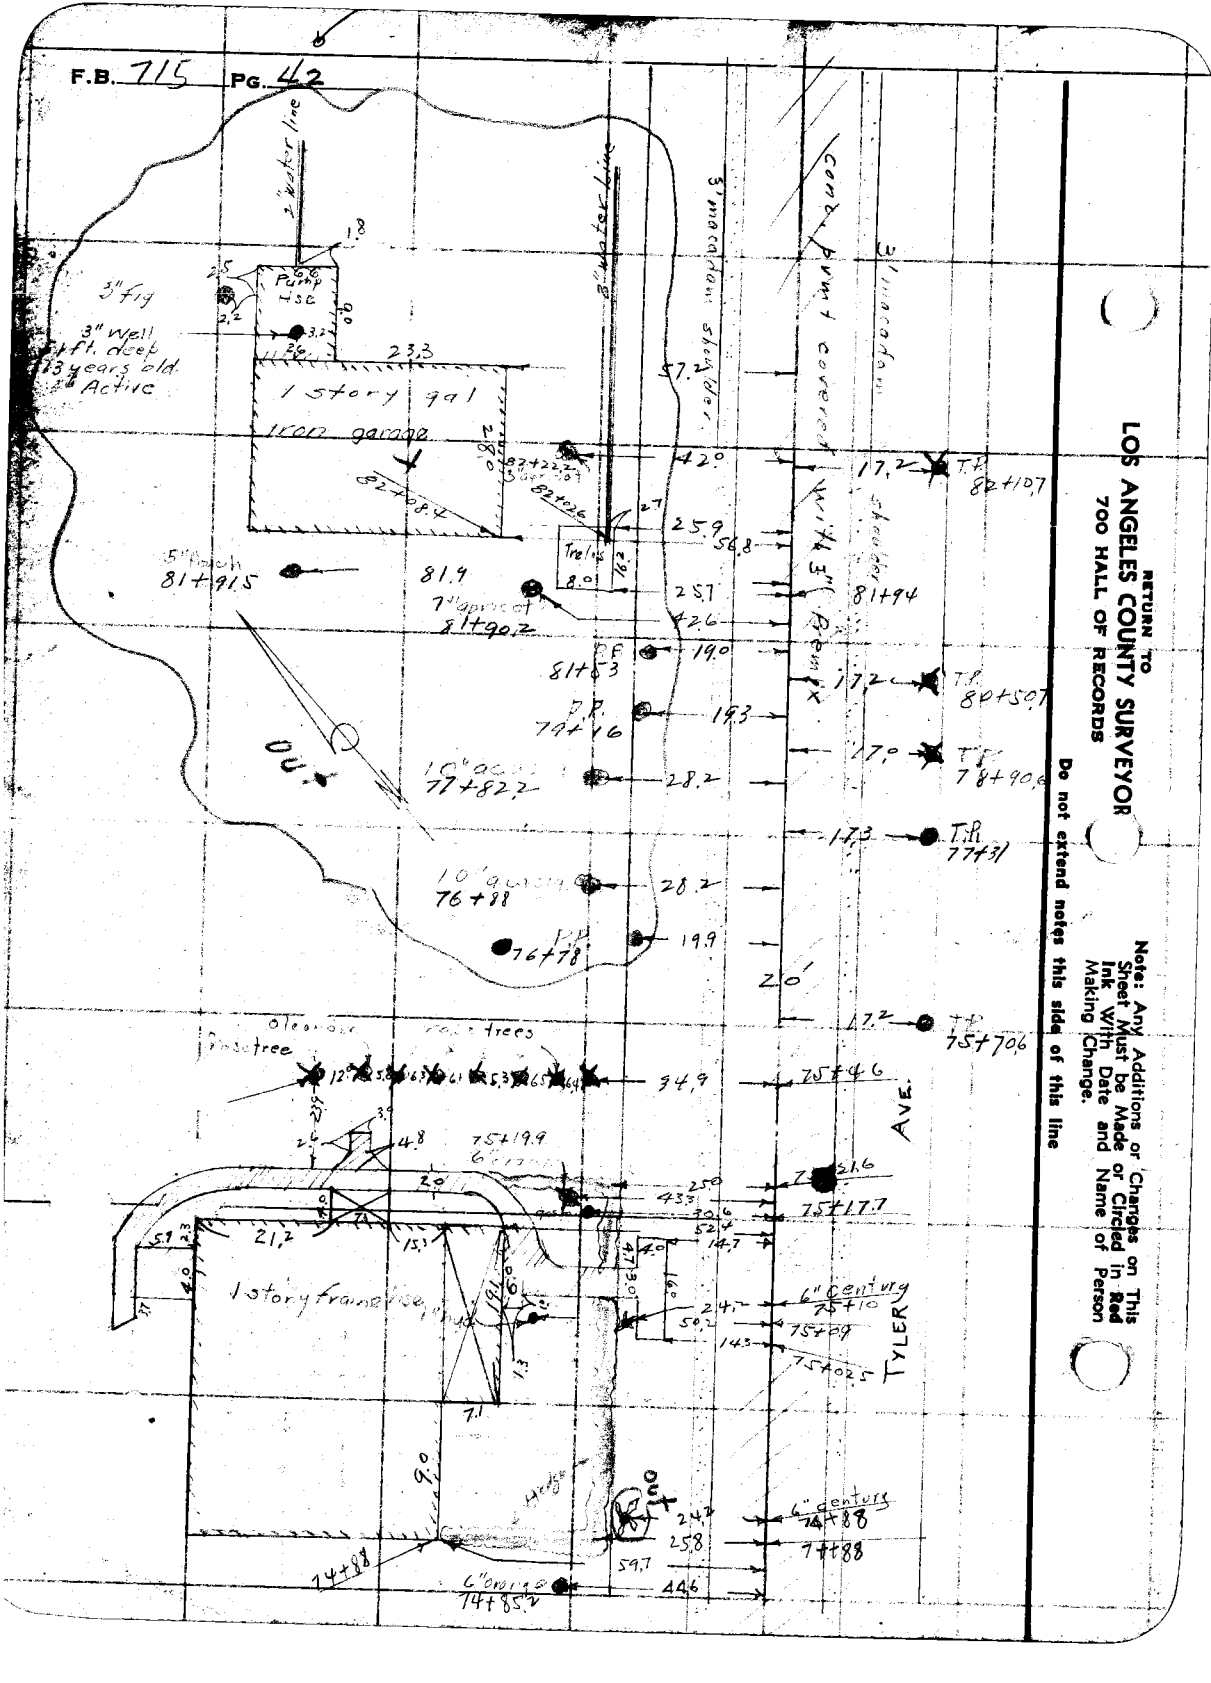
F.B. 715 PG. 42
RETURN TO
LOS ANGELES COUNTY SURVEYOR
700 HALL OF RECORDS
Note: Any Additions or Changes on This Sheet Must be Made or Circled in Red Ink With Date and Name of Person Making Change.
Do not extend notes this side of this line
3" fig
3" well
4 ft. deep
13 years old
Active
Pump Hse
1 story gal iron garage
Trellis
5" peach
7" apricot
10" acacia
10" acacia
Oleanders
Pine tree
Palm trees
1 story frame house
6" century
6" century
6" century
Ave.
TYLER

Notes Ck'd by	Survey of Peck Rd
Map No. C.S.B-135-2	W. O. 7052 Tape No. St'd °F.
Office Work J. P. Price	Surveyed by H F EVANS
Checked dar	Notes HFE 478 Date 6-29-54
Date Aug. 39	Indexed

F.B. 715 Pg. 43

Note: Any Additions or Changes on This Sheet Must be Made or Circled in Red Ink With Date and Name of Person Making Change.

Do not extend notes this side of this line

RETURN TO
LOS ANGELES COUNTY SURVEYOR
700 HALL OF RECORDS

FORM 247 10M 11-38

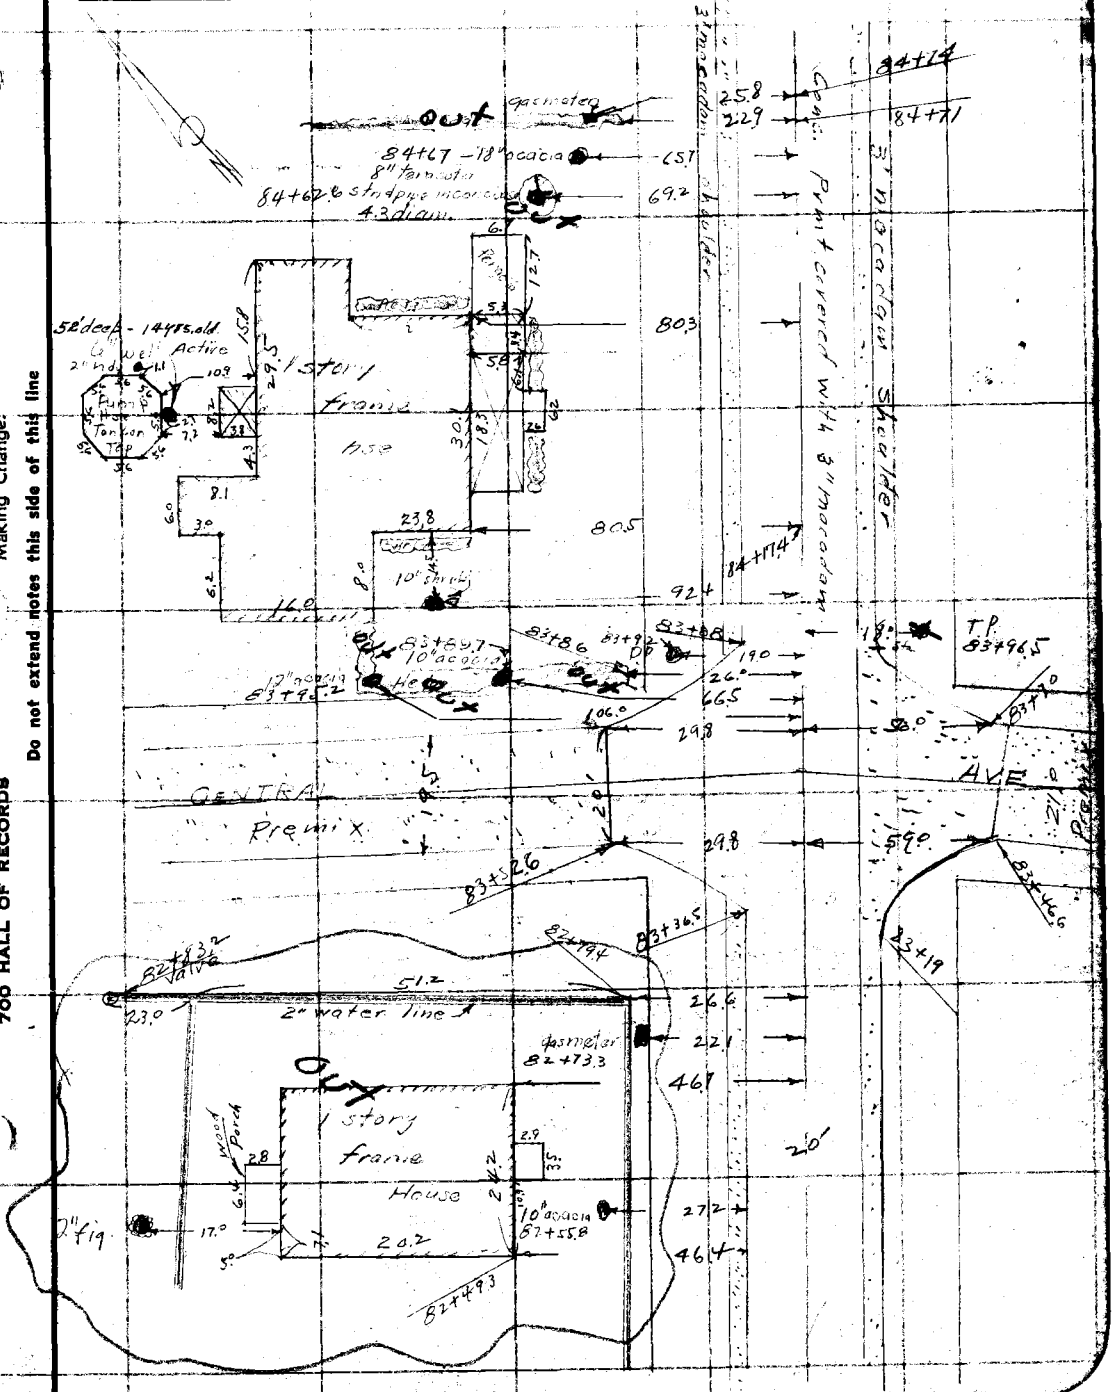
Peck Rd
Gas meter
8" tamarack
8" pipe inc. cond.
4.3 diam.
58' deep - 14" ø.s.d. Active
2" ind. well
1 story frame house
Frame
House
Wood Porch

RETURN TO
LOS ANGELES COUNTY SURVEYOR
700 HALL OF RECORDS

Note: Any Additions or Changes on This Sheet Must be Made or Circled in Red Ink With Date and Name of Person Making Change.

Do not extend notes this side of this line

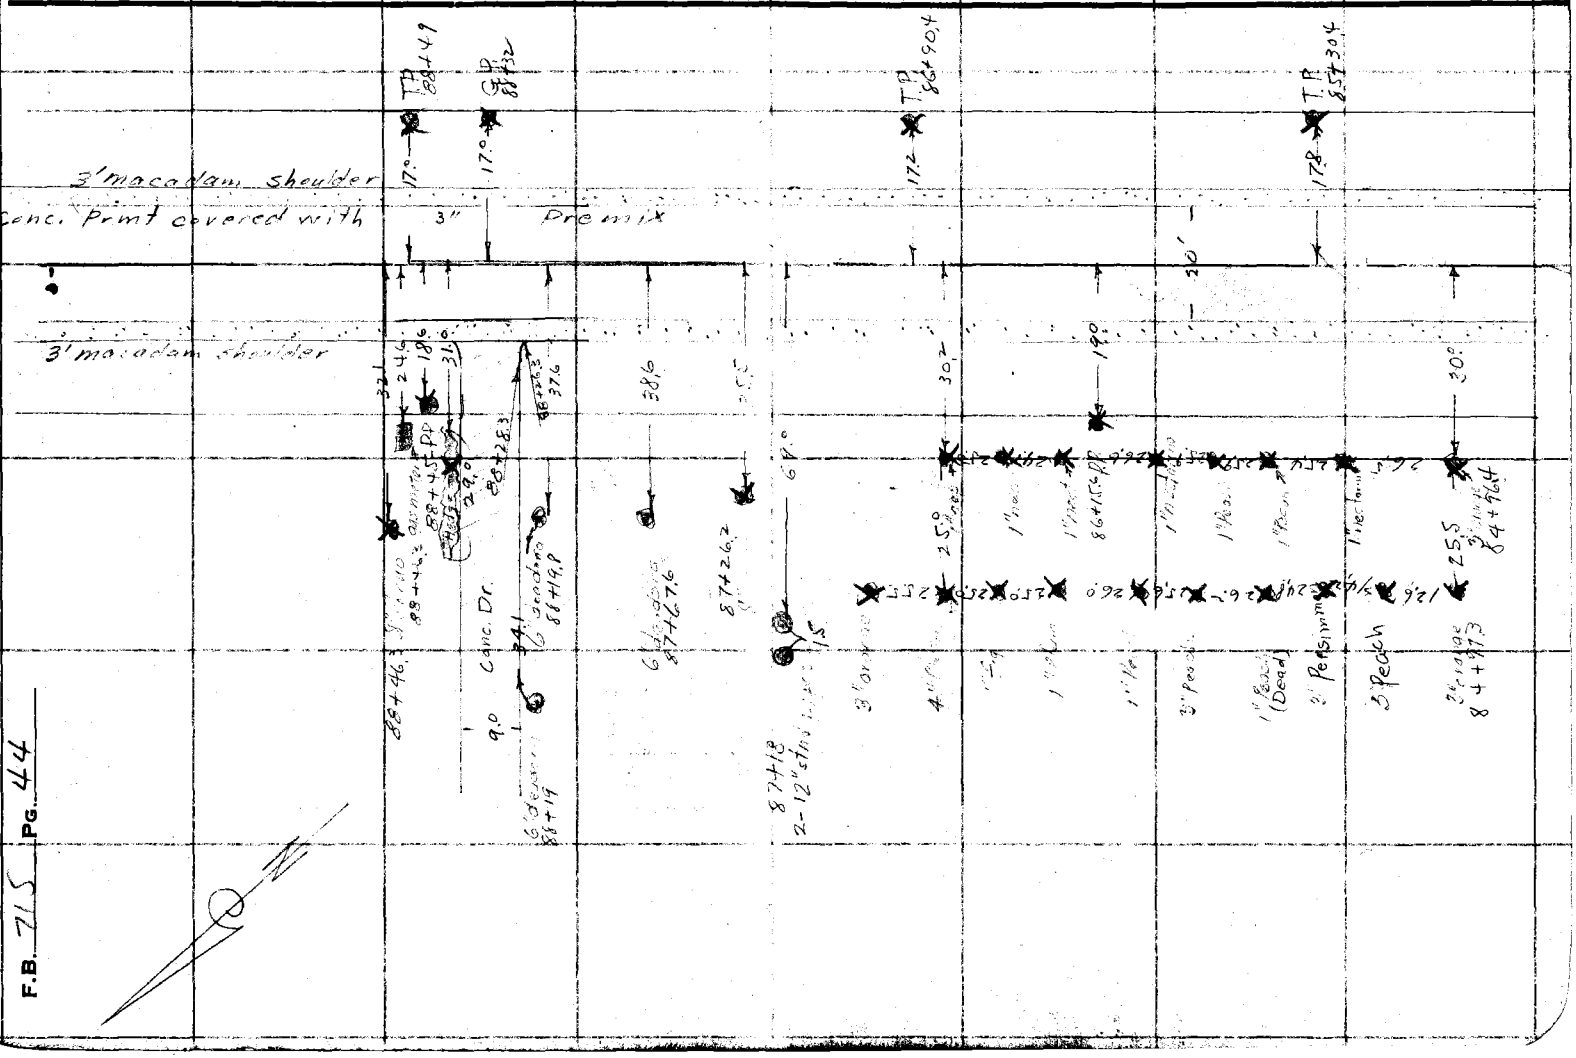
3' macadam shoulder
Conc. P/mt covered with
3"
Pre mix
3' macadam shoulder
T.P. 84+49
G.P. 85+32
T.P. 86+90.4
T.P. 85+30.4
17.0
17.0
17.2
17.8
30'
30'
30'
30'
18.6
31.0
32.1
24.5
Conc. Dr.
9.0
68°
25.0°
25.5
12.6
Pepper
Pepper
Pepper

Notes Ck'd by	Survey of PECK RD
Map No. C.S. B-135-2	W. O. 7032 Tape No. St'd °F.
Office Work J. D. Price	Surveyed by H F EVANS
Checked Jak	Notes HFE 4 7B Date 6-30-39
Date Aug. '39	Indexed A. C. Johnson

F.B. 115 PG. 45

Note: Any Additions or Changes on This Sheet Must be Made or Circled in Red Ink With Date and Name of Person Making Change

Do not extend notes this side of this line

RETURN TO
LOS ANGELES COUNTY SURVEYOR
7do HALL OF RECORDS

FORM 247 10M 11-38

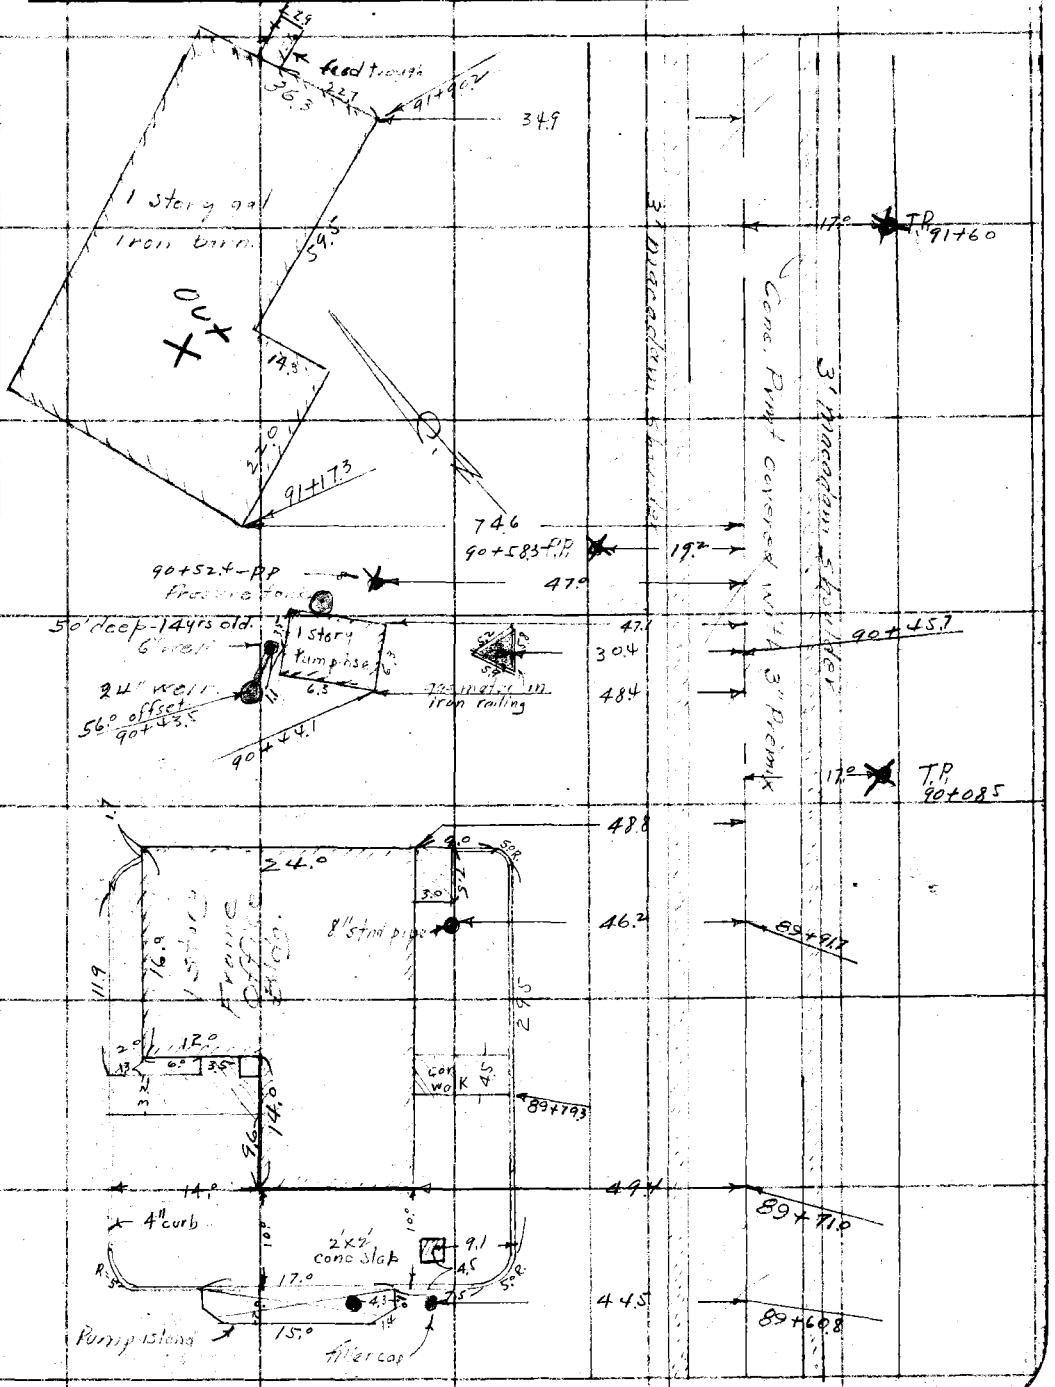

RETURN TO
LOS ANGELES COUNTY SURVEYOR
700 HALL OF RECORDS

Note: Any Additions or Changes on This Sheet Must be Made or Circled in Red Ink With Date and Name of Person Making Change.

Do not extend notes this side of this line

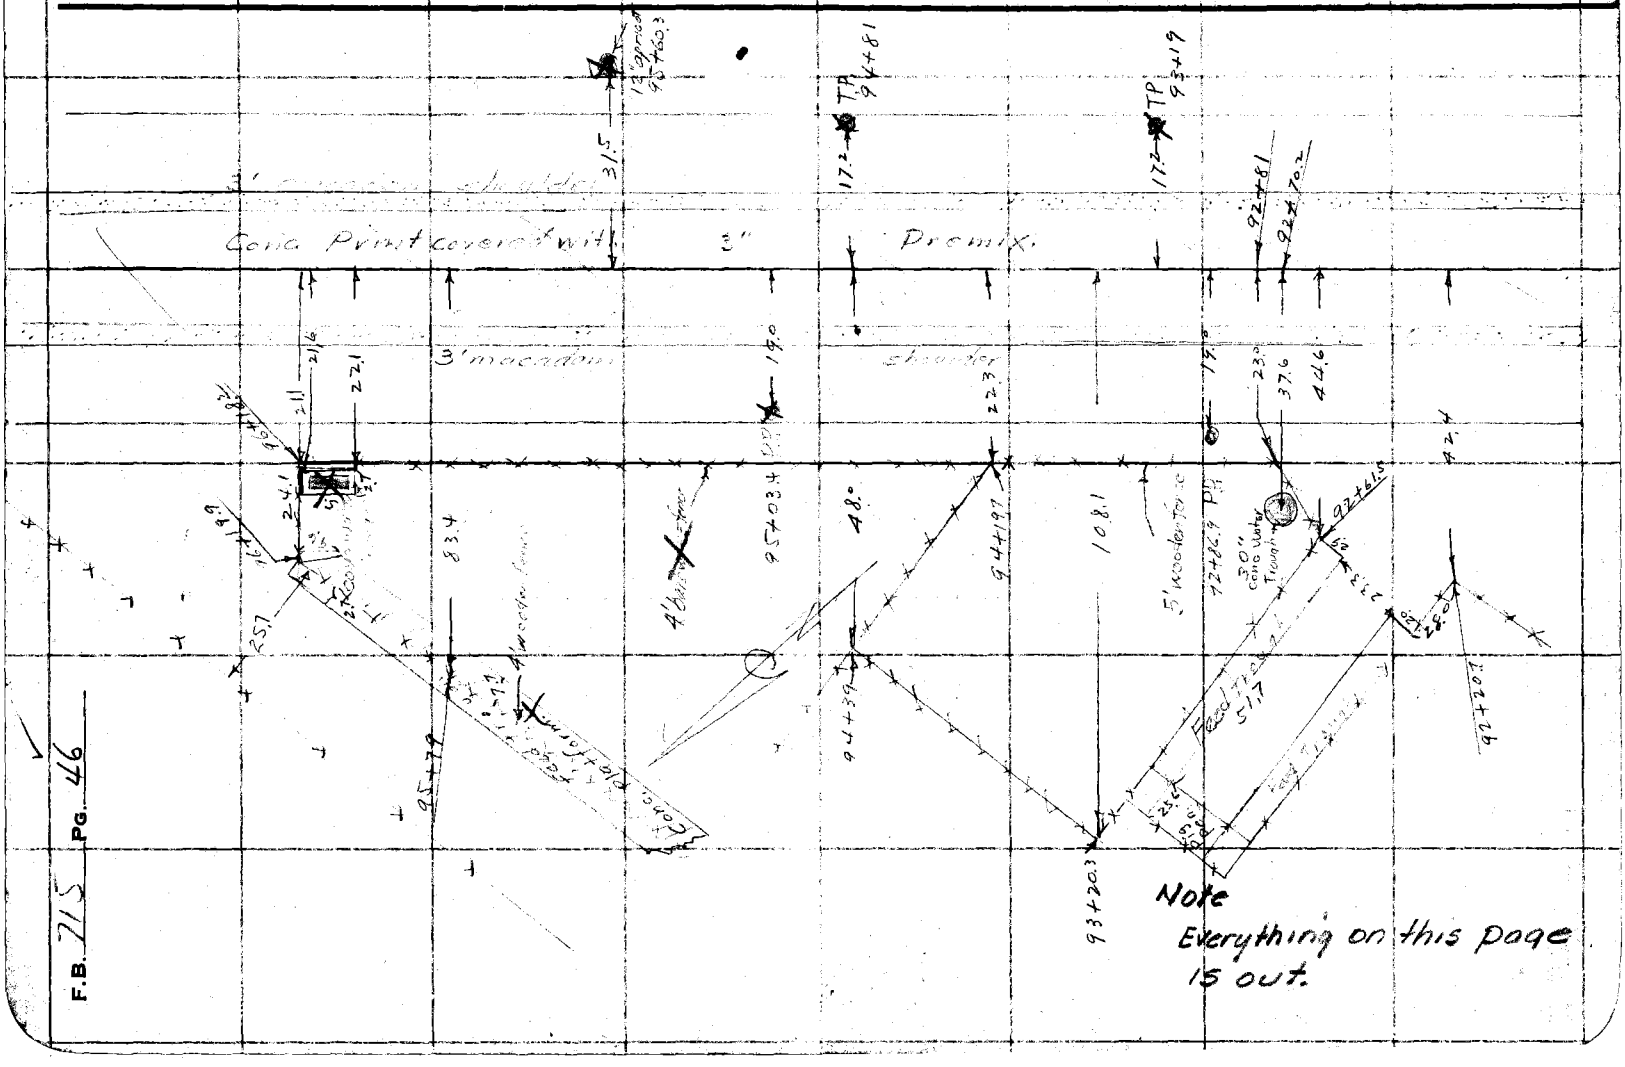

F.B. 715 PG. 46

Notes Ck'd by	Survey of TRACT
Map No. C.S.B-1351	W. O 7052 Tape No. St'd °F.
Office Work J.D. Price	Surveyed by HF EVANS
Checked CAR	Notes HFE 9 7/8 Date 6-30-37
Date Aug. '39	Indexed A. C. Johnson

F.B. 215 PG. 47

Note: Any Additions or Changes on This Sheet Must be Made or Circled in Red Ink With Date and Name of Person Making Change.

Do not extend notes this side of this line

RETURN TO
LOS ANGELES COUNTY SURVEYOR
700 HALL OF RECORDS

FORM 247 10M 11-38

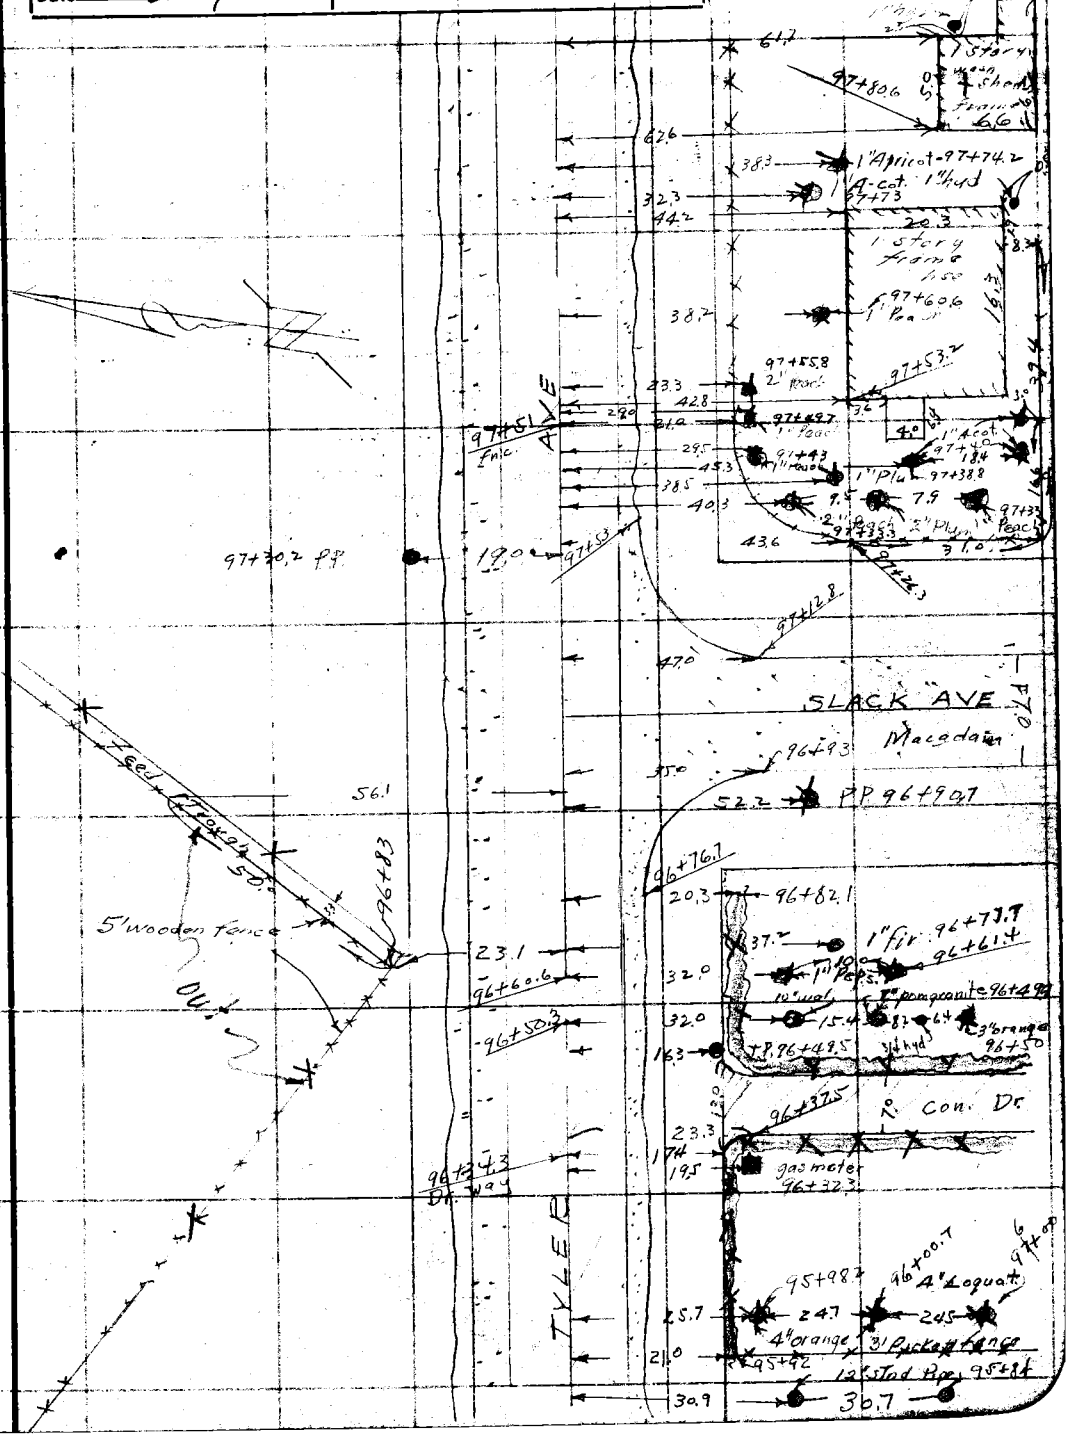

F.B. 715 PG. 48

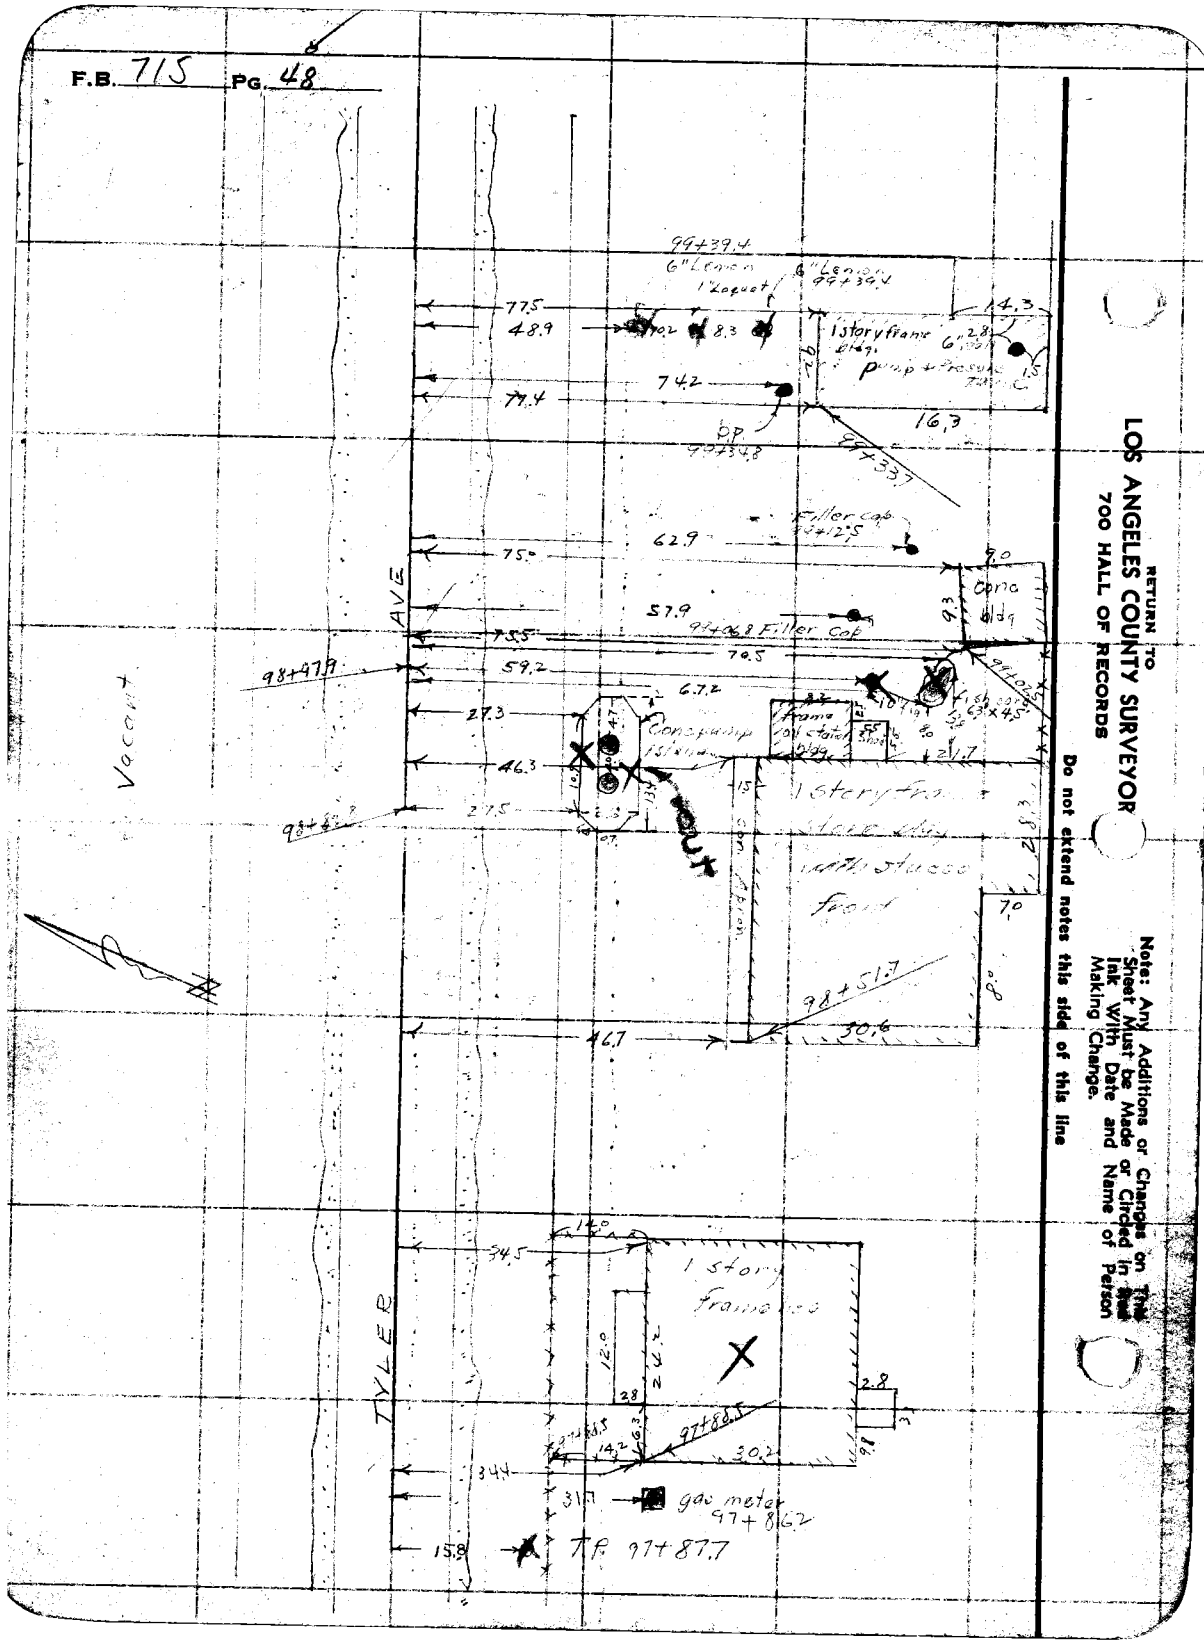
99+39.4
6" Lemon
99+36.4
6" Lemon
12" Loquat
77.5
48.9
8.3
14.3
1 story frame
bldg.
pump + treasure
74.2
77.4
16.3
BP
99+34.8
Filler cap
99+12.5
62.9
75.0
9.0
Conc
bldg
57.9
99+08.8 Filler cap
75.5
70.5
98+47.9
59.2
67.2
27.3
Conc pump
station
46.3
98+42.9
27.5
1 story fra
stucco
with stucco
front
98+51.7
30.6
46.7
VACANT
AVE
14.0
34.5
1 story
frame
12.0
24.2
28
2.8
97+88.5
14.2
30.2
34.4
31.7
gas meter
97+81.62
15.8
TP 97+87.7
TYLER
RETURN TO
LOS ANGELES COUNTY SURVEYOR
700 HALL OF RECORDS
Do not extend notes this side of this line
Note: Any Additions or Changes on This Sheet Must be Made or Circled in Red Ink With Date and Name of Person Making Change.

Notes Ck'd by	Survey of PECK RD
Map No. C.S.B-1361	W. O. 765 & Tape No. St'd °F.
Office Work J. D. Price	Surveyed by HFEVANS
Checked CMR	Notes HFE 478 Date 6-30-37
Date Aug. '39	Indexed A. C. Johnson

F.B. 215 Pg. 49

Note: Any Additions or Changes on this Sheet Must be Made or Circled in Red Ink With Date and Name of Person Making Change.

Do not extend notes this side of this line

RETURN TO
LOS ANGELES COUNTY SURVEYOR
700 HALL OF RECORDS

FORM A-87 10M 11-38

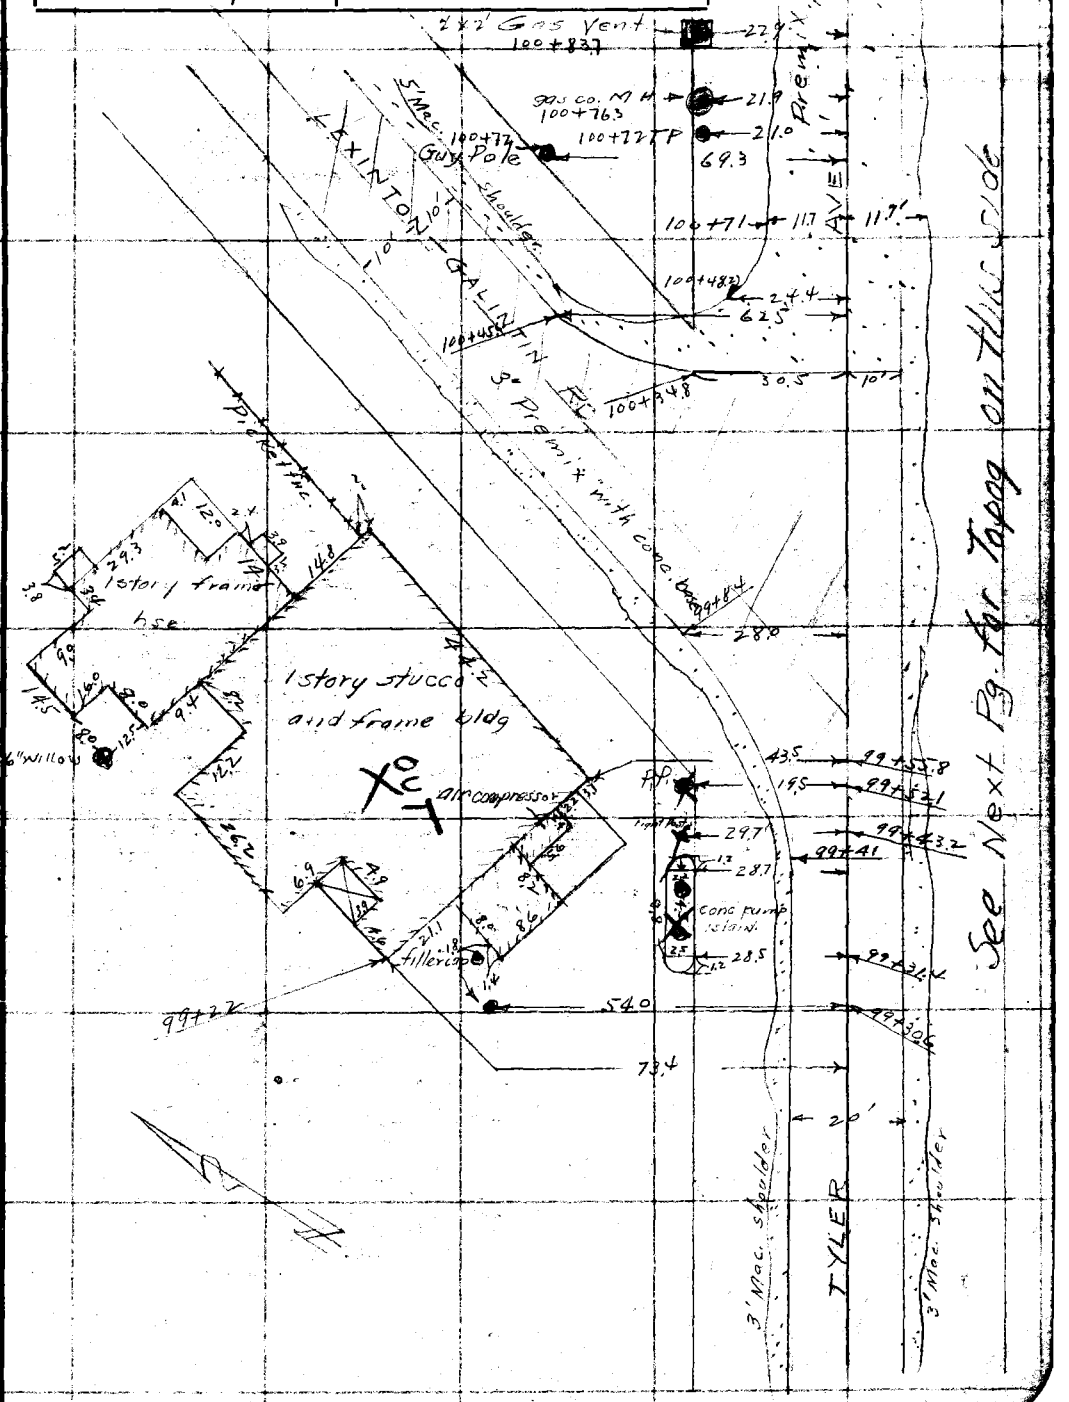

F.B. 715 PG. 50

RETURN TO
LOS ANGELES COUNTY SURVEYOR
700 HALL OF RECORDS

Note: Any Additions or Changes on this Sheet Must be Made or Circled in red Ink With Date and Name of Person Making Change.

Do not extend notes this side of this line

AVE
TYLER
LEXINGTON-GULF FIN RD.
Hedge
Dirt Dr.
Shrubbery
Hedge
chick wire fnc
1 story frame
1 story frame
con walk
slab

Notes Ck'd by	Survey of BECK RD
Map No. C.S.B-1351-2	W. O. 7052 Tape No. St'd °F.
Office Work J. D. Price.	Surveyed by H F EVANS
Checked Aug	Notes HF & TE Date 7-1-37
Date Aug. 37	Indexed A. C. Johnson

F.B. 715 Pg. 51

Note: Any Additions or Changes on This Sheet Must be Made or Circled in Red Ink With Date and Name of Person Making Change

Do not extend notes this side of this line

RETURN TO
LOS ANGELES COUNTY SURVEYOR
700 HALL OF RECORDS

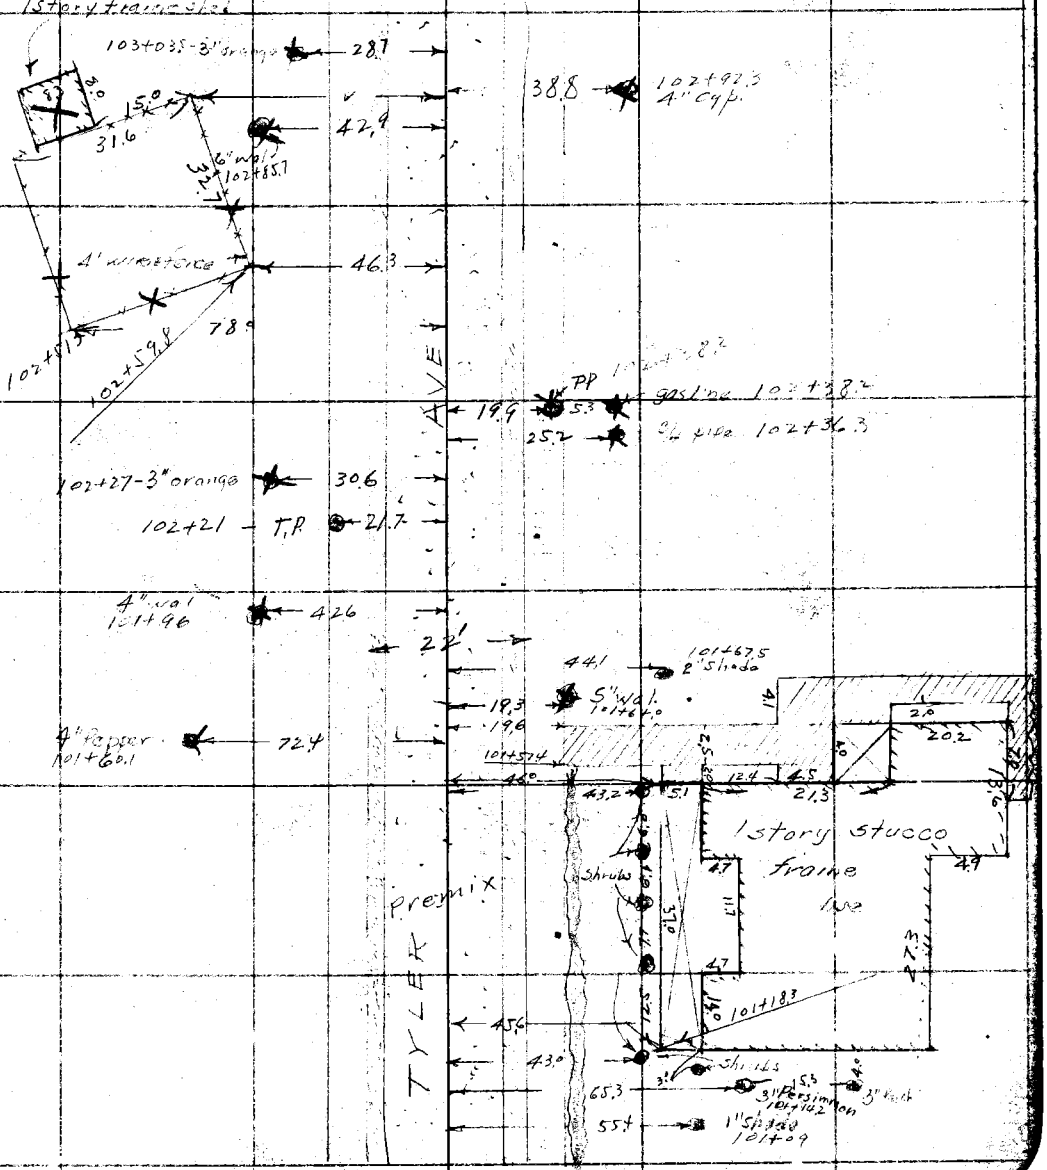

F.B. 715 PG. 52

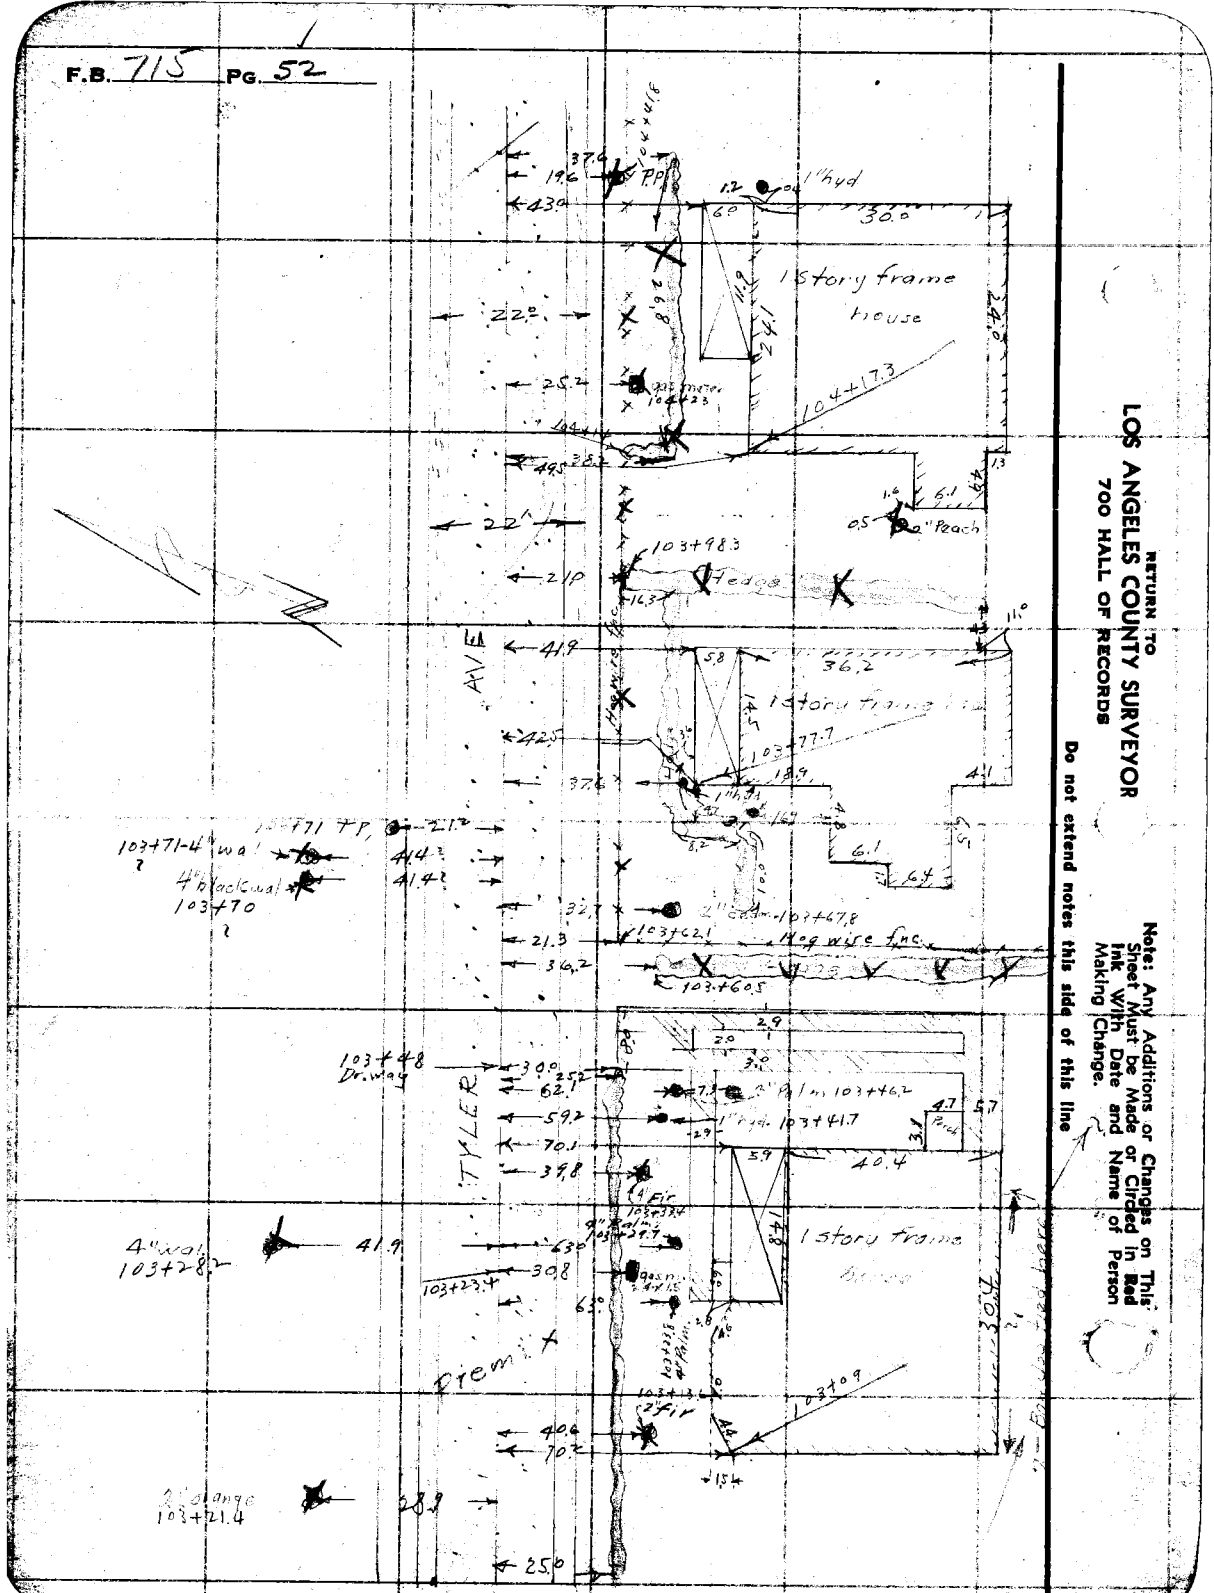
1 story frame house
1 story frame
1 story frame house
TYLER
Fence
Hedge

Notes Ck'd by	Survey of BECK RD
Map No. C.S.B-1357-2	W. O. 7052 Tape No. St'd °F.
Office Work J.D. Price	Surveyed by H.F. EVANS
Checked Oak	Notes LF # 78 Date 7-1-37
Date Aug 39	Indexed A. C. Johnson

F.B. 1/0 Pg. 53

Note: Any Additions or Changes on This Sheet Must be Made or Circled in Red Ink With Date and Name of Person Making Change.

Do not extend notes this side of this line

RETURN TO
LOS ANGELES COUNTY SURVEYOR
700 HALL OF RECORDS

FORM 247 10M 11-38

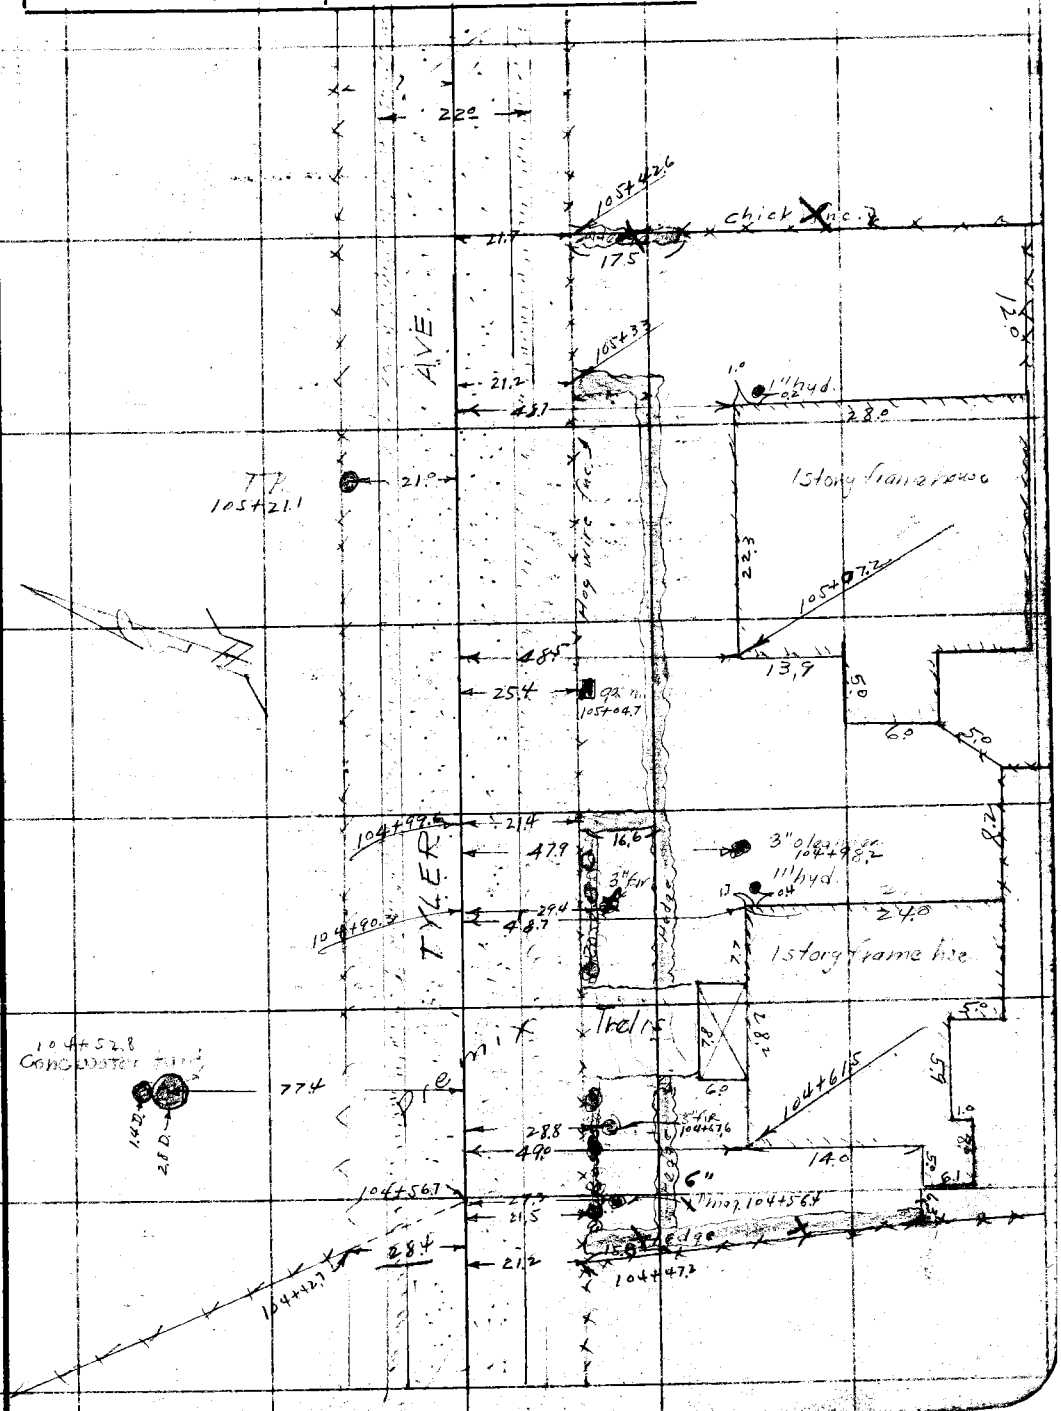

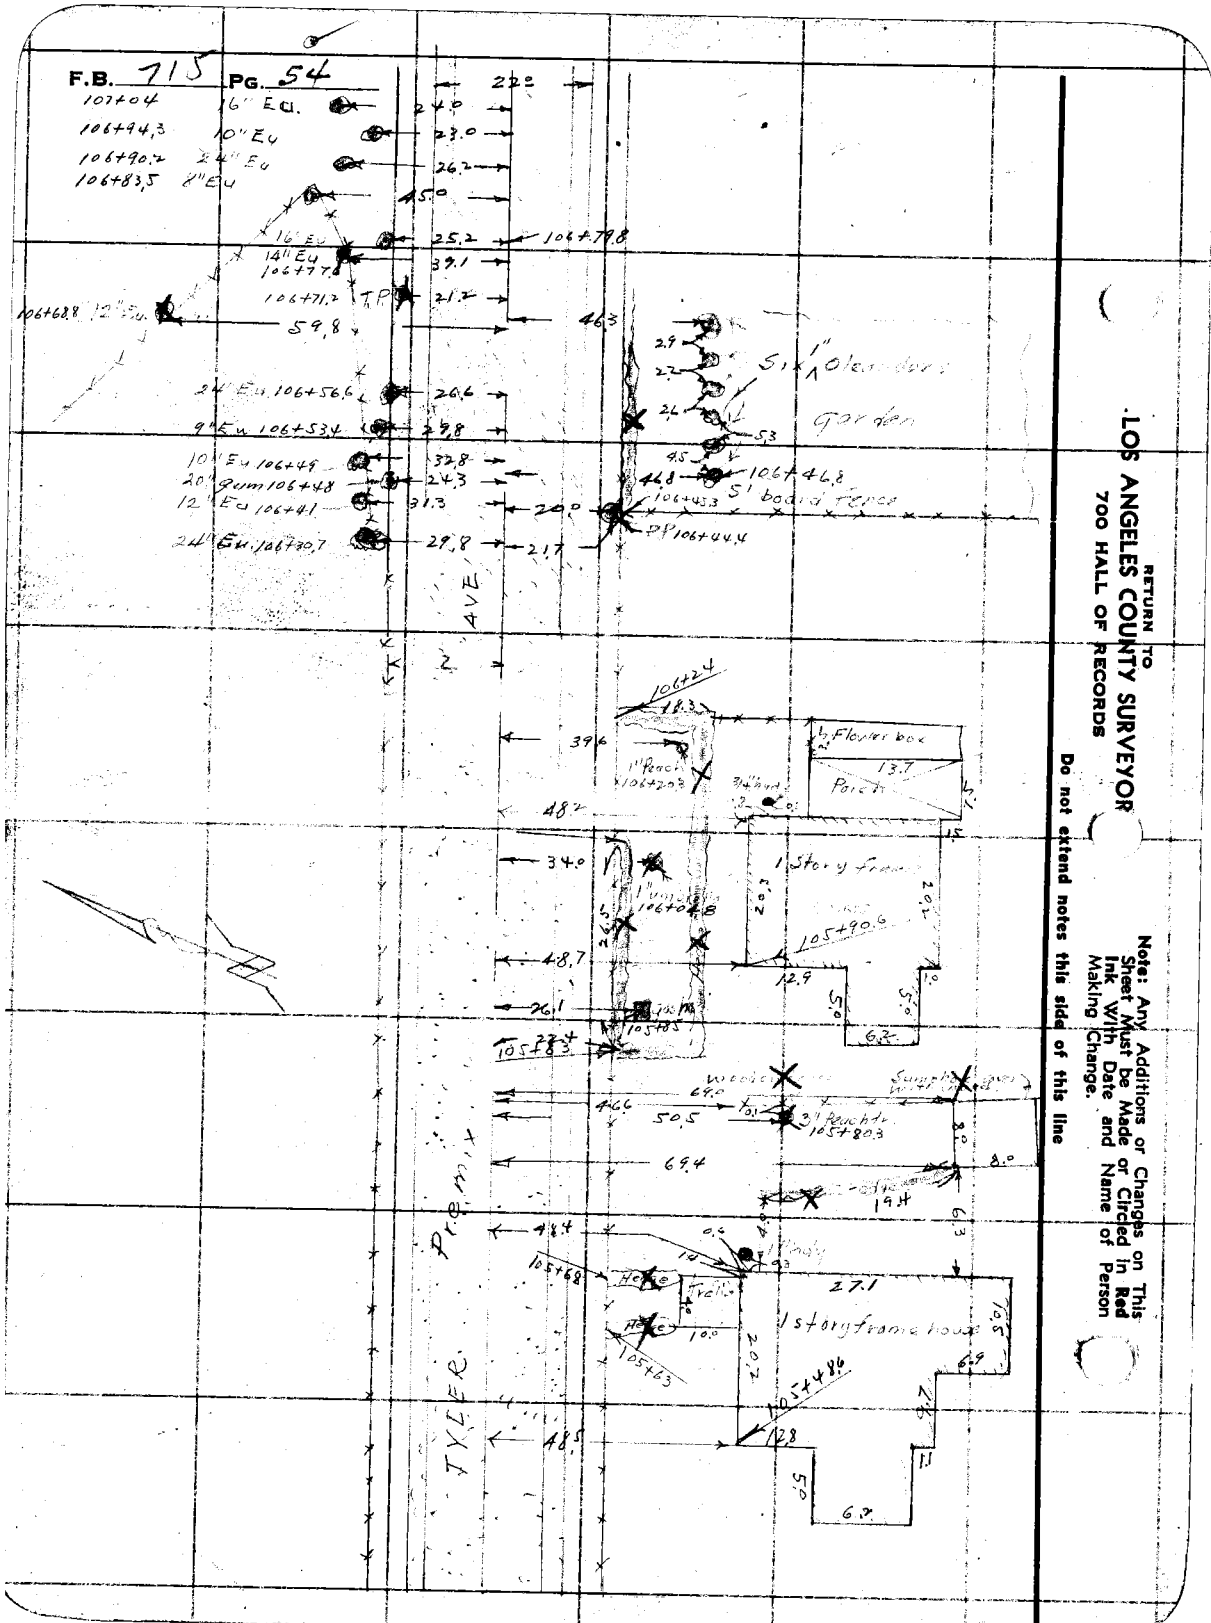

RETURN TO
LOS ANGELES COUNTY SURVEYOR
700 HALL OF RECORDS

Note: Any Additions or Changes on This Sheet Must be Made or Circled in Red Ink With Date and Name of Person Making Change.

Do not extend notes this side of this line

Notes Ck'd by	Survey of
Map No. C.S. B-135/92	W. O. 7652 Tape No. St'd °F.
Office Work J. D. Price	Surveyed by H F EVANS
Checked Aug	Notes HFEH-78 Date 7-1-37
Date Aug '39	Indexed A. C. Johnson

F.B. 11 Pg. 55

Note: Any Additions or Changes on This Sheet Must be Made or Circled in Red Ink With Date and Name of Person Making Change.

Do not extend notes this side of this line

RETURN TO
LOS ANGELES COUNTY SURVEYOR
700 HALL OF RECORDS

FORM 247 10M 11-35

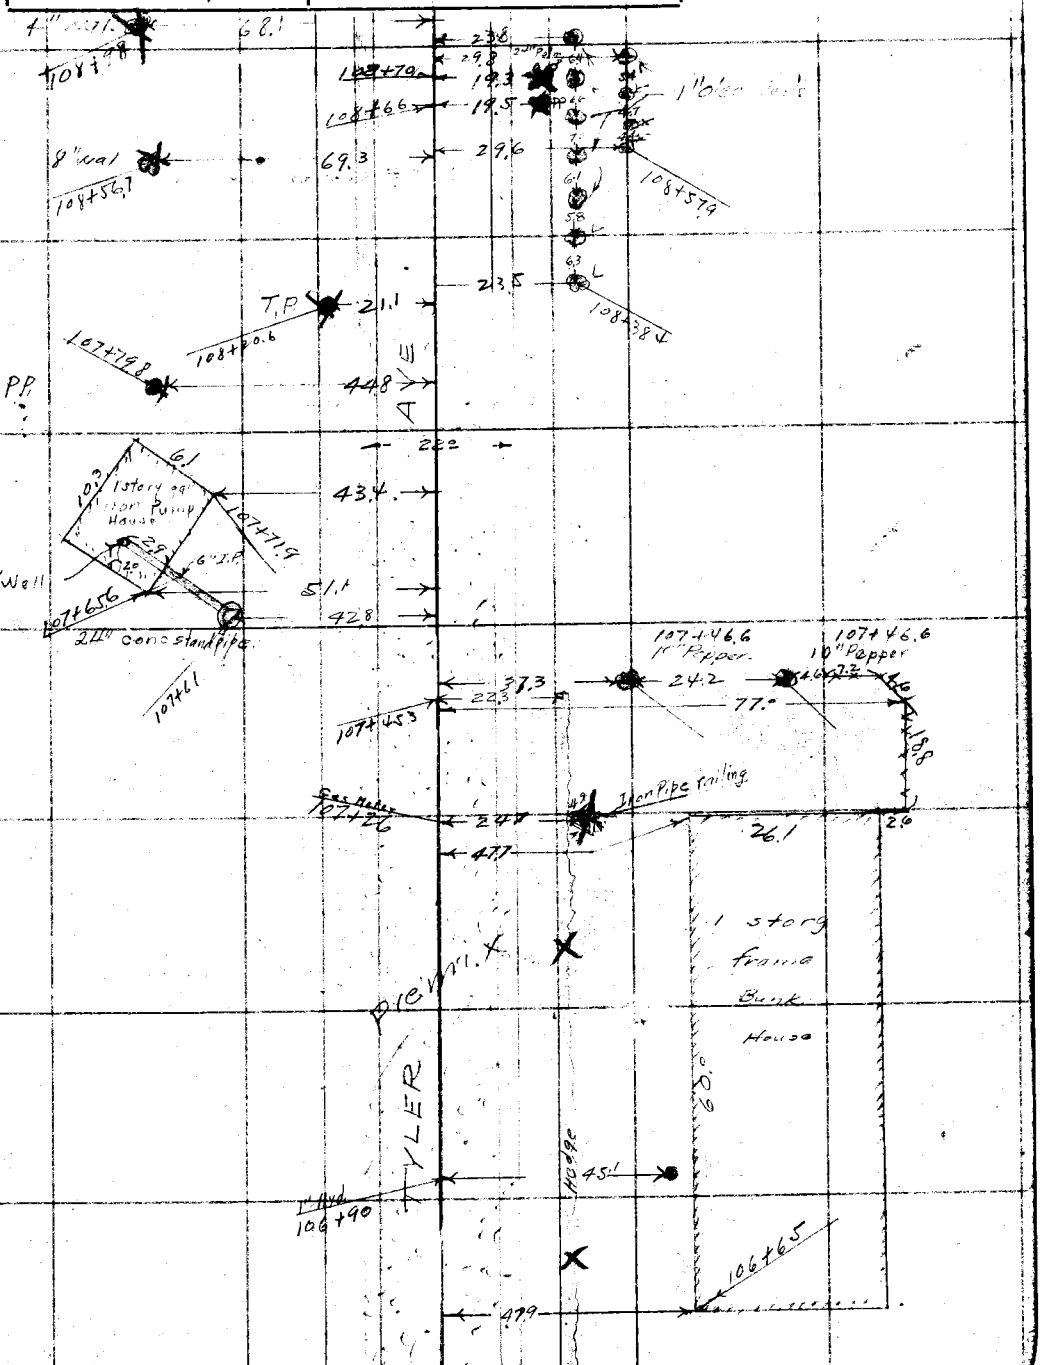

F.B. 715 PG. 56

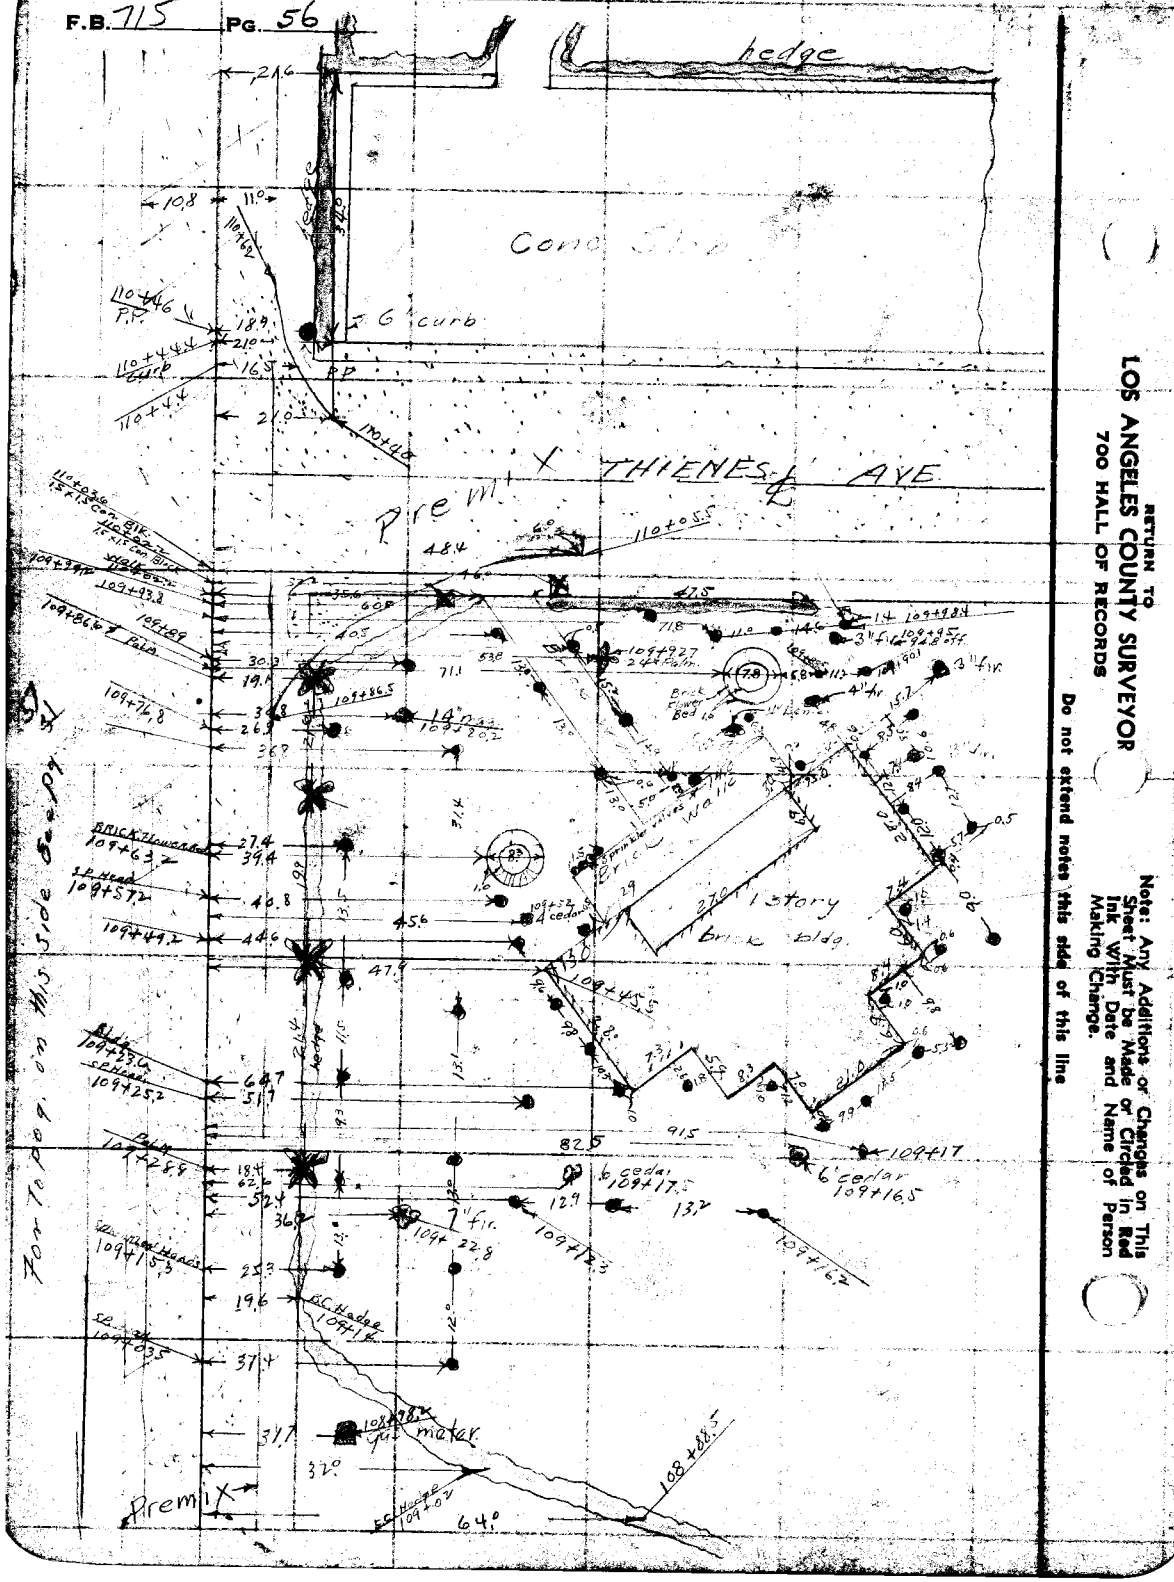
hedge
Conc Slab
6" curb
THIENES AVE
Prem.
48.4
110+05.5
27.5
71.8
71.1
53.0
Brick Flower Bed
1 story brick bldg.
27.0
45.6
47.4
82.5
91.5
109+17
6" cedar 109+17.5
6" cedar 109+16.5
109+16.2
109+13.3
109+15.3
109+03.5
109+08.5
108+68.5
Prem.
64.0
32.0
AC Header
water meter
4" cedar
7" fir.
3" fir
4" fir
Sprinkler valve
Brick Wall
S.P. Heads
Palm
Palm
Palm

Notes Ck'd by	Survey of Peck Rd
Map No. C.S. B-135	W. O. 705 Tape No. St'd °F.
Office Work J. D. Price	Surveyed by LE Evans
Checked aak	Notes LEE 4-7B Date 7-14-39
Date Aug. '39	Indexed C Johnson

F.B. 715 Pg. 57

Note: Any Additions or Changes on This Sheet Must be Made or Circled in Red Ink With Date and Name of Person Making Change

Do not extend notes this side of this line

LOS ANGELES COUNTY SURVEYOR
700 HALL OF RECORDS

FORM 8-07 10M 11-38

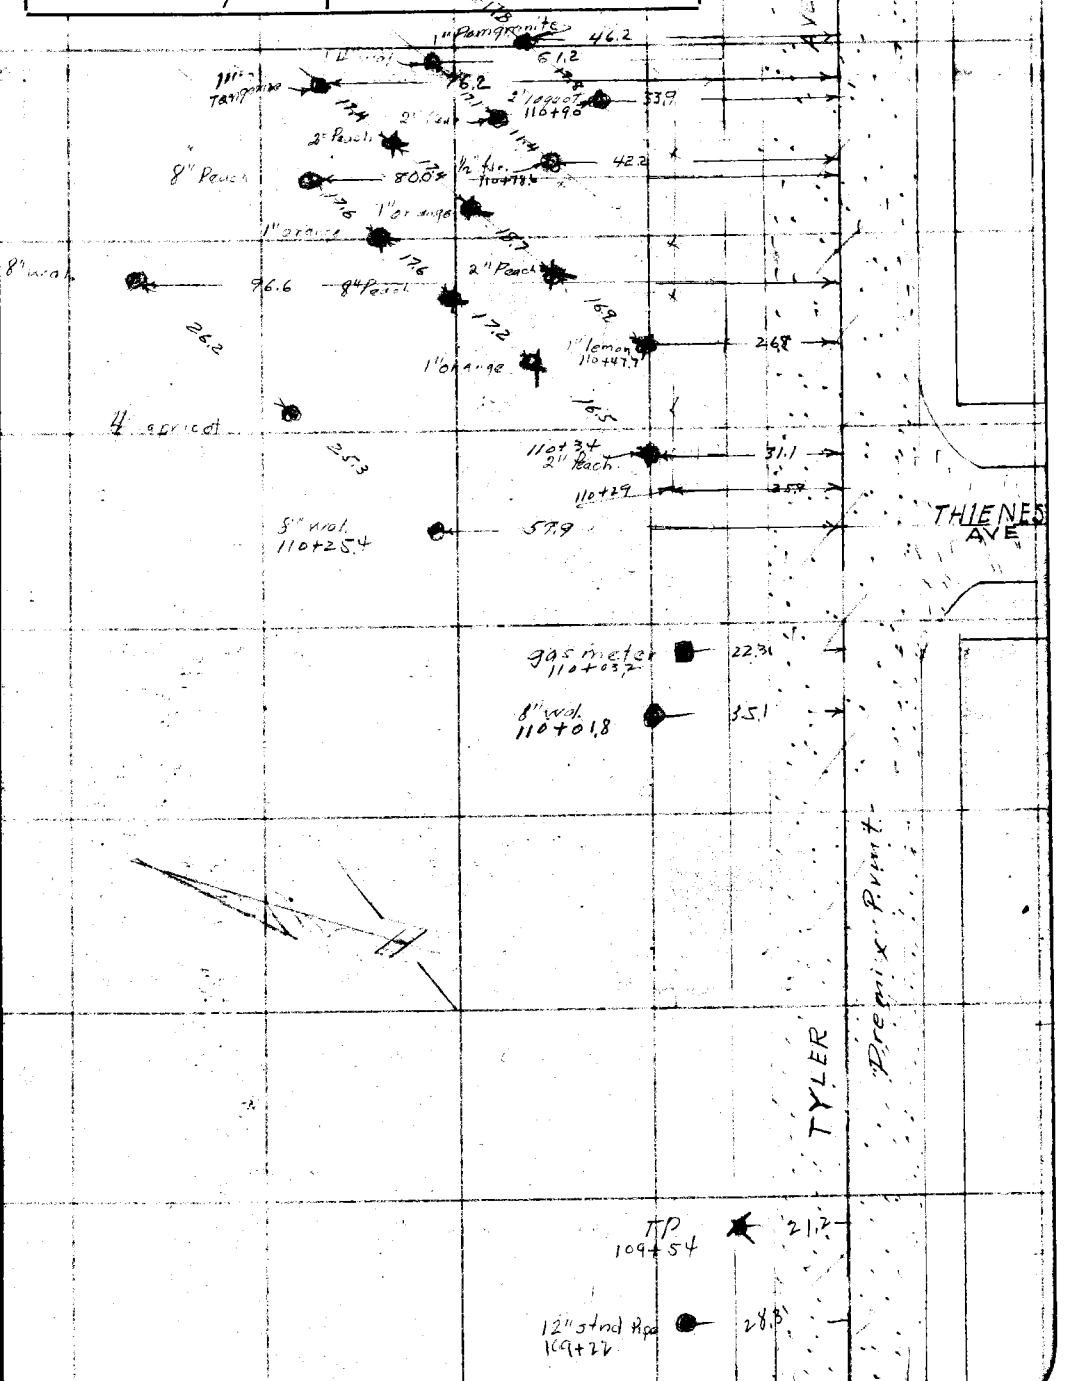

F.B. 715 Pg. 58

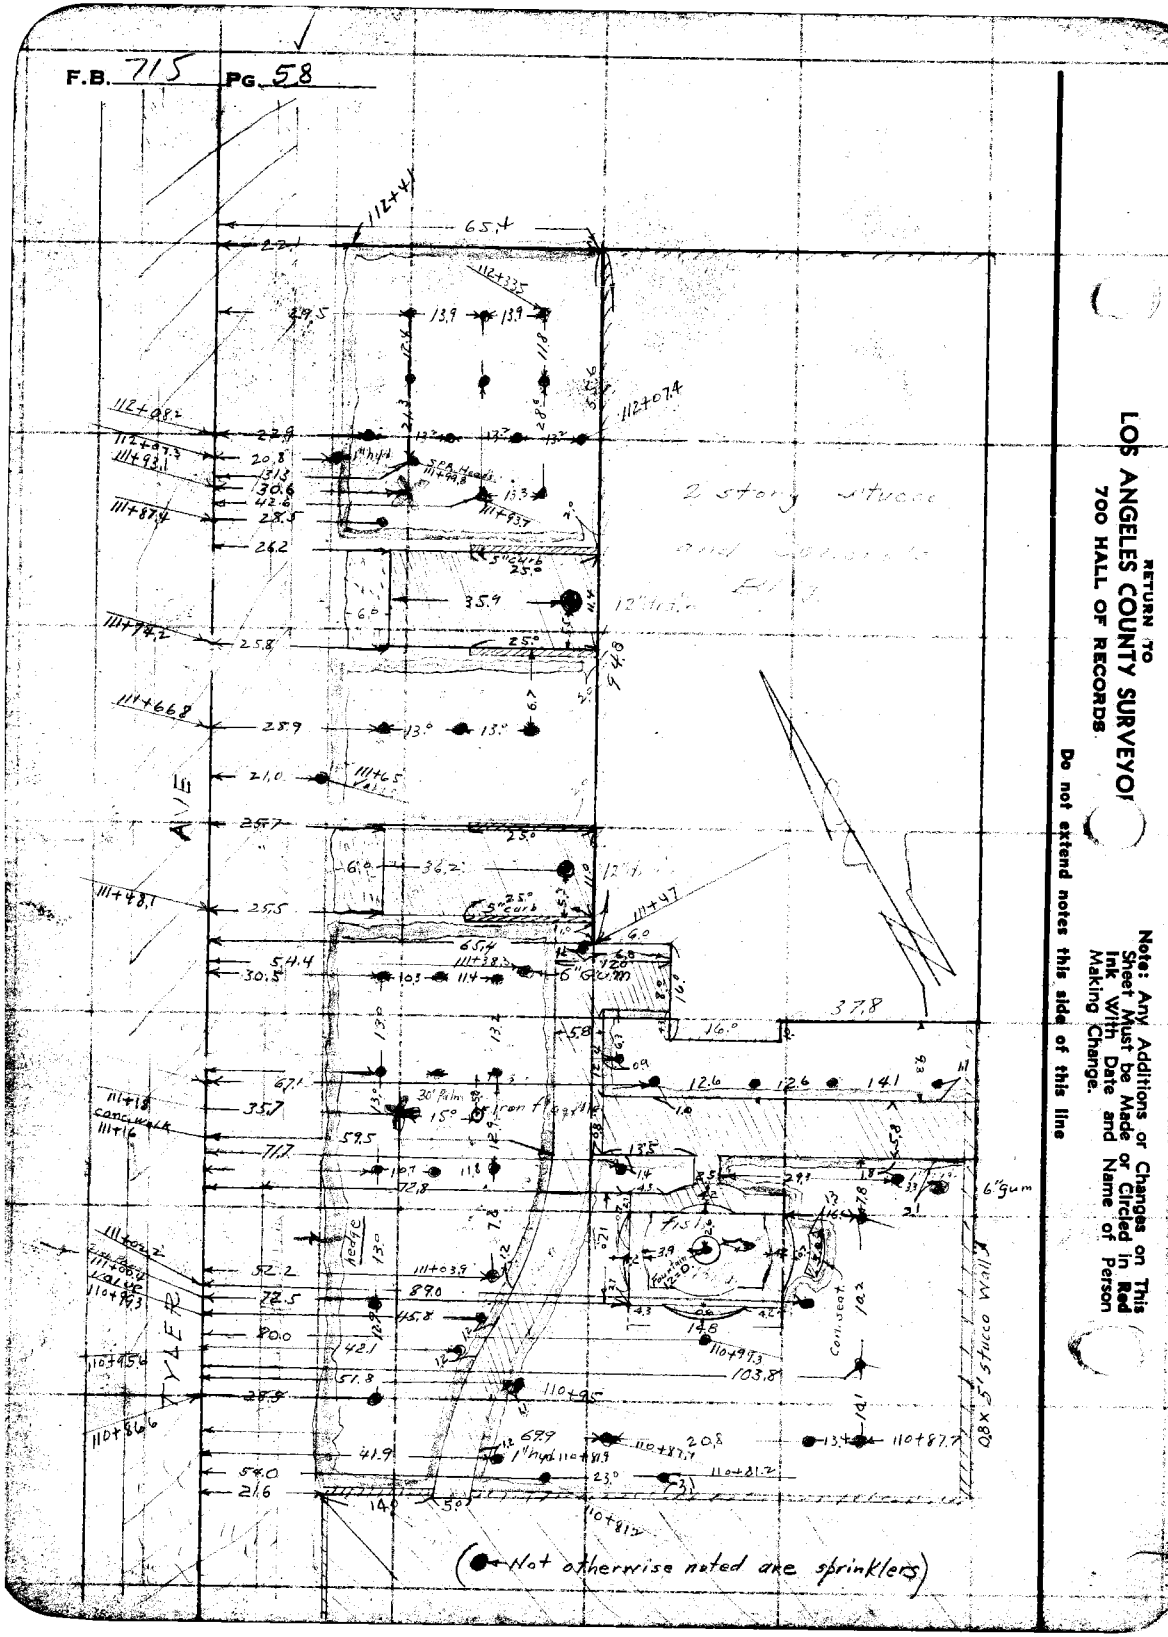

RETURN TO
LOS ANGELES COUNTY SURVEYOR
700 HALL OF RECORDS

Note: Any Additions or Changes on This Sheet Must be Made or Circled in Red Ink With Date and Name of Person Making Change.

Do not extend notes this side of this line

Notes Ck'd by	Survey of Peck Rd
Map No. C.S. B-1351	W. O. 7052 Tape No. St'd °F.
Office Work J.D. Price	Surveyed by H.F. Evans
Checked Oak	Notes HE & TB Date 7-14-37
Date Aug. '39	Indexed C. Johnson

F.B. 20 Pg. 59

Note: Any Additions or Changes on This Sheet Must be Made or Circled in Red Ink With Date and Name of Person Making Change.

Do not extend notes this side of this line

RETURN TO
LOS ANGELES COUNTY SURVEYOR
700 HALL OF RECORDS

FORM 247 10M 11-38

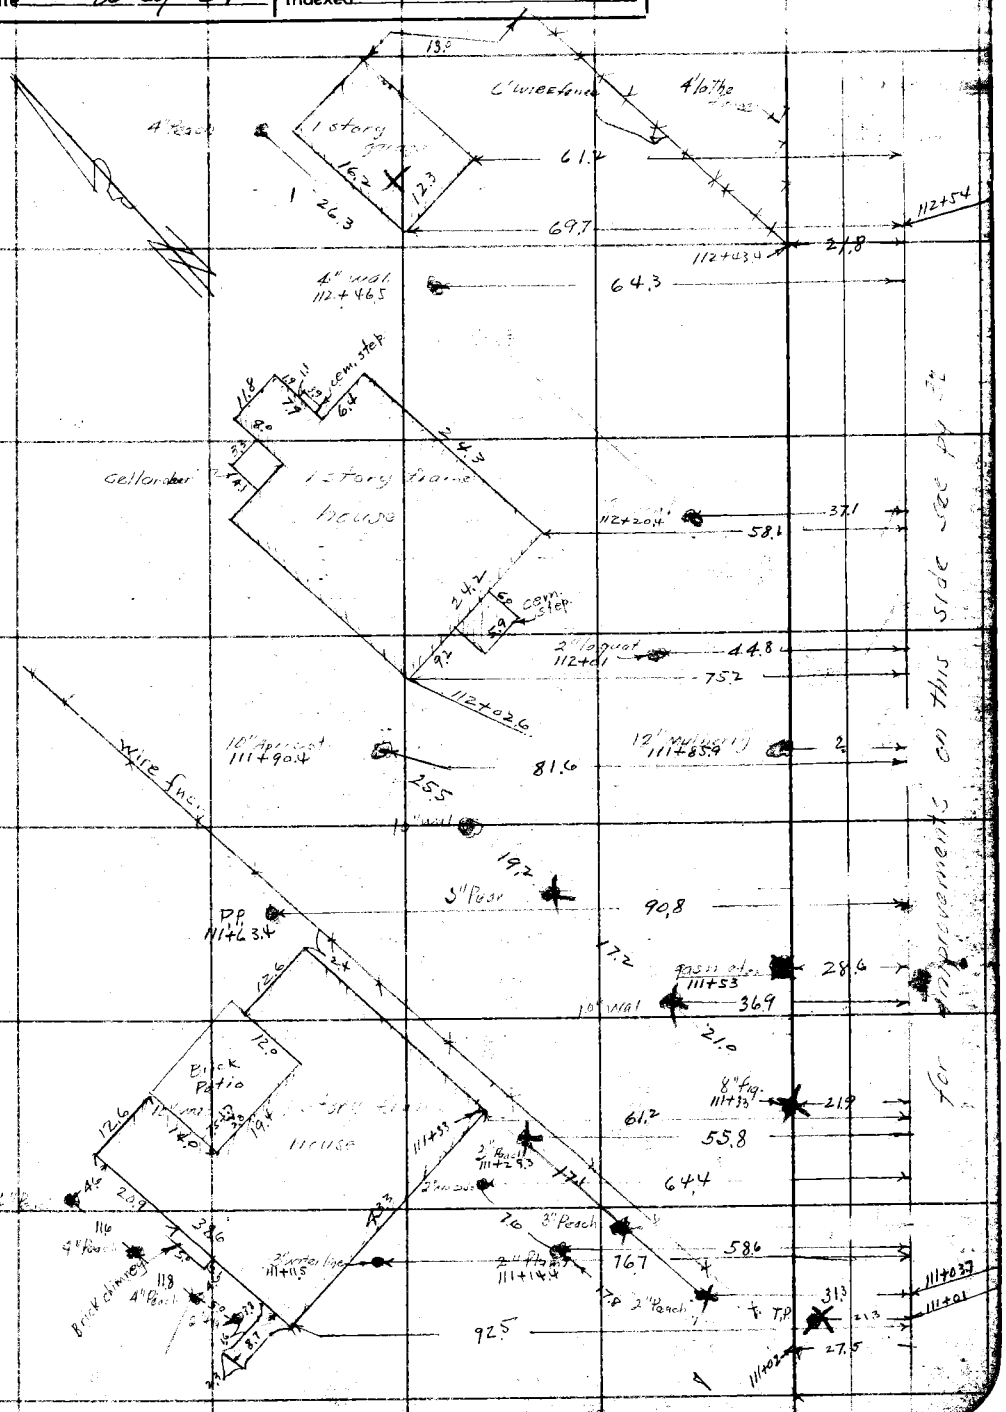

RETURN TO
LOS ANGELES COUNTY SURVEYOR
700 HALL OF RECORDS

Note: Any Additions or Changes on This Sheet Must be Made or Circled in **Red** Ink With Date and Name of Person Making Change.

Do not extend notes this side of this line

F.B. 715 PG. 60

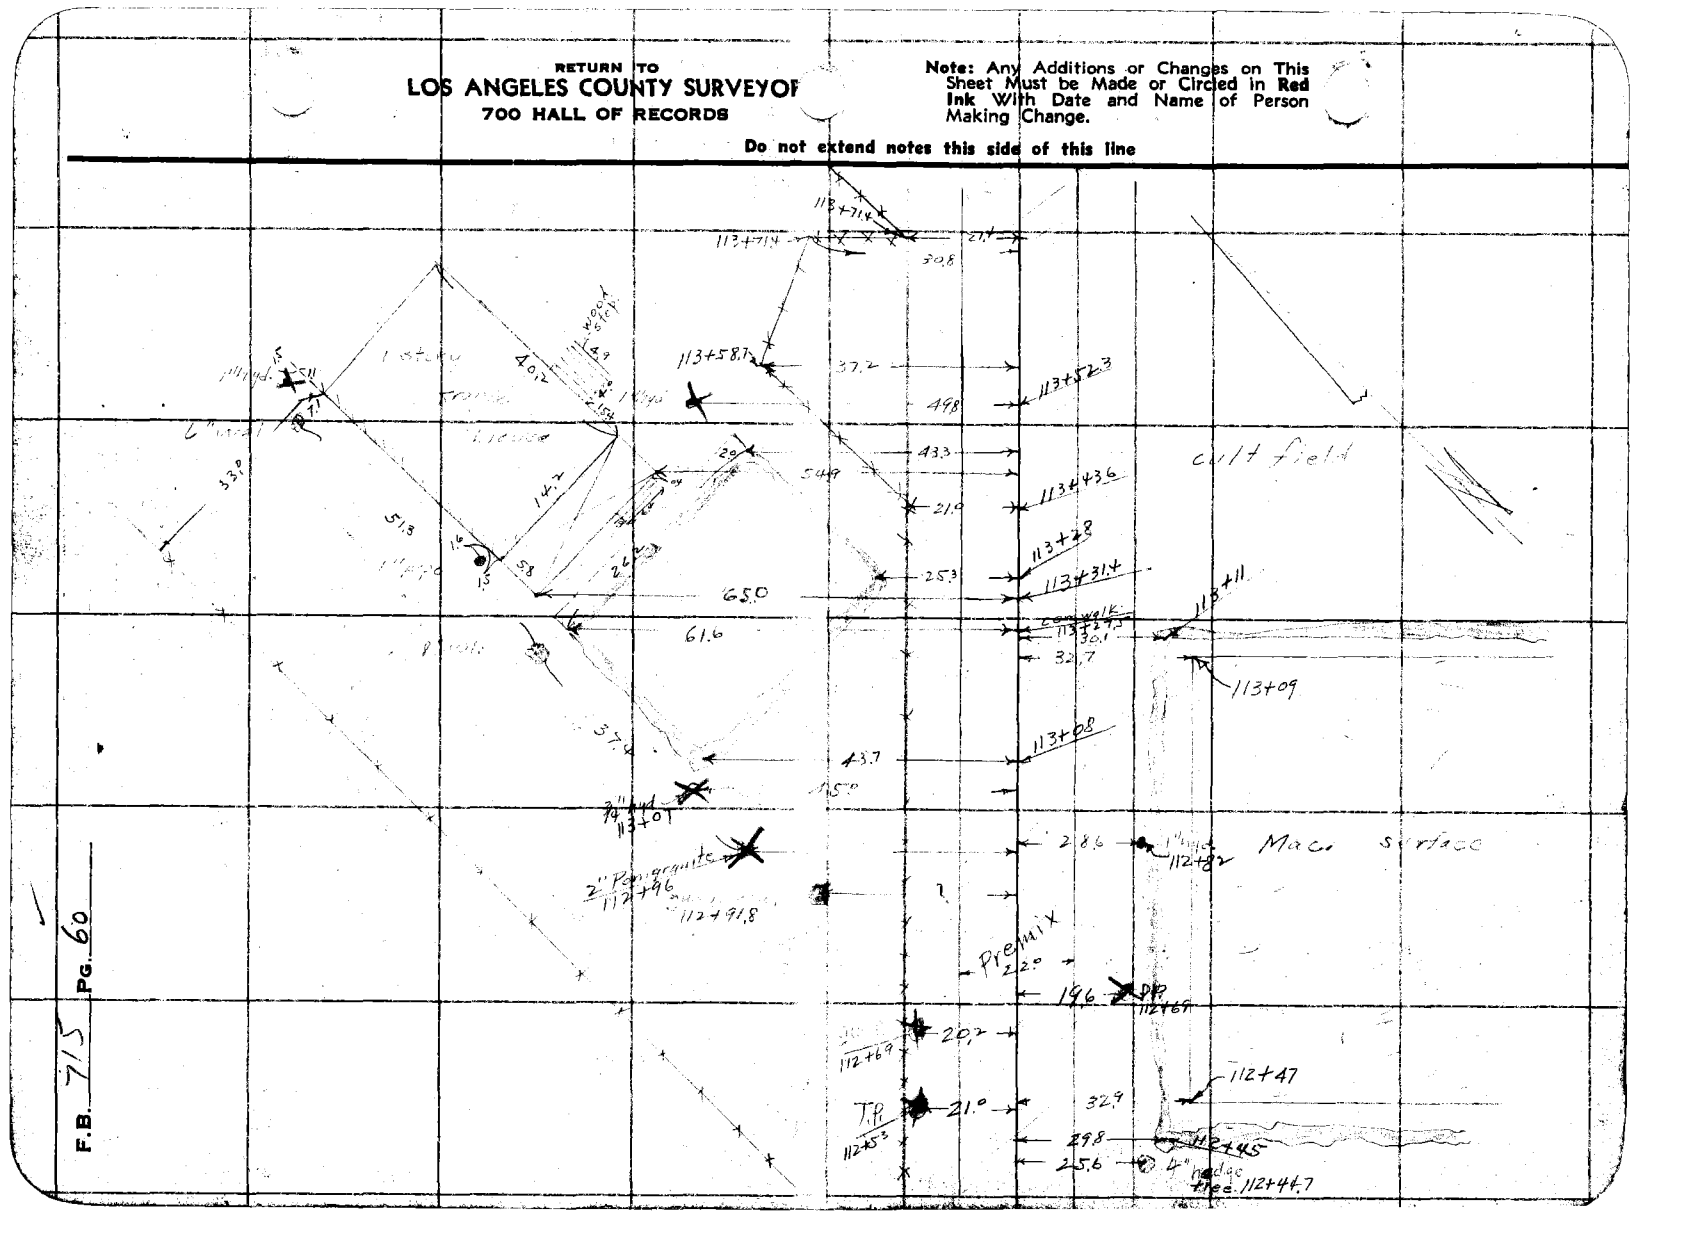

Notes Ck'd by	Survey of
Map No. C.S. B 135-1	W. O.	Tape No.	St'd °F.
Office Work J. D. Price	Surveyed by
Checked	Notes	Date
Date Aug. '39	Indexed

F.B. Pg. 61

Note: Any Additions or Changes on This Sheet Must be Made or Circled in Red Ink With Date and Name of Person Making Change.

Do not extend notes this side of this line

RETURN TO
LOS ANGELES COUNTY SURVEYOR
700 HALL OF RECORDS

FORM 247 10M 11-38

F.B. 715 Pg. 62

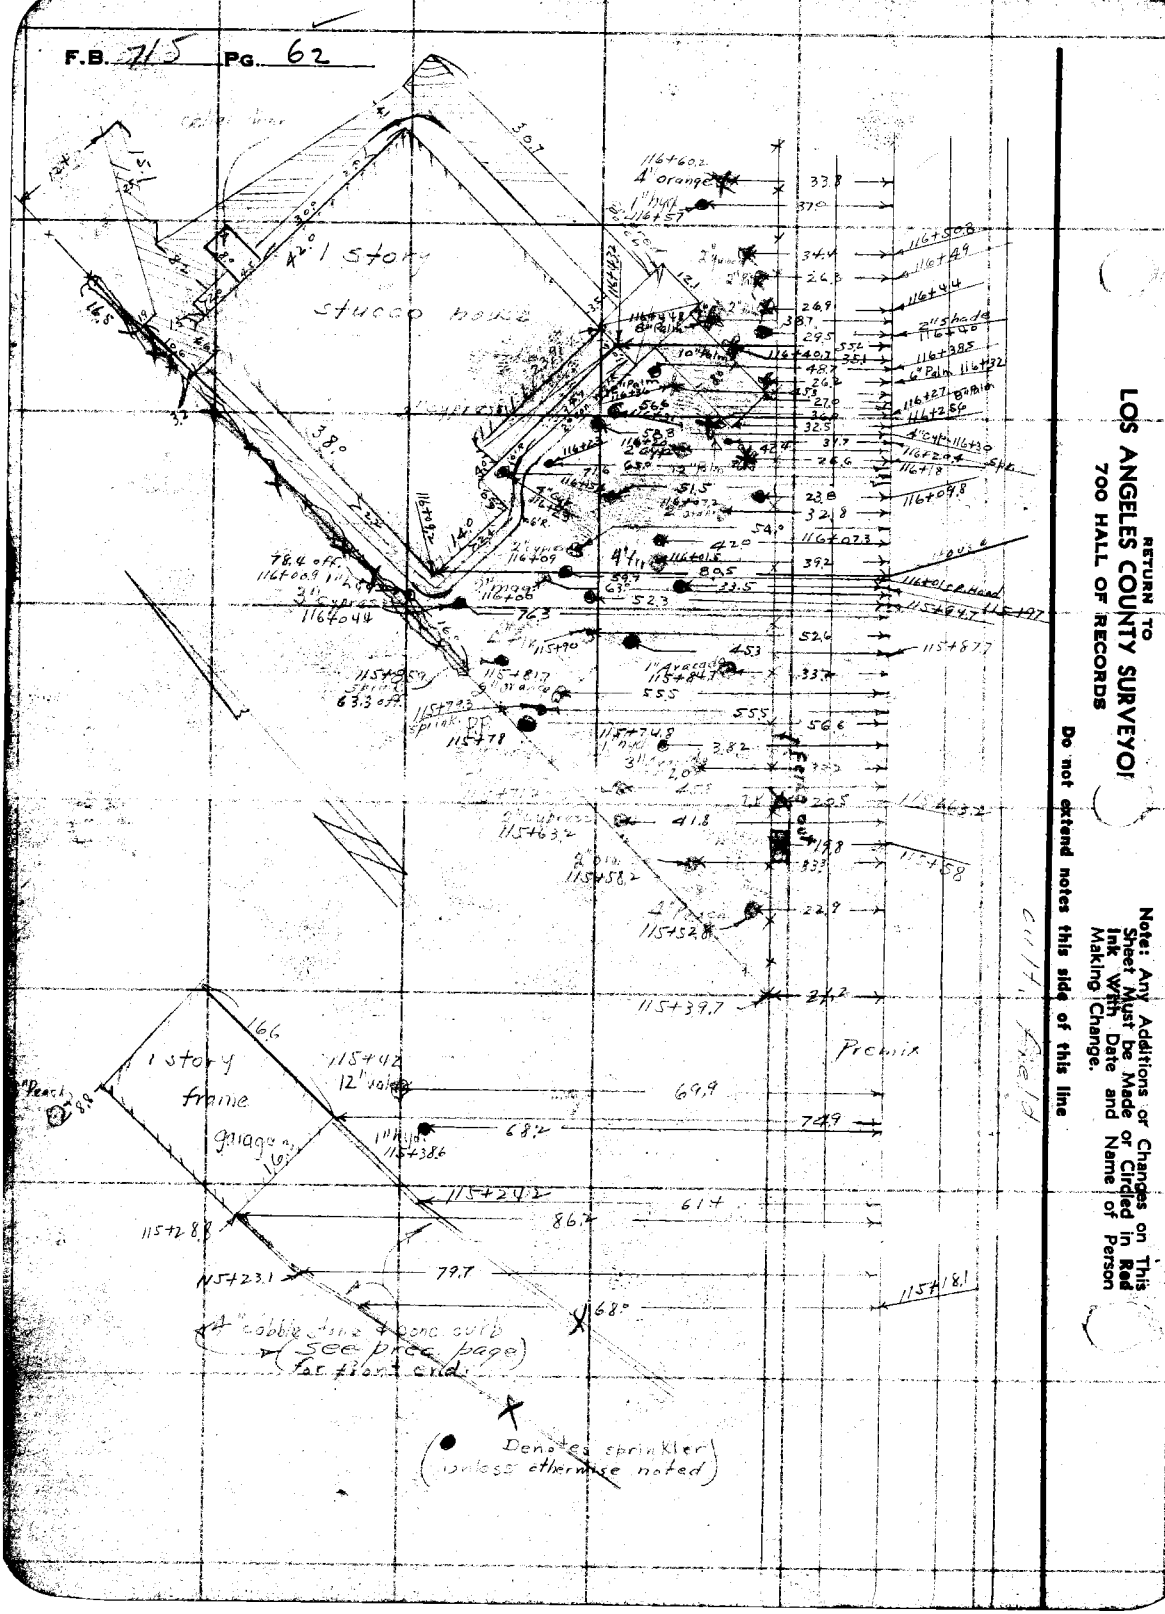

RETURN TO
LOS ANGELES COUNTY SURVEYOR
700 HALL OF RECORDS

Note: Any Additions or Changes on This Sheet Must be Made or Circled in Red Ink With Date and Name of Person Making Change.

Do not extend notes this side of this line

Notes Ck'd by	Survey of Pico Rd
Map No. C.S. B-135	W. O. 7052 Tape No. St'd °F.
Office Work J. D. Price	Surveyed by H F EVANS
Checked Car	Notes F-L-9 7 E Date 7-14-37
Date Aug '37	Indexed A. C. Johnson

F.B. [illegible] Pg. 63

RETURN TO
LOS ANGELES COUNTY SURVEYOR
7do HALL OF RECORDS

Note: Any Additions or Changes on This Sheet Must be Made or Circled in Red Ink With Date and Name of Person Making Change

Do not extend notes this side of this line

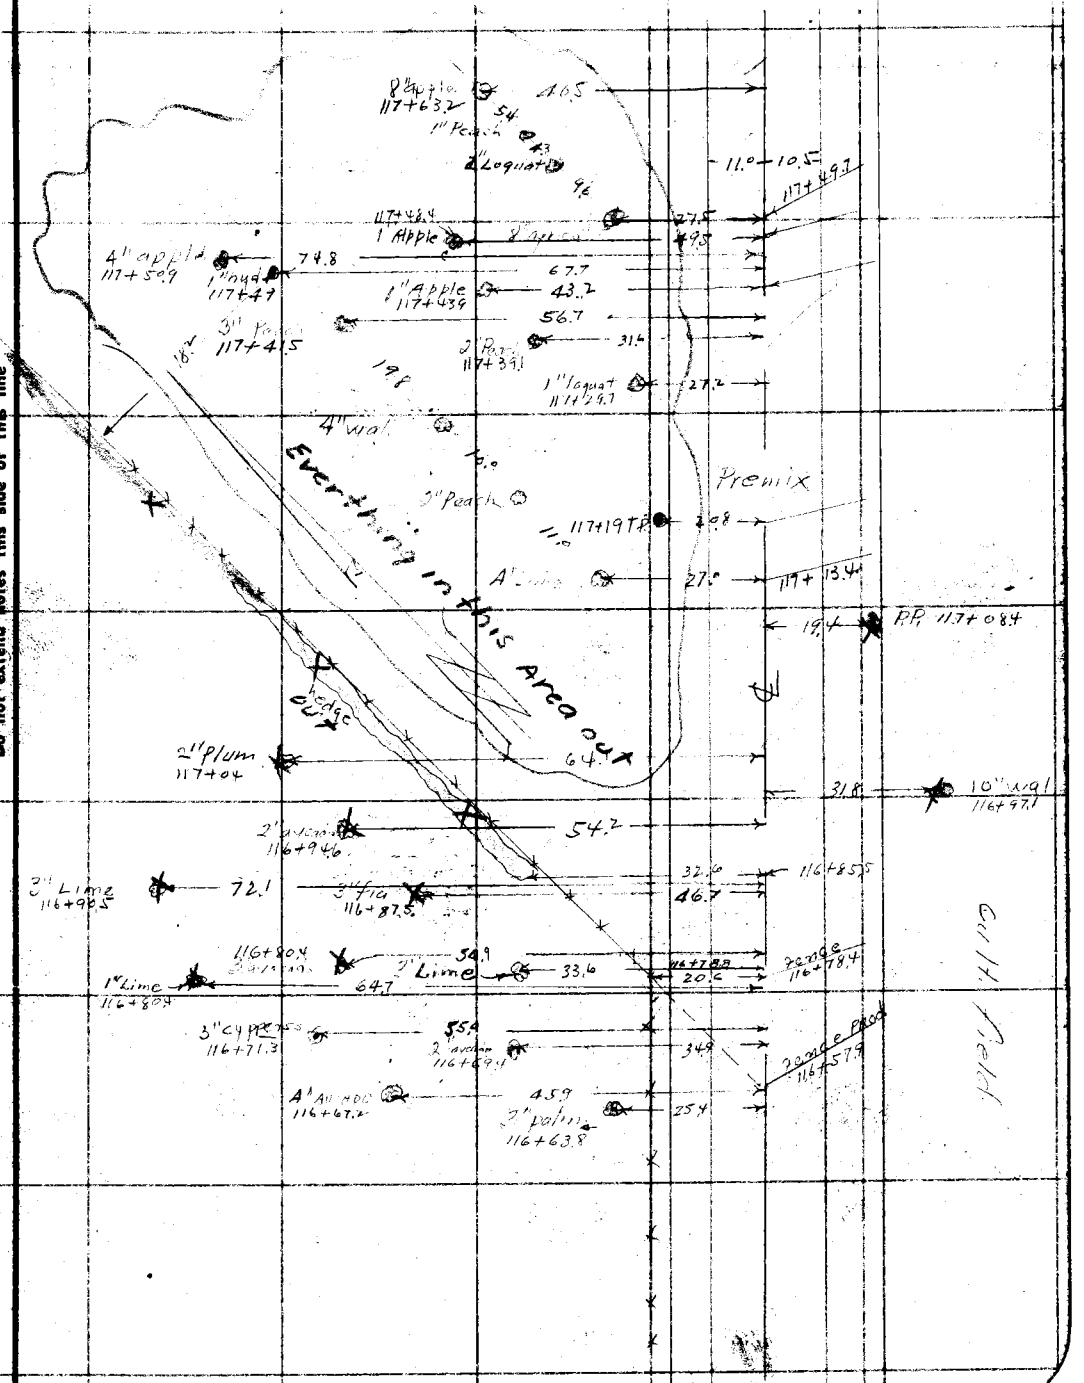

FORM 247 10M 11-36

F.B. 715 PG. 64

RETURN TO
LOS ANGELES COUNTY SURVEYOR
700 HALL OF RECORDS

Note: Any Additions or Changes on this Sheet Must be Made or Circled in Red Ink With Date and Name of Person Making Change.

Do not extend notes this side of this line


FORM 247 10M 11-35

RETURN TO
LOS ANGELES COUNTY SURVEYOR
700 HALL OF RECORDS

Note: Any Additions or Changes on This Sheet Must be Made or Circled in **Red Ink** With Date and Name of Person Making Change.

Do not extend notes this side of this line

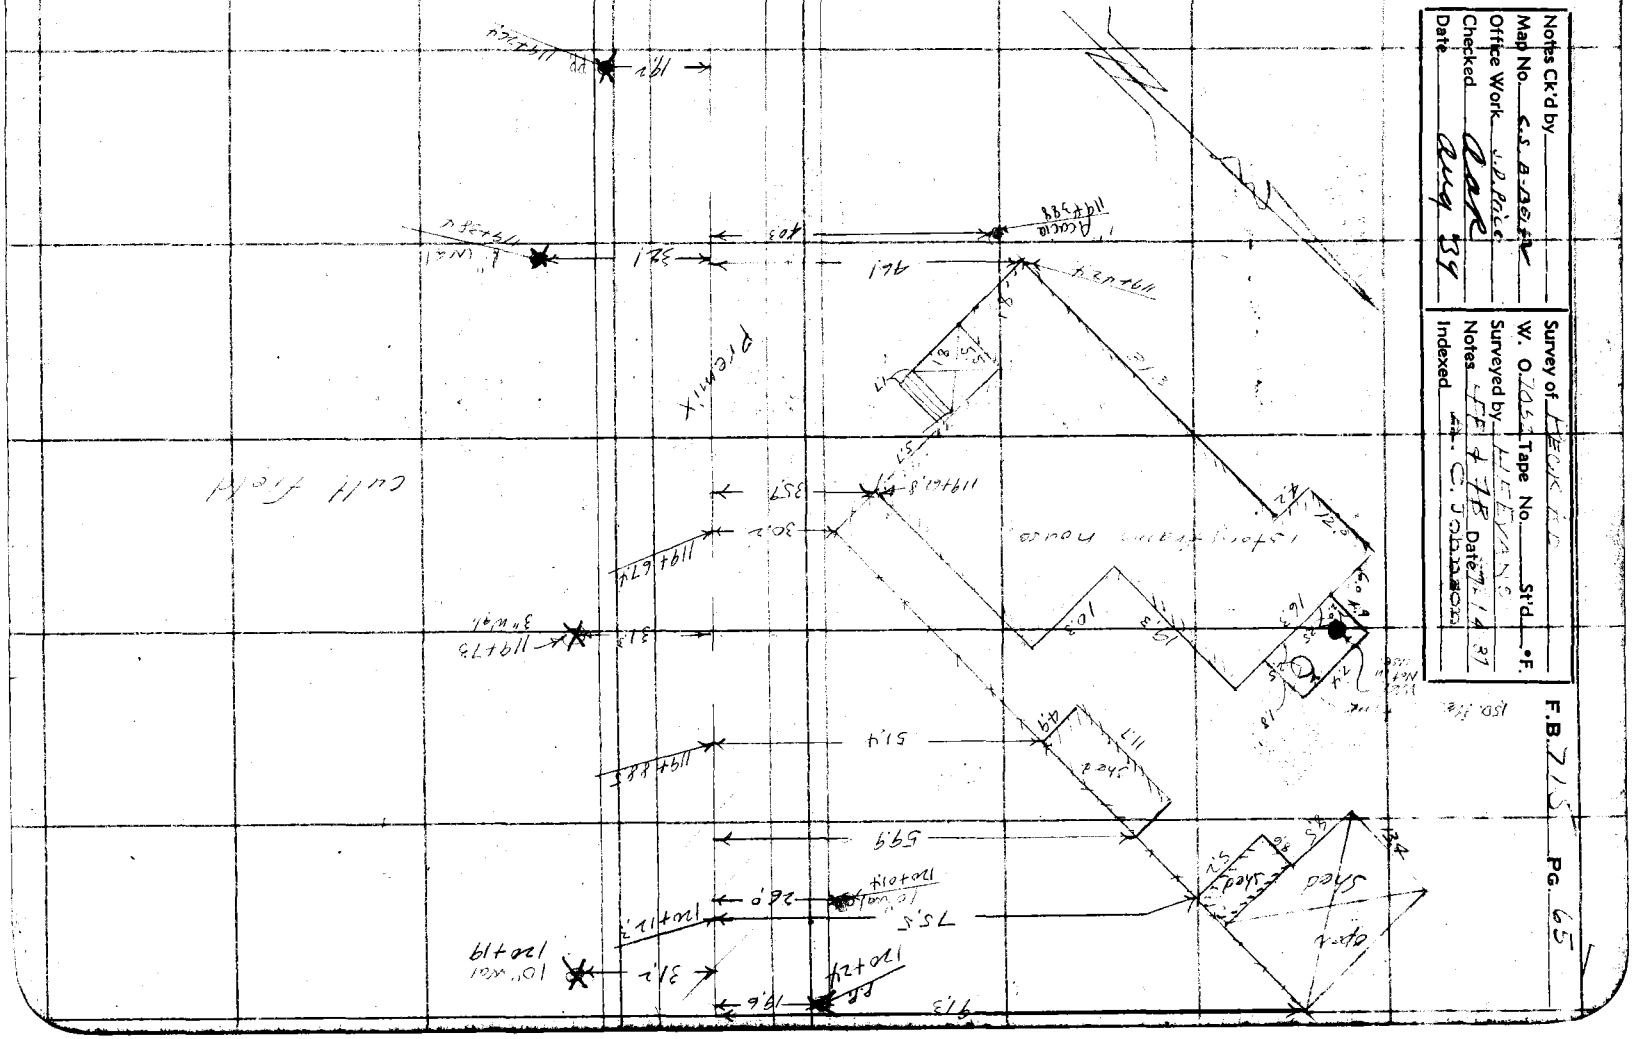

RETURN TO
LOS ANGELES COUNTY SURVEYOR
700 HALL OF RECORDS

Note: Any Additions or Changes on This Sheet Must be Made or Circled in Red Ink With Date and Name of Person Making Change.

Do not extend notes this side of this line

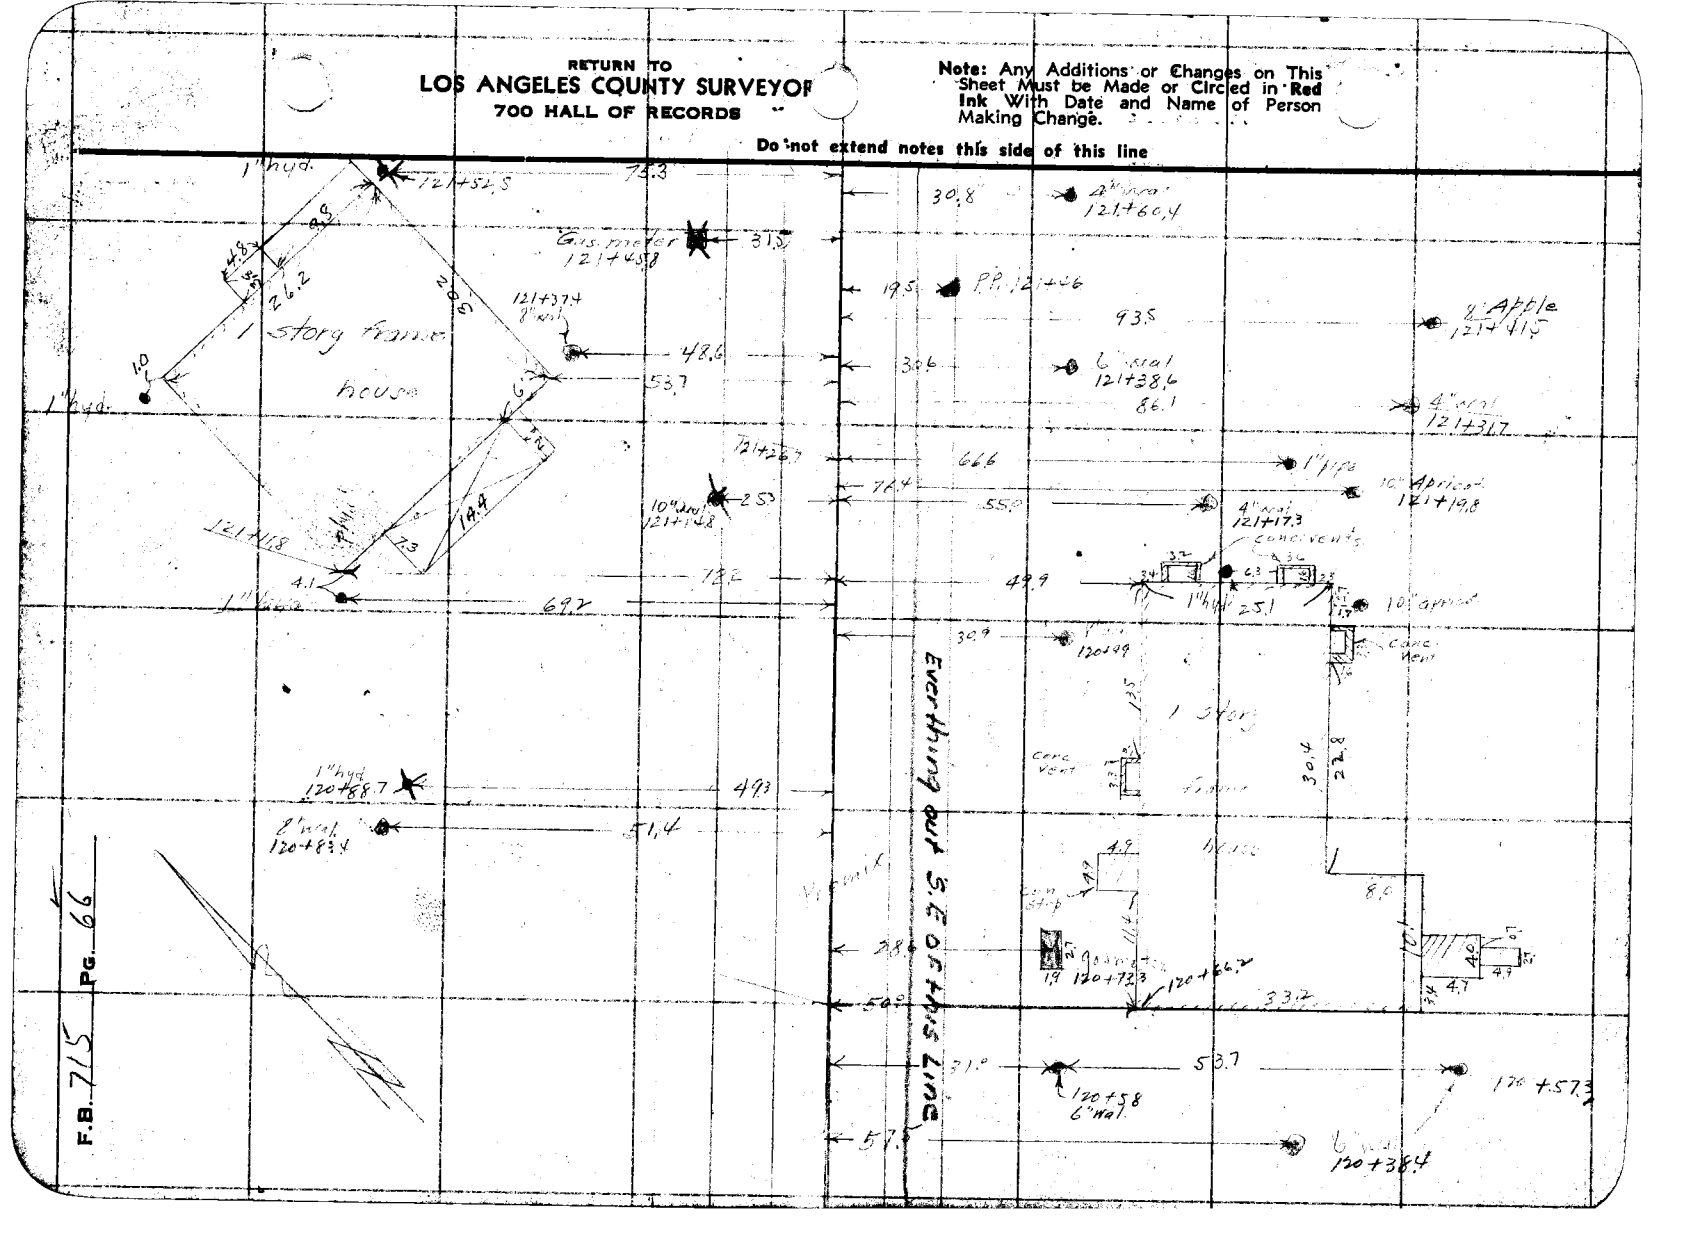

F.B. 715 Pg. 66

Notes Ck'd by	Survey of
Map No. C-S. B-139-W	W. O. 705 Tape No. St'd °F.
Office Work J. P. Cole	Surveyed by H E
Checked Aug	Notes Date 7-14-37
Date Aug. 139	Indexed C. Johnson

F.B. 1 PG. 67

Note: Any Additions or Changes on This Sheet Must be Made or Circled in Red Ink With Date and Name of Person Making Change.

Do not extend notes this side of this line

RETURN TO
LOS ANGELES COUNTY SURVEYOR
700 HALL OF RECORDS

FORM 247 10M 11-35

65.6
20.0
PR 123+17
IP 123+26
45.8
15.7
1 Story
19.0
16.5
7.0
34.3
5.0
OUX
3.0
5.0
10.1
8.8
122+74.3
21.3
46.0
24.8
3" CI
122+71.2
52.0
122+59.8
Note
Everything
on property
is out
84.2
29.1
4" Iron
122+41.5
13.3
6°
0.4
1" Iron
17.1
24
37
9.1
6°
0.7
3.1
1/2" Pipe
17.1
64
Frame
9.4
45
Prem. x
10' Alley
14.8
18.5
12.8
0.2
121+83.6
18.2
29.1
15.7
OUT
IP 121+75.8
19.7
76.5
85.1
80.7
121+68
6" CI
4" CI
121+67.2
1" Iron
21 FLS

F.B. 715 PG. 68

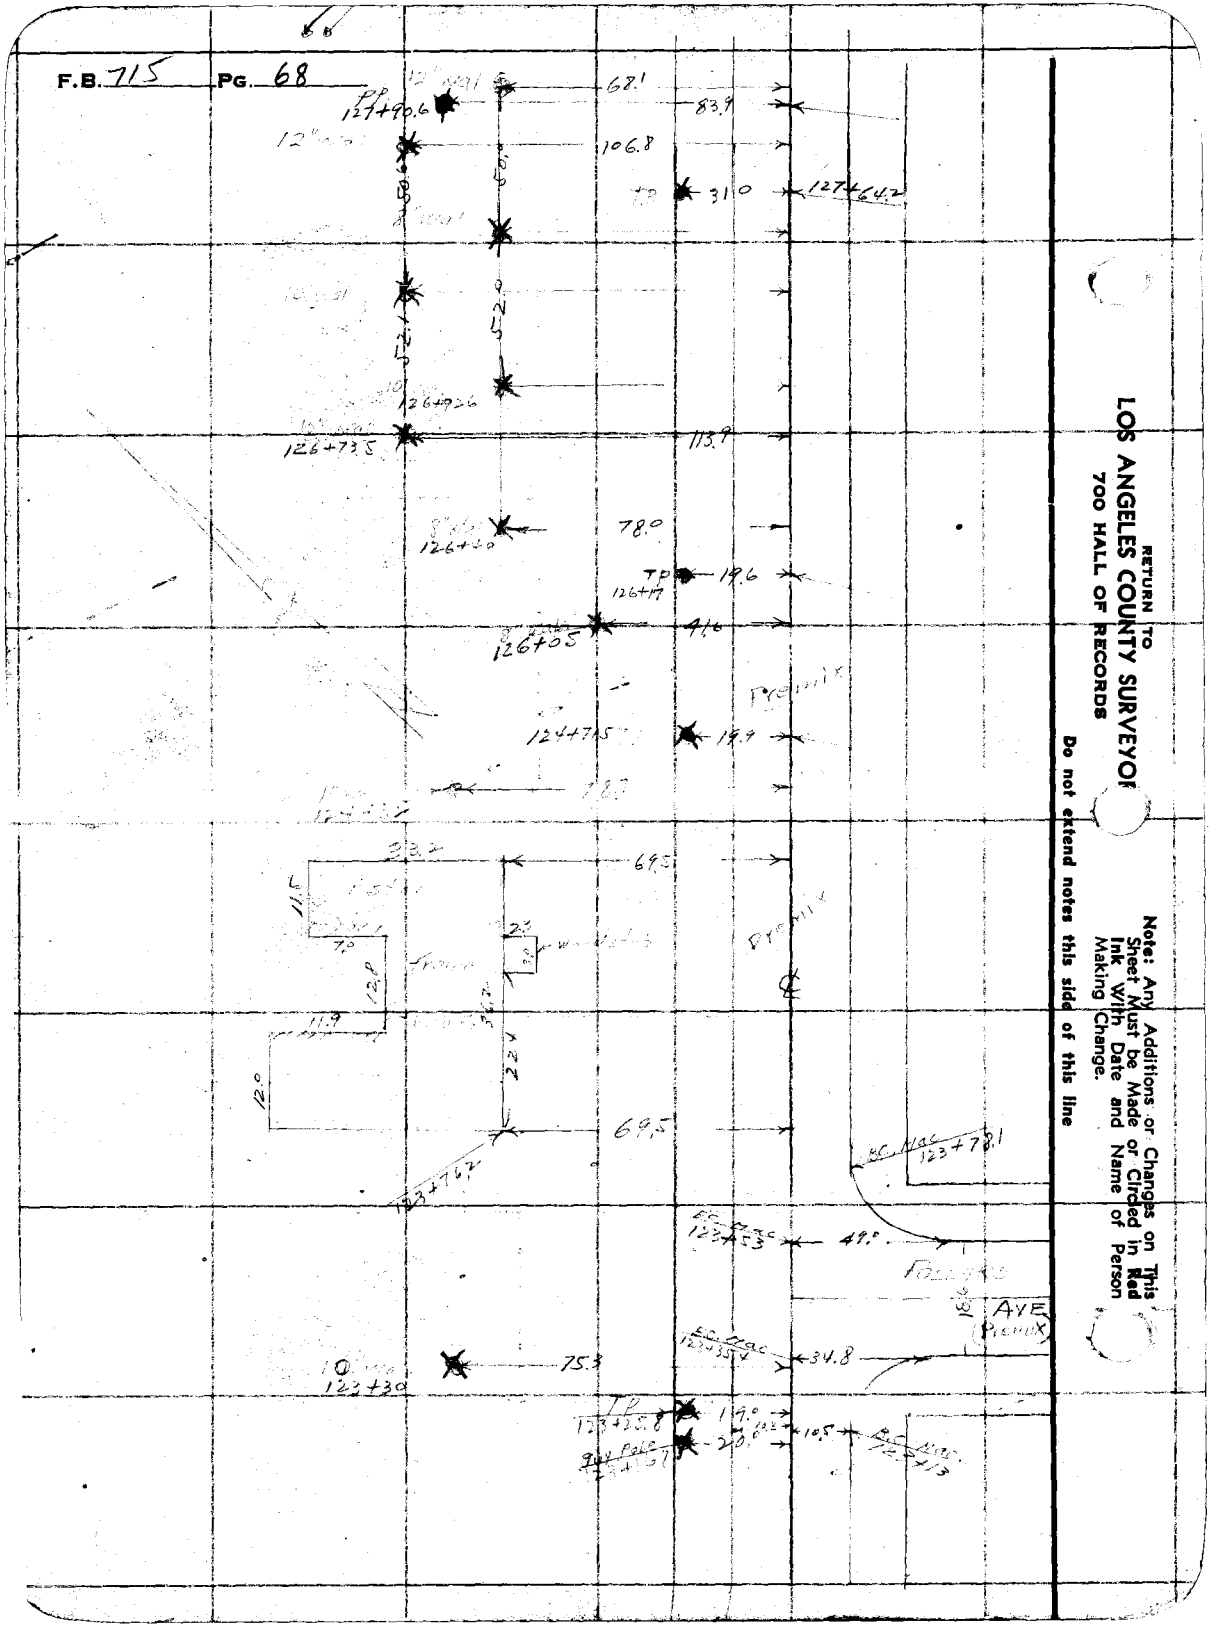

RETURN TO
LOS ANGELES COUNTY SURVEYOR
700 HALL OF RECORDS

Do not extend notes this side of this line

Note: Any Additions or Changes on This Sheet Must be Made or Circled in Red Ink With Date and Name of Person Making Change.

Notes Ck'd by		Survey of Reel 22	F.B. 715 Pg. 69
Map No. C.S. B 1351-2		W. O. 7022 Tape No.	St'd °F.
Office Work J.D. Price.		Surveyed by	
Checked Oak		Notes 1-24-39	Date 2-14-39
Date Aug. '39		Indexed A. C. Johnson	

Note: Any Additions or Changes on This Sheet Must be Made or Circled in Red Ink With Date and Name of Person Making Change.

Do not extend notes this side of this line

LOS ANGELES COUNTY SURVEYOR
700 HALL OF RECORDS

FORM 347 10M 11-38

WEAVER

TYLER

Note: Everything on this page is Bur

for house in this photo see pg. 70

12" wal
12" Std pipe
12" Std
15" wal
10" wal
8" wal
12" wal
4" Pipe
8" pipe
5" Pipe
14" wal
10" Plum
12" Std pipe
PPP
Painted
Stone

RETURN TO
LOS ANGELES COUNTY SURVEYOR
700 HALL OF RECORDS

Note: Any Additions or Changes on This Sheet Must be Made or Circled in Red Ink With Date and Name of Person Making Change.

Do not extend notes this side of this line

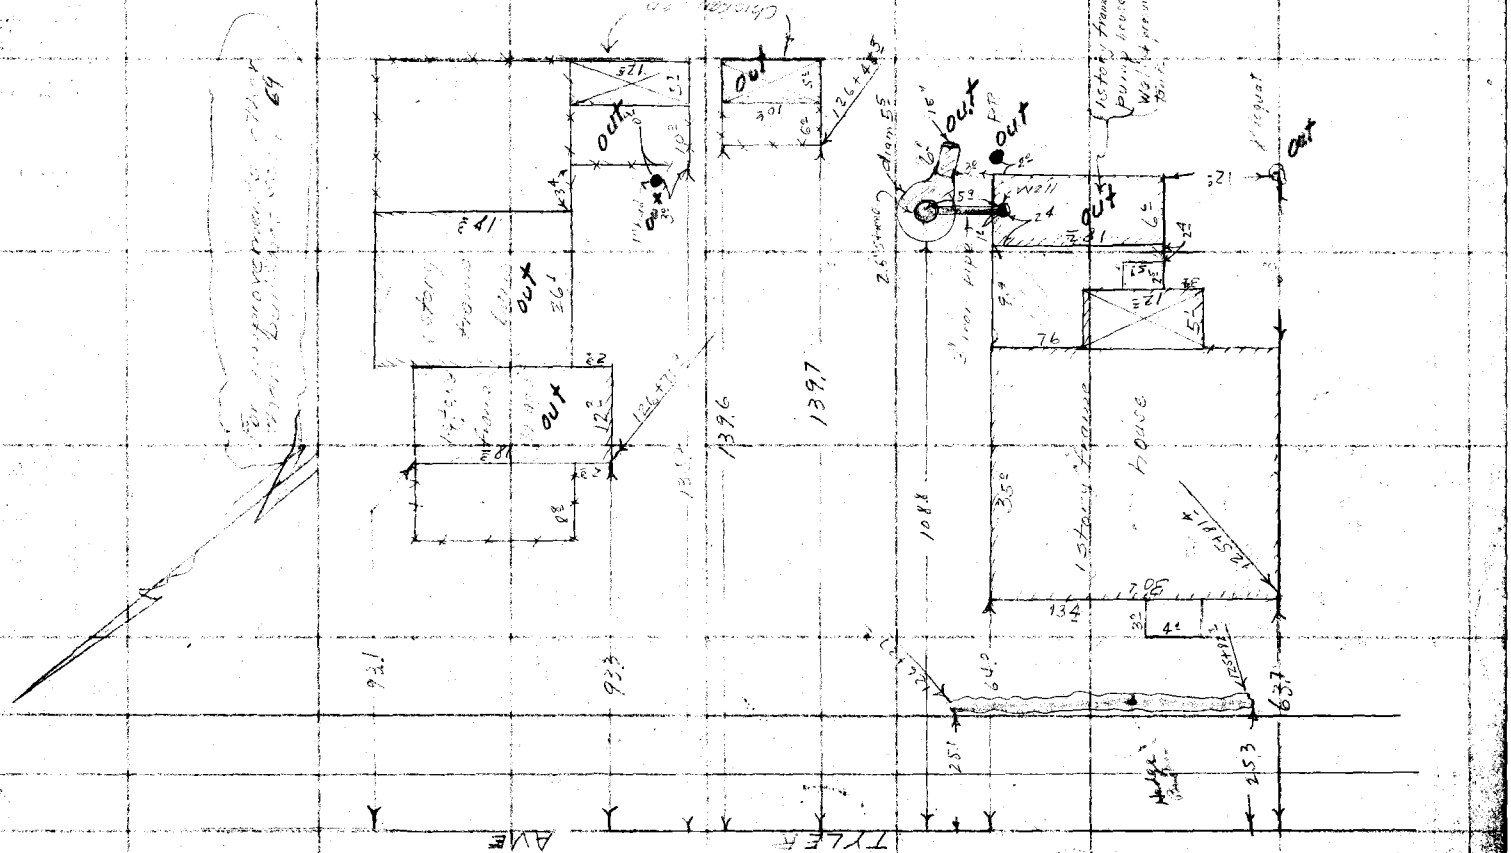

F.B. 715 Pg. 70

FORM 247 10M 11-38

RETURN TO
LOS ANGELES COUNTY SURVEYOR
700 HALL OF RECORDS

Note: Any Additions or Changes on This Sheet Must be Made or Circled in **Red Ink** With Date and Name of Person Making Change.

Do not extend notes this side of this line

Notes Ck'd by _____
Map No. E.S. B-135 W
Office Work J. D. Price
Checked Quap. '39
Date

Survey of W. O. 7654 Tape No. 296 Std. 66°F.
Surveyed by E. Yates
Notes
Date 7-15-37
Indexed Wm. C. Jennison

F.B. 725 Pg. 71

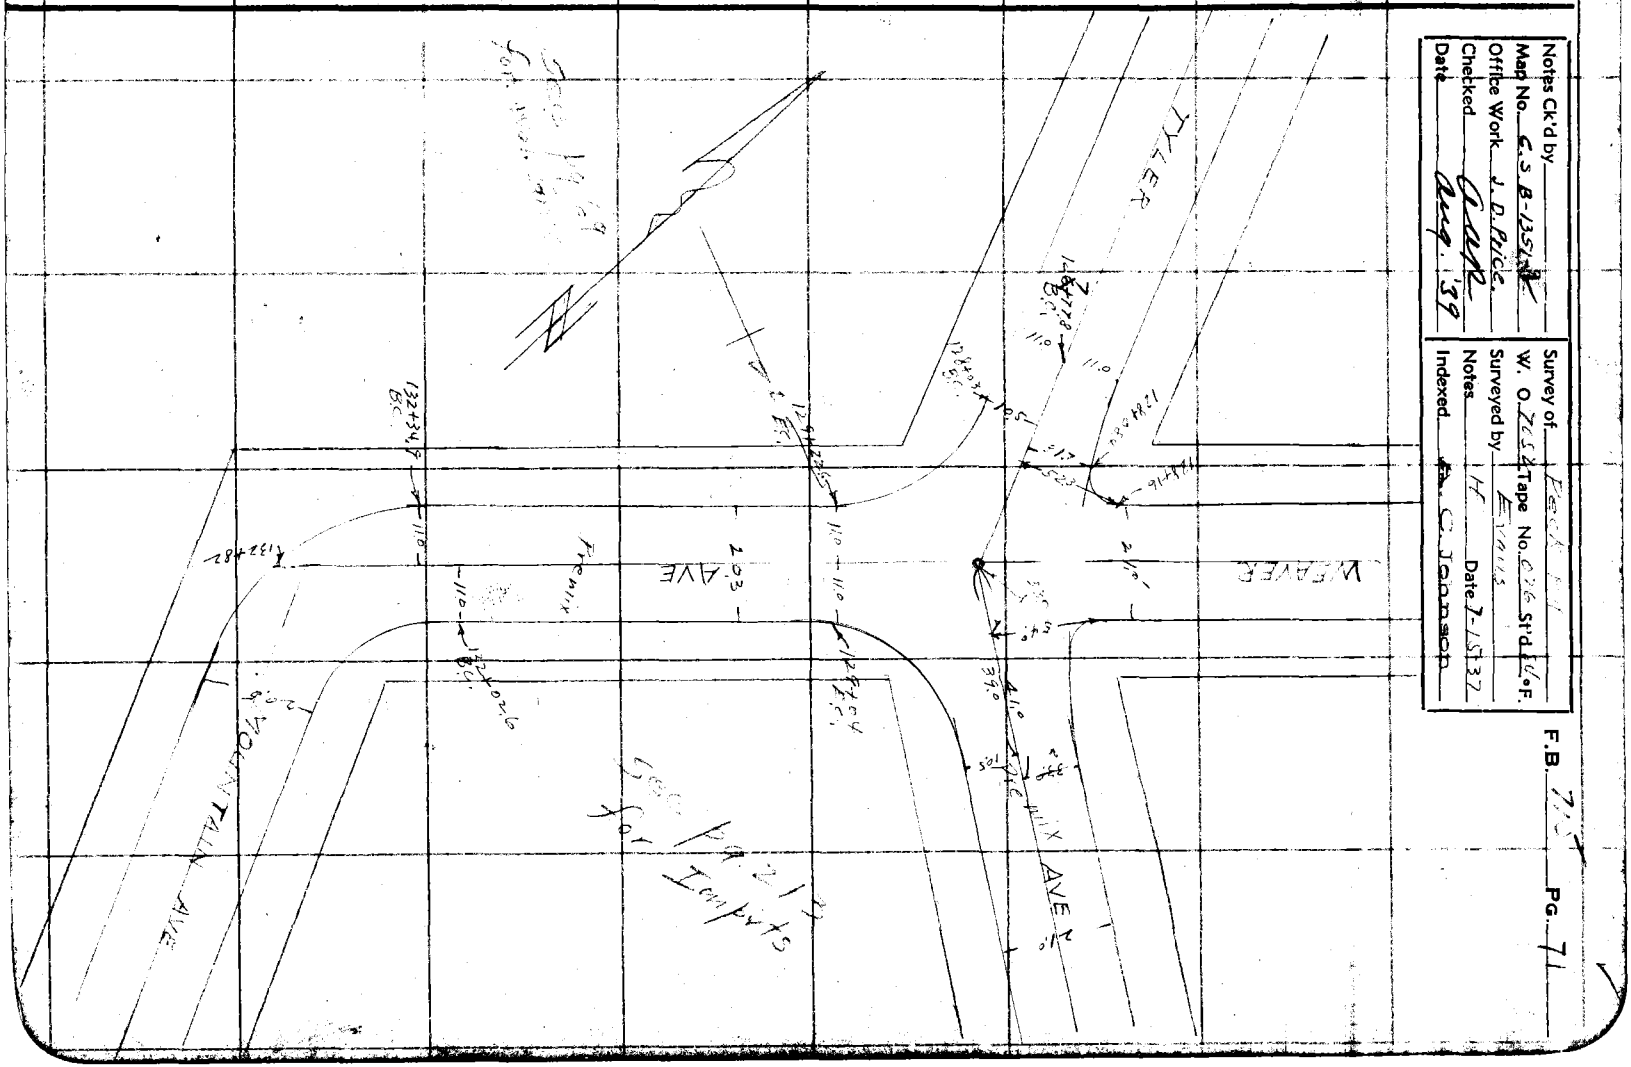
TYLER
NEAVER
AVE
AVE
AVE
AVE
110
110
110

RETURN TO
LOS ANGELES COUNTY SURVEYOR
700 HALL OF RECORDS

Note: Any Additions or Changes on This Sheet Must be Made or Circled in **Red Ink** With Date and Name of Person Making Change.

Do not extend notes this side of this line

F.B. 715 PG. 72

Notes Ck'd by	Survey of Keck Sd
Map No. C.S. B-139-4	W. O. 7012 Tape No. 026 St'd 4/4 F.
Office Work J.D. Price 7-19-37	Surveyed by Evans
Checked aar	Notes NE Date 7-27-37
Date Aug. 139	Indexed A. C. Jones 7-23-37

F.B. 215 Pg. 73

PRELIMINARY SURVEY.

TRANSIT LINES

FROM GARVEY AVE.

TO RAMONA BLVD.

EVANS
BLANCHARD
SEDIG
SMITH
O'BRIEN.

FINAL E - Pgs. 165-173

Note: Any Additions or Changes on This Sheet Must be Made or Circled in Red Ink With Date and Name of Person Making Change.

Do not extend notes this side of this line

RETURN TO
LOS ANGELES COUNTY SURVEYOR
700 HALL OF RECORDS

FORM 247 10M 11-35

RETURN TO
LOS ANGELES COUNTY SURVEYOR
700 HALL OF RECORDS

Note: Any Additions or Changes on This Sheet Must be Made or Circled in **Red Ink** With Date and Name of Person Making Change.

Do not extend notes this side of this line

46, A-5

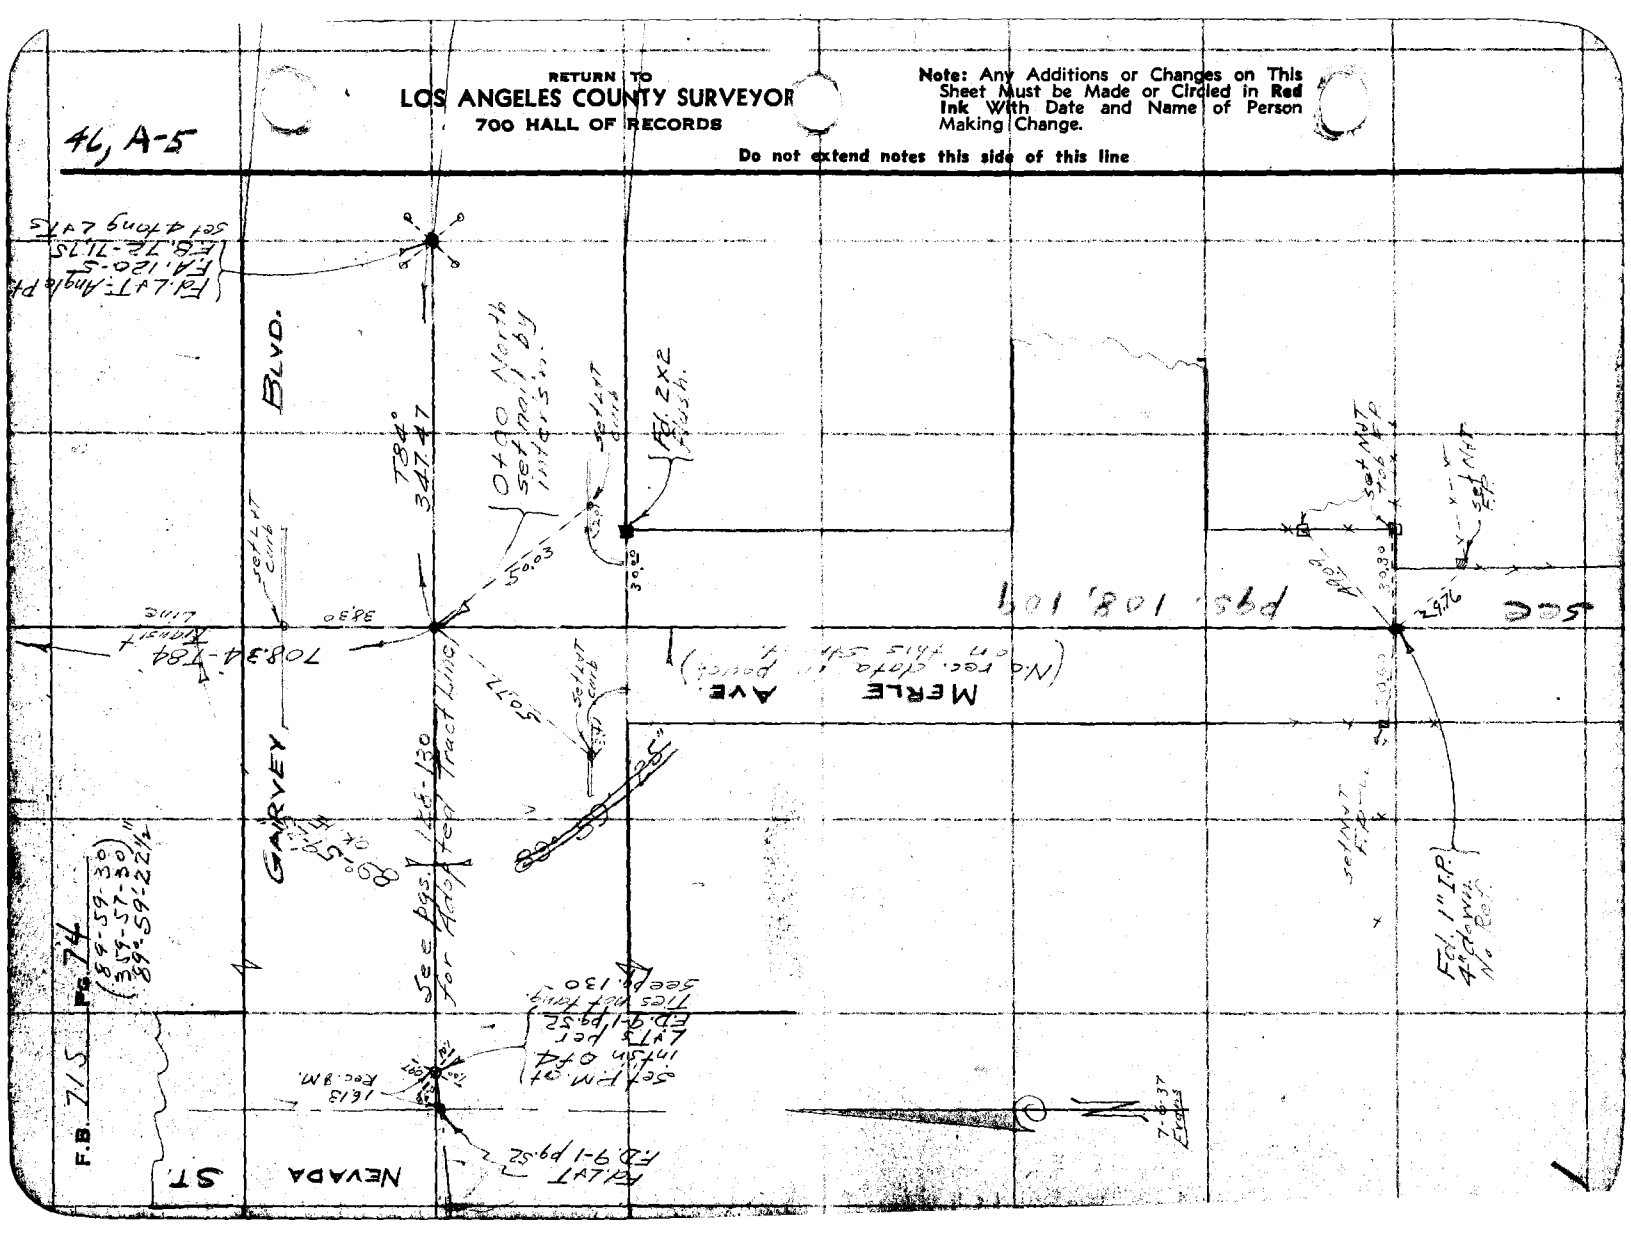
BLVD.
GARVEY
NEVADA ST.
MERLE AVE.
Set Nail & Tag
Fd. 2x2 Brass
Fd. 1" I.P. No Tag
Fd. L&T
Fd. L&T: Angle Pt
Set 4"Dong L&TS
Fd. 1" I.P. No Tag
Set PK Nail & Tag
Set Nail & Tag
Set L&T
Set L&T
Set L&T

Notes Ck'd by	Survey of FECK RD
Map No. C.S.B. 125 9	W. O. 7052 Tape No. 026 St'd 84 F.
Office Work J.D. Price - 7-13-37	Surveyed by EVANS
Checked Carl	Notes FE Date 7/6/37
Date Aug. '37	Indexed

F.B. 215 Pg. 75

16 A-5

Note: Any Additions or Changes on This Sheet Must be Made or Circled in Red Ink With Date and Name of Person Making Change.

Do not extend notes this side of this line

RETURN TO
LOS ANGELES COUNTY SURVEYOR
700 HALL OF RECORDS

242.05 - T 90° = 242.06

242.06

7+15.97
Set 2×2
12" 4n.

7+08.34
Set S.W.H.T.
by intersn

Set N+T
S.F.P.

TYLER ST.

BODGER ST.

56.14

7.63

(See Pg. 127 for Adopted ℄)

373.40

To C.S. Mon.
@ Meeker Rd.
Pg. 76

Set L+T
Corner

142°-32'-00"

89°-55'-10"

F/ 2×2, 8" dn.
R.B. 72-81
C.S. Mon.
per Pg. 127

Transit Line
708.34

373.39 - T 90° = 373.40

(142-32-00
210-08-00
142°-32-08"

(89°-55'-15"
359°-40'-30" Lt
89°-55'-15"

FORM 247 10M 11-35

RETURN TO
LOS ANGELES COUNTY SURVEYOR
700 HALL OF RECORDS

Note: Any Additions or Changes on This Sheet Must be Made or Circled in Red Ink With Date and Name of Person Making Change.

Do not extend notes this side of this line

46, A-5

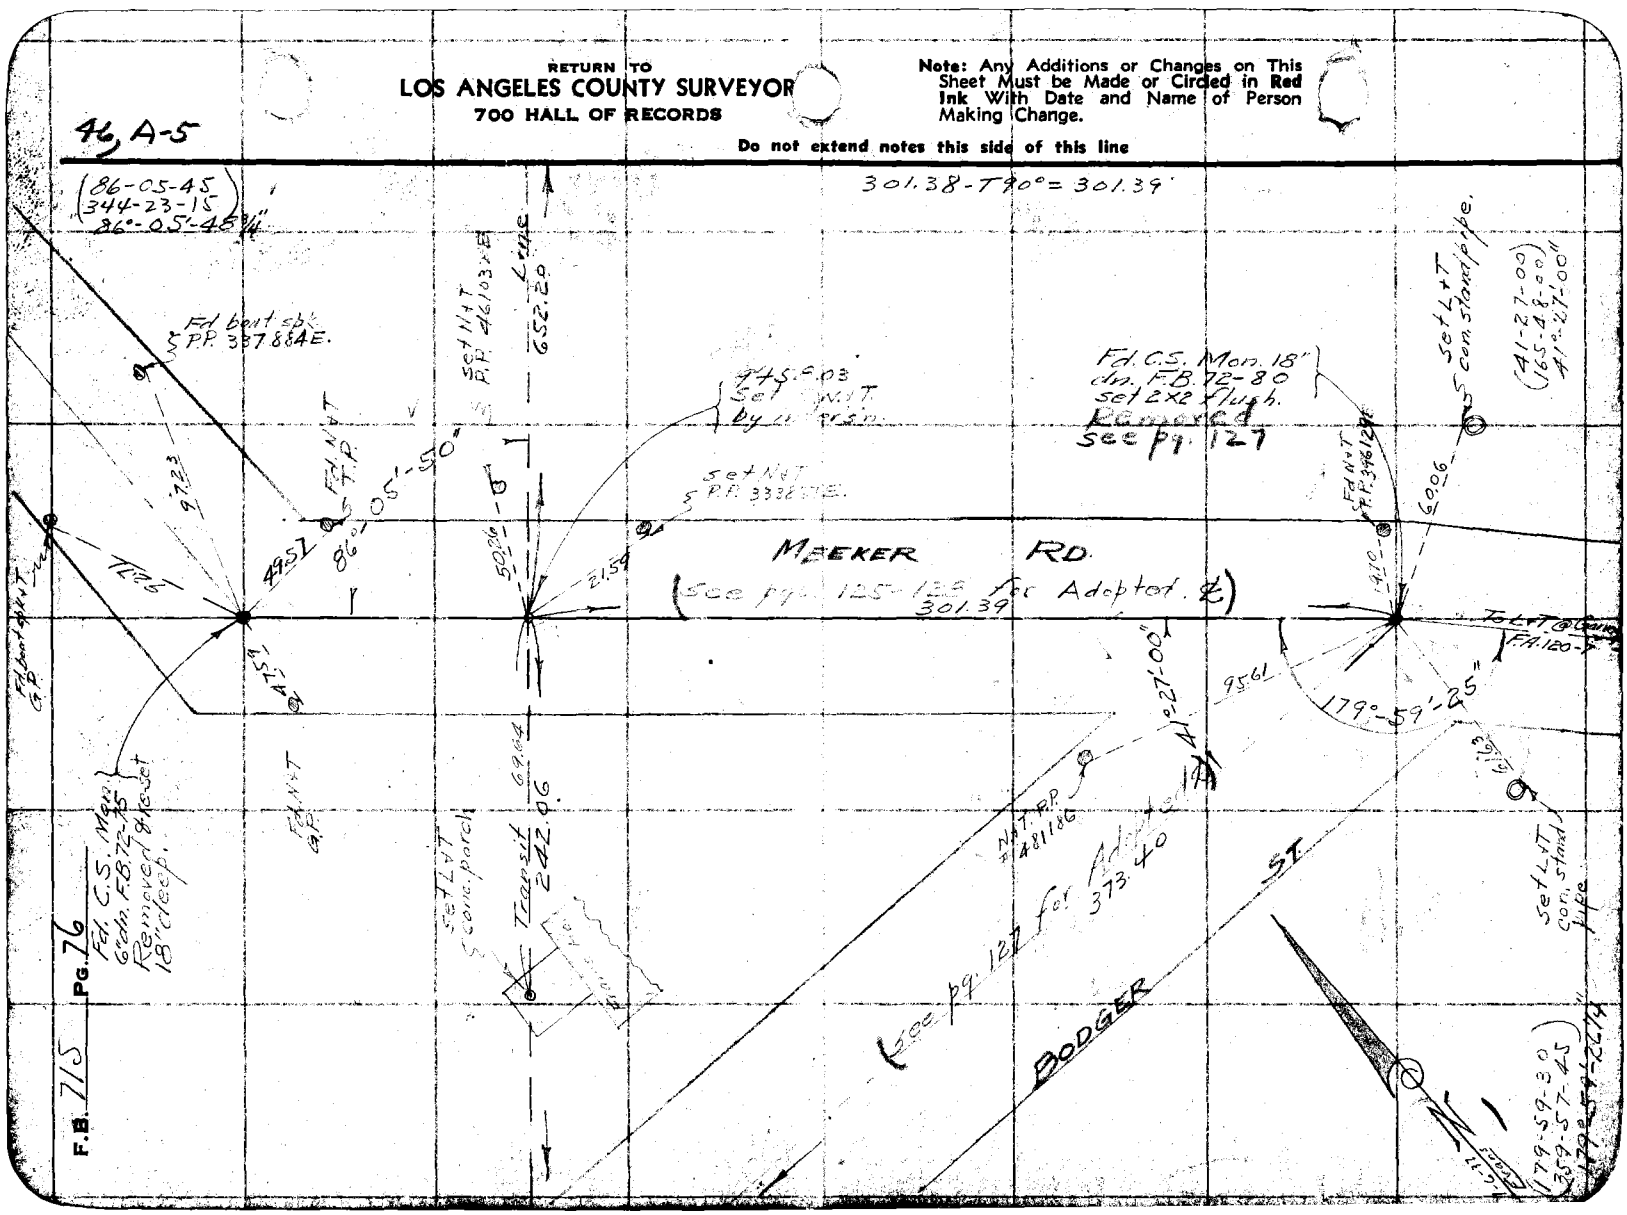

Notes Ck'd by	Survey of PECK RD.
Map No. C. S. B- 1861-2	W. O. 7052 Tape No. 026 St'd 24° F.
Office Work J. D. Price	Surveyed by EVANS.
Checked AAR	Notes HE Date 7-6-37
Date Aug. '39	Indexed A. C. Johnson

F.B. 715 PG. 77

46, A-5

Note: Any Additions or Changes on This Sheet Must be Made or Circled in Red Ink With Date and Name of Person Making Change.

Do not extend notes this side of this line

RETURN TO
LOS ANGELES COUNTY SURVEYOR
700 HALL OF RECORDS

FORM 247 10M 11-35

(86°14-45)
(344°59-15")
86°-14'-48¾"

LOT 14 LOT 15

Fd. 3×3 I.P. Flush.

AMADOR ST.

86°14'-50"

694.24 Transit Line

LOT 7

Fd. old 1×2 16760.52

4.32

cut + iron F.P.

20.23

12.23

4.16

20.23

20.02

Nail

See pg 123 for adopted ℄

16740.56
Set 1×2 by inter'sn.

17.34

30.33

Nut P.P. S 19°62' E

16720.08
Fd. 4" I.P. Flush.

3.12

MEEKER RD.

652.20

LOT 26.

15700.15
Fd. ¾" I.P. 6" high.

13+00.19
Fd. 2×2. No tack. 4" high.

5.13

C.S.

RETURN TO
LOS ANGELES COUNTY SURVEYOR
700 HALL OF RECORDS

Note: Any Additions or Changes on This Sheet Must be Made or Circled in **Red** Ink With Date and Name of Person Making Change.

Do not extend notes this side of this line

46, A-5

PECK RD.

(See Pg 122.)

POMONA BLVD.

(93-29-45)
13-58-45
93°-28'-41 1/4"

746.14

N&T F.B.

23+73.79
Set 1x2

X con gas meter

Set 1x2

T&T 301.00

2265

23+33.30
Set Nail
by intersn

23+34.86
Set Nail
by intersn

86°-12'-05"

(86-12-00)
344-48-15
86°-12-03 1/4"

F.B. 745 Pg. 78

F&L&T with 4 Tang
L&T 4 ties per F.B.
S20-187

F&L&T with 4 Tang
L&T 4 ties per F.B.
S20-139

Notes Ck'd by A. A. B	Survey of PECK RD.
Map No. C. S. B-135-1	W. O. 7056 Tape No. 026 St'd 66°F.
Office Work J. D. P.	Surveyed by EVANS
Checked AAC	Notes HE Date 7-9-37
Date Aug. 39	Indexed A. C. Johnson

F.B. 715 Pg. 79

46 A-5

PECK RD

Fd. L & T con. stand pipe

Fd. SW & T Tel. P.

Fd. L.S. mag. 48" d. Replaces 3/4" I.P. shown F.B. 24-67 per F.B. 520-138 Set 2 x 2 & cap, tk. flush.

Set L & T conc. base wig wag

Fd. SW & T P.P.

Set 1 x 1

Fd. 2" I.P. flush No tack. N.W'ly Cor. Tr. 9942

S.P. R.R.

Set Nail in Tracks 31+72.68

259.52 - T 24°

Set 1 x 2

Set 1 x 2 By Inters.

Set Nail in P.P.

746.14

Transit Line

44.70

84° 402.63'

88°-08'-10"

88°-08'-45"

Set Nail in Tel. P.

(88-08-45) 352-35-00 88°-08-45"

Fd. 1 1/2" I.P. & tk. flush. N.E'ly cor. Tr. 9942

Set 1 x 1

(88-08-15) 352-52-45 88°-08-11½"

Note: Any Additions or Changes on This Sheet Must be Made or Circled in Red Ink With Date and Name of Person Making Change.

Do not extend notes this side of this line

RETURN TO LOS ANGELES COUNTY SURVEYOR 700 HALL OF RECORDS

FORM 247 10M 11-38

RETURN TO
LOS ANGELES COUNTY SURVEYOR
700 HALL OF RECORDS

Note: Any Additions or Changes on This Sheet Must be Made or Circled in Red Ink With Date and Name of Person Making Change.

Do not extend notes this side of this line

16, A-5 + B-5

Set L + T Conc. Walk & Prod

PECK RD.

Fd. 1" □ iron bar, 2" dn. per R.D. Z-378-56

Set Nail

Fd. NAT - Eside P.K. # 137037E

Fd. 3/4" I.P. Cem. & tag illegible 1.5' dn. F.B. 1141-66 R.D. Z-141-10

0+23.50 Fd. 1½" I.P. fl. No tk.

2+22.43 Fd. 1½" I.P. P+T Flush

1+23.46 Fd. chiselled 2X2, flush

3+21.52 Fd. 1½" I.P. P+T fl.

4+18.07 Fd. 1½ I.P. P+T. fl.

14+83.48 Fd. 2" I.P. 3' dn. per R.D. Z-378-56

18+19.52 Fd. 1½" I.P. Flush, No tk. R.D. Z-378-56

Set L+T Conc. water b.v.

72°-39-35" = Tie No 29

Line S.P.

Fd. NAT (72°-39-30 290-38-15 72°-39-33¾"

Set NAIL by L.H.S.n.

STEWART AVE.

Set ¾" I.P. cem. & cap. tk. 15' dn. on Tract line

per R.D. Z 378-56, 57

Set L+T

Fd. NAT 8" Umbrella

19+75.68 from W. Fd. 2x2, 10" dn. per R.D. Z-378-57 Set 1X1 Flush

Reset 2-4-33 HE

375.66-T68°=375.62

17+02.35 Fd. 2" I.P. Flush.

Set NAIL & Reflector

Fd. 1½" I.P. Flush per R.D. Z-378-56

S.P. R.R.

Set NAIL & Tack No.

Fd. Nail & Shiner

Fd. Nail & Shiner

Fd. NAIL & Shiner

Fd. NAT # 137410

Fd. Nail & Shiner

Fd. Nail & Shiner

Fd. Nail & Shiner

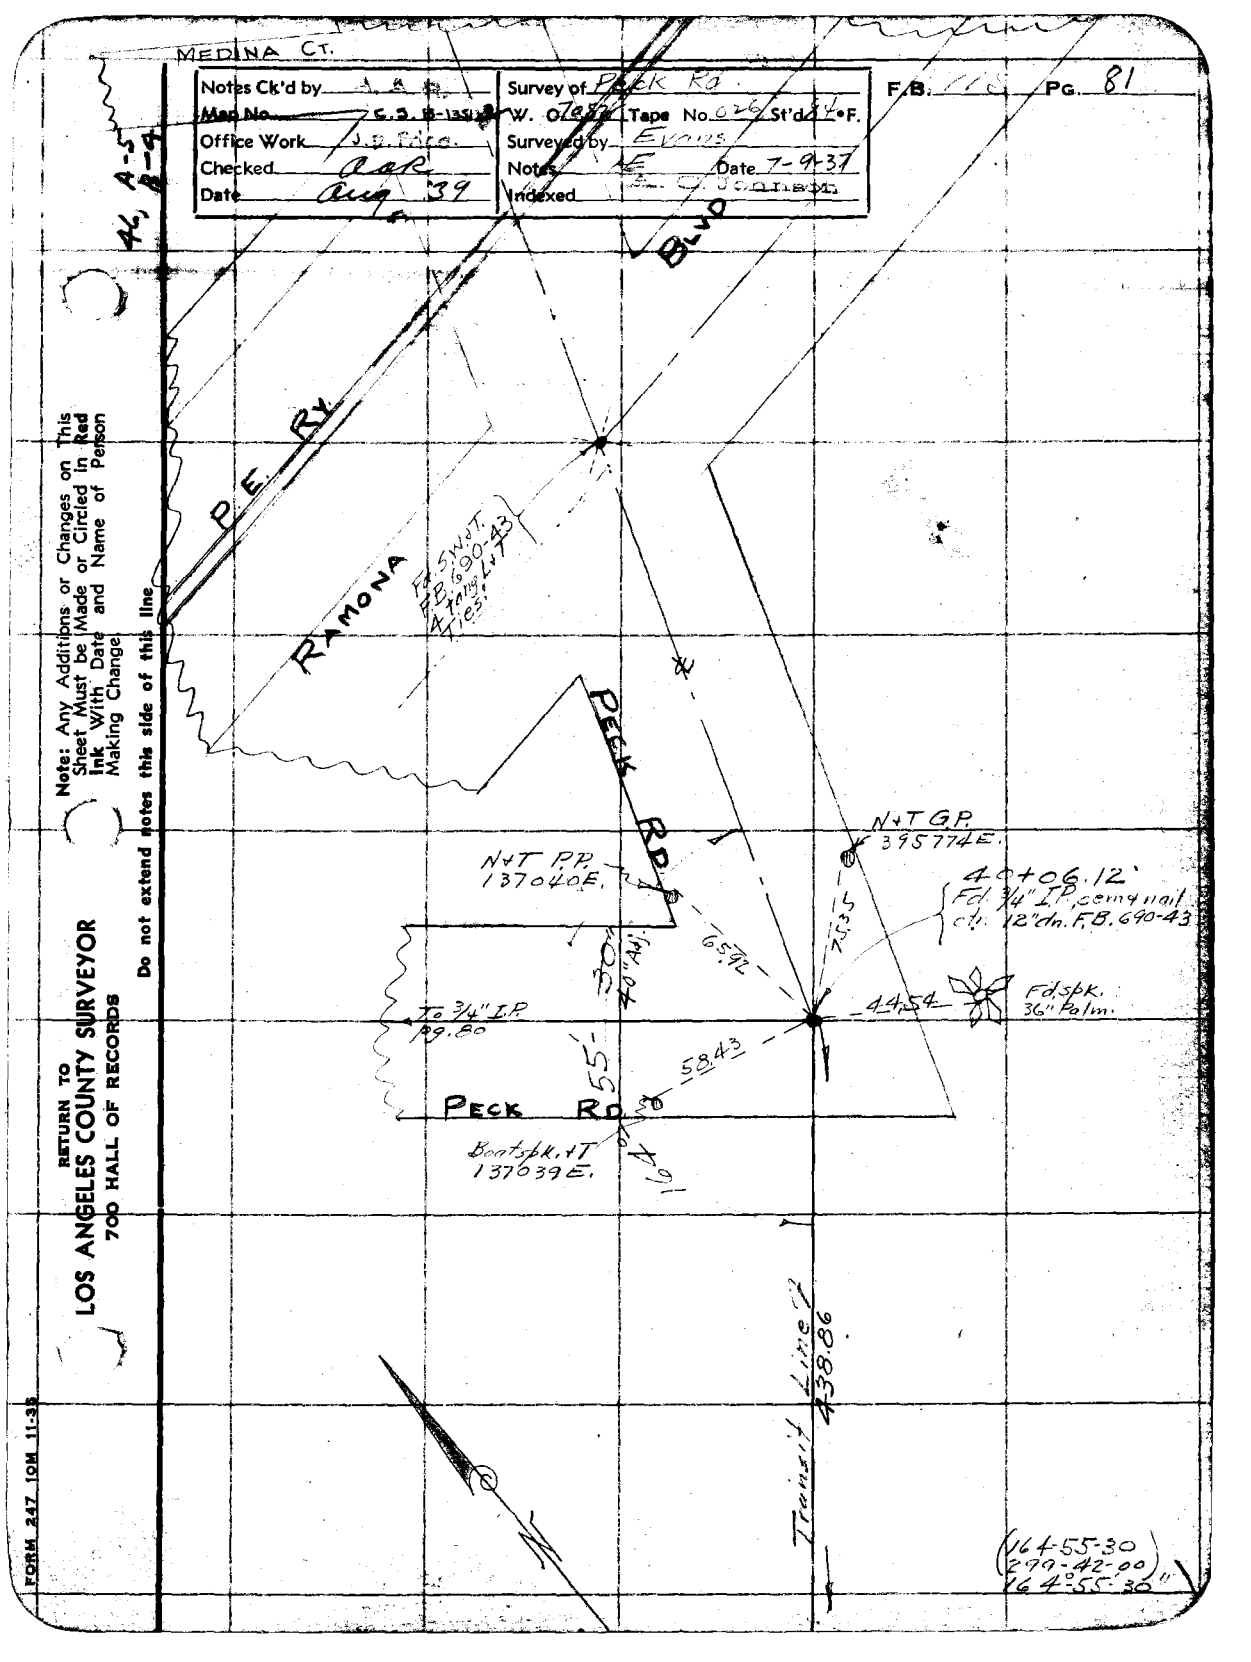
MEDINA CT.
Notes Ck'd by
Map No. C.S. B-1351
Office Work J.D. Pace.
Checked CAR
Date Aug 5 '39
Survey of Peck Rd.
W. O. 7852 Tape No. 026 St'd 24 °F.
Surveyed by Evans
Notes NE Date 7-9-37
Indexed
F.B. 11 Pg. 81
BLVD
P.E. RY.
RAMONA
Fd. S.W.J.T. P.B. 690-43 & ring & ties. L.T.
PECK RD.
N+T PP 137040E.
N+T GP 395774E.
40+06.12' Fd. 3/4" I.P. cem'd nail ctr. 12" dn. F.B. 690-43
30' to Adj.
6.59
75.35
To 3/4" I.P. 99.80
44.54
Fd. spk. 36" Palm.
55'
58.43
PECK RD.
Boat spk. JT 137039E.
Transit Line
438.86
(164-55-30)
(279-42-00)
164°55'30"
Note: Any Additions or Changes on This Sheet Must be Made or Circled in Red Ink With Date and Name of Person Making Change
Do not extend notes this side of this line
RETURN TO
LOS ANGELES COUNTY SURVEYOR
700 HALL OF RECORDS
FORM 247 10M 11-38

RETURN TO
LOS ANGELES COUNTY SURVEYOR
700 HALL OF RECORDS

Note: Any Additions or Changes on This Sheet Must be Made or Circled in **Red Ink** With Date and Name of Person Making Change.

Do not extend notes this side of this line

F.B. 715 PG. 82

Notes Ck'd by A. A. D	Survey of PECK RD
Map No. C.S. B-1351-V	W. O. 7052 Tape No. St'd °F.
Office Work J. D. Price	Surveyed by H.F.E. VANS
Checked Aug.	Notes HF & FR Date 7-24-39
Date Aug. '39	Indexed C. Johnson

F.B. 110 Pg. 83

Note: Any Additions or Changes on This Sheet Must be Made or Circled in Red Ink With Date and Name of Person Making Change.

Do not extend notes this side of this line

RETURN TO
LOS ANGELES COUNTY SURVEYOR
700 HALL OF RECORDS

745.97
2½

BODGER 7408.34 SW VT 7.0 AVE

PREMIX

10.6

32.1 6784.3 15" conc standpipe

(Boot Field)

6" conc curb

Conc gutter

Premix shoulder

GARVEY 38.04 0.00 North AVE 38.04 20'

5/8" Nail

Conc. Concrete Pvmt.

28.0 38.07 20.0

15'

Premix shoulder

6" conc curb

Line

5.9

39

12'R

Conc gutter

IMPV'TS.
GARVEY AVE.
To
RAMONA BLVD.

17.99 18.14

MERLE AVE

Transit (Premix)

N

(See pg. 120)

FORM 247 10M 11-38

RETURN TO
LOS ANGELES COUNTY SURVEYOR
700 HALL OF RECORDS

Note: Any Additions or Changes on This Sheet Must be Made or Circled in Red Ink With Date and Name of Person Making Change.

Do not extend notes this side of this line

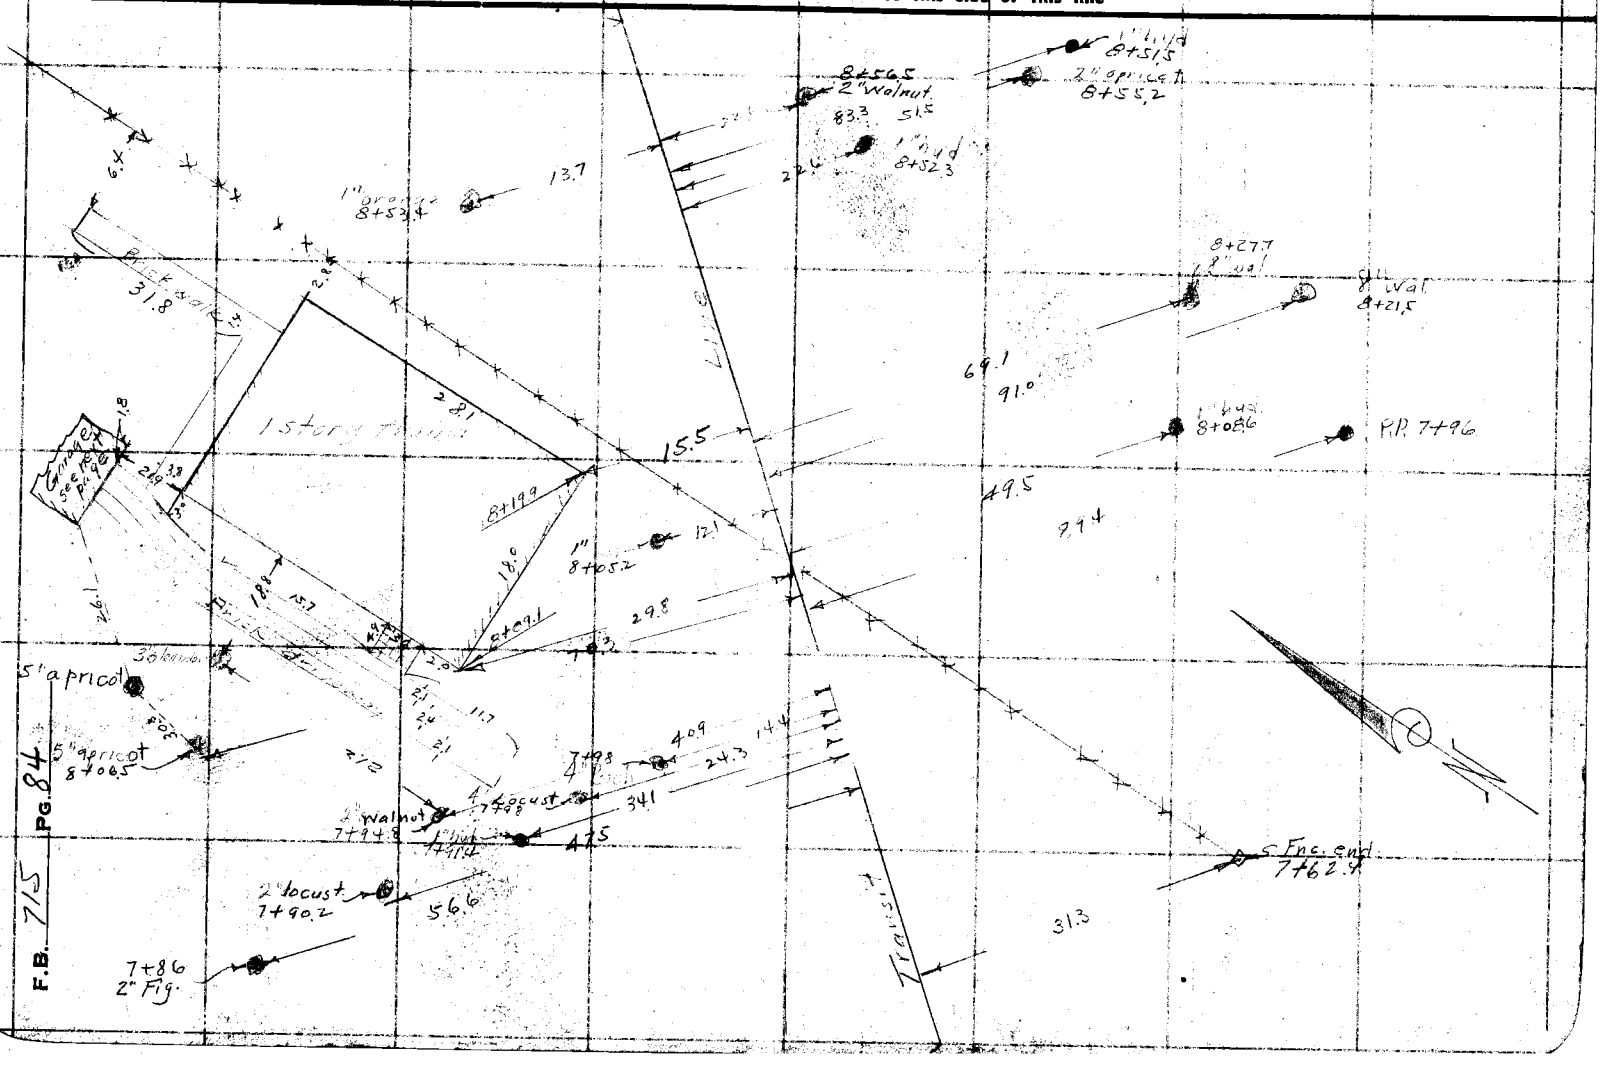

Notes Ckd by [illegible]
Map No. C.S.B-1351
Office Work J.D. Price
Checked Lap
Date Aug '39

Survey of [illegible]
W. O. 7057 Tape No. St'd °F.
Surveyed by H F Evans
Notes HFE 7H B Date 7-7-31
Indexed C Johnson

F.B. [illegible] PG. 85

Note: Any Additions or Changes on This Sheet Must be Made or Circled in Red Ink With Date and Name of Person Making Change.

Do not extend notes this side of this line

RETURN TO
LOS ANGELES COUNTY SURVEYOR
700 HALL OF RECORDS

FORM 247 10M 11-38

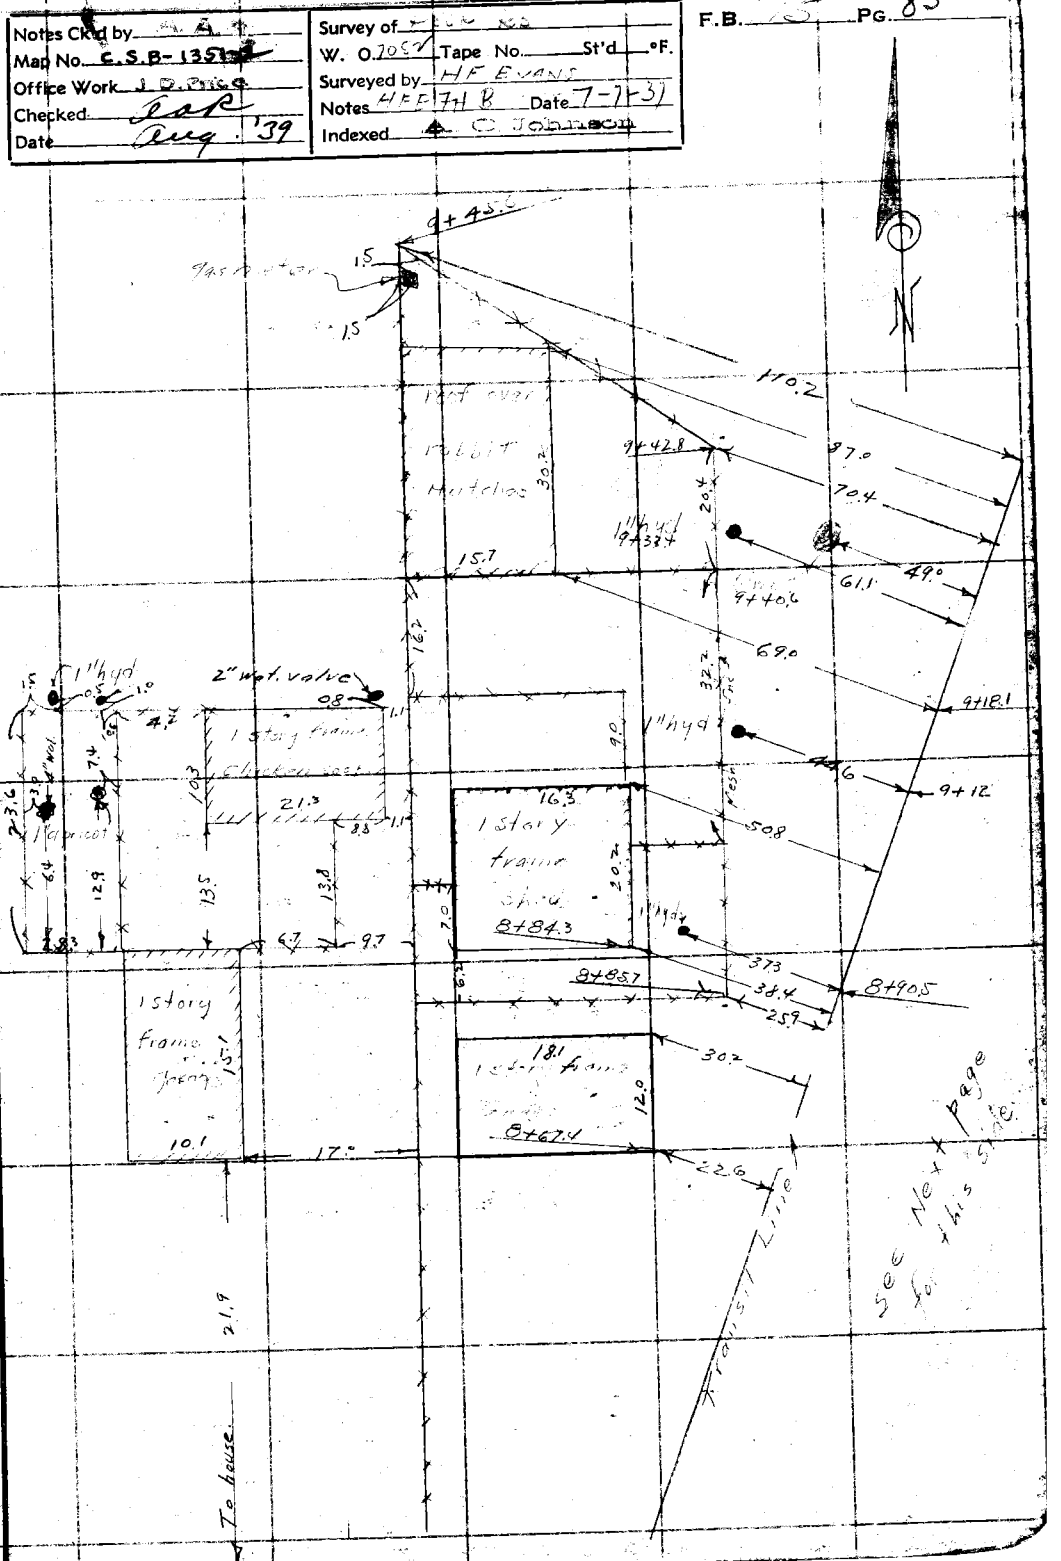

RETURN TO
LOS ANGELES COUNTY SURVEYOR
700 HALL OF RECORDS

Note: Any Additions or Changes on This Sheet Must be Made or Circled in **Red** Ink With Date and Name of Person Making Change.

Do not extend notes this side of this line

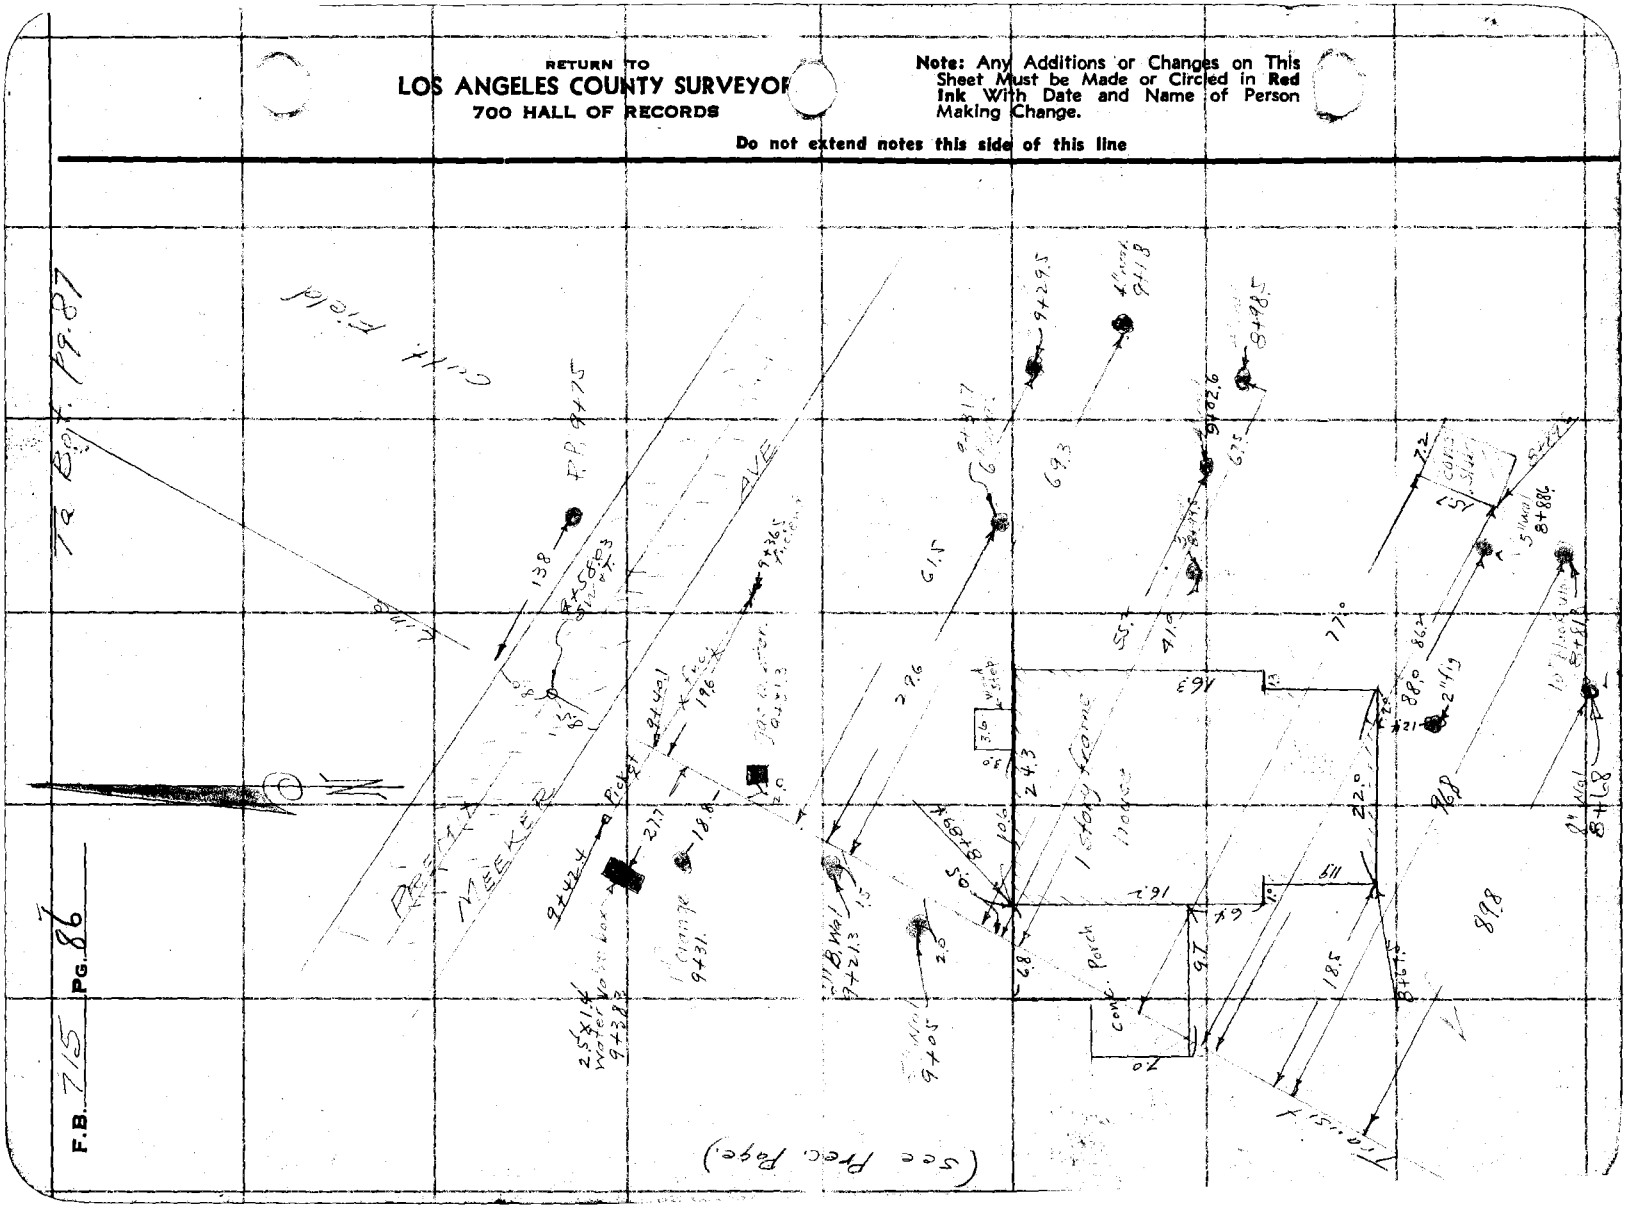

Notes Ck'd by	E. A.	Survey of	Rockford
Map No.	C.S. 0-1351	W. O.	1002 Tape No. St'd °F.
Office Work	Price	Surveyed by	E. Evans
Checked	Raeser	Notes	Date 11-27-38
Date	Jan. '38	Indexed	G. C. Johnson

F.B. 115 Pg. 66A

Note: Any Additions or Changes on This Sheet Must be Made or Circled in Red Ink With Date and Name of Person Making Change.

Do not extend notes this side of this line

RETURN TO
LOS ANGELES COUNTY SURVEYOR
700 HALL OF RECORDS

FORM 247 10M 11-38

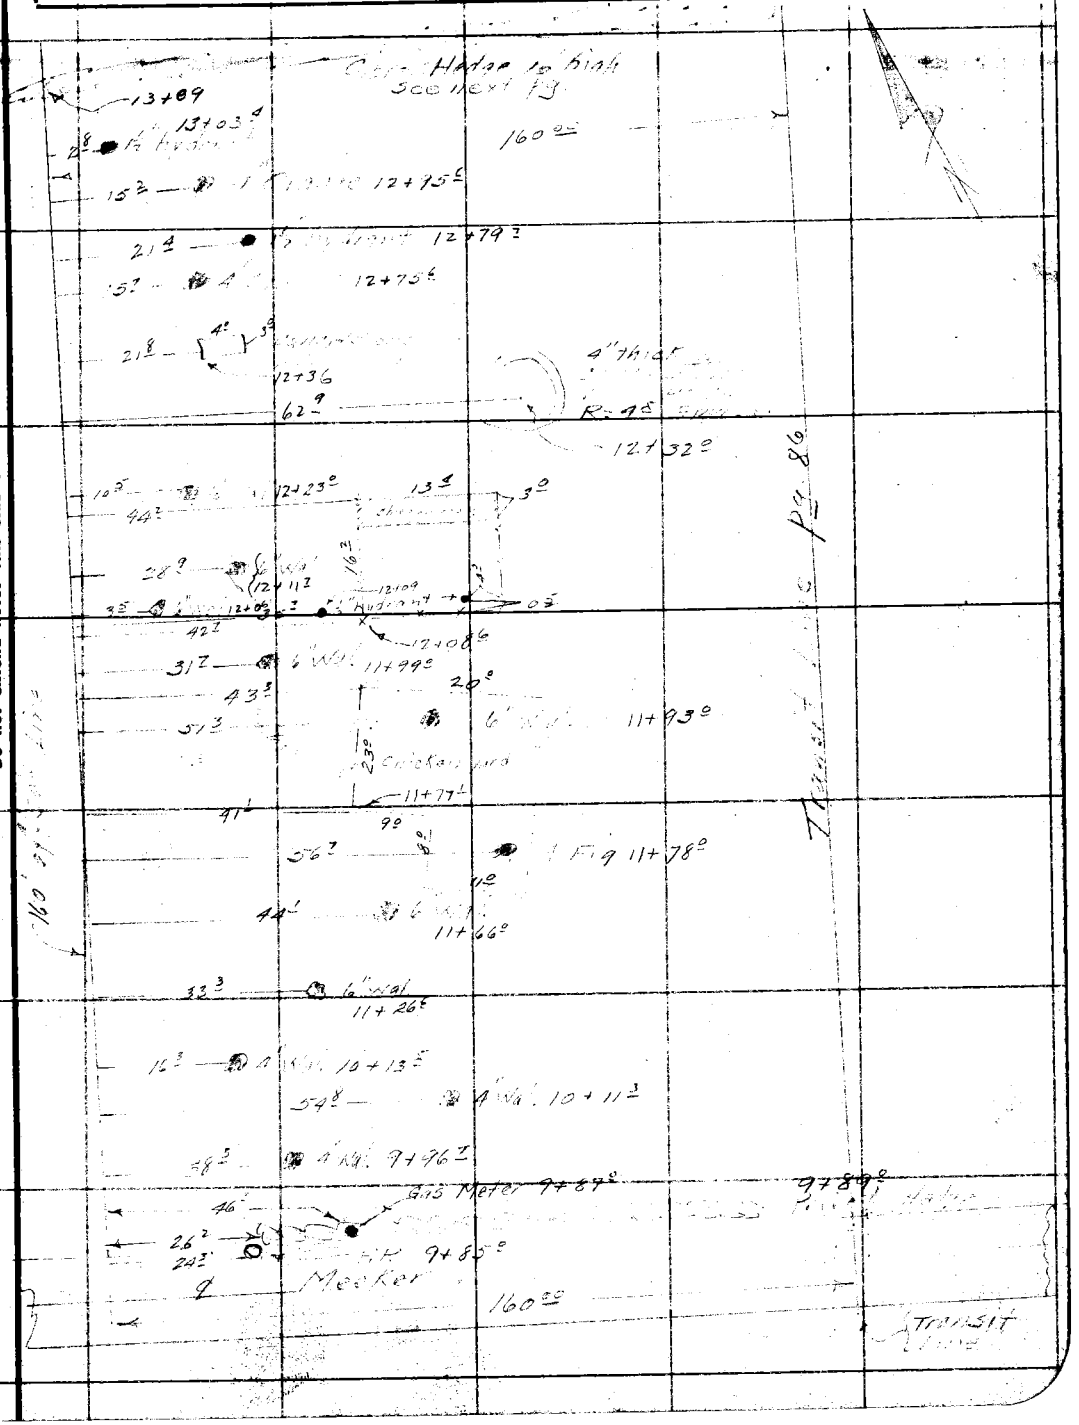

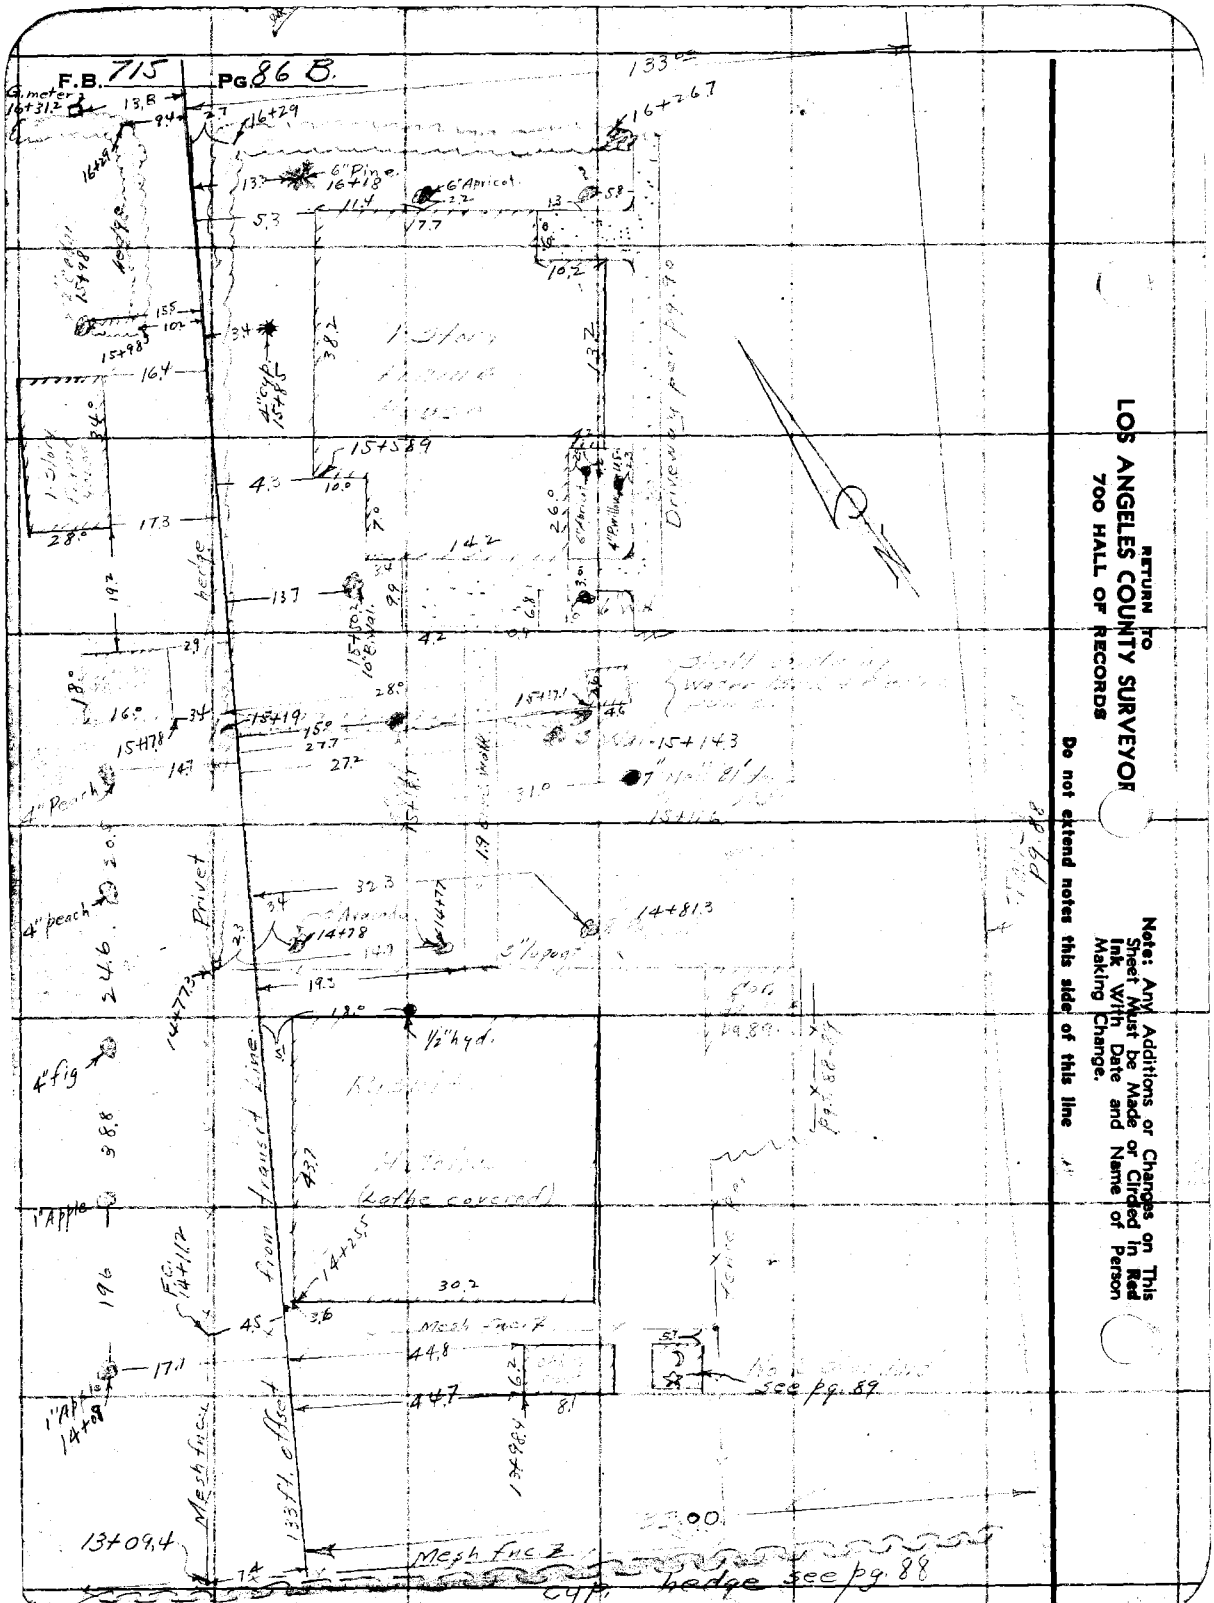
F.B. 715 Pg. 86 B.
RETURN TO
LOS ANGELES COUNTY SURVEYOR
700 HALL OF RECORDS
Do not extend notes this side of this line
Note: Any Additions or Changes on This Sheet Must be Made or Circled in Red Ink With Date and Name of Person Making Change.
See pg. 89
See pg. 88

Notes Ck'd by	Survey of
Map No. B-1351	W. O. 7122 Tape No. St'd °F.
Office Work Price	Surveyed by
Checked Roeser	Notes Date 11/21/36
Date Jan. '38	Indexed

F.B. 715 Pg. 86

Notes Any Additions or Changes on This Sheet must be Made or Circled in Red with Date and Name of Person Making Change.

Do not extend notes this side of this line

RETURN TO
LOS ANGELES COUNTY SURVEYOR
700 HALL OF RECORDS

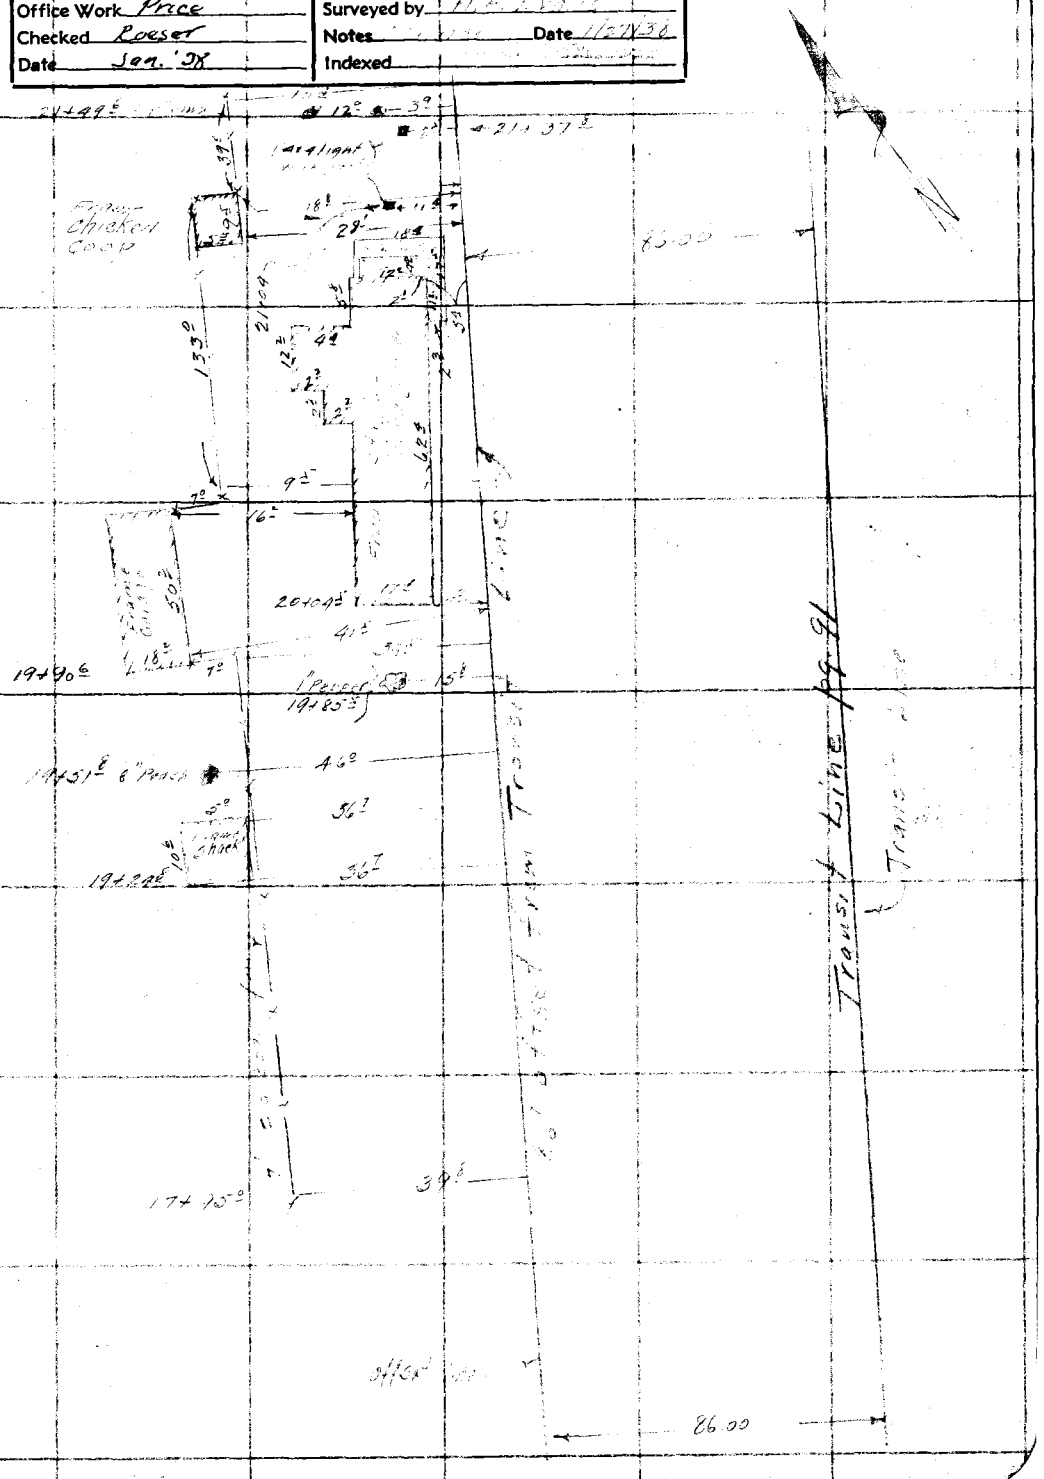

FORM 247 10M 11-38

RETURN TO
LOS ANGELES COUNTY SURVEYOR
700 HALL OF RECORDS

Note: Any Additions or Changes on This Sheet Must be Made or Circled in **Red Ink** With Date and Name of Person Making Change.

Do not extend notes this side of this line

F.B. 715 Pg. 86 D.

Notes Ck'd by	Survey of
Map No. S.S. B-1351-2	W. O. 7252 Tape No. St'd °F.
Office Work J.D. Price	Surveyed by H F EVANS
Checked Cap	Notes HE & HB Date 7-1-31
Date Aug '34	Indexed A. Cross

F.B. 216 Pg. 87

Note: Any Additions or Changes on This Sheet Must be Made or Circled in Red Ink With Date and Name of Person Making Change.

Do not extend notes this side of this line

RETURN TO
LOS ANGELES COUNTY SURVEYOR
700 HALL OF RECORDS

FORM 247 10M 11-35

4" Laurel 11+81.2
11+82.8 N.W.
11+75.5 3" apricot
11+77 11" Ivy
2" Pear 11+70.7
2" cherry 11+66.8
11+60 3" Pear
5" Wal 11+45.1
11+60.2 11" Acacia
4" Apricot 11+59.2
11+38.2
11+33
4" Wal 11+18.6
4" 11+14.5
5" Wal 10+88.4
11" Wal
4" Wal
10+51.7 4" Wal
4" Pear 10+48.6
4" Apricot 10+35.2
4" Wal 10+36.3
5" Wal 10+24.8
5" Wal 10+08.3
10+00
5" Wal 9+91.3
5" Wal 9+82.5
Privet hedge

31.1
22.9
35.4
58.3
90.7
78.6
24.6
90.6
31.2
78.9
57.5
47.9
11.6
60.2
79.7
35.8
32°
14°
62.1
48.4
21°
24.2
50.1
83.2
94.8
41.2
39.4
58.1
27°
150
10+06
83.4
29.2
39.2
96.3
30.4
12.1

Transit Line Flower Field

from top pg. 86

F.B. 715 PG. 88

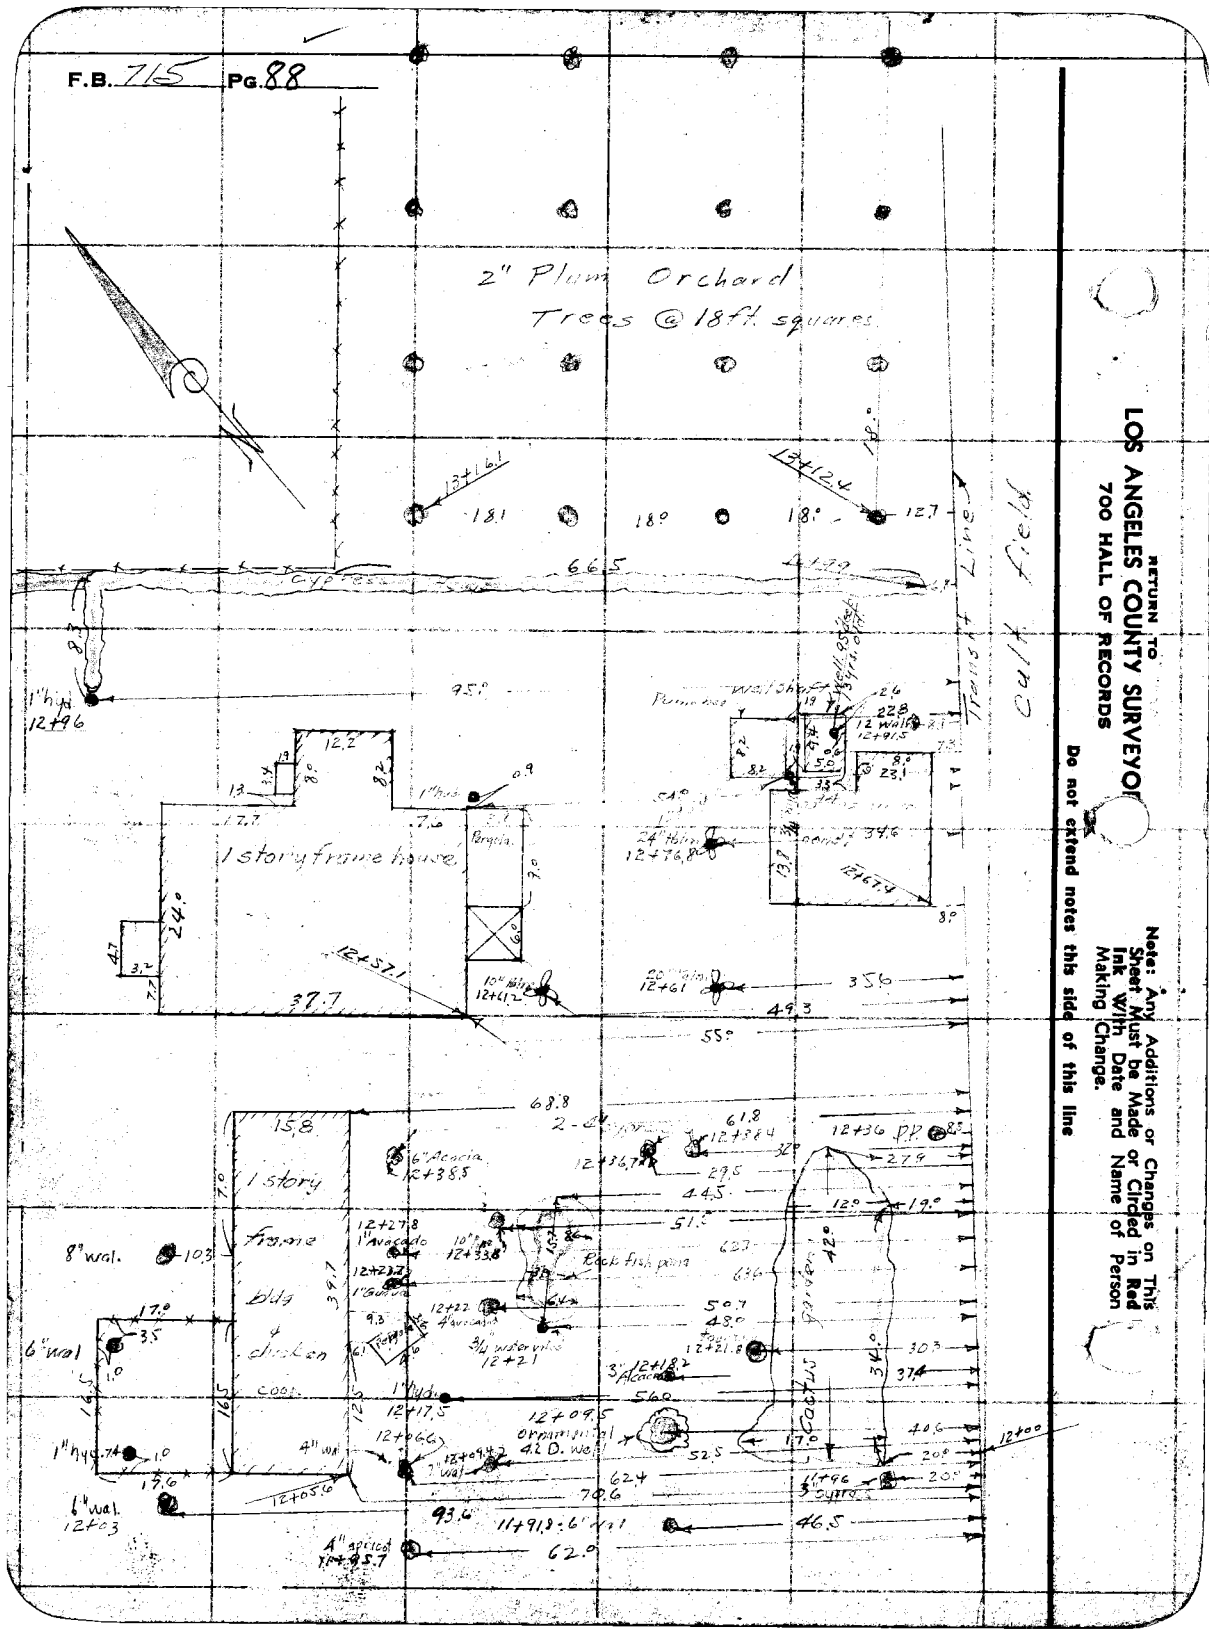

RETURN TO
LOS ANGELES COUNTY SURVEYOR
700 HALL OF RECORDS

Note: Any Additions or Changes on This Sheet Must be Made or Circled in Red Ink With Date and Name of Person Making Change.

Do not extend notes this side of this line

Notes Ck'd by	Survey of Pace Ave
Map No. C.S. B-1351-2	W. O. 7052 Tape No. St'd °F.
Office Work J.D. Price	Surveyed by HEEvans
Checked Clark	Notes HE #70 C. Jones Date 7-7-39
Date Aug. '39	Indexed

F.B. 115 Pg. 89

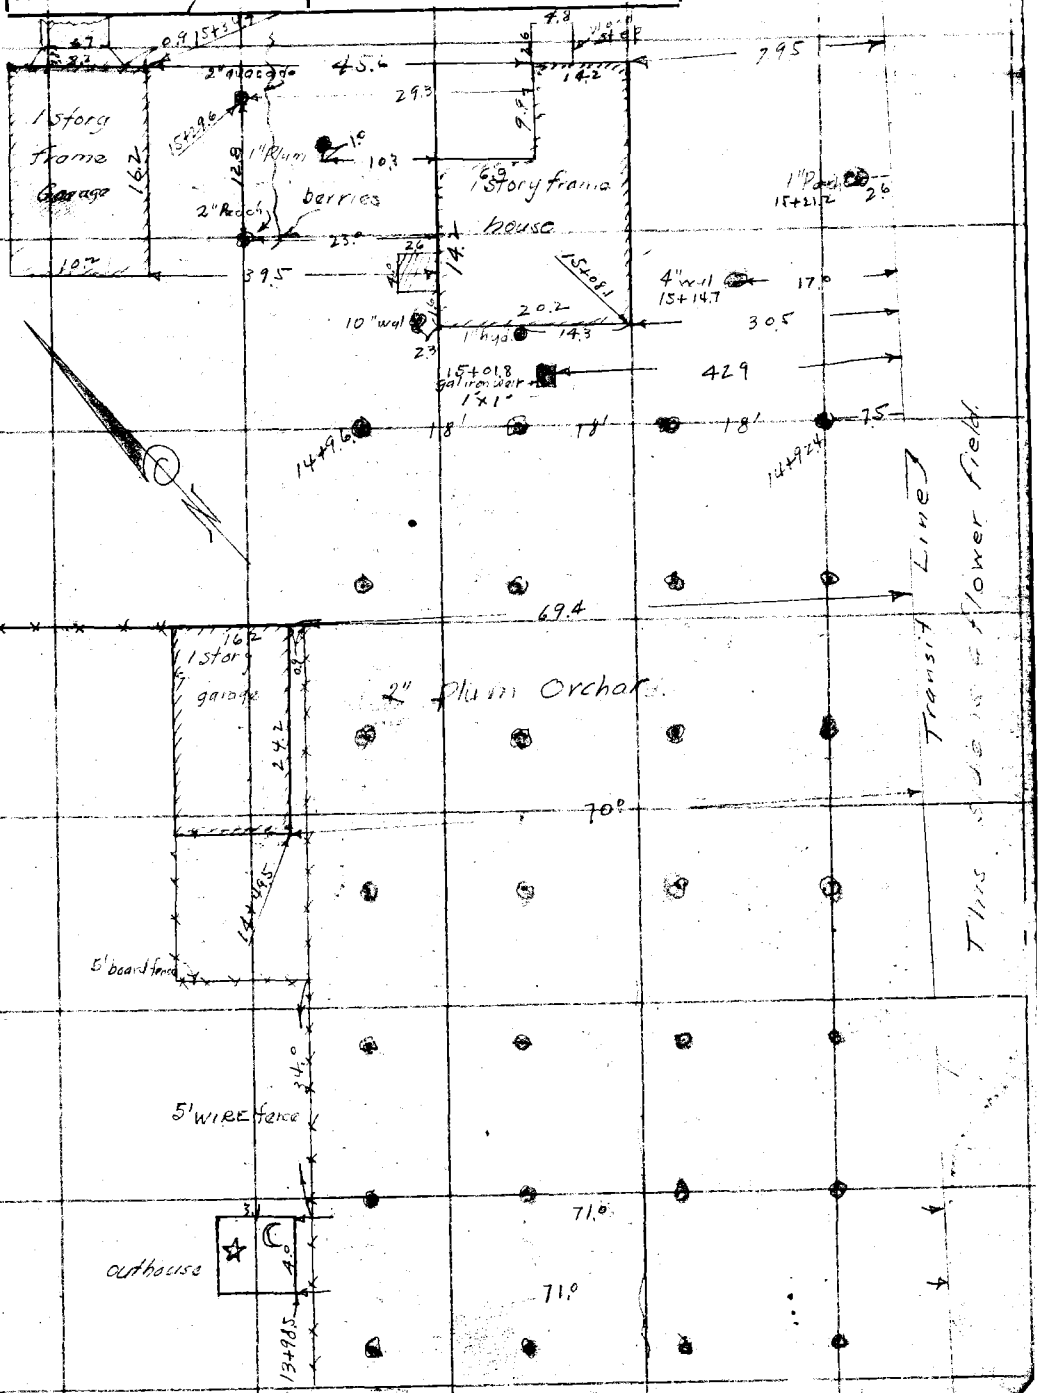

Note: Any Additions or Changes on This Sheet Must be Made or Circled in Red Ink With Date and Name of Person Making Change

Do not extend notes this side of this line

RETURN TO
LOS ANGELES COUNTY SURVEYOR
700 HALL OF RECORDS

FORM 247 10M 11-38

RETURN TO
LOS ANGELES COUNTY SURVEYOR
700 HALL OF RECORDS

Note: Any Additions or Changes on This Sheet Must be Made or Circled in **Red** Ink With Date and Name of Person Making Change.

Do not extend notes this side of this line

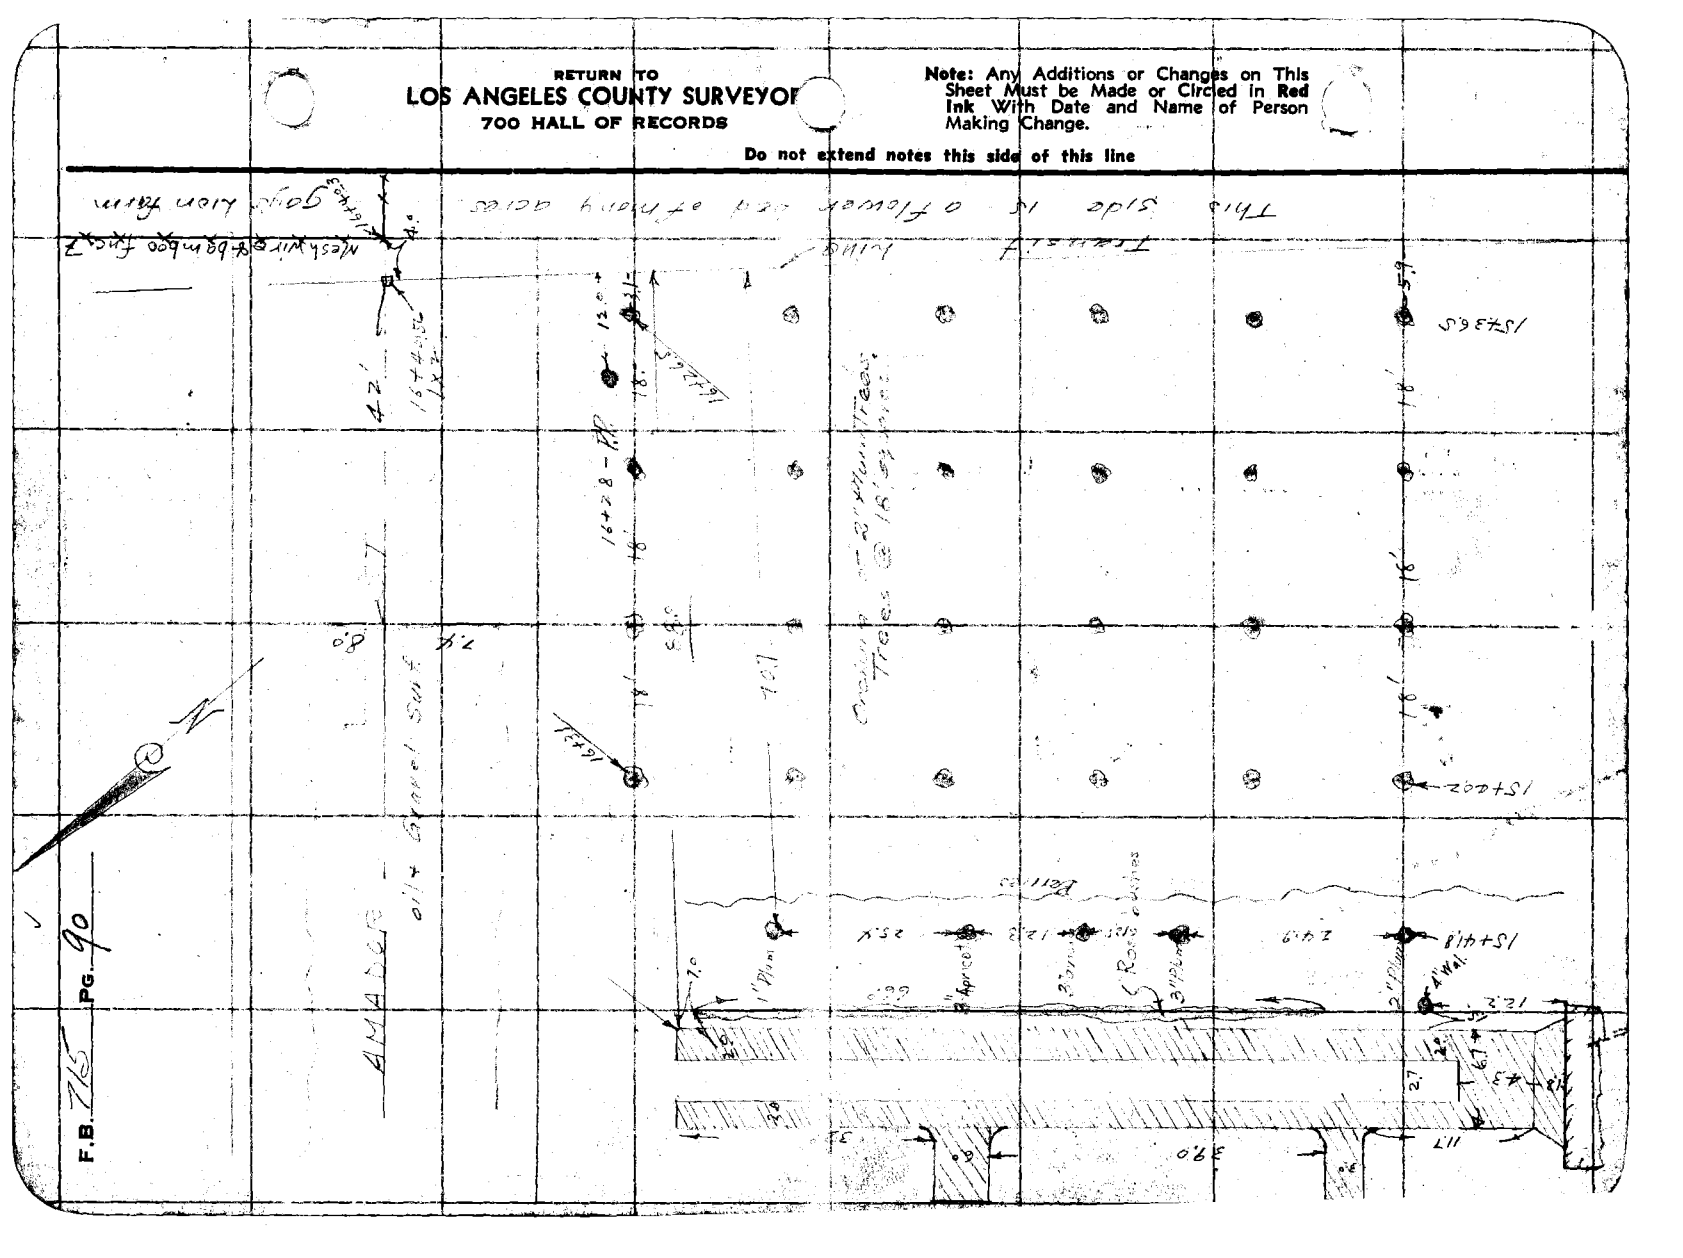

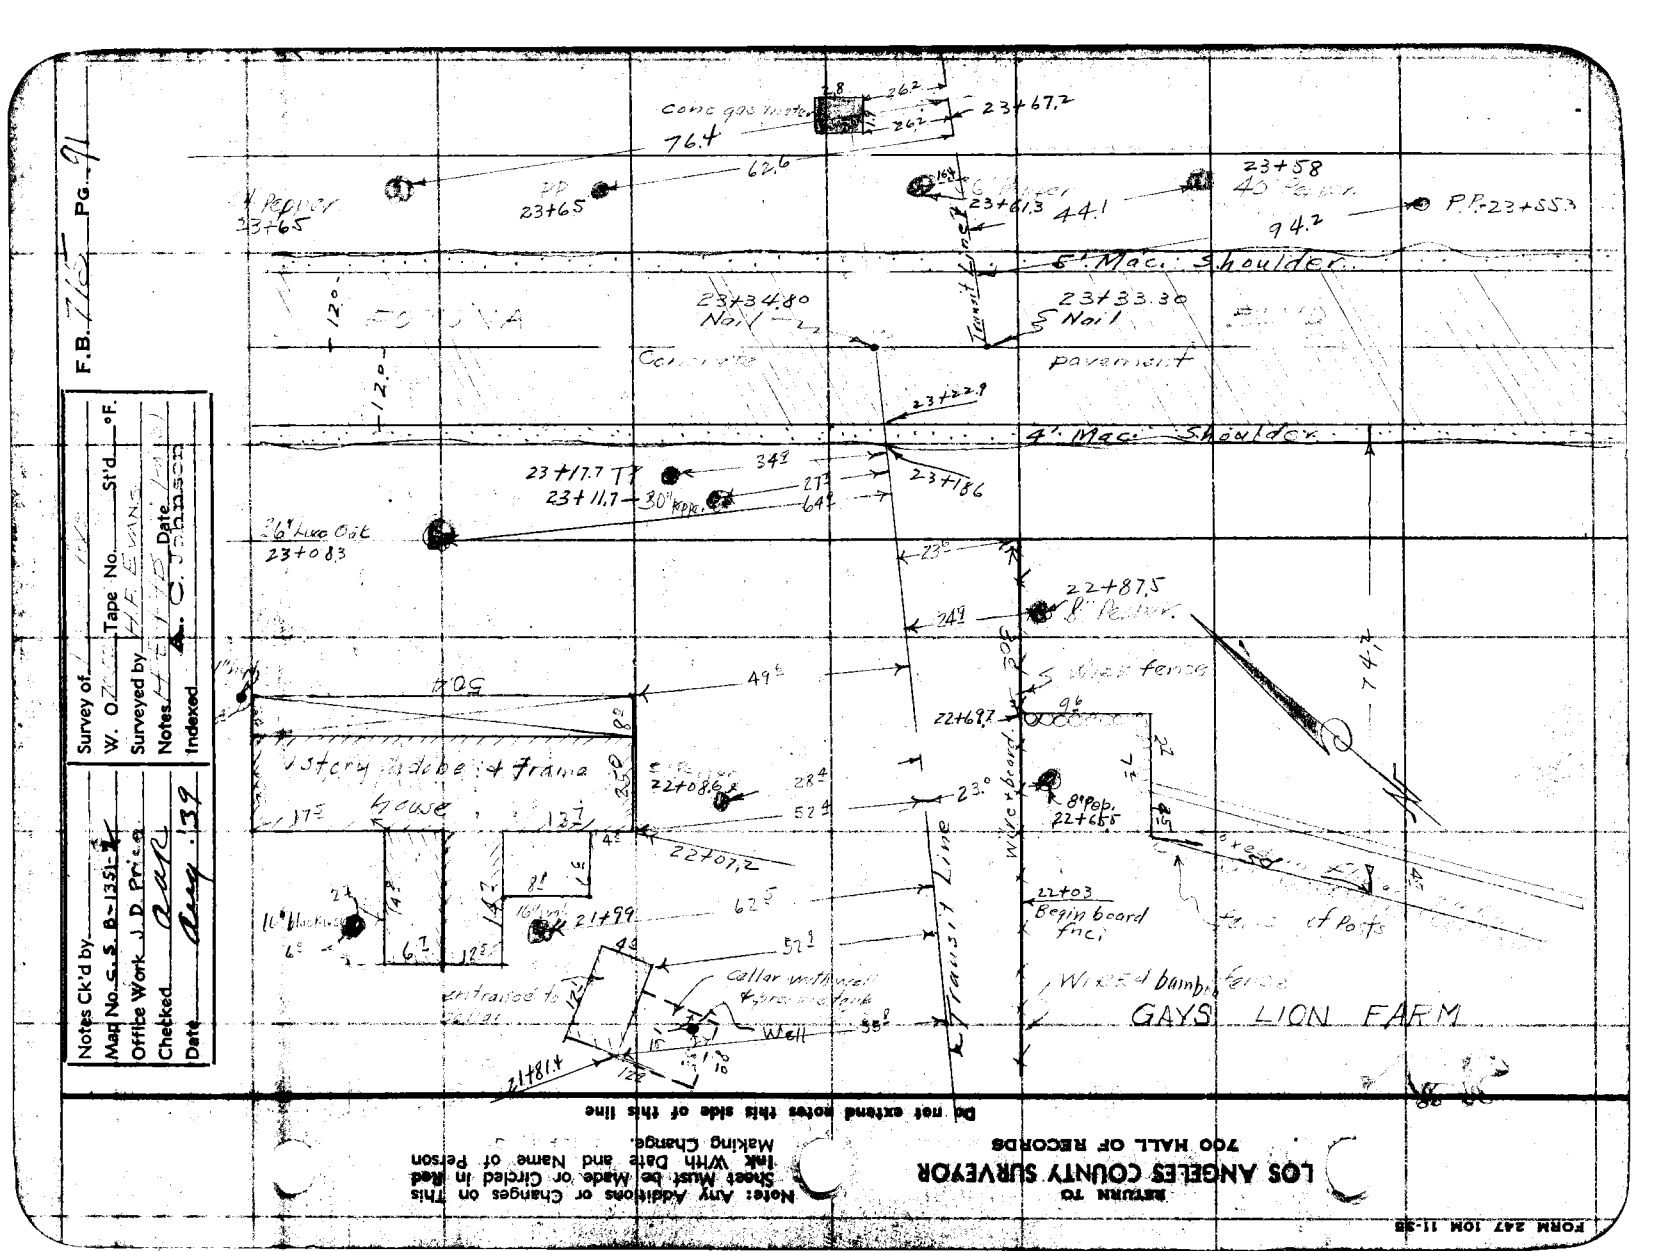
Survey of W. O.
Tape No.
St'd °F.
Surveyed by H.E. EVANS
Date 1-15-35
Notes
Indexed A.C. Johnson
Notes Ck'd by
Map No. S.S. B-135
Office Work J.D. Price
Checked Ray
Date Aug. 139
Conc gas mete
76.4
62.6
23+65
23+67.2
23+58
44.1
94.2
P.P. 23+55.3
23+61.3
6" Mac. Shoulder
120'
23+34.80
Nail
23+33.30
Nail
pavement
23+22.9
4' Mac. Shoulder
23+17.7 T
23+11.7 30" RDM.
34
27
64
23+18.6
36" Live Oak
23+08.3
23
24
22+87.5
8" Pepper
Shed fence
49
50
22+69.7
96
74.2
22+08.6
28
52
23°
8" Pepp.
22+65.5
Wire fence
Transit Line
22+07.2
62
57
Collar with wood
Well
55
21+81.4
22+03
Begin board fnci
Wired bamboo fence
GAYS LION FARM
Do not extend notes this side of this line
RETURN TO
LOS ANGELES COUNTY SURVEYOR
700 HALL OF RECORDS
Note: Any Additions or Changes on This Sheet Must be Made or Circled in Red Ink With Date and Name of Person Making Change.
FORM 247 10M 11-38

RETURN TO
LOS ANGELES COUNTY SURVEYOR
700 HALL OF RECORDS

Note: Any Additions or Changes on This Sheet Must be Made or Circled in **Red** Ink With Date and Name of Person Making Change.

Do not extend notes this side of this line

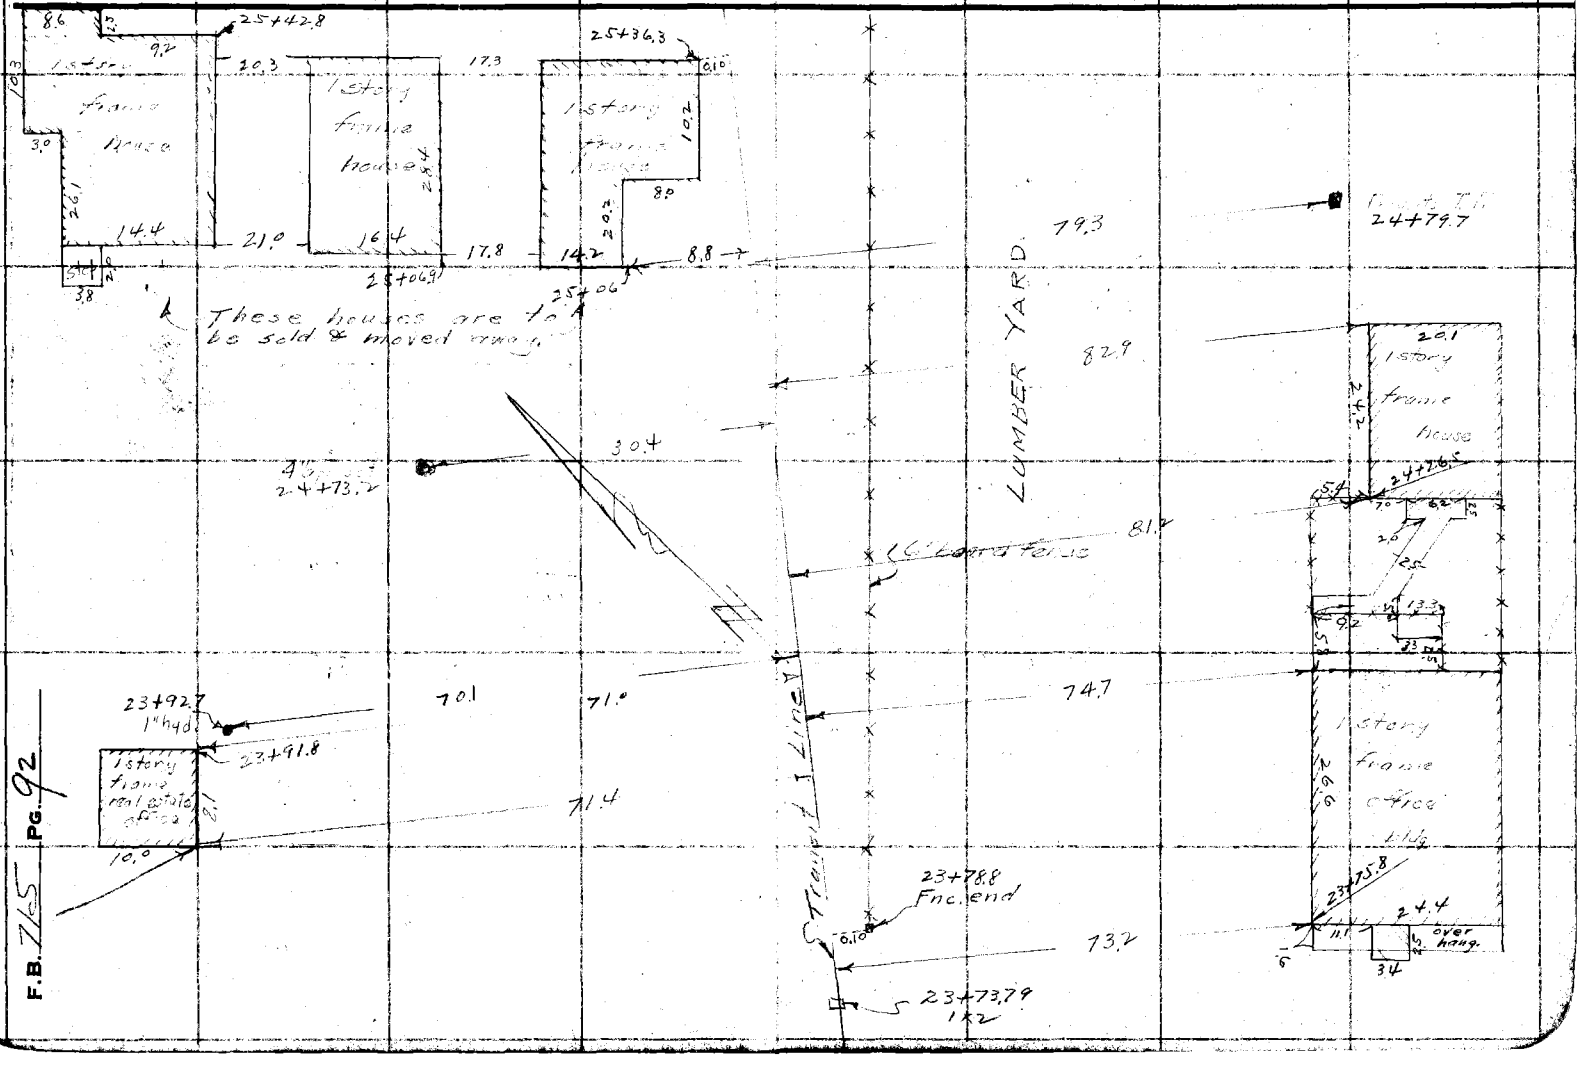

FORM 247 10M 11-35

RETURN TO
LOS ANGELES COUNTY SURVEYOR
700 HALL OF RECORDS

Note: Any Additions or Changes on This Sheet Must be Made or Circled in **Red Ink** With Date and Name of Person Making Change.

Do not extend notes this side of this line

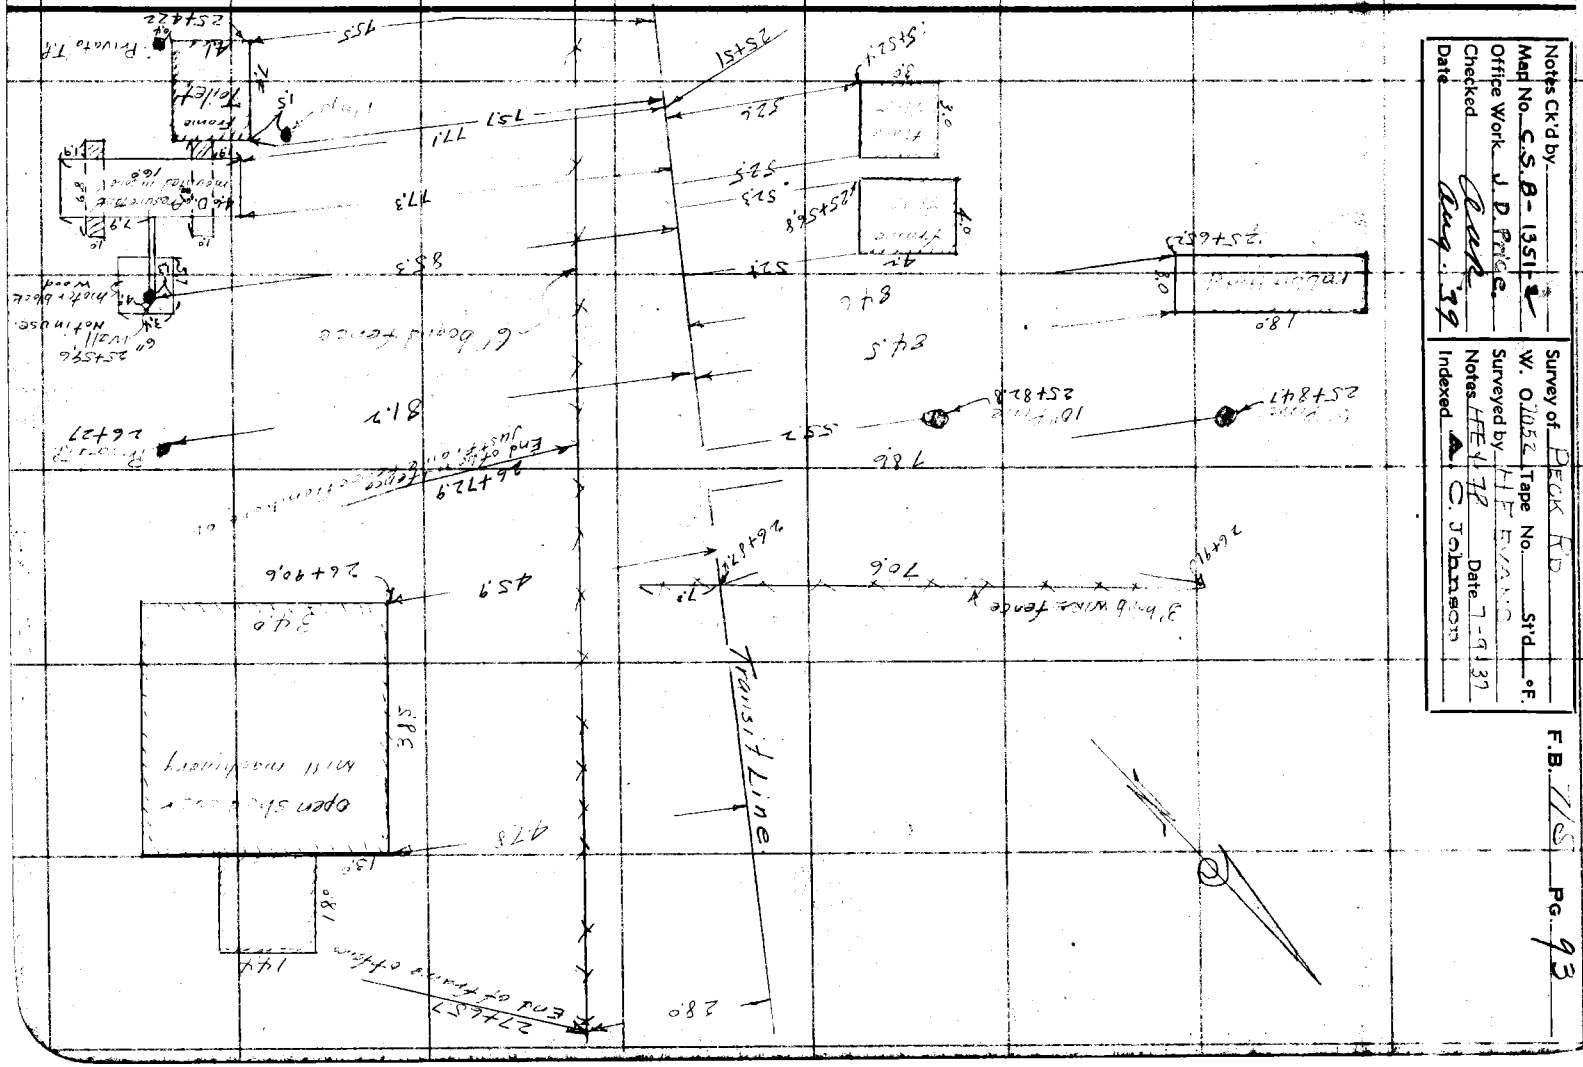
Transit Line
End of fence
End of fence
End of fence
Rivota T.R.
Open shed
Mail Mailbox
Well
Concrete
Mounted in post
Wood
Wood
Not in use
Wall
Old board fence
3 b'd wire fence
Tree
Tree
Tree

RETURN TO
LOS ANGELES COUNTY SURVEYOR
700 HALL OF RECORDS

Note: Any Additions or Changes on This Sheet Must be Made or Circled in Red Ink With Date and Name of Person Making Change.

Do not extend notes this side of this line

F.B. 715 Pg. 94

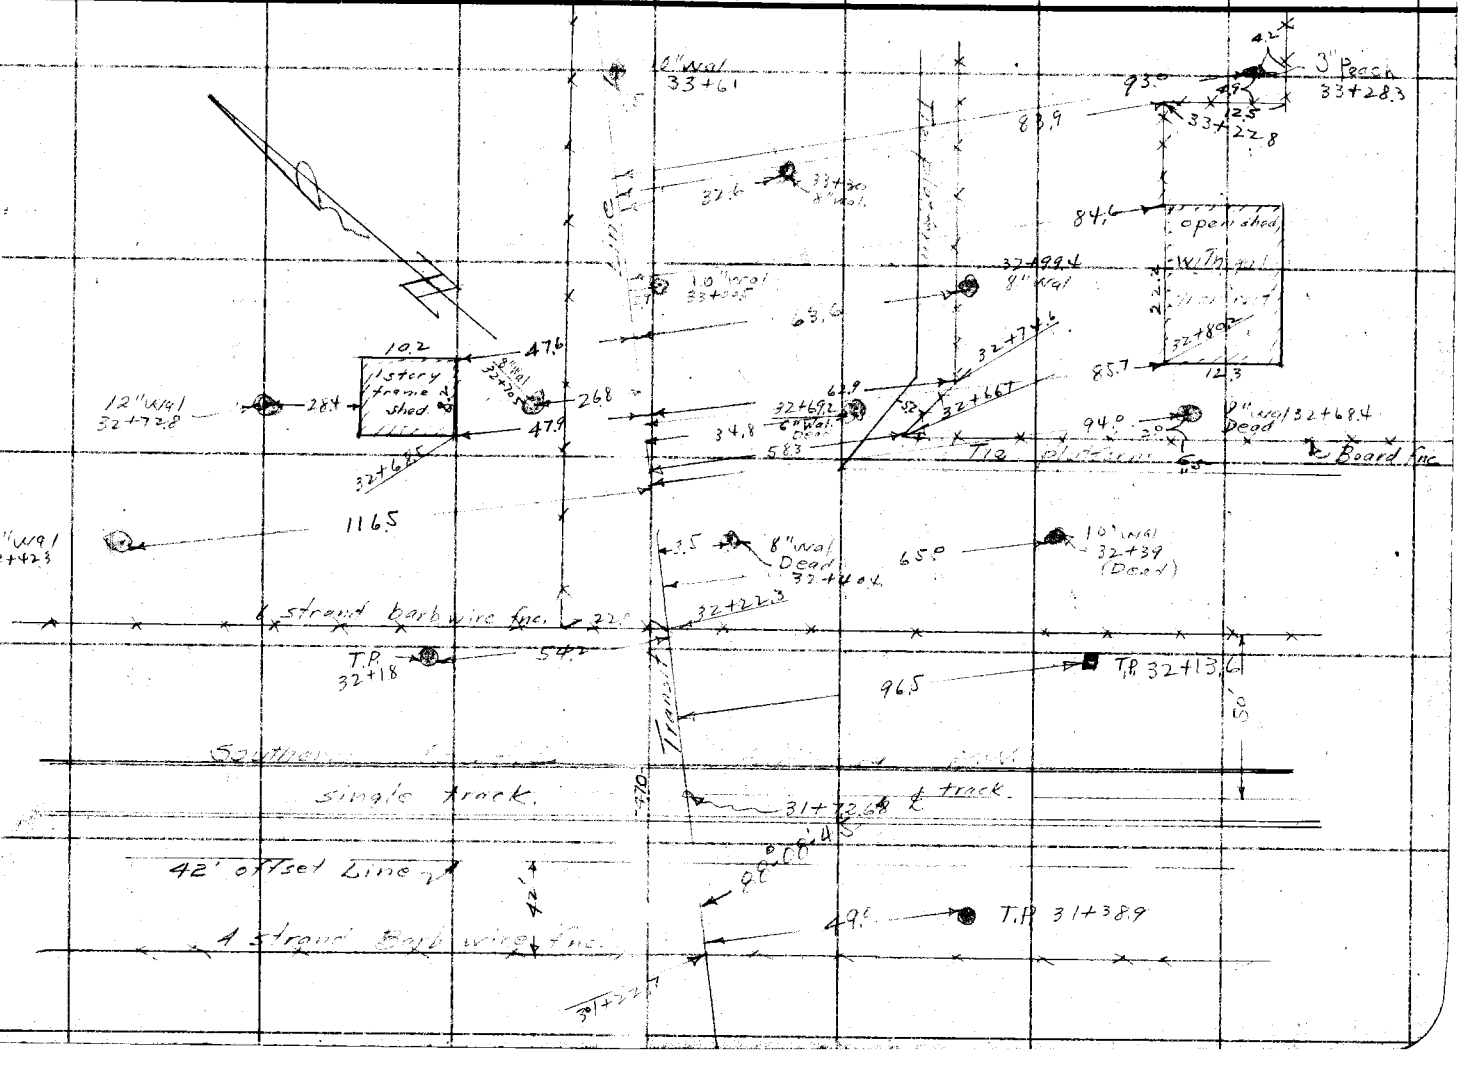

Notes Ck'd by	Survey of BECK RD
Map No. C.S.B-1351-V	W. 0.765 Tape No. St'd °F.
Office Work J. D. Price	Surveyed by H.F. EVANS
Checked AAP	Notes HFE 4 712 Date 7-9-37
Date Aug. '39	Indexed A. C. Johnson

F.B. 115 Pg. 95

Note: Any Additions or Changes on This Sheet Must be Made or Circled in Red Ink With Date and Name of Person Making Change.

Do not extend notes this side of this line

RETURN TO
LOS ANGELES COUNTY SURVEYOR
700 HALL OF RECORDS

FORM 247 10M 11-38

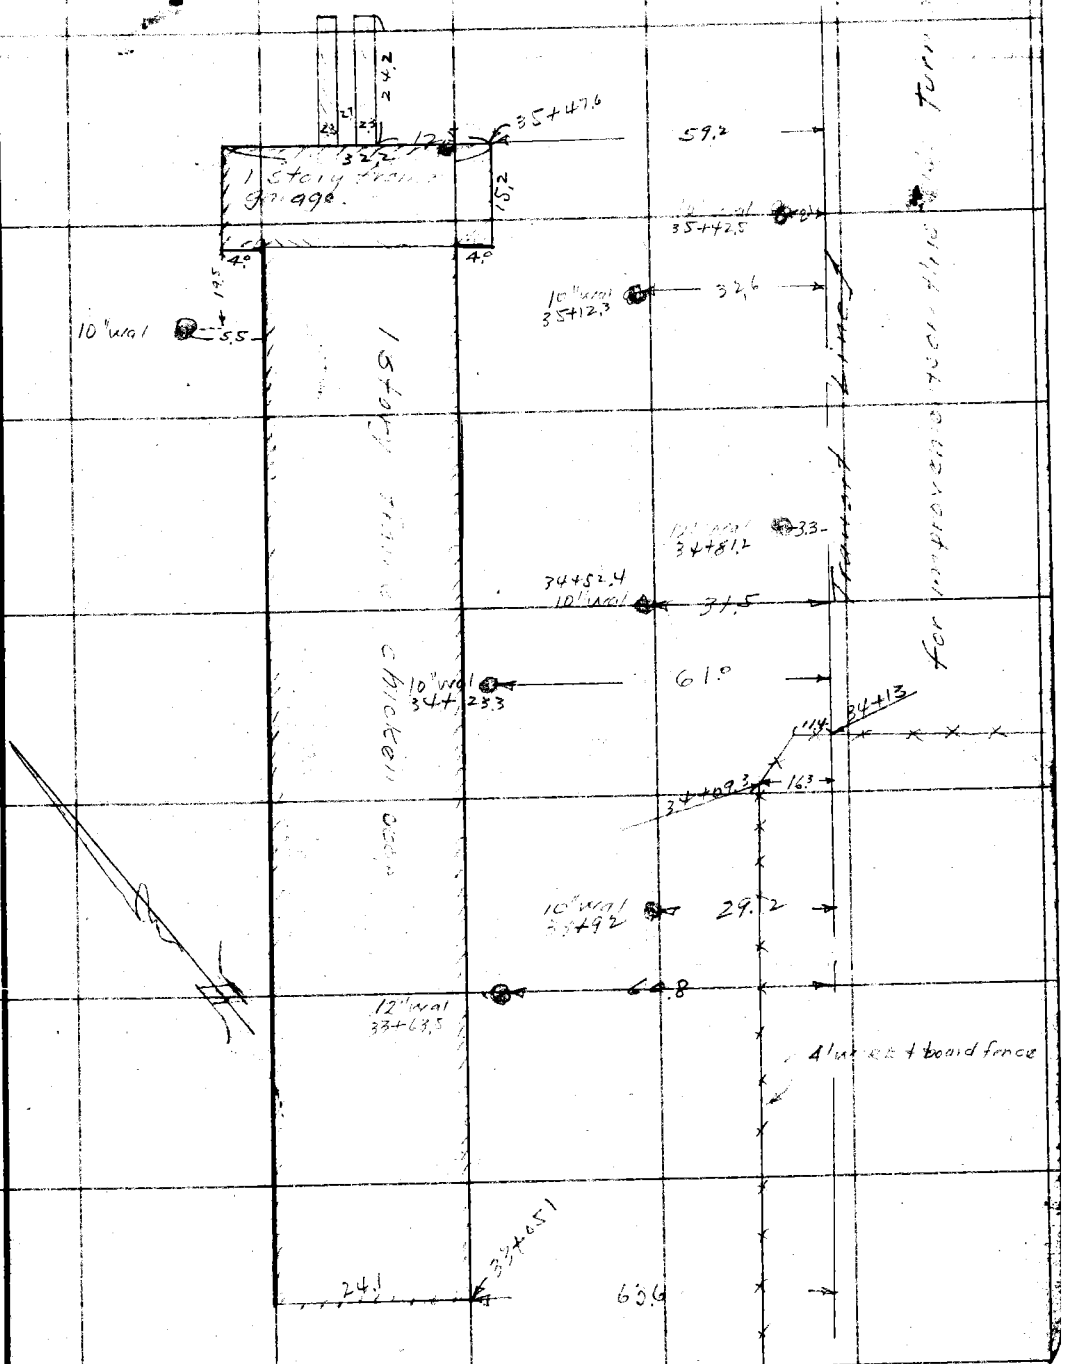

F.B. 715 Pg. 96

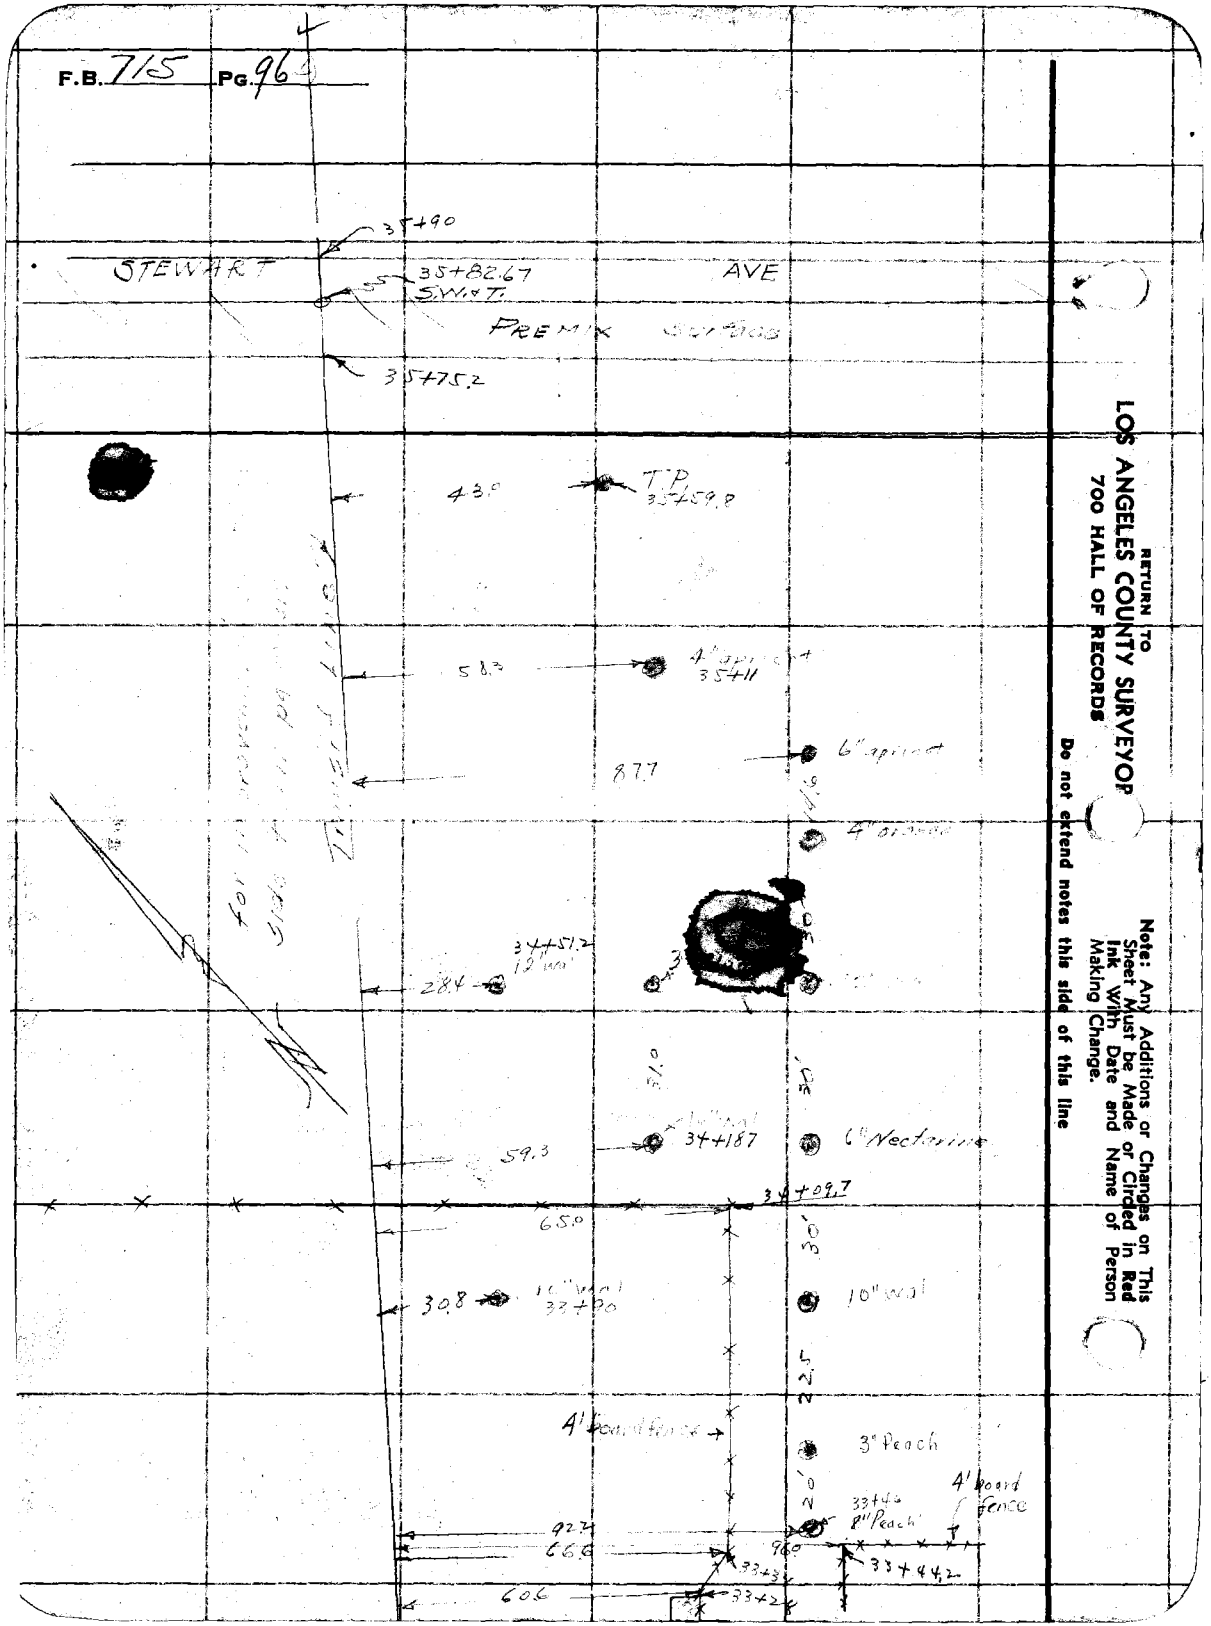

RETURN TO
LOS ANGELES COUNTY SURVEYOR
700 HALL OF RECORDS

Note: Any Additions or Changes on This Sheet Must be Made or Circled in Red Ink With Date and Name of Person Making Change.

Do not extend notes this side of this line

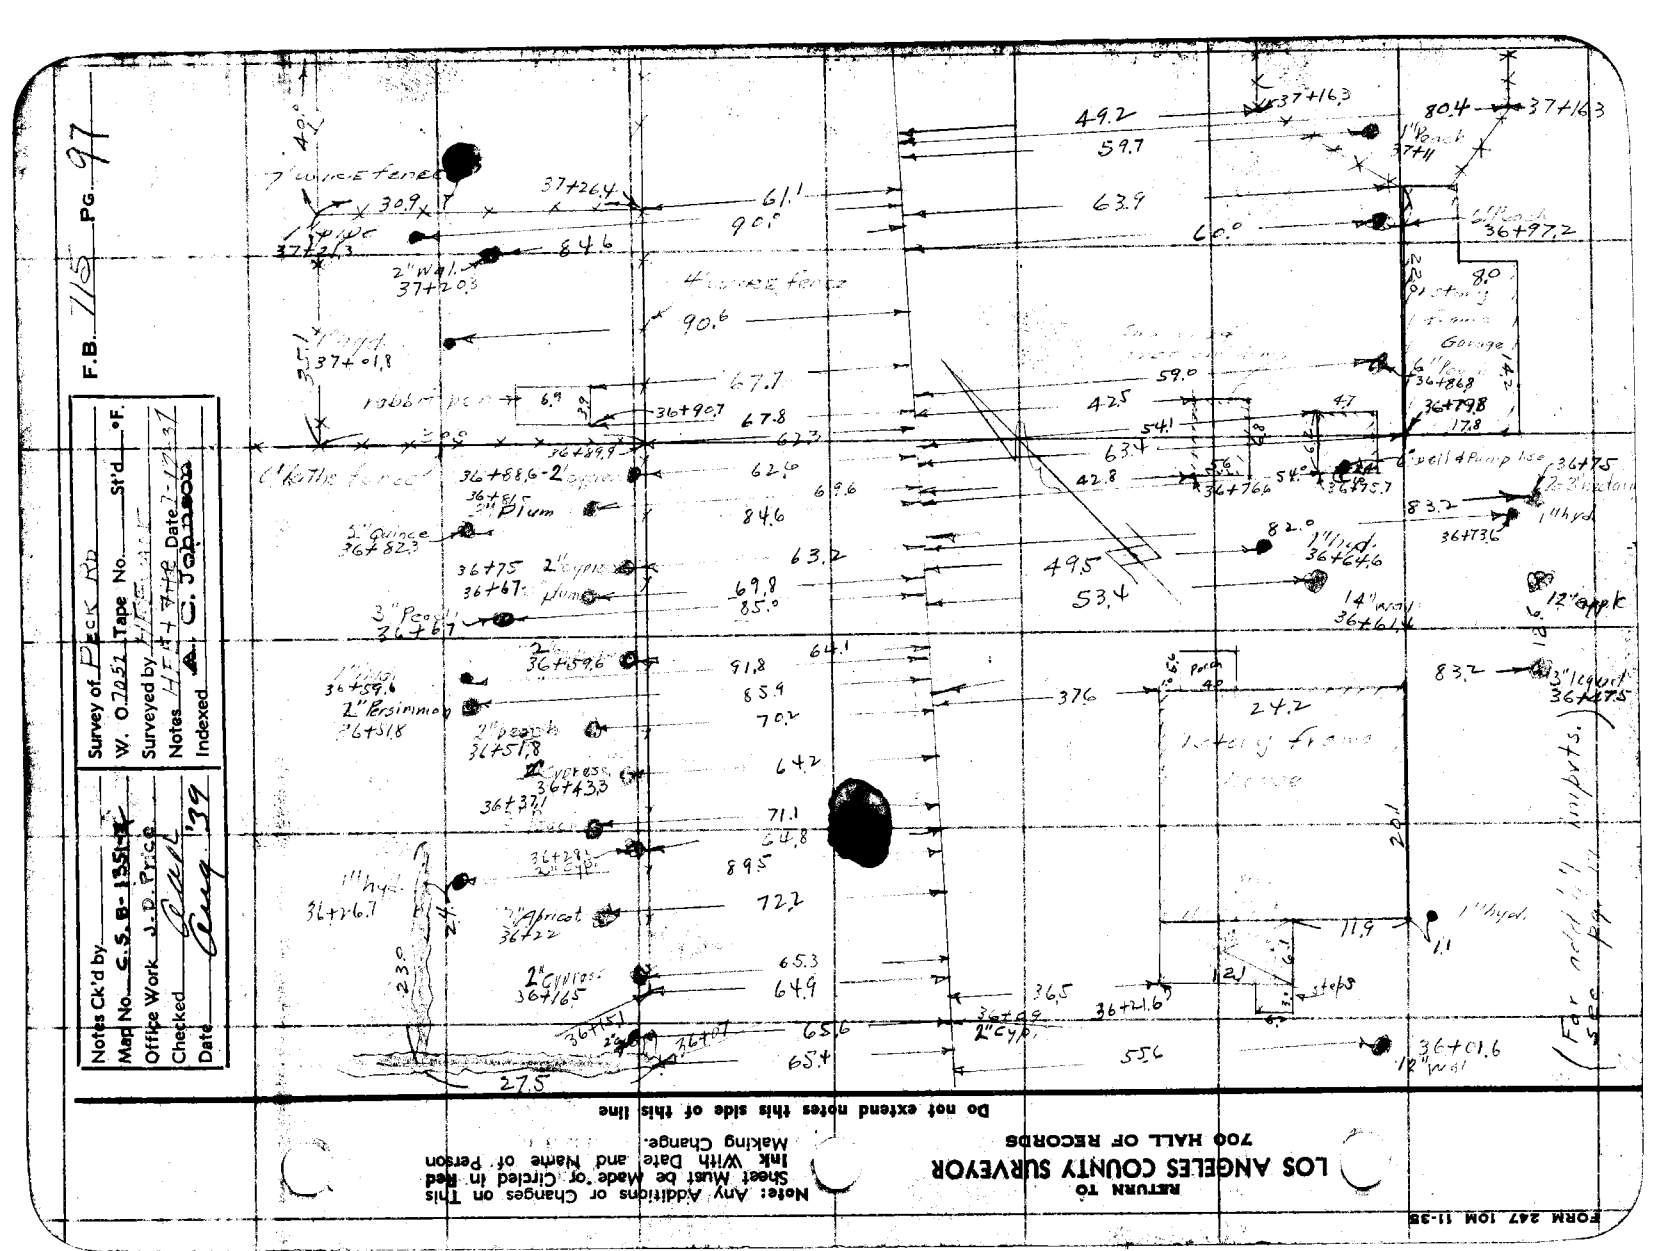
F.B. 115 Pg. 97
Survey of Beck Rd
W. O. 70252 Tape No. Std. °F.
Surveyed by LFE
Notes LFE 4-7-38 Date 7-12-37
Indexed C. Johnson
Notes Ck'd by
Map No. C.S.B. 1351
Office Work J.D. Price
Checked Gang
Date Gang '38
RETURN TO
LOS ANGELES COUNTY SURVEYOR
700 HALL OF RECORDS
Note: Any Additions or Changes on This Sheet Must be Made or Circled in Red Ink With Date and Name of Person Making Change.
Do not extend notes this side of this line
FORM 247 10M 11-38
Far right, see pg. 11 Amphrts.

RETURN TO
LOS ANGELES COUNTY SURVEYOR
700 HALL OF RECORDS

Note: Any Additions or Changes on This Sheet Must be Made or Circled in Red Ink With Date and Name of Person Making Change.

Do not extend notes this side of this line

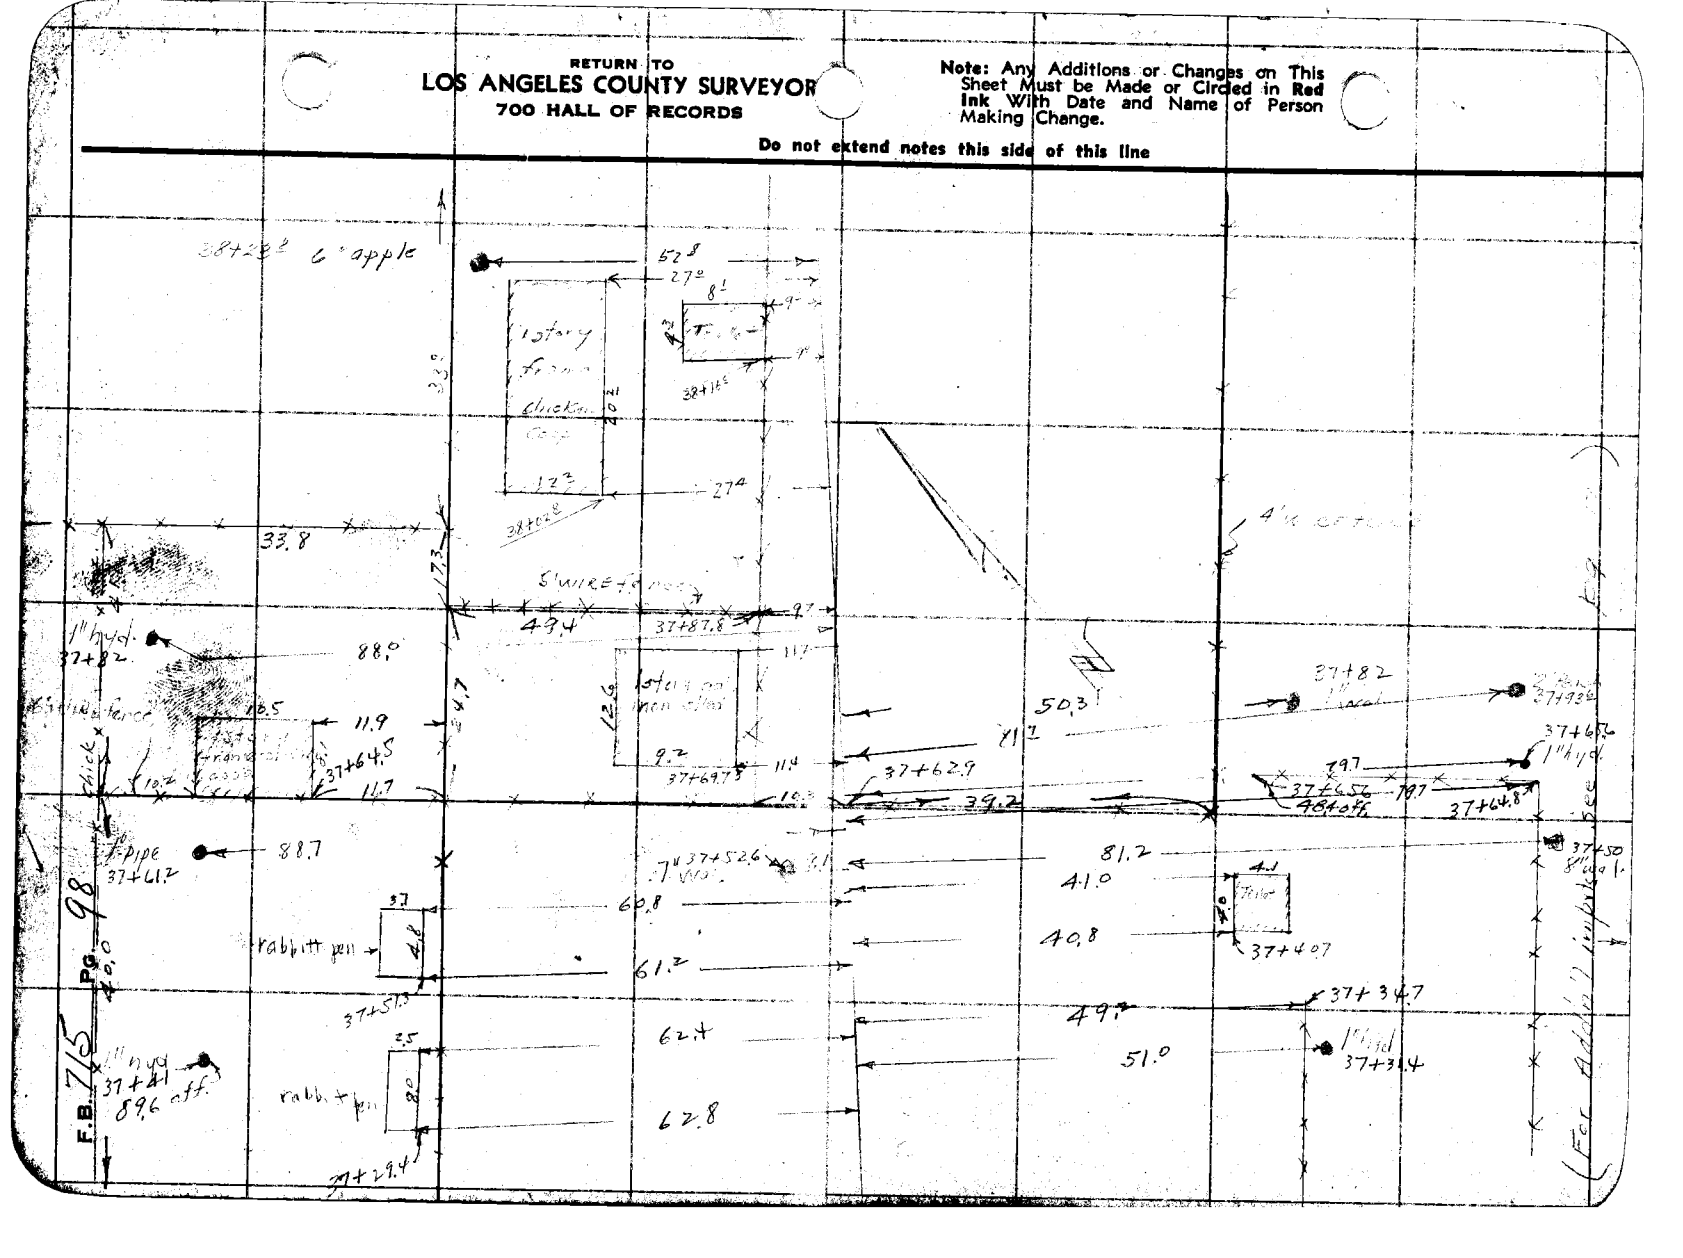

Notes Ck'd by	Survey of
Map No. C.S. B-1351	W. O. 7652 Tape No. St'd °F.
Office Work J.D. Price	Surveyed by H.F. EVANS.
Checked Carr	Notes HE & TE Date 7-12-37
Date Aug '39	Indexed A. C. Johnson

F.B. 715 Pg. 99

Note: Any Additions or Changes on This Sheet Must be Made or Circled in Red Ink With Date and Name of Person Making Change.

Do not extend notes this side of this line

LOS ANGELES COUNTY SURVEYOR
700 HALL OF RECORDS

FORM 247 10M 11-38

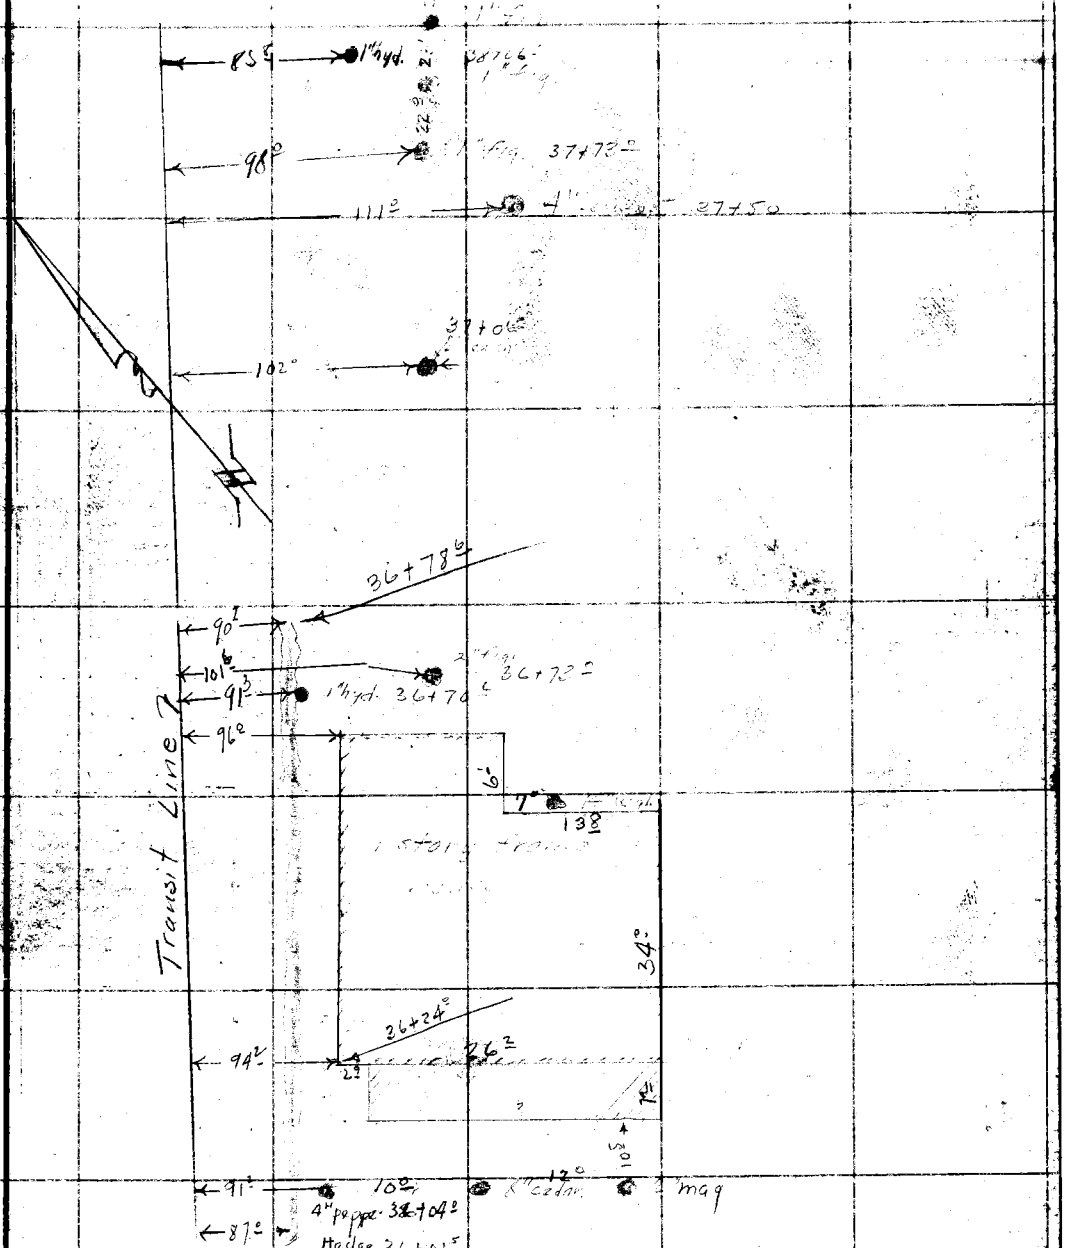

RETURN TO
LOS ANGELES COUNTY SURVEYOR
700 HALL OF RECORDS

Note: Any Additions or Changes on This Sheet Must be Made or Circled in Red Ink With Date and Name of Person Making Change.

Do not extend notes this side of this line

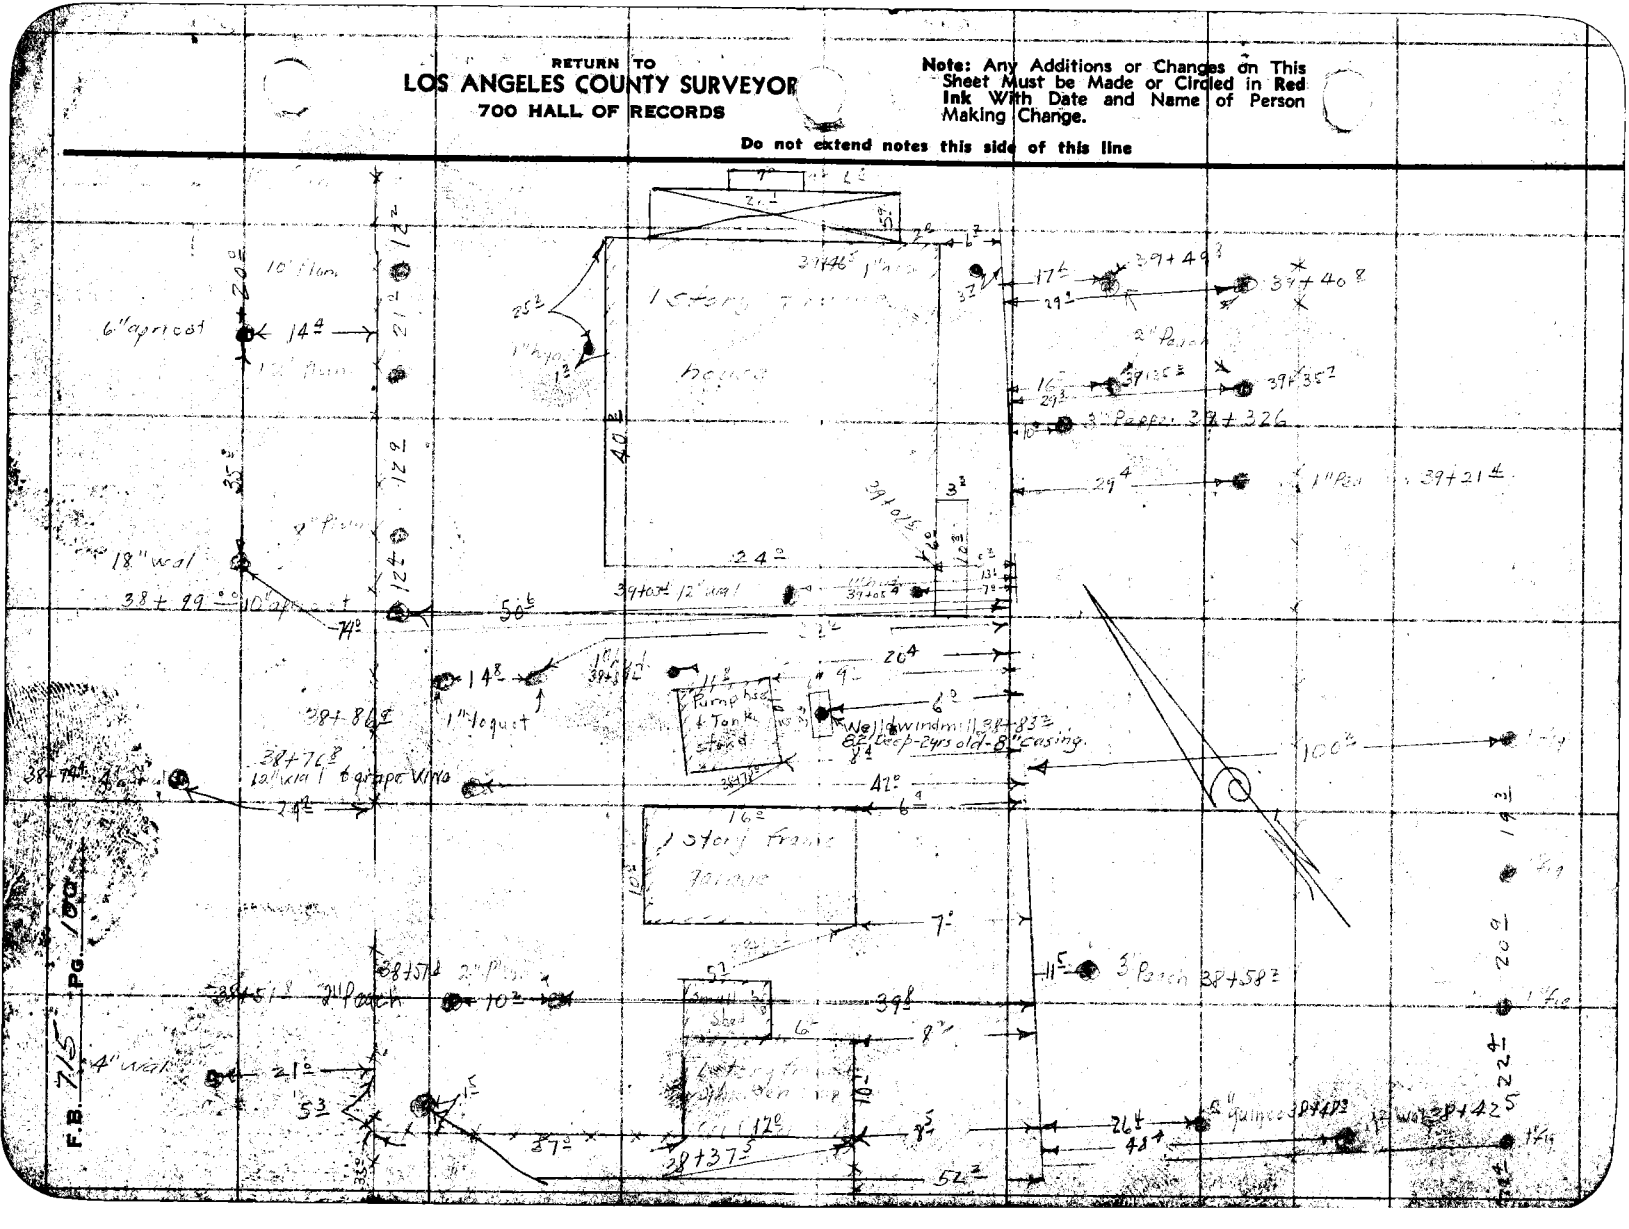

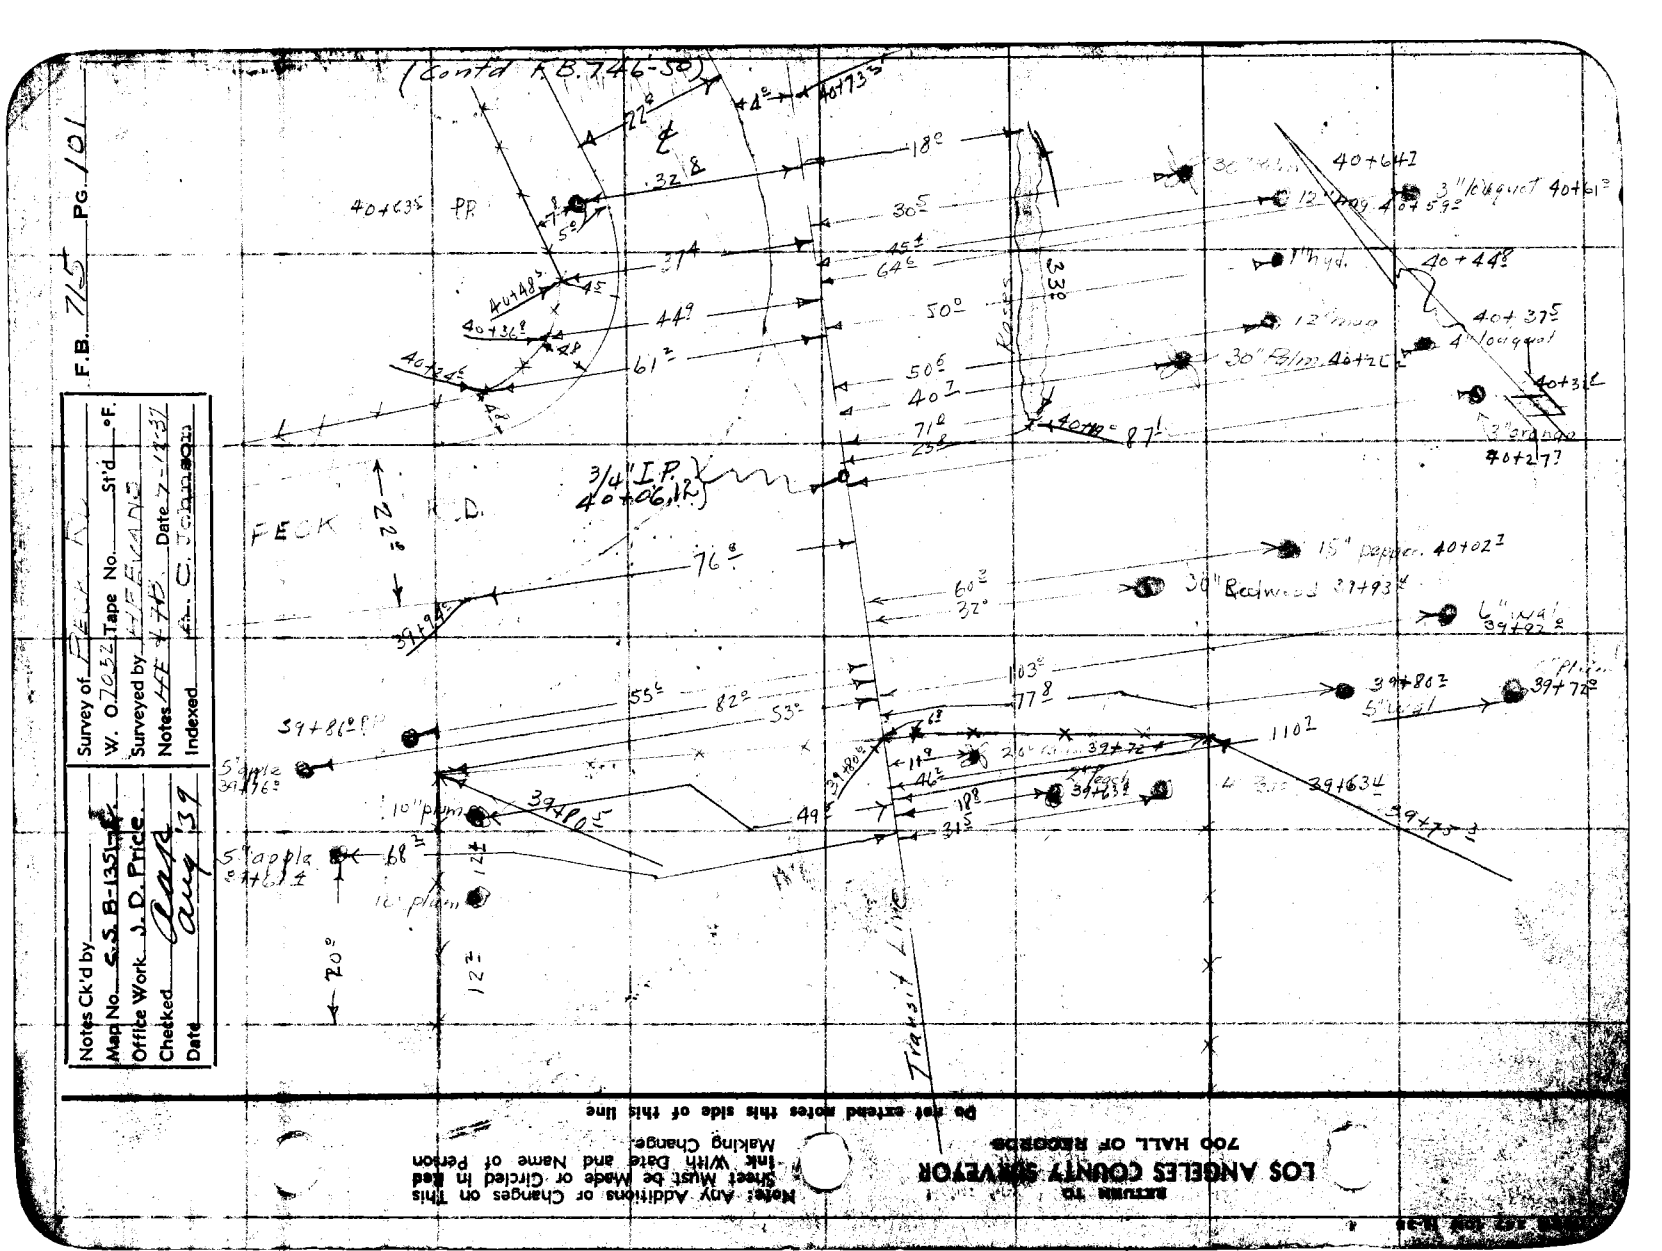


Survey of FECK RD.	
W. O. 7032 Tape No.	St'd °F.
Indexed C. Johnson	

Notes Ck'd by	
Map No. S.S. B-135	
Offile Work J.D. Pricle	
Checked Aug '39	
Date	

Note: Any Additions or Changes on This Sheet Must be Made or Circled in Red Ink With Date and Name of Person Making Changes.

RETURN TO
LOS ANGELES COUNTY SURVEYOR
700 HALL OF RECORDS

Do not extend notes this side of this line

F.B. 715 Pg. 102

PRELIMINARY SURVEY

& MERLE AVE.
From
MT. VIEW RD.
To
GARVEY AVE.

H.F. Eyons
H.M. Smith
D.S. Sedig
N.R. Smith

FINAL 2-161-167 Pgs.

RETURN TO
LOS ANGELES COUNTY SURVEYOR
700 HALL OF RECORDS

Note: Any Additions or Changes on This Sheet Must be Made or Circled in Red Ink With Date and Name of Person Making Change.

Do not extend notes this side of this line

FORM 247 10M 11-35

RETURN TO
LOS ANGELES COUNTY SURVEYOR
700 HALL OF RECORDS

Note: Any Additions or Changes on This Sheet Must be Made or Circled in Red Ink With Date and Name of Person Making Change.

Do not extend notes this side of this line

336-1

Notes Ck'd by
Map No. B-1351-2
Office Work Price Rear
Checked
Date Aug. '37

Survey of Peck Rd.
W. O. 7254 Tape No. 643 St'd 44° F.
Surveyed by Evans
Notes
Indexed Date 7-29-37
8-2-37

F.B. 215 Pg. 103

℄ per F.B. 715-203, 204

MT VIEW

134°-55'-40"

FOR PROPOSED CENTER LINE OF PECK ROAD SEE P. 161

248.96-T84°

℄ MERLE AVE. PRODUCED

352.55-T84°

Cross Mark set 5 Wt by 11 Forsyth

To ℄ Kingsburn

RD.

(134-55-45)
(1799-42-45)
1340-55-44½"

1

RETURN TO
LOS ANGELES COUNTY SURVEYOR
700 HALL OF RECORDS

Note: Any Additions or Changes on This Sheet Must be Made or Circled in Red Ink With Date and Name of Person Making Change.

37JC-1

Do not extend notes this side of this line

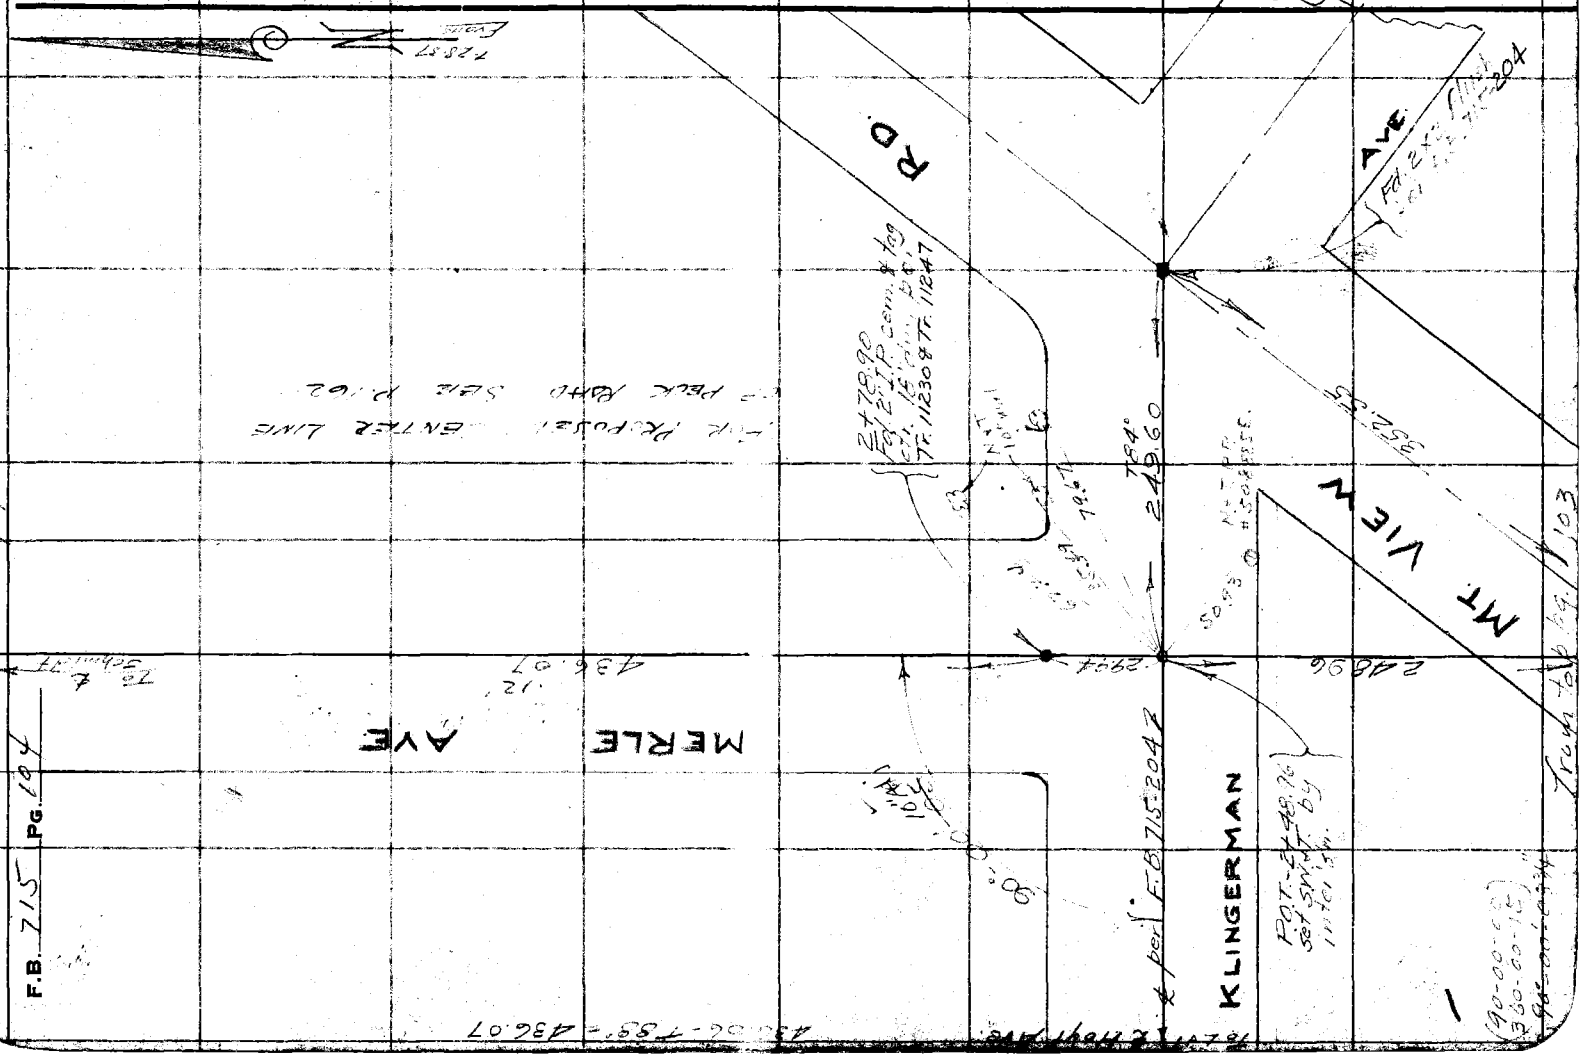
MT VIEW AVE
KLINGERMAN
MERLE AVE
Z+78.90 Ext. 15' P.C.P. cem. & tag Tr. 11230 & Tr. 11247
Ext. 10' Tr. 11247
N 44° E
10' Wall
S 89° 19' E
784'
249.60
50.93
N 44° E
#3042 E.C.
2824
436.07
436.07
To L1. side bg. Los
Set PK Nail & Tag
Set PK Nail & Tag
Set PK Nail & Tag

Notes Ck'd by A. A. R.	Survey of Peck Rd
Map No. C.S.B-135-1	W. O. 7052 Tape No. 043 St'd 34° F.
Office Work J.D.Price.	Surveyed by Evans
Checked AMR	Notes Date 7-28-37
Date Aug. '39	Indexed A. C. Johnson

F.B. 715 Pg. 105

(90-01-00
360-03-30
90° 00-52½"

37C-1

TYLER AVE.

Fd 2" I.P. com. plug, tk. & tag 14" dn. Tr. 11253

(179-59-30
359-58-15
179-59-33¾"

179°-59'-35"

Fd. 2" I.P. com. plug, tk. & tag 16" dn. Tr. 11253 & Tr. 11230

FOR PROPOSED ℄ OF PECK ROAD SEE P. 162

N & T PP #5159666

(90°-00'-00")

90°-00'-55"

MERLE AVE.

49.85

436.07

401.50

64.27

48.10

N & T Nimal. 7-14-97 Fd. 2" I.P. com. plug tack & tag, 16" dn. per Tr. 11230. Set 1"x1" flush above I.P.

N & T 12.12

SCHMIDT RD.

Fd. 2" I.P. com. plug, tack & tag 2.0" dn. Tr. 11247. See F.B. 715-205

Note: Any Additions or Changes on This Sheet Must be Made or Circled in Red Ink With Date and Name of Person Making Change.

Do not extend notes this side of this line

RETURN TO
LOS ANGELES COUNTY SURVEYOR
700 HALL OF RECORDS

FORM 247 10M 11-35

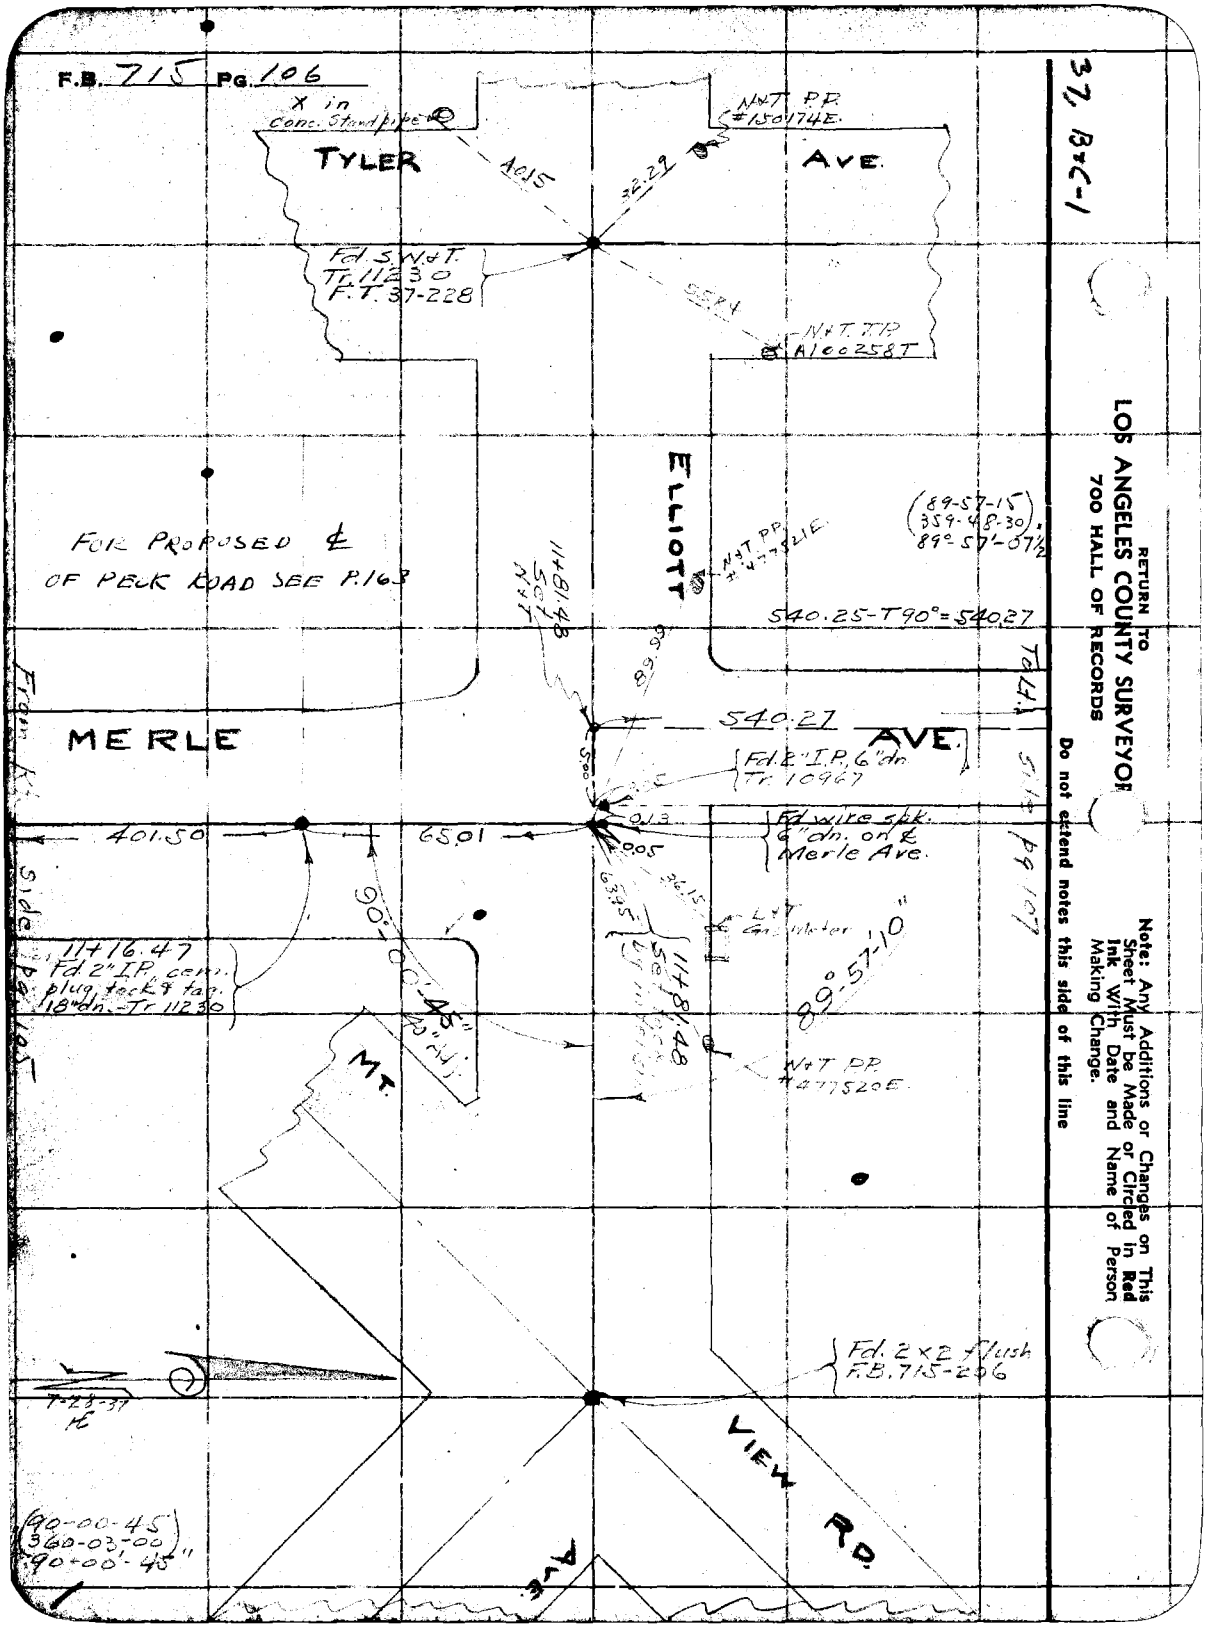
F.B. 715 Pg. 106
37, B7C-1
RETURN TO
LOS ANGELES COUNTY SURVEYOR
700 HALL OF RECORDS
Note: Any Additions or Changes on This Sheet Must be Made or Circled in Red Ink With Date and Name of Person Making Change.
Do not extend notes this side of this line
X in Conc. Standpipe
TYLER
AVE.
N&T PP #150174E.
40.15
32.29
Fd. S N&T. Tr. 11230 F.T. 37-228
N&T. TP #A100258T
ELLIOT
FOR PROPOSED ℄ OF PECK ROAD SEE P.163
N&T PP #477821E.
(89-57-15) 359-48-30 89°-57-07½
S40.25-T90°=S40.27
11481.48 S89°-57'-15"E
89.99
MERLE
540.27
AVE.
Fd. 1" I.P. 6" dn. Tr. 10967
Fd. wire spk. 6" dn. on ℄ Merle Ave.
401.50
65.01
0.13
0.05
Side
11716.47 Fd. 2" I.P. corr. plug tack & tag 18" dn. Tr. 11230
90°-00'-45"
MT.
11481.48 S89°-57'-15"E
N&T PP #477520E.
89°-57'-10"
Fd. 2x2 flush F.B. 715-296
T-22-37 M
VIEW RD.
AVE.
(90-00-45) 360-03-00 90-00-45"

Notes Ck'd by
Map No. C.S.B-135
Office Work J.D. Price.
Checked Oak
Date Aug. '39

Survey of Peck Rd.
W. O. 7052 Tape No. 043 St'd 82' F.
Surveyed by EVANS
Notes LE Date 7-28-39
Indexed

F.B. 715 Pg. 107

37 C-1

348.83 - T 90° = 348.84

Fd. 2" I.P. cem. plug, tk. 9 too, 46' Sm. Tr. 10967

N. 1 T.S. #498215E.

105-23-30
61-36-00
105-23-30"

L of T Gas meter

3452

3092

L of T Gas meter

N 45 00 E

348.84

S

105° 23'-30"

FOR PROPOSED ℄ OF PECK ROAD SEE P. 164

17+21.75 Set 1x2 flush by intersn.

Fd. 1" I.P.

MERLE ST.

540.27

5 ft offset

217.32

S 72°

S 19°

Fd. 2" I.P. cem. plug, tk. 9 too, 44' Sm. Tr. 10967

N & T Gas

2597

21.97

Set 1" x 2" flush

217.31 - T 90° = 217.32

Note: Any Additions or Changes on This Sheet Must be Made or Circled in Red Ink With Date and Name of Person Making Change

Do not extend notes this side of this line

RETURN TO
LOS ANGELES COUNTY SURVEYOR
700 HALL OF RECORDS

FORM 247 10M 11-38

RETURN TO
LOS ANGELES COUNTY SURVEYOR
700 HALL OF RECORDS

Note: Any Additions or Changes on This Sheet Must be Made or Circled in Red Ink With Date and Name of Person Making Change.

Do not extend notes this side of this line

46, A-5

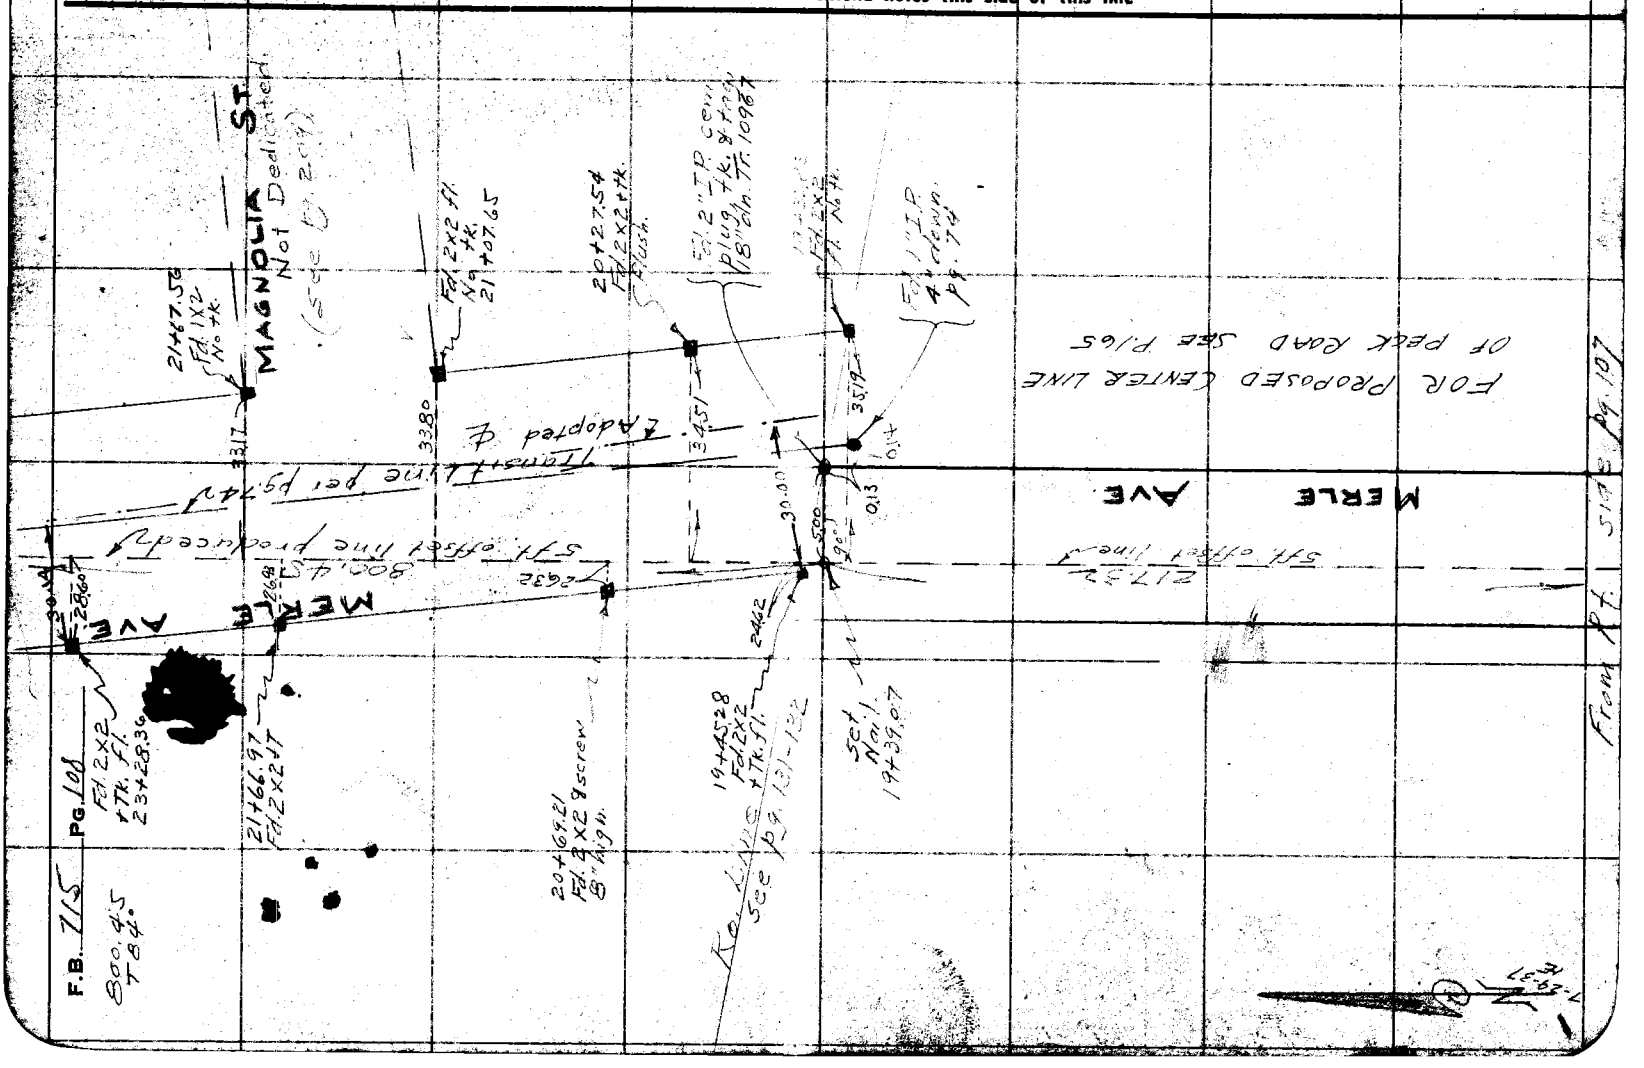

Notes Ck'd by T.A.	Survey of Peck Rd.
Map No. C.S. B-135-1	W. O. 7052 Tape No. C43 St'd ☐ F.
Office Work J.D. Price.	Surveyed by E. [illegible]
Checked aaR	Notes [illegible] Date 7-29-37
Date Aug. '39	Indexed A.C. [illegible]

F.B. 715 Pg. 109

(90+32-45
362+10-45)
90°32'40"

4, 4-5

Note: Any Additions or Changes on This Sheet Must be Made or Circled in Red Ink With Date and Name of Person Making Change.

Do not extend notes this side of this line

RETURN TO
LOS ANGELES COUNTY SURVEYOR
700 HALL OF RECORDS

FORM 247 10M 11-38

See pgs. 128-130 for Adopted S. Line Tr. 3480 & per pg. 74

Fd. Nail pg. 74 2+00 N.

2.58

27+39.52 Set Nail by Intersn.

GARVEY AVE.

26+89.73 Fd. 2x2 ✓ N. Flush.

30.00 22.08 23.92 30.00

26+89.20 Fd. 2x2 ✓ Tk. 3" dn.

90°-32'-40" Prolong. Curve

E. Transit Line

Adopted ℄

AVE.

Fd. 1x2 ✓ Tk. 25+39.03

30.56

MERLE

E. 13-29

Fd. 2" I.P. corr. ✓ nail. ctr. flush. 24+89.31

30.16

29.87

Fd. 2x2 ✓ N. 3" high. 24+89.88

Fd. 2x2 ✓ Tk. 4" high. 24+48.90

29.79

30.28

Fd. 1.2x2, No Tk. Flush 24+49.85

30.76

Fd. 2x2 No Tk., 3" high 24+09.35

FOR PROPOSED CENTER LINE OF PECK ROAD SEE R. 166 P. 167

RETURN TO
LOS ANGELES COUNTY SURVEYOR
700 HALL OF RECORDS

Note: Any Additions or Changes on This Sheet Must be Made or Circled in **Red Ink** With Date and Name of Person Making Change.

Do not extend notes this side of this line

F.B. 715 PG. 110

Notes Ck'd by	Survey of Peck Rd
Map No. C.S.B-1351	W. O. 705 Tape No. 043 St'd 4V°F.
Office Work J. D. PRICE	Surveyed by Evans
Checked Clark	Notes F Date 7-29-37
Date Aug. '39	Indexed

F.B. 715 Pg. 111

Note: Any Additions or Changes on This Sheet Must be Made or Circled in Red Ink With Date and Name of Person Making Change.

Do not extend notes this side of this line

RETURN TO
LOS ANGELES COUNTY SURVEYOR
700 HALL OF RECORDS

FORM 247 10M 11-38

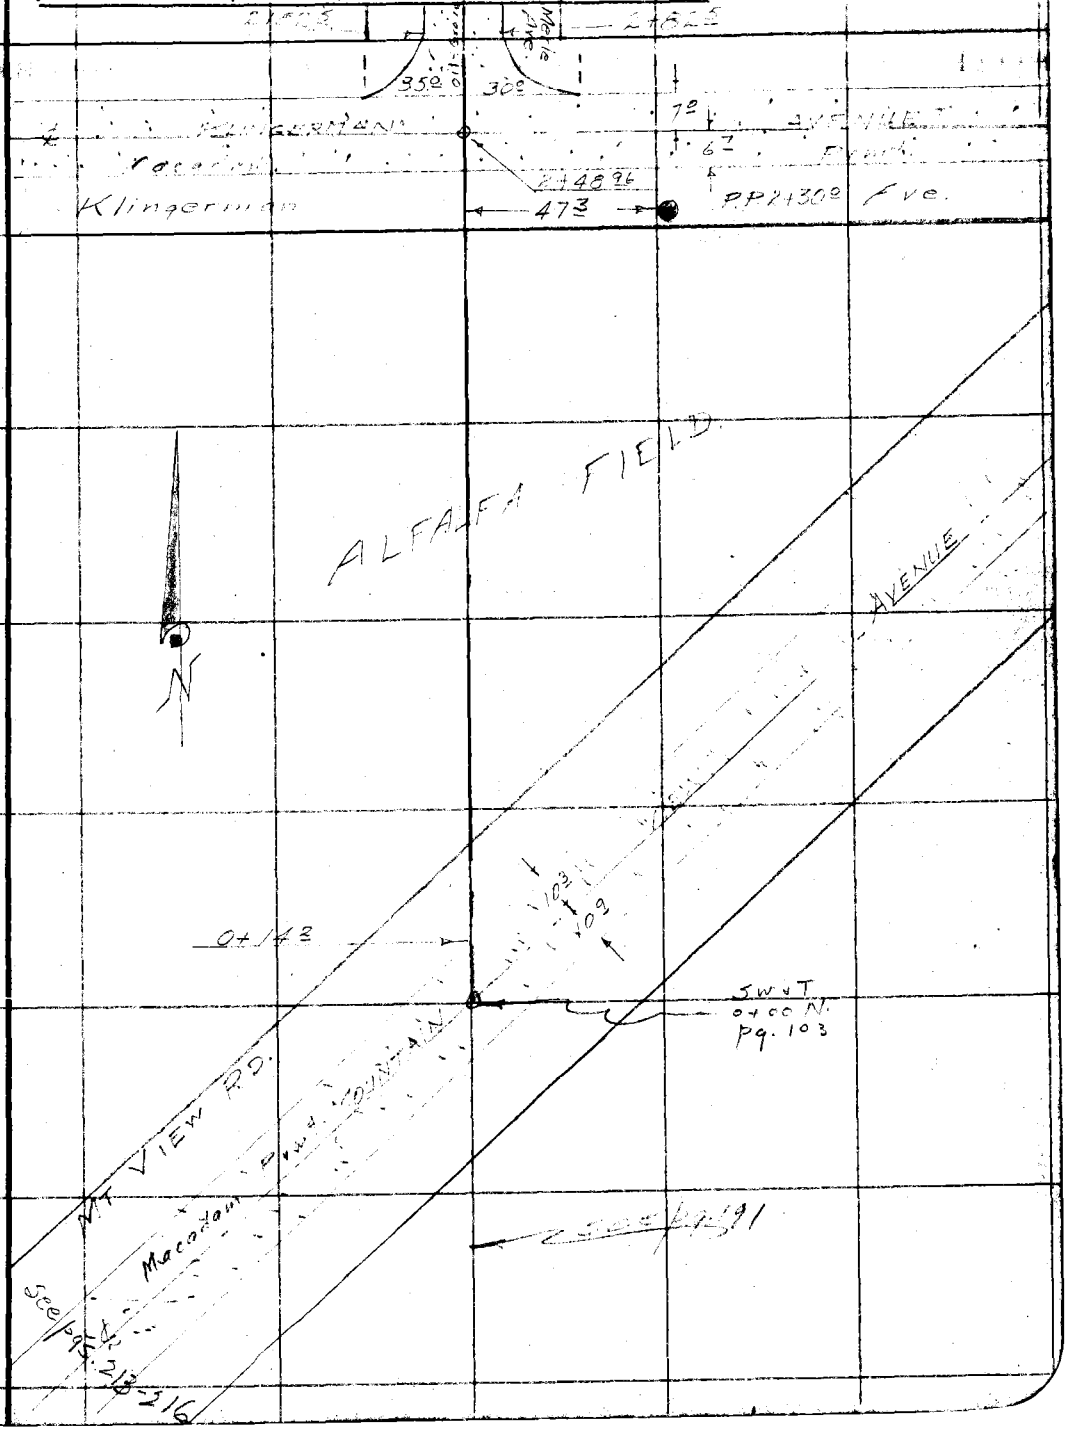

RETURN TO
LOS ANGELES COUNTY SURVEYOR
700 HALL OF RECORDS

Note: Any Additions or Changes on This Sheet Must be Made or Circled in **Red** Ink With Date and Name of Person Making Change.

Do not extend notes this side of this line

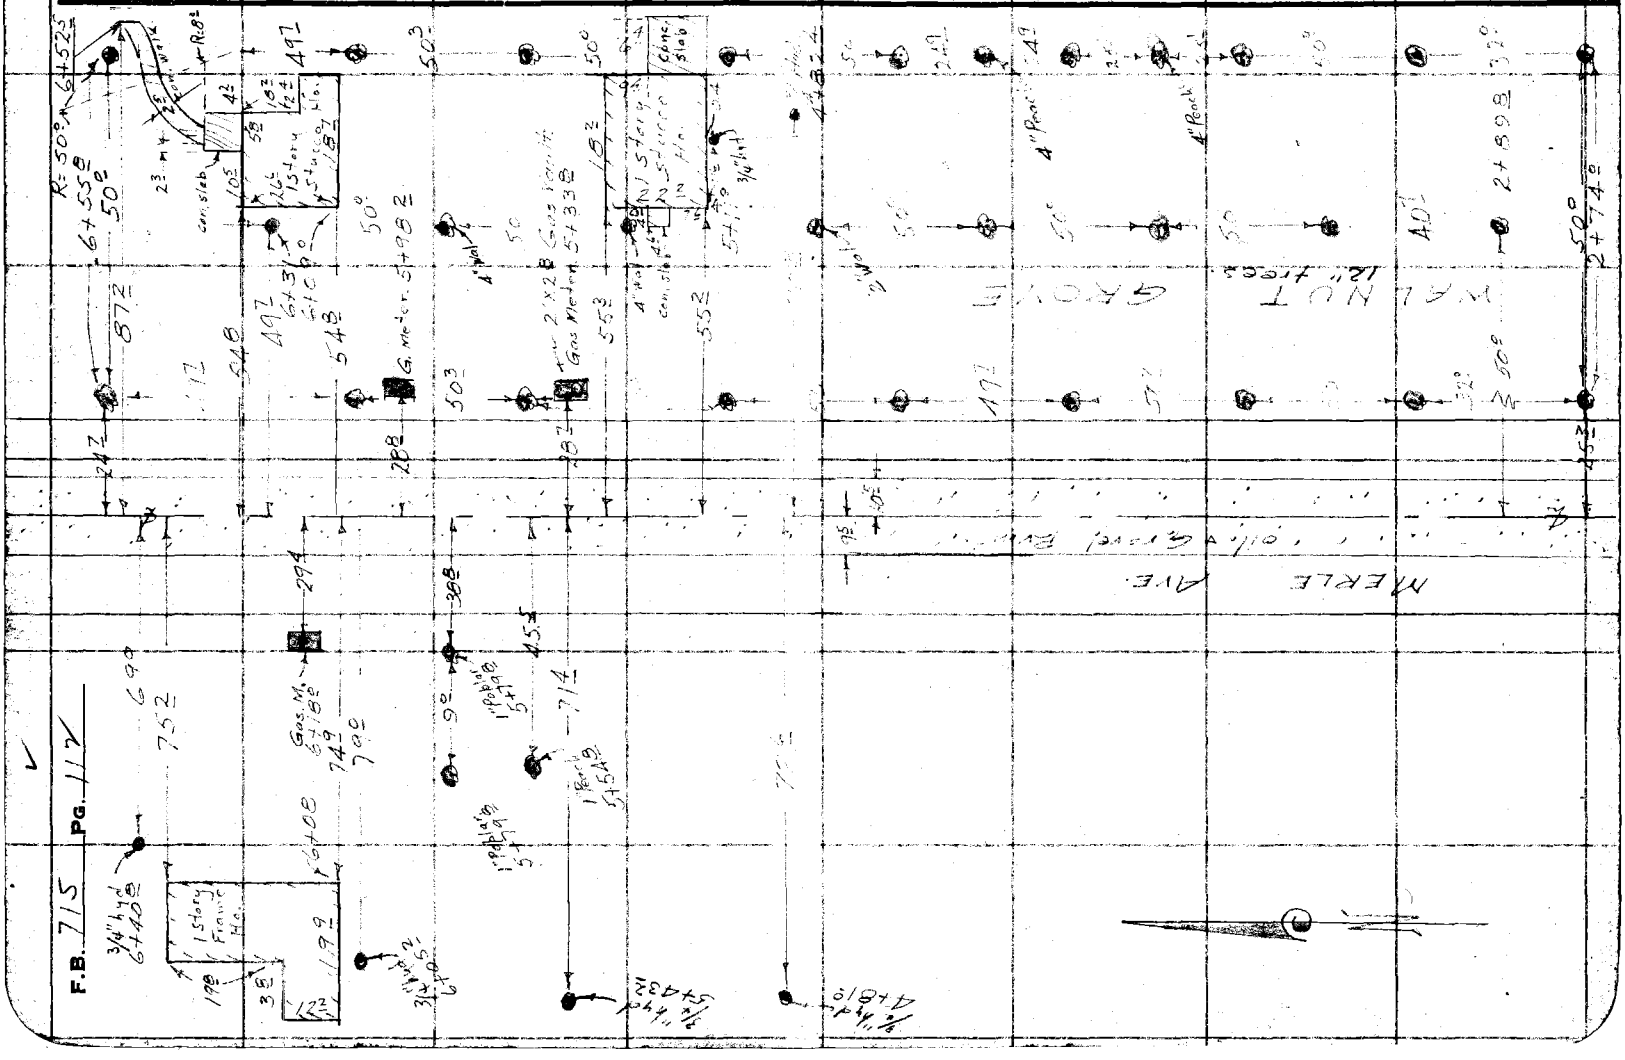
F.B. 715 PG. 117
MERLE AVE.
4" Pond
Gas Meter
1 Story Frame Ho.
Conc. Slab
Gas Meter
2 X 2 B
Gas Meter

Notes Ck'd by A.B.T.	Survey of Rock Rd
Map No. C.S.B-1351	W. O. 7-52 Tape No. C43 St'd C4 F.
Office Work J.D. Price	Surveyed by Evans
Checked Aar	Notes LF Date 7-29-37
Date Aug. '39	Indexed A. C Johnson

F.B. 715 Pg. 113

Note: Any Additions or Changes on This Sheet Must be Made or Circled in Red Ink With Date and Name of Person Making Change.

Do not extend notes this side of this line

RETURN TO
LOS ANGELES COUNTY SURVEYOR
700 HALL OF RECORDS

FORM 247 10M 11-38

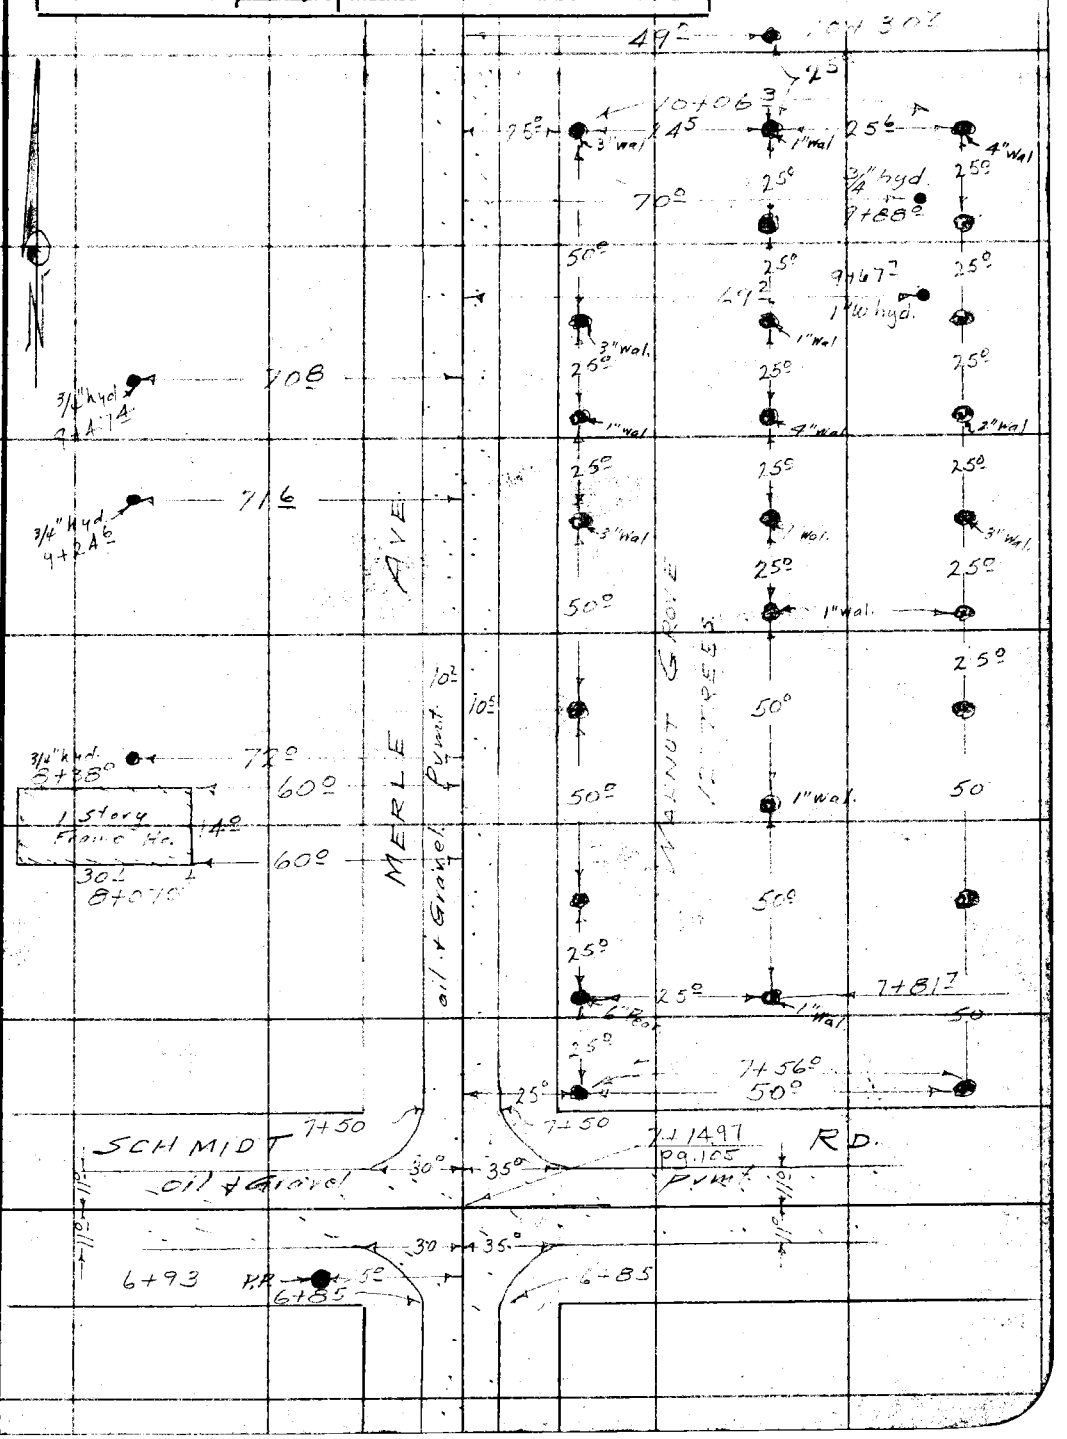

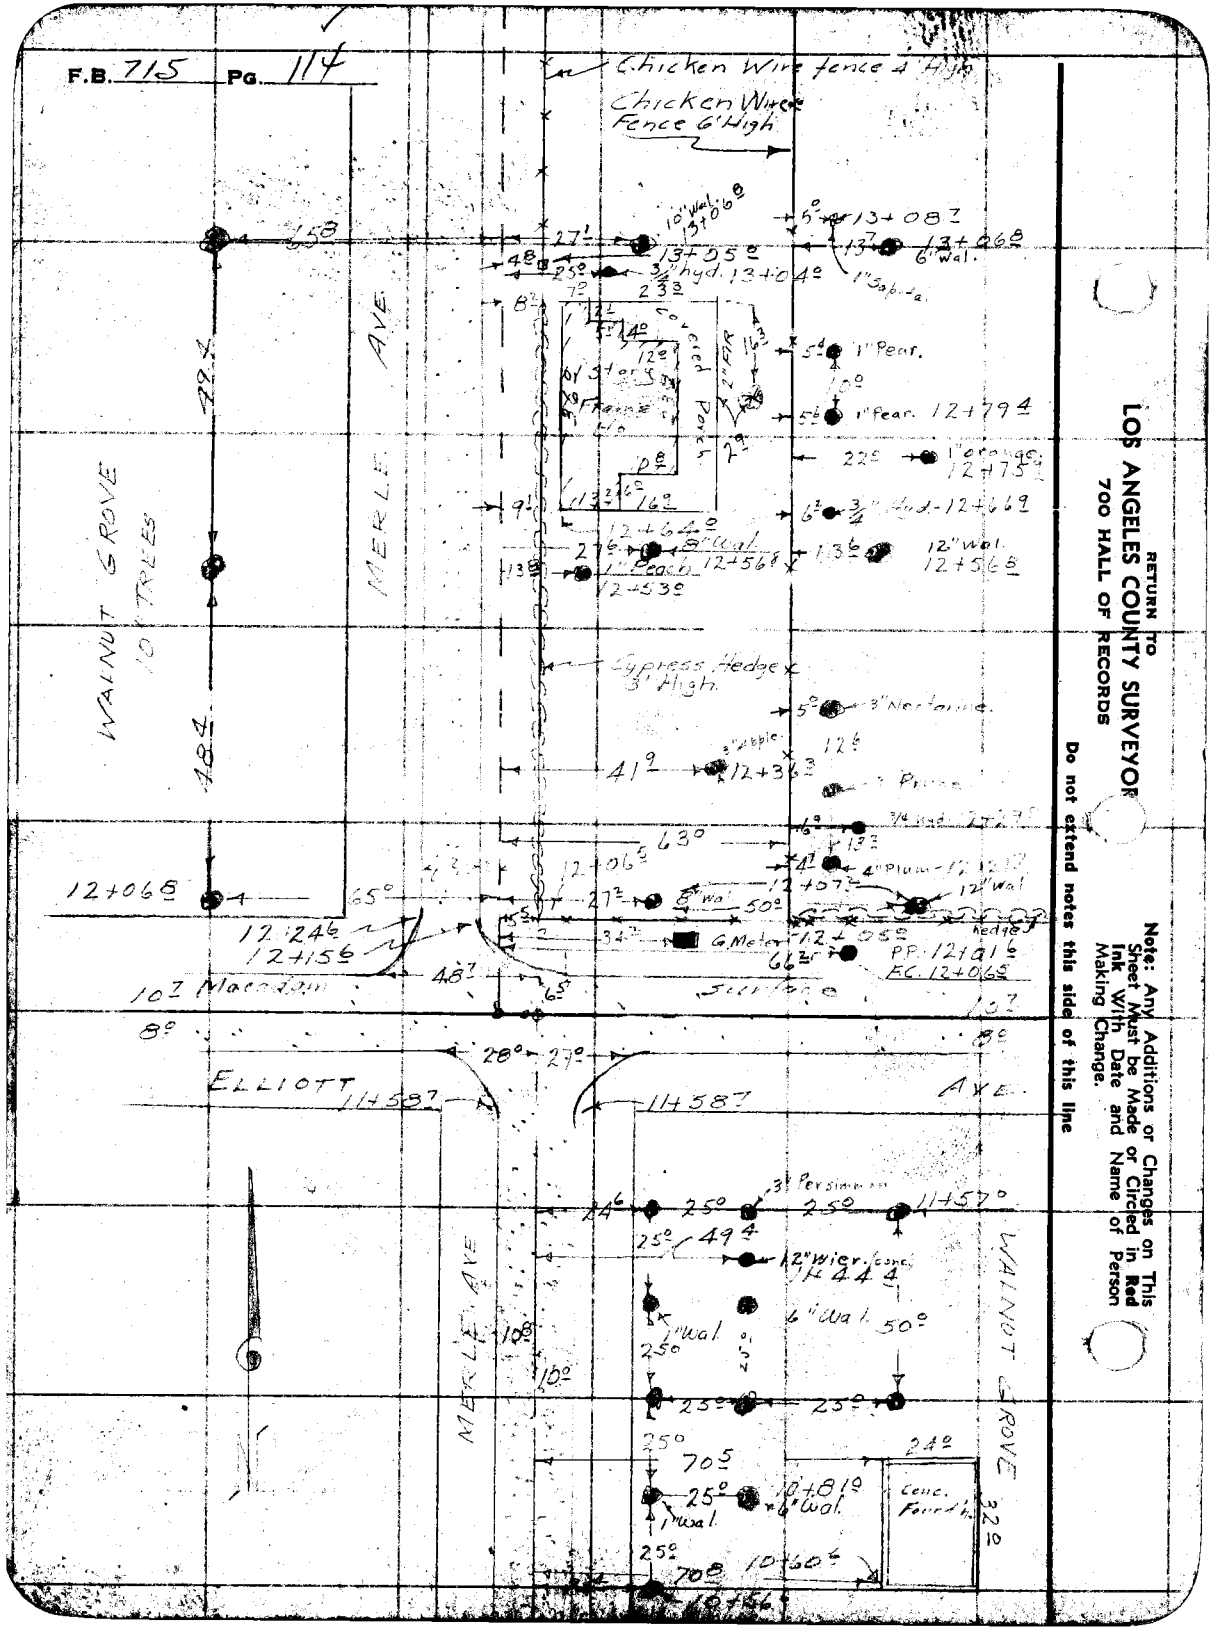
F.B. 715 Pg. 114
Chicken Wire fence 4' High
Chicken Wire Fence 6' High
MERLE AVE
WALNUT GROVE
ELLIOTT
AVE.
Cypress Hedge 3' High

Notes Ck'd by A. A. P.
Map No. C. S. B-1351-24
Office Work J. D. Price
Checked Carr
Date Aug. '39

Survey of Heck Ed
W. 0°52' Tape No. 43 St'd 84 °F.
Surveyed by Evans
Notes AE Date 7-24-31
Indexed A. C. Johnson

F.B. 715 Pg. 115

Note: Any Additions or Changes on This Sheet Must be Made or Circled in Red Ink With Date and Name of Person Making Changd.

Do not extend notes this side of this line

RETURN TO
LOS ANGELES COUNTY SURVEYOR
700 HALL OF RECORDS

FORM 247 10M 11-38

Chicken Wire Fence 6' High
14+63
14+62
14+58
14+57
14+56
Lathe House
14+47
14+44
14+39
20' Rubble incinerator
14+31
Aviary
14+16
14+11
14+06
1 Story Frame Garage
13+85
13+78
13+75
13+68
13+57
13+52
MARLE AVE
Macadam
13+50
13+43
13+35
13+22
13+18
13+14
63'

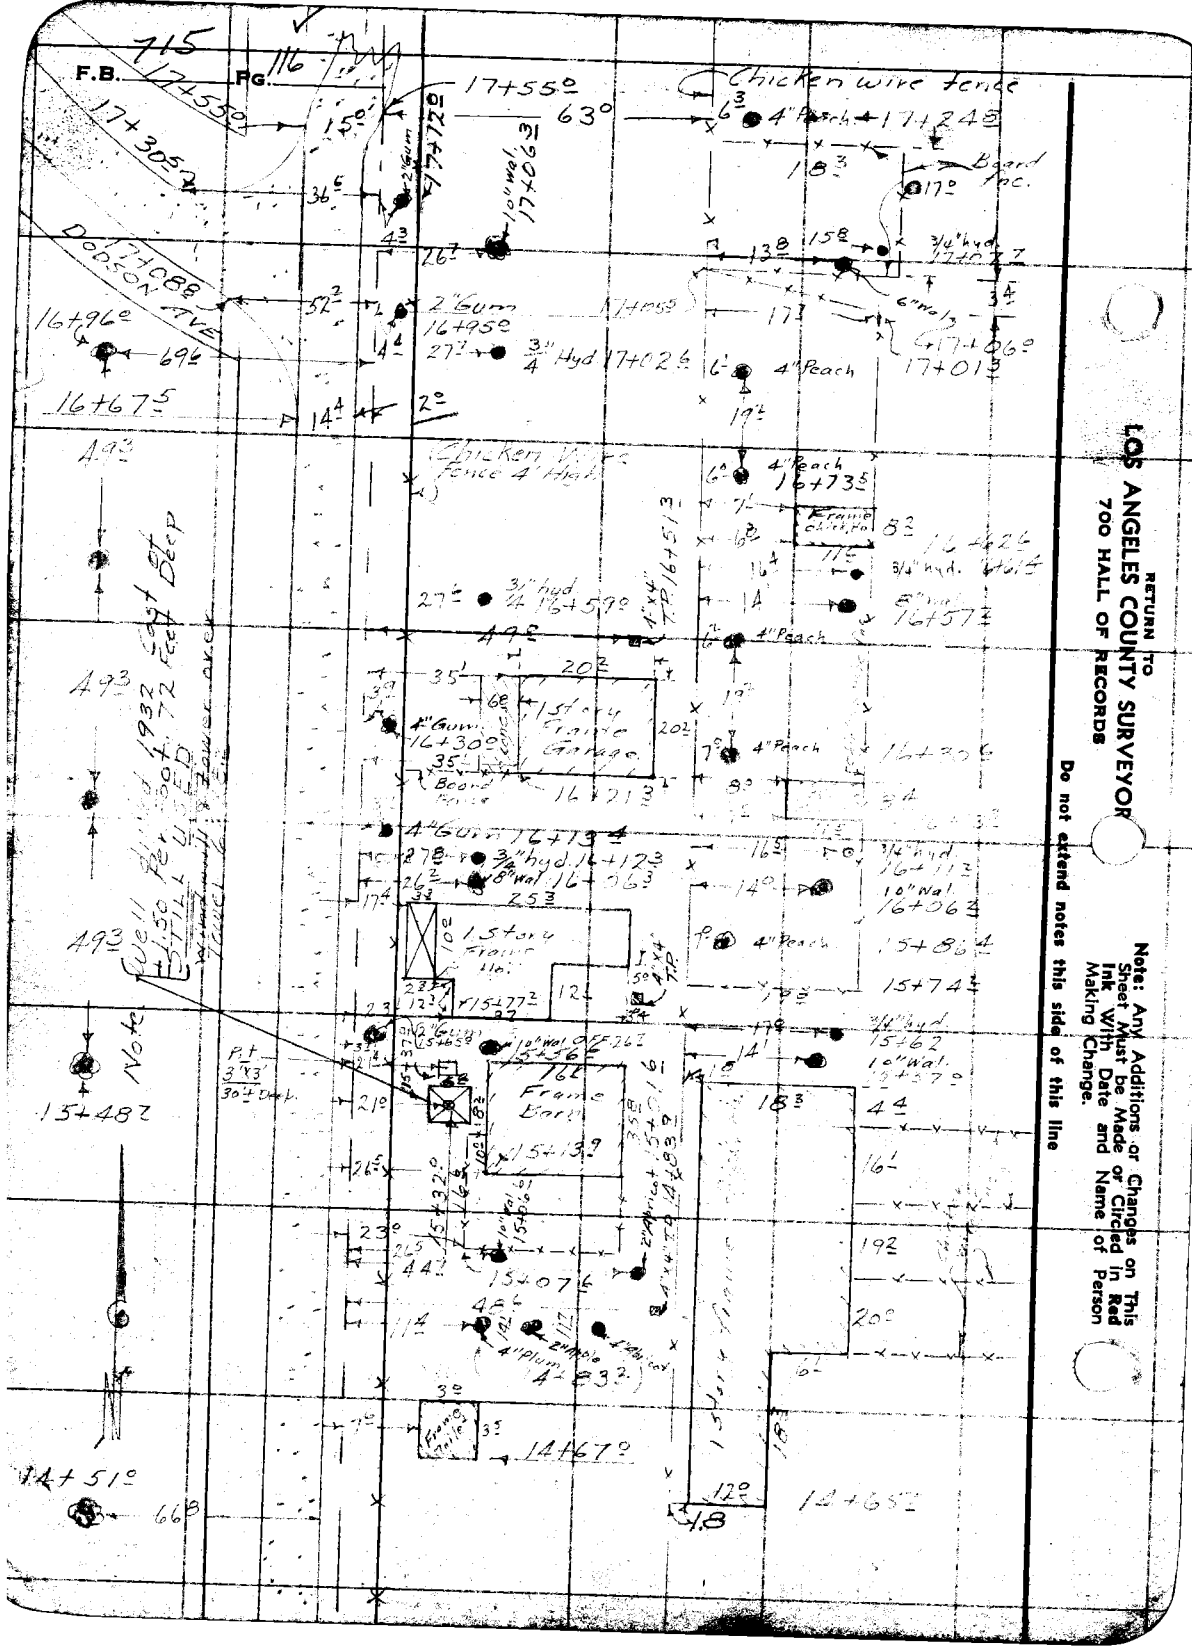
F.B.
Pg.
715
116
Chicken wire fence
Board fnc.
Dodson Ave
2" Gum
10" Wal.
4" Peach
3/4" Hyd.
6" Wal.
Frame Garage
Frame Barn
Frame Stable
Well
Tank
Tower
Note
A93
Note: Any Additions or Changes on This Sheet Must be Made in Red Ink With Date and Name of Person Making Change.
Do not extend notes this side of this line
RETURN TO
LOS ANGELES COUNTY SURVEYOR
700 HALL OF RECORDS

Notes Ck'd by	Survey of Peck Rd
Map No. C.S. B-1351-R	W. O 7014 Tape No. 643 St'd 4 F.
Office Work J.D. Price	Surveyed by [illegible]
Checked Aar	Notes [illegible] Date 7-31-37
Date Aug. 39	Indexed C. Johns

F.B. 215 PG. 117

Note: Any Additions or Changes on This Sheet Must be Made or Circled in Red Ink With Date and Name of Person Making Change.

Do not extend notes this side of this line

RETURN TO
LOS ANGELES COUNTY SURVEYOR
700 HALL OF RECORDS

FORM 247 10M 11-35

Hog wire fence 4' High

Barb wire fence 4' High

Hog wire fence 4' High

4" Cedar

12" Wal. Lav 19+32.4

19+33.2

Gas M. 19+5.8

12" wal. 19+06.2

18+90

1" Hyd. 18+93

2" Apple 18+78.2

6" Wal. 18+56.0 OFF 14.0 From Fence

2" Apple

3" Apple 18+26.2

3/4" Hyd. OFF from fence 19.9

8" wal. 18+07.8

OFF from fence 13.6

18+04.3

2" sig. 17+76.0

3/4" Hyd 17+57.0

10" wal. 17+55.9

17+46.3

4" Peach 17+44.5

48.8

1/2" Pin Tag 17+25.3

3/4" Hyd.

Frame Shed

Frame Shed

Frame Shed

Old Walnut Trees

Old Walnut Trees

Old Walnut Trees

RETURN TO
LOS ANGELES COUNTY SURVEYOR
700 HALL OF RECORDS

Note: Any Additions or Changes on This Sheet Must be Made or Circled in **Red Ink** With Date and Name of Person Making Change.

Do not extend notes this side of this line

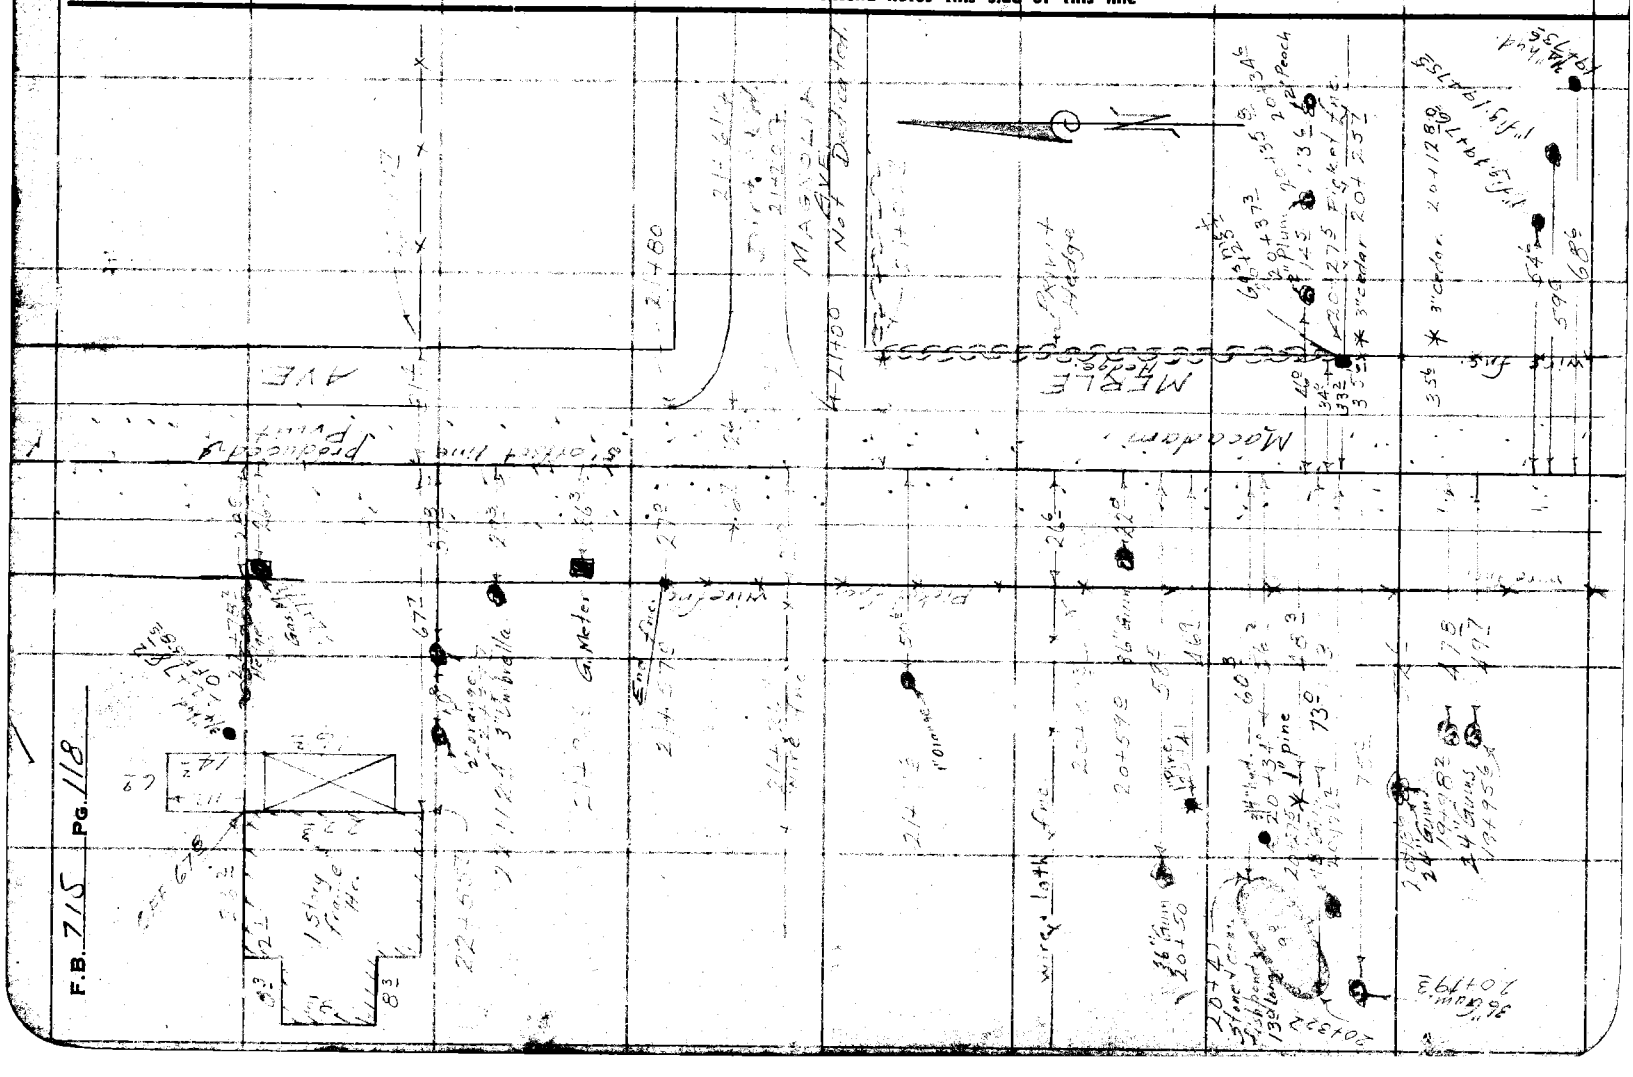
F.B. 715 PG. 118
MAGNOLIA
Not Dedicated
MERLE
Macadam
Wire Fence
Wire Fence
Wire Fence

Notes Ck'd by	Survey of Rock Rd.
Map No. C.S. B-1351-K	W. O. 7052 Tape No. 043 St'd 84 °F.
Office Work J. D. Price	Surveyed by
Checked Aug	Notes Date 7-30-37
Date Aug '39	Indexed

F.B. 715 Pg. 119

Note: Any Additions or Changes on This Sheet Must be Made or Circled in Red Ink With Date and Name of Person Making Change.

Do not extend notes this side of this line

RETURN TO
LOS ANGELES COUNTY SURVEYOR
700 HALL OF RECORDS

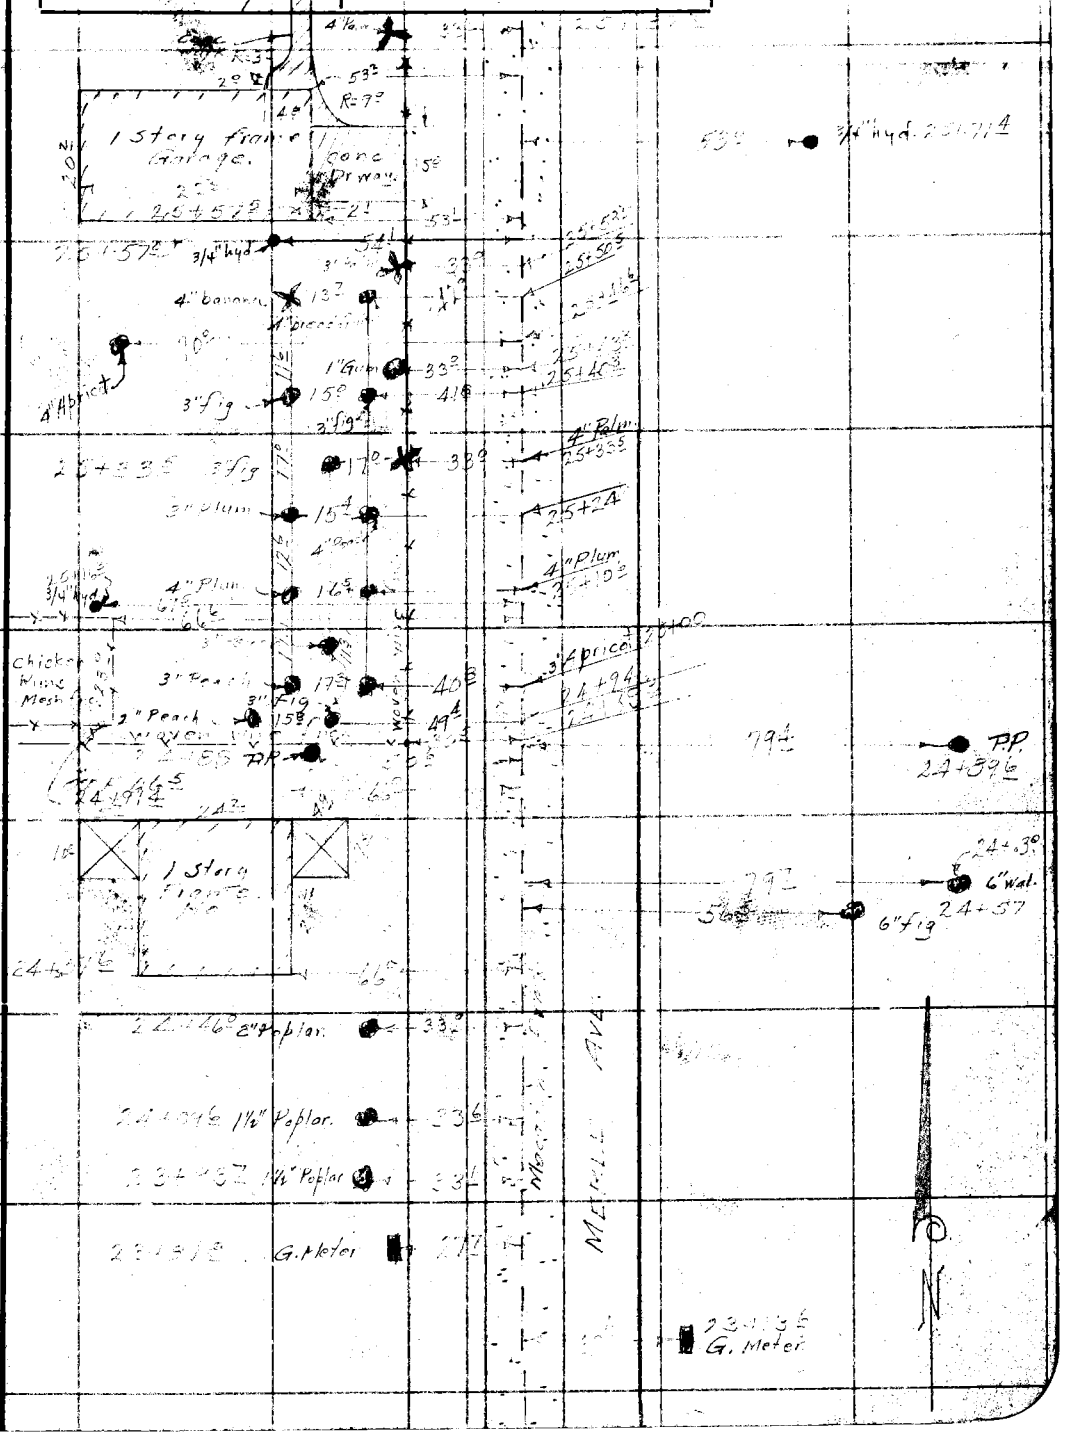

FORM 247 10M 11-35

RETURN TO
LOS ANGELES COUNTY SURVEYOR
700 HALL OF RECORDS

Note: Any Additions or Changes on This Sheet Must be Made or Circled in **Red** Ink With Date and Name of Person Making Change.

Do not extend notes this side of this line

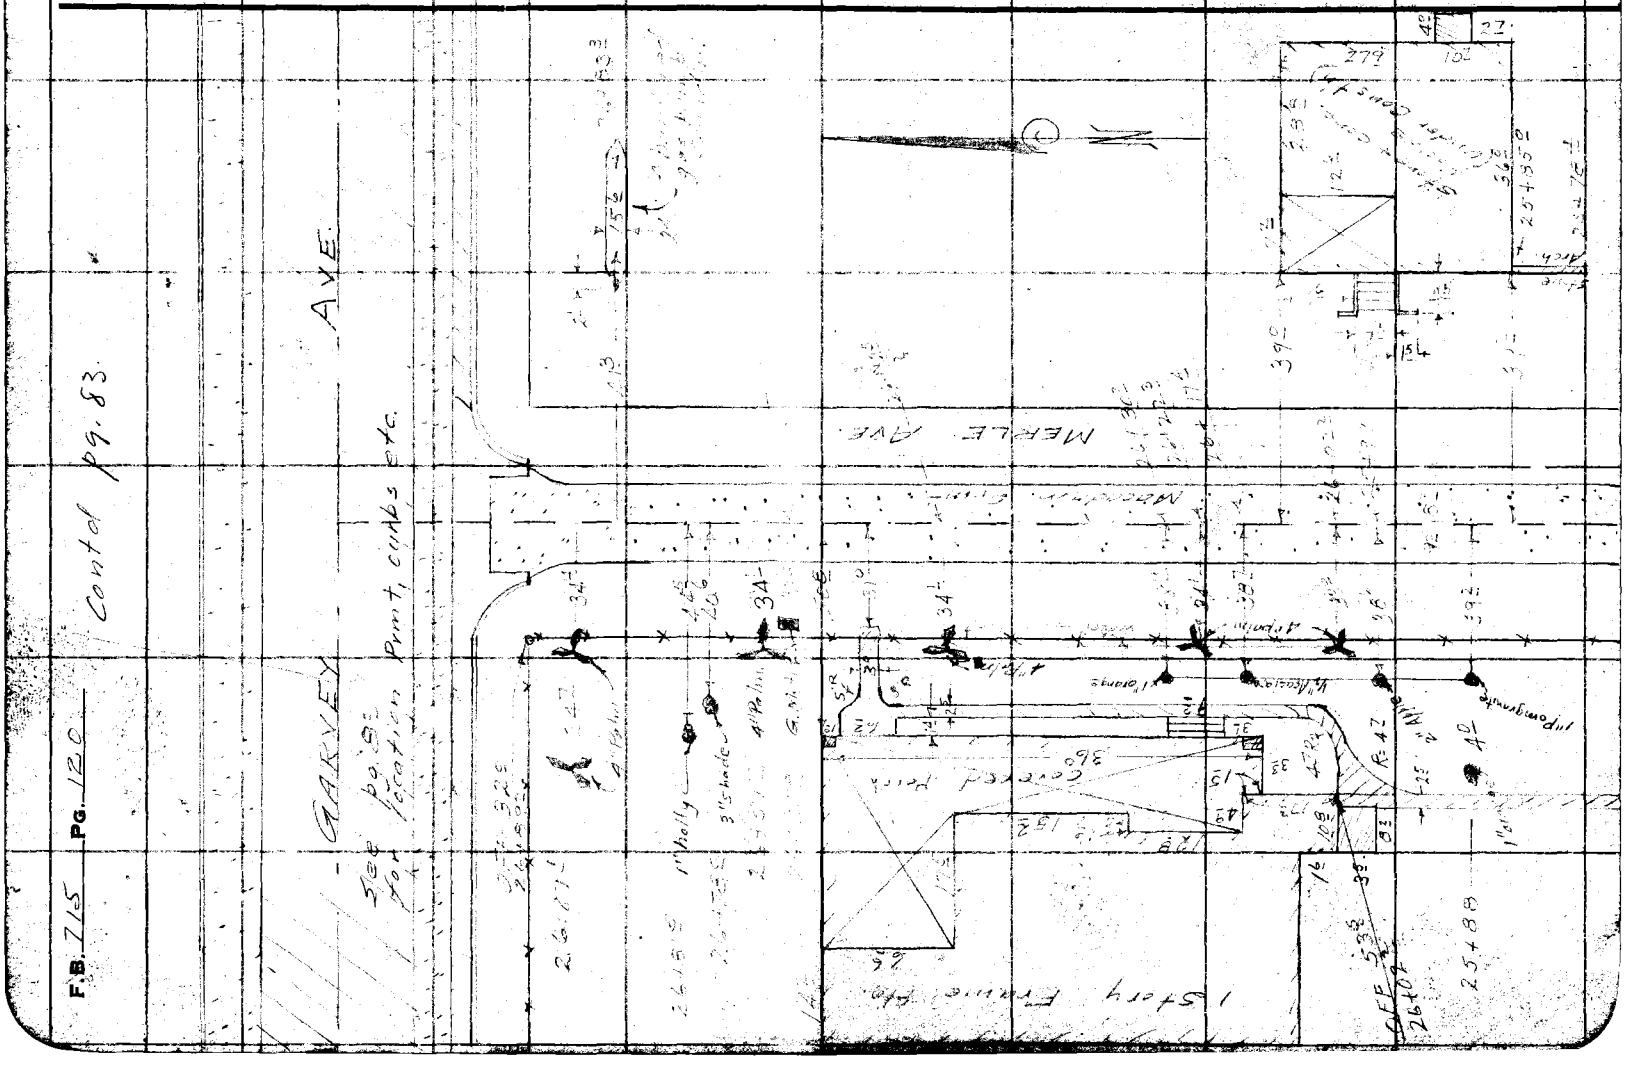

Notes Ck'd by. A.A.R.	Survey of Peck Road
Map No. S.S.B-135[illegible]	W. O. 7052 Tape No. 040 St'd 84 °F.
Office Work J.D. Price.	Surveyed by L.D. Moore
Checked aar	Notes Moore Date Oct 1937
Date Aug. '39	Indexed 10-27-37

F.B. 715 Pg. 121

SURVEY
TO
ESTABLISH
E MEEKER ROAD
PER TRACT 3480
FOR
PECK ROAD
Job # 7052

Moore
Scott
Lawson
Scott

Note: Any Additions or Changes on This Sheet Must be Made or Circled in Red Ink With Date and Name of Person Making Change.

Do not extend notes this side of this line

RETURN TO
LOS ANGELES COUNTY SURVEYOR
700 HALL OF RECORDS

FORM 247 10M 11-38

RETURN TO
LOS ANGELES COUNTY SURVEYOR
700 HALL OF RECORDS

Note: Any Additions or Changes on This Sheet Must be Made or Circled in Red Ink With Date and Name of Person Making Change.

Do not extend notes this side of this line

46-A-5

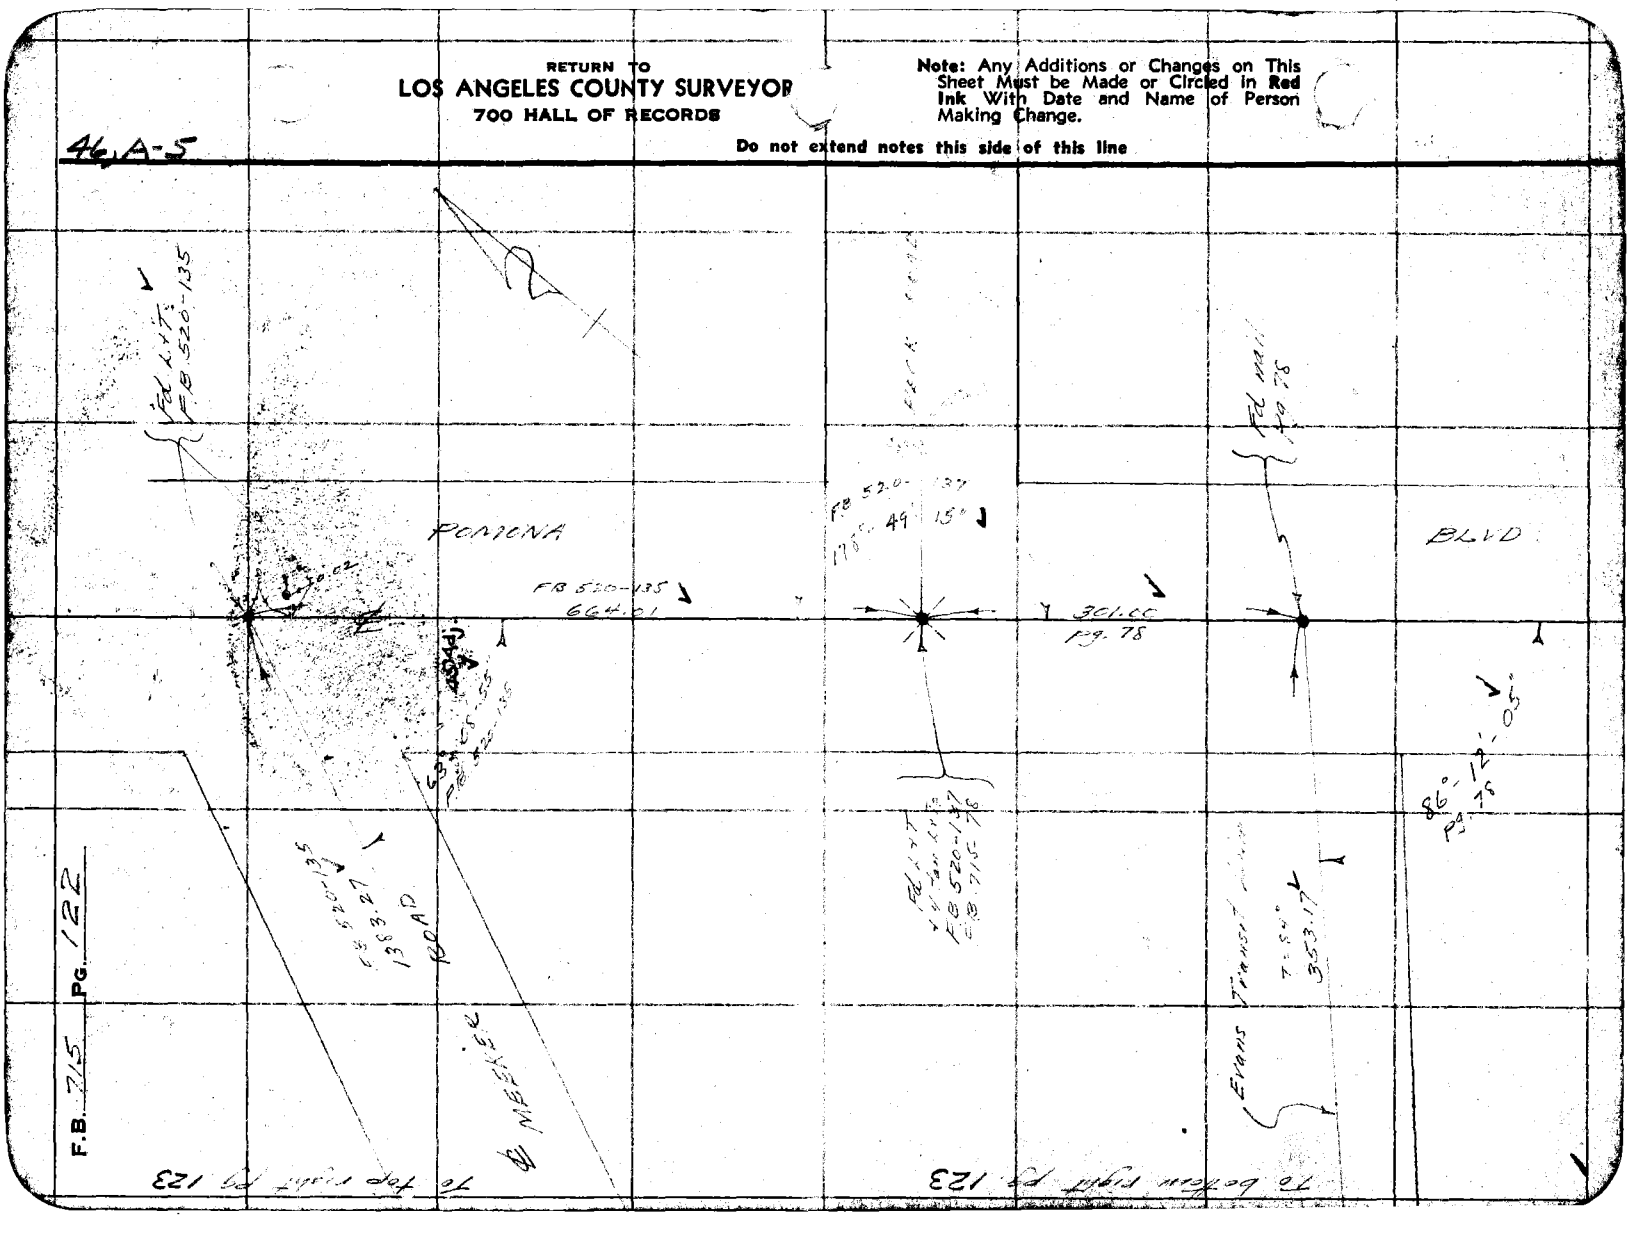
POMONA
BLVD
FB 520-135
664.01
FB 520-135
FB 520-135
301.66
pg. 78
FB 520-135
FB 520-135
FB 520-135

Notes Ck'd by Mc Pherson.	Survey of
Map No. C.S. B-1351-2	W. O 7652 Tape No. 045 St'd 84° F.
Office Work J.D. Price.	Surveyed by
Checked	Notes Moore Date 10-19-31
Date Aug. '39	Indexed

F.B. 716 Pg. 123

45,45

Note: Any Additions or Changes on This Sheet Must be Made or Circled in Red Ink With Date and Name of Person Making Change.

Do not extend notes this side of this line

RETURN TO
LOS ANGELES COUNTY SURVEYOR
700 HALL OF RECORDS

FORM 247 10M 11-35

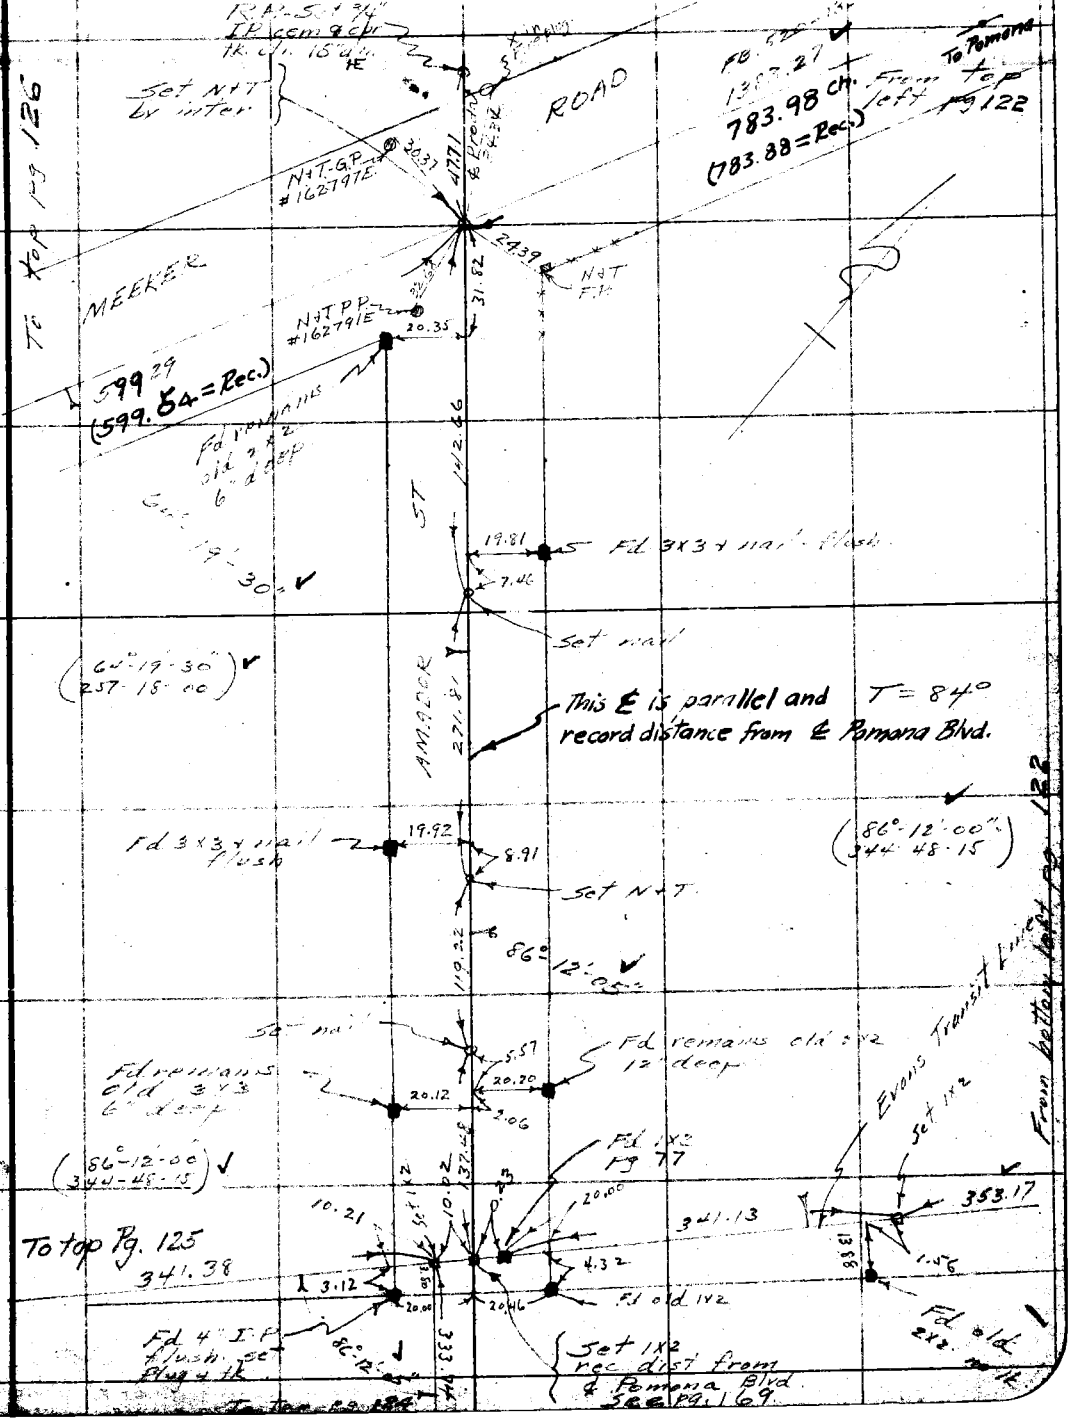

RETURN TO
LOS ANGELES COUNTY SURVEYOR
700 HALL OF RECORDS

Note: Any Additions or Changes on This Sheet Must be Made or Circled In **Red** Ink With Date and Name of Person Making Change.

Do not extend notes this side of this line

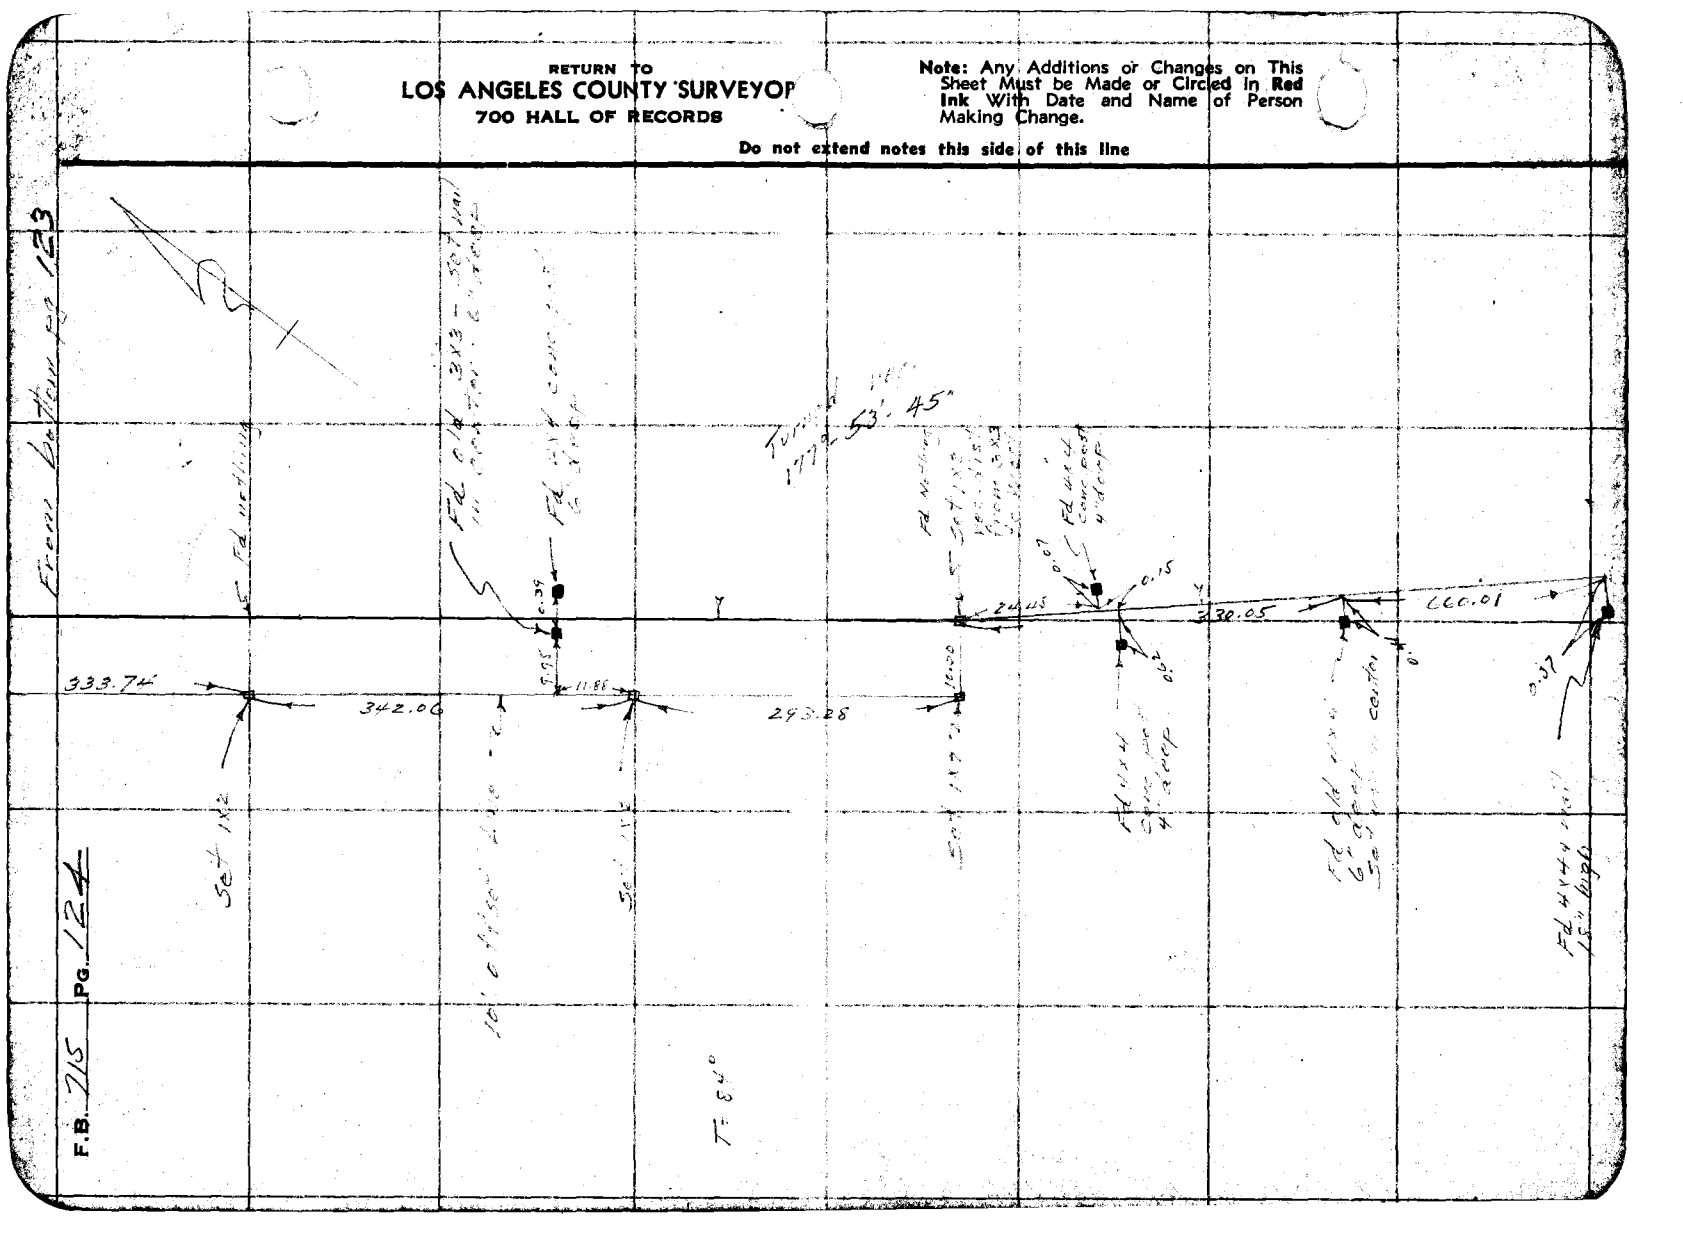

Notes Ck'd by McPherson	Survey of Base Line	F.B. 215	Pg. 125
Map No. S.S. B-1351-2	W. O. 7052 Tape No. 040 St'd 84 °F.		
Office Work J.D. Price	Surveyed by L. L. Moore		
Checked AAR	Notes L Moore Date 10-26-37		
Date Aug. 39	Indexed		

76 A-5

From bottom left pg 125

341.35

Fd ¾ I.P. 5.74

Fd 2x2 Pg 77

0.15

11.22

Set 1x2

T = 84°

Evans Transit Line

(93° 48' 00" 15-15-45)

330.31

93° 48'

To right pg 126

To left pg 127

Fd remains old 4x4 Set nail in Center FB 72-75 6" deep

15.62

0.53

15.65

Fd iron bar & Punch Mark 6" deep FB. 72-75

20.25

19.75

20.83 Calc.

16.99

300.63

MEEKER

ROAD

333.18

0.61

Set N+T

Fd S.T.&W. Pg. 76

Note - Wade & Meeker Ave parallel to Pomona Blvd and passing through 9 Tkns C.S. Mon at angle point to West

RETURN TO
LOS ANGELES COUNTY SURVEYOR
700 HALL OF RECORDS

Note: Any Additions or Changes on This Sheet Must be Made or Circled in Red Ink With Date and Name of Person Making Change.

Do not extend notes this side of this line

FORM 247 10M 11-38

RETURN TO
LOS ANGELES COUNTY SURVEYOR
700 HALL OF RECORDS

Note: Any Additions or Changes on This Sheet Must be Made or Circled in Red Ink With Date and Name of Person Making Change.

Do not extend notes this side of this line

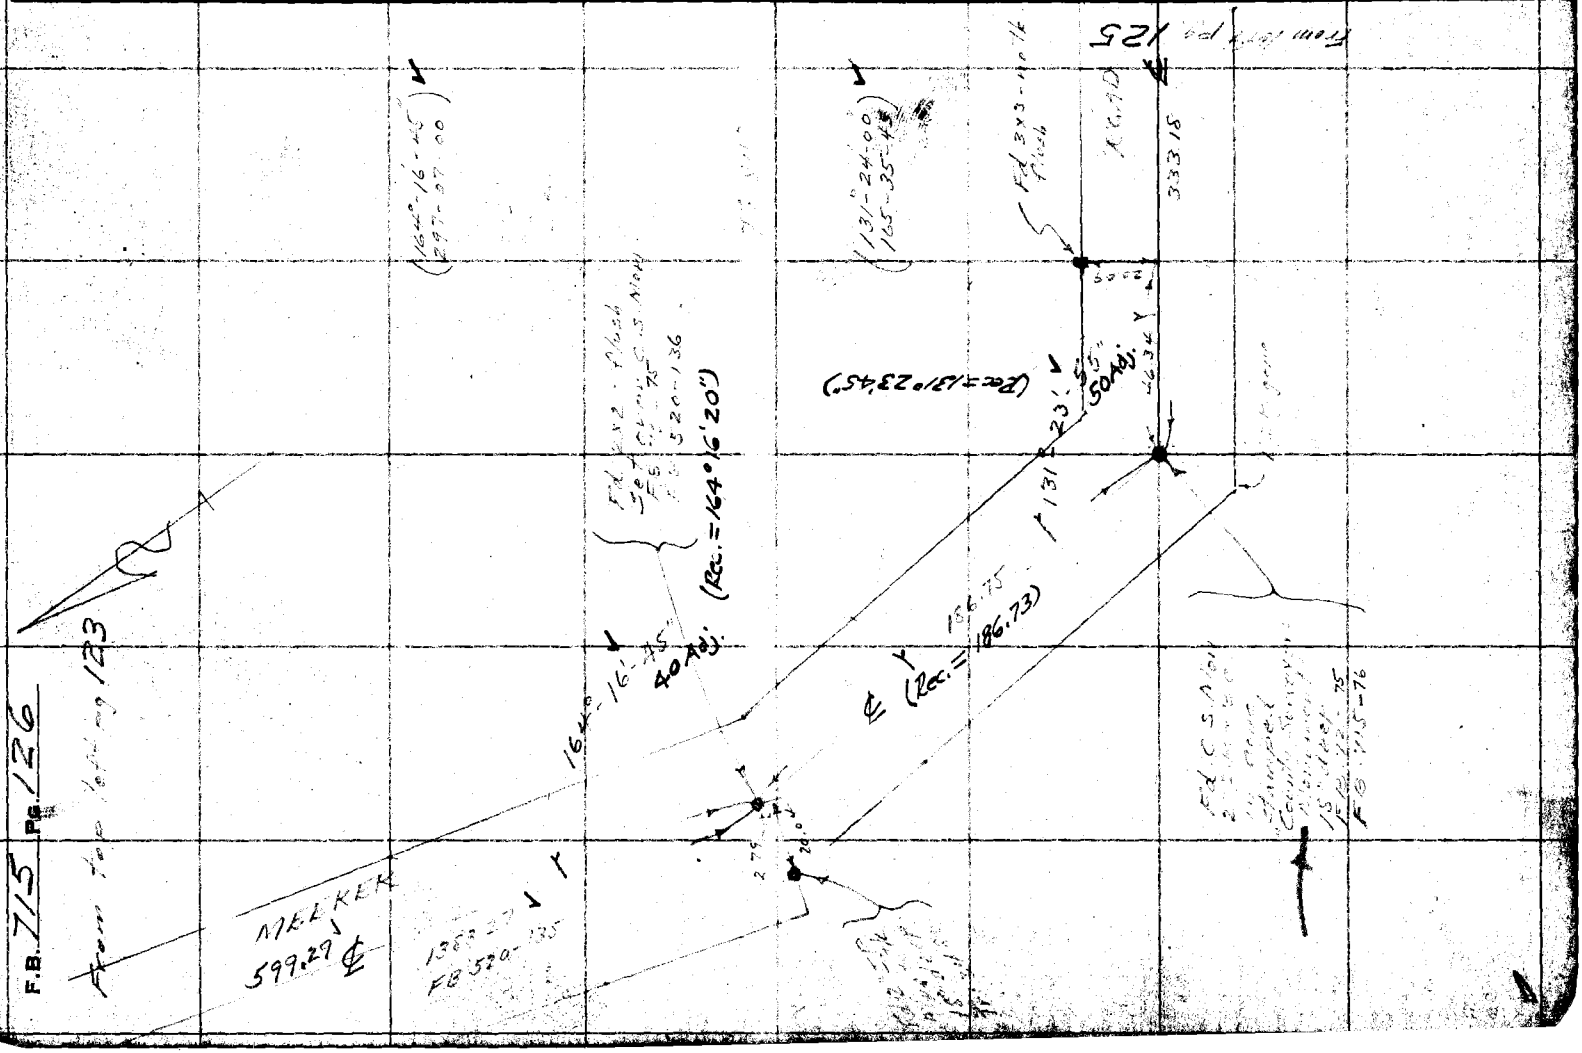

Notes Ck'd by McPherson	Survey of Peck Road
Map No. C.S. 8-1351-1	W. O. 7052 Tape No. 940 St'd 84 °F.
Office Work J. D. Price	Surveyed by L. D. Moore
Checked CAR	Notes Moore Date 10-26-37
Date Aug. 39	Indexed

F.B. 715 Pg. 127

To top right Pg 128

(138°-35'-15" / 194-21-30)

Chained distance from ℄ Badger to S. Line T 3S R 11W
3480 = 1077.51
Rec. = (1077.33)

Fd NIT I.P.

Set S.T.&W. on inter. to replace with old C.S. 11-26-37

11 NIT as shown Set in Pvmt.

Fd 2x2 Mush Set over C.S. Mon
FB 72-80
FB 715-74
FB 235-66
Remove ca. C.S. Mon (11-26-37)

(Rec. = 138° 36' 45")

Fd remains old 4x4 - 4" deep Set nail in center Stake leaving 0.15 W and 0.05 South Used to fix ℄ Badger.

Distance from ℄ of Badger to 4 Pts. is 633.81 chained. (Rec. = 633.81)

125

MEEKER ROAD

330.63

Pt in Pvmt

ST.

Sprinkler

1343.88 (1343.93 = Rec.)

Fd 1½" I.P. Probably guard

Fd 2x2 - Mush

23.76 24.21

0.41 8.79

Set

Δ = 84°

BODGER

835.22

(179°-56'-45" / 359-56-45)

179°-56'-40"

Fd 2x2 - 8" deep
FB 72 - 81
FB 715 - 75
FB 235-66
Replaced with C.S. Mon (11-26-37)
1" I.P.C. in cent
18" deep - marked ℄ down

SURVEYOR COUNTY F.E. 2177

Fd S.T.&W.
FB 235-66

Fd L.&T.

35.7

℄ TYLER

Fd L.&T.

67.35

ST.

10.02

Fd L.&T.

conc. pave.

Note: Any Additions or Changes on This Sheet Must be Made in Red Ink With Date and Name of Person Making Change.

Do not extend notes this side of this line

RETURN TO
LOS ANGELES COUNTY SURVEYOR
700 HALL OF RECORDS

46) A-5

FORM 247 10M 11-35

RETURN TO
LOS ANGELES COUNTY SURVEYOR
700 HALL OF RECORDS

Note: Any Additions or Changes on This Sheet Must be Made or Circled in Red Ink With Date and Name of Person Making Change.

Do not extend notes this side of this line

46, A+B-5

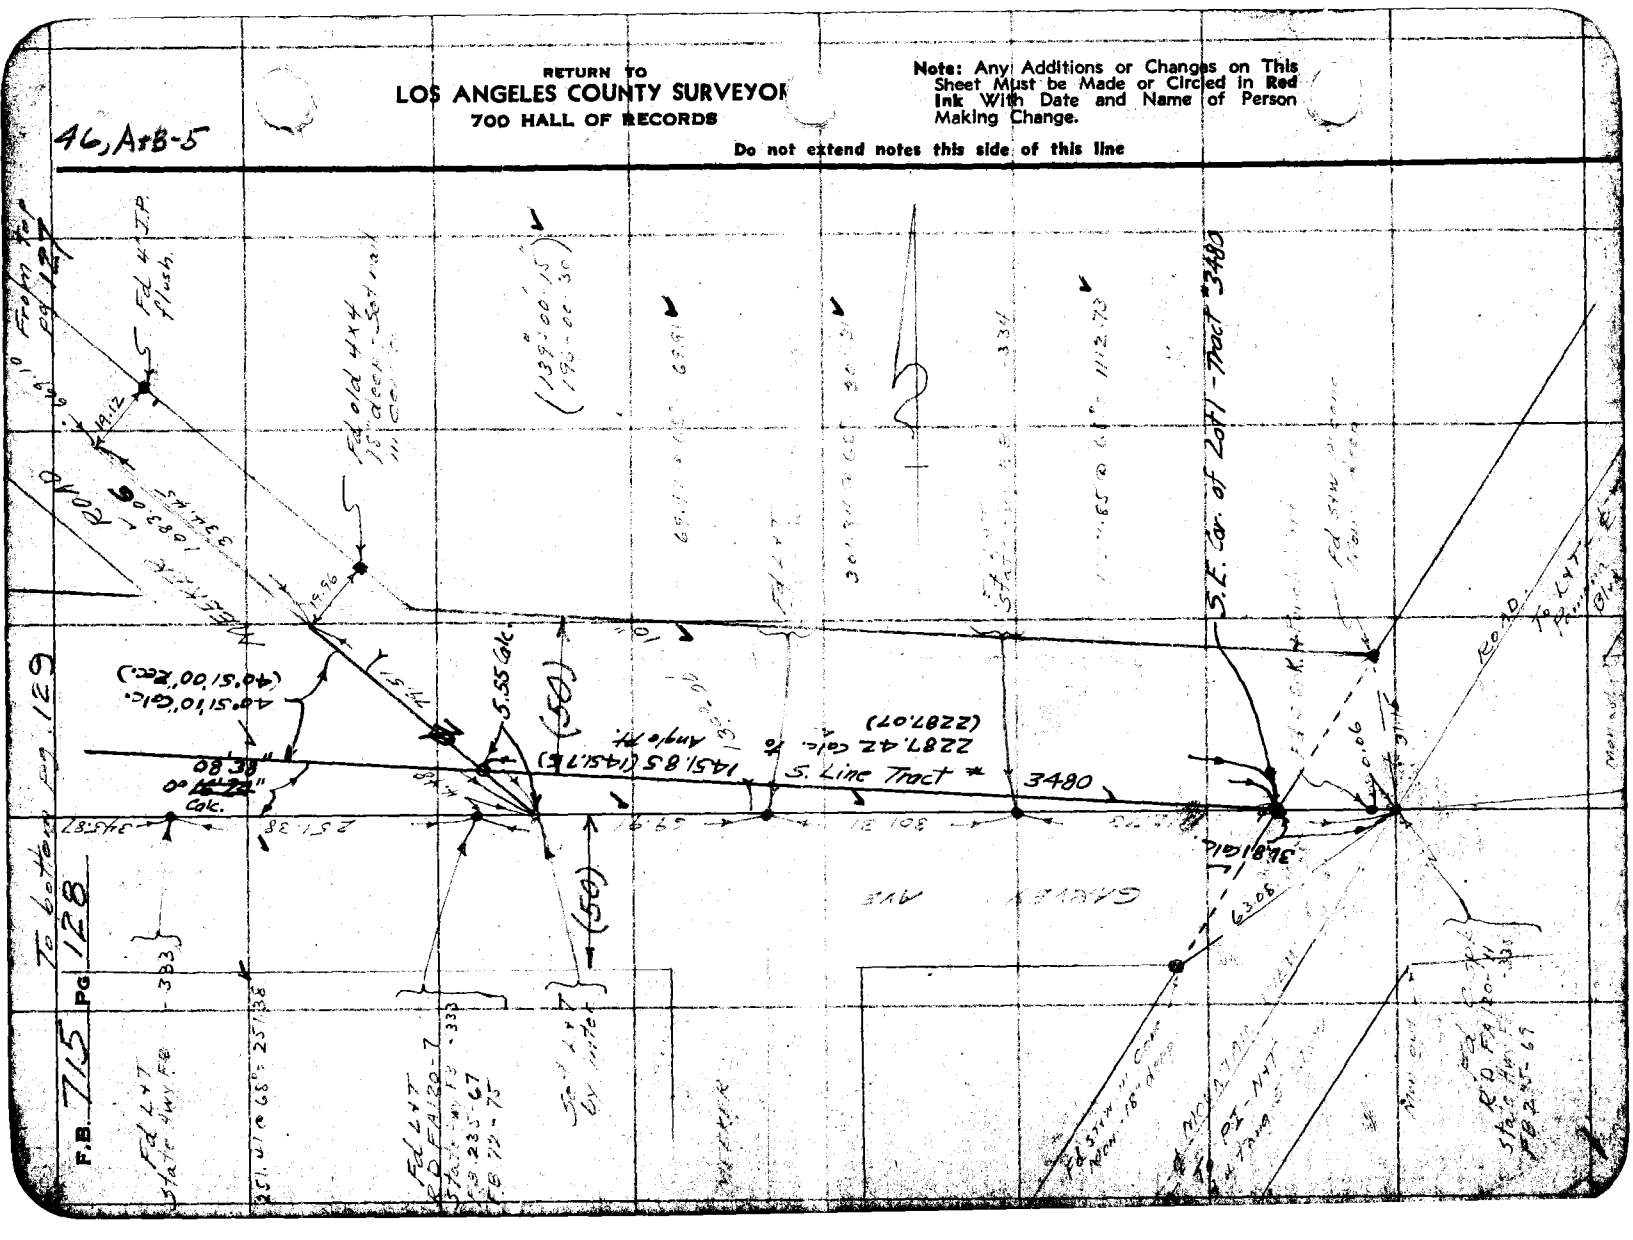
S.E. Cor. of 20ft. - Tract #3480
S. Line Tract # 3480
1451.85 (1451.7 E)
2287.42 calc. to Angle Pt.
(2287.07)
5.55 Calc.
(50)
(50)
(40.51'10" Calc.)
(40.51'00" Calc.)
0°
Calc.
3480 Calc.
To bottom Pg. 129
F.B. 715 Pg 1128
Fd L+T
State Hwy Fd
Fd L+T
Fd 1/2" I.P.
Fd 1/4" I.P.
Flush.
Fd 1/2" I.P.
No Tag - Set
Fd L+T
Fd L+T
Fd L+T

Notes Ck'd by M=Thurman	Survey of Rear Lead
Map No. C.S.B-135 1 & 2	W. O. 7052 Tape No. 040 St'd 84° F.
Office Work J. D Price.	Surveyed by V. D Moore
Checked Carr.	Notes Moore Date 10-25-37
Date Aug. '39	Indexed

F.B. 715 Pg. 129

46 A-5

To D-Tr. of 130

Fd 1/2" I.P. State Hwy F.B. -331

(50) AVE (50)

C.S.B-882.

209.04 @ 60° = 209.21

Centerline and Section Line per (Tract 3262, C.S. 8592, C.S. 8954 and This is not ℄ of Right of Way.

South Line of Tract 3480

2298.42 Calc. (2292.07)

Fd 1/2" I.P. State Hwy F.B. -331

MERLE ST.

347.57 @ 66° = 347.52

Angle Point. Fd L+T R.D.F.A/20-5 State Hwy. F.B. -332 F.B. 235-67 F.B. 72-75

Fd Spk + W in conc. Mon 8" deep.

(179° 44' -30" / 358 - 58 - 00)

30.04 0.30 Calc. 5.74

Fd Spk + W in conc Mon 8" deep

Angle Point in S. Line of Tract 3480 by Prop. E. + W.

238.34 @ 66° = 238.31

Fd L+T State Hwy F.B. 332

GAREY

345.91 @ 66° = 345.87

2287.42 Calc. (2287.07) 180°32'45" Calc. ℄ = 10 Rad. ℄ per Tr. 3480

From Top pg 128

Note: Any Additions or Changes on This Sheet Must be Made or Circled in Red Ink With Date and Name of Person Making Change.

Do not extend notes this side of this line

RETURN TO
LOS ANGELES COUNTY SURVEYOR
700 HALL OF RECORDS

FORM 247 10M 11-38

RETURN TO
LOS ANGELES COUNTY SURVEYOR
700 HALL OF RECORDS

Note: Any Additions or Changes on This Sheet Must be Made or Circled in Red Ink With Date and Name of Person Making Change.

Do not extend notes this side of this line

46/A-5

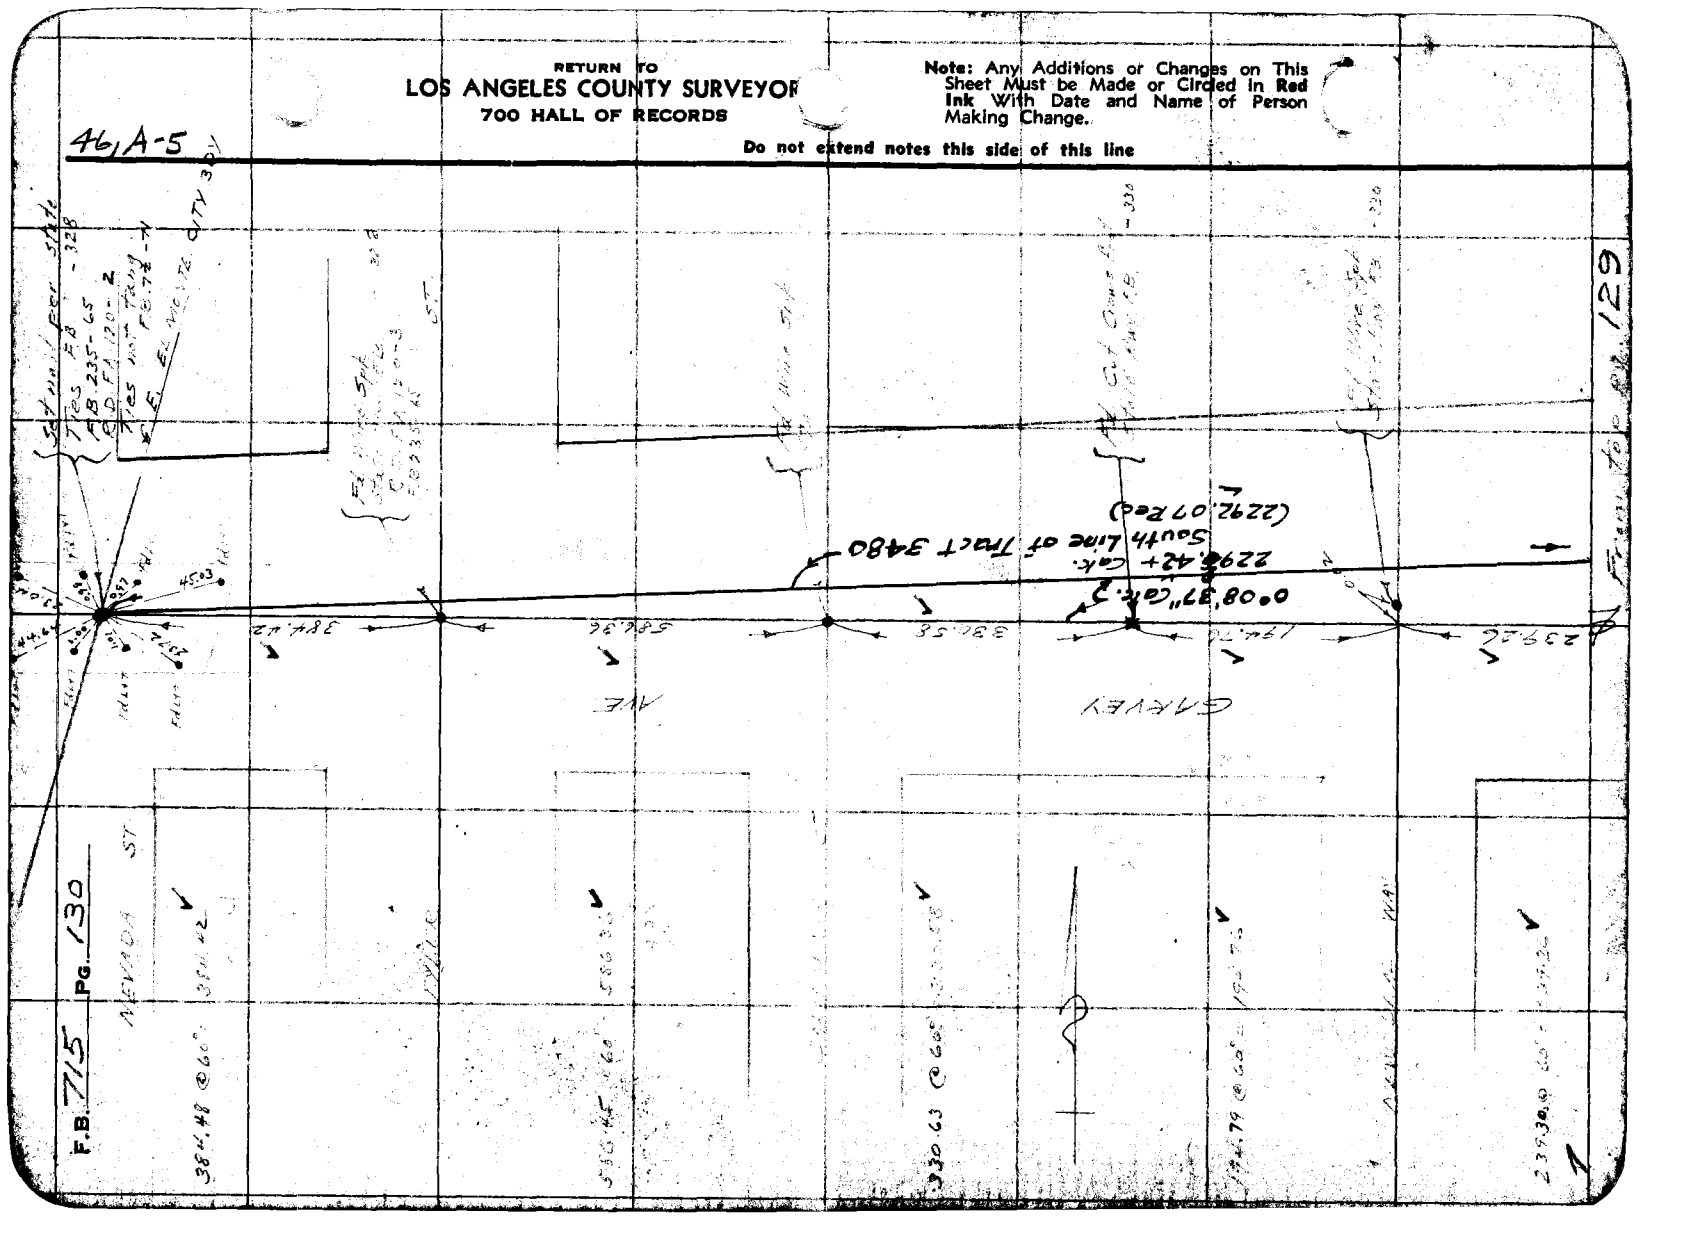

Notes Ck'd by A. A. P.	Survey of PECK RD.
Map No. C.S. B-1991-2	W. 08178 Tape No 067 St'd 94 °F.
Office Work J. D. Price.	Surveyed by EVANS.
Checked Carr	Notes L Date 11-30-37
Date Aug '39	Indexed 3-22-38

F.B. 715 Pg. 131

Ag A-5

To Bot. Pg. 132

N'ly Bdry Rd. Potrero Grande C.S. B-1048

220.11'

348

Fd. 2" I.P. flush. No Tk.

304.83-T80°=304.82

304.82

Fd. 1½" I.P. flush. No Tk. - Appears to have been disturbed.

Set 1X2

290

PORTION OF N'LY B'DRY OF RO. POTRERO GRANDE Rgs. 131-132

(1090.13 R(C.S.))

121°-46'-35"

Fd. 1½" I.P. (No Tk.), flush. - F.L. 5', P.G. 1' per C.S. B-1048 - Used for line

Set Nail

300

per

MT VIEW

1208

Fd. S.W. & T. per pg. 207

(121-46-30)
(127-06-15)
121°-46'-33¾"

Pg. 207

AVE.

To Pg. 207

Set Nail & Tin Tag

Note: Any Additions or Changes on This Sheet Must be Made or Circled in Red Ink With Date and Name of Person Making Change.

Do not extend notes this side of this line

RETURN TO
LOS ANGELES COUNTY SURVEYOR
700 HALL OF RECORDS

FORM 247 10M 11-38

F.B. 715 Pg. 132

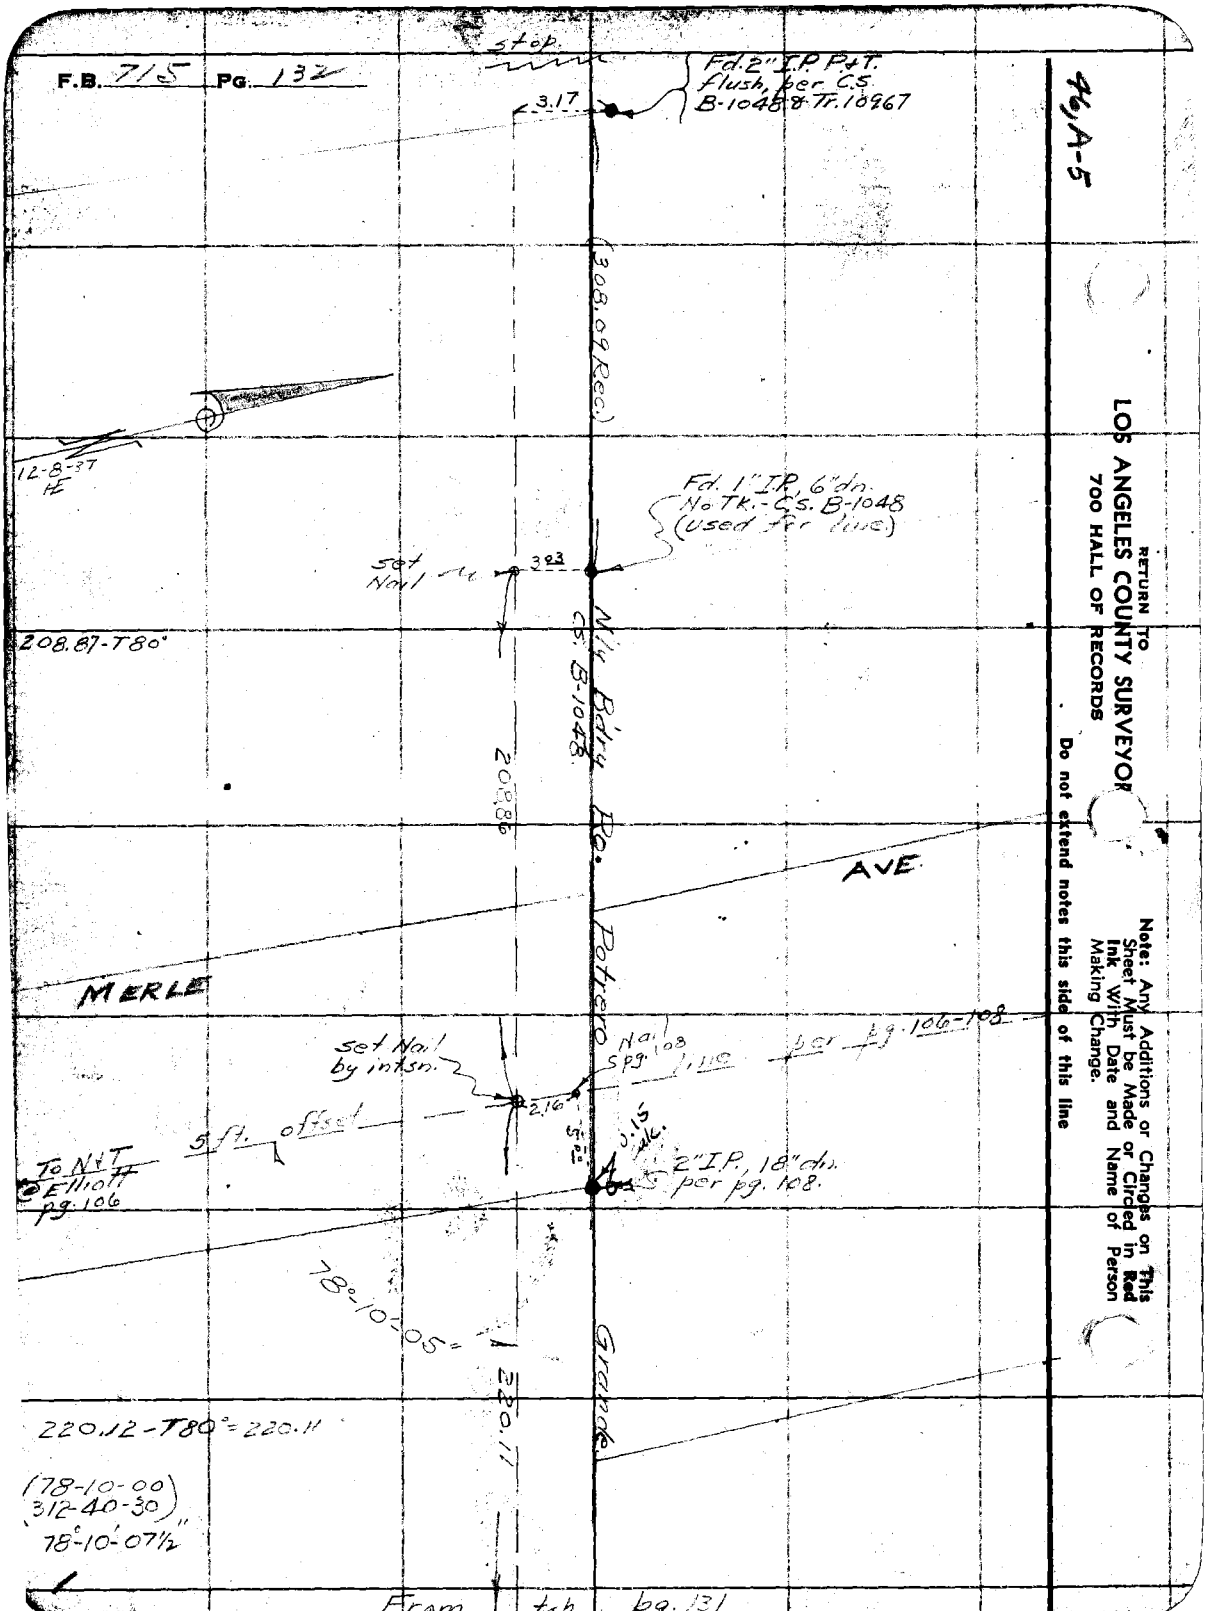

RETURN TO
LOS ANGELES COUNTY SURVEYOR
700 HALL OF RECORDS

Do not extend notes this side of this line

Note: Any Additions or Changes on This Sheet Must be Made or Circled in Red Ink With Date and Name of Person Making Change.

46, A-5

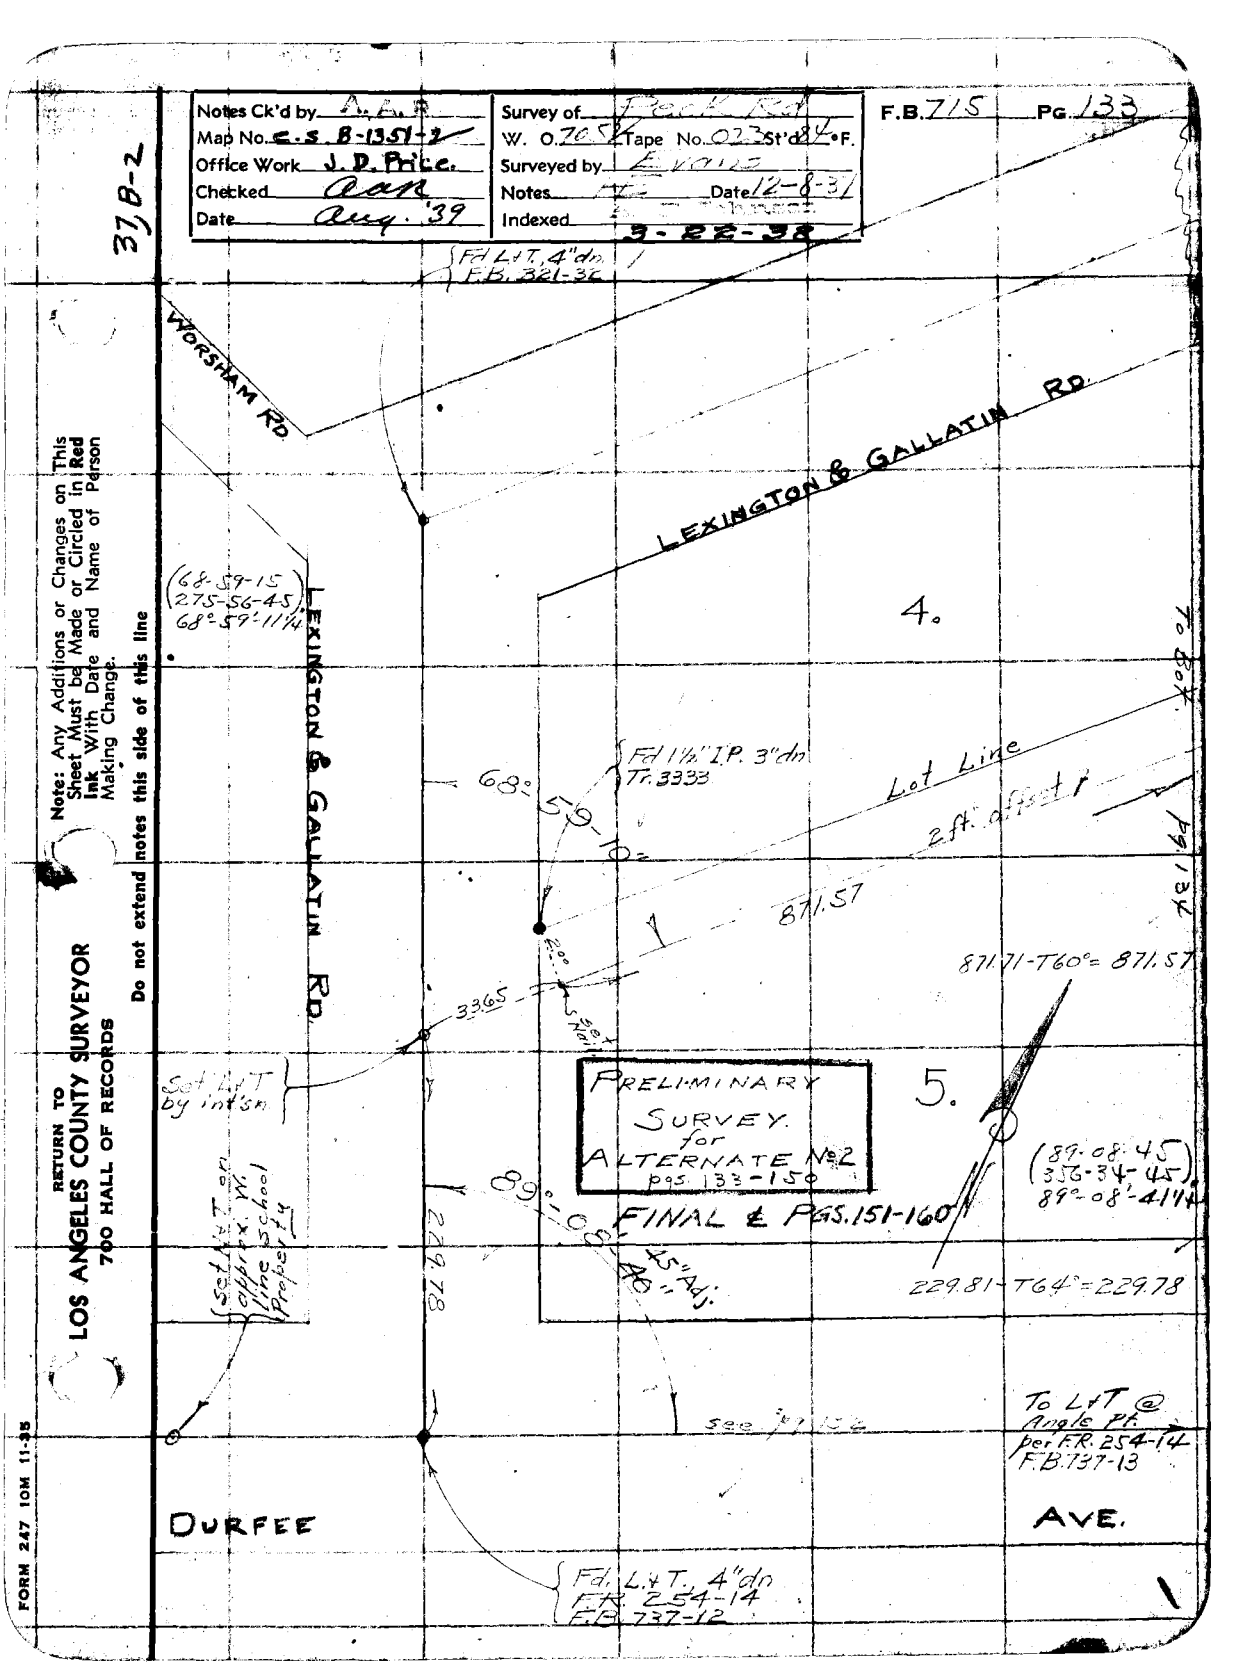
Notes Ck'd by A.A.S.
Map No. C.S.B-1351-2
Office Work J.D. Price.
Checked Carr
Date Aug. '39
Notes Date 12-8-31
Indexed
5-22-38
F.B. 715 Pg. 133
37 B-2
Fd L & T, 4" dn
F.B. 321-32
WORSHAM RD.
LEXINGTON & GALLATIN RD.
(68-59-15
275-56-45
68°-59'-11¼"
LEXINGTON & GALLATIN RD.
4.
Fd 1½" I.P. 3" dn
Tr. 3333
68°-59'-10"
Lot Line
2 ft. offset
871.57
871.71-T60°=871.57
3365
Set Nail
PRELIMINARY
SURVEY
for
ALTERNATE No 2
pgs. 133-150
FINAL & PGS. 151-160
5.
(89-08-45
358-34-45
89°-08'-41¼"
89°-08'-45"-Adj.
229.78
229.81-T64°=229.78
Set L & T on Conc. Wk. 15' Sch. Line Proj. 1'
To L & T @ Angle Pt. per F.R. 254-14 F.B. 737-13
DURFEE
AVE.
Fd. L. & T. 4" dn
F.R. 254-14
F.B. 737-12
Note: Any Additions or Changes on This Sheet Must be Made or Circled in Red Ink With Date and Name of Person Making Change.
Do not extend notes this side of this line
RETURN TO
LOS ANGELES COUNTY SURVEYOR
700 HALL OF RECORDS
FORM 247 10M 11-38

RETURN TO
LOS ANGELES COUNTY SURVEYOR
700 HALL OF RECORDS

Note: Any Additions or Changes on This Sheet Must be Made or Circled in **Red** Ink With Date and Name of Person Making Change.

Do not extend notes this side of this line

37 B-2

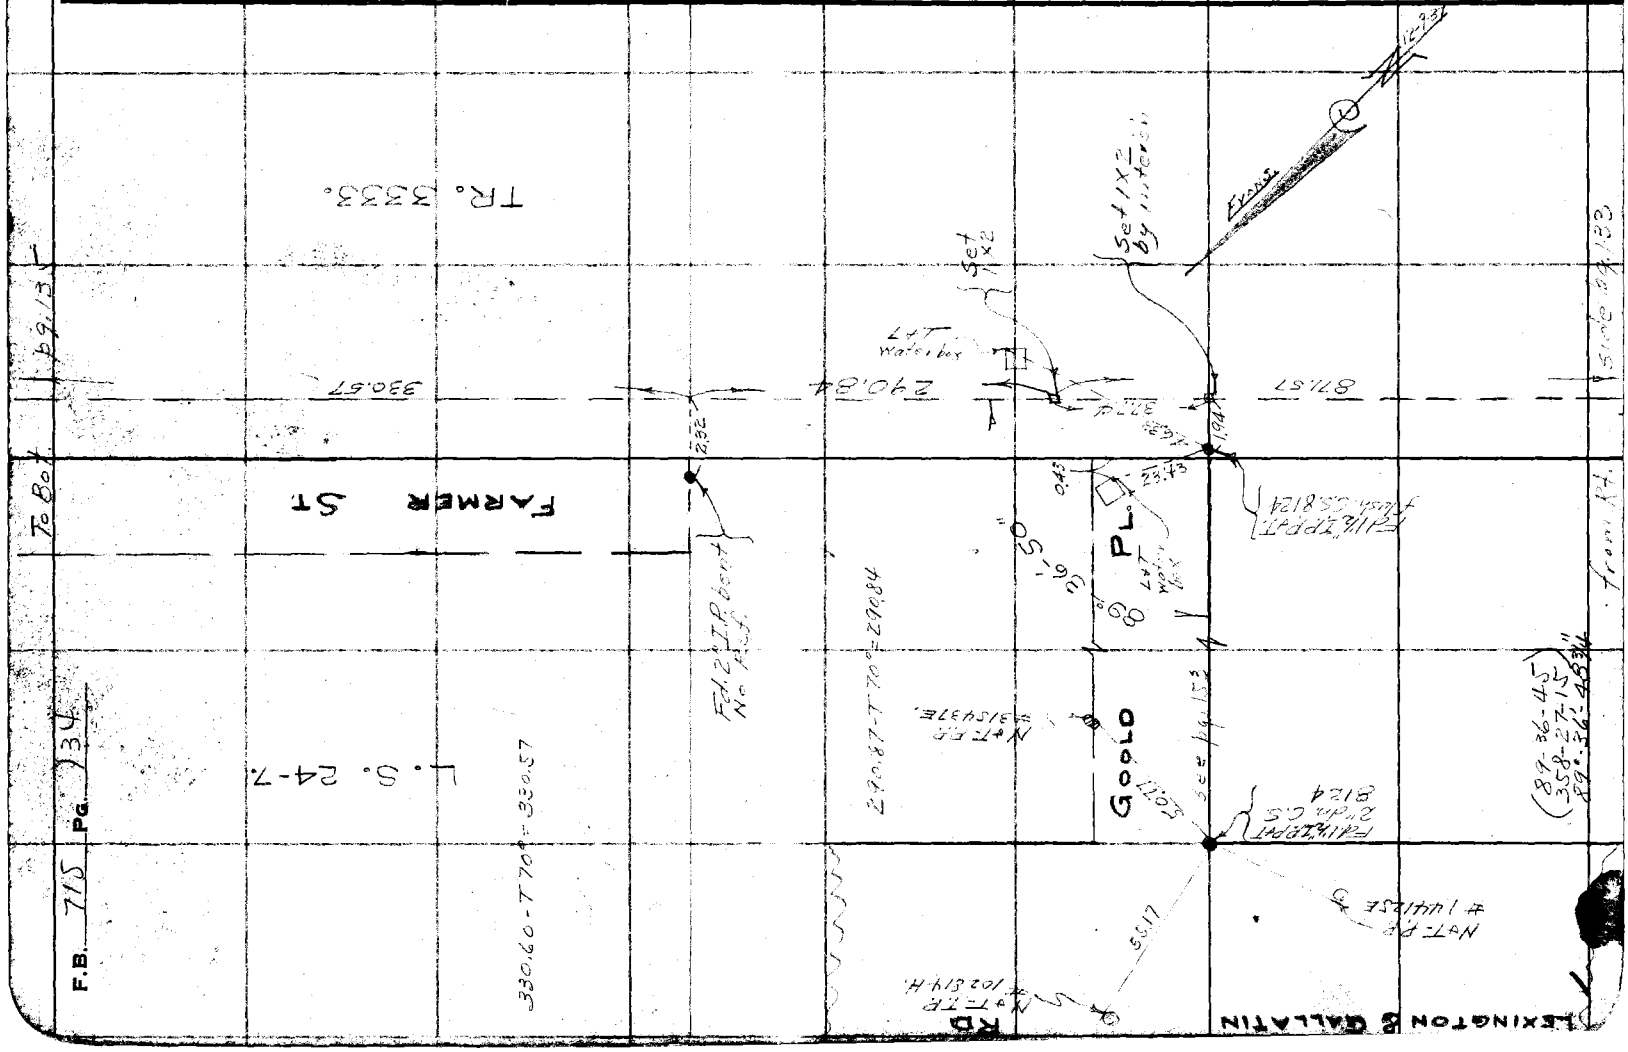
TR. 3333.
FARMER ST
To Box
F.B. 715 Pg. 34
L. S. 24-7.
330.57
330.60-T 70°-330.57
Fd. 2" I.P. Bent No Tag
290.84
290.87-T 70°-290.84
Set 1"x2"
Set 1"x2" By ,,,,
Water box
Fence
Fd. Tack

FORM 247 10M 11-38

RETURN TO
LOS ANGELES COUNTY SURVEYOR
700 HALL OF RECORDS

Note: Any Additions or Changes on This Sheet Must be Made or Circled in Red Ink With Date and Name of Person Making Change.

Do not extend notes this side of this line

37, B-2

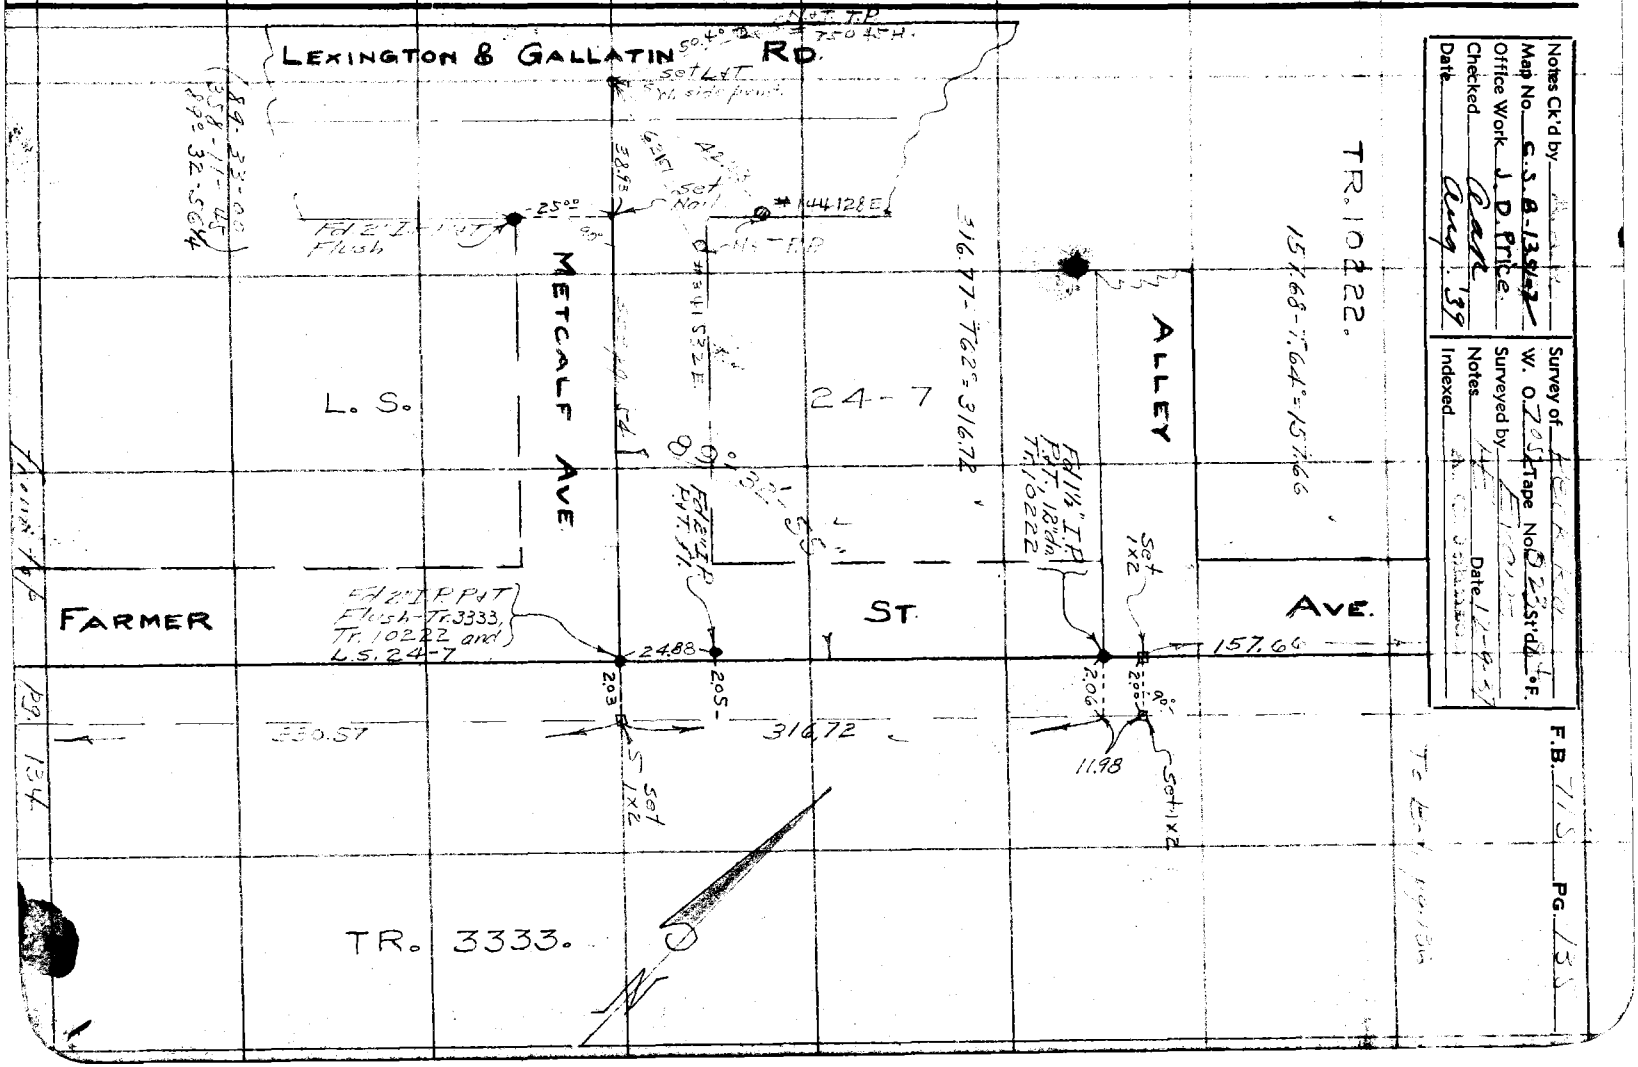

Notes Ck'd by
Map No. C.S.B-13,947
Office Work J. D. Price.
Date

Survey of
W. O.
Tape No.
Surveyed by
Notes
Date
Indexed


F.B. 715 Pg. 136

To Bot. pg. 137

3787

RETURN TO
LOS ANGELES COUNTY SURVEYOR
700 HALL OF RECORDS

Note: Any Additions or Changes on This Sheet Must be Made or Circled in Red Ink With Date and Name of Person Making Change.

Do not extend notes this side of this line

375.33-T66°=375.29

Fd 2" I.P. Tagged Tr. 3333, Tr. 10222, F.B. 321-51

0.09

375.29

(90-15-15)
(361-01-15)
90°-15'-18¾"

301.54-T66°=301.50

10222

3333

AVE.

FARMER

Fd 1/4" x 4" stake Used for Pt. F.B. 404-11

PROP'D FIFTH AVE
C.S. B-191-9.

0.07

ANDREWS ST.

LEXINGTON & GALLATIN RD.

Set chis. Tk. in edge of 4x4 by intersect See pg. 135

See pg. 18 Tr. 10222 Fd 1/4" I.P. F.B. 321-50 F.B. 404-11

135.42-T64°=135.40

135.40

Fd 2" I.P. 6" on Tr. 3333 & Tr. 10222

0.24

137.66

From top

Pg. 135

Notes Ck'd by A.A.	Survey of Peck Rd
Map No. C.S. B-1361-2	W. O. 705 Tape No. 022 St'd 33 F.
Office Work J. D. Price.	Surveyed by [illegible]
Checked Aak	Notes H. Date 12-10-37
Date Aug. 39	Indexed [illegible]

F.B. 715 Pg. 131

37 B-2

(74-59-45)
(299-58-45)
74°59'-41"

616.86-T66°=616.79

To Bch. Pg. 128

Set 2"x2"x14" on. 6" in. 1.0' in.

Fd 1½" I.P. in mon. 4"dn. L.S. 4431

Fd 2"x2" stake in ground 2'N. & 2'E. of Mon. FB 321-51, FB 333-71 & 22, L.S. 2547

74°59'-40"

616.79

0.32

0.64

Set Nail

28.21

209

Set PM.

161

Fd 2" I.P. in mon. 4" dn. FB 321-51

FAWCETT AVE.

.68

S 57° 05' E

102.14

Set 2"x2", 6" dn. by inter's'n Replaced with 3/4" I.P. con. 9" p. tk. 18" dn. per pg. 156

375.29

LEXINGTON & GALLATIN RD.

S 40° 31' 55" E

FARMER AVE.

(164-32-00)
(298-07-45)
164°-31'-56"

(89-32-15)
(358°-07-00)
89°-32'-15"

From top - Pg 136

RETURN TO
LOS ANGELES COUNTY SURVEYOR
700 HALL OF RECORDS

Do not extend notes this side of this line

Note: Any Additions or Changes on This Sheet Must be Made or Circled in Red Ink With Date and Name of Person Making Change.

FORM 247 10M 11-35

RETURN TO
LOS ANGELES COUNTY SURVEYOR
700 HALL OF RECORDS

Note: Any Additions or Changes on This Sheet Must be Made or Circled in **Red Ink** With Date and Name of Person Making Change.

Do not extend notes this side of this line

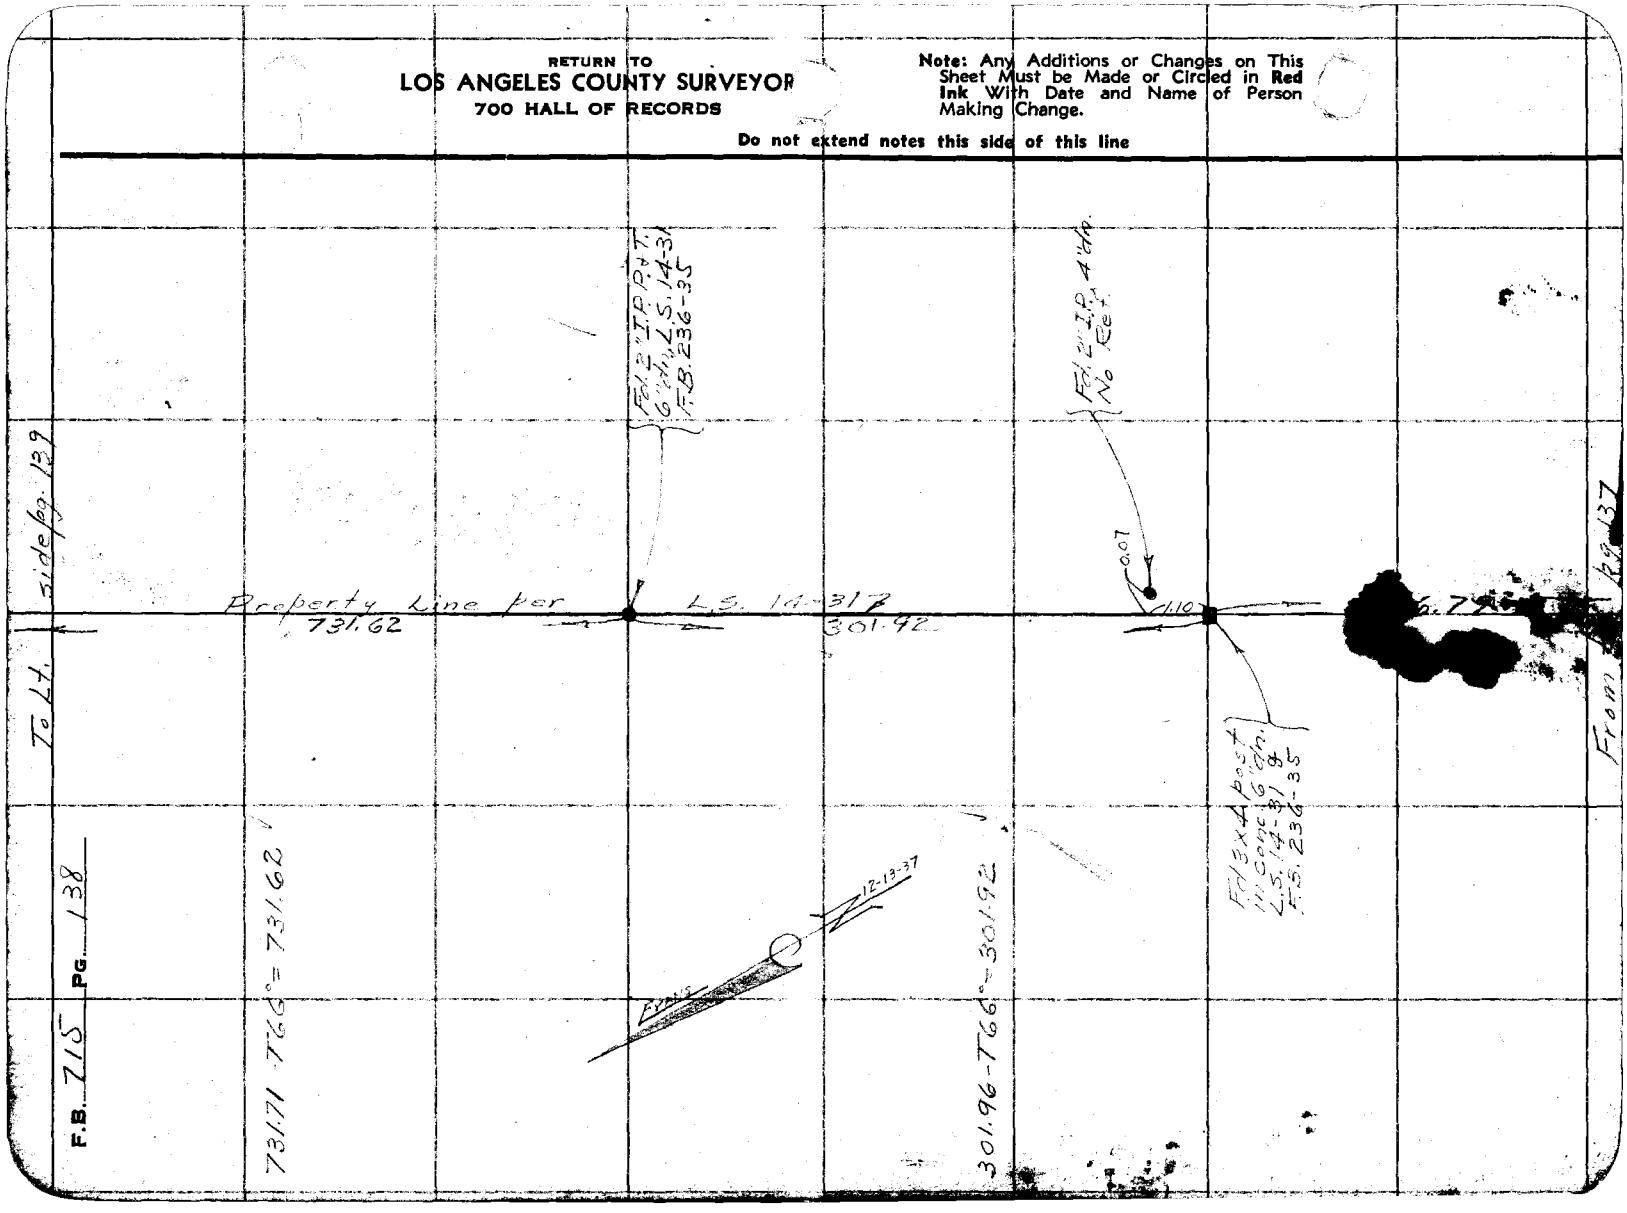

Notes Ck'd by A. A. P.	Survey of Heck Rd
Map No. S.B. B-1351-2	W. O 2052 Tape No 023 St'd 8" F.
Office Work J. D. Price	Surveyed by Evans
Checked Aap	Notes HF Date 12-12-37
Date Aug. '39	Indexed

F.B. 715 Pg. 139
(176-05-30
3 W 11-22-30)
17½° = 1.37½

37 B-2

Fd. L x L above C.S. mon per R9 20.

Fd. 2" I.P. 6" dp. per C.S. 14-31 & F.B. 236-35 Set plug & tk

176-05-30

627.45

683.16

731.62

683.21 - 72° = 683.16

75°-45'-15" Adj.

1220.20

CENTRAL AVE

(75-45-15)
(303-01-00)
75° 45'-15"

Fd. C.S. mon. 4" dp. per F.B. 236-35 5 of 2x2, ft.

DURFEE AVE

Note: Any Additions or Changes on This Sheet Must be Made or Circled in Red Ink With Date and Name of Person Making Change.

Do not extend notes this side of this line

RETURN TO
LOS ANGELES COUNTY SURVEYOR
700 HALL OF RECORDS

FORM 247 10M 11-38

RETURN TO
LOS ANGELES COUNTY SURVEYOR
700 HALL OF RECORDS

Note: Any Additions or Changes on This Sheet Must be Made or Circled in Red Ink With Date and Name of Person Making Change.

Do not extend notes this side of this line

37 B-2

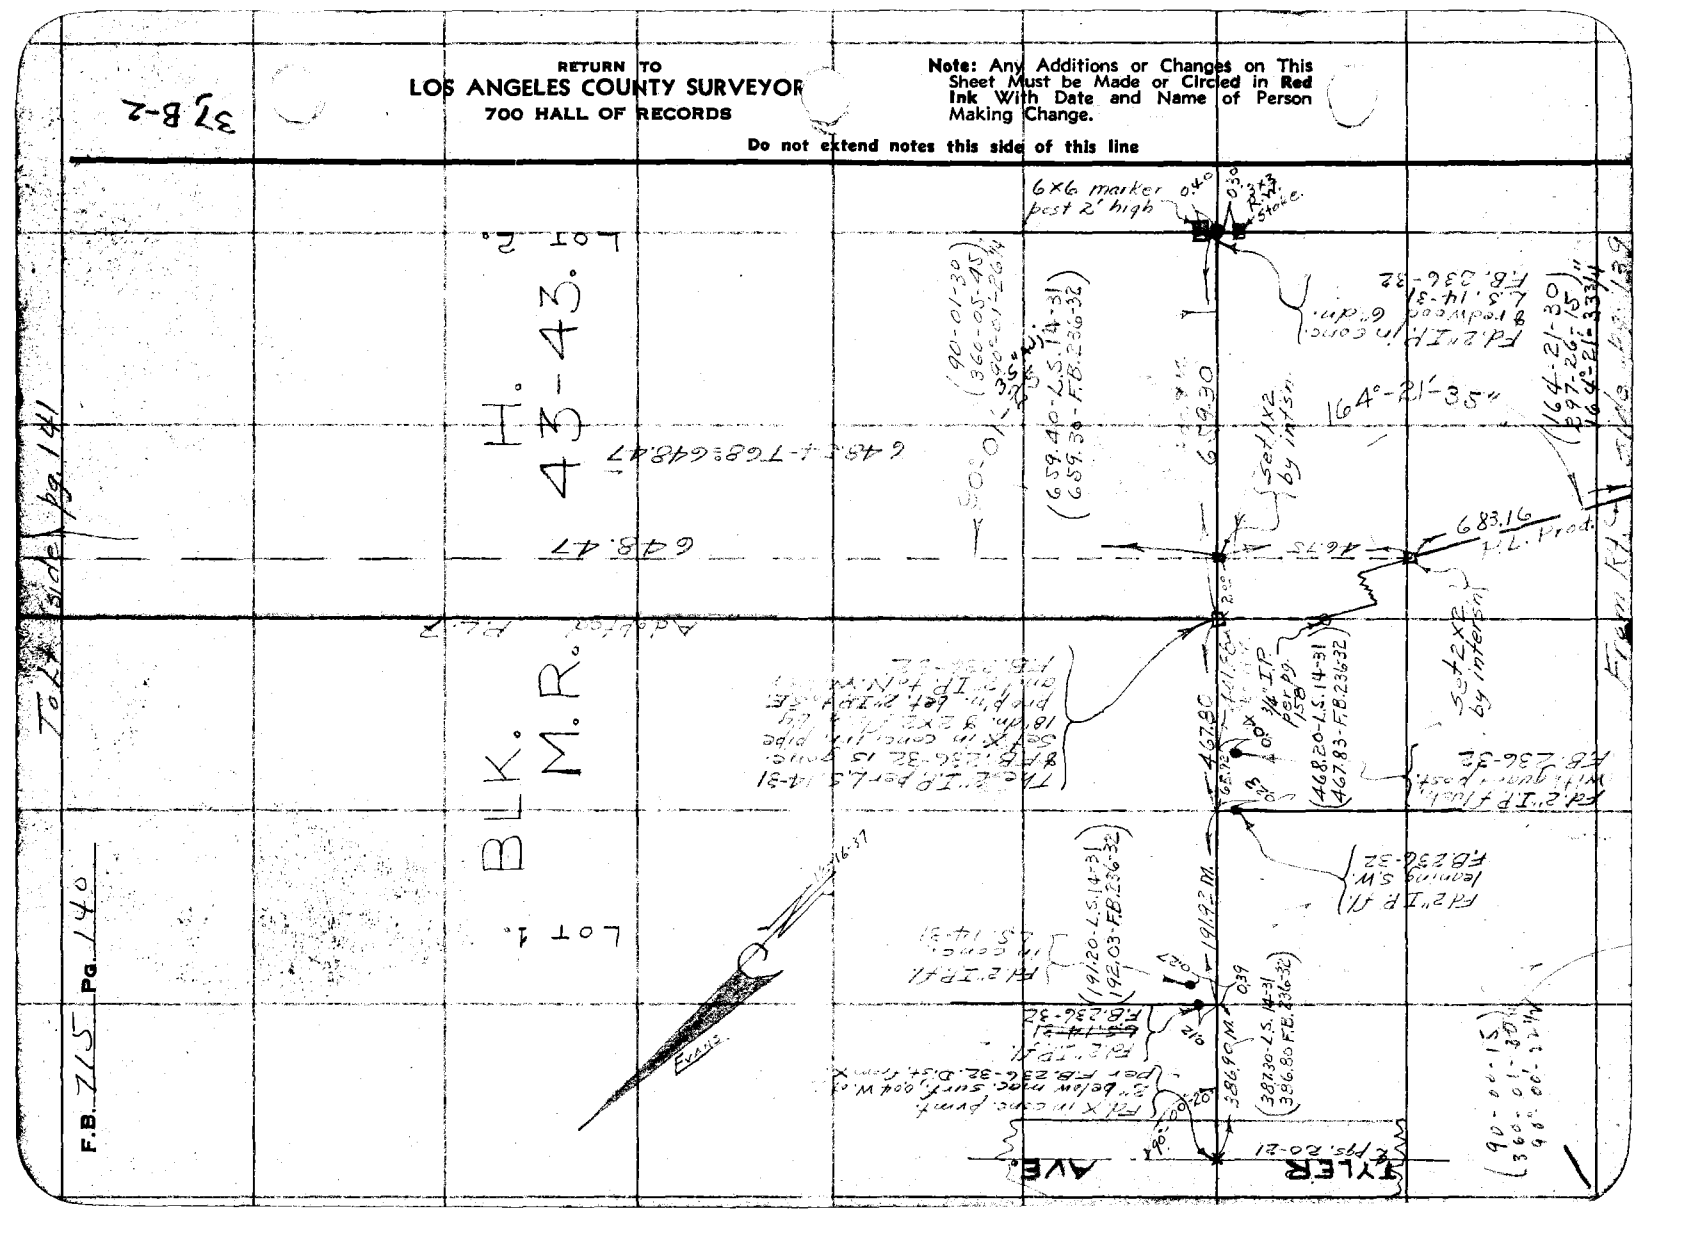

F.B. 715 Pg. 140

To Face Side Pg. 141

Notes Ck'd by A. P.	Survey of Peck Rd
Map No. C.S. B-135-2	W. 0Z052 Tape No. 063 St'd @ 4°F.
Office Work J. D. Price.	Surveyed by E. Mills
Checked aur	Notes LA Date 12-16-37
Date Aug '39	Indexed

F.B. 715 PG. 141

37, B-2

TYLER AVE.

(90°-01-45"
360-07-15
99°-01-48¾"

Fd. 2" I.P. ft.
L.S. 14-31
F.B. 236-32

357.03

Fd. Aunt Sok. 1/2 Rd. per pg. 21

387.08-T66°-387.03

SLACK

2489

MT. VIEW AVE.
(Not Constd.)

BLK. 1

90°-01-59"

661.37

RD.

661.45-T66°-661.37

Fd. 3x4 R.W., 6"dn. No pipe found. See F.B. 236-33

3/4" I.P. pg. 159

Fd. 1½" I.P. 3" dn., per C.S. 8124

2220

181

2543

648.47

660.22

658.76

Set N¾T by intsn.

660.26-T74°-660.23

Top pg. 139

BLK. H

BLK. G

179°-55-40
359°-12-45
179°-55-41¼"

179°-55'-40"-0.10

Fd. 2x2 Pluck per pg. 21 Replaced with ¾ J.H. cem. & cpl. 16"d 8"x2" bolt

25.00

Fd. 1" I.P. + tk. in 3x4 R.W. 6"dn.- pg. 21 F.B. 236-33

1122.58

658.82-T70°-658.76

To top pg. 142

To Title Pg. 143

Note: Any Additions or Changes on This Sheet Must be Made or Circled in Red Ink With Date and Name of Person Making Change.

Do not extend notes this side of this line

RETURN TO
LOS ANGELES COUNTY SURVEYOR
700 HALL OF RECORDS

FORM 247 10M 11-35

RETURN TO
LOS ANGELES COUNTY SURVEYOR
700 HALL OF RECORDS

Note: Any Additions or Changes on This Sheet Must be Made or Circled in Red Ink With Date and Name of Person Making Change.

Do not extend notes this side of this line

37, B-2

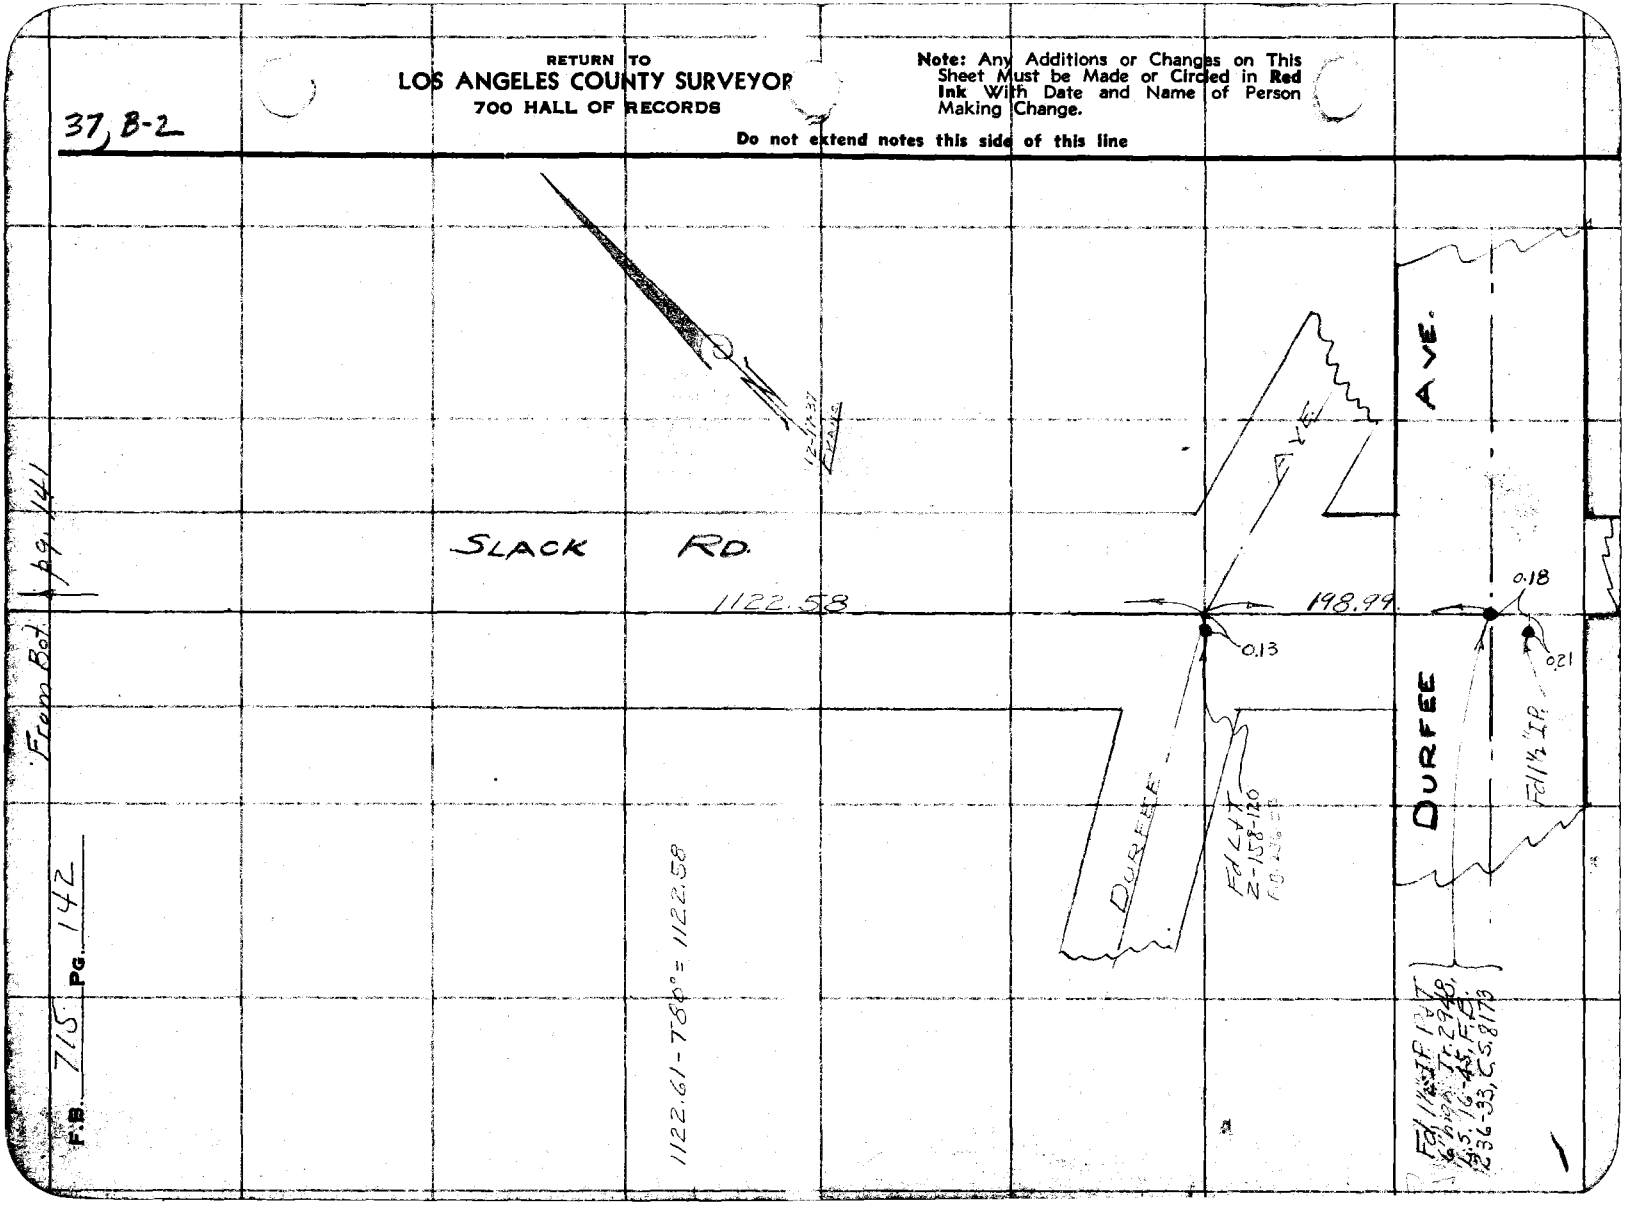

Notes Ck'd by	Survey of
Map No. C.S. B-135 1-2	W. O. 7052 Tape No. 223 St'd 84 °F.
Office Work J. D. Price	Surveyed by Evans
Checked Clark	Notes HC Date 12-17-35
Date Aug 39	Indexed

F.B. 715 Pg. 142

(Fd. S W & T per pg. 23 (This same pg.)

37 B-2

TYLER AVE.

THIENES

(90-00-45)
360-02-45
90°-00'-41¼"

1048.09-T64°=1047.95

1047.95

MT. VIEW (Not Const'd.) AVE.

Note: Any Additions or Changes on This Sheet Must be Made or Circled in Red Ink With Date and Name of Person Making Change

Do not extend notes this side of this line

RETURN TO
LOS ANGELES COUNTY SURVEYOR
700 HALL OF RECORDS

1.

90-00'-40"

Fd. N¾" I.P. & small Hill

Fd. old 2x2 & Tk 14" dn.

0.02

¾" I.P. pg. 159

217.4

25.02

299.6

658.76

661.74

COGSWELL RD.

Set N & T by interpn

2.

TR. 11333

AVE.

658.54

Fd. N & T

1.32

0.64

24.62

Fd. ¾" I.P. flush

3.

1321.54-T68°=1321.40

4.

1321.40

Fd. L & T pg. 23

0.13

Fd. L & T pg. 23

DURFEE AVE.

FORM 247 10M 11-35

RETURN TO
LOS ANGELES COUNTY SURVEYOR
700 HALL OF RECORDS

Note: Any Additions or Changes on This Sheet Must be Made or Circled in Red Ink With Date and Name of Person Making Change.

Do not extend notes this side of this line

31 C-2

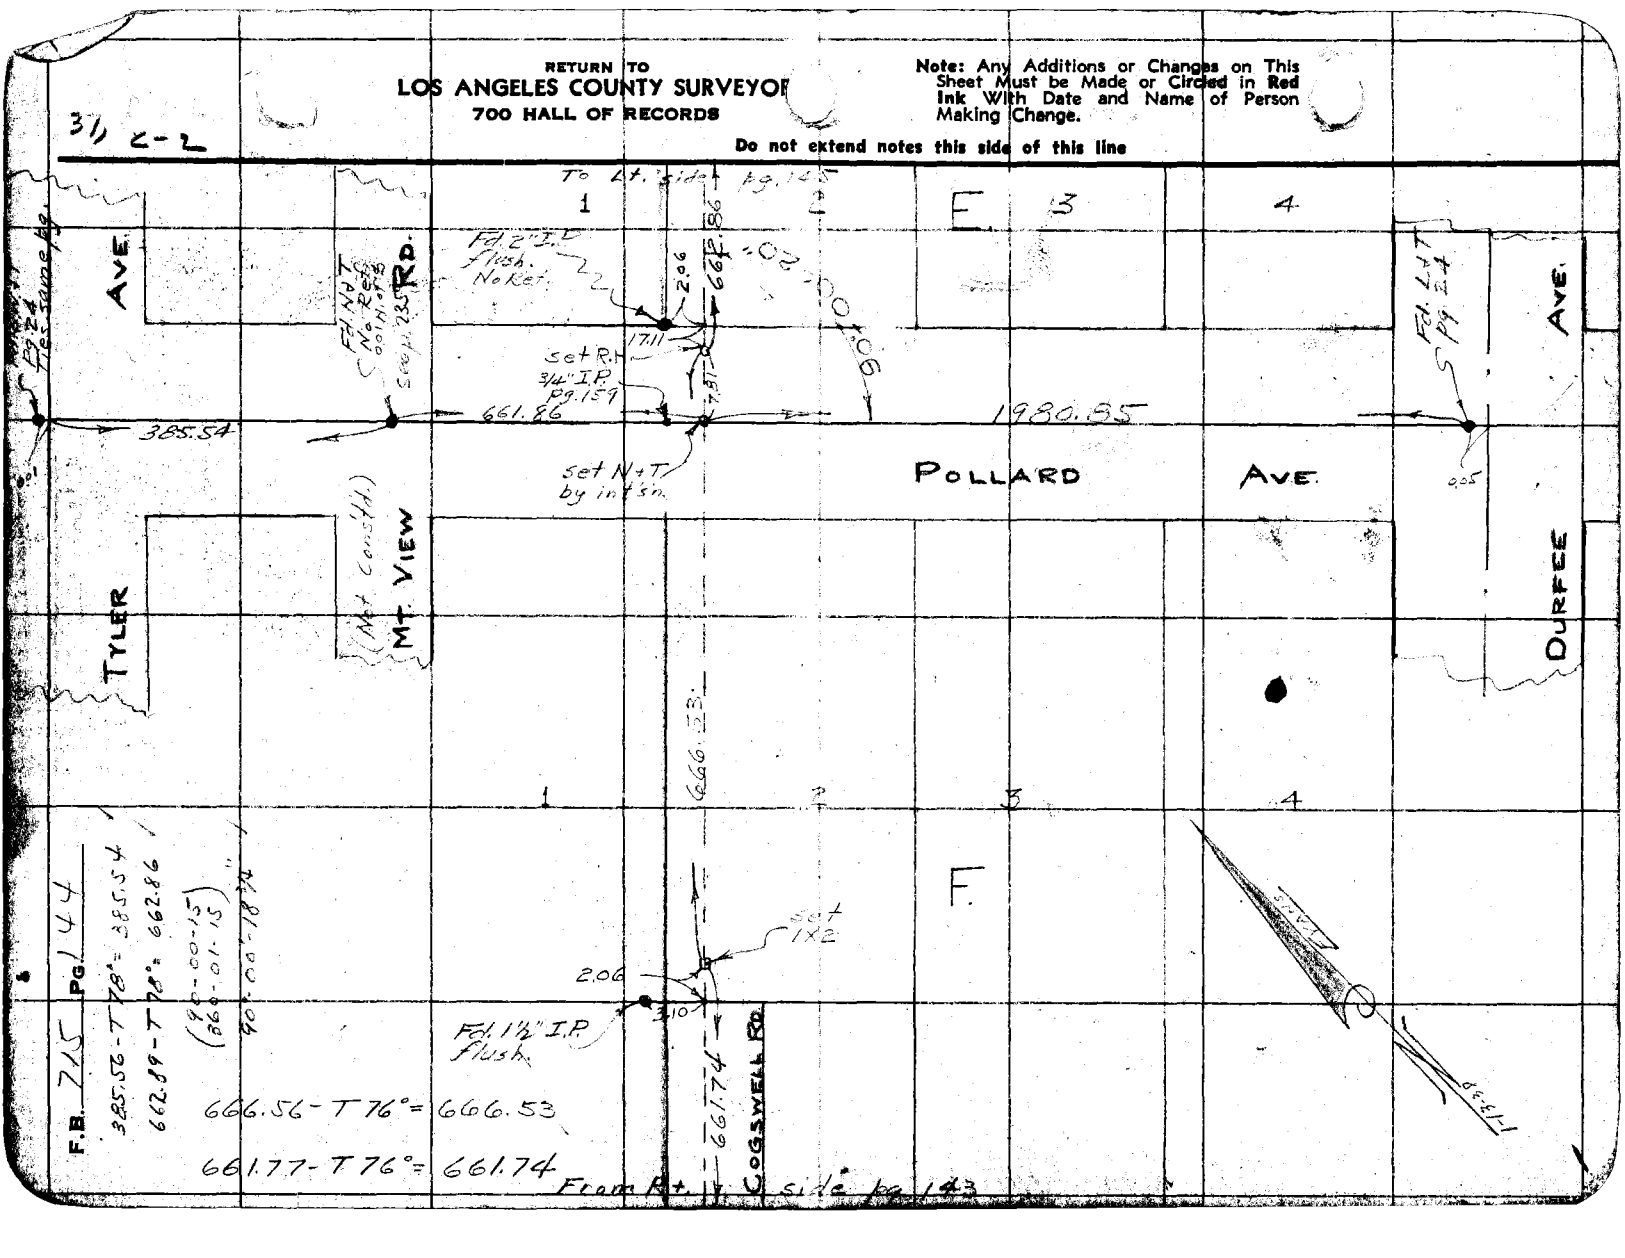

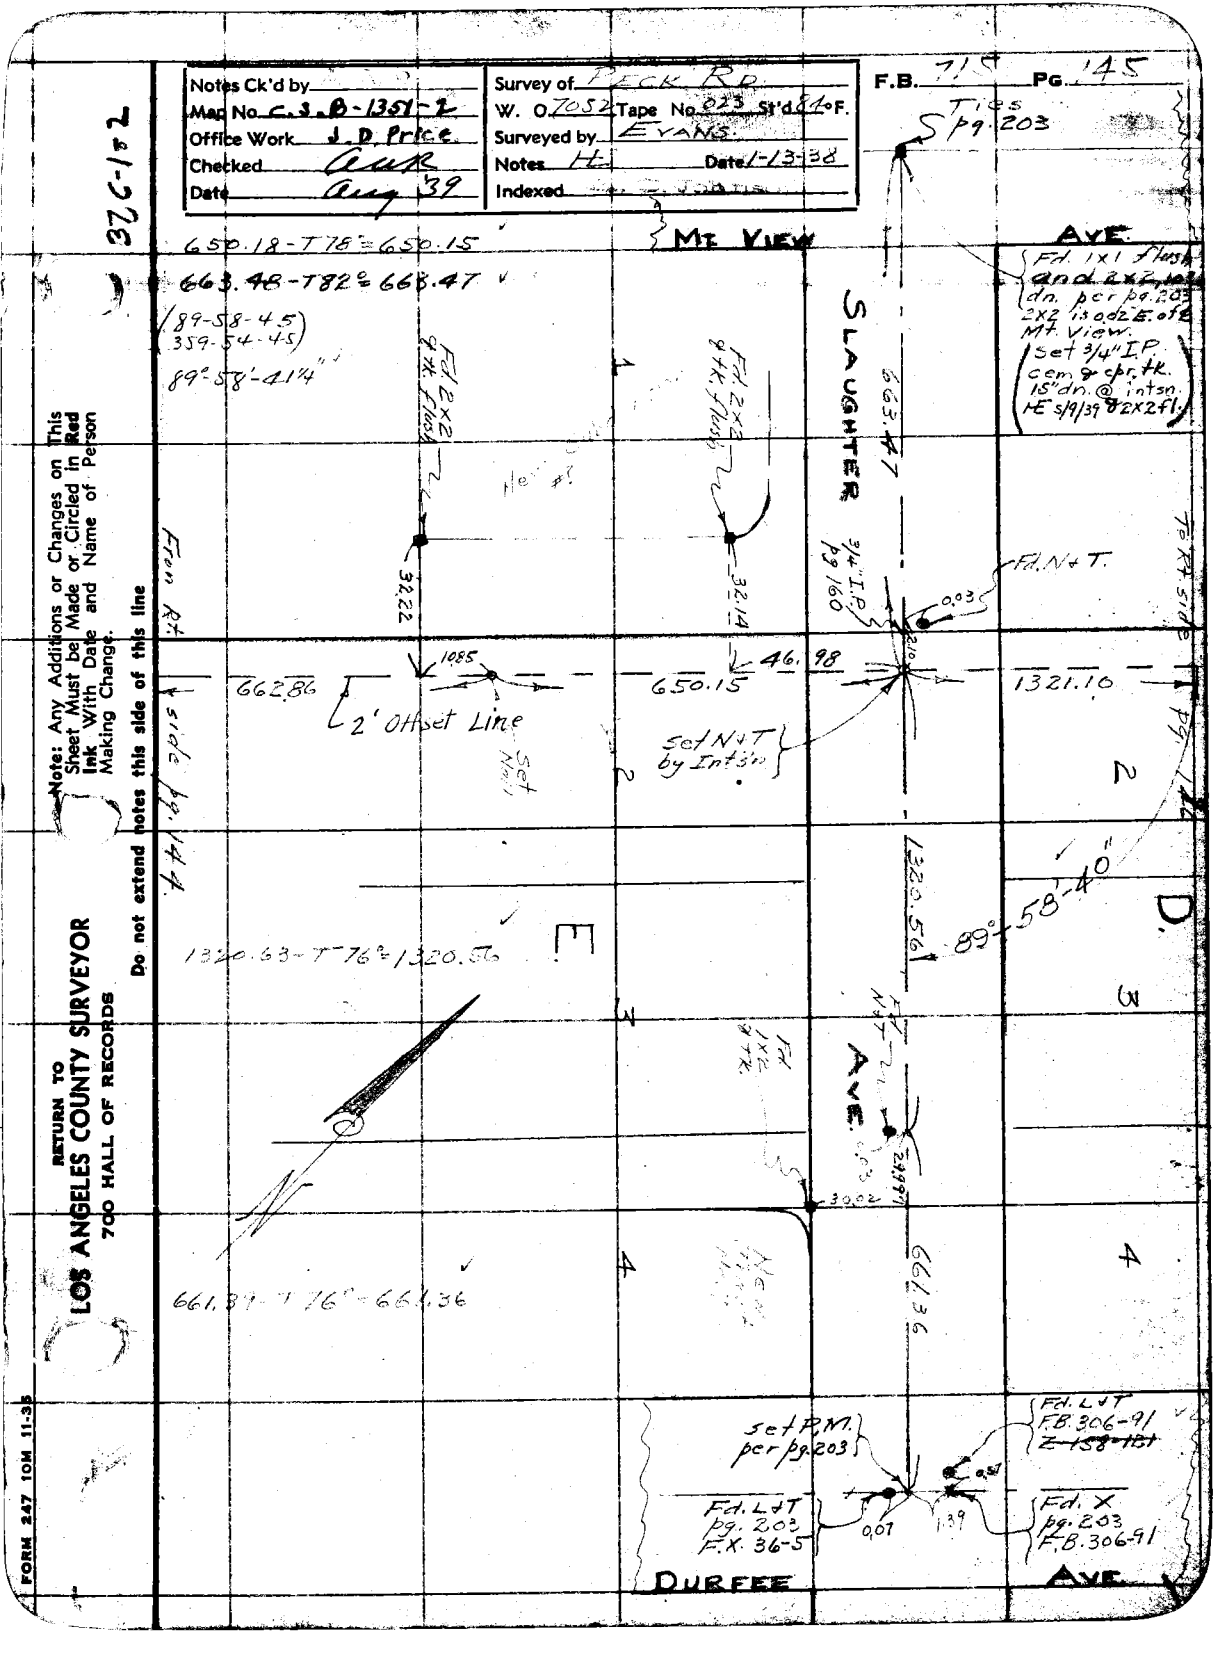
Notes Ck'd by
Map No. C.S.B-1351-2
Office Work J. D. Price
Checked Cmk
Date Aug 39
Survey of PECK RD
W. O. 7052 Tape No. 023 St'd 64° F.
Surveyed by EVANS.
Notes H. Date 7-13-38
Indexed
F.B. 714 Pg. 145
37 C-182
650.18-T 78'=650.15
663.48-T 82'=668.47
(89-58-45)
359-54-45
89°-58'-41¼"
Mt View
Ties Pg. 203
AVE.
Fd. 1x1 Flush and 2x2, 10" dn. per pg. 203 2x2 is 0.2 E. of &
Mt View.
Set ¾" IP cem. & chr. tk. 15" dn. @ intsn. ME 5/9/39 82X2 fl.
SLAUGHTER
663.47
Fd. 2x2 & tk. Flush
Fd. 2x2 & tk. Flush
3/4" I.P. Pg 160
Fd. N & T.
0.03
2.10
Fr. R/
32.22
32.14
1085
662.86
2' Offset Line
Set Nail
650.15
46.98
Set N & T by Intsn
1321.10
To R/W Line
Pg. 144
Note: Any Additions or Changes on This Sheet Must be Made or Circled in Red Ink With Date and Name of Person Making Change.
Do not extend notes this side of this line
side Pg. 144
1320.63-T 76'=1320.56
1320.56
89°-58'-40"
D.
E.
Fd. 1x2 & tk.
2.69
3.00
661.81-T 76'=661.36
661.36
Set P.M. per pg. 203
Fd. L & T pg. 203 F.X. 36-5
0.07
1.39
Fd. L & T F.B. 306-91
Fd. X pg. 203 F.B. 306-91
DURFEE
AVE.
RETURN TO
LOS ANGELES COUNTY SURVEYOR
700 HALL OF RECORDS
FORM 247 10M 11-38

RETURN TO
LOS ANGELES COUNTY SURVEYOR
700 HALL OF RECORDS

Note: Any Additions or Changes on This Sheet Must be Made or Circled in Red Ink With Date and Name of Person Making Change.

Do not extend notes this side of this line

37, C-1

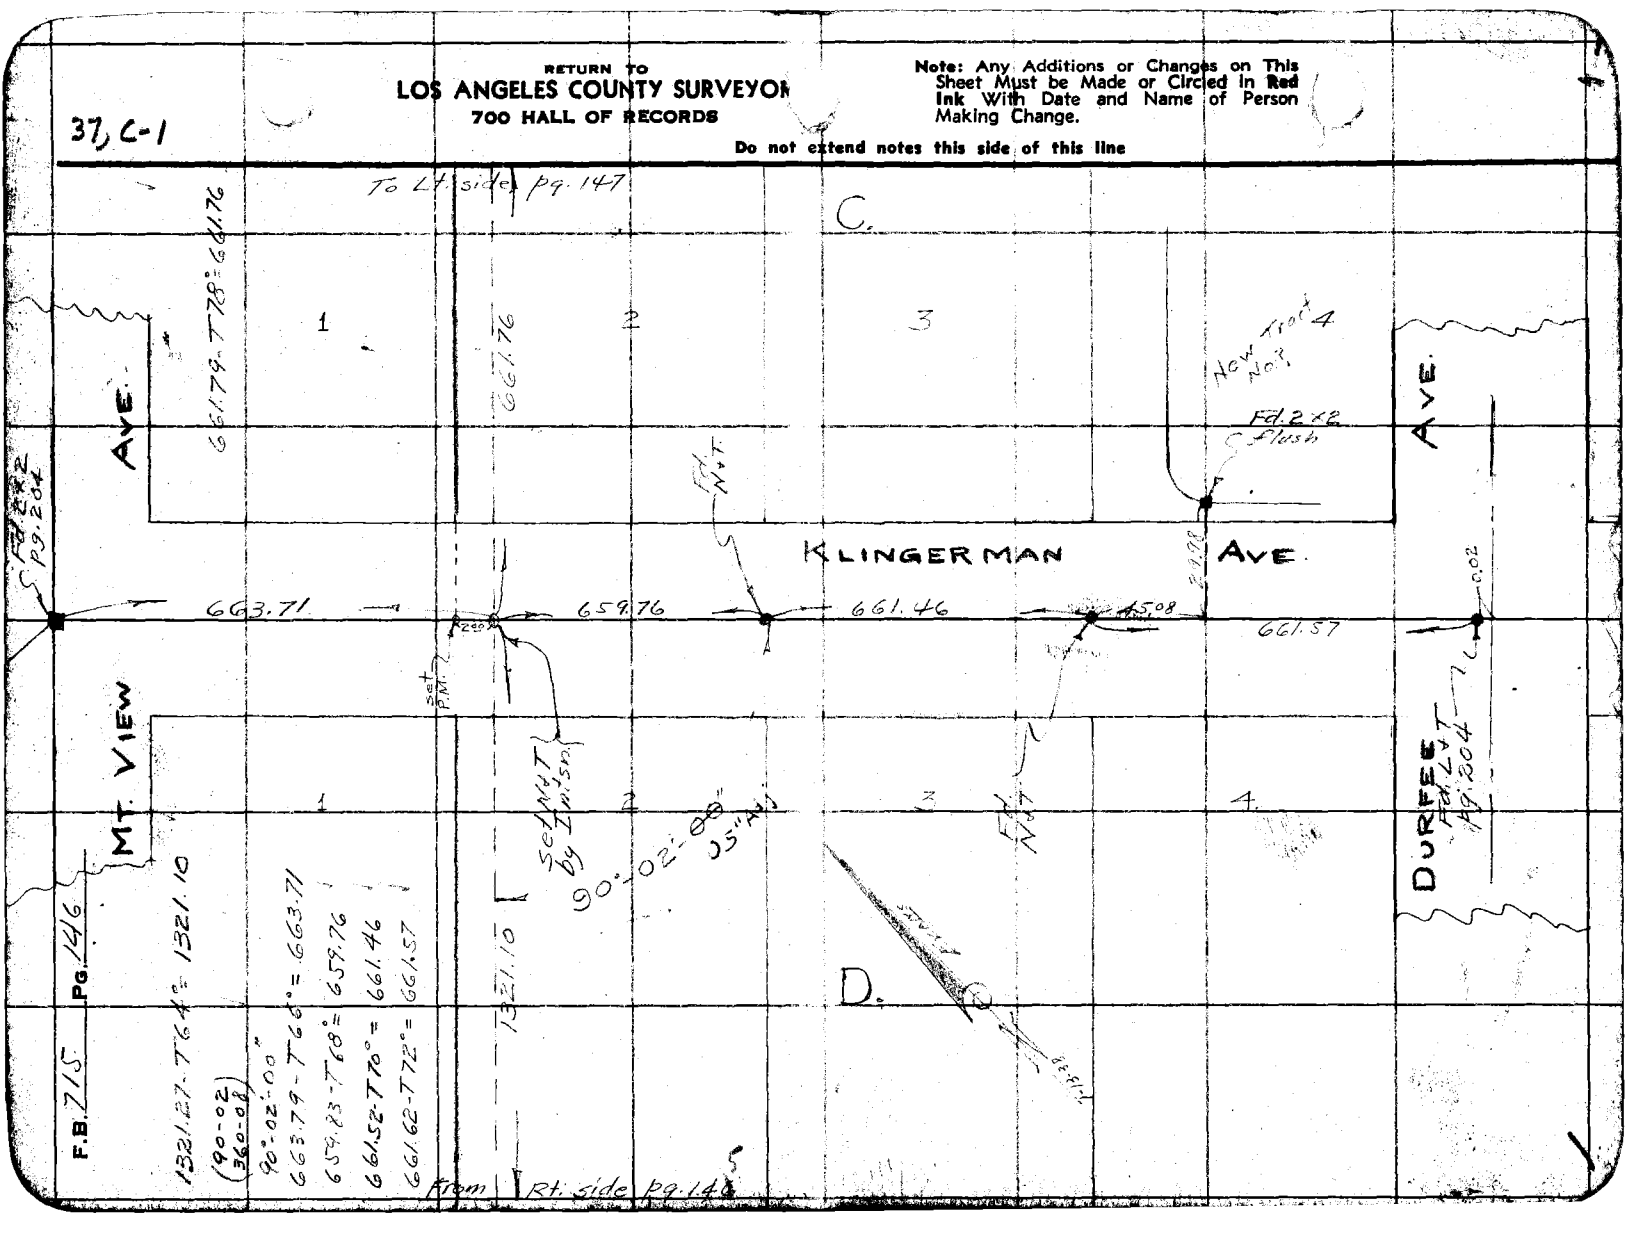

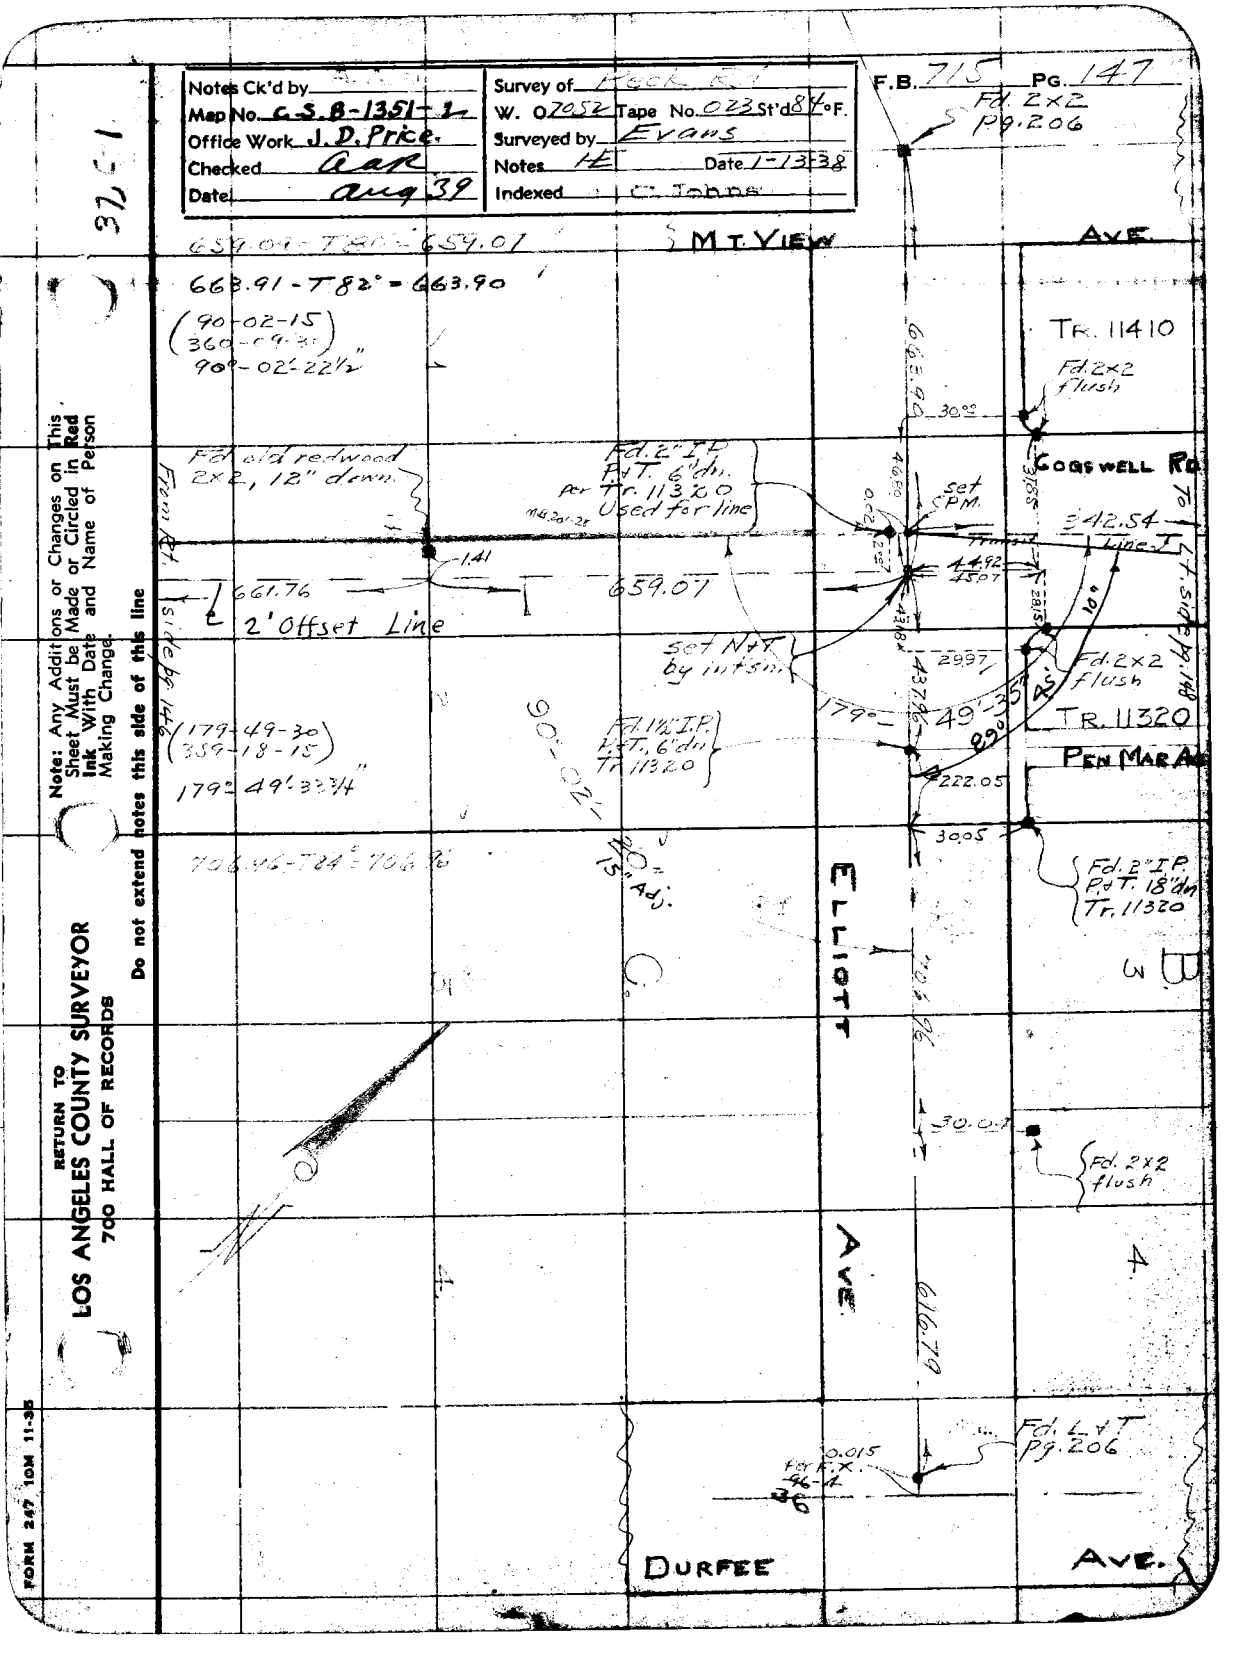
Notes Ck'd by
Map No. C.S.B-1351-1
Office Work J.D. Price.
Checked aak
Date aug 39
Survey of Rock Rd
W. O 7052 Tape No. 023 St'd 84° F.
Surveyed by Evans
Notes HE Date 1-1338
Indexed C. Johns
F.B. 715 Pg. 147
Fd. 2x2 Pg. 206
37-1
659.01 - T82° - 659.01
663.91 - T82° - 663.90
(90-02-15)
(360-59-30)
90°-02'-22½"
MT. VIEW AVE.
TR. 11410
Fd. 2x2 flush
COGSWELL RD.
Fd. old redwood 2x2, 12" down.
Fd. 2" I.P. P&T. 6" dn. per Tr. 11320 Used for line
set CPM.
342.54
Line 1
661.76
659.07
2' Offset Line
Set Nail by inters.
Fd. 2x2 flush
TR. 11320
PEN MAR AVE.
(179-49-30)
(359-18-15)
179° 49' 32¾"
90°-02'-
Fd. 1½" I.P. P&T. 6" dn. Tr. 11320
222.05
706.96 - T84° - 706.96
40.15 Adj.
Fd. 2" I.P. P&T. 18" dn. Tr. 11320
ELLIOTT AVE.
30.07
Fd. 2x2 flush
616.79
Fd. L&T Pg. 206
0.015 for F.X.
DURFEE AVE.
RETURN TO
LOS ANGELES COUNTY SURVEYOR
7dO HALL OF RECORDS
Note: Any Additions or Changes on This Sheet Must be Made or Circled in Red Ink With Date and Name of Person Making Change.
Do not extend notes this side of this line
FORM 247 10M 11-35

RETURN TO
LOS ANGELES COUNTY SURVEYOR
700 HALL OF RECORDS

Note: Any Additions or Changes on This Sheet Must be Made or Circled in Red Ink With Date and Name of Person Making Change.

Do not extend notes this side of this line

37, C-1

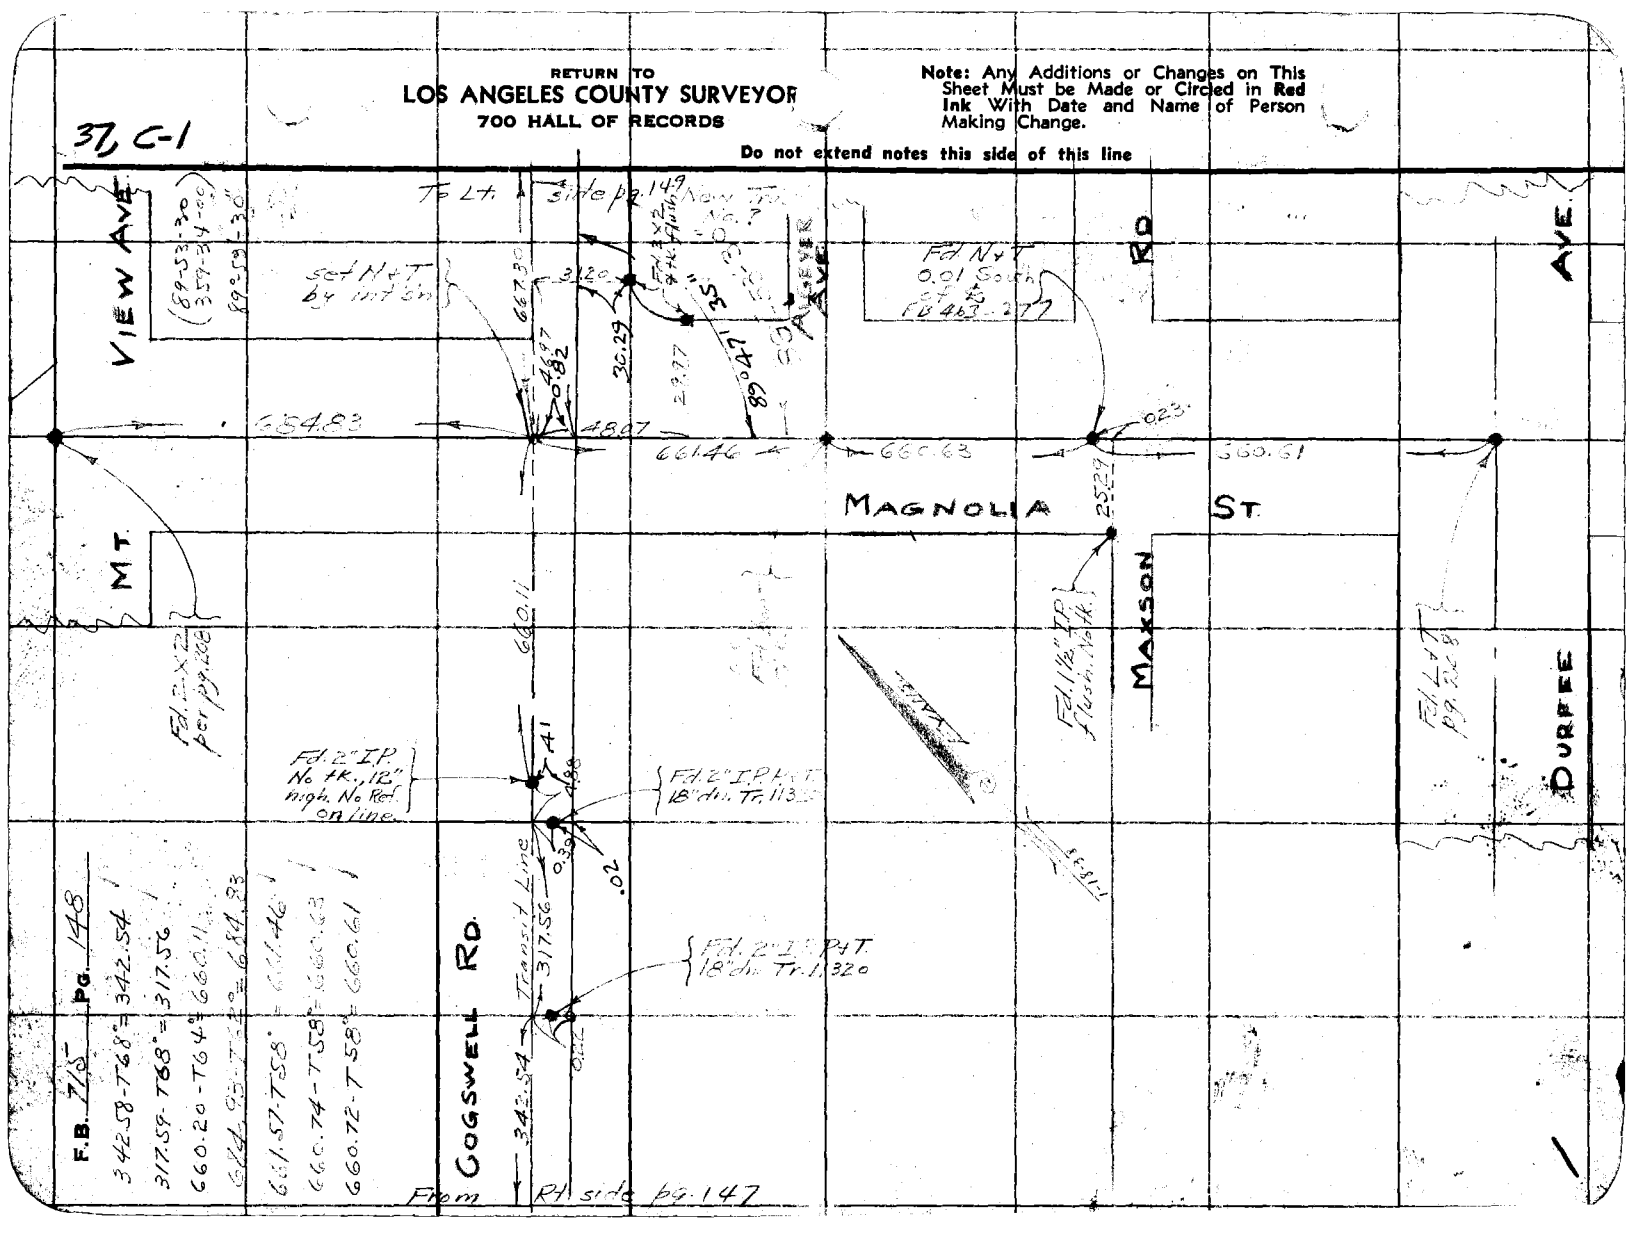

FORM 247 10M 11-55

RETURN TO
LOS ANGELES COUNTY SURVEYOR
700 HALL OF RECORDS

Note: Any Additions or Changes on This Sheet Must be Made or Circled in **Red Ink** With Date and Name of Person Making Change.

Do not extend notes this side of this line

37 C-1

Notes Ck'd by
Map No. C.S. B-1351-1
Office Work J. D. Price
Checked
Date Aug. '59

Survey of
W. O.
Tape No. Std.
Surveyed by
Date
Notes
Indexed

F.B. PG

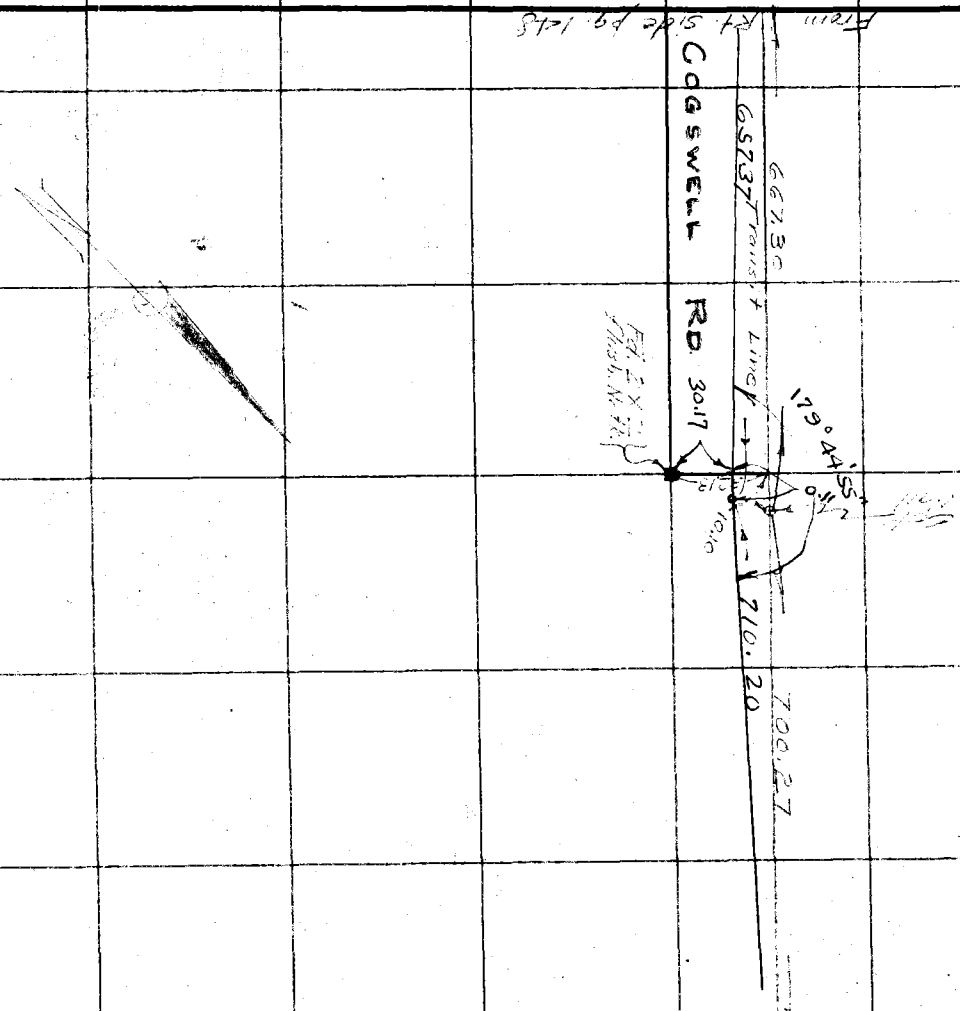

F.B. 715 PG. 150

GARVEY

141.91-T60°=141.89'

(104-28-41W
S1-58-45)

104°-28'-41"W

Fd. L.S.T. with 4 fams. L.S.T. tied per F.B. 510-142 & C.S. B-1216-1

Fd. L.S.T. per F.B. 510-142 & C.S. B-1216-1

GOSSWELL RD.

KERN

EVANS

POMONA

BLVD.

Transit Zero-27 Line

710.20

Fd. 1½" I.P. F.T. in conc. flush. Per Tr. No. 4018 & C.S. B-12.16 S.F.T.

2.27

0.10

Cut V in conc. print. by this

104°19'10"

104°-28'-40"W

2043.44-T60°=2043.12

2043.12

BLVD.

OLIVE

AVE.

Fd. L.S.T. with 4 fams. L.S.T. tied per F.B. 510-142 & C.S. B-1216-1

LOS ANGELES COUNTY SURVEYOR
700 HALL OF RECORDS

RETURN TO

Note: Any Additions or Changes on This Sheet Must be Made or Circled in Red Ink With Date and Name of Person Making Change.

Do not extend notes this side of this line

45 B-5

Notes Ck'd by A. L.	Survey of Peck Rd.
Map No. C.S. B-135-1	W. O. 7052 Tape No. 025 St'd 4 °F.
Office Work J. D. Price	Surveyed by
Checked aar	Notes Date 2-14-38
Date Aug. 39	Indexed 5-16-38

F.B. 10 Pg. 151

PROPOSED ℄ PECK RD. FROM DURFEE AVE. TO RAMONA BLVD.

ALTERNATE ROUTE NO. 2.

For ALTERNATE No. 3 See Pgs. 225-238

A. L. Evans
L. L. Fannin
C. S. Seelig
J. D. Price
N. R. Smith

NOTE:

PROPOSED ℄ SHOWN ON PAGES 152 to 160 ABANDONED

Note: Any Additions or Changes on This Sheet Must be Made or Circled in Red Ink With Date and Name of Person Making Change.

Do not extend notes this side of this line

RETURN TO
LOS ANGELES COUNTY SURVEYOR
700 HALL OF RECORDS

FORM 247 10M 11-38

RETURN TO
LOS ANGELES COUNTY SURVEYOR
700 HALL OF RECORDS

Note: Any Additions or Changes on This Sheet Must be Made or Circled in Red Ink With Date and Name of Person Making Change.

Do not extend notes this side of this line

37, B-2

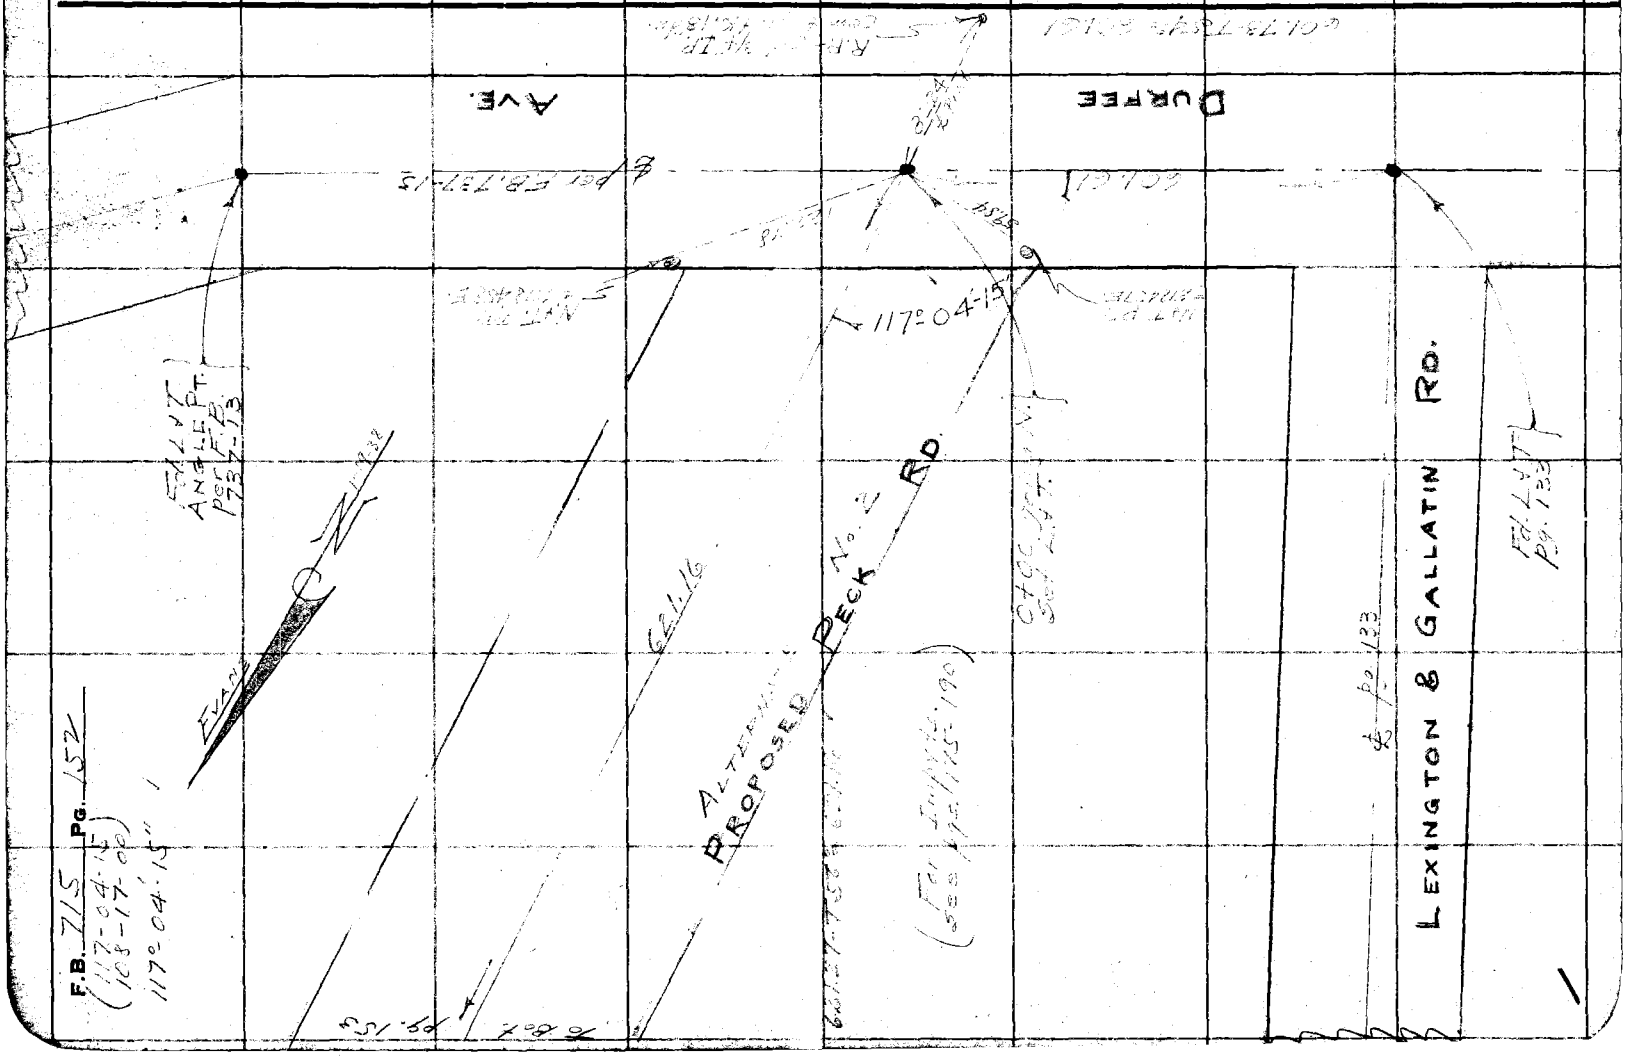

Notes Ck'd by A. [illegible]	Survey of [illegible]
Map No. C.S. B-1361-1	W. O. [illegible] Tape No. [illegible] St'd [illegible] °F.
Office Work J. D. Price.	Surveyed by [illegible]
Checked Aug.	Notes [illegible] Date 1-17-39
Date Aug. '39	Indexed

F.B. [illegible] PG.
137-13-45
(188-55-15)
137-13-48 3/4

37 B-2

To Sht 1 pg 154

EC. 9+78.99

Δ = [illegible]
R = 1000
T = 391.59
L = 746.47

P.I. - Set 3/4" I.P. cem. 9 in. tk. 6 in. 18" deep.

Set 3/4" I.P. (4" mon. in intsn.

Fd. 1" I.P. pg. 134

GOOLD PL.

Fd. 1" I.P. pg. 134

PROPOSED PECK RD.

From 1st side pg. 15

RETURN TO
LOS ANGELES COUNTY SURVEYOR
700 HALL OF RECORDS

Note: Any Additions or Changes on This Sheet Must be Made or Circled in Red Ink With Date and Name of Person Making Change.

Do not extend notes this side of this line

FORM 247 10M 11-38

RETURN TO
LOS ANGELES COUNTY SURVEYOR
700 HALL OF RECORDS

37 B-2

Note: Any Additions or Changes on This Sheet Must be Made or Circled in **Red Ink** With Date and Name of Person Making Change.

Do not extend notes this side of this line

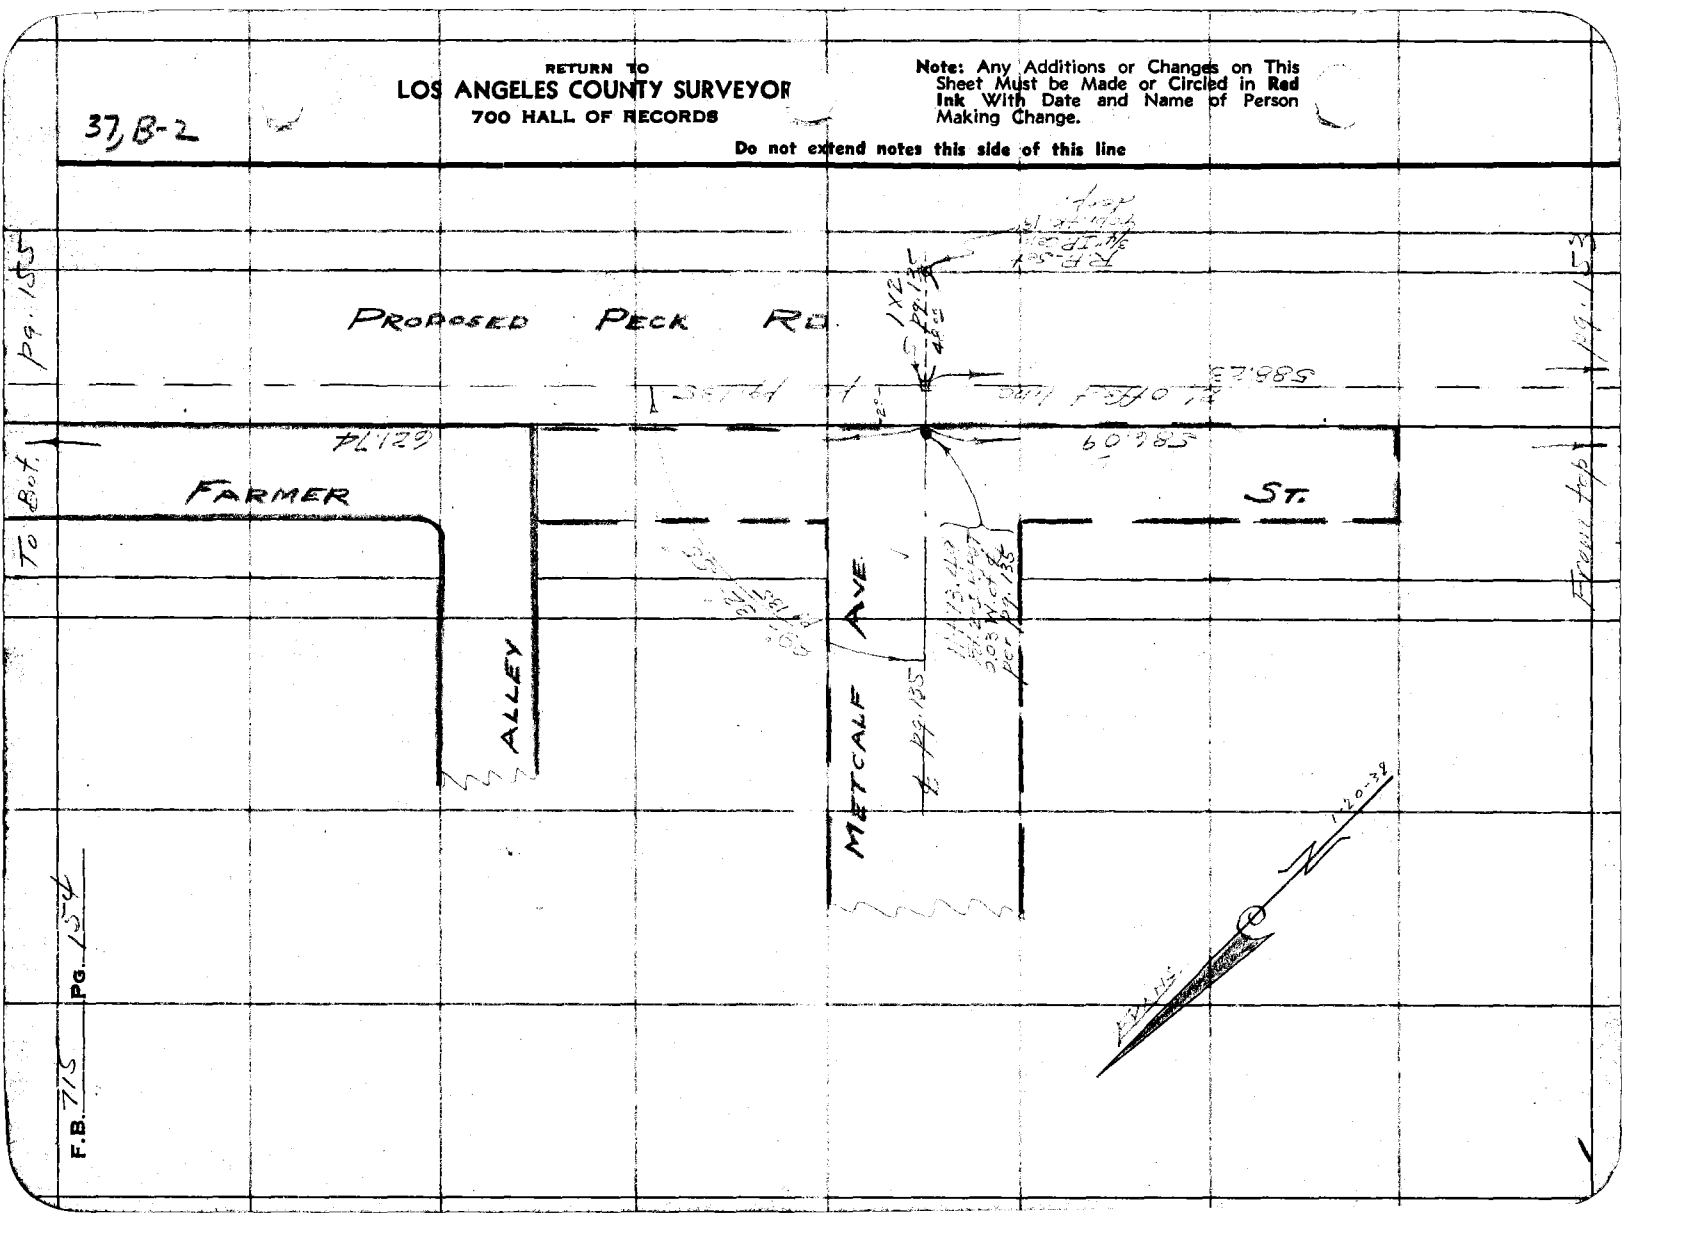

FORM 247 10M 11-38

RETURN TO
LOS ANGELES COUNTY SURVEYOR
700 HALL OF RECORDS

Note: Any Additions or Changes on This Sheet Must be Made or Circled in Red Ink With Date and Name of Person Making Change.

37 B-2

Do not extend notes this side of this line

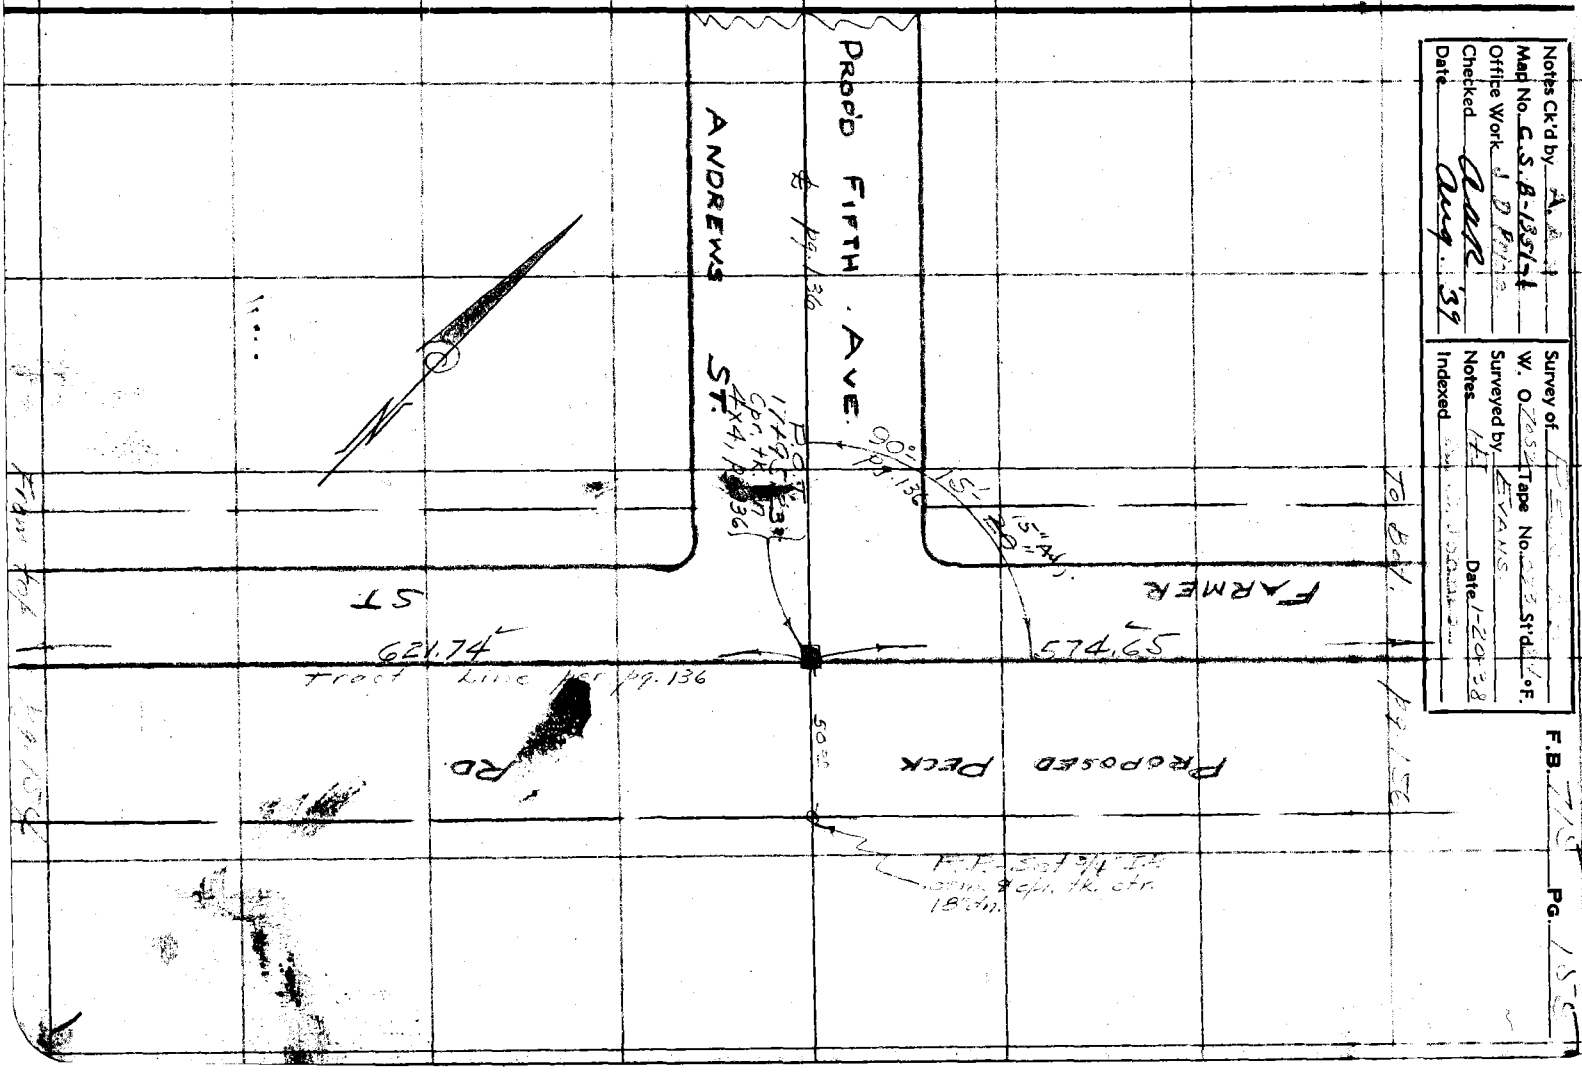

Notes Ck'd by A. E. J.
Map No. C.S. B-13514
Office Work J. D. P.
Checked Aug.
Date Aug. 39

Survey of
W. O.
Surveyed by
Notes
Indexed

Tape No.
Std.
Date 1-20-38

F.B.
Pg.

37, B-2

RETURN TO
LOS ANGELES COUNTY SURVEYOR
700 HALL OF RECORDS

Note: Any Additions or Changes on This Sheet Must be Made or Circled in Red Ink With Date and Name of Person Making Change.

Do not extend notes this side of this line

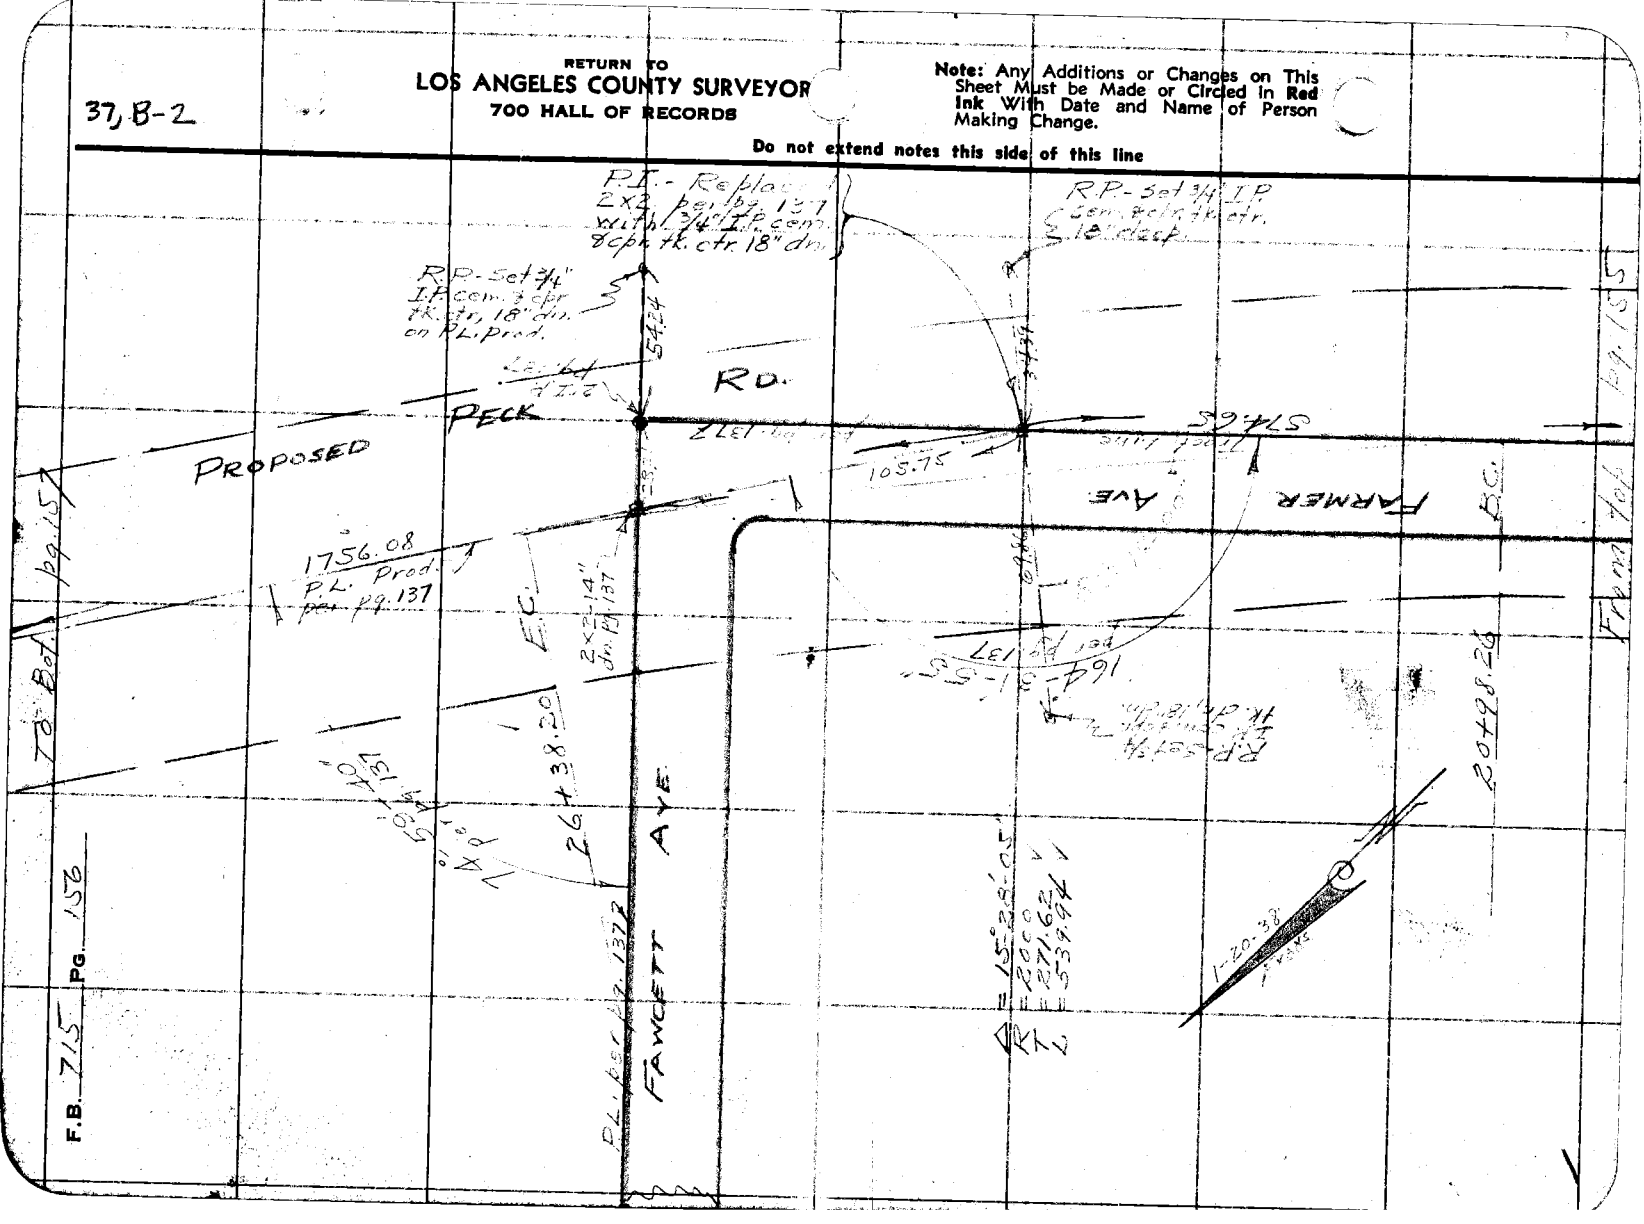

FORM 247 10M 11-35

RETURN TO
LOS ANGELES COUNTY SURVEYOR
700 HALL OF RECORDS

Note: Any Additions or Changes on This Sheet Must be Made or Circled in Red Ink With Date and Name of Person Making Change.

Do not extend notes this side of this line

378-2

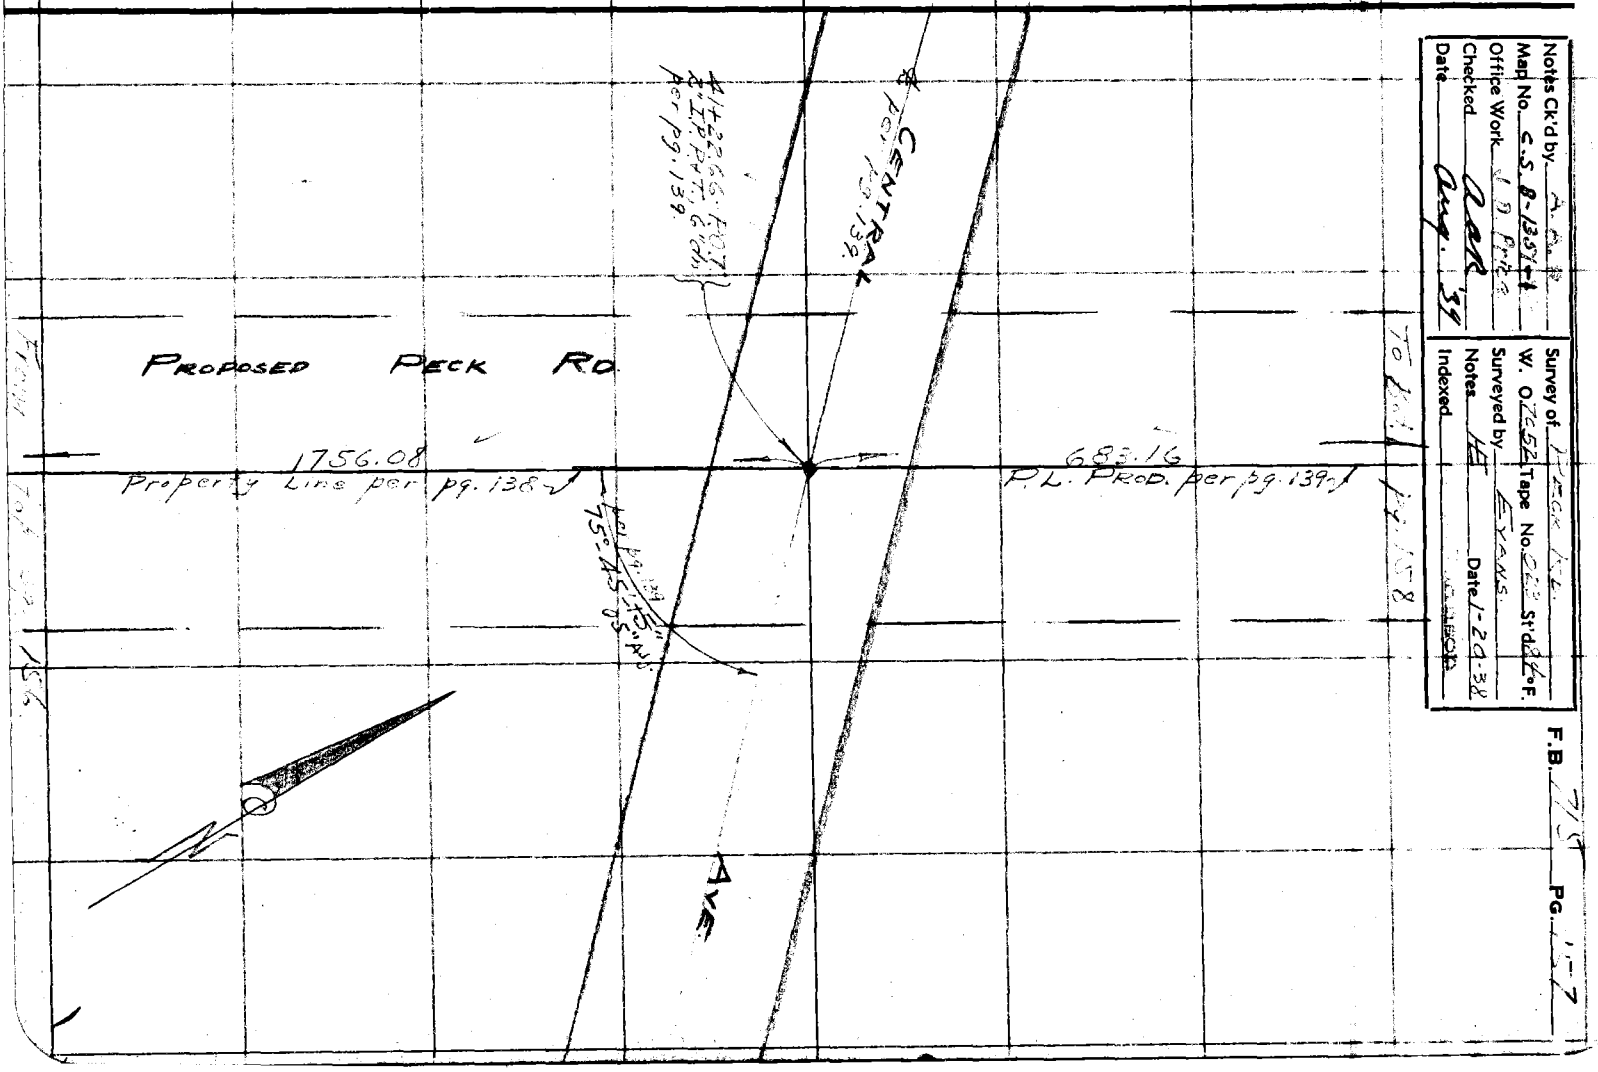

Notes Ck'd by _____
Map No. C.S. 8-13 & 14
Office Work _____
Checked _____
Date Aug. '37

Survey of Peck Rd.
W. O. 7652 Tape No. 222 Std. 62°F.
Surveyed by Evans
Notes HE
Indexed _____
Date 1-20-38

F.B. 713 PG. 157

RETURN TO
LOS ANGELES COUNTY SURVEYOR
700 HALL OF R[redacted]OS

Note: Any Additions or Changes on This Sheet Must be Made or Circled in **Red** Ink With Date and Name of Person Making Change.

37JB-2

Do not extend notes this side of this line

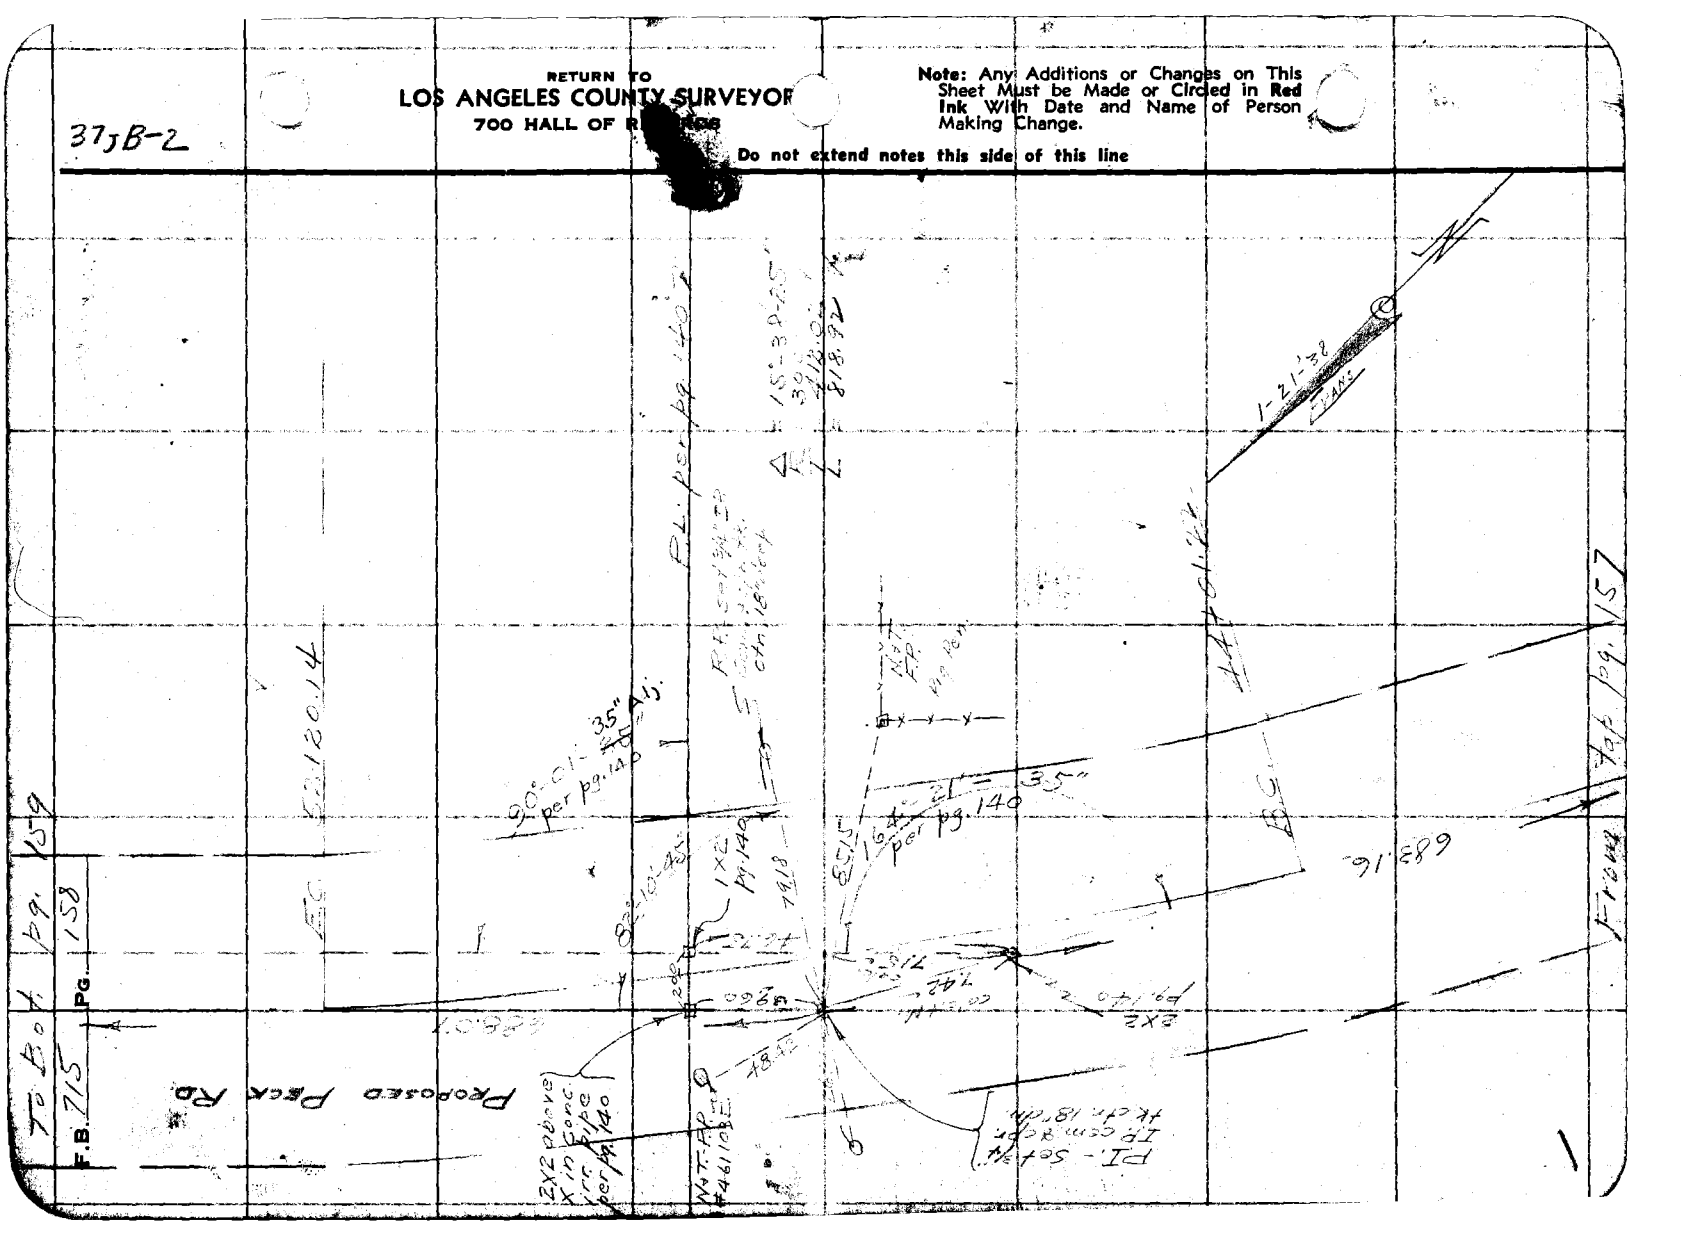

Notes Ck'd by	Survey of Peck Rd.
Map No. C.S. B-1351-1&2	W. O. 7052 Tape No. 023 St'd 34 F.
Office Work J.D. Price	Surveyed by EVANS
Checked AAR	Notes HE Date 1-21-38
Date Aug. 39	Indexed

F.B. 715 Pg. 159

37 C2

RETURN TO
LOS ANGELES COUNTY SURVEYOR
700 HALL OF RECORDS

Note: Any Additions or Changes on This Sheet Must be Made or Circled in Red Ink With Date and Name of Person Making Change.

Do not extend notes this side of this line

FORM 247 10M 11-38

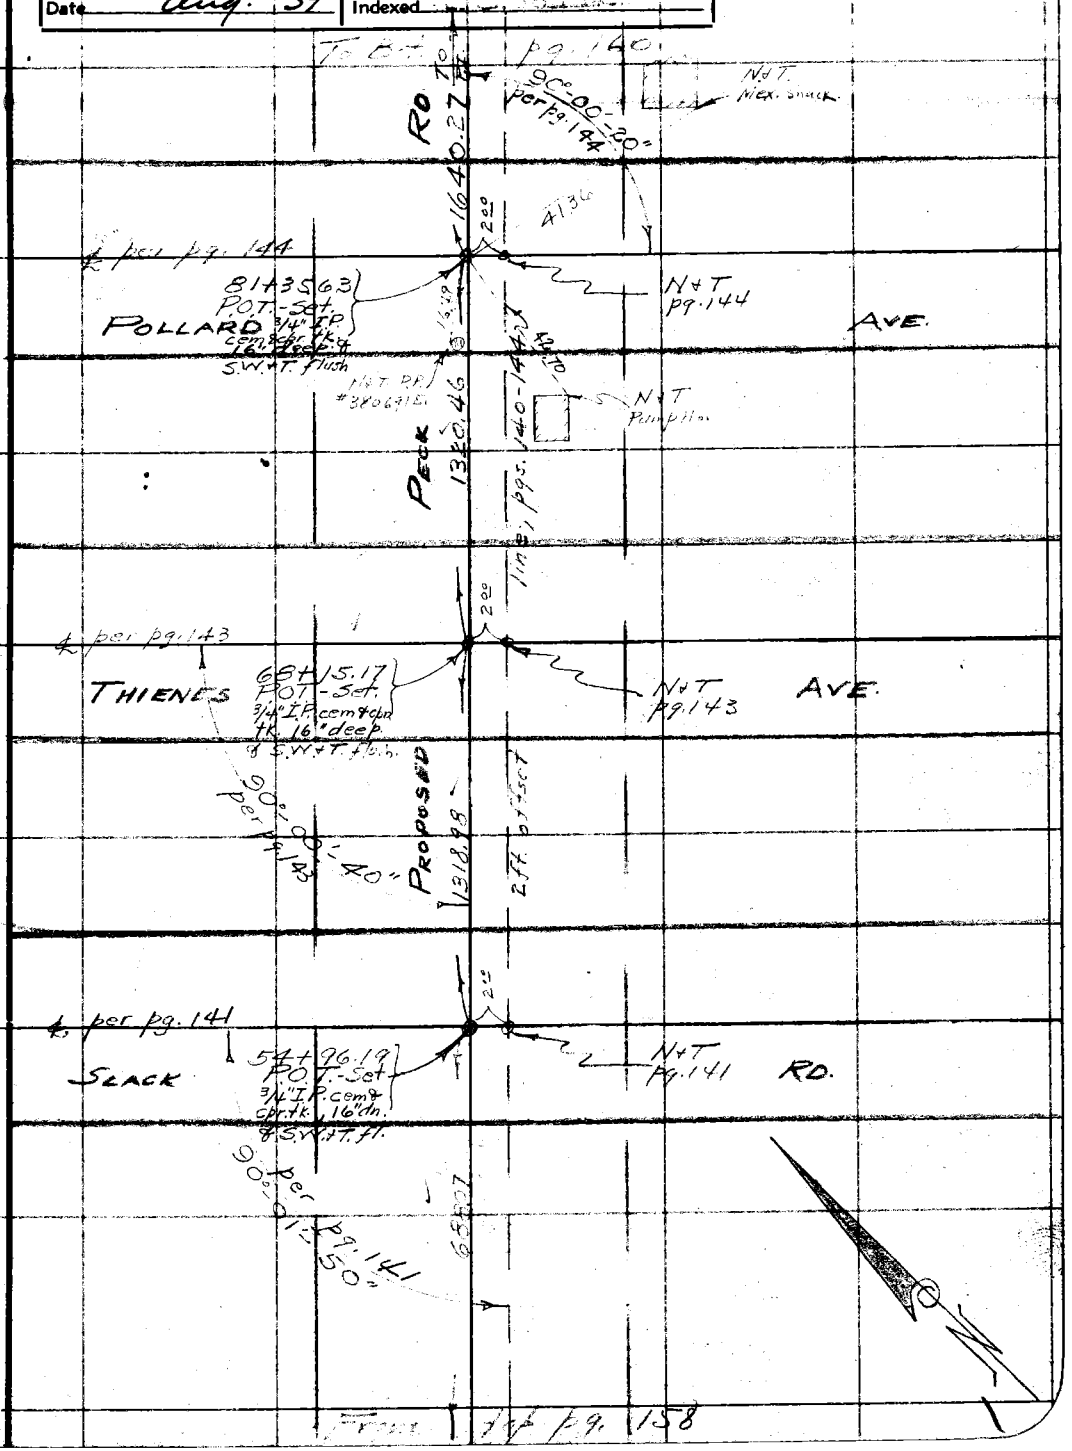

RETURN TO
LOS ANGELES COUNTY SURVEYOR
700 HALL OF RECORDS

Note: Any Additions or Changes on This Sheet Must be Made or Circled in Red Ink With Date and Name of Person Making Change.

Do not extend notes this side of this line

37 C-1

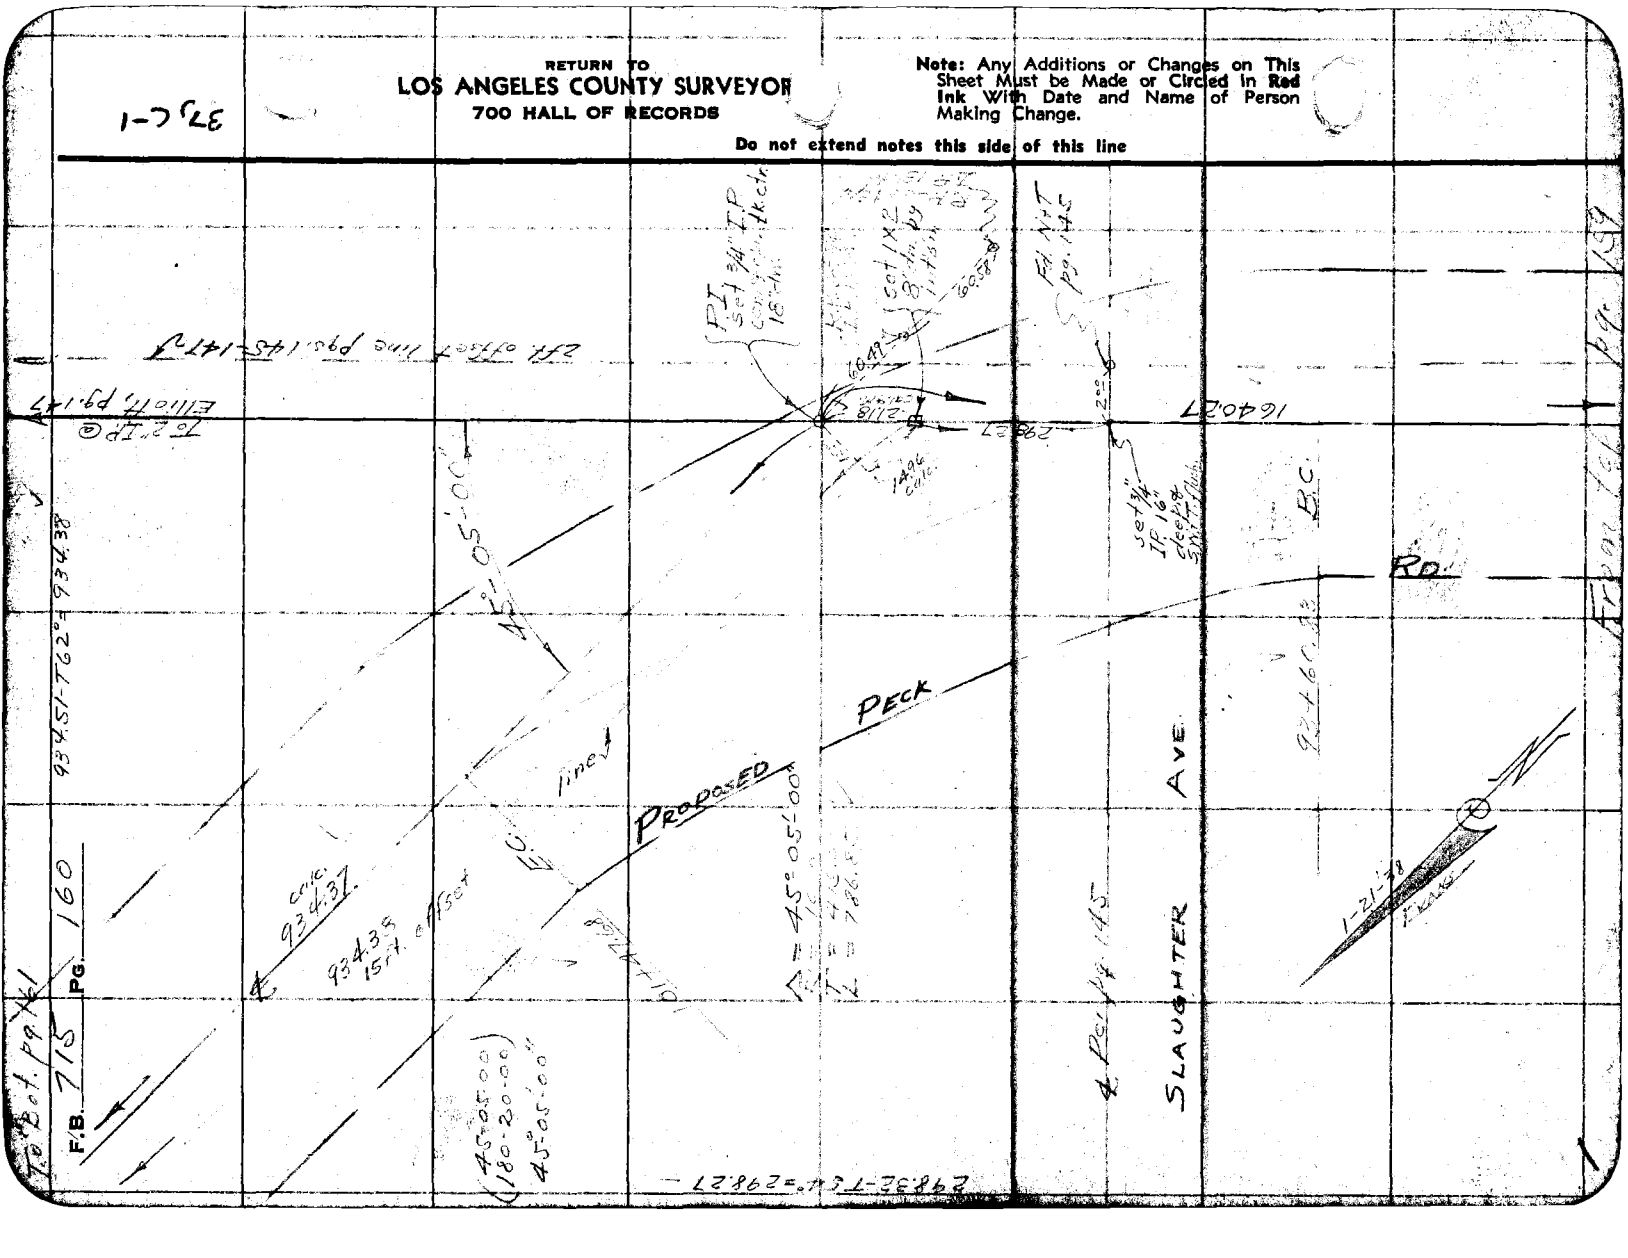

Notes Ck'd by	Survey of LECK KR.
Map No. C.S. B-1351-121	W. O. 7052 Tape No. 023 St'd 24 °F.
Office Work J. D. PRICE	Surveyed by EVANS
Checked AUR	Notes HE Date 12/1/38
Date Aug. '39	Indexed

F.B. 715 Pg. 161

37 C-1

(134-55-30)
(178-42-15)
134°55'33¾"

To Eon Av. 162

To Pilgrim Ave

(For Imprvts. see pgs. 111-120)

10.8+74.46 E.C.

ALTERNATE No 3
See pg. 238

Δ = 45°04'25"
R = 500
T = 207.48
L = 393.34

256.10
Measured
241.15

Per pg 102
352.55

RD.

106+66.98
P.O.T.
Set ¾" I.P.
conc. ckr. tk. ckr.
16" in. - Set
2 X 2 Flush.

Fl. S.W.T.
pg. 103.

(For Imprvts. see pgs. 175-190)

15°00'

14.95
10.13
11.06

134.35

P 237-238
Set wire spk
ft. by intsn

MT. VIEW

10+41.12
B.C.

924.38
15°11'00" Rt.

934.37

PEAK RD.
PROPOSED

From top pg. 160

Note: Any Additions or Changes on This Sheet Must be Made or Circled in Red Ink With Date and Name of Person Making Change.

Do not extend notes this side of this line

RETURN TO
LOS ANGELES COUNTY SURVEYOR
720 HALL OF RECORDS

FORM 247 10M 11-38

RETURN TO
LOS ANGELES COUNTY SURVEYOR
700 HALL OF RECORDS

Note: Any Additions or Changes on This Sheet Must be Made or Circled in Red Ink With Date and Name of Person Making Change.

Do not extend notes this side of this line

1-32E

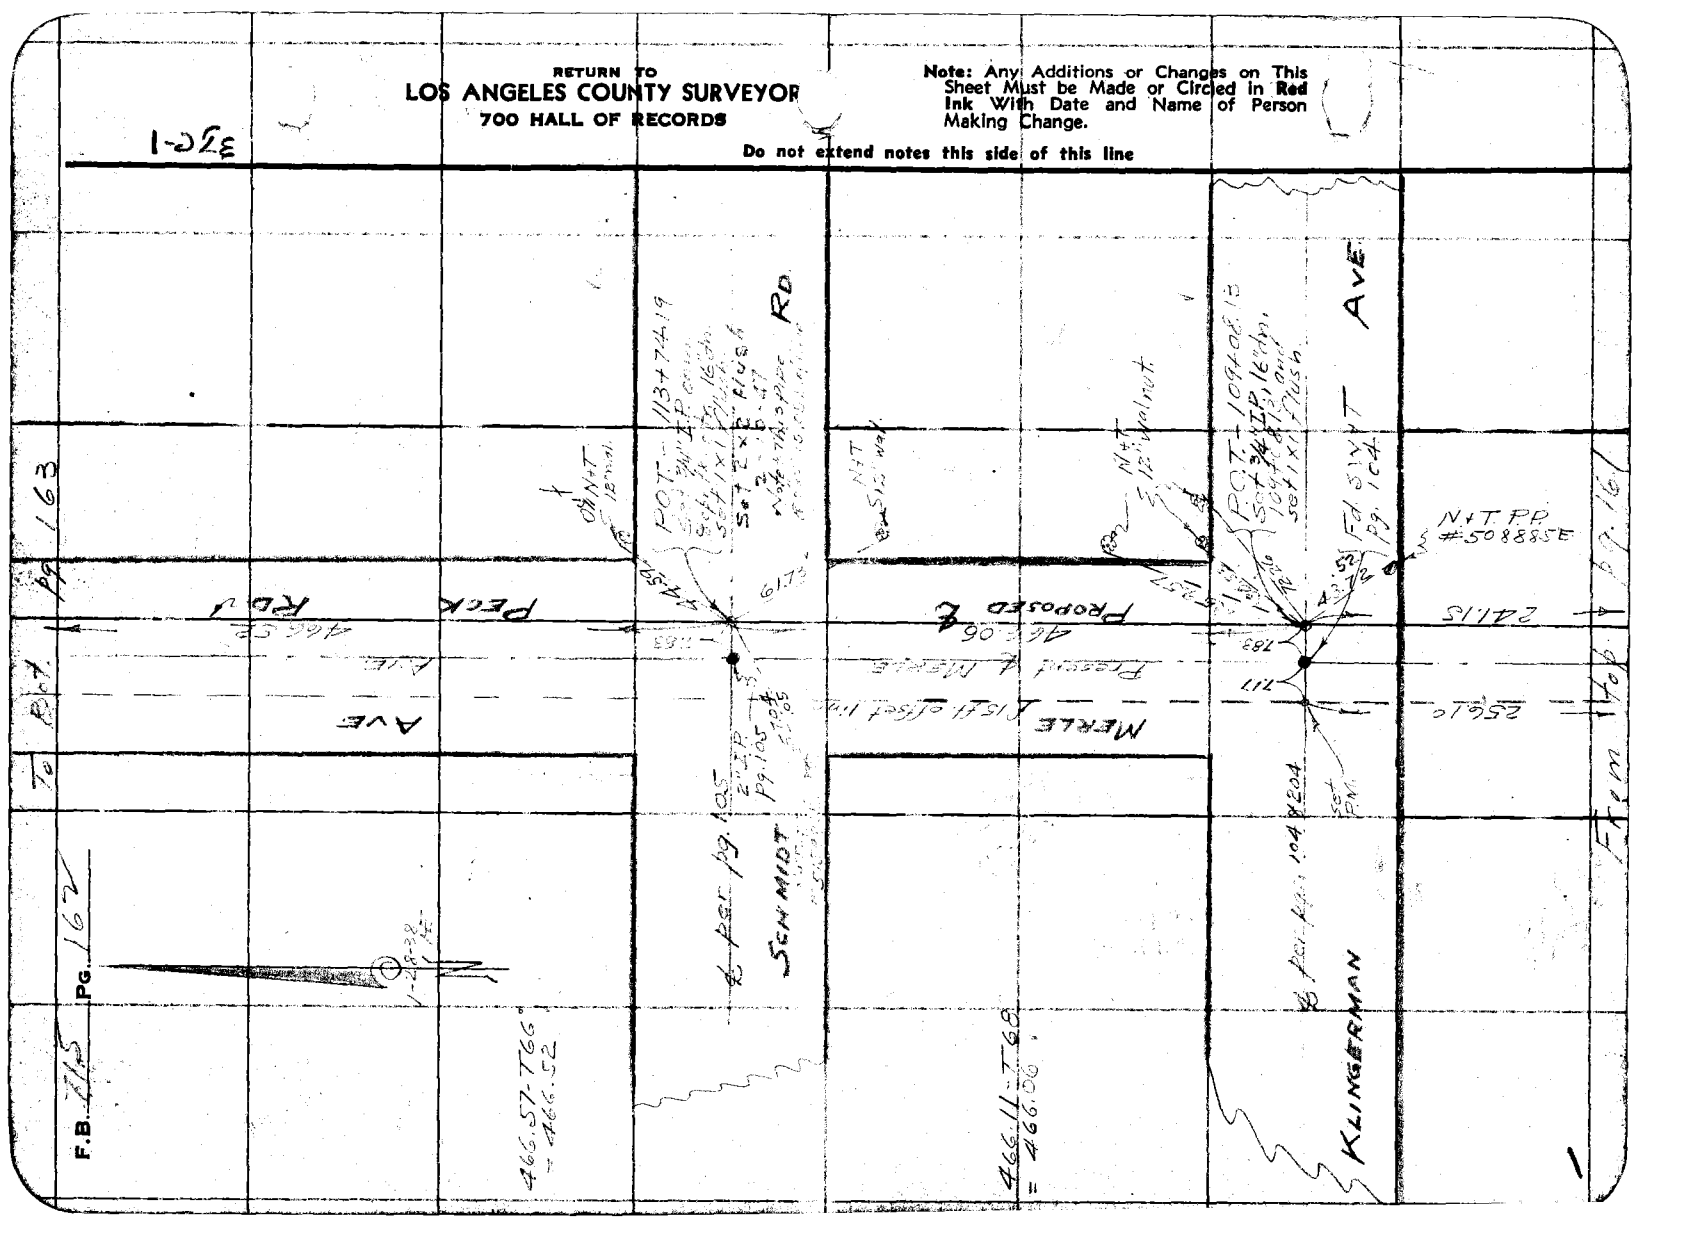

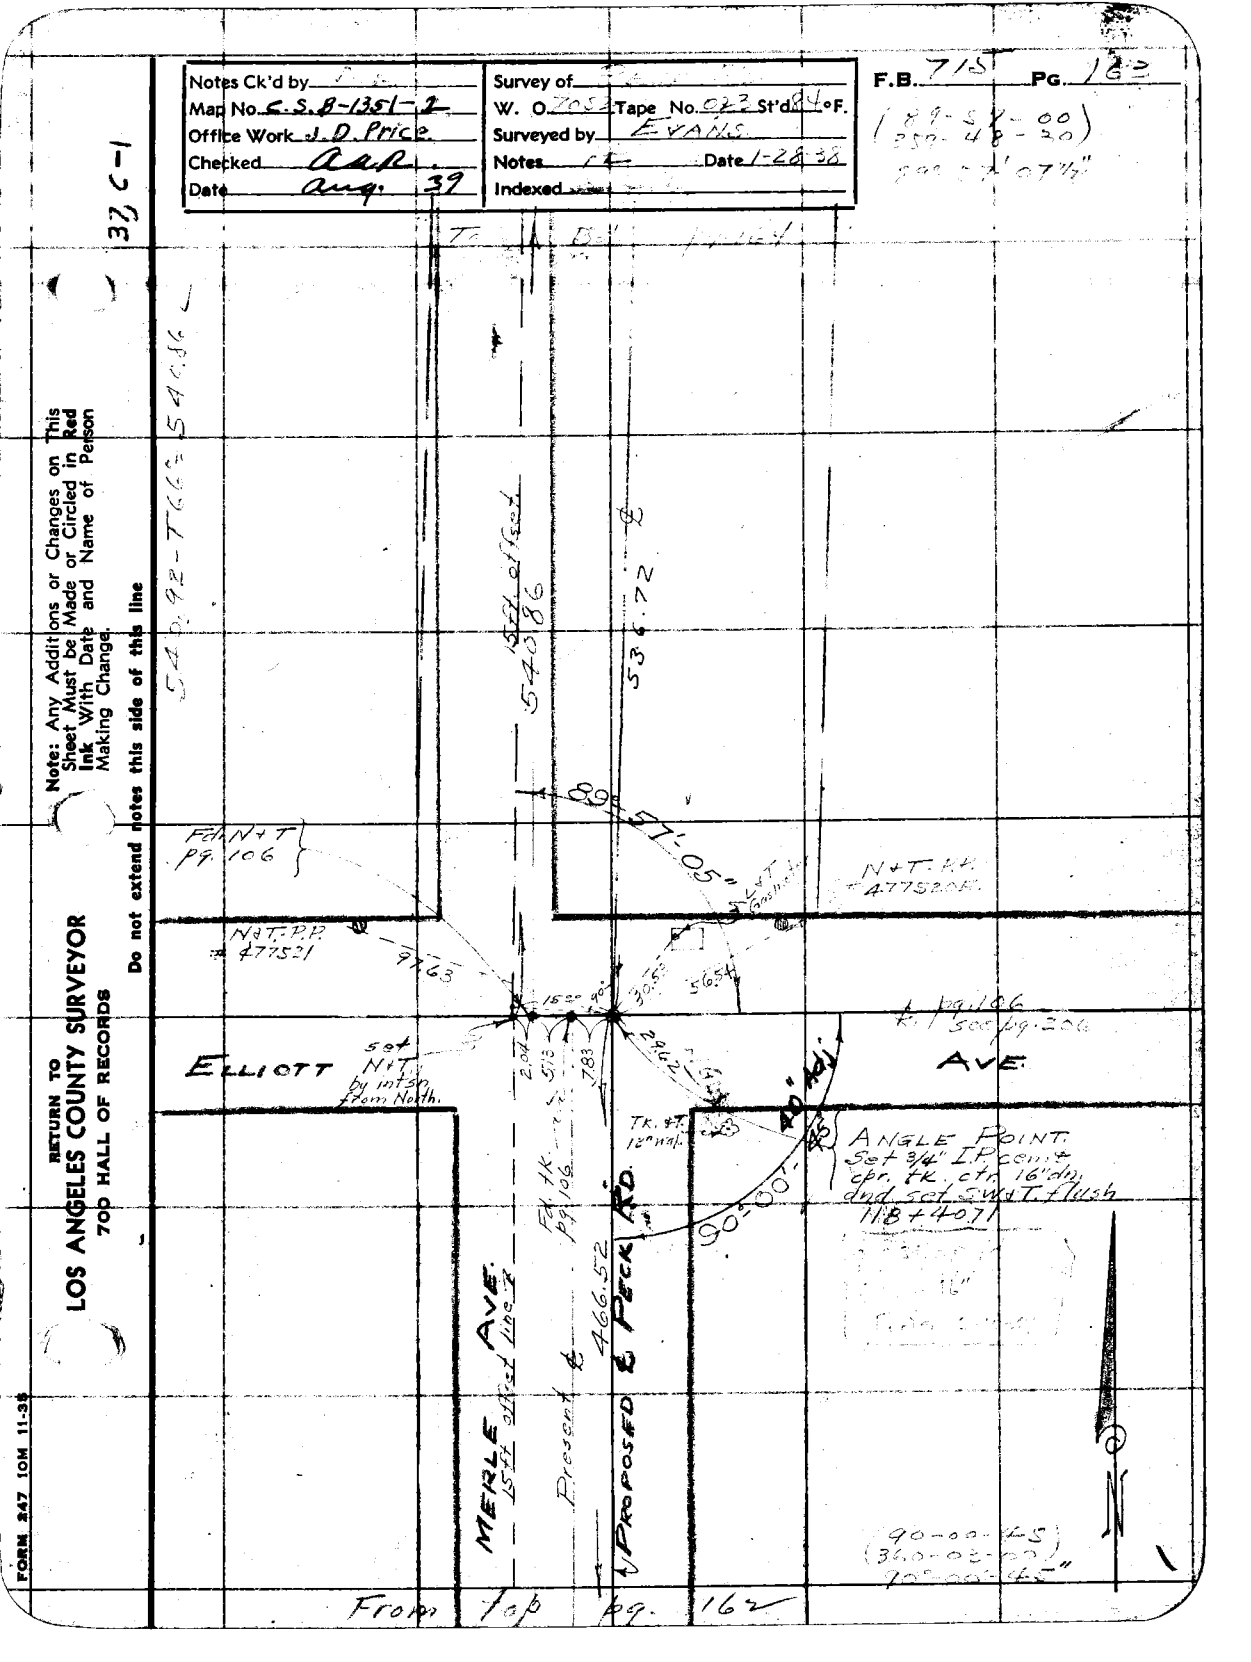
Notes Ck'd by
Map No. C.S.B-1351-2
Office Work J.D. Price
Checked A.A.R.
Date Aug. 39
Survey of
W. O. 7054 Tape No. 023 St'd 84 °F.
Surveyed by EVANS
Notes Date 1-28-38
Indexed
F.B. 715 Pg. 162
(89-57-00
350-48-20
500-21'07½"
37 C-1
Note: Any Additions or Changes on This Sheet Must be Made or Circled in Red Ink With Date and Name of Person Making Change.
Do not extend notes this side of this line
RETURN TO
LOS ANGELES COUNTY SURVEYOR
700 HALL OF RECORDS
FORM 247 10M 11-38
S4°-92-TTG"-S4.46'
Sta of Rest
540.86
536.72
89-57-05"
F&N+T Pg. 106
N&T-PP #47752
N&T-PP #47752
9763
5654
Set N+T by intsn from North.
ELLIOTT
AVE.
Pg. 106
Pg. 206
2.07
5.13
7.83
2.82
TK. & T. 12" nail.
40'
ANGLE POINT
Set 3/4" IP cen. in apr. TK, ctr. 16" dia. dnd set S.W.T. Flush
118+407
90-00-00"
MERLE AVE.
Present ℄
466.52
PROPOSED E. PECK RD.
(90-00-45)
(360-02-00)
From Top Pg. 162

RETURN TO
LOS ANGELES COUNTY SURVEYOR
700 HALL OF RECORDS

Note: Any Additions or Changes on This Sheet Must be Made or Circled in Red Ink With Date and Name of Person Making Change.

Do not extend notes this side of this line

37,C-1

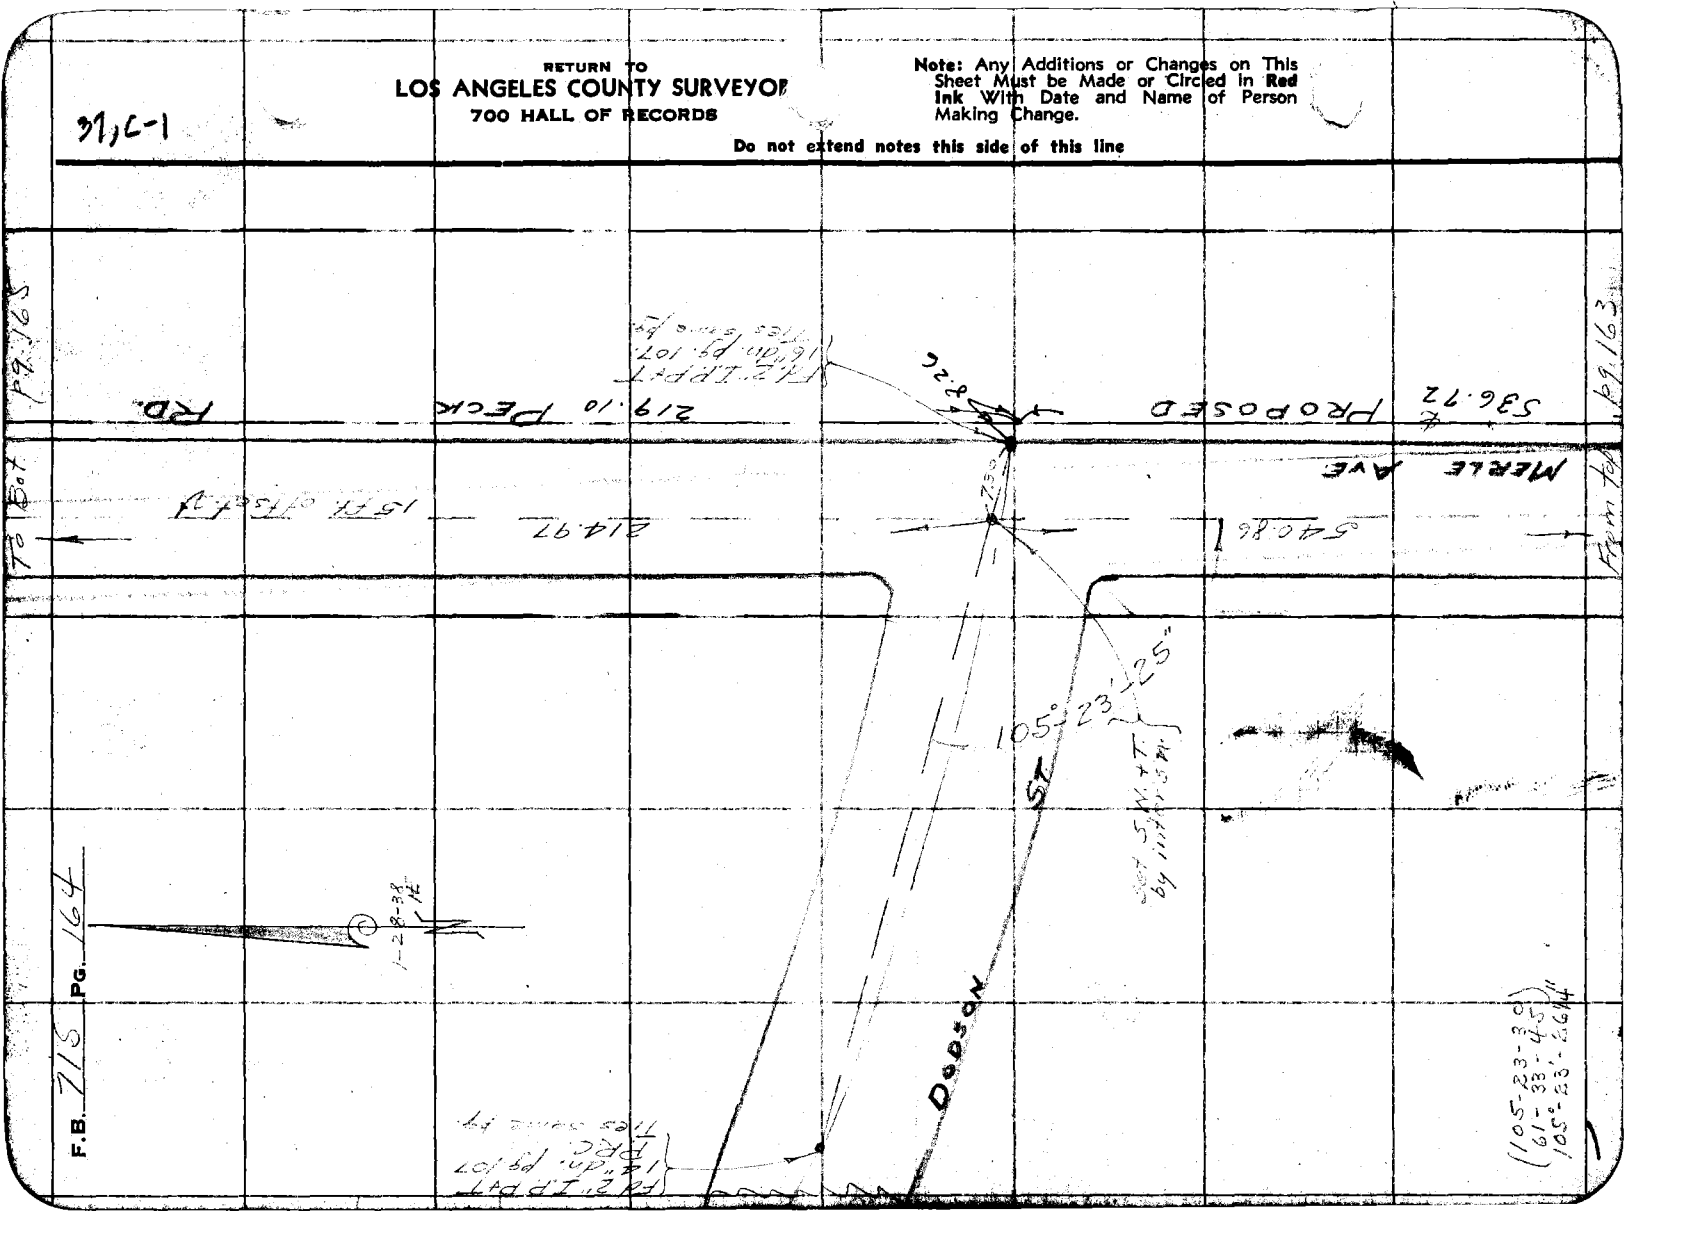

FORM 247 10M 11-35

RETURN TO
LOS ANGELES COUNTY SURVEYOR
700 HALL OF RECORDS

Note: Any Additions or Changes on This Sheet Must be Made or Circled in **Red Ink** With Date and Name of Person Making Change.

Do not extend notes this side of this line

46, A-5

215.00 + TJ 5% = 21497

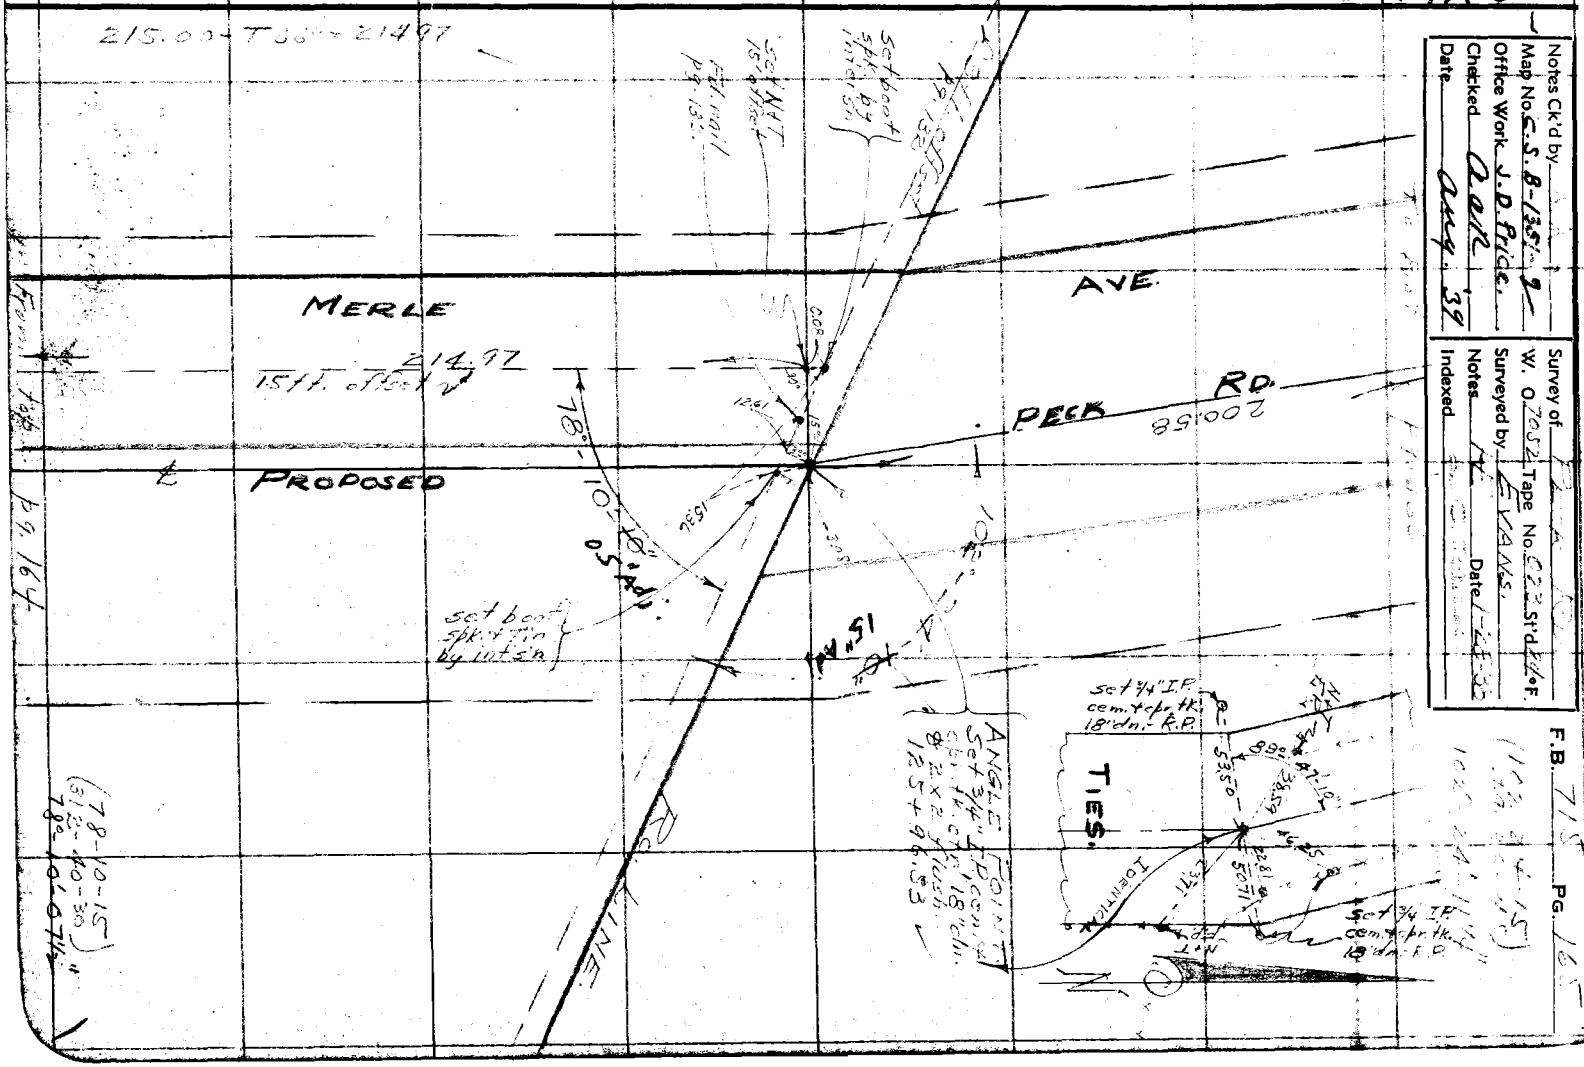

Notes Ck'd by
Map No. C.S. B-135 1
Office Work J.D. Price
Checked Carl
Date Aug. '39

Survey of
W. O. 7052 Tape No. 622 St'd F.
Surveyed by E. KANES
Notes
Indexed Date 1-24-39

F.B. 715 PG. 16

RETURN TO
LOS ANGELES COUNTY SURVEYOR
700 HALL OF RECORDS

Note: Any Additions or Changes on This Sheet Must be Made or Circled in **Red** Ink With Date and Name of Person Making Change.

Do not extend notes this side of this line

46, A-5

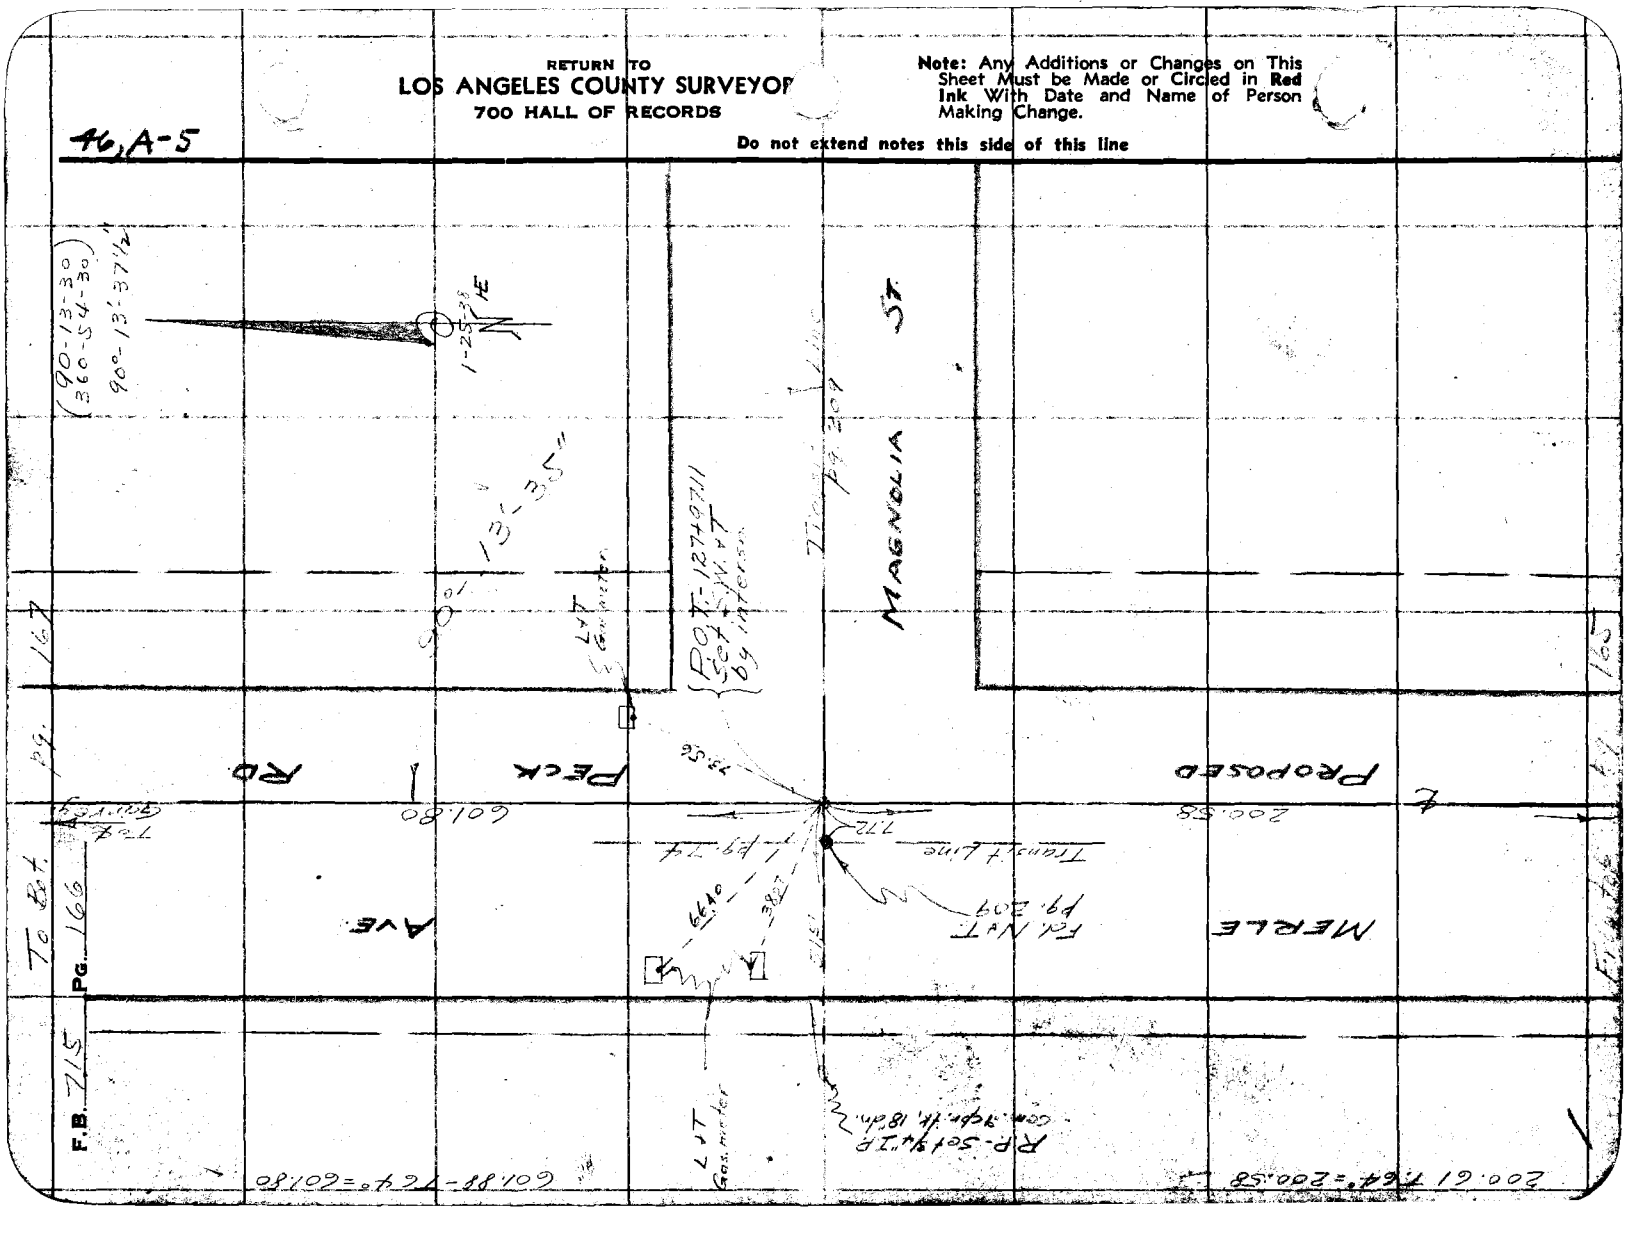

Notes Ck'd by
Map No. C.S. B-1351-3
Office Work J. D. Price
Checked AAR
Date Aug. 39

Survey of
W. O. 7054 Tape No. 023 St'd 66 F.
Surveyed by EVANS
Notes HA Date 1-25-38
Indexed 1-27-38

F.B. 715 Pg. 167

709.52 + 2.98 = 709.50

4 A 4-5

(89-58-45
359-55-15
89-58-45)
89-58-48¾ ✓

(For Imp. Pts. see pgs. 83-101)

(179-59-30
45-
179-59-26¼ ✓

Pera Rd.
70.50

58.50

GARVEY

Ave.

179-59-26

Note: Any Additions or Changes on This Sheet Must be Made in Red Ink With Date and Name of Person Making Change.

Do not extend notes this side of this line

from pg. 74. 339.96 To ℄ pg. 74

℄ par pg. 74

Fd nail pg. 74

733+98.91
ANGLE POINT
Set nail in Exp. Joint, with 4 tang Lγ. ties

(For Imp'vts see pgs. 111-120)

MERLE Ave.

Proposed 601.80

From ℄ A Pg. 166

RETURN TO
LOS ANGELES COUNTY SURVEYOR
700 HALL OF RECORDS

FORM 247 10M 11-38

RETURN TO
LOS ANGELES COUNTY SURVEYOR
700 HALL OF RECORDS

Note: Any Additions or Changes on This Sheet Must be Made or Circled in Red Ink With Date and Name of Person Making Change.

Do not extend notes this side of this line

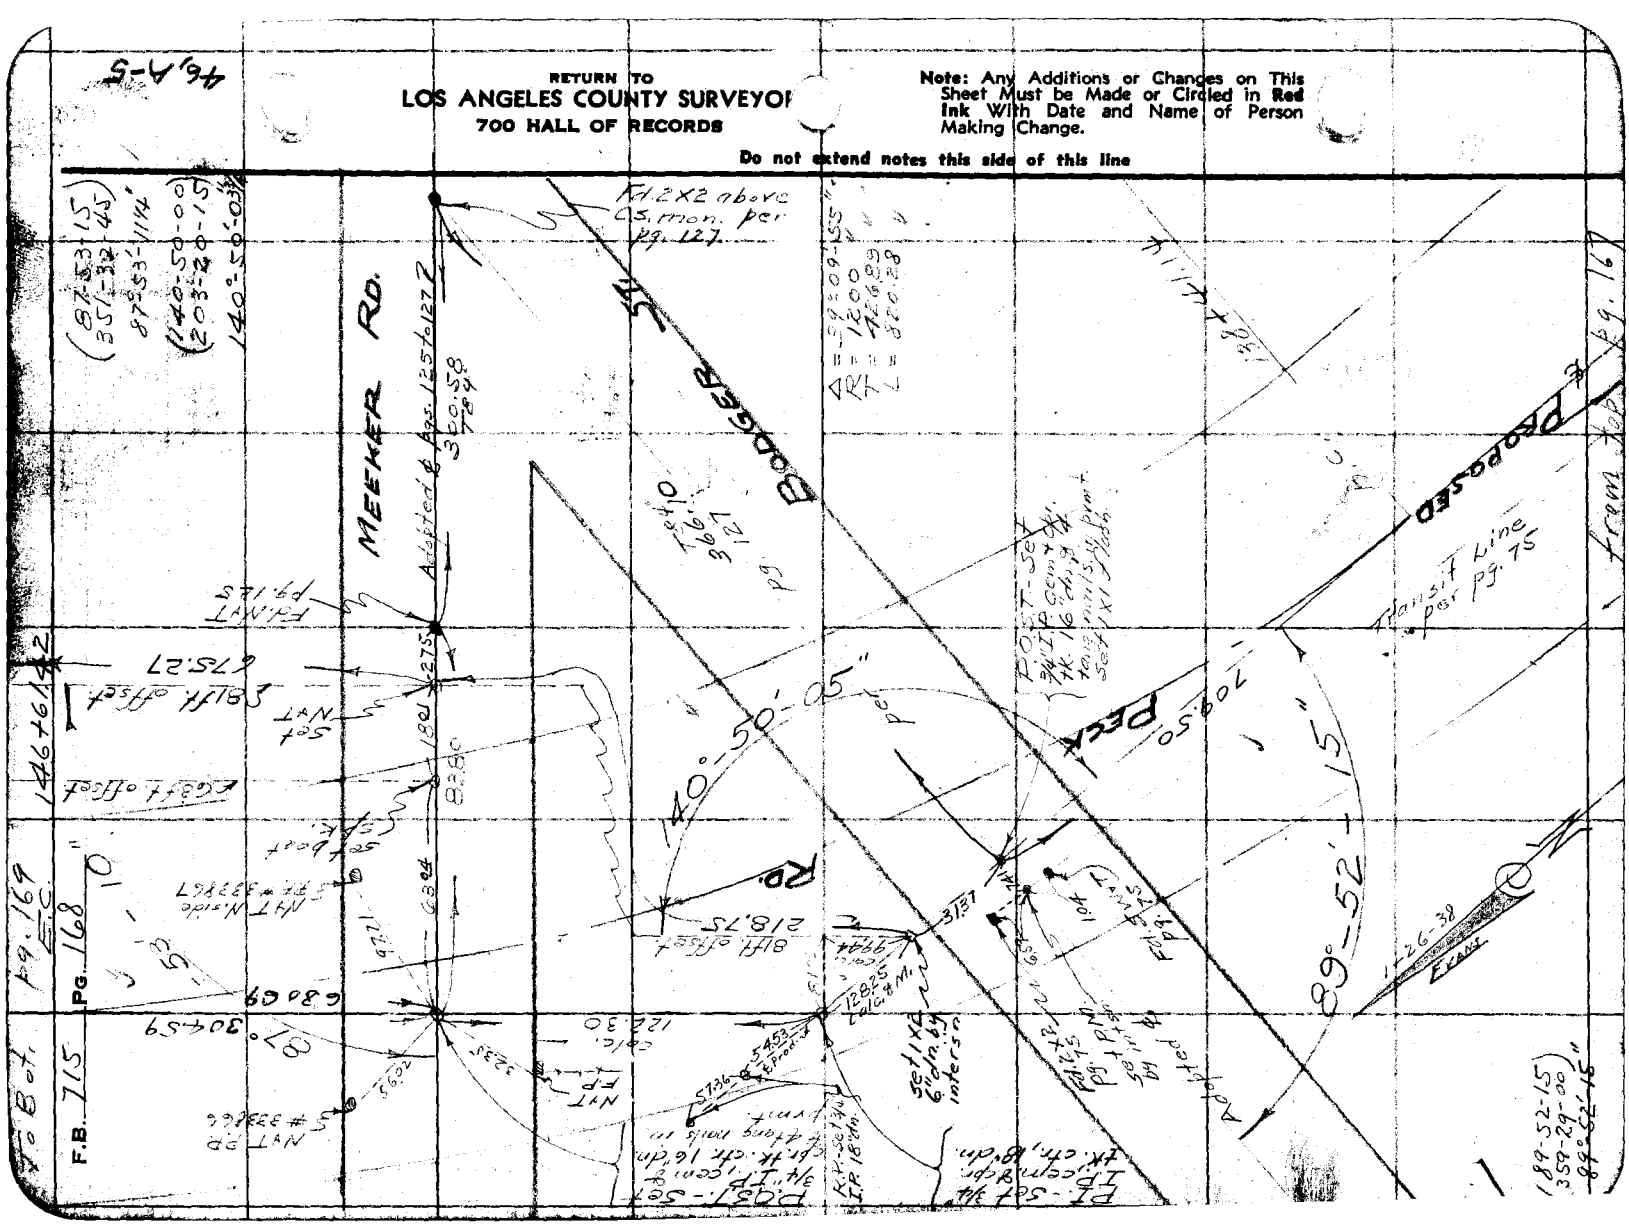

Notes Ck'd by	Survey of Park Rd.
Map No. C.S.B-1351-2	W. O. 70524 Tape No. 023 St'd 81° F.
Office Work J.D. Price	Surveyed by EVANS.
Checked Carl	Notes HE Date 1-26-38
Date Aug. 39	Indexed

F.B. 715 Pg. 169

4, A-5

(87-53-15)
(351-32-45)
87°53'-11¼"
693.52-T78°=693.49

PARK RD

693.49

693.49

87° 53' 10"

AMADOR ST.

℄ per pg. 123

150+37.52-P.O.T.
Set ¾" I.P. cem.
4 pr. tk. str. 16"
dn. & 2X2 flush.

Calc. M.
6.04
C7.83

0.66

Fd. 1X2
Spg. 123
x.5

Iron
F.P.

S 4.10

608

18.00°

90°

set
1X2

set 1X2

PROPOSED

376.10

680.69

set 2X2
by 14.20

63 Lt. of set 7

81.44 of set 7
675.27

E.C. 146+41.42

63.00

304.39

675.29-T80°=675.27

from top pg. 168

RETURN TO
LOS ANGELES COUNTY SURVEYOR
700 HALL OF RECORDS

Note: Any Additions or Changes on This Sheet Must be Made or Circled in Red Ink With Date and Name of Person Making Change.

Do not extend notes this side of this line

FORM 247 10M 11-38

To Bot. pg. 171

F.B. 715 PG. 170

(90-25-45)
361-43-30
90° 25' 52 1/2"

46 A-5

RETURN TO
LOS ANGELES COUNTY SURVEYOR
700 HALL OF RECORDS

Note: Any Additions or Changes on This Sheet Must be Made or Circled in Red Ink With Date and Name of Person Making Change.

Do not extend notes this side of this line

DIV. No 2

829.86

829.34

90°

N 0° 1' 50" W

5 x 1 1/4 T 24" Pepper

76.53

P.I. - ANGLE PT. set nail in Exp. joint, with 4 long. Lr Ts. 157+31.01

5.57

5.57

5.57

Notes Ck'd by	Survey of TECK RD.
Map No. C.S.B-1351-21	W. O. 7054 Tape No. 123 St'd 84 °F.
Office Work J.D. Cook	Surveyed by EVANS.
Checked aak.	Notes HE Date 1-27-38
Date Aug. 39	Indexed C. JOHNSON

F.B. 715 PG. 171

46, A-5

To Bet. Hy & Elz

RD.

417.95

417.95

165+68.35

8.00

S. P. RR.

8.00

Set 2 x 2, 6" ctrs. by inters.

& P/W J

8.00

5340 Fill 1x2 pg. 79

42.00

42.00

91°-11'-11" 50.00 Arc

PECK

PROPOSED

829.34

829.86

Elz

18.00

18.00

Elz & Pomona

830.01-T-58"=827.86

From top pg. 170

(91-12-00
864-47-45
91°-11-56"

11

Note: Any Additions or Changes on This Sheet Must be Made or Circled in Red Ink With Date and Name of Person Making Change

Do not extend notes this side of this line

RETURN TO
LOS ANGELES COUNTY SURVEYOR
700 HALL OF RECORDS

FORM 247 10M 11-38

RETURN TO
LOS ANGELES COUNTY SURVEYOR
700 HALL OF RECORDS

Note: Any Additions or Changes on This Sheet Must be Made or Circled in Red Ink With Date and Name of Person Making Change.

Do not extend notes this side of this line

46 A-5

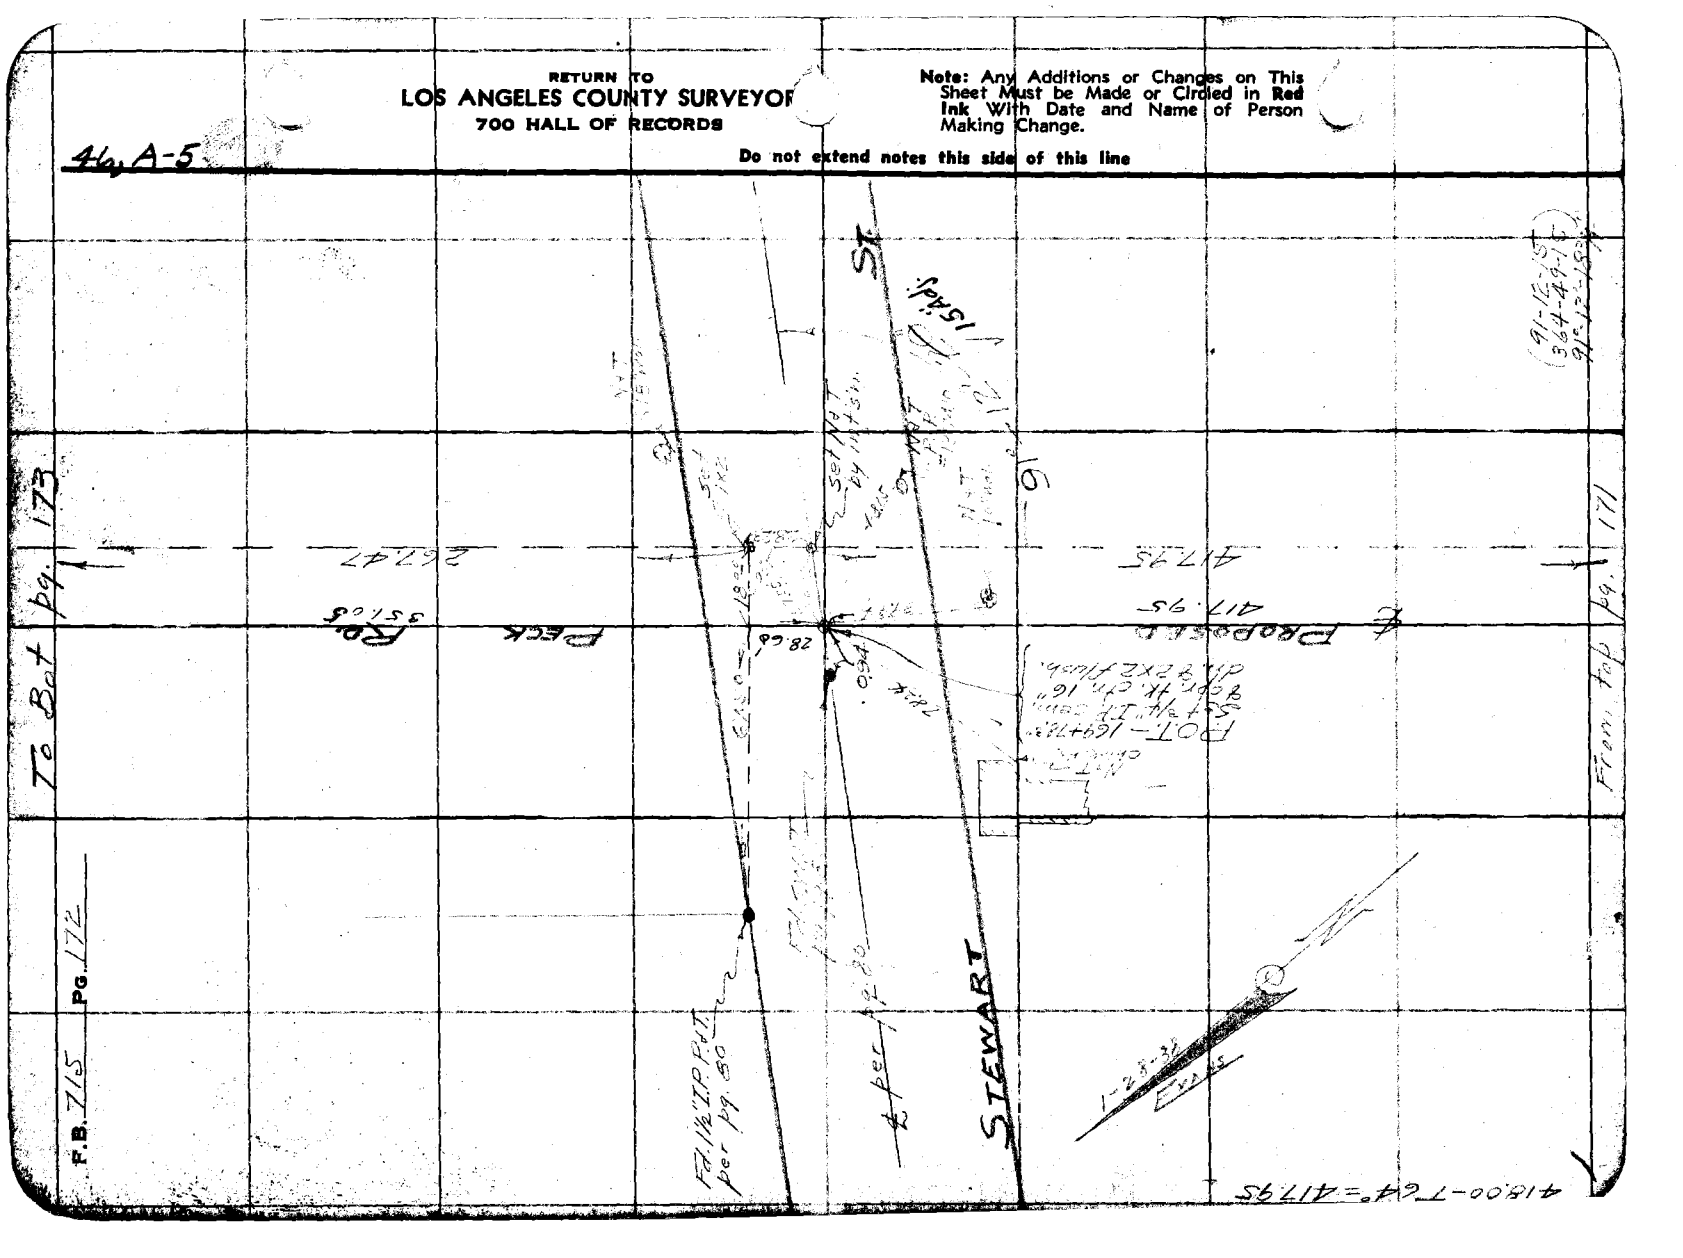

Notes Ck'd by	Survey of PECK RD.
Map No. C.S. B-351-2	W. O. 7052 Tape No. 023 St'd ☐ °F.
Office Work J. D. Price	Surveyed by EVANS
Checked CAR	Notes AE Date 1-31-38
Date Aug. 39	Indexed

F.B. 715 PG. 73

46, A-5

(74-41-15
278-41-45)
74°-41'-11¼"

PECK RD

T.P. 3/4" I.P. Pg. 8C

74°

41'-10"

175+64.2 E.C.

PECK RD

P.O.S.T. Fd 3/4" I.P. 12" dn. per Pg. 51 F.B. 690-43

5 H W, 36" hardwood

Δ = 18°-08'-00" Adj.
R = 1500
L = ~~471.46~~ 474.73

239.37

75.68

Sec. A-Acc.

80.35 N&T Stop F.P.

30.96

P.I.-Set 3/4" I.P. cem. & dr. Tk. ctr. 18" dn.

R.P.-Set 3/4" I.P. cem. & dr. Tk., 18" dn.

N&T Stop F.P.

S 2.62 W

Set 2x2, 14" dn. by mtls in.

161°-52'-00" Adj.

54.97 calc.

PECK RD

35.08

170+89.68 P.C.

PROPOSED

267.47

26150 - T64° = 26747

(161-52-00)
287-28-15
161°-52-03¾

From Top, Pg. 182

RETURN TO
LOS ANGELES COUNTY SURVEYOR
720 HALL OF RECORDS

Note: Any Additions or Changes on This Sheet Must be Made or Circled in Red Ink With Date, and Name of Person Making Change.

Do not extend notes this side of this line

FORM 247 10M 11-38

RETURN TO
LOS ANGELES COUNTY SURVEYOR
700 HALL OF RECORDS

Note: Any Additions or Changes on This Sheet Must be Made or Circled in Red Ink With Date and Name of Person Making Change.

Do not extend notes this side of this line

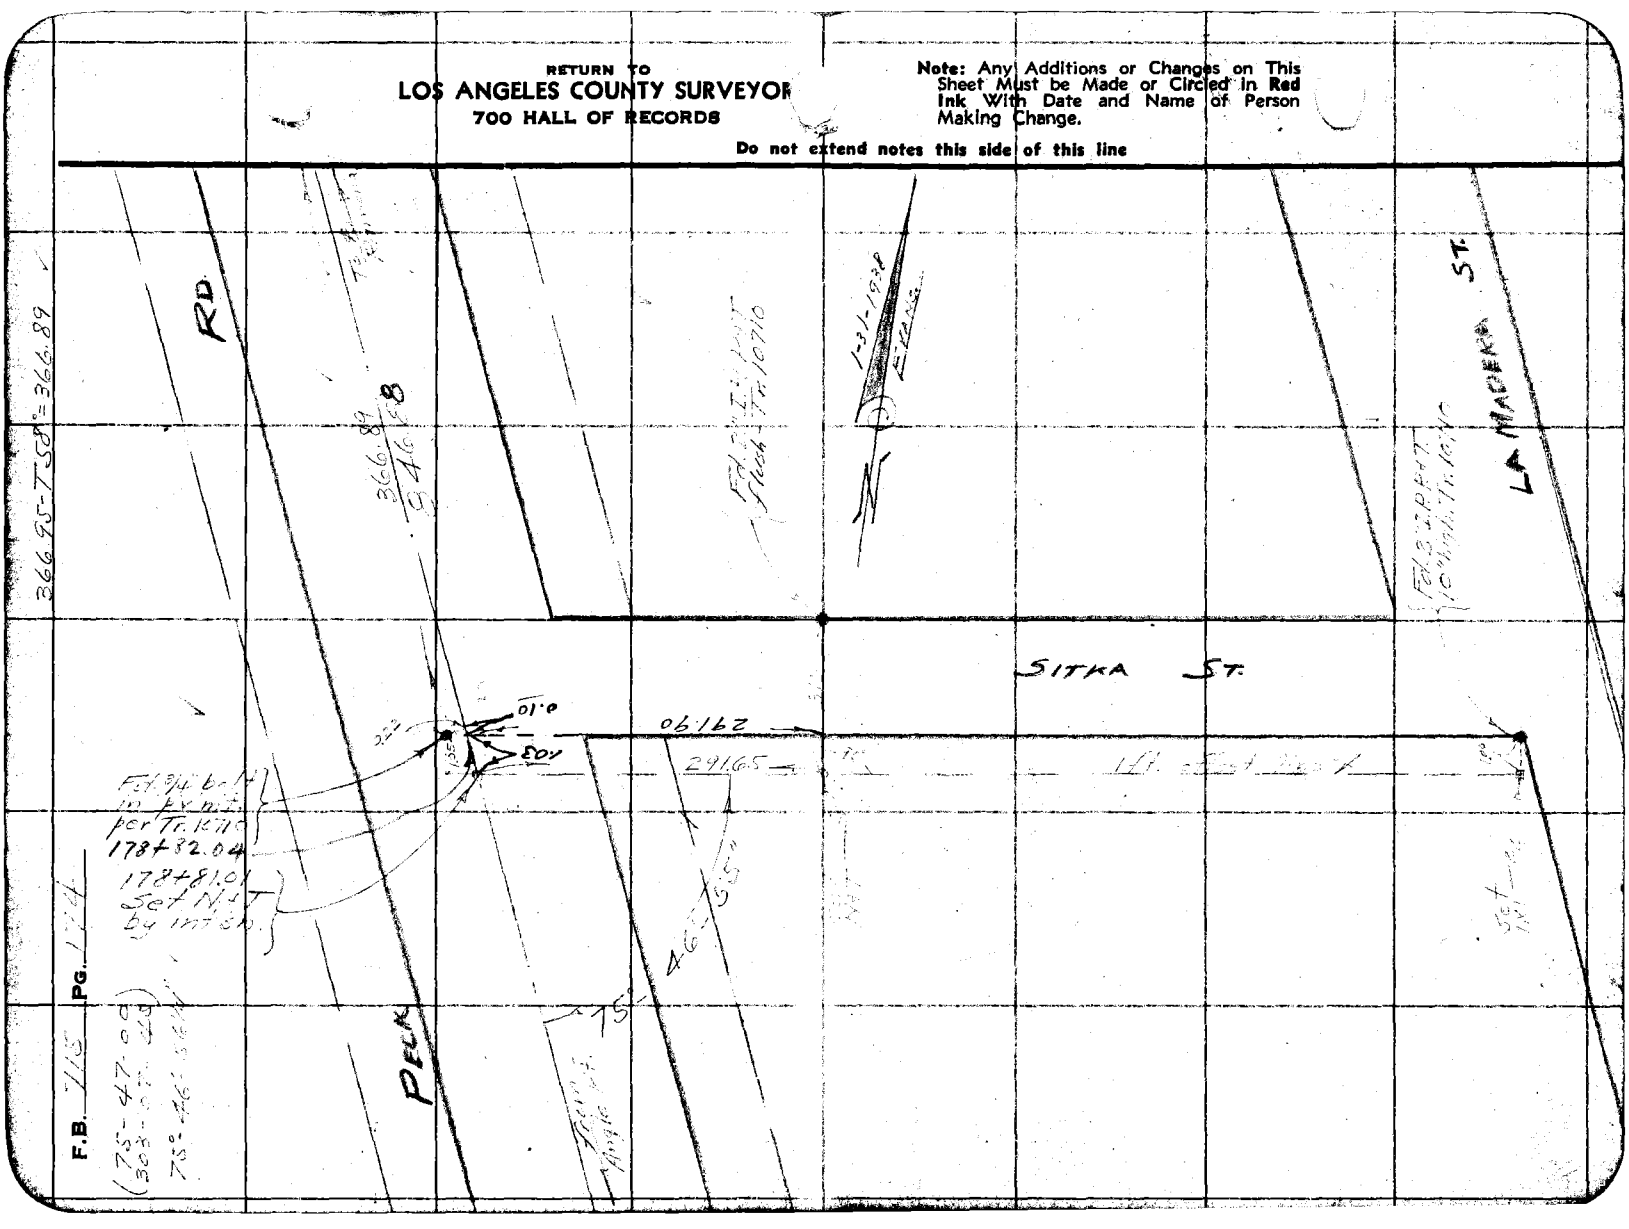

Notes Ck'd by	Survey of
Map No. C.S. B-1361-2	W. O. 7052 Tape No. 036 St'd. 84°F.
Office Work J.D. Price	Surveyed by EVANS
Checked AAR.	Notes HE Date 6-7-36
Date Aug 39	Indexed

F.B. 714 PG. 175

45 B-4

Continued in F.B. 746-6

(10°-47'-30" + 71+10-30 = 10°-47'-31½")

Fd. "IP" P.V.T. 4" deep, per T= 11202 & L.S. 32-26

183+39.70 Fd. L & T T= 10710 & Z-132-92

MEDINA CT.

12°-25" (calc)

148.99

2509

1321

Fd. L & T ties checks shown in R.D. F.C. 46 & 183+39.70

Transit Line

UNION R.R.

RD.

Fd. 2" W.I.P.

To Stk. with 4 tang. L & T's @ Cogswell Ave.

R.E. RY.

LOT

SAN BERNARDINO

per F.B. 690-43.

182+47.90 Fd. 2" W.I.P. & 4 tang. L & T ties per F.B. 690-43 & F.B. 715-81

120°-50'-20"

366.89

846.88

PECK

To Stk.

To Angle Pt.

(120°-50'-15")
(123°-21'-15")
120°-50'-18¾"

N

Note: Any Additions or Changes on This Sheet Must be Made or Circled in Red Ink With Date and Name of Person Making Change.

Do not extend notes this side of this line

RETURN TO
LOS ANGELES COUNTY SURVEYOR
700 HALL OF RECORDS

FORM 247 10M 11-38

RETURN TO
LOS ANGELES COUNTY SURVEYOR
700 HALL OF RECORDS

Note: Any Additions or Changes on This Sheet Must be Made or Circled in **Red Ink** With Date and Name of Person Making Change.

Do not extend notes this side of this line

F.B. 715 PG. 176

Notes Ck'd by		Survey of	
Map No. C.S.B. 1351-1		W. O.	Tape No. St'd °F.
Office Work J. D. Price		Surveyed by	
Checked aar		Notes	Date
Date Aug. 39		Indexed	3-22-38

F.B. PG. 77

Note: Any Additions or Changes on This Sheet Must be Made or Circled in Red Ink With Date and Name of Person Making Change.

Do not extend notes this side of this line

RETURN TO
LOS ANGELES COUNTY SURVEYOR
700 HALL OF RECORDS

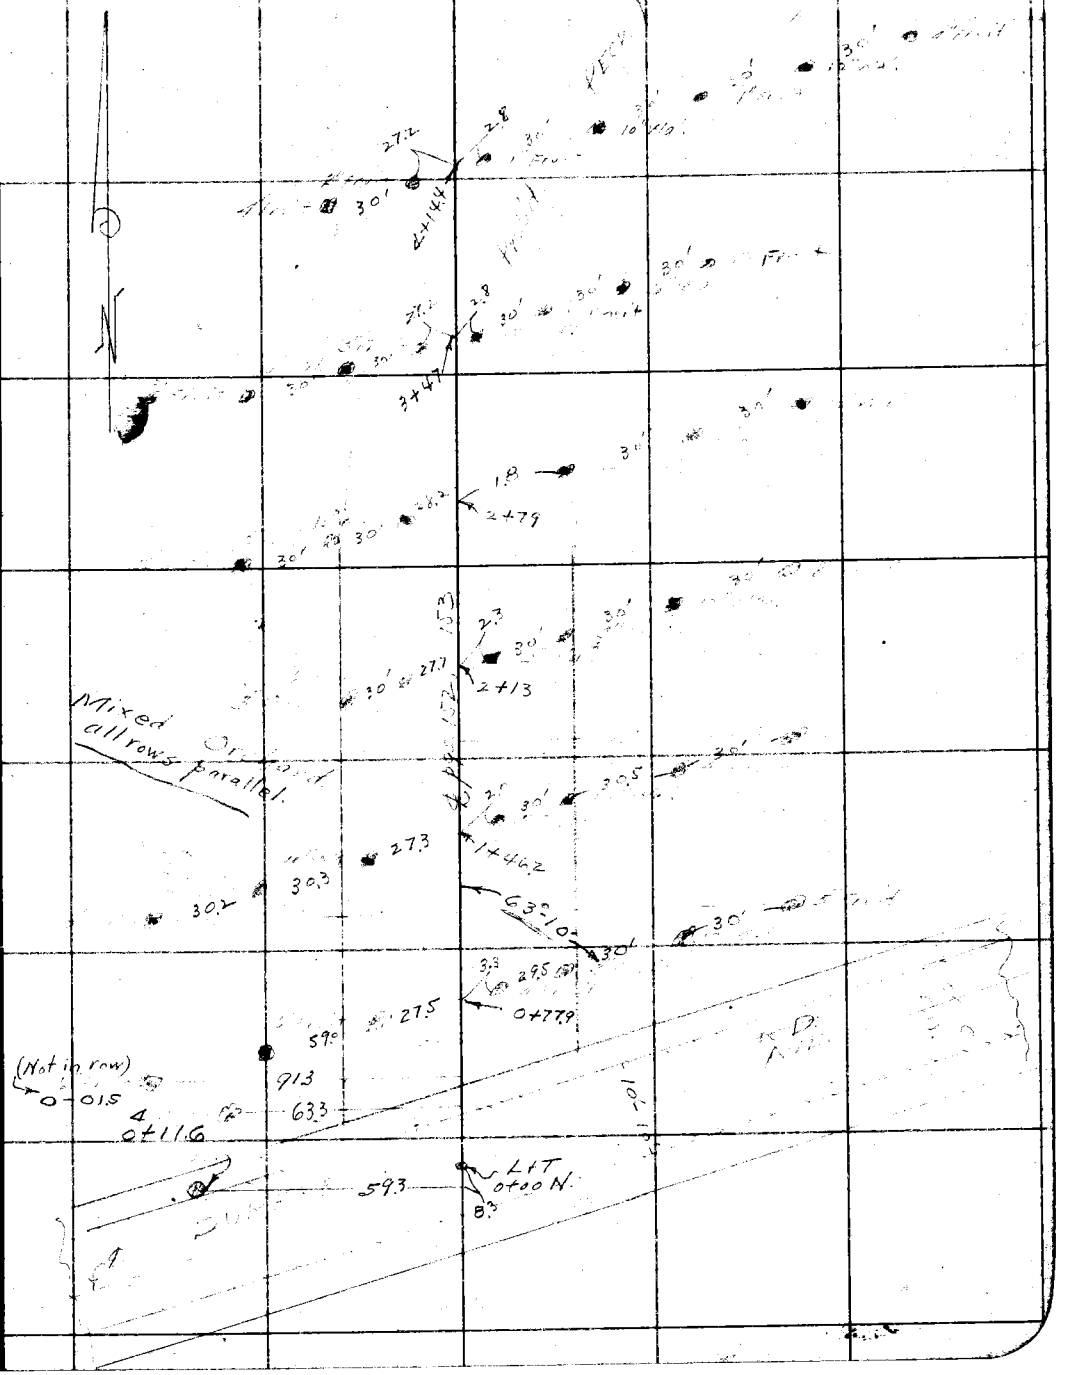

FORM 247 10M 11-38

RETURN TO
LOS ANGELES COUNTY SURVEYOR
700 HALL OF RECORDS

Note: Any Additions or Changes on This Sheet Must be Made or Circled in **Red Ink** With Date and Name of Person Making Change.

Do not extend notes this side of this line

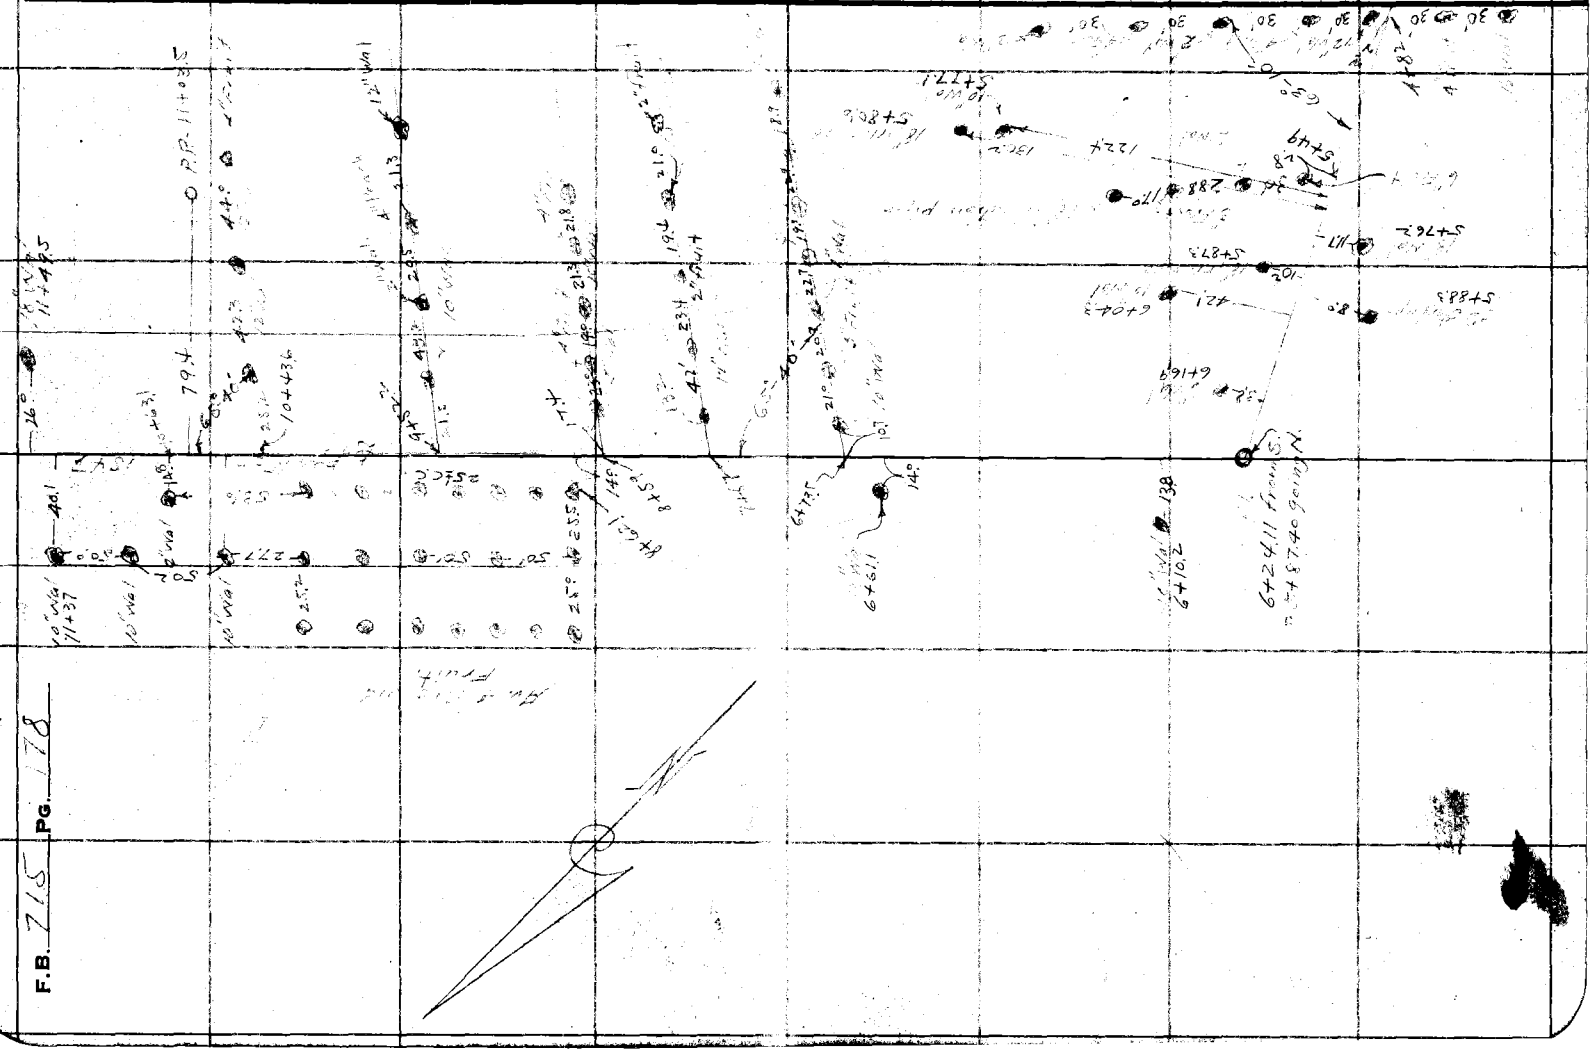

F.B. 715 PG. 178

Notes Ck'd by	Survey of
Map No. C.S.B-1351-1	W. O. 7052 Tape No. St'd °F.
Office Work J. D. Price.	Surveyed by H. F. Evans
Checked AAR	Notes Date 1/21/26
Date Aug 39	Indexed

F.B. PG. 179

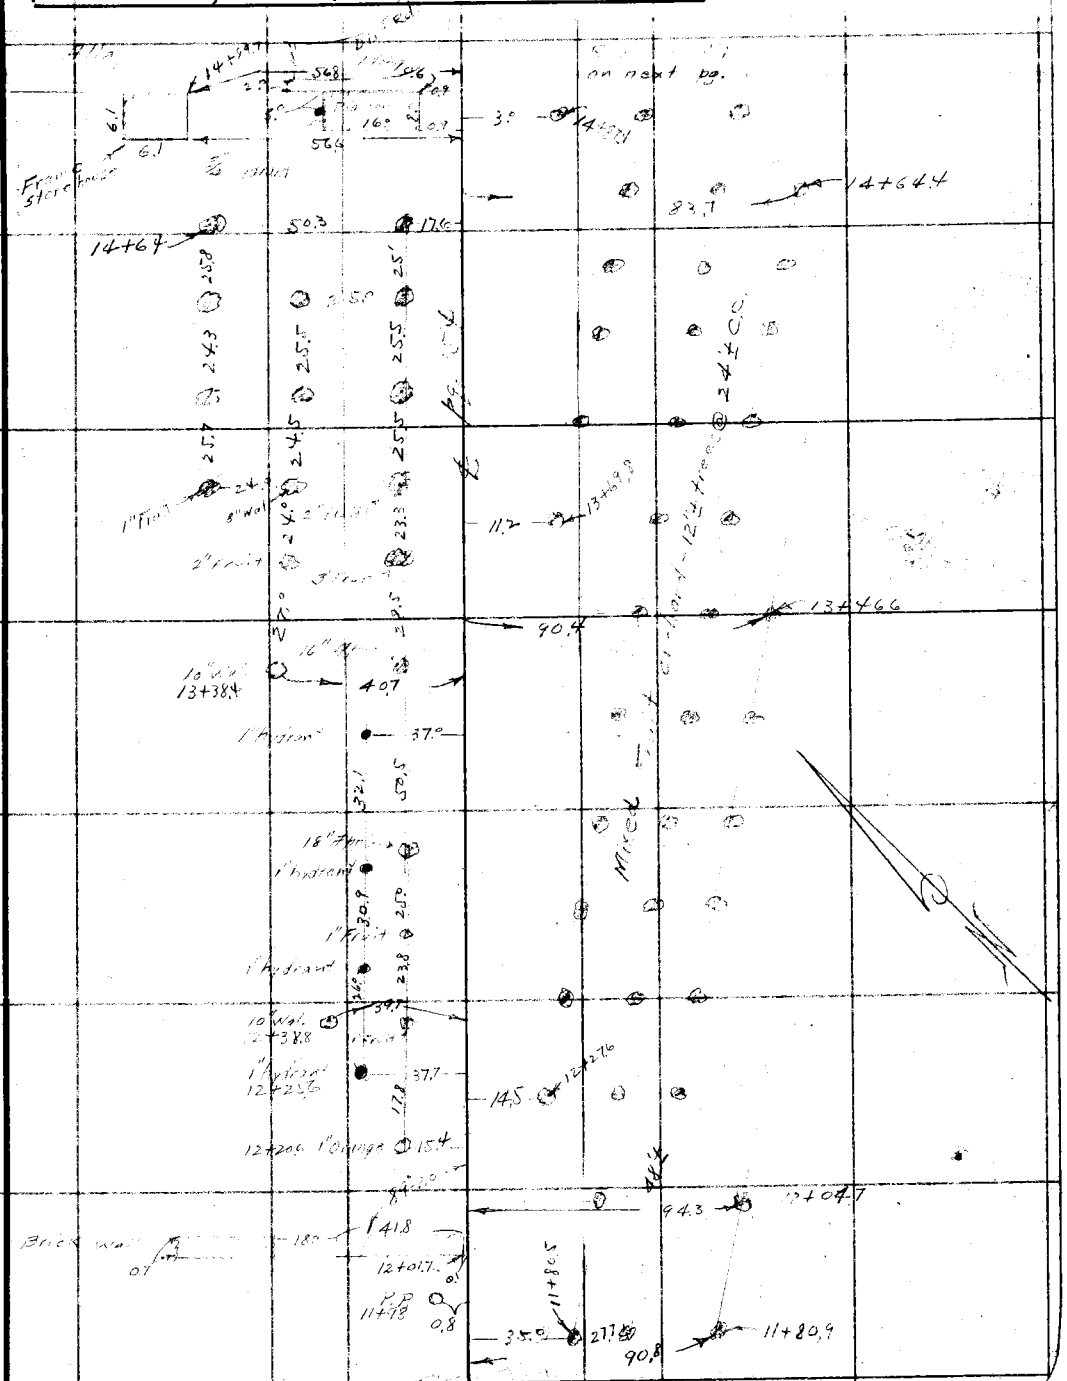

RETURN TO
LOS ANGELES COUNTY SURVEYOR
700 HALL OF RECORDS

Note: Any Additions or Changes on This Sheet Must be Made or Circled in Red Ink With Date and Name of Person Making Change.

Do not extend notes this side of this line

FORM 247 10M 11-38

F.B. 715 Pg. 180

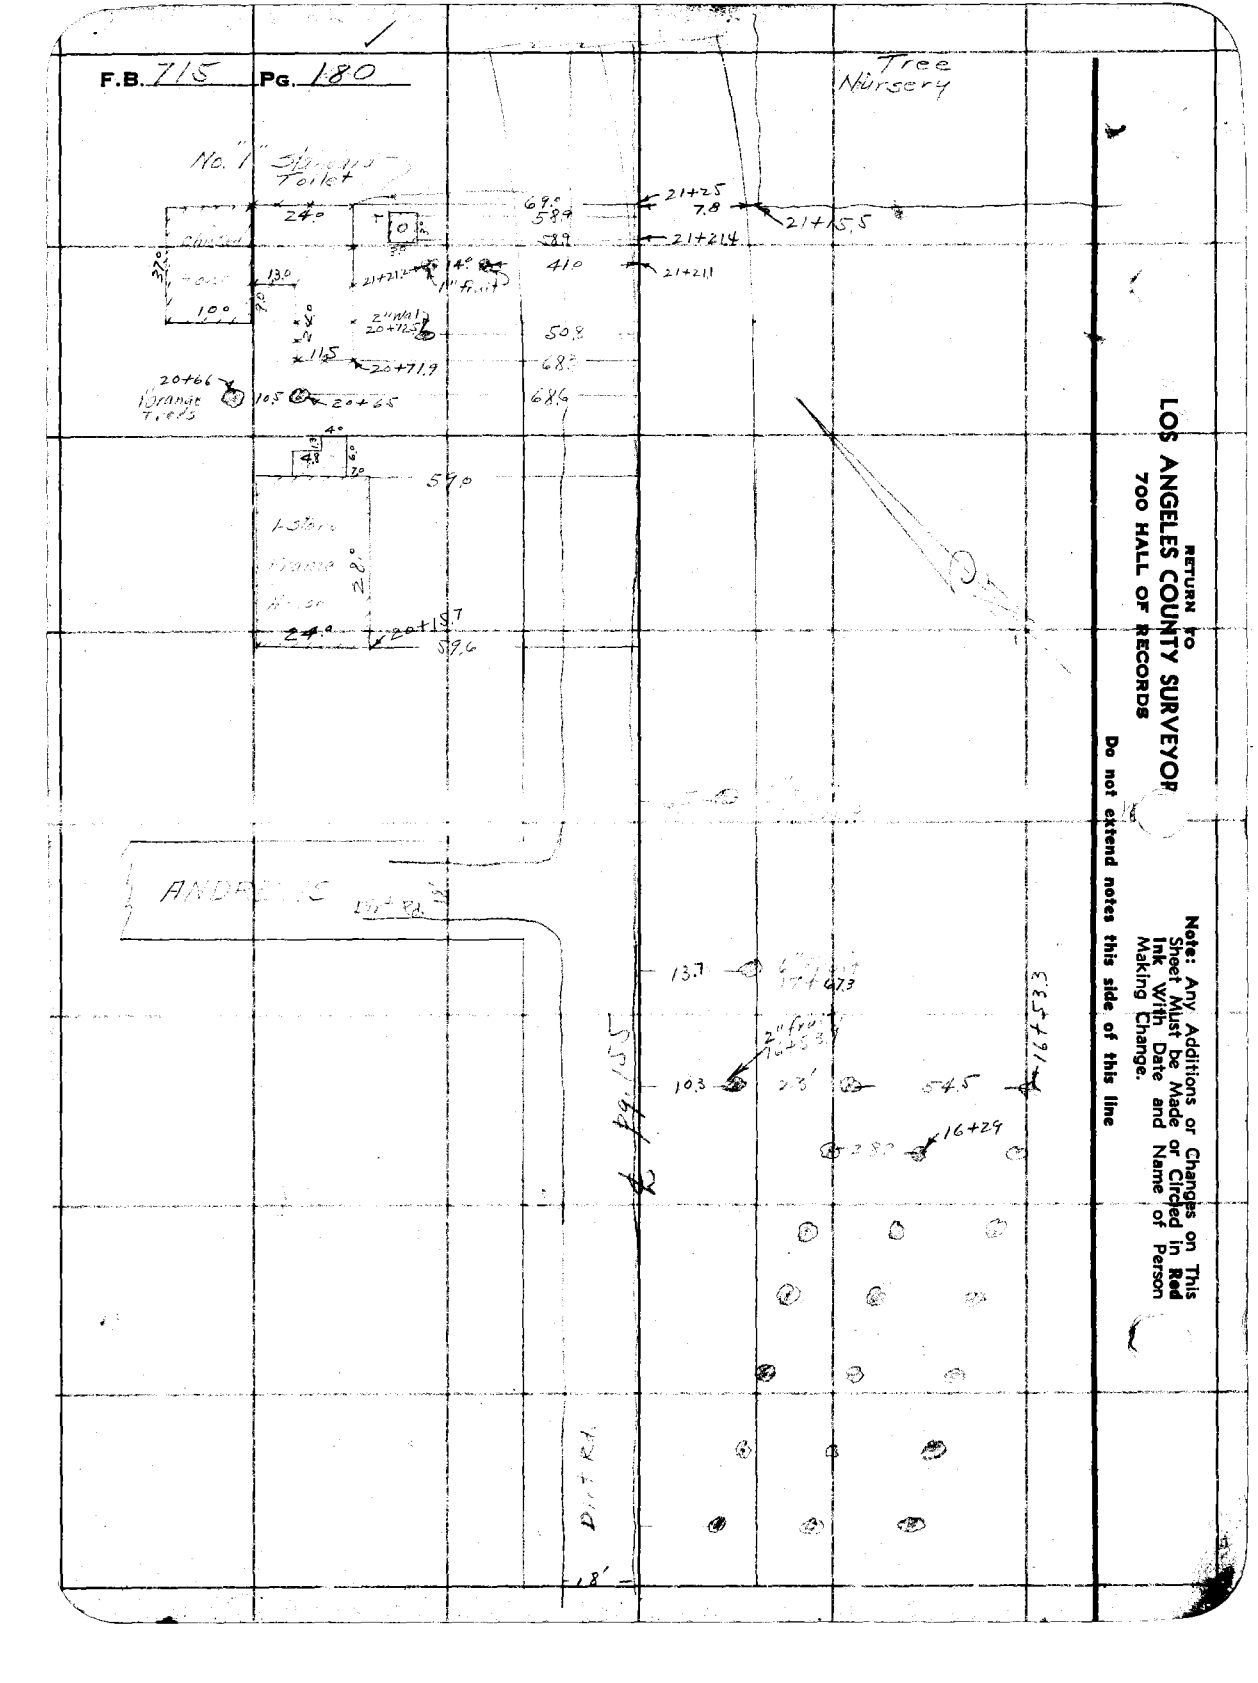

RETURN TO
LOS ANGELES COUNTY SURVEYOR
700 HALL OF RECORDS

Note: Any Additions or Changes on This Sheet Must be Made or Circled in Red Ink With Date and Name of Person Making Change.

Do not extend notes this side of this line

Notes Ck'd by	Survey of
Map No. C.S.B-135[illegible]	W. O. Tape No. St'd °F.
Office Work J. D. Price	Surveyed by [illegible]
Checked [illegible]	Notes [illegible] Date 1/21/36
Date Aug 39	Indexed

F.B. [illegible] Pg. 181

Note: Any Additions or Changes on This Sheet Must be Made or Circled in Red Ink With Date and Name of Person Making Change.

Do not extend notes this side of this line

RETURN TO
LOS ANGELES COUNTY SURVEYOR
700 HALL OF RECORDS

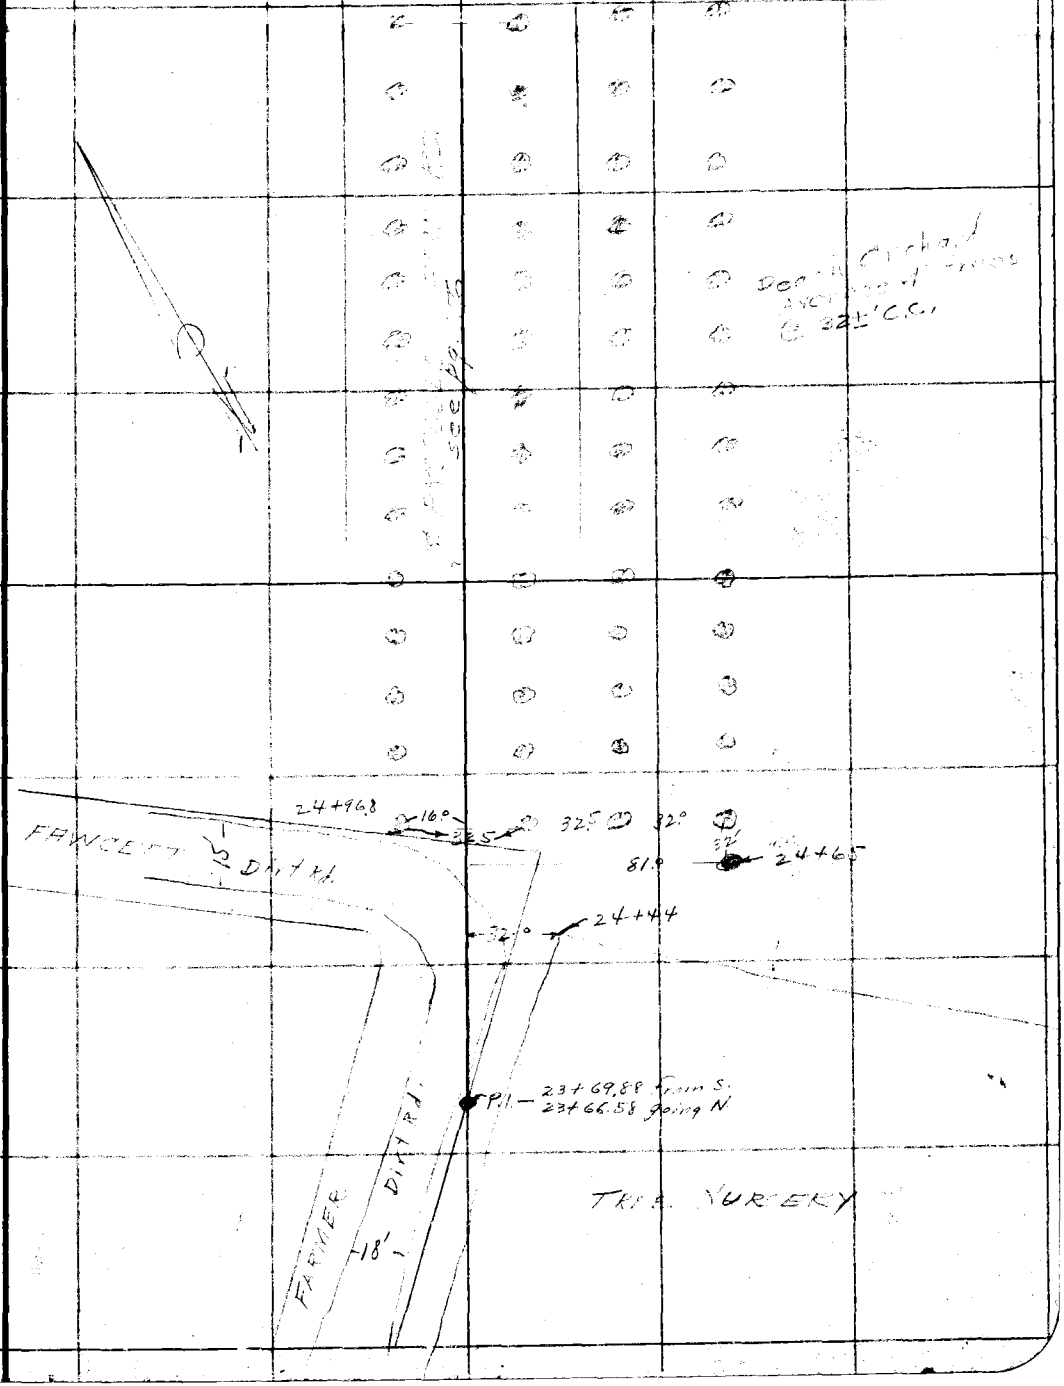

FORM 247 10M 11-35

RETURN TO
LOS ANGELES COUNTY SURVEYOR
700 HALL OF RECORDS

Note: Any Additions or Changes on This Sheet Must be Made or Circled in **Red Ink** With Date and Name of Person Making Change.

Do not extend notes this side of this line

F.B. 715 PG. 182

FORM 247 10M 11-33

RETURN TO
LOS ANGELES COUNTY SURVEYOR
700 HALL OF RECORDS

Note: Any Additions or Changes on This Sheet Must be Made or Circled in **Red Ink** With Date and Name of Person Making Change.

Do not extend notes this side of this line

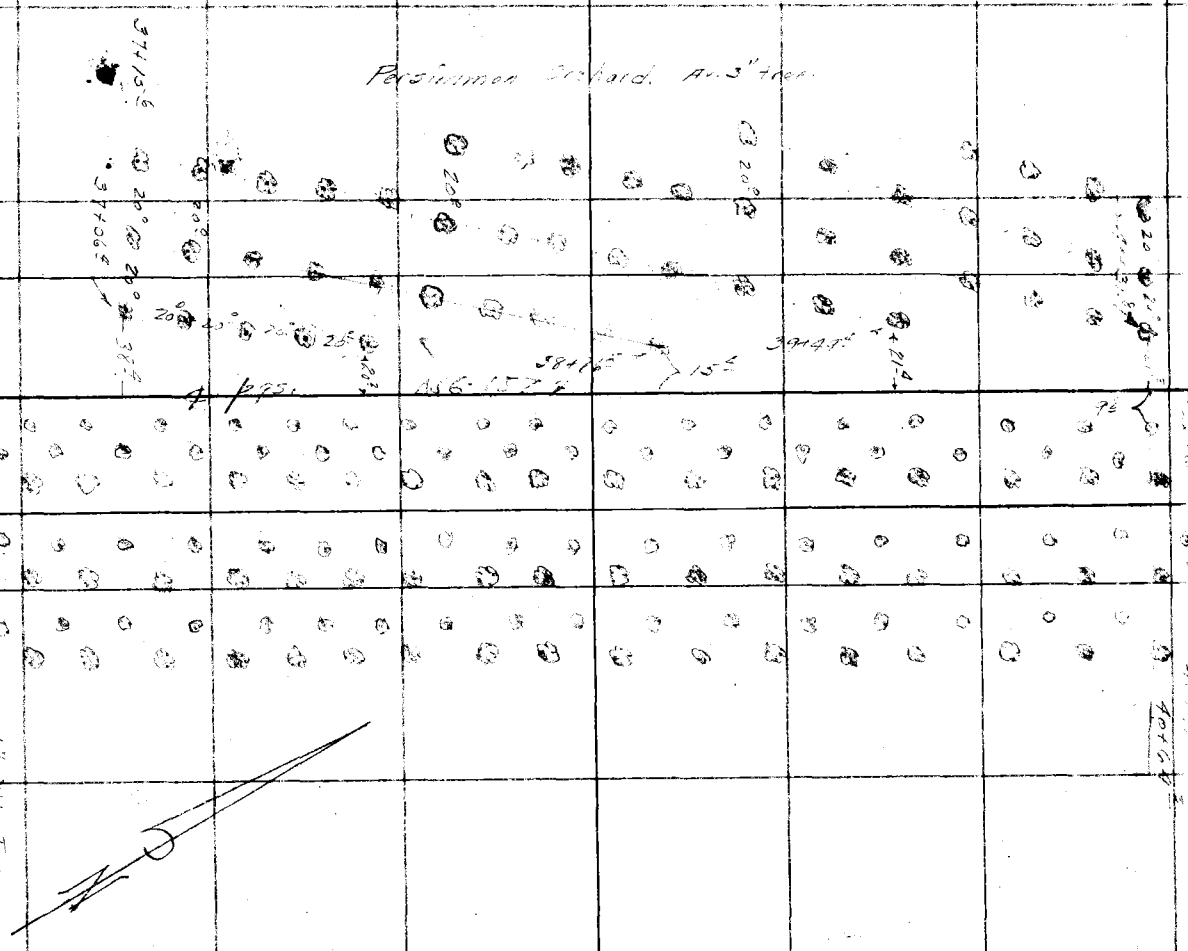

Notes Ck'd by _____
Map No. C.3.8-13.5[illegible]
Office Work J. D. Fricd
Checked Date Aug. 39

Survey of _____
W. O. _____ Tape No. _____ St'd _____ °F.
Surveyed by _____
Notes _____ Date 12/12/36
Indexed _____

F.B. _____ Pg. 163

RETURN TO
LOS ANGELES COUNTY SURVEYOR
700 HALL OF RECORDS

Note: Any Additions or Changes on This Sheet Must be Made or Circled in **Red Ink** With Date and Name of Person Making Change.

Do not extend notes this side of this line

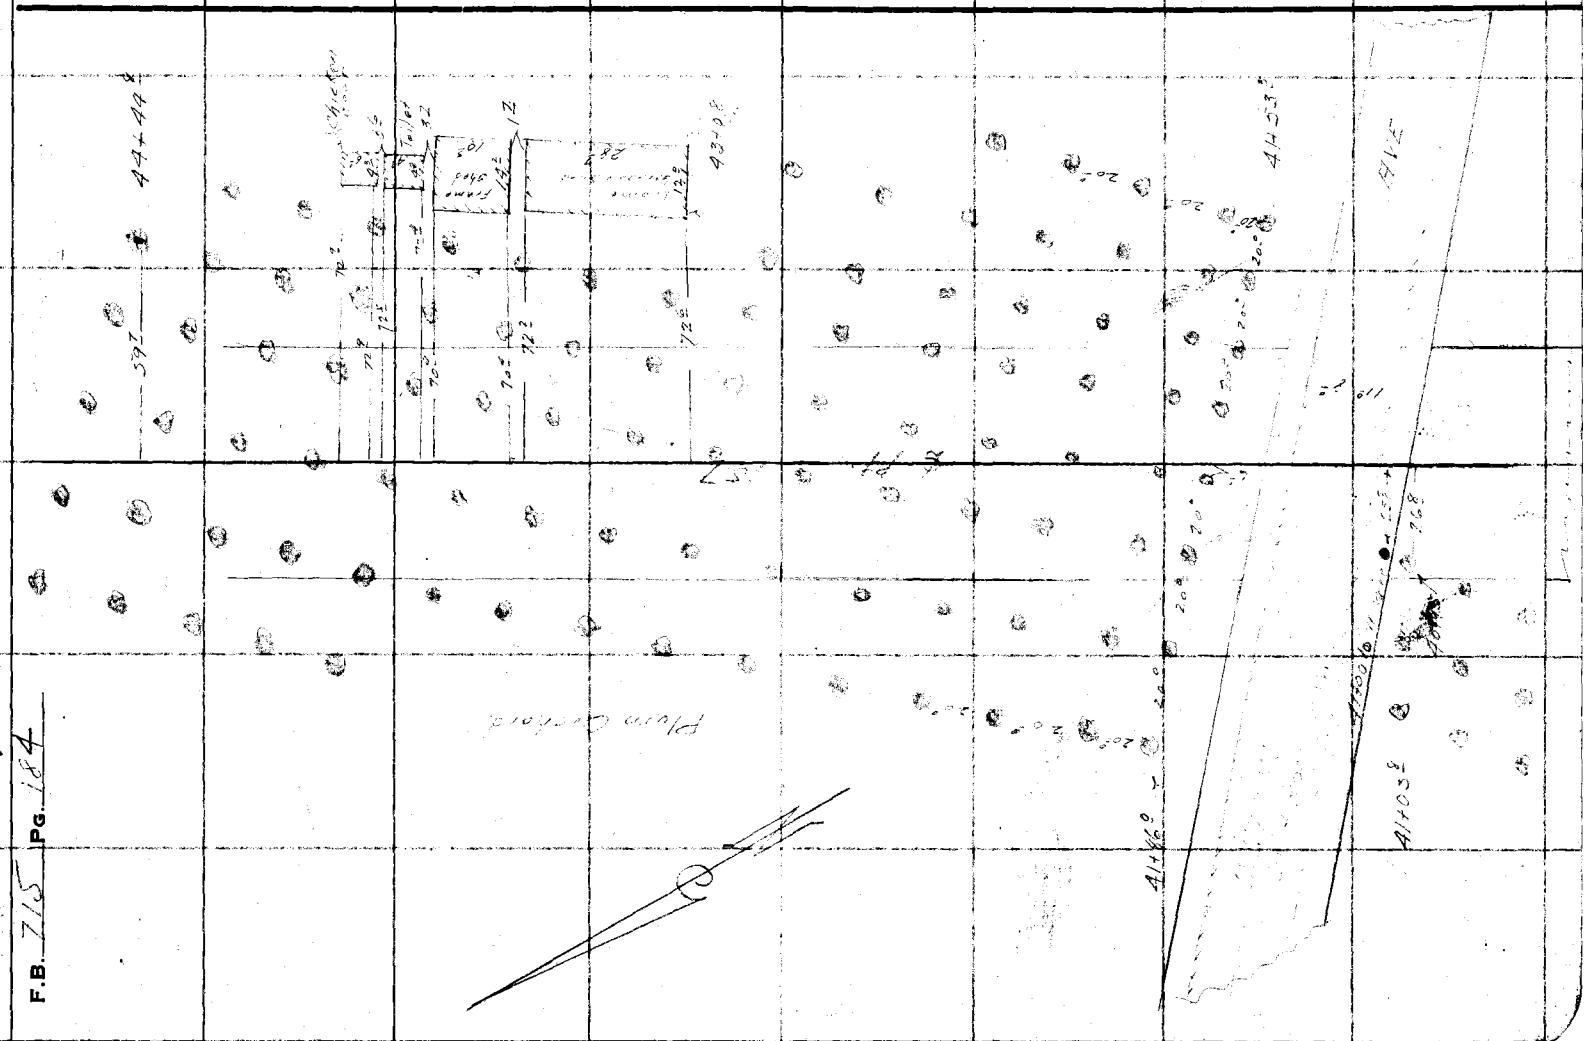

F.B. 715 PG. 184

FORM 247 10M 11-35

RETURN TO
LOS ANGELES COUNTY SURVEYOR
700 HALL OF RECORDS

Note: Any Additions or Changes on This Sheet Must be Made or Circled in Red Ink With Date and Name of Person Making Change.

Do not extend notes this side of this line

Notes Ck'd by _____
Map No. C.S.B-13514
Office Work J. P. Price
Checked [illegible]
Date Aug. 39

Survey of _____
W. O. _____ Tape No. _____ St'd _____ °F.
Surveyed by _____ Notes _____ Date _____
Indexed _____

F.B. _____ Pg. _____

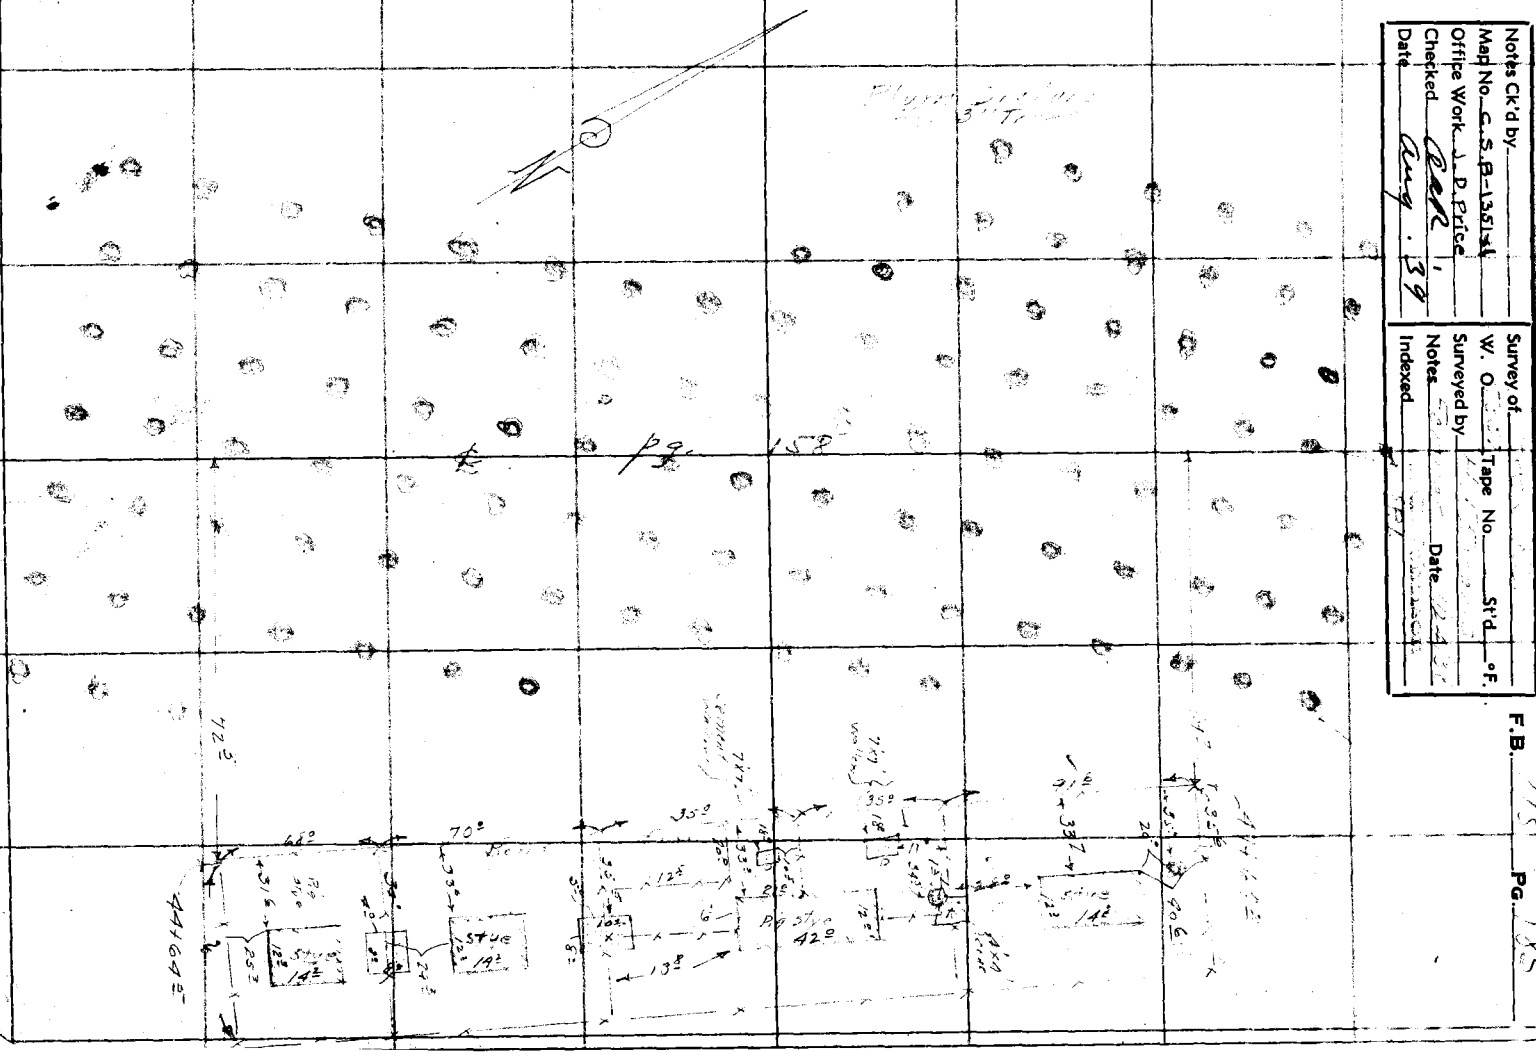

RETURN TO
LOS ANGELES COUNTY SURVEYOR
700 HALL OF RECORDS

Note: Any Additions or Changes on This Sheet Must be Made or Circled in **Red Ink** With Date and Name of Person Making Change.

Do not extend notes this side of this line

F.B. 715 PG. 186

FORM 247 10M 11-35

RETURN TO
LOS ANGELES COUNTY SURVEYOR
700 HALL OF RECORDS

Note: Any Additions or Changes on This Sheet Must be Made or Circled In **Red Ink** With Date and Name of Person Making Change.

Do not extend notes this side of this line

Notes Ck'd by
Map No. S.S.B-1351-21
Office Work J. D. Price
Checked
Date Aug. 39

Survey of
W. O. Tape No. St'd °F.
Surveyed by
Notes Date
Indexed

F.B. PG.

Plum

& Pg. 159

RETURN TO
LOS ANGELES COUNTY SURVEYOR
700 HALL OF RECORDS

Note: Any Additions or Changes on This Sheet Must be Made or Circled In **Red Ink** With Date and Name of Person Making Change.

Do not extend notes this side of this line

F.B. 735 PG. 188

Notes Ck'd by	Survey of
Map No. C.S. B-1351	W. O.	Tape No.	St'd °F.
Office Work J. D. Price	Surveyed by
Checked Dan	Notes	Date 12-4-39
Date Aug. 39	Indexed

F.B. 715 PG. 189

Note: Any Additions or Changes on This Sheet Must be Made in Red Ink With Date and Name of Person Making Change.

Do not extend notes this side of this line

RETURN TO
LOS ANGELES COUNTY SURVEYOR
700 HALL OF RECORDS

74+75.2

12" Wal

6" Wal

6" Wal

6" Wal

72+11.2

6" Wa

6 Wal

10" Wal

10" Wal

10" Wal 68+70.8

68+03.3

Pav.

" Thick
Oil + Rock

APP

67+07.1

62.3

FORM 247 10M 11-38

F.B. 715 PG. 190

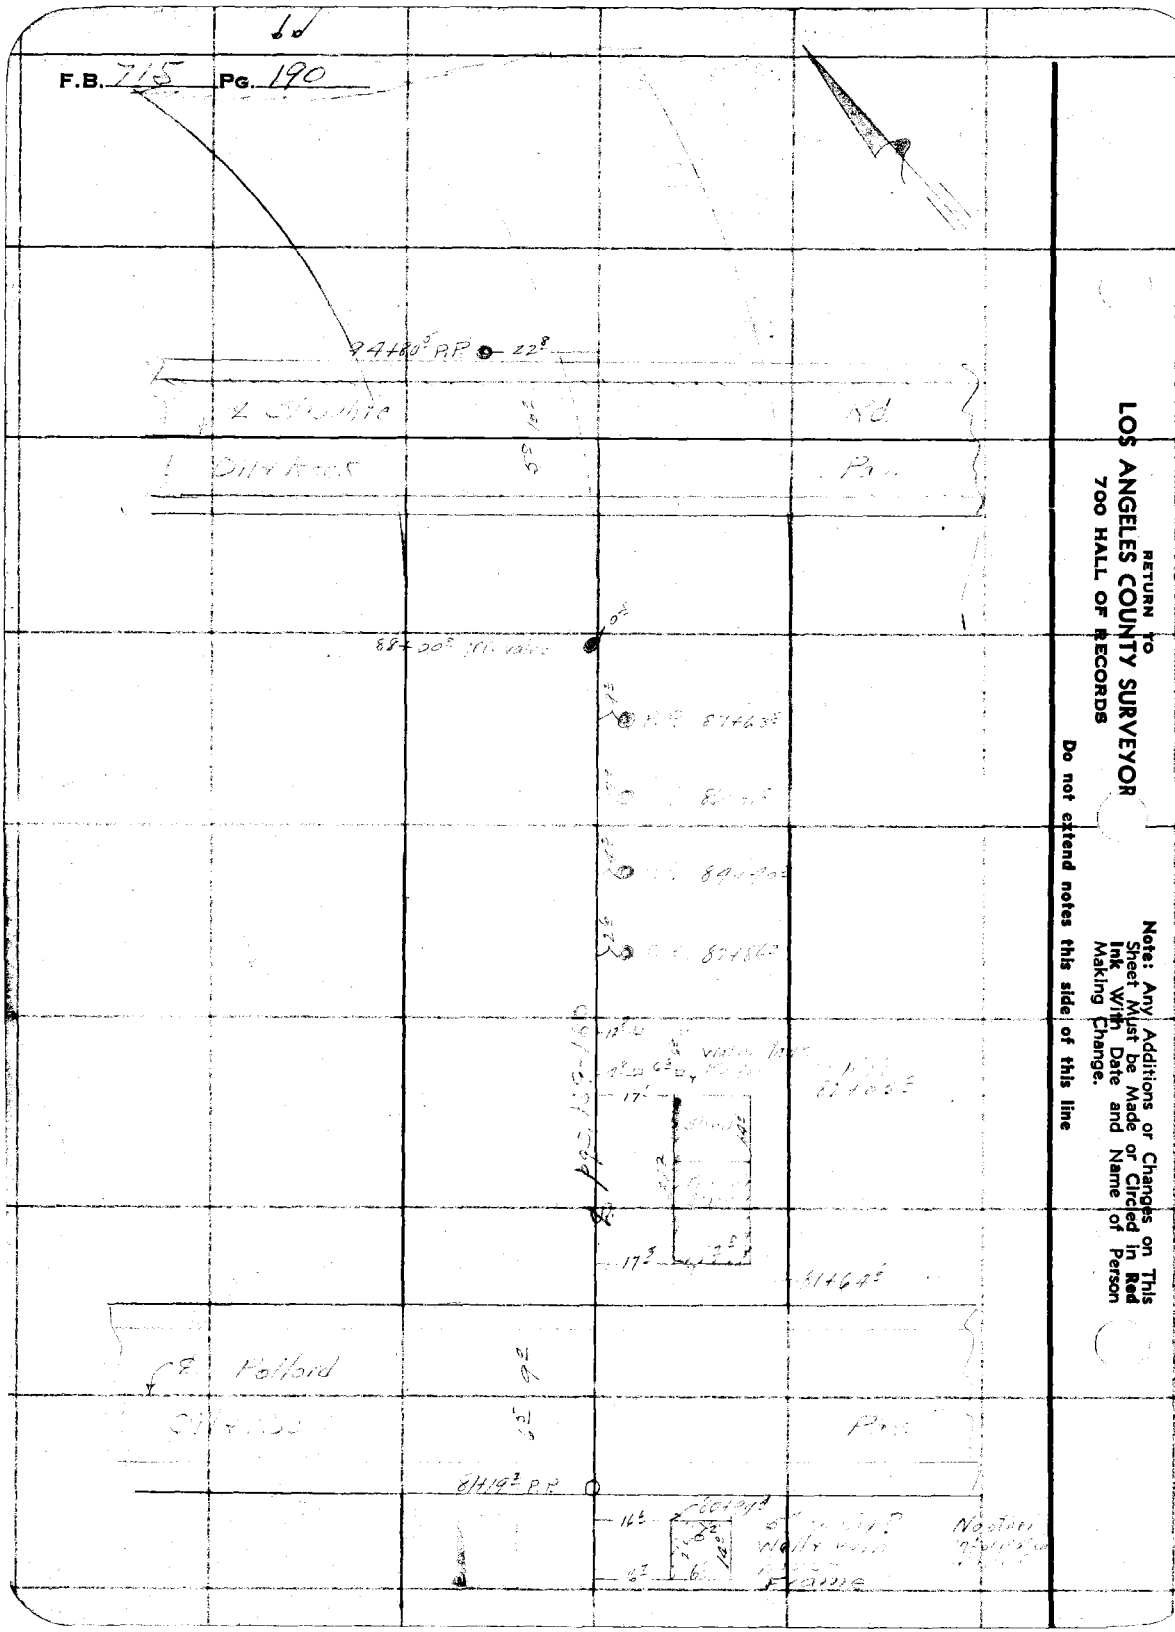

RETURN TO
LOS ANGELES COUNTY SURVEYOR
700 HALL OF RECORDS

Note: Any Additions or Changes on This Sheet Must be Made or Circled in Red Ink With Date and Name of Person Making Change.

Do not extend notes this side of this line

Notes Ck'd by	Survey of
Map No. C.S.B-1351-1&2	W. O. 203-3 Tape No. St'd °F.
Office Work J. D. Price	Surveyed by
Checked Car	Notes Date 12-1-39
Date Aug. 39	Indexed

F.B. [illegible] Pg. 121

Cor. 1-1 pg. 111

106+66.98

Ft Mt. View
Dirt Rock

Frame Shack

65'

64.5

Pass 160+16.1

102+42.9

102+32.1

101+76.3

N 97°75-2° from S.E.
Pl. of B. 11-236.1 long N.

Note: Any Additions or Changes on This Sheet Must be Made or Circled in Red Ink With Date and Name of Person Making Change.

Do not extend notes this side of this line

RETURN TO
LOS ANGELES COUNTY SURVEYOR
700 HALL OF RECORDS

FORM 247 10M 11-38

RETURN TO
LOS ANGELES COUNTY SURVEYOR
700 HALL OF RECORDS

Note: Any Additions or Changes on This Sheet Must be Made or Circled in Red Ink With Date and Name of Person Making Change.

Do not extend notes this side of this line

F.B. 765 Pg. 192

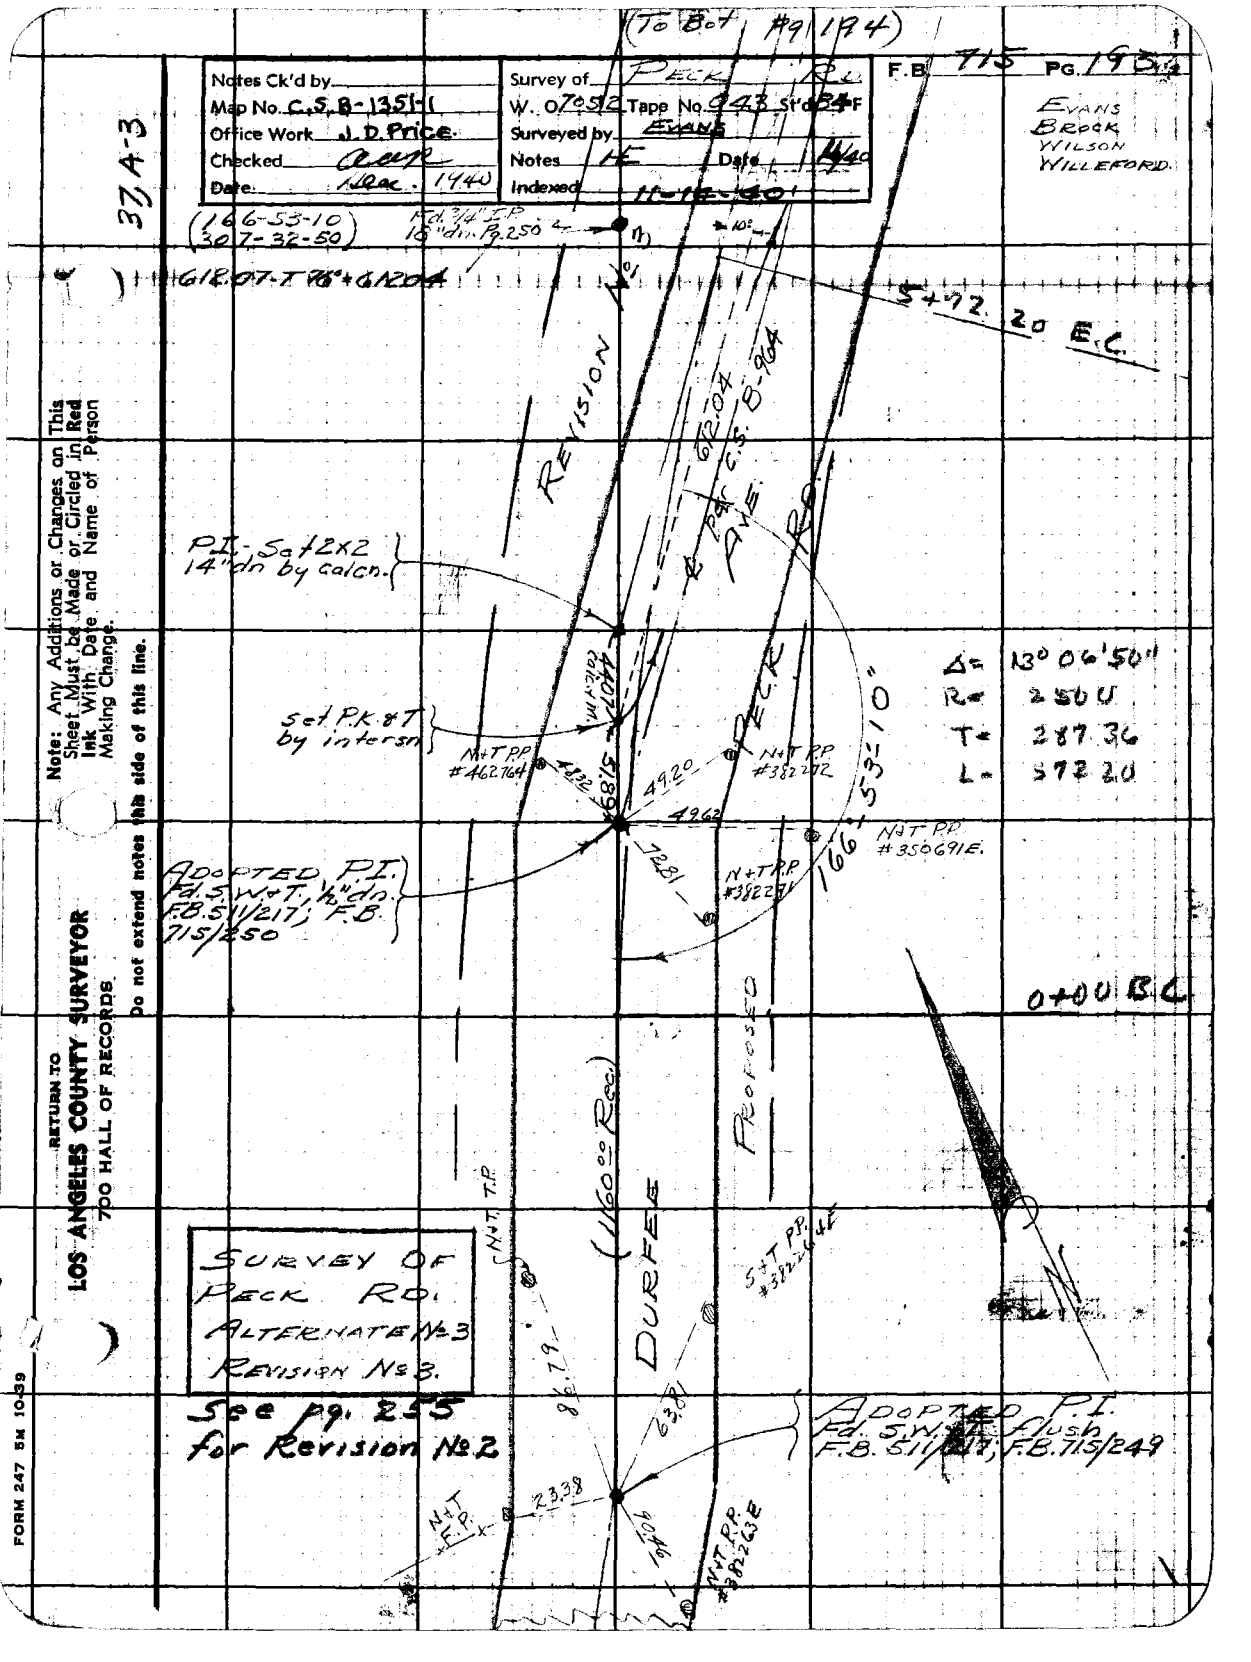
(To Bot #9 1194)
Notes Ck'd by
Map No. C.S. B-1351-1
Office Work J. D. Price
Checked Acup
Date 10 Dec. 1940
Survey of Peck Rd.
W. O. 7052 Tape No. 943 St'd 33' F
Surveyed by Evans
Notes HE Date 11/40
Indexed 11-12-40
F.B. 715 Pg. 195-2
Evans Brock Wilson Willeford.
374-3
(166-53-10 307-32-50)
Fd. 3/4" I.P. 18" dn. Pg. 250
618.07 - T 76+62.04
5+72.20 E.C.
REVISION
Peck C.S. B-964
Peck Ave.
P.I. Sq. 12x2 14" dn by calcn.
Set P.K. & T by interscn
N+T P.P. #462764
N+T P.P. #382282
N+T P.P. #350691E.
Δ= 13° 06' 50"
R= 2500
T= 287.36
L= 572.20
5°-3'-10"
618.07
49.20
49.62
12.81
166.1
Adopted P.I. Fd. S.W. N+T, 1/2" dp. F.B. 511/217, F.B. 715/250
0+00 B.C.
Proposed
Durfee (1160.00 Rec.)
N+T T.P.
S+T P.P. #382264E
Survey of Peck Rd. Alternate No. 3 Revision No. 3.
See Pg. 255 for Revision No. 2
Adopted P.I. Fd. S.W. N+T flush F.B. 511/217, F.B. 715/249
81.79
23.81
23.38
10.96
N+T P.P. #382263E
N+T P.P.
Note: Any Additions or Changes on This Sheet Must be Made or Circled in Red Ink With Date and Name of Person Making Change.
Do not extend notes this side of this line.
RETURN TO
LOS ANGELES COUNTY SURVEYOR
700 HALL OF RECORDS
FORM 247 5M 10-39

RETURN TO
LOS ANGELES COUNTY SURVEYOR
700 HALL OF RECORDS

37 A-3

Note: Any Additions or Changes on This Sheet Must be Made or Circled in Red Ink With Date and Name of Person Making Change.

Do not extend notes this side of this line.

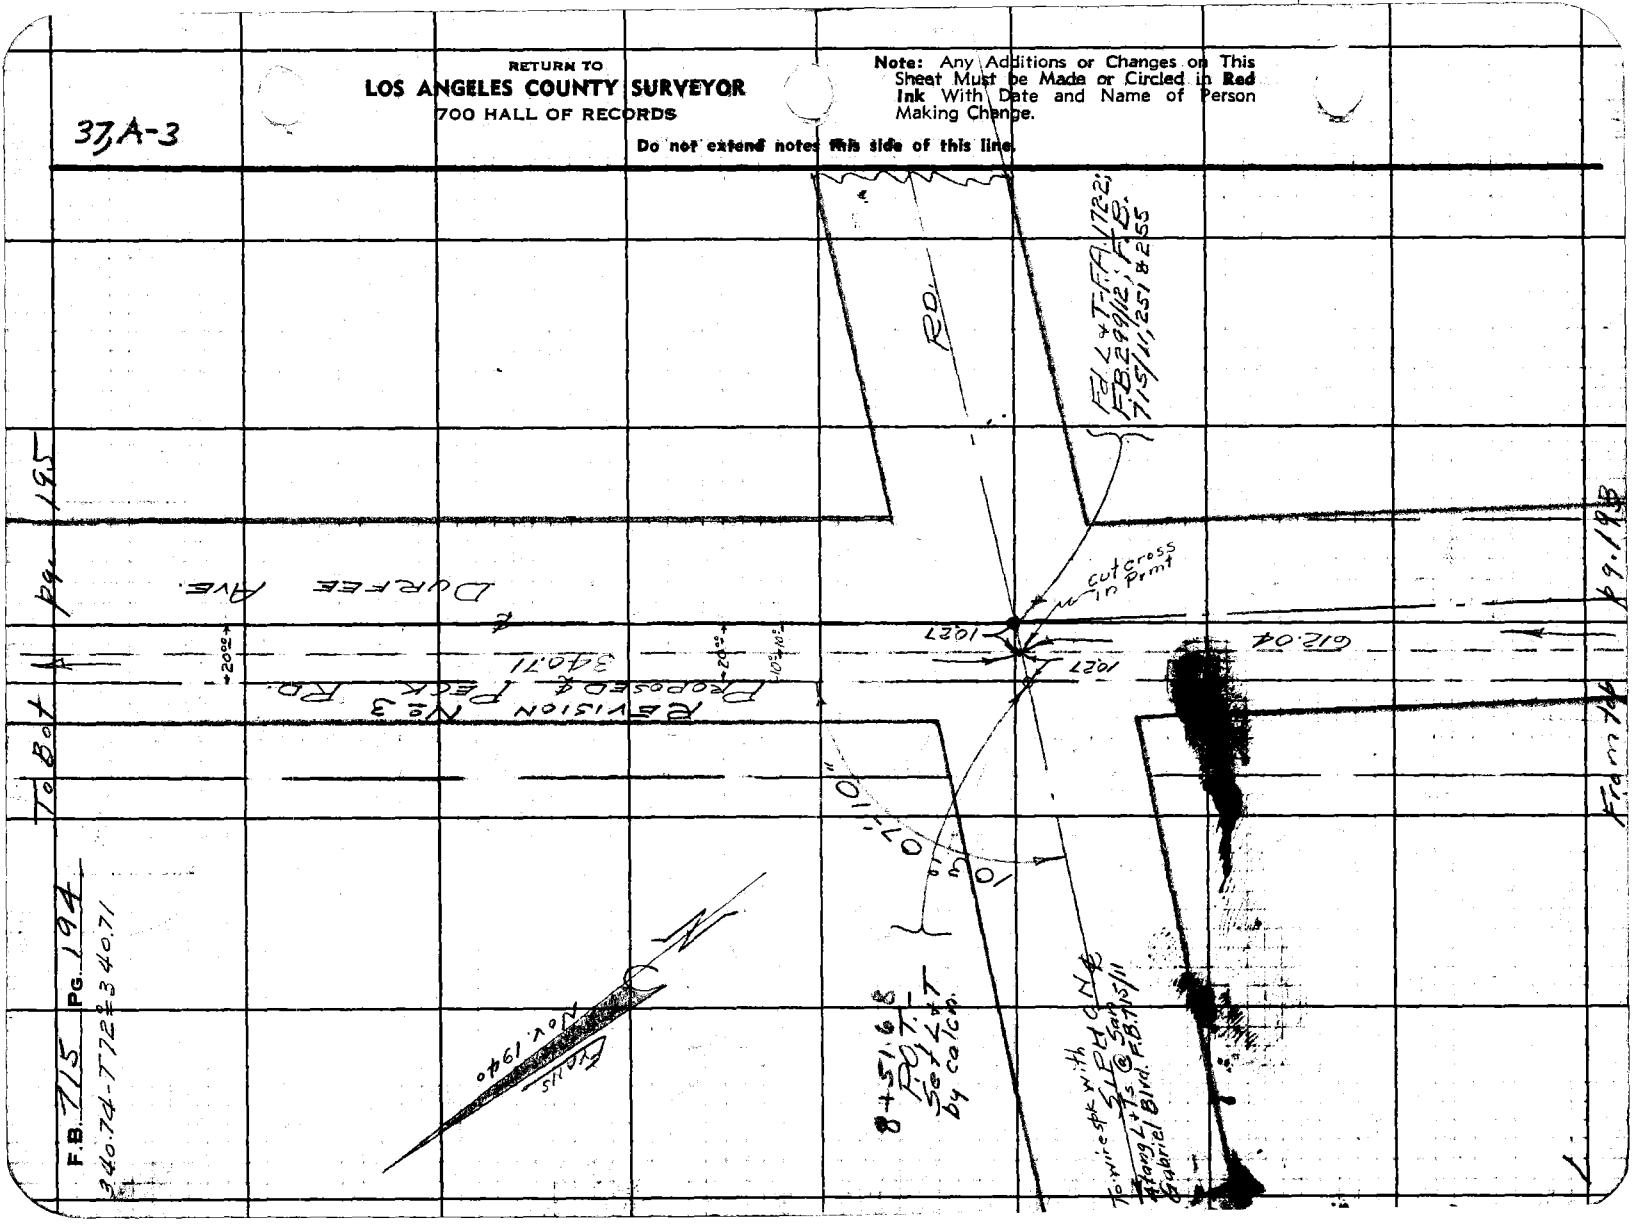

FORM 247 5M 10-39

RETURN TO
LOS ANGELES COUNTY SURVEYOR
700 HALL OF RECORDS

Note: Any Additions or Changes on This Sheet Must be Made or Circled in Red Ink With Date and Name of Person Making Change.

Do not extend notes this side of this line.

37, A-3

57537 - T68° = 57531

Notes Ck'd by
Map No. C.S.B. 131-11
Office Work J. D. Price
Checked Clerk
Date 1944

To Bay Fy.

Survey of
W. O.
Tape No. 043 Sta 84F
Surveyed by EVANS
Notes
Indexed
Date Nov 46

F.B. 715 PG. 196

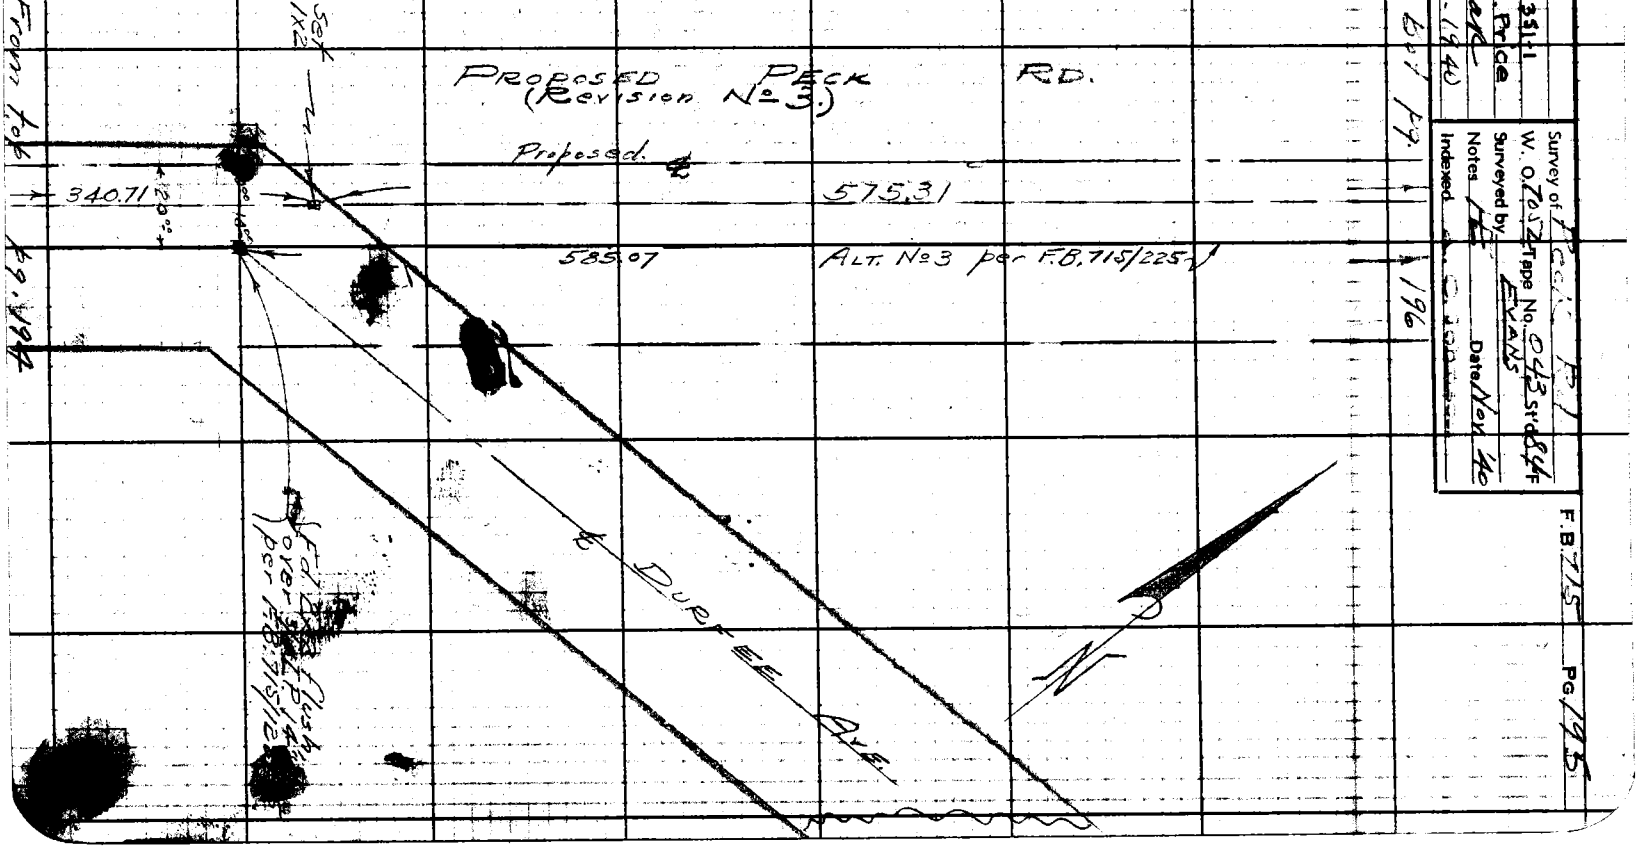

RETURN TO
LOS ANGELES COUNTY SURVEYOR
700 HALL OF RECORDS

Note: Any Additions or Changes on This Sheet Must Be Made or Circled in Red Ink With Date and Name of Person Making Changes

Do not extend notes this side of this line

37 A-3

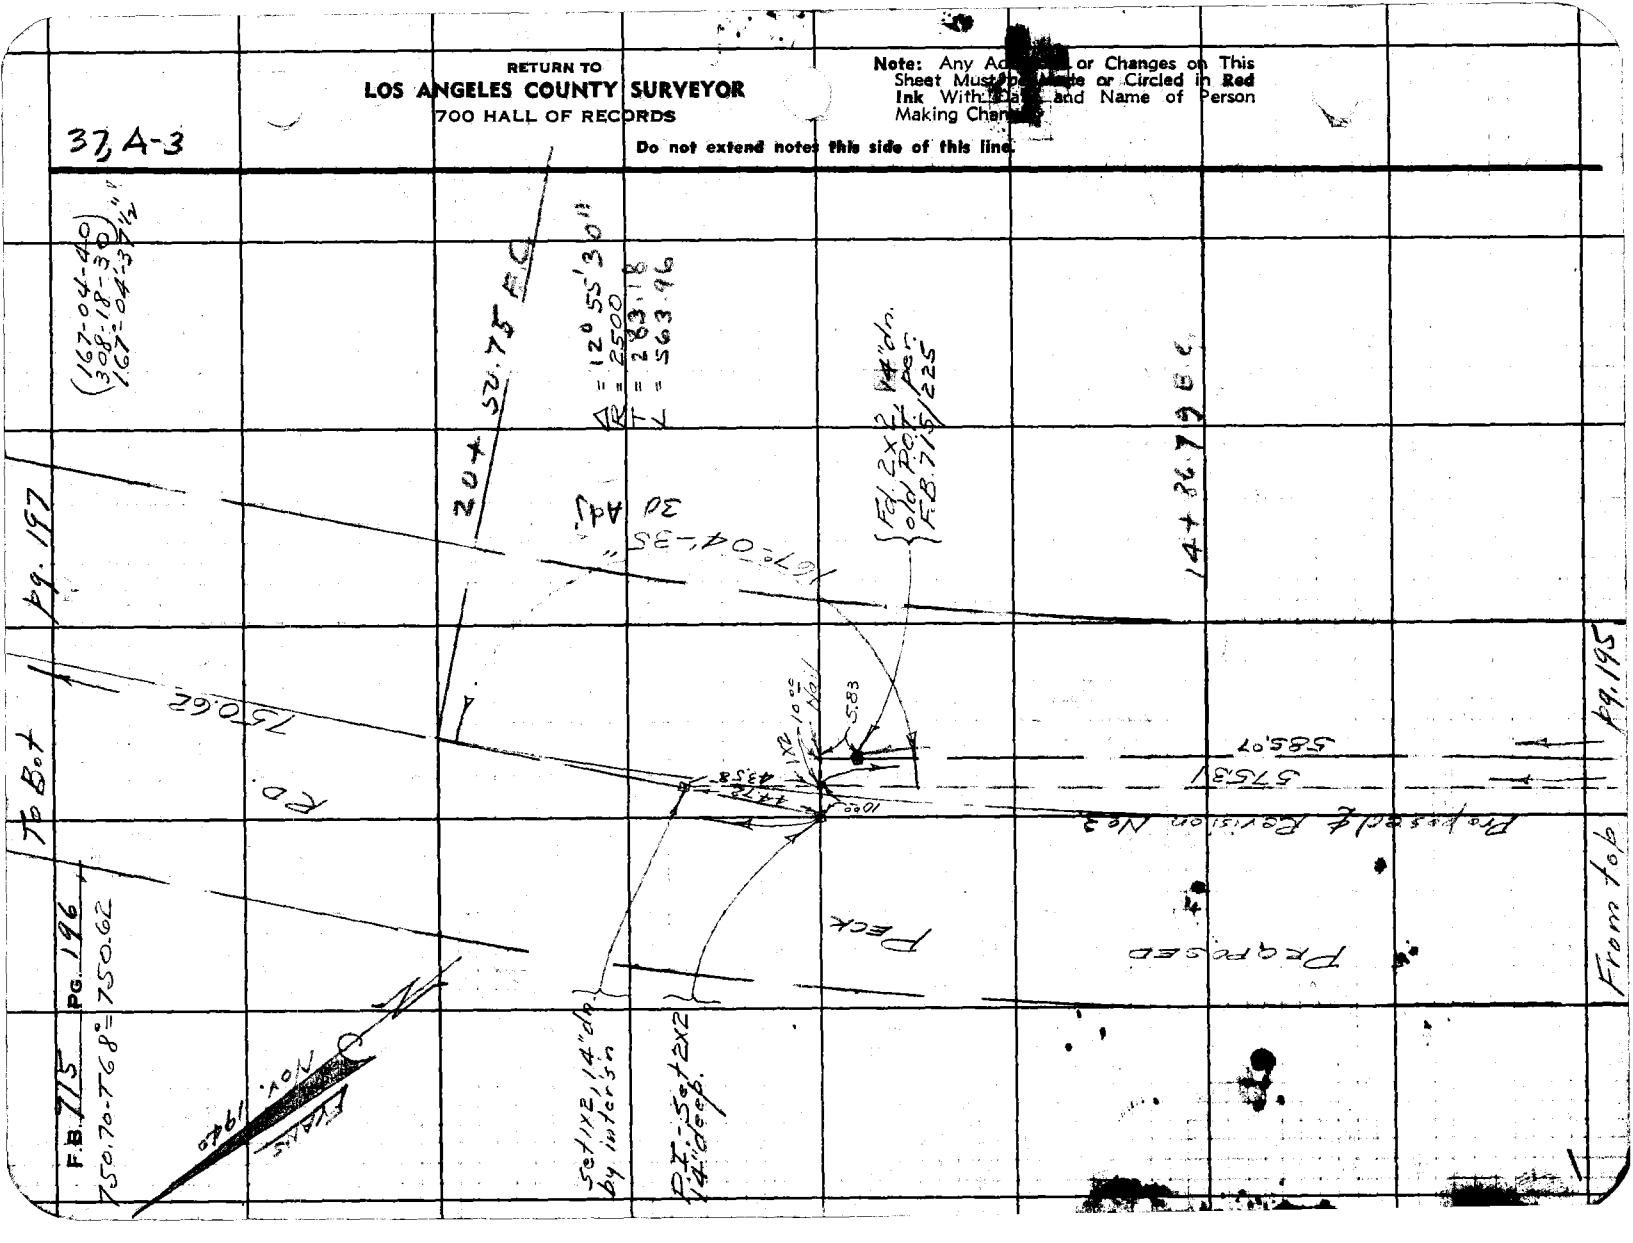

FORM 247 5M 10-39

RETURN TO
LOS ANGELES COUNTY SURVEYOR
700 HALL OF RECORDS

Note: Any Additions or Changes on This Sheet Must be Made or Circled in **Red Ink** With Date and Name of Person Making Change.

Do not extend notes this side of this line.

37 A-2

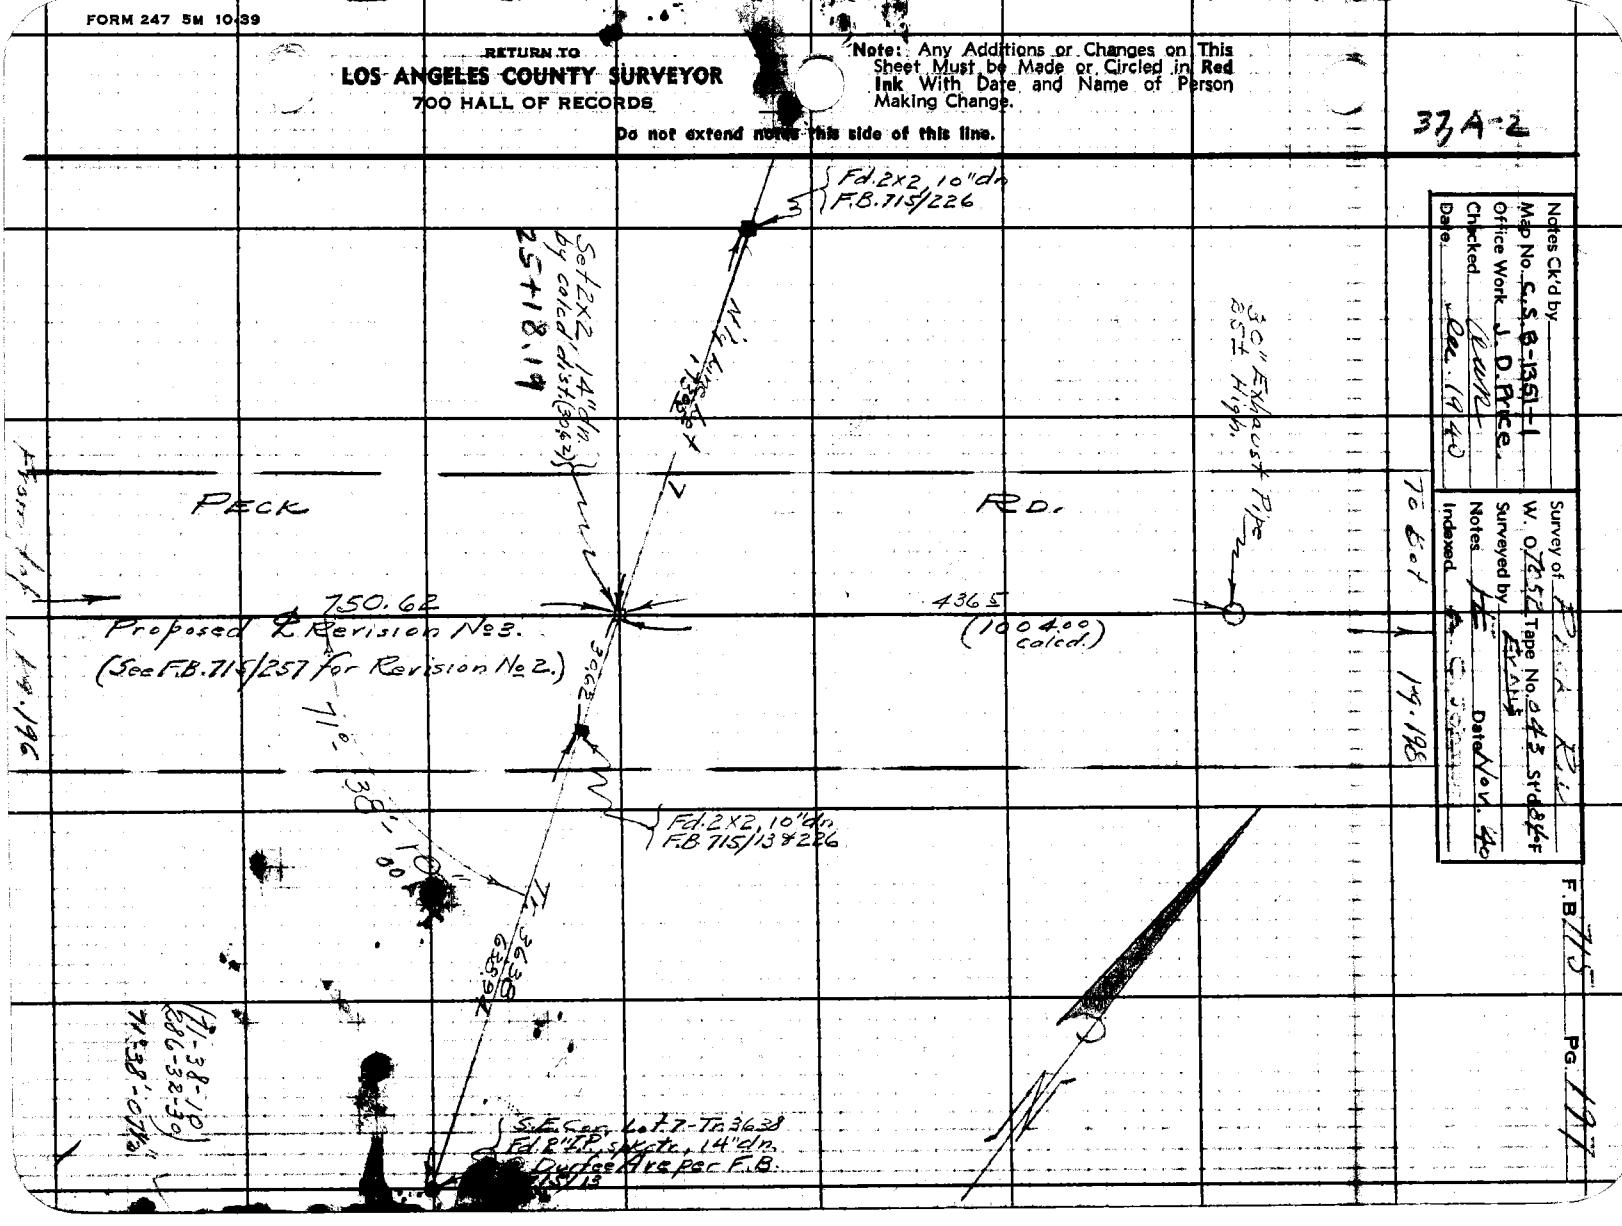

Notes Ck'd by _____
Map No. C.S. B-135-1
Office Work J. D. Price.
Checked Lewis
Date Dec. 1940



RETURN TO
LOS ANGELES COUNTY SURVEYOR
700 HALL OF RECORDS

Note: Any Additions or Changes on This Sheet Must be Made or Corrected in Red Ink With Date and Name of Person Making Change.

Do not extend notes this side of this line.

37, A-2

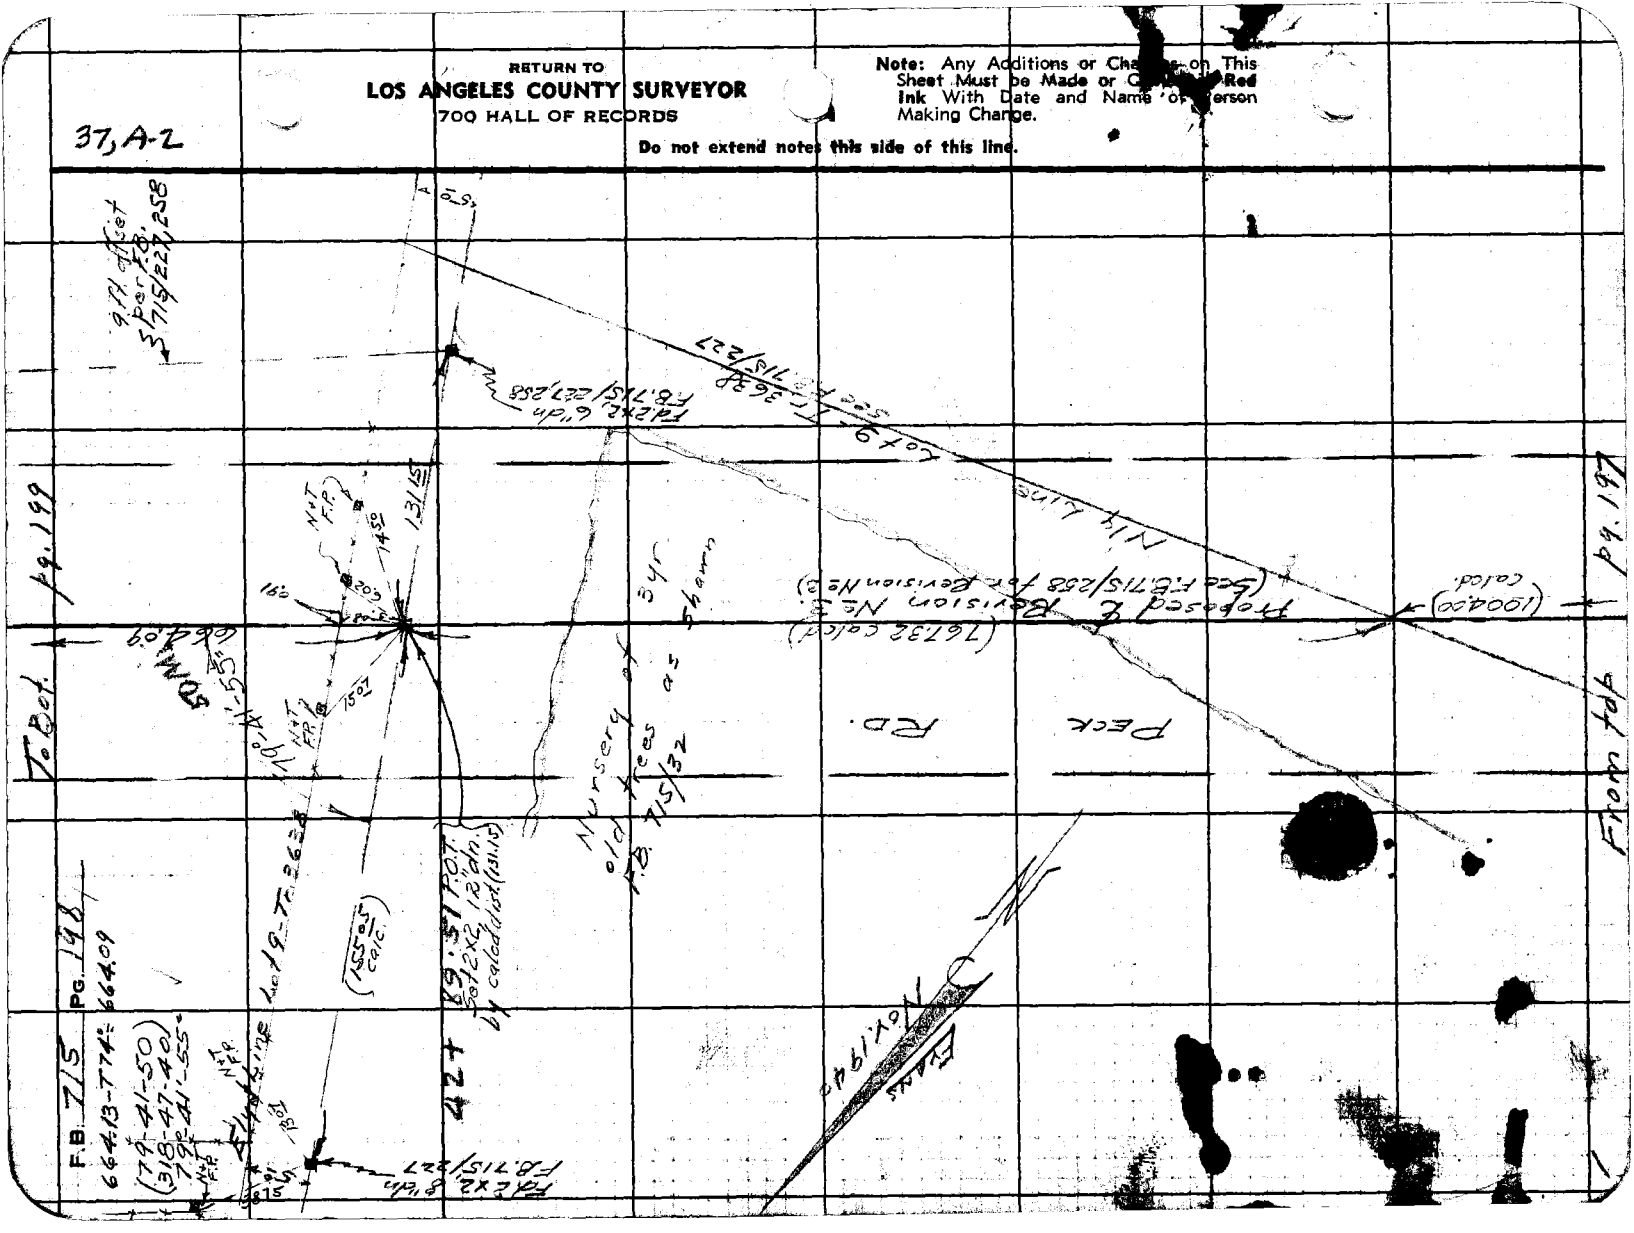

Notes Ck'd by
Map No. C.S. B-139-1
Office Work J. D. Price
Checked CAR
Date 10a 14 40

Survey of PECK RD
W. O. 7052 Tape No. 642 St'd 54 OF
Surveyed by EVANS
Notes HE Date 11/40
Indexed A. C. Johnson

F.B. 715 PG. 197

3J 41-2

769.77 - T 76 = 769.73

From fok pg. 200

(136-37-20)
186-29-20
136°-37'-20"

RD.

Meas. 722.23

R 45 Sta. on F.B. 715/228, 258

POT 49+53.60
Set 2x2, 12"dn by intsn.

769.73 N01

Fd. 2" IP PVT 6"dn F.B. 715/16, 228

Fd. 2x2, 14"dn. F.B. 715/228

Boot spk & T G.P.

136°-37'-20" (Adj.)

Rest spk + T P.P. # 29+28.3 E

Rev. (See F.B. 715/258 for Revision No. 2)

(770.35 calc.)

N14°Line Lot 3, BLK 1, MR 43-43

Fd. W. spk in conc. post F.B. 715/16

PECK

664.09 E

Proposed

From fok pg. 198

Note: Any Additions or Changes on This Sheets Must be Made or Circled in Red Ink With Date and Name of Person Making Change.

Do not extend notes this side of this line

RETURN TO
LOS ANGELES COUNTY SURVEYOR
700 HALL OF RECORDS

FORM 247 SM 10-37

F.B. 715 Pg. 200

(174-35-30)
338-22-10
174° 35' 32½" ✓
EQUATION
13+91.72 going NE
= 61+95.0 P from S.W.
E.C.

cont'd from pg. 229

T & E Fifth Fdn. Surv.

Platted.
C.S.B-1351-1
J.D. Price

37 B-2

1233.75 calc.

Δ = 5° 24' 35"
R = 10,000
T = 472.44
L = 944.18

174°-35'-30" Adj.

P.I. - Set 2x2, 14" deep.

Rd.

Revised 1.463
(See P.B. 715/258 for Revision No. 2)

52+50.89 B.C.

722.23

Q/A & of Sherm. F.B. 715/228 & 258

Rock

Prop. set 1.673 ℄

Fence

Fence Post

From Top pg. 199

RETURN TO
LOS ANGELES COUNTY SURVEYOR
700 HALL OF RECORDS

Note: Any Additions or Changes on This Sheets Must be Made or Circled in Red Ink With Date and Name of Person Making Change.

Do not extend notes this side of this line

Notes Ck'd by A.A.R.	Survey of Mt. View Ave.	F.B. 715 Pg. 20
Map No. C.S. B-1413	W. O. 7139 Tape No. 043 St'd 84 F.	
Office Work J. D. Price.	Surveyed by Evans	
Checked [illegible]	Notes H.A. Date 7-28-37	
Date June 40	Indexed [illegible] 8-2-37	

SURVEY OF MT. VIEW RD. FROM WEAVER AVE. TO POMONA BLVD.

(For Index Sketch See Pg. 10.)

Hugh F. Evans - Dep.
Herbert M. Smith - ↑
Delbert S. Seely - H.C.
Nathan R. Smith - R.C.
A. H. Fenner - ↑
B. Chittle - R.C.

Note: Any Additions or Changes on This Sheet Must be Made or Circled in Red Ink With Date and Name of Person Making Change.

Do not extend notes this side of this line

RETURN TO
LOS ANGELES COUNTY SURVEYOR
700 HALL OF RECORDS

FORM 247 10M 11-35

To Lt. Side pg. 203

F.B. 715 Pg. 202

NE 3-11-38

~~114-39~~ (114-39-15)
~~98-36-15~~ (98-37-15)

~~114° 37' 03¾"~~ 114° - 38' - 18¾"

633.67 - T 92° 633.70

37, C-1

RETURN TO SURVEYOR
LOS ANGELES COUNTY
700 HALL OF RECORDS

Note: Any Additions or Changes on This Sheet Must be Made or Circled in Red Ink With Date and Name of Person Making Change.

Do not extend notes this side of this line

MT. VIEW RD.

633.70'

7-26-37 NE

See P. 10
For Inter Section

1.15
1.08

114° 39'

WEAVER AVE.

NE 3-11-38

41
~~42~~ 44

422.25 per R/S

To E. TYLER

2740

To page 336

90 - 75 - 42

Fd. 2 x 2 flush
See FB. 306-65
For ties see
pg. 25
~~Set~~ Q to Xer
¼" I.P. 12" under

Fd. 2" I.P. plug & spk.
6" dia. on E prod.
F.B. 306-82 & R.D.
Z 158-125.
See F.B. 715-25

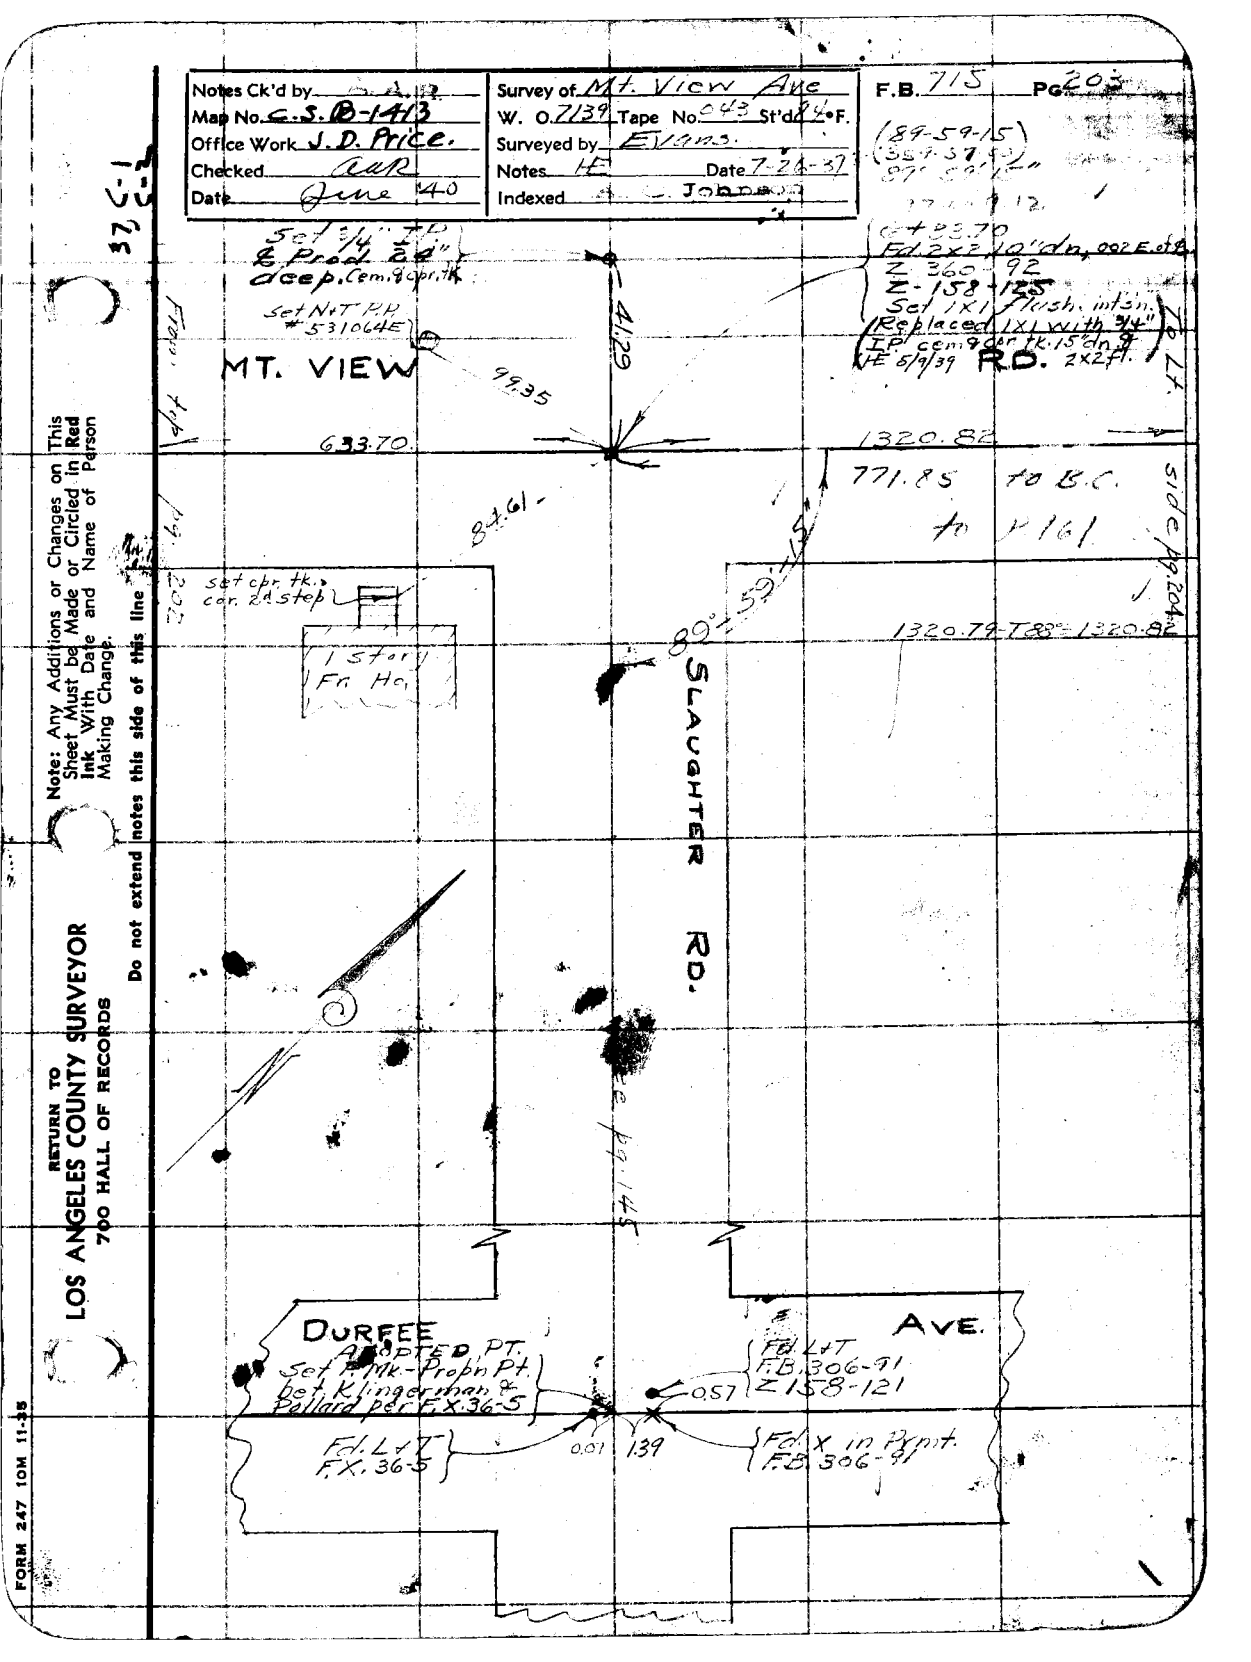
Notes Ck'd by
Map No. C.S. B-1413
Office Work J.D. Price.
Checked CAR
Date June '40
Survey of Mt. View Ave
W. O. 7139 Tape No. 043 St'd 24 F.
Surveyed by Evans.
Notes HE Date 7-24-37
Indexed Johnson
F.B. 715 Pg. 20
(89-59-15)
(357.37 ft.)
97.00 ft.
Set 3/4" I.P. & prod. 24" accep. Cem. & cor. tk.
Set N&T H.H. #5-31064E
MT. VIEW
99.35
633.70
4126
Fd. 2x2, 10' dn, .002 E of B
Z 360-92
Z-158-125
Set 1X1 flush, into sn.
Replaced 1X1 with 3/4" I.P. cem. & cor. tk. 15' dn. 3/4" HE 6/9/39
RD. 2x2 ft.
1320.82
771.85 to B.C.
to P161
Side Pg. 204
84.61
set cor. tk. & cor. 24 step
1 Story Fr. Ho.
89°-59'-15"
1320.79 T 89°-1320.82
SLAUGHTER RD.
Side Pg. 145
DURFEE AVE.
ADOPTED PT.
Set 1" Mk. - Propn Pt. bet. Klingerman & Pollard per F.X. 36-5
Fd. L & T F.X. 36-5
0.01
139
0.57
Fd. L & T F.B. 306-91 Z 158-121
Fd. X in Pvmt. F.B. 306-91
RETURN TO LOS ANGELES COUNTY SURVEYOR 700 HALL OF RECORDS
Do not extend notes this side of this line
Note: Any Additions or Changes on This Sheet Must be Made or Circled In Red Ink With Date and Name of Person Making Change.
37 C-1
C-2
FORM 247 10M 11-35

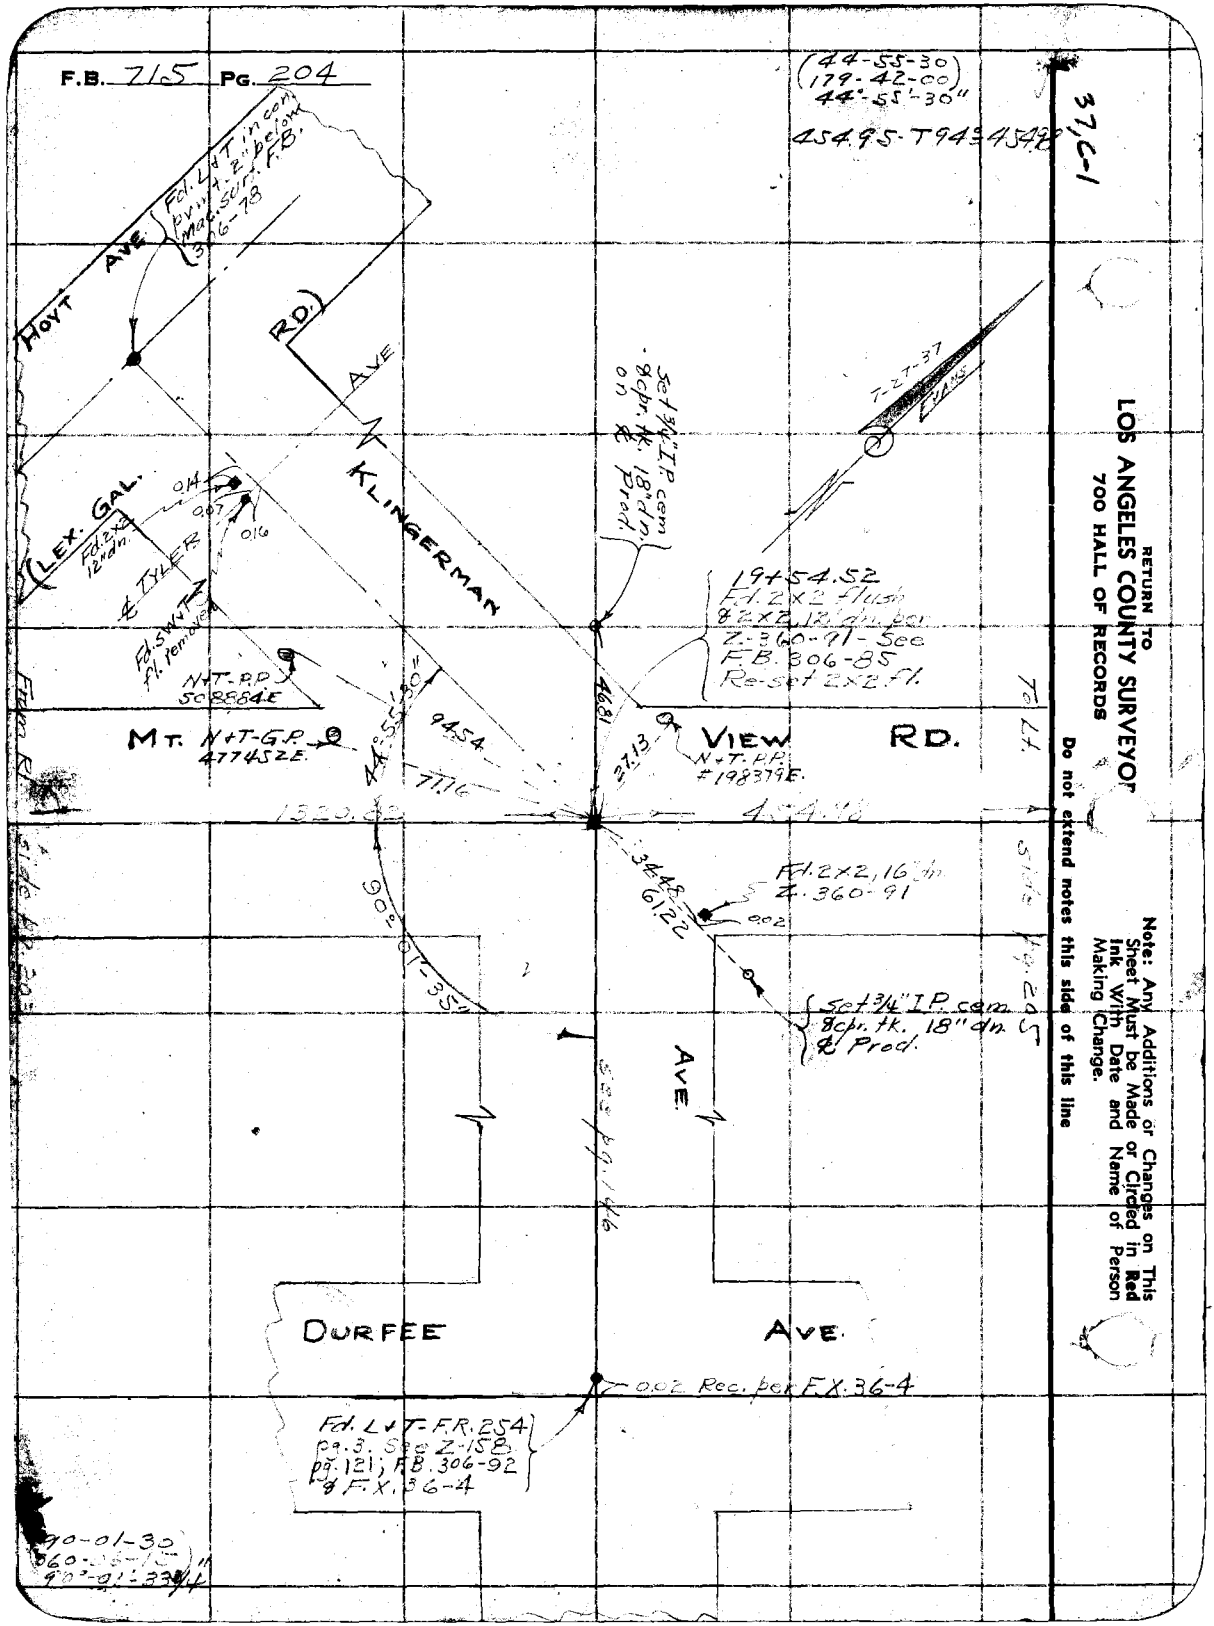
F.B. 715 Pg. 204
(44-55-30)
179-42-00
44°-55'-30"
454.95-T943-454.95
37,C-1
HOYT AVE
Fd. L & T. in conc. pvmt. 2" below mag. Surv. F.B. 316-78
RD.)
AVE
KLINGERMAN
Set 3/4" I.P. cem. 8 cpr. tk. 18" on & Prod.
7-2-T-37
LEX. GAL.
OH
0.07
0.16
& TYLER
Fd. 3x3 12" in.
Fd. SWLT Pl. 1cm below
N+T-R.P. 508884E
N+T-G.P. 477452E.
MT. VIEW
N+T-R.P. #198379E.
RD.
TO L.T.
44°-55'-30"
94.54
77.76
46.81
37.13
1320.00
1954.52
Fd. 1 x 2 Flush
Fd. 2 x 2 18" dn. pen
Z. 360-91 - See
F.B. 306-85
Re-set 2 x 2 Fl.
Fd. 2x2, 16" dn.
Z. 360-91
0.02
34.45
61.22
90°
61-35
Set 3/4" I.P. cem. 8 cpr. tk. 18" dn. & Prod.
AVE.
DURFEE
AVE.
0.02 Rec. per F.X. 36-4
Fd. L & T - F.R. 254 pg. 3. See Z-152 pg. 121; F.B. 306-92 & F.X. 36-4
70-01-30
360-15-12
90°-01'-33"
RETURN TO
LOS ANGELES COUNTY SURVEYOR
700 HALL OF RECORDS
Note: Any Additions or Changes on This Sheet Must be Made or Circled in Red Ink With Date and Name of Person Making Change.
Do not extend notes this side of this line

Notes Ck'd by		Survey of Mt. View Ave.	F.B. 715 Pg. 205
Map No. C.S.B.-143		W. O. 7120 Tape No. 43 St'd 84 °F.	
Office Work J.D. Price.		Surveyed by Evans	
Checked		Notes H. Date 7-27-31	
Date June '40		Indexed	

37C-1

RETURN TO
LOS ANGELES COUNTY SURVEYOR
700 HALL OF RECORDS

Note: Any Additions or Changes on This Sheet Must be Made or Circled in Red Ink With Date and Name of Person Making Change.

Do not extend notes this side of this line

865.61 ? 14' 865.73'

Fd 2" I.P. conc. plug tack & Tag, 20" dn. per Tr. 11247.

SCHMIDT RD.

FRM. RY.

NAT-P.P. #477451E.

89° 59-52"

90.94

454.98

NHT-P.P. 217311E.

88.53

E65.73

MT. VIEW

RD.

41.64

S 1/2 Rg. 204

S 1/2 Rg. 206

Fd 2" I.P. conc. plug tack & Tag, 0.01 W. of ℄ Grade, per Tr. 11247

22409.50

90.21

Set 3/4" I.P. conc. 8 gch. HK. ctr. 18" in. E. Pad.

Set L.N.T. conc. walk.

(90-00
359-59-30
89-59-52½"

FORM 247 10M 11-38

RETURN TO
LOS ANGELES COUNTY SURVEYOR
700 HALL OF RECORDS

Note: Any Additions or Changes on This Sheet Must be Made or Circled in Red Ink With Date and Name of Person Making Change.

Do not extend notes this side of this line

37, C-1

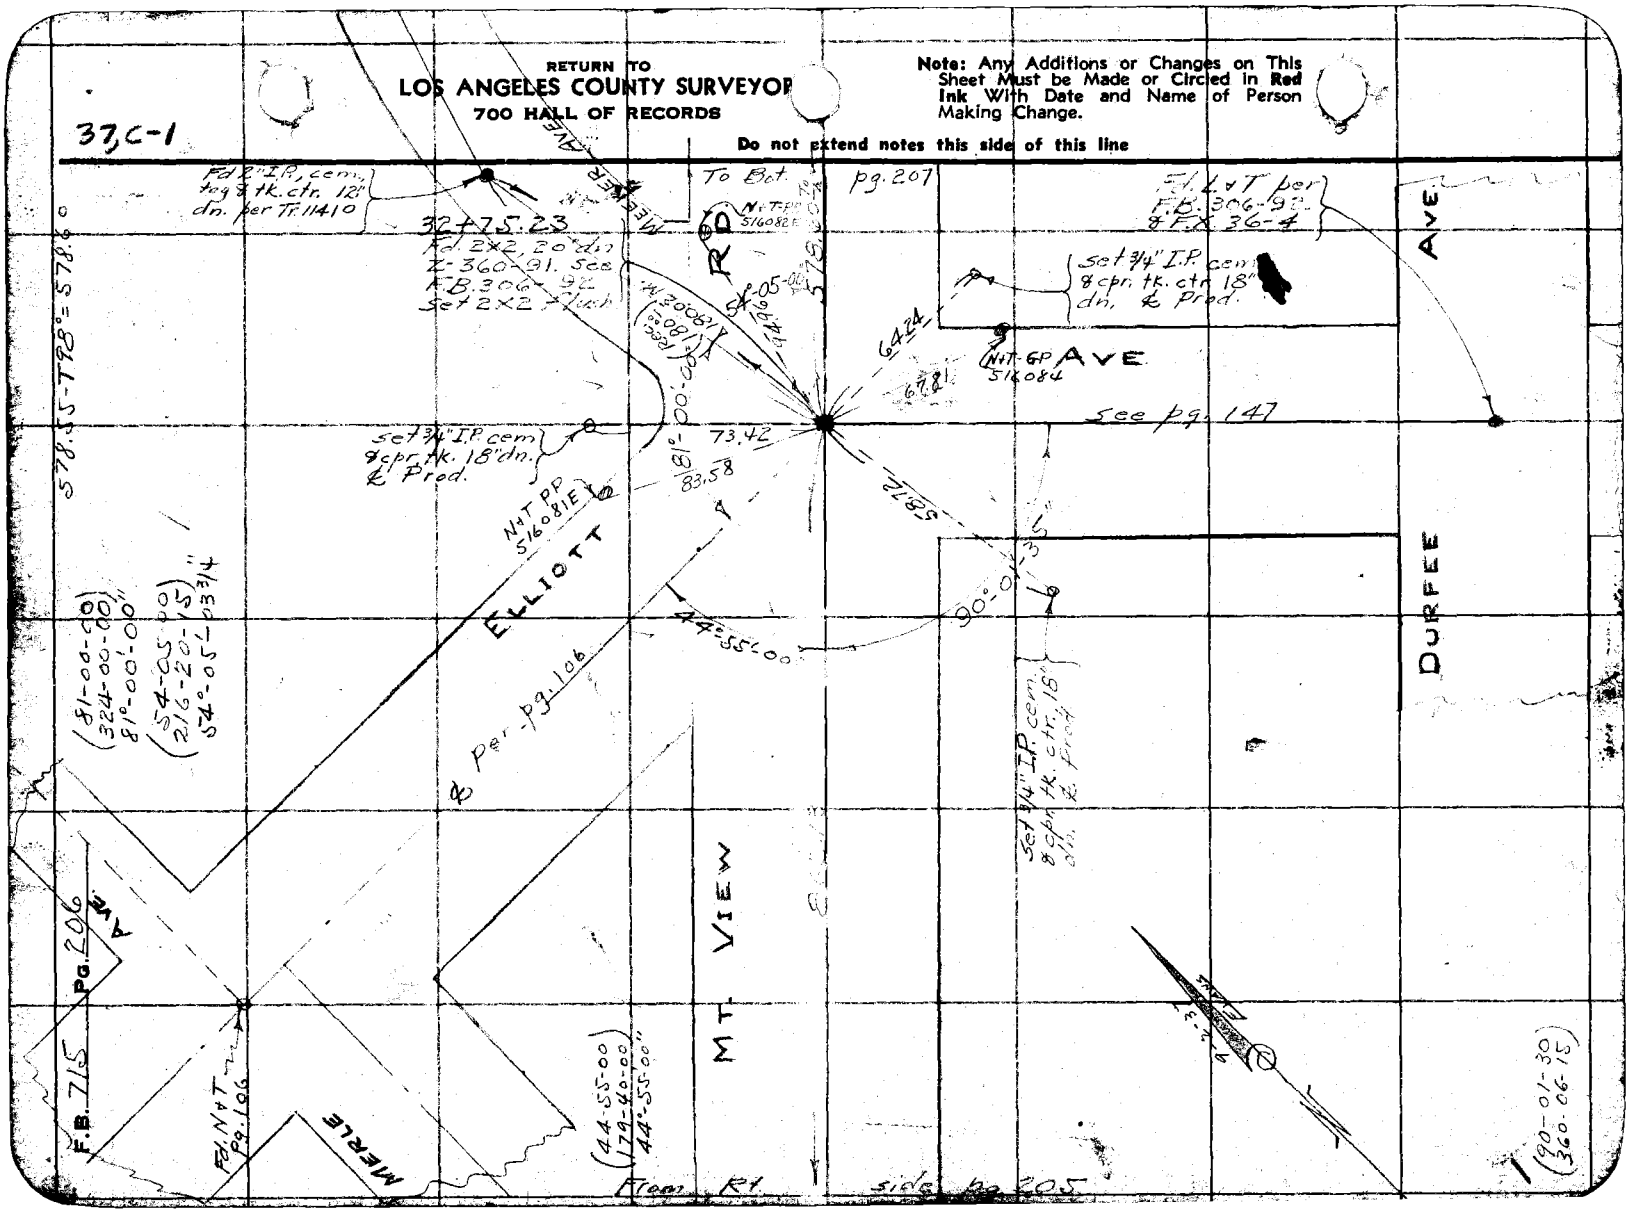

To Lt. side pg. 206

Notes Ck'd by A.A.R.	Survey of Mt. View Rd.
Map No. C.S. B-1413	W. O. 7137 Tape No. 243 St'd 84° F.
Office Work J.D. Price	Surveyed by Evans
Checked RAR	Notes [illegible] Date 9-2-37
Date June 40	Indexed

F.B. 715 Pg. 201

4,4-5

Note: Any Additions or Changes on This Sheet Must be Made or Circled in Red Ink With Date and Name of Person Making Change.

Do not extend notes this side of this line

RETURN TO
LOS ANGELES COUNTY SURVEYOR
700 HALL OF RECORDS

Set 3/4" IP cem. & pr. tk. 18" dn.

747.86

Fd. 1½" IP No. Tk - Per Tr. 3262 & F.B. 7-77 C.S. B-1048

8.4-20"

40.98

90°

0.31

39.86

Fd. N & T 12" Wal.

38+53.83
Fd. 2x2, 10" dn. per Z-360-94
Set S.W. & T. flush above stake
Replaced with 3/4" IP cem. & pr. tk. ctr. 18" dn. & 2x2 fl. 12-2-37.

Removed S.W. & T. 12-2-37

40.49

S 0°-08'-10" E

40.08

Re. Line Per pg. 131

18.1

N 89°-51'-50" E

90°-42'-50"

N & T P.P. 2173041

Set 3/4" IP cem. & pr. tk. 18" dn.

N & T 12" Wal

MT. VIEW RD.

5786.0

8-34-15
3-54-17-20
148°-54'-22½"

From Rt. side pg. 206

FORM 247 10M 11-35

M.B. 209

F.B. 715 PG. 208

Note

There being no data on Magnolia St. (West of Mt. View) in work pouch, no attempt has been made to establish ℄. Points found were tied to transit line as shown in order to adopt ℄ after description is available.
HE

MAGNOLIA

Transit line

St.

5+73.13 Fd. 2×2 & Tk.

4+76.55 Fd. 2×2

3+51.32 Fd. 2×2 & Tk.

2+73.52 Fd. 2×2 (No Tk) in 4" Tr.

Set 3/8" I.P. Cem. & Cor. Tk. 18 on E. Prod.

(178-46-45)
355-07-15
178°-46'-48¾"

(132-44-00)
170-56-15
132°-44'-03¾"

46+25.75 North to Other Monuments by Intersection

Set 3/8" I.P. Cem. & Tk. 2×2

1+84.76

N&T PP. At Tree

178 46 50

Holly Fd. 2×2 & Tk.

N&T-PP 9/72 OH

N&T T.P.

72.47

747.86

636.83

MT. VIEW RD.

88°-29'-50"

636.89-TTo=636.83

Set Spike & Tag in Top of Curb

Fd. 3/4" I.P. Cem. & Tk. 12-3.37

Replaced with 3/4" I.P. Cem. & Punch. 18 on ℄ 12-3.37

N&T-PP 1624

N&T-PP 1624 E

MAGNOLIA AVE.

Fd. L&T per F.B. 463-277

DURFEE AVE.

(88-29-45)
353-59-15
88°-29'-48¾"

RETURN TO
LOS ANGELES COUNTY SURVEYOR
700 HALL OF RECORDS

Note: Any Additions or Changes on This Sheet Must be Made or Circled in Red Ink With Date and Name of Person Making Change.

Do not extend notes this side of this line

4-5

Notes Ck'd by	Survey of Mt. View Ave.
Map No. C.S.B-1413	W. 0.7139 Tape No. 042 St'd 84°F.
Office Work J.D. Price	Surveyed by Evans
Checked CAR	Notes HA Date 9-3-31
Date June 20	Indexed

F.B. 715 Pg. 209

(90-12-30
360-50-15
90-12-32¾"

MERLE AVE.

To T.P. pg. 74

Transit Line 198.86 per pg. 74

21+28.09 Set N+T. by intersn.

20+97.68 Fd. 2×2 — 30.29 — 24.80 — 20+97.96 Fd. 1×2

19+18.38 Fd. 2×2 & tk. — 30.00 — 17+59.86 Fd. 2×2

30.01 — 30.10

17+75.34 Fd. 2×2

MAGNOLIA

DEE ST.

90°-12'-35"

17+01.20 Fd. 2×2 — 29.79 — 30.05 — 16+99.79 Fd. 2×2 & tk.

16+21.17 Fd. 2×2 — 29.58 — 30.28 — 15+41.47 Fd. 2×2 & tk.

13+39.43 Fd. 2×2 — 30.04 — 30.10 — 13+39.51 Fd. 2×2

MUSGROVE AVE.

Transit Line

30.09

12+79.28 Fd. 2×2

ST.

10+86.98 Fd. 2×2 — 30.44 — 29.07 — 10+86.95 Fd. 2×2 & Tk.

9+04.74 Fd. 2×2 — 30.28 — 28.17 — 9+04.94 Fd. 1×2 8" dia.

MEEKER AVE.

32.11 — 28.69

8+45.08 Fd. 2×2 — 8+45.18 Fd. 1×2 8" dia.

From 4 to 4 pg. 208

46 A-5

Note: Any Additions or Changes on This Sheet Must be Made or Circled in Red Ink With Date and Name of Person Making Change.

Do not extend notes this side of this line

RETURN TO
LOS ANGELES COUNTY SURVEYOR
700 HALL OF RECORDS

FORM 247 10M 11-38

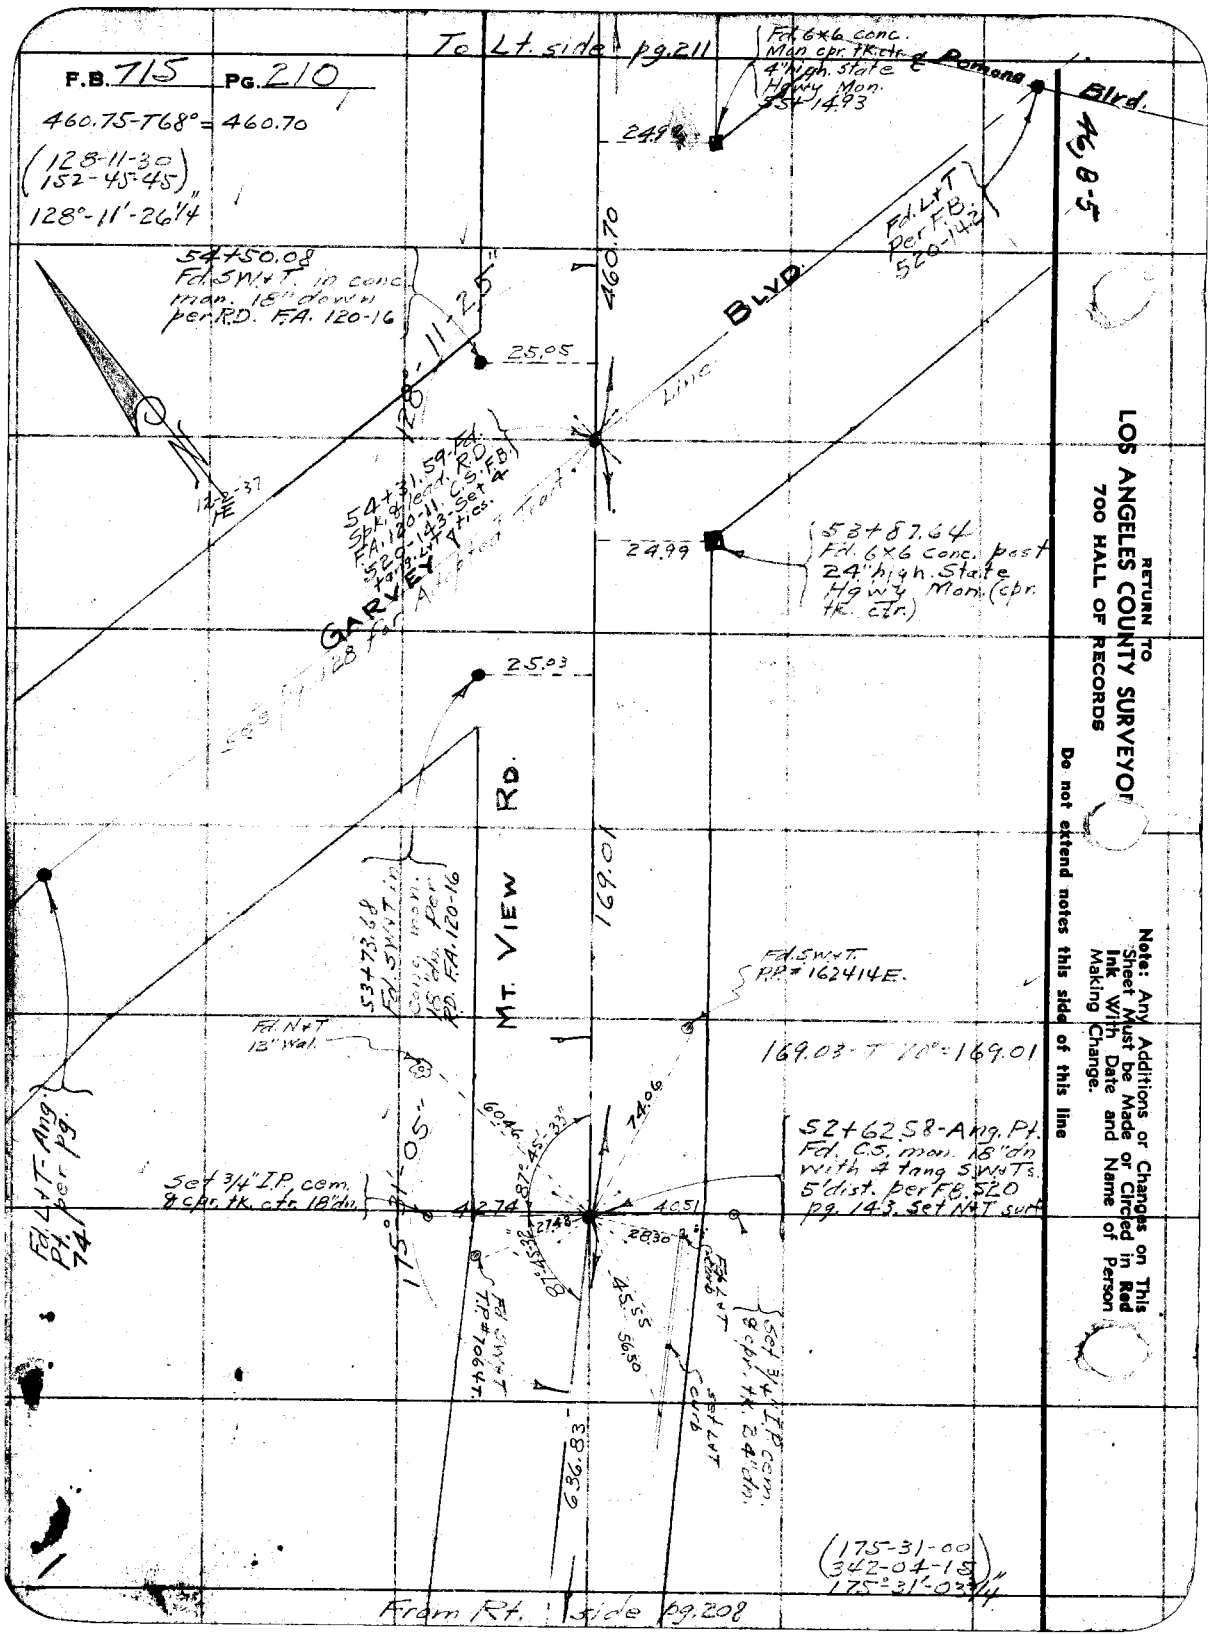
To Lt. side pg. 211
F.B. 715 PG. 210
460.75-T68°=460.70
(128-11-30)
(52-45-45)
128°-11'-26"
Fd 6x6 conc. Mon cpr. tk. ctr. & 4" high State Highway Mon. 554+93
Pomona Blvd.
46, 8-5
24.99
460.70
Fd. L+T per F.B. 520-142
54+50.08 Fd. SW+T. in conc. mon. 18" down per R.D. F.A. 120-16
25.05
BLVD
54+31.59 Fd. Spk. & tack R.D. F.A. 120-11 F.B. 520-143 Set 4 tacks
GARVEY
53+87.64 Fd. 6x6 conc. post 24" high State Hwy Mon. (cpr. tk. ctr.)
24.99
25.03
MT. VIEW RD.
169.01
53+73.68 Fd. SW+T. in conc. mon. per R.D. F.A. 120-16
Fd. SW+T. PP# 162414E.
Fd. N+T 12" Wal.
169.03-T 1°=169.01
52+62.58-Ang. Pt. Fd. C.S. mon. 18" dn with 4 tang SW+Ts. 5' dist. per F.B. 520 pg. 143. Set N+T sub
60.46
87°-45'-33"
74.06
Set 3/4" I.P. cem. & cpr. tk. ctr. 18" dn.
42.74
40.51
27.48
28.30
Fd. N+T
Fd. L+T
Fd. SW+T PP# 170447
45.55
56.80
Set L+T
Set 3/4" I.P. cem. & cpr. tk. 24" dn.
636.83
(175-31-00)
(342-04-15)
175°-31'-03"
From Rt. side pg. 208
RETURN TO LOS ANGELES COUNTY SURVEYOR 700 HALL OF RECORDS
Note: Any Additions or Changes on This Sheet Must be Made or Circled in Red Ink With Date and Name of Person Making Change.
Do not extend notes this side of this line

Notes Ck'd by	Survey of MT. VIEW AV.
Map No. E.S.B-143	W. O. 7129 Tape No. 68 St'd 8 ft. F.
Office Work J. D. Price	Surveyed by EVANS
Checked A.W.R.	Notes H Date 12-2-37
Date June '40	Indexed

F.B. 715 Pg. 21

45 B-5

(90-00-15)
(360-00-45)
90°-00'-11¼"

ANGLE POINT
Fd. L&T with
4 tang. L&T ties
per p.g. 78 & F.B.
520-139

(90-42-15)
(362-49-00)
90°-42'-15"

POMONA

Fd. 2" I.P. conc.
in R. of Way, 18" ch.
per T.T. 10516
Set 2X2 Hub

LANSDALE

58.492.29
Fd. L&T with 4
tang. L&T ties per
F.B. 520-141
End of Survey

90°-00'-15"

MT. VIEW

AVE

180°-00'

460.70

(179-17-30)
(357-10-00)
179°-17'-30"

179°-17'-30"

BLVD.

NAT. FB

IDENTICAL

ST.

5.78'

38.95

36.58

42.46

FENCE

Set ¾" I.P. conc.
& Cap, Pt. 18" ch.
& Prod.
Fence S 47°55' E

Fd. L&T
p.g. 210
F.B. 520-142

GARVEY

BLVD.

Note: Any Additions or Changes on This Sheet Must be Made or Circled in Red Ink With Date and Name of Person Making Change.

Do not extend notes this side of this line

RETURN TO
LOS ANGELES COUNTY SURVEYOR
700 HALL OF RECORDS

FORM 247 10M 11-35

RETURN TO
LOS ANGELES COUNTY SURVEYOR
700 HALL OF RECORDS

Note: Any Additions or Changes on This Sheet Must be Made or Circled in **Red Ink** With Date and Name of Person Making Change.

Do not extend notes this side of this line

F.B. 715 Pg. 212

Notes Ck'd by A.A.R.	Survey of Mt. View Ave.
Map No. C.S.B 1913	W. O. 7139 Tape No. 067 St'd 84 °F.
Office Work J. D. Price	Surveyed by Evans
Checked Clark	Notes Farmer Date 12-3-31
Date June 40	Indexed

F.B. 715 Pg. 213

Note: Any Additions or Changes on This Sheet Must be Made or Circled in Red Ink With Date and Name of Person Making Change.

Do not extend notes this side of this line

RETURN TO
LOS ANGELES COUNTY SURVEYOR
700 HALL OF RECORDS

FORM 247 10M 11-35

4°
23.4 G.P. 132+78.1
132+57.4 P.I.
4.8
28.6
37.5
133+42.8
132+30 B.C.
132+26.5
24°
23°
132+14 B.C.
79.7
148.2
18°
131+90.2
Cabin
Garage
Magnolia
142.7
33.6
3" Peach 132+13.9
24.8
2" Peach
103.0
74.2
91.7
49.2
75.5
105.8
28.8
Fruit Tree
Frame House
1-Story
84.1
99.5
85.7
Gas Meters
131+72.2
3 Orange 131+57.0
131+30.4
4" Peach
33.8
1" Peach
14.8
131+18.4
74.6
131+02.7
81.0
61.1
19.2
33.3
P.P. 131+00
4" W.I. 130+90.2
54.7
130+89
12'
130+82.4
4"
86.4
Heavy Weeds
89.1
72.9
35.2
130+59.4
71.9
14.8
130+57.7
3" Persimmon
25.4
130+59.5
P.C.
Cyp. hedge
24' Prem. Print.
WEAVER AVE.
See Peck Rd Survey, Bk 69 for Inputs, this side
TYLER AVE.
128+52.69
3/4" I.P. 18" ctr
per pg

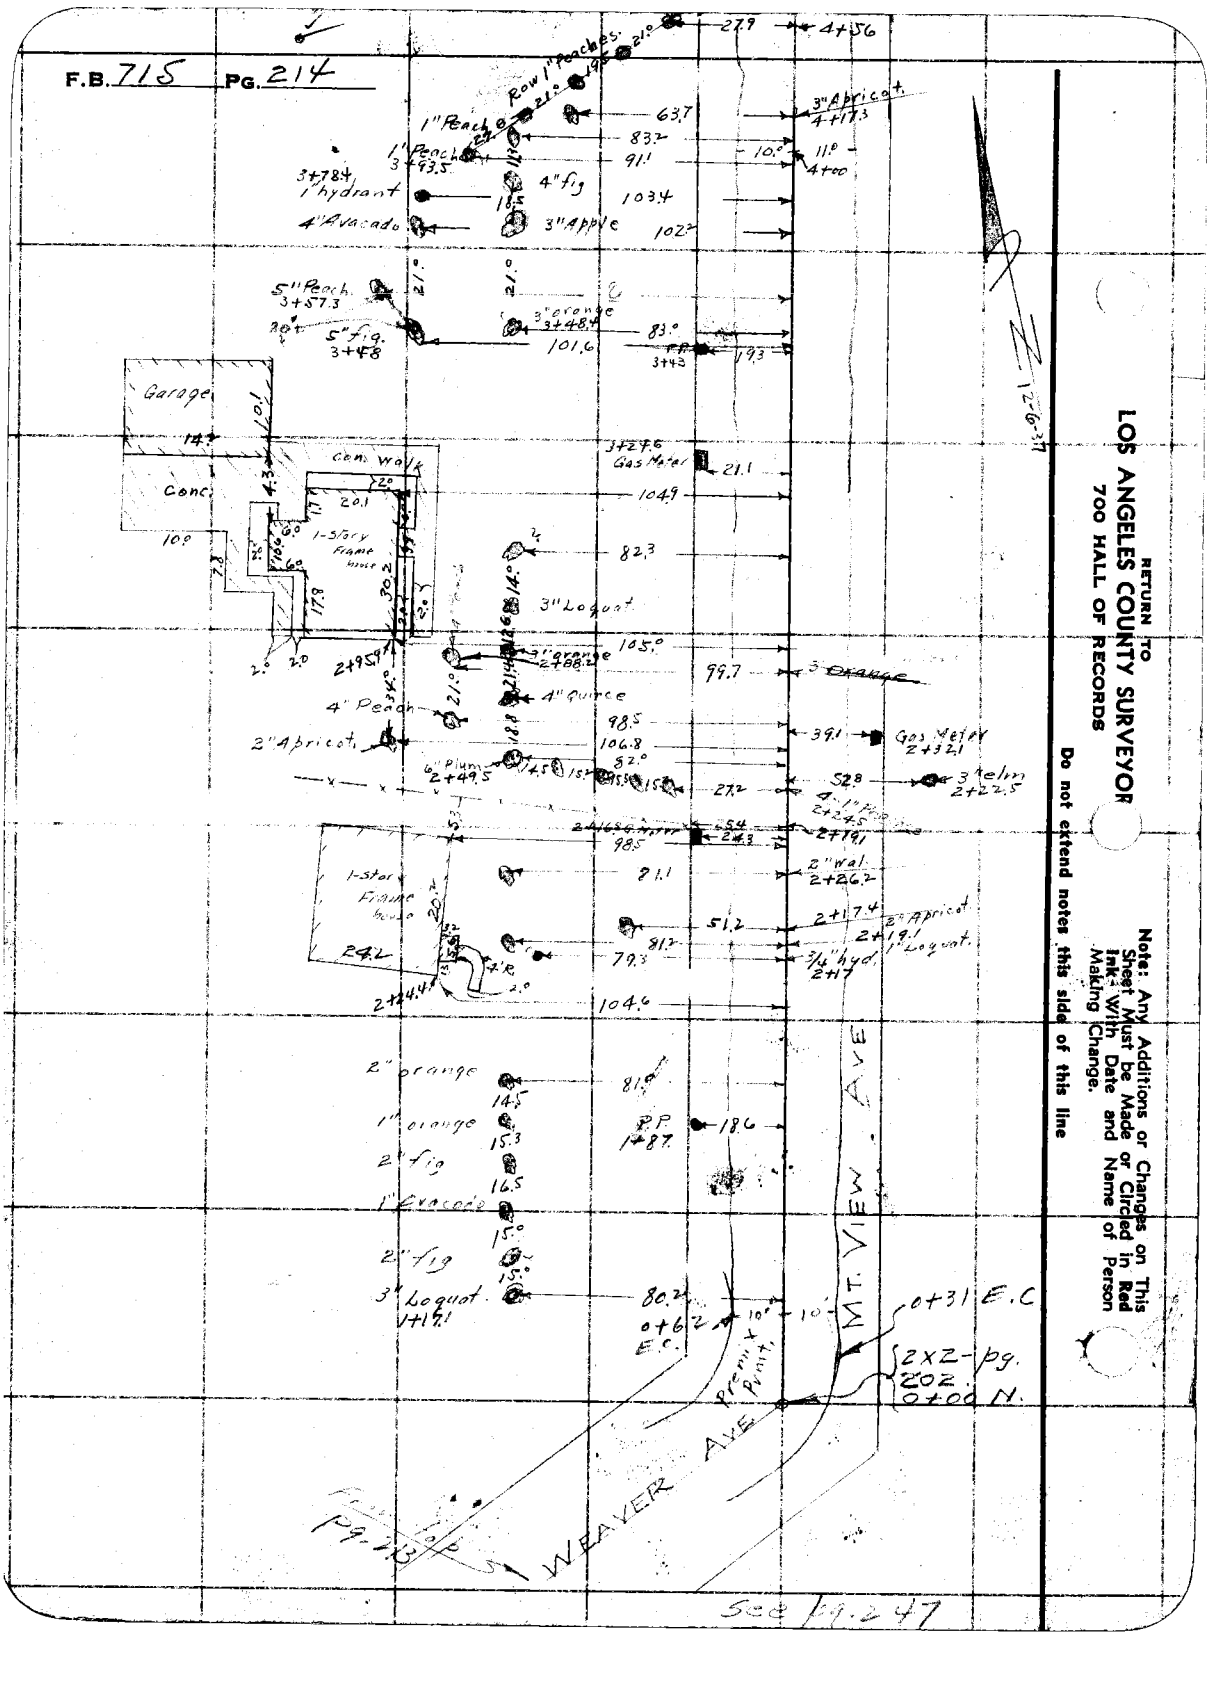
F.B. 715 PG. 214
RETURN TO
LOS ANGELES COUNTY SURVEYOR
700 HALL OF RECORDS
Note: Any Additions or Changes on This Sheet Must be Made or Circled in Red Ink With Date and Name of Person Making Change.
Do not extend notes this side of this line
Garage
Conc.
Conc. Walk
1-Story Frame house
Gas Meter
3" Loquat
4" Peach
2" Apricot
6" Plum
1" Peach
3+784 1" hydrant
4" Avocado
4" fig
3" Apple
5" Peach
5" fig.
3" orange
2" orange
1" orange
2" fig
1" Cracoe
3" Loquat
Gas Meter
3" Apricot
3" Lemon
4" Quince
2" Walnut
1" Loquat
3/4" hyd
MT. VIEW AVE.
WEAVER AVE
Page 213
See Pg. 247
2XZ-pg. 202.
0+00 N.
0+31 E.C.
0+62 E.C.
Point of Beginning

Notes Ck'd by	Survey of Mt. View Ave
Map No. C.S. B-14/3	W. 07139 Tape No. 067 St'd 74 °F.
Office Work J. D. Price	Surveyed by Evans
Checked CAR	Notes Fowler Date 12-6-37
Date June 40	Indexed [illegible]

F.B. 715 Pg. 215

Note: Any Additions or Changes on This Sheet Must be Made or Circled in Red Ink With Date and Name of Person Making Change.

Do not extend notes this side of this line

RETURN TO
LOS ANGELES COUNTY SURVEYOR
700 HALL OF RECORDS

FORM 247 10M 11-38

Cult. Field

Cult. Field

6+67.8 C.

10.5

42.°

6+46 E.C.

SLAUGHTER RD.

19.°

Macadam surf.

42°

6+27 E.C.

10.5

10.5

6+00 B.C.

AVE

5+83.3
30" Palm

36.7

67.°

26.4

Wood Porch

1-Story Frame house

6.0

6.7

7.1

7.0

5.3

20.3

22.1

6.0

5+66.6

66.3

5+57.4

5+56.3
Gas Meter

F.C. 5+41.7

24.6

28.1

36.9

30" Palm, 5+49.1

Wire fnc.

P.P. 5+36.7

21.1

5+34.3
10" Apple

27.5

68.°

18" Magnolia 5+32.7

Cultivated

MOUNTAIN VIEW
(Map of)
(Private)
24' Wide

Cultivated

RETURN TO
LOS ANGELES COUNTY SURVEYOR
700 HALL OF RECORDS

Note: Any Additions or Changes on This Sheet Must be Made or Circled in **Red** Ink With Date and Name of Person Making Change.

Do not extend notes this side of this line

F.B. 715 PG. 2/6

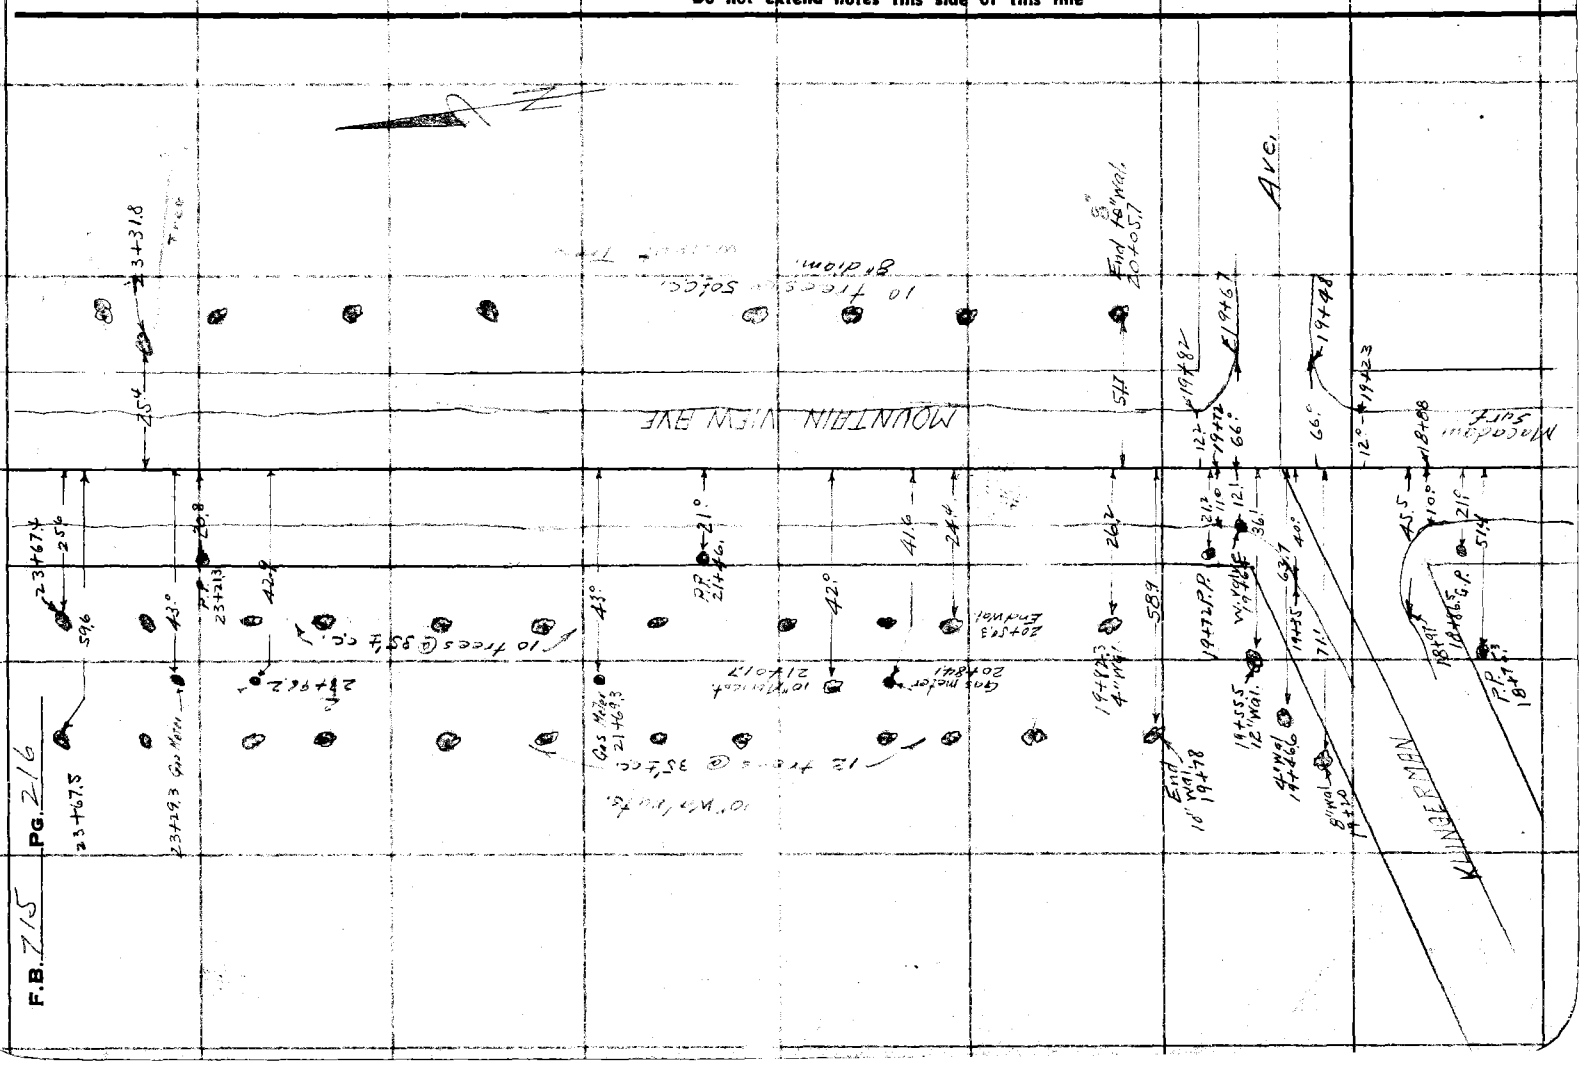

Notes Ck'd by	Survey of Mt. View Ave
Map No. C.S.B-1413	W. 0.7/39 Tape No. 067 St'd 66°F.
Office Work J. D. Price	Surveyed by Evans
Checked Carl	Notes Fenner Date 12-4-37
Date June 40	Indexed


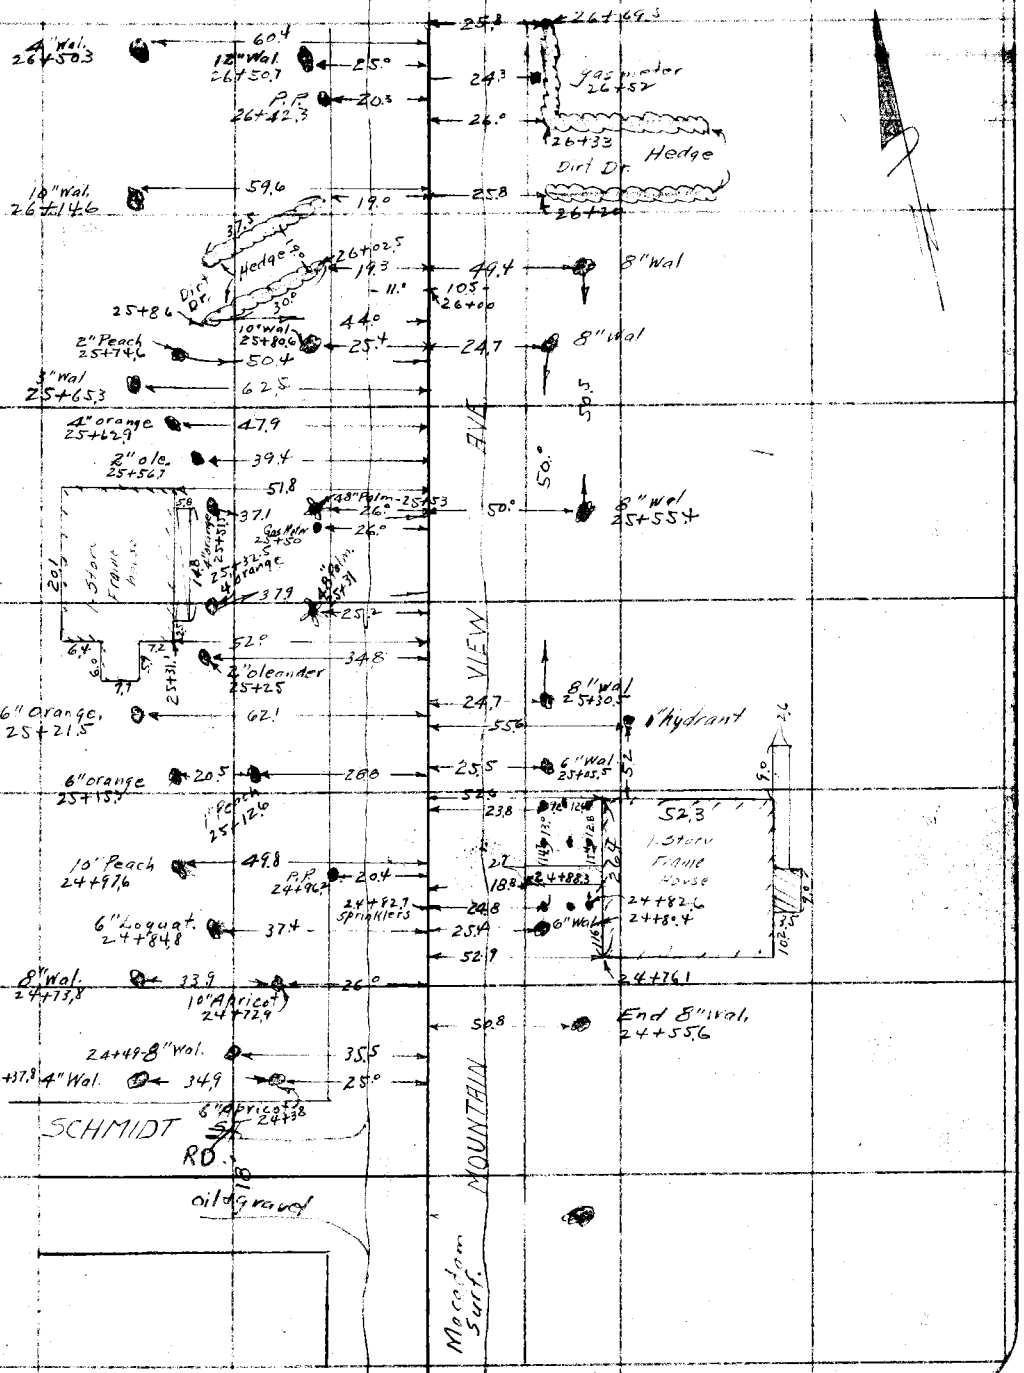

RETURN TO
LOS ANGELES COUNTY SURVEYOR
700 HALL OF RECORDS

Note: Any Additions or Changes on This Sheet Must be Made or Circled in Red Ink With Date and Name of Person Making Change.

Do not extend notes this side of this line

FORM 247 10M 11-38

F.B. 715 PG. 218

RETURN TO
LOS ANGELES COUNTY SURVEYOR
700 HALL OF RECORDS

Note: Any Additions or Changes on This Sheet Must be Made or Circled in Red Ink With Date and Name of Person Making Change.

Do not extend notes this side of this line

ELLIOT

AVE.

MOUNTAIN VIEW AVE.

Macculloch Surf

31+80.3 End Row.

10" Apple 31+63.9

PP 31+67.6

PP 31+22.7

30+90 8" Apple

Gas Meter 29+41.7

PP 29+86

Gas Meter 28+11.2

PP 28+09

Gas Meter 29+12.7

28+92.4 1" Apricot

28+79 3" orange

Gas Meter 28+46.5

27+19.5

26+85 10" Wal

26+85 6" Wal

26+98

2 orange

59.7 32.4 42.8 25.9 20.7 41.4 41.8 20.2 41.4 20.6 24' 27.5 43' 23.9 44.8 44.1 25.5

Notes Ck'd by	Survey of Mountain View Ave
Map No. C.S.B-1413.	W. O. Tape No. St'd °F.
Office Work J.D. Price.	Surveyed by H.F. Ellis
Checked [illegible]	Notes Fence Date 12/6/37
Date June 40	Indexed [illegible] Johnson

F.B. 715 Pg. 219

Note: Any Additions or Changes on This Sheet Must be Made or Circled in Red Ink With Date and Name of Person Making Change.

Do not extend notes this side of this line

RETURN TO
LOS ANGELES COUNTY SURVEYOR
700 HALL OF RECORDS

FORM 247 10M 11-35

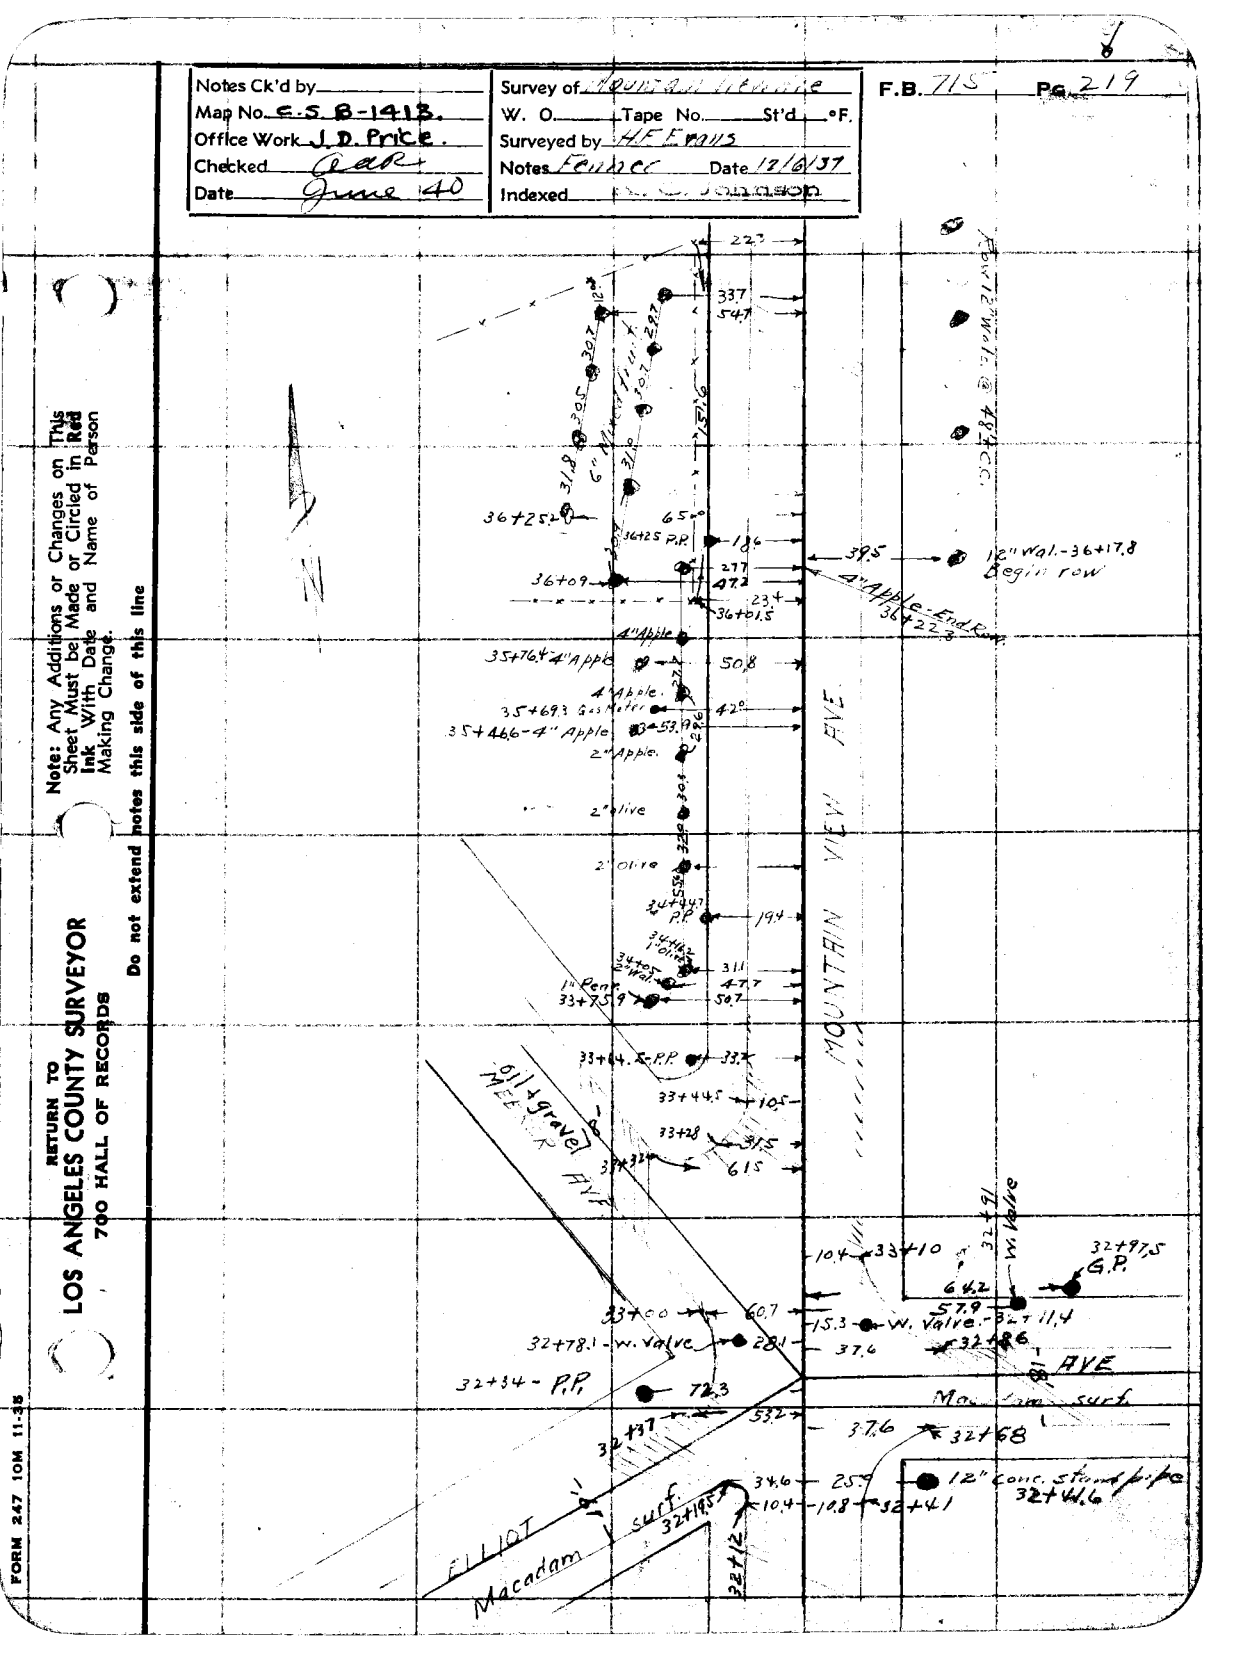

F.B. 715 Pg. 220

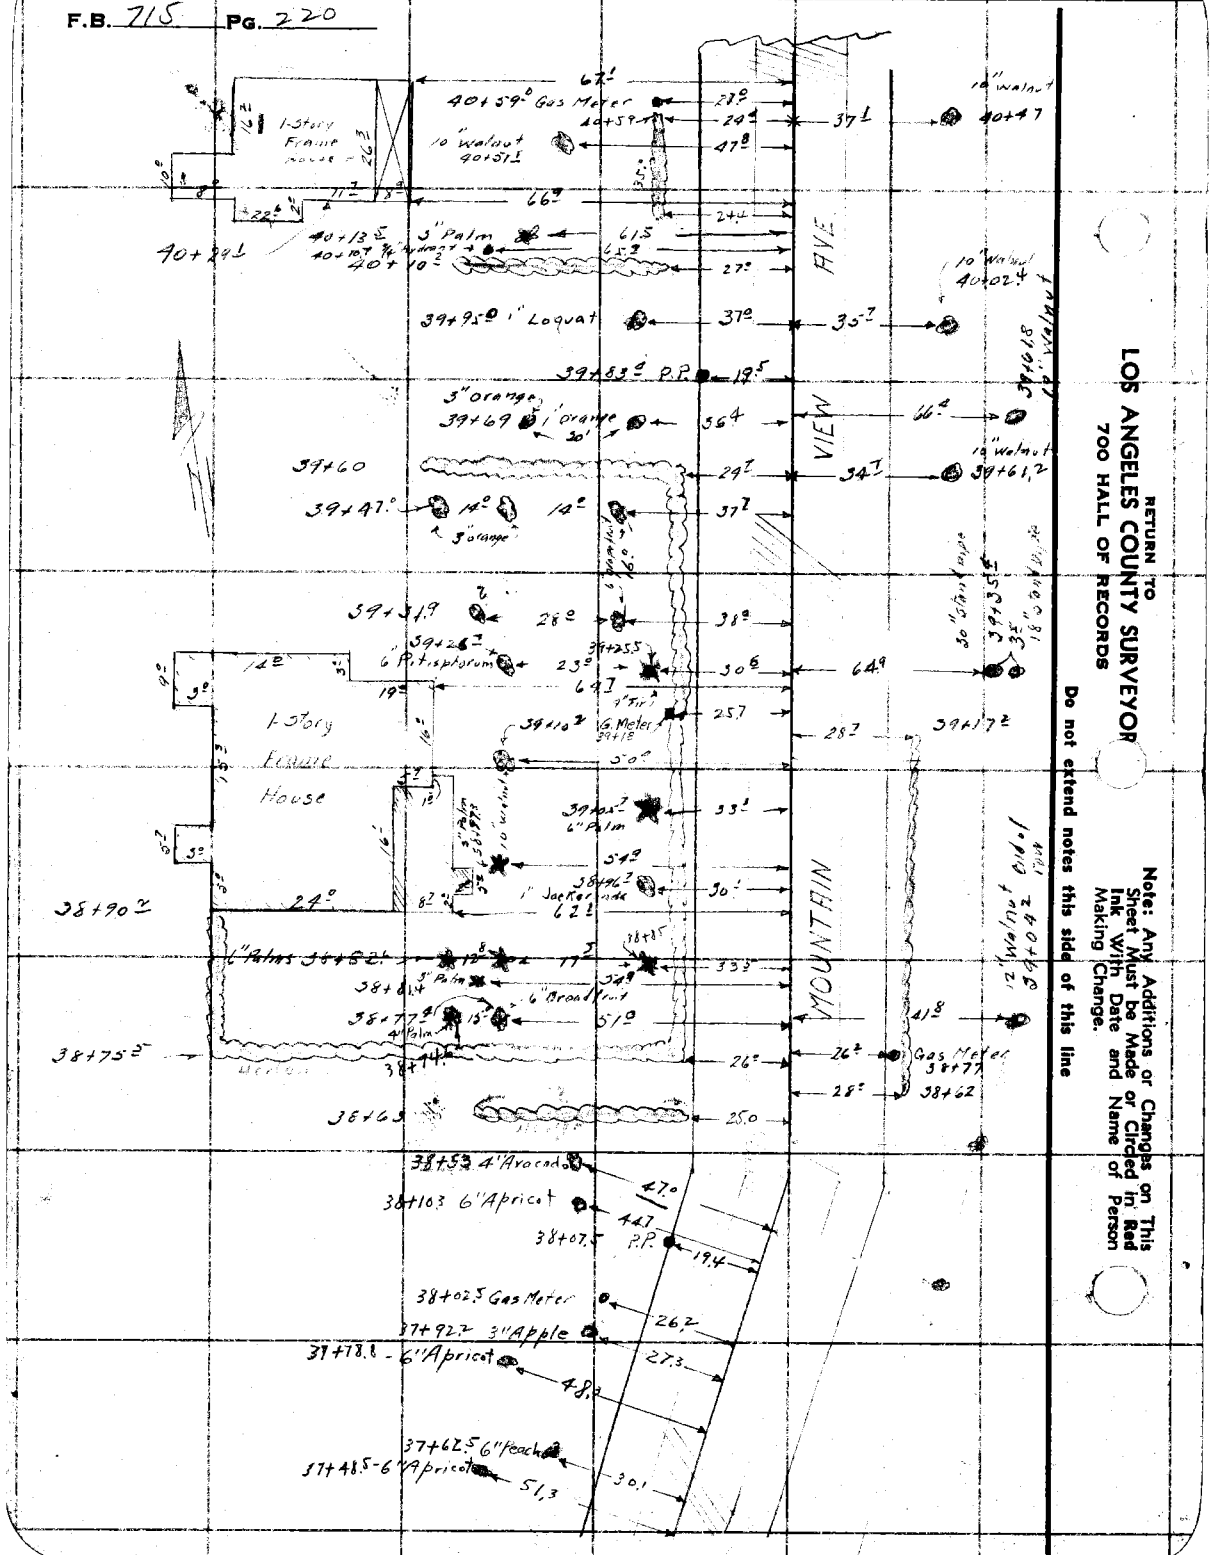
1-Story Frame House
40+59.0 Gas Meter
10" Walnut 40+51.5
3" Palm
40+13.5
40+24.1
40+10.2
39+95.0 1" Loquat
39+83.2 P.P.
3" orange
39+69
39+60
39+47.0
3" orange
39+31.9
39+26.2
6" Pittisporum
1-Story Frame House
39+10.2 G. Meter 39+18
39+05.7
6" Palm
10" Walnut
38+96.2
1" Jacaranda
38+90.2
24.0
6" Palms 38+82.2
38+81.4
3" Palm
6" Broadleaf
38+77.9
4" Palm
38+75.2
38+63
38+53 4" Avocado
38+10.3 6" Apricot
38+07.2 P.P.
38+02.5 Gas Meter
37+92.2 3" Apple
37+78.8 - 6" Apricot
37+62.5 6" Peach
37+48.5 - 6" Apricot
VIEW AVE
MOUNTAIN
10" Walnut 40+47
10" Walnut 40+02.4
39+61.8 12" Walnut
39+61.2
12" Walnut 39+04.2
38+77 Gas Meter 38+62
RETURN TO
LOS ANGELES COUNTY SURVEYOR
700 HALL OF RECORDS
Note: Any Additions or Changes on This Sheet Must be Made or Circled in Red Ink With Date and Name of Person Making Change.
Do not extend notes this side of this line

Notes Ck'd by	Survey of Mt. View Ave
Map No. C.S.B-1413.	W. O. Tape No. St'd °F.
Office Work J.D. Price.	Surveyed by H.F. Evans
Checked CAR	Notes Fenner Date 12/9/37
Date June 40	Indexed

F.B. 715 Pg. 221

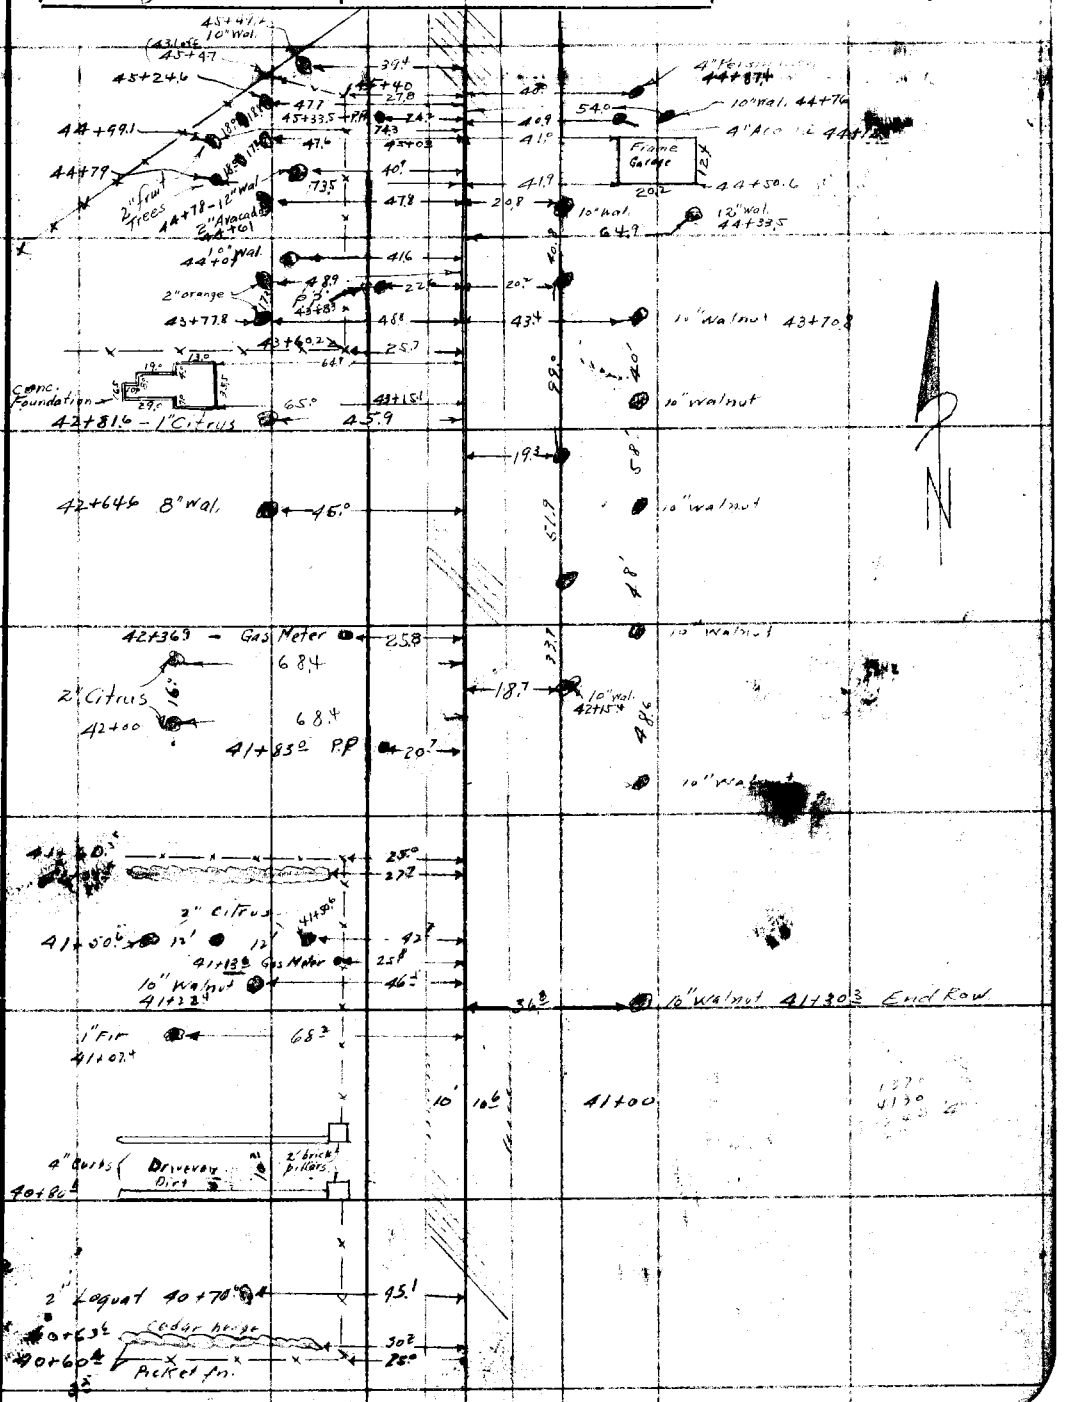

Note: Any Additions or Changes on This Sheet Must be Made or Circled in Red Ink With Date and Name of Person Making Change.

Do not extend notes this side of this line

RETURN TO
LOS ANGELES COUNTY SURVEYOR
700 HALL OF RECORDS

FORM 247 10M 11-35

F.B. 715 Pg. 222

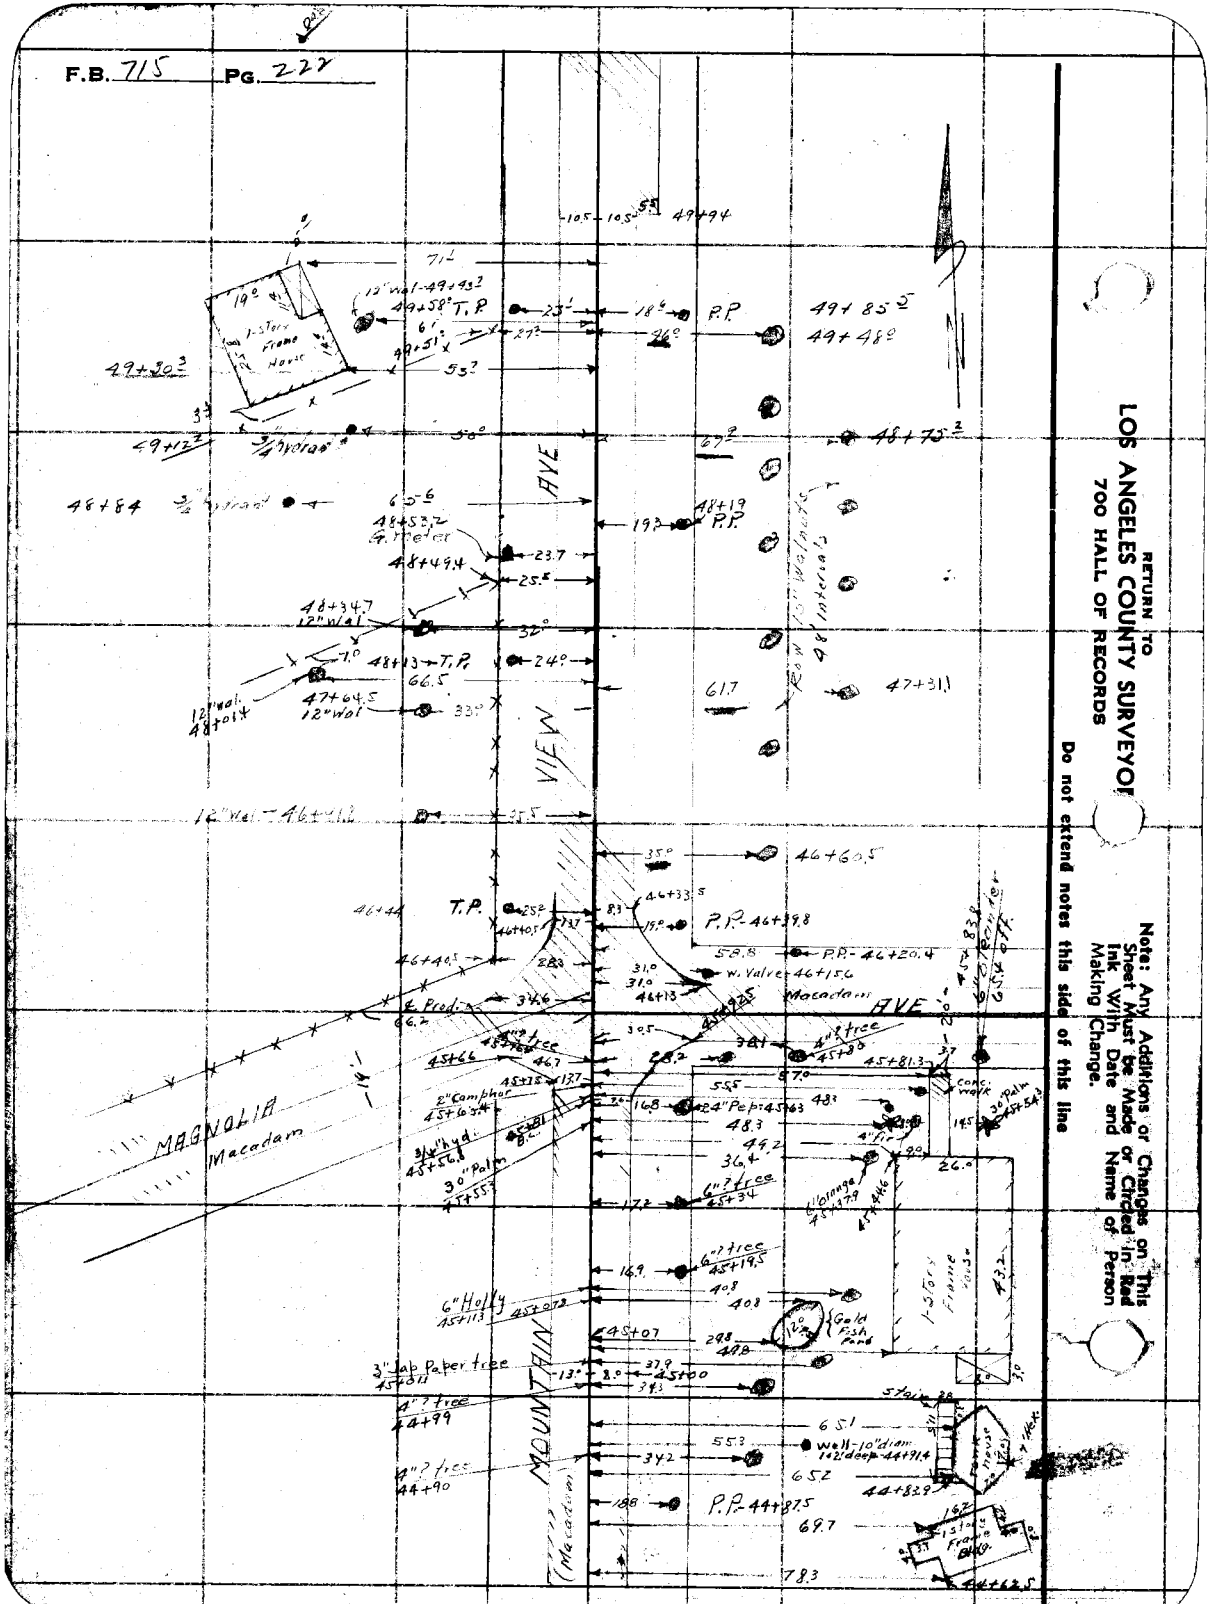
RETURN TO
LOS ANGELES COUNTY SURVEYOR
700 HALL OF RECORDS
Do not extend notes this side of this line
Note: Any Additions or Changes on This Sheet Must be Made or Circled in Red Ink With Date and Name of Person Making Change.
VIEW AVE
MAGNOLIA
Macadam
MOUNTAIN
(Macadam)
AVE
1-Story Frame House
T.P.
P.P.
W. Valve
Gold Fish Pond
Well-10"diam 142'deep

Notes Ck'd by	Survey of Mt. View Ave
Map No. C.S. B-1413	W. O. Tape No. St'd °F.
Office Work J.D. Price	Surveyed by H.E. Evans
Checked [illegible]	Notes Fender Date 12/6/37
Date June 40	Indexed


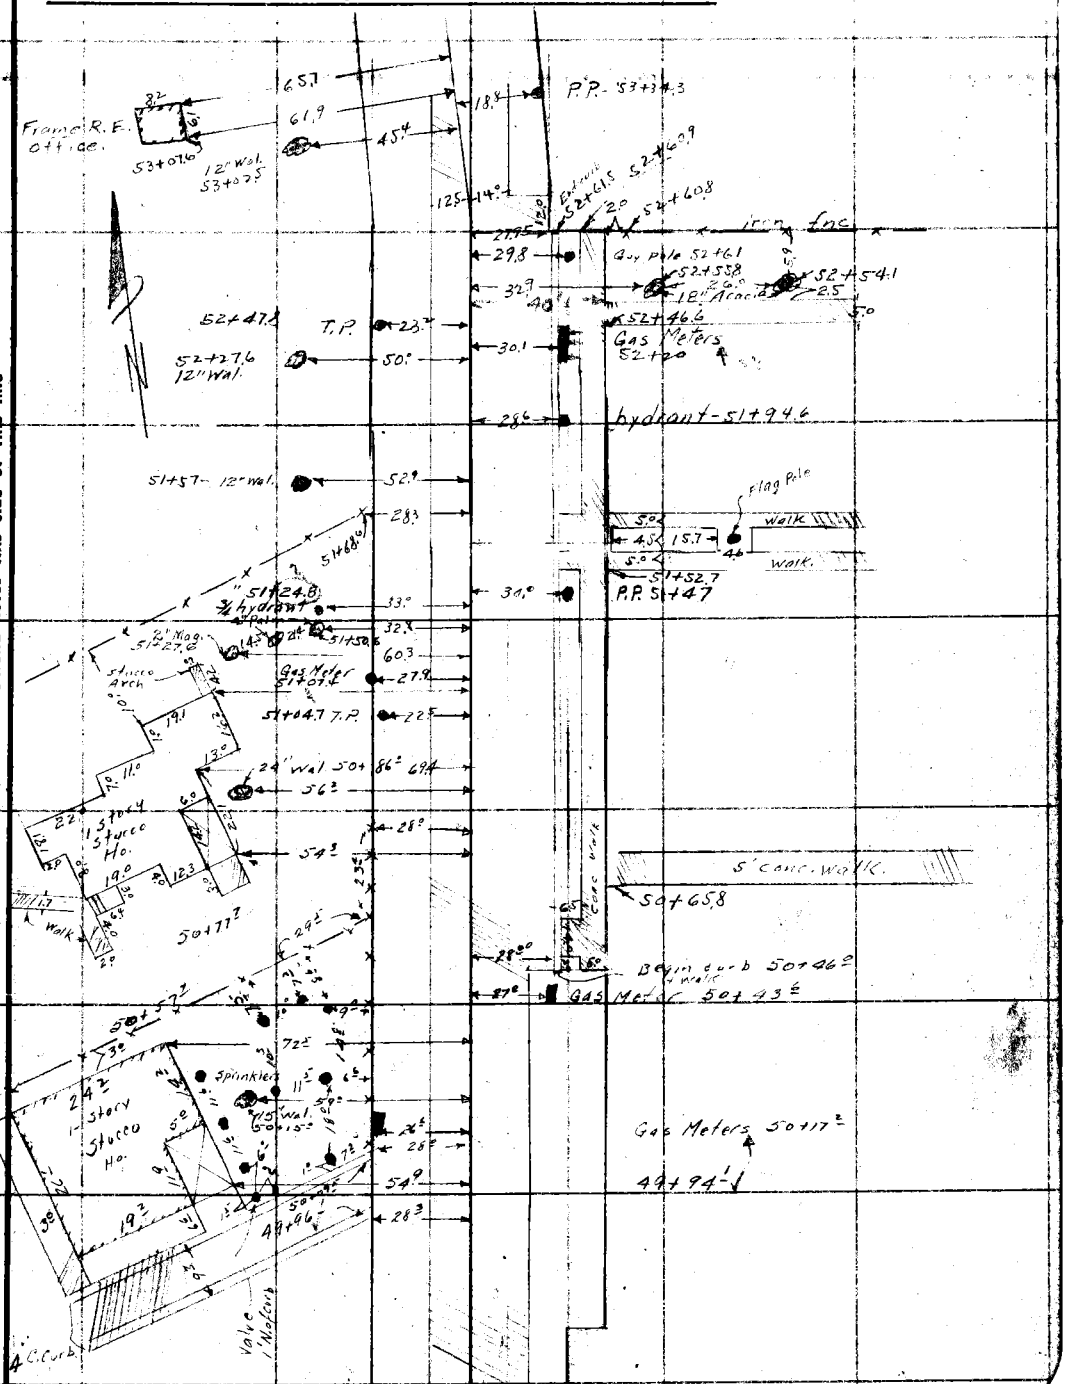

Note: Any Additions or Changes on This Sheet Must be Made or Circled in Red Ink With Date and Name of Person Making Change.

Do not extend notes this side of this line

RETURN TO
LOS ANGELES COUNTY SURVEYOR
700 HALL OF RECORDS

FORM 247 10M 11-38

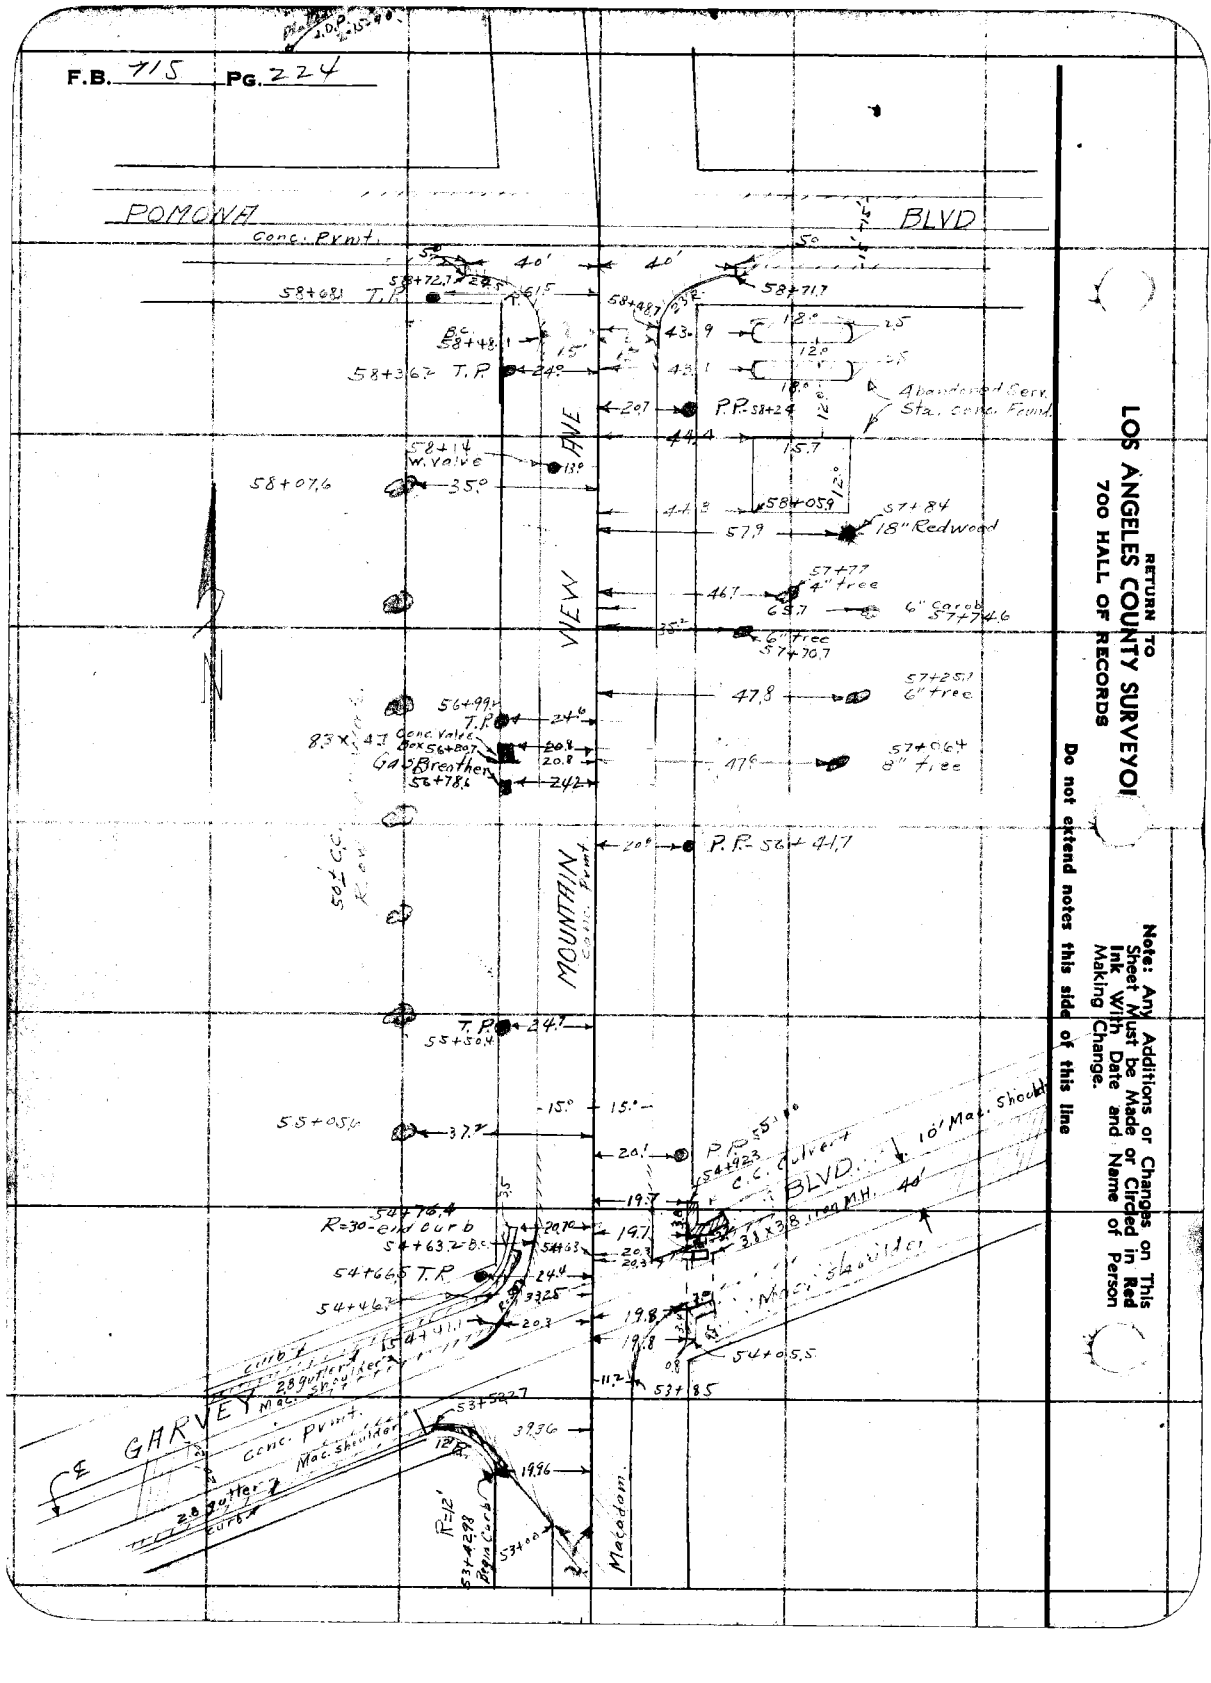
F.B. 715 Pg. 224
POMONA
Conc. Pvmt
BLVD
58+68.1 T.P.
58+72.7
58+98.7
58+71.7
58+36.7 T.P.
P.P. 58+24
Abandoned Conc. Sta., Conc. Found.
58+07.6
58+59
57+84
18" Redwood
57+77
4" tree
6" Carob 57+74.6
6" tree 57+70.7
57+25.1
6" tree
56+99.1 T.P.
Conc. Valve Box 56+80.7
Gas Breather 56+78.1
57+06.4
8" Tree
P.P. 56+41.7
MOUNTAIN
T.P. 55+50.4
55+05.4
P.P. 54+92.3
C.C. Culvert
10' Mac. Shoulder
R=30-Conc. Curb
54+63.2
54+66.5 T.P.
54+46.2
Mac. shoulder
Curb & Gutter
28' Gutter to Gutter
GARVEY
Conc. Pvmt.
Mac. shoulder
53+59.7
R=12'
53+42.98 B.C. Curb
Macadam.
NOTE: Any Additions or Changes on This Sheet Must be Made in Red Ink With Date and Name of Person Making Change.
Do not extend notes this side of this line
RETURN TO
LOS ANGELES COUNTY SURVEYOR
700 HALL OF RECORDS

FORM 247 10M 11-38

RETURN TO
LOS ANGELES COUNTY SURVEYOR
700 HALL OF RECORDS

Note: Any Additions or Changes on This Sheet Must be Made or Circled in Red Ink With Date and Name of Person Making Change.

Do not extend notes this side of this line

37 A-3

Notes Ck'd by
Map No. C.S. B-135-1
Office Work J. D. Price.
Checked Aug. 39
Date

Survey of W. O.
Surveyed by
Notes
Indexed

Tape No. 36 Std. 62°F.
Date 3-22-39

F.B. 715 Pg. 22

Revision No 3
Pg. 195

1 per F.B. 715-114 & 522.79 Pol. to Sta. 11

To E. Siphon Rd F.B. 715-11 DURFEE

586.0' & Durfee Ave

82+33 Pol.

P.O.T. Set 2x2, 14" in.

This Revised see pgs. 255-256 for Revision No 2

See F.B. 715-12

AVE.

See pgs 8-9 for index.

PECK RD.
ALTERNATE No 3.

From

SIPHON RD.

To

1 KLINGERMAN AVE.

See pgs 118 & 151 For Alt. #1&2

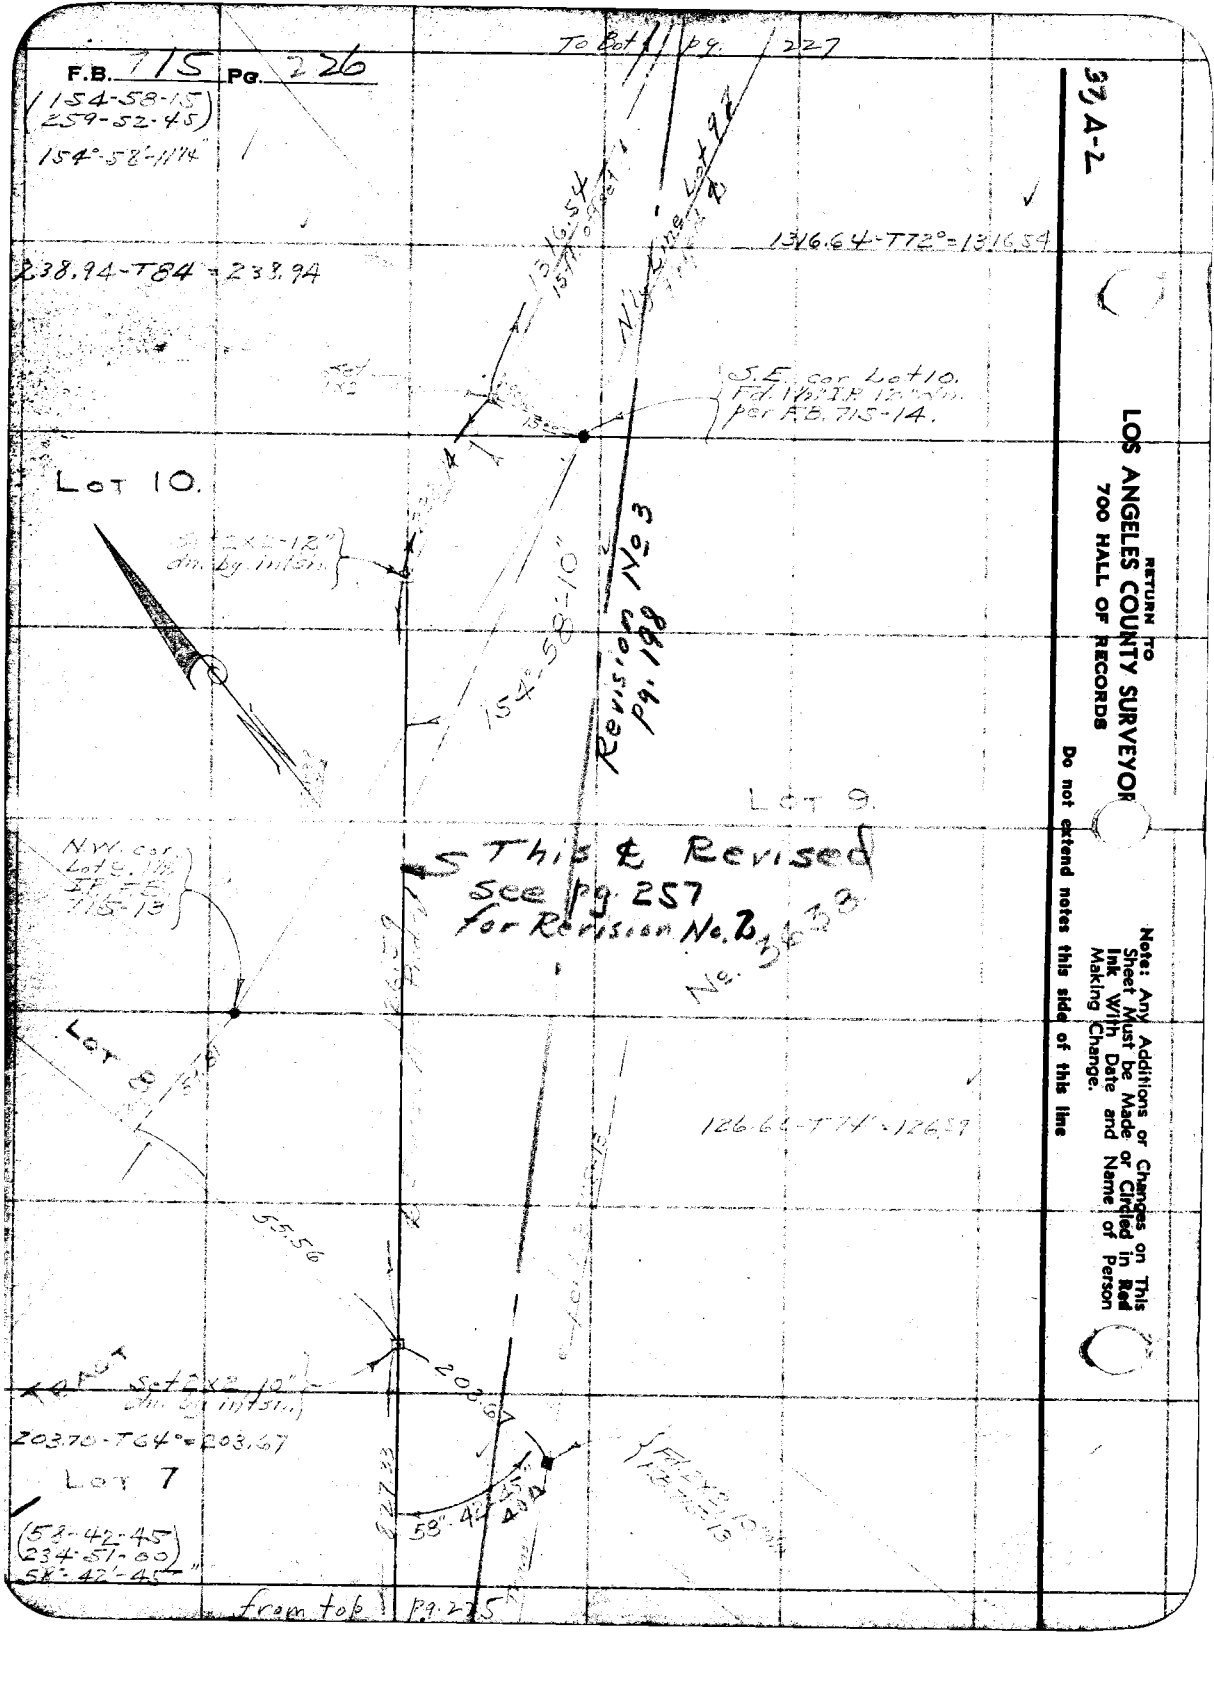

37 A-2

RETURN TO
LOS ANGELES COUNTY SURVEYOR
700 HALL OF RECORDS

Do not extend notes this side of this line

Note: Any Additions or Changes on This Sheet Must be Made or Circled in Red Ink With Date and Name of Person Making Change.

Notes Ck'd by	Survey of
Map No. C.S.B-1351-1	W. O. 7052 Tape No. [illegible] St'd [illegible] °F.
Office Work J.D. Price.	Surveyed by EVANS
Checked AUR	Notes HE Date 6-21-38
Date Aug. '39	Indexed

F.B. 715 Pg. 227

(105-42-45
62-51-15
[illegible])

To Ext. [illegible]

G.P.C. Brass cap Mon. 4" high F.B. 715-14,15

FH 2" I.P., 3" high F.B. 715-14,15 Tr. 3655

105°-42'

1.17 found 1" scored brass

S E'ly Line Lot 9

9°

1°-19'

0.87 ft.

54.99

0.27 ft. offset F.B. 715-15

P.I. - Pg. 258

266.2'

19.96'

Set 2"x2" 6" deep by inters.

Set 2"x2", 10" in by inters.

FH 1½" I.P. F.B. 715-15 Ties Pg. 130

(162-28-30
289-34-15
162-28-30 M)

N&T top of P.P.

Revision No 3 per Pg. 198

New ℄ Lot per Pg. 258

Probable ℄ Alley

This & Revised See Pg. 258 for Revision No 2

From 10A Pg. 246

RETURN TO
LOS ANGELES COUNTY SURVEYOR
700 HALL OF RECORDS

Note: Any Additions or Changes on This Sheet Must be Made or Circled in Red Ink With Date and Name of Person Making Change.

Do not extend notes this side of this line

FORM 247 10M 11-38

RETURN TO
LOS ANGELES COUNTY SURVEYOR
700 HALL OF RECORDS

Note: Any Additions or Changes on This Sheet Must be Made or Circled in Red Ink With Date and Name of Person Making Change.

Do not extend notes this side of this line

37, B-2

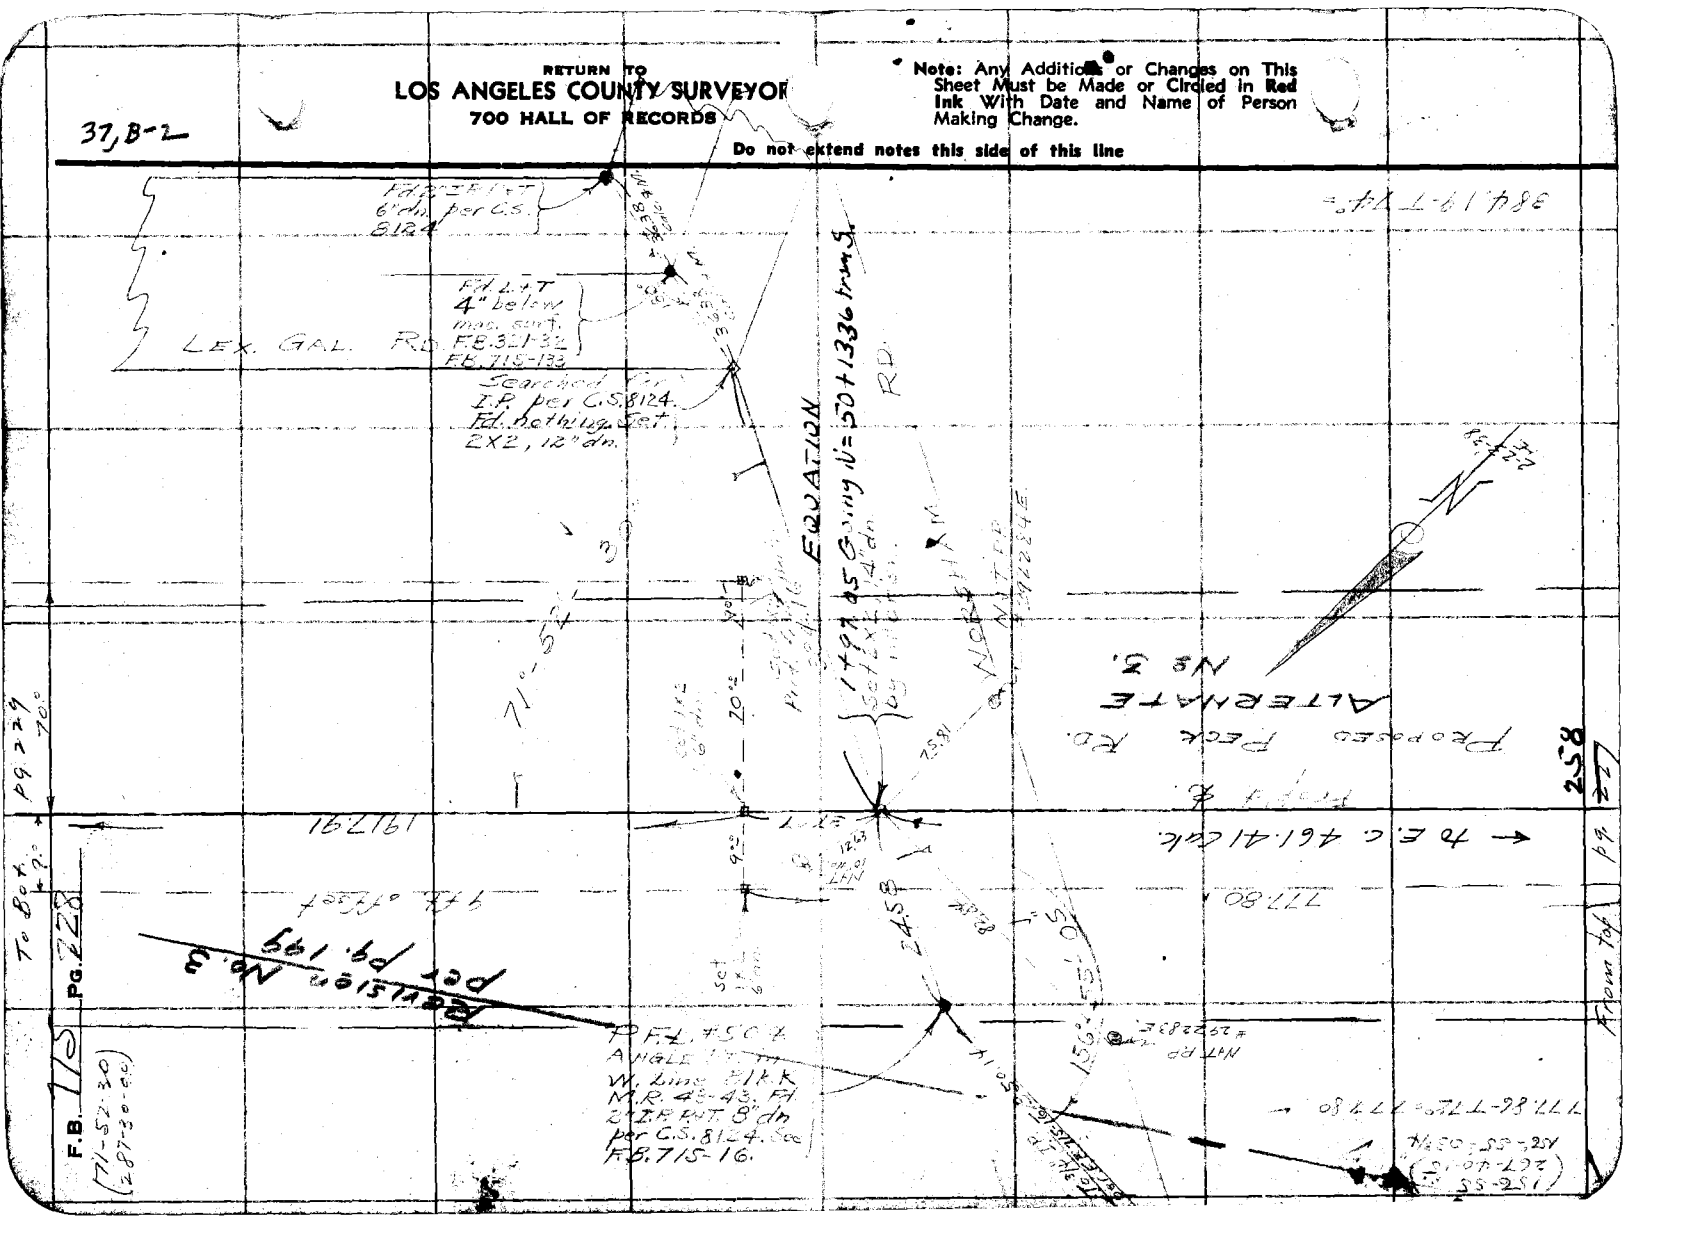
LEX. GAL. RD
ALTERNATE No. 3
PROPOSED PECK RD.
PG. 229
PG. 228
F.B. 715
(71-S2-30)
(287-30-00)
To Bor. 42°
Pct Pg. 199
PFL, TSC & ANGLE PT in W. Line P1k & M.R. 43-43, FI 2" I.P. FNT 8" dn per C.S. 8124. See F.B. 715-16.
LOS ANGELES COUNTY SURVEYOR
700 HALL OF RECORDS

Note: Any Additions or Changes on This Sheet Must be Made or Circled in Red Ink With Date and Name of Person Making Change.

Do not extend notes this side of this line

37, B-2

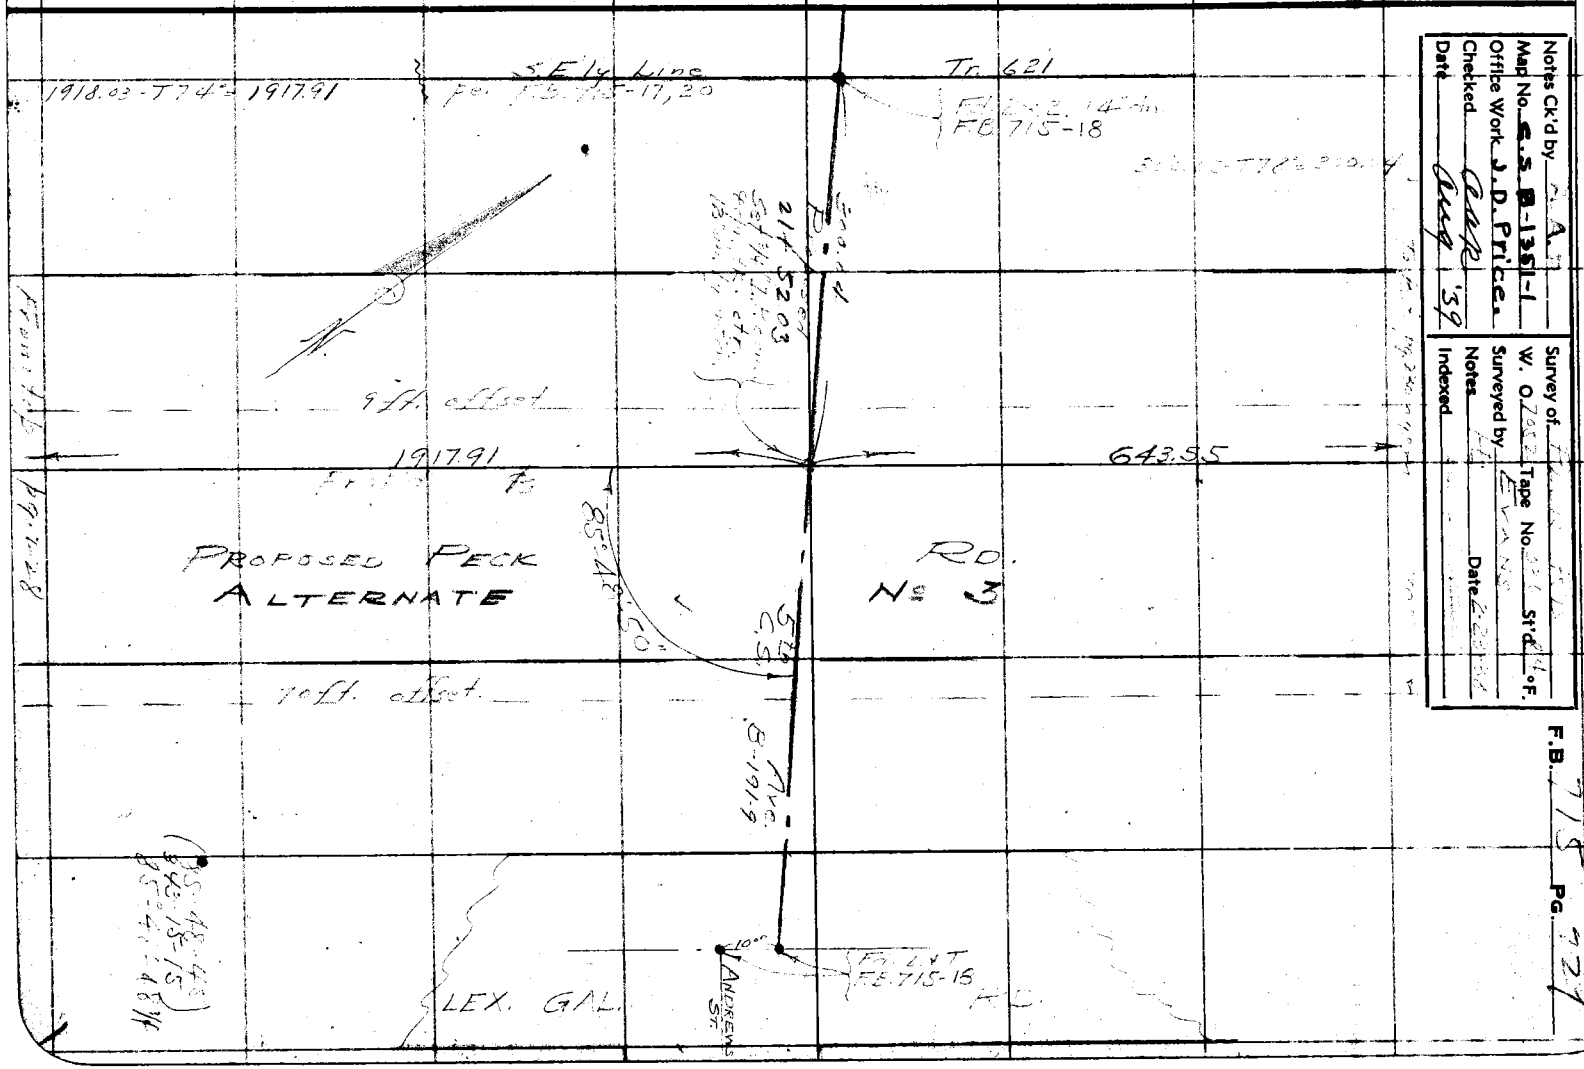

Notes Ck'd by [illegible]
Map No. C.S. B-135-1
Office Work J.D. Price
Checked [illegible]
Date Aug '39

Survey of W. O. [illegible]
Surveyed by [illegible]
Notes
Indexed
Tape No. [illegible] St'd [illegible] °F.
Date [illegible]


RETURN TO
LOS ANGELES COUNTY SURVEYOR
700 HALL OF RECORDS

Note: Any Additions or Changes on This Sheet Must be Made or Circled in Red Ink With Date and Name of Person Making Change.

Do not extend notes this side of this line

37, B-2

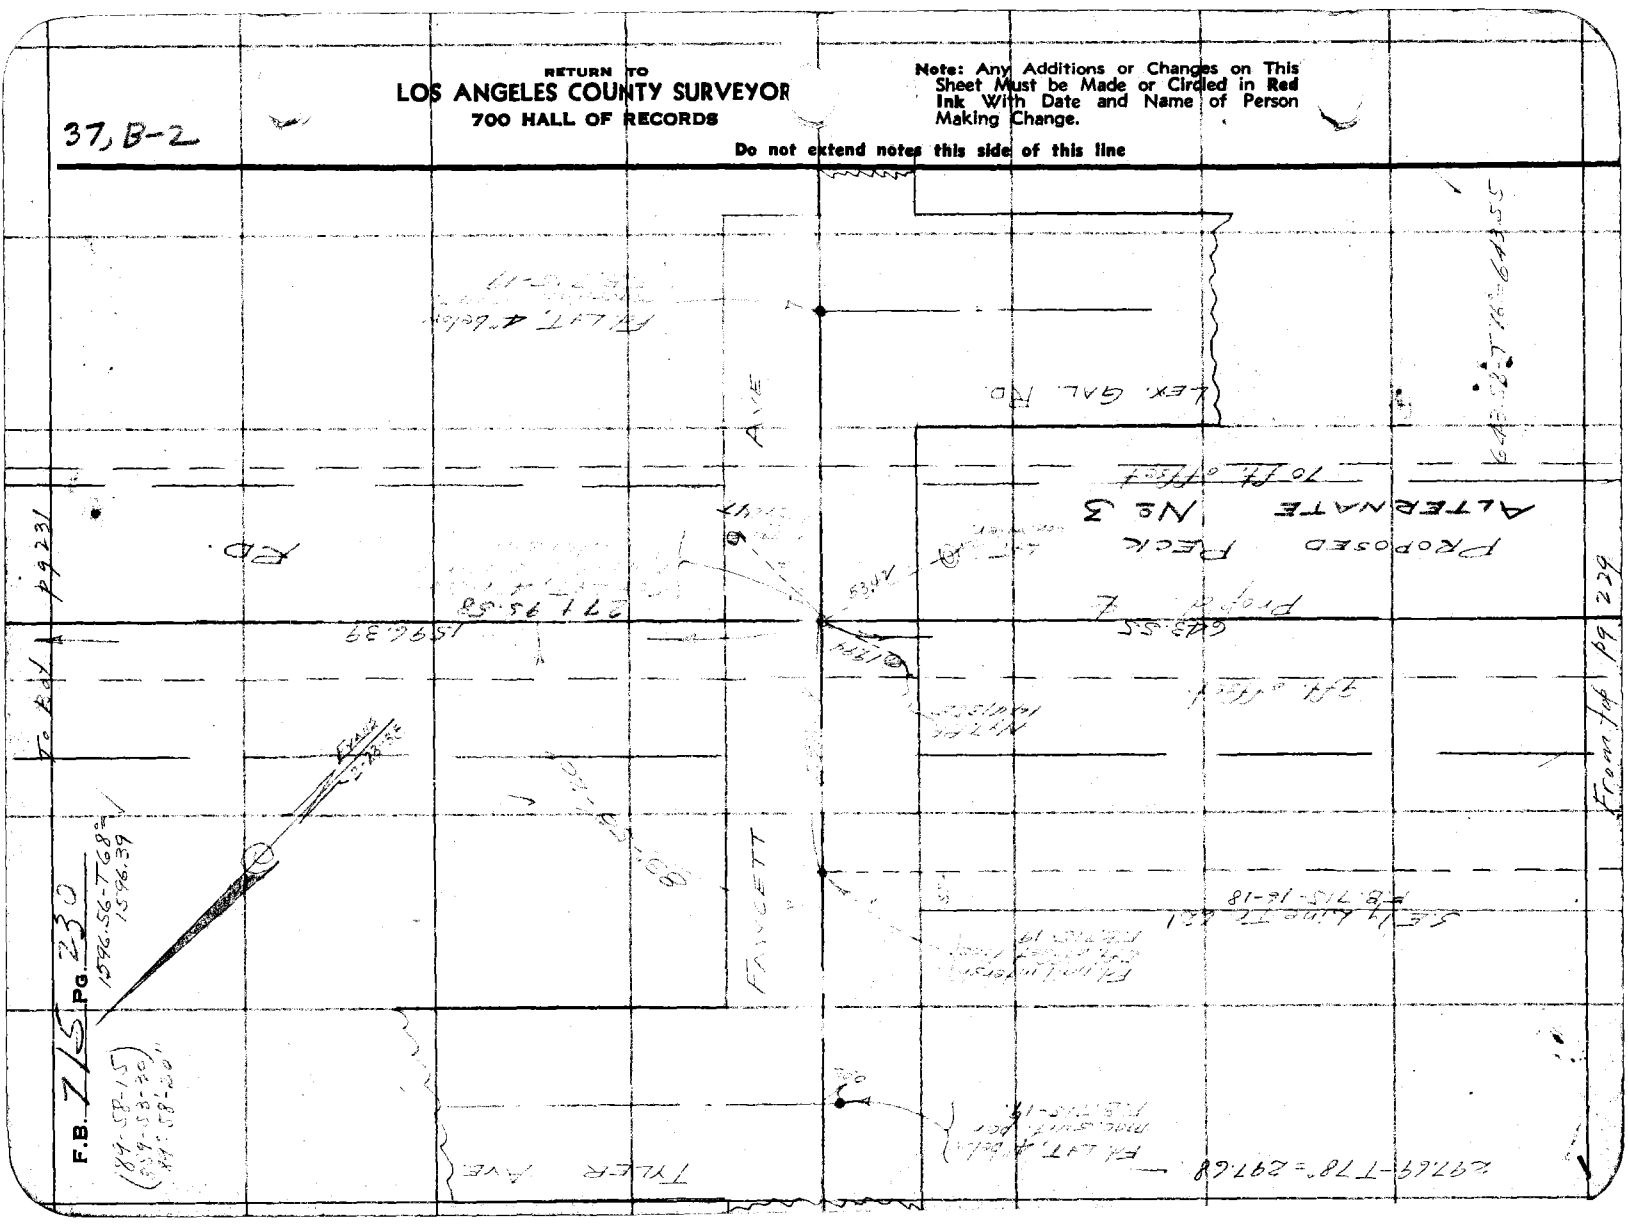

FORM 247 10M 11-38

RETURN TO
LOS ANGELES COUNTY SURVEYOR
700 HALL OF RECORDS

Note: Any Additions or Changes on This Sheet Must be Made or Circled In Red Ink With Date and Name of Person Making Change.

Do not extend notes this side of this line

37 B-2

Notes Ck'd by
Map No. C.S. B-1351-1
Office Work J. D. Price
Checked
Date Aug. 39

Survey of W. 0.705-2 Tape No. 236 St'd 66'F.
Surveyed by E. EVANS
Notes
Indexed
Date 4-5-38

F.B. 175 Pg. 21

L+T per pg. 20

(132.57-115.57) 10-08-45

329-32'-11"W

42°-32'-10"

43+79.77 Sta. Sta. Ahead of Int.

709.33

T.B.M.

1596.39

PROPOSED ALTERNATE PECK No 3

RD.

218.59

AVE.

C.S. Mon. 30' dn. per pg. 20

218.61 T72°-218.54

RETURN TO
LOS ANGELES COUNTY SURVEYOR
700 HALL OF RECORDS

37,B-2

Note: Any Additions or Changes on This Sheet Must be Made or Circled in Red Ink With Date and Name of Person Making Change.

Do not extend notes this side of this line

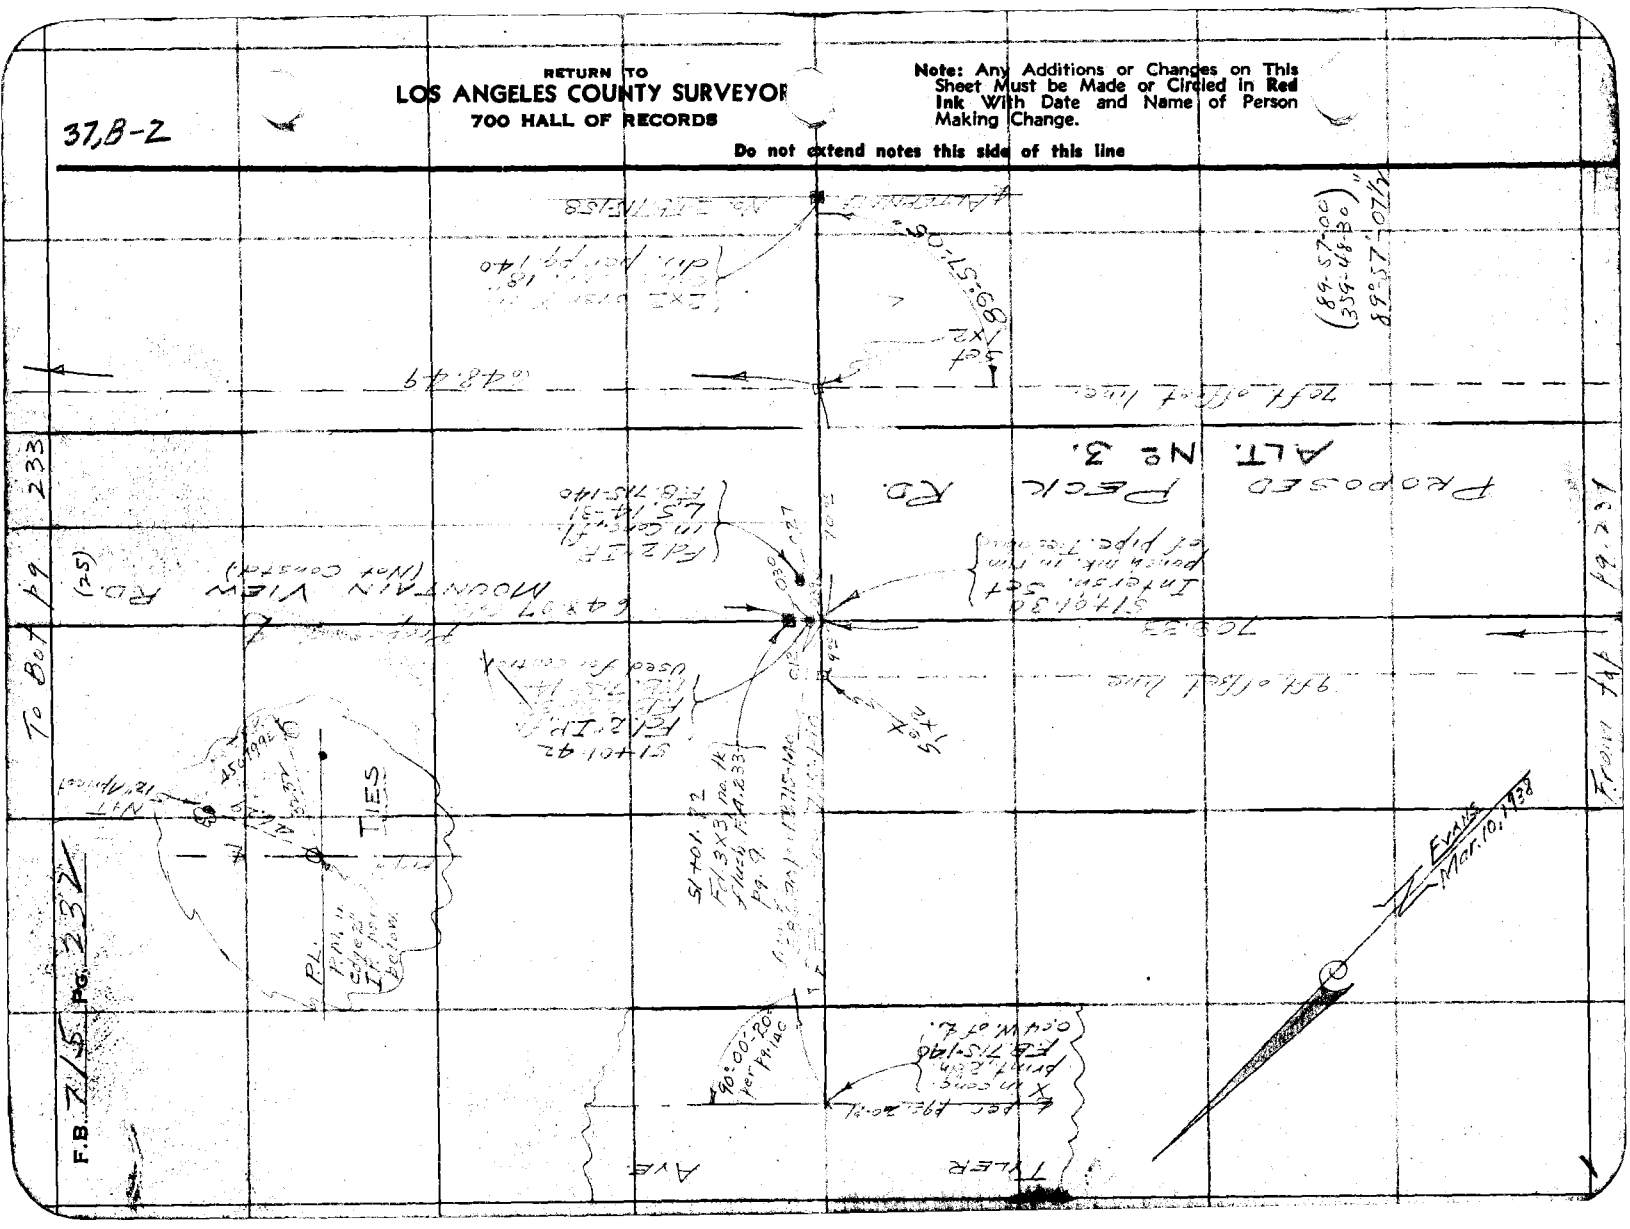

FORM 247 10M 11-58

RETURN TO
LOS ANGELES COUNTY SURVEYOR
700 HALL OF RECORDS

Note: Any Additions or Changes on This Sheet Must be Made or Circled in Red Ink With Date and Name of Person Making Change.

Do not extend notes this side of this line

37, B-2

Notes Ck'd by
Map No. C.S.B-138-1
Office Work J. P. Price
Checked Quig. Part 37
Date

Survey of W. O. 7652
Surveyed by EVANS
Notes
Indexed
Tape No. C35 Std & "F"
Date

F.B. 715 PG. 132

TYLER AVE.

FD. bent 4" x 4" Post
2' Dn. E3.715-219

EXIST. R/W
East 33.00
FD. 1" I.P.

657.64-T76°
657.58

SLACK

POT. 57+49.79
Set 3/8" I.P. cem'd
cpi. tk. 15" dn.
LE 5/8/59

N&T PP
#435560E

456.35-T74°=456.32

Proposed ℄

1318.65 Calc. (25)

RD.

24.89

70.00

MOUNTAIN VIEW
(Not constr.)

FD. I.P. (bent)
L.S. 14-318 F.B.
715-141

6.93

PROPOSED
ALT. No. 3

L & T
con. wire

RD.

70 ft. offset line

648.49

657.58

661.09

Set Post spk.
8' T. by intersn

N&T PP
#435561E

648.53-T74°=648.49

Private No. 2

FD. bent 3/4" IR F.B. 715-159

(90-03-15" E)
90°-03'-11"

RETURN TO
LOS ANGELES COUNTY SURVEYOR
700 HALL OF RECORDS

Note: Any Additions or Changes on This Sheet Must be Made or Circled in Red Ink With Date and Name of Person Making Change.

Do not extend notes this side of this line

37B-2

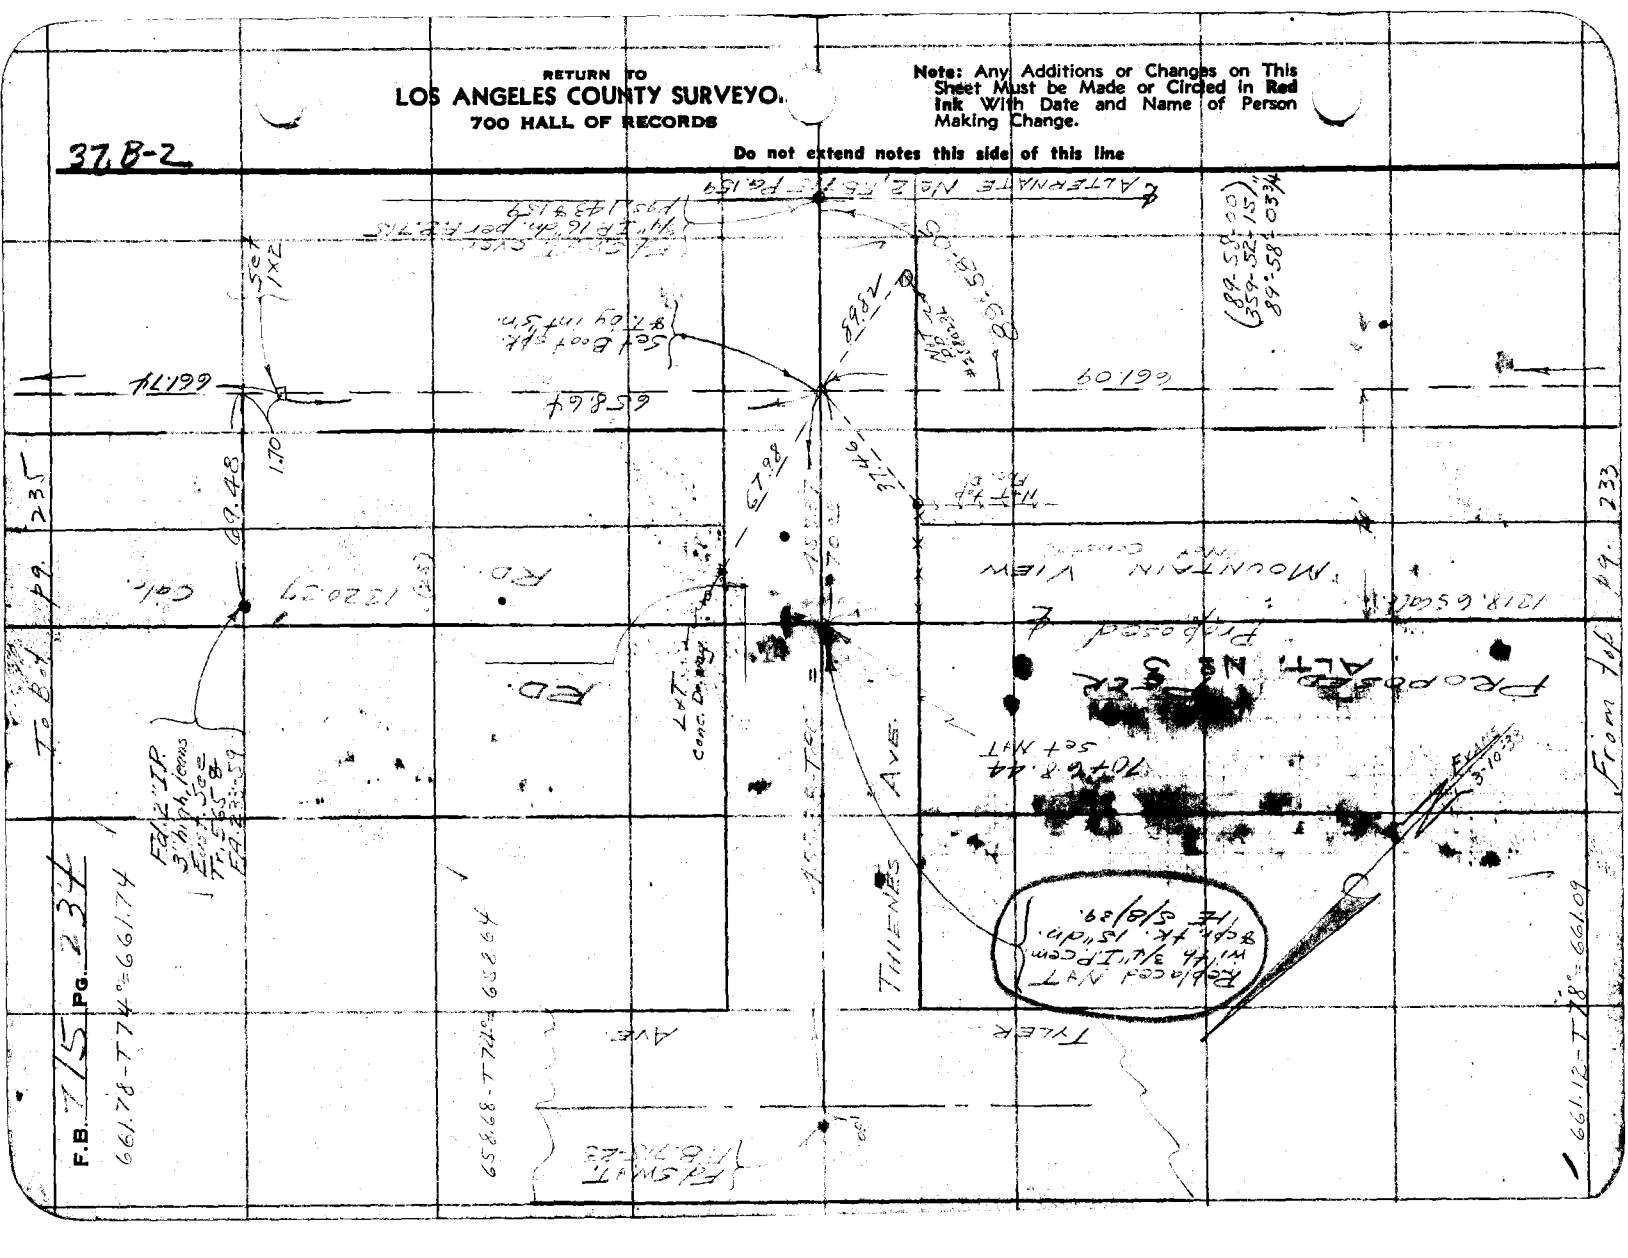
F.B. 715 PG. 234
66.78-T7.74=66.74
Set 1X2
1.70
0.48
Set Boot Plt. @ 7.09 Int S'n.
Set 1X2 on Pipe 1.43 N 1.59
66.09
65.64
67.98
1.46
Conc. Curb

FORM 247 10M 11-38

RETURN TO
LOS ANGELES COUNTY SURVEYOR
700 HALL OF RECORDS

Note: Any Additions or Changes on This Sheet Must be Made or Circled in Red Ink With Date and Name of Person Making Change.

Do not extend notes this side of this line

3 B-1

Notes Ck'd by
Map No. C.S. B-135-1
Office Work J.D. Price
Checked Clark
Date Aug. '39

Survey of W. O.
Surveyed by
Notes
Indexed

Tape No. Std. 66 F.
Date 3-10-38

F.B. 715 PG. 237

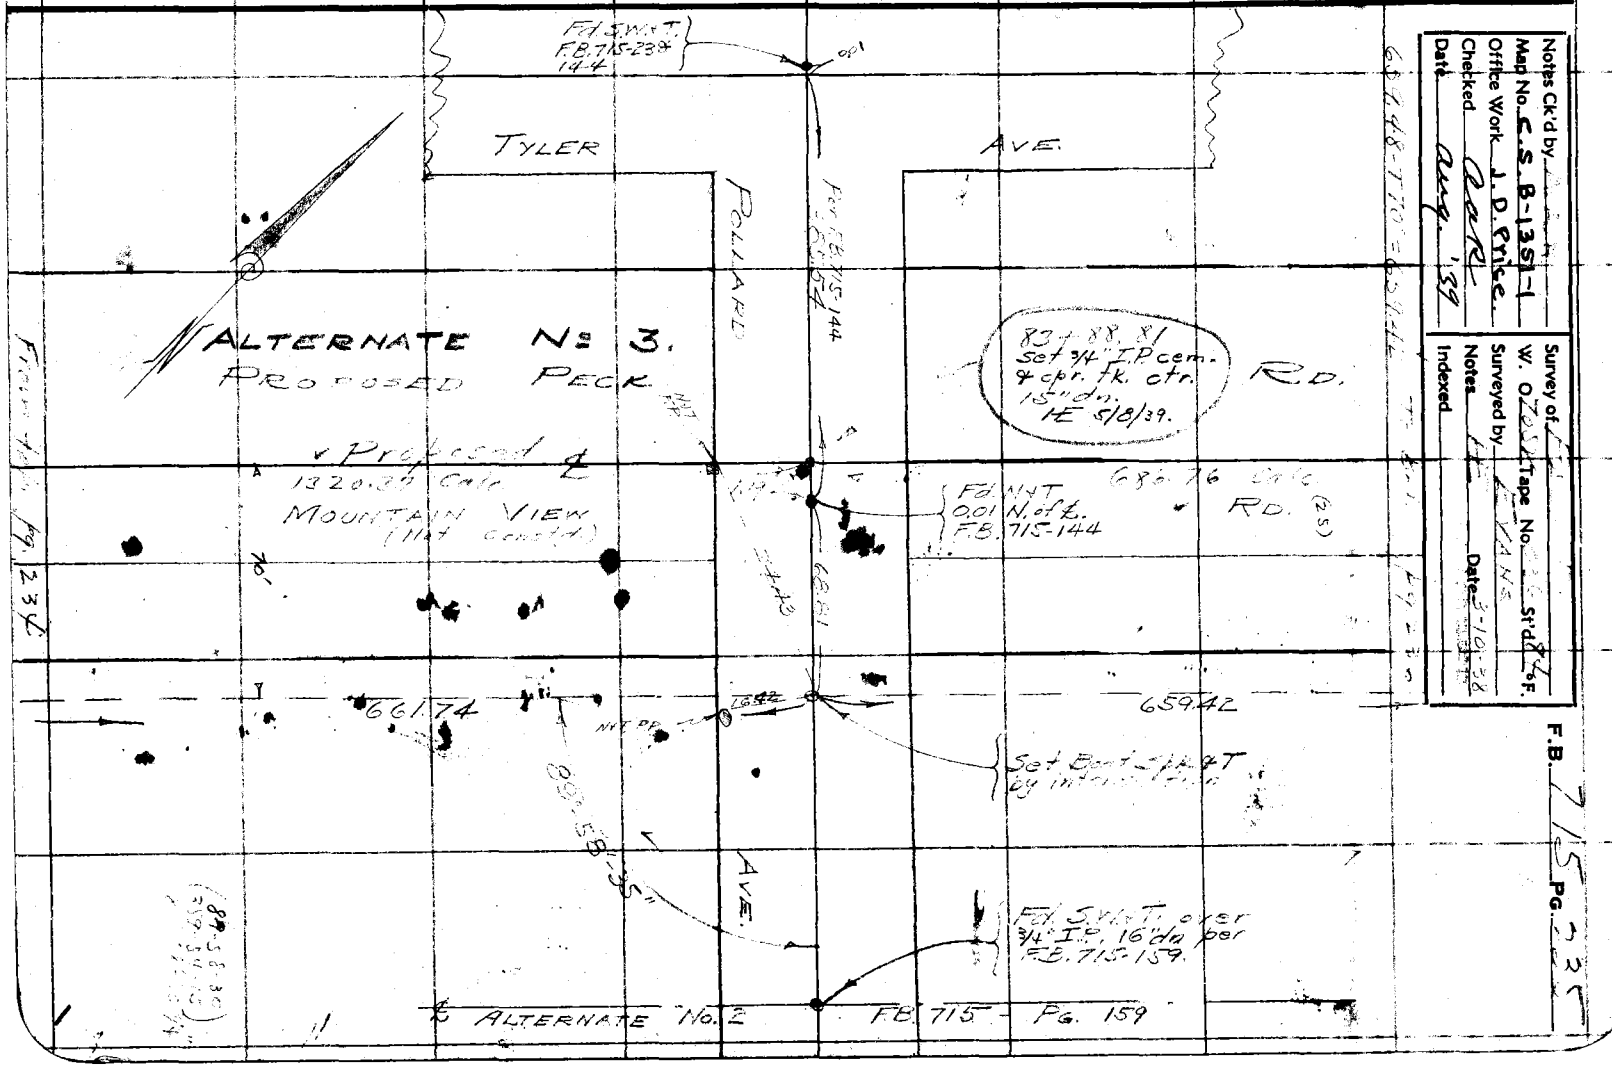

RETURN TO
LOS ANGELES COUNTY SURVEYOR
700 HALL OF RECORDS

Note: Any Additions or Changes on This Sheet Must be Made or Circled in Red Ink With Date and Name of Person Making Change.

37, C-1

Do not extend notes this side of this line

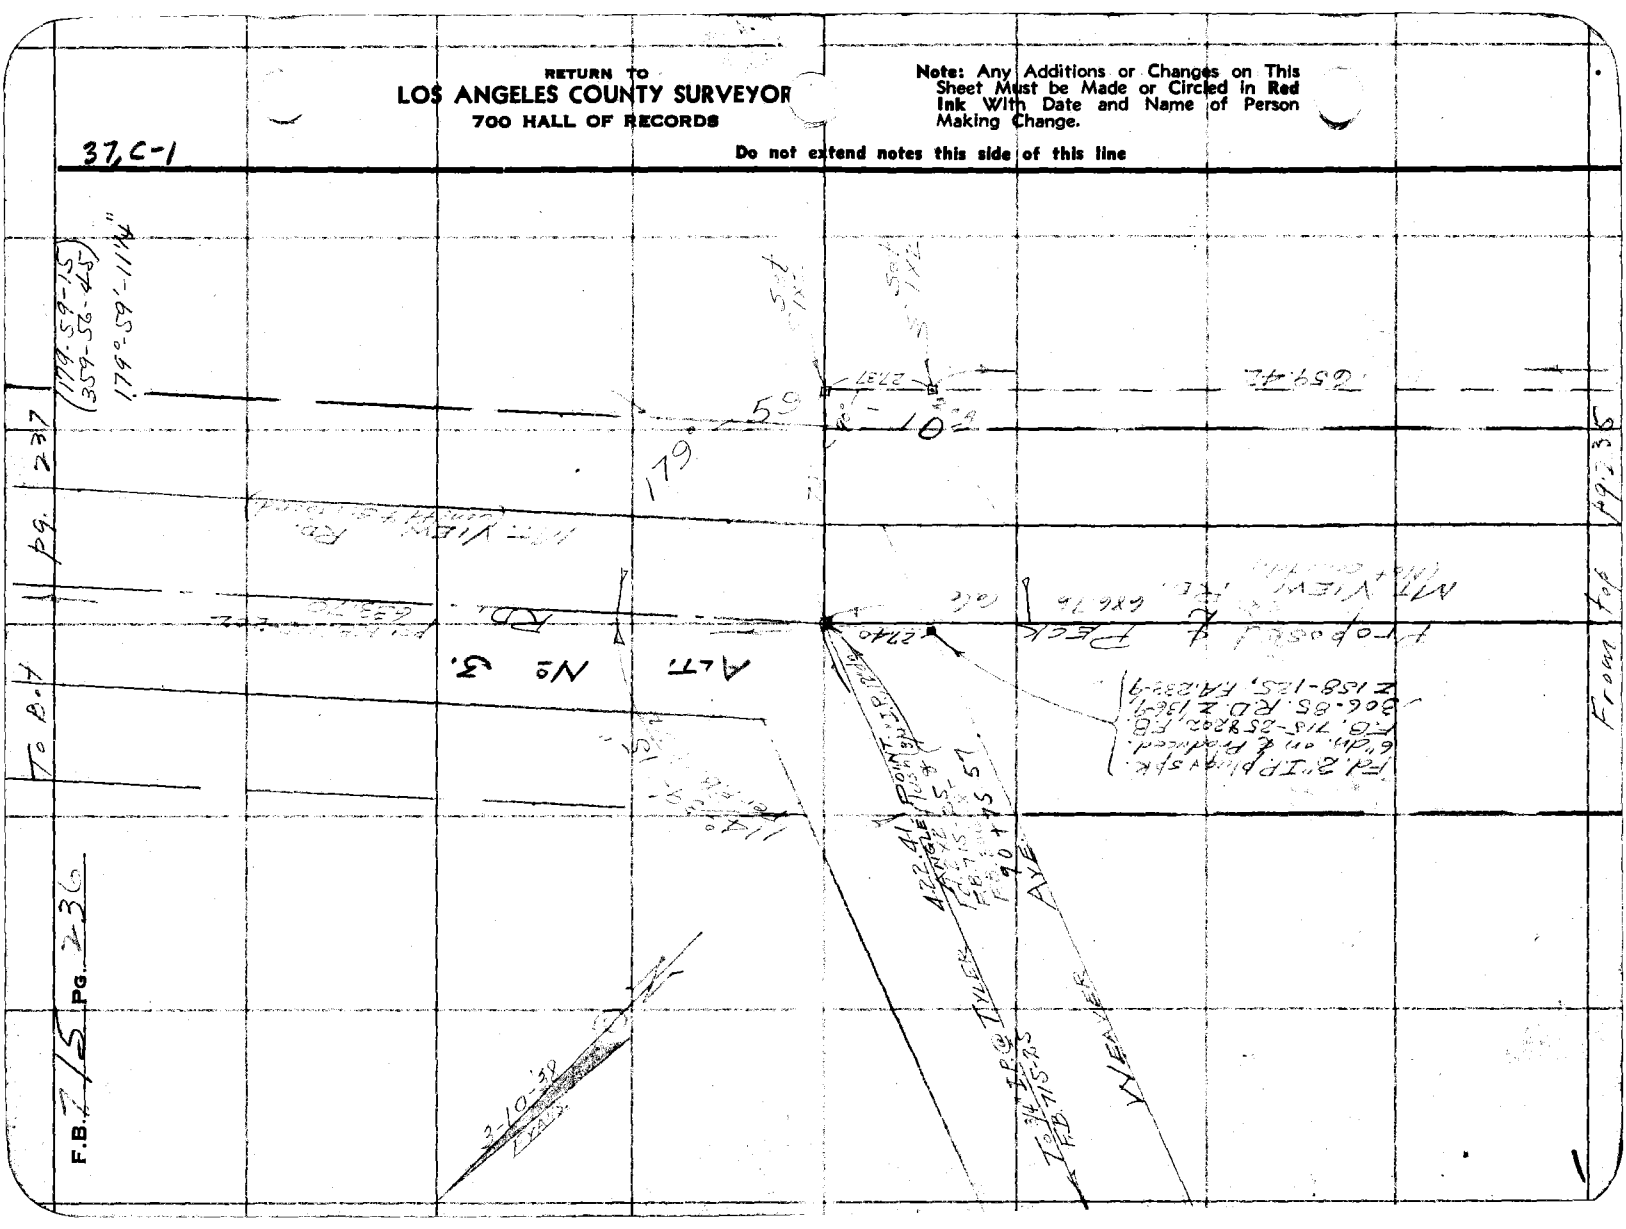

FORM 247 10M 11-38

RETURN TO
LOS ANGELES COUNTY SURVEYOR
700 HALL OF RECORDS

Note: Any Additions or Changes on This Sheet Must be Made or Circled in Red Ink With Date and Name of Person Making Change.

Do not extend notes this side of this line

37 C-1

97+09.27

FB. 715-147
Replaced with
3/4" IP conc. 24" L.
15 L.O. IE 5/9/39.
9 se + 2x2 Fl.

MT VIEW RD.

979.35

PROPOSED PECK ALT. No 3.

PECK RD.

STA. 97+15.03 = 15.03 Ahead

Ft. Swt. Tabs
3/4" IP dn. 16" pot
FB. 715-160

ALTERNATE No 2
FB. 715-160

Notes Ck'd by [illegible]
Map No. ES. B-1351-1
Office Work J. D. Pitts
Checked Aug.
Date Aug. 1939

Survey of PECK RD.
W. O. 7055 Tape No. C36 St'd. 100 F.
Surveyed by [illegible]
Notes [illegible] Date [illegible]
Indexed [illegible]

F.B. 715 PG. 137

RETURN TO
LOS ANGELES COUNTY SURVEYOR
700 HALL OF RECORDS

Note: Any Additions or Changes on This Sheet Must be Made or Circled in Red Ink With Date and Name of Person Making Change.

Do not extend notes this side of this line

37 C-1

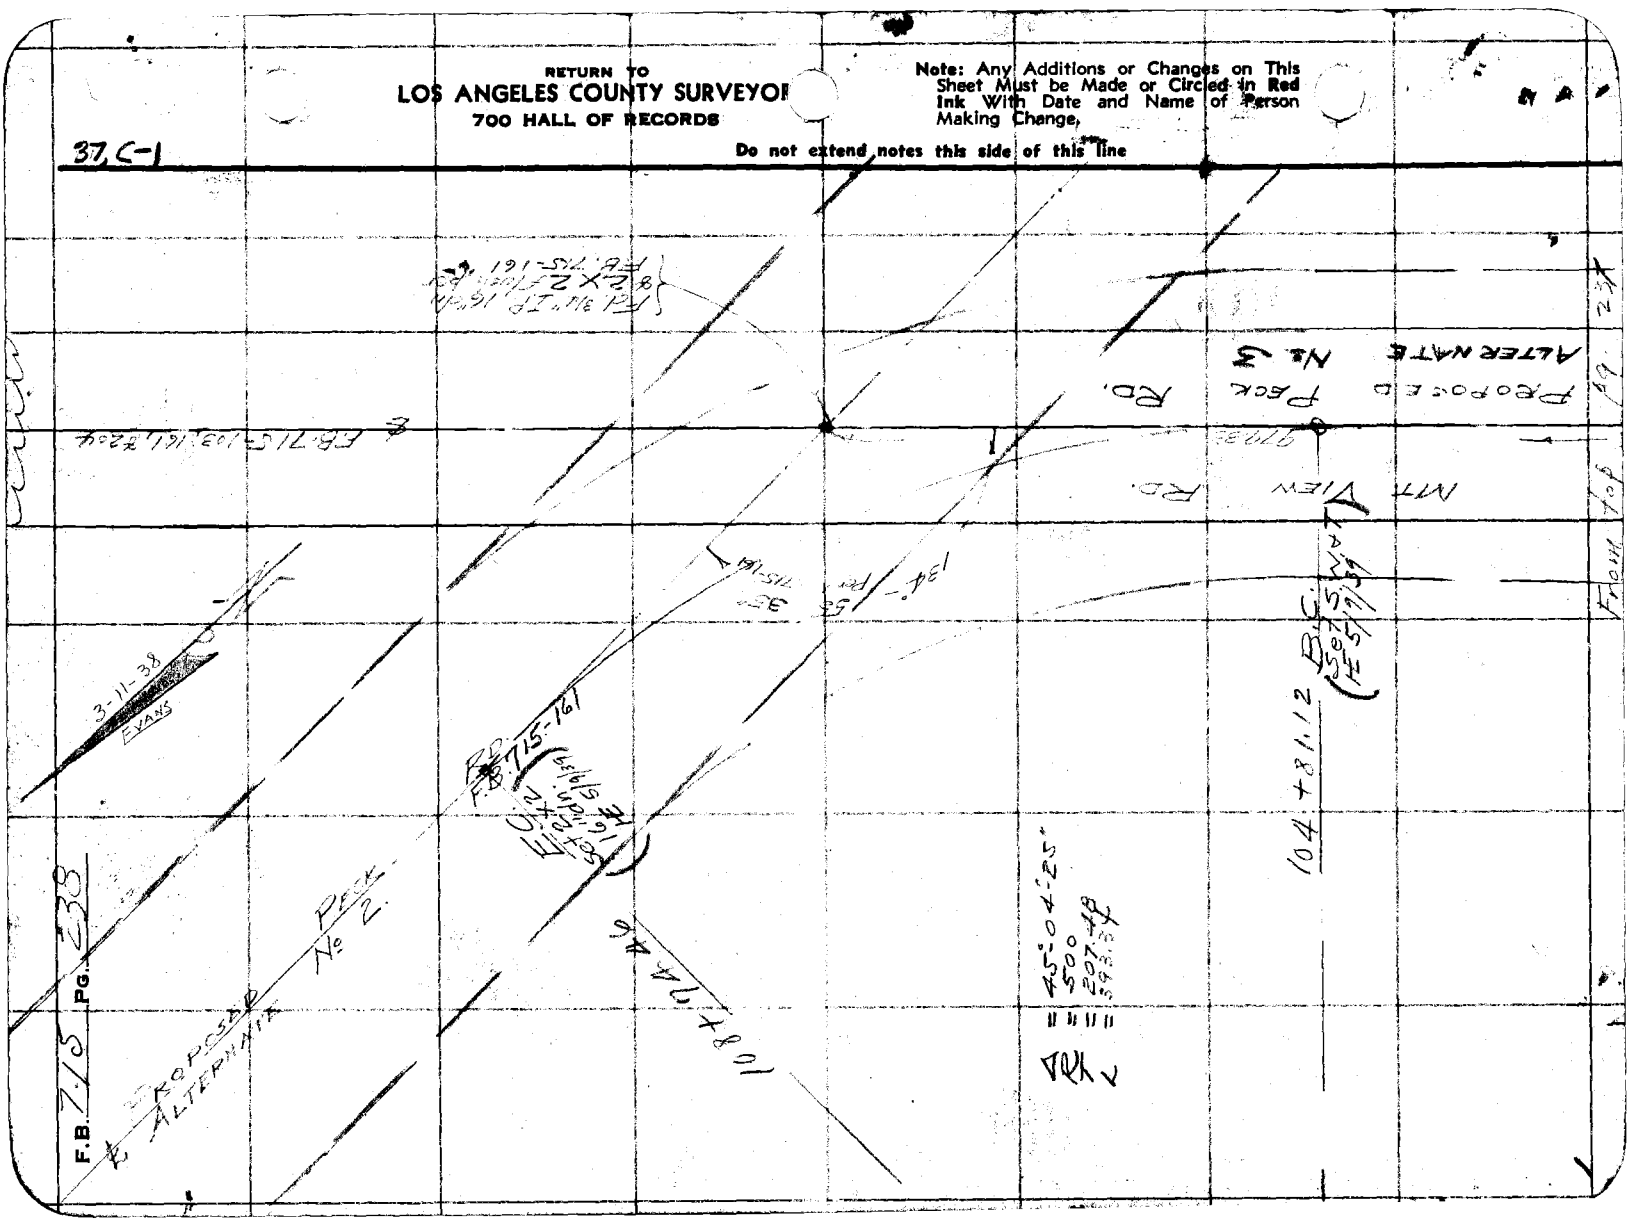

FORM 247 10M 11-35

RETURN TO
LOS ANGELES COUNTY SURVEYOR
700 HALL OF RECORDS

Note: Any Additions or Changes on This Sheet Must be Made or Circled in Red Ink With Date and Name of Person Making Change.

Do not extend notes this side of this line

37, A-2

Notes Ck'd by [illegible]
Map No. C.S.D.-13514
Office Work L.D. Price
Checked [illegible]
Date Aug. '57

Survey of
W. O.
Surveyed by
Notes
Indexed

Tape No. St'd °F.
Date

F.B. PG.

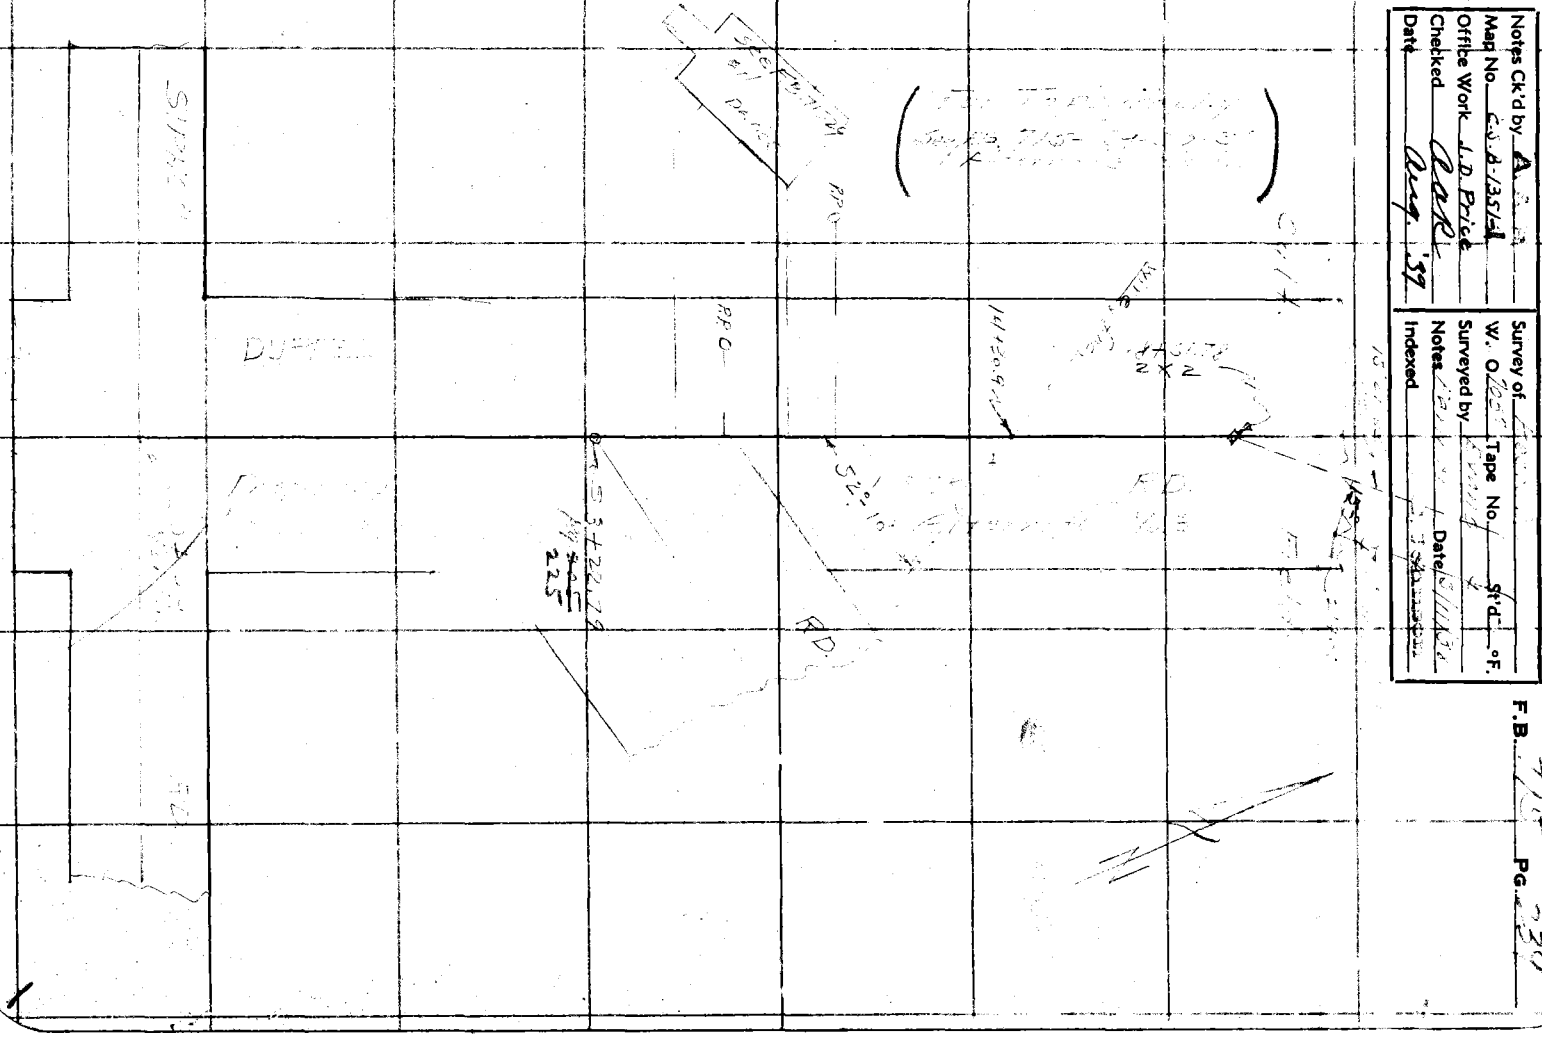

F.B. 715 PG. 240

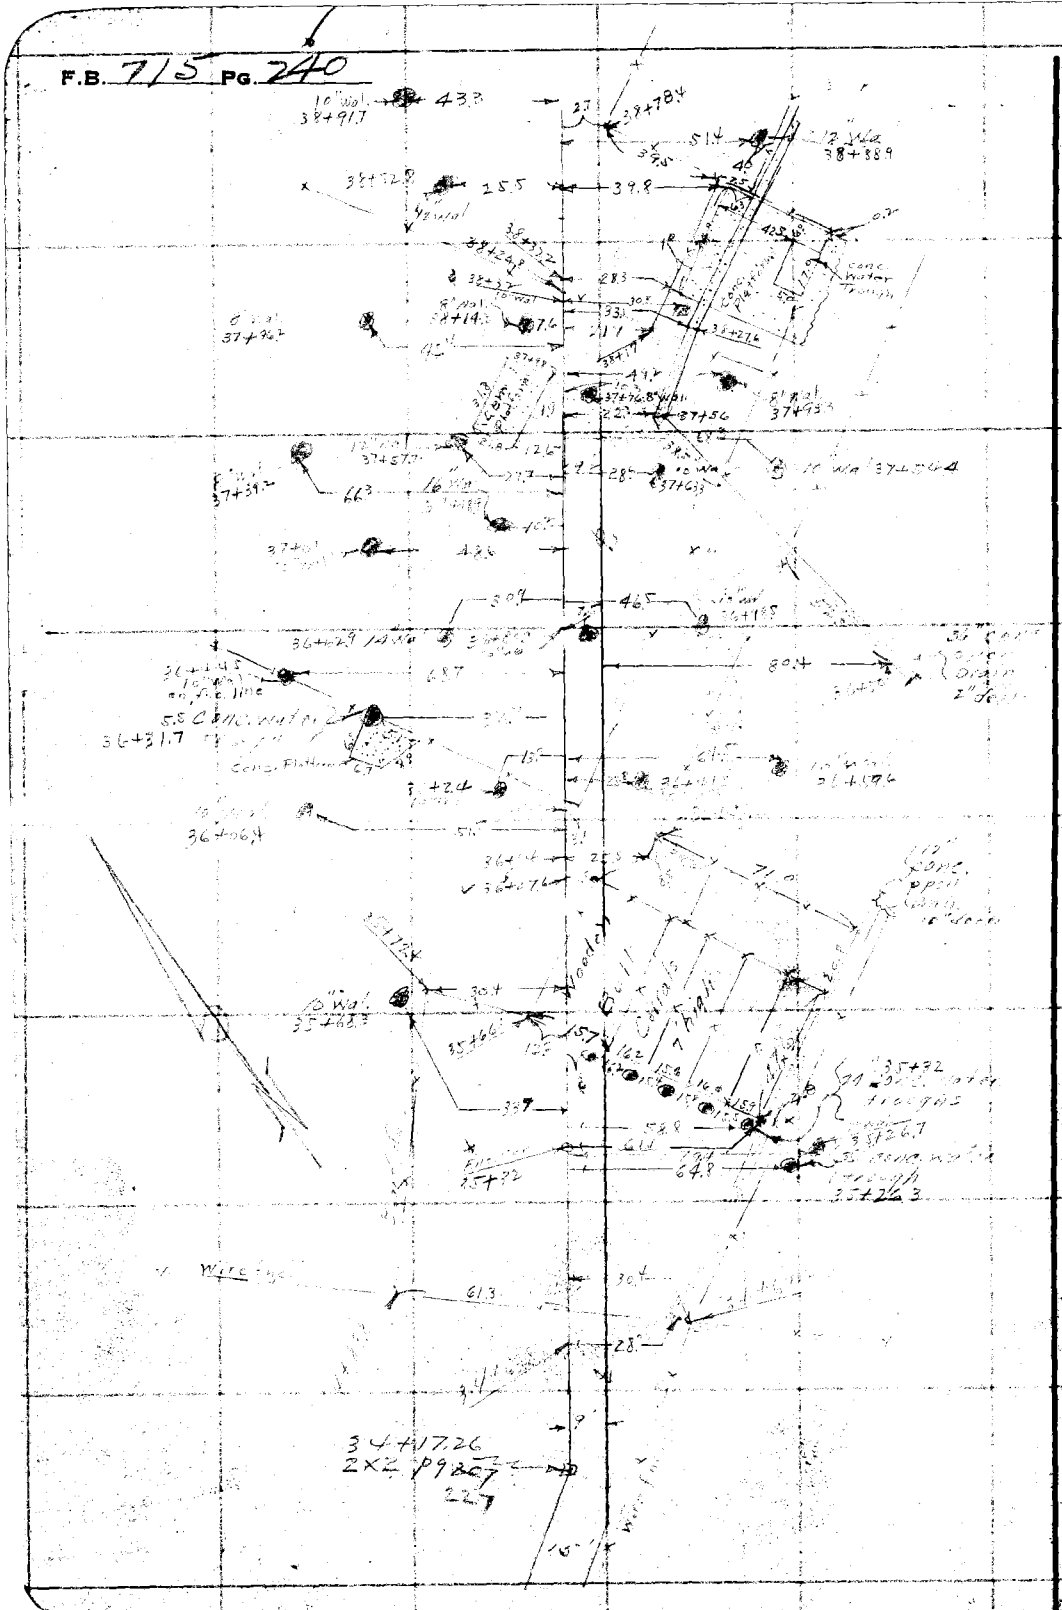

RETURN TO
LOS ANGELES COUNTY SURVEYOR
700 HALL OF RECORDS

Note: Any Additions or Changes on This Sheet Must be Made or Circled in Red Ink With Date and Name of Person Making Change.

Do not extend notes this side of this line

Notes Ck'd by	Survey of
Map No. C.S. B-135/3	W. O. Tape No. St'd °F.
Office Work J.D. Price.	Surveyed by
Checked Geo. R.	Notes Date
Date Aug. '39	Indexed 3-22-38

F.B. 715 PG. 41

Note: Any Additions or Changes on This Sheet Must be Made or Circled in Red Ink With Date and Name of Person Making Change

Do not extend notes this side of this line

RETURN TO
LOS ANGELES COUNTY SURVEYOR
700 HALL OF RECORDS

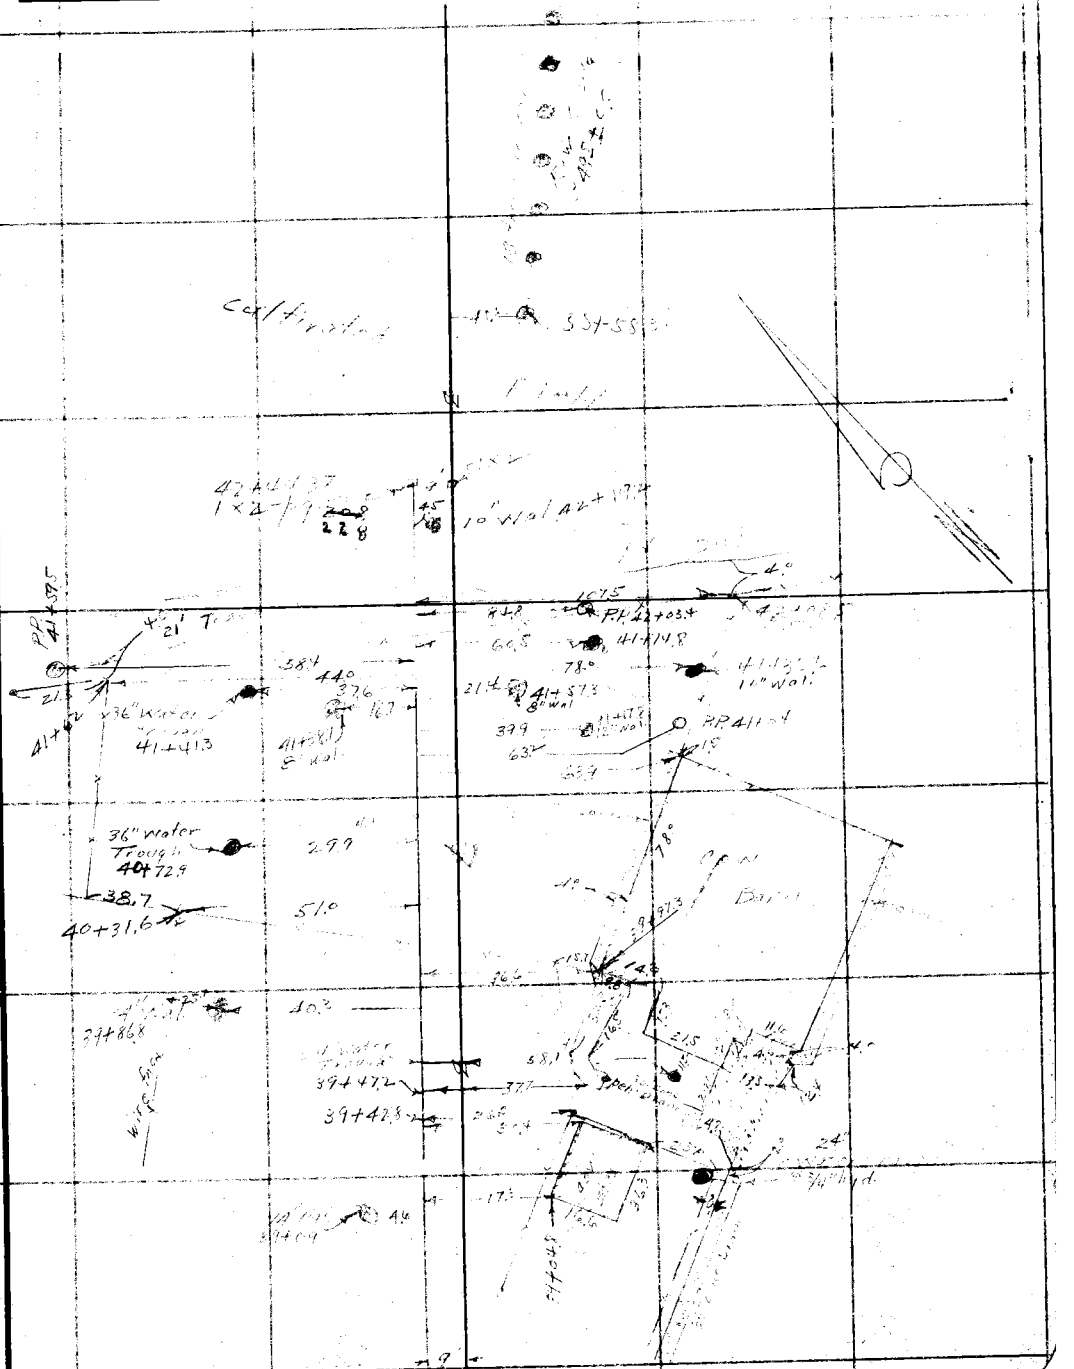

FORM 247 10M 11-38

RETURN TO
LOS ANGELES COUNTY SURVEYOR
700 HALL OF RECORDS

Note: Any Additions or Changes on This Sheet Must be Made or Circled in **Red Ink** With Date and Name of Person Making Change.

Do not extend notes this side of this line

F.B. 715 PG. 22

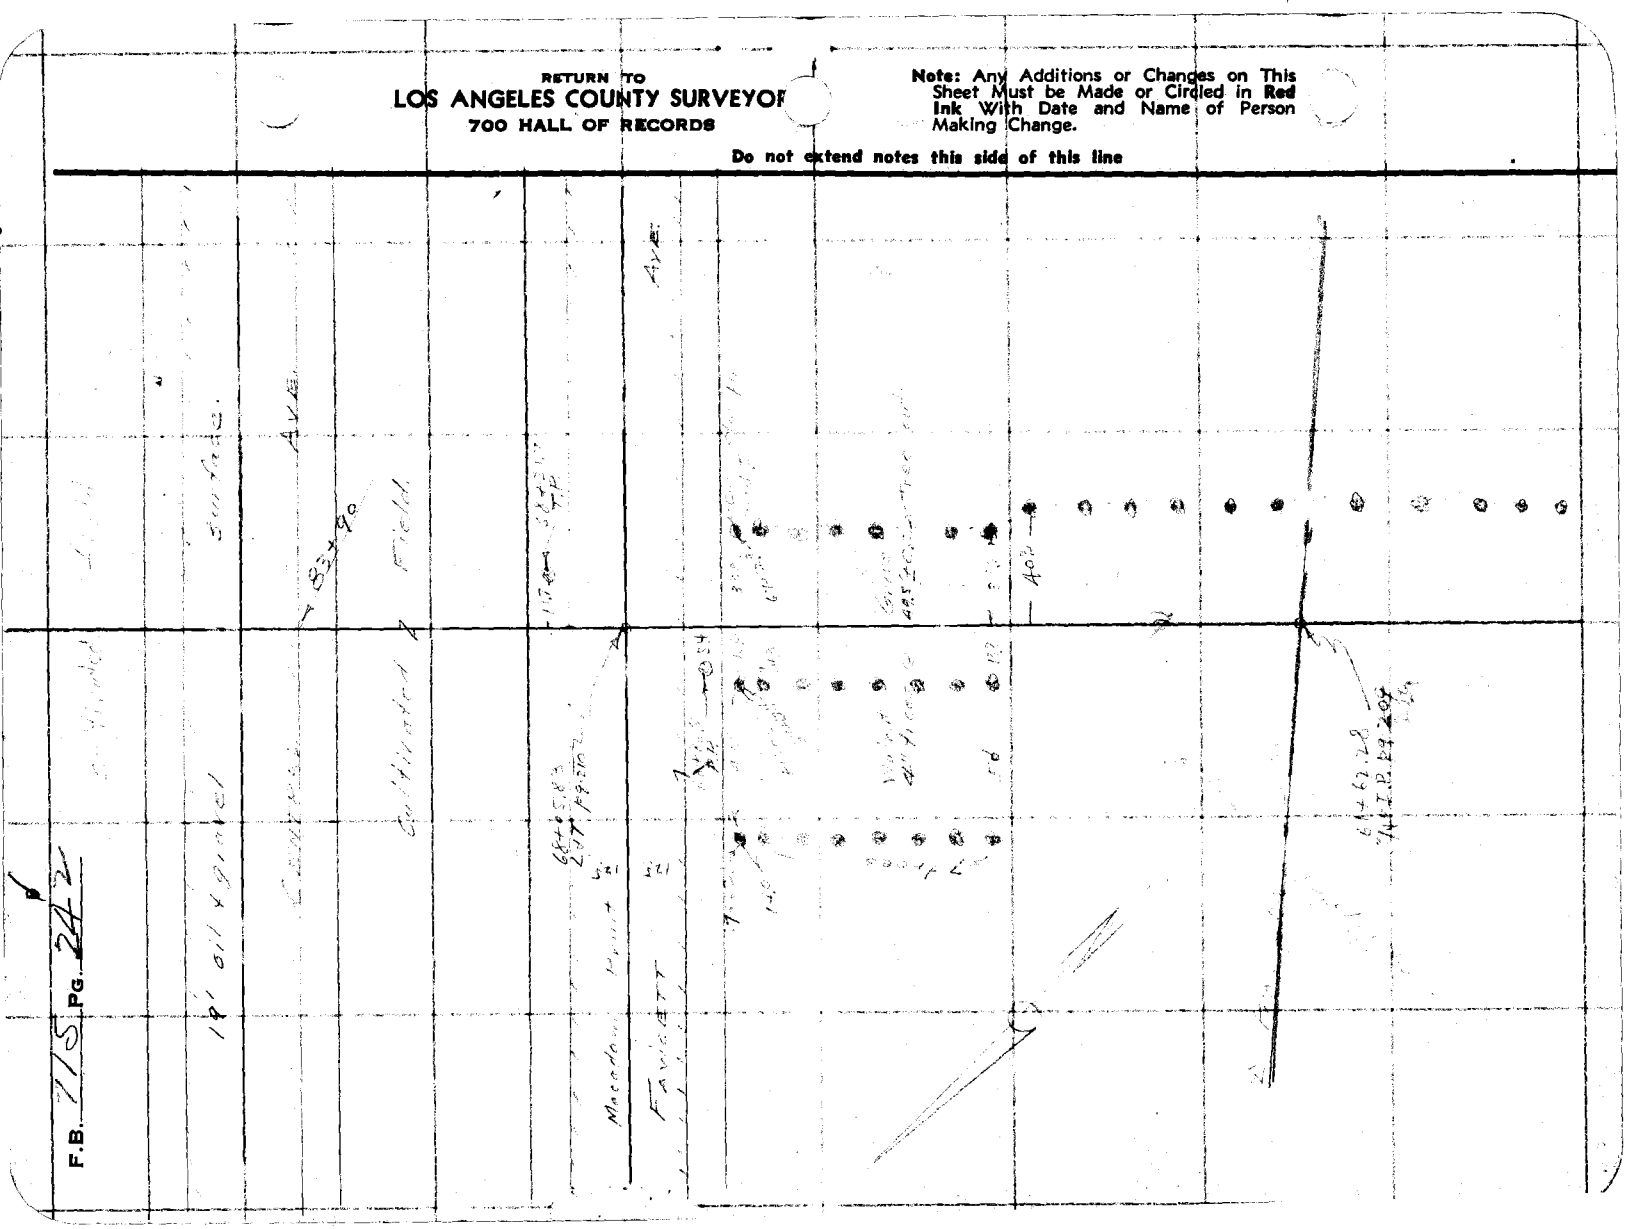

Notes Ck'd by	Survey of
Map No. C.S. B-1357-1	W. O. Tape No. St'd °F.
Office Work J. P. Price	Surveyed by EVANS
Checked Capt	Notes Date
Date Aug. '39	Indexed

F.B. 715 PG. 42

Note: Any Additions or Changes on This Sheet Must be Made or Circled in Red Ink With Date and Name of Person Making Change.

Do not extend notes this side of this line

RETURN TO
LOS ANGELES COUNTY SURVEYOR
700 HALL OF RECORDS

FORM 247 10M 11-38

77+07.8

Row

77+13.9

75°

77+14

P.I.

P.I.

1X2-91+11.49
P.P. 232

P.P. 232

F.B. 715 PG. 247

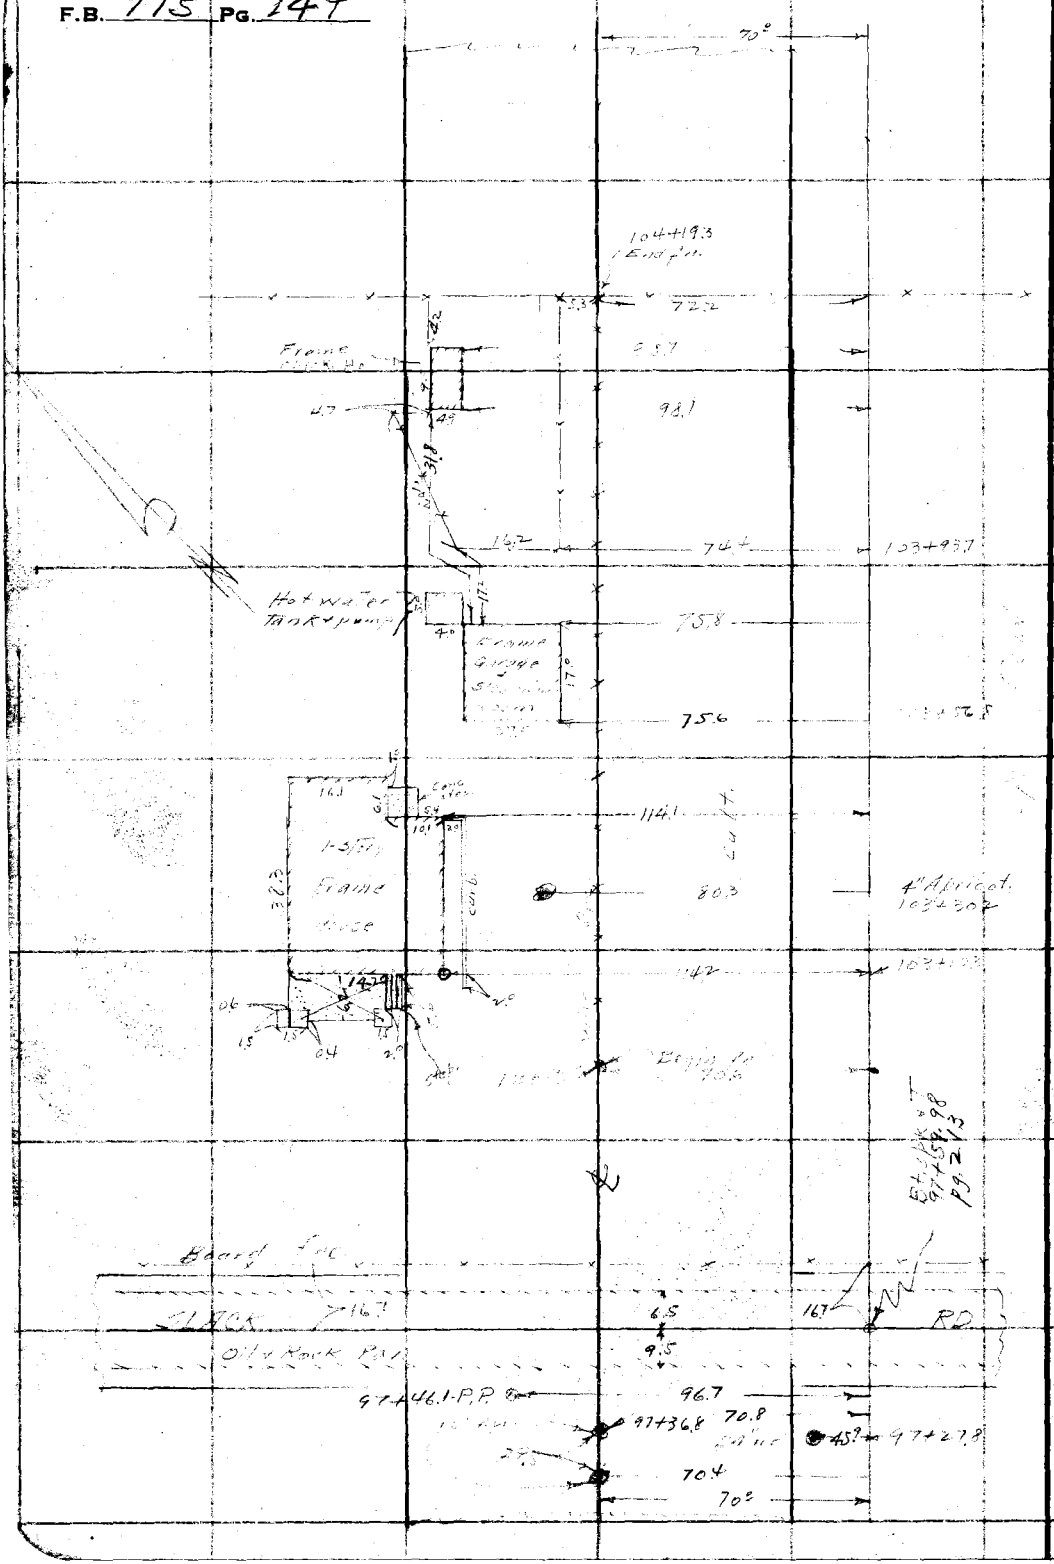

RETURN TO
LOS ANGELES COUNTY SURVEYOR
700 HALL OF RECORDS

Note: Any Additions or Changes on This Sheet Must be Made or Circled in Red Ink With Date and Name of Person Making Change.

Do not extend notes this side of this line

Notes Ck'd by	Survey of
Map No. C.S. B-1351-1	W. O. 20[illegible] Tape No. St'd °F.
Office Work J. D. Price.	Surveyed by
Checked OAR	Notes Date
Date Aug. '39	Indexed

F.B. 715 Pg. 45

Note: Any Additions or Changes on This Sheet Must be Made or Circled in Red Ink With Date and Name of Person Making Change.

Do not extend notes this side of this line

RETURN TO
LOS ANGELES COUNTY SURVEYOR
700 HALL OF RECORDS

FORM 247 10M 11-38

RETURN TO
LOS ANGELES COUNTY SURVEYOR
700 HALL OF RECORDS

Note: Any Additions or Changes on This Sheet Must be Made or Circled in Red Ink With Date and Name of Person Making Change.

Do not extend notes this side of this line

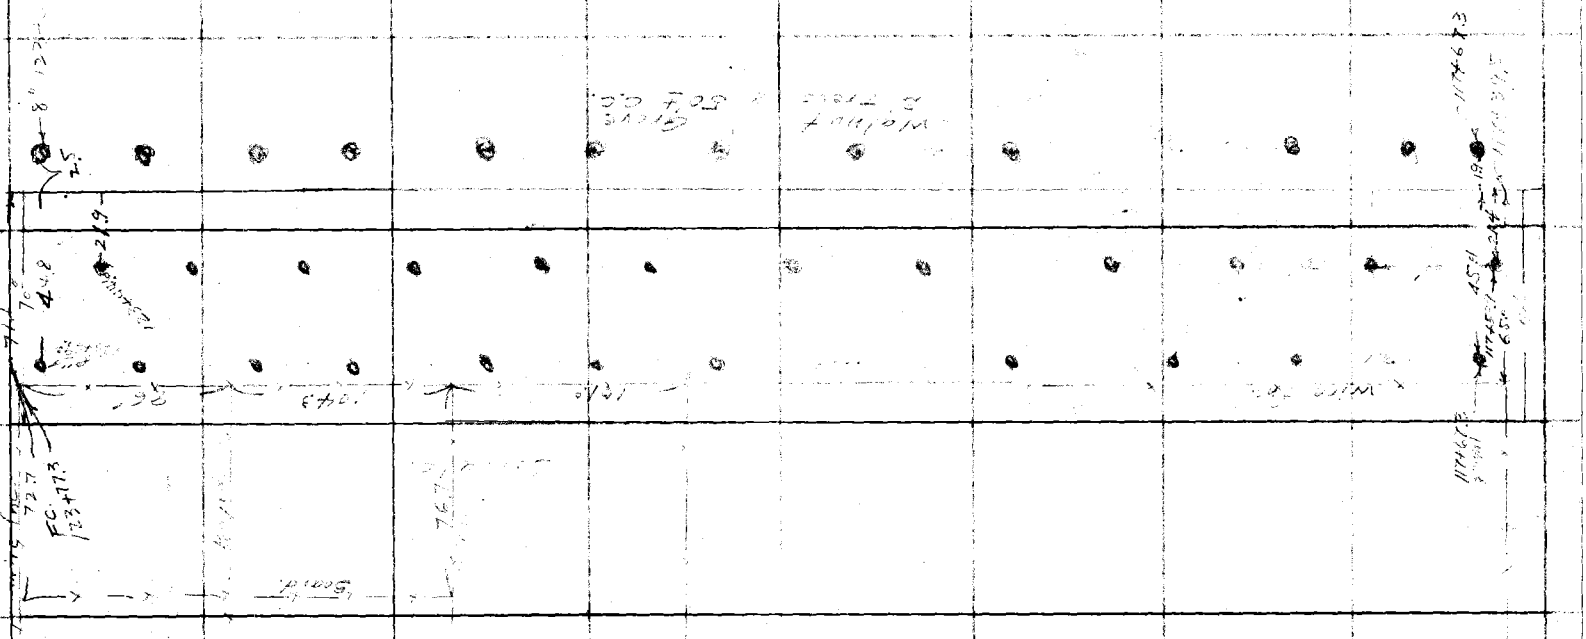

F.B. 715 Pg. 246

Notes Ck'd by	Survey of
Map No. C.S.B. 135-1	W. O. Tape No. St'd °F.
Office Work J. D. Price	Surveyed by
Checked	Notes Date
Date Aug. 39	Indexed

F.B. 715 Pg. 241

33 C-1

FOR POINTS NORTH OF WEAVER SEE F.B. 715-214

VIEW MT.

WEAVER AVE

70'

85'

90'

RETURN TO
LOS ANGELES COUNTY SURVEYOR
700 HALL OF RECORDS

Note: Any Additions or Changes on This Sheet Must be Made or Circled in Red Ink With Date and Name of Person Making Change.

Do not extend notes this side of this line

FORM 247 10M 11-38

RETURN TO
LOS ANGELES COUNTY SURVEYOR
700 HALL OF RECORDS

Note: Any Additions or Changes on This Sheet Must be Made or Circled in **Red Ink** With Date and Name of Person Making Change.

Do not extend notes this side of this line

F.B. 715 Pg. 248

Notes Ck'd by
Map No. GS-B-139-1
Office Work J. R. Price
Checked
Date

Survey of
W. O. 7052 Tape No. 013 St'd 2 VF
Surveyed by EVANS
Notes H Date 5-'39
Indexed
5-11-39

F.B. 715 PG. 279

To Ext. Apg. 250

LINE CHANGE.
REVISION No. 1
ALTERNATE No. 3.
From
SIPHON RD
to
WORSHAM RD.
(See pg. 225 for orig. line)

EVANS-H
BROCK-K
NAUMAN-HC
SEDIG.-R.C.
MAXWELL-R.C.

Adopted & Rec. G.S. B-9644
(1160.00 Rad.)

DURFEE AVE.

ADOPTED P.I.
Fd. GRANT, Flush
by ties, F.B. 511/217
(Ties pg. 193)

Note: Any Additions or Changes on This Sheets Must be Made or Circled in Red Ink With Date and Name of Person Making Change.

Do not extend notes this side of this line

RETURN TO
LOS ANGELES COUNTY SURVEYOR
700 HALL OF RECORDS

FORM 247 5M 10-37

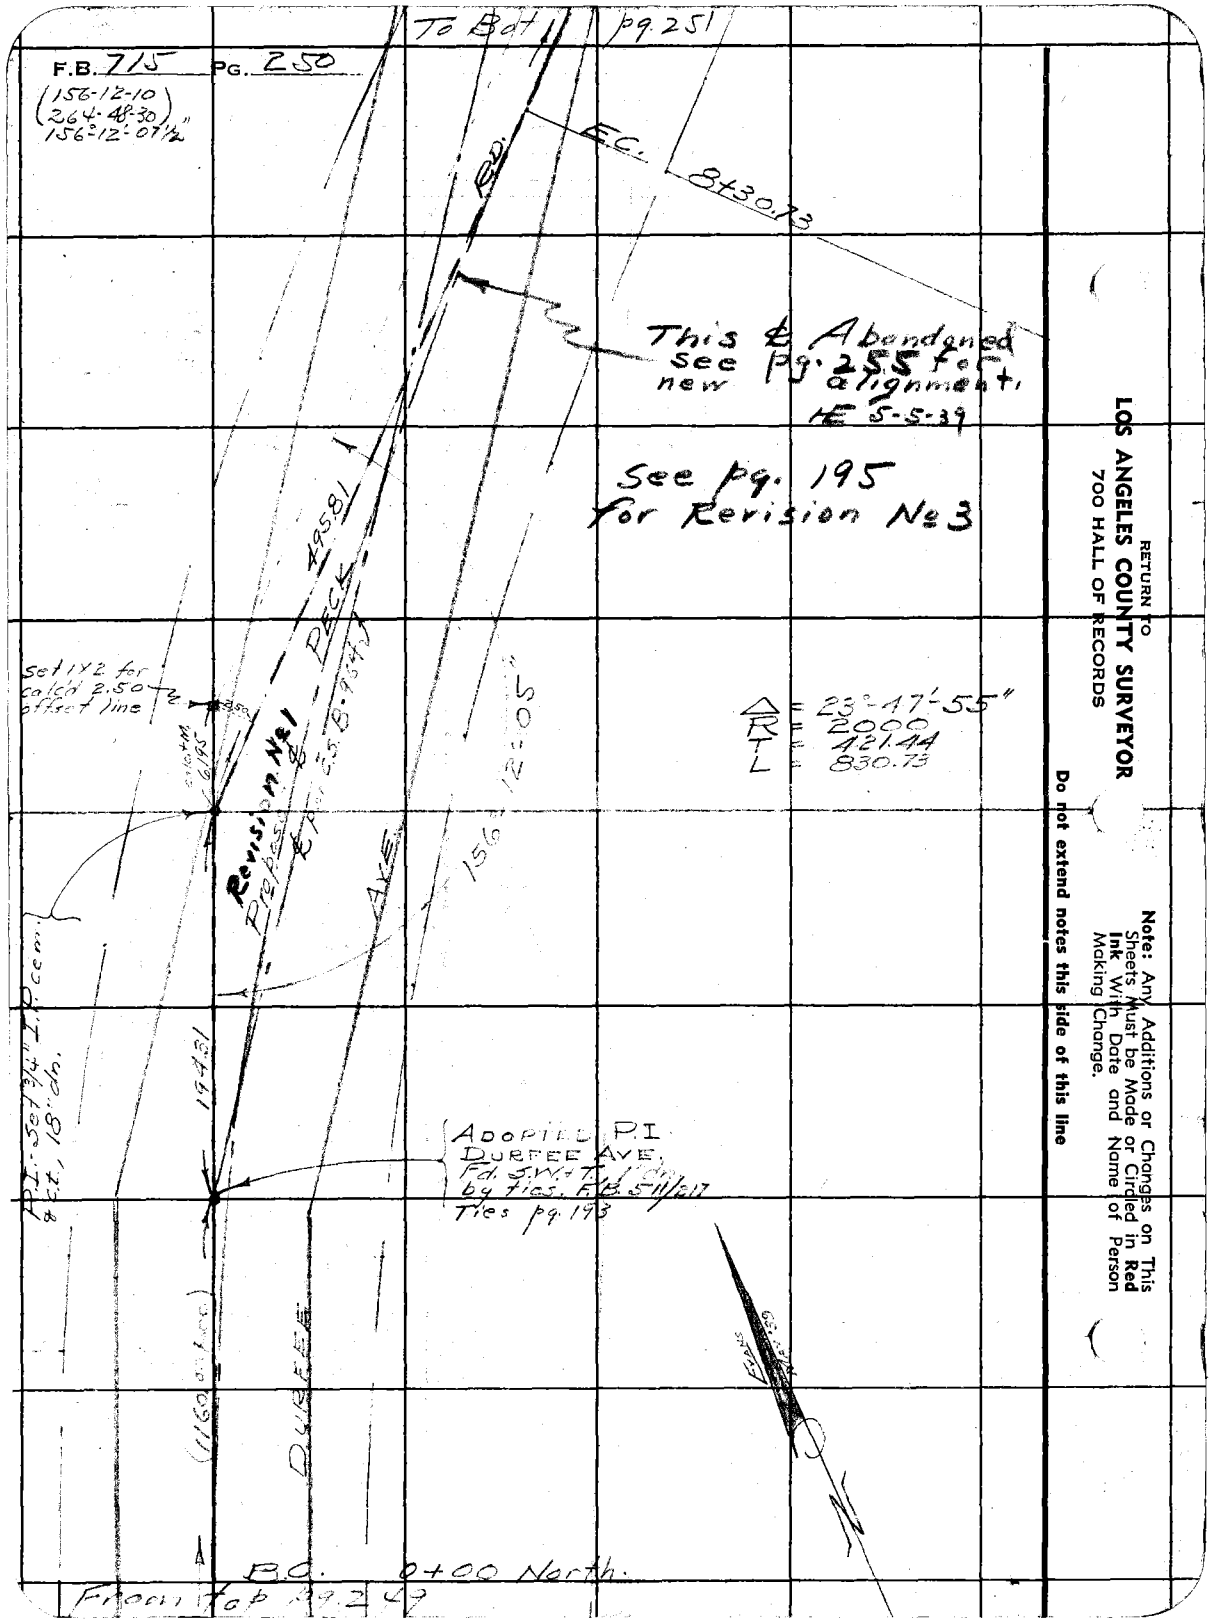
To Bat 1 pg. 251
F.B. 715 PG. 250
(156-12-10)
(264-48-30)
156-12-07½"
P.C. 8430.73
This & Abandoned
See pg. 255 for
new alignment
E 5-5-39
See pg. 195
for Revision No 3
RETURN TO
LOS ANGELES COUNTY SURVEYOR
700 HALL OF RECORDS
Note: Any Additions or Changes on This Sheets Must be Made or Circled in Red Ink With Date and Name of Person Making Change.
Do not extend notes this side of this line
Set 1½ for
calcd 2.50
offset line
Revision No 1
Pipeline
E Apr 35 8-1934
49581
PECK
AVE
156-12-10"
Δ = 23°-17'-55"
R = 2000
L = 421.44
T = 830.73
1943.81
ADOPTED P.I.
DURFEE AVE.
Fd. 3/4" I.P. in ch.
by ties. F.B. 5-11/217
Ties pg. 193
DURFEE
(1150 ± Prop.)
B.C. 0+00 North.
From Top pg. 249

Notes Ck'd by
Map No. C.S.B-137-1
Office Work by J. D. Price
Checked
Date

Survey of Peck Rd
W. O. 7052 Tape No. 013 St'd 84 OF
Surveyed by EVANS
Notes FE Date 5-139
Indexed

F.B. 715 PG. 251

See Pg. 195 for Revision No 3

To Bk pg. 251

37.4-3

AVE.

179.44

Revision No 1.

RD.

This ℄ Abandoned see pg. 255 for New Alignment.

Fd SW ℄ F.B. 715-11 F.B. 541-25

76° Per F.B.

51' 715-11 40"

℄ RD.

SIPHON

set N℄T

50.88

P.O.T. - 9+05.10 Set S.W. ℄ T. INTERSN.

179°-50'-55"

113°-49'-15"

PECK

SURFEE

Fd L℄T Per F.B. 715-11 See F.B. 299-12 F.B. 511-21 78 F.A. 172-2

Revision No 1.

495.81

PROPOSED

495.81 - T 84°

(179-50-50)
359-23-30
179°-50'-52½"

(113-49-10)
95-16-50
113°-49'-12½"

From ℄ pg 250

Note: Any Additions or Changes on This Sheets Must be Made or Circled in Ink With Date and Name of Person Making Change.

Do not extend notes this side of this line

RETURN TO
LOS ANGELES COUNTY SURVEYOR
700 HALL OF RECORDS

FORM 247 5M 10-37

F.B. 715 PG. 252

To Bot. pg. 253

37 A-3

RETURN TO
LOS ANGELES COUNTY SURVEYOR
700 HALL OF RECORDS

Note: Any Additions or Changes on This Sheets Must be Made or Circled in Red Ink With Date and Name of Person Making Change.

Do not extend notes this side of this line

(152-25-50
249-43-30
152°25'52½"

1045.77-T 76'=1045.72

This & Abandoned
See pg. 256 for
New Alignment.

See Pg. 195
for Revision
No. 3.

152°-25'-55"

1045.72

AVE.

F.L.&T.-RT.
F.B. 715-12
F.B. 721-24

P.O.T.-1410.52
Set L&T by int's'n.

RD.

PRICK

DURFEE

218.18

320.98

320.98

320°-49'-30"=320.98

F.L.&T.
F.B. 715-12

17.67

Set 1"x2" Stake
by Transit Int's'n.

PROPOSED

REVISION No. 1

P.O.T.-10.44
Set 2"x2"-18"

R=8°
2,500

179.44

From Top

pg. 251

To Bot pg. 254

Notes Ck'd by
Map No. S.S.B-134-1
Office Work J.D. Price
Checked
Date

Survey of PECK RD
W. O. 7052 Tape No. 013 St'd 24 OF
Surveyed by EVANS
Notes HE Date MAY 1939
Indexed

F.B. 715 Pg. 253

449.37 - T66° = 449.32

37 A-2

(69-23-30)
(277-33-50)
69°-23'-27½"

Fd. 2x2 Loaded in F.B. 715 pg. 13

69°-23'-30"

W¼ Line Lot 8

PECK RD. No. 1

This ℄ Abandoned
See pg. 257 for
New ℄

See pg. 197
for Revision No. 3

P.O.T. - Set 2x2, 14" dn. ℄ intersn.

T.L. 6.38
449.32

S.E. cor. Lot 7, Tr. 3638 - Fd. 2" I.P. cem. & spikes ctr. 14" dn. by 1.5' bears E. 0.7 & S. 1.3.

DUFFEE AVE.

2.50 offset ℄ Proposed
1045.72

REVISION

PROPOSED

From Top

pg. 252

RETURN TO
LOS ANGELES COUNTY SURVEYOR
700 HALL OF RECORDS

Note: Any Additions or Changes on This Sheets Must be Made or Circled in Red Ink With Date and Name of Person Making Change.

Do not extend notes this side of this line

FORM 247 5M 10-37

F.B. 715 PG. 254

See pg 227

90° offset line
F.B. 715-227

Ely Line Lot 9 - Tr. 3638

5 ft. offset line

set nail

20' 9'

2.66'

P.I. set 3/4" I.P.
Con't at 18" ±dn.

Fd. 2 x 2
12" dn. per
F.B. 715-227

This ℄ Abandoned
See pg. 258 for new ℄

See pg. 198 for
Revision No 3

REVISED

From F.B. pg. 253

RETURN TO
LOS ANGELES COUNTY SURVEYOR
700 HALL OF RECORDS

Note: Any Additions or Changes on This Sheets Must be Made or Circled in Red Ink With Date and Name of Person Making Change.

Do not extend notes this side of this line

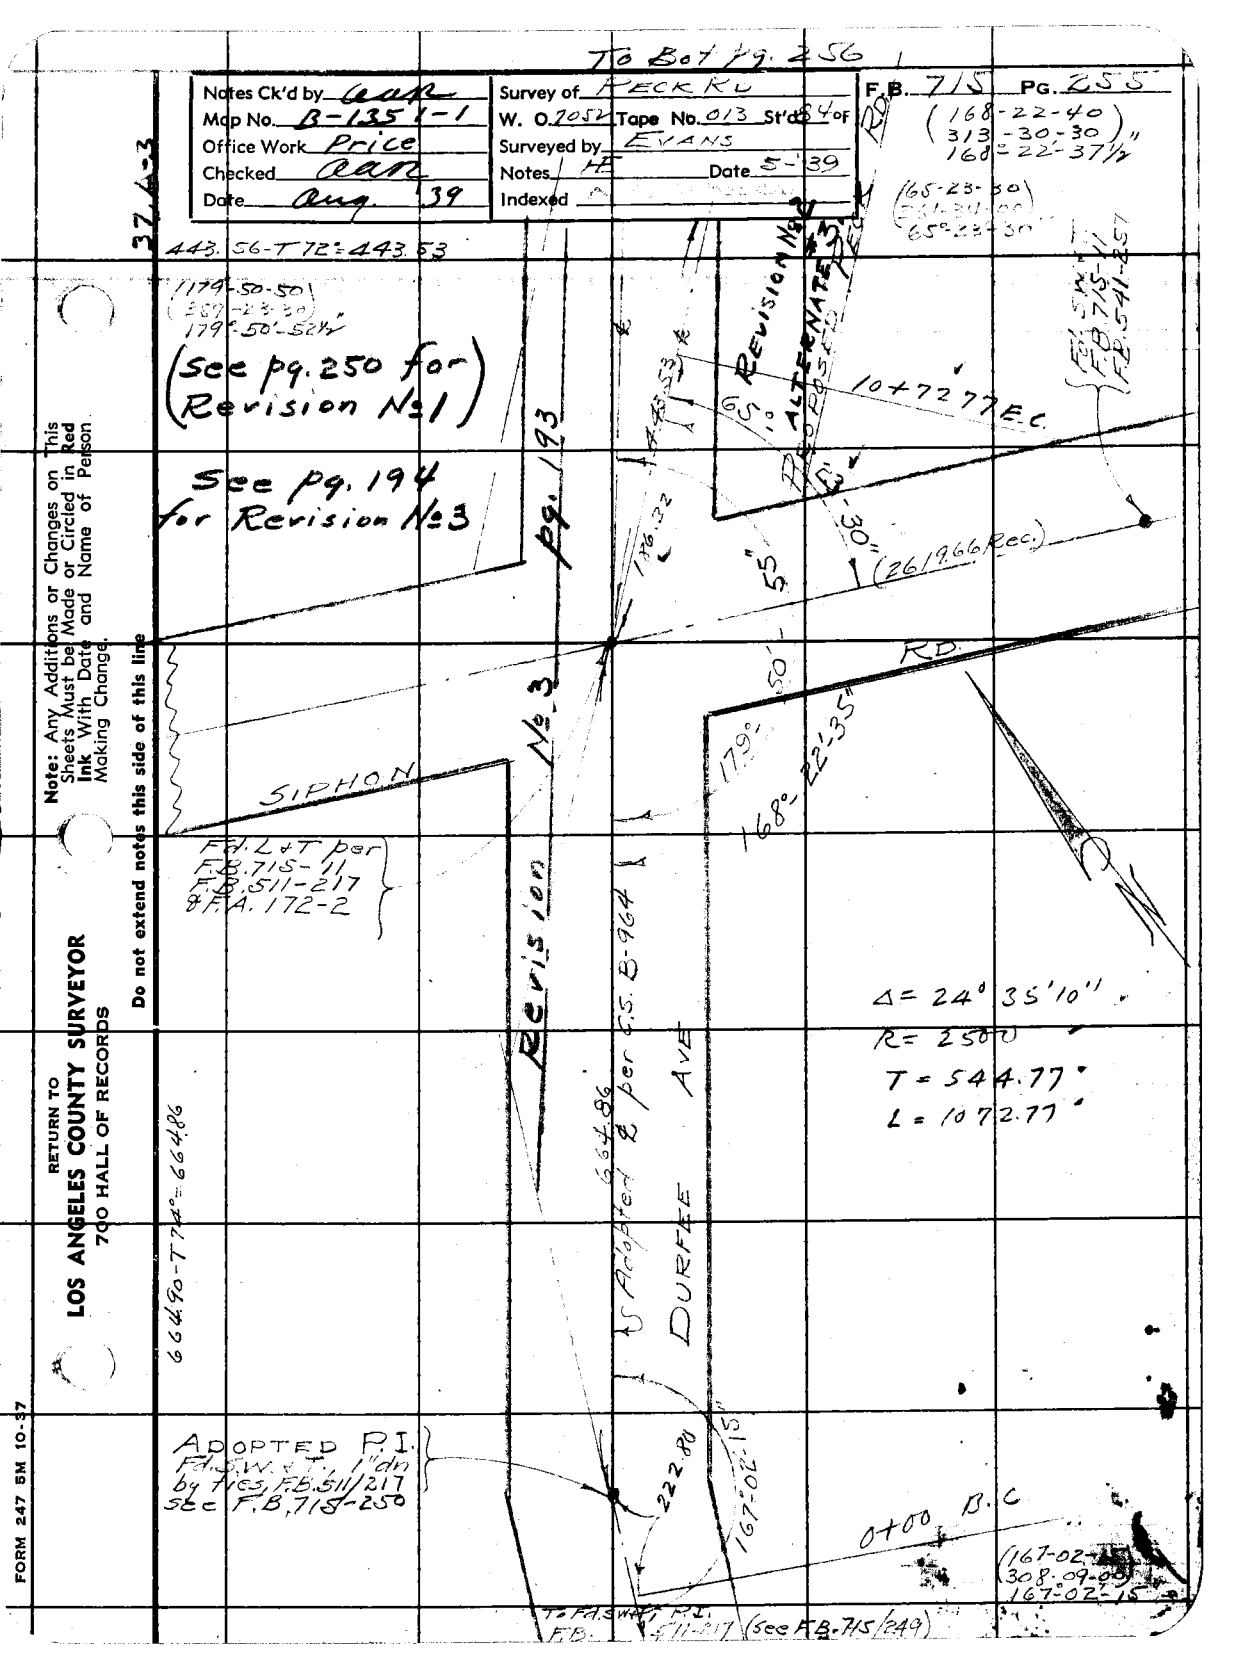
To Bot Pg. 256
Notes Ck'd by CAR
Map No. B-135 1-1
Office Work Price
Checked CAR
Date Aug. 39
Survey of PECK RD
W. O. 2052 Tape No. 013 St'd 84°F
Surveyed by EVANS
Notes HE Date 5-'39
Indexed
F.B. 715 Pg. 255
(168-22-40
313-30-30
160°-22-37½"
(65-23-30
65°-23-30"
37.6-3
443.56-T 72=443.53
(179-50-50
359-23-30
179°-50-52½"
(See pg. 250 for
(Revision No 1)
See pg. 194
for Revision No 3
Pg. 193
Revision No. 3
65° ALTERNATE
10+72.77 E.C.
(26.966 Rec.)
RD.
179°-50'-55"
168°-22'-35"
SIPHON
Fd. L & T per
F.B. 715-11
F.B. 511-217
& F.A. 172-2
Revision
664.86
Adopted & per C.S. B-964
DURFEE AVE
Δ = 24° 35' 10"
R = 2500
T = 544.77'
L = 1072.77'
664.90-T 72=664.86
ADOPTED P.I.
Fd. S.W. & 1" dn
by T.C.S. F.B. 511/217
Sec F.B. 715-250
222.80
167-02-15
0+00 B.C
(167-02-15
308-09-00
167-02-15
To Fd. S.W. & P.I.
F.B. 511-217 (see F.B. 715/249)
RETURN TO
LOS ANGELES COUNTY SURVEYOR
700 HALL OF RECORDS
Note: Any Additions or Changes on This Sheets Must be Made or Circled in Red Ink With Date and Name of Person Making Change.
Do not extend notes this side of this line
FORM 247 BM 10-57

RETURN TO
LOS ANGELES COUNTY SURVEYOR
700 HALL OF RECORDS

Note: Any Additions or Changes on This Sheets Must be Made or Circled in **Red Ink** With Date and Name of Person Making Change.

Do not extend notes this side of this line

37 A-3

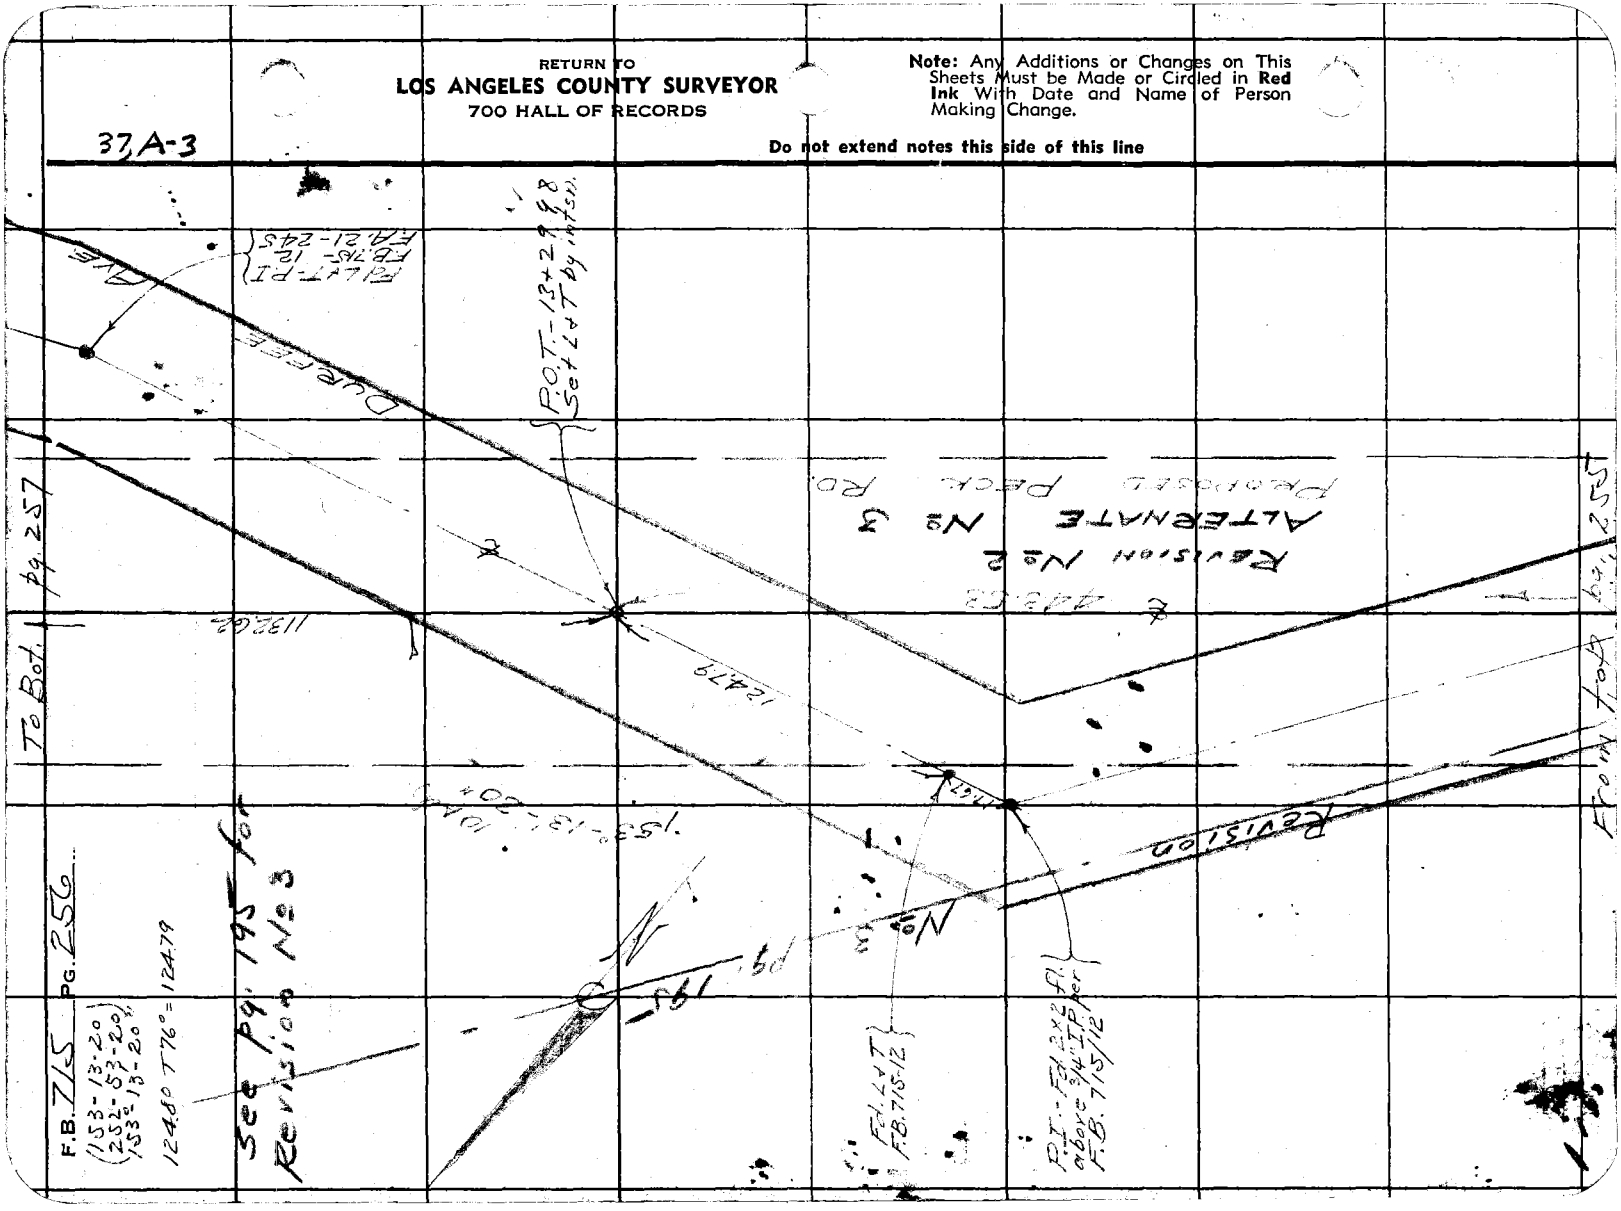

FORM 247 5M 10-37

RETURN TO
LOS ANGELES COUNTY SURVEYOR
700 HALL OF RECORDS

Note: Any Additions or Changes on This Sheets Must be Made or Circled in Red Ink With Date and Name of Person Making Change.

Do not extend notes this side of this line

37-A-2

Notes Ck'd by Quirk
Map No. B-1351-1
Office Work Price
Checked Quirk
Date Aug. '38

Survey of W. O. 2623
Tape No. 613 Std. 8 1/4 F
Surveyed by EVANS
Date May 31
Notes
Indexed

F.B. 715 Pg. 257

1132.71 - T72° = 1132.62

See Pg. 197 for Revision No. 3

Revision No. 3 Pg. 197

P.O.T. - 24+62.60 Set 2"x2", 14" dn. by inter. sta.

Fd. 2"x2" 10" dn. F.B. 715-226

W. Line Lot 7 Tr. 3638

From Pg. 256

1132.62

289.9

1812.97

Revision No. 2
Alternate No. 3.
Proposed Peck Rd.

109.01

S 21°-16' E 215.72

0.95 S. Fence Post

Wire fence around tanks

F.B. 746-1962

Steel Tanks

S.E. cor Lot 7 Tr. 3638
Fd. 2" I.P. conc. & spk. ctr. 14" dn., by ties F.B. 715-13

Durfee Ave.

1813.16 - T 68° = 1812.97

475.98 - 766° = 475.92

(104-44-40)
(79-46-40)
(0.0904.0918 1/2)

F.B. 715 PG. 258

(176-02-30
344-10-10
176°-02'-32½"

See Pg. 227-228.

461.41
Calc to Workman Rd.

46+20.74 E.C.

37.82

R/S
R.S. 31/88
Pg. 198

Ely line Lot 9 Tr. 3638

5 ft. offset line

R.P. - Set 3/4" I.P. Cem. & C.L. chk. 15" deep.

(R.P. Set 3/4" I.P. Cem. 18 dn.

R.P. - Set 3/4" I.P. Cem. & C.L. chk. 18 dn.

Fd. 2x2-12" dn. F.B. 715-227

79.89

105°-42' Ref. F.B. 715-227

S 44°-30'-00" W

50'

90°

90°

90°

Δ = 3°-57'-25"
R = 10000
T = 345.45
L = 690.62

Lot 9 - Tr. 3638

Ely Line

Revision No 2
ALTERNATE
PROPOSED PECK RD.

See P.S. 198 for Revision No 3

EVANS
MAY 1959

37+30.12 E.C.

From top Pg. 257

LOS ANGELES COUNTY SURVEYOR
700 HALL OF RECORDS

Return To

Do not extend notes this side of this line

Additions or Changes on This Sheet Must be Made or Circled in Red Ink With Date and Name of Person Making Change.