Survey of
W. O. Tape No. St'd °F
Surveyed by
Notes Date
Indexed

F. B. Pg.

Date

76-3005 2x7 10M

Profile No. 78-11 | Notes Rod. | Plotted | Job No. | Division No. L.B.
Date | Date | Survey of
X-Sec. No. | Notes Chkd. | Checked | Survey by | Notes A. C. Johnson | Date
Date | Date | Map No. | Indexed

FIRE CISTERN SYSTEM
PROFILE AND CROSS SECTIONS
ON
TUNA CAN. RD. FROM TANK
SITE NO 3 TO POWER LINE
VICINITY PE 106
J.N 5211

d/o - EC CURVE NO 103 FD 695-103

(Pages 1 to 14) Note- These B.M's. are adjusted to agree with datum per (U.S. 1120) O.S.C.+G.S. 1929
A.E. Timmons

NOTE: ANY ADDITIONS OR CHANGES ON THIS SHEET MUST BE MADE, OR CIRCLED IN RED INK, WITH DATE AND NAME OF PERSON MAKING CHANGE

Do not extend notes this side of this line

PLEASE RETURN TO
LOS ANGELES COUNTY SURVEYOR
700 HALL OF RECORDS

Form [illegible]

STATION	B.S.	H.I.	F.S.	ELEV.

Form 307 5M 10-34

PLEASE RETURN TO
LOS ANGELES COUNTY SURVEYOR
700 HALL OF RECORDS

NOTE: ANY ADDITIONS OR CHANGES ON THIS SHEET MUST BE MADE OR CIRCLED IN RED INK, WITH DATE AND NAME OF PERSON MAKING CHANGE

Do not extend notes this side of this line

Profile No. 21-11 Power & Light Co. Notes Plotted Date 6-11-37 X-Sec. No.
Division No. 5211 Notes Checked Date JUN 4 1937 H. L. MARTIN Checked Date JUN 7 1937 Notes Chkd. L. MARTIN Date JUN 7 1937
Job. No. 5211 Notes Survey of FIRE SYSTEM Notes Survey by STEVENSON Notes Indexed C. JAMESON Date 5-26-37

(Tuna Canyon Rd.) (at Sta 0+23)

STATION	B. S.	H. I.	F. S	ELEV.	
B.M. 11A	5.97	1752.161		1746.991	3/4" IP 20 N. ± Fernwood Pacific Dr. 60'W Forestry TP # 3-56 FB 695-8 Datum per U.S.G.S. Adj. of 1928 (U.S. 1140)
0+0			5.32	1746.4	±
			4.60	1743.6	11° R c/l ~11 Pos
			5.50	1741.6	2° L
			6.7	1746.3	5.5 L Gutter
			0.0	1753.0	15° L
0+25					
			5.6	1741.4	30 L c/l
			6.4	1746.6	11° L Tangent
			7.2	1743.8	17° L Curve
			3.3	1744.5	4° L c/l
			2.5	1744.3	±
			7.7	1745.3	10° L E/C/L
0+50			10.90	1742.06	74 R E/C/L
			10.74	1742.22	±
			10.8	1742.06	30 L c/l
			11.6	1741.4	124 L Gutter
			11.0	1742.0	15 L ~ p. on L
			12.7	1740.3	30° L R/W.
TP	0.387	1741.598	11.75	1741.211	

Form 307 5M 10-34

PLEASE RETURN TO
LOS ANGELES COUNTY SURVEYOR
700 HALL OF RECORDS

NOTE: ANY ADDITIONS OR CHANGES ON THIS SHEET MUST BE MADE OR CIRCLED IN RED INK, WITH DATE AND NAME OF PERSON MAKING CHANGE

Do not extend notes this side of this line

Profile No. 78-17 Div. No. 3611 Division No. [illegible] L.B. 7725 Pg. [illegible]
X. Sec. [illegible] Date 4 1933 Date 6-11-33 Survey of [illegible]
No. [illegible] Name of [illegible] MARTIN Checked A. L. MARTIN Survey by Stevenson Notes A. C. Johnson Date [illegible]
Date JUN 7 1933 Date JUN 7 1933 Map No. 78-18 Indexed [illegible]

STATION	B. S.	H. I.	F. S	ELEV.		
		1741.598				
0+75			1.82	1739.78	℄	
			2.1	39.5	38 R So. & E ℄	
			1.50	40.10	89 L No. E & R/	
			1.60	40.00	18° L	
			3.7	37.9	26° L Gutter	
			3.4	38.2	30° L	
1+00			4.18	37.42	℄	
			1.4	37.2	℄ Ed. So 2° R	
			3.5	38.1	Ed Ed. No. 11.2 L	
			2.7	38.9	17° L Top bank	
			6.9	34.7	30° L	
			10.8	30.8	38° L Top S/ to Her	
1+25			6.58	35.02	℄ So. Ed Pole	
			5.30	36.30	12.3 L No Ed	
			4.50	37.10	19.4 L Top bank	
			12.0	29 78.60	30 L To a S/.	
			13.5	28.1	35 L	
1+50			8.35	33.25	℄ S. Ed Ed	
			7.6	34.0	12.3 L No Ed	
			7.5	34.1	10° L Top bank	

Form 307 5M 10-34

PLEASE RETURN TO
LOS ANGELES COUNTY SURVEYOR
700 HALL OF RECORDS

NOTE: ANY ADDITIONS OR CHANGES ON THIS SHEET MUST BE MADE OR CIRCLED IN RED INK, WITH DATE AND NAME OF PERSON MAKING CHANGE

Do not extend notes this side of this line

L.B. 1225 P.G. 8

Job. No. 5211 Division No. Notes Miscellaneous Plotted Profile
Survey of FIRE CISTERN SYSTEM Date JUN 4 1937 No. 28-18
Survey by Sherrill Notes 3 Notes Chkd. H. L. MARTIN Checked H. L. MARTIN X-Sec.
Indexed A. C. Johnson Date 6-28-37 Date JUN 7 1937 Date JUN 7 1937 No.

STATION	B. S.	H. I.	F. S	ELEV.		
		1741.595				
			14.8	1726.8	30° L	
			21.9	197	13° L	Bldr
14+75			10.35	3125	L	
			10.6	310	3° L	Shed cl
			7.8	318	10° L	Shed cl
			7.5	321	11° L	Tree
			30.0	216	30° L	Bldg
			25.9	162	45° L	Shed Dr.
+[illegible]	0.805	1721.[illegible]	10.71	[illegible].805		
+40.0			2.50	2932	L	
			2.5	290	3.7 L	Shed cl
			3.7	279	11° E	Shed
			1.9	297	8° L	Shed
			1.8	298	12° L	Tree Bush
			13.2	183	5° L	Bldg
			11.5	121	40° L	Lt Con
24+25			4.16	2752	L	
			1.5	271	55° L	Shed
			5.6	260	9.7 L	Cutler
			3.9	277	63 L	Shed
			3.9	27.7	115 L	Tree bank

Form 307 5M 10-34

PLEASE RETURN TO
LOS ANGELES COUNTY SURVEYOR
700 HALL OF RECORDS

NOTE: ANY ADDITIONS OR CHANGES ON THIS SHEET MUST BE MADE OR CIRCLED IN RED INK, WITH DATE AND NAME OF PERSON MAKING CHANGE

Do not extend notes this side of this line

Profile No. 78-18 Date N 4 1937 Platted Date 6-11-37 Map No. ____ Division No. ____ L. B. ____ Pg. ____
X-Sec. No. ____ Notes Chkd. MARTIN Survey of ____ Notes ____
Date JUN 7 1937 Checked H. L. MARTIN Survey by ____ Date ____
Date JUN 7 1937 Map No. 78-18 Indexed A. C. Johnson

STATION	B. S.	H. I.	F. S	ELEV.		
		1731.6				
			15.5	17161	30 L	4/W
			18.6	090	40.8 L	bot. Dr.
1+47.77			5.2	258	80 L	
			5.2	252	78 L	4 of
			7.4	242	108 L	Gutter
			5.2	2598	43 L	2 of
			5.5	261	77 L	Top bank
			12.4	132	30 L	Rim
			25.2	058	45 L	bot. D
2+75			7.8	238	80 L	
			5.4	230	100 L	4 of S
			7.6	220	120 L	Gutter
			5.5	241	55 L	
			7.2	243	77 L	Top bank
			8.6	130	30 L	
			5.5	096	100 L	
#1	4.50	1726.1	3.55	1722.61		
3+00			1.32	2154	80 L	
			1.77	2089	40 R	So. Curb
			2.4	20,5	53 R	

Form 307 5M 10-34

PLEASE RETURN TO
LOS ANGELES COUNTY SURVEYOR
700 HALL OF RECORDS

NOTE: ANY ADDITIONS OR CHANGES ON THIS SHEET MUST BE MADE OR CIRCLED IN RED INK, WITH DATE AND NAME OF PERSON MAKING CHANGE

Do not extend notes this side of this line

Book 225 P.G. 30 Job No. 521 Division No. Notes Plotted Date 6-1-37 Profile No. 2-18
Survey of Pipe Culvert Sys. Notes Date 4 1937 Checked H.L. MARTIN X-Sec. No.
Survey by A. C. Johnson Notes Date JUN 7 1937 Chkd H.L. MARTIN Date JUN 7 1937
Indexed A. C. Johnson Date

STATION	B. S.	H. I.	F. S	ELEV.		
		1722.81				
			0.7	1722	11.5 L	Inlet
			1.3	1721.6	21.3 L	Top bank
			7.3	156	31.3 L	Bot bk
			9.5	134	45° L	
34+25			2.5	204	Side bank &	
			1.0	189	[illegible]	Gallon
			3.7	192	43 L	Inlet
			3.7	192	19° L	" "
			[illegible]	200	[illegible]	Storage
			4.1	188	35° L	" "
			2.7	178	[illegible]	
			7.5	154	45° L	
34+57.20			[illegible]	2036	[illegible]	Side bank
			8.5	147	8 L	Gutter
			7.75	1511	25 L	Inlet
			2.6	173	[illegible]	" "
			5.3	~~165~~	30 L	Inlet
			2.1	178	25 L	Top bank
			7.7	132	14 L	

Form 387 5M 10-34

PLEASE RETURN TO
LOS ANGELES COUNTY SURVEYOR
700 HALL OF RECORDS

NOTE: ANY ADDITIONS OR CHANGES ON THIS SHEET MUST BE MADE OR CIRCLED IN RED INK, WITH DATE AND NAME OF PERSON MAKING CHANGE

Do not extend notes this side of this line

STATION	B. S.	H. I.	F. S	ELEV.		
		172.861				
31 52 35			9.4	17135	E 1/2 d	
			9.5	134	2° R	
			8.1	1474	18° L 1/2 ed	
			7.0	159	24.2 L	
			10.1	129	30° L	
			16.2	067	40° L	SI Cor.
4+00			10.2	1263	E	
			13.0	130	1/2 ed	
			12.0	124	15.8 R Gutter	
			10.8	121	9.4 L 1/2 Rd	
			10.3	126	11.6 L Top bank	
			19.7	032	30° L	
			24.3	16983	40° L	SI Cor.
T.P.	1.988	173.257	11.59	171.271	S	
4+25			2.32	1004	S	
			1.4	109	1/2 ed	
			2.2	101	8.2 R	Gutter
			2.3	10.0	18 L	1/2 ed
			1.7	10.4	11 L	Top Bank
			12.8	003	11 L	

Profile No. [illegible] Division No. [illegible]
Datum 1912 Date 6-11-37 Survey of [illegible]
Notes Chkd. MARTIN Checked H. L. MARTIN Survey by Stevenson Notes
Date JUN 7 1937 Date JUN 7 1937 Map No. 78-E Indexed A. C. Jacobsen Date 5-28-37
No. X-Sec. No.

L.B. 765 Pg. 77

Form 307 5M 10-34

PLEASE RETURN TO
LOS ANGELES COUNTY SURVEYOR
700 HALL OF RECORDS

NOTE: ANY ADDITIONS OR CHANGES ON THIS SHEET MUST BE MADE OR CIRCLED IN RED INK, WITH DATE AND NAME OF PERSON MAKING CHANGE

Do not extend notes this side of this line

L.E. 225 P.G. 12 | Job. No. 521 | Division No. | Notes | Date JUN | Checked H. L. MARTIN | Date JUN 7 1937 | Profile | Plotted | Date | No. 18-18 | X-Sec. | No.

Survey of Edgewood System | Notes | Date JUN 7 1937

Survey by Stevenson | Notes | Date 5-28-37

Indexed by C. Johnson | Date

STATION	B. S.	H. I.	F. S	ELEV.		
		1712.257				
			[illegible]	16945	[illegible]	
			[illegible]	893	[illegible]	
	8.8	1709.912	[illegible]	[illegible]		
1+50			1.8	0809	℄	
			1.2	0866	10.7 RE ed	
			3.2	077	13.6 E Gutter	
			3.1	078	37 L ed ed	
			1.4	075	53 L Top bank L	
			19.1	16908	30 L	
			25.4	885	40 L	
4+75			3.1	170620	℄	
			3.3	066	8.1 E ed ed	
			3.8	061	10.6 E Gutter	
			4.1	058	6.1 L ed. ed.	
			3.8	061	10.2 L. Top bank	
			15.3	16946	30 L	
			23.0	869	40 L	
5+10.48			6.4	17035	℄	
			6.3	036	6.7 E ed ed	
			7.2	027	8.7 E Gutter	

Form 307 5M 10-34

PLEASE RETURN TO
LOS ANGELES COUNTY SURVEYOR
700 HALL OF RECORDS

NOTE: ANY ADDITIONS OR CHANGES ON THIS SHEET MUST BE MADE OR CIRCLED IN RED INK, WITH DATE AND NAME OF PERSON MAKING CHANGE

Do not extend notes this side of this line

STATION	B. S.	H. I.	F. S.	ELEV.	
		1709.912 ✓			
St 10.48			6.9	17030	7° N E & Rd
			7.1	028	11.5 L
			18.7	1691 2	30 L
			23.3	866	40 L
St 50			9.32	1700 59	℄
			9.6	003	6.2 R Ed Rd
			10.9	1699 9	9.3 RG Utter
			9.7	1700 2	7.2 L Ed Rd
			9.1	008	10.5 L Top bank
			21.6	1688 3	30. L
			26.0	839	40 L
St 75			11.33	98.58	℄
TP	0.485	1698.969 ✓	11.428	1698.484 ✓	
6+00			2.24	9673	℄
			2.5	965	7.5 E Ed Rd
			3.2	958	9.8 R
			2.1	969	6.1 Ed Rd
			1.8	972	11.4 L T.p Bank
			13.9	851	36 L
			19.2	798	40 L

Book No. 77-17 Division No. — L.B. 225 Pg. 18
X-Sec. No. — Survey of TOPOGRAPHY SYSTEM
Notes Checked L.L. SMITH Survey by T.J.S. Notes
Dated JUN 7 1937 Checked L.L. SMITH Map No. 26-18 Indexed A. C. Johnson Date 6-1-37

Form 307 5M 10-34

PLEASE RETURN TO
LOS ANGELES COUNTY SURVEYOR
700 HALL OF RECORDS

NOTE: ANY ADDITIONS OR CHANGES ON THIS SHEET MUST BE MADE OR CIRCLED IN RED INK, WITH DATE AND NAME OF PERSON MAKING CHANGE

Do not extend notes this side of this line

L.B. 225 P.G. 14 Job. No. 52/1 Division No. Notes Sheet 1 of 2 Sheets Plotted Sheet No. 1937
Survey of Pre Cisten System Date JUN 4 1937 Date 6-21-37 No.
Survey by T 7 S Notes T 5 Notes Chkd H. L. MARTIN Checked H. L. MARTIN X-Sec.
Indexed A. C. Johnson Date 6-1-37 Date JUN 7 1937 Date JUN 7 1937 No.

STATION	B. S.	H. I.	F. S	ELEV.		
		1698.969 ✓				
6+50			5.7	1693	±	
			6.3	927	72 ℄ ed ed	
			7.0	920	104 R Gutter	
			5.4	936	56 L ed Rd	
			5.0	940	89 L Top bank	
			8.0	870	20° L	
			16.8	822	30 L	
			20.5	785	41 L	
7+01.08			8.7	903	±	
			10.2	888	12 L ed Rd	
			11.5	875	15.5 R Gutter	
			8.5	905	25 L ed ed	
			8.3	907	8.0 L Top bank	
			16.9	821	25.5 L } Tel line ±	
			18.8	802	30° L	
			22.4	766	40° L	
7+25			10.5	885		
			10.5	885	12 L ed Rd	
			12.3	867	15° R " "	
			12.8	862	18½ R Gutter	

Form 307 5M 10-34

PLEASE RETURN TO
LOS ANGELES COUNTY SURVEYOR
700 HALL OF RECORDS

NOTE: ANY ADDITIONS OR CHANGES ON THIS SHEET MUST BE MADE OR CIRCLED IN RED INK, WITH DATE AND NAME OF PERSON MAKING CHANGE

Do not extend notes this side of this line

STATION	B. S.	H. I.	F. S	ELEV.		
		1698.969 ✓				
			10.0	1689.0	7° L	Top bank
			21.0	780	30° L	
			24.3	747	38° L	
			25.0	740	42° L	
T.P	0.425	1687.729 ✓	1.665	1687.304 ✓		
7+50			1.6	86.1	E. also Edrd	
			30	847	15.5 R Edrd	
			3.7	840	17.3 R	Gutter
			1.1	866	6° L	Top bank
			17.5	702	30° L	
			21.8	659	40° L	
7+75			4.2	835	℄	
			5.5	822	13° R Edrd	
			6.0	817	14.2 R	Gutter
			4.0	837	3.6 L	
			3.7	840	10.5 L	Top bank
			12.0	757	25 L	
			15.7	720	30 L	Approx ℄ Prop Ditch
			23.0	647	40 L	
7+94.90 C/L 7+75			6.6	811	℄	

No. 7211 Sec. X

Drawn 4 1937 Date 6-1-37 Job No. 5211 Division No. L.B. 225 Pg. 28

Notes Chkd. L. [illegible] Date JUN 7 1937 Survey of FLOOD CONTROL SYSTEM

Notes Checked MARTIN Survey by PETERSON Notes Date 6-1-37

Date JUN 7 1937 Map No. 78-18 Indexed A. C. Jobbings

Form 307 5M 10-34

PLEASE RETURN TO
LOS ANGELES COUNTY SURVEYOR
700 HALL OF RECORDS

NOTE: ANY ADDITIONS OR CHANGES ON THIS SHEET MUST BE MADE OR CIRCLED IN RED INK, WITH DATE AND NAME OF PERSON MAKING CHANGE

Do not extend notes this side of this line

L.B. 725 P.G. 14 Job No. 521 Division No. Notes Red Phone Date 6-1-37 No.
Survey of Pipe System Date Notes Checked Date X-Sec. No.
Survey by T.J.S. Notes Notes Checked Date
Indexed by C. Johnson Date 6-1-37 Date 4 1937 Date

STATION	B. S.	H. I.	F. S	ELEV.		
		1687.729				
EC 7+98.83			7.0	1680 7	℄	
8+16.48			5.0	1682 7	℄ Easement	
T.P.	4.953	1684 294	.838	1671.341		
8+23			4 70	167 59		
T.P.	0 727	1673 340	11 681	1677 613		
8+53			10 20	1663 140		
T.P.	1 943	1663 827	11 456	1661 884		
8+75			6 40	1657 43		
8+90			8 70	1655 13	E.P.	
9+00			7 20	1656 93	Top Bnk.	
9+25			4 30	1652 53		
9+50			10 60	1653 23		
T.P. 9+50	0.052	1653 250	10 629	1652 198		
9+75			3 80	1649 45		
9+91.03			5 70	1649 55		
10+00			7 90	1649 350		
T.P.	0 060	1642 114	11 196	1642 054		
10+25			2 20	1639 918		
10+50			8 70	1633 418		
T.P.	0 450	1630 643	11 921	1630 193		

Form 307 5M 10-34

PLEASE RETURN TO
LOS ANGELES COUNTY SURVEYOR
700 HALL OF RECORDS

NOTE: ANY ADDITIONS OR CHANGES ON THIS SHEET MUST BE MADE OR CIRCLED IN RED INK, WITH DATE AND NAME OF PERSON MAKING CHANGE

Do not extend notes this side of this line

STATION	B. S.	H. I.	F. S	ELEV.	
		1630	643		
#1068 P.O.T. 10+62.7			1.50	1629.14	
+75			5.70	1624 94	
10+90 T.P.	0 864	1619	749 11.758	1618 885	Brk
T.P. #1069	0 536	1608	805 11.48	1608 269	
P.O.T. 11+15			5.0	1603 805	
11+23			8.1	1600 70	Top Rock Cliff
T.P.	1 355	1598	340 11.82	1596 985	
11+28			6.80	1591 54	Brk in Rock Cliff
11+29			14.40	1583 94	Bot of " "
11+50			12.30	1586 04	
T.P.	0 696	1587	731 11.305	1587 035	
11+65			4.30	1583 43	Brk
12+00			15.56	1572 23	
T.P.	0 62	1579	95 8.401	1579 330	
12+25			9.90	1570 05	
+50			9.40	1570 55	
+75			5.50	1574 45	
13+16			5.20	1574 75	
13+25			5.00	1574 95	Top Bank
+39			9.90	1570 05	Top Cut

Notes Red [illegible] Plotted [illegible] Job No. 321 Division No. L. B. 225 Pg. 22
Date 6-17-37 Survey of Fire System
Sec. No. Notes Checked Date Survey by Notes
Date 4 1937 Map No. 28-18 Indexed C. Johnson Date

Form 307 SM 10-36

PLEASE RETURN TO
LOS ANGELES COUNTY SURVEYOR
700 HALL OF RECORDS

NOTE: ANY ADDITIONS OR CHANGES ON THIS SHEET MUST BE MADE OR CIRCLED IN RED INK, WITH DATE AND NAME OF PERSON MAKING CHANGE

Do not extend notes this side of this line

Project No. [illegible] Page No. 87-12
Date 4-1-37 X-Sect. No.
Notes Red
Date
Notes CHAS. E. TRAVIS Checked
Date JUN 4 1937 Date
Notes
Surveyed by A. E. Johnson Date
Inducted

STATION	B. S.	H. I.	F. S	ELEV.	
		1579 950.			
13+43			11.40	1568 55	Center
T.B.M.	3 328	1578 523.	4 755	~~1573 195~~ 1575 221.	Adj. Top 2" I.P. Prop Line 1½' So Sta 13+16. 45/L
T.P.	10512	1588 545.	0 49	1577 033.	
T.P.	10460	1598 817.	0 188	1588 357.	
T.P.	11 15	1609 544.	0 423	1597 394.	
T.P.	10 698	1619 893.	0 349	1608 195.	
T.P.	10 443	1629 653.	0 683	1619 210.	
T.P.	1040	1639 376.	0 677	1628 976.	
T.P.	10 051	1648 587.	0 840	1638 536.	
T.P.	11.00	16 58 786.	0 801	1647 786.	
T.P.	8 915	1666. 870.	0 831	1657 955.	
BM# E1			3 305	~~1666 565~~ 1663.604.	BM: bolt, spk & tin in rock outcrop vicinity of I-107. - F.B. 107-77 F.B. ref 609 = 23 B.M. used on Everding F.T. Elev. 1663.604 ✓ Elev. 1663.604 Agrees with datum per (U.S. 1140) U.S.C. & G.S. 1928 Adjustment.

Notes Ck'd by	Roemer	Survey of	
Map No.	B-1631-7-1	W. O.	Tape No. St'd °F.
Office Work	White	Surveyed by	
Checked	AAR	Notes	Date
Date	1941	Indexed	

F.B. 725 Pg. 19

WS 57-D3

Note: Any Additions or Changes on This Sheet Must be Made or Circled in Red Ink With Date and Name of Person Making Change.

Do not extend notes this side of this line

RETURN TO
LOS ANGELES COUNTY SURVEYOR
700 HALL OF RECORDS

WS 129-D27 BM

Proportioned Line
P-55

See F.B. 826 P141 for Adopted Lines.

F.B. 695 Pg 229

F.B. 695 Pg 229

F.B. 695 Pg 229

Pg 20

Pacific Dr

Fernwood

FORM 247 10M 11-38

F.B. 725 Pg. 20

W3.59-D-3

RETURN TO
LOS ANGELES COUNTY SURVEYOR
700 HALL OF RECORDS

Do not extend notes this side of this line

Note: Any Additions or Changes on This Sheet Must be Made or Circled in Red Ink With Date and Name of Person Making Change.

W5.129-097 4-1

Cont. to back page 21

For Adopted & See F.B. 826-120

Proportioned L of C and ties P54

Cont. to back page 19

To E Grandview DR WEST - See P-106

For Adopted & See F.B. 826-116

Map No. B-1631-1	W. O. 5211 Tape No. St'd •F.
Office Work White	Surveyed by
Checked AAR	Notes Date
Date 1941	Indexed

W.S. 57-D-3

Page 22

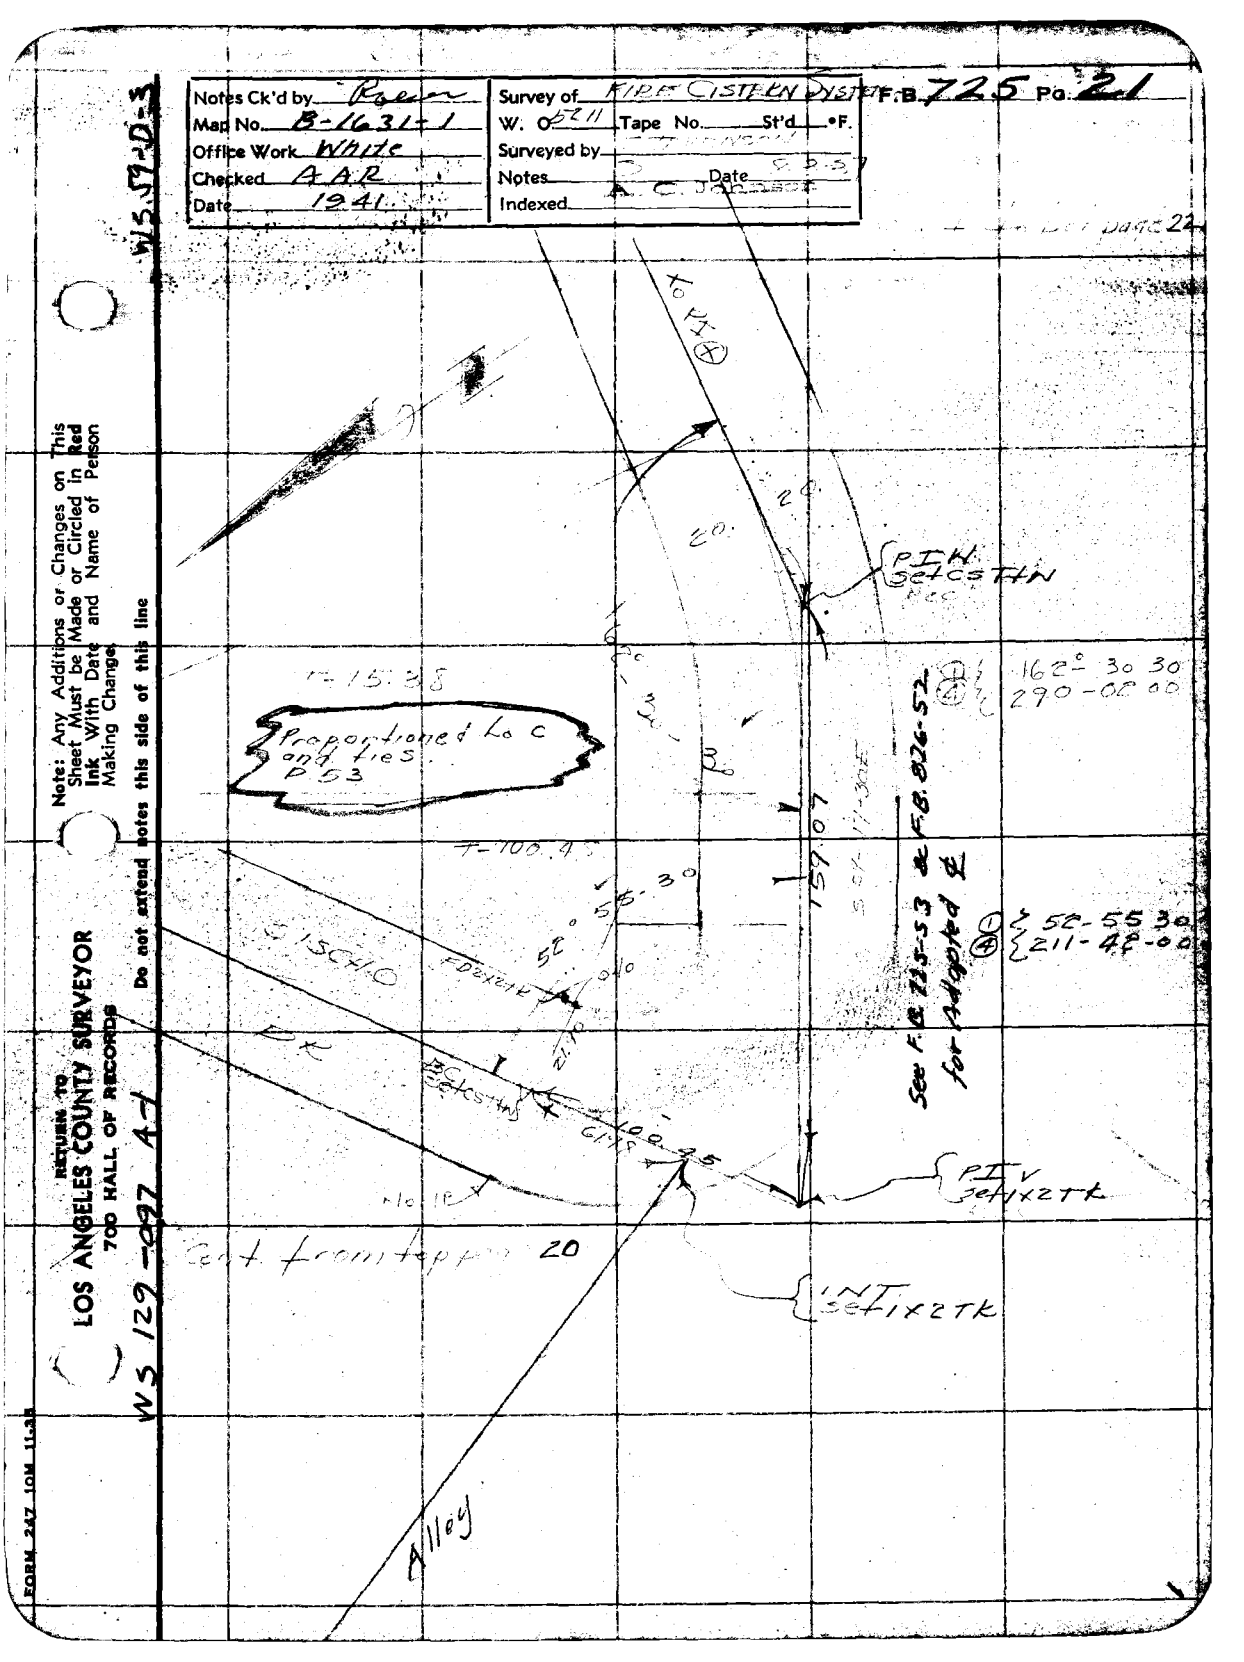

Note: Any Additions or Changes on This Sheet Must be Made or Circled in Red Ink With Date and Name of Person Making Change

Do not extend notes this side of this line

RETURN TO
LOS ANGELES COUNTY SURVEYOR
700 HALL OF RECORDS

WS 129-097 A-1

FORM 247 10M 11-38

RETURN TO
LOS ANGELES COUNTY SURVEYOR
700 HALL OF RECORDS

Note: Any Additions or Changes on This Sheet Must be Made or Circled in Red Ink With Date and Name of Person Making Change.

Do not extend notes this side of this line

WS 59-D-3

WS 129-D97 B-1

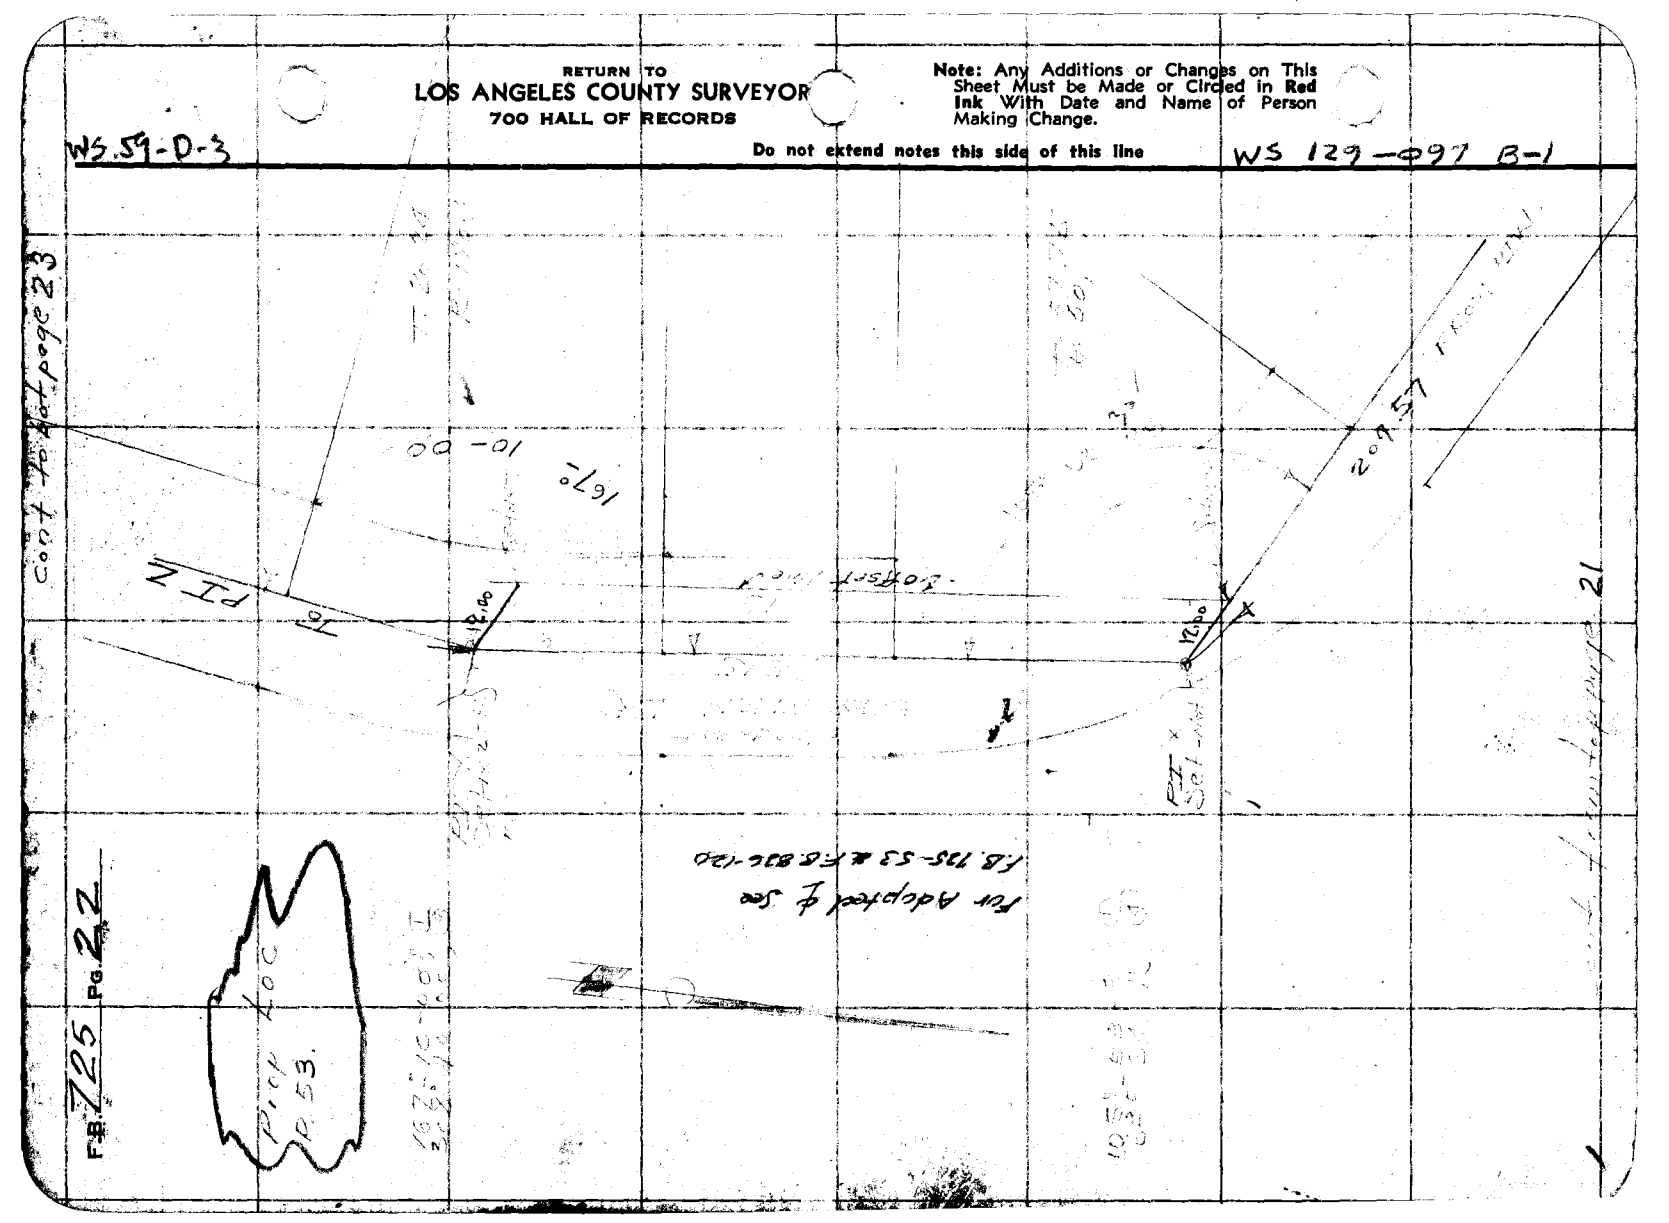

RETURN TO
LOS ANGELES COUNTY SURVEYOR
700 HALL OF RECORDS

Note: Any Additions or Changes on This Sheet Must be Made or Circled in Red Ink With Date and Name of Person Making Change

Do not extend notes this side of this line

FORM 247 10M 11-38

W.S. 57-A-5
W.S. 57-D-3

Notes Ck'd by Olsen
Map No. B-163-1
Office Work White
Checked AAR
Date 1941

Survey of FIRE Cisterns System
W. O. 5211 Tape No. St'd sF.
Surveyed by Stevenson
Notes S Date 8+
Indexed A. C. Johnson

F.B. 725 PG. 23

See Prof Not Tr Line

37

Fd 2" I.P. No Tag

Set Nail & Tag

CROYDON

LANE

(See pg 24)

TR 7531

SEE P. 110 Observation Dr

Set 1x2 TK INT. 824

Fd 2x2 TK

161° - 30

53.41

15

(Not Set) Set L.S. 52 REC ANG

3379

INT. Set CST+W.

107

206.70

℄ of line

TR LINE

Fd 1" I.P. Plug + TK

69-29-15

1488

TR 8851 BLO

(RR Not to scale)

Correct TR Map No. 8859 Pl-5 Lot 9 N.C.

90°

R/N EC Fd 2" I.P. Plug + TK

90°

3.49

Fd 2x2 TK

Co. on

EC Set 1x2 TK

EC

2975

① 161-30 15
④ 286° 01 00

① 69-29 15
④ 277 57 00
T-1726
R-10935

See F.B. 725-SJ & F.B. 826-120 for Adopted ℄

TIES P.52

P.I. Z Fd 2x2 TK

DR.

16800 3.5

① ℄ 162-3-40
④ ℄ 288 14 30.

EC

38

OBSERVATION

To P.I. Y Pg 22

20

20

RETURN TO
LOS ANGELES COUNTY SURVEYOR
700 HALL OF RECORDS

Note: Any Additions or Changes on This Sheet Must be Made or Circled in **Red** Ink With Date and Name of Person Making Change.

Do not extend notes this side of this line

W 5.58-A-3

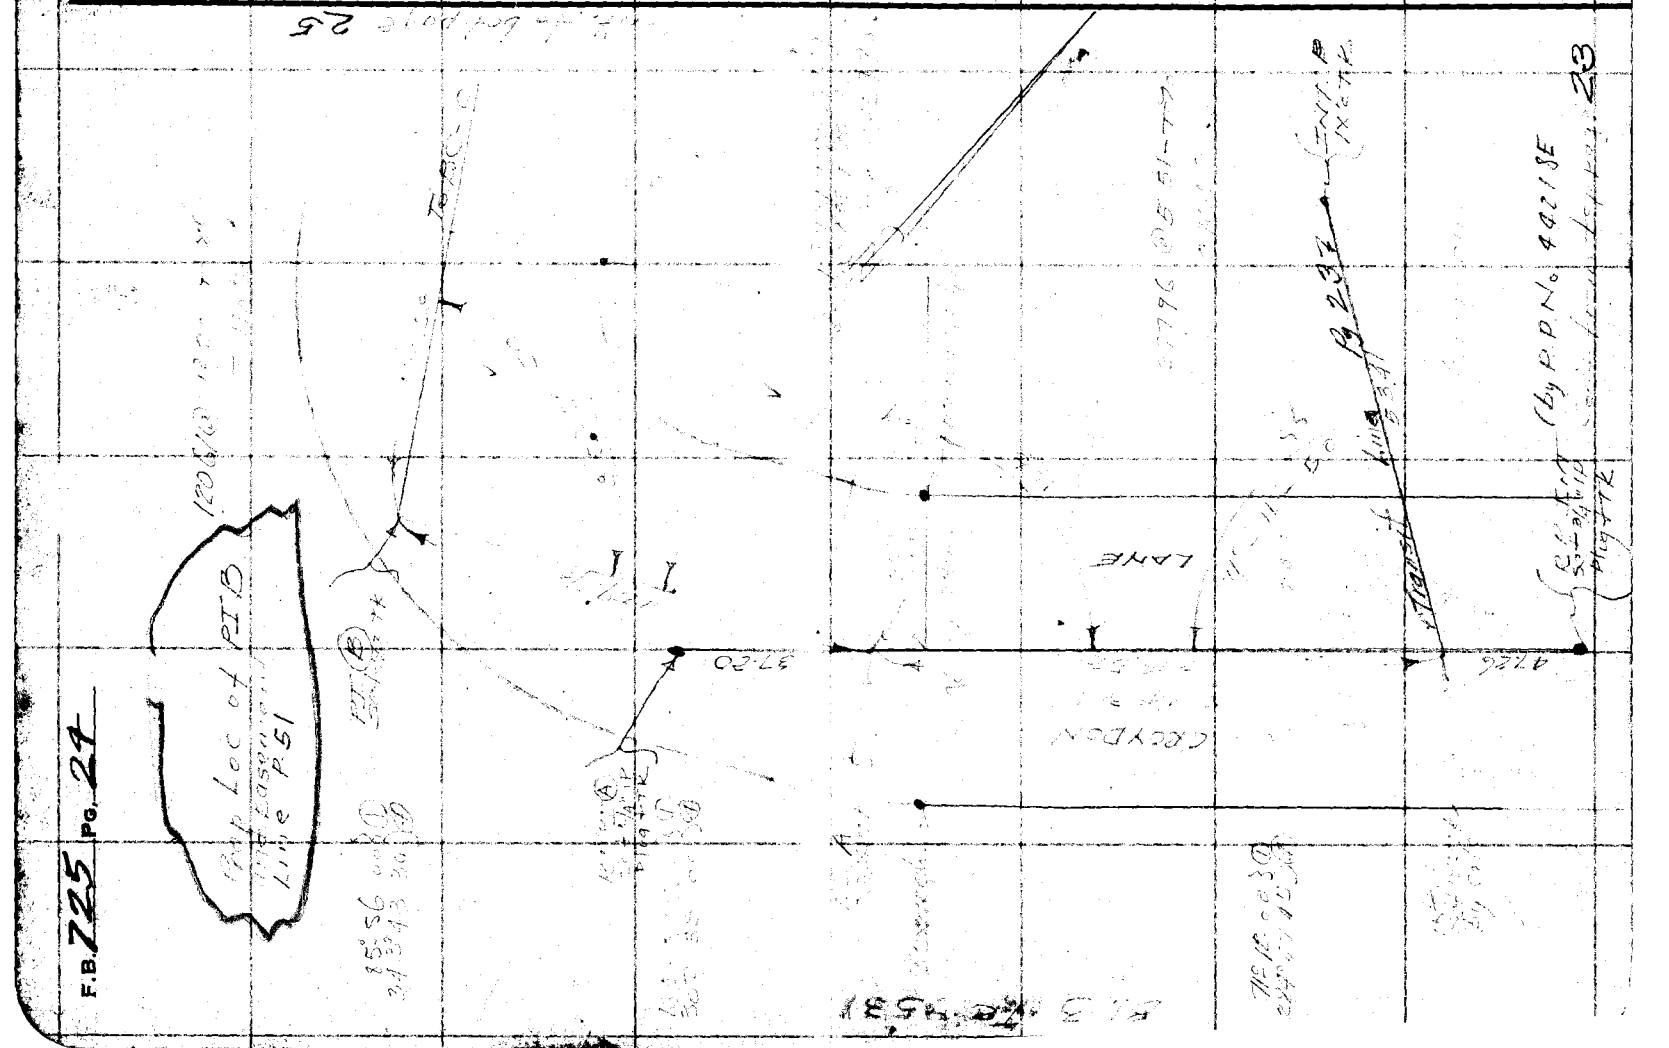

W.S.58-A-5

Notes Ck'd by Rolen	Survey of
Map No.	W. O. Tape No. St'd °F.
Office Work	Surveyed by
Checked	Notes Date
Date	Indexed

F.B. 725 PG. 25

Ref. page 26

Disp P.S. + Easement Line P 50

24

19.94

Found No plug

78.44

20.00

17.98

17.70

RETURN TO
LOS ANGELES COUNTY SURVEYOR
7do HALL OF RECORDS

Note: Any Additions or Changes on This Sheet Must be Made or Circled in Red Ink With Date and Name of Person Making Change

Do not extend notes this side of this line

FORM 247 10M 11-35

RETURN TO
LOS ANGELES COUNTY SURVEYOR
700 HALL OF RECORDS

Note: Any Additions or Changes on This Sheet Must be Made or Circled in Red Ink With Date and Name of Person Making Change.

Do not extend notes this side of this line

WS 58-A-3

WS-122-97A-1

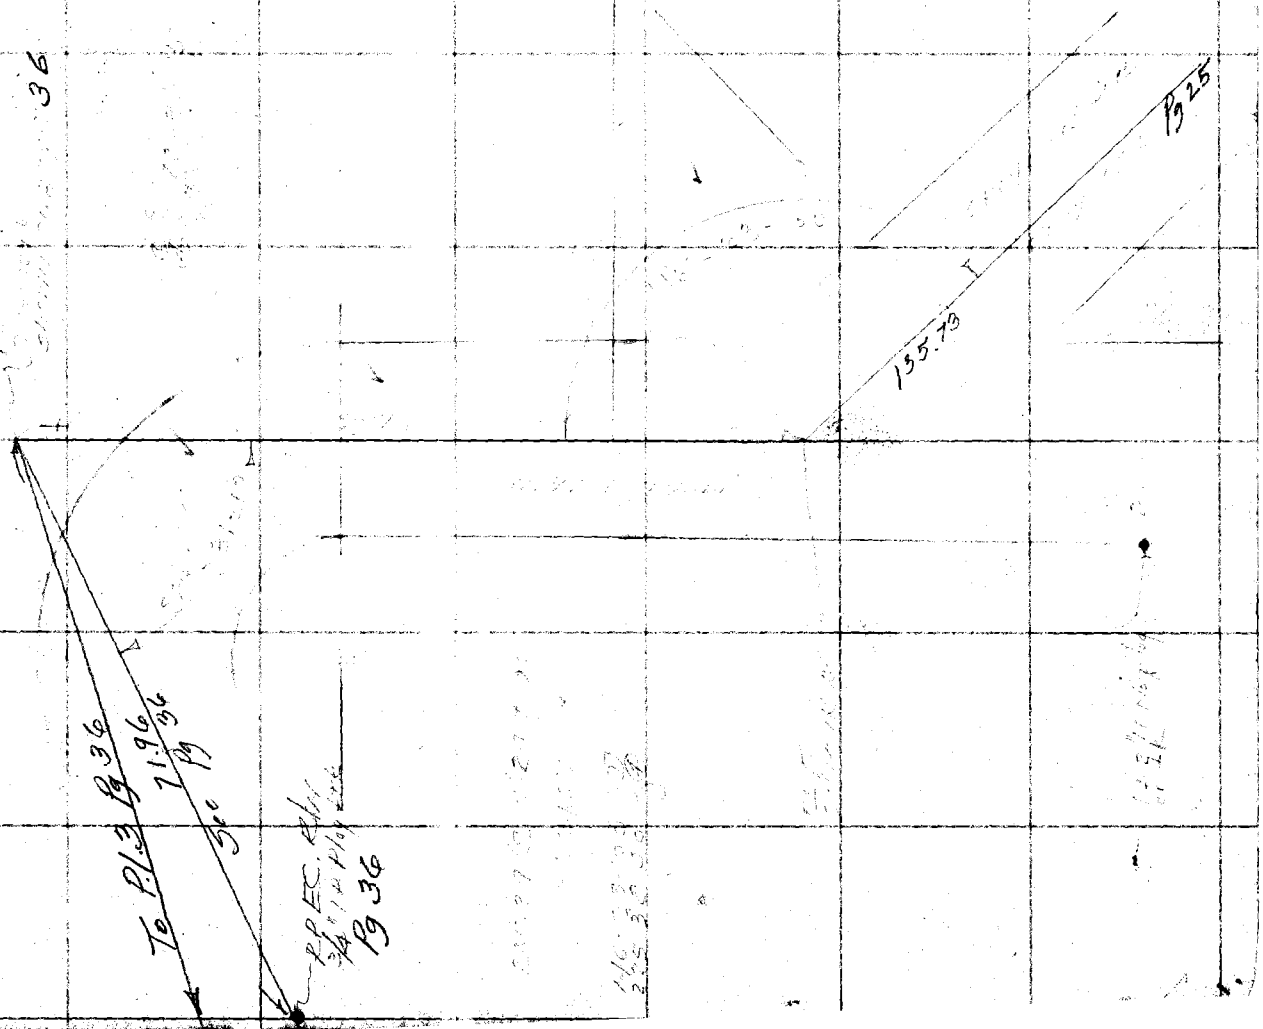

F.B. 725 PG. 26

Notes Ck'd by	Survey of
Map No. B-1375	W. O. Tape No. St'd °F.
Office Work Noel	Surveyed by
Checked Rowe	Notes Date
Date Nov 1 37	Indexed A. C. Johnson

F.B. 725 PG. 27

Note: Any Additions or Changes on This Sheet Must be Made or Circled in Red Ink With Date and Name of Person Making Change.

Do not extend notes this side of this line

RETURN TO
LOS ANGELES COUNTY SURVEYOR
700 HALL OF RECORDS

FORM 247 10M 11-35

PIPE LOCATION
FROM RESERVOIR SITE NO 3
TO TOPANGO CAN FORESTRY STA
J.N 5211

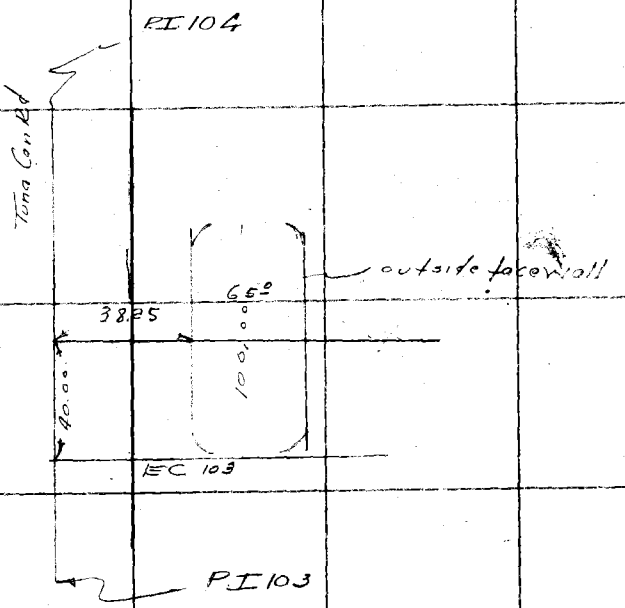

F.B. 725 PG. 28

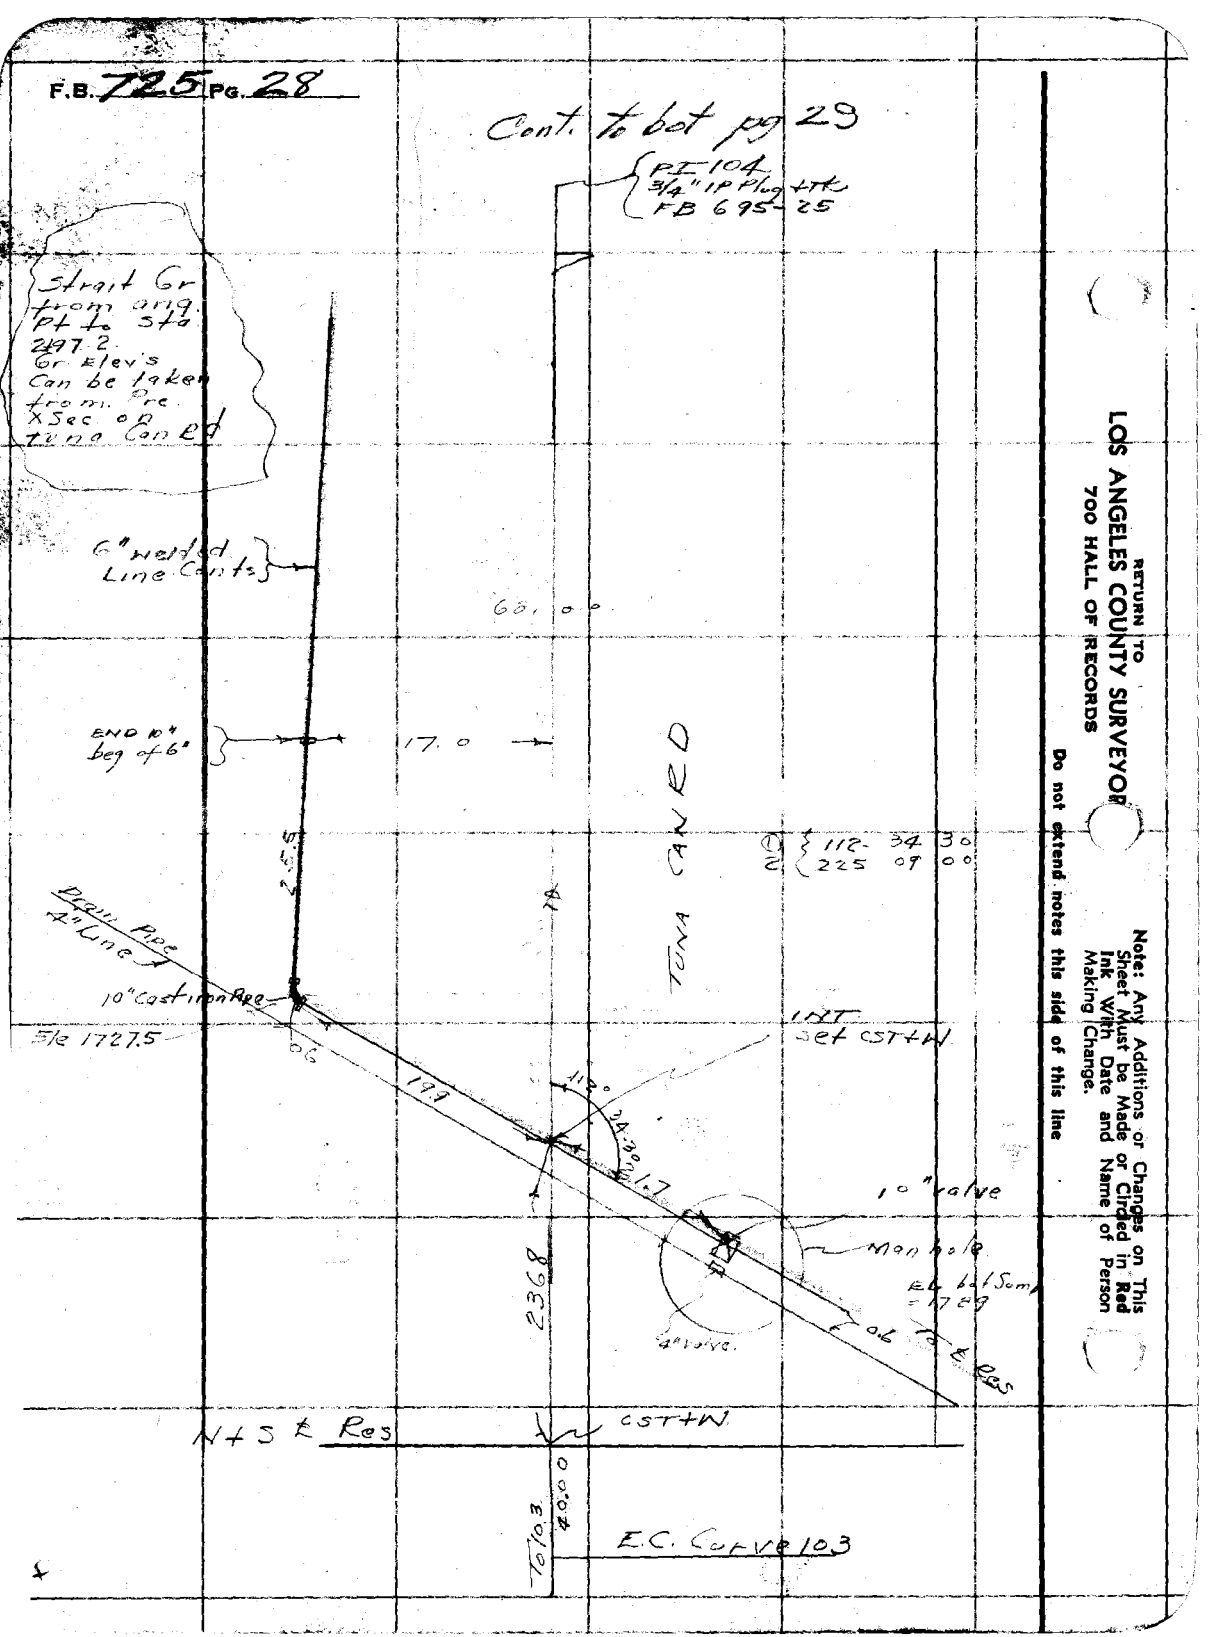

RETURN TO
LOS ANGELES COUNTY SURVEYOR
700 HALL OF RECORDS

Note: Any Additions or Changes on This Sheet Must be Made or Circled in Red Ink With Date and Name of Person Making Change.

Do not extend notes this side of this line

Notes Ck'd by	Survey of
Map No. B-1378	W. O.	Tape No.	St'd °F.
Office Work	Surveyed by
Checked	Notes	Date
Date 11-1-37	Indexed A. C. Johnson

F.B. 725 PG. 29

30

TUNA CAN RD

28

6.0

RETURN TO
LOS ANGELES COUNTY SURVEYOR
700 HALL OF RECORDS

Note: Any Additions or Changes on This Sheet Must be Made or Circled in Red Ink With Date and Name of Person Making Change.

Do not extend notes this side of this line

FORM 247 10M 11-35

F.B. 725 PG. 30

RETURN TO
LOS ANGELES COUNTY SURVEYOR
700 HALL OF RECORDS

Note: Any Additions or Changes on This Sheet Must be Made or Circled in Red Ink With Date and Name of Person Making Change.

Do not extend notes this side of this line

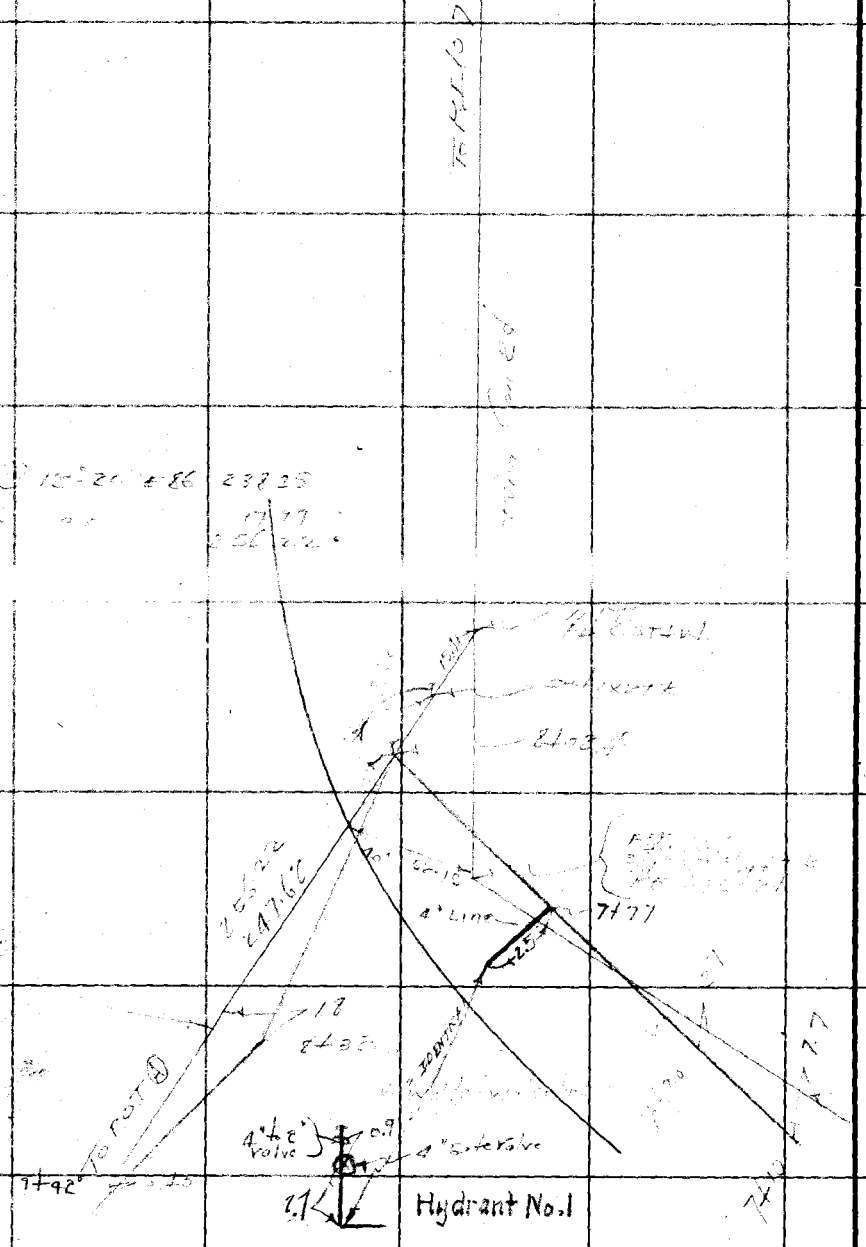

31

29

Notes Ck'd by	Survey of FIRE CISTERN SYSTEM
Map No. B-1375	W. O. 5211 Tape No. 9 St'd 84° F.
Office Work Layout	Surveyed by STEVENSON
Ch [redacted] Reed	Notes T.Y.S. Date 7-12-37
Date 11-1-37	Indexed [illegible]

F.B. 725 Pg. 31

32

2° 11+82°

P.C. 11+51.5

random line

11°-30' 50

7.7 A

11+15.5

41°-32 00 (C) (A)
100° 07 30

11+04.0 1.5

P.O.T. (B) set 10" nail 11 to 1 50

6" welded Pipe

5743 @ 26°16 = 515.0

P.O.T. (A) set 10 Bill 10+50

± 3° [illegible]

T. A. Stevenson
F. S. Livingston
H. W. Baker
H. E. Forney
T. A. Hope

7+42°

Cont. from the page 30

RETURN TO
LOS ANGELES COUNTY SURVEYOR
700 HALL OF RECORDS

Note: Any Additions or Changes on This Sheet Must be Made or Circled in Red Ink With Date and Name of Person Making Change

Do not extend notes this side of this line

FORM 247 10M 11-35

F.B. 725 PG. 32

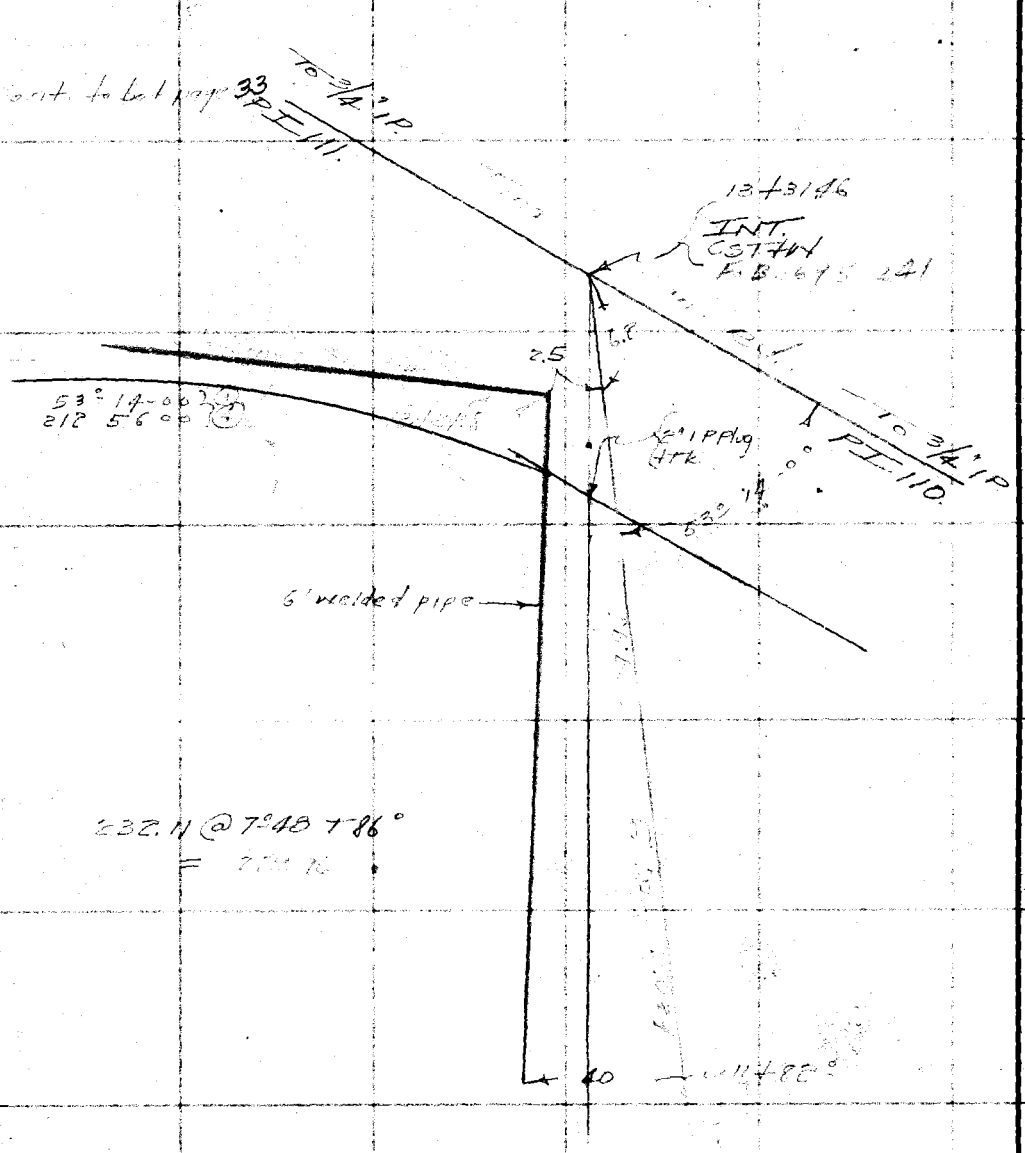

RETURN TO
LOS ANGELES COUNTY SURVEYOR
700 HALL OF RECORDS

Do not extend notes this side of this line

Note: Any Additions or Changes on This Sheet Must be Made or Circled in Red Ink With Date and Name of Person Making Change.

Cont. from book 31

Notes Ck'd by Roem	Survey of
Map No. B-1375	W. O. Tape No. St'd °F.
Office Work Lyons	Surveyed by
Checked Roem	Notes Date
Date 11-1-37	Indexed

F:B. 725 PG. 83

Note: Any Additions or Changes on This Sheet Must be Made or Circled in Red Ink With Date and Name of Person Making Change

Do not extend notes this side of this line

RETURN TO
LOS ANGELES COUNTY SURVEYOR
700 HALL OF RECORDS

FORM 247 10M 11-38

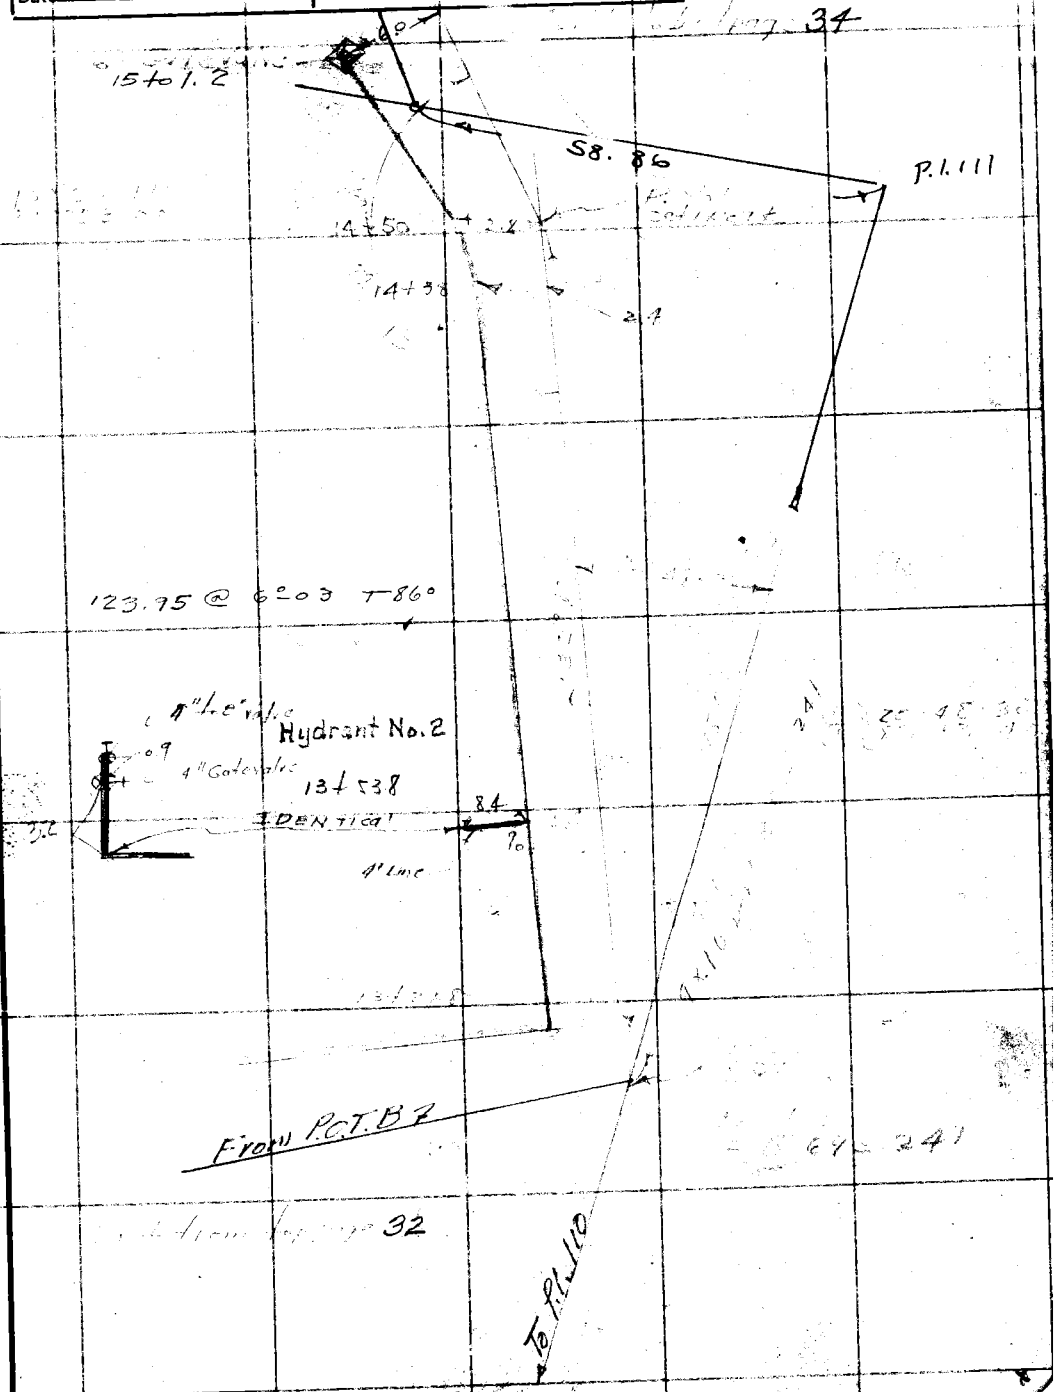

RETURN TO
LOS ANGELES COUNTY SURVEYOR
700 HALL OF RECORDS

Note: Any Additions or Changes on This Sheet Must be Made or Circled in **Red Ink** With Date and Name of Person Making Change.

Do not extend notes this side of this line

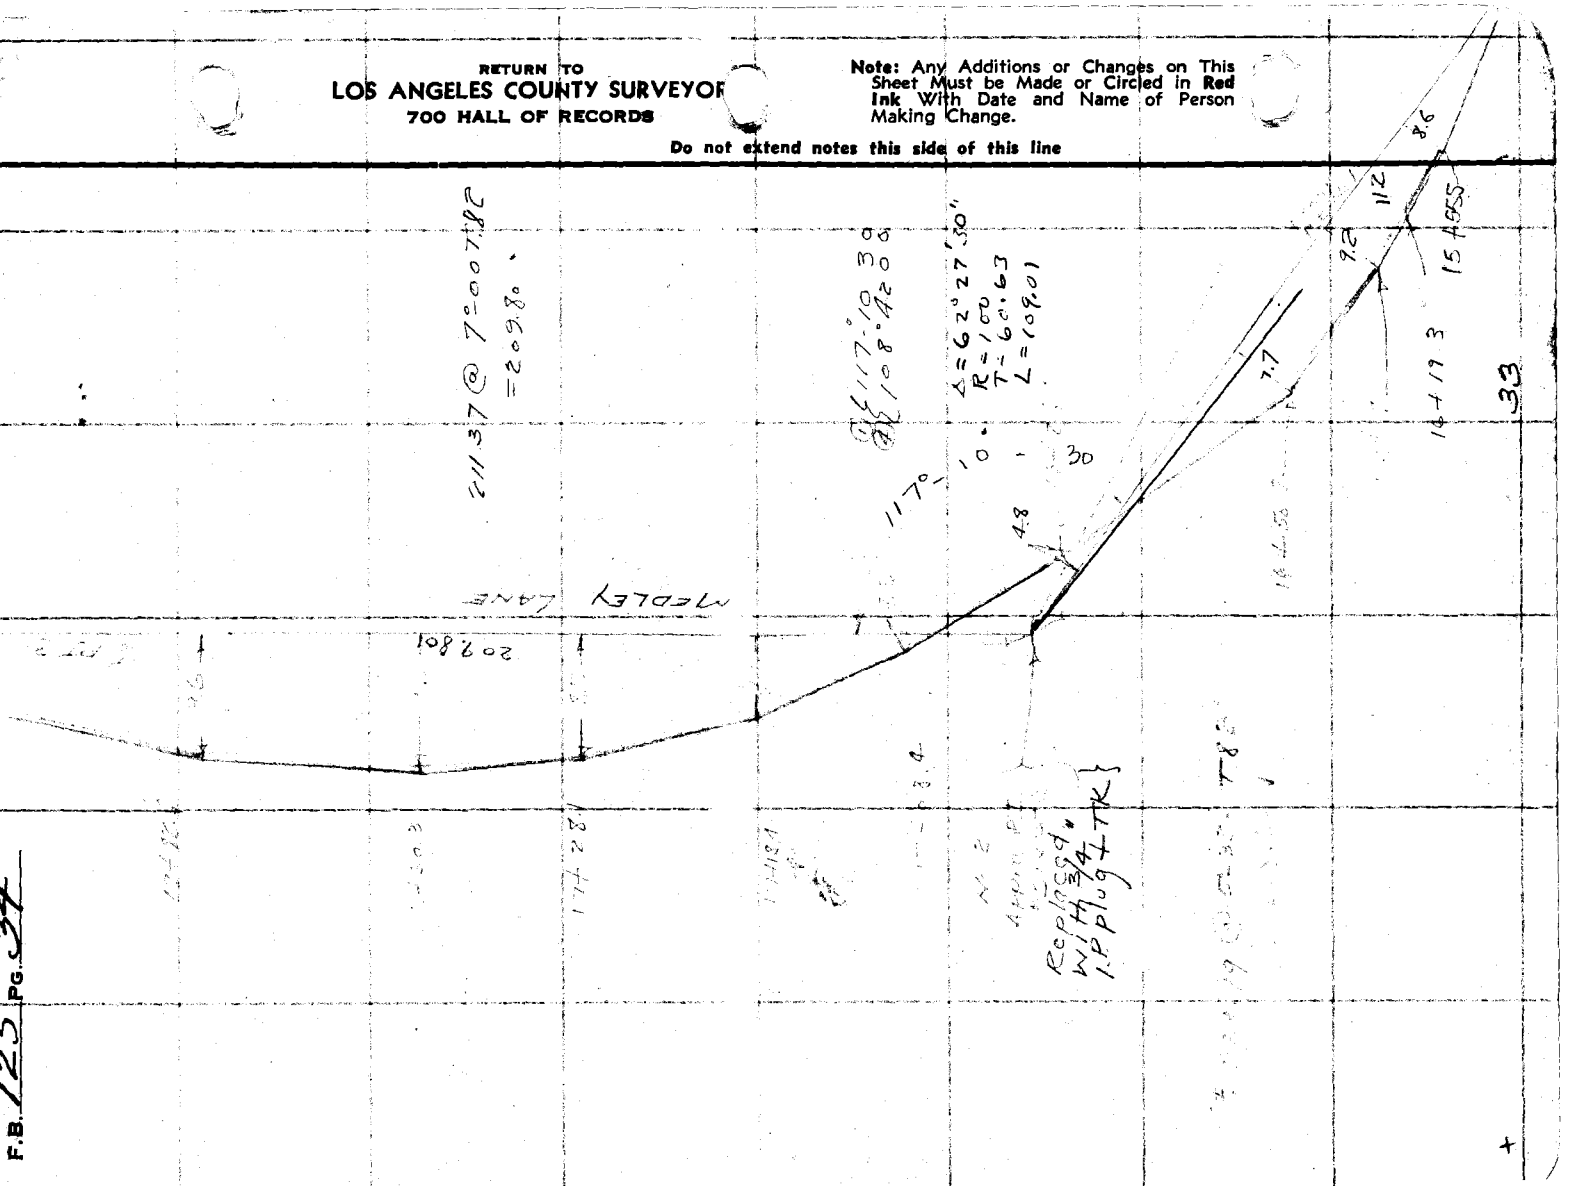

Notes Ck'd by Rocan	Survey of TRACT
Map No. B-1375	W. O. 5211 Tape No. St'd °F.
Office Work [illegible]	Surveyed by Stevens
Checked Rocan	Notes TS Date 11-37
Date 11-1-37	Indexed A. C. Johnson

F.B. 725 Pg. 35

36

APPROPINQ'S

140° 32' 45"
202° 10' 30"

Δ = 39°25'15"
R = 150
T = 53.74
L = 103.20

140° 32' 40"

MEDLEY LANE

18+34.2

Cont from top page 34

Note: Any Additions or Changes on This Sheet Must be Made or Circled in Red Ink With Date and Name of Person Making Change.

Do not extend notes this side of this line

RETURN TO
LOS ANGELES COUNTY SURVEYOR
700 HALL OF RECORDS

FORM 247 10M 11-35

F.B. 725 PG. 36

Pipe Line Loc Contson P.63

Closer tie see Pg 26

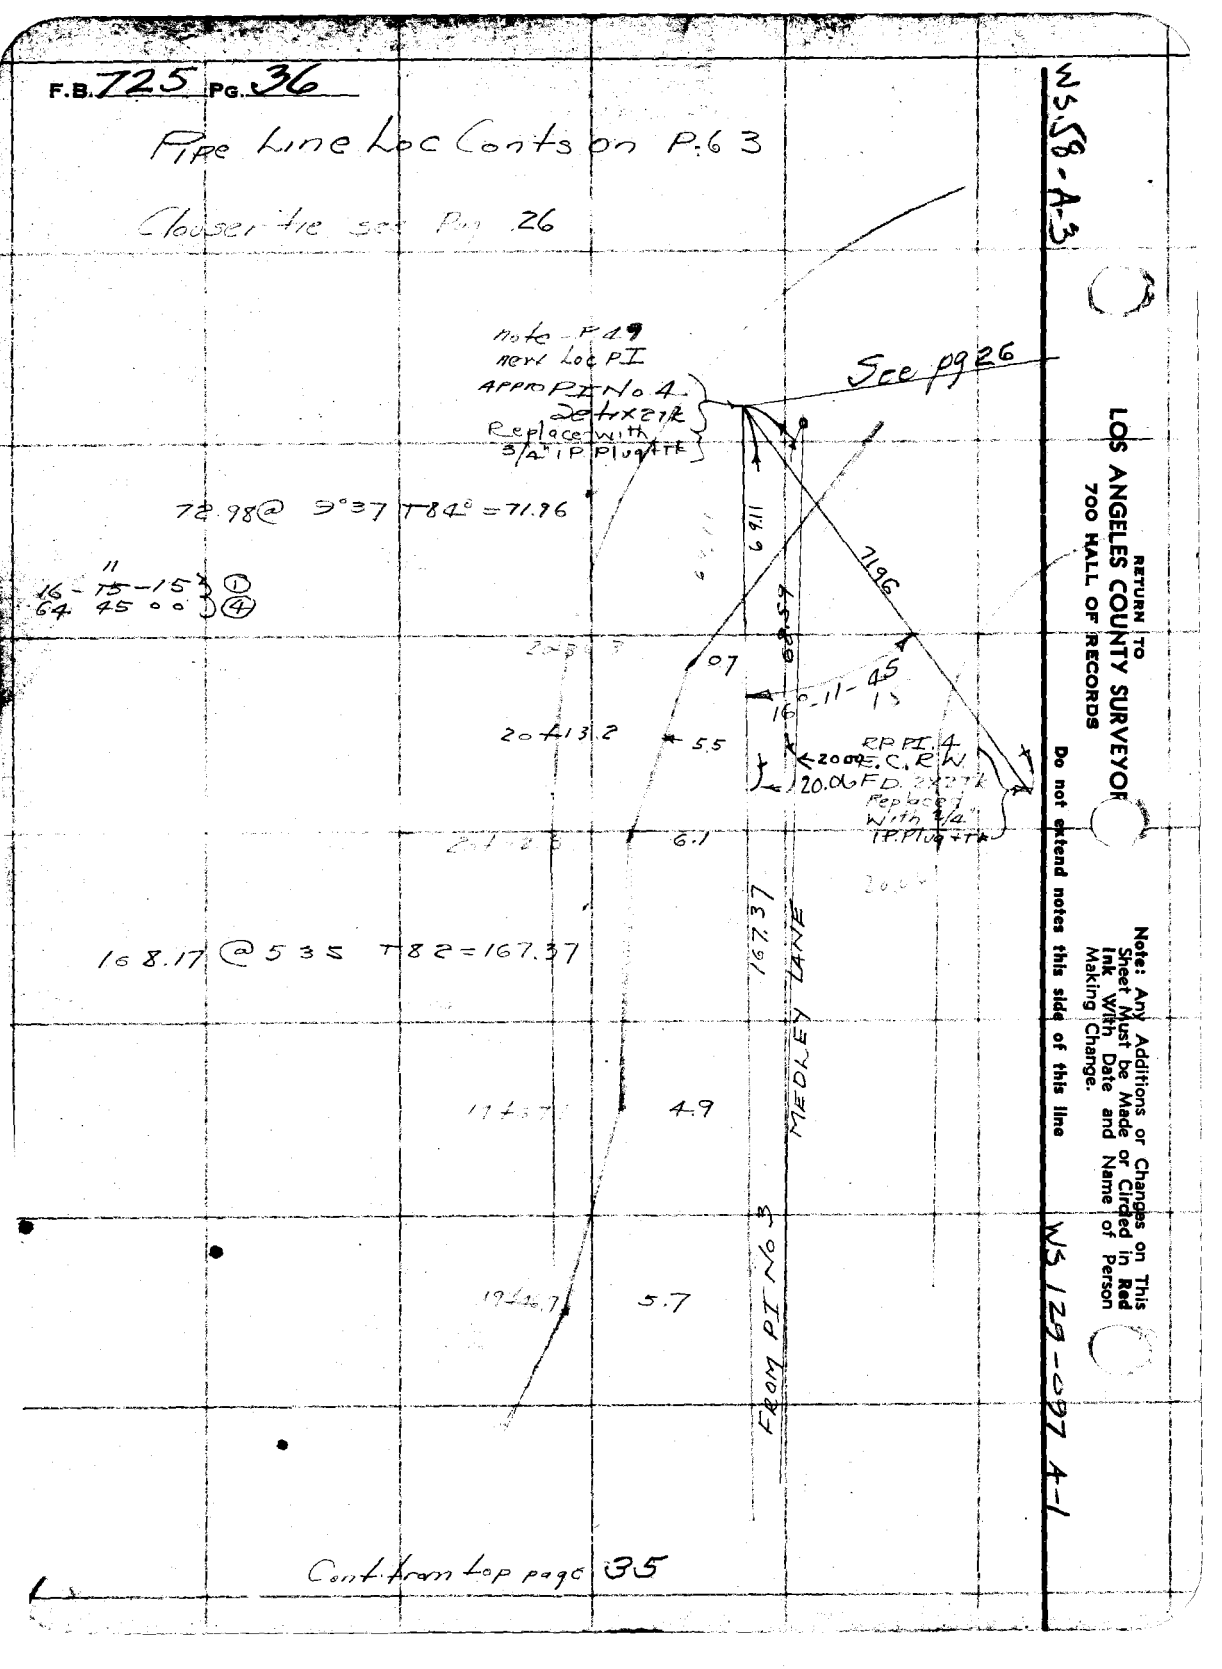

RETURN TO
LOS ANGELES COUNTY SURVEYOR
700 HALL OF RECORDS

Do not extend notes this side of this line

Note: Any Additions or Changes on This Sheet Must be Made or Circled in Red Ink with Date and Name of Person Making Change.

WS 58-A-3

WS 129-697 A-1

Profile No. | Notes Red. | Plotted Lund | Job No. | Division No. | F. B. 725 Pg. 37

Date | Date | Survey of

X-Sec. No. | Notes Chkd. | Checked Roesa | Survey by | Notes | Date

Date | Date 11-1-27 | Map No. B-1275 | Indexed C. J.

PROFILE ON 6" PIPE LINE

FIRE CISTERN SYSTEM

SITE No 3.

5211

STATION	B. S.	H. I.	F. S.	ELEV.

6 H. Nicholson
HE Forney 7
Mo. Taylor Rd

NOTE: ANY ADDITIONS OR CHANGES ON THIS SHEET MUST BE MADE OR CIRCLED IN RED INK, WITH DATE AND NAME OF PERSON MAKING CHANGE

Do not extend notes this side of this line

PLEASE RETURN TO
LOS ANGELES COUNTY SURVEYOR
700 HALL OF RECORDS

Form 307 5M 11-35

Form 307 5M 11-35

PLEASE RETURN TO
LOS ANGELES COUNTY SURVEYOR
700 HALL OF RECORDS

NOTE: ANY ADDITIONS OR CHANGES ON THIS SHEET MUST BE MADE OR CIRCLED IN RED INK, WITH DATE AND NAME OF PERSON MAKING CHANGE

Do not extend notes this side of this line

F.B. 725 Pg. 38 | Job No. 5211 | Division No. | Notes Red. | Plotted | Profile No.
Survey of FIRE CISTERN SYSTEM | Date | Date | X-Sec. No.
Survey by STEVENSON | Notes | Notes Chkd. | Checked
Indexed | Date | Date | Date

STATION	B. S.	H. I.	F. S.	ELEV.		
					FB 725 P28	
BM #11	3.425	1723.595		1719.170	Cutspk FB. 695-8	
2+79.2			3.2	172		
6			0.6	171		
G						
3+18			4.8	171		

Form 307 5M 11-35

PLEASE RETURN TO
LOS ANGELES COUNTY SURVEYOR
700 HALL OF RECORDS

NOTE: ANY ADDITIONS OR CHANGES ON THIS SHEET MUST BE MADE OR CIRCLED IN RED INK, WITH DATE AND NAME OF PERSON MAKING CHANGE

Do not extend notes this side of this line

STATION	B. S.	H. I.	F. S.	ELEV.		
		1723.295				
G			23	1721.0		
3+40			6.5	16.8	Pipe	
Gr.			3.6	20.1		
3+63			7.5	17.8		
Gr.			5.1	18.2		
3+73			8.2	15.1		
G			5.8	17.5		
3+85			2.0	15.3	Top II	
Ground			6.9	16.4		
T.P.	1.10	1712.40	11.995	1711.300		
H+29			3.2	1709.2		
GR			1.8	10.6		
4+51			5.2	7.2	T.P. I.P	
GR			3.2	9.2		
4+72			7.2	2		
GE			2.0	7.2		
T.P.	0.82	1708.17	12.05	1700.35		
5+60			2.5	1698.7		
GR			0.6	1695		
T.P.	2.24	1697.96	11.45	1689.72		

Profile
No. _____ Notes Red _____ Plotted Entered Job No. _____ Division No. _____
X-Sec. No. _____ Date _____ Date _____ Survey of _____
Notes Chkd. _____ Checked Rogers Survey by _____ Notes _____
Date _____ Date 11-7-57 Map No. B-1375 Indexed Date _____

F. B. 725 Pg. 39

Form 307 5M 11-35

PLEASE RETURN TO
LOS ANGELES COUNTY SURVEYOR
700 HALL OF RECORDS

NOTE: ANY ADDITIONS OR CHANGES ON THIS SHEET MUST BE MADE OR CIRCLED IN RED INK, WITH DATE AND NAME OF PERSON MAKING CHANGE

Do not extend notes this side of this line

F. B. 725 PG. 40 | Job No. 5211 | Division No. | Profile No. | Plotted Date | Notes Red. Date | X-Sec. No. | Checked Date | Notes Chkd. Date | Survey of | Survey by STEPHENSON | Notes FERRY | Indexed Date

STATION	B. S.	H. I.	F. S.	ELEV.	
7+10		1691.96	2.7	[illegible]	TOP I.P
Gr			9.7	[illegible]	
7+32			2	[illegible]	TOP I.P
Gr		✓	2.3	[illegible]	
T.P	5.24	1684.035	11.165	[illegible]	
8+22			2.0	1672.1	TOP I.P
Gr		✓	4.7	[illegible]	
I.P	22.5	1673.595	[illegible]	1671.37	✓
8+32			11.95	62 64	TOP. I.P
Gr.			9.9	6[illegible]	
T.P	0.26	1662.23 ✓	11.625	1651.970	✓
8+44			4.7	57 5	TOP I.P
Gr			3.0	5[illegible]	
8+67			8.0	54 2	TOP I.P
Gr			6.95	5[illegible]	
8+77			4.55	5[illegible]	TOP I.P
Gr			2.1	[illegible]	
T.P	0.205	1651.225 ✓	11.21	1650	✓
9+42			2.26	[illegible]	TOP I.P
Gr.			0.60	50 62	
9+64			5.1	46 1	TOP I.P

Form 307 5M 11-35

PLEASE RETURN TO
LOS ANGELES COUNTY SURVEYOR
700 HALL OF RECORDS

NOTE: ANY ADDITIONS OR CHANGES ON THIS SHEET MUST BE MADE OR CIRCLED IN RED INK, WITH DATE AND NAME OF PERSON MAKING CHANGE

Do not extend notes this side of this line

STATION	B. S.	H. I.	F. S.	ELEV.	
G.K.		1641.225	2.8	48.4	
T.P.	0.20	1640.175	11.25	1689.975	
10+08			2.5	37.7	Top. T.P.
G.K.			0.60	39.6	
10+39			8.3	31.9	Top. T.P.
G.K.			6.4	33.9	
T.P.	0.55	1629.210	5.2	1624.0	
10+50			4.0	25.2	Top. T.P.
G.K.			2.3	26.9	
10+71			12.2	17.0	Top. T.P.
G.K.			10.4	18.8	
T.P.	.075	1617.520	11.765	1605.755	
T.P.	.42	1606.555	11.385	1602.135	
11+04			6.55	60.0	Top. T.P.
G.K.			5.85	60.70	
T.P.	.06	1595.685	10.93	1595.625	
11+07.5			11.30	58.38	Toe of Slope
Pipe			2.7	93.0	Top of Pipe above Toe
11+15			11.70	84.0	
G.K.			10.50	85.2	

Profile No. ____ Notes Rod. ____ Plotted ____ Job No. ____ Division ____
X-Sec. No. ____ Date ____ Date ____ Survey of ____
Notes Chkd. ____ Checked ____ Survey by ____ Notes ____
Date ____ Date 11-17-37 Map No. B-1375 Endorsed ____ C. Job ____ Date ____

F.B. 725 PG. 41

Form 307 5M 11-35

PLEASE RETURN TO
LOS ANGELES COUNTY SURVEYOR
700 HALL OF RECORDS

NOTE: ANY ADDITIONS OR CHANGES ON THIS SHEET MUST BE MADE OR CIRCLED IN RED INK, WITH DATE AND NAME OF PERSON MAKING CHANGE

Do not extend notes this side of this line

Profile No. ____ X-Sec. No. ____

Plotted ____ Date ____ Checked ____ Date ____

Notes Red ____ Date ____ Notes Chkd ____ Date ____

Division No. ____ Job No. ____

Notes ____ Date ____

Survey of ____

Survey by ____

Indexed ____

F.B. 725 PG. 42

STATION	B. S.	H. I.	F. S.	ELEV.	
		1595.68			
T.P	0.26	1584.085	11.86	1583.825	
11+51			5.2		TOP I.P
Gr			4.7		
11+60			7.3		TOP. I.P.
Gr			6.9		
11+69			10.00		TOP I.P
Gr			9.2		
T.P	6.79	1579.605	11.46	1572.625	
11+82			8.9		TOP I.P
Gr			6.89		
12+04			12.2		TOP I.P.
Gr			8.0		
12+25			10.25		TOP I.P
Gr			8.9		
12+44			9.15		TOP I.P.
Gr			5.9		
12+59			7.4		TOP I.P.
Gr			9.5		
12+57			7.25		TOP. I.P.
Gr			4.9		

Form 307 5M 11-35

PLEASE RETURN TO
LOS ANGELES COUNTY SURVEYOR
700 HALL OF RECORDS

NOTE: ANY ADDITIONS OR CHANGES ON THIS SHEET MUST BE MADE OR CIRCLED IN RED INK, WITH DATE AND NAME OF PERSON MAKING CHANGE

Do not extend notes this side of this line

STATION	B. S.	H. I. 1579.60	F. S.	ELEV.	
13+10			9.4	70 2	Top I.P.
Gr.			6.9	72 7	
13+			11.9	67 7	Top I.P.
Gr.			9.5	70 1	
13+27.8			12.95	66 6	Top. I.P.
Gr			11.0	68 6	
T.B.M.			4.405	1575.209	2" I.P. West r/w BC Curve No 111 - Tuna Can Rd. FB. 695
T.P.	0.365	1569.305	10.66	1568.940	
13+53.8			4.8	64 5	Top I.P.
Gr			2.9	66 4	
14+00			9.7	59 6	Top I.P.
Gr			8.4	60 9	
14+15.8			11.4	57 9	Top I.P.
Gr			9.6	59 7	
14+50			12 1	57 2	Top I.P.
14+50			12 1	57 2	
Gr			11 32	57 71	
14+38.0			12.9	56 4	I.P.
Gr			10.6	58 7	
TP	0.85	1558.925	11.23	1558.075	

Profile
No. ____ Notes Red ____ Plotted Current ____ Job No. 22 ____ Division No. ____
X-Sec. ____ Date ____ Date ____ Survey of ____
No. ____ Notes Chkd ____ Checked Rogers ____ Survey by ____ Notes ____ Date ____
Date ____ Date 11-1-37 Map No. B-1375 Indexed ____ Date ____

F.B. 725 PG. 43

Form 307 5M 11-35

PLEASE RETURN TO
LOS ANGELES COUNTY SURVEYOR
700 HALL OF RECORDS

NOTE: ANY ADDITIONS OR CHANGES ON THIS SHEET MUST BE MADE OR CIRCLED IN RED INK, WITH DATE AND NAME OF PERSON MAKING CHANGE

Do not extend notes this side of this line

Profile No. ____ X-Sec. No. ____

Job No. 5211 Division No. ____ Notes Red. ____ Plotted ____ Date ____ Notes Chkd. ____ Checked ____ Date ____ Date ____

F.B. 725 Pg. 49

Survey of ____ Notes ____

Survey by ____ Date ____

Indexed ____ Date ____

STATION	B. S.	H. I.	F. S.	ELEV.	
15+00		1558.9[illegible]	5.9	[illegible]	Top I.P.
Gr			4.0	[illegible]	
15+10.2			4.7	[illegible]	Top or Water Valve
Gr			3.8	[illegible]	
15+32.8			7.4	[illegible]	Top I.P.
Gr			5.3	[illegible]	
15+55.5			9.4	[illegible]	Top I.P.
Gr.			7.5	[illegible]	
T.P.	0.00	1547.215	11.71	1547.215	✓
16+00			2.2	[illegible]	Top I.P.
Gr			0.4	[illegible]	
16+19.3			4.2	[illegible]	Top I.P.
Gr.			2.5	[illegible]	
16+41.8			6.9	[illegible]	Top I.P.
Gr			5.5	[illegible]	
16+50.8			3.0	[illegible]	Top I.P.
Gr			6.3	[illegible]	
16+80.3			[illegible]	[illegible]	Top I.P.
Gr			9.6	[illegible]	
T.P.	0.34	1536.030	11.525	1535.[illegible]	✓

Form 307 5M 11-35

PLEASE RETURN TO
LOS ANGELES COUNTY SURVEYOR
700 HALL OF RECORDS

NOTE: ANY ADDITIONS OR CHANGES ON THIS SHEET MUST BE MADE OR CIRCLED IN RED INK, WITH DATE AND NAME OF PERSON MAKING CHANGE

Do not extend notes this side of this line

Profile No. ____ X-Sec. No. ____ Notes Red ____ Date ____ Notes Chkd. ____ Date ____ Plotted Wood Date ____ Checked Reeves Date 11-6-37 Job No. 234 Division No. ____ Survey of Fox Canyon Survey by Stevenson Map No. 18-1375 Notes Rainey Date 7-20-37 Indexed ____ F. B. 725 Pg. 45

STATION	B. S.	H. I.	F. S.	ELEV.		
16+98		1536.039	1.8	34.2	Top I.P.	
Gr.			0.0	36.0		
17+08			3.2	32.8	Top I.P.	
Gr			1.2	34.8		
17+18			4.3	31.7	Top I.P.	
Gr.			2.5	33.5		
17+29			5.5	30.5	Top I.P.	
Gr.			3.6	32.4		
17+50			8.3	27.7	Top I.P.	
Gr			6.5	29.5		
17+82			10.3	25.7	Top I.P.	
Gr			8.5	27.5		
T.P	0.22	1524.34	11.91	1524.120		
18+24			3.6	20.7	Top I.P.	
Gr			2.1	22.2		
18+34			4.9	19.4	Top I.P.	
Gr			3.0	21.3		
18+68			8.9	15.4	Top I.P.	
Gr			7.1	17.2		
18+90			12.0	12.3	Top I.P.	
Gr			9.9	14.4		

Form 307 5M 11-35

PLEASE RETURN TO
LOS ANGELES COUNTY SURVEYOR
700 HALL OF RECORDS

NOTE: ANY ADDITIONS OR CHANGES ON THIS SHEET MUST BE MADE OR CIRCLED IN RED INK, WITH DATE AND NAME OF PERSON MAKING CHANGE

Do not extend notes this side of this line

F.B. 725 PG. 46

Job No. 5211 Division No. Plotted Profile
Survey of FIRE CISTERN SYSTEM Notes Red. Date No. X-Sec.
Survey by Stevenson Notes Ford Date Checked Date No.
Indexed Date

STATION	B. S.	H. I.	F. S.	ELEV.	
		1524.34			
T.P.	.01	1512.58	11.77	1512.57	
19+01 6			1.4	11 2	Top I.P.
G.H.			0.00	12 6	
19+13 8			2.5	11 1	Top I.P.
G.H.			0.80	13	
19+23 4			3.2	12 8	Top. I.P.
G.H.			1.4	13 2	
19+46 9			4.9	12 7	Top I.P.
G.H.			3.0	13	
19+67 10			6.8	12 8	Top I.P.
G.H.			4.8	13	
20+02 3			9.6	12	Top I.P.
G.H.			8.1	13	
20+13 2			10.2	12 3	Top I.P.
G.H.			8.9	13	
T.B.M.	0.965	1502.575	10.47	1502.11 4	
BM 3-1			6.115	1496.460	+ 3/4" I.P. P.I. No 4 - Pipeline Loc Medley Lane

Profile Contd on P-67

Notes Ck'd by	Survey of
Map No.	W. O. Tape No. St'd °F.
Office Work	Surveyed by
Checked	Notes Date
Date	Indexed 12-14-37

F.B. 725 Pg. 47

FIRE CISTERN SYSTEM

J. N. 5211

PIPE LINES IN FERNWOOD STS.

Note: Any Additions or Changes on This Sheet Must be Made or Circled in Red Ink With Date and Name of Person Making Change.

Do not extend notes this side of this line

RETURN TO
LOS ANGELES COUNTY SURVEYOR
700 HALL OF RECORDS

FORM 247 10M 11-35

RETURN TO
LOS ANGELES COUNTY SURVEYOR
700 HALL OF RECORDS

Note: Any Additions or Changes on This Sheet Must be Made or Circled in **Red Ink** With Date and Name of Person Making Change.

Do not extend notes this side of this line

F.B. _____ PG. 18

Form 307 5M 11-35

PLEASE RETURN TO
LOS ANGELES COUNTY SURVEYOR
700 HALL OF RECORDS

NOTE: ANY ADDITIONS OR CHANGES ON THIS SHEET MUST BE MADE OR CIRCLED IN RED INK, WITH DATE AND NAME OF PERSON MAKING CHANGE

Do not extend notes this side of this line

5

STATION	B.S.	H.I.	F.S.	ELEV.		
B.M.	1st. Run	Diff	2nd	3rd	ADJ El	

Profile

No. Notes Red Plotted Job No. Division No. F.B. PG.

X-Sec. Date Date Survey of

No. Notes Chkd Checked Survey by Notes

Date Date Map No. Indexed Date Date

F. B. 728 Pg. 48 | Job No. 1575 | Division No. | Notes Red. | Plotted | Profile

Survey of | Date | Date | No.

Survey by | Notes | Notes Chkd. | Checked | X-Sec.

Indexed C. Johnson | Date | Date | Date | No.

5

Form 30c JM 11-35

PLEASE RETURN TO
LOS ANGELES COUNTY SURVEYOR
700 HALL OF RECORDS

Do not extend notes this side of this line

NOTE: ANY ADDITIONS OR CHANGES ON THIS SHEET MUST BE MADE OR CIRCLED IN RED INK, WITH DATE AND NAME OF PERSON MAKING CHANGE

STATION	B. S.	H. I.	F. S.	ELEV.
B.M.				
	Lat. Rup	Diff	2nd	3rd

FORM 247 10M 11-35

RETURN TO
LOS ANGELES COUNTY SURVEYOR
700 HALL OF RECORDS

WS 129-097 A-1

Note: Any Additions or Changes on This Sheet Must be Made or Circled in **Red Ink** With Date and Name of Person Making Change.

Do not extend notes this side of this line

WS 58- A-7

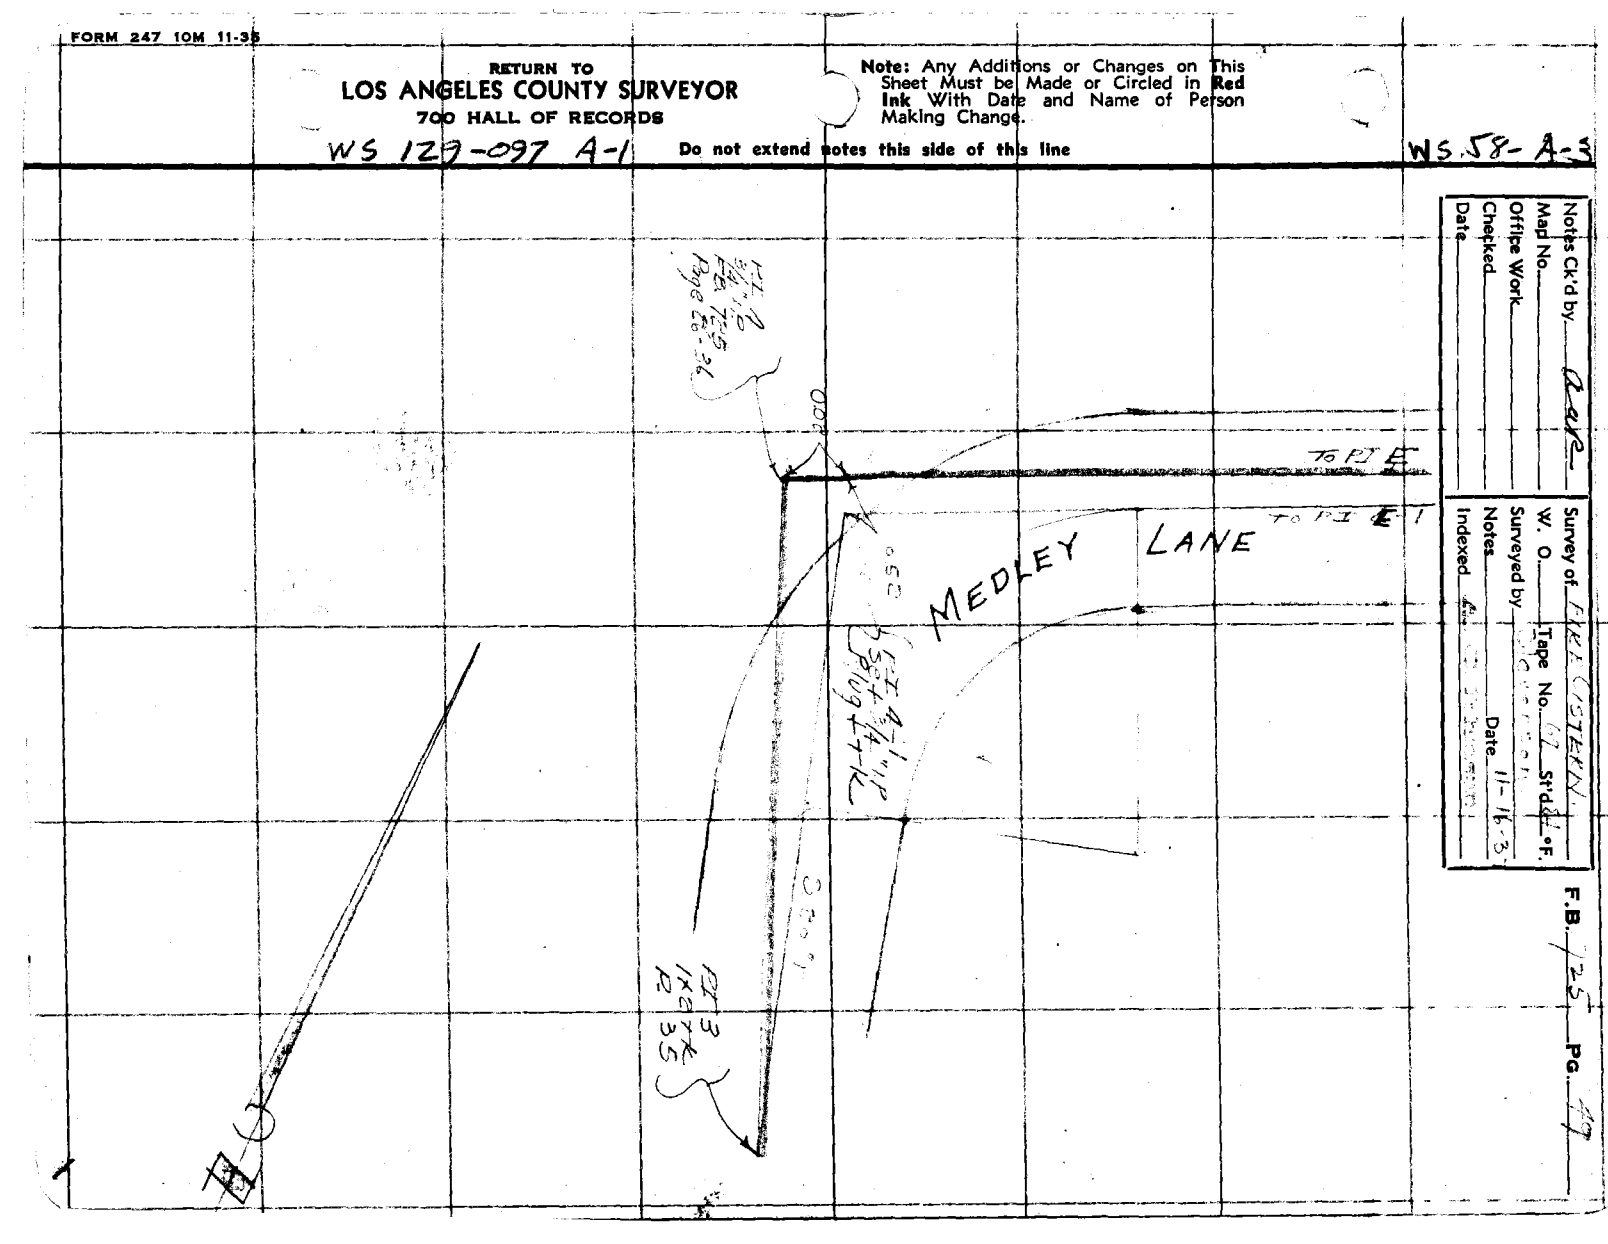

Notes Ck'd by Rapp
Map No.
Office Work
Checked
Date

W. O. Tape No. Std. °F.
Surveyed by
Notes Date 11-16-3
Indexed

F.B. 125 PG. 47

RETURN TO
LOS ANGELES COUNTY SURVEYOR
700 HALL OF RECORDS

Note: Any Additions or Changes on This Sheet Must be Made or Circled in Red Ink With Date and Name of Person Making Change.

Do not extend notes this side of this line

WS 58-A-3

WS 129-097 A-1

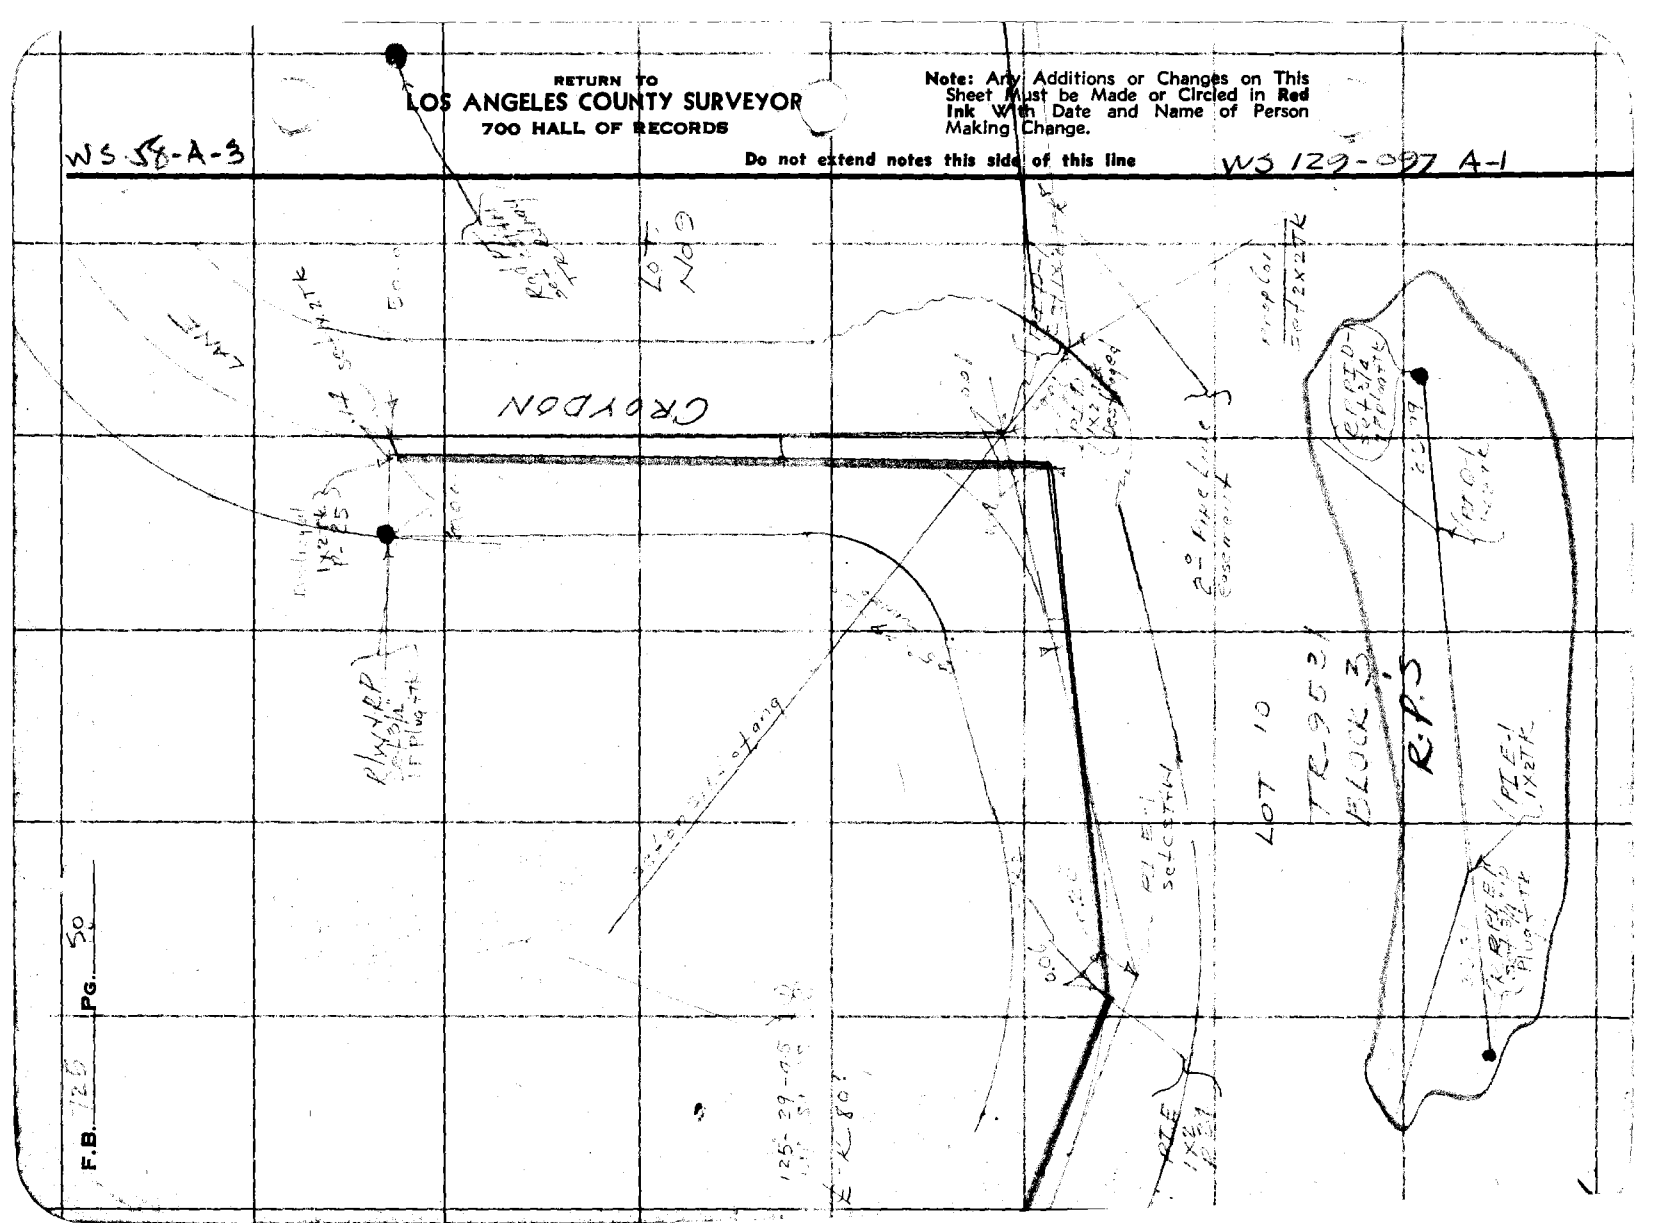

Notes Ck'd by aap	Survey of [illegible]
Map No.	W. O. 9211 Tape No. [illegible] St'd [illegible] °F.
Office Work	Surveyed by [illegible]
Checked	Notes [illegible] Date 11-9-37
Date	Indexed [illegible]

F.B. [illegible] PG. 51

WS.SE-4-3

Note: Any Additions or Changes on This Sheet Must be Made or Circled in Red Ink With Date and Name of Person Making Change.

Do not extend notes this side of this line

RETURN TO
LOS ANGELES COUNTY SURVEYOR
700 HALL OF RECORDS

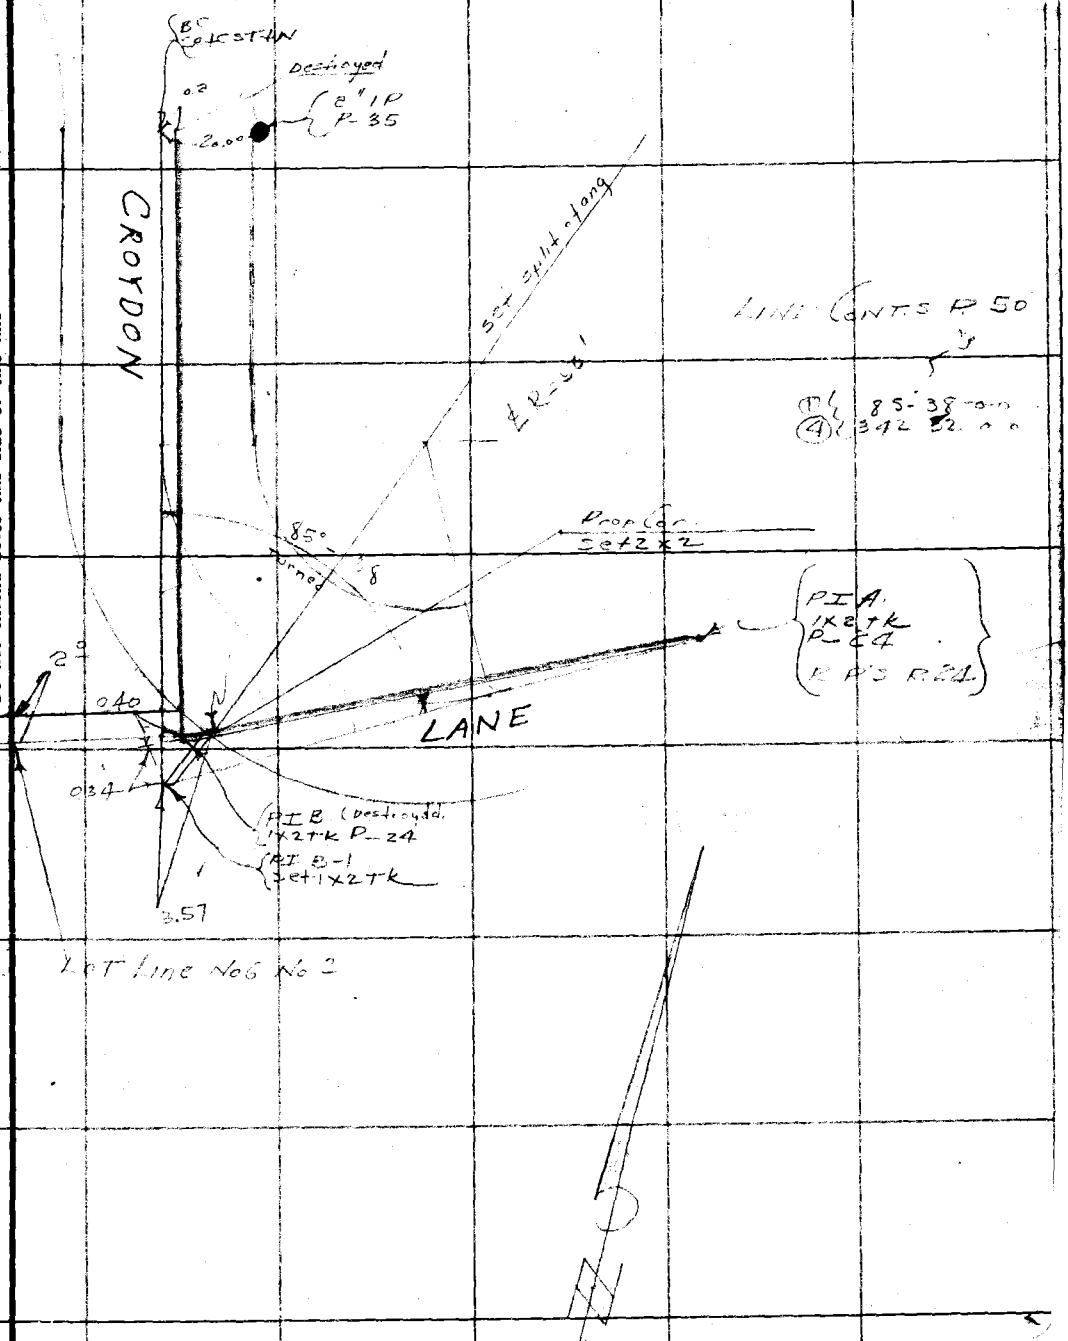

FORM 247 10M 11-35

Cont. to bot page 53


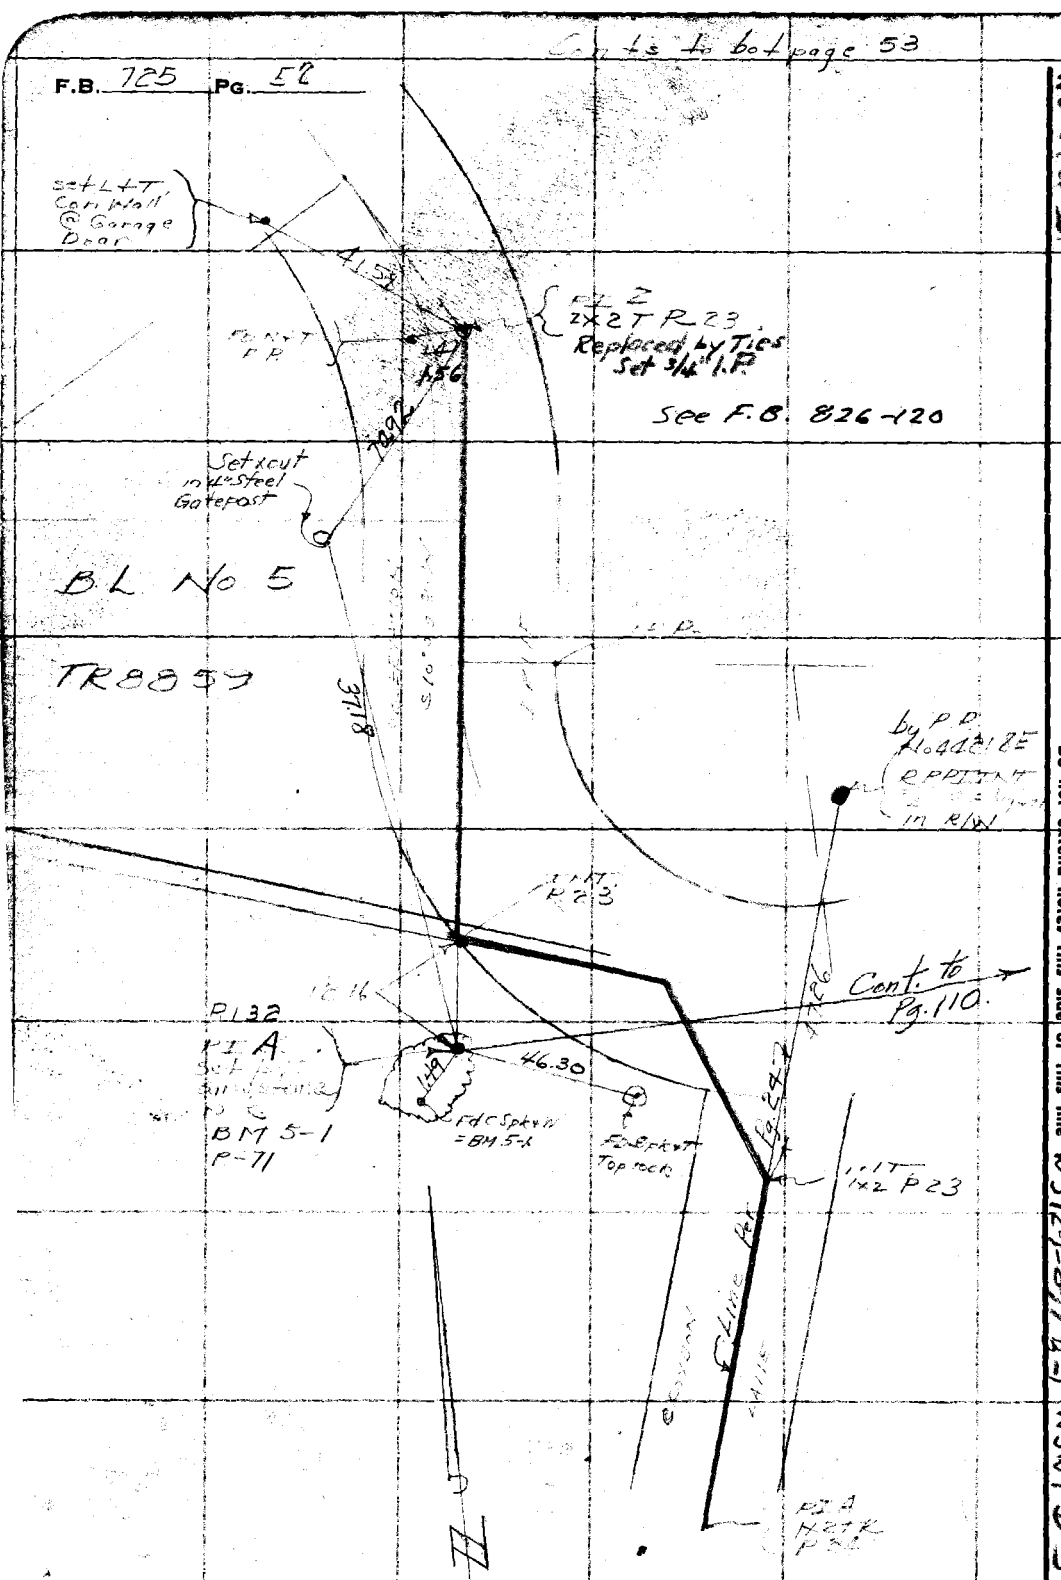

RETURN TO
LOS ANGELES COUNTY SURVEYOR
700 HALL OF RECORDS

Do not extend notes this side of this line

Note: Any Additions or Changes on This Sheet Must be Made or Circled in Red Ink With Date and Name of Person Making Change.

WS 129-027 B-1

WS 59-D-3

WS 59-D-3

Notes Ck'd by AAR	Survey of [illegible] F.B. 765 Pg. 53
Map No. B-163 Y-1	W. O. 8211 Tape No. St'd °F.
Office Work White	Surveyed by STEVENSON
Checked AAR	Notes T C S Date 11-16-37
Date 1941	Indexed A. C. Swanson

WS 127-D3

Note: Any Additions or Changes on This Sheet Must be Made or Circled in Red Ink With Date and Name of Person Making Change.

Do not extend notes this side of this line

RETURN TO
LOS ANGELES COUNTY SURVEYOR
700 HALL OF RECORDS

WS 129-097 A-1

FORM 247 10M 11-38

Cont. to bot page 51

ALLEY

Set N+T 5' above 6r to Arc only

PI V 1x2 TK R-81

67.00

30.55

18.6

1.88

.10

Set 3/4" IP P.L.S. TK

ICCHO DRIVE

55.86

TR 8859

PI-V-1 Set 3/4" IP P.L.S. TK

Set N+T 4x4 Tel Pole

Note: For additional points & Ties See pg. 50 - FB 826

0.8C

PIW C.S.W. 1961

PI W-1 Set C.S.T.H. 6" Down used

10.4

Note: This & Retraced - See FB 826/120

S 76° 17' E

OBSERVATION DRIVE

1x2 # Line 1x2 #22

BL-5

PI X Set 10 nail

120.05

0.59

PI X-1' Set 3/4" IRP L.S. TK Not disturbed Ties Hereon

0.82

8.59

Set N+T P.P.

2063

Copper Tack Front Hse.

PI Y Destroyed

-.7

3.80

PI Y-1 1x2 TK Not disturbed Ties Hereon

OFFSET P.I. per FB 826/120 F.D. L+T in wall

0.19

9.00

8.36

1.80

46.90

Set Lot in Landing P.I. Z

Cont. from top page 52

F.B. 725 Pg. 54

176.24 @ 2°46 T80 176.02
118.11 @ 7°55 T80 117.98
145.90 @ 7°12 T80 145.73
590 439.73
144.63
3

WS 59-D-3

Red Transit Line P.20
yellow True Line

To ℄ Cumpston West see P-106

TR 8859
BL 3

1x2 TK P.20

From P.I.

To P.I.
3
14463 C.L.

T.N.
set 3/4 IP plug +TK

13.64
See F.B. 826-116-118

GRAND

2" IP P.20

BL No 8

ALLEY 10'

LOT 10

LOT 11

LOT 12

2X2 TK P.20

0.3

See F.B. 826-120

Set TW P.20

3/4 IP 0.53

℄ SISCHO DRIVE

195

set 3/4" IP 6" Down

1.33

WS 129-097 A-1

RETURN TO
LOS ANGELES COUNTY SURVEYOR
700 HALL OF RECORDS

Do not extend notes this side of this line

Note: Any Additions or Changes on This Sheet Must be Made or Circled in Red Ink With Date and Name of Person Making Change.

1

Notes Ck'd by AAR	Survey of ARC EASTERN SYSTEM
Map No. B-1631-1	W. O. 5011 Tape No. 69 St'd 84° F.
Office Work White	Surveyed by Stevenson
Checked AAR	Notes T.T.S. Date 11-17-37
Date 1941	Indexed

F.B. 153 PG. 55

Cont to bot page 56

W.S. 59-D-3

Note: Any Additions or Changes on This Sheet Must be Made or Circled in Red Ink With Date and Name of Person Making Change.

Do not extend notes this side of this line

RETURN TO
LOS ANGELES COUNTY SURVEYOR
700 HALL OF RECORDS

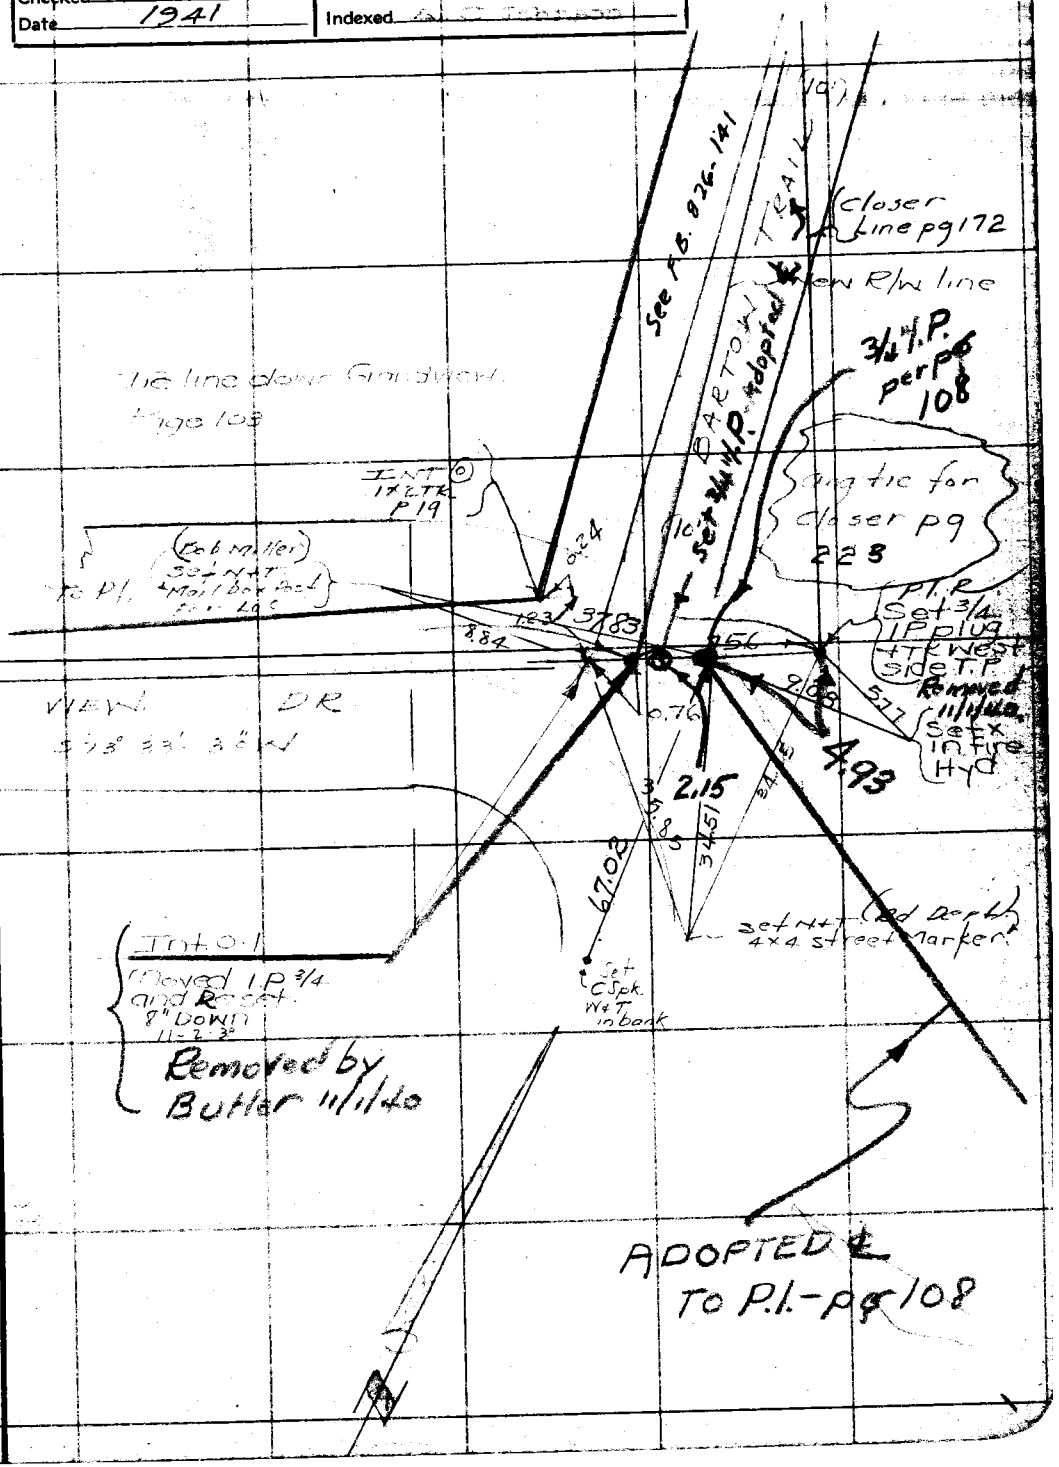

FORM 247 10M 11-38

RETURN TO
LOS ANGELES COUNTY SURVEYOR
700 HALL OF RECORDS

Note: Any Additions or Changes on This Sheet Must be Made or Circled in Red Ink With Date and Name of Person Making Change.

Do not extend notes this side of this line

WS.59-D-3

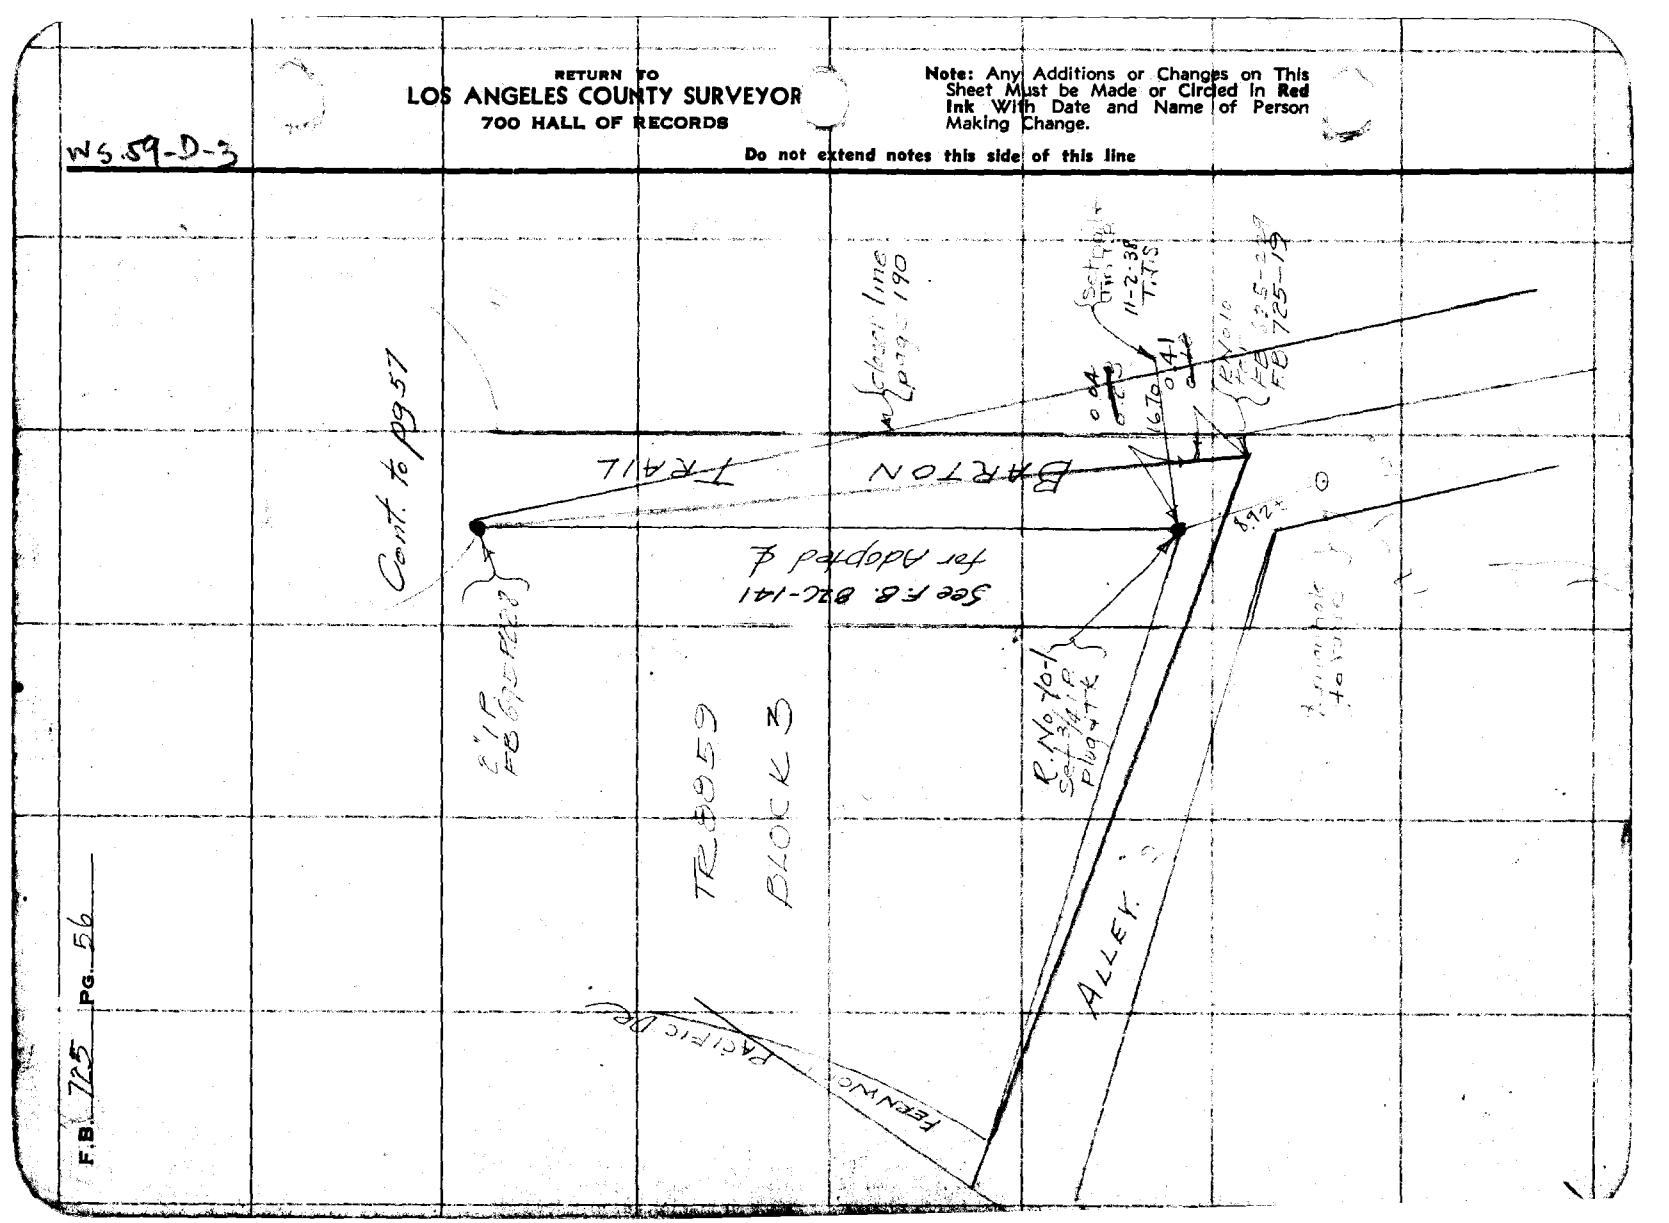

Notes Ck'd by AAR	Survey of Fernwood Tract
Map No. B-1631-1-2	W. O. 8267 Tape No. St'd. °F.
Office Work White	Surveyed by Stevenson
Checked AAR	Notes Date 11-2-38
Date 1941	Indexed

F.B. 725 PG. 57

W3 59-D-3

FERNWOOD PACIFIC

Drive

Set nail & tin in Sandstone rock

345.0

Not Set

Details of Fernwood Pacific See F.B. 695-226

Int. ESTAW F.B. 695 pgs 226

Set nail & tin on Street Marker

+ 3/4" IP @ Post

F.B. 695-226

95.75

96.14

70 ft

Adopted TRAIL

Pt. Set 3/4" IP plug & Tk. 8" Down

ALPINE

30.50

175.44

10° 00' 55" W

151.46

TR 5664

TR 8859

Set nail & tin in F.B.

Set in Gate Post

107° 56' 10"

AZ No 27 F.B. 695 - P. 228

22.46

44.78

.26

Set 3/4" IP plug & Tk. 8' Down

PARK TRAIL

133

See F.B. 826-141 for Adopted

Cont from pg 56

BARTON TRAIL

Note: Any Additions or Changes on This Sheet Must be Made or Circled in Red Ink With Date and Name of Person Making Change.

Do not extend notes this side of this line

RETURN TO
LOS ANGELES COUNTY SURVEYOR
700 HALL OF RECORDS

W3 129-297 8-1

FORM 247 10M 11-35

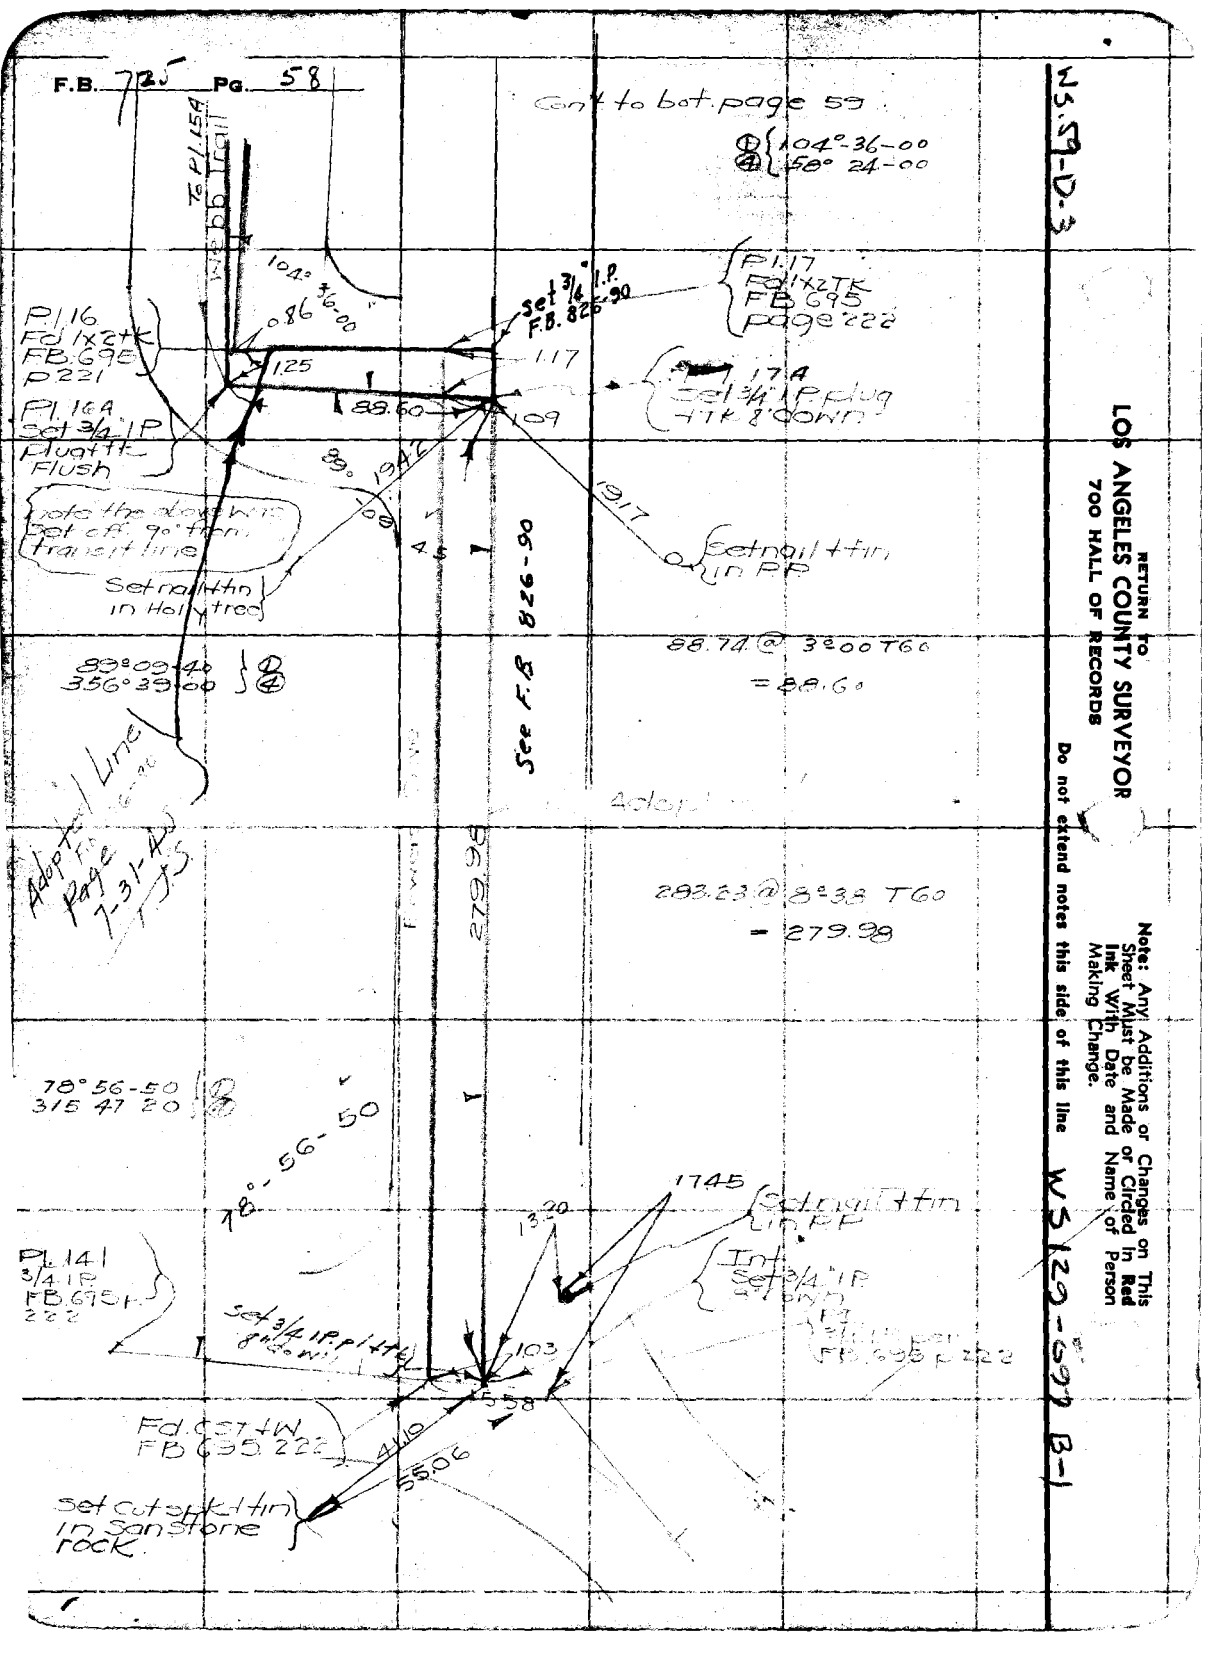

RETURN TO
LOS ANGELES COUNTY SURVEYOR
700 HALL OF RECORDS

Do not extend notes this side of this line

Note: Any Additions or Changes on This Sheet Must be Made or Circled in Red Ink With Date and Name of Person Making Change.

W5.59-D-3

W5129-597 B-1

Notes Ck'd by Chap	Survey of Hollywood Hills
Map No. B-1631-2	W. O. 8202 Tape No. St'd °F.
Office Work White	Surveyed by Stevenson
Checked AAR	Notes T.T.S Date 11-3-39
Date 1941	Indexed

F.B. 225 PG. 59

W 59-D-5

RETURN TO
LOS ANGELES COUNTY SURVEYOR
700 HALL OF RECORDS
WS 132-092 B-1

Note: Any Additions or Changes on This Sheet Must be Made or Circled in Red Ink With Date and Name of Person Making Change
Do not extend notes this side of this line

Cont. to bot. of pg 60

From Pl. 24

Pl 13
Fd 1X2 tk
F.B. 655
page 221

Pl 13A
Set 3/4 I.P.
Plug + tk
8" down

114.56

Log 59.35

3-25-40
T.J.S

Pl 14
Fd 1X2 tk
F.B. 695-221

0.82
0.73

Pl
Set 3/4 I.P. plug
8 down

S 60° A.B. 826-30-91

Dist. + Angles
2-26-40

Transit Line

WEBB TRAIL

228.91 @ 14°-05 T60°

Adopted Line
P.C.
F.B. 826-90-94
7-31-40
T.J.S

Pl
Fd 1X2 tk
F.B. 695
P. 222

① 172°-40-10
④ 330° 40 40

Set x in Concrete

Garage

172° 40 - 0

12.63

1.10

Pl. 15A
Set 3/4 I.P.
Plug + TK
8" down

3.12

23.85

141.22 @ 9°-25 T60°
= 139.39

From Pl. 16A 139.50

Jet x in curb

Cont. from top page 58

RETURN TO
LOS ANGELES COUNTY SURVEYOR
700 HALL OF RECORDS

Note: Any Additions or Changes on This Sheet Must be Made or Circled in Red Ink With Date and Name of Person Making Change.

Do not extend notes this side of this line

WS59-D-3

WJ129-097 B-1

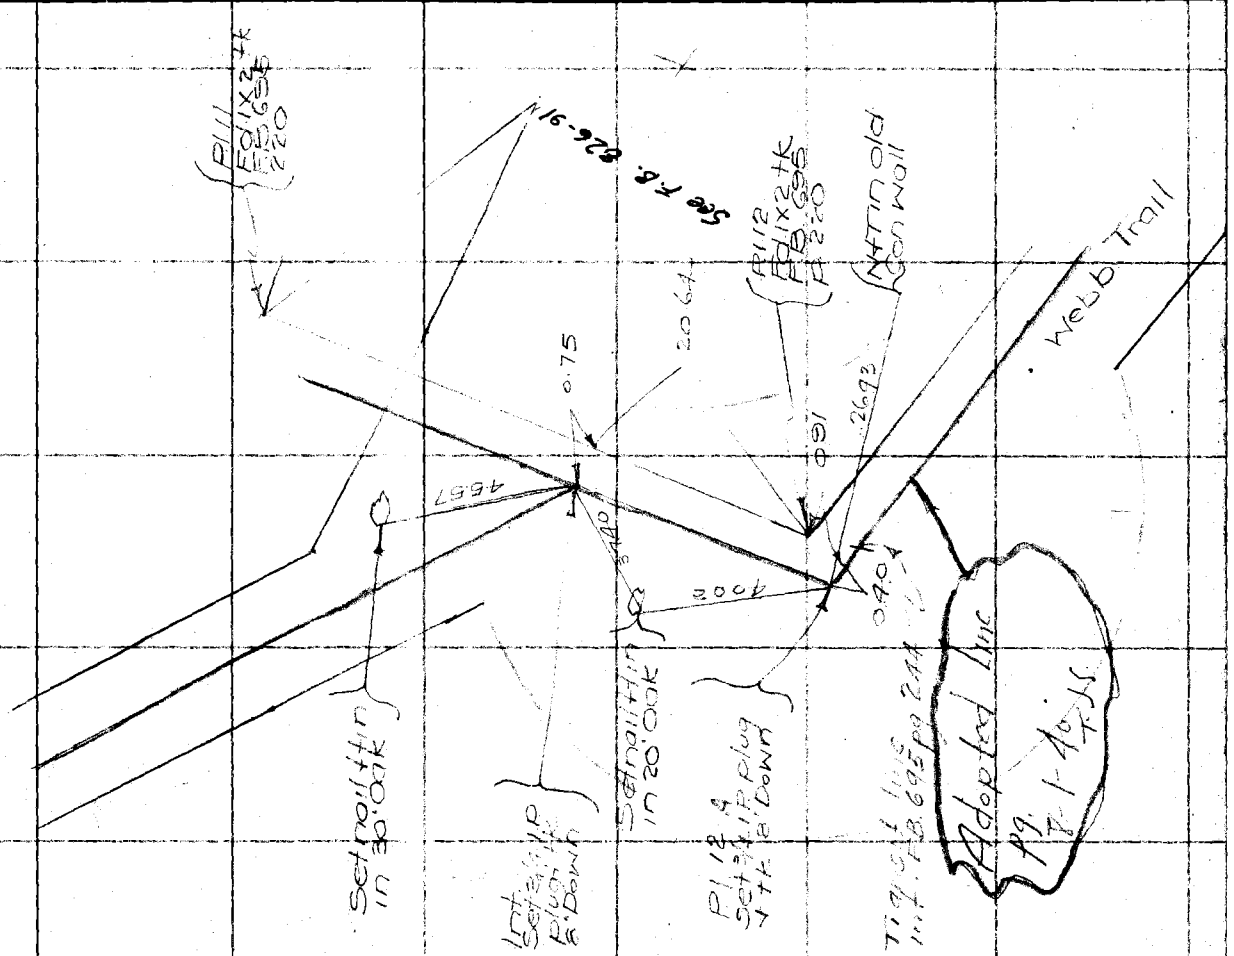

F.B. 725 PG. 60

FORM 247 10M 11-35

RETURN TO
LOS ANGELES COUNTY SURVEYOR
700 HALL OF RECORDS

Note: Any Additions or Changes on This Sheet Must be Made or Circled in **Red Ink** With Date and Name of Person Making Change.

Do not extend notes this side of this line

Notes Ck'd by
Map No.
Office Work
Checked
Date

Survey of
W. O. Tape No. St'd °F.
Surveyed by
Notes
Date
Indexed

F.B. PG.

RETURN TO
LOS ANGELES COUNTY SURVEYOR
700 HALL OF RECORDS

Note: Any Additions or Changes on This Sheet Must be Made or Circled in **Red Ink** With Date and Name of Person Making Change.

Do not extend notes this side of this line

F.B. 125 PG. 62

Notes Ck'd by	Survey of Fernwood Rd
Map No.	W. O. 820 Tape No. St'd °F.
Office Work	Surveyed by
Checked	Notes Date 1-24-38
Date	Indexed 4-14-38

F.B. 725 Pg. 65

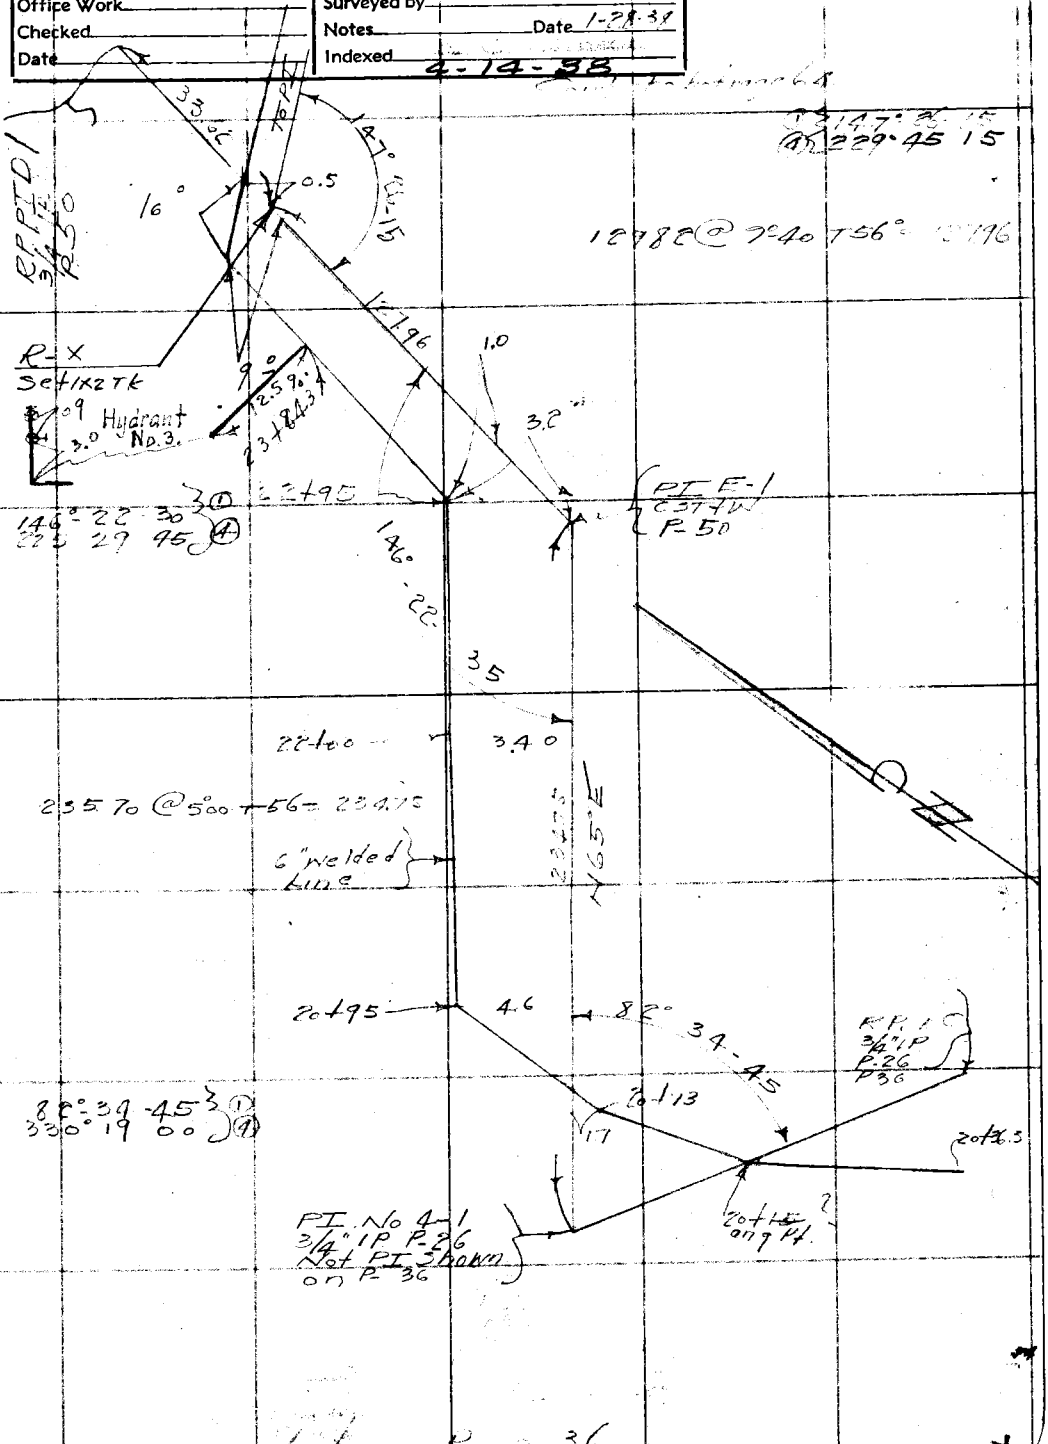

from Pg 36

RETURN TO
LOS ANGELES COUNTY SURVEYOR
700 HALL OF RECORDS

Note: Any Additions or Changes on This Sheet Must be Made or Circled in Red Ink With Date and Name of Person Making Change.

Do not extend notes this side of this line

FORM 247 10M 11-38

F.B. 725 PG. 64

Con't to bot page 65

278.30 @ 6°16 T56 = 276.60

27+72.70

4.4

27+16.30

164°-19-45 ⑤
297°18 4.5 ④

1.9

SPIA
1x2 Tk
P=1
P

19°-19-40

26+50

1.0

25+57

25+30.7

N 61°30 E

0.6

266.48

19185 @ 10°58 T56 188.32
7980 @ 11°35 T 56 178.16
266.48

5°11'05"

FROM R

Con't from top page 63

RETURN TO
LOS ANGELES COUNTY SURVEYOR
700 HALL OF RECORDS

Note: Any Additions or Changes on This Sheet Must be Made or Circled in Red Ink With Date and Name of Person Making Change.

Do not extend notes this side of this line

Notes Ck'd by OWP	Survey of Farmwood
Map No.	W. O. 807 Tape No. 69 St'd 44 F.
Office Work	Surveyed by Stevenson
Checked	Notes Date 1-28-38
Date	Indexed

F.B. 5-5 Pg. CC

Cont. to bot page

PI Y-1
P 53

3.4

6" Gate Valve

N 10° 45 E 12.13

2.

PI Z
2×2 TK
P 23-P 52

30+37.5

3.2

134° 48 30 ①
179° 13 45 ④

13.4°

48.58

A8

R5

Hydrant No. 4

Fire Hyd. Ver

1" Fire Valve

1" valve

0.9

0.0

1:1

12.54

78.93 @ 4°24 F56
= 78.69.

78.69

30+12.5

11.8

6

R.T. INT
EDIX27R
P 28

100° 11 30 ①
40 45 45 ④

27+37.3

100-111

27+47.2

13.3

12.5

27+50

12.2

5.8

Cont. from top page 81

RETURN TO
LOS ANGELES COUNTY SURVEYOR
700 HALL OF RECORDS

Note: Any Additions or Changes on This Sheet Must be Made or Circled in Red Ink With Date and Name of Person Making Change.

Do not extend notes this side of this line

FORM 247 10M 11-35

Cont. to bot page 95

F.B. 725 Pg. 66

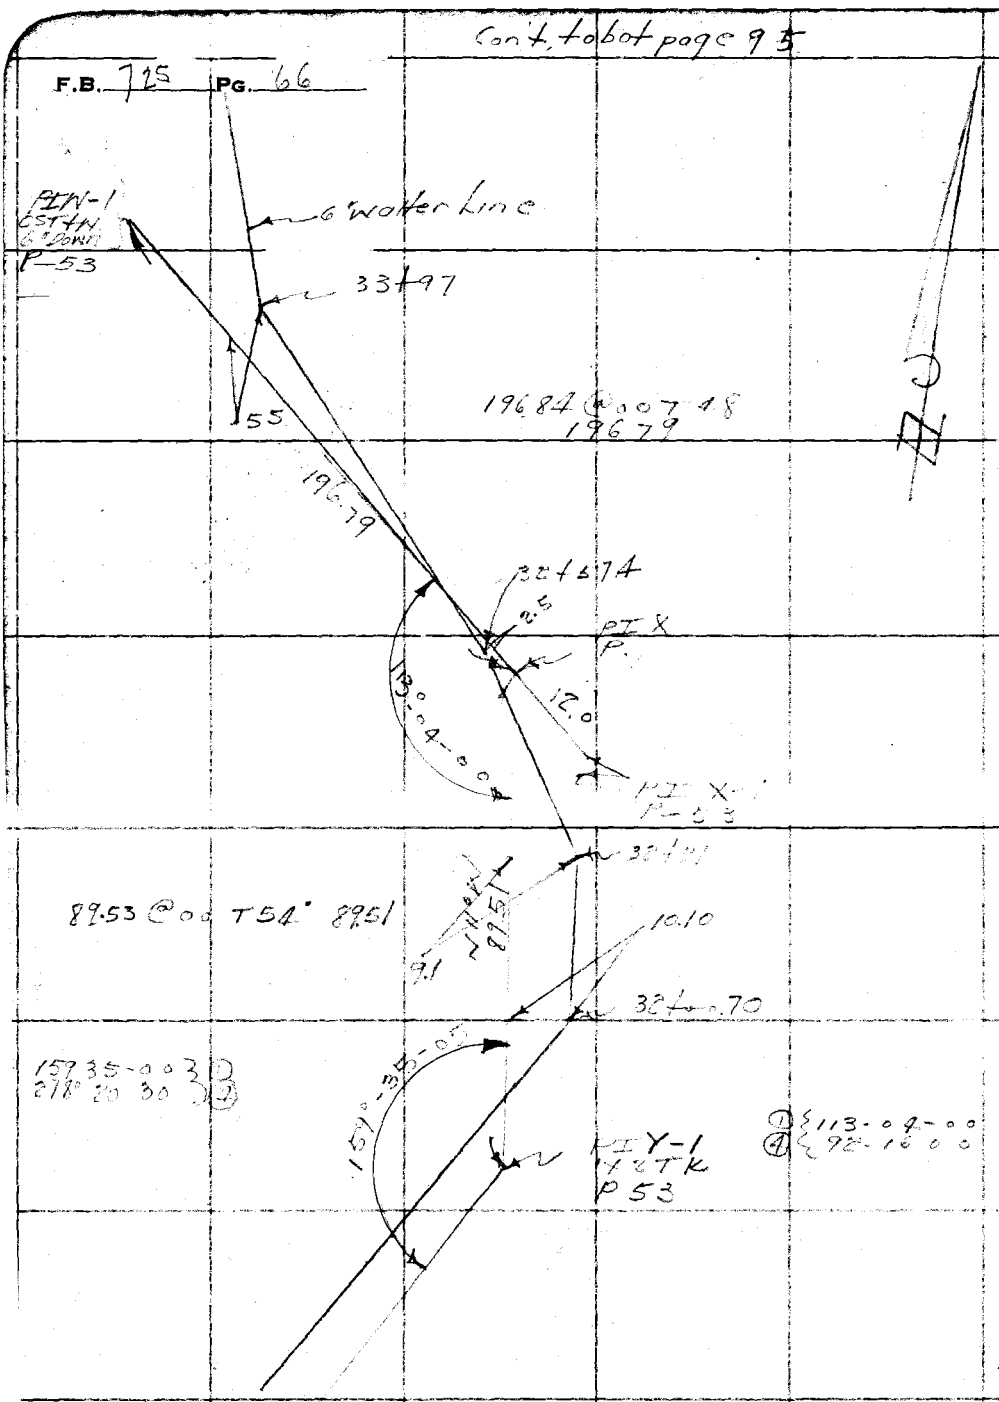

RETURN TO
LOS ANGELES COUNTY SURVEYOR
700 HALL OF RECORDS

Note: Any Additions or Changes on This Sheet Must be Made or Circled in Red Ink With Date and Name of Person Making Change.

Do not extend notes this side of this line

Profile No. _____ X-Sec. No. _____

Notes Red. _____ Date _____ Notes Chkd. _____ Date _____

Plotted _____ Date _____ Checked _____ Date _____

Job No. _____ Survey of _____ Survey by _____ Map No. _____

Division No. _____ Notes _____ Indexed _____

F. B. 725 PG. 67

Date 4-14-38

NOTE: ANY ADDITIONS OR CHANGES ON THIS SHEET MUST BE MADE OR CIRCLED IN RED INK, WITH DATE AND NAME OF PERSON MAKING CHANGE

Do not extend notes this side of this line

PLEASE RETURN TO
LOS ANGELES COUNTY SURVEYOR
700 HALL OF RECORDS

Form 307 5M 10-37

STATION	B. S.	H. I.	F. S.	ELEV.	
					Continuation of Profile on 6" Water Line Rd's Fire Cistern System
					T. No. 8209
					Job Name Fernwood Rds

Form 307 5M 10-37

PLEASE RETURN TO
LOS ANGELES COUNTY SURVEYOR
700 HALL OF RECORDS

NOTE: ANY ADDITIONS OR CHANGES ON THIS SHEET MUST BE MADE OR CIRCLED IN RED INK, WITH DATE AND NAME OF PERSON MAKING CHANGE

Do not extend notes this side of this line

F.B. 725 PG. 68 | Job No. 8809 | Division No. | Notes Red. | Plotted | Profile
Survey of Fernwood RDS | Date | Date | No.
Survey by Heyenson Notes: T-T-S. | Notes Chkd. | Checked | X-Sec.
Indexed Date 1-28-38 | Date | Date | No.

STATION	B. S.	H. I.	F. S.	ELEV.		
B.M. No 3-1	3.870	1500.33		1496.460	3/4" I.P. plug + Tk P.I. No 4.	P-46
20+51.0			2.3	98.1 ✓	I.P. Top	
			0.6	99.7 ✓	Gr.	
20+73.0			3.7	96.6 ✓	Pipe Top	
			2.9	97.4 ✓	Gr.	
20+95			5.5	94.8 ✓	Pipe Top	
			4.1	96.2 ✓	Gr.	
21+50			9.3	91.0 ✓	Gr.	
		✓	10.9	89.4 ✓	Top I.P.	
T.P.	0.511	1490.067	10.78	1489.556 ✓		
22+00			5.6	94.5 ✓	Top I.P.	6" Welded
			4.1	95.0 ✓	Gr.	
22+50			9.0	91.1 ✓	Gr.	
		✓	10.6	89.5 ✓	Top I.P.	
T.P.	0.553	1479.354 ✓	11.566	1478.501 ✓		
22+95			5.0	94.4 ✓	I.P.	
			2.8	96.6 ✓	Gr.	
23+50			11.5	89.9 ✓	Gr.	
			13.7	87.7 ✓	I.P.	
T.P.	0.720	1468.549 ✓	11.525	1467.829 ✓		

Form 307 5M 10-37

PLEASE RETURN TO
LOS ANGELES COUNTY SURVEYOR
700 HALL OF RECORDS

NOTE: ANY ADDITIONS OR CHANGES ON THIS SHEET MUST BE MADE OR CIRCLED IN RED INK, WITH DATE AND NAME OF PERSON MAKING CHANGE

Do not extend notes this side of this line

Profile No. ____ Notes Red. ____ Plotted ____ Job No. 1209 Division No. ____
X-Sec. No. ____ Date ____ Date ____ Survey of Kenwood Rd. ____
Notes Chkd. ____ Checked ____ Survey by Stevenson Noted ____ Date 1-28-38
Date ____ Date ____ Map No. ____ Indexed ____ Date ____

F. B. 125 Pg. 64

STATION	B. S.	H. I.	F. S.	ELEV.		
		1468.549				
24+0590			10.2	584	Top I.P.	
			9.2	594	Gr.	
BM. 4.1	0.327	1459.325	9.551	1458.998	Set Cut Spk+Washer Top Large Sycamore 6.0 Rt	
24+5530			6.6	527	Top I.P.	7-50 Sta 24+45 2.5 Rt Soap
			4.6	547	Gr.	
TP	0.110	1450.375	7.06	1450.315		
24+95			8.4	420	Top Pipe	
			5.7	449	Gr.	
TP	0.302	1439.728	10.975	1439.426		
25+307			1.7	300	Top I.P.	
			7.0	327	Gr.	
TP	1.231	1429.647	11.312	1428.416		
25+432			6.6	231	Top I.P.	
			5.2	245	Gr.	
TP	1.244	1419.018	11.873	1417.774		
26+00			4.1	149	Top I.P.	
			2.5	165	Gr.	
26+60			11.6	074	Top I.P.	
			9.4	096	Gr.	

Form 307 5M 10-37

PLEASE RETURN TO
LOS ANGELES COUNTY SURVEYOR
700 HALL OF RECORDS

NOTE: ANY ADDITIONS OR CHANGES ON THIS SHEET MUST BE MADE OR CIRCLED IN RED INK, WITH DATE AND NAME OF PERSON MAKING CHANGE

Do not extend notes this side of this line

F. B. 125 Pg. 70 | Job No. 8209 | Division No. | Profile
Survey of Fernwood Rds | Plotted | No.
Survey by Stevenson | Notes | Notes Red. | Date | X-Sec.
Indexed | Date 1-28-38 | Notes Chkd. | Date | Checked | Date | No.

STATION	B. S.	H. I.	F. S.	ELEV.		
		1419.018				
T.P.	0.810	1408.291	11.537	1407.481		
T.P.			6.5	1 8 1	Top IP	
			5.0	3 3	Gr	
27+12.30			6.9	1 4	Top IP	
			6.0	3 3	Gr	
27+50			7.8	1 3 5	Top IP	
			4.8	9 7	Gr	
T.P.	0.583	1397.264	11.55	1396.741		
28+00			4.9	2 4	Top IP	
			3.1	9 2	Gr	
28+50			12.2	1	Top IP	
			11.1	2	Gr	
T.P.	0.204	1385.62	11.848	1385.416		
29+00			7.7	9	Top IP	
			6.6	8	Gr	
29+33			11.5	7 4 1	Top IP	
			9.3	7 2	Gr	
T.P.	0.967	1375.224	11.363	1374.257		
29+47.2			3.7	5		
			0.9	7 2 3		

Form 307 SM 10-37

PLEASE RETURN TO
LOS ANGELES COUNTY SURVEYOR
700 HALL OF RECORDS

NOTE: ANY ADDITIONS OR CHANGES ON THIS SHEET MUST BE MADE OR CIRCLED IN RED INK, WITH DATE AND NAME OF PERSON MAKING CHANGE

Do not extend notes this side of this line

STATION	B. S.	H. I.	F. S.	ELEV.		
		1375.224				
29+673			5.9	693	Top IP	
			3.0	722	Gr	
29+837			11.7	625	Top IP	
			8.8	664	Gr	
TP	5.342	1368.751	11.815	1363.409		
30+39[illegible]			7.6	612	Top IP	
			5.6	632	Gr	
30+80			6.9	669	Top IP	
			5.2	63[illegible]	Gr	
31+[illegible]			7.0	6[illegible]8	Top IP	
			4.7	641	Gr	
+185			6.4	634	Top IP	
			4.7	641	Gr	(ck to here
BM 51	5.109	1367.115	6.265	1361.186	Cut Spk in [illegible]	by PE For-P. 52
31+50			3.0	64[illegible]	Gr	
			1.6	633	IP Top	
32+00.1			2.9	630	Gr	
32+			1.4	635	IP Top	
32+21			3.4	645		
			4.9	630		

Profile
No. ____ Notes Red. ____ Plotted ____ Job No. 1609 Division No. ____ F. B. 735 PG. 11
X-Sec. ____ Date ____ Date ____ Survey of FERNWOOD-[illegible]
No. ____ Notes Chkd. ____ Checked ____ Survey by [illegible] Notes ____ Date 1-28-38
Date ____ Date ____ Map No. ____ Indexed ____ Date ____

Form 307 5M 10-37

PLEASE RETURN TO
LOS ANGELES COUNTY SURVEYOR
700 HALL OF RECORDS

NOTE: ANY ADDITIONS OR CHANGES ON THIS SHEET MUST BE MADE OR CIRCLED IN RED INK, WITH DATE AND NAME OF PERSON MAKING CHANGE

Do not extend notes this side of this line

F. B. 725 Pg. 72 | Job No. 8209 Division No. | Notes Red. | Plotted | Profile
Survey of Norwood Rds | Date | Date | No.
Survey by Stevenson Notes T.4.5 | Notes Chkd. | Checked | X-Sec.
Indexed [illegible] Date 2-18-38 | Date | Date | No.

STATION	B. S.	H. I.	F. S.	ELEV.		
		1367.895				
TP	7.758	1371.486	4.167	1363.728	Spk in PP 4462	E. opposite Sta 32+21
32+57.4			7.4	641	Gr.	
			9.0	625	Top of W	
33+00			8.0	635	Gr.	
			9.4	621	Top of W	
+50			1.8	642	Gr.	
			8.2	629	Top of W	
33+77			5.0	646	Gr.	
			6.5	644	Top of W	
34+55			3.2	648	Gr.	
			4.6	647	Top of W	
+693			3.4	648	Gr.	
			5.9	646	Top of W	
35+00			4.8	647	Gr.	
			6.3	645	Top of W	
35+09.9			11.9	639	Gr.	
			13.2	638	Top of W	
TP	3.223	1363.53	11.178	1360.308		
PP-6-1	1 3/0	1361.513	2.228	1359.285	Set bog-spk in Sandstone bed for 1'R. Sta 35+70 Consider Observation	

Form 307 5M 10-37

PLEASE RETURN TO
LOS ANGELES COUNTY SURVEYOR
700 HALL OF RECORDS

NOTE: ANY ADDITIONS OR CHANGES ON THIS SHEET MUST BE MADE OR CIRCLED IN RED INK, WITH DATE AND NAME OF PERSON MAKING CHANGE

Do not extend notes this side of this line

STATION	B. S.	H. I.	F. S.	ELEV.		
		1361.518				
36+00			2.0	535	Gr	
			9.6	519	IP	
1+94			4.9	571	Gr	
			5.0	556	IP	
36+33.4			4.5	570	Gr	
			5.1	564	IP	
36+50			8.7	528	Gr	
			10.5	313	IP	
T.P.	1.148	1351.304	11.357	1350.156		
+63.6			3.0	303	Gr	
			4.1	472	IP	Top
+77			8.5	128	Gr	
			9.9	111.4	IP	Top
T.P.	0.658	1340.168	11.788	1339.516		
36+70			3.1	271	Gr	
			4.3	359	Top IP	
37+10			11.9	283	Gr	
			13.4	268	Top IP	
T.P.	0.913	1329.368	11.713	1328.455		

Profile
No. Date Date Map No. Indexed Date

Form 307 5M 10-37

PLEASE RETURN TO
LOS ANGELES COUNTY SURVEYOR
700 HALL OF RECORDS

NOTE: ANY ADDITIONS OR CHANGES ON THIS SHEET MUST BE MADE OR CIRCLED IN RED INK, WITH DATE AND NAME OF PERSON MAKING CHANGE

F. B. 725 Pg. 74 | Job No. 8209 Division No. | Profile | Notes Red. | Plotted | No. | X-Sec.
Survey of Ferro Ave. | Date | Date | Date | No.
Survey by Sievers | Notes | Notes Chkd. | Checked
Indexed [illegible] | Date 2-18-38 | Date | Date

Do not extend notes this side of this line

STATION	B. S.	H. I.	F. S.	ELEV.		
		1329.368				
37+00			6.8	[illegible]	Gr.	
			8.0	[illegible]	I.P.	
T.P.	0.586	1317.796	11.958	1305.838		
37+40			1.7	[illegible]	Gr.	
			2.7	1315	I.P.	
+98.7			5.8	1288	Gr.	
			6.3	1177		
	0.930	1307.164	11.668	1305.234	set bar tagged n.c.s.c.	#340 1895 on Ground mon.
37+87.			3.2	[illegible]	Gr.	
			4.7	1325	I.P.	
37+715			2.6	[illegible]	Gr.	
			4.1	[illegible]	I.P.	
38+01			3.8	[illegible]	Gr.	
			5.8	[illegible]	I.P.	
38+60			4.3	[illegible]	Gr.	
			5.9	[illegible]	I.P.	
39+17.0			4.7	[illegible]	Gr.	
			6.2	[illegible]	I.P.	
39+50			7.7	[illegible]	Gr.	
			9.2	[illegible]	I.P.	

Form 307 5M 10-37

PLEASE RETURN TO
LOS ANGELES COUNTY SURVEYOR
700 HALL OF RECORDS

NOTE: ANY ADDITIONS OR CHANGES ON THIS SHEET MUST BE MADE OR CIRCLED IN RED INK, WITH DATE AND NAME OF PERSON MAKING CHANGE

Do not extend notes this side of this line

STATION	B. S.	H. I.	F. S.	ELEV.		
		1307.164				
4+00			11.3	1295.9	C.	
			12.9	1274	IP	
TP	0.919	1296.944	11.691	1275.253		
+60			7.7	865	Gr	
1			11.5	859	IP	
TP	0.921	1285.156	11.790	1273.366		
41+00			6.7	785	C	
+67.1			7.7	755	Gr	
			12.2	740	IP	
TP	0.376	1273.915	11.607	1273.543		
41+55			2.3	716	Gr	
			3.9	708	IP	
42+028			5.7	682	Gr	
			7.7	662	IP	
42+086			6.9	679	Gr	
			7.9	660	IP	
BM 7-1	0.761	1268.935	5.741	1268.174	set [illegible] 11" SCI	[illegible]
TP	0.636	1257.334	11.637	1245.698		
41+42.8			9.0	483	Gr	
			10.7	466	IP	

Profile
Notes Red. ____ Plotted ____ Job No. 1691 Division No. ____
No. ____ Date ____ Date ____ Survey of [illegible]
X-Sec. ____ Notes Chkd. ____ Checked ____ Survey by [illegible] Notes ____ Date ____
No. ____ Date ____ Date ____ Map No. ____ Indexed ____ Date ____

F.B. 1691 PG. 13

Form 307_5M 10-37

PLEASE RETURN TO
LOS ANGELES COUNTY SURVEYOR
700 HALL OF RECORDS

NOTE: ANY ADDITIONS OR CHANGES ON THIS SHEET MUST BE MADE OR CIRCLED IN RED INK, WITH DATE AND NAME OF PERSON MAKING CHANGE

Do not extend notes this side of this line

Survey by Stevenson | Notes | Notes Chkd. | Checked | X-Sec.
Indexed | Date | Date | Date | No.

STATION	B. S.	H. I.	F. S.	ELEV.		
		1251.384				
T.P.	0.246	1246.040	11.540	1234.494		
T.P.	0.271	1238.727	11.584	1227.456		
42+82.0			11.0	227.7	G.r	
			12.6	226.1	I.P.	
T.P.	0.359	1223.698	11.388	1212.339		
T.P.	0.276	1212.426	11.548	1200.878		
43+10			3.0	209.4		
			1.4	211.0		
T.P.	0.283	1201.183	11.566	1189.617		
43+30			3.1	1197.3	G.r	
			0.1	1197.0	I.P.	
T.P.	0.315	1189.456	12.015	1177.441		
43+518	0		2.4	1187.1	G.r	
			4.3	1185.2	I.P.	
43+85			10.8	1174.7		
			12.2	1173.3		
BM-8-1	.508	1181.213	8.150	1172.705	Set bent spk in conc. curb 6'W of sta 43+75 & 5' S of int to alley and Barlow Way.	
+88.9			3.5	1177.7		
			5.2	1176.0	I.P.	

Form 307 5M 10-37

PLEASE RETURN TO
LOS ANGELES COUNTY SURVEYOR
700 HALL OF RECORDS

NOTE: ANY ADDITIONS OR CHANGES ON THIS SHEET MUST BE MADE OR CIRCLED IN RED INK, WITH DATE AND NAME OF PERSON MAKING CHANGE

Do not extend notes this side of this line

STATION	B. S.	H. I.	F. S.	ELEV.		
		12 81 213 ✓				
44+00			7.2	74 0 ✓	Gr	
			8 5	72 7 ✓	I.P.	
T.P.	0 378	1170. 220 ✓	11.371	1169. 842 ✓		
14+50			11.2	59 0 ✓	Gr	
			13 2	57 8 ✓	I.P.	
T.P.	0 233	1158. 966 ✓	11.487	1158. 733 ✓		
44+55			1.0	91 0 ✓	Gr	
			2.9	56 1 ✓	I.P.	
44+91			9 0	50 0 ✓	I.P. in air	
			14.0	45 0 ✓	Gr	
45+02			19 8	39 8 ✓	I.P.	
45+26			30 2	28 8 ✓	bot con Gr	
			21.0	38 0 ✓	I.P.	
45+46			22.0	37 0 ✓	I.P. + Gr	
45+57			55	53 5 ✓	I.P. in air	
			7.1	51 5 ✓	Gr.	
T.P.	2 421	1158 792 ✓	2 595	1156 371 ✓		
45+95.2			2.7	56 1 ✓	Top I.P.	
			0.2	58 6 ✓	Gr	

Profile
Notes Red. Plotted Job No. 801 Division No.
No. Date Date Survey of Notes
X-Sec. Date Date Survey by Date
Notes Chkd. Checked Map No. Indexed
No. Date Date Date

F. B. 725 PG. 17

Form 307 5M 10-37

PLEASE RETURN TO
LOS ANGELES COUNTY SURVEYOR
700 HALL OF RECORDS

NOTE: ANY ADDITIONS OR CHANGES ON THIS SHEET MUST BE MADE OR CIRCLED IN RED INK, WITH DATE AND NAME OF PERSON MAKING CHANGE

Do not extend notes this side of this line

F. B. 725 PG. 78 | Job No. 8209 Division No. | Notes Red. | Plotted | Profile
Survey of Lynbrook Rds | Date | Date | No.
Survey by Stevenson | Notes T 7 S. | Notes Chkd. | Checked | X-Sec.
Indexed | Date 3-14-38 | Date | Date | No.

STATION	B. S.	H. I.	F. S.	ELEV.		
		1158.792				
46+50.52			8.7	1150.1'	IP	
			7.6	12'	Gr	
46+81			15	43'	Gr	
			11.0	28'	IP	
TP	0.715	1147.916	11.591	1147.201		
47+37.6			3.2	29'	Gr	
			4.2	37'	IP	
47+50			5.0	29'	Gr	
			6.0	24'	IP	
TP	0.513	1137.63	11.40	1136.516		
48+00			2.6	24'	Gr	
			4.1	32.9'	IP	
+50			10.2	26.8'	Gr	
			11.7	25.3'	IP	
TP	0.453	1125.792	11.690	1125.339		
49+00			7.6	18.2'	Gr	
			8.1	17.7'	IP	
TP	0.992	1115661	11.123	1114.669		
49+41.2			2.7	12.8'	Gr	
			4.7	11.0'	IP	

Form 307 5M 10-37

PLEASE RETURN TO
LOS ANGELES COUNTY SURVEYOR
700 HALL OF RECORDS

NOTE: ANY ADDITIONS OR CHANGES ON THIS SHEET MUST BE MADE OR CIRCLED IN RED INK, WITH DATE AND NAME OF PERSON MAKING CHANGE

Do not extend notes this side of this line

STATION	B. S.	H. I.	F. S.	ELEV.		
		1115.461				
50+19.9			7.1	1108.6	Gr	
			8.6	87.1	IP	
50+40.2			7.3	86.4	Gr	
			10.8	84.9	IP	
50+58.8			11.1	84.6	Gr	
			10.6	1099.1	IP	
	3.308	1102.90	11.267	1104.394		
50+18			4.7	98.5		
			6.2	96.5		
BM No 9-1	0.999	1101.738	2.963	1100.739	3/4" IP PI 23 Post FB 695 P28 Ferrwood RCA	
51+02.2			1.3	100.4	Gr	
			2.8	98.9	IP	
51+21.7			2.9	98.8	Gr	
			4.5	97.2	IP	
+39.3			4.1	97.6	Gr	
			5.6	96.1	IP	
51+56			4.6	97.1	Gr	
			7.1	94.6	IP	
+61.3			5.2	96.5	Gr	
			7.7	96.0	IP	

Profile No.
X-Sec. No.
Notes Red. Date
Notes Chkd. Date
Plotted Date
Checked Date
Job No. 8209 Division No.
Survey of FERNWOOD RDS
Survey by STEVENSON Notes
Map No. Indexed
Date
Date
F. B. 725 PG. 77

Form 307 5M 10-37

PLEASE RETURN TO
LOS ANGELES COUNTY SURVEYOR
700 HALL OF RECORDS

NOTE: ANY ADDITIONS OR CHANGES ON THIS SHEET MUST BE MADE OR CIRCLED IN RED INK, WITH DATE AND NAME OF PERSON MAKING CHANGE

Do not extend notes this side of this line

F. B. 735 PG. 80 | Job No. 8809 Division No. | Profile No. | Plotted | Notes Red. | X-Sec. No.
Survey of Kenwood Rd | Date | Date | Date
Survey by Stevenson | Notes T-35 | Notes Chkd. | Checked
Indexed | Date 3- | Date | Date

STATION	B. S.	H. I.	F. S.	ELEV.	
		1101.738			
52+			7.1	1046	Gr
			8.6	1031	IP
52+51			7.4	1043	Gr
			8.9	1028	IP
52+382			9.4	1023	Gr
			10.9	1008	IP
+462			9.9	1018	Gr
			11.5	1002	IP
+542			10.4	1013	Gr
			11.7	1000.8	IP
TP	0.585	1091.585	11.658	1079.080	
53+33.2			7.8	1083.8	Gr
53+			9.3	1082.3	IP
53+45.2			8.7	1082.9	Gr
			10.2	1081.4	IP
53+586			9.9	1081.7	Gr
			11.4	1080.2	IP
53+735			11.5	1080.1	Gr
			13.0	1078.6	IP

Form 307 5M 10-37

PLEASE RETURN TO
LOS ANGELES COUNTY SURVEYOR
700 HALL OF RECORDS

NOTE: ANY ADDITIONS OR CHANGES ON THIS SHEET MUST BE MADE OR CIRCLED IN RED INK, WITH DATE AND NAME OF PERSON MAKING CHANGE

Do not extend notes this side of this line

STATION	B. S.	H. I.	F. S.	ELEV.		
		1090.585				
TP	2.109	1083.259	11.435	1079.15		
54+25.3			6.9	75.4	Gr	
			8.0	74.3	"	
54+39.7			8.1	74.2	Gr	
			9.8	72.5	IP	
54+51.2			9.7	72.6	Gr	
			11.8	71.1	IP	
54+72.			12.3	70.9	Gr	
			13.8	69.5	IP	
TP.	0.181	1070.901	11.539	1070.720		
55+17.6			9.0	71.9	Gr	
			11.5	69.4	IP	
55+94.7			11.3	69.6		
			13.3	69.6		
BM No. 101	0.334	1060.854	10.281	1060.620	Set Cutspk in PP No 240 199E Fernwood Rd & Bonner Dr.	
56+			3.2	69.6	Gr	
			4.7	56.2	IP	
42+26			8.1	52.8	Gr	
			9.8	51.1	IP	

Profile
Notes Red. ____ Plotted ____ Job No. 1101 Division No. 4
No. ____ Date ____ Date ____ Survey of Fernwood Rds
X-Sec. ____ Notes Chkd ____ Checked ____ Survey by Jackson Notes ____ Date 3-12-58
No. ____ Date ____ Date ____ Map No. ____ Indexed ____ Date ____
F. B. 325 PG. 81

Form 307 5M 10-37

PLEASE RETURN TO
LOS ANGELES COUNTY SURVEYOR
700 HALL OF RECORDS

NOTE: ANY ADDITIONS OR CHANGES ON THIS SHEET MUST BE MADE OR CIRCLED IN RED INK, WITH DATE AND NAME OF PERSON MAKING CHANGE

Do not extend notes this side of this line

F. B. 725 Pg. 78 | Job No. 8209 Division No. | Notes Red. | Plotted | Profile
Survey of Kenwood Rd | Date | Date | No.
Survey by Stevenson | Notes T.T.S. | Notes Chkd. | Checked | X-Sec.
Indexed | Date 3-15-38 | Date | Date | No.

STATION	B. S.	H. I.	F. S.	ELEV.		
		1060.854				
T.P.	0.345	1049.620	11.579	1037.275		
56+50			0.7	1048.9	Gr	
			2.2	1047.4	I.P.	
57+00			7.6	1042.0		
			9.1	1040.5		
TP	0.358	1038.302	11.676	1026.944		
57+34			1.4	1036.9	Gr	
			2.7	1035.6	IP	
+50			2.7	1035.6	Gr	
			2.9	1035.4	IP	
TP	0.285	1027.57	11.019	1016.283		
58+00			1.6	1025.9	Gr	
			2.2	1025.3	IP	
+50			9.7	1017.8	Gr	
			11.2	1016.3	IP	
+53.6			10.4	1017.1	Gr	
			11.9	1015.6	IP	
BM 11-1	0.524	1018.341	9.711	1017.817	Set Cut Cross in P.P. 3.4 ft E	Power Co Pole TR
54+50			7.4	1010.9	Gr	
			8.7	1009.6	IP	

Form 307 5M 10-37

PLEASE RETURN TO
LOS ANGELES COUNTY SURVEYOR
700 HALL OF RECORDS

NOTE: ANY ADDITIONS OR CHANGES ON THIS SHEET MUST BE MADE OR CIRCLED IN RED INK, WITH DATE AND NAME OF PERSON MAKING CHANGE

Do not extend notes this side of this line

STATION	B. S.	H. I.	F. S.	ELEV.		
		1018.341				
57+285			10 5	78	Gr	
			11.5	68	IP	
TP	0.777	1008.199	10.917	1007.422		
57+527			4 0	34 2	Gr	
			5 3	29	IP	
Cafe			9 5	998 7	Gr	
			11.0	997 2	IP	
TP	0.512	997 068	11.643	196.556		
60+00			6 7	99 4	Gr	
			8 2	98 9	IP	
TP	0.004	785.942	11.730	785.338		
60+99.8			4.8	81 1	Gr	
			5.7	80 2	IP	
TP	0.330	774.734	11.538	774.404		
61+00			5.9	68 8	Gr	
			7.1	676	IP	
TP	0.519	763 470	11.783	962 951		
62+00			7.9	556	Gr	
			8.8	547	IP	

Profile
Date _____ Date _____ Map No. _____ Indexed _____ Date _____

Form 307 5M 10-37

PLEASE RETURN TO
LOS ANGELES COUNTY SURVEYOR
700 HALL OF RECORDS

NOTE: ANY ADDITIONS OR CHANGES ON THIS SHEET MUST BE MADE OR CIRCLED IN RED INK, WITH DATE AND NAME OF PERSON MAKING CHANGE

Do not extend notes this side of this line

F. B. 705 Pg. 84 | Job No. 8209 Division No. Notes Red. Plotted Profile
Survey of Ferraro et al Date Date No.
Survey by Iverson Notes Chkd. Checked X-Sec.
Indexed Date 3-15-38 Date Date No.

STATION	B. S.	H. I.	F. S.	ELEV.	
		983 470			
TP	0.38	751 .308	11.730	97 .540	
62+50			10.0	9	
			1 3	6	
TP	0.483	74 .950	11.451	94 .457	
62+783			6.7	2	Gr
			7 1	2	IP
63+00			7	2	Gr
			12.9	2	IP
TP	0.463	727 .133	11.47	70	
63+10 L			1 2	2	Gr
			3 9	2	IP
63+50			8.1	2	Gr
			7.5	2	IP
TP	1.88	722 53	7.71	720.639	
63+62			2.2	2	
63+62			3 7	1	
64+00			9 7		
			6 2	1	
BM-12-1	0.189	91 8.167	4.550	91 .918	Set COTAM in root 30" dia. Chestnut at Webb's House - Webb Trail. 40 ± North of

Form 307 5M 10-37

PLEASE RETURN TO
LOS ANGELES COUNTY SURVEYOR
700 HALL OF RECORDS

NOTE: ANY ADDITIONS OR CHANGES ON THIS SHEET MUST BE MADE OR CIRCLED IN RED INK, WITH DATE AND NAME OF PERSON MAKING CHANGE

Do not extend notes this side of this line

STATION	B. S.	H. I.	F. S.	ELEV.		
•		718.167				
64+135			4.7	713.5	Gr	
			4.7	"	IP	
+237			9.1	709.1	Gr	
			11.5	706.7	IP	
TP	0.688	To 8.449	10.406	707.761		
TP	1.283	898.372	11.360	891.087		
64+384			8.9	713.5	IP and Gr	
64+43			10.7	707	Bot. Con Pipe to Sewer	
64+73			8.5	709.9	IP on Ground	
64+87			2.1	713.3	Gr	
			6.3	713.1	IP	
64+91			0.9	717.5	Gr	
			2.4	716.0	IP	
	11.435	709.127	0.680	697.692		
65+01			0.1	709.0	IP + Gr	
	11.019	717.480	3.666	706.461		
65+23			5.4	141	Gr + IP	
	5585	723.112	1.253	717.527		
65+50			3.2	719		
			5.3	717		

Profile
No. X-Sec.

Form 307 5M 10-37

PLEASE RETURN TO
LOS ANGELES COUNTY SURVEYOR
700 HALL OF RECORDS

NOTE: ANY ADDITIONS OR CHANGES ON THIS SHEET MUST BE MADE OR CIRCLED IN RED INK, WITH DATE AND NAME OF PERSON MAKING CHANGE

Do not extend notes this side of this line

F.B. 725 Pg. 86 | Job No. 8209 | Division No. | Profile
Survey of Fernwood | Notes Red. | Date | No.
Survey by Stevenson | Notes Chkd. | Date | X-Sec.
Indexed | Date 3-15-38 | Date | Checked | Date | No.

STATION	B. S.	H. I.	F. S.	ELEV.		
		923.112				
65+71.5			3.5	[illegible]	Gr	
			6.1	917.0	IP	
5+76.7			8.6	[illegible]	Gr	
			11.0	912.1	IP	
-at 4"						
65+82.2			9.6	[illegible]	Gr	
			11.6	911.5	IP	
	0.470	911.786	11.816	911.970		
66+			1.1	910.4	Gr	
			3.5	[illegible]	IP	
+25			5.2	[illegible]	Gr	
			7.7	[illegible]		
66+67.5			12.3	[illegible]		{Continued from Main Line Profile page 91}
			14.8	910.0		
+P.	1.518	922.814	0.470	911.296		
Continue to Fernwood Pacific Drive						
-to-65+82.2			11.2	911.6	12" Corrugated [illegible] of 3/4" an 1"	
			7.4	[illegible]	Gr	
0+14.6			8.8	[illegible]	Gr	
			10.7	[illegible]	IP	

Form 307 5M 10-37

PLEASE RETURN TO
LOS ANGELES COUNTY SURVEYOR
700 HALL OF RECORDS

NOTE: ANY ADDITIONS OR CHANGES ON THIS SHEET MUST BE MADE OR CIRCLED IN RED INK, WITH DATE AND NAME OF PERSON MAKING CHANGE

Do not extend notes this side of this line

Profile No. ____ X-Sec. No. ____ Notes Rcd. ____ Date ____ Notes Chkd. ____ Date ____ Plotted ____ Date ____ Checked ____ Date ____ Job No. 1201 Division No. ____ Survey of Fernwood, Rd. Survey by T.T.S. Notes T.T.S. Date 3-15-38 Map No. ____ Indexed ____ Date ____ F. B. 72 PG. 87

STATION	B. S.	H. I.	F. S.	ELEV.		
		1000.814	✓			
0+63.6			1.5	921.3	Gr	
			3.5	196	IP	
T.P.	10.980	933.230	0.566	922.248		
1+00			6.3	26.9	Gr	
			8.0	25.2	IP	
1+50			1.7	31.5	Gr	
			2.5	30.7	IP	
T.P.			0.613	932.617		
1+71			5.3		Gr	
			7.3		IP	
M.P.-13.1	10.423	943.65[illegible]	5.285	938.227	Set C.S.T.H.W. in 6" R.C. Low Wall N. Side of Fernwood Pacific Dr. @ Ox Bow Way — and Hillcrest	
T.P.	11.375	954.304	0.736	942.918	(see Profile page 2)	
T.P.	10.918	964.665	0.632	953.677		
T.P.	10.618	974.383	0.900	963.765		
T.P.	10.442	984.124	0.701	973.682		
T.P.	10.778	994.197	0.705	983.419		
T.P.	5.710	999.254	0.663	993.544		
T.P.	11.119	1005.530	4.443	994.411		
			6.221	1000.309	B.M. No 3 — Cut spk + Tin in base, east side of 24" Oak Left Sta 2281+ LB 318-P-8	

Sta 411+83

F. B. 725 PG. 88 | Job No. 8209 | Division No. | Notes Red. | Plotted | Profile

Survey of Fernwood Lts | Date | Date | No.

Survey by Stevenson | Notes 7 15 | Notes Chkd. | Checked | X-Sec.

Indexed | Date 3- | Date | Date | No.

STATION	B. S.	H. I.	F. S.	ELEV.

Form 307 5M 10-37

PLEASE RETURN TO
LOS ANGELES COUNTY SURVEYOR
700 HALL OF RECORDS

Do not extend notes this side of this line

NOTE: ANY ADDITIONS OR CHANGES ON THIS SHEET MUST BE MADE OR CIRCLED IN RED INK, WITH DATE AND NAME OF PERSON MAKING CHANGE

Profile No. | Notes Red. | Plotted | Job No. | Division No. | F. B. 725 PG. 89

Date | Date | Survey of

X-Sec. No. | Notes Chkd. | Checked | Survey by | Notes | Date

Date | Date | Map No. | Indexed | Date

PROFILE ON

1" WATER LINE - BETWEEN 6" WATER LINE AND FERNWOOD ALPINE DR. - LOCATED IN ALLEY BETWEEN GRANDVIEW AND ALPINE DR.

T. N 8209

CHARGE TO FERNWOOD R&S

TRANSIT LINE P-13

STATION	B. S.	H. I.	F. S.	ELEV.

NOTE: ANY ADDITIONS OR CHANGES ON THIS SHEET MUST BE MADE OR CIRCLED IN RED INK, WITH DATE AND NAME OF PERSON MAKING CHANGE

Do not extend notes this side of this line

PLEASE RETURN TO
LOS ANGELES COUNTY SURVEYOR
700 HALL OF RECORDS

Form 307 5M 10-57

Form 307 5M 10-37

PLEASE RETURN TO
LOS ANGELES COUNTY SURVEYOR
700 HALL OF RECORDS

NOTE: ANY ADDITIONS OR CHANGES ON THIS SHEET MUST BE MADE OR CIRCLED IN RED INK, WITH DATE AND NAME OF PERSON MAKING CHANGE

Do not extend notes this side of this line

F.B. 725 Pg. 90 | Job No. 8209 | Division No. | Profile
Survey of Fernwood Rds | Platted | No.
Survey by Stevenson | Notes Red. | Date | X-Sec.
Notes 7-7-38 | Date | Notes Chkd. | Checked | No.
Indexed | Date 3-15-38 | Date | Date

STATION	B. S.	H. I.	F. S.	ELEV.		
DM-8-1	1.293	1181.998		1180.705	P-748	
0+02.6			4.0	1178	Gr	
			5.9	1176	IP	
0+63.1			1.0	1181	Gr	
			3.1	1178	IP	
0+68.7			6.6	1175	Gr + IP	Pipe crosses from 0+68.7 to 1+12
0+91			2.41	1179	Bot Con — IP approx 18' above	
1+12			3.6	1178	IP and Gr.	
TP	11.727	1192.835	0.590	1181.108		
	11.489	1203.681	0.643	1192.192		
1+29.8			9.6	1194	Gr	
			9.6	1194	IP	
TP	11.417	1214.591	0.507	1203.174		
1+56.1			6.1	1208.49	Gr	
			4.5	1210	IP	
TP	11.095	1224.871	0.815	1213.776		
1+80.6			10.0	1214.9	IP + Gr	
TP	10.536	1234.595	0.812	1224.059		
2+18.7			8.5	1226.1	Gr	
			9.1	1225.5	IP	

Form 307 5M 10-37

PLEASE RETURN TO
LOS ANGELES COUNTY SURVEYOR
700 HALL OF RECORDS

NOTE: ANY ADDITIONS OR CHANGES ON THIS SHEET MUST BE MADE OR CIRCLED IN RED INK, WITH DATE AND NAME OF PERSON MAKING CHANGE

Do not extend notes this side of this line

STATION	B. S.	H. I.	F. S.	ELEV.		
		1234.595				
	5.343	1239.038	0.900	1233.695		
C+36.7 Gr I.P.			2.5	36.5		
			3.3	35.9	Set Cut Spk Washer + Tin in rock 50' N. of Hub on Fernwood Pacific Dr. vicinity PT. 128	
B M			6.320	1232.714		
					No Change	
	(Continuation of Main Centerline Line from Calo Key)					
K.17-13-1	4.00	937.117		932.12	Set + Tin in Yellow Yoke at Fernwood Pacific + Hillcrest Dr L.B. 725 - Page 87 - Profile P. 86	
T.P.	0.100	925.704	11.623	925.604		
T.P.	0.145	914.509	11.340	914.364		
T.P.	0.034	902.787	11.756	902.753		
66+25			6.3	896.5	I.P.	
			4.9	87.9	Top Gr.	
67+11			10.4	92.4	I.P.	
			8.7	141	Gr.	
67+20.8			11.0	91.8	I.P.	
			9.5	93.3	Gr.	
67+32.8			10.4	92.4	Gr.	
			11.9	80.1	I.P.	
T.P.	0.878	891.920	11.745	891.042		

Profile Notes Red. Plotted Job No. 8247 Division No. F.B. 725 PG. 21
No. Date Date Survey of Pellerson
X-Sec. Notes Chkd. Checked Survey by Stevenson Notes Date 3-15-38
No. Date Date Map No. Indexed Date

Form 307 5M 10-37

PLEASE RETURN TO
LOS ANGELES COUNTY SURVEYOR
700 HALL OF RECORDS

NOTE: ANY ADDITIONS OR CHANGES ON THIS SHEET MUST BE MADE OR CIRCLED IN RED INK, WITH DATE AND NAME OF PERSON MAKING CHANGE

Do not extend notes this side of this line

B. Pg. 92 | Job No. 8209 Division No. | Profile No.
Survey of Fernwood Rds | Notes Red. | Plotted | X-Sec. No.
Survey by Stevenson Notes T.J.S. | Notes Chkd. | Checked
Indexed | Date 1-16-39 | Date | Date

STATION	B. S.	H. I.	F. S.	ELEV.		
		891.920 ✓				
67+99.5			5.3	8.6 ✓	Gr	
			6.8	13.1 ✓	I.P.	
68+32.7			10.3	11.6 ✓	Gr	
		✓	11.8	8.1 ✓	I.P.	
T.P.	0.012	880.328	11.604	868.316 ✓		
+87.4			11.0	7.3 ✓	Gr	
			10.5	6.8 ✓	I.P.	
67+13.2			12.5	4.8 ✓	Gr	
		✓	14.0	6.3 ✓	I.P.	
T.P.	0.422	868.986	11.764	868.564 ✓		
67+14.7			10.4	8.6 ✓	Gr.	
"		✓	11.9	5.1 ✓	I.P.	
T.P.	0.145	857.226	11.905	857.081 ✓		
70+36.3			2.7	5.5 ✓	Gr.	
			4.2	3.0 ✓	I.P.	
70+86.0			7.3	4.9 ✓	Gr	
			10.9	46.3 ✓		
T.P. (A)			11.994	811.232 ✓		

Cont. on page 115

Notes Ck'd by	Survey of Fernwood RDS
Map No.	W. O. 8 Co 7 Tape No. St'd °F.
Office Work	Surveyed by Stevenson
Checked	Notes 1-15 Date 3-14-38
Date	Indexed

F.B. 725 Pg. 93

Note: Any Additions or Changes on This Sheet Must be Made or Circled in Red Ink With Date and Name of Person Making Change.

Do not extend notes this side of this line

RETURN TO
LOS ANGELES COUNTY SURVEYOR
700 HALL OF RECORDS

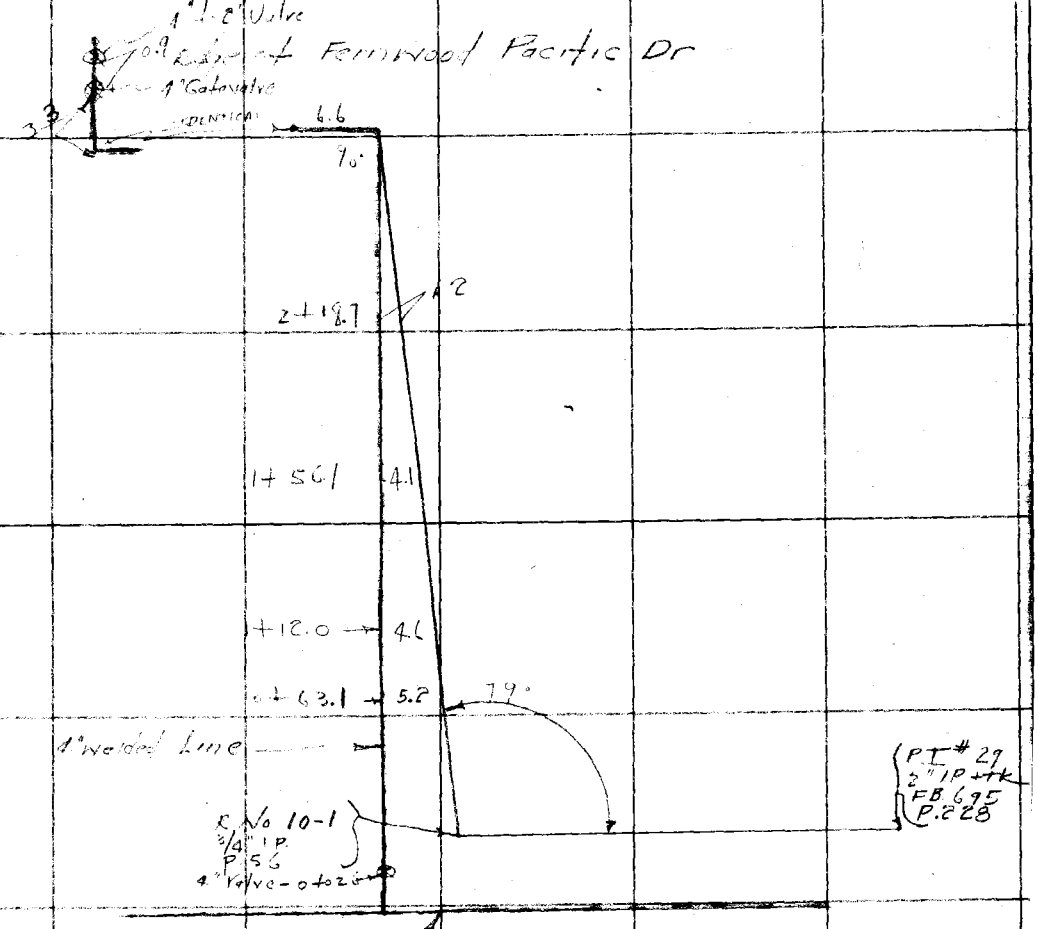

FORM 247 10M 11-35

RETURN TO
LOS ANGELES COUNTY SURVEYOR
700 HALL OF RECORDS

Note: Any Additions or Changes on This Sheet Must be Made or Circled in **Red** Ink With Date and Name of Person Making Change.

Do not extend notes this side of this line

F.B. 125 Pg.

Notes Ck'd by	Survey of
Map No.	W. O.	Tape No.	St'd °F.
Office Work	Surveyed by
Checked	Notes	Date
Date	Indexed

F.B. Pg. 96

Note: Any Additions or Changes on This Sheet Must be Made or Circled in Red Ink With Date and Name of Person Making Change.

Do not extend notes this side of this line

RETURN TO
LOS ANGELES COUNTY SURVEYOR
700 HALL OF RECORDS

FORM 247 10M 11-35

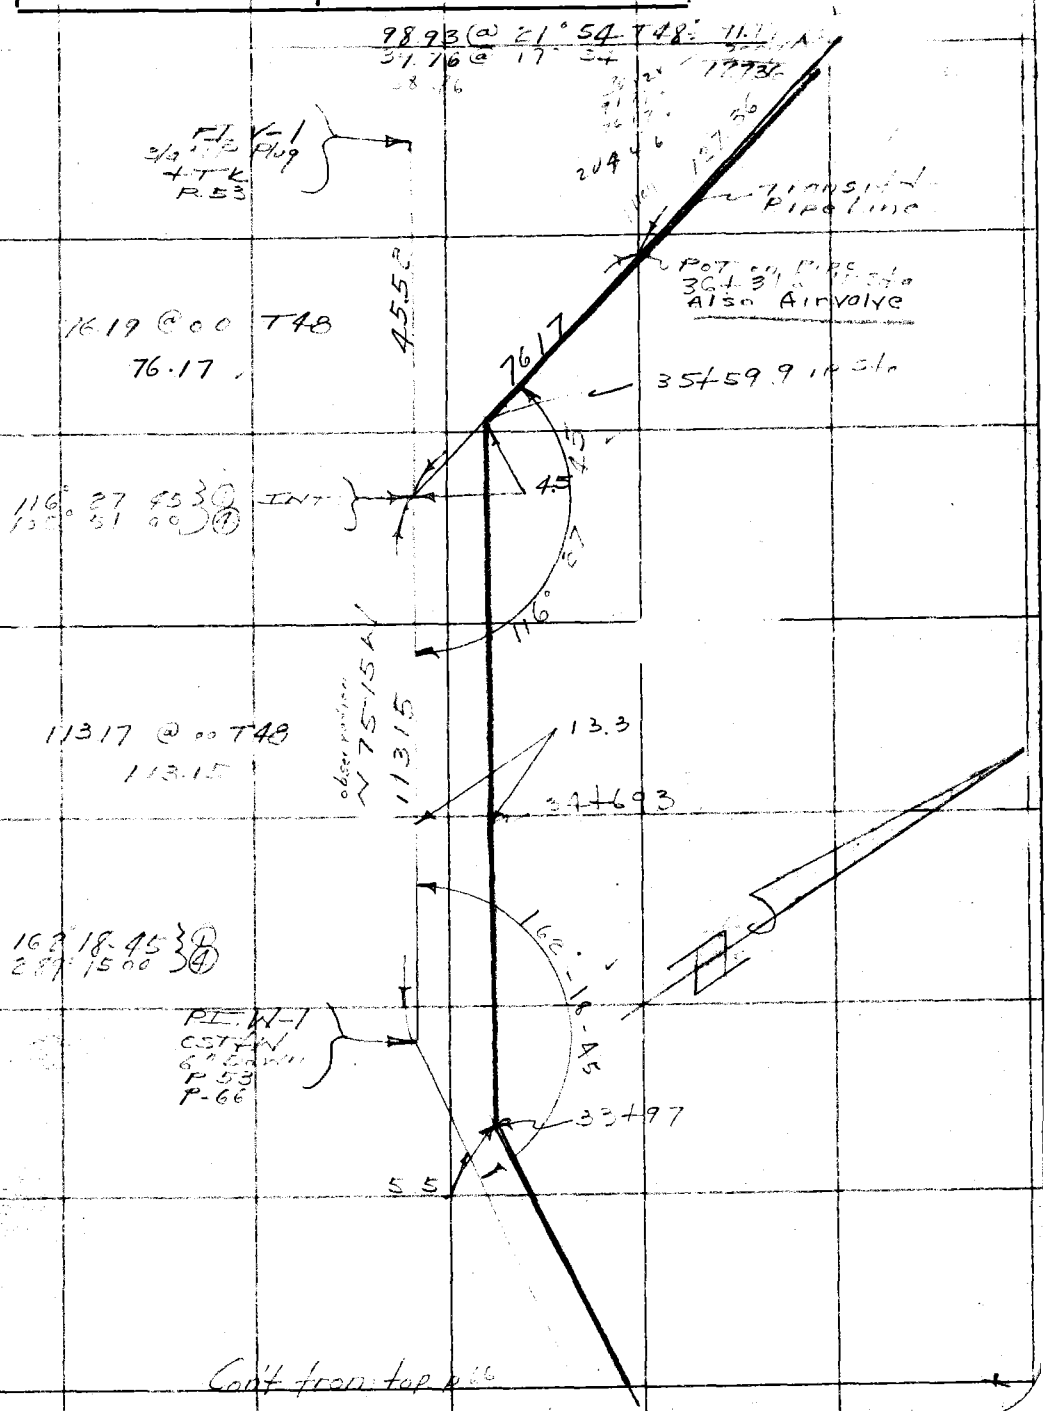

F.B. 725 PG. 96

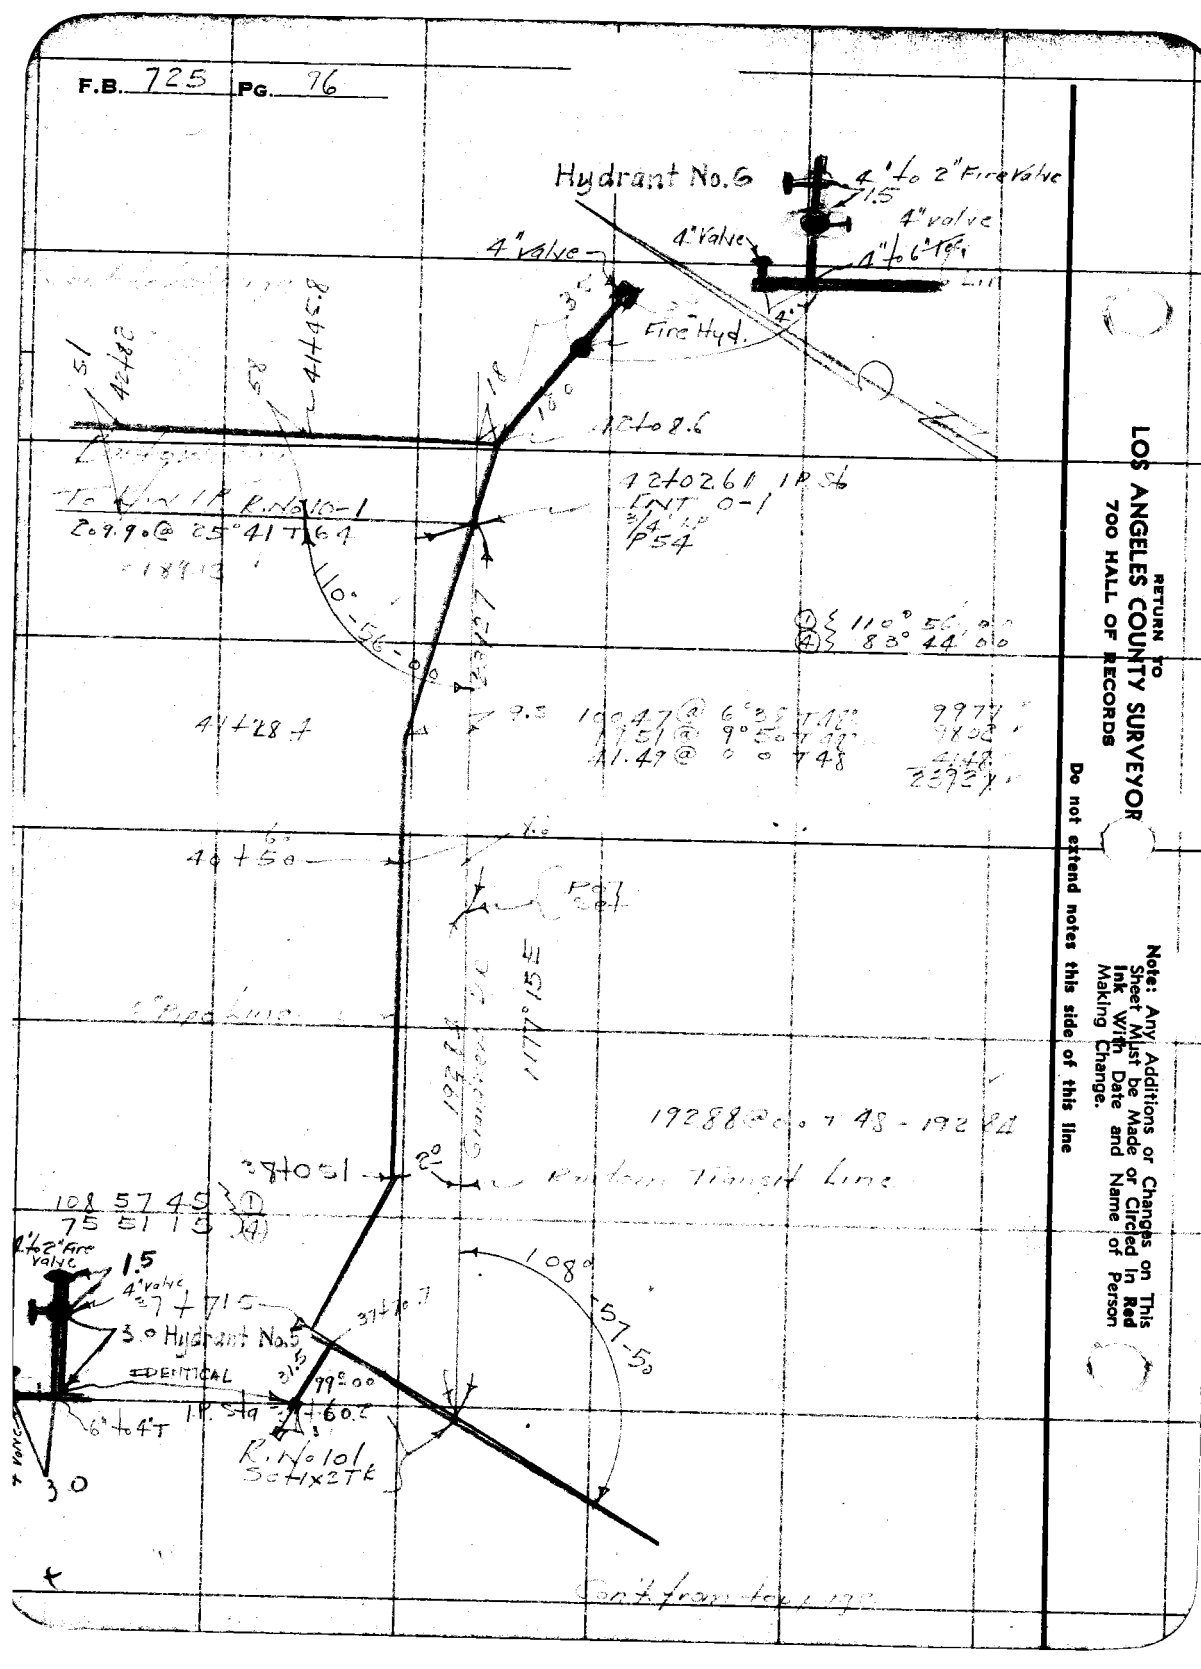

RETURN TO
LOS ANGELES COUNTY SURVEYOR
700 HALL OF RECORDS

Note: Any Additions or Changes on This Sheet Must be Made or Circled in Red Ink With Date and Name of Person Making Change.

Do not extend notes this side of this line

Notes Ck'd by AeR	Survey of Ten Thousand Ave
Map No.	W. O. 3809 Tape No. 67 St'd °F.
Office Work	Surveyed by Stevenson
Checked	Notes TJS Date 2-21-38
Date	Indexed

F.B. — Pg. 27

Cont. from bot page

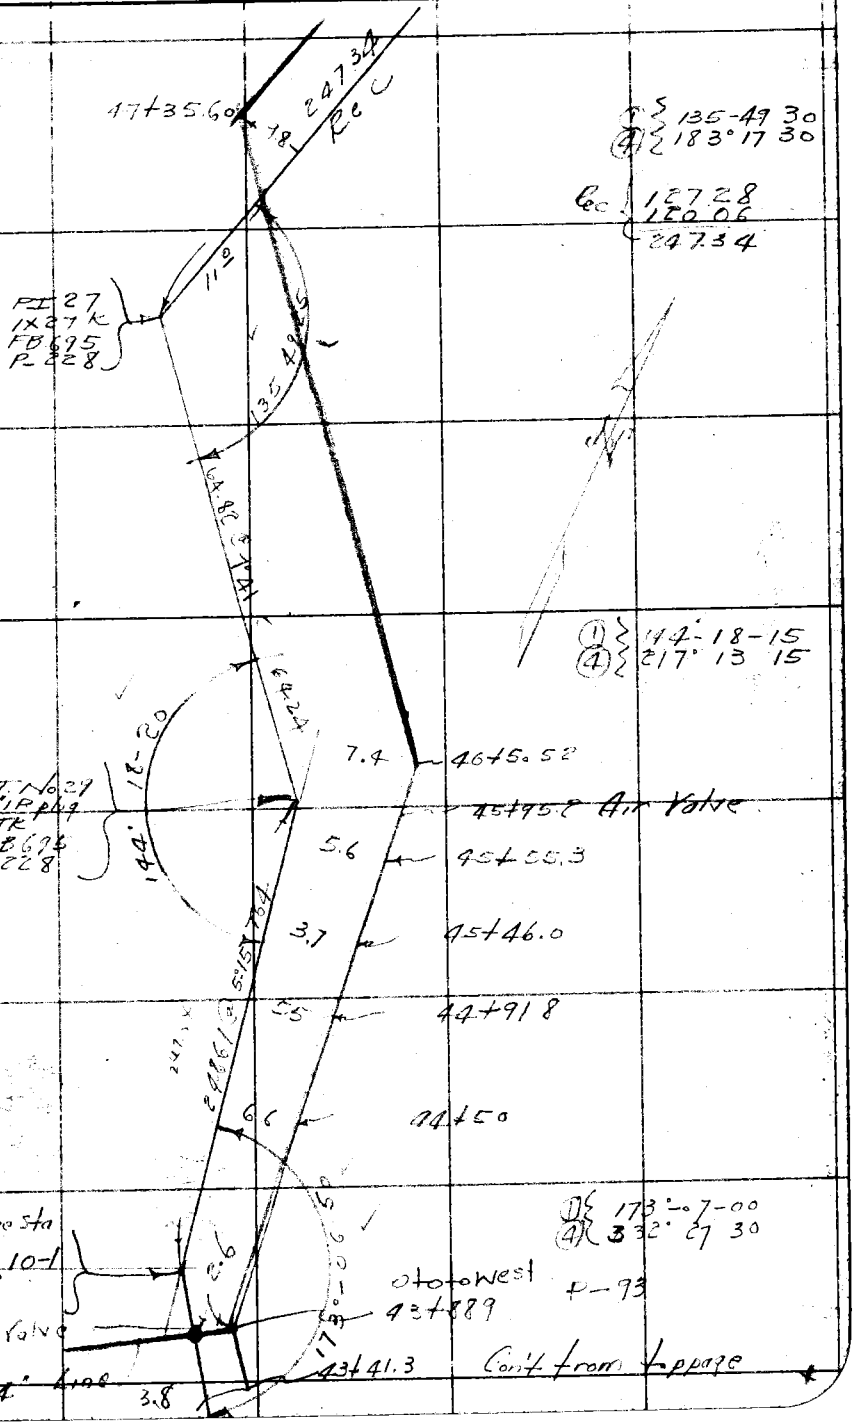

Note: Any Additions or Changes on This Sheet Must be Made or Circled in Red Ink With Date and Name of Person Making Change.

Do not extend notes this side of this line

RETURN TO
LOS ANGELES COUNTY SURVEYOR
700 HALL OF RECORDS

FORM 247 10M 11-35

F.B. 725 PG. 98

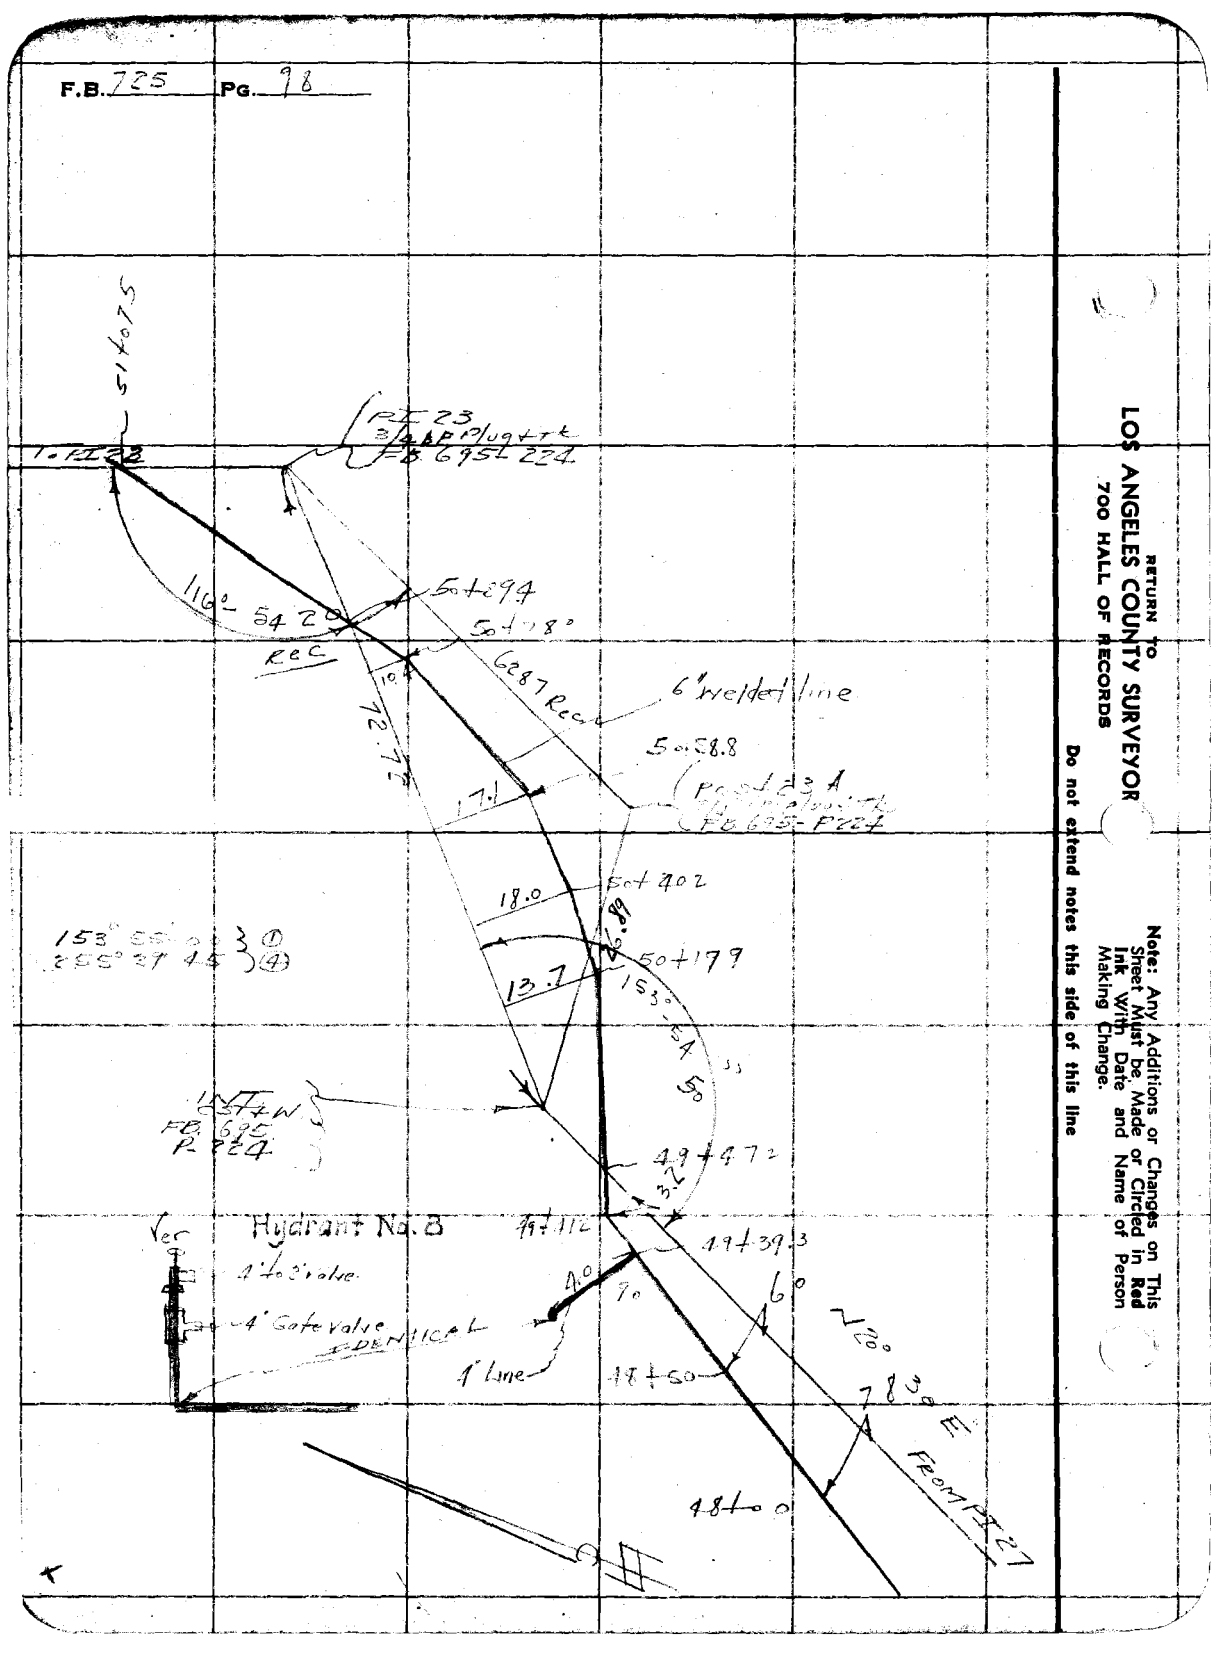

RETURN TO
LOS ANGELES COUNTY SURVEYOR
700 HALL OF RECORDS

Note: Any Additions or Changes on This Sheet Must be Made or Circled in Red Ink With Date and Name of Person Making Change.

Do not extend notes this side of this line

Notes Ck'd by Aust	Survey of Fernwood Rds
Map No.	W. O. 8209 Tape No. St'd °F.
Office Work	Surveyed by Johnson
Checked	Notes Date
Date	Indexed

F.B. 765 PG. 99

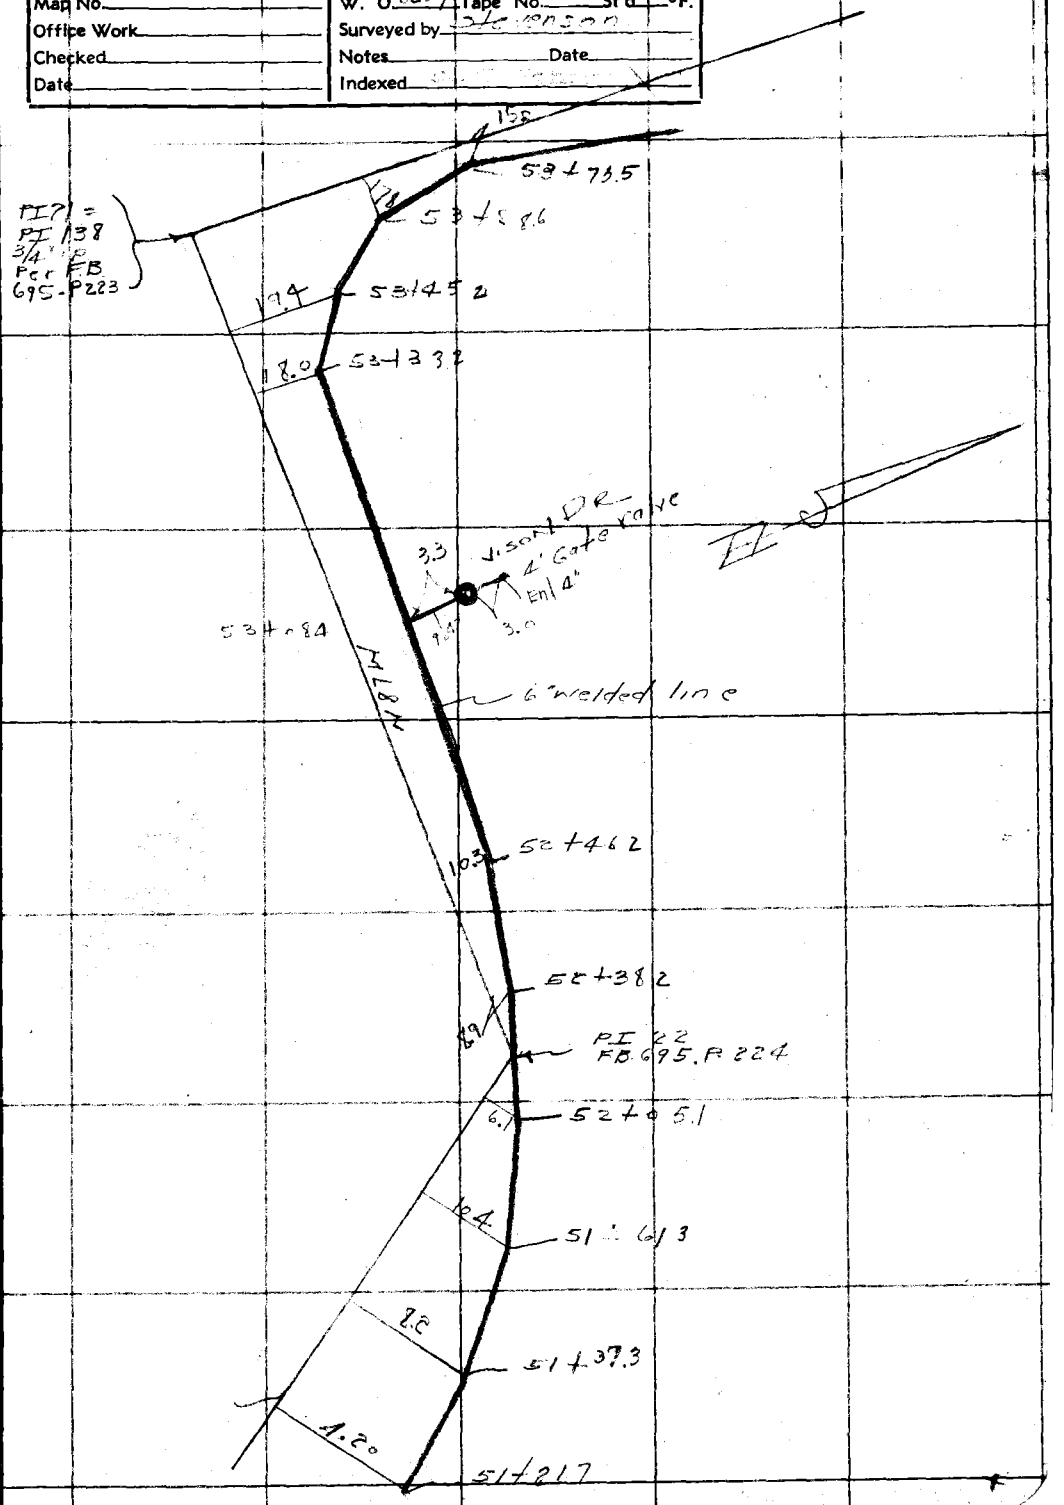

Note: Any Additions or Changes on This Sheet Must be Made or Circled in Red Ink With Date and Name of Person Making Change.

Do not extend notes this side of this line

RETURN TO
LOS ANGELES COUNTY SURVEYOR
700 HALL OF RECORDS

FORM 247 10M 11-35

F.B. 725 Pg. 100

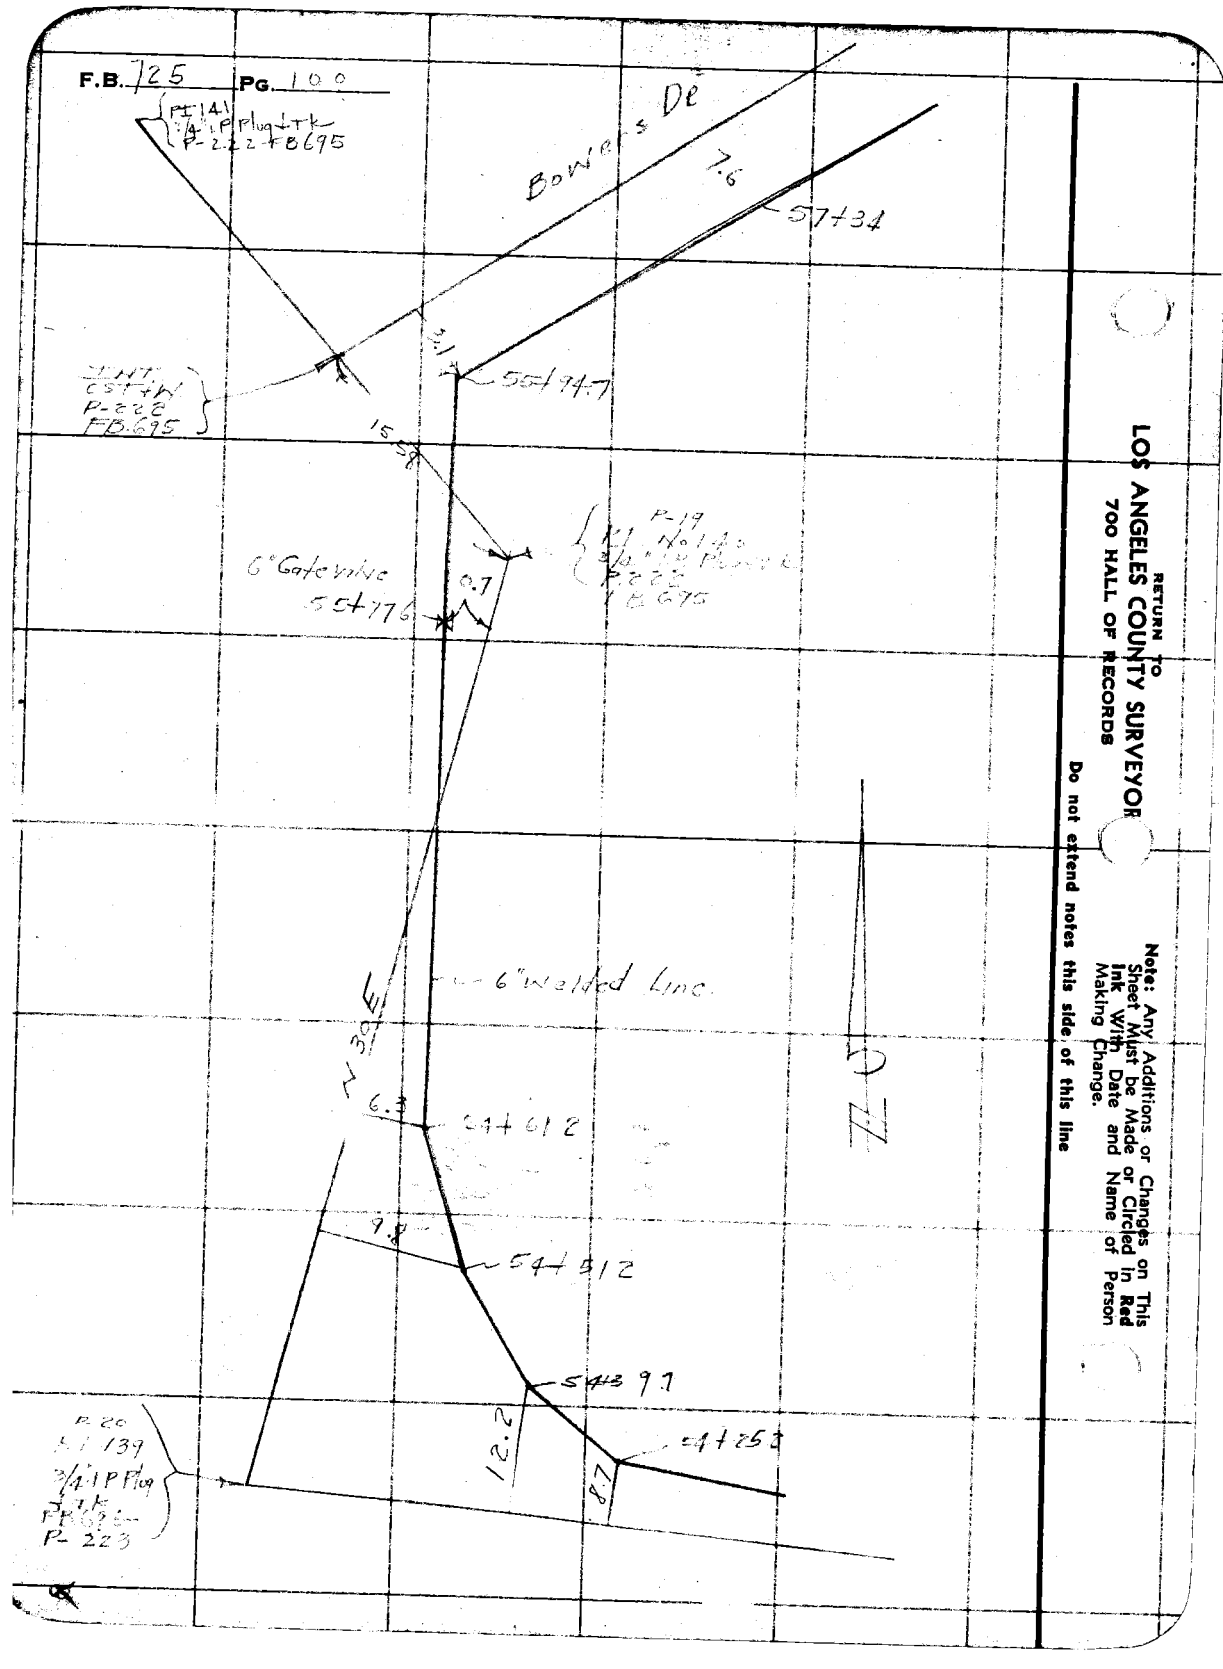

RETURN TO
LOS ANGELES COUNTY SURVEYOR
700 HALL OF RECORDS

Note: Any Additions or Changes on This Sheet Must be Made or Circled in Red Ink With Date and Name of Person Making Change.

Do not extend notes this side of this line

Notes Ck'd by: dap	Survey of: Fernwood Rd
Map No.	W. O. 1209 Tape No. St'd °F.
Office Work	Surveyed by: Stevenson
Checked	Notes: 1-45 Date: 3-15-38
Date	Indexed


Note: Any Additions or Changes on This Sheet Must be Made or Circled in Red Ink With Date and Name of Person Making Change.

Do not extend notes this side of this line

RETURN TO
LOS ANGELES COUNTY SURVEYOR
700 HALL OF RECORDS

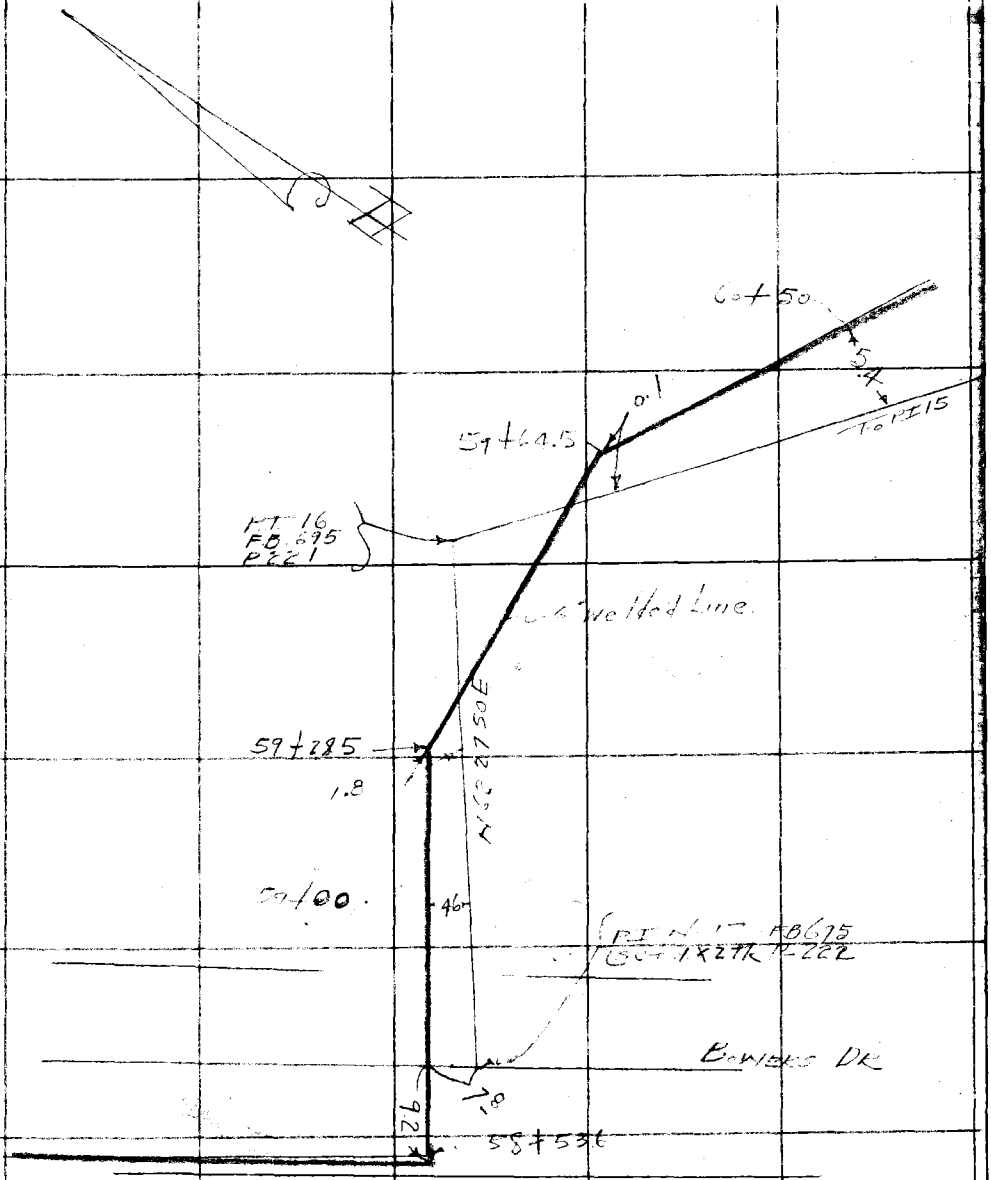

FORM 247 10M 11-35

Cont. to bot page

F.B. 725 Pg. 102

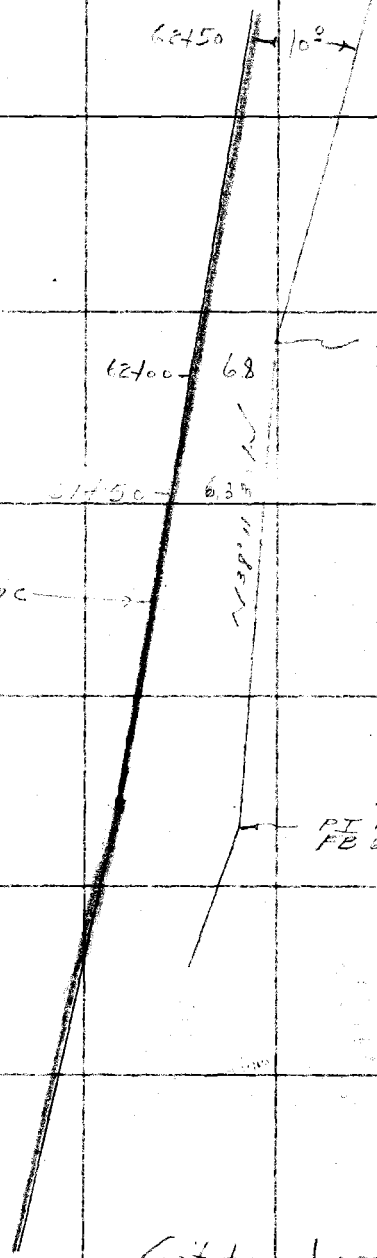

X

Cont from top page 101

RETURN TO
LOS ANGELES COUNTY SURVEYOR
700 HALL OF RECORDS

Do not extend notes this side of this line

Note: Any Additions or Changes on This Sheet Must be Made or Circled in Red Ink With Date and Name of Person Making Change.

Notes Ck'd by aak	Survey of Farmwood Rd
Map No.	W. O. 8209 Tape No. St'd °F.
Office Work	Surveyed by Stevenson
Checked	Notes T.T.S. Date 3-15-38
Date	Indexed


Cont. to L.L. page 104

14+13.5

168° 56' 45" } Δ
15° 47' 00" } Δ

Plus } 6+40.1 ℄
I.P. } angle at Setback

31.94 @ 7° 34' T 15.98

4" to 2" TEE

Hydrant No. 9

0.9

3.3

IDENTICAL

4" welded line

7.3

2.0

I.P.

45

168° 56'

6" welded line

N 10° W

123

IT 12
FB 695
P. 220

angle at Setback

0

1

47

104

139° 47' 15"
199° 08' 45"

IT 13
FB 695
P. 220

6+78.3

104

Cont. from top page

RETURN TO
LOS ANGELES COUNTY SURVEYOR
700 HALL OF RECORDS

Note: Any Additions or Changes on This Sheet Must be Made or Circled in Red Ink With Date and Name of Person Making Change.

Do not extend notes this side of this line

FORM 247 10M 11-38

F.B. 725 PG. 104

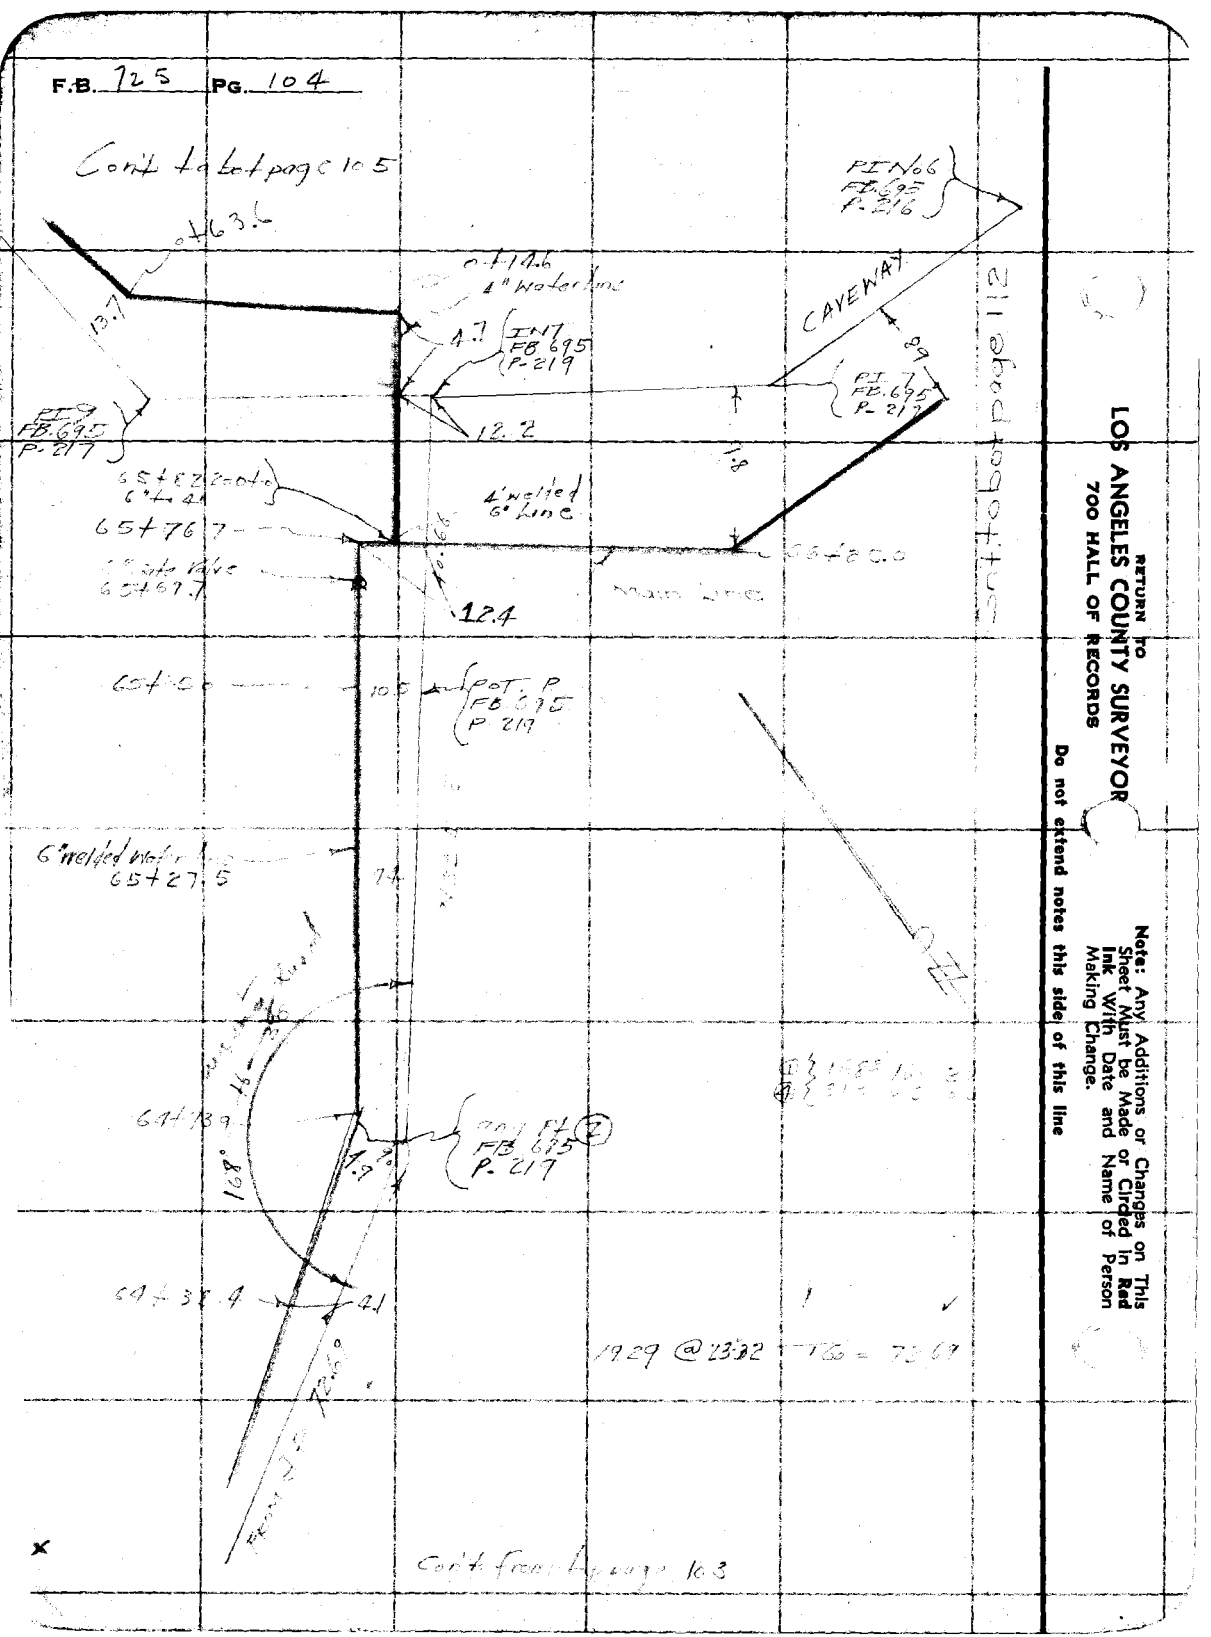

RETURN TO
LOS ANGELES COUNTY SURVEYOR
700 HALL OF RECORDS

Note: Any Additions or Changes on This Sheet Must be Made or Circled in Red Ink With Date and Name of Person Making Change.

Do not extend notes this side of this line

Notes Ck'd by	Survey of Fernwood Rds
Map No.	W. O. 8209 Tape No. 67 St'd 66 °F.
Office Work	Surveyed by Stevenson
Checked	Notes T.S. Date 3-14-38
Date	Indexed

F.B. 725 Pg. 105

Note: Any Additions or Changes on This Sheet Must be Made or Circled in Red Ink With Date and Name of Person Making Change.

Do not extend notes this side of this line

RETURN TO
LOS ANGELES COUNTY SURVEYOR
700 HALL OF RECORDS

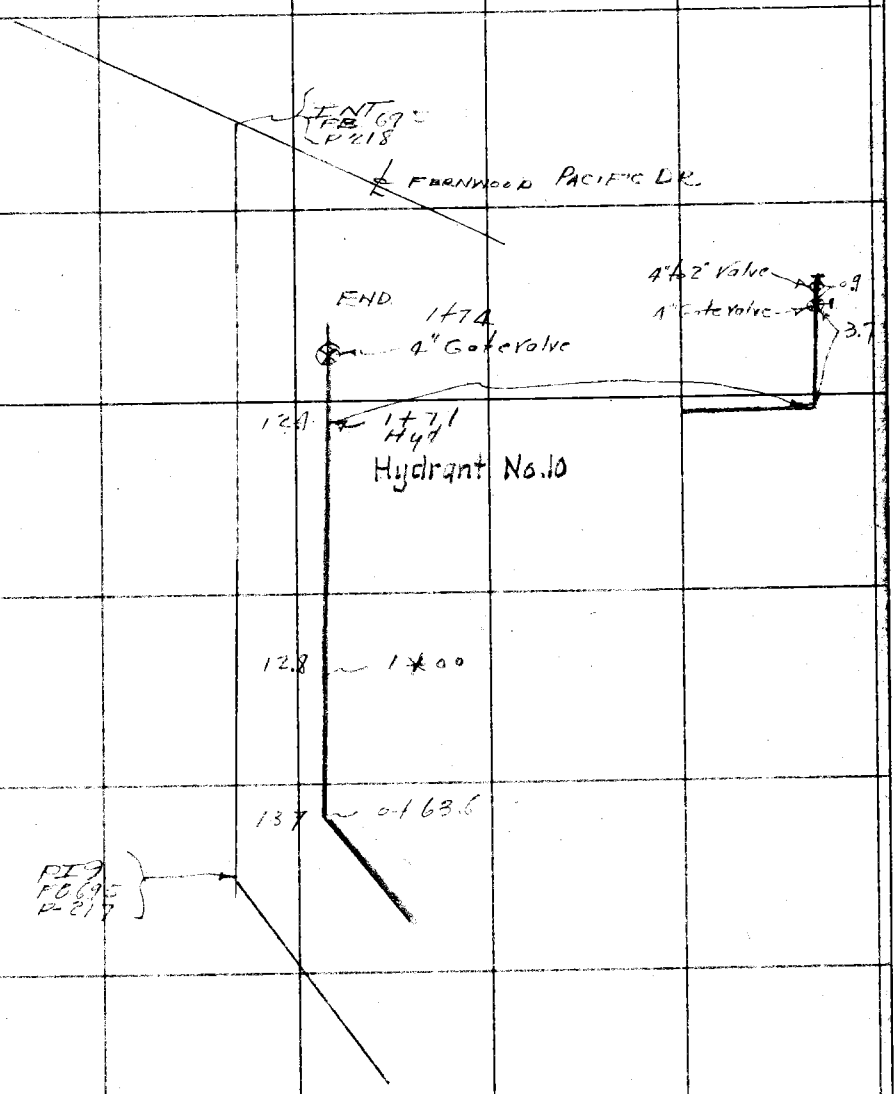

Cont. from top page 104

FORM 247 10M 11-35

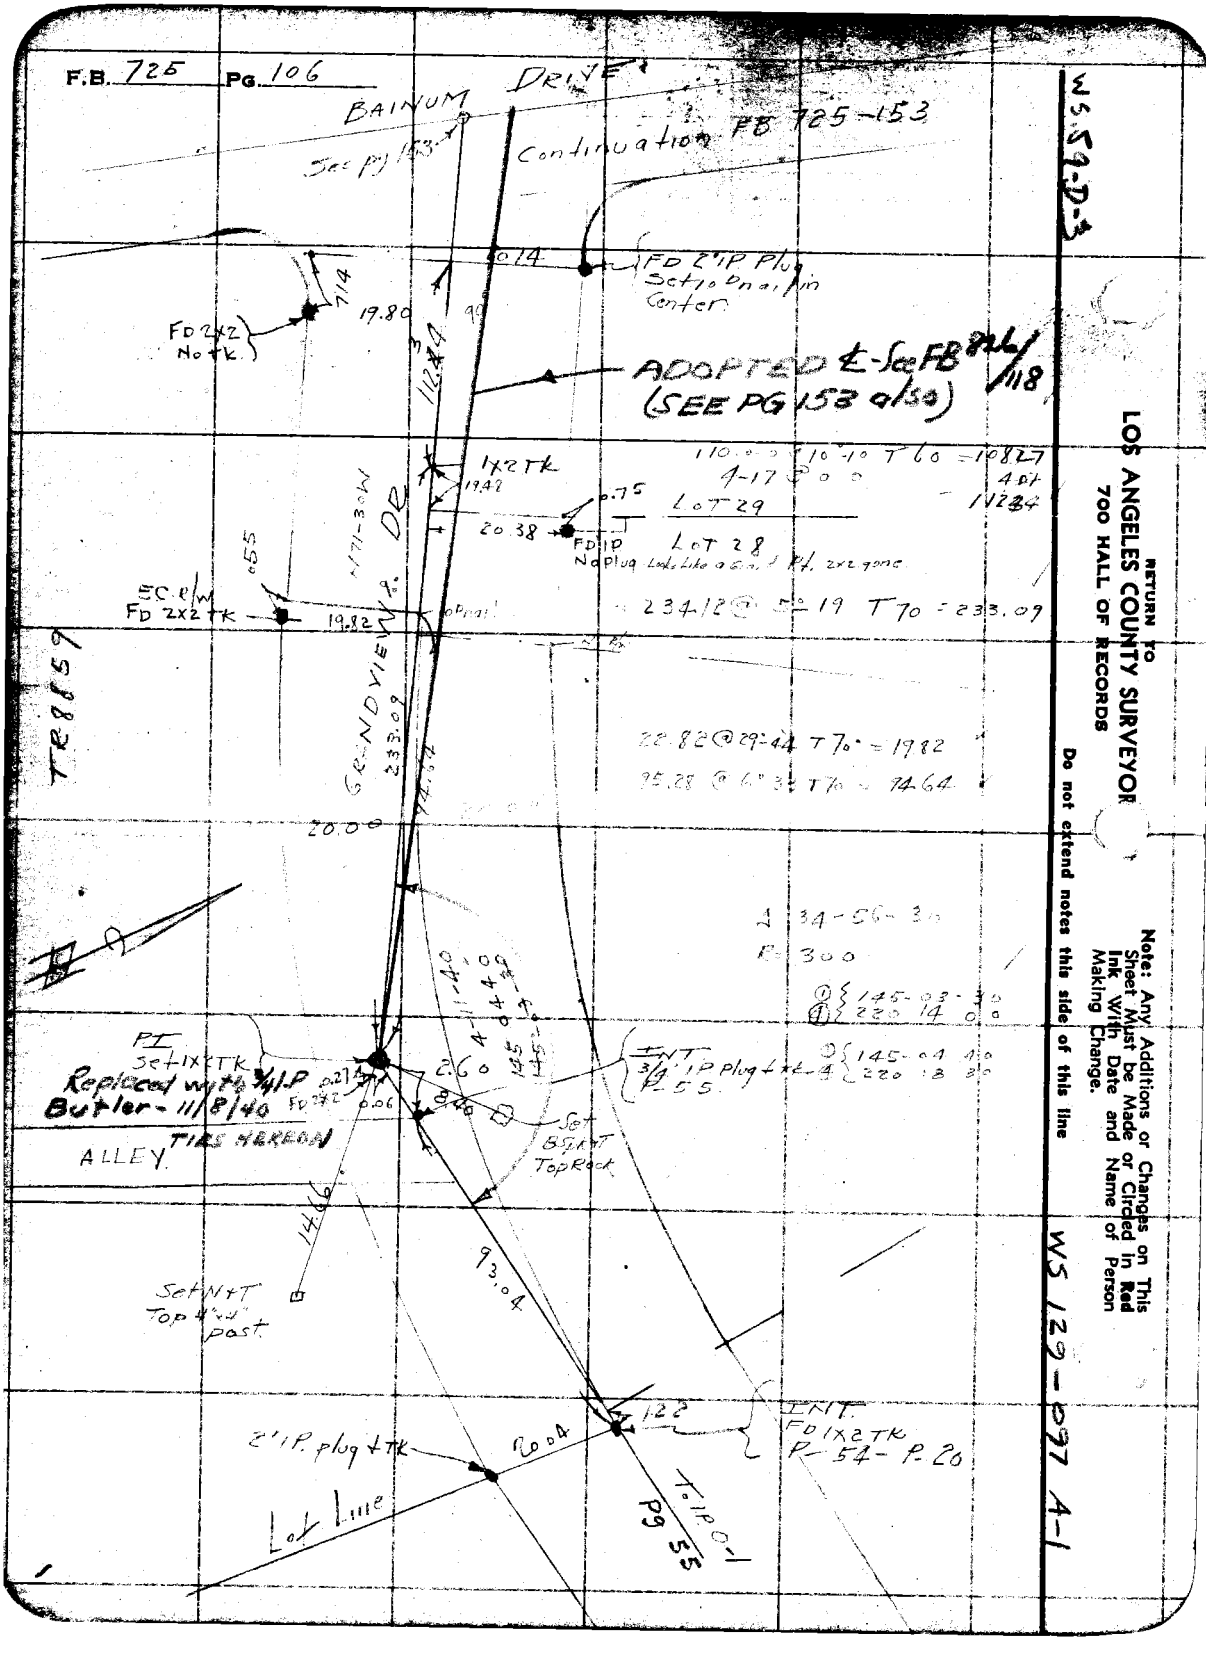
F.B. 725 Pg. 106
BAINUM DRIVE
Continuation FB 725-153
See Pg 153
FD 2" IP Plug Set to Brass Pin Center
FD 2x2 No Tk.
ADOPTED & See FB 725/118 (SEE PG 153 a/so)
1x2 TK
FD IP No Plug Looks Like a Car, 1 Pt. 2x2 gone
Lot 29
Lot 28
EC e/w FD 2x2 TK
PI Set 1x2 TK Replaced with 3/4 IP Butler - 11/8/40
ALLEY TIES HEREON
Set 8" NT Top Rock
Set NxT Top 4"x4" post
INT 3/4" IP plug + tk
INT FD 1x2 TK P-54 - P-26
2" I.P. plug + TK
Lot Line
To IP on Pg 55
RETURN TO LOS ANGELES COUNTY SURVEYOR 700 HALL OF RECORDS
Do not extend notes this side of this line
Note: Any Additions or Changes on This Sheet Must be Made or Circled in Red Ink With Date and Name of Person Making Change.
WS 129 - P97 A-1
WS 51-D-3

WS 17-D-3

Notes Ck'd by		Survey of Fernwood Rds	F.B. 125 Pg. 107
Map No. B-1631-1		W. O. 8209 Tape No. 69 St'd 66 OF	
Office Work White		Surveyed by Stevenson	
Checked A.A.R.		Notes TJS Date 1-1-38	
Date 1941		Indexed	

Cont. to bot page 105

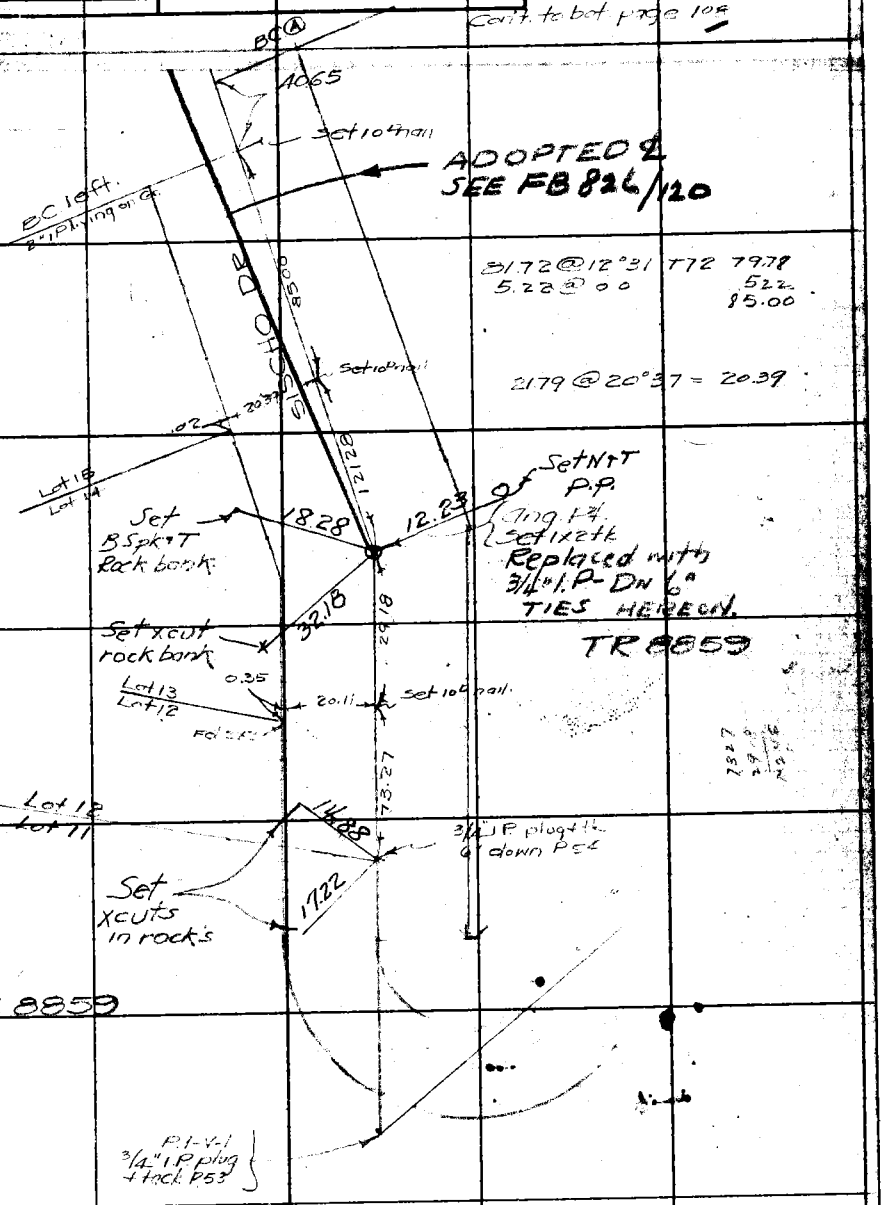

31.72 @ 12°31 T 72 79.78
5.22 @ 0 0 522
85.00

21.79 @ 20°37 = 20.39

RETURN TO
LOS ANGELES COUNTY SURVEYOR
700 HALL OF RECORDS

WS 129-097 A-1

Note: Any Additions or Changes to this Sheets Must be Made or Circled in Red Ink With Date and Name of Person Making Change.

Do not extend notes this side of this line

FORM 247 5M 10-37

F.B. 725 PG. 108

Cont. to bet. page 109

WS 59-D-3

TR 8259

01 N06

ADOPTED

℄ - See F.B. 826/114-116

RETURN TO
LOS ANGELES COUNTY SURVEYOR
700 HALL OF RECORDS

Note: Any Additions or Changes on This Sheets Must be Made or Circled in Red Ink With Date and Name of Person Making Change.

Do not extend notes this side of this line

260.06 @ 11°50 TBE 25.453
Y 24.83
37935
Minus 1.87
37748

29.93 @ 18°10 TTE 28.44
2.80 @ 0°0 2.80
31.24

104°36 30 ①
58°26 15 ②

142°20 45 ①
209°23 00 ②

133°54 30 ①
175°38 00 ②

110°48 15 ①
83°13 15 ②

1-30-20

Set 5/8" I.P. Cont'd pg 54

tie line for angle closer pg 202

NEW P.I. #101A Set C1/2" I.P. W+T

Set C ST+W

Set 3/4" I.P.

RUNYON TRAIL

29.49

P.I. 101 (A) Set C ST+W

8.20

4.98

Sint 0-1 R55 3/4" I.P. tg+Tt 14.2

Grandview Cont. I.P. page 54

20 45 30 45

34.48

11.73

10.00

Set AXT's in rock bank 5' High

6.07

31.24

4.54

14.04

104° 26 35

NEW P.I. Set 3/4" I.P.

Set 3/4" I.P.

TIES - HEREON

2174 @ 22°43 TBE 20.05

23.35

POT Set 3/4" I.P.

DR

50.22

FD NT 18" OAK

Cont from for page 107

Set C Spot W+T in bank

WS 129-097 B-1

W.S. 59-D-15

Notes Ck'd by		Survey of Reinvised 5%	F.B. 725 Pg. 109
Map No. B-1631-1		W. O. 8709 Tape No. 69 Std 84 of	
Office Work White		Surveyed by Stevenson	
Checked AAR		Notes T.J.S. Date 4-1-39	
Date 1941		Indexed	

Sent to bot page 141

ADOPTED ℄
See
FB 826/114

DRIVE

Fd 2" IP plug + tk
0.36

Set bent pk
Side Swivel
Stone

18.40
90°
19.79
33.67
1.53
0.35
P/ 102 (A)
Set 1x2 tk
15.73
17.26
Set N+T PP

NEW
P.I. #102A
Set 3/4" I.P.
TIES HEREON.

9534 @ 11°32 - 9342
3.48 @ 0 0 348
9689

17° 24' 15"
R = 450
L = 137.90

Set N+Tg
in rock tank

VIEW
46.11

5-11-40

170° 24-15 10
321° 37 10
36 40

Lot 13

Lot 14

283
76°
21.15
96.99

Fd 2x2 tk

128.86 @ 14°-21 TBC = 128.93
Minus .188
128.75

TR 8859

Lot 14

0.57
18.82
Fd 2x2 tk

Lot 15

GRAND

Note: Any Additions or Changes on This Sheets Must be Made or Circled in Red Ink With Date and Name of Person Making Change.

Do not extend notes this side of this line

RETURN TO
LOS ANGELES COUNTY SURVEYOR
700 HALL OF RECORDS

FORM 247 SM 10-37

F.B. 725 PG. 110

Cont to bot page 111

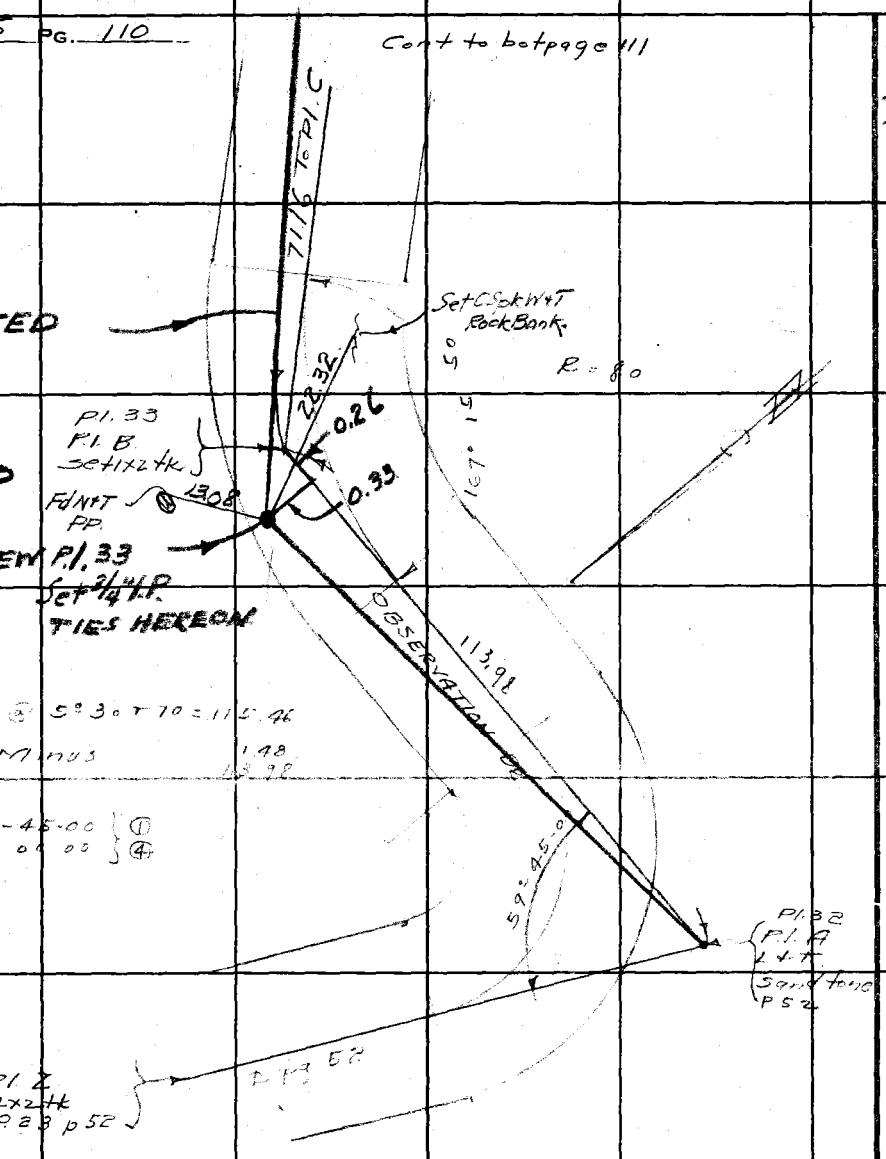

ADOPTED
℄
SEE
F.B.
824/120

Cont. from page 23

RETURN TO
LOS ANGELES COUNTY SURVEYOR
700 HALL OF RECORDS

Note: Any Additions or Changes on This Sheets Must be Made or Circled in Red Ink With Date and Name of Person Making Change.

Do not extend notes this side of this line

WS 59-D-3

WS 129-097 B-1

WS 59-D-3

Notes Ck'd by	
Map No. B-1631-1	
Office Work White	
Checked AAR	
Date 1941	

Survey of Fernwood Rds	
W. O. 1609	Tape No. 69 St'd 84 OF
Surveyed by Stevenson	
Notes T.T.S	Date 4-6-38
Indexed	

F.B. 725 PG. 111

Set 1x2 TK

Cont. to Bot. page 192

1.08

21.81

FD 2" I.P. Plug + TK

28.53

FD 2X2 TK Lot 3

187.1

142.01

1377.61 to P.I.

14100 @ 7°47 = 139.70
231
V142.01

Lot 2

137.46 @ 8°-03 T60
= 136.11
Plus 21.53
157.64
R 180

Set N+T Acacia tree

13.47

13.56

PI 35
Set 1x2 TK
10 Down

0.45

1.04

Set N+T in stud

Garage

R 4.50

23.61

167.0'

ADOPTED
&
SEE FB 826/122

Lot 7

Lot 6

OBSERVED N 67°22'W 10

74.11

P.O.T. set 10 nail

FD N+T P.P.

64.43

53-10

PI 34
Set 1x2 TK

R 80 NEW PI 34
Set ¾" I.P.
TIES HEREON

0.47

146

0.45

FD N+T P.P.

64.91

146°-53-10
227°-32-30

FROM PI B

Cont from top page 110.

RETURN TO
LOS ANGELES COUNTY SURVEYOR
700 HALL OF RECORDS

WS 122-027 B-1

Note: Any Additions or Changes on This Sheets Must be Made or Circled in Red Ink With Date and Name of Person Making Change

Do not extend notes this side of this line

FORM 247 5M 10-37

Cont to bot page 112

F.B. 725 PG. 112

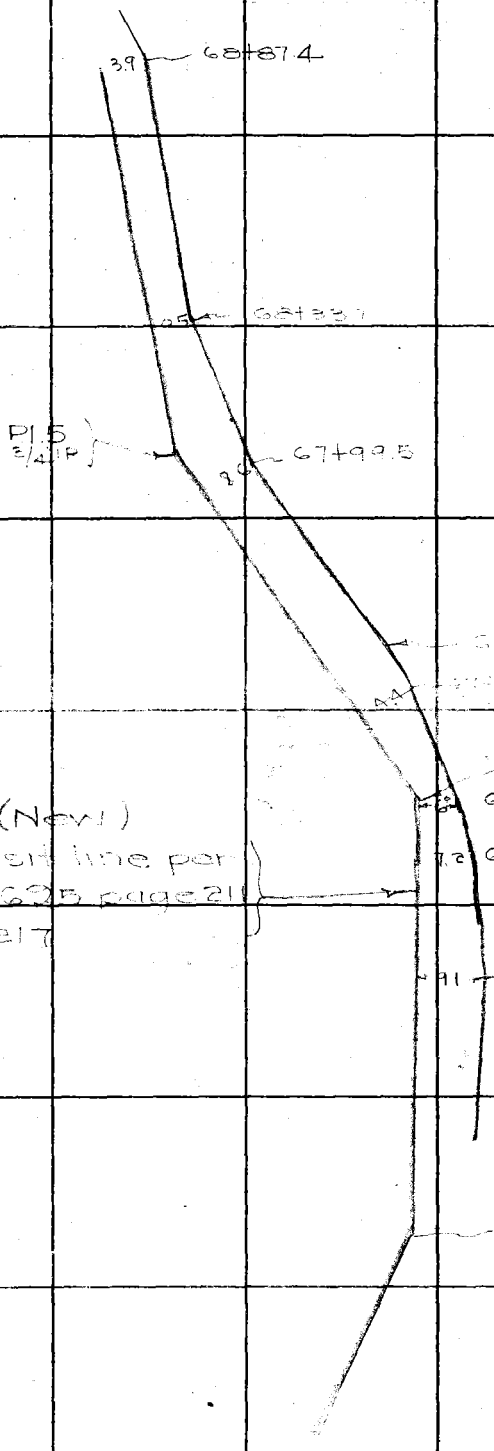

Cont from top page 154

RETURN TO
LOS ANGELES COUNTY SURVEYOR
700 HALL OF RECORDS

Note: Any Additions or Changes on This Sheets Must be Made or Circled in Red Ink With Date and Name of Person Making Change.

Do not extend notes this side of this line

Notes Ck'd by	Survey of Ferrwood Rds
Map No.	W. O. 8109 Tape No. St'd °F.
Office Work	Surveyed by
Checked	Notes Date 1-13-39
Date	Indexed 3-27-39

F.B. 725 PG. 12

Note: Any Additions or Changes on This Sheet Must be Made or Circled in Red Ink With Date and Name of Person Making Change.

Do not extend notes this side of this line

RETURN TO
LOS ANGELES COUNTY SURVEYOR
700 HALL OF RECORDS

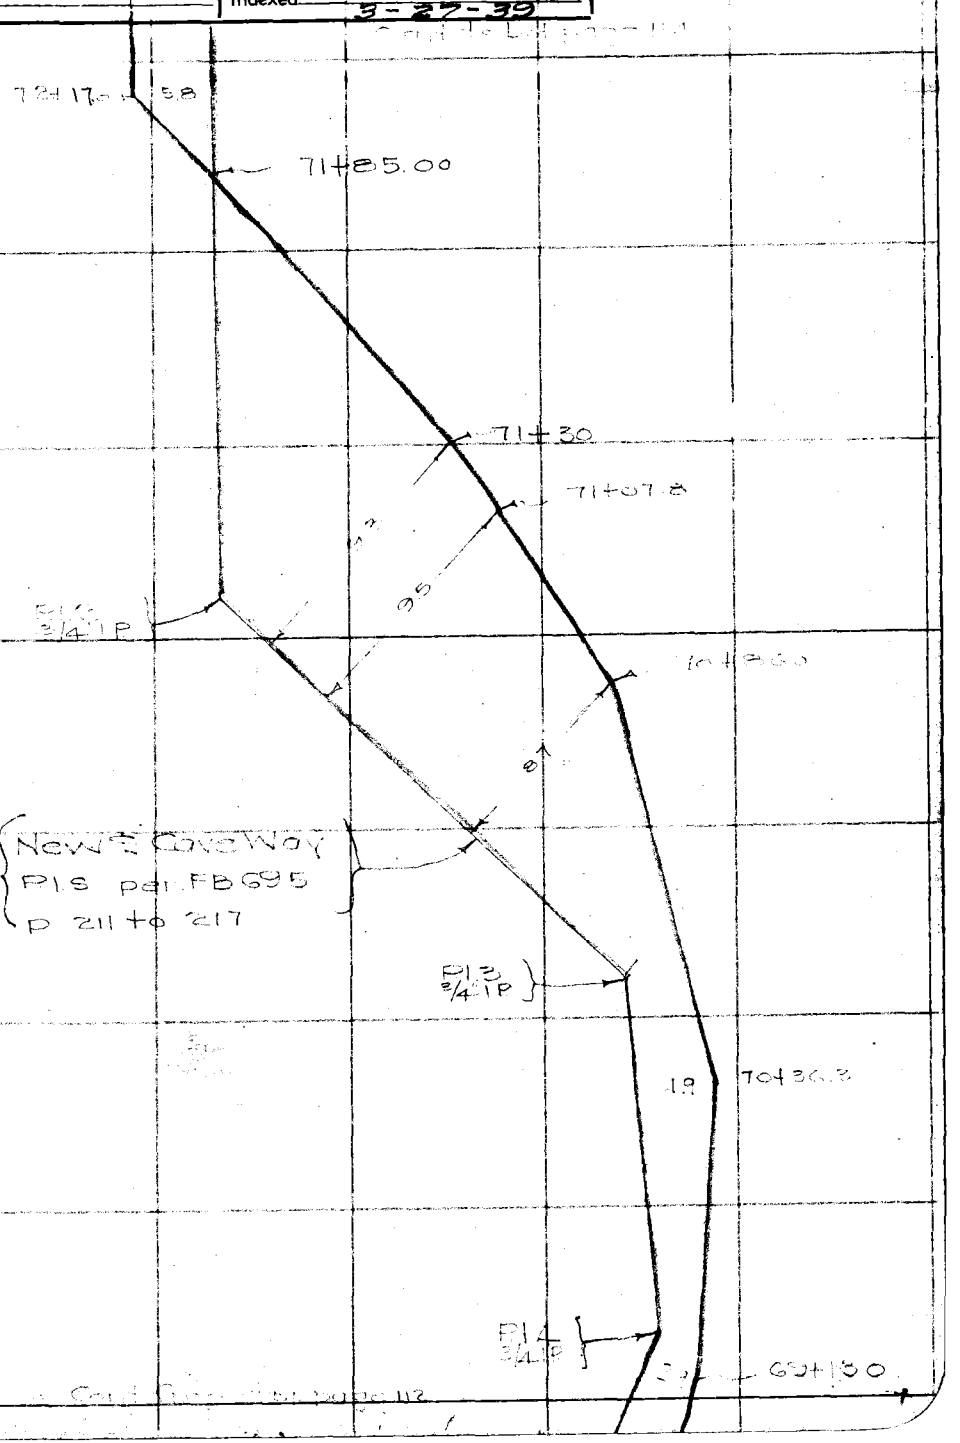

FORM 247 10M 11-36

F.B. 725 PG. 114

Cont from top page 113

RETURN TO
LOS ANGELES COUNTY SURVEYOR
700 HALL OF RECORDS

Note: Any Additions or Changes on This Sheet Must be Made or Circled in Red Ink With Date and Name of Person Making Change.

Do not extend notes this side of this line

Form 307 5M 10-37

PLEASE RETURN TO
LOS ANGELES COUNTY SURVEYOR
700 HALL OF RECORDS

NOTE: ANY ADDITIONS OR CHANGES ON THIS SHEET MUST BE MADE OR CIRCLED IN RED INK, WITH DATE AND NAME OF PERSON MAKING CHANGE

Do not extend notes this side of this line

STATION	B. S.	H. I.	F. S.	ELEV.		
	(Continuation of Profile from page 52)					
T.P.A	0.[illegible]	845.752		845.232		
71+30.0			4.4	841	Gr	
"			5.7	839.5	IP	
T.P.	2.282	834.427	11.607	834.145		
71+94.6			8.8	825.6	IP	
			7.0	827.4	Gr	
72+17			11.70	822.7	IP	
			10.5	823.9	Gr	
T.P.	1.380	824.152	11.655	822.772		
73+15			7.4	818	IP	
			5.8	821.4	Gr	
72+71.5			6.4	820.8	IP	
			4.5	822.7	Gr	
T.P.	6.250	830.425	2.977	824.175	Set Nail & Tole	
T.P.	1.96[illegible]	[illegible]	6.250	824.175	Set cut Sp. in [illegible]	
74+11			[illegible]	819	[illegible]	
			7.3	818.3	IP	
			[illegible]	819.2	[illegible]	
			[illegible]	818.0	[illegible]	

Profile
No. X-Sec. No.
Notes Red. Date Notes Chkd. Date
Plotted Date Checked Date
Job No. [illegible] Division No.
Survey of [illegible] Notes Date
Survey by [illegible] Notes Date
Map No. Indexed Date 3-27-39

F.B. 72 PG. 115

Form 307 5M 10-37

PLEASE RETURN TO
LOS ANGELES COUNTY SURVEYOR
700 HALL OF RECORDS

NOTE: ANY ADDITIONS OR CHANGES ON THIS SHEET MUST BE MADE OR CIRCLED IN RED INK, WITH DATE AND NAME OF PERSON MAKING CHANGE

Do not extend notes this side of this line

F. B. 7225 Pg. 116 | Job No. 3264 | Division No. 6285 | Notes Red. | Plotted | Profile No.
Survey of [illegible] | Date | Date | X-Sec. No.
Survey by [illegible] | Notes [illegible] | Notes Chkd. | Checked
Indexed | Date [illegible] | Date | Date

STATION	B. S.	H. I.	F. S.	ELEV.		
		82.5 626				
74+59			9.1	6 6	SI	
			10.1	15 0	IP	
TP	0.415	626.220	11.505	614.660		
74+88.1			3.2	10 91	CL	
			1.5	3 71	IP	
TP	2.914	626.134	1.005	625.220		
75+14			9.2	79 X 6	CL	
			12.2	7 7 6	IP	
TP	1.484	626.605	11.124	615.121		
[illegible]	[illegible]	[illegible]	[illegible]	[illegible]	[illegible]	
[illegible]	[illegible]	782 116	[illegible]	[illegible]		
[illegible]	1.369	771 911	[illegible]	770 342		
[illegible]			[illegible]	6 3 1	CL	
[illegible]			[illegible]	6 1 9	IP	
[illegible]			[illegible]	[illegible]	[illegible]	
TP	[illegible]	[illegible]	11.85 [illegible]	770.361		
[illegible]	2.357	773.990	11.132	771.658		
76+69			3.1	4 7 9	CL	
			4.7	4 7 3	IP	
[illegible]			11.2	4 5 1		
			12.7	39 3 1		

Form 307 5M 10-37

PLEASE RETURN TO
LOS ANGELES COUNTY SURVEYOR
700 HALL OF RECORDS

NOTE: ANY ADDITIONS OR CHANGES ON THIS SHEET MUST BE MADE OR CIRCLED IN RED INK, WITH DATE AND NAME OF PERSON MAKING CHANGE

Do not extend notes this side of this line

STATION	B. S.	H. I.	F. S.	ELEV.		
				740.4		
				392		
				399		
				384		
				395		
				392		
					737.448	USII40

Profile No.
Notes Red. Date Plotted Date Job No. Division No.
X-Sec. No.
Notes Chkd. Date Checked Date Survey of Survey by Map No. Notes Indexed Date Date

F.B. 725 PG. 117

F. B. 725 PG. 118 | Job No. | Division No. | Notes Red. | Plotted | Profile

Survey of | Date | Date | No.

Survey by | Notes | Notes Chkd. | Checked | X-Sec.

Indexed | Date | Date | Date | No.

STATION	B. S.	H. I.	F. S.	ELEV.	

Form 307 5M 10-37

PLEASE RETURN TO
LOS ANGELES COUNTY SURVEYOR
700 HALL OF RECORDS

Do not extend notes this side of this line

NOTE: ANY ADDITIONS OR CHANGES ON THIS SHEET MUST BE MADE OR CIRCLED IN RED INK, WITH DATE AND NAME OF PERSON MAKING CHANGE

Notes Ck'd by	Survey of	F.B. 72	Pg. 119
Map No. B-1631-3	W. O.	Tape No.	St'd OF
Office Work White	Surveyed by		
Checked AAR	Notes	Date	
Date 1941	Indexed 3-22-39		

Fernwood Roads

Location of Easement

on Lot 2 Tract 8319.

J.N. 9209

T.J. Stevenson
S.H. Nichols
W.F. Harris
R.W. Scott

Note: Any Additions or Changes on This Sheets Must be Made or Circled in Red Ink With Date and Name of Person Making Change.

Do not extend notes this side of this line

RETURN TO
LOS ANGELES COUNTY SURVEYOR
700 HALL OF RECORDS

FORM 247 5M 10-37

F.B. 725 Pg. 120

Cont. to bot page 121

WS 59-D-3

RETURN TO
LOS ANGELES COUNTY SURVEYOR
700 HALL OF RECORDS

Do not extend notes this side of this line

Note: Any Additions or Changes on This Sheets Must be Made or Circled in Red ink With Date and Name of Person Making Change.

WS 129-097 B-1

162.80 @ 3°14 — T62 = 162.54

85°48'30" ①
343°14'00" ④

89°43'00" ①
358°52'15" ④

175.07 to P.I.

P.I. not Fd. set 5/8 x 24" iron pipe with plastic plug stamped LS 5971

Fern Wood Pacific Dr

128°03'10"

128°03'15" ①
④ 52°1[illegible]'30"

F.I. 3/4" I.P. plug stamped LS 5971
FB 695 213

See F.B. 826-138-139

Lovelace Way

85°

LOT 2

43 TT 8213

8°19'

N

162.54

See F.B. 826-132

① 85°48'30"
④ 343°14'00"

05

50

146.00

Set CSTHW

P.I. set by calc. Traverse from P.I.s Fd. to ∑ for Closure Tack

41.52

P.I. 3
Fd CSTHW
FB 695-p213

141.00 @ 19°08 T 70 13319
12.81 @ 00 1781
146.00

P.I. Not Fd. nothing set

FORM 247 5M 10-37

RETURN TO
LOS ANGELES COUNTY SURVEYOR
700 HALL OF RECORDS

Note: Any Additions or Changes on This Sheets Must be Made or Circled in **Red Ink** With Date and Name of Person Making Change.

WS 129 - 097 B-1

Do not extend notes this side of this line

WS 59-D-3

Notes Ck'd by _____
Map No. B-16 31-3
Office Work White
Checked AAK
Date 1941

Survey of Idlewood Rd
W. O. 8209 Tape No. ____ Std. ____ of
Surveyed by Stevenson
Notes 7 J S Date 2-14-39
Indexed

F.B. 1 [illegible] Pg. 127

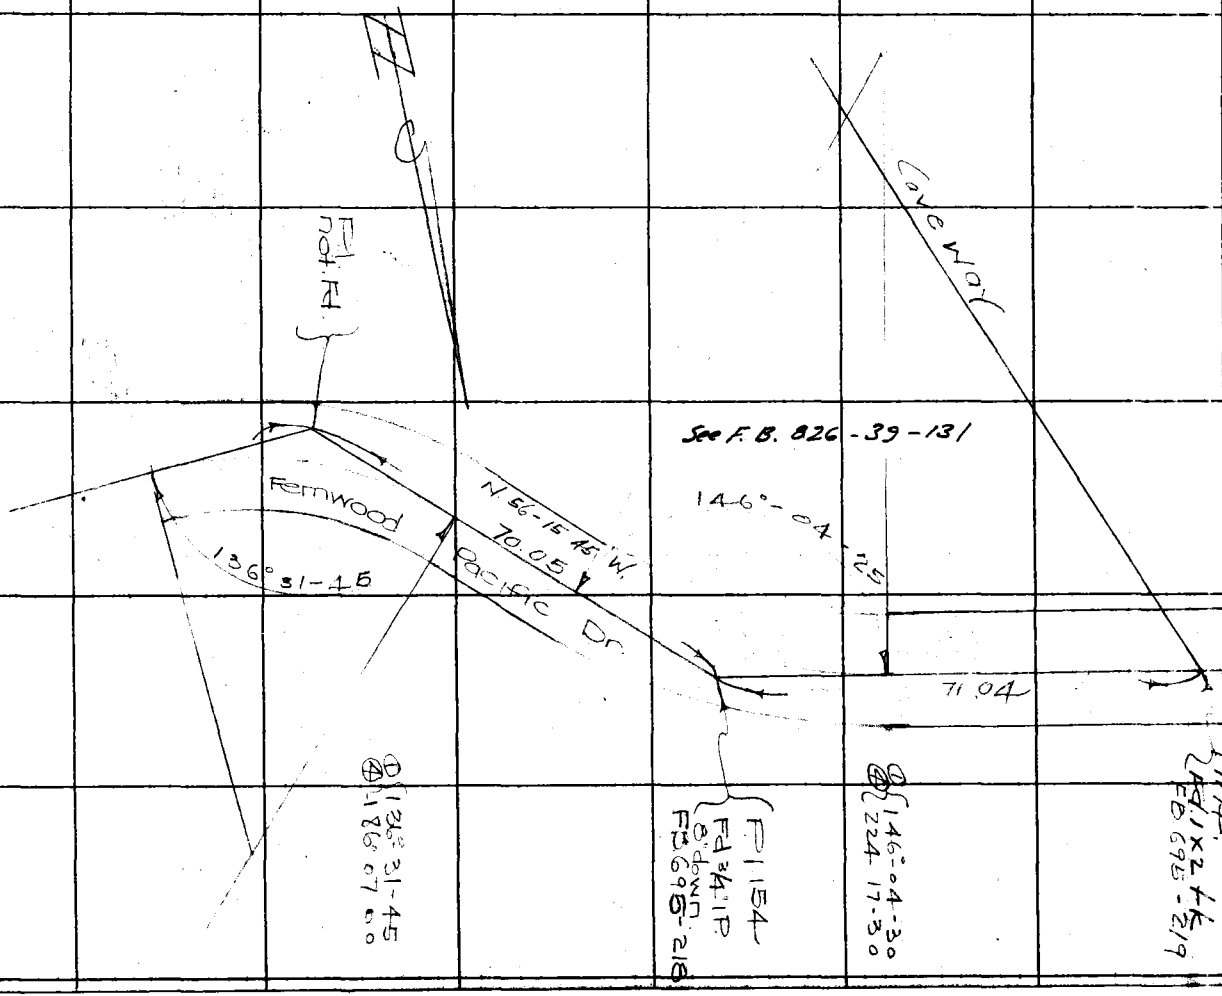

RETURN TO
LOS ANGELES COUNTY SURVEYOR
700 HALL OF RECORDS

Note: Any Additions or Changes on This Sheets Must be Made or Circled in **Red Ink** With Date and Name of Person Making Change.

Do not extend notes this side of this line

F.B. 725 PG. 122

Notes Ck'd by A. A.	Survey of	F.B. 725	PG. 123
Map No.	W. O. Tape No. St'd of		
Office Work	Surveyed by		
Checked	Notes Date		
Date	Indexed 12-2-32		

SURVEY OF

FLENWOOD HTS

J.N 32209

T.J. Stevenson
G.H. Nichols
R.W. SCOTT

Note: Any Additions or Changes on This Sheets Must be Made or Circled in Red Ink With Date and Name of Person Making Change

Do not extend notes this side of this line

RETURN TO
LOS ANGELES COUNTY SURVEYOR
700 HALL OF RECORDS

FORM 247 5M 10-37

RETURN TO
LOS ANGELES COUNTY SURVEYOR
700 HALL OF RECORDS

Note: Any Additions or Changes on This Sheets Must be Made or Circled in **Red Ink** With Date and Name of Person Making Change.

Do not extend notes this side of this line

INDEX SHEET

F.B. 725 PG. 124

Sec line - Random line FB 524 pgs 112 to 119

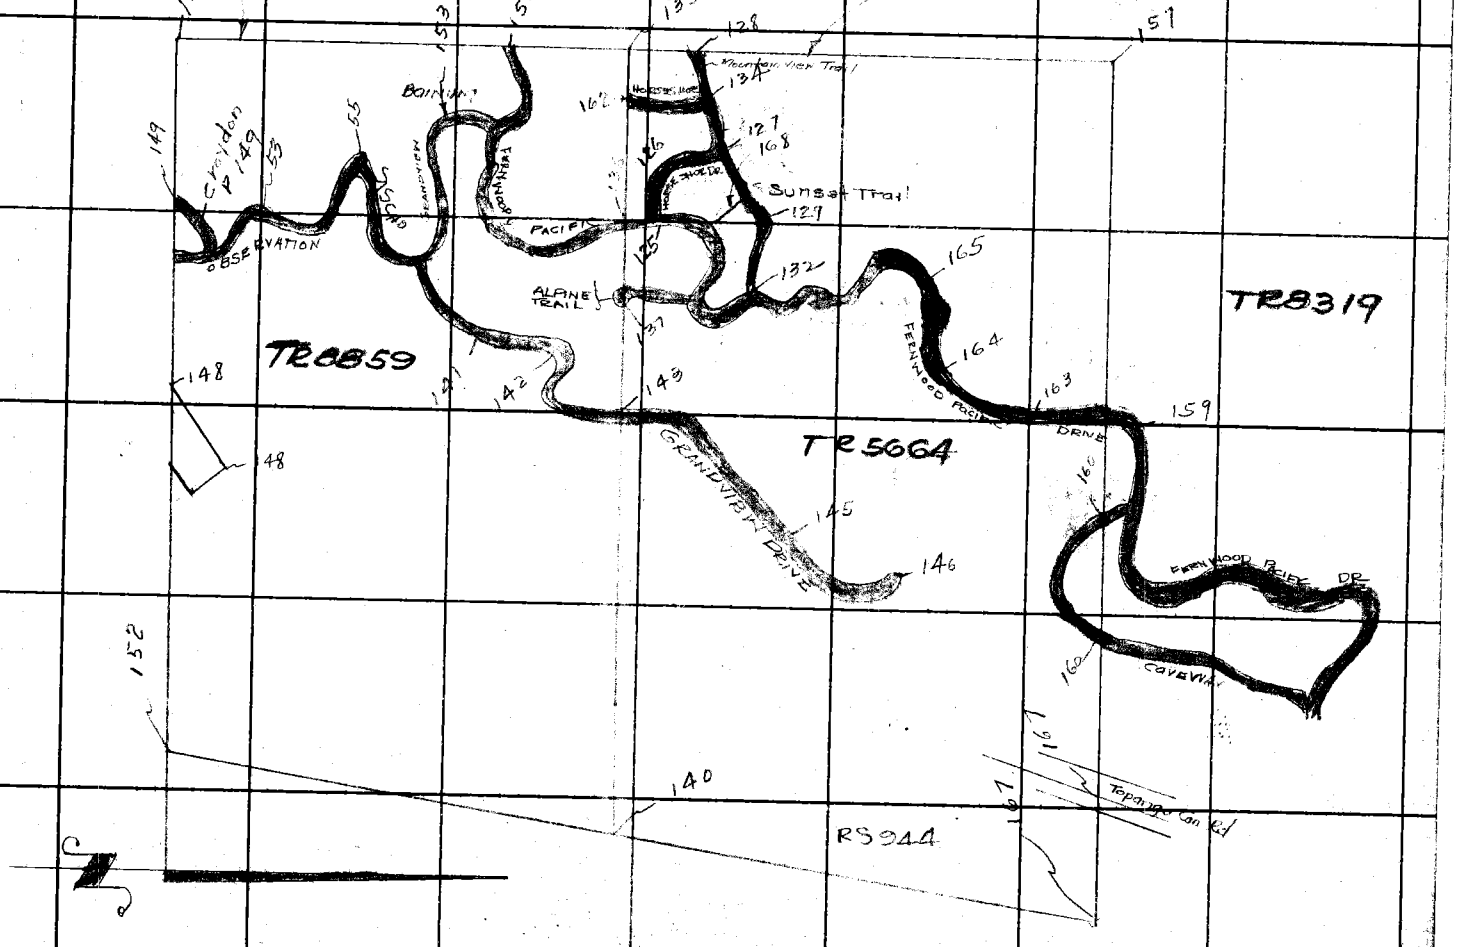

Armored Sts

Notes Ck'd by A.A.R.	Survey of Horseshoe Dr	F.B. 725	Pg. 125
Map No. B-1631-2	W. O. [illegible] Tape No.	St'd	OF
Office Work White	Surveyed by Stevenson		
Checked AAR	Notes T.J.S	Date 10-25-39	
Date 1941	Indexed		

W 5.59-D-3

Cont to bot. page 126

LOT 7

20. 20.

Fd.

To P.I.

HORSESHOE DRIVE

N 86°23-40 W

15593@ 5°31 T60°
= 155.18

Adopted Line
8-5-40
T.J.S

155.18

LOT 8

{98°34-10
{34°16 40

TRACT 5964
BI 28

34-10

98°

Set. N+T P.P

38.19

P.O.T.
Fd 3/4 I.P. pg 44
FB 695-230

24.98

12°

16539

To P.I.
Fd 3/4 I.P.

208.72

Int set C.S.T+W by us

To P.R.P.I.

FERNWOOD
PACIFIC DR
Transit Line FB 695 Pg 230 -231

10.38

12°

Set N+T
Evergreen Tree

210.16 @ 6°30 T60 208.72

Minus

48.35
160.37
24.98
185.45

RETURN TO
LOS ANGELES COUNTY SURVEYOR
700 HALL OF RECORDS

WS 129-37 4-1

Note: Any Additions or Changes on This Sheets Must be Made or Circled in Red Ink With Date and Name of Person Making Change

Do not extend notes this side of this line

FORM 247 5M 10-37

F.B. 725 PG. 126

Con't. to bot. page 127

RETURN TO
LOS ANGELES COUNTY SURVEYOR
700 HALL OF RECORDS

Note: Any Additions or Changes on This Sheets Must be Made or Circled in Red Ink With Date and Name of Person Making Change.

Do not extend notes this side of this line

TRACT 5664
BK 28

Adopted Line 9-5-40 T.J.S.

20. 20.

To Pl.

DRIVE

HORSESHOE

23.21 @ 24°36 = 2.10

Fd 2x2 +++

7.13

19.26

Set N++ 7.12

11.12 NW

27.83

70°14'

Set N++ 3.12

121°47'30"
127°10'00"

121°

27.83

43.3

Fd. 2x2 ++

Pl. Set 1x2++ 3/4

Replaced with 1" pl+++ 8-5-40 T.J.S.

LOT 4

3.13

20.

19.96

27.83

3785 @ 1°35

Set 1x2++

70°15'

19.96

30 ++

Fd 2x2 ++

0.27

Cont. from Top Pg. 125

LOT 7

RETURN TO
LOS ANGELES COUNTY SURVEYOR
700 HALL OF RECORDS
WS 129-097 14

Note: Any Additions or Changes on This Sheets Must be Made or Circled in Red Ink With Date and Name of Person Making Change.
Do not extend notes this side of this line

FORM 247 5M 10-37

WS 39-D-3

Notes Ck'd by A. A. F.
Map No. B-16 81-2
Office Work White
Checked AAR
Date 1941

Survey of Horseshoe Dr. W. of Sunset Tape No. 69 Std 34 of
Surveyed by Peterson
Notes Date
Indexed

F.B. 725 PG. 127

(C)

Cont to bot. page 128

10' off line

To PI

To BC

30.38

Z 2.19 @ 2044

30.38

Not set.

82.20

62.38

17.5

122.79

2807

Fd 2x2 tk

1858

Set Stake Rock

53-30

Sec. p. 132A

169° 53-30

Set 1x2 tk

N+TPR

BL. 25

TR 5664

2' off

169° 53-30

319° 34.00

79

HORSESHOE DR

N 60° 19.20 E

112.04

20.

20.

Set CS T+N

20.06

20.06

Fd 2x2 tk

Fd 2x2 tk

LOT 1

Cont from top page @ 126

88° 30 30

54° 32-00

R = 50

T = 51.32

51.32

Set 3/4 IP

P.I

Set 1x2 tk

From PI Z 0437

Set 1x2 tk

23.68

& Sunset Dr.

See Pg 129

F.B. 725 PG. 128

13+36.90
R No 5
Fd. 1X2 tk
FB 524 p 114

15+14.48 Tgt
Set 1x2 tk

120.71 @ 21°-15 T58° 112.48
69.97 @ 26°-51 T58° 62.42
2.68 @ 0 0 T58 2.68
177.58

62°-08-00 ①
248-31-40 ④
62° 07-55

186.50 @ 2°-49 T58°
= 186.25 v

Line Cont's Horseshoe Dr P.134

Set 1x2 tk

Random Sec line

R17W

R16W

20.0

20.0

62°-07-55

R No 7
Fd. 1x2 tk
FB 524 pg 114

Mountain View TRAIL

See F.B. 826-88

No 1 P

LOT 1

Water line Construct along this line Not Fd.

1 = 47.39
R = 45.97

0.58
260.2
186.25

Fd. 1x2

For Adopted

LOT 2

4922 @ 8°-17
48.71 v

168° 08 ②
312° 32 ③

0.20

Set 1x2 offset

LOT 3

TR 5064 BK 9

10' offset

20.0

From 8.C.

From 20'

HORSESHOE DR

From top page

127

RETURN TO
LOS ANGELES COUNTY SURVEYOR
700 HALL OF RECORDS

Note: Any Additions or Changes on This Sheets Must be Made or Circled in Red Ink With Date and Name of Person Making Change.

Do not extend notes this side of this line

W3.59-D-3

WS 129-097 4-1

Notes Ck'd by A.A.R.	Survey of Horseshoe Dr.
Map No. B-1631-2	W. O. 5058 Tape No. 69 St'd 24 of
Office Work White	Surveyed by Stevenson
Checked AAR	Notes T.J.S. Date 10-26-89
Date 1941	Indexed

F.B. 765 Pg. 129

WS 59-D-3

Cont. to bot page 126

52.40 = 17°52' T60 = 49.87

POT set & on rock

15.0 15.0 49.87

P.I. 3/4 lead spike in sandstone boulder

{17° 20 40
{69° 22 30

34.82

LINE

adopted

14864 = 14+00 T60 = 14400 468 14868

{80° 19' 20"
{321° 17' 20"
{80 19 20

C 9.16 1650 See p. 132A

R = 180.39
T = 28.23

20

Set 3/4 IP pl+tk

See p. 132A

80° 19' 20"

80+18.10
32 52 20

SUNSET

14.48

34.75

R = 25

15.0

13° 05' 20"

R 25 30

Set 3/4 IP pl+tk rock

R 80.0

Set 3/4 IP pl+tk

To Pl.

DRIVE

HORSESHOE

Pat pg. 126

30.54

23.68

34.50

Pl. 1x2 tk pg 127

Pl. Estimate Replaced with 3/4 IP pl+tk

Cont. from bot page 127

RETURN TO
LOS ANGELES COUNTY SURVEYOR
700 HALL OF RECORDS

WS 122-097

Do not extend notes this side of this line

Note: Any Additions or Changes on This Sheets Must be Made or Circled in Red Ink With Date and Name of Person Making Change

FORM 247 5M 10-37

Cont. to bot. page 131

F.B. 725 Pg. 130 (F)

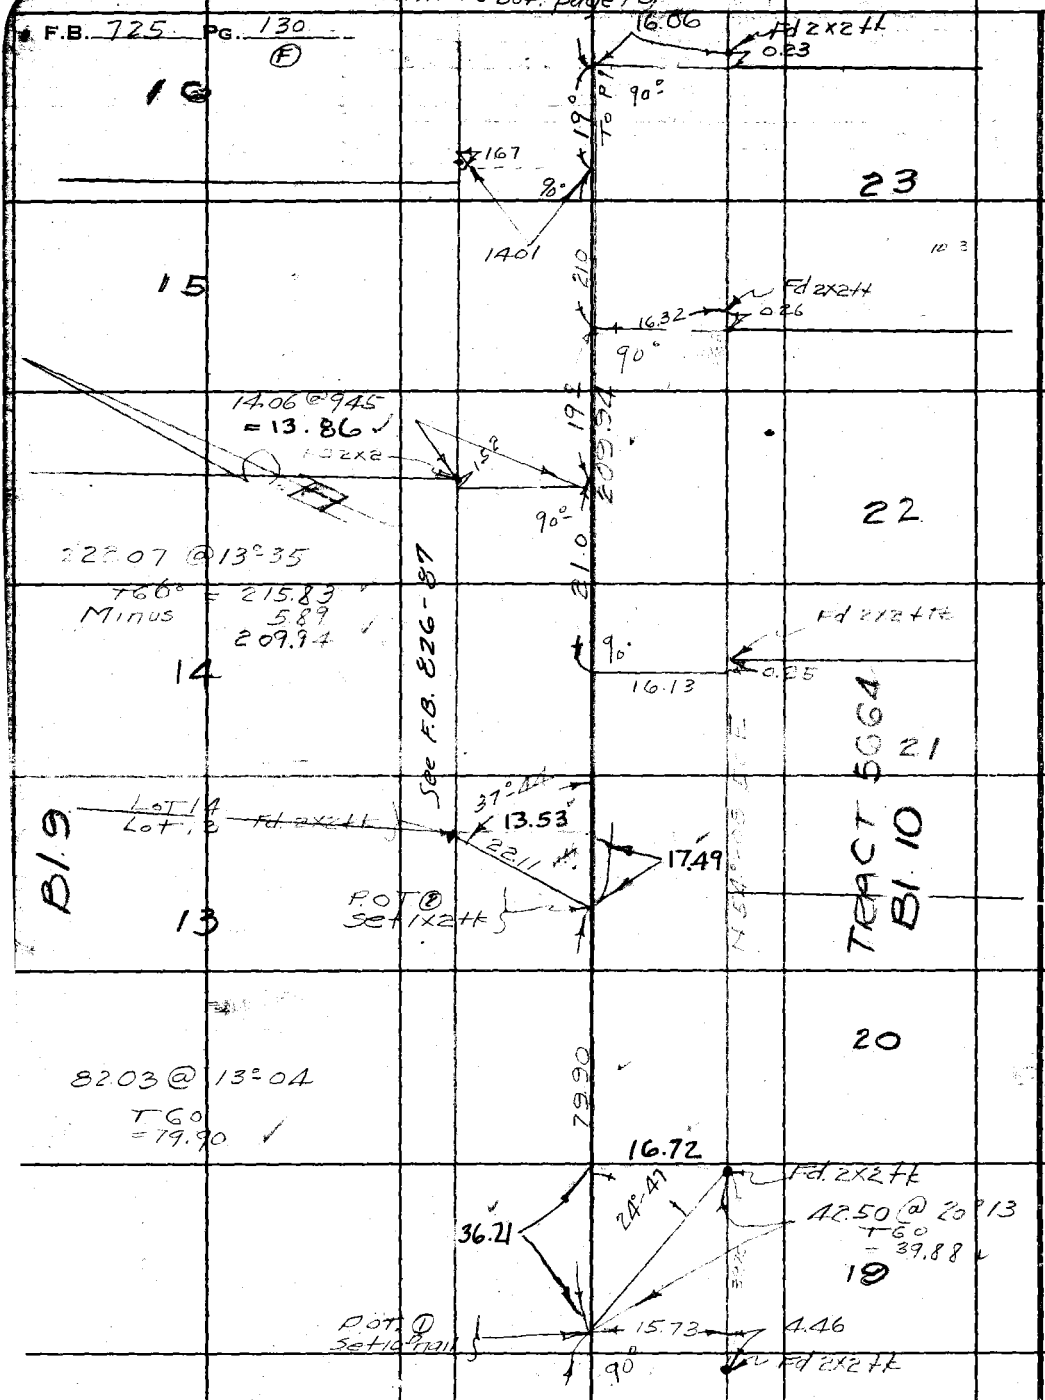

Cont. from top page (E) 129

RETURN TO
LOS ANGELES COUNTY SURVEYOR
700 HALL OF RECORDS

Note: Any Additions or Changes on This Sheets Must be Made or Circled in Red Ink With Date and Name of Person Making Change.

Do not extend notes this side of this line

W.S. 59-D-3

Notes Ck'd by A. A. R.
Map No. 13-163-2
Office Work White
Checked AAR
Date 1941

Survey of Horseshoe Dr
W. O. 5058 Tape No. 69 St'd 24 of
Surveyed by Stevenson
Notes T.J.S Date 10-26-39
Indexed

F.B. 725 Pg. 131

Note: Any Additions or Changes on This Sheets Must be Made or Circled in Red Ink With Date and Name of Person Making Change

Do not extend notes this side of this line

RETURN TO
LOS ANGELES COUNTY SURVEYOR
700 HALL OF RECORDS

FORM 247 SM 10-37

Cont to bot. page (A) 13c

24

19

18

17

16

TRACT 5664
Bl. 9

TRACT 5664
Bl. 10

BLOCK 10

25

Fd 2x2 tk

Fd 5/8 IR tk

Fd 2x2 tk

Fd 2x2 tk

Fd 2x2

F.B. 725 PG. 132 (H)

127-01-40 (1) (4)
148 07 30

55° 22' 50 (1) (4)
227° 31' 30

Cont. to pg 133

55° 22' 50

FERNWOOD

T.P.P.

14 55-25

13.66

1x2+k Set 1x2+k By int

34.50

20.82

To Pl. 140 3/4 IP 12" Down Ref FB 695 Pg 222

Pl 141 Fd 3/4 IP Ref FB. 695 Pg 222

1x2+k

DRIVE

127-01-50

PACIFIC

127.94

S69°39E

Pl 142 Fd 1x2+k Set 3/4 IP

Fd remains of old 2x2 Set Nail & 3/4 IP Diff. Dist.

P.P.Pl Set Nail 3/4" I.P. pg 144

SUNSET From TRAIL Pl.

Cont from top page 131

W5 54-D-3

RETURN TO
LOS ANGELES COUNTY SURVEYOR
700 HALL OF RECORDS

Note: Any Additions or Changes on This Sheets Must be Made or Circled in Red Ink With Date and Name of Person Making Change.

Do not extend notes this side of this line

W5 129-207 B-1

WS 59-P-3

Notes Ck'd by A. A.	Survey of Fernwood Sts
Map No. B-1631-2	W. O. 0209 Tape No. Std °F
Office Work White	Surveyed by Stevenson
Checked A.A.R	Notes T.J.S Date 12-28,39
Date 1941	Indexed

F.B. 725 Pg. 132

Note: Any Additions or Changes on This Sheet Must be Made or Circled in Red Ink With Date and Name of Person Making Change.

RETURN TO
LOS ANGELES COUNTY SURVEYOR
700 HALL OF RECORDS

WS 129-097 A-1 Do not extend notes this side of this line.

FERNWOOD STS

169°53'20" ①
319°33'20" ④
79-53-20

169°53'20"

Fd 1x2 tk
P. 127

HORSESHOE DR.

99°59'50"

① 99°29'30"
④ 53°52'40"
88°29'30"

INT. Set 1x2 tk
Fd 1x2 tk P. 127

20

INT.
Fd. 1x2 tk
P. 127

80°19'10"

80°19'10"
321°16'40"

Boat Spk
in Sandstone
P. 129

SUNSET TRAIL 162°47'10"

168°47'10"
290°40'40"
168°40'10"

Con't next page

FORM 247 5M 10-39

RETURN TO
LOS ANGELES COUNTY SURVEYOR
700 HALL OF RECORDS

Note: Any Additions or Changes on This Sheet Must be Made or Circled in **Red Ink** With Date and Name of Person Making Change.

Do not extend notes this side of this line.

WS. 59-D-3

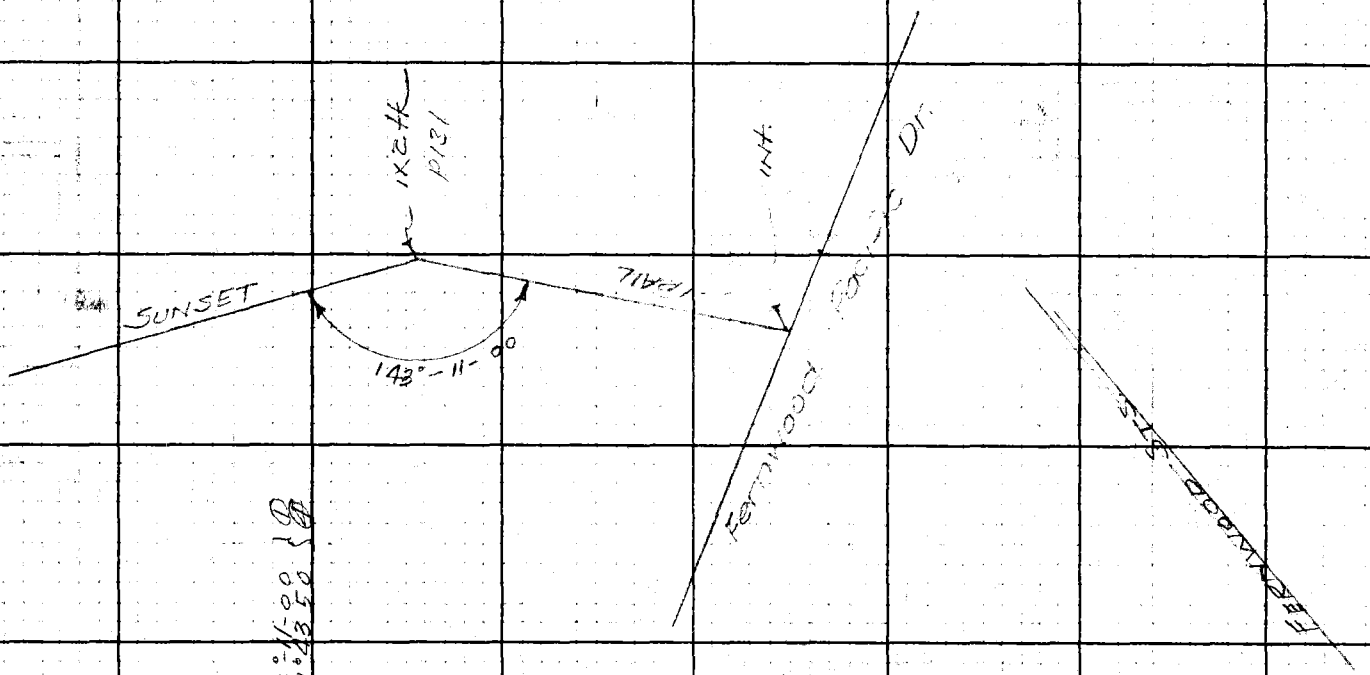

143°-11-00 E
E12.43.50

F.B. 725 Pg. 132 &

FORM 247 5M 10-37

RETURN TO
LOS ANGELES COUNTY SURVEYOR
700 HALL OF RECORDS

Note: Any Additions or Changes on This Sheets Must be Made or Circled in **Red Ink** With Date and Name of Person Making Change.

WS 129-097 B-1

Do not extend notes this side of this line

Notes Ck'd by A.A.R.
Map No. B-16.8/-2
Office Work Atlantic
Checked A.A.R.
Date 1941

Survey of Forrestbee Dr
W. O. Tape No. St'd
Surveyed by Stevenson
Notes T.L.S. Date
Indexed

F.B. 734 PG. 133

{ EPP 1.143
FB 662 pg 18
Pd. 2X2+tk
Set 3/4 IP pg+tk

P.I. 143
Set 3/4 IP

37

To POST
page 166
Right side

Forrestbee Dr

Pt. from left side page 132

PACIFIC

1359

20

14°

44'

To P.I. 142

OLIVE

{ 141° 44 40
206 58 40

132°	53	55	
224°	39	05	
233°	11	15	
122°	26	45	
116°	54	20	
100°	30	00	
201°	06	25	
116°	08	55	
248°	44	40	
264°	25	50	
181°	47	30	
120°			
180°	19	20	
197°	20	40	
143°	11	10	
155°	22	50	
205°	04	35	
127	01	40	
2880	41	00	

RETURN TO
LOS ANGELES COUNTY SURVEYOR
700 HALL OF RECORDS

Note: Any Additions or Changes on This Sheets Must be Made or Circled in **Red Ink** With Date and Name of Person Making Change.

Do not extend notes this side of this line

WS 59-D-3

WS 129-097 A1

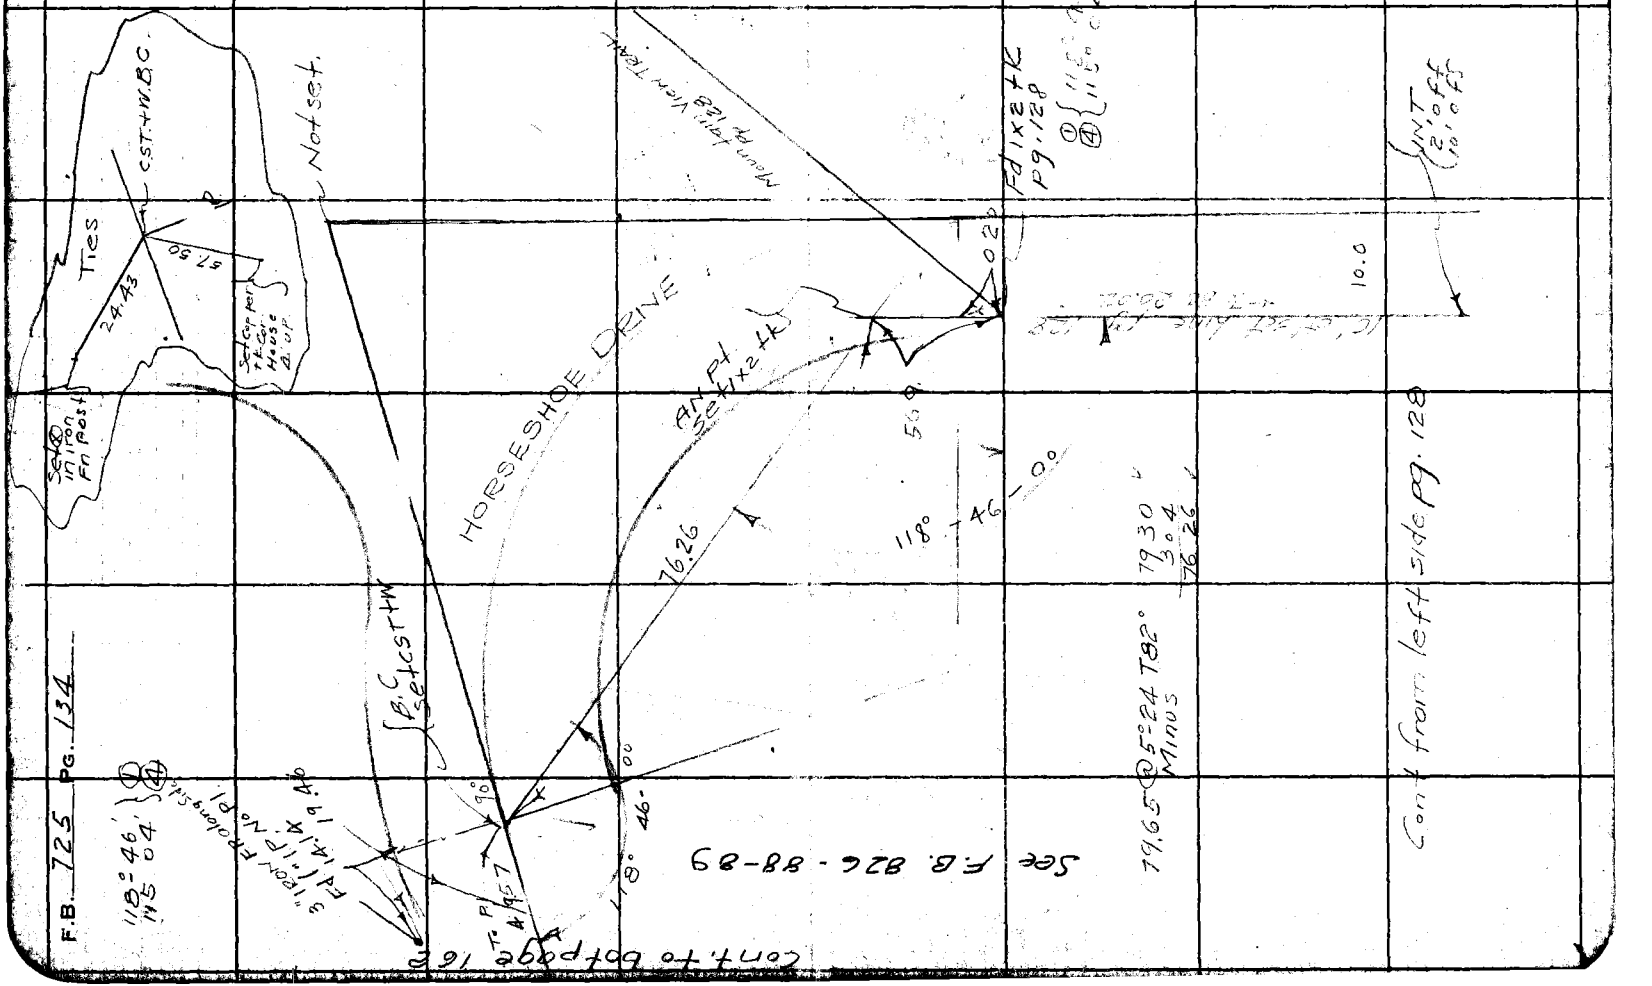

Notes Ck'd by A. A. R.	Survey of Rowland Sts
Map No. B-163 1-2	W. 0.2809 Tape No. 69 St'd 84 of F
Office Work White	Surveyed by Stevenson
Checked A A R	Notes T. J. S Date 10-8-39
Date 1941	Indexed

F.B. 725 Pg. 135

Cont. to bot. page 136

3 S 19-D-3

Note: Any Additions or Changes on This Sheets Must be Made or Circled in Red Ink With Date and Name of Person Making Change

Do not extend notes this side of this line

RETURN TO
LOS ANGELES COUNTY SURVEYOR
700 HALL OF RECORDS

W 3 129-027 4-1

FORM 247 5M 10-37

BLOCK 24

LOT 9

LOT 32

S89°57'40"E 2135.96 Tract Line

196.39

219.46 @ 10°15 T 90°
= 215.96

SEE F.B. 826 P. 89

POT 3 set 1x24k

HORSESHOE DR

140.69 @ 17°06 T 90
= 134.47

No 1P

For intersection see page 162

90°14'50"

1+54.90 POT @ set 1x24k

1+35.0 POT ① set 1x24k

① 90°14'50"
④ 360°59'40"

7458 @ 14°20 T 90
72.26

TR 5664 BL 26

LOT 6

LOT 1

TR 8859 BL 2

R.17.W.

S.18

R No 7 and 1x24k F.B. 524 P. 114

P No 5 F.B. 524 P. 114 13.61

0.53

This line Con'ts on bot. page 147

INT. set x in boulder

Random Sec line

R.18.W.

See p. 147

S.13

T. 1. S.

RETURN TO
LOS ANGELES COUNTY SURVEYOR
700 HALL OF RECORDS

Note: Any Additions or Changes on This Sheets Must be Made or Circled in **Red Ink** With Date and Name of Person Making Change.

Do not extend notes this side of this line

WS 59-D-3

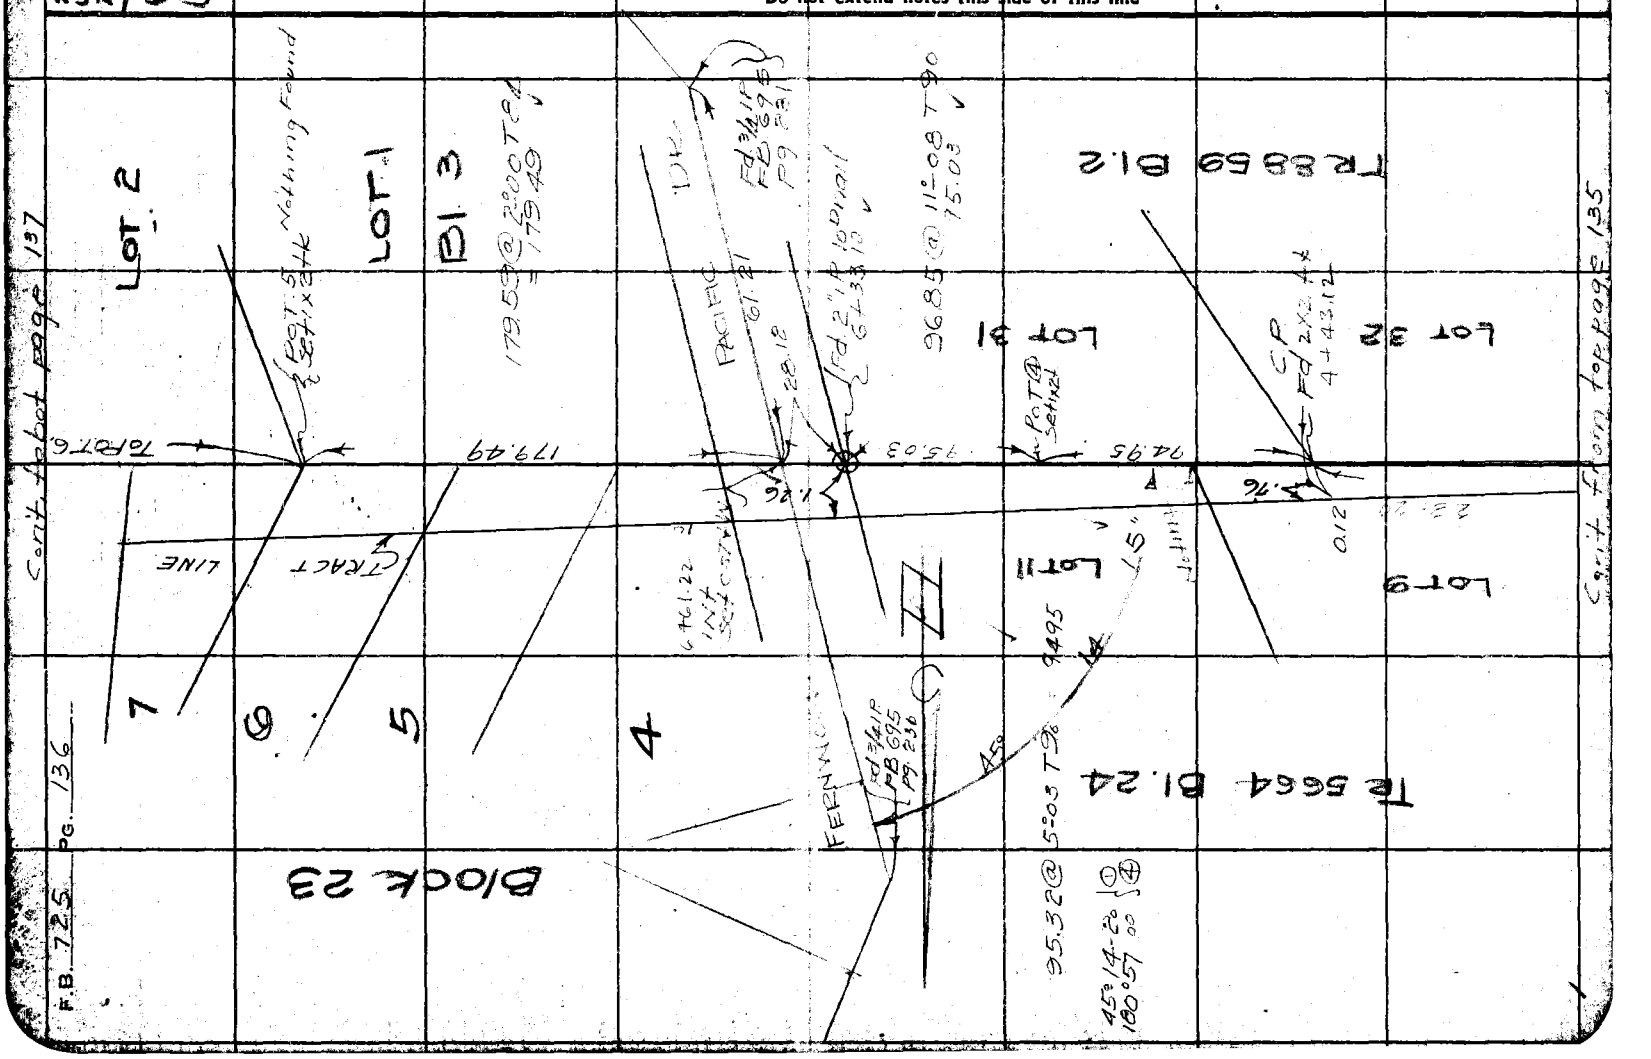
LOT 2
LOT 1
BL 3
TR 8859 BL 2
LOT 31
LOT 32
LOT 9
LOT 11
BLOCK 23
TR 5664 BL 24
TRACT LINE
TORTG.
E.O.T. 3.5' ± Nothing Found
179.49
179.59 @ 2°20 T=4
L=349
PACIFIC
FD 3/4" IP PB 69 PG 81
FD 2" IP NO DRIVIT
96.85 @ 11°08 T=90
L=15.03
15.03
94.95
FD 3/4" IP NO TAG
SET NAIL
CP FD 2" X 2" 4"
4+43.12
28.18
6761.22
N 1°26' E
N 1°26' E
FERNANDO
FD 3/4" IP PB 695 PG 236
45°
95.32 @ 5°03 T=
9495
45°14-26
180°57'00"
S 1°26' E
S 1°26' E
S 1°26' E

Notes Ck'd by	Survey of Edmund St
Map No. B-1631-1-2	W. O. 8209 Tape No. 69 St'd 99 OF
Office Work White	Surveyed by Stevenson
Checked AAR	Notes T.J.S Date 10-31-39
Date 1941	Indexed

F.B. 725 PG. 137

Cont. to bet page 129

W.S. 59-D-4

194.22 @ 18°58 T84 = 183.68

120.93 @ 7°53 T84 = 119.79

129.20 @ 7°24 T84 = 127.44

.40

PART

TRAIL

Bl. 4

TR 8859

Bl. 22

1

45

69° 02

1 1836.3

109°

For Closer to Grandview see p9

1 190

① ℄ 109°-49'-40

④ ℄ 73° 18' 50

① ℄ 69° 02' 40

④ ℄ 276° 11-00

RD

2½x2½

49

45

old ½

126

133

119.79

127.44

30.50

32.94

ALPINE

TRAIL

P1 3/4 IP FB 725 Pg 57

13

72.14

0A3 11+06.60 1d 2x2 Tk LRE 4.88

80.37 @ 22°-27 T86 = 74.28

Minus 2.14

72.14

12

11+77.05 Fd 2x2 Tk

POT. 7 Set 1x2 Tk

2.83

27.67

131

69.76 @ 15°-35 T90 67.14

72.77 @ 15°-49 T90 70.01

11

67.14

70.01

27.67

3

10+09.92 POT. 6 Set 1x2 Tk

10+00.58 Fd. 2x2 Tk

1.76

9.34

0.2

169.53 @ 3°-33 T8 = 169.21

10

9

169.21

2

Bl.

8

Cont. from top page 136

RETURN TO
LOS ANGELES COUNTY SURVEYOR
700 HALL OF RECORDS

W.S. 129-097 B-1

TR 5664 Bl. 23

Note: Any Additions or Changes on This Sheets Must be Made or Circled in Red Ink With Date and Name of Person Making Change

Do not extend notes this side of this line

FORM 247 5M 10-37

Cont to bot page 139

F.B. 725 Pg. 138

17+40.38
Fd. ½" IP

759

17+47.97
POT 10
Set 1x24

0.75

2.71

E P
Set 1x24

ALLEY

Tract Line

Lot 5
TR 5654 B1-19

Lot 21
TR 8859 B1.6

Set 9

Cont. from top page 137

RETURN TO
LOS ANGELES COUNTY SURVEYOR
700 HALL OF RECORDS

Note: Any Additions or Changes on This Sheets Must be Made or Circled in Red Ink With Date and Name of Person Making Change.

Do not extend notes this side of this line

Notes Ck'd by		Survey of	
Map No.	B-1631-1-2	W. O.	Tape No.	St'd	of
Office Work	White	Surveyed by	Stevenson
Checked	AAR	Notes	T.J.S	Date	11-2-39
Date	1941	Indexed	

F.B. 755 PG. 139

Cont'd to b.t. page 140

Note: Any Additions or Changes on This Sheets Must be Made or Circled in Red Ink With Date and Name of Person Making Change

Do not extend notes this side of this line

RETURN TO
LOS ANGELES COUNTY SURVEYOR
700 HALL OF RECORDS

SEE F.B. 826-112

CLAIMS

55.30 @ 23°37' = 50.67

POT 12
Set 1x2 tk

VIEW DRIVE

Rd ties mon page 143

Lot 1
TR 566
B1-19

Tract Line

50.67

① 141° 49.30
② 207° 18 30
③ 54° 36 30

POT 11
Set 1x2 tk

131.43 S 31° 36' E
= 129.58
TANUS 11.80
118.38

Cont from top page 138

FORM 247 5M 10-37

RETURN TO
LOS ANGELES COUNTY SURVEYOR
700 HALL OF RECORDS

Note: Any Additions or Changes on This Sheets Must be Made or Circled in **Red Ink** With Date and Name of Person Making Change.

Do not extend notes this side of this line

WS 58-A-2

WS 129-097 B-1

F.B. 725 PG. 140

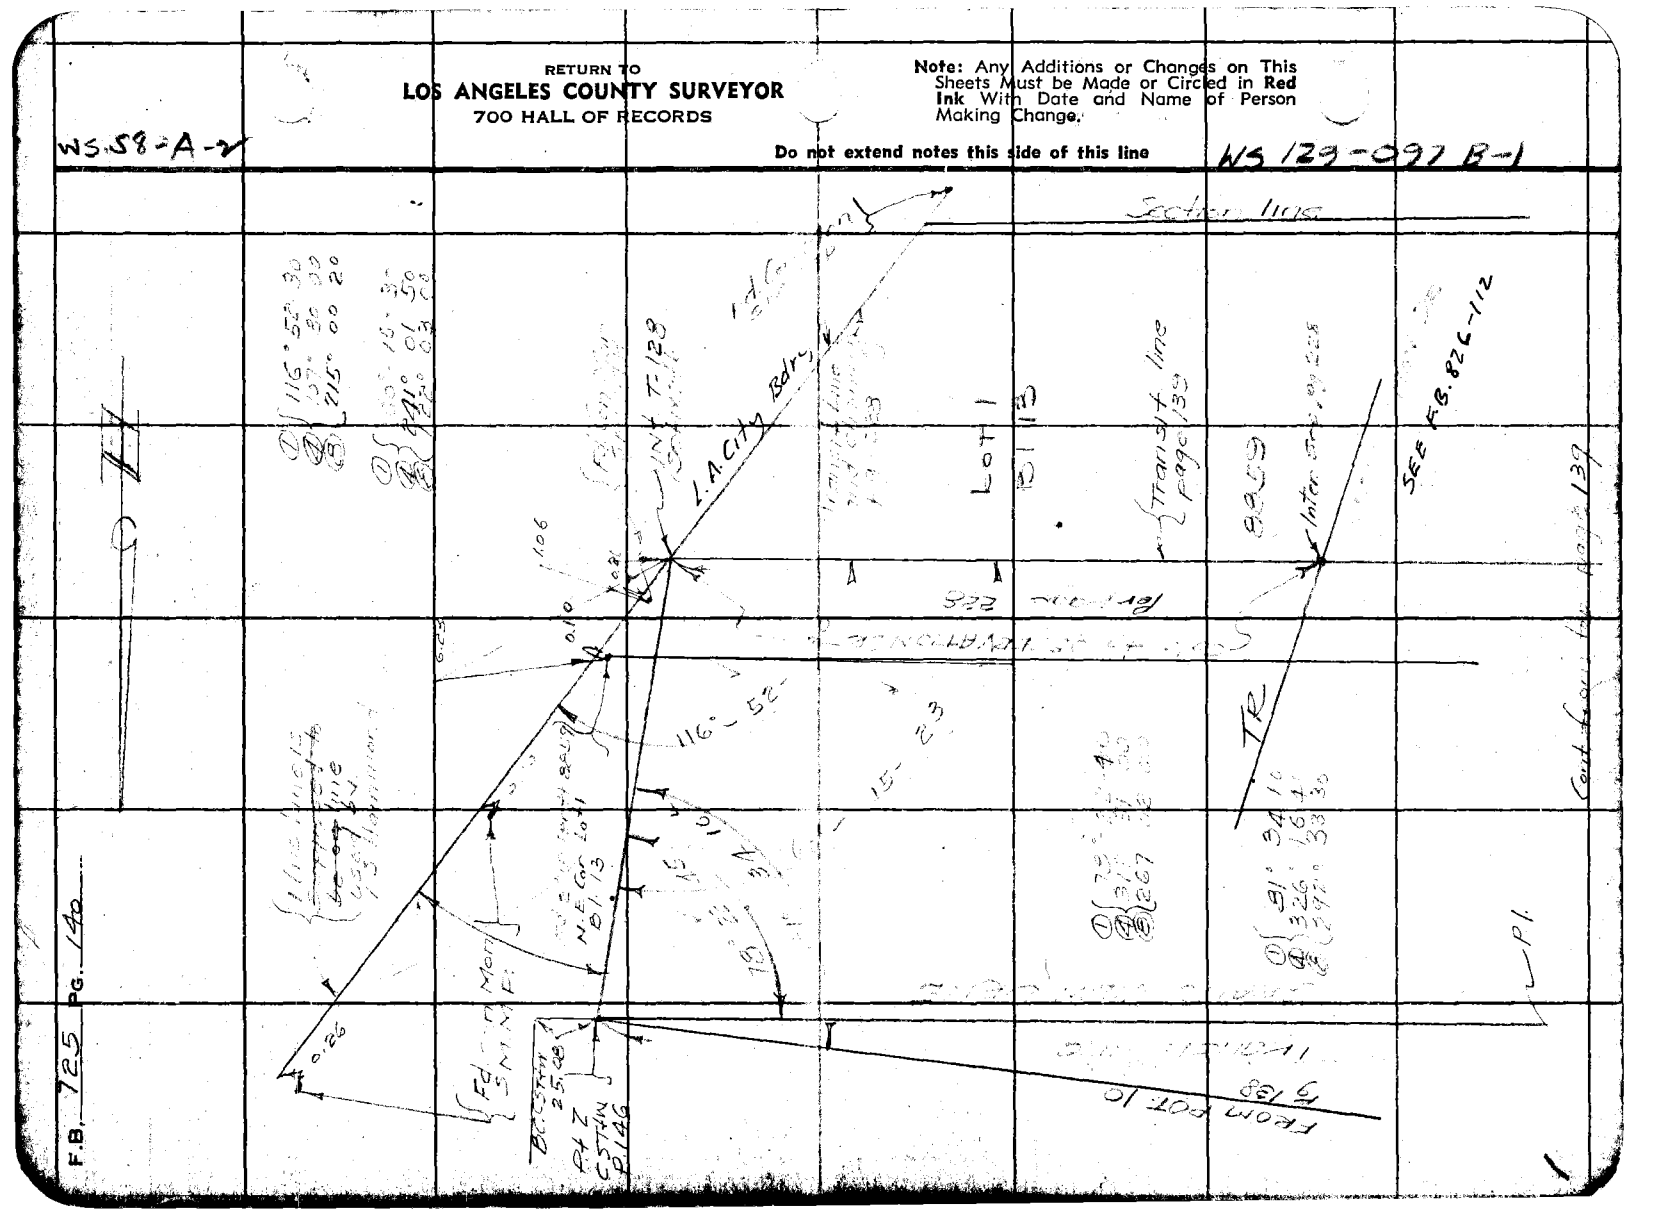

Notes Ck'd by [illegible]
Map No. B-1631-1
Office Work White
Checked AAR
Date 1941

Survey of Fernwood Sts
W. O. 8209 Tape No. 69 St'd 84 of
Surveyed by Stevenson
Notes T. J. S Date 11-1-39
Indexed

F.B. 725 Pg. 141

WS 129-093

Note: Any Additions or Changes on This Sheets Must be Made or Circled in Red Ink With Date and Name of Person Making Change

Do not extend notes this side of this line

RETURN TO
LOS ANGELES COUNTY SURVEYOR
700 HALL OF RECORDS

WS 129-092 B-1

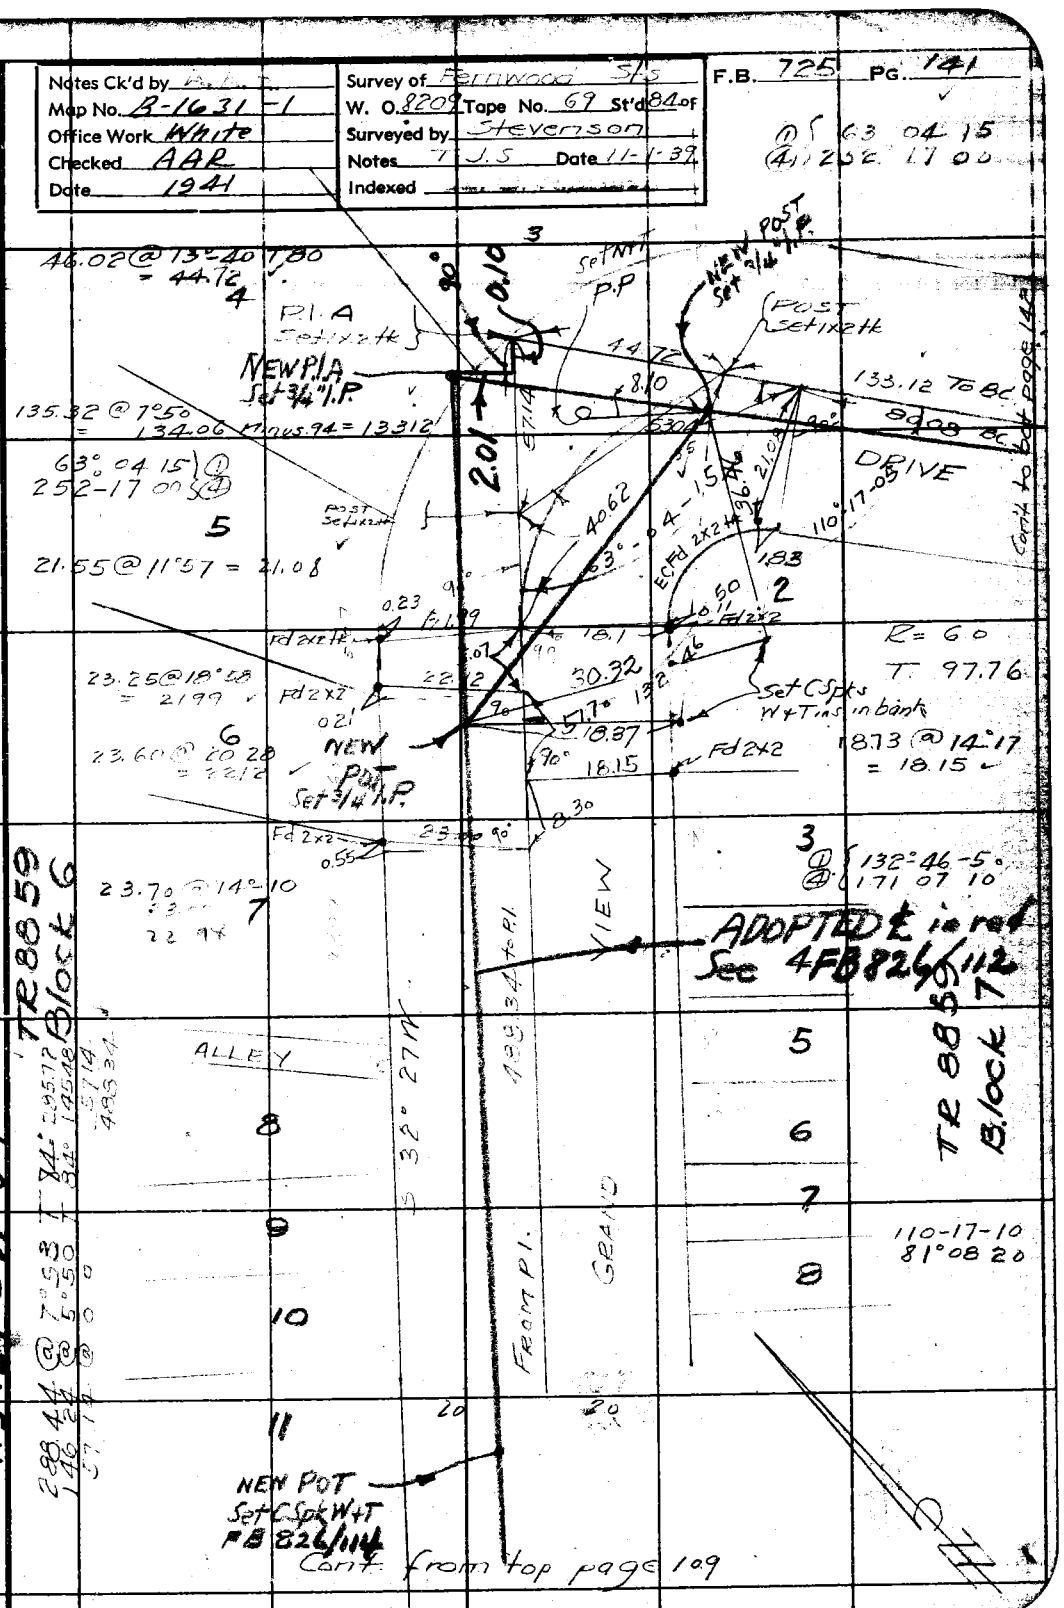

FORM 247 5M 10-37

F.B. 725 PG. 142

Cont to bot page 143

158°-14-00 ①
272 56 00 ④

P.R.C

2

R-1485?
T 28.55

NEW "
P.I." C
Set 3/4" P.

Fd 2x2 Tk

066

23.18 @ 15°25 22.35

76.57 @ 10°-03 T66 - 75.39
Minus 4.64
70.75

67°41-20 ①
270°45-10 ④

ADOPTED E
Sec FB 826/112
TR 8859

B16

R.P
Set 3/4 IP

R 41.79 NEW EC-3/4" I.P.

T = 101.82

Set 3/4" I.P.

10" Gum

Set NAT

Fd 2x2 Tk

Set 3/4" I.P.

Cont from page 141

Cont from page 141

Fd 2x2 Tk

Curve (B)

POST Set 3/4" I.P.

P.I. Set NAIL & Tk

NEW B.C 3/4" I.P.

100.1 @ 10°-01 = 99.74 - 7887 = 77.32

21.93 @ 16°-39 T80 = 21.01

22.76 @ 14° 28 = 22.04

for int. see page 213

ARNOTT TRAIL

B19

EC Set CST+TW

18

① 112°-18-10
④ 69-17-10

Tgt P.I.

89.52

1.64

17

P.I. C
Set CST+TW

20.55

14.00

20.35

9°

20.17

Set

Fd CST+TW

Set

50.44

50.65 D 20°

1.44

20.0

1.52

1.87

0.79

25.56

0.94

1.96

3.02 Set NAT Pf

N 52°-32-30 E

W5.59-D-13

W5/29-D97 13-1

RETURN TO
LOS ANGELES COUNTY SURVEYOR
700 HALL OF RECORDS

Note: Any Additions or Changes on This Sheets Must be Made or Circled in Red Ink With Date and Name of Person Making Change.

Do not extend notes this side of this line

Notes Ck'd by	Survey of Fellows 1 St.
Map No. B-1631-1-2	W. O. 8202 Tape No. St'd OF
Office Work White	Surveyed by Stevenson
Checked AAR	Notes T. J. S. Date
Date 1941	Indexed

F.B. 729 PG. 143

Note: Any Additions or Changes on This Sheets Must be Made or Circled in Red Ink With Date and Name of Person Making Change.

Do not extend notes this side of this line

RETURN TO
LOS ANGELES COUNTY SURVEYOR
720 HALL OF RECORDS

FORM 247 BM 10-37

Lot 2
Lot 1
Fd 2x2 tk
37.21 @ 15° 35
TR 5664
148
5.84
90°
35.56
10' off line
GRAND VIEW DRIVE
Notation of Connection
POT 1" 1x2 tk
Transit line page 139
193.88 @ 3° 25 @ 66°
19165
plus 5061
241.92
2
241.91
10 ft off line
N16° 59 E
INT set c ST+W
Direction of line
- 28 55
TR 8859
POT 1" 1x2 tk
Set X Cut in rock
20
8.52
1869
12.08
NYT
30.67
34.90
65.47
NEW P.I. "D" Set 1" I.P.
22.44
TR 8859
P.I. P set nail
155° 15 00
261° 00 00
22.10
PRC
R 50
T 10.97
Set 1" I.P.
Set L+T POT 10 Rock
20
Cont. from top page 142

F.B. 725 PG. 144

Cont. to bot. page 145

WS 59-D-3

RETURN TO
LOS ANGELES COUNTY SURVEYOR
700 HALL OF RECORDS

Note: Any Additions or Changes on This Sheets Must be Made or Circled in Red Ink With Date and Name of Person Making Change.

Do not extend notes this side of this line

WS 129-D-7 B-1

TR 9550

N 58 31 30 E

GRAND VIEW

247.72 TO PI

244.75 @ [illegible] TO

247.72

ADOPTED ℄
See F.B. 824/108

10

Fd 2x2 tie

TR-5664

138° 27 30
193 50

11

R=50
T=

Tie line FB. 826

17.46

13.71

14.61

23.70

Set 3/4 IP on Edge set

Not set 11.59

17.34

Set Lead spike in Sandstone boulder

P.I. "E"
Set 3/4" I.P.
TIES HEREON

10.69

Lot 4

36 12 @ 4-57 TO

Fd 2x2 ft

3

39.98

35.7

10' off line

Cont. from for page 143

W.S. 59-D-3

Notes Ck'd by A.A.R.	Survey of
Map No. B-1631-2	W. O. Tape No. 19 St'd 14 OF
Office Work White	Surveyed by Stevenson
Checked AAR	Notes T.J.S. Date 11-2-37
Date 1941	Indexed

F.B. 725 Pg. 145

Cont'd in next page 146

Note: Any Additions or Changes on This Sheets Must be Made or Circled in Red Ink With Date and Name of Person Making Change

Do not extend notes this side of this line

RETURN TO
LOS ANGELES COUNTY SURVEYOR
7DO HALL OF RECORDS

TR 5664

TR 8959 81/10

ADOPTED
E S.F.B.
See pg. 110
FB 826

Fd old 2x2 flush

5413

20.13

20.67

20.7 P.C.

Fd 2x2 + tk L.S. 1127 flush

N 42° 06 E

GRAND VIEW

Pl. 34.33 To S.C.

279.55 @ 5°06 T/O

= 278.33

plus 1.99

346.36

6.24

19.62

Fd 1/2" I.P.

26.69

1.22

30.0

Solder

20.47

Fd 3/4" I.P. plug + tk

170 34 30

322 18 00

2.33

9.22

21.25

21.57

Set X on Foundation 1.0 to house

43.79

44.64

170°

Set Nail & P.P.

32.58

37.06

047

P.I.F. Set C.S.T. & W.

NEW P.I. "F" Set 3/4" I.P. TIES HEREON.

FROM C.S.T. & W.

Cont. from top page 144

FORM 247 5M 10-37

RETURN TO
LOS ANGELES COUNTY SURVEYOR
700 HALL OF RECORDS

Note: Any Additions or Changes on This Sheets Must be Made or Circled in **Red Ink** With Date and Name of Person Making Change.

Do not extend notes this side of this line

WS.59-D-3

WS 129-027 B-1

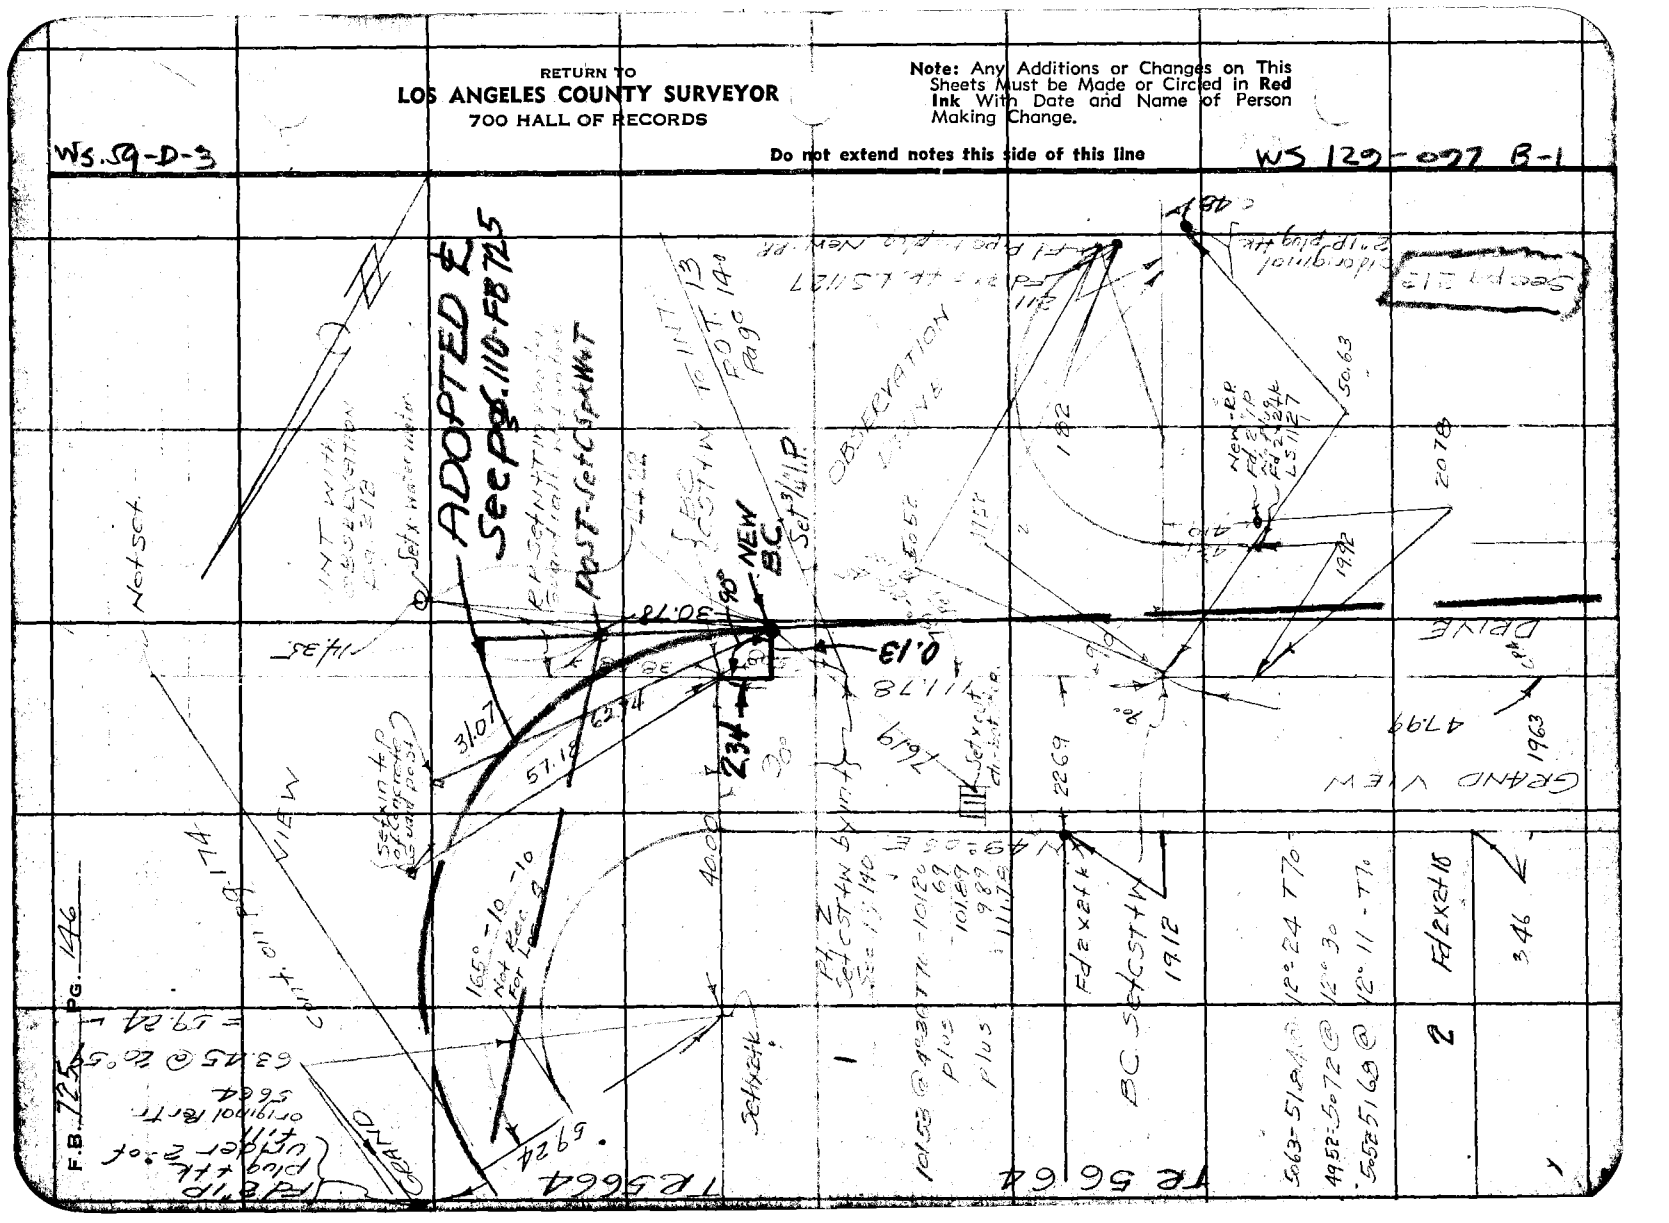
ADOPTED
Sec Pg 110 FB 725
POST-Set C&GPoint
NEW BC
Set 3/4" I.P.
Set x mark in wall
INT with base line
Set Point in Concrete

Notes Ck'd by		Survey of Fairway Sts	F.B. 725 Pg. 147
Map No. B-163-1		W. O. 8209 Tape No. 69 St'd 34 of F	
Office Work White		Surveyed by Stevenson	
Checked AAR		Notes T.L.S Date 11-9-39	
Date 1941		Indexed	

W.S. 58-A-3

Cont to bot page 148

This line run and intermediate FB 525 pg 23

To 2x2

5378 CP

Fd 2" IP Plug Tk

LOT 2

56.16 @ 16°-02

= 53.81

516.81

Fd 2x2 Tk

0.31

427

10.19

10.27

292

R=22 set 1x2 Tk

L 12.54

165.75 @ 0°-38 T62

= 163.39

16339

279.15

R=21 set 1x2 Tk

North Line Tr. 953

Tr 8859 Bl 5 Lot 1

Transit Line

Tr 9531 Bl 3 Lot 1

237.81 @ 1° 05

273.1 @ 34°-29

277.73

22.52

320.25

90°-18-00 ①

361°-11-40 ④

60.39 @ 12°-43 T62 = 58.90

SURVEYOR M 912 COUNTY MONUMENT 13 18 24 T1S

39°-17-55

of 58.9 c

R 20 set 1x2 Tk

5890

306

Fd 1½" IP set in Concrete

Fd 1½" IP set in Concrete

2.91

Transit line correct - FB 524 pg 112 to 114

From 10D nail Tr. Cor. Rec Dist FB 524 - 1322.33

Continuation of Line bot. page 135

RETURN TO
LOS ANGELES COUNTY SURVEYOR
700 HALL OF RECORDS

Do not extend notes this side of this line

Note: Any Additions or Changes on This Sheets Must be Made or Circled in Red Ink With Date and Name of Person Making Change

W.S. 129-097 A-1

FORM 247 SM 10-37

RETURN TO
LOS ANGELES COUNTY SURVEYOR
700 HALL OF RECORDS

Note: Any Additions or Changes on This Sheets Must be Made or Circled in **Red Ink** With Date and Name of Person Making Change.

Do not extend notes this side of this line

WS 58-A-3

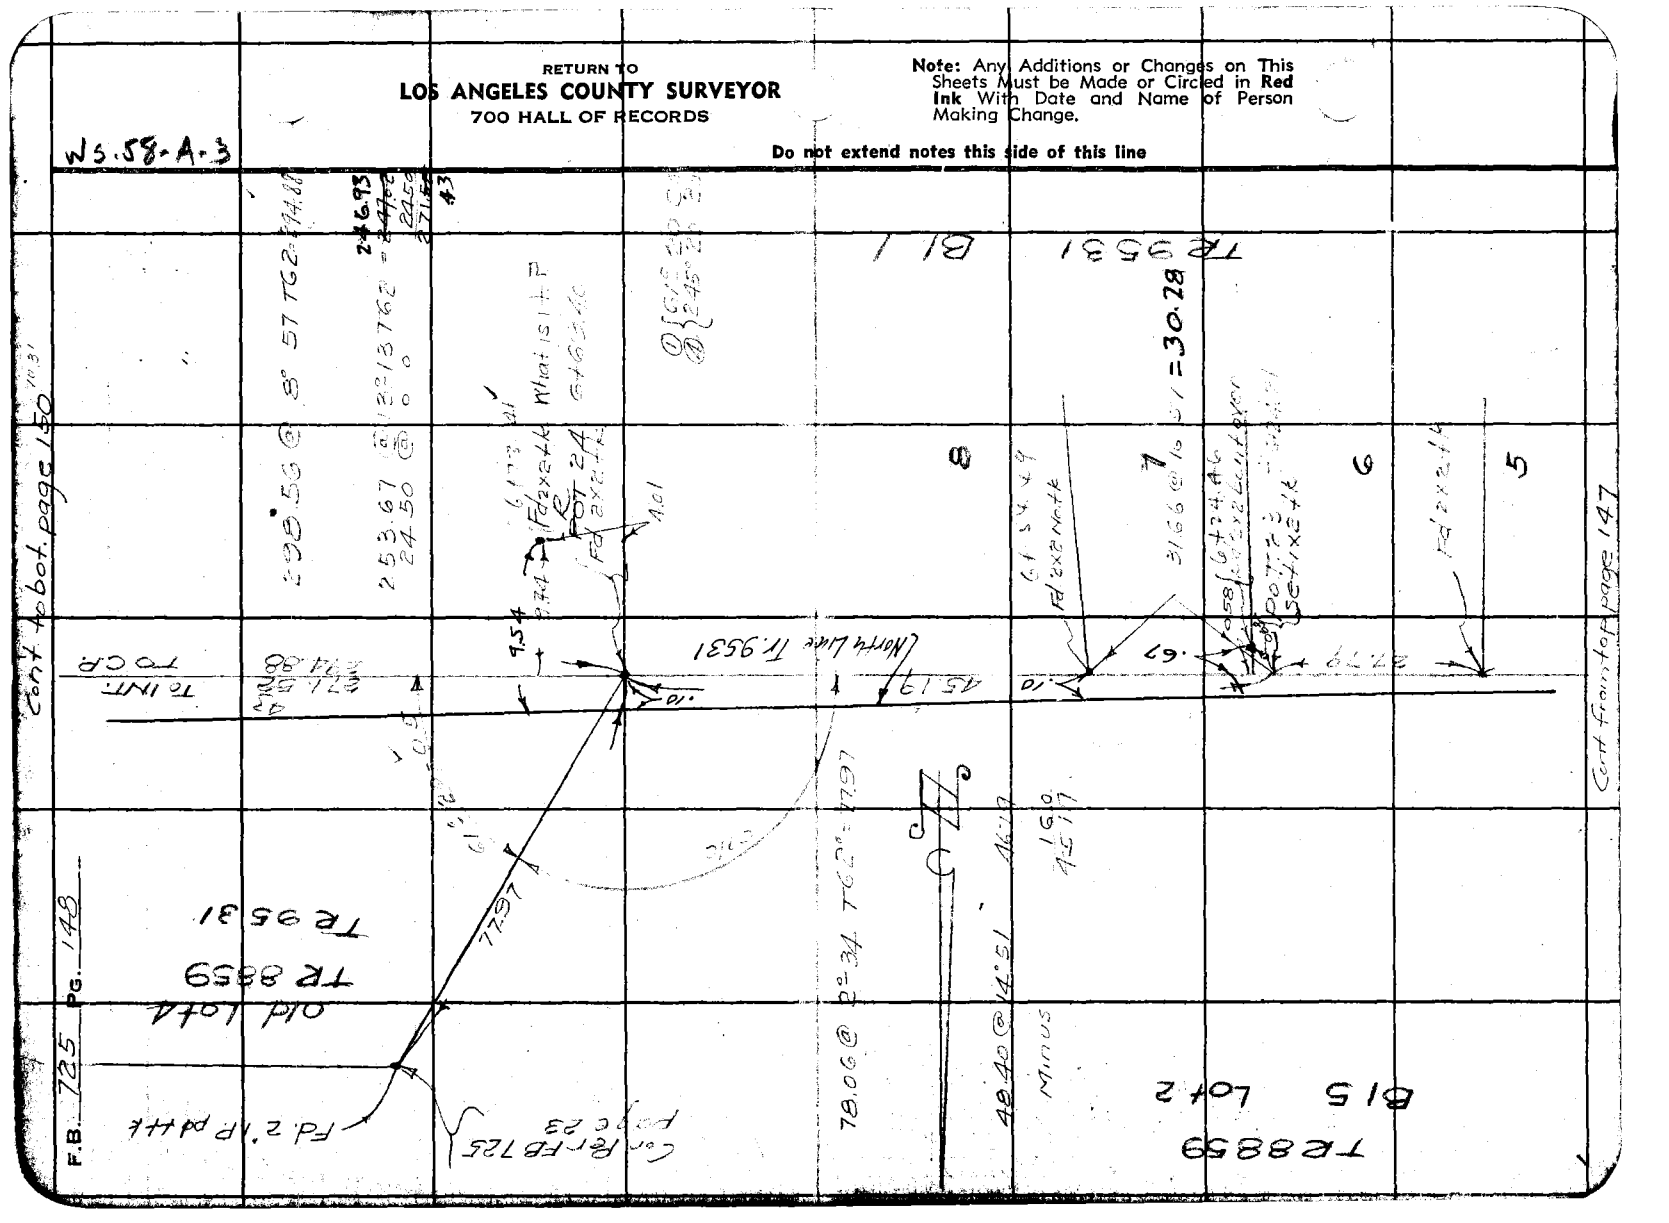

W 5.58-A-3

Notes Ck'd by A. A. R.	Survey of FERNWOOD ST'S	F.B. 165	Pg. 149
Map No. B-1631-1	W. O. 8209 Tape No. 62 St'd 84 °F		
Office Work White	Surveyed by STEVENSON		
Checked A A R	Notes T. & S. Date 11-9-38		
Date 1941	Indexed		

Cont to Lot 1 page 158

Set 1½ 2 1k
1.0
15.33
Fd 2x2 t
13+50 789.23
R
1 37 60.4
Set 1x2 1k
25 27
25 26

11+61.47
59
26.23
20536 @ 1°09
57 24 @ 00 T62 = 51.23
262.33
20510 Fd 2x2
0.76
57.15

139.50
13983 @ 3°49 T62 - ~~1389~~
61.07 @ 10°03 = 60.13
49.68 @ 12°14 = 48.96
33.47 @ 11°16 = 32.82
3282
Offset Sy. at
10+ 55.22
Fd 2x2 1k
60
R No 26 11+03.78
Set 1x2 1k
48.55

INT. to
LECHO DR FB 826

RP PIA
Fd 3/4 IP
pg 24

10+ 2.65
Fd 2" IP pl 17k
0.22
North Line
Tract 9531

CP 7+69.28

7404

9+40.83
Int. R 25
Set C5T+W

45° 40-10 ①
182° 40-40 ④

Lot 12
TR 9531

CROYDON
LANE

45° 40'

RP PIA
Fd 3/4 IP
page 24

Cont from top page

Lot 1
TR 9531
Bl. 3

RETURN TO
LOS ANGELES COUNTY SURVEYOR
700 HALL OF RECORDS

Note: Any Additions or Changes on This Sheets Must be Made or Circled in Red Ink With Date and Name of Person Making Change.

Do not extend notes this side of this line

FORM 247 5M 10-37

F.B. 725 PG. 150

Cont to bot page 151

RETURN TO
LOS ANGELES COUNTY SURVEYOR
700 HALL OF RECORDS

Note: Any Additions or Changes on This Sheets Must be Made or Circled in Red Ink With Date and Name of Person Making Change.

Do not extend notes this side of this line

TR 8959 81/17

TR 8959 81/3

To 1873

1-29889

POT 29
1x2 ft

21.94 @ 4°32 = 21.77

Fd 1/2" IP 2' UP

L.S. 1527

17+71.12

17+11.07
CP

1155

0.52 16+70.93
Fd 2x2 ft

9.00
Fd 2½ Inch ft

0.79

16+61.13

104.46
14°29

135

14627 @ 14°58 T66° = 4129

R=37.1' off

7

6

5

24.95

15+23.24
Fd 2x2 No ft

0.12

206.00 @ 8°35 T66 = 203.61'
119.73 @ 6°33'64

14+50.90
Fd 1" IP

4.18

Tract 25117
Sht 2 of 3
For Adopted

Lot 4

1.0 1248.61
POT 27
1x2 ft
original from stake

1° off

See Sht 3 for Page 149

W S 58-A-11
W S 59-D-11

Notes Ck'd by		Survey of	
Map No.	B-1631-1	W. O.	8209
Office Work	White	Tape No.	69
Checked	AAR	Surveyed by	Stevenson
Date	1941	Notes	
		Date	11-10-37
		Indexed	

F.B. 725 PG. 151

Note: Any Additions or Changes on This Sheets Must be Made or Circled in Red Ink With Date and Name of Person Making Change

Do not extend notes this side of this line

RETURN TO
LOS ANGELES COUNTY SURVEYOR
700 HALL OF RECORDS

WS 129-B7 B-1

Cont. to Lot page 152

257.76 @ 11°07 TBO = 252.93

171.95 @ 18°-06 TBO = 166.29

162.97 @ 21°02 TBO = 152.11

141.35 @ 28°52 TBO = 123.79

TR 8859

66.81 @ 42°39 TBO = 60.28

189.40 @ 12° 55

30.16
30
124.54
219.69
.46

186°35-40 ①
146° ④

Fd 2"x2"x6"tk
20+50.4 L

0.98
Fd 2x2 Nail
20+50.4 L

0.56
Fd 2x2 tk
20+22 10°

0.74
Fd 2" IP pl
+tk
19+72.4 L

TRACT 9531
For Adopted Tract Line
See B. 231

93.13 @ 30°40
TBO = 80.11

18+98.31
POT 21 1 of R
5"+ 1x2 tk

Fd 2"x2"x6"tk pl + tk

126°

18+5.12
POT 20

Lexington Transit
N 118

INT Safford Lane

LOT 53 TR 9531 BK

219.69

TR 8859

POT 20
19 of 3

1.09
Plug + Tack

LOT 52
TR 9531
BL. 3

42.31 @ 19°35
= 39.86

41.64 @ 19°56 TBR 39.14

Cont. from top page 150

FORM 247 5M 10-37

F.B. _____ PG. 152

201.80 @ 7°36 @ 76° = 200.00
188.49 @ 0 0 @ 76 = 188.47
388.47

WS 58-A-3

116° 49-20 ① ②
107° 17 40 ③ ④

11.59 @ 13° 00 T 80° = 11.29

① { 1° 38-40
④ { 2.16° 34 30

Fd. x+k Bag. Lies

023

Chained by Hammond.

Stamp Fd. Cor. Mon. Corner on line 0.4 E. of corner

Chained Line Pg. 225

Tract Line & Rancho Line

Fd. 1/2" pipe 0.31 E. of corner

Stamp Fd. Cor. Mon. Corner on line 0.4 E. of corner

11.31

POST 4/4 Pg. 194.

388.47

116-19-25

51°-38-35

Post. Bet. Fd. x+k's

Angle Chain

89°	15	55
116	49	30
16	07	30
98	17	25
36	00	00

53.20

94°

① { 94°38 20
④ { 18°18 10

1" = 4' line

Original transit

TR 9531 LOTS 3 BL 4

From R-3

R1.40 Fd. L+T

Cont. from top page

WS 129-97 B-1

RETURN TO
LOS ANGELES COUNTY SURVEYOR
700 HALL OF RECORDS

Note: Any Additions or Changes on This Sheets Must be Made or Circled in Red Ink With Date and Name of Person Making Change.

Do not extend notes this side of this line

WS 79-0-3

Notes Ck'd by A.A.R.	Survey of Bellwood St
Map No. B-163 1-1	W. O. 8209 Tape No. 69 St'd 84 OF
Office Work White	Surveyed by STEVENSON
Checked AAR	Notes T.J.S Date 11-13-39
Date 1941	Indexed

F.B. 725 PG. 153

Note: Any Additions or Changes on This Sheets Must be Made or Circled in Red Ink With Date and Name of Person Making Change

Do not extend notes this side of this line

RETURN TO
LOS ANGELES COUNTY SURVEYOR
7do HALL OF RECORDS

WS 129-097 A-1

FORM 247 5M 10-37

Cont to left Side page 155

25 Sty Fr. Hse

Set Copper Tack

83°-24'-00" (1)
333° 36' 10" S (A)

0.14

Fd N+T Culvert Marker

Pl. C Set 1x24

NEW Pl. C" Set 3/4" I.P. DN 6"

Set N+T 4" California Mahogoney

R.P. Spike Tie Rd. Z373

TO INT. See pg 155

TO PG. 155

Set C Spk WHT in rock bank

ADOPTED

Δ = 96°-36

R = 50.00

SEE FB 826/18

Rd Dept. ℄.

(1) 95°-24
(2) 210 36

TRACT 8859
BL 3 LOT 31

TGO 163.21 @ 1°39 163.15
45.02 45.02
208.17

Δ = 84°-36
R = 35
T = 31.84

NEW Pl "B" Set 3/4" I.P. DN 6"

N62 [illegible] 32
230.21 @ 5°11

1146.6
2292.8
82

℄ "I.P. pl + tk 344.76

Fd N+T Cul. Marker

P.I. Set 1x24

Set Tack Tie

Set C Spk WHT rock bank

To Pg 106

From Pl 344.76

Rd P.I.

Cont from top pg 106

Cont on Pg

Cont. to bot page 155

F.B. 725 PG. 154

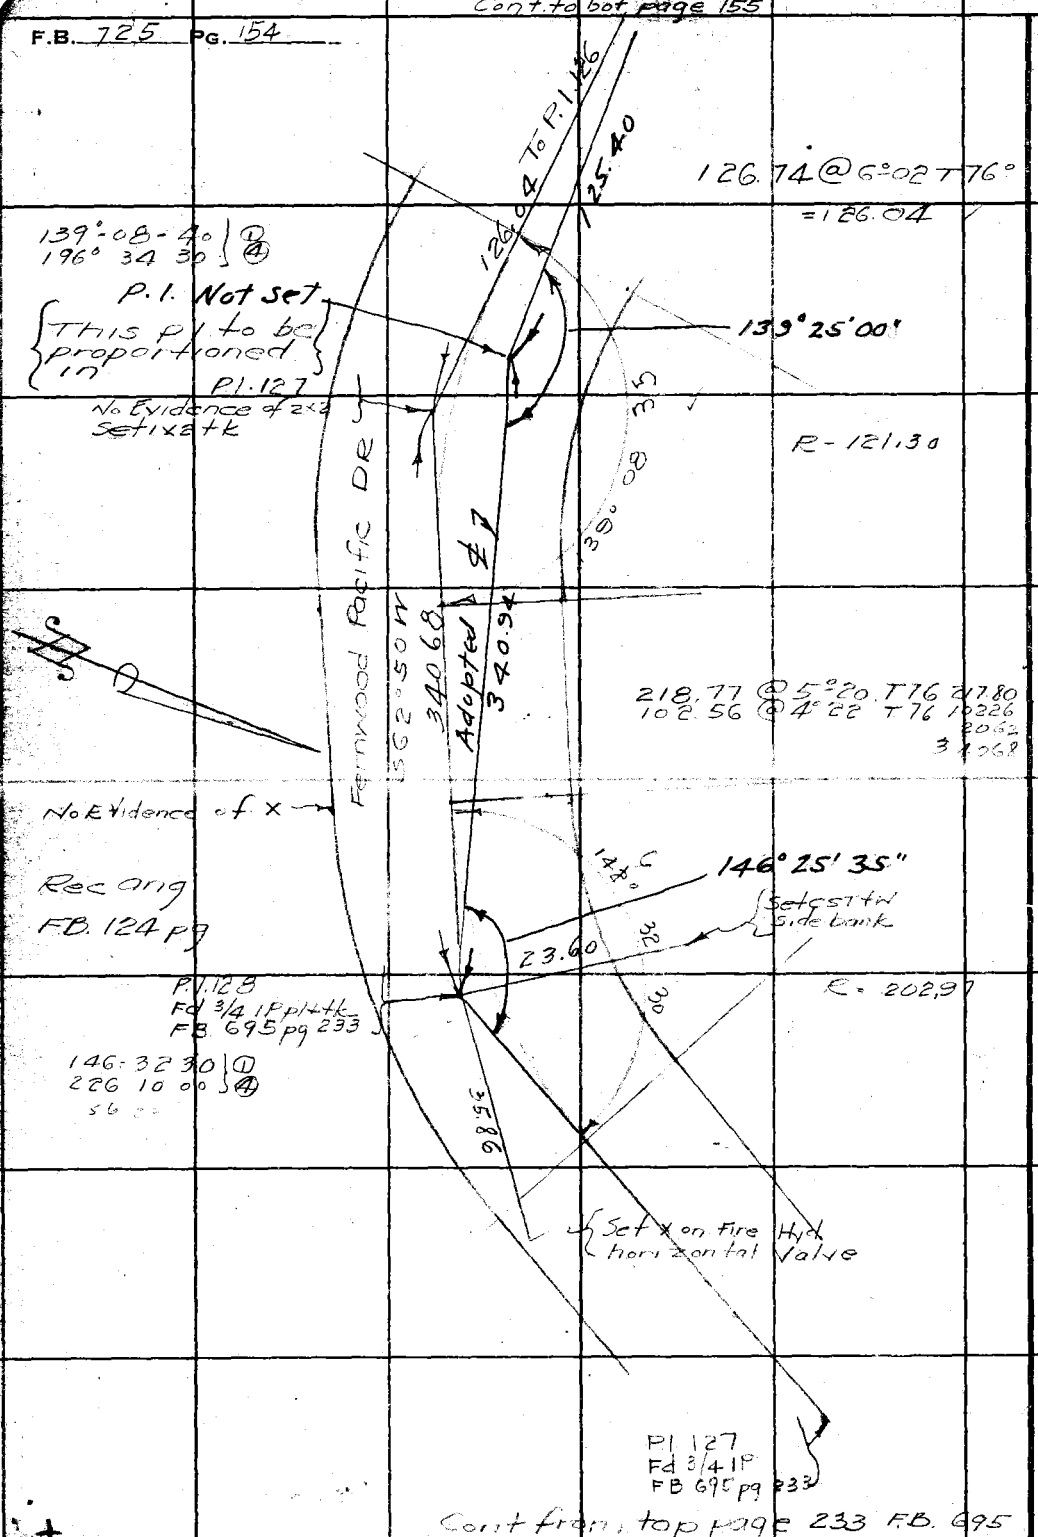

Cont from top page 233 FB. 695

RETURN TO
LOS ANGELES COUNTY SURVEYOR
700 HALL OF RECORDS

Note: Any Additions or Changes on This Sheets Must be Made or Circled in Red Ink With Date and Name of Person Making Change.

Do not extend notes this side of this line

Notes Ck'd by		Survey of Fernwood 3fs	F.B. 725 Pg. 155
Map No. 8-163-1		W. O. 8209 Tape No. 69 St'd 24 OF	
Office Work White		Surveyed by Stevenson	
Checked AAR		Notes T J.S Date 11-14-39	
Date 1941		Indexed	

WS 39-D-2

Cont. from F.B. 725 Pg. 154

To 156

OPEN

PAVED PTC

N

① 141° 33
④ 206° 12 10

P.I. 125
Fd 2x2 No tk
used center,
replaced with
3/4" I.P 10" Down
Per F.B. 124 pg 27

Set copper tk

Frank house

141°
27.01
33 42.10

Set copper tk

R = 86.36

89.15
108.67

20-00

54°

℄ INT
Set 3/4" I.P-Dm.6"
① 54°-20 00
④ 217° 2000

Set x Cut
ctr. hdwall
108.88 @ 3°-27 T76
108.67

Cont from top 153

BAINUM DRIVE

FD Cut x in 7 Destroyed
19.55-Level

INT
Set cut x T+W
by int.

FERNWOOD

Set x cut
ctr-bot-Cone Step
R = 50.94

119°01-00
116°04 00

ADOPTED ℄
SEE F.B. 826/118

Fd. 2x2 +k
O K.

1975

51.28

P.I. 126
Set 1x2 +k
By int

125.40

25.59 @ 18°-16 T76
24.30

P.P
Fd old 2x2 No tk
used center

Cont. from top page 154

RETURN TO
LOS ANGELES COUNTY SURVEYOR
720 HALL OF RECORDS

WS 122-097 4-1

Note: Any Additions or Changes on This Sheets Must be Made or Circled in Red Ink With Date and Name of Person Making Change.

Do not extend notes this side of this line

FORM 247 5M 10-37

725 PG. 156

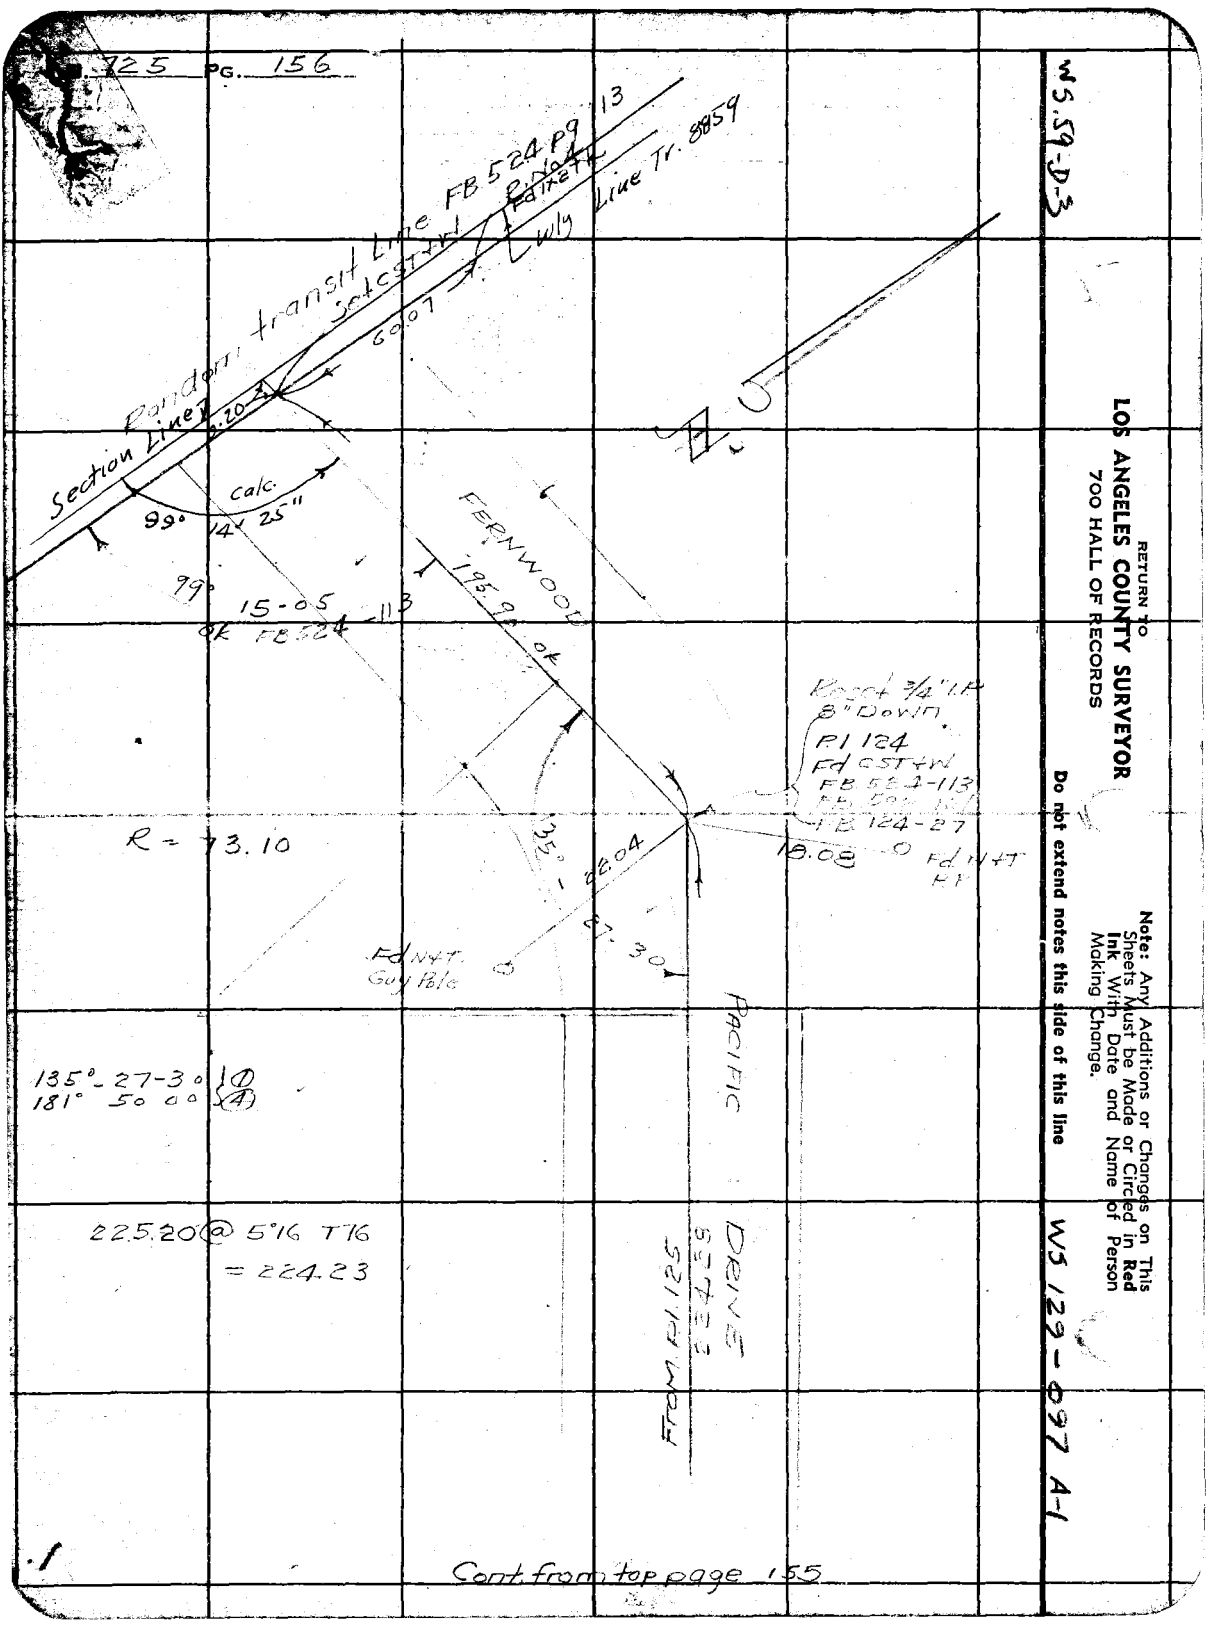

135°-27-30 (10)
181° 50 00 (4)

225.20 @ 5°16 T76
= 224.23

Cont. from top page 155

WS 59-D-3

WS 129-097 A-1

RETURN TO
LOS ANGELES COUNTY SURVEYOR
700 HALL OF RECORDS

Note: Any Additions or Changes on This Sheets Must be Made or Circled in Red Ink With Date and Name of Person Making Change.

Do not extend notes this side of this line

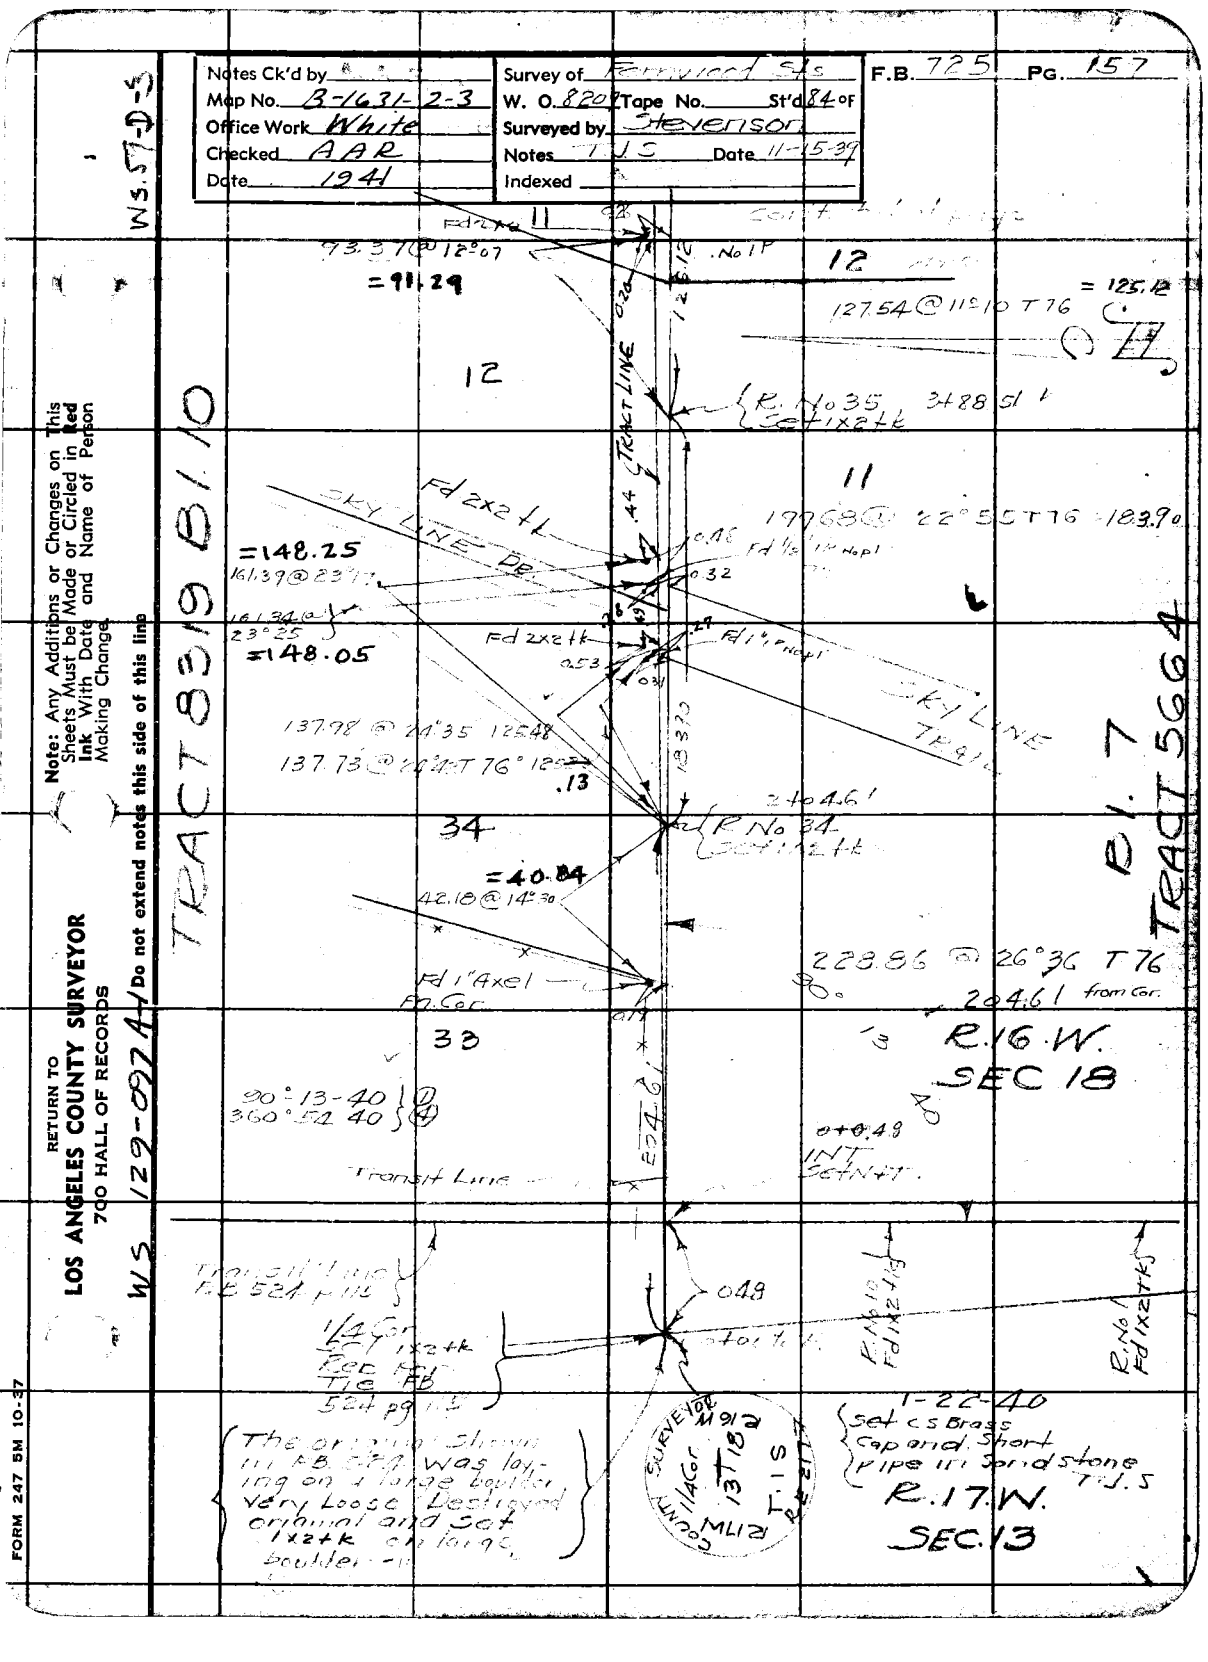
Notes Ck'd by
Map No. B-1631-2-3
Office Work White
Checked AAR
Date 1941
W. O. 8207 Tape No. St'd 84 OF
Surveyed by Stevenson
Notes 1 1 5 Date 11-15-39
Indexed
F.B. 725 Pg. 157
W3.57-D-5
TRACT 8319 BK 110
Note: Any Additions or Changes on This Sheets Must be Made or Circled in Red Ink With Date and Name of Person Making Change.
Do not extend notes this side of this line
RETURN TO
LOS ANGELES COUNTY SURVEYOR
720 HALL OF RECORDS
WS 129-0924
FORM 247 BM 10-37
TRACT 5664
BK. 7
R.16.W.
SEC 18
R.17.W.
SEC.13
TRACT LINE
SKY LINE DR.
SKY LINE TR'L
Transit Line
Fd 2x2 tk
Fd 1" Pipe
Fd 1" Axel
Fd 1x2 tk
R/W
R No 35
R No 34
R No 1
PO Cor
Set 1x2 tk
Set Cs Brass Cap and Short Pipe in Sandstone
1-22-40
T.J.S.
SURVEYOR M 912
LOS ANGELES
CO.
73.37 @ 12°07
= 91.29
127.54 @ 11°10 T 76
= 125.12
197.68 @ 22°55 T 76 = 183.90
= 148.25
161.39 @ 23°17'
161.34 @ 23°25
= 148.05
137.98 @ 24°35 125.48
137.73 @ 24°41' T 76° 125.13
240.46'
= 40.84
42.18 @ 14°30
228.86 @ 26°36 T 76
90° 20.46' from Cor.
90° 13-40
360° 54 40
EDA 61'
0+00.48
INT SETN+T.
048
1/4 Cor 1x2 tk
Rec Fd
Tie FB
524 pg 115
The original shown in F.B. 524 was lying on a large boulder. Very Loose. Destroyed original and set 1x2 tk on large boulder.

RETURN TO
LOS ANGELES COUNTY SURVEYOR
700 HALL OF RECORDS

Note: Any Additions or Changes on This Sheets Must be Made or Circled in **Red Ink** With Date and Name of Person Making Change.

Do not extend notes this side of this line

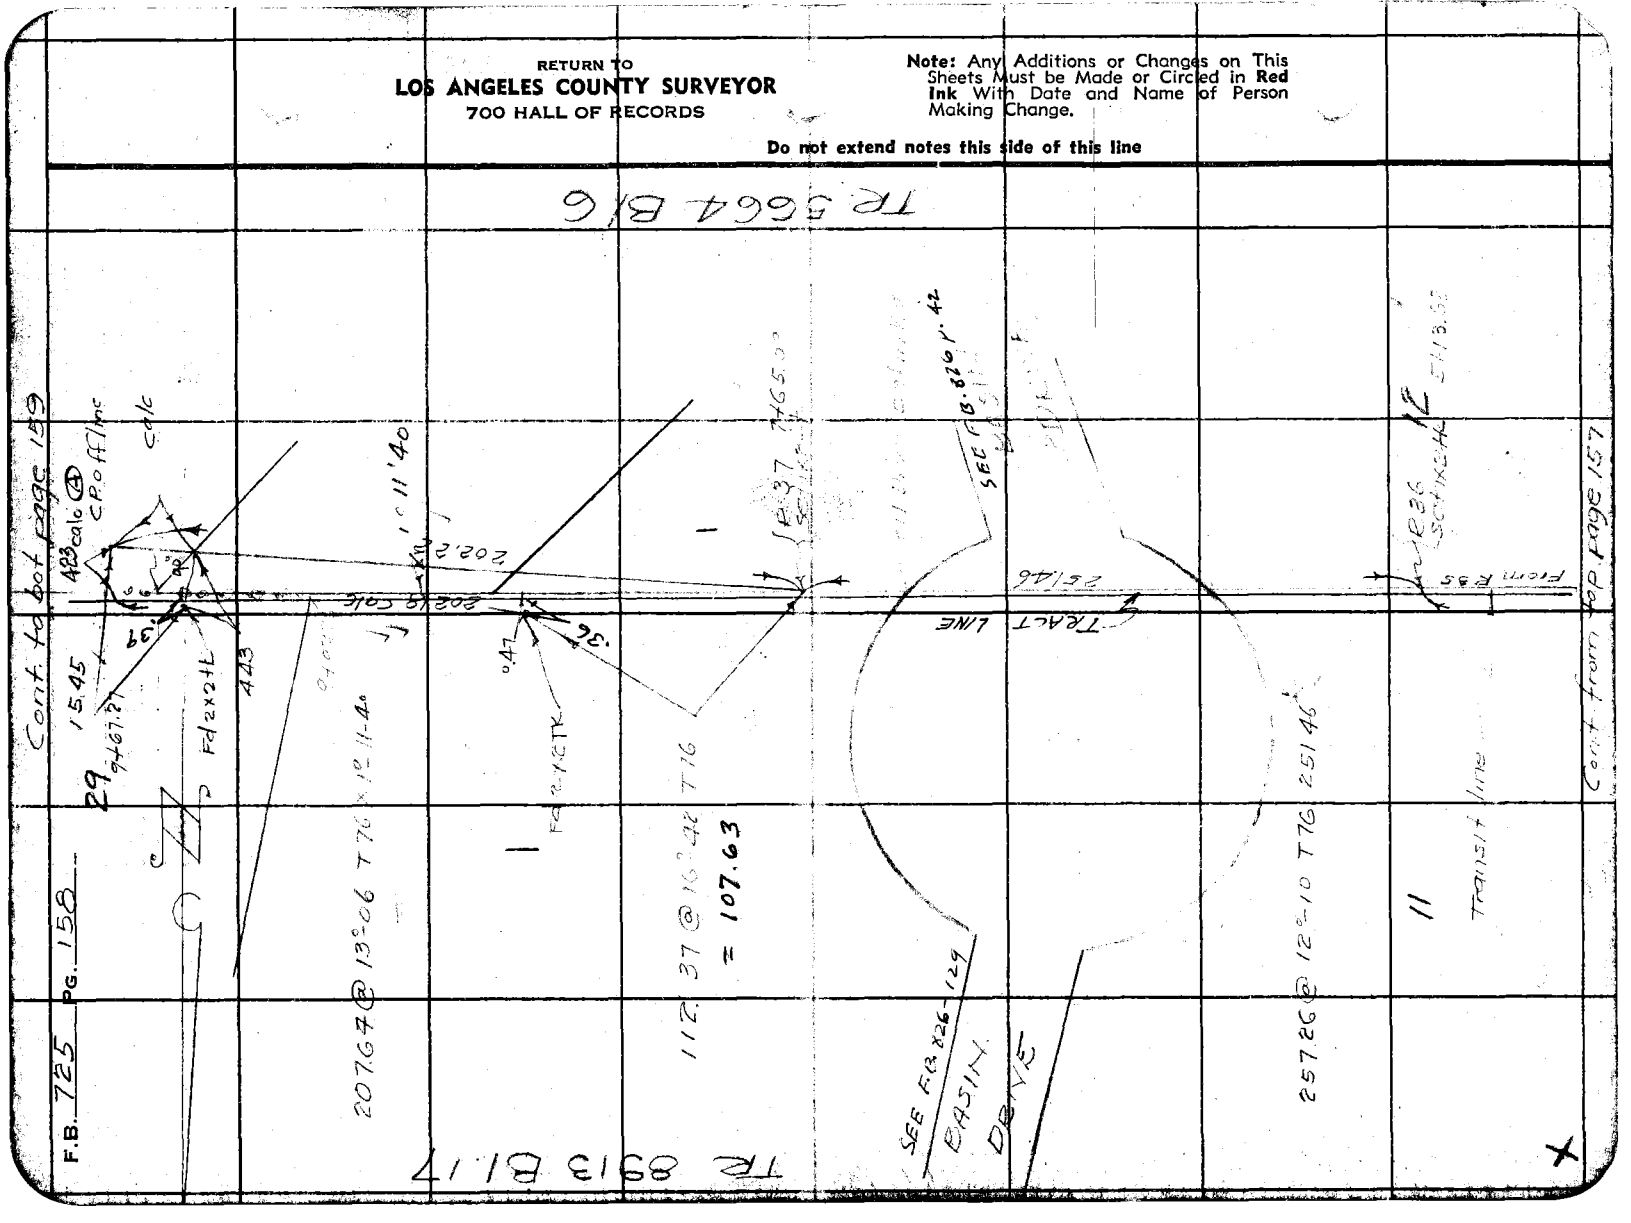

 

WS 39-D-3

Notes Ck'd by	Survey of Fernwood 345
Map No. B-1631-2-3	W. O. 8209 Tape No. 69 St'd 84 OF
Office Work White	Surveyed by Stevenson
Checked AAR	Notes T.J.S Date 11-15-39
Date 1941.	Indexed

F.B. 725 PG. 159

Note: Any Additions or Changes on This Sheets Must be Made or Circled in Red Ink With Date and Name of Person Making Change.

Do not extend notes this side of this line

RETURN TO
LOS ANGELES COUNTY SURVEYOR
720 HALL OF RECORDS

FORM 247 5M 10-37

T.R. 9942 Bl 12

Bl 6 T.R. 5664 Bl 5

TRACT LINE

FERNWOOD PACIFIC DRIVE

FB 695 pg 218
To 1x2 in t pg 160

Tic

To Pl. 151

P

Pl. 152

45.29

24.25

Set N+T 10" Mnc

N+T Mnc

143° 41
212° 17

R. No 39
set 1x2 ht

5°

1x2

76.77

50

76.77@2°-14 T 76.71

14.3

104.64

10478@2°35 T76
=104.64

Pl. 153
3/4 I.P.
FB 695
pg 218

2175

21158@4°21 T 76 = 210.95

107°-14-40
68 58 40

Set 1x2 tk

78.35@3°47 T76

78.18

107 87.01

70°

19'-10"

70° 19 20
281 16 40

Hub mark

107 14

set N+T shoemack

Pl
Set 1x2 tk
10+83.64
INT R38
set 1x2 TK

149.9

12.98

101.80

Pl. 152
Fd 2x2
set 3/4 IP

210.95

Pl. 151
Fd 2x2
set 3/4 IP

46.8

24.52

201

113.20

116.37 calc

118.64@17°23 T76
=113.20

calc 28.77

C.P.P.
1x2 tk

Set boat spk
Sandstone
boulder

Cont on pg 163-L

Cont from top page 158

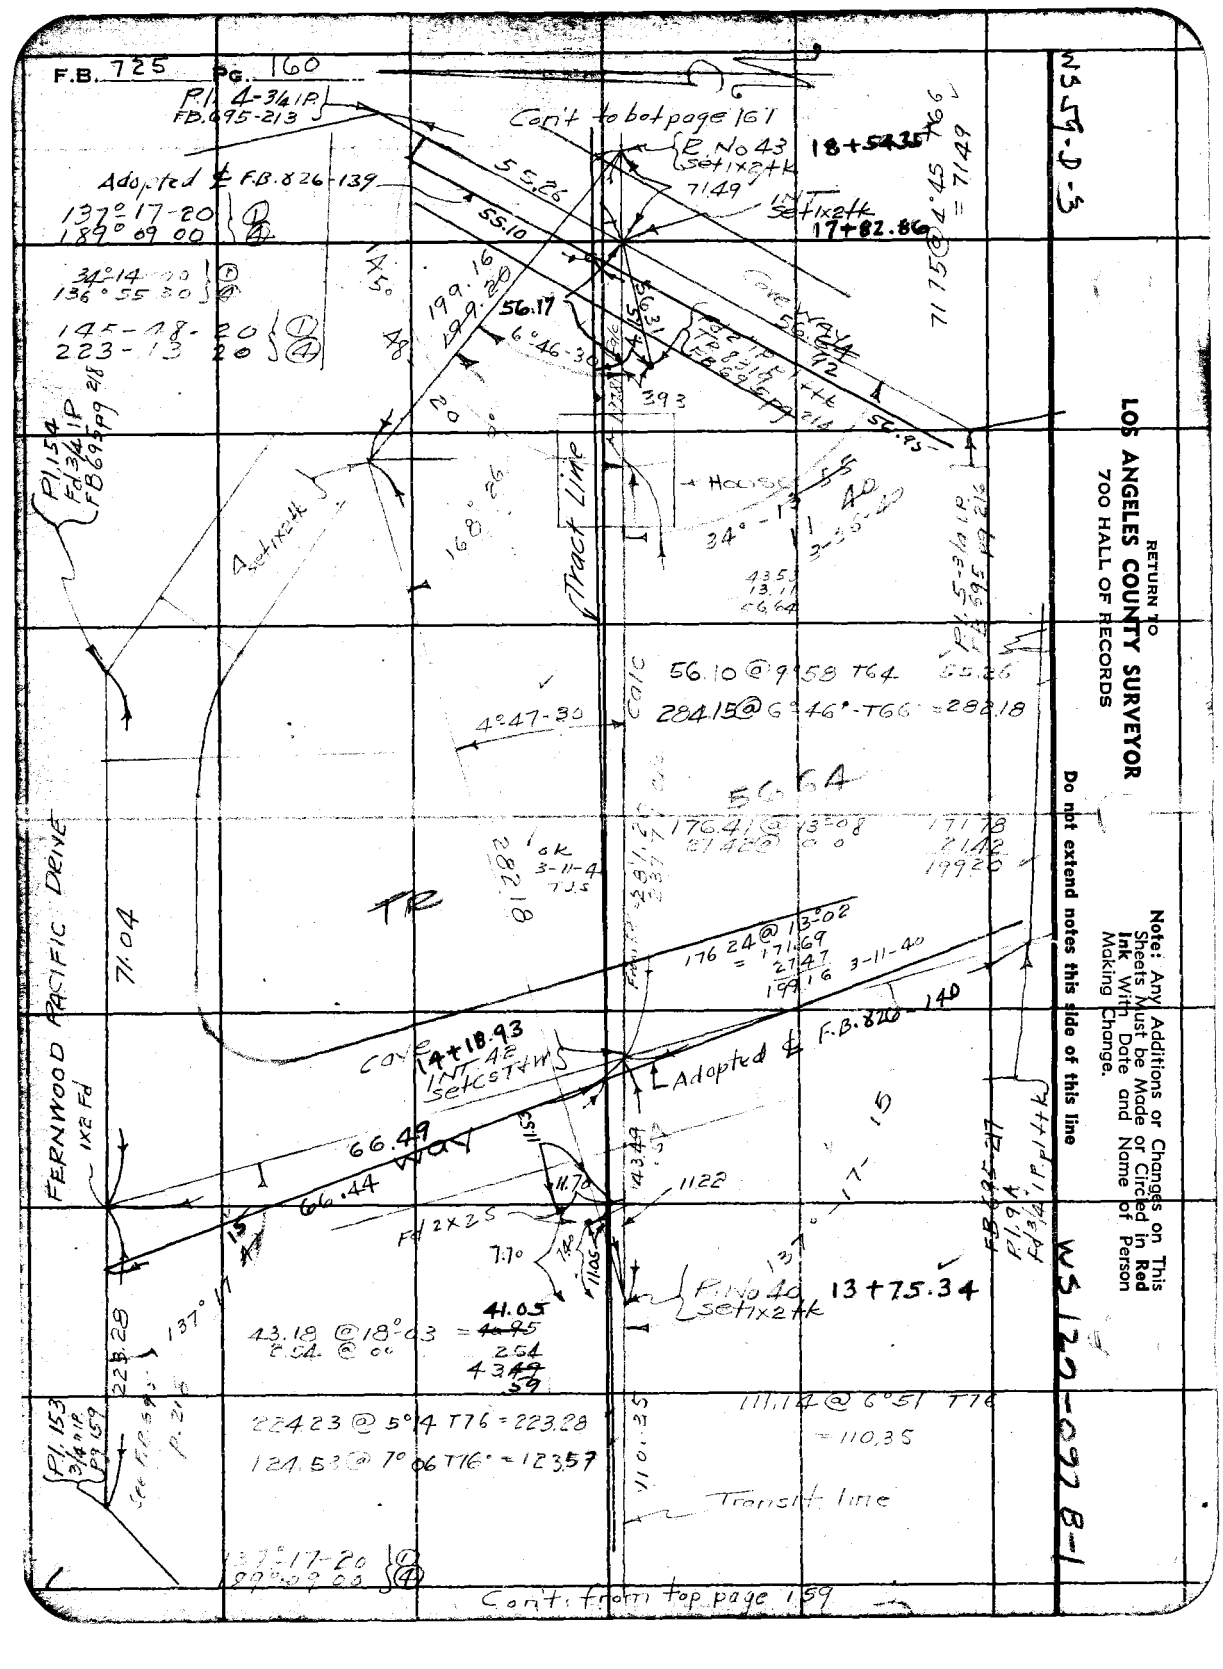
F.B. 725 PG. 160
Pl. 4-3 1/4 IP FD. 695-213
Cont'd to bot page 161
E. No 43 Set 1x2 tk
18+54.35
Adopted ℄ F.B. 826-139
137° 17' 20"
189° 09' 00"
55.26
55.10
199.16
199.20
56.17
6° 46' 30"
Track Line
168° 26'
Pl. 1.54 FD 3/4 IP FB 692 pg 218
Pl. 5-3/4 IP FB 595 pg 216
34° 14' 20"
136° 55' 30"
145-18-20
223-13-20
56.10 @ 9° 58' T64 = 55.36
28415 @ 6° 46' - T66 = 298.18
4° 47' 30"
56.64
FERNWOOD PACIFIC DRIVE
71.04
66.49
66.44
60' Way
Cor 14+18.93 INT AE Set 5/8 T+W
Adopted ℄ F.B. 820-140
176 24 @ 13° 02' = 171.69
27.47
199.16
3-11-40
1x2 Fd
Fd 2x2
7.10
41.05
43.18 @ 18° 03' = 43.49
2.54
43.49
13+75.34
Fd Nail & Set 1x2 tk
111.12 @ 6° 51' T76 = 110.35
110.35
Transit line
22423 @ 5° 14' T76 = 223.28
124.53 @ 7° 06' T76 = 123.57
137° 17' 20"
89° 09' 00"
Pl. 153 3/4 IP FB 659 pg 218
Cont. from top page 159
RETURN TO
LOS ANGELES COUNTY SURVEYOR
700 HALL OF RECORDS
Do not extend notes this side of this line
Note: Any Additions or Changes on This Sheets Must be Made or Circled in Red Ink With Date and Name of Person Making Change.
W5 17-097 B-1
W5 19-3

Notes Ck'd by A. R. S.	Survey of Fenimore T.S.	F.B. 725	Pg. 161
Map No. B-1631-2-3	W. O. 8902 Tape No. 69 St'd 84 of		
Office Work White	Surveyed by Stevenson		
Checked AAR	Notes T.L.S Date 11-17-37		
Date 1941	Indexed		

Note: Any Additions or Changes on This Sheets Must be Made or Circled in Red Ink With Date and Name of Person Making Change.

Do not extend notes this side of this line

RETURN TO
LOS ANGELES COUNTY SURVEYOR
700 HALL OF RECORDS

FORM 247 5M 10-37

Cont. to bot page 167

B1 15

B1 14

TR 8319

TR 5664

Lot 10

Tract Line

c/l to int. & sec.

R 45

21.06

9.47

19.96

20+47.18

RE 2" IP Plug Tk FB 695 pg. 214

6.73

T. 2" IP pg. 167

109.44

45°-42-00

170.50

193.78 @ 28°-22 T70 = 170.50

R. No. 44

42.94 @ 10° - 766 = 42.29

42.29

45°-43-00 ①
182° 52 00 ②④

Calc

R No 43
previously shown

18+54.35

Cont. from top page 160

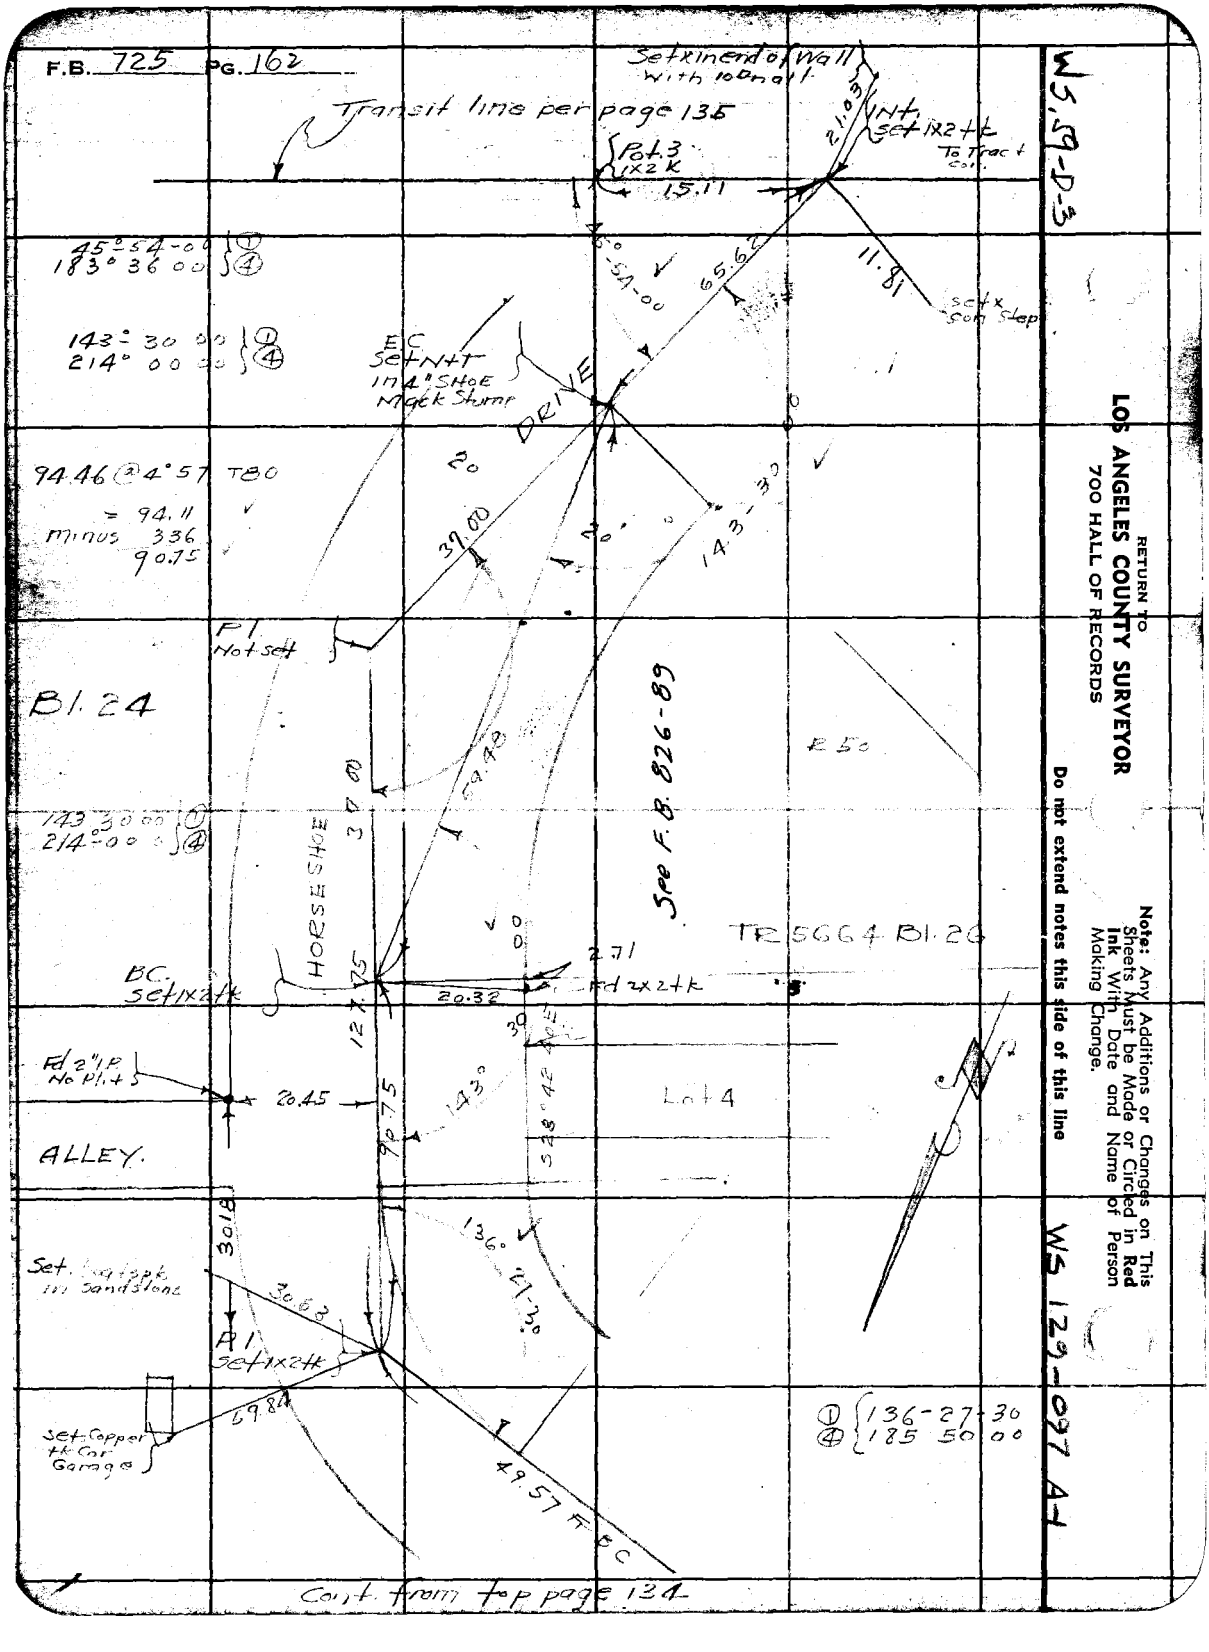
F.B. 725 Pg. 162
Set x in end of wall with 100 nail
Transit line per page 135
Pot 3 1x2 k
15.11
2.10 E
INT Set 1x2 + k To Tract Cor.
W 5, 59-D-3
45° 54-00
183° 36 00
143° 30 00
214° 00 00
EC Set N+T 1/4" Shoe Mack Stump
DRIVE
11.81
Set x Sidewalk
94.46 @ 4°57 TBO
= 94.11
Minus 3.36
90.75
20
39.00
14.3-30
P1 Not set
Bl. 24
See F.B. 826-89
R 50
69.42
30.00
HORSE SHOE
TR 5664 Bl. 26
BC. Set 1x2 + k
20.32
Fd 2x2 + k
Fd 2" I.P. No Pl. + T
20.45
ALLEY.
Lot 4
S 38° 42' E 40.5
143°
136°
27.30
30.18
30.62
Set. Copper in Sandstone
A1 Set 1x2 + k
69.84
Set Copper in Car Garage
49.57 to EC
136-27-30
185 50 00
Cont. from top page 134
RETURN TO
LOS ANGELES COUNTY SURVEYOR
700 HALL OF RECORDS
Note: Any Additions or Changes on This Sheets Must be Made or Circled in Red Ink With Date and Name of Person Making Change.
Do not extend notes this side of this line
WS 129-097 A-1

Notes Ck'd by		Survey of Fernwood Sts	F.B. 735 Pg. 163
Map No. B-163 1-2		W. O. 8209 Tape No. 69 St'd 84 OF	
Office Work White		Surveyed by Stevenson	
Checked AAR		Notes T.J.S Date 11-20-39	
Date 1941		Indexed	

WS 19-D-3

Col. to bolpage 162

Set Nail & tag

Grange

122.13 T 80° = 122.13

DRIVE

TO F.B. 1149

122.13

125°-56-30 ①
143°46 10 ④

80.21

39.9

P.I. 156
Fd old 2½"
No tk Set
3/4" CP 10" Dwn
old ties gone
F.B. 1228 pg 14

26.91

27.07

99.6

R. 5.

Set boat spk in sandstone

125°

Set C.S.T.&W. Side rock bank

FERNWOOD PACIFIC

N 69° 15' W
181.95

25.48 @ 2°57 T 18 25.48
157.01 @ 4°38 T 180 156.56
181.96

EC

P.I. 157
¾ I.P.
pg-159

103°-44 20

R = 50.

① 103°-44 20
④ 58°-57 20

40.0

20

20

TO P.I. 152
pg 159

Bot Rock

Con't from pg 159

Note: Any Additions or Changes on This Sheets Must be Made in Red Ink or Circled in Red With Date and Name of Person Making Change.

Do not extend notes this side of this line

RETURN TO
LOS ANGELES COUNTY SURVEYOR
700 HALL OF RECORDS

WS 129-092 B-1

FORM 247 5M 10-37

F.B. 725 PG. 164

Cont. to bot. page 165

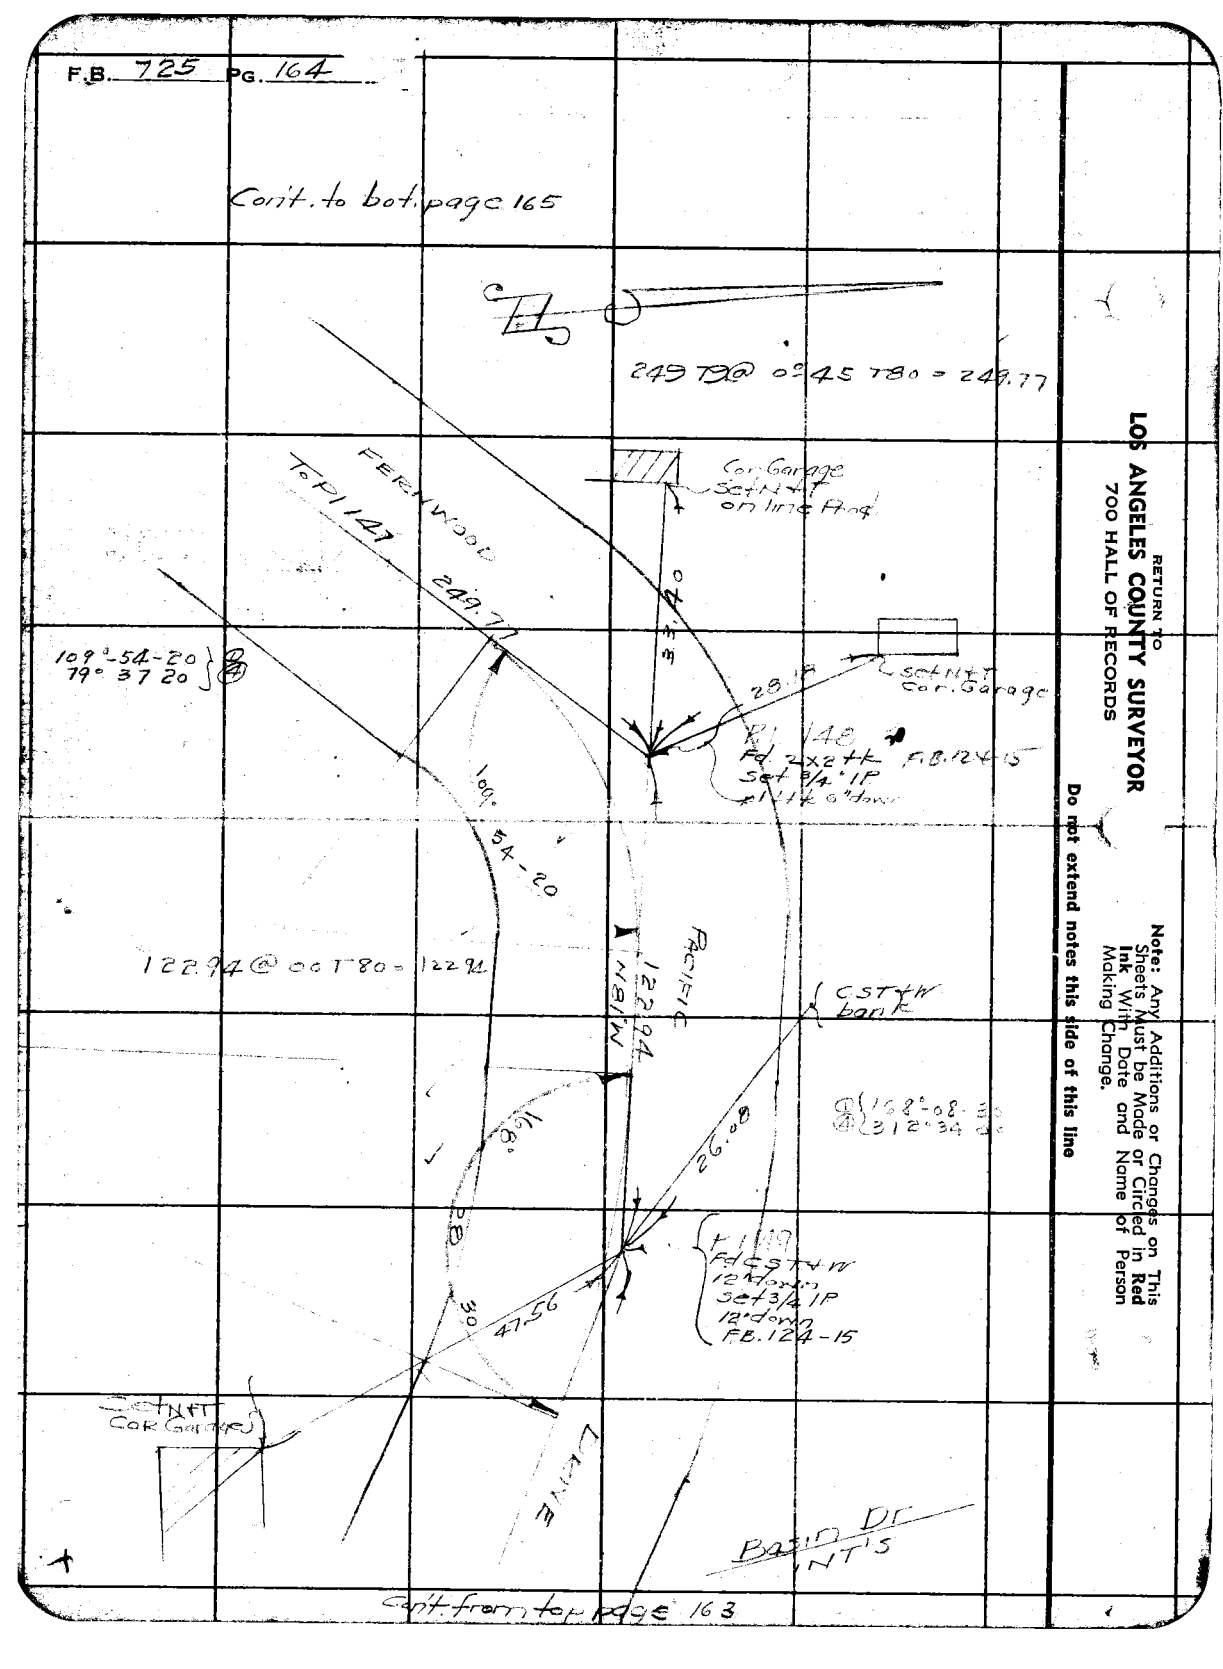

RETURN TO
LOS ANGELES COUNTY SURVEYOR
700 HALL OF RECORDS

Note: Any Additions or Changes on This Sheets Must be Made or Circled in Red Ink With Date and Name of Person Making Change.

Do not extend notes this side of this line

Notes Ck'd by A.A.R.	Survey of Fernwood 5th
Map No. B-1631-2	W. O. 8209 Tape No. 69 St'd 84°F
Office Work White	Surveyed by Stevenson
Checked AAR	Notes T.J.S Date 11-20-39
Date 1941	Indexed

F.B. 725 PG. 165

WS. 59-D3

Con't to bot page 166

FERNWOOD

96.67

R 55

1.24 RECORD -18-15

86 F.B. 82C

Pl. 146 set 3/4 I.P Per Rec Pl. Dist and the distance

F.B. 124 page 16

G.A. New 7.77 calc

Fd. Spike Tin. oak Set G.S.T.M. on Same oak higher up

① 126°-18-15
④ 145°-13-00

PACIFIC

78.75

① 102°-26-30
④ 49°-46-00

Set N+T Pepper tr.

Set N+T Power pole

63.80

92.20

Pl. 147 Fd Spk+Tin in Sandstone ledge F.B. 124 pg 16

R = 50

37.20

Con't from top page 164

RETURN TO
LOS ANGELES COUNTY SURVEYOR
700 HALL OF RECORDS

WS 122-097 B-1

Note: Any Additions or Changes on This Sheets Must be Made or Circled in Red Ink With Date and Name of Person Making Change.

Do not extend notes this side of this line

FORM 247 5M 10-37

F.B. 725 PG. 166

WS 59-D-3

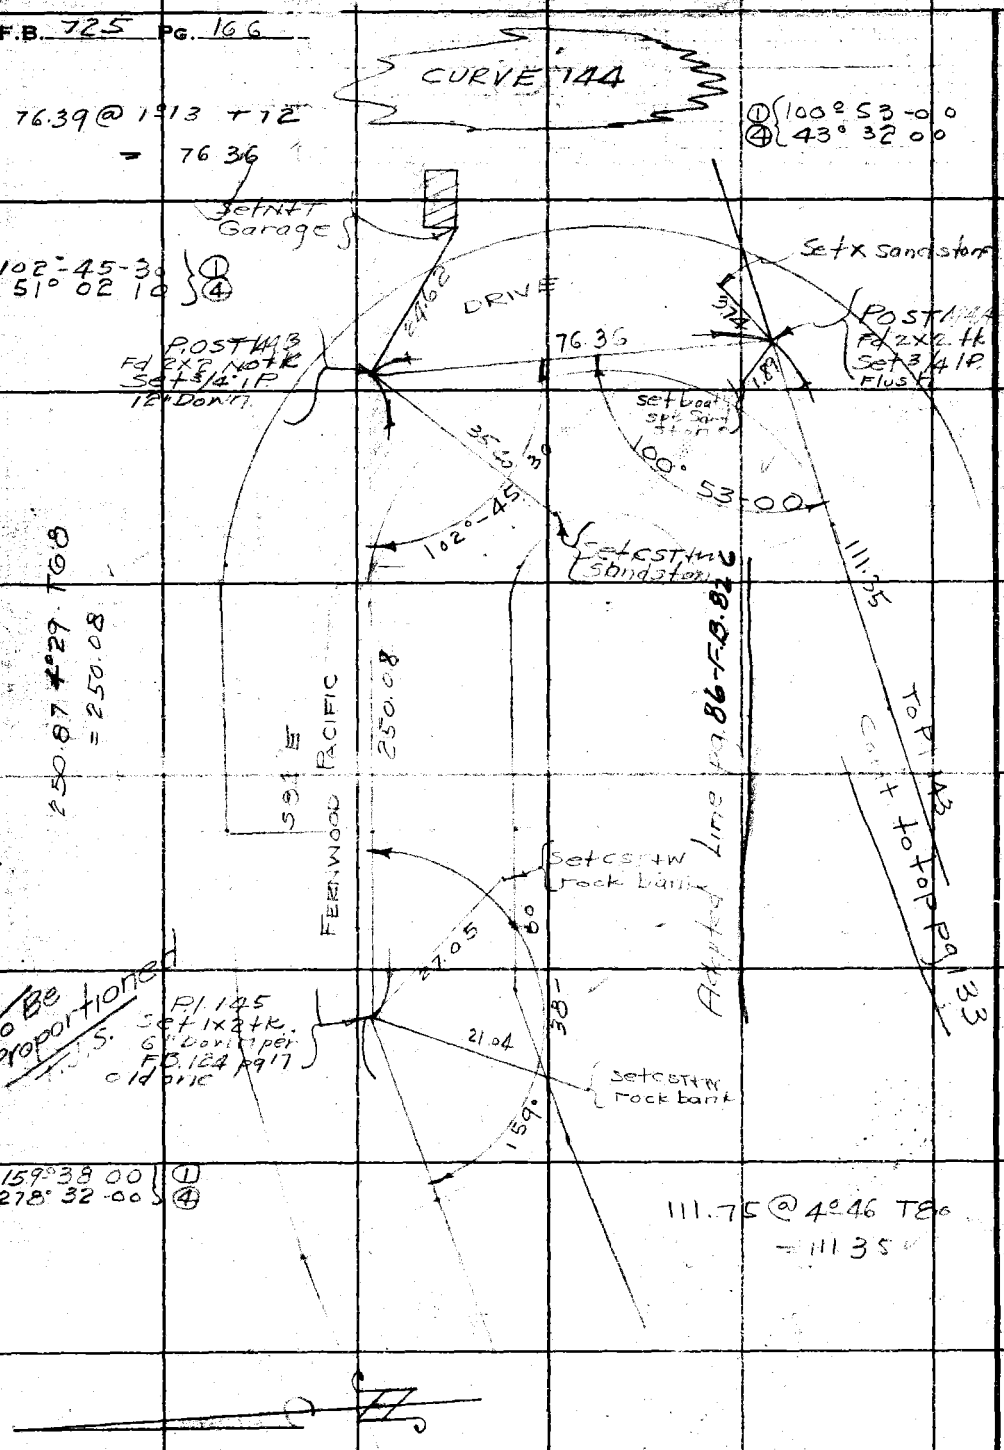

RETURN TO
LOS ANGELES COUNTY SURVEYOR
700 HALL OF RECORDS

Note: Any Additions or Changes on This Sheets Must be Made or Circled in Red Ink With Date and Name of Person Making Change.

Do not extend notes this side of this line

Notes Ck'd by A. A. S.	Survey of Terminal Sts	F.B. 725	Pg. 167
Map No. B-163-1-3-2	W. O. 8209 Tape No. 69 St'd 84 of		
Office Work White	Surveyed by Stevenson		
Checked AAR	Notes T.J.S Date 11-22-39		
Date 1941	Indexed		

WS 18-A-2
WS 19-D-3

Note: Any Additions or Changes on This Sheets Must be Made in Red Ink With Date and Name of Person Making Change.

Do not extend notes this side of this line

RETURN TO
LOS ANGELES COUNTY SURVEYOR
700 HALL OF RECORDS

WS 12-09 B-1

Hamond Line same as used on pages 140 - 152

62° 39-00 ①
250° 35 50 ④
141° 12 20 ⑧

Fd 3x3 Tk or Rd Prop. F.X 63-26

INT set 1x2 tk

SMK P Con Mon page 142

44°-42-10 ①
178° 48 20 ④
357° 36 30 ⑧

029
044

62° 39-00

FRANK LLOYD PROPERTY
LS ~~944~~ 48-36

35.43 @ 00
55.74 @ 24°49-50 60
85.03

427.89 Rec.

Transit line

33°14-20 ①
132°57 20 ④
265°54 10 ⑧

Fd 2" IP plug + tag # 2059

041
02

89°47-30 ①
359° 10 00 ④
358° 20 00 ⑧

Fd 2x2 and tag No 2059 LS MAP NO ~~944~~ 48-36

70° 22-00 ①
1° 40 20 ④

Exception

00° 25-00

33° 52-10 ①
135° 28-20 ④
270° 57 20 ⑧

Calls for 2" IP

420.43 Record

Tract Line

Record of Survey Map No ~~944~~ 48-36

Fd 2" IP pl +tk

(Note check this dist. by Traverse from E Topanga Base line for base line)

826.71 Record

INT set 1x2 tk

.06

44° 42-05

33° 52-10

89° 47-30

EC Fd 2x2 tk

1.46° 45-45 0.39 L&C Turned in Sand

0.71

25.03

86.03

Fd Spike in

BC Fd 2x2 tk

INT Set Spike in

TOPANGO CANYON ROAD

209.68

Fd Spike in .03 West of line .05

set 1x2 tk

177.78

From BM No 43 Pg 161

Rd Cont's on pg 169

7238

24.27

178.32 @ 4°22 T 76 = 177.78

Cont'd from top page 168

RB 725 PG. 168

W.S.T. - D-3

Meander line through Blk 10 Sunset Troll To Fernwood Pacific

TR 5664
Bl. 10

Con't from the middle page 131.

SUNSET TRAIL

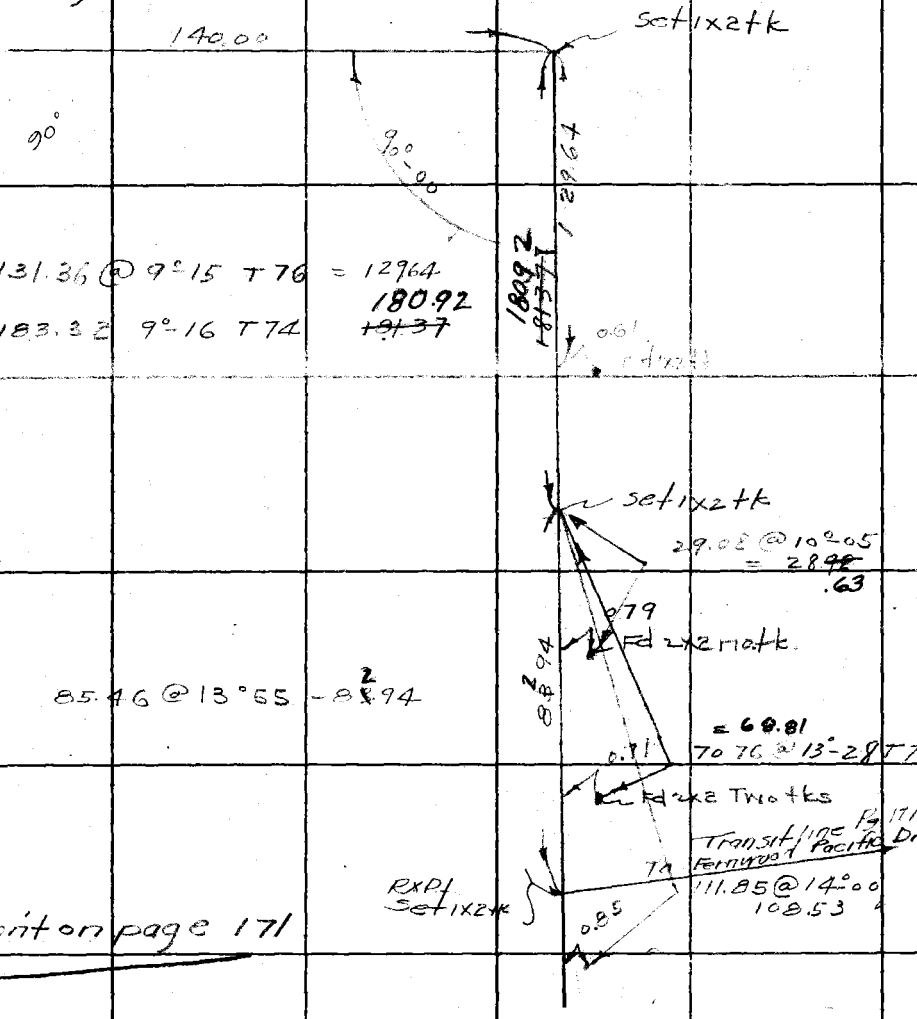

Con't on page 171

RETURN TO
LOS ANGELES COUNTY SURVEYOR
700 HALL OF RECORDS

Note: Any Additions or Changes on This Sheets Must be Made in Red Ink With Date and Name of Person Making Change.

Do not extend notes this side of this line

Notes Ck'd by A. A. R.	Survey of Hollywood Sts
Map No. B-1631-3	W. O. 8209 Tape No. St'd °F
Office Work White	Surveyed by STEVENSON
Checked AAR	Notes T. J. S. Date 11-27-39
Date 1941	Indexed

F.B. 785 PG. 166

WS. 59-D-3

Cont. to bot page 170

16591 @ 00 T64° = 16589

℄ Per Rd Dept FX63 pg 25

141° 32' 30
206° 10' 20

℄ P.I. 165.89

Post Set & STHW 51.67

Fd. Con Mon 8" deep

Not set

141° 32' 30

40.04

Record.
Δ 200
T = 158.92
L = 268.58

141° 31' 45
206° 07' 00

11296 @ 00 T64° = 112.95

173.30

Set STHW

48.28

EC 368+70.47
Fd. Cut spk. in Con
6 Dev. Rd Dept.
FX63 Pg 25

24152 @ 5°09 T64 = 2210
Minus
221

EC 369+83.35
Fd 2x2 stk
Rd. Dept. FX63 pg 25

Topanga Canyon Road
Mag N 8° 30' E

112.95

Record
Δ =
R = 350
T 221.77
L = 395.35

115-16-50
10 10 07 30

221.75

115° x 5° 40 Adj

Post 1x2 stk

Fd cutspike in Con R.D. FX.63 pg 25

43.95

44.19 @ 5°58 = 43.95

This ℄ shown on page 167

Cont from page 167

exet stk

W5 120-097 B-1

RETURN TO
LOS ANGELES COUNTY SURVEYOR
700 HALL OF RECORDS

Note: Any Additions or Changes on This Sheet Must be Made or Circled in Red Ink With Date and Name of Person Making Change.

Do not extend notes this side of this line.

FORM 247 5M 10-39

WS 19-D-3

RETURN TO
LOS ANGELES COUNTY SURVEYOR
900 HALL OF RECORDS

Do not extend notes this side of this line.

Note: Any Additions or Changes on This Sheet Must be Made or Circled in Red Ink With Date and Name of Person Making Change.

WS 120-027 B-1

Con't from top page 169

Notes Chkd by A.A.B.
Map No. B-1636-2
Office Work Watts
Checked AAR
1941

Survey of Fernwood Sts
W. O. 8209 Tape No. St'd °F
Surveyed by Stevenson
Notes T.J.S Date 11-29-39
Indexed

F.B. 725 PG. 171

W5 129-097 4-1

RETURN TO
LOS ANGELES COUNTY SURVEYOR
700 HALL OF RECORDS

Note: Any Additions or Changes on This Sheet Must be Made or Circled in Red Ink With Date and Name of Person Making Change.

Do not extend notes this side of this line.

FORM 247 5M 10-39

CURVE 133

FERNWOOD

PACIFIC

DRIVE

POST
3/4"IP
PB 695
PG 230

94.31

14°

73°

112.78

98° 37' 10" ①
34° 28' 50" ④

73° 00' 40" ②
292° 02' 40" ③

78° 37' 10"

P.C. Pt
1x2
P-168

TOR-Y Pt

POST
3/4 IP
PB 695
PG 230

116.88 @ 14°38 T68°
= 112.78

RETURN TO
LOS ANGELES COUNTY SURVEYOR
700 HALL OF RECORDS

Note: Any Additions or Changes on This Sheet Must be Made or Circled in **Red Ink** With Date and Name of Person Making Change.

Do not extend notes this side of this line.

FB 725 PG 172

Notes Ck'd by A. A. B.	Survey of
Map No. B-1631-2	W. O. Tape No. St'd °F
Office Work White	Surveyed by
Checked AAR	Notes Date
Date 1941	Indexed 2-14-40

F.B. 725 PG. 173

FERNWOOD STS

J.N 8209

GRAND VIEW DR

T. J. STEVENSON
G. H. NICHOLS
A. CARRASCO
R. W. SCOTT

Note: Any Additions or Changes on This Sheet Must be Made or Circled in Red Ink With Date and Name of Person Making Change

Do not extend notes this side of this line.

RETURN TO
LOS ANGELES COUNTY SURVEYOR
700 HALL OF RECORDS

FORM 247 5M 10-39

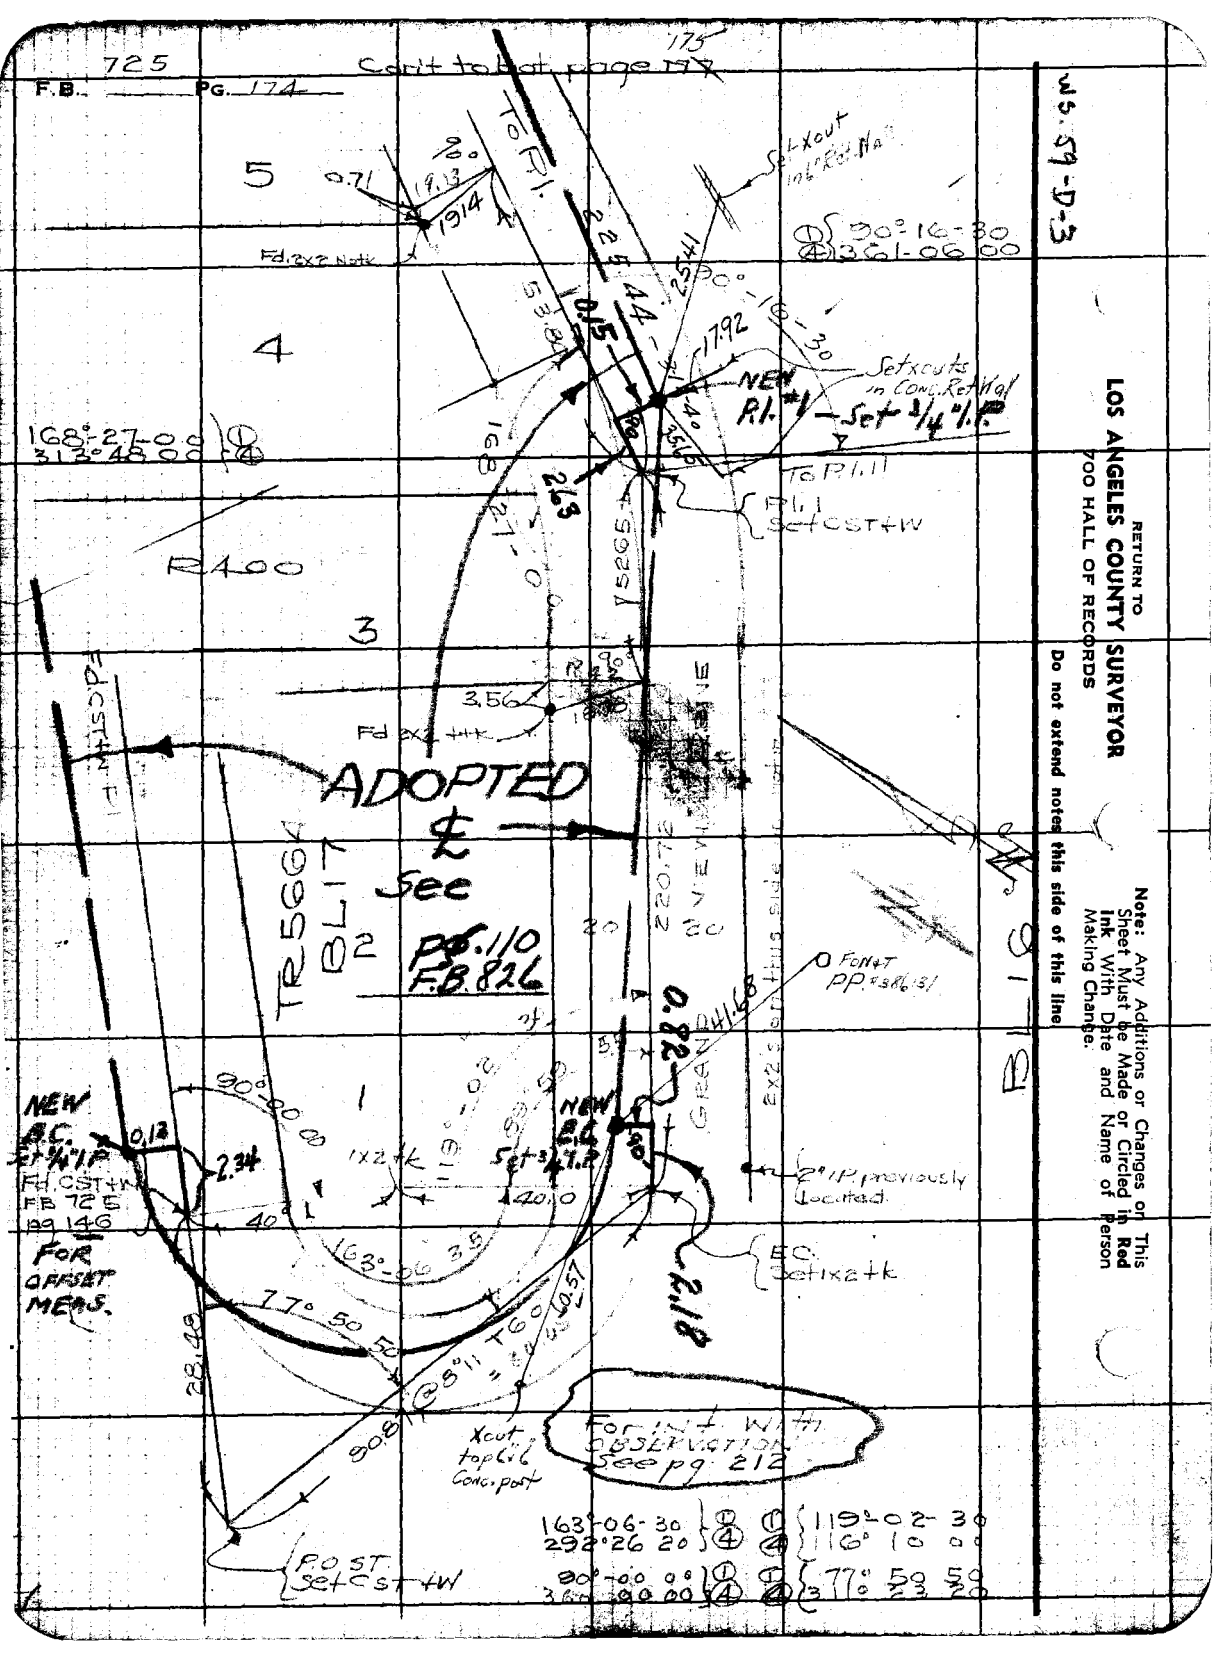

W.S. 59-D-3

RETURN TO
LOS ANGELES COUNTY SURVEYOR
700 HALL OF RECORDS

Do not extend notes this side of this line

Note: Any Additions or Changes on This Sheet Must be Made or Circled in Red Ink With Date and Name of Person Making Change.

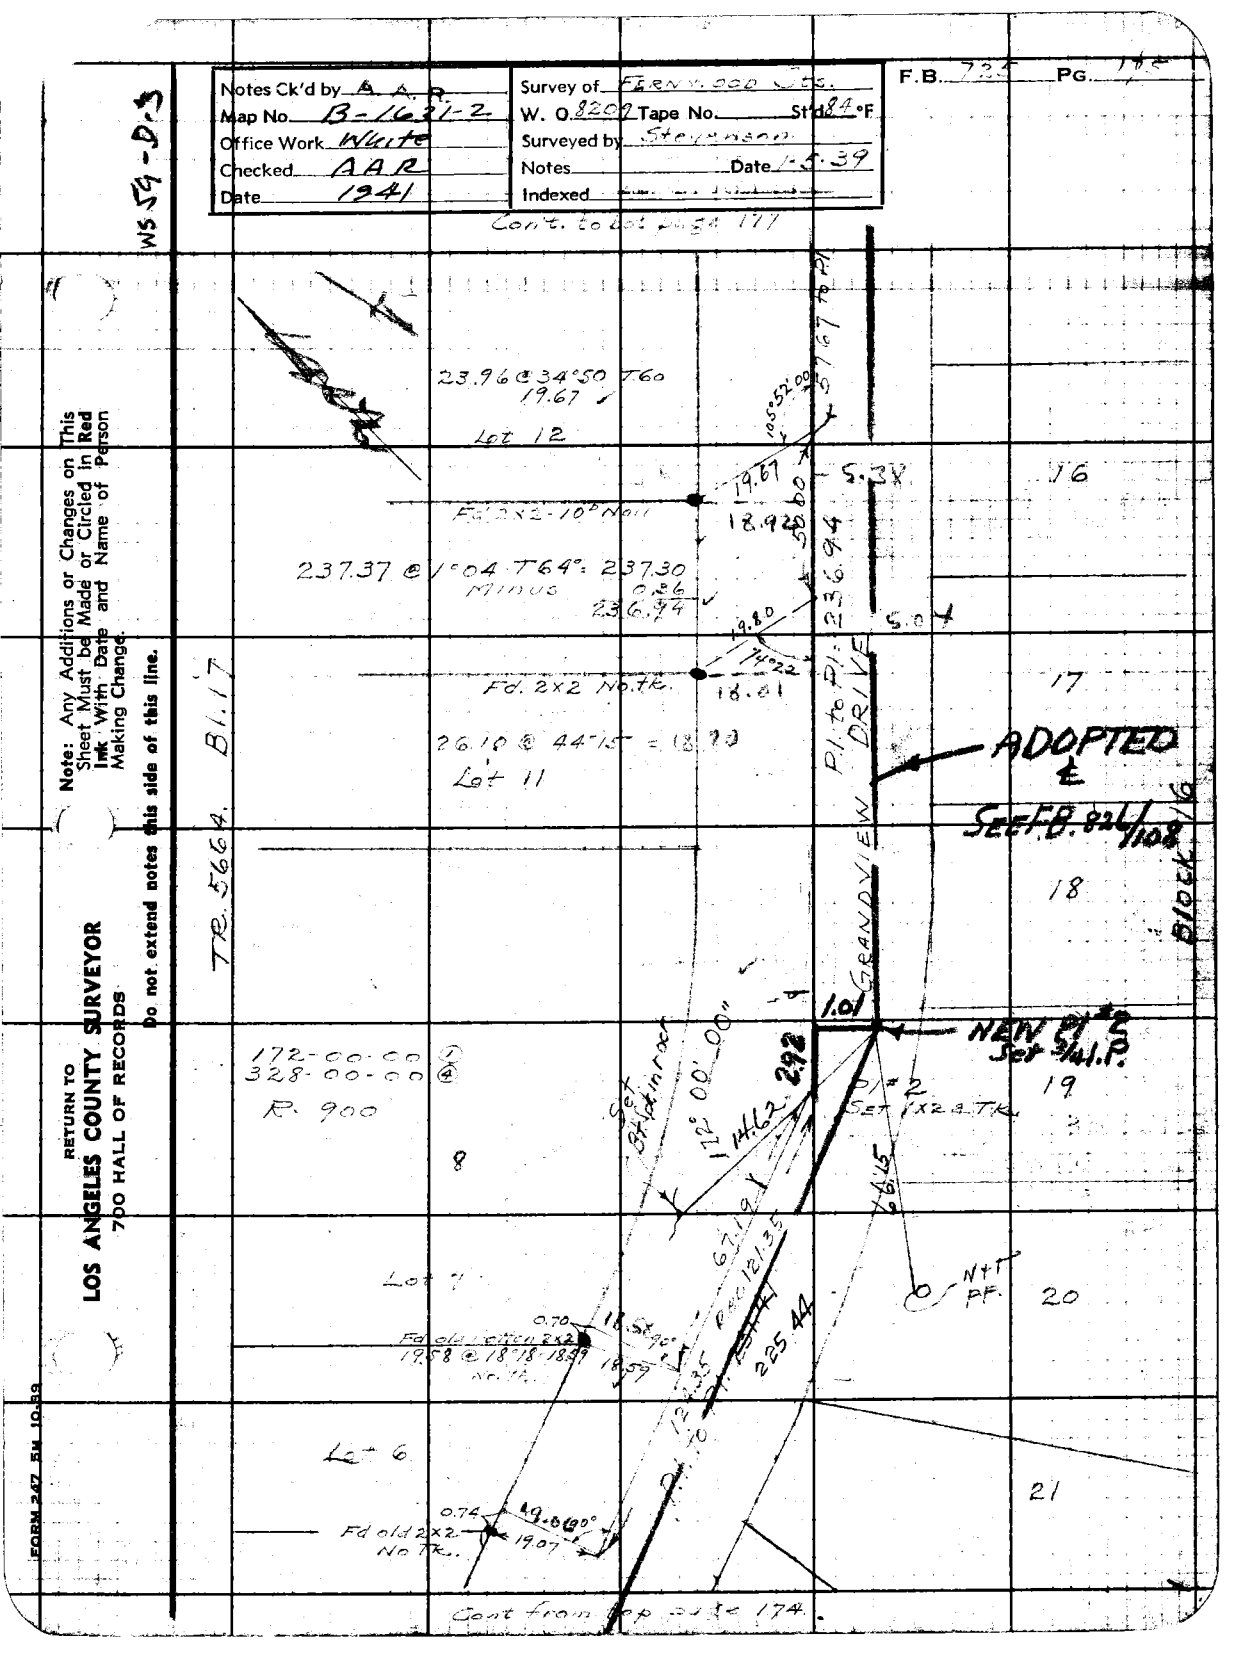
Notes Ck'd by A. A. R.
Map No. B-1631-2
Office Work White
Checked AAR
Date 1941
Survey of Ferny. 000 Co.
W. O. 8209 Tape No. Std 84°F
Surveyed by Stevenson
Notes Date 1-5-39
Indexed
F.B. 754 PG. 146
WS 59-D.3
Cont. to Lot 54 111
23.96 @ 34°50 T60
19.67
Lot 12
105°52'00"
19.67 to PI
5.3X
16
Fd 2x2-10° N&W
18.92
237.37 @ 1°04 T64°: 237.30
Minus 0.26
236.94
19.80
74°22'
Fd. 2x2 No TK.
18.61
5.04
17
26.10 @ 44°15' = 18.99
Lot 11
PI to PI: 236.94
DRIVE
ADOPTED
See F.B. 824/108
Tr. 5664. Bl. 17
18
BLOCK
GRANDVIEW
1.01
NEW PI #2
Set 5/41 I.P.
19
172-00-00
328-00-00
R. 900
8
Set Skidmore
172° 00' 00"
114.62
2.92
PI #2
Set 1x2 4 TK
67.19
R=1213.35
T=61.45
225.44
Lot 7
Fd old 1 stem 2x2
19.58 @ 18°18' 18.99
No TK.
0.70
18.57
90°
N+T PF.
20
Lot 6
0.74
19.07
Fd old 2x2 No TK.
21
Cont from Sheet 174.
RETURN TO
LOS ANGELES COUNTY SURVEYOR
700 HALL OF RECORDS
Note: Any Additions or Changes on This Sheet Must be Made or Circled in Red Ink With Date and Name of Person Making Change.
Do not extend notes this side of this line.
FORM 247 5M 10-53

RETURN TO
LOS ANGELES COUNTY SURVEYOR
700 HALL OF RECORDS

Note: Any Additions or Changes on This Sheet Must be Made or Circled in **Red Ink** With Date and Name of Person Making Change.

Do not extend notes this side of this line.

WS 59-D-3

WS 129-097 B-1

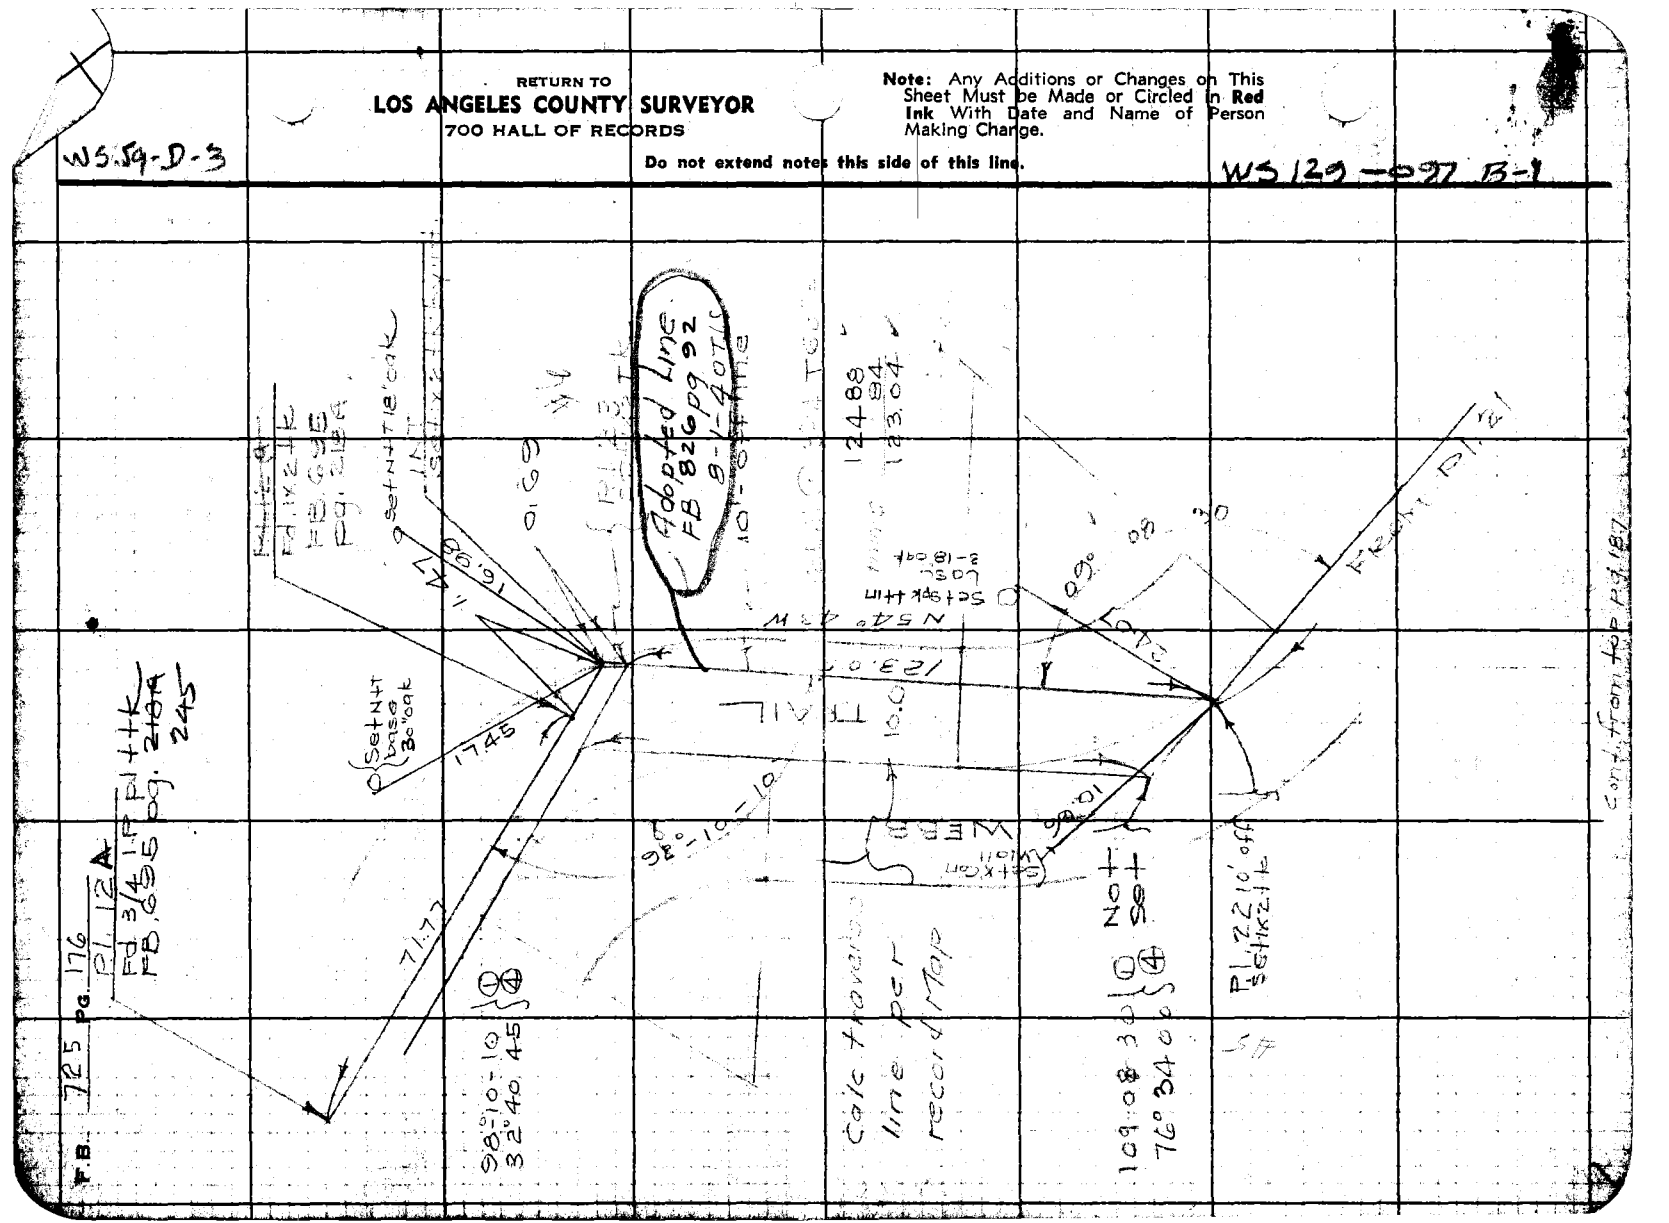
Adopted Line
FB 826 pg 92
8-1-40 T.L.
10-0 Alley
Set Nail & Tag
Set Nail in Post
Set Nail & Tag
Base 30.09
Set Nail in Post
Set Nail & Tag
Set Nail & Tag
Set Nail & Tag

W 59-D-3

Notes Ck'd by A.A.R.
Map No. B-16 3 1-2
Office Work White
Checked AAR
Date 1941

Survey of Kenwood #5
W. O. 8209 Tape No. Std °F
Surveyed by [illegible]
Notes T.I.S. Date 1-5-39
Indexed

F.B. 725 PG. 177

BLOCK 21

Note: Any Additions or Changes on This Sheet Must be Made or Circled in Red Ink With Date and Name of Person Making Change.

Do not extend notes this side of this line.

RETURN TO
LOS ANGELES COUNTY SURVEYOR
700 HALL OF RECORDS

WS 122-297 B-1

FORM 247 5M 10-39

Set xcut in bot. step

CSpkWt OFFSET EC-ACCT BANK 7.00

NEW E.C.

Set 3/4" I.P.

EC-4 Set Nail & Tin CSpkWt

NEW EC

Set 3/4" I.P.

Set CSpkWt Tel. 2.0

Set Nail & Tin Boulder

Set CSTkW

TIE To Boulder Trail FB. 826

Set CSTkW

Set CSTkW

ADOPTED

See pg. 108 FB. 826

NEW P.I.

Set 3/4" I.P.

Set CSTkW

FD CSpkWt Tin Tag

FD. 2x2 Nail

Set CSTkW

Cont. from top page 175

Cont. to bot. page 179

TR 5664

F.B. 725 PG. 178

Con't to bot. page 179

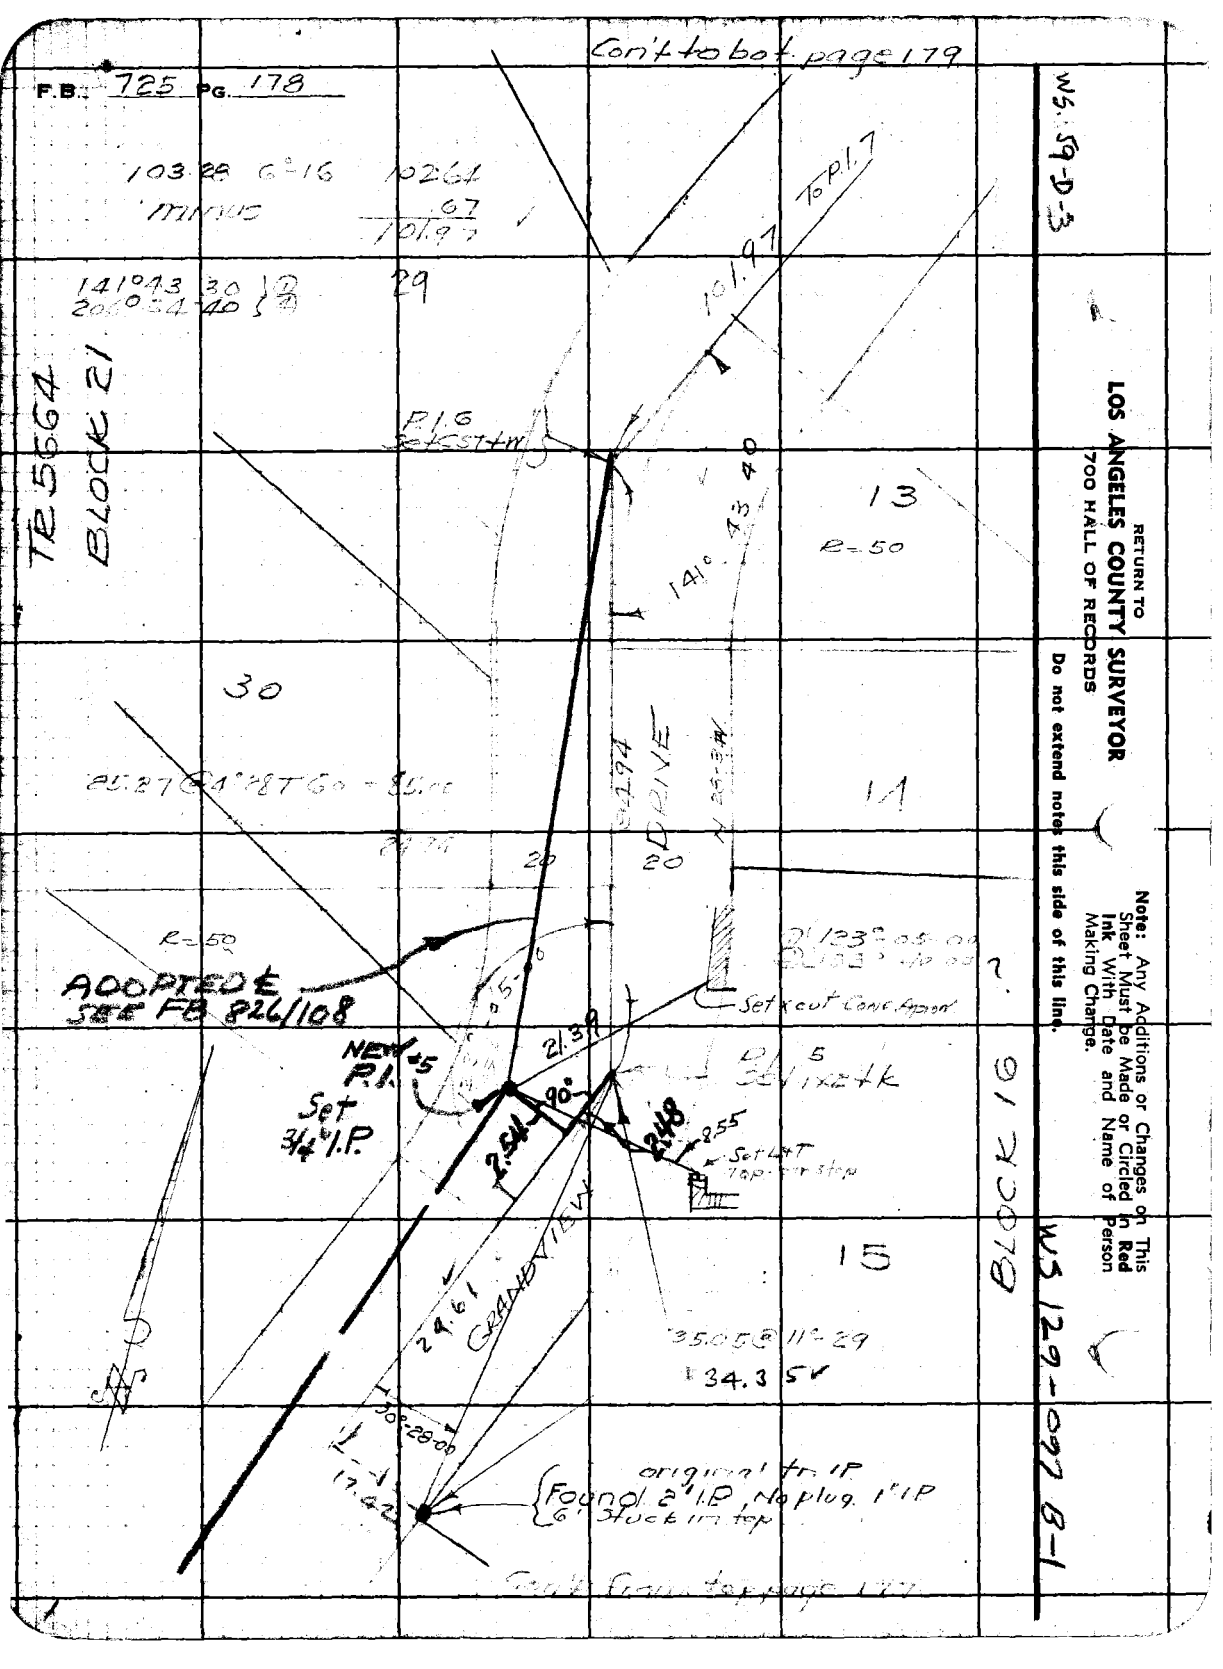

Cont from top page 177

RETURN TO
LOS ANGELES COUNTY SURVEYOR
700 HALL OF RECORDS

Do not extend notes this side of this line.

Note: Any Additions or Changes on This Sheet Must be Made or Circled in Red Ink With Date and Name of Person Making Change.

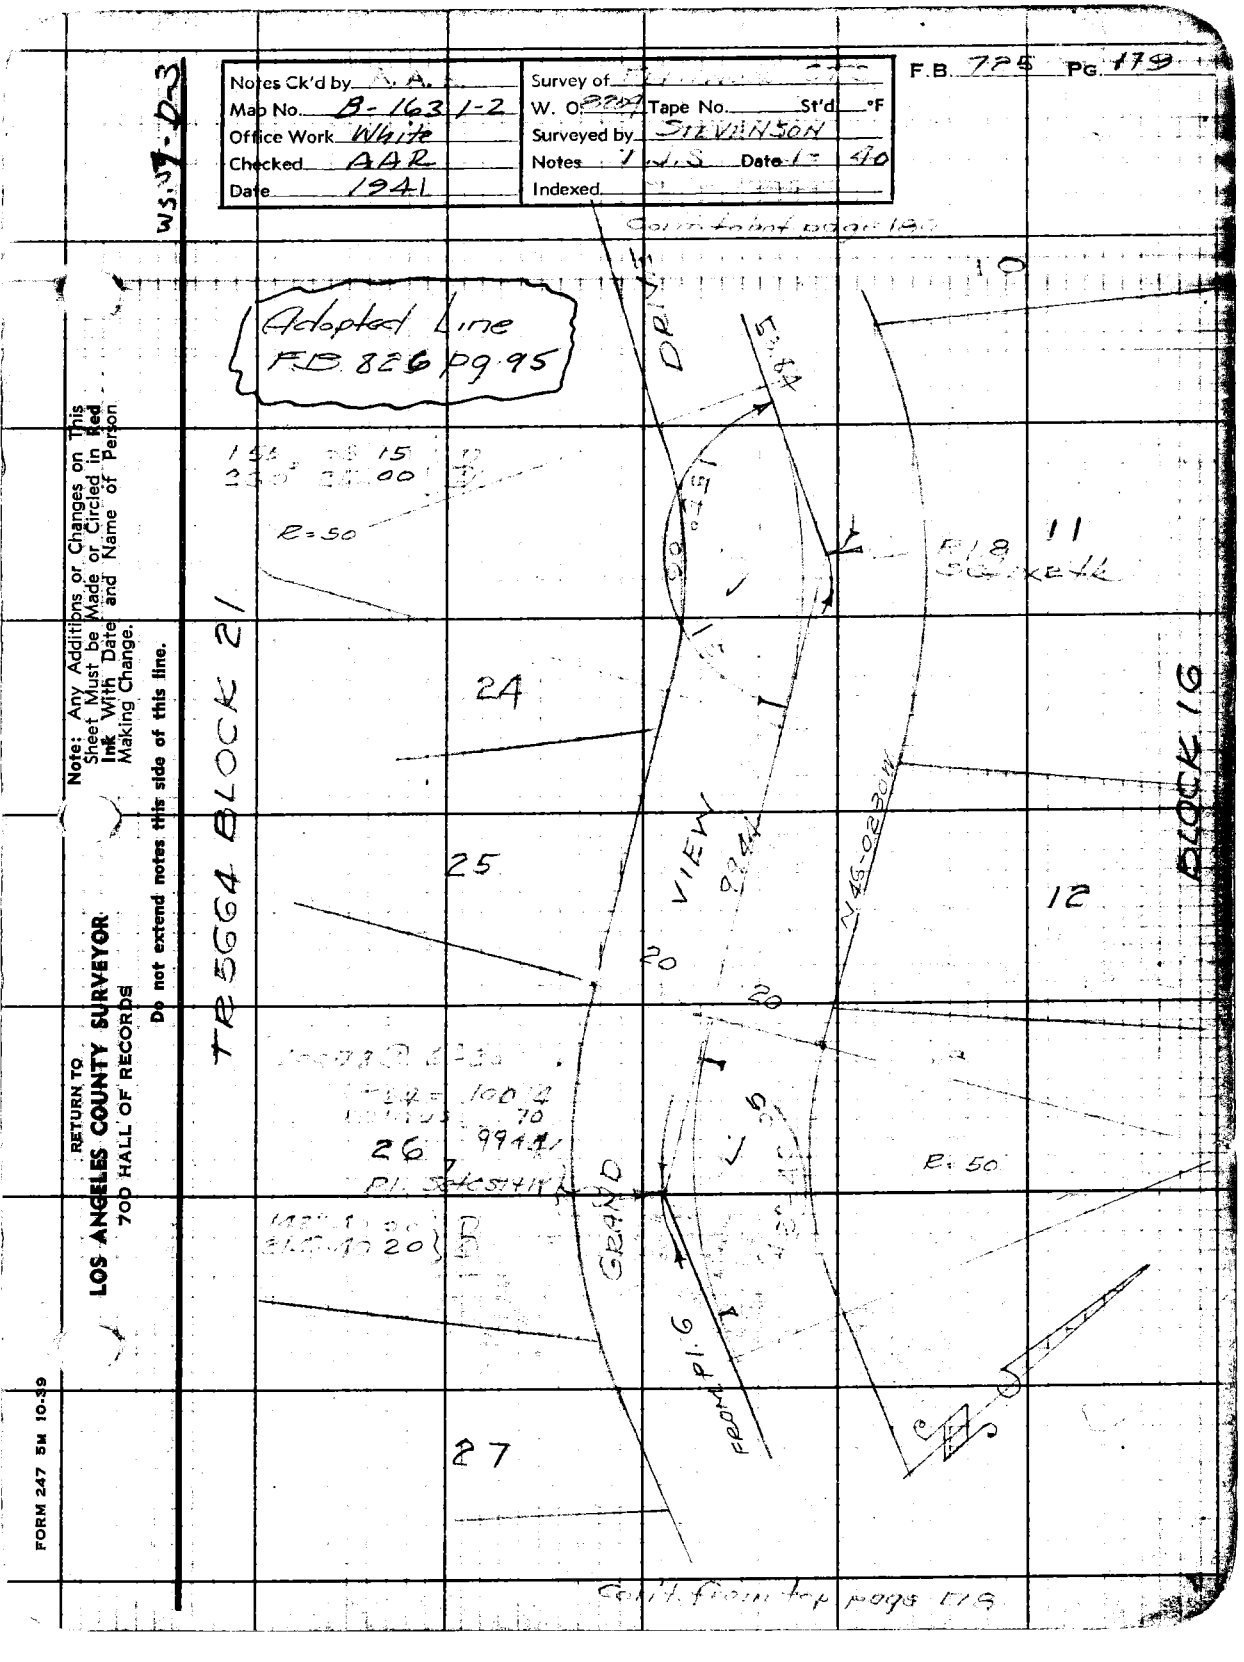
W3.3-D-3
Notes Ck'd by A.A.
Map No. B-163 1-2
Office Work White
Checked AAR
Date 1941
Survey of
W. O. Tape No. St'd °F
Surveyed by STEVENSON
Notes V.V.S. Date 1-40
Indexed
F.B. 725 Pg. 179
Adopted Line
F.B. 826 pg. 95
Cont. from map 18
DRIVE
TR 5664 BLOCK 21
BLOCK 16
VIEW
GRAND
Cont'd from top page 119
RETURN TO
LOS ANGELES COUNTY SURVEYOR
700 HALL OF RECORDS
Note: Any Additions or Changes on This Sheet Must be Made or Circled in Red Ink With Date and Name of Person Making Change.
Do not extend notes this side of this line.
FORM 247 5M 10-39

RETURN TO
LOS ANGELES COUNTY SURVEYOR
700 HALL OF RECORDS

Note: Any Additions or Changes on This Sheet Must be Made or Circled in **Red Ink** With Date and Name of Person Making Change.

Do not extend notes this side of this line.

WS 59-D-3

WS 129-097 B-1

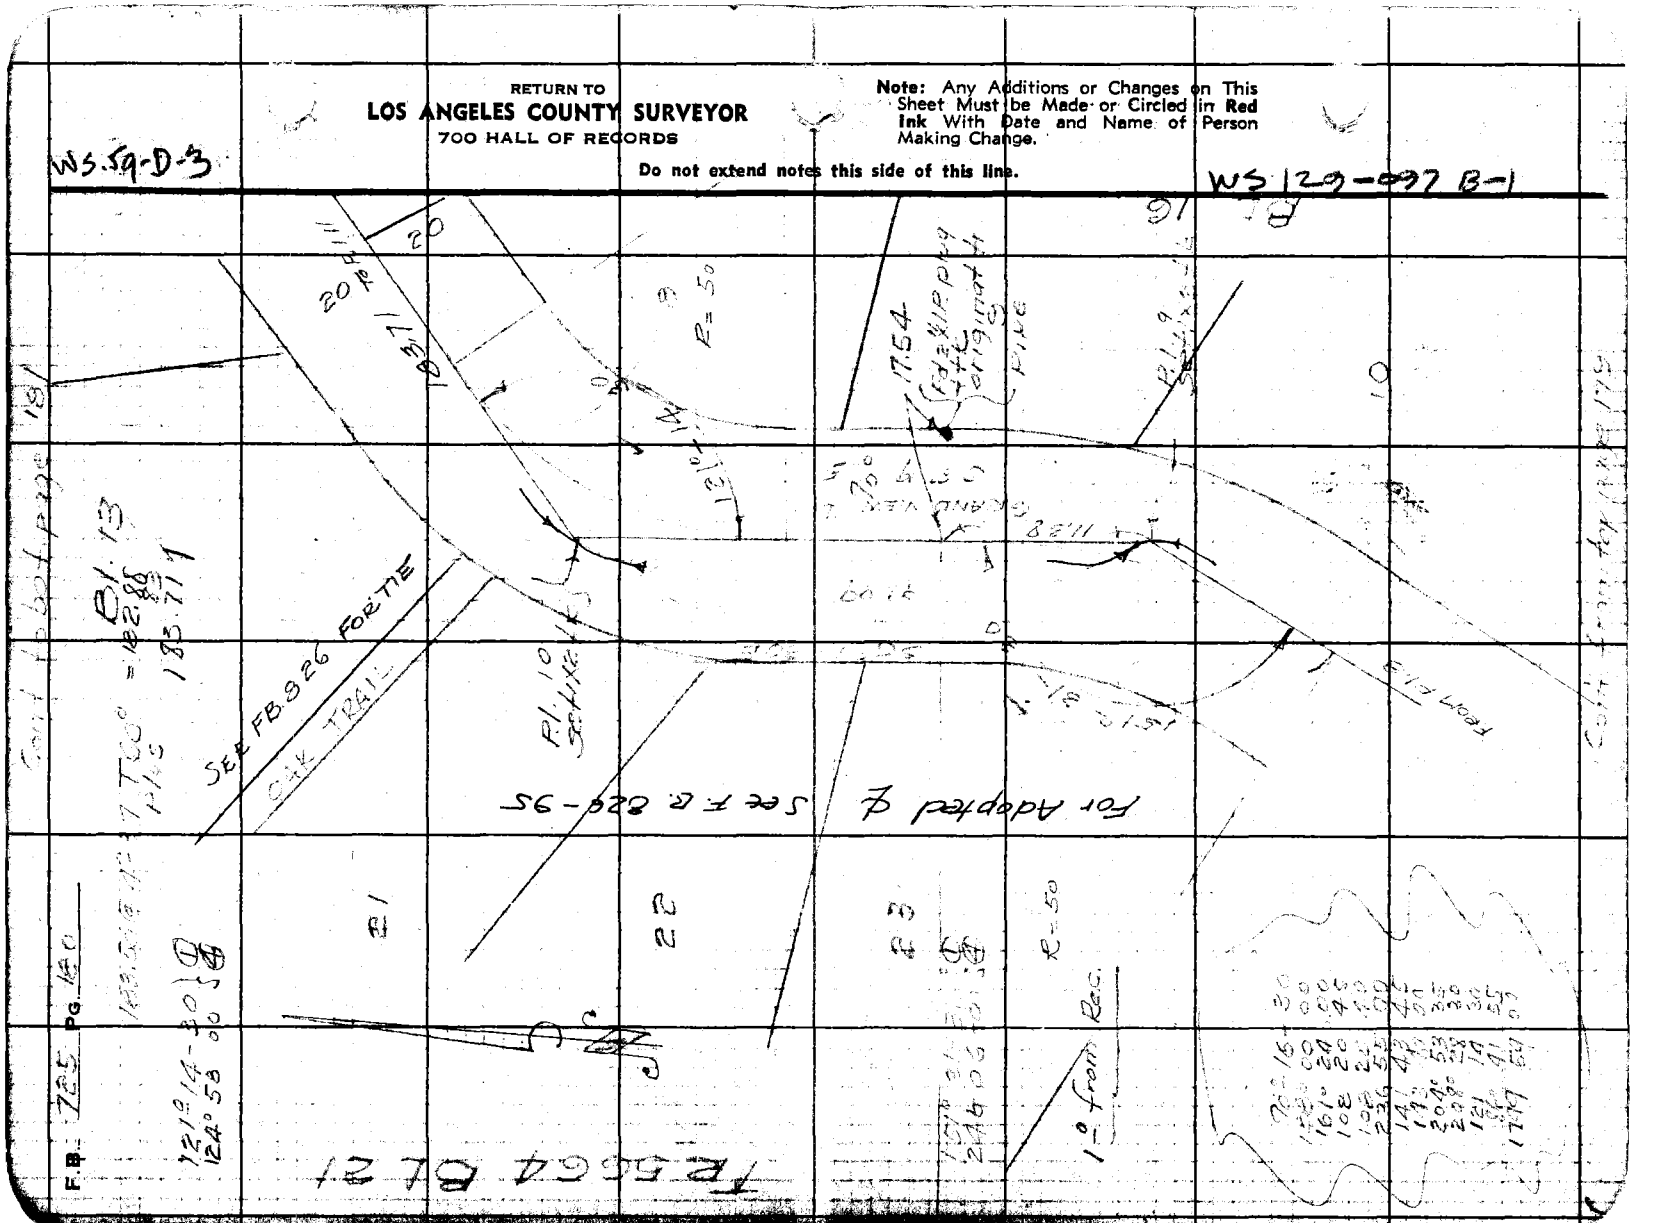

WS 57-D-5

Notes Ck'd by	Survey of
Map No. B-1631-2	W. O. 3283 Tape No. 69 Std 84°F
Office Work White	Surveyed by STEVENSON
Checked AAR	Notes T.J.S Date 1-8-40
Date 1941	Indexed

F.B. 775 Pg. 181

Note: Any Additions or Changes on This Sheet Must be Made or Circled in Red Ink With Date and Name of Person Making Change.

Do not extend notes this side of this line.

RETURN TO
LOS ANGELES COUNTY SURVEYOR
700 HALL OF RECORDS

FORM 247 FW 10-39

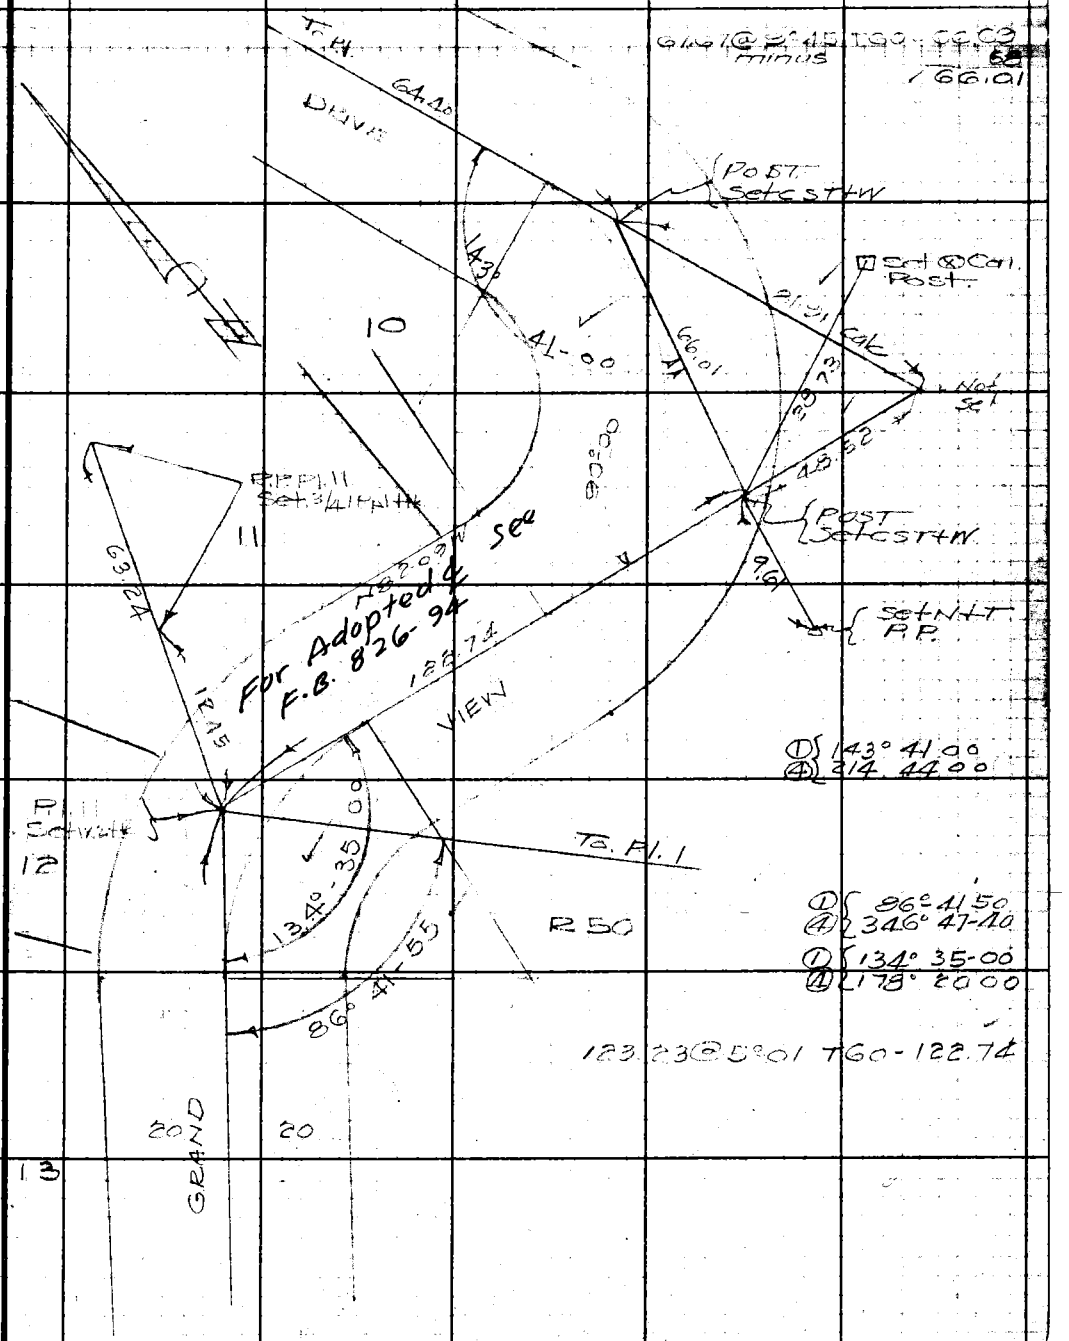

Cont. from top Page 180

RETURN TO
LOS ANGELES COUNTY SURVEYOR
700 HALL OF RECORDS

Note: Any Additions or Changes on This Sheet Must be Made or Circled in **Red Ink** With Date and Name of Person Making Change.

Do not extend notes this side of this line.

WS 54-D-3

WS 129-097 B-1

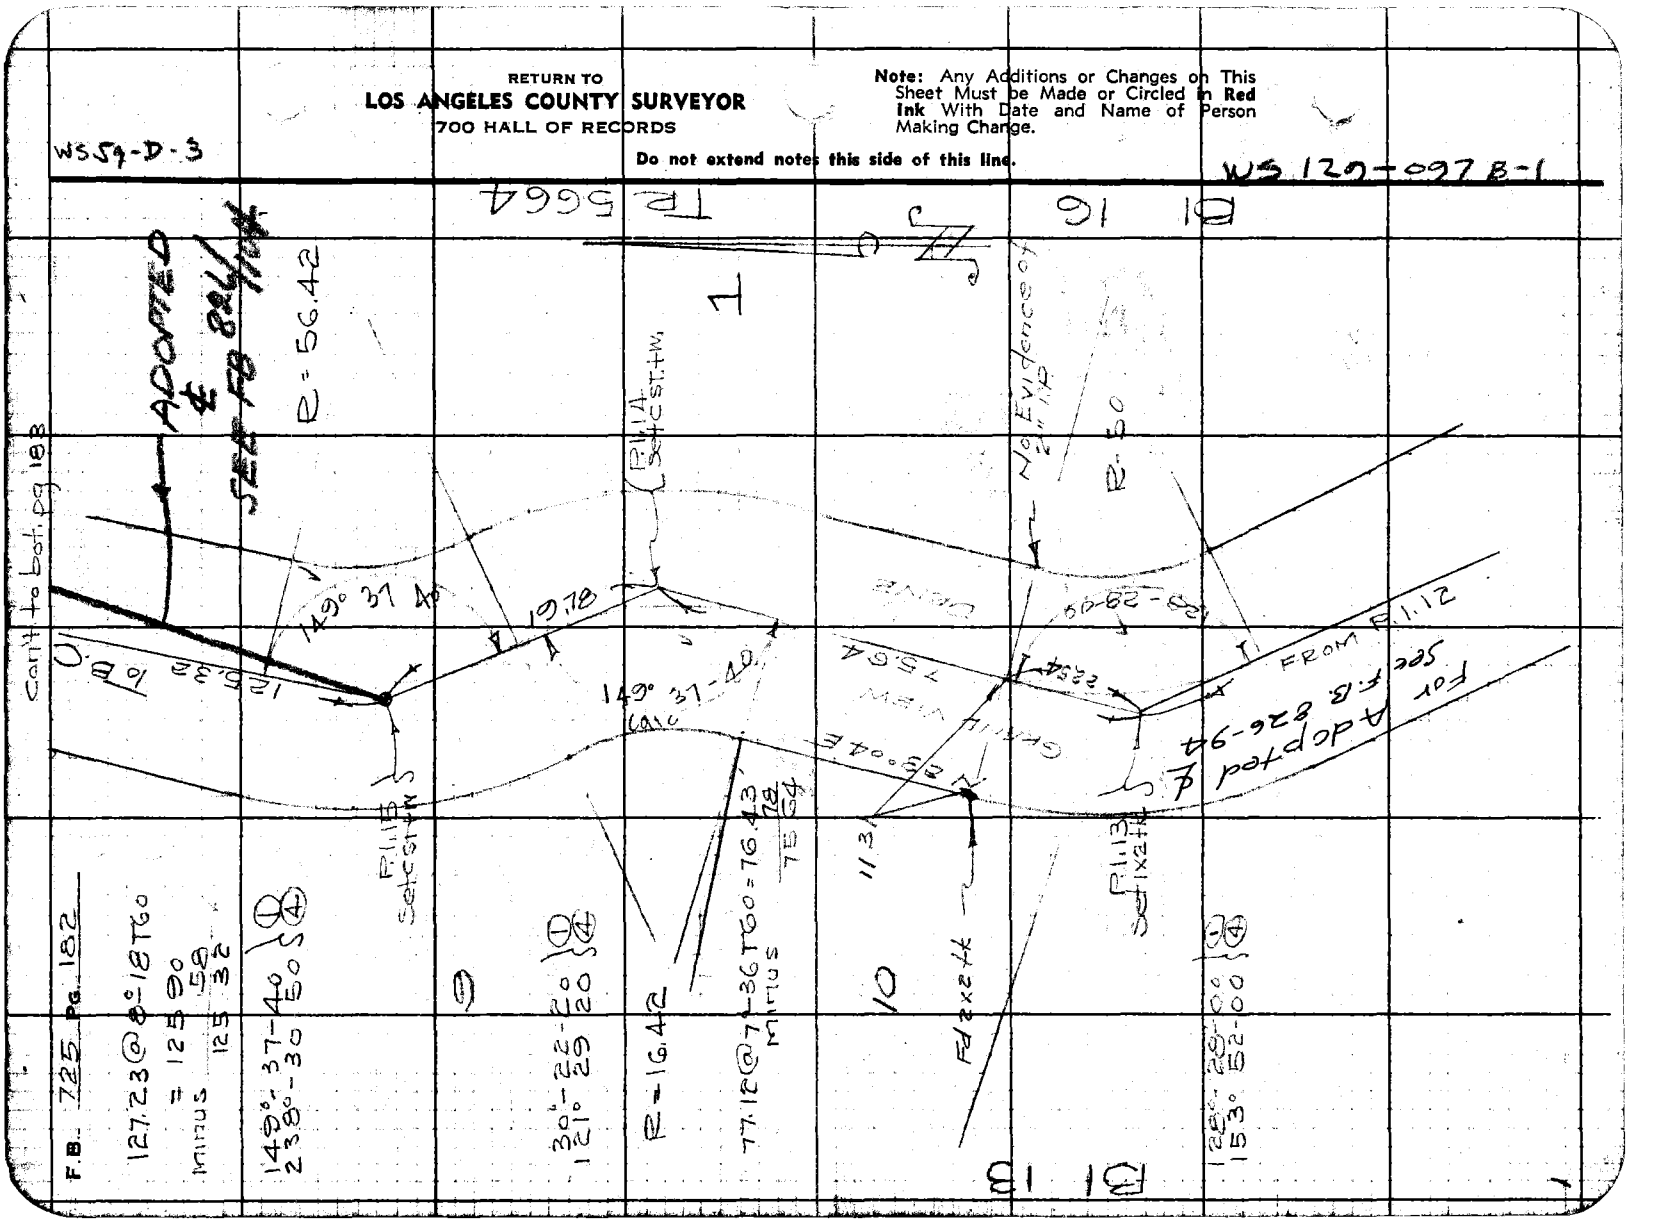

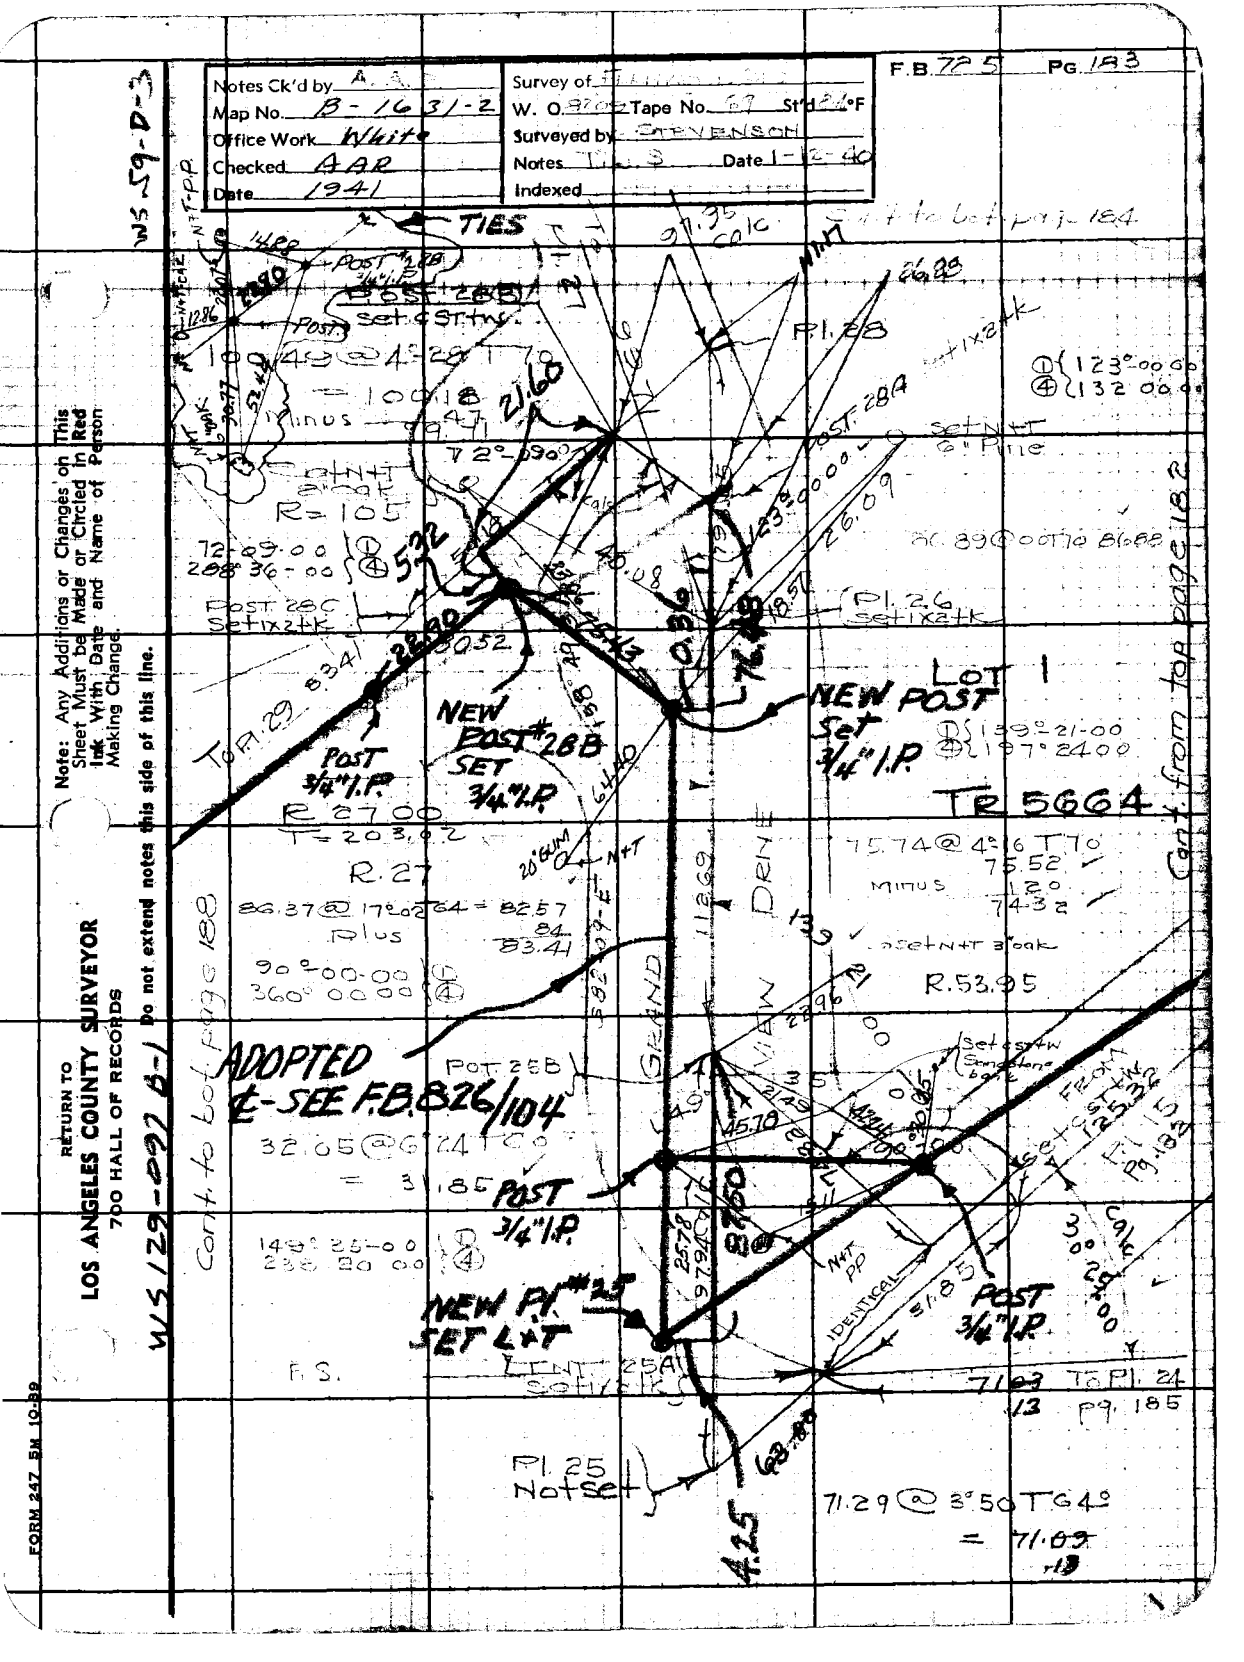
Notes Ck'd by A. A.
Map No. B-1631-2
Office Work White
Checked AAR
Date 1941
Survey of
W. O. 9702 Tape No. 67 St'd 72°F
Surveyed by STEVENSON
Notes T. L. 3 Date 1-12-40
Indexed
F.B. 725 PG. 193
WS-59-D-3
TIES
POST 28A
SET NT
POST 28B
SET ST. TW.
POST 28C
SET IX & TK
NEW POST #28B SET 3/4" I.P.
NEW POST SET 3/4" I.P.
POST 3/4" I.P.
NEW P.I. #25 SET L&T
P.I. 25 Not Set
P.I. 26
P.I. 26 SET IX & TK
LOT 1
TR 5664
R=2700
R=105
R.27
R.53.95
ADOPTED
C-SEE F.B. 826/104
POST 25B
POST 3/4" I.P.
GRAND VIEW DRIVE
IDENTICAL
F.S.
Cont. to bot. page 182
Cont. from top page 182
Cont. to bot. page 184
Cont. from top page 184
TO P.I. 24
P9. 185
RETURN TO
LOS ANGELES COUNTY SURVEYOR
700 HALL OF RECORDS
WS 129-092 B-1
Note: Any Additions or Changes on This Sheet Must be Made or Circled in Red Ink With Date and Name of Person Making Change.
Do not extend notes this side of this line.
FORM 247 5M 10-52

RETURN TO
LOS ANGELES COUNTY SURVEYOR
700 HALL OF RECORDS

Note: Any Additions or Changes on This Sheet Must be Made or Circled in **Red Ink** With Date and Name of Person Making Change.

Do not extend notes this side of this line.

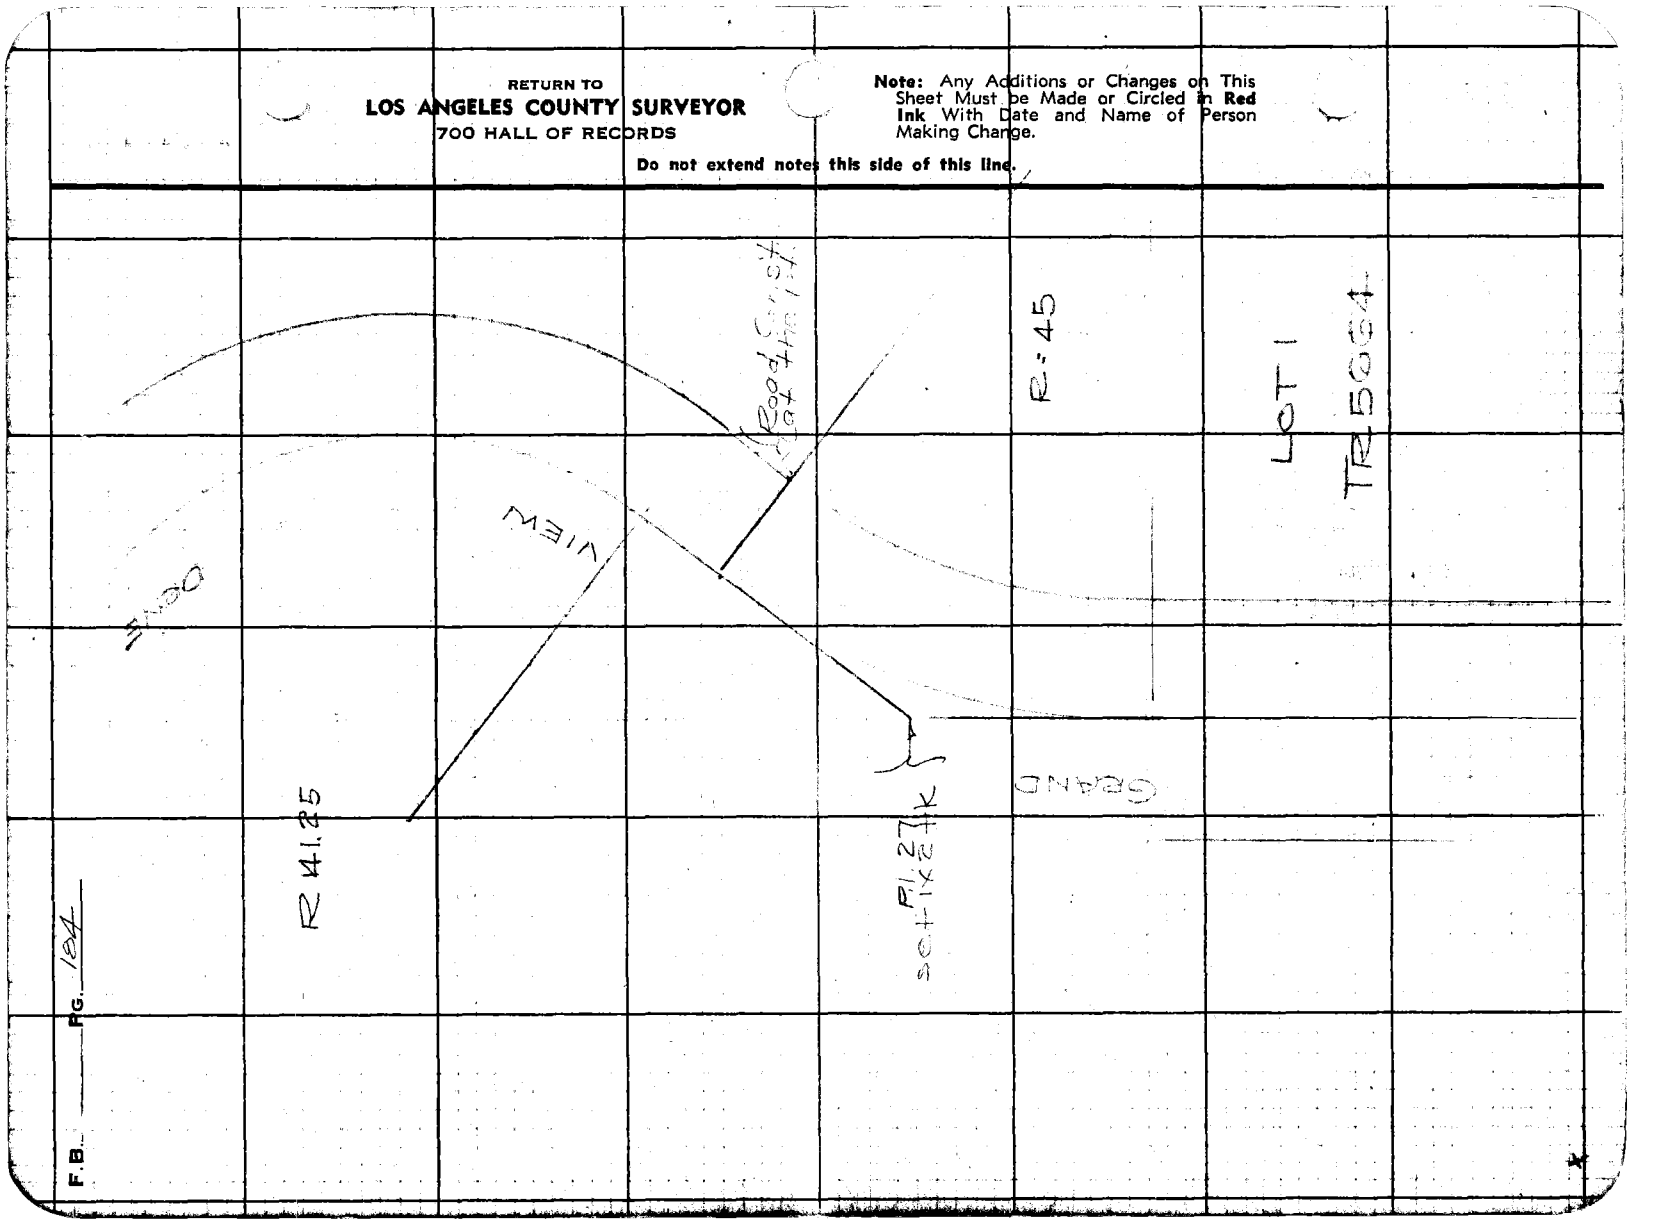

F.B. _____ PG. 184

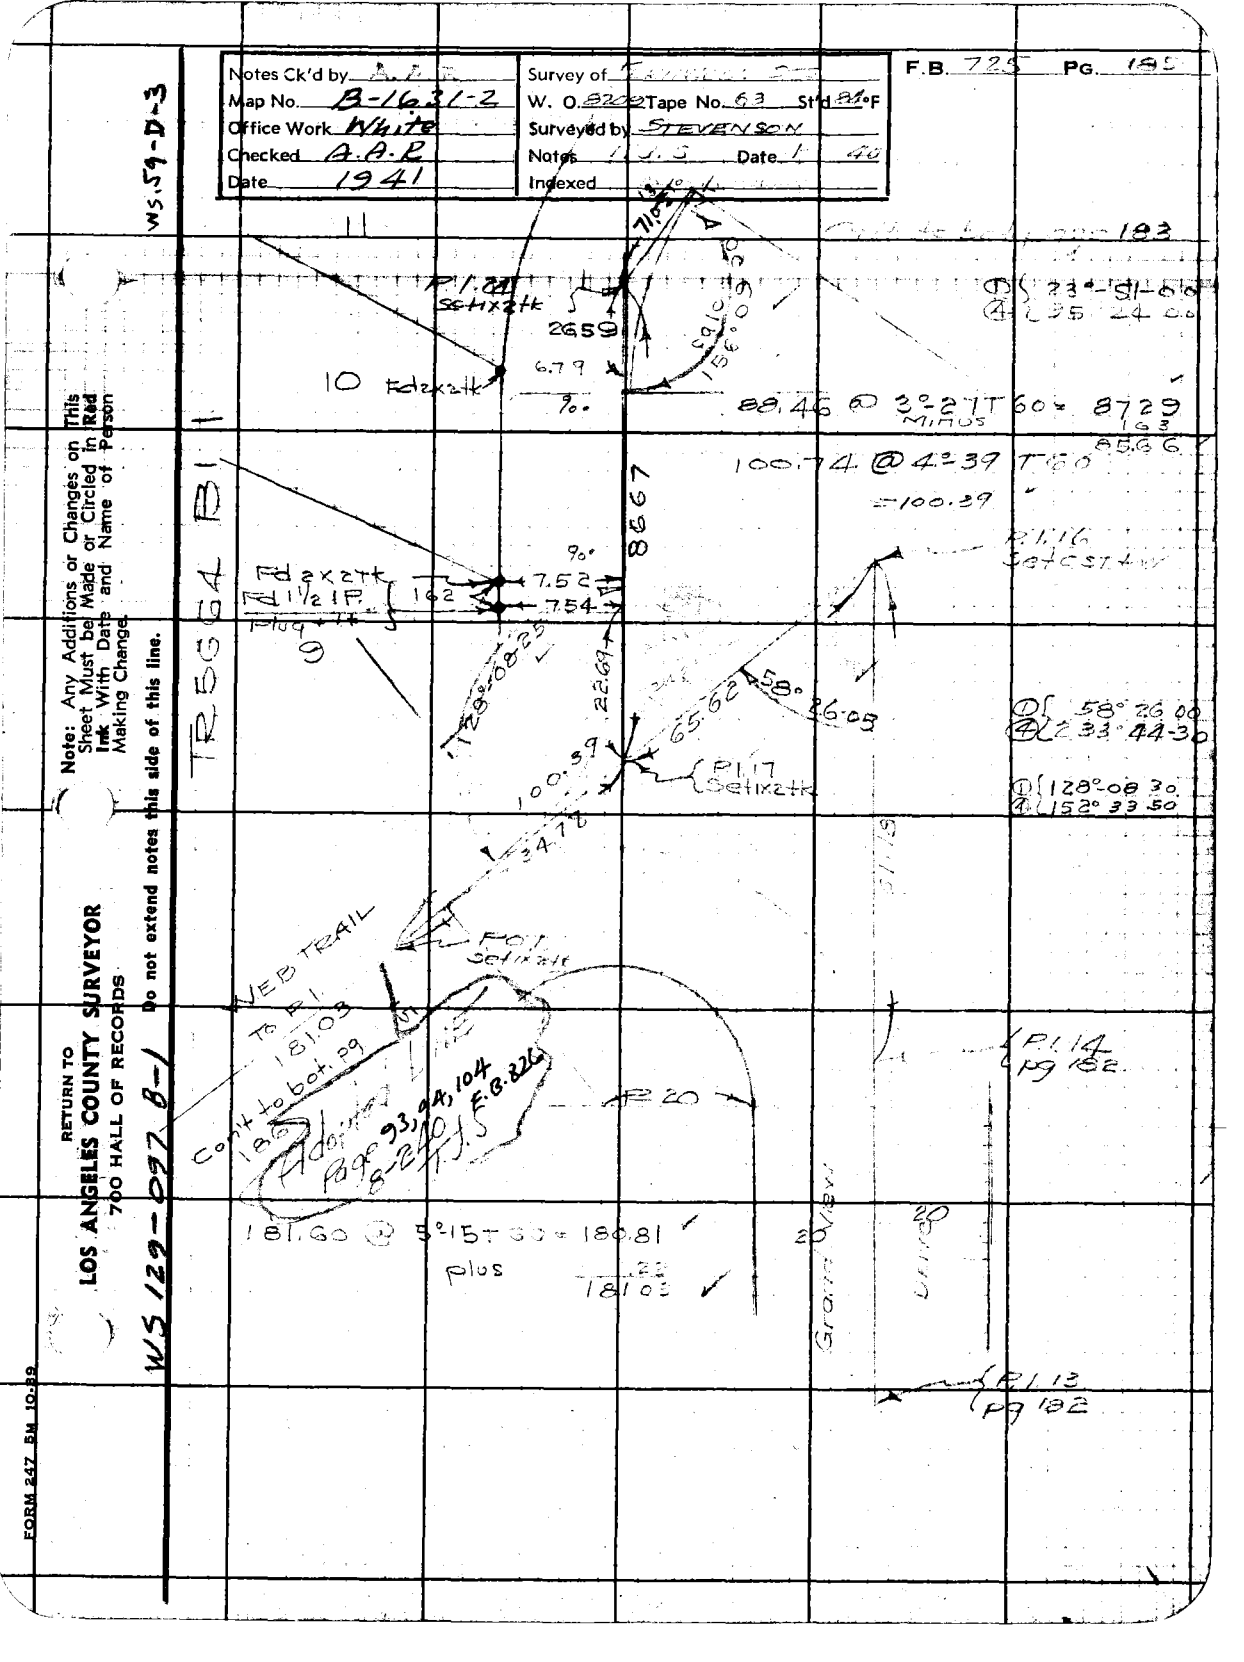
Notes Ck'd by A.P.
Map No. B-1631-2
Office Work White
Checked A.A.R
Date 1941
Survey of
W. O. 8270 Tape No. 63 St'd 71°F
Surveyed by STEVENSON
Notes J.J.S Date 1-40
Indexed
F.B. 725 Pg. 195
WS 59-D-3
WS 129-D27 B-1
RETURN TO
LOS ANGELES COUNTY SURVEYOR
700 HALL OF RECORDS
Note: Any Additions or Changes on This Sheet Must be Made or Circled in Red Ink With Date and Name of Person Making Change.
Do not extend notes this side of this line.
FORM 247 BM 10-39
TR 5564
8667
P1.22 Set 1x2 tk
2659
6.79
10 Fd 2x2 tk
88.46 @ 3°-27 T 60 = 87.29
MINUS
100.74 @ 4°-39 T 60
= 100.39
85.66
P1.16 Set 1x2 tk
7.52
7.54
162
Plug + tk
22.69
65.62
58°
26.09
100.39
P1.17 Set 1x2 tk
Δ 58° 26 00
D 233 44-30
Δ 128°-08 30
D 152° 33 50
VED TRAIL
To P1
181.03
Cont to bot pg
Page 93, 94, 104
R 20
181.60 @ 5°15 T 60 = 180.81
plus
181.03
P1.14
Pg 182
P1.13
Pg 182

F.B. 725 Pg. 186

Cont. to bot. page 187

86.92 @ 5°03 T60

86.58
3.52
90.10

3

N67°21'30"E 90.10

To P.I. 20

148°-15-00 Set N+T
233 00 00 14" oak

4

17.61 Set N+T 12" oak

19.70 148°-15-00

P.I. 19 Set CST+W

75.18 @ 3°51 T60 = 75.00
minus 74.60

5

14.48

74.60

TRAV

Set N+T 8" oak

13.27

8.12

Set N+T 6" oak

162°-08-00
298°-32-00

1943
P.I. 18
Set CST+W

6

Adopted line
F.B. 826
Pg. 93 F.B.
8-2-49
1-5-5

7

Cont. from top page 185

W 59-D-3

RETURN TO
LOS ANGELES COUNTY SURVEYOR
700 HALL OF RECORDS

Do not extend notes this side of this line.

Note: Any Additions or Changes on This Sheet Must be Made or Circled in Red Ink With Date and Name of Person Making Change.

TR 5064 B1.

W 5 120-092 B1

Notes Ck'd by	Survey of
Map No. B-1631-2	W. O. 3200 Tape No. 60 Std. 66°F
Office Work White	Surveyed by STEVENSON
Checked AAR	Notes J.S. Date
Date 1941	Indexed

F.B. 725 Pg. 187

W3.59-D-3

Cont. to p. 176

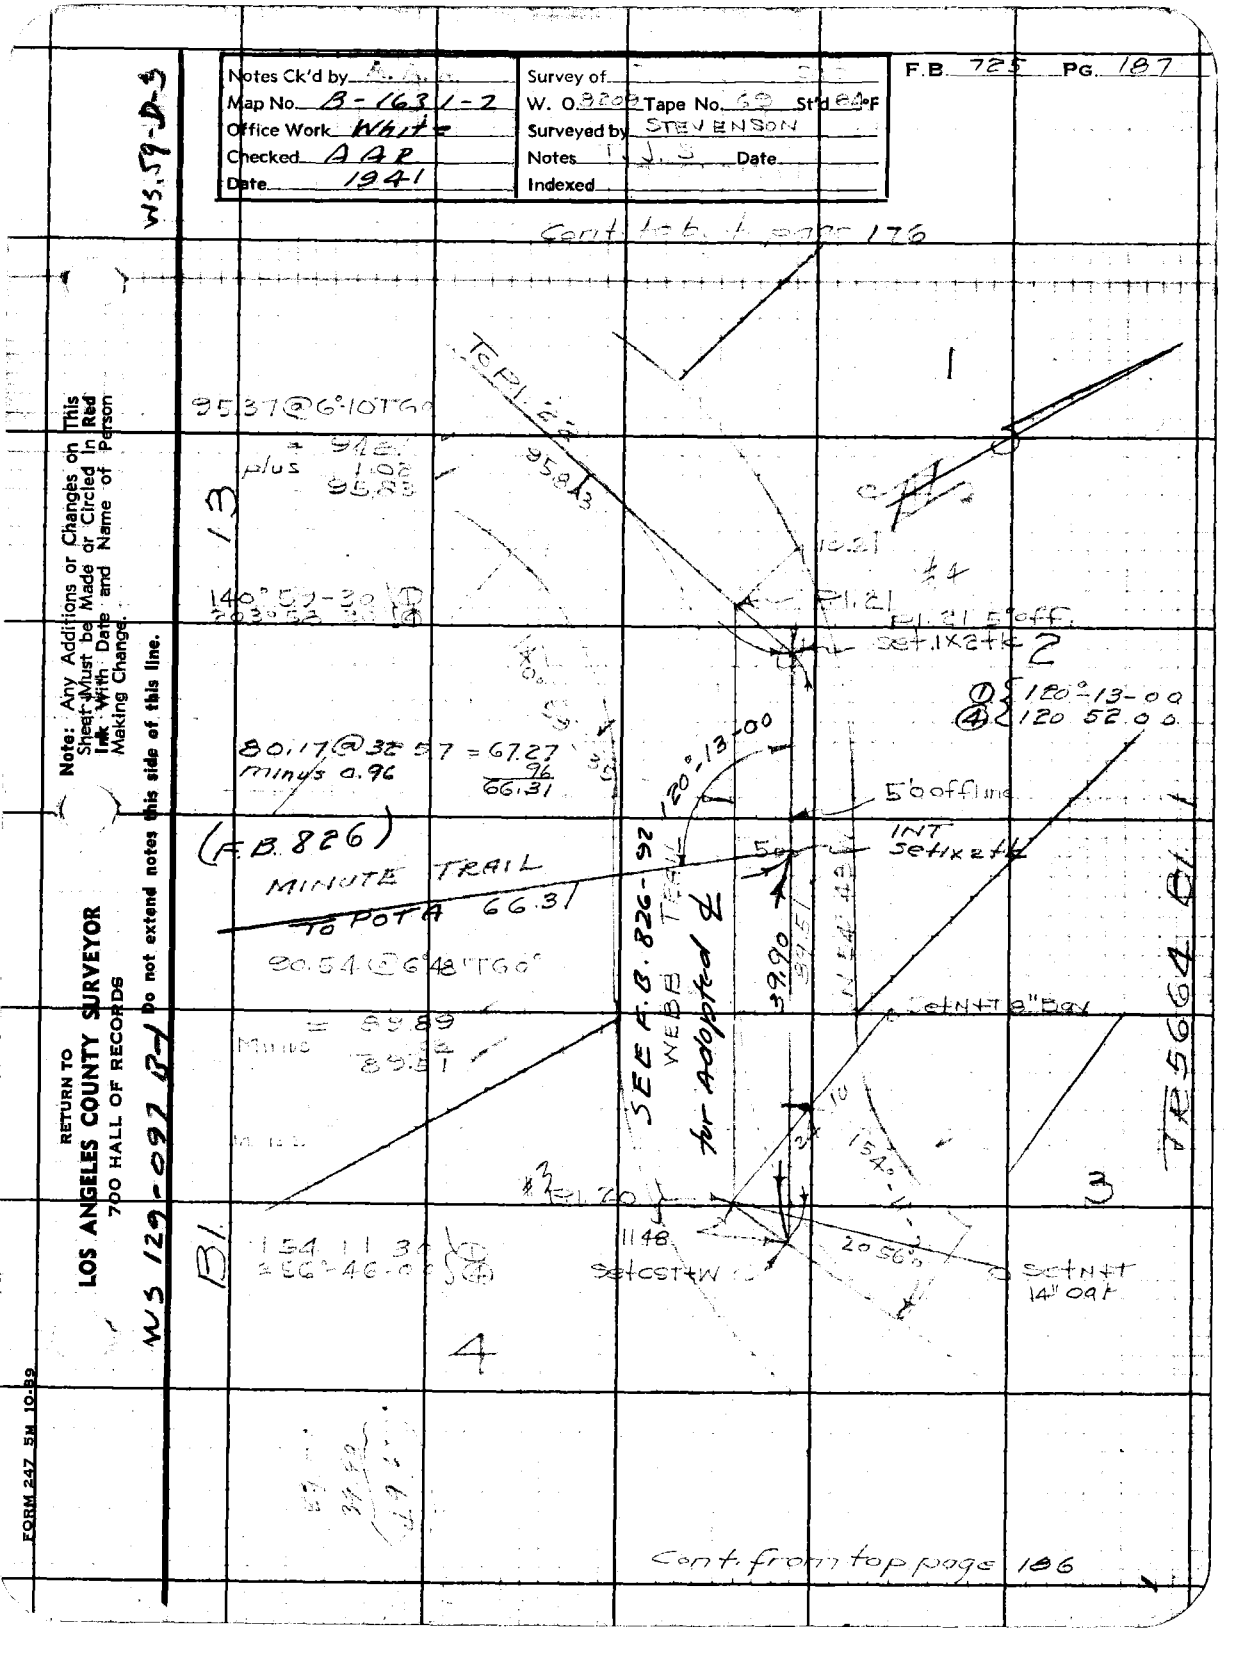

Cont. from top page 186

RETURN TO
LOS ANGELES COUNTY SURVEYOR
700 HALL OF RECORDS
WS 129-092 87

Note: Any Additions or Changes on This Sheet Must be Made or Circled In Red Ink With Date and Name of Person Making Change.
Do not extend notes this side of this line.

FORM 247 5M 10-89

F.B. 725 PG. 188

Con't to bot. page 189

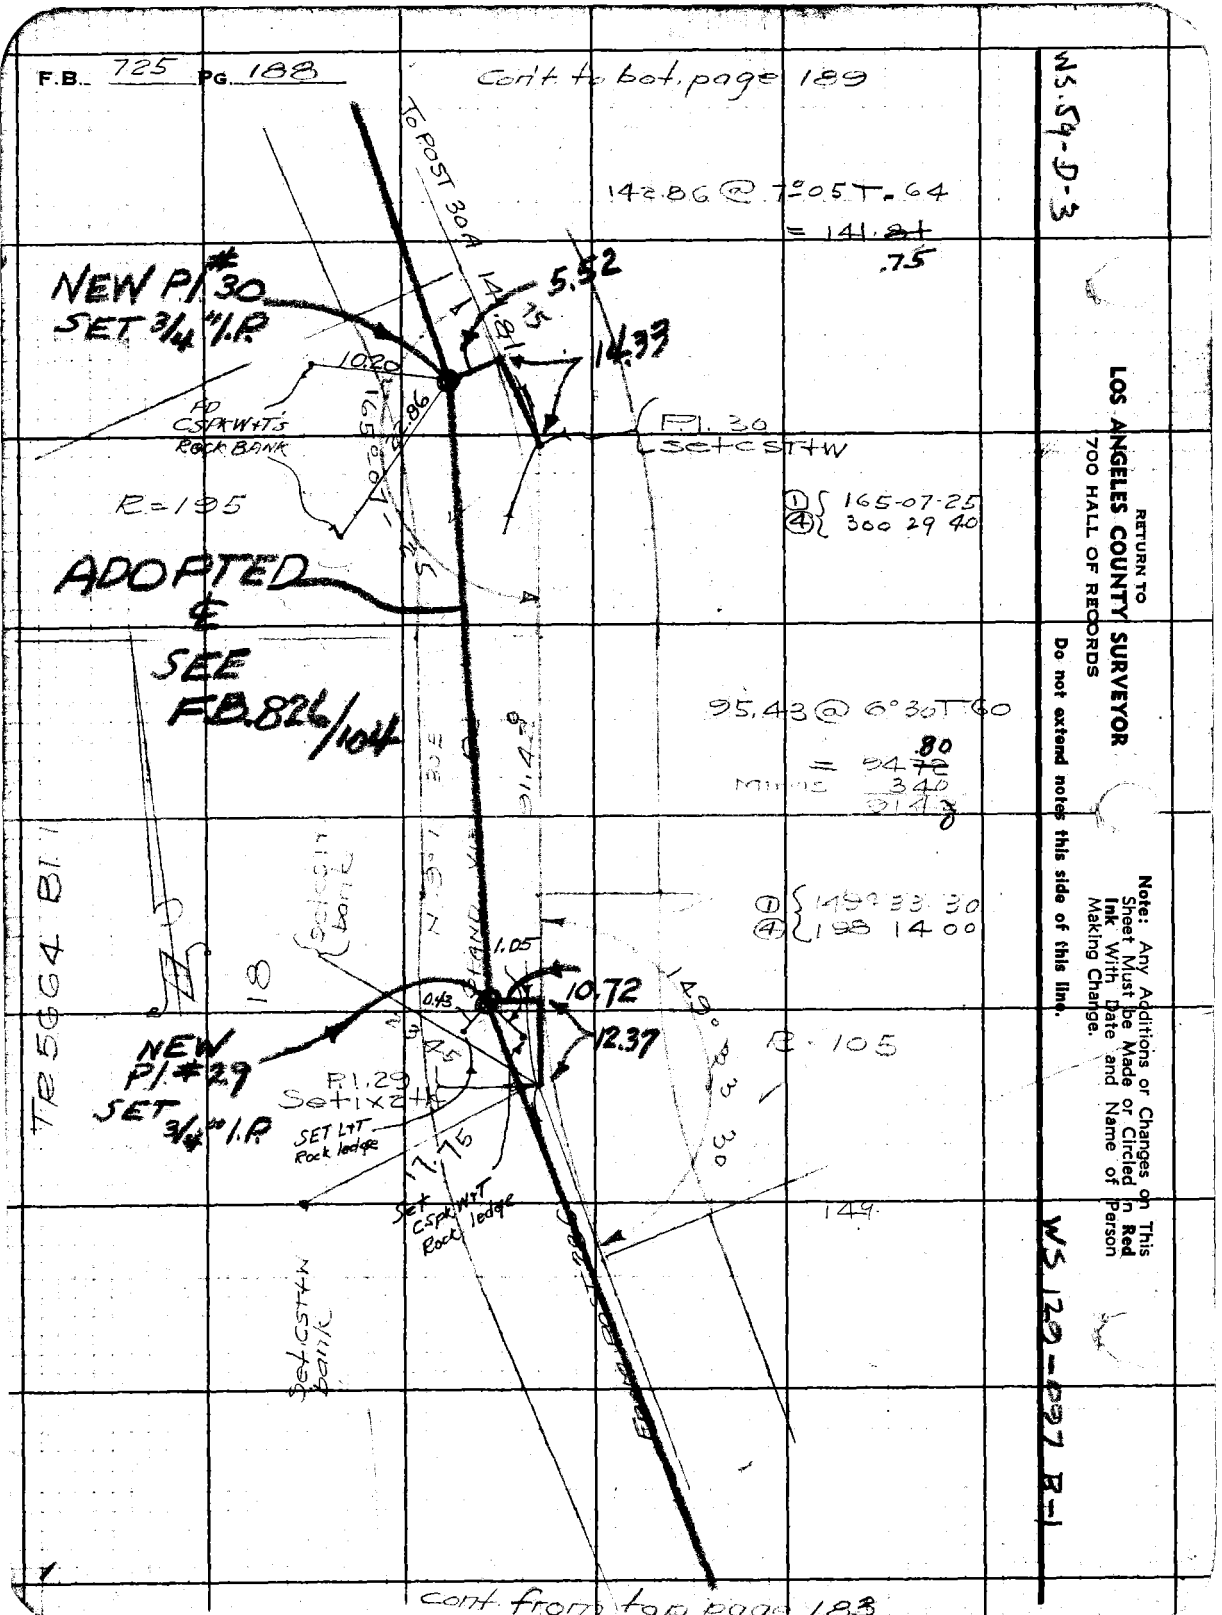

cont from top page 183

RETURN TO
LOS ANGELES COUNTY SURVEYOR
700 HALL OF RECORDS

Do not extend notes this side of this line.

Note: Any Additions or Changes on This Sheet Must be Made or Circled in Red Ink With Date and Name of Person Making Change.

W5.54-D-3

W5 129-027 B-1

W.S.59-D-3

Notes Ck'd by	Survey of Farmington Tract
Map No. B-1631-2	W. O. 8202 Tape No. 69 St'd 100'F
Office Work White	Surveyed by STEVENSON
Checked AAR	Notes T.M.S. Date 1-15-42
Date 1941	Indexed

F.B. 725 Pg. 189

Note: Any Additions or Changes on This Sheet Must be Made or Circled in Red Ink; With Date and Name of Person Making Change.

Do not extend notes this side of this line.

RETURN TO
LOS ANGELES COUNTY SURVEYOR
700 HALL OF RECORDS

FORM 247 5M 10-39

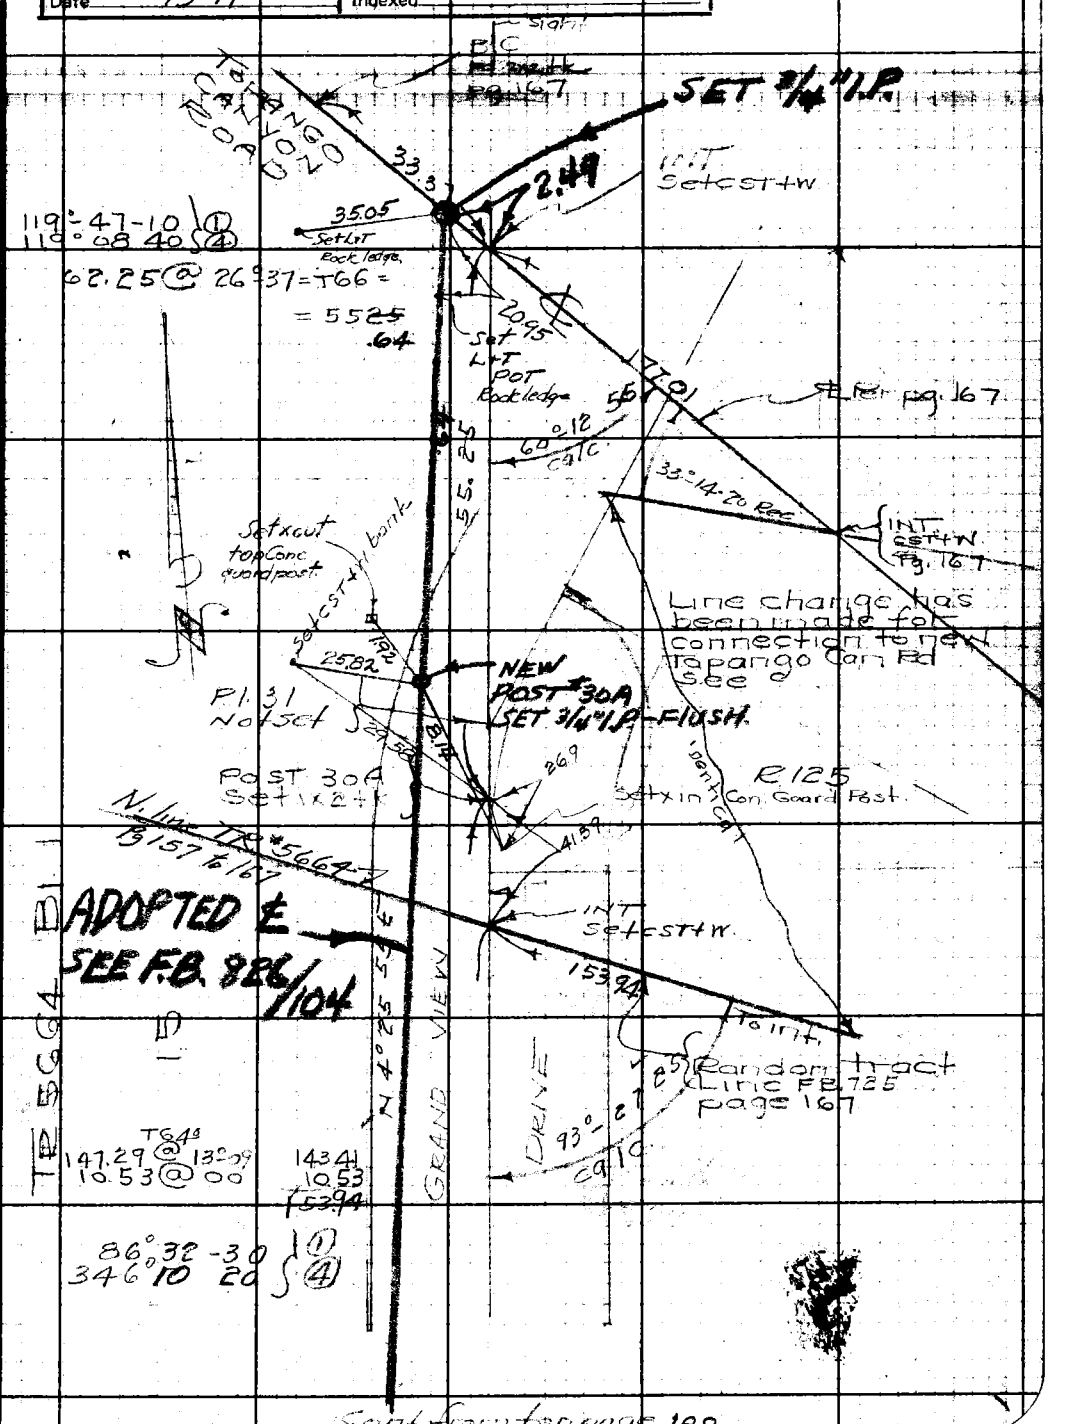

RETURN TO
LOS ANGELES COUNTY SURVEYOR
700 HALL OF RECORDS

Note: Any Additions or Changes on This Sheet Must be Made or Circled in **Red Ink** With Date and Name of Person Making Change.

Do not extend notes this side of this line.

WS 59-D-3

WS 129-092 4-1

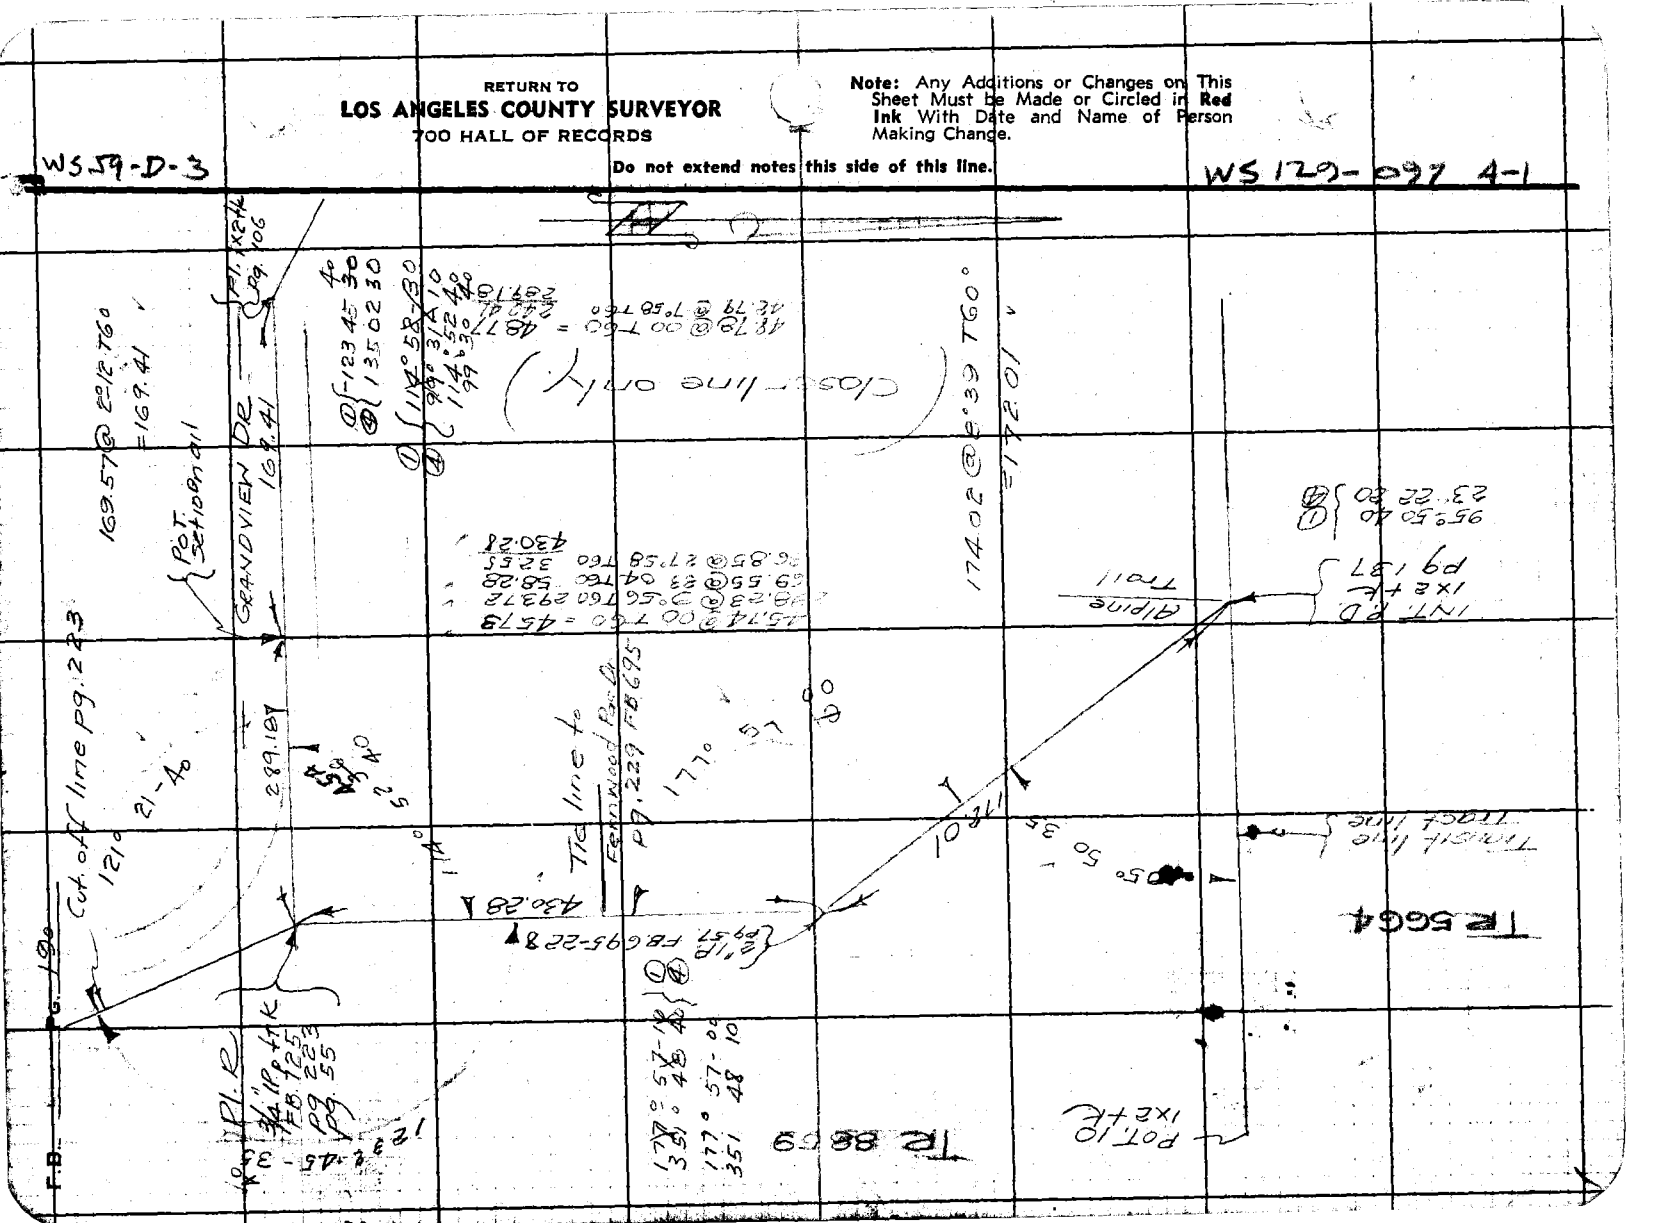

Notes Ck'd by	Survey of
Map No. B-1631-1	W. O. Tape No. St'd °F
Office Work White	Surveyed by
Checked OAR	Notes Date
Date 1941	Indexed 2-14-40

F.B. 725 PG. 191

FERNWOOD STS

J.N 8209

OBSERVATION DRIVE

T. J. Stevenson
G. H. Nichols
A. Carrasco
R. W. Scott

Note: Any Additions or Changes on This Sheet Must be Made or Circled in Red Ink With Date and Name of Person Making Change.

Do not extend notes this side of this line.

RETURN TO
LOS ANGELES COUNTY SURVEYOR
700 HALL OF RECORDS

FORM 247 5M 10-39

Cont to bot page 193

F.B. 725 Pg. 192

66.16 @ 10°49 TCO = 64.97
minus .87
64.10

WS 97-D-3

RETURN TO
LOS ANGELES COUNTY SURVEYOR
700 HALL OF RECORDS

Do not extend notes this side of this line.

Note: Any Additions or Changes on This Sheet Must be Made or Circled in Red Ink With Date and Name of Person Making Change.

WS 129-097 B-1

6

R. 50

64.10

156° 50 30
267° 22 00

5

P.I. 37
Set CS T+W
Side bank

1.65

Set CS T+W
Rock Bank

NEW
5 P.I. 37
Set 3/4" I.P.

10.63

TR 8859

ADOPTED
SEE FB 824/122

138.63 @ 5°45 TCO
= 138.99
minus 4.09
134.81

Set CS T+W
Rock Bank

Fd N+T
P.P.

3

Set CS T+W
Rock Bank

P.I. 36
Set 1X2 T+W

1.02

BENZING TRAIL
SEE PAGE 221

1.36

157° 20 00
269° 20 00

76° 40 10
306° 40 40

To 3/4 I.P.
INT. Grand View
Barlow Trail
Pg 223

NEW
P.I. 36
Set 3/4" I.P.
TIES HEREON

From P.I. 35

Cont from top page 111

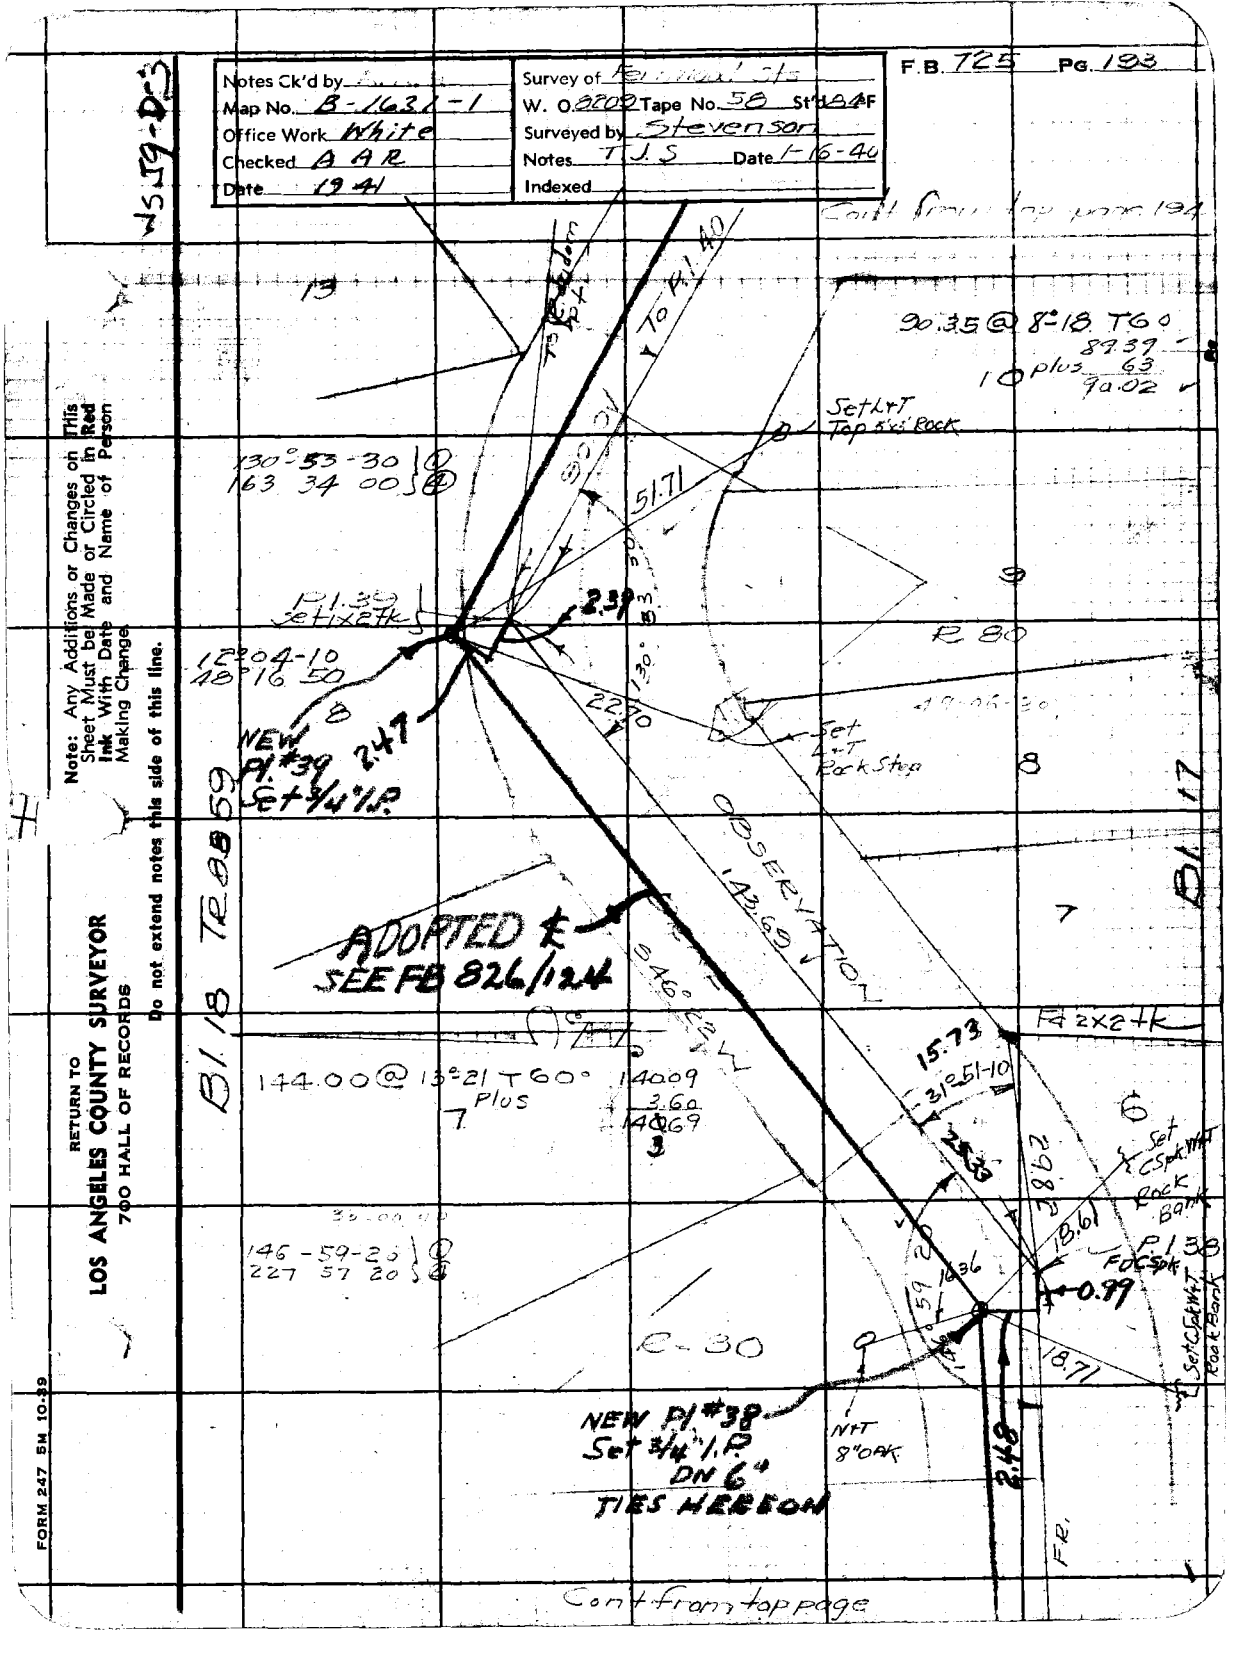
Notes Ck'd by
Map No. B-1631-1
Office Work White
Checked A A R
Date 1941
Surveyed by Stevenson
Notes T.J.S Date 1-16-40
Indexed
F.B. 725 Pg. 193
Cont from top page 194
T 8.4 dec
TO P.I. 40
90.35 @ 8°-18 T60
89.39
10 plus 63
90.02
Set LrT Top 5"x5" Rock
130°-53-30
163 34 00
51.71
P.I. 39 Set 1"x2" Pk
2.39
12°04-10
48°16 50
NEW P.I. #39 Set 3/4" I.P.
2.47
R 80
Set 4"x4" Rock Stga
OBSERVATION
183.69
ADOPTED
SEE FB 826/124
144.00 @ 13°-21 T60°
14009
7 Plus
3.60
14069
3
15.73
-31°-51-10
P.I. 38 Set 1"x2"x4"
25.29
18.62
Set CSpk WMT Rock Bank
18.61
P.I. 38 FD CSpk
+0.99
146-59-20
227 57 20
C-30
NEW P.I. #38 Set 3/4" I.P. DN 6"
TIES HEREON
NAT 8" OAK
Set CSpk WMT Rock Bank
Cont from top page
Note: Any Additions or Changes on This Sheet Must be Made or Circled in Red Ink With Date and Name of Person Making Change
Do not extend notes this side of this line.
RETURN TO
LOS ANGELES COUNTY SURVEYOR
700 HALL OF RECORDS
FORM 247 5M 10-39

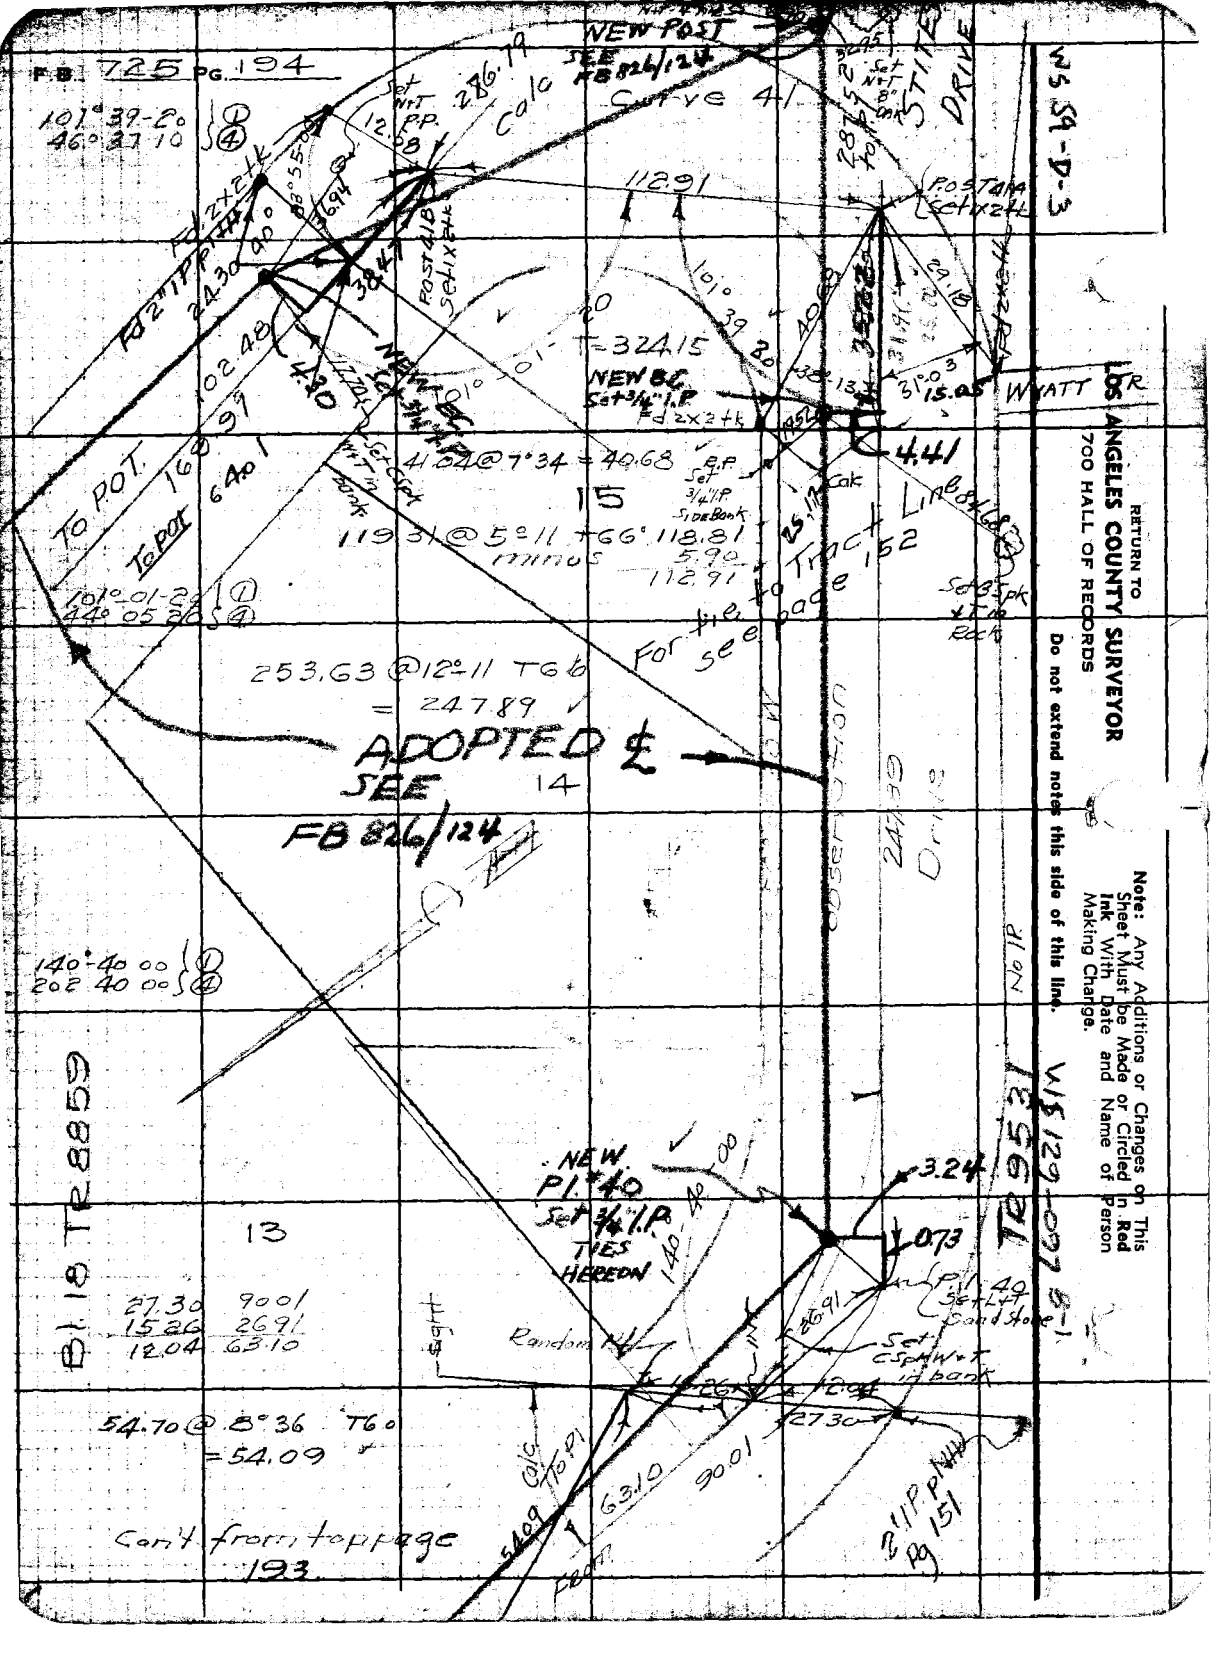
F.B. 725 PG. 194
NEW POST
SEE FB 824/124
Curve 41
Set NAIL 12 P.P.
Fd 2"x2"tk
Fd 2"TP PK
POST 418 Set 1x2 tk
POST Set 1x2 tk
112.91
Set NAIL & Tag
Set NAIL 8" in Conc
STILE
DRIVE
WS 59-D-3
LOS ANGELES COUNTY SURVEYOR
700 HALL OF RECORDS
RETURN TO
Do not extend notes this side of this line.
Note: Any Additions or Changes on This Sheet Must be Made or Circled in Red Ink With Date and Name of Person Making Change.
WYATT DR
NEW BC Set 3/4" I.P. Fd 2x2 tk
Set NAIL & Tag
Set NAIL & Tag in Book
Set 3/4" I.P. SIDEWalk
Oak
Tract 15252
Set Spk & Tag Back
Set NAIL & Tag in Book
To POT.
To POT.
ADOPTED ℄
SEE 14
FB 826/124
Observation Drive
NEW P.I. 40
Set 3/4" I.P. TIES HEREON
Set Lead & Tack
Set CS PK NAIL in Box
Random
Set Lead & Tack
Set NAIL & Tag in Box
Set NAIL & Tag
Set NAIL & Tag
Set NAIL & Tag

Date _____ Notes by _____ Chief Party _____ F.B. _____ Pg. 195

Platted by A.A.	W. O. No. 8209 D. S. O. No.
Date 1	Location
Map No. B-1631-1	Surveyed by
Platting C'k'd by AAR	Date 1-16-41
Date 1941	Indexed

W 5.59-D-1

Notes: ANY ADDITIONS OR CHANGES OF THIS SHEET MUST BE MADE OR CIRCLED IN Red. WITH DATE AND NAME OF PERSON MAKING CHANGE.

RETURN TO LOS ANGELES COUNTY SURVEYOR Do not extend notes this side of this line

W5 129-097 87

Cont to Dat page 196

NEW P.I. #43
Set 3/4" I.P

92°41'30" ①
10°46'00" ④

PUNYON Tr
Page 216
To F.I. 44A

6.93
Set boat spk
Tin Sand Stone
P.I. 43
Set x cut
7.15
90°
2.82
132.16

11.61
14.24
0.89
32°41'30"

ADOPTED & SEE F.B.
R 50 826/124

Set cut x cut Sandstone
Fd 1x2 tk
15.48
16.89 @ 88°43'10"
=

13°51 T 54°
-133.13
91
132.16

B1 18 Tr 8959

9

10

11

Observation
207.65

215.82 @ 5°47 T 50
= 214.68
Minus 207.65

147°27'00" ①
229°48'00" ④

Fd 2x2 tk

25°10
15.06
2.16
14°
R 50
NEW P.I. #42
Set 3/4" I.P
TIES HEREON

32.06
16.69.00
1955
Set boat spk
Tin Sand Stone

P.I. 42
Set CST+W

70.31 @ 22°47 T 60.0957
206
161

2.61
10.96
14.47
67.51

30.75 @ 11°20 T 6
= 30.32
set boat spk
Tin Sand Stone

POT. 42A
Set CST+W
26.09
From P.I. 41
32°35'
30°42'
15.40

Cont from top page 194

Fd 2x2 tk

F.B. 725 Pg. 196 Chief Party Notes by Date

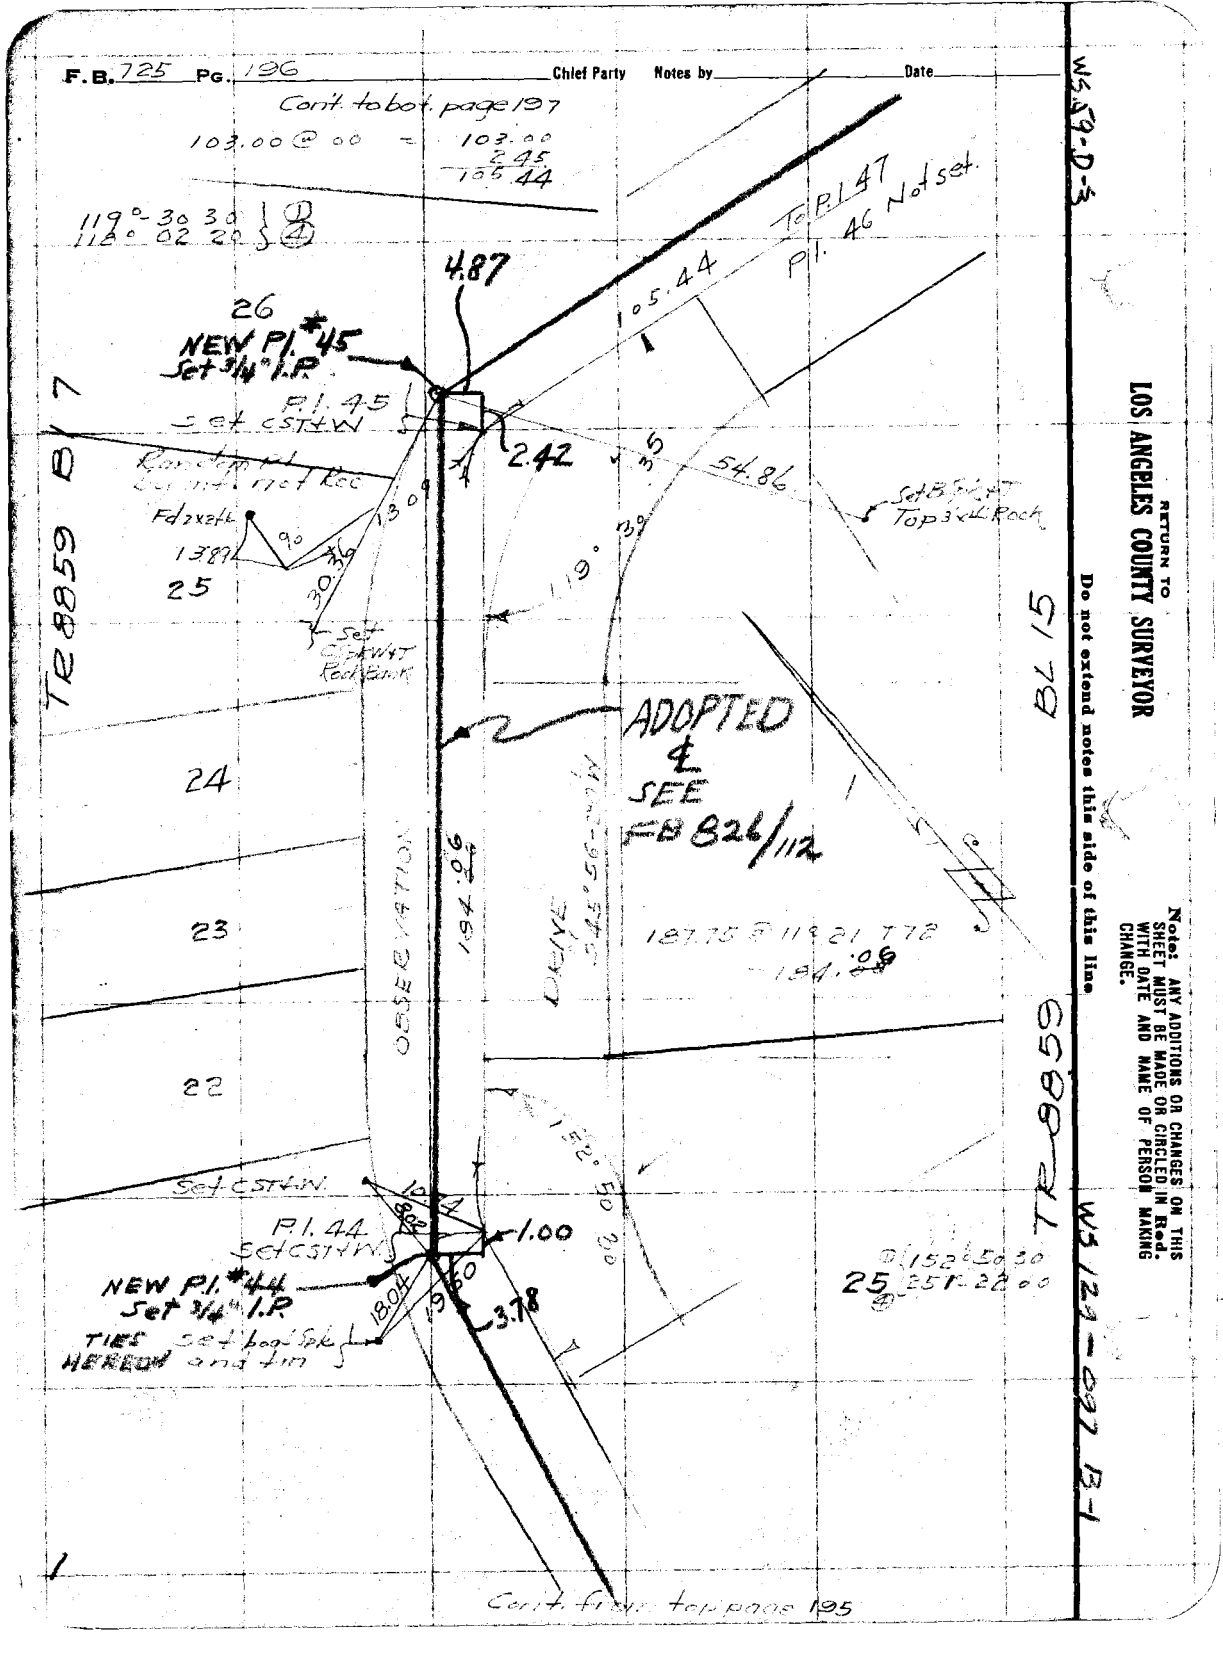

RETURN TO
LOS ANGELES COUNTY SURVEYOR

Do not extend notes this side of this line

Note: ANY ADDITIONS OR CHANGES ON THIS SHEET MUST BE MADE OR CIRCLED IN Red. WITH DATE AND NAME OF PERSON MAKING CHANGE.

Cont. from top page 195

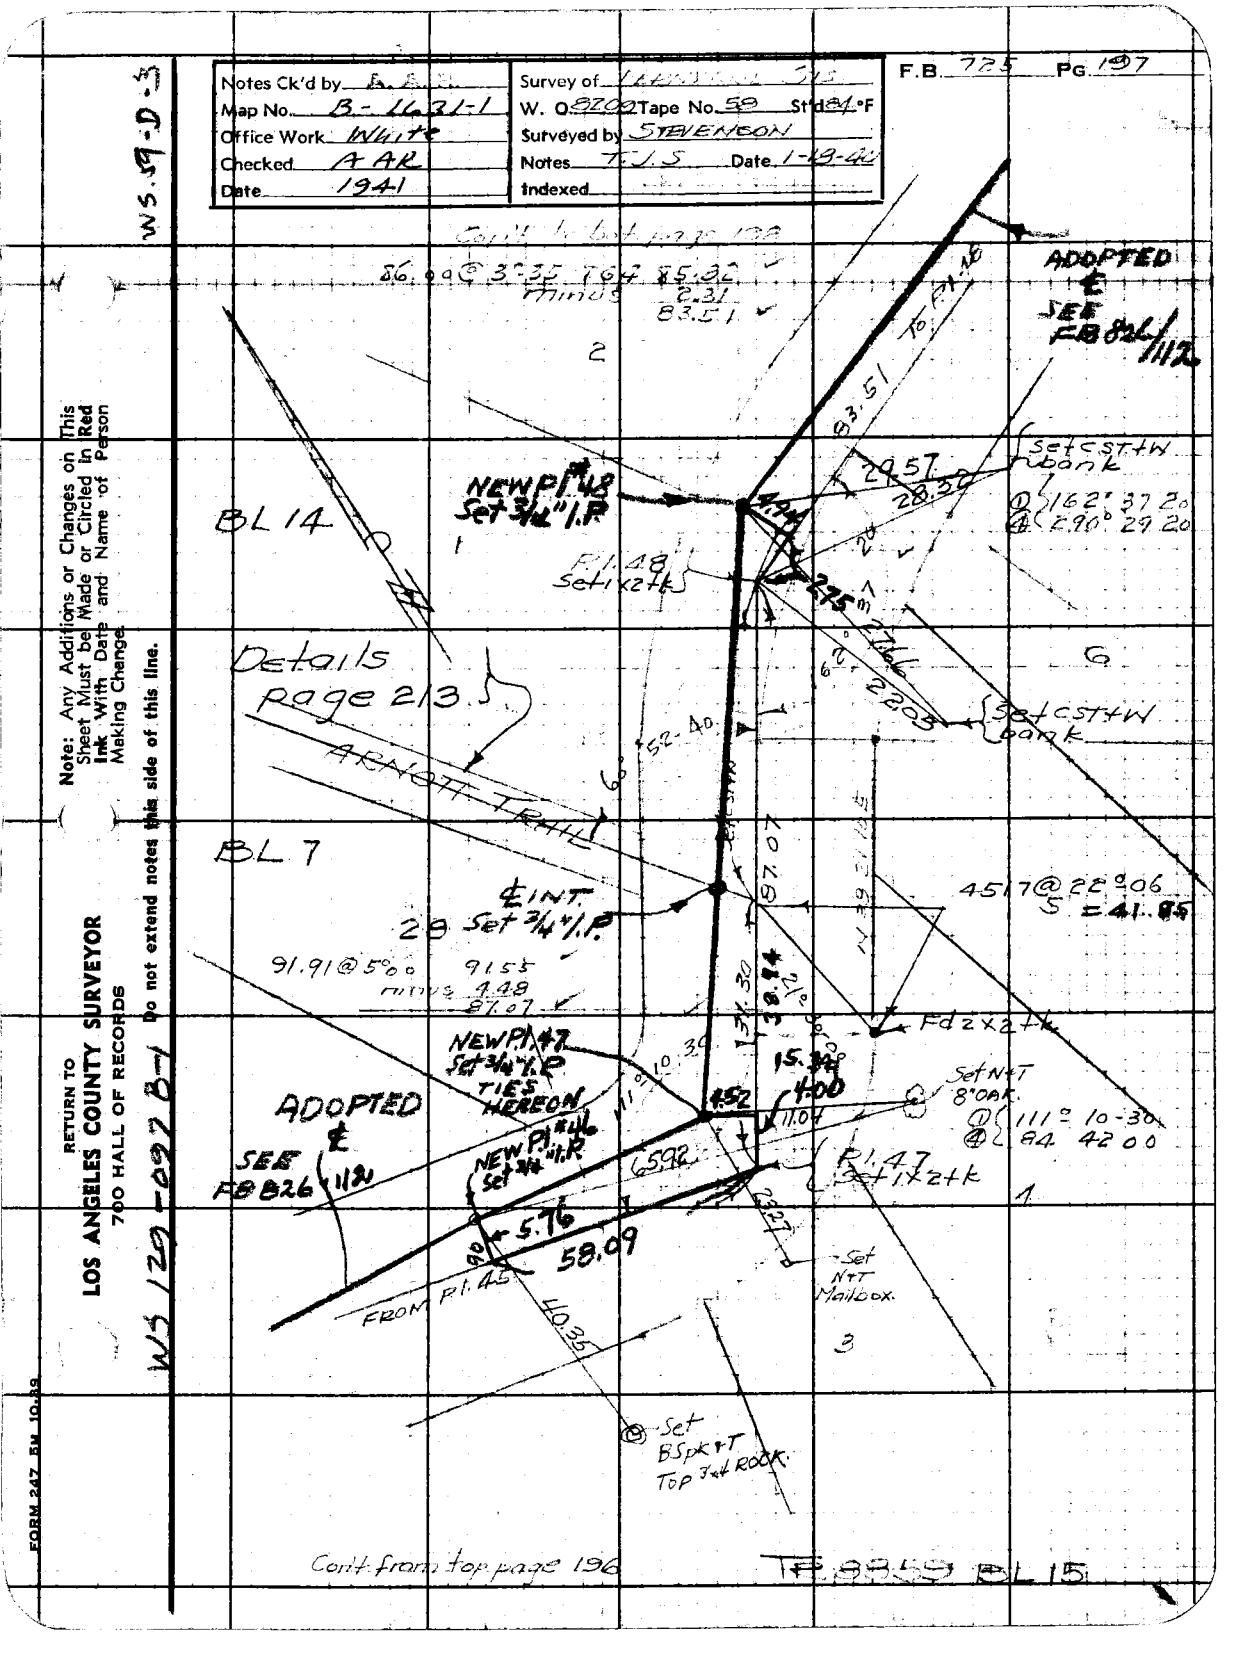
Notes Ck'd by
Map No. B-1631-1
Office Work White
Checked AAR
Date 1941
Survey of
W. O.
Tape No. 50
Std. °F
Surveyed by STEVENSON
Notes T.J.S Date 1-29-41
Indexed
F.B. 725 Pg. 197
WS 59-D-3
Note: Any Additions or Changes on This Sheet Must be Made or Circled in Red Ink With Date and Name of Person Making Change
Do not extend notes this side of this line.
RETURN TO
LOS ANGELES COUNTY SURVEYOR
700 HALL OF RECORDS
WS 129-092 B-1
FORM 247 RM 10-59
ADOPTED
SEE FB 826/1112
set CST+W bank
Details page 213
BL 7
℄ INT.
28 Set 3/4" I.P
Set B.Spk+T Top 7x4 ROCK.
Cont. from top page 196
T.R. 8359 BL 15

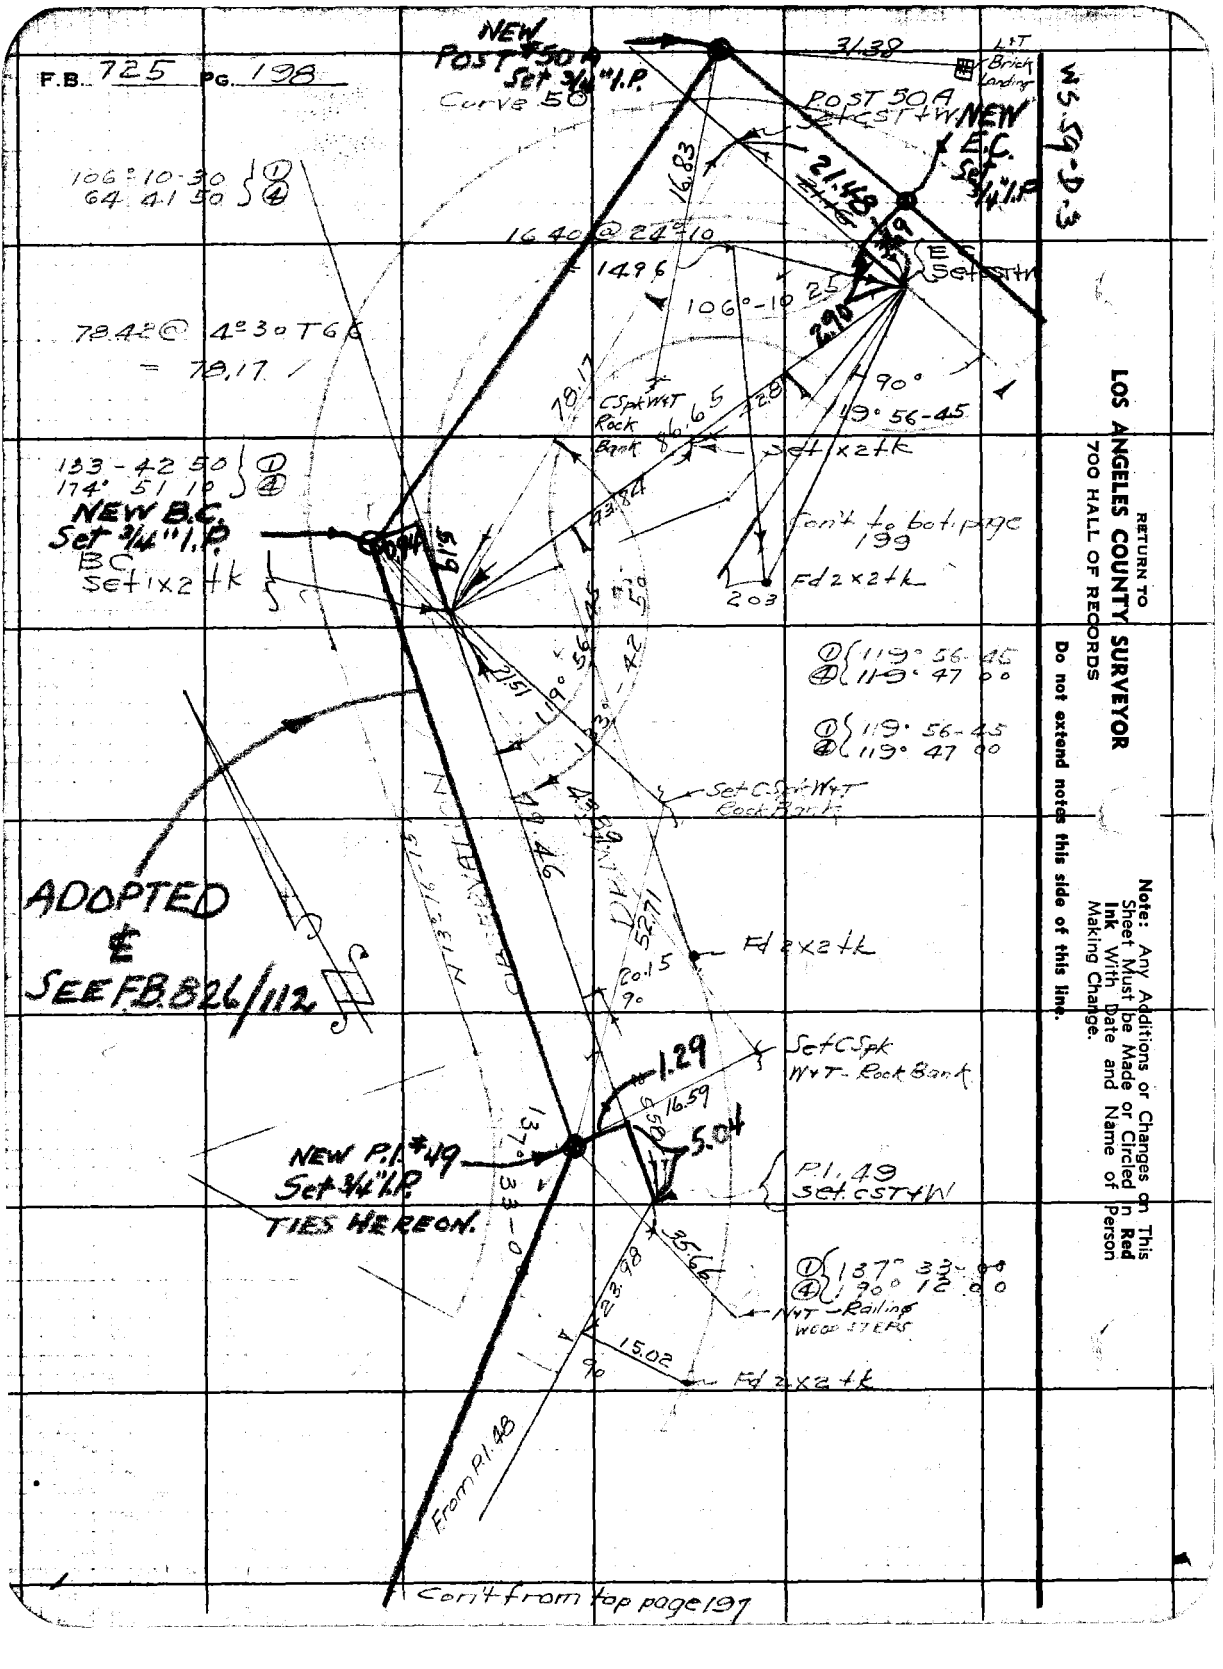
F.B. 725 PG. 198
NEW POST #50 Set 3/4" I.P.
Curve 50
POST 50A Set CST+W
NEW E.C. Set 3/4" I.P.
Brick Landing
W.S. Sq-D-3
106° 10' 30" ① ④
64 41 50
16.40 @ 22.10
1496
106°-10 25
21.48
16.83
E.C. Set Str
2.90
90°
19° 56-45
78.42 © 4° 30' T 6 B
= 78.17
78.17
C Spk W+T Rock
Bank 46.65
Set 1x2 tk
133-42 50 ① ④
174° 51 10 ④
NEW B.C. Set 3/4" I.P.
BC Set 1x2 tk
43.84
5.15
Cont to bot page 199
Fd 2x2 tk
203
119° 56-45 ①
119° 47 00 ④
119° 56-45 ①
119° 47 00 ④
Set C Spk W+T Rock Bank
ADOPTED & SEE F.B. 826/112
N 13° 26' E 75
48.46
52.71
Fd 2x2 tk
20.15
9°
Set C Spk W+T Rock Bank
1.29
16.59
5.04
NEW P.I. #49 Set 3/4" I.P. TIES HEREON.
137° 33-00
P.I. 49 Set CST+W
35.66
23.78
N+T Railing WOOD STEPS
15.02
Fd 2x2 tk
From P.I. 48
Cont from top page 197
RETURN TO
LOS ANGELES COUNTY SURVEYOR
700 HALL OF RECORDS
Do not extend notes this side of this line.
Note: Any Additions or Changes on This Sheet Must be Made or Circled in Red Ink With Date and Name of Person Making Change.

W5.59-D-3

Notes Ck'd by	Survey of FERNWOOD T.J.S
Map No. B-1631-1	W. O. 8209 Tape No. 59 Std. 84°F
Office Work White	Surveyed by STEVENSON
Checked AAR	Notes T.J.S Date 1-
Date 1941	Indexed

F.B. 725 PG. 199

Cont. to Corr. p. 200

53.26 @ 2°-20 T64
53.21
minus 30
52.91 ✓

169°-47-00 ① 20
319°-08-00 ④
09 90

P.I. 32 set C St. H.W.

NEW P.I. #32
SET ¾" I.P.

79.32 @ 1°-22 - 7189
minus 30
78.91 ✓

ADOPTED &
SEE
FB 826/112 & 126

157°-42-30 ① 20
270°-50-00 ④
49 10

NEW P.I. #51
SET ¾" I.P.

Cont. from top page 198

63.19 @ 8°-09 T64
-.54
minus 1-5
58.99

Note: Any Additions or Changes on This Sheet Must be Made or Circled in Red Ink With Date and Name of Person Making Change
Do not extend notes this side of this line.

RETURN TO
LOS ANGELES COUNTY SURVEYOR
700 HALL OF RECORDS

FORM 247 EM 10-39

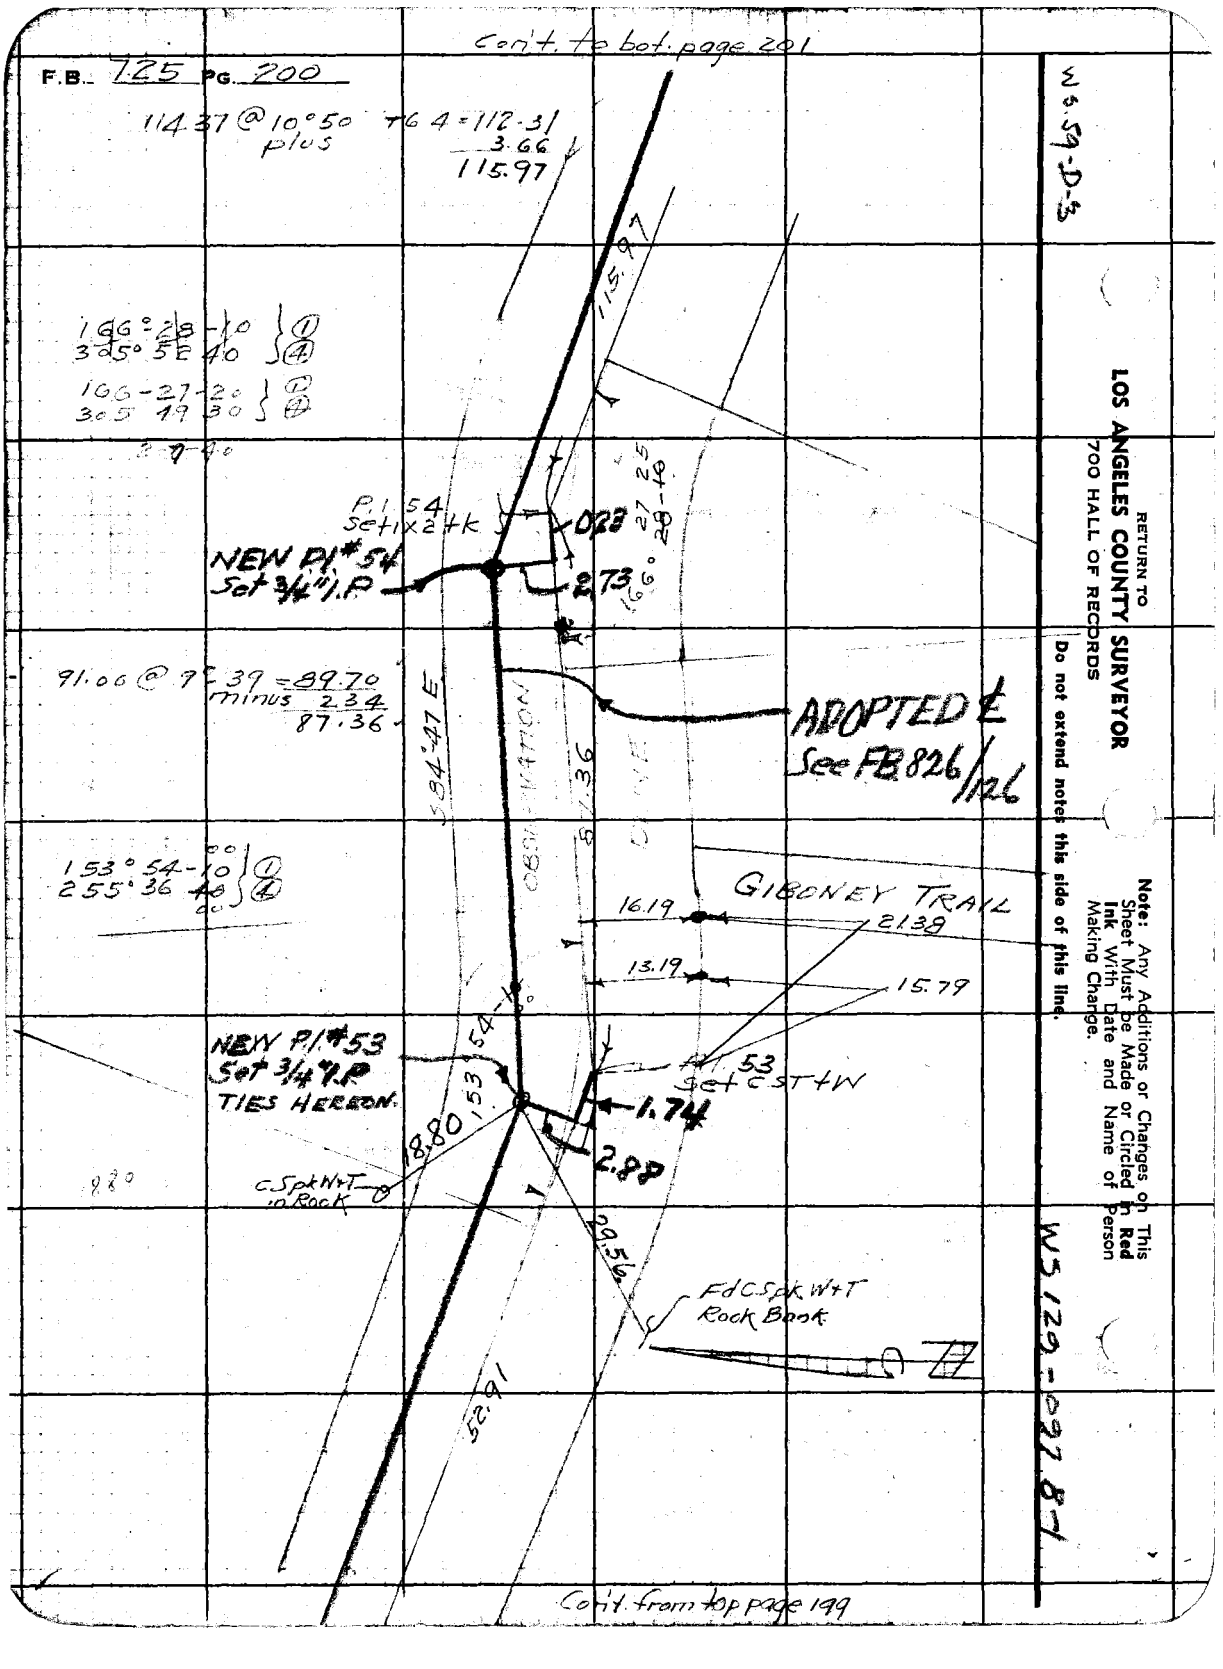
Con't to bot. page 201
F.B. 725 PG. 200
114.37 @ 10°50 plus
T6 4 = 112.31
3.66
115.97
115.97
166°28'10" ①
345°5E 40 ④
166-27-20 ②
345 19 30 ③
P.I. 54
Set 1x24k
028
NEW P.I. #54
Set 3/4" I.P
2.73
91.00 @ 7°39 = 89.70
minus 2.34
87.36
S 94°47 E
87.36
ADOPTED ℄
See FB 826/126
153°54'10" ①
255°36'40" ④
GIBONEY TRAIL
16.19
21.39
13.19
15.79
NEW P.I. #53
Set 3/4" I.P
TIES HEREON.
18.80
153°54'
P.I. 53
Set CST+W
1.74
2.88
C.S.pk W+T
in Rock
29.56
Fd C.S.pk W+T
Rock Book
52.91
Con't from top page 199
RETURN TO
LOS ANGELES COUNTY SURVEYOR
700 HALL OF RECORDS
Do not extend notes this side of this line.
Note: Any Additions or Changes on This Sheet Must be Made or Circled in Red Ink With Date and Name of Person Making Change.
W 5 59-D-5
WS 129-027 8-1

Notes Ck'd by A.A.R.	Survey of Fernwood St's
Map No. B-1631-1	W. O. 8209 Tape No. Std. °F
Office Work White	Surveyed by Stevenson
Checked A.A.R.	Notes T.J.S. Date
Date 1941	Indexed

F.B. 175 Pg. 201

Cont. to bot page 202

POT 2 1x2 ft ↑↓

PPP Set 3/4" I.P.

55.04 @ 13°29 T60
= 53.51
minus 4.71
49.80

29.93

0.82

0.90

0.95

LET

NEW Pl. #56
Set 3/4" I.P.

Pl. 56
Set C ST+W

① 131° 59 20
④ 167° 57 20

28.27 @ 12°45 = 2.708

89.58 @ 13°51 = 8.696

minus 513
8.183

131°

59.50

40

32.00

27.83

72° 59

Random lot line

60.36

Cont. from pg 202

R.P. Pl. 56
Set 3/4" I.P.

LOT 20

Set C ST+W

ADOPTED &
SEE F.B. 826/126

TR 8859

B1.14

79°-59-40 ①
319° 58. 40 ④

S 89° 22. 50 E

OBSERVATION

Set 3/4" I.P.
by INT.-RAP's

47.66 @ 6°08 T60
= 47.38
.271
44.67

44.67
9-11-40
41.68
DEPTH

73.57

35
50

52

NEW Pl. #55
Set 3/4" I.P.
TIES HEREON

161°

Pl. 55
Set C ST+W

① 161° 51 30
④ 287° 29 20
① 161°-51 20
④ 287° 29 20

1.73 18.36

0.72

Set L+T
on Brick Step
Fd. 2x2 ft (3rd ")

10.73

29.76

29.76

17.89

Fd. 2x2 ft

Set
B.Spk+T
side Rock

Cont. from top pg 200

RETURN TO
LOS ANGELES COUNTY SURVEYOR
700 HALL OF RECORDS

Note: Any Additions or Changes on This Sheet Must be Made or Circled in Red Ink With Date and Name of Person Making Change.

Do not extend notes this side of this line.

FORM 247 5M 10-39

F.B. _____ Pg. 202

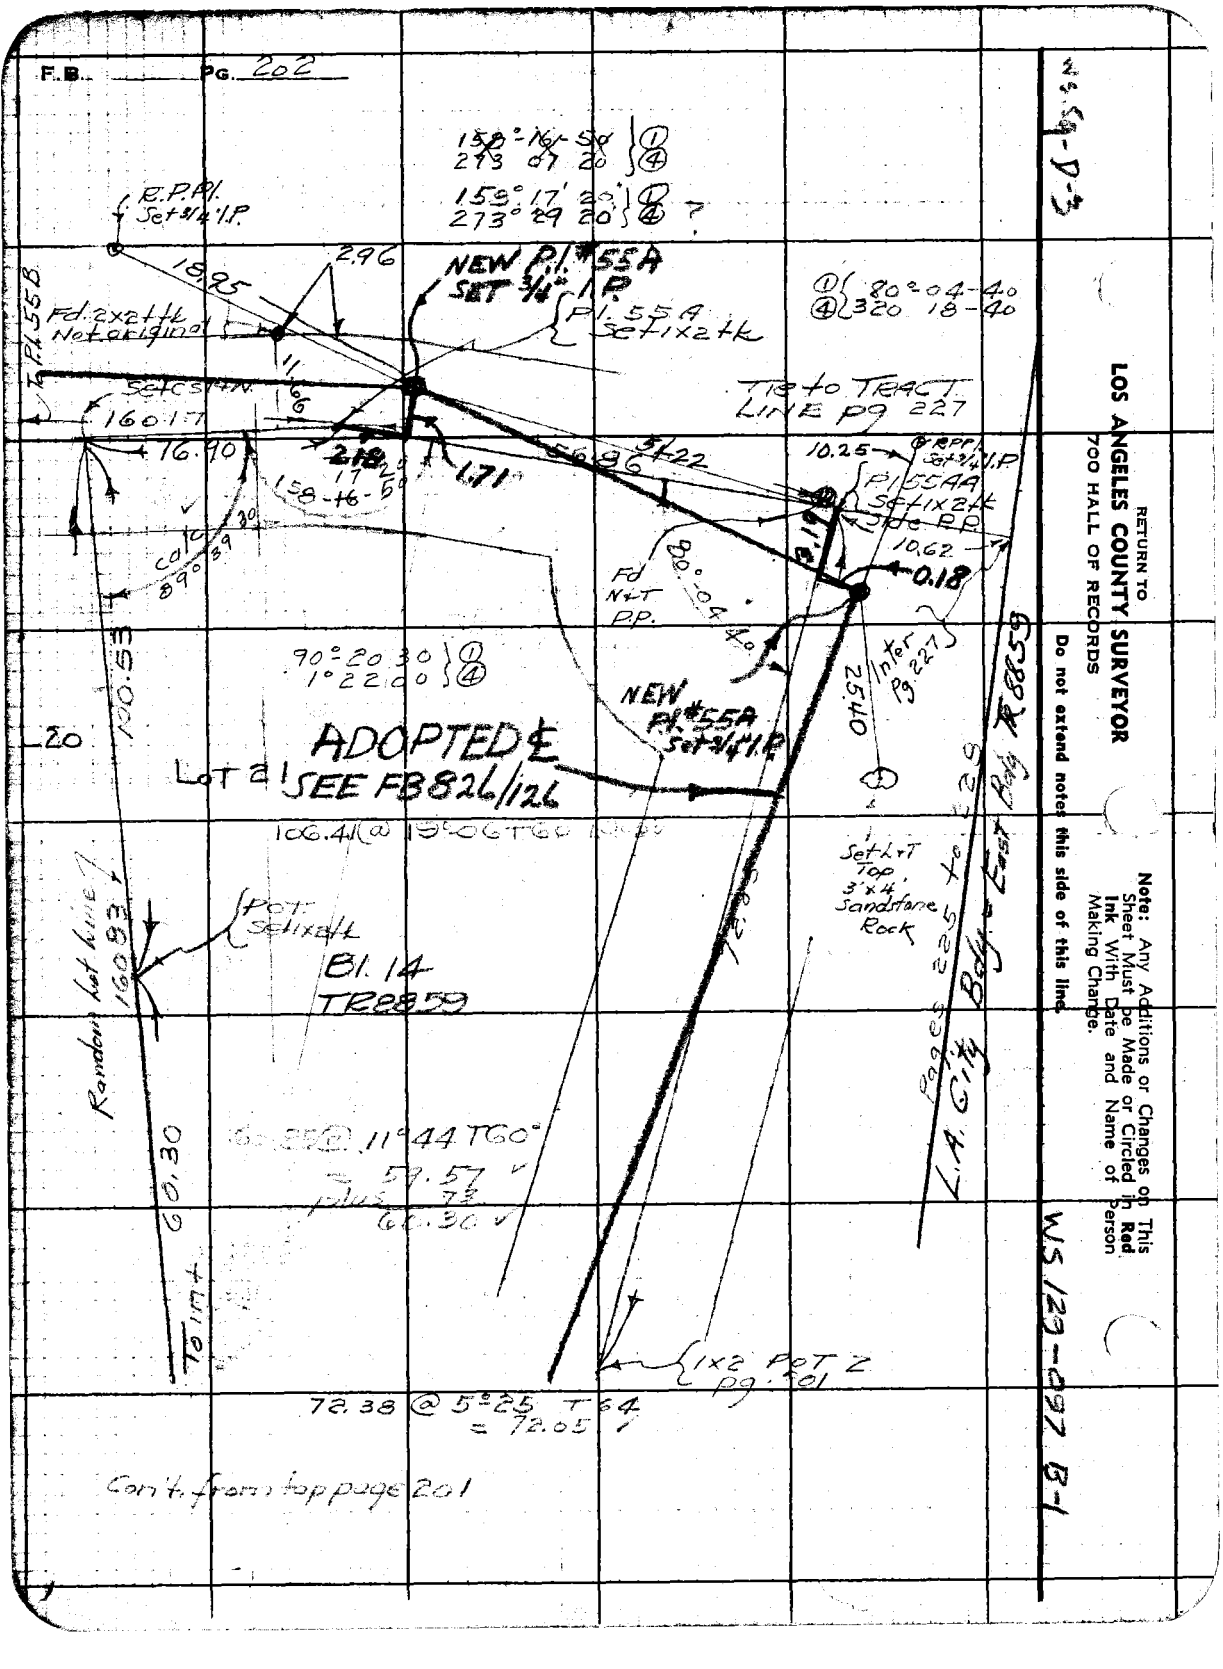

158° 16' 50" (1) (4)
273° 07' 20"

159° 17' 20" (1) (4) ?
273° 89' 20"

(1) 80° 04' 40"
(4) 320° 18' 40"

TIE to TRACT LINE PG 227

90° 20' 30" (1) (4)
1° 22' 00"

W.S. 6-P-3

WS 129-097 B-1

RETURN TO
LOS ANGELES COUNTY SURVEYOR
700 HALL OF RECORDS

Do not extend notes this side of this line.

Note: Any Additions or Changes on This Sheet Must be Made or Circled in Red Ink With Date and Name of Person Making Change.

Notes Ck'd by	Survey of
Map No. B-1631-1	W. O.	Tape No. 58 Std. 84°F
Office Work White	Surveyed by Stevenson
Checked AAR	Notes	Date 1-27-40
Date 1941	Indexed

F.B. 725 PG. 203

Cont. from F.B. 724 pg. 204

Note: Any Additions or Changes on This Sheet Must be Made or Circled in Red Ink With Date and Name of Person Making Change

Do not extend notes this side of this line.

RETURN TO
LOS ANGELES COUNTY SURVEYOR
700 HALL OF RECORDS

FORM 247 RM 10-39

68.40 @ 15°53 T 60
= 65.78
Minus .67
65.11

Rd 2x6 Tk
P1.55C
Set 1x2 1/4

0.11
0.64

62.51 @ 1°25 T 60
= 62.48

NEW
P1.55C - Set 3/4" I.P

ADOPTED
SEE FB. 826 112.6

Set
CSDKWT
ROCK LEDGE

POT
Set 1x2 Tk

17

24.11 @ 27°00 T 60
2149

P1.39.79
Off 2149

Rd 2x6 Tk

Rd 2x6 Tk

18

33.96 @ 8°02
33.63

P1.55B
Set 1 1/4 I.P
Wood steps

0.88

0.73

Frame
steps.

19

166.41 @ 5°33
T 60 165.60
Minus .83
160.17

Set Lt T
Sandstone
Ledge.

Cont. from F.B. 202

118.80 @ 2°33 T 60
= 118.65
Minus .65
118.00

1.43°23
R-70

NEW P1.55B
SET 3/4 I.P

Set 186° 37 20
BS Lt T 186° 29 20
in Rock

4-6-40
127°06'50"
148°47'10"
127°07'30"
148°30'00"
Set Lt T 2x4 Rock
R = 50.

B1.13 TR 8855

F.B. 725 Pg 204

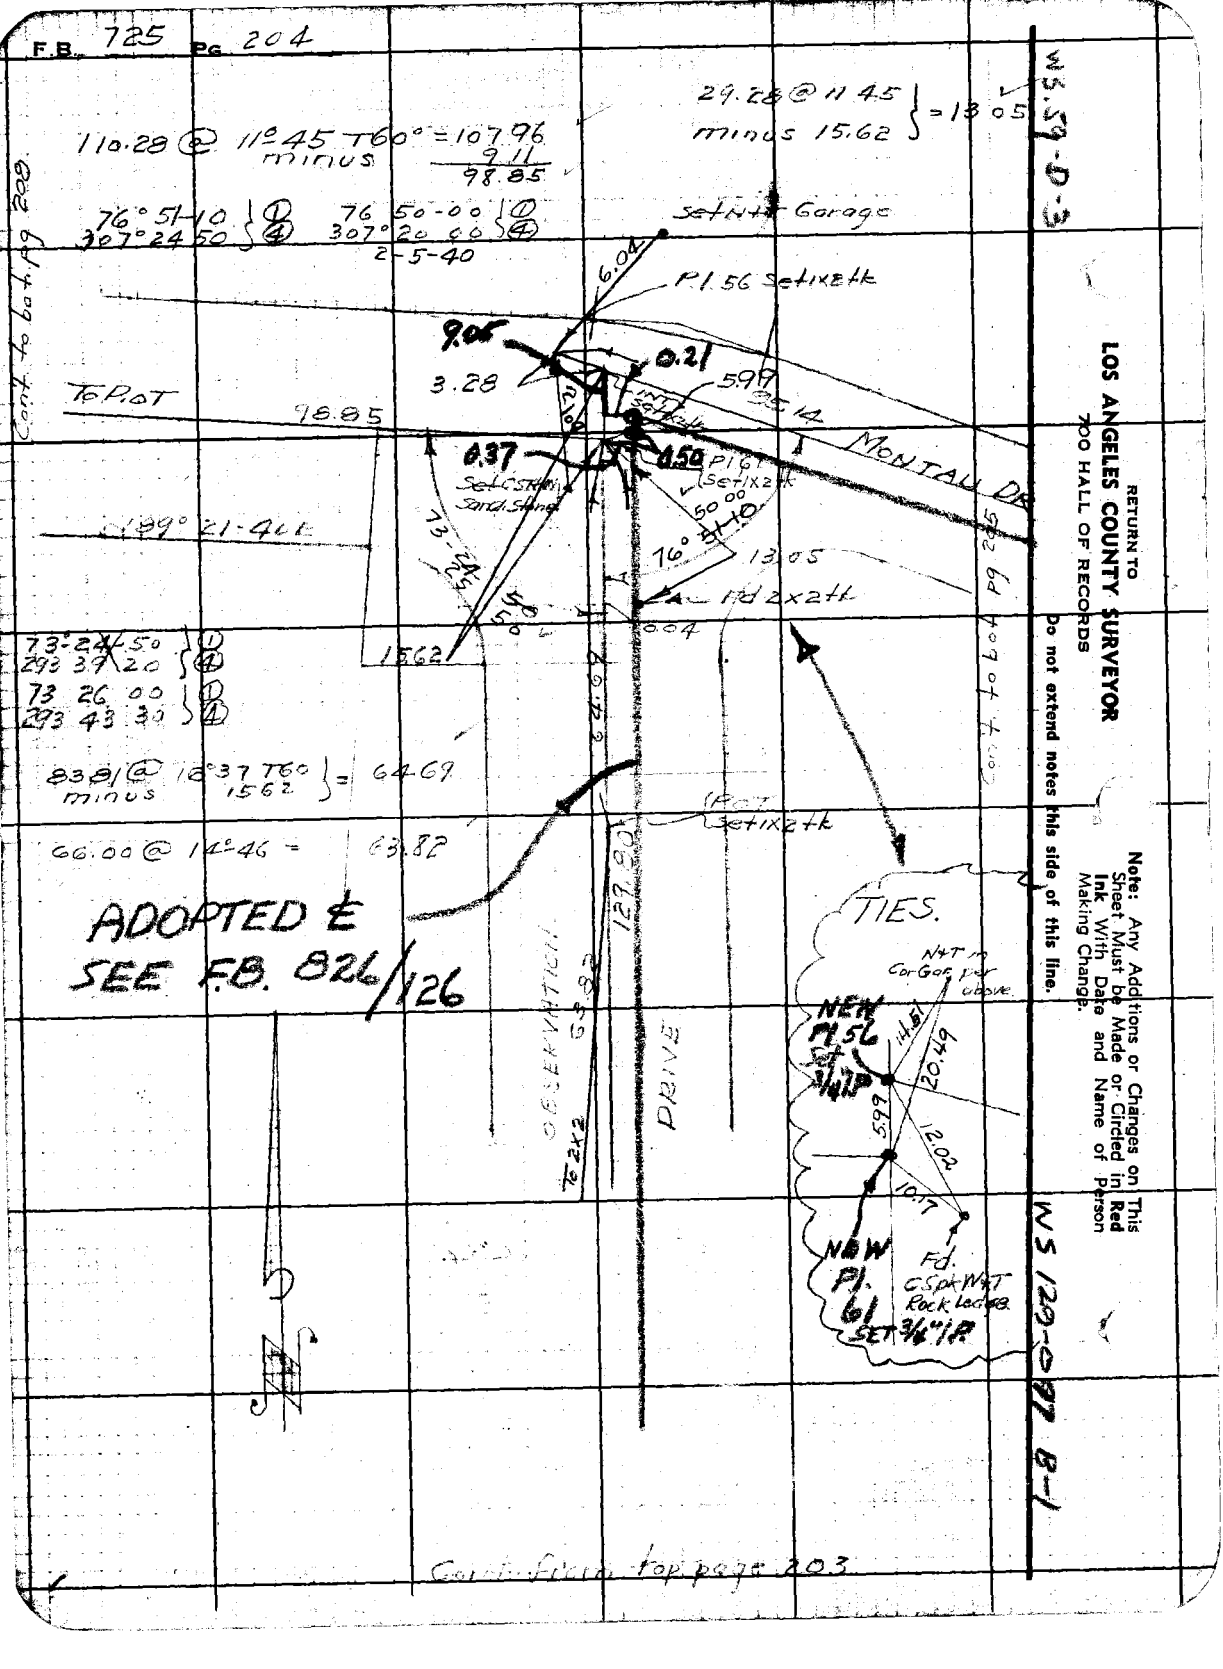

Continued from top page 203

Notes Ck'd by	Survey of FERNWOOD S/S
Map No. B-163.1 -1	W. O. 8202 Tape No. SS St. 24°F
Office Work White	Surveyed by STEVENSON
Checked AAR	Notes T.J.S Date 1-18-40
Date 1341	Indexed

F.B. 775 PG. 205

Cont. to Lot, page 206

@ 118° 33' 10"
@ 52° 12' 40"
Returned Tramming

To R.1.55 ±

RPPI Set 3/4" I.P. 3

P.I. 58 Set 1x2 stk

Set stk + T - Side brick wall

NEW P.I. #58 Set 3/4" I.P. TIES HEREON

Set stk + T - RPPI Brick foundation

ADOPTED & SEE F.B. 826/126

MONTAG

N 58° 18' 15" E 179.15

105.81

Fd 3/4" I.P. 3" up stamped tabe replacement of 2x2

POT 57A Set 1x2 stk

107.92 @ 11° 14'

T 48 - 105.81

72.35 @ 00 72.34

17815

Set bootspk tm.

NEW P.I. #57 Set 3/4" I.P. TIES

P.I. 57 Set 1x2 stk

Fd 2x2 stk

118° 14' 15" ① 112° 57' 00" ④

118 - 13 50 ① 112° 55 00 ④

2-5-40

set cut spike

Set LIT

TIES

Fd B Spk

From R.1.56

14

Cont. from top page 204

Fd C Spk

TR 8859 BL 13

RETURN TO
LOS ANGELES COUNTY SURVEYOR
700 HALL OF RECORDS

Note: Any Additions or Changes on This Sheet Must be Made or Circled in Red Ink With Date and Name of Person Making Change

Do not extend notes this side of this line.

FORM 247 5M 10-39

F.B. 725 PG. 206

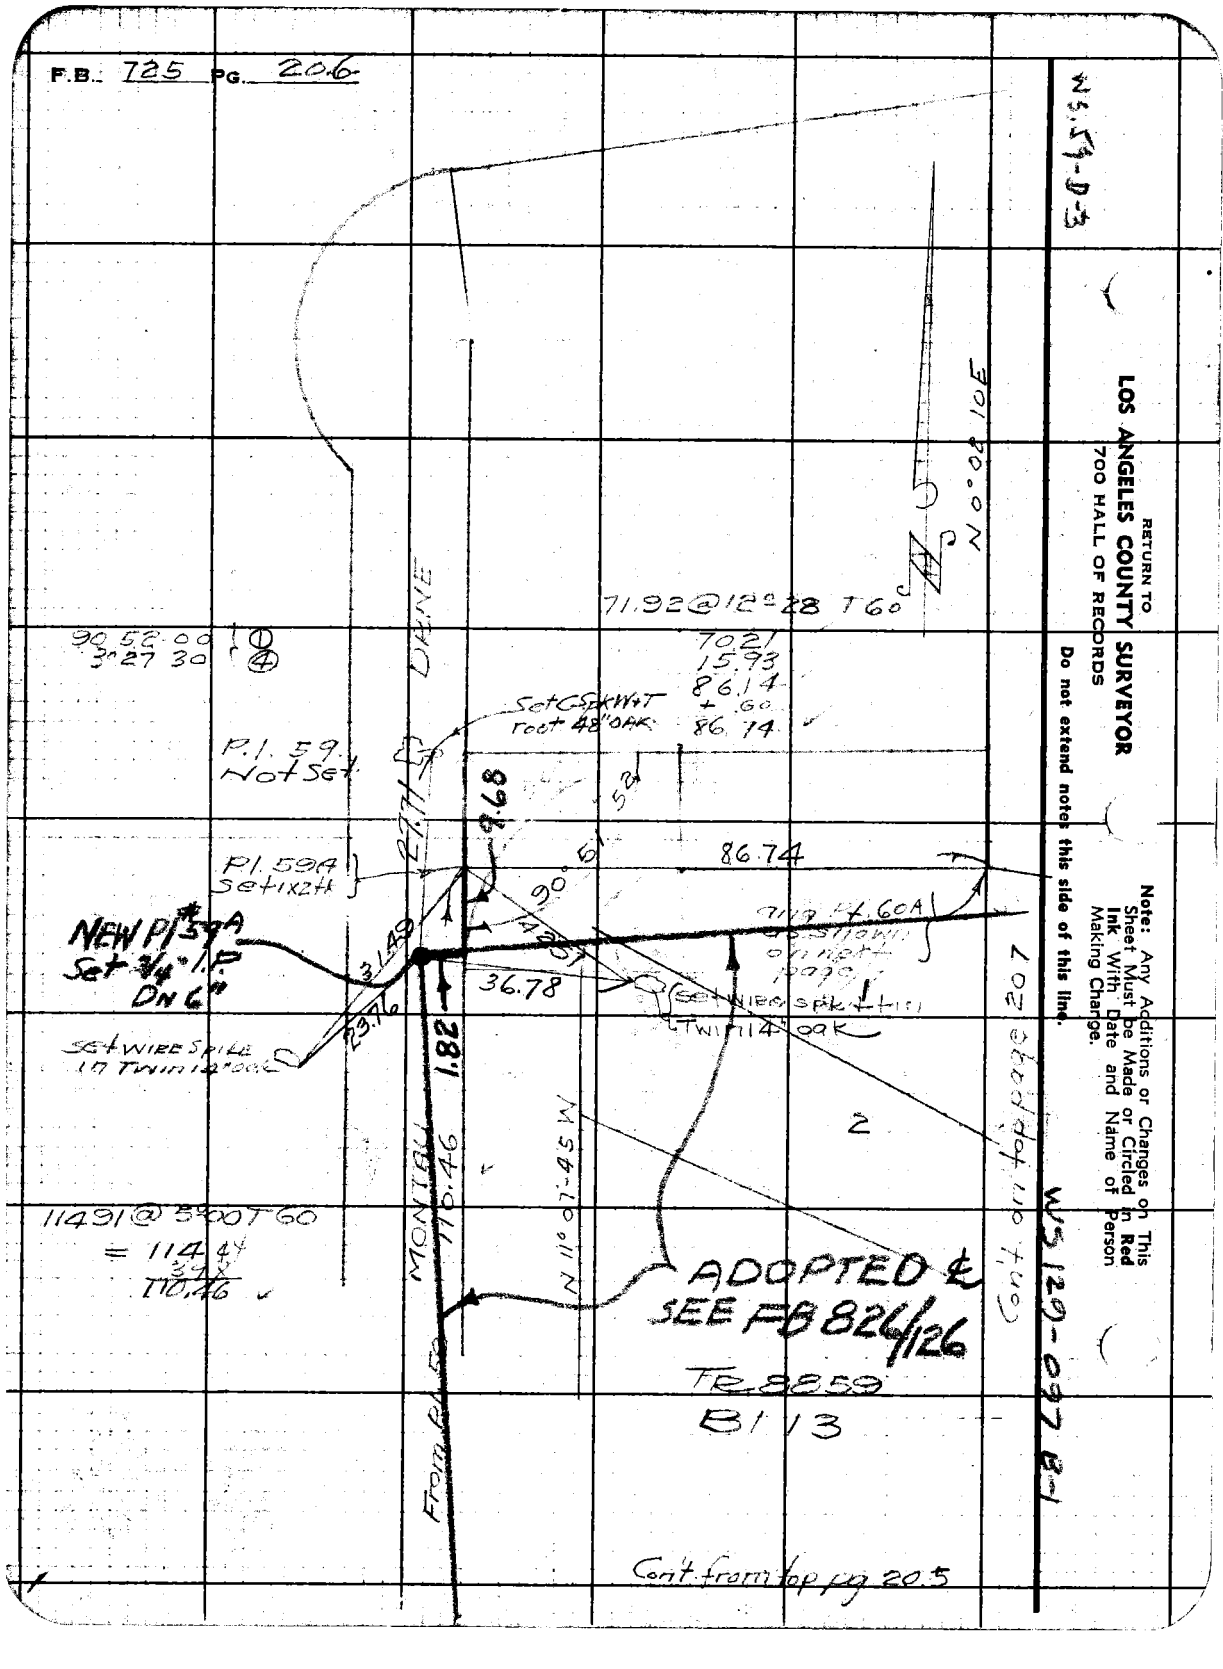
N 5.59-D-3
RETURN TO
LOS ANGELES COUNTY SURVEYOR
700 HALL OF RECORDS
Do not extend notes this side of this line.
Note: Any Additions or Changes on This Sheet Must be Made or Circled in Red Ink With Date and Name of Person Making Change.
W 5 129-097 B-1
N 0°08'10" E
71.92@12°28' T60
702
15.93
86.14
+.60
86.74
90°52'00"
3°27'30"
P.I. 59
Not Set
Set CSPK W+T
root 48" OAK
DANE
27.71
9.68
86.74
P.I. 59A
Set 1X2H
90°
NEW P.I. 59A
Set 3/4" I.P.
DN 6"
3.49
14.51
36.78
23.76
SET WIRE SPIKE
IN TWIN 12" OAK
1.82
9+10.46
MONTELL
FOUND PIPE
N 11°07'45" W
11491@5°00' T60
= 114.94
T10.46
2
ADOPTED &
SEE FB 824/126
TR 8859
B1 13
Cont from top pg 20.5

W5.58-A-2
W5.79-D-3

Notes Ck'd by	Survey of
Map No. 9-1631-1-2	W. O. 9200 Tape No. 59 St. 84°F
Office Work White	Surveyed by STEVENSON
Checked AAR	Notes Date 1/16/40
Date 1941	Indexed

F.B. 725 Pg. 207

Note: Any Additions or Changes on This Sheet Must be Made or Circled in Red Ink With Date and Name of Person Making Change.

RETURN TO
LOS ANGELES COUNTY SURVEYOR
700 HALL OF RECORDS

Do not extend notes this side of this line.

WS 120-097 B-1

FORM 247 5M 10-39

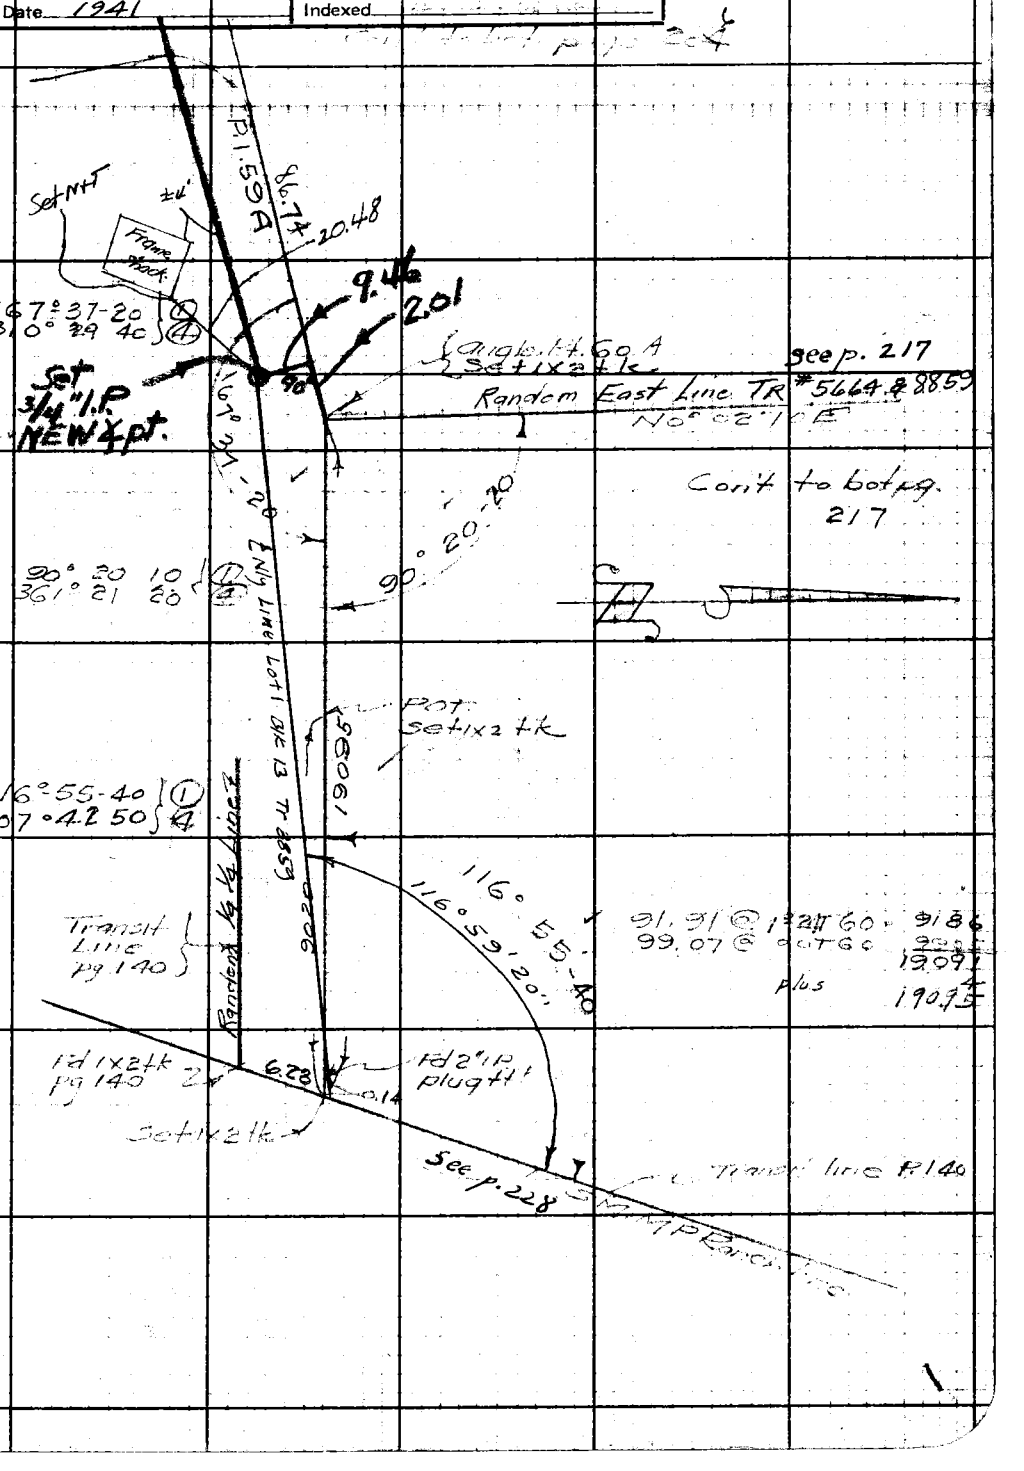

RETURN TO
LOS ANGELES COUNTY SURVEYOR
700 HALL OF RECORDS

Note: Any Additions or Changes on This Sheet Must be Made or Circled in **Red Ink** With Date and Name of Person Making Change.

Do not extend notes this side of this line.

WS.59-D-3

WS 129-092 B-1

Cont'd from page 209

TR 8850
BLK 10

Rd 2x2Hk

20.0'

Set Bkt in Sid Road

Curve Data

Fd. 62 I.P. Not Set

BC Curve Data

Cont'd from page 204

See F.B. 824-12 for adopted CL SEE AVENUE

TOBC 193.28

F.B. 725 PG. 208

Notes Ck'd by A. A. R.	Survey of Chain
Map No. B-1631-1-2	W. 8209 Tape No. 58 Std. 64°F
Office Work White	Surveyed by Stevenson
Checked A A R	Notes T.J.S. Date
Date 1941	Indexed

F.B. 775 PG. 209

Cont. to Bk. MM 210

10

133.28 @ 2°-24. T 60° 132.81
minus 2.42
130.39

To P.164

ADOPTED
℄ 10
See
F.B. 826/110

130.39 DENT

11

158°-04'-15"
272°-19'-40"
158.04 15 ①
272 17 00 ②

Set boat Spk in boulder

158.04 to P.163

60.0

0.57

P.163
Set CST+W
Replaced
with 3/4" I.P.
DN 6"
12

INT. P.228

12

Finish Line pg 228

TR 8959 Bl. 10

Fd 2x2+k

13

20.0

8.0

Set CST+W

S 31° 46' 30" W

5.45

13

Bl. 11

14

OBSERVATION

Cont. from top page 208

Note: Any Additions or Changes on This Sheet Must be Made or Circled in Red Ink With Date and Name of Person Making Change.

Do not extend notes this side of this line.

RETURN TO
LOS ANGELES COUNTY SURVEYOR
700 HALL OF RECORDS

FORM 247 5M 10-39

Cont to bot. page 211

F.B. 725 PG. 210

117.93@00 TG 0
= 117.92
777
125.69

159°46'20" ① ④
279°07'00"
05 40

0.67
0.75
12.5.69
To P.L.66
23.39
Set x cut top Conc. guard No 1" post.
7
P.L.65 Set 1x24
17.55
18.33
Set CSTHW bank
6
NEW P.L. #65 Set 3/4" I.P.
set x top Con. Guard Rail Post
Y
80.60@ 3°50 TG 6°
= 80.42
minus 1 03
79.39
ADOPTED & SEE FB 826/110
B
TRACT 5.B. 110
OBSERVATION
DRIVE
7
Set L+T in Rock
13.10
755
20.65
0.48
0.42
20.65
47
50
NEW P.L. 64 Set 9 3/4" I.P.
Set N+T P.P.
2811
127°50'15" ① ④
231°21'00"
127°50'50"
231°23'35"
P.L. 64 Set 1x24
B
69.80
Set L+T Top 16x12x12 Rock
ALLEY
Cont from top of page 209

RETURN TO
LOS ANGELES COUNTY SURVEYOR
700 HALL OF RECORDS

Do not extend notes this side of this line.

Note: Any Additions or Changes on This Sheet Must be Made or Circled in Red Ink With Date and Name of Person Making Change.

W.S.T.9-D-3

F.B. 725 PG. 211

Notes Ck'd by	Survey of
Map No. B-1621-2	W. O. 8209 Tape No. SP Sta 9A +F
Office Work White	Surveyed by Stevenson
Checked AAR	Notes
Date 1941	Indexed

WS 19-D-5

Note: Any Additions or Changes on This Sheet Must be Made or Circled in Red Ink With Date and Name of Person Making Change.

Do not extend notes this side of this line.

RETURN TO
LOS ANGELES COUNTY SURVEYOR
700 HALL OF RECORDS

FORM 247 5M 10-39

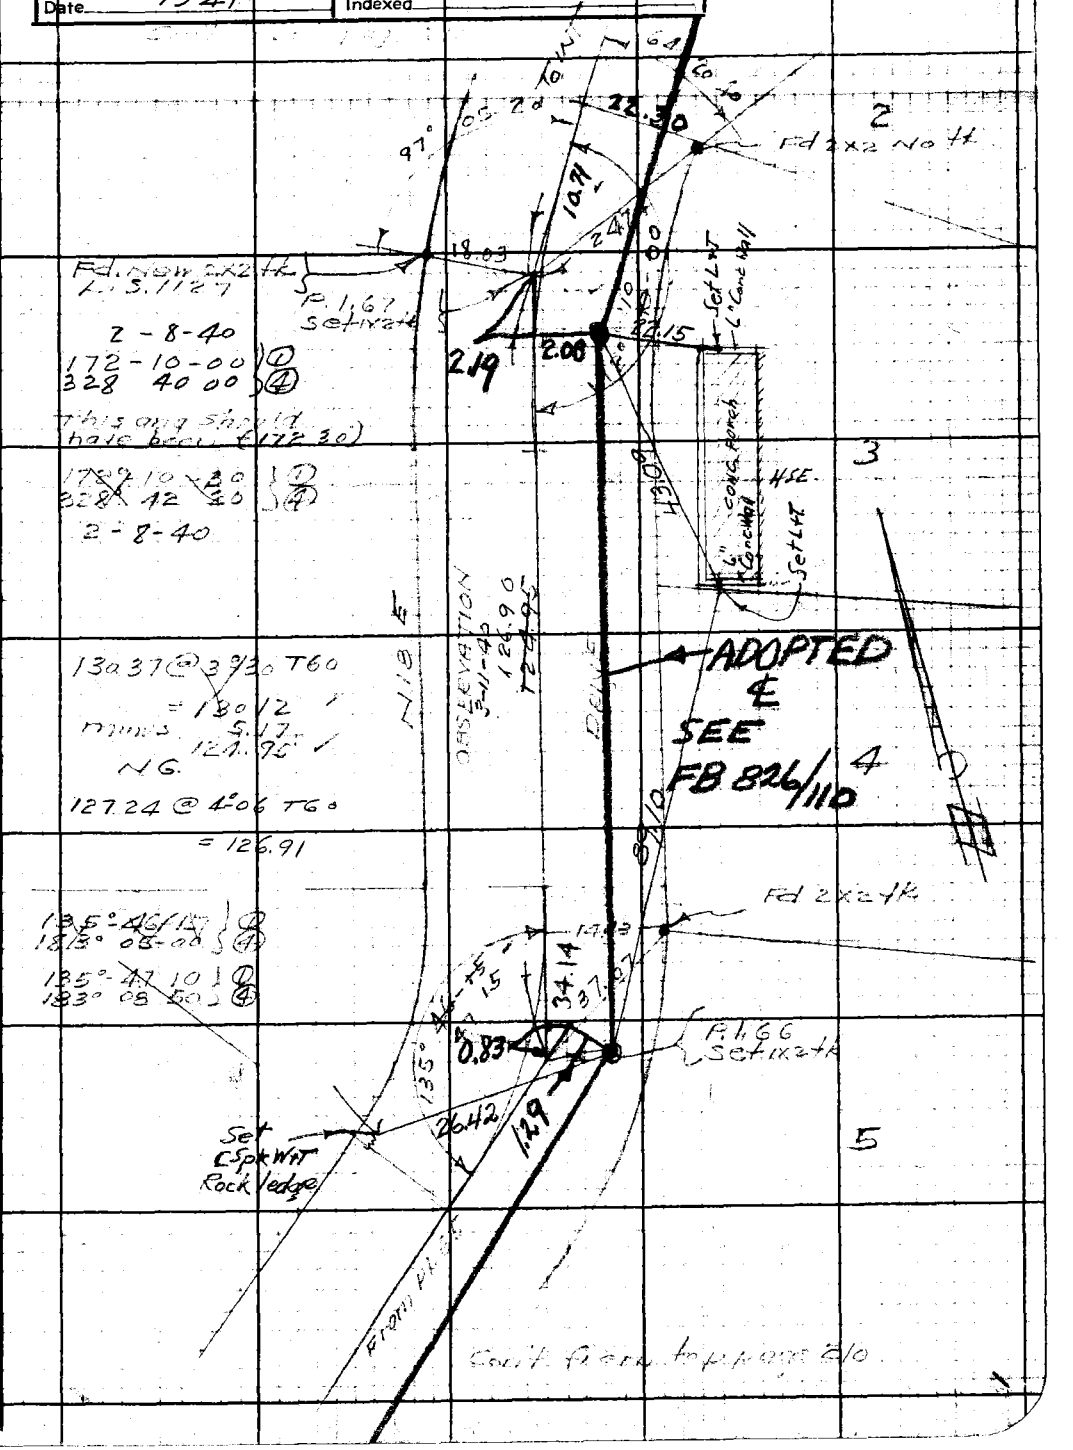

F.B. 725 Pg. 212

W.S. 59-D-3

RETURN TO
LOS ANGELES COUNTY SURVEYOR
700 HALL OF RECORDS

Do not extend notes this side of this line.

Note: Any Additions or Changes on This Sheet Must Be Made or Circled in Red Ink With Date and Name of Person Making Change.

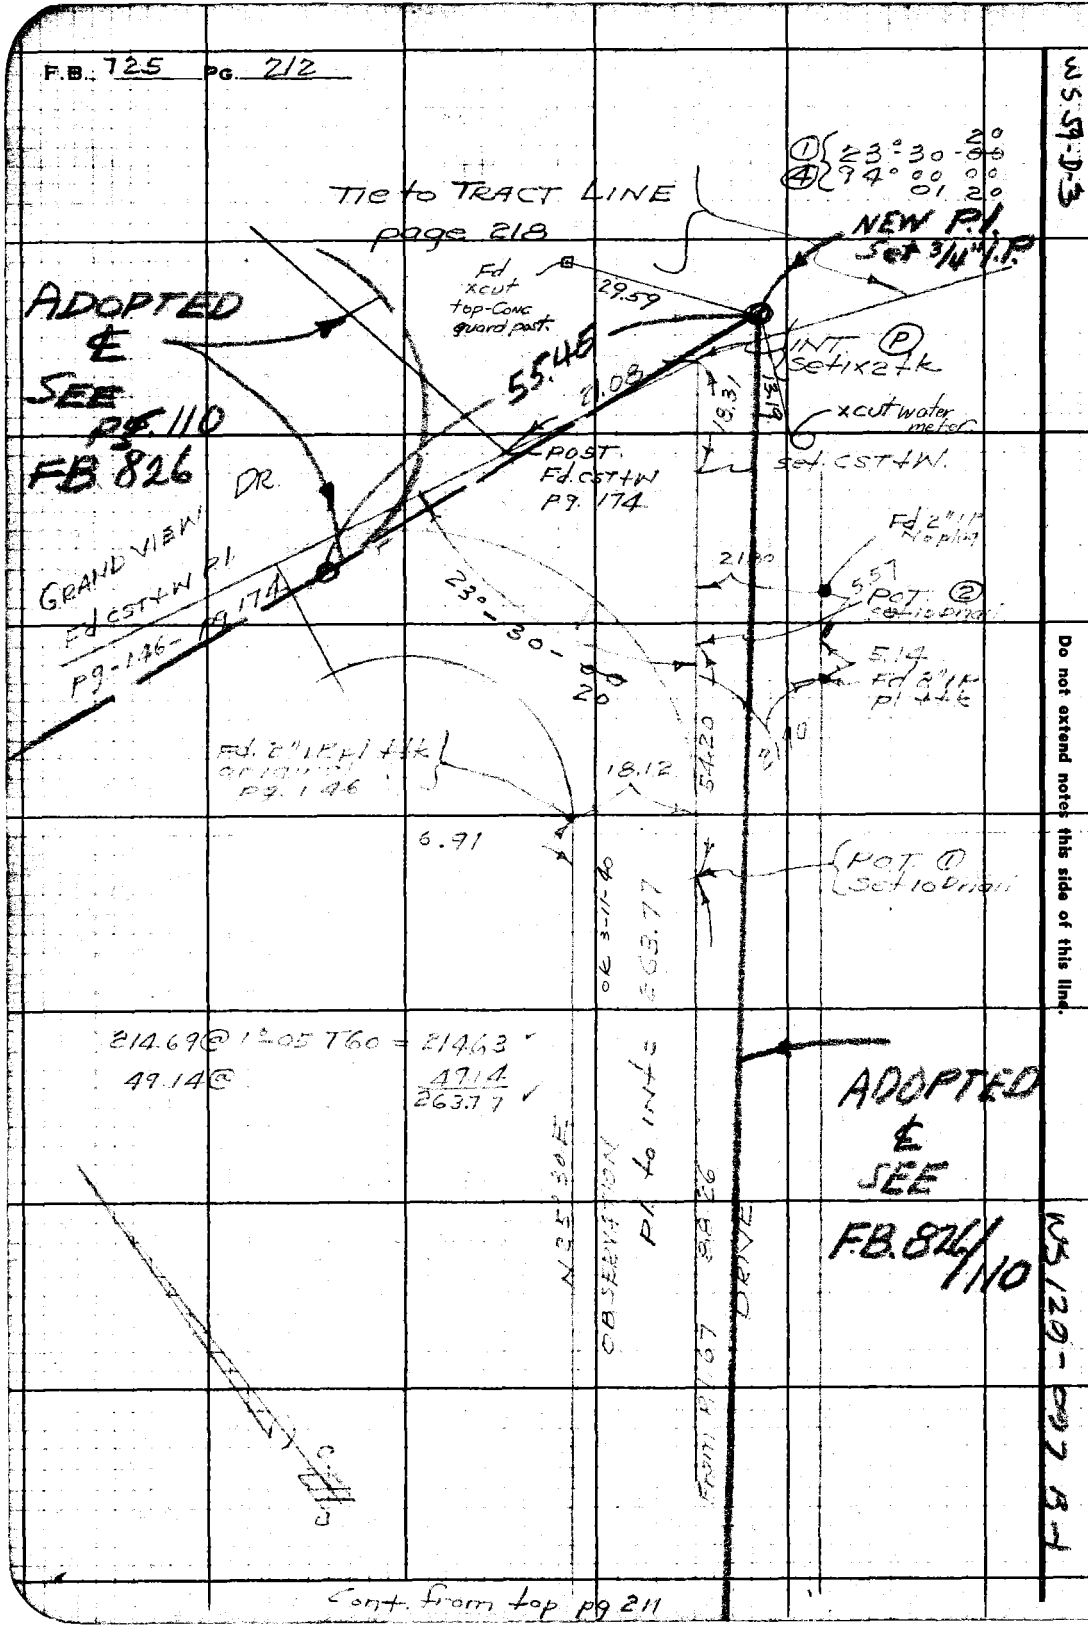

W5,57-D-3

Notes Ck'd by	Survey of Fairwood Est.
Map No. B-1631-1	W. O. 8209 Tape No. 58 Std 84°F
Office Work White	Surveyed by Stevenson
Checked AAR	Notes T. J. S Date 1-29-40
Date 1941	Indexed

F.B. 125 Pg. 213

139.81 @ .5°06 T 70 = 139.55

SEE F.B 826-143 for Adopted ℄

Fd 2" I.P. no plug

139.25

TAXON COMM. 10 INC.

TRAIL

Fd 2x2 ft

295

9.95

12.45

11.41

11.14

17.55

Fd 2" I.P. plug 2 ft

10.39

0 m

50

La Rouche Trail

145°

125°

01

S 1°30 E

125.02

203.34 @ 4°37 T 70 102.66

255

205.21

126.87 @ 1°17 T 72 = 126.83

① 125°01'30

④ 140°06'00

Fd I.P. Set 1x2 ft

① 60° 52' 40

④ 243° 30' 40

N 12

ARVIO

126.83

60° 52'

70

To Pl. 48 Pg. 197

From 31.30 P.147

C.S.T.H.W. OBSERVATION DRIVE

RETURN TO
LOS ANGELES COUNTY SURVEYOR
700 HALL OF RECORDS

Note: Any Additions or Changes on This Sheet Must be Made or Circled in Red Ink With Date and Name of Person Making Change.

Do not extend notes this side of this line.

W5 122-032 134

FORM 247 5M 10-38

RETURN TO
LOS ANGELES COUNTY SURVEYOR
700 HALL OF RECORDS

Note: Any Additions or Changes on This Sheet Must be Made or Circled in **Red Ink** With Date and Name of Person Making Change.

Do not extend notes this side of this line.

WS.59-D-3

WS 129-097 B-1

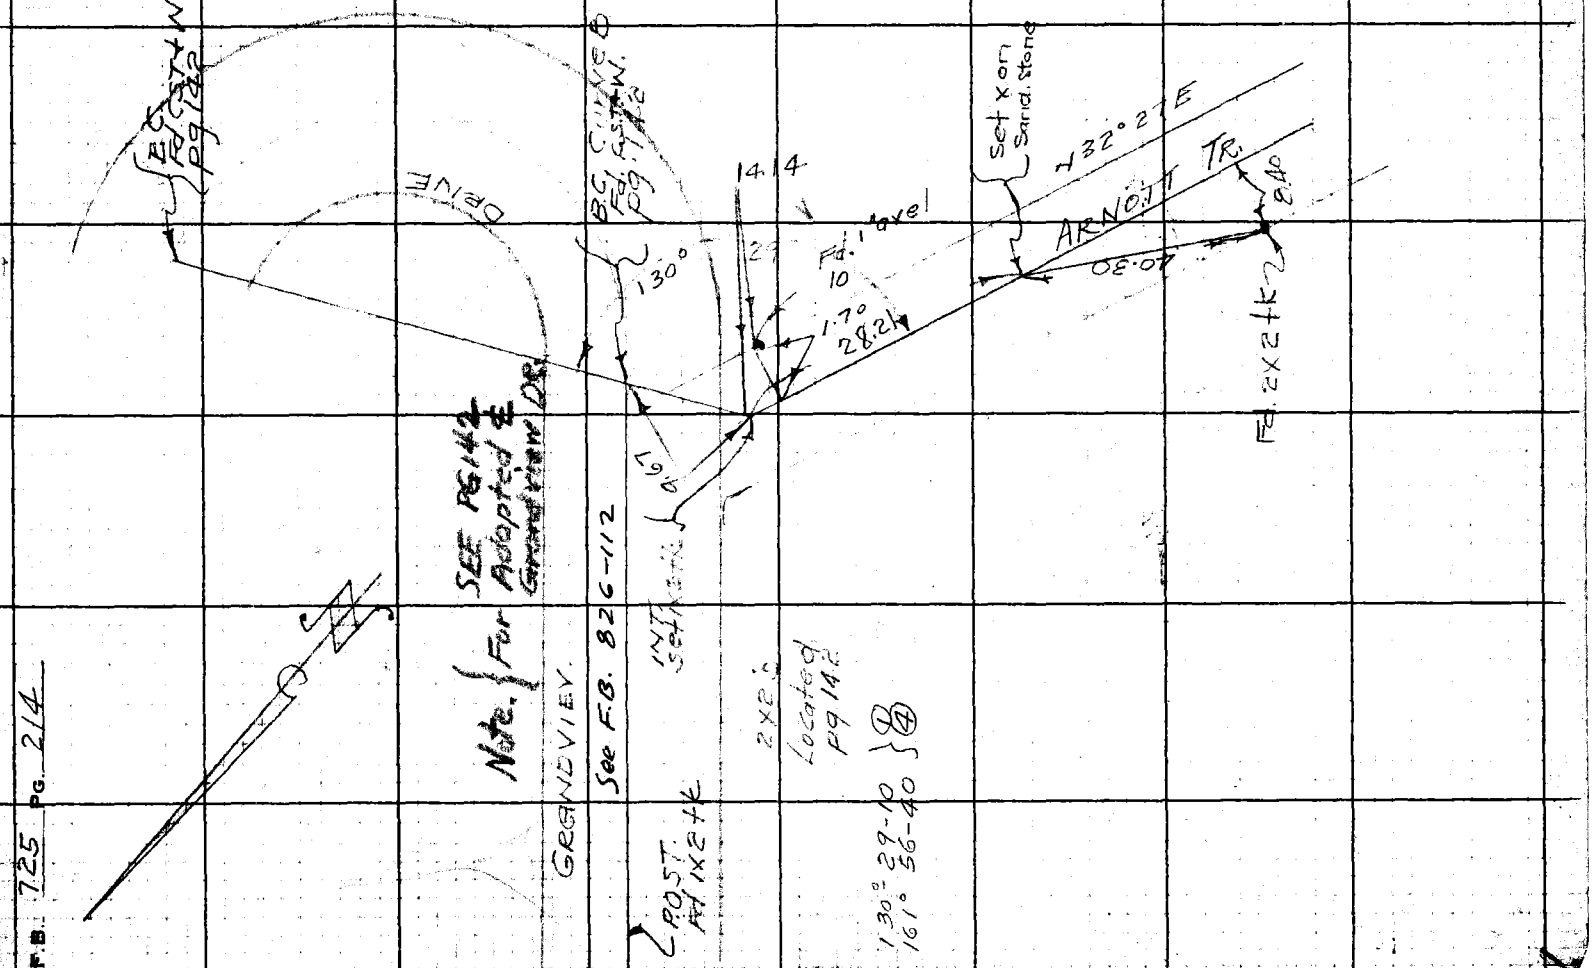

Notes Ck'd by	Survey of FERNWOOD STS
Map No. B-1631-1	W. O. 8209 Tape No. 58 St'd °F
Office Work White	Surveyed by Stevenson
Checked AAR	Notes T. J. S. Date 1-30-40
Date 1941	Indexed

F.B. 725 Pg 215

W.S. 59-D-5

Cont to bk, pg. 221

Note: Any Additions or Changes on This Sheet Must be Made or Circled in Red Ink With Date and Name of Person Making Change.

Do not extend notes this side of this line.

RETURN TO
LOS ANGELES COUNTY SURVEYOR
700 HALL OF RECORDS

WS 129-297 B-1

FORM 247 SM 10-39

To POT 60.85

3.3

Fd 2x2 Pk

5.96

BEN 21" G

TREE

Fd 8x2 Pk

BEARDSLEY TRAIL

61.44 @ 7°54 TGO
= 60.85

R.I. 93A
set 1x2 Pk

142°

17' 15"

1457

142-17-15
209°09 00

15140 @ 4°22 TGO

= 150.91
minus 4.33
146.61

LOT 19
BI-7

SEE F.B. 826-143
for Adopted ℄
RUNYON TR.

146.61

RUNYON TRAIL

S 47° 57' 15" E

TR 8859

① 90°-00 00
④ 360°-00 00

R.I. 102 2x2
pg 109

GRAND VIEW.

2948

R.I. 101A
pg 108

DRIVE

INT. SECTION

Con't. from pg. 108

F.B. 725 Pg. 216

Cont. on pg. 195

68.10 @ 11°56 T60°
66.63

W5.59-D-5

OBSERVATION
To PI 44
66.63
DRIVE 244E

INT Set 1x2 tk

Fd 2x2 Na tk

0.65

PI 43
pg. 195

95.50

15°04-40

7.5°-04-40 ①
300 18 50 ④

99.36 @ 20°30 T60
93.06
plus 2.44
95.50

385°40 E

RUNYON

TRAIL

POT Set 1x2 tk

75.41

79.68 @ 18°49 T60
= 75.41

6925

SEE FB 826-142
for Adopted ℄

Cont from top page 215

RETURN TO
LOS ANGELES COUNTY SURVEYOR
700 HALL OF RECORDS

Do not extend notes this side of this line.

Note: Any Additions or Changes on This Sheet Must be Made or Circled in Red Ink With Date and Name of Person Making Change.

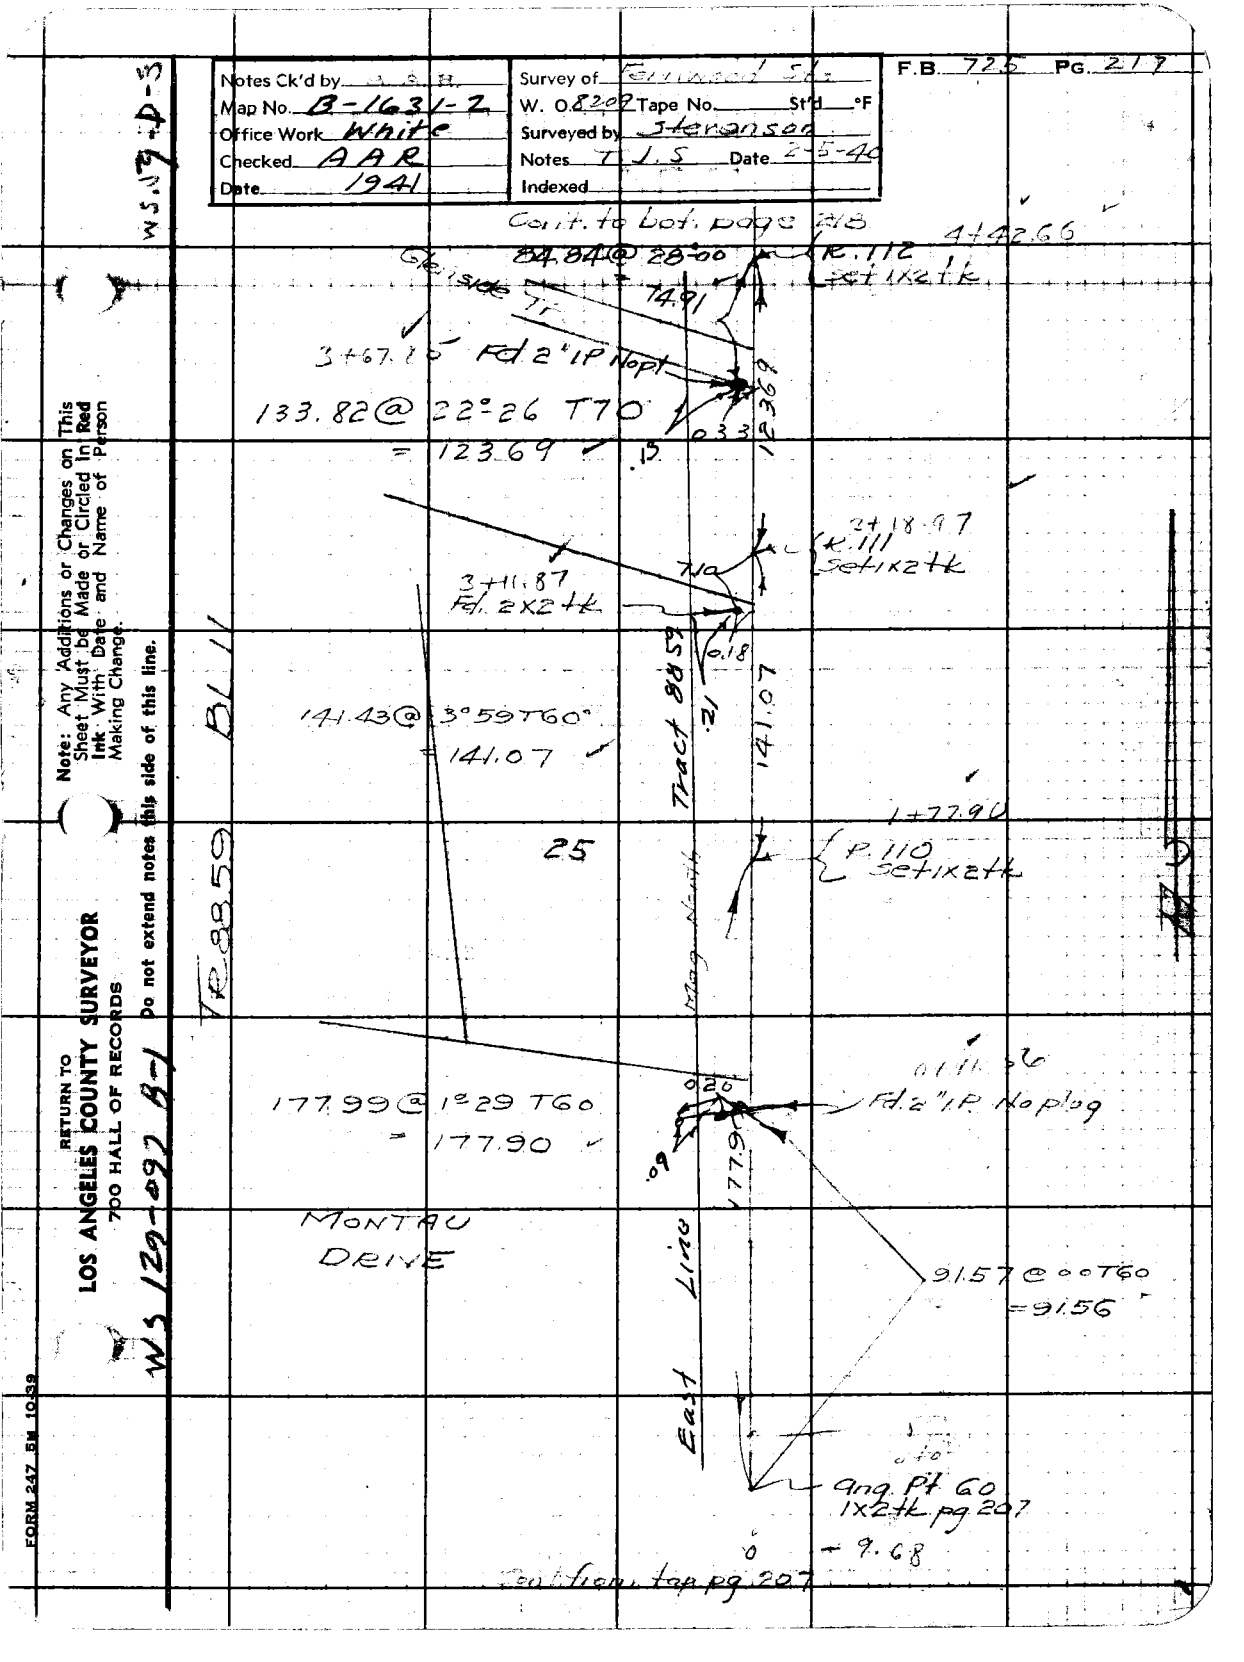
Notes Ck'd by
Map No. B-163 1-2
Office Work White
Checked AAR
Date 1941
Survey of Fellows' Sts
W. O. 8202 Tape No. St'd °F
Surveyed by Jteran500
Notes T.J.S Date 2-5-40
Indexed
F.B. 725 PG. 217
W5.17 4-5
Cont. to bot. page 218
84.84@ 28°00
R.112
set 1x2 tk
4+42.66
74.91
3+67.15 Fd 2"IP Nopl
133.82@ 22°26 T70
= 123.69
123.69
.15
.33
3+18.97
R.111
set 1x2 tk
3+11.87
Fd. 2x2 tk
N/a
.18
141.43@ 3°59 T60°
= 141.07
141.07
.21
Tract 8859
1+77.96
R.110
set 1x2 tk
25
R-8859
Mag. North
177.99@ 1°29 T60
= 177.90
177.90
.09
.20
Fd 2" I.P. No plug
MONTAU
DRIVE
East Line
91.57@ 0°0 T60
= 91.56
Orig. Pt 60
1x2 tk pg 207
= 9.68
RETURN TO
LOS ANGELES COUNTY SURVEYOR
700 HALL OF RECORDS
W5 129-92 B-1
Note: Any Additions or Changes on This Sheet Must be Made or Circled in Red Ink With Date and Name of Person Making Change.
Do not extend notes this side of this line.
FORM 247 5M 10-39

Cont. to bot. page 219

F.B. 725 Pg. 218

TR 5664 BLK. 15

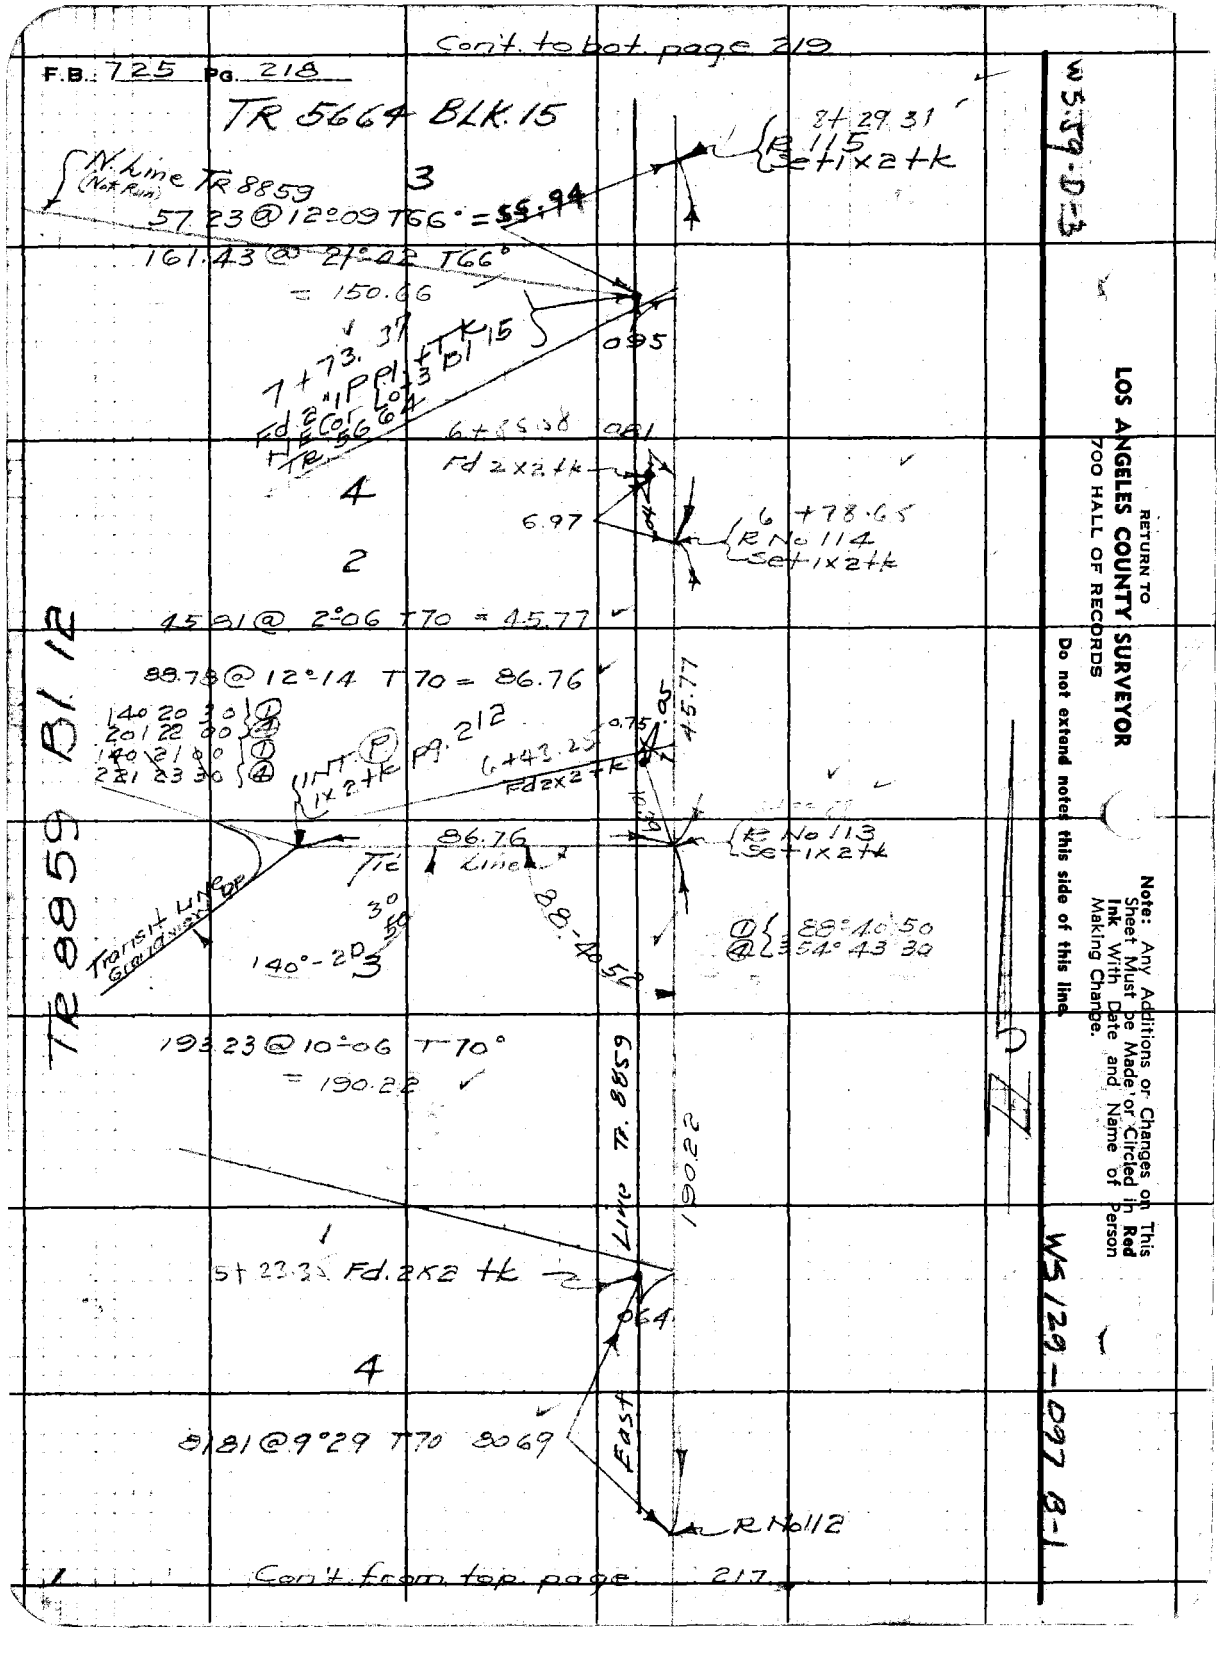
N. line TR 8859 (Not Run)
57.23 @ 12°09 T66° = 55.94
161.43 @ 21°02 T66°
= 150.66
3+29.31
R 115
Set 1x2+k
095
7+73.
1 PP
Fd 2" IP
Fd 2x2+k
6+85.58
091
Fd 2x2+k
6.97
6+78.65
R No 114
Set 1x2+k
4
2
45.81 @ 2°06 T70 = 45.77
88.78 @ 12°14 T70 = 86.76
140 20 30
201 22 00
140 21 00
221 23 30
11+T.P.
1x2+k
P.A. 212
6+43.25
Fd 2x2+k
0.75
0.05
45.77
86.76
Line
R No 113
Set 1x2+k
88°40'50
354°43'30
Transit Line
Grid West
140°-20
3°
50
88.40
193.23 @ 10°06 T70°
= 190.22
N. line TR 8859
190.22
1
5+23.3
Fd. 2x2 tk
064
4
81.81 @ 9°29 T70 90.69
East
R No 112
Cont. from top. page 217

TR 8859 B1 12

W5.39-D-3

W5/29-097 B-1

RETURN TO
LOS ANGELES COUNTY SURVEYOR
700 HALL OF RECORDS

Do not extend notes this side of this line

Note: Any Additions or Changes on This Sheet Must be Made or Circled in Red Ink With Date and Name of Person Making Change.

W.S.J. 9-D-3

Notes Ck'd by	Survey of
Map No. B-1631-2	W. O. 8209 Tape No. 67 St'd 84°F
Office Work White	Surveyed by Stevenson
Checked AAR	Notes T. J. S Date 2-5-40
Date 1941	Indexed

F.B. 431 PG. 219

Cont to but. page 220

231.78 @ 11°06 T 60 22.150'
1.48 @ - - 1.48'
230.30'

To INT.

138.81 @ 12°46 T 60 = 135.36'

R 11 Set 1x2 tk

FALLS DRIVE

135.36

R 116 Set 1x2 tk

121.44 @ 17°14 T 66° 115.98'

115.98

St 29 31 R 115 pre. page

Radius point

2" I.P.

Cont from top page 218

Note: Any Additions or Changes on This Sheet Must be Made or Circled in Red Ink With Date and Name of Person Making Change.

Do not extend notes this side of this line.

RETURN TO
LOS ANGELES COUNTY SURVEYOR
700 HALL OF RECORDS

TR 5664 B1 15

FORM 247 5M 10-39

RETURN TO
LOS ANGELES COUNTY SURVEYOR
700 HALL OF RECORDS

Note: Any Additions or Changes on This Sheet Must be Made or Circled in **Red Ink** With Date and Name of Person Making Change.

Do not extend notes this side of this line.

WS 59-D-3

WS 129-097 B-1

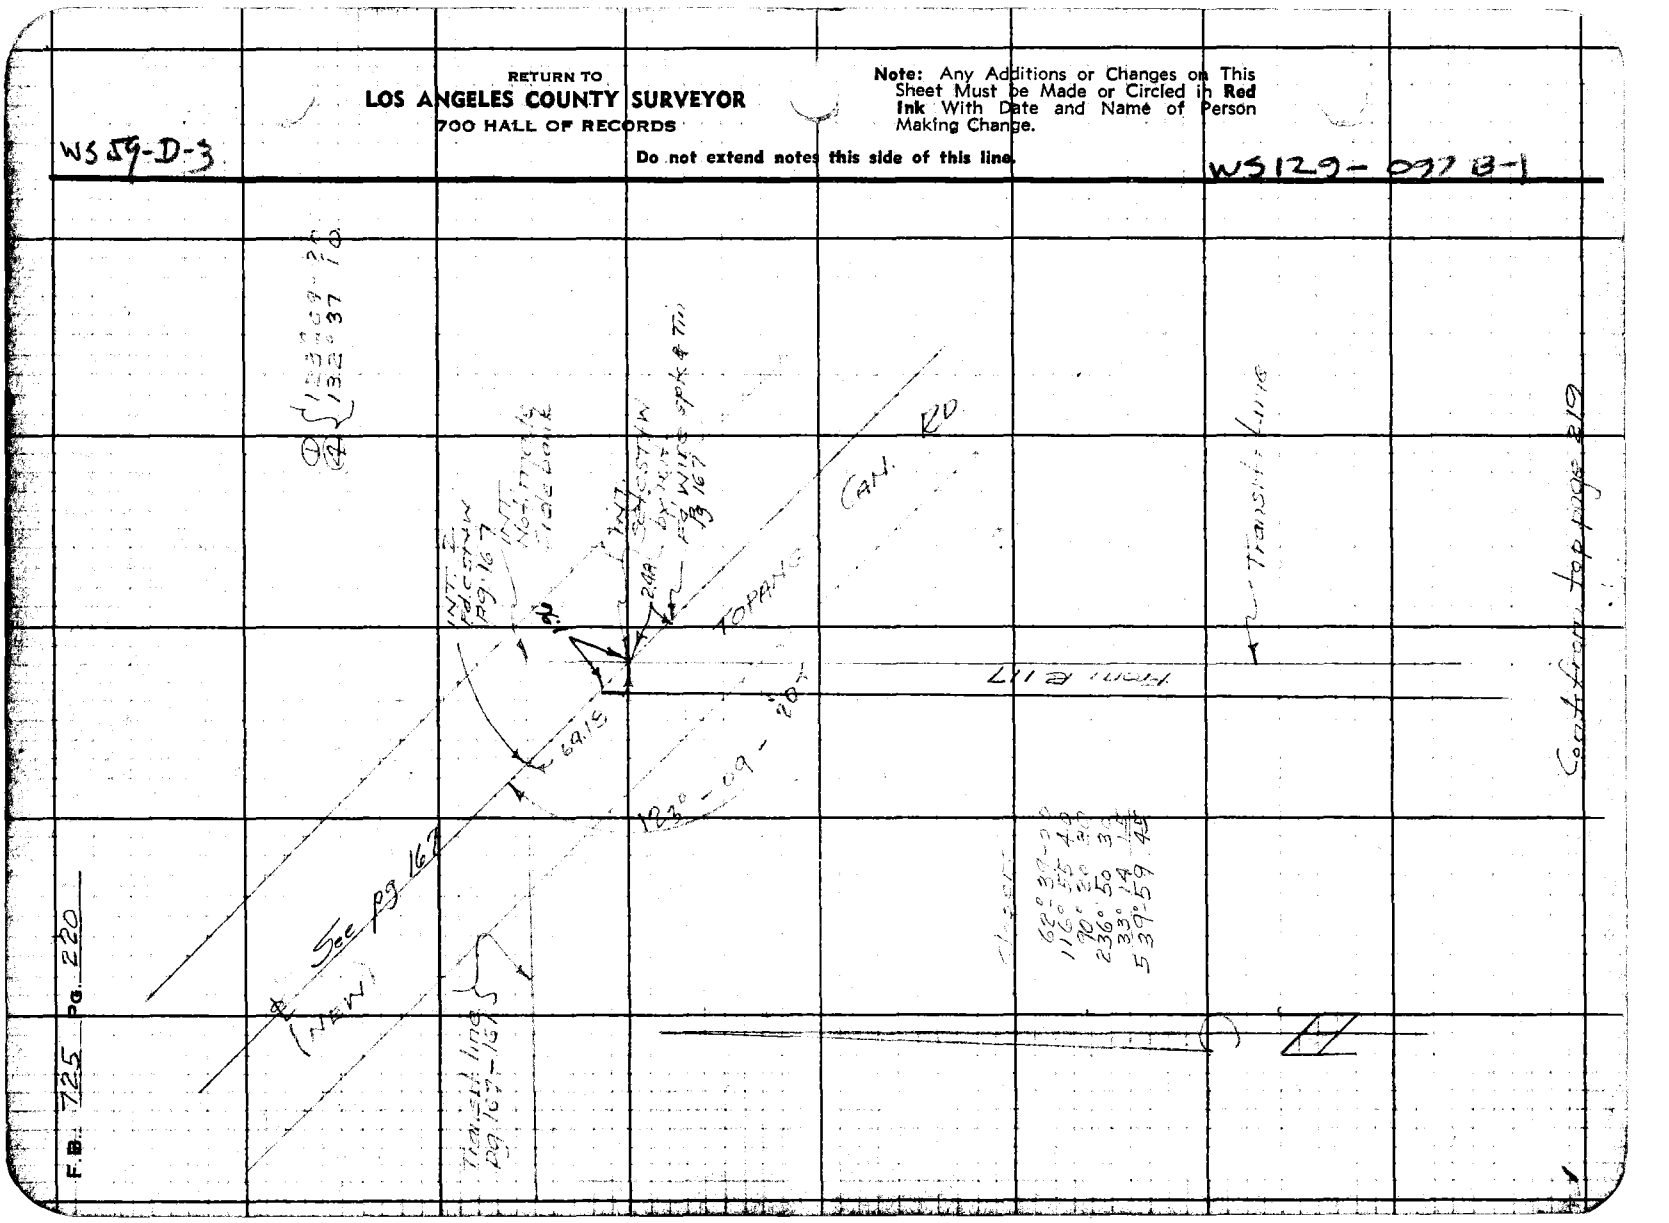

Notes Ck'd by I. A.	Survey of FERNWOOD STS
Map No. B-1631-1	W. O. 8209 Tape No. 68 Std 84°F
Office Work White	Surveyed by STEVENSON
Checked AAR	Notes T.J.S Date 2-9-40
Date 1941	Indexed

F.B. 725 221

P.B. 35
Fd 1x2 tk
pg 111

INT Set 1x2 tk

233

OBSERVATION DRIVE

100°39'

Ⓓ 100°37'10"
Ⓐ 42°37'00"

MORE DATA ON TR
8913 IN F B 826

B1.19
R1.36
Fd 1x2 tk
pg 192

TB 8859

S1°09'-20"W

For Adopted & See F B 826 - 122-142

BENZING TRAIL

38342

28374 @ 12°47 T60 27668
113.38 @ 20°14 T60 10637
plus 37
38342

5755 @ 11°51 T60 5630

POT 118
Set 1x2 tk

Ⓓ 130°55'50"
Ⓐ 163°48'20"

5630

130

515

50

WS 129-097 B-1

RETURN TO
LOS ANGELES COUNTY SURVEYOR
700 HALL OF RECORDS

Note: Any Additions or Changes on This Sheet Must be Made or Circled in Red Ink With Date and Name of Person Making Change.
Do not extend notes this side of this line.

FORM 247 5M 10-38

W.S. 59-D-3

226/

APN 10-103A 215

RUNYON TRAIL

for Adopted & see F.B. 826-124

GARFIELD VIEW DRIVE

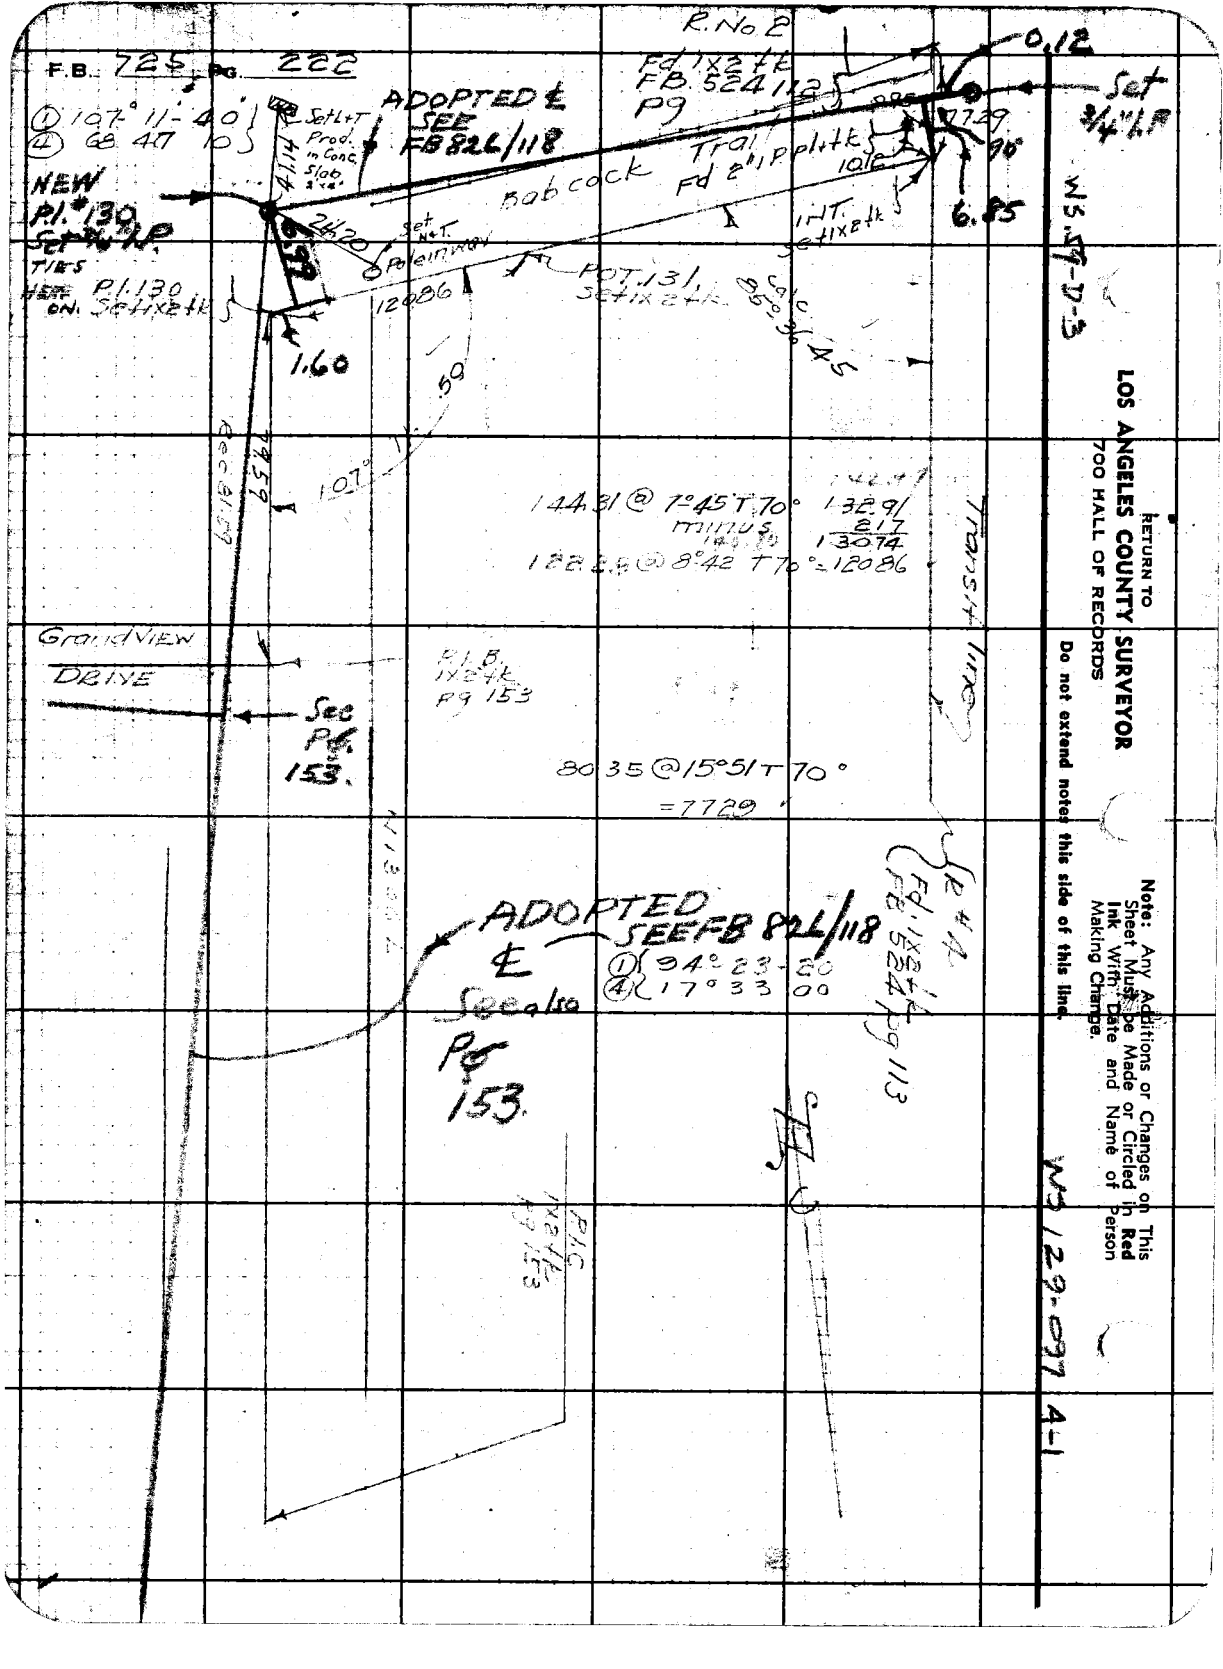
F.B. 725 Pg. 222
R. No 2
Fd 1x2 tk
FB 524/113
P9
0.12
Set 3/4" I.P.
ADOPTED & SEE FB 826/118
① 107° 11' 40"
④ 68 47 10
NEW P.I. #130 Set 3/4" I.P. TIES
Set L+T Prod. in Conc. Slab
4.14
6.99
2.20
Set N+T. Preliminary
Bob cock Trail
Fd 2" I.P. pl+tks
INT. 1" I.P. 1 tk
7729
90
101°
6.85
WS. 9-17-3
POT. 131 Set 1x2 tk
12086
1.60
50
107°
Rec. 107°
Grandview Drive
See Pg. 153.
R.L.S. 1x2 tk P9 153
14431 @ 7°45' T 70° 132.91
MINUS 2.17
130.74
12086 @ 8°42 T 70° = 12086
Transit line
80 35 @ 15°51 T 70°
= 7729'
ADOPTED & SEE FB 826/118
① 94° 23' 30"
④ 17° 33' 00"
See also Pg 153.
Fd 1x2 tk FB 524/113 Pg 113
WS 12-9-97 A-1
RETURN TO
LOS ANGELES COUNTY SURVEYOR
700 HALL OF RECORDS
Do not extend notes this side of this line.
Note: Any Additions or Changes on This Sheet Must Be Made or Circled in Red Ink With Date and Name of Person Making Change.

W.S. 39-D-3

Notes Ck'd by	Survey of
Map No. B-1631-1	W. O.	Tape No.	Std °F
Office Work White	Surveyed by STEVENSON
Checked AAR	Notes	Date 1-5-39
Date 1941	Indexed

F.B. 725 PG. 223

Cut off line for closure

89° 53-00 ①
359 31 50 ④
89° 54-00
359 35 30

Pipe may have shifted
very wet bank

159.39

Pl. 3/4 IP
FB. 725
Pg 55

To Pl. 34
OBSERVATION
DRIVE
Page 192

Pl. 10 IP
FB 725
Pg 108

① 96° 23-10
④ 25 33 20
⑥ 210 19 50

Int 3/4 IP
Pg 55

121° 21-40

T.S. 2 26 15

96° 23 15

For closer
To Tr. line
see pg 190

See F.B. 826
p. 116 & 141

① 121° 21-00
④ 125° 24 10

① 121° 21- 40
④ 125° 26 40

160.25 @ S 49 T 60
= 159.39

GRAND VIEW DRIVE

Pl. 3/4 IP FB 725 Pg 55

GRAND VIEW DRIVE

Note: Any Additions or Changes on This Sheet Must be Made or Circled in Red Ink With Date and Name of Person Making Change.

Do not extend notes this side of this line.

RETURN TO
LOS ANGELES COUNTY SURVEYOR
700 HALL OF RECORDS

FORM 247 5M 10-39

RETURN TO
LOS ANGELES COUNTY SURVEYOR
700 HALL OF RECORDS

Note: Any Additions or Changes on This Sheet Must be Made or Circled in **Red Ink** With Date and Name of Person Making Change.

Do not extend notes this side of this line.

F.B. _____ PG. _____

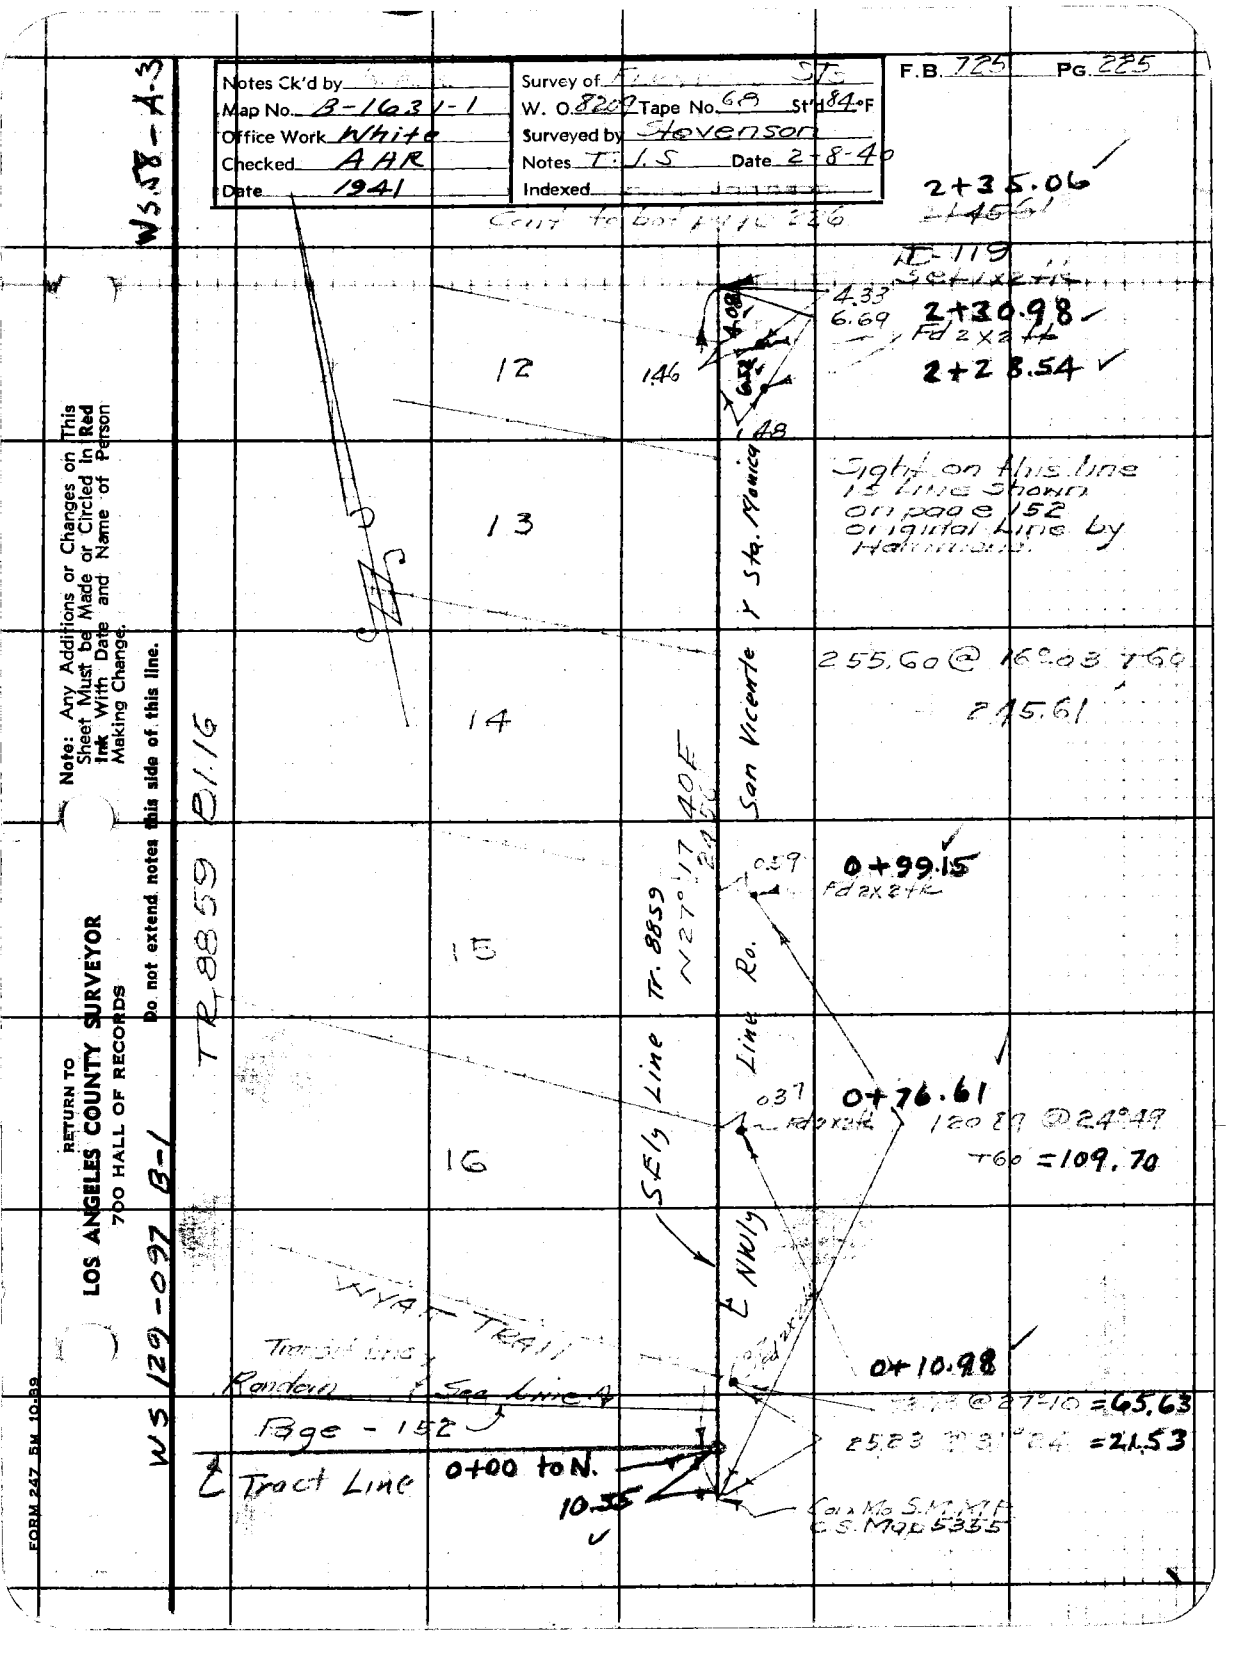
Notes Ck'd by
Map No. B-1631-1
Office Work White
Checked AAR
Date 1941
Survey of
W. O. 8209 Tape No. 68 Std 84°F
Surveyed by Stevenson
Notes T. J. S Date 2-8-40
Indexed
F.B. 725 Pg. 225
W.S. 78-A-3
Cont to bot page 226
2+35.06
RE-119
Set nail
2+30.98
Fd 2x2 tk
2+28.54
12
13
14
15
16
146
4.33
6.69
4.08
6.22
48
Sight on this line is line shown on page 152 of original Line by Hammack
255.60 @ 16°08'
215.61
San Vicente y Sta. Monica
Tr. 8859
N27°17'40"E
0.39
0+99.15
Fd 2x2 tk
Ro.
Line
0.37
0+76.61
Fd 2x2 tk
120.89 Δ 24°49'
T60 = 109.70
S.E'ly Line
E N.W'ly
0+10.98
@ 27°10' = 65.63
25.23 = 21.53
Cal. Mo. S.M. Ass'n
C.S. Mon. 5335
TR 8859
B-1
W.S. 120-097
Page - 152
℄ Tract Line
0+00 to N.
10.55
RETURN TO
LOS ANGELES COUNTY SURVEYOR
700 HALL OF RECORDS
Note: Any Additions or Changes on This Sheet Must be Made or Circled in Red Ink With Date and Name of Person Making Change.
Do not extend notes this side of this line.
FORM 247 5M 10-39

Cont. to bot. page 227

F.B. 125 PG. 226

14353 @ 20°-29 T60
=134.44
plus 3.56
138.00

8+21.37

T123 Set Pk in roof.

House

18949 @ 10°-35 T60
=186.35

9

6+35.02

T122 6+45.5*
Set 1x2 Tk
6.47

4.86

Fd 1x2 Tk
6+30.16

4.28

20324 @ 19°45 T60°
=191.24

191.24

4+43.78

Set 1x2 Tk

5301 @ 10°-30 T60
=53.45

53.45

3+90.33

10

T120
Set 1x2 Tk

155.55 @ 3°18 T70
=155.27

155.27

1.74

Fd 2x2 Lk
2+75.00

11

39.94

41.75 @ 16°46
=39.98

T119
1x2 Tk pr Pg.

X

Cont. from top page 225

TR 8859 B/16

RETURN TO
LOS ANGELES COUNTY SURVEYOR
900 HALL OF RECORDS

Do not extend notes this side of this line

Note: Any Additions or Changes on This Sheet Must be Made or Circled in Red Ink With Date and Name of Person Making Change.

Notes Ck'd by	Survey of FARMDALE S/S
Map No. B-1631-1	W. O. 8201 Tape No. 68 Sta 24°F
Office Work White	Surveyed by STEVENSON
Checked AAR	Notes T.J.S. Date 2-9-40
Date 1941	Indexed

F.B. 725 Pg. 227

W3.57-D-3

Cont to bot. page 228

80.45 Ⓢ 19°24 T60
= 7892

5

11°21'00"

12+05.67
Fd 2x2 tk

3.68

18.09

1845 @ 09°37'30" = 11+87.58
T 126
Set 1x2 tk
18.13

6

22.00

2252 @ 5°25 = 22.42
Fd 2x2 tk

11+65.58

4.32

7

193.84 @ 19°59 T68
= 192.15

11°06'

To F. 129 Next Pg.

① 70°05-10
④ 280°21 00
⑤ 200 41 40

10+05.43
15.98

To 16.00
T 125
Set 1x2 tk

① 24°56-00
④ 339 44 00

10°05-00

810'

47.53 @ 14°17 T60
= 46.06

84°56-00

46.06

Pl. 55A
Pg. 202

OBSERVATION
DR.

Pl. 55AA
Pg. 202

10.62

9+59.37
INT. T 124
Set 1x2 tk
by int.

Cont. from top page 226.

TR 8859 81 13

WS 129-022 C-1

RETURN TO
LOS ANGELES COUNTY SURVEYOR
700 HALL OF RECORDS

Note: Any Additions or Changes on This Sheet Must be Made or Circled In Red Ink With Date and Name of Person Making Change.

Do not extend notes this side of this line.

FORM 247 5M 10-39

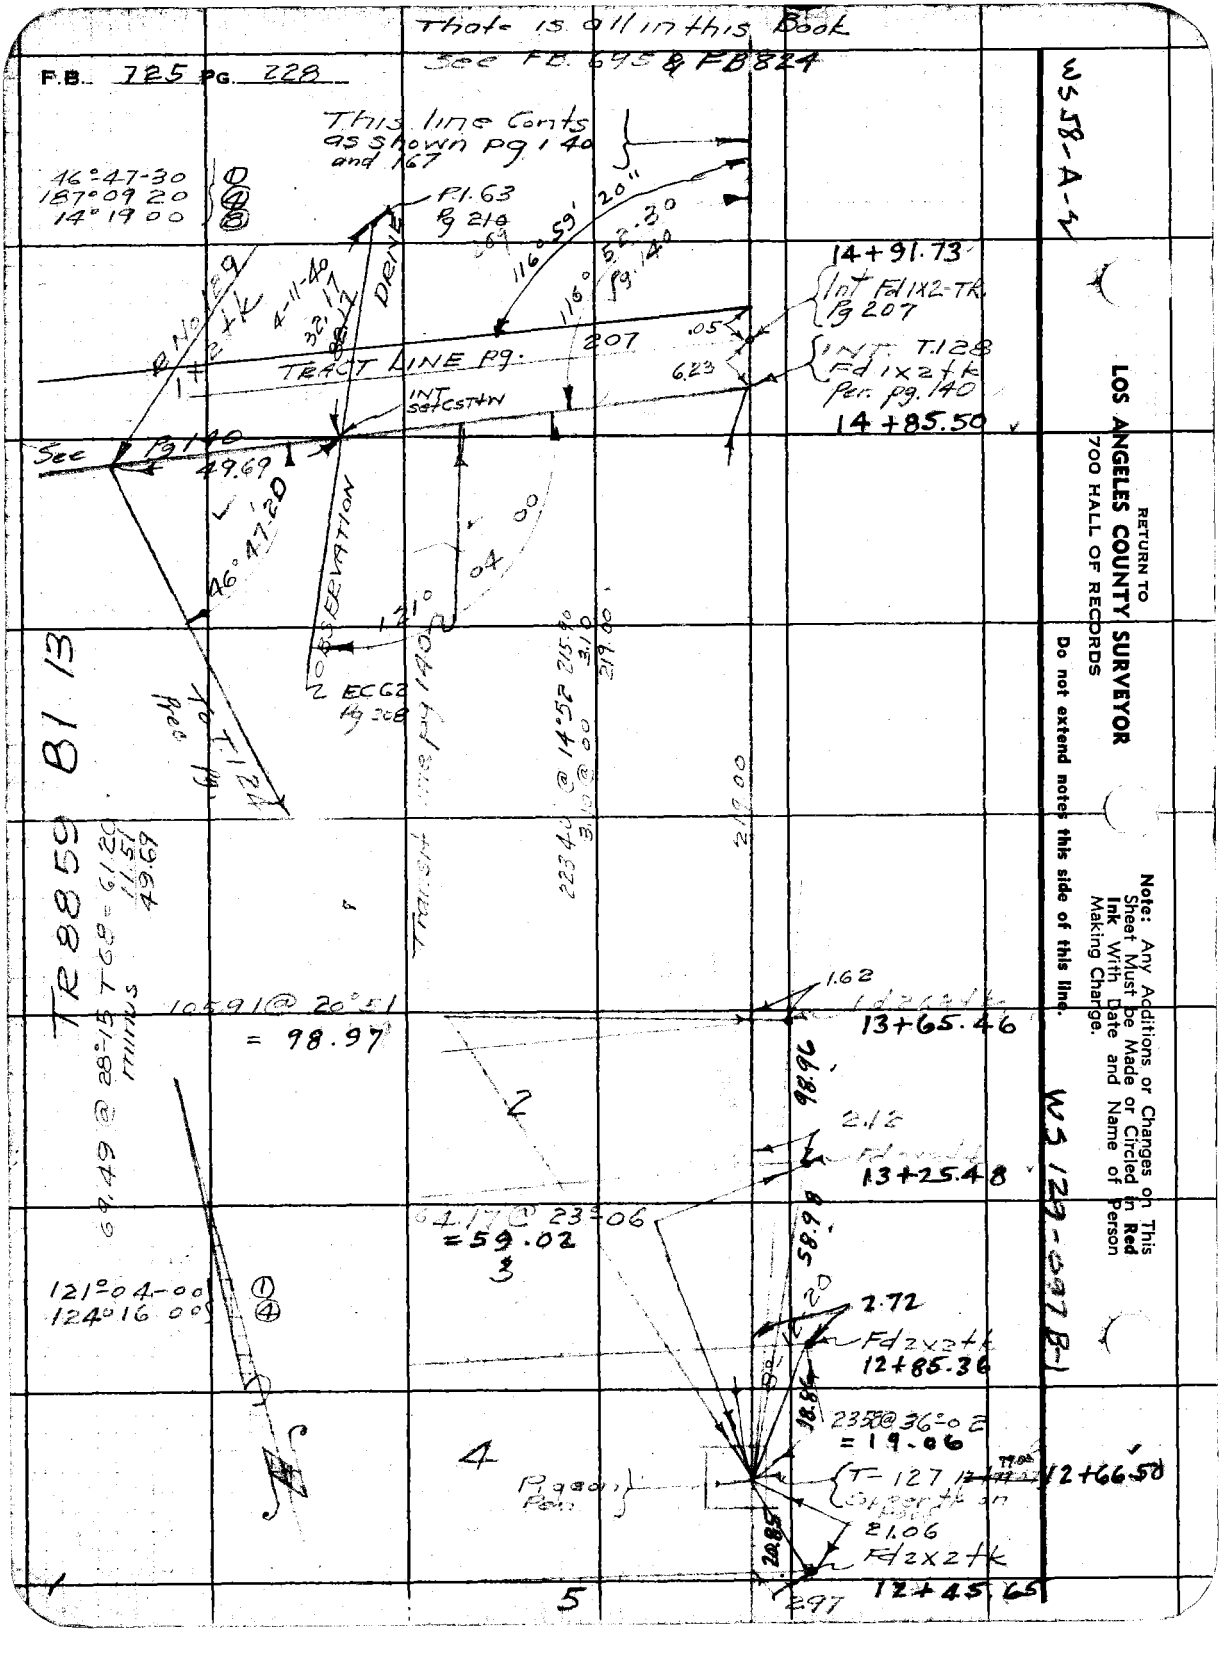
That is all in this Book
See FB 695 & FB 824
F.B. 725 PG. 228
This line Conts as shown pg 140 and 167
46°47-30
187°09 20
14°19 00
PI 1.63
Pg 218
116°59'
20"
52.30
Pg 140
14+91.73
Int Fd 1x2-TK
Pg 207
TRACT LINE Pg: 207
.05
6.23
INT T.128
Fd 1x2+k
Per. pg. 140
14+85.50
INT SEC CST HW
See 131-40
49.69
46°47'20"
121°
04 00
OBSERVATION
EC G2
Pg 208
T.T 124
Rad
TR 8855 81 13
223.40
@ 14°52 215.90
31.00
219.00
2.00
1.62
13+65.46
98.96
2.12
13+25.48
= 98.97
= 59.02
121°04-00
124°16 00
2.72
Fd 2x2+k
12+85.36
58.96
2350 @ 36°02
= 19.06
T-127
12+66.50
21.06
Fd 2x2+k
12+45.65
297
WSJ 129-297 B-1
WSJ8-A-4
RETURN TO
LOS ANGELES COUNTY SURVEYOR
700 HALL OF RECORDS
Do not extend notes this side of this line.
Note: Any Additions or Changes on This Sheet Must be Made or Circled in Red Ink With Date and Name of Person Making Change.

FORM 247 5M 10-39

RETURN TO
LOS ANGELES COUNTY SURVEYOR
700 HALL OF RECORDS

Note: Any Additions or Changes on This Sheet Must be Made or Circled in Red Ink With Date and Name of Person Making Change.

Do not extend notes this side of this line.

WS.58-A-(1)

Notes Ck'd by
Map No. B-1631-L
Office Work 4 AB
Checked
Date

Survey of
W. O. 8229 Tape No. Std °F
Surveyed by
Notes
Date
Indexed

F.B. 725 PG. 229

for Transit Line See Pages 150-151

TRACT NO 8859

LOT 53 TR 9531

Continued from p. 231

Copied from Office Records

4 5 6 7 9 10

28 29 30 52

North Line

Tract 9531.59

TRACT NO 9531

RETURN TO
LOS ANGELES COUNTY SURVEYOR
700 HALL OF RECORDS

Note: Any Additions or Changes on This Sheet Must be Made or Circled in **Red Ink** With Date and Name of Person Making Change.

Do not extend notes this side of this line.

F.B. 7255 PG. 230

FORM 247 5M 10-59

RETURN TO
LOS ANGELES COUNTY SURVEYOR
700 HALL OF RECORDS

Note: Any Additions or Changes on This Sheet Must be Made or Circled in **Red Ink** With Date and Name of Person Making Change.

Do not extend notes this side of this line.

WS 129-097 B-1

WS 58-A-7

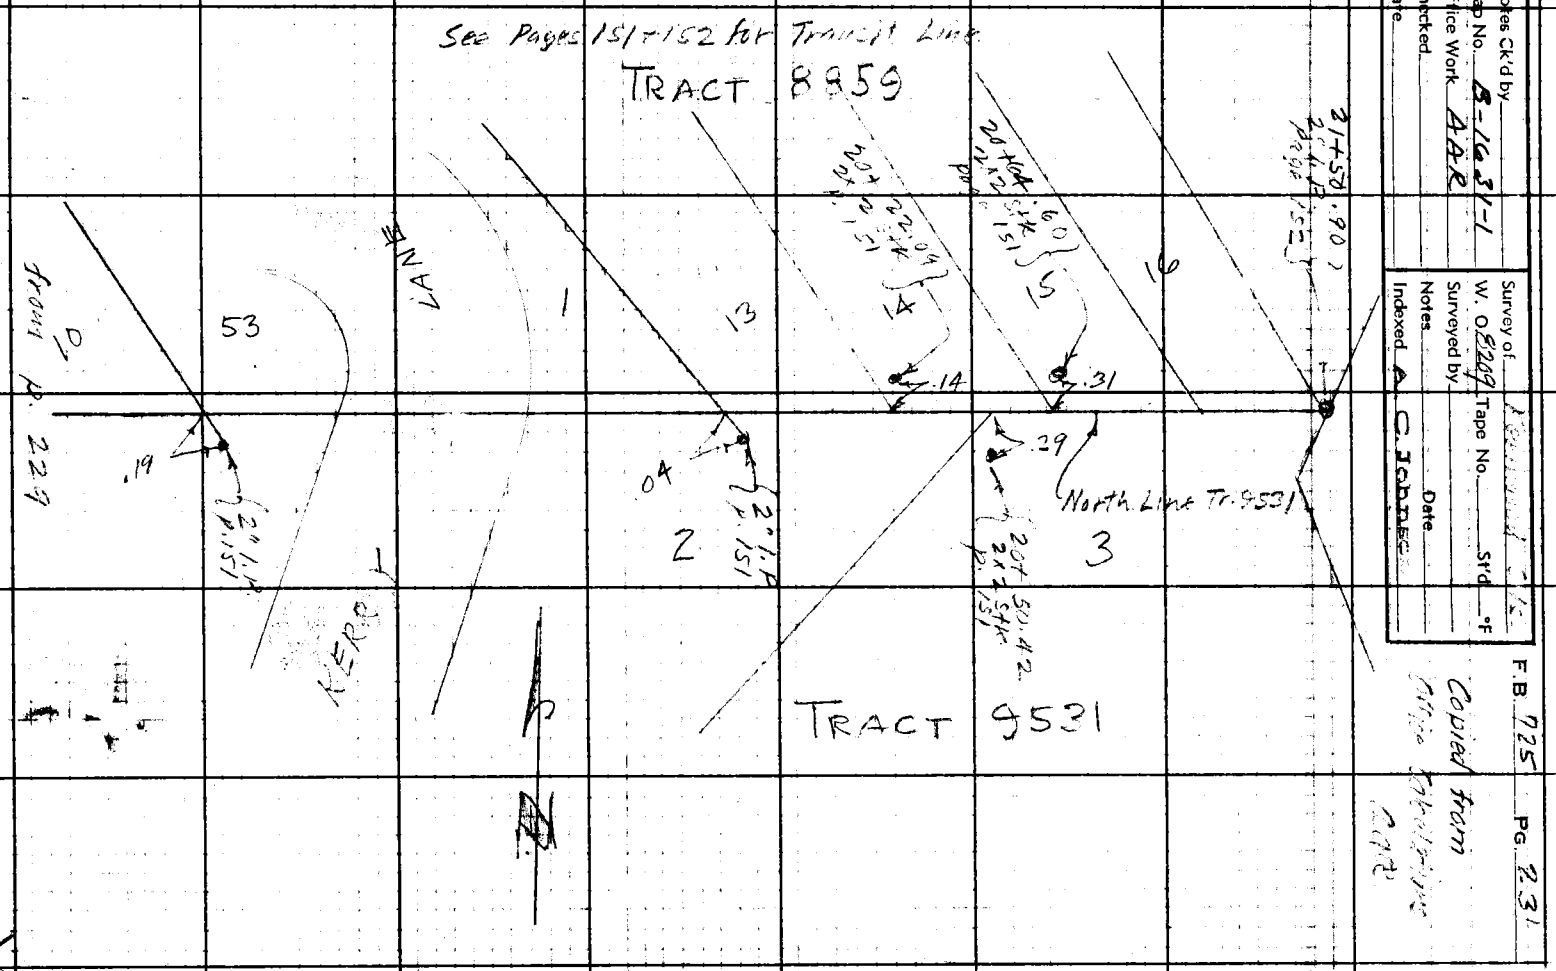
See Pages 151-152 for Tract Line
TRACT 8959
TRACT 9531
North Line Tr. 9531
53
1
13
14
15
16
2
3
.19
.04
.14
.31
.29
2" I.P. 151
2" I.P. 151
2" I.P. 151
2" I.P. 151
50.42 2nd 5THR 151
2nd P.P. 151
2nd P.P. 151
2nd P.P.

RETURN TO
LOS ANGELES COUNTY SURVEYOR
700 HALL OF RECORDS

Note: Any Additions or Changes on This Sheet Must be Made or Circled in **Red Ink** With Date and Name of Person Making Change.

Do not extend notes this side of this line.

F.B. 725 Pg. 232

F. B. 725 PG. 233

Notes Ck'd by	Survey of TOPANGA CN ROAD
Map No.	W. O. R-699 Tape No. 029 St'd. 84 °F
Office Work	Surveyed by F. H. BLANCHARD
Checked	Notes F. H. BLANCHARD Date 10-17-52
Date	Indexed A. C. Johnson 11-5-52

Note: Any Additions or Changes on This Sheet Must be Made or Circled in Red Ink With Date and Name of Person Making Change.

Do not extend notes this side of this line.

RETURN TO
LOS ANGELES COUNTY SURVEYOR
726 LOS ANGELES COUNTY
ENGINEERING BLDG.

TOPANGA CN ROAD

J.N. R-699

On Topanga Cn Road 1200 south of Topanga Cn Fire Station and at the int of Grand View Drive and Topanga Cn Road.

Oct 1952

Ref
EX 63-25-2
FB 725-183

Blanchard
Shoemaker
Uharriet
Voge
Grant

76F3095 247 2-51

RETURN TO
LOS ANGELES COUNTY SURVEYOR
725 LOS ANGELES COUNTY
ENGINEERING BLDG.

Note: Any Additions or Changes on This Sheet Must be Made or Circled in Red Ink With Date and Name of Person Making Change.

Do not extend notes this side of this line.

INDEX

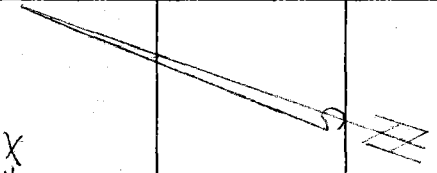

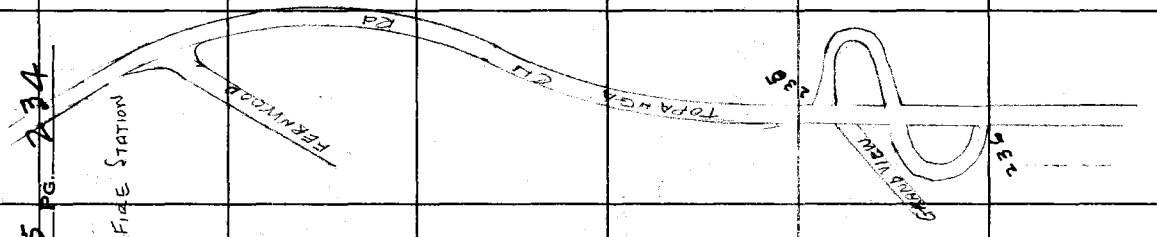

F.B. 725 PG. 234

F. B. 725 PG. 235

Notes Ck'd by	Survey of Topanga Cn Kegs
Map No.	W. O. 8129 Tape No. 029 St'd. 84 °F
Office Work	Surveyed By F. H. BLANCHARD
Checked	Notes F. H. BLANCHARD Date 10-22-52
Date	Indexed A. C. Johnson

W.S. 69, C-3

Note: Any Additions or Changes on This Sheet Must be Made or Circled in Red Ink With Date and Name of Person Making Change.

Do not extend notes this side of this line.

RETURN TO
LOS ANGELES COUNTY SURVEYOR
726 LOS ANGELES COUNTY
ENGINEERING BLDG.

WS 1129 - 077 B-1

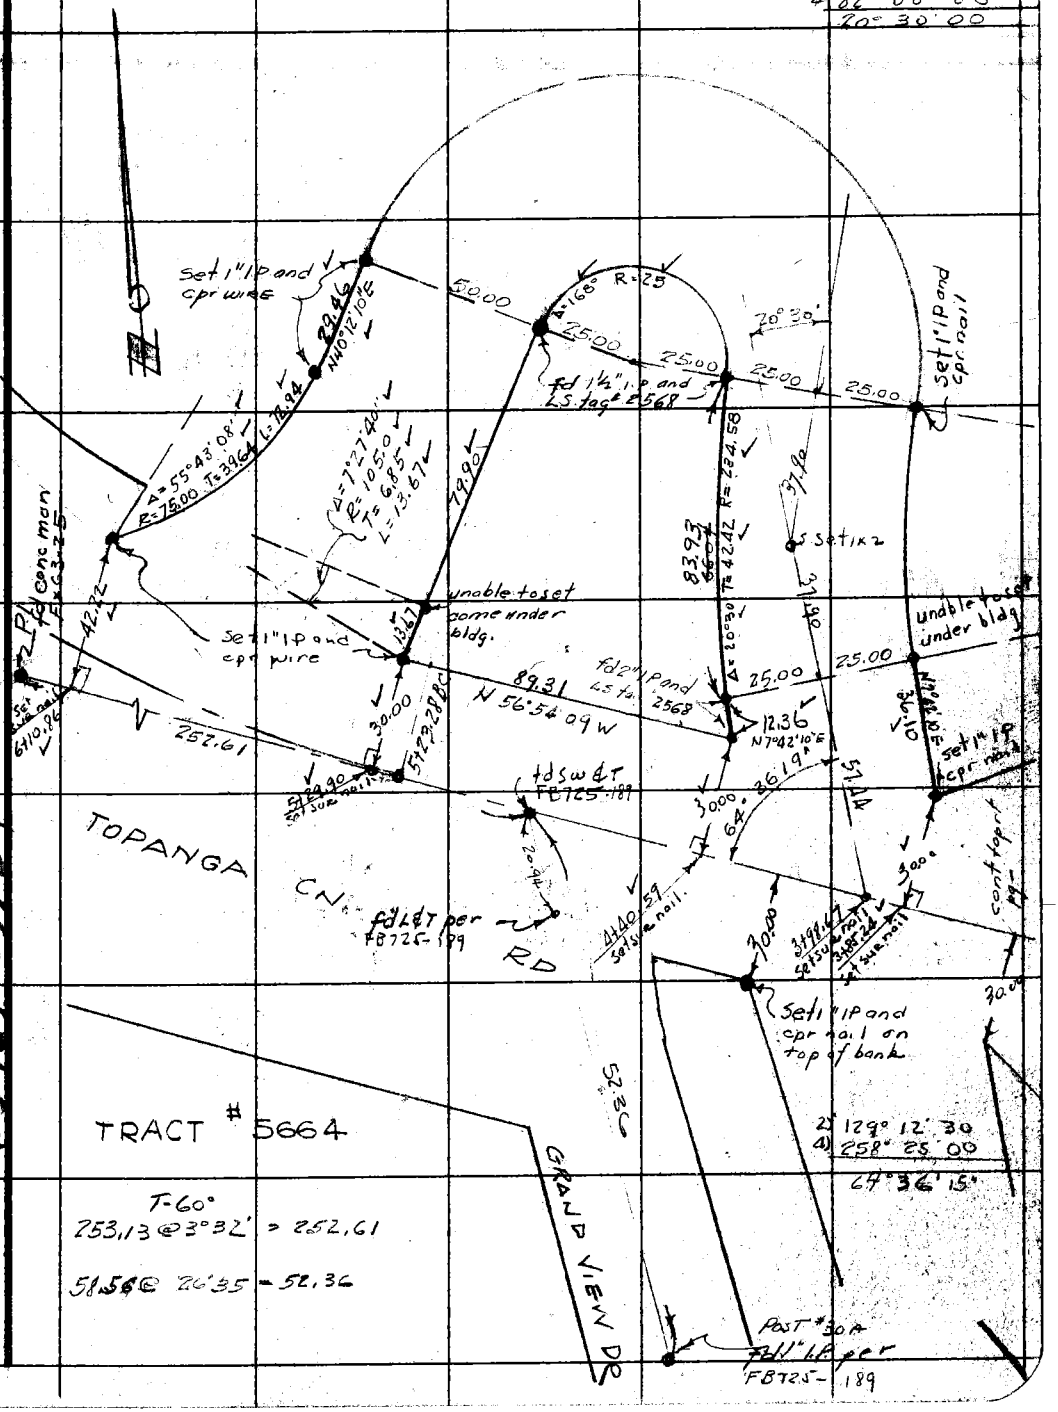

76F309S 247 2-51

F. B. 725 PG. 236

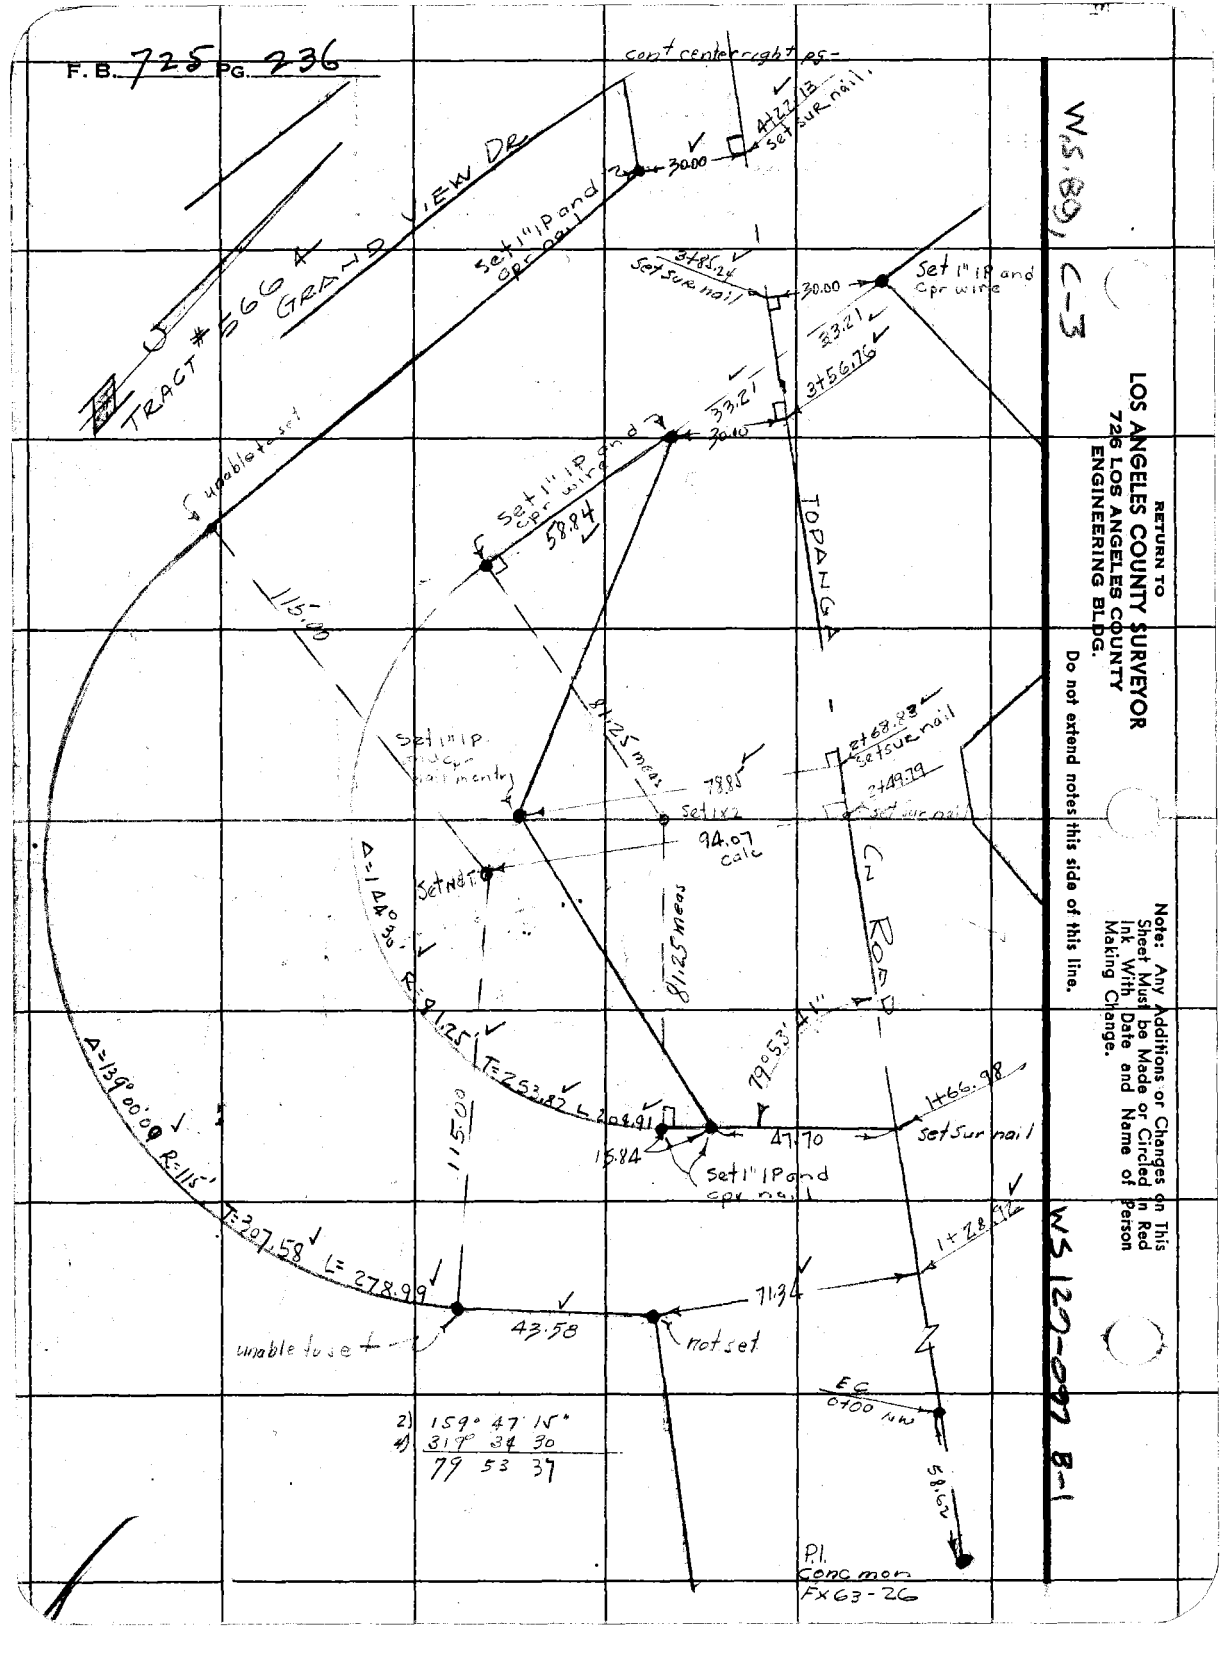

RETURN TO
LOS ANGELES COUNTY SURVEYOR
726 LOS ANGELES COUNTY
ENGINEERING BLDG.

Do not extend notes this side of this line.

Note: Any Additions or Changes on This Sheet Must be Made or Circled in Red Ink With Date and Name of Person Making Change.

Notes Ck'd by	Survey of FERNWOOD STREETS
Map No. B-1631-3	W. O. 002126 Tape No. 106 St'd. 58 °F
Office Work	Surveyed by C. H. BLANCHARD
Checked	Notes Date 5-24-54
Date	Indexed A. C. Johnson 6-11-54

F. B. 796 Pg. 237

FERNWOOD STREETS

J. N. 002126

Sky Line Trail from Tract 8134 to Valley View and from Valley View to Summit Drive

MAY ~ 1954

R.F.

FB 856
Tract Map 8313 sht 3 & 4

Party
Blanchard
Wharmet
Goodwin
Robbins
Stein

Added to C.S. 8-1631-3

Note: Any Additions or Changes on This Sheet Must be Made or Circled in Red Ink With Date and Name of Person Making Change.

Do not extend notes this side of this line.

RETURN TO
LOS ANGELES COUNTY SURVEYOR
726 LOS ANGELES COUNTY
ENGINEERING BLDG.

76FS095 247 4-53

RETURN TO
LOS ANGELES COUNTY SURVEYOR
726 LOS ANGELES COUNTY
ENGINEERING BLDG.

Note: Any Additions or Changes on This Sheet Must be Made or Circled in Red Ink With Date and Name of Person Making Change.

Do not extend notes this side of this line.

INDEX

F.B. 725 PG. 238

Notes Ck'd by	Survey of FERNWOOD STREET
Map No.	W. O. M200 Tape No. 106 St'd. 68 °F
Office Work	Surveyed by Blanchard
Checked	Notes Blanchard Date 5 24 54
Date	Indexed A. C. Johnson

F. B. 726 Pg. 200

Note: Any Additions or Changes on This Sheet Must be Made or Circled in Red Ink With Date and Name of Person Making Change.

Do not extend notes this side of this line.

RETURN TO
LOS ANGELES COUNTY SURVEYOR
726 LOS ANGELES COUNTY
ENGINEERING BLDG.

TRACT No 8317

BLOCK - 11

BLOCK - 8

P/# fd 3/4" I.P. 6" dn per F.B. 826-74

P/# fd 3/4" I.P. 6" dn per F.B. 826-74 .01 east of line

P/# fd SWBT per F.B. 826-74 pg-245

0+#.00 P/# set 2 sun nail & tin. pg 245

24.11

56.91

23.00

161°07'00"

2) 322°14'00"
4) 284 28 00
6) 246 42 00
161°07'00

F62
159.99 @ 0°00 = 159.98

159.98

cont to pg 2 of 2

76F3095 247 4-58

F. B. 725 Pg. 240

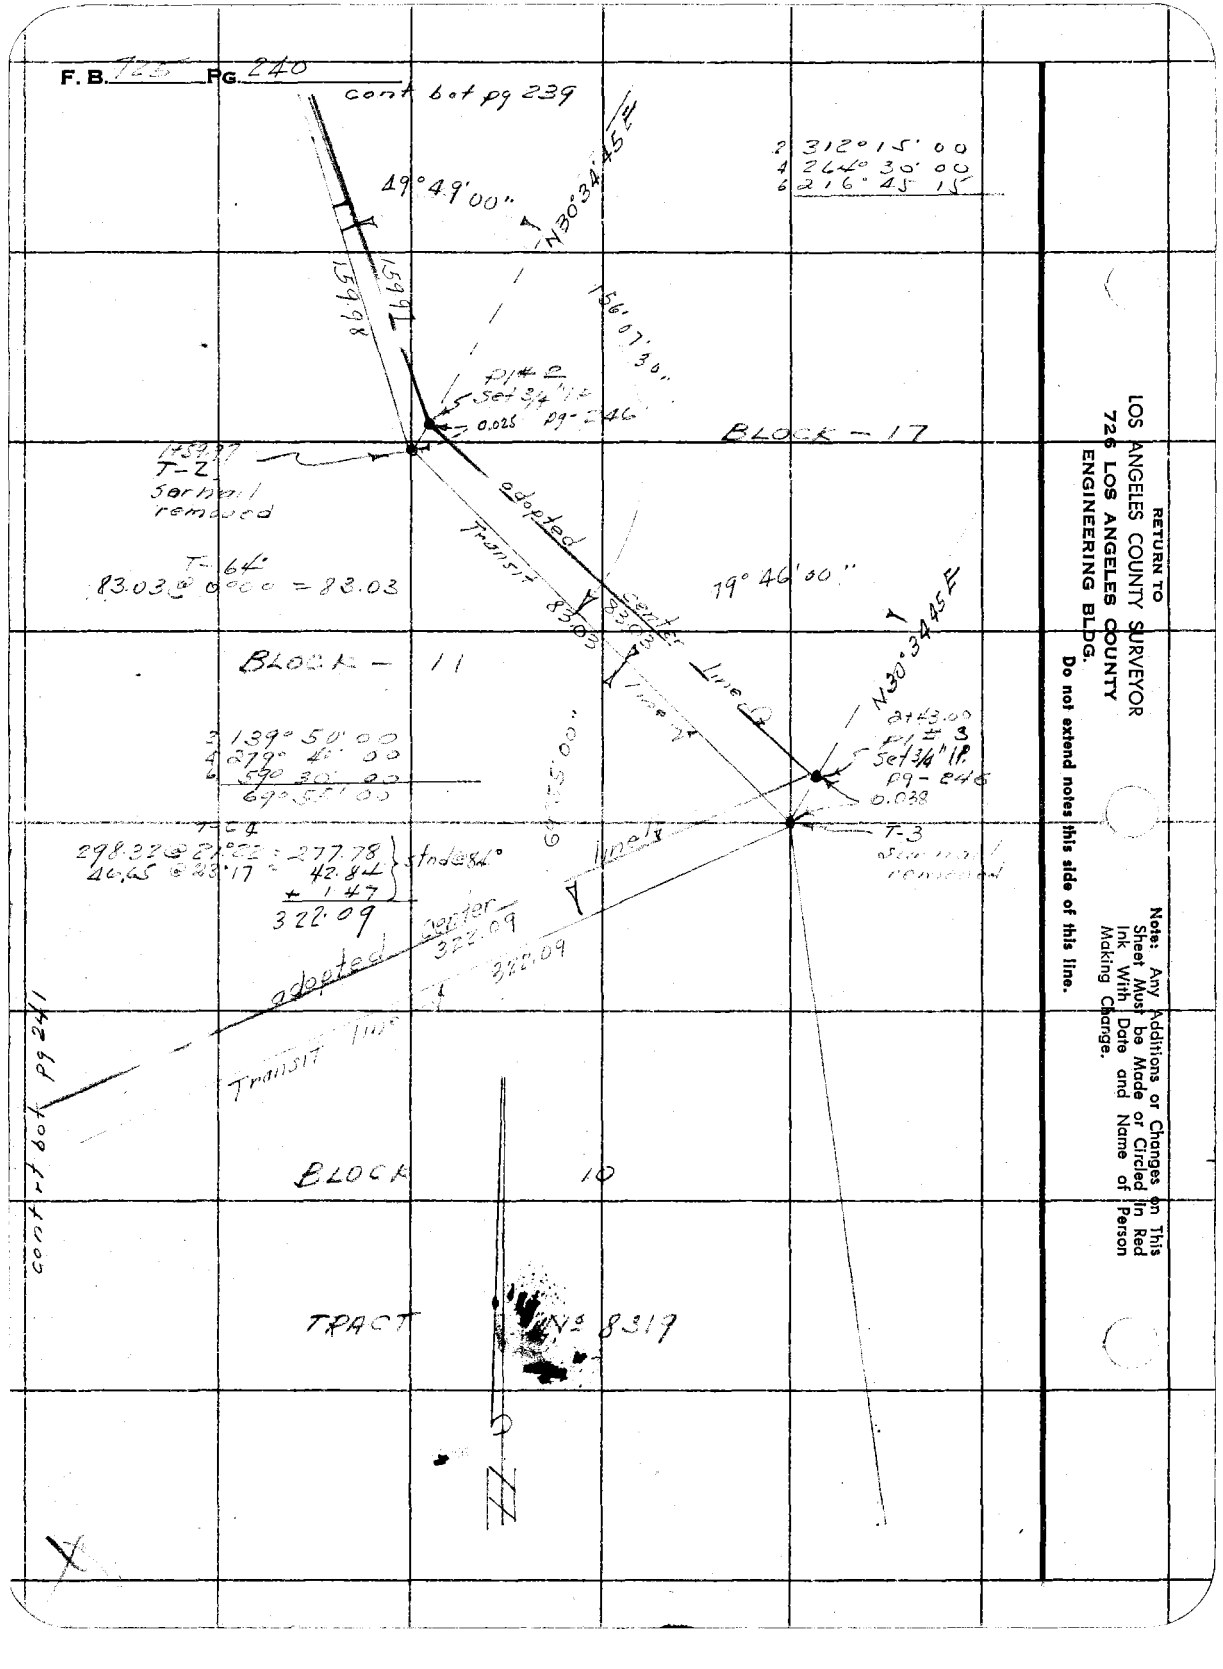

RETURN TO
LOS ANGELES COUNTY SURVEYOR
726 LOS ANGELES COUNTY
ENGINEERING BLDG.

Do not extend notes this side of this line.

Note: Any Additions or Changes on This Sheet Must be Made or Circled in Red Ink With Date and Name of Person Making Change.

Office Work	Surveyed by Blanchard
Checked	Notes Blanchard Date 5-28-54
Date	Indexed A. C. Johnson

F. B. 795 Pg. 241

Note: Any Additions or Changes on This Sheet Must be Made or Circled in Red Ink With Date and Name of Person Making Change.

Do not extend notes this side of this line.

RETURN TO
LOS ANGELES COUNTY SURVEYOR
726 LOS ANGELES COUNTY
ENGINEERING BLDG.

76FS09S 247 4-58

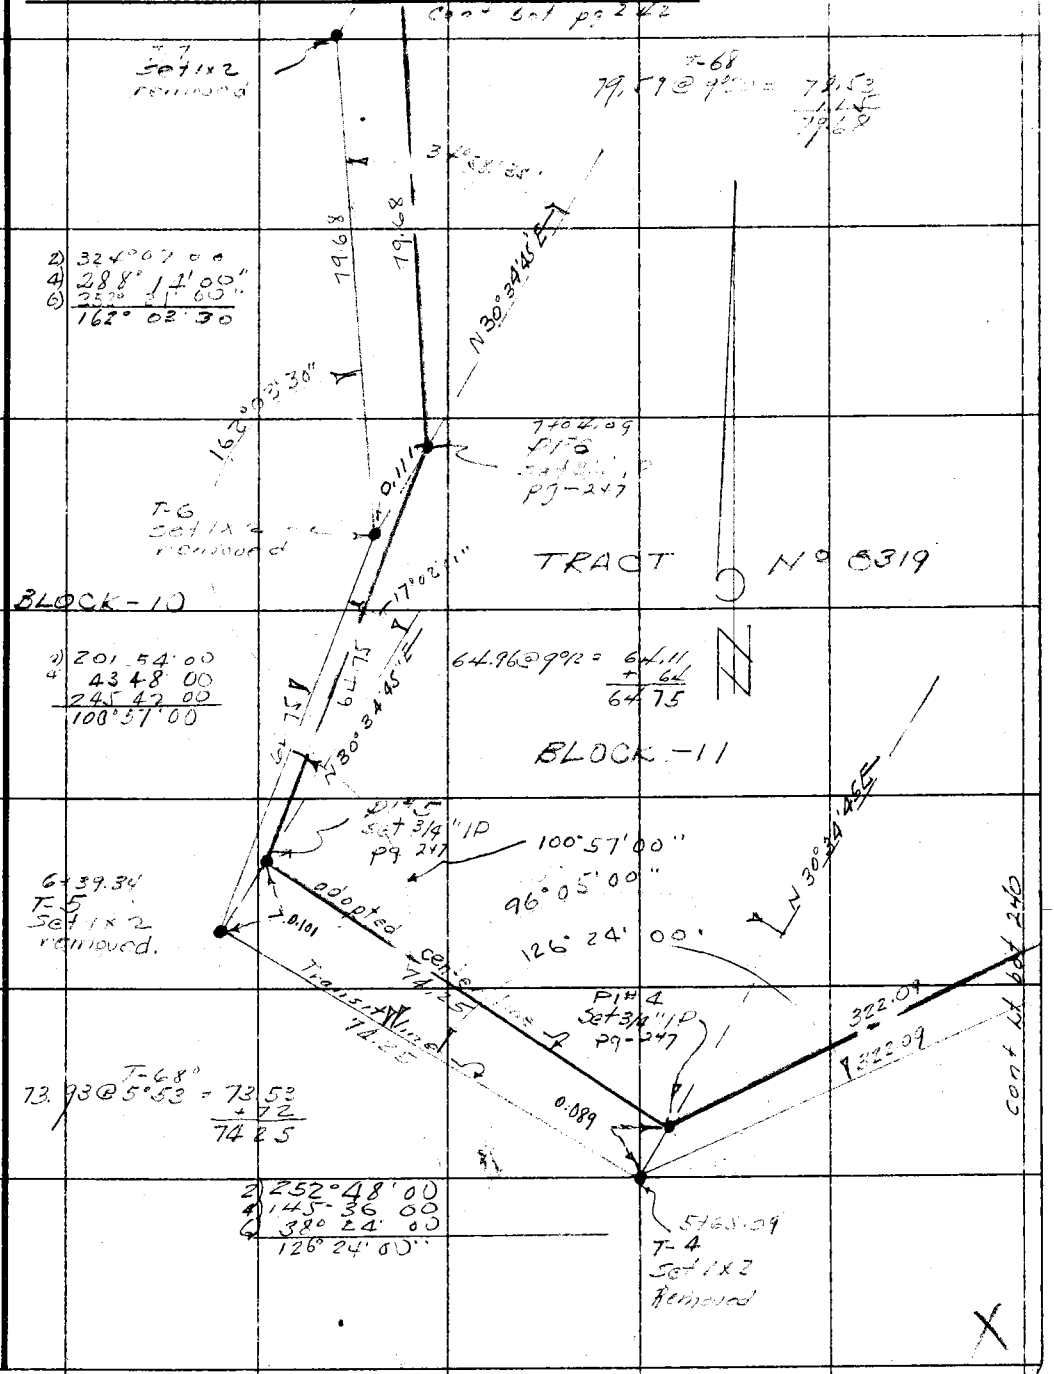

F. B. 725 Pg. 242

T-9

Cont. bot pg-243

T=70°
157.68 @ 7°24' = 156.84
1.68
158.02

Adopted

158.02 Center

Transit

2) 315° 29' 30"
3) 270° 59' 00"
4) 226° 28' 30"
157° 42' 45"

BLOCK - 11

BLOCK - 10

94° 32' 30"

N 36° 45" E

8+60.95

Set 1x2 nailed

0.13±

Set 1x2 nailed

TRACT No 8319

77.18

157°44'45"

52°18'15"

N 36° 45" E

0.12±

2) 325° 20' 30"
4) 290° 41' 00"
6) 256° 01' 30"
162° 40' 15"

T-64

77.748 14°18 = 75.32
186
77.18

Set 1x2 nailed

162° 40' 15"

Cont top pg 244

RETURN TO
LOS ANGELES COUNTY SURVEYOR
725 LOS ANGELES COUNTY
ENGINEERING BLDG.
Do not extend notes this side of this line.

Note: Any Additions or Changes on This Sheet Must be Made or Circled in Red Ink With Date and Name of Person Making Change.

Map No.	W. O. 9021 Tape No. 106 St'd. 68 °F
Office Work	Surveyed by Blanchard
Checked	Notes Blanchard Date 5-28-54
Date	Indexed A. C. Johnson

F. B. 77 Pg. 243

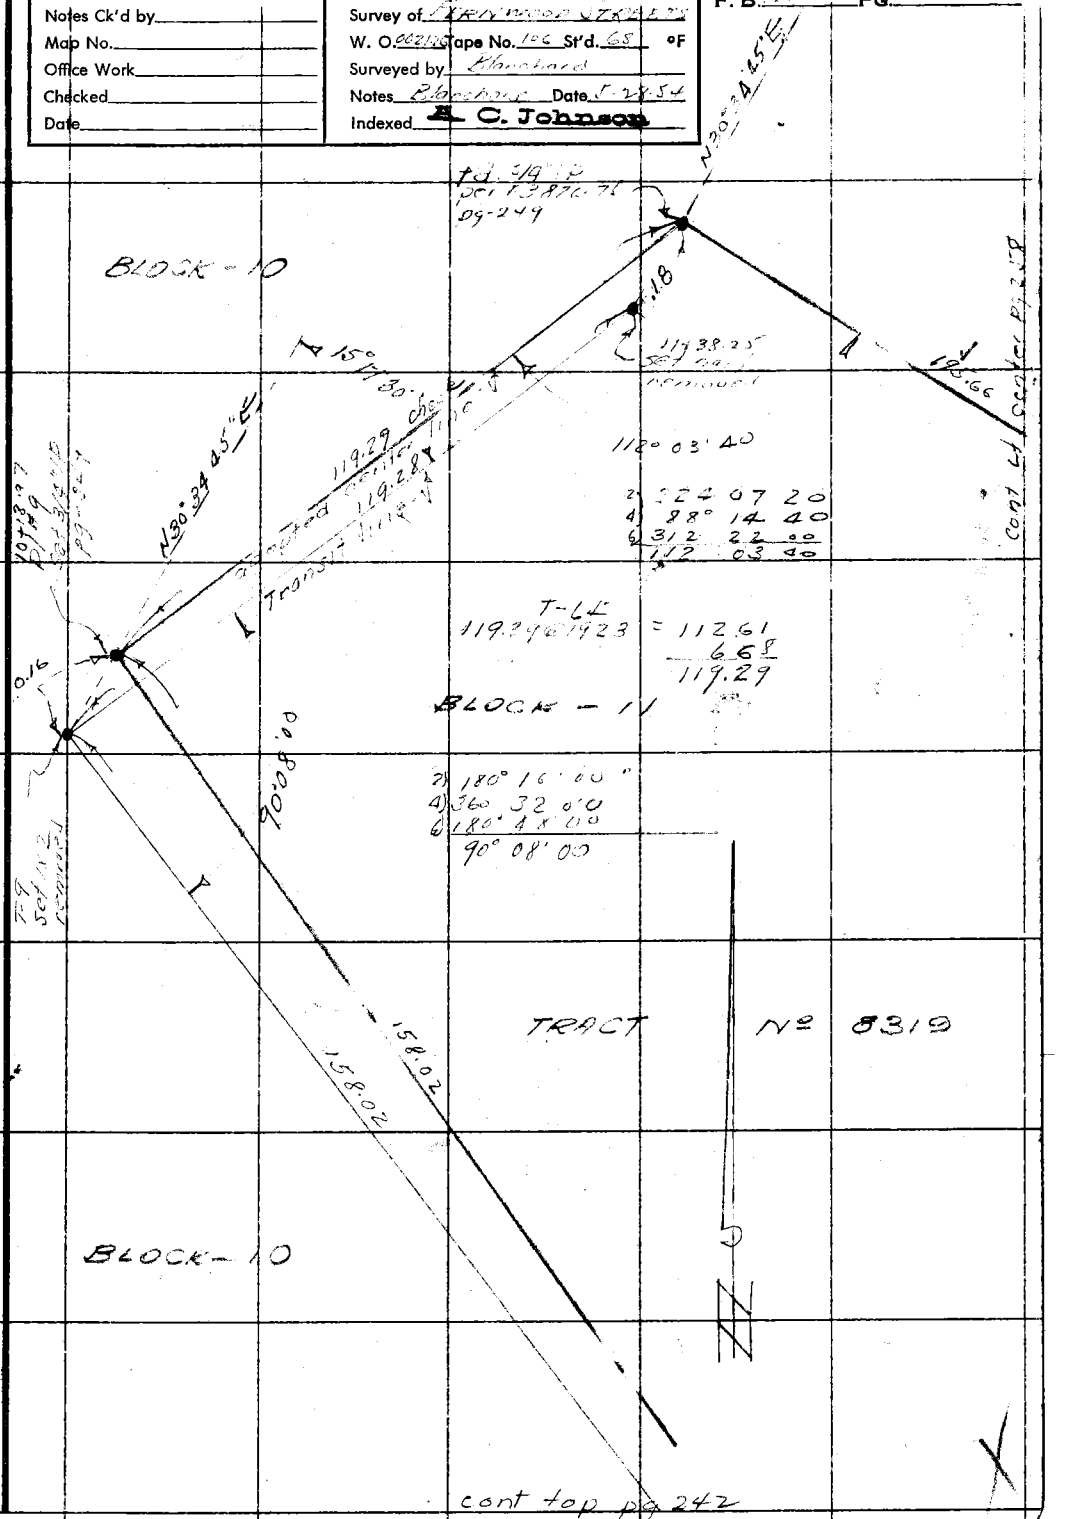

Note: Any Additions or Changes on This Sheet Must be Made or Circled in Red Ink With Date and Name of Person Making Change.

Do not extend notes this side of this line.

RETURN TO
LOS ANGELES COUNTY SURVEYOR
726 LOS ANGELES COUNTY
ENGINEERING BLDG.

76F3095 247 4-53

F. B. 705 Pg. 21

Cont dot pg 284

WS 89C-3

RETURN TO
LOS ANGELES COUNTY SURVEYOR
726 LOS ANGELES COUNTY
ENGINEERING BLDG.
Do not extend notes this side of this line.

Note: Any Additions or Changes on This Sheet Must be Made or Circled in Red Ink With Date and Name of Person Making Change.

WS 129-097 A-1

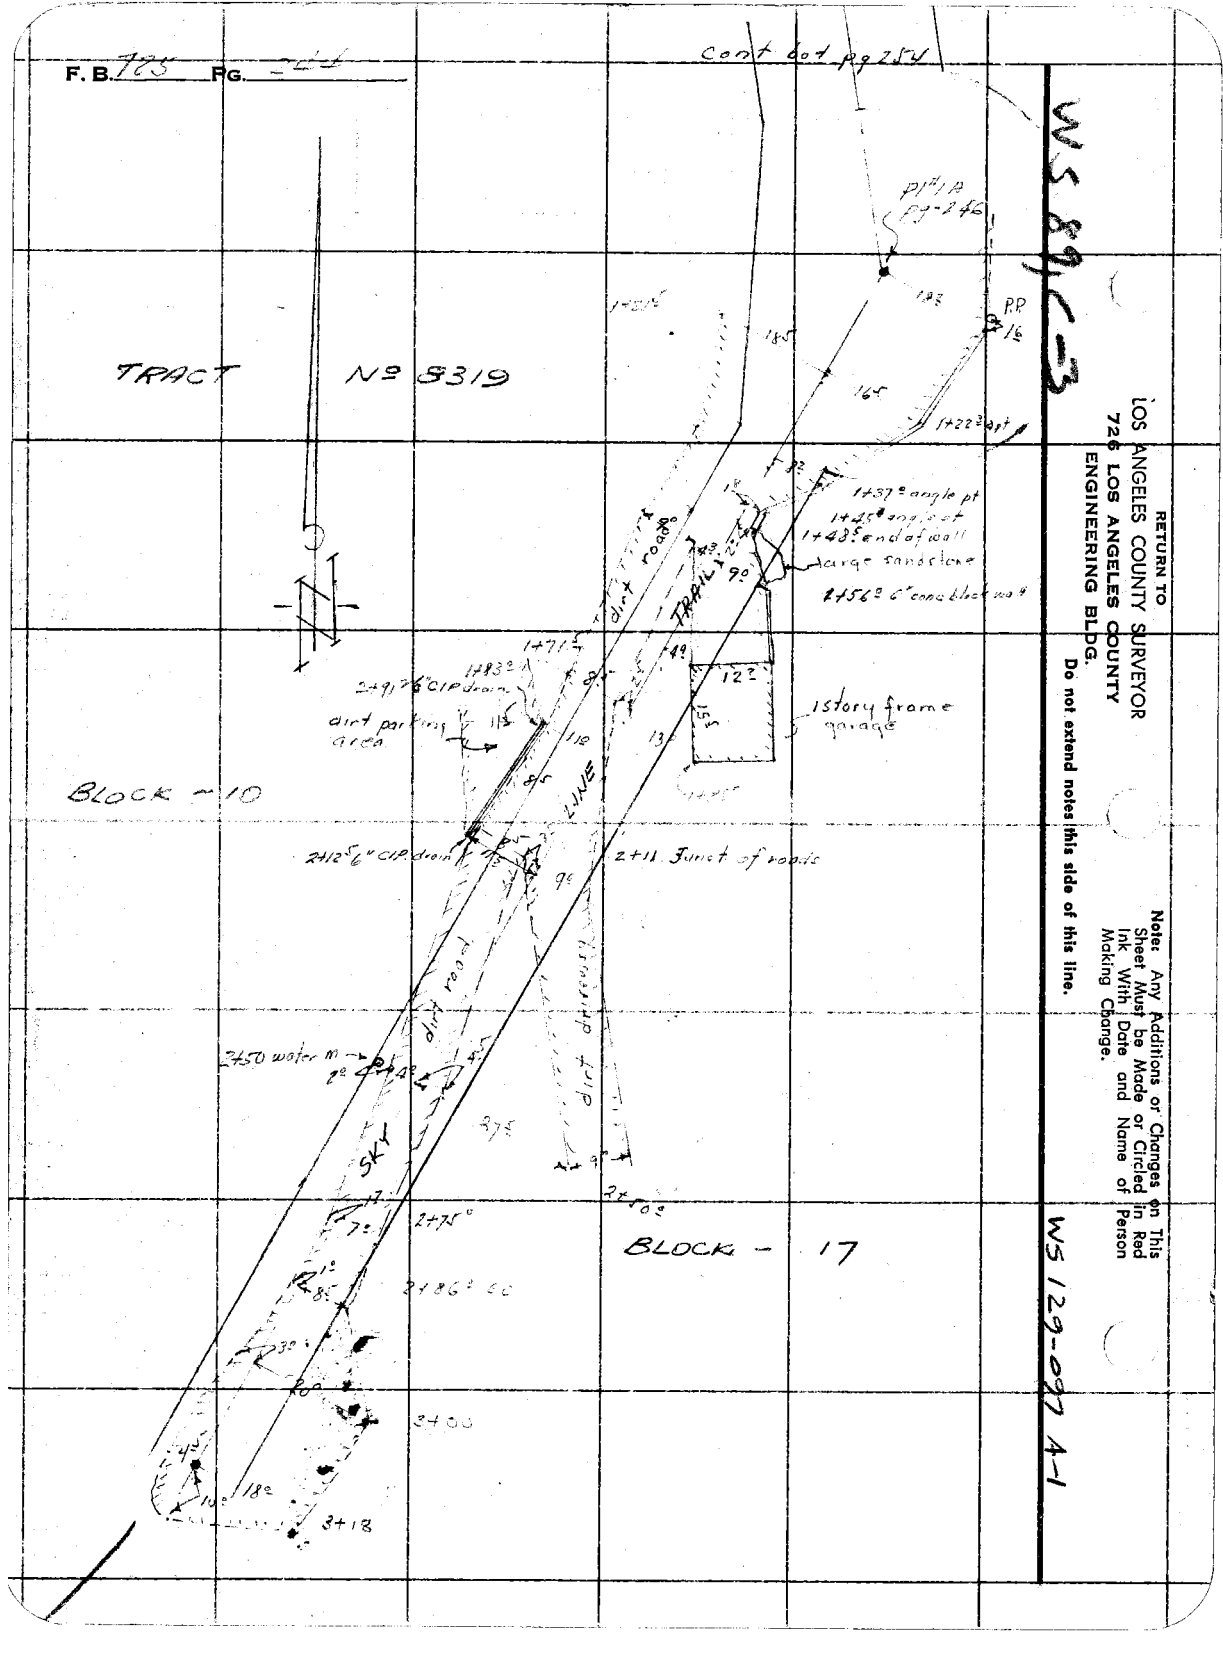

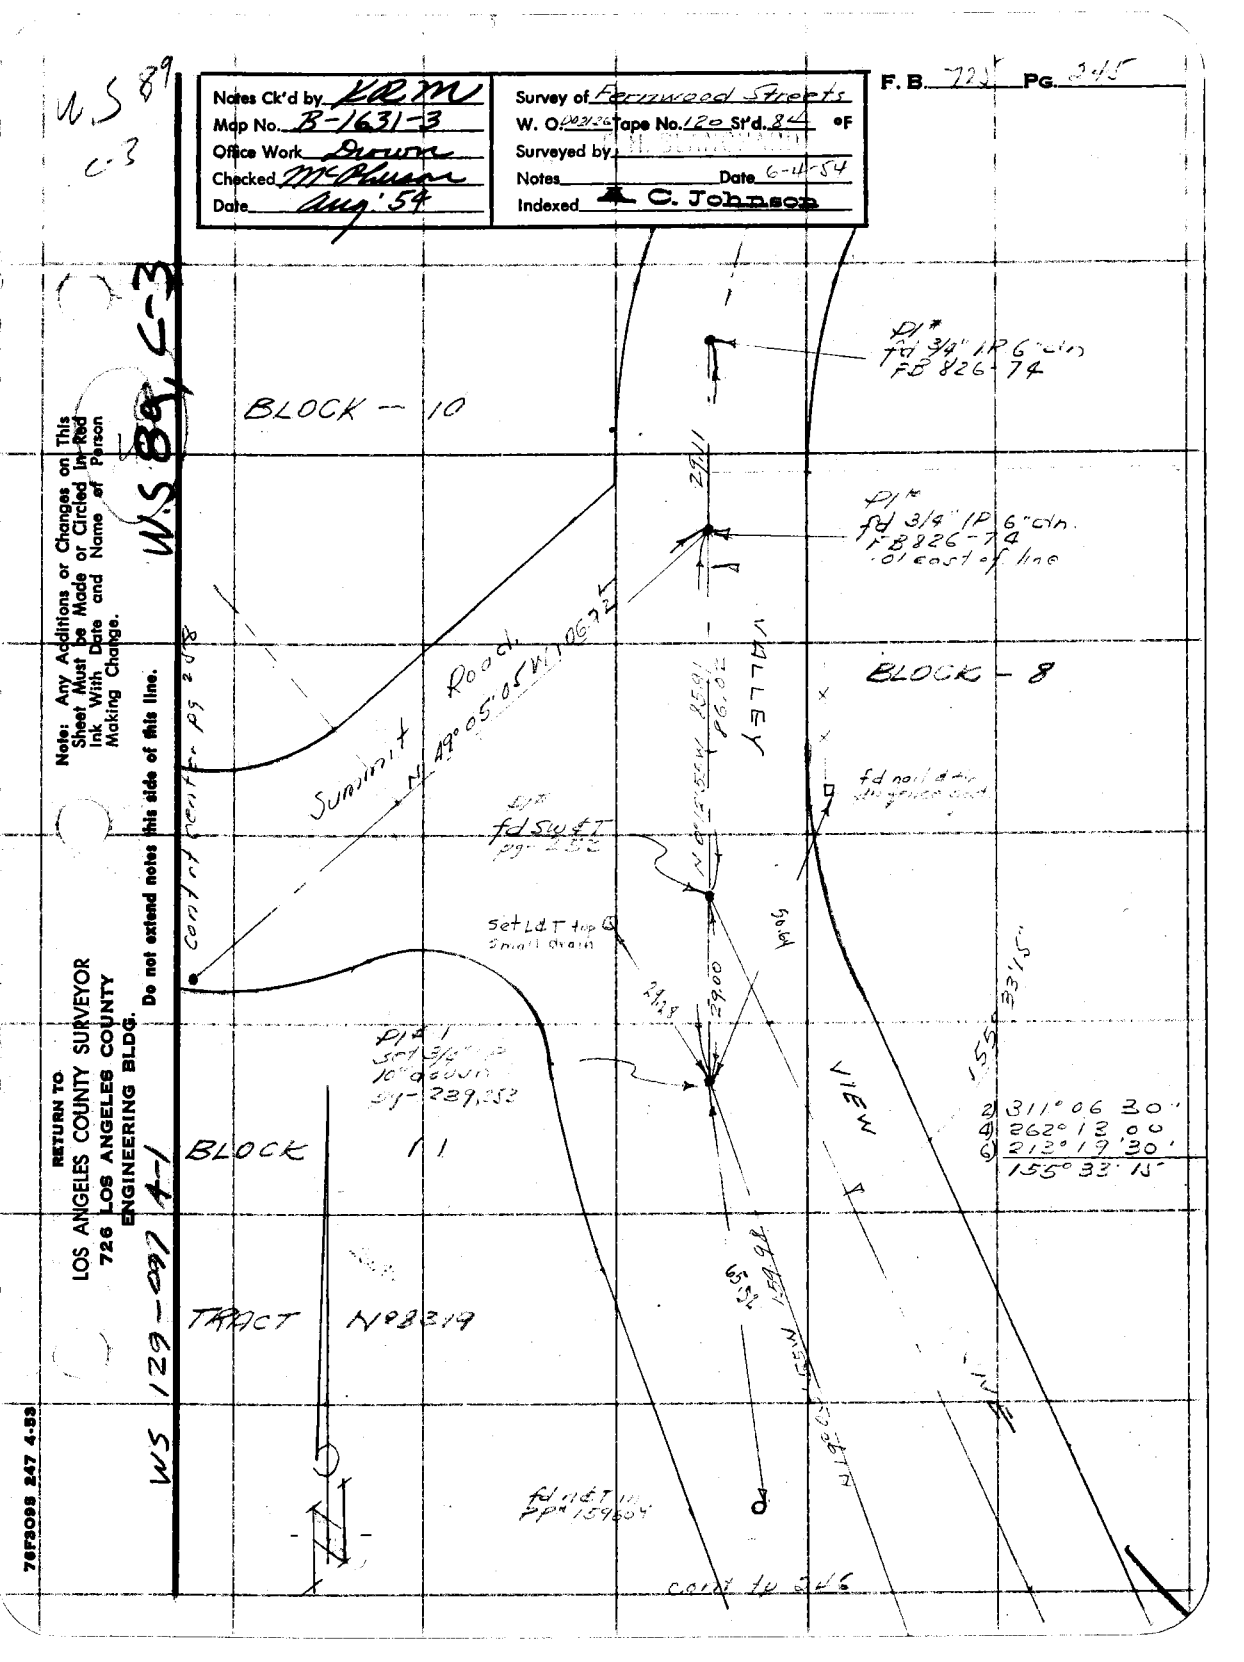
W.S 89 C-3
Notes Ck'd by KRM
Map No. B-1631-3
Office Work Drawn
Checked McPherson
Date Aug. '54
Survey of Farmwood Streets
W. O. 4093-26 Tape No. 120 St'd. 84 °F
Surveyed by
Notes Date 6-4-54
Indexed C. Johnson
F. B. 725 Pg. 345
W.S 89, C-3
BLOCK -- 10
BLOCK - 8
BLOCK 11
TRACT No 8219
Summit Road
N 49° 05' 05" W 106.25
VALLEY
Valley R/W
Set L&T top of small drain
fd nail & tag
fd 3/4" IP 6" dn. FB 826-74
fd 3/4" IP 6" dn. FB 826-74 .01 east of line
fd nail & tag
fd L&T
P1#1 Set 3/4" IP 10" deep
2900
155° 33' 15"
2 311° 06' 30"
4 362° 13' 00"
6 213° 19' 30"
155° 33' 15"
Note: Any Additions or Changes on This Sheet Must be Made or Circled in Red Ink With Date and Name of Person Making Change.
Do not extend notes this side of this line.
RETURN TO
LOS ANGELES COUNTY SURVEYOR
726 LOS ANGELES COUNTY
ENGINEERING BLDG.
WS 129-097 4-1
76F3098 247 4-53

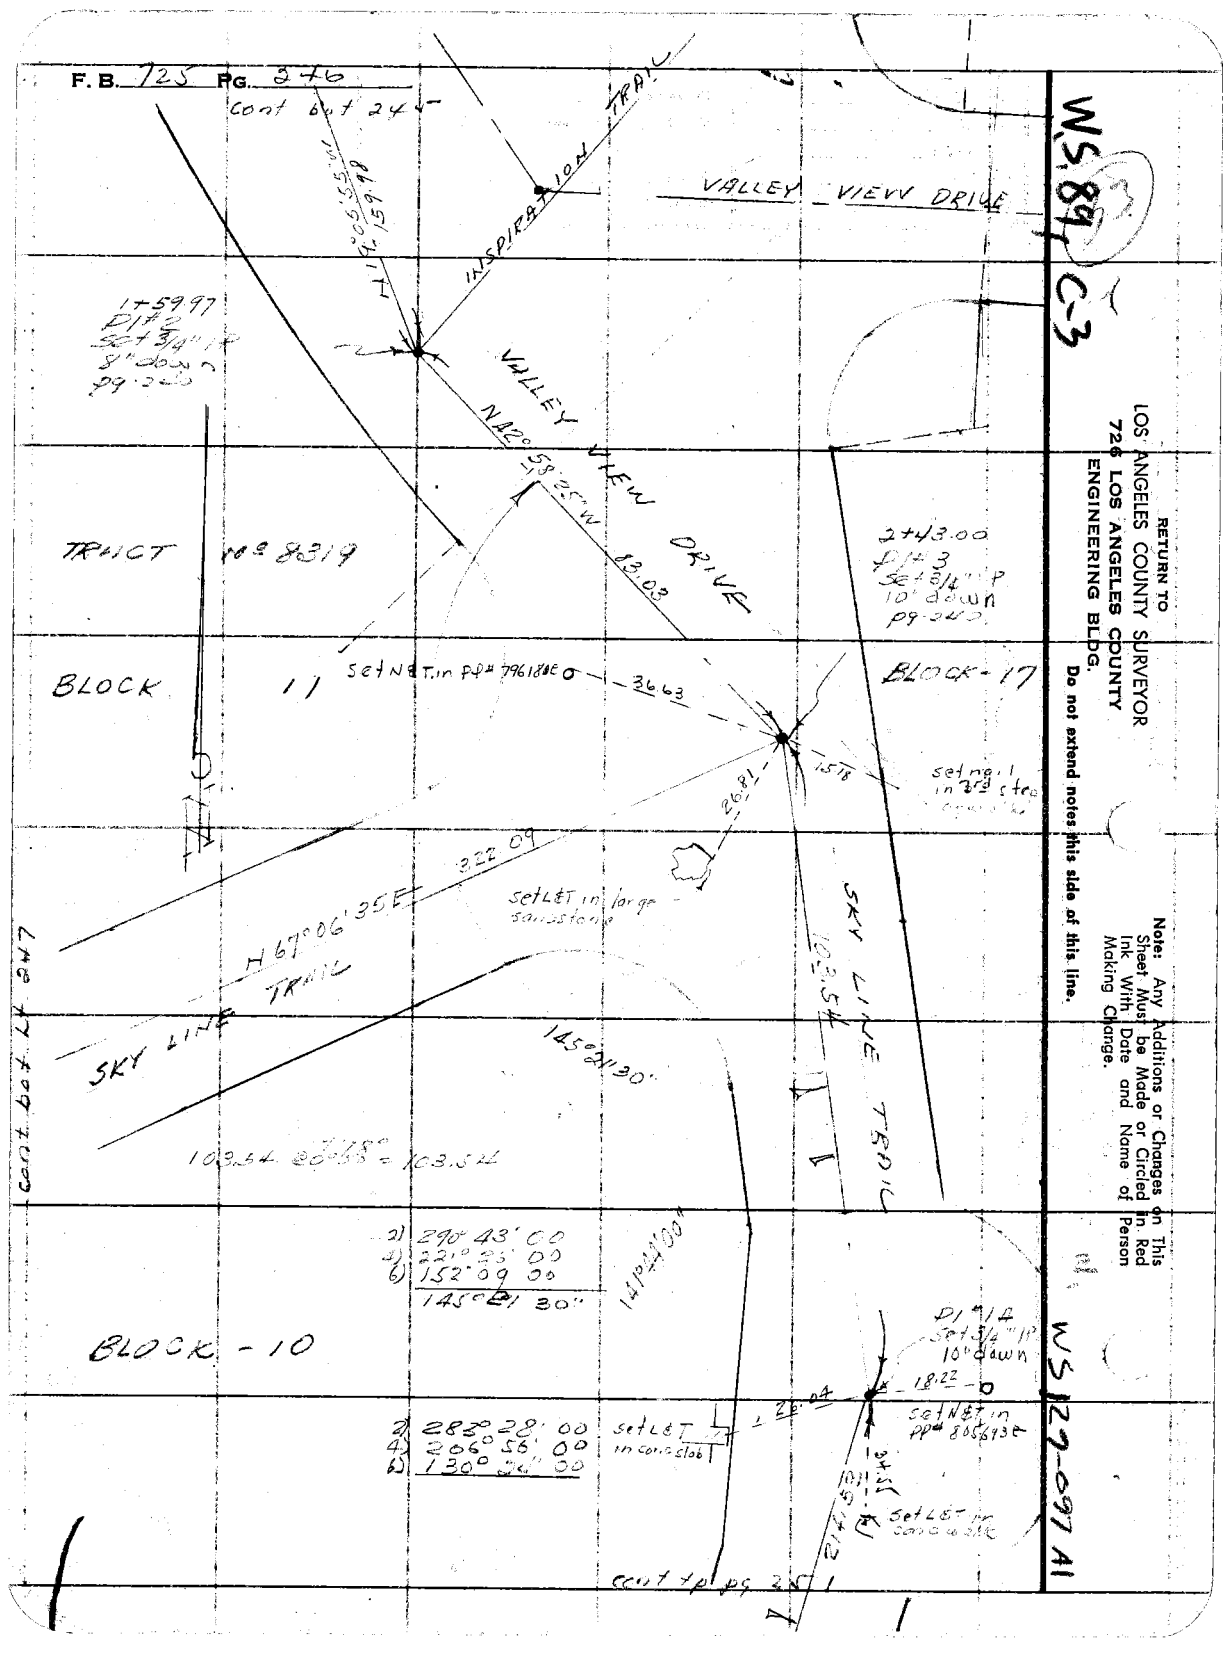
cont 6 of 24
WS 84 C-3
VALLEY VIEW DRIVE
INSPIRATION TRAIL
VALLEY VIEW DRIVE
N42°58'15"W 83.03
TRACT no. 8319
BLOCK 11
BLOCK - 17
BLOCK - 10
set N&T in PP# 7961806
3.63
set nail in 2x3 stake
set L&T in large sandstone
SKY LINE TRAIL
SKY LINE
H 67°06'35"E 322.09
145°21'30"
103.54
1) 290° 43' 00
2) 221° 55' 00
3) 152° 09' 00
145° 21' 30"
set L&T in conc slab
set N&T in PP# 8056934
cont to pg 3
RETURN TO
LOS ANGELES COUNTY SURVEYOR
726 LOS ANGELES COUNTY
ENGINEERING BLDG.
Do not extend notes this side of this line.
Note: Any Additions or Changes on This Sheet Must be Made or Circled in Red Ink With Date and Name of Person Making Change.
WS 127-097 A1

Notes Ck'd by: [illegible]	Survey of: Fernwood Streets
Map No.: B-1631-3	W. O. 622140 Tape No. 963 St'd. 68° °F
Office Work: Drayton	Surveyed by:
Checked: McPherson	Notes: Date 6-4-54
Date: Aug '54	Indexed: A. C. Johnson

F. B. [illegible] Pg. [illegible]

W.S. 89, E-3

Note: Any Additions or Changes on This Sheet Must Be Made or Circled in Red Ink With Date and Name of Person Making Change.

Do not extend notes this side of this line.

RETURN TO
LOS ANGELES COUNTY SURVEYOR
726 LOS ANGELES COUNTY
ENGINEERING BLDG.

WS 129-091 A-1

TRACT No 8319

BLOCK 11

LOT 30

LOT 31

BLOCK 10

LINE N 1° 49' 05" E. 728.68

7½' 7½'

set L&T in conc strip

7104.09
P/#6
Set 3/4" I.P
2' below in.
Pg-241

SKY
N 89° 45' 35" E 64.75

fd old car axle

N 89° 45' 35" E 20.82

set 1x2

Pg-241
D/#5 6439.50
Set 3/4" I.P flush
set L&T in conc curb

10.72

13.24

22.46

R. 21.40

18.18

15.00

N 89° 17' 25" W 21.42

set 1x2

set N&T in 30" oak 10' up

15.00

Garage

set L&T in conc slab

Δ 45° 26' 09" R= 55.00

74.25

30.31

3765.09
D/#4
Set 3/4" I.P
flush
Pg-241

6.48

11.37

Δ= 52° 36' R= 75.00.

fd ½" I.P

Set N&T in PP "5838976"

N 67° 06' 35" E 322.09

30.31

3.70'

15.00

5' East of Center Pg 246

7EF3088 247 4-53

F.B. 725 PG. 248

cont' on pg 249

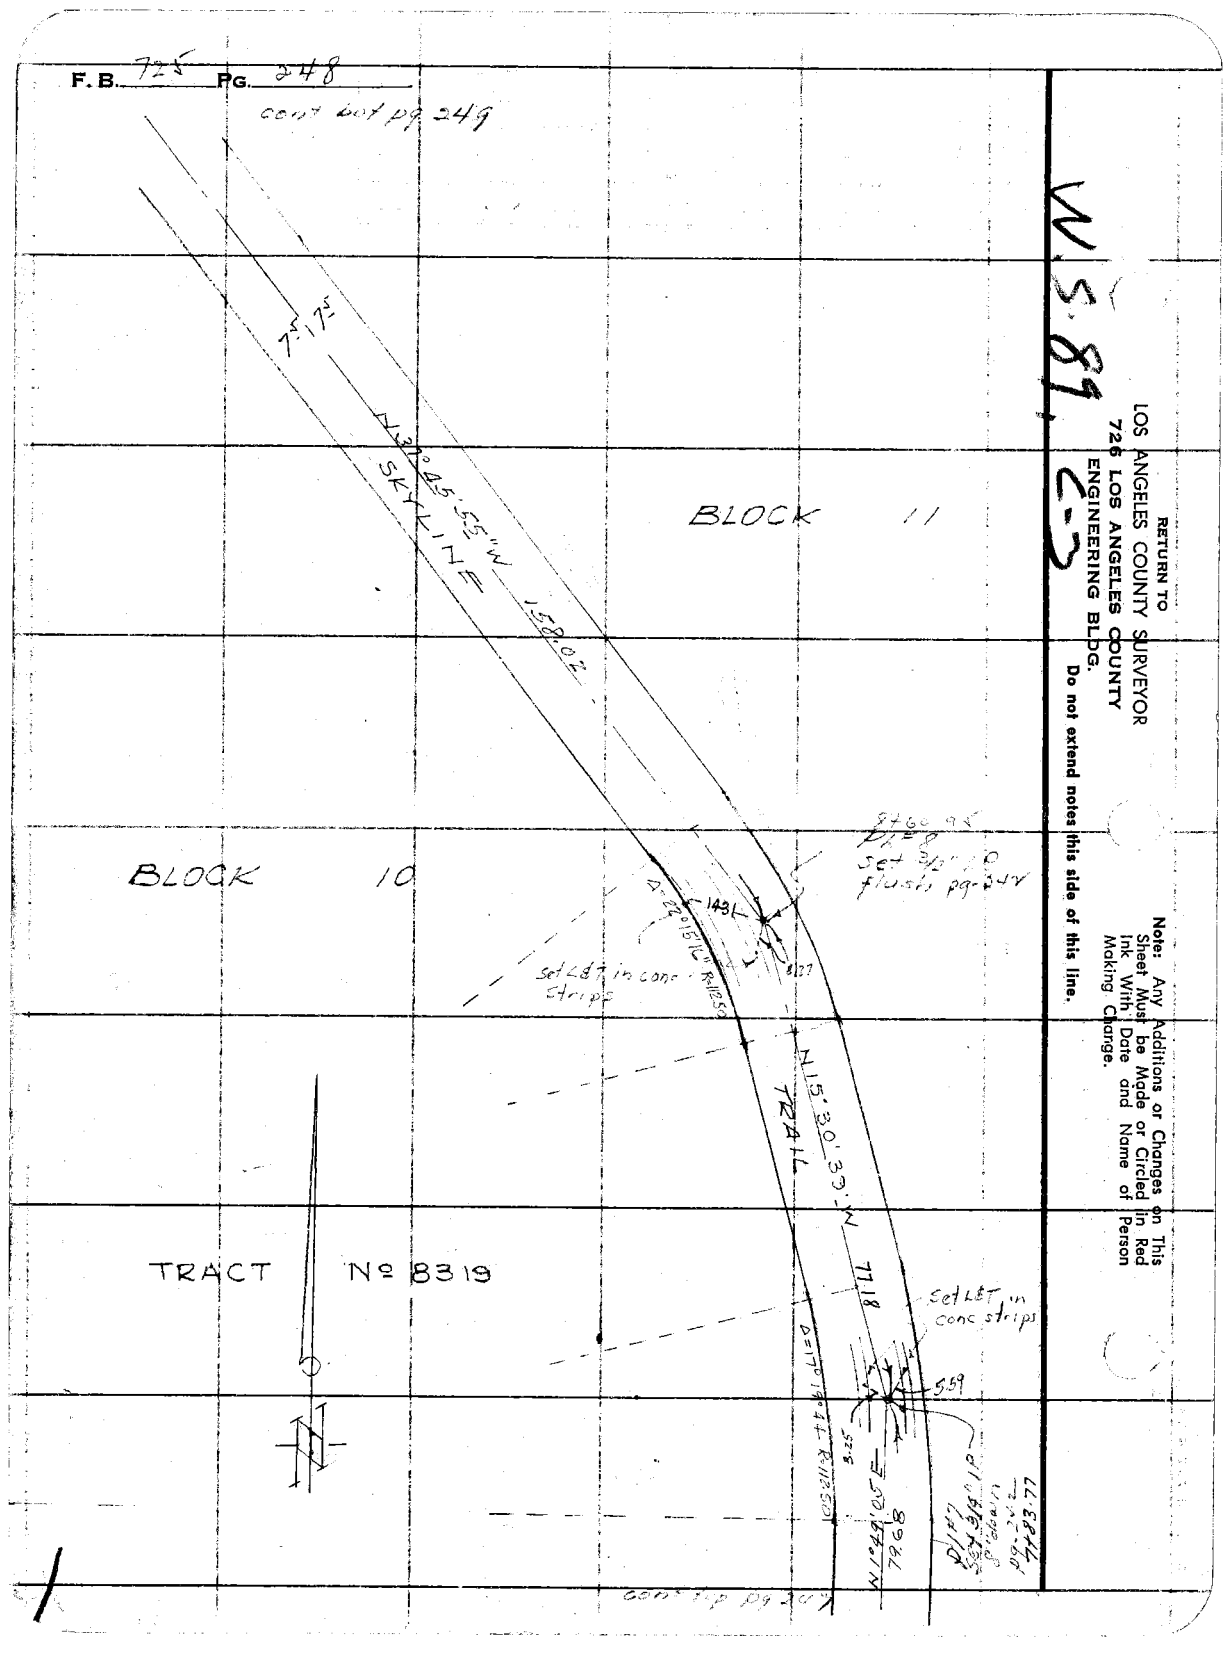

N.S. 89, 2-3

RETURN TO
LOS ANGELES COUNTY SURVEYOR
726 LOS ANGELES COUNTY
ENGINEERING BLDG.
Do not extend notes this side of this line.

Note: Any Additions or Changes on This Sheet Must be Made or Circled in Red Ink With Date and Name of Person Making Change.

Notes Ck'd by MRM	Survey of Fernwood Streets
Map No. B-1631-3	W. O. 00712 Tape No. 63 Std. 68° °F
Office Work Drawn	Surveyed by F. H. BLANCHARD
Checked MEPherson	Notes Date 6-4-54
Date Aug. '54	Indexed R. C. Johnson

F. B. 725 Pg. 2-19

W.S. 89 C-3

Note: Any Additions or Changes on This Sheet Must be Made or Circled in Red Ink With Date and Name of Person Making Change.

RETURN TO
LOS ANGELES COUNTY SURVEYOR
726 LOS ANGELES COUNTY
ENGINEERING BLDG.

WS 129-097 4-1

Do not extend notes this side of this line.

BLOCK 10

BLOCK 11

TRACT No 8319

Set 4" sq sandstone

11+38.25 fd 3/4" IP per F 8826-75

N 59° 57' 25" W 145.66'

Survey Line Tract

Set 3/4" IP in conc

R = 50'

Δ = 67° 56' 30"

N 5° 06' 05" E = 119.28'

10+18.97 P/Ng Set 3/4" IP flush

R = 42.50

Δ = 84° 52' 00"

SKY LINE TRAIL

N 37° 45' 55" W 158.02'

Cont'd on pg 248

7673008 847 4-53

RETURN TO
LOS ANGELES COUNTY SURVEYOR
726 LOS ANGELES COUNTY
ENGINEERING BLDG.

Note: Any Additions or Changes on This Sheet Must be Made or Circled in Red Ink With Date and Name of Person Making Change.

Do not extend notes this side of this line.

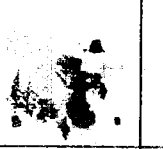

F.B. 225 PG. 256

Notes Ck'd by KRM
Map No. B-1631-3
Office Work Dixon
Checked McKinnon
Date Aug. 54

Survey of Fernwood Streets
W. O. 00211-2 Tape No. 103 St'd. 34 oF
Surveyed by C. H. BLANCHARD
Notes Date 6-4-54
Indexed C. Johnson

F. B. 432 Pg. 51

cont bot pg 246

W.S. 89, C-3

Note: Any Additions or Changes on This Sheet Must be Made or Circled in Red Ink With Date and Name of Person Making Change.

Do not extend notes this side of this line.

RETURN TO
LOS ANGELES COUNTY SURVEYOR
726 LOS ANGELES COUNTY
ENGINEERING BLDG.

WS 129 - 0974-1

78F3099 247 4-53

10

44

BLOCK

TRACT Nº 8319

BLOCK - 17

SKY LINE TERR.

214.53

fd 1/2" I.P probably on line marker

2.04

fd 10" x 10" 2x2 & monument

40.11

set L&T in sandstone

29.35

set bt spk & washer 6" down

set L&T in sandstone

Pt "A" set 3/4" I.P 10" down

P12,86@ 7.46 = 210.91
3.62
214.53

RETURN TO
LOS ANGELES COUNTY SURVEYOR
725 LOS ANGELES COUNTY
ENGINEERING BLDG.

Note: Any Additions or Changes on This Sheet Must be Made or Circled In Red Ink With Date and Name of Person Making Change.

Do not extend notes this side of this line.

F. B. _____ PG. 2 v 2

Notes Ck'd by KRM
Map No. B-1631-3
Office Work Drawn
Checked McMunson
Date Aug. '54

Survey of FARMDALE STREETS
W. O. [illegible] Tape No. ____ St'd. 82° °F
Surveyed by Blanchard
Notes Blanchard Date 5-11-54
Indexed R. C. Johnson

F. B. 725 PG. 25

W.S. 89-C3

Note: Any Additions or Changes on This Sheet Must be Made or Circled in Red Ink With Date and Name of Person Making Change.

Do not extend notes this side of this line.

RETURN TO
LOS ANGELES COUNTY SURVEYOR
726 LOS ANGELES COUNTY
ENGINEERING BLDG.

WS 129-27 A-1

TRACT

Block 10

DRIVE

SUMMIT

DRIVE

VIEW

VALLEY

Fd 3/4" IP 6"dn per FB 826-74

Pl Fd 3/4" IP 6"dn per FB 826-74 .01 E. of line

Block 8

No 8319

Pl Fd SW'ly per FB 826-74 pg 24

SEC 18

T1S. R16W

0+00 Pl #1 Set SUR on l & from pg 245

39.00

VALLEY VIEW DRIVE

Block 11

0+43° BC

0+63° PP

0+70 road

0+49 CURVE

top edge 254

76F3095 247 4-53

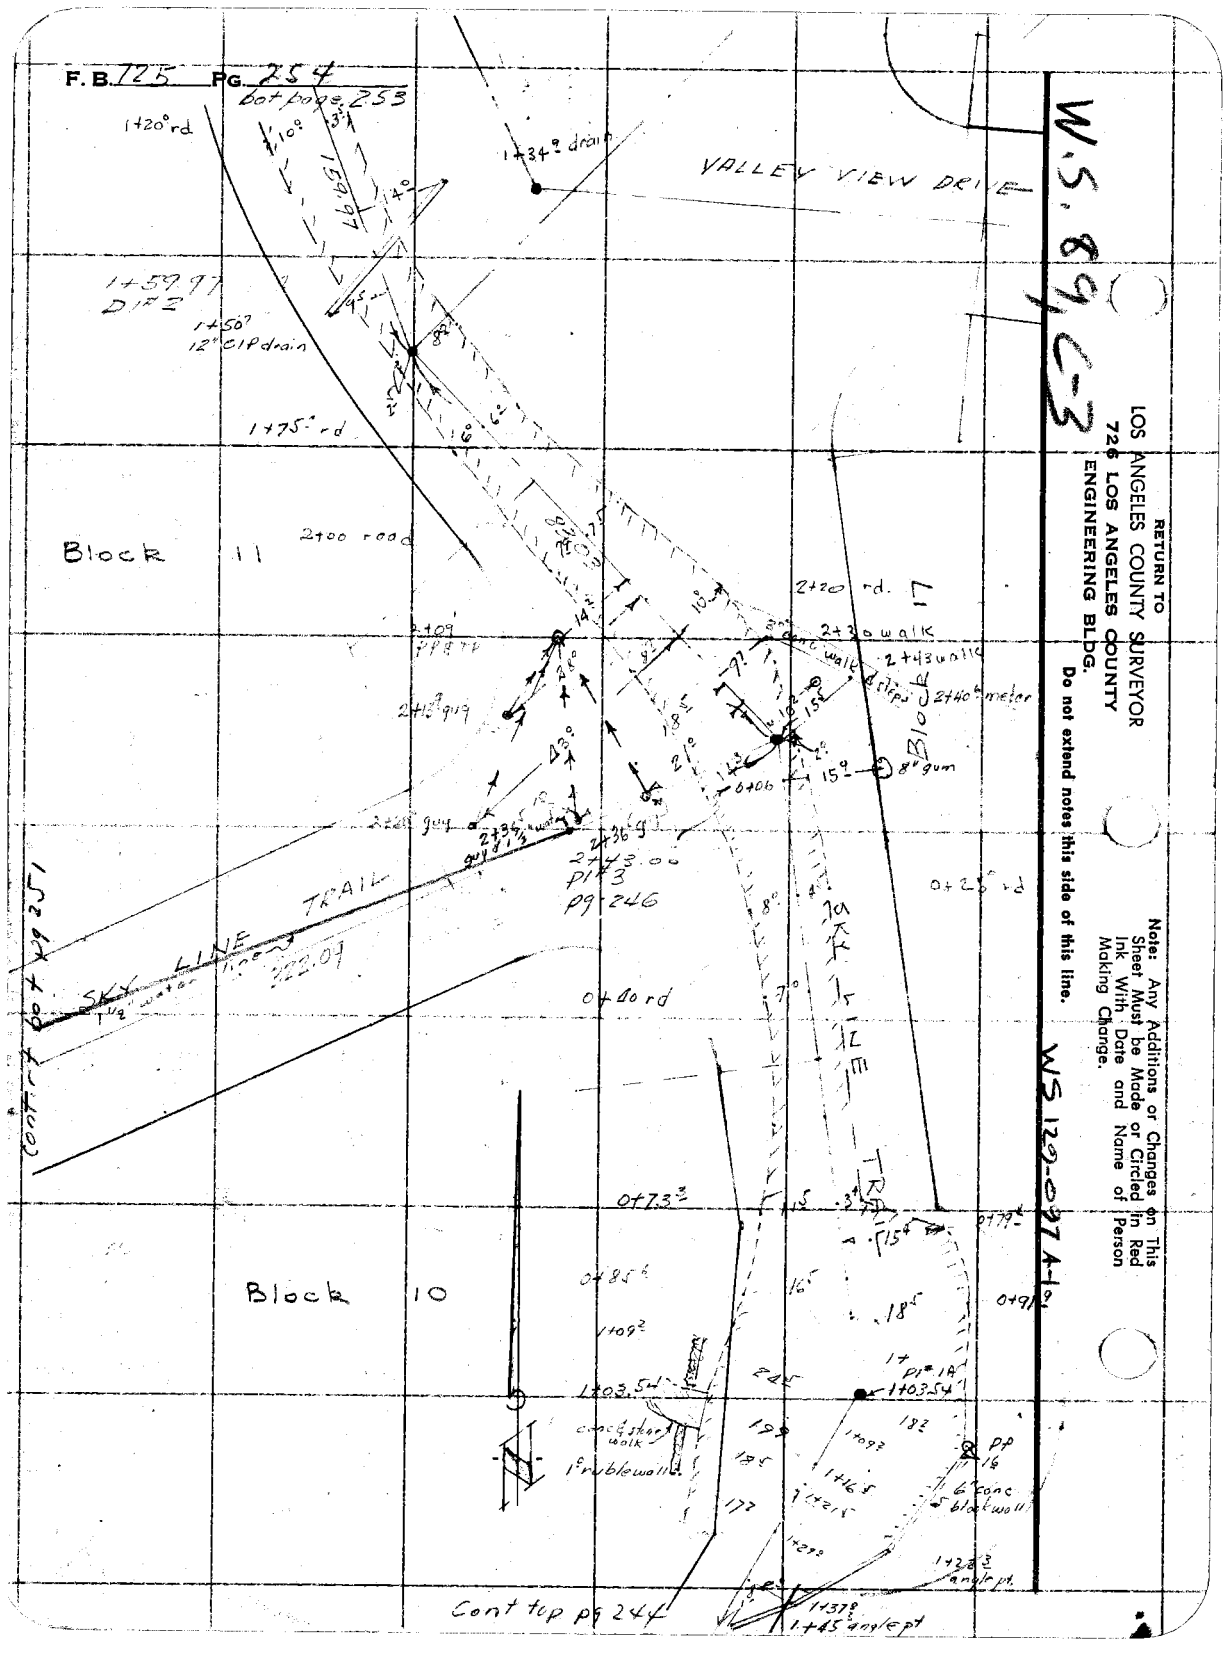
bot page 253
1+20° rd
1+34° drain
VALLEY VIEW DRIVE
1+59.97
DIF 2
1+50°
12" CIP drain
1+75° rd
Block 11
2+00 road
2+20 rd.
2+30 walk
2+43 walk
2+40 meter
8" gum
2+43.00
PI #3
pg 246
SKY LINE TRAIL
0+40 rd
Block 10
1+03.54
1+09.2
1+46.8
1+42.8
1+37.8
1+45 angle pt
Cont top pg 244
Cont from pg 251
RETURN TO
LOS ANGELES COUNTY SURVEYOR
726 LOS ANGELES COUNTY
ENGINEERING BLDG.
Do not extend notes this side of this line.
Note: Any Additions or Changes on This Sheet Must be Made or Circled in Red Ink With Date and Name of Person Making Change.
W.S. 89 C-3
WS 129-0.97 A+01

Notes Ck'd by KRM	Survey of FERNWOOD STREETS
Map No. B-1631-3	W. O. 0221.26 Tape No. St'd. 84 °F
Office Work Drawn	Surveyed by Blanchard
Checked McPhaun	Notes Blanchard Date 5-11-54
Date Aug '54	Indexed C. Johnson

F. B. 725 PG. 155

W.S. 89-C-3

Note: Any Additions or Changes on This Sheet Must be Made or Circled in Red Ink With Date and Name of Person Making Change.

Do not extend notes this side of this line.

RETURN TO
LOS ANGELES COUNTY SURVEYOR
726 LOS ANGELES COUNTY
ENGINEERING BLDG.

WS 129-0927 A-1

TRACT

No 8319

Block 11

Block 6

7783.77 P.T.

7466. Stad 200 strip

7425 strip

7404.09 P.T.C

6489' strip

6476' 3" acacia

6470' beginning Conic Strip

SEC 19

T 1 S

R 16 W

Cent. Ad. center 25'

fd cor axle at cor of fence

5' barb wire fence

10.72

+39 P.T. 34

2" pipe

set 1/2"

1-story frame House

6409' acacia

6342' Misc

6431' 36" oak

Set 1x2 5'39' Winston

6148' acacia

2 story 1 story frame Garage

2' conc walk

6438' 5' wire fence

30.21

LINE

5' Barb wire fence 6.44

5765.09 P.T.C

SEC. 09

TRAIL

76FSOS 247 4-53

F. B. 725 PG. 256

cont bot 257

10+18.97
D/F 9

9475

9466.80

slab int &

SKY

9450

Block 11

9435

TRACT No 8310

9400

Block 10

8+60.95
D/F 9

conc strip

8+50

8400

7+83.77
D/F 7

SEC 18
T1S R16W

TRAIL

cont top 255

W.S 89 C3

RETURN TO
LOS ANGELES COUNTY SURVEYOR
726 LOS ANGELES COUNTY
ENGINEERING BLDG.

Note: Any Additions or Changes on This Sheet Must be Made or Circled in Red Ink With Date and Name of Person Making Change.

Do not extend notes this side of this line.

Notes Ck'd by KRM	Survey of FERNWOOD STREETS
Map No. B-1631-3	W. O. 8021-14 Tape No. 106 St'd. 68 °F
Office Work Drawn	Surveyed by Blanchard
Checked McPherson	Notes Blanchard Date 5-27-54
Date Aug. '54	Indexed C. Johnson

F. B. 775 Pg. 2-9

W.S. 89, <3

Note: Any Additions or Changes on This Sheet Must be Made or Circled in Red Ink With Date and Name of Person Making Change.

Do not extend notes this side of this line.

RETURN TO
LOS ANGELES COUNTY SURVEYOR
726 LOS ANGELES COUNTY
ENGINEERING BLDG.

WS 129-92 4-1

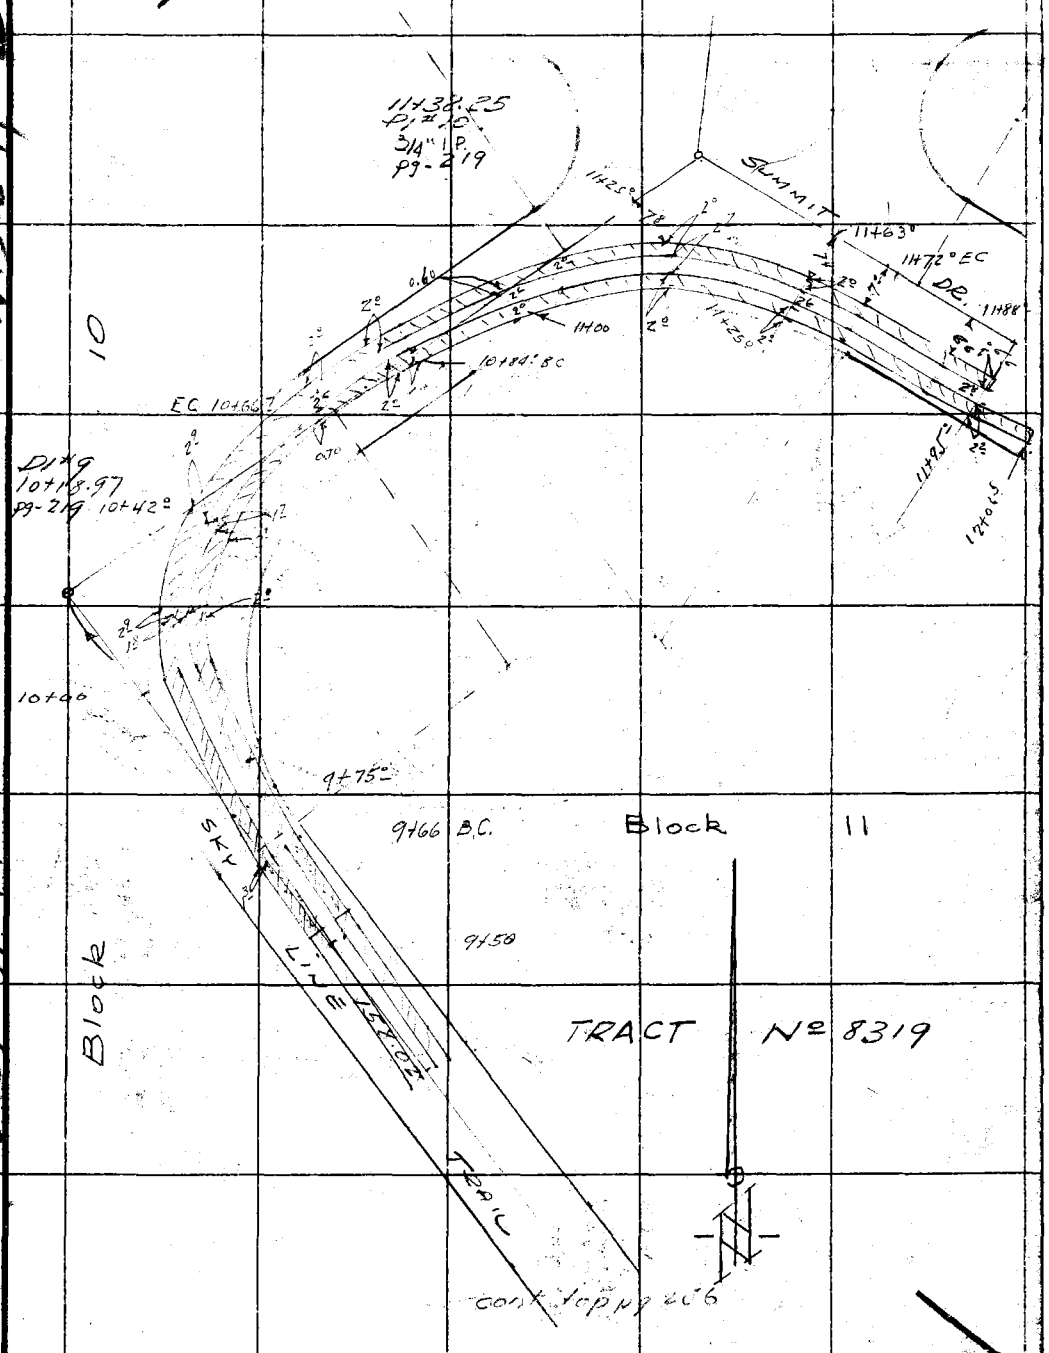

76F9098 247 4-53

F. B. 125 Pg. 258

W.S. 89 C-3

RETURN TO
LOS ANGELES COUNTY SURVEYOR
726 LOS ANGELES COUNTY
ENGINEERING BLDG.
Do not extend notes this side of this line.

Note: Any Additions or Changes on This Sheet Must be Made or Circled in Red Ink With Date and Name of Person Making Change.

W.S. 129-97 A-1

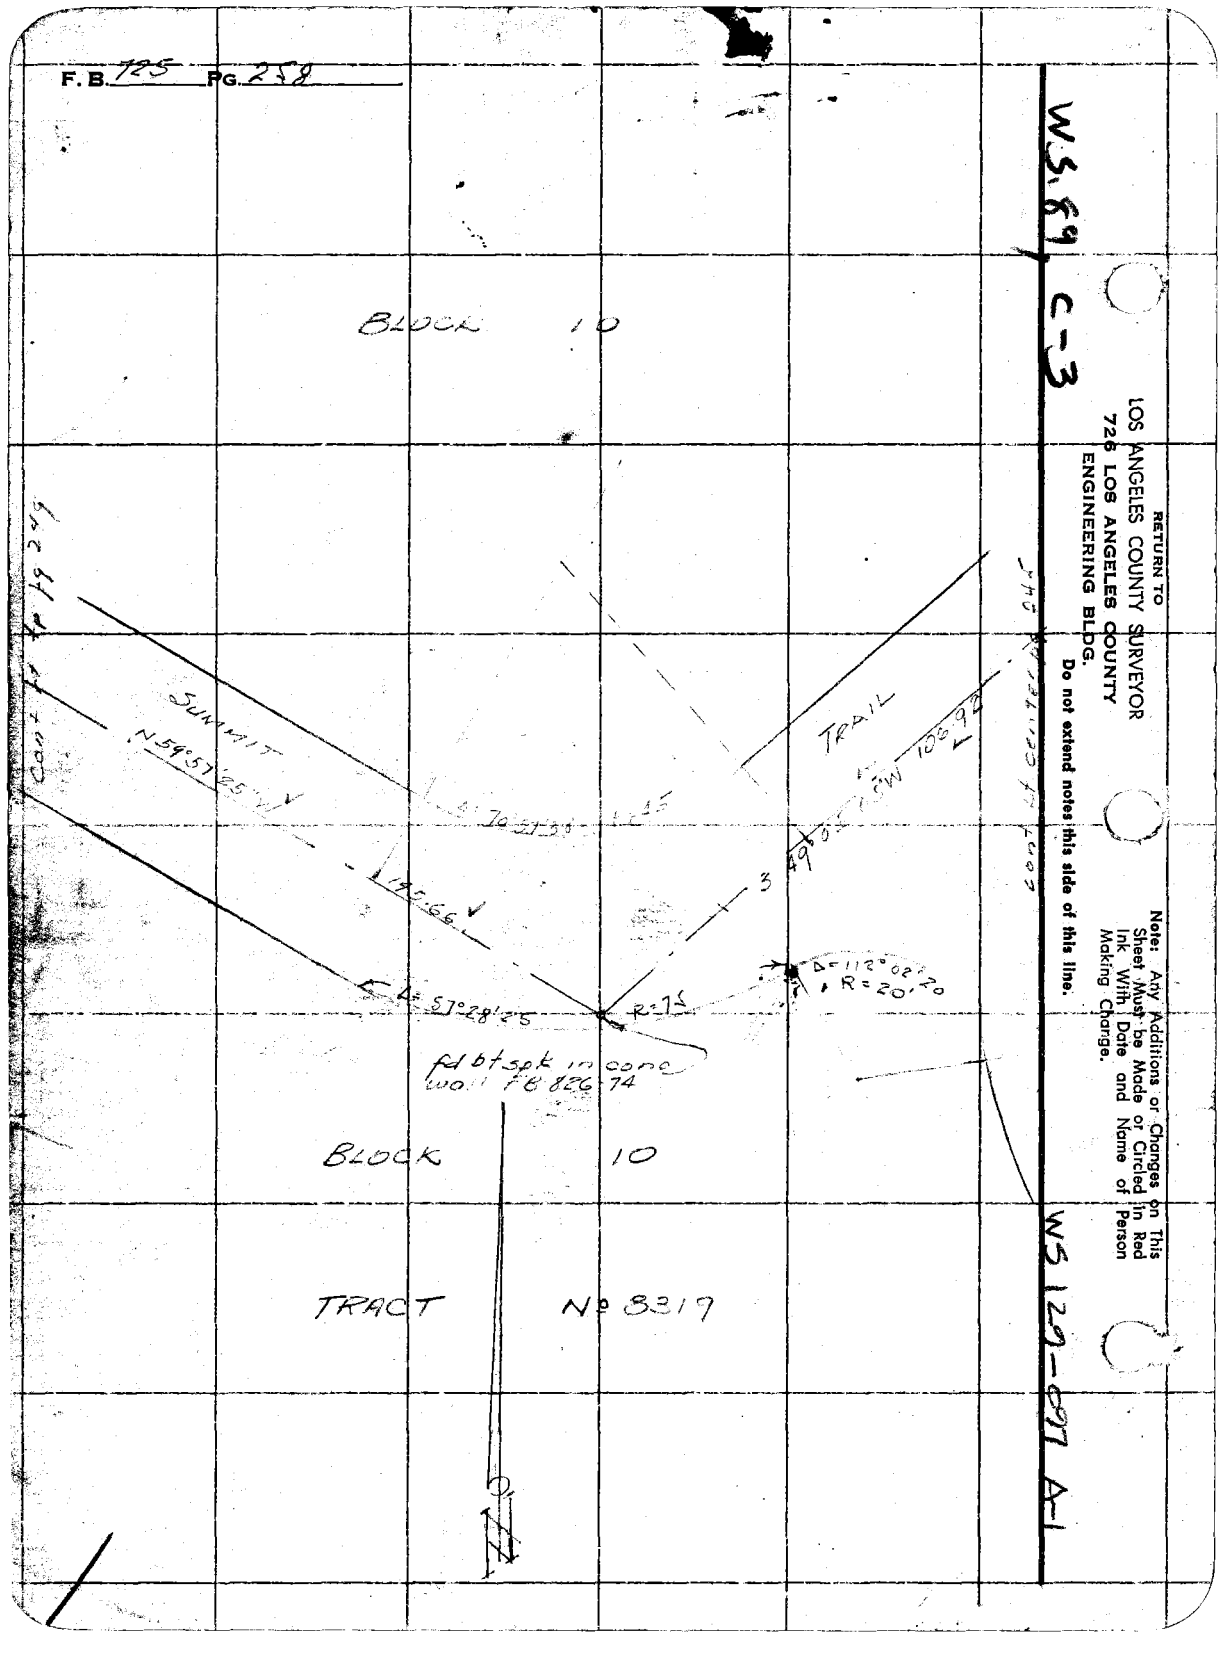

Notes Ck'd by J. Cavataio	Survey of TOPANGA CYN. AREA
Map No.	JN 0303.00 Tape 238 Std. 64 °F
Office Work	Surveyed by L.V. SMITH
Checked	Notes L.V. SMITH Date 4-22-70
Date	Indexed C.J. GALLI MAY 4 '70

F. B. 725 PG. 25 1

TOPANGA CYN. AREA

J.N. 0303.00

AMLAR ROAD
(SEABEE TRAIL)

℄ SURVEY OF AMLAR ROAD PER ROM. 30.05 & 1 CF 1935

APRIL 1970

Note: Any Additions or Changes on this Sheet Must be Made or Circled in Red Ink With Date and Name of Person Making Change.

PLEASE RETURN TO
COUNTY OF LOS ANGELES
DEPARTMENT OF COUNTY ENGINEER
403 LOS ANGELES COUNTY ENGINEERING BLDG.

Do not extend this side of this line.

REF.
ROM 30.05
RUF 81410-7-8
CF 1938
F.B. 2661-90-91
F.B. 3105-172-173

PARTY
L.V. SMITH
B.R. JACKSON
V.L. HOCKABY
A.F. LUND III

26F3095 CE #310 3-68

PLEASE RETURN TO
COUNTY OF LOS ANGELES
DEPARTMENT OF COUNTY ENGINEER
403 LOS ANGELES COUNTY ENGINEERING BLDG.

Note: Any Additions or Changes on This Sheet Must be Made or Circled in Red Ink With Date and Name of Person Making Change.

Do not extend this side of this line.

INDEX

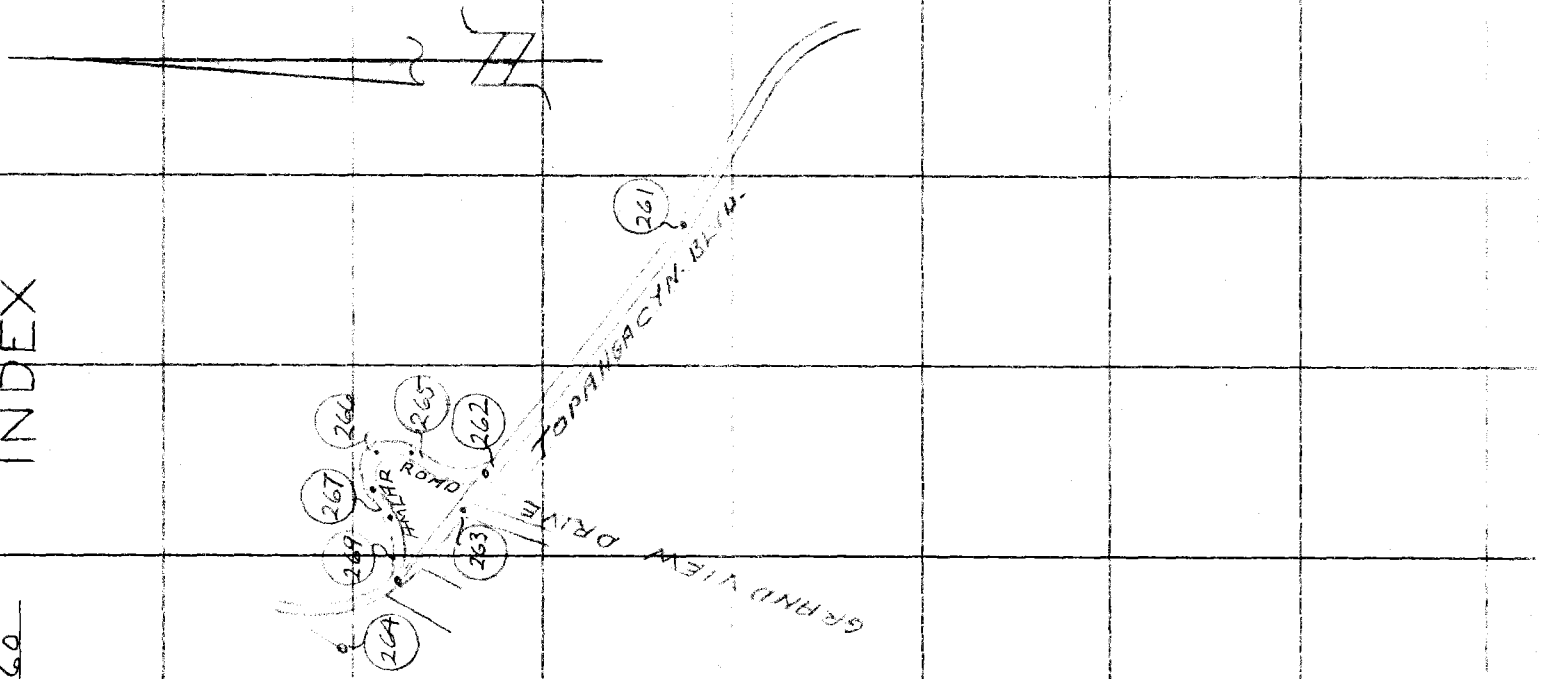

F.B. 725 Pg 260

J. Cavalaio

Notes Ck'd by _____
Map No. _____
Office Work _____
Checked _____
Date _____

Survey of TOWNCH, TIN AREA
JN 307-00 Tape 238 Std 64 °F
Surveyed by L.V. SMITH
Notes L.V. SMITH Date 4-70
Indexed C.J. GAELL

F.B. 725 Pg. 261

Note: Any Additions or Changes on this Sheet Must be Made or Circled in Red Ink With Date and Name of Person Making Change.

Do not extend this side of this line.

PLEASE RETURN TO
LOS ANGELES COUNTY ENGINEER
403 Los Angeles County Engineering Bldg.

WS 127-217 B-1

125.91 @ LEV.
T = 70° = 125.90'

SET LG NT.
SPK. W. TIN
FLUSH IN
PVMT.

331.39'
RIGHT
PG 262

TOWNCH

FD. N. & TIN
IN T.P.
27618 Y
F.B. 2661-90
" 3105-172

125.90'

CYN. BLVD.

T.C. TR
P.I.
FD. CUT SHM. IN
CONC. DIV. 12'
PER F.B. 2661-90
SET SLEEVE & WELL
COVER

40.29'

47.04'

42.68'

FD. N. & TIN
IN T.P.
75104LE

331.42' @ LEV.
T = 70° = 331.39'

FD. 87 SPK
W. & TIN
UP 6' PER
F.B. 2661-90
F.B. 3105-172

765098 CE #310 9/67

F.B. 725 PG. 262

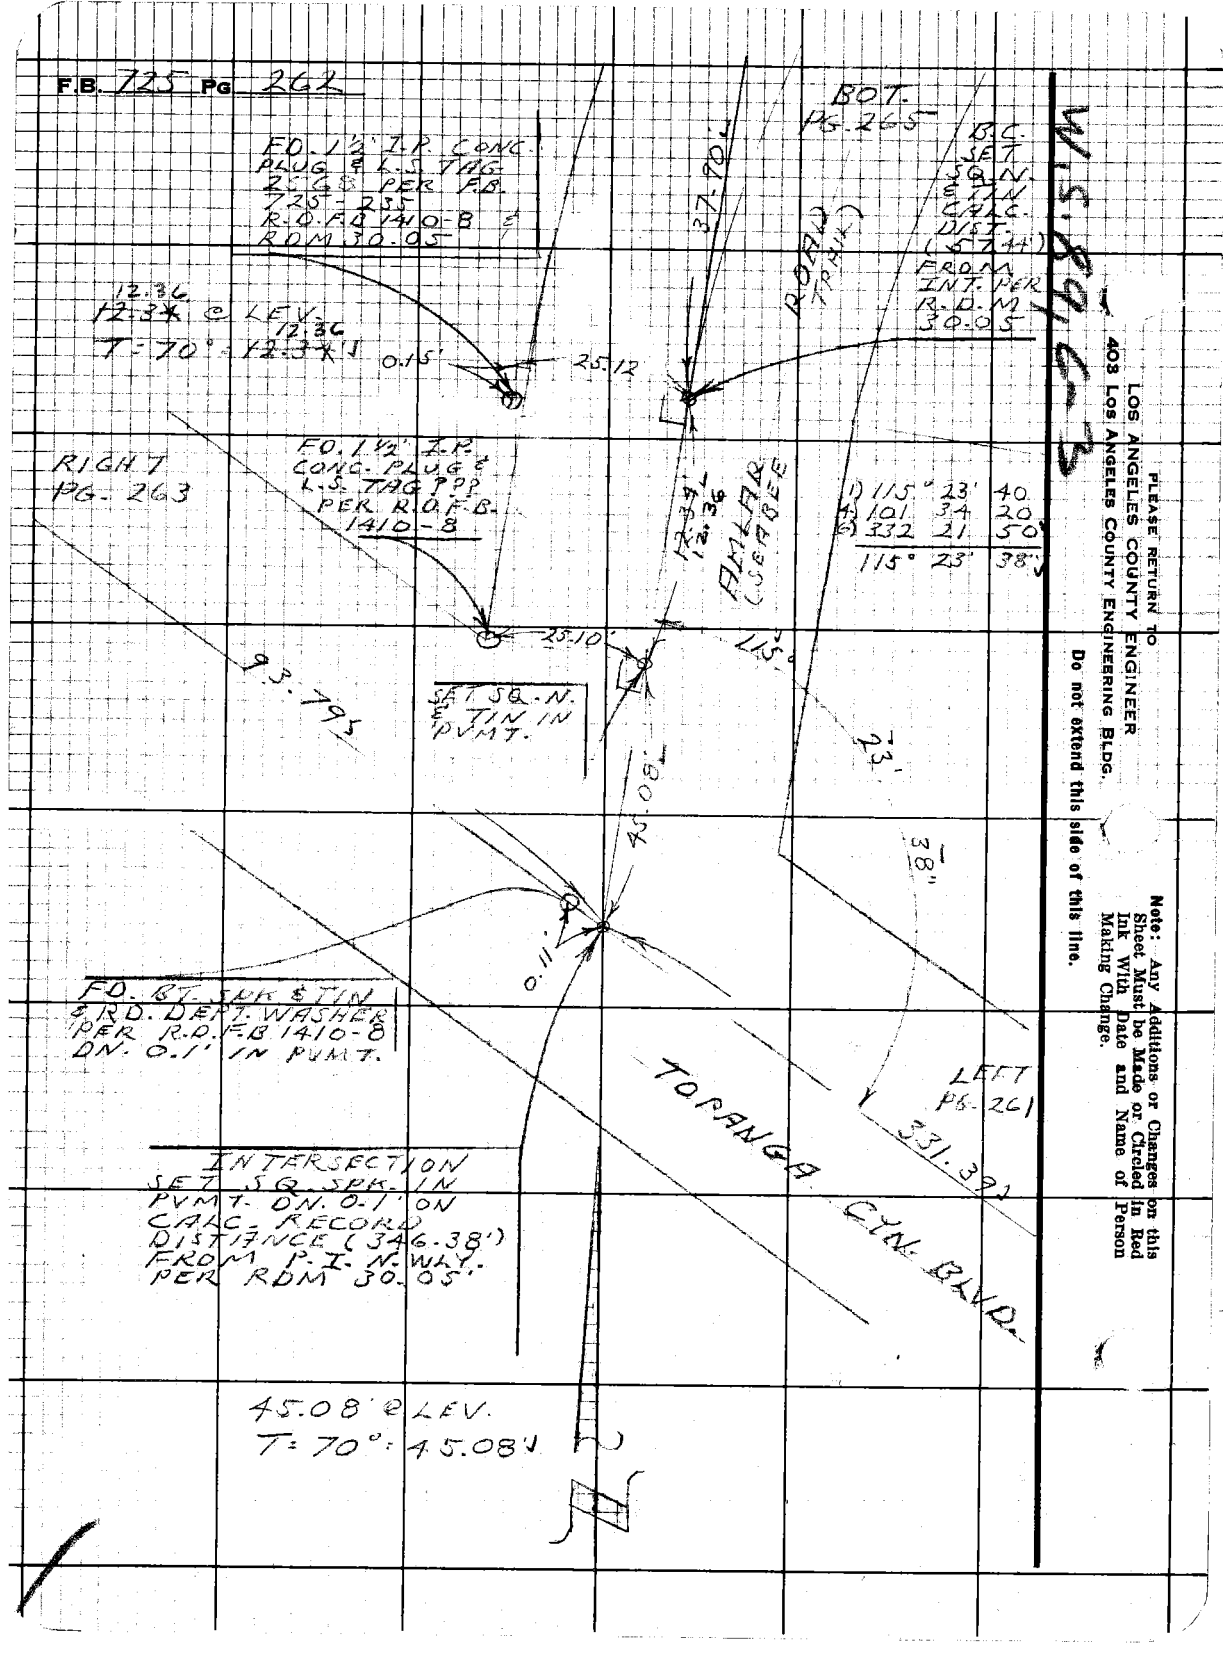
FD. 1 1/2" I.P. CONC. PLUG & L.S. TAG 2.26 PER F.B. 725-255 R.O.F.B. 1410-8 RDM 30.05'
12.36
12.37
@ ELEV. 12.36
T = 70°: 12.37'
0.15'
25.12
BOT. PG. 265
37.70'
ROAD (PVT.)
B.C. SET SQ.N. SPK. IN CURB (OFFSET 0.44') FROM INT. PER R.D.M. 30.05
W.S. SPG. 3
PLEASE RETURN TO LOS ANGELES COUNTY ENGINEER 403 LOS ANGELES COUNTY ENGINEERING BLDG.
Note: Any Additions or Changes on this Sheet Must be Made or Circled in Red Ink With Date and Name of Person Making Change.
Do not extend this side of this line.
RIGHT PG. 263
FD. 1 1/2" I.P. CONC. PLUG & L.S. TAG PP PER R.O.F.B. 1410-8
12.39'
12.36
ANLAR (SEABEE)
(1) 115° 23' 40"
(2) 101 34 20
(3) 332 21 50
115° 23' 38"
25.10'
115°
93.79'
SET SQ. N. SPK. IN PVMT.
45.08'
23'
38"
0.11'
FD. ST. SPK & TIN & RD. DEPT. WASHER PER R.D.F.B. 1410-8 DN. 0.1' IN PVMT.
LEFT PG. 261
331.39'
TOPANGA CYN. BLVD.
INTERSECTION SET SQ. SPK. IN PVMT. DN. 0.1' ON CALC. = RECORD DISTANCE (346.38') FROM P.I. N. WLY. PER RDM 30.05'
45.08' @ ELEV.
T = 70°: 45.08'

J. Cavataio

Notes Ck'd by
Map No.
Office Work
Checked
Date

Survey of Torrance Sym. Area
JN 705-00 Tape 250 Std 84 °F
Surveyed by L.V. Smith
Notes L.V. Smith Date 4-70
Indexed C. J. GALLI MW 4 70

F.B. 725 Pg. 263

143.50 ± L.E.V.
T = 69° 143.48 ✓

INTERSECTION
F.D. 1" I.P. CONC.
PLUG & L.A.C.O. ENG'R.
TAG ON 12" PEAR
F.B. 3105-17 &
SET SLEEVE &
WELL CAP

RIGHT
PG. 264

143.79 ✓

TORRANCE

93.79 ✓

LEFT
PG. 262

GRAND VIEW DRIVE

93.80 ± L.E.V.
T = 70° 93.79 ✓

WS 8 C-3

Note: Any Additions or Changes on this Sheet Must be Made or Circled in Red Ink With Date and Name of Person Making Change.

Do not extend this side of this line.

PLEASE RETURN TO
LOS ANGELES COUNTY ENGINEER
403 Los Angeles County Engineering Bldg.

TEPSCO CE #310 8-67

F.B. 725 Pg 264

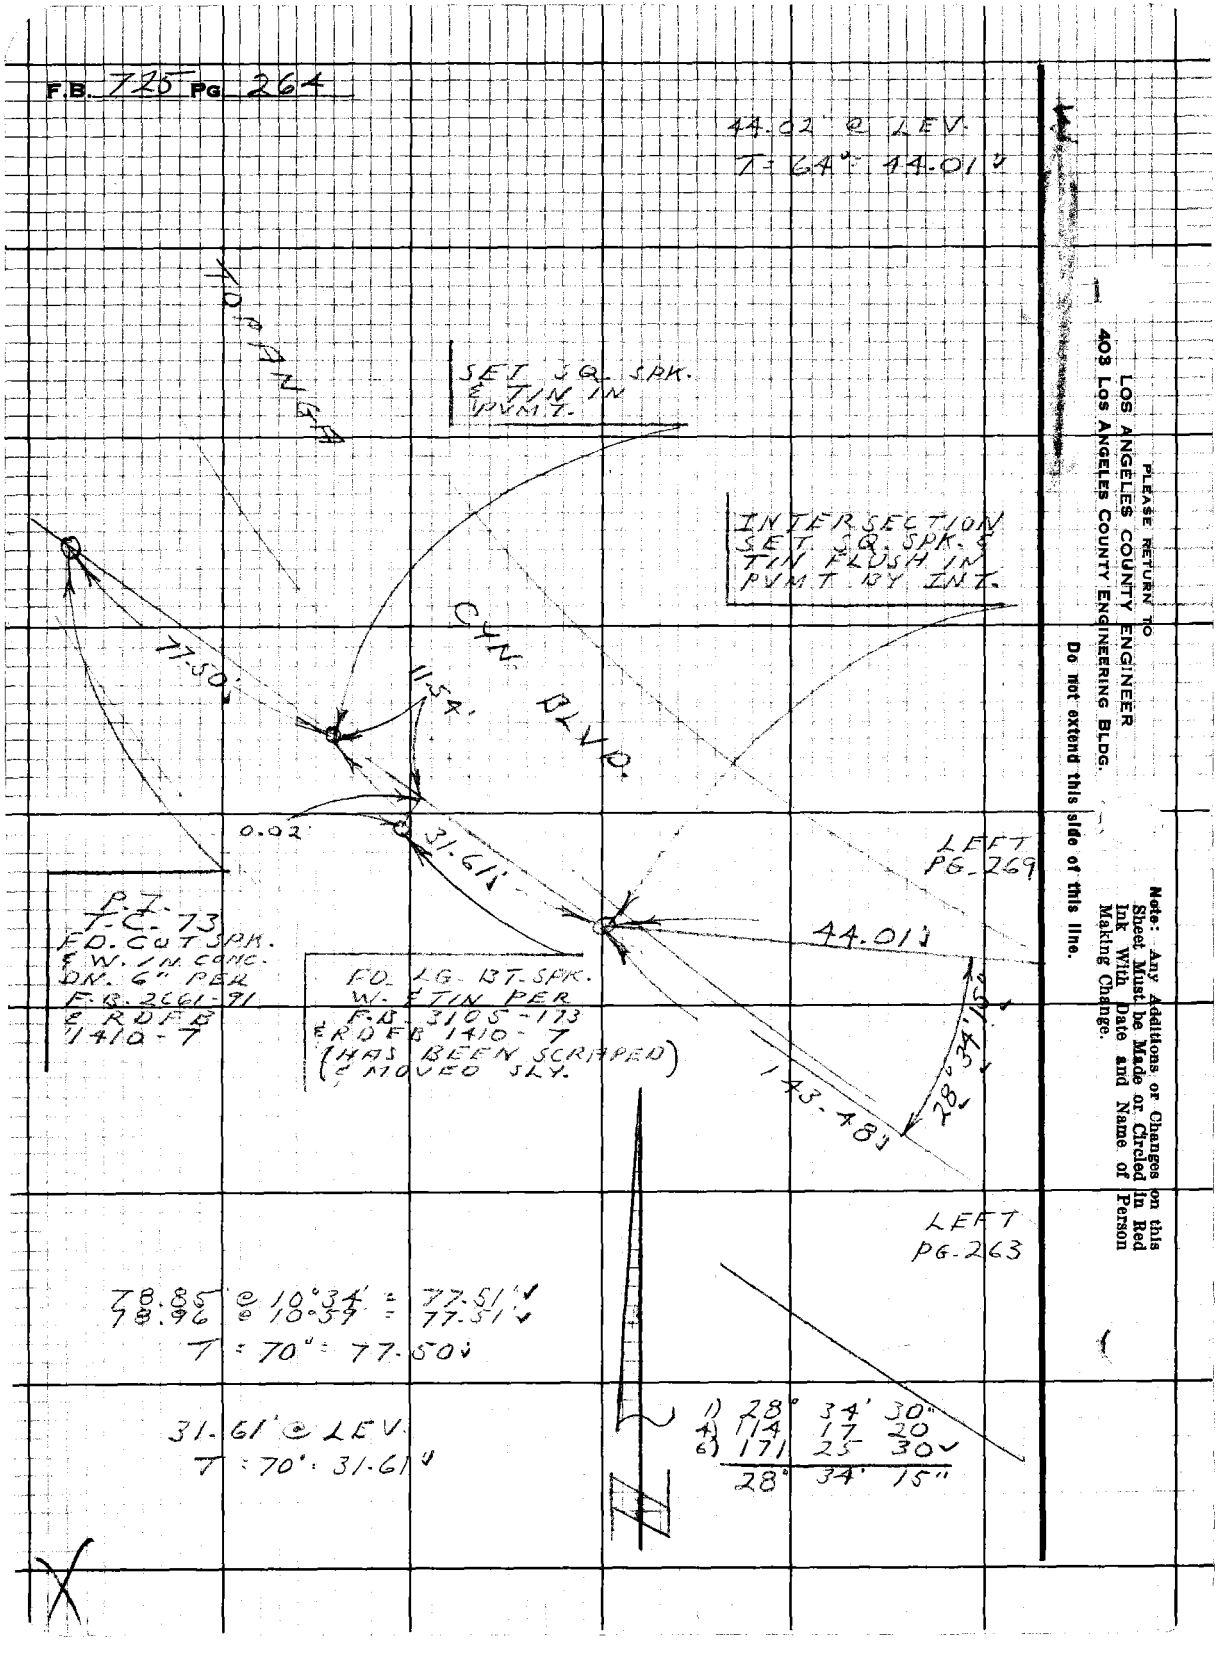

PLEASE RETURN TO
LOS ANGELES COUNTY ENGINEER
403 Los Angeles County Engineering Bldg.

Note: Any Additions or Changes on this Sheet Must be Made or Circled in Red Ink With Date and Name of Person Making Change.

Do not extend this side of this line.

Notes Ck'd by J. Cavataio	Survey of TOPANGA CTN WALL
Map No.	JN 0303.40 Tape 238 Std. 84 °F
Office Work	Surveyed by L. V. SMITH
Checked	Notes L. V. SMITH Date 4-70
Date	Indexed D. J. GALLI MAY 4 70

F. B. 725 PG. 2

1) 20° 30' 00"
2) 42 00 00
3) 123 30 00
20° 30' 00"

W 5896-3

13 O.T.
PG. 266

AMBER (SEMI-SEE) ROAD TRAIL

66.91

FD. BT. SPK. & TIN RD. WASHER DN 0.1' IN PVMT. PER R.D.F.B. 1410-8

1) 42° 00' 00"
2) 168 00 00
3) 252 00 00
42° 00' 00"

P.R.C. SET SQ. SPK. & TIN ON RECORD DELTA ANGLE & CALC. DISTANCE 37.90' FROM R.I. S.WLY PER R.D.M. 30.05

42° 00' 00"

20° 30' 00"

0.01

FD. 1½" I.P. CONC. PLUG & TAG "LS 2568" PER F.B. 725-135 & R.D.F.B. 1410-8

25.10

1.00' FENCE

FD. 2x2 & NAIL FLUSH PER R.D.F.B. 1410-8

40.57

0.03'

37.90'

0.12'

37.90' @ LEV.
T = 70° 37.90

P.I. SET SQ. SPK. & TIN FLUSH PER R.D.M. 30.05 ON CALC. SEMI-TANG. DISTANCE 37.90' FROM E.C. SLY.

37.90' @ LEV.
T = 70° 37.90

37.90'

TOP PG. 262

Note: Any Additions or Changes on This Sheet Must be Made or Circled in Red Ink With Date and Name of Person Making Change.

Do not extend this side of this line.

PLEASE RETURN TO
COUNTY OF LOS ANGELES
DEPARTMENT OF COUNTY ENGINEER
403 LOS ANGELES COUNTY ENGINEERING BLDG.

76F 3095 CE#310 3-68

F. B. 725 PG. 266

W.S.O. 6-3

PLEASE RETURN TO
COUNTY OF LOS ANGELES
DEPARTMENT OF COUNTY ENGINEER
403 LOS ANGELES COUNTY ENGINEERING BLDG.

Note: Any Additions or Changes on This Sheet Must Be Made or Circled in Red Ink With Date and Name of Person Making Change.

Do not extend this side of this line.

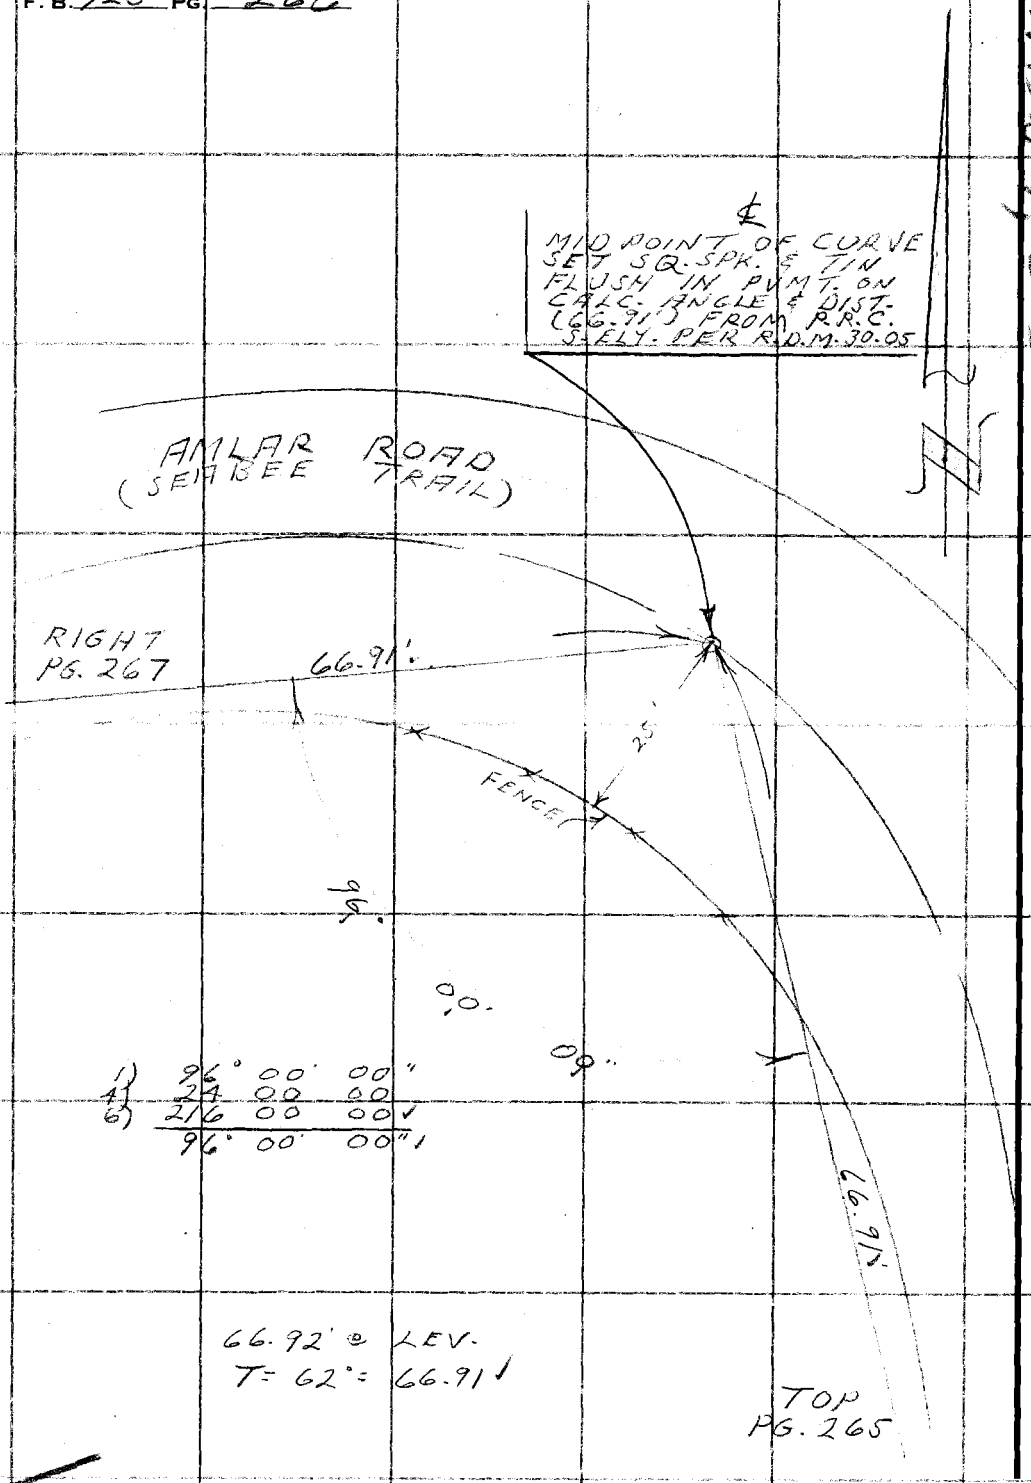

1) 96° 00' 00"
4) 24 00 00
6) 216 00 00 ✓
96° 00' 00" ✓

66.92' @ LEV.
T = 62° = 66.91 ✓

Notes Ck'd by J. Cavataio	Survey of TOPANGA CYN. ROAD
Map No.	JN 0303.00 Tape 238 Std 84 °F
Office Work	Surveyed by L.V. SMITH
Checked	Notes L.V. SMITH Date 4-30-70
Date	Indexed C.J. GALLI MAY 4 '70

F. B. 12 1 PG. 267

W.S. 84 C-3

Note: Any Additions or Changes on this Sheet Must be Made or Circled in Red Ink With Date and Name of Person Making Change.

Do not extend this side of this line.

PLEASE RETURN TO
COUNTY OF LOS ANGELES
DEPARTMENT OF COUNTY ENGINEER
403 LOS ANGELES COUNTY ENGINEERING BLDG.

66.92' @ LEV.
T = 64° = 66.91'

E.C.
SET SQ. SPK. & TIN
ON CALC. ANGLE &
DISTANCE FROM
MID-POINT OF
CURVE PER
R.D.M. 30.05

FD. 1" I.P. & CPR.
WIRE DN. 0.05'
PER F.B. 725-235

AMLAR ROAD
(SEE TREE TRAIL)

FD. SPK. & TIN RD F.B. 1410-7

0.02'

0.04'

FD. BT. SPK. & TIN WITH RD. DEPT. W. DN. 1" PER R.D.F.B. 1410-7

25.03'

25.80'

LEFT PG. 266

66.91'

FENCE

24.93'

0.07'

0.08'

0.01'

79.16'

0.81'

FD. 1½" I.P. CONC. PLUG & L.S. TAG "2566 UP 1" PER F.B. 725-235 & R.D.F.B. 1410-7

138'

TOP PG. 268

1) 138° 00' 00"
2) 192 00 00 ✓
3) 108 00 00 ✓
138° 00' 00" ✓

76F3095 CE#310 3-68

F. B. 725 PG 268

W.S. 89 C-3

29.46' @ LFV.
T = 64° = 29.16'

LEFT
PG. 267

FD. 1" I.P. CONC.
PLUG & CPR. WIRE
PER F.B. 725-235

℄ CURVE

R = 100'
Δ = 32° 02' 07"
TANG. 28.71'

0.04'

25.05'

29.46'

FD. BT. SPK. & TIN
WITH RD. DEPT.
WASHER DN.
0.1' PER
R.D.F.B. 1410-7

0.12'

2.4'

AMLAR ROAD
(SEABEE TRAIL)

28.71'

SHED

B.C.
SET SQ. SPK. & TIN
FLUSH IN PVMT.
ON RECORD ANGLE
& DISTANCE (29.46')
FROM E.C. N.ELY.
PER R.D.M 30.05

RIGHT
PG. 269

28.71'
32° 02' 05"

P.I.
SET SQ. SPK. & TIN
IN PVMT ON
CALC. SEMI TANG.
DISTANCE (28.71')
FROM P.C.

28.71' @ LFV.
T = 64° = 28.71'

1) 32° 02' 07" R
4) 128 08 30
6) 192 12 30
32° 02' 05"

PLEASE RETURN TO
COUNTY OF LOS ANGELES
DEPARTMENT OF COUNTY ENGINEER
403 LOS ANGELES COUNTY ENGINEERING BLDG.

Do not extend this side of this line.

Note: Any Additions or Changes on This Sheet Must Be Made or Circled in Red Ink With Date and Name of Person Making Change.

Notes Ck'd by J. Cavataio	Survey of TOPANGA CYN. BLVD.
Map No.	JN 0307-00 Tape 238 Std. 84 °F
Office Work	Surveyed by L.V. SMITH
Checked	Notes L.V. SMITH Date 4-21-70
Date	Indexed C.J. GALLI MW 4 70

F. B. 125 PG. 267

19.71' @ 1 EV
T: 64° 19.71'

W.S. 89, C-3

Note: Any Additions or Changes on This Sheet Must be Made or Circled in Red Ink With Date and Name of Person Making Change.

Do not extend this side of this line.

PLEASE RETURN TO
COUNTY OF LOS ANGELES
DEPARTMENT OF COUNTY ENGINEER
403 LOS ANGELES COUNTY ENGINEERING BLDG.

WS 129-237 B-1

1) 157° 41' 59" R
2) 270 48 00
3) 22 11 50
157° 41' 59"

℄
R = 100'
Δ = 22°18'49"
TANG = 19.71

SET SQ. V.A. & TIN FLUSH IN PVMT. AT CALC. E.C. OF ELY. P/L PER R.D.M. 30.05

SEARCHED FOR SURVEY POINT FD. NOTHING

(SEABEE TRAIL) AMLAR RD. LEFT PG. 268

157° 41' 59"

2.67'

28.71'

RIGHT PG. 264 (25')

44.01'

19.71'

19.71'

24.92'

28.23'

SET SQ. SPK. & T. FLUSH IN PVMT. AT CALC. E.C. OF WLY. P/L PER C.F. 1938

FD. N. & TAG IN CONC. DN. 0.1' L.S. 2686 PER R.O.F.B. 1410-7

TOPANGA CYN. BLVD.

P.I.
SET SQ. SPK. & TIN FLUSH IN PVMT. ON CALC. DISTANCE FROM E.C. OF ELY. P/L (19.71') PER C.F. 1938

19.71' @ 1 EV.
T: 64° 19.71'

16F3095 C.E.#310 3-68

PLEASE RETURN TO
COUNTY OF LOS ANGELES
DEPARTMENT OF COUNTY ENGINEER
403 LOS ANGELES COUNTY ENGINEERING BLDG.

Note: Any Additions or Changes on This Sheet Must be Made or Circled in Red Ink With Date and Name of Person Making Change.

Do not extend this side of this line.

F. B. 725 PG 270

76F3095 CE#310 3-68

PLEASE RETURN TO
COUNTY OF LOS ANGELES
DEPARTMENT OF COUNTY ENGINEER
403 LOS ANGELES COUNTY ENGINEERING BLDG.

Note: Any Additions or Changes on This Sheet Must be Made or Circled in Red Ink With Date and Name of Person Making Change.

Do not extend this side of this line.

Notes Ck'd by _____
Map No. _____
Office Work _____
Checked _____
Date _____

Survey of _____
JN _____ Tape _____ Std _____ °F
Surveyed by _____
Notes _____ Date _____
Indexed C. J. GALLI SEP 10 71

F. B. _____ PG. _____

PLEASE RETURN TO
COUNTY OF LOS ANGELES
DEPARTMENT OF COUNTY ENGINEER
403 LOS ANGELES COUNTY ENGINEERING BLDG.

Note: Any Additions or Changes on This Sheet Must be Made or Circled in Red Ink With Date and Name of Person Making Change.

Do not extend this side of this line.

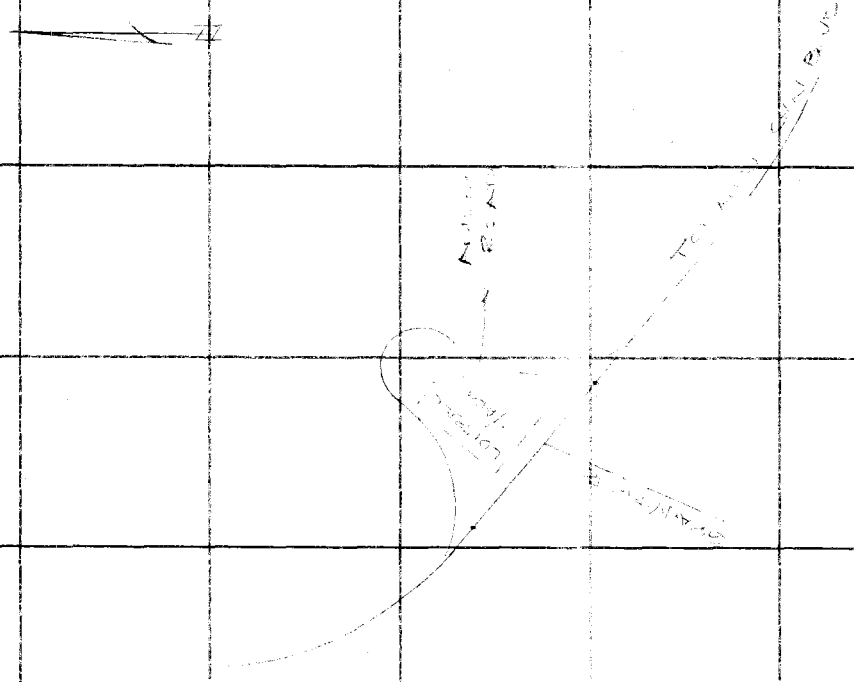

F. B. _____ PG. _____

Notes Ck'd by D. SAPPELL	Survey of AMLAR ROAD
Map No.	JN 0303.0P Tape 157 Std 84° °F
Office Work	Surveyed by SW/RL
Checked	Notes Date 9-17-71
Date	Indexed J. M. PALMERI SEP 20 '71

F. B. _____ PG. _____

PLEASE RETURN TO
COUNTY OF LOS ANGELES
DEPARTMENT OF COUNTY ENGINEER
403 LOS ANGELES COUNTY ENGINEERING BLDG.

Note: Any Additions or Changes on This Sheet Must be Made or Circled in Red Ink With Date and Name of Person Making Change.

Do not extend this side of this line.

US 101 - 23.7

WS 89 C-3

B.C.
SET LG. ET SPK.
WASH. & TIN FROM
FD. SQ HD. & TIN (E.C.)
F.B. 725-76 ET.
PER REC. ANGLE
& DIST (80.11) PER
C.S. 791E

T = 80.00 (a)
21.95 LEV
219.5

AMLAR ROAD

21.95

80.11

(25)

(25)

5.16 ET L.V.S.
SET SQ. SPK & TIN AT
CALC. POSITION OF
AMLAR RD. PER C.S. 791S
& N'LY R/W OF TOPANGA
CYN BLVD

T = 80.00 (a)
46.60 LEV
46.60

T = 80.00 (a)
78.05 LEV
78.05

FD. SQ HD
& TIN REF
F.B. 725-
269

16.31
16.32

46.6

1) 82-54-20
4) 321-37-40
6) 137-26-10
725 54 10

78.05

1.68

TOPANGA CYN BLVD.

65.42

18.44

REF FM 1045
& PK 725

INTER
SET LG. ET SPK
WASH. & TIN BY
INTER. OF REC
ANGLE FROM
N'LY/L.C. & E.
TOPANGA CYN
BLVD. D. PER F.B.
725-269

T = 80.00 (a)
65.42 LEV =
65.42

76F309S CE#310 3-68

PLEASE RETURN TO
COUNTY OF LOS ANGELES
DEPARTMENT OF COUNTY ENGINEER
403 LOS ANGELES COUNTY ENGINEERING BLDG.

Note: Any Additions or Changes on This Sheet Must be Made or Circled in Red Ink With Date and Name of Person Making Change.

Do not extend this side of this line.

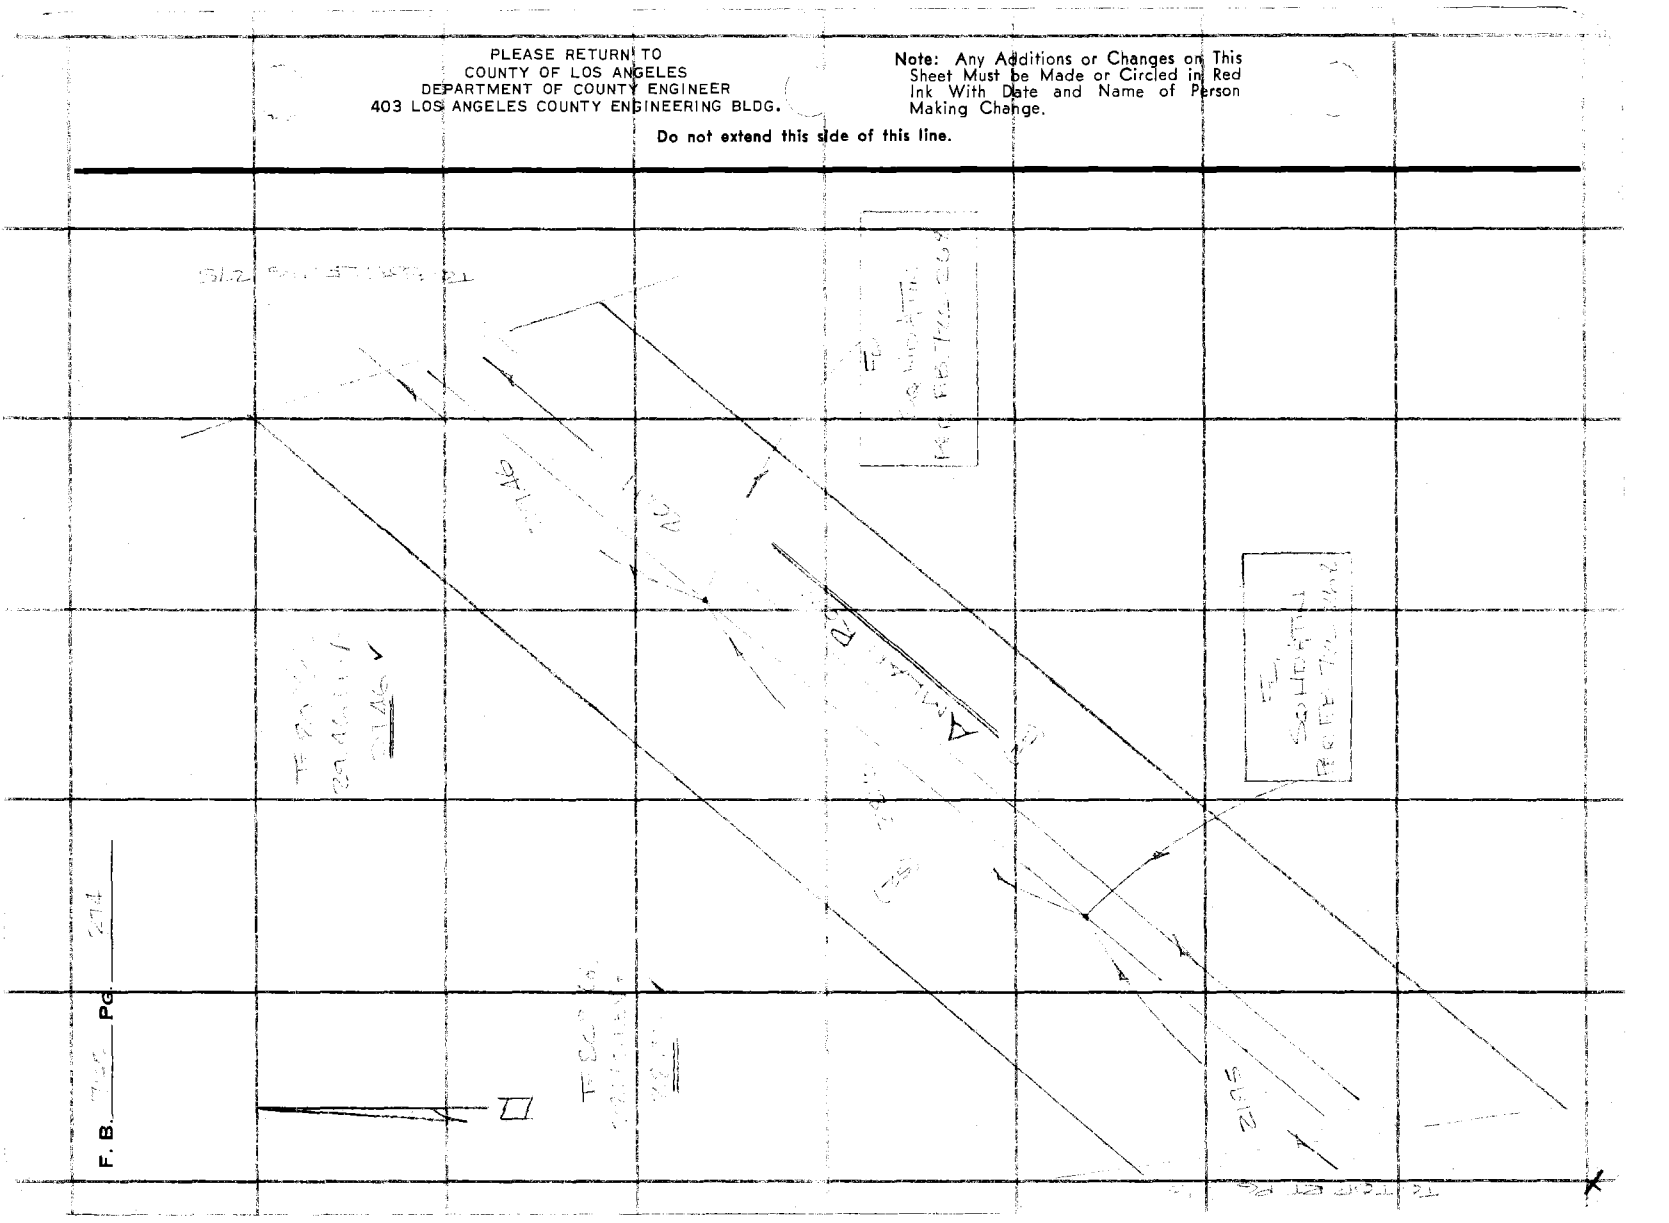

F. B. 772 Pg. 27

Notes Ck'd by D. CAMPBELL	Survey of AMLAC ROAD
Map No.	JN 0303 Tape 157 Std 84 °F
Office Work	Surveyed by SMITH
Checked	Notes JACKSON Date 9-1-71
Date	Indexed T. M. PALMERI SEP 10 71

F. B. [illegible] PG. 3/6

Note: Any Additions or Changes on This Sheet Must be Made or Circled in Red Ink With Date and Name of Person Making Change.

Do not extend this side of this line.

PLEASE RETURN TO
COUNTY OF LOS ANGELES
DEPARTMENT OF COUNTY ENGINEER
403 LOS ANGELES COUNTY ENGINEERING BLDG.

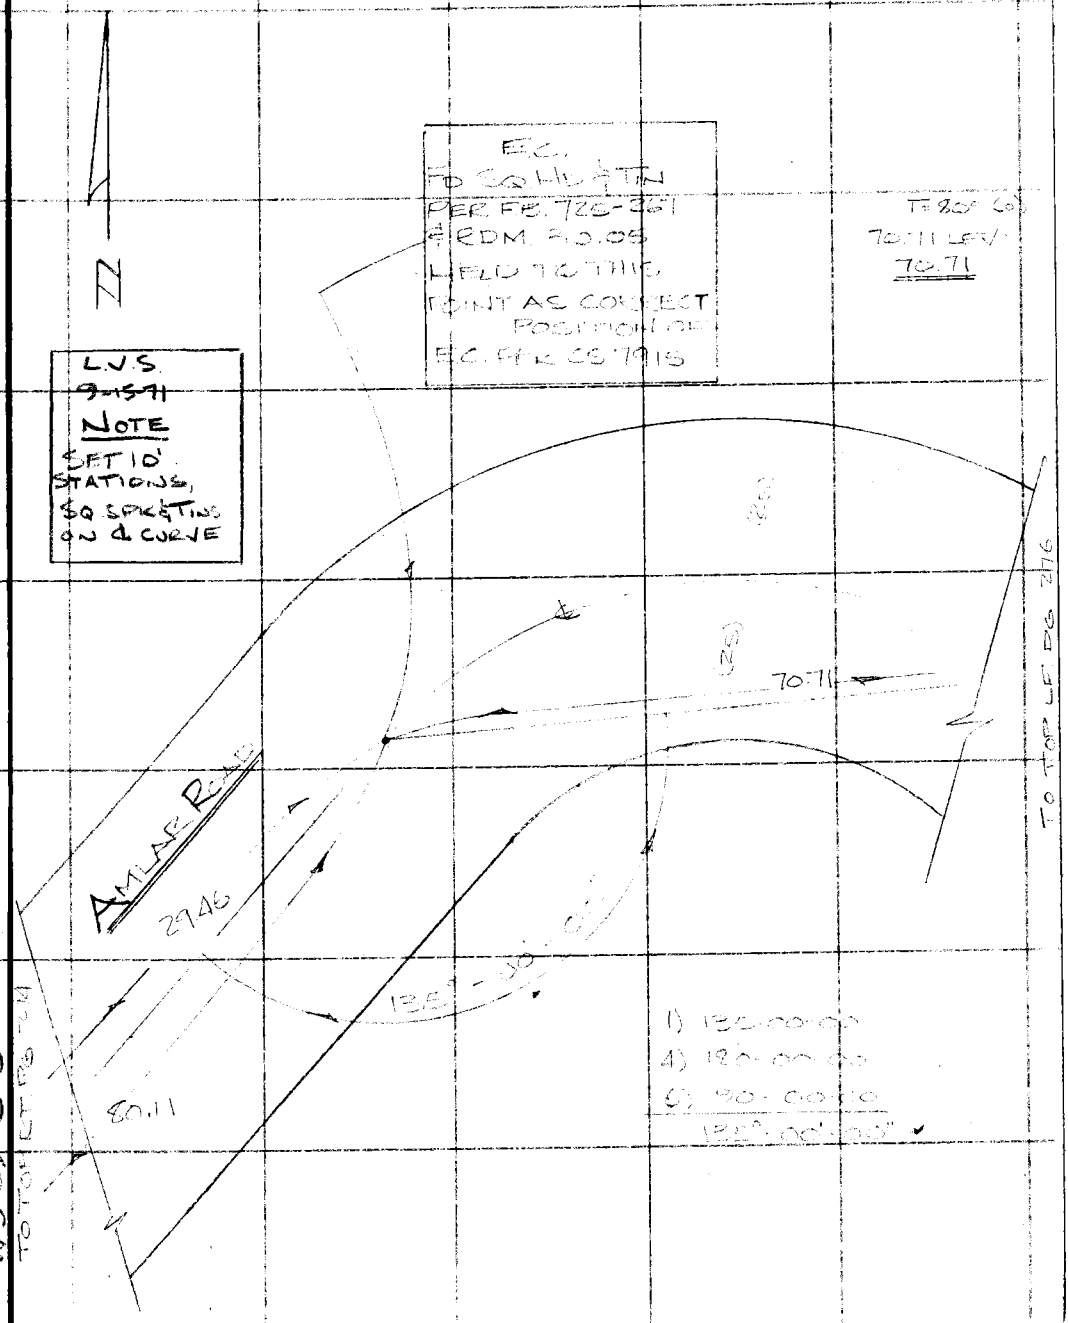

JF3095 CE#310 3-68

PLEASE RETURN TO
COUNTY OF LOS ANGELES
DEPARTMENT OF COUNTY ENGINEER
403 LOS ANGELES COUNTY ENGINEERING BLDG.

Note: Any Additions or Changes on This Sheet Must be Made or Circled in Red Ink With Date and Name of Person Making Change.

Do not extend this side of this line.

WS 91 C-3

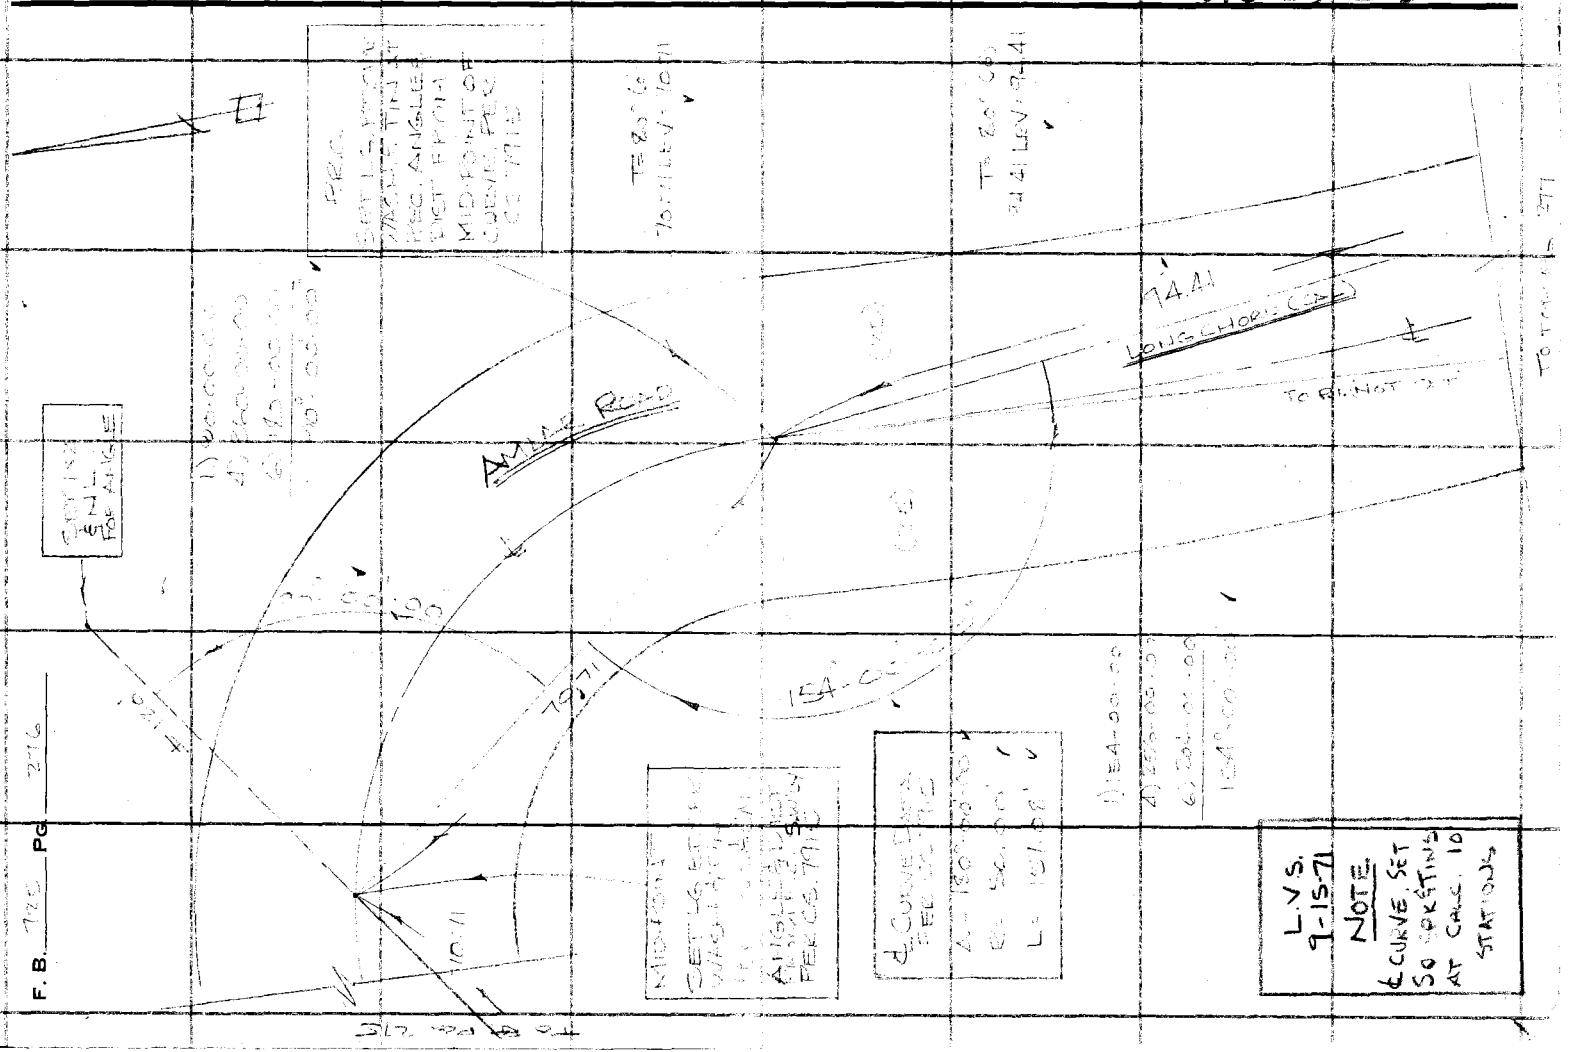

F. B. 770 Pg. 216

Notes Ck'd by [illegible]
Map No.
Office Work
Checked
Date

Survey of AMLAR ROAD
JN 023 300 Tape 154 Std. [illegible] °F
Surveyed by SMITH
Notes [illegible] Date 2-4-71
Indexed T. M. PALMERI 10 71

F. B. 716 PG. [illegible]

L.V.S.
9.15.71
NOTE
℄ CURVE, SET
SQ. SPK & TINS
AT CALC. 10'
STATIONS

Note: Any Additions or Changes on this Sheet Must Be Made or Circled in Red Ink With Date and Name of Person Making Change.

PLEASE RETURN TO
COUNTY OF LOS ANGELES
DEPARTMENT OF COUNTY ENGINEER
103 LOS ANGELES COUNTY ENGINEERING BLDG.

PROD (+) FOR ANGLE

℄ CURVE DATA
[illegible]
Δ = 7°50'00"
R = 746.00'
L = 96.17

P.I. NOT SET

LONG VIEW

AMLAR ROAD

B.C.
SET LS, ET, JK, WASH & TIN AT REC. & CAL. ANGLE POINT FROM P.C. (N.W.) P.C.C. 79+15

1) 19°00'00"
4) 76°00'00"
6) 114°00'00"
✓ 19°00'00"

[illegible] BLVD.

T = 80° (c)
24.49 LEV = 24.77

30.00
TOPO 278

24.49

TO [illegible]

F 8095 CE#310 3-68

F. B. 715 PG 27

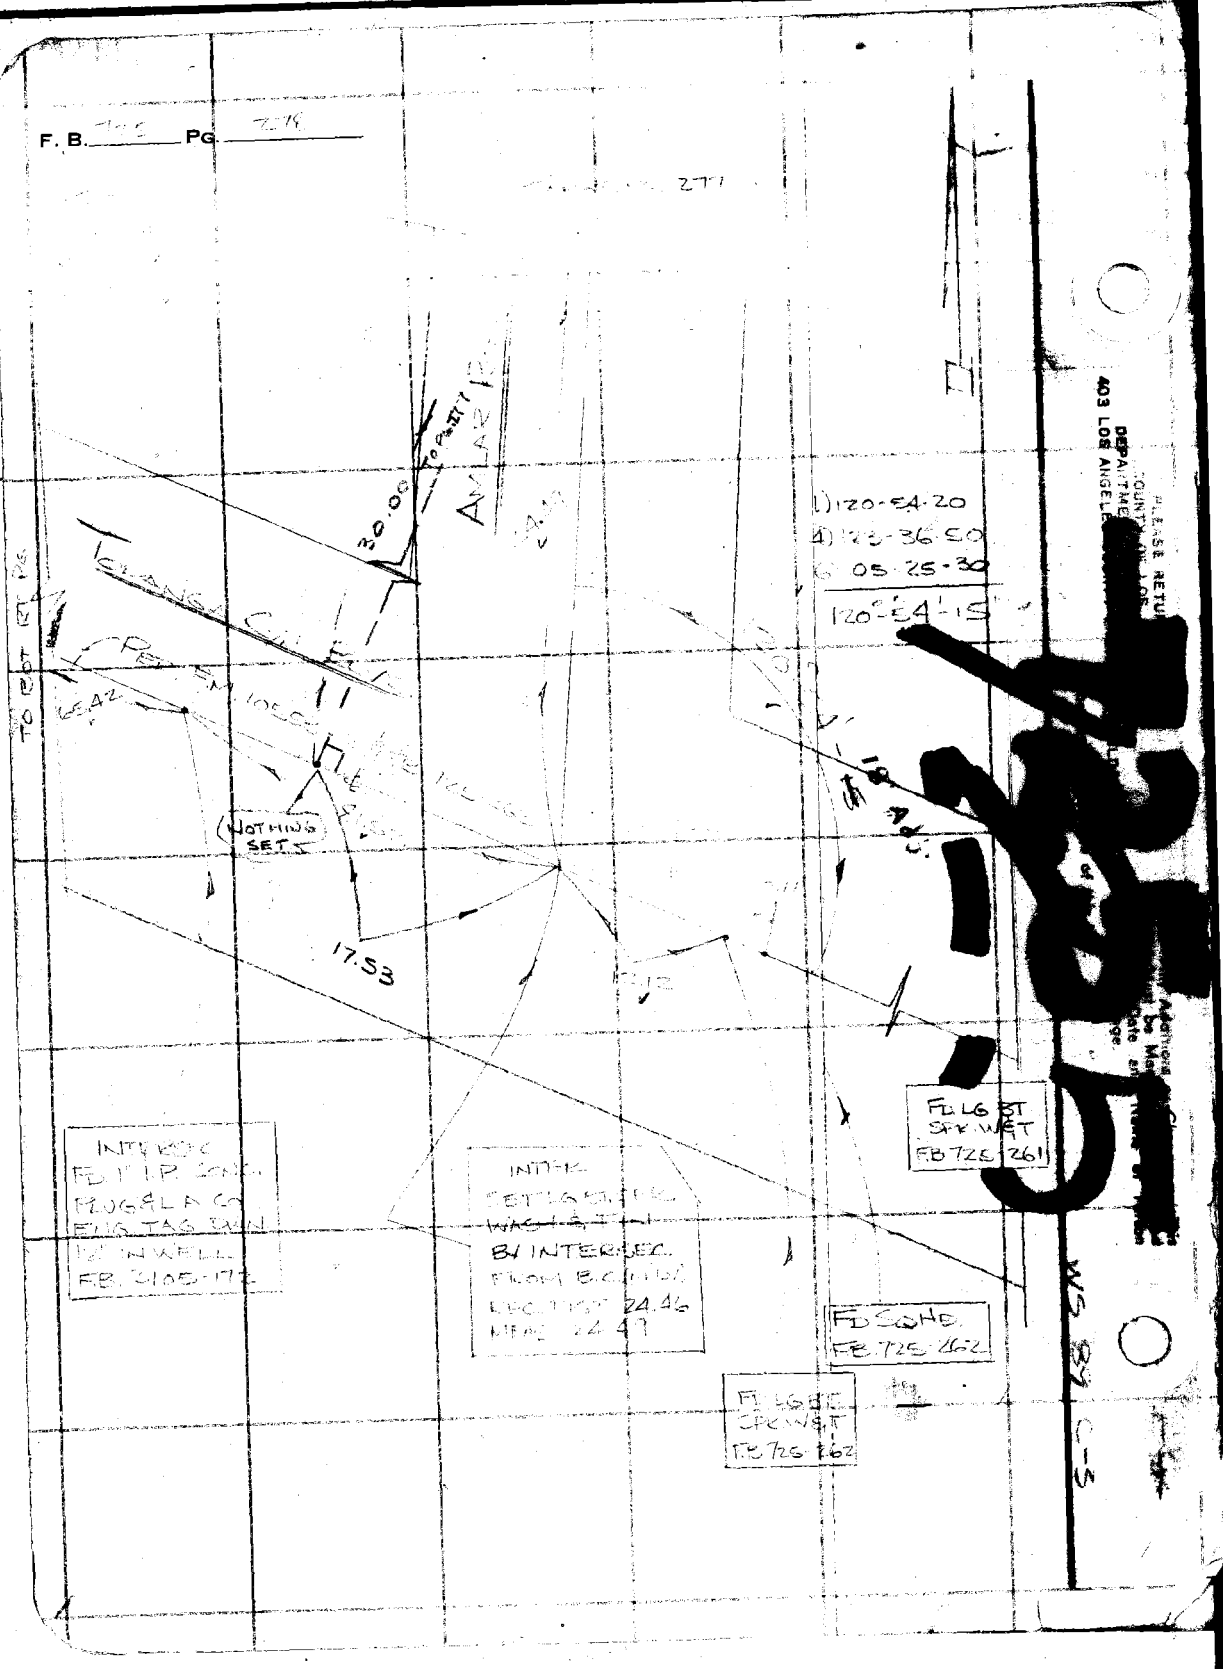
30.06
ANGLAR IR
65.42
(NOTHING SET)
17.53
1) 120-54-20
4) 23-36-50
05-25-30
120°-54'-15"
FD L&T SPK W&T FB 725 261
FD SCRIBE FB 725 262
FD L&T SPK W&T FB 725 262
403 LOS ANGELES
WS 87 C-3