Notes Ck'd by D. M. Finley
Map No. B-1492
Work H. U. M. H.
Ck'd D. M. Finley
Apr. 1941

Survey of El Segundo Blvd
W. O. 8207 Tape No. St'd °F.
Surveyed by L. D. Moore
Notes Moore Date Jan 1938
Indexed L. C. Jones
5-1-38

F.B. 739 PG. 3

SURVEY
of
EL SEGUNDO BLVD
from
WESTERN AVE
to
INGLEWOOD-REDONDO BLVD

Job # 8207

Moore
" "
" Son
" "

Jan. 11 1938 -

Microfilmed April 87

F.B. 739 PG. 4

To bottom pg 5

INDEX SKETCH

TOPOG. - PAGES 51+

ARLINGTON

AVE

WESTERN

AVE

57

C.S. B-1492-1

E.C. SEGMENT

RR

PE

10

9


Notes Ck'd by D. M. Finley	Survey of [illegible]	F.B. [illegible]	PG. [illegible]
Map No. B-1492	W. O. [illegible] Tape No.	St'd °F.	
Office Work H U M H	Surveyed by L. D. Moore		
Checked D. M. Finley	Notes [illegible] Date Jan 19[illegible]		
Date Apr. 1941	Indexed [illegible]		

C.S.B-1492

DOTY AVE

19 20 17 18 16 16 16 16 14 14 13 13 15 15 15 15 12 12 11 11

CONTINUE AVE



YUKON AVE

1350'

Note: Any Additions or Changes on This Sheet Must be Made or Circled in Red Ink With Date and Name of Person Making Change

Do not extend notes this side of this line

RETURN TO
LOS ANGELES COUNTY SURVEYOR
700 HALL OF RECORDS

FORM 247 10M 11-38

Township No. 4

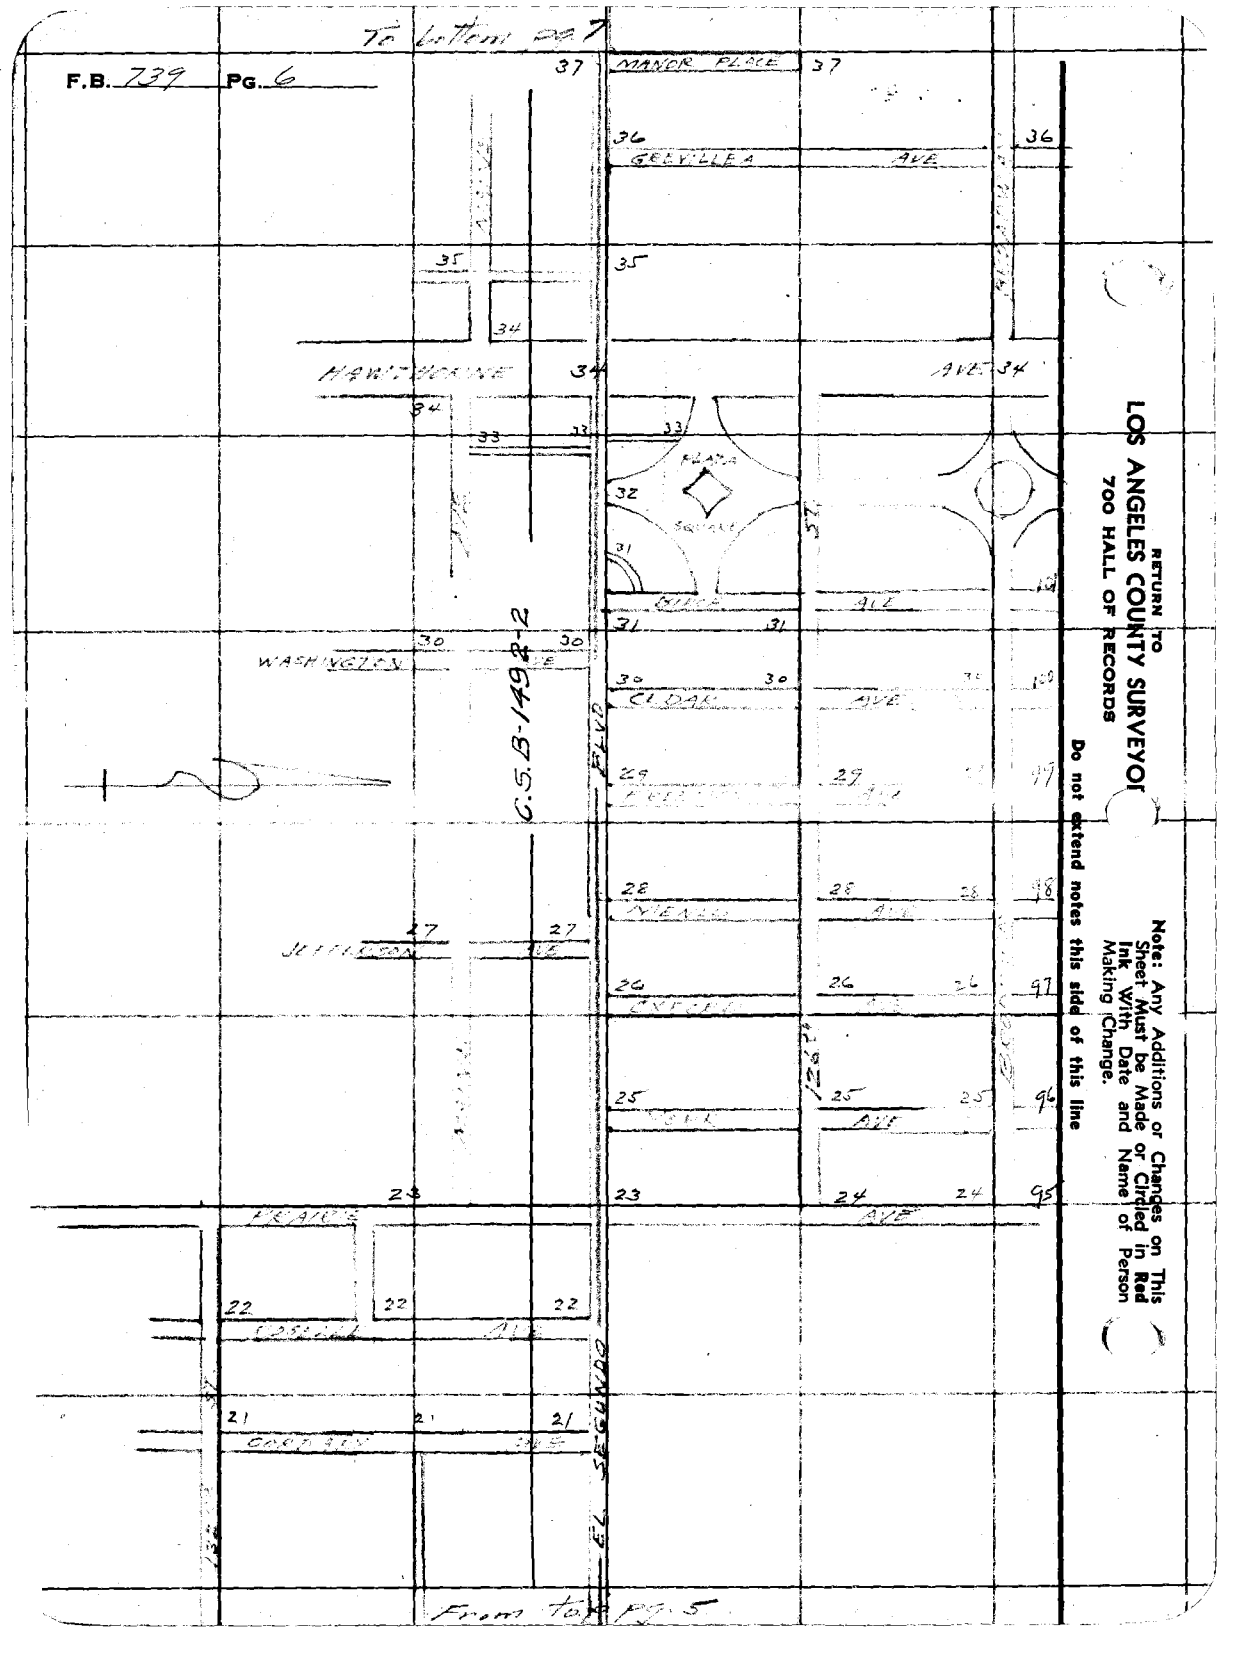
To bottom pg 7
F.B. 739 PG. 6
MANOR PLACE
GREYVILLEA AVE
HAWTHORNE AVE
PLAZA
SQUARE
CIRCLE AVE
WASHINGTON BLVD
CEDAR AVE
WISTARIA
JUANITA AVE
CYPRESS AVE
C.S.B-149 #-2
RETURN TO
LOS ANGELES COUNTY SURVEYOR
700 HALL OF RECORDS
Do not extend notes this side of this line
Note: Any Additions or Changes on This Sheet Must be Made or Circled in Red Ink With Date and Name of Person Making Change.
From top pg. 5

Notes Ck'd by D. M. Finley	Survey of [illegible]
Map No. B-1492-	W. O. 8247 Tape No. 051 St'd 84 °F.
Office Work H.U.M.H.	Surveyed by [illegible]
Checked D. M. Finley	Notes [illegible] Date Jan. 1940
Date Apr. 1941	Indexed

F.B. [illegible] PG. 7

Note: Any Additions or Changes on This Sheet Must be Made or Circled in Red Ink With Date and Name of Person Making Change.

Do not extend notes this side of this line

RETURN TO
LOS ANGELES COUNTY SURVEYOR
700 HALL OF RECORDS

C.S.B-1492-3

ANZA

SHAUT

INGLEWOOD

W. Bd.

BLVD

ST

AVE

PE. R.R.

45 44 43 42 41 40 39 38

From top Ap. 6

FORM 247 10M 11-35

RETURN TO
LOS ANGELES COUNTY SURVEYOR
700 HALL OF RECORDS

Note: Any Additions or Changes on This Sheet Must be Made or Circled in **Red Ink** With Date and Name of Person Making Change.

Do not extend notes this side of this line

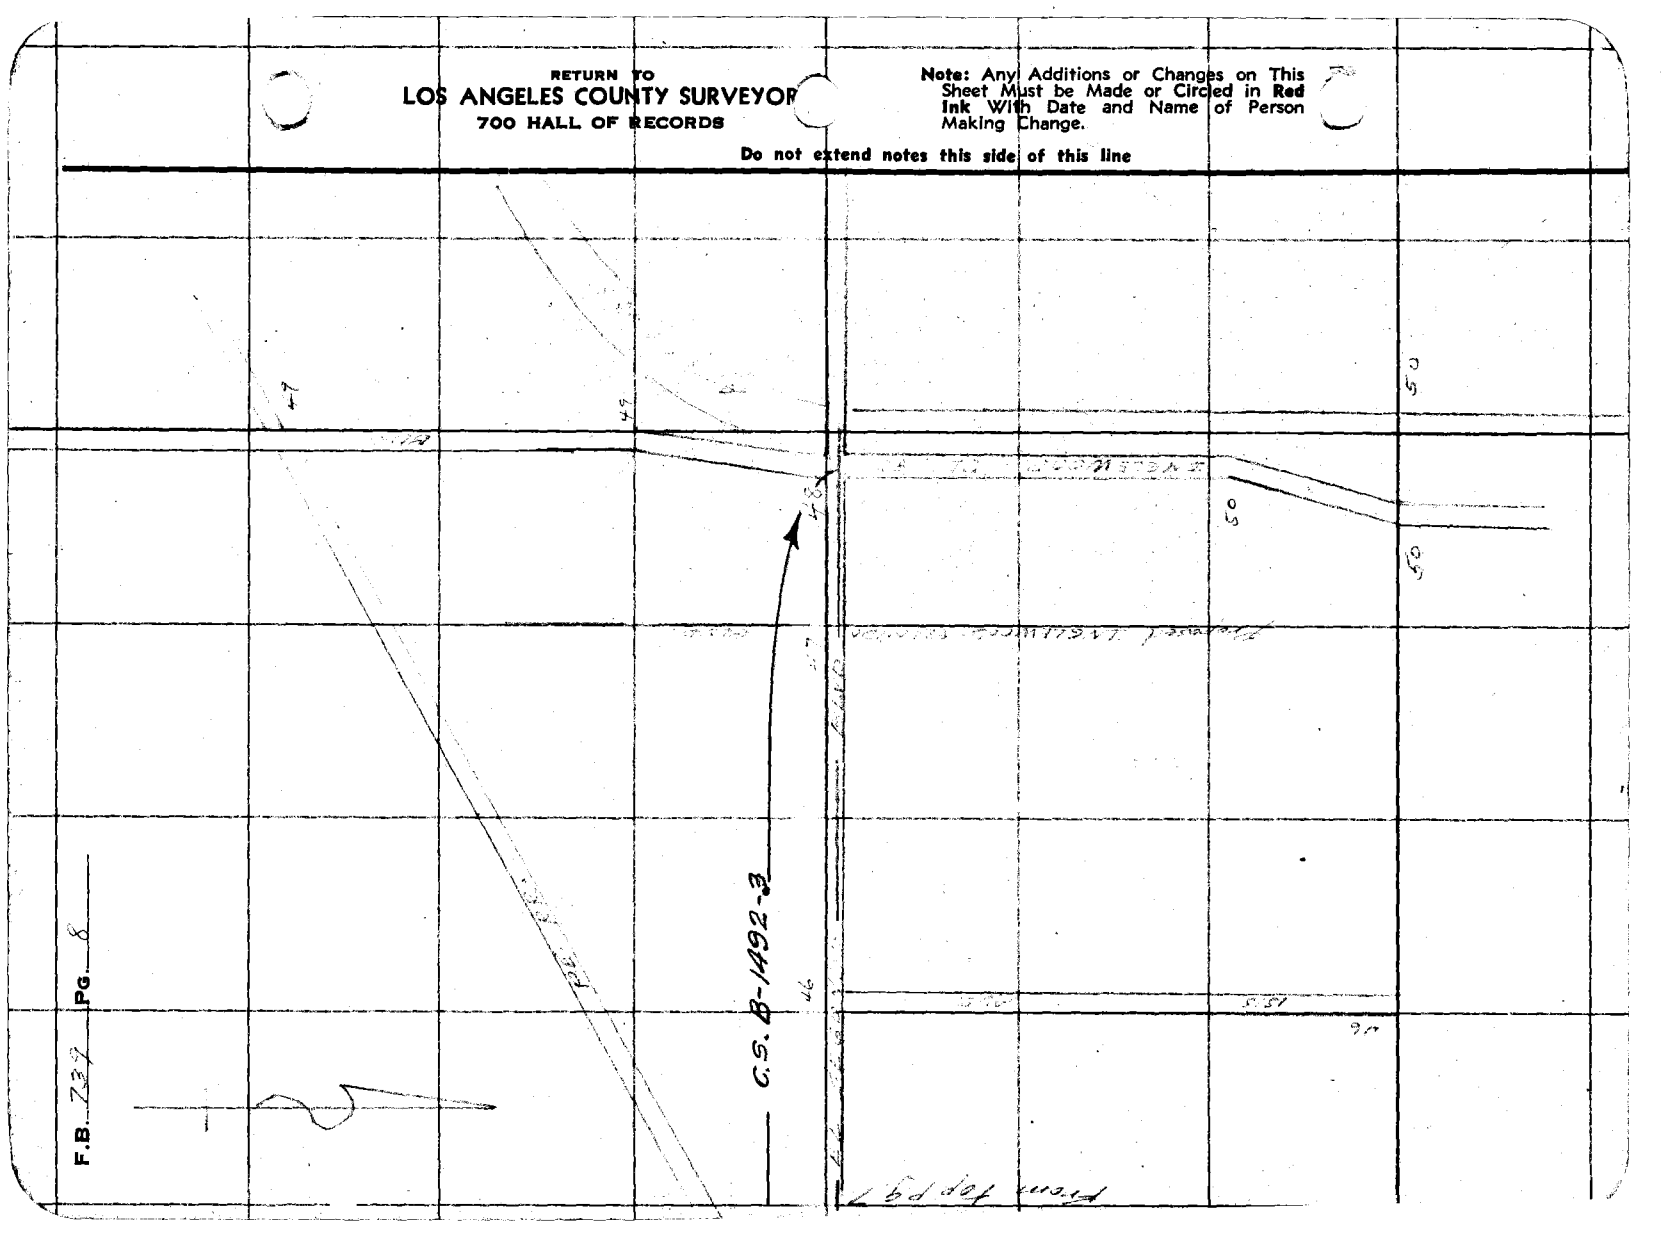

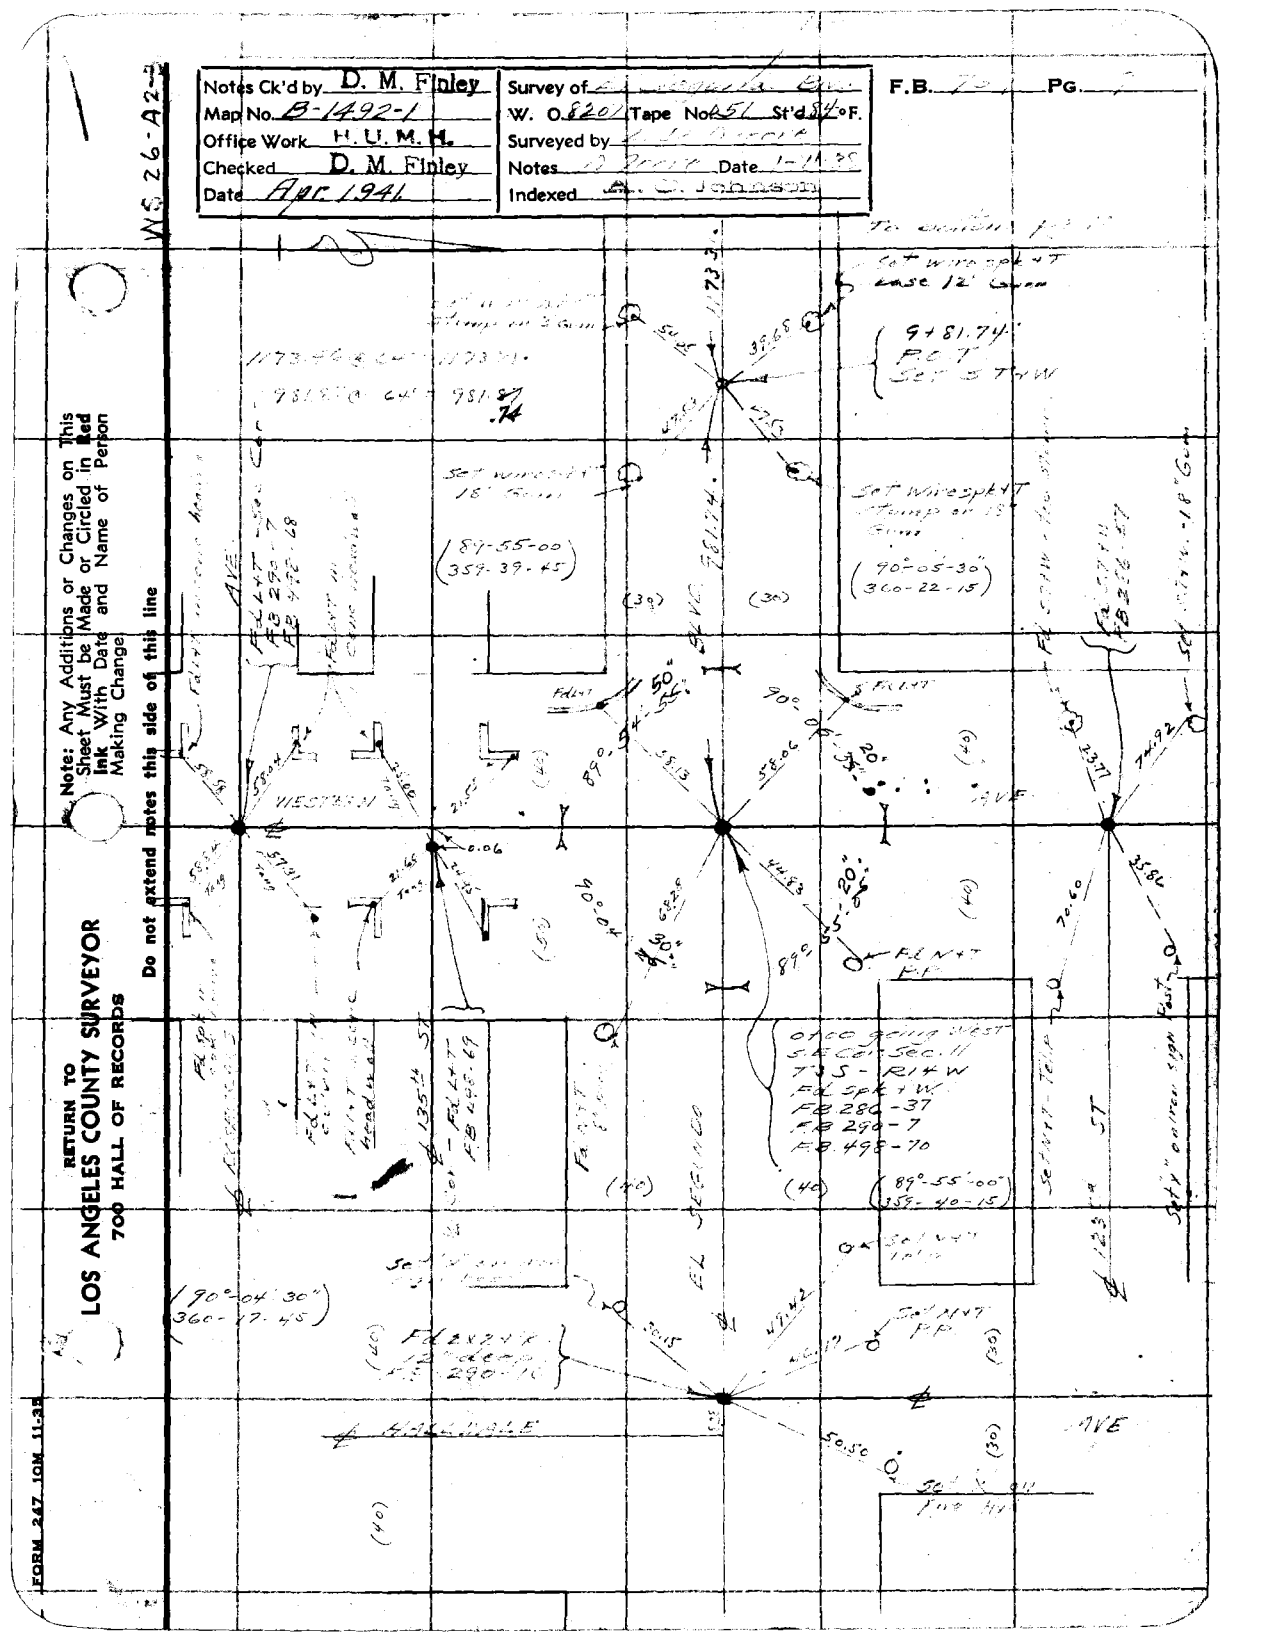
Notes Ck'd by D. M. Finley
Map No. B-1492-1
Office Work H. U. M. H.
Checked D. M. Finley
Date Apr. 1941
Survey of
W. O. 8201 Tape No. 57 St'd 84° F.
Surveyed by
Notes Date 1-11-38
Indexed A. C. Johnson
F.B. Pg.
WS 26-A2
Note: Any Additions or Changes on This Sheet Must be Made in Red Ink With Date and Name of Person Making Change
Do not extend notes this side of this line
RETURN TO
LOS ANGELES COUNTY SURVEYOR
700 HALL OF RECORDS
FORM 247 10M 11-38
Set wire spk LT case 12" Conc
9+81.74
P.C.T.
Set 3 T+W
Set Wire spk LT Stamp on 18" Conc
(87-55-00)
(359-39-45)
(90°-05'-30")
(360-22-15)
(89°-55'-00")
(359-40-15)
(90°-04'-30")
(360-17-45)
Fd Wire spk LT
Fd 290-7
Fd 290-48
Fd 498-70
Fd 290-37
Fd 135.14 St
Fd 135.69
Fd 290-7
Fd 290-10
Fd 498-70
Fd 290-37
Fd Wire spk LT
Fd 290-7

RETURN TO
LOS ANGELES COUNTY SURVEYOR
700 HALL OF RECORDS

Note: Any Additions or Changes on This Sheet Must be Made or Circled in Red Ink With Date and Name of Person Making Change.

Do not extend notes this side of this line

W S 25-E1
W S 26-A2-3

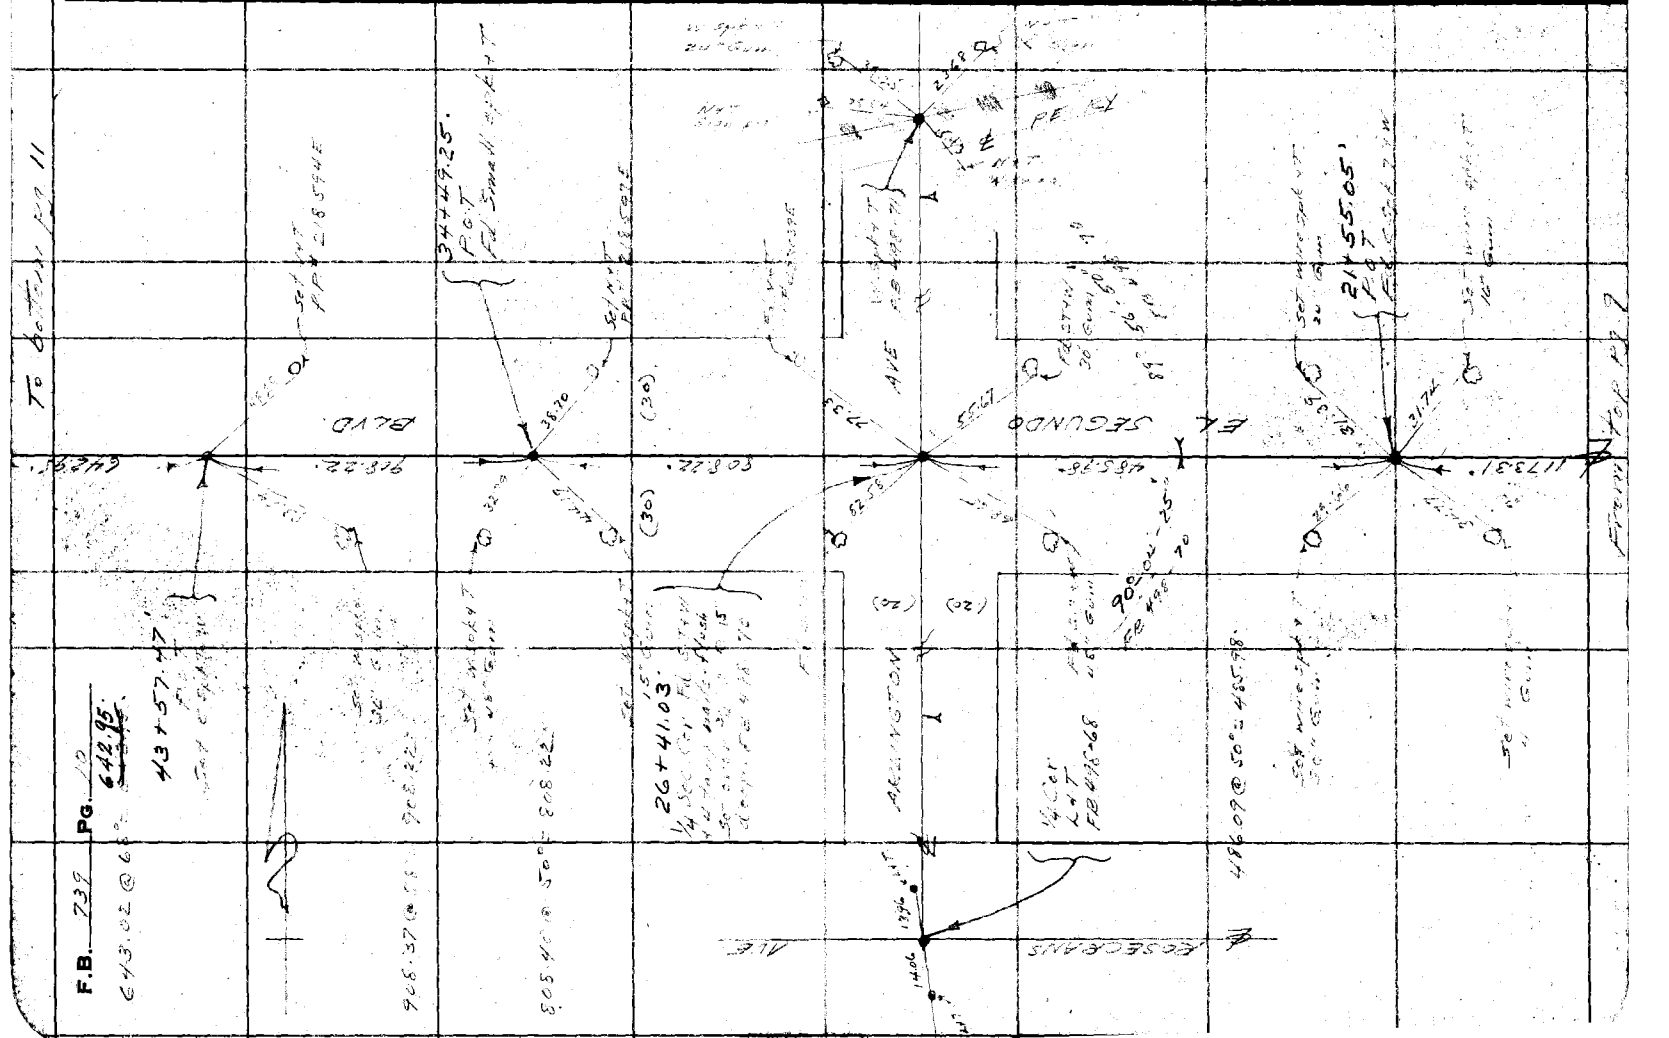

Notes Ck'd by D. M. Finley	Survey of El Segundo Blvd	F.B. 737	Pg. 11
Map No. B-1492-1	W. O. 8201 Tape No. 651 St'd 64° F.		
Office Work H. U. M. H.	Surveyed by L. A. Moore		
Checked D. M. Finley	Notes Moore Date 1-12-38		
Date Apr. 1941	Indexed		

W.S. 25-D1-2

Note: Any Additions or Changes on This Sheet Must be Made or Circled in Red Ink With Date and Name of Person Making Change.

Do not extend notes this side of this line

RETURN TO
LOS ANGELES COUNTY SURVEYOR
700 HALL OF RECORDS

FORM 8-67 10M 11-38

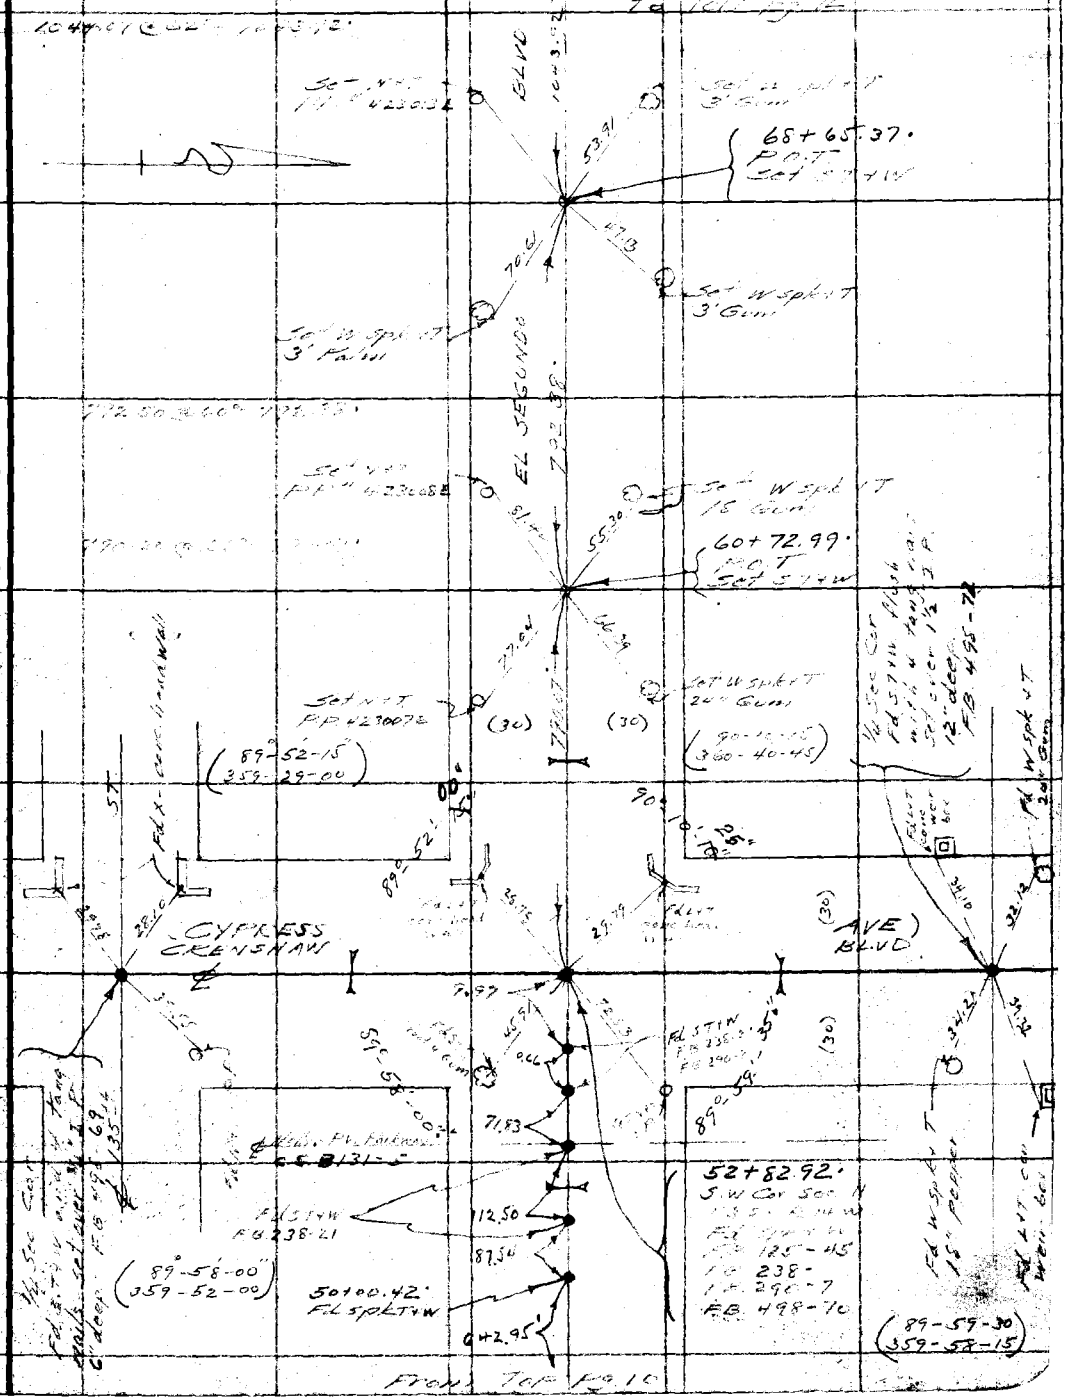

RETURN TO
LOS ANGELES COUNTY SURVEYOR
700 HALL OF RECORDS

Note: Any Additions or Changes on This Sheet Must be Made or Circled in **Red** Ink With Date and Name of Person Making Change.

WS 25-D1

Do not extend notes this side of this line

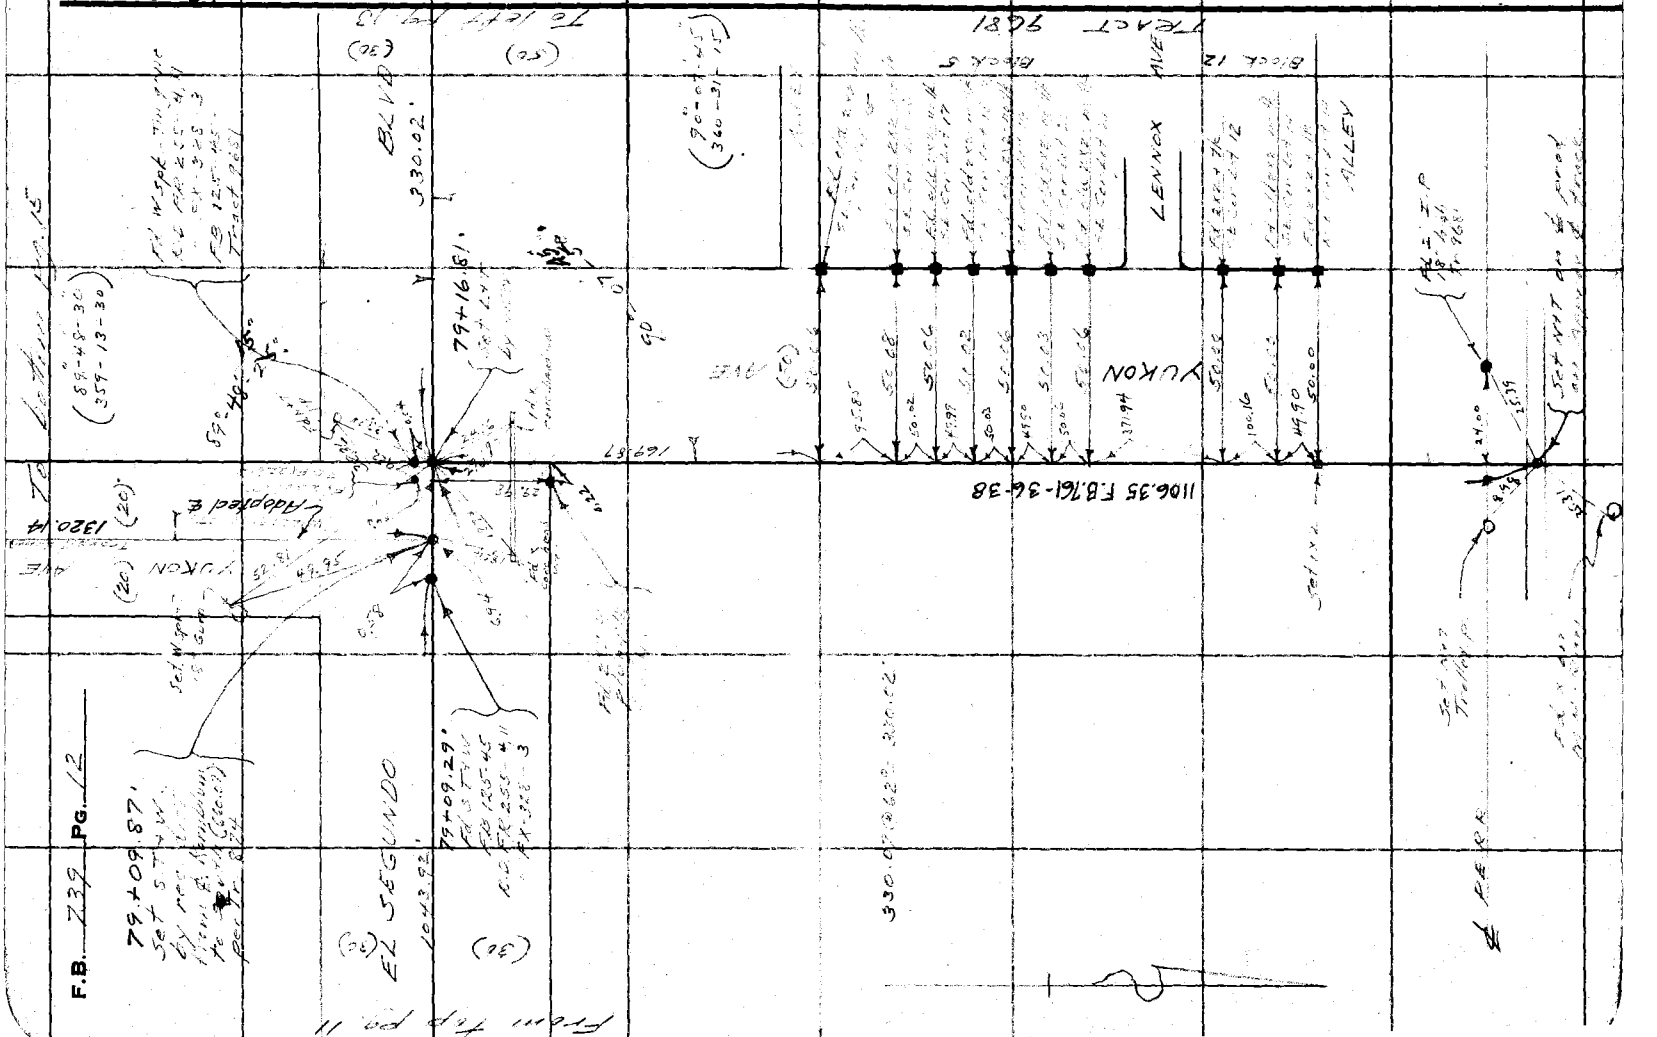

Notes Ck'd by D. M. Finley	Survey of	F.B.	PG.
Map No. B-1492-2	W. O.	Tape No.	St'd °F.
Office Work H. U. M. H.	Surveyed by		
Checked D. M. Finley	Notes	Date	
Date Apr. 1941.	Indexed		

W 525-D1

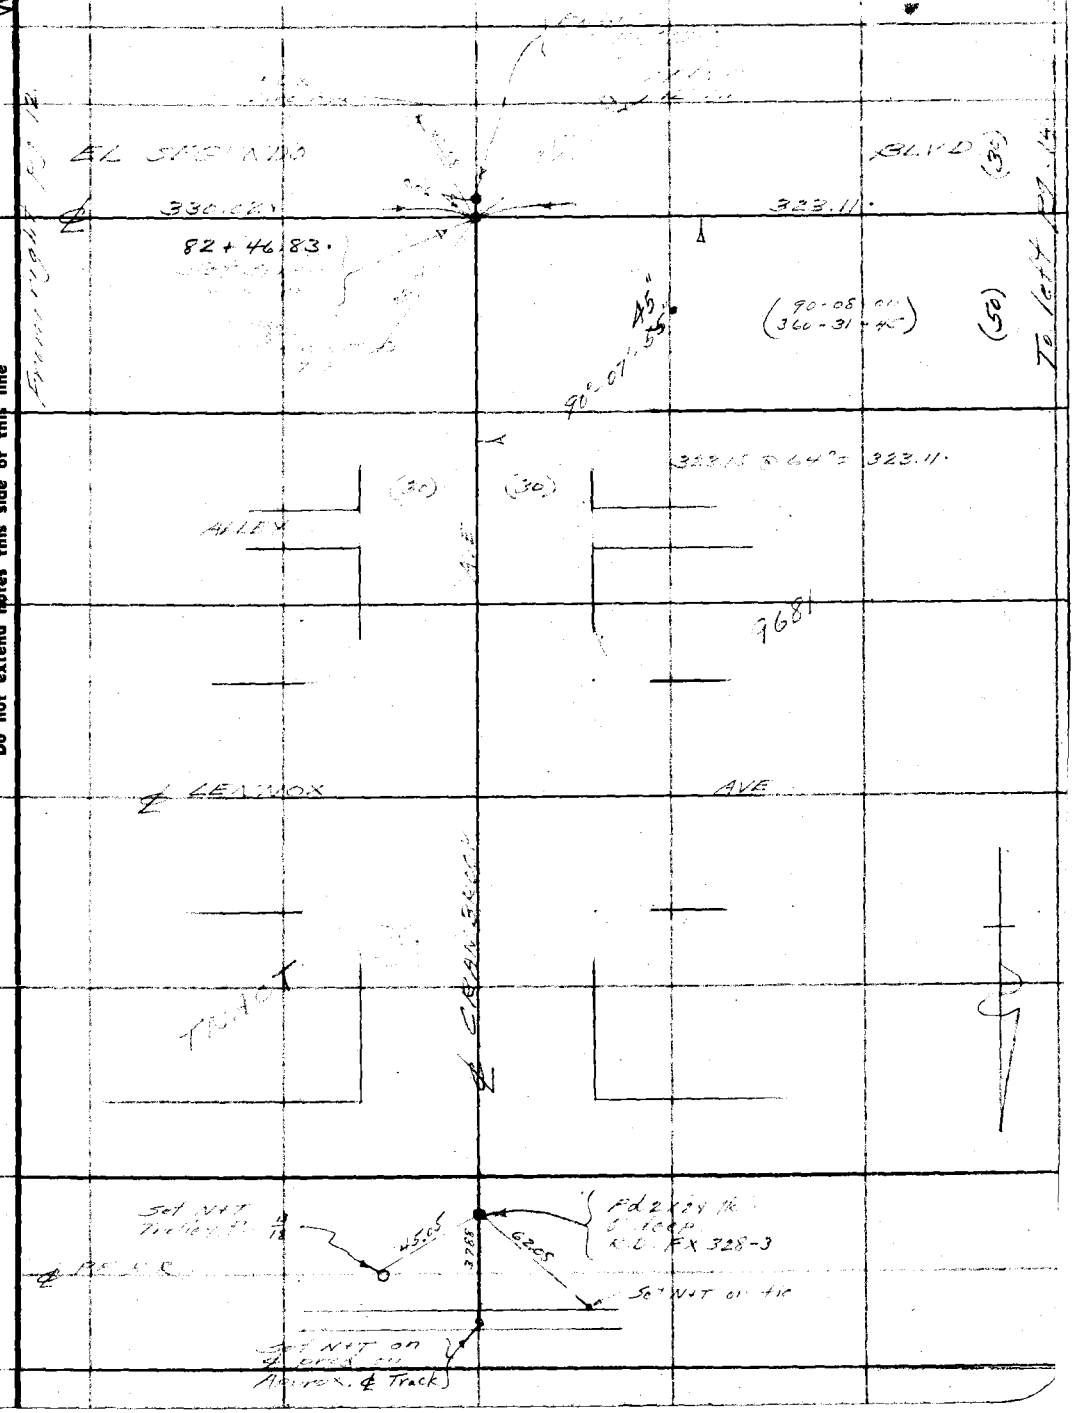

RETURN TO
LOS ANGELES COUNTY SURVEYOR
700 HALL OF RECORDS

Note: Any Additions or Changes on This Sheet Must be Made or Circled in Red Ink With Date and Name of Person Making Change

Do not extend notes this side of this line

FORM 247 10M 11-35

RETURN TO
LOS ANGELES COUNTY SURVEYOR
700 HALL OF RECORDS

Note: Any Additions or Changes on This Sheet Must be Made or Circled in **Red Ink** With Date and Name of Person Making Change.

Do not extend notes this side of this line

W S 25-D-1

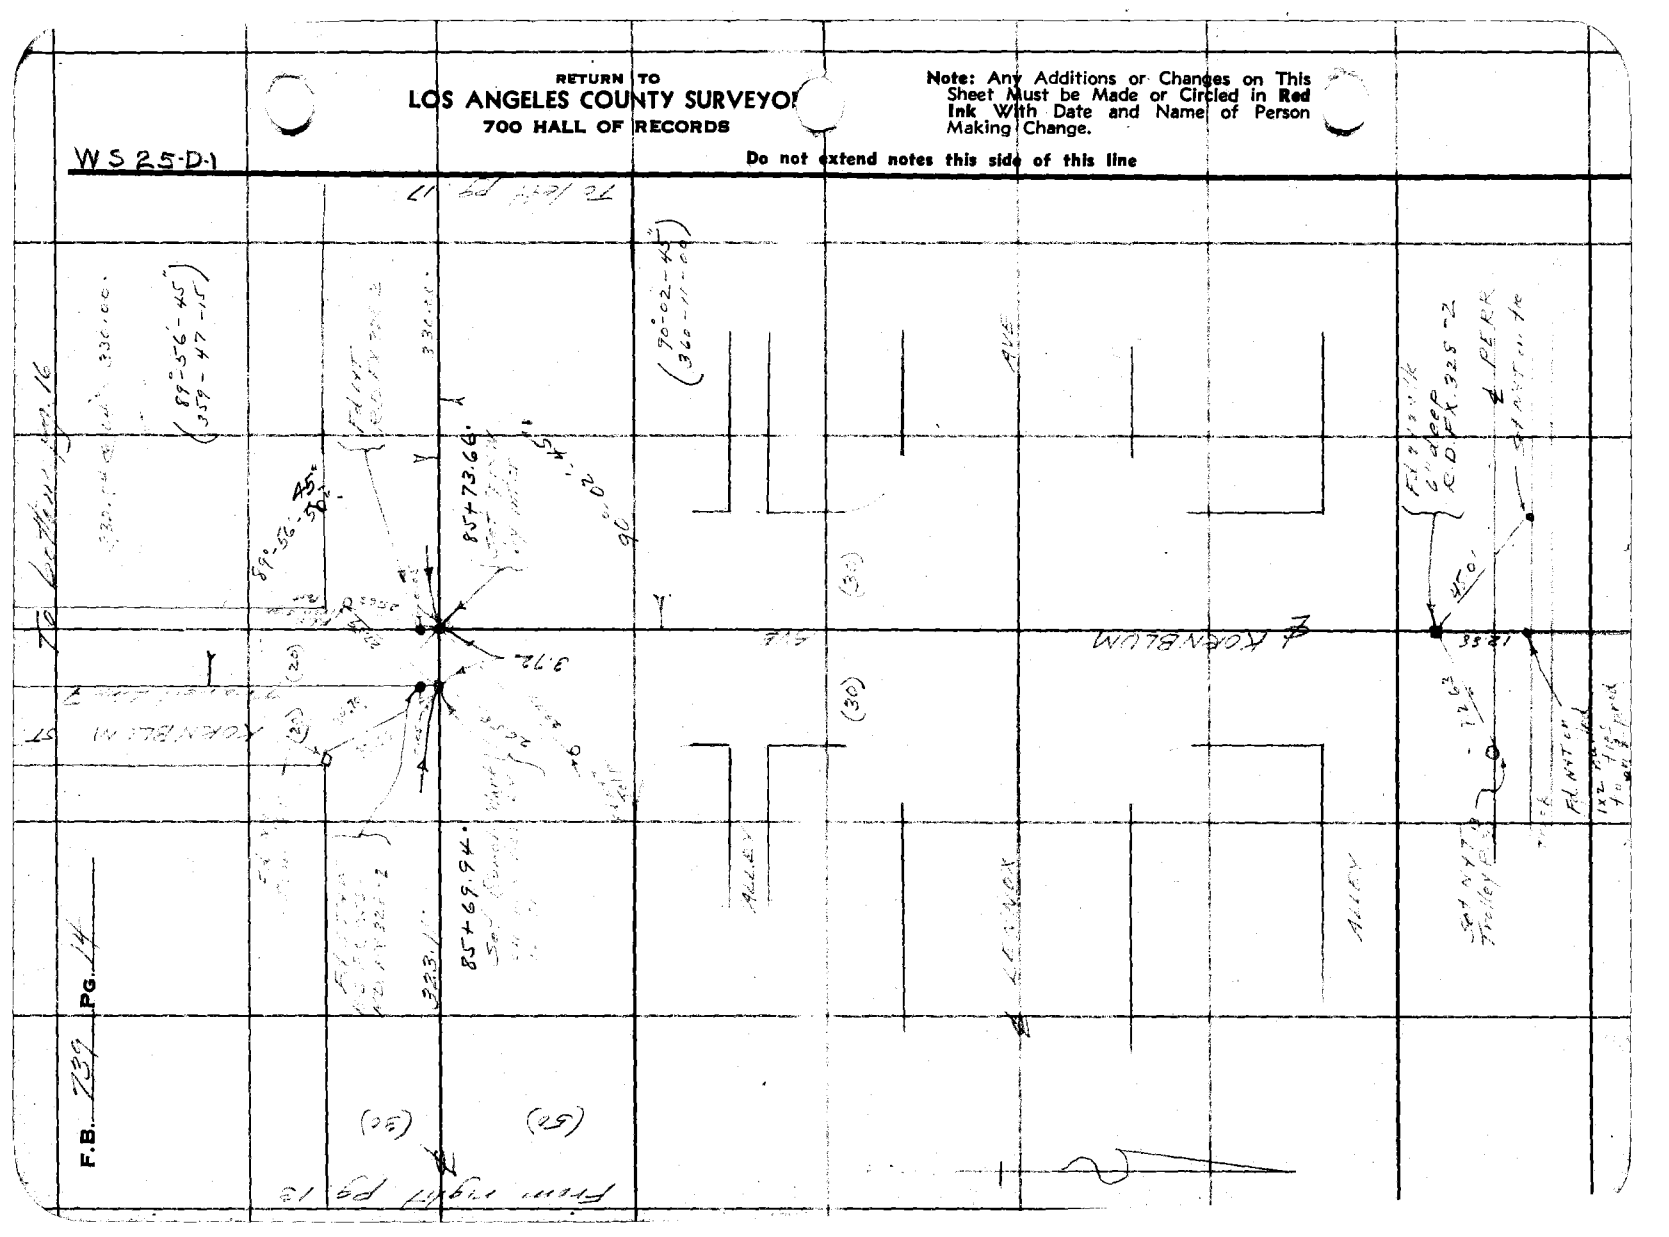
F.B. 739 Pg. 14
(30)
(31)
(32)
(33)
ALLEY
ALLEY
AVE
AVE
85+73.66
85+69.94
90°-00'-02"
89°-56'-45"
70°-02'-45"
45°-56'-45"
3.72
1.26
45°
FD. 1" I.P. & DISC
FD. NAIL & DISC
FD. NAIL & TAG
FD. NAIL & TAG
FD. NAIL & TAG

WS 25 D1-2

Notes Ck'd by D. M. Finley	Survey of	F.B.	Pg.
Map No. B-1492-2	W. O. & 207 Tape No. C-1 St'd. °F.		
Office Work H. U. M. H.	Surveyed by		
Checked D. M. Finley	Notes Date		
Date Apr 1941	Indexed		

Note: Any Additions or Changes on This Sheet Must be Made or Circled in Red Ink With Date and Name of Person Making Change

Do not extend notes this side of this line

RETURN TO
LOS ANGELES COUNTY SURVEYOR
700 HALL OF RECORDS

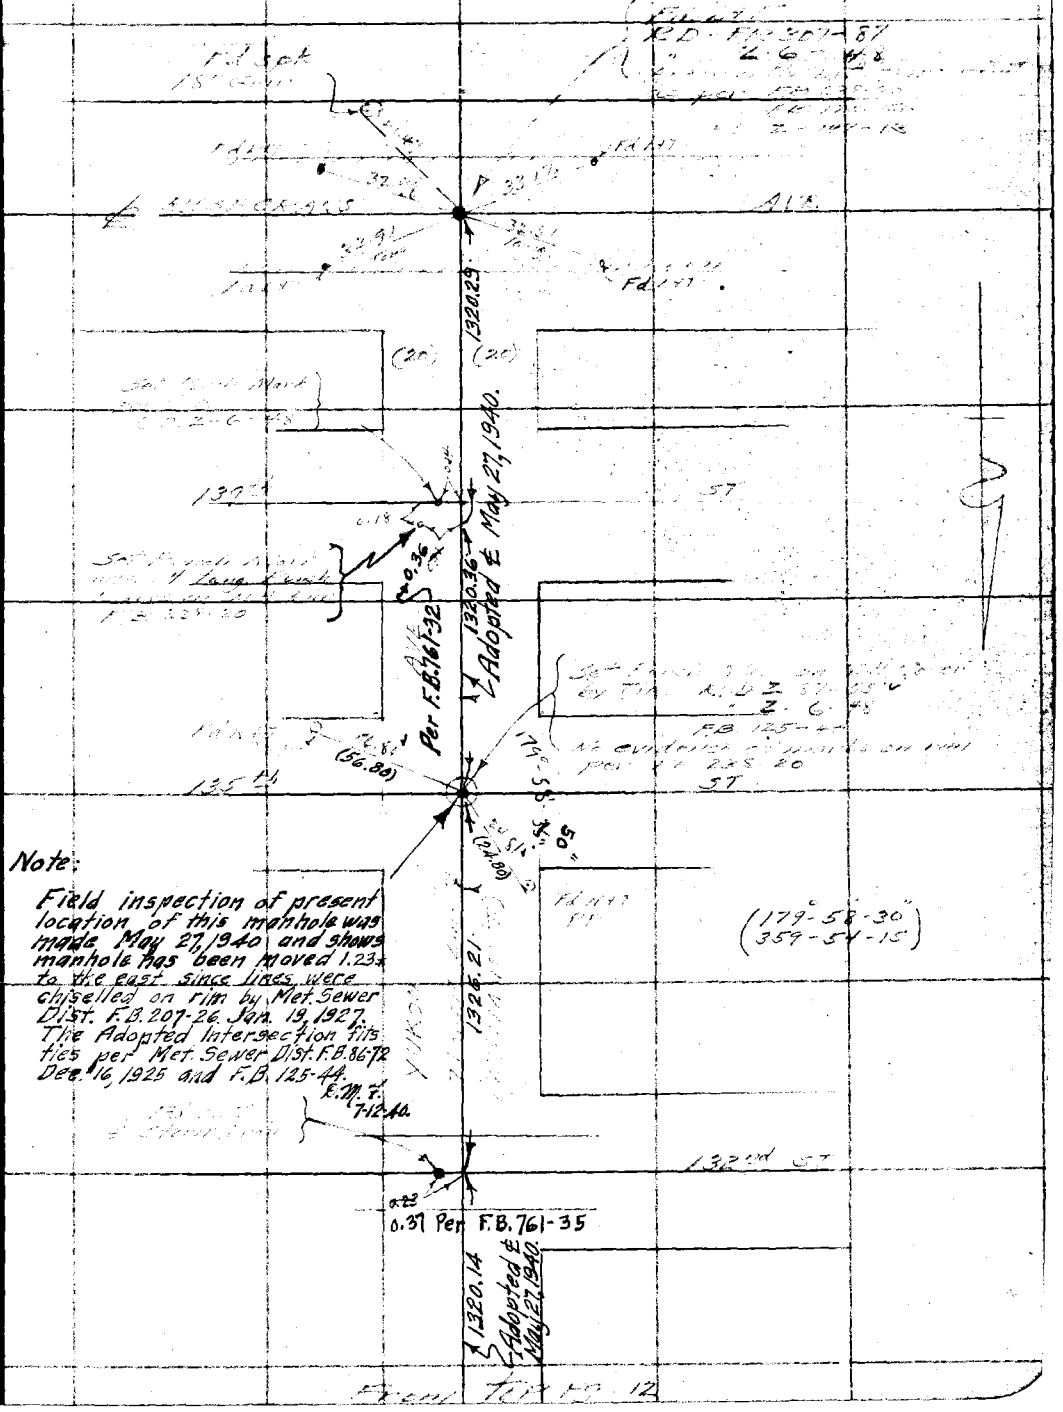

Note:

Field inspection of present location of this manhole was made May 27, 1940 and shows manhole has been moved 1.23± to the east since lines were chiselled on rim by Met. Sewer Dist. F.B. 207-26 Jan. 19, 1927. The Adopted Intersection ties ties per Met. Sewer Dist. F.B. 86-72 Dec. 16, 1925 and F.B. 125-44.

E.M.F. 7-12-40.

FORM 247 10M 11-38

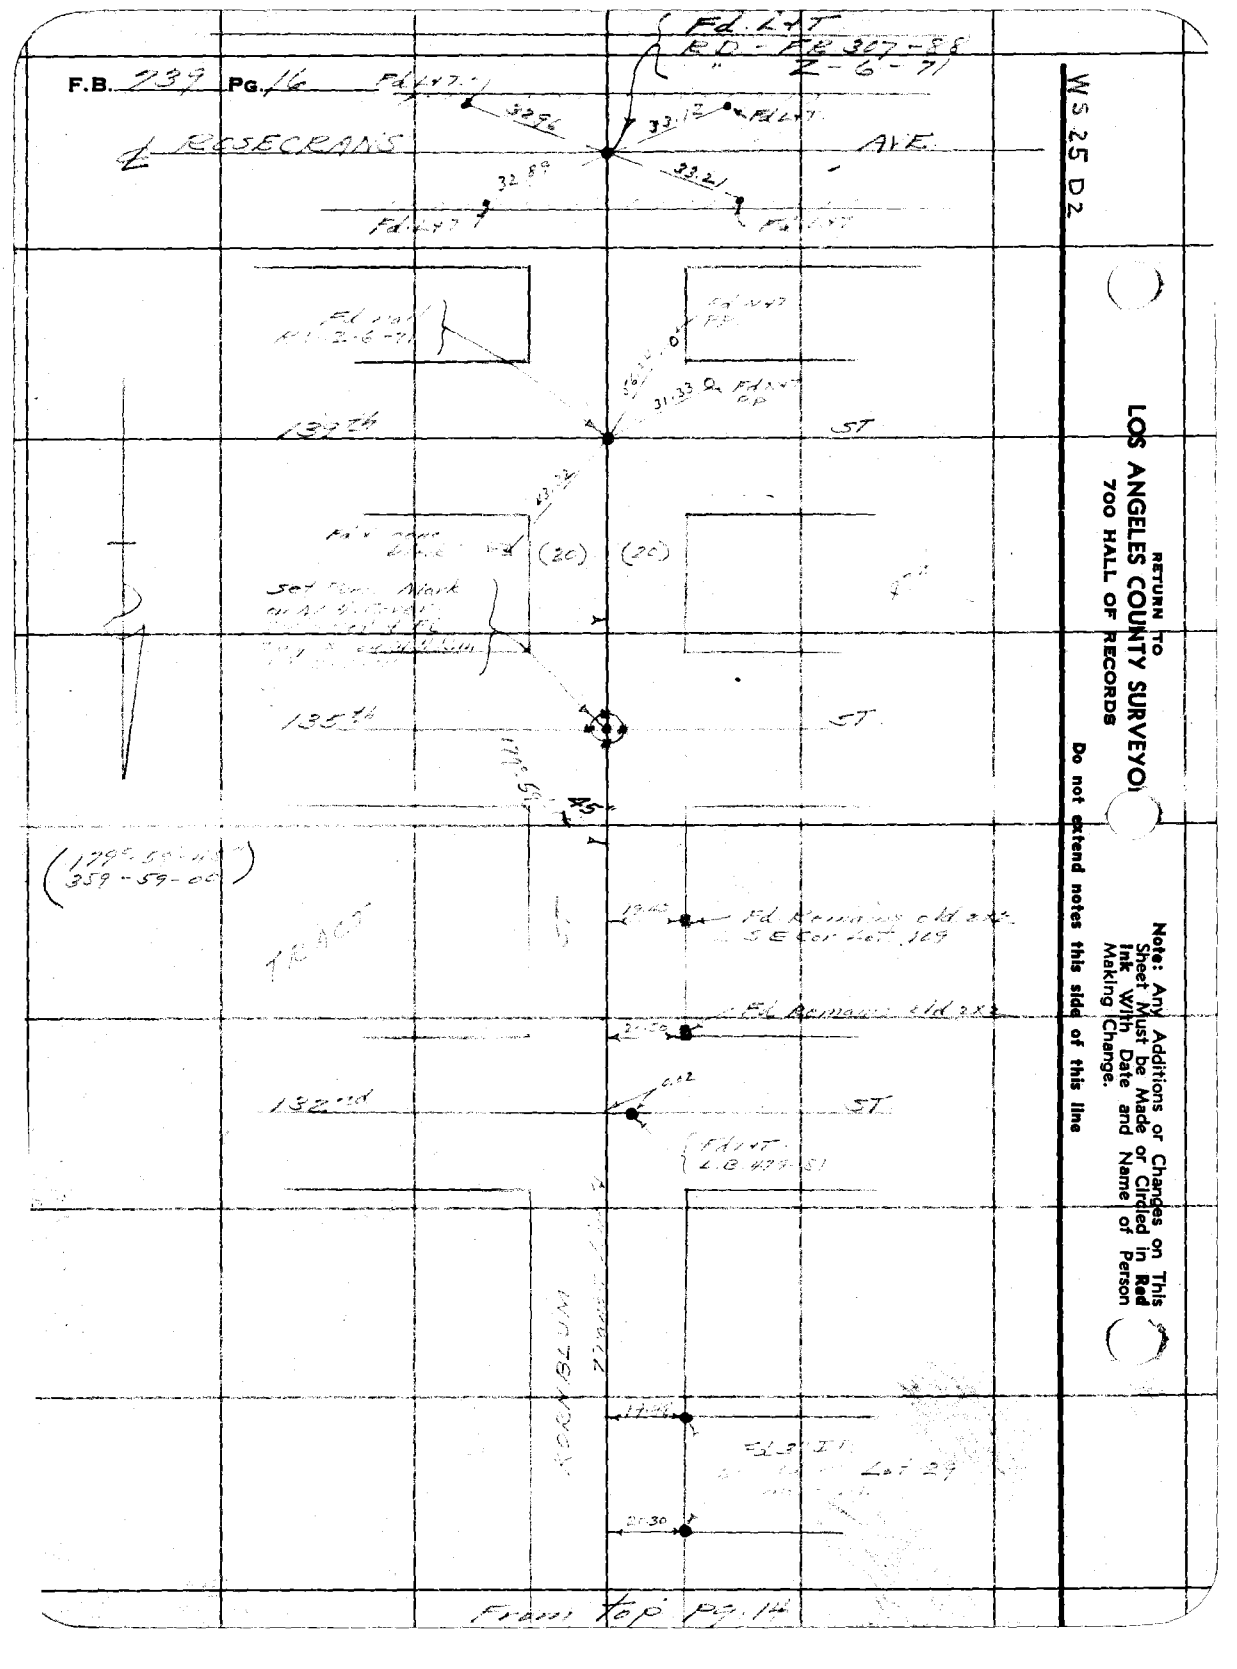
F.B. 739 Pg. 16
Fd. L.H.T.
R.D. - R.E. 347-58
Z-6-71
ROSECRANS
AVE.
32.96
33.12
32.89
33.21
Fd L.H.T.
Fd L.H.T.
Fd L.H.T.
Fd L.H.T.
Fd L.H.T.
R.E. 347-58
Z-6-71
Fd L.H.T.
Fd L.H.T.
31.33 Q
Fd L.H.T.
CP
132nd
ST
23.74
Fd L.H.T.
(20)
(20)
Set Chis. Mark
on Ext. Prop. Line
135th
ST
179°-59'-45"
359-59-00
45
1
Fd Remon. Mkd. X
S.E. Cor. Lot 169
Fd Remon. Mkd. X
132nd
ST
Fd L.H.T.
L.C. 499-51
Lot 29
Fd L.H.T.
From top pg. 14
WS 25 D2
RETURN TO
LOS ANGELES COUNTY SURVEYOR
700 HALL OF RECORDS
Do not extend notes this side of this line
Note: Any Additions or Changes on This Sheet Must be Made or Circled in Red Ink With Date and Name of Person Making Change.

Notes Ck'd by D. M. Finley	Survey of	F.B.	Pg.
Map No. B-1492-2	W. O. 8220 Tape No. 031 St'd 68° F.		
Office Work H. U. M. H.	Surveyed by		
Checked D. M. Finley	Notes Date		
Date Apr. 1941	Indexed		

W.S. 25 - D1

Note: Any Additions or Changes on This Sheet Must be Made or Circled in Red Ink With Date and Name of Person Making Change!

Do not extend notes this side of this line

RETURN TO
LOS ANGELES COUNTY SURVEYOR
700 HALL OF RECORDS

Chained 11/4/42
Tape #031 Std. 68°
644.56 @ 68°
C. A. Benson

644.56

656.20'

326.24'

BLVD

Left P.J. 21

To Top P.O. 30

FORM 247 10M 11-38

RETURN TO
LOS ANGELES COUNTY SURVEYOR
700 HALL OF RECORDS

Note: Any Additions or Changes on This Sheet Must be Made or Circled in Red Ink With Date and Name of Person Making Change.

WS-2501

Do not extend notes this side of this line

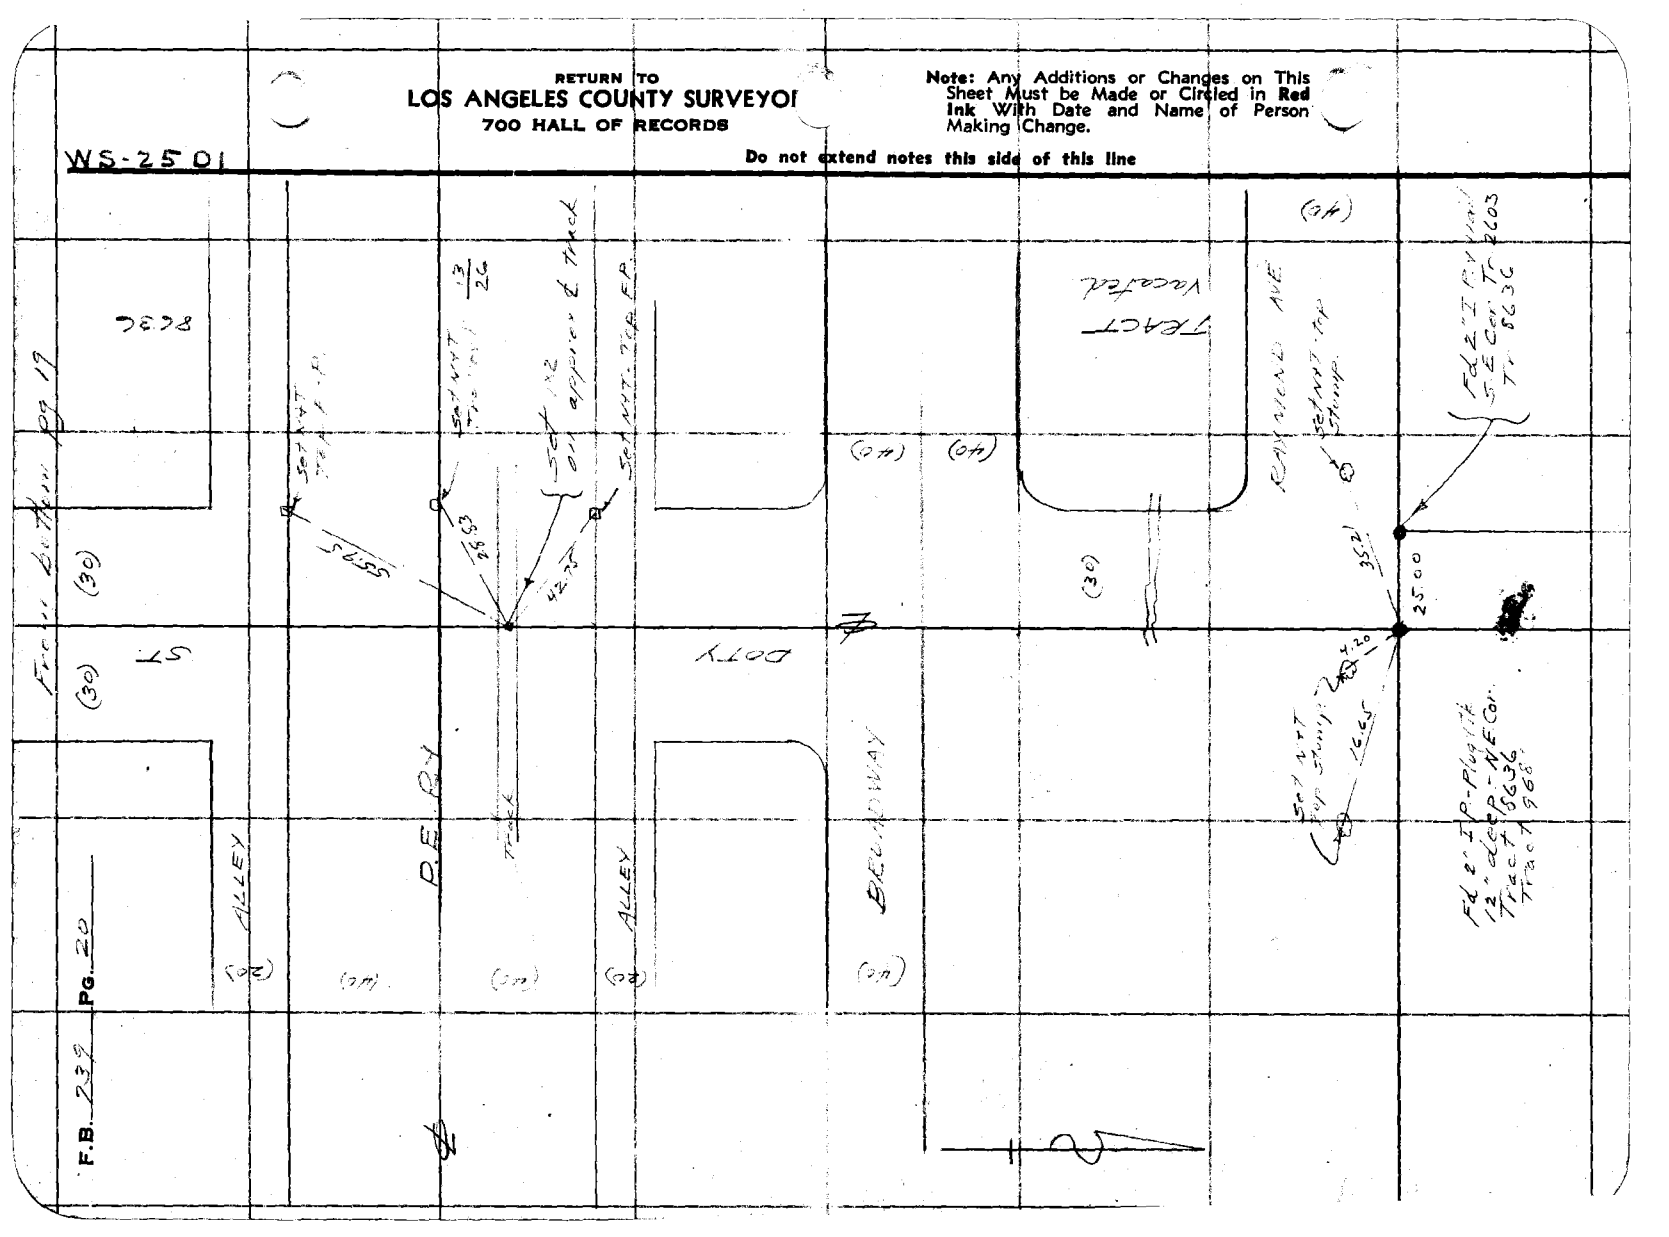
TRACT
Vacated
ALLEY
ALLEY
P.E. RY
TRACK
SET NAIL
SET NAIL
SET NAIL

Notes Ck'd by D. M. Finley	Survey of
Map No. B-1492-2	W. O. 1201 Tape No. 25 St'd 62° F.
Office Work H. U. M. H.	Surveyed by
Checked D. M. Finley	Notes Date 10-38
Date Apr. 1941	Indexed

F.B. PG

W.S. 25-21

Note: Any Additions or Changes on This Sheet Must be Made or Circled in Red Ink With Date and Name of Person Making Change

Do not extend notes this side of this line

RETURN TO
LOS ANGELES COUNTY SURVEYOR
700 HALL OF RECORDS

FORM 247 10M 11-38

EL SEGUNDO

89+03.66'

326.24'

90°02'30"

(90°-02'-30"
360-00-15)

Fd old 2x2 no tk

Fd old 2x2 no tk SW cor Lot 6

Fd old 2x2 no tk SW cor Lot 4

Fd old 2x2 no tk

Fd old 2x2 no tk

Fd old 2x2 no tk

Fd old 2x2 no tk

Fd old 2x2 no tk

Fd old 2x2 no tk

Fd old 2x2 no tk

30.00

30.00

30.00

30.00

30.00

30.00

30.00

30.00

ST

Block 10

TRACT

9681

LENNOX

AVE

EUCLID

To Sec. Fig. 18

To Fig. 18

F.B. 739 PG. 18

From bottom of 17

WS 25-D1

RETURN TO
LOS ANGELES COUNTY SURVEYOR
700 HALL OF RECORDS

Note: Any Additions or Changes on This Sheet Must be Made or Circled in Red Ink With Date and Name of Person Making Change.

Do not extend notes this side of this line

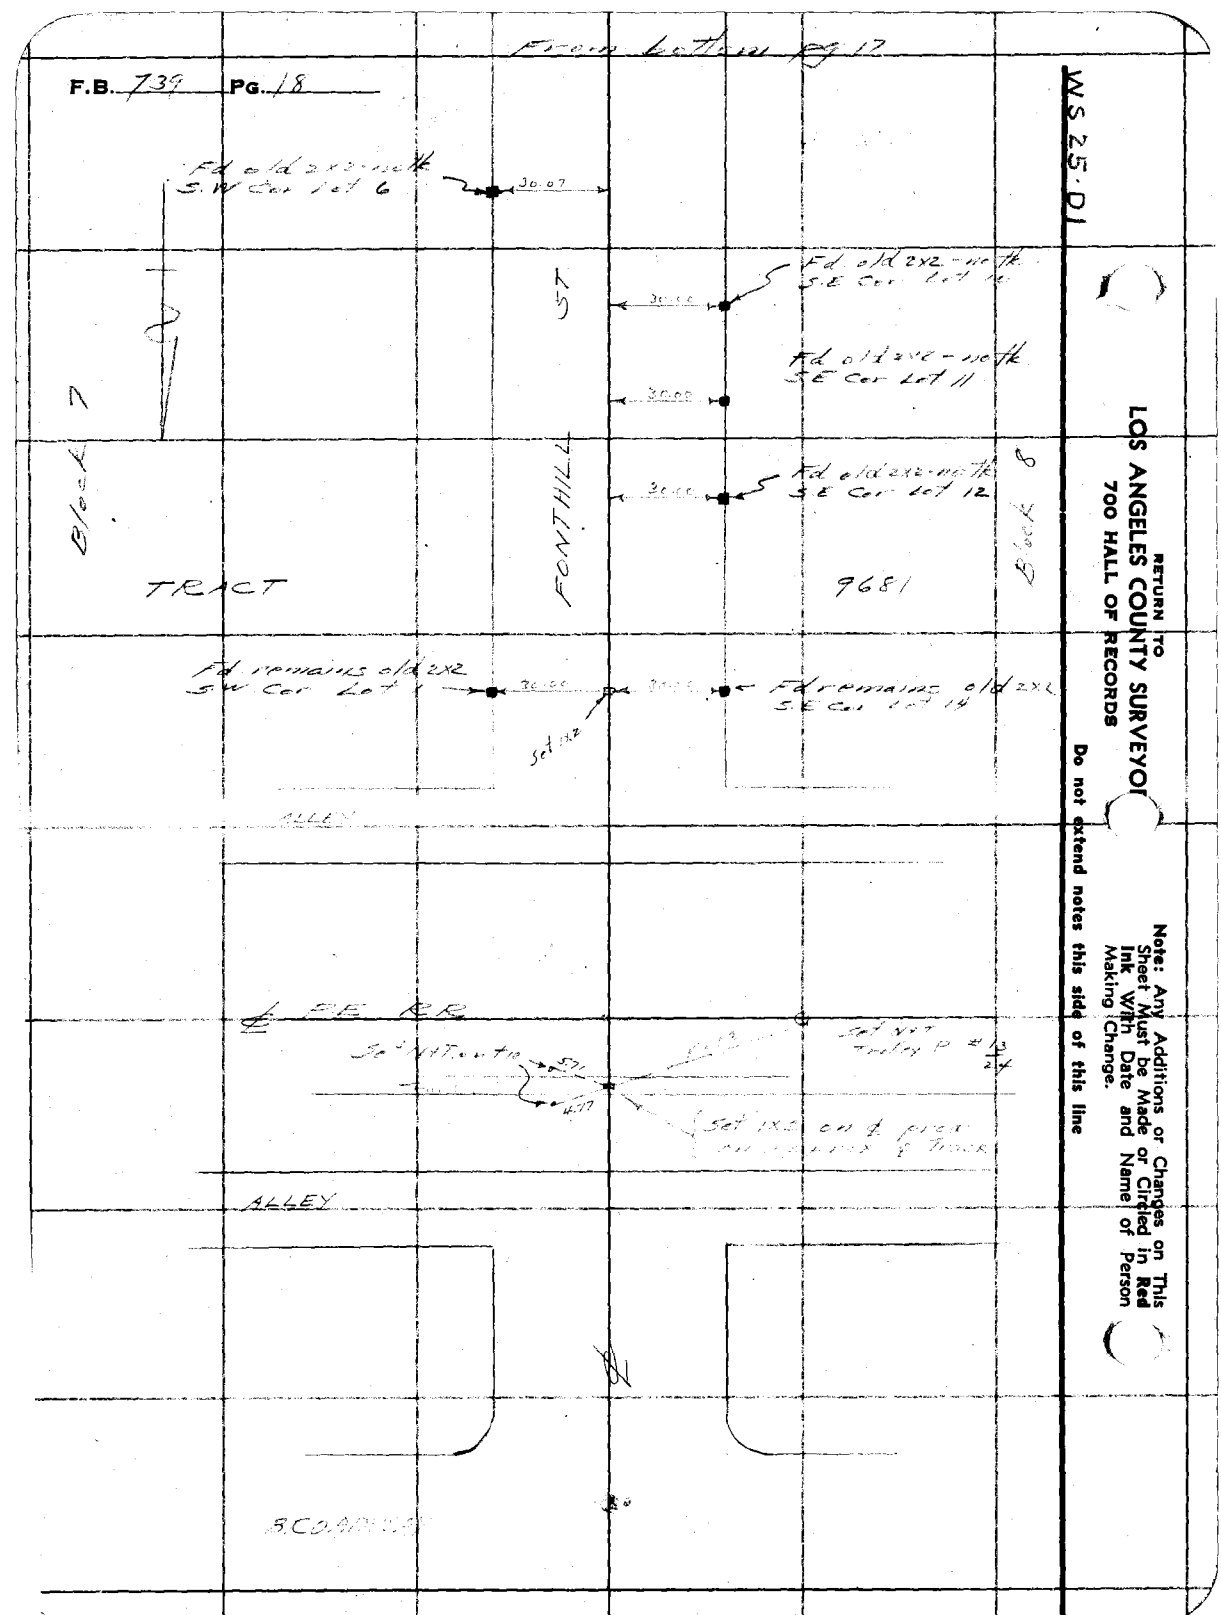

WS 25-D1

Notes Ck'd by D. M. Finley	Survey of El Segundo Blvd.	F.B. 757	PG. 21
Map No. B-1492-2	W. O. 8247 Tape No. 051 St'd 74° F.		
Office Work H. U. M. H.	Surveyed by [illegible]		
Checked D. M. Finley	Notes [illegible] Date 1-24-38		
Date Apr. 1941	Indexed [illegible]		

Note: Any Additions or Changes on This Sheet Must be Made in Red Ink With Date and Name of Person Making Change

Do not extend notes this side of this line

RETURN TO
LOS ANGELES COUNTY SURVEYOR
700 HALL OF RECORDS

132' M

ST

25.00

Set Nail

(25)

Fd 2½" I.P. Flush Mk. Tract 8271

25.00

Fd Copper Nail

(179° 59' 30")
359° 59' 30"

Fd Iron Pipe

Fd Nail

Set X on Curb
Sign Post

Fd 2"x2"x14" Stake

179°

(20) (20)

330.12 @ 0.0' 330.08'

(90° 03' 44")
360° 15' 00"

CARDENAS

98+90.01
Set STW
by Inter.

90°-03'-44"

POINT OF BEGINNING

EL SEGUNDO BLVD

330.08'

656.20'

0.08

Set Copper Nail
2' Guri

Fd Spike
3' Gum

Fd Nail

FORM 247 10M 11-38

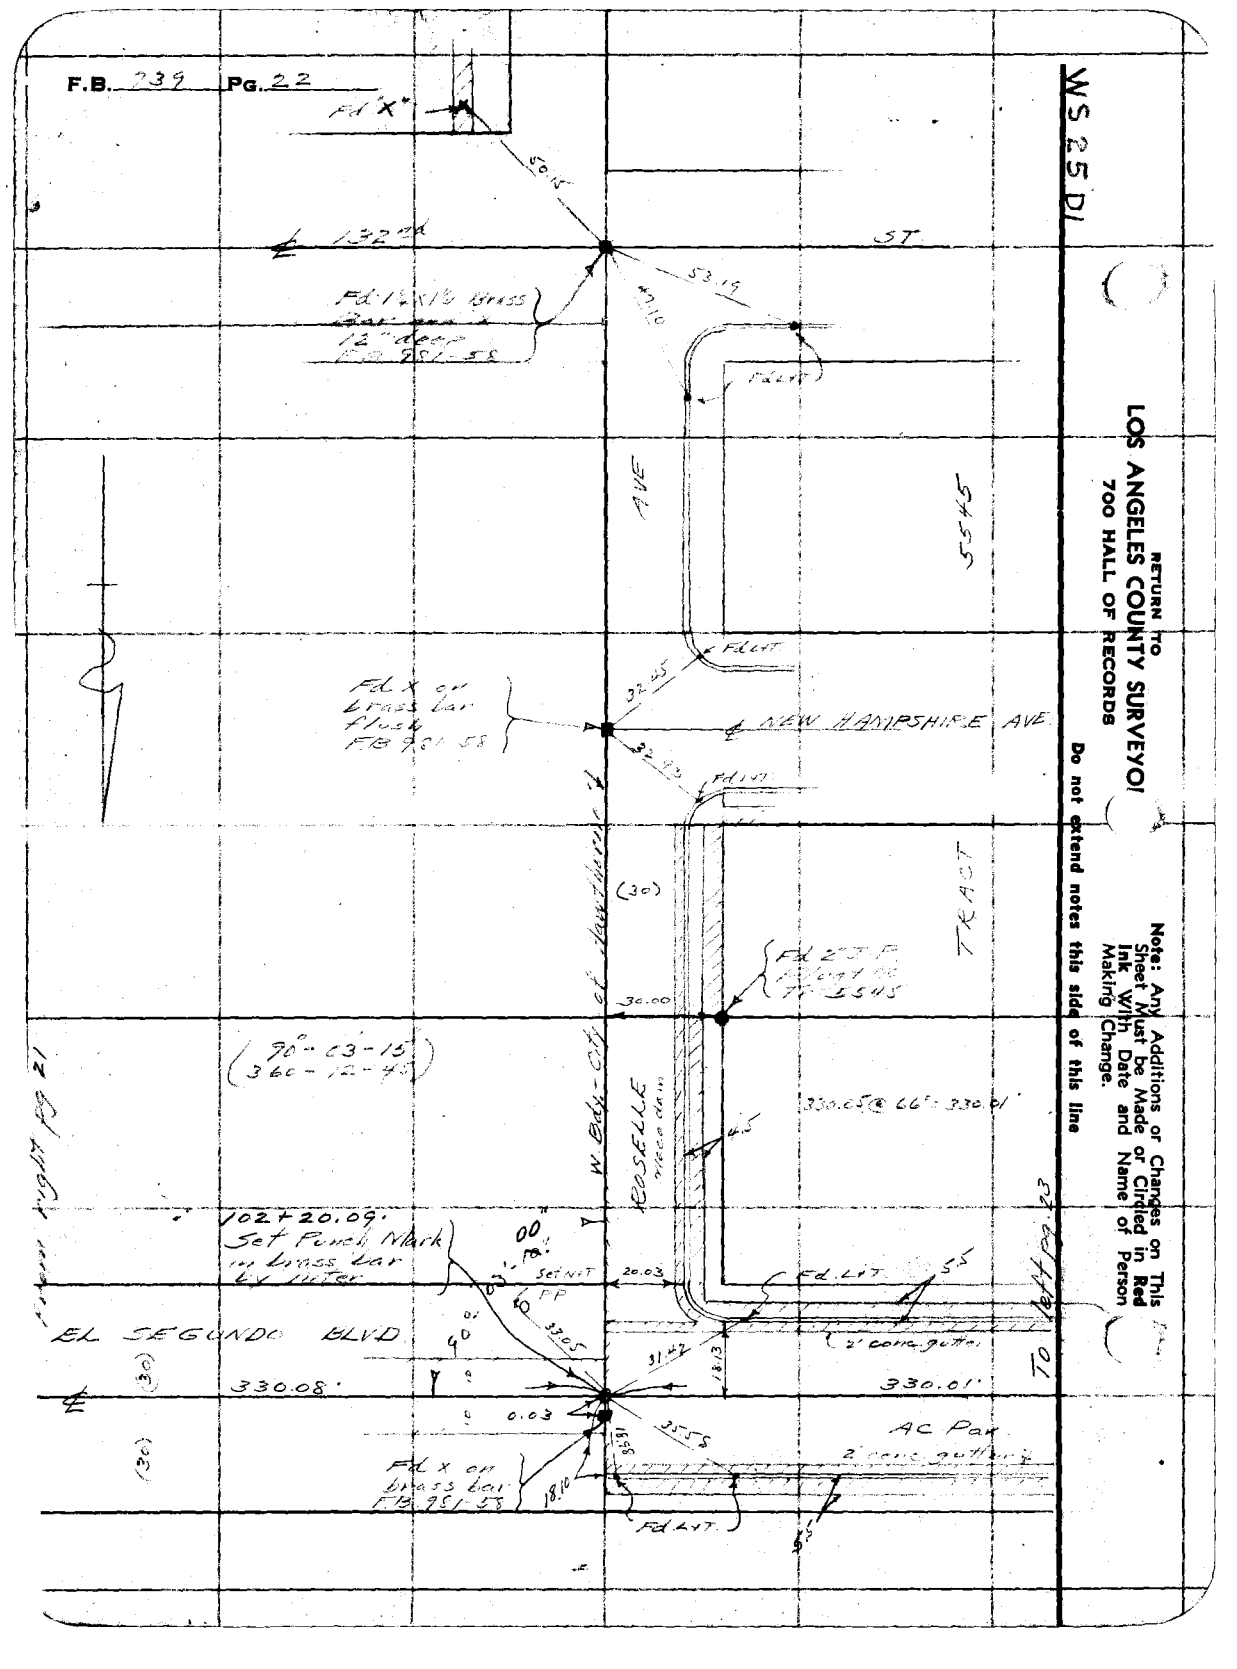
F.B. 239 Pg. 22
WS 25 D1
RETURN TO
LOS ANGELES COUNTY SURVEYOR
700 HALL OF RECORDS
Note: Any Additions or Changes on This Sheet Must be Made or Circled in Red Ink With Date and Name of Person Making Change.
Do not extend notes this side of this line
Fd "X"
50.15
℄ 132.00
ST
53.19
43.10
Fd 1/2" x 1/2 brass bar 12" deep FB 951-58
Fd LIT
AVE
5545
Fd X on brass bar flush FB 951-58
℄ NEW HAMPSHIRE AVE
32.45
Fd LIT
(30)
W. Bdy - City of Hawthorne
TRACT
Fd 2" P Flush FB 5545
30.00
(90° - 03' - 15")
(360 - 12' - 45")
330.05' @ 66' = 330.01'
ROSELLE
1027 + 20.09'
Set Punch Mark in brass bar LV Inter
00"
Set N.I.T.
20.03
Fd. LIT.
55
PP
EL SEGUNDO BLVD
40
330.05'
31.47
18.13
2' conc. gutter
330.08'
330.01'
0.03
35.55
AC Pav
2' conc. gutter
Fd X on brass bar FB 951-58
18.10
Fd LIT.
55
TO

Notes Ck'd by D. M. Finley	Survey of El Segundo 12	F.B.	PG.
Map No. B-1492-2	W. O. 8220 Tape No.	St'd 84°F.	
Office Work K. U. M. H.	Surveyed by		
Checked D. M. Finley	Notes	Date 1-24-41	
Date Apr. 1941	Indexed		

WS 25 D1

Note: Any Additions or Changes on This Sheet Must be Made in Red Ink or Circled With Date and Name of Person Making Change

Do not extend notes this side of this line

RETURN TO
LOS ANGELES COUNTY SURVEYOR
700 HALL OF RECORDS

NEW HAMPSHIRE AVE

MAINE AVE

PRAIRIE

EL SEGUNDO

Fd X on Brass Bar F.B 951-52

105 + 50.10 Fd X on Iron Bar F.B 951-52 Inglewood G-11 Replaced with Std. Traverse Mon. & Hand Hole Cover F.B 2251-75

330.01'

To Top pg. 24

WS 25 D1

FORM 247 10M 11-38

RETURN TO
LOS ANGELES COUNTY SURVEYOR
700 HALL OF RECORDS

Note: Any Additions or Changes on This Sheet Must be Made or Circled in Red Ink With Date and Name of Person Making Change.

Do not extend notes this side of this line

WS 25-D1

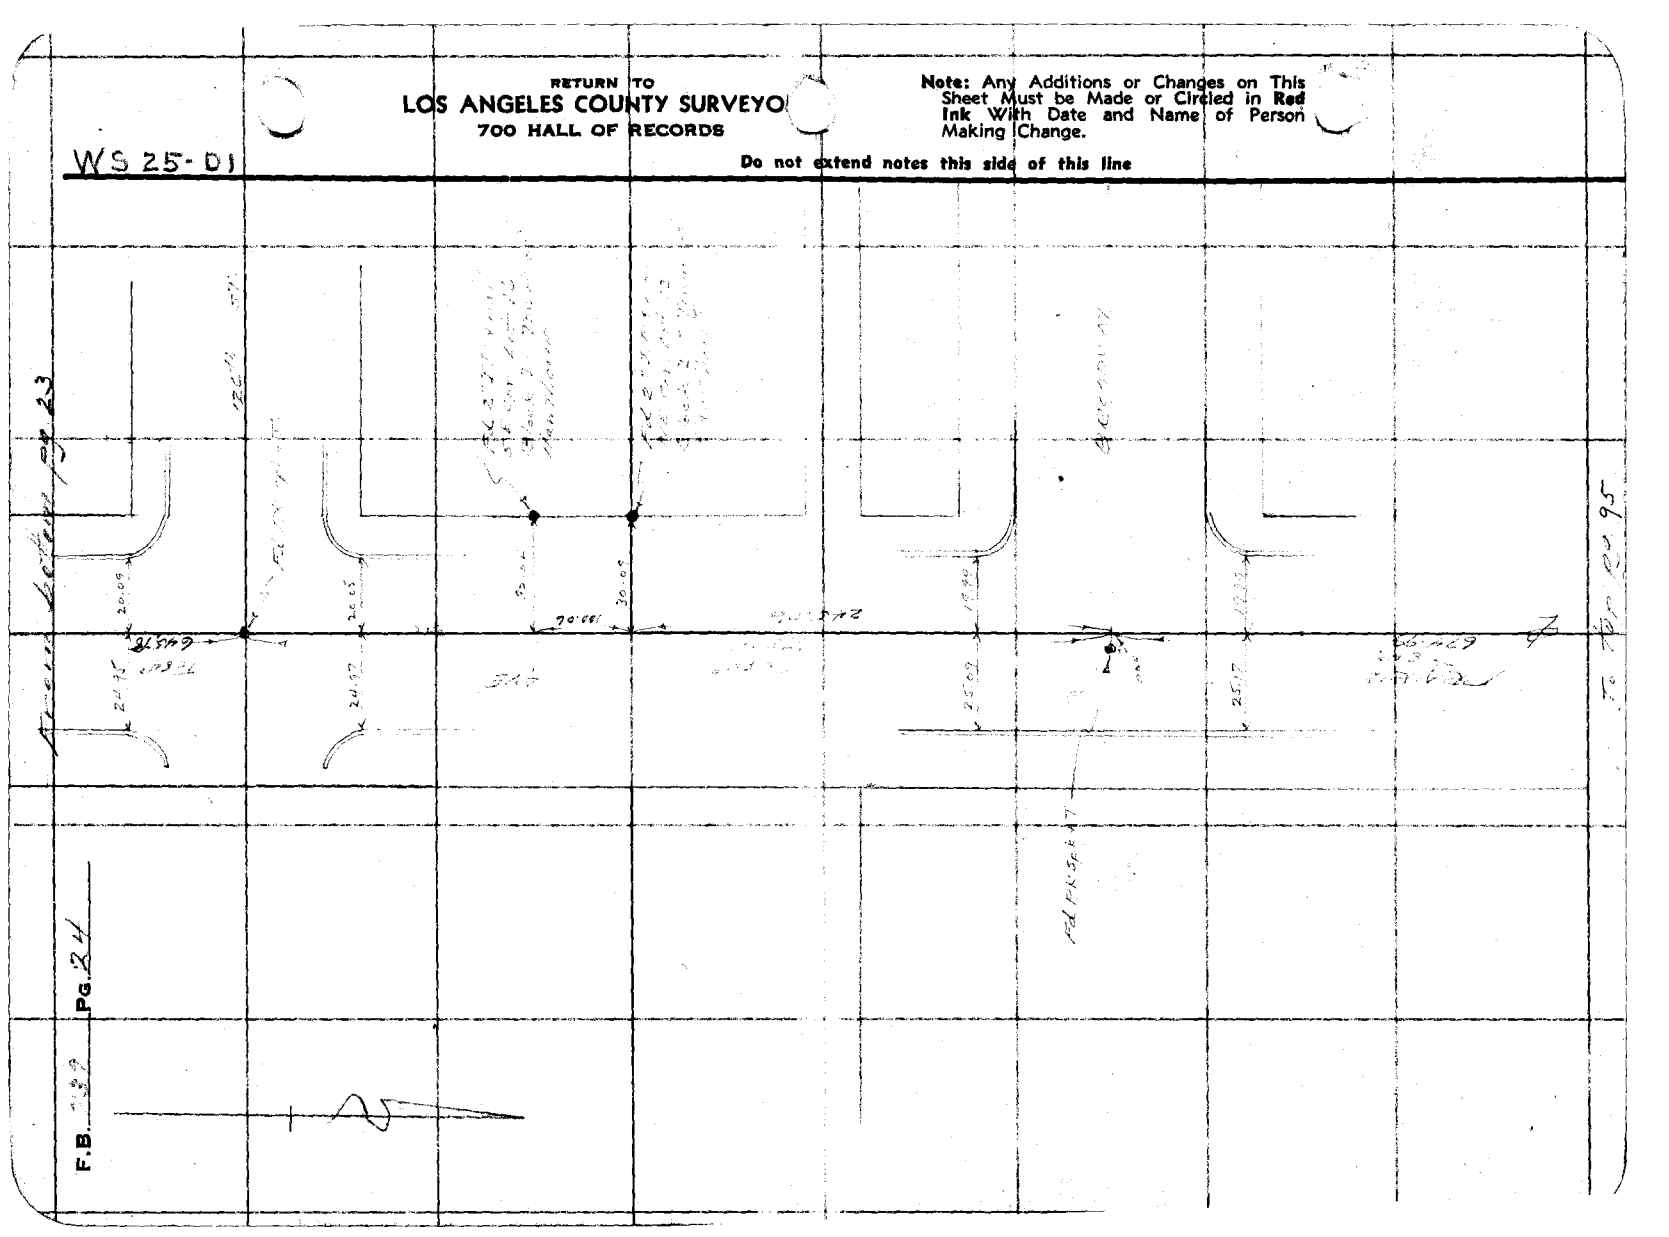

F.B. 389 PG. 24

W 525 D1

Notes Ck'd by D. M. Finley	Survey of El Segundo Blvd
Map No. B-1492-2	W. O. 8207 Tape No. 651 St'd 84° F.
Office Work H.U.M.H.	Surveyed by L. D. Nicoe
Checked D. M. Finley	Notes Nicoe Date 8-30-40
Date Apr 1941	Indexed

F.B. 735 PG. 25

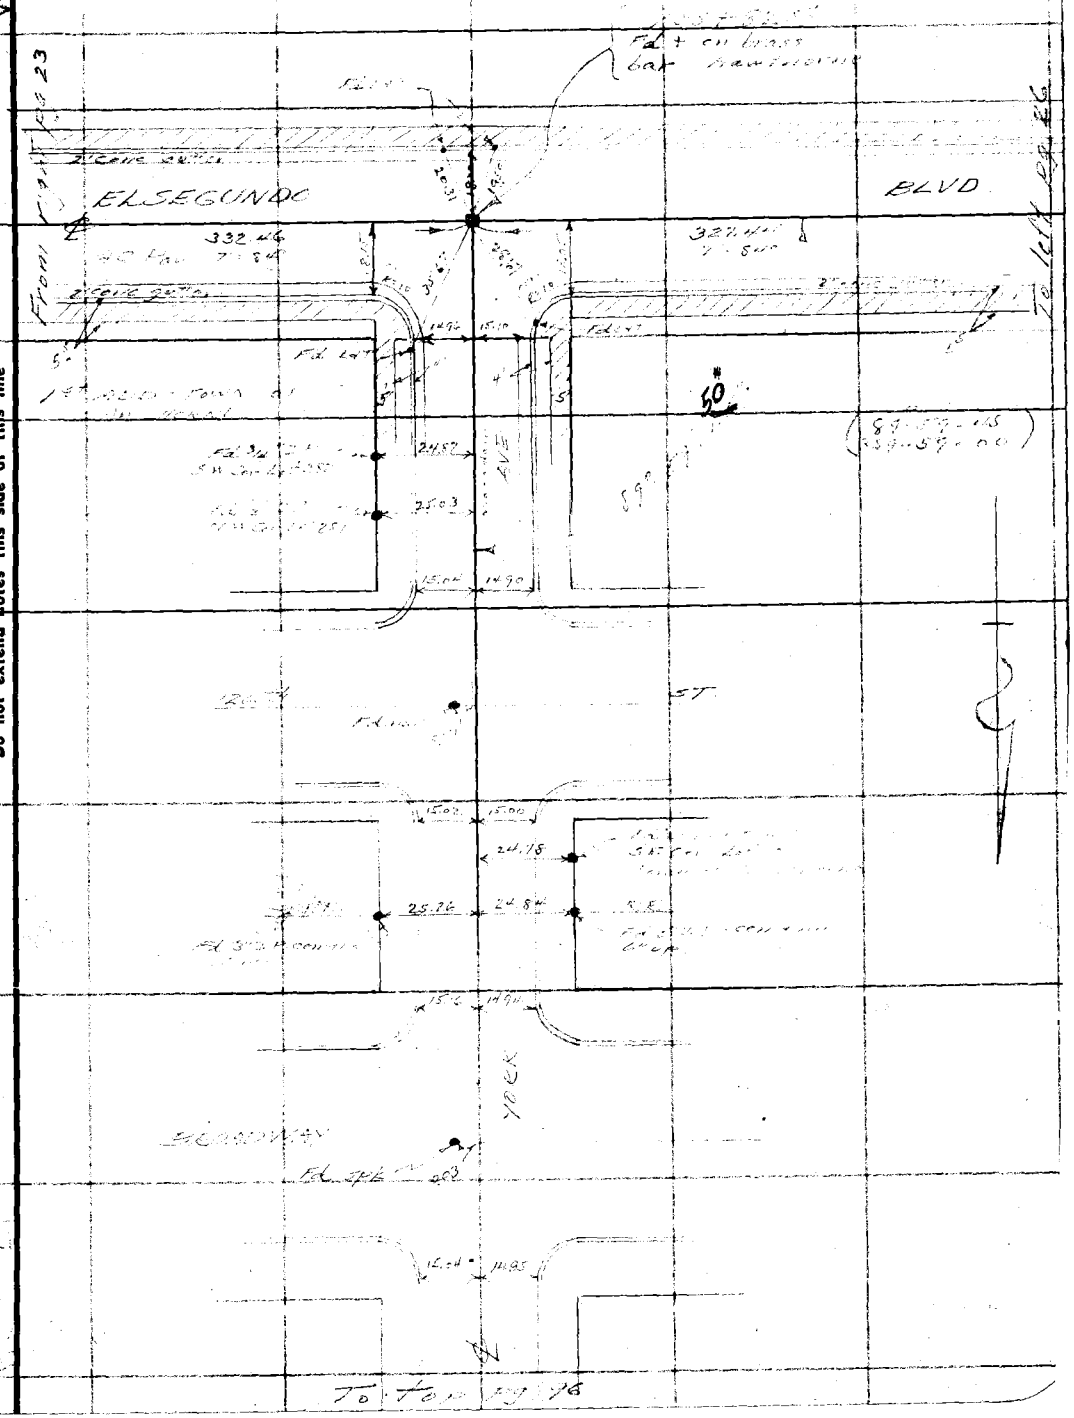

Note: Any Additions or Changes on This Sheet Must be Made in Red Ink With Date and Name of Person Making Change.

Do not extend notes this side of this line

RETURN TO
LOS ANGELES COUNTY SURVEYOR
700 HALL OF RECORDS

FORM 247 10M 11-38

RETURN TO
LOS ANGELES COUNTY SURVEYOR
700 HALL OF RECORDS

Note: Any Additions or Changes on This Sheet Must be Made or Circled in **Red** Ink With Date and Name of Person Making Change.

Do not extend notes this side of this line

WS-25 D1

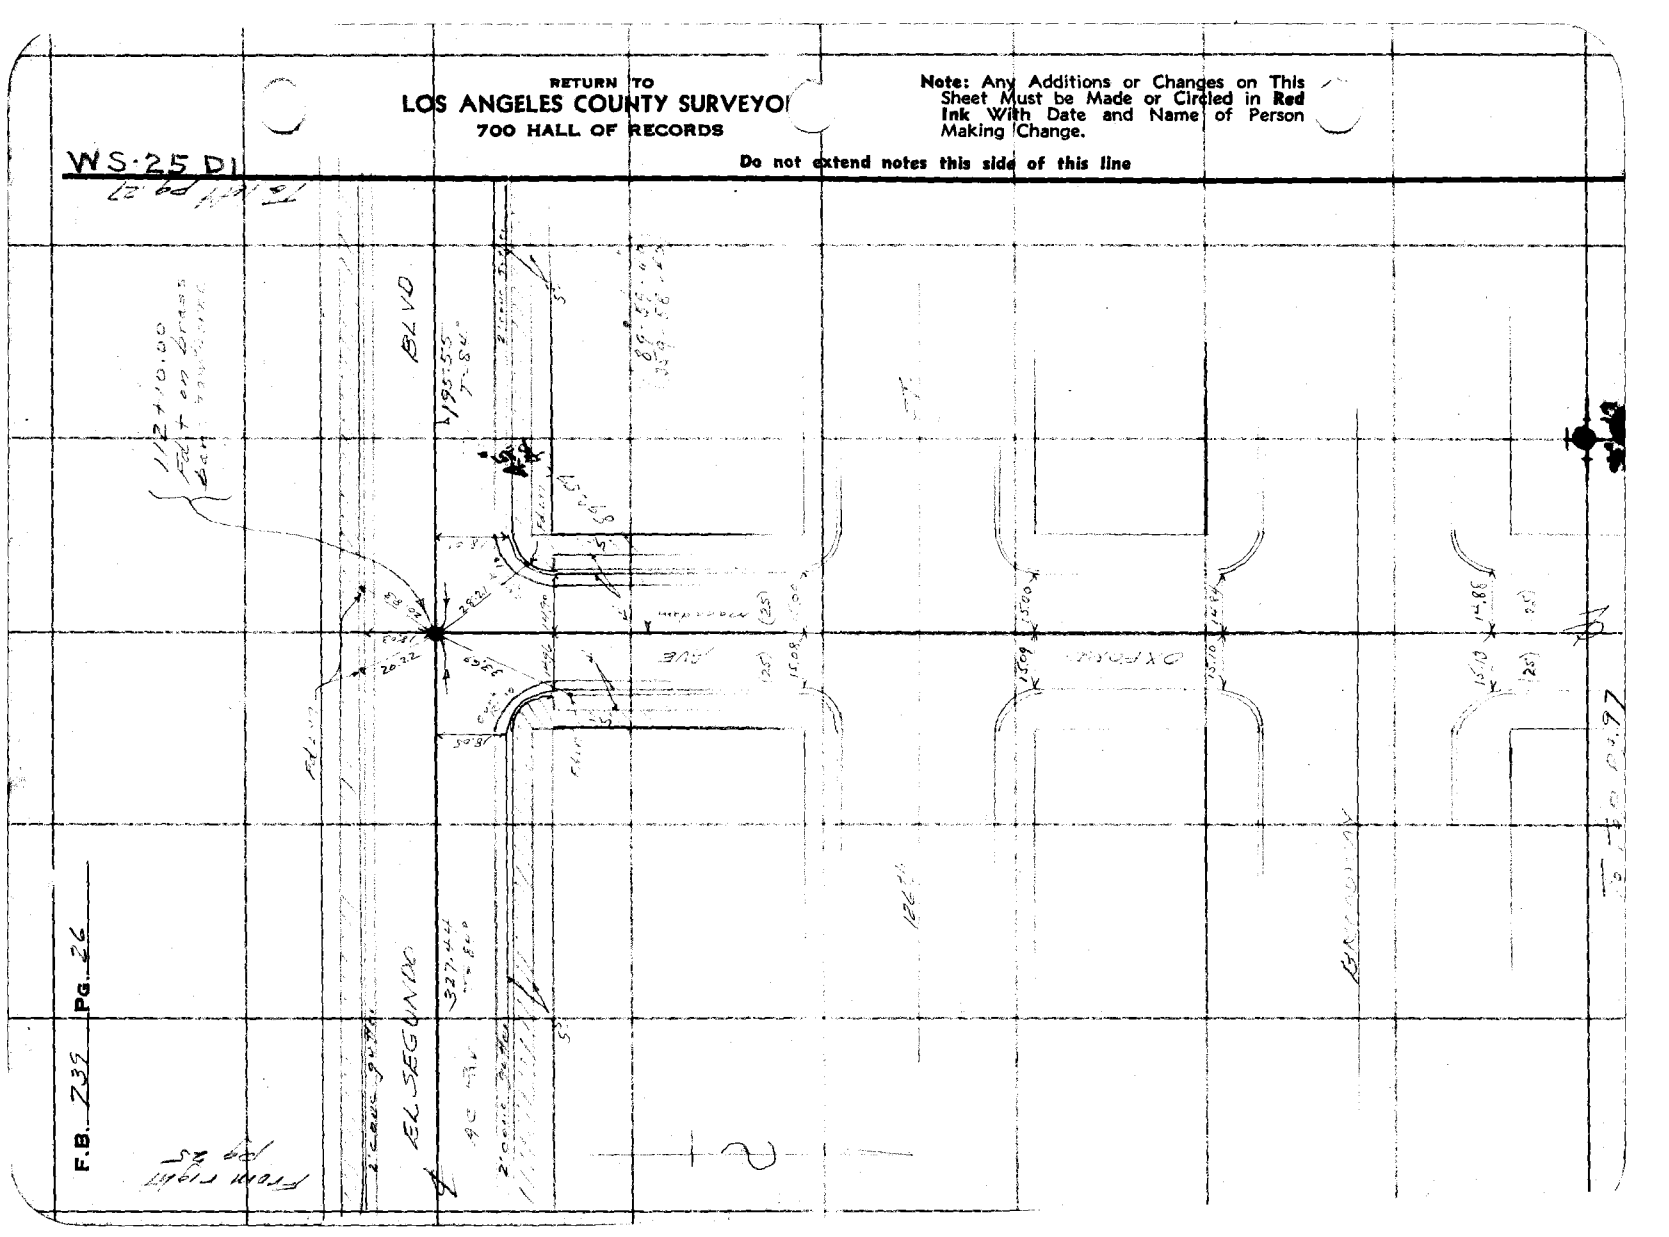

Notes Ck'd by D. M. Finley	Survey of
Map No. 9-1492-2	W. O. 824 Tape No.	St'd	°F.
Office Work H. U. M. H.	Surveyed by
Checked D. M. Finley	Notes	Date
Date Apr. 1941	Indexed

F.B. 339 PG. 27

W 525 D1

Note: Any Additions or Changes on This Sheet Must be Made or Circled in Red Ink With Date and Name of Person Making Change.

Do not extend notes this side of this line

RETURN TO
LOS ANGELES COUNTY SURVEYOR
700 HALL OF RECORDS

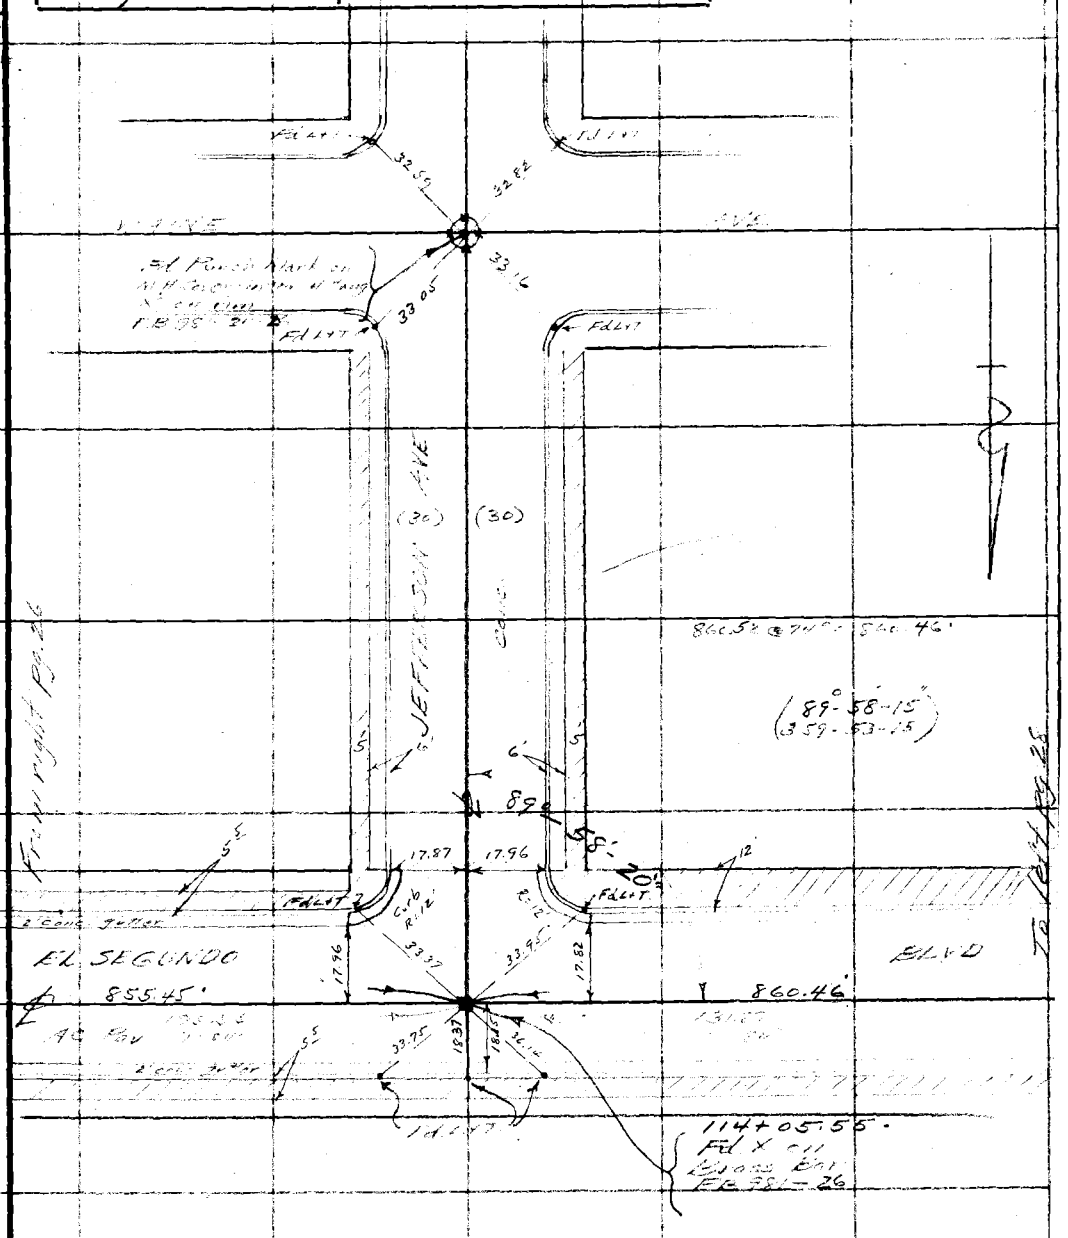

FORM 247 10M 11-38

RETURN TO
LOS ANGELES COUNTY SURVEYOR
700 HALL OF RECORDS

Note: Any Additions or Changes on This Sheet Must be Made or Circled in **Red** Ink With Date and Name of Person Making Change.

Do not extend notes this side of this line

WS 25 D1

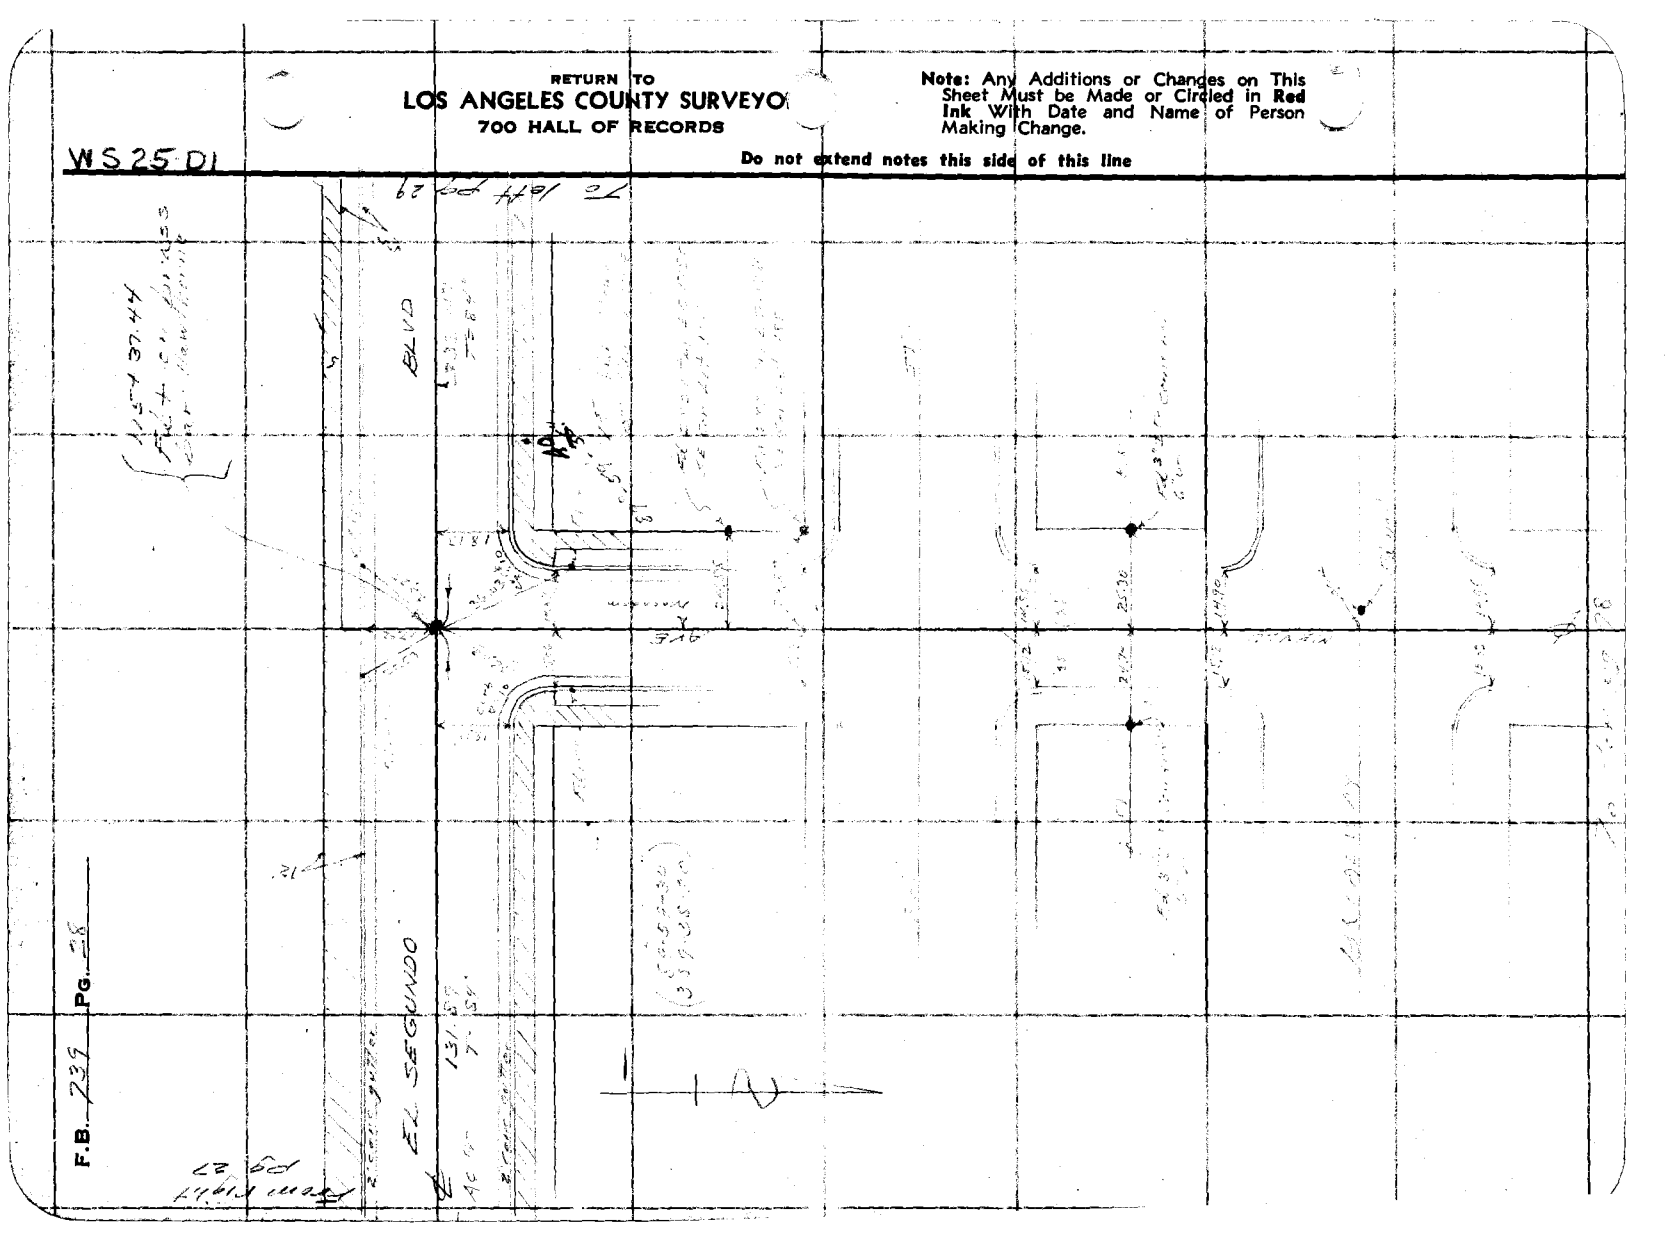

F.B. 239 PG. 18

Notes Ck'd by D. M. Finley	Survey of
Map No. A-1492-2	W. O. 8207 Tape No. 05 St'd 68° F.
Office Work H. U. M. H.	Surveyed by
Checked D. M. Finley	Notes Y Scale Date 8-30-40
Date Apr 1941	Indexed

F.B. 324 Pg. 99

WS-25-D1

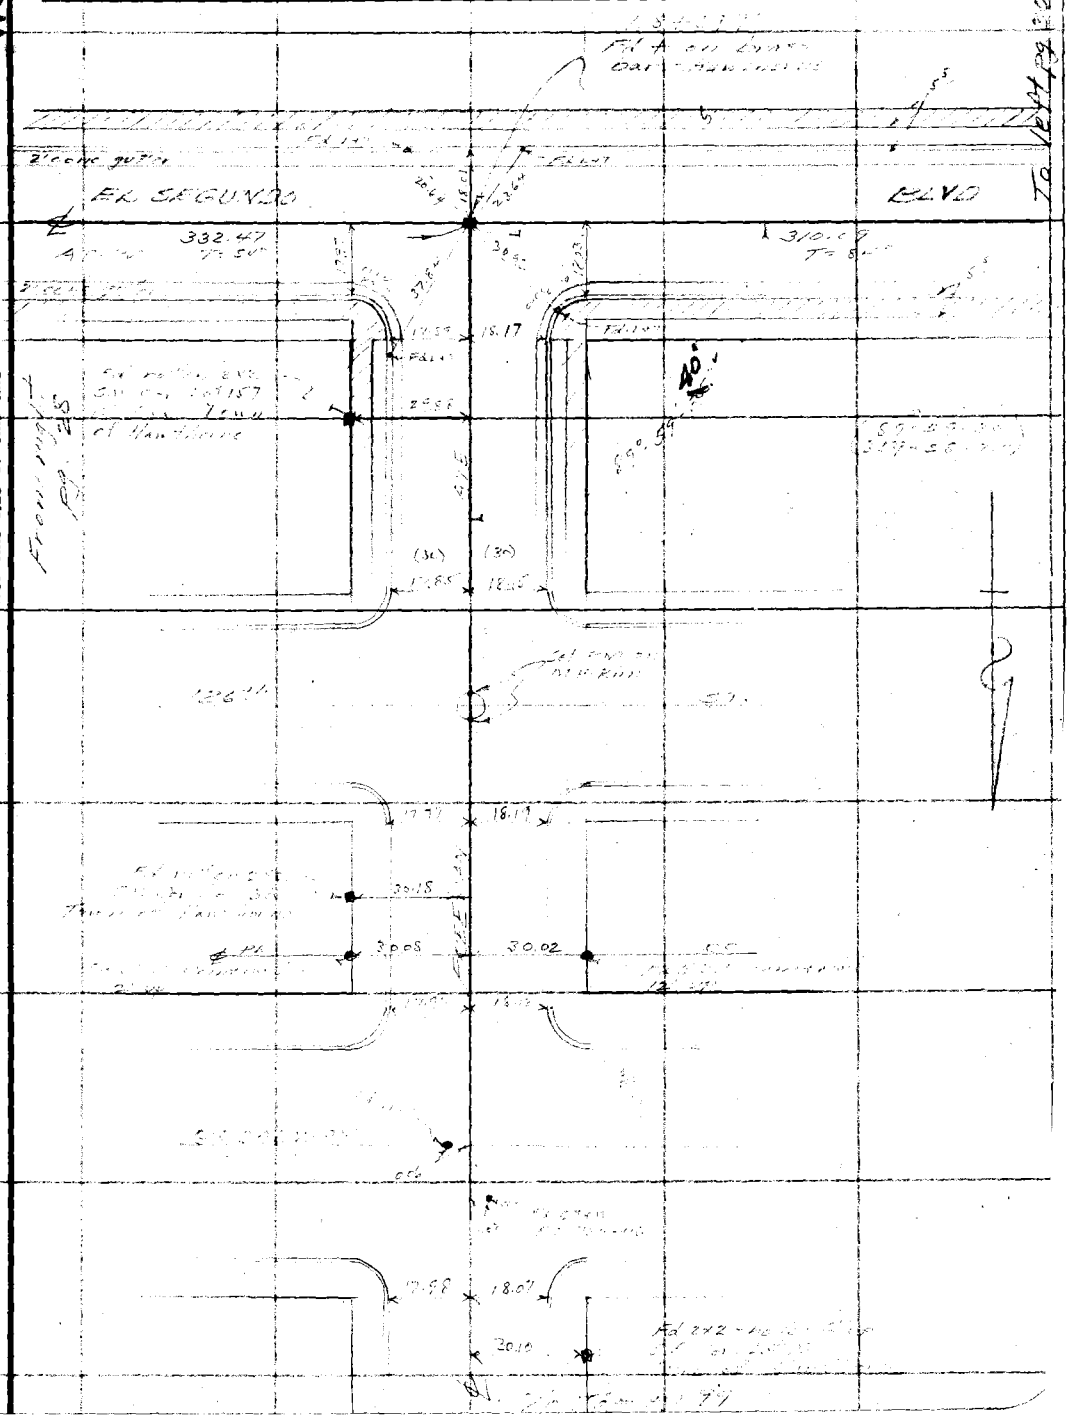

RETURN TO
LOS ANGELES COUNTY SURVEYOR
700 HALL OF RECORDS

Note: Any Additions or Changes on This Sheet Must be Made or Circled in Red Ink With Date and Name of Person Making Change

Do not extend notes this side of this line

FORM 247 10M 11-38

F.B. 239 PG. 30

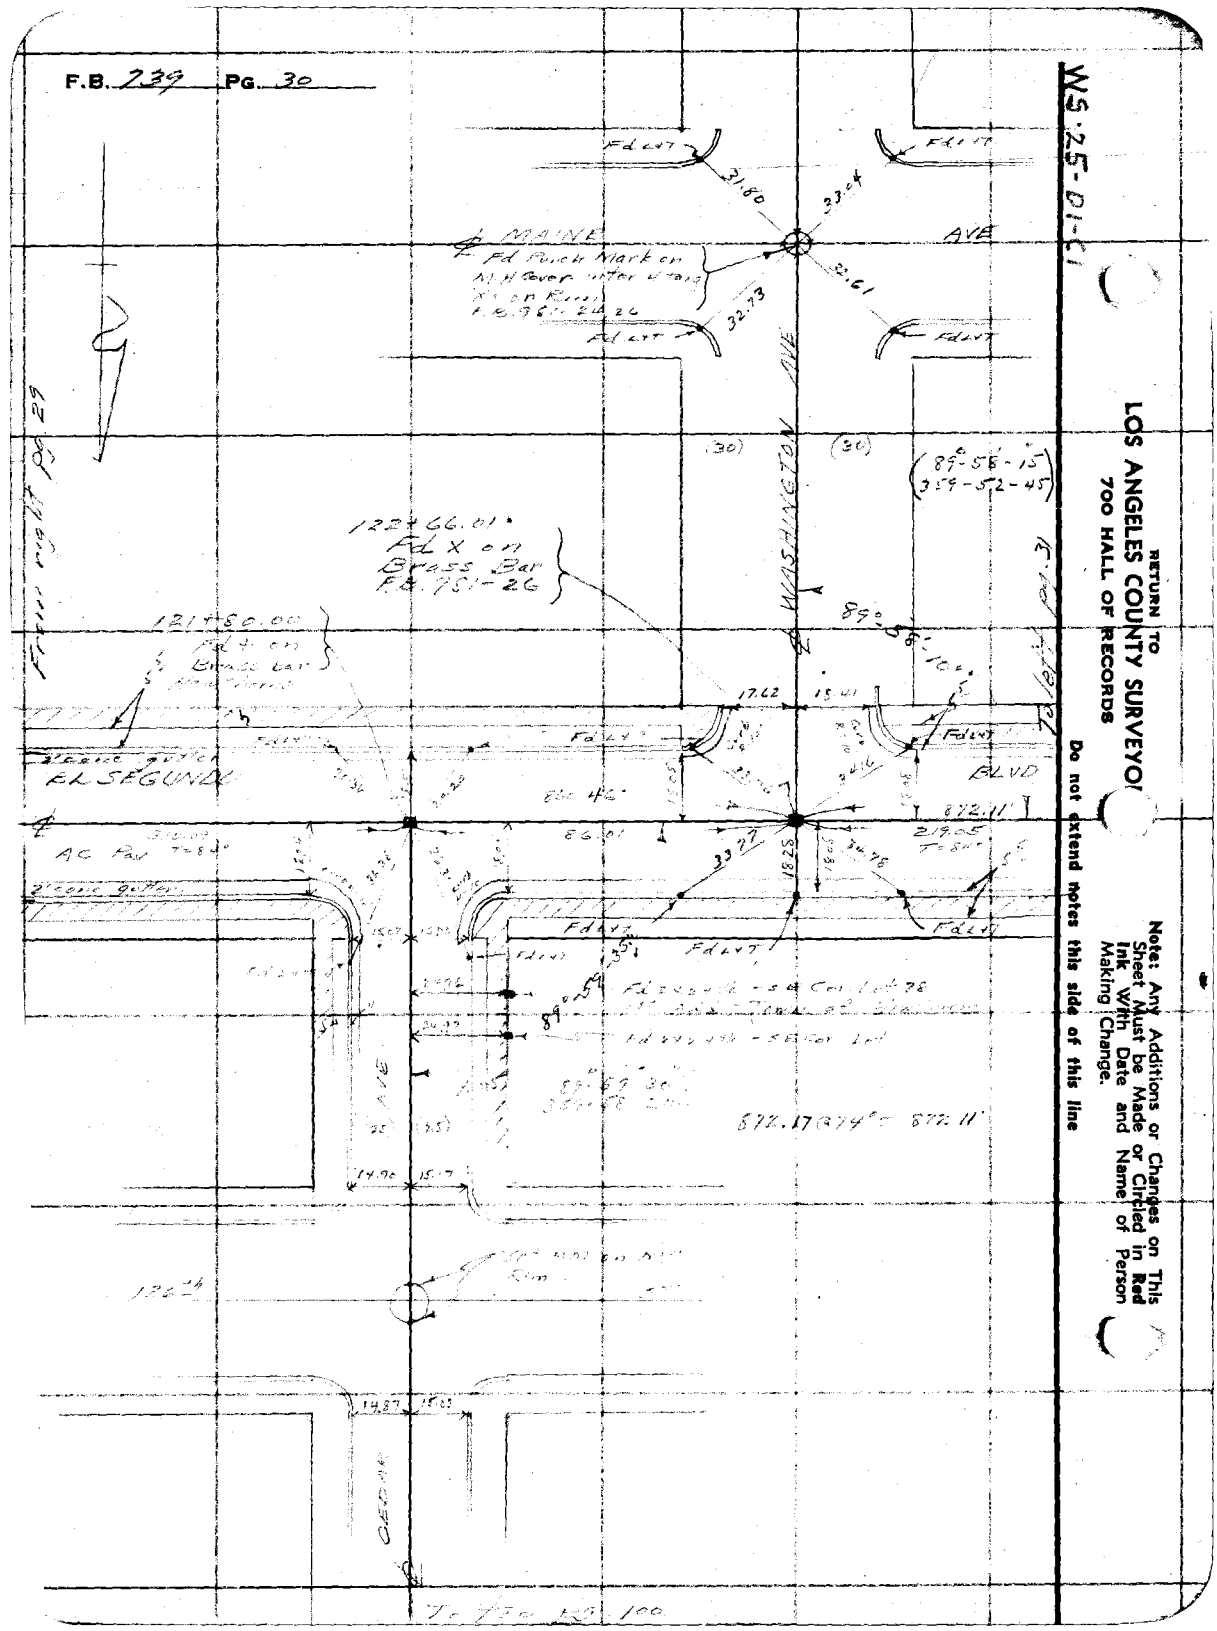
MAINE
AVE
WASHINGTON
BLVD
EL SEGUNDO
Fd L+T
Fd L+T 0.98' & 2.26
Fd X on Brass Bar Fd. 751-26
Fd X on Brass Bar
Fd L+T
AC Pav
Ac Pav
Concrete Gutter
Fd L+T 0.54 Ctr Inter 78
Fd L+T 0.54 Ctr Inter 78
872.17 (874') 872.11'
89° 56' 15"
3.59-52-45
89° 56' 10"
89° 56' 30"
89° 56' 30"
89° 48'
89° 54'
86.01
872.11'
219.05
T=84°
T=84°
17.62
15.41
32.73
32.61
33.04
31.80
33.27
33.76
18.25
14.96
15.17
14.87
15.03
12.24
(30)
(30)
(35)
(35)
(35

Notes Ck'd by D. M. Finley	Survey of	F.B.	Pg.
Map No. B-1492-2	W. O.	Tape No.	St'd °F.
Office Work W. H. M. H.	Surveyed by		
Checked D. M. Finley	Notes	Date	
Date Apr. 1941	Indexed		

WS 25-C1

Note: Any Additions or Changes on This Sheet Must be Made or Circled in Red Ink With Date and Name of Person Making Change

Do not extend notes this side of this line

RETURN TO
LOS ANGELES COUNTY SURVEYOR
700 HALL OF RECORDS

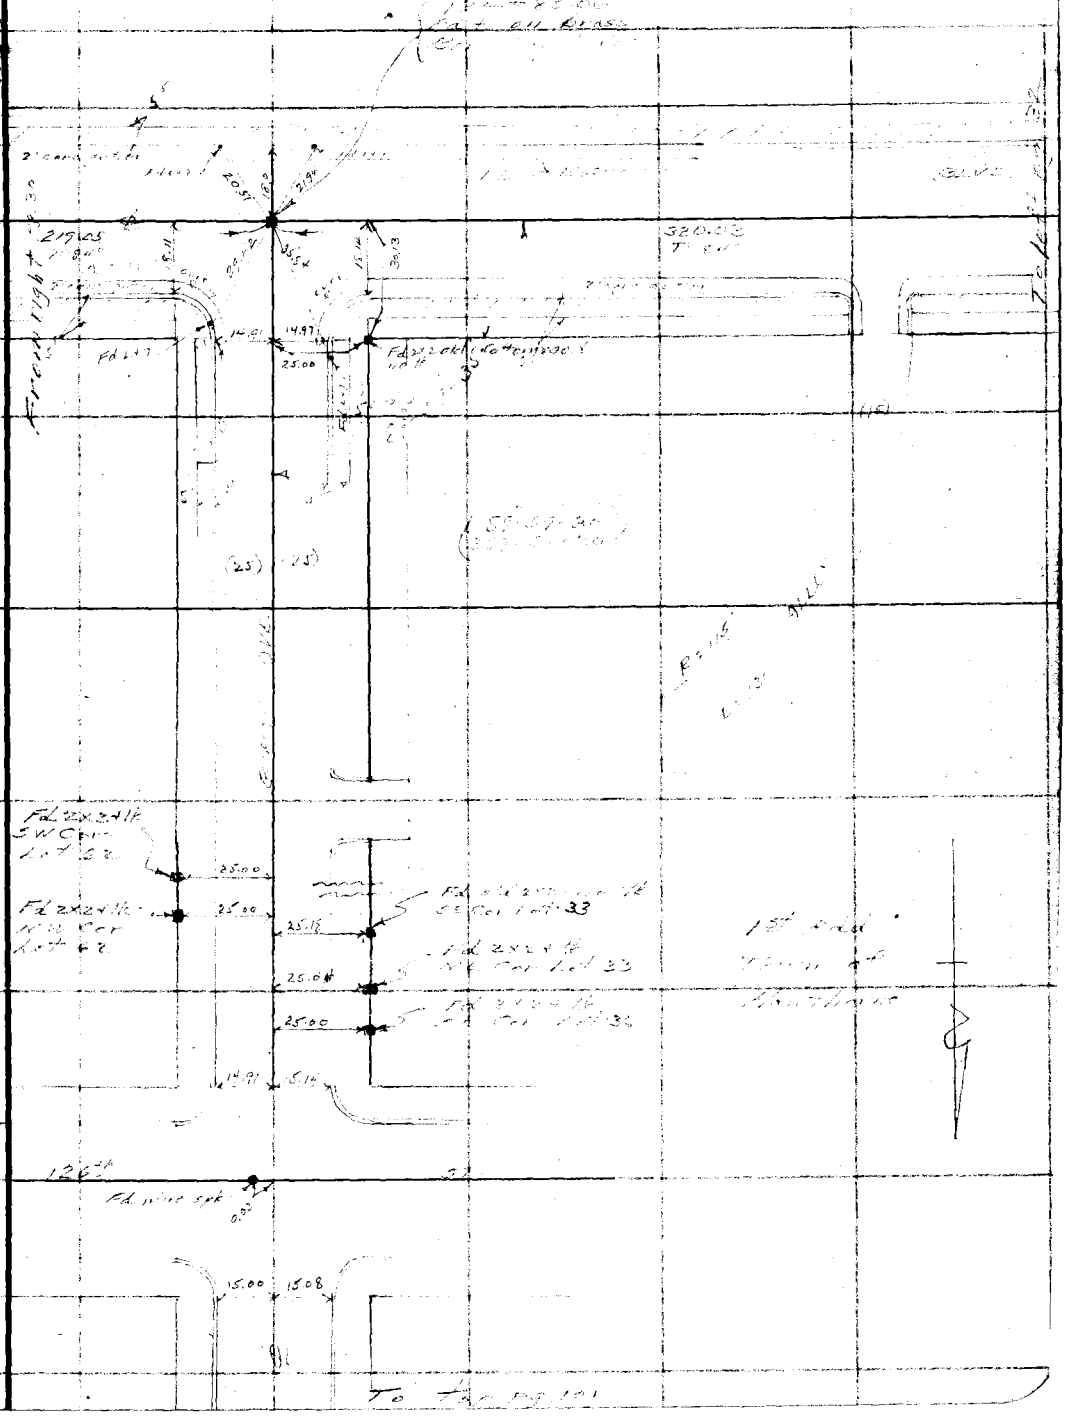

FORM 247 10M 11-38

RETURN TO
LOS ANGELES COUNTY SURVEYOR
700 HALL OF RECORDS

Note: Any Additions or Changes on This Sheet Must be Made or Circled in **Red** Ink With Date and Name of Person Making Change.

Do not extend notes this side of this line

WS-25-C1

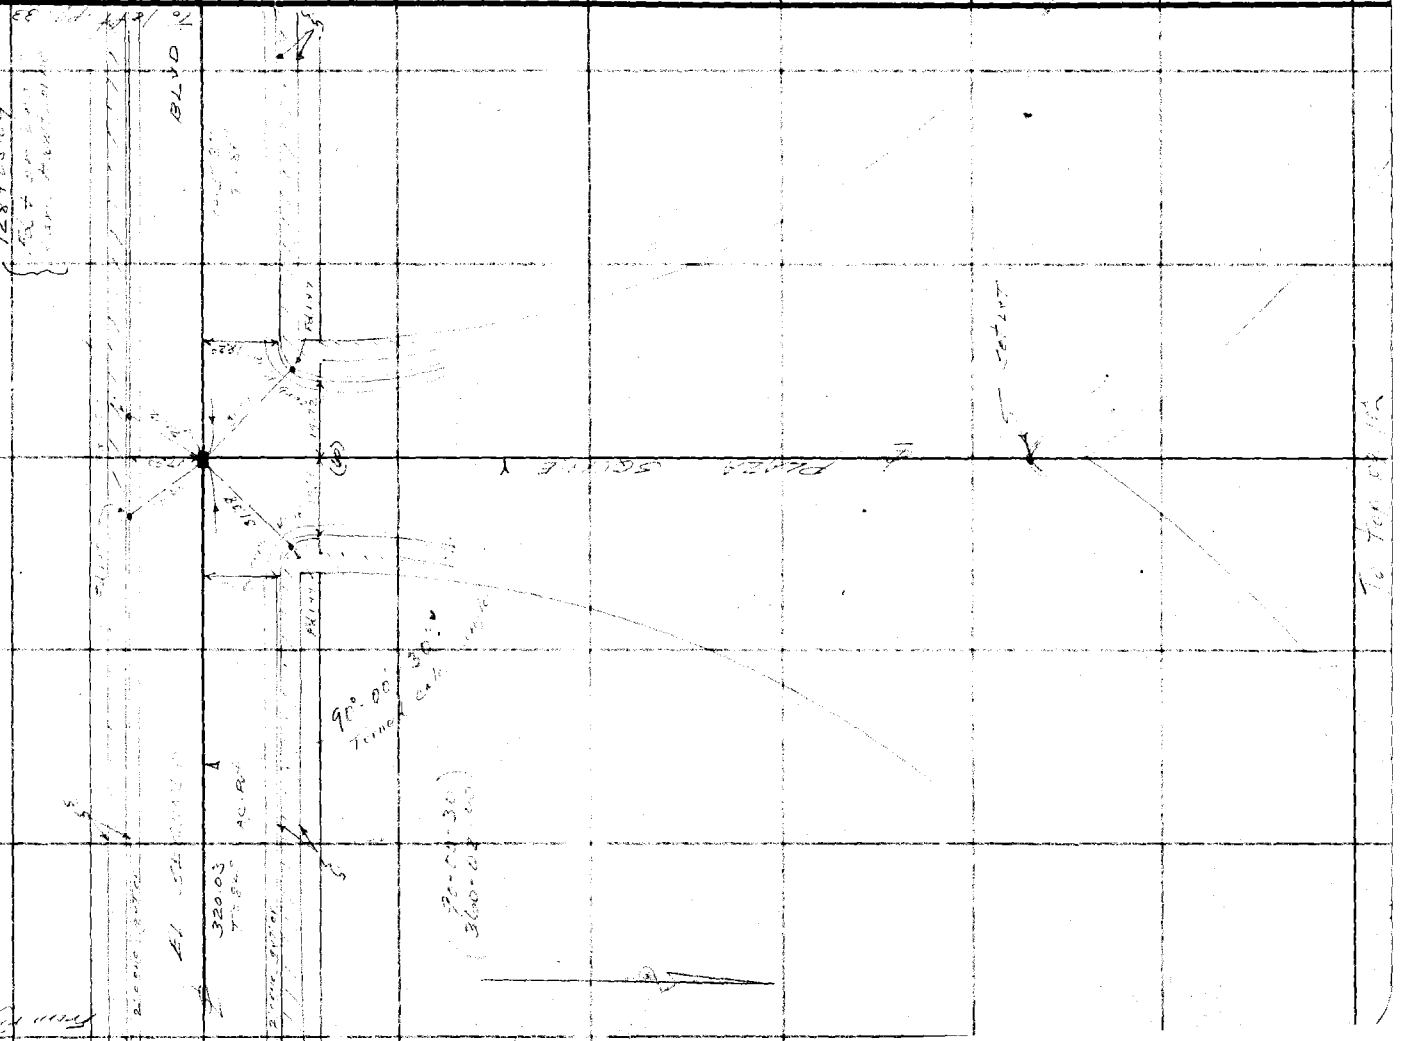

F.B. 239 PG. 32

Notes Ck'd by D. M. Finley	Survey of
Map No. 9-1492-2	W. O. 822 Tape No. St'd °F.
Office Work H. U. M. H.	Surveyed by
Checked D. M. Finley	Notes Date
Date Apr. 1941	Indexed

F.B. Pg.

W.S. 25-C1

Note: Any Additions or Changes on This Sheet Must be Made or Circled in Red Ink With Date and Name of Person Making Change

Do not extend notes this side of this line

RETURN TO
LOS ANGELES COUNTY SURVEYOR
700 HALL OF RECORDS

129+70.10
Set STW by proportion between ℄ Plaza and ℄ Main Avenue per T.M. 8641

FORM 247 10M 11-38

RETURN TO
LOS ANGELES COUNTY SURVEYOR
700 HALL OF RECORDS

Note: Any Additions or Changes on This Sheet Must be Made or Circled in **Red Ink** With Date and Name of Person Making Change.

WS-25-C1

Do not extend notes this side of this line

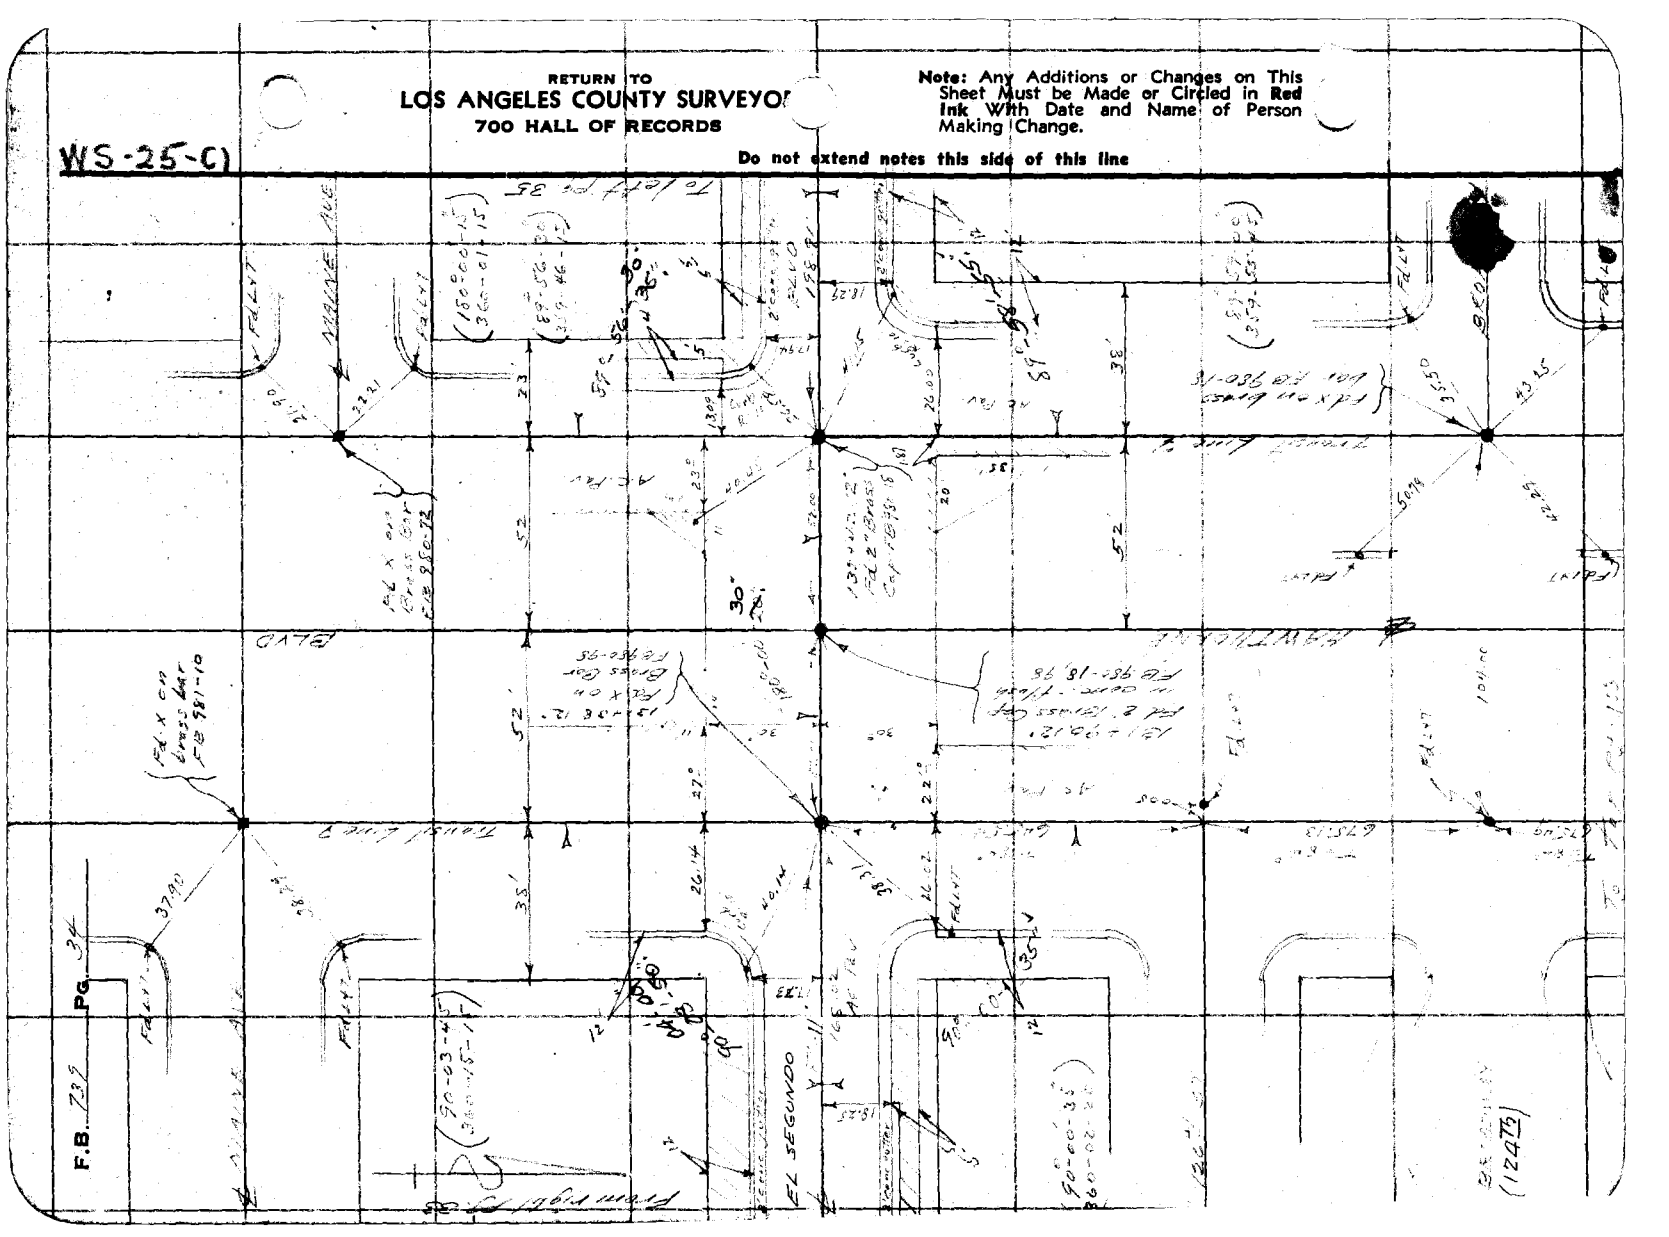

W S-25-C1

Notes Ck'd by D. M. Finley	Survey of El Segundo Blvd
Map No. B-1492-2	W. O. 8207 Tape No. 051 St'd 84° F.
Office Work B. U. M. Hd.	Surveyed by L. M. Moore
Checked D. M. Finley	Notes A. Hwy C. Date 1-28-38
Date Apr. 1941	Indexed

F.B. 23 Pg. 1-5

Note: Any Additions or Changes on this Sheet Must be Made or Circled in Red Ink With Date and Name of Person Making Change

Do not extend notes this side of this line

RETURN TO
LOS ANGELES COUNTY SURVEYOR
700 HALL OF RECORDS

FORM 247 10M 11-38

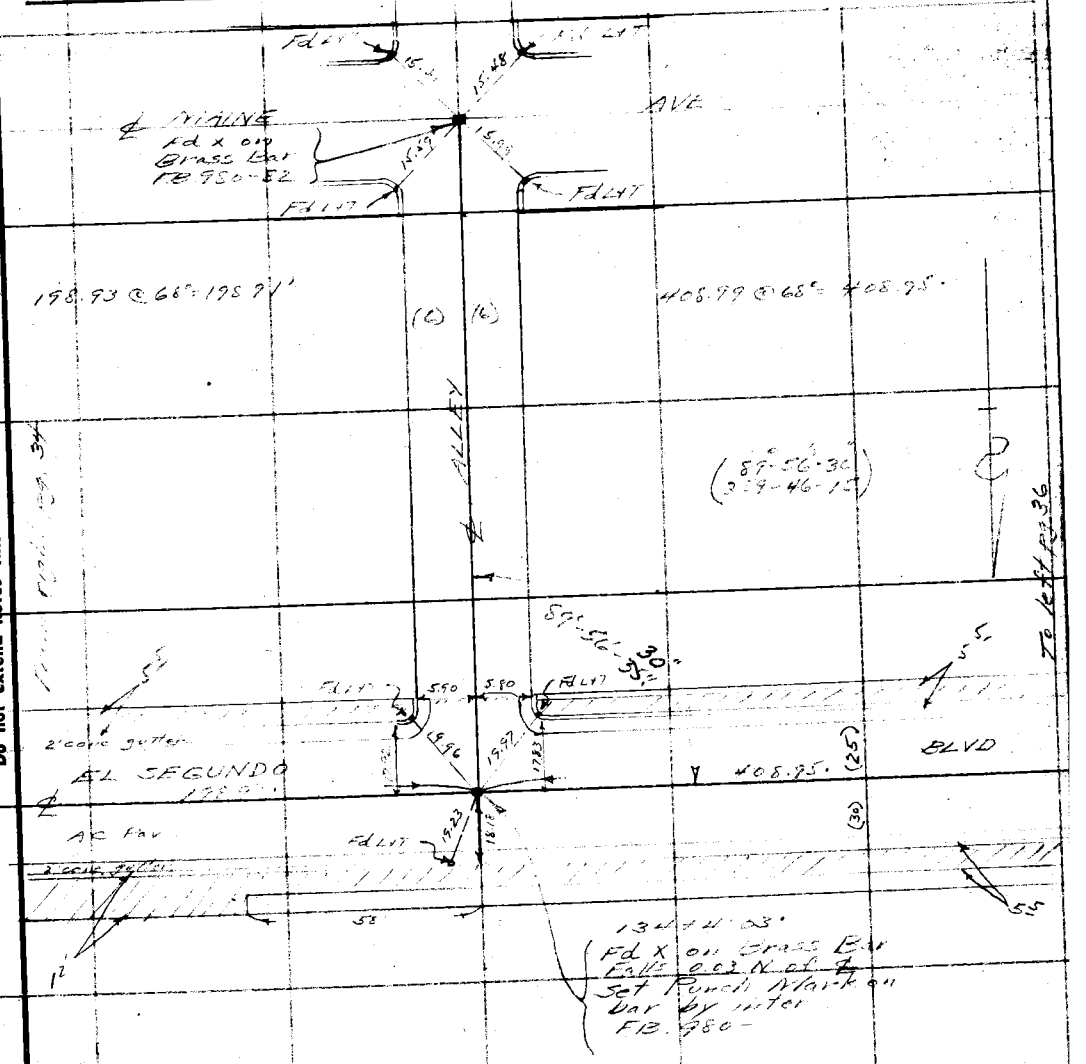

RETURN TO
LOS ANGELES COUNTY SURVEYOR
700 HALL OF RECORDS

Note: Any Additions or Changes on This Sheet Must be Made or Circled in **Red** Ink With Date and Name of Person Making Change.

Do not extend notes this side of this line

WS-25-C1

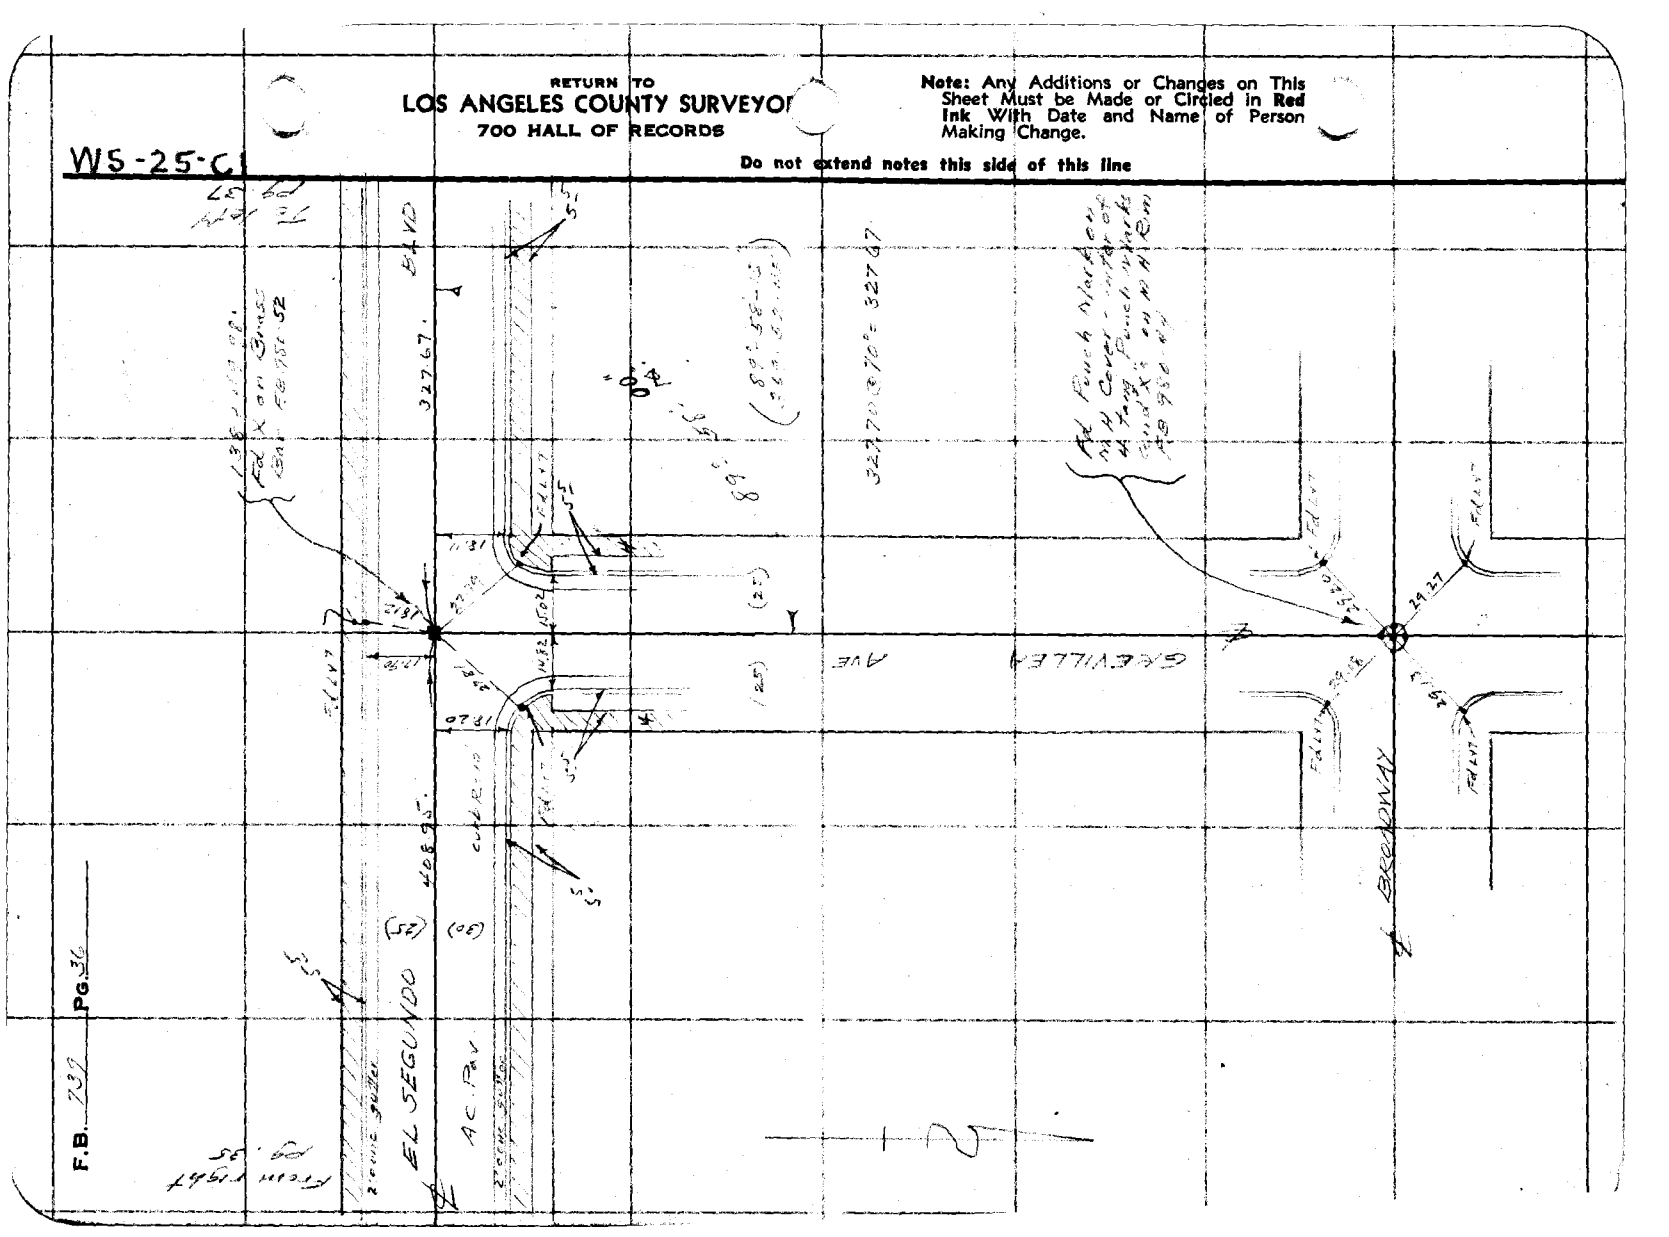
EL SEGUNDO BLVD
AVE

Notes Ck'd by D. M. Finley	Survey of El Segundo Blvd
Map No. B-1492-2	W. O. 8207 Tape No. C 51 St'd 66 F.
Office Work H. U. M. H.	Surveyed by [illegible]
Checked D. M. Finley	Notes [illegible] Date 1-25-38
Date Apr. 1941	Indexed

F.B. [illegible] PG. 27

WS-25-C

From Pg 36

Adx on brass bar F8980-20

Set STW by proportion between ℄ Grevillea and ℄ Penrose per Tr 7706, Tr 720, Tr 5482, Tr 5479

To Pg 38

EL SEGUNDO

327.67'

332.68'

BLVD

(25)

(30)

A.C. Pav (with)

Fd L+T Pipe out

Fd L+T Pipe out

(25) (25)

89°

Tract 5482

332.71 @ 70° = 332.68'

(89°-58'-00" / 359°-53'-15")

Tract 5479

PLACE

TRACT 7706

Fd 2x2 w/ tk flush

25.03

Lot 20 Tract 720

25.00

Fd 2" P + nail flush

Lot 21 (19) Tract 720

TRAVILLA LINE

MANOR

Set Wire spk w/ T

25.00

Fd 2" P flush

Note: Any Additions or Changes on This Sheet Must be Made or Circled in Red Ink With Date and Name of Person Making Change.

Do not extend notes this side of this line

RETURN TO LOS ANGELES COUNTY SURVEYOR 700 HALL OF RECORDS

FORM 247 10M 11-38

F.B. 339 PG. 38

WS-25-C

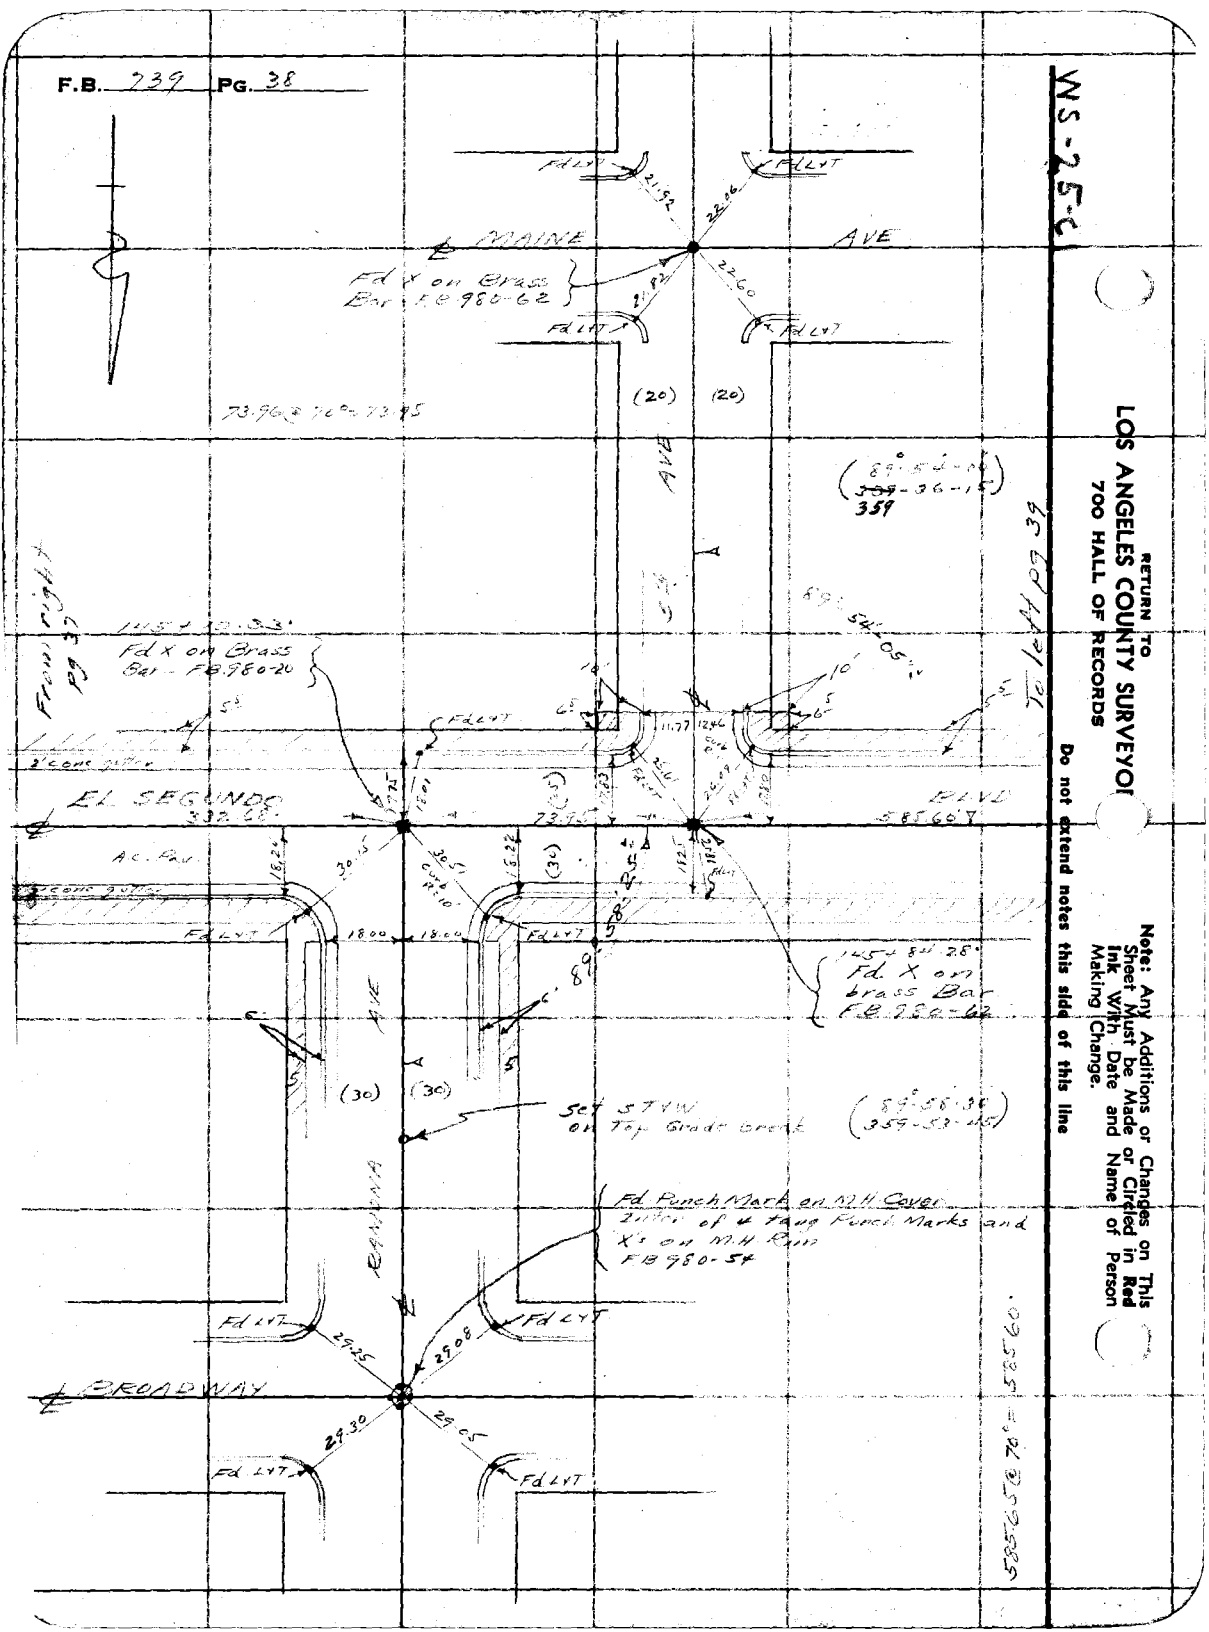

RETURN TO
LOS ANGELES COUNTY SURVEYOR
700 HALL OF RECORDS

Do not extend notes this side of this line

Note: Any Additions or Changes on This Sheet Must be Made or Circled in Red Ink With Date and Name of Person Making Change.

Notes Ck'd by D. M. Finley	Survey of EA Segundo Blvd.	F.B. 73	Pg. 35
Map No. B-1492-283	W. O. 8207 Tape No. 051 St'd 24 °F.		
Office Work H. U. M. H.	Surveyed by [illegible]		
Checked D. M. Finley	Notes [illegible] Date 2-27-35		
Date Apr. 1941.	Indexed		

WS 25-C1

From Left Pg 38

To Left Pg 40

EL SEGUNDO BLVD

327.67'

S 89° 57' 20" W

(S 89° 57' 15" W)

(359° 49' 30")

AVE

EUCALYPTUS

BROADWAY

Fd Punch Mark on M H Cover - Witness Punch Mark and X on M H Rim

Fd 2" Sq. Iron Pipe

Note: Any Additions or Changes on This Sheet Must be Made or Circled in Red Ink With Date and Name of Person Making Change.

Do not extend notes this side of this line

RETURN TO
LOS ANGELES COUNTY SURVEYOR
700 HALL OF RECORDS

FORM 247 10M 11-38

F.B. 739 Pg. 40

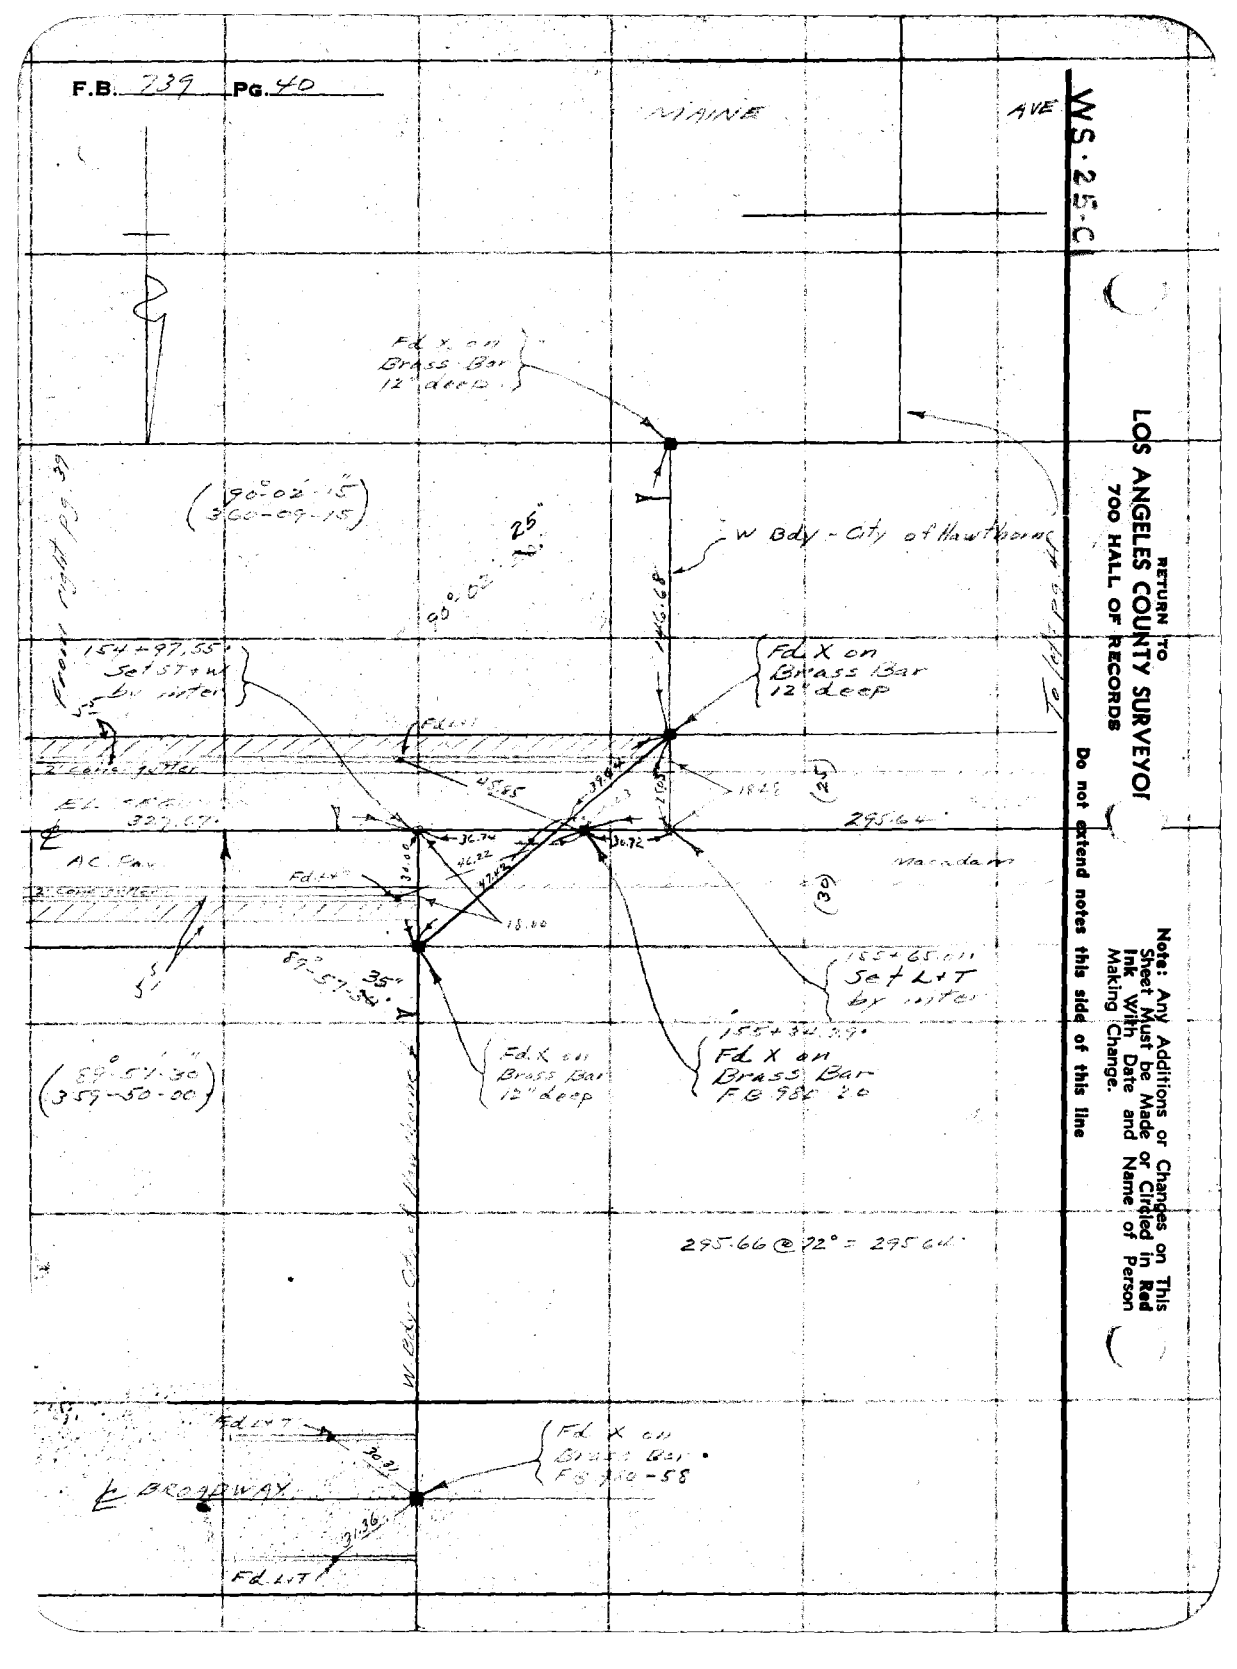

RETURN TO
LOS ANGELES COUNTY SURVEYOR
700 HALL OF RECORDS

Note: Any Additions or Changes on This Sheet Must be Made or Circled in Red Ink With Date and Name of Person Making Change.

Do not extend notes this side of this line

WS. 25-C1

Notes Ck'd by D. M. Finley	Survey of [illegible]
Map No. B-1492-3.	W. O. 8207 Tape No. 06 St'd 64° F.
Office Work H. U. M. H.	Surveyed by [illegible]
Checked D. M. Finley	Notes [illegible] Date 1-27-42
Date Apr. 1941	Indexed [illegible]

F.B. 39 Pg. 4

Note: Any Additions or Changes on This Sheet Must be Made or Circled in Red Ink With Date and Name of Person Making Change.

Do not extend notes this side of this line

RETURN TO
LOS ANGELES COUNTY SURVEYOR
700 HALL OF RECORDS

FORM 247 10M 11-38

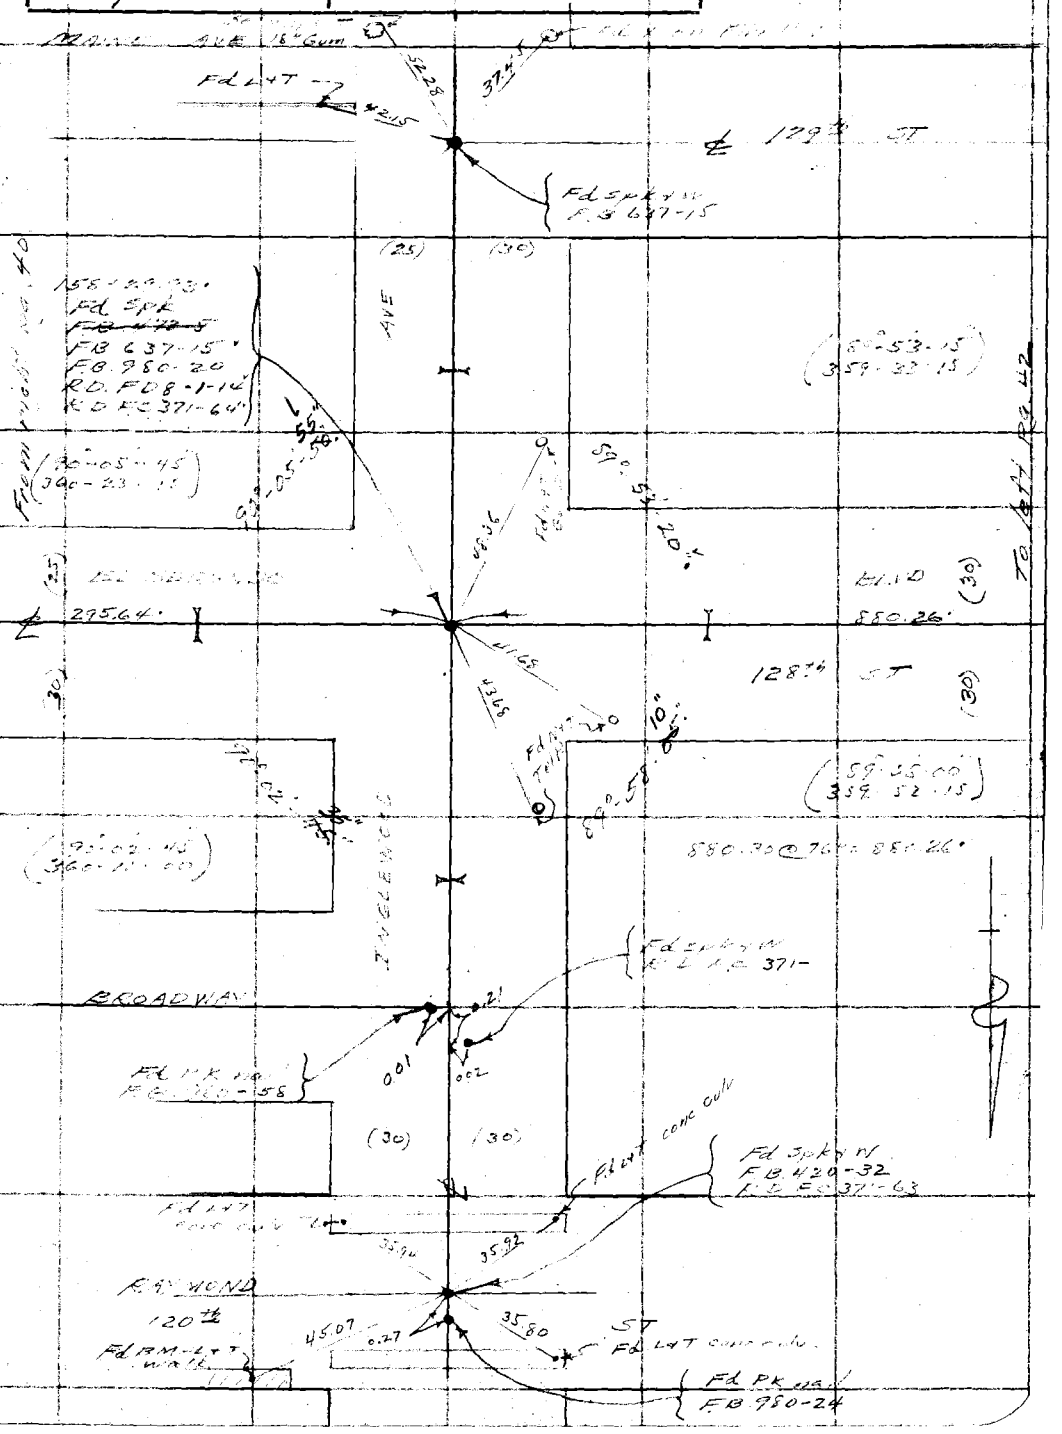

F.B. 239 Pg. 42

WS #5-21

RETURN TO
LOS ANGELES COUNTY SURVEYOR
700 HALL OF RECORDS

Note: Any Additions or Changes on This Sheet Must be Made or Circled in Red Ink With Date and Name of Person Making Change.

Do not extend notes this side of this line

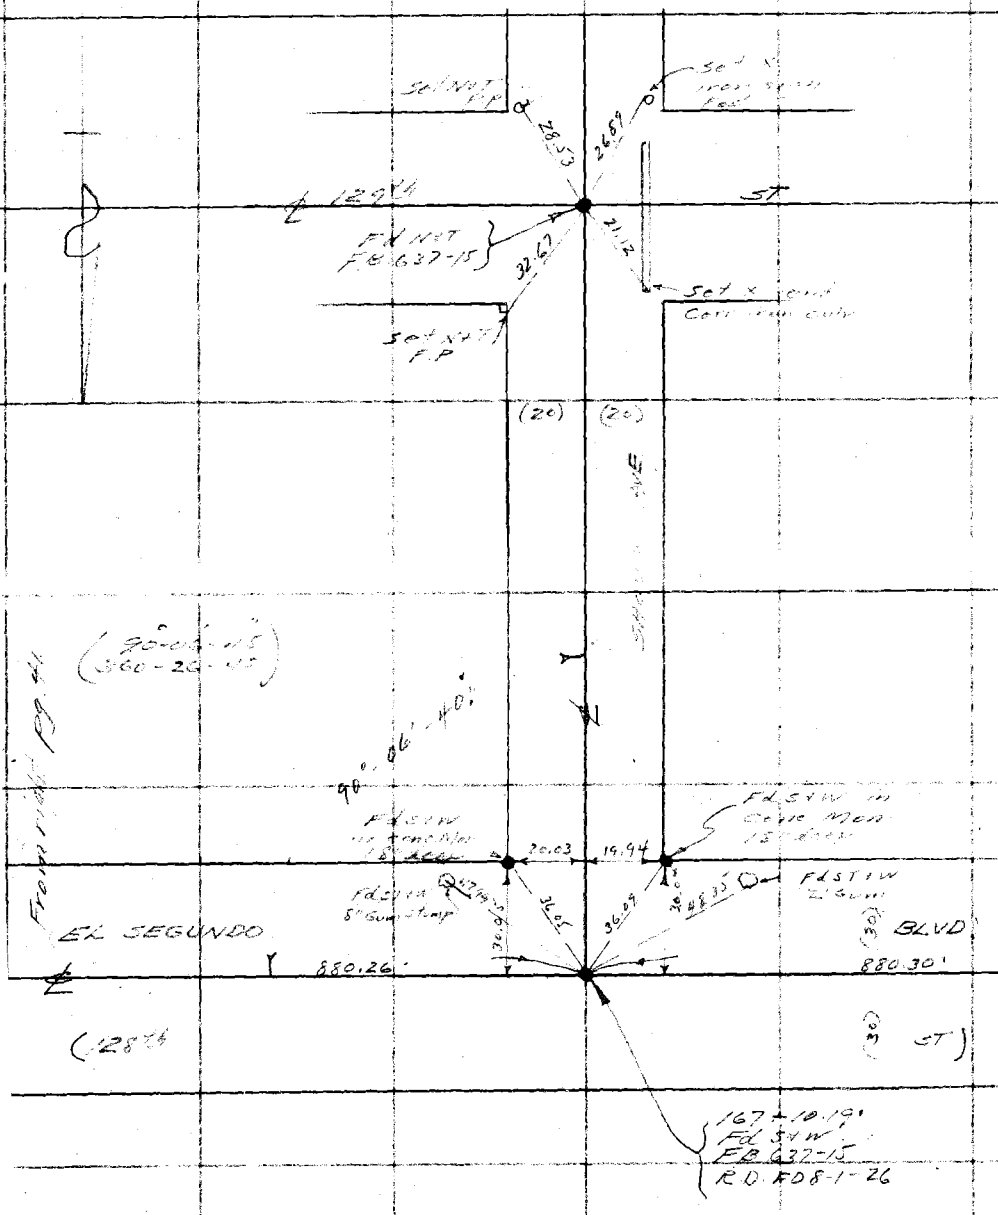

Notes Ck'd by D. M. Finley	Survey of		F.B. 72 Pg. 43
Map No. B-1492-3	W. O.	Tape No.	St'd °F.
Office Work H. U. M. H.	Surveyed by		
Checked D. M. Finley	Notes	Date	
Date Apr. 1941	Indexed		

MS 25 C1

Note: Any Additions or Changes on This Sheet Must be Made or Circled in Red Ink With Date and Name of Person Making Change.

Do not extend notes this side of this line

RETURN TO
LOS ANGELES COUNTY SURVEYOR
700 HALL OF RECORDS

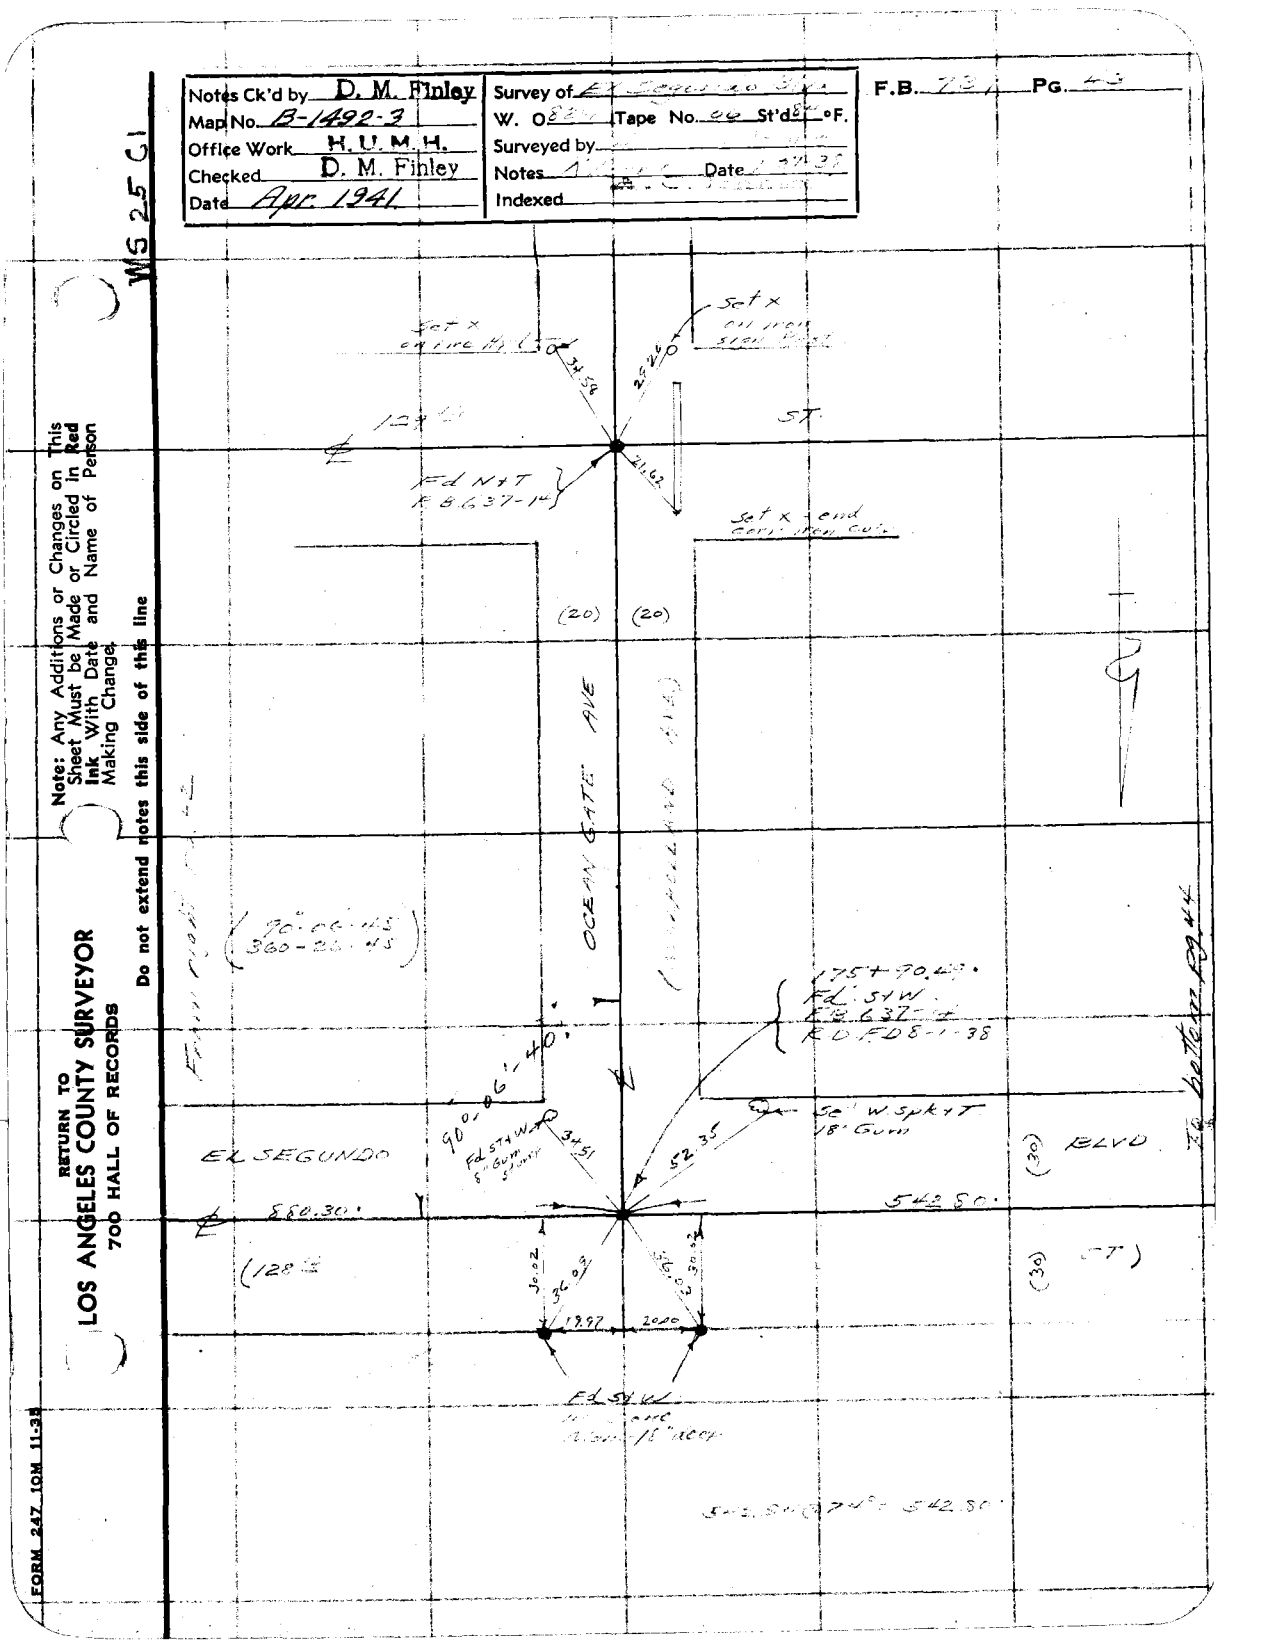

FORM 247 10M 11-38

RETURN TO
LOS ANGELES COUNTY SURVEYOR
700 HALL OF RECORDS

Note: Any Additions or Changes on This Sheet Must be Made or Circled in Red Ink With Date and Name of Person Making Change.

Do not extend notes this side of this line

WS 25 C1

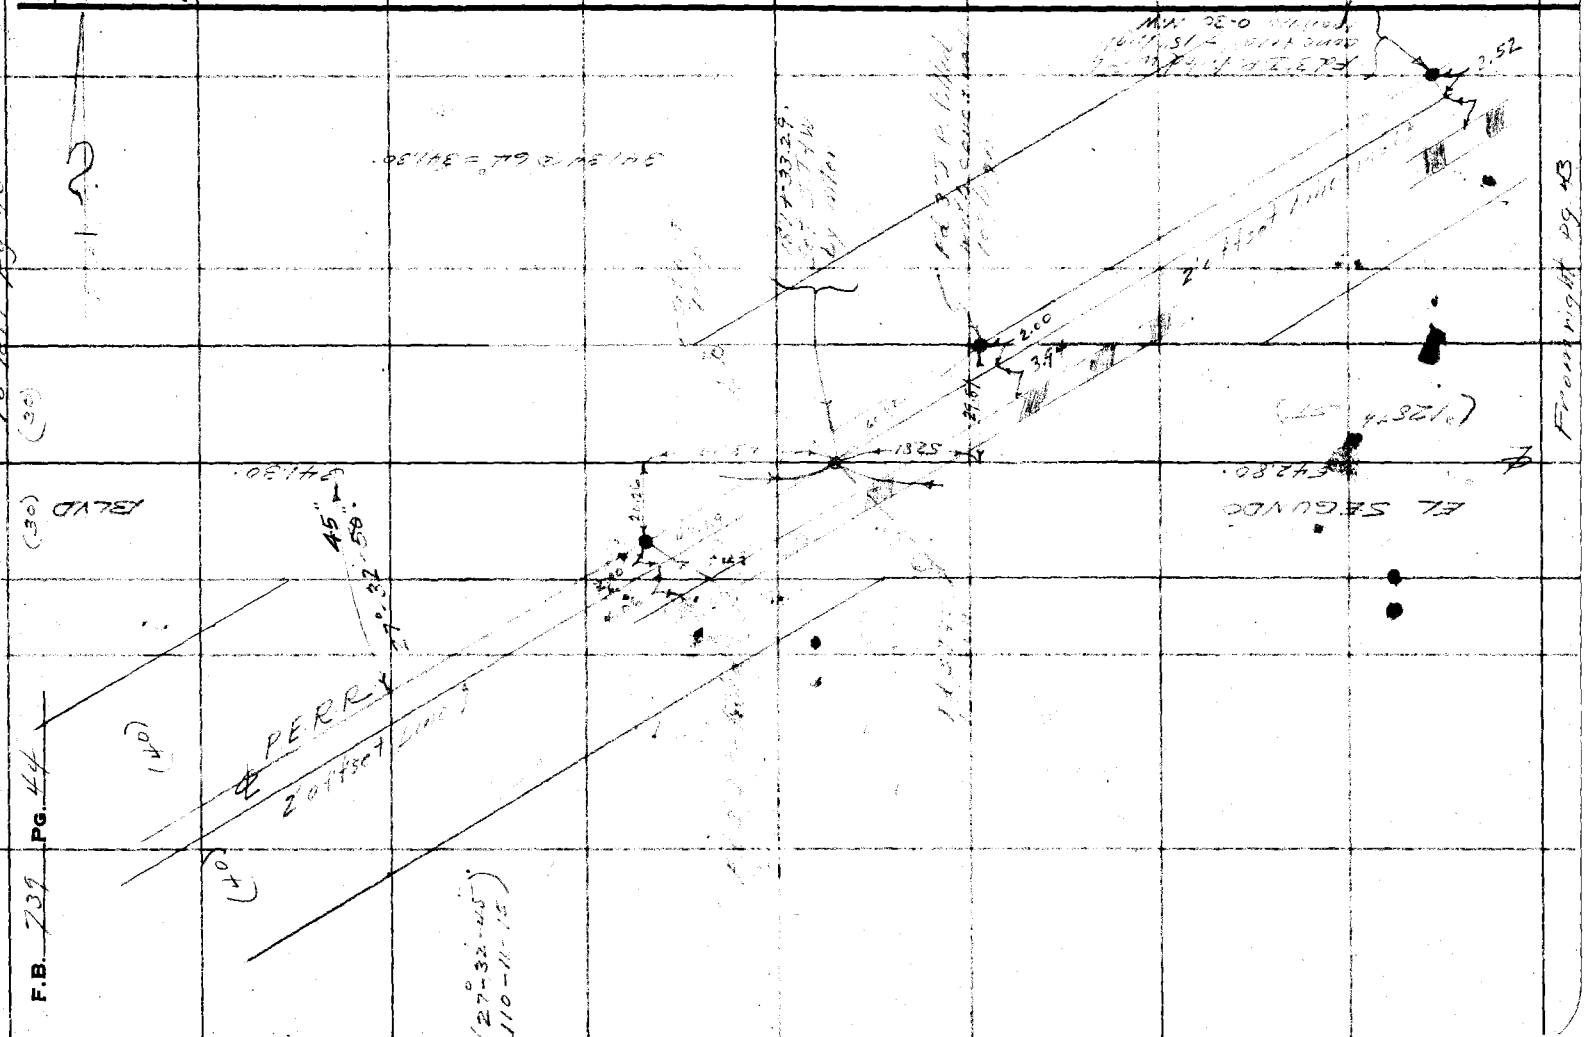

Notes Ck'd by D. M. Finley	Survey of	F.B.	Pg.
Map No. B-1492-3	W. O. 824 Tape No. 06 St'd. °F.		
Office Work H.U.M.H.	Surveyed by		
Checked D. M. Finley	Notes Date		
Date Apr. 1941	Indexed		

WS 25-C1

Note: Any Additions or Changes on This Sheet Must be Made or Circled in Red Ink With Date and Name of Person Making Change.

Do not extend notes this side of this line

RETURN TO
LOS ANGELES COUNTY SURVEYOR
700 HALL OF RECORDS

FORM 247 10M 11-38

RETURN TO
LOS ANGELES COUNTY SURVEYOR
700 HALL OF RECORDS

Note: Any Additions or Changes on This Sheet Must be Made or Circled in **Red Ink** With Date and Name of Person Making Change.

Do not extend notes this side of this line

WS 25 B1-C1

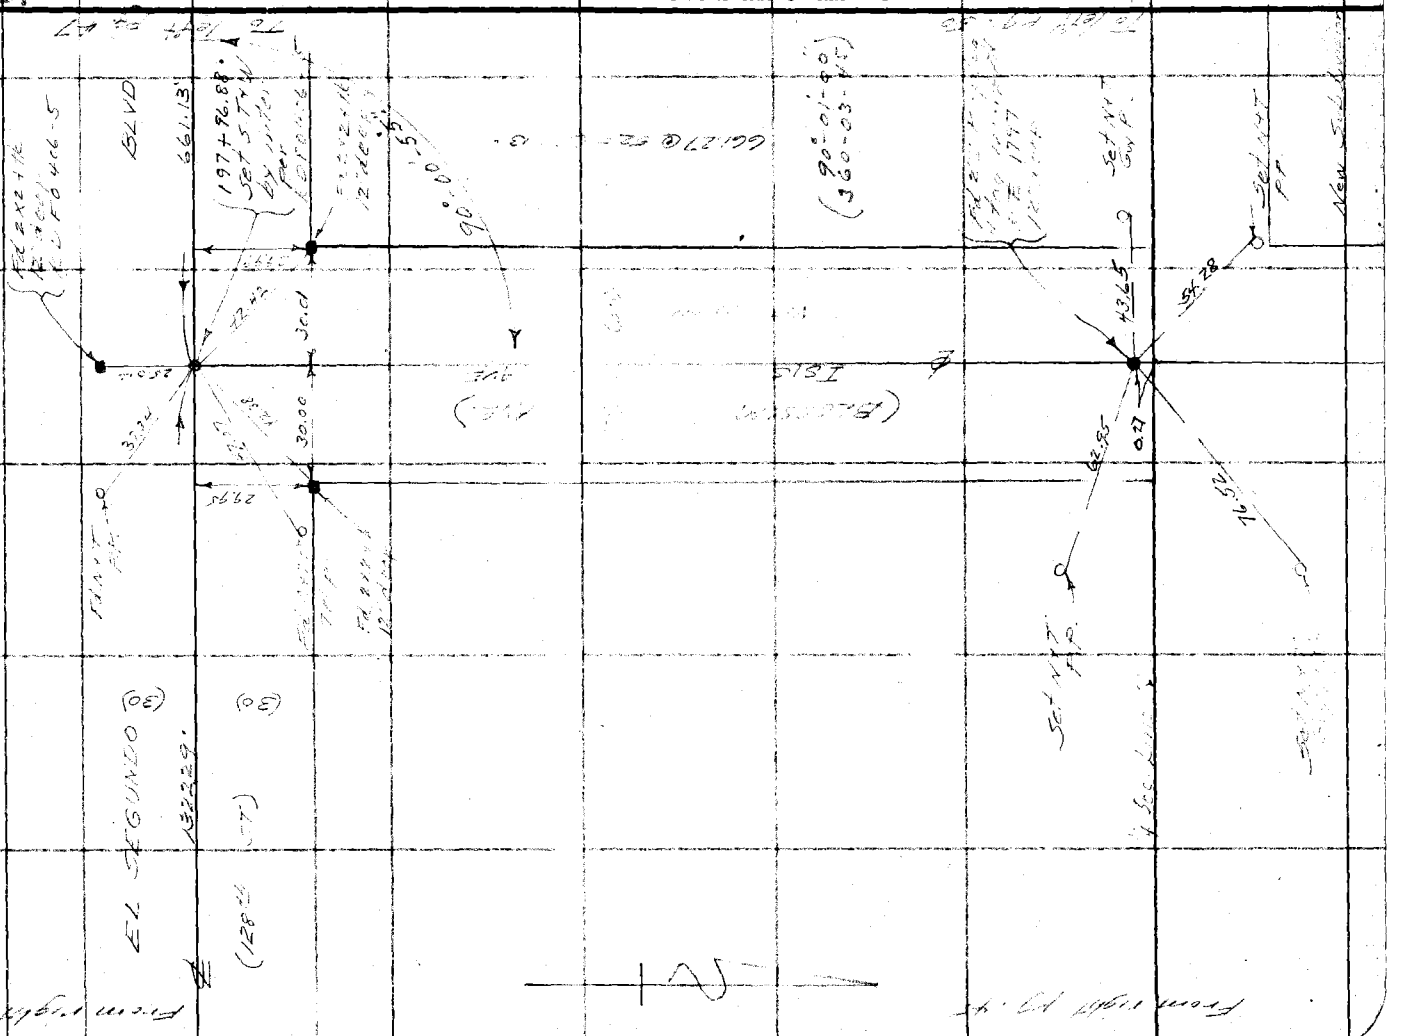
BLVD
661.13'
197+86.88
SET STA
90°00'00"
1.55'
30.00'
30.00'
SET NAIL
SET NAIL
SET NAIL

FORM 247 10M 11-35

RETURN TO
LOS ANGELES COUNTY SURVEYOR
700 HALL OF RECORDS

Note: Any Additions or Changes on This Sheet Must be Made or Circled in Red Ink With Date and Name of Person Making Change.

Do not extend notes this side of this line

WS-25-B1

Notes Ck'd by D. M. Finley
Mad No. B-1892-3
Office Work E. U. M. H.
Checked D. M. Finley
Date Apr 1941

Survey of
W. O. 8207 Tape No. Std. °F.
Surveyed by
Notes Date
Indexed

F.B. Pg.

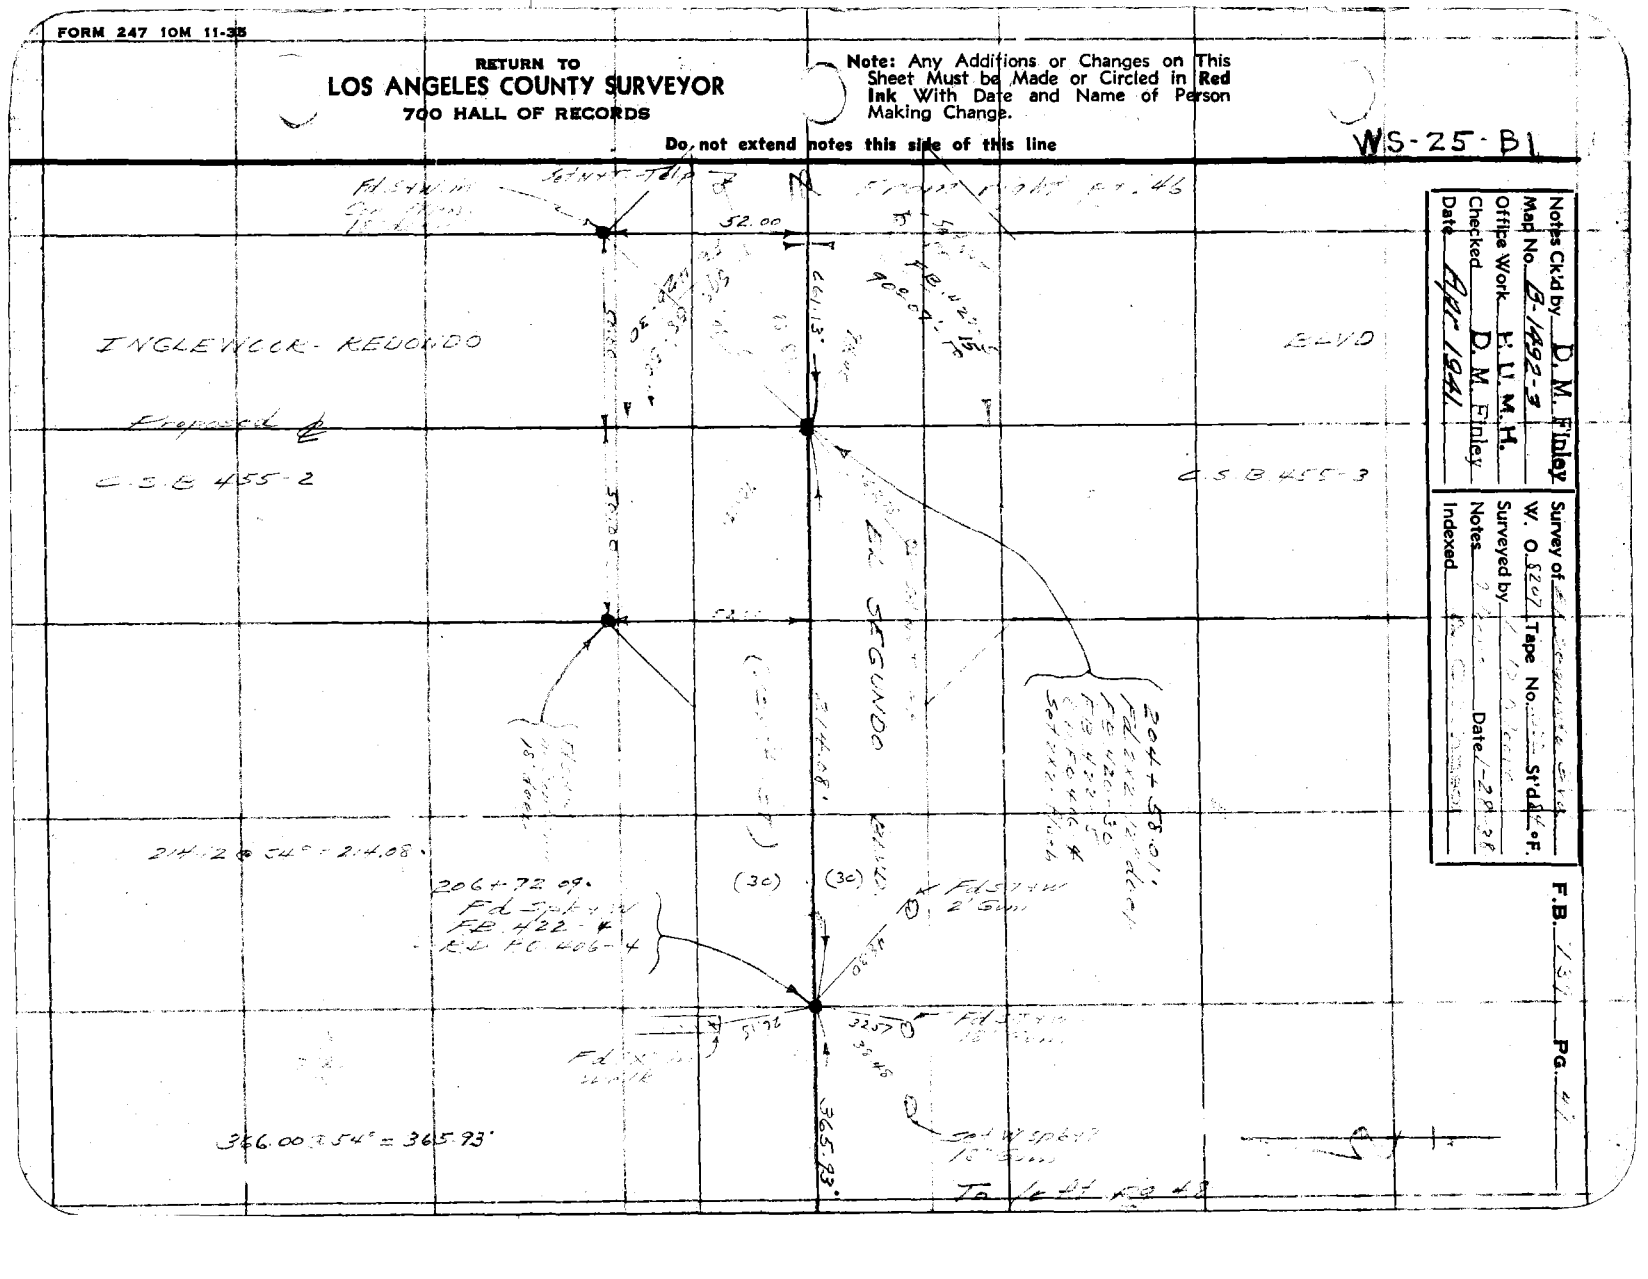

RETURN TO
LOS ANGELES COUNTY SURVEYOR
700 HALL OF RECORDS

Note: Any Additions or Changes on This Sheet Must be Made or Circled in **Red Ink** With Date and Name of Person Making Change.

Do not extend notes this side of this line

WS 25 B1

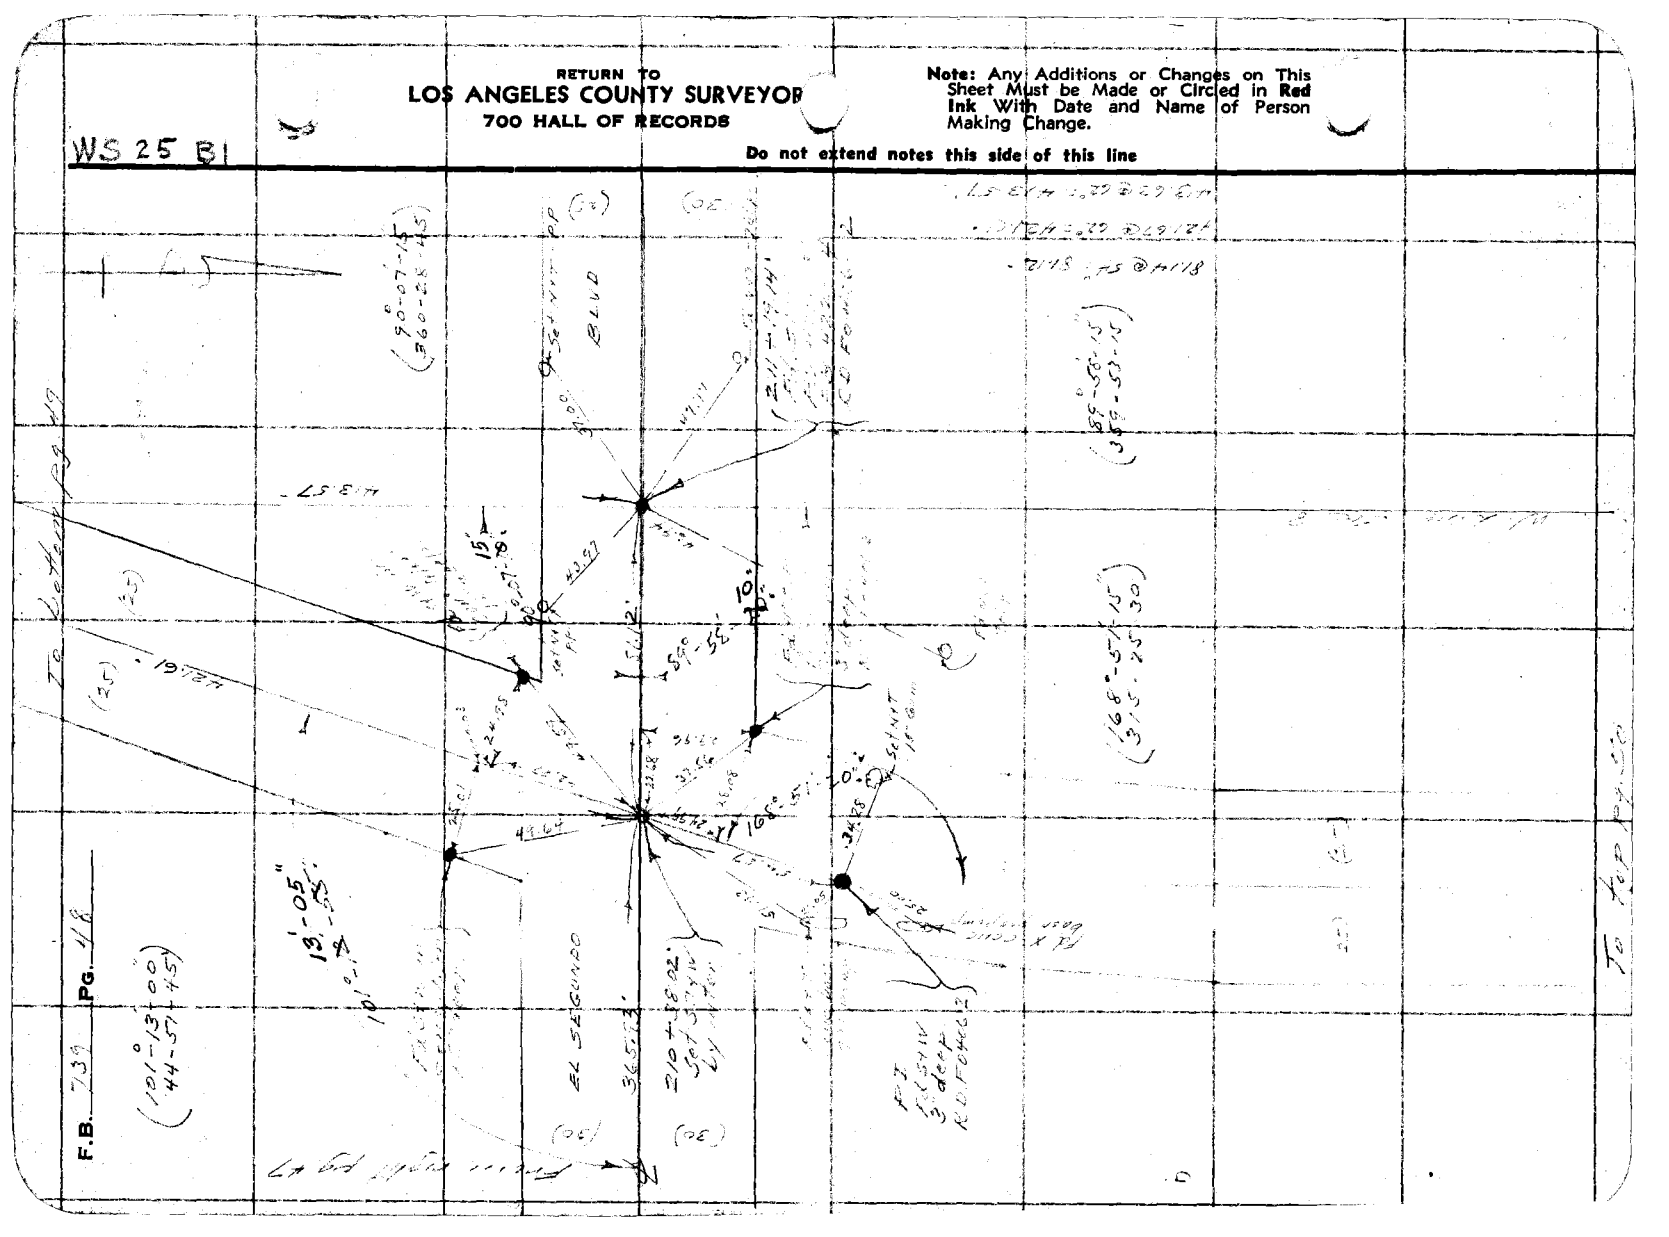

Notes Ck'd by D. M. Finley	Survey of [illegible]
Map No. B-1492-3	W. O. 5207 Tape No. 039 St'd 64 °F.
Office Work H. U. M. H.	Surveyed by [illegible]
Checked D. M. Finley	Notes [illegible] Date 2-1-38
Date Apr. 1941.	Indexed [illegible]

F.B. [illegible] PG. [illegible]

WS 25 B1

Note: Any Additions or Changes on This Sheet Must be Made or Circled in Red Ink With Date and Name of Person Making Change.

Do not extend notes this side of this line

RETURN TO
LOS ANGELES COUNTY SURVEYOR
700 HALL OF RECORDS

FORM 247 10M 11-36

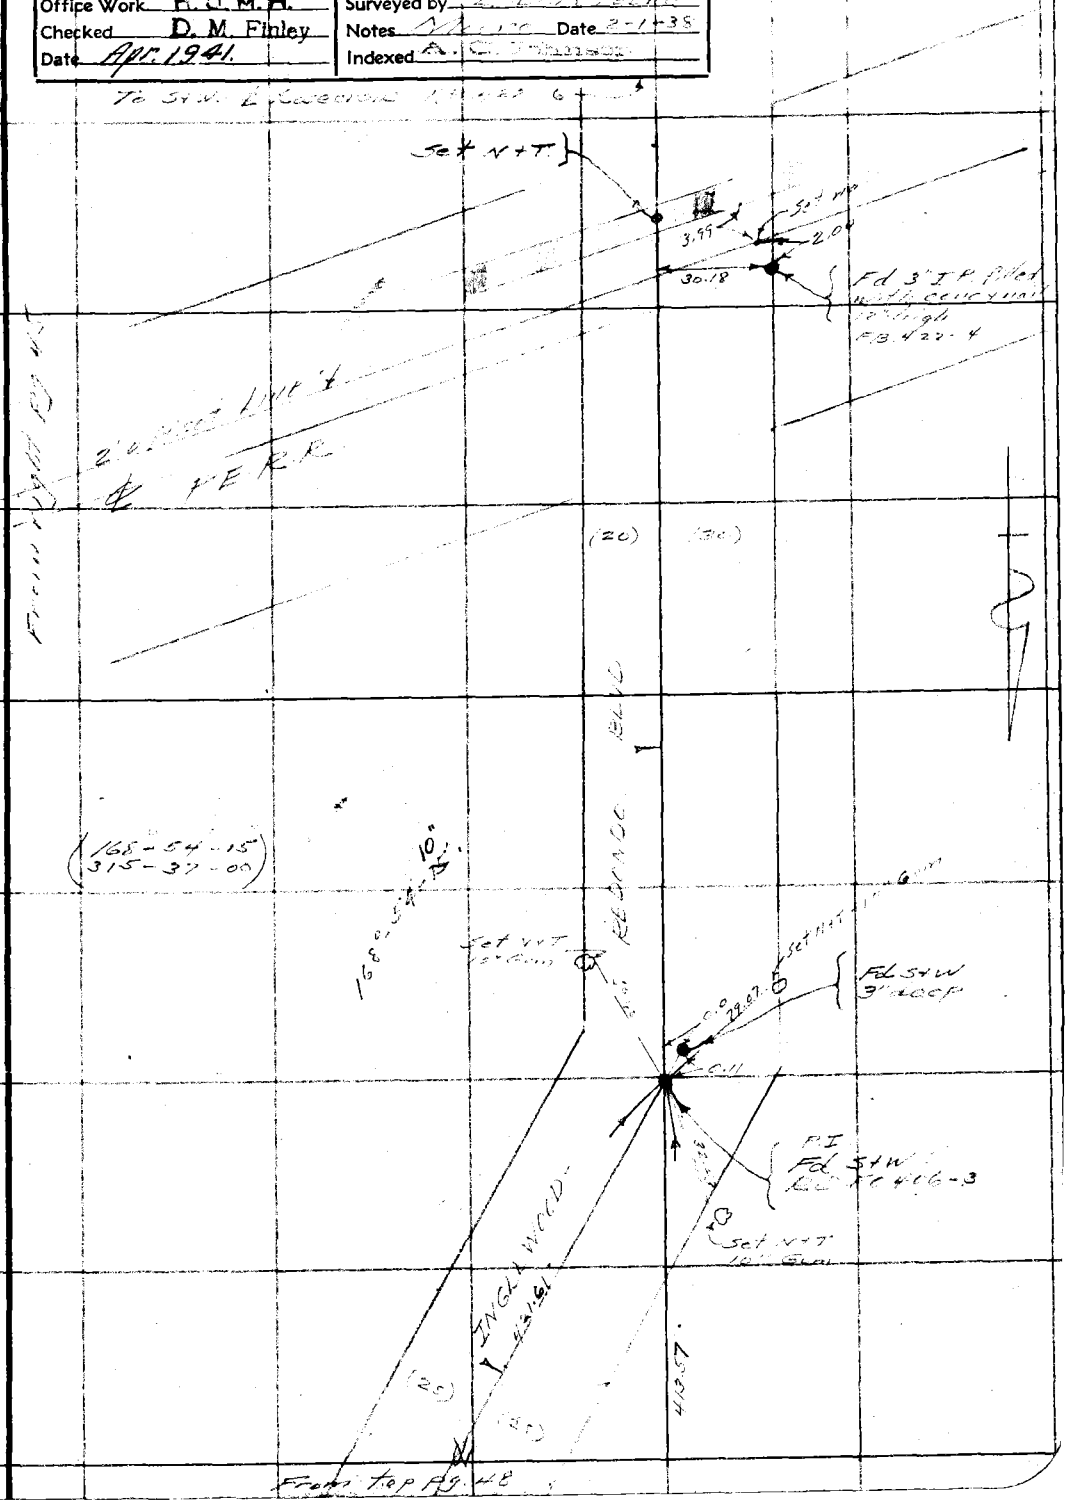

RETURN TO
LOS ANGELES COUNTY SURVEYOR
700 HALL OF RECORDS

Note: Any Additions or Changes on This Sheet Must be Made or Circled in **Red Ink** With Date and Name of Person Making Change.

WS 25 B2

Do not extend notes this side of this line

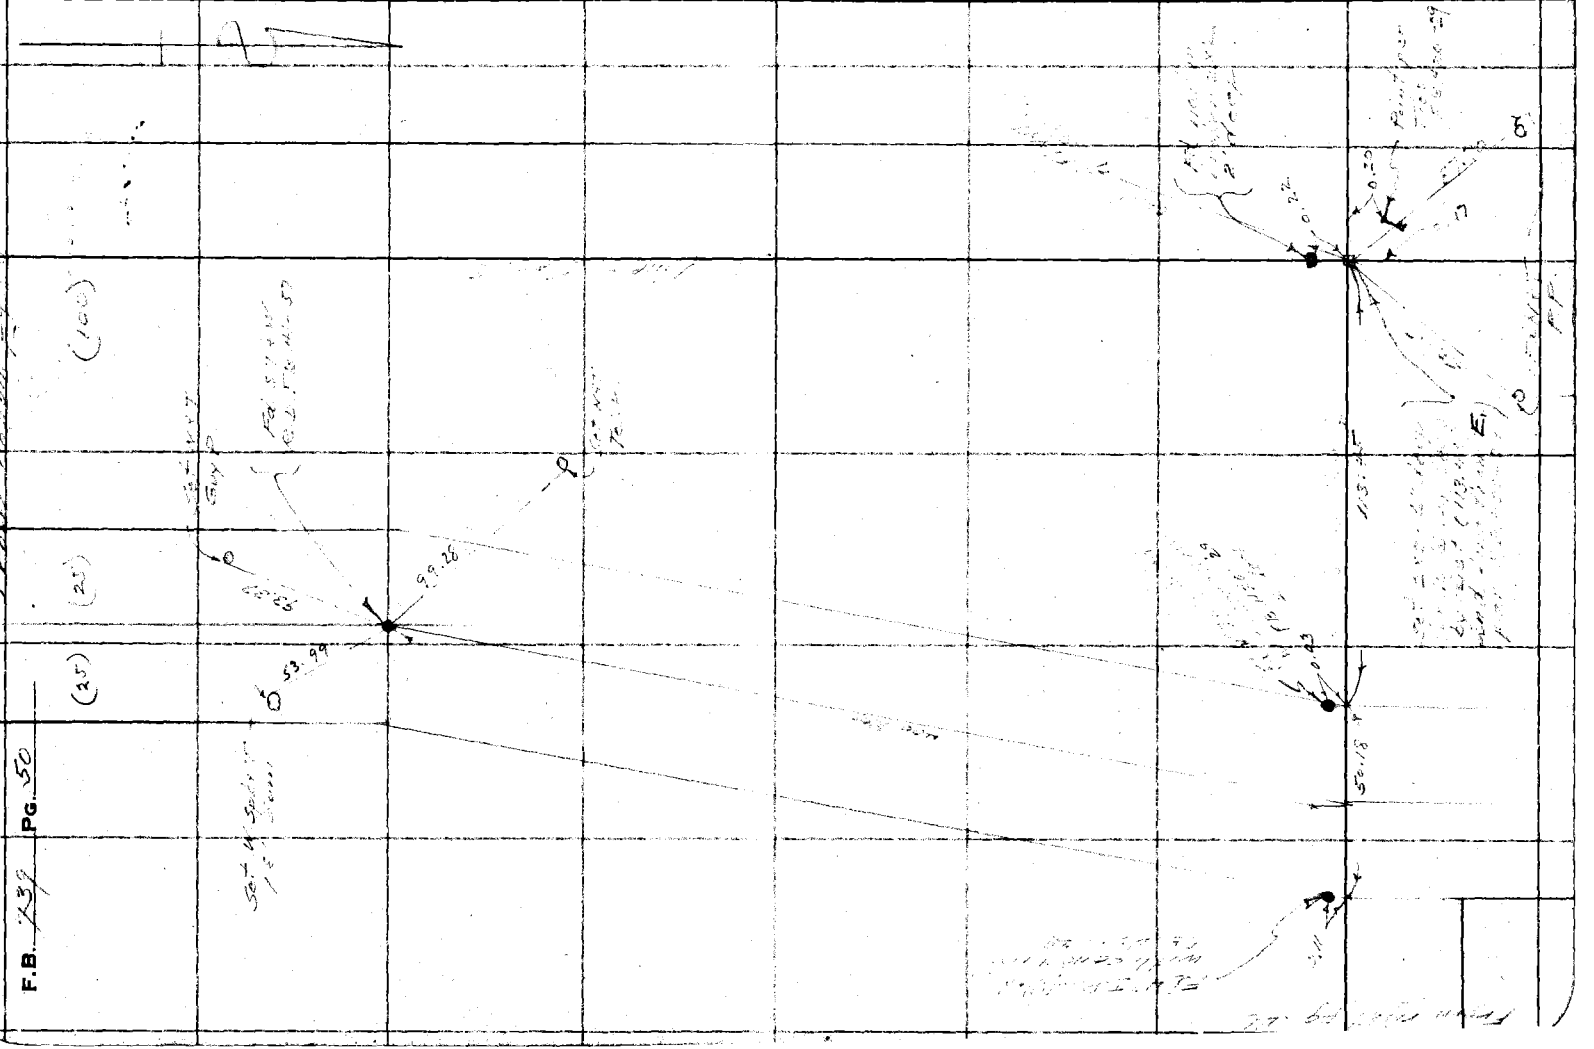

Notes Ck'd by D. M. Finley	Survey of El Segundo Blvd.	F.B. 739	Pg. 51
Map No. B-1492-1	W. O. 8207 Tape No.	St'd	of
Office Work H. U. M. H.	Surveyed by L. D. Moore		
Checked D. M. Finley	Notes ? cove Date 2-6-36		
Date Apr. 1941	Indexed		

TOPOGRAPHY
ON
EL SEGUNDO BLVD
FROM
WESTERN AVE
TO
INGLEWOOD REDONDO BLVD
Jo.L # 8207

Note: Any Additions or Changes on This Sheets Must be Made or Circled in Red Ink With Date and Name of Person Making Change.

Do not extend notes this side of this line

RETURN TO
LOS ANGELES COUNTY SURVEYOR
700 HALL OF RECORDS

FORM 247 5M 10-37

RETURN TO
LOS ANGELES COUNTY SURVEYOR
700 HALL OF RECORDS

Note: Any Additions or Changes on This Sheets Must be Made or Circled in **Red Ink** With Date and Name of Person Making Change.

Do not extend notes this side of this line

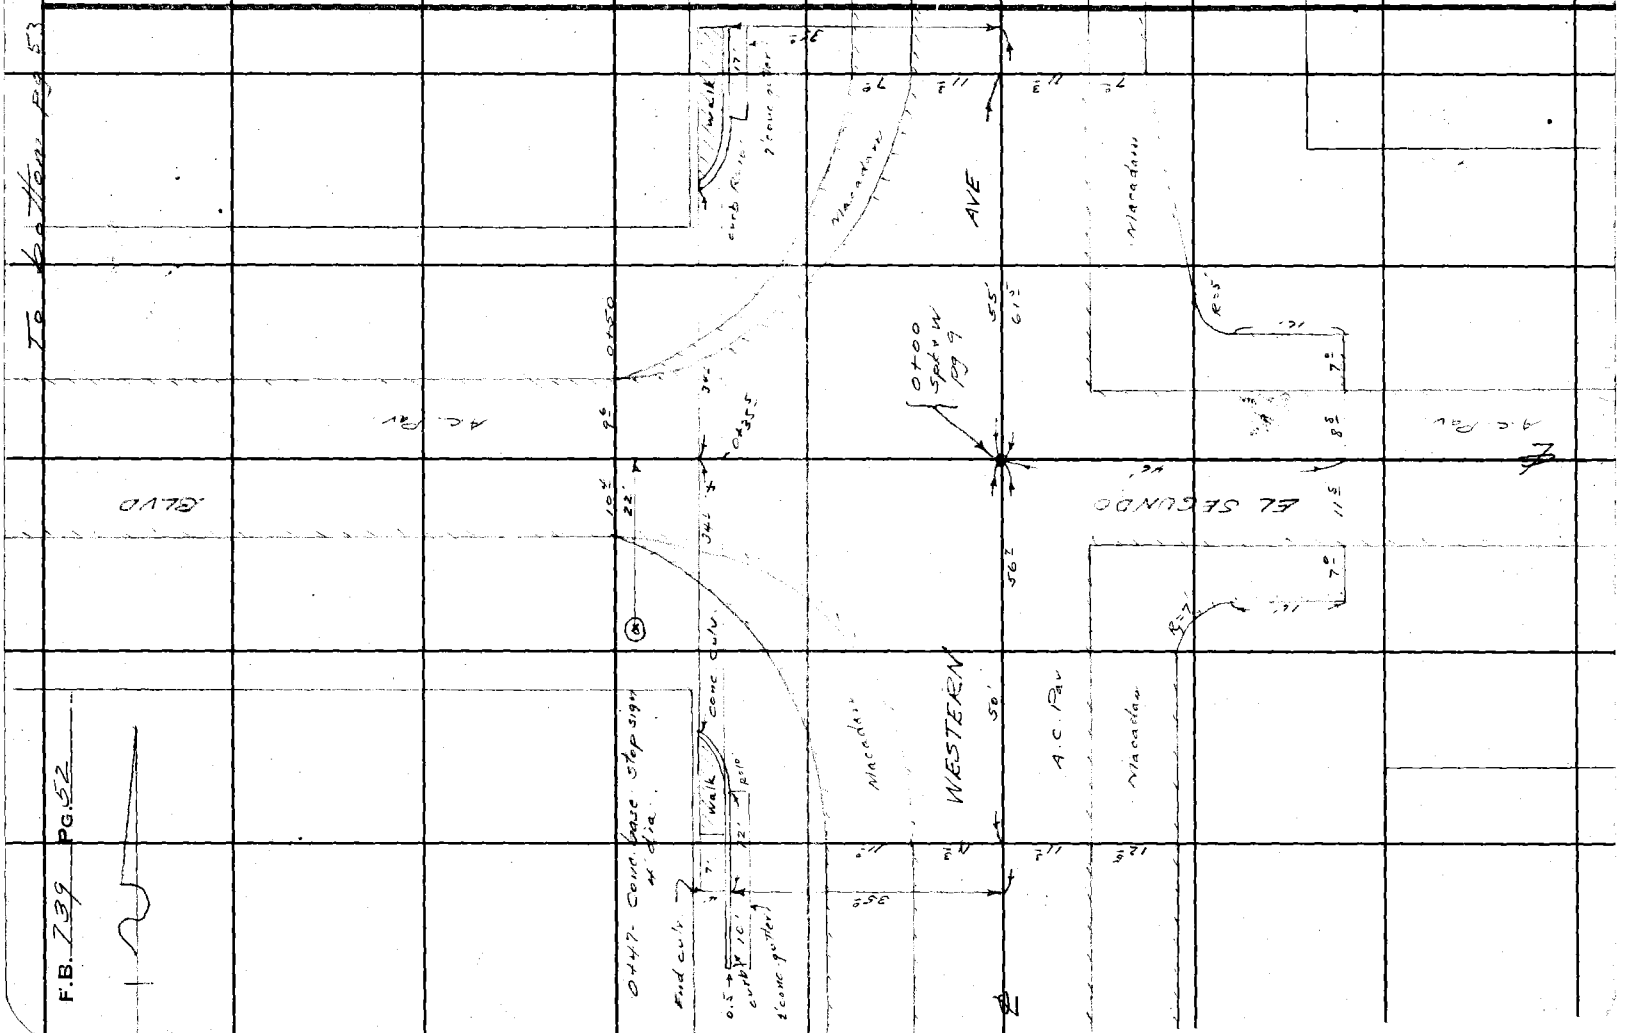

Notes Ck'd by D. M. Finley	Survey of El Segundo Blvd	F.B. [illegible]	PG.
Map No. B-1492-1	W. O. 8207 Tape No.	St'd	of
Office Work H. U. M. H.	Surveyed by Moore		
Checked D. M. Finley	Notes Moore Date 2-2-38		
Date Apr. 1941	Indexed		

Note: Any Additions or Changes on This Sheets Must be Made or Circled in Red Ink With Date and Name of Person Making Change.

Do not extend notes this side of this line

RETURN TO
LOS ANGELES COUNTY SURVEYOR
700 HALL OF RECORDS

FORM 247 5M 10-37

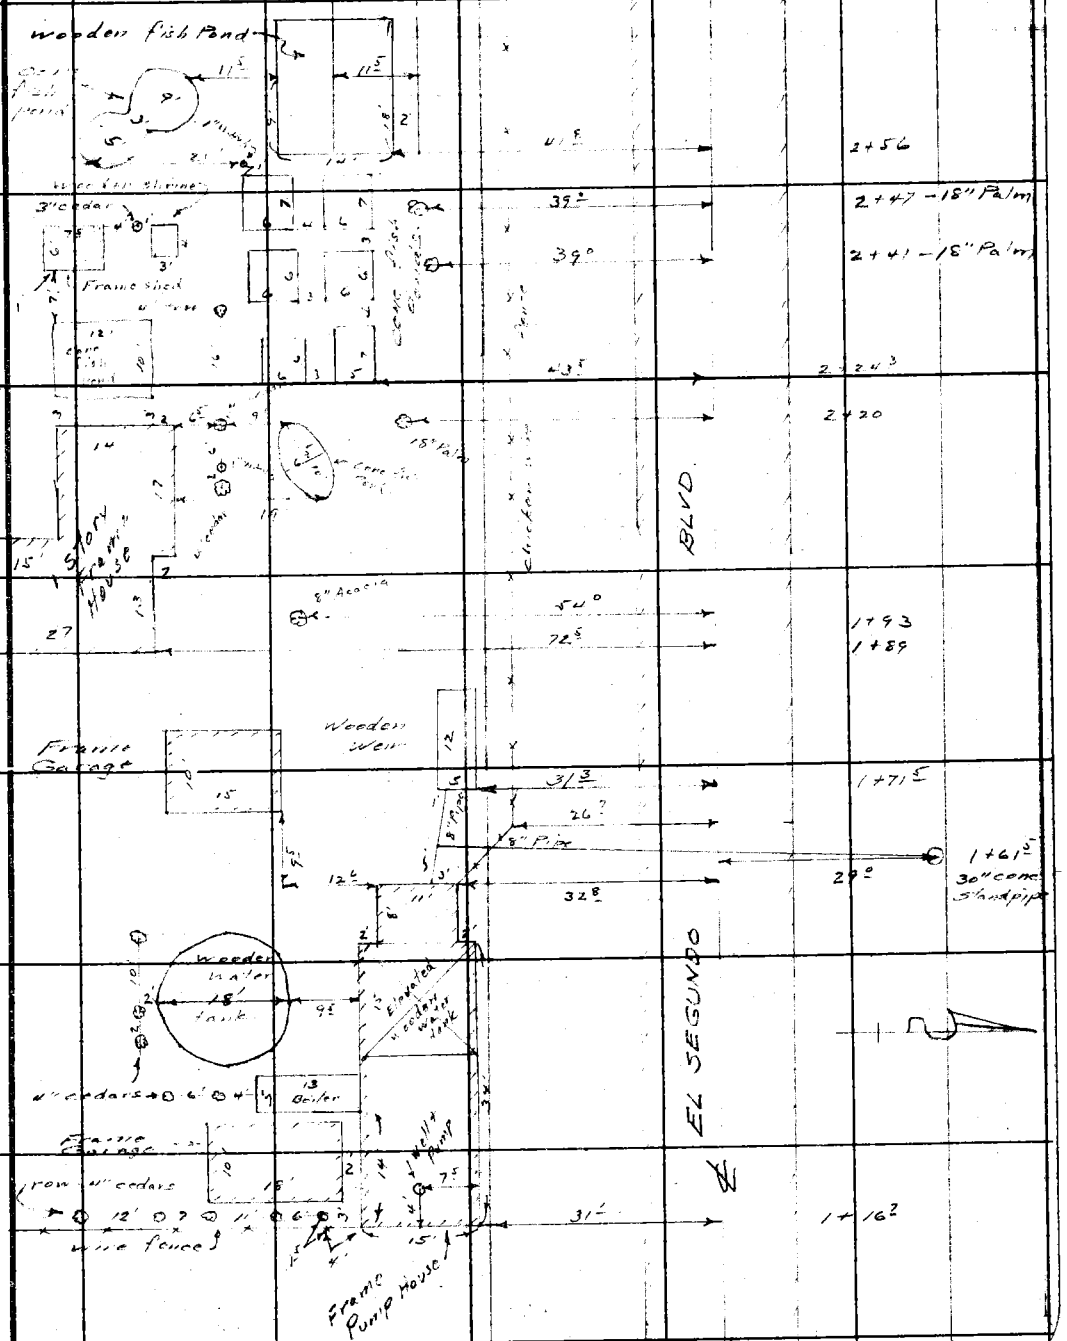

From Top pg. 42

F.B. 739 PG. 54

Sta	OFFSET L	OFFSET R	Size inches		Sta	OFFSET L	OFFSET R	Size inches	
0+22		80'	12	Gum	5+23		24'	12	Gum
+40		74'		Telp.	+28	26'		24	"
+62		32'		" "	+40	"		"	"
1+00		81'	8	Gum	+44		24'	30	"
+27		24'	30	"	+48	26'		"	"
+41	26'		24	"	+55	"		24	"
+43		68'	8	"	+55		24'	"	"
+51			30	"	+61	26'		30	"
+65	26'		"	"	+65		24'	24	"
+68	"		"	"	+72	26'		12	"
+87	"		"	"	+80	"		24	"
+99	"		"	"	+88	"		"	"
2+10		24'	"	"	+95	"		"	"
+18		"	24	"	6+04	"		12	"
+19	26'		"	"	+08	"		24	"
+26	"		"	"	+24	"		48	"
+31	"		12	"	+36	"		24	"
+35	"		24	"	+43		24'	12	"
+35		24'	"	"	+44	26'		24	"
+46	26'		"	"	+49		32'		Telp.
+55		24'	"	"	+50	26'		12	Gum
+56		31'		Telp.	+57	"		48	"
+58		24'	24	Gum	+61		24'	12	"
+75	26'		"	"	+65	"		30	"
+79	"		36	"	+77	"		6	"
+90	"		18	"	+85	26'		18	"
+95		24'	36	"	+89		24'	30	"
3+00		"	18	"	+93	26'		24	"
+06	26'		24	"	+98	"		12	"
+09	"		12	"	7+02		24'	30	"
+12		24'	24	"	+16	26'		12	"
+13	26'		"	"	+22	"		36	"
+15		24'	"	"	+32	"		30	"
+20	26'		"	"	+40		24'	"	"
+22	75'		"	"	+44			18	"
+31		24'	"	"	+57	26'		"	"
+32	63'		6	"	+64		24'	24	"
+34	26'		24	"	+66	26'		"	"
+37	"		"	"	+73	"		"	"
+41	"		"	"	+86	"		"	"
+47	63'		"	"	+87		24'	30	"
+56		24'	12	"	+97	26'		18	"
+59	48'		"	"	8+01	"		"	"
+66	26'		30	"	+13	"		"	"
+77	"		"	"	+17			24	"
+88		24'	"	"	+25		24'	"	"
+90	26'		18	"	+21			6	"
4+03		24'	30	"	+21	26'		30	"
+07	26'		24	"	+26		24'	6	"
+12		24'	18	"	+35		"	12	"
+20		"	24	"	+37		"	"	"
+37.5	26'		"	"	+41		"	30	"
+42	"		12	"	+42	26'		"	"
+45	"		"	"	+50		24'	12	"
+45		24'	30	"	+54		32'		Telp.
+51	26'		"	"	+54		24'	12	Gum
+52		32'		Telp.	+55	26'		"	"
+56		24	24	Gum	+67	"		18	"
+59	26'		"	"	+70	"		"	"
+66	"		"	"	+79	"		"	"
+70	"		12	"	+86		24'	30	"
+74	"		"	"	+90	"		18	"
+78	"		24	"	+92	26'		"	"
+84		24'	"	"	+95	"		"	"
+88		"	"	"	9+01	"		"	"
+95			"	"	+05		24'	"	"
+99	26'		18	"	+09		"	24	"
5+03	"		"	"	+11	26'		36	"
+07	"		12	"	+19	"		12	"
+12		24'	30	"	+22		24'	"	"
+16	26'		12	"	+25		"	18	"
+19	"		24	"	+27	26'		"	"
+23	"		"	"	+31	"		24	"

RETURN TO
LOS ANGELES COUNTY SURVEYOR
700 HALL OF RECORDS

Note: Any Additions or Changes on This Sheets Must be Made or Circled in Red Ink With Date and Name of Person Making Change.

Do not extend notes this side of this line

Notes Ck'd by D. M. Finley	Survey of El Segundo Blvd	F.B. 139	Pg. 55
Map No. B-1492-1	W. O. 8207 Tape No. St'd °F		
Office Work H. U. M. H.	Surveyed by Moore		
Checked D. M. Finley	Notes Moore Date 2-2-38		
Date Apr. 1941	Indexed A. C. Johnson		

Sta	OFFSET L	OFFSET R	Size inches		Sta	OFFSET L	OFFSET R	Size inches	
9 +34		24°	12	Gum	12 +83		24°	24	Gum
+36	26°		18	"	+58	26°		18	"
+38		24°	"	"	+59		24°	6	"
+40	26°		"	"	+61		31Z		Tel P.
+46		24°	"	"	+63	26°		6	Gum
+59		"	"	"	+66	"		"	"
+63		"	"	"	+68		24°	24	"
+64	26°		30	"	+71	26°		12	"
+68	"		18	"	+74	"		36	"
+75		24°	"	"	+77		24°	30	"
+79	26°		30	"	+79	26°		12	"
+81		24°	8	"	+82		24°	36	"
+90	26°		24	"	+83	26°		12	"
+97		24°	"	"	+86	"		12	"
10 +01		"	"	"	+90	"		24	"
+03	26°		30	"	+98	"		18	"
+09	62°		8	"	13 +04	"		36	"
+15		24°	"	"	+19	"		24	"
+18		"	24	"	+23	"		"	"
+22		"	"	"	+35	"		"	"
+24	26°		"	"	+36		34°	12	"
+31		24°	18	"	+40	26°		"	"
+33	26°		24	"	+43	"		24	"
+40		24°	30	"	+47	"		"	"
+48	26°		36	"	+53		20°	12	"
+51		24°	30	"	+55	26°		18	"
+53	26°		"	"	+63	"		30	"
+60		24°	6	"	+68	"		18	"
+61		31Z		Tel P.	+74	"		12	"
+63		24°	18	Gum	+78	"		"	"
+66		"	30	"	+96	"		30	"
+70		"	"	"	14 +11	"		36	"
+80	26°		24	"	+61		31Z		Tel P.
+85	"		12	"	15 +14	45°		18	Gum
11 +07	"		"	"	+37		55°	12	"
+15		24°	30	"	+81		54°	"	"
+19	26°		"	"	+81		83°	"	"
+28	"		"	"	+93	25°		"	"
+48		24°	"	"	+94		70°	"	"
+49	26°		18	"	+96	35°		24	"
+67		24°	12	"	16 +50	26°		"	"
+72	26°		30	"	+55			"	"
+77		24°	"	"	+56		24°	30	"
+80	26°		12	"	+60	26°		24	"
+84		24°	"	"	+60		31Z		Tel P.
+84	26°		6	"	+65		24	24	Gum
+87		24°	18	"	+70	26°		"	"
+90	26°		36	"	+75	"		36	"
+93		24°	6	"	+76		24	18	"
+96		"	24	"	+81		"	24	"
+97	26°		6	"	+85		"	15	"
12 +00	"		30	"	17 +46	26°		24	"
N +00		24°	18	"	+65	"		"	"
+05		"	6	"	+69	"		36	"
+09		"	24	"	+74	"		18	"
+11	26°		"	"	+59	25°			P.P.
+13		24°	"	"	+62		31Z		Tel P.
+18	26°		"	"	19 +10	26°		30	Gum
+26	"		"	"	+11		24°	24	"
+29		24°	12	"	+15	26°		36	"
+30	26°		18	"	+24		24°	24	"
+33		24°	30	"	+26	26°		30	"
+35	26°		12	"	+30		46°	4	Cedar
+43	"		24	"	+35	26°		18	Gum
+47	"		12	"	+38		24°	"	"
+49		24°	24	"	+40	26°		18	"
+51	26		"	"	+44	"		"	"

Note: Any Additions or Changes on This Sheets Must be Made or Circled in Red Ink With Date and Name of Person Making Change.

Do not extend notes this side of this line

RETURN TO
LOS ANGELES COUNTY SURVEYOR
700 HALL OF RECORDS

FORM 247 5M 10-37

F.B. 739 PG. 56

To bottom pg. 57

RETURN TO
LOS ANGELES COUNTY SURVEYOR
700 HALL OF RECORDS

Note: Any Additions or Changes on This Sheets Must be Made or Circled in Red Ink With Date and Name of Person Making Change.

Do not extend notes this side of this line

52'
49.2'
7+37
3
reservoir
wire fence
52'
53'
7+97
EL SEGUNDO BLVD
55'
52.5'
6+82
3
reservoir
wire fence
8.2'
86.2'
26
22
18.5
22
8
3
47.2'
5+62
1 story Frame House, Garage & Shed
10
10
32
42
7
13
27
13
12.5
76.7'
5+06
lattice fence
26.2'
3+06
11.5
15.1
From top pg. 55

Notes Ck'd by D. M. Finley	Survey of El Segundo Blvd	F.B. 39	Pg. 57
Map No. B-1492-1	W. O. 8202 Tape No.	St'd	OF
Office Work H.U.M.H.	Surveyed by Moore		
Checked D. M. Finley	Notes Moore Date 2-	36	
Date Apr. 1941	Indexed		

To top Page

1 Story Frame Shed

1 Wooden Fence

Water meters

Water & gas meters

Water meter

Gas meters

1 Story Frame House

Wire Fence

1 Story Frame House

Frame Sheds

EL SEGUNDO BLVD

Front top Pg 56

RETURN TO
LOS ANGELES COUNTY SURVEYOR
700 HALL OF RECORDS

Note: Any Additions or Changes on This Sheets Must be Made or Circled in Red Ink With Date and Name of Person Making Change.

Do not extend notes this side of this line

FORM 247 SM 10-37

F.B. 739 PG. 58

Sta.	OFFSET L	OFFSET R	Size inches		Sta.	OFFSET L	OFFSET R	Size inches	
19+48	26°		12	Gum	23+25	26°		12	Acacia
+53	"		24	"	+25	42.5°		"	"
+54		24°	30	"	+25	62.5°		18	Pepper
+58		"	8	"	+32		24°	24	Gum
+62		45.5°	4	Cedar	+37		"	"	"
+62		77°	4	Acacia	+42		"	6	"
+63	26°		8	Gum	+47	34°		3	"
+66	"		12	"	+47	41°		6	"
+71	"		"	"	+57	26°		12	Pepper
+73		24°	30	"	+60		24°	18	Gum
+74	26°		24	"	+67		31.7		Tel P
+78	"		18	"	+68		24°	24	Gum
+81		24°	24	"	+72		"	18	"
+83	26°		"	"	+85	36.5°		12	Cypress
+87	"		18	"	+85	40°		"	"
+96	"		"	"	+88		24°	30	Gum
+98		24°	"	"	+99	26°		18	"
20+03	26°		24	"	24 +22		24°	24	"
+08	"		"	"	+23	56°		8	"
+15		24°	12	"	+27	26.5°		12	Pepper
+20		"	"	"	+27	75°		24	"
+24		"	36	"	+33	38°		3	"
+36	26°		12	"	+35	57.5°		4	Cypress
+36		24°	"	"	+37	67°		12	Gum
+39	26°		24	"	+40		24°	18	"
+51	"		18	"	+44		"	"	"
+55	"		6	"	+49	78°		"	"
+59	"		18	"	+51	48°		6	"
+61		31?		Tel P	+51	62°		12	"
+63	26°		24	Gum	+53	44°		4	Cedar
+68	"		18	"	+60	78°		6	Gum
+72	"		6	"	+62	75°		"	"
+78		24°	36	"	+65		24°	30	"
+87	26°		"	"	+66	26°		24	Pepper
+89		24°	24	"	+68	63°		6	Gum
+98	26°		"	"	+68	68°		6	"
21+00		24°	30	"	+70	65°		6	"
+04		"	6	"	+73	65°		6	"
+13		"	18	"	+75	79°		4	"
+20		"	30	"	+78	65°		6	Magnolia
+30			8	"	+82	64°		12	Gum
+33	26°		30	"	+82	78.5°		"	"
+35		24°	12	"	+87	62°		6	"
+36	26°		24	"	+87	79°		12	"
+40	"		"	"	+91	26°		6	"
+42		24°	18	"	+91	82°		24	"
+44	26°		"	"	+93	60°		8	"
+50		24°	24	"	+94	82°		"	"
+51	26°		"	"	+96	82°		"	"
+54	"		"	"	25 +01		24°	30	"
+55		24°	"	"	+04	63°		6	"
+57	26°		12	"	+06	79°		"	"
+59		24°	30	"	+09	79°		6	"
+72	26°		24	"	+09	79°		"	"
+75		24°	18	"	+15	56°		12	"
+89	26°		36	"	+15	63°		"	"
+93		31?		Tel P	+23	64°		6	"
+95		24°	36	Gum	+23	73°		"	"
22+00	26°		24	"	+23	90°		"	"
+02		24°	"	"	+26		24°	24	"
+09	26°		"	"	+27	53°		8	"
+11	"		"	"	+27	65.5°		"	"
+39	"		"	"	+27	86°		"	"
+41		24°	36	"	+30		24°	12	"
+54		"	"	"	+32	24°		24	"
+79	46.5°		20	Cedar	+41		24°	18	"
+84	26°		12	Pepper	+42		30?		Tel P
+85		24°	36	Gum	+44	35°		3	Acacia
+94	55°			Grove Palms	+46	48.5°		12	Gum
23+02		24°	18	Gum	+49	58°		"	"
+11		"	36	"	+56		24°	"	"
+19	30°		24	Palm	+78	26°		30	"
+20		24°	72	Gum	+83	0°		12	"

RETURN TO
LOS ANGELES COUNTY SURVEYOR
700 HALL OF RECORDS

Note: Any Additions or Changes on This Sheets Must be Made or Circled in Red Ink With Date and Name of Person Making Change.

Do not extend notes this side of this line

Notes Ck'd by D. M. Finley	Survey of El Segundo Blvd.	F.B. 739	PG. 59
Map No. B-1492-1	W. O. 8202 Tape No.	St'd	of
Office Work P. U. M. H.	Surveyed by Moore		
Checked D. M. Finley	Notes Moore Date 2-2-38		
Date Apr. 1941	Indexed		

Note: Any Additions or Changes on This Sheets Must be Made or Circled in Red Ink With Date and Name of Person Making Change.

Do not extend notes this side of this line

RETURN TO
LOS ANGELES COUNTY SURVEYOR
700 HALL OF RECORDS

FORM 247 5M 10-37

Sta	OFFSET L	OFFSET R	Size inches		Sta	OFFSET L	OFFSET R	Size inches	
25+91		24°	30	Gum	31+	31°		24	Gum
26+20		2°		P.P.	+	"		"	"
+23	28°		36	Gum	+	"		"	"
+25		75°		P.P.	+	"		12	"
+34	27°			Tel.P.	+	"		6	"
+74	31°			Gum	33+	"		30	"
27+07	"		24	"	+	"		6	"
+16		19°		P.P.	+	"		18	"
+19	31°		24	Gum	+	"		6	"
+39	"		12	"	+	"		"	"
+49	"		"	"	+	"		"	"
+60	"		"	"	+	"		"	"
+51	"		"	"	+	"		12	"
+62	"		"	"	+	"		"	"
+66	"		"	"	+	"		"	"
+90	"		24	"	+	31°		18	"
28+05	"		"	"	+	"		"	"
+13	"			P.P.	+	"		"	"
+38	31°	17°		Tel.P.	+	"		24	"
+38	31°		24	Gum	34+	"	13°	"	P.P.
+72	"		12	"	+	31°		6	Gum
+76	"		"	"	+	"		18	"
+50	"		"	"	+	"		"	"
+60	"		24	"	+	"		6	"
+80	"		"	"	+	"		24	"
29+05	"		18	"	+	"		"	"
+					+	"		12	"
+28					35+65		19°	48	P.P.
+45			24		36+54	31°		"	Gum
+62		19°		P.P.	37+15	"		"	"
+67	31°		24	Gum	+		19°		P.P.
+74	"		12	"	+	31°		30	Gum
+86	"		24	"	38+62		19°		P.P.
+97	31°			Tel.P.	40+15		"		"
+92	31°		24	Gum	+		"		"
30+02	"		18	"	42+35	31°		30	Gum
+25	"				+ 52			12	"
+37	"		30	"	+ 60			24	"
+57	"		18	"	+ 75			18	"
+23	"			"	+ 82			24	"
+					43+15		17°		P.P.
+					44+66		"		"
+					+ 70	47°		12	Gum
+					+ 81	31°		24	"
+					+ 91	"		36	"
+			30	"	45+12		17°		P.P.
+			"	"	+ 75		67°		"
+			"	"	47+62		19°		"
+			"	"	49+10		"		"
31+				P.P.	50+35	31°		24	Gum
+		17°		P.P.	+			12	"
+	31°		30	Gum	+			18	"
+	"		12	"	+			18	"
+	"		24	"	+			"	"
+	"		"	"	+			"	"
+	"		"	"	+			"	PP
+					+ 68	31°		18	Gum
+					+			"	"
+					+			"	"
+					+			"	"
32+					51+			24	"
+			6		+			"	"
+			24		+ 93			"	"
+			"	"	+ 98			12	"
+			"	"	+ 93			30	"
+	64	19°		P.P.	+ 50	"		18	"
+	73	31°	6	Gum	+ 60			"	"

RETURN TO
LOS ANGELES COUNTY SURVEYOR
700 HALL OF RECORDS

Note: Any Additions or Changes on This Sheets Must be Made or Circled in **Red Ink** With Date and Name of Person Making Change.

Do not extend notes this side of this line

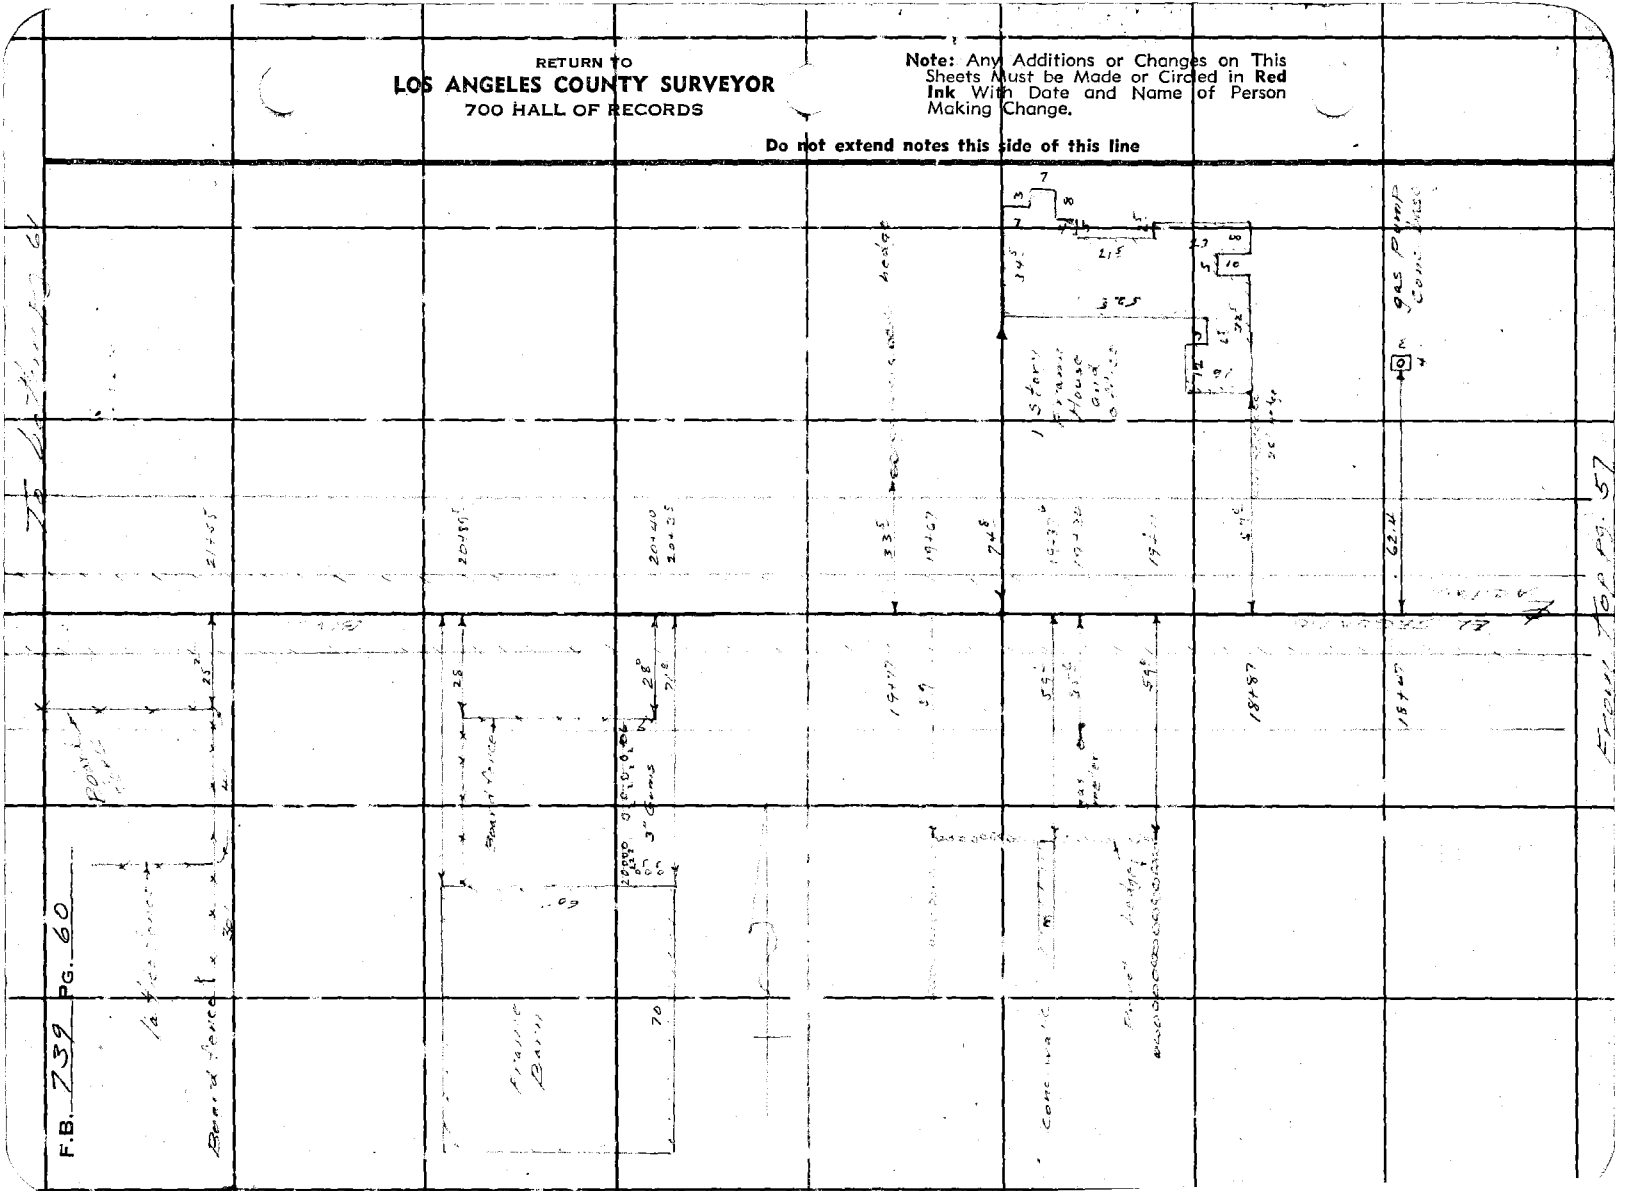

Notes Ck'd by D. M. Finley	Survey of	F.B.	Pg.
Map No. B-1492-1	W. O.	Tape No.	St'd °F
Office Work H. U. M. H.	Surveyed by		
Checked D. M. Finley	Notes	Date	
Date Apr. 1941	Indexed		

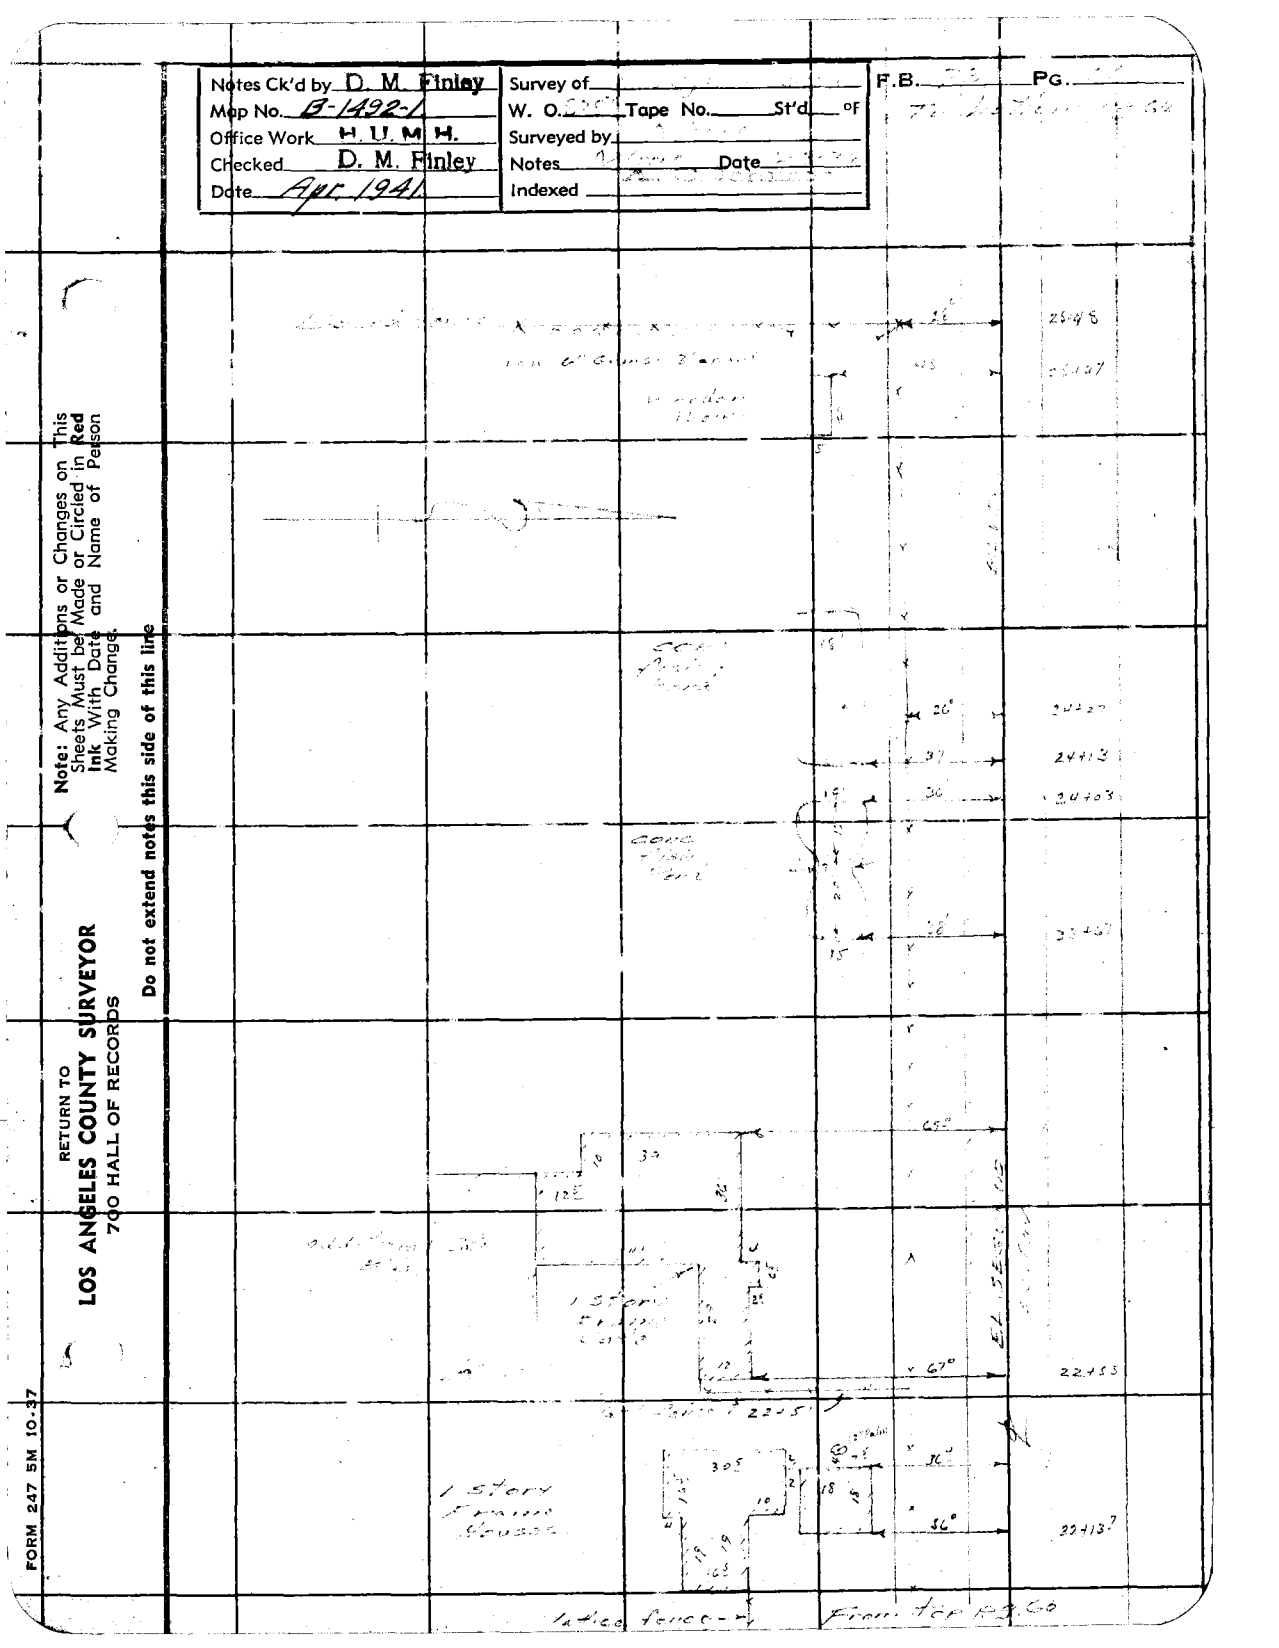

Note: Any Additions or Changes on This Sheets Must be Made or Circled in Red Ink With Date and Name of Person Making Change.

Do not extend notes this side of this line

RETURN TO
LOS ANGELES COUNTY SURVEYOR
700 HALL OF RECORDS

FORM 247 SM 10-37

RETURN TO
LOS ANGELES COUNTY SURVEYOR
700 HALL OF RECORDS

Note: Any Additions or Changes on This Sheets Must be Made or Circled in **Red Ink** With Date and Name of Person Making Change.

Do not extend notes this side of this line

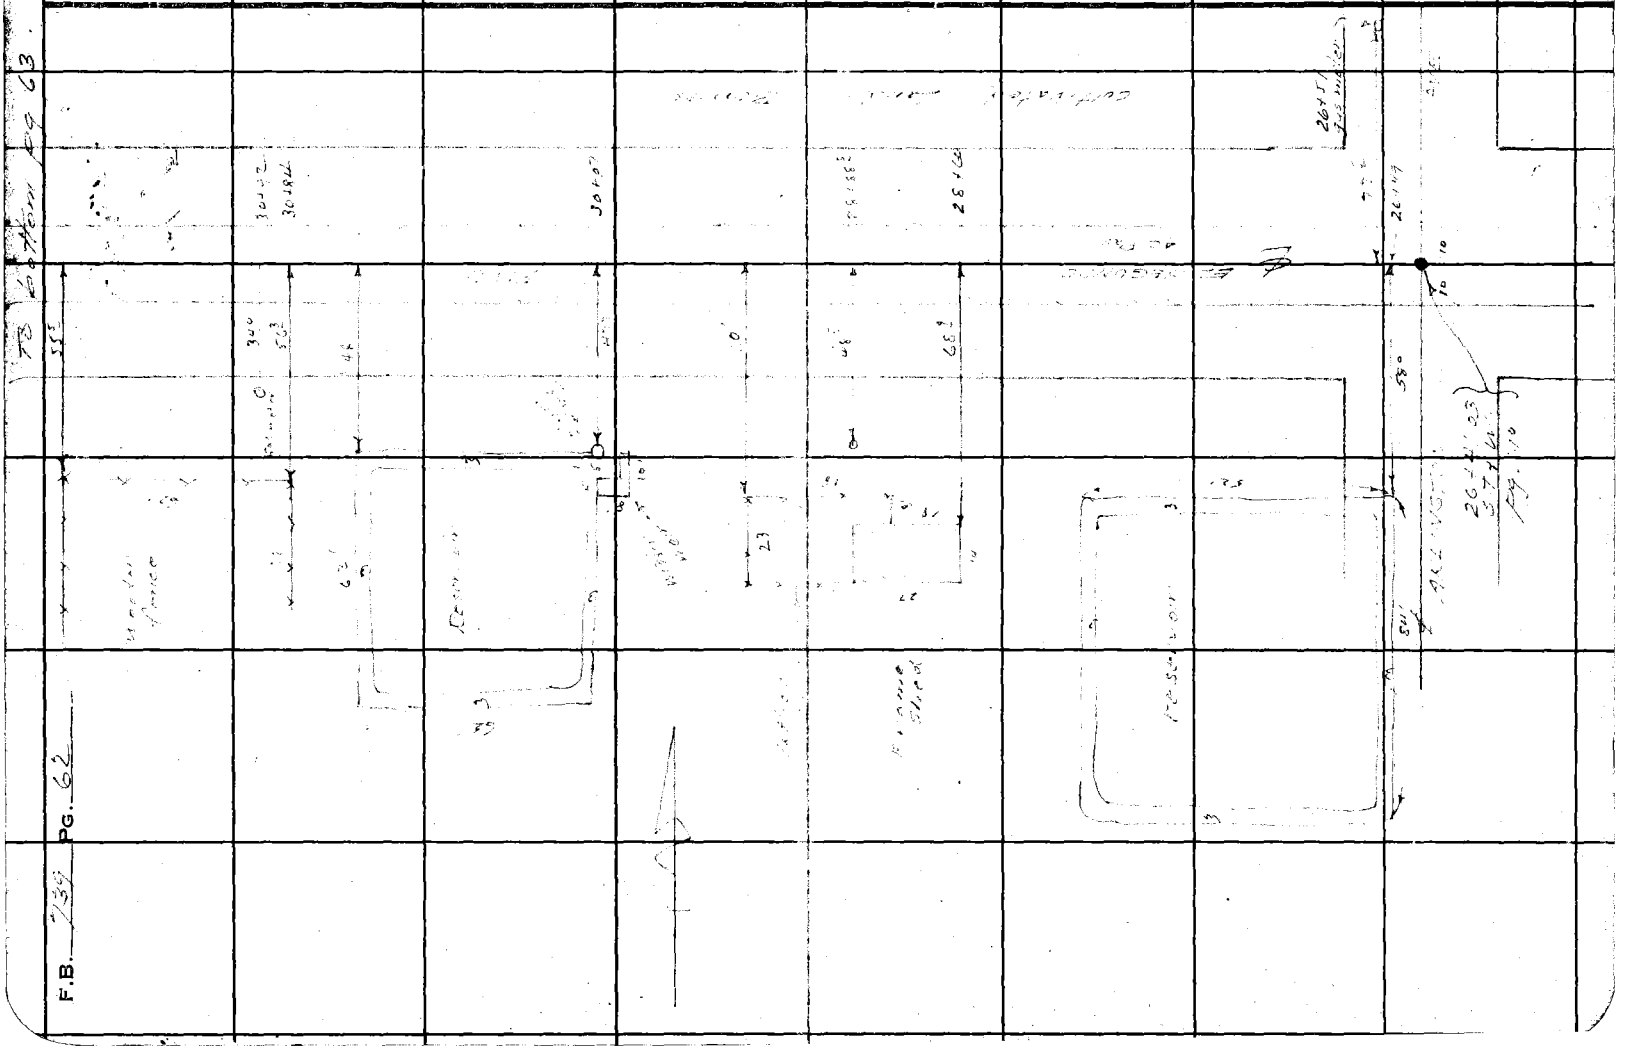


Notes Ck'd by D. M. Finley	Survey of		F.B. PG.
Map No. B-1492-1	W. O.	Tape No. St'd OF	
Office Work H.U.M.H.	Surveyed by		
Checked D. M. Finley	Notes	Date	
Date Apr. 1941.	Indexed		

Note: Any Additions or Changes on This Sheets Must be Made or Circled in Red Ink With Date and Name of Person Making Change.

Do not extend notes this side of this line

RETURN TO
LOS ANGELES COUNTY SURVEYOR
700 HALL OF RECORDS

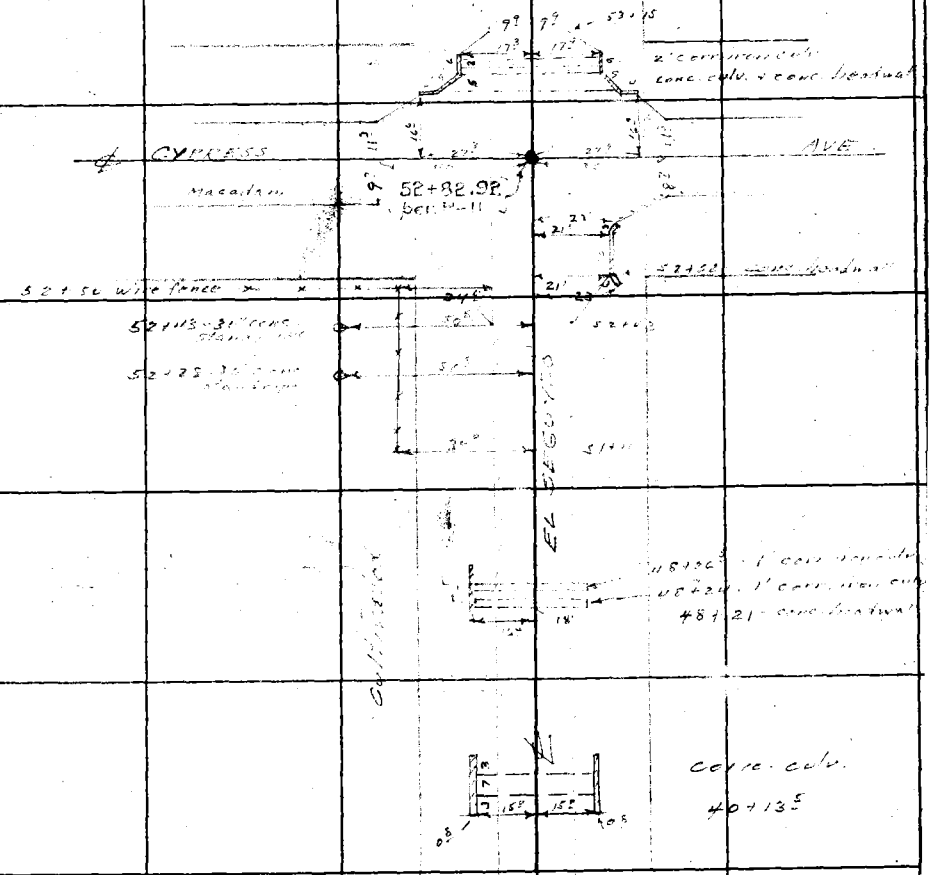

FORM 247 5M 10-37

F.B. 239 PG. 64

Sta	Offset L	Offset R	Size inches			Sta	Offset L	Offset R	Size inches	
51+66	31L		18	Gum	71	+88	21R		36	Palm
+76	"		24	"		+93		30L	18	Gum
+83	"		18	"	72	+116	21R		36	Palm
+91	"		"			+120	"		"	"
52+08	"		"			+130		30L	"	Gum
+12	"		"			+132	21R		"	Palm
+13		11L	"	PP	73	161	"		"	"
+17	31R		24	Gum		+169		30L	"	Gum
+26	"		12	"		+193	21R		"	Palm
+25	"		18	"		+193	24R		"	Fig
+47	"		30	"		+6	22R		36	Palm
+59			12	"		+28		24L	"	Gum
+64		31R		PP		+29				Gum
+04	31R		"		74	+6			"	"
53+20		30L	24	Gum		+6			"	"
+58		28L		Guy P		+74			"	"
+68	24R			PP		+77		24L		Gum
54+15		30L	24	Gum		+80	24R			PP
+27		"	"	"	75	+93	21R		36	Palm
+86		"	"	"		+96		30L	"	Gum
55+25		"	"	"		+53			"	Palm
+41	24R		PP			+76		24L	"	Gum
+67		30L	24	Gum		+81	21R		"	Palm
56+47		"	"	"		+89			"	"
+57	25R		12	"	76	+18			"	"
+93	24R			PP		+20		30L	18	Gum
58+46	"		"	"		+30	24R			PP
+75		30L	24	Gum		+41	21R		36	Palm
59+78		"	30	"		+45			"	"
60+00	24R		PP			+79		36L	12	Gum
+15		30L	30	Gum		+52			"	"
+71		"	"	"		+76			"	Palm
61+26		"	"	"		+84			"	Gum
+51	24R		PP			+83	"		"	"
+78		30L	24	Gum		+64	24R			PP
62+54		"	"	"		+88	30R		36	Palm
+99	24R		PP		77	+22			"	"
63+20		30L	12	Gum		+30		30L	12	Gum
+73		"	"	"		+51	21R		24	Palm
+83		"	30	"		+55		30L	12	"
64+03		"	12	"		+92	21R		36	Palm
+48	24R		PP			+92	46L		12	Gum
+95		30L	18	Gum		+62	50R		36	Palm
65+36		"	"	"	79	+92	78L		"	"
+50			24	"		+30	65R			PP
66+01	21R		36	Palm		+39		30L	12	Gum
+01	24R		PP			+40	24R			PP
+54		30L	36	Gum	80	+47		22R		Tel P
+81		"	18	"		+49		27R	12	Gum
67+10	21R		36	Palm		+93	24R			PP
+37		24L	18	Gum	82	+21		22R		Tel P
+39	21R		36	Palm		+39	41R		2	Lemon
+04	24R		PP			+66	22R		6	Fig
+61		30L	18	Gum		+72	23L		10"	cedar
+81	21R		36	Palm		+80	26R		"	Fig
+98		30L	18	Gum	83	+28	20R		6	"
68+31		"	24	"		+72	27L		"	Palm
+84	24R		PP			+75		22R		Tel P
69+05		30L	48	Gum		+90	24R			PP
+42	21R		36	Palm		+92	27L		6"	Palm
+55		30L	24	Gum		+97	33L		"	Acacia
70+00	21R		24	Palm	84	+02	79L		"	Fig
+28		30L	18	Gum	85	+40		22R		Tel P
+99	21R		36	Palm		+99	24R			PP
+33	24R		PP		86	+72	"			"
+52	21R		36	Palm		+84		22R		Tel P
+57	66R		"	Lemon	87	+34	30		12	Gum
+97		30L	18	Gum	88	+03	24R			PP
71+09	21R		36	Palm		+38		22R		Tel P
+34	"		"	"	89	+53	24R			PP
36		30L	24	Gum		+73	51L		2	Abrona
+59	21R		36	Palm		+91	34R		1	Avacado
+79	24R		PP			+93	70		6	Banana

RETURN TO
LOS ANGELES COUNTY SURVEYOR
700 HALL OF RECORDS

Note: Any Additions or Changes on This Sheets Must be Made or Circled in Red Ink With Date and Name of Person Making Change.

Do not extend notes this side of this line

Notes Ck'd by D. M. Finley	Survey of	F.B.	PG.
Map No. B-1492-1&2	W. O.	Tape No.	St'd OF
Office Work H. U. M. H.	Surveyed by		
Checked D. M. Finley	Notes	Date 2-4-38	
Date Apr. 1941	Indexed		

Note: Any Additions or Changes on This Sheets Must be Made or Circled in Red Ink With Date and Name of Person Making Change.

Do not extend notes this side of this line

RETURN TO
LOS ANGELES COUNTY SURVEYOR
700 HALL OF RECORDS

FORM 247 5M 10-37

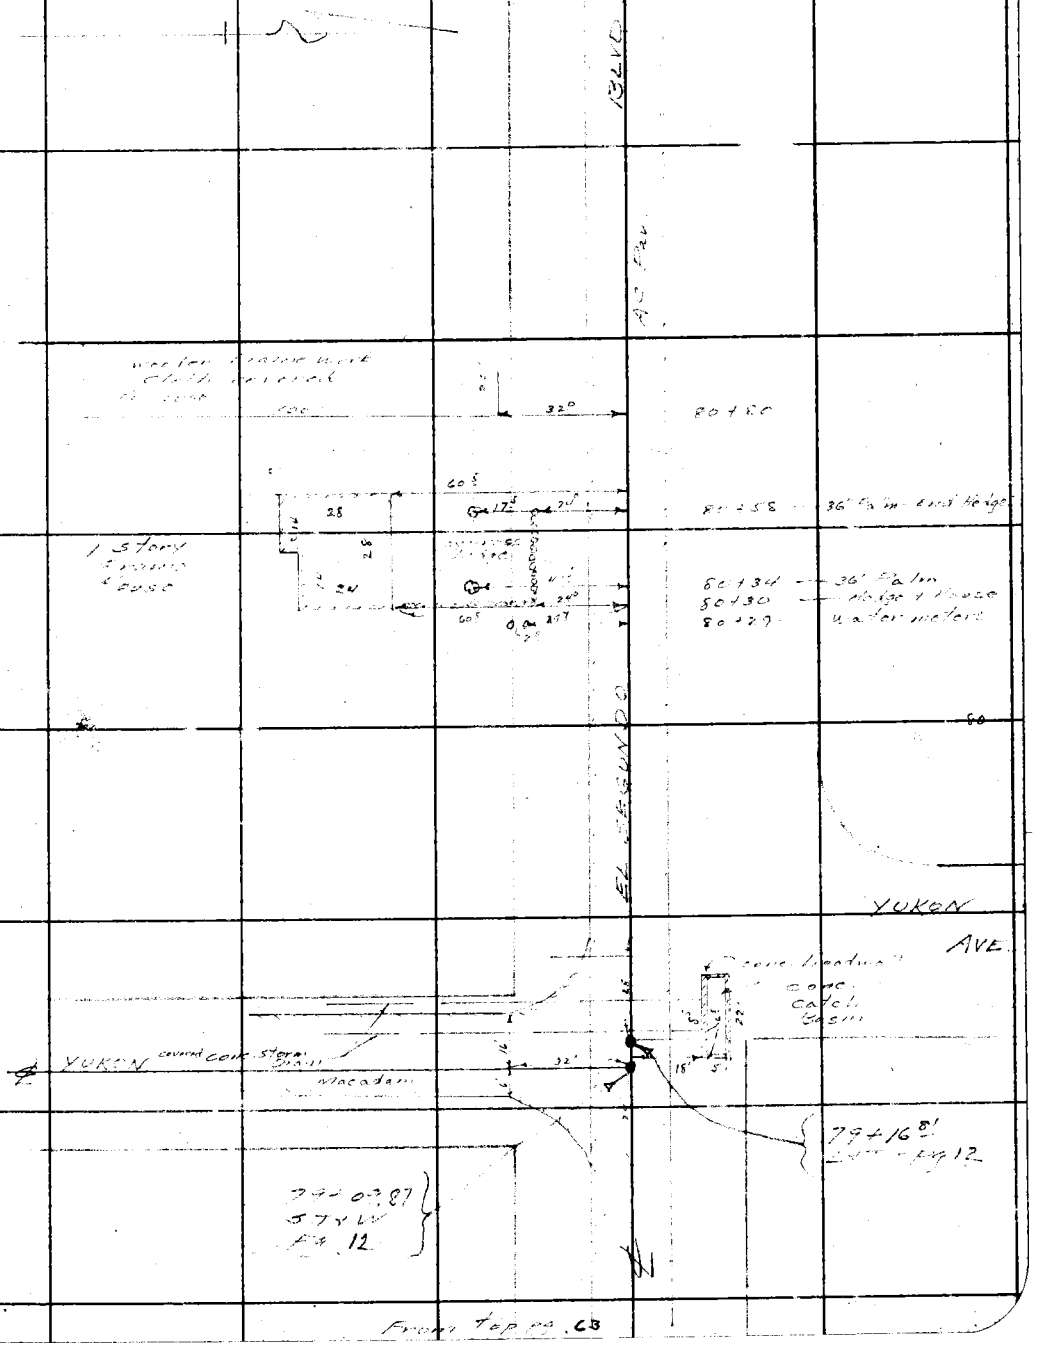

F.B. 739 PG. 66

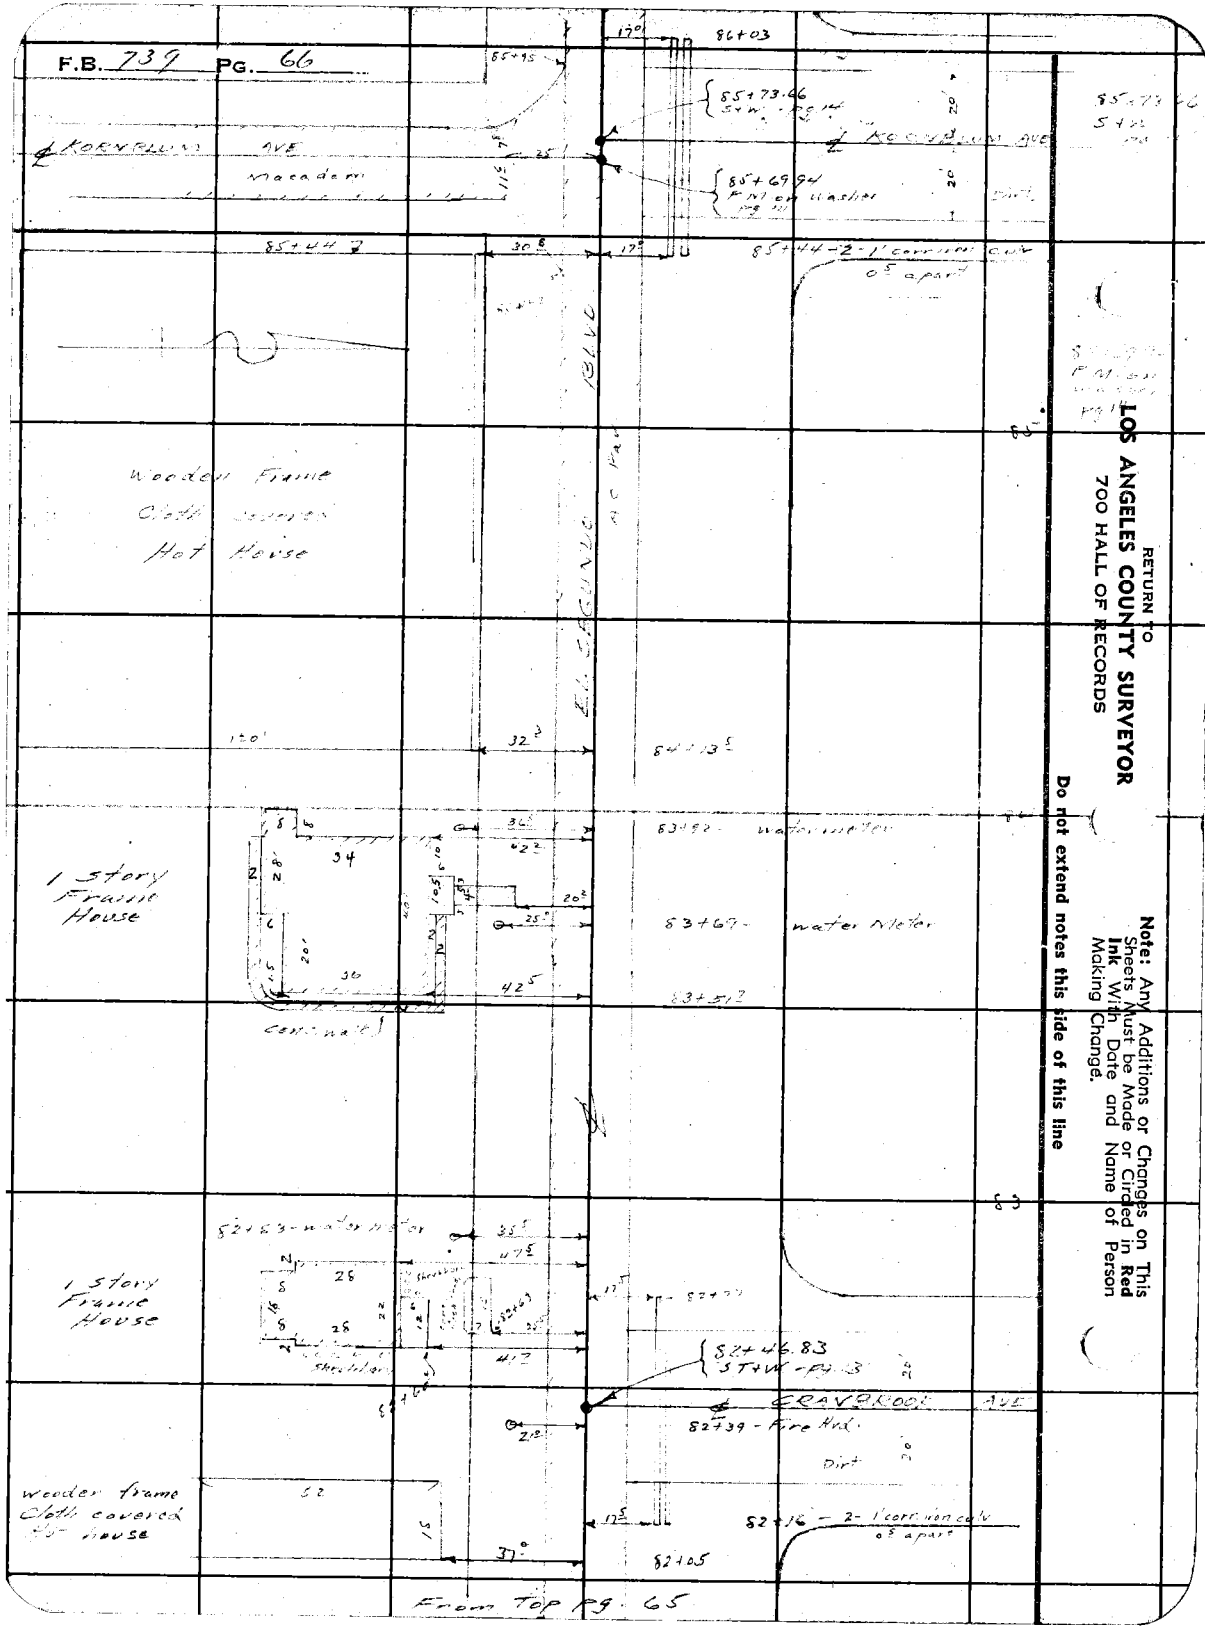

RETURN TO
LOS ANGELES COUNTY SURVEYOR
700 HALL OF RECORDS

Note: Any Additions or Changes on This Sheets Must be Made or Circled in **Red Ink** With Date and Name of Person Making Change.

Do not extend notes this side of this line

Notes Ck'd by D. M. Finley	Survey of [illegible]	F.B. [illegible]	Pg. 67
Map No. B-1492-2	W. O. 8[illegible] Tape No.	St'd	°F
Office Work H. U. M. H.	Surveyed by [illegible]		
Checked D. M. Finley	Notes [illegible] Date		
Date Apr. 1941	Indexed		

[illegible] to bottom pg. 65

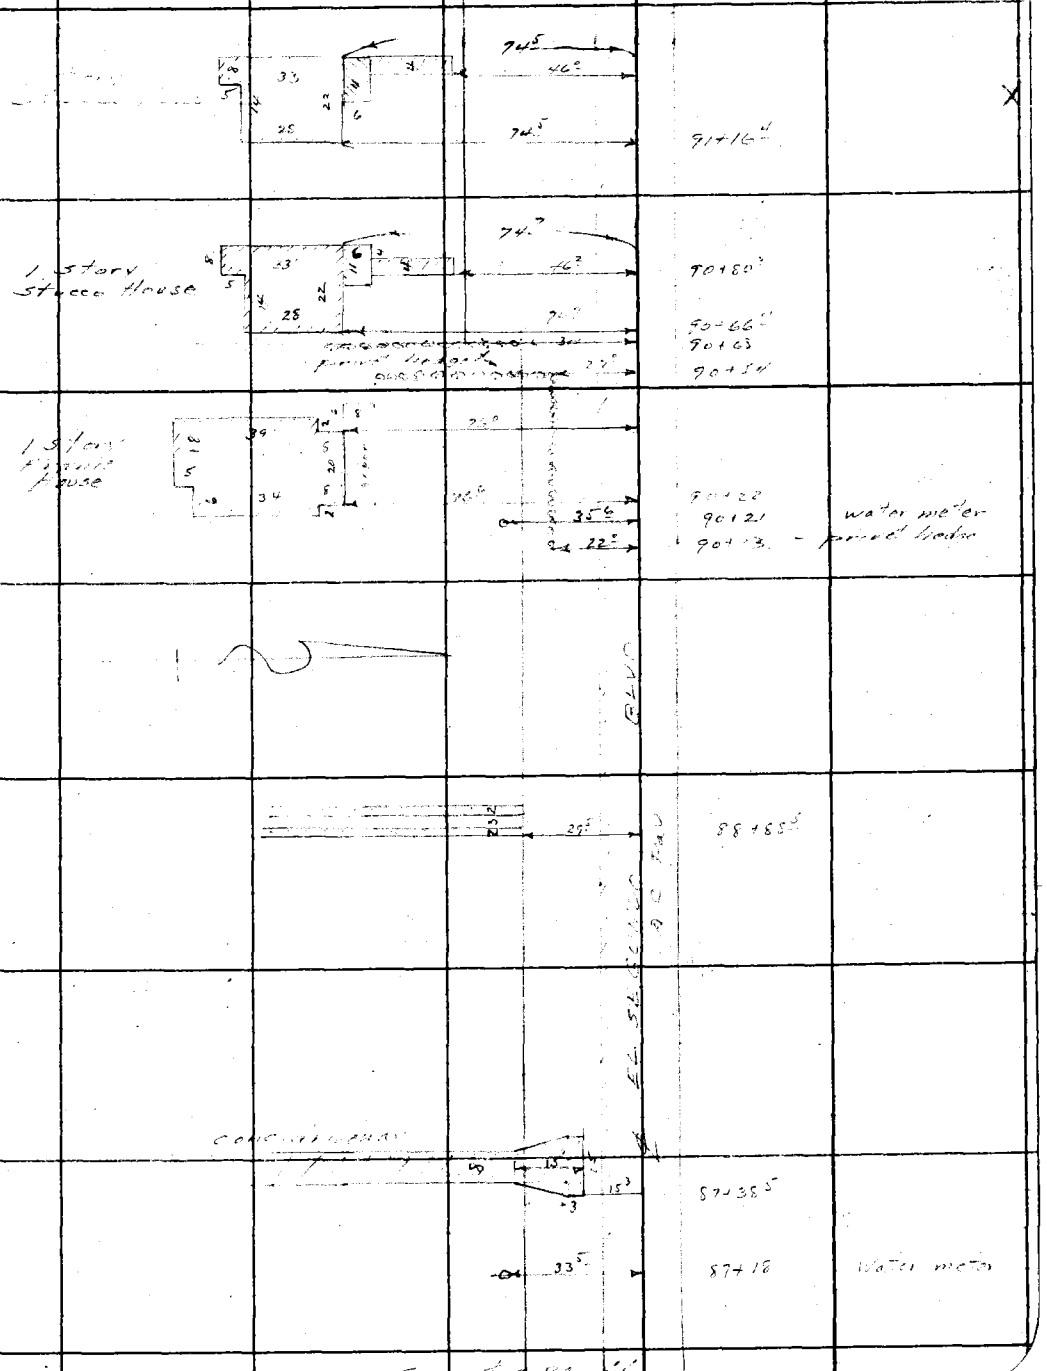

Note: Any Additions or Changes on This Sheets Must be Made or Circled in Red Ink With Date and Name of Person Making Change.

Do not extend notes this side of this line

RETURN TO
LOS ANGELES COUNTY SURVEYOR
700 HALL OF RECORDS

FORM 247 SM 10-37

From top pg. 66

F.B. 739 PG. 68

Sta	OFFSET L	OFFSET R	Size inches		Sta	OFFSET L	OFFSET R	Size inches	
89+99		22°		Tel P	97+13		31⅝	24	Gum
90+13	28⅝		3	Castor bean	+15		"	12	"
+13	35⅝		3	Almond	+25		"	24	"
+13	50°		6	Almond	+34		"	"	"
+13	69°		3	Avocado	+37		"	"	"
+25		20⅝	4	Gum	+43		"	12	"
+27	29°		4	Fir	+49		"	24	"
+45	37°		3	Orange	+57		"	12	"
+65	30°		18	Gum	+62		"	"	"
+91	24°			PP	+69		"	"	"
91+64		22°		Tel P	+78		"	"	"
92+47	24°			PP	+96		"	"	"
92+4		31⅝	12	Gum	+98		"	"	"
+48		"	24	"	98+02		"	"	"
+58		"	"	"	+07		"	24	"
+62		"	"	"	+16		"	"	"
+71		"	"	"	+28		"	"	"
+87		"	"	"	+32		22°		Tel P
+91		"	"	"	+41		31⅝	18	Gum
+96		"	"	"	+46		"	"	"
93+02		"	"	"	+50		"	12	"
+18		"	"	"	+55		"	24	"
+24		"	"	"	+62	24°			PP
+34		"	"	"	+68		31⅝	12	Gum
+39		22°		Tel P	+82		"	"	"
+46		31⅝	24	Gum	+97		"	30	"
+51		"	"	"	99+05		"	"	"
+71		"	"	"	+76	24°			PP
+88		"	"	"	+99		22°		Tel P
+90	42°		6	Fir	100+39		31⅝	48	Gum
+93	31⅝		24	Gum	+50		"	36	"
+95	24°			PP	+56	24°			PP
94+05	24°			PP	101+07		31⅝	18	Gum
+07		31⅝	24	Gum	+16		"	24	"
+15		"	"	"	+72		22°		Tel P
+23		"	"	"	+95		31⅝	24	Gum
+28	28°		3	Acacia	+96	24°			PP
+32		31⅝	24	Gum	102+06				PP
+37		"	"	"	+09		31⅝	12	Gum
+49		"	12	"	+15		"	18	"
+54		"	"	"	+18		"	"	"
+62		"	"	"	+38		"	30	"
+65		"	24	"	+53		"	"	"
+81		"	36	"	+69		"	18	"
+85	28°		3	Acacia	+73		"	12	"
+93		31⅝	24	Gum	+79		"	"	"
+99		"	"	"	+83	19⅞			PP
95+04		"	"	"	+84		31⅝	12	Gum
+08		"	"	"	+91		"	"	"
+10		22°		Tel P		Note:	L.S. =	Cast iron	
+12		31⅝	24	Gum				Light Standard	
+17		"	"	"					
+20		"	"	"	103+00		19⅞		L.S.
+28		"	6	"	+06		31⅝	12	Gum
+35		"	36	"	+14		"	18	"
+57	24°			PP	+22		"	12	"
96+16		31⅝	36	Gum	+36		19⅞		Tel P
+23		"	12	"	+38		31⅝	12	Gum
+38		"	24	"	+60		"	24	"
+42		"	"	"	+63		"	"	"
+52		"	"	"	+82		"	18	"
+59		"	12	"	+87		"	"	"
+62		"	"	"	+98		"	"	"
+66		"	"	"	104+11	19⅞			L.S.
+67		32°		Tel P	+20		31⅝	24	Gum
+74		31⅝	12	Gum	+39	19⅞			PP
+77		"	"	"	+54		31⅝	18	Gum
+89	28°		3	Acacia	+61		"	"	"
+90		31⅝	24	Gum	+70		"	"	"
+95		"	"	"	+83		19⅞		Tel P
97+08		"	"	"	+88		31⅝	18	Gum
+10	24°			PP	105+03		"	24	"

RETURN TO
LOS ANGELES COUNTY SURVEYOR
700 HALL OF RECORDS

Note: Any Additions or Changes on This Sheets Must be Made or Circled in **Red Ink** With Date and Name of Person Making Change.

Do not extend notes this side of this line

Notes Ck'd by D. M. Finley	Survey of		F.B. 73 Pg. 6a
Map No. B-1492-2	W. O. 820	Tape No.	St'd OF
Office Work H U M H	Surveyed by	Moore	
Checked D. M. Finley	Notes	Moore Date	2-4-38
Date Apr. 1941	Indexed		

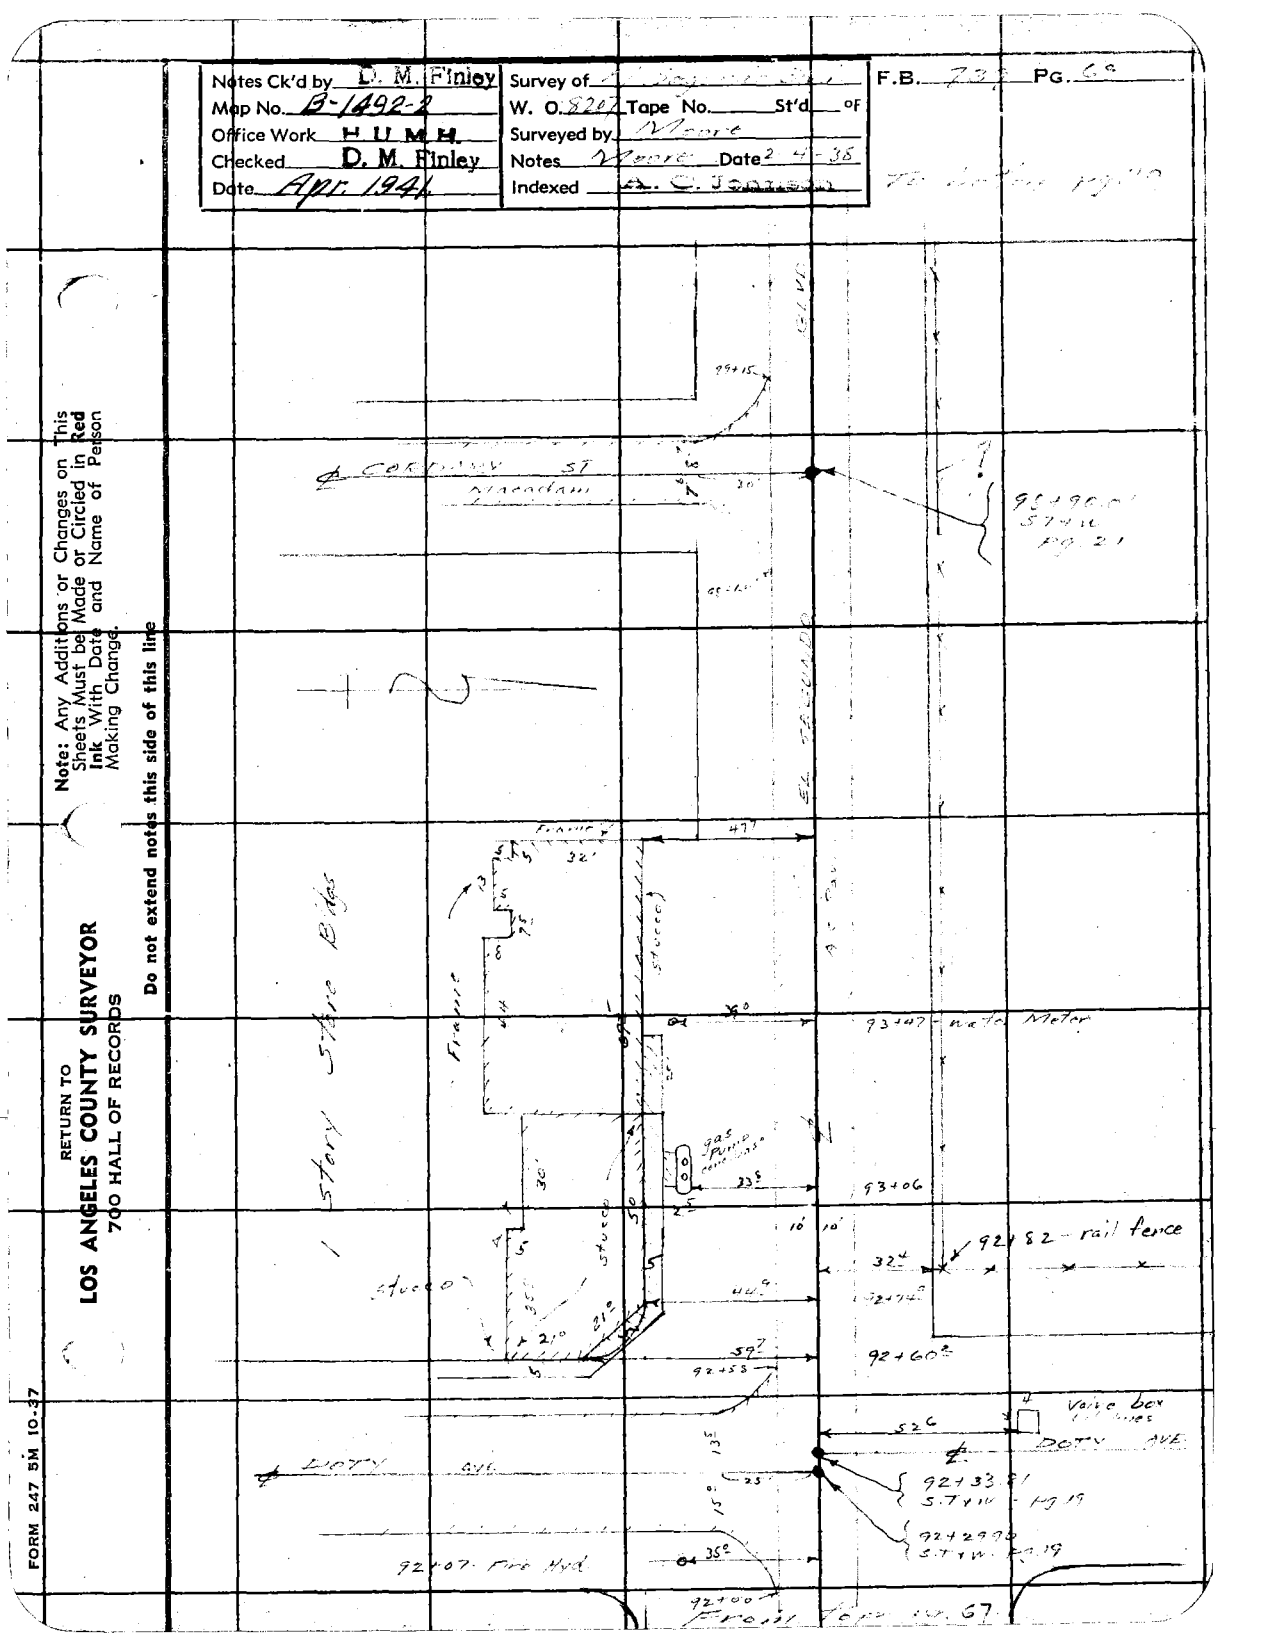

Note: Any Additions or Changes on This Sheets Must be Made or Circled in Red Ink With Date and Name of Person Making Change.

Do not extend notes this side of this line

RETURN TO
LOS ANGELES COUNTY SURVEYOR
700 HALL OF RECORDS

FORM 247 5M 10-37

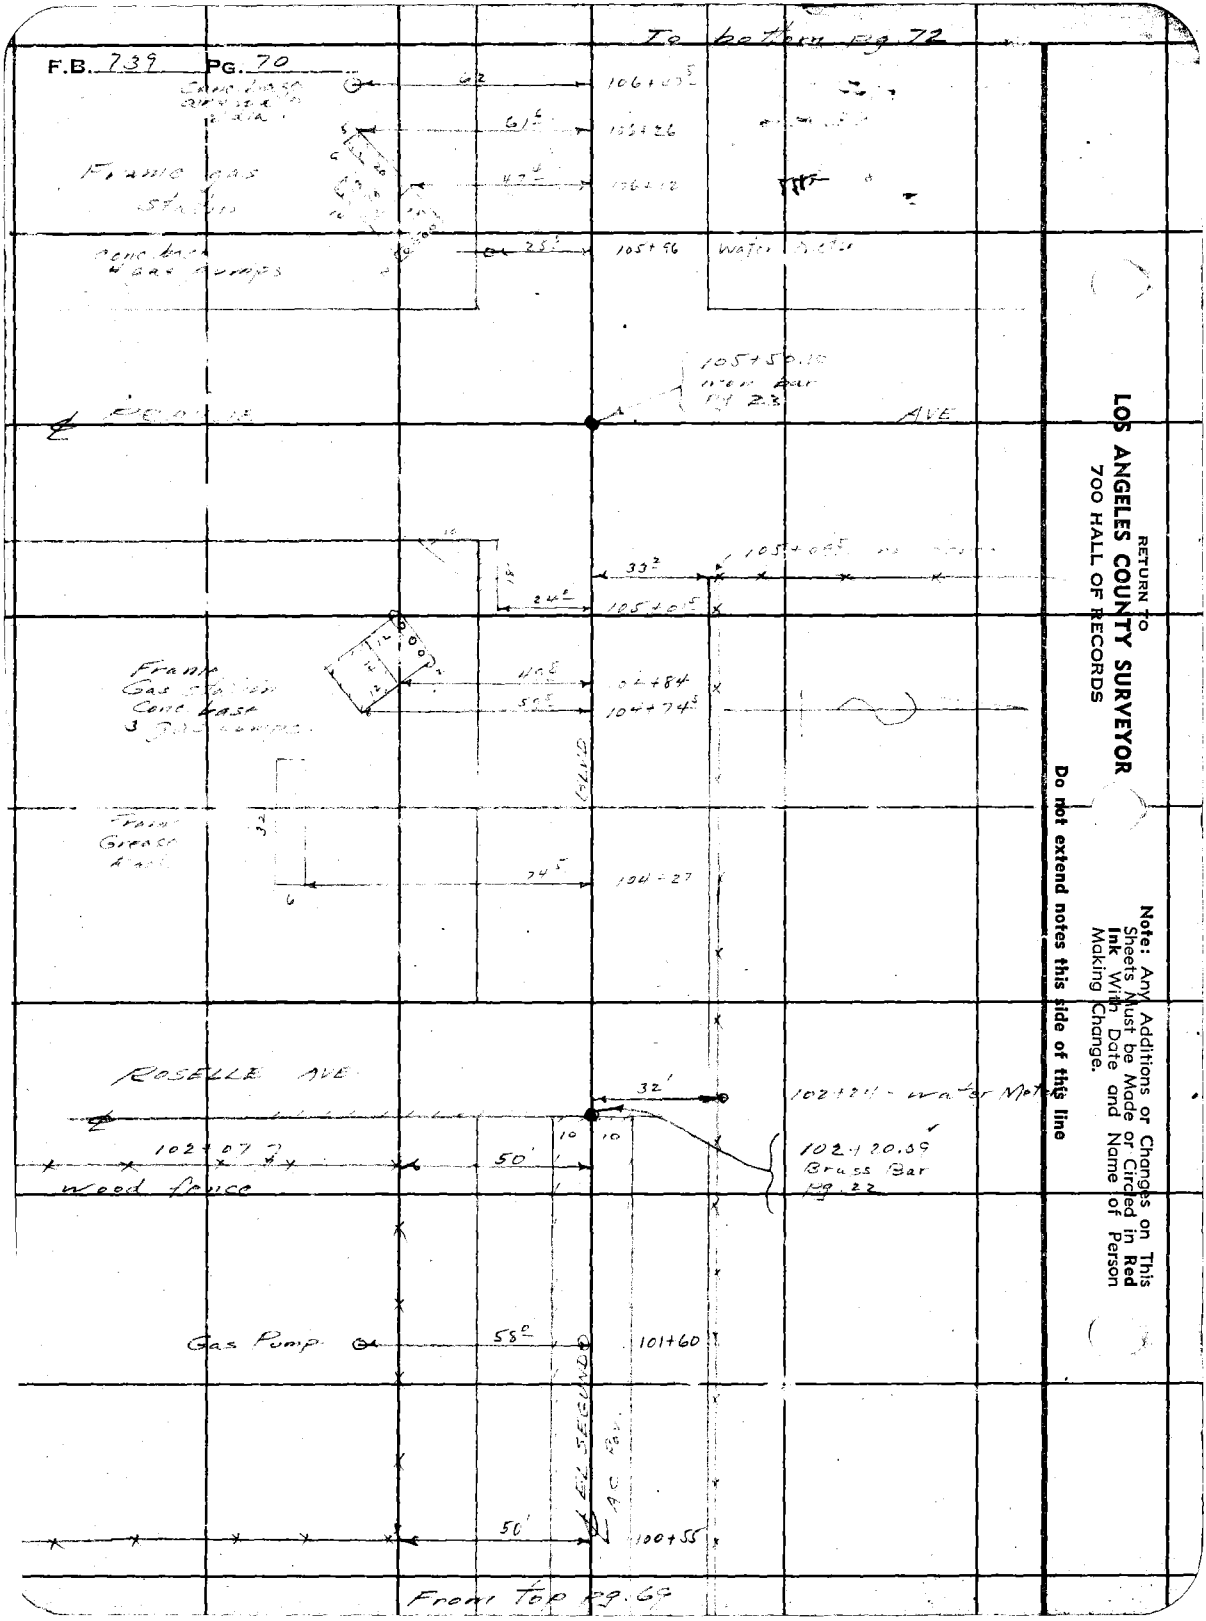

RETURN TO
LOS ANGELES COUNTY SURVEYOR
700 HALL OF RECORDS

Note: Any Additions or Changes on This Sheets Must be Made or Circled in **Red Ink** With Date and Name of Person Making Change.

Do not extend notes this side of this line

Notes Ck'd by D. M. Finley
Map No. B-1492-2
Office Work H. U. M. H.
Checked D. M. Finley
Date Apr. 1944

Survey of
W. O. 820 Tape No. St'd OF
Surveyed by
Notes Date
Indexed

F.B. PG.

Note: Any Additions or Changes on This Sheets Must be Made or Circled in Red Ink With Date and Name of Person Making Change.

Do not extend notes this side of this line

RETURN TO
LOS ANGELES COUNTY SURVEYOR
700 HALL OF RECORDS

FORM 247 5M 10-37

F.B. 739 PG. 72

To Bk. 739 Pg. 73

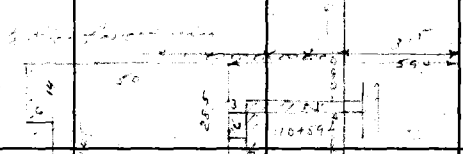

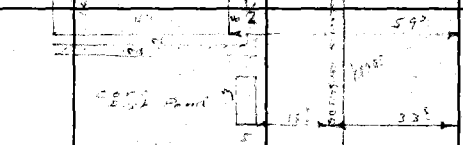

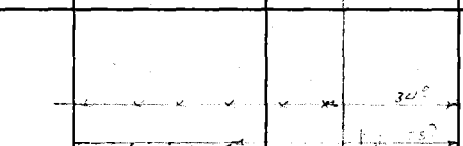

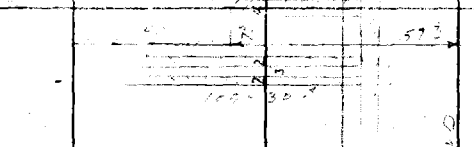

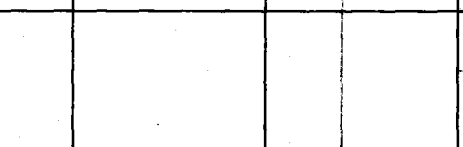

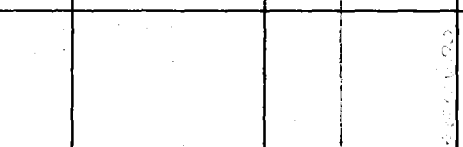

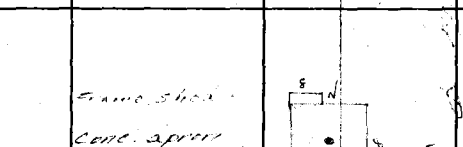

To Bk. 739 Pg. 70

RETURN TO
LOS ANGELES COUNTY SURVEYOR
700 HALL OF RECORDS

Note: Any Additions or Changes on This Sheets Must be Made or Circled in **Red Ink** With Date and Name of Person Making Change.

Do not extend notes this side of this line

Notes Ck'd by D. M. Finley	Survey of [illegible]	F.B. [illegible]	PG. [illegible]
Map No. B-1492-2	W. O. 8207 Tape No. St'd °F.		
Office Work H. U. M. H.	Surveyed by [illegible]		
Checked D. M. Finley	Notes [illegible] Date [illegible]		
Date Apr. 1946	Indexed A. C. Johnson		

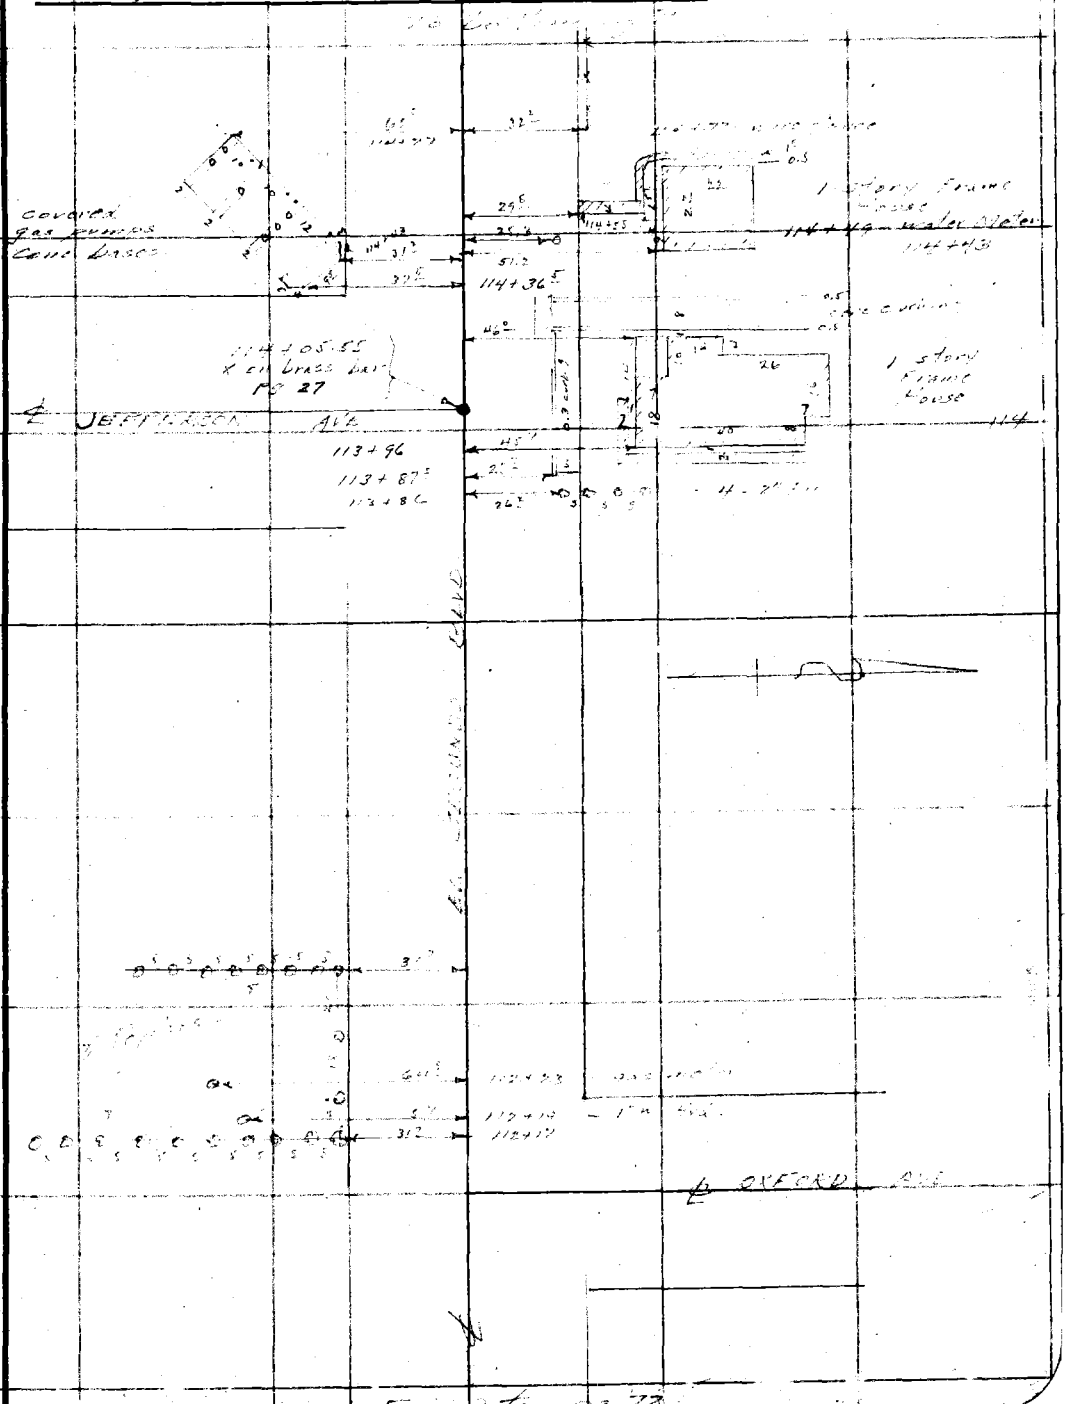

Note: Any Additions or Changes on This Sheet Must be Made or Circled in Red Ink With Date and Name of Person Making Change.

Do not extend notes this side of this line

RETURN TO
LOS ANGELES COUNTY SURVEYOR
700 HALL OF RECORDS

FORM 247 10M 11-45

F.B. 739 PG. 141

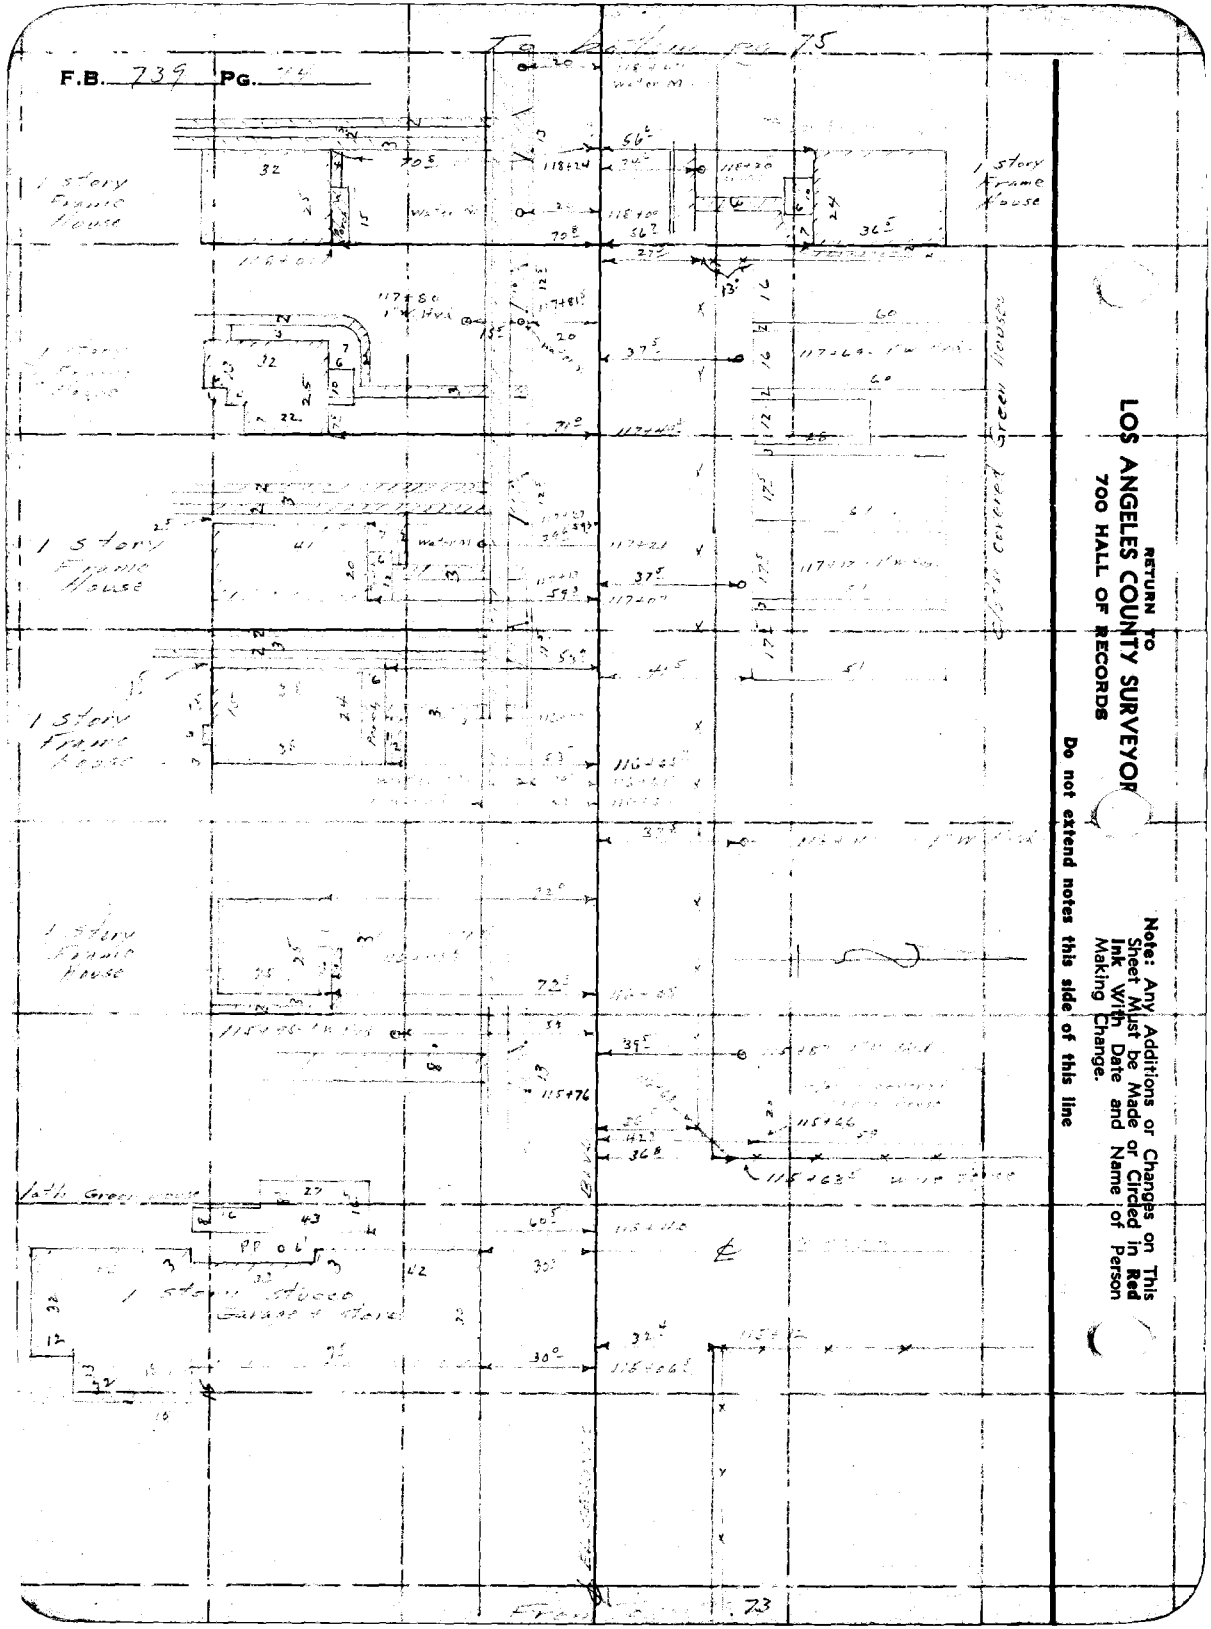
1 Story Frame House
1 Story Frame House
1 Story Frame House
1 Story Frame House
1 Story Frame House
Wall on M
Wall on M
Wall on M

Notes Ck'd by D. M. Finley	Survey of Laguna Land
Map No. B-1492-2	W. O. 8207 Tape No. St'd °F.
Office Work H. U. M. H.	Surveyed by Moore
Checked D. M. Finley	Notes Moore Date 2-14-36
Date Apr. 1941	Indexed A. C. Johnson

F.B. 732 PG. 20

Note: Any Additions or Changes on This Sheet Must be Made or Circled in Red Ink With Date and Name of Person Making Change.

Do not extend notes this side of this line

RETURN TO
LOS ANGELES COUNTY SURVEYOR
7oo HALL OF RECORDS

FORM 247 10M 11-35

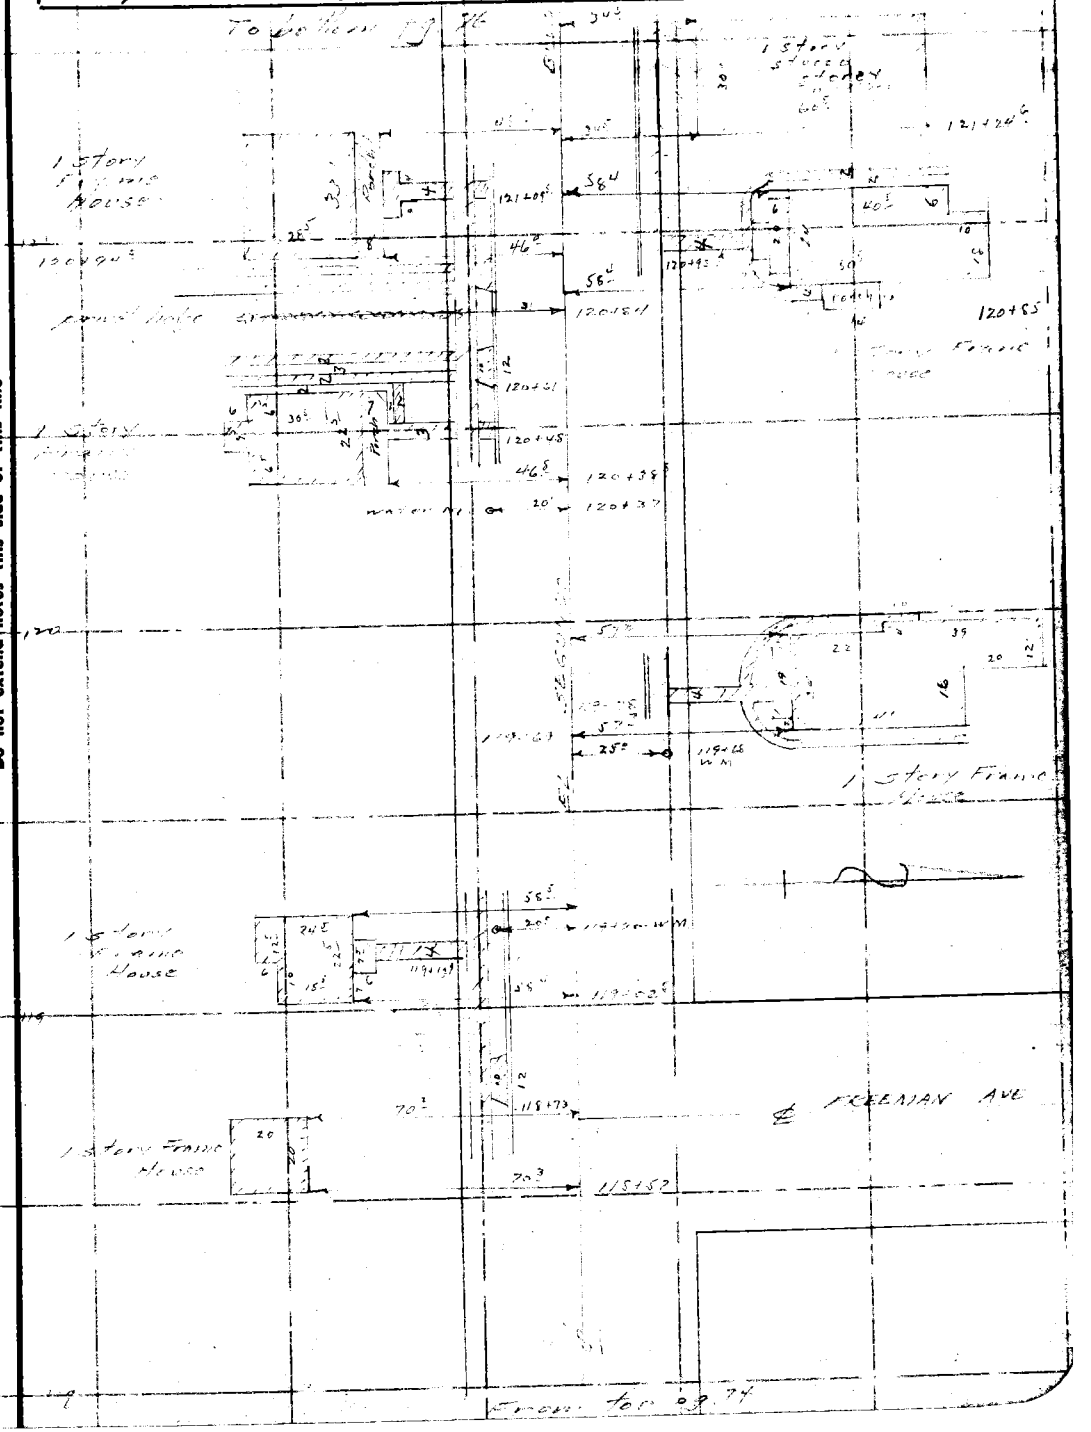

RETURN TO
LOS ANGELES COUNTY SURVEYOR
700 HALL OF RECORDS

Note: Any Additions or Changes on This Sheet Must be Made or Circled in **Red Ink** With Date and Name of Person Making Change.

Do not extend notes this side of this line

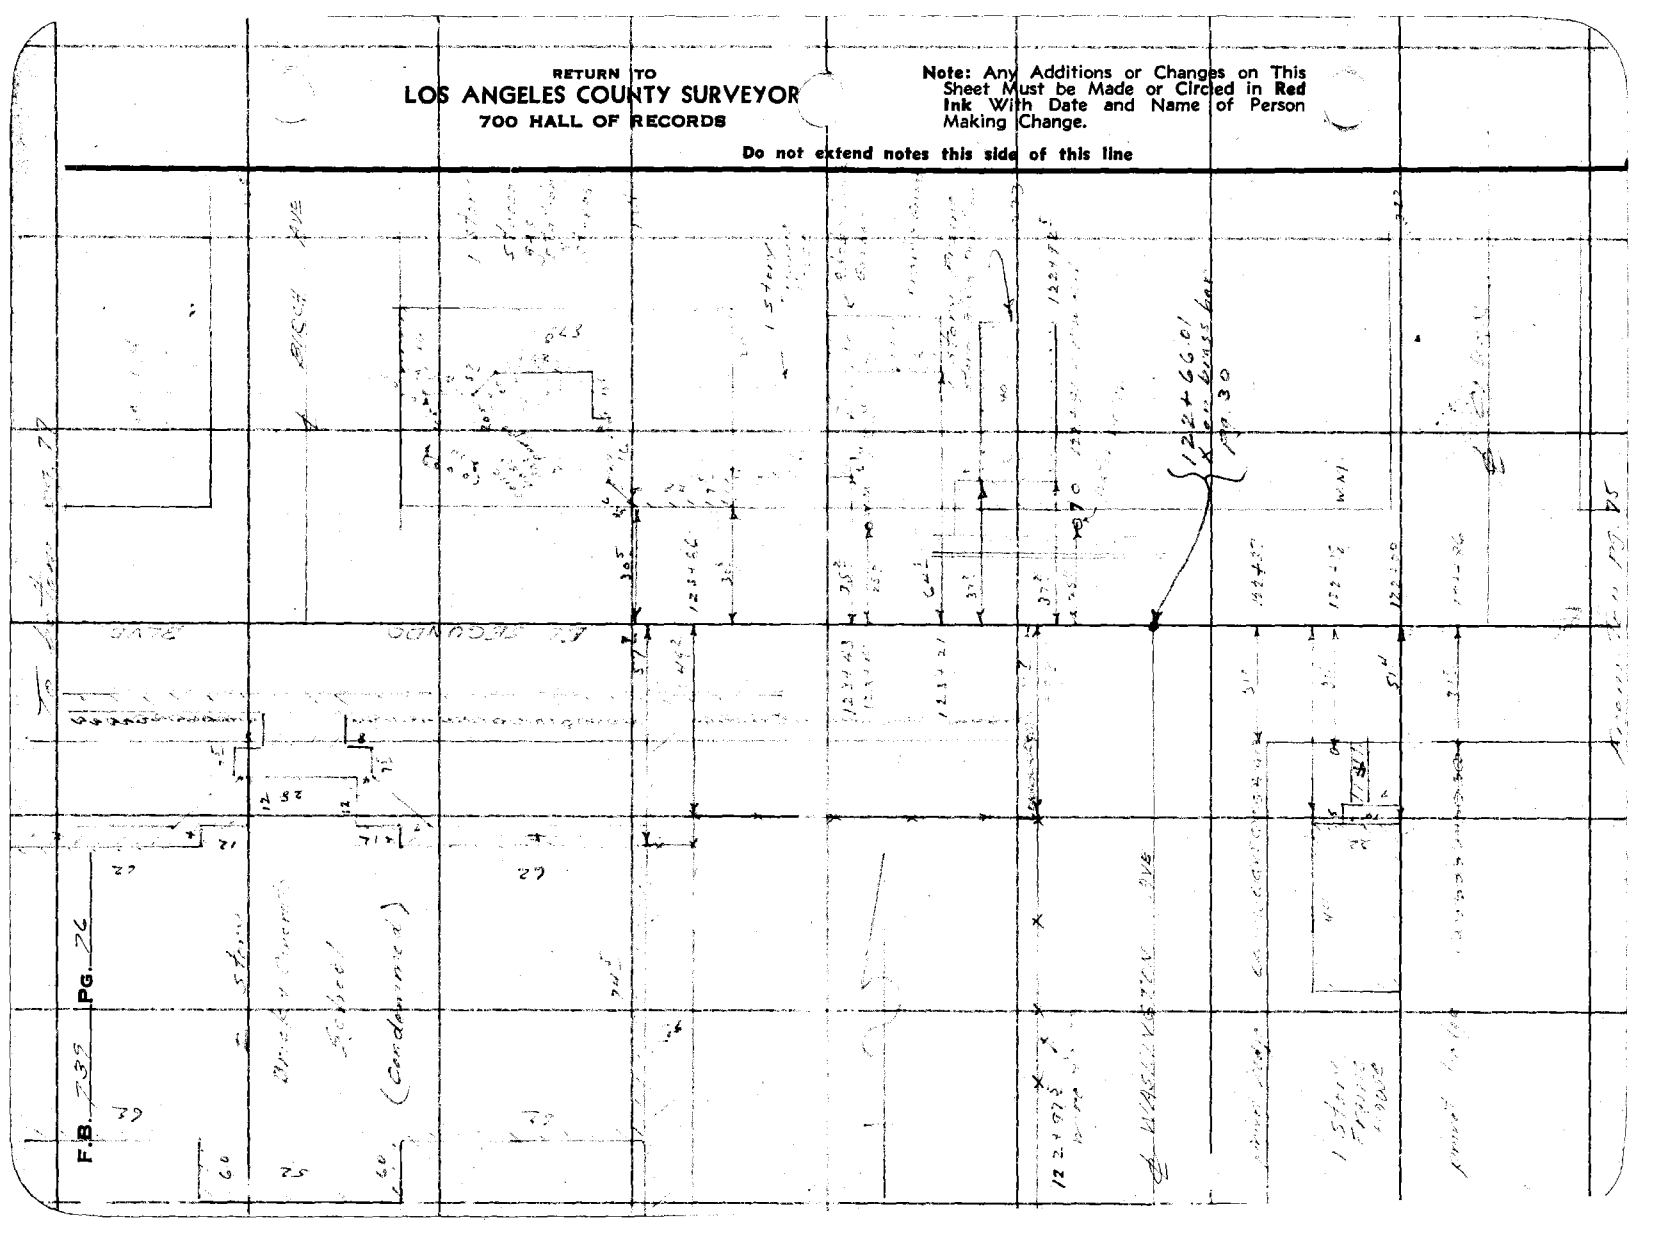

FORM 247 10M 11-35

RETURN TO
LOS ANGELES COUNTY SURVEYOR
700 HALL OF RECORDS

Note: Any Additions or Changes on This Sheet Must be Made or Circled in Red Ink With Date and Name of Person Making Change.

Do not extend notes this side of this line

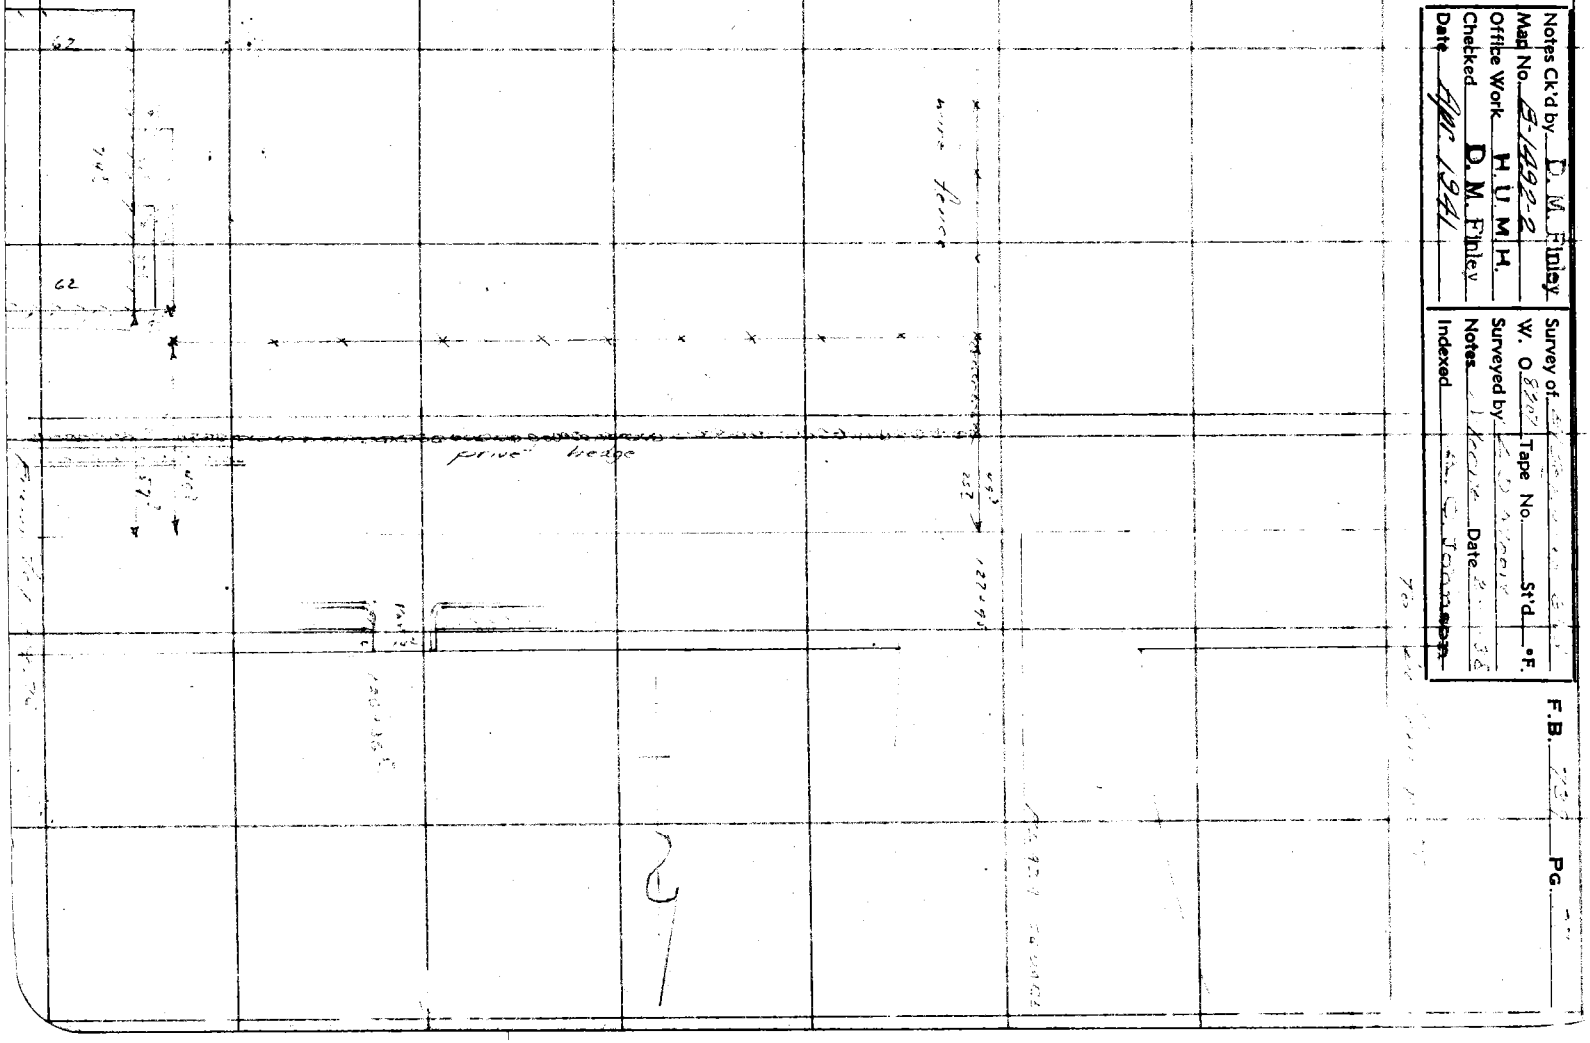

Notes Ck'd by D. M. Finley

Surveyed by
Notes
Indexed

Tape No. St'd. °F.
Date

F.B. PG.

F.B. 239 PG. 28

To Victoria pg 80

RETURN TO
LOS ANGELES COUNTY SURVEYOR
700 HALL OF RECORDS

Note: Any Additions or Changes on This Sheet Must be Made or Circled in Red Ink With Date and Name of Person Making Change.

Do not extend notes this side of this line

1 Story
Brick & Conc.

Stores

1 Story
Concrete
Store

131 + 90.12
2" Brass Cap
pg 34

Found Tack pg. 77

Notes Ck'd by D. M. Finley	Survey of	F.B.	PG.
Map No. B-1492-2&3.	W. O.	Tape No.	St'd °F.
Office Work H.U.M.H.	Surveyed by		
Checked D. M. Finley	Notes	Date 2-14-38	
Date Apl. 1941	Indexed		

Note: Any Additions or Changes on This Sheet Must be Made or Circled in Red Ink With Date and Name of Person Making Change.

Do not extend notes this side of this line

RETURN TO
LOS ANGELES COUNTY SURVEYOR
700 HALL OF RECORDS

Sta	Offset L	Offset R	Size Species		Sta	Offset L	Offset R	Size Species	
128+27		45	4	Palm	146+05	19			L.S.
+29		72	"	"	+07.5	"			Fire Hyd
+41	19			Fire Hyd	+16.5		55	6	Fig
+96	"			L.S.	+36		"	10	"
129+51		19		PP	+74		18		PP
130+20	"			L.S.	147+05	53		3	Fir
+66				PP	+34	51		"	"
131+02	19			L.S.	+62	51.5		10	camphor
+08		29		"	+75	35.5		12	Palm
+69		33		PP	+82	52		24	Pine
+88		31		PP	148+04.5	36.5		12	Palm
132+64.5	19			L.S.	+08	52.5		24	Pine
+70		29		"	+19	32		12	Palm
+81		19		PP	+19		19		L.S.
+89	19			Fire Hyd	+26	52		6	Camphor
133+77				L.S.	+26	71.5		12	Acacia
134+27.5		19		PP	+50	19			L.S.
+53		78		"	+57		72.5	6	Peach
135+02		24		Hydrant	+87		50	"	"
+04		24			149+68.5		19		PP
+41		30	8	Fig	+95		45	12	Palm
+71		52	"	"	150+05		19		L.S.
+83	19			L.S.	+24		"		PP
+96		19		PP	+50	19			LS.
136+52		"		L.S.	151+45		19		"
+67.5		65	3	Pepper	+53	24			Guy P
+84		30		Water M	+53		31		"
137+19.5		19		PP	+70	19			L.S.
+57.5	19			L.S.	+87		34	2	Pine
138+21.5		19		"	+87		39	24	Palm
+45	19			"	+87		42	6	Fir
+69.5		53		Tel P	+87		54.5	3	Acacia
+73	19			Fire Hyd	+87		60.5	2	Fir
+81.5		19		PP	+87		63		PP
139+47.5		"		L.S.	+87		76.5	4	Fir
140+54	19			"	+97		31	12	Pepper
+63.5		19		PP	152+01		19		PP
141+09	24			W.M.	+07.5		31	4	Palm
+47.5		67	6	Palm	+09.5	19			Fire Hyd
+47.5		71	"	"	+36		30	3	Bush
+47.5		75	"	"	+43		70	6	Fig
+52.5		19		L.S.	+45		30	8	Fir
+76.5	19			"	+45	38		4	Pine
+81	24.5			W.M.	+71		19		L.S.
142+04	24		18	Fir	+81	36.5		6	Acacia
+04	36		6	"	153+08	38.5		6	Pine
+04		19		PP	+30		30	3	Cedar
+34		73	2	Fig	+32		"	"	"
+49.5		24		W.M.	+41			"	"
+58		58	6	Tree	+57			"	"
+68		43	12	Peach	154+61.5		19		PP
+91		19		L.S.	+70	19			L.S.
143+79.5		"		PP	+75		30	2	cedar
144+02	19			L.S.	+79		"	"	"
+80.5		19		"	+87		"	"	"
145+08	19			"	+95		"	"	"
+30		56		PP	+97		"	"	"
+43.5		19		PP	155+04		"	"	"
+62		55	4	Guy P	+57		"	"	"
+70	49			PP	+69		"	"	"
+83.5		55	12	Fig	+14		"	"	"
+84.5		19		L.S.	+21		"	"	"
+99	47			Guy P	+73		"	"	"
146+01		55	6	Fig	+70		19		L.S.
+01		74.5	6	Pedal	+77		36	"	Cedar

FORM 247 10M 11-35

To bottom pg 81

F.B. 739 PG. 80

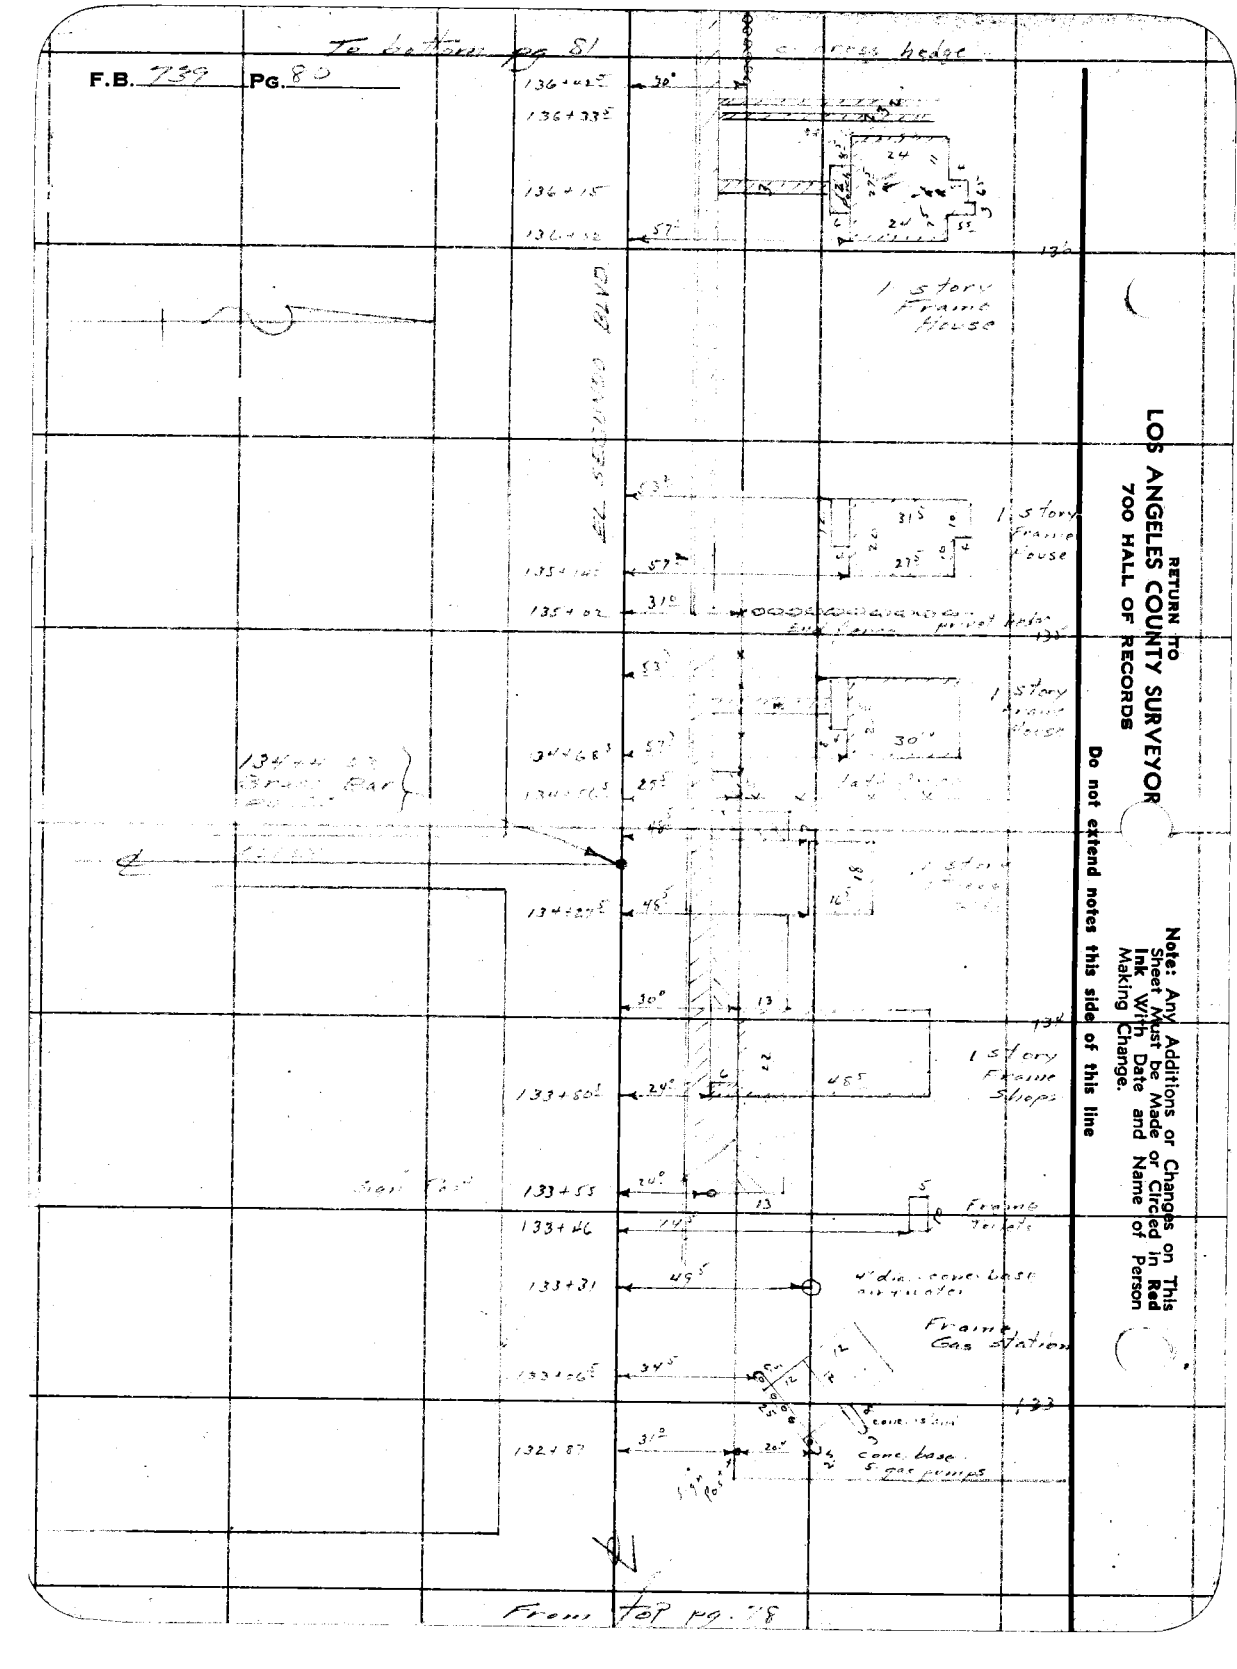

RETURN TO
LOS ANGELES COUNTY SURVEYOR
700 HALL OF RECORDS

Do not extend notes this side of this line

Note: Any Additions or Changes on This Sheet Must be Made or Circled in Red Ink With Date and Name of Person Making Change.

Notes Ck'd by D. M. Finley	Survey of	F.B.	PG.
Map No. B-1492-2	W. O. 8207	Tape No.	St'd °F.
Office Work H. U. M. H.	Surveyed by		
Checked D. M. Finley	Notes	Date	
Date Apr. 1941	Indexed		

Note: Any Additions or Changes on This Sheet Must be Made or Circled in Red Ink With Date and Name of Person Making Change.

Do not extend notes this side of this line

RETURN TO
LOS ANGELES COUNTY SURVEYOR
700 HALL OF RECORDS

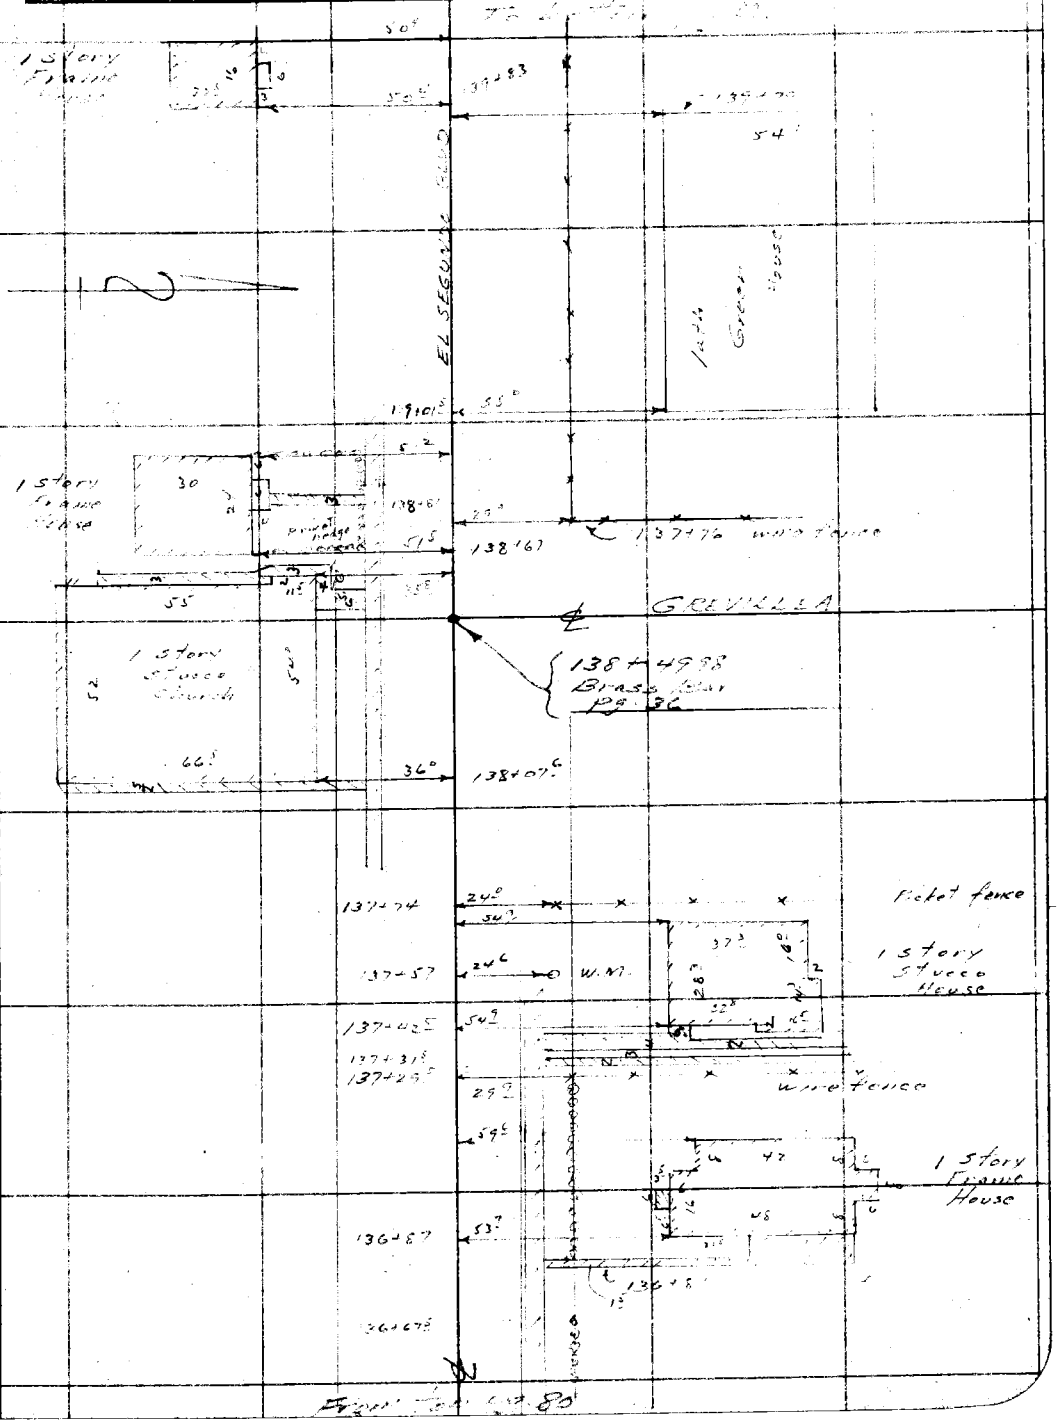

FORM 247 10M 11-55

F.B. 239 Pg. 82

To Bottom pg 83

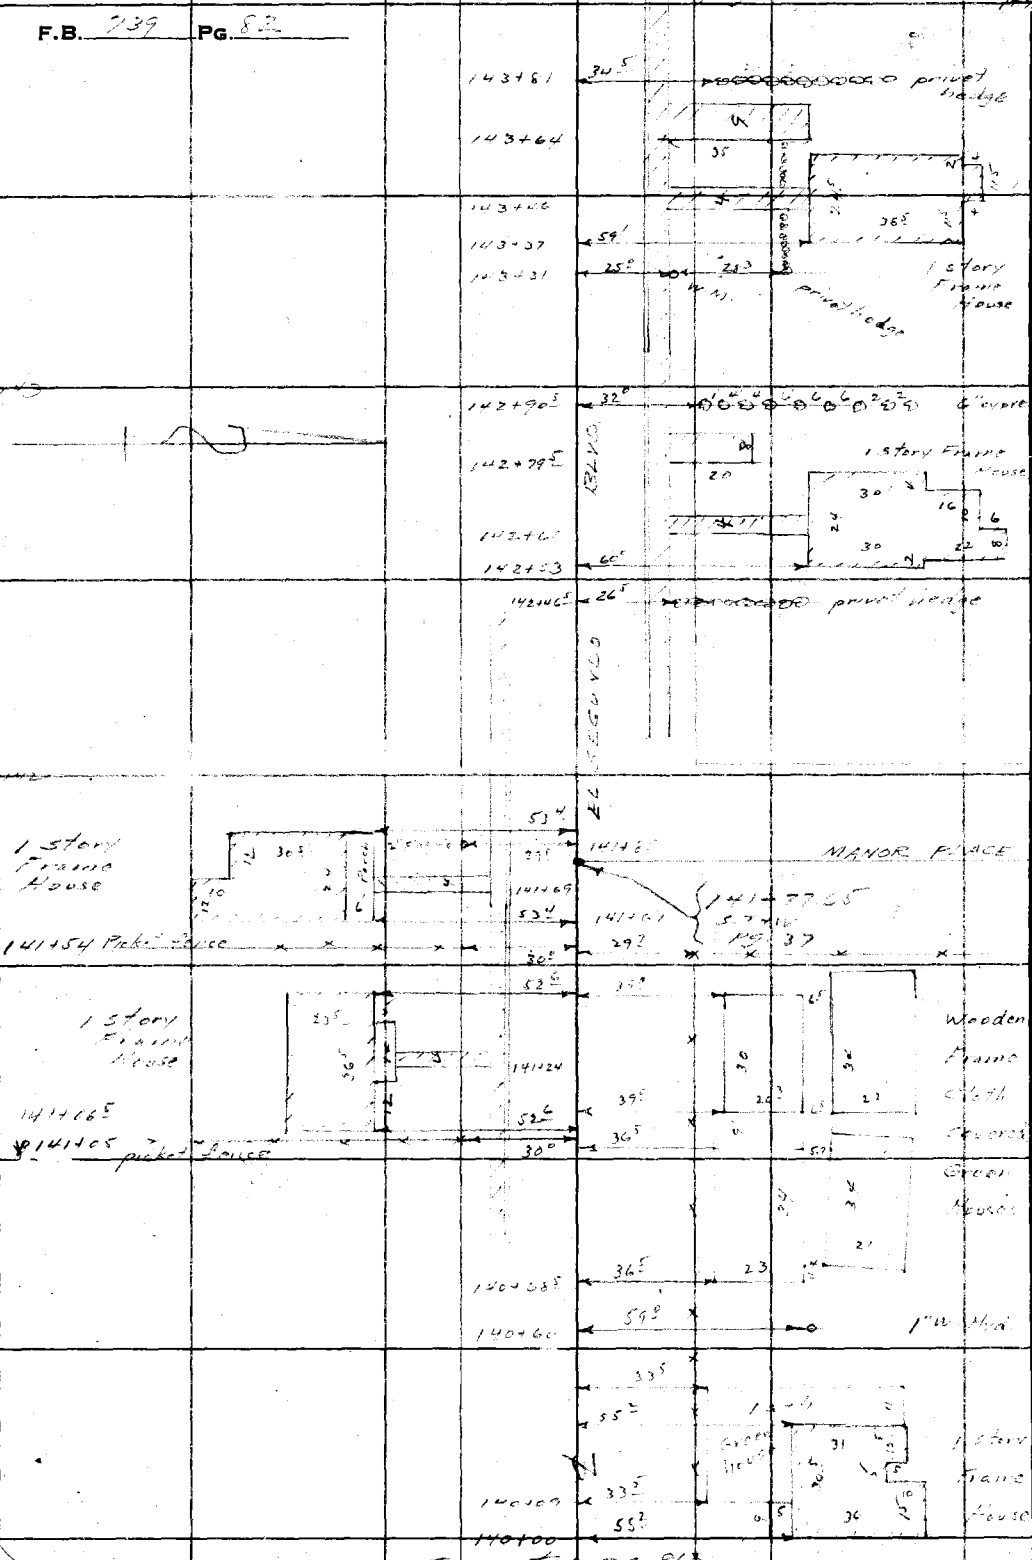

From Top pg 81

RETURN TO
LOS ANGELES COUNTY SURVEYOR
700 HALL OF RECORDS

Do not extend notes this side of this line

Note: Any Additions or Changes on This Sheet Must be Made or Circled in Red Ink With Date and Name of Person Making Change.

Notes Ck'd by D. M. Finley	Survey of	F.B.	Pg.
Map No. B-1492-2	W. O. 825 Tape No.	St'd.	OF
Office Work H. U. M. H.	Surveyed by		
Checked D. M. Finley	Notes	Date 2-16-38	
Date Apr 1941	Indexed A. C. Johnson		

Note: Any Additions or Changes on This Sheets Must be Made or Circled in Red Ink With Date and Name of Person Making Change.

Do not extend notes this side of this line

RETURN TO
LOS ANGELES COUNTY SURVEYOR
700 HALL OF RECORDS

FORM 247 5M 10-37

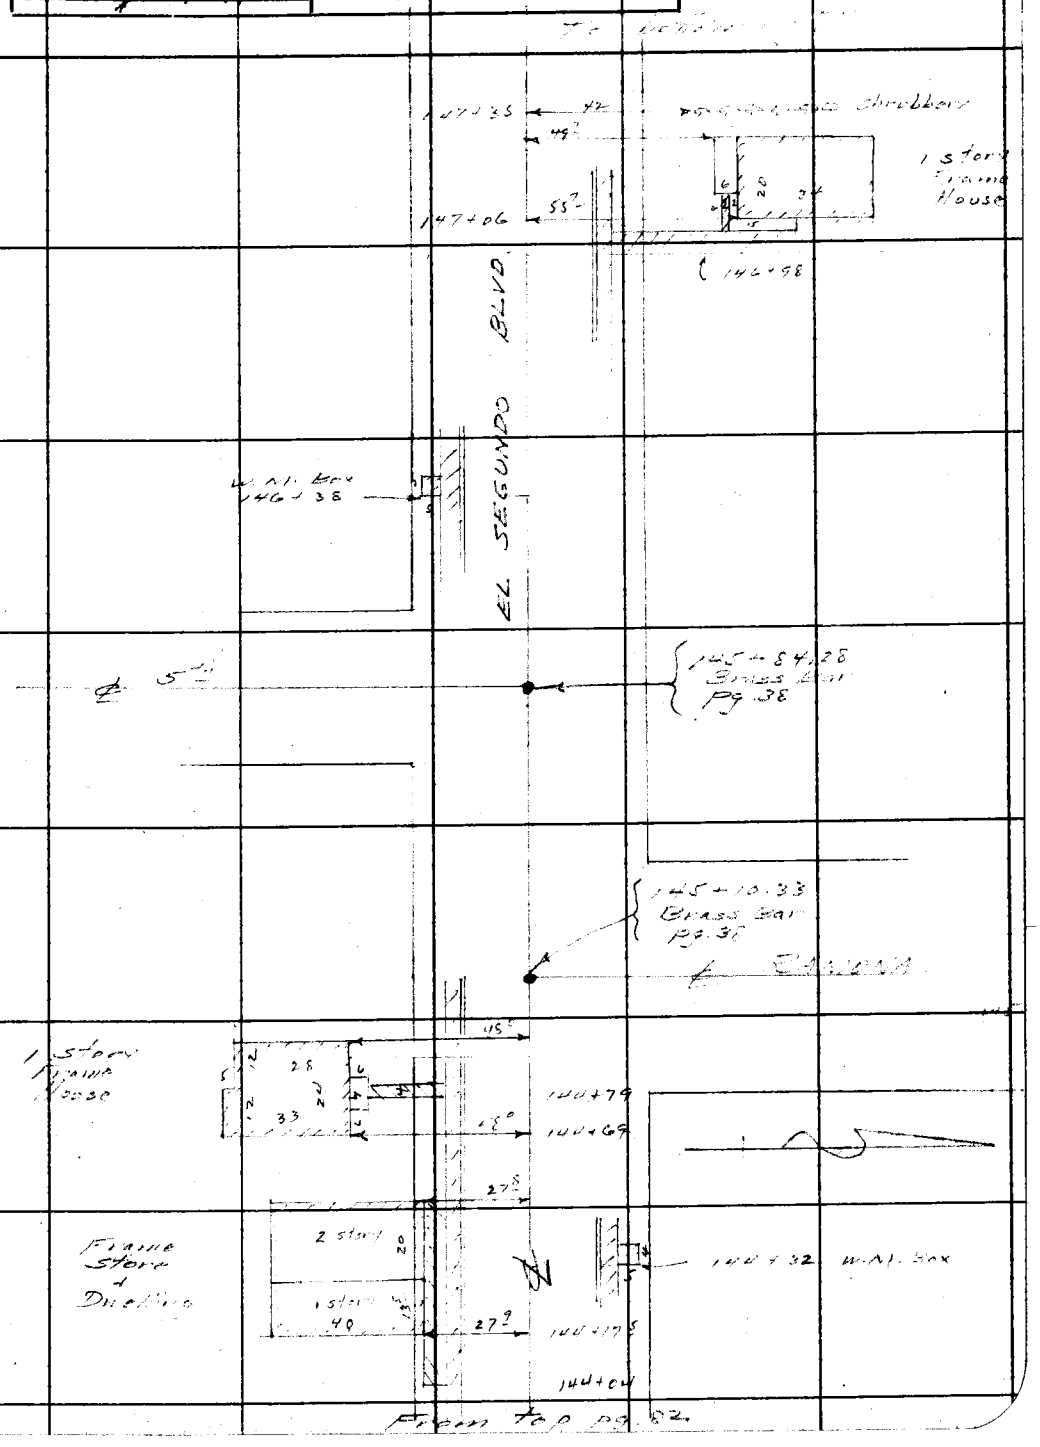

To bottom pg. 85

F.B. 730 PG. 84

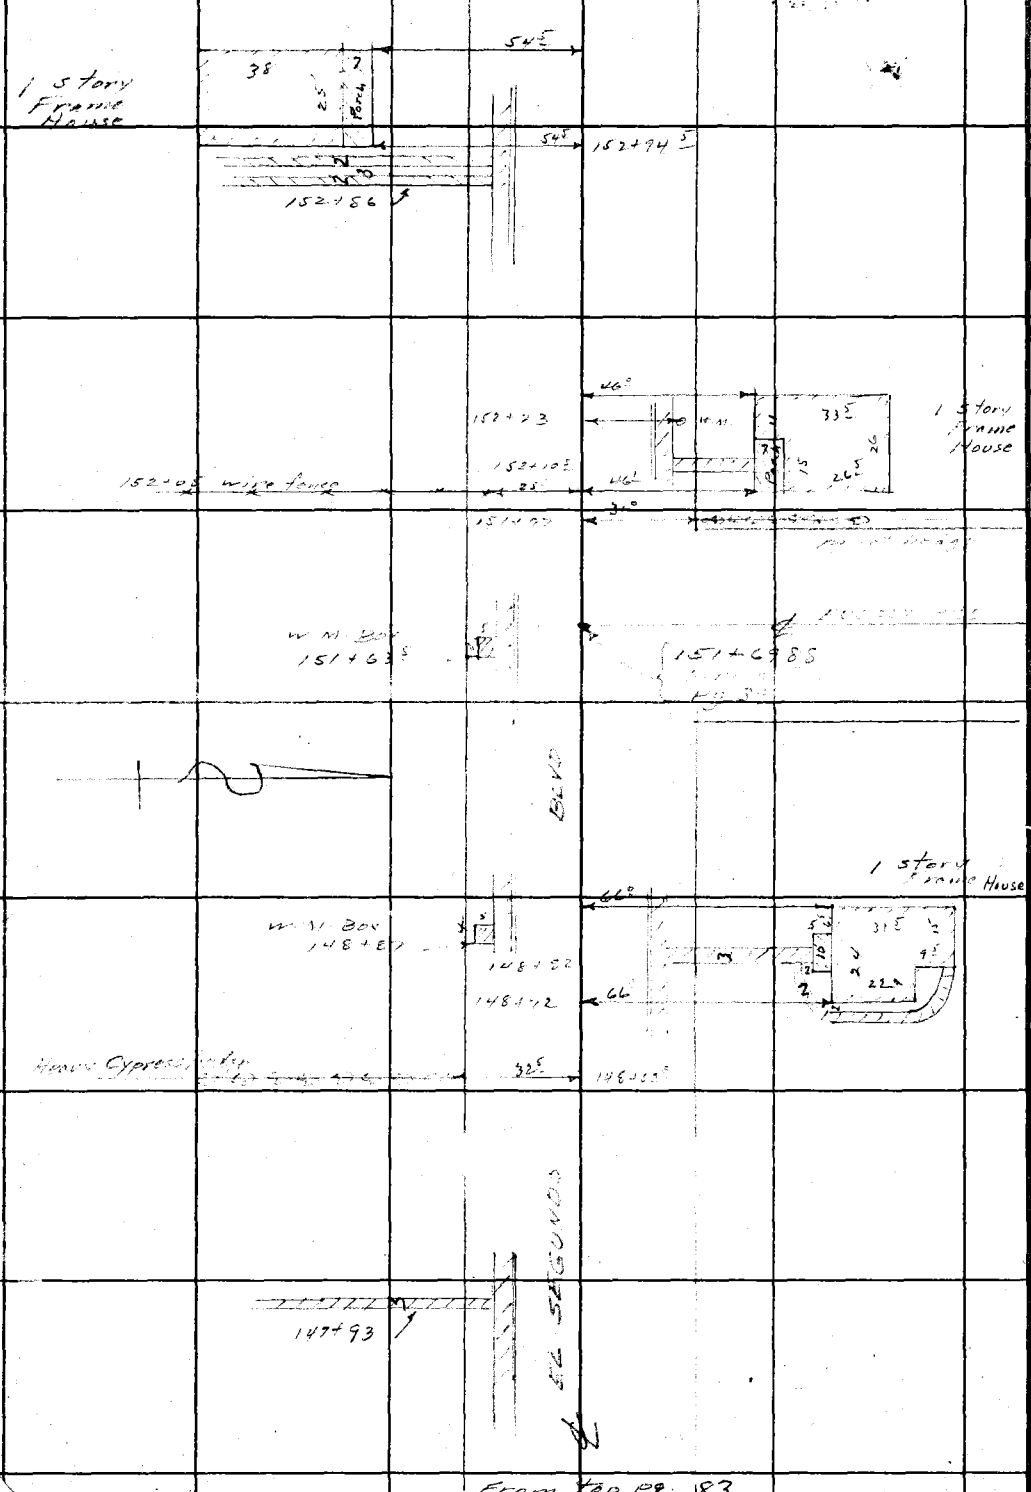

From top pg. 183

RETURN TO
LOS ANGELES COUNTY SURVEYOR
700 HALL OF RECORDS

Note: Any Additions or Changes on This Sheets Must be Made or Circled in Red Ink With Date and Name of Person Making Change.

Do not extend notes this side of this line

Notes Ck'd by D. M. Finley	Survey of 4th Sequoia Alpa	F.B. 73	Pg. 65
Map No. B-1492-3	W. O. 8207 Tape No.	St'd	OF
Office Work H.U.M.H.	Surveyed by N Keare		
Checked D. M. Finley	Notes N Keare Date 2-16-38		
Date Apr. 1941	Indexed C. Johnson		

To bottom of 67

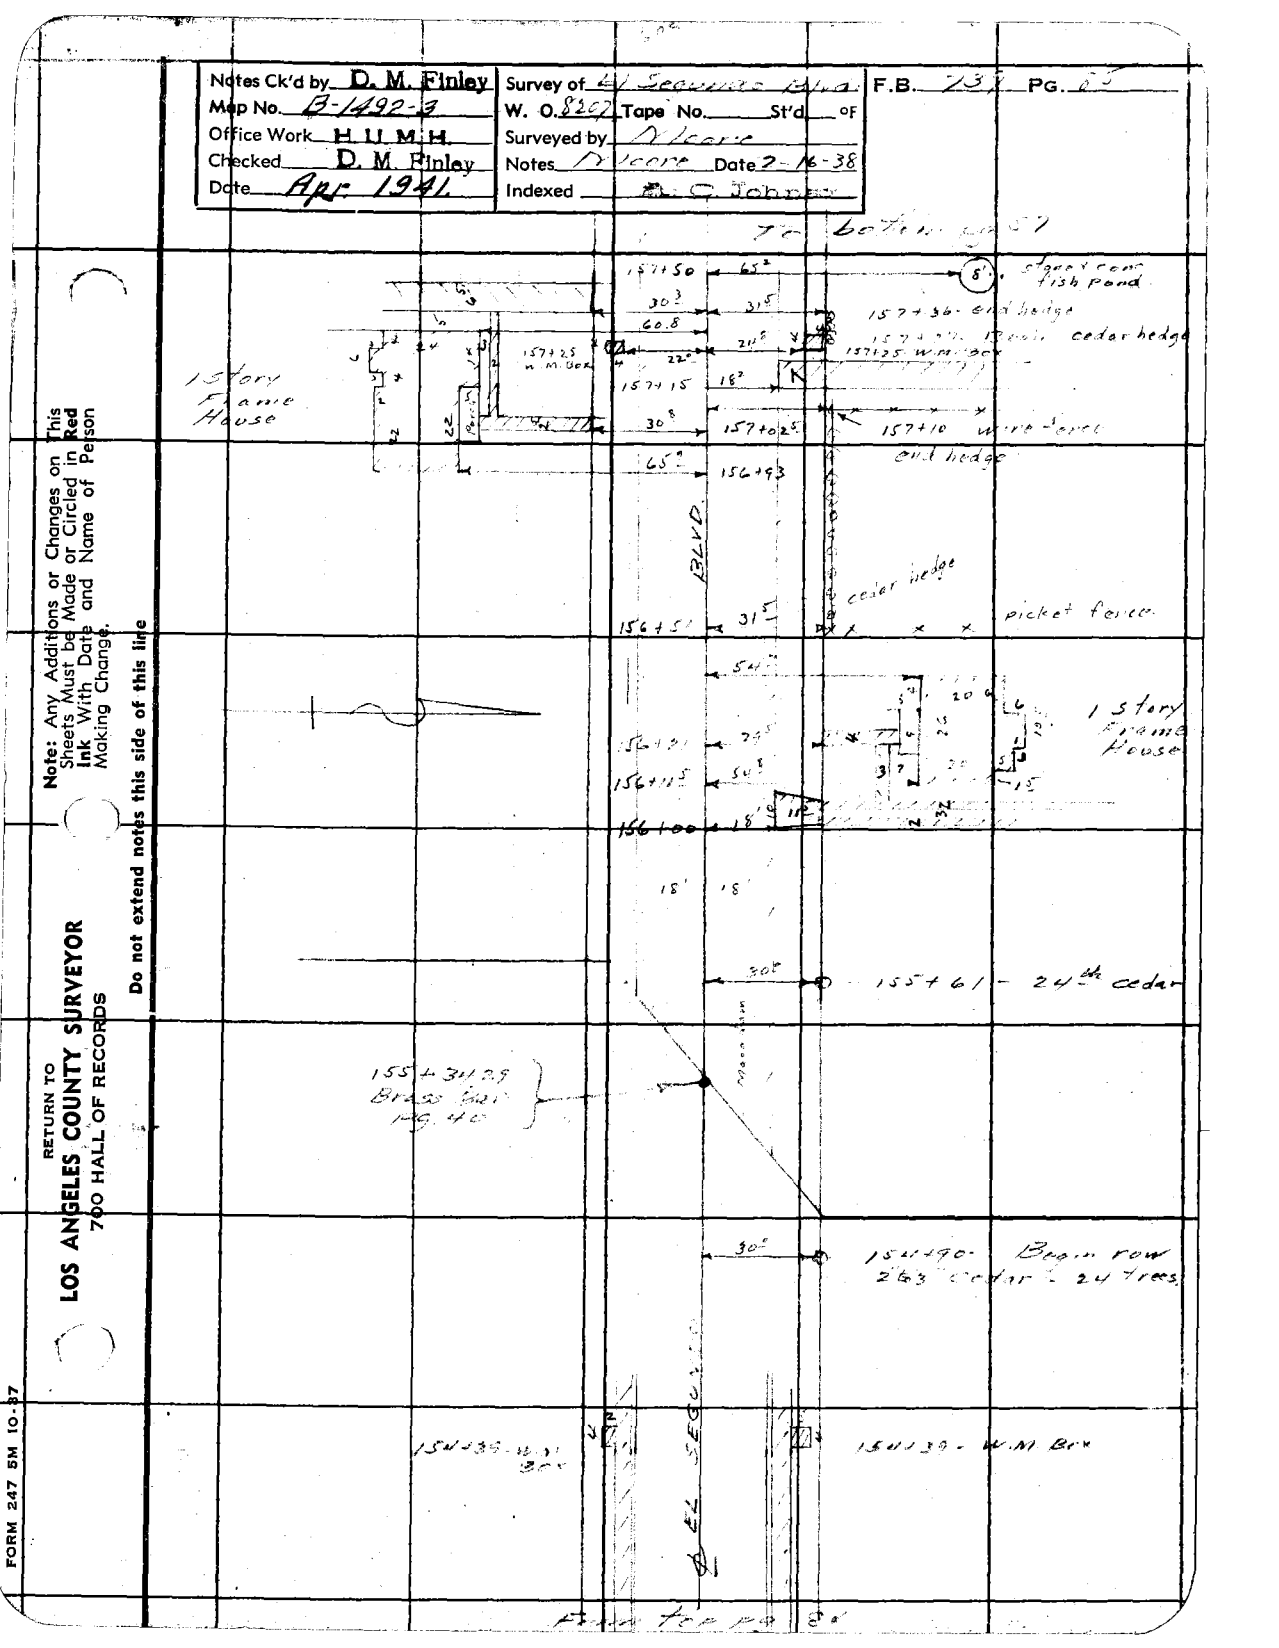

Note: Any Additions or Changes on This Sheets Must be Made or Circled in Red Ink With Date and Name of Person Making Change.

Do not extend notes this side of this line

RETURN TO
LOS ANGELES COUNTY SURVEYOR
700 HALL OF RECORDS

FORM 247 5M 10-37

F.B. 239 PG. 86

Sta	Offset L	Offset R	Size	Class		Sta	Offset L	Offset R	Size	Class	
155 + 12		19 Lt		PP	167	+ 92.5	27 Lt		12"	Gum	
+ 97		30°	8	Cedar	168	+ 03		26.5 Lt		Tel P	
156 + 14		"	"	"		+ 16.5	49 Lt		2	Fig	
+ 34		"	"	"		+ 16.5	63 Lt		2	"	
+ 57		20 Lt		PP.		+ 27	27.5 Lt		12	Gum	
+ 66		21 Lt		W.M.		+ 79	"		"	"	
+ 63		20 Lt		2" Fire Hyd	169	+ 04	"		"	"	
+ 64		20.5 Lt		W.M.		+ 14	31.5 Lt		"	"	
+ 68		23.5 Lt	4	Cedar		+ 30	"		"	"	
+ 90		"	"	Pepper		+ 46	"		"	"	
157 + 10		"	"	"		+ 58	"		"	"	
+ 10		59°	"	Acacia		+ 83	"		"	"	
+ 27		23.5 Lt	"	Pepper		+ 91	"		"	"	
+ 30		37.5 Lt	"	Fig		+ 98	"		"	"	
+ 30		59 Lt	"	"	170	+ 03	"		"	"	
+ 32.5		71°	24	Palm		+ 11.5	"	26.5 Lt		Tel P	
+ 40		23.5 Lt	6	Pepper		+ 14	31.5 Lt		12	Gum	
+ 45		47°	18	Pine		+ 23	27.5 Lt		"	"	
+ 64		71°	"	Palm		+ 47	"		"	"	
+ 66		47.5 Lt	6	Pepper		+ 51	31.5 Lt		"	"	
+ 67		23.5 Lt	"	"		+ 59	"		"	"	
+ 71		51°	8	Fig		+ 73	"		"	"	
+ 78		30°	6	"		+ 84	27.5 Lt		"	"	
+ 78		72°	6	Pine		+ 89	31.5 Lt		"	"	
+ 92		20°	10"	PP.	171	+ 04	"		"	"	
158 + 06		60.5	10"	Acacia		+ 24	"		"	"	
+ 06		80°	18	Palm		+ 50	27.5 Lt		"	"	
+ 50	44°			Tel P		+ 72	"		"	"	
+ 50		38.5 Lt		"	172	+ 12	"		"	"	
+ 62.5		26.5 Lt		"		+ 21	"		"	"	
160 + 00		27°		"		+ 25	31.5 Lt		"	"	
+ 23	37.5 Lt		2					26°			
+ 48	22.5 Lt			W.M.							
+ 65	25.5 Lt		12	Gum		+ 82	"		"	"	
+ 82	"		"	"		+ 89	"		"	"	
+ 98	"		"	"		+ 73	31.5 Lt		"	"	
161 + 01	61		"	"		+ 98	27.5 Lt		"	"	
+ 03	29.5 Lt		"	"	173	+ 22	"		"	"	
+ 16	66		"	"		+ 26	31.5 Lt		"	"	
+ 18	29.5 Lt		"	"		+ 43	"		"	"	
+ 44		27°		Tel P.		+ 64	27.5 Lt		"	"	
+ 46	29.5 Lt		12	Gum		+ 85	"		"	"	
+ 49	23.5 Lt		"	"	174	+ 20	"		"	"	
+ 59	"		"	"		+ 25	31.5 Lt		"	"	
+ 75	"		"	"		+ 44	27.5 Lt		"	"	
+ 84	"		"	"		+ 55	"	26°		Tel P.	
162 + 06	"		"	"		+ 73	31.5 Lt		12	Gum	
+ 09	29.5 Lt		"	"		+ 80	27.5 Lt		"	"	
+ 21	23.5 Lt		"	"	175	+ 02	"		"	"	
+ 63.5	"		"	"		+ 11	"		"	"	
+ 92.5	29.5 Lt		"	"		+ 20	"		"	"	
163 + 02	"		"	"		+ 33	31.5 Lt		"	"	
+ 10	"		"	"		+ 39	27.5 Lt		"	"	
+ 27	"		"	"		+ 45	"		"	"	
+ 61	"		"	"		+ 55	"		"	"	
+ 69.5		27°		Tel P.		+ 58	31.5 Lt		"	"	
164 + 12	38.5 Lt		6	Fig		+ 71	27.5 Lt		"	"	
+ 65	73		12	Fig	176	+ 32	33°		"	"	
165 + 24	29.5 Lt		"	Gum		+ 42	"		"	"	
+ 37	25.5 Lt		"	"		+ 67		26°		Tel P.	
+ 41	29.5 Lt		"	"		+ 83	29°		12	Gum	
+ 51			"	"	177	+ 91		26°		Tel P.	
+ 86		26.5 Lt		Tel P	178	+ 92		25.5 Lt		"	
166 + 06	29.5 Lt		12	Gum	179	+ 35	35.5 Lt		12	Gum	
+ 27	25.5 Lt		"	"		+ 41	31.5 Lt		"	"	
+ 70	"		"	"		+ 45	35.5 Lt		"	"	
167 + 26	47.5 Lt		6	Pepper		+ 67	31.5 Lt		"	"	
+ 35	41.5 Lt			Fire Hyd		+ 72	35.5 Lt		"	"	
+ 39	49°		2	Peach		+ 94	31.5 Lt		"	"	
+ 39	63		2	"	180	+ 20	"		"	"	
+ 51	27		12	Gum		+ 29	"		"	"	
+ 56	49°		3	Peach		+ 31.5	"	25.5 Lt		Tel P.	
+ 58	63		"			+ 55	31.5 Lt		12	Gum	

RETURN TO
LOS ANGELES COUNTY SURVEYOR
700 HALL OF RECORDS

Note: Any Additions or Changes on This Sheets Must be Made or Circled in **Red Ink** With Date and Name of Person Making Change.

Do not extend notes this side of this line

Notes Ck'd by D. M. Finley	Survey of	F.B. 23	PG. 27
Map No. A-1492-3	W. O. 8207 Tape No.	St'd	OF
Office Work H. U. M. H.	Surveyed by Moore		
Checked D. M. Finley	Notes Moore Date 2-16-38		
Date Apr. 1941	Indexed A. C. Johnson		

To [illegible]

Note: Any Additions or Changes on This Sheets Must be Made or Circled in Red Ink With Date and Name of Person Making Change.

Do not extend notes this side of this line

RETURN TO
LOS ANGELES COUNTY SURVEYOR
700 HALL OF RECORDS

Picket fence

BLVD.

Store

Frame Garage

Frame Shed

Conc. base gas & water

Steel gas station

Conc. base & gas pumps

Conc. island

158+29.93
Spk - pg. 41

ENGLEWOOD

AVE

Cedar hedge

Frame office

From top pg 85

FORM 247 5M 10-37

F.B. 739 PG. 88

To bottom pg. 89

RETURN TO
LOS ANGELES COUNTY SURVEYOR
700 HALL OF RECORDS

Note: Any Additions or Changes on This Sheets Must be Made or Circled in Red Ink With Date and Name of Person Making Change.

Do not extend notes this side of this line

12

ALLEY

40'

168+24

S.W. ST. GEORGE

wire fence

34'

167+33

new curbs

40'

167+26

℄ SHOUP

30'

167+10

169+10


164+56

164+50 LT

164+48 LT

24½'

24½'

40'

164+45

From top pg. 87

Notes Ck'd by D. M. Finley	Survey of [illegible]	F.B. [illegible]	PG. [illegible]
Map No. A-1492-3	W. O. 8207 Tape No.	St'd	°F
Office Work H. U. M. H.	Surveyed by Moore		
Checked D. M. Finley	Notes Moore	Date 2-16-38	
Date Apr. 1941	Indexed [illegible]		

To [illegible]

182+18 - conc. headwall

181+33.2 [illegible]

181+37 conc. headwall

181+25

181+15

1' corr. iron cv'v

181+31.5 - conc. headwall

180+81

signal box

180+56 - conc. headwall

RR

[illegible]

[illegible]

[illegible]

Note: Any Additions or Changes on This Sheets Must be Made or Circled in Red Ink With Date and Name of Person Making Change.

Do not extend notes this side of this line

RETURN TO
LOS ANGELES COUNTY SURVEYOR
700 HALL OF RECORDS

FORM 247 5M 10-37

F.B. 739 PG. 90

Sta	Offset L	Offset R	Size inches		Sta	Offset L	Offset R	Size inches	
180+60		17		Wigwag Pole	206+93		39		12 Twin
+80	35		12	Gum	+94		27	12	Century
+86		27		Trolley P.	+99	27		18	Gum
+98	31		12	Gum	207+11	32		6	"
181+10	35		"	"	+18	"		18	"
+32	"		"	"	+52		23		T.P.
+72		25		Tel P	+58	51		15	Cedar
182+23	45			Trolley P	+58	77		"	"
+68	29		12	Gum	+93	23			PP
+73	33		"	"	+71	18			Guy P
+77	29		"	"	+71		22		T.P.
+88	"		"	"	208+55		21		"
183+00	25		"	"	+73	22			PP
+09	"		"	"	+25	56			Tel P
+18	"		"	"	+25	71		8	Acacia
+22		25		Tel P	+58		71	12	Gum
+31	31		12	Gum	+75	18			P.P.
+38	"		"	"	+92		37		T.P.
+44	35		"	"					
+54	"		"	"					
184+32	36		"	"					
185+40		25		T.P.					
187+42		"		"					
189+48		"		"					
190+18		74		P.P.					
+18	21			"					
191+51		24		T.P.					
+57	21			P.P.					
193+16	"			"					
+53		24		T.P.					
194+66	21			P.P.					
195+52		24		T.P.					
+75	21			"					
197+57		24		T.P.					
+62	21			P.P.					
199+18	22			"					
+62		24		T.P.					
200+69	22			P.P.					
201+69		24		T.P.					
202+15	22			P.P.					
203+66	22			"					
+77		23		T.P.					
205+16	22			"					
+30		23	12	Pepper					
+50		32	3	Peach					
+66		"	"	"					
+66		48	"	"					
+68	28		18	Gum					
+76	"		"	"					
+82		32	3	Peach					
+82		48	"	"					
+87		23		T.P.					
+94		"	12	Pepper					
+95		48	6	Fig					
+98		64	"	"					
206+23		34	12	Palm					
+31		29	6	loquat					
+31		44	3	orange					
+31		59	6	lemon					
+36	32		18	Gum					
+42	"		6	"					
+47		53		2" W Hyd					
+48	27		18	Gum					
+48		29	4	loquat					
+48		44	6	lime					
+48		59	6	orange					
+56	27		6	Gum					
+62	32		"	"					
+65		29	12	Avacado					
+66	23			P.P.					
+75	"			"					
+80	32		18	Gum					
+83		29	6	Avacado					

RETURN TO
LOS ANGELES COUNTY SURVEYOR
700 HALL OF RECORDS

Note: Any Additions or Changes on This Sheets Must be Made or Circled in Red Ink With Date and Name of Person Making Change.

Do not extend notes this side of this line

Notes Ck'd by D. M. Finley	Survey of [illegible]	F.B. 739	PG. 91
Map No. B-1492-3	W. O. 8104 Tape No. St'd OF		
Office Work H.U.M.H.	Surveyed by D. Goetz		
Checked D. M. Finley	Notes Date 2-16-43		
Date Apr. 1941	Indexed [illegible]		

Note: Any Additions or Changes on This Sheets Must be Made or Circled in Red Ink With Date and Name of Person Making Change.

Do not extend notes this side of this line

RETURN TO
LOS ANGELES COUNTY SURVEYOR
700 HALL OF RECORDS

FORM 247 5M 10-37

202.39

202.38

1" conc. iron

19

197+96.88
S 7°W - 96 M.

1515

15.6 9.5

not open

Conc. block
& oil well.
(abandoned)

60'

65

ANZA

18W - 74.59
S 7°W. - 96 M.

Frank Topp 89

To bottom pg. 93

F.B. 739 PG. 92

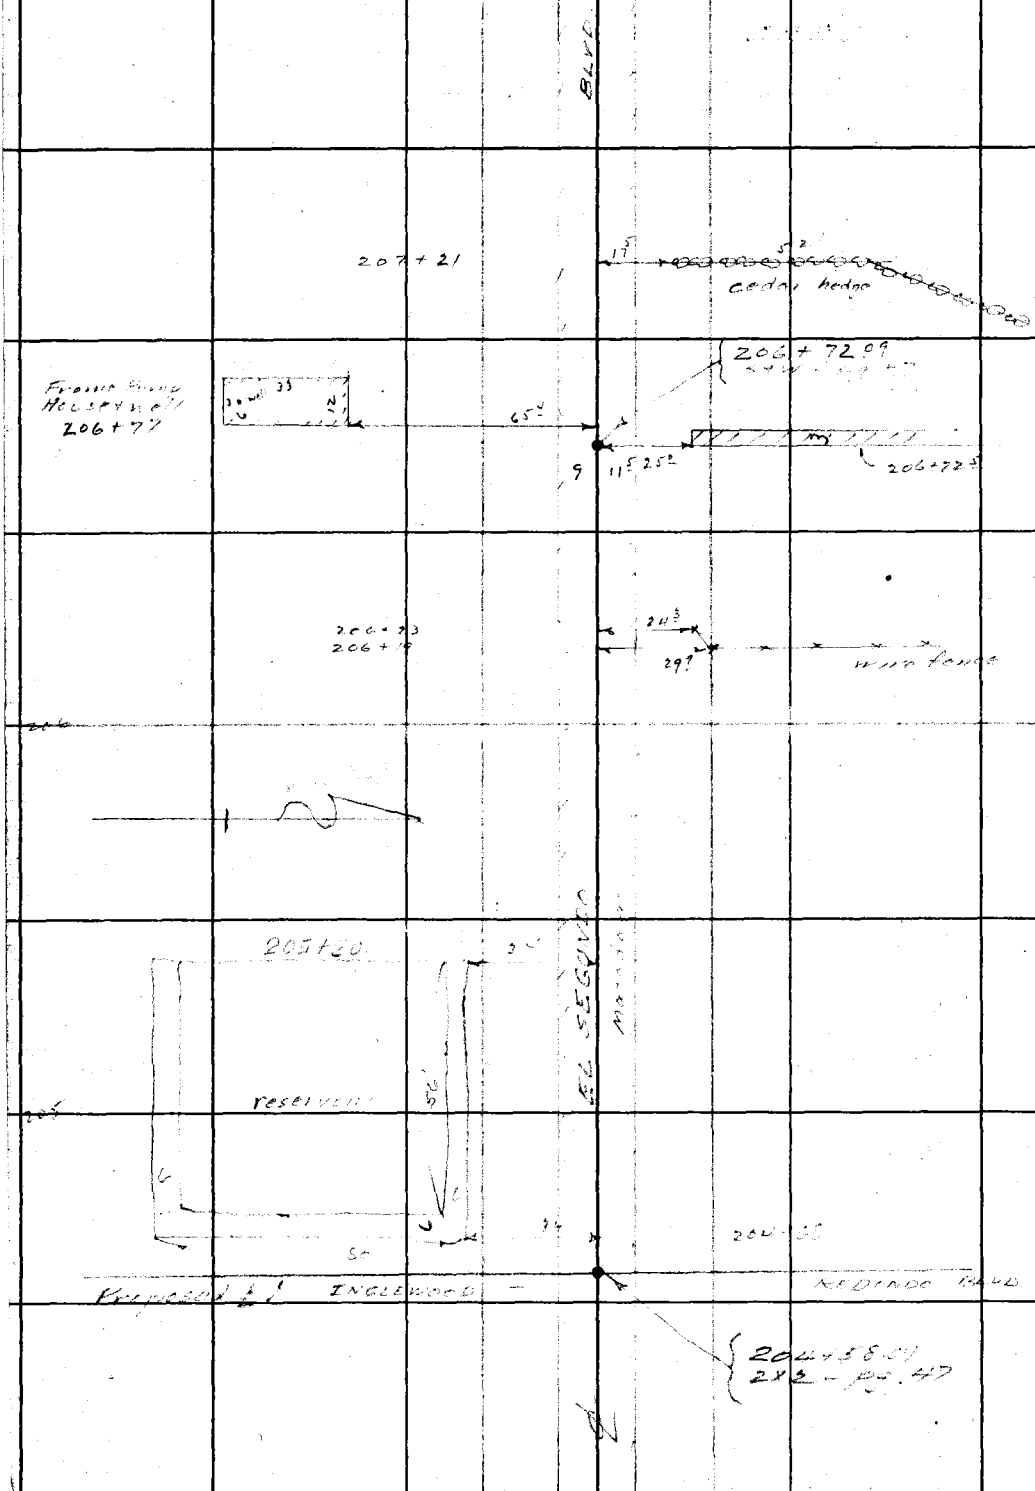

From top pg. 91

RETURN TO
LOS ANGELES COUNTY SURVEYOR
700 HALL OF RECORDS

Note: Any Additions or Changes on This Sheets Must be Made or Circled in **Red Ink** With Date and Name of Person Making Change.

Do not extend notes this side of this line

Notes Ck'd by D. M. Finley
Map No. B-1492-3
Office Work H. U. M. H.
Checked D. M. Finley
Date Apr. 1941

Survey of 6th Segment 3rd Unit
W. O. 8207 Tape No. St'd OF
Surveyed by
Notes Date 2-14-38
Indexed A. C. Johnson

F.B. 791 Pg.

Note: Any Additions or Changes on This Sheets Must be Made or Circled in Red Ink With Date and Name of Person Making Change.

Do not extend notes this side of this line

RETURN TO
LOS ANGELES COUNTY SURVEYOR
700 HALL OF RECORDS

FORM 247 5M 10-37

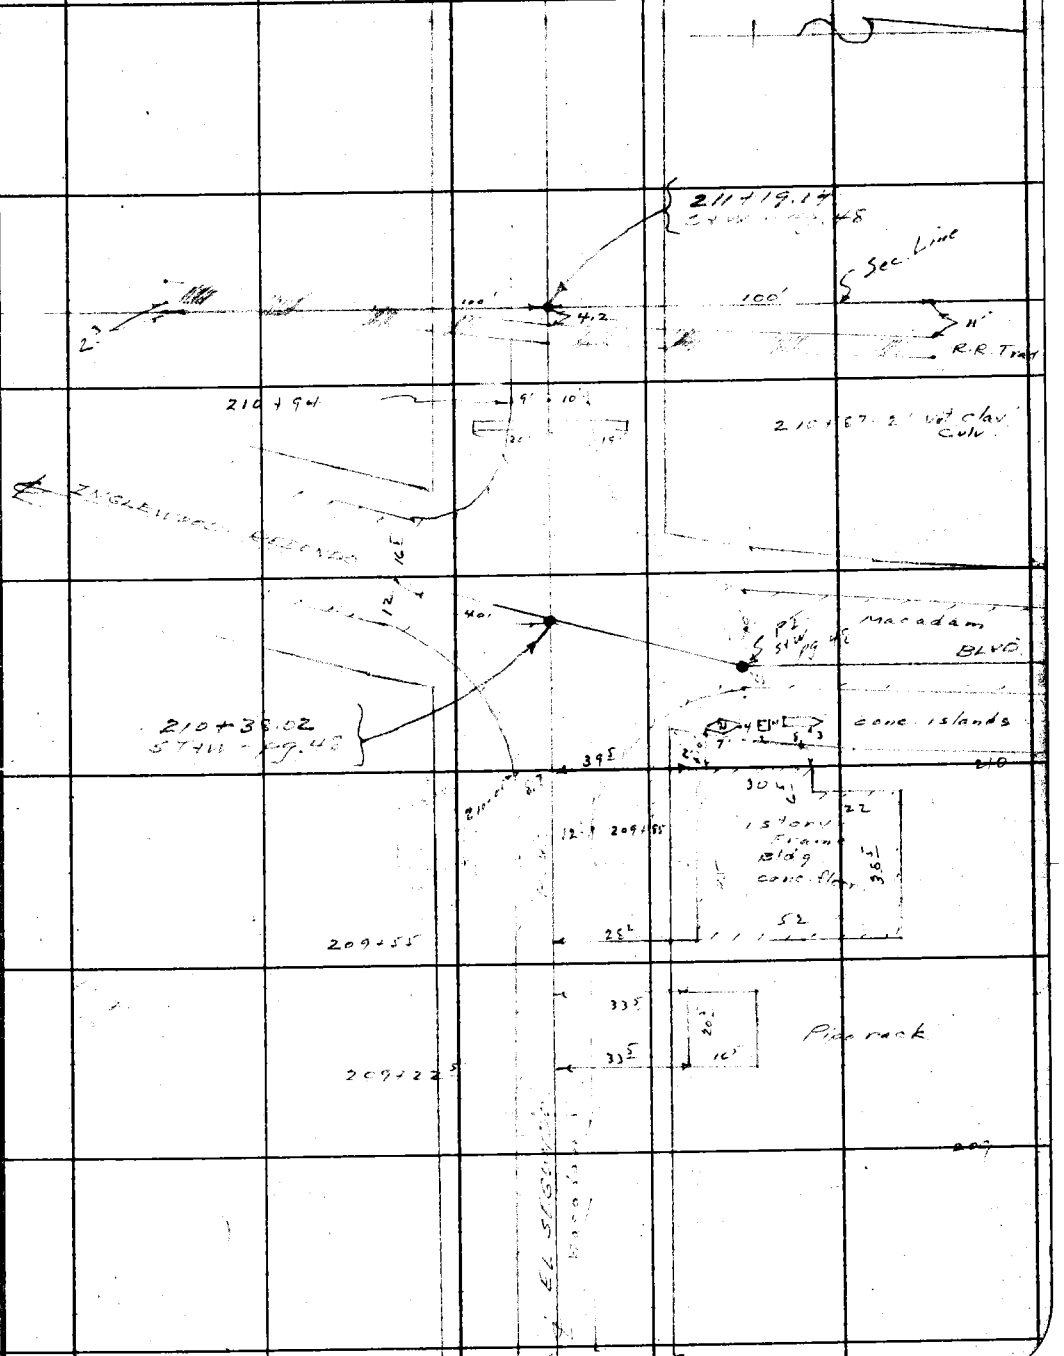

RETURN TO
LOS ANGELES COUNTY SURVEYOR
700 HALL OF RECORDS

Note: Any Additions or Changes on This Sheets Must be Made or Circled in **Red Ink** With Date and Name of Person Making Change.

Do not extend notes this side of this line

F.B. 739 Pg. 94

COPIES TO

CENTINELA VALLEY

(REGIONAL OFFICE)

pages 95 thru 106

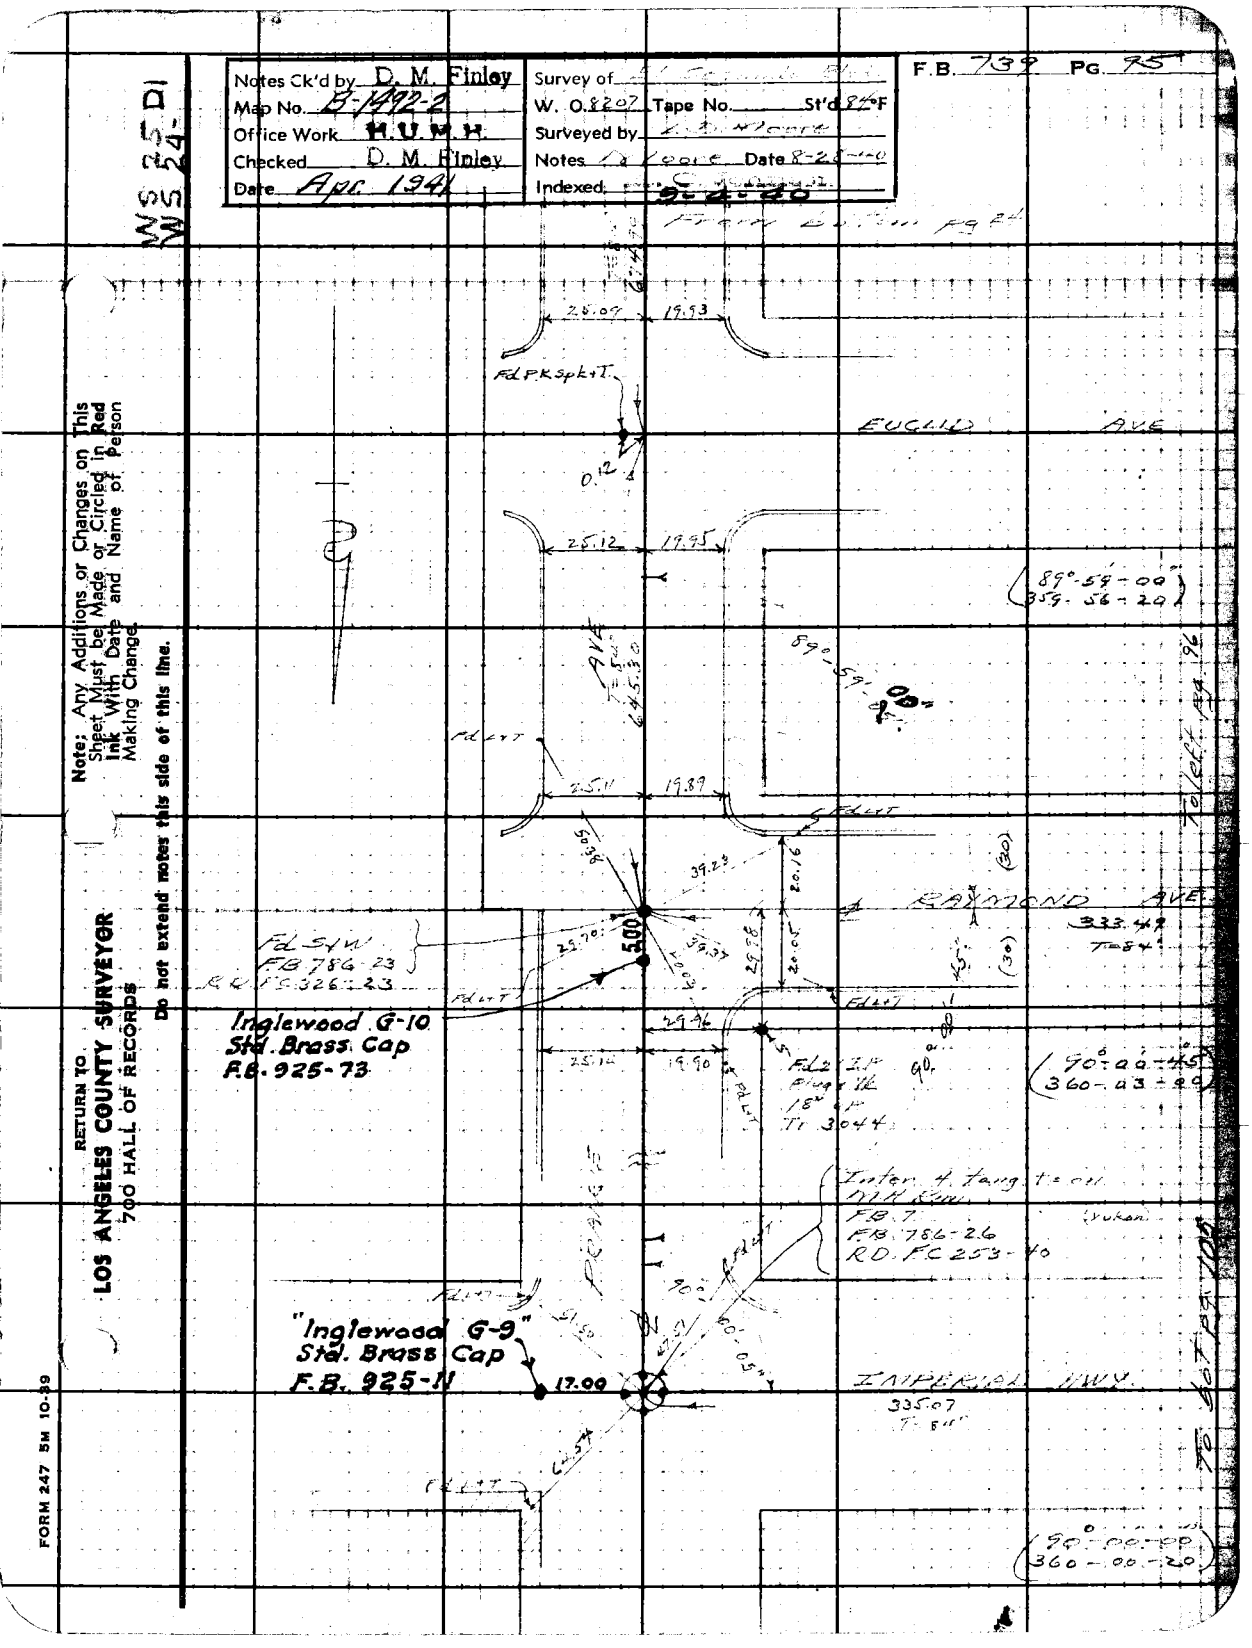
Notes Ck'd by D. M. Finley
Map No. B-1492-2
Office Work H.U.M.H.
Checked D. M. Finley
Date Apr. 1941
Survey of
W. O. 8207 Tape No. St'd 84°F
Surveyed by
Notes Date 8-25-40
Indexed 9-4-40
F.B. 739 PG. 95
WS 25-D1
WS 24-
Note: Any Additions or Changes on This Sheet Must be Made in Red Ink With Date and Name of Person Making Change
Do not extend notes this side of this line.
RETURN TO
LOS ANGELES COUNTY SURVEYOR
700 HALL OF RECORDS
FORM 247 5M 10-39
EUCLID AVE
RAYMOND AVE
IMPERIAL HWY.
Inglewood G-10
Std. Brass Cap
F.B. 925-73
"Inglewood G-9"
Std. Brass Cap
F.B. 925-N
17.00
FdLtT
FdP.K.Spk+T.
FdSpkW
FB 786-23
RO FC 326-23
FdL+P
Plug+Tk
18" D
Tr 3044
FB 7
FB 786-26
RO FC 253-40
(Yukon)
89°-59-00"
359-56-20
90°-00-45"
360-03-00
90°-00-00"
360-00-20
333.47
T=84'
335.07
T=84'

F.B. 739 Pg. 96

From bot pg. 25

WS 25 D1

RETURN TO
LOS ANGELES COUNTY SURVEYOR
700 HALL OF RECORDS

Note: Any Additions or Changes on This Sheet Must Be Made or Circled in Red Ink With Date and Name of Person Making Change.

Do not extend notes this side of this line.

4 AVE.

25.11

5" Pd 1½" I.P. -18" up.
S.E. Cor. Lot 27
Town of Hawthorne

Pd 2x2 + Tk

25.11

14.96

15.06

EUCLID AVE

15.01

14.94

(25) (25)

Set P.M. on N.H. Cover & X Tang. P.C. on N.H. Curb by proportion between ℄ Prairie & ℄ Freeman per 2nd S.L.A. Town of Hawthorne and Tr. 3044 - Allowing ½ error in block between Prairie and York - found by Tr. 3044.

YORK

℄

14.98

14.77

Set Cut

Set Cut

29.66

29.35

RAYMOND

℄

333.49
T = 84°

AVE

327.48
T = 84°

15.15

14.90

Pd Cut

Pd Cut

Notes Ck'd by D. M. Finley		Survey of El Segundo to Blvd	F.B. 73 PG. 97
Map No. B-1492-2		W. O. 8247 Topo No.	St'd Et °F
Office Work H. U. M. H.		Surveyed by M Deere	
Checked D. M. Finley		Notes M Deere Date 8-25-40	
Date Apr 1941		Indexed	

WS 25 D1

Note: Any Additions or Changes on This Sheet Must be Made or Circled in Red Ink With Date and Name of Person Making Change.

Do not extend notes this side of this line.

RETURN TO
LOS ANGELES COUNTY SURVEYOR
700 HALL OF RECORDS

FORM 247 5M 10-39

From cor Pt 26

EUCLID AVE

15.05 15.03

14.96 15.14

(15) (15)

EUCLID

15.04 15.06

50° 47' 29.83 50° 06' 30.19

RAYMOND AVE

327.48 I = 5°

327.48 I = 7° 64

79.85

Fd L+T 15.10 15.06 Fd L+T

50° STAW & W Tang Pk Sp
On Projection Line of
& Square and & Prop Mar
Engr. 2nd Add Town of
Plan Map Ave and Ft. 39.44

RETURN TO
LOS ANGELES COUNTY SURVEYOR
700 HALL OF RECORDS

Note: Any Additions or Changes on This Sheet Must be Made or Circled in **Red Ink** With Date and Name of Person Making Change.

Do not extend notes this side of this line.

WS 25 D

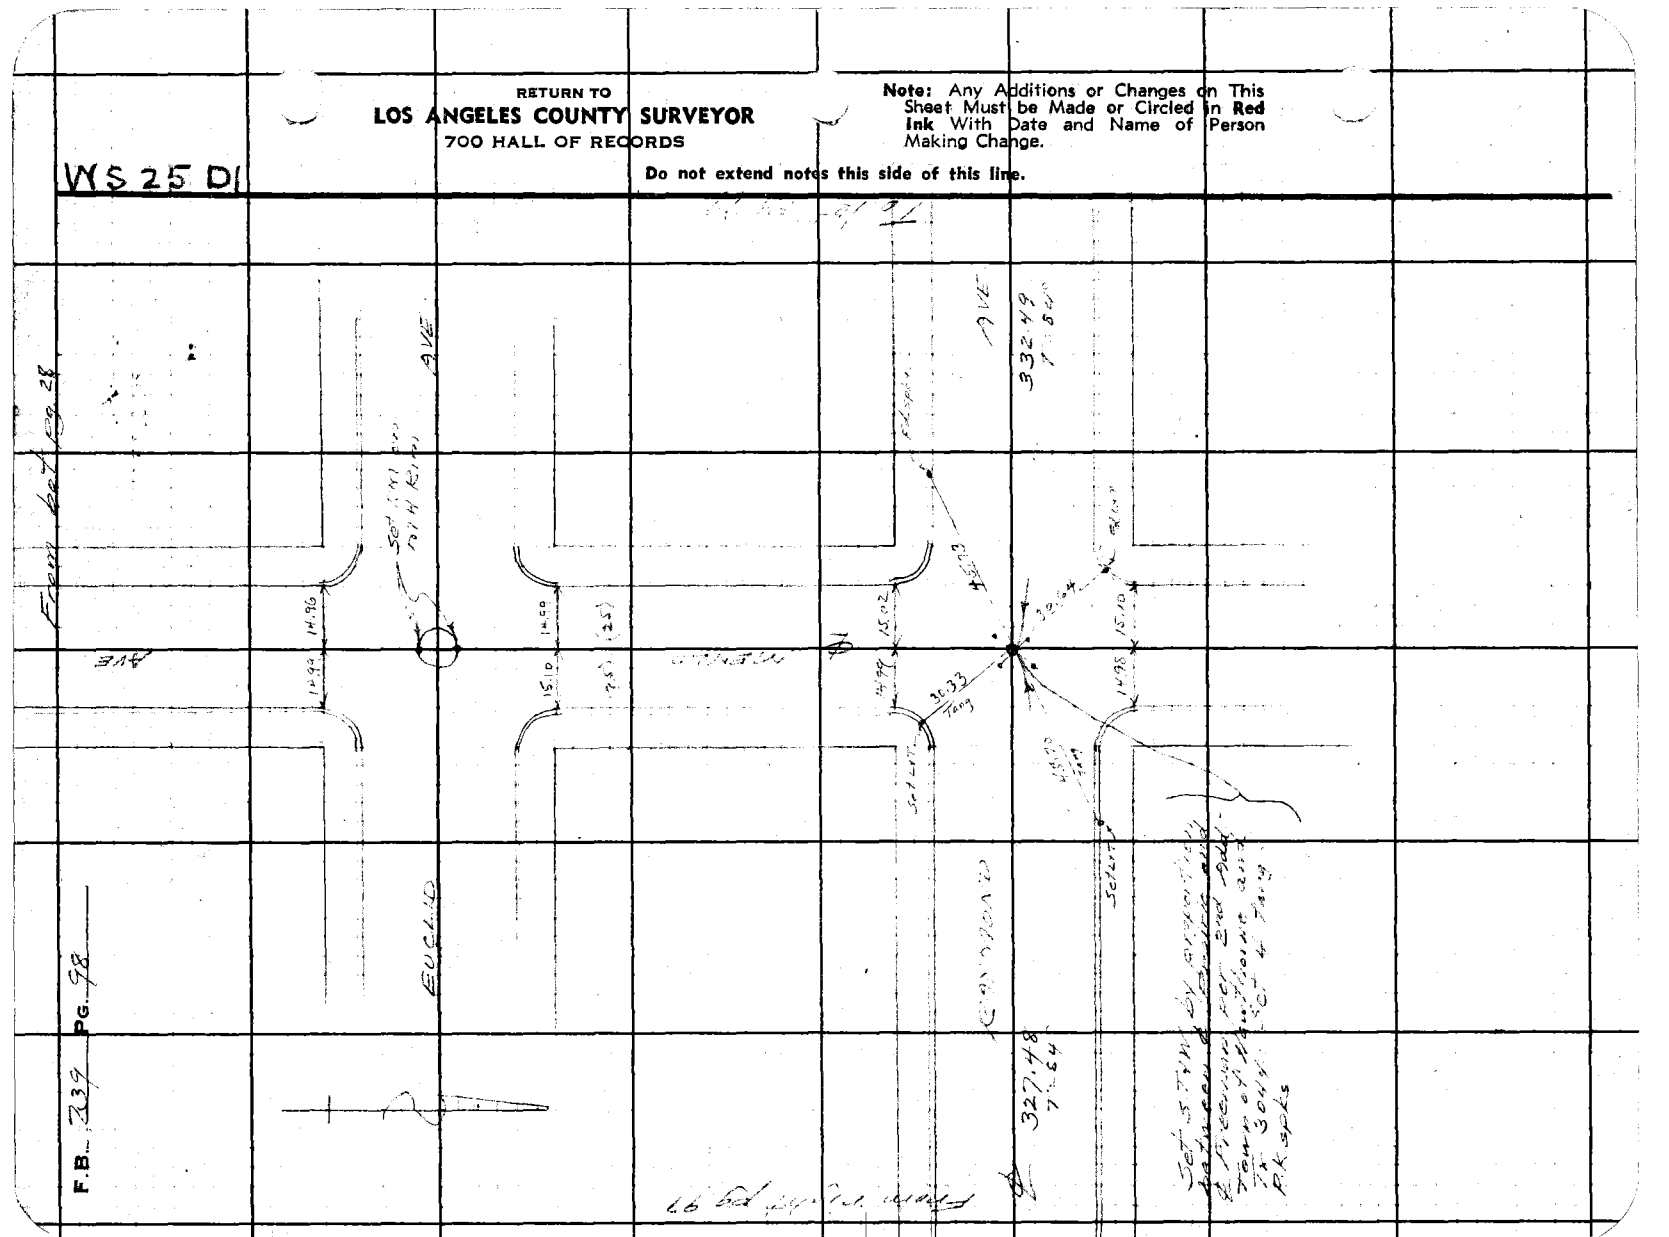

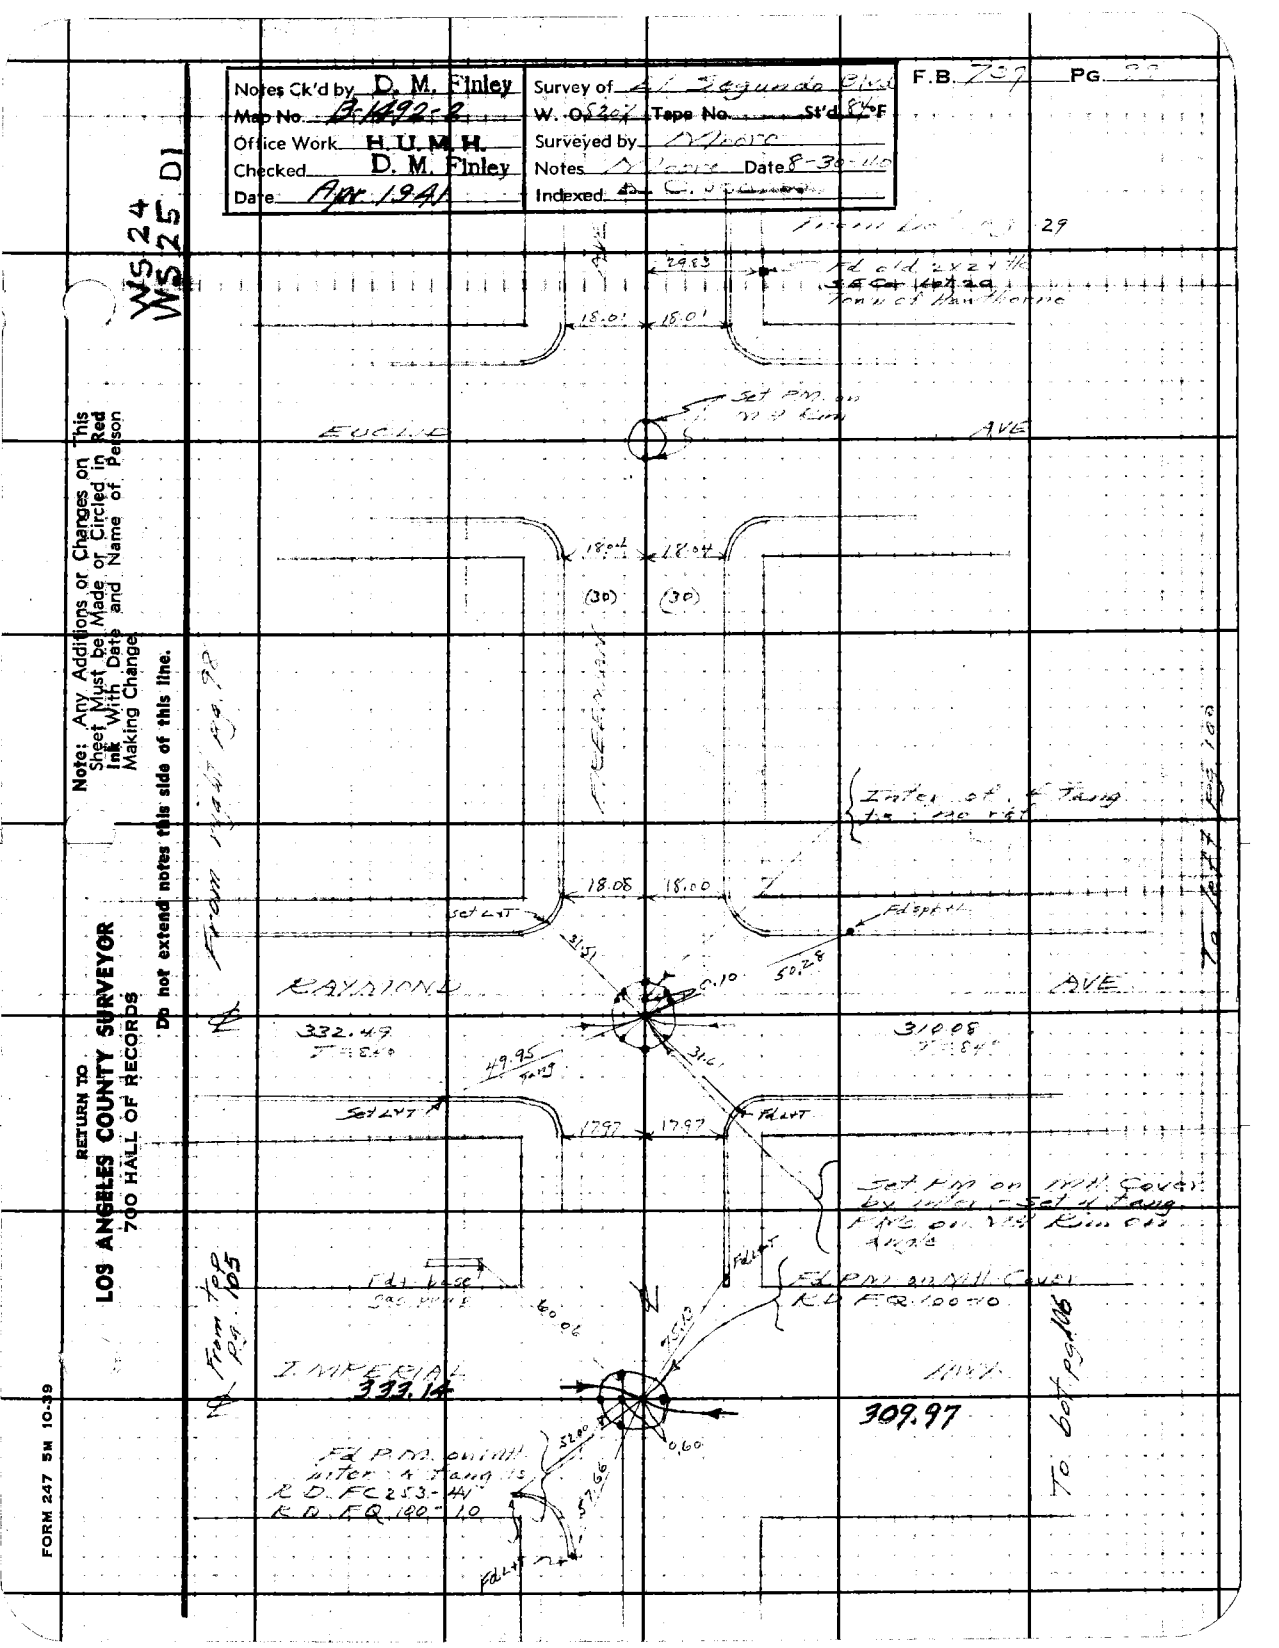
Notes Ck'd by D. M. Finley
Map No. B-1492-2
Office Work H.U.M.H.
Checked D. M. Finley
Date Apr. 1941
Survey of El Segundo Blvd
WS 24
WS 25 D1
Note: Any Additions or Changes on This Sheet Must be Made in Red Ink With Date and Name of Person Making Change
Do not extend notes this side of this line.
RETURN TO
LOS ANGELES COUNTY SURVEYOR
700 HALL OF RECORDS
EUCLID AVE
RAYMOND AVE
IMPERIAL AVE
18.01
18.04
18.08
18.00
17.97
29.83
Set PM on top of curb
Fd old cut X in top of curb
Intsct of 4" Pang tie: 1.10 FEET
Set LAT
Fd spk
Fd PM on curb
Set PM on INAH Cover by Intsct - Set 4" Pang PK on top of curb on angle
Fd PM on INAH Cover R.D. FR. 100-10
Fd PM on curb Intsct 4" Pang tie: R.D. FC 253-44 R.D. FR. 100-10
332.49
310.08
309.97
333.14
FORM 247 5M 10-39

RETURN TO
LOS ANGELES COUNTY SURVEYOR
700 HALL OF RECORDS

Note: Any Additions or Changes on This Sheet Must be Made or Circled in **Red Ink** With Date and Name of Person Making Change.

Do not extend notes this side of this line.

WS 25 D1

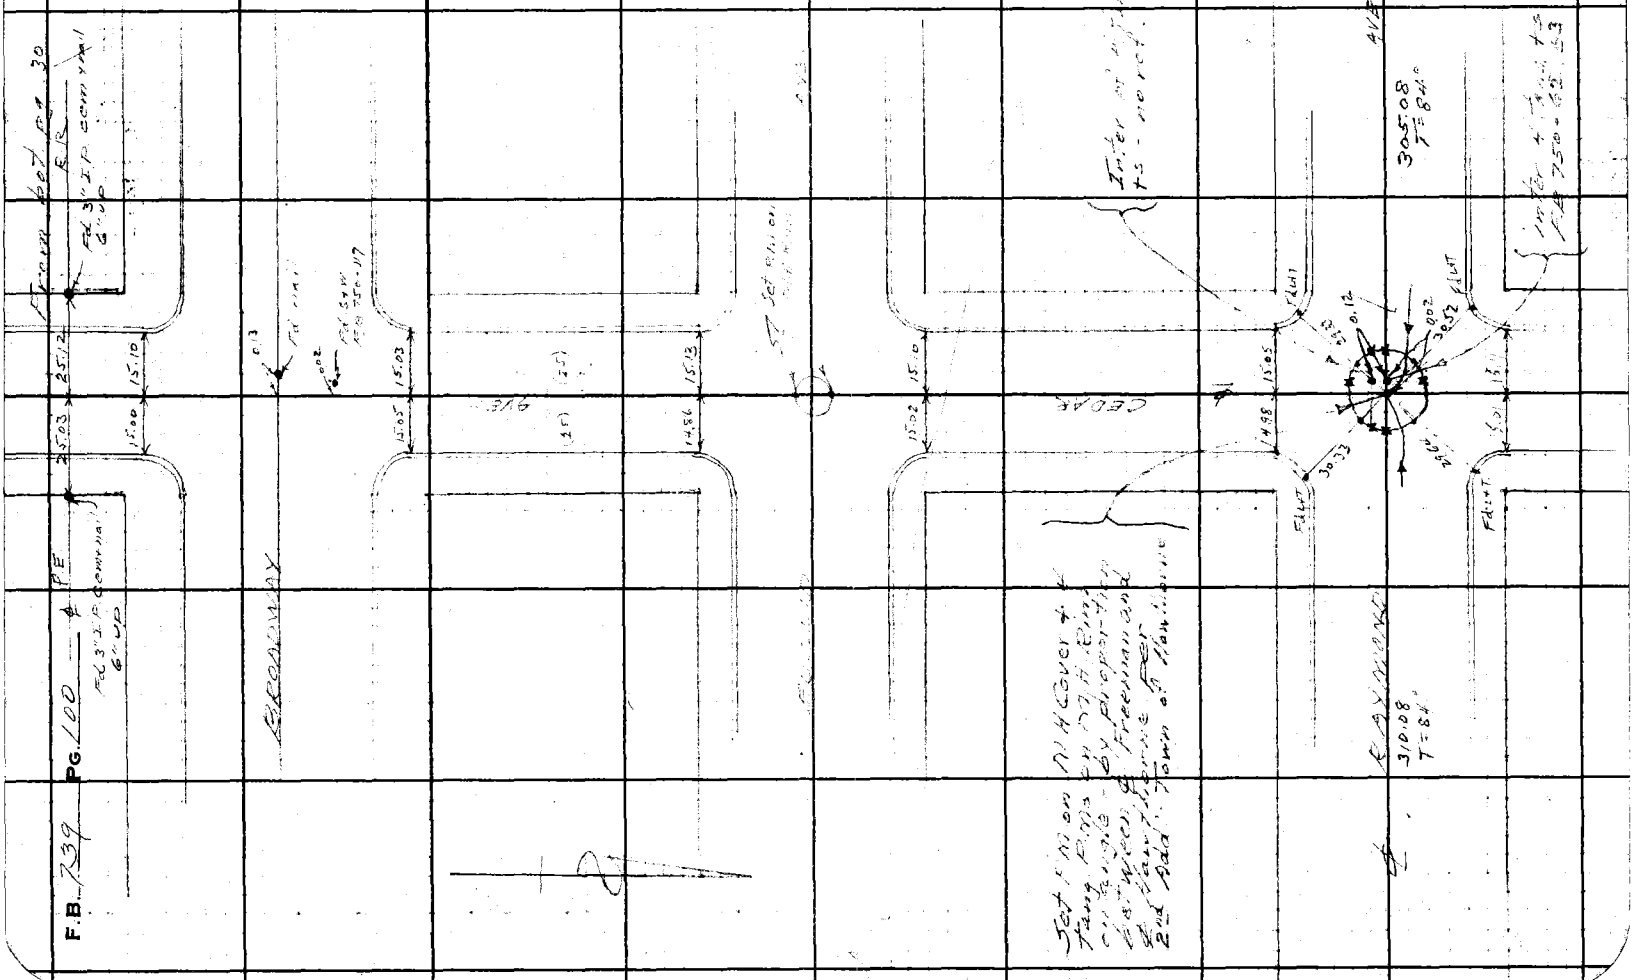
F.B. 739 PG. 100
PE
Fd 3/4" P comm
6" up
BROADWAY
AVE
CEDAR
AVE
Fd 3/4" P comm
6" up

Notes Ck'd by D. M. Finley
Map No. B-1492-2
Office Work H.U.M.H.
Checked D. M. Finley
Date Apr 1941

Survey of E. Imperial Blvd
W. O. 82-97 Tape No. — St'd 84 °F
Surveyed by Moore
Notes — Date 8-30-40
Indexed —

F.B. 73 Pg. 161

From Ld. pg. 21

W.S. 25-C1

Note: Any Additions or Changes on This Sheet Must be Made in Red Ink With Date and Name of Person Making Change

Do not extend notes this side of this line.

RETURN TO
LOS ANGELES COUNTY SURVEYOR
700 HALL OF RECORDS

FORM 247 5M 10-39

BROADWAY

EUCLID AVE

RAYMOND AVE

Fd 3" I.P. County mon. 4" up.

Fd 2x2 x 1/4 SW Cor. Lot 35 Town of Hawthorne

Fd 2x2 x 1/4 SE Cor. Lot 24 Town of Hawthorne

Fd N+T

Fd Punch & tack FB 750-64 Checks Engr. Tran. Set N. tack Punch on N.W. brass on angle

Center & Tang. Pnts. not rec'd.

305.08
T=84°

320.09
T=84°

25.68 25.18 15.01 14.94 14.89 15.05 24.78 25.05 14.96 15.13 14.95 15.07 15.00 15.16 14.88 15.11

RETURN TO
LOS ANGELES COUNTY SURVEYOR
700 HALL OF RECORDS

Note: Any Additions or Changes on This Sheet Must be Made or Circled in **Red Ink** With Date and Name of Person Making Change.

WS 25-C1

Do not extend notes this side of this line.

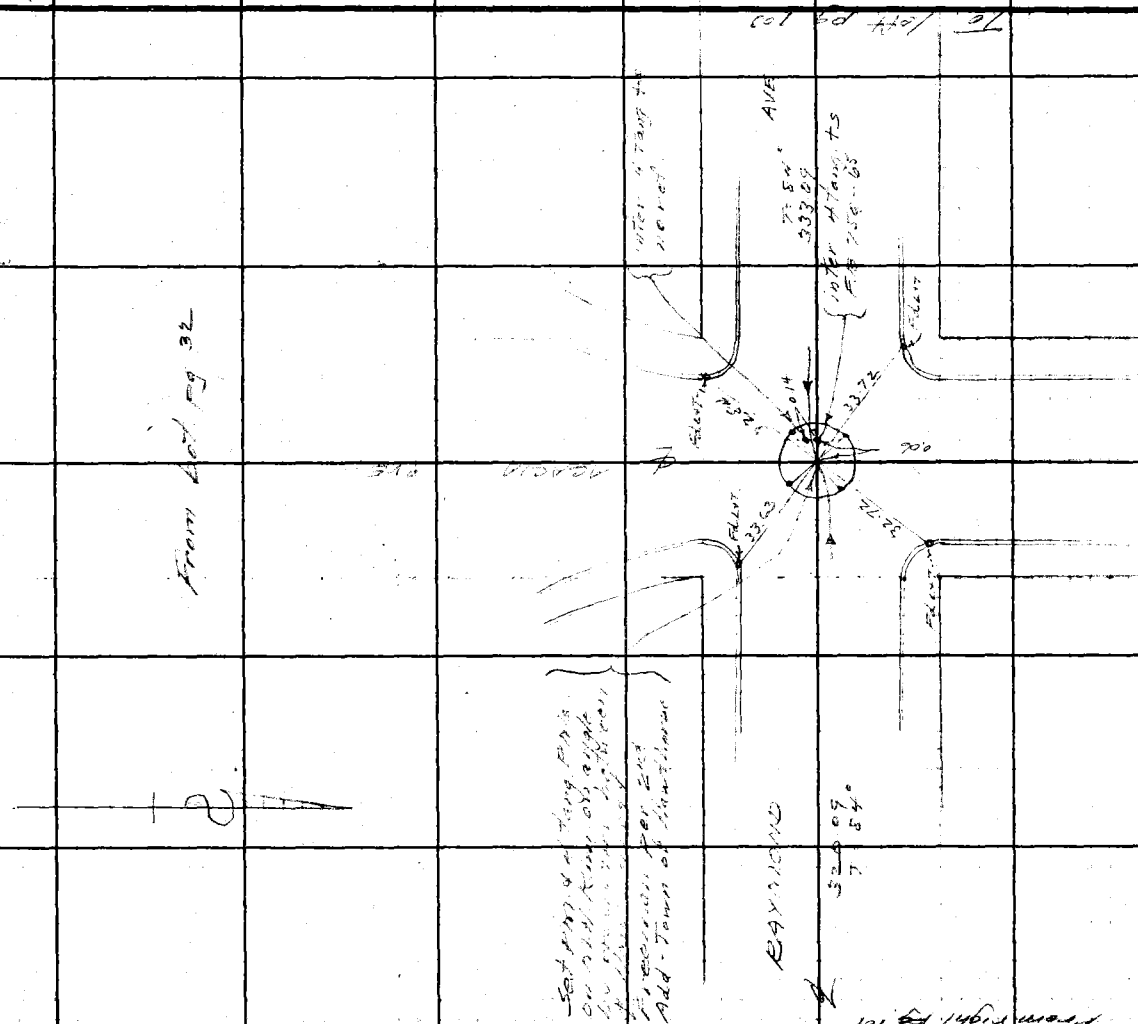

F.B. 739 PG. 102

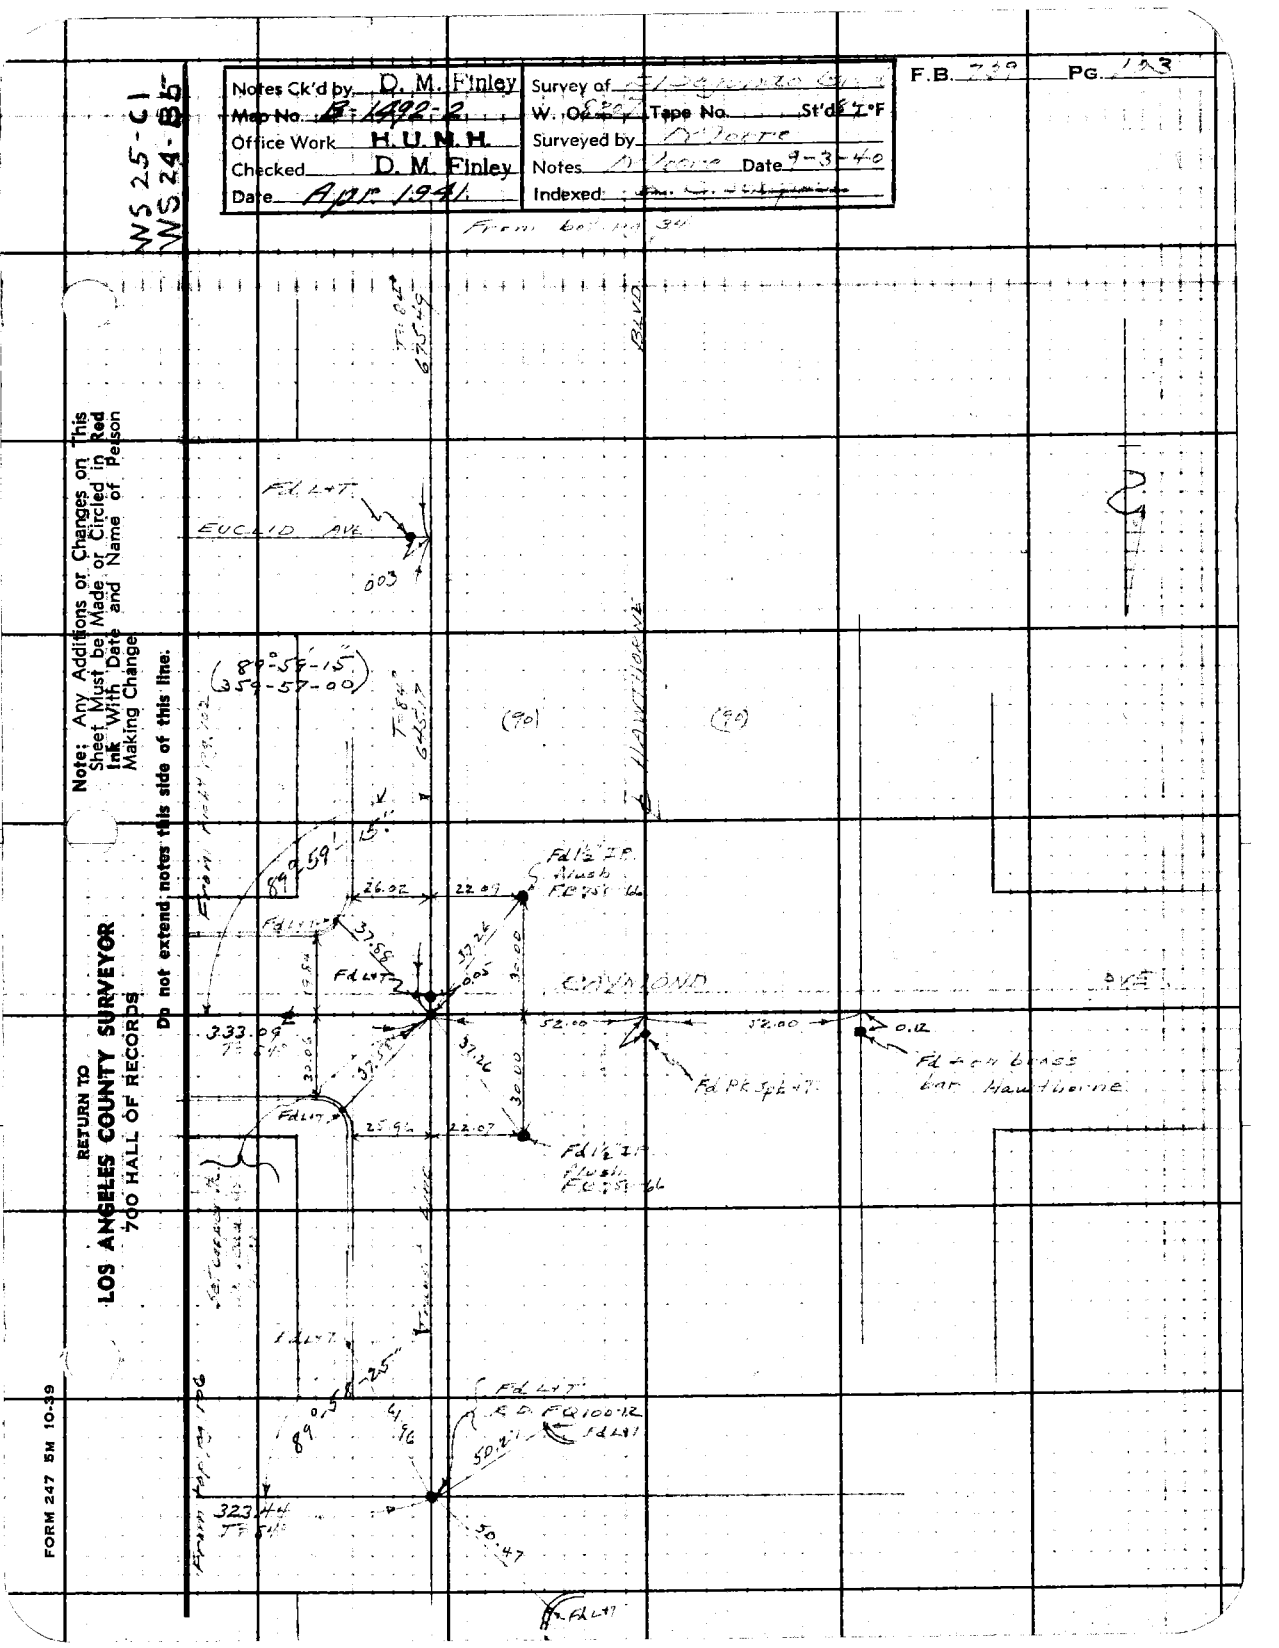
Notes Ck'd by D. M. Finley
Map No. B 1499-2
Office Work H. U. M. H.
Checked D. M. Finley
Date Apr. 1941
Survey of
W. O.
Tape No.
St'd
Surveyed by
Notes
Date 9-3-40
Indexed
F.B.
PG.
WS 25-C1
WS 24-B5
Note: Any Additions or Changes on This Sheet Must be Made in Red Ink With Date and Name of Person Making Change
Do not extend notes this side of this line.
RETURN TO
LOS ANGELES COUNTY SURVEYOR
700 HALL OF RECORDS
FORM 247 5M 10-39
EUCLID AVE
HAWTHORNE
(90)
(89°-59'-15")
(359-57-00)
333.09
323.44
Fd 1/2 IP
Fd L+T
Fd Pk Spk
Fd 1/4 brass
bar Hawthorne

RETURN TO
LOS ANGELES COUNTY SURVEYOR
700 HALL OF RECORDS

Note: Any Additions or Changes on This Sheet Must be Made or Circled in **Red Ink** With Date and Name of Person Making Change.

Do not extend notes this side of this line.

F.B. 339 PG. 104

Notes Ck'd by D. M. Finley
Map No. B-1492-2
Office Work H. U. M. H.
Checked D. M. Finley
Date Apr. 1941

Survey of Eastern Blvd
W. O. 8207 Tape No. St'd 84°F
Surveyed by Moore
Notes Moore Date 8-20-40
Indexed

F.B. 733 Pg. 125

To lower left hwy 99

WS 24-B5

Note: Any Additions or Changes on This Sheet Must be Made or Circled in Ink With Date and Name of Person Making Change

Do not extend notes this side of this line.

RETURN TO
LOS ANGELES COUNTY SURVEYOR
700 HALL OF RECORDS

FORM 247 5M 10-39

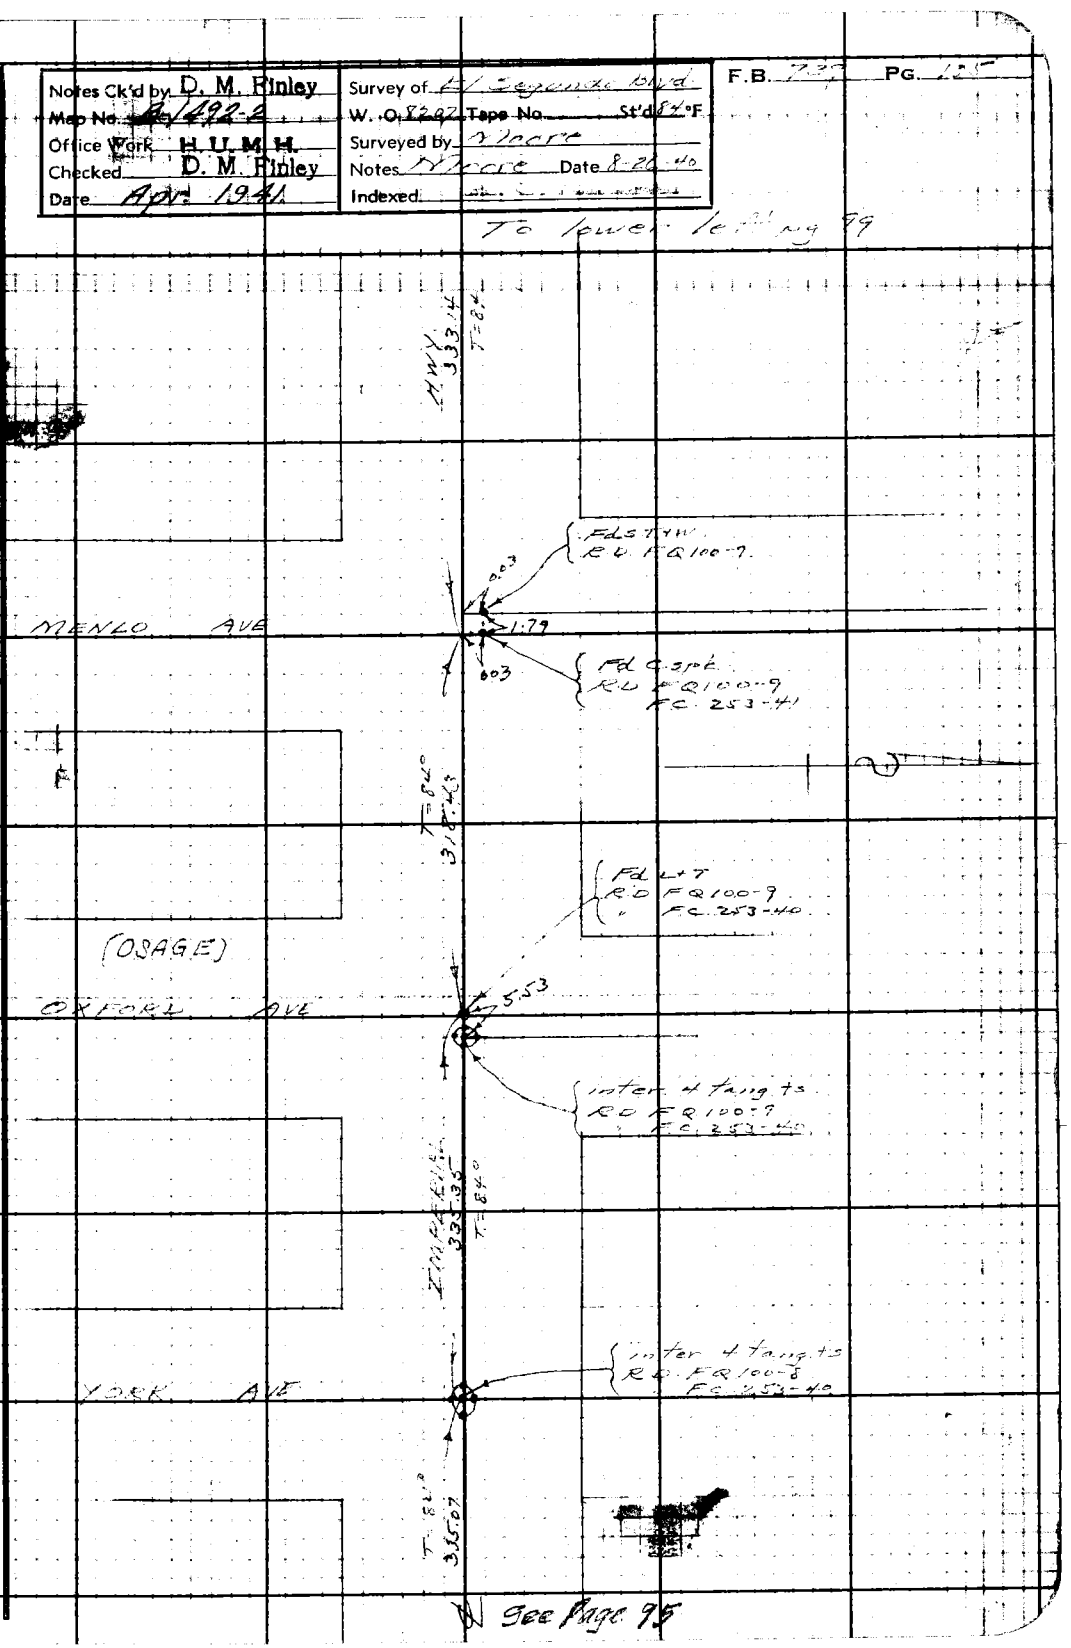

See Page 95

RETURN TO
LOS ANGELES COUNTY SURVEYOR
700 HALL OF RECORDS

Note: Any Additions or Changes on This Sheet Must be Made or Circled in **Red Ink** With Date and Name of Person Making Change.

WS 24-B5

Do not extend notes this side of this line.

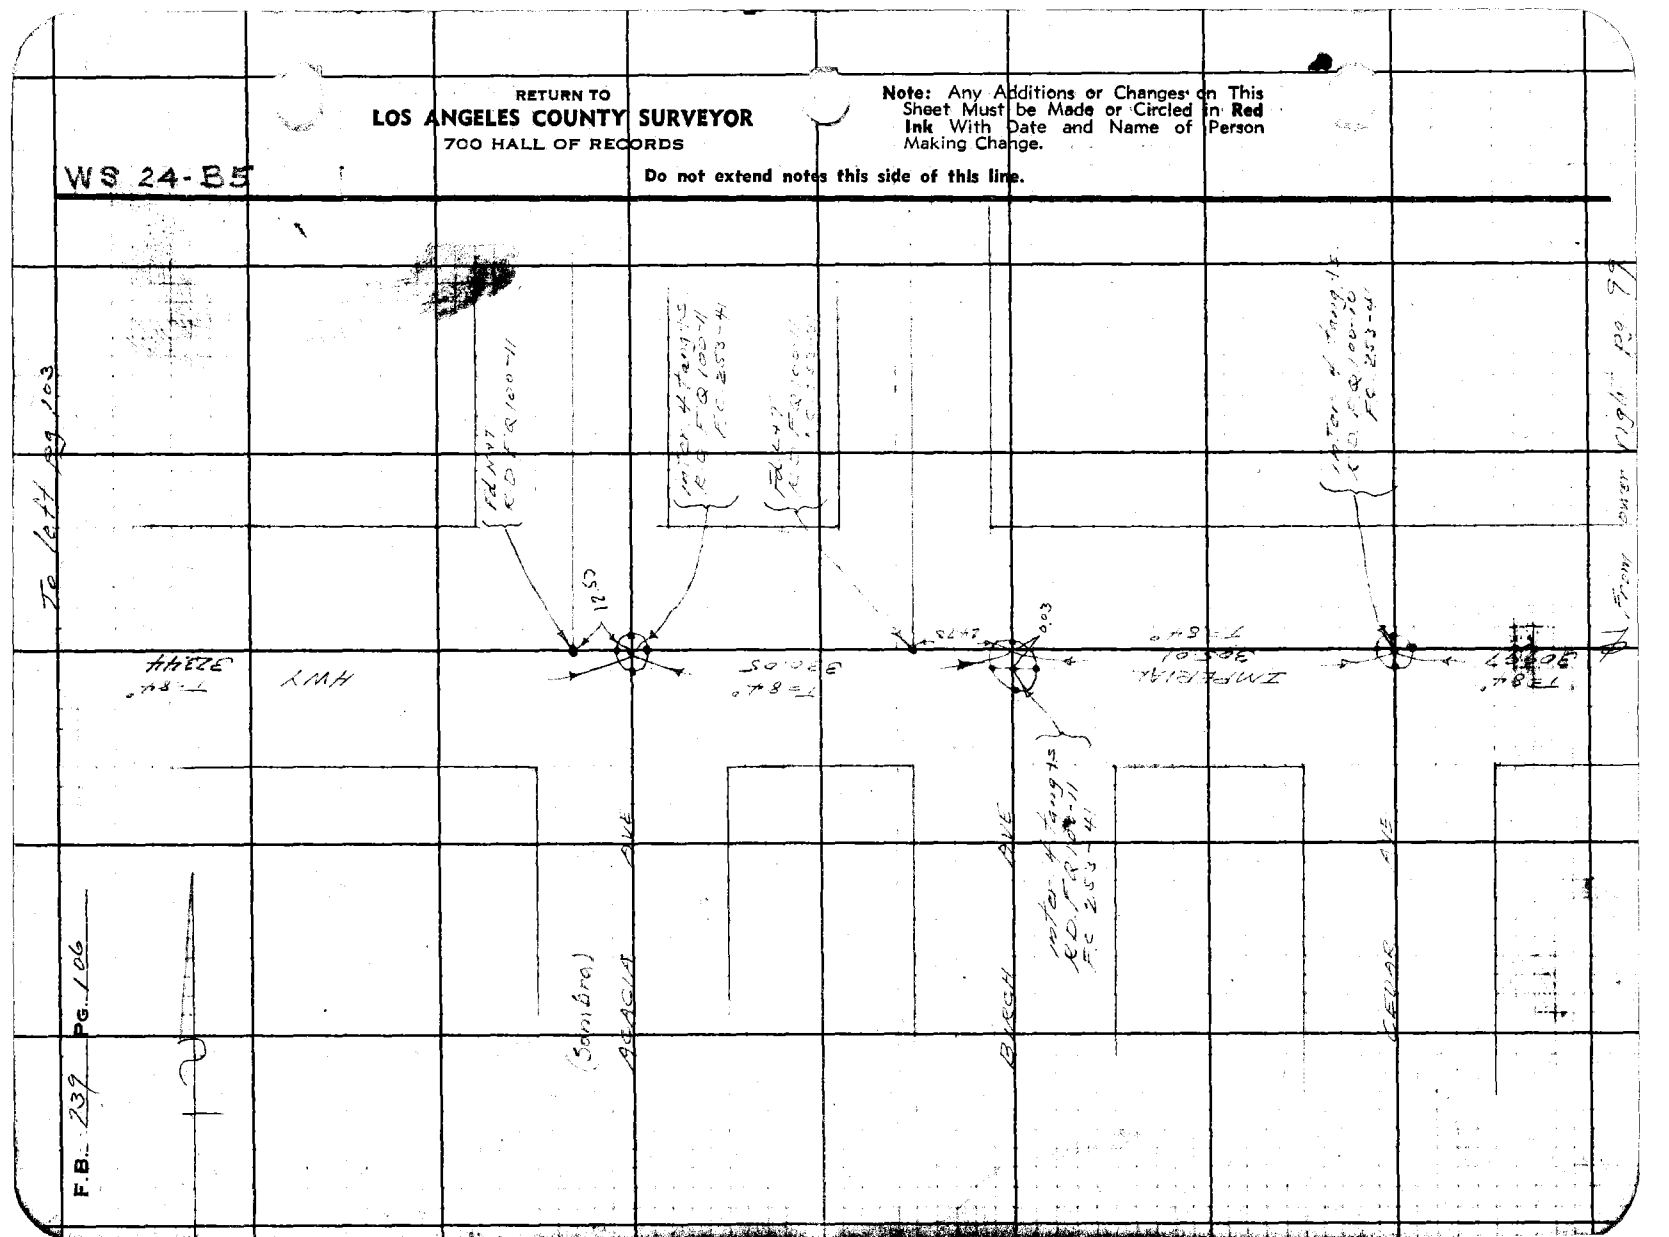

F.B. 239 PG. 106

F. B. 139 PG. 107

Notes Ck'd by	Survey of El Segundo Blvd (Alt) (21)
Map No.	W. O. 0912.37 Tape No. 5176 St'd. 68 °F
Office Work	Surveyed by [illegible]
Checked	Notes [illegible] Date 9/[illegible]/55
Date	Indexed C. Johnson 10-11-55

EL SEGUNDO BLVD.
(21) APPRAISAL

J.N. - 0912.37

LOCATION OF IMPROVEMENTS

From 0400± West of Normandie Ave.
Easterly to 1300± Normandie Ave

Ref. 7.39 Pg. 107 & Pg. 128

H.E. Goodcell Chief
[illegible]
M. Cal Poole Field Man
W. Deane, Chainman

Note: Any Additions or Changes on This Sheet Must be Made or Circled In Red Ink With Date and Name of Person Making Change.

Do not extend notes this side of this line.

RETURN TO
LOS ANGELES COUNTY SURVEYOR
726 LOS ANGELES COUNTY
ENGINEERING BLDG.

76F309S S&E #247. 8-54

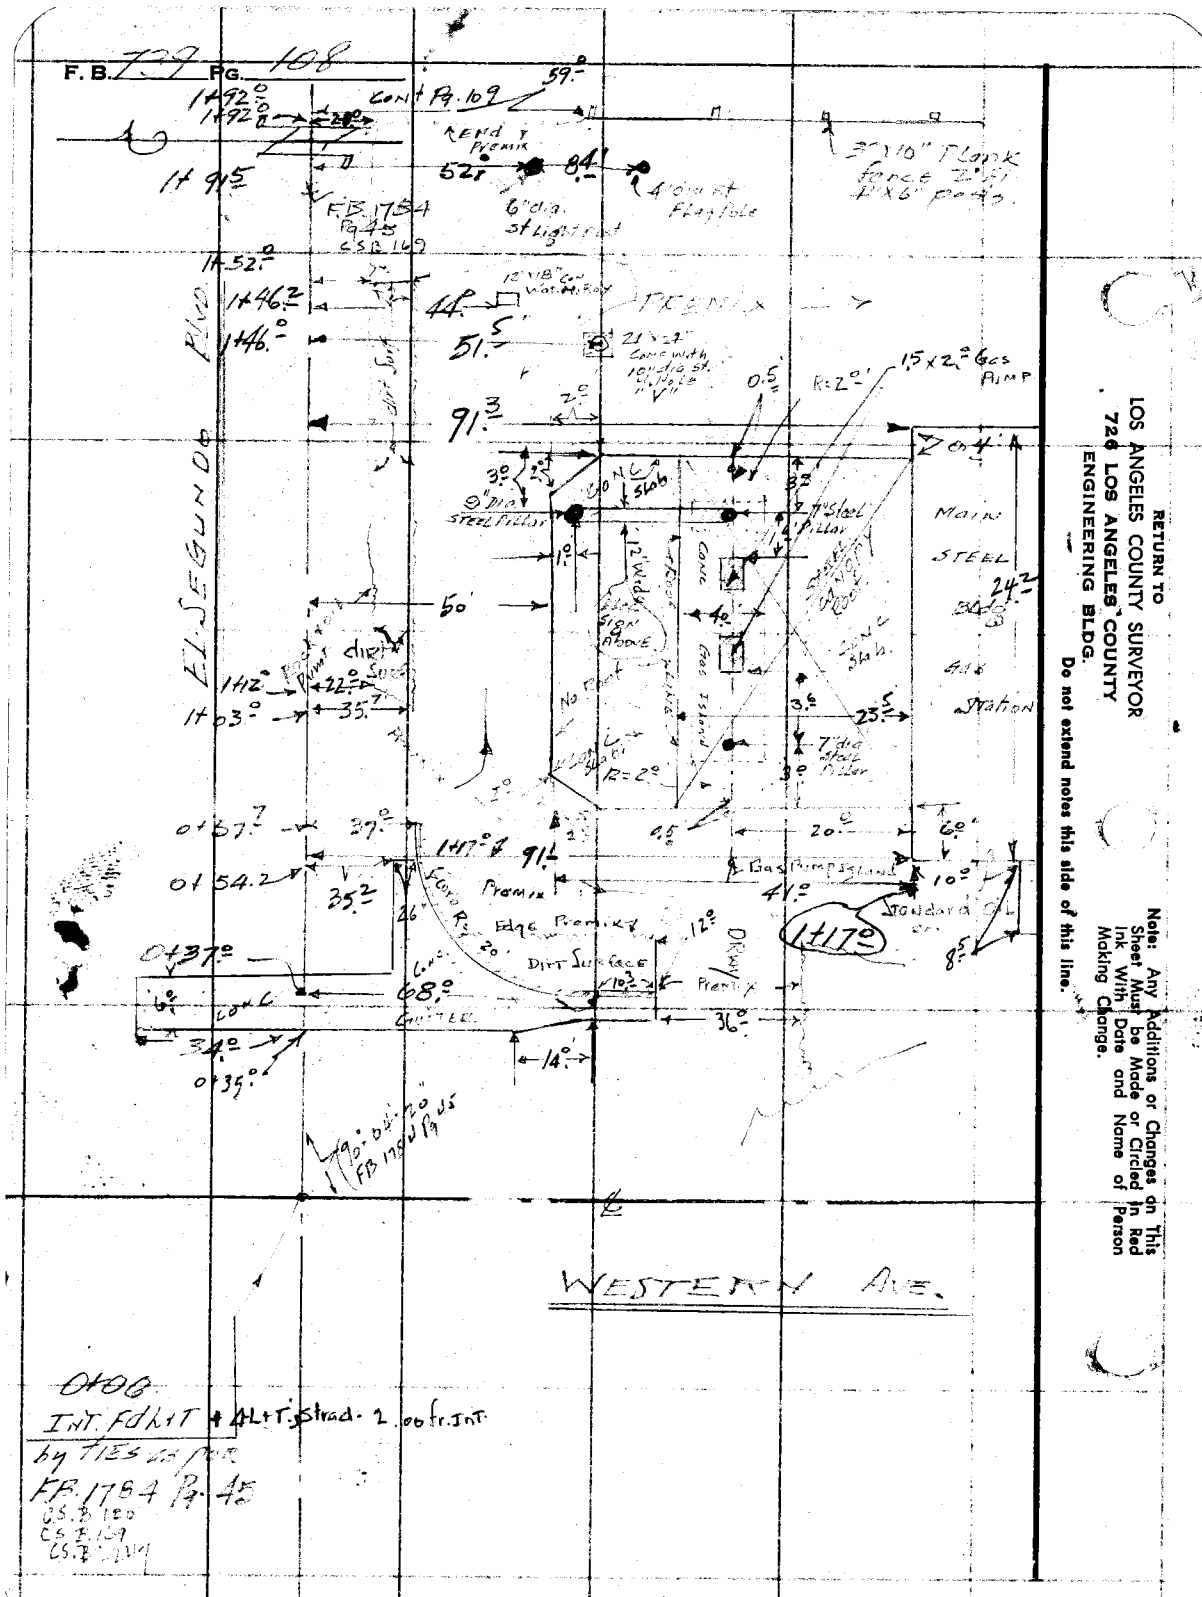

RETURN TO
LOS ANGELES COUNTY SURVEYOR
726 LOS ANGELES COUNTY
ENGINEERING BLDG.
Do not extend notes this side of this line.

Note: Any Additions or Changes on This Sheet Must be Made or Circled in Red Ink With Date and Name of Person Making Change.

F.B. 722 PG. 107

Notes Ck'd by
Map No.
Office Work
Checked
Date

Survey of El Segundo Blvd
W.O. 312-37 Tape No. 0176 St'd. 68 °F
Surveyed by
Notes Date 10-3-55
Indexed A. C. Johnson

Note: Any Additions or Changes on This Sheet Must be Made or Circled in Red Ink With Date and Name of Person Making Change

Do not extend notes this side of this line.

RETURN TO
LOS ANGELES COUNTY SURVEYOR
726 LOS ANGELES COUNTY
ENGINEERING BLDG.

76F309S 247 2-51

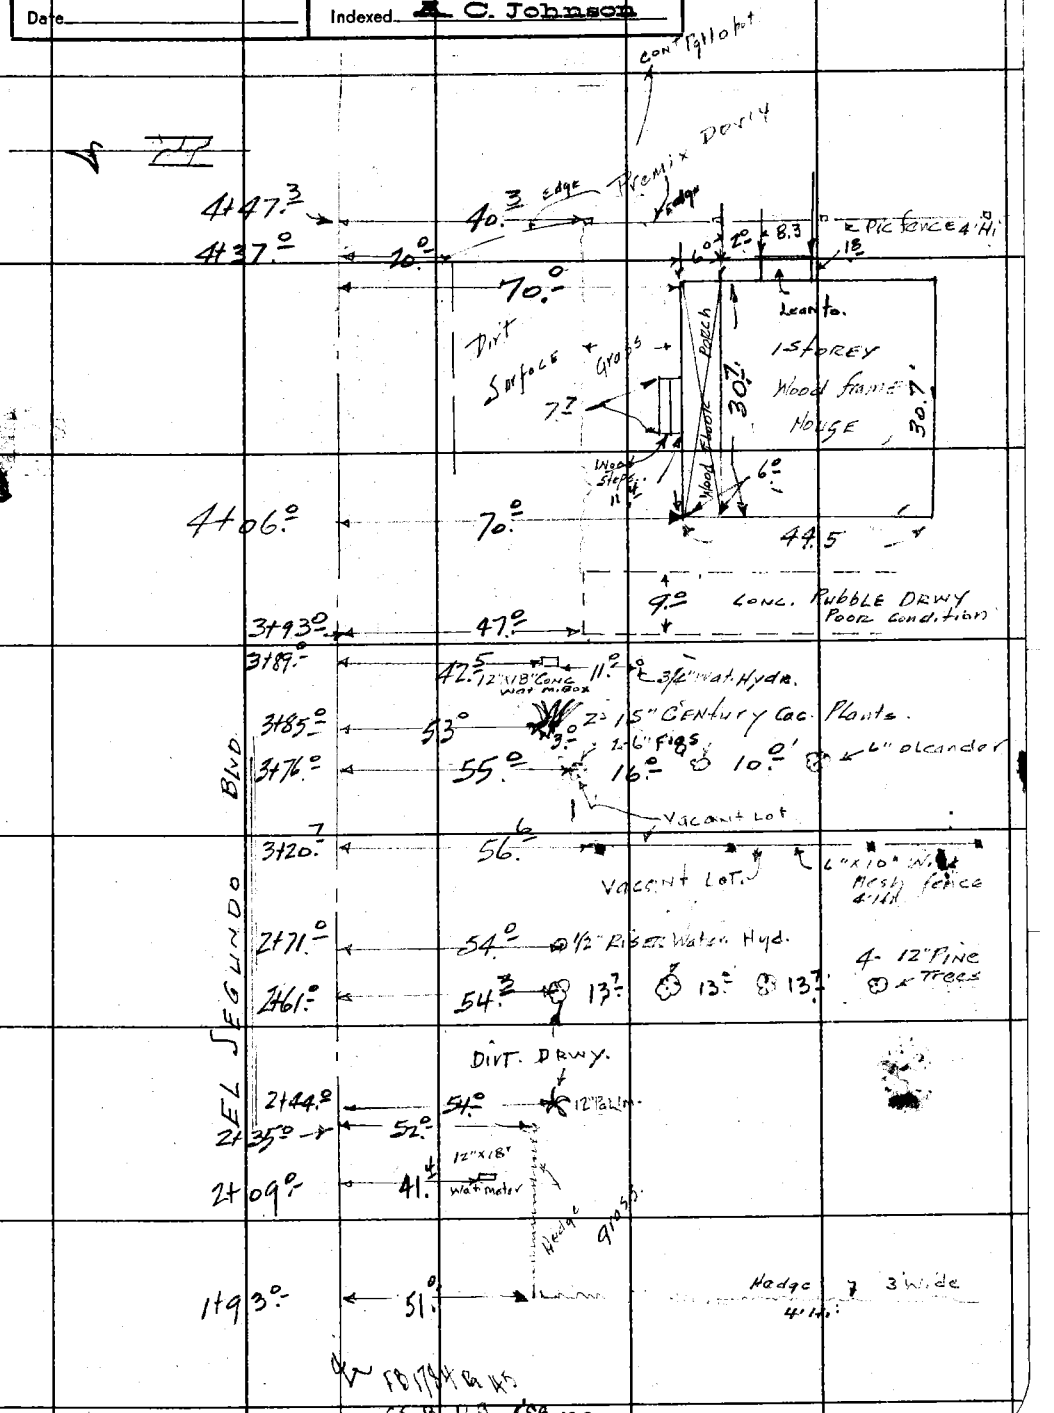

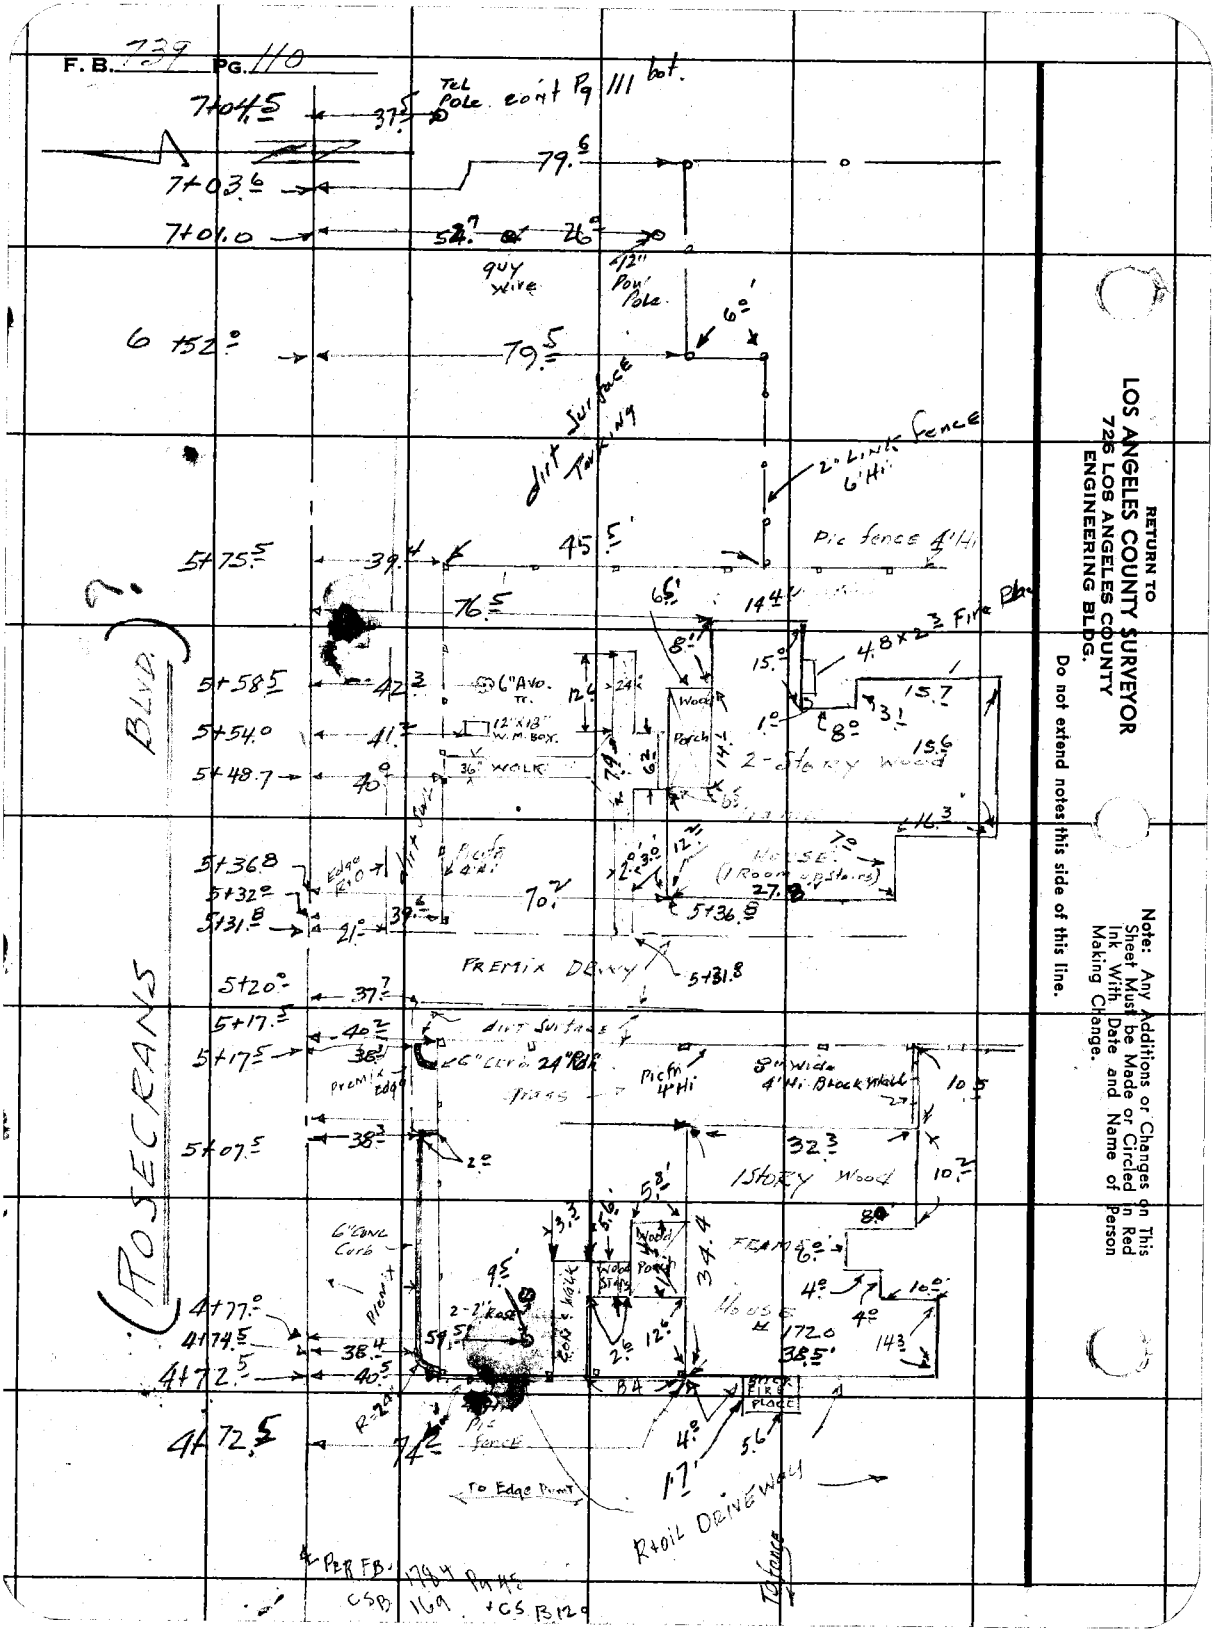
F. B. 739 PG. 110
Tel Pole cont Pg 111 bot.
7+04.5
37.5
79.6
7+03.6
7+01.0
54.7
76.0
guy wire
4"/3" Pow Pole
6 +52.0
79.5
6.0'
Surface dirt Parking
2" Link Fence 6' Hi
Pic fence 4' Hi
5+75.5
39.4
45.5'
76.5
14.4
6.5'
8.1'
15.0'
4.8x3 Fire Bldg
5+58.5
42.3
6" Asbo. Tr.
12x18" W.M. Box
12.6
24.1
Wood Porch
14.2
1.0'
8.0'
15.7
3.1
15.6
2-story wood
5+54.0
41.7
5+48.7
40.0
36" WALK
79.2
N 16° E
16.3
5+36.8
Edge of Pvmt
Fence 4' Hi
12.1'
2.0'
3.0'
Wood SHED (1 Room upstairs)
7.0
27.2
5+32.0
5+31.8
39.6
21.0
70.2
5+36.8
PREMIX DRIVEWAY
5+31.8
5+20.0
37.7
5+17.3
40.2
Dirt Surface
5+17.5
38.2
Premix Edge
6" Conc. Curb 24" R&R
Pic fence 4' Hi
8" Wide 4' Hi Block Wall
10.5
27
5+07.5
38.3
2.0'
32.3
1 STORY Wood
10.2'
Concrete Curb
Planter
5.8'
5.6'
3.3
Wood Porch
34.4
FRAME
6.0'
8.0'
9.5'
4+77.0
4+74.5
38.4
2-2' Rock
5.5'
2.0'
12.6'
4.0'
4.0'
10.0'
4+72.5
40.5
BRICK FIRE PLACE
5.6'
4+72.5
P=2.0'
Pic fence
4.0'
17'
To Edge Pvmt
R+OIL DRIVEWAY
Telephone
PER FB. 1784 PAGE
CSB 169 + CS B120
RETURN TO
LOS ANGELES COUNTY SURVEYOR
726 LOS ANGELES COUNTY
ENGINEERING BLDG.
Do not extend notes this side of this line.
Note: Any Additions or Changes on This Sheet Must be Made or Circled in Red Ink With Date and Name of Person Making Change.
ROSECRANS BLVD.

Notes Ck'd by	Survey of
Map No.	W. O. Tape No. 0176 St'd. 68 °F
Office Work	Surveyed by
Checked	Notes Date 10-6-55
Date	Indexed C. Johnson

F. B. PG.

Note: Any Additions or Changes on This Sheet Must be Made or Circled In Red Ink With Date and Name of Person Making Change.

Do not extend notes this side of this line.

RETURN TO
LOS ANGELES COUNTY SURVEYOR
726 LOS ANGELES COUNTY
ENGINEERING BLDG.

11+28.0 20°

11+12.6 20° 38.2 48.5 49.0° 10.3 5.0' 31.5

11+02.6 42°

10+89.52 49° 10.5 0.2'

10+89.0 34.3

10+88.7 51°

10+00.0 51°

9+00 51° 72.7

8+00 51° 34.7

FB 1764
SB. 169
LSB. 120

7+82.1 72.8

Hooked 14.0 27.0

6.5 7°

40.0°

3 1/2" Iron post
gate

2" Iron Post

150'

7+09 Intersection

7+06.7 50.7

15.1'

40

Wood 29.5

6.1 21.1

6.6' 4.3 4.8 17 12 32.8

Lean-to

Cone

Hood

Asphalt

Loose gravel

Ditch

Sidewalk

BLVD.

ST

EL

76FBOOS 247 4-58

F. B. 739 Pg. 112

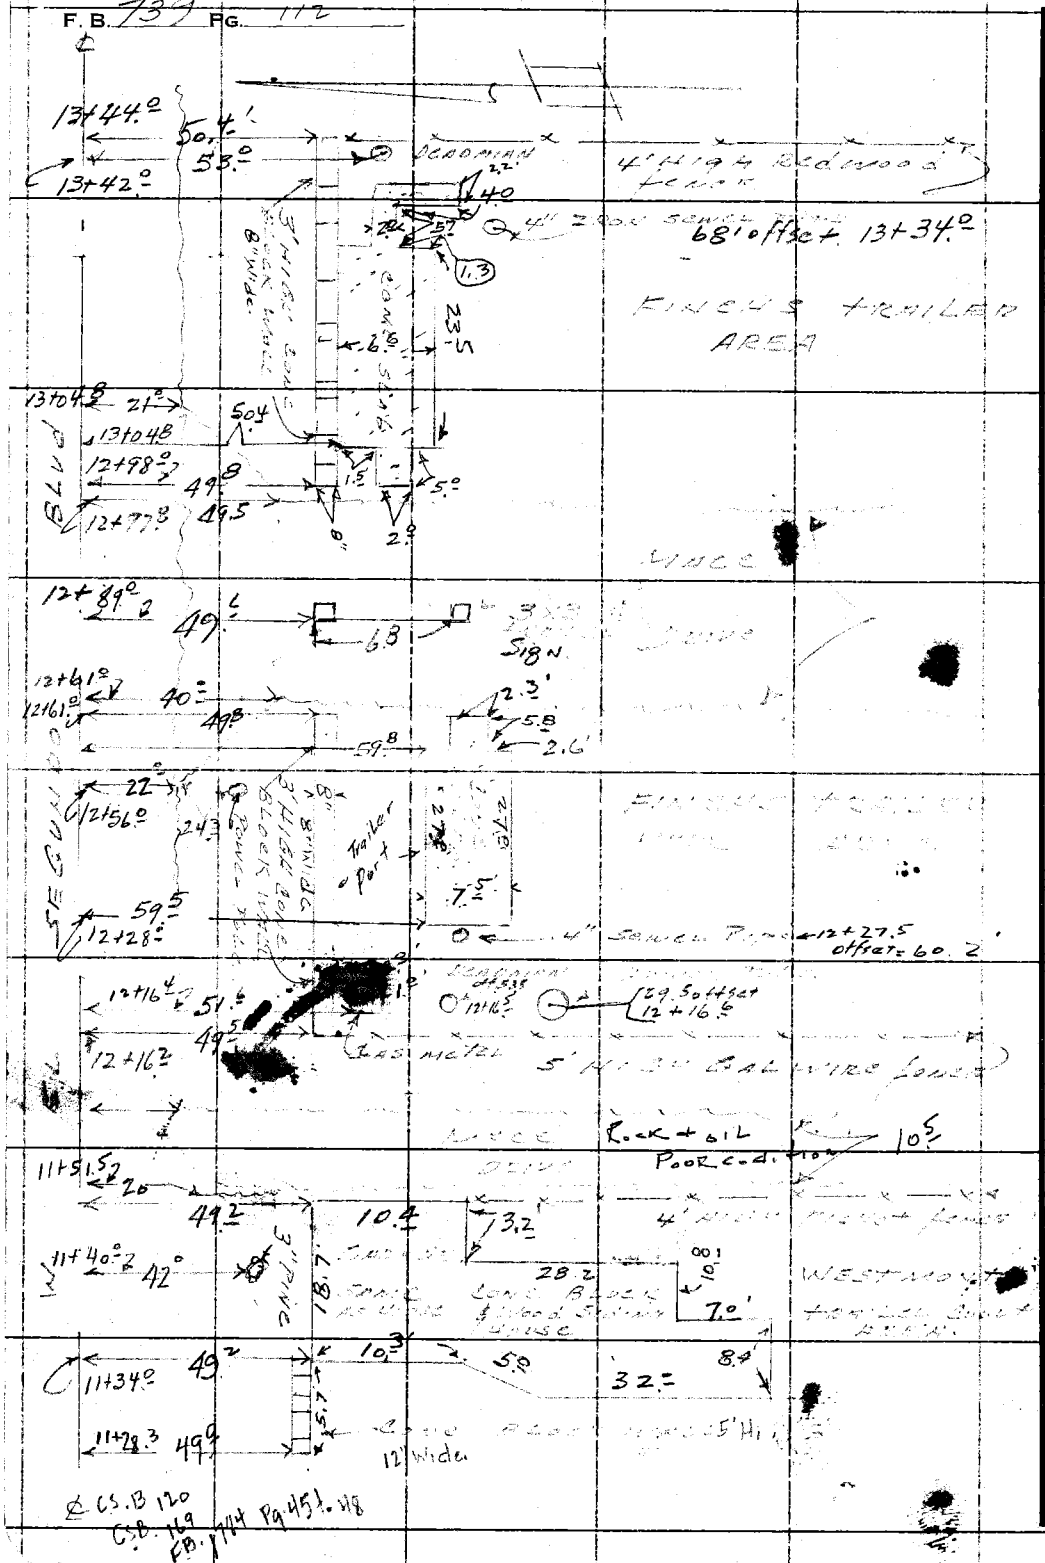

RETURN TO
LOS ANGELES COUNTY SURVEYOR
720 LOS ANGELES COUNTY
ENGINEERING BLDG.

Do not extend notes this side of this line.

Note: Any Additions or Changes on This Sheet Must be Made or Circled in Red Ink With Date and Name of Person Making Change.

Notes Ck'd by	Survey of EL SEGUNDO BLVD
Map No.	W. O. 0912.37 Tape No. 0176 St'd. 68 °F
Office Work	Surveyed by
Checked	Notes Date
Date	Indexed C. Johnson

F. B. 1784 PG. 40

Note: Any Additions or Changes on This Sheet Must be Made or Circled in Red Ink With Date and Name of Person Making Change.

Do not extend notes this side of this line.

RETURN TO
LOS ANGELES COUNTY SURVEYOR
726 LOS ANGELES COUNTY
ENGINEERING BLDG.

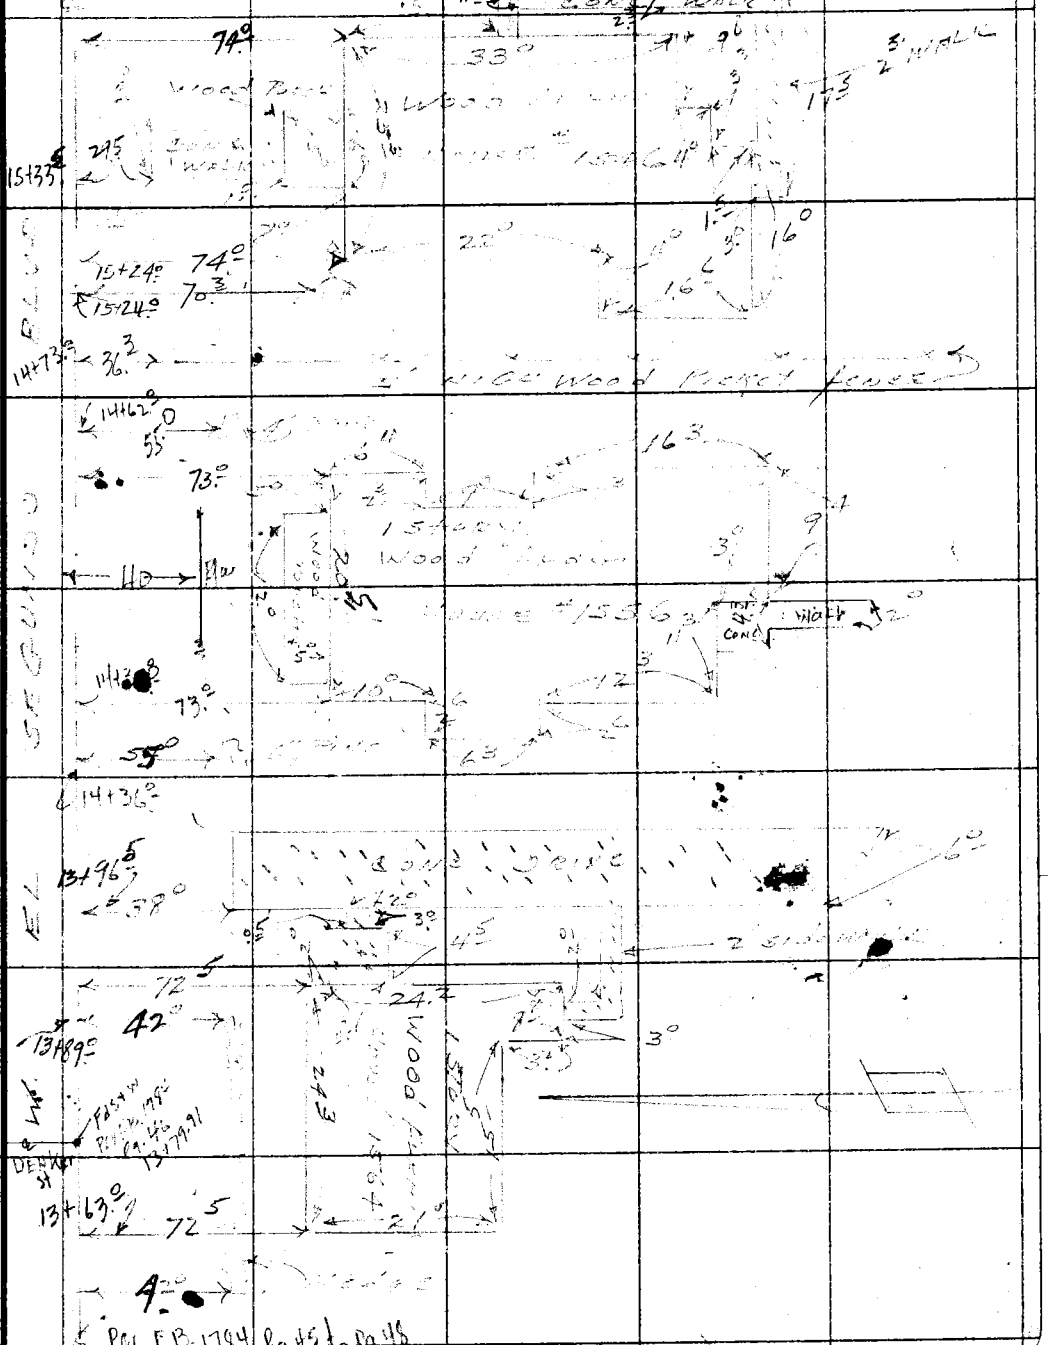

76FSOOS 247 4.53

F. B. 134 Pg. 114

(40') ℄ (40')

(89)

20+86.7 22°

(40')

20+66° 50°

90°04' as FB. 1784 Pg 47

HALLDALE AVE

89.9

20+58.13 Int B's. Fd Nothing Set Punch Mark by Rec. Dist. on Halldale Ave to North per FB. 1784 Pg 47

Fd Spk 2 on B 4

℄ FB 1784 Pg 47

20+46° 36.5 (40')

(40')

20+37.5 22°

20+18.8 39° 40

Hedge 1' wide 3' H.

75°

28.

3.1 Fronts ON

12.5

19+23.3

18+64.0 15°

78° Hedge

18+00 40 Hedge 84.8

17+58.2 59°

17+47.4 54.5

17+37.5 54.5

3' Wide

17+33.0

43°

17+30.0

17+30.5 OFF 41.3

41°

84.8 DRWY.

2' Wide

17+20.0

15+70.2 59.3 10" Zoquar

15+56.5 25°

FB. 1784 Pg 45 to Pg 43 Resp no Cor Pg 3

RETURN TO
LOS ANGELES COUNTY SURVEYOR
726 LOS ANGELES COUNTY
ENGINEERING BLDG.

Do not extend notes this side of this line.

Note: Any Additions or Changes on This Sheet Must be Made or Circled in Red Ink With Date and Name of Person Making Change.

Notes Ck'd by	Survey of
Map No.	W. O. Tape No. St'd. °F
Office Work	Surveyed by
Checked	Notes Date
Date	Indexed C. Johnson

F. B. Pg.

Note: Any Additions or Changes on This Sheet Must be Made or Circled in Red Ink With Date and Name of Person Making Change.

Do not extend notes this side of this line.

RETURN TO
LOS ANGELES COUNTY SURVEYOR
726 LOS ANGELES COUNTY
ENGINEERING BLDG.

EL SEGUNDO

W.

78FSOSS 247 4-53

F. B. 137 PG. 10

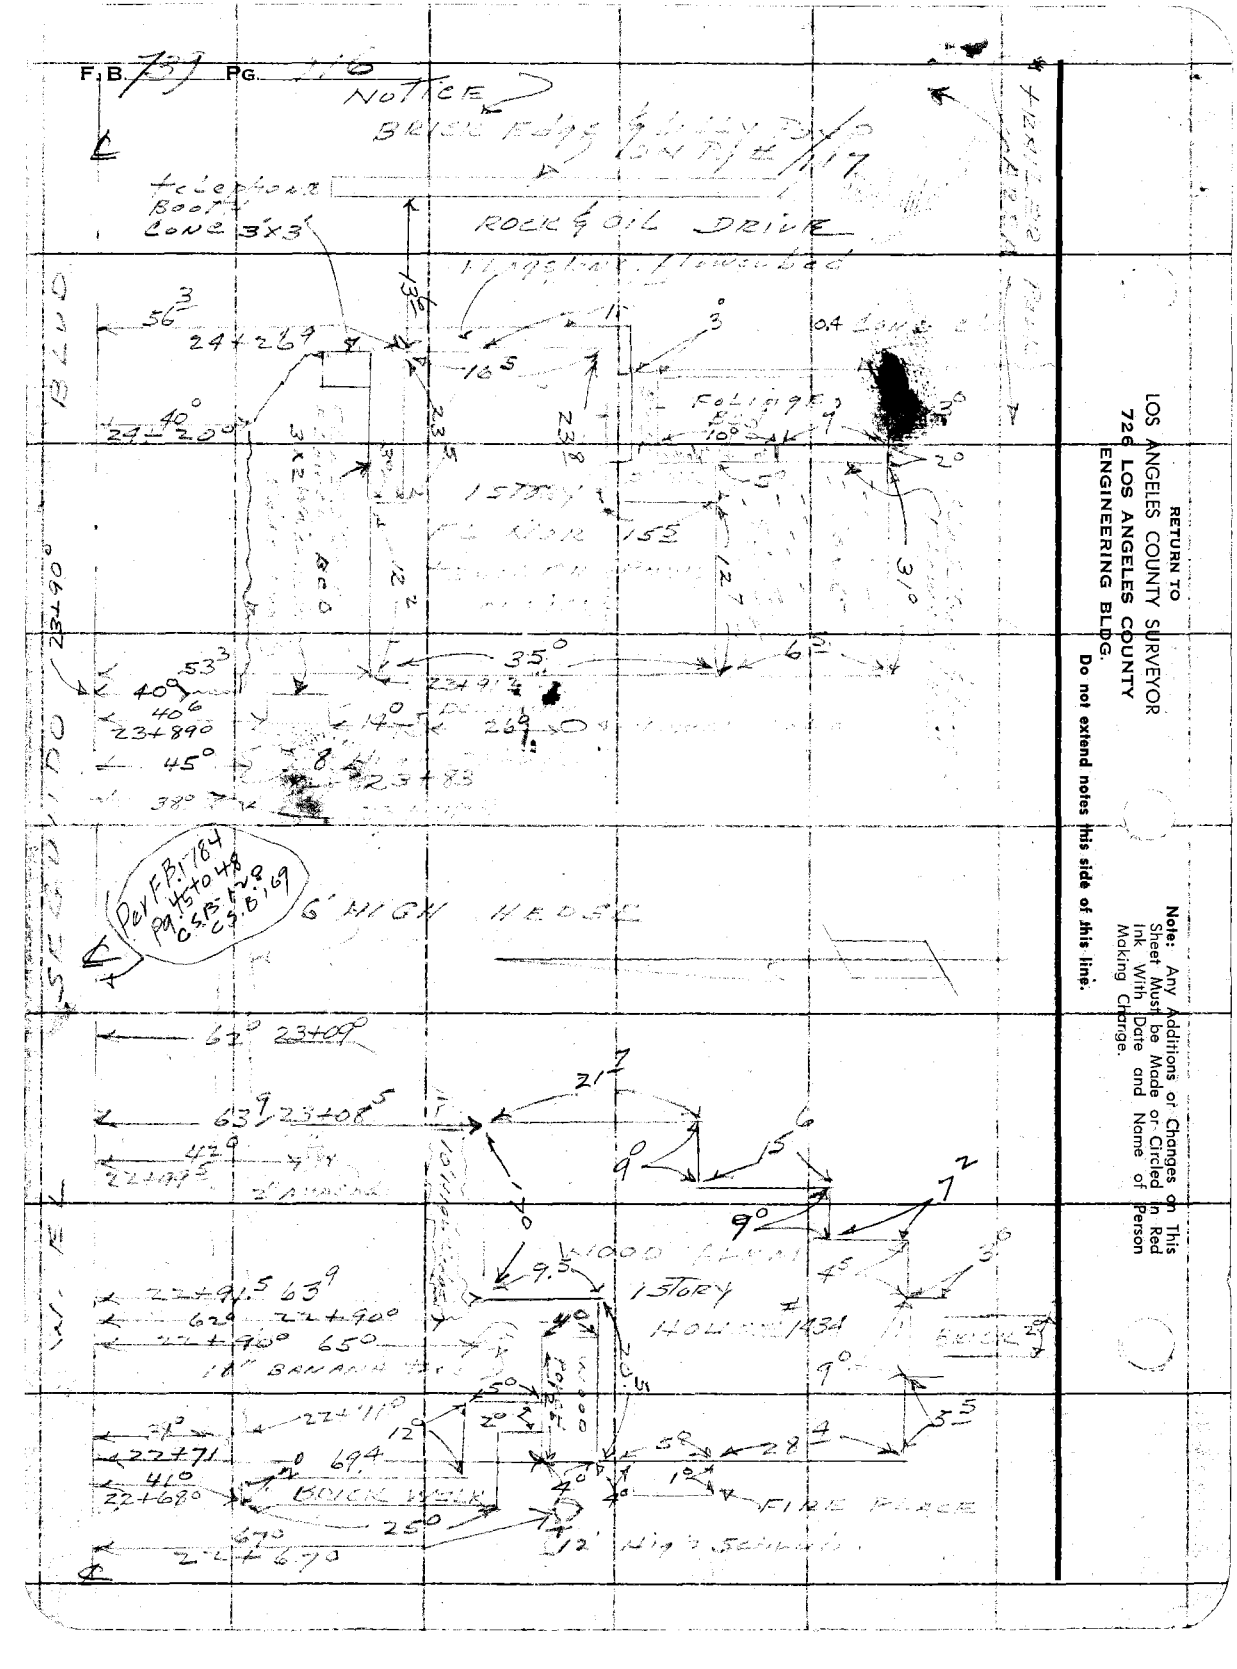

RETURN TO
LOS ANGELES COUNTY SURVEYOR
726 LOS ANGELES COUNTY
ENGINEERING BLDG.

Note: Any Additions or Changes on This Sheet Must be Made or Circled in Red Ink With Date and Name of Person Making Change.

Do not extend notes this side of this line.

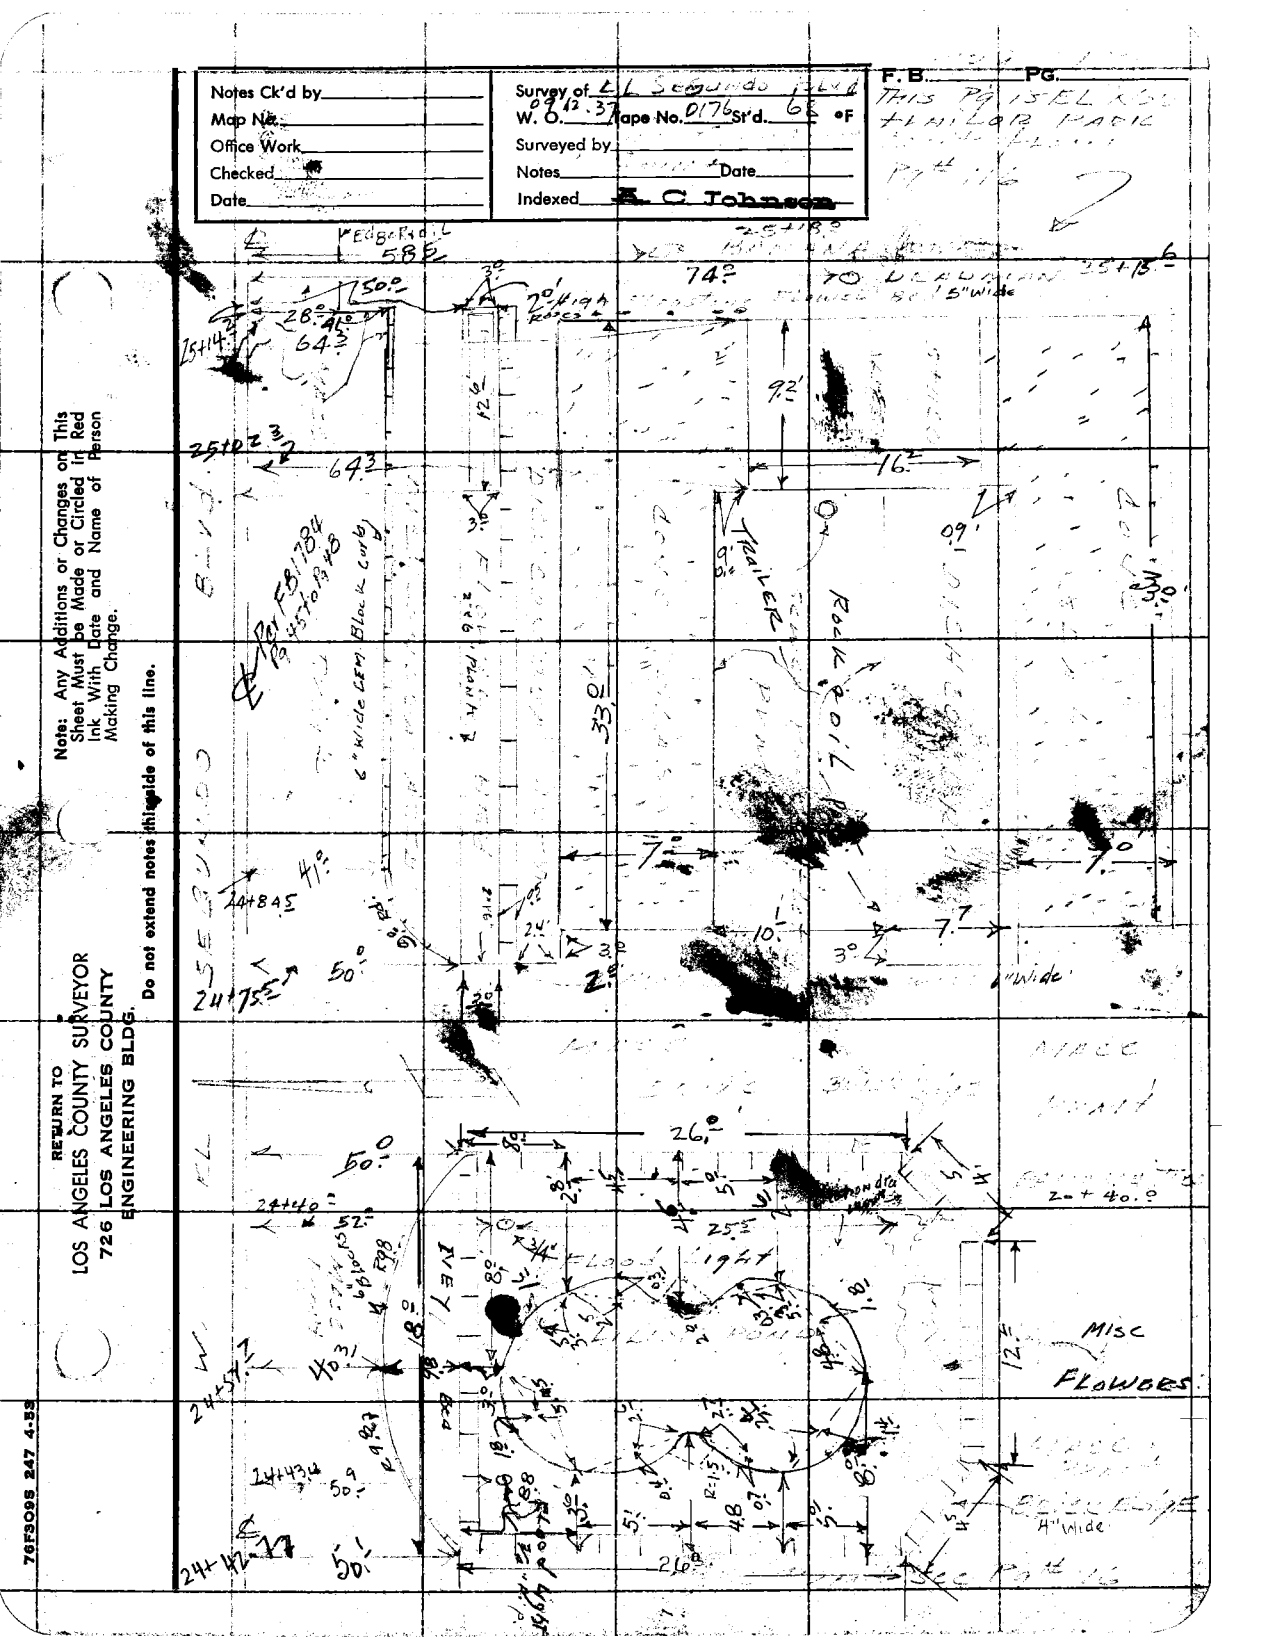
Notes Ck'd by
Map No.
Office Work
Checked
Date
Survey of
W. O. 0912.37
Tape No. D176 St'd. 62 °F
Surveyed by
Notes Date
Indexed A. C. Johnson
F. B. PG.
Note: Any Additions or Changes on This Sheet Must be Made or Circled in Red Ink With Date and Name of Person Making Change.
Do not extend notes this side of this line.
RETURN TO
LOS ANGELES COUNTY SURVEYOR
726 LOS ANGELES COUNTY
ENGINEERING BLDG.
76FSO95 247 4-53
Misc
Flowers

F.B. 737 PG. 118

RETURN TO
LOS ANGELES COUNTY SURVEYOR
726 LOS ANGELES COUNTY
ENGINEERING BLDG.
Do not extend notes this side of this line.

Note: Any Additions or Changes on This Sheet Must be Made or Circled in Red Ink With Date and Name of Person Making Change.

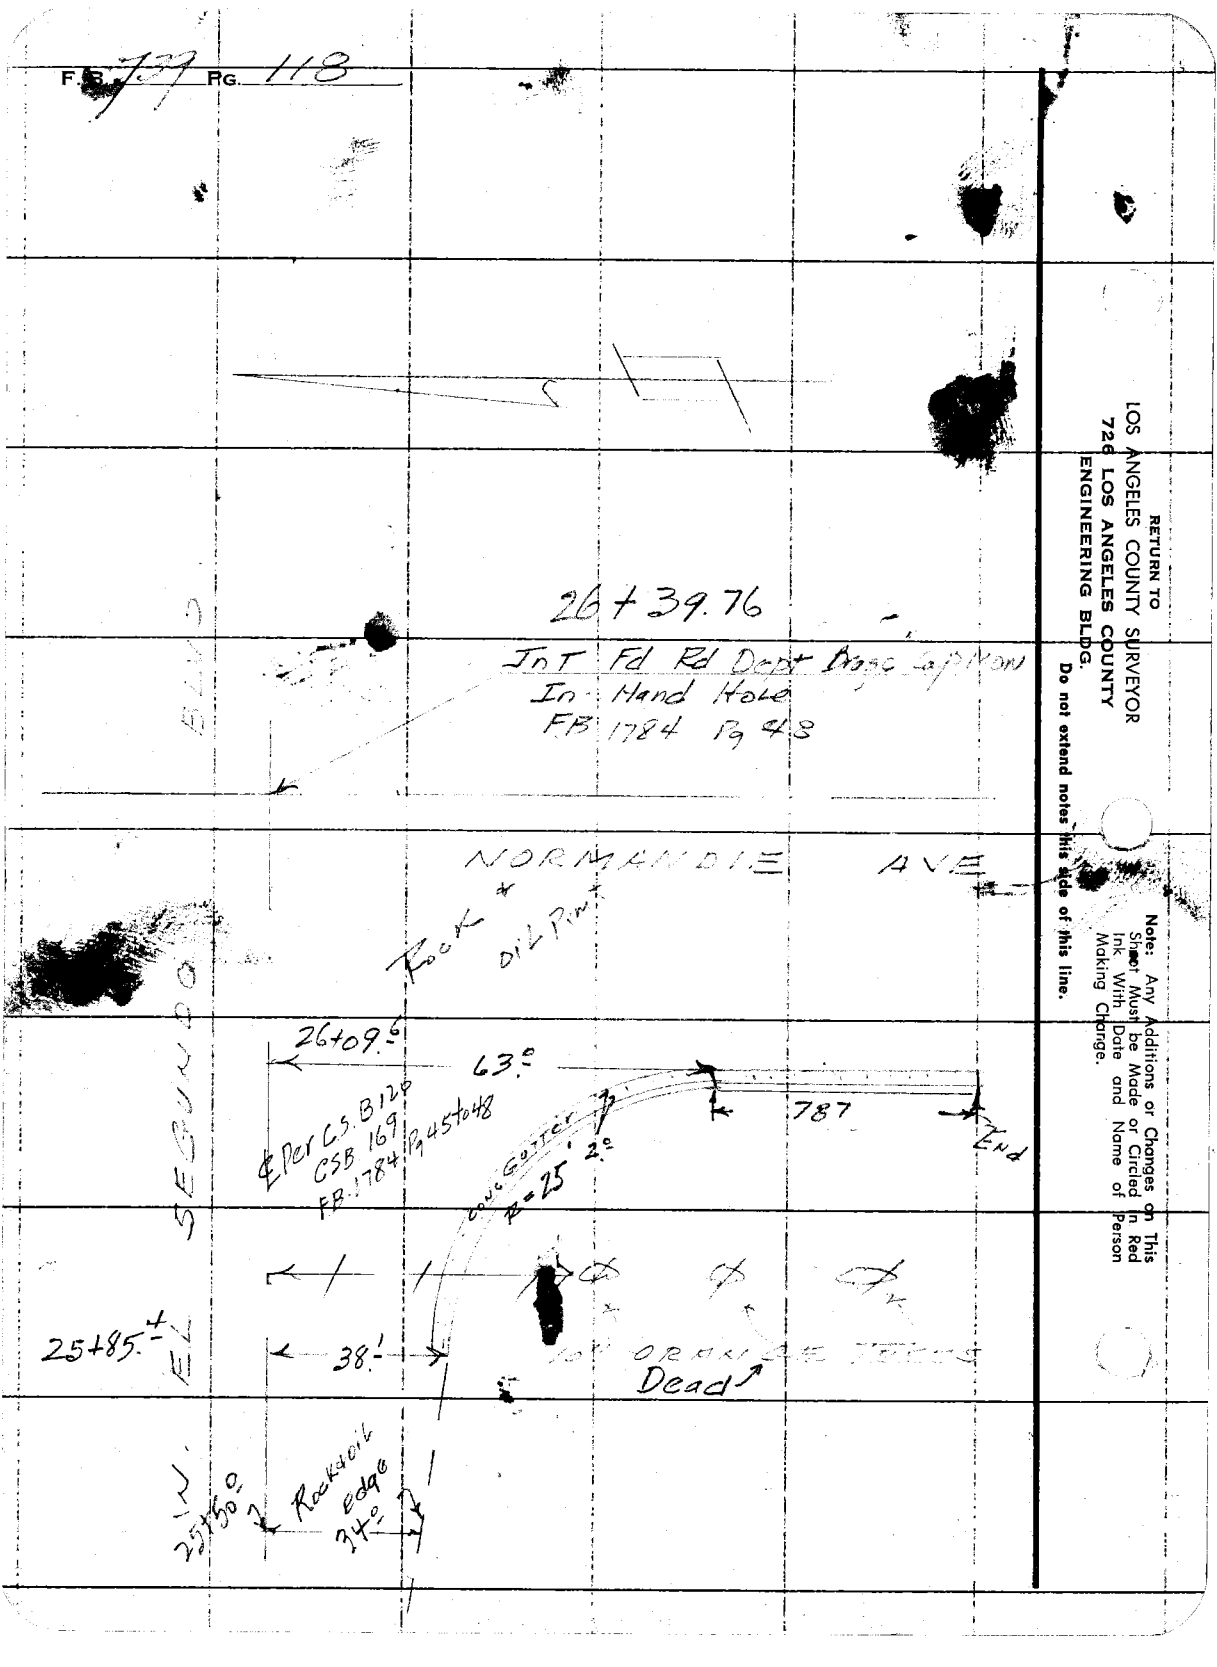

Notes Ck'd by	Survey of EL SEGUNDO BLVD.
Map No.	W.O. D413-27 Tape No. 0176 St'd. 6E °F
Office Work	Surveyed by H.E. Grandquist
Checked	Notes LE GAULT Date 10-3-55
Date	Indexed C. Johnson

F.B. 739 PG. 119

Note: Any Additions or Changes on This Sheet Must be Made or Circled in Red Ink With Date and Name of Person Making Change.

Do not extend notes this side of this line.

RETURN TO
LOS ANGELES COUNTY SURVEYOR
726 LOS ANGELES COUNTY
ENGINEERING BLDG.

76F3095 247 2-51

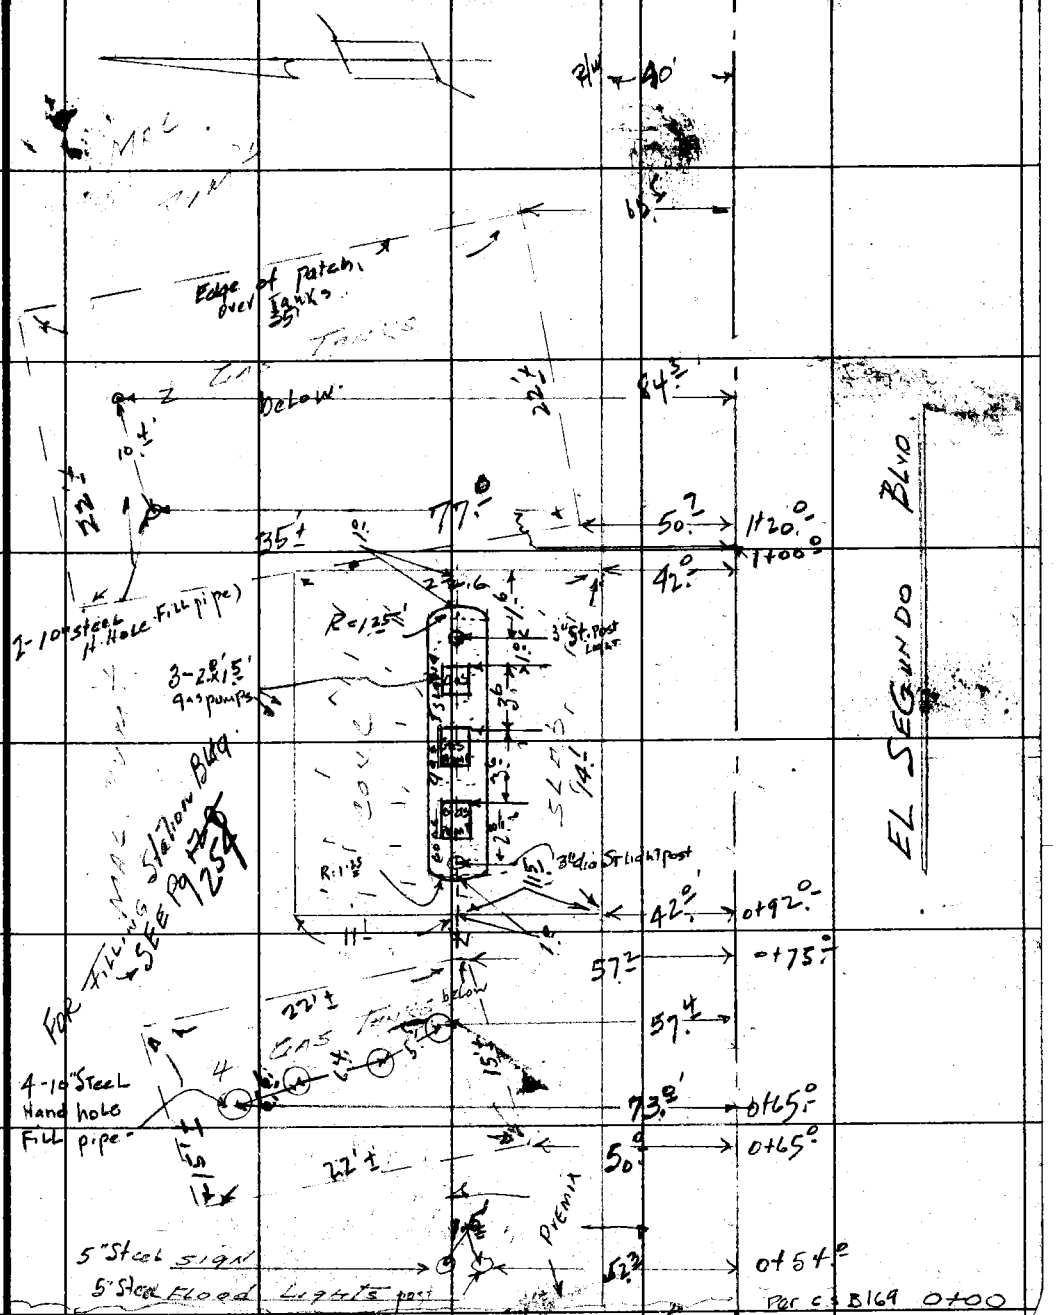

F. B. 739 PG. 120

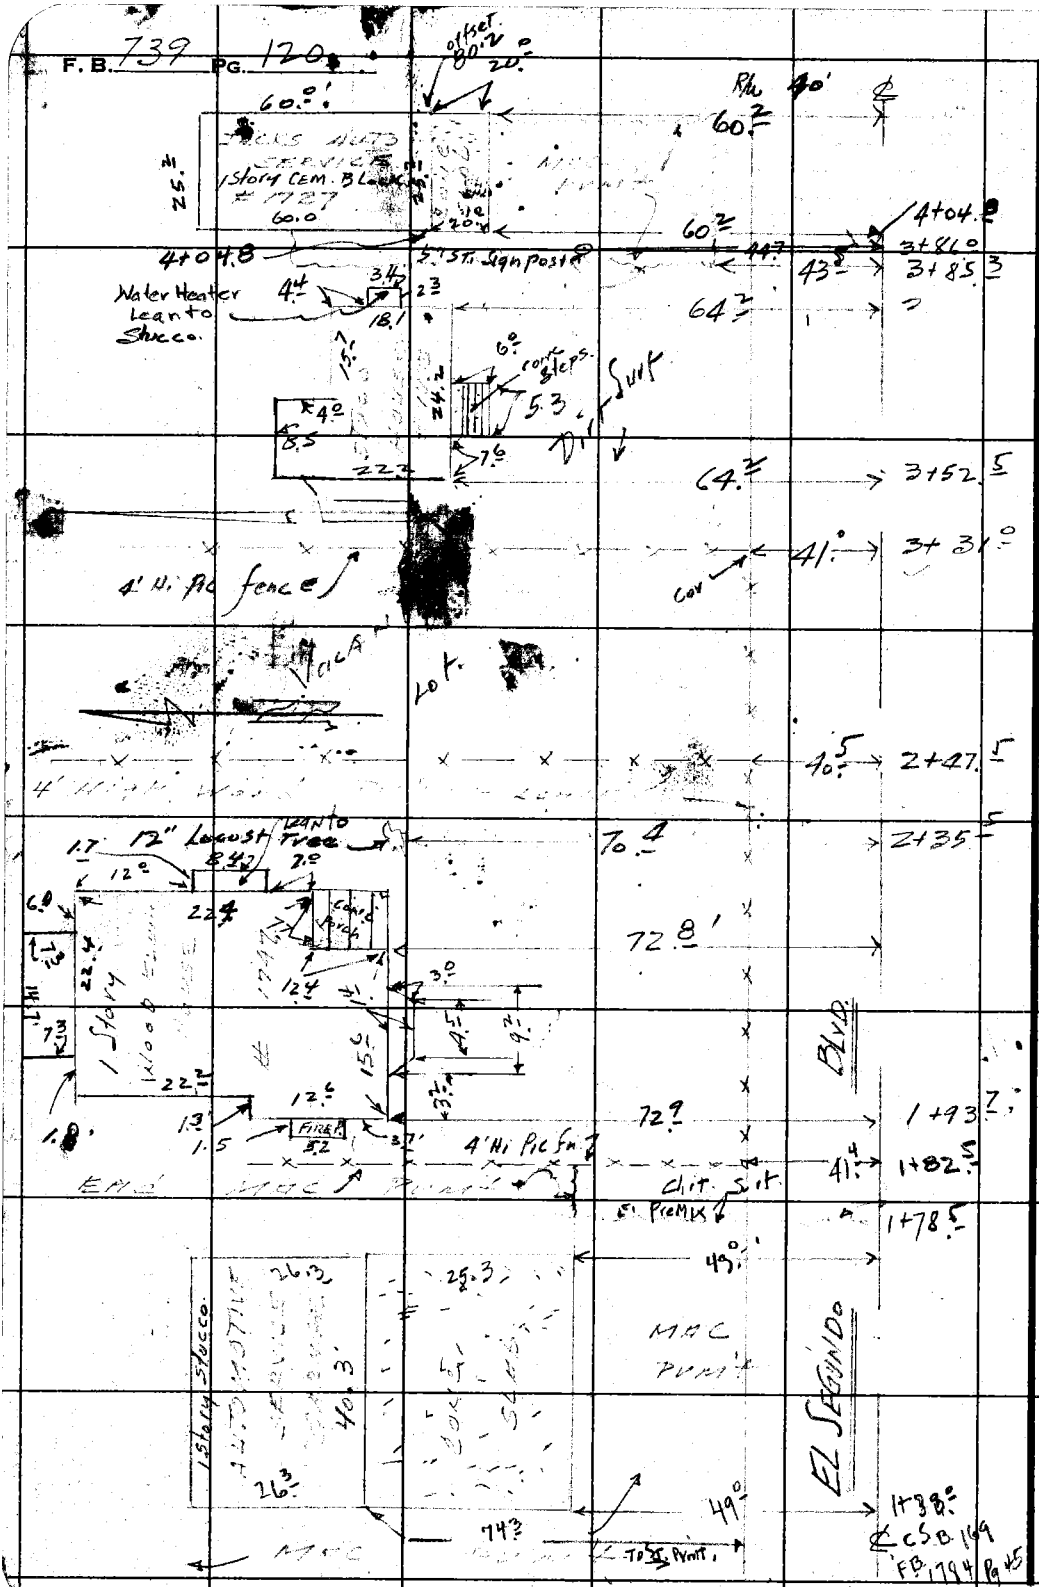

RETURN TO
LOS ANGELES COUNTY SURVEYOR
726 LOS ANGELES COUNTY
ENGINEERING BLDG.

Do not extend notes this side of this line.

Note: Any Additions or Changes on This Sheet Must be Made or Circled in Red Ink With Date and Name of Person Making Change.

Notes Ck'd by	Survey of EL SEGUNDO BLVD.
Map No.	W.O. 2.37 Tape No. #176 St'd. 65 °F
Office Work	Surveyed by G. WISE
Checked	Notes LE GRAND TAPE Date 10-3-55
Date	Indexed C. Johnson

F.B. 739 PG. 121

Note: Any Additions or Changes on This Sheet Must be Made or Circled in Red Ink With Date and Name of Person Making Change.

Do not extend notes this side of this line.

RETURN TO
LOS ANGELES COUNTY SURVEYOR
726 LOS ANGELES COUNTY
ENGINEERING BLDG.

VACANT LOT.

115.0'

49.2

40.2

MACHINE SHOP

1 STORY STUCCO

STONE SILO

CONC. SLAB

STORE

LIVING QUARTERS

dirt surface

Vacant ground

POWER POLE #9105

4" x 12" Posts Sign

(38' x (30')

Pk. & L Park 1784 Lg 46 (Not open or Constr.)

Power Pole #9105

Occasional

Pacific Electric Ry.

4 17" Plank (poles)

64.8

24.8

32.6

18.0

8.7

50.2

89.6

60.4

62.8

67.8

68.0

8.5

8.6

26.5

55.8

53.0

55.0

22.5

35.2

40.2

18.4

15.4

16.2

12.7

7+45.6

9+39.5

9+10.0

8+90.8

10+54.8

10+40.0

6+81.0

5+56.2

7/69.97 FB 1784 Pg 46

J. Ford Stw

CS 8

76F309S S&E #247. 8-54

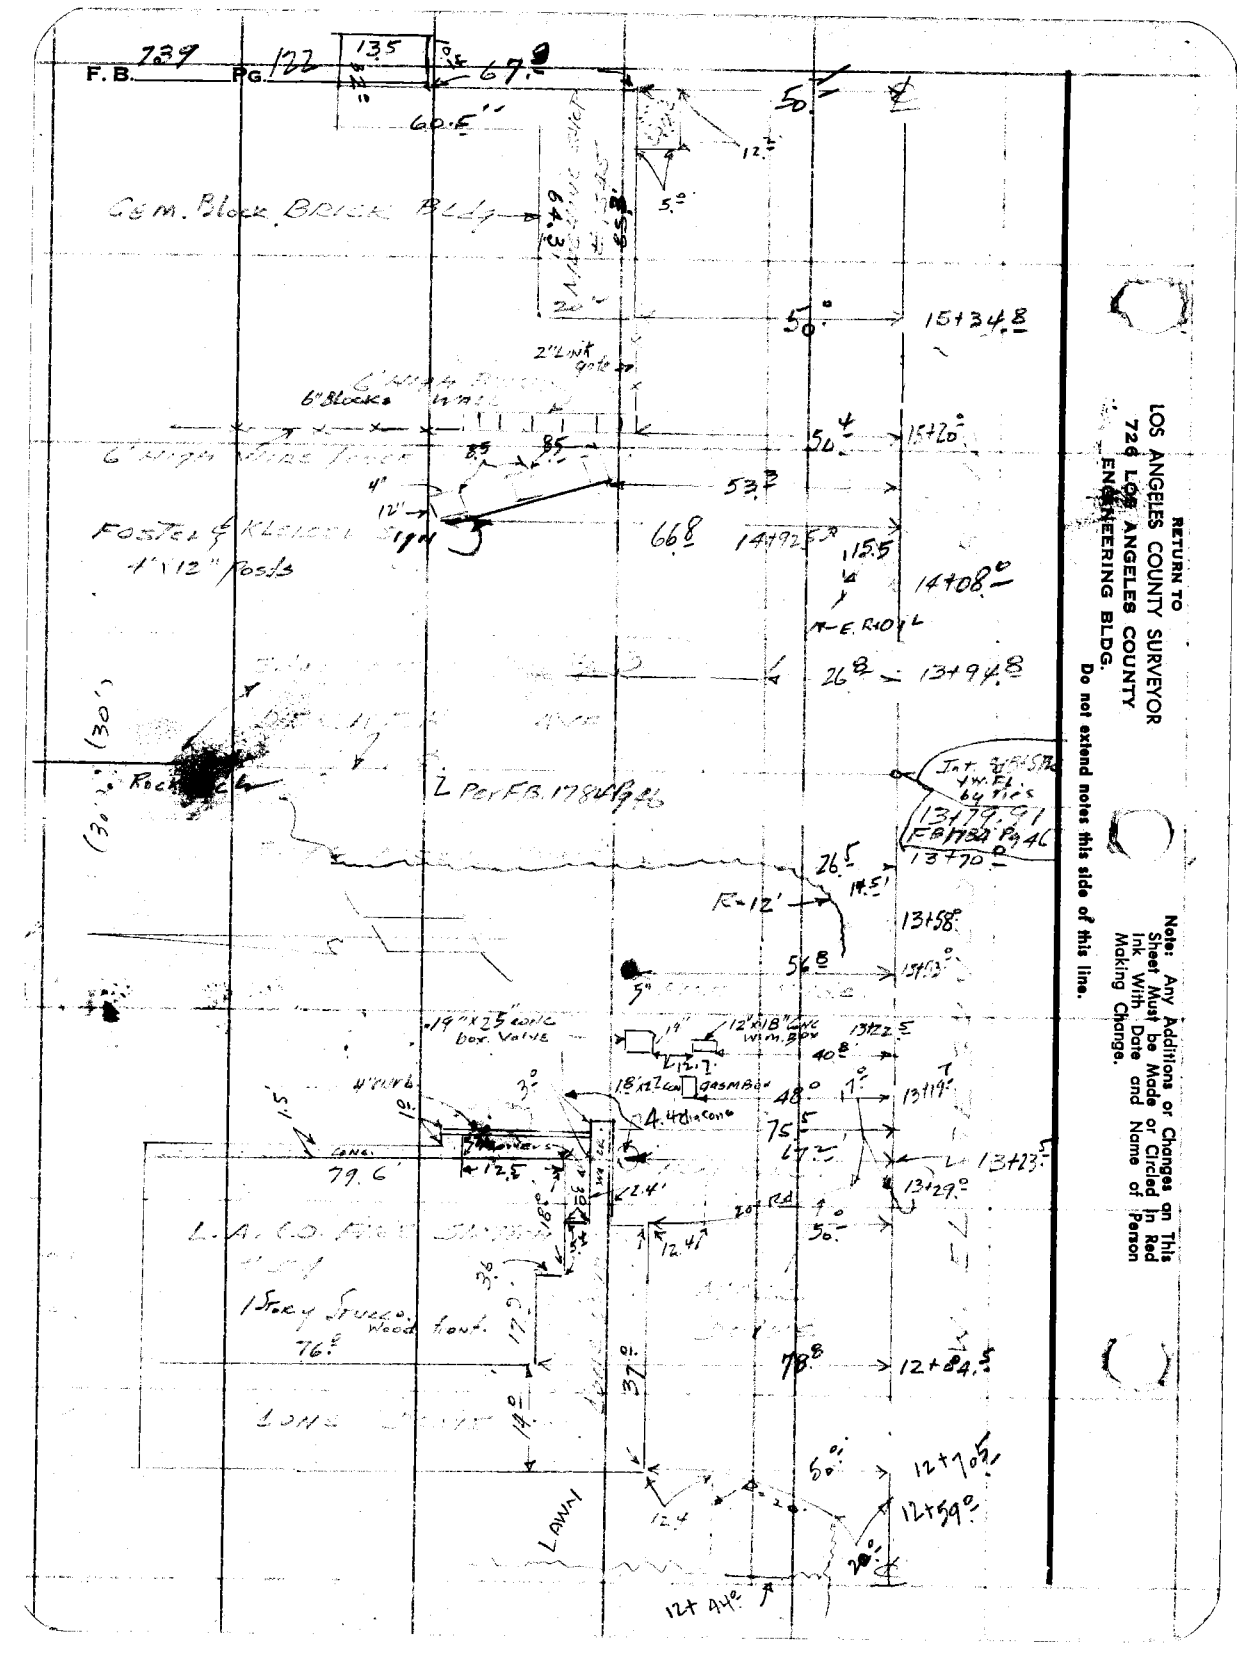

RETURN TO
LOS ANGELES COUNTY SURVEYOR
720 LOS ANGELES COUNTY
ENGINEERING BLDG.

Do not extend notes this side of this line.

Note: Any Additions or Changes on This Sheet Must be Made or Circled in Red Ink With Date and Name of Person Making Change.

F.B. 737 PG. 123

Notes Ck'd by
Map No.
Office Work
Checked
Date

Survey of
W. O. 07123 Tape No. 8176 St'd. 68 °F
Surveyed by
Notes Date 10-7-55
Indexed C. Johnson

Note: Any Additions or Changes on This Sheet Must be Made or Circled in Red Ink With Date and Name of Person Making Change.

Do not extend notes this side of this line.

RETURN TO
LOS ANGELES COUNTY SURVEYOR
726 LOS ANGELES COUNTY
ENGINEERING BLDG.

76F3085 247 4.55

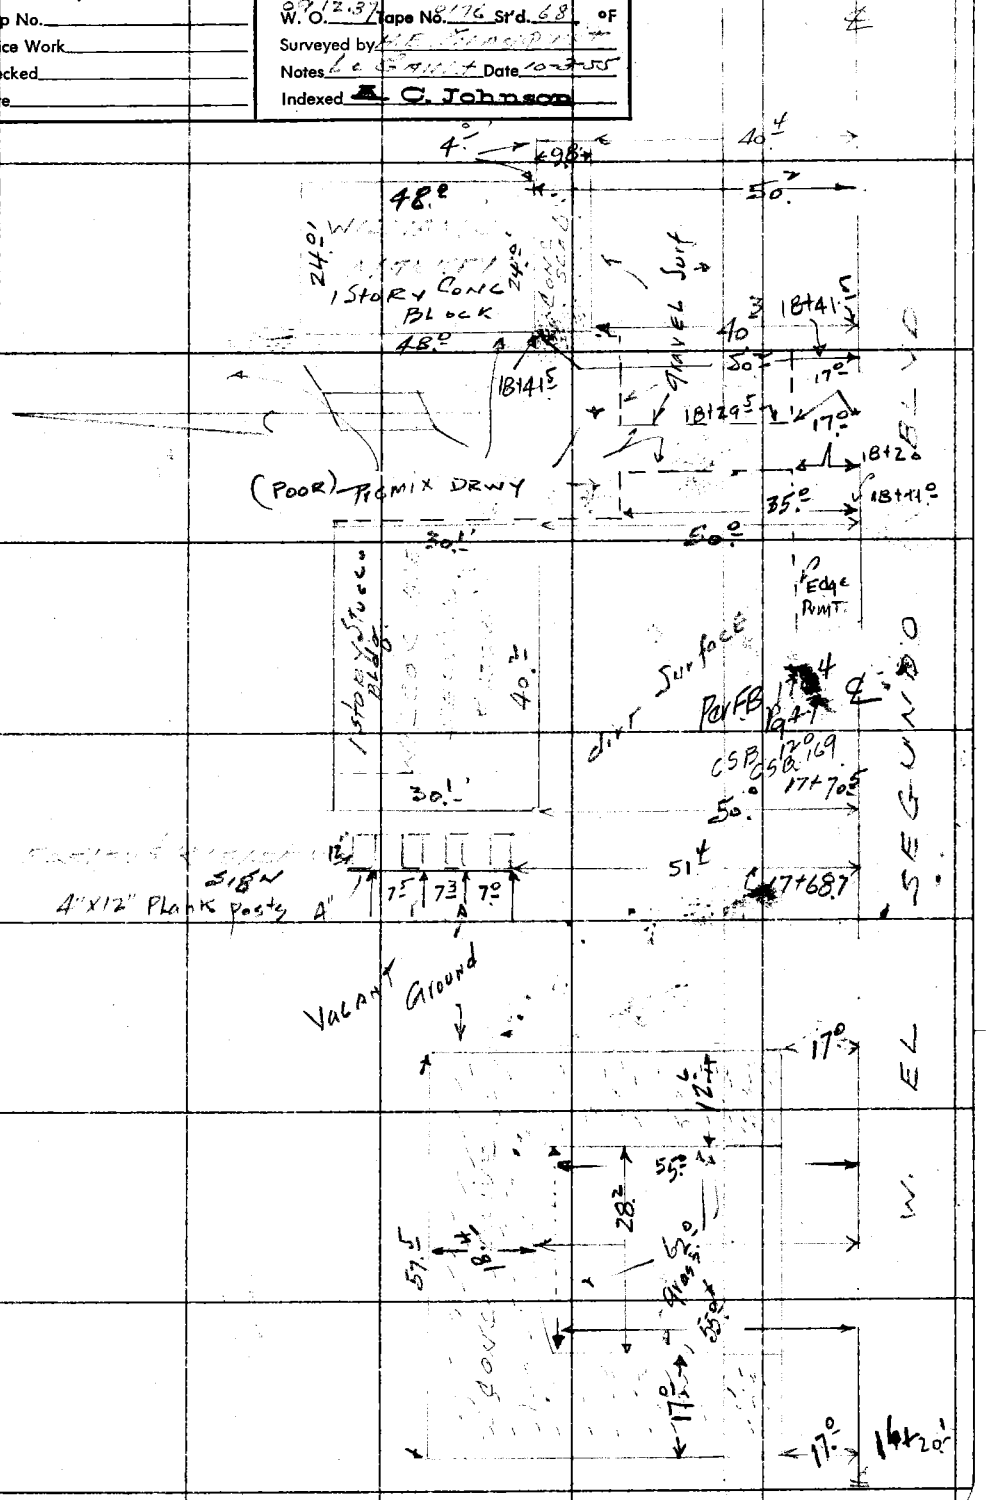

F.B. 739 Pg. 124

Contd. on Page 251

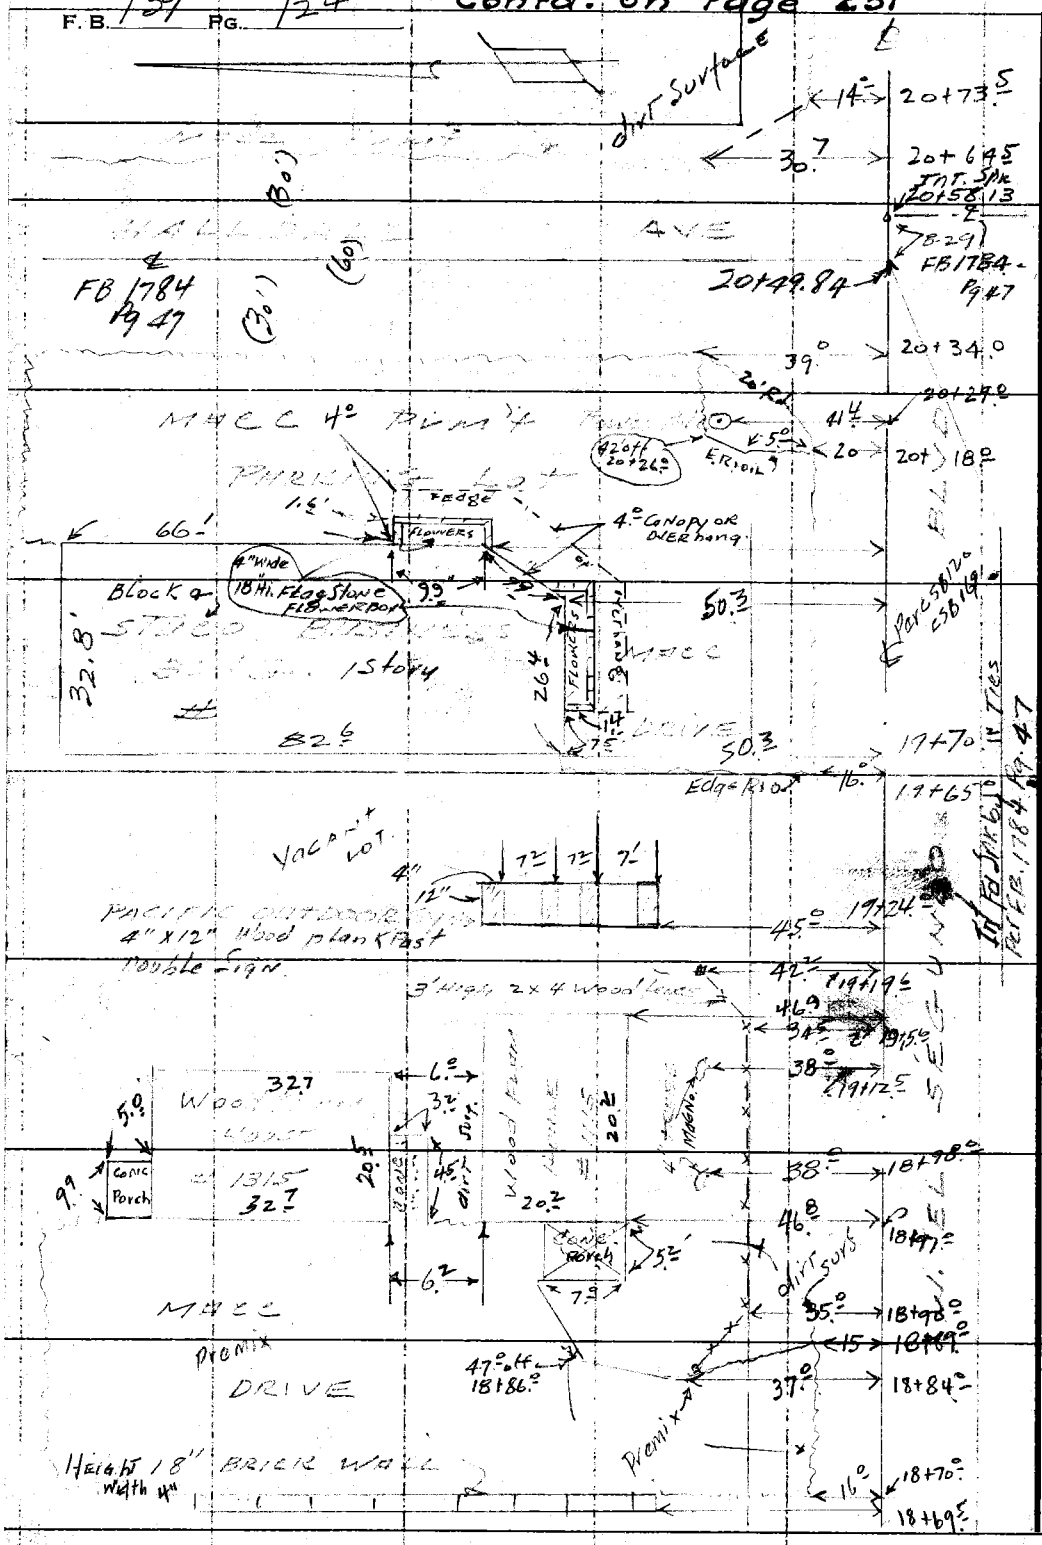

COPIES TO

CENTINELA VALLEY

(REGIONAL OFFICE)

pages 125 thru 162

Notes Ck'd by D. M. Finley	Survey of [illegible]	F.B. [illegible]	Pg. 125
Map No. B-1427	W. O. 8208 Tape No. St'd °F.		
Office Work H. H. REYNOLDS	Surveyed by [illegible]		
Checked D. M. Finley	Notes [illegible] Date		
Date Jan. 1940	Indexed 5-17-38		

SURVEY
OF
CENTURY BLVD.
FROM
WESTERN AVE.
TO
ANZA AVE.
Job # 8208

March & Apr 1938

[illegible]

Note: Any Additions or Changes on This Sheet Must be Made or Circled in Red Ink With Date and Name of Person Making Change.

Do not extend notes this side of this line

RETURN TO
LOS ANGELES COUNTY SURVEYOR
700 HALL OF RECORDS

FORM 247 10M 11-38

To Gotten pg 127

F.B. 739 Pg. 126

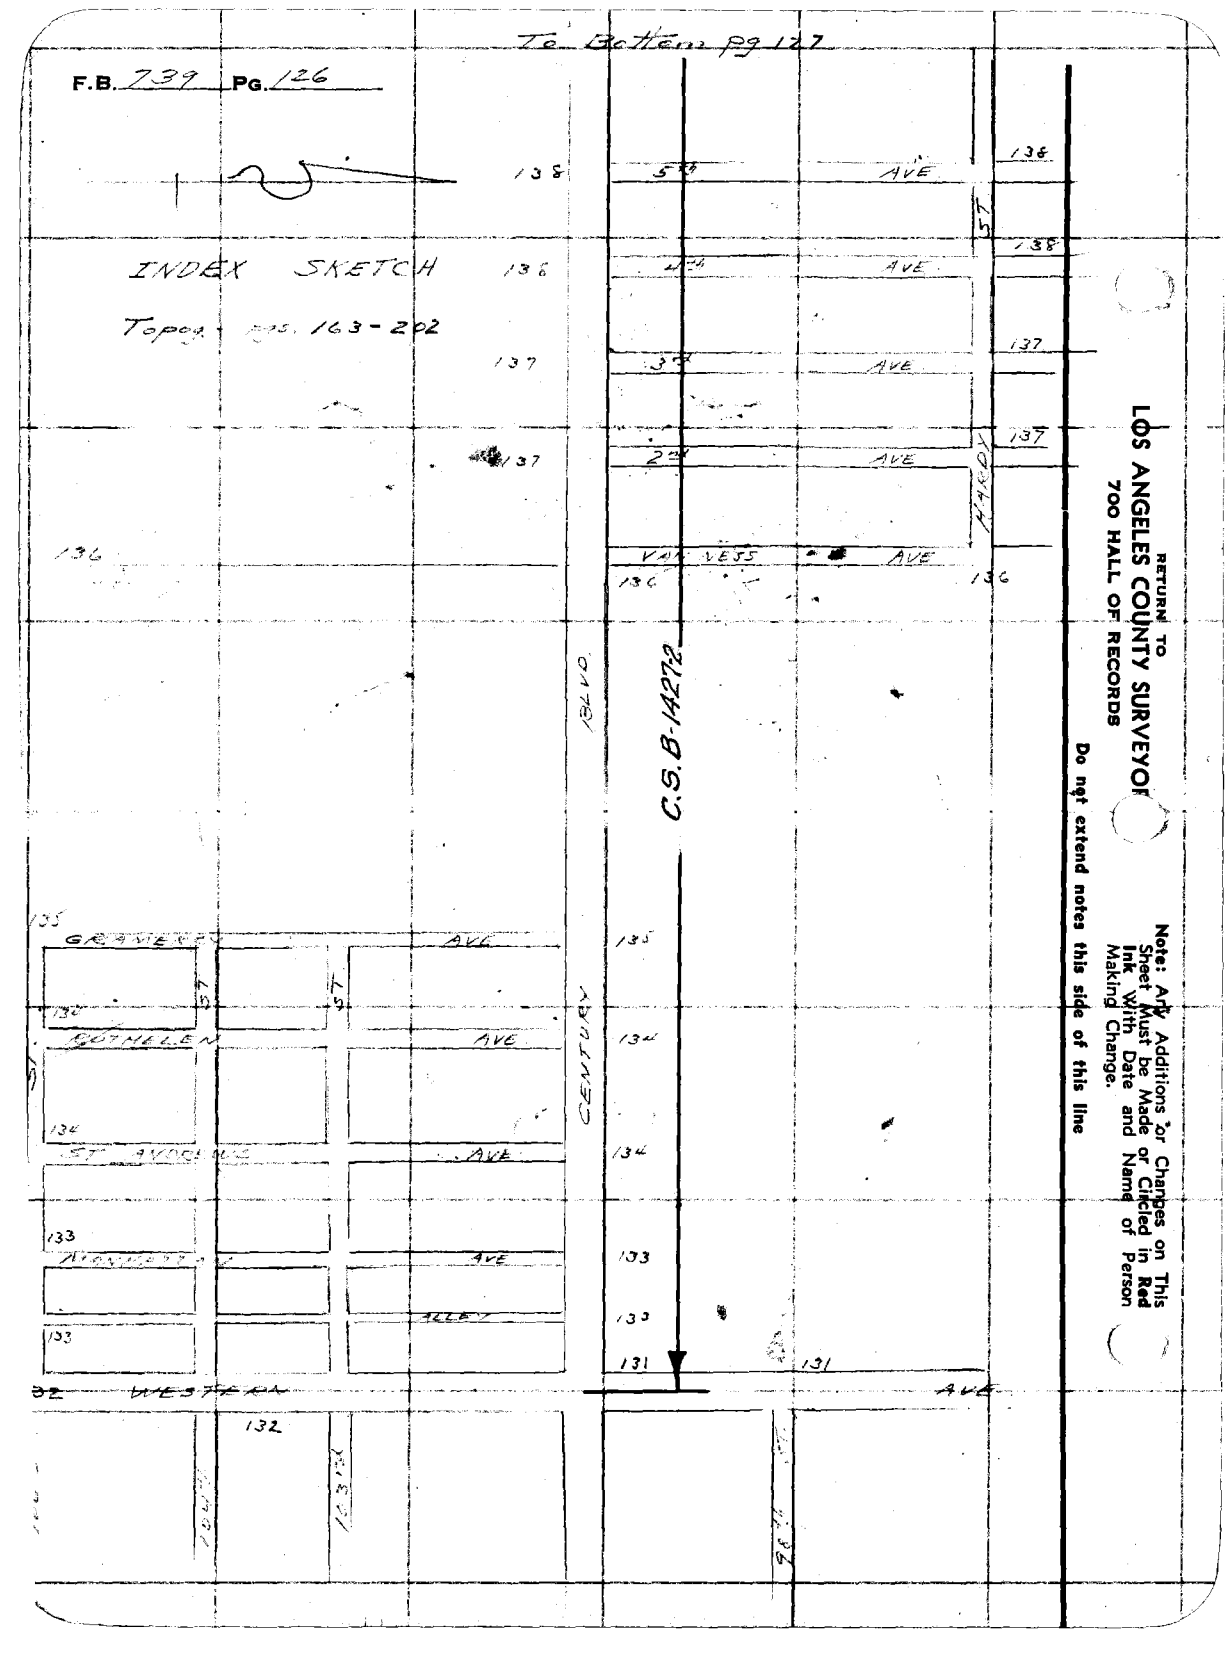

RETURN TO
LOS ANGELES COUNTY SURVEYOR
700 HALL OF RECORDS

Note: Any Additions or Changes on This Sheet Must be Made or Circled in Red Ink With Date and Name of Person Making Change.

Do not extend notes this side of this line

Notes Ck'd by	D. M. Finley	Survey of	
Map No.	B-1427	W. O. 2205	Tape No. St'd °F.
Office Work	H. H. REYNOLDS	Surveyed by	
Checked	D. M. Finley	Notes	Date
Date	Jan 1940	Indexed	

F.B. 737 PG. 127

RETURN TO
LOS ANGELES COUNTY SURVEYOR
700 HALL OF RECORDS

Note: Any Additions or Changes on This Sheet Must be Made or Circled in Red Ink With Date and Name of Person Making Change.

Do not extend notes this side of this line

YUKON AVE

CENTINELA BLVD

C.S. B-1427-2

CRENSHAW BLVD.

1140

139

FORM 247 10M 11-38

FROM FOR NO. 126

RETURN TO
LOS ANGELES COUNTY SURVEYOR
700 HALL OF RECORDS

Note: Any Additions or Changes on This Sheet Must be Made or Circled in **Red** Ink With Date and Name of Person Making Change.

Do not extend notes this side of this line

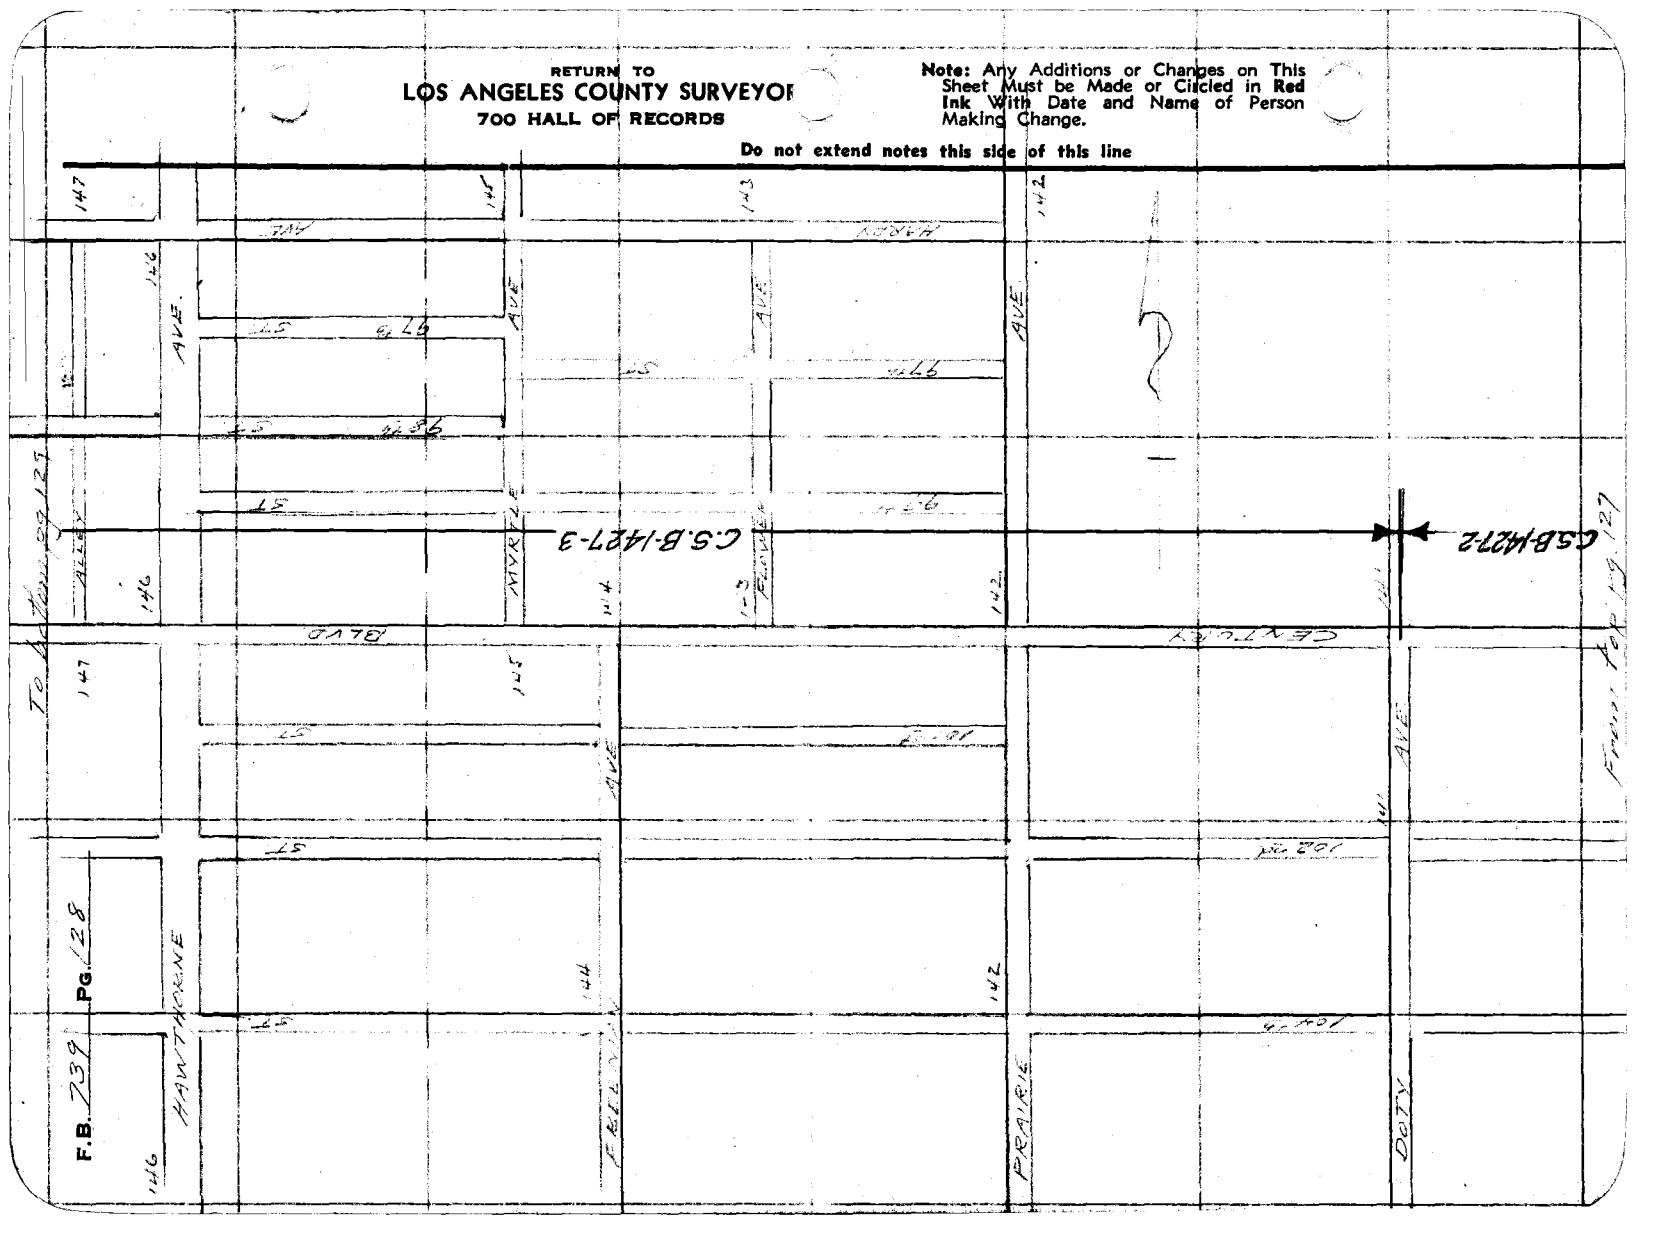

Notes Ck'd by D. M. Finley	Survey of
Map No. B-1427	W. O. 8108 Tape No. St'd °F.
Office Work H. REYNOLDS	Surveyed by
Checked D. M. Finley	Notes Date
Date Jan. 1940.	Indexed

F.B. 734 PG. 100

Note: Any Additions or Changes on This Sheet Must be Made or Circled in Red Ink With Date and Name of Person Making Change.

Do not extend notes this side of this line

RETURN TO
LOS ANGELES COUNTY SURVEYOR
700 HALL OF RECORDS

FORM 247 10M 11-38

To Burbank Blvd 50

FELTON AVE 159

BUFORD AVE 158

BURL AVE 157

INGLEWOOD 156

DALEROSE AVE 155

CONDON AVE 154

FAIRMEAD AVE 152

MANSEL AVE 151

GREVILLEA 150

BURIN AVE 148

BLVD

59TH ST

C.S.B-1427-4

ROSEWOOD

EUCALYPTUS

ELEUS

MAPLE

ST

AVE

From top pg. 128

RETURN TO
LOS ANGELES COUNTY SURVEYOR
700 HALL OF RECORDS

Note: Any Additions or Changes on This Sheet Must be Made or Circled in **Red** Ink With Date and Name of Person Making Change.

Do not extend notes this side of this line

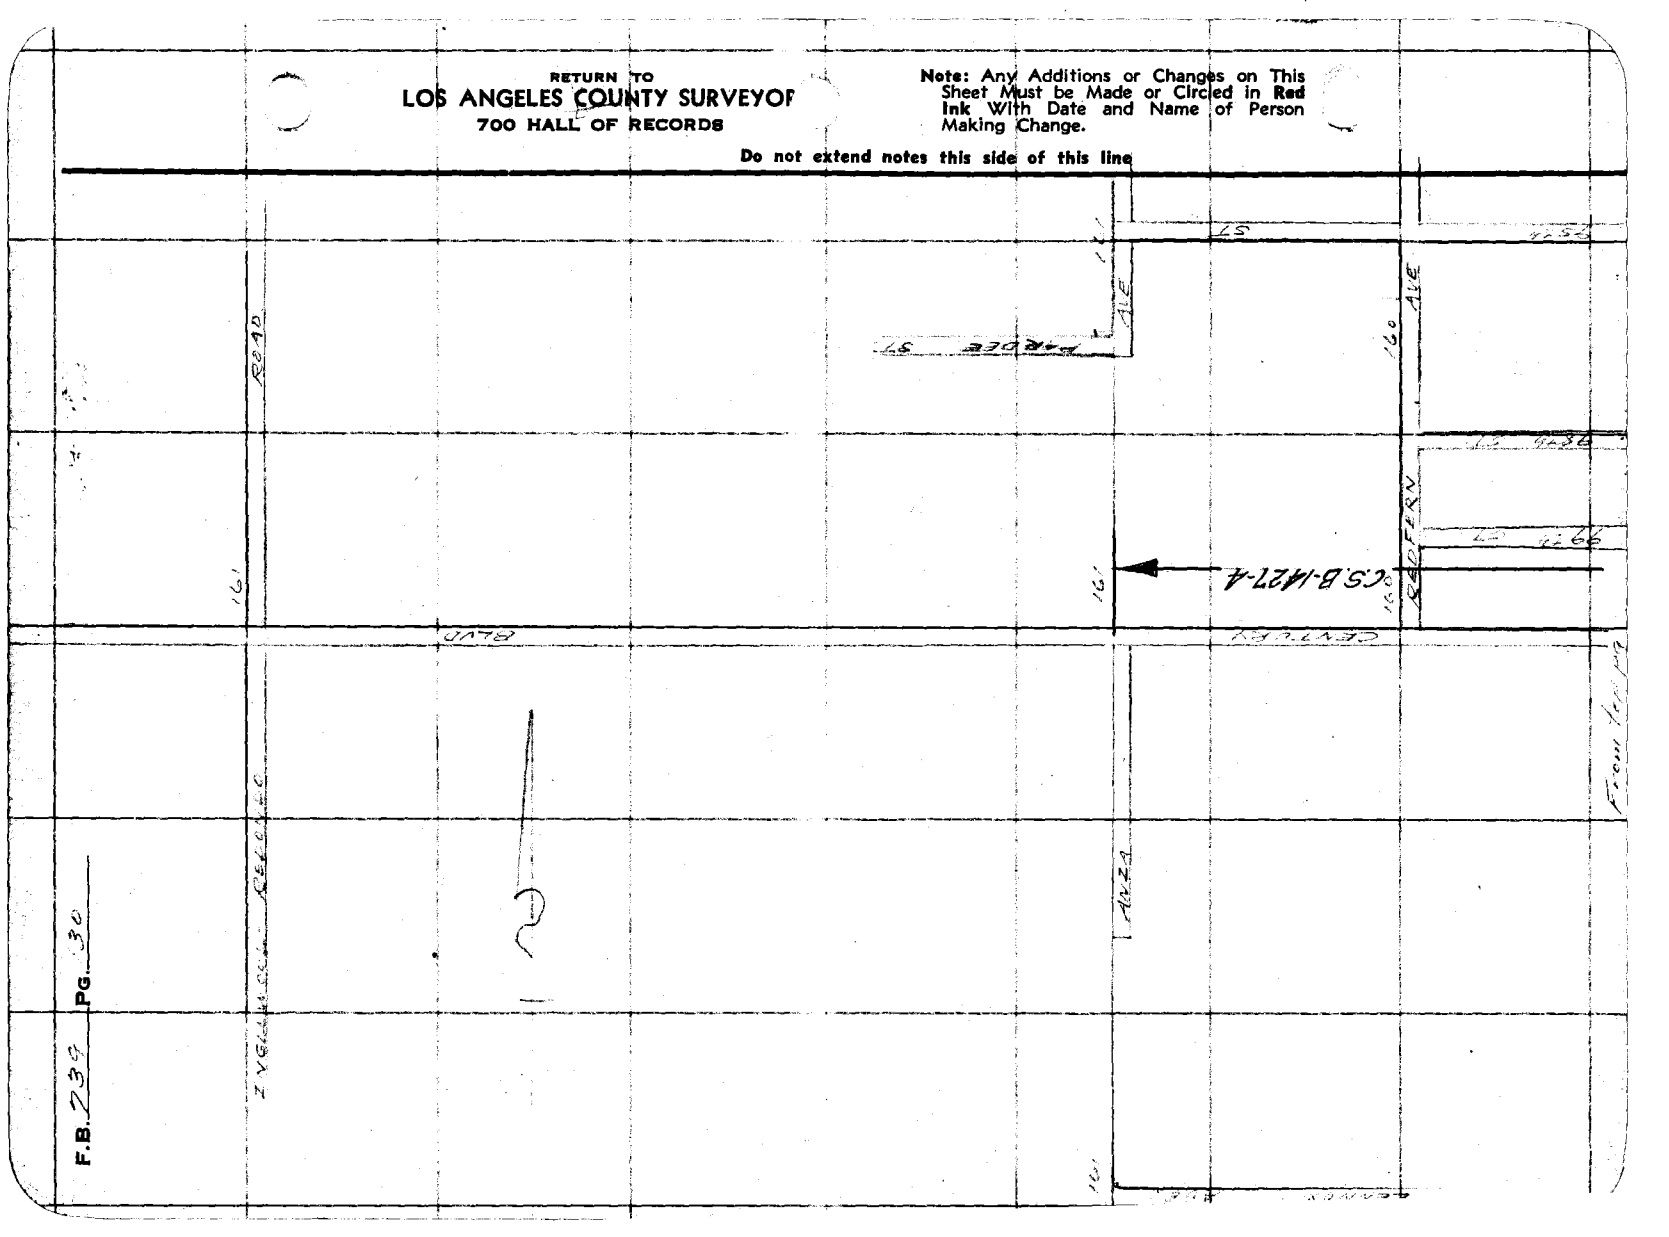

Notes Ck'd by D. M. Finley	Survey of Century Blvd	F.B. 73	Pg. 131
Map No. B-1427-2	W. O. 8208 Tape No. 32 St'd 100 °F.		
Office Work H. H. REYNOLDS	Surveyed by L. A. Wilcox		
Checked D. M. Finley	Notes Mylar Date 3-8-38		
Date Jan. 1940	Indexed 5-12-38		

WS 24-05

Note: Any Additions or Changes on this Sheet Must be Made or Circled in Red Ink With Date and Name of Person Making Change.

Do not extend notes this side of this line

RETURN TO
LOS ANGELES COUNTY SURVEYOR
700 HALL OF RECORDS

FORM 247 10M 11-35

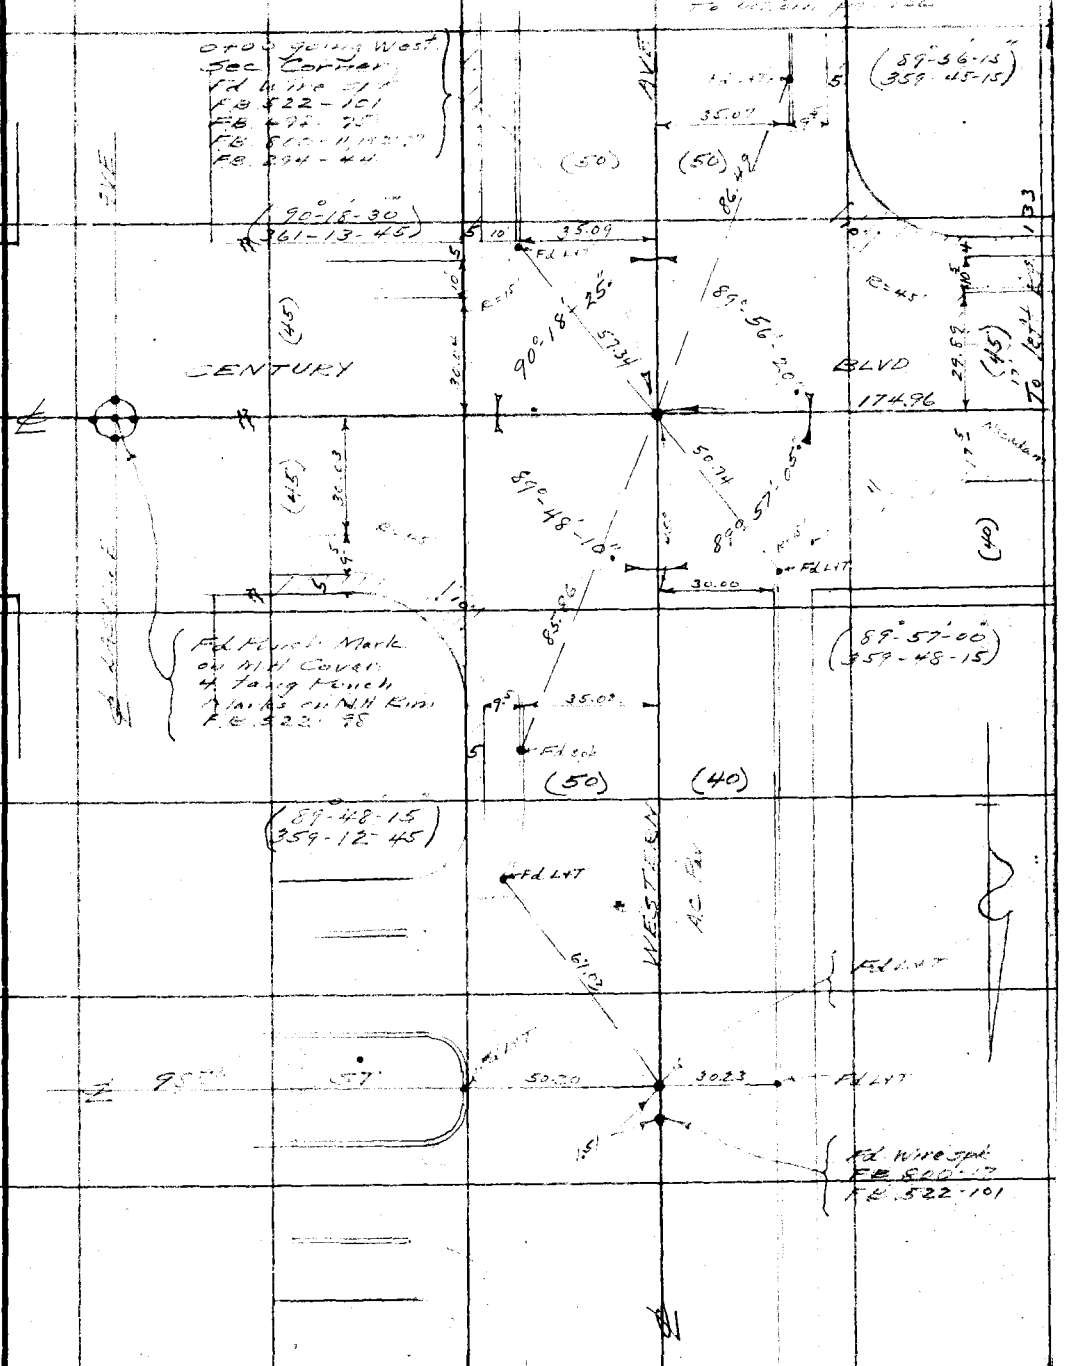

RETURN TO
LOS ANGELES COUNTY SURVEYOR
700 HALL OF RECORDS

Note: Any Additions or Changes on This Sheet Must be Made or Circled in **Red** Ink With Date and Name of Person Making Change.

Do not extend notes this side of this line

WS 26 A1

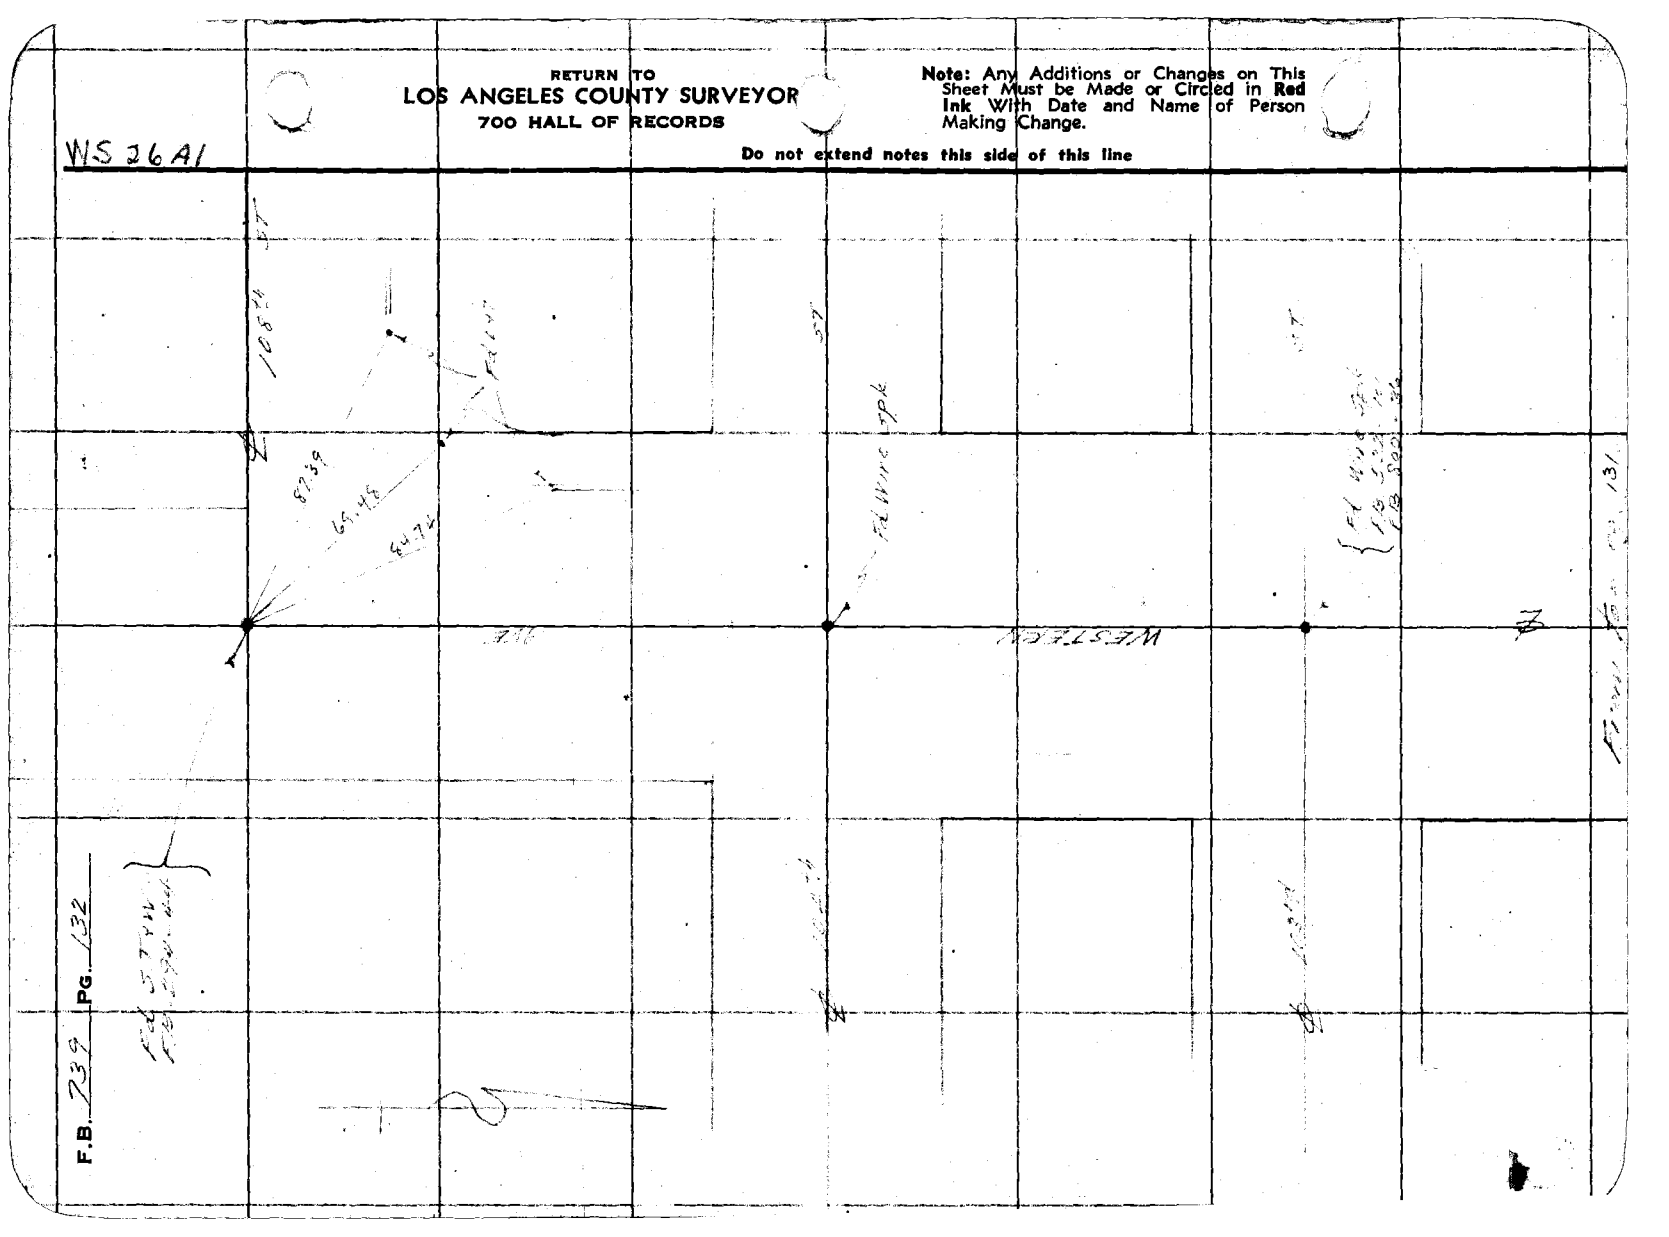

N 526-A1
WS 24-D5

Notes Ck'd by D. M. Finley	Survey of
Map No. B-1427-2	W. O. 5268 Tape No. 032 Std. ☐ F.
Office Work H. H. REYNOLDS	Surveyed by
Checked D. M. Finley	Notes Date 3-11-38
Date Jan 1940.	Indexed

F.B. 739 Pg. 133

Note: Any Additions or Changes on This Sheet Must be Made or Circled In Red Ink With Date and Name of Person Making Change.

Do not extend notes this side of this line

RETURN TO
LOS ANGELES COUNTY SURVEYOR
700 HALL OF RECORDS

TRACT

PLACE

97.59

7906

CENTURY BLVD

ALLEY

174.96'

173.58'

320.03'

174.98 @ 64° = 174.96'

173.60 @ 64° = 173.58'

320.07 @ 64° = 320.03'

FORM 247 10M 11-38

RETURN TO
LOS ANGELES COUNTY SURVEYOR
700 HALL OF RECORDS

Note: Any Additions or Changes on This Sheet Must be Made or Circled in **Red Ink** With Date and Name of Person Making Change.

Do not extend notes this side of this line

WS 24-D5
WS 26 A1

F.B. 739 Pg. 134

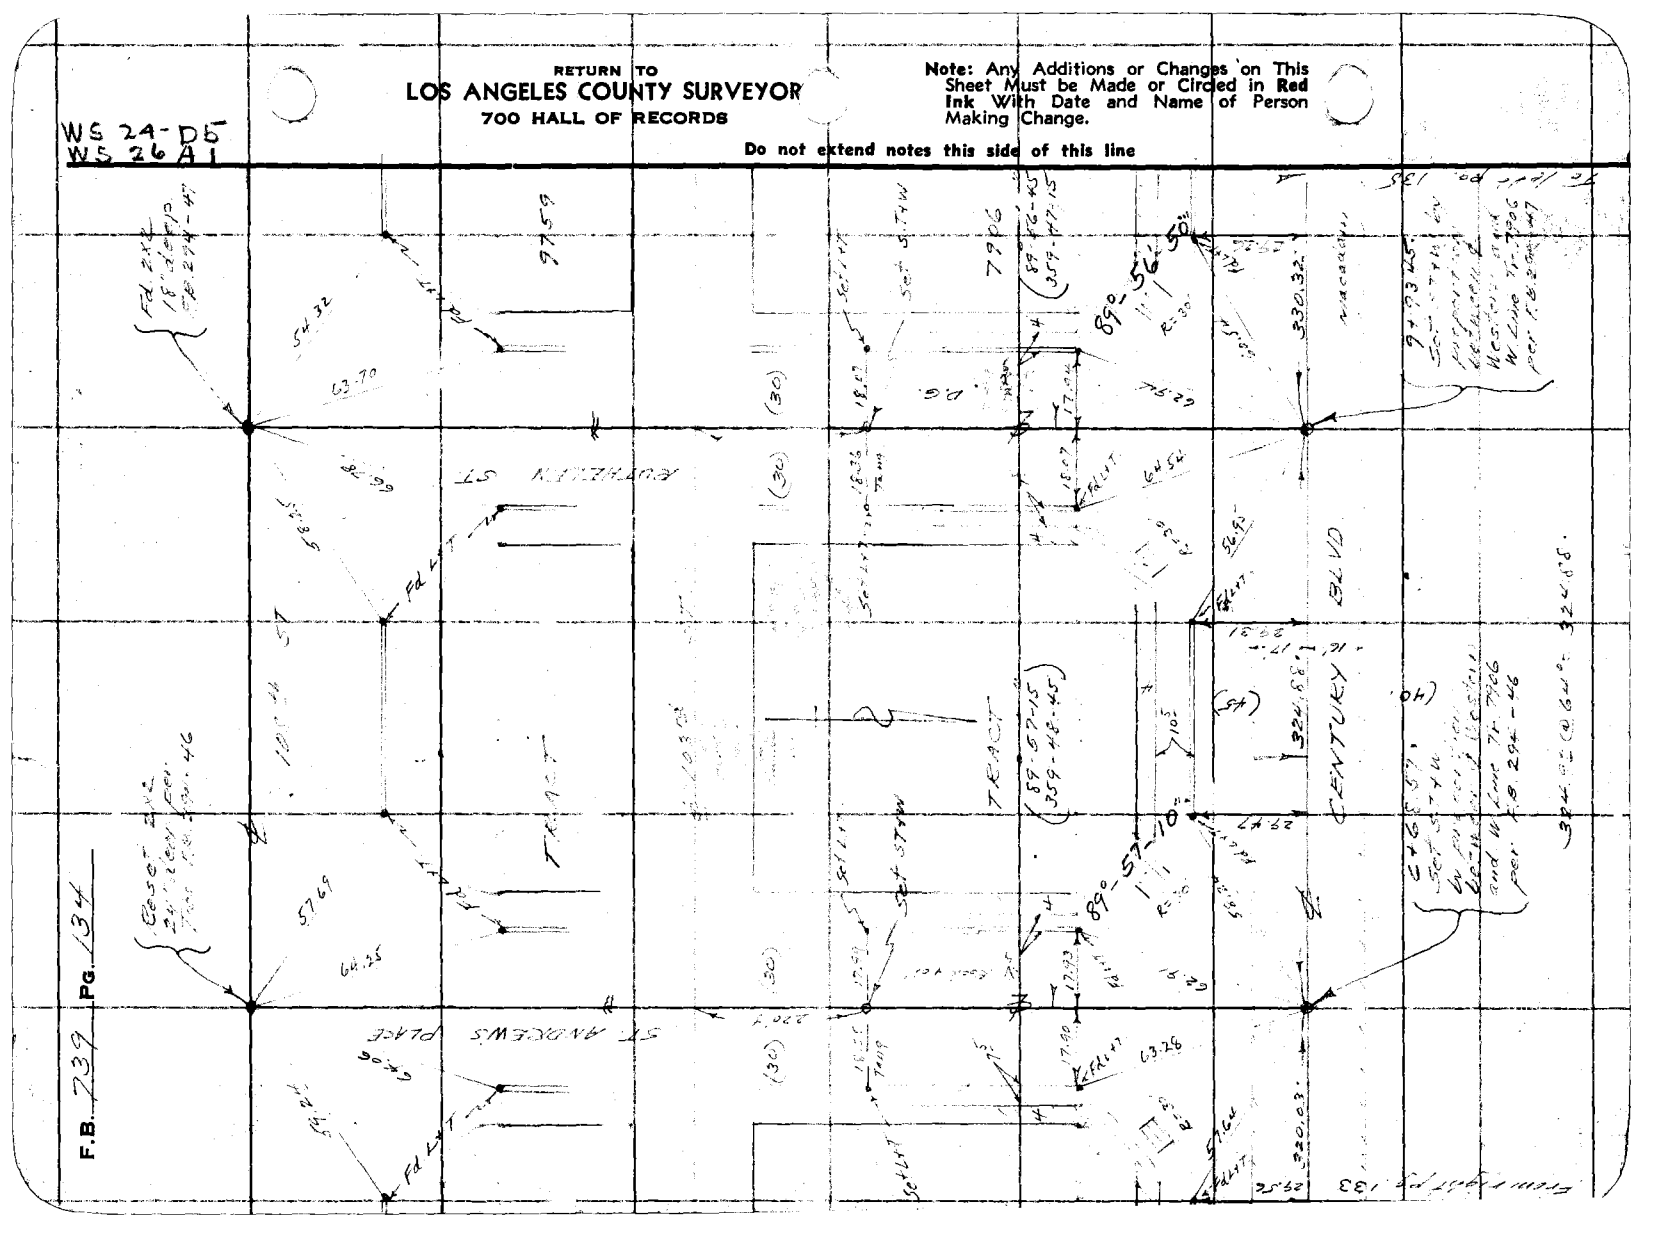
CENTURY
89°-56'-50"
89°-57'-10"
330.32'
S 89°-56'-50" W
N 89°-56'-50" E
TRACT
(30)
(54)
FD 2"x2" 18' LOF I.D. 2194-47

Notes Ck'd by D. M. Finley	Survey of Century Blvd		F.B. 737 PG. 135
Map No. B-1427-2	W. O. 8208 Tape No. 032 St'd 2 °F.		
Office Work H. H. REYNOLDS	Surveyed by [illegible]		
Checked D. M. Finley	Notes [illegible] Date 2-11-38		
Date Jan 1940.	Indexed [illegible]		

WS 24 - D5
WS 26 A1

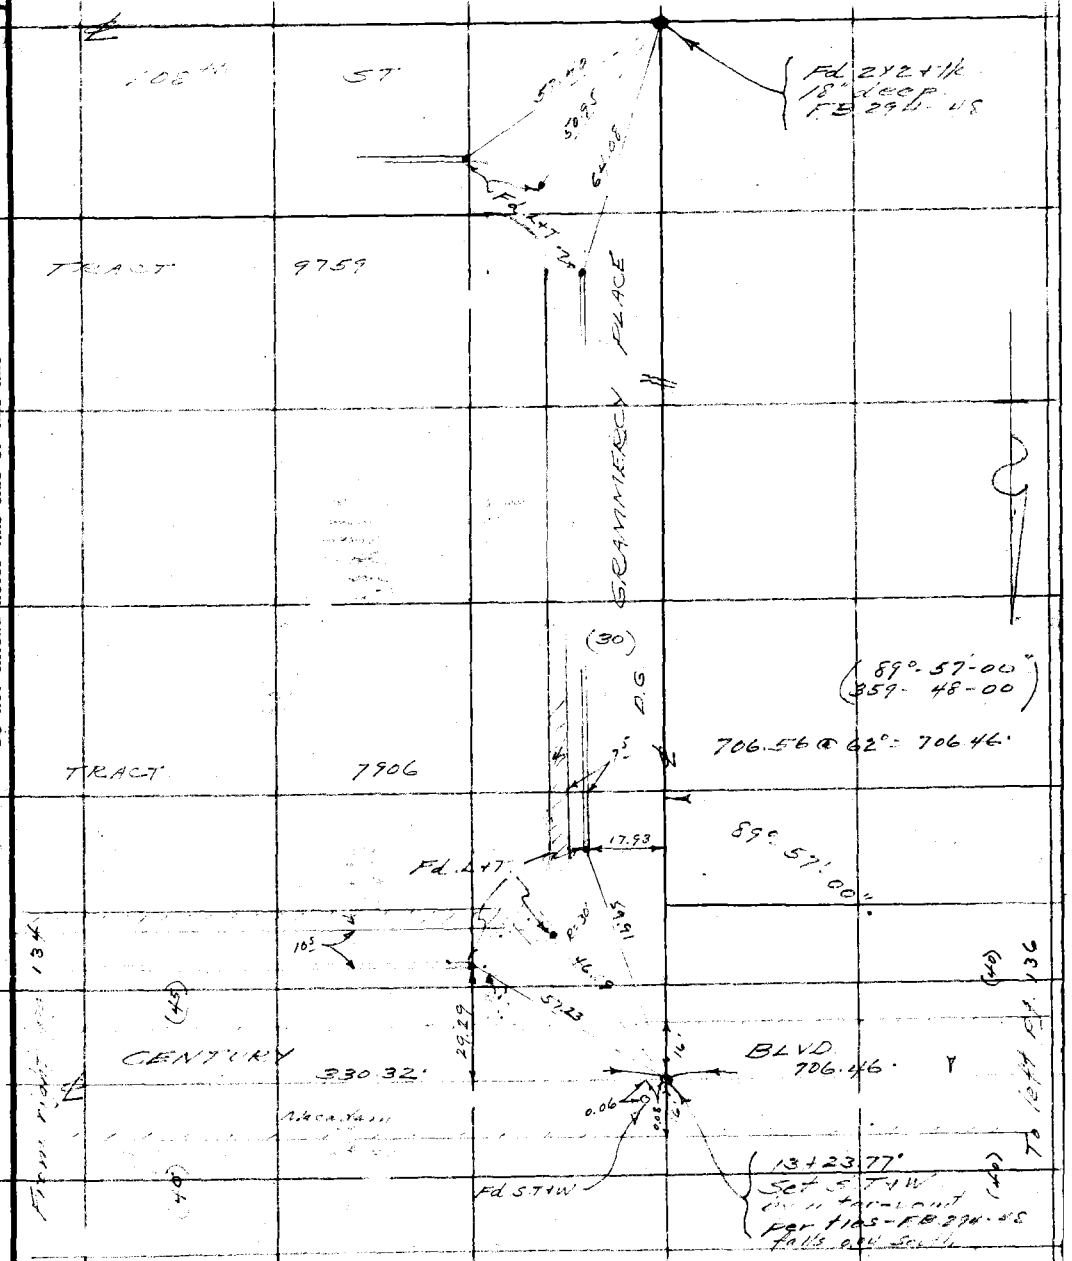

Note: Any Additions or Changes on This Sheet Must be Made or Circled in Red Ink With Date and Name of Person Making Change.

Do not extend notes this side of this line

RETURN TO
LOS ANGELES COUNTY SURVEYOR
700 HALL OF RECORDS

FORM 247 10M 11-38

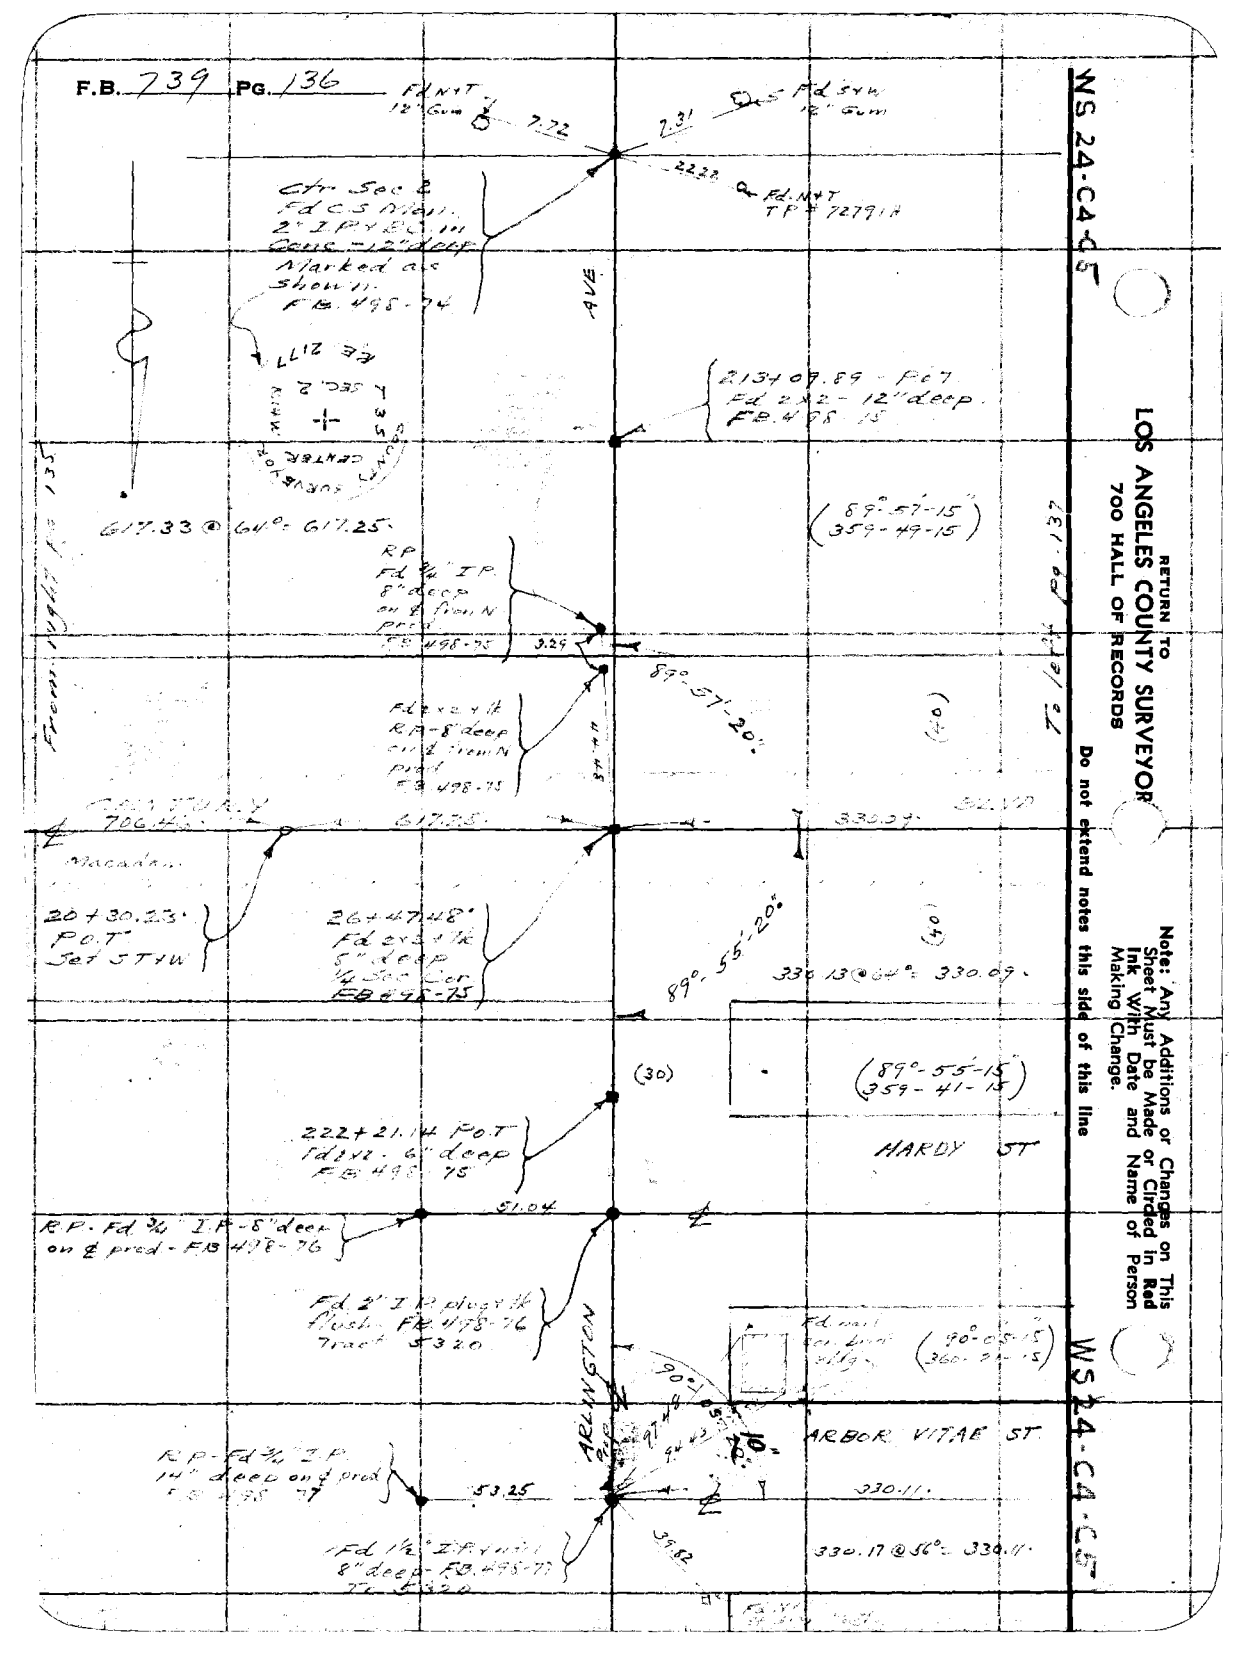
F.B. 739 PG. 136
WS 24-C4-C5
RETURN TO
LOS ANGELES COUNTY SURVEYOR
700 HALL OF RECORDS
Do not extend notes this side of this line
Note: Any Additions or Changes on This Sheet Must be Made or Circled in Red Ink With Date and Name of Person Making Change.
Ctr. Sec. 2
Fd CS Mon.
2" IP x 2' in
Conc. 12" deep
Marked as
Shown.
FB. 498-74
Fd NAIL
TP # 727911
Fd 2134 09.89 - P.C.
Fd 2 x 2 - 12" deep.
FB. 498-75
617.33 @ 64°: 617.25
RP
Fd ¾" I.P.
8" deep
on ℄ from N
prod
FB 498-75
3.29
89°-57'-20"
(89°-57'-15")
(359-49-15)
Fd x cut
RP - 8" deep
on ℄ from N
prod
FB 498-75
3.44 N
706 ft. ±
617.25
330.09
Macadam
20+30.23
P.O.T.
Set STYW
26+47.48
Fd cut x
5" deep
¼ Sec. Cor.
FB 498-75
89°-55'-20"
330.13 @ 64°: 330.09
(30)
(89°-55'-15")
(359-41-15)
222+21.14 P.O.T.
Fd ½" - 6" deep
FB 498-75
MARDY ST
51.04
RP. Fd ¾" I.P. - 8" deep
on ℄ prod - FB 498-76
Fd 2" I.P. plug with
flush. FB 498-76
Tract 5320
ARLINGTON AVE
Fd nail
for hub
tag illegible
(90°-05'-15")
(360-)
90°-05'-15"
97.43
10'
ARBOR VITAE ST
330.11
RP - Fd ¾" I.P.
14" deep on ℄ prod
53.25
Fd 1½" I.P. x nail
8" deep - FB 498-77
Tr. 5320
39.82
330.17 @ 56°: 330.11
WS 24-C4-C5

RETURN TO
LOS ANGELES COUNTY SURVEYOR
700 HALL OF RECORDS

Note: Any Additions or Changes on This Sheet Must be Made or Circled in Red Ink With Date and Name of Person Making Change.

WS24 C4 C5

Do not extend notes this side of this line

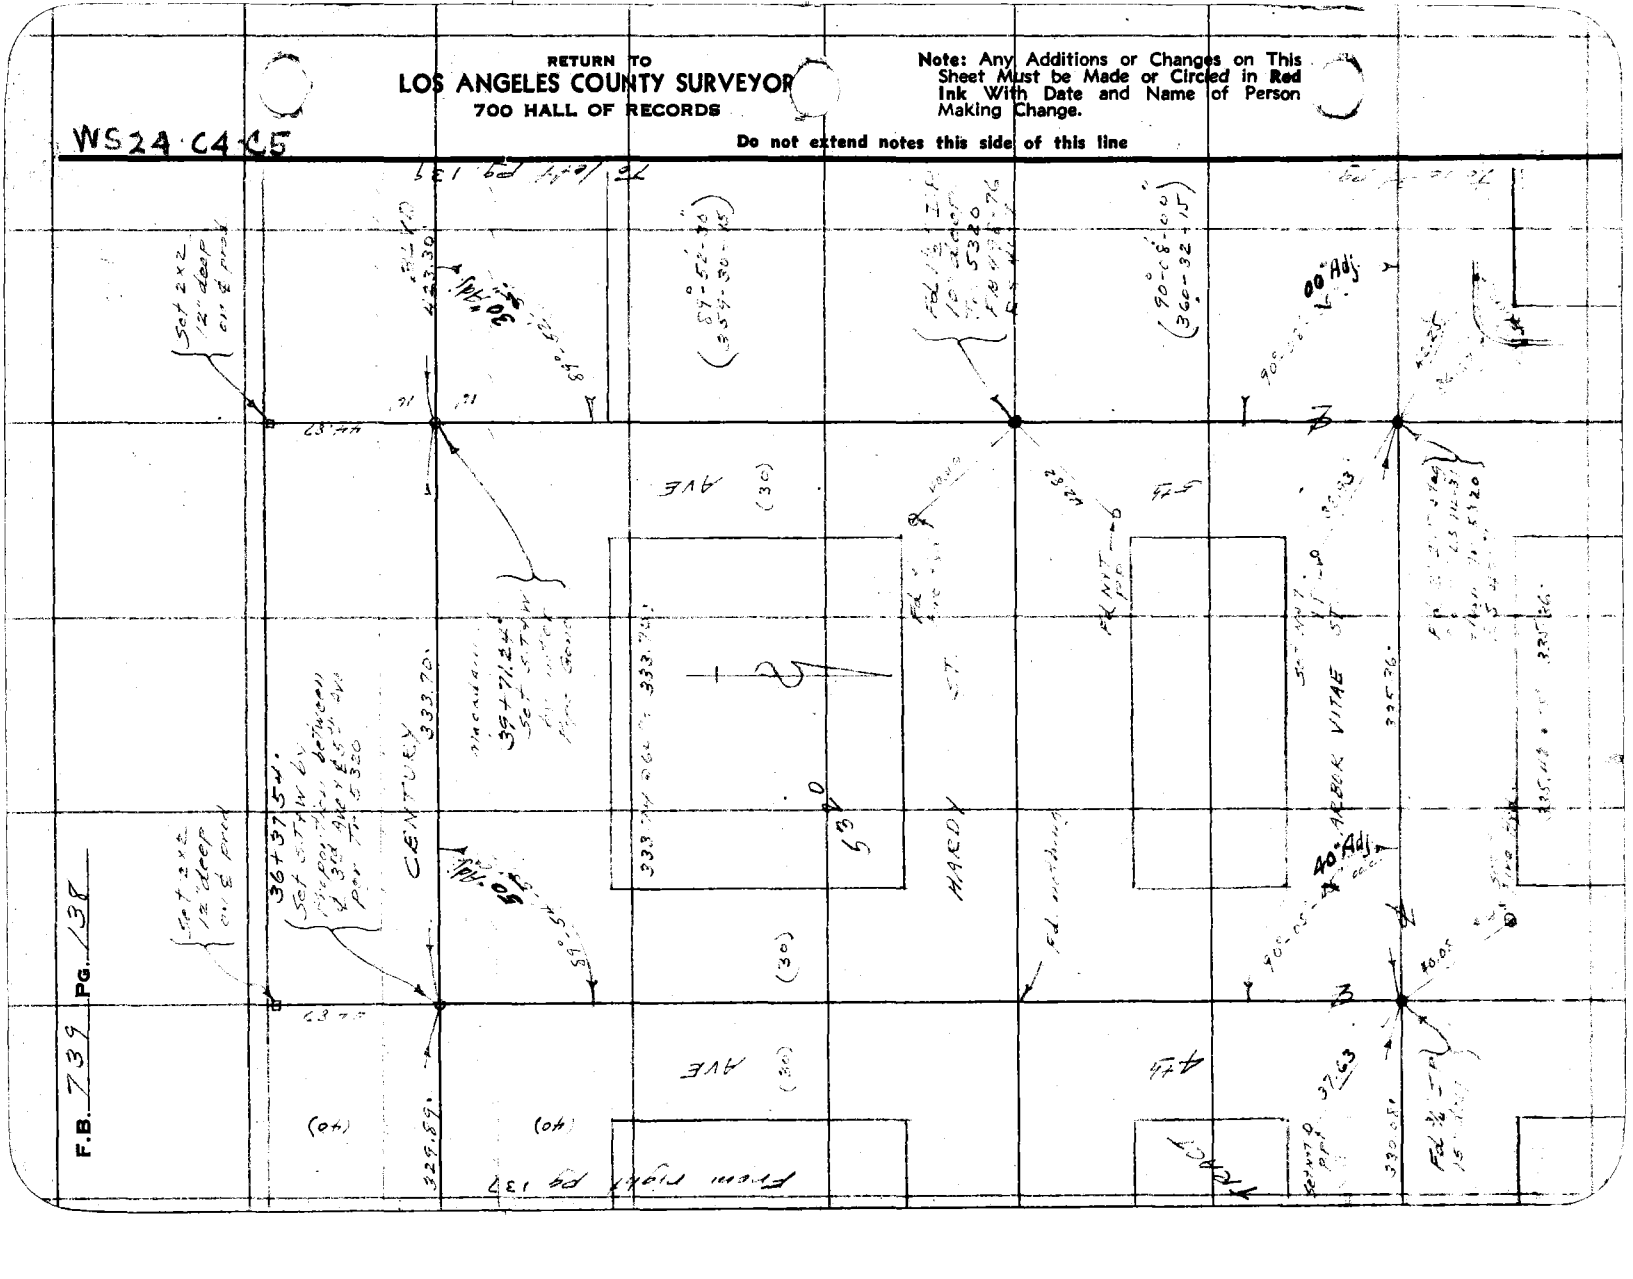

FORM 247 10M 11-45

RETURN TO
LOS ANGELES COUNTY SURVEYOR
700 HALL OF RECORDS

Note: Any Additions or Changes on This Sheet Must be Made or Circled in Red Ink With Date and Name of Person Making Change.

Do not extend notes this side of this line

WS 24-C4-C5

Notes Ck'd by D. M. Finley	Survey of
Map No. B-1427-2	W. O. 8200 Tape No. 032 St'd 8+0 F.
Office Work H. H. REYNOLDS	Surveyed by
Checked D. M. Finley	Notes Date 3-17-38
Date Jan. 1940	Indexed

F.B. 733 Pg. 37

29+77.37.

330.07 ⊂

330.08'

329.67'

330.09'

330.11'

330.07.

330.08'

330.12 @ Cen. 330.08'

329.83 @ Cen. 329.89'

330.0 @ 12' 330.0 S.

330.0 @ 12' 330.0 S.

AVE

HARDY ST

AVE

ROAD

BLVD

CENTURY

To Ivy

Set Nail & Tag

Set Nail & Tag

Set Nail & Tag

Notes Ck'd by D. M. Finley	Survey of Control Net
Map No. B-1427-2	W. O. 8265 Tape No. 032 St'd 62° F.
Office Work H. H. REYNOLDS	Surveyed by L. D. Moore
Checked D. M. Finley	Notes L. Moore Date 3-15-38
Date Jan. 1940	Indexed

F.B. 5 PG. 139

WS 24 C4-C5

RETURN TO
LOS ANGELES COUNTY SURVEYOR
700 HALL OF RECORDS

Note: Any Additions or Changes on This Sheet Must be Made or Circled in Red Ink With Date and Name of Person Making Change.

Do not extend notes this side of this line

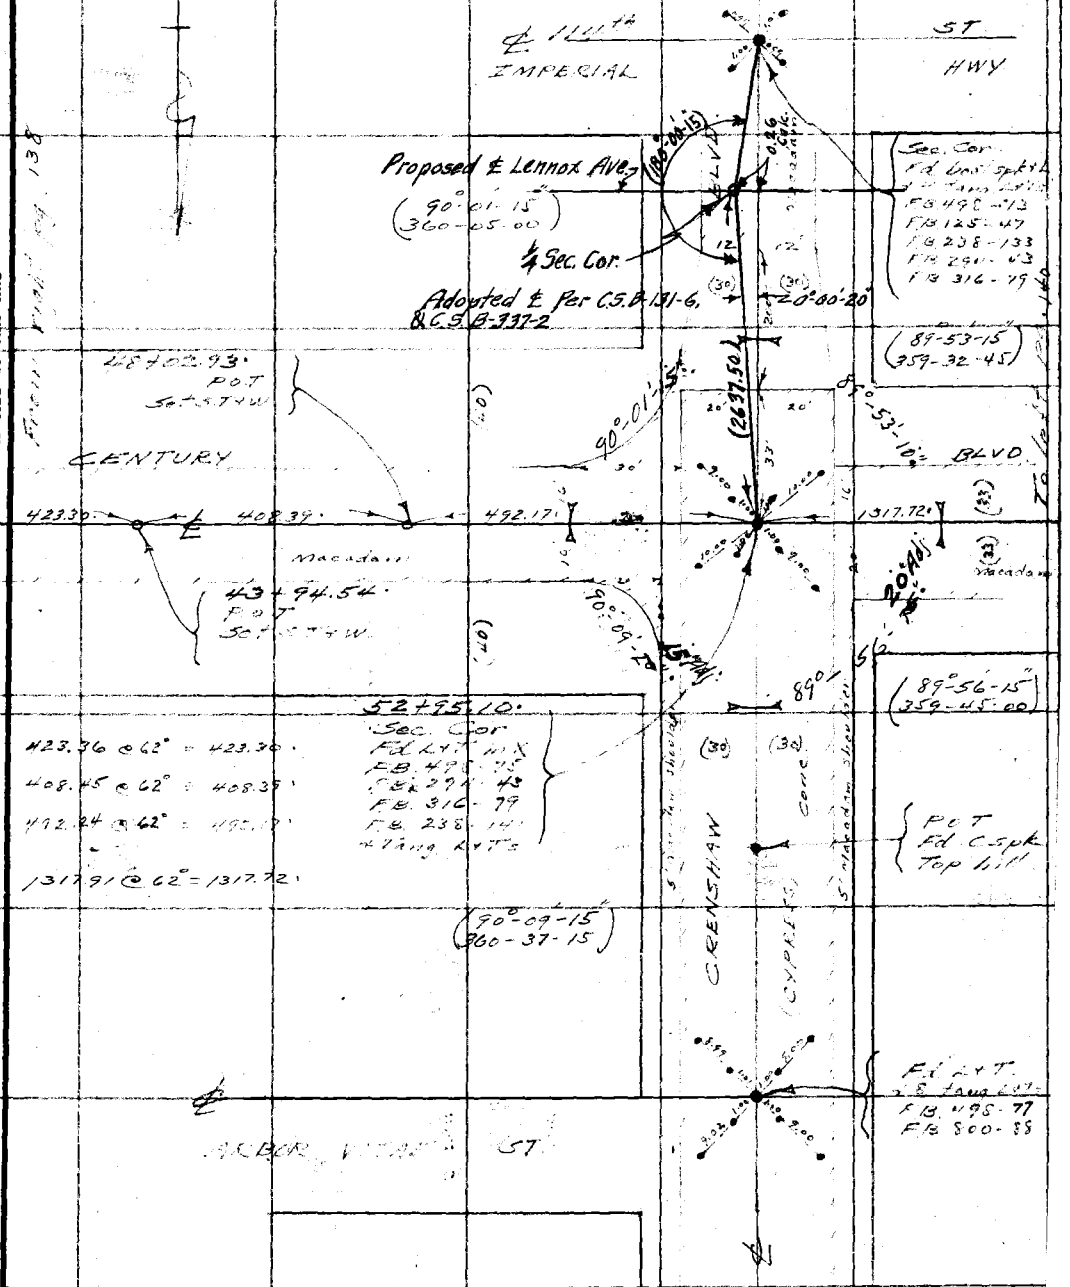

FORM 247 10M 11-35

RETURN TO
LOS ANGELES COUNTY SURVEYOR
700 HALL OF RECORDS

Note: Any Additions or Changes on This Sheet Must be Made or Circled in **Red** Ink With Date and Name of Person Making Change.

Do not extend notes this side of this line

W S 24 C5

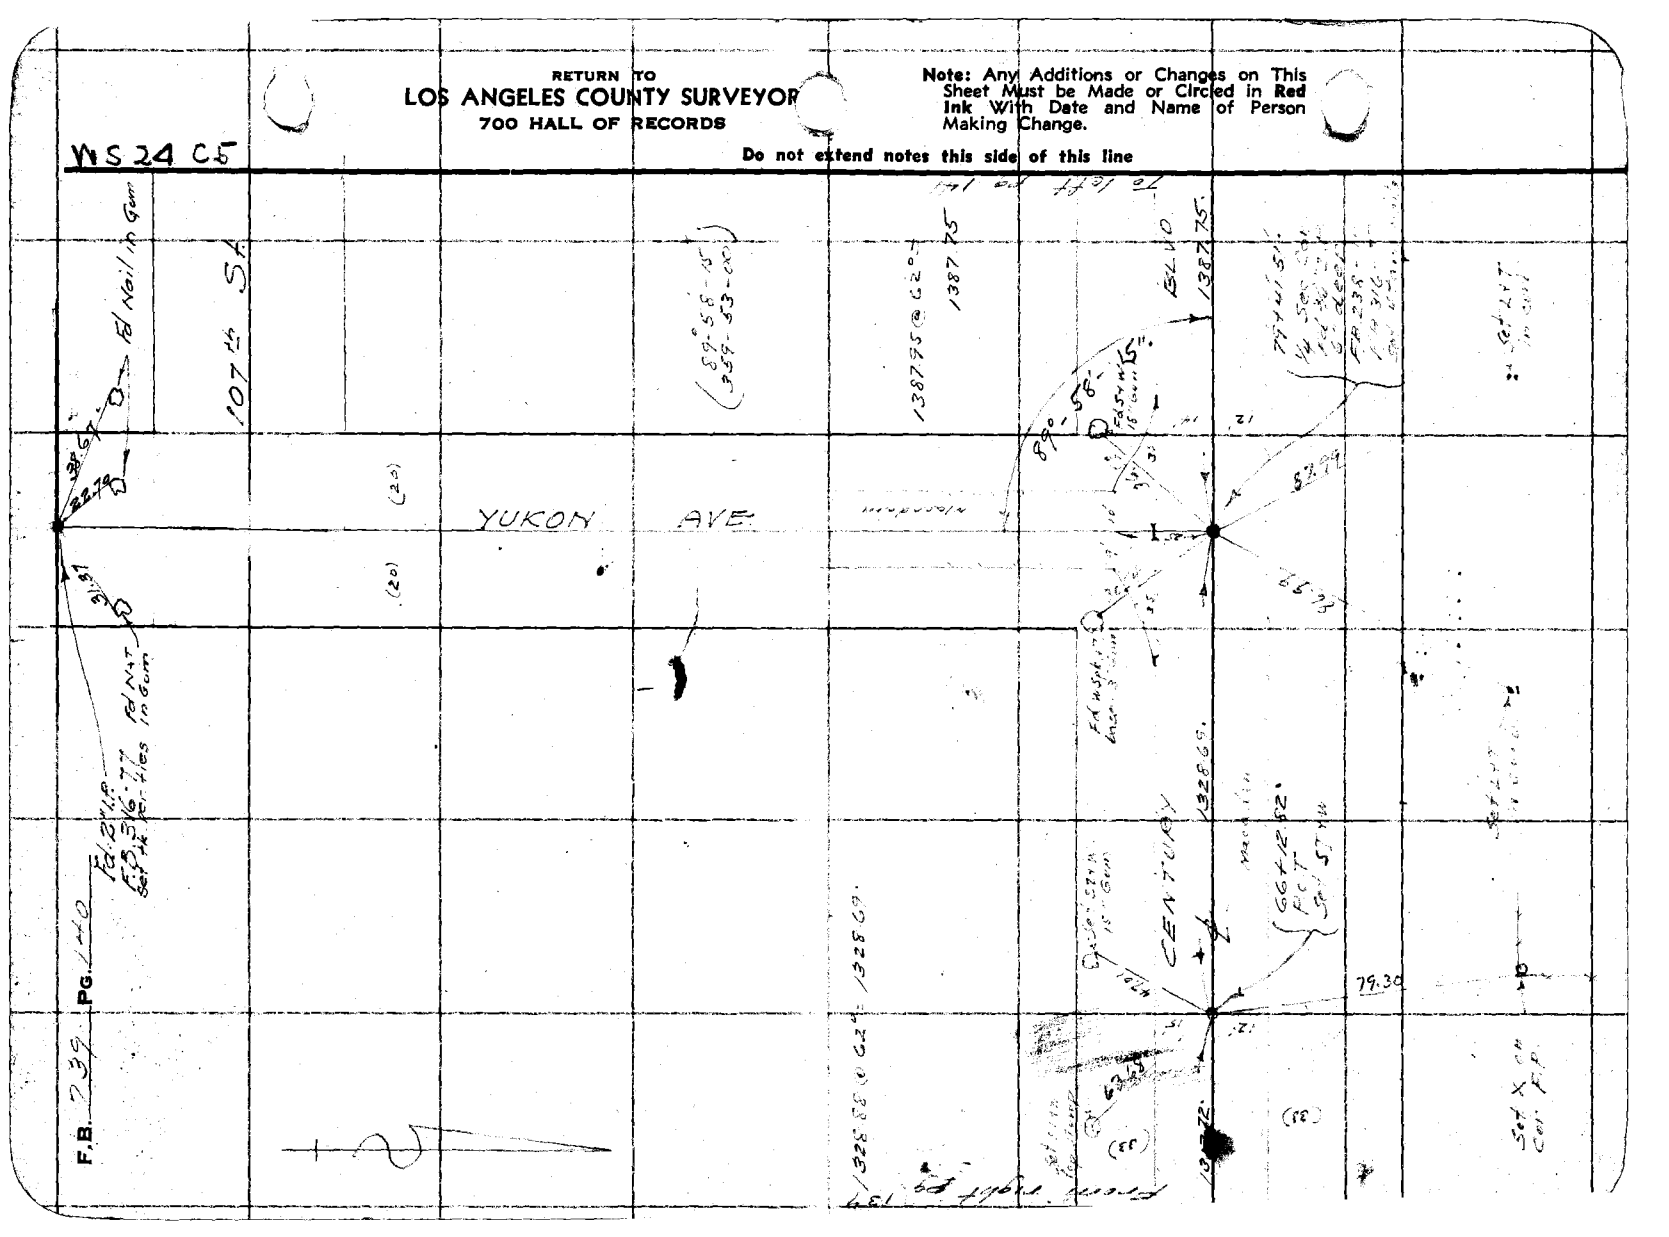
YUKON AVE.
(20)
(20)
(22)
(22)
79.30
1387.75
1387.75
1387.75 @ 62°
1328.69
1328.69
1328.69
1328.69 @ 62°
89°-58'-45"
(89°-58'-15")
(359°-53'-00")
CENTERLINE
Found nail in Cover
Found nail in Cover
Found nail in Cover

Notes Ck'd by D. M. Finley	Survey of	F.B.	PG.
Map No. B-1427-2	W. O. 5208 Tape No. C 32 St'd	° F.	
Office Work H. H. REYNOLDS	Surveyed by		
Checked D. M. Finley	Notes	Date 9-14-38	
Date Jan. 1940	Indexed		

WS 24-C5

Note: Any Additions or Changes on This Sheet Must be Made or Circled in Red Ink With Date and Name of Person Making Change.

Do not extend notes this side of this line

RETURN TO
LOS ANGELES COUNTY SURVEYOR
700 HALL OF RECORDS

Fd 4 X's on MH rim
LB 788-35
Set PM on MH cover

(25) (25)

AVE

102nd

ST

L+T

32.40

31.74

30.82

Not in PP

L+T

Adopted ℄
per R.S. 757-32.

CITY

1258.27 @ 0.2° = 1258.09

(90-01-30)
(360-06-15)

90°-02'-01"-35.24

R=7738

1258.09

CENTURY

1387.75

BLVD

(33)

(32)

(33)

Macadam

0.18

Set ¾" Iron Pipe
F.B. 757-32

93+29.26
Fd 2X2+1K

(50)

WS 24-C5

FORM 247 10M 11-35

F.B. 739 Pg. 142

WS 24-B5

RETURN TO
LOS ANGELES COUNTY SURVEYOR
700 HALL OF RECORDS

Note: Any Additions or Changes on This Sheet Must be Made or Circled in Red Ink With Date and Name of Person Making Change.

Do not extend notes this side of this line

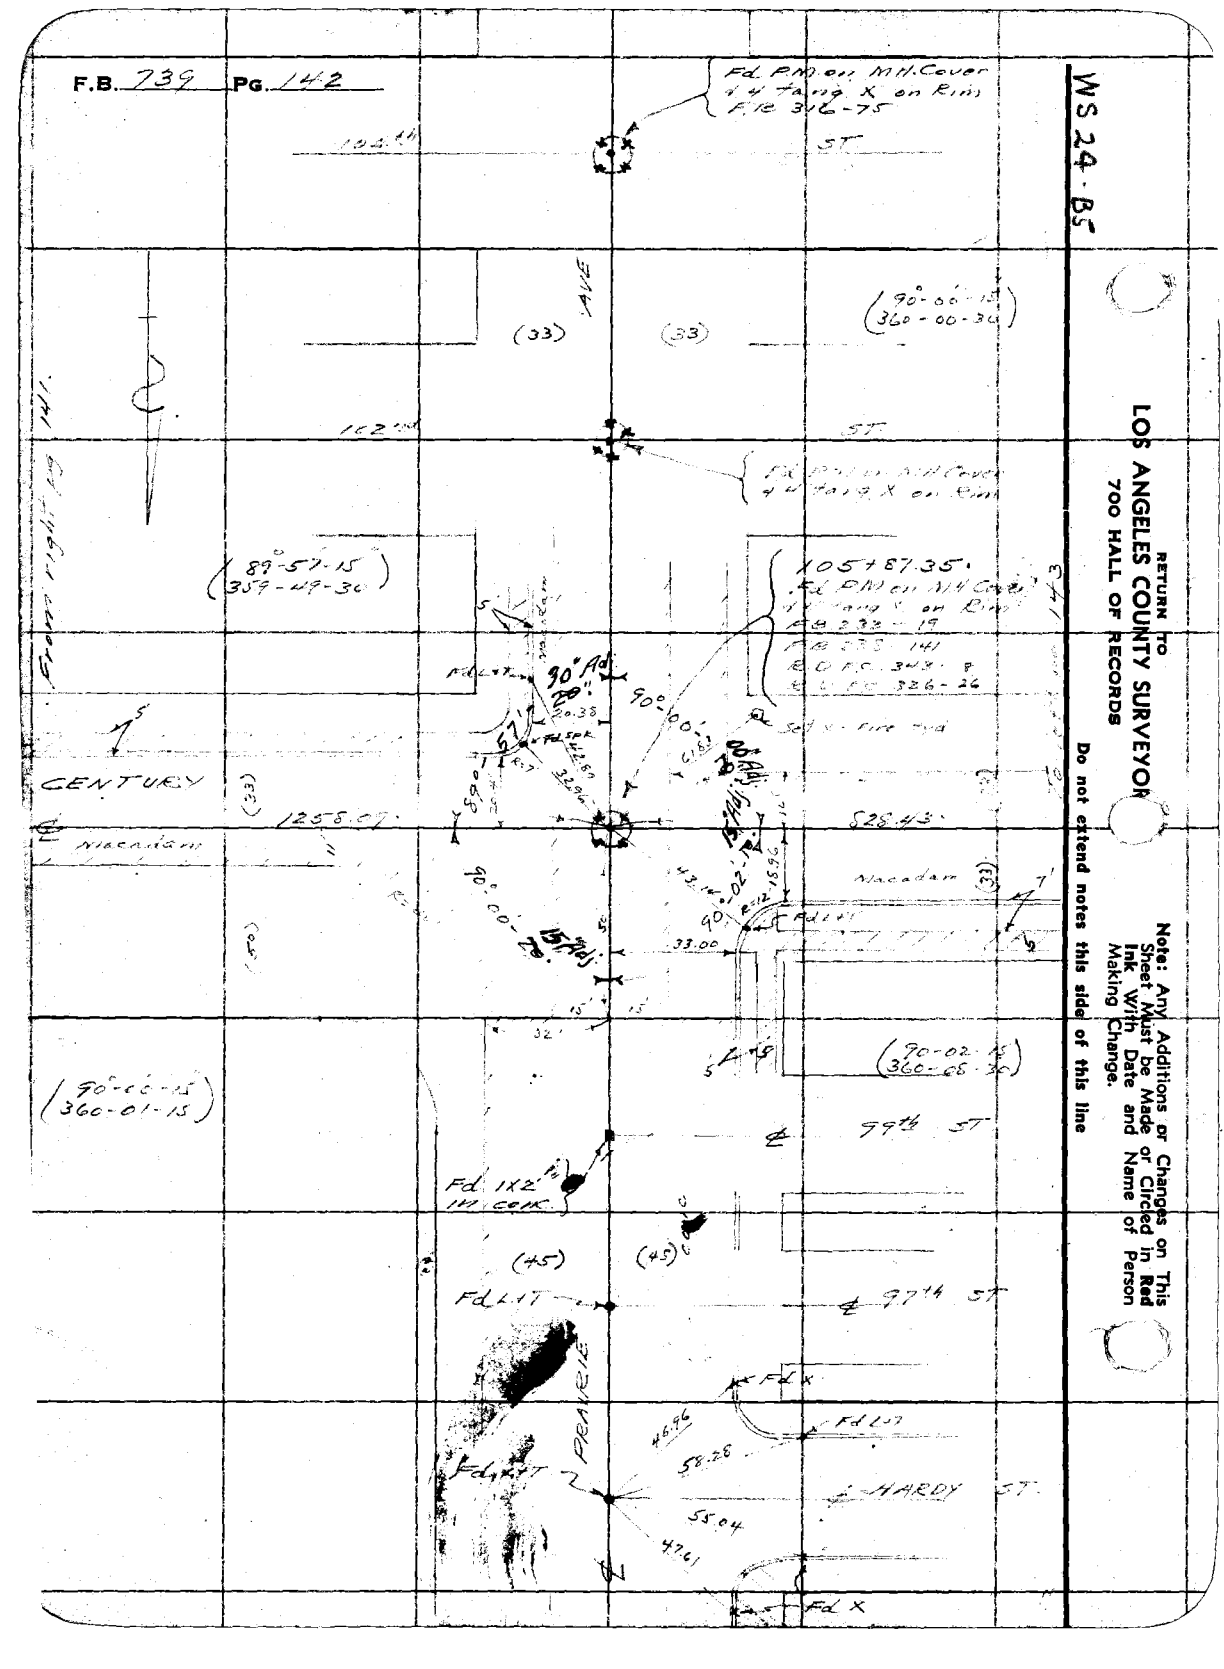

Notes Ck'd by D. M. Finley	Survey of [illegible]
Map No. B-1427-2	W. O. 8208 Tape No. 932 St'd [illegible]°F.
Office Work H. H. REYNOLDS	Surveyed by L. D. Woolf
Checked D. M. Finley	Notes [illegible] Date 3-17-38
Date Jan. 1940	Indexed [illegible]

F.B. 773 PG. 145

WS 24-B5

828.56 @ 60° = 828.43.

1144.15.78.
Set A.M. on M.H. Cover
[illegible] R.O.Fd. 3N3.13
Set ℄ Tang. P.M. on M.H. Rim

To 1427-1

CENTURY BLVD

491.61.

828.43. (33)

Meridian (33)

From 1427-1 Fd. 1.42

33.02 13.00 25.56 16.26 1877 46.07 2.5'

R=27 15.93 15.90 R=27 Fd LWT 1.1

Fd 2x2 + 1.0' ft. 30.10 Fd 2x2 + 1.1' 40

491.68 @ 62° = 491.61.

Fd 2x2 + 1ft

30.08

ALLEY

Fd bent 5' ST.

(30) (30)

(90° 01' 30")
(360° 05' 45")

℄ 99.44 ST.

Set PM on M.H. Cover
1.0' ft. Fd. Tack PM on M.H. Rim

30.10

ALLEY

Fd 2x2 + 1.1' ft.

30.00

℄ 97.44 ST.

Fd. S.T. + W.

Fd. 1x2 - 0.8' ft.

30.02 30.18

Fd. 2x2 - 1.0' ft.

ALLEY

Fd 2x2 + 1ft

Fd LWT.

Fd LWT.

℄ 49.61 ST.

Fd NAIL
P.B. 233-30

19.37 33.22

Fd LWT.

RETURN TO
LOS ANGELES COUNTY SURVEYOR
700 HALL OF RECORDS

Note: Any Additions or Changes on This Sheet Must be Made or Circled in Red Ink With Date and Name of Person Making Change.

Do not extend notes this side of this line

FORM 247 10M 11-35

RETURN TO
LOS ANGELES COUNTY SURVEYOR
700 HALL OF RECORDS

Notes: Any Additions or Changes on This Sheet Must be Made or Circled in Red Ink With Date and Name of Person Making Change.

Do not extend notes this side of this line

WS 24-A5

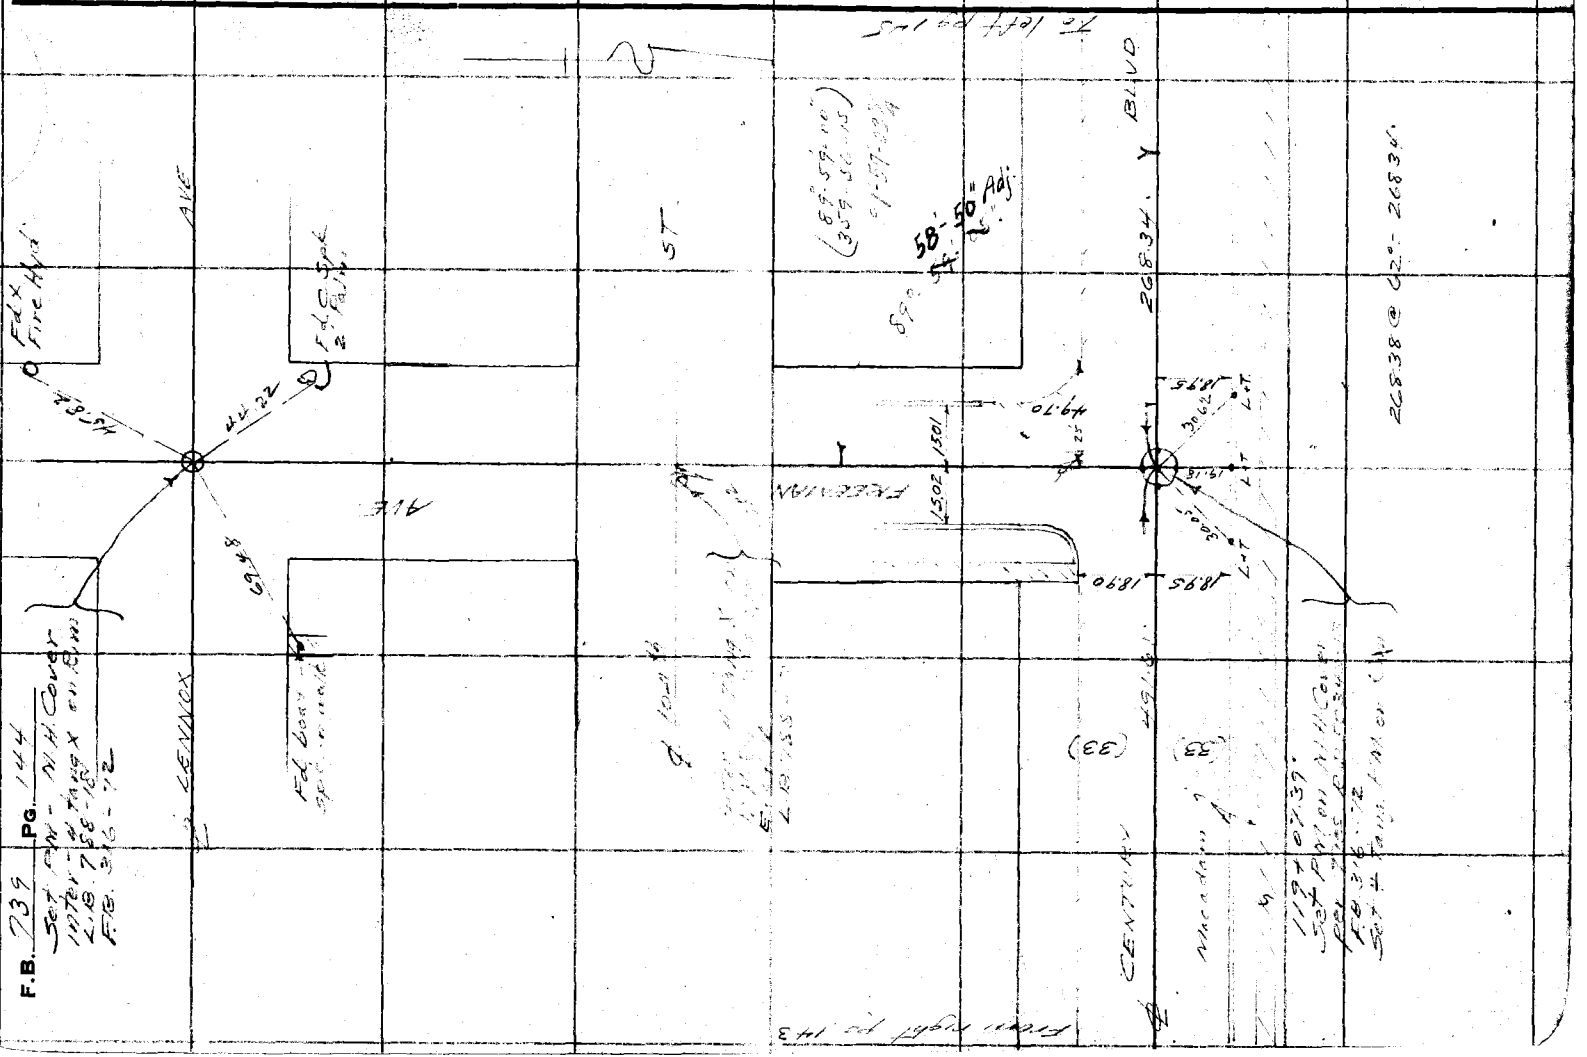

F.B. 739 Pg. 144
F.B. 316 - 12

Notes Ck'd by D. M. Finley
Map No. B-1427-3
Office Work H. H. REYNOLDS
Checked D. M. Finley
Date Jan 1940.

Survey of
W. O. 8208 Tape No. 032 St'd [illegible]°F.
Surveyed by Moore
Notes Moore, Date 3-[illegible]-35
Indexed

F.B. 737 PG. 115

WS 24-B5

Note: Any Additions or Changes on This Sheet Must be Made or Circled in Red Ink With Date and Name of Person Making Change

Do not extend notes this side of this line

RETURN TO
LOS ANGELES COUNTY SURVEYOR
700 HALL OF RECORDS

FORM 247 10M 11-38

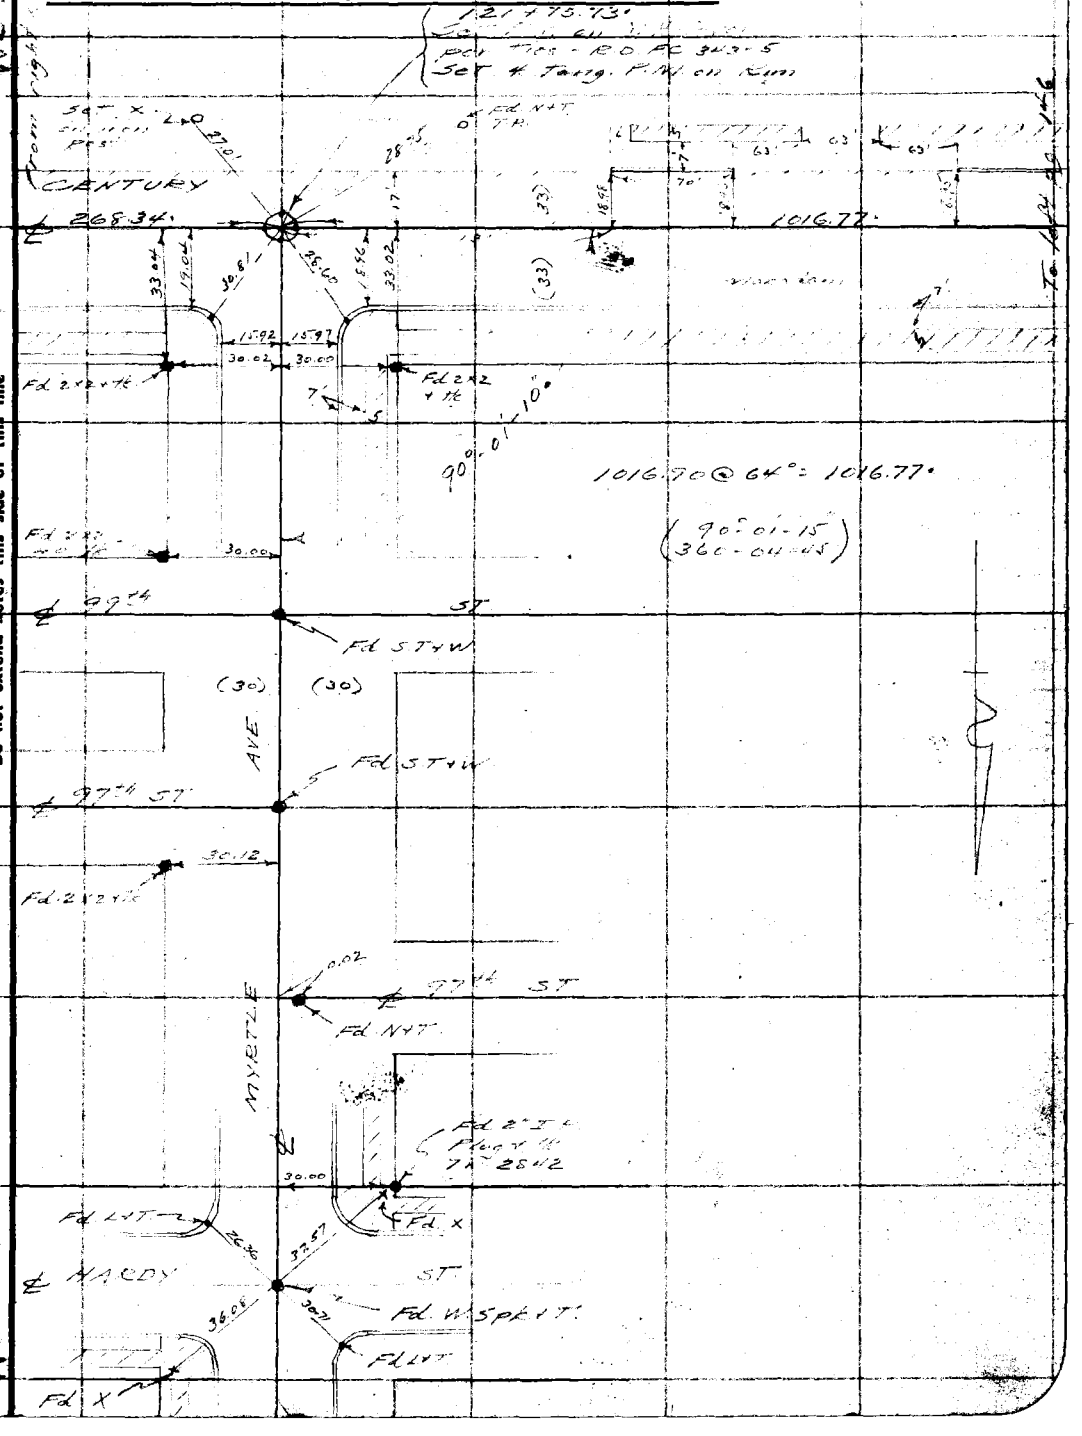

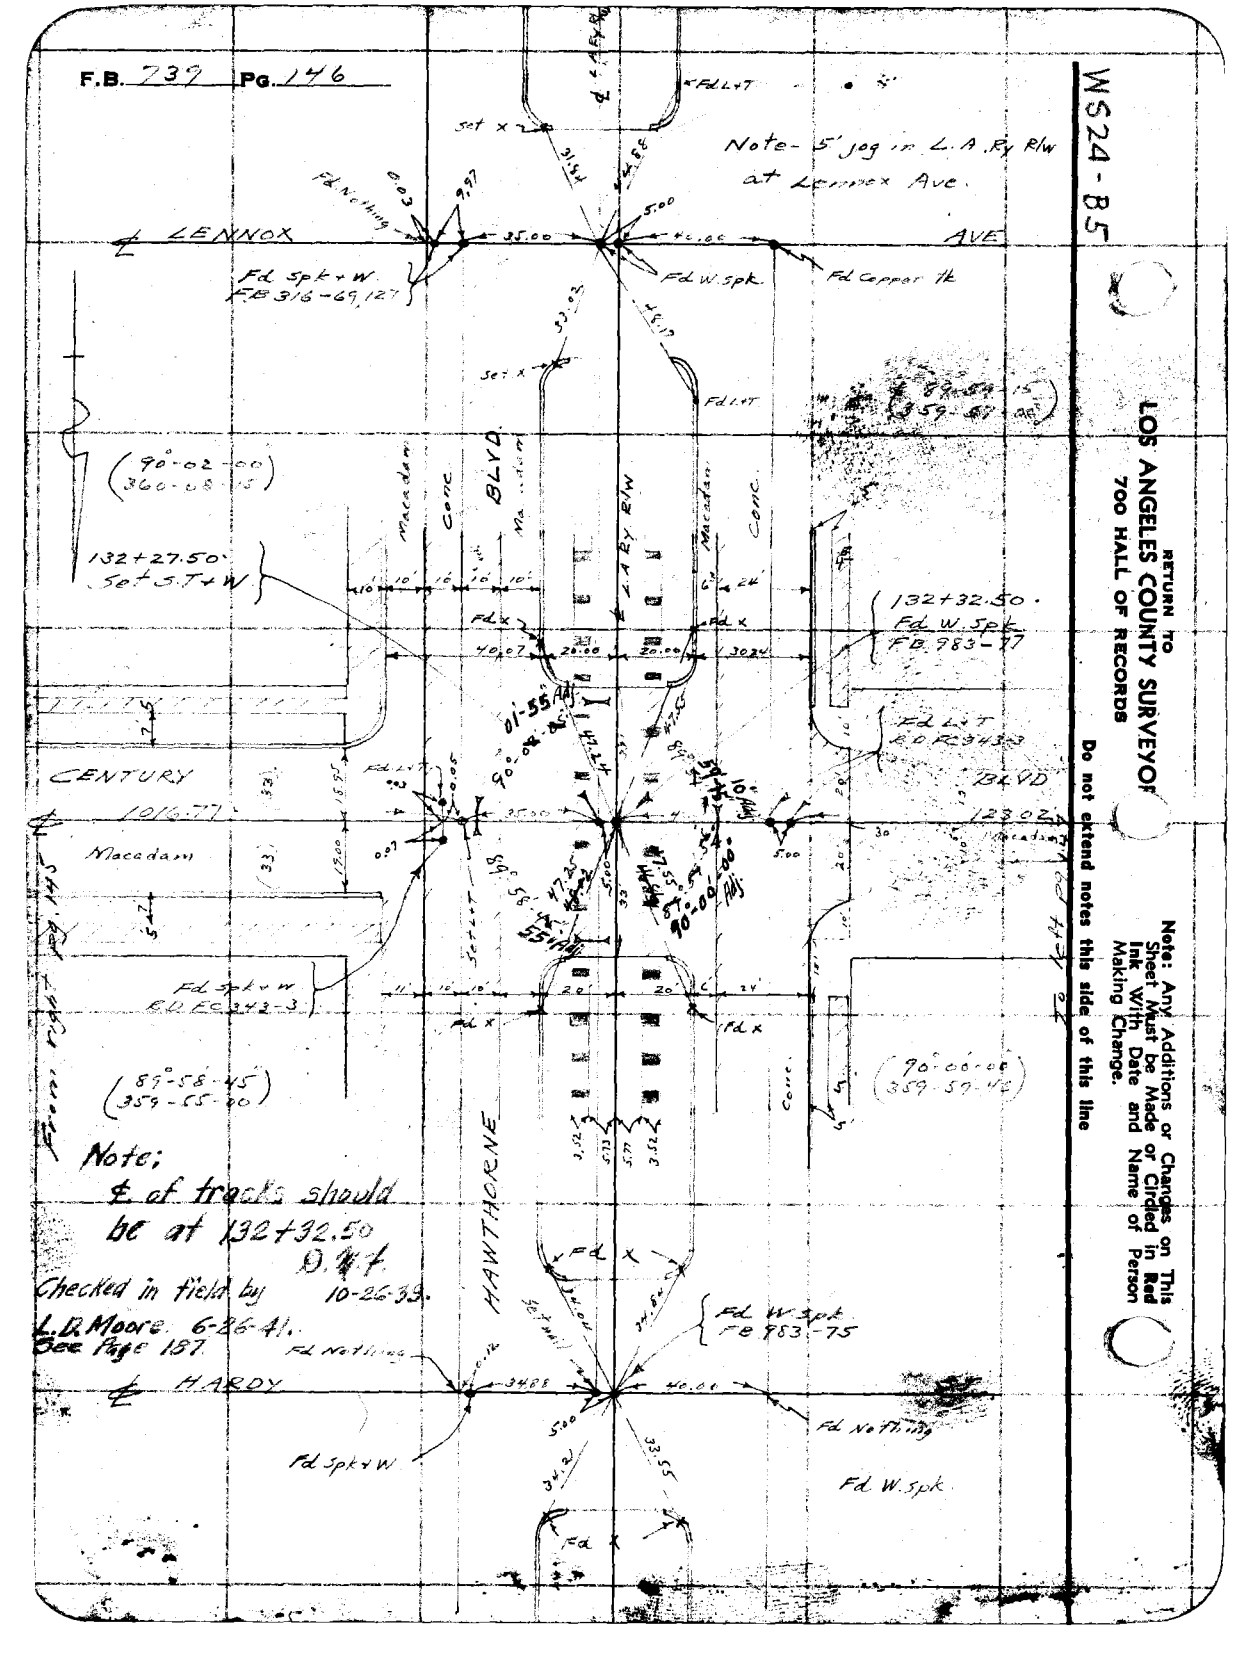
F.B. 739 Pg. 146
W524-85
RETURN TO
LOS ANGELES COUNTY SURVEYOR
700 HALL OF RECORDS
Do not extend notes this side of this line
Note: Any Additions or Changes on This Sheet Must be Made or Circled in Red Ink With Date and Name of Person Making Change.
Note- 5' jog in L.A.Ry R/w at Lennox Ave.
℄ LENNOX AVE
℄ L.A.Ry R/w
℄ CENTURY BLVD
℄ HAWTHORNE
℄ HARDY
Fd Spk + W. FB 316-69, 127
Fd W. Spk.
Fd Copper Tk
Fd Nothing
Set X
Fd L+T
Macadam
Conc.
132+27.50 Set S.T+W
132+32.50 Fd W. Spk. FB 983-77
Fd L+T R.O.R 3432
Fd Spk + W R.O.R 3432-3
Fd W. Spk FB 983-75
Fd Spk + W
Fd W. Spk
Fd X
(90°-02'-00" 360-00-15)
(89°-58'-45" 359-55-00)
(90°-00'-00" 359-57-45)
01-55
Note; ℄ of tracks should be at 132+32.50 D.W.F.
Checked in field by L.D. Moore 6-26-41. 10-26-33.
See Page 137

Notes Ck'd by D. M. Finley	Survey of Century Blvd	F.B. 732	Pg. 17
Map No. B-1427-3	W. O. 8208 Tape No. 032 St'd 64 °F.		
Office Work H. H. REYNOLDS	Surveyed by L.D. Moore		
Checked D. M. Finley	Notes M Moore Date 3-28-38		
Date Jan. 1940	Indexed		

VIS-24-B5

172.59 @ 70° = 172.57'

From right pg 176

134+00.53' Set STW Del. File FB 983-41

17 +W - NM from ℄ Century FB 983-41

To left pg 146

(33)

℄ CENTURY BLVD

123.62' Macadam

172.57'

(33)

123.03 @ 70° = 123.02'

(89-59-45 269-58-30)

98th ST.

℄ ALLEY

Fd 2 x 2. FB. 983 - 43

Fd X - ↓

39.23

HARDY ST.

40.85

18 Ft.

Fd X - ↓

Fd ↓ ↑

Note: Any Additions or Changes on This Sheet Must be Made or Circled in Red Ink With Date and Name of Person Making Change

Do not extend notes this side of this line

RETURN TO
LOS ANGELES COUNTY SURVEYOR
700 HALL OF RECORDS

FORM 247 10M 11-38

F.B. 239 PG. 42

WS 24-B5

RETURN TO
LOS ANGELES COUNTY SURVEYOR
700 HALL OF RECORDS

Do not extend notes this side of this line

Note: Any Additions or Changes on This Sheet Must be Made or Circled in Red Ink With Date and Name of Person Making Change.

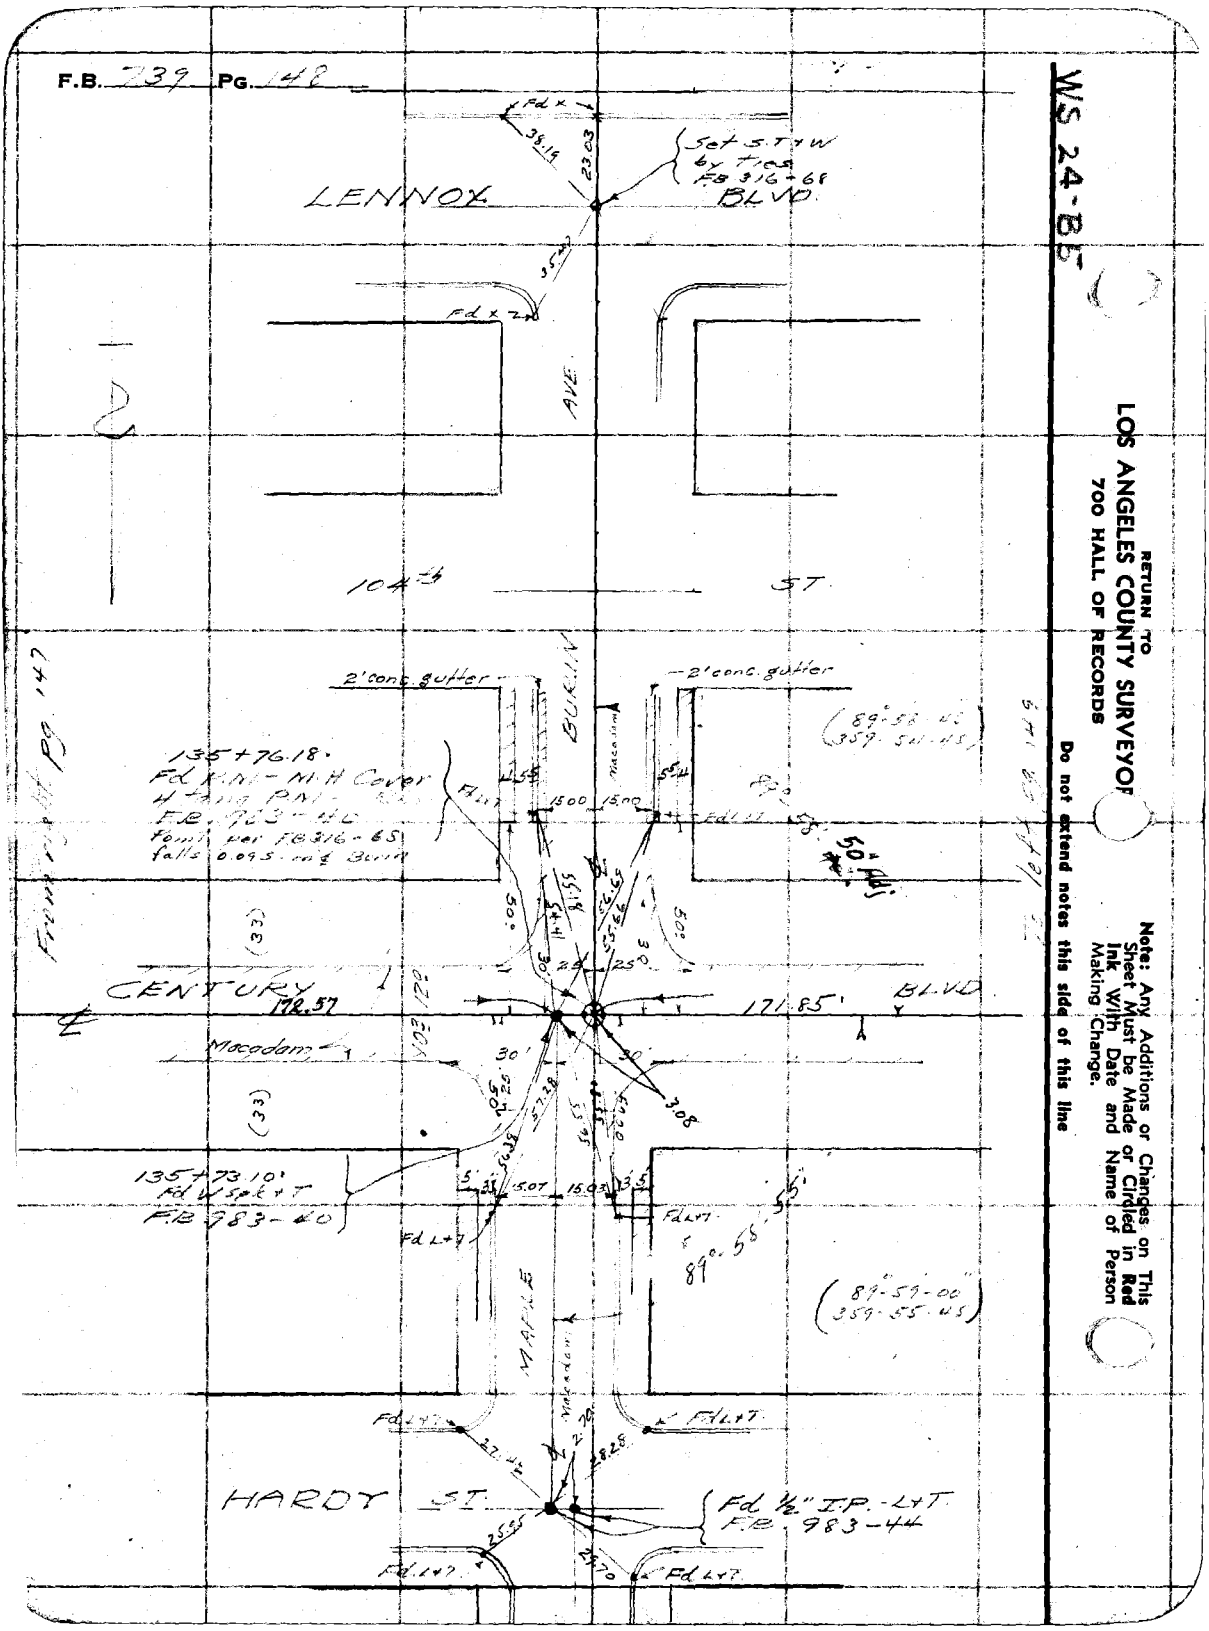

WS-4-B5

Notes Ck'd by D. M. Finley	Survey of CENTURY BLVD
Map No. B-1427-3	W. O. 8206 Tape No. 632 St'd 84 °F.
Office Work H. H. REYNOLDS	Surveyed by L.D. Moore
Checked D. M. Finley	Notes L Moore Date 3-21-38
Date Jan. 1940.	Indexed

F.B. 23 Pg. 147

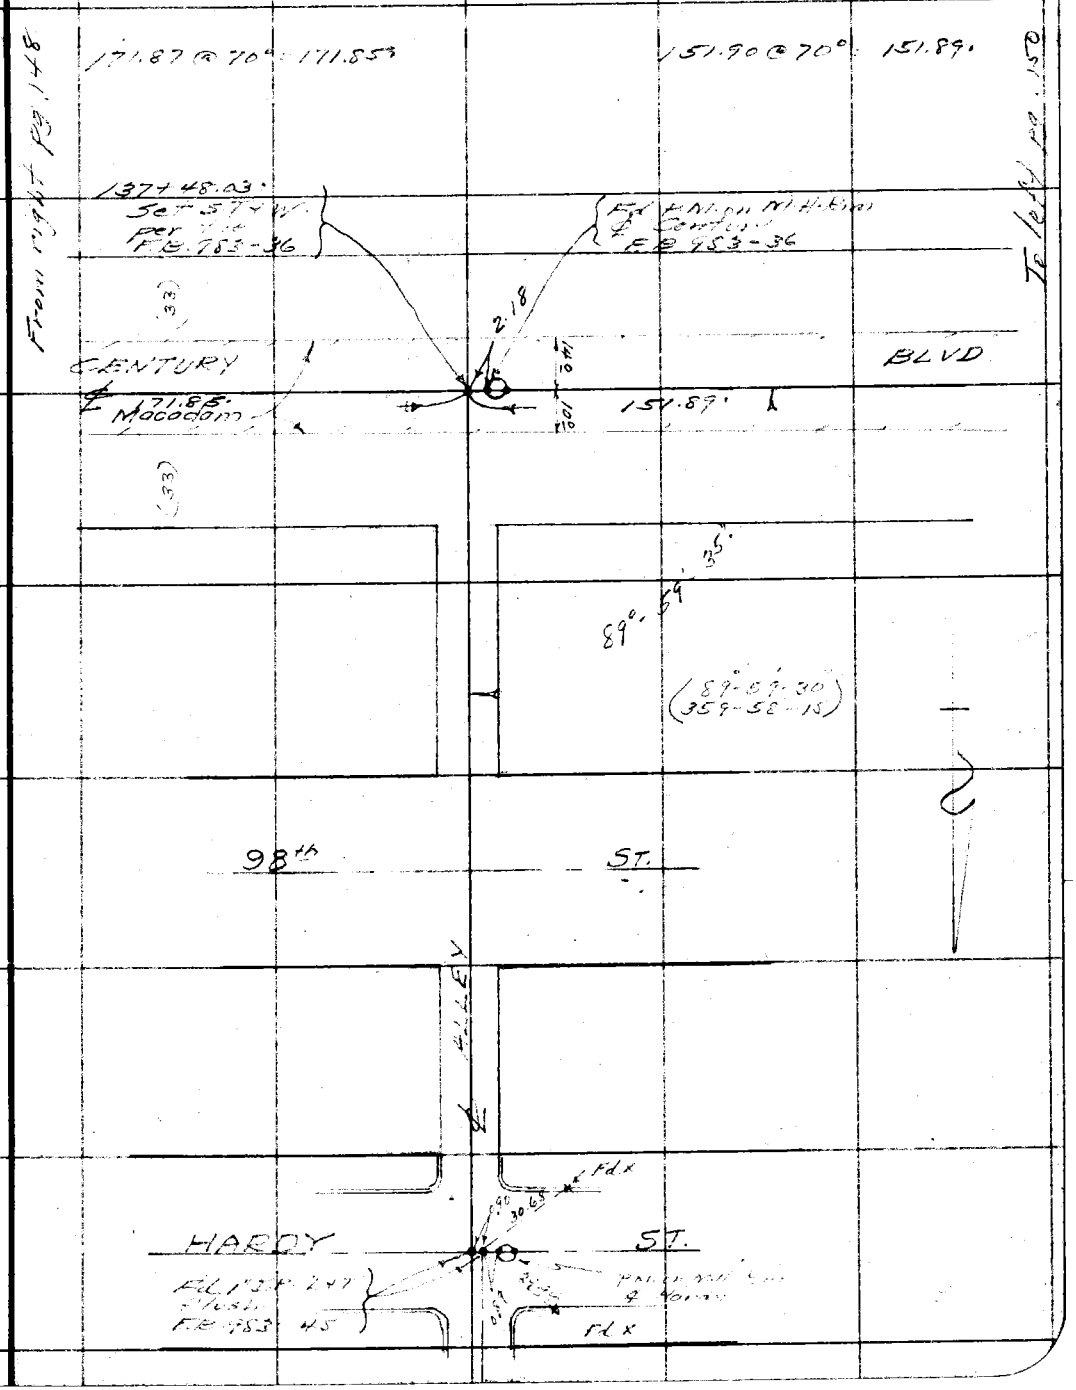

RETURN TO
LOS ANGELES COUNTY SURVEYOR
700 HALL OF RECORDS

Note: Any Additions or Changes on This Sheet Must be Made or Circled in Red Ink With Date and Name of Person Making Change.

Do not extend notes this side of this line

FORM 247 10M 11-38

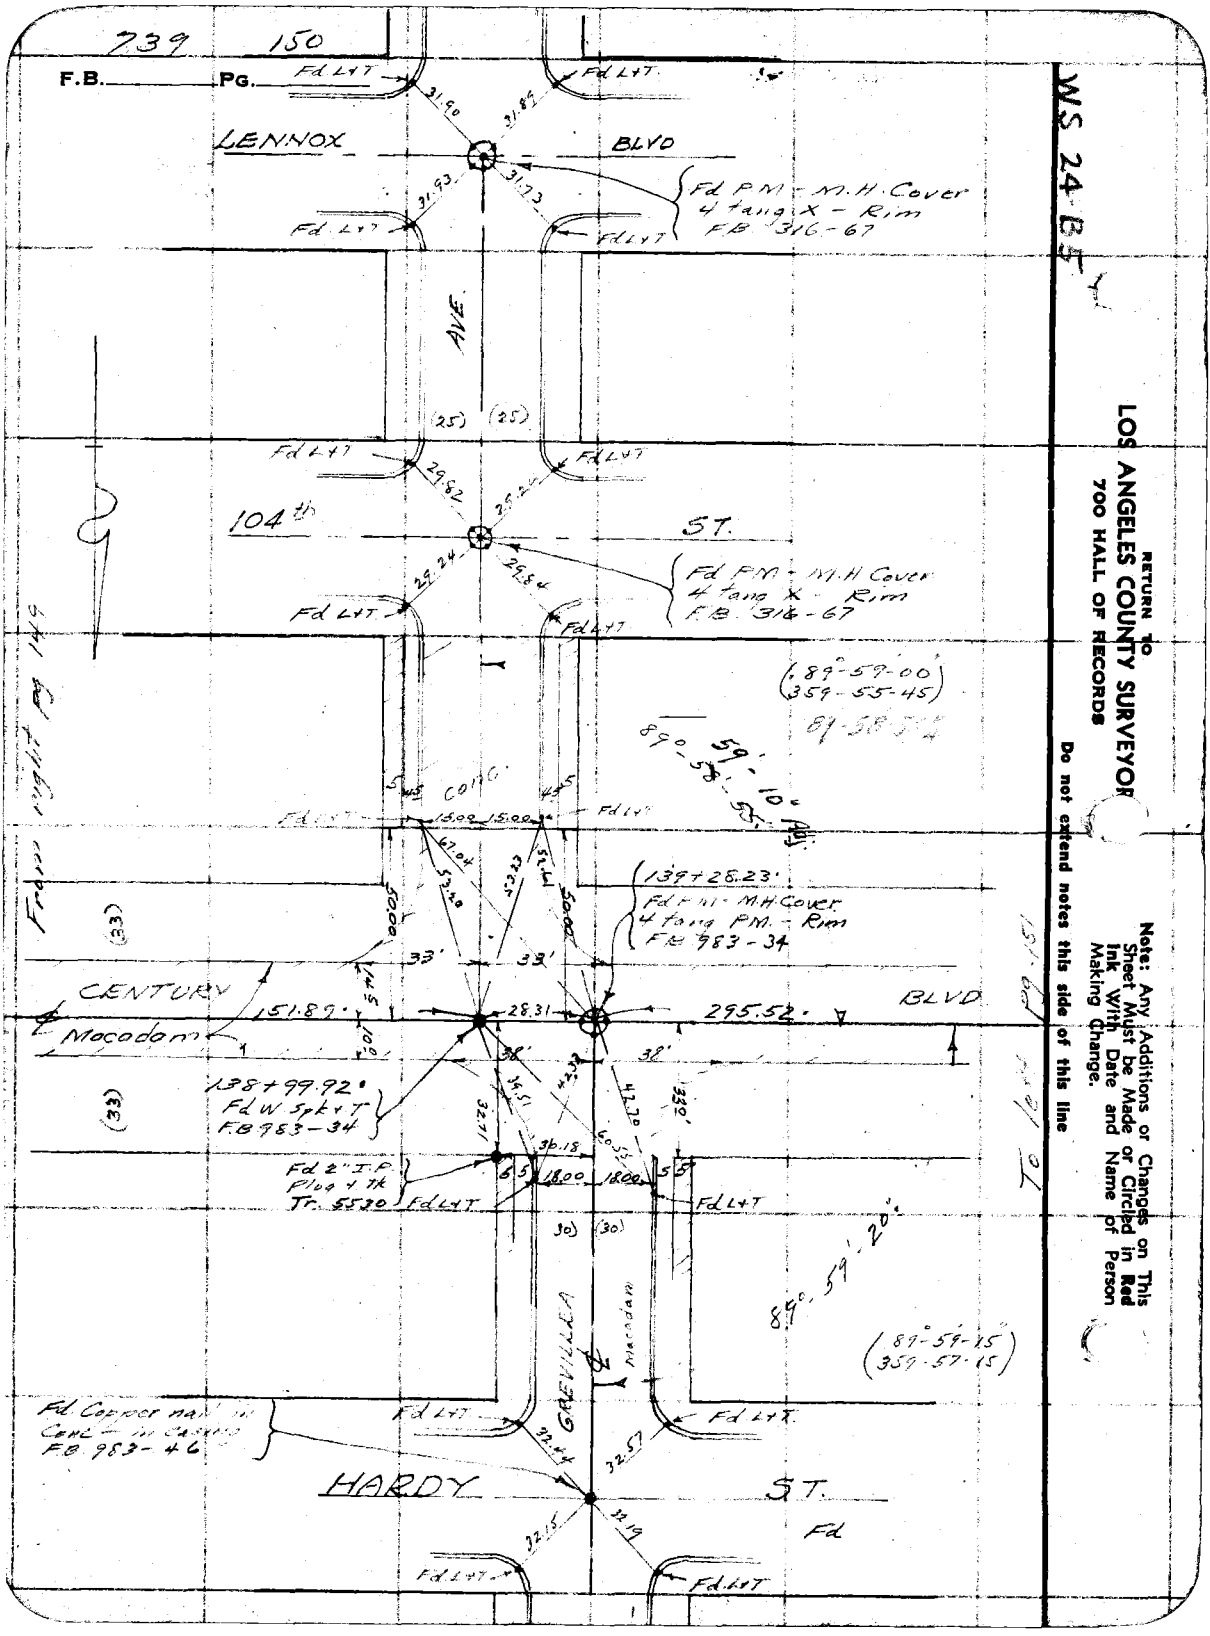
739 150
F.B. PG.
WS 24 B5
RETURN TO
LOS ANGELES COUNTY SURVEYOR
700 HALL OF RECORDS
Note: Any Additions or Changes on This Sheet Must be Made in Ink With Date and Name of Person Making Change.
Do not extend notes this side of this line
LENNOX BLVD
Fd P.K. - M.H. Cover
4 faing X - Rim
FB 316-67
ALE AVE
104th ST.
Fd P.K. - M.H. Cover
4 faing X - Rim
FB 316-67
(89°-59-00")
(359-55-45)
89-58-55
59.10'
CENTURY
Mocadam
BLVD
139+28.23'
Fd P.K. - M.H. Cover
4 faing P.K. - Rim
FB 983-34
138+99.92'
Fd W Spk+T
FB 983-34
Fd 2" I.P.
Plug & Tk
Tr. 5530
89°-59'-20"
(89°-59-15")
(359-57-15)
GREVILLEA
Macadam
Fd Copper nail in
Conc - in casing
FB 983-46
HARDY ST.
Fd

Notes Ck'd by D. M. Finley	Survey of Century Blvd
Map No. B-1427-4	W. O. 1208 Tape No. 032 St'd 84° F.
Office Work H. H. REYNOLDS	Surveyed by L. D. Moore
Checked D. M. Finley	Notes 2 sets Date 3-29-38
Date Jan. 1940	Indexed

F.B. 123 Pg. 51

N 24 - B 5

Note: Any Additions or Changes on This Sheet Must be Made or Circled in Red Ink With Date and Name of Person Making Change.

Do not extend notes this side of this line

RETURN TO
LOS ANGELES COUNTY SURVEYOR
700 HALL OF RECORDS

FORM 247 10M 11-38

Fd L+T

39.53

53.26

LENNOX BLVD.

43.00

Fd L+T

Fd S T+W
FB 316-66

(25) (25)

MANSEL AVE

104th ST.

Fd 3x2-14" deep
Chiseled T in S FB 316-66

0.04 W

2' conc. gutter

2' conc. gutter

From 104th St. 150

295.54 @ 72° = 295.52

4.68

14.99

15.00

5.94

Macadam

(89°-58'-45")
359-55-00

S 89°-58'-45" E

59.94

To left 153

60.15

55.09

54.24

30.38

30.38

25'

25'

10.16

(33)

CENTURY BLVD

295.52

14.57

305.18

Macadam

25

22

142+38.32
Fd P.M. - M.H. Cover
4 tang P.M. - Rim
FB 983-33

142+23.75
Fd 2x2 x 1ft
6" deep
FB 983-33

36.26

36.26

31.74

31.74

15.10

14.92

15.10

Fd L+T

3'

5'

5'

3'

Fd L+T

Fd 2" I.P. + tag 1448
Tr 11033

WALNUT

(179°-44'-00")
359-04-15

24.93

24.93

Fd 2" I.P. + tag 1448
Tr 11184

15' Concrete Section

Macadam

15' Concrete Section

WALNUT

89°-58'-25"

(89°-58'-30")
359-53-45

Set Nail

Set X

Set X

HARDY

98th ST.

26.17

26.62

26.07

25.52

Fd P.M. - M.H. Cover
4 tang Cast Iron Rim

Fd X

Fd X





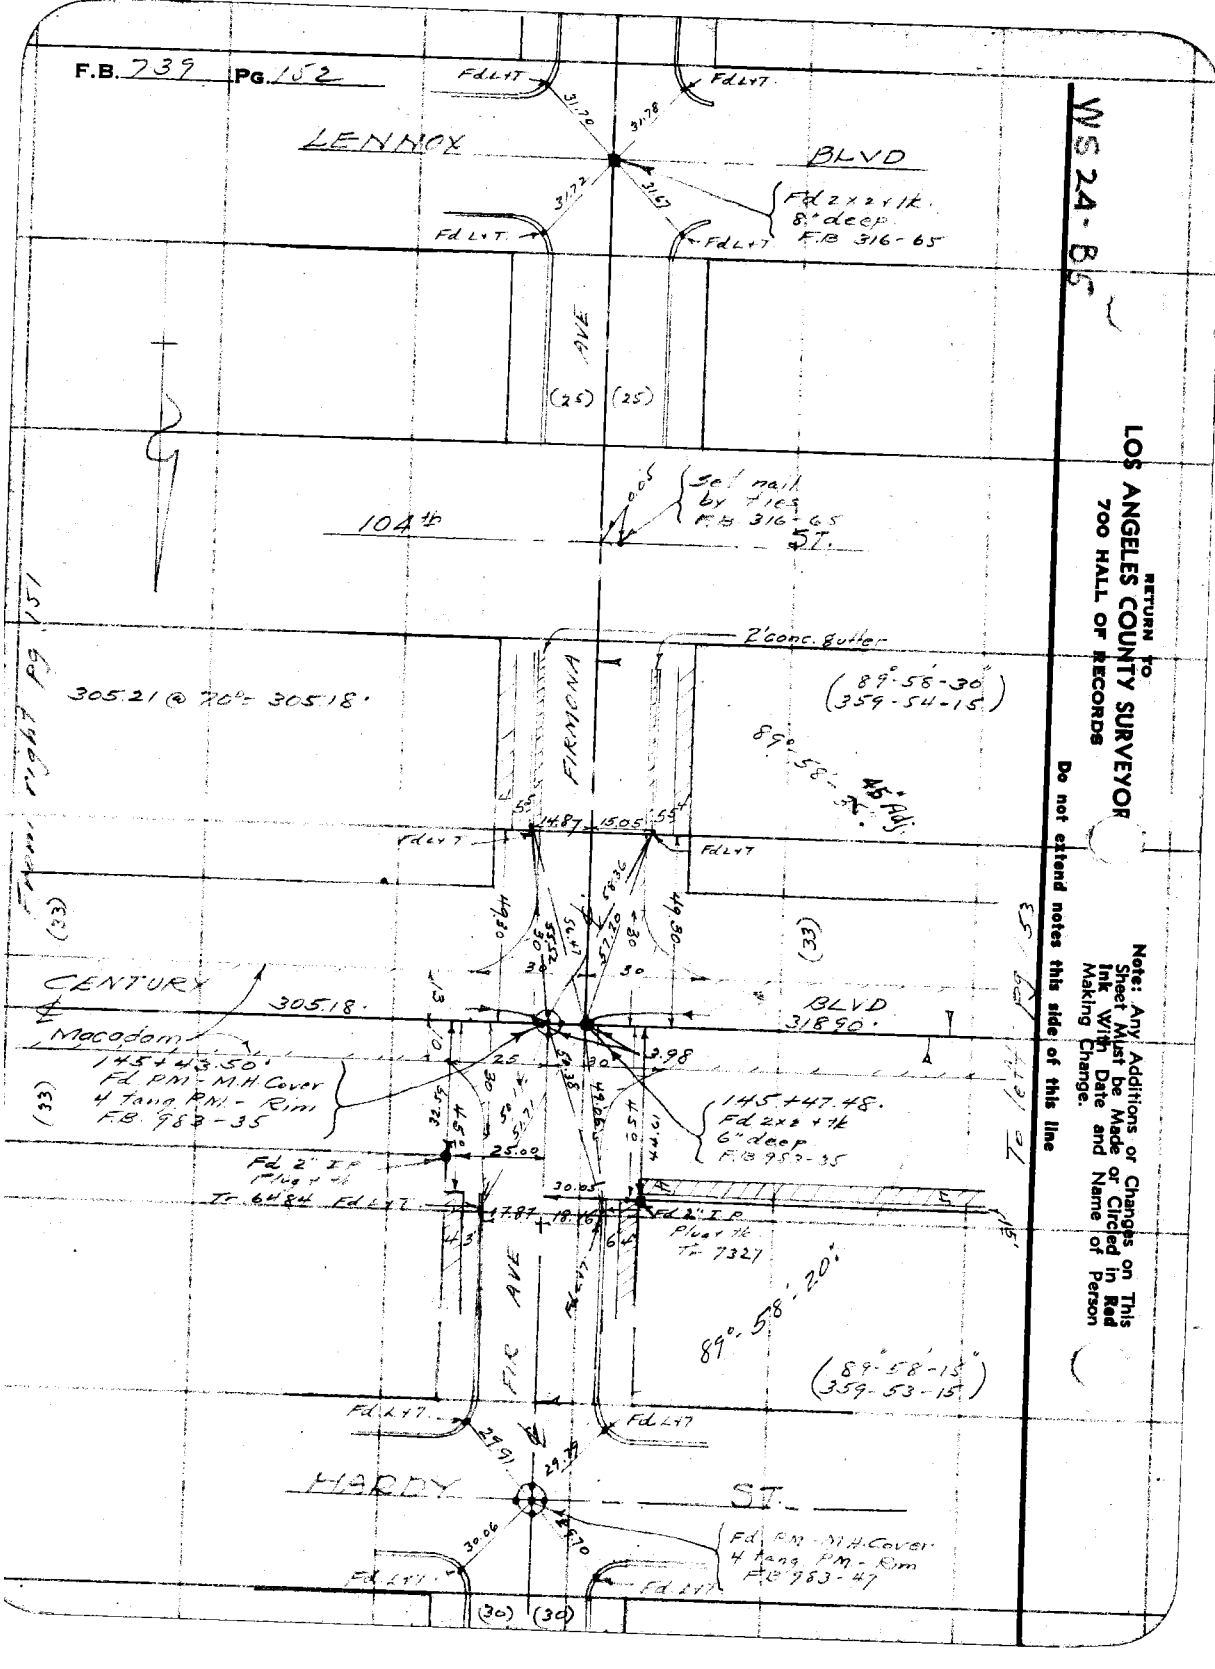
F.B. 739 Pg. 152
WS 24-B5
LENNOX BLVD
Fd 2x2x1/2. 8" deep F.B. 316-65
Fd L+T.
AVE
(26) (25)
104th ST.
Set nail by tie F.B. 316-65
0.05
2' conc. gutter
305.21 @ 70° - 305.18'
(89°-58'-30" 359-54-15)
89°-58'-30" 45° Adj.
FIRMONA
55'
1487
1505
55'
Fd L+T
(33)
CENTURY
Macadam
305.18'
BLVD
31890'
145+43.50'
Fd PM - M.H. Cover
4 Tang PM - Rim
F.B. 983-35
145+47.48.
Fd 2x2 x 1/2
6" deep
F.B. 952-35
3.98
Fd 2" I.P.
Tr. 6484
7.87
18.16
Fd 2" I.P.
Plug + Tk
Tr. 7327
FIR AVE
89°-58'-20"
(89°-58'-15" 359-53-15)
HARDY ST.
29.91
29.94
30.06
Fd PM - M.H. Cover
4 Tang PM - Rim
F.B. 983-47
(30) (30)
RETURN TO
LOS ANGELES COUNTY SURVEYOR
700 HALL OF RECORDS
Note: Any Additions or Changes on This Sheet Must be Made or Circled in Red Ink With Date and Name of Person Making Change.
Do not extend notes this side of this line

Notes Ck'd by D. M. Finley	Survey of Century Blvd.
Map No. B-1427-4	W. O. 8208 Tape No. 032 St'd ft. F.
Office Work H. H. REYNOLDS	Surveyed by L.D. Moore
Checked D. M. Finley	Notes Moore Date 3-29-38
Date Jan. 1940	Indexed

F.B. 73 Pg. 150

WS 24 B5

Note: Any Additions or Changes on This Sheet Must be Made or Circled in Red Ink With Date and Name of Person Making Change.

Do not extend notes this side of this line

RETURN TO
LOS ANGELES COUNTY SURVEYOR
700 HALL OF RECORDS

FORM 247 10M 11-38

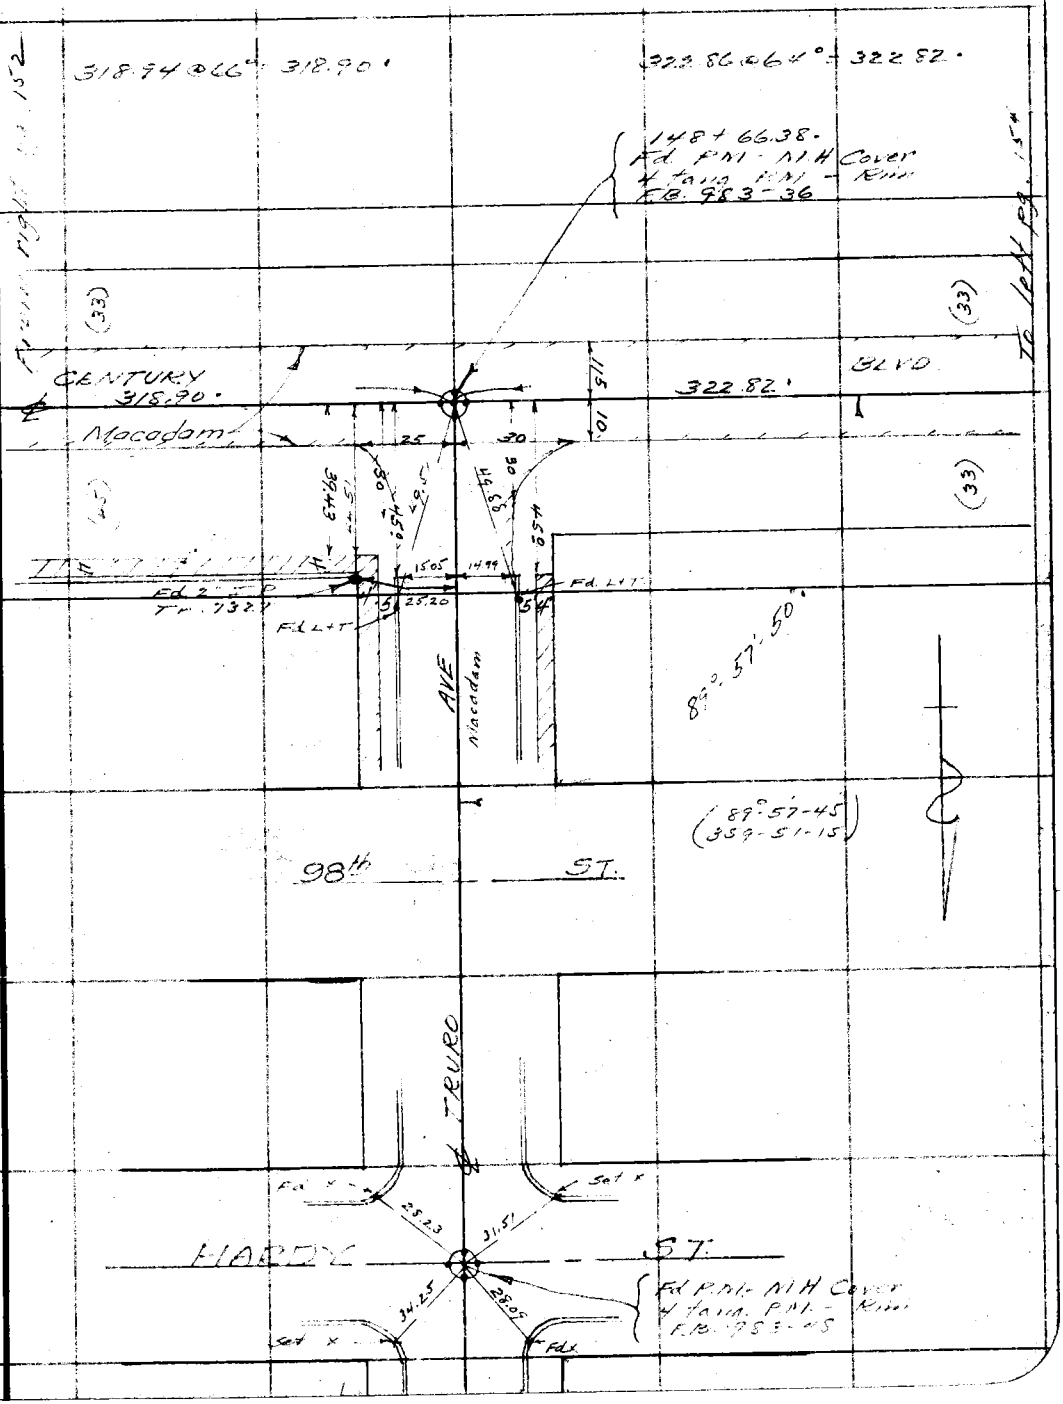

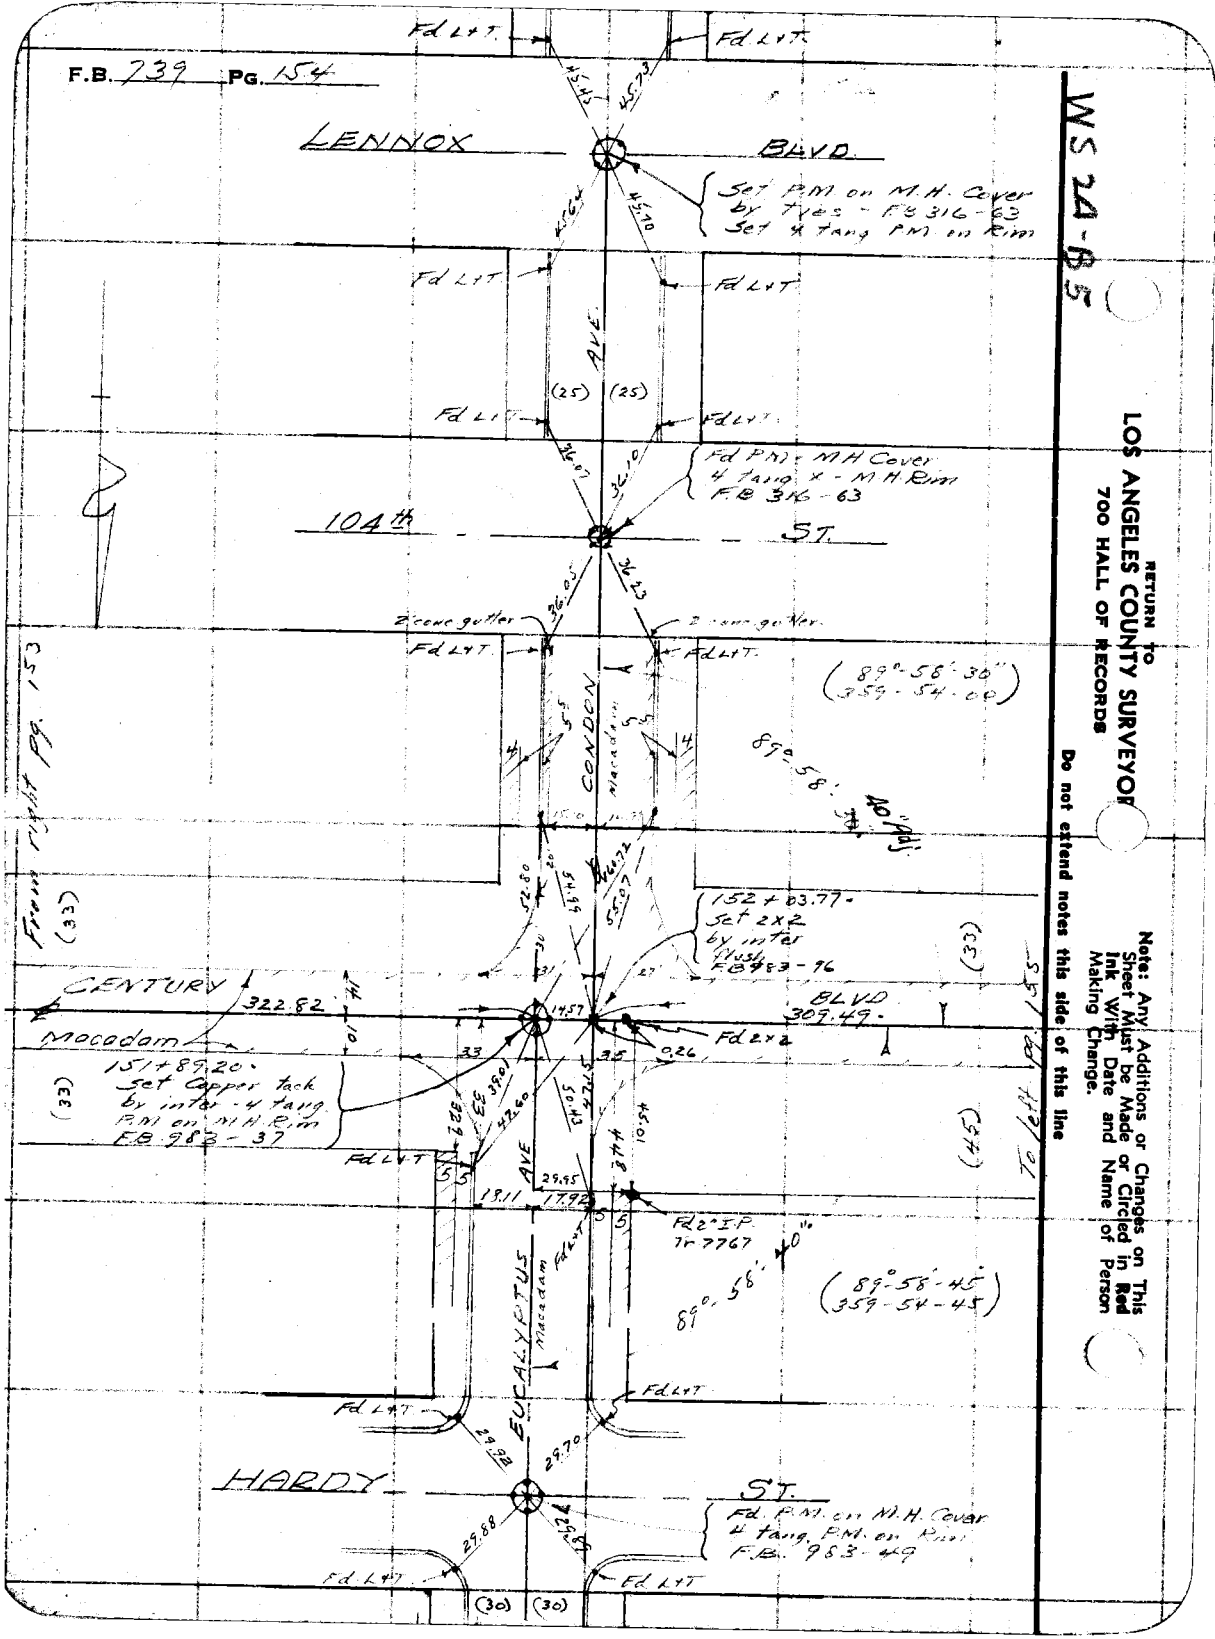
F.B. 239 PG. 154
WS 24-95
LENNOX BLVD
104th ST.
CENTURY Mocodam
HARDY ST.
EUCALYPTUS AVE
CONDON AVE
Fd L+T.
Set P.M. on M.H. Cover by Tyes - F.B. 316-63 Set 4 tang P.M. on Rim
Fd P.M. - M.H. Cover 4 tang X - M.H. Rim F.B. 316-63
2 conc gutter
(89°-58'-30" 359-54-00)
89°-58'-45"
152+83.77 - Set 2x2 by inter flush F.B. 983-76
322.82
BLVD 309.49
Fd 2x2
0.26
151+89.20 - Set Copper tack by inter - 4 tang P.M. on M.H. Rim F.B. 983-37
Fd 2" I.P. Tr 7767
(89°-58'-45" 359-54-45)
Fd L+T
29.92
29.70
29.88
(30)
(33)
(45)
From Right Pg. 153
To Right
RETURN TO LOS ANGELES COUNTY SURVEYOR 700 HALL OF RECORDS
Note: Any Additions or Changes on This Sheet Must be Made or Circled in Red Ink With Date and Name of Person Making Change.
Do not extend notes this side of this line

Notes Ck'd by D. M. Finley	Survey of Century Blvd
Map No. B-1427-4	W. O. 8208 Tape No. 032 St'd 34° F.
Office Work H. H. REYNOLDS	Surveyed by L. D. Moore
Checked D. M. Finley	Notes N Moore Date 3-31-38
Date Jan 1940	Indexed A. C. Jordan

F.B. [illegible] PG. 155

MS 54-8

RETURN TO
LOS ANGELES COUNTY SURVEYOR
700 HALL OF RECORDS

Note: Any Additions or Changes on This Sheet Must be Made or Circled in Red Ink With Date and Name of Person Making Change.

Do not extend notes this side of this line

FORM 247 10M 11-38

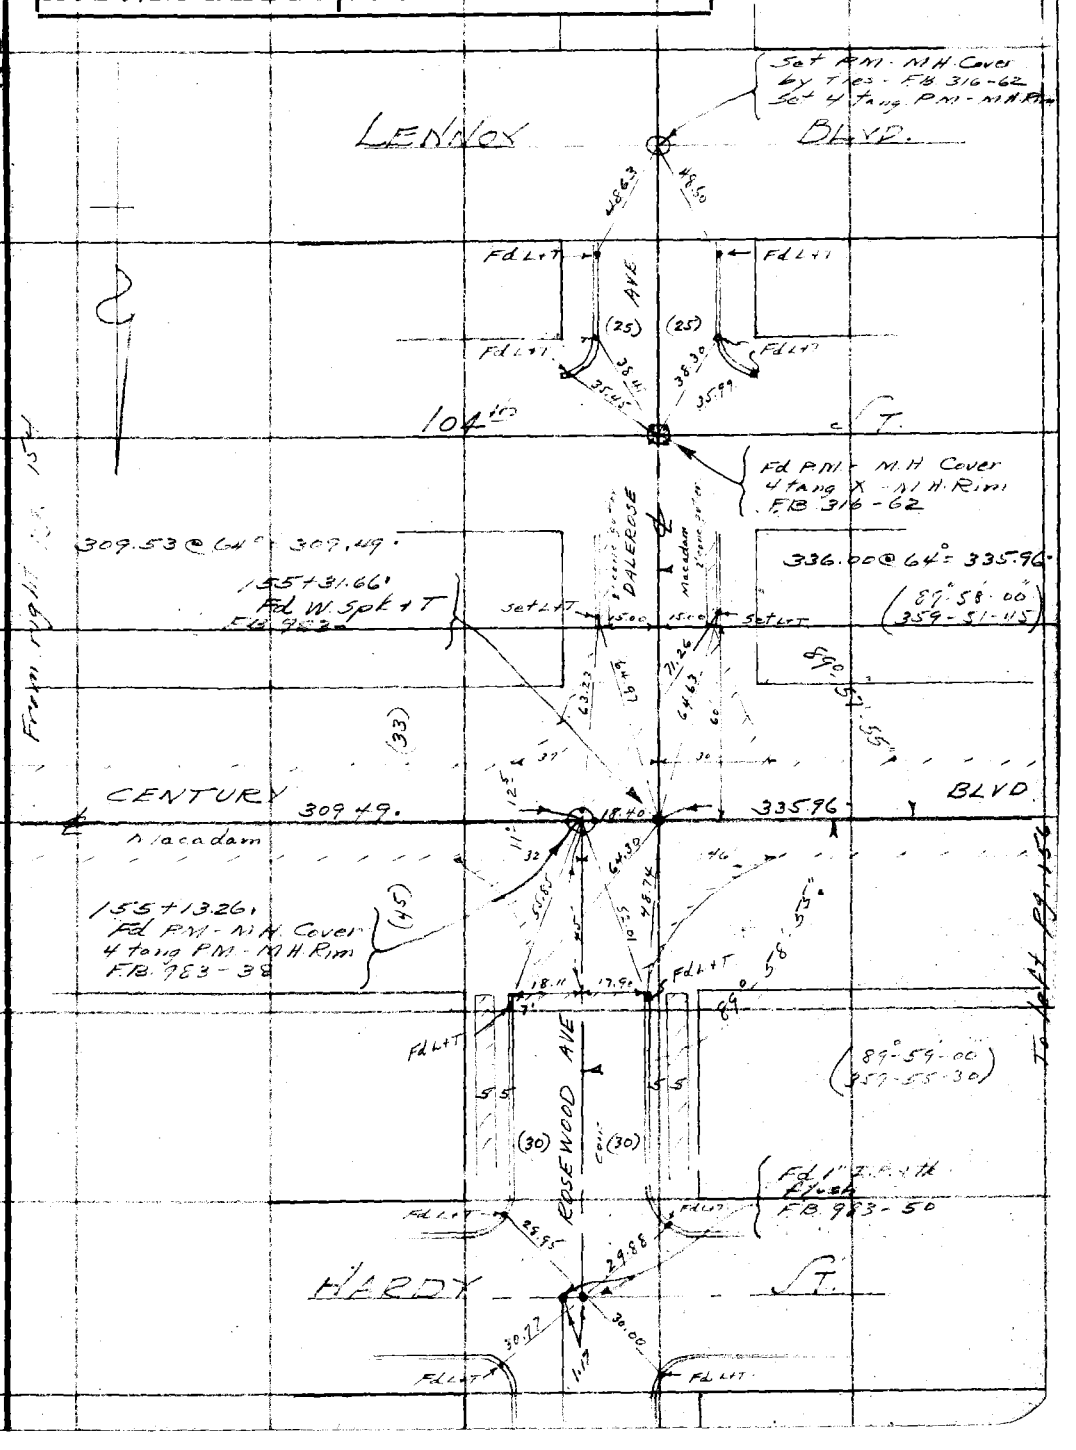

RETURN TO
LOS ANGELES COUNTY SURVEYOR
700 HALL OF RECORDS

Note: Any Additions or Changes on This Sheet Must be Made or Circled in Red Ink With Date and Name of Person Making Change.

WS 24 B5

Do not extend notes this side of this line

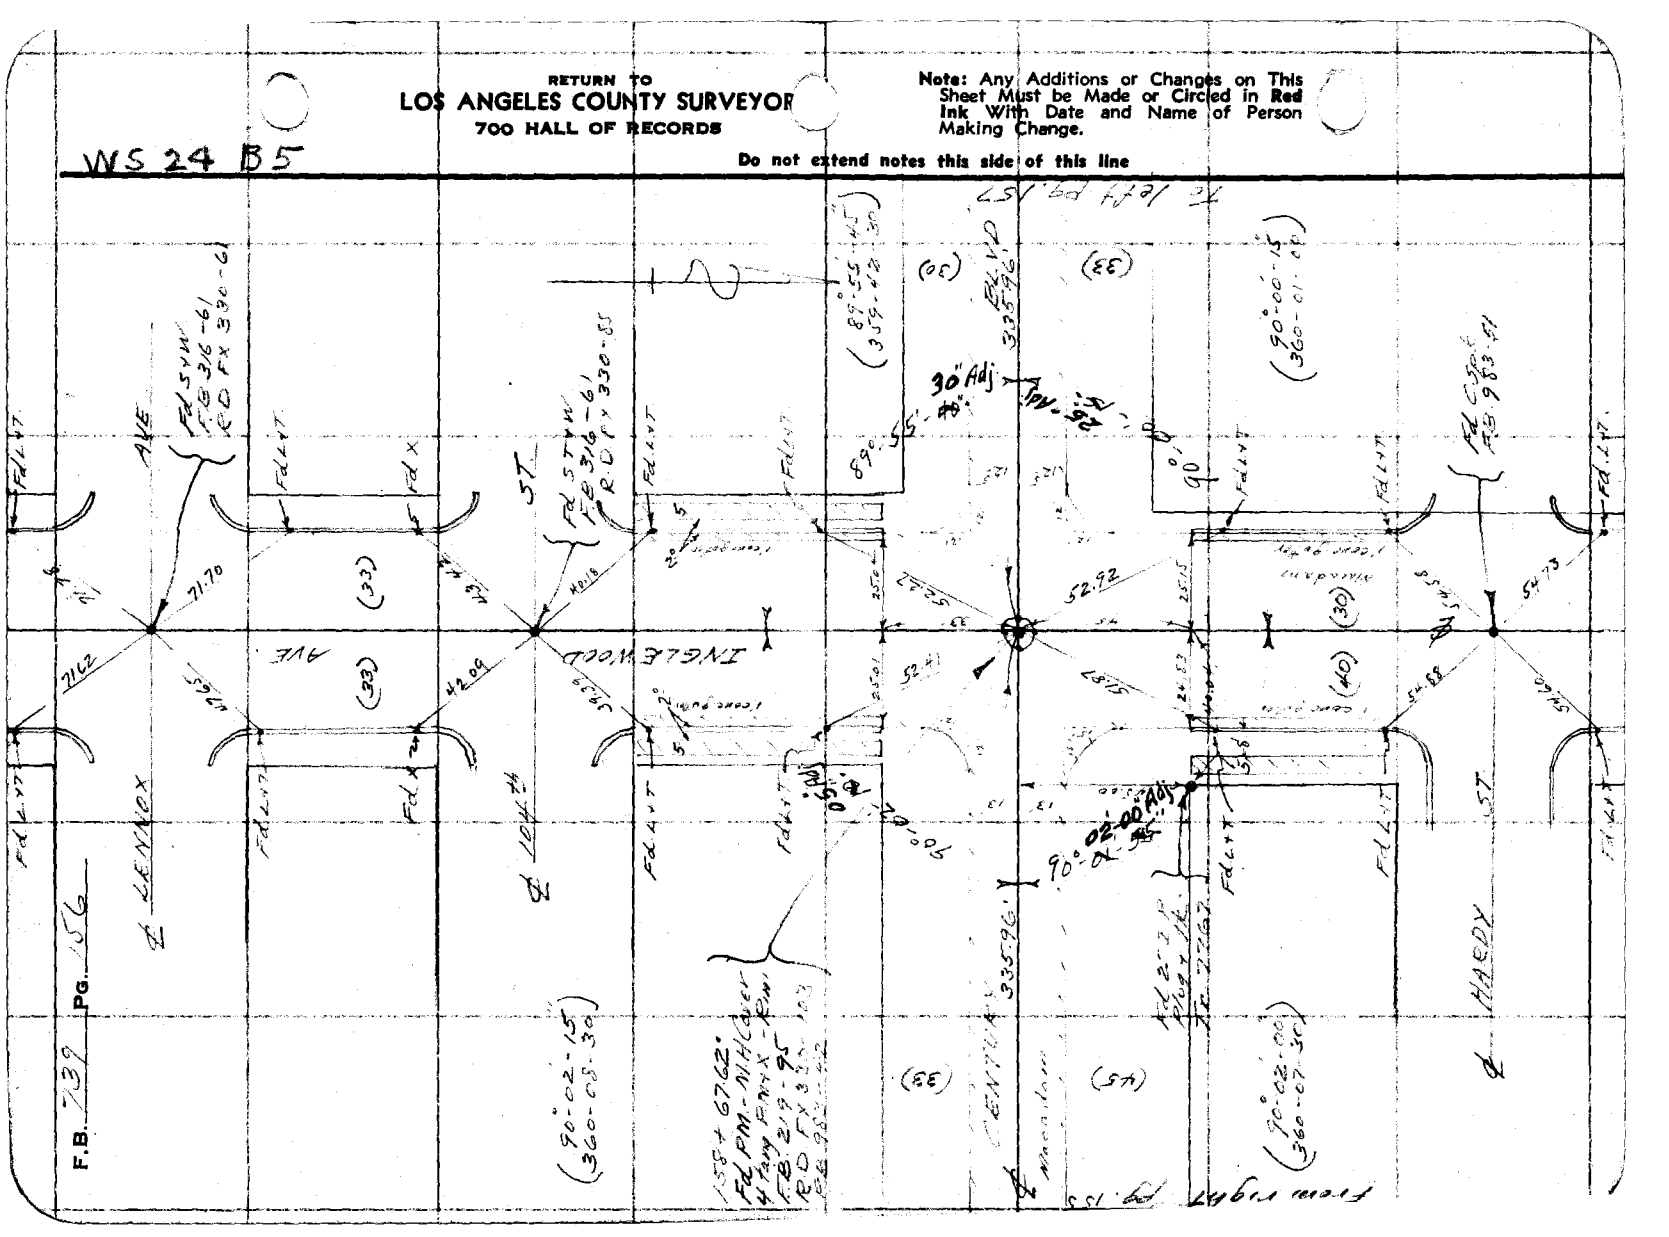

Notes Ck'd by D. M. Finley	Survey of Century Blvd
Map No. B-1427-4	W. O. 8205 Tape No. 032 St'd 100 F.
Office Work H. H. REYNOLDS	Surveyed by L. D. Moore
Checked D. M. Finley	Notes M Moore Date 3-31-38
Date Jan. 1940	Indexed

F.B. 73 Pg. 157

WS 24-B5

Note: Any Additions or Changes on This Sheet Must be Made or Circled in Red Ink With Date and Name of Person Making Change

Do not extend notes this side of this line

RETURN TO
LOS ANGELES COUNTY SURVEYOR
700 HALL OF RECORDS

FORM 247 10M 11-38

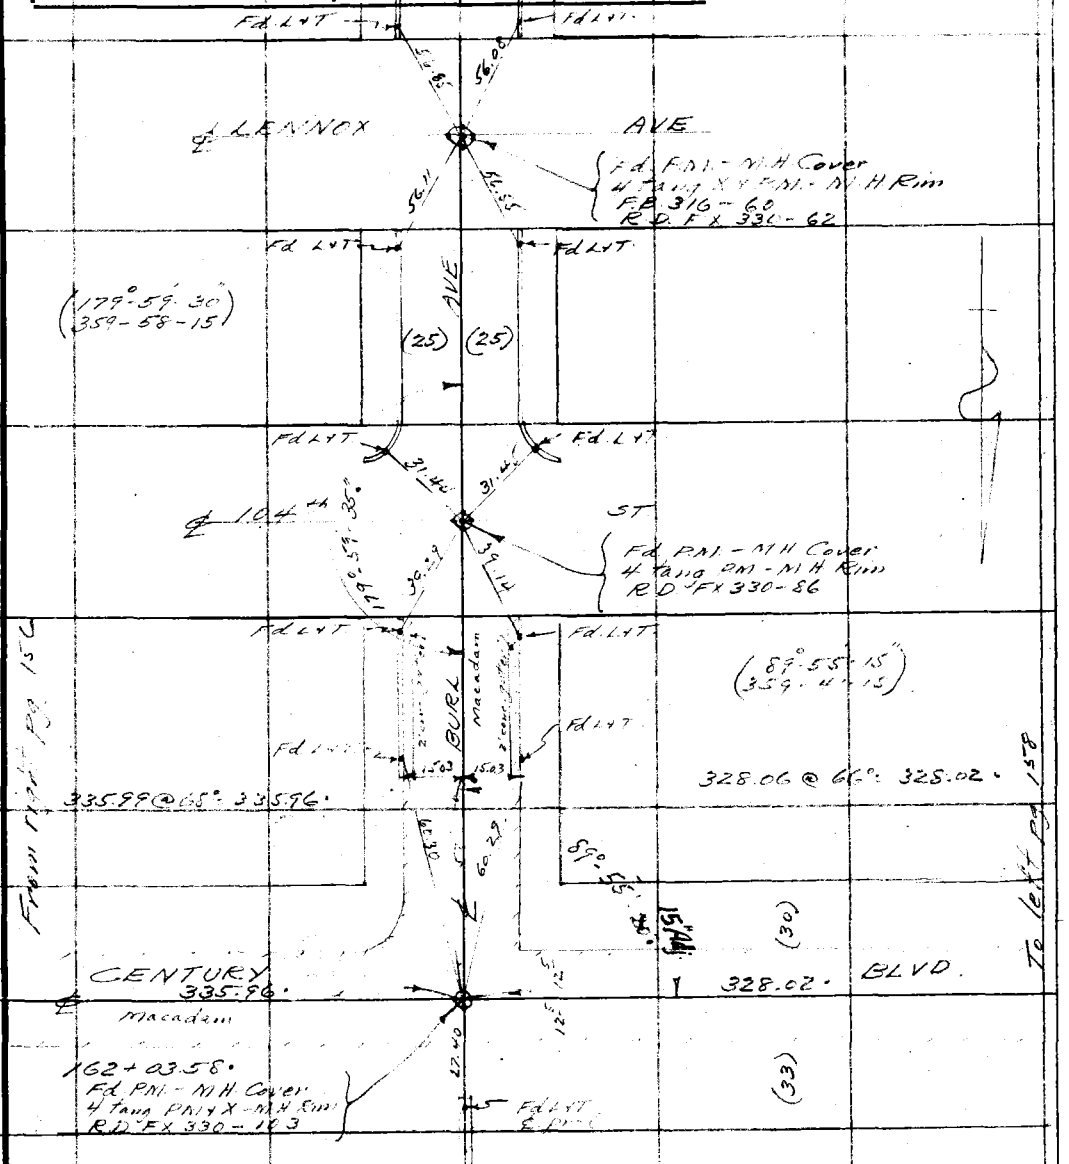

F.B. 739 Pg. 158

WS 24 B5

RETURN TO
LOS ANGELES COUNTY SURVEYOR
700 HALL OF RECORDS

Note: Any Additions or Changes on This Sheet Must be Made or Circled in Red Ink With Date and Name of Person Making Change.

Do not extend notes this side of this line

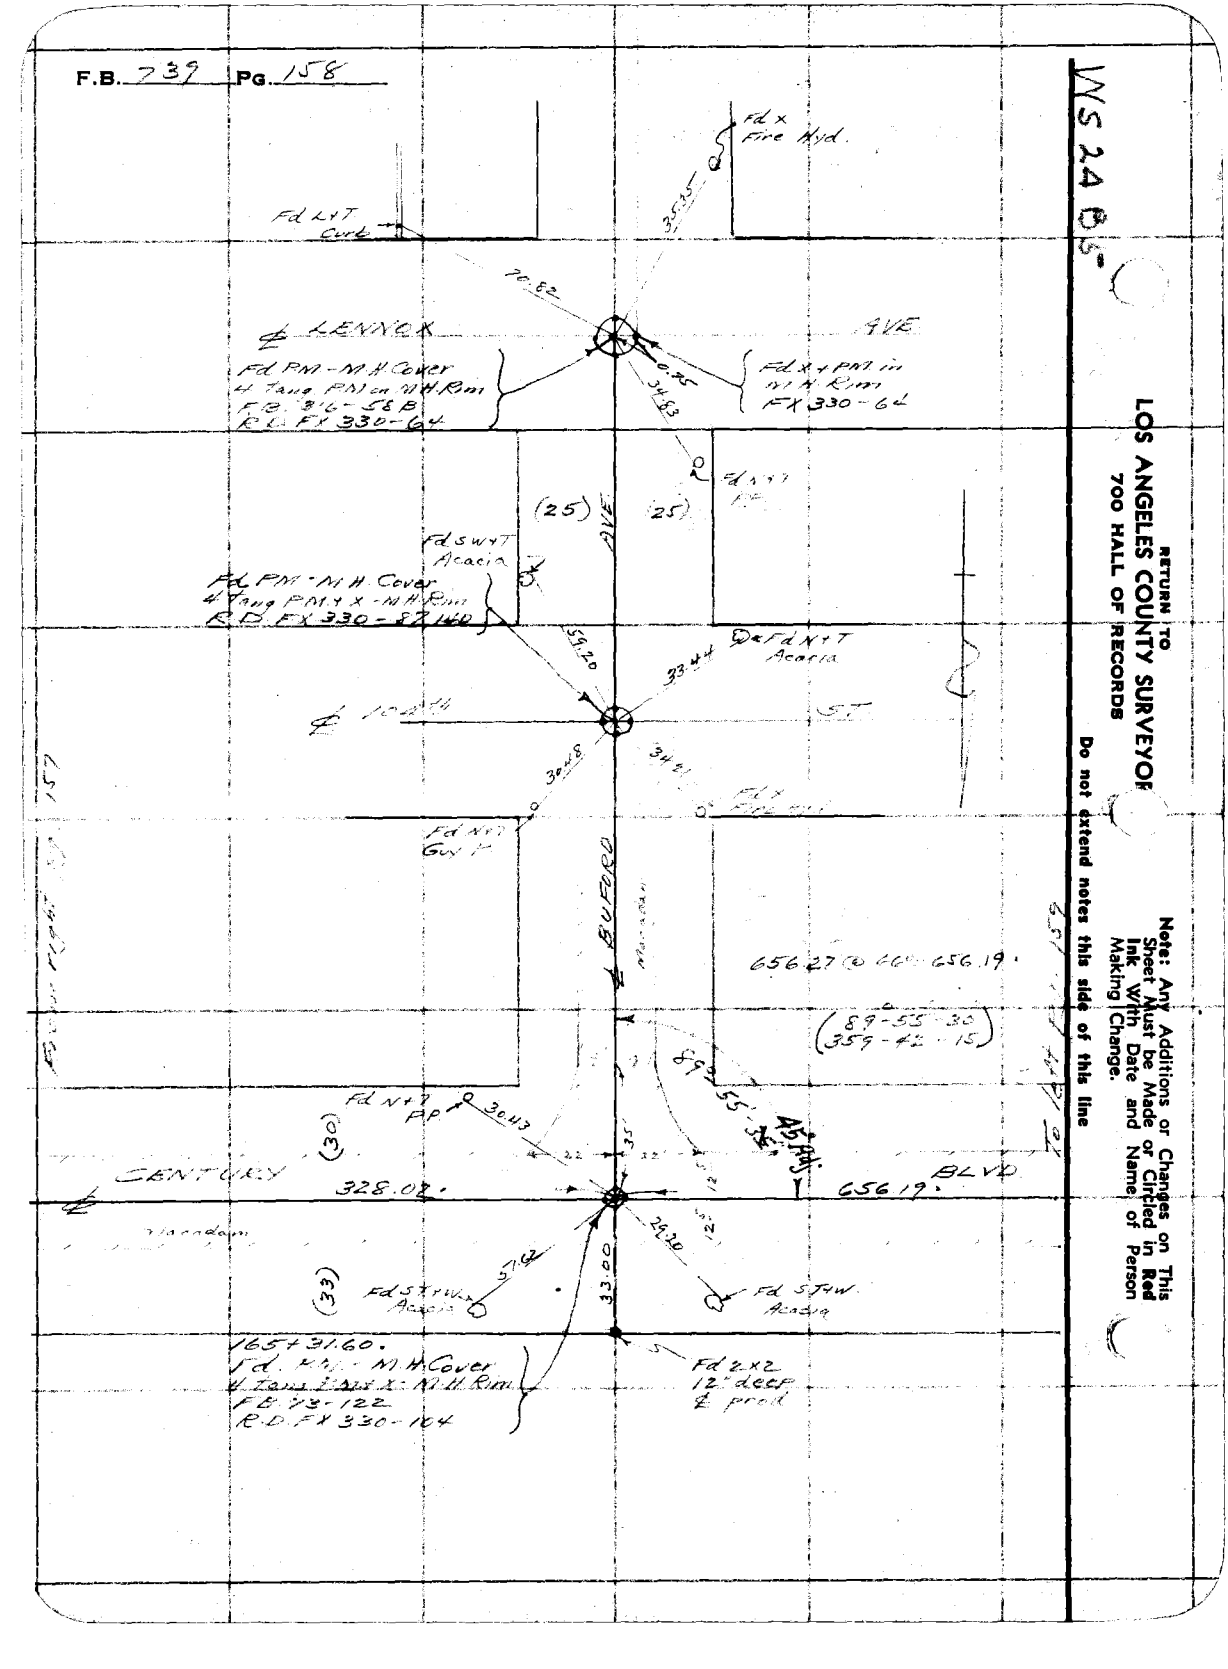

WS 24 45

Notes Ck'd by D. M. Finley	Survey of
Map No. B-1427-4	W. O. 8208 Tape No. 232 St'd 62° F.
Office Work H. H. REYNOLDS	Surveyed by
Checked D. M. Finley	Notes Date
Date Jan. 1940.	Indexed

F.B. Pg.

Note: Any Additions or Changes on This Sheet Must be Made or Circled in Red Ink With Date and Name of Person Making Change.

Do not extend notes this side of this line

RETURN TO
LOS ANGELES COUNTY SURVEYOR
700 HALL OF RECORDS

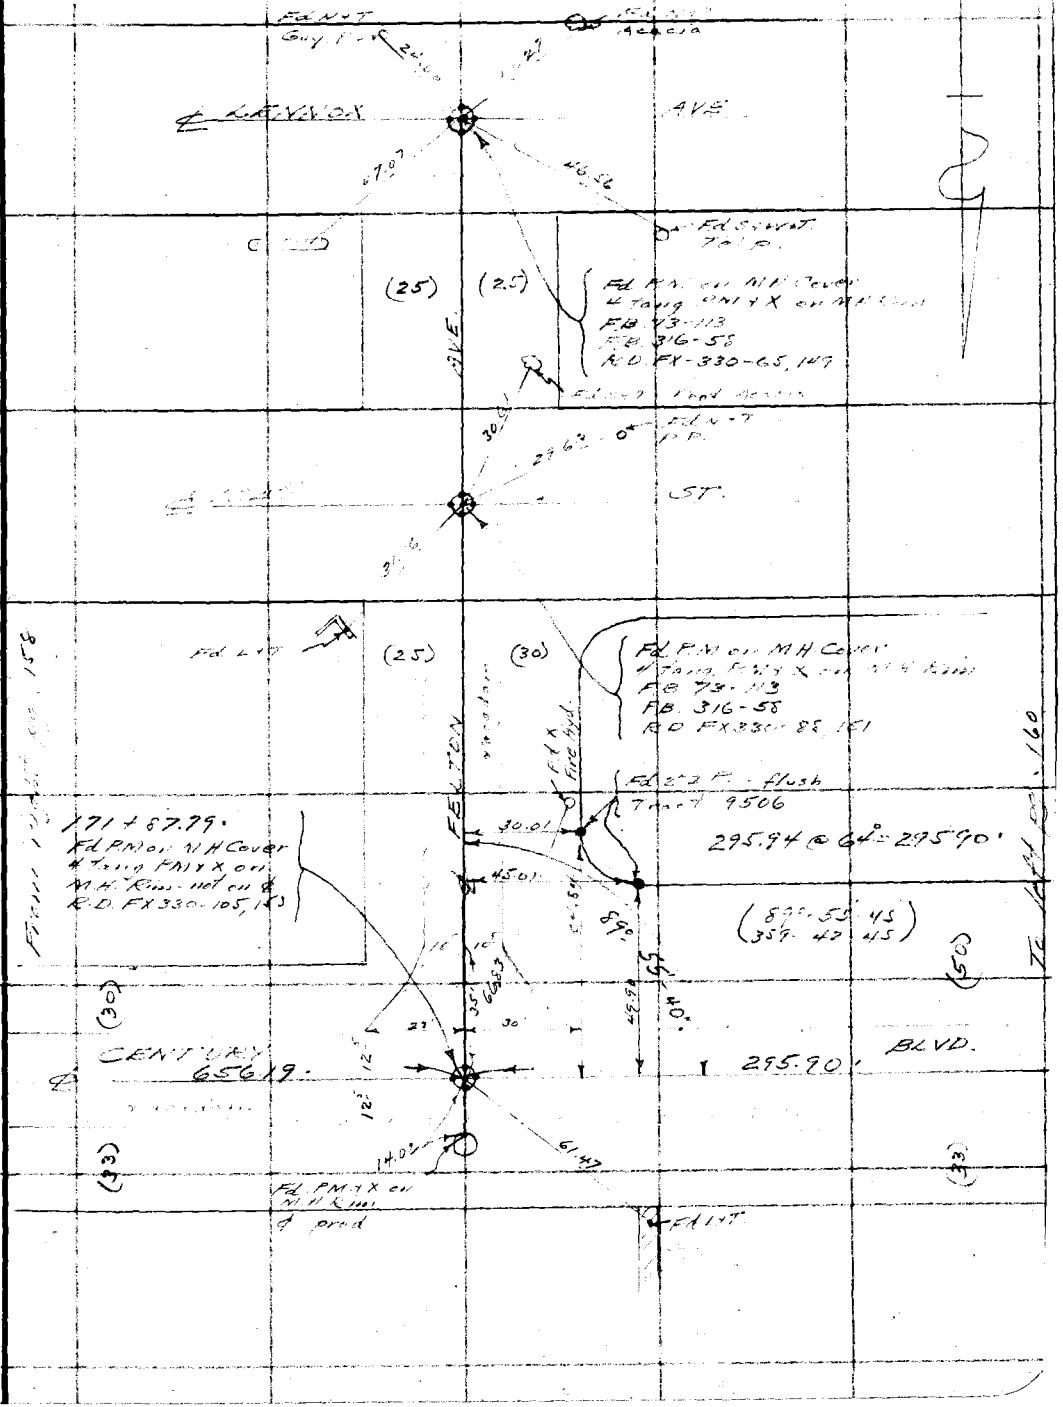

FORM 247 10M 11-38

RETURN TO
LOS ANGELES COUNTY SURVEYOR
700 HALL OF RECORDS

Note: Any Additions or Changes on This Sheet Must be Made or Circled in **Red** Ink With Date and Name of Person Making Change.

Do not extend notes this side of this line

WS 24 A5

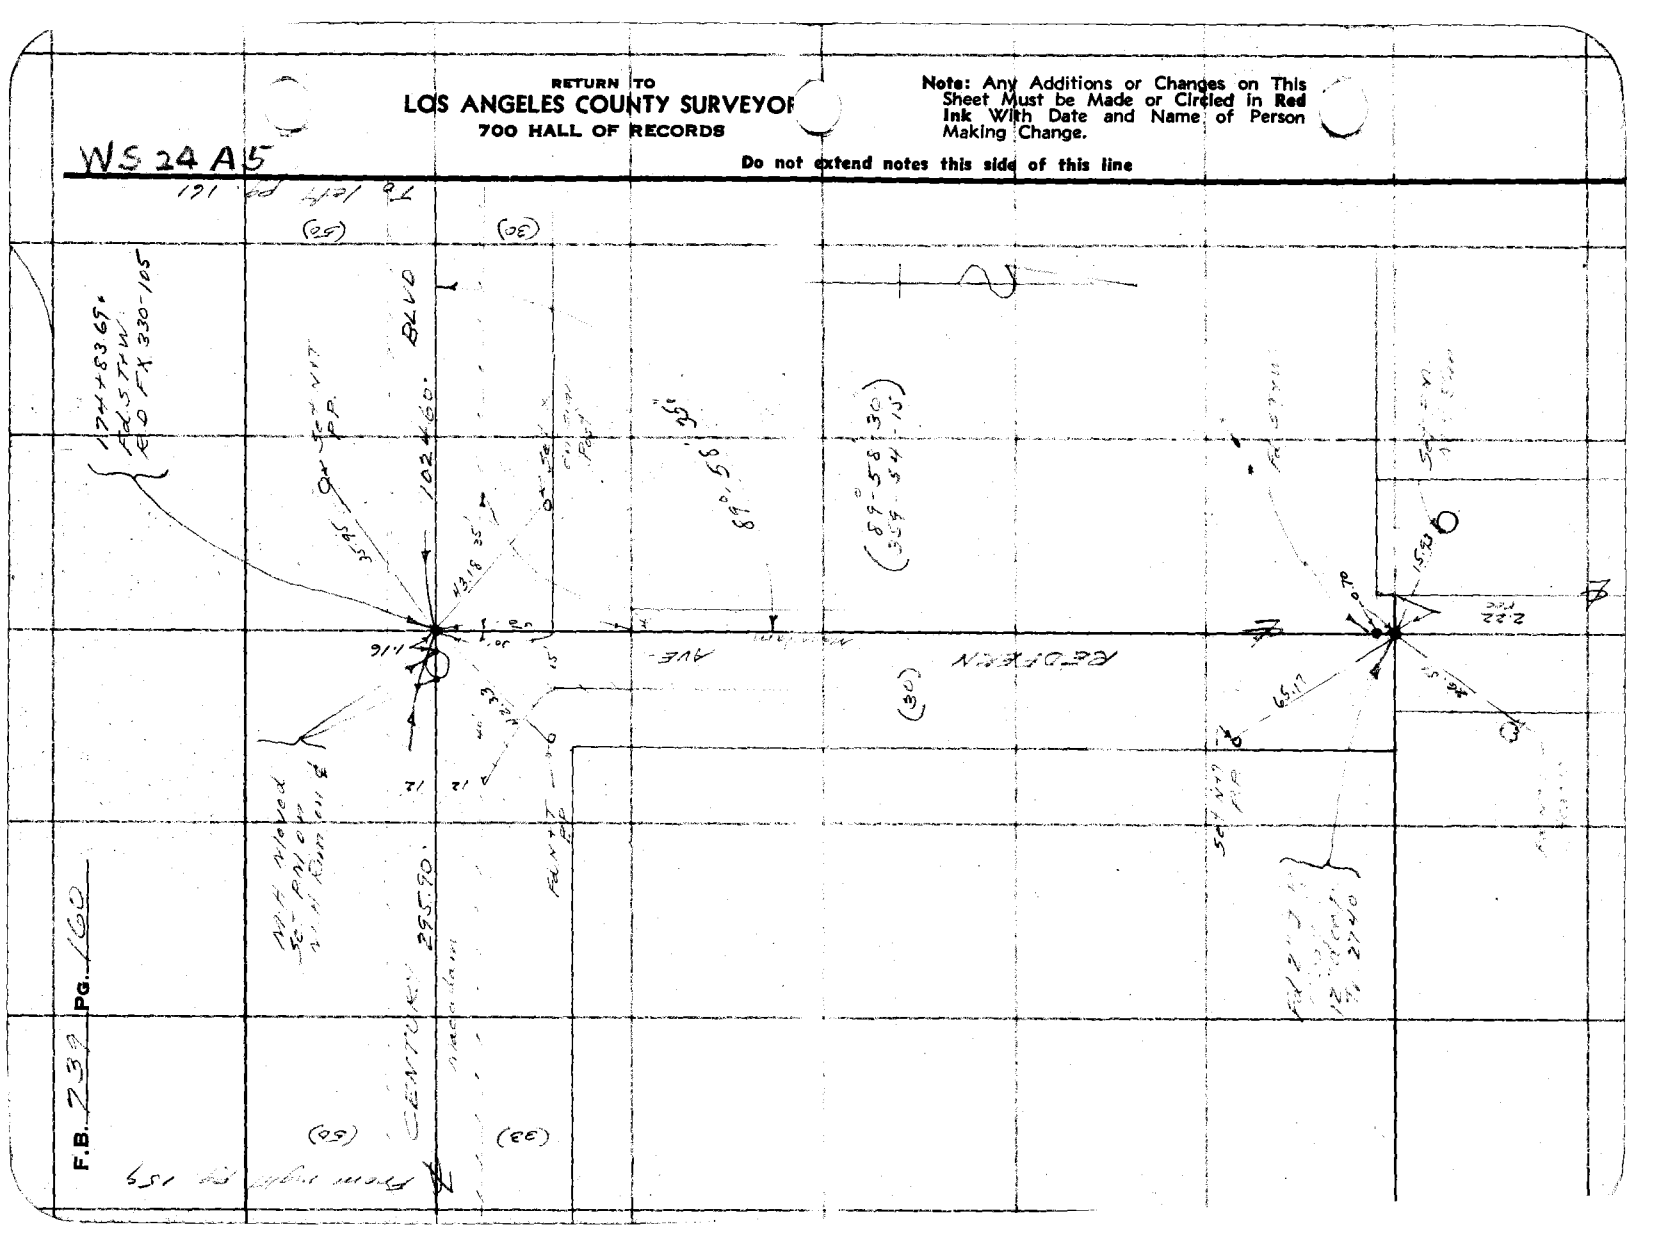

Notes Ck'd by D. M. Finley	Survey of Century Blvd
Map No. B-1427-4	W. O. 8208 Tape No. 032 St'd [illegible] °F.
Office Work H. H. REYNOLDS	Surveyed by [illegible]
Checked D. M. Finley	Notes [illegible] Date 4-1-38
Date Jan. 1940.	Indexed [illegible]

F.B. 737 Pg. [illegible]

A45
M5 24 A5

Note: Any Additions or Changes on This Sheet Must Be Made or Circled in Red Ink With Date and Name of Person Making Change.

Do not extend notes this side of this line

RETURN TO
LOS ANGELES COUNTY SURVEYOR
700 HALL OF RECORDS








RETURN TO
LOS ANGELES COUNTY SURVEYOR
700 HALL OF RECORDS

Note: Any Additions or Changes on This Sheet Must be Made or Circled in **Red** Ink With Date and Name of Person Making Change.

Do not extend notes this side of this line

F.B. 739 Pg. 162

Notes Ck'd by D. M. Finley	Survey of [illegible]
Map No. B-1427-2	W. O. 8208 Tape No. St'd °F.
Office Work H. H. REYNOLDS	Surveyed by [illegible]
Checked D. M. Finley	Notes [illegible] Date
Date Jan. 1940.	Indexed A. C. Jenkins 5-17-38

F.B. 79 Pg. 42

TOPOGRAPHY
ON
CENTURY BLVD
FROM
WESTERN AVE
TO
ANZA AVE
Job # 8208

Note: Any Additions or Changes on This Sheet Must be Made or Circled in Red Ink With Date and Name of Person Making Change

Do not extend notes this side of this line

RETURN TO
LOS ANGELES COUNTY SURVEYOR
700 HALL OF RECORDS

FORM 247 10M 11-38

F.B. 739 PG. 164

To 4th Floor pg. 165

RETURN TO
LOS ANGELES COUNTY SURVEYOR
700 HALL OF RECORDS

Note: Any Additions or Changes on This Sheet Must be Made or Circled in Red Ink With Date and Name of Person Making Change.

Do not extend notes this side of this line

℄ 2nd ST.

3+46.5 tie
2 x 2 - pg 133

3106 - 3-3" Gums

60'

2 x 2 w. valve box - can't locate

32.5'

1+74.5 - Spike in tree
1-6" - PP

32'

1+86 - Gum

39'

1+74.9C
S.T.W.
pg. 133

1+68.5 Tel. P.

72'

℄ ALLEY

1+60.5 } Water Line
1+58.5 } Pressure gauges

32'

0+77 - PP

32'

CENTINELA

0+40 - 4" Carob

9+36.5

75.5'

PP 25 Fire Hyd

72'

0+36.5
4" Carob

℄ WESTERN AVE

0+00 going West
Wire Spk. - pg. 131

N

Notes Ck'd by D. M. Finley	Survey of
Map No. B-1427-2	W. O. 8208 Tape No. St'd °F.
Office Work H. H. REYNOLDS	Surveyed by
Checked D. M. Finley	Notes Date 4-5-38
Date Jan 1940.	Indexed

F.B. PG.

Note: Any Additions or Changes on This Sheet Must be Made or Circled in Red Ink With Date and Name of Person Making Change

Do not extend notes this side of this line

RETURN TO
LOS ANGELES COUNTY SURVEYOR
700 HALL OF RECORDS

FORM 247 10M 11-38

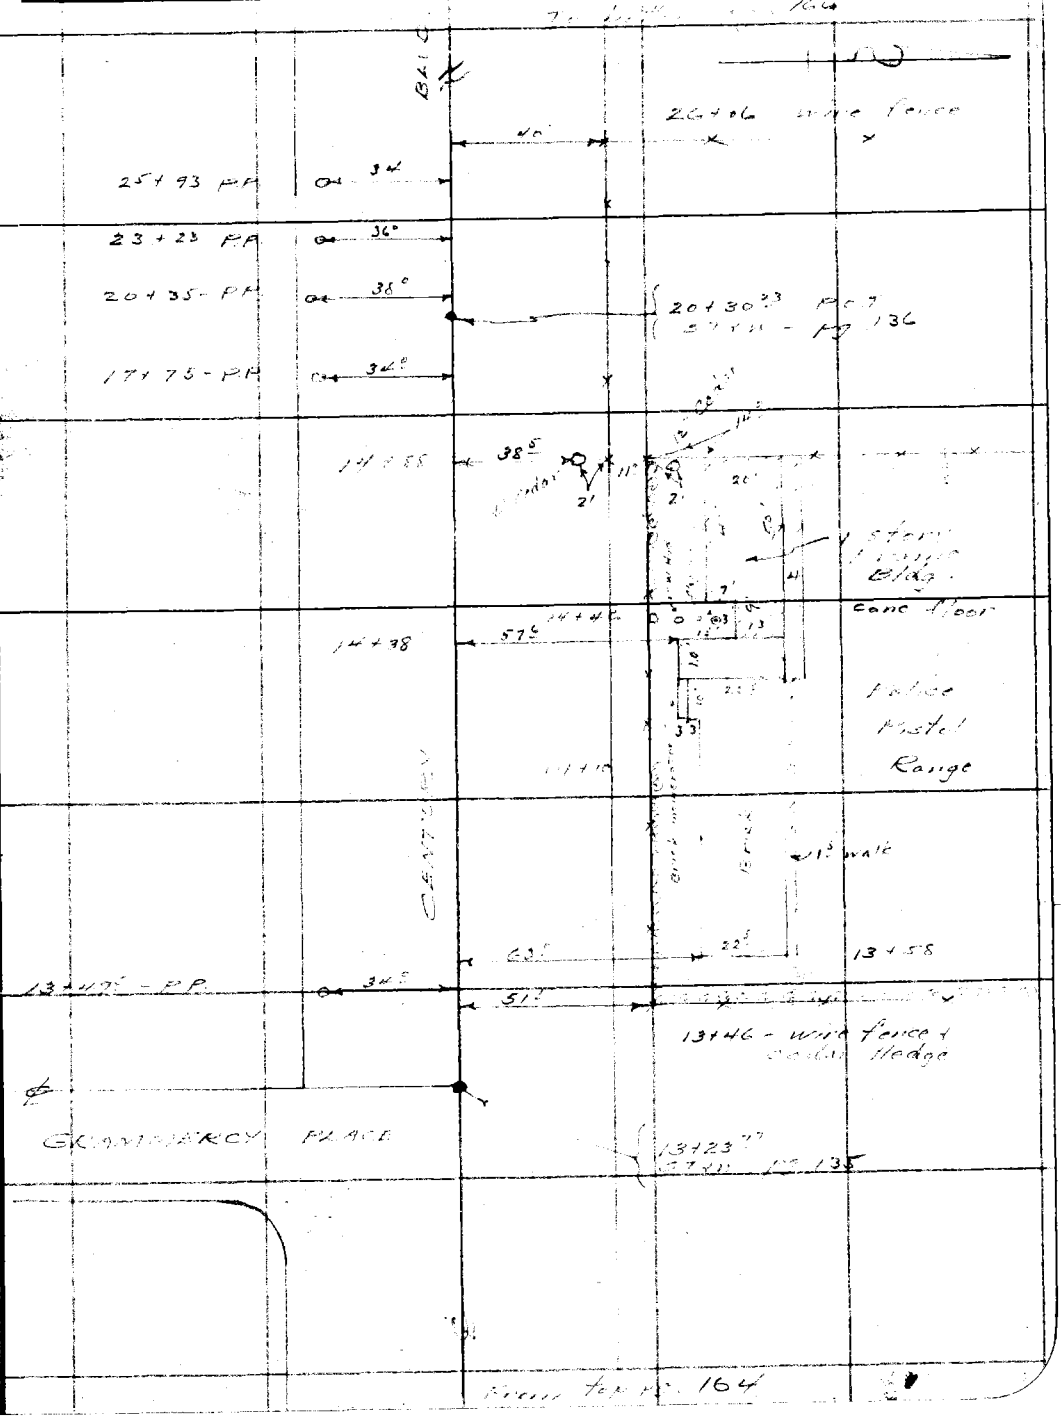

F.B. 239 PG. 166

To bottom pg 167

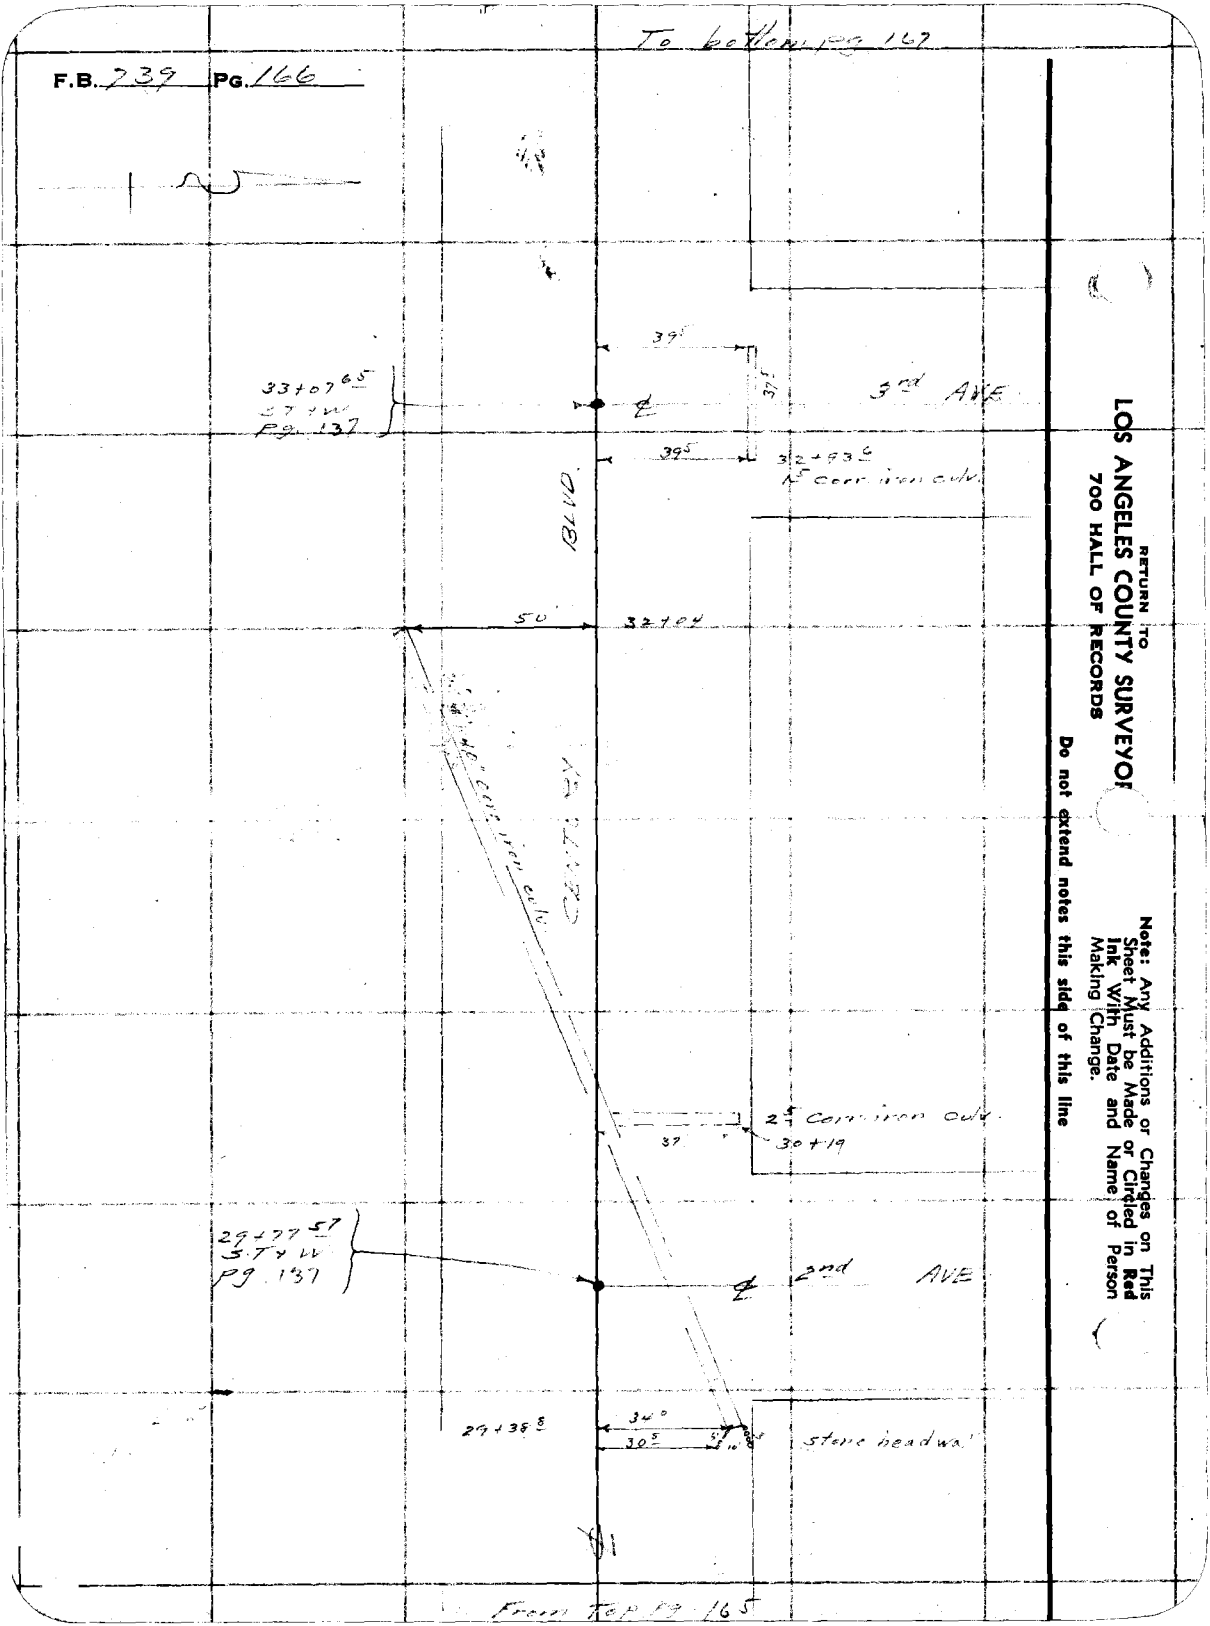

From Top Pg. 165

RETURN TO
LOS ANGELES COUNTY SURVEYOR
700 HALL OF RECORDS

Note: Any Additions or Changes on This Sheet Must be Made or Circled in Red Ink With Date and Name of Person Making Change.

Do not extend notes this side of this line

Notes Ck'd by D. M. Finley	Survey of Grading Gas
Map No. B-1427-2	W. O. 8205 Tape No. St'd °F.
Office Work H. H. REYNOLDS	Surveyed by [illegible]
Checked D. M. Finley	Notes [illegible] Date 4-5-40
Date Jan. 1940	Indexed A. C. Jobelot

F.B. [illegible] Pg. 127

Note: Any Additions or Changes on This Sheet Must be Made or Circled in Red Ink With Date and Name of Person Making Change

Do not extend notes this side of this line

RETURN TO
LOS ANGELES COUNTY SURVEYOR
700 HALL OF RECORDS

FORM 247 10M 11-38

Blackberries

56+80

50+69 - 1" wooden Nume

47

25°

54+86 - 6" Gum

36'

50+23 - PP

55+00 - PP

24.5

53+35 - Begin new PP

53+26 - Fire Hyd

175

CRENSHAW

52+95 "
L 47 PG 139

53+65 Guy P

BLVD.

43+70 - water valve

24°

43+74.5' P & T

39+71.24
S-7-41
PG 138

CENTURY

5th AVE

39+48 water valve

24.5

Fire Hyd 166

To bottom pg - 169

F.B. 239 PG. 168

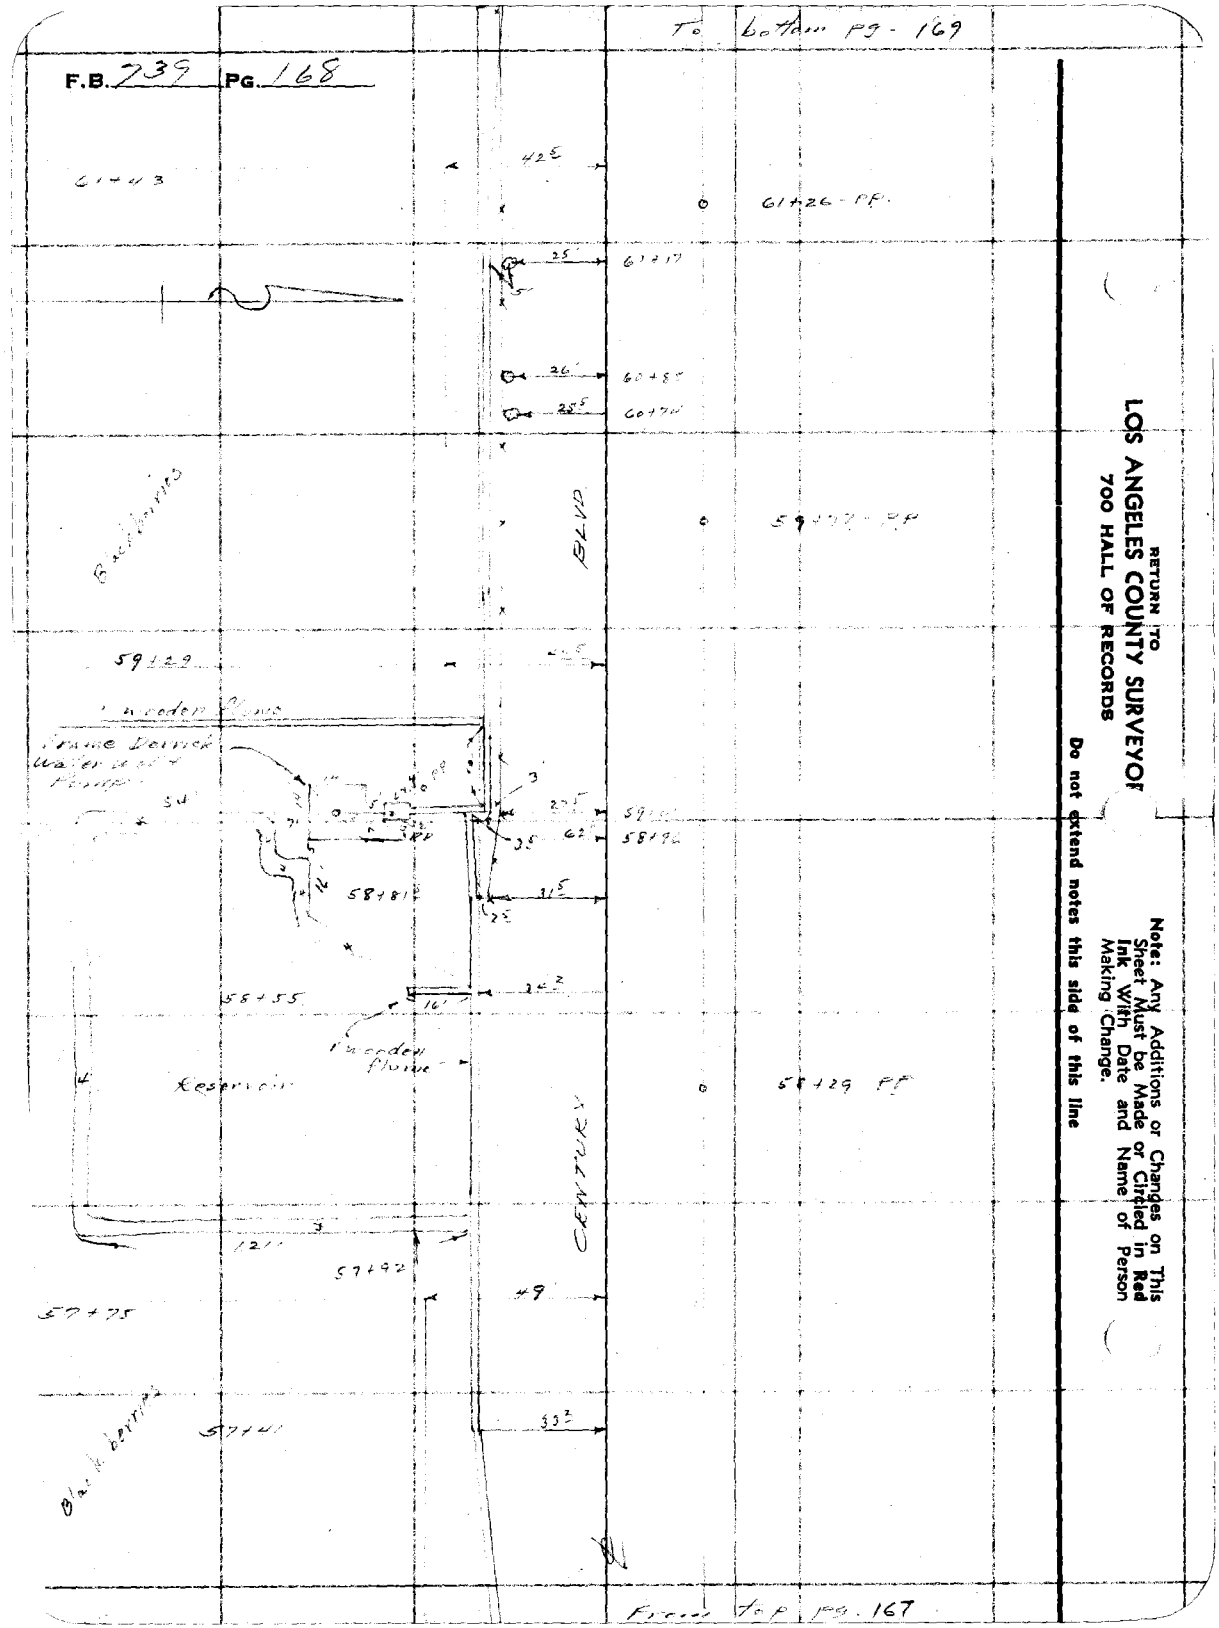

From top pg. 167

RETURN TO
LOS ANGELES COUNTY SURVEYOR
700 HALL OF RECORDS

Do not extend notes this side of this line

Note: Any Additions or Changes on This Sheet Must be Made or Circled in Red Ink With Date and Name of Person Making Change.

Notes Ck'd by D. M. Finley	Survey of		F.B. 735 PG.
Map No. B-1427-2	W. O. 5205	Tape No.	St'd °F.
Office Work H. H. REYNOLDS	Surveyed by L. D. Moore		
Checked D. M. Finley	Notes	Date 4-5-38	
Date Jan. 1940.	Indexed		

RETURN TO
LOS ANGELES COUNTY SURVEYOR
700 HALL OF RECORDS

Note: Any Additions or Changes on This Sheet Must be Made or Circled in Red Ink With Date and Name of Person Making Change

Do not extend notes this side of this line

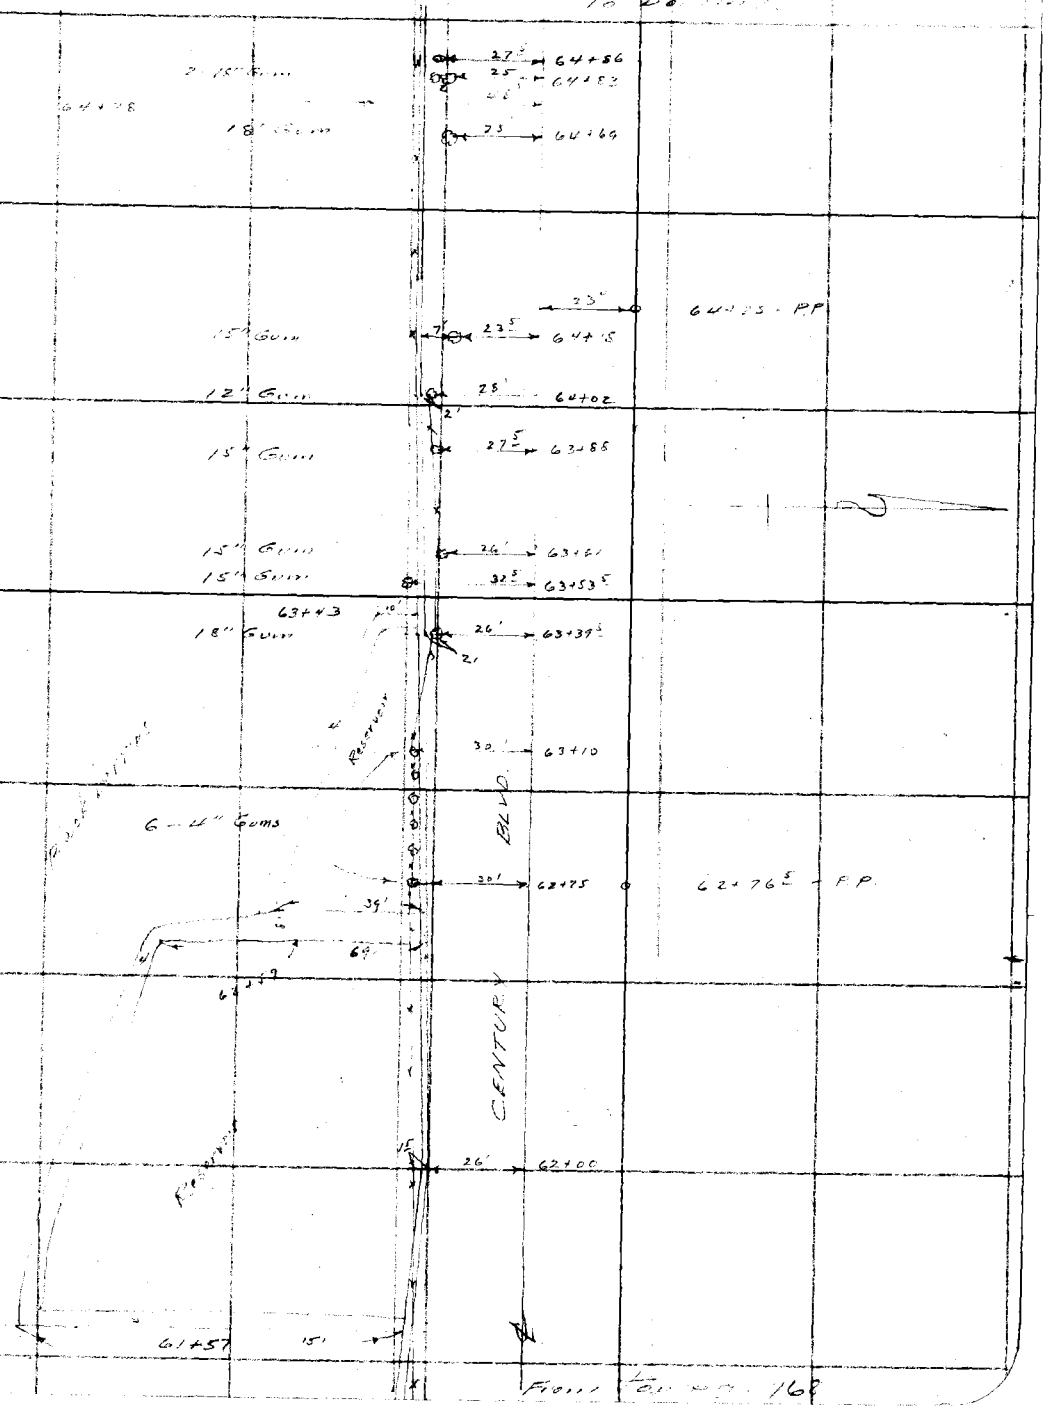

FORM 247 10M 11-38

F.B. 239 PG. 170

To bottom Pg 171

RETURN TO
LOS ANGELES COUNTY SURVEYOR
700 HALL OF RECORDS

Note: Any Additions or Changes on This Sheet Must be Made or Circled in Red Ink With Date and Name of Person Making Change.

Do not extend notes this side of this line

21.5 68+34.5 PP

68+79

68+60

28 68+38

68+42 PP

68+19

Cone Stand 15' high - not in use

57.9

27.5 67+66

63.3

67+81.5

67+71

CAMP

22.5 67+28 PP

67+16 BM

15" Gum 52.5 67+13

66+98 15" Gum 26.0 73'

66+94 PP

15" Gum 32.5 66+80

6" Gum 28 66+74

12" Gum 28 66+64

2-8" Gum 33 66+58

1 wooden stump 12" Gum 22.5 66+50

6" Gum 73' 66+43

30.5 66+32

66+22 58'

59.5 16' 66+22

79' 66+17.8

66+12.52 POT

65+83 - PP

CENTERLINE

RESERVOIR

40' 65+62

9-4" Guns

1 wooden stump and fence 65+07.5

22.7 65+03

30.5 64+96

67

From top Pg. 169

Notes Ck'd by D. M. Finley	Survey of	F.B. 734	Pg. 171
Map No. B-1427-2	W. O. 8208 Tape No.	St'd	°F.
Office Work H. H. REYNOLDS	Surveyed by		
Checked D. M. Finley	Notes N/Book	Date 4-5-35	
Date Jan. 1940	Indexed		

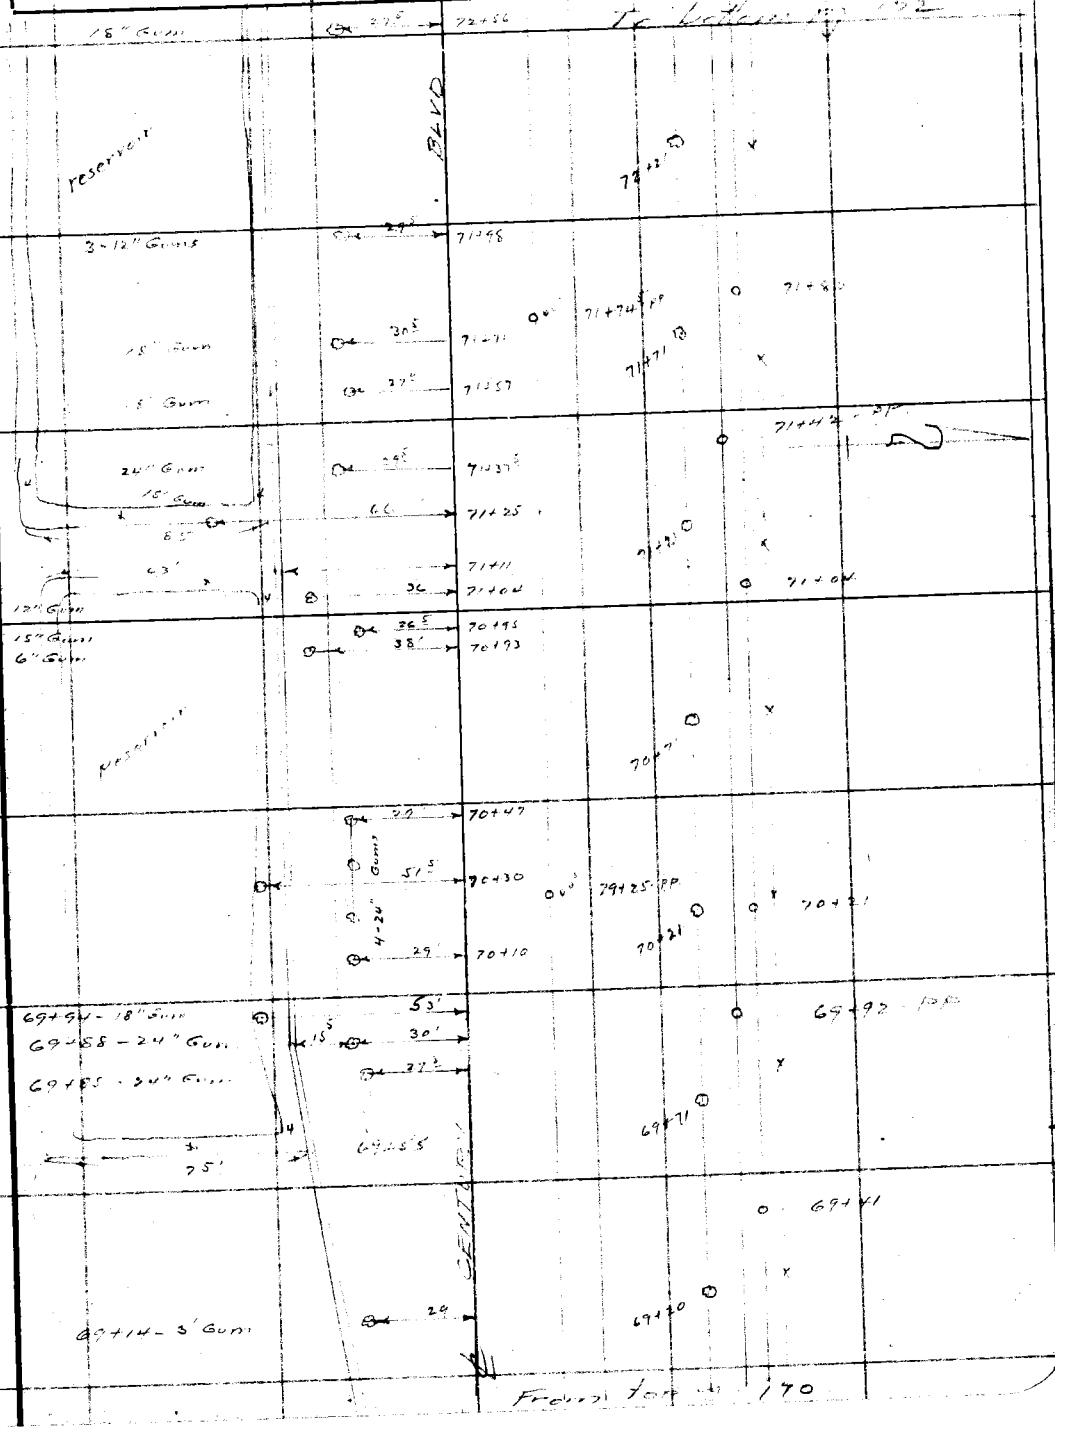

Note: Any Additions or Changes on This Sheet Must be Made or Circled in Red Ink With Date and Name of Person Making Change

Do not extend notes this side of this line

RETURN TO
LOS ANGELES COUNTY SURVEYOR
700 HALL OF RECORDS

FORM 247 10M 11-38

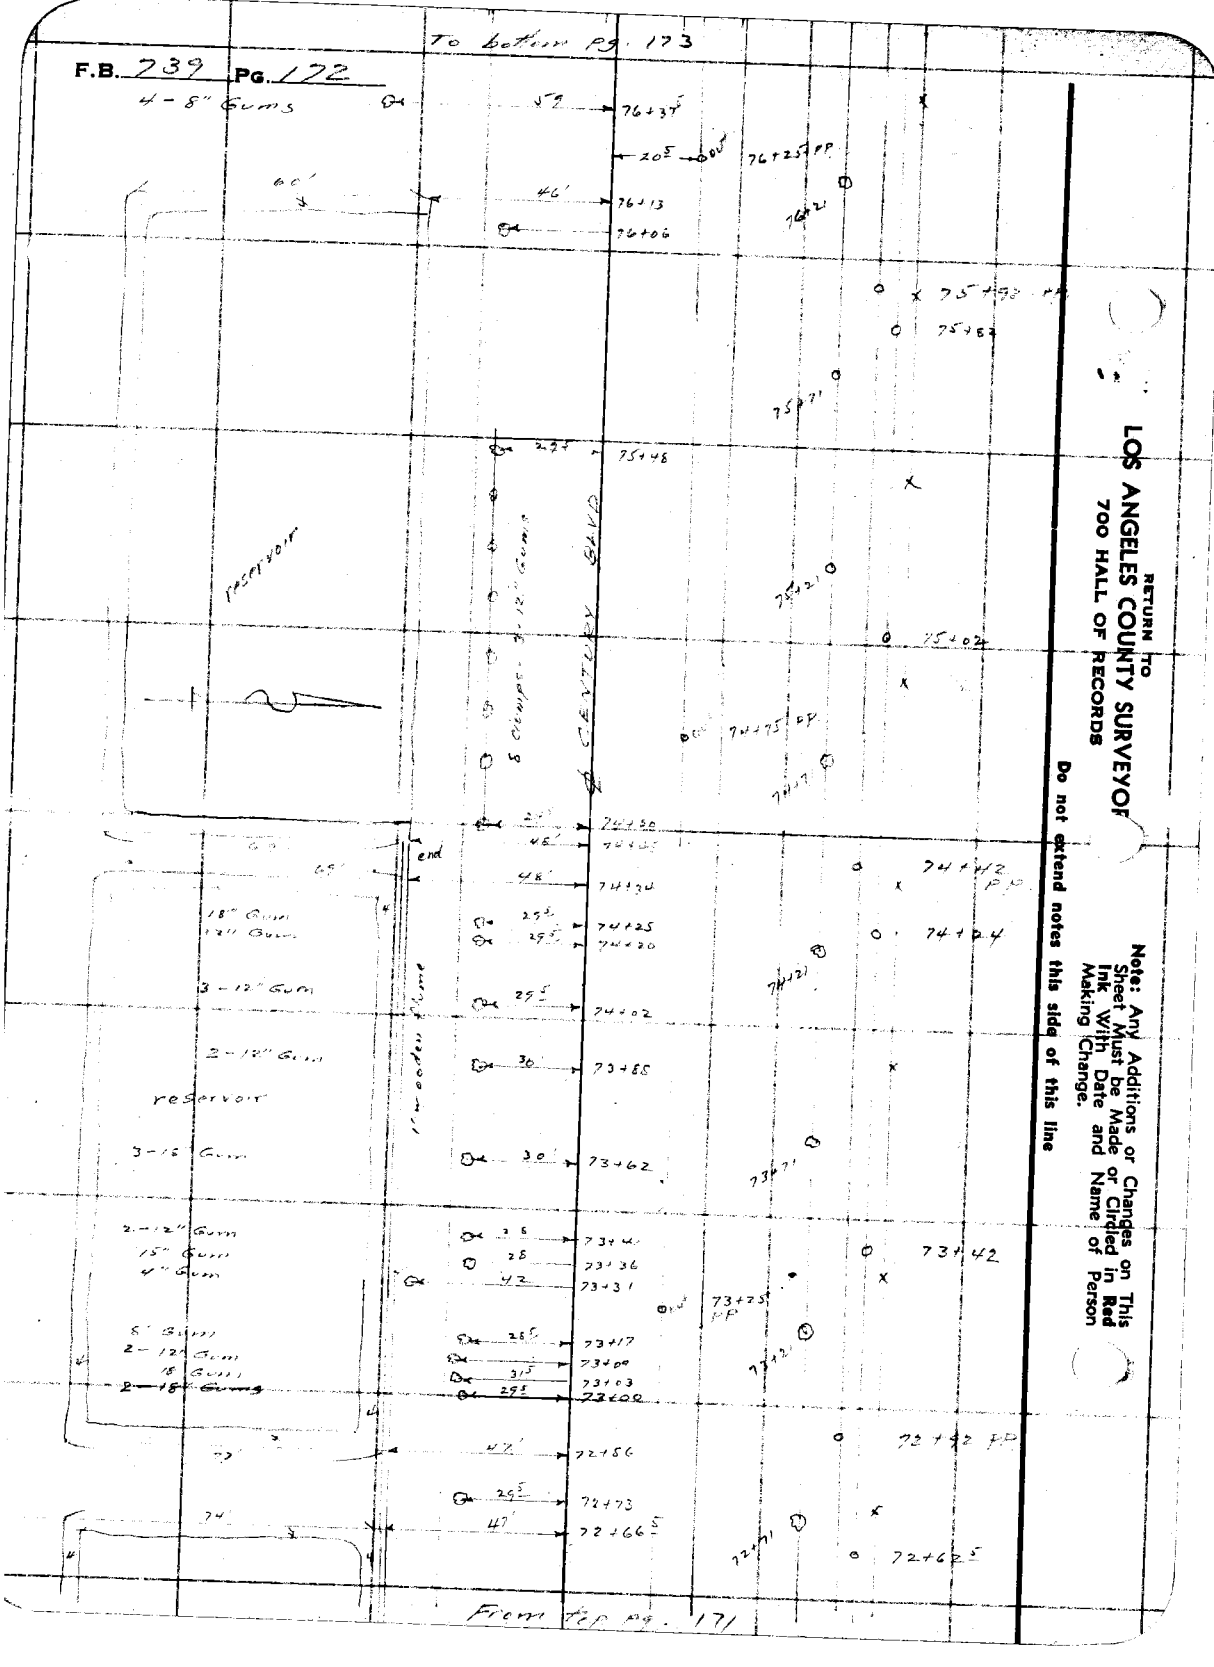
To bottom pg. 173
F.B. 239 Pg. 172
4 - 8" Gums
RETURN TO
LOS ANGELES COUNTY SURVEYOR
700 HALL OF RECORDS
Note: Any Additions or Changes on This Sheet Must be Made or Circled in Red Ink With Date and Name of Person Making Change.
Do not extend notes this side of this line
CENTURY BLVD
reservoir
end
From top pg. 171

Map No. B-1427-2	W. O. 8208 Tape No. St'd °F.
Office Work H. H. REYNOLDS	Surveyed by
Checked D. M. Finley	Notes Date 4-5-38
Date Jan. 1940.	Indexed

F.B. 736 Pg. 172

RETURN TO
LOS ANGELES COUNTY SURVEYOR
700 HALL OF RECORDS

Note: Any Additions or Changes on This Sheet Must be Made or Circled in Red Ink With Date and Name of Person Making Change

Do not extend notes this side of this line

FORM 247 10M 11-38

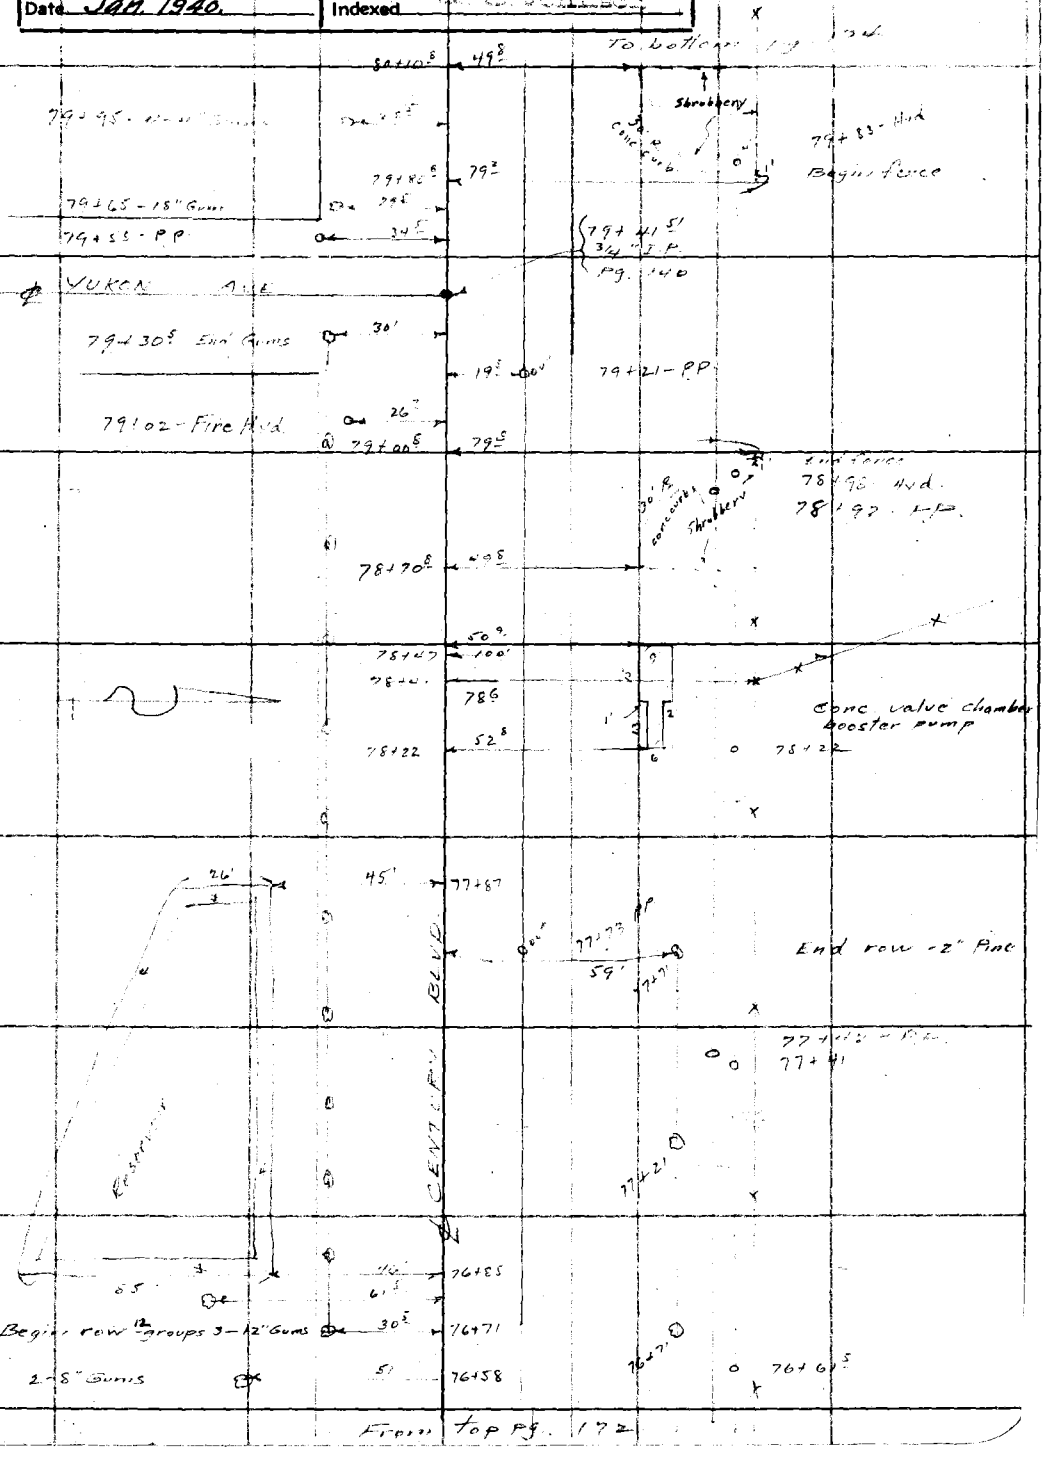

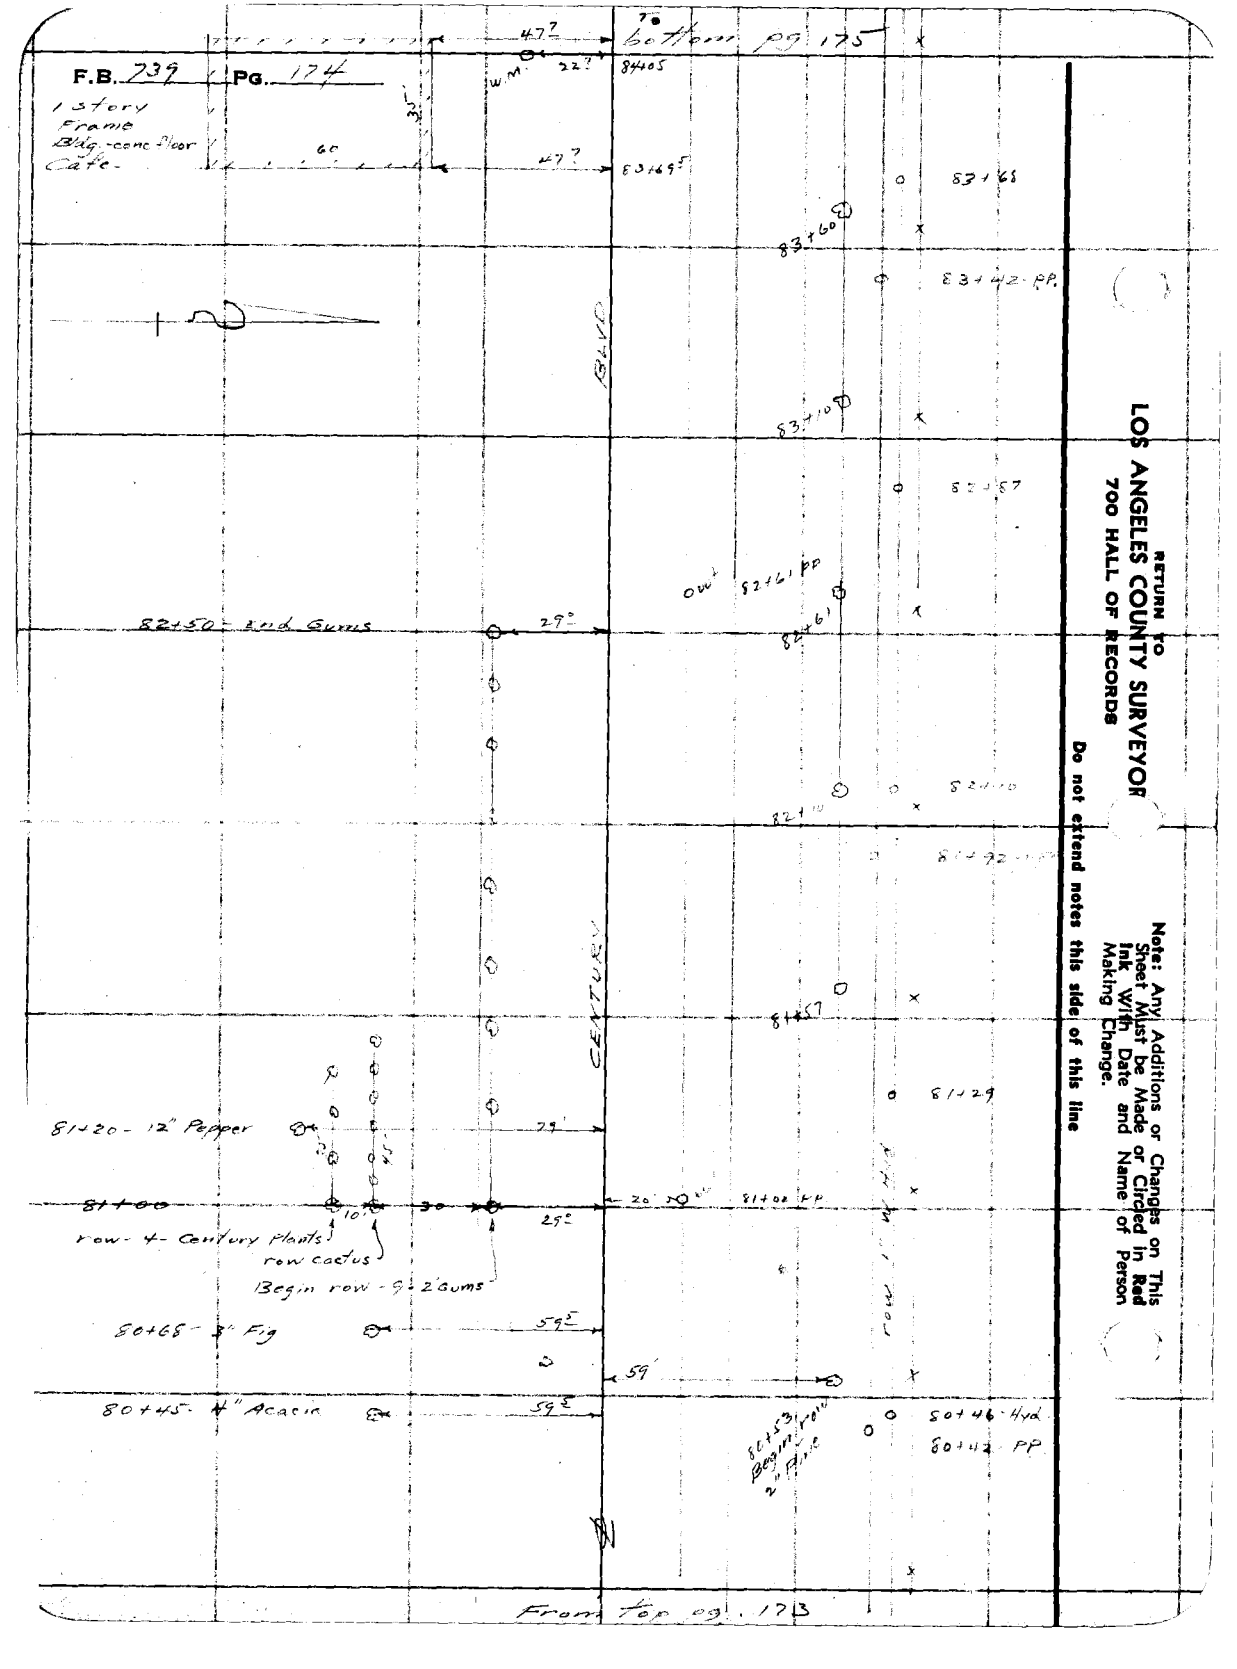

RETURN TO
LOS ANGELES COUNTY SURVEYOR
700 HALL OF RECORDS

Note: Any Additions or Changes on This Sheet Must be Made or Circled in Red Ink With Date and Name of Person Making Change.

Do not extend notes this side of this line

Notes Ck'd by D. M. Finley	Survey of	F.B. 228	Pg. 175
Map No. B-1427-2	W. O.	Tape No.	St'd °F.
Office Work H. H. REYNOLDS	Surveyed by		
Checked D. M. Finley	Notes	Date 4-26-38	
Date Jan. 1940.	Indexed		

Note: Any Additions or Changes on This Sheet Must be Made or Circled in Red Ink With Date and Name of Person Making Change.

Do not extend notes this side of this line

RETURN TO
LOS ANGELES COUNTY SURVEYOR
700 HALL OF RECORDS

87+42 - Board Fence

87+20 - 3" Acacia

30'

87+15 PP

87+15

86+86

86+61 - Board Fence

30'

86+65

86+35 - 15" Gum

30'

86+12 - 2-12" Gum

30'

86+15

86+05

85+94 - 48" Gum

30'

85+88 - 12" Gum

30'

85+80 - 18" Gum

30'

48'

85+72

20'

85+67 PP

85+61

48'

85+54

85+27

85+13


84+89 PP

84+46

84+47

84+8 PP

84+10

CENTERLINE


FORM 247 10M 11-38

F.B. 739 PG. 176


91+42 - 18" Gum

91+29 - 24" Gum

91+29

90+95 Double Conc. Inlet Cur. Opening 2'-0" Head Wall

90+66 - 12" Gum

90+62 - 18" Gum

90+58 - 18" Gum

90+32 - 12" Gum

90+23 - 12" Gum

90+14 - 12" Gum

90+12 FP

90+00 FP

90+00

1 Story Frame House

89+12 - privet hedge

89+11 - 6" Acacia

89+34

89+28

89+24

89+39 - MP

89+24

88+92 - 2-4" Cypress

88+88 - 4" Pine

1 Story Frame House

88+44

88+03

88+04

88+05

88+22 - wire fence

88+09 - 4" tree

88+15

1 Story Frame House

87+98

87+82

87+80

87+71 - 6" Fir

87+62 - 18" Palm

87+51 - 12" Pine

87+46

87+64

From fol. 175

RETURN TO
LOS ANGELES COUNTY SURVEYOR
700 HALL OF RECORDS

Note: Any Additions or Changes on This Sheet Must be Made or Circled in Red Ink With Date and Name of Person Making Change.

Do not extend notes this side of this line

Notes Ck'd by D. M. Finley	Survey of	F.B. 225	Pg. 177
Map No. B-1427-2	W. O. 5201 Tape No.	St'd	°F.
Office Work H. H. REYNOLDS	Surveyed by		
Checked D. M. Finley	Notes Office	Date 4-26-38	
Date Jan. 1940.	Indexed		

To top of pg. 178

94+55 - cedar hedge

94+30 - 48" Palm

1 Story Frame House

93+87.5

93+83 - 4" Palm

93+78 - 1" W. Hyd.

93+67 - 4" Diam. lattice fence

93+55 - Cedar Hedge

93+48 - 18" Palm Tree

93+54 PP

93+29.2 2 x 2 mg. in

E. 20TH AVE.

92+90 - Fire Hyd.

92+76.9 End fence

92+75 Hyd

92+46.5

92+33 - 18" Gum

92+30 - 18" Gum

92+12 - 24" Gum

92+12

91+98

91+96 - 48" Gum

91+72 - 24" Gum

91+58 - 12" Gum

91+51 - 48" Gum

91+62 PP

91+65

From top of pg. 176

Note: Any Additions or Changes on This Sheet Must be Made or Circled in Red Ink With Date and Name of Person Making Change.

Do not extend notes this side of this line

RETURN TO
LOS ANGELES COUNTY SURVEYOR
700 HALL OF RECORDS

FORM 247 10M 11-38

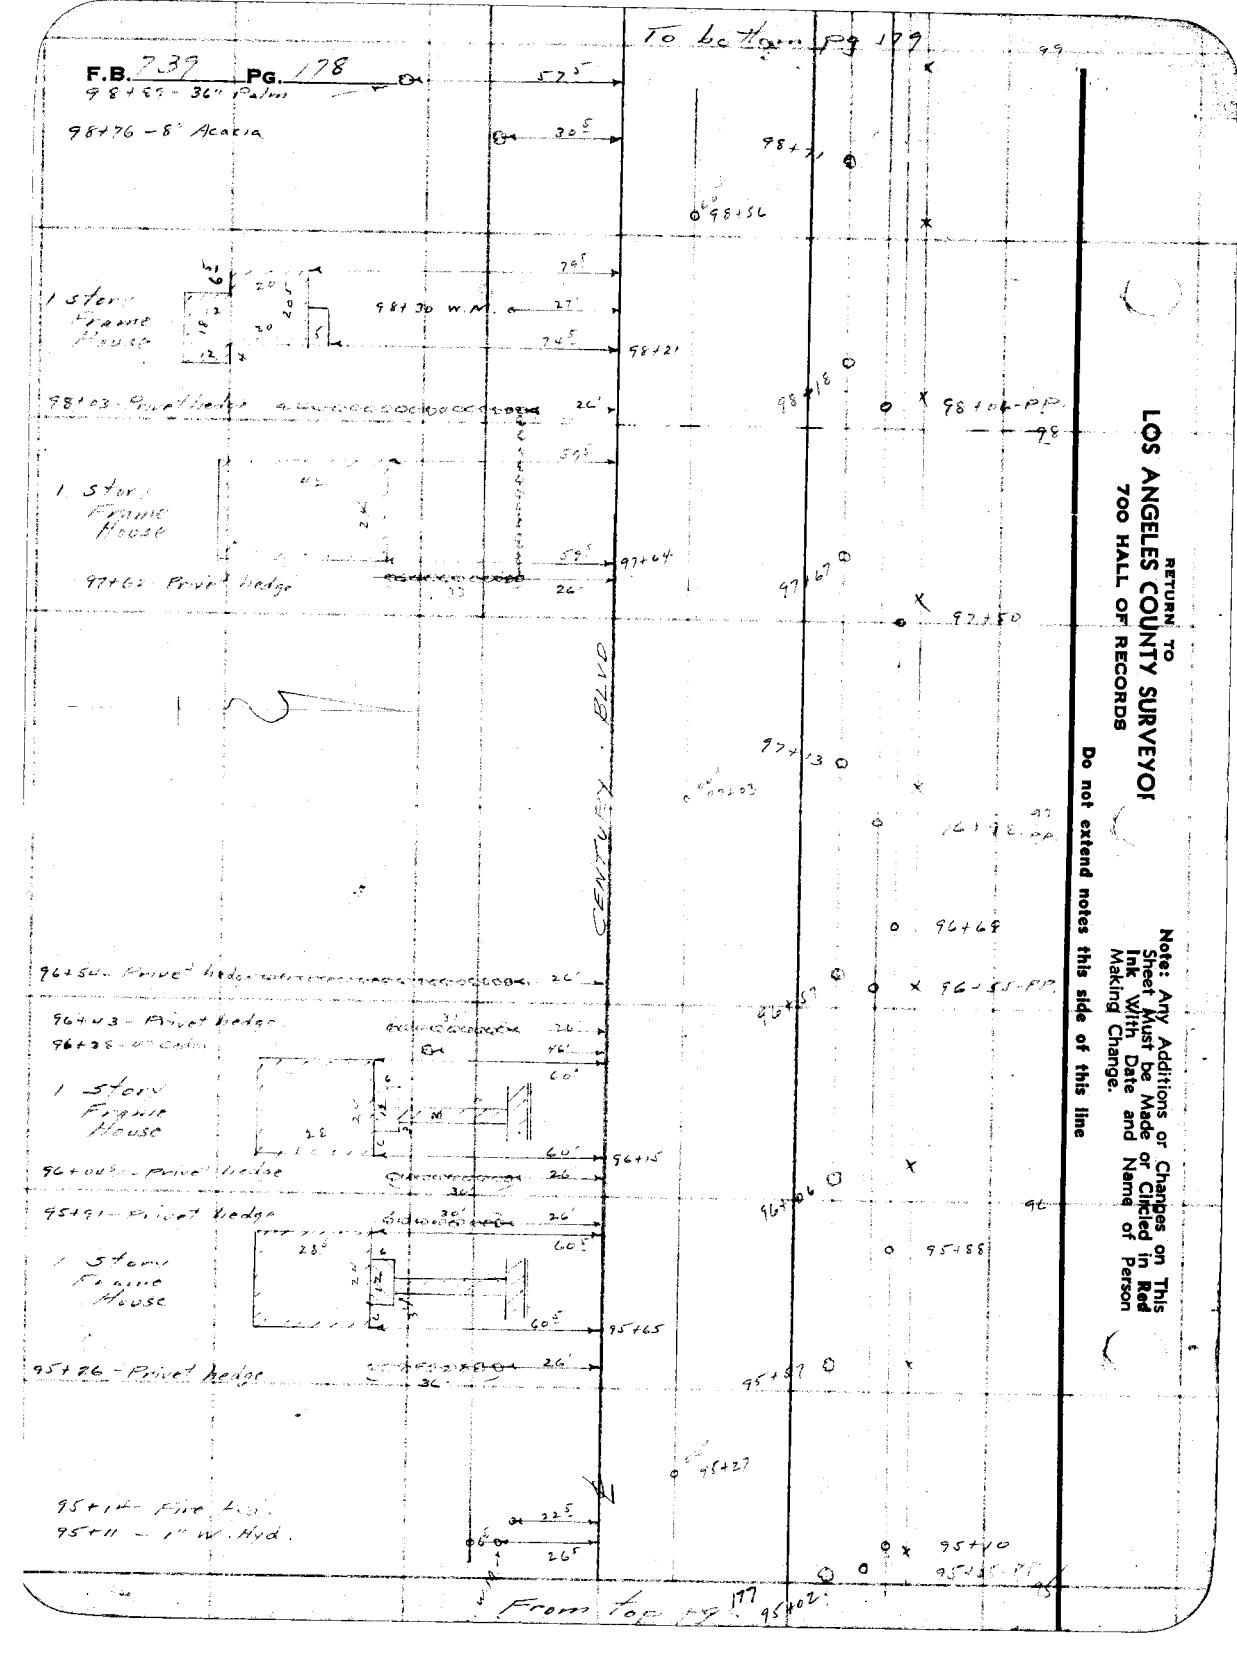
F.B. 739 PG. 178
To bottom pg 179
98+69 - 36" Pine
98+76 - 8" Acacia
98+30 W.M.
1 Story Frame House
98+03 - Privet Hedge
1 Story Frame House
97+62 Privet Hedge
96+54 - Privet Hedge
96+43 - Privet Hedge
96+38 - 4" Cedar
1 Story Frame House
96+04 - Privet Hedge
95+91 - Privet Hedge
1 Story Frame House
95+76 - Privet Hedge
95+14 - Fire Hyd.
95+11 - 1" W. Hyd.
From top pg 177
RETURN TO
LOS ANGELES COUNTY SURVEYOR
700 HALL OF RECORDS
Note: Any Additions or Changes on This Sheet Must be Made or Circled in Red Ink with Date and Name of Person Making Change.
Do not extend notes this side of this line

Notes Ck'd by D. M. Finley	Survey of		F.B. 739 Pg. 179
Map No. B-1427-9	W. O. 5206	Tape No.	St'd °F.
Office Work H. H. REYNOLDS	Surveyed by		
Checked D. M. Finley	Notes None	Date 4-26-38	
Date Jan. 1940.	Indexed		

RETURN TO
LOS ANGELES COUNTY SURVEYOR
700 HALL OF RECORDS

Note: Any Additions or Changes on This Sheet Must be Made or Circled in Red Ink With Date and Name of Person Making Change.

Do not extend notes this side of this line

FORM 247 10M 11-35

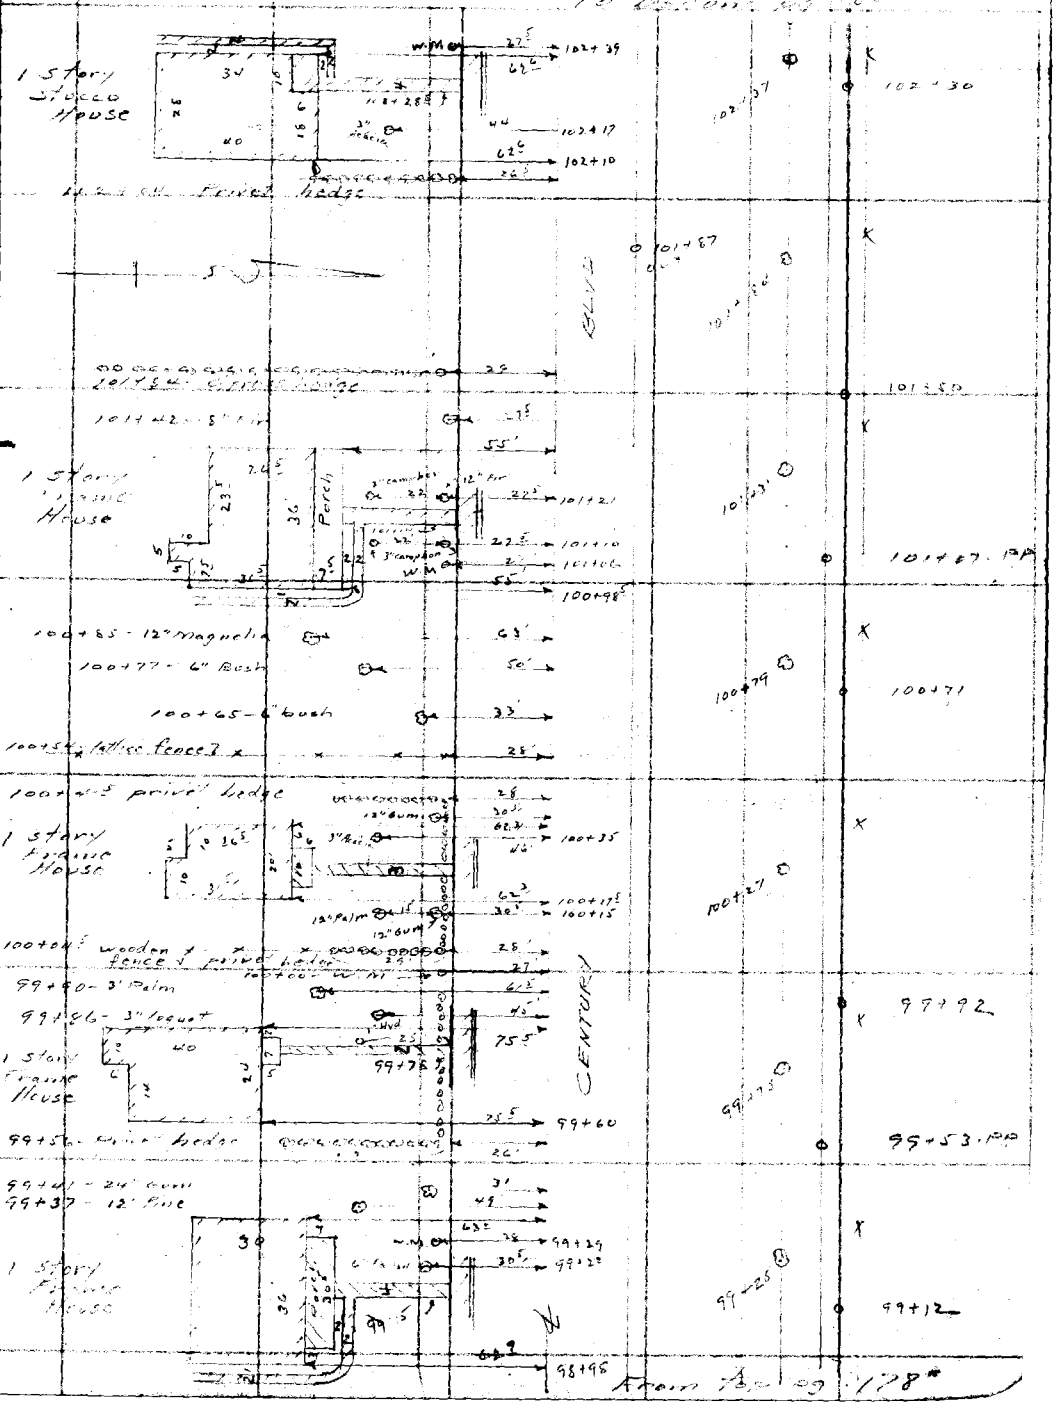

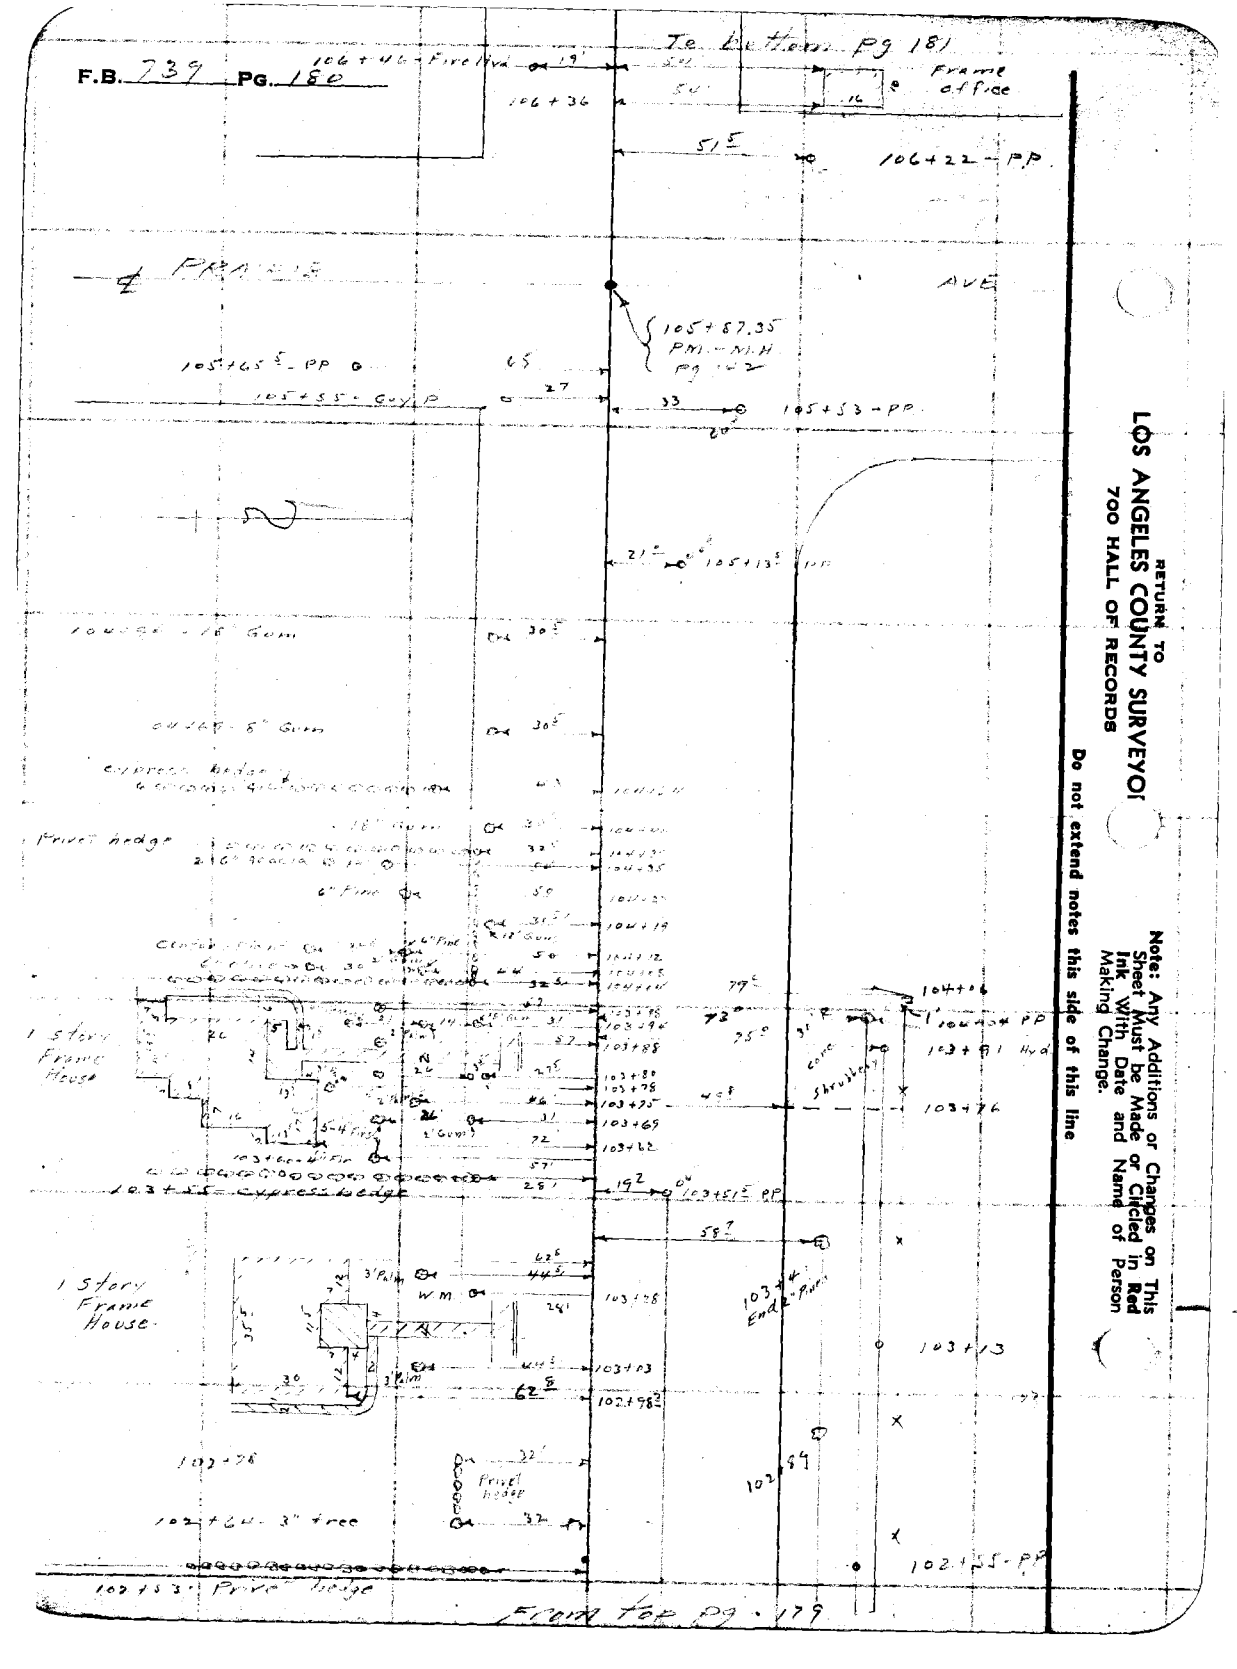
F.B. 739 PG. 180
Frame office
106+22 - P.P.
AVE
105+87.35 PM. - N.H. Pg 102
105+65.5 - P.P.
105+55 - Guy P.
105+53 - P.P.
105+13.5 P.P.
Privet hedge
1 Story Frame House
103+51.5 P.P.
103+41 Hyd
103+26
1 Story Frame House
103+13
102+98.2
102+53 - Privet hedge
102+55 - P.P.
From Top Pg. 179
RETURN TO
LOS ANGELES COUNTY SURVEYOR
700 HALL OF RECORDS
Note: Any Additions or Changes on This Sheet Must be Made or Circled in Red Ink With Date and Name of Person Making Change.
Do not extend notes this side of this line

Notes Ck'd by D. M. Finley	Survey of	F.B.	Pg.
Map No. B-1427-3	W. O. 8206 Tape No.	St'd	°F.
Office Work H. H. REYNOLDS	Surveyed by		
Checked D. M. Finley	Notes	Date 4-24-38	
Date Jan. 1940.	Indexed		

Note: Any Additions or Changes on This Sheet Must be Made or Circled in Red Ink With Date and Name of Person Making Change.

Do not extend notes this side of this line

RETURN TO
LOS ANGELES COUNTY SURVEYOR
700 HALL OF RECORDS

FORM 247 10M 11-38

108+99 - lattice fence + P.P.

108+85 - 8" acacia

108+31 - 20" Palm

1 Story Frame House

109+23.5

109+23.5 - 4" Peach

3 - 2" oranges 109+10

34' 1 story Frame House

108+75

108+85 - 18" Palm + lattice fence

108+52 - 12" acacia

1 story frame house 108+26

108+30 - PP

108+18 - 18" Palm

42' 1 Story Frame House

107+95

107+85 - 12" acacia + lattice fence

107+52 - 18" Palm

106+56 - 18" Palm

From Tor. 1-9 180

F.B. 739 PG. 182

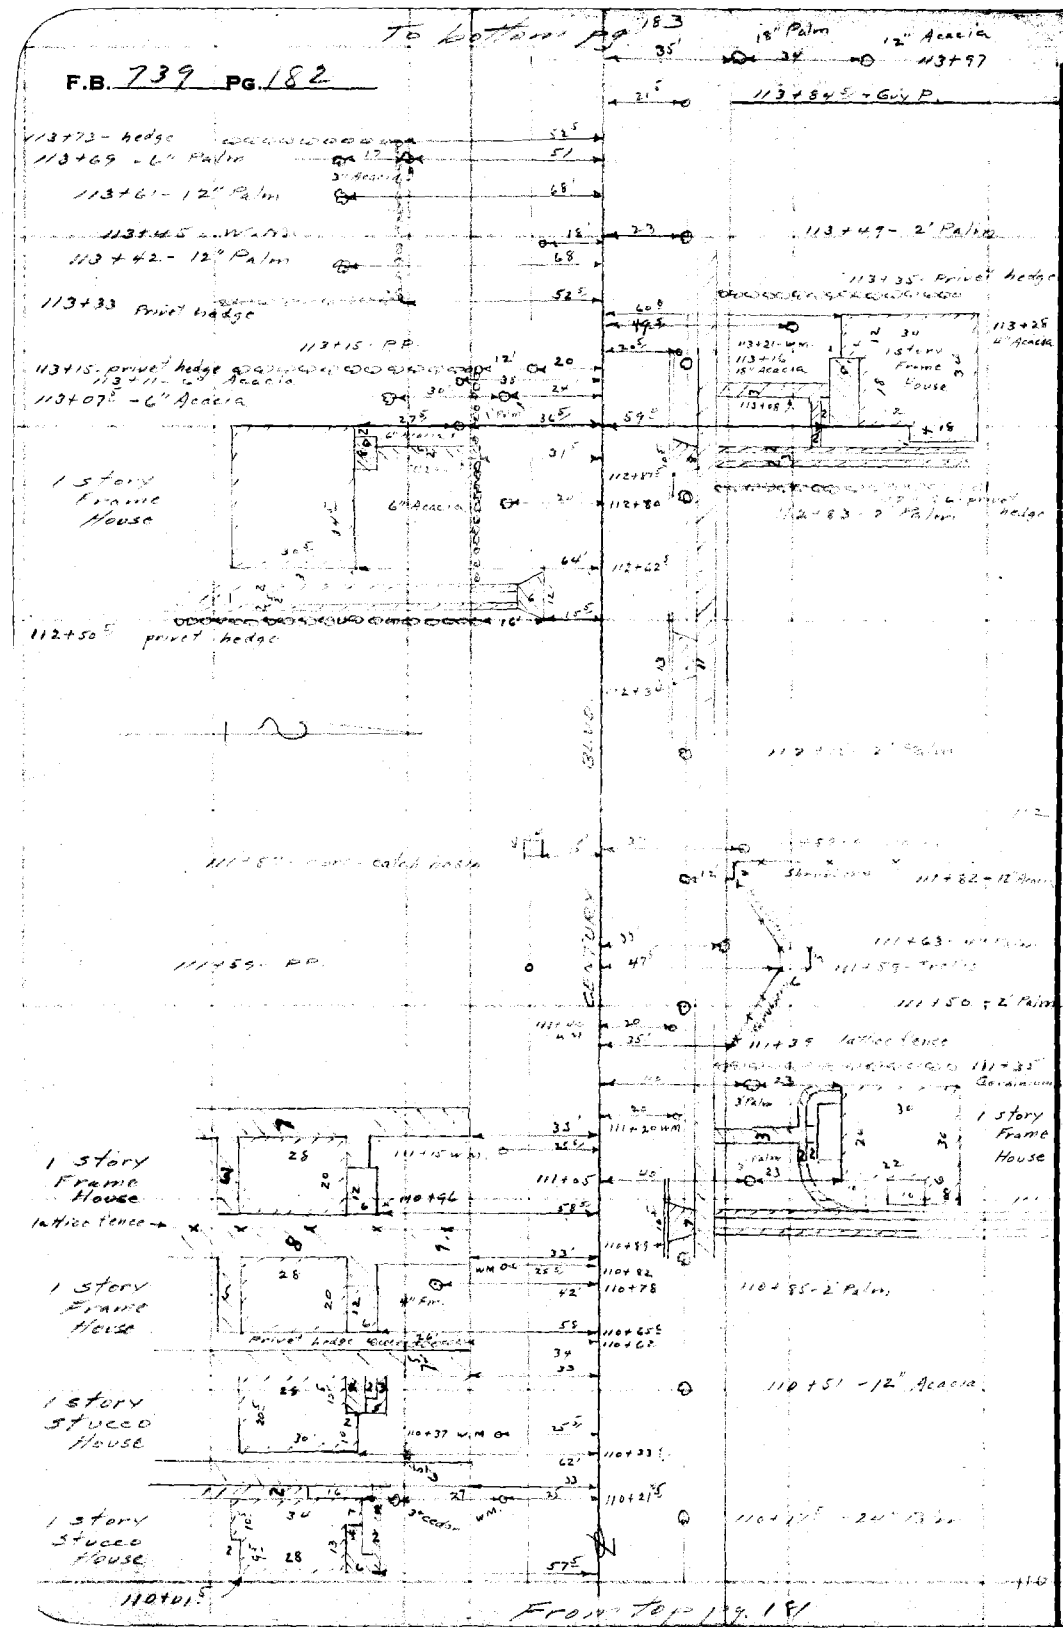

RETURN TO
LOS ANGELES COUNTY SURVEYOR
700 HALL OF RECORDS

Do not extend notes this side of this line

Note: Any Additions or Changes on This Sheet Must be Made or Circled in Red Ink With Date and Name of Person Making Change.

Notes Ck'd by D. M. Finley	Survey of	F.B. 739	Pg. 183
Map No. B-1427-9	W. O. 8208 Tape No.	St'd °F.	
Office Work H. H. REYNOLDS	Surveyed by		
Checked D. M. Finley	Notes	Date 4-24-35	
Date Jan 1940.	Indexed		

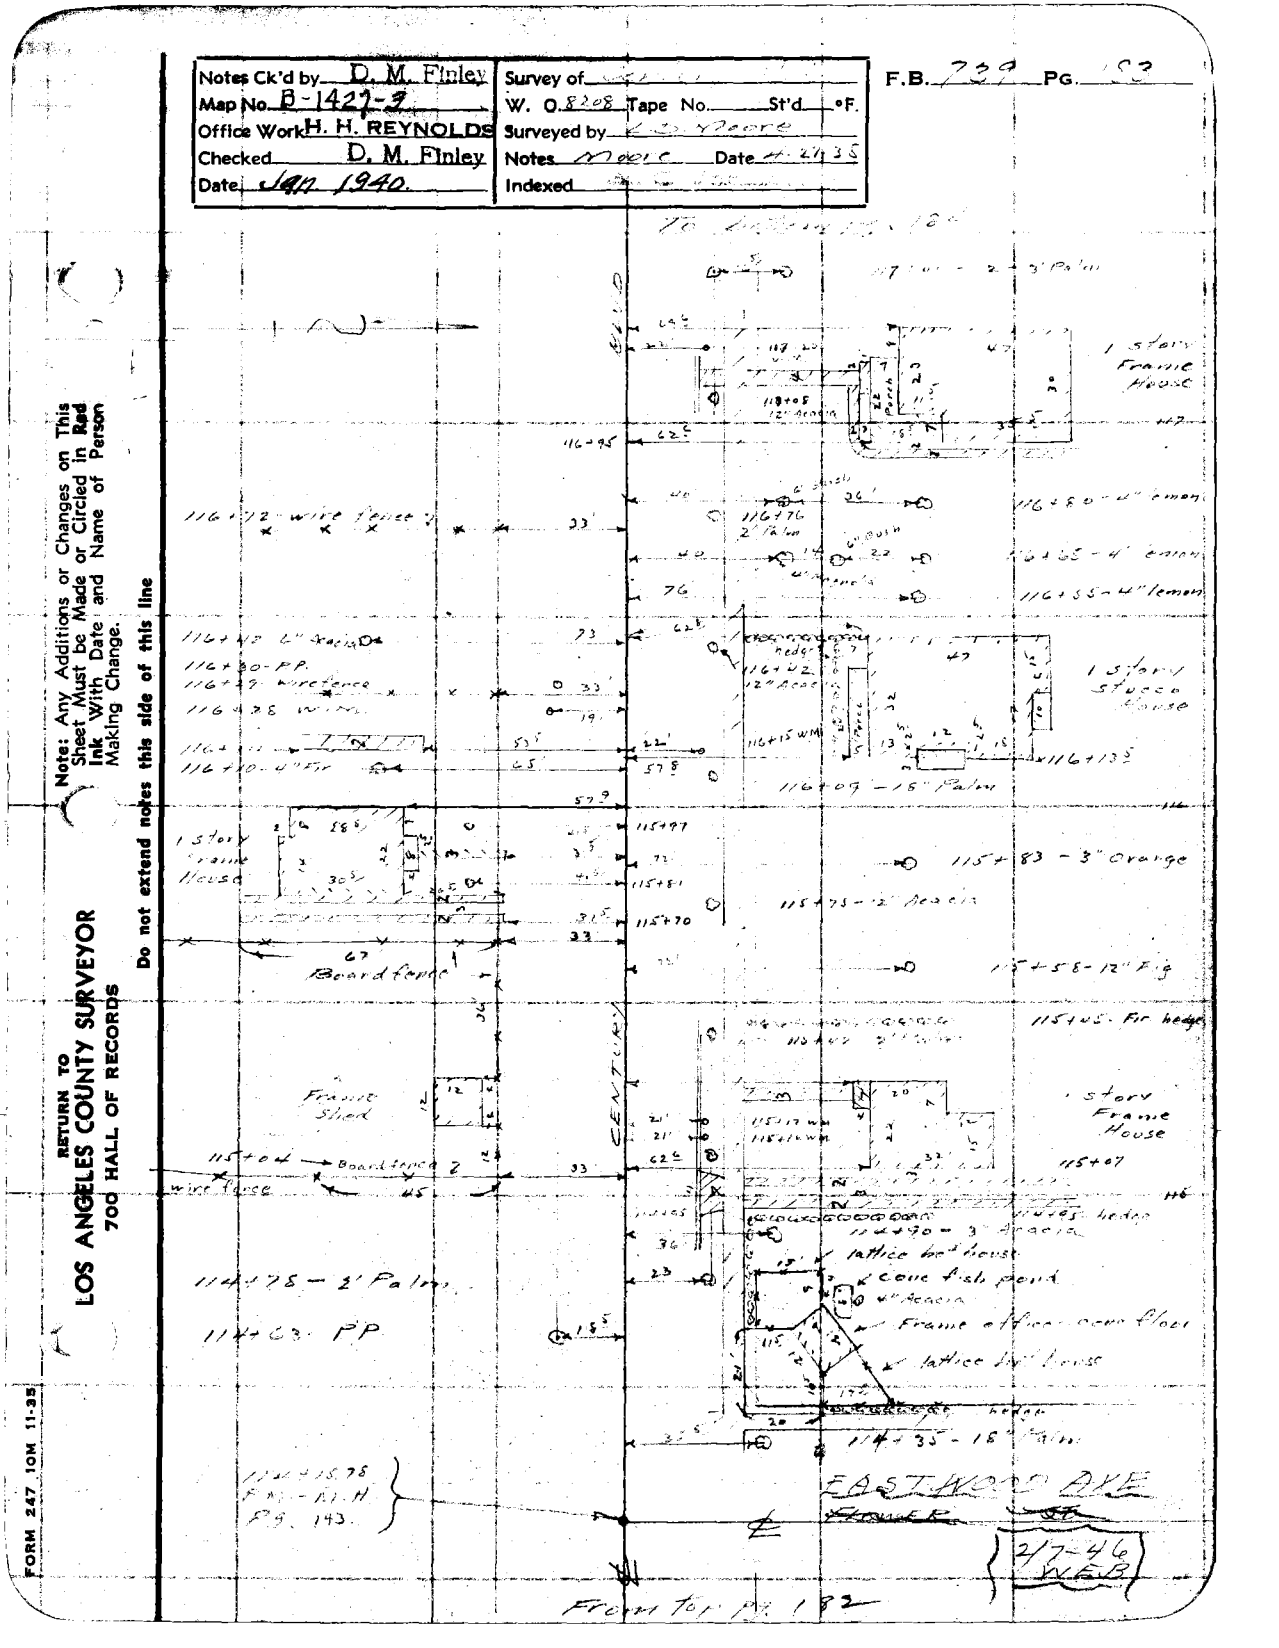

Note: Any Additions or Changes on This Sheet Must be Made or Circled in Red Ink With Date and Name of Person Making Change.

Do not extend notes this side of this line

RETURN TO
LOS ANGELES COUNTY SURVEYOR
7OO HALL OF RECORDS

FORM 247 10M 11-35

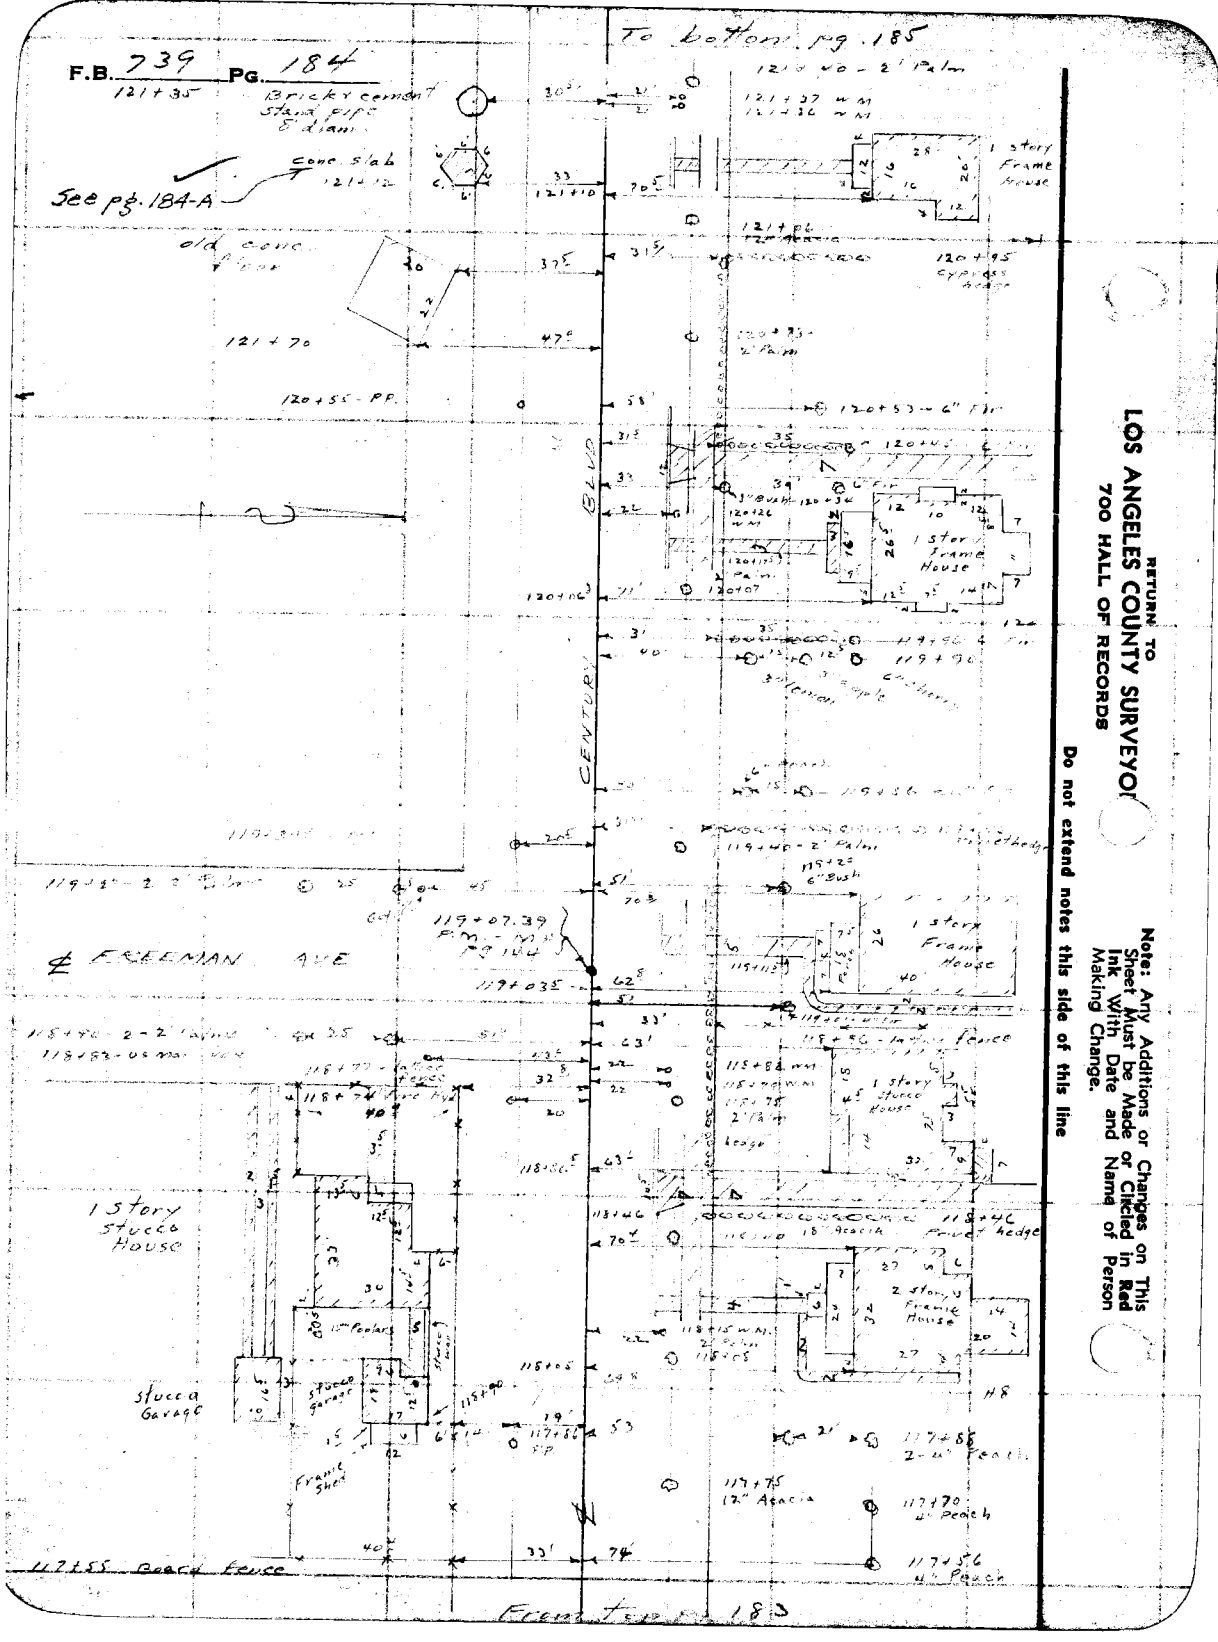
F.B. 739 Pg. 184
To bottom pg. 185
See pg. 184-A
Brick & cement Stand pipe 8' diam.
Conc slab
old conc floor
1 story Frame House
1 story Frame House
1 story Frame House
1 story Stucco House
1 story Stucco House
2 story Frame House
Stucco Garage
Stucco Garage
Frame Shed
CENTURY BLVD
FREEMAN AVE

Notes Ck'd by J.D.Price.	Survey of Century Blvd
Map No. C.S.D-1427-2	W, O 8208 Tape No. St'd °F
Office Work J.D.Price.	Surveyed by WALLACE
Checked	Notes Wallace Date 3-5-47
Date	Indexed 3-17-47

F.B. 737 Pg. 184-A

Note: Any Additions or Changes on This Sheet Must be Made or Circled in Red Ink With Date and Name of Person Making Change.

Do not extend notes this side of this line.

RETURN TO
LOS ANGELES COUNTY SURVEYOR
700 HALL OF RECORDS

60.1

62.0

MYRTLE AVE

BLVD

121+75.73
F.B. 739-145

30'

30'

WELL PIT
P+ 75' deep

15'

8'

329'

37'

121+15.6

121+13.7

Pump over well

Well approx. 700' deep

33'

33'

CENTURY

FORM 247 5M 5-46

F. B. 739 PG. 1642

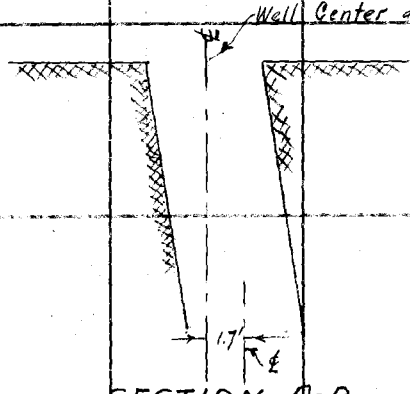

SECTION A-A

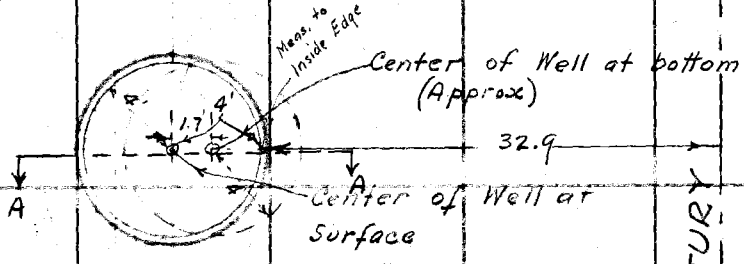

PLAN

BLVD

CENTURY

℄

12" Well Casing in Center of pit at bottom as per owner.

Well lined with brick - 1" Plaster inside face Wall approx 1.5' thick at top Iron steps to bottom of well - NOT SAFE

Copied from E.C. Wallace Notes of 3-10-47 by A.C. Johnson in order to combine field book pages.

Platted on C.S.B-1427-3, March 24, 1947, by J.D. Price.

RETURN TO
LOS ANGELES COUNTY SURVEYOR
7DO HALL OF RECORDS

Do not extend notes this side of this line

Note: Any Additions or Changes on This Sheet Must be Made or Circled in Red Ink With Date and Name of Person Making Change.

F.B. 737 Pg. 184

Notes Ck'd by	Survey of [redacted]
Map No.	W. O. Tape No. St'd °F
Office Work	Surveyed by E. C. WALLACE
Checked	Notes E. C. WALLACE Date 3-14-47
Date	Indexed

Note: Any Additions or Changes on This Sheet Must be Made or Circled in Red Ink With Date and Name of Person Making Change.

Do not extend notes this side of this line.

RETURN TO LOS ANGELES COUNTY SURVEYOR 700 HALL OF RECORDS

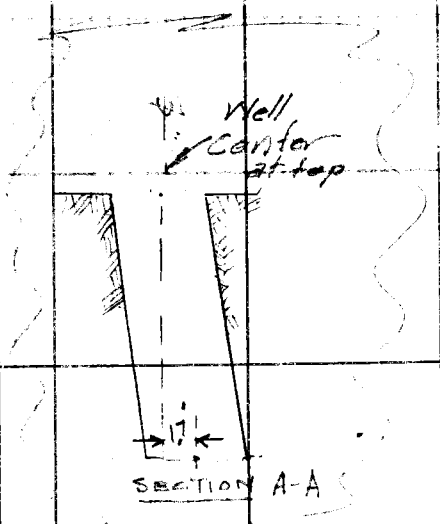

CENTURY BLVD.

Copied to FB 789-18 & 19

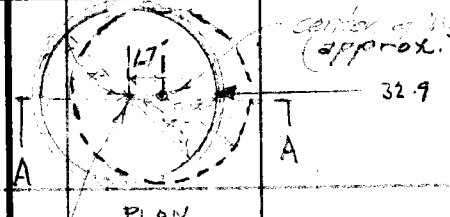

12" Well casin in center of pit at bottom as per owner

Well lined with Brick - 1" Plaster inside face

Wall approx 15' thick at top

Iron steps to bottom of well - Not safe

FORM 247 5M 5-46

RETURN TO
LOS ANGELES COUNTY SURVEYOR
700 HALL OF RECORDS

Note: Any Additions or Changes on This Sheet Must be Made or Circled in **Red** Ink With Date and Name of **Person** Making Change.

Do not extend notes this side of this line.

F. B. 737 PG. 184

Notes Ck'd by D. M. Finley	Survey of
Map No. B-1427-9	W. O. 8288 Tape No. St'd °F.
Office Work H. H. REYNOLDS	Surveyed by L. L. Moore
Checked D. M. Finley	Notes Date 4-27-38
Date JAN. 1940.	Indexed

F.B. 724 PG. 15

RETURN TO
LOS ANGELES COUNTY SURVEYOR
700 HALL OF RECORDS

Note: Any Additions or Changes on This Sheet Must be Made or Circled in Red Ink With Date and Name of Person Making Change.

Do not extend notes this side of this line

FORM 247 10M' 11-35

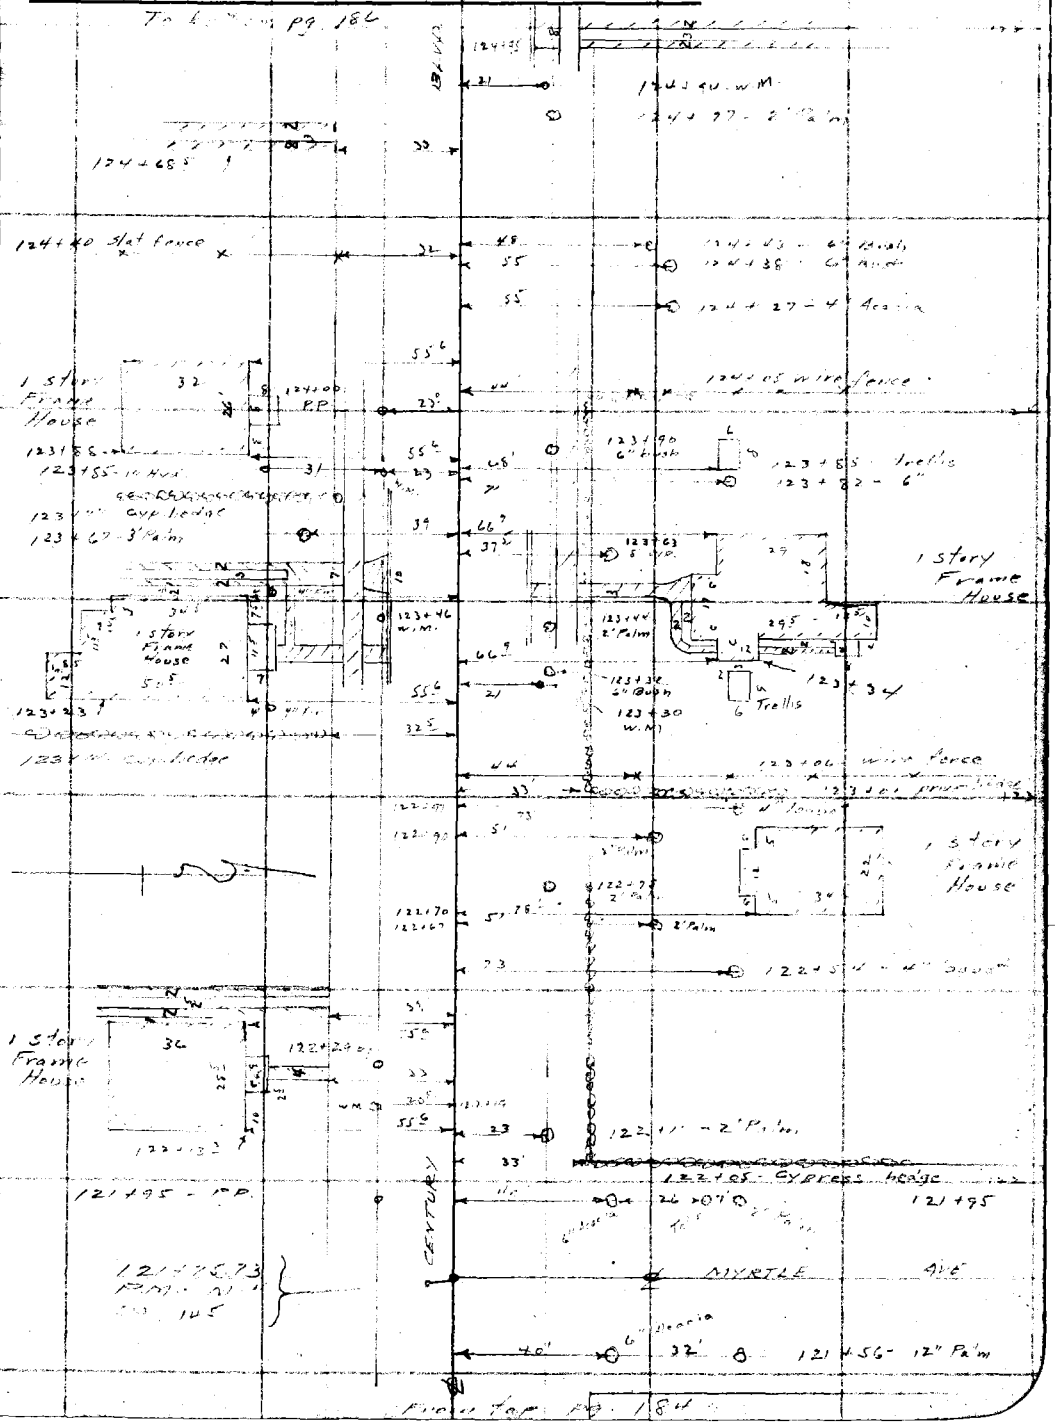

To Bottom pg. 187

F.B. 239 Pg. 186

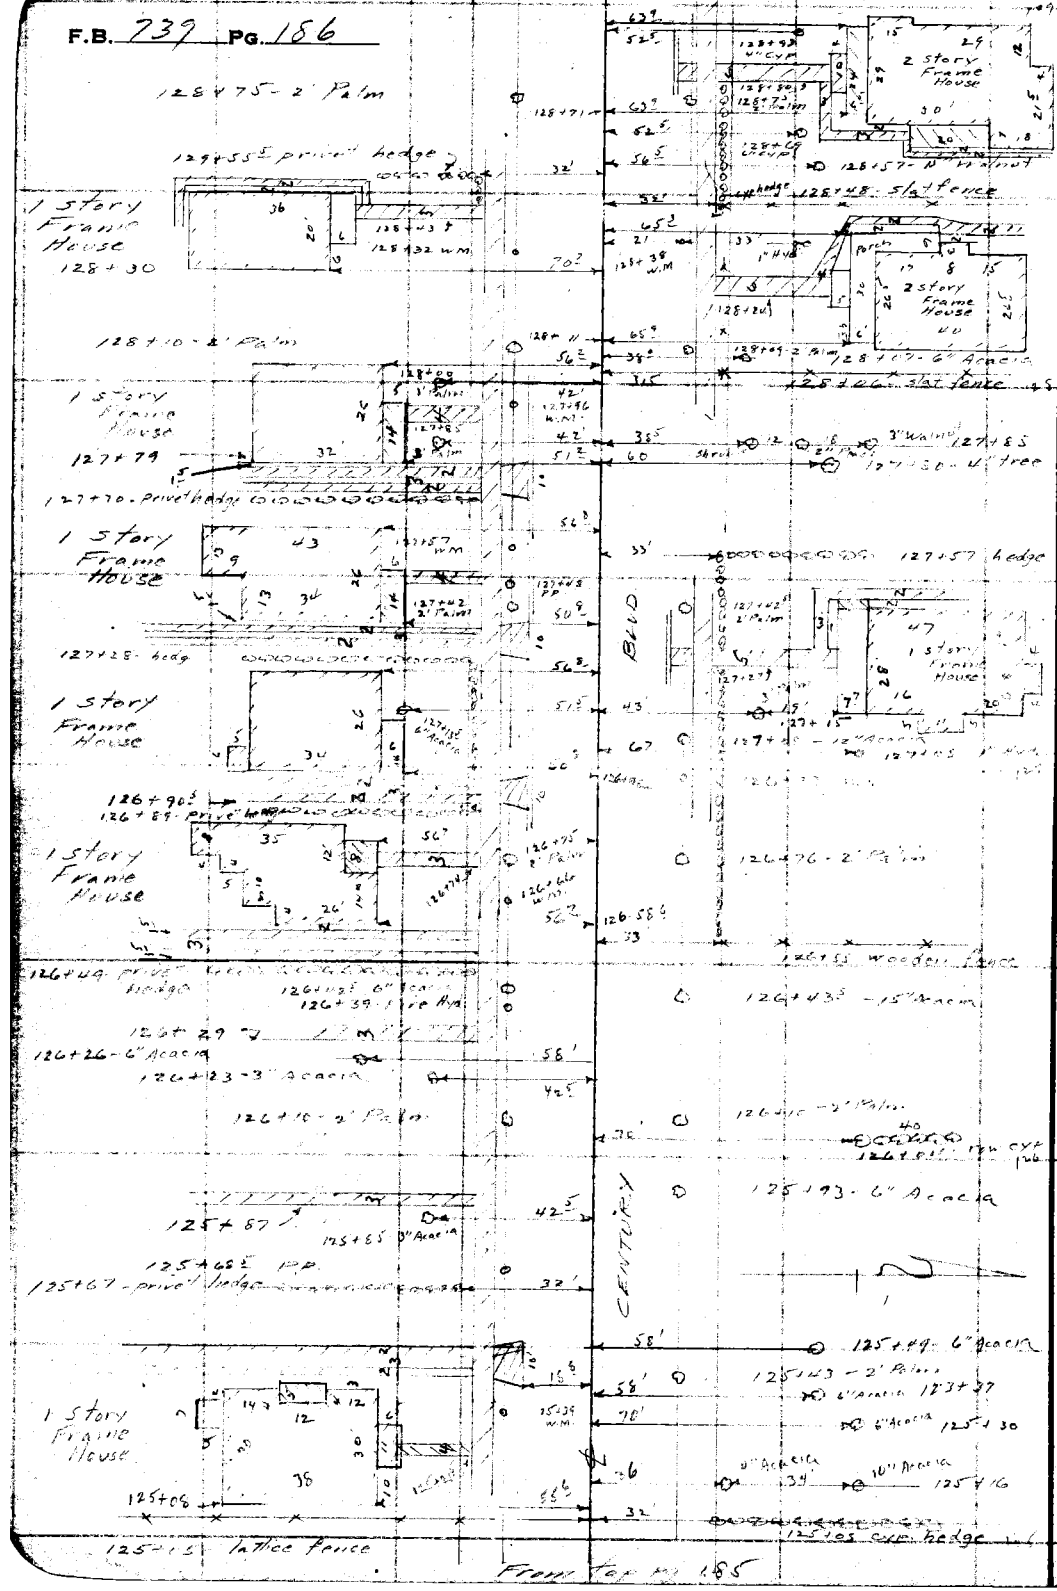

RETURN TO
LOS ANGELES COUNTY SURVEYOR
700 HALL OF RECORDS

Note: Any Additions or Changes on This Sheet Must be Made or Circled in Red Ink With Date and Name of Person Making Change.

Do not extend notes this side of this line

Notes Ck'd by D. M. Finley	Survey of	F.B. 239	PG. 187
Map No. B-1427-2	W. O. 5205 Tape No.	St'd °F.	
Office Work H. H. REYNOLDS	Surveyed by		
Checked D. M. Finley	Notes	Date 5-24-40	
Date Jan. 1940	Indexed		

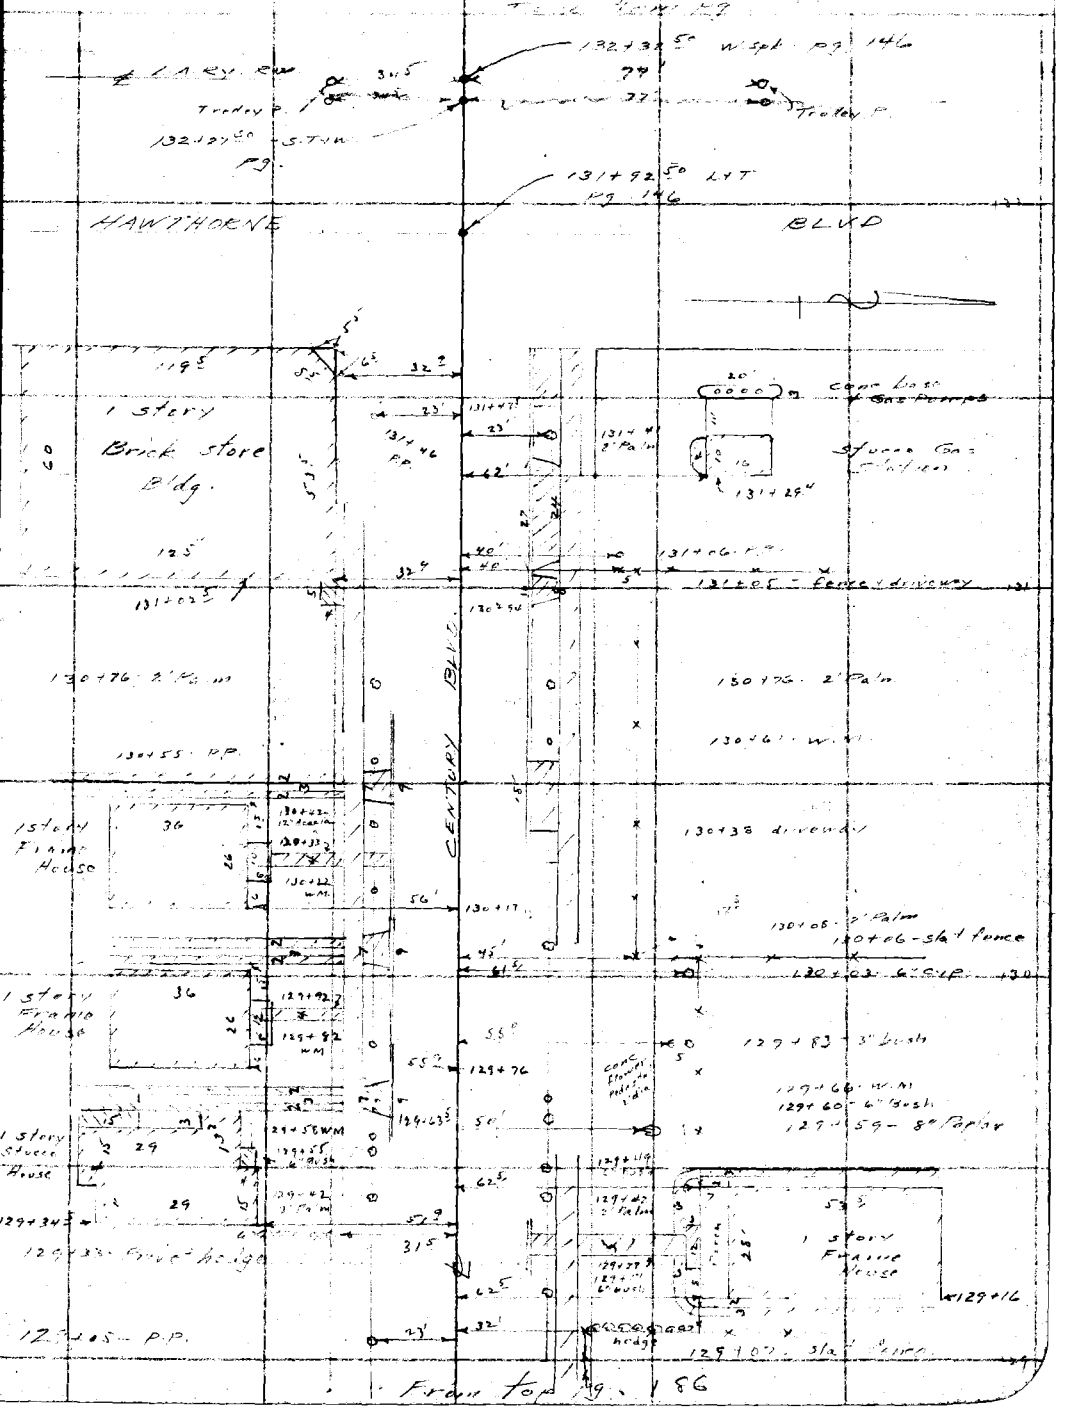

Note: Any Additions or Changes on This Sheet Must be Made or Circled in Red Ink With Date and Name of Person Making Change.

Do not extend notes this side of this line

RETURN TO
LOS ANGELES COUNTY SURVEYOR
700 HALL OF RECORDS

FORM 247 10M 11-38

F.B. 739 Pg. 188

To bottom pg. 189

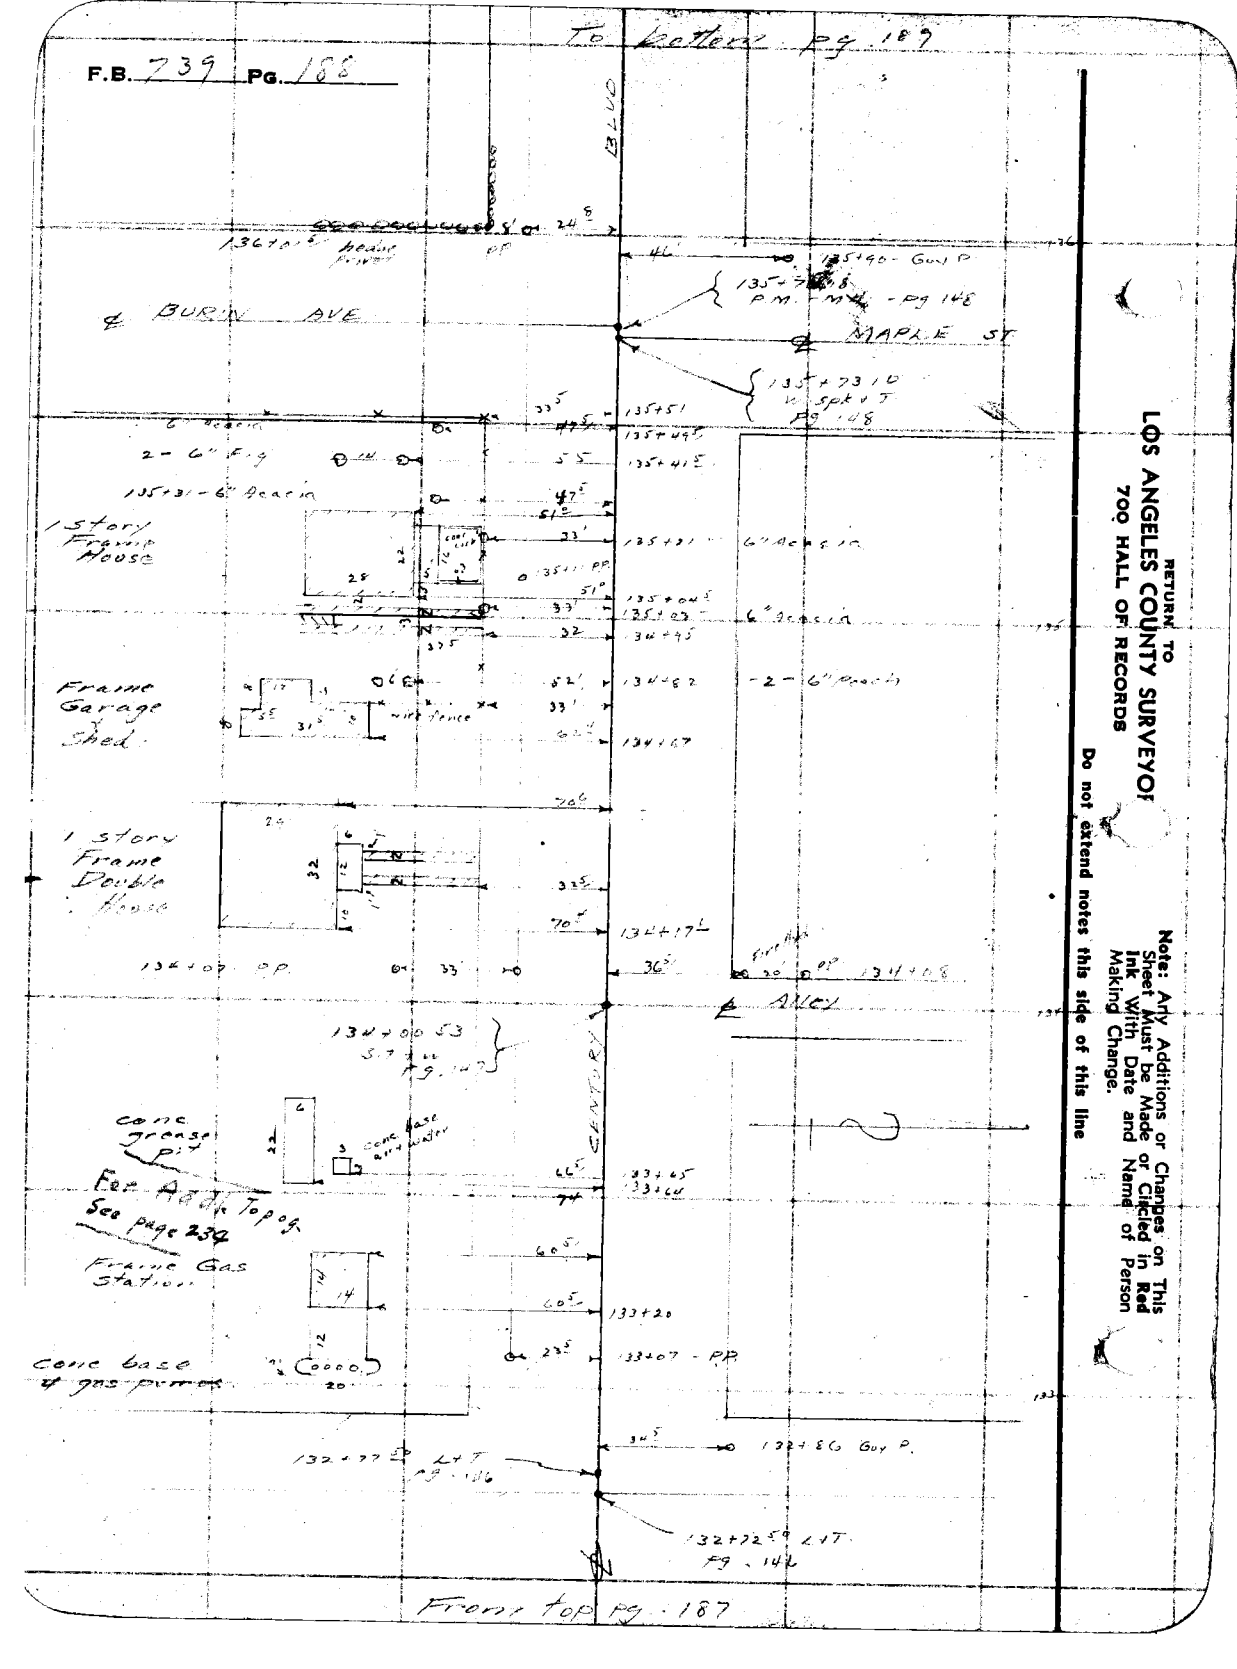

From top pg. 187

RETURN TO
LOS ANGELES COUNTY SURVEYOR
700 HALL OF RECORDS

Note: Any Additions or Changes on This Sheet Must be Made or Circled in Red Ink With Date and Name of Person Making Change.

Do not extend notes this side of this line

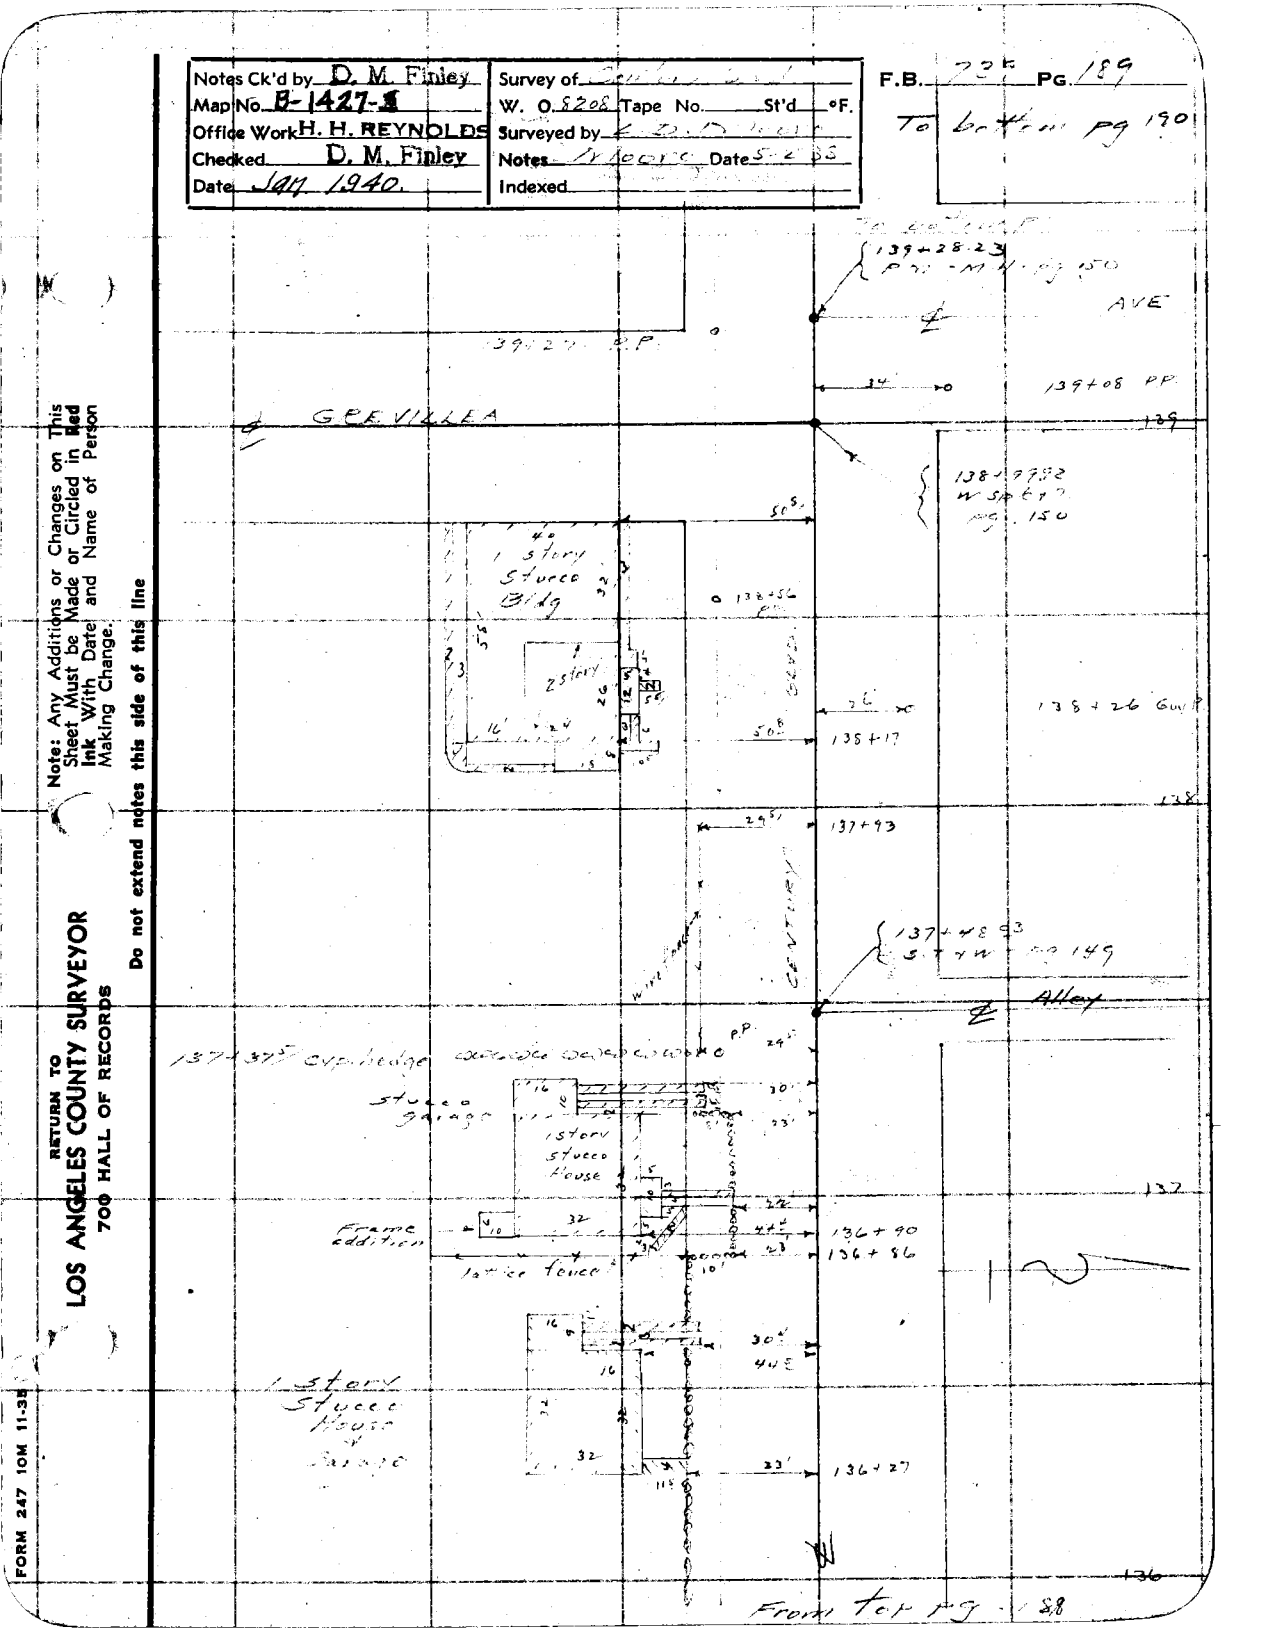
Notes Ck'd by D. M. Finley
Map No. B-1427-1
Office Work H. H. REYNOLDS
Checked D. M. Finley
Date Jan 1940.
Survey of
W. O. 8208 Tape No. St'd °F.
Surveyed by
Notes Date
Indexed
F.B. 72 Pg. 189
To bottom pg 190
139+28.23
P.C. - M.M. pg 150
AVE
39+27 P.P.
34
139+08 PP
GREVILLEA
138+79.32
W Sta Eq
pg. 150
50'S.
40
1 Story
Stucco
Bldg
138+56
25
1 Story
26
16'
138+17
138+26 Gu
29'S.
137+93
137+43.93
S. T. W. pg 149
Alley
137+37.5 eve. ledge
Stucco
Garage
1 Story
Stucco
House
Frame
addition
32
136+90
136+86
30'
44.5
1 Story
Stucco
House
&
Garage
32
33'
136+27
From top pg 188
Notes: Any Additions or Changes on This Sheet Must be Made or Circled in Red Ink With Date and Name of Person Making Change.
Do not extend notes this side of this line
RETURN TO
LOS ANGELES COUNTY SURVEYOR
700 HALL OF RECORDS
FORM 247 10M 11-38

F.B. 739 PG. 190

To Sheet pg. 191

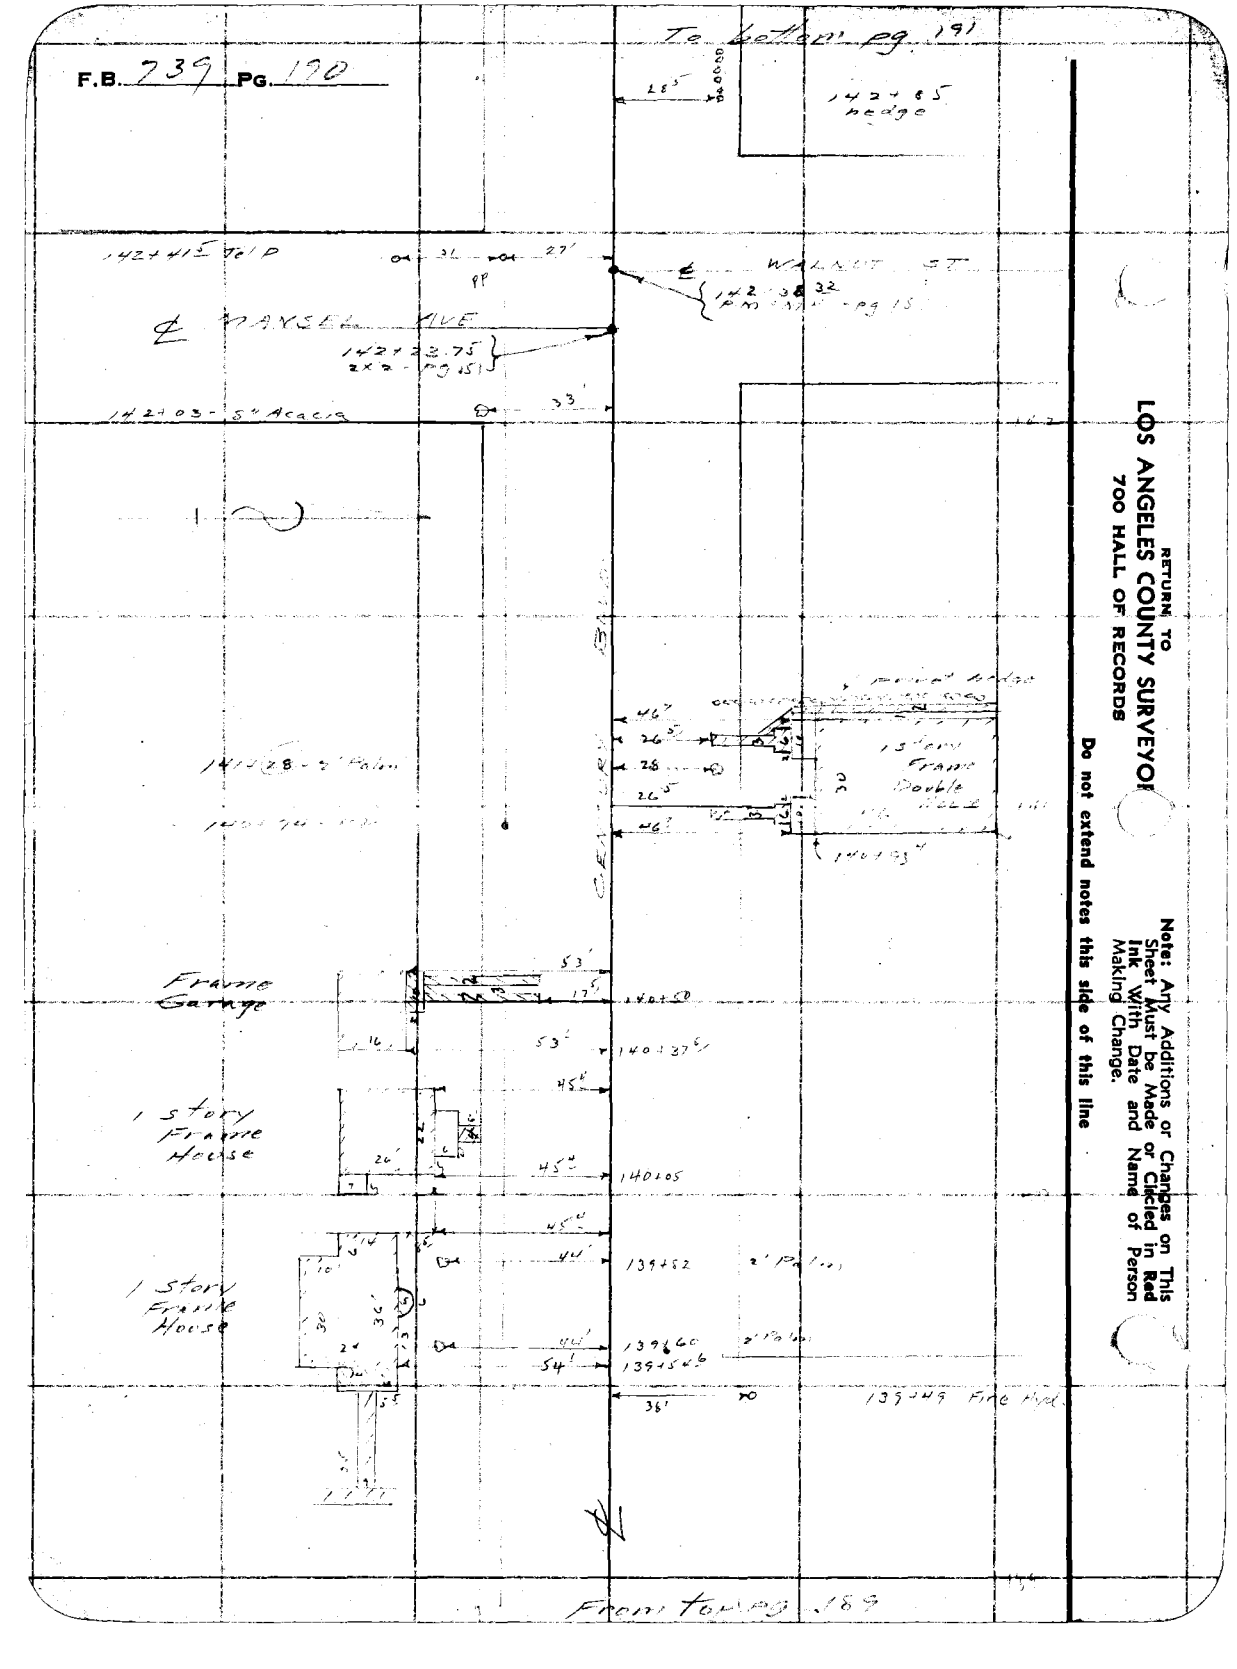

From Sheet pg. 189

RETURN TO
LOS ANGELES COUNTY SURVEYOR
700 HALL OF RECORDS

Note: Any Additions or Changes on This Sheet Must be Made or Circled in Red Ink With Date and Name of Person Making Change.

Do not extend notes this side of this line

Notes Ck'd by D. M. Finley	Survey of	F.B. 73	Pg. 91
Map No. B-1427-4	W. O. 8208 Tape No.	St'd °F.	
Office Work H. H. REYNOLDS	Surveyed by		
Checked D. M. Finley	Notes	Date 5-2-38	
Date Jan. 1940	Indexed		

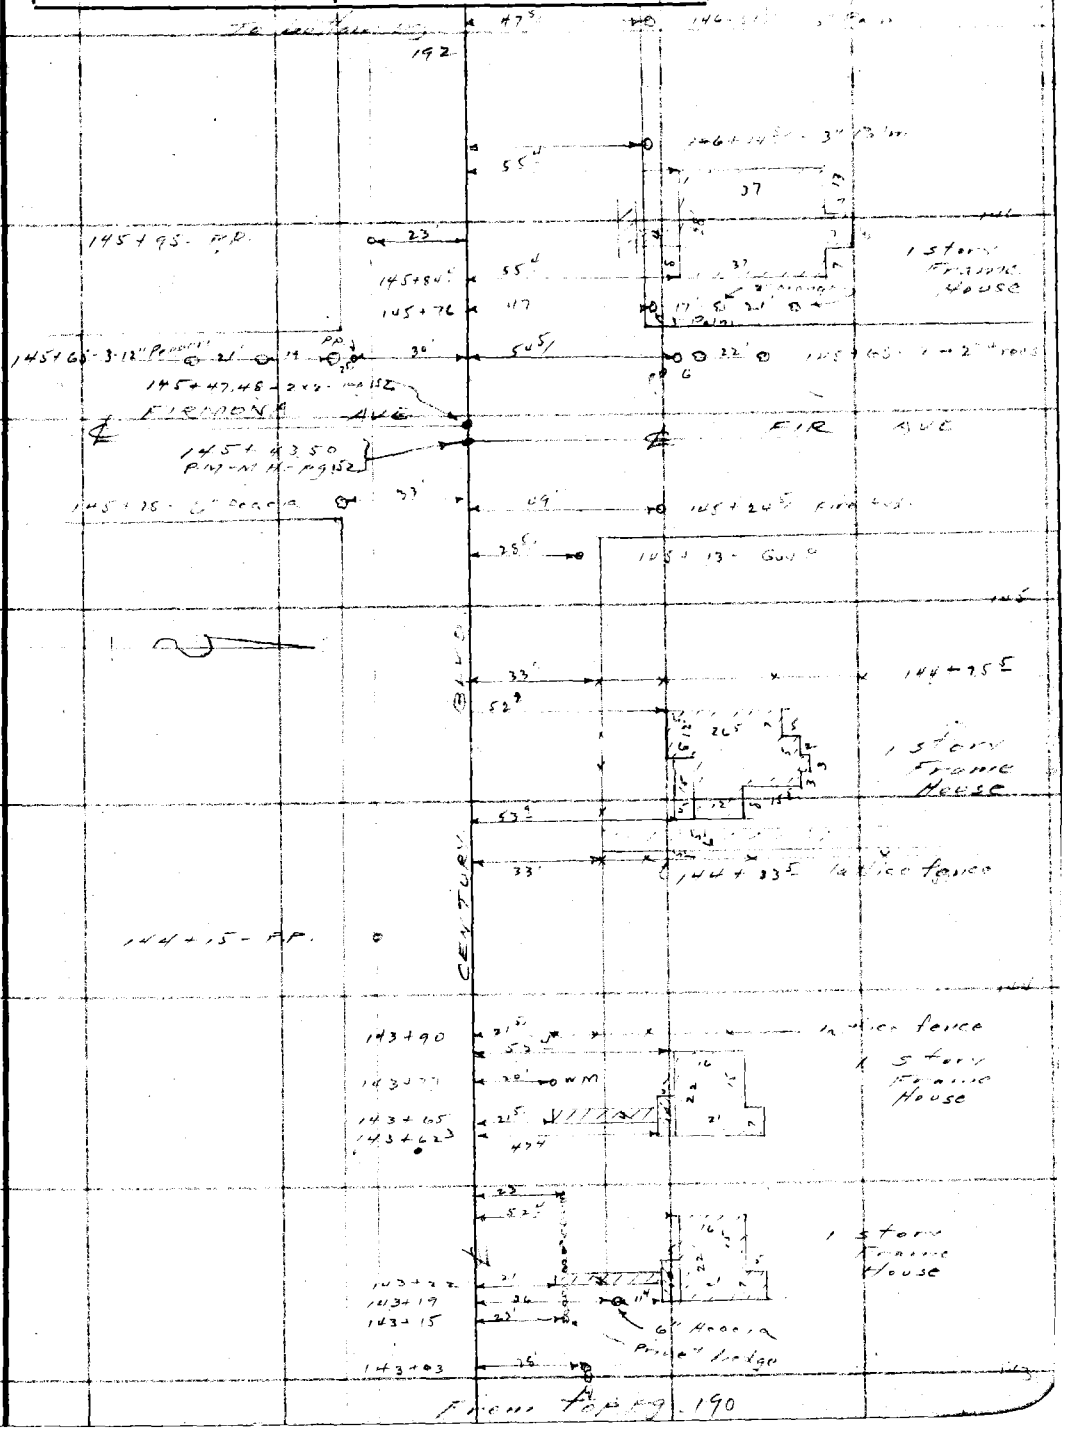

RETURN TO
LOS ANGELES COUNTY SURVEYOR
700 HALL OF RECORDS

Note: Any Additions or Changes on This Sheet Must be Made or Circled in Red Ink With Date and Name of Person Making Change.

Do not extend notes this side of this line

FORM 247 10M 11-38

F.B. 239 PG. 192

To Lot 1 on pg 193

1 Story Frame House

1 Story Frame House

1 Story Frame House

1 Story Frame House

TEURO AVE

BLVD.

CENTURY

From Lot on pg 191

RETURN TO
LOS ANGELES COUNTY SURVEYOR
700 HALL OF RECORDS

Do not extend notes this side of this line

Note: Any Additions or Changes on This Sheet Must be Made or Circled in Red Ink With Date and Name of Person Making Change.

Notes Ck'd by D. M. Finley	Survey of		F.B. 734 PG. 142
Map No. B-1427-2	W. O.	Tape No.	St'd °F.
Office Work H. H. REYNOLDS	Surveyed by		
Checked D. M. Finley	Notes	Date	
Date Jan 1940	Indexed		

RETURN TO
LOS ANGELES COUNTY SURVEYOR
700 HALL OF RECORDS

Note: Any Additions or Changes on This Sheet Must be Made or Circled in Red Ink With Date and Name of Person Making Change.

Do not extend notes this side of this line

FORM 247 10M 11-38

To follow pg 194

Board Fence
3-12" Gums
Board Fence
Glass Int House
12" Oak
2 Story Frame House
1 Story Stucco House
152+30 - Wire Fence
Concrete Curb
BLVD
152+30 - Guy P
EUCALYPTUS AVE
151+68 - 12" Acacia
151+75 - Ent Wire Fence
151+61 - 16" Pine
Concrete Curb
151+57 - Guy P
151+41 - 12" Pine
151+24 - 2" Pine
CENTURY
2 Story Frame House
1 Story Frame House
150+86
150+71 PP
150+73.5 - 3" Avocado
150+61.5 Privet Hedge

From top pg 192

F.B. 739 Pg. 194

To bottom pg. 195

158+14 E. ℄ row 6" walnuts

157+74

157+34

156+94 ±

156+85 ±

155+73 - Base from 6" walnuts

155+52 ± PP

155+47 Fire Hyd

50'

58'

59'

50'

22'

66'

49'

68'

66.7'

49'

33.5'

35.5'

63.2'

77'

conc. base

conc. floor

37 1 story Stucco House

156+84 PP

156+00 ± C/L

BLVD

℄ DOLL ROSA AVE

℄ ROSEWOOD AVE

℄ CRAWFORD

155+66 W Spk & Tag PP 1.75

155+26 PK Nail & Tag PP 1.55

From top pg. 193

RETURN TO
LOS ANGELES COUNTY SURVEYOR
700 HALL OF RECORDS

Note: Any Additions or Changes on This Sheet Must be Made or Circled in Red Ink With Date and Name of Person Making Change.

Do not extend notes this side of this line

Notes Ck'd by D. M. Finley
Map No. B-1427-4
Office Work H. H. REYNOLDS
Checked D. M. Finley
Date Jan 1940.

Survey of
W. O. 5208 Tape No. St'd °F.
Surveyed by
Notes Date 5-3-38
Indexed

F.B. 728 PG. 195

Note: Any Additions or Changes on This Sheet Must be Made or Circled in Red Ink With Date and Name of Person Making Change

Do not extend notes this side of this line

RETURN TO
LOS ANGELES COUNTY SURVEYOR
700 HALL OF RECORDS

FORM 247 10M 11-38

F.B. 739 PG. 196

To bottom Pg. 197

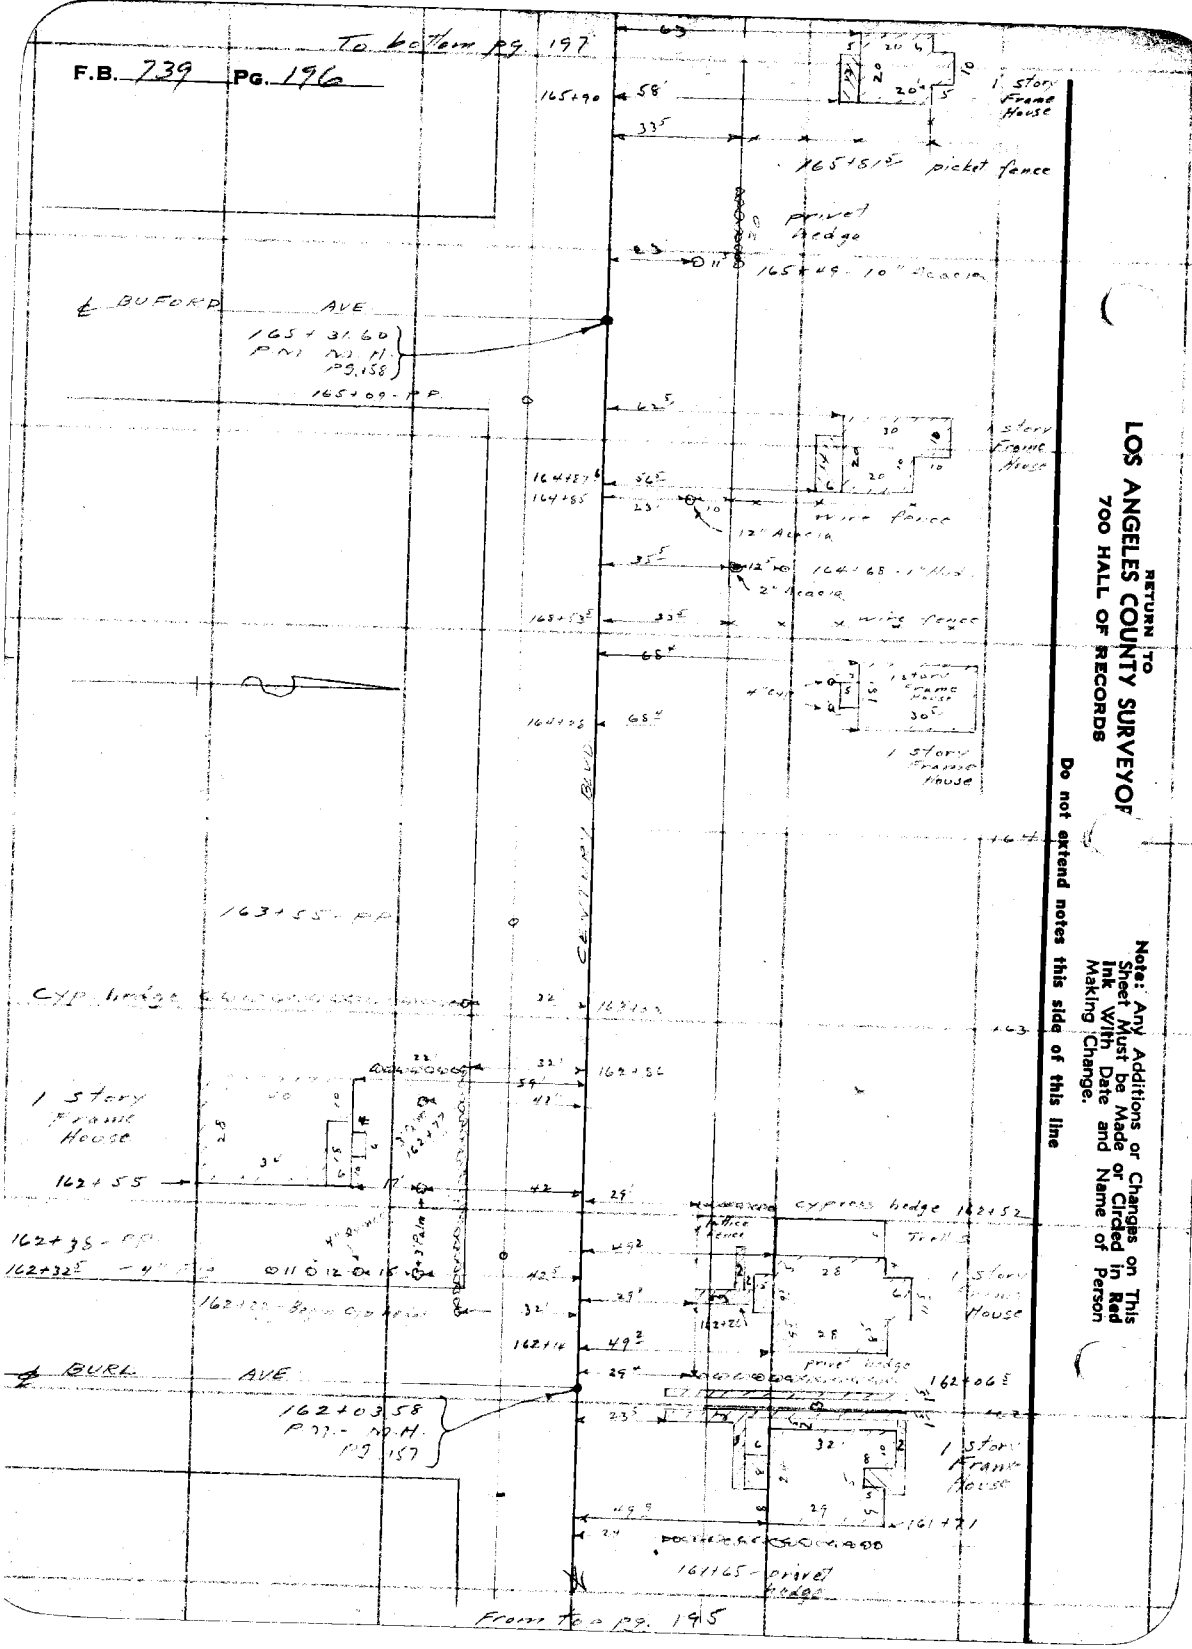

From Pg. 195

RETURN TO
LOS ANGELES COUNTY SURVEYOR
700 HALL OF RECORDS

Note: Any Additions or Changes on This Sheet Must be Made or Circled in Red Ink With Date and Name of Person Making Change.

Do not extend notes this side of this line

Notes Ck'd by D. M. Finley	Survey of Centinela
Map No. B-1427-4	W. O. 8208 Tape No. St'd °F.
Office Work H. H. REYNOLDS	Surveyed by C. D. Moore
Checked D. M. Finley	Notes N/Gore Date 5-3-38
Date Jan. 1940	Indexed

F.B. 224 PG. 197

To bottom pg.

169+30 PP

Blvd

Wire fence

168+69 23°

168+60 23°

168+33 64'

Lattice fence

1 story frame house

168+41 28'

32'

Lattice fence

168+20 26'

168+05 23°

Lattice fence

167+89 PP.

167+55 52°

33'

28

23

16

1 story frame House

167+42 53°

Century

166+78 35'

166+43 35'

Conc. curb

53'

40'

4" Cyp

1 story frame House

166+52°

166+42 53'

166+35 36°

36°

16

21'

3 - 6" Nectarine

166+15 - 3" Peach

166+15 11" Bush

From Top pg. 196

Note: Any Additions or Changes on This Sheet Must be Made or Circled in Red Ink With Date and Name of Person Making Change

Do not extend notes this side of this line

RETURN TO
LOS ANGELES COUNTY SURVEYOR
700 HALL OF RECORDS

FORM 247 10M 11-38

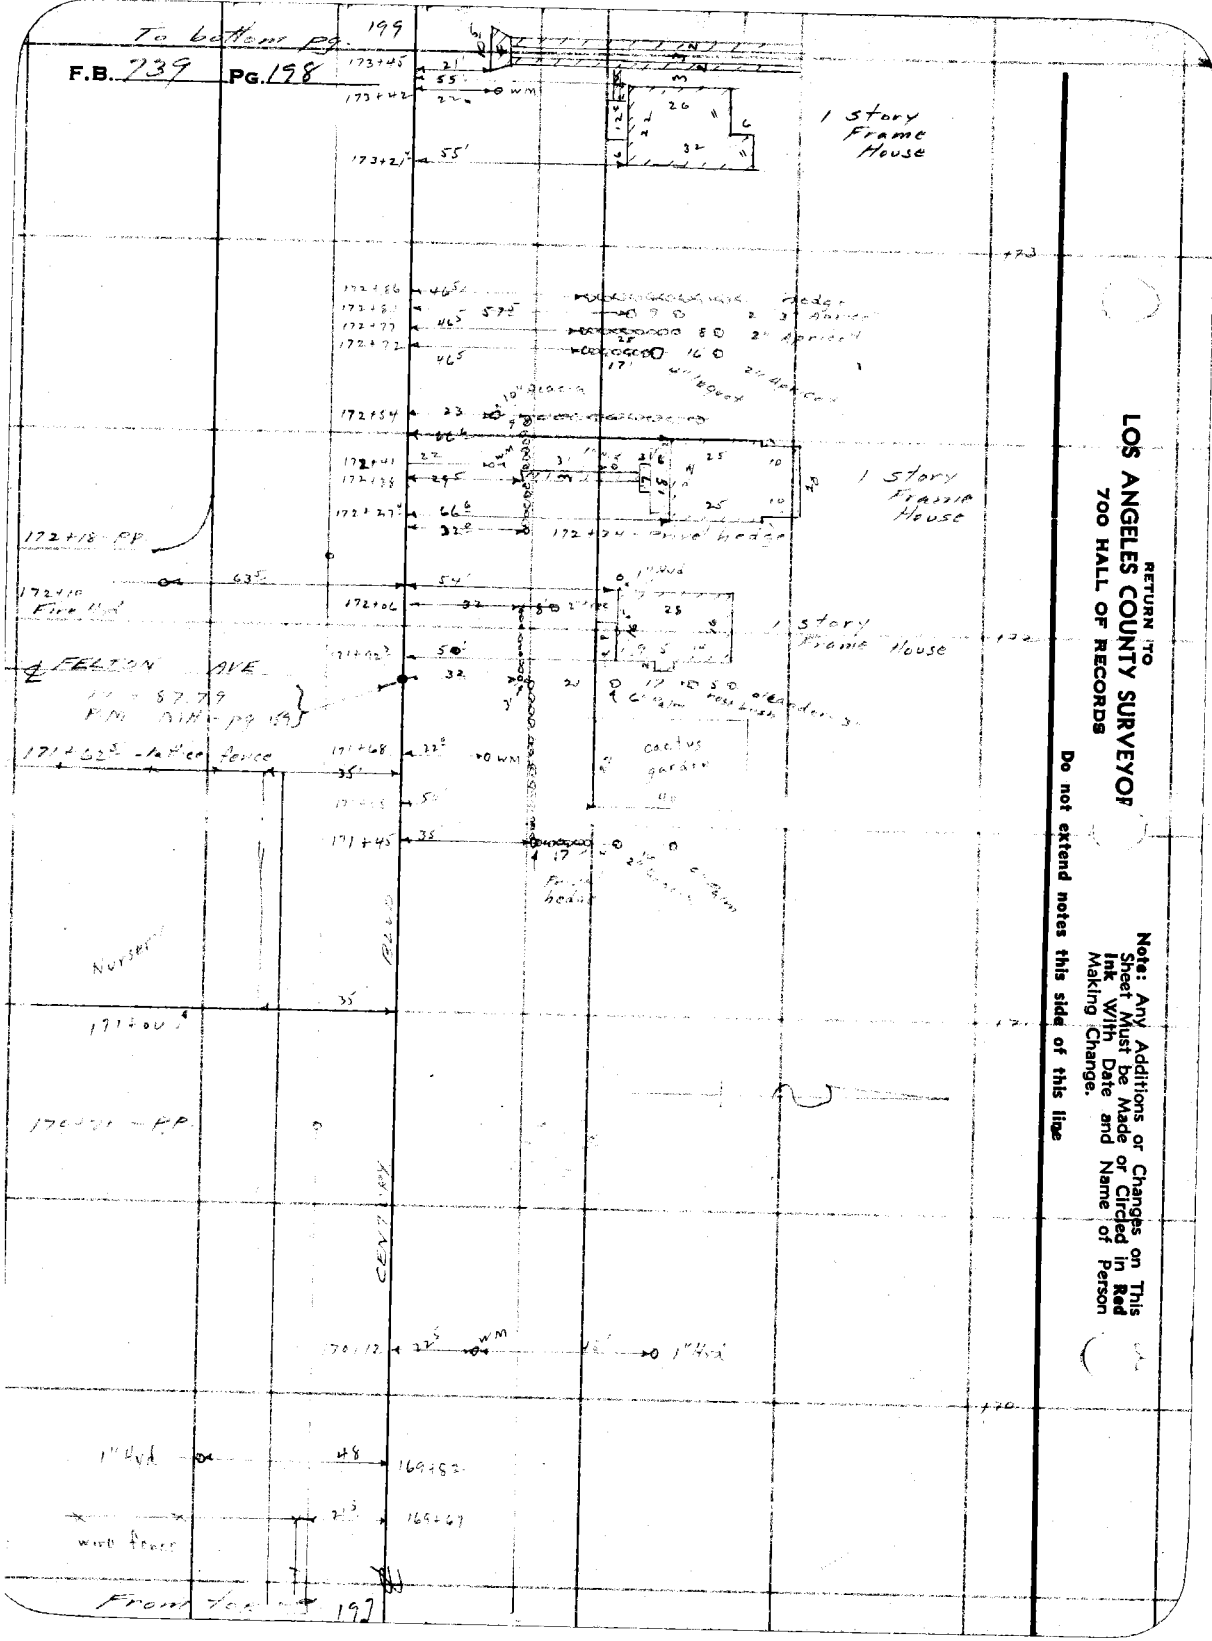
To bottom pg. 199
F.B. 739 PG. 198
1 Story Frame House
1 Story Frame House
1 Story Frame House
FELTON AVE
NURSERY
RETURN TO
LOS ANGELES COUNTY SURVEYOR
700 HALL OF RECORDS
Do not extend notes this side of this line
Note: Any Additions or Changes on This Sheet Must be Made or Circled in Red Ink With Date and Name of Person Making Change.

Notes Ck'd by D. M. Finley	Survey of		F.B. 239 Pg. 199
Map No. B-1427-4	W. O. 5206	Tape No.	St'd °F.
Office Work H. H. REYNOLDS	Surveyed by		
Checked D. M. Finley	Notes	Date	
Date Jan. 1940.	Indexed		

RETURN TO
LOS ANGELES COUNTY SURVEYOR
700 HALL OF RECORDS

Note: Any Additions or Changes on This Sheet Must be Made or Circled in Red Ink With Date and Name of Person Making Change

Do not extend notes this side of this line

wire fence

176+63 P.P.

176+59

34.5

rail fence

CENTER LINE

34.5

wire & rail fence

175+13.5 P.P.

175+14.5

1111+83.69
S 74° 11' W
199.60

REDFERN AVE

17" Acacia

1 Story Frame House

1 Story Frame House

173+63.5

Finish Top 198

To Bottom pg. 201

F.B. 739 PG. 200

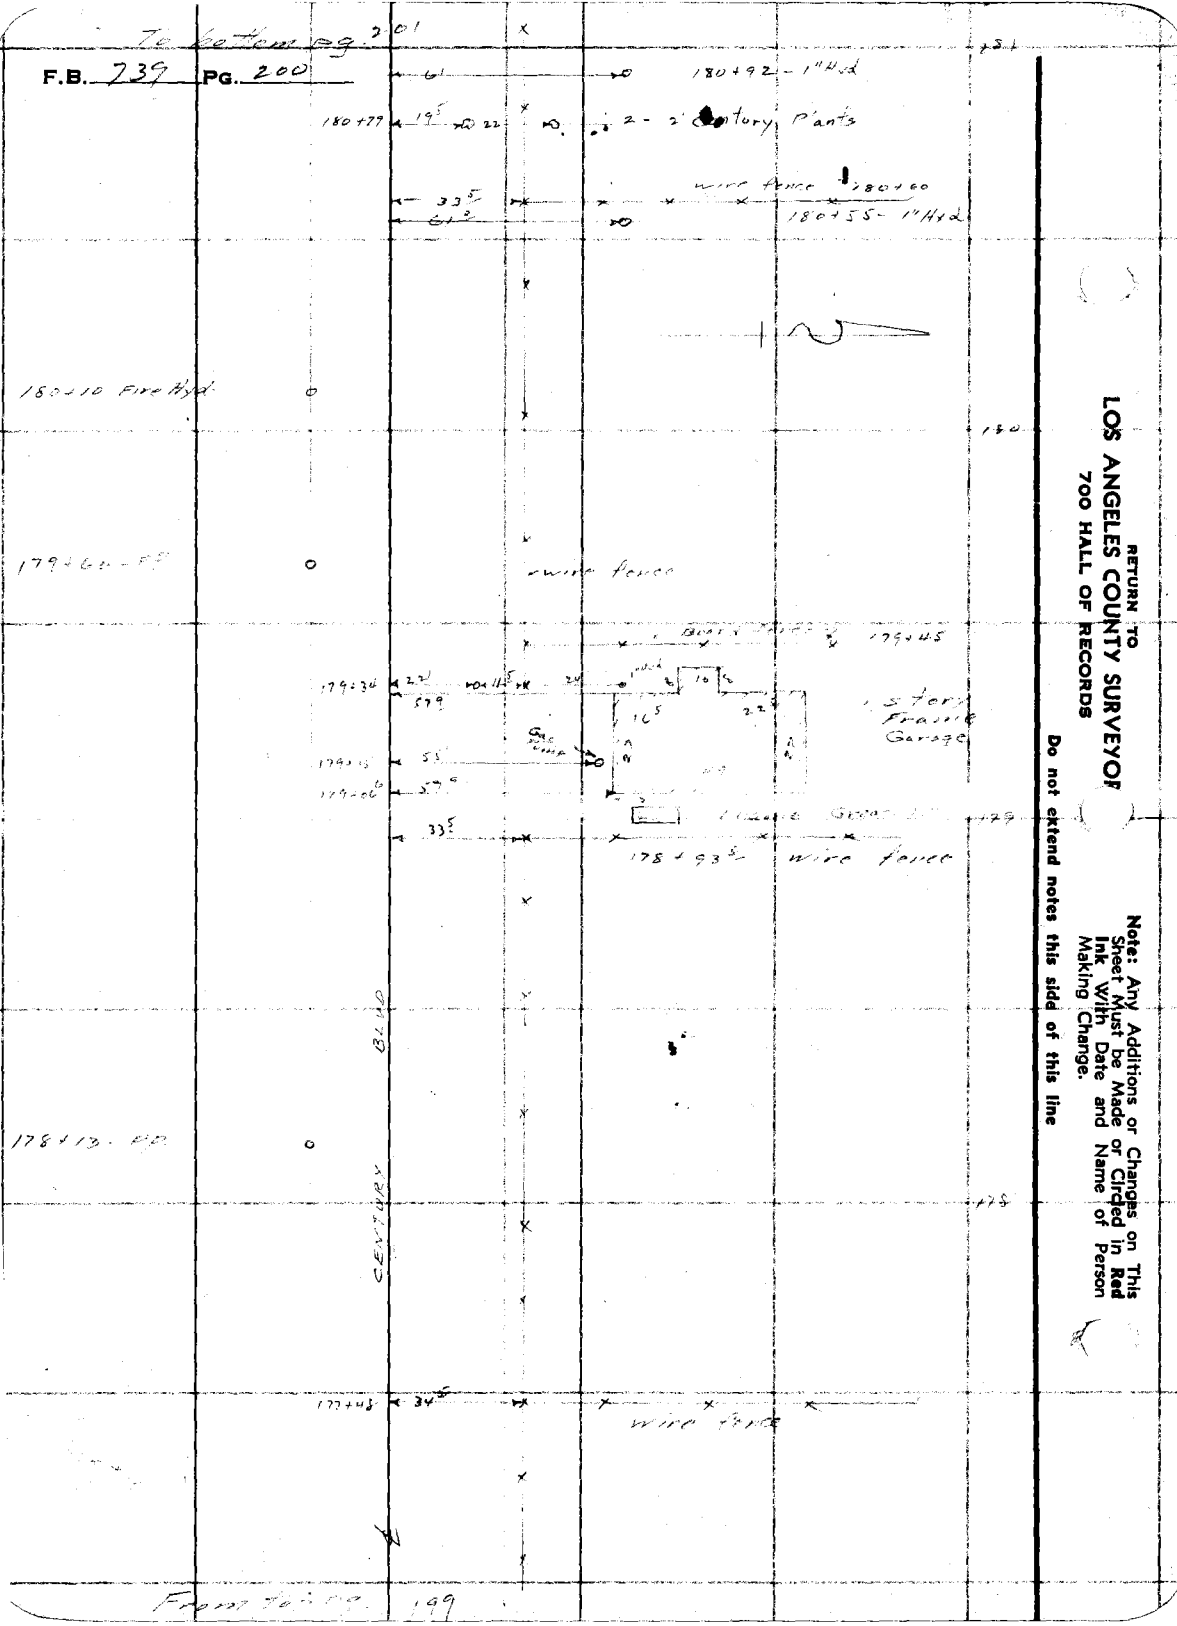

RETURN TO
LOS ANGELES COUNTY SURVEYOR
700 HALL OF RECORDS

Note: Any Additions or Changes on This Sheet Must be Made or Circled in Red Ink With Date and Name of Person Making Change.

Do not extend notes this side of this line

Notes Ck'd by D. M. Finley	Survey of
Map No. B-1427-4	W. O. 8208 Tape No. St'd °F.
Office Work H. H. REYNOLDS	Surveyed by
Checked D. M. Finley	Notes Date
Date Jan 1940.	Indexed

F.B. 724 PG. 201

Note: Any Additions or Changes on This Sheet Must be Made or Circled in Red Ink With Date and Name of Person Making Change

Do not extend notes this side of this line

RETURN TO
LOS ANGELES COUNTY SURVEYOR
700 HALL OF RECORDS

FORM 247 10M 11-38

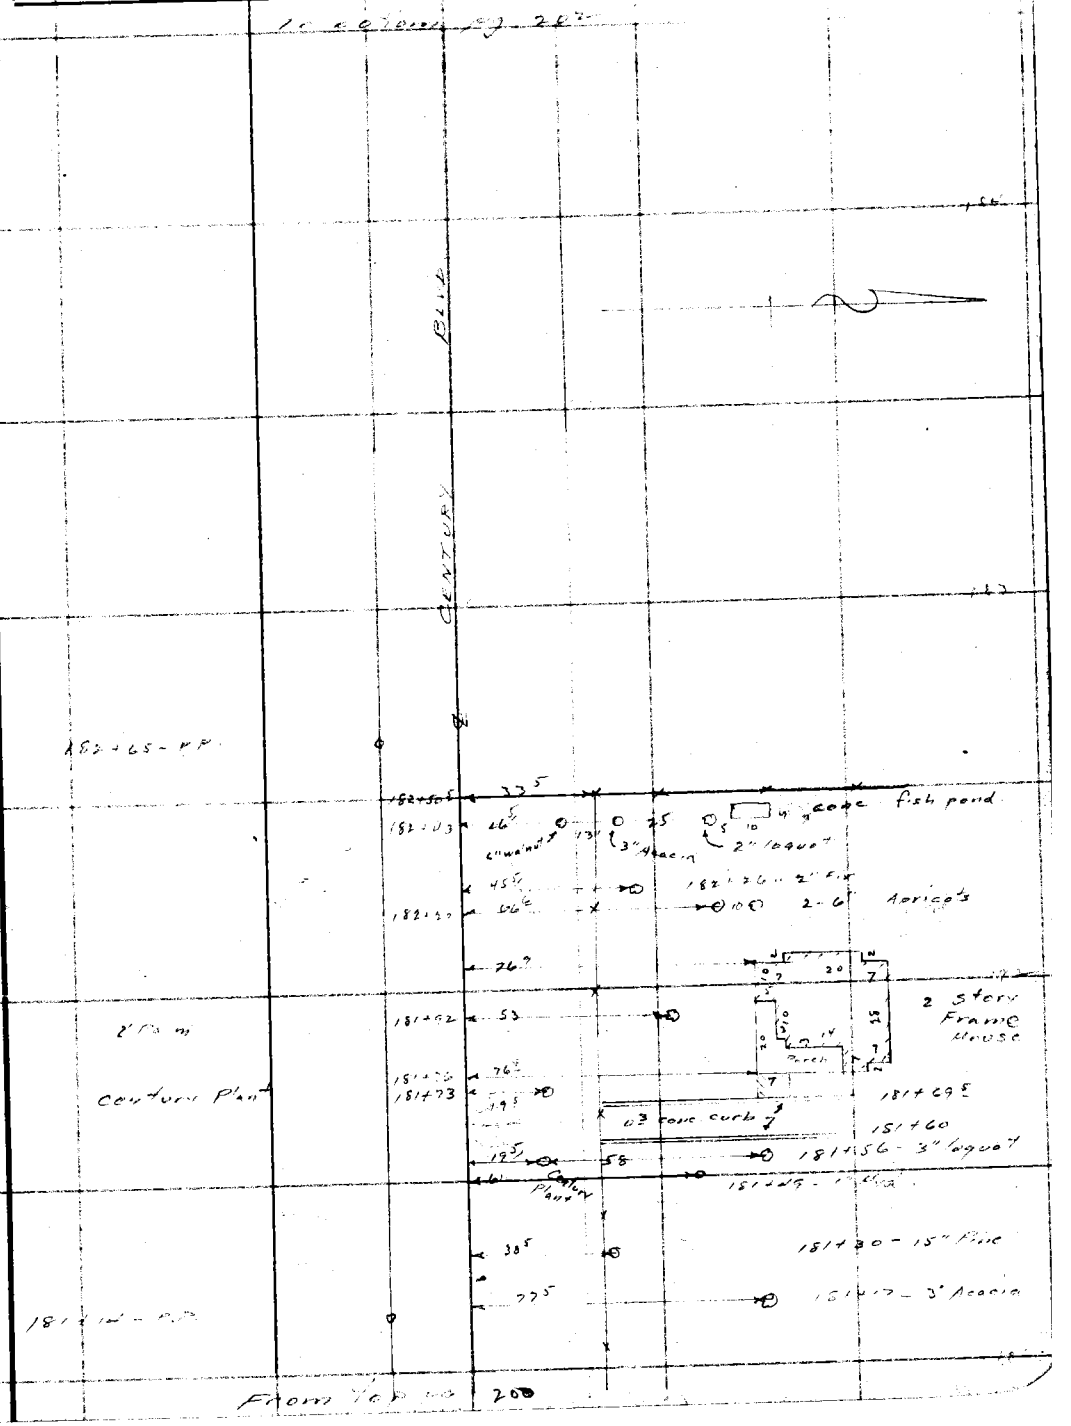

F.B. 739 Pg. 202

RETURN TO
LOS ANGELES COUNTY SURVEYOR
700 HALL OF RECORDS

Note: Any Additions or Changes on This Sheet Must be Made or Circled in Red Ink With Date and Name of Person Making Change.

Do not extend notes this side of this line

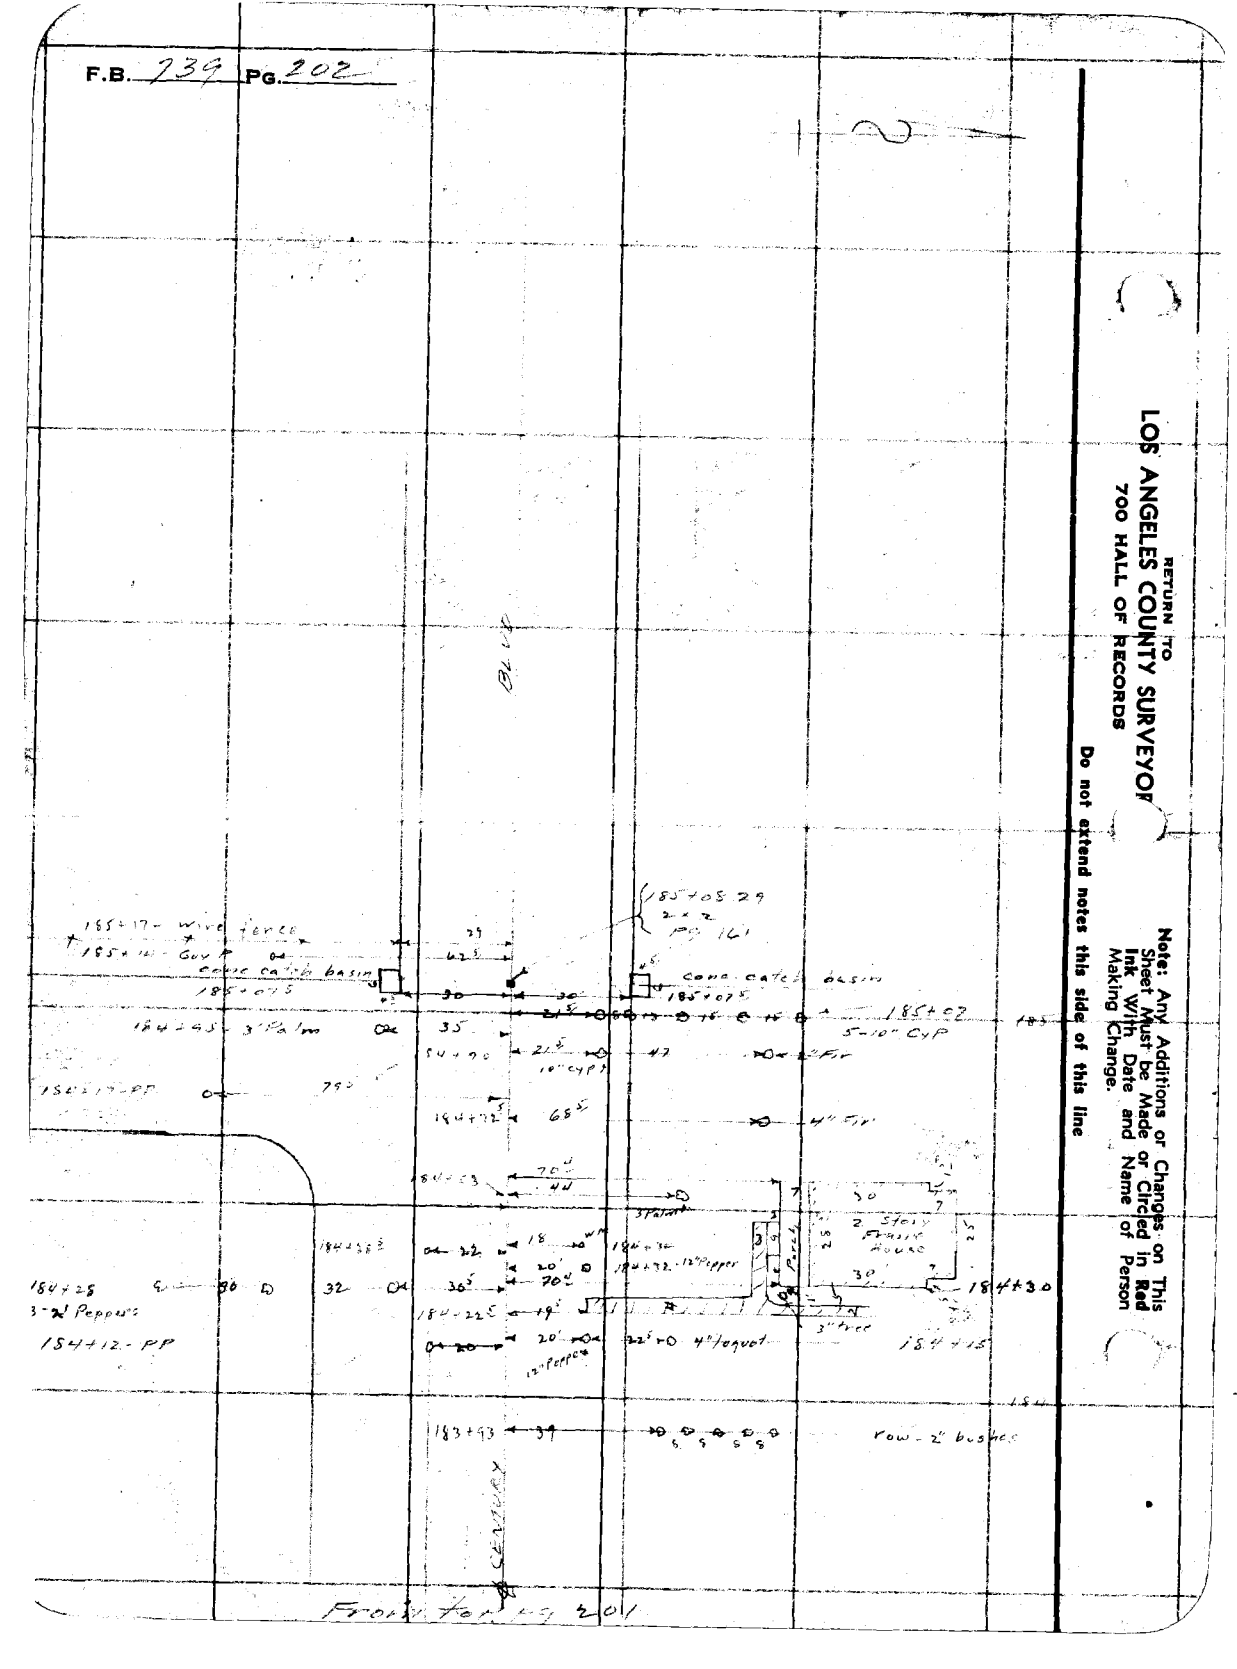

COPIES TO

CENTINELA VALLEY

(REGIONAL OFFICE)

pages 203 thru 208

Notes Ck'd by D.M. Finley	Survey of [illegible]
Map No. B-1427-4	W. 08208 Tape No. [illegible] St'd 84° F.
Office Work H. H. REYNOLDS	Surveyed by L.D. Nichols
Checked D. M. Finley	Notes D. Nichols Date 5-25-36
Date Jan. 1940.	Indexed 6-9-38

F.B. 334 Pg. 203

Note: Any Additions or Changes on This Sheet Must be Made or Circled in Red Ink With Date and Name of Person Making Change

Do not extend notes this side of this line

SURVEY
OF
CENTURY BLVD.
FROM
SUCCESS AVE.
TO
CENTRAL AVE.
Job # 6208

Moore
Nichols
Lawson
Scott

May 1936

RETURN TO
LOS ANGELES COUNTY SURVEYOR
700 HALL OF RECORDS

FORM 247 10M 11-35

F.B. 739 PG. 204

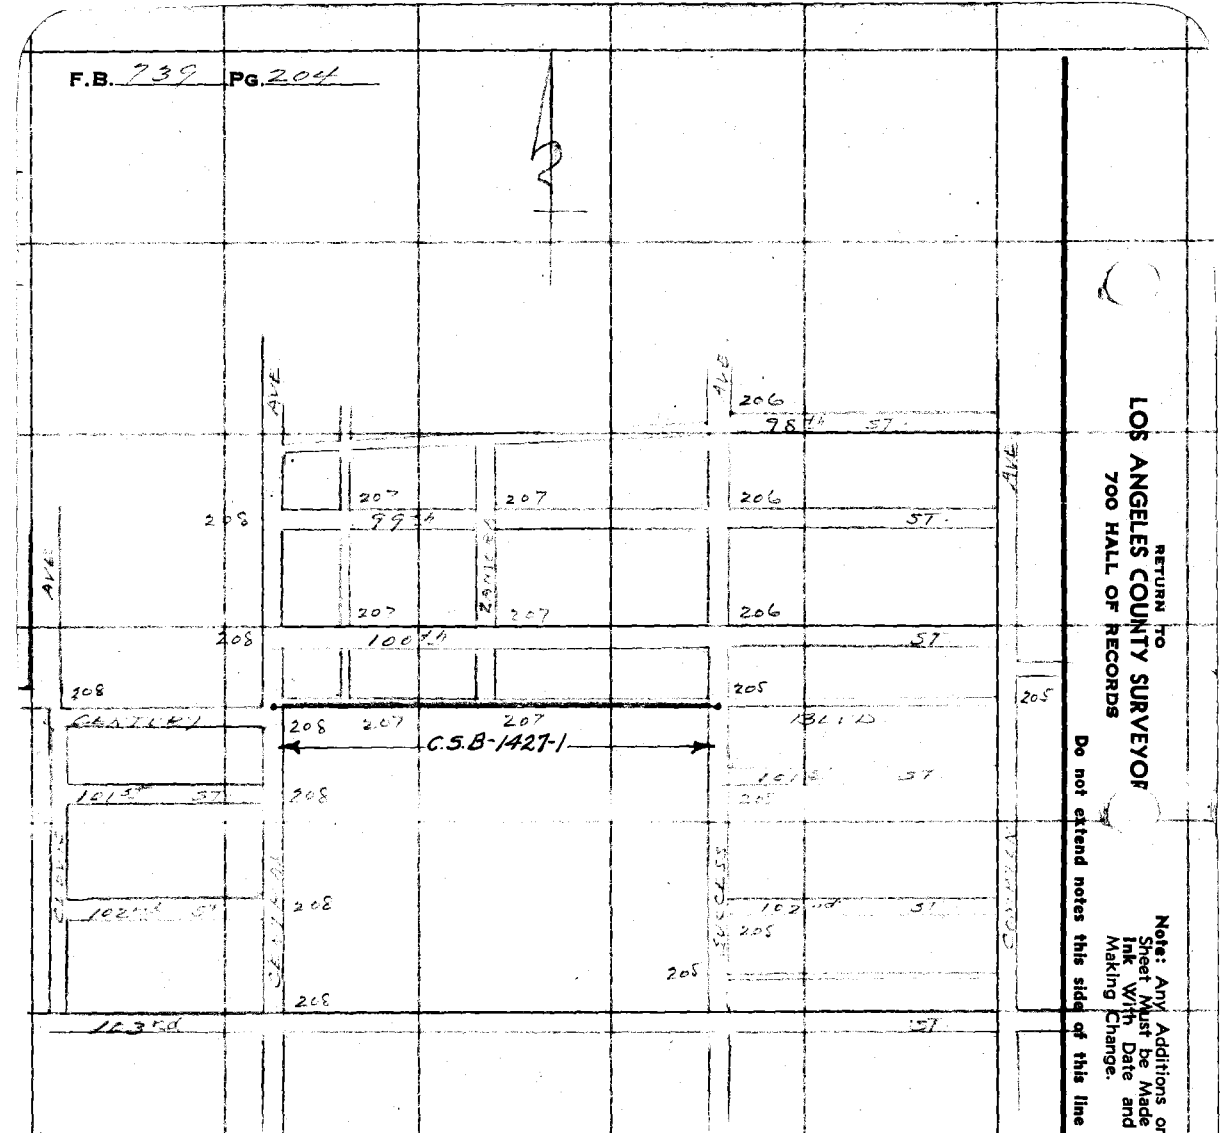
ALLEY
206
78.74
57.
207
207
206
208
99.74
57.
207
207
206
208
100.24
57
208
205
205
CENTER
208
207
207
C.S.B-1427-1
BLVD
101.5
57
208
102.24
57
208
205
208
208
205
102.56
57
RETURN TO
LOS ANGELES COUNTY SURVEYOR
700 HALL OF RECORDS
Do not extend notes this side of this line
Note: Any Additions or Changes on This Sheet Must be Made or Circled in Red Ink With Date and Name of Person Making Change.
Topography pgs. 209 - 220

Notes Ck'd by D.M.Finley	Survey of
Map No. B-1427-2	W. O. 8208 Tape No. 622 St'd 84 °F.
Office Work H. H. REYNOLDS	Surveyed by
Checked D. M. Finley	Notes Date 5-25-38
Date Jan. 1940.	Indexed

F.B. 734 PG. 5

(89° 54' 40" / 359 38 45)

(Fd 2" I.P. / 360. 21 15)

To Junction Ave. 20

Other Bearing West

Set 5/8" rd. iron per F.B. 983-9

15 Rd.

90° 05' 15" 89° 54' 45"

Set Nail & Tag

29.15 Tan

28.40 Tan

29.58

Fd Nail & Tag

ALLEY

764.86

20.00

7.60

Fd 2" I.P. 7" deep F.B. 983-9

Fd 2" I.P. 6" deep F.B. 983-9

Fd Nail & Tag Cover initials 4 Tang. F.M.Co. Elev. F.B. 391-76 F.B. 983-10

Angle Point Set 5/8" rd. iron per F.B. 983-9 See detail

30.00

Fd 5/8" rd. iron F.B. 474-20 F.B. 983-9

Fd 5/8" rd. iron F.B. 474-20 Removed.

5/8" rd. iron New Set

7.60

0.14

0.04

1.50

Succession

279.

Fd Nail

101.

ST.

27.85

Fd Nail

T = 84°

Fd 5/8" rd. iron F.B. 474-20 F.B. 983-9

162.24 ST.

(179° 35' 30" / 358 22 00)

Fd 5/8" rd. iron F.B. 474-20 F.B. 983-11

ALLEY

Fd 2" I.P. Mon. Well

32.24

10.02

25.41

3.16

Fd x on Rock

1 x 1 x 24" Post

Concrete

AVE

100.41

ST

23.12

21.22

24.17

Fd Nail & Tag

COMPTON

Fd Nail & Tag

RETURN TO
LOS ANGELES COUNTY SURVEYOR
700 HALL OF RECORDS

Note: Any Additions or Changes on This Sheet Must be Made or Circled in Red Ink With Date and Name of Person Making Change

Do not extend notes this side of this line

FORM 247 10M 11-38

F.B. 739 PG. 206

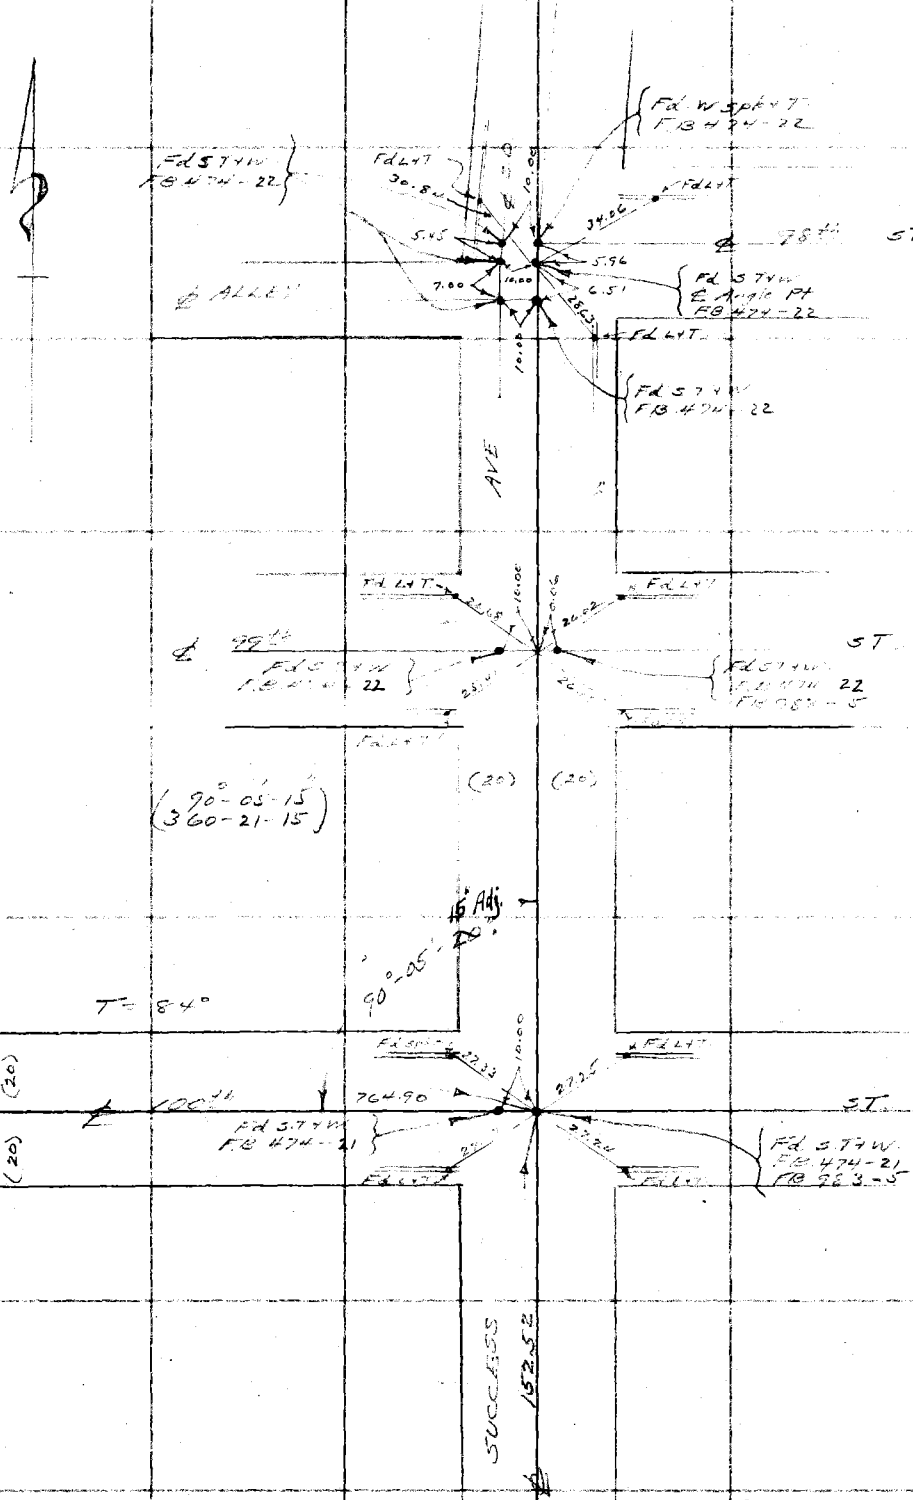

WS 786

RETURN TO
LOS ANGELES COUNTY SURVEYOR
700 HALL OF RECORDS

Note: Any Additions or Changes on This Sheet Must be Made or Circled in Red Ink With Date and Name of Person Making Change.

Do not extend notes this side of this line

Notes Ck'd by D.M. Finley	Survey of	F.B. 752 Pg. 207
Map No. B-1427-1	W. O. 8266 Tape No. 632 St'd 84 °F.	
Office Work H. H. REYNOLDS	Surveyed by	
Checked D. M. Finley	Notes	Date 5-24-35
Date Jan 1940.	Indexed	

WS 7 - B6

To right pg. 205

151.45

158.80

Set Nail & tag RE 583-3

FdLHT

152.52

ALLEY

18.09

17.91

18.02

18.02

1346.18
Fd 2"x2" Ik
6" deep
RE 583-7

89° 52' 15"

(89-52-15)
(359-28-45)

(75) (75)

(20) (20)

T = 84.0

601.32

ALLEY

(90-05-00)
360-20-15

100.00

COUNTY

90.00

80° 05' 05"

ZAMORA

152.52

25.43

25.33

25.59

25.67

.86

Set Nail & tag RE 583-4 Ly 1.41 W of Ext. of N line

54' 55"

89°

764.86 (M)

764.90

Set Tack & tag RE 583-4

(89-55-00)
359-39-45

From left pg. 205

From left pg. 206

RETURN TO
LOS ANGELES COUNTY SURVEYOR
700 HALL OF RECORDS

Note: Any Additions or Changes on This Sheet Must be Made or Circled in Red Ink With Date and Name of Person Making Change

Do not extend notes this side of this line

FORM 247 10M 11-35

WS 26-C1
WS 7-B6

RETURN TO
LOS ANGELES COUNTY SURVEYOR
700 HALL OF RECORDS

Note: Any Additions or Changes on This Sheet Must be Made or Circled in **Red Ink** With Date and Name of Person Making Change.

Do not extend notes this side of this line

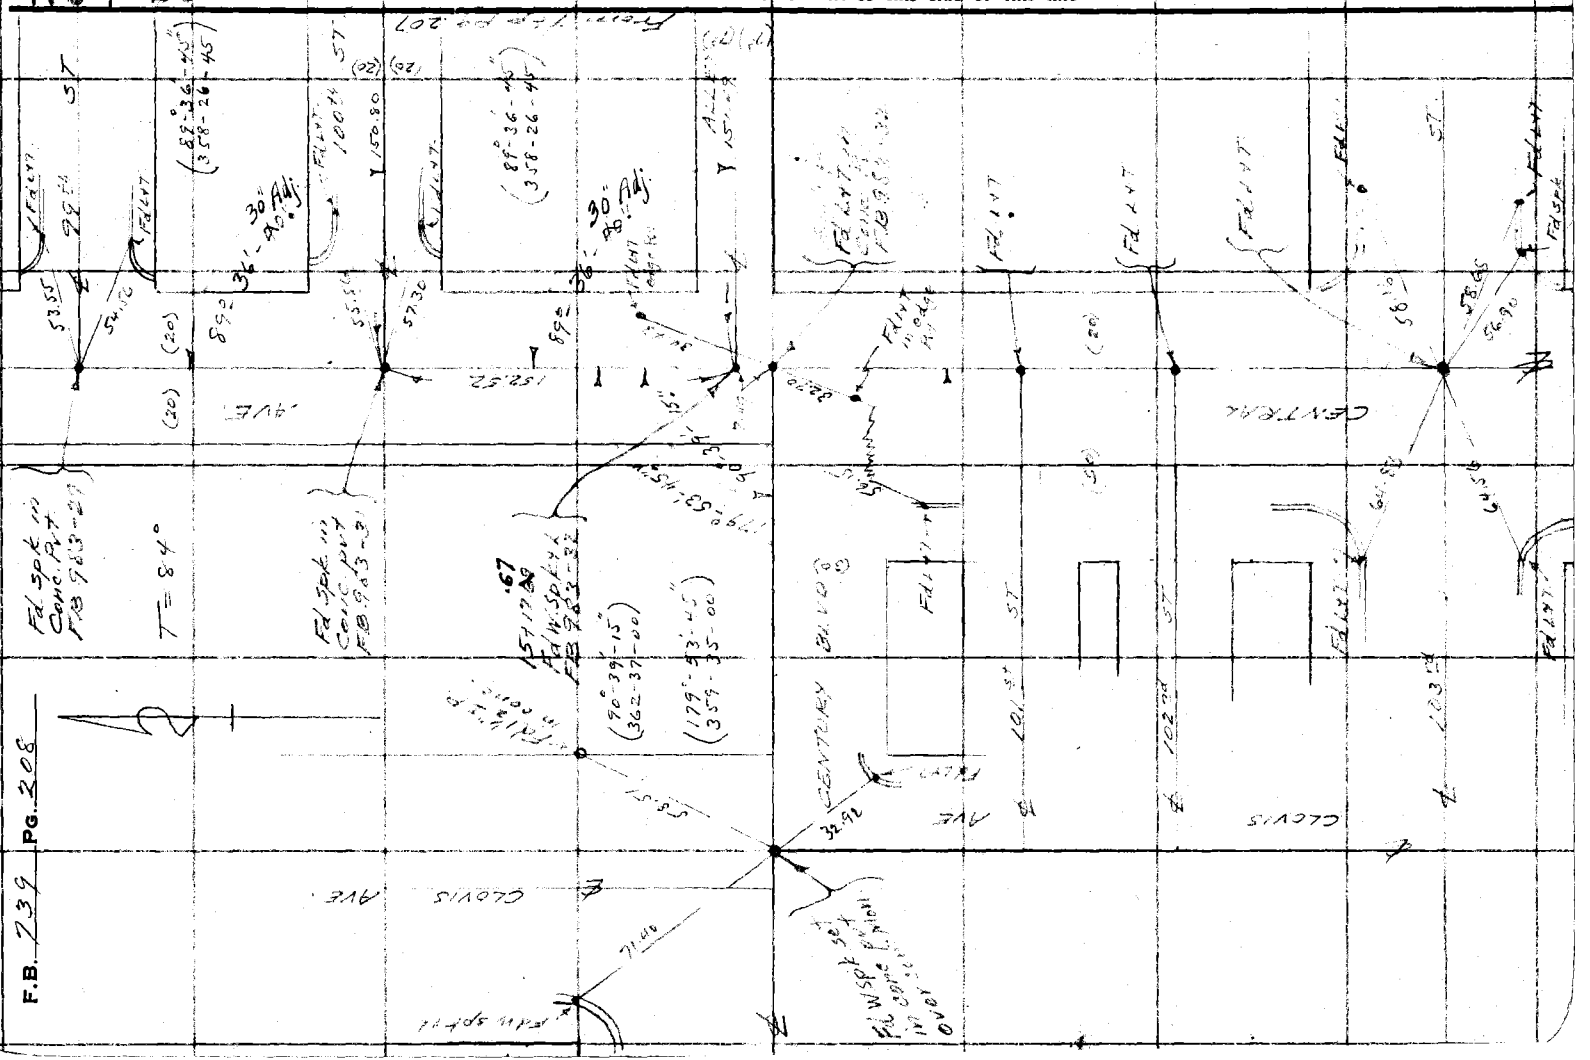

Notes Ck'd by D. M. Finley	Survey of Century Blvd	F.B. 23[illegible]	Pg. [illegible]
Map No. B-1427-3	W. O. 8205 Tape No. St'd °F.		
Office Work H. H. REYNOLDS	Surveyed by L. O. D. Wolfe		
Checked D. M. Finley	Notes D. Wolfe Date 6-7-38		
Date Jan. 1940.	Indexed [illegible]		

TOPOGRAPHY
ON
CENTURY BLVD
FROM
SUCCESS AVE
TO
CENTRAL AVE
Job # 8205

Note: Any Additions or Changes on This Sheet Must be Made or Circled in Red Ink With Date and Name of Person Making Change

Do not extend notes this side of this line

RETURN TO
LOS ANGELES COUNTY SURVEYOR
700 HALL OF RECORDS

FORM 247 10M 11-38

RETURN TO
LOS ANGELES COUNTY SURVEYOR
700 HALL OF RECORDS

Note: Any Additions or Changes on This Sheet Must be Made or Circled in Red Ink With Date and Name of Person Making Change.

Do not extend notes this side of this line

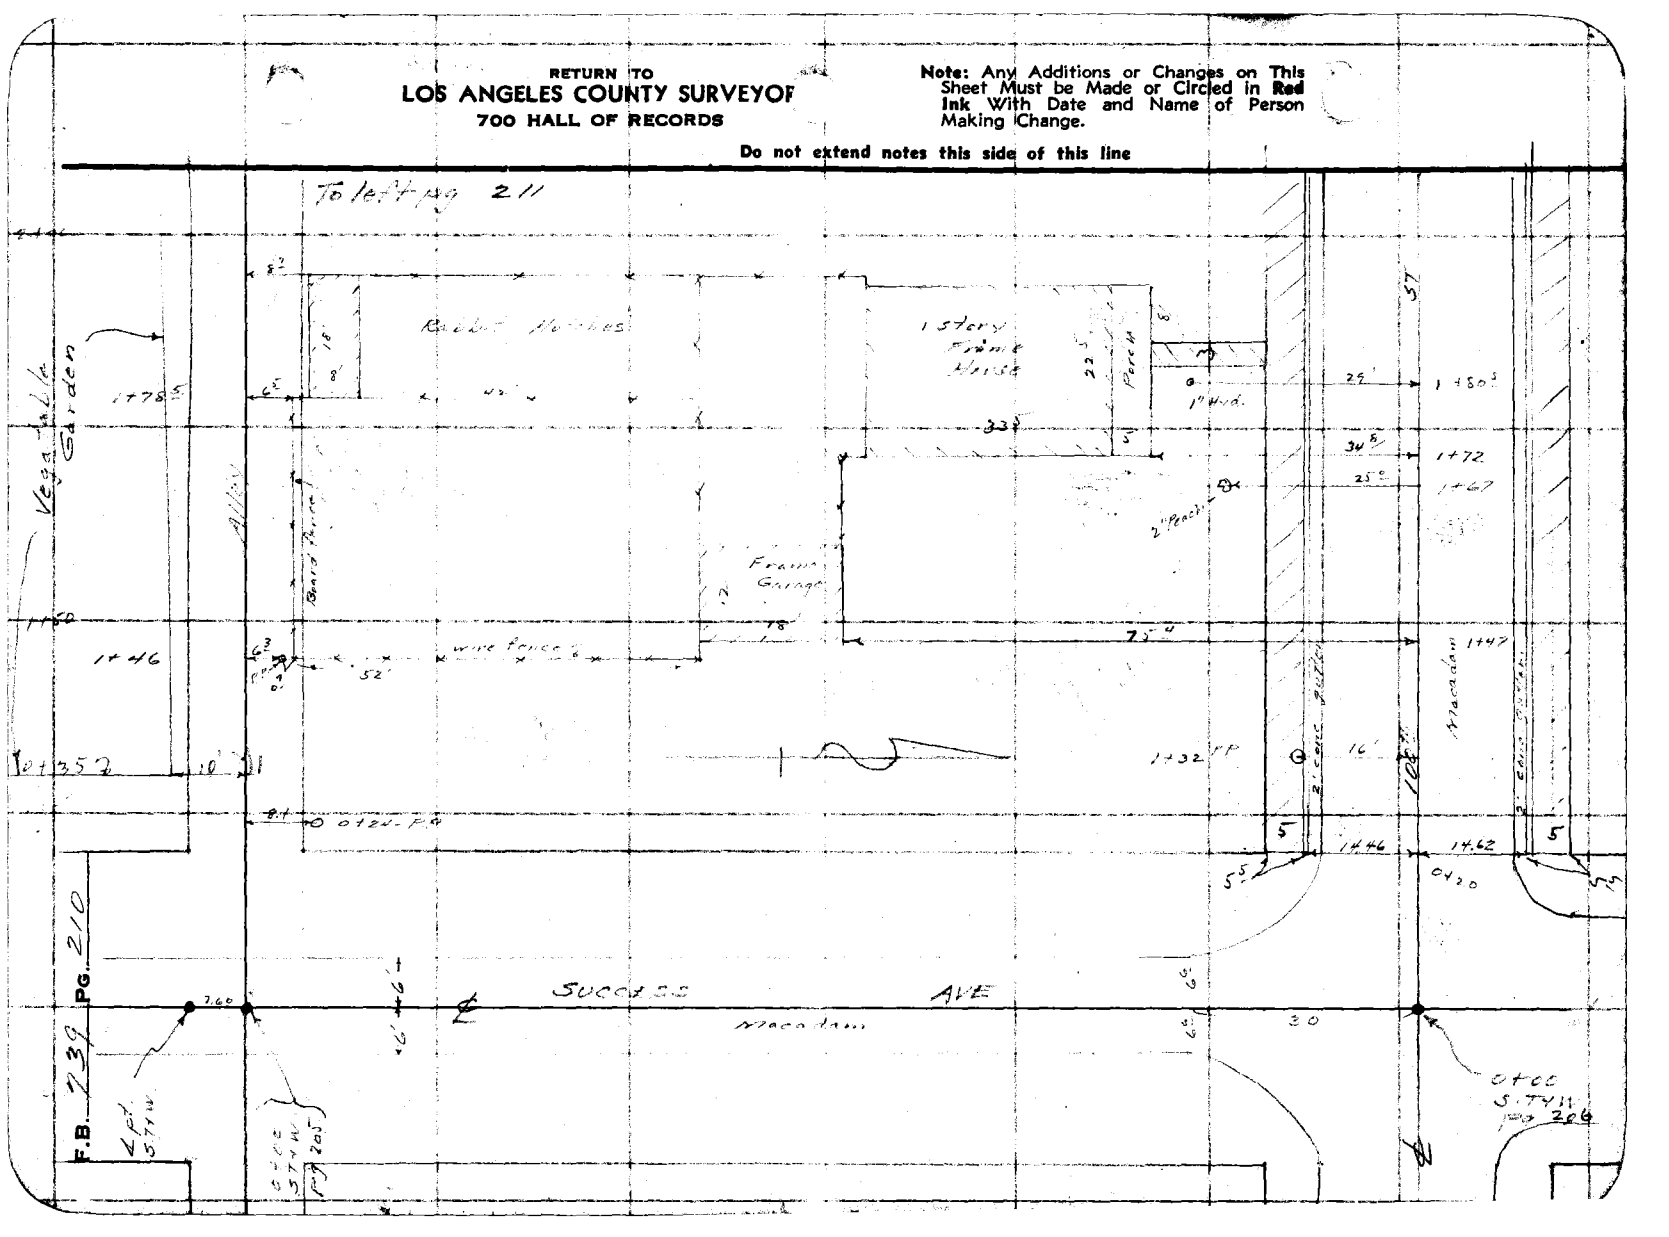

Notes Ck'd by D. M. Finley		Survey of	
Map No. B-1427-L		W. O. 5205	Tape No. St'd °F.
Office Work H. H. REYNOLDS		Surveyed by	
Checked D. M. Finley		Notes	Date
Date Jan. 1940		Indexed 6-9-38	

F.B. 739 PG. 211

Vegetable Garden

Note: Any Additions or Changes on This Sheet Must be Made in Red Ink With Date and Name of Person Making Change.

Do not extend notes this side of this line

RETURN TO
LOS ANGELES COUNTY SURVEYOR
700 HALL OF RECORDS

FORM 247 10M 11-38

RETURN TO
LOS ANGELES COUNTY SURVEYOR
700 HALL OF RECORDS

Note: Any Additions or Changes on This Sheet Must be Made or Circled in **Red Ink** With Date and Name of Person Making Change.

Do not extend notes this side of this line

F.B. 739 PG. 212

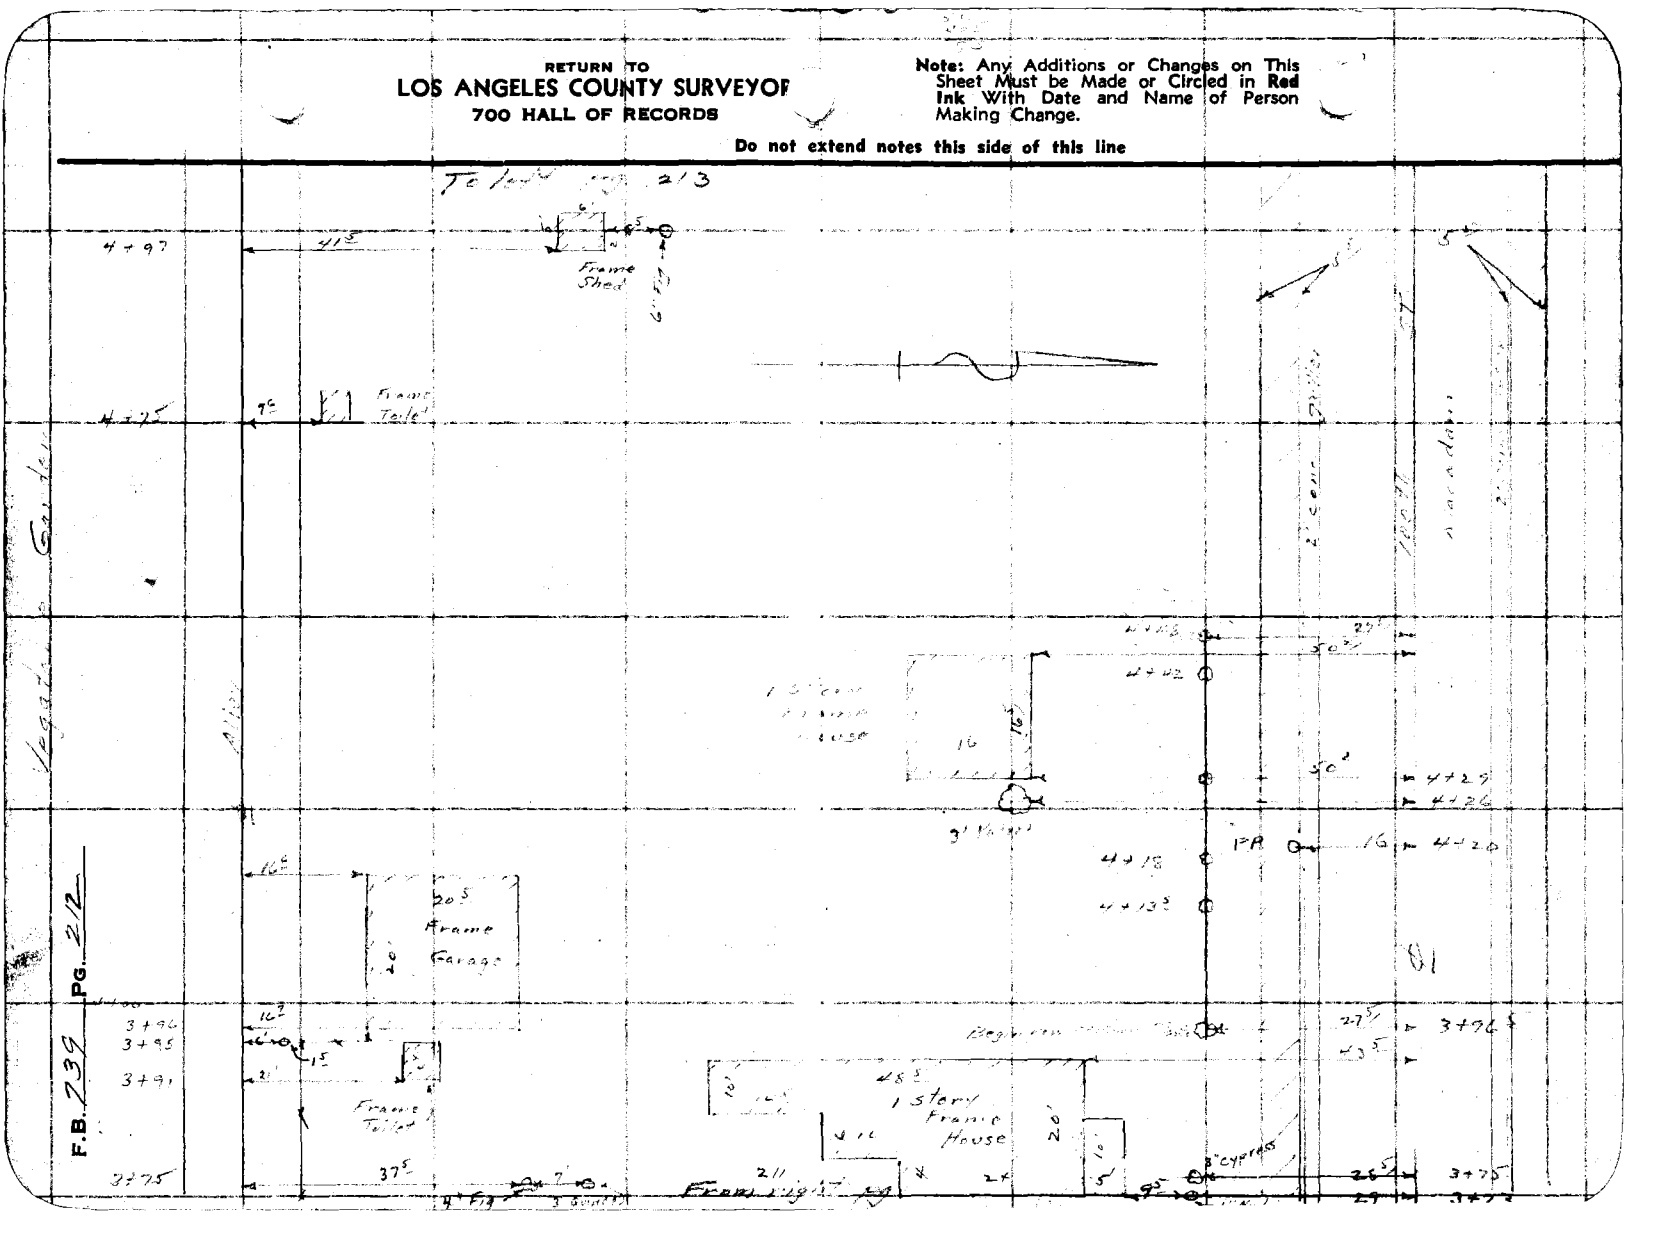

FORM 247 10M 11-35

RETURN TO
LOS ANGELES COUNTY SURVEYOR
700 HALL OF RECORDS

Note: Any Additions or Changes on This Sheet Must be Made or Circled in **Red Ink** With Date and Name of Person Making Change

Do not extend notes this side of this line

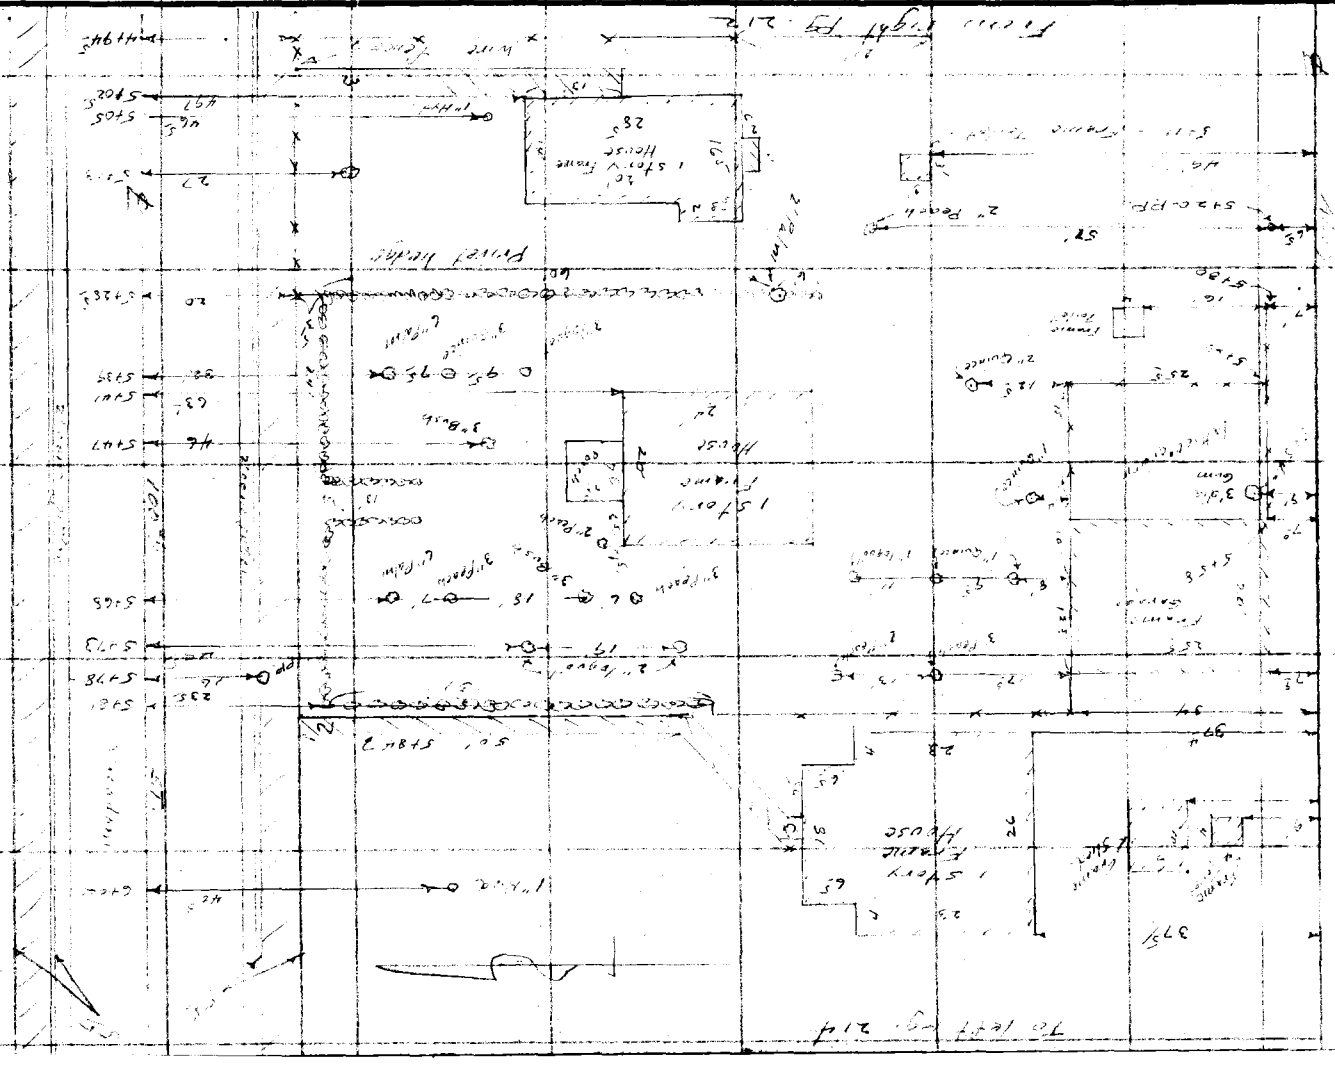

Notes Ck'd by D. M. Finley
Map No. B-1427-1
Office Work H. H. REYNOLDS
Checked D. M. Finley
Date Jan. 1946

Survey of
W. O. 2255 Tape No. Std. °F.
Surveyed by
Notes
Date 6-1-36
Indexed

F.B. 231 PG. 21

RETURN TO
LOS ANGELES COUNTY SURVEYOR
700 HALL OF RECORDS

Note: Any Additions or Changes on This Sheet Must be Made or Circled in **Red** Ink With Date and Name of Person Making Change.

Do not extend notes this side of this line

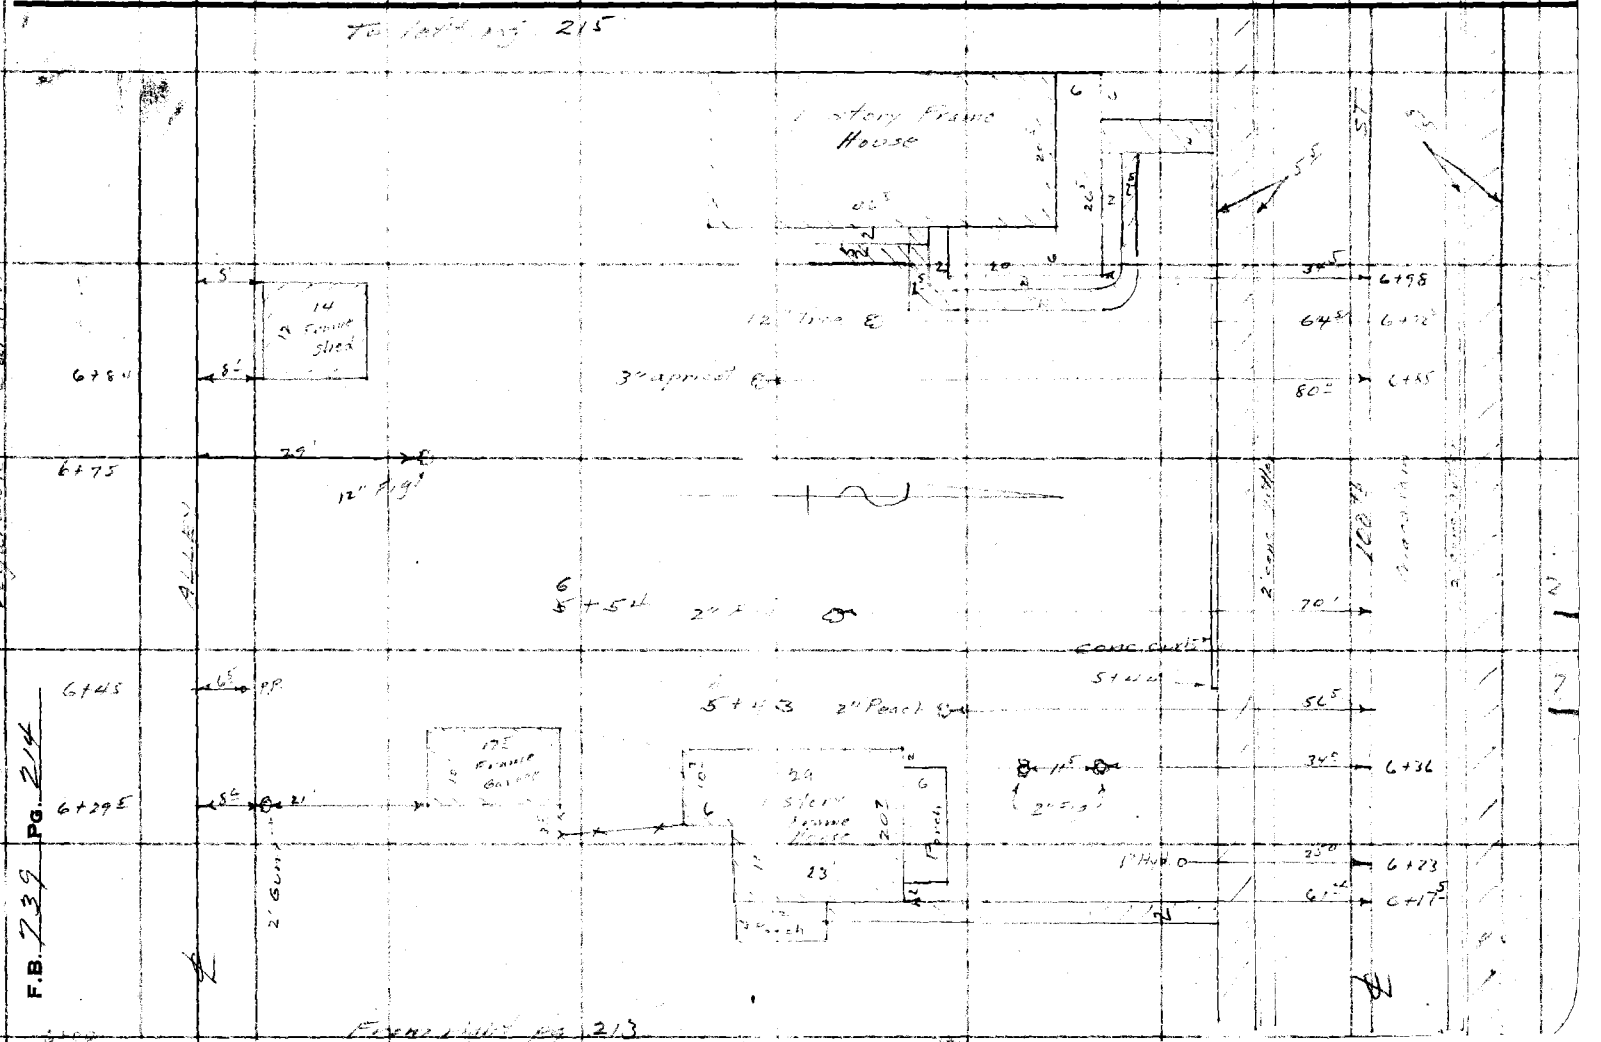

FORM 247 10M 11-35

RETURN TO
LOS ANGELES COUNTY SURVEYOR
700 HALL OF RECORDS

Note: Any Additions or Changes on This Sheet Must be Made or Circled in **Red Ink** With Date and Name of Person Making Change.

Do not extend notes this side of this line

Notes Ck'd by
Map No. B-1427-1
Office Work H. H. REYNOLDS
Checked D. M. Finley
Date Jan. 1940

Survey of
W. O.
Tape No. St'd. °F.
Surveyed by
Notes
Date
Indexed

F.B. PG.

RETURN TO
LOS ANGELES COUNTY SURVEYOR
700 HALL OF RECORDS

Note: Any Additions or Changes on This Sheet Must be Made or Circled in Red Ink With Date and Name of Person Making Change.

Do not extend notes this side of this line

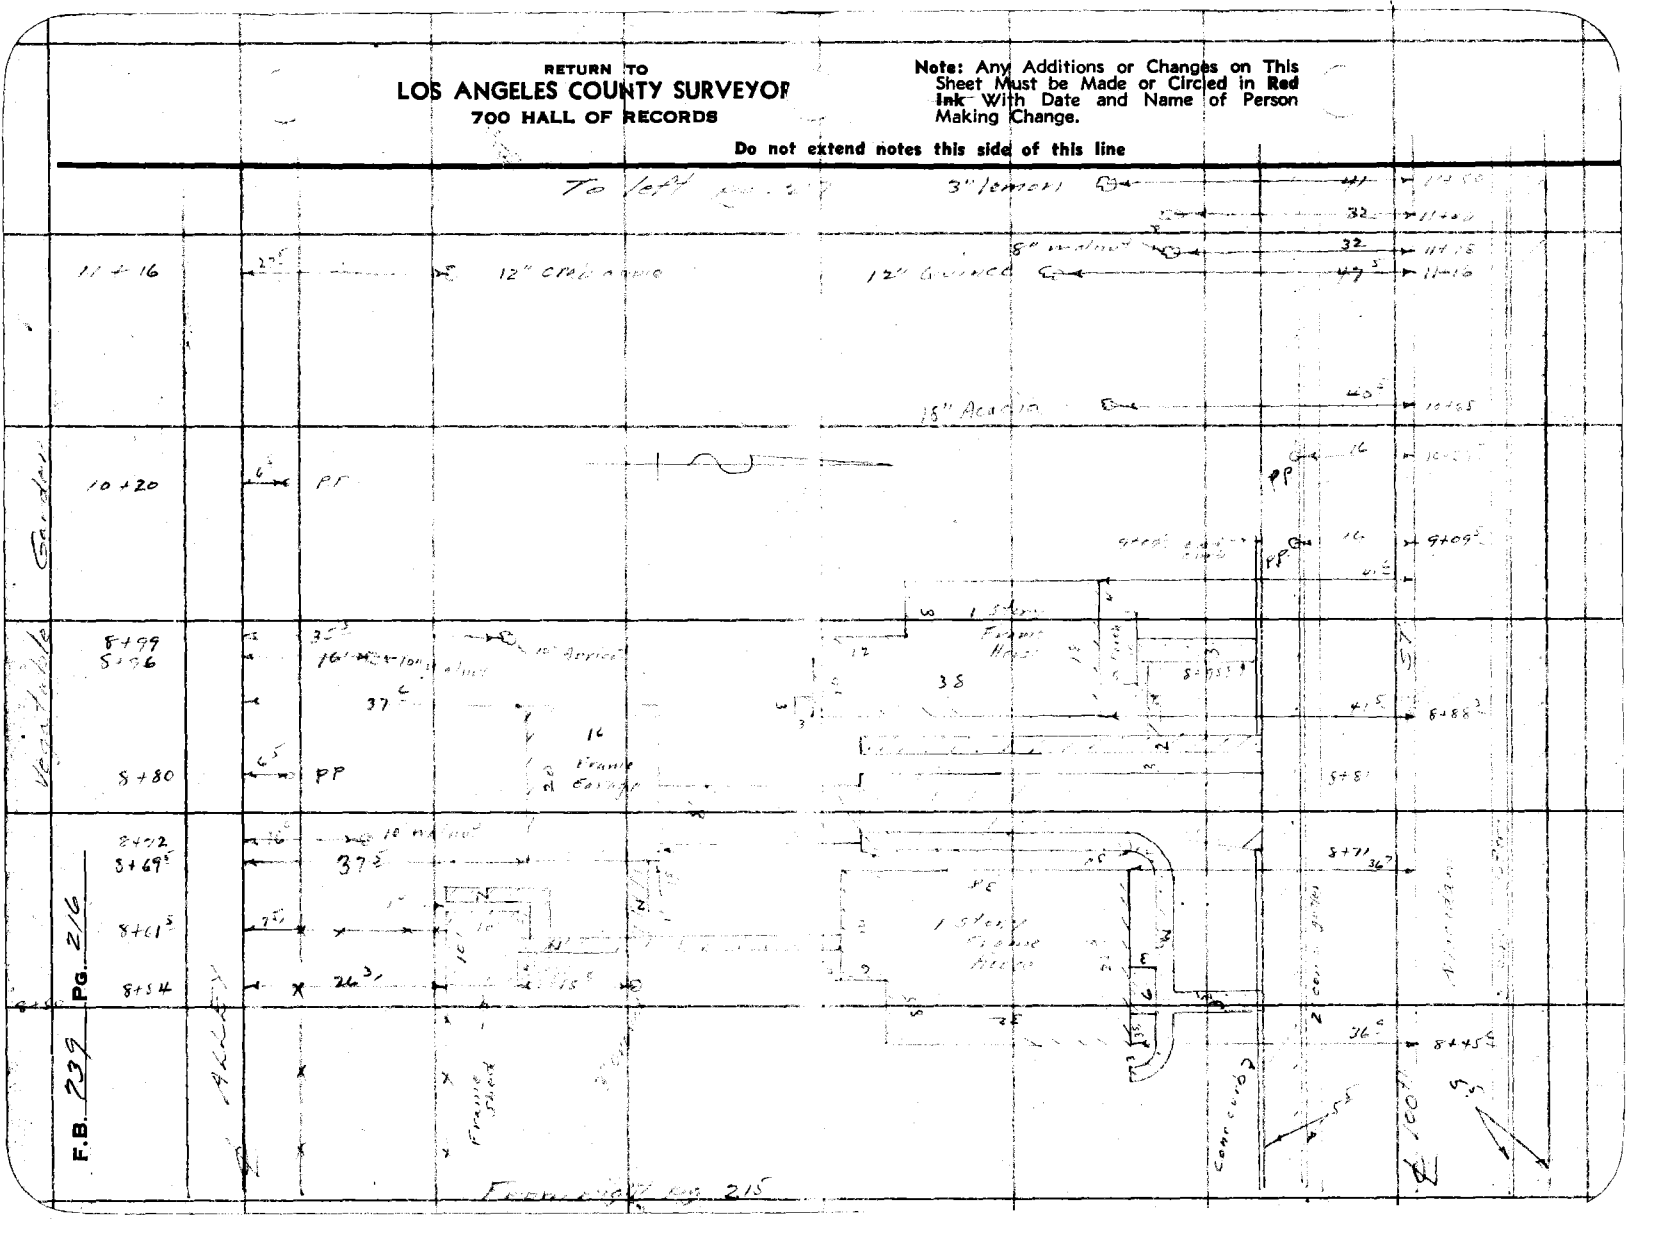

FORM 247 10M 11-38

RETURN TO
LOS ANGELES COUNTY SURVEYOR
700 HALL OF RECORDS

Note: Any Additions or Changes on This Sheet Must be Made or Circled in **Red Ink** With Date and Name of Person Making Change.

Do not extend notes this side of this line

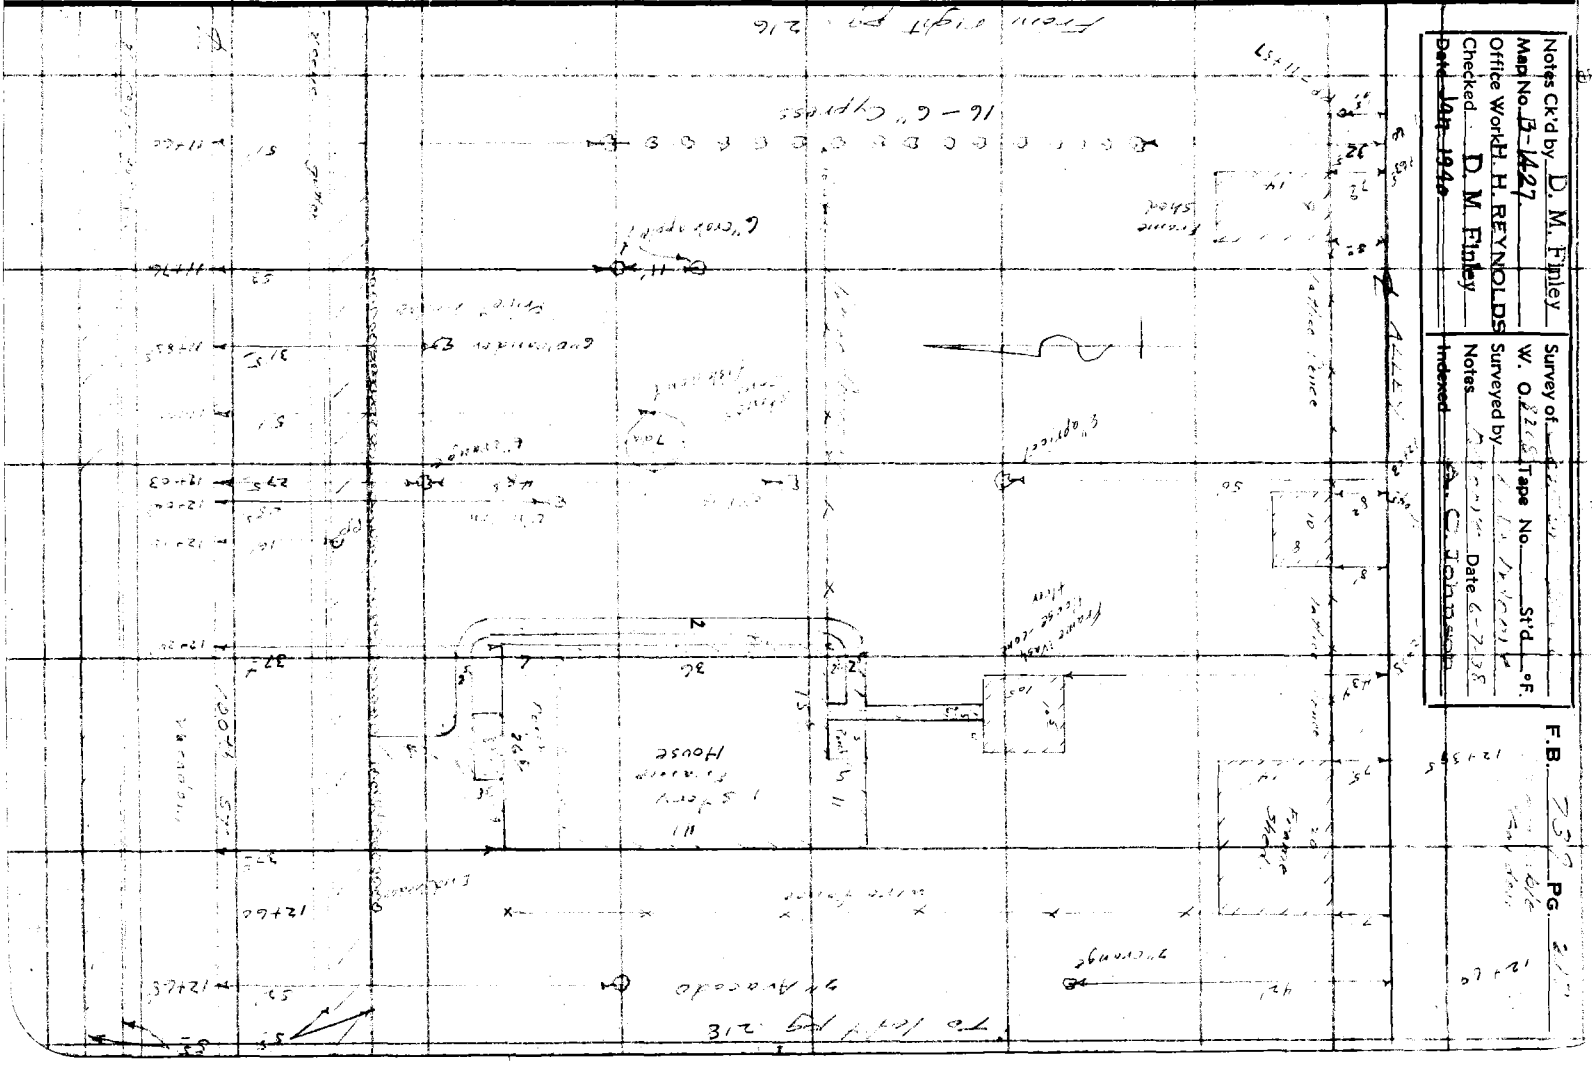

Notes Ck'd by D. M. Finley
Map No. B-1427
Office Work H. H. REYNOLDS
Checked D. M. Finley
Date Jan 1940

Survey of
W. O.
Tape No. St'd. °F.
Surveyed by
Notes Date 6-7-38
Indexed

F.B. PG.

RETURN TO
LOS ANGELES COUNTY SURVEYOR
700 HALL OF RECORDS

Note: Any Additions or Changes on This Sheet Must be Made or Circled in Red Ink With Date and Name of Person Making Change.

Do not extend notes this side of this line

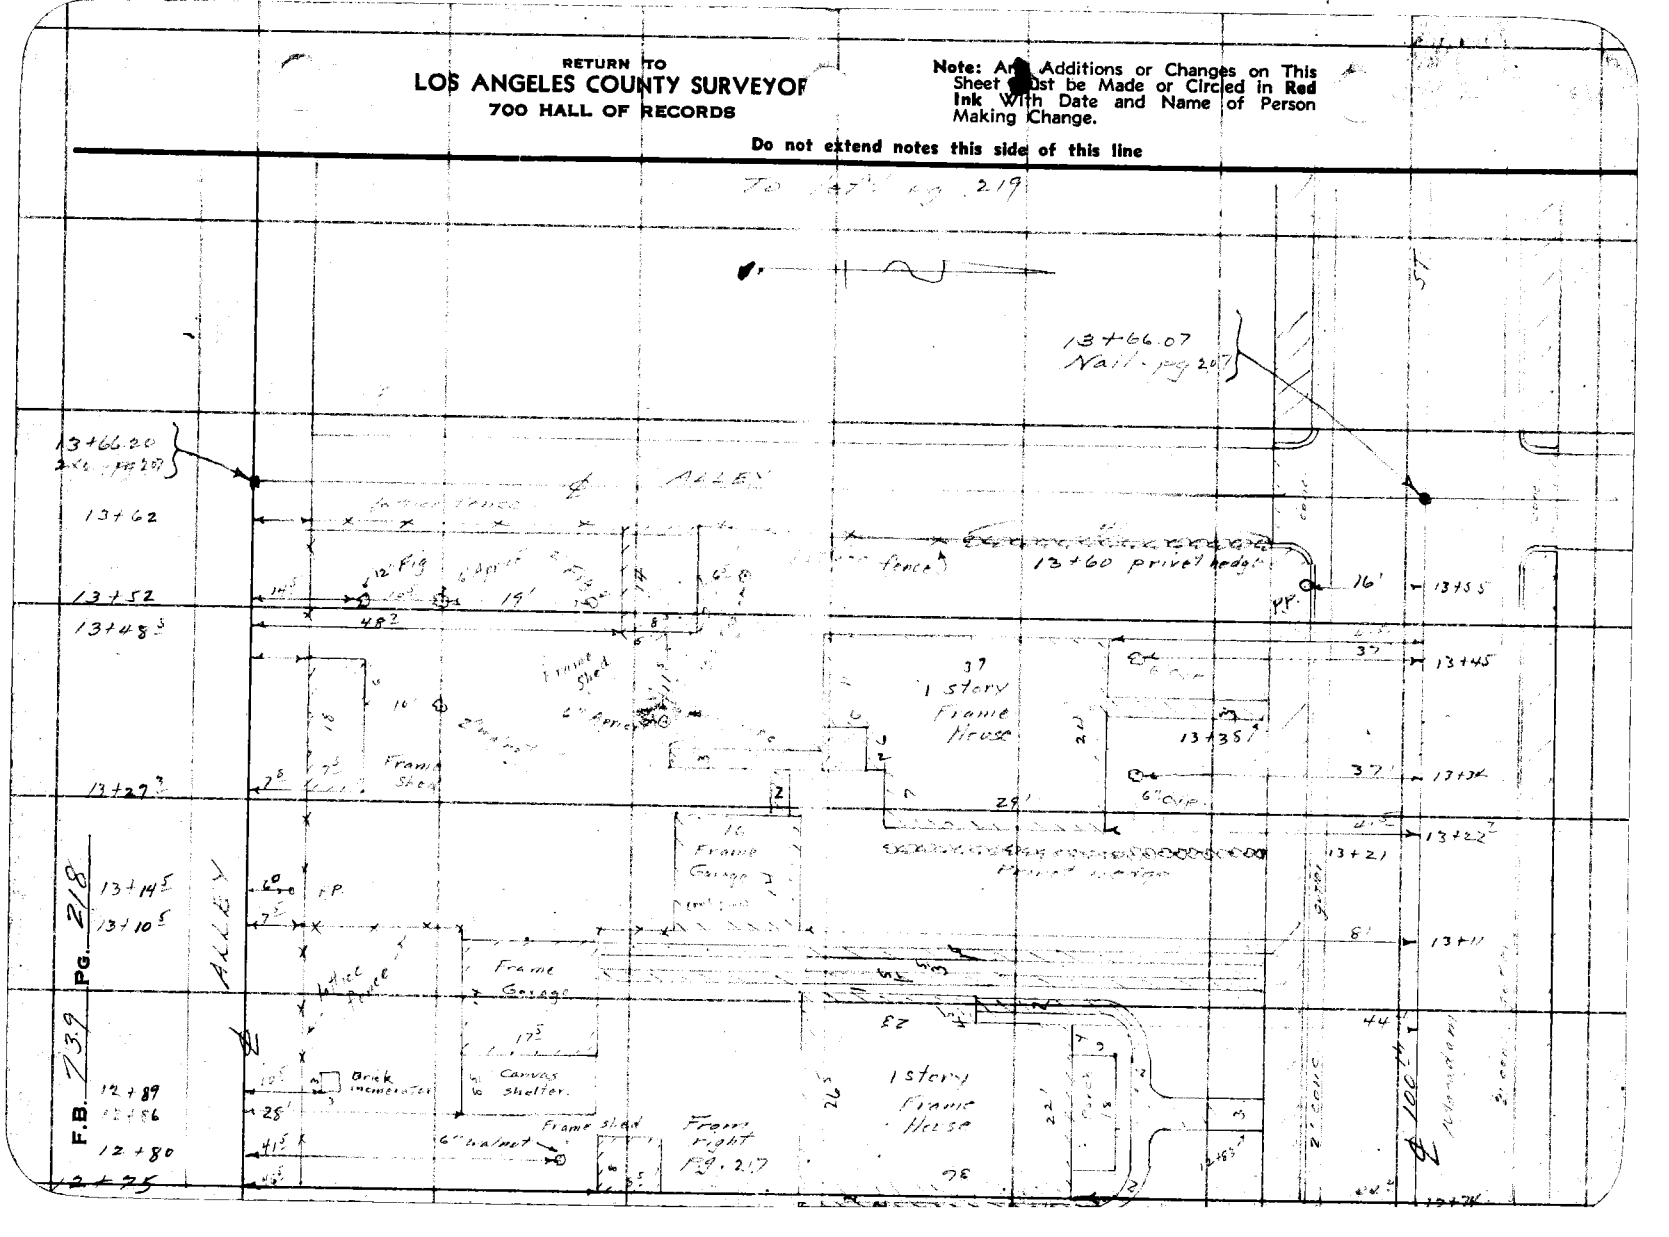

Notes Ck'd by	Survey of Century Blvd
Map No. B-1427-1	W. O. 5868 Tape No. St'd °F.
Office Work H. H. REYNOLDS	Surveyed by J. Reynolds
Checked D. M. Finley	Notes Moore Date 6-7-38
Date Jan. 1940.	Indexed A. C. Johnson

F.B. 139 Pg. 217

Vegetable Garden

CENTURY BLVD

ALLEY

15+17.69 W Spike in P.P. Lt. 206

15+16.87 Spike in P.P. Lt. 206

CENTRAL AVE.

PAVEMENT

Note: Any Additions or Changes on This Sheet Must be Made or Circled in Red Ink With Date and Name of Person Making Change.

Do not extend notes this side of this line

RETURN TO
LOS ANGELES COUNTY SURVEYOR
700 HALL OF RECORDS

FORM 247 10M 11-38

RETURN TO
LOS ANGELES COUNTY SURVEYOR
700 HALL OF RECORDS

Note: Any Additions or Changes on This Sheet Must be Made or Circled in **Red Ink** With Date and Name of Person Making Change.

Do not extend notes this side of this line

F.B. 239 Pg. 220

Notes Ck'd by	Survey of Century Blvd.
Map No.	W. O. 8208 Tape No. Std. °F
Office Work	Surveyed by W.E. Braden
Checked	Notes Holmes Date 2/6-46
Date	Indexed

F.B. 739 PG. 281

CENTURY BLVD.

ADDITIONAL TOPOG.

Prairie Ave to Freeman Ave
so. side

J.N. 8208

FEB. - 1946

W.E. Braden
D.E. Holmes
A.R. Faulstich
L.J. Bowles

Note: Any Additions or Changes on This Sheet Must be Made in Ink With Date Made or Circled in Red and Name of Person Making Change

Do not extend notes this side of this line.

RETURN TO
LOS ANGELES COUNTY SURVEYOR
700 HALL OF RECORDS

FORM 247 SM 12-42

F.B. 739 Pg 222

105+87.35 S.M.H. F.B. 739-142

℄ PRAIRIE AVE

N 35°

33°

19.5 W.M. 106+52°

18°

108+33.7

54.5

Conc. Blocks

44°

108+41.8

23.2

1 STORY STUCCO STORE Bldg

20°

31°

13°

18°

12°

21.5 W.M. 108+21.5

109+25.5 S.S.M.H.

109+36.5 32.6

4° Picket fence

4° W.W. fence

62.6

21.1

Stucco Garage

20.1

109+45.5 65.4

Century Blvd

109+65.0 19.7 W.M.

65.1

1 Story Stucco House

111+28.5 47.8

92.3

4° Picket fence

257.0

30.5

175

111+39.0 25.5 W.M.

1 Story Frame

47.7

Motor Court Under Construction.

111+70.5 S.S.M.H.

To Top. Page 223

RETURN TO
LOS ANGELES COUNTY SURVEYOR
700 HALL OF RECORDS

Do not extend notes this side of this line.

Note: Any Additions or Changes on This Sheet Must be Made or Circled in Red Ink With Date and Name of Person Making Change.

Notes Ck'd by	Survey of Century Blvd
Map No.	W. O. 2202 Tape No. Std °F
Office Work	Surveyed by W.E Braden
Checked	Notes Holmes Date 2-7-46
Date	Indexed C. Jensen

F.B. 739 Pg. 223

Note: Any Additions or Changes on This Sheet Must be Made or Circled in Red Ink With Date and Name of Person Making Change.

Do not extend notes this side of this line.

RETURN TO
LOS ANGELES COUNTY SURVEYOR
700 HALL OF RECORDS

FORM 247 3M 12-49

cont. from bot. Page 222

47'

Motor court under construction

25'

111+69 — 47' — 47'

38' 17' 30' 17' 30'

1 Story Frame 16' 16' 16' 16'

33' 17' 30' 17' 30'

257'

113+12+12'
S.D.M.H.

East Wood Ave

P.M. - M.H.
F.B. 739-143 - 183
114+15 28

115+04 — 72' — Blvd

6' board fence

Century (33)

634'

72'

115+96 — 18' — W.M.

116+62 S.S.M.H.

117+24 — 19' — 2'x2' Conc. Slab — H.H.

117+34 — 16' — C.H.H. 24 — H.H.

P.M. - M.H.
F.B. 739-144-184
119+07 39

Freeman Ave

RETURN TO
LOS ANGELES COUNTY SURVEYOR
700 HALL OF RECORDS

Note: Any Additions or Changes on This Sheet Must be Made or Circled in **Red Ink** With Date and Name of Person Making Change.

Do not extend notes this side of this line.

F.B. 1739 PG. 224

Notes Ck'd by	Survey of Century Blvd
Map No.	W. O. 8268 Tape No. Std °F
Office Work	Surveyed by W E Braden
Checked	Notes Date 2/8/46
Date	Indexed

F.B. 739 Pg. 223

CENTURY BLVD

ADD. TOPOG.

Hawthorne Ave to Inglewood Ave

J.N. E208

FEB. 1946

W E Braden
D E Holmes
A R Barlett
I J Bowles

Note: Any Additions or Changes on This Sheet Must be Made in Red Ink or Circled With Date and Name of Person Making Change.

Do not extend notes this side of this line.

RETURN TO
LOS ANGELES COUNTY SURVEYOR
700 HALL OF RECORDS

FORM 247 3M 12-49

F.B. 739 PG. 226

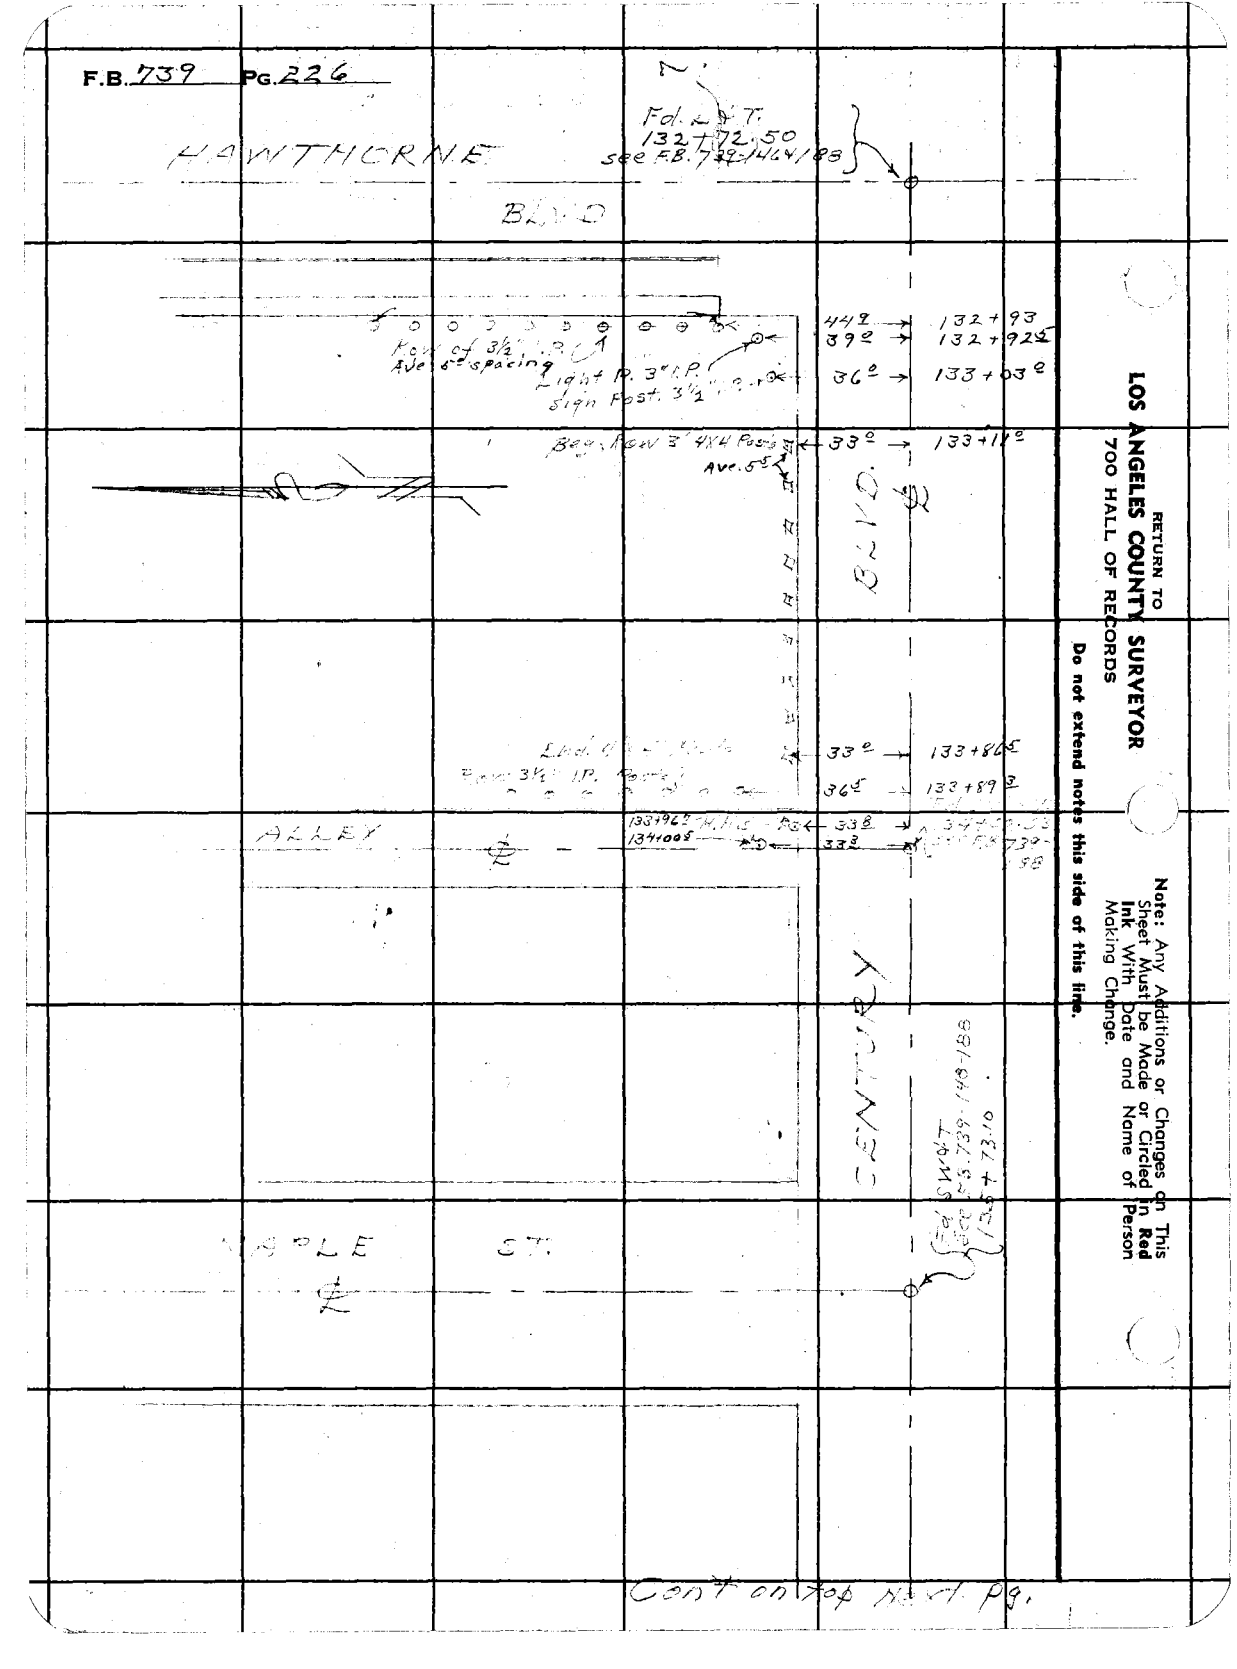

RETURN TO
LOS ANGELES COUNTY SURVEYOR
700 HALL OF RECORDS

Do not extend notes this side of this line.

Note: Any Additions or Changes on This Sheet Must be Made or Circled in Red Ink With Date and Name of Person Making Change.

Cont on top next pg.

Notes Ck'd by	Survey of Century Blvd
Map No.	W. O. 5208 Tape No. Std °F
Office Work	Surveyed by W. E. Braden
Checked	Notes Braden Date 2/11/46
Date	Indexed

F.B. 1739 Pg. 227

Cont'd from Vol. 1687 Pg.

535

329

136+40

BLVD

945

137+40

53

329

ALLEY

137+45 ℄ MH's

325

CENTURY

GREVILLEA

Pvt. path over Telephone cond. right

45°

AVE

38°

139+42.5

Outfall 12" Drain pipe

137+69.5

19

Cont on top of Next Pg.

Note: Any Additions or Changes on This Sheet Must be Made in Red Ink With Date and Name of Person Making Change

Do not extend notes this side of this line.

RETURN TO
LOS ANGELES COUNTY SURVEYOR
700 HALL OF RECORDS

FORM 247 3M 12-9

F.B. 739 Pg. 228

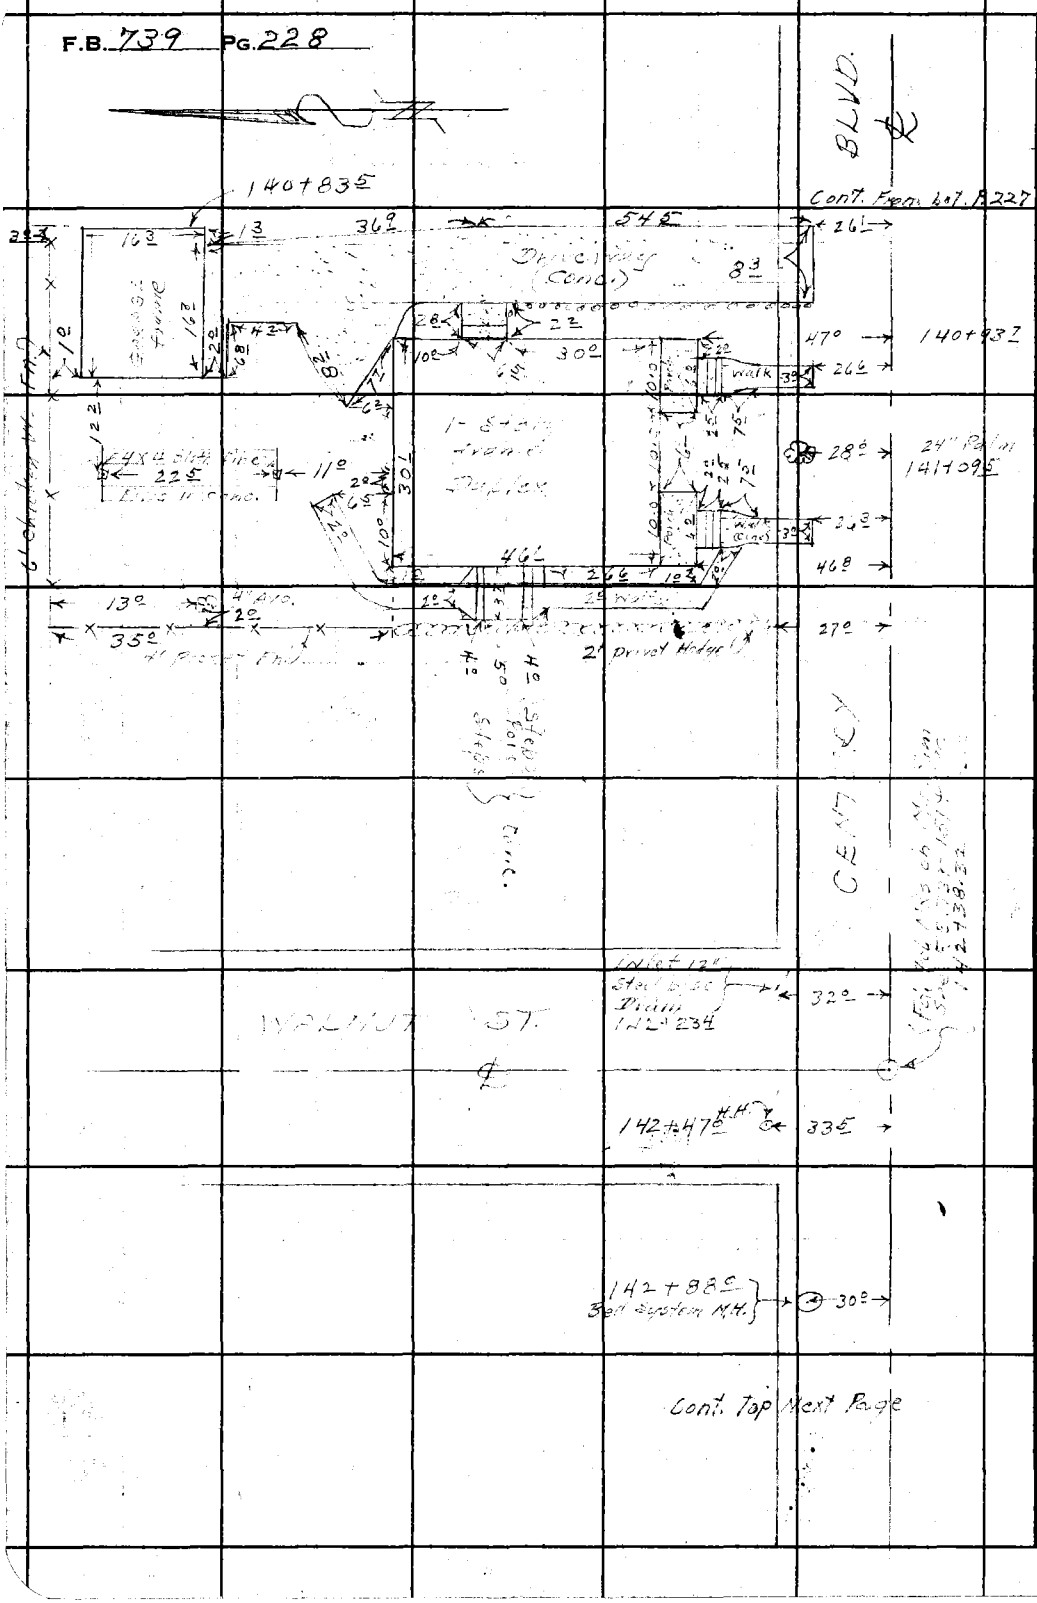

RETURN TO
LOS ANGELES COUNTY SURVEYOR
700 HALL OF RECORDS

Do not extend notes this side of this line.

Note: Any Additions or Changes on This Sheet Must be Made or Circled in **Red Ink** With Date and Name of Person Making Change.

Notes Ck'd by	Survey of Century Blvd
Map No.	W. O. 8208 Tape No. Std °F
Office Work	Surveyed by W.E. Braden
Checked	Notes Holmes Date 2-11-46
Date	Indexed A. C. JONES

F.B. 739 PG. 229

Note: Any Additions or Changes on This Sheet Must be Made or Circled in Red Ink With Date and Name of Person Making Change

Do not extend notes this side of this line.

RETURN TO
LOS ANGELES COUNTY SURVEYOR
700 HALL OF RECORDS

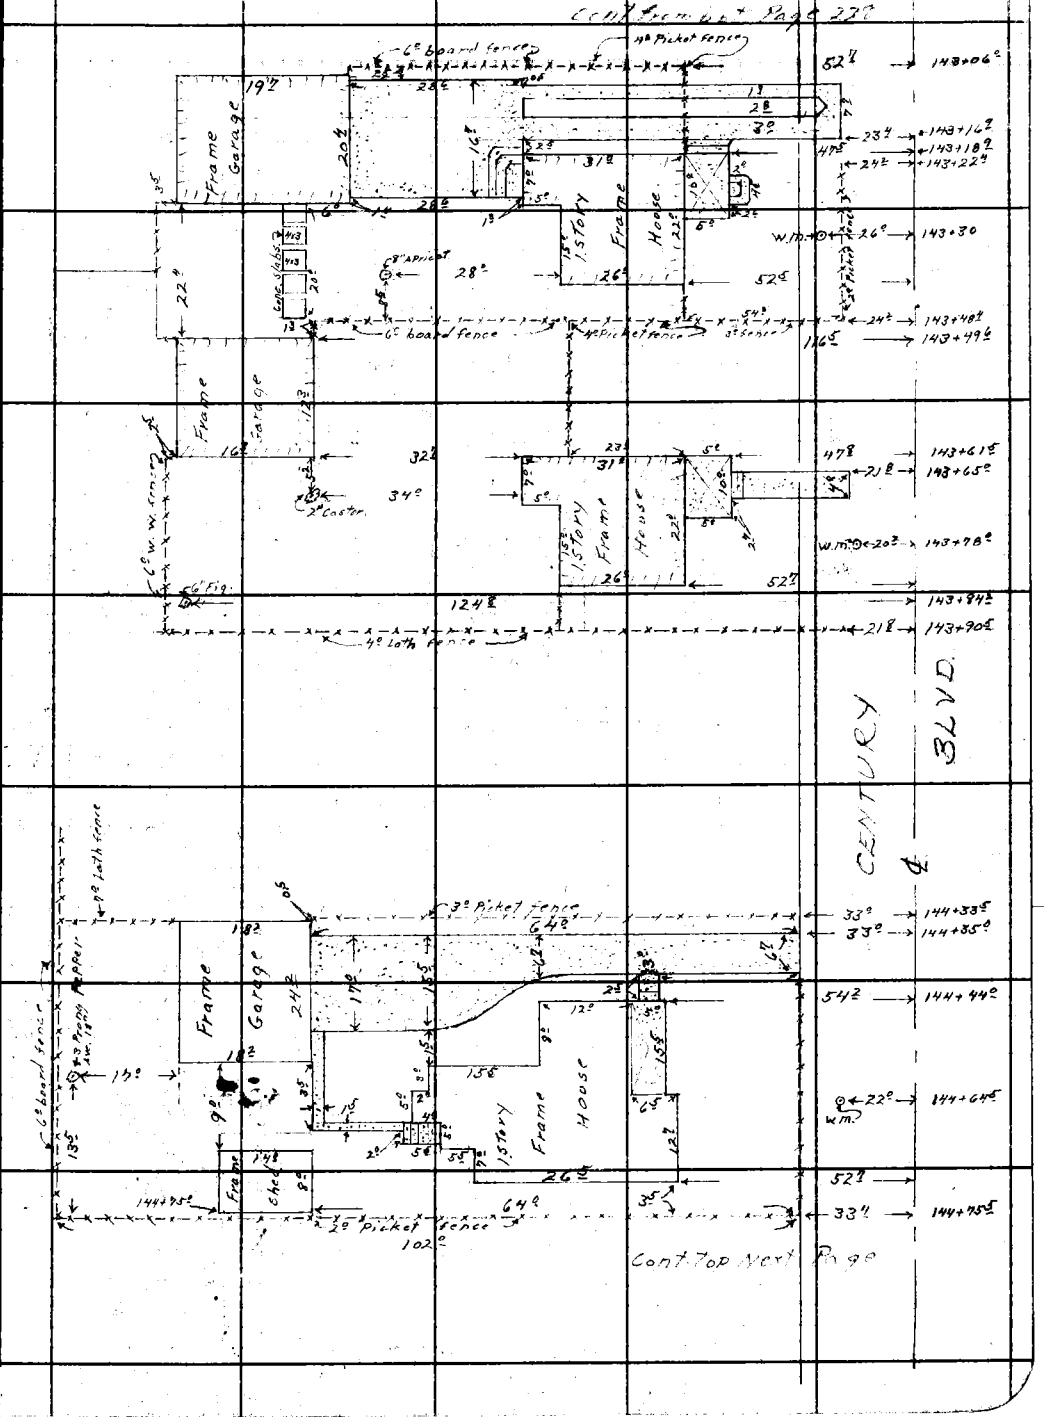

FORM 247 3M 12-45

F.B. 739 Pg. 230

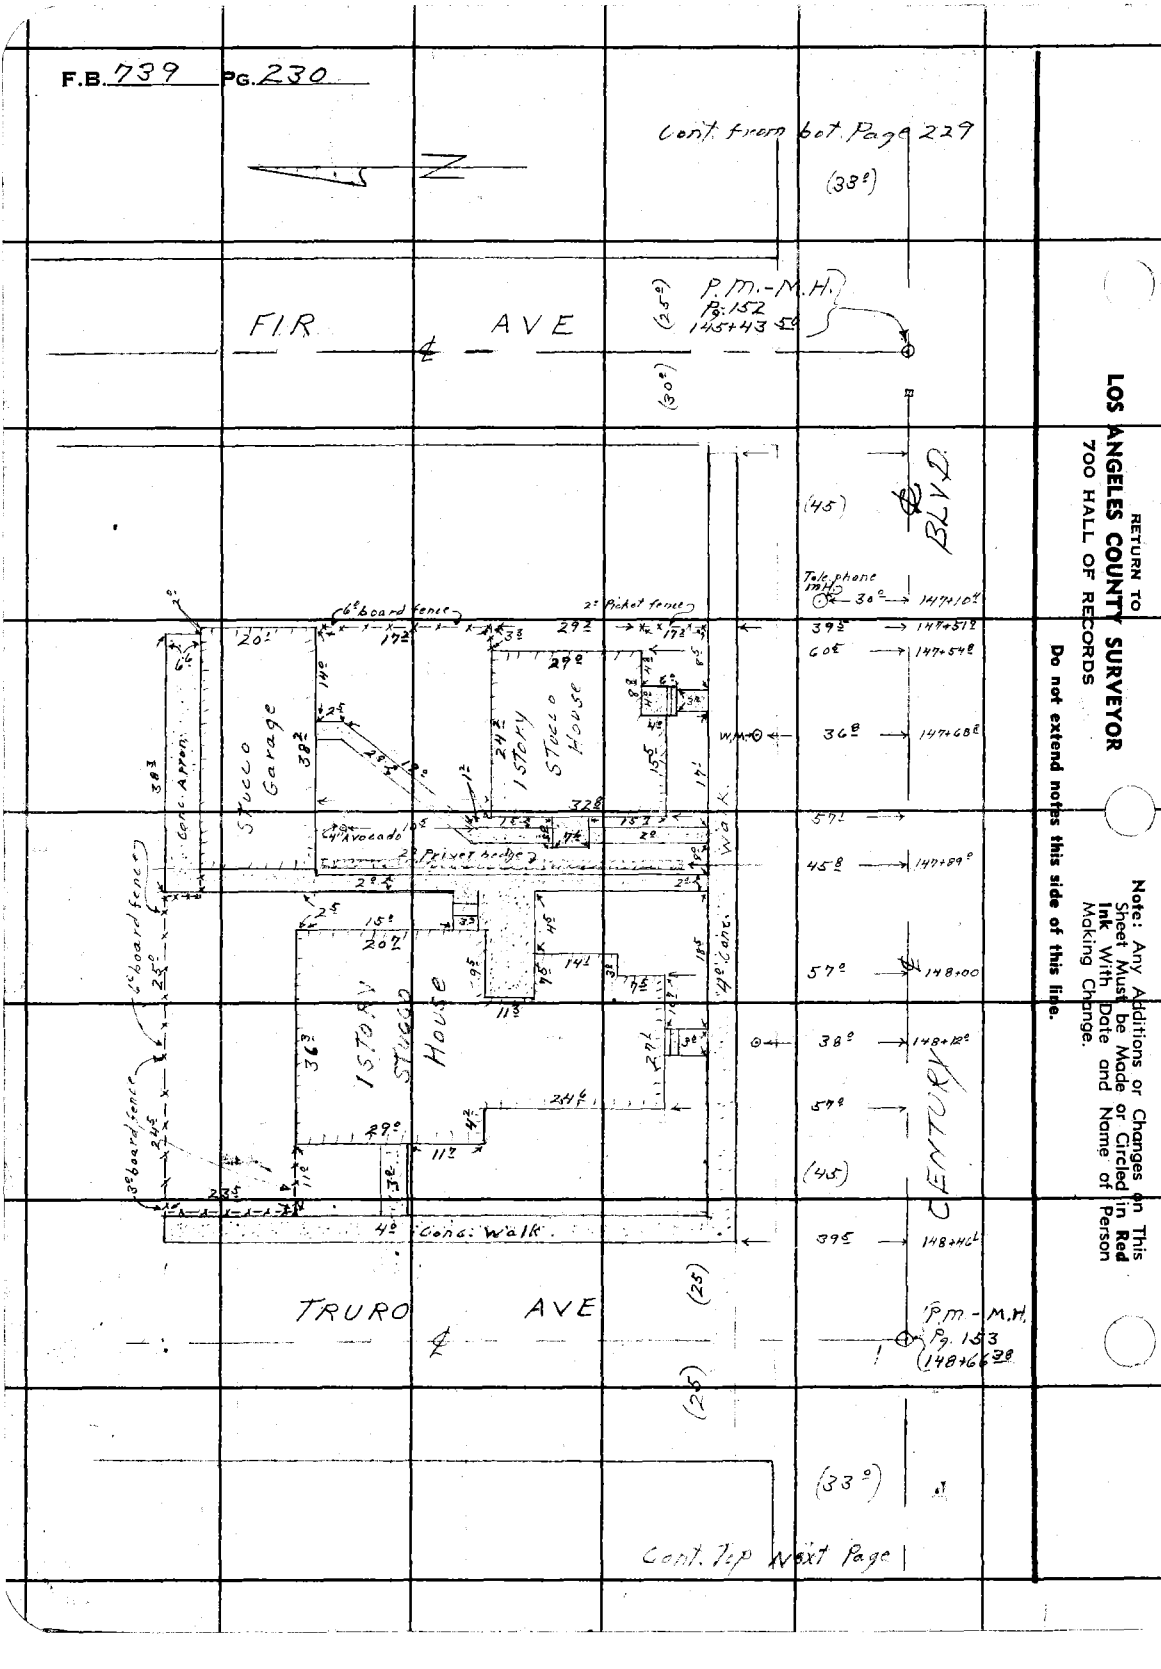

RETURN TO
LOS ANGELES COUNTY SURVEYOR
700 HALL OF RECORDS

Note: Any Additions or Changes on This Sheet Must be Made or Circled in Red Ink With Date and Name of Person Making Change.

Do not extend notes this side of this line.

Notes Ck'd by		Survey of Century Blvd.	F.B. 139 Pg. 231
Map No.		W. O. 8208 Tape No.	Std °F
Office Work		Surveyed by WE Bradell	
Checked		Notes Blacker Date 2/13-26	
Date		Indexed	

Note: Any Additions or Changes on This Sheet Must be Made or Circled in Red Ink With Date and Name of Person Making Change.

Do not extend notes this side of this line.

RETURN TO
LOS ANGELES COUNTY SURVEYOR
700 HALL OF RECORDS

FORM 247 3M 12-60

Cont. from b.f. Page 230

TRURO AVE

Fd. P.K. N. on N.H. Bears N. 33° E. 1.92 148+73.6 N.H. 44 Left

148+73.6 N.H. 44 Left

148+78.5 T.H. 47 Left

Fire Plug 148+83.0 47 Left

Note: Strike Dr. at top of pg. 192. Reset 5.4 New conc. Curb

150+56.5 32.5 Right

Driveway (conc) 6.8

EUCALYPTUS AVE

Fd. P.K. N. on N.H. Bears S. 39° W. 1.92 151+59.20

151+70.3 T.H. 44 Left

151+07.7 S.M.H. 48 Left

Fire Plug 152+09.1 48 Left

152+11.3 Inlet 12" Drain E. 32 Right

152+24.4 Bel. light n. M.H. 30 Right

153+02.5 35.13 S.D. M.H. 28.3 Right

Cont. bot Next Page

F.B. 739 Pg. 232

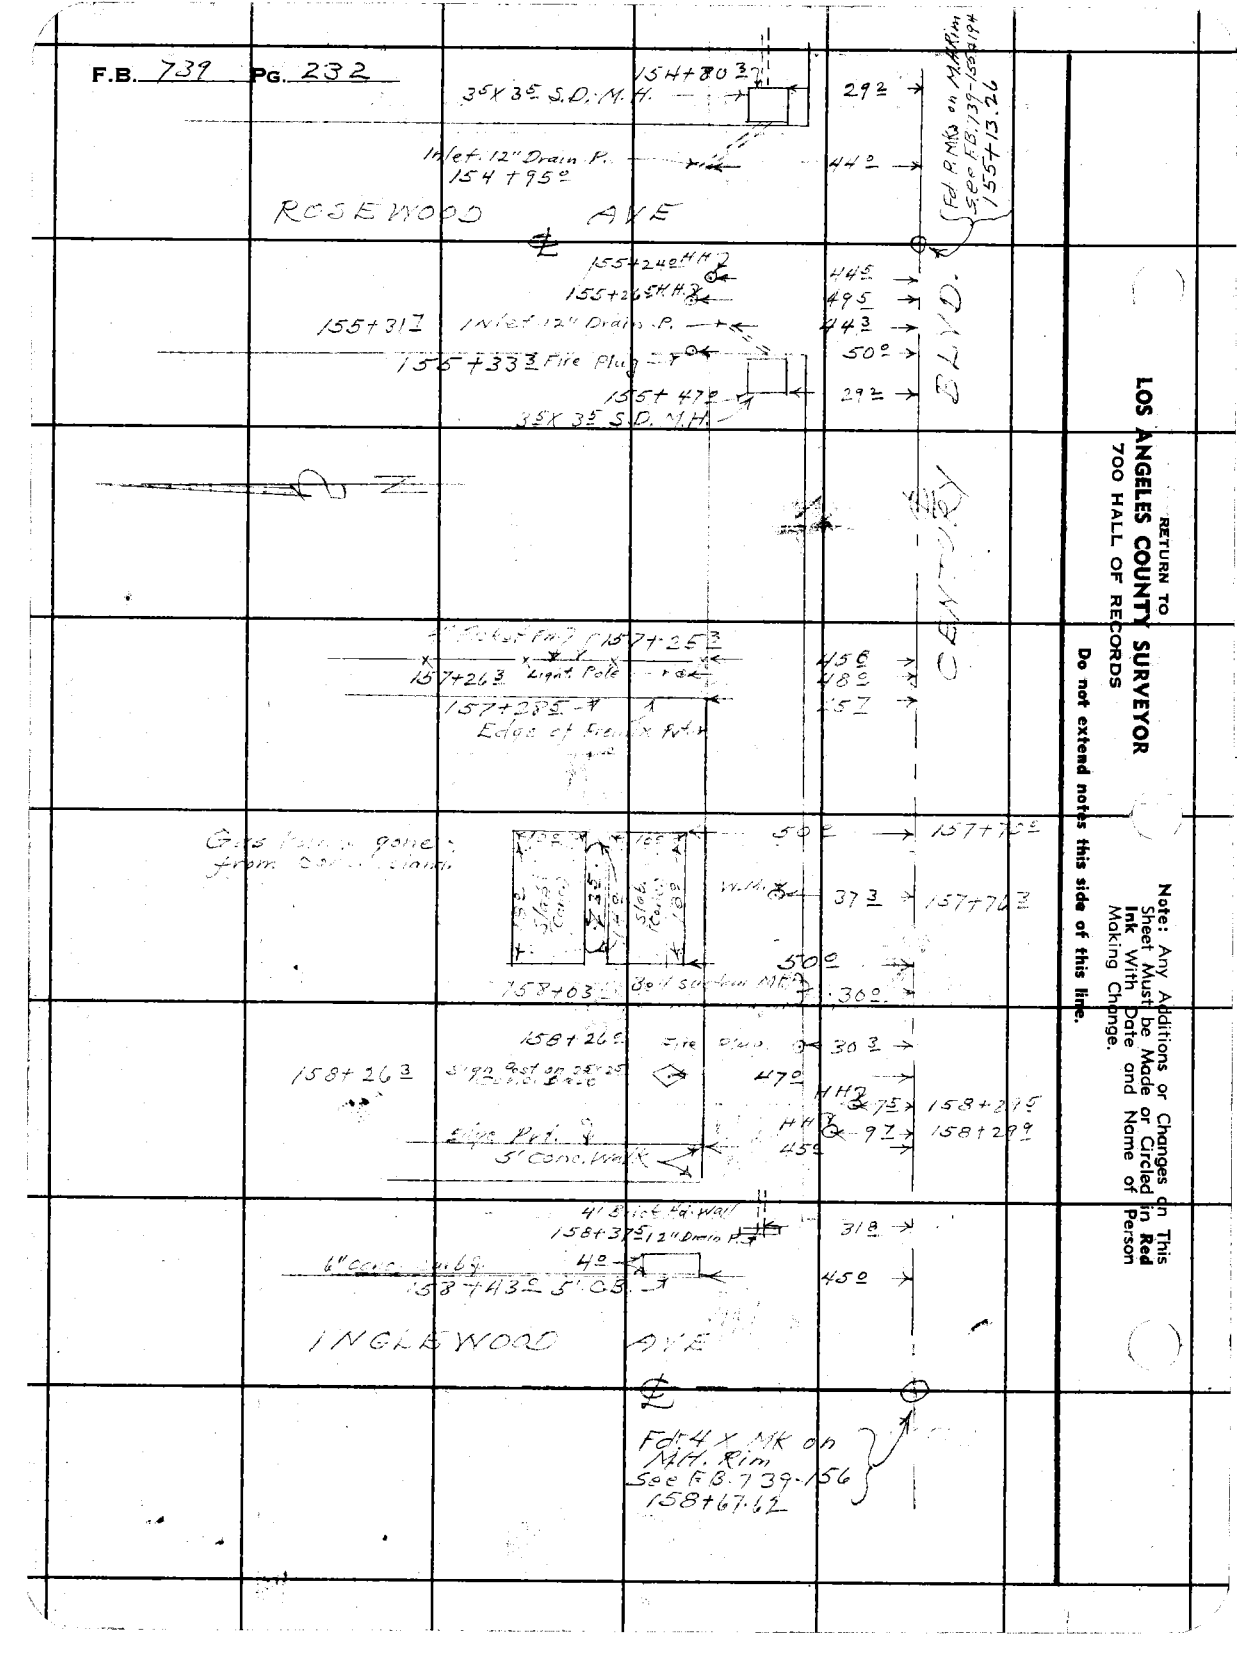

RETURN TO
LOS ANGELES COUNTY SURVEYOR
700 HALL OF RECORDS

Do not extend notes this side of this line.

Note: Any Additions or Changes on This Sheet Must be Made or Circled in Red Ink With Date and Name of Person Making Change.

FORM 247 5M 11-41

RETURN TO
LOS ANGELES COUNTY SURVEYOR
700 HALL OF RECORDS

Note: Any Additions or Changes on This Sheet Must be Made or Circled in Red Ink With Date and Name of Person Making Change.

Do not extend notes this side of this line.

Notes Ck'd by_____
Map No._____
Office Work_____
Checked_____
Date_____

Survey of_____
W. O._____ Tape No._____ St'd_____ °F
Surveyed by_____
Notes_____ Date_____
Indexed_____

F.B. 739 1 PG. 23

F.B. 739 PG. 234

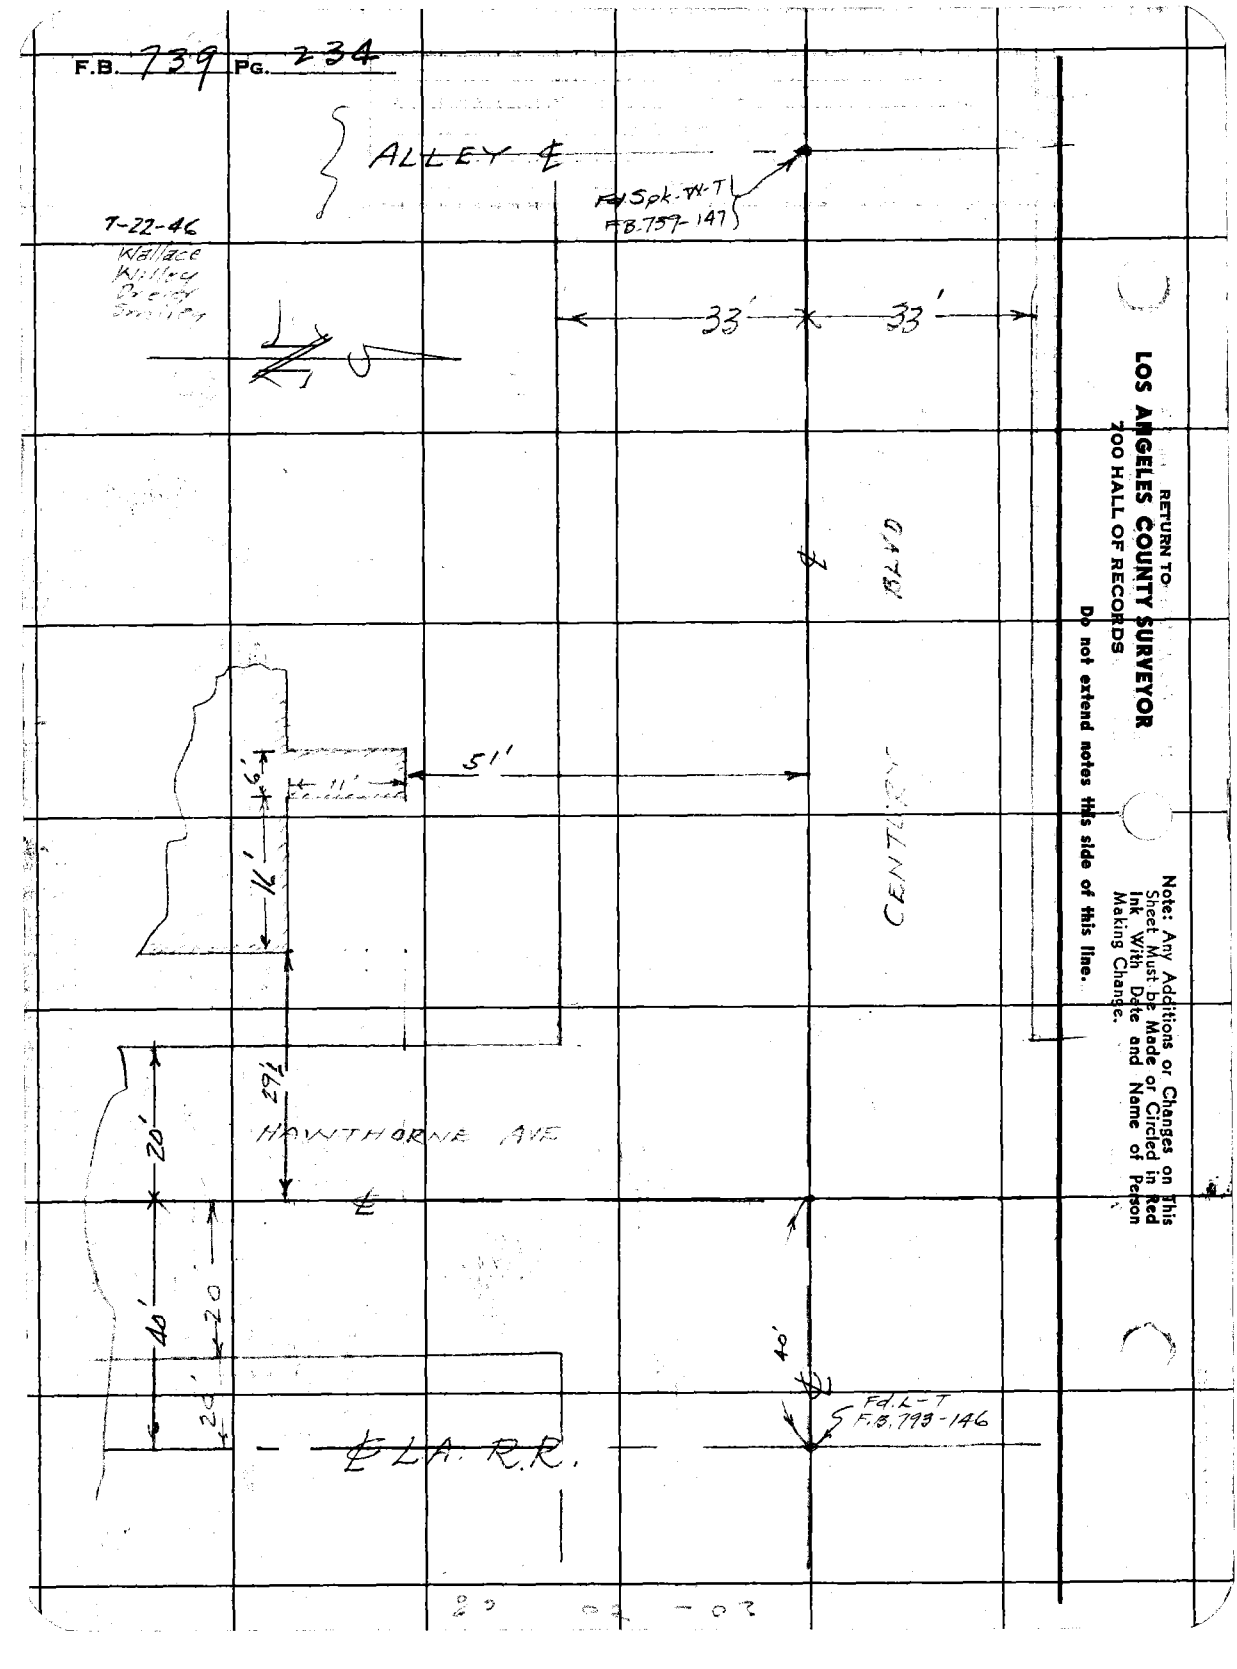

RETURN TO
LOS ANGELES COUNTY SURVEYOR
700 HALL OF RECORDS

Do not extend notes this side of this line.

Note: Any Additions or Changes on This Sheet Must Be Made or Circled in Red Ink With Date and Name of Person Making Change.

Notes Ck'd by	Survey of
Map No.	W. O. Tape No. St'd °F.
Office Work	Surveyed by
Checked	Notes Date
Date	Indexed

F.B. 139 PG 235

2355, 2358 Blade

RETURN TO
LOS ANGELES COUNTY SURVEYOR
700 HALL OF RECORDS

Note: Any Additions or Changes on This Sheet Must be Made or Circled in Red Ink With Date and Name of Person Making Change

Do not extend notes this side of this line

FORM 247 10M 11-38

RETURN TO
LOS ANGELES COUNTY SURVEYOR
700 HALL OF RECORDS

Note: Any Additions or Changes on This Sheet Must be Made or Circled in **Red** Ink With Date and Name of Person Making Change.

Do not extend notes this side of this line

F.B. 739 Pg. 138

F.B. 739 PG. 29

Notes Ck'd by	Survey of AVIATION BLVD. (4) APPRAISAL
Map No.	W. O. 0912.72 Tape No. 8176 St'd. 65 °F
Office Work	Surveyed by H.E. Grandstaff
Checked	Notes [illegible] Date 6/1/55
Date	Indexed A. C. Johnson 10-14-55

J. N. 0912.72

AVIATION BLVD. (4) APPRAISAL

From Compton Blvd.
To City of L. Sepulveda Blvd.

Note: Any Additions or Changes on This Sheet Must be Made or Circled in Red Ink With Date and Name of Person Making Change.

Do not extend notes this side of this line.

RETURN TO
LOS ANGELES COUNTY SURVEYOR
726 LOS ANGELES COUNTY
ENGINEERING BLDG.

H.E. Grandstaff, Chief
L. Hawks, Jr.
M. Lewis, Field Chief
M. Jones, Field Chief

'76F3093 247 4-53

F.B. 739 PG. 240

cont bot Pg 241

1"x6" Board fence Crest High

Wire fence 6' high 6"x6" Posts at approx. 12 Foot Intervals.

1487.2' 35'±

Tot. Dist. 1419.28'

AVIATION (FORMERLY ENGLEWOOD BLVD.)

1419.32 @ 64° = 1419.28
1224.43
Total 2644.71

49.87

R.P. Pot. 1 Set 3/4" I.P. 12" deep

0.13'

35° 1224.28

Fd Nail 2' deep
F.B. 422 Pg 13
C.S.B. 455-3

Fd C.S. Spray Washer 2' deep Tangent C.S.B. 455-3 & F.B. 422 Pg 13

& Por C.S.B. 455-3

35

1224.46 @ 64° = 1224.13

(1224.28 C.S.B. 455-3 Mon. = 1224.43)

Fd Punch Mark in Lead & 4 Punch Marks on Rim of S.M.H. Per F.B. 1922 Pg 66

35' Light Std. Mon. 21.6' to Curb

C.S.B. 455-3

West ½ Cor. Sec. 20 T 3 S. R 11 W.

Fd Nail & part of Tin. F.B. 1922/66 to post

35° 21.6'

41.52

20'

COMPTON BLVD.

MAGNOLIA AVE.

(40')

93.00'

61.02'

79.31'

66.48'

Fd Root Nail & Lead

SET LIT

WALK

SET LIT

(40')

Fd Root Nail & Lead

BLVD.

RETURN TO
LOS ANGELES COUNTY SURVEYOR
726 LOS ANGELES COUNTY
ENGINEERING BLDG.
Do not extend notes this side of this line.

Note: Any Additions or Changes on This Sheet Must be Made or Circled in Red Ink With Date and Name of Person Making Change.

Notes Ck'd by	Survey of AVIATION BLVD.
Map No.	W. O.	Tape No. 2176	St'd. 68	°F
Office Work	Surveyed by
Checked	Notes H.E.G.	Date 10-10-55
Date	Indexed C. Johnson

F. B. 739 PG. 241

Cont to Fd 242

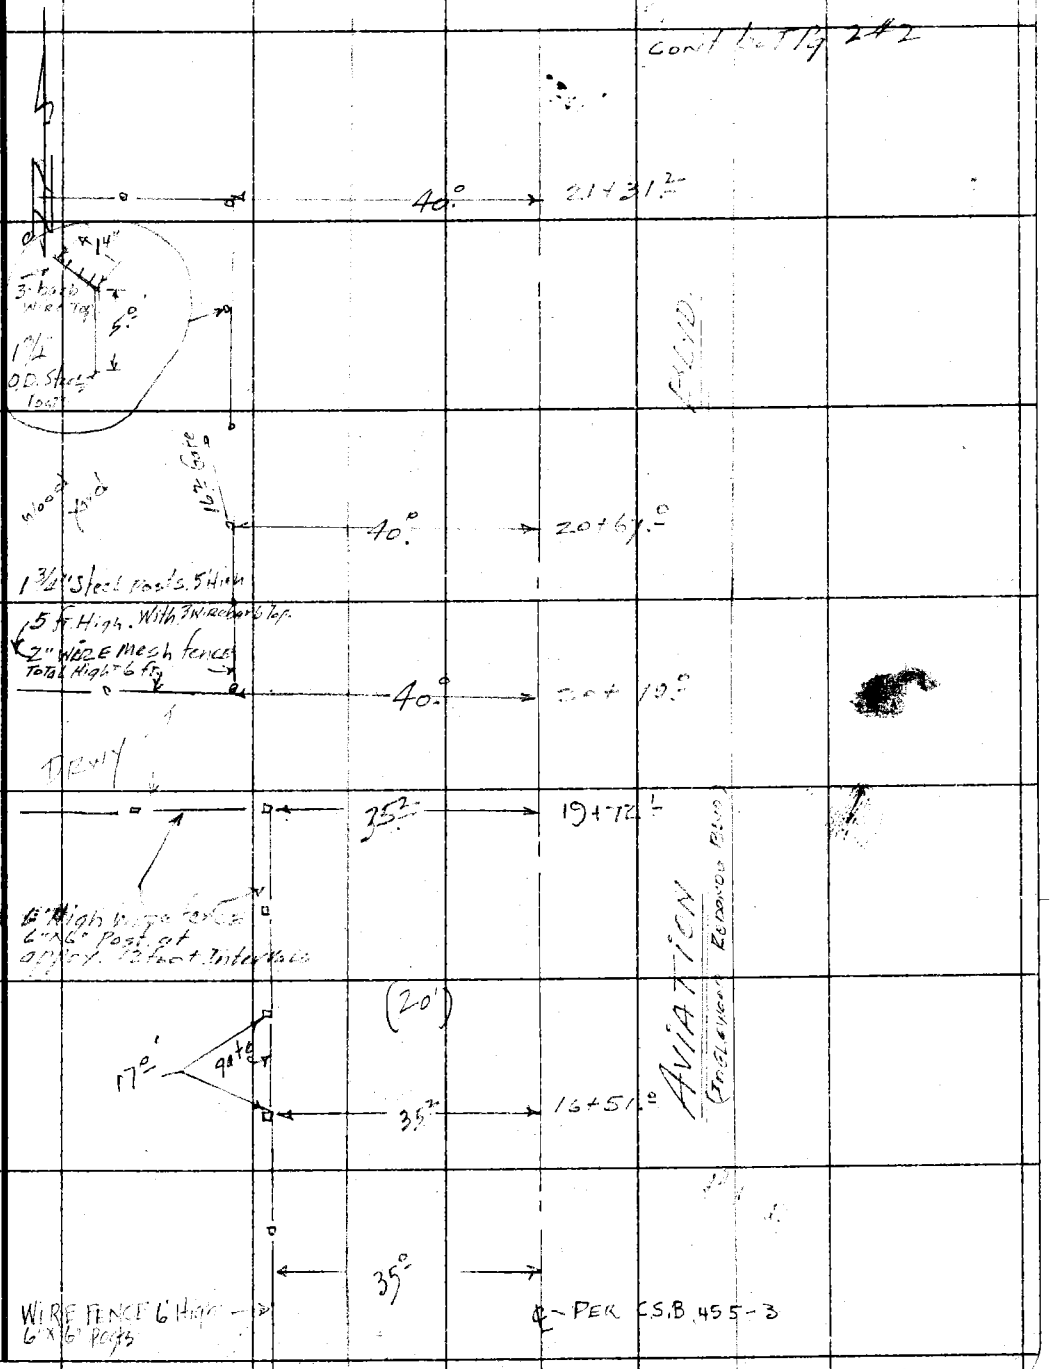

Note: Any Additions or Changes on This Sheet Must be Made or Circled in Red Ink With Date and Name of Person Making Change.

Do not extend notes this side of this line.

RETURN TO
LOS ANGELES COUNTY SURVEYOR
726 LOS ANGELES COUNTY
ENGINEERING BLDG.

76FSOBS 247 4-53

RETURN TO
LOS ANGELES COUNTY SURVEYOR
726 LOS ANGELES COUNTY
ENGINEERING BLDG.

Note: Any Additions or Changes on This Sheet Must be Made or Circled in Red Ink With Date and Name of Person Making Change.

Do not extend notes this side of this line.

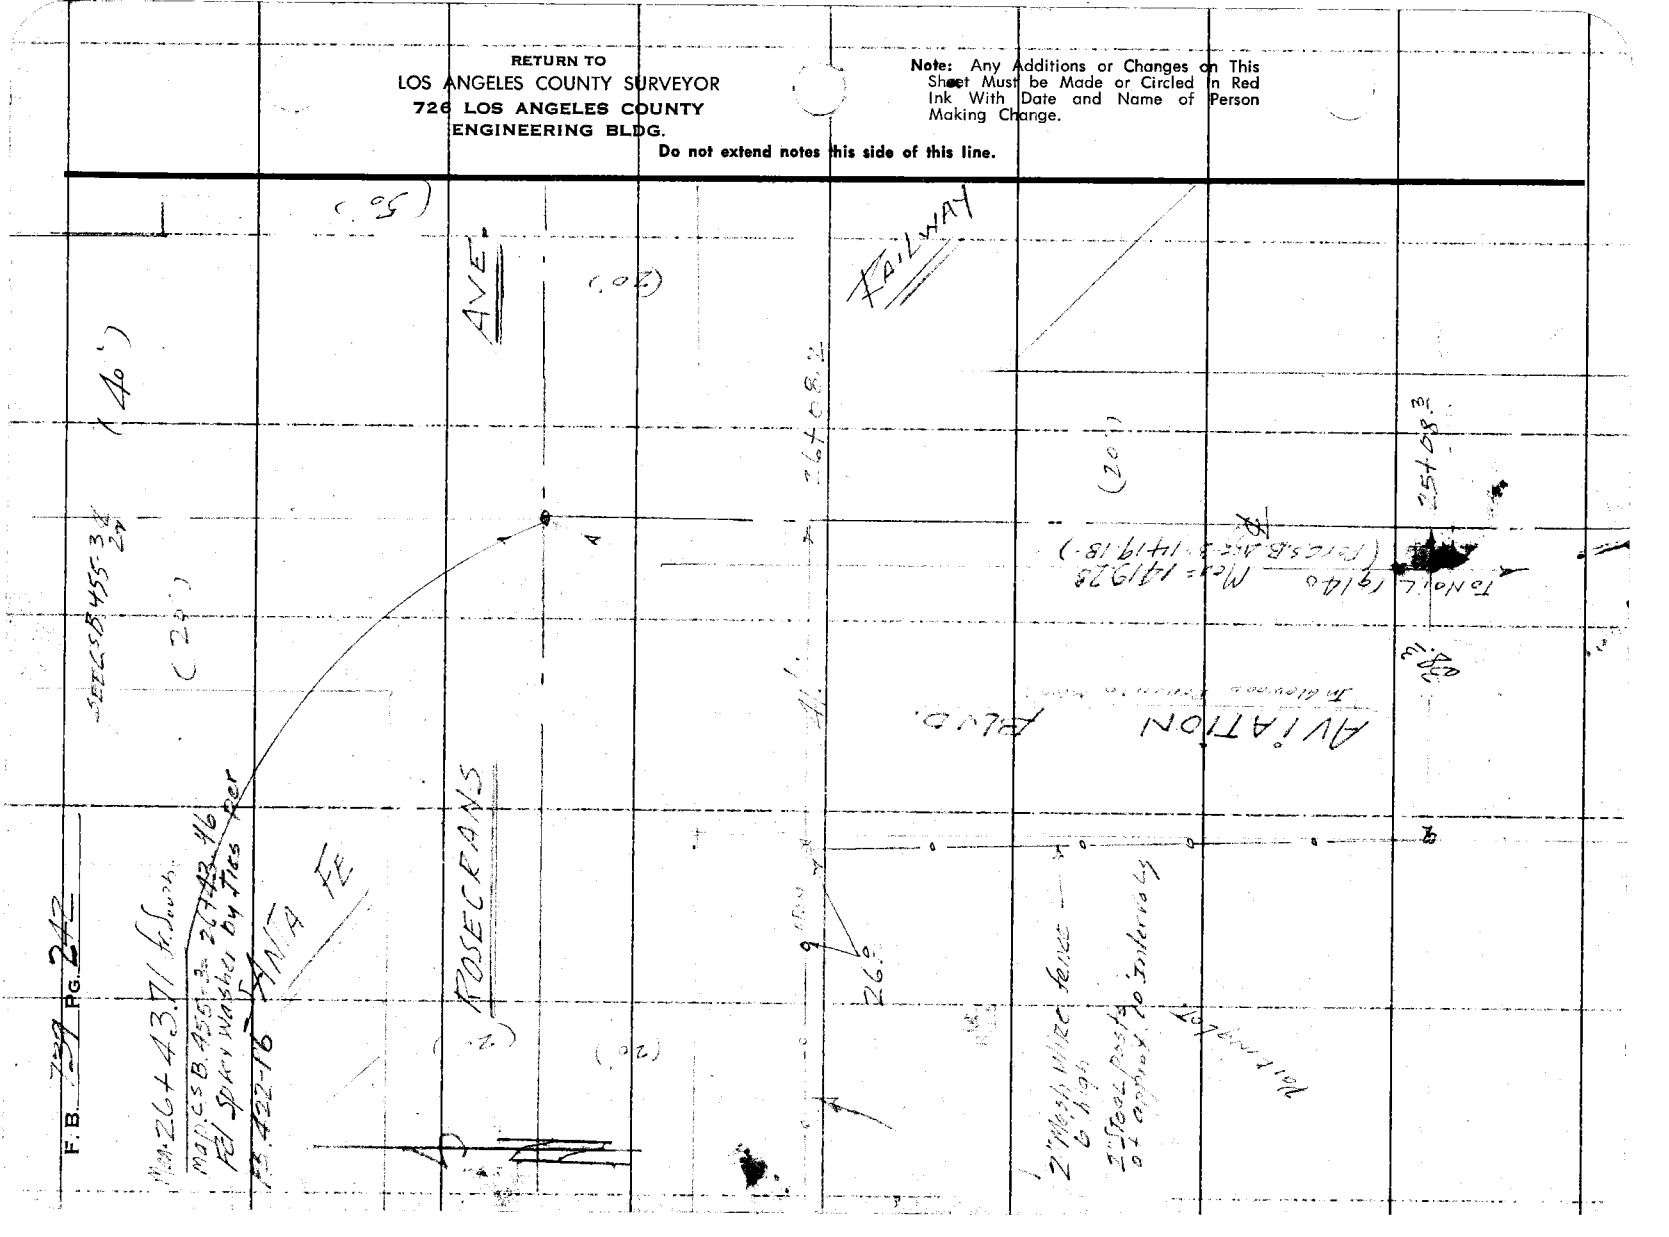
AVE
RAILWAY
ROSECRANS
SANTA FE
AVIATION
BLVD.
(40')
(30')
(20')
(.05)
(.02)
(.02)
(.02

Notes Ck'd by	Survey of Aviation Blvd (4)
Map No.	W. O. 09[illegible]72 Tape No. 0176 St'd. 66 °F
Office Work	Surveyed by [illegible]
Checked	Notes [illegible] Date [illegible]
Date	Indexed K. C. Johnson

F. B. 739 PG. 2-3

Note: Any Additions or Changes on This Sheet Must be Made in Red Ink or Circled With Date and Name of Person Making Change.

Do not extend notes this side of this line.

RETURN TO
LOS ANGELES COUNTY SURVEYOR
726 LOS ANGELES COUNTY
ENGINEERING BLDG.

AVIATION BLVD. (4) APPRAISAL

J.N. 0912 [illegible]

LOCATION of 6 ft. Cyclone fence AND 8 foot CEMENT Block wall West Side of Aviation Blvd.

FROM P.E. R/W N'ly to EL SEGUNDO BLVD.

AB 739 Pg. 43 to 46

M. A. [illegible] CHIEF
F. BLOCKS Instr.
M. CERICOLA. Rd. Chain
H. [illegible] Rd. Chain

76F3095 247 4-53

F. B. 739 PG. 244

Cont'd from Pg 245

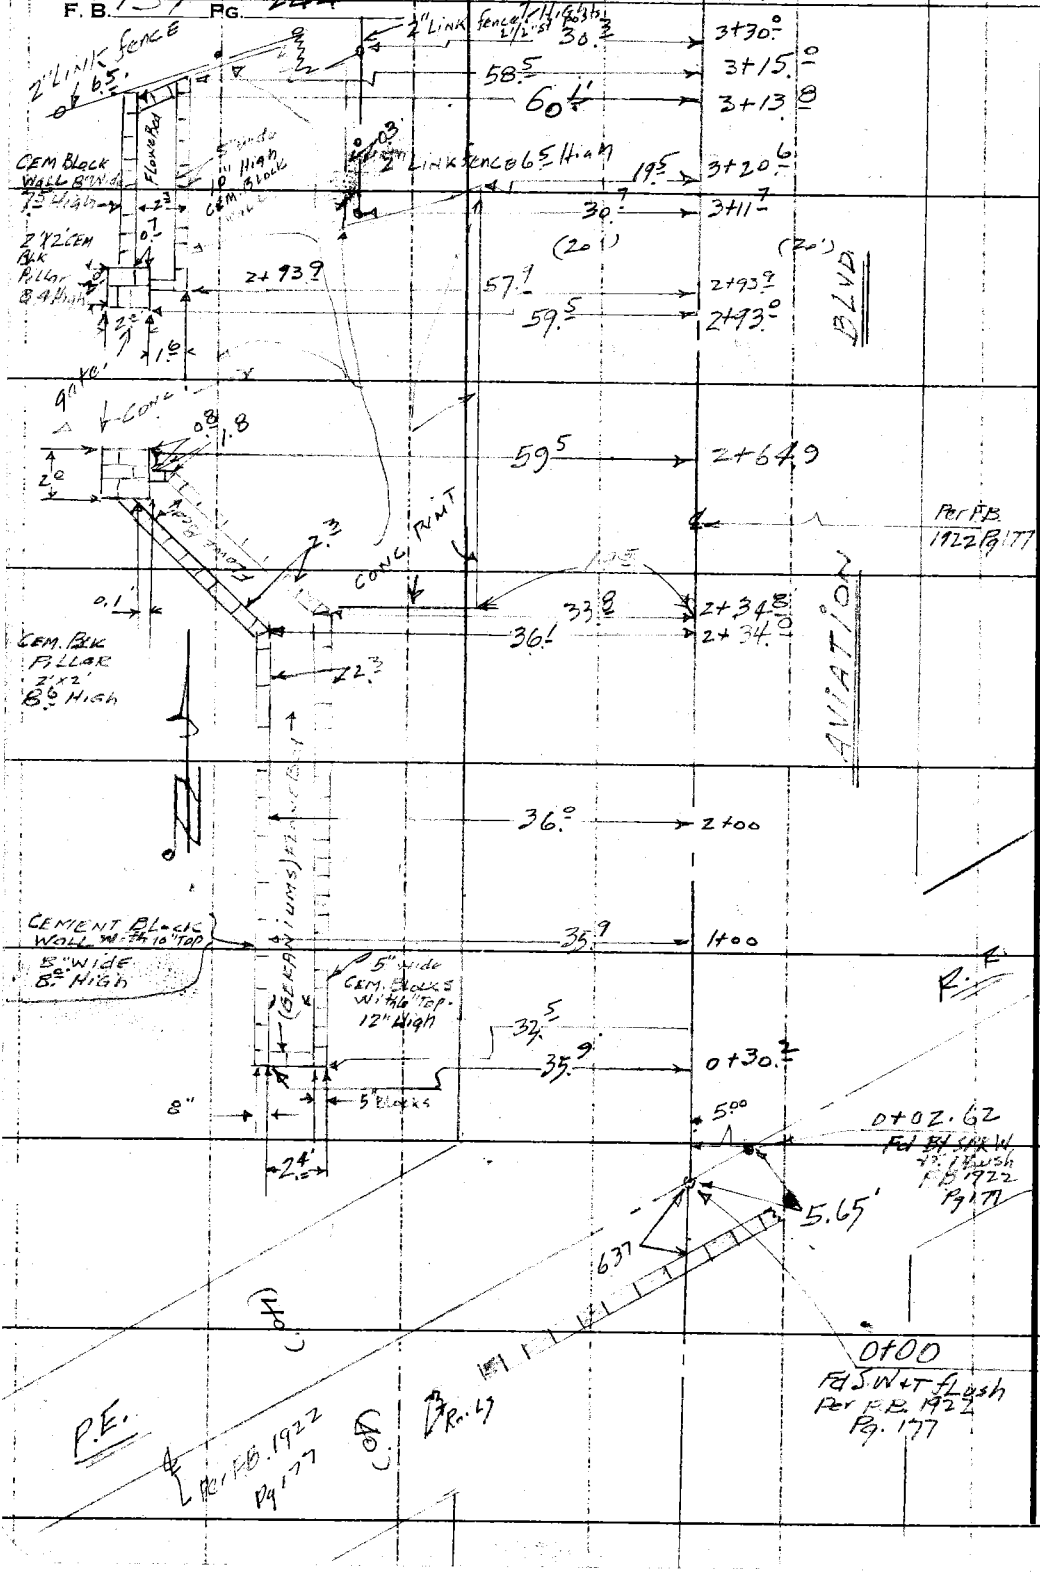

RETURN TO
LOS ANGELES COUNTY SURVEYOR
726 LOS ANGELES COUNTY
ENGINEERING BLDG.

Do not extend notes this side of this line.

Note: Any Additions or Changes on This Sheet Must be Made or Circled in Red Ink With Date and Name of Person Making Change.

F.B. 739 PG. 245

Notes Ck'd by
Map No.
Office Work
Checked
Date

Survey of AVIATION BLVD. W. 8/2.72 Tape No. 0176 St'd. 68 °F
Surveyed by L.E. Cunningham
Notes L.E.S. Date 10/11/55
Indexed C. Johnson

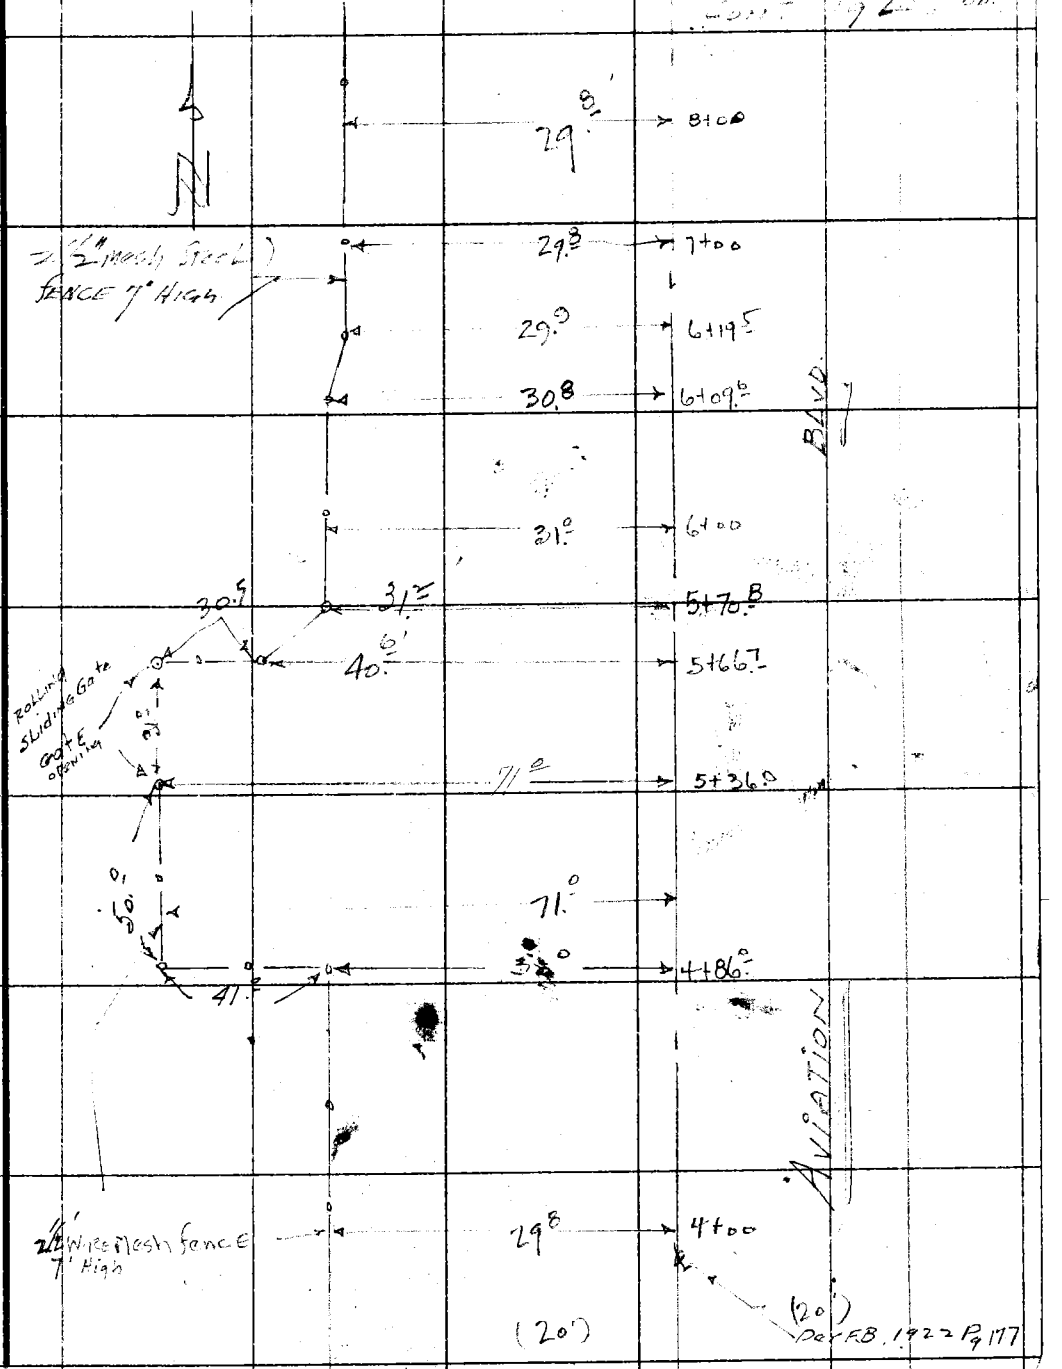

Note: Any Additions or Changes on This Sheet Must be Made or Circled in Red Ink With Date and Name of Person Making Change.

Do not extend notes this side of this line.

RETURN TO
LOS ANGELES COUNTY SURVEYOR
726 LOS ANGELES COUNTY
ENGINEERING BLDG.

76FSOS 247 4-53

F. B. 739 Pg. 246

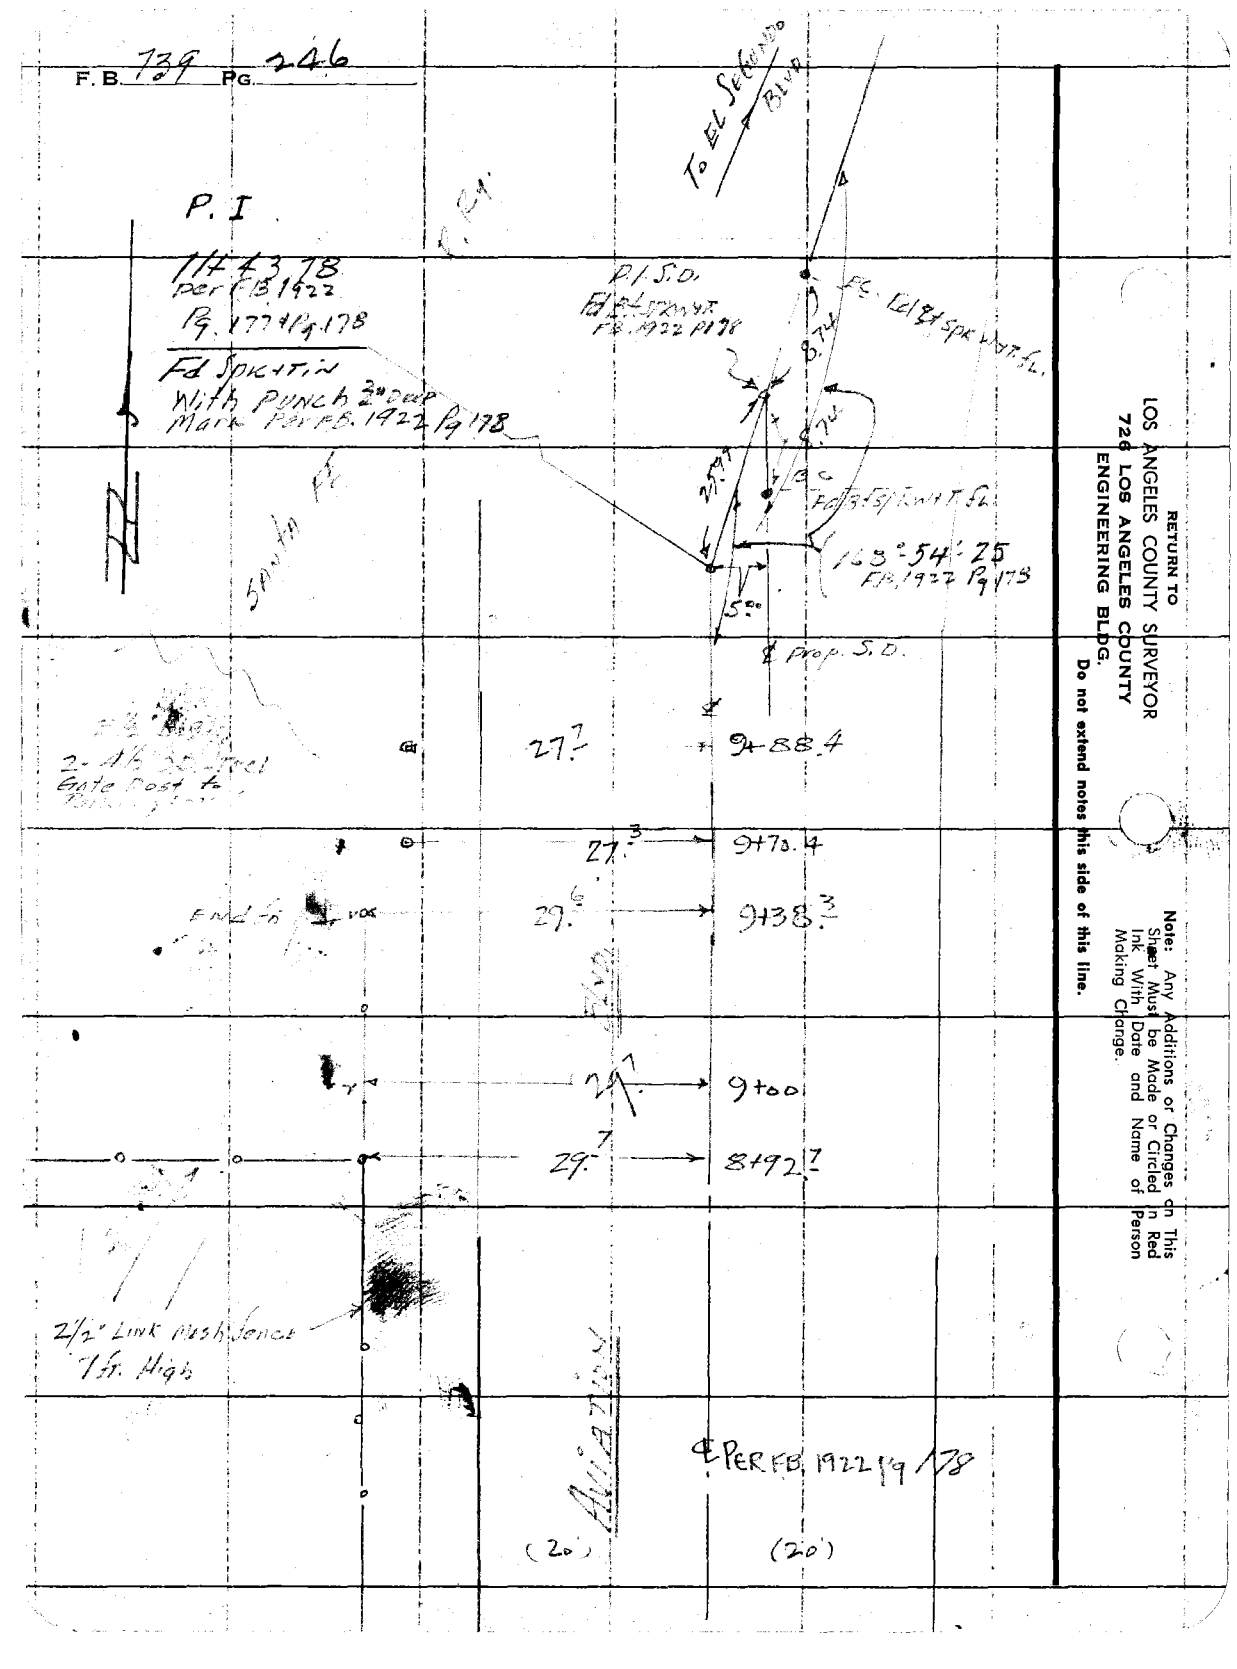

RETURN TO
LOS ANGELES COUNTY SURVEYOR
726 LOS ANGELES COUNTY
ENGINEERING BLDG.
Do not extend notes this side of this line.

Note: Any Additions or Changes on This Sheet Must be Made or Circled in Red Ink With Date and Name of Person Making Change.

247

F. B. [illegible] PG.

Notes Ck'd by
Map No.
Office Work
Checked
Date

Survey of [illegible]
W. O. 0912.72 Tape No. 01 St'd. 68 °F
Surveyed by [illegible]
Notes H.F.G. Date 10/1/68
Indexed C. Johnson

AVIATION Blvd. [illegible]

IN 0912.72

Location of Monuments on east side of Aviation Blvd. from El Segundo Blvd. N'ly 400.1'

[illegible] 2.73) [illegible] 1.27 to [illegible] 99

Note: Any Additions or Changes on This Sheet Must be Made in Red Ink With Date and Name of Person Making Change.

Do not extend notes this side of this line.

RETURN TO
LOS ANGELES COUNTY SURVEYOR
726 LOS ANGELES COUNTY
ENGINEERING BLDG.

[illegible] chief
F. E. Brooks Asst.
R. Castanola Hd. Chain
W. Dennis Chain

76F3008 247 4-53

F. B. 739 Pg. 248

D 168-50-40
E 315-23-09
A 168-50-45
C 293-04-40
A 168-50-46 2/3

CONT. Rd Dept FB 243 Pg. 122

T & C S. Mon 120 1/2 St.

C.N.T. Pg 149 1/2 ot

Side of Bldg SEE NEXT Pg

17.52.3

35.3

30.2

Conc. Slab

0.6

19.5

0.8

1.0

8.4

11.3

17°

3.2

0.3

34.9

38.2

22.0

26.2

3/4" Weld Hydr.

(168° 50' M = 168° 50' 46 2/3)

19 R and T FB 243 Pg. 121

(25 Par Rd FB 243 P121)

1+00.0 P.I. El Segundo Blvd.

TRANSIT LINE Per Rd Dept FB 243 Pg 121

4" 2 2 2 3 SEWER Pipes

6.8

Per Rd Dept FB. 243 Pg. 121 SEE FB. 739 Pg. 48

(0.19' FB 243 Pg 121)

1 STORY Wood FRAME Bldg Conc. Floor

19.8

W.O.S.

15.2

11.0

Rd FB 243 P121

(168°-5' FB 243 Pg 121)

0 187.5

22.5

Pow Box

27.0

0 186.0

65.2

1.0

15.0

Fd Witness Post

SEE Rd Dept FB. 243 Pg 121 For This Control

3/4" Riser with Valve Gas. Main 8" Dia

41.1 S.F.E. Rd

(30')

54.55 Prod (54.57)

Fd SPK in Hub Tack

Per. Rd Dept FB. 243 Pg. 121

Prod from North

(80' R/W 1948)

81.12

(421.56 FB. 243 P121 Rd)

421.61 FB 739 Pg 48

(421.56 FB 1922 Pg 179 R/W)

EL SEGUNDO BLVD

L 101°-13'-30" Rd FB 243 Pg 121 101°-13'-05" S.F.B. 739 - R/W

(40')

(25')

(25')

Pg 149 1/2 M.S.W.

P.I.

Fd. SPK x W. Flush Per Rd Dept FB. 243 Pg 121 "Co. Sur. FB. 1922 Pg. 179

RETURN TO
LOS ANGELES COUNTY SURVEYOR
726 LOS ANGELES COUNTY
ENGINEERING BLDG.

Do not extend notes this side of this line.

Note: Any Additions or Changes on This Sheet Must be Made or Circled in Red Ink With Date and Name of Person Making Change.

F. B. 738 PG. 249

Notes Ck'd by	Survey of
Map No.	W. O. 77 Tape No. 0176 St'd. 68 °F
Office Work	Surveyed by
Checked	Notes Date
Date	Indexed A. C. Johnson

RETURN TO
LOS ANGELES COUNTY SURVEYOR
726 LOS ANGELES COUNTY
ENGINEERING BLDG.

Note: Any Additions or Changes on This Sheet Must be Made or Circled In Red Ink With Date and Name of Person Making Change.

Do not extend notes this side of this line.

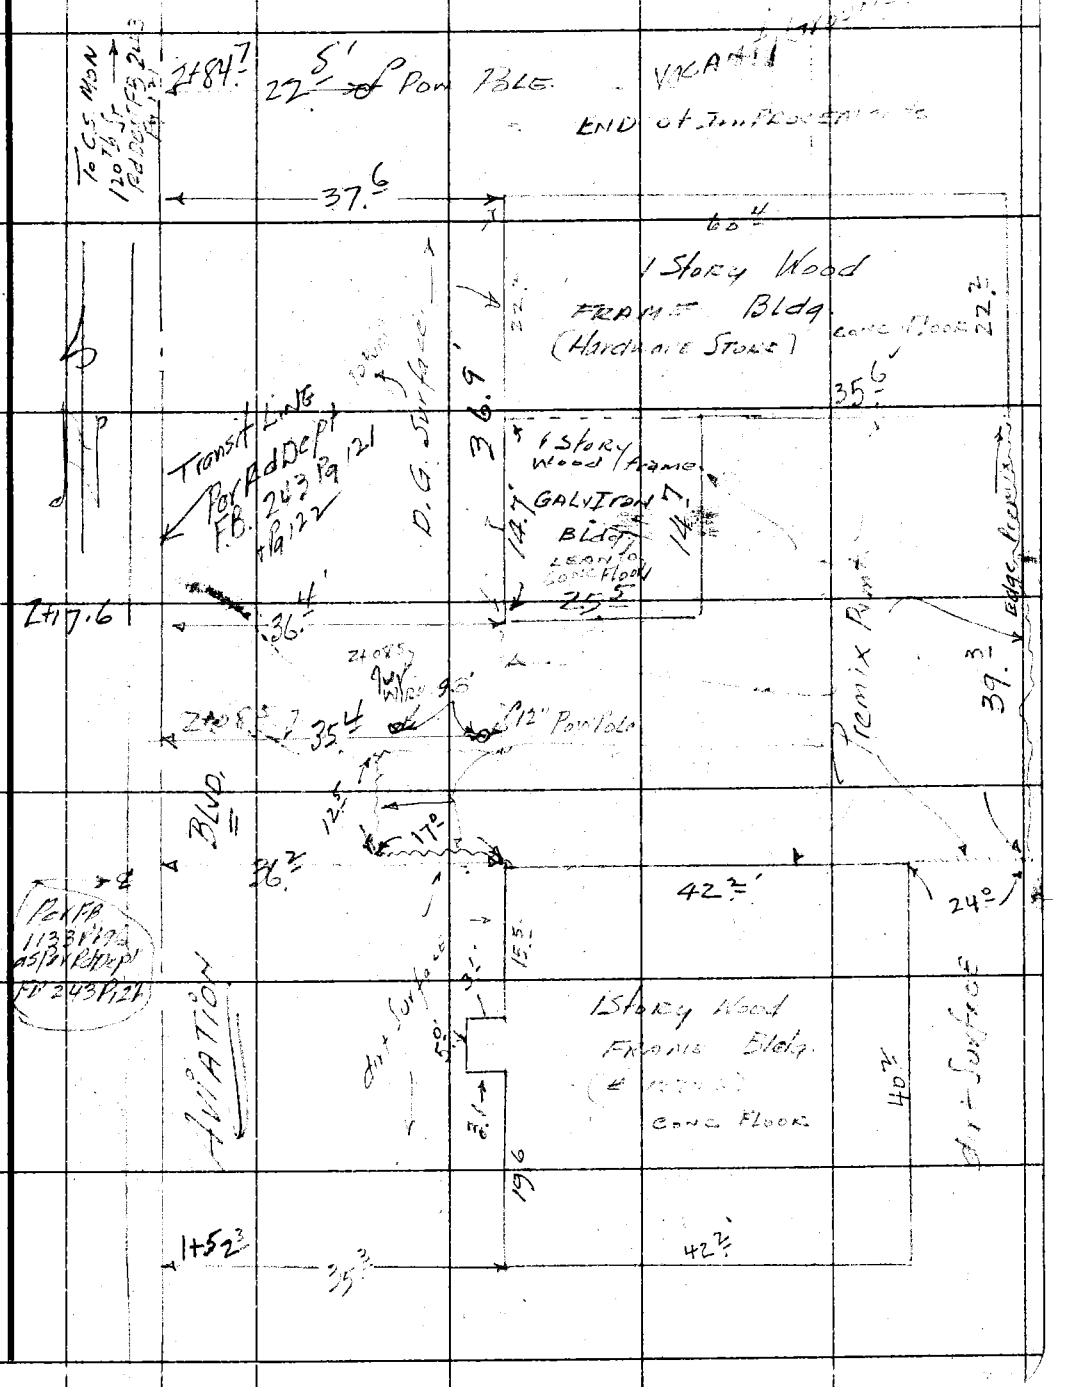

76FSOS 247 4-83

RETURN TO
LOS ANGELES COUNTY SURVEYOR
726 LOS ANGELES COUNTY
ENGINEERING BLDG.

Note: Any Additions or Changes on This Sheet Must be Made or Circled in Red Ink With Date and Name of Person Making Change.

Do not extend notes this side of this line.

F. B. 1941 PG. 250

F. B. 727 PG. 251

Notes Ck'd by
Map No.
Office Work
Checked
Date

Survey of
W. O. 37 Tape No. 176 St'd. 68 °F
Surveyed by H. E. CHRISTENSEN
Notes HEC & C. Hill Date 10-4-57
Indexed C. Johnson

Note: Any Additions or Changes on This Sheet Must be Made or Circled In Red Ink With Date and Name of Person Making Change.

Do not extend notes this side of this line.

RETURN TO
LOS ANGELES COUNTY SURVEYOR
726 LOS ANGELES COUNTY
ENGINEERING BLDG.

Pelr F.B. 1784
Pg. 46 to 48
C.S.B. 120
C.S.B. 169

9.9
Loose Gravel
75.0
20.3'
18.8
Roofed
4.0
36.4
Wood
Shed
18.4
24.3
75.0
22+34.0
38.8
9.2
45.2
17.8
Shed
10.5
4.4
45'
10.
75.0
35.7
Brick
Roofed
Shed
27.2
27.2
75.0
21+85.0
6" Wide
65.0
30.6
21+79.8
Concrete Walk
50.6
26.7
4.0
Finished Portion
30" Wide
5.7'
24"
24.0
21+51.7
Concrete Walk
56.8
Shed
50.
15.7
64.8
21+26.5
38" Wide
30.5
Wood Canopy
Roofed Shed
11.0
5.8
4"x6" Mesh fence
51.0
20+85.5

Contd. From Pg. 124

76FS095 247 4-55

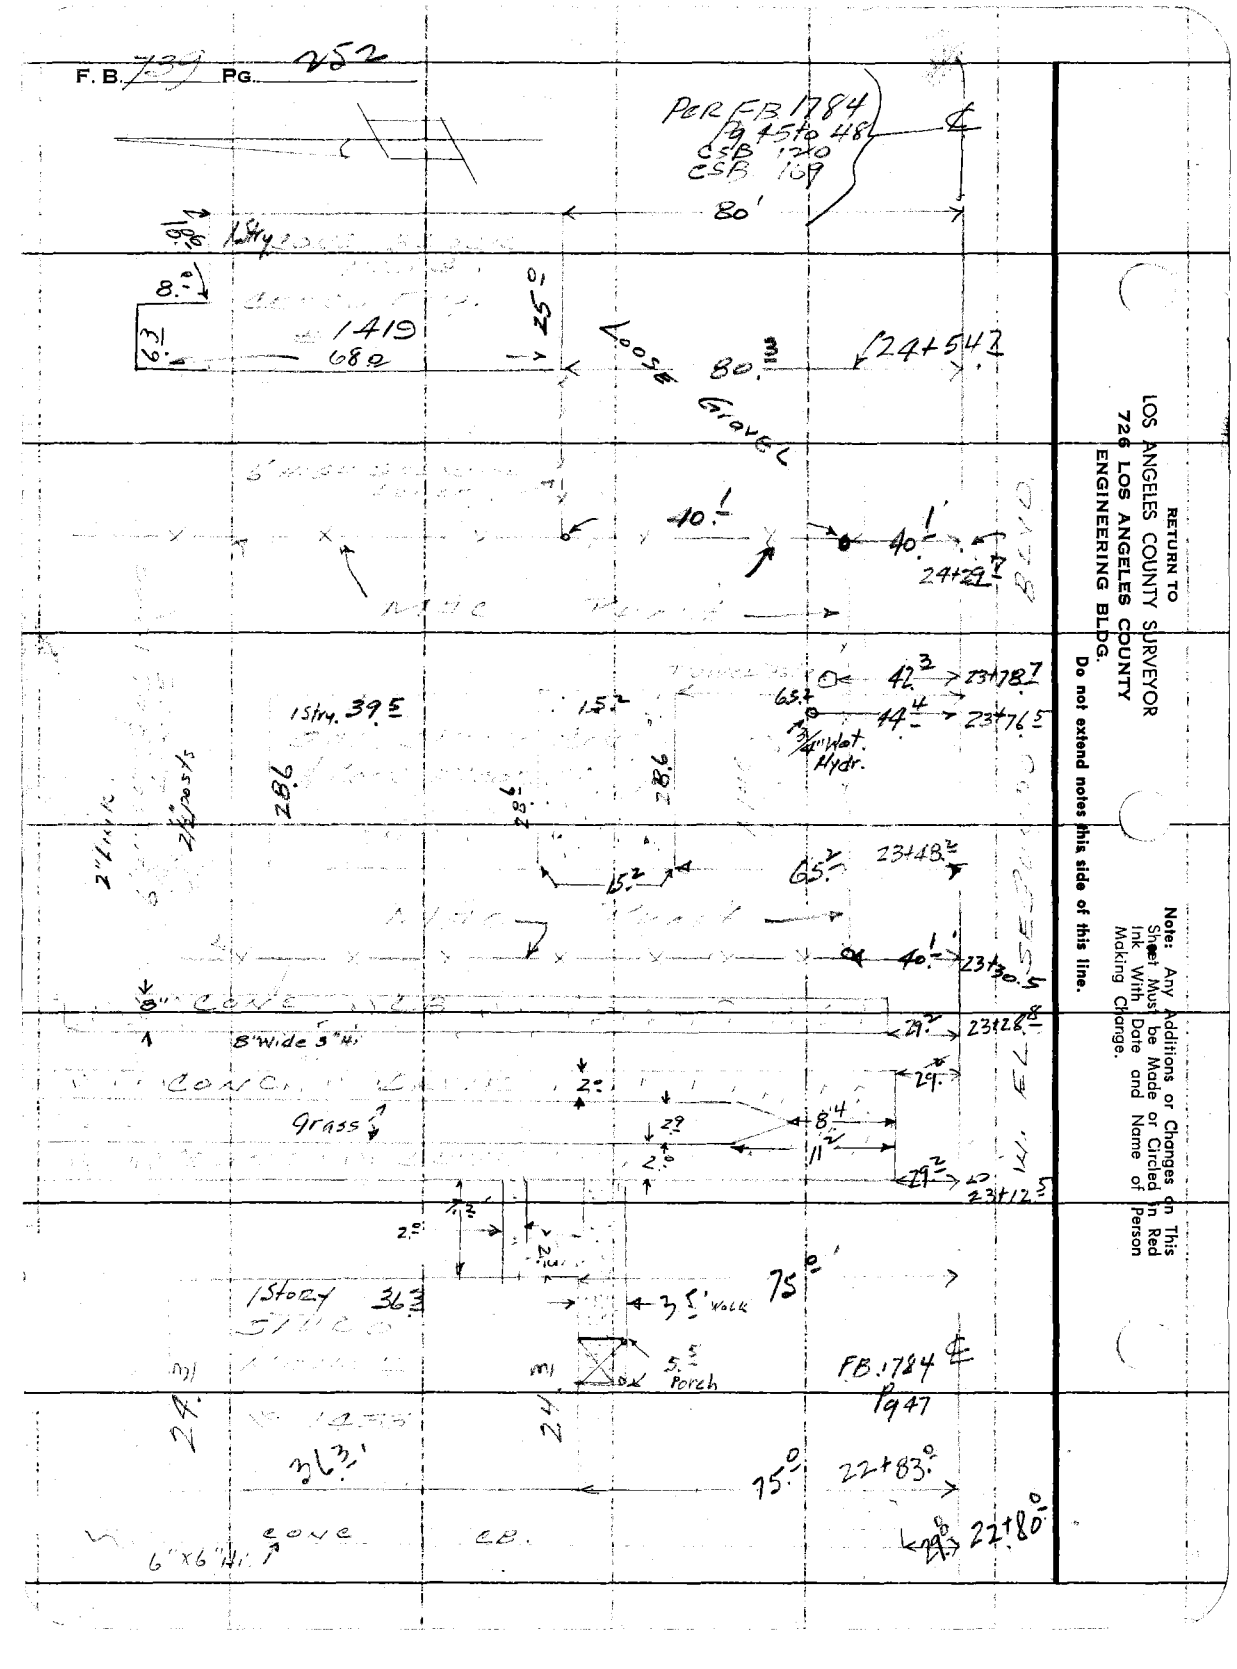

RETURN TO
LOS ANGELES COUNTY SURVEYOR
726 LOS ANGELES COUNTY
ENGINEERING BLDG.

Do not extend notes this side of this line.

Note: Any Additions or Changes on This Sheet Must be Made or Circled In Red Ink With Date and Name of Person Making Change.

Notes Ck'd by	Survey of
Map No.	W. O. Tape No. 176 St'd. 68 °F
Office Work	Surveyed by HEG
Checked	Notes Date 10-4-55
Date	Indexed A. C. Johnson

F. B. 784 Pg. 253

Note: Any Additions or Changes on This Sheet Must be Made or Circled in Red Ink With Date and Name of Person Making Change.

Do not extend notes this side of this line.

RETURN TO
LOS ANGELES COUNTY SURVEYOR
726 LOS ANGELES COUNTY
ENGINEERING BLDG.

76F3095 247 4-53

(40')
℄ Par FB 1784 Pg 48
Int. Fd. Radial Mon. in H. Hole
26+39.76
41.2
Conc. Gutter
Curb
2°
R=20'
26+09.7
63.9'
R=25'
38.2'
25+86.0
4-4"x12" Planks
7.5
7'
6.8'
12"
4"
54.1'
25+84.2
20°
25+28.9
OK
Double Sign
Par CSB 1170
CSB 1691
℄
79.8'
40.
25+63.8
22.3'
1 Story
51.8'
9.2
8.0' Wood Porch
Roof
No Roof
18.3'
Wood Porch
4.8
3.7'
9.2
10.3 Lean-to
22.2'
31.1'
18.3'
℄ Par FB 178 Pg 44
(40')
51.7'
25+41.5
5" Peach
5" Peach
3" Peach
4" Plum
47.5'
78.5'
9.0'
40.4
25+30.0
48.3'
25+23.0
58.4'
25+14.0
5" Peach Tr.
2-5" Peach
10.8'
13.2'
58.3'
25+00.0
5"Curb
Loose Gravel
2"Curb
39.8'
24+82.7
39.8'
24+80.5

RETURN TO
LOS ANGELES COUNTY SURVEYOR
726 LOS ANGELES COUNTY
ENGINEERING BLDG.

Note: Any Additions or Changes on This Sheet Must be Made or Circled in Red Ink With Date and Name of Person Making Change.

Do not extend notes this side of this line.
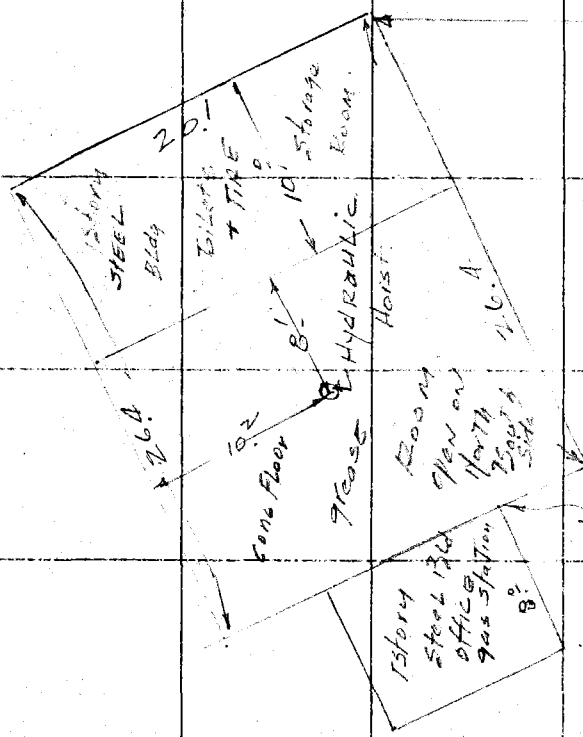
F.B. 739 PG. 254