Notes Ck'd by	Survey of MT WILSON TOLL RD
Mosaic	W. O. Tape No. St'd °F.
Office Work	Surveyed by
Checked	Notes Date
Date	Indexed

F.B. 754 PG. 1

ALIGNMENT DATA
MT WILSON TOLL RD

Note: Any Additions or Changes on This Sheet Must be Made in Ink and Initialed, Dated and Name of Person Making Change

Be sure to extend lines this side of this line

Returns to
LOS ANGELES COUNTY SURVEYOR
700 HALL OF RECORDS

RETURN TO
LOS ANGELES COUNTY SURVEYOR
700 HALL OF RECORDS

Note: Any Additions or Changes on This Sheet Must be Made or Circled in **Red Ink** With Date and Name of Person Making Change.

Do not extend notes this side of this line

F.B. 1355 PG. 2

Notes Ck'd by	Survey of
Map No. B-1217-1	W. O. 8149 Tape No. 07 St'd 33 °F.
Office Work F. A. W.	Surveyed by
Checked	Notes Date
Date 7-6-40	Indexed

F.B. 755T Pg. 3

W.O. 50-D-1

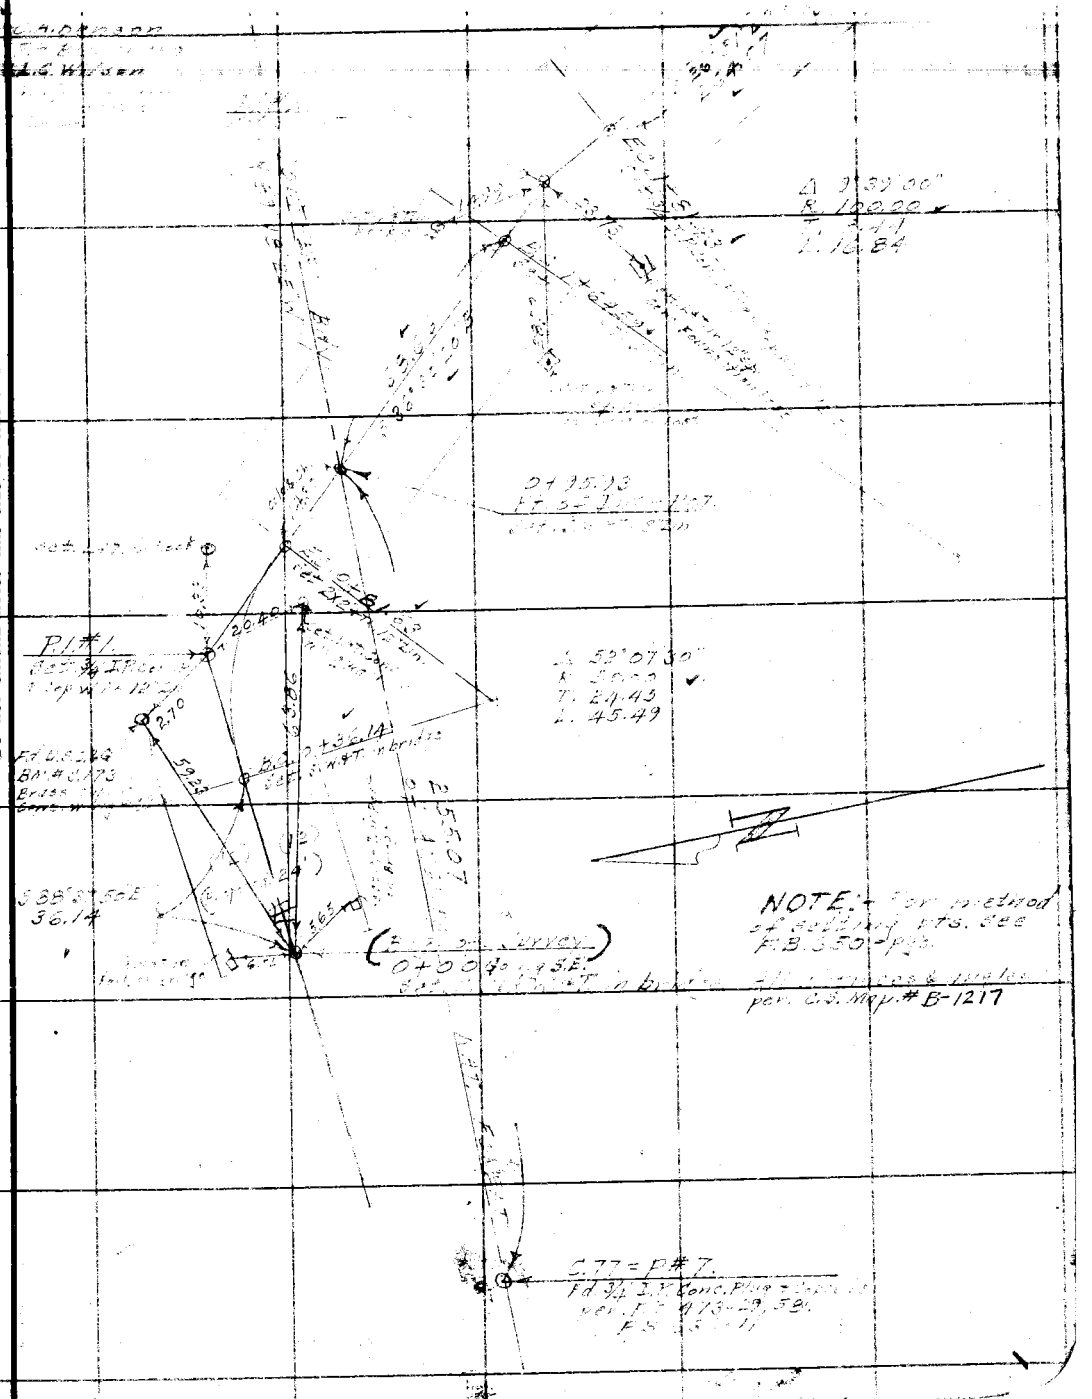

Note: Any Additions or Changes on This Sheet Must be Made or Circled in Red Ink With Date and Name of Person Making Change.

Do not extend notes this side of this line

RETURN TO
LOS ANGELES COUNTY SURVEYOR
700 HALL OF RECORDS

FORM 247 10M 11-38

F.B. 755 PG. 4

WS 50-0-1

RETURN TO
LOS ANGELES COUNTY SURVEYOR
700 HALL OF RECORDS

Do not extend notes this side of this line

Note: Any Additions or Changes on This Sheet Must be Made or Circled in Red Ink With Date and Name of Person Making Change.

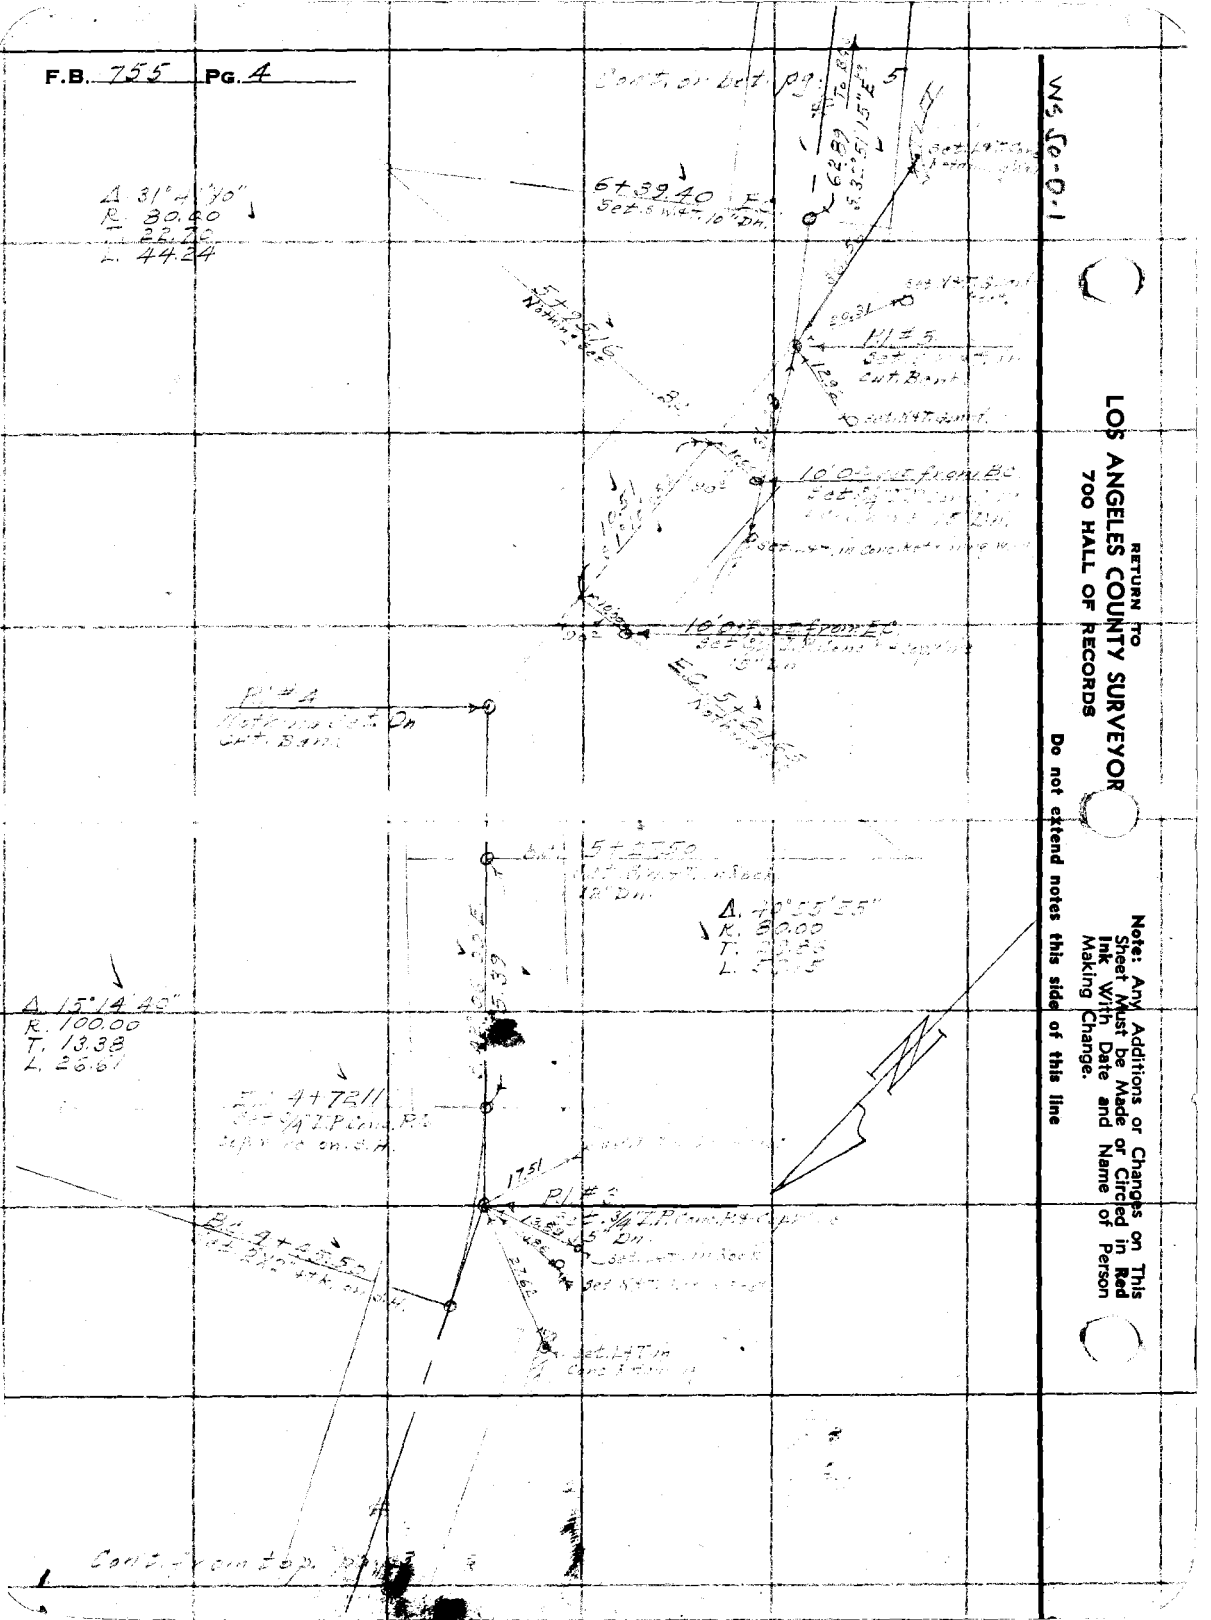

Notes Ck'd by	Survey of
Map No. 9-17-7-1	W. O. 5141 Tape No. 07 St'd 54 F.
Office Work F. A. W.	Surveyed by
Checked	Notes Date
Date 12-3-40	Indexed

F.B. 745 Pg. 5

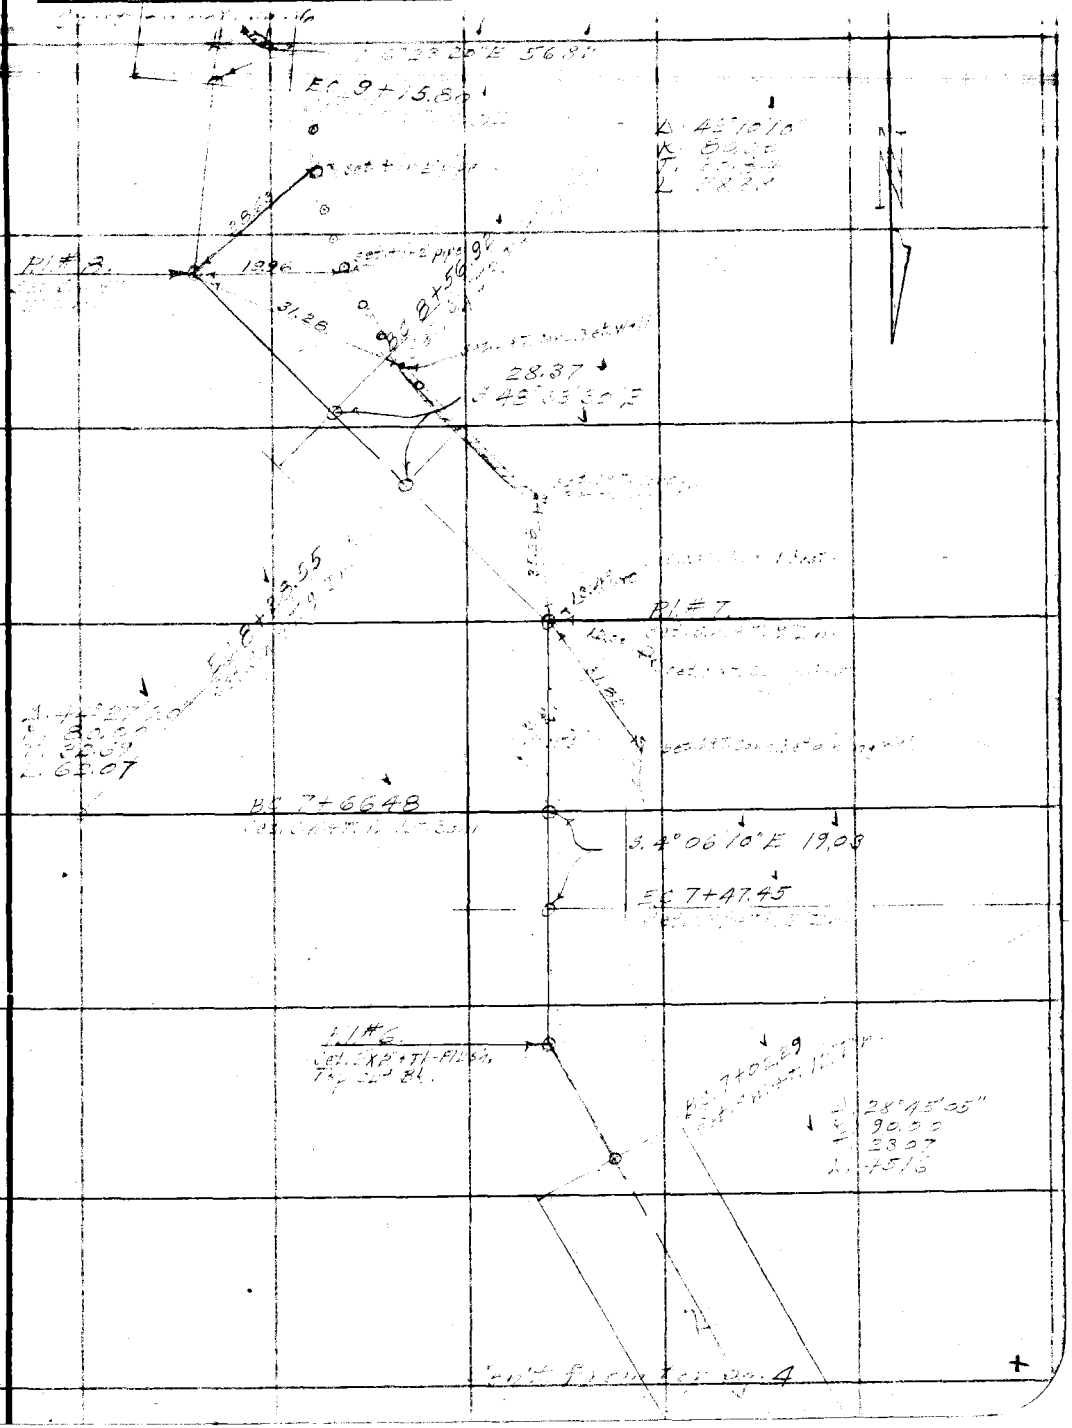

Note: Any Additions or Changes on This Sheet Must be Made or Circled in Red Ink With Date and Name of Person Making Change.

Do not extend notes this side of this line

RETURN TO
LOS ANGELES COUNTY SURVEYOR
700 HALL OF RECORDS

FORM 247 10M 11-35

RETURN TO
LOS ANGELES COUNTY SURVEYOR
700 HALL OF RECORDS

Note: Any Additions or Changes on This Sheet Must be Made or Circled in **Red Ink** With Date and Name of Person Making Change.

Do not extend notes this side of this line

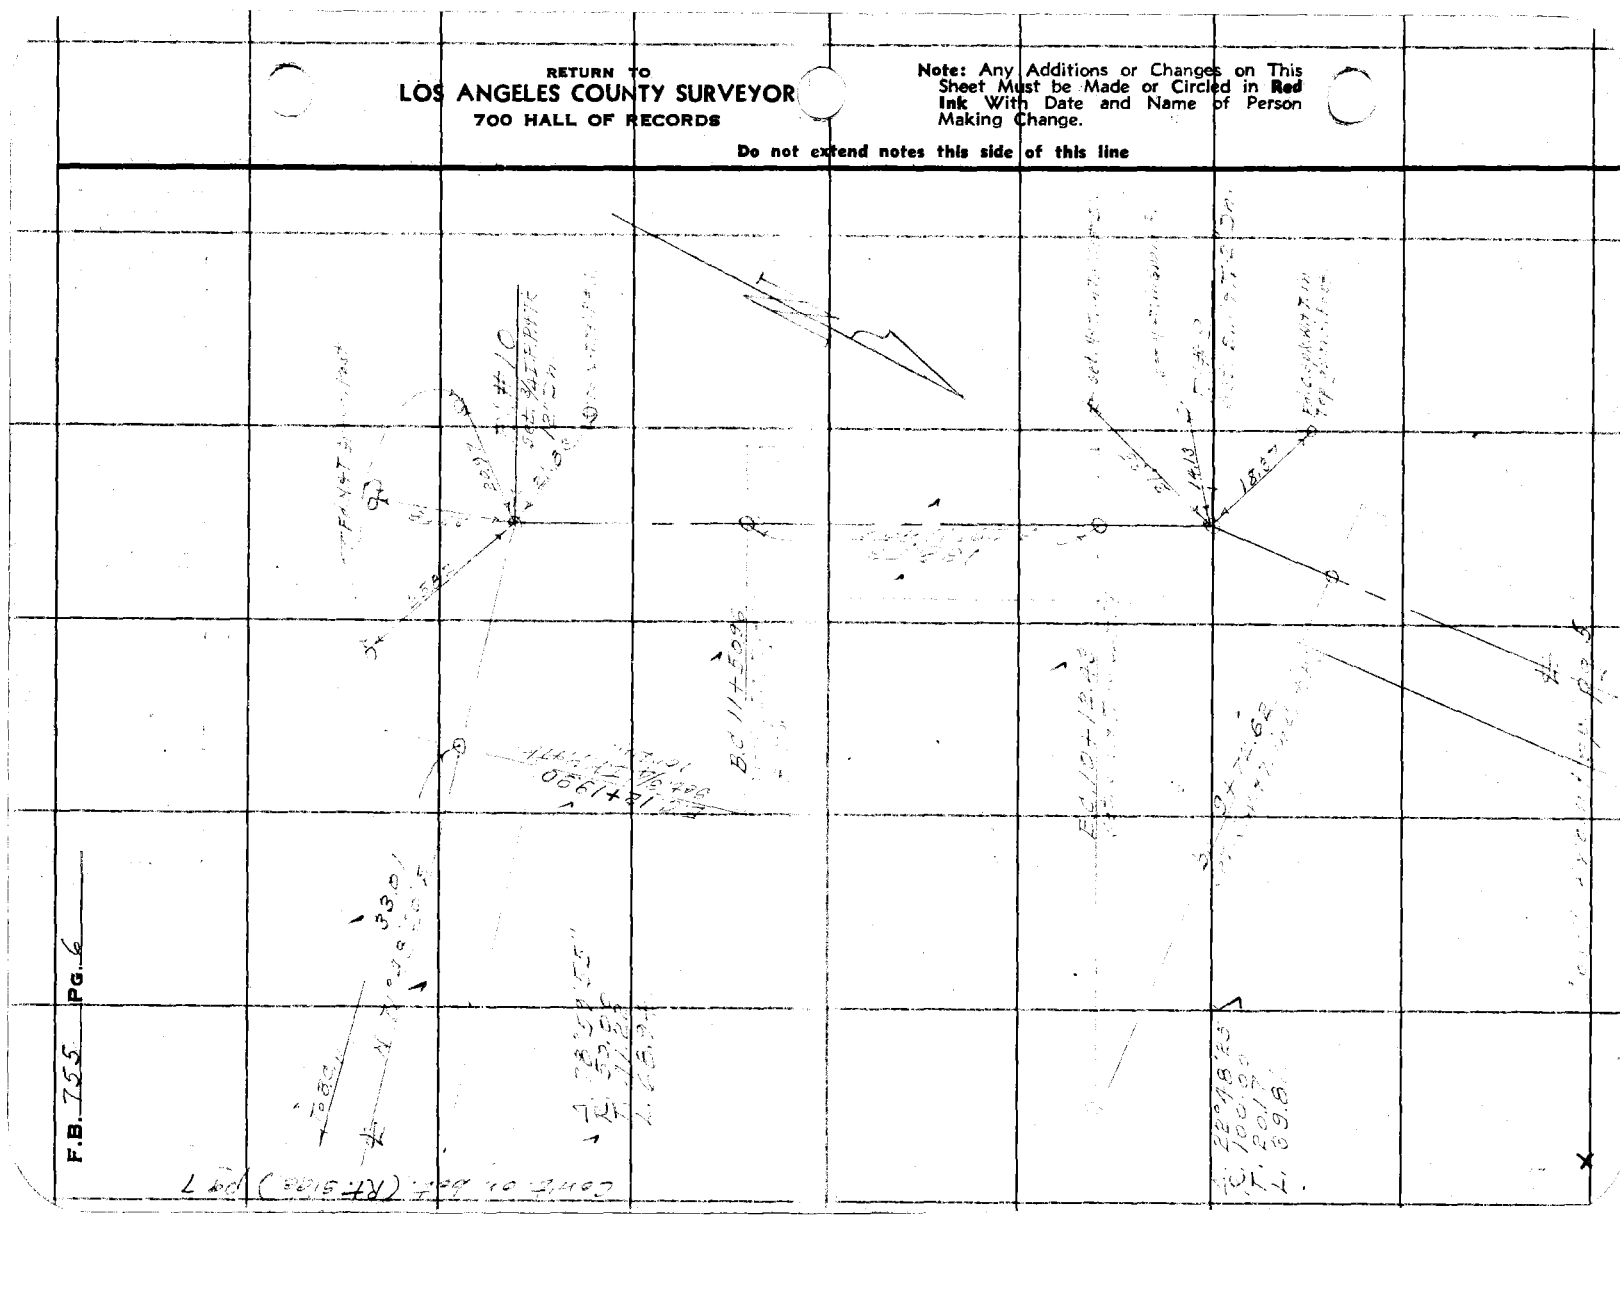

F.B. 755 PG. 6

W.S. 50-D-1

Notes Ck'd by	Survey of
Map No. D	W. O. 2179 Tape No. St'd 32°F.
Office Work F. A. W.	Surveyed by
Checked Dr. [illegible]	Notes Date
Date 12-3-31	Indexed

F.B. [illegible] PG. 7

Note: Any Additions or Changes on This Sheet Must be Made or Circled in Red Ink With Date and Name of Person Making Change.

Do not extend notes this side of this line

RETURN TO
LOS ANGELES COUNTY SURVEYOR
720 HALL OF RECORDS

FORM 247 10M 11-35

RETURN TO
LOS ANGELES COUNTY SURVEYOR
700 HALL OF RECORDS

Note: Any Additions or Changes on This Sheet Must be Made or Circled in **Red Ink** With Date and Name of Person Making Change.

Do not extend notes this side of this line

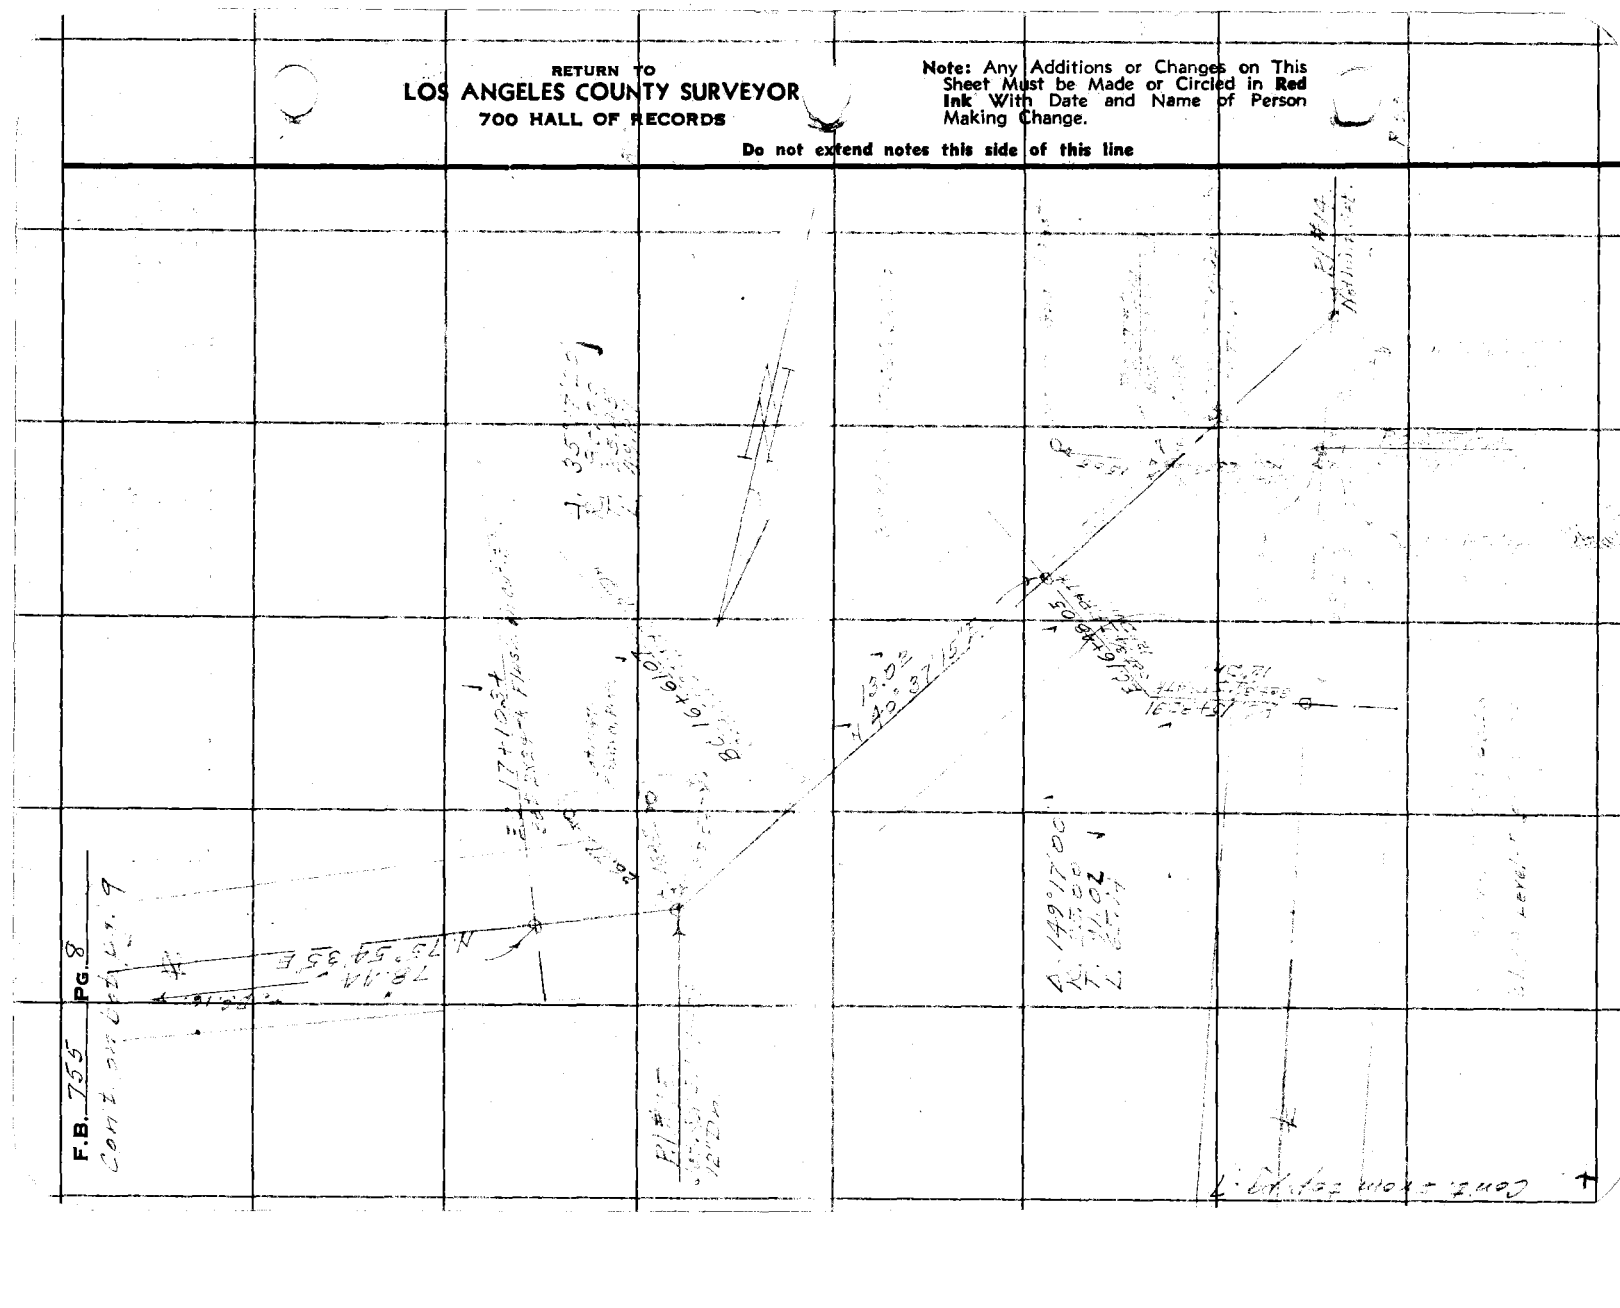

Notes Ck'd by	Survey of
Map No. 9-1017-1	W. O. 1 Tape No. 1 St'd F.
Office Work F. A. W.	Surveyed by
Checked Orig.	Notes Date
Date 12-3-40	Indexed A. C.

F.B. Pg.

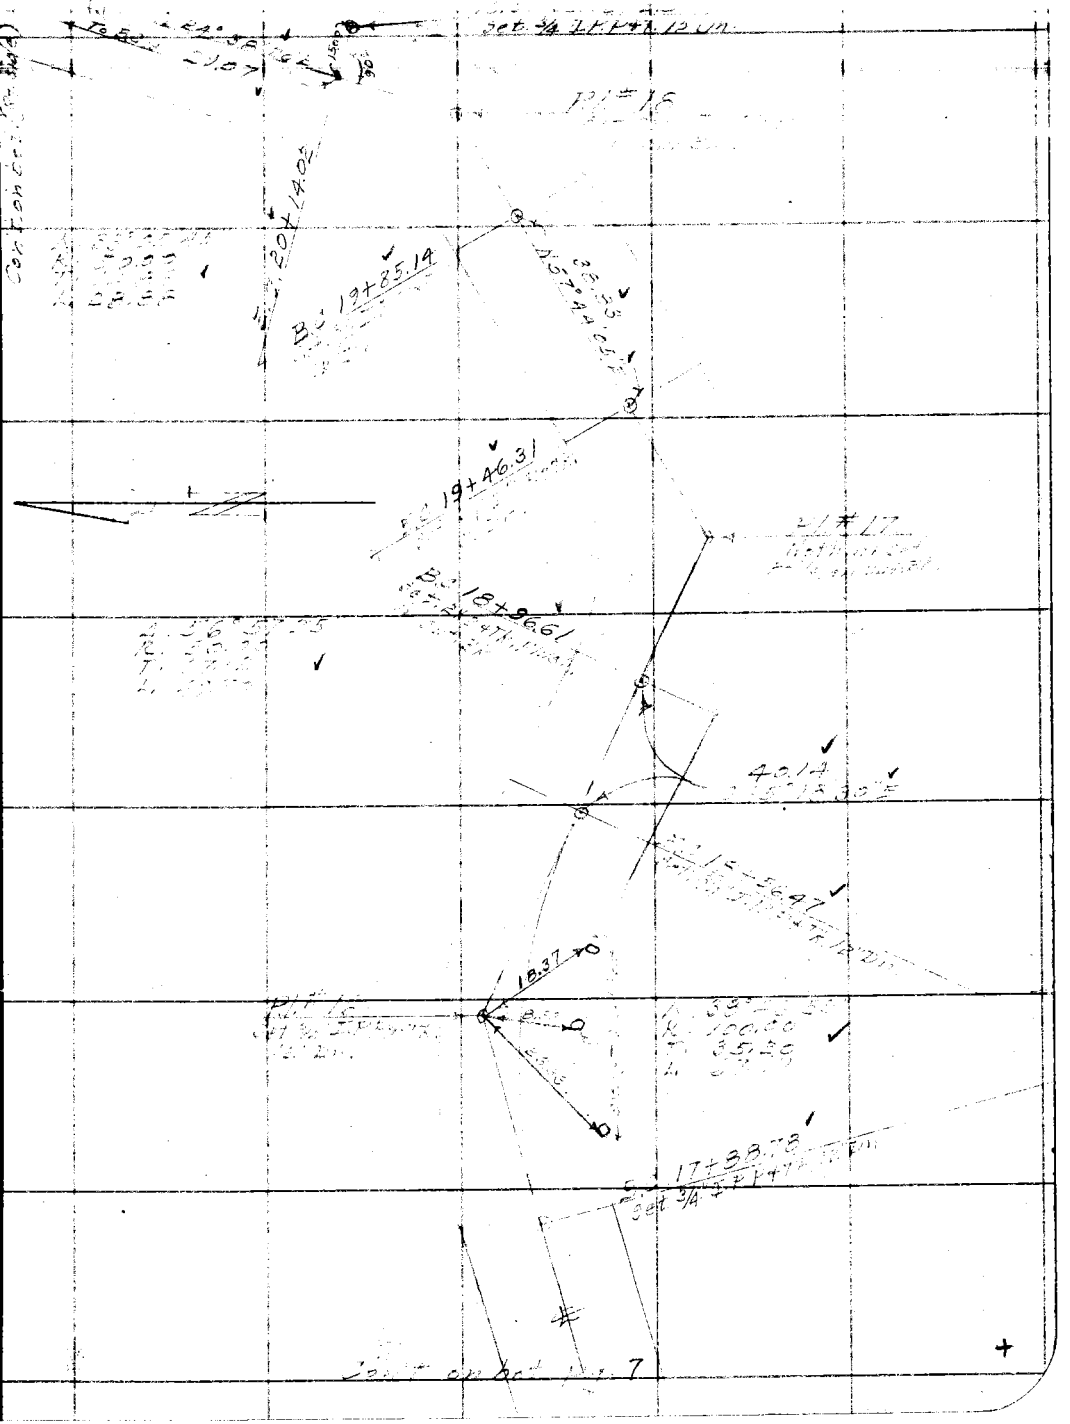

Note: Any Additions or Changes on This Sheet Must be Made or Circled in Red Ink With Date and Name of Person Making Change.

Do not extend notes this side of this line

RETURN TO
LOS ANGELES COUNTY SURVEYOR
700 HALL OF RECORDS

FORM 247 10M 11-35

RETURN TO
LOS ANGELES COUNTY SURVEYOR
700 HALL OF RECORDS

Note: Any Additions or Changes on This Sheet Must be Made or Circled in **Red Ink** With Date and Name of Person Making Change.

Do not extend notes this side of this line

W.S. 50-D-1

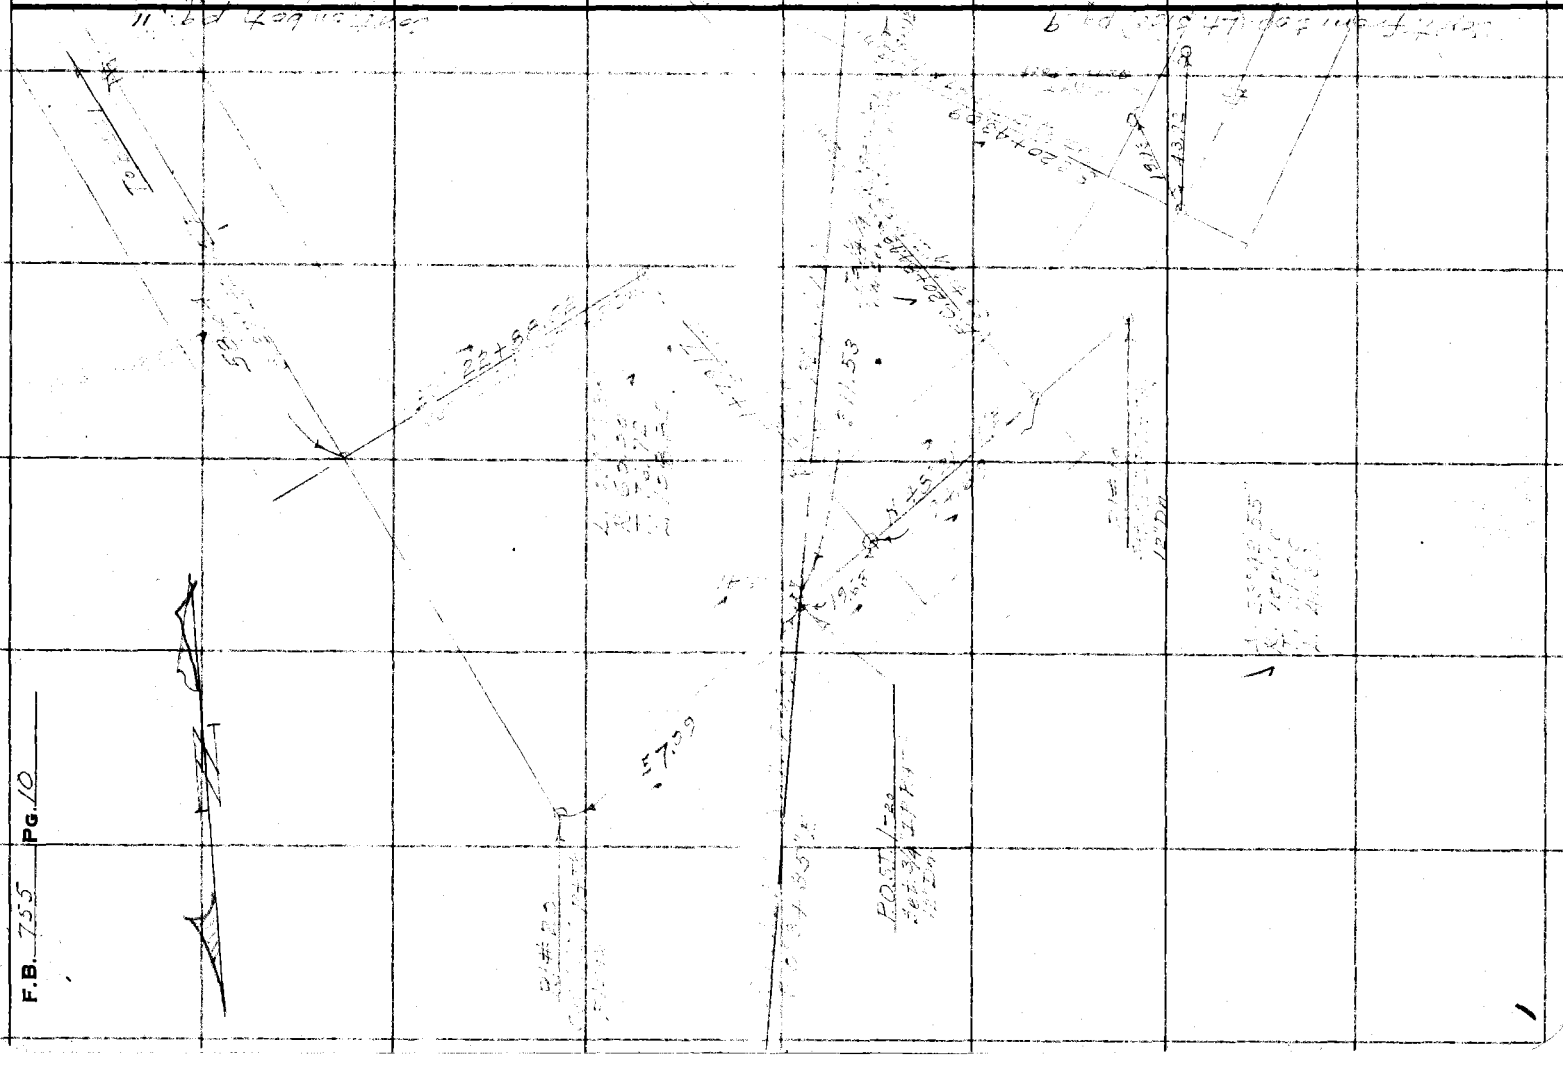

Notes Ck'd by		Survey of	F.B. Pg.
Map No.		W. O. Tape No. St'd °F.	
Office Work	F. A. W.	Surveyed by	
Checked	Dr ewa	Notes Date	
Date	12-3-40	Indexed	

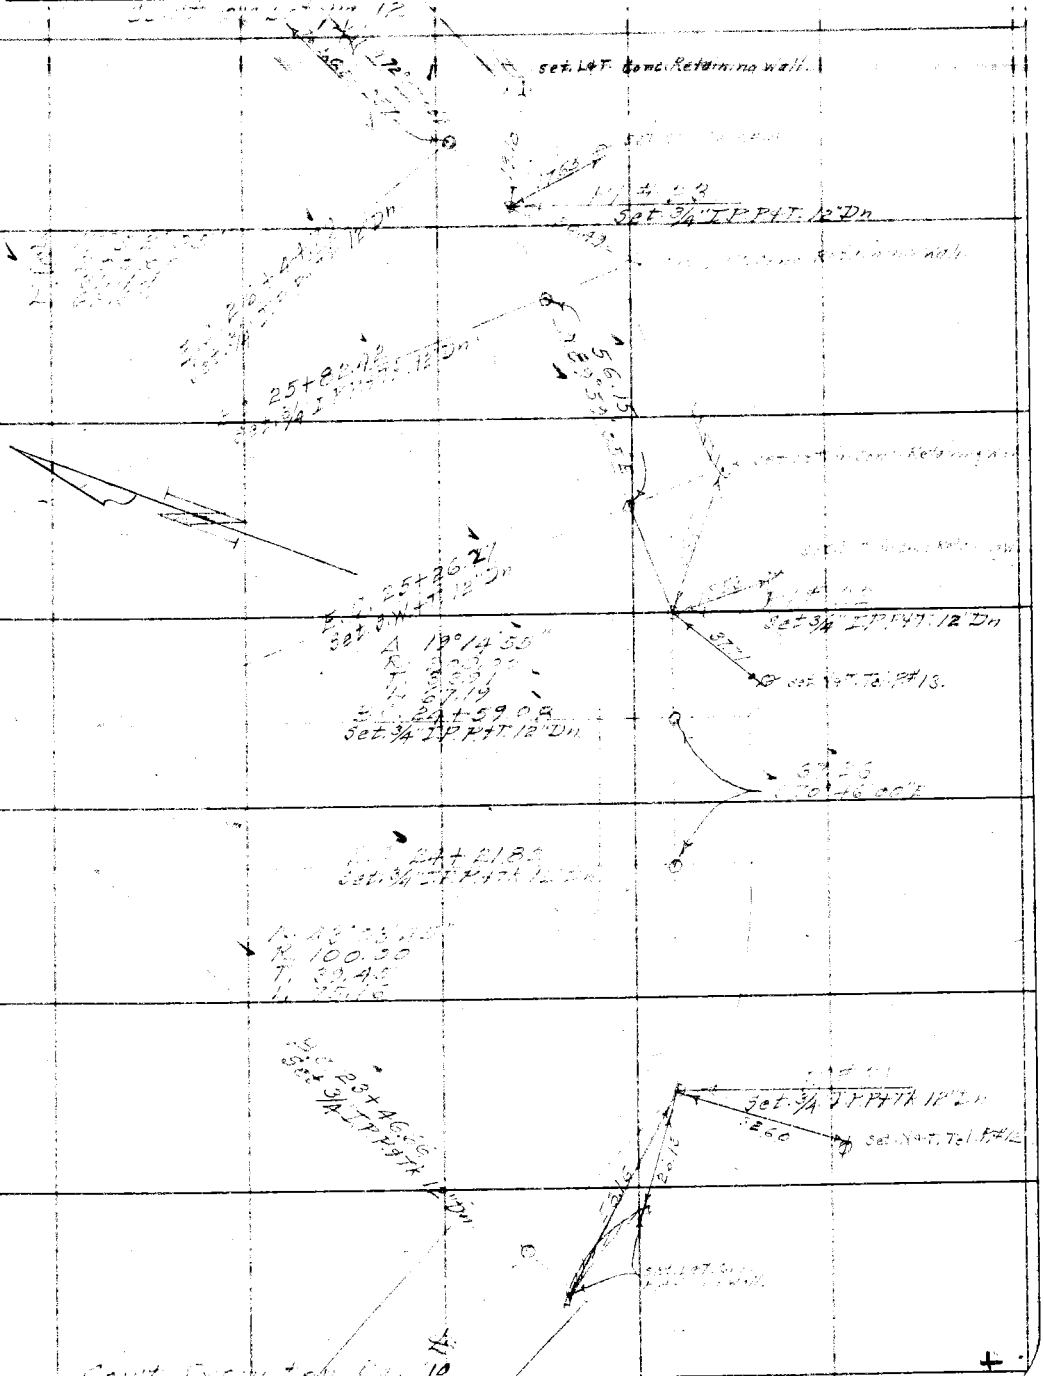

Note: Any Additions or Changes on This Sheet Must be Made or Circled in Red Ink With Date and Name of Person Making Change.

Do not extend notes this side of this line

RETURN TO
LOS ANGELES COUNTY SURVEYOR
700 HALL OF RECORDS

FORM 247 10M 11-35

RETURN TO
LOS ANGELES COUNTY SURVEYOR
700 HALL OF RECORDS

Note: Any Additions or Changes on This Sheet Must be Made or Circled in **Red Ink** With Date and Name of Person Making Change.

Do not extend notes this side of this line

WS 50 - D-1

F.B. 755 PG. 12

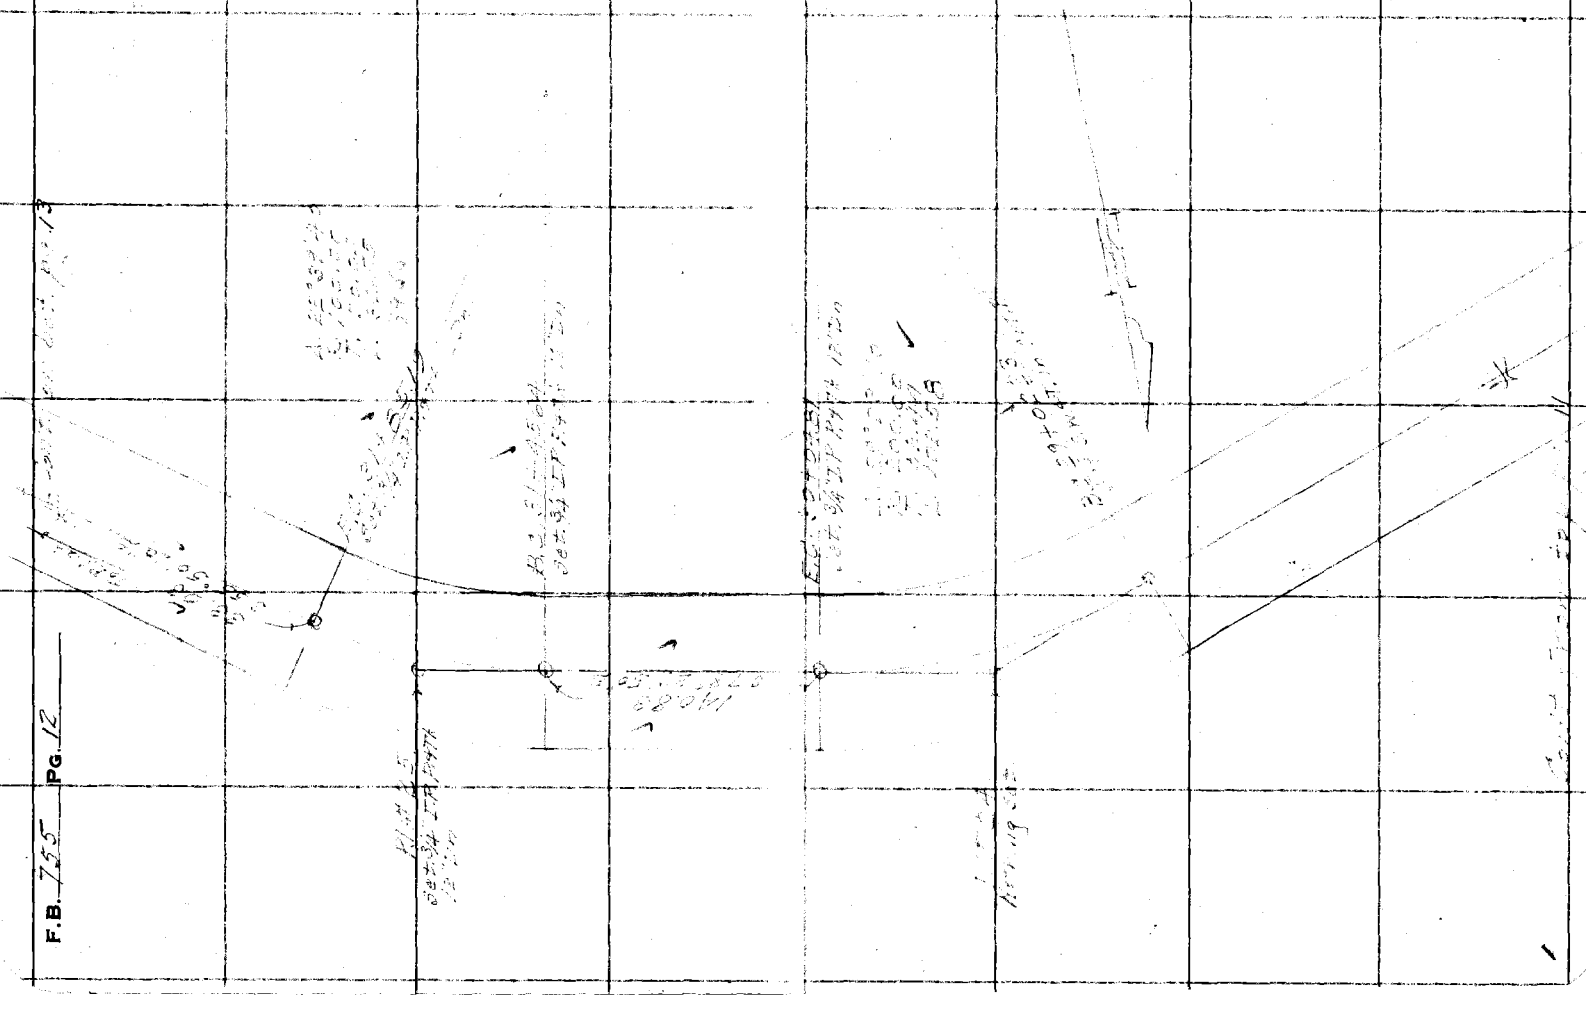

Notes Ck'd by	Survey of
Map No.	W. O. Tape No. St'd °F.
Office Work F. A. W.	Surveyed by
Checked	Notes Date
Date	Indexed

F.B. Pg.

Note: Any Additions or Changes on This Sheet Must be Made or Circled in Red Ink With Date and Name of Person Making Change

Do not extend notes this side of this line

RETURN TO
LOS ANGELES COUNTY SURVEYOR
700 HALL OF RECORDS

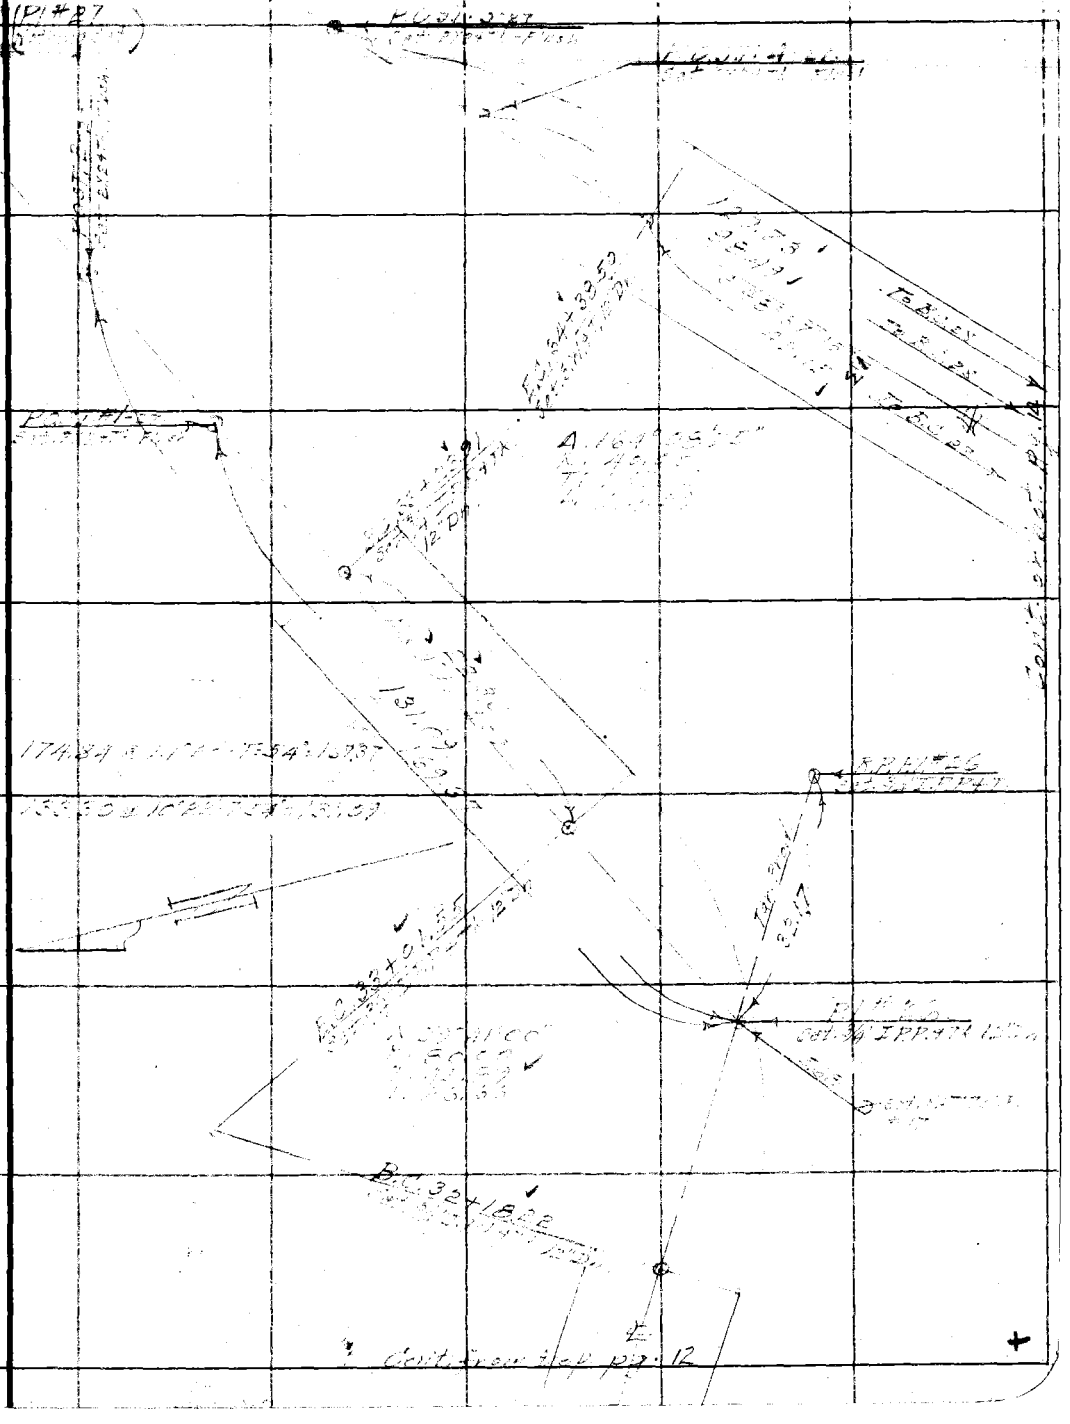

FORM 247 10M 11-38

RETURN TO
LOS ANGELES COUNTY SURVEYOR
700 HALL OF RECORDS

Note: Any Additions or Changes on This Sheet Must be Made or Circled in Red Ink With Date and Name of Person Making Change.

Do not extend notes this side of this line

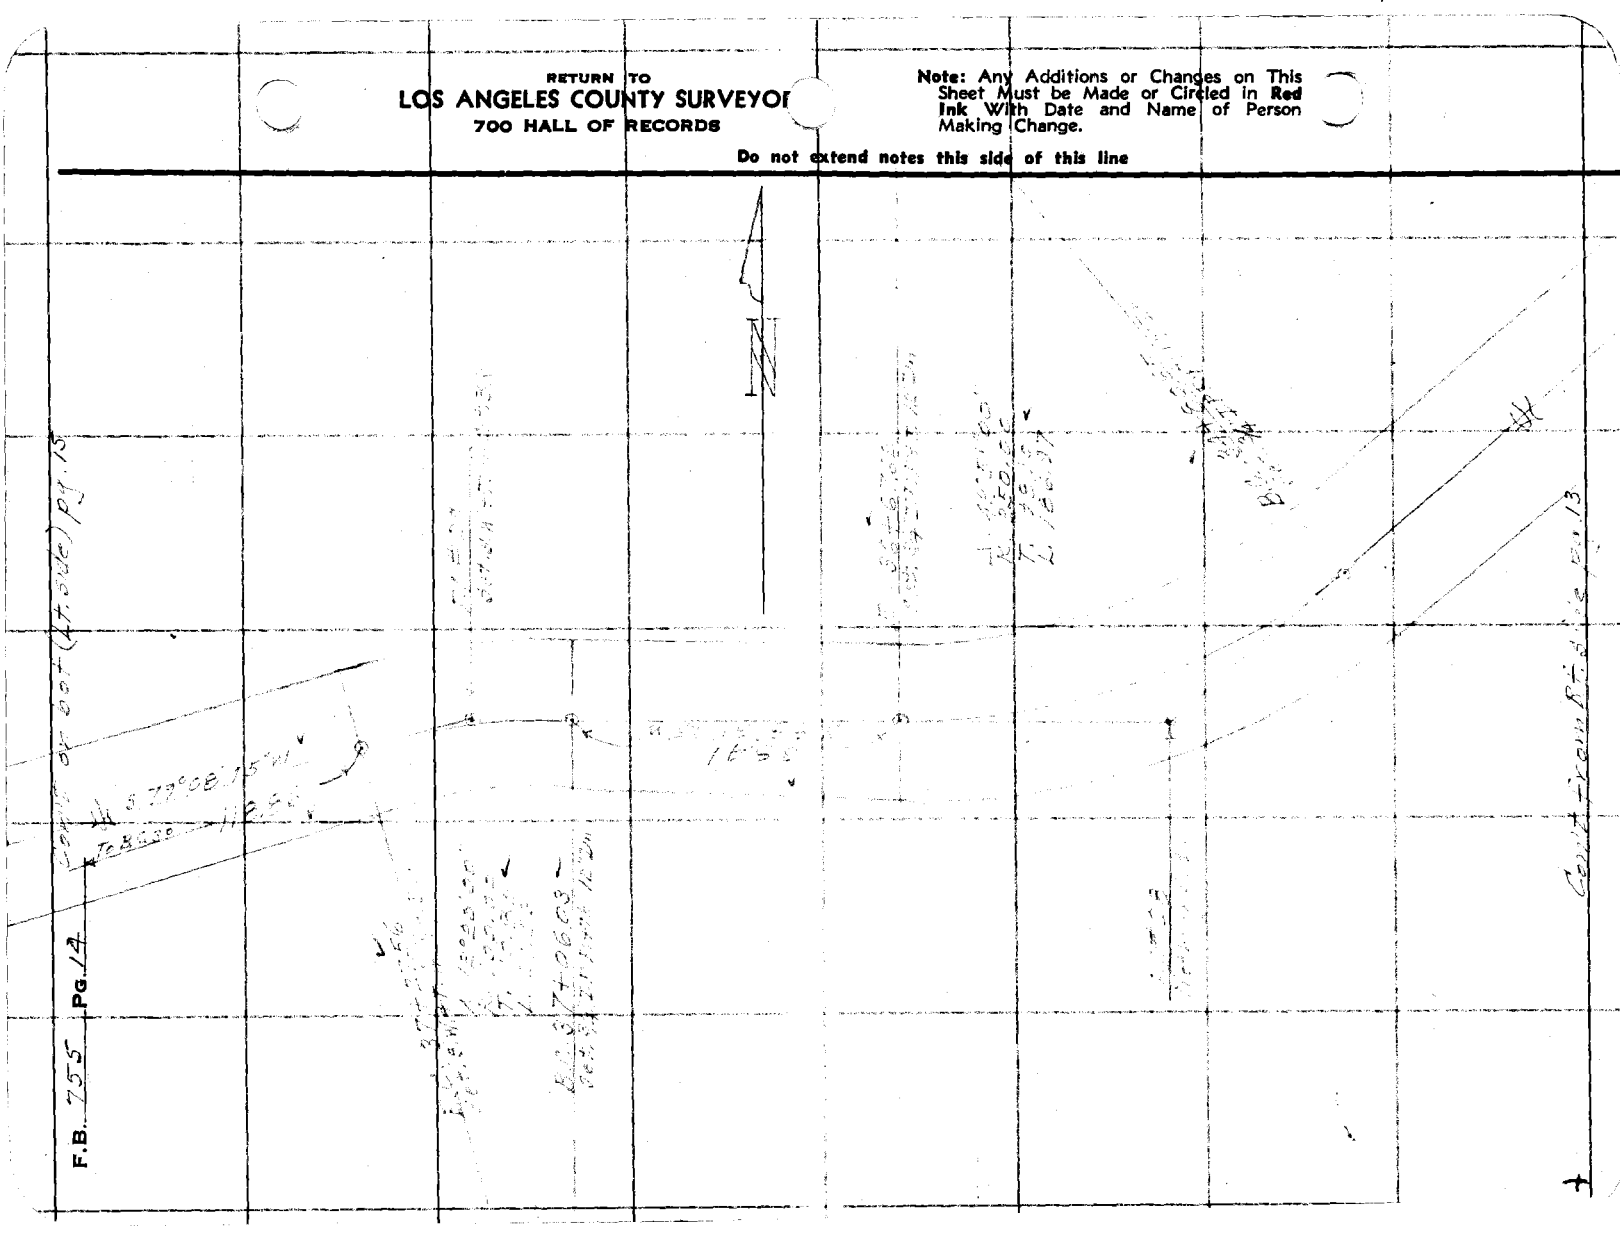

FORM 247 10M 11-35

RETURN TO
LOS ANGELES COUNTY SURVEYOR
700 HALL OF RECORDS

Note: Any Additions or Changes on This Sheet Must be Made or Circled in Red Ink With Date and Name of Person Making Change.

Do not extend notes this side of this line

WS 50 - D-2

Notes Ck'd by
Map No. 2
Office Work F. A. W
Checked
Date

Survey of
W. O. Tape No. Std. °F.
Surveyed by
Notes Date
Indexed

F.B. P/#31 PG.

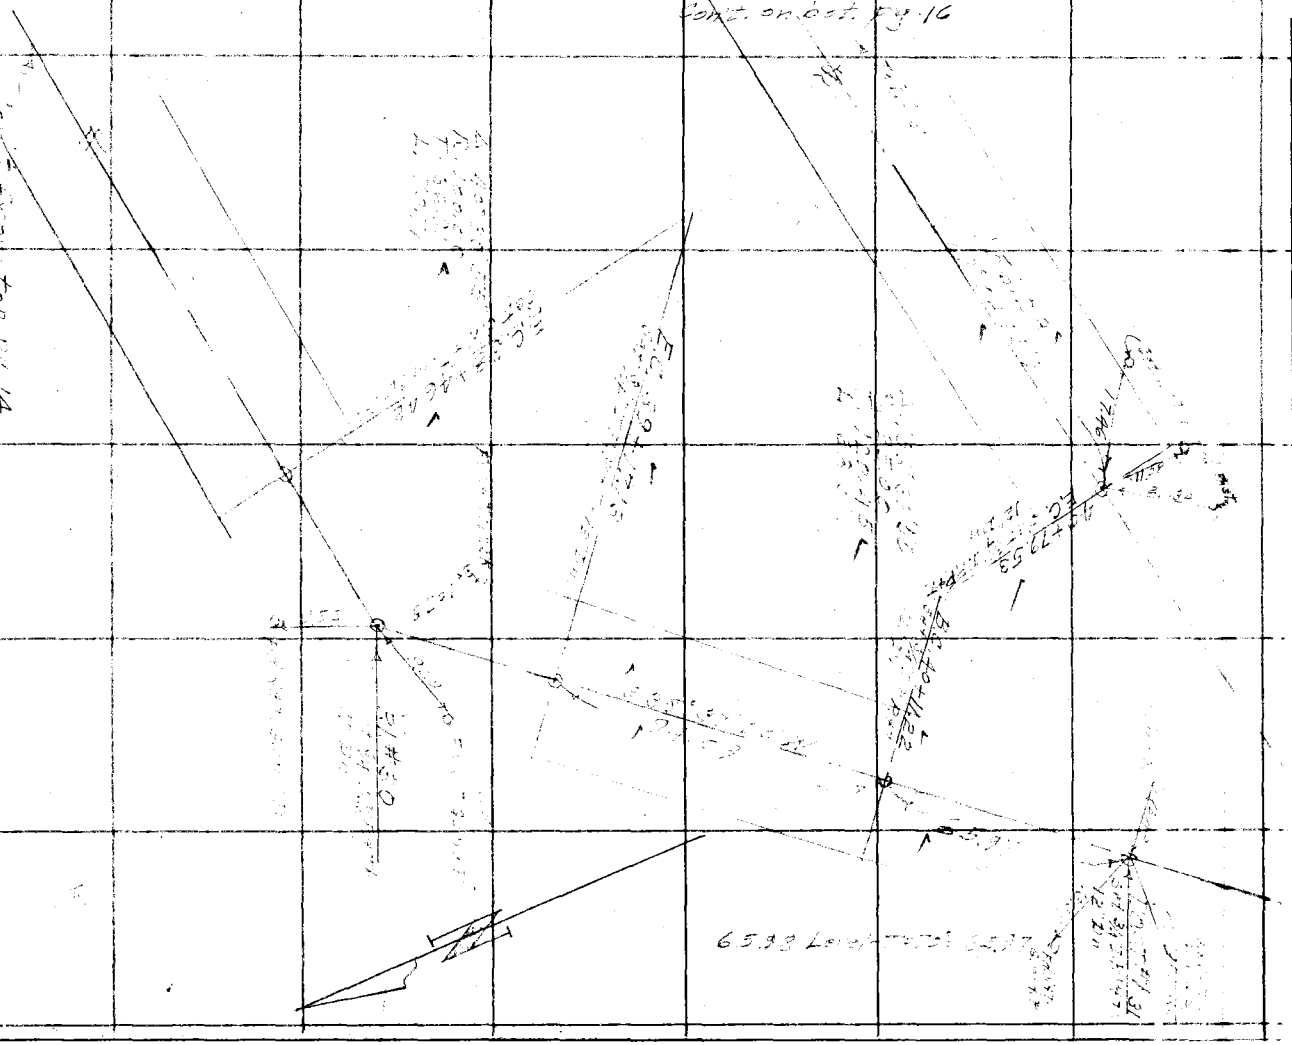

RETURN TO
LOS ANGELES COUNTY SURVEYOR
700 HALL OF RECORDS

Note: Any Additions or Changes on This Sheet Must be Made or Circled in Red Ink With Date and Name of Person Making Change.

Do not extend notes this side of this line

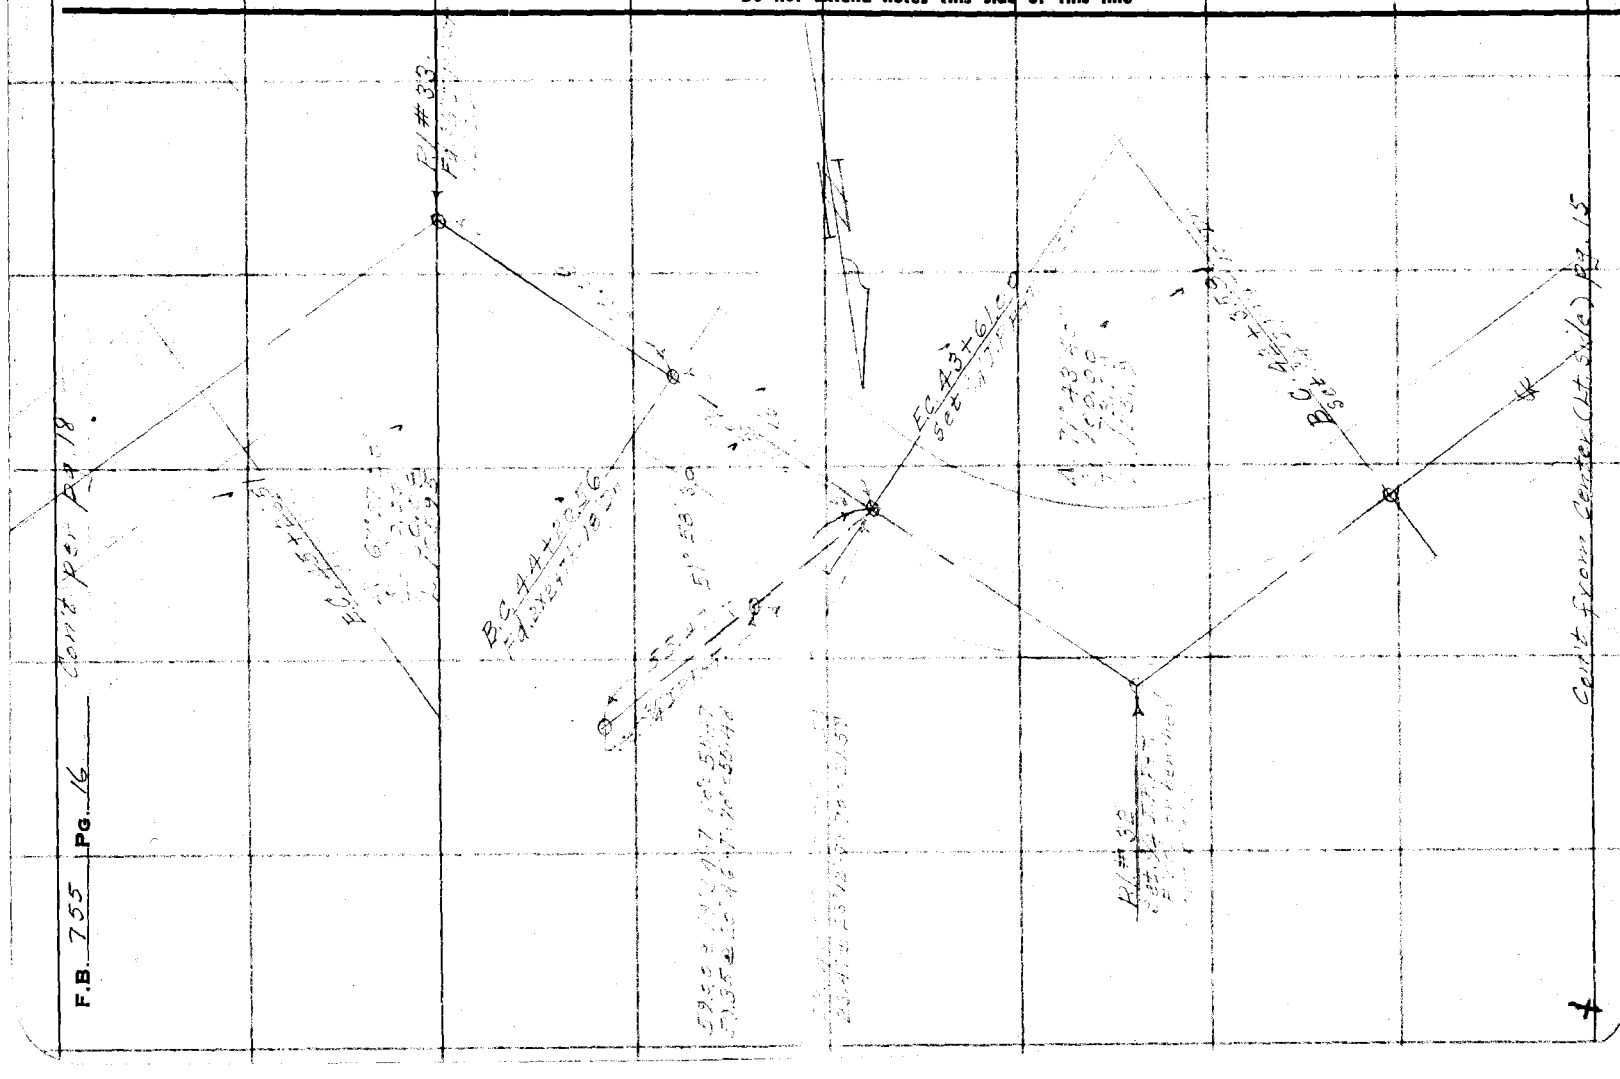

Notes Ck'd by	Survey of
Map No. 3	W. O. 5112 Tape No. St'd °F.
Office Work F. A. W.	Surveyed by
Checked	Notes Date
Date	Indexed

F.B. Pg.

Note: Any Additions or Changes on This Sheet Must be Made in Red Ink With Date and Name of Person Making Change

Do not extend notes this side of this line

RETURN TO
LOS ANGELES COUNTY SURVEYOR
700 HALL OF RECORDS

FORM 247 10M 11-38

F.B. 755 Pg. 18

Con at bottom page 19

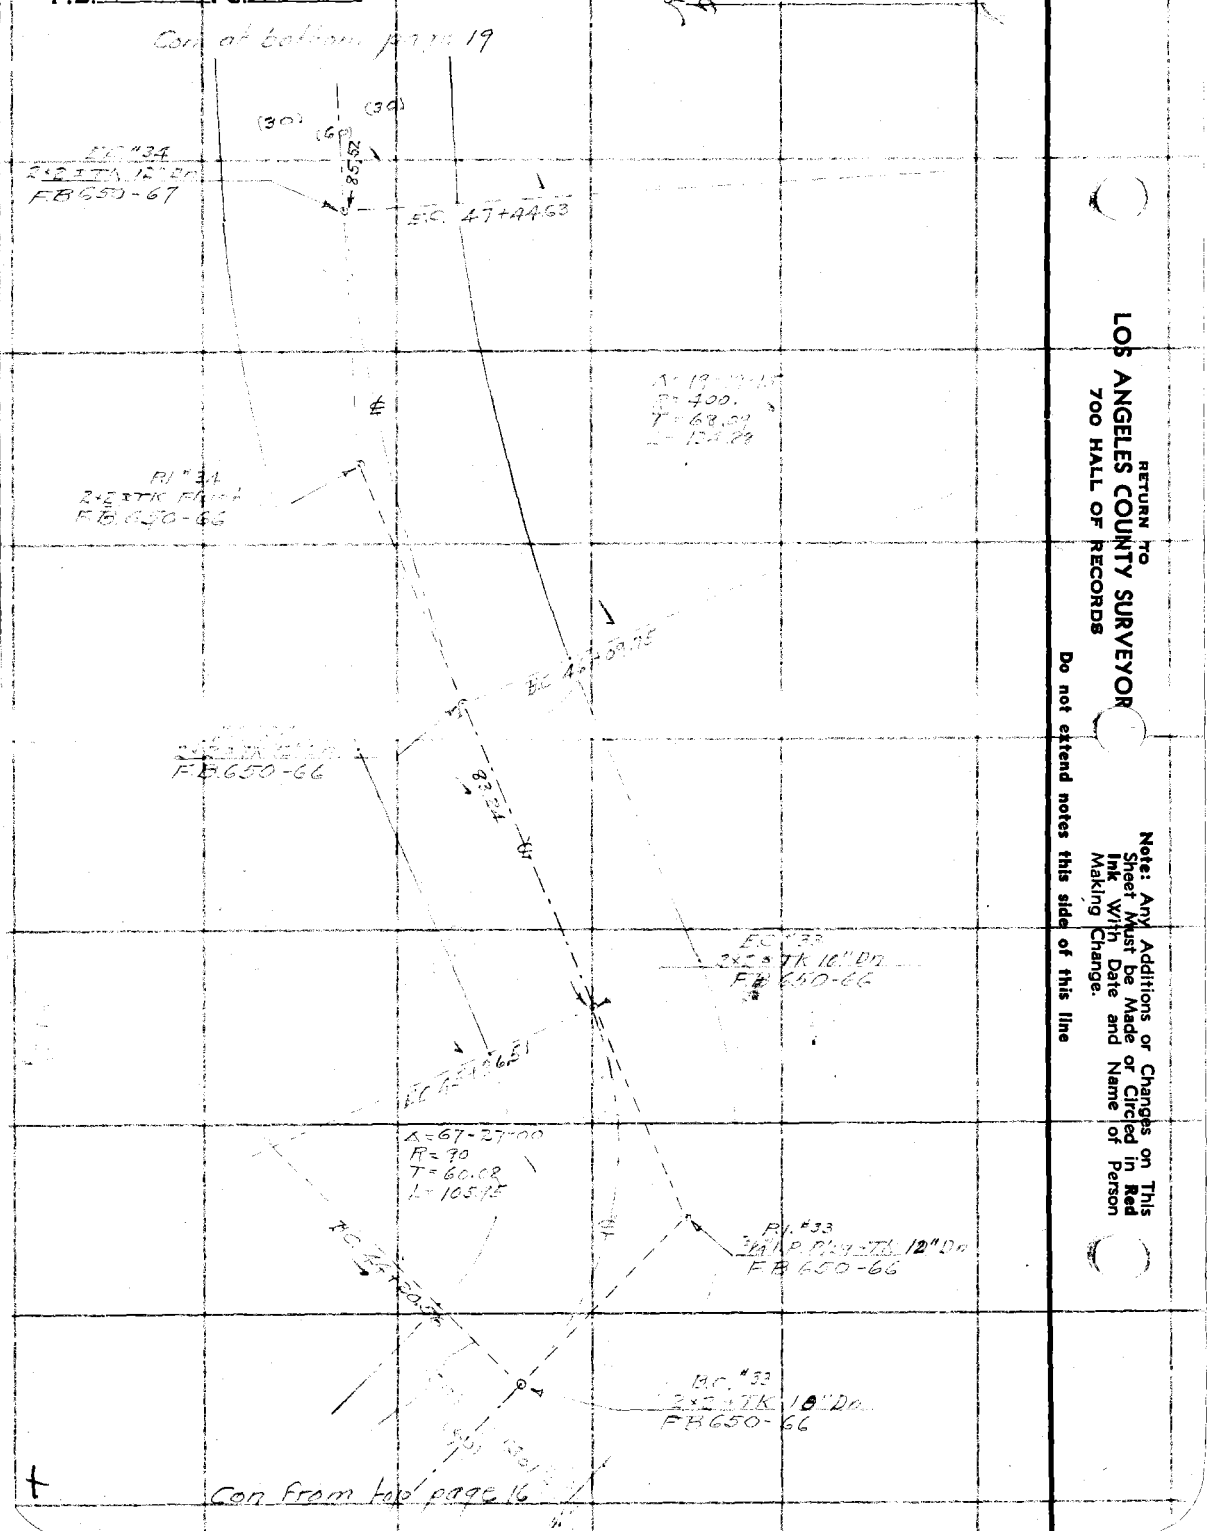

Con From Hdl page 16

RETURN TO
LOS ANGELES COUNTY SURVEYOR
700 HALL OF RECORDS

Note: Any Additions or Changes on This Sheet Must be Made or Circled in Red Ink With Date and Name of Person Making Change.

Do not extend notes this side of this line

Notes Ck'd by	Survey of
Map No.	W. O. Tape No. St'd °F.
Office Work F. A. W.	Surveyed by
Checked	Notes Date
Date	Indexed

F.B. PG.

MS 2-2-2

Note: Any Additions or Changes on This Sheet Must be Made or Circled in Red Ink With Date and Name of Person Making Change.

Do not extend notes this side of this line

RETURN TO
LOS ANGELES COUNTY SURVEYOR
700 HALL OF RECORDS

Cont. from page 20

(30) (30)

4" I.P. FB 650-67

EC 48+44.08

A = 7
R = 500
T = 32.01
L = 63.93

3/4" I.P. FB 650-67

EC

FB 650-67

BC 48+

Cont. from page 18

FORM 247 10M 11-35

F.B. 755 Pg. 20

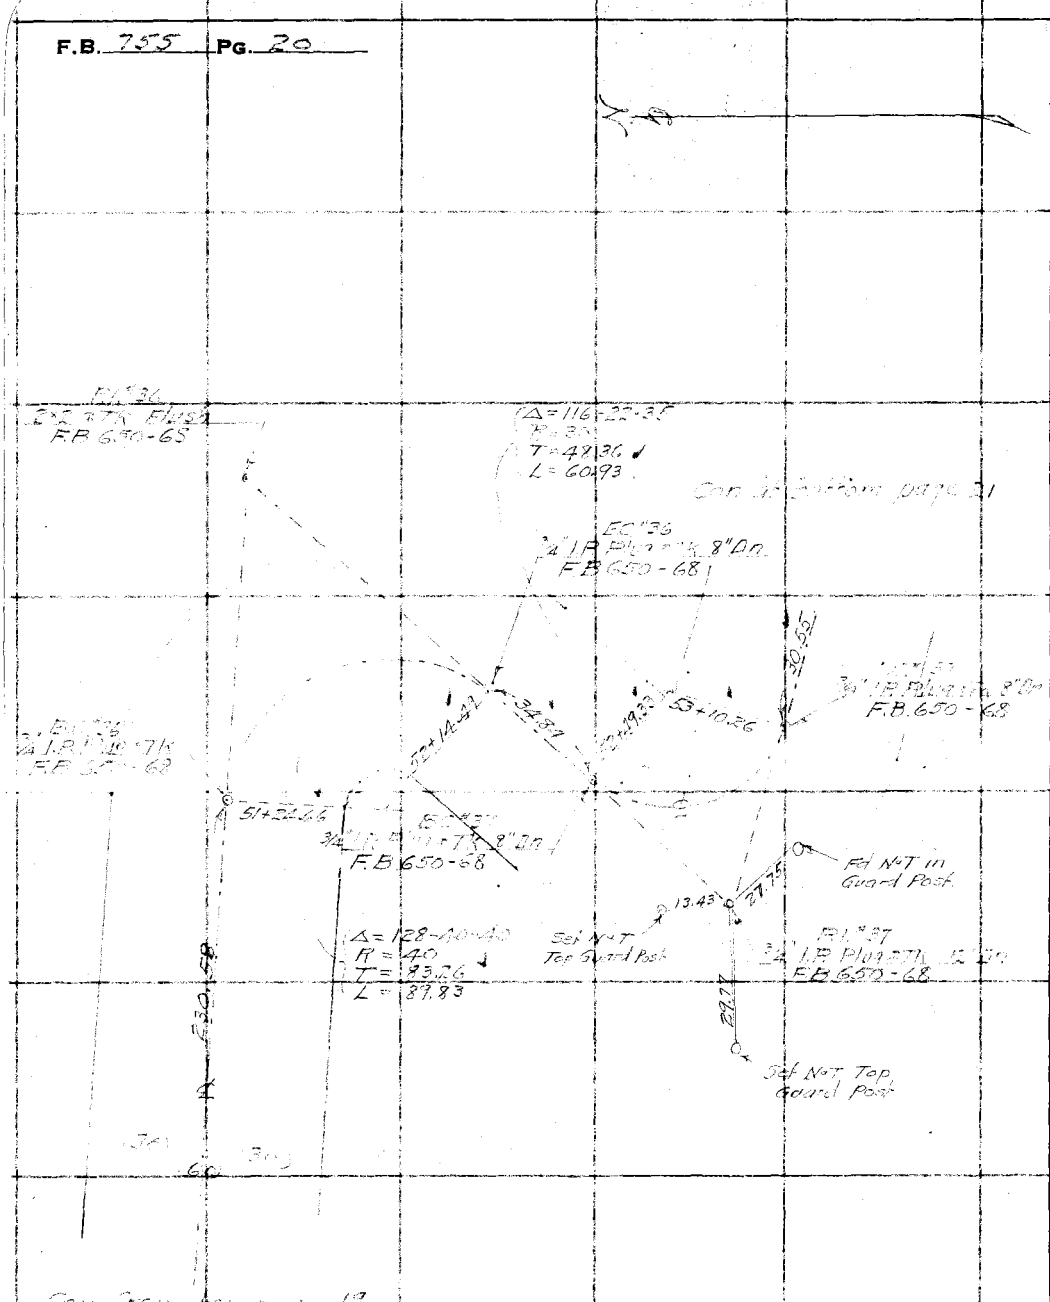

RETURN TO
LOS ANGELES COUNTY SURVEYOR
700 HALL OF RECORDS

Note: Any Additions or Changes on This Sheet Must be Made or Circled in Red Ink With Date and Name of Person Making Change.

Do not extend notes this side of this line

Notes Ck'd by	Survey of
Map No.	W. O. Tape No. St'd °F.
Office Work F. A. W.	Surveyed by
Checked	Notes Date
Date	Indexed

F.B. PG.

Note: Any Additions or Changes on This Sheet Must be Made or Circled in Red Ink With Date and Name of Person Making Change.

Do not extend notes this side of this line

RETURN TO
LOS ANGELES COUNTY SURVEYOR
7DO HALL OF RECORDS

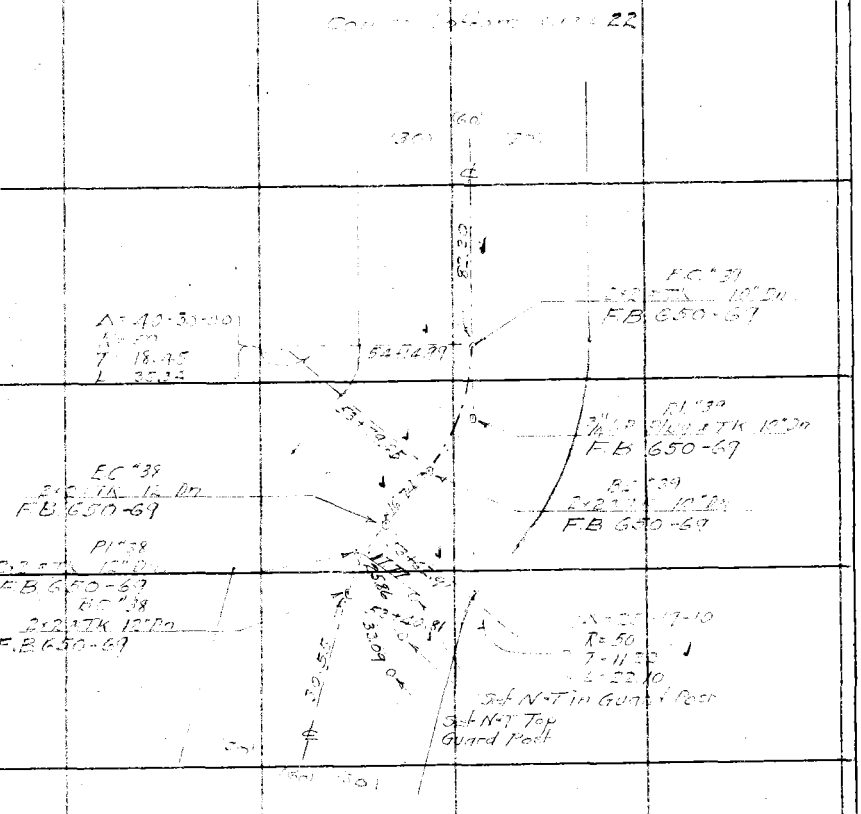

Cont. from page 20

FORM 247 10M 11-58

F.B. 755 Pg. 22

W5,50-D-7

RETURN TO
LOS ANGELES COUNTY SURVEYOR
700 HALL OF RECORDS

Note: Any Additions or Changes on This Sheet Must be Made or Circled in Red Ink With Date and Name of Person Making Change.

Do not extend notes this side of this line

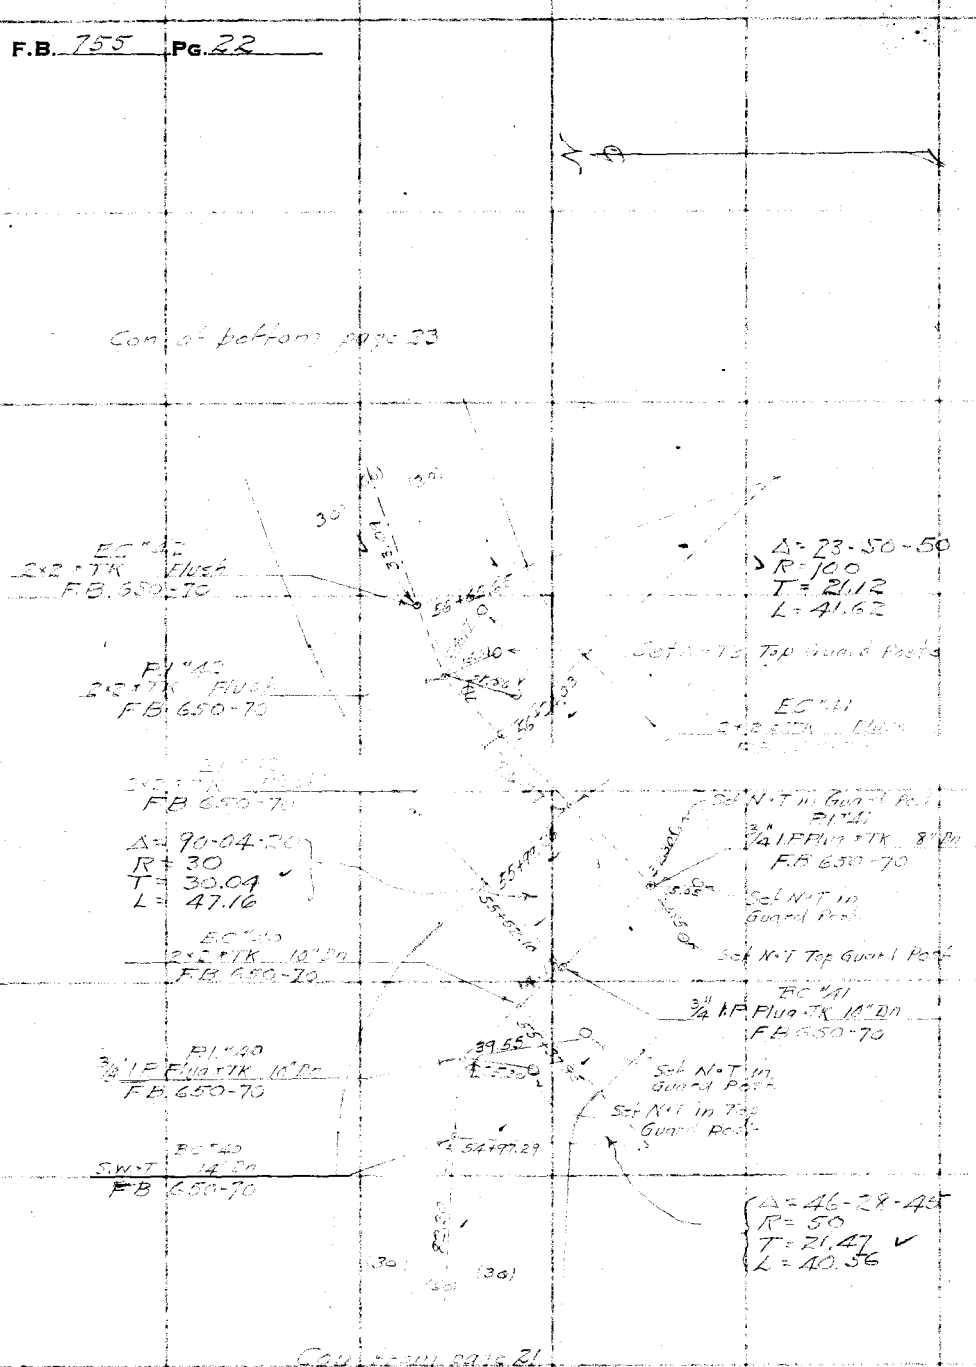

Notes Ck'd by	Survey of
Map No.	W. O.	Tape No.	St'd °F.
Office Work F. A. W.	Surveyed by
Checked	Notes	Date
Date	Indexed

F.B. Pg.

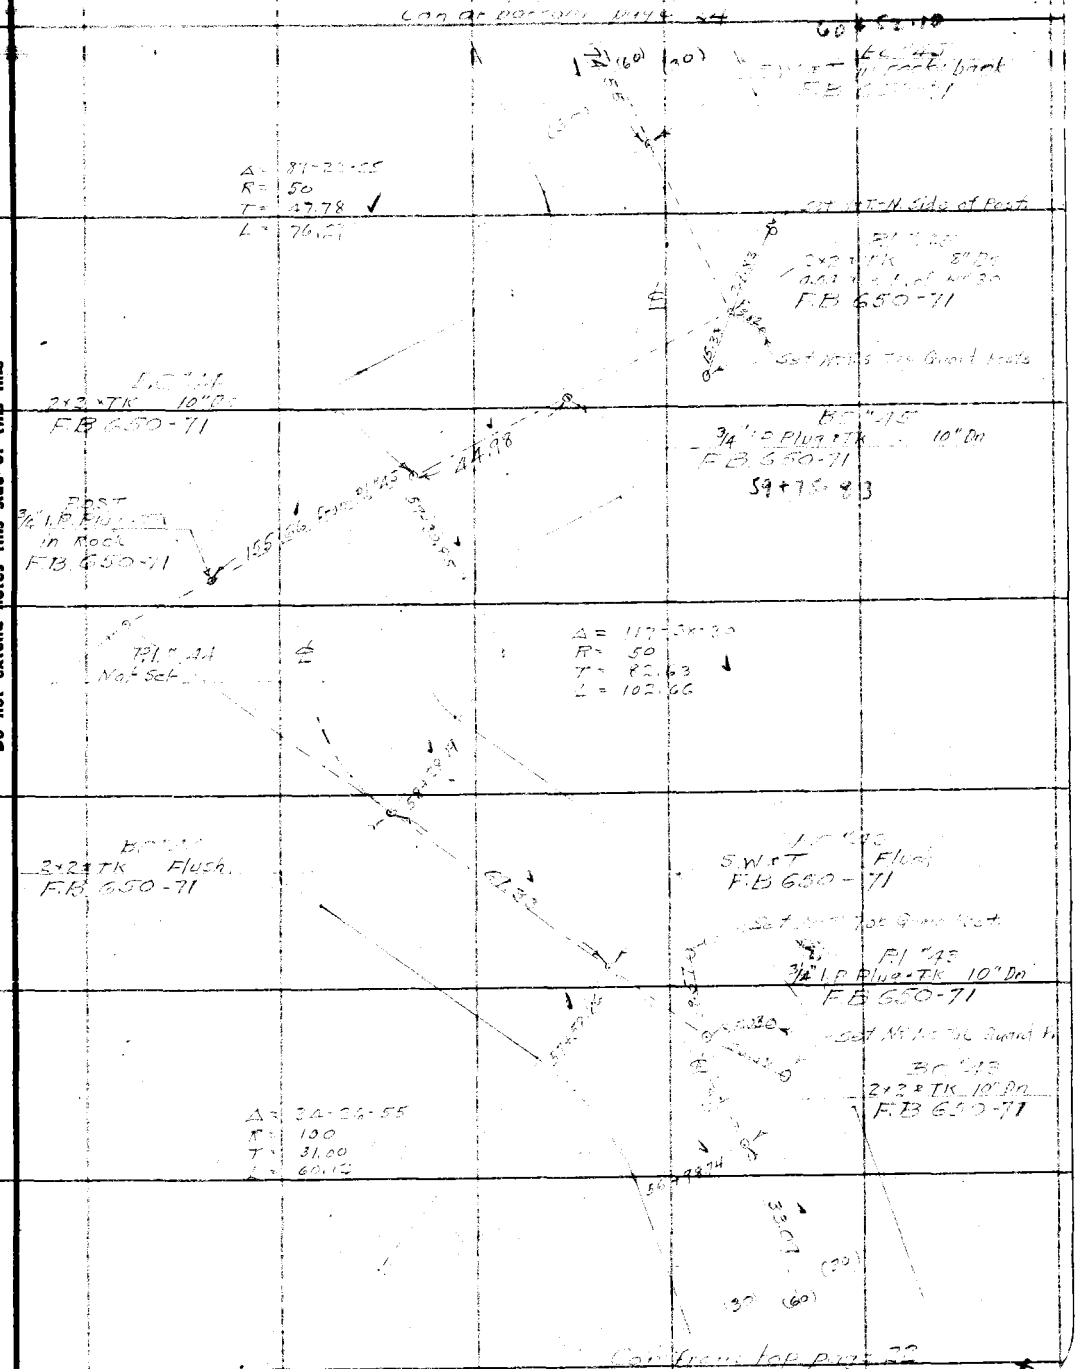

Note: Any Additions or Changes on This Sheet Must be Made or Circled in Red Ink With Date and Name of Person Making Change.

Do not extend notes this side of this line

RETURN TO
LOS ANGELES COUNTY SURVEYOR
700 HALL OF RECORDS

FORM 247 10M 11-38

RETURN TO
LOS ANGELES COUNTY SURVEYOR
700 HALL OF RECORDS

Note: Any Additions or Changes on This Sheet Must be Made or Circled in **Red Ink** With Date and Name of Person Making Change.

WS 50-D-2

Do not extend notes this side of this line

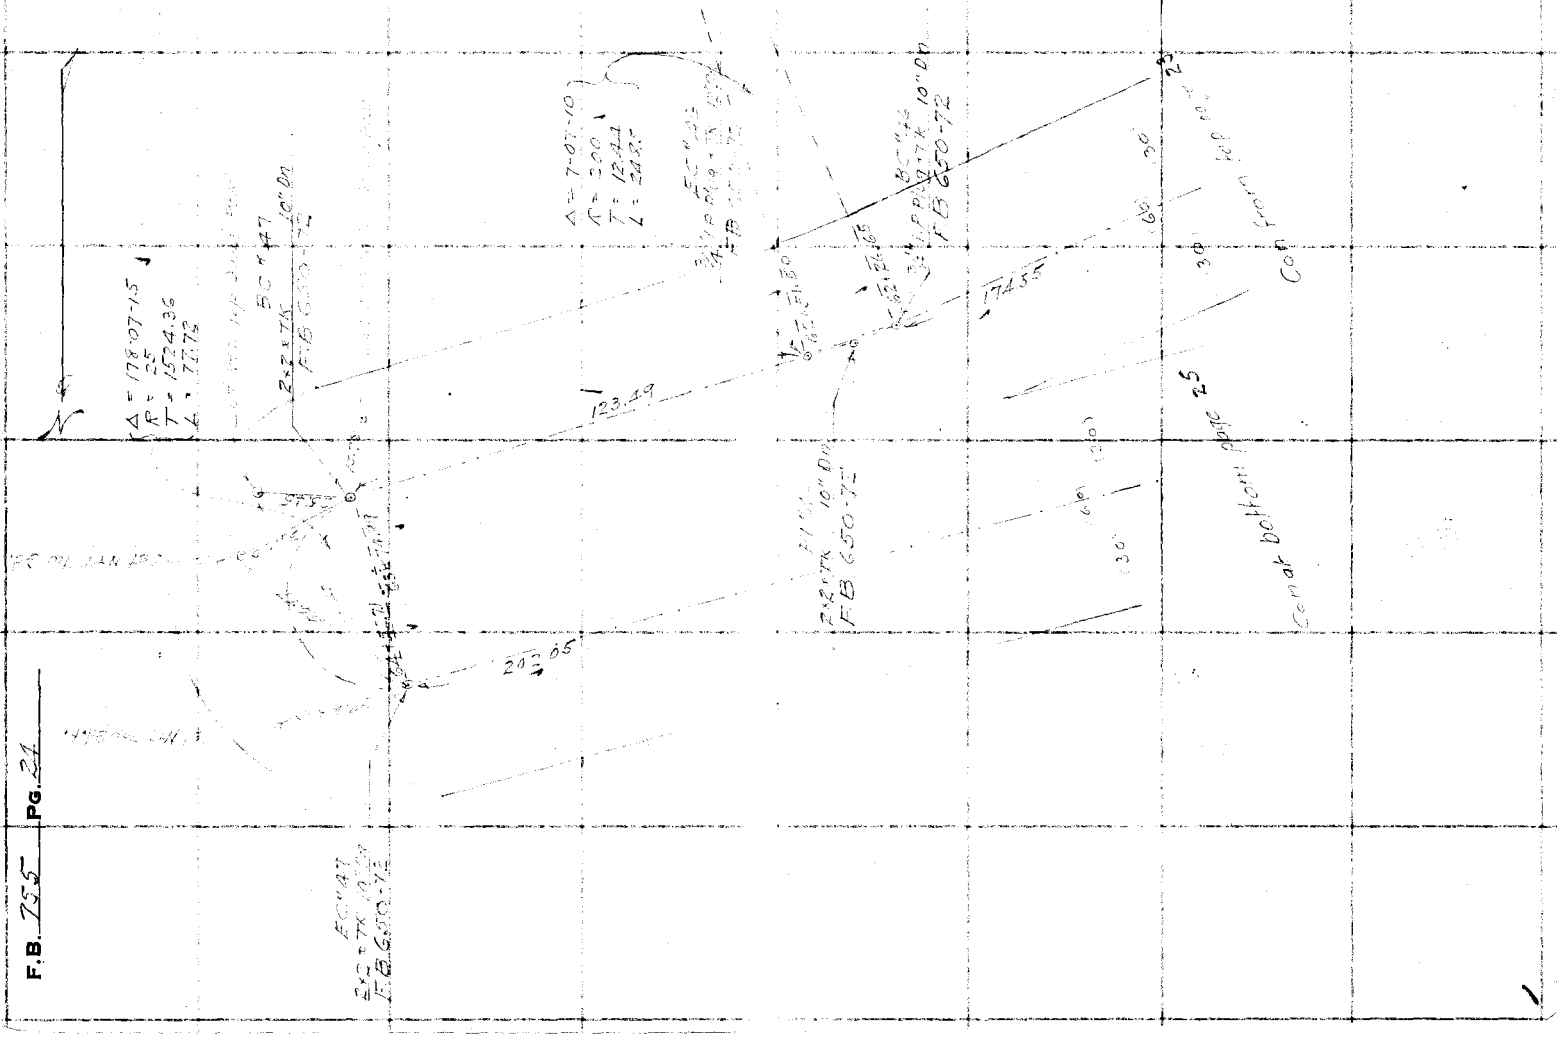

F.B. 755 PG. 24

Notes Ck'd by	Survey of
Map No.	W. O. 8149 Tape No. St'd °F.
Office Work	Surveyed by
Checked	Notes Date
Date	Indexed

F.B. PG.

Con at bottom right page 26

Δ=88-56-50
R=100
T=98.18
L=153.29

P.I. #49

EC #48

BC #49

P.I. #48

Δ=66-41-40
R=130
T=85.55
L=151.32

EC #48

66+54.76

Con from bottom page 24

Note: Any Additions or Changes on This Sheet Must be Made or Circled in Red Ink With Date and Name of Person Making Change.

Do not extend notes this side of this line

RETURN TO
LOS ANGELES COUNTY SURVEYOR
700 HALL OF RECORDS

FORM 247 10M 11-65

RETURN TO
LOS ANGELES COUNTY SURVEYOR
700 HALL OF RECORDS

Note: Any Additions or Changes on This Sheet Must be Made or Circled in Red Ink With Date and Name of Person Making Change.

WS 50 - D-2

Do not extend notes this side of this line

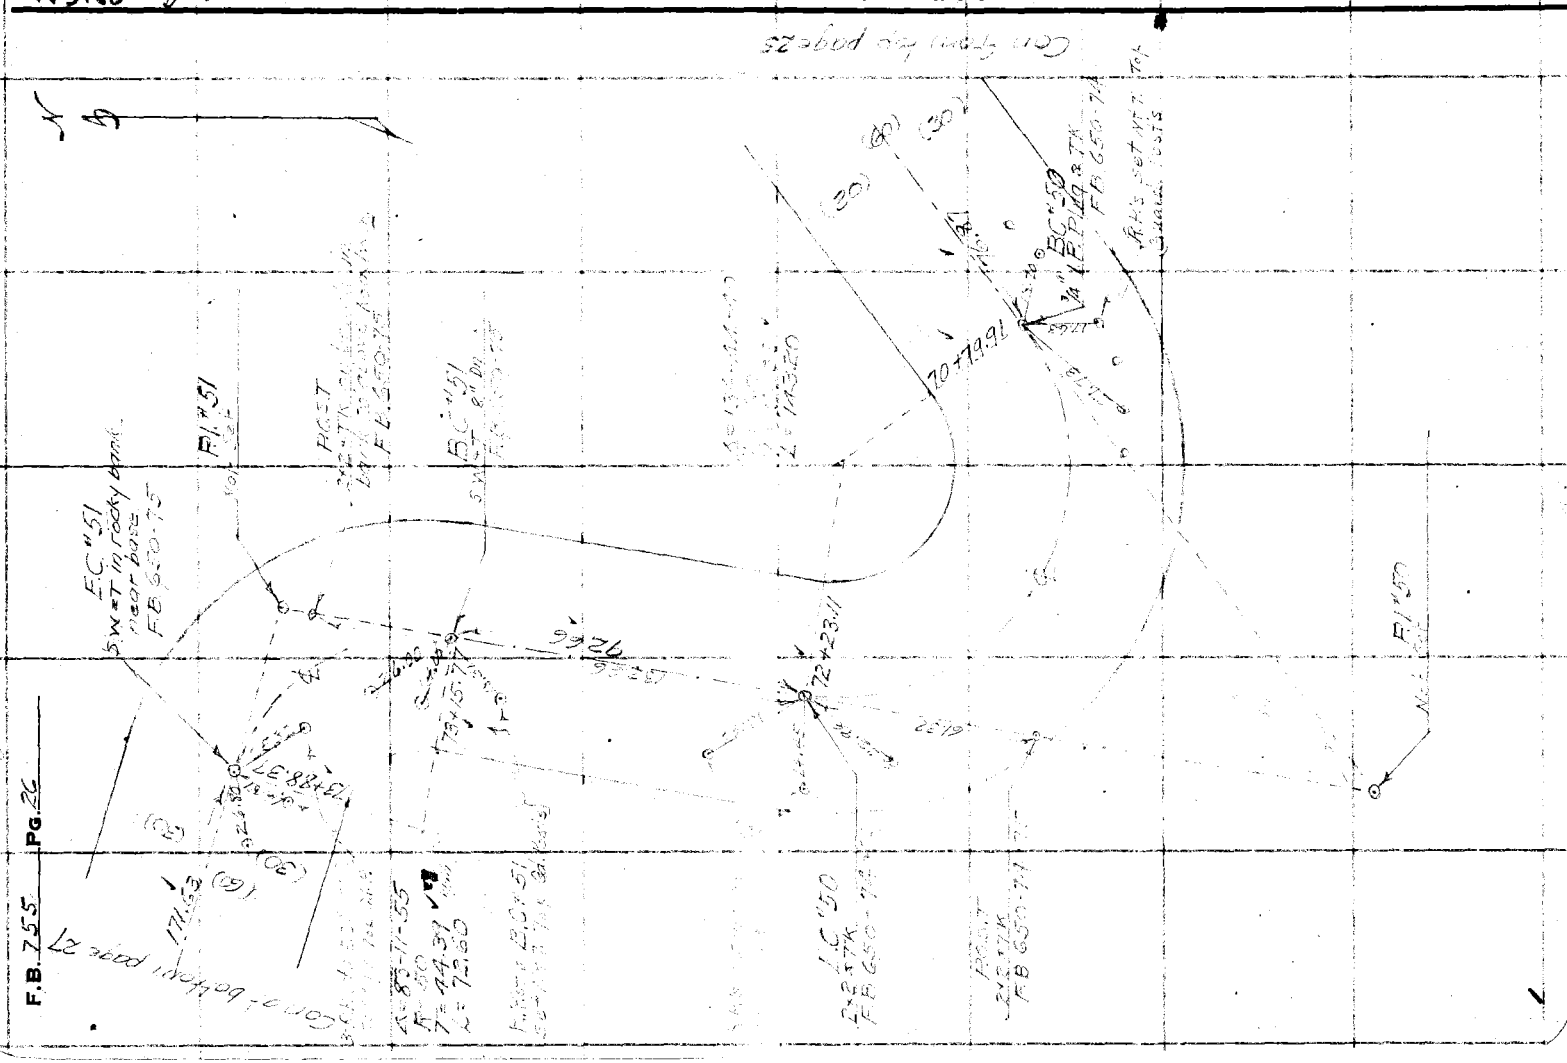
F.B. 755 Pg. 26
EC 1151
SW ⇌ in rocky bank
near base
F.B. 670-75
PI 1151
PCC T
BC 1151
EC 1150
PI 1150
70+79.91
72+23.11
LE 88+61
Curve Data
Δ = 80-11-55
R = 300
T = 44.37
L = 72.65
Δ = 13-44-40
R = 1146.28
T = 134.20
L = 268.79
Δ = 2-48-00
R = 1146.28
T = 24.85
L = 49.69

Notes Ck'd by	Survey of
Map No. B-10	W. O. Tape No. St'd °F.
Office Work F. A. W.	Surveyed by
Checked	Notes Date
Date 12-4-	Indexed

F.B. Pg.

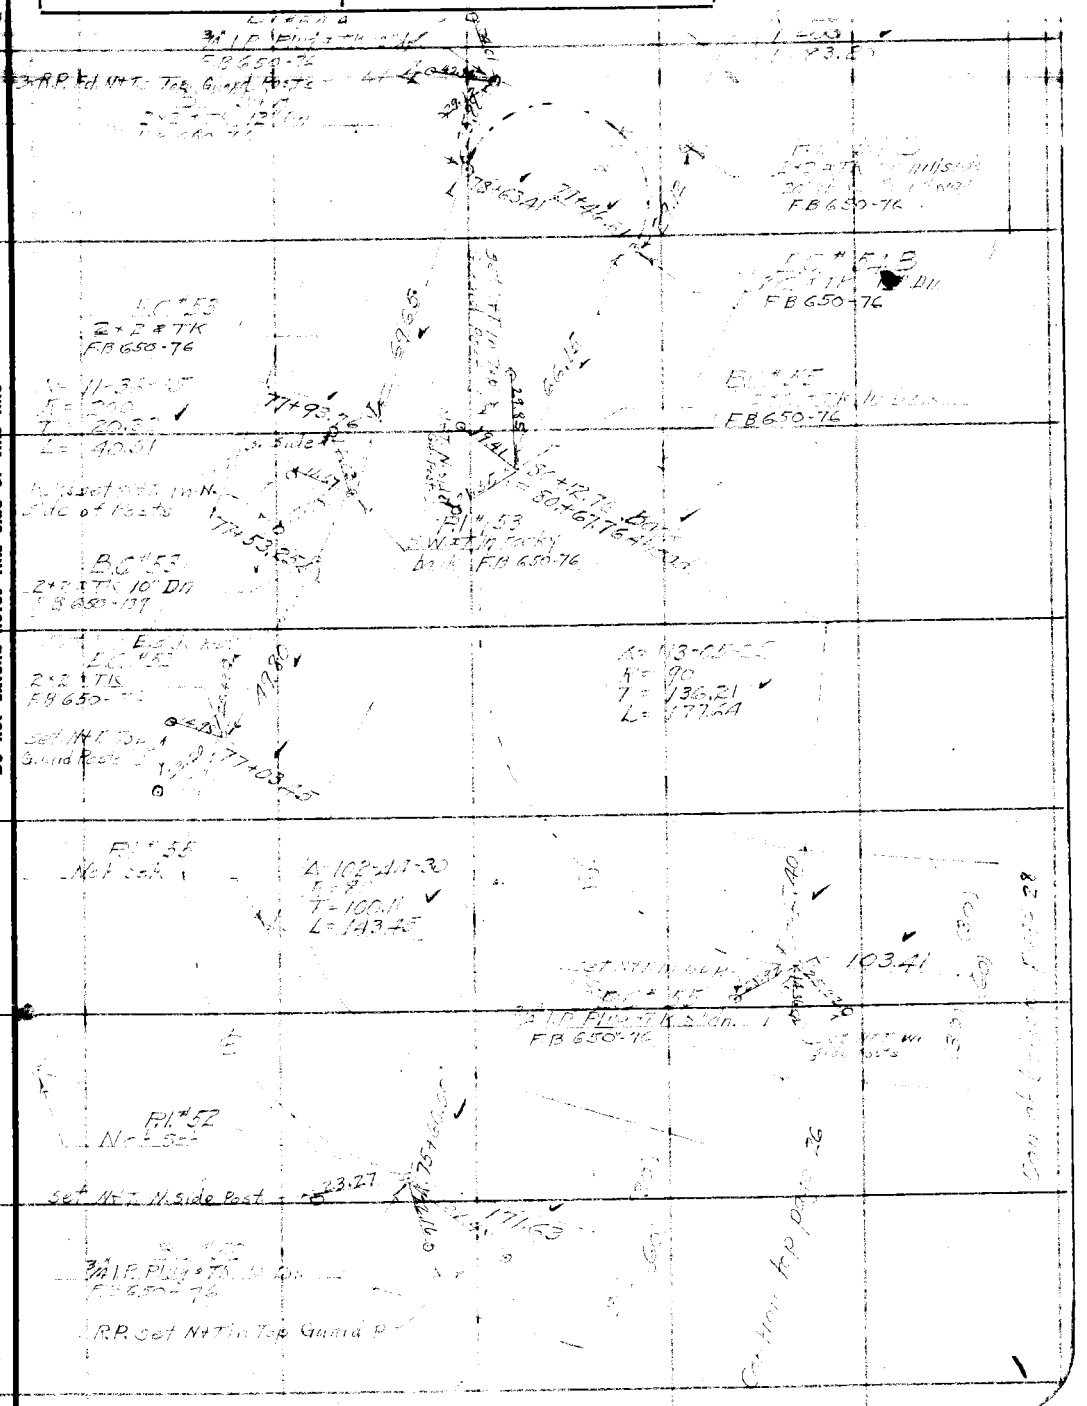

Note: Any Additions or Changes on This Sheet Must be Made or Circled in Red Ink With Date and Name of Person Making Change.

Do not extend notes this side of this line

RETURN TO
LOS ANGELES COUNTY SURVEYOR
700 HALL OF RECORDS

FORM 247 10M 11-58

F.B. 755 Pg. 29

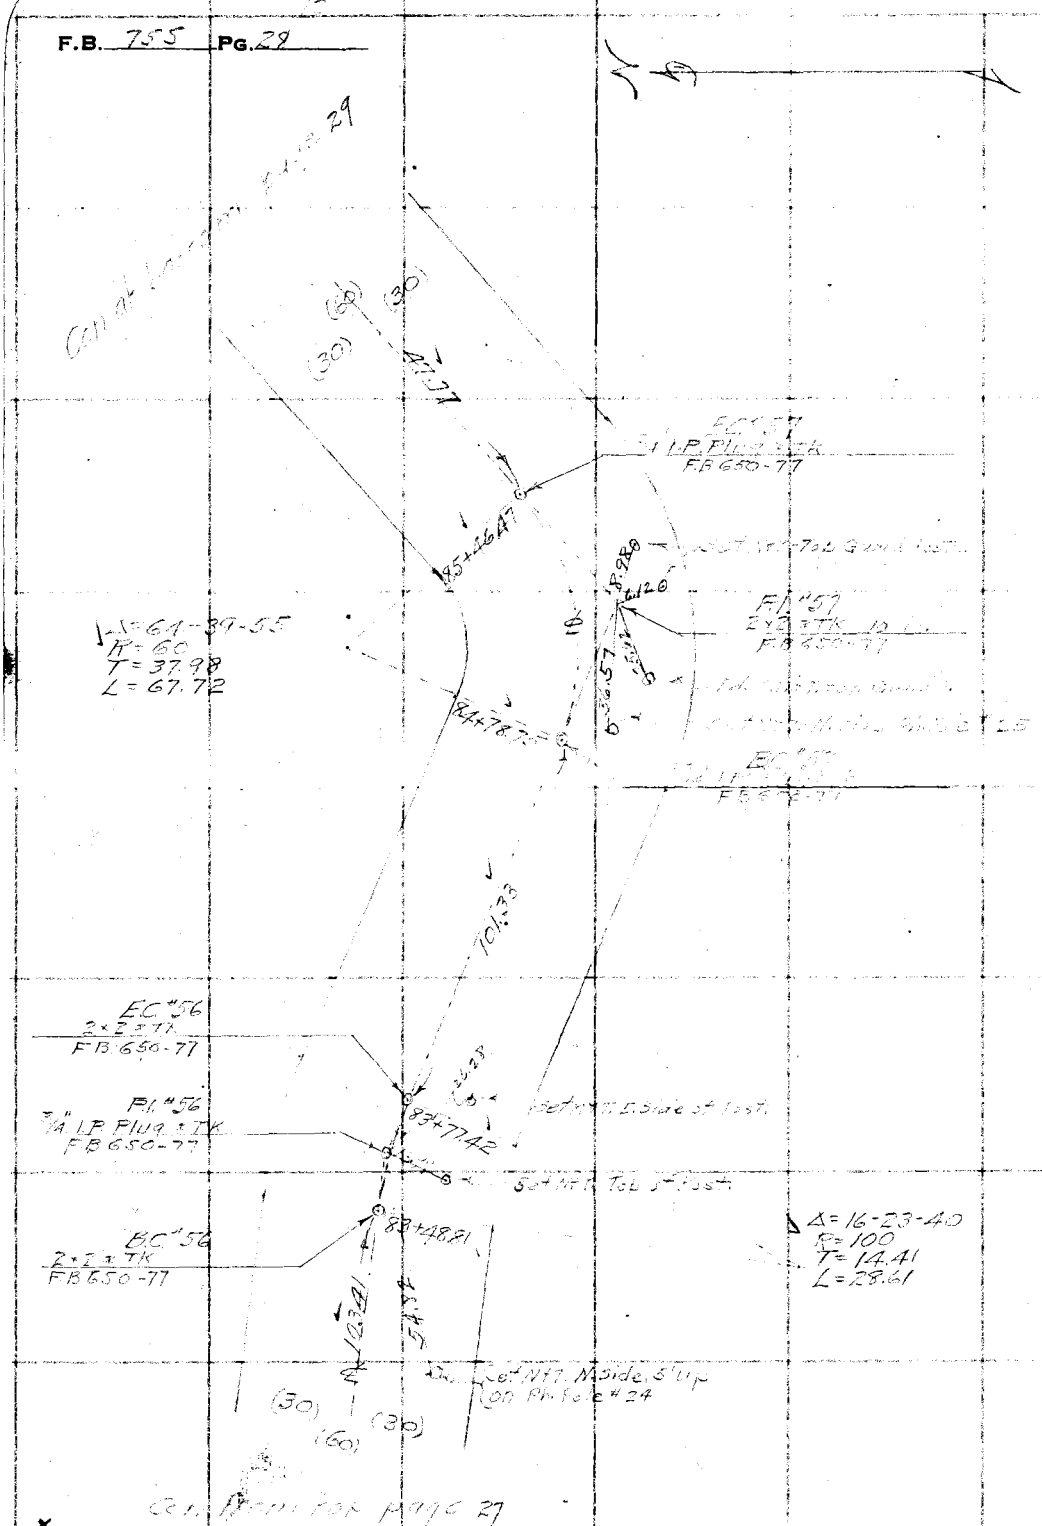

RETURN TO
LOS ANGELES COUNTY SURVEYOR
700 HALL OF RECORDS

Note: Any Additions or Changes on This Sheet Must be Made or Circled in Red Ink With Date and Name of Person Making Change.

Do not extend notes this side of this line

Notes Ck'd by	Survey of
Map No. 3	W. O. 2147 Tape No. St'd °F.
Office Work F. A. W.	Surveyed by W. A. Miller
Checked D. E. Aw	Notes Date
Date 12-4-62	Indexed

F.B. 755 PG. 29

W. S. D. - 1

RETURN TO
LOS ANGELES COUNTY SURVEYOR
700 HALL OF RECORDS

Note: Any Additions or Changes on This Sheet Must be Made or Circled in Red Ink With Date and Name of Person Making Change.

Do not extend notes this side of this line

FORM 247 10M 11-35

RETURN TO
LOS ANGELES COUNTY SURVEYOR
700 HALL OF RECORDS

Note: Any Additions or Changes on This Sheet Must be Made or Circled in **Red Ink** With Date and Name of Person Making Change.

WS.50-E-1

Do not extend notes this side of this line

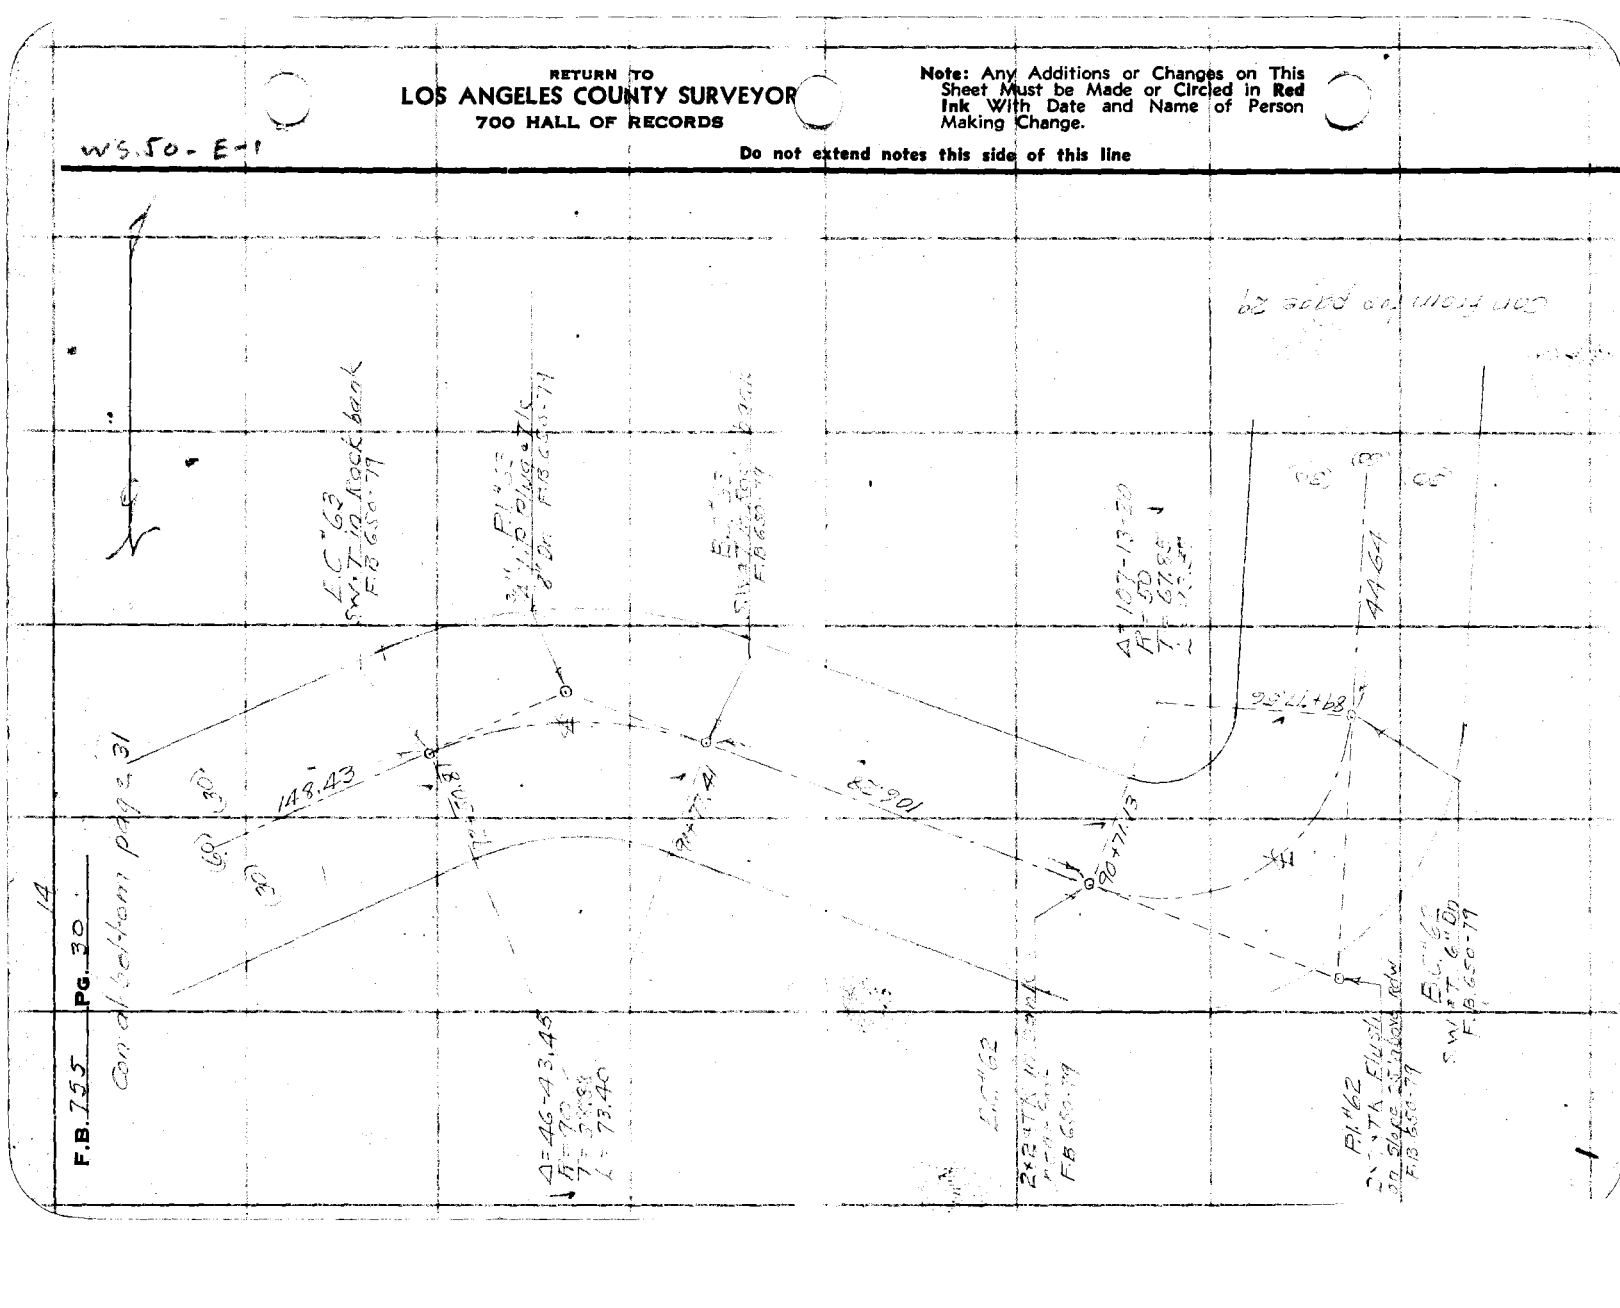
F.B. 755 PG. 30
Con'd from bottom pg. 31
148.43
Δ=46°43'45"
R=70'
T=30.38
L=73.40
Δ=107°13'20"
R=50'
T=67.65
L=93.54
Con't from page 29
Con't on page 31

Notes Ck'd by	Survey of
Map No. B-12 '7-1 F. A. W.	W. O. 2149 Tape No. St'd °F.
Office Work Dr cmd	Surveyed by N.A. Miller
Checked	Notes Date 4-1-62
Date 12-4-62	Indexed

F.B. [illegible] Pg. 71

Con. 74 bottom page 36.

3/4" I.P. Plug & Tk 6" Dp. F.B. 650-81

96+59.95

Set 1X1 W.F.T. in bank 6" up

Set 3/4 I.P. 5" up on Rk. Falls → 23.86

Δ = 60-16-15
R = 80
T = 46.24
L = 84.15

3/4" I.P. "66 I.P. Plug & Tk 12" Dp. F.B. 650-81

Set W.F.T. in Bank 6" up

11.94

95+75.80

E.C. "65 Nothing Set High Bank with overhang F.B. 650-80

B.C. "66 S.W.F.T. 8" Dp. F.B. 650-81

P.I. "65 S.W.F.T. 8" Dp. In road. F.B. 650-80

95+43.67

B.C. "65 Set 2X2 in R.R. [illegible] up F.B. 650-80

94+87.62

(60) (30) (30) Set Nail N. side Fn. P. #30

Δ = 32-06-55
R = 100
T = 28.78
L = 56.05

EC "64 Set 2x2 in bank F.B. 650-80

94+24.93

Set X in Top Conc Wall

Δ = 14-43-10
R = 100
T = 12.92
L = 25.69

P.I. "64 2x2 x TK 12" Dp. F.B. 650-80

93+99.24

Set W.F.T. 5' up W side Fn Pole #29

B.C. 64 S.W.F.T. in Rocky Bank F.B. 650-80

Con. from top page 36

Note: Any Additions or Changes on This Sheet Must be Made or Circled In Red Ink With Date and Name of Person Making Change.

Do not extend notes this side of this line

RETURN TO
LOS ANGELES COUNTY SURVEYOR
700 HALL OF RECORDS

FORM 247 10M 11-35

16

F.B. 755 Pg. 32

W S.50-E-1

RETURN TO
LOS ANGELES COUNTY SURVEYOR
700 HALL OF RECORDS

Note: Any Additions or Changes on This Sheet Must be Made or Circled in Red Ink With Date and Name of Person Making Change.

Do not extend notes this side of this line

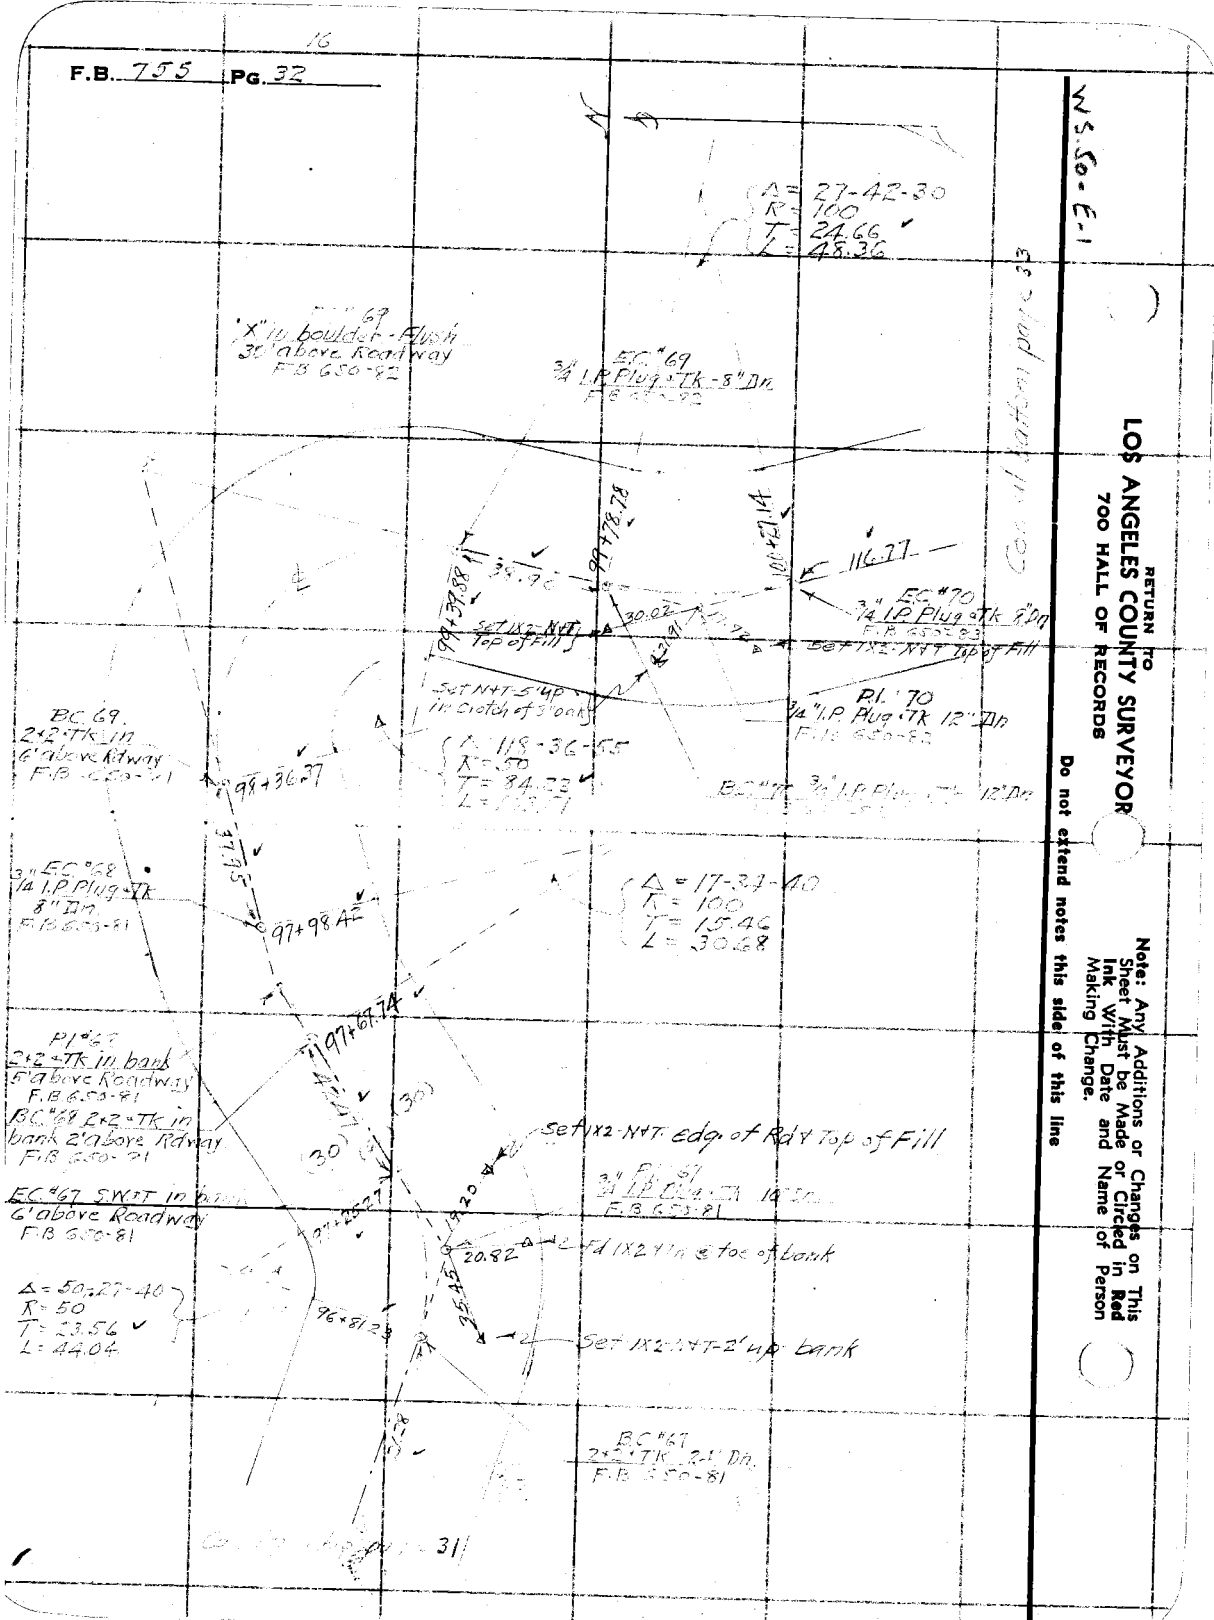

Notes Ck'd by	Survey of
Map No. B-62	W. O.	Tape No.	St'd °F.
Office Work F. A. W.	Surveyed by
Checked	Notes	Date
Date	Indexed

F.B. Pg. 32

Note: Any Additions or Changes on This Sheet Must be Made or Circled in Red Ink With Date and Name of Person Making Change.

Do not extend notes this side of this line

RETURN TO
LOS ANGELES COUNTY SURVEYOR
700 HALL OF RECORDS

FORM 247 10M 11-35

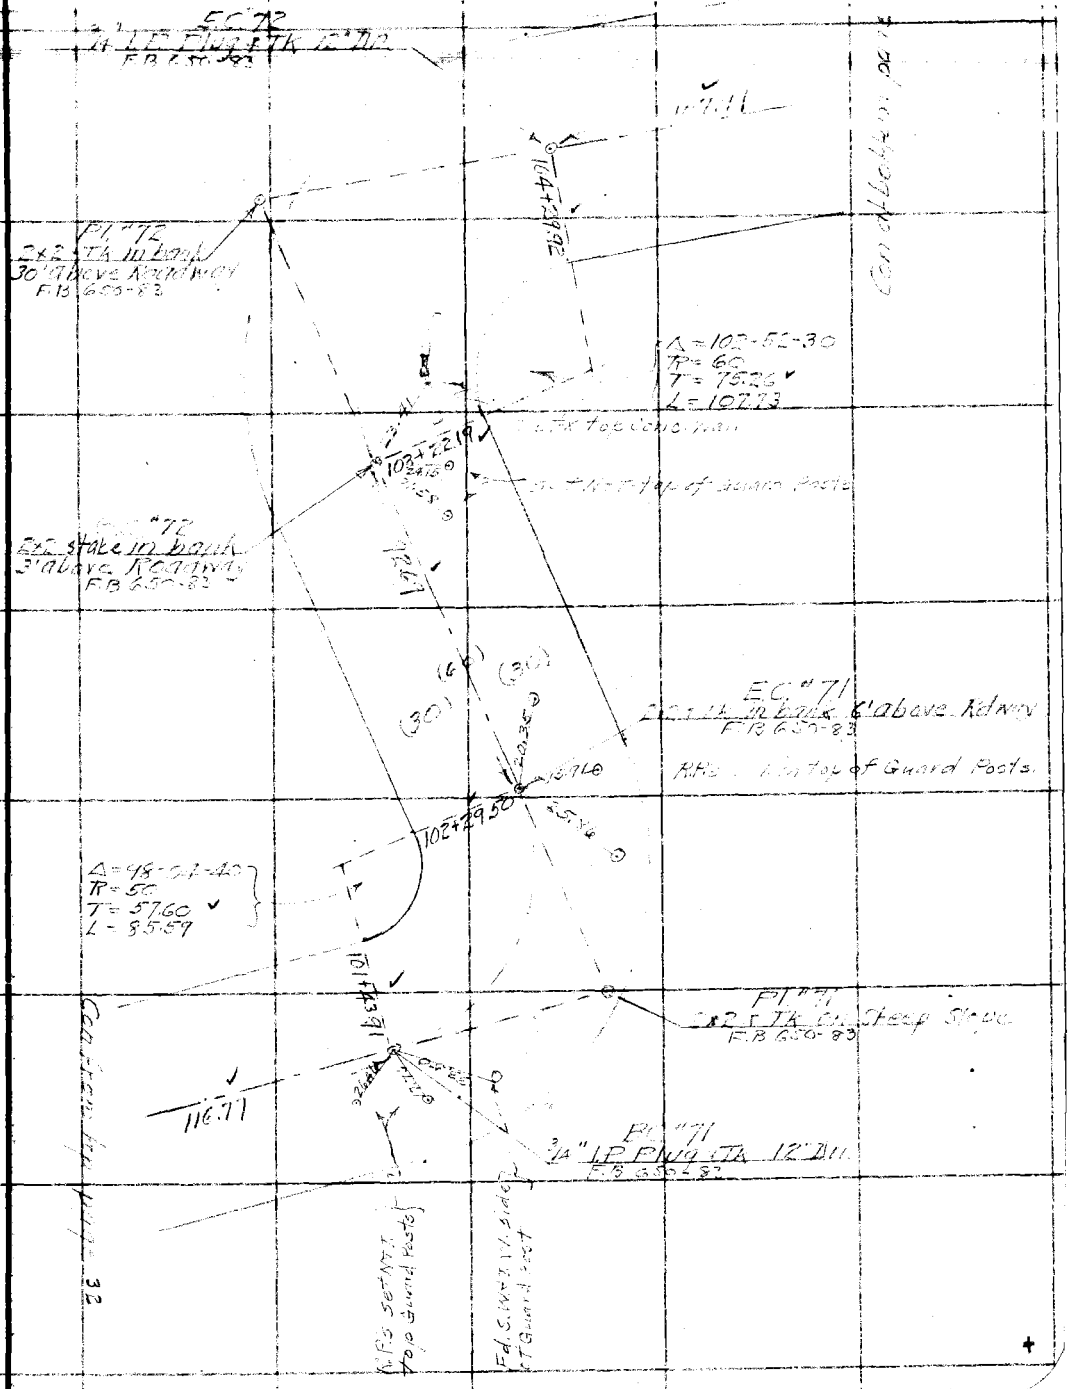
EC "72"
1/2" I.P. Flush w/ TA 12" Dia.
F.B. 650-83
Pl. "72"
2x2 TA in Bank
30' Above Roadway
F.B. 650-83
Δ = 102°-52'-30"
R = 60
T = 75.26
L = 107.73
EC "71"
2x2 TA in Bank 6' Above Roadway
F.B. 650-83
Pl. "71"
F.B. 650-83
Δ = 98°-57'-40"
R = 50
T = 57.60
L = 85.97
116.77

RETURN TO
LOS ANGELES COUNTY SURVEYOR
700 HALL OF RECORDS

Note: Any Additions or Changes on This Sheet Must be Made or Circled in **Red Ink** With Date and Name of Person Making Change.

Do not extend notes this side of this line

WS 50-E-2

F.B. 755 Pg. 34

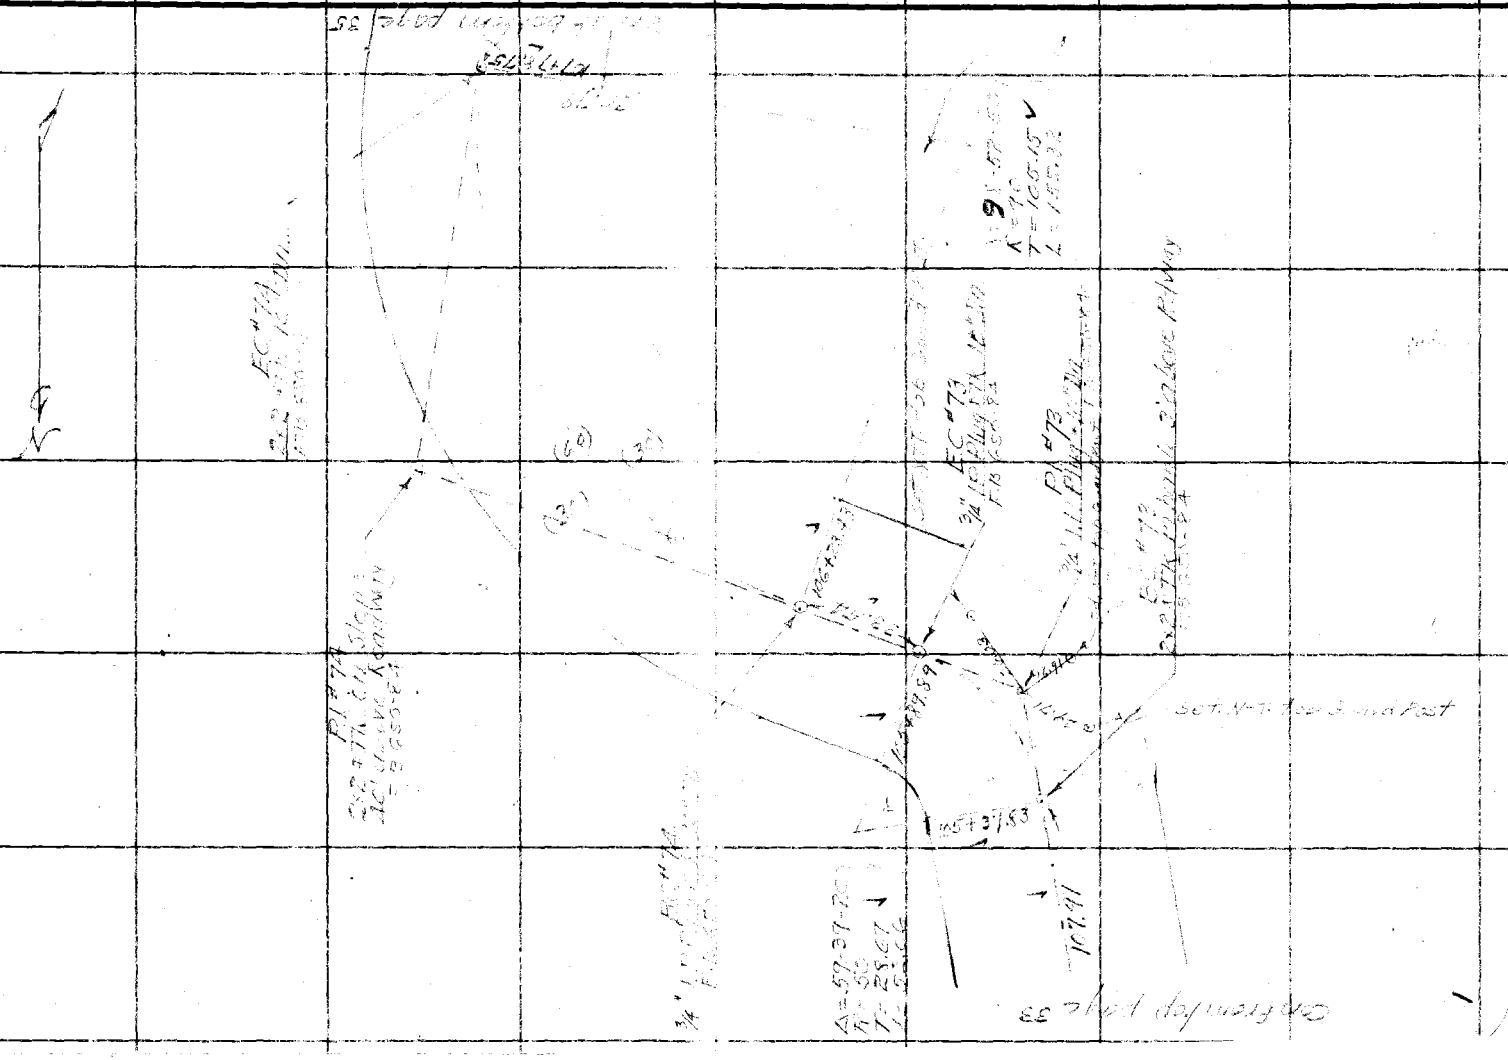
EC #73
EC #73
EC #73
Pl #73
Pl #73
Pl

Notes Ck'd by	Survey of
Map No.	W. O. 8149 Tape No. St'd °F.
Office Work	Surveyed by
Checked	Notes Date
Date	Indexed

F.B. PG.

Con at bottom page 36

3/4" I.P. Plug in Tk 6" Dp.

BC "75
Plug in Tk 8" Dp.

PI "76
Chis + 6" Dp
F.B. 650-85

PI "76
S.W.T. 8" Dp.
F.B. 650-85

PI "76
2x2 Tk 10" Dp
F.B. 650-85

PI "75
2x2 Tk on Slope
6' below Roadway
F.B. 650-85

110+43.46

110+19.99

108+93.90

Δ = 13-21-40
R = 100
T = 11.99
L = 23.87

Δ = 130-50-50
R = 40
T = 70.48
L = 81.37

(30) (60) (30)

Con at bottom page 34

Q 2.12
Q 16.66

Set W.T. outside Bottom of guard Posts

Note: Any Additions or Changes on This Sheet Must be Made or Circled in Red Ink With Date and Name of Person Making Change.

Do not extend notes this side of this line

RETURN TO
LOS ANGELES COUNTY SURVEYOR
700 HALL OF RECORDS

FORM 247 10M 11-35

F.B. 755 Pg. 36

Con o' bottom pg. 37

EC "79"
¾" I.P. Flush TK in back
2' above Roadway
F.B. 650-86

PI "79"
2x2 TK in bank
6" above Roadway
F.B. 650-86

BC "79"
V.T. in Rock Bank
F.B. 650-86

Δ = 20-03-10
R = 100
T = 17.69
L = 35.01

112+86.12

112+51.11

112+12.96

EC "78"
"X" on Rock at
level of Roadway
F.B. 650-86

Δ = 30-14-55
R = 100
T = 27.50
L = 53.67

PI "78"
SW3T 6" Dn
F.B. 650-86

111+60.41
8.70

111+51.71

EC "77"
SW3T 6" Dn
F.B. 650-86

BC "78"
SW3T 6" Dn
F.B. 650-86

PI "77"
"X" in Rock Slope
5' above Roadway
F.B. 650-86

110+90.80 Ahd
110+79.52 BK

Δ = 43-37-15
R = 80
T = 32.00
L = 60.91

BC "77"
2x2 TK 8" Dn
F.B. 650-86

Con from top page 35

RETURN TO
LOS ANGELES COUNTY SURVEYOR
700 HALL OF RECORDS

Note: Any Additions or Changes on This Sheet Must be Made or Circled in Red Ink With Date and Name of Person Making Change.

Do not extend notes this side of this line

WS 50-E-2

Notes Ck'd by	Survey of Wilson Tract
Map No.	W. O. 2149 Tape No. St'd °F.
Office Work F. A. W.	Surveyed by W. A. Millon
Checked Dr. Eaw	Notes Millon Date Apr 1937
Date 12-4-41	Indexed

F.B. Pg.

Note: Any Additions or Changes on This Sheet Must be Made or Circled in Red Ink With Date and Name of Person Making Change.

Do not extend notes this side of this line

RETURN TO
LOS ANGELES COUNTY SURVEYOR
700 HALL OF RECORDS

FORM 247 10M 11-35

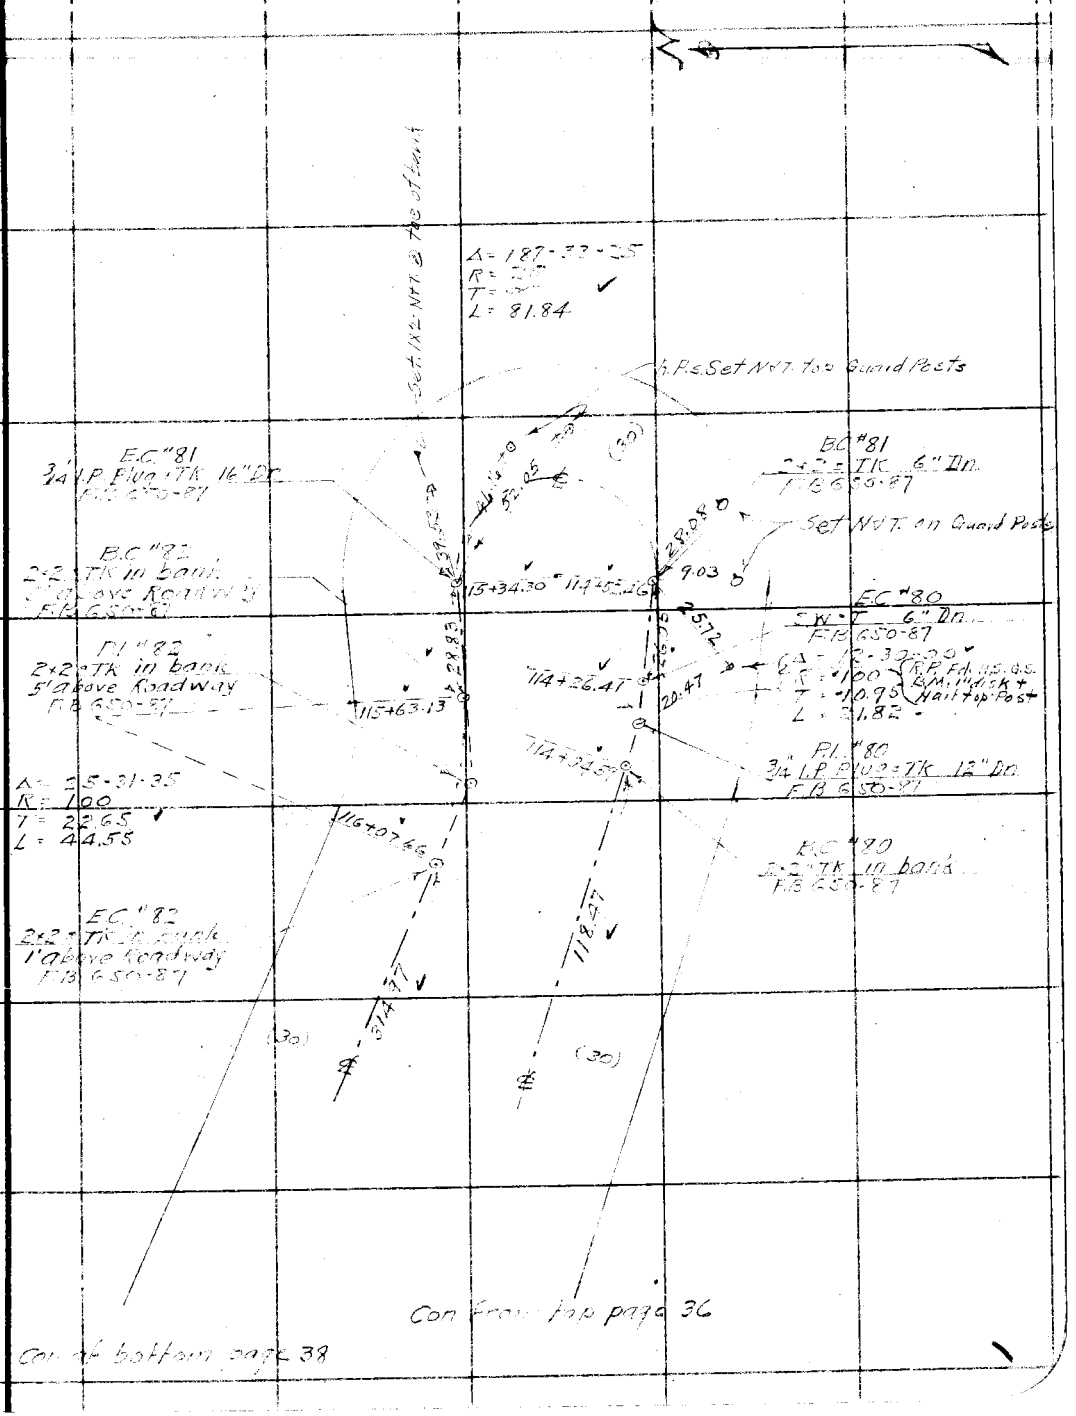

F.B. 755 Pg. 38

WS 50-E-2

Con at bottom page 39

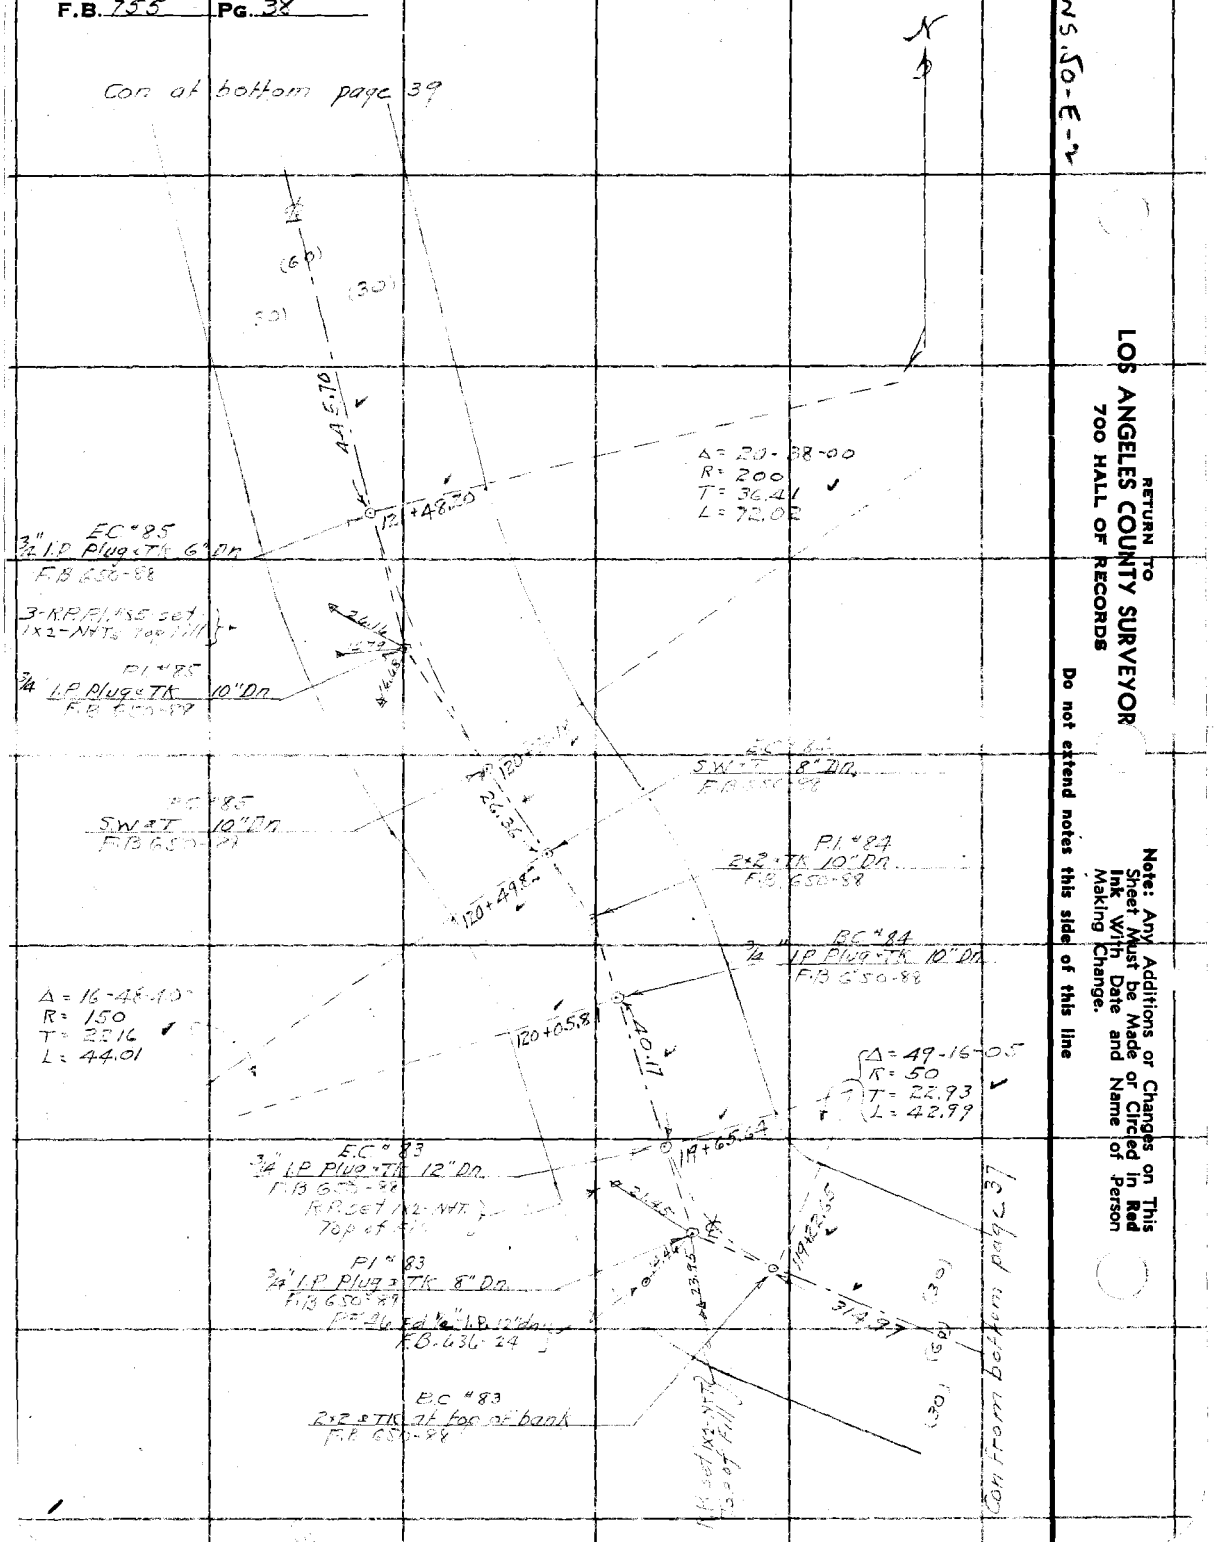

RETURN TO
LOS ANGELES COUNTY SURVEYOR
700 HALL OF RECORDS

Note: Any Additions or Changes on This Sheet Must be Made or Circled in Red Ink With Date and Name of Person Making Change.

Do not extend notes this side of this line

Notes Ck'd by	Survey of
Map No.	W. O. 2147 Tape No. St'd °F.
Office Work F. A. W.	Surveyed by W. A. Miller
Checked	Notes Miller Date Aug. 1937
Date	Indexed

F.B. Pg. 37

Note: Any Additions or Changes on This Sheet Must be Made or Circled in Red Ink With Date and Name of Person Making Change.

Do not extend notes this side of this line

RETURN TO
LOS ANGELES COUNTY SURVEYOR
700 HALL OF RECORDS

Con on p. 41 by C.A. Hinson

EC "86
S.W. "T" Flush.
F.B. 650-89

3/4" I.P. set N.T. on side of Guard Posts as shown

P.I. "86
3/4" I.P. Plug "TK" 6" Dp
F.B. 650-89

RC "86
2x2 "TK" 6" Dp
F.B. 650-89

Set N.T. 5' up on W. side 10" Pine

126+27.25

125+93.90

Δ = 19-06-20
R = 100
T = 16.83
L = 33.35

(60)
30
30
℄

Con from top page 38

FORM 247 10M 11-36

RETURN TO
LOS ANGELES COUNTY SURVEYOR
700 HALL OF RECORDS

Note: Any Additions or Changes on This Sheet Must be Made or Circled in **Red Ink** With Date and Name of Person Making Change.

Do not extend notes this side of this line

F.B. 755 Pg. 46

Notes Ck'd by	Survey of
Map No. B	W. O.	Tape No.	St'd °F.
Office Work F. A. W.	Surveyed by
Checked	Notes	Date
Date	Indexed

F.B. PG.

W 13-E-1

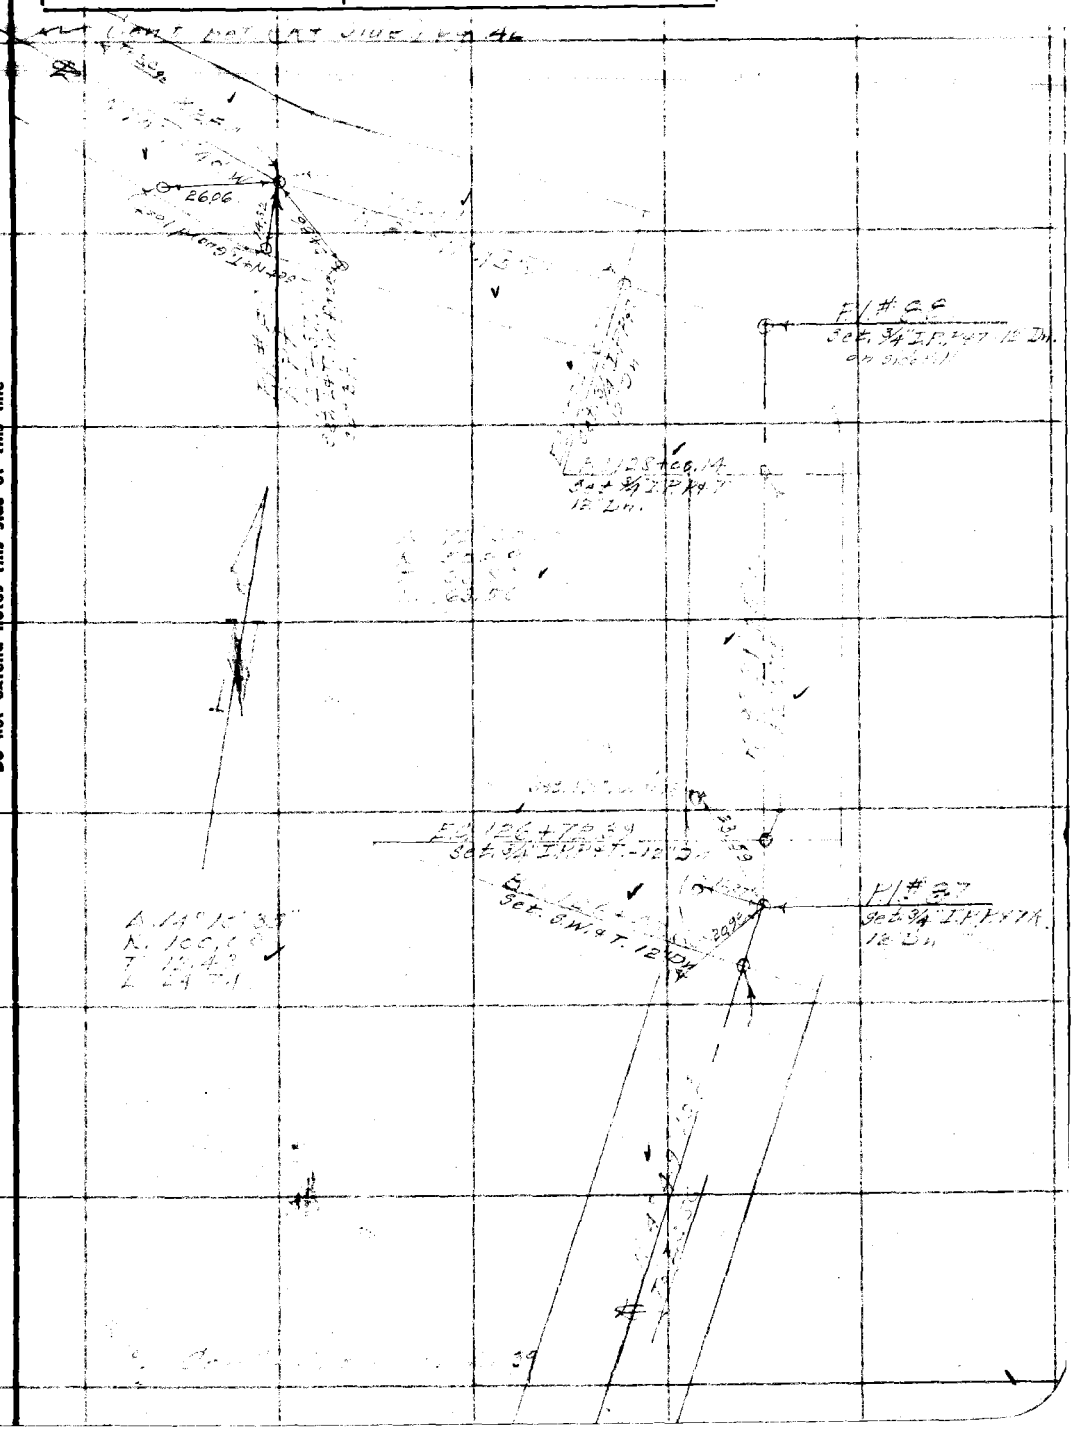

Note: Any Additions or Changes on This Sheet Must be Made or Circled in Red Ink With Date and Name of Person Making Change.

Do not extend notes this side of this line

RETURN TO
LOS ANGELES COUNTY SURVEYOR
700 HALL OF RECORDS

FORM 247 10M 11-38

RETURN TO
LOS ANGELES COUNTY SURVEYOR
700 HALL OF RECORDS

Note: Any Additions or Changes on This Sheet Must be Made or Circled in **Red Ink** With Date and Name of Person Making Change.

Do not extend notes this side of this line

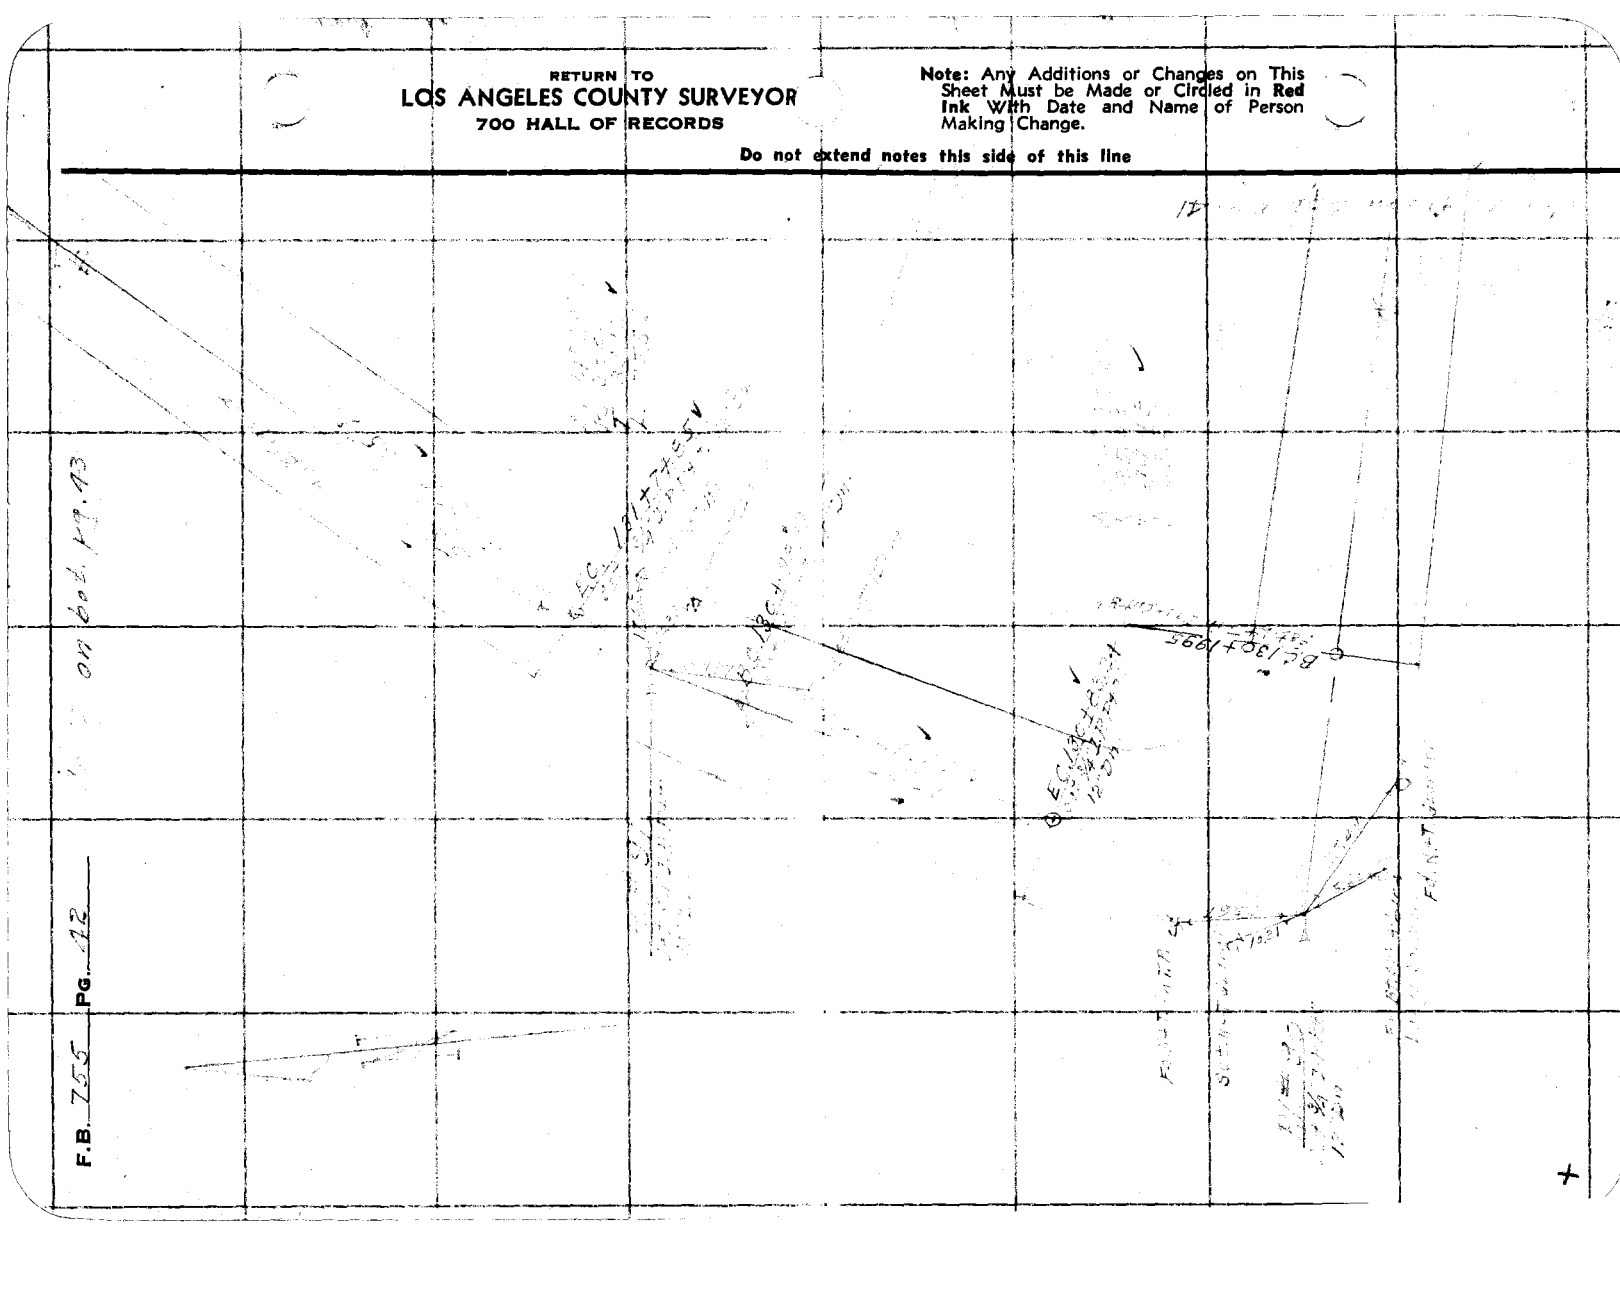

Notes Ck'd by	Survey of
Map No.	W. O. Tape No. St'd. °F.
Office Work F. A. W	Surveyed by
Checked	Notes Date
Date	Indexed

F.B. PG.

Note: Any Additions or Changes on This Sheet Must be Made or Circled in Red Ink With Date and Name of Person Making Change

Do not extend notes this side of this line

RETURN TO
LOS ANGELES COUNTY SURVEYOR
700 HALL OF RECORDS

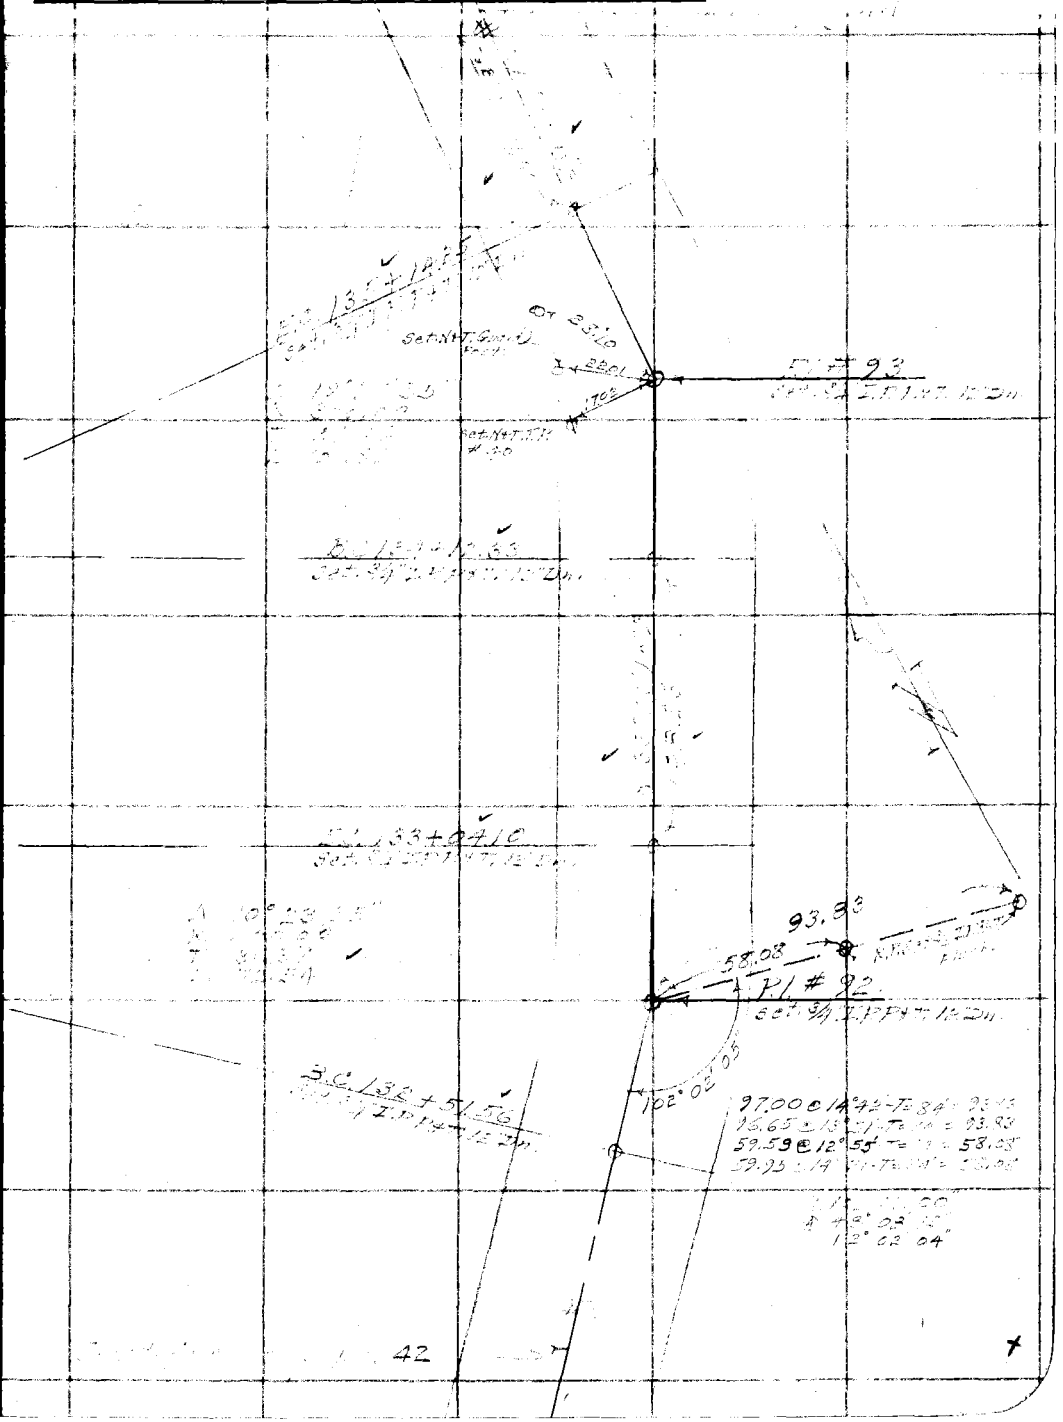

FORM 247 10M 11-38

RETURN TO
LOS ANGELES COUNTY SURVEYOR
700 HALL OF RECORDS

Note: Any Additions or Changes on This Sheet Must be Made or Circled in **Red Ink** With Date and Name of Person Making Change.

WS 50-E-1

Do not extend notes this side of this line

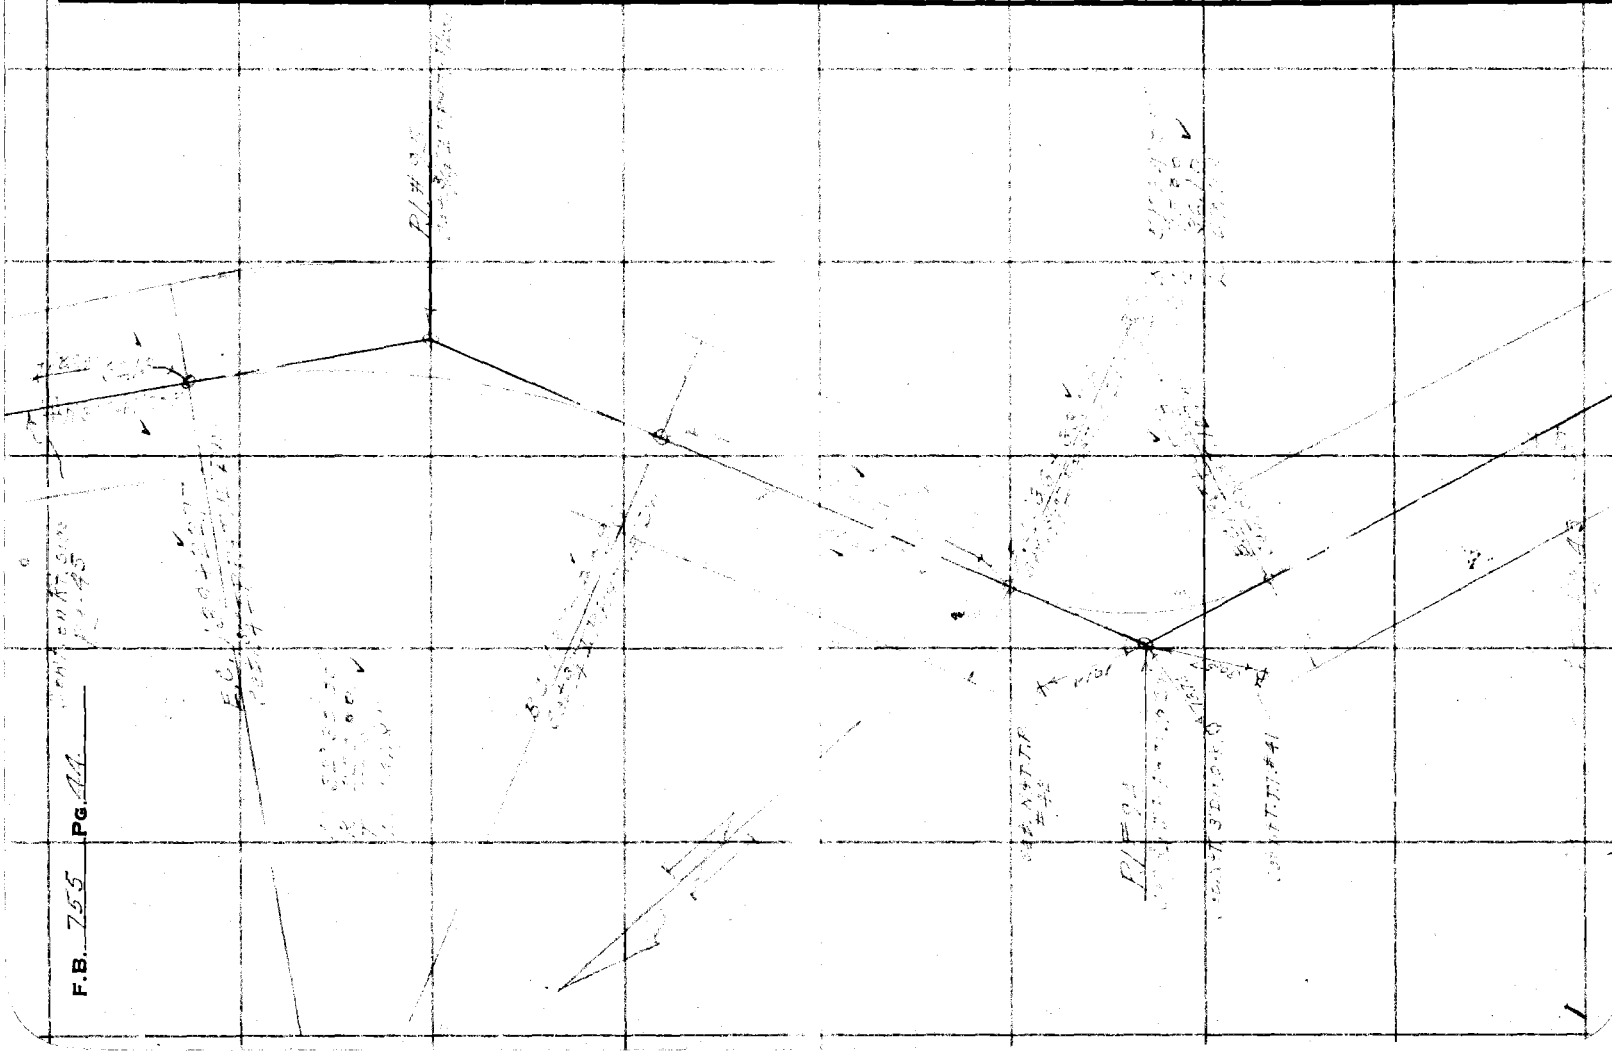

F.B. 755 Pg. 44

FORM 247 10M 11-38

RETURN TO
LOS ANGELES COUNTY SURVEYOR
700 HALL OF RECORDS

W5.50 - E-1

Note: Any Additions or Changes on This Sheet Must be Made or Circled in Red Ink With Date and Name of Person Making Change.

Do not extend notes this side of this line

Notes Ck'd by _____
Map No. 5
Office Work F A W
Checked _____
Date _____

Survey of _____
W. O. _____ Tape No. _____ Std. _____ °F.
Surveyed by _____
Notes _____ Date _____
Indexed _____

F.B. _____ PG. _____

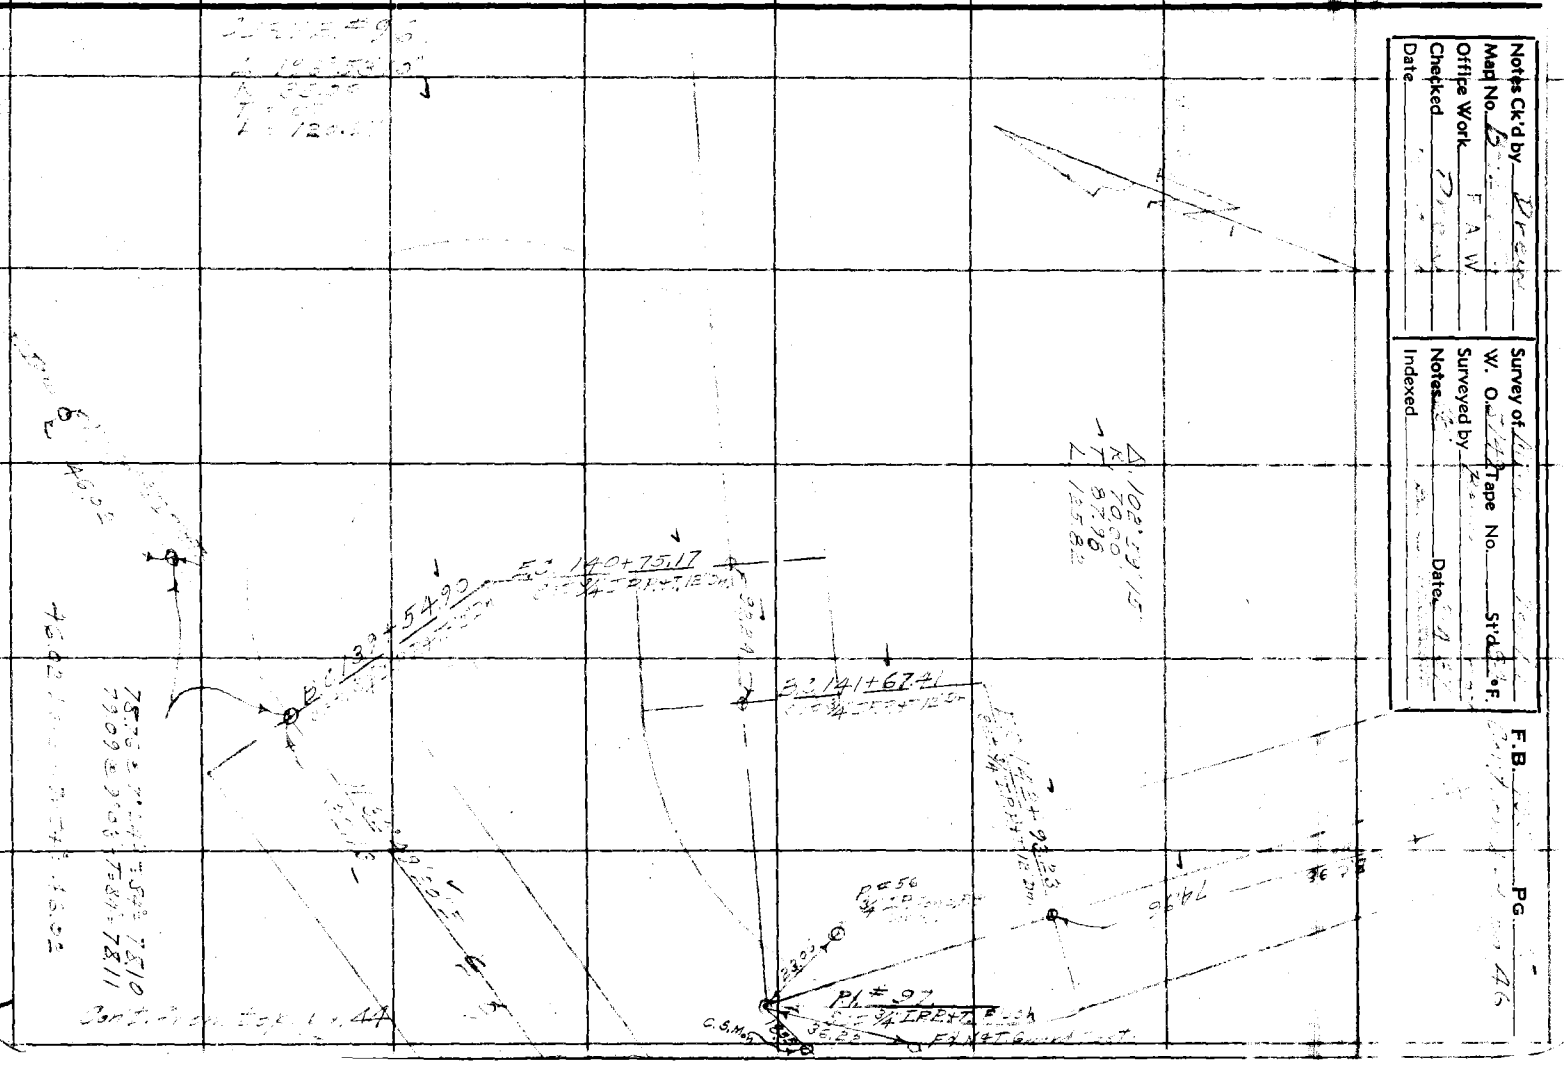

RETURN TO
LOS ANGELES COUNTY SURVEYOR
700 HALL OF RECORDS

Note: Any Additions or Changes on This Sheet Must be Made or Circled in **Red Ink** With Date and Name of Person Making Change.

Do not extend notes this side of this line

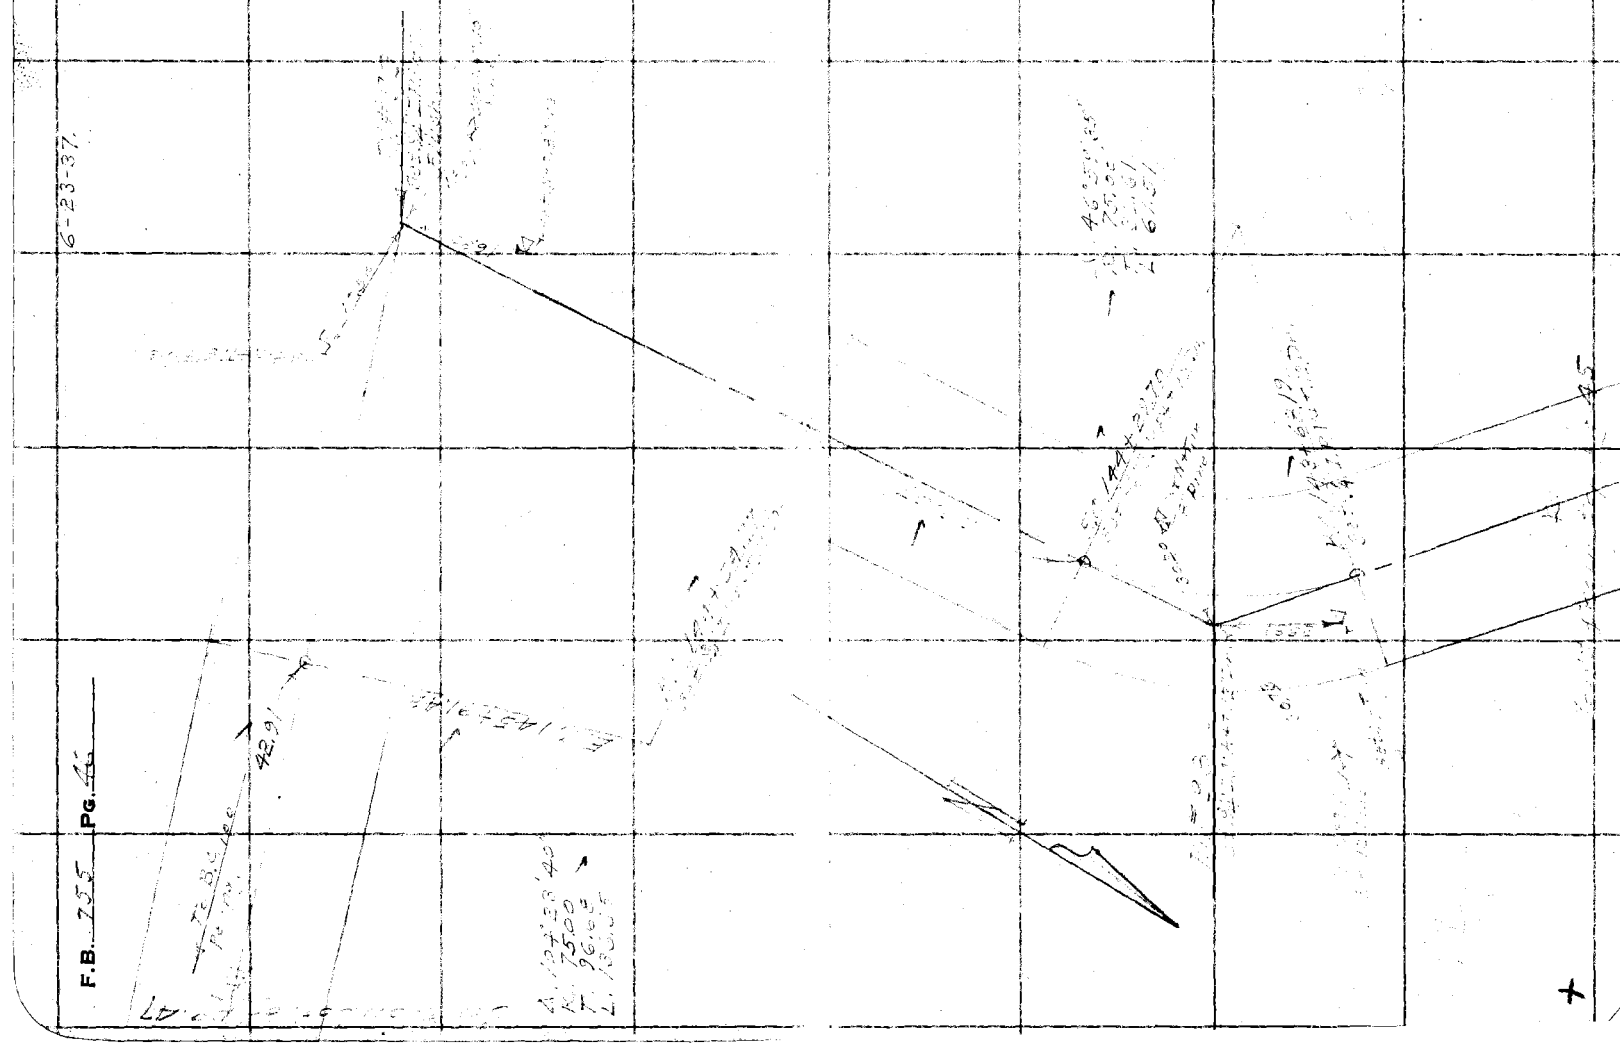

Notes Ck'd by	Survey of
Map No.	W. O. Tape No. St'd °F.
Office Work F. A. W.	Surveyed by
Checked Drew	Notes Date
Date 12-4-40	Indexed

F.B. PG.

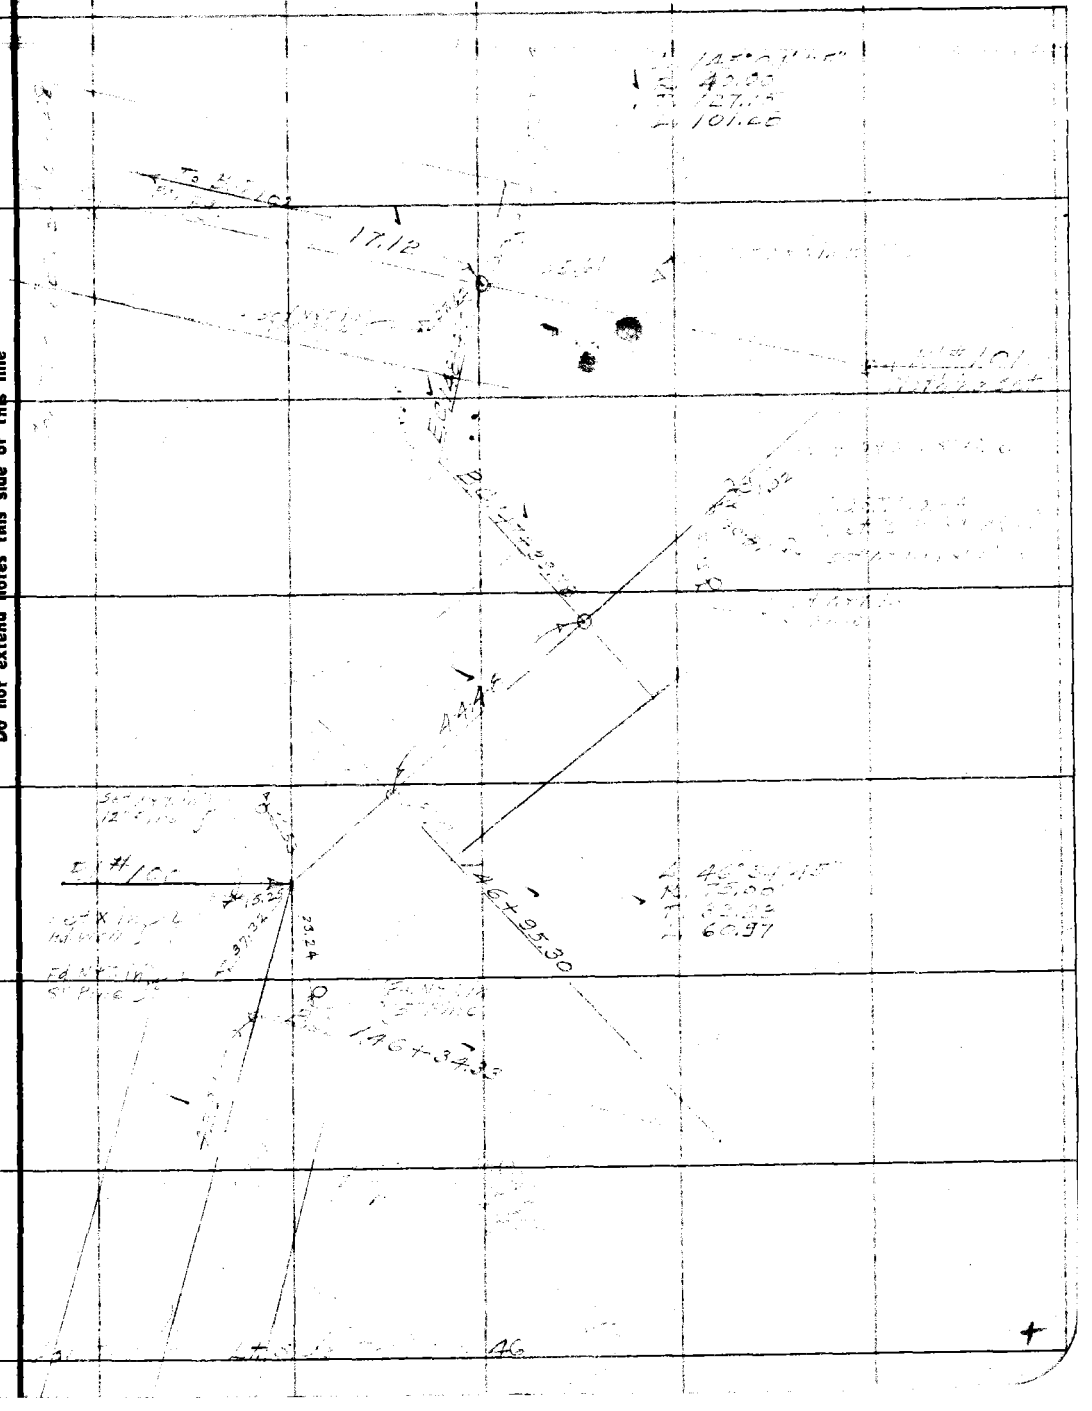

Note: Any Additions or Changes on This Sheet Must be Made or Circled in Red Ink With Date and Name of Person Making Change.

Do not extend notes this side of this line

RETURN TO
LOS ANGELES COUNTY SURVEYOR
7DO HALL OF RECORDS

FORM 247 10M 11-38

RETURN TO
LOS ANGELES COUNTY SURVEYOR
700 HALL OF RECORDS

Note: Any Additions or Changes on This Sheet Must be Made or Circled in **Red Ink** With Date and Name of Person Making Change.

WS 50-E-1

Do not extend notes this side of this line

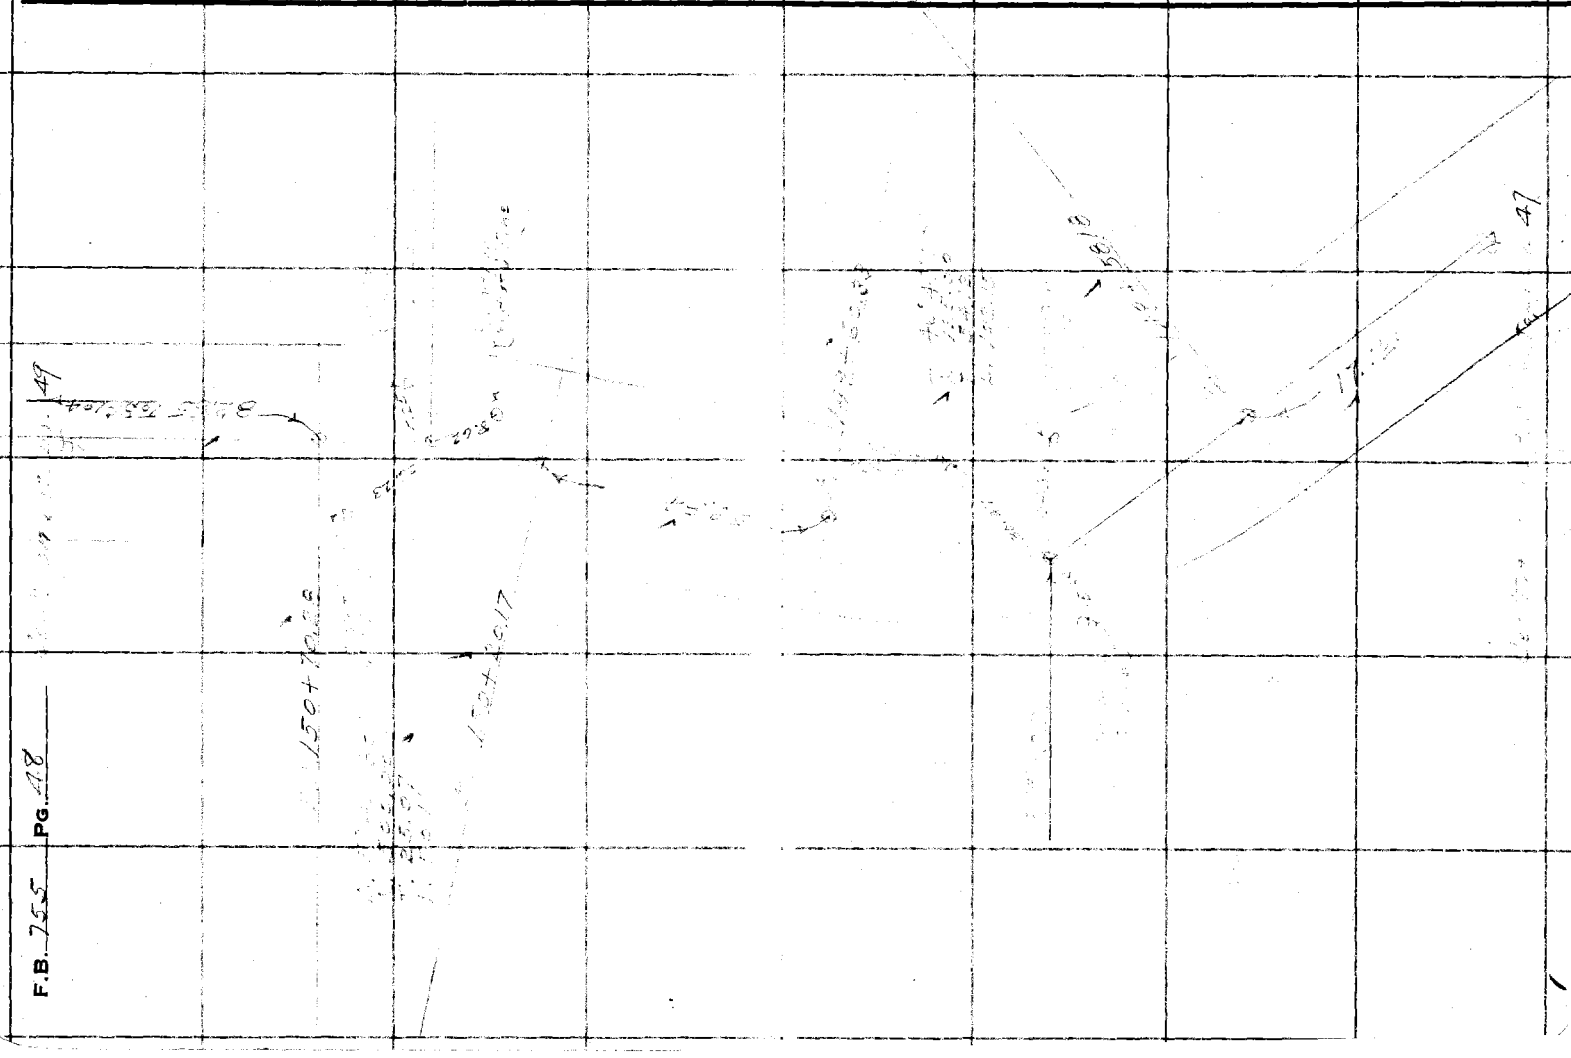

Notes Ck'd by	Survey of
Map No. 5 157	W. O. 3147 Tape No. St'd °F.
Office Work	Surveyed by W.A. Miller
Checked	Notes Date
Date	Indexed

F.B. PG.

N

Con of Location page 20

1" = 50'

WS 16-E-1

Note: Any Additions or Changes on This Sheet Must be Made in Red Ink or Circled in Red With Date and Name of Person Making Change

Do not extend notes this side of this line

RETURN TO
LOS ANGELES COUNTY SURVEYOR
700 HALL OF RECORDS

FORM 247 10M 11-35

154+06.55 ℄

Set X on W. side of large Sy. Elm

Δ = 45-08-35
R = 150
T = 62.35
L = 118.18

P.I. "105
Cut ⅛ in Conc.
3" Dia.
F.B. 650-97

3/4 I.P. Plug & Tag
F.B. 650-97

152+88.03 ℄

(30) (30)

57.6

3/4 I.P. Plug & Tag
8" Dia.
F.B. 650-97

P.I. "104
3/4 I.P. Plug & Tag
10" Dia.
F.B. 650-97

151+43.45 ℄

Set X in Top of Hdwl

Set X in Top of Hdwl

Set X in Top of Hdwl

Set X on W. side of large Sy. Elm

3" Pine

Δ = 11-05-50
R = 150
T = 38.86
L = 77.47

B.C. "104
3/4 I.P. Plug & Tag
12" Dia.
F.B. [illegible]-97

151+54.73 ℄

Con from 2 sp pg 48

RETURN TO
LOS ANGELES COUNTY SURVEYOR
700 HALL OF RECORDS

Note: Any Additions or Changes on This Sheet Must be Made or Circled in **Red Ink** With Date and Name of Person Making Change.

W.S. 50-E-1

Do not extend notes this side of this line

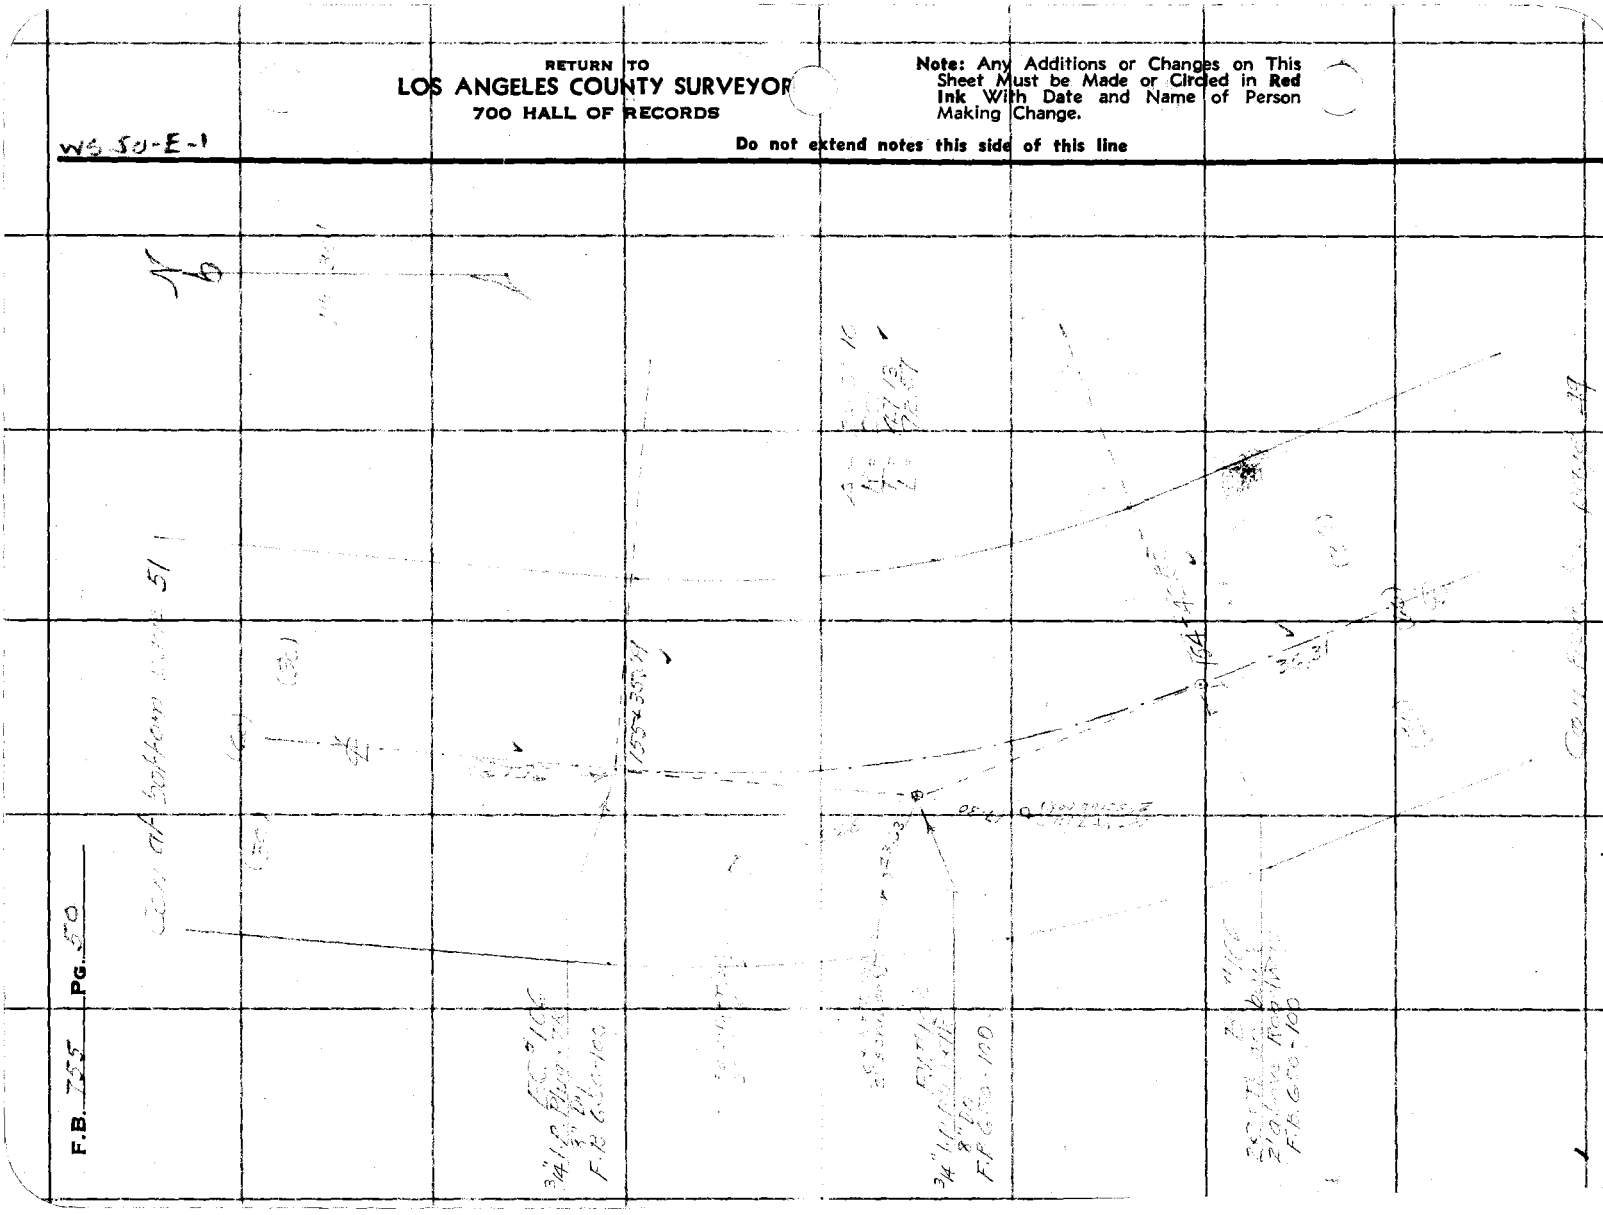

F.B. 755 Pg. 50

Notes Ck'd by	Survey of
Map No.	W. O.	Tape No.	St'd °F.
Office Work	Surveyed by
Checked	Notes	Date
Date	Indexed

F.B. Pg.

Note: Any Additions or Changes on This Sheet Must be Made or Circled in Red Ink With Date and Name of Person Making Change.

Do not extend notes this side of this line

RETURN TO
LOS ANGELES COUNTY SURVEYOR
700 HALL OF RECORDS

FORM 247 10M 11-35

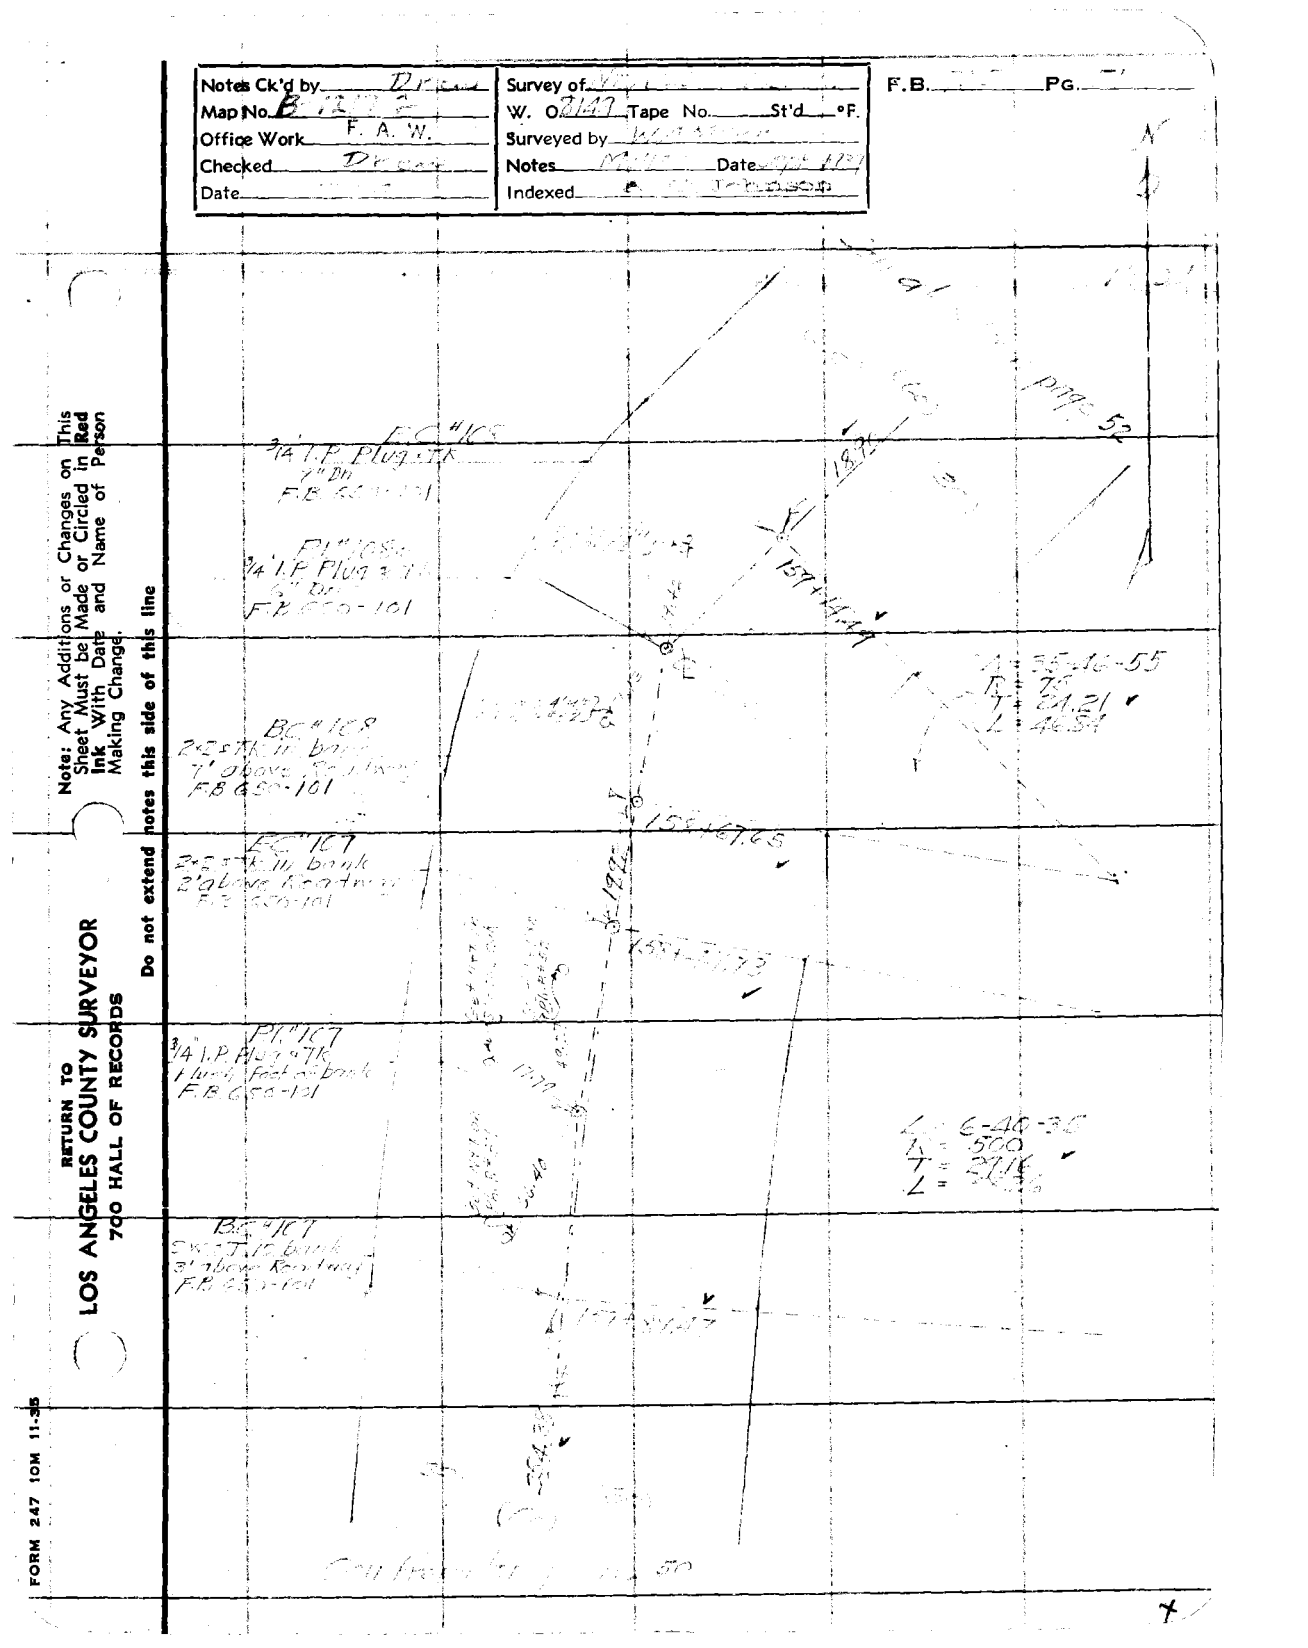

RETURN TO
LOS ANGELES COUNTY SURVEYOR
700 HALL OF RECORDS

Note: Any Additions or Changes on This Sheet Must be Made or Circled in **Red Ink** With Date and Name of Person Making Change.

Do not extend notes this side of this line

2 S 50-E-1

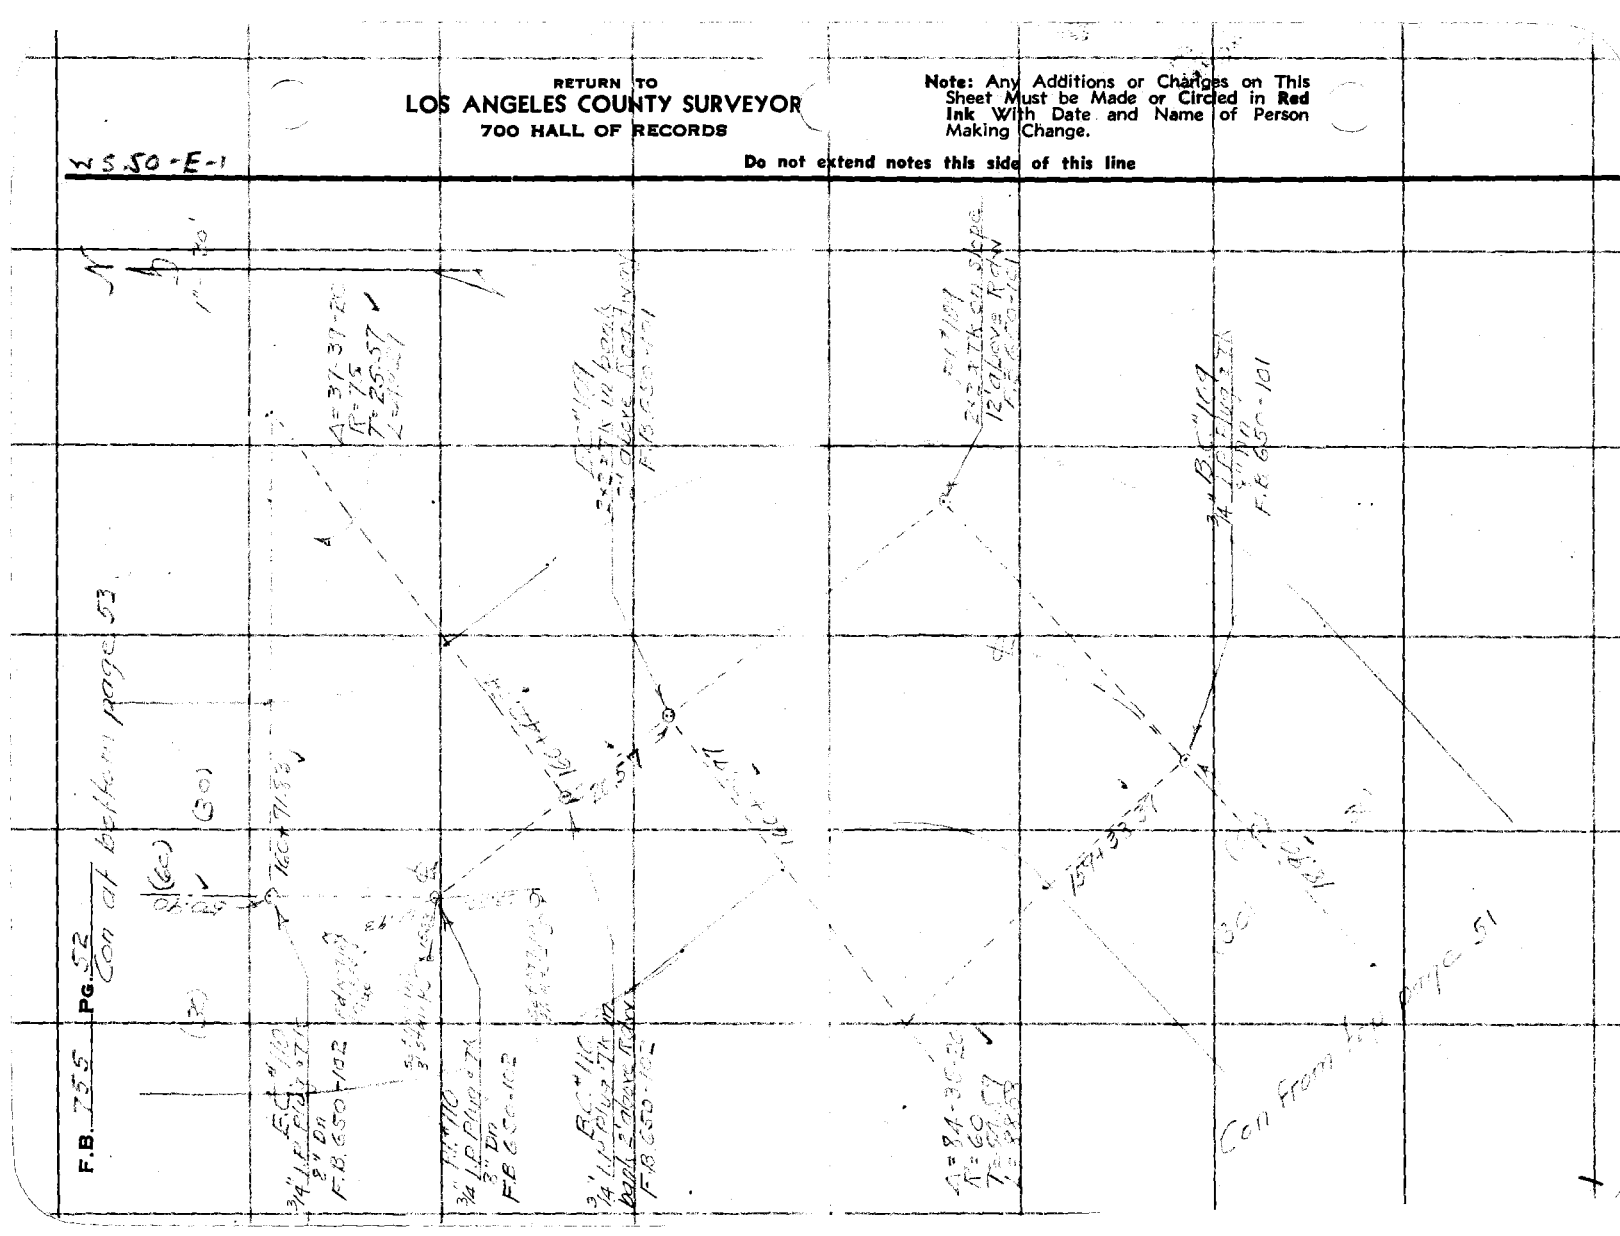

Notes Ck'd by [illegible]
Map No. B-1217-3
Office Work F A W
Checked D F S
Date 12-4-[illegible]

Survey of [illegible]
W. O. [illegible] Tape No. [illegible] St'd [illegible] °F.
Surveyed by W A [illegible]
Notes [illegible] Date [illegible]
Indexed [illegible]

F.B. [illegible] PG. 52

Note: Any Additions or Changes on This Sheet Must be Made or Circled in Red Ink With Date and Name of Person Making Change.

Do not extend notes this side of this line

RETURN TO
LOS ANGELES COUNTY SURVEYOR
700 HALL OF RECORDS

FORM 247 10M 11-58

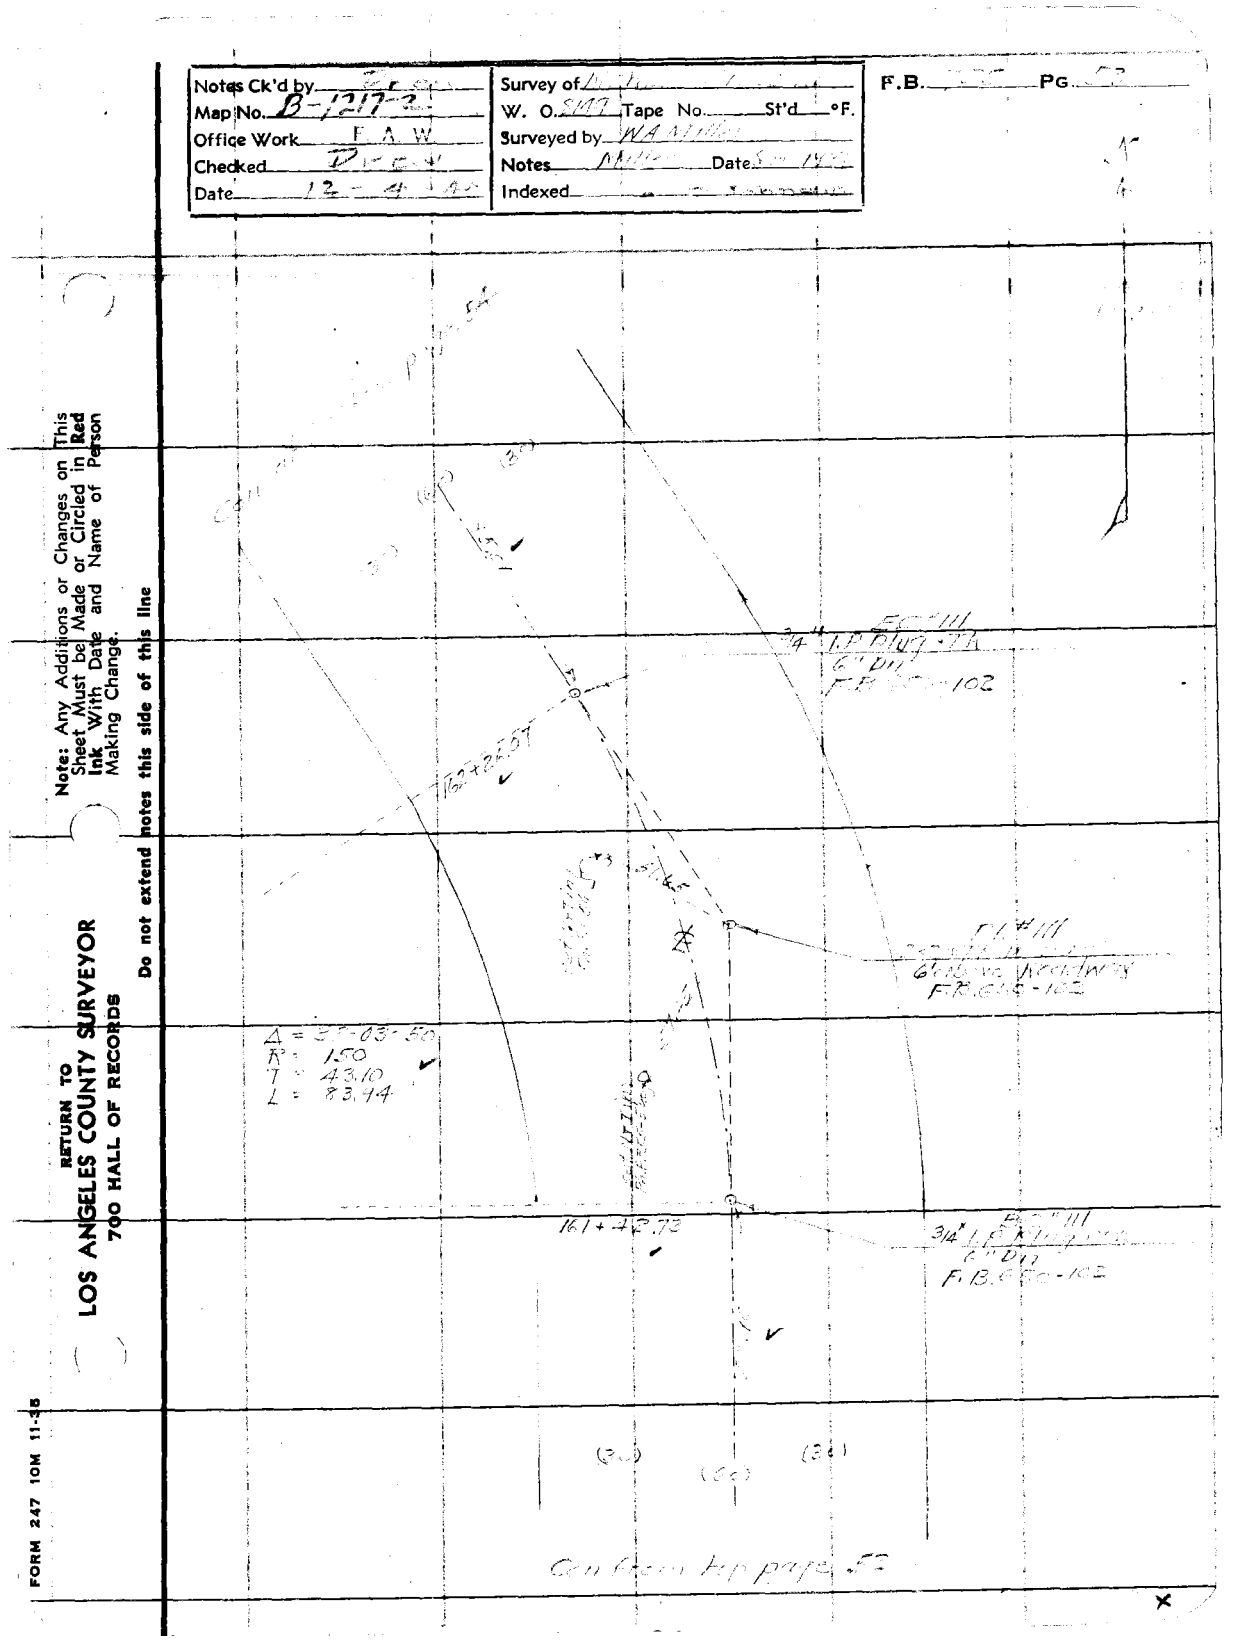

Continued on page 53

RETURN TO
LOS ANGELES COUNTY SURVEYOR
700 HALL OF RECORDS

Note: Any Additions or Changes on This Sheet Must be Made or Circled in **Red** Ink With Date and Name of Person Making Change.

WS 50-E-1

Do not extend notes this side of this line

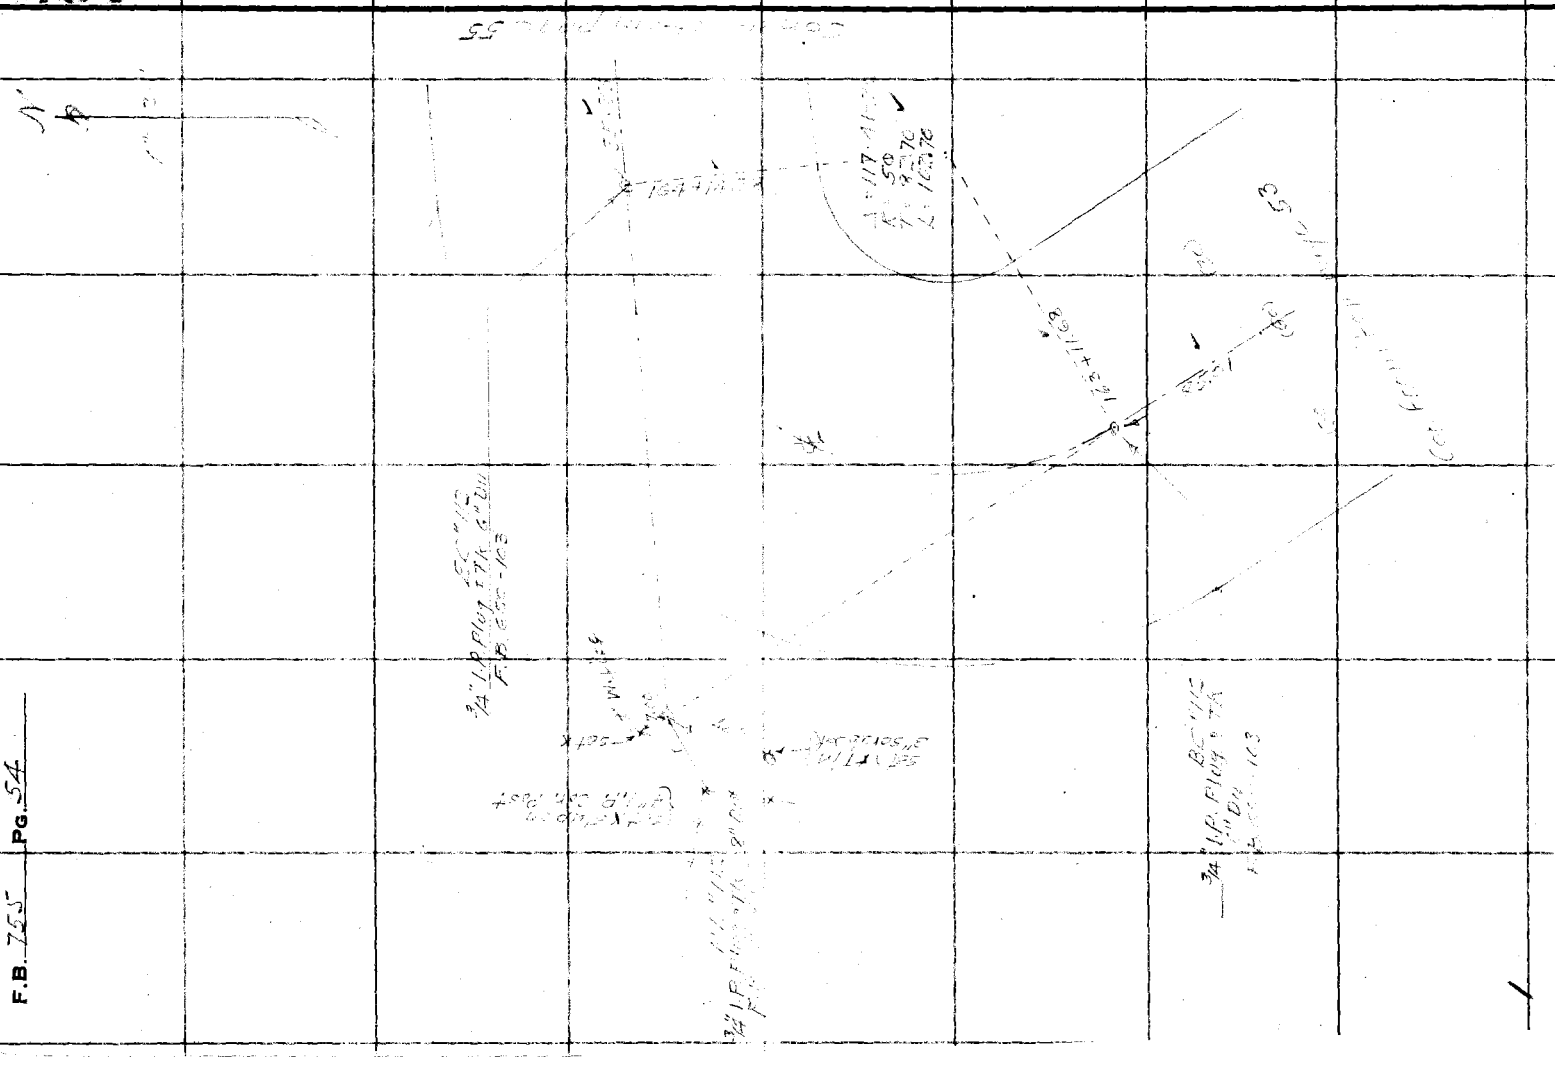

F.B. 755 Pg. 54

Notes Ck'd by	Survey of
Map No. B-12 P. 3	W. O. 8149 Tape No. St'd °F.
Office Work F. A. W.	Surveyed by W. A. Miller
Checked D. C. A. A.	Notes Miller Date Apr 1931
Date 12-4-50	Indexed

F.B. Pg.

MT WILSON TOLL ROAD
J.N 8149
ALIGNMENT DATA
P.I. 13 to P.I.

Miller
Byrne
Stewart CA.
Chute
Stewart O.B.

Note: Any Additions or Changes on This Sheet Must be Made in Red Ink or Circled in Red With Date and Name of Person Making Change.

Do not extend notes this side of this line

RETURN TO
LOS ANGELES COUNTY SURVEYOR
700 HALL OF RECORDS

FORM 247 10M 11-35

RETURN TO
LOS ANGELES COUNTY SURVEYOR
700 HALL OF RECORDS

Note: Any Additions or Changes on This Sheet Must be Made or Circled in **Red Ink** With Date and Name of Person Making Change.

Do not extend notes this side of this line

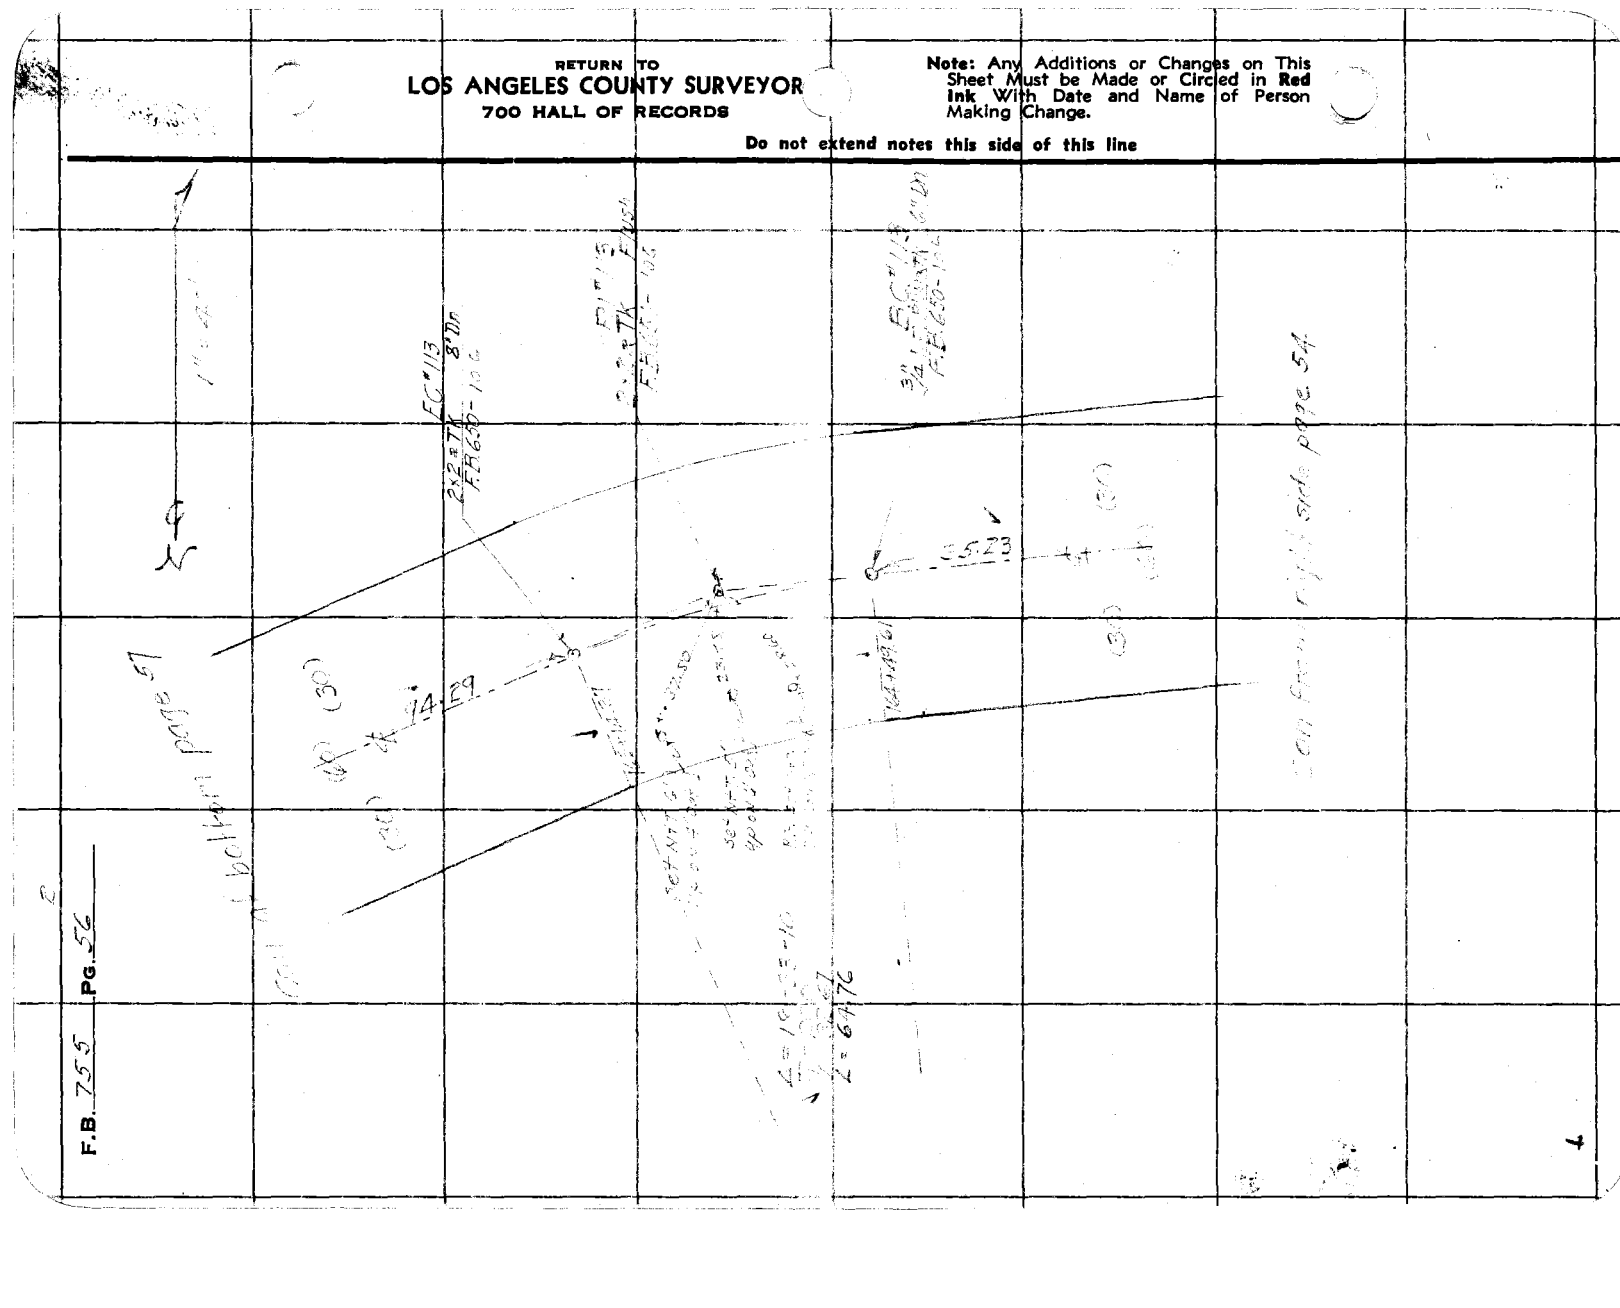

F.B. 755 Pg. 56

Notes Ck'd by	Survey of
Map No.	W. O. 8177 Tape No. St'd °F.
Office Work F. A. W.	Surveyed by
Checked	Notes Date Apr 1977
Date	Indexed

F.B. PG.

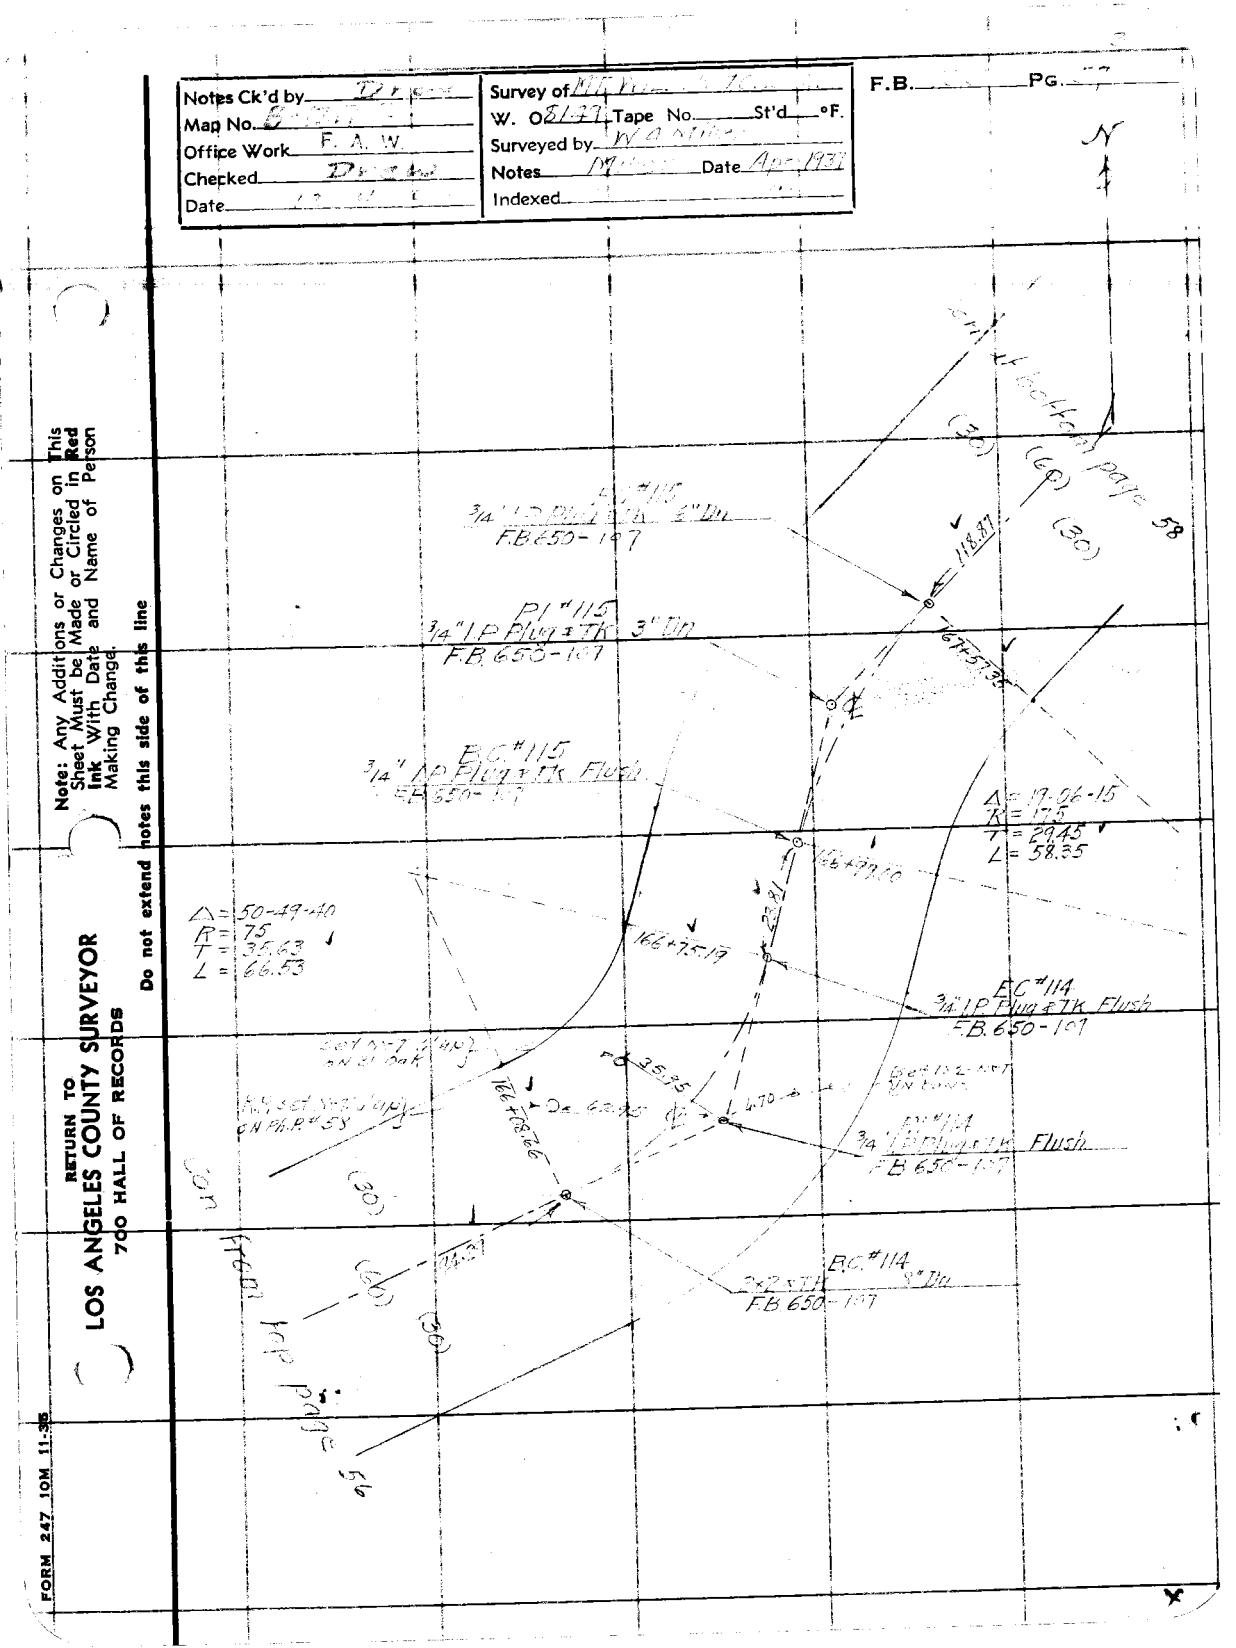

Note: Any Additions or Changes on This Sheet Must be Made or Circled in Red Ink With Date and Name of Person Making Change.

Do not extend notes this side of this line

RETURN TO
LOS ANGELES COUNTY SURVEYOR
700 HALL OF RECORDS

FORM 247 10M 11-75

RETURN TO
LOS ANGELES COUNTY SURVEYOR
700 HALL OF RECORDS

Note: Any Additions or Changes on This Sheet Must be Made or Circled in **Red Ink** With Date and Name of Person Making Change.

Do not extend notes this side of this line

WS 50-E-1

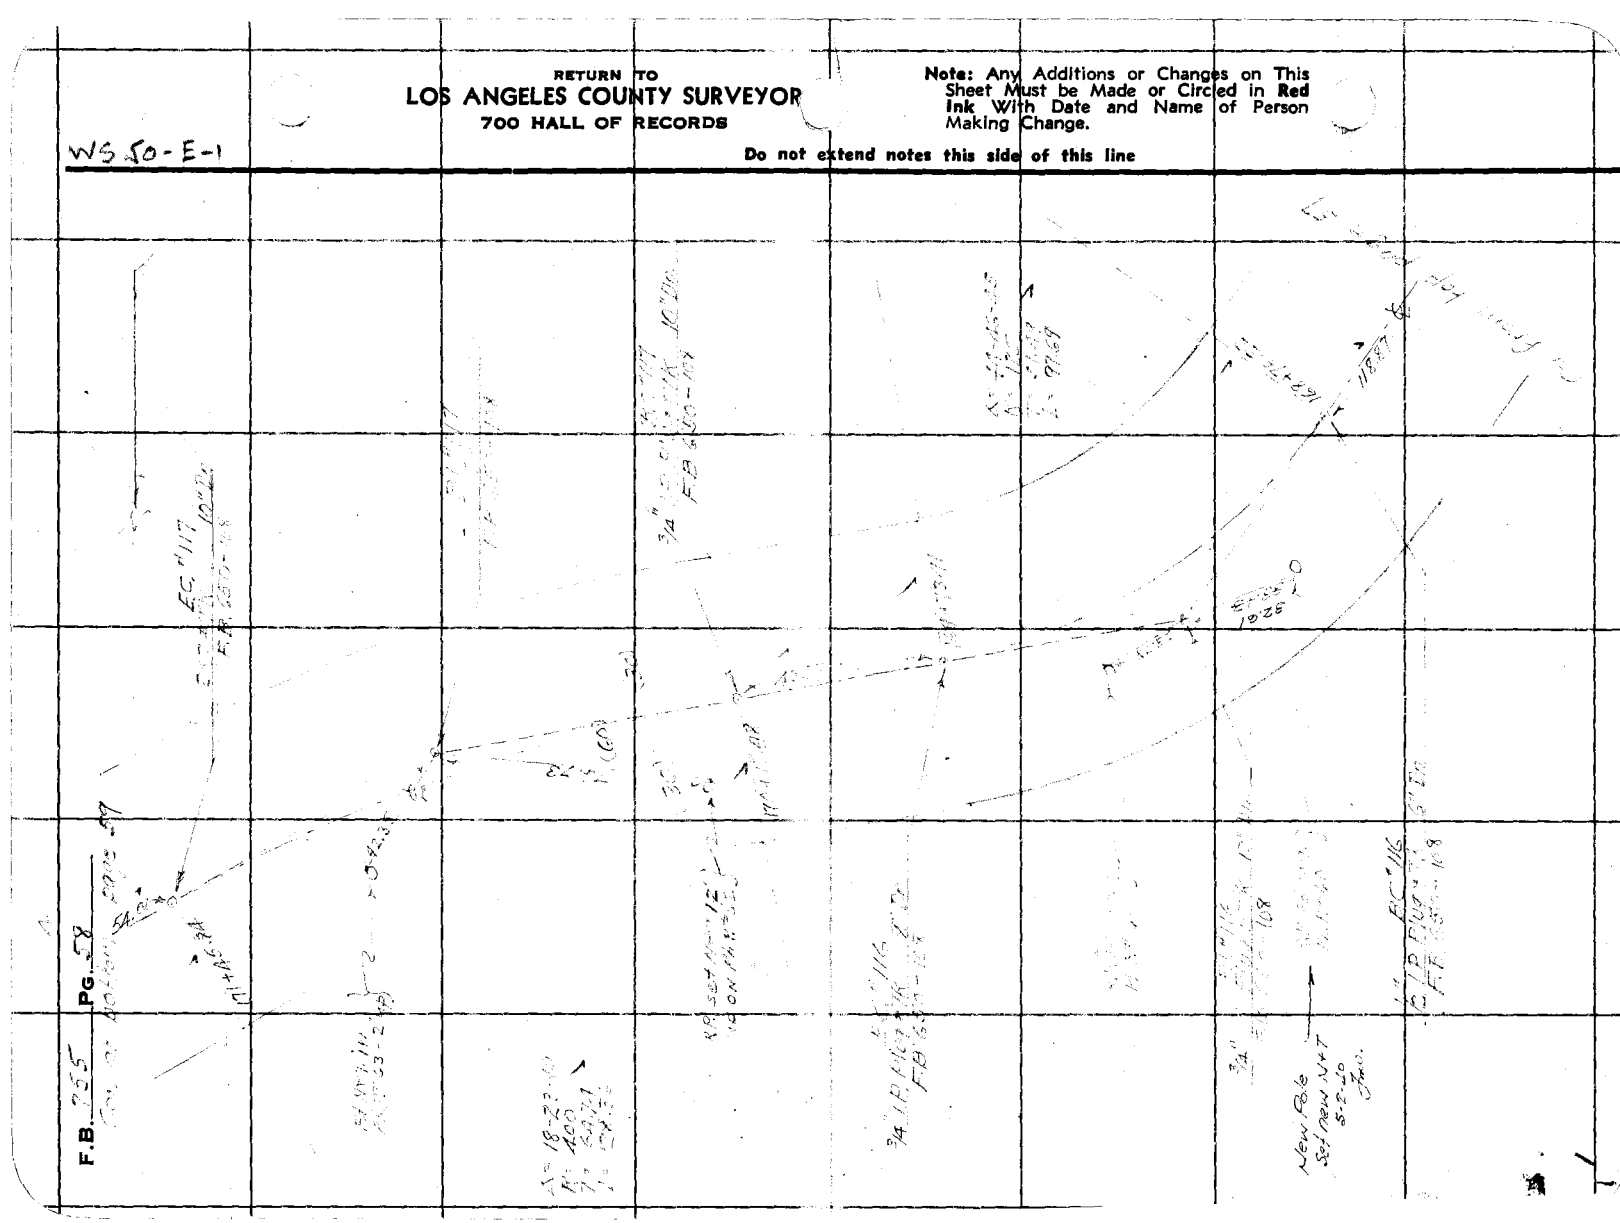

Notes Ck'd by	Survey of
Map No.	W. O. Tape No. St'd °F.
Office Work F. A. W.	Surveyed by
Checked	Notes Date
Date	Indexed

F.B. Pg.

RETURN TO
LOS ANGELES COUNTY SURVEYOR
700 HALL OF RECORDS

Note: Any Additions or Changes on This Sheet Must be Made or Circled in Red Ink With Date and Name of Person Making Change.

Do not extend notes this side of this line

EC #119
FB 650-109

3/4" IP
FB 650-109
10" Dn.

EC #118
3/4" I.P. Plug
FB 650-109
10" Dn.

3/4" I.P.
FB 650-109
8" Dn.

Δ=8-38-30
R=300
T=27.67
L=45.25

FORM 247 10M 11-38

F.B. 755 Pg. 60

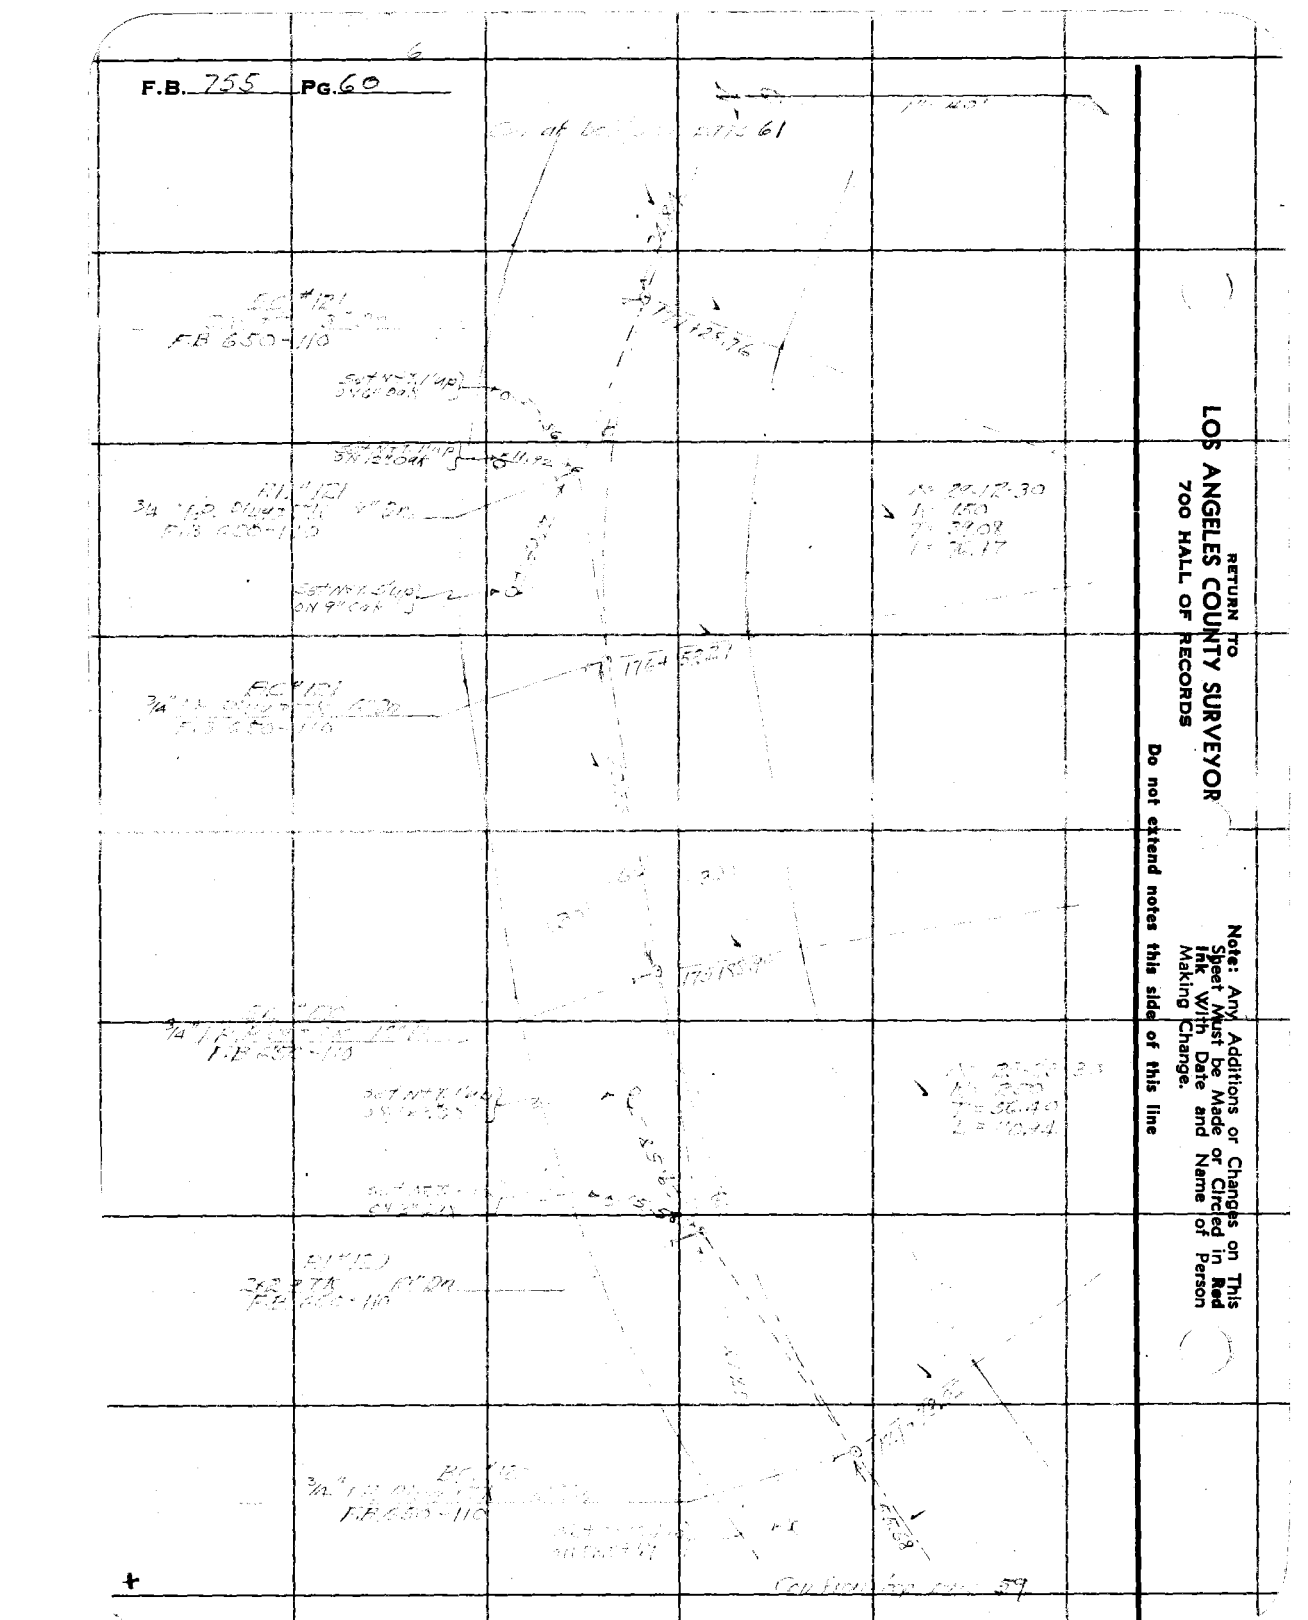

RETURN TO
LOS ANGELES COUNTY SURVEYOR
700 HALL OF RECORDS

Do not extend notes this side of this line

Note: Any Additions or Changes on This Sheet Must be Made or Circled in Red Ink With Date and Name of Person Making Change.

Notes Ck'd by	Survey of
Map No.	W. O.	Tape No.	St'd °F.
Office Work	Surveyed by
Checked	Notes	Date
Date	Indexed

F.B. PG.

N 45-A-1

Note: Any Additions or Changes on This Sheet Must be Made or Circled in Red Ink With Date and Name of Person Making Change.

Do not extend notes this side of this line

RETURN TO
LOS ANGELES COUNTY SURVEYOR
7OD HALL OF RECORDS

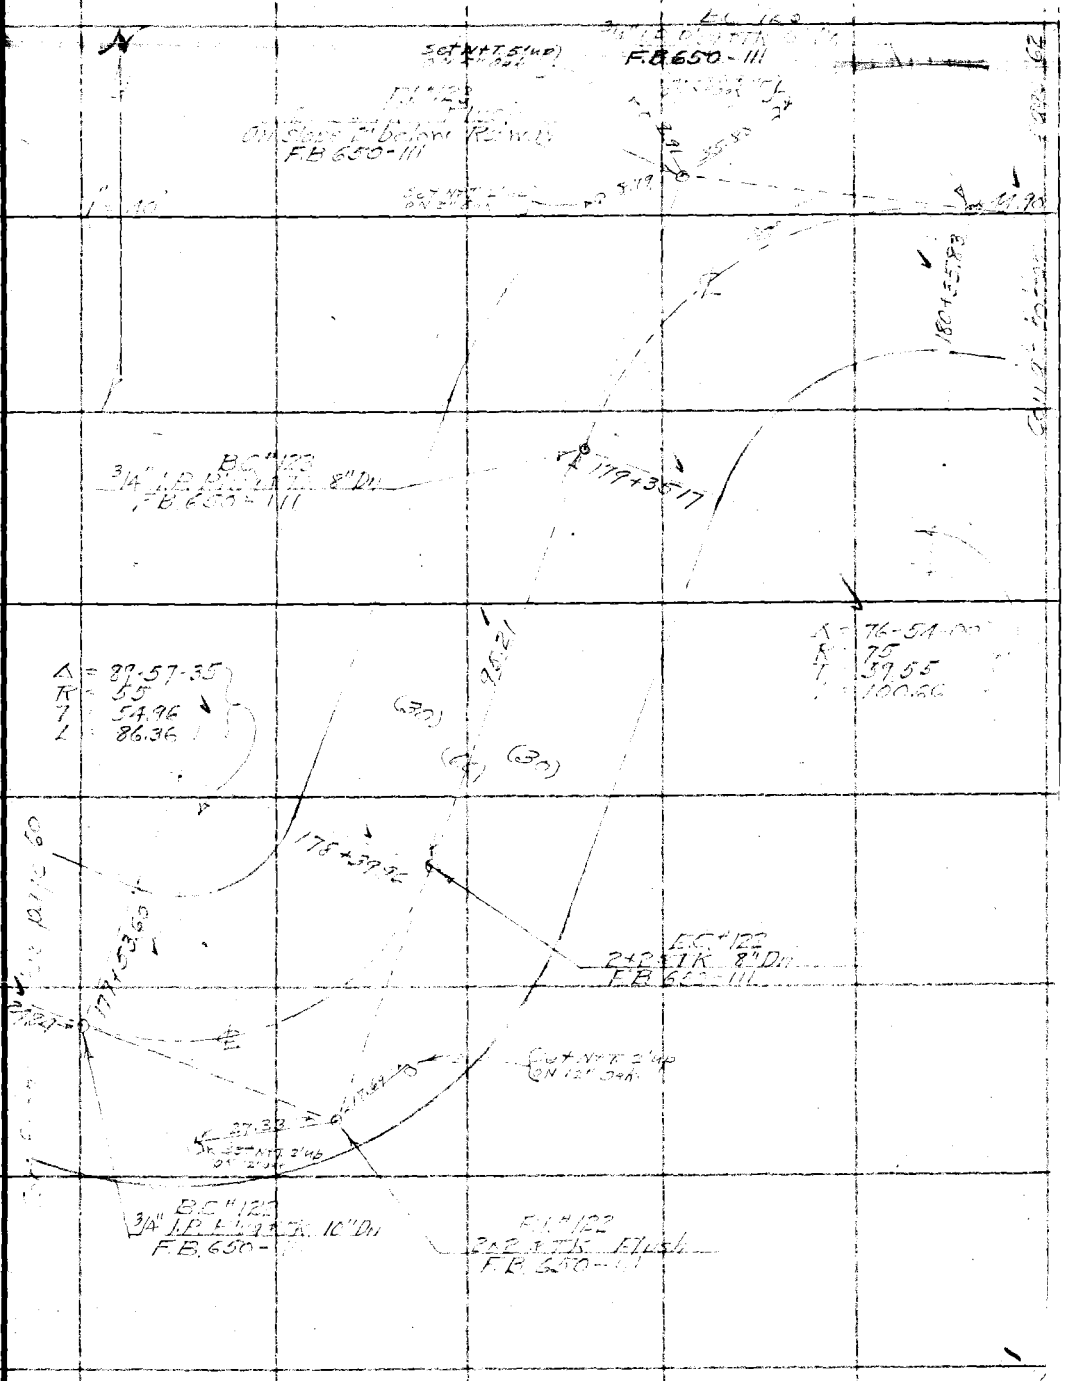

FORM 247 10M 11-38

8

F.B. 755 Pg. 62

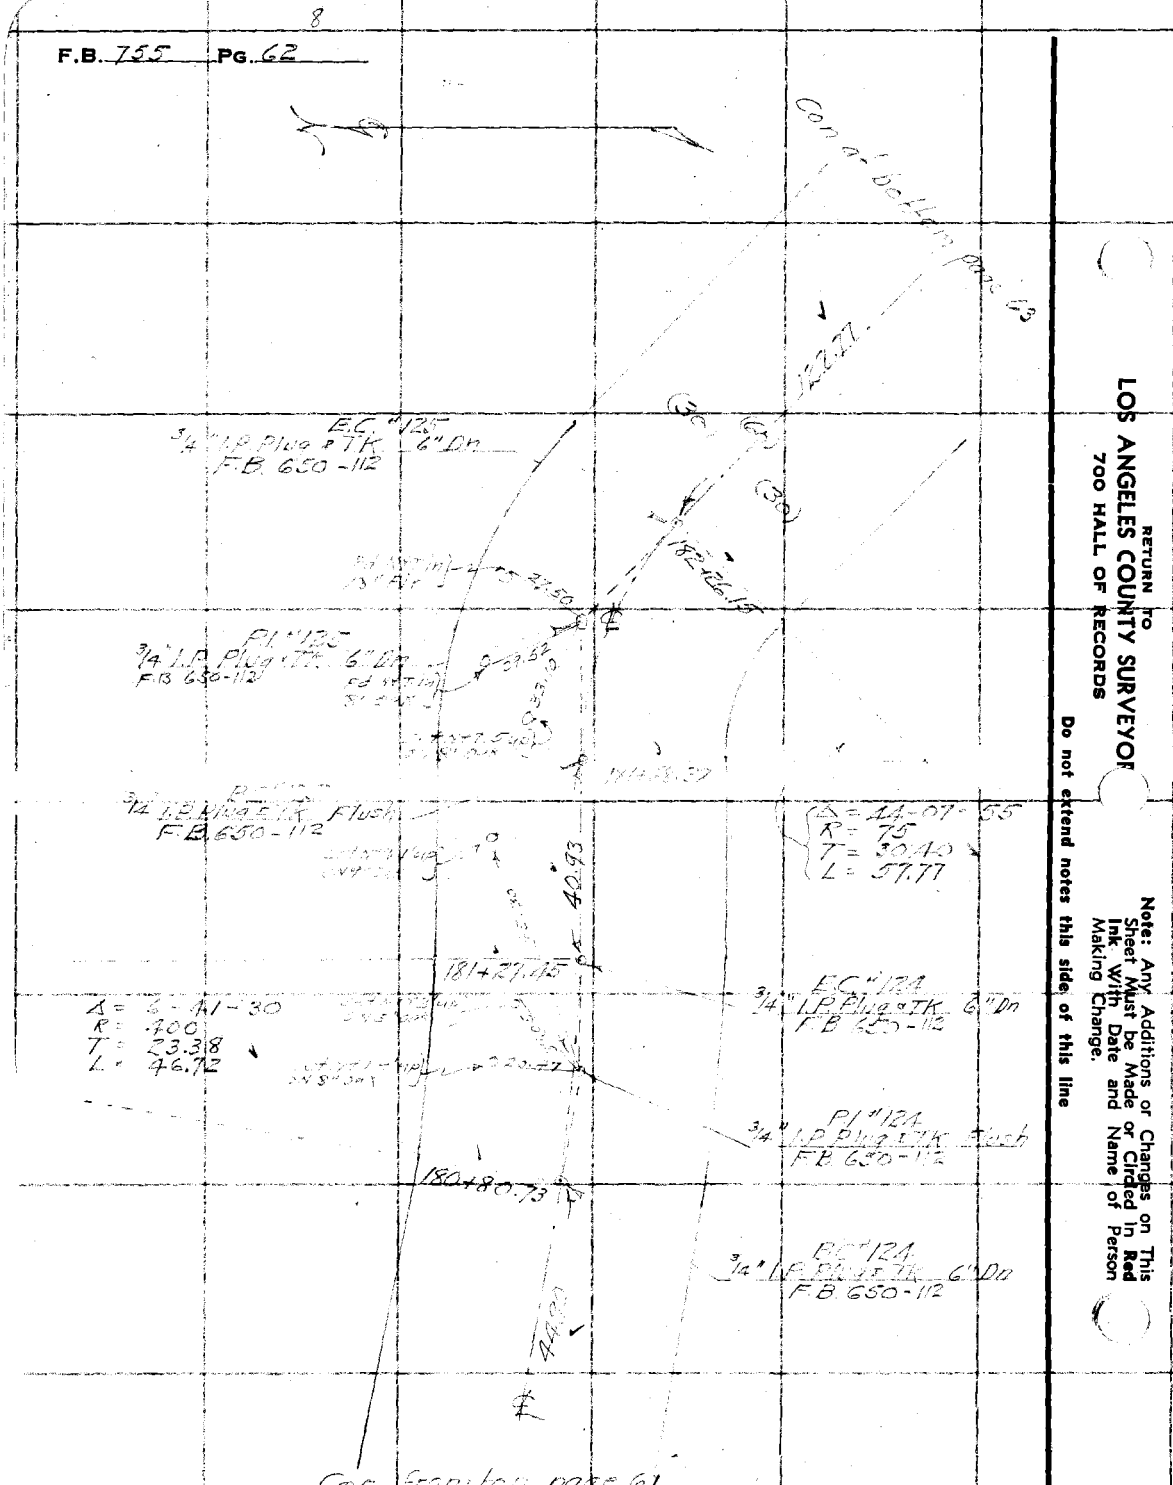

RETURN TO
LOS ANGELES COUNTY SURVEYOR
700 HALL OF RECORDS

Note: Any Additions or Changes on This Sheet Must be Made or Circled in Red Ink with Date and Name of Person Making Change.

Do not extend notes this side of this line

Notes Ck'd by	Survey of
Map No. B-12 17-2	W. O. 8149 Tape No. St'd °F.
Office Work F. A. W.	Surveyed by
Checked Draw	Notes Miller Date Apr 1937
Date 12-4-40	Indexed

F.B. PG.

Notes: ANY ADDITIONS OR CHANGES ON THIS SHEET MUST BE MADE OR CIRCLED IN Red Ink. WITH DATE AND NAME OF PERSON MAKING CHANGE.

Do not extend notes this side of this line

RETURN TO
LOS ANGELES COUNTY SURVEYOR
700 HALL OF RECORDS

FORM 247 10M 8-31

1" = 40'

Con from top page 62

Con at bottom page 63

Δ = 103-56-05
R = 40
T = 51.14 ✓
L = 72.56

(30) (30) (30) (30) (6P)

72+87.77 ✓

82+59.91

84+27.13 ✓

BC #126
SW 1" 6" Dn
F.B. 650-113

E.C. #126
¾" I.P. Plug "TK 8" Dn
F.B. 650-113

P.I. #126
¾" I.P. Plug "TK on Steep
Slope 20' above Roadway
F.B. 650-113

F.B. 755 PG. 64

W.S.S.-A-1

RETURN TO
LOS ANGELES COUNTY SURVEYOR
700 HALL OF RECORDS

Note: ANY ADDITIONS OR CHANGES ON THIS SHEET MUST BE MADE OR CIRCLED IN Red Ink. WITH DATE AND NAME OF PERSON MAKING CHANGE.

Do not extend notes this side of this line

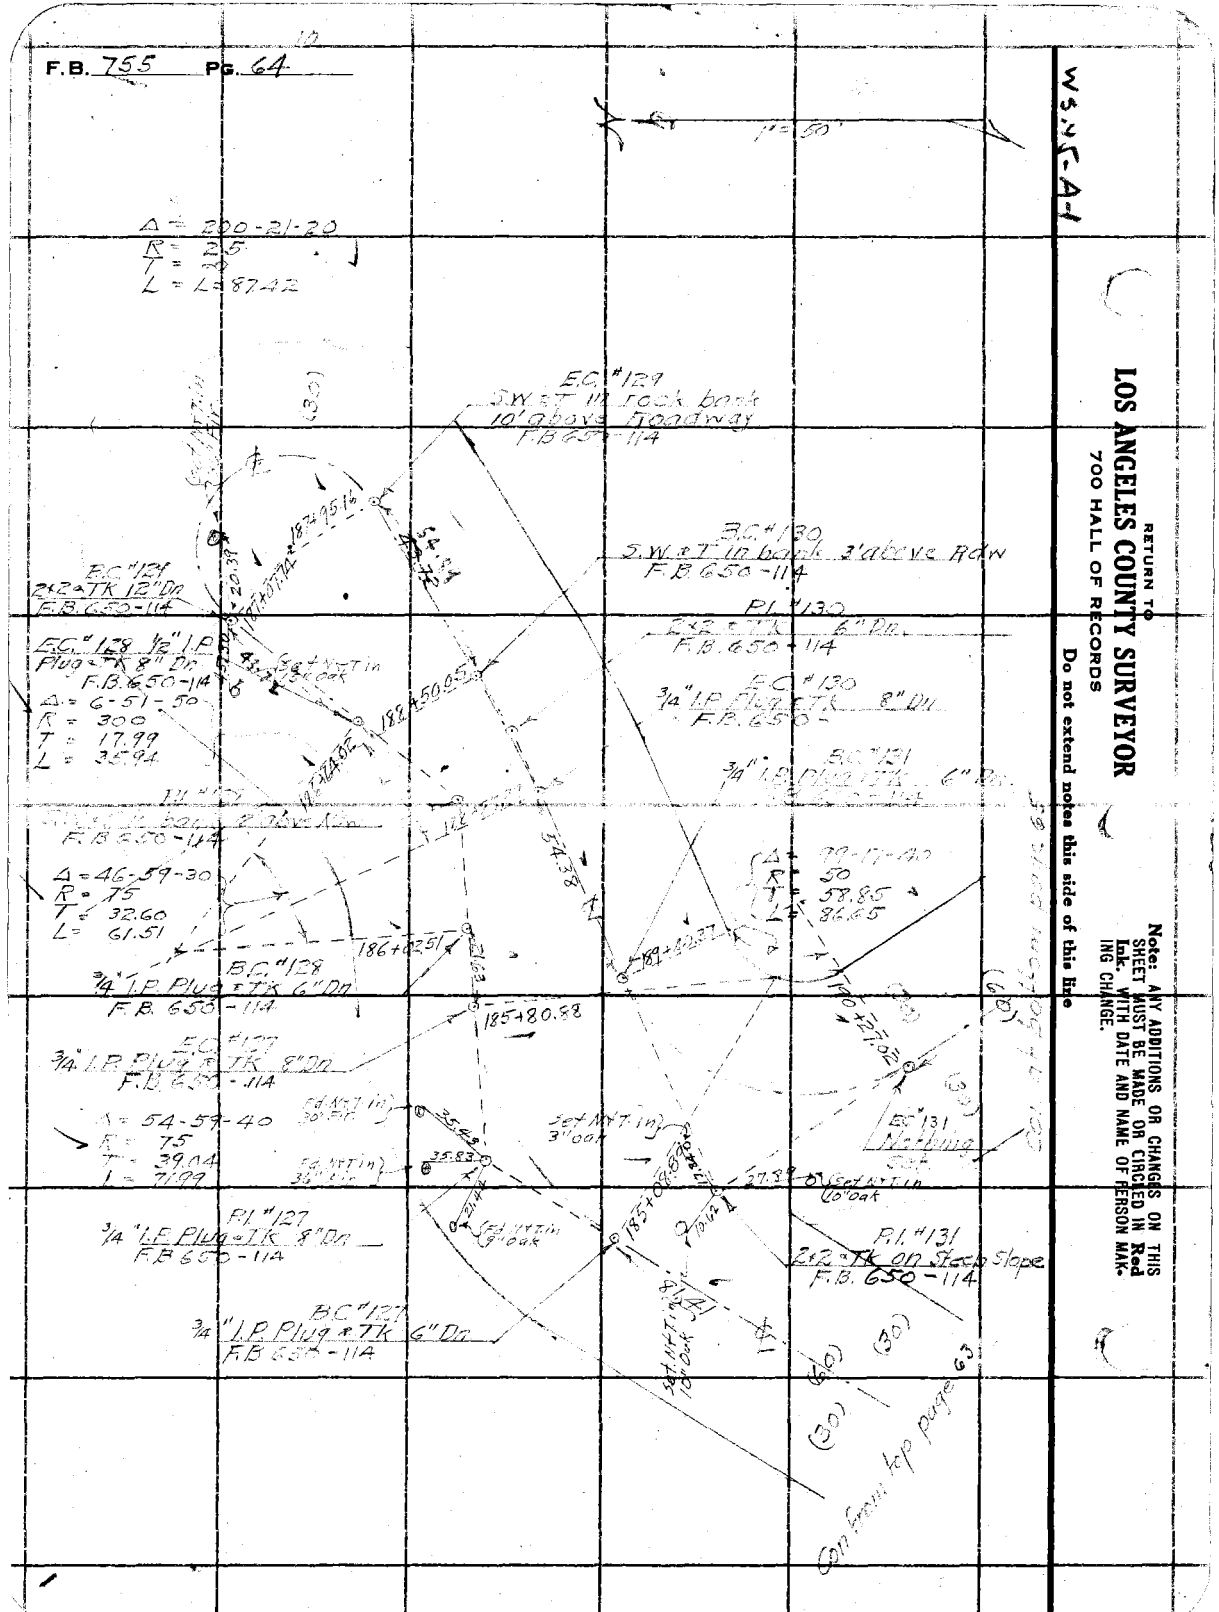

Notes Ck'd by		Survey of	
Map No.	D-12'7-3	W. O.	8149
Office Work	F. A. W.	Tape No.	St'd °F.
Checked	Drews	Surveyed by	W. A. Miller
Date	12-6-40	Notes	Miller Date May 1937
		Indexed	A. C. Johnson

F.B. 725 Pg. 65

W. 4-5-A1

Note: ANY ADDITIONS OR CHANGES ON THIS SHEET MUST BE MADE OR CIRCLED IN Red Ink, WITH DATE AND NAME OF PERSON MAKING CHANGE.

RETURN TO
LOS ANGELES COUNTY SURVEYOR
700 HALL OF RECORDS
Do not extend notes this side of this line

Rod. 1
2"x2"x7" TK on hillside
40' above Roadway
F.B. 650-115

EC #133
S.W.ly T in bank 3' above Rdw
F.B. 650-115

Set N'ly T in 10" Oak

Set N'ly T in 4" Oak

17.25

194.79

197+96.15

193+33.44

37.29

Δ = 147-46-20
R = 150
T = 173.07
L = 128.96

Δ = 69°-37-45
R = 75
T = 52.15
L = 91.14

EC #134 2"x2"x7" TK
Top bank. F.B. 650-115

194+24.58

(30)

(60)

(30)

Set N'ly T in 20" Oak

30.26

18.38

Fd N'ly T in 8" Oak

Set N'ly T in 9" Oak

Con. from bottom page 63

BC #134 12" L.P. Plug & TK
8" Dn F.B. 650-115

P.I. #134
¾" L.P. Plug & TK 12" Dn
F.B. 650-115

191+67.19

BC #133
¾" L.P. Plug & TK 6" Dn
F.B. 650-115

Δ = 4-16-05
R = 300
T = 11.18
L = 22.35

61.52

191+05.67

EC #132
¾" L.P. Plug & TK
6" Dn F.B. 650-115

190+83.32

P.I. #132
¾" L.P. Plug & TK
6" Dn F.B. 650-115

BC #132
S.W.ly T 6" Dn
F.B. 650-115

56.30

(60)

(30)

(30)

Con. from bottom page 64

FORM 247 10M 5-31

RETURN TO
LOS ANGELES COUNTY SURVEYOR
700 HALL OF RECORDS

Note: ANY ADDITIONS OR CHANGES ON THIS SHEET MUST BE MADE OR CIRCLED IN **Red Ink.** WITH DATE AND NAME OF PERSON MAKING CHANGE.

Do not extend notes this side of this line

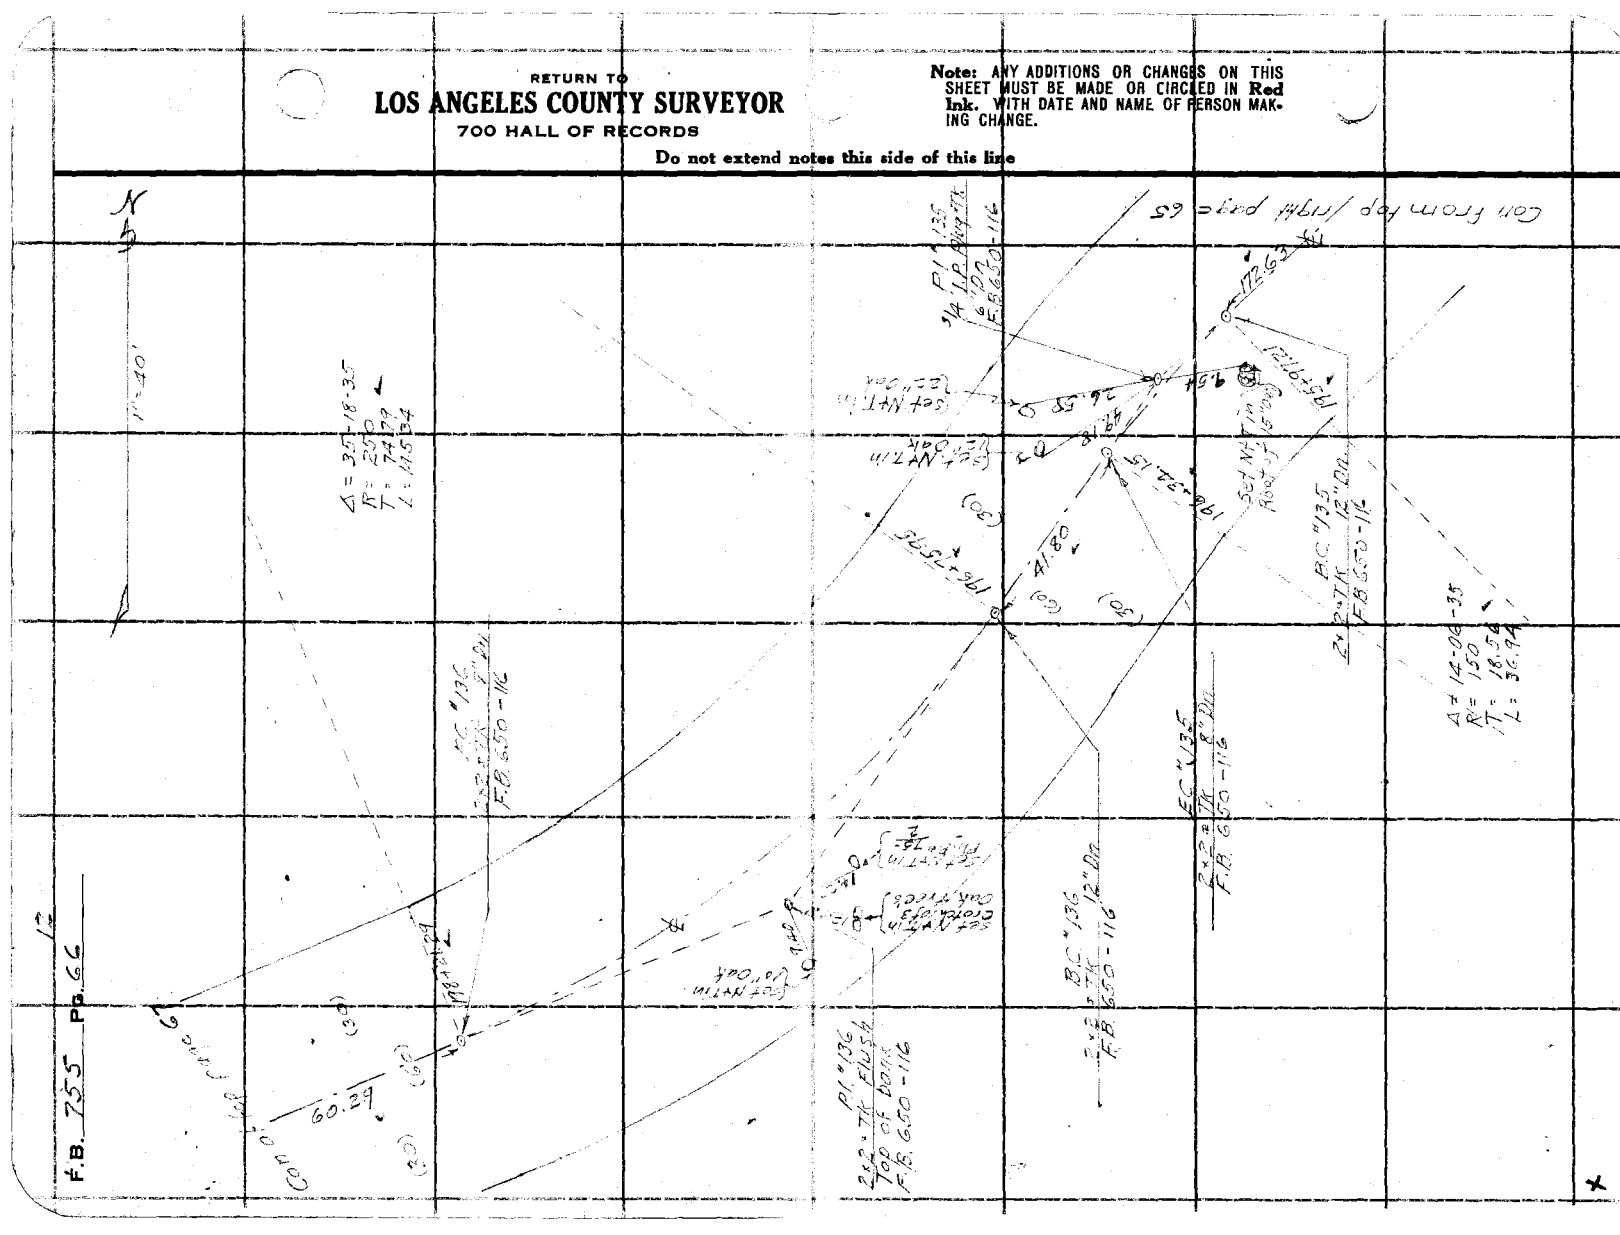
N
1"=40'
Con from top /119th pole = 65
P.I. #135
1/4 LP Ang. Tk
F.B. 650-116
172.62'
Δ = 37°18'35"
R = 250
T = 74.79
L = 162.84
(S)
(S)
(S)
(S)
A'80
196+75.96
196+24.15
BC #135
12" Dia
2x2" Tk
F.B. 650-116
Δ = 14°04'35"
R = 150
T = 18.56
L = 36.84
EC #135
2x2" Tk
F.B. 650-116
EC #136
2x2" Tk
F.B. 650-116
BC #136
12" Dia
2x2" Tk
F.B. 650-116
P.I. #136
2x2" Tk Flush
Top of Bolt
F.B. 650-116

Notes Ck'd by Dr.	Survey of M.
Map No. B-1217-2	W. O. 8147 Tape No. St'd °F.
Office Work F. A. W.	Surveyed by W. A. Miller
Checked Dr.	Notes Miller Date May 1937
Date 12-4-40	Indexed C. Johnson

F.B. 754 Pg. 67

Ty. 45-A-1

Note: ANY ADDITIONS OR CHANGES ON THIS SHEET MUST BE MADE OR CIRCLED IN Red Ink, WITH DATE AND NAME OF PERSON MAKING CHANGE.

Do not extend notes this side of this line

RETURN TO
LOS ANGELES COUNTY SURVEYOR
700 HALL OF RECORDS

FORM 247 10M 8-31

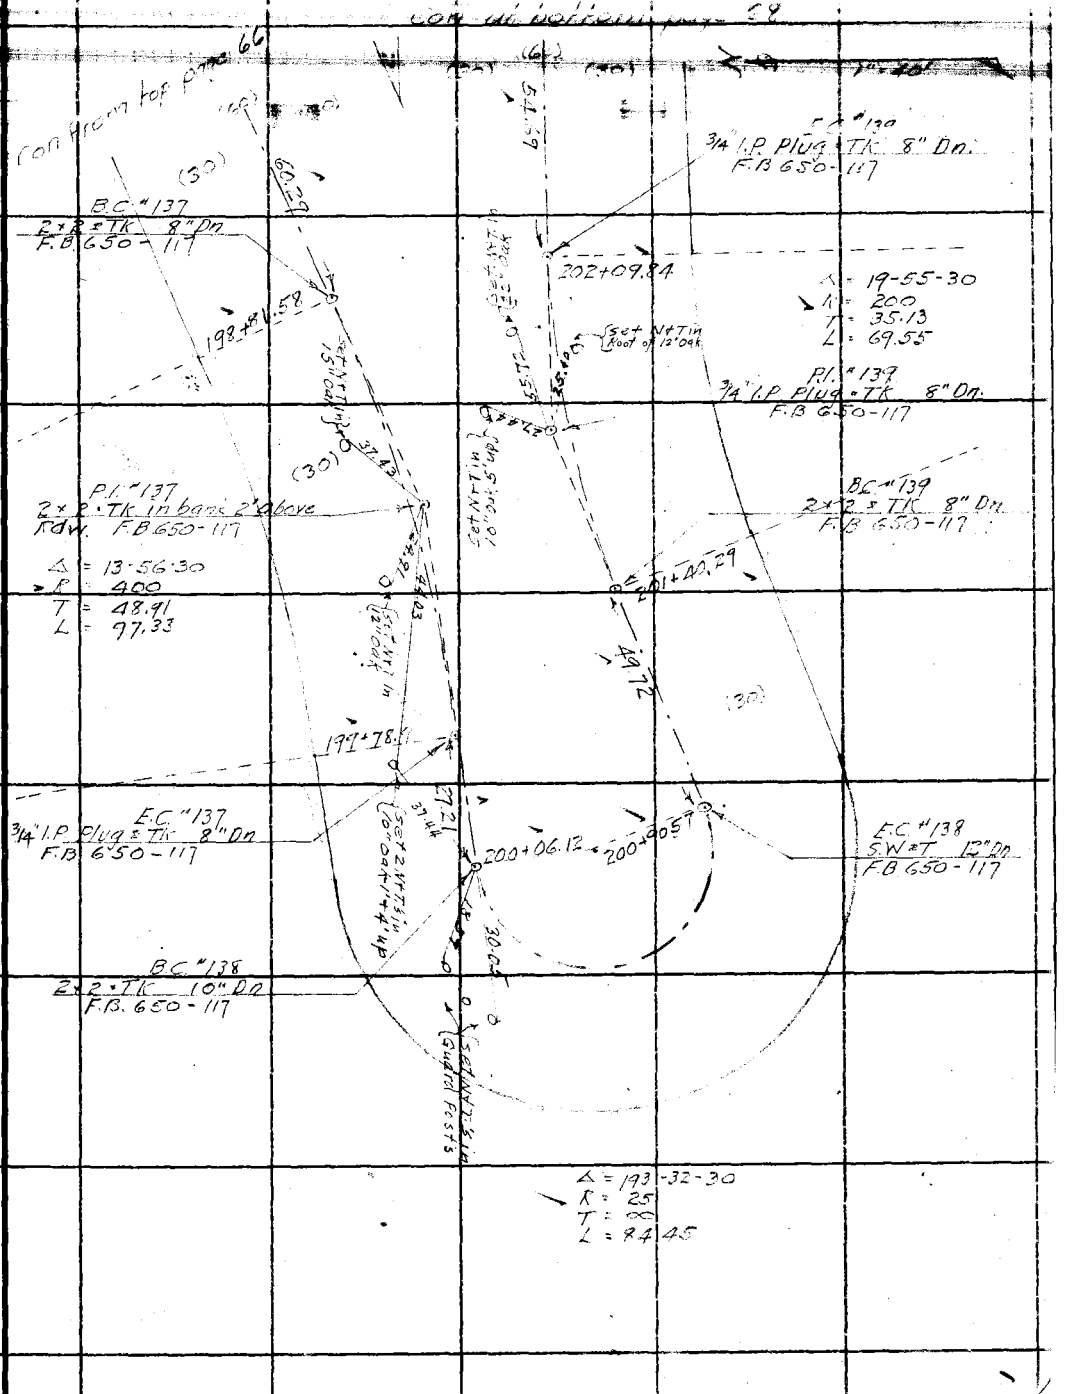

14

F.B. 755 Pg. 68

Con at bottom page 69

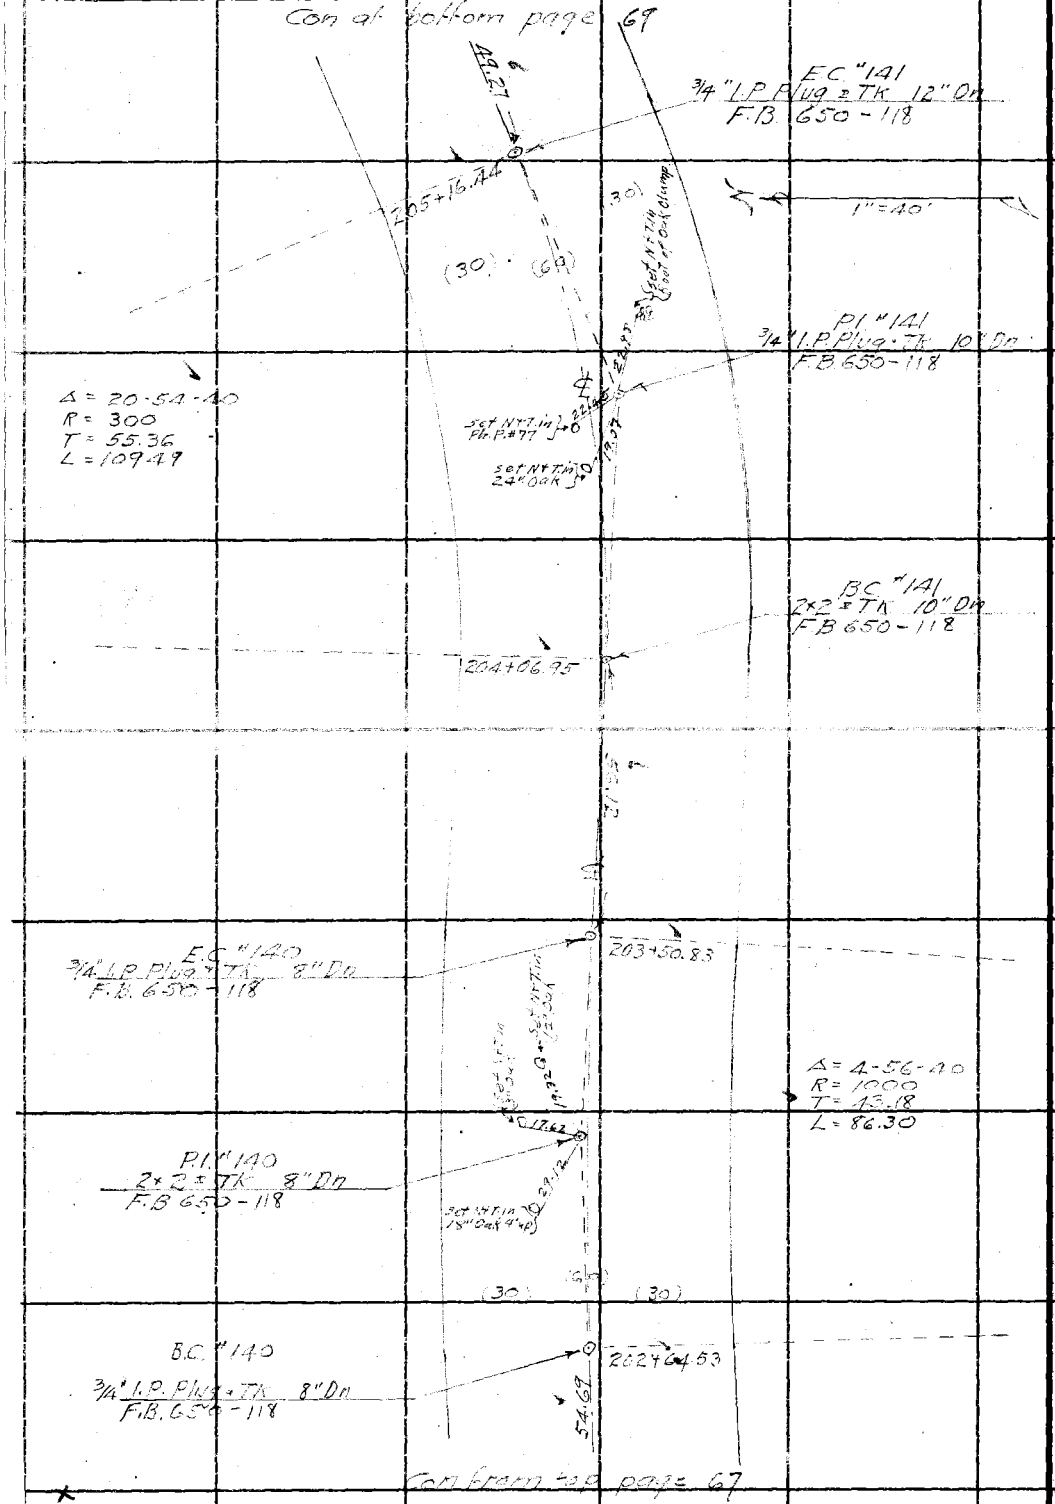

RETURN TO
LOS ANGELES COUNTY SURVEYOR
700 HALL OF RECORDS

Do not extend notes this side of this line

Note: ANY ADDITIONS OR CHANGES ON THIS SHEET MUST BE MADE OR CIRCLED IN Red Ink. WITH DATE AND NAME OF PERSON MAKING CHANGE.

Notes Ck'd by Drew	Survey of [illegible]
Map No. 8-1217-2	W. O. 8447 Tape No. ___ St'd ___ °F.
Office Work F. A. W.	Surveyed by W. A. Miller
Checked Drew	Notes Miller Date May 1937
Date 12-4-40	Indexed ___

F.B. 650 Pg. 19

W.V.S.-A-1

Con at bottom page 70

(CD)

(30) (30)

178.22

207+27.33

EC "142
2×2"×7" 10" Dp
F.B. 650-119

Δ = 23°39'00"
R = 400
T = 81.93
L = 161.62

14.09

PI "142
¾" I.P. Plug 7" Dp
F.B. 650-119

205+65.71

49.27

B.C. "142
¾" I.P. Plug 7" 8" Dp
F.B. 650-119

(40) (30)

(30)

Con from top page 68

Note: ANY ADDITIONS OR CHANGES ON THIS SHEET MUST BE MADE OR CIRCLED IN Red Ink. WITH DATE AND NAME OF PERSON MAKING CHANGE.

Do not extend notes this side of this line

RETURN TO
LOS ANGELES COUNTY SURVEYOR
700 HALL OF RECORDS

FORM 247 10M 5-31

16

F.B. 755 Pg. 70

Con at bottom page 71

N

1" = 40'

(30) (60) (30)

N

3+48.11

E.C. "143
¼" I.P. Plug + TK 12" On
F.B. 650-120

20+89.59

Fd. Nail & Shr. Mon.

Δ = 4-43-50
R = 1000
T = 41.34
L = 82.

E.C. "143
2x2" TK 12" On
F.B. 650-120

Fd. Nail in 3" Oak Mon.

20+07.03

E.C. "143
2x2" TK 12" On
F.B. 650-120

17.70

(30) (60) (30)

N

Con from top page 57

RETURN TO
LOS ANGELES COUNTY SURVEYOR
700 HALL OF RECORDS
Do not extend notes this side of this line

Note: ANY ADDITIONS OR CHANGES ON THIS SHEET MUST BE MADE OR CIRCLED IN Red Ink. WITH DATE AND NAME OF PERSON MAKING CHANGE.

Notes Ck'd by D.	Survey of
Map No. C-12-17-7	W. O. 8149 Tape No. St'd of.
Office Work F. A. W	Surveyed by W.A.Miller
Checked Drew	Notes Miller Date May 1937
Date 12-4-40	Indexed E. O. Johnson

F.B. 755 Pg. 71

17

WS 46-A-1

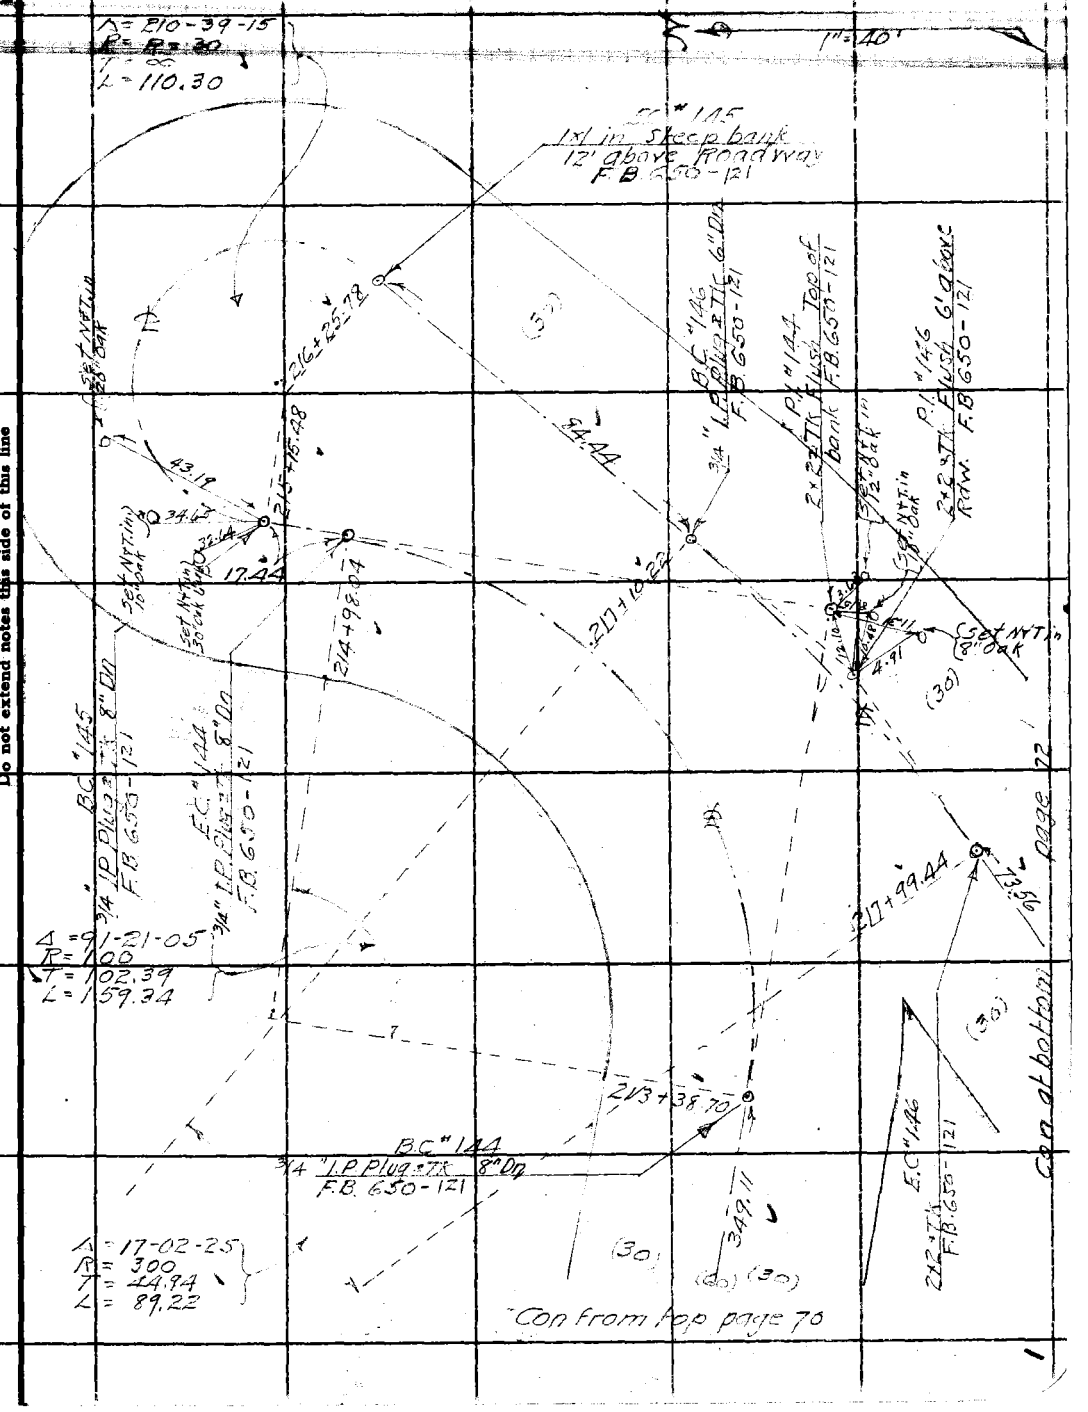

Note: ANY ADDITIONS OR CHANGES ON THIS SHEET MUST BE MADE OR CIRCLED IN Red Ink. WITH DATE AND NAME OF PERSON MAKING CHANGE.

Do not extend notes this side of this line

RETURN TO
LOS ANGELES COUNTY SURVEYOR
700 HALL OF RECORDS

FORM 247 10M 5-31

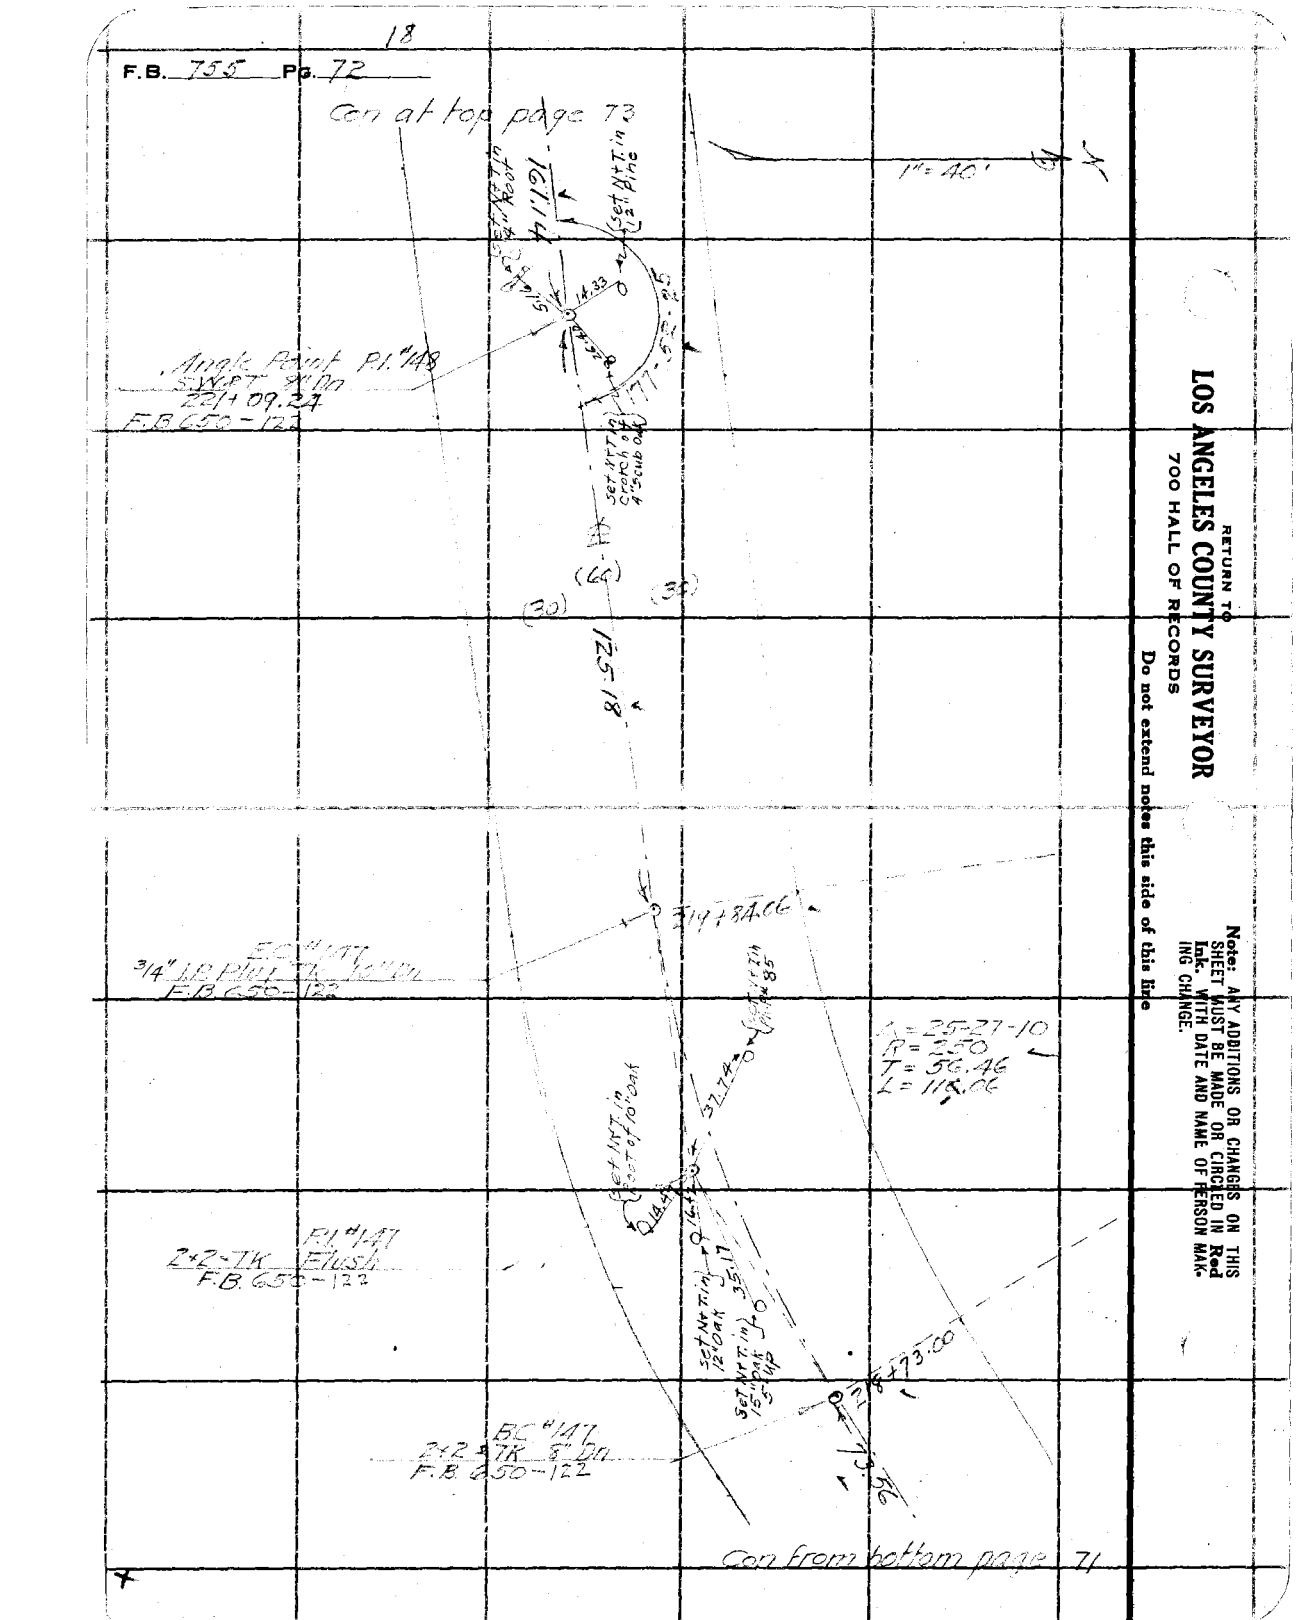
18
F.B. 755 Pg. 72
Con at top page 73
1" = 40'
F.B. 650-122
Δ = 25-27-10
R = 250
T = 56.46
L = 112.06
2"x2"-7K
F.B. 650-122
Set Nail & Tin
12" Oak
Set Nail & Tin
15" Oak
273.00
BC "147
2"x2"-7K
F.B. 650-122
Con from bottom page 71
RETURN TO
LOS ANGELES COUNTY SURVEYOR
700 HALL OF RECORDS
Do not extend notes this side of this line
Note: ANY ADDITIONS OR CHANGES ON THIS SHEET MUST BE MADE OR CIRCLED IN Red Ink. WITH DATE AND NAME OF PERSON MAKING CHANGE.

W 45-A-1

Notes Ck'd by Drew	Survey of N.T. WILSON TR. 4
Map No. B-1217-2	W. O. 8149 Tape No. St'd °F.
Office Work F. A. W.	Surveyed by W. S. Miller
Checked Drew	Notes Miller Date May 1927
Date 1-3-28	Indexed A. C. Johnson

F.B. PG.



(60) (30) (30) (30) (30) (60)

BC "149 2x2 x TK 10"Dn F.B. 650-123

222+70.38

Δ = 4-00-30
R = 500
T = 17.50
L = 34.98

Set N+T in 15"Oak

Set N+T in 9" Oak

FP "147 2x2 x TK 10"Dn F.B. 650-123

Set N+T in 15" Oak

223+05.36

EC "152 2x2 x TK 6"Dn F.B. 650-123

EC "149 3/4" I.P. Plug x TK 8"Dn F.B. 650-123

223+86.80

Set N+T in 10" Oak

Set N+T in 15" Oak

Δ = 35-34-30
R = 100
T = 32.08
L = 62.09

BC "150 3/4" I.P. Plug x TK 8"Dn F.B. 650-123

PI "152 S.W.T 4"Dn F.B. 650-123

Δ = 8-20-40
R = 100
T = 7.29
L = 14.56

Set N+T in 8" Oak Stump

223+78.10

225+24.71

BC "152 2x2 x TK in rock bank 4' above Roadway F.B. 650-123

223+92.66

PI "150 2x2 x TK 8"Dn F.B. 650-123

EC "151 1x1 in rock bank 9' above Roadway F.B. 650-123

Set N+T in 10" Pipe

224+11.56

224+99.63

EC "150 2x2 x TK 10"Dn F.B. 650-123

BC "151 2x2 x TK 12"Dn F.B. 650-123

Set N+T in Guard Post

Δ = 201-51-35
R = 25
T = ~
L = 88.07

Note: ANY ADDITIONS OR CHANGES ON THIS SHEET MUST BE MADE OR CIRCLED IN Red Ink. WITH DATE AND NAME OF PERSON MAKING CHANGE.

Do not extend notes this side of this line

RETURN TO
LOS ANGELES COUNTY SURVEYOR
700 HALL OF RECORDS

FORM 247 10M 8-31

F.B. 755 Pg. 74

Con at bottom page 75

1" = 50'

E31+39.48

3/4" I.P. EC "153 Plug & Tk 8" Dn F.B. 650-124

(30) (30) (30)

Δ = 21°-03'-05"
R = 900
T = 167.22
L = 330.67

Set Nail & Shiner in 18" Oak

Set Nail & Shiner in 8" Oak 22.95' N 10.30' E

EC "153 2 x 2 x 7" Flush at top of bank F.B. 650-124

(30) (30) (30)

EC "153 SW Ret 6" Dn F.B. 650-124

22840.81

Con from top page 73

RETURN TO
LOS ANGELES COUNTY SURVEYOR
700 HALL OF RECORDS

Do not extend notes this side of this line

Note: ANY ADDITIONS OR CHANGES ON THIS SHEET MUST BE MADE OR CIRCLED IN Red Ink. WITH DATE AND NAME OF PERSON MAK-ING CHANGE.

Notes Ck'd by	Drew	Survey of	NT Wilson Tol. Ad
Map No.	B-12-12-2	W. O.	8149
Office Work	F. A. W.	Tape No.	St'd °F.
Checked	12-4-4	Surveyed by	
Date		Notes	Mylar Date June 1937
		Indexed	

F.B. PG. 75

W.43-A-2

1" = 40'

Con. of 4 Lg. Curves page 76

Δ = 13°20'55"
R = 300
T = 35.11
L = 69.89

EC "155 2.32± TK 12" Dn F.B. 650-125

Set NAIL in 12" Pine

Set NAIL in 6" Manzanita

P.I. "156 3/4" I.P. Plug & TK 12" Dn F.B. 650-125

EC "155 3/4" I.P. Plug & TK 12" Dn F.B. 650-125

EC "154 3/4" I.P. Plug & TK 12" Dn F.B. 650-125

P.I. "154 2.32 ± TK 12" Dn F.B. 650-125

Set NAIL in 20" Pine

Set NAIL in 15" Pine

Fd. NAIL in Ph. P#89

EC "154 2.32 ± TK 12" Dn F.B. 650-125

Δ = 40°-20'-40"
R = 150
T = 55.11
L = 105.62

Con. from fol. page 74

Note: ANY ADDITIONS OR CHANGES ON THIS SHEET MUST BE MADE OR CIRCLED IN Red Ink, WITH DATE AND NAME OF PERSON MAKING CHANGE.

Do not extend notes this side of this line

RETURN TO
LOS ANGELES COUNTY SURVEYOR
700 HALL OF RECORDS

FORM 247 10M 5-31

F.B. 755 PG 76

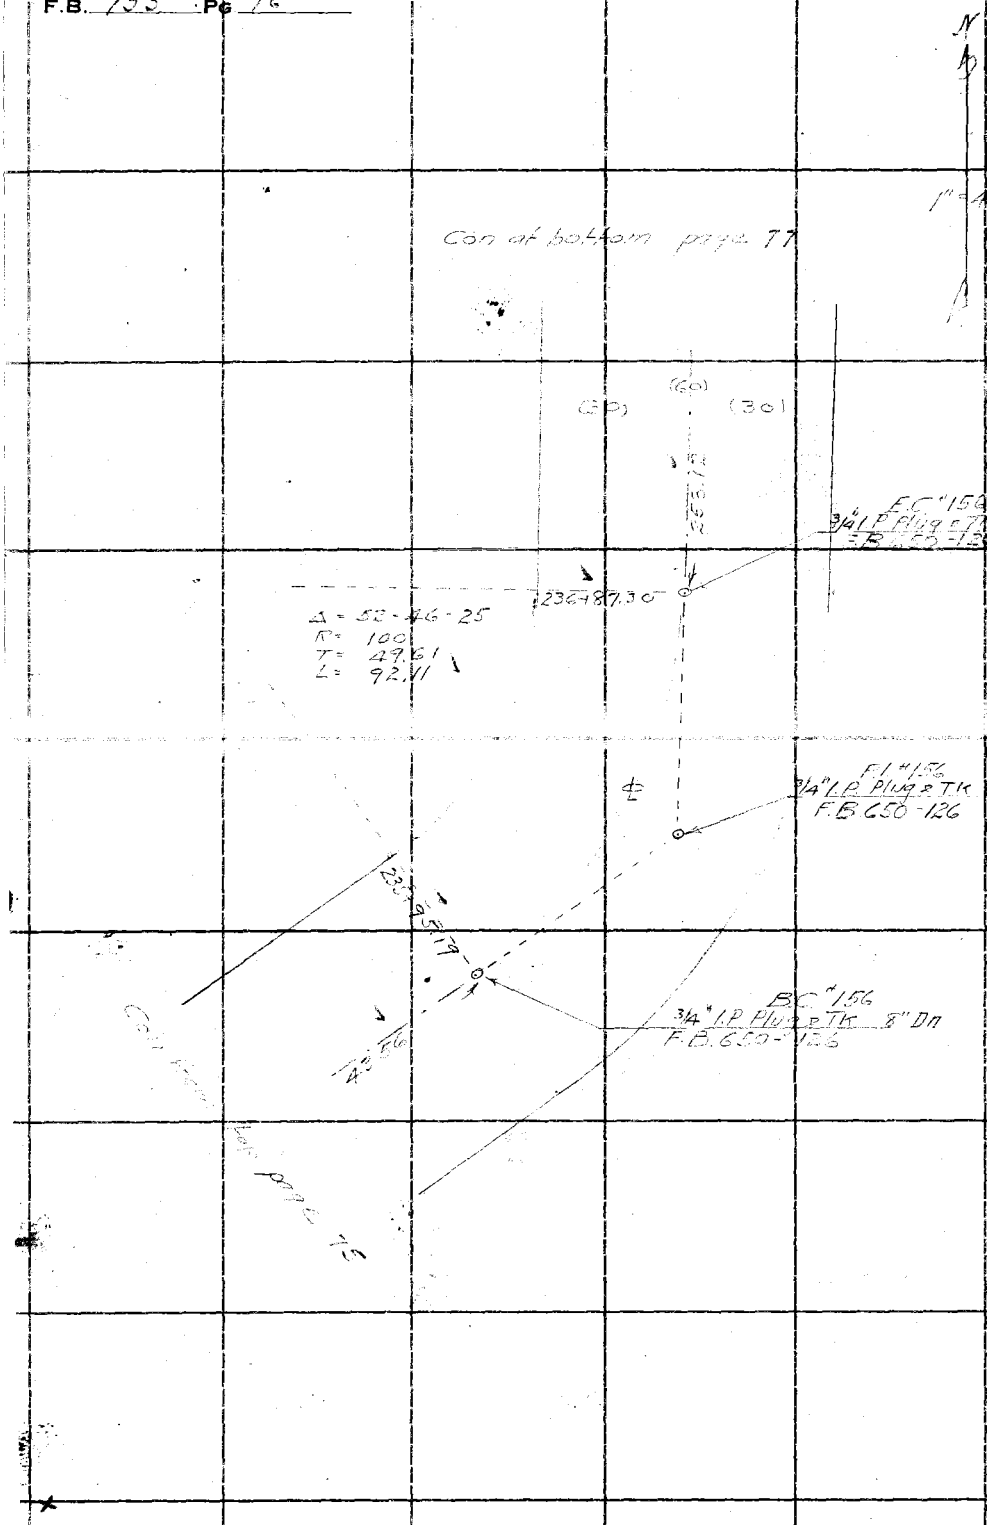

RETURN TO
LOS ANGELES COUNTY SURVEYOR
700 HALL OF RECORDS

Do not extend notes this side of this line

Note: ANY ADDITIONS OR CHANGES ON THIS SHEET MUST BE MADE OR CIRCLED IN Red Ink. WITH DATE AND NAME OF PERSON MAKING CHANGE.

W.S. 45-A-1

Notes Ck'd by Drew	Survey of MT WILSON TOLL RD
Map No. B-12 T-2	W. O. 3149 Tape No. ____ St'd ____ °F.
Office Work F. A. W.	Surveyed by ____
Checked Drew	Notes ____ Date June 1937
Date ____	Indexed ____

F.B. ____ PG. ____

N

Continuation page 78

(60)

(30)

N 12° 24' E

E.C. "158
S.W.⊄T. 4" Dn
F.B. 650-127

239+06.15

Δ = 23-46-40
R = 125
T = 26.32
L = 51.88

Set N⊄T. 4' up
Up. Ph. P#97

N 0°-11'-25" W

P.I. "158
S.W.⊄T. 6" Dn
F.B. 650-127

20.17

103.79

Set N⊄T. 2' up
Up. Ph. P#96

Fd. N⊄T. 4' up
Up. Ph. P.R.P. #95

240+54.27

E.C. "157
S.W.⊄T. 6" Dn
F.B. 650-127

B.C. "158
S.W.⊄T. 8" Dn
F.B. 650-127

32.18

240+21.59

P.I. "157
S.W.⊄T. in bank
F.B. 650-127

Set N⊄T. 4' up
ON Ph. P#96

49.34

238+89.24

Set N⊄T in
Guy Pole

Set N⊄T in
Ph. P#95

Δ = 37-06-45
R = 125
T = 41.96
L = 80.97

239+40.42

B.C. "157
3/4" I.P. Plug ⊄ R. 6" Dn
F.B. 650-127

123.15

(30)

(60)

(30)

Con. from top page 76

RETURN TO
LOS ANGELES COUNTY SURVEYOR
700 HALL OF RECORDS

Note: ANY ADDITIONS OR CHANGES ON THIS SHEET MUST BE MADE OR CIRCLED IN Red Ink. WITH DATE AND NAME OF PERSON MAKING CHANGE.

Do not extend notes this side of this line

FORM 247 10M 5-31

RETURN TO
LOS ANGELES COUNTY SURVEYOR
700 HALL OF RECORDS

Note: ANY ADDITIONS OR CHANGES ON THIS SHEET MUST BE MADE OR CIRCLED IN Red Ink. WITH DATE AND NAME OF PERSON MAKING CHANGE.

Do not extend notes this side of this line

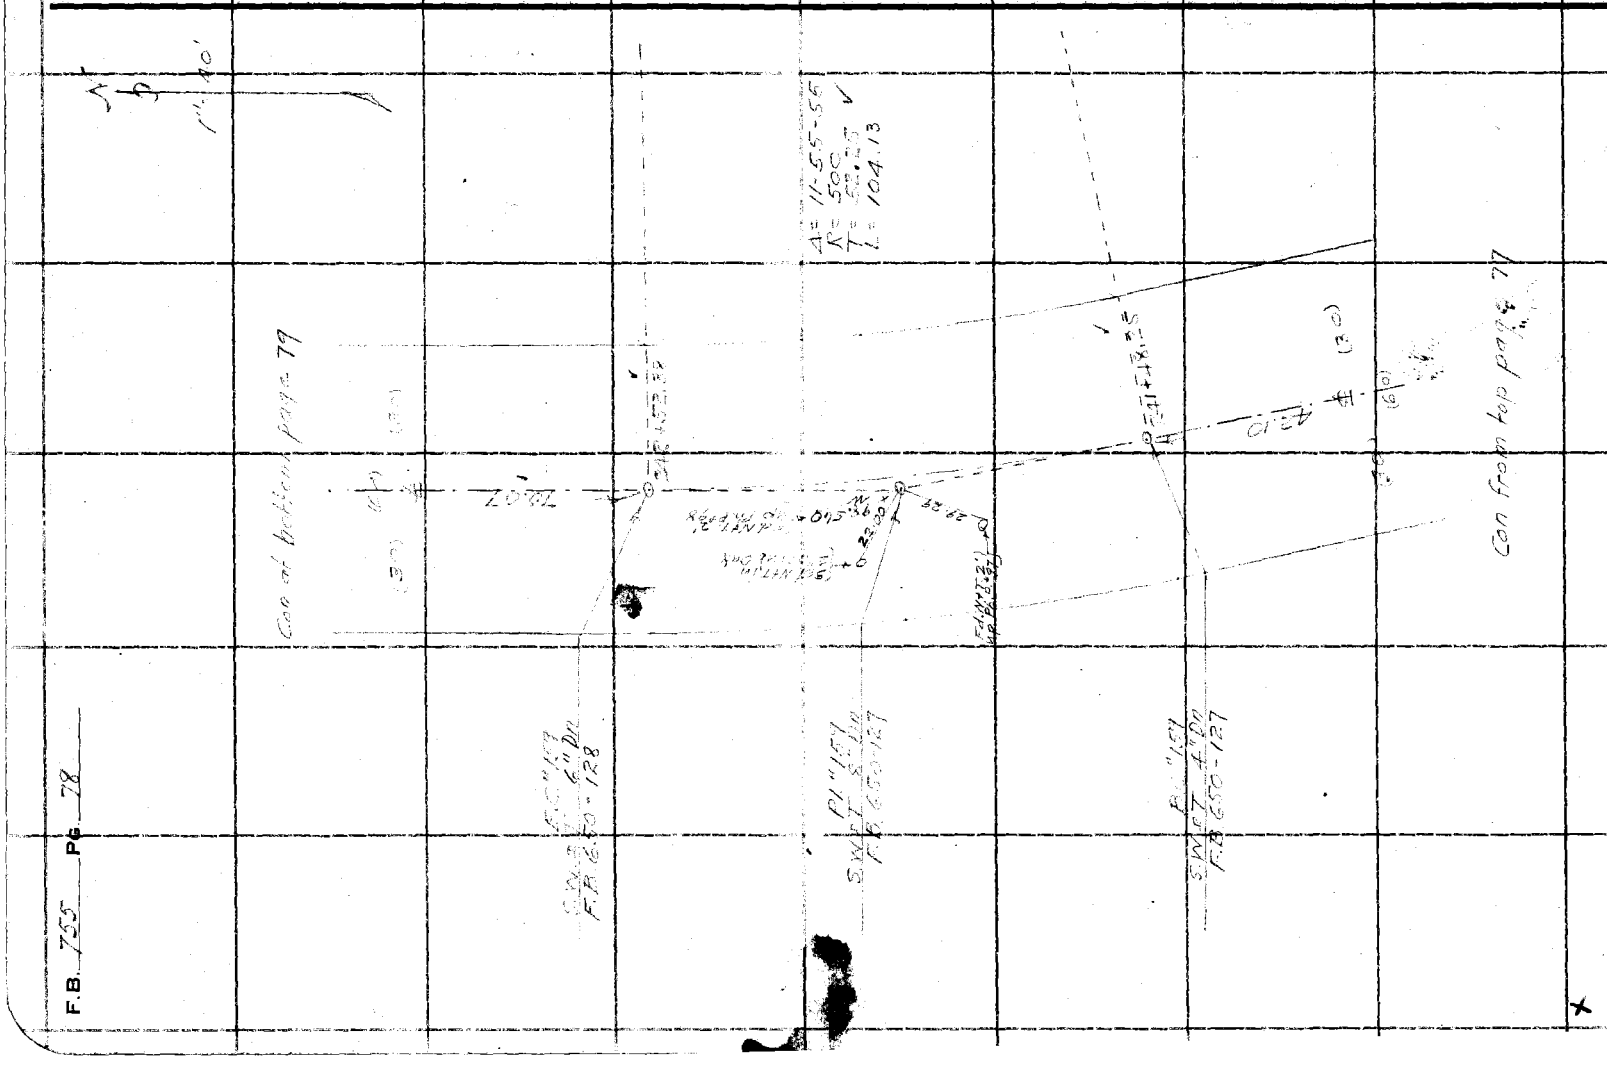

Notes Ck'd by Draw	Survey of MT WILSON 1964 AP
Map No. B-1217-2	W. O. 8149 Tape No. St'd °F.
Office Work F. A. W.	Surveyed by W. A. MILLER
Checked Draw	Notes MT Plat Date July 1967
Date	Indexed

F.B. Pg. 70

N

1" = 40'

Con. from top page 78

EC "161
SW & T 8" Dn
F.B. 650-128

129.46

244+93.42

Δ = 77-56-15
R = 50
T = 40.44 ✓
L = 68.01

PI "161
3¼" I.P. Plug + TK 2" Dn
F.B. 650-128

244+30.41

EC "160
2×2 = TK 8" Dn
F.B. 650-128

BC "161
SW & T 8" Dn
F.B. 650-128

36.23

PI "160
2×2 = TK in bank
9' above Roadway
F.B. 650-128

243+94.18

Δ = 54-47-50
R = 75
T = 38.87
L = 71.78

243+22.45

BC "160
3¼" I.P. Plug + TK
10" Dn
F.B. 650-128

70.07

(30) (60) (30)

Note: ANY ADDITIONS OR CHANGES ON THIS SHEET MUST BE MADE OR CIRCLED IN Red Ink. WITH DATE AND NAME OF PERSON MAKING CHANGE

RETURN TO
LOS ANGELES COUNTY SURVEYOR
700 HALL OF RECORDS

Do not extend notes this side of this line

FORM 247 10M 5-31

F.B. 755 Pg 80

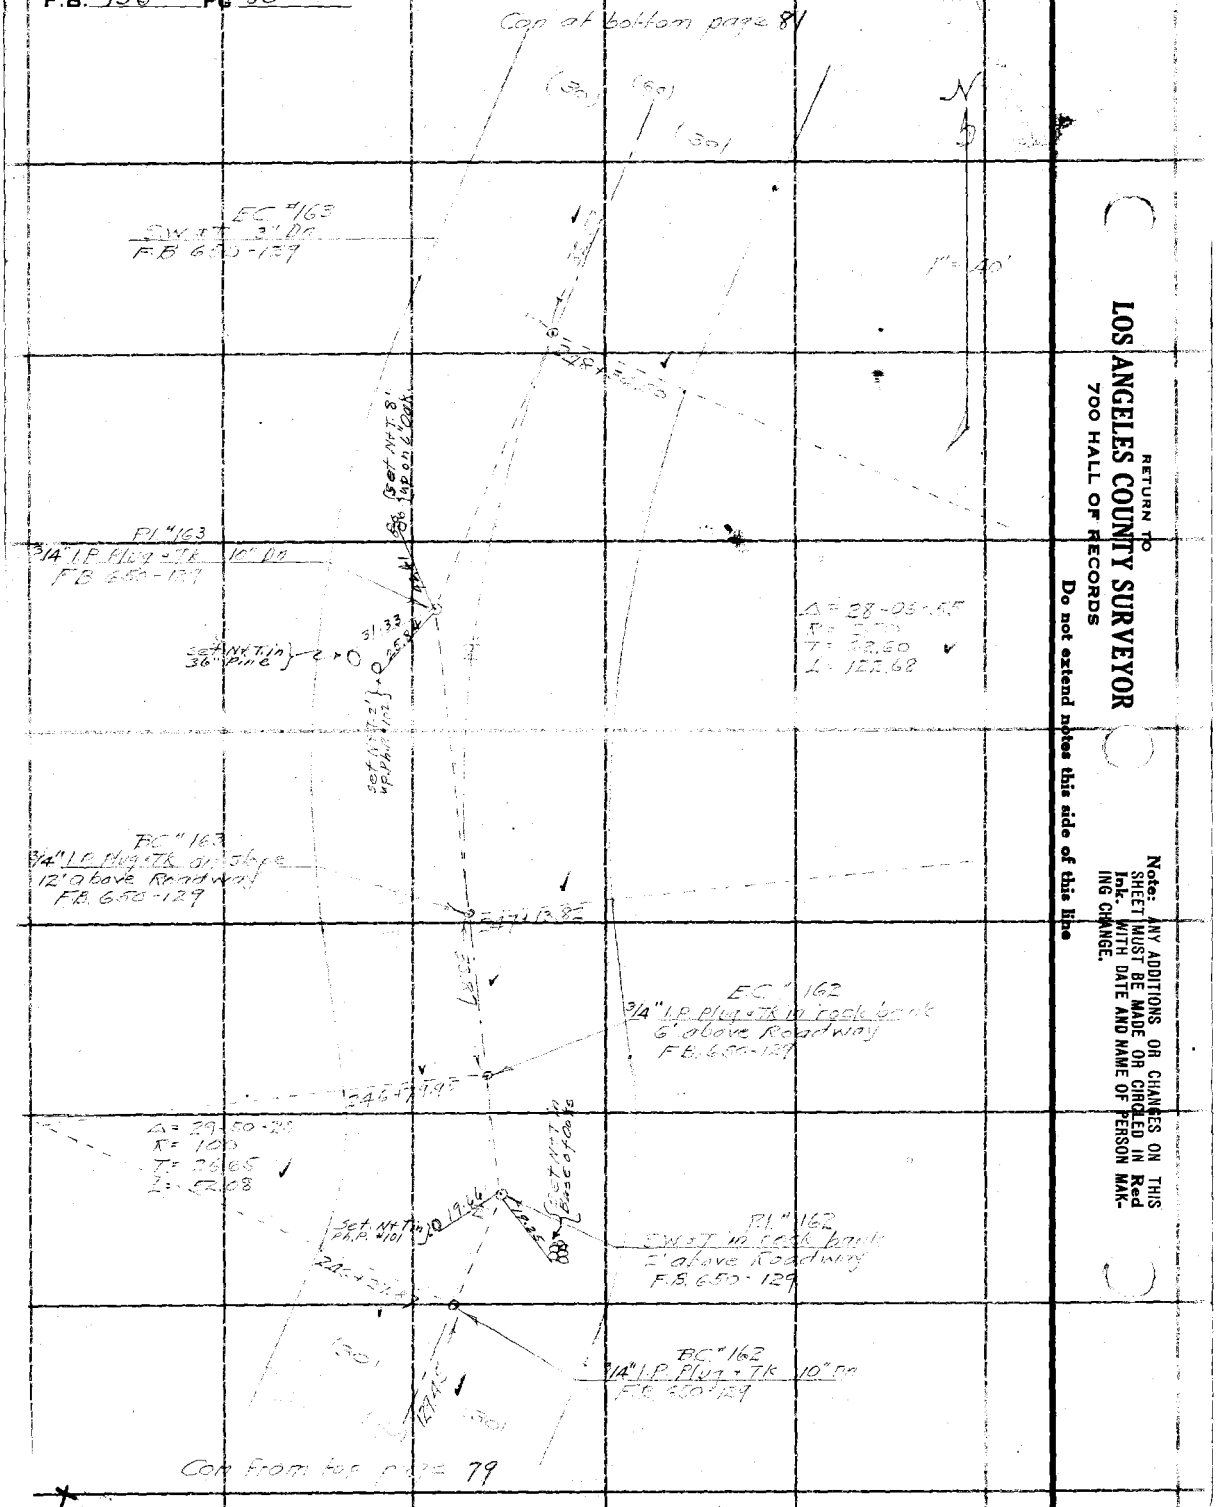
Con at bottom page 81
(30)
(30)
(30)
N
1" = 40'
EC #163
CW x T 3.00
F.B. 650-129
PI "163
3/4" I.P. Plug + Tk 10" Dp
F.B. 650-129

Notes Ck'd by	Survey of
Map No.	W. O. Tape No. St'd °F.
Office Work F. A. W.	Surveyed by
Checked	Notes Date
Date 12-4-44	Indexed

F.B. Pg. 31

Note: Any Additions or Changes on This Sheet Must be Made in Red Ink or Circled in Red With Date and Name of Person Making Change.

Do not extend notes this side of this line

RETURN TO
LOS ANGELES COUNTY SURVEYOR
700 HALL OF RECORDS

FORM 247 10M 11-38

RETURN TO
LOS ANGELES COUNTY SURVEYOR
700 HALL OF RECORDS

Note: Any Additions or Changes on This Sheet Must be Made or Circled in **Red Ink** With Date and Name of Person Making Change.

Do not extend notes this side of this line

F.B. 755 PG. 82

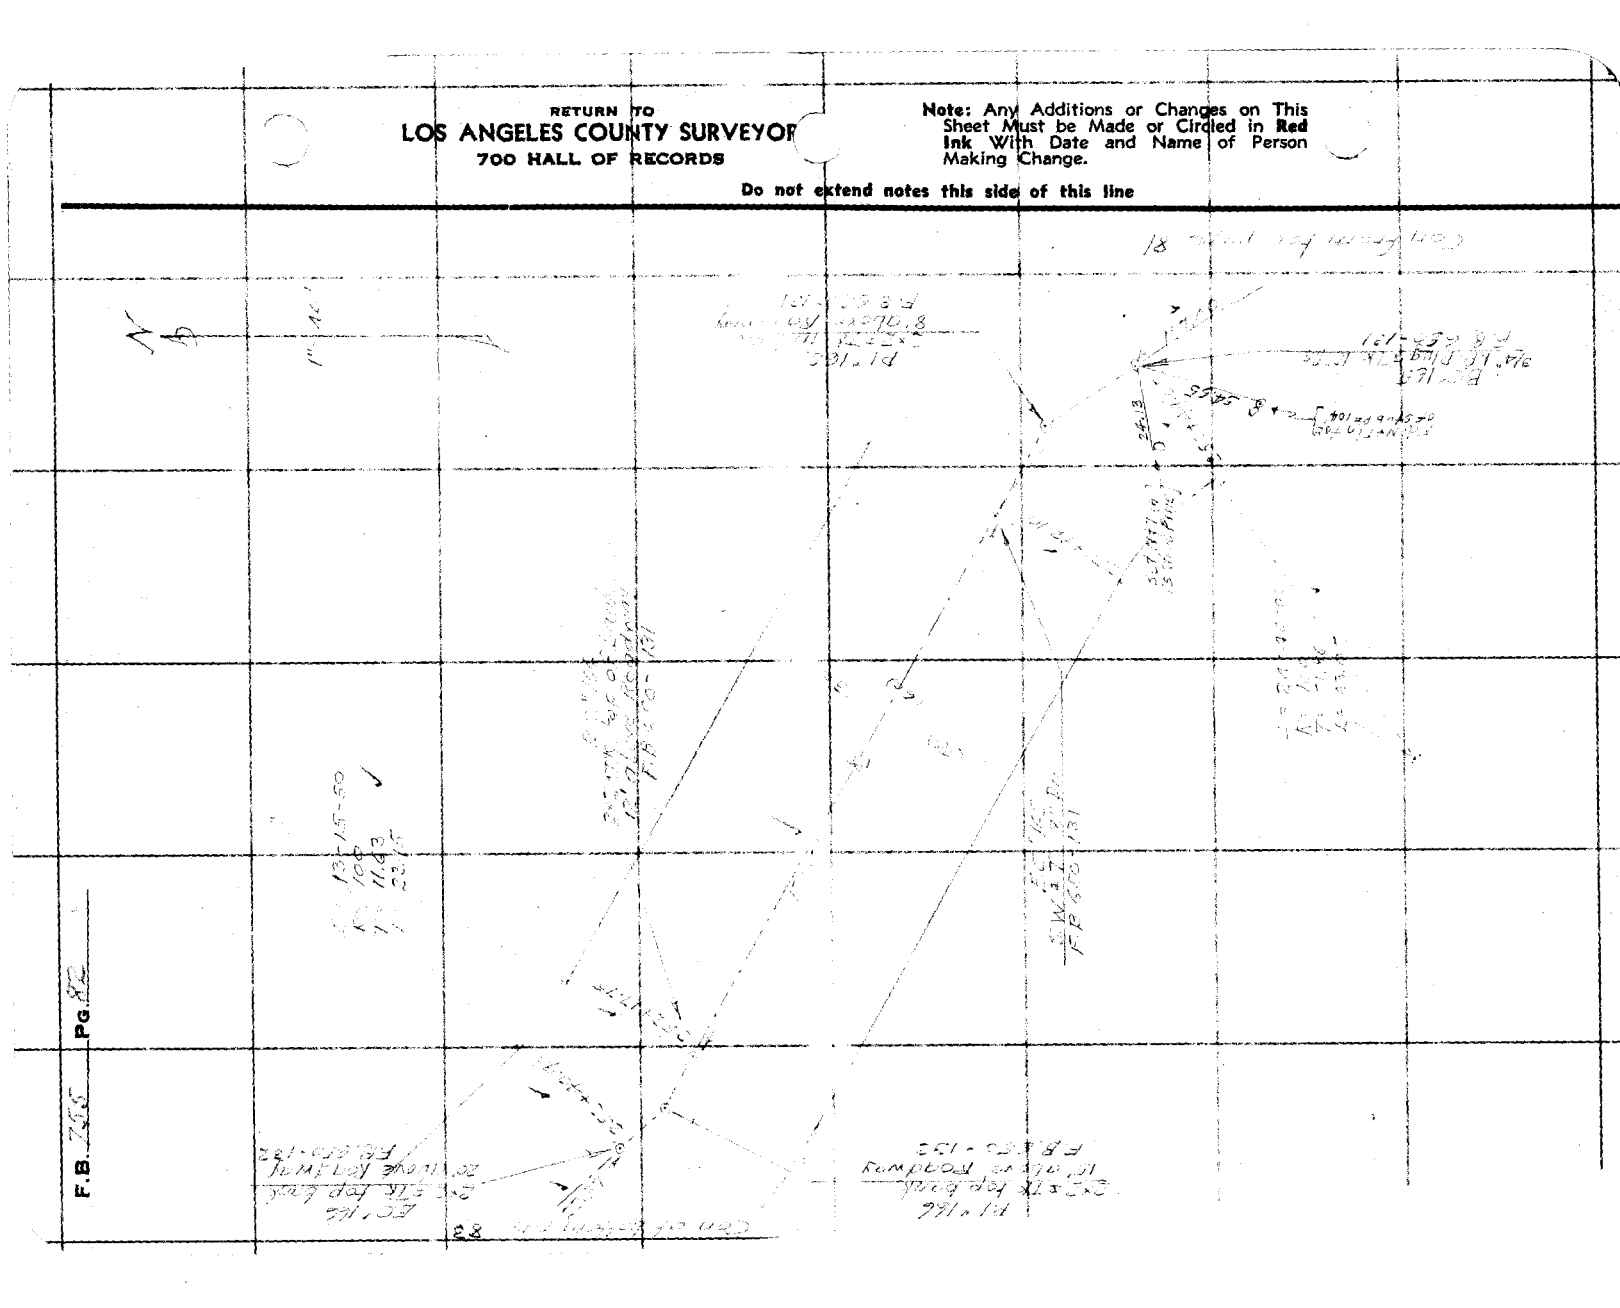

Notes Ck'd by	Survey of
Map No.	W. O. Tape No. St'd °F.
Office Work	Surveyed by
Checked	Notes Date
Date	Indexed

F.B. Pg.

W 45-A-1

Note: Any Additions or Changes on This Sheet Must be Made or Circled in Red Ink With Date and Name of Person Making Change.

Do not extend notes this side of this line

RETURN TO
LOS ANGELES COUNTY SURVEYOR
700 HALL OF RECORDS

FORM 247 10M 11-38

RETURN TO
LOS ANGELES COUNTY SURVEYOR
700 HALL OF RECORDS

Note: Any Additions or Changes on This Sheet Must be Made or Circled in **Red Ink** With Date and Name of Person Making Change.

Do not extend notes this side of this line

F.B. 716 Pg. 84

Notes Ck'd by		Survey of	F.B. Pg.
Map No.		W. O.	Tape No. St'd °F.
Office Work		Surveyed by	
Checked		Notes	Date
Date		Indexed	

RETURN TO
LOS ANGELES COUNTY SURVEYOR
700 HALL OF RECORDS

Note: Any Additions or Changes on This Sheet Must be Made or Circled in Red Ink With Date and Name of Person Making Change

Do not extend notes this side of this line

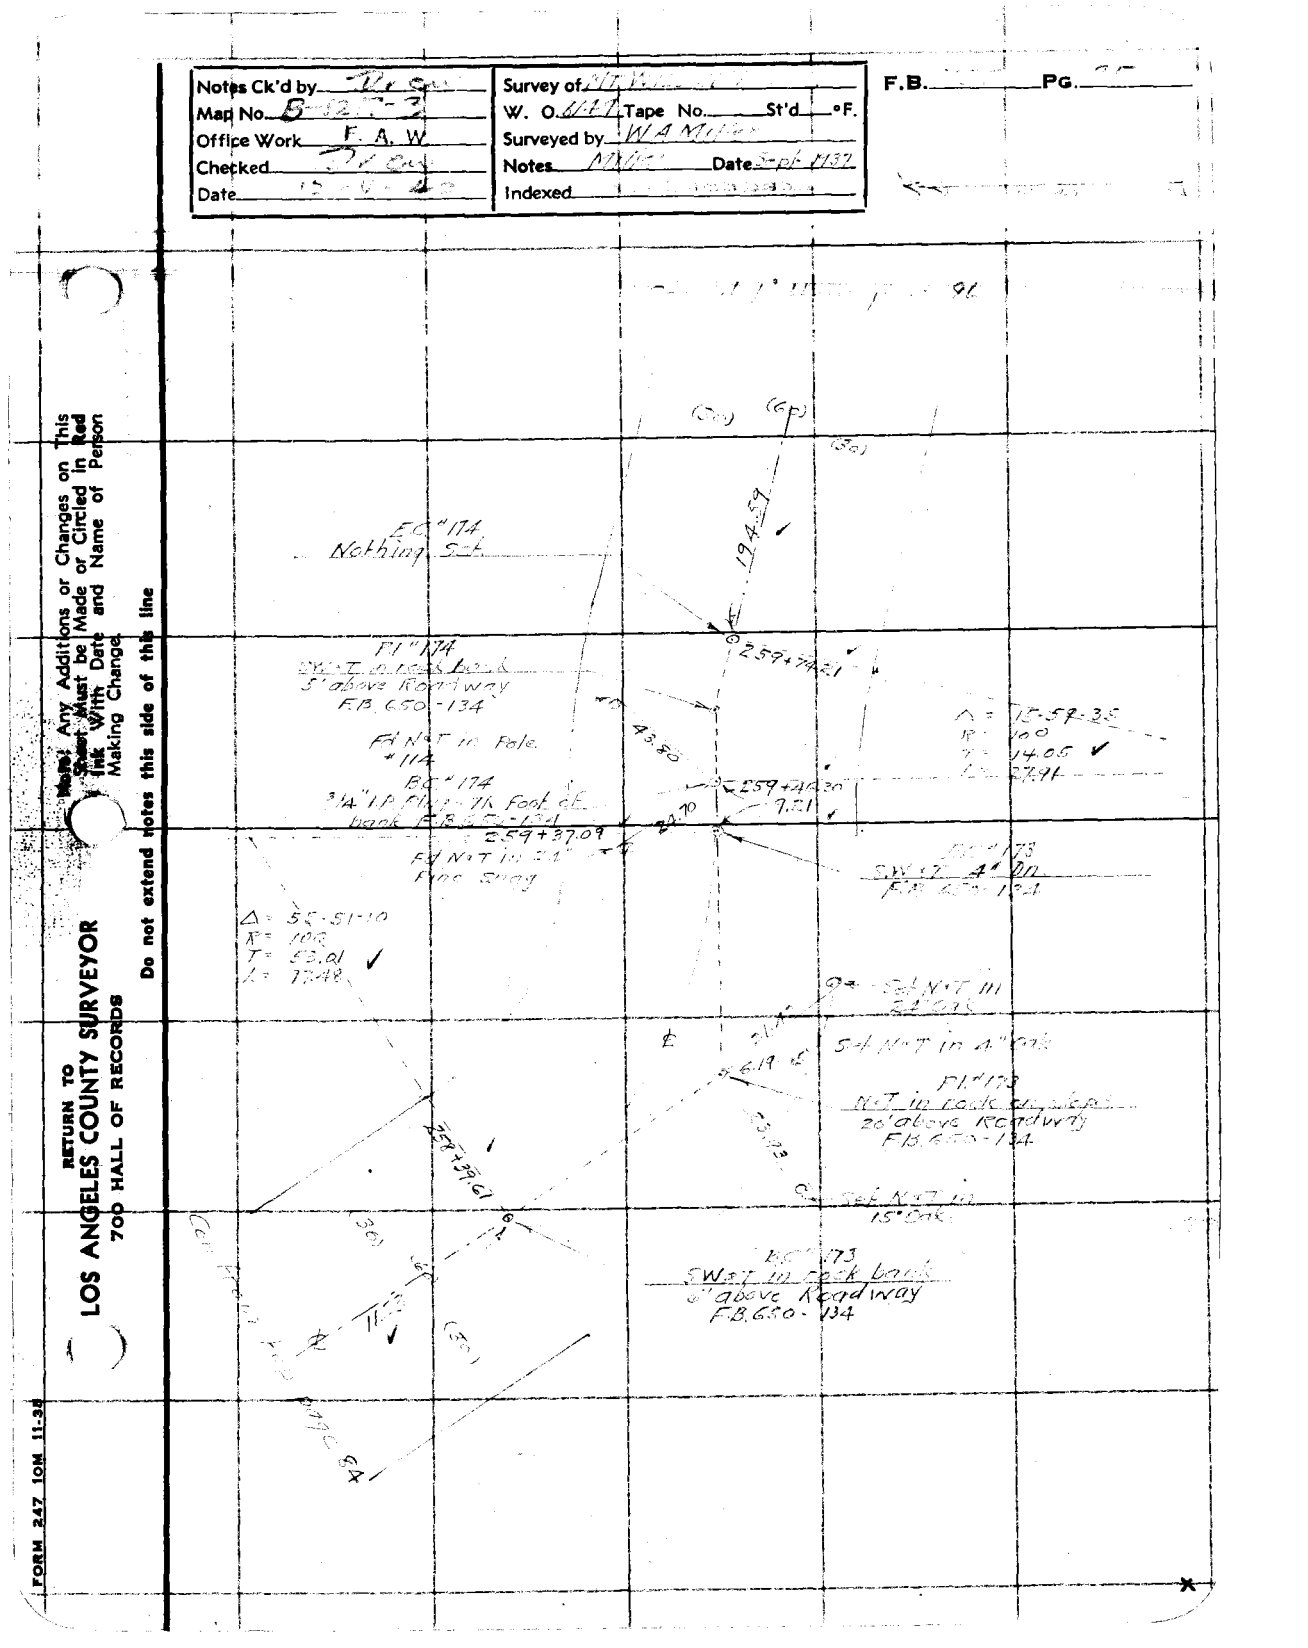

FORM 247 10M 11-38

RETURN TO
LOS ANGELES COUNTY SURVEYOR
700 HALL OF RECORDS

Note: Any Additions or Changes on This Sheet Must be Made or Circled in **Red Ink** With Date and Name of Person Making Change.

Do not extend notes this side of this line

F.B. 755 Pg. 86

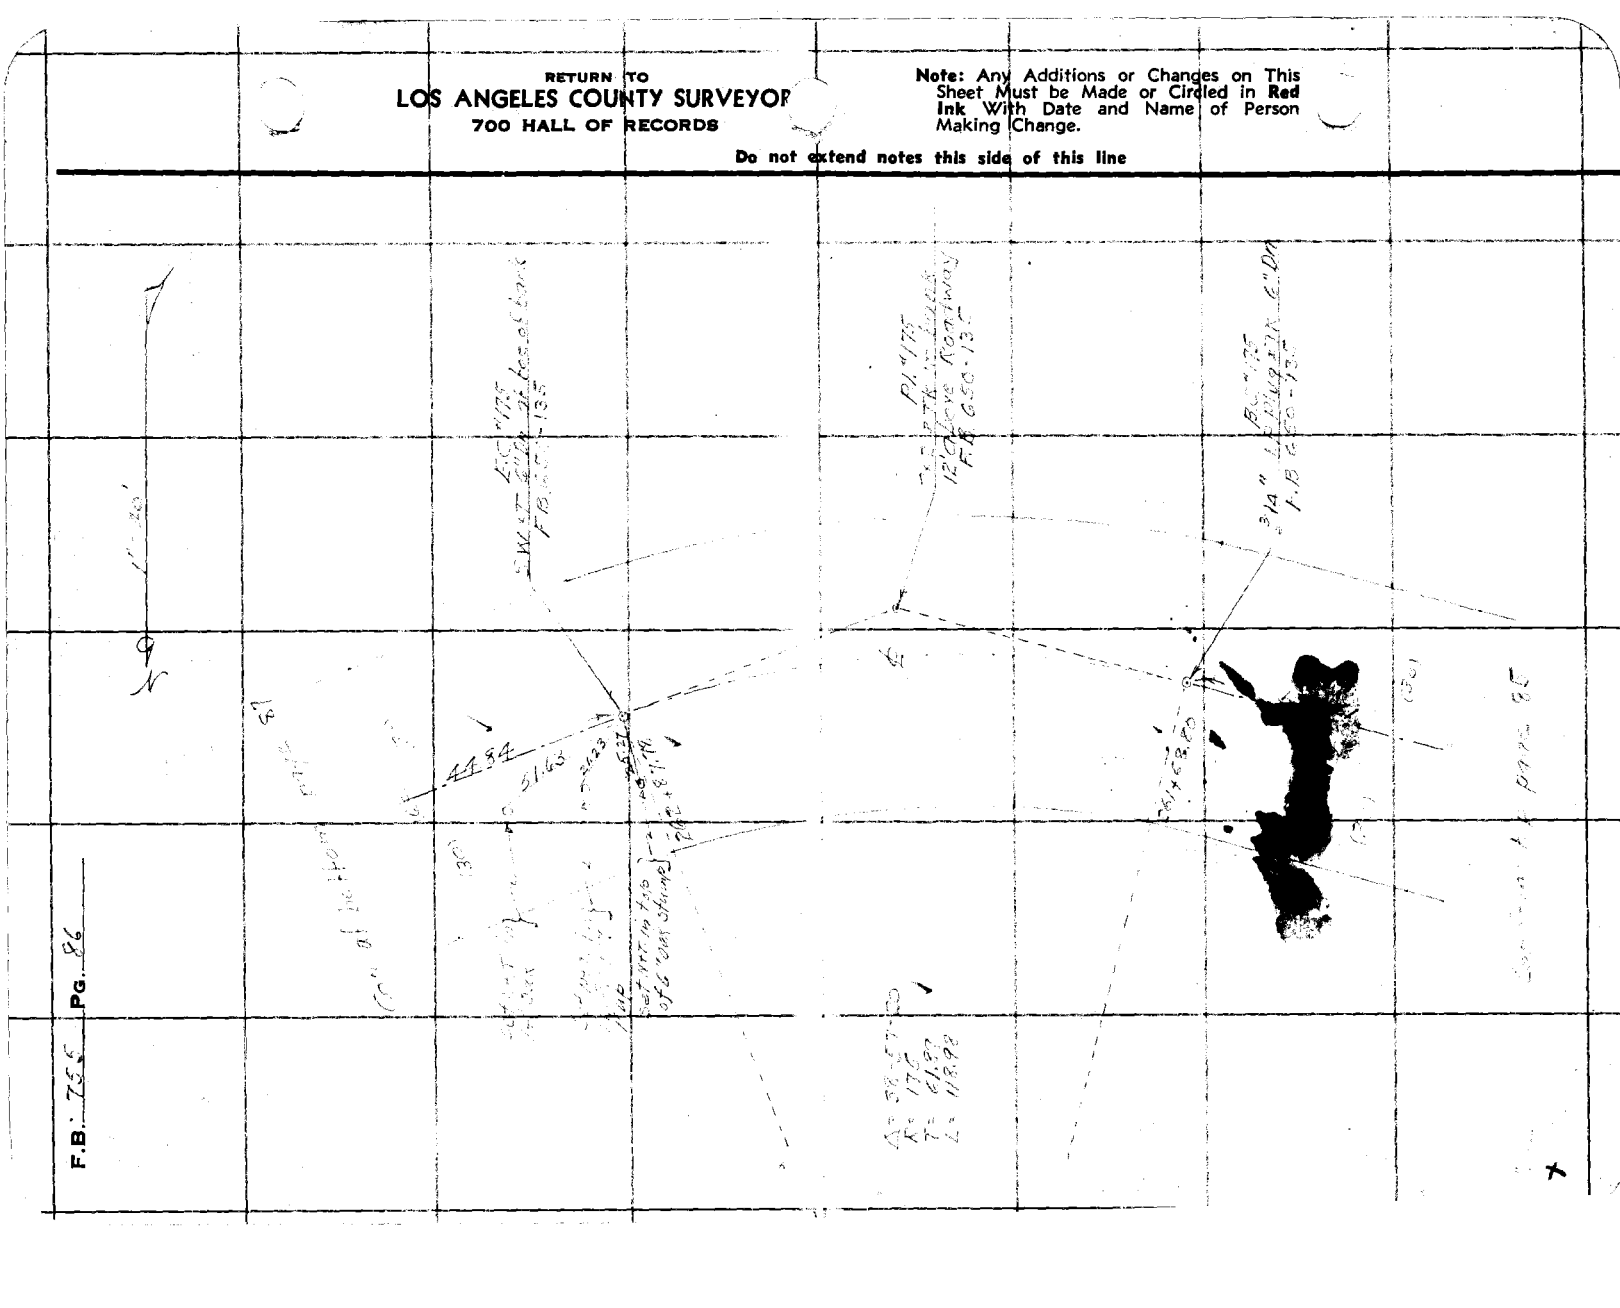

Notes Ck'd by	Survey of
Map No. B-1217.3	W. O. 8147 Tape No. St'd °F.
Office Work F. A. W.	Surveyed by W A Miller
Checked	Notes Date
Date	Indexed

F.B. PG.

W.S.-45-A-1

Note: Any Additions or Changes on This Sheet Must be Made or Circled in Red Ink With Date and Name of Person Making Change.

Do not extend notes this side of this line

RETURN TO
LOS ANGELES COUNTY SURVEYOR
700 HALL OF RECORDS

FORM 247 10M 11-38

S W ly I" bank
10' ± ve Roadway
FB 650-134

2 x 4 Stk on Slope
10' ± ve Roadway
FB 650-135

1789

Δ = 87-31-25
R = 100
T = 95.71
L = 152.76

Set NAIL in
8" Conc

Fd. NAIL in
14" Oak

POB 11.93

POB 31.34

BC "176
SW ly 6" ±
" top of bank
FB 650-135

96

F.B. 755 Pg. 88

Cont. of bottom page 89

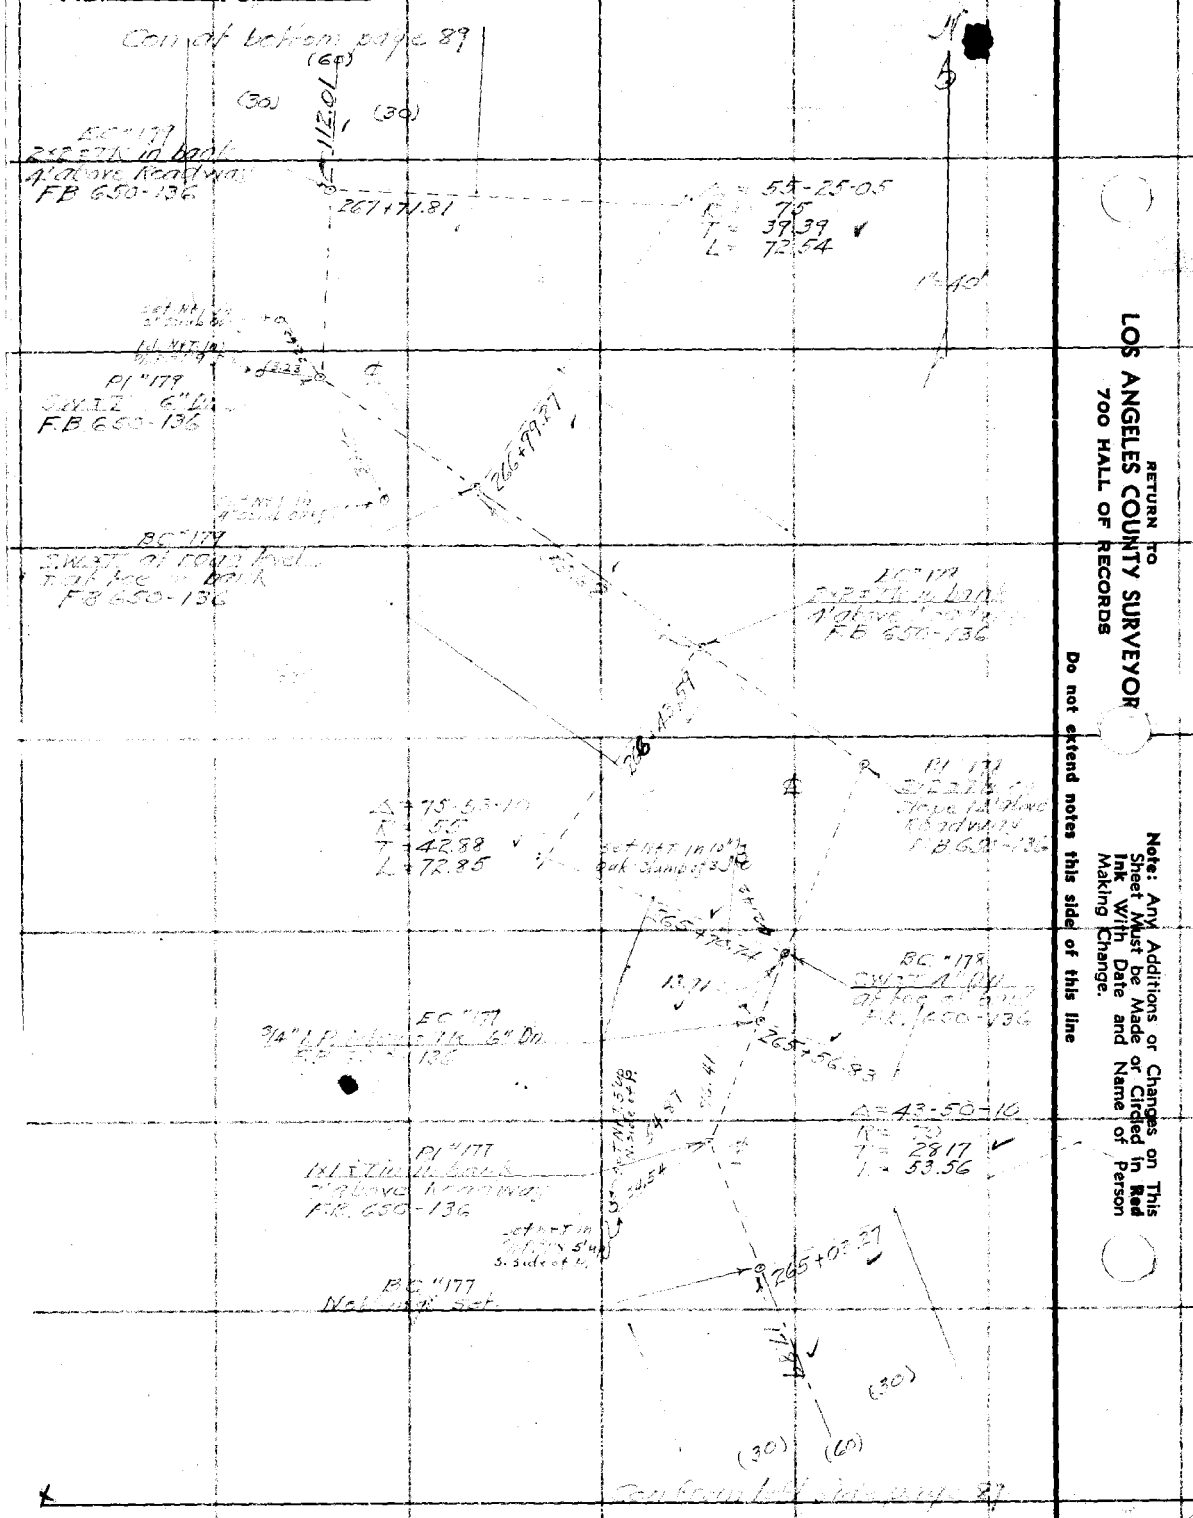

RETURN TO
LOS ANGELES COUNTY SURVEYOR
700 HALL OF RECORDS

Note: Any Additions or Changes on This Sheet Must be Made or Circled in Red Ink With Date and Name of Person Making Change.

Do not extend notes this side of this line

Notes Ck'd by: Dr Carr	Survey of: [illegible]
Map No. B-1241-3	W. O. [illegible] Tape No. ____ St'd ____ °F.
Office Work: F. A. W.	Surveyed by: W. C. Miller
Checked: Dr Carr	Notes: [illegible] Date: [illegible]
Date: [illegible]	Indexed: [illegible]

F.B. ____ PG. 89

Note: Any Additions or Changes on This Sheet Must be Made or Circled in Red Ink With Date and Name of Person Making Change.

Do not extend notes this side of this line

RETURN TO
LOS ANGELES COUNTY SURVEYOR
700 HALL OF RECORDS

FORM 247 10M 11-38

EC #181
3/4" L P Rivet 7" K 6" Dia
at face of bank
F.B. 650-137

P.I. #181
3/4" L P Rivet 7" K 6" Dia
at face of bank
F.B. 650-137

BC #181
3/4" L P Rivet 7" K 6" Dia
at face of bank
F.B. 650-137

EC #180
3/4" L P Rivet 7" K 6" Dia
at face of bank
F.B. 650-137

P.I. #180
3/4" L P Rivet 7" K 6" Dia
at face of bank
F.B. 650-137

BC #180
3/4" L P Rivet 7" K Flush
at face of bank
F.B. 650-137

Δ = 46-05-55
R = 40
T = 33.05
L = 70.46

Δ = 10-55-
R = 200
T = 19.02
L = 37.93

(50)
(30)
(60)

Con from Map page 88

Con from Map page 89

X

F.B. 755 PG. 90

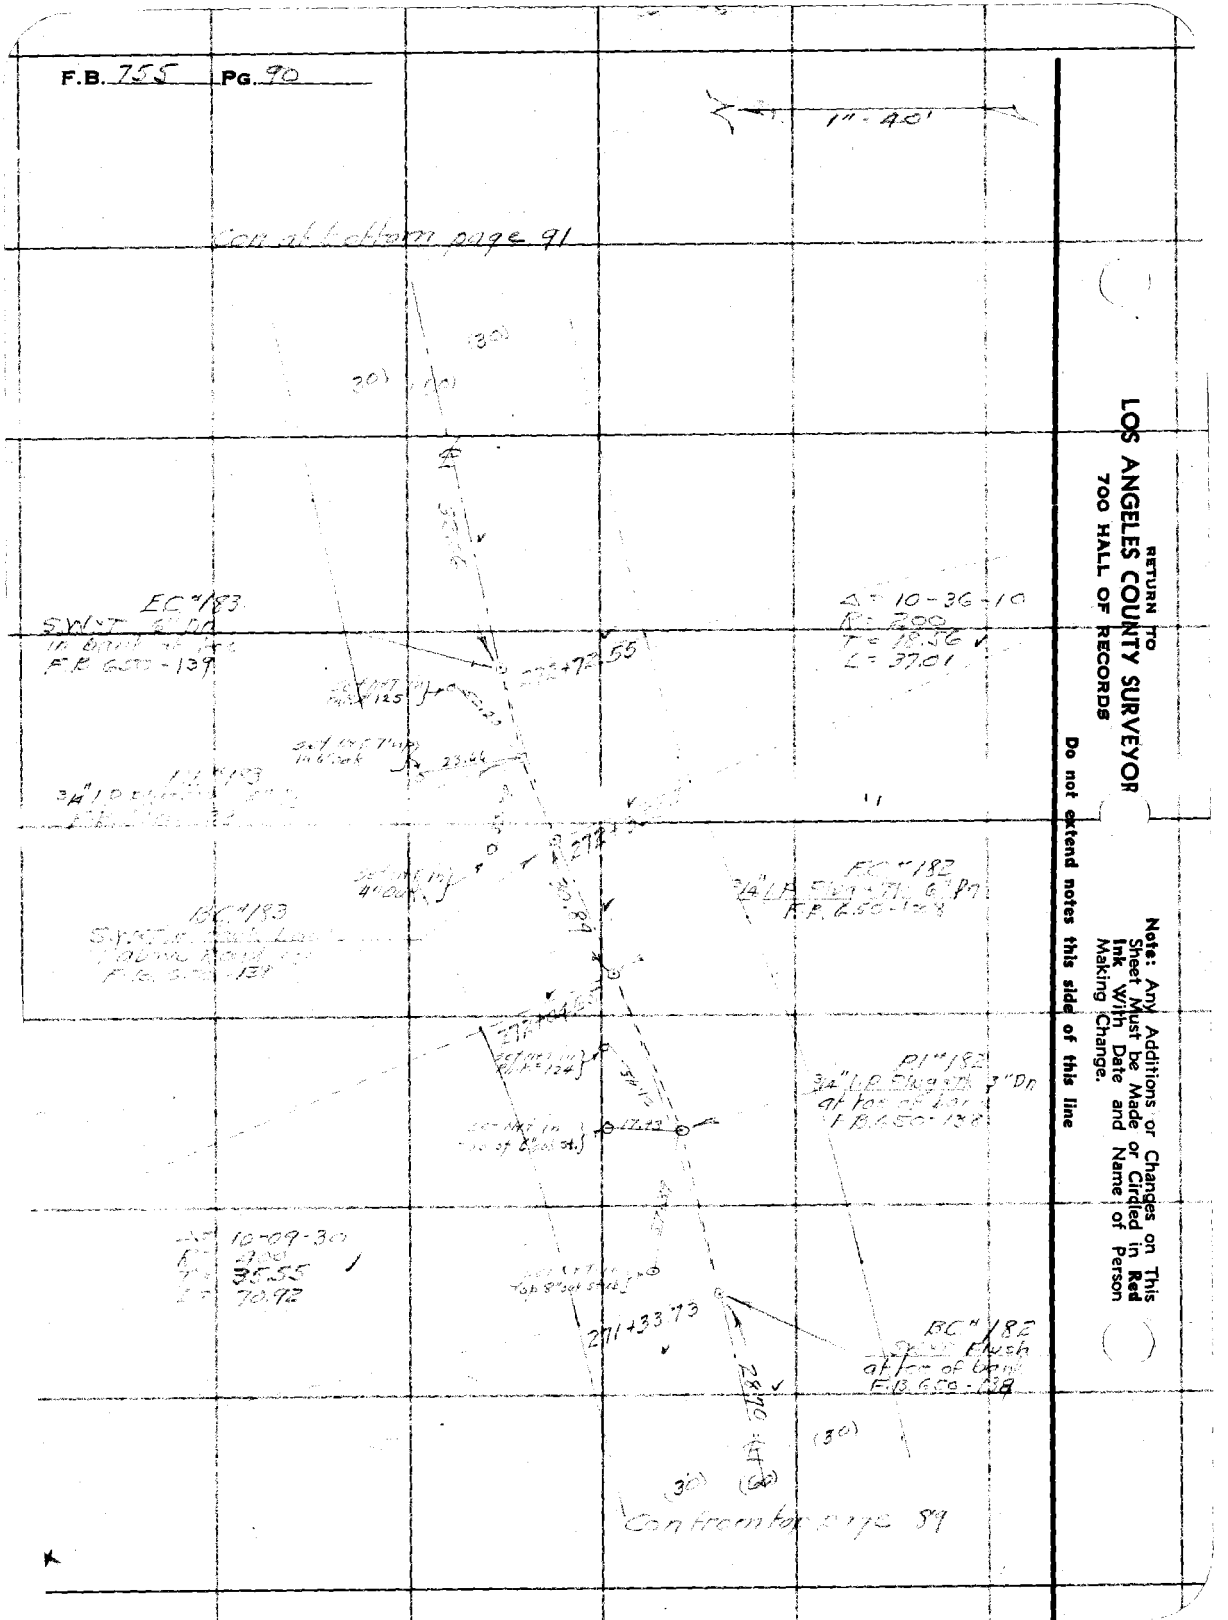

RETURN TO
LOS ANGELES COUNTY SURVEYOR
700 HALL OF RECORDS

Do not extend notes this side of this line

Note: Any Additions or Changes on This Sheet Must be Made or Circled in Red Ink With Date and Name of Person Making Change.

WS 45-A-1

Notes Ck'd by	Survey of
Map No. B-1215	W. O.	Tape No.	St'd °F.
Office Work	Surveyed by
Checked	Notes	Date
Date	Indexed

F.B. PG.

Note: Any Additions or Changes on This Sheet Must be Made or Circled in Red Ink With Date and Name of Person Making Change.

Do not extend notes this side of this line

RETURN TO
LOS ANGELES COUNTY SURVEYOR
700 HALL OF RECORDS

FORM 247 10M 11-38

F.B. 755 Pg. 92

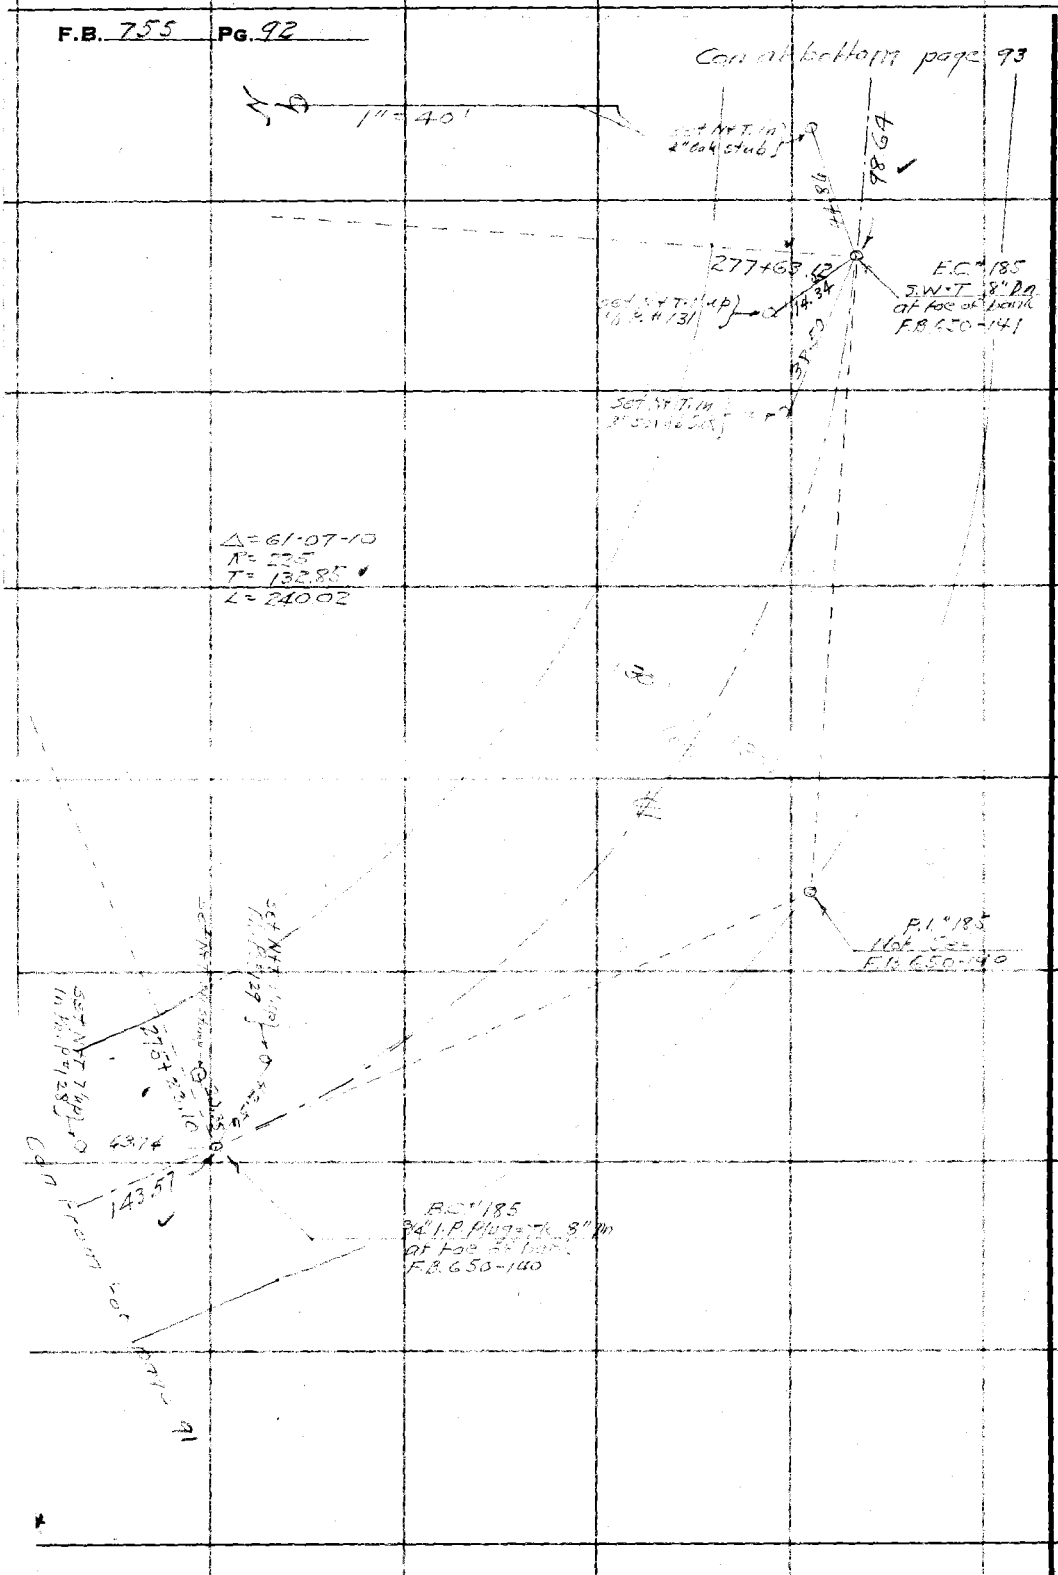

RETURN TO
LOS ANGELES COUNTY SURVEYOR
700 HALL OF RECORDS

Note: Any Additions or Changes on This Sheet Must be Made or Circled in Red Ink With Date and Name of Person Making Change.

Do not extend notes this side of this line

Notes Ck'd by		Survey of	F.B. PG.
Map No.		W. O. 8147 Tape No. St'd °F.	
Office Work	F. A. W.	Surveyed by	
Checked		Notes Date	
Date		Indexed	

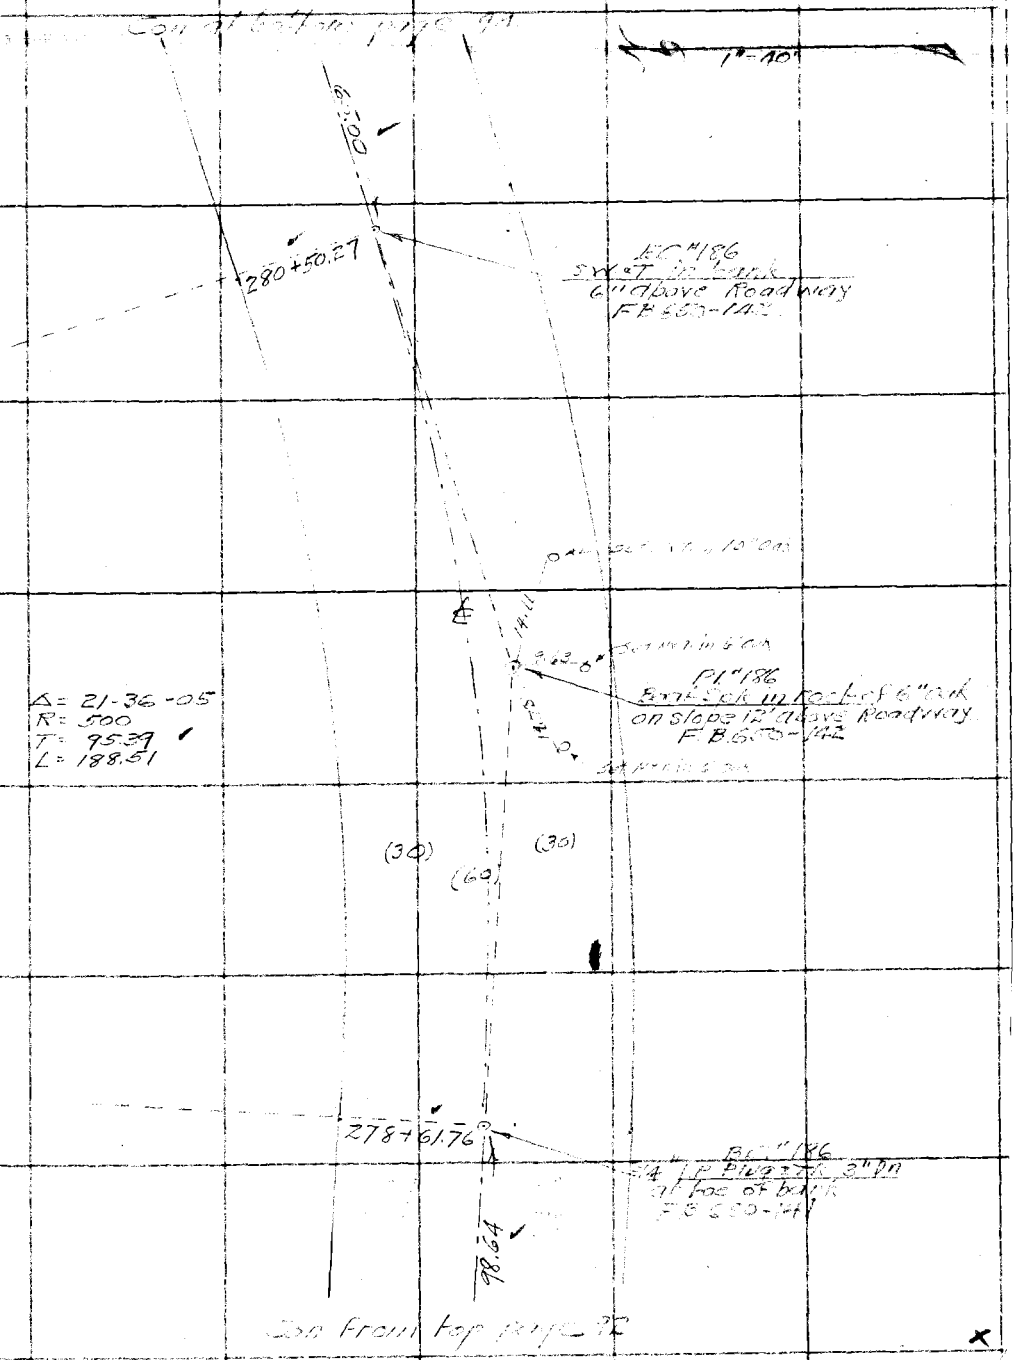

Note: Any Additions or Changes on This Sheet Must be Made or Circled in Red Ink With Date and Name of Person Making Change.

Do not extend notes this side of this line

RETURN TO
LOS ANGELES COUNTY SURVEYOR
700 HALL OF RECORDS

FORM 247 10M 11-58

F.B. 755 PG. 94

W3.45-A-1

RETURN TO
LOS ANGELES COUNTY SURVEYOR
700 HALL OF RECORDS

Note: Any Additions or Changes on This Sheet Must be Made or Circled in Red Ink With Date and Name of Person Making Change.

Do not extend notes this side of this line

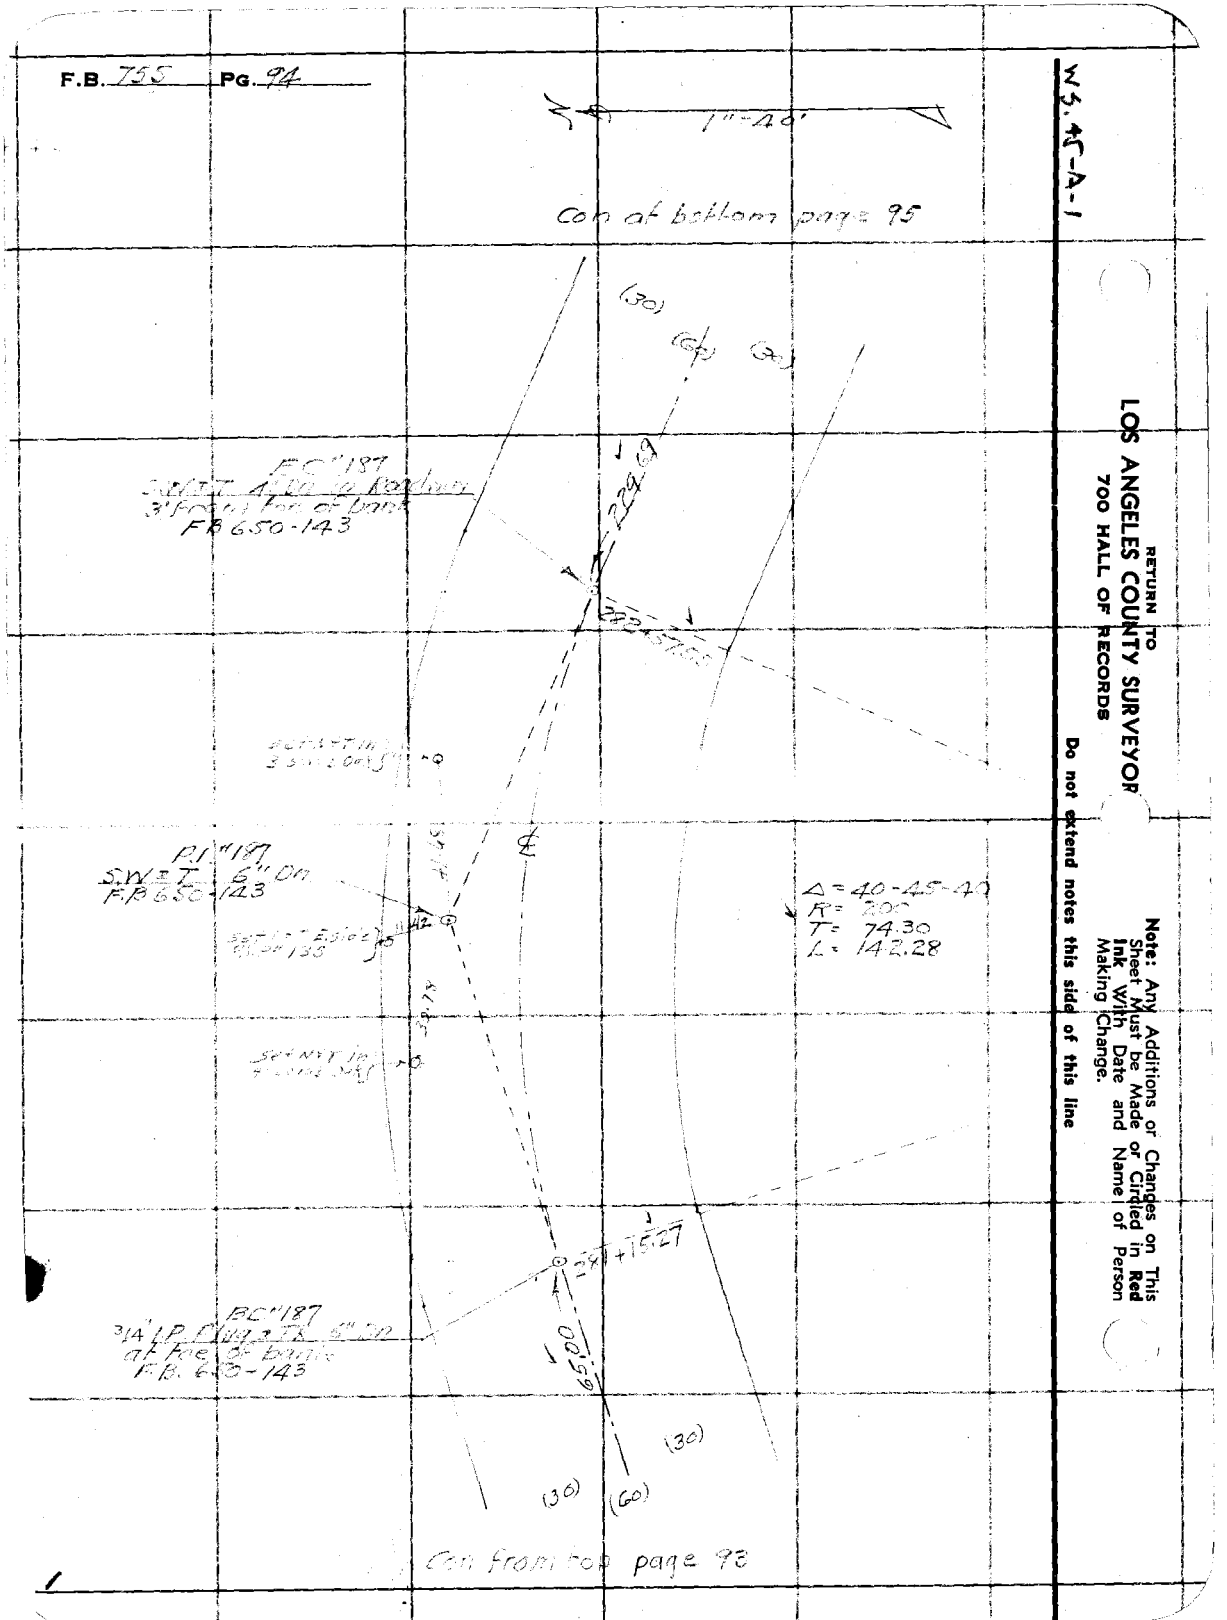

Notes Ck'd by	Survey of
Map No.	W. O.	Tape No.	St'd °F.
Office Work	Surveyed by
Checked	Notes	Date
Date	Indexed

F.B. Pg.

96

EC #188
S.W. cor. T. 3" DI
at face of bank
F.B. 650-144

285+53.88

Δ = 37°36'30"
R = 150'
T = 34.25'
L = 65.84'

PI #188
3/4" LEBUM PK in bnat
1' above Roadway
F.B. 650-144

BC #188
S.W. cor. T. 6" DI
at face of bank
F.B. 650-144

(30) (60) (30)

Note: Any Additions or Changes on This Sheet Must be Made or Circled in Red Ink With Date and Name of Person Making Change

Do not extend notes this side of this line

RETURN TO
LOS ANGELES COUNTY SURVEYOR
700 HALL OF RECORDS

FORM 247 10M 11-38

F.B. 755 Pg. 96

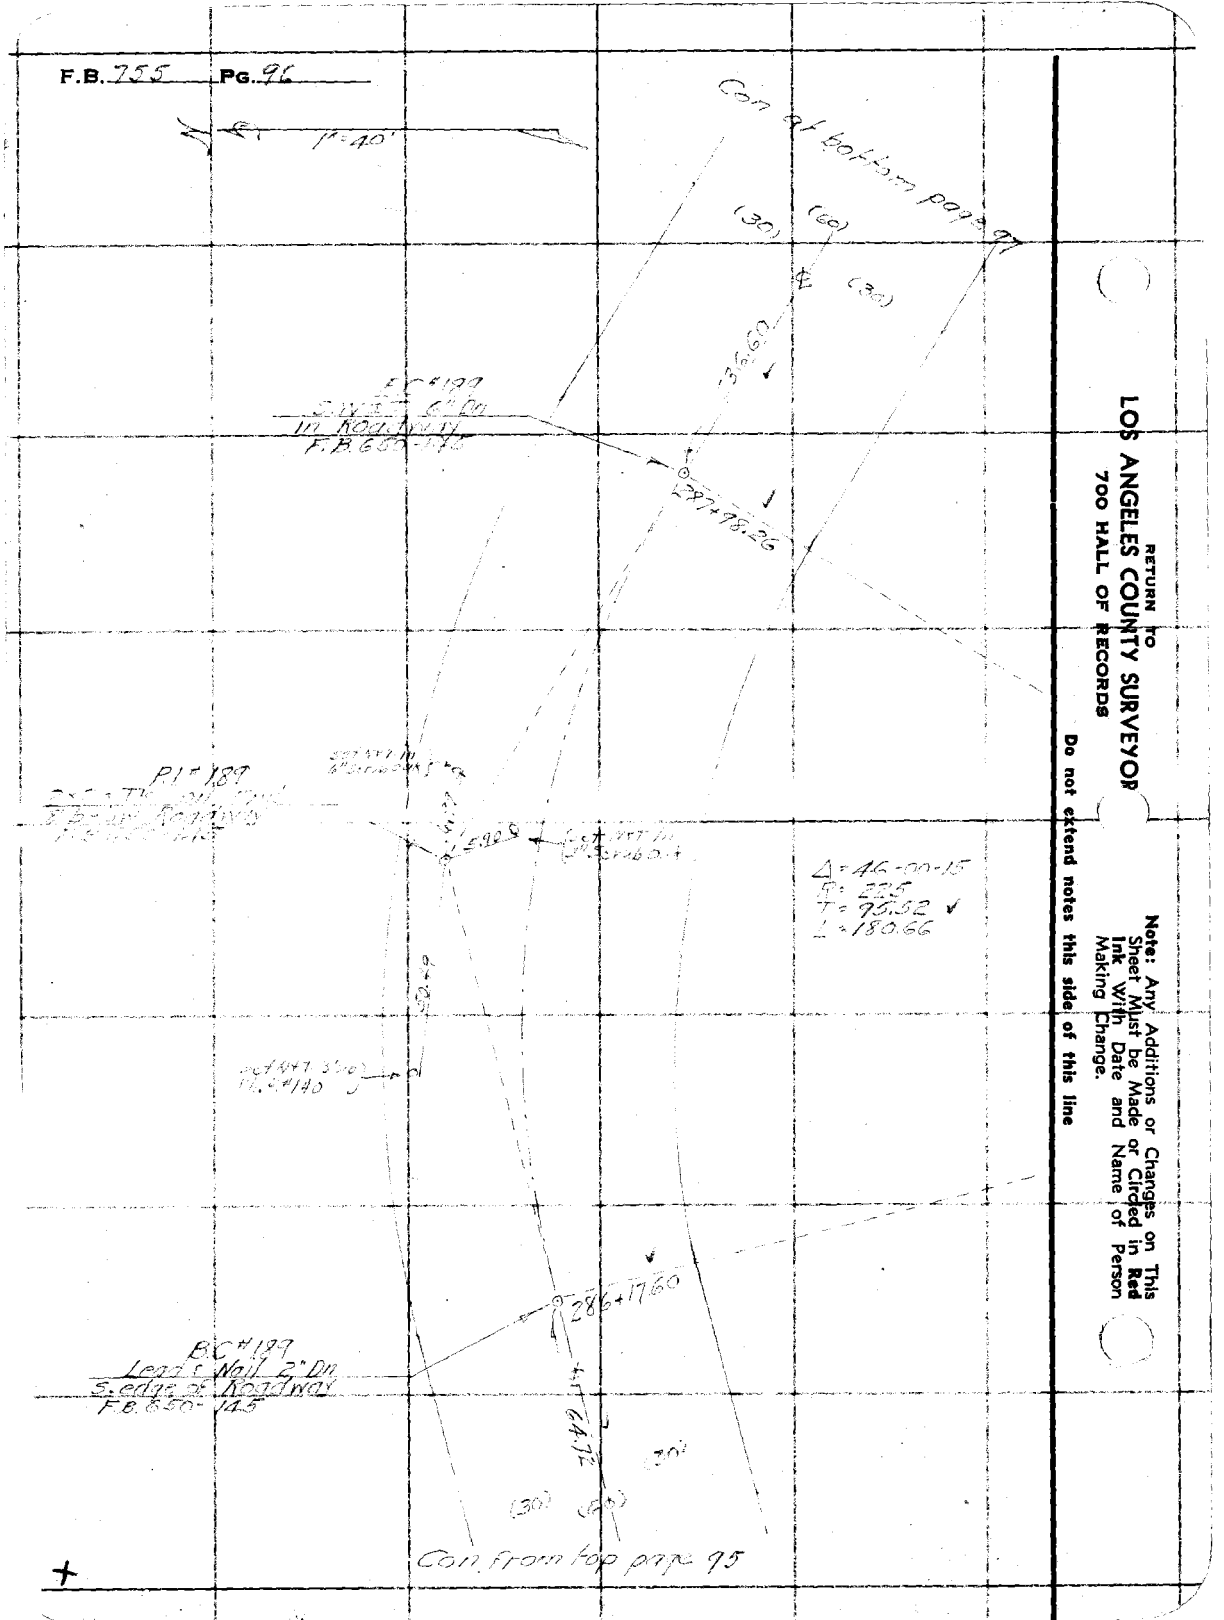

RETURN TO
LOS ANGELES COUNTY SURVEYOR
700 HALL OF RECORDS

Do not extend notes this side of this line

Note: Any Additions or Changes on This Sheet Must be Made or Circled in Red Ink With Date and Name of Person Making Change.

Notes Ck'd by		Survey of	F.B. PG.
Map No.		W. O.	Tape No. St'd °F.
Office Work	F. A. W.	Surveyed by	
Checked		Notes	Date
Date		Indexed	

W. 05 - A-1

Note: Any Additions or Changes on This Sheet Must be Made or Circled in Red Ink With Date and Name of Person Making Change.

Do not extend notes this side of this line

RETURN TO
LOS ANGELES COUNTY SURVEYOR
700 HALL OF RECORDS

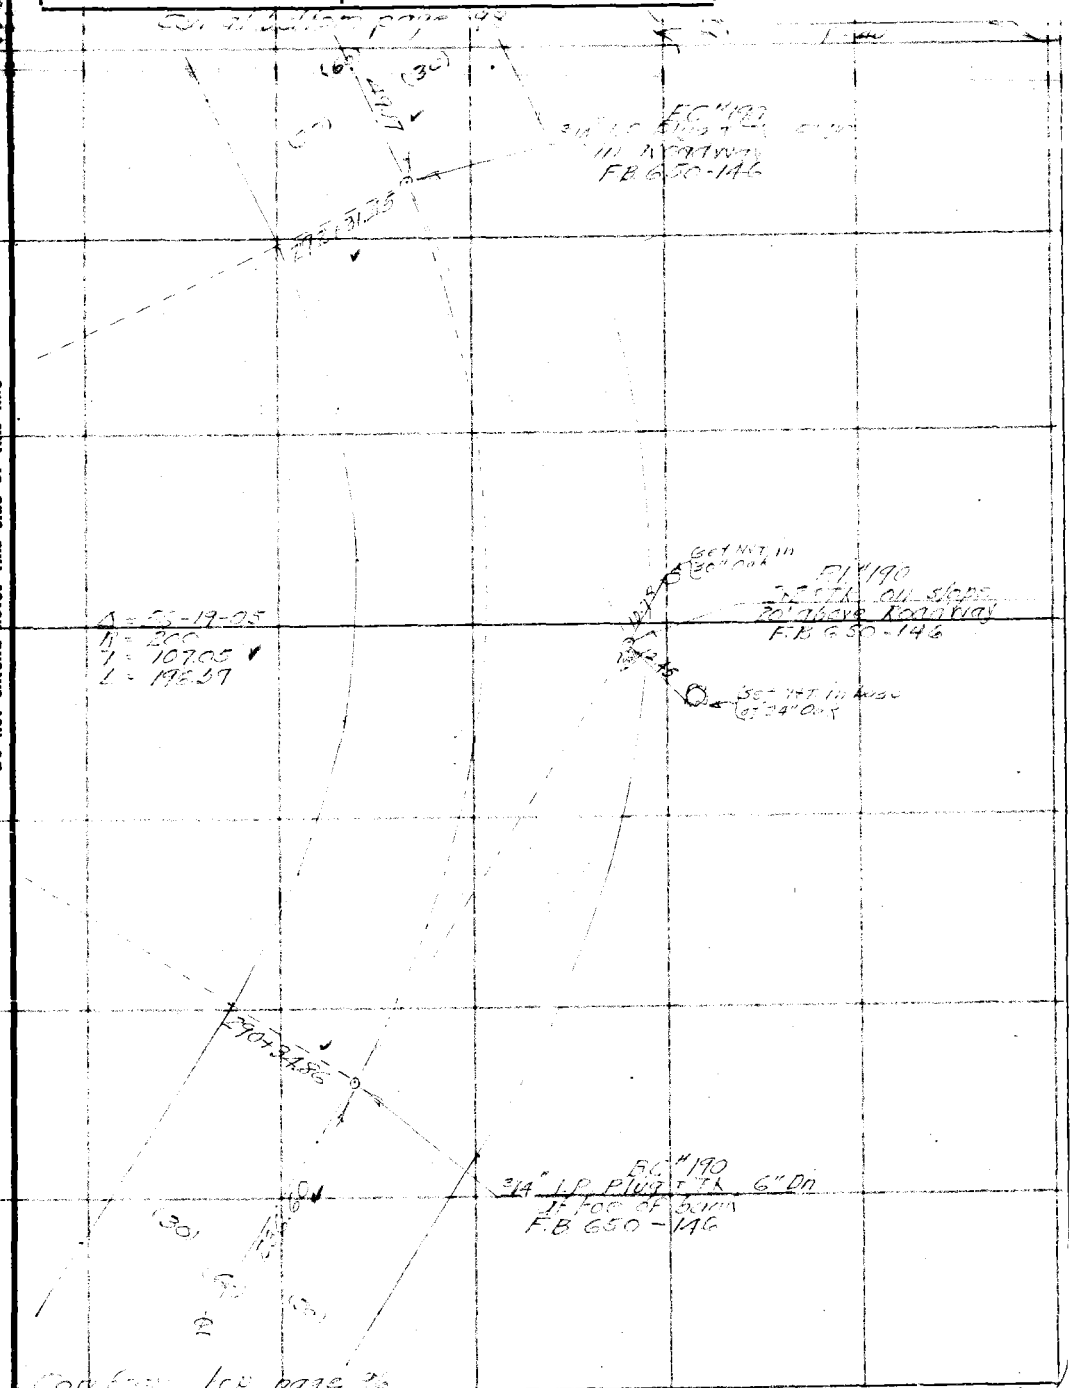

FORM 247 10M 11-35

RETURN TO
LOS ANGELES COUNTY SURVEYOR
700 HALL OF RECORDS

Note: Any Additions or Changes on This Sheet Must be Made or Circled In **Red** Ink With Date and Name of Person Making Change.

Do not extend notes this side of this line

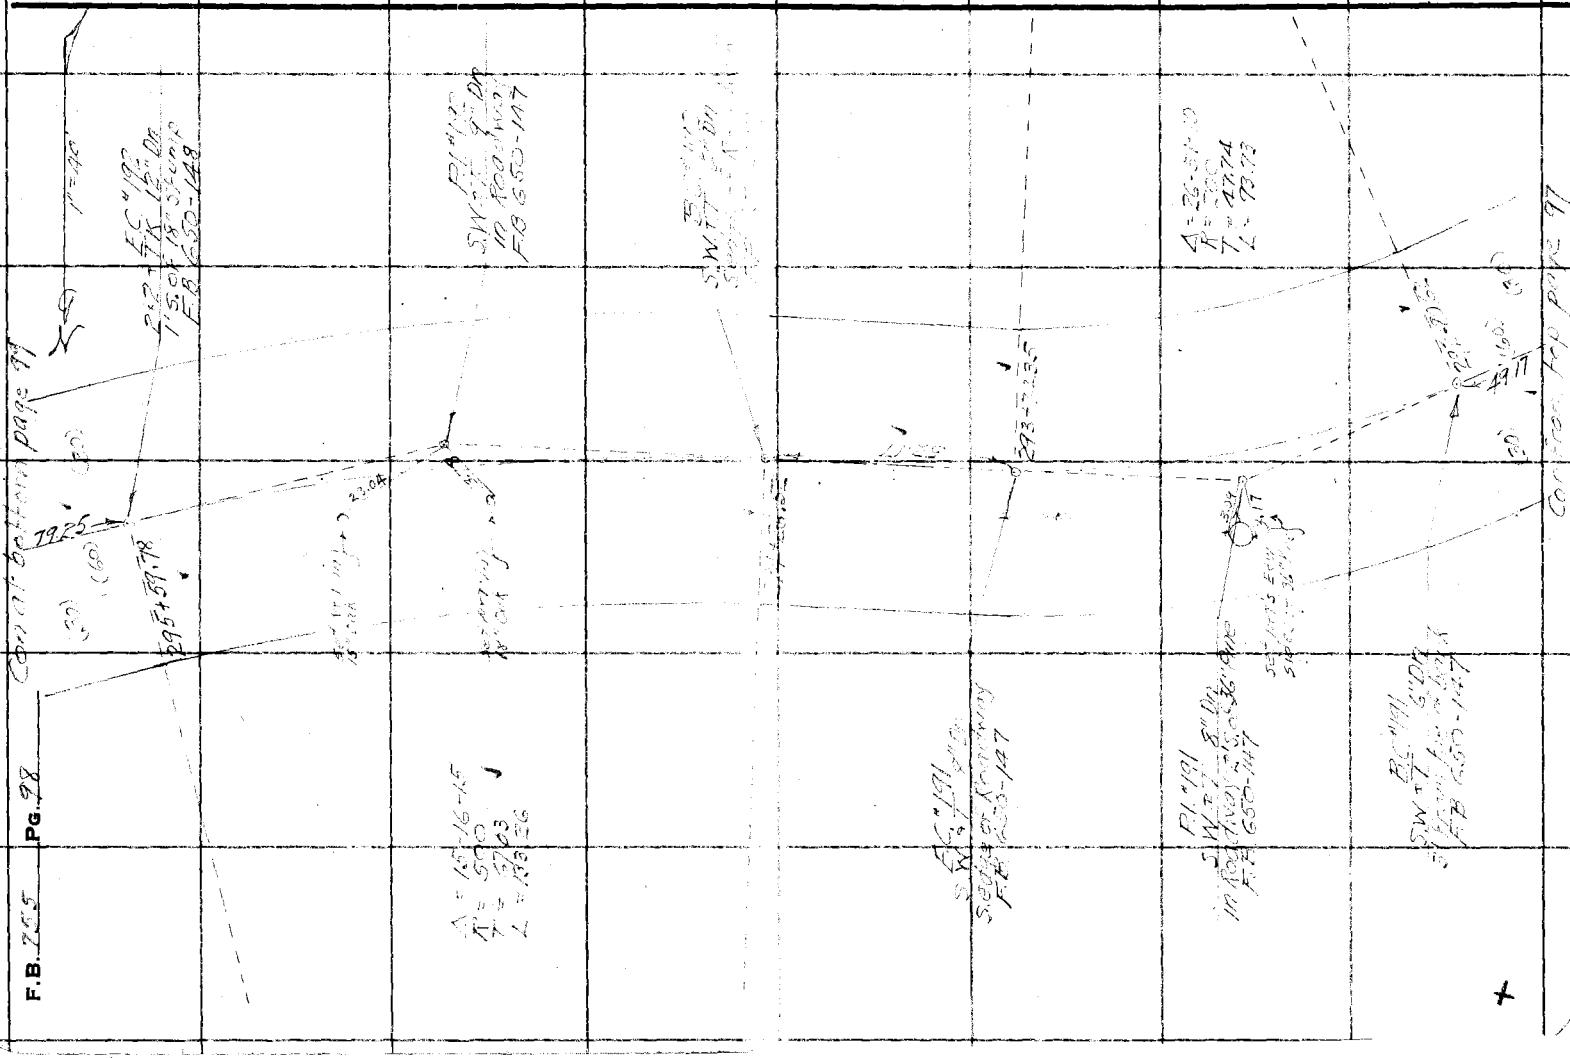

Notes Ck'd by	Survey of
Map No.	W. O. 8449 Tape No. St'd °F.
Office Work F. A. W.	Surveyed by W.A. Miller
Checked D.T.S.M.	Notes Date
Date 12-12-40	Indexed

F.B. PG.

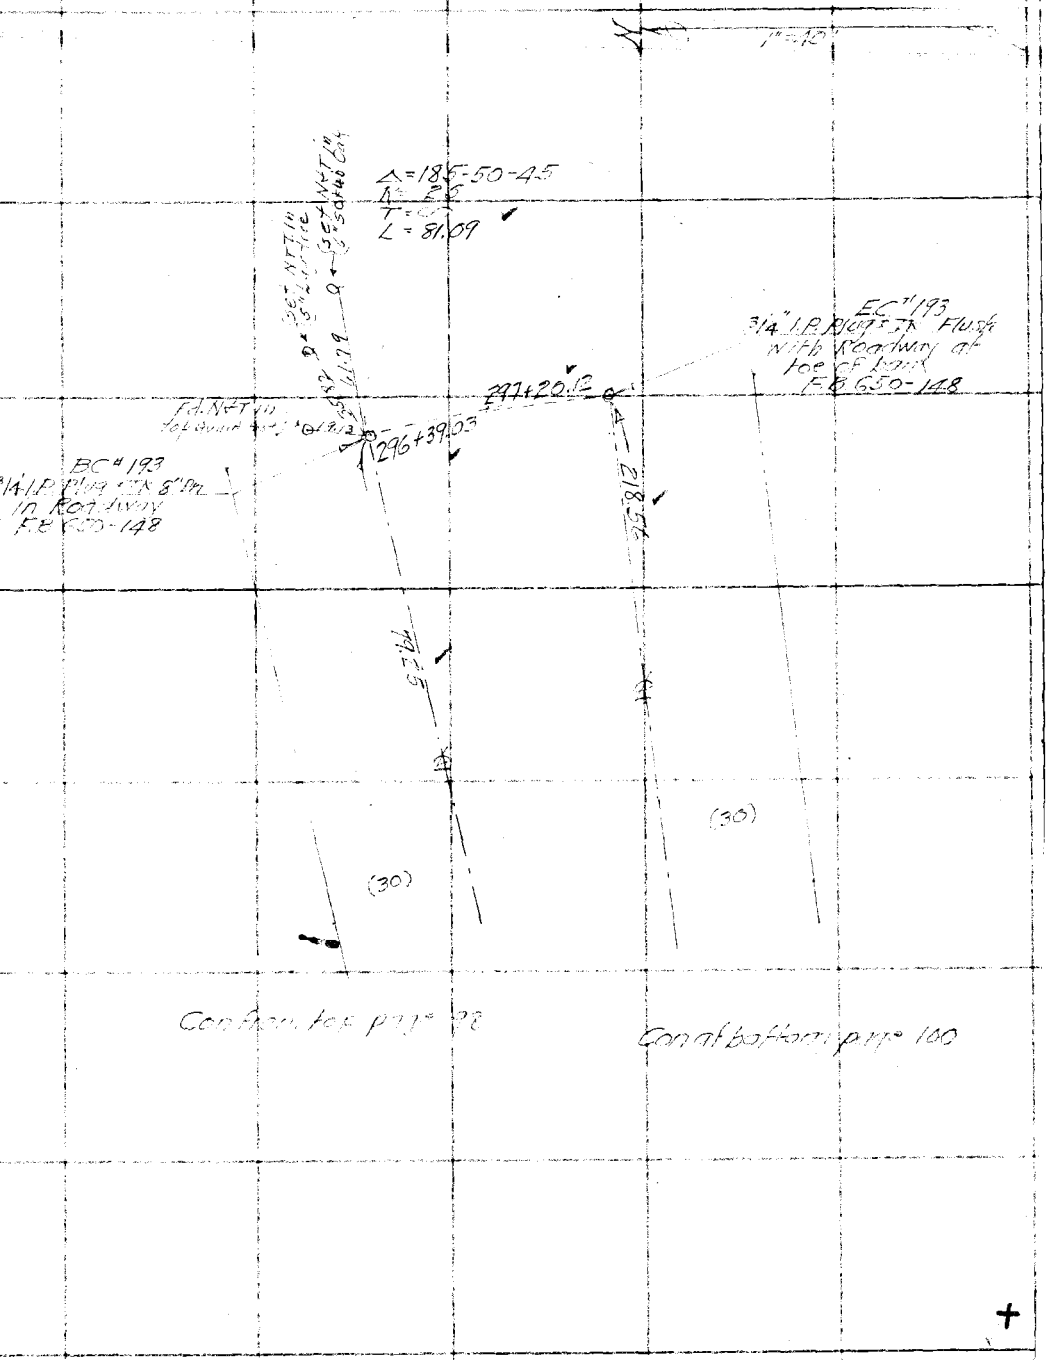

Note: Any Additions or Changes on This Sheet Must be Made or Circled in Red Ink With Date and Name of Person Making Change.

Do not extend notes this side of this line

RETURN TO
LOS ANGELES COUNTY SURVEYOR
700 HALL OF RECORDS

FORM 247 10M 11-38

F.B. 755 PG. 100

RETURN TO
LOS ANGELES COUNTY SURVEYOR
700 HALL OF RECORDS

Note: Any Additions or Changes on This Sheet Must be Made or Circled in Red Ink With Date and Name of Person Making Change.

Do not extend notes this side of this line

Notes Ck'd by
Map No. B 12.7 3
Office Work F. A. W.
Checked
Date 12-9-37

Survey of MT WILSON TOLL RD
W. O. 8149 Tape No. St'd °F.
Surveyed by W.A. Miller
Notes Miller Date Oct 1937
Indexed

F.B. PG.

WS VS-A-1

Note: Any Additions or Changes on This Sheet Must be Made or Circled in Red Ink With Date and Name of Person Making Change.

Do not extend notes this side of this line

RETURN TO
LOS ANGELES COUNTY SURVEYOR
700 HALL OF RECORDS

EC #197
3/4" I.P. Plug & TK 6" Dn
W. edge of Roadway
F.B. 650-150

Set N.T. in bldg. Sunline

PI #197
3/4" I.P. Plug & TK 8" Dn
in Roadway
F.B. 650-150

Δ = 13-08-55
R = 300
T = 34.57
L = 68.85

Con from top page 100

EC #197
3/4" I.P. Plug & TK 8" Dn
in Roadway
F.B. 650-150

303+28.57

(30) (60) (30) (30) (30)

Set N.T. in 3" oak

Set N.T. in 6" oak

302+71.72

Set N.T. in 3" oak

302+71.93

Δ = 152-58-55
T = 35
R = 146.68
L = 93.42

EC #196
2x2 x TK 10" Dn
in Roadway
F.B. 650-150

EC #196
3/4" I.P. Plug & TK
8" Dn at West
edge of Roadway
F.B. 650-150


USGS B.M. Brass Cap
Set in large boulder

Set N.T. in 6" oak

Set N.T. in 8" oak
3' up

PI #196
2x2 x TK Flush
on rocky ridge
F.B. 650-150

4952

FORM 247 10M 11-35

F.B. 755 PG. 102

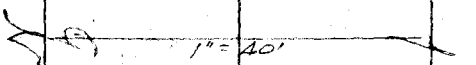

Con at bottom page 103

(60)
(30) (30)

EC "198
2½ x 7/8 in bank
8' above Roadway
F.B. 650-151

307+42.51

Δ = 19°-03'-00"
R = 350.00
T = 58.86
L = 116.38

PI "198
¾" I.P. Plug + Tk in bank
1' above Roadway
F.B. 650-151

304+75.73

SC "198
2½ x 7/8 in bank
6' above Roadway
F.B. 650-151

(30)
(60)
(30)

Con from top page 101

RETURN TO
LOS ANGELES COUNTY SURVEYOR
700 HALL OF RECORDS

Note: Any Additions or Changes on This Sheet Must be Made or Circled in Red Ink With Date and Name of Person Making Change.

Do not extend notes this side of this line

W.C. VS-A-1

Notes Ck'd by	Survey of
Map No. B-1217	W. O.	Tape No.	St'd °F.
Office Work F. A. W.	Surveyed by
Checked	Notes	Date
Date	Indexed

F.B. PG. 103

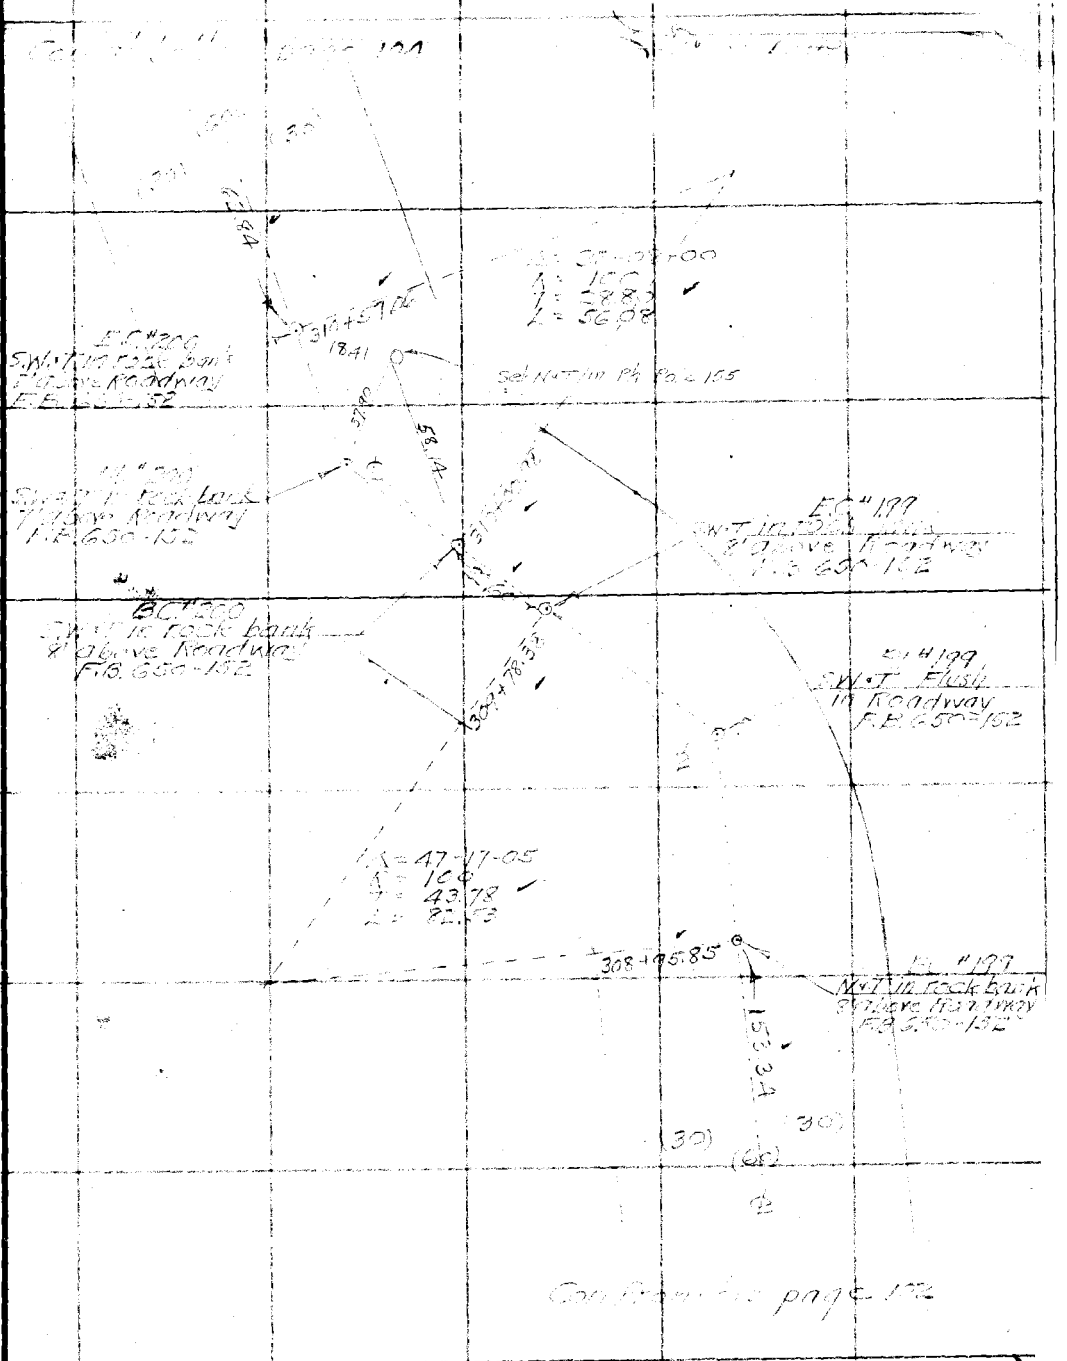

Note: Any Additions or Changes on This Sheet Must be Made in Red Ink or Circled With Date and Name of Person Making Change.

Do not extend notes this side of this line

RETURN TO
LOS ANGELES COUNTY SURVEYOR
700 HALL OF RECORDS

FORM 247 10M 11-35

F.B. 755 PG. 104

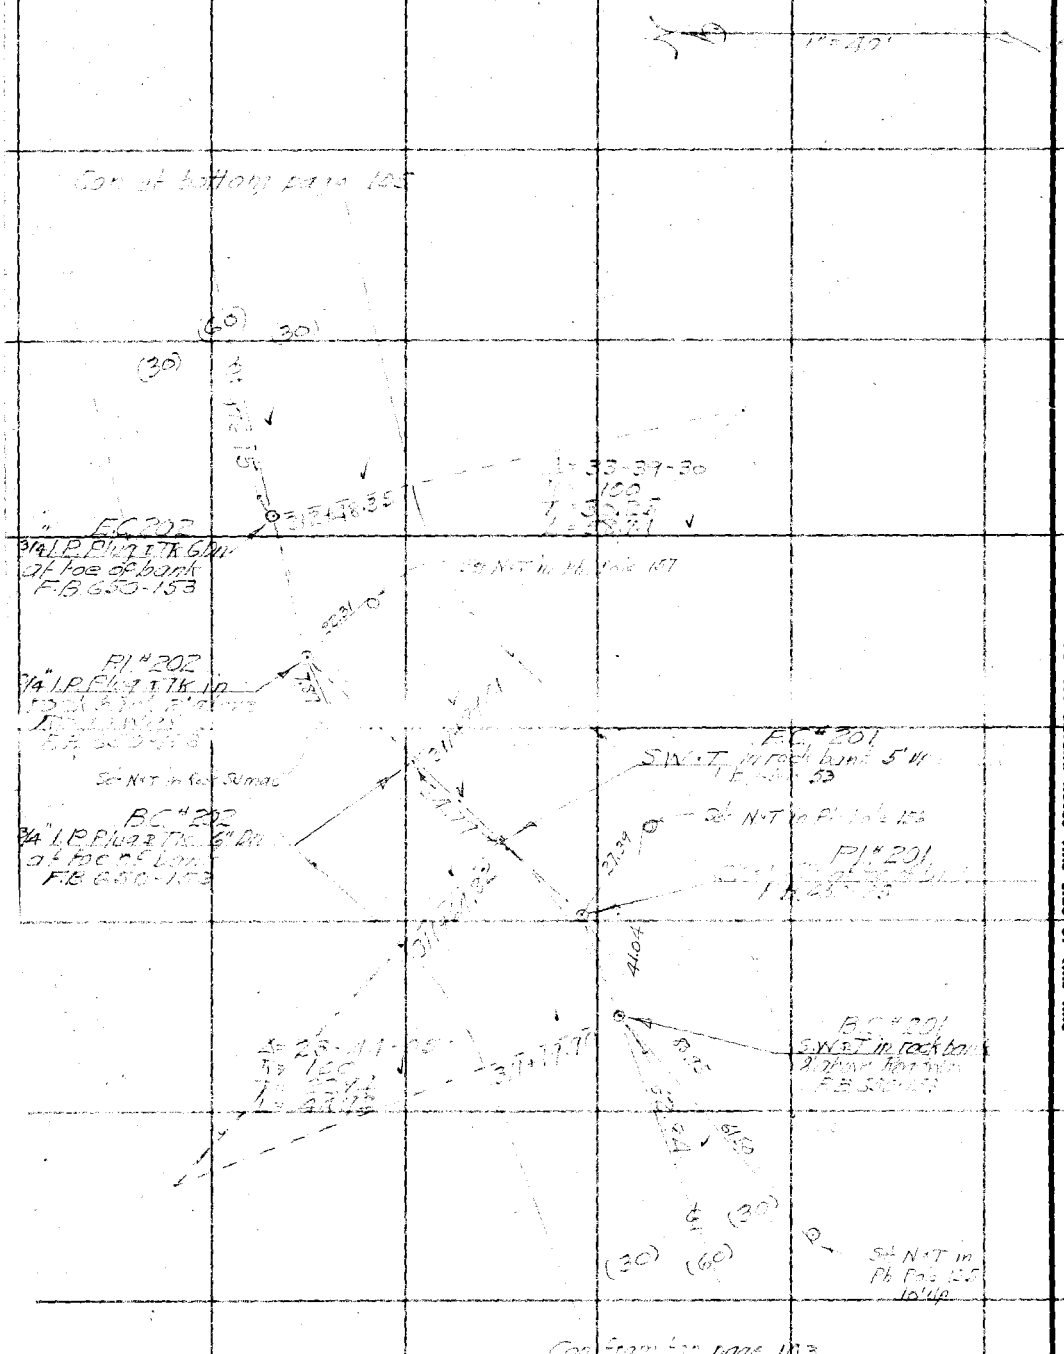

RETURN TO
LOS ANGELES COUNTY SURVEYOR
700 HALL OF RECORDS

Note: Any Additions or Changes on This Sheet Must be Made or Circled in Red Ink With Date and Name of Person Making Change.

Do not extend notes this side of this line

Notes Ck'd by	Survey of
Map No.	W. O.	Tape No.	St'd °F.
Office Work F. A. W.	Surveyed by
Checked	Notes	Date
Date	Indexed

F.B. Pg.

Con at bottom left page 100

1" = 40'

"X" on rock 0.2' Dp at toe of bank F.B. 650-154

316+58.46

Δ = 31°-11'-50"
R = 65'
T = 18.76
L = 36.53

P.I. 120+

2½" I.P. Tk. in Bank 3' above R/W F.B. 650-154

316+21.84

B.C. 120+

3/4" I.P. Plug & Tk. 3" Dp at toe of bank F.B. 650-154

(60')

℄

(30)

(30)

S.W.I.P. 6" Dp at toe of bank F.B. 650-154

Set N.T. in Pk Pole 160'

12.88

30.34

315+57.73

Set N.T. in 3" oak

P.I. 203

L.T. in rock in Ctr. of Roadway F.B. 650-154

Δ = 19°-16'-00"
R = 500'
T = 67.01
L = 133.95

B.C. 203

3/4" I.P. Plug & Tk. 6" Dp at toe of bank F.B. 650-154

314+57.50

17.15

Con from top of page 101

RETURN TO
LOS ANGELES COUNTY SURVEYOR
700 HALL OF RECORDS

Note: Any Additions or Changes on This Sheet Must be Made or Circled in Red Ink With Date and Name of Person Making Change

Do not extend notes this side of this line

FORM 247 10M 11-38

F.B. 795 PG. 106

W.S. 45-A-1

RETURN TO
LOS ANGELES COUNTY SURVEYOR
700 HALL OF RECORDS

Do not extend notes this side of this line

Note: Any Additions or Changes on This Sheet Must be Made or Circled in Red Ink With Date and Name of Person Making Change.

N

40'

1" = 40'

Road to Canyon

EC #206
"X" in rock CBAF 12' above Rdwy
F.B. 650-155

P.I. #206
3/4" I.P. Plug & TK in large boulder 35' above Rdwy
F.B. 650-155

(30) (60) (30)

12½ ℄

BC #207
3/4" I.P. Plug & TK in rock bank 2' above Rdwy
F.B. 650-155

Δ = 84°-00'-00"
R = 50
T = 52.64
L = 73.31

Δ = 67°-30'-00"
R = 100
T = 63.11
L = 117.79

EC #205
N & T in rock bank
8' above Roadway
F.B. 650-155

(60) (30) 19.57 (30)

P.I. #205
3/4" I.P. Plug & TK 6" Dp
in Roadway
F.B. 650-155

Set N & T in Pole 161

BC #205
N & T in rock bank
8' Above Roadway
F.B. 650-155

Con from top page 105

Set L & T in large rock at Bottom of Emb

Notes Ck'd by	Survey of
Map No. B-12-72	W. O. Tape No. St'd °F.
Office Work F. A. W.	Surveyed by
Checked	Notes Date
Date	Indexed

F.B. PG. 127

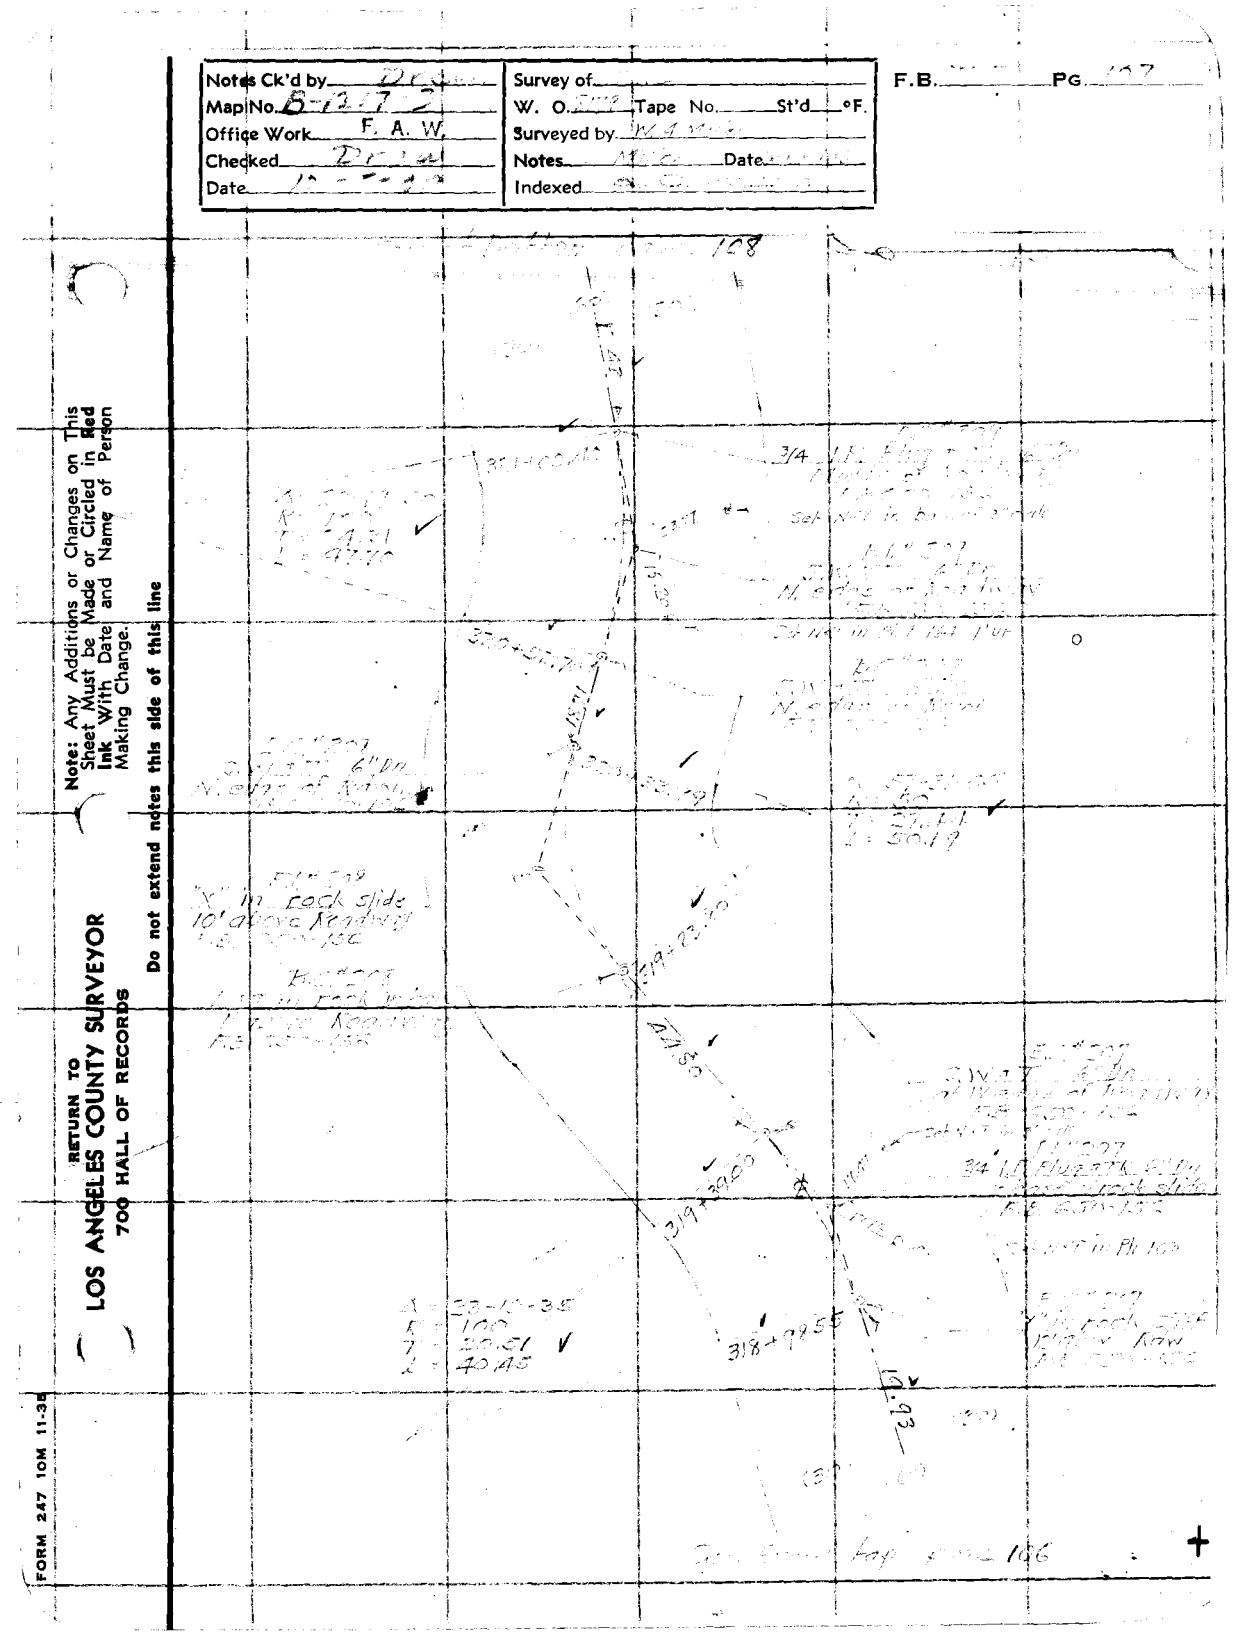

Note: Any Additions or Changes on This Sheet Must be Made or Circled in Red Ink With Date and Name of Person Making Change.

Do not extend notes this side of this line

RETURN TO
LOS ANGELES COUNTY SURVEYOR
700 HALL OF RECORDS

FORM 247 10M 11-35

F.B. 755 Pg. 108

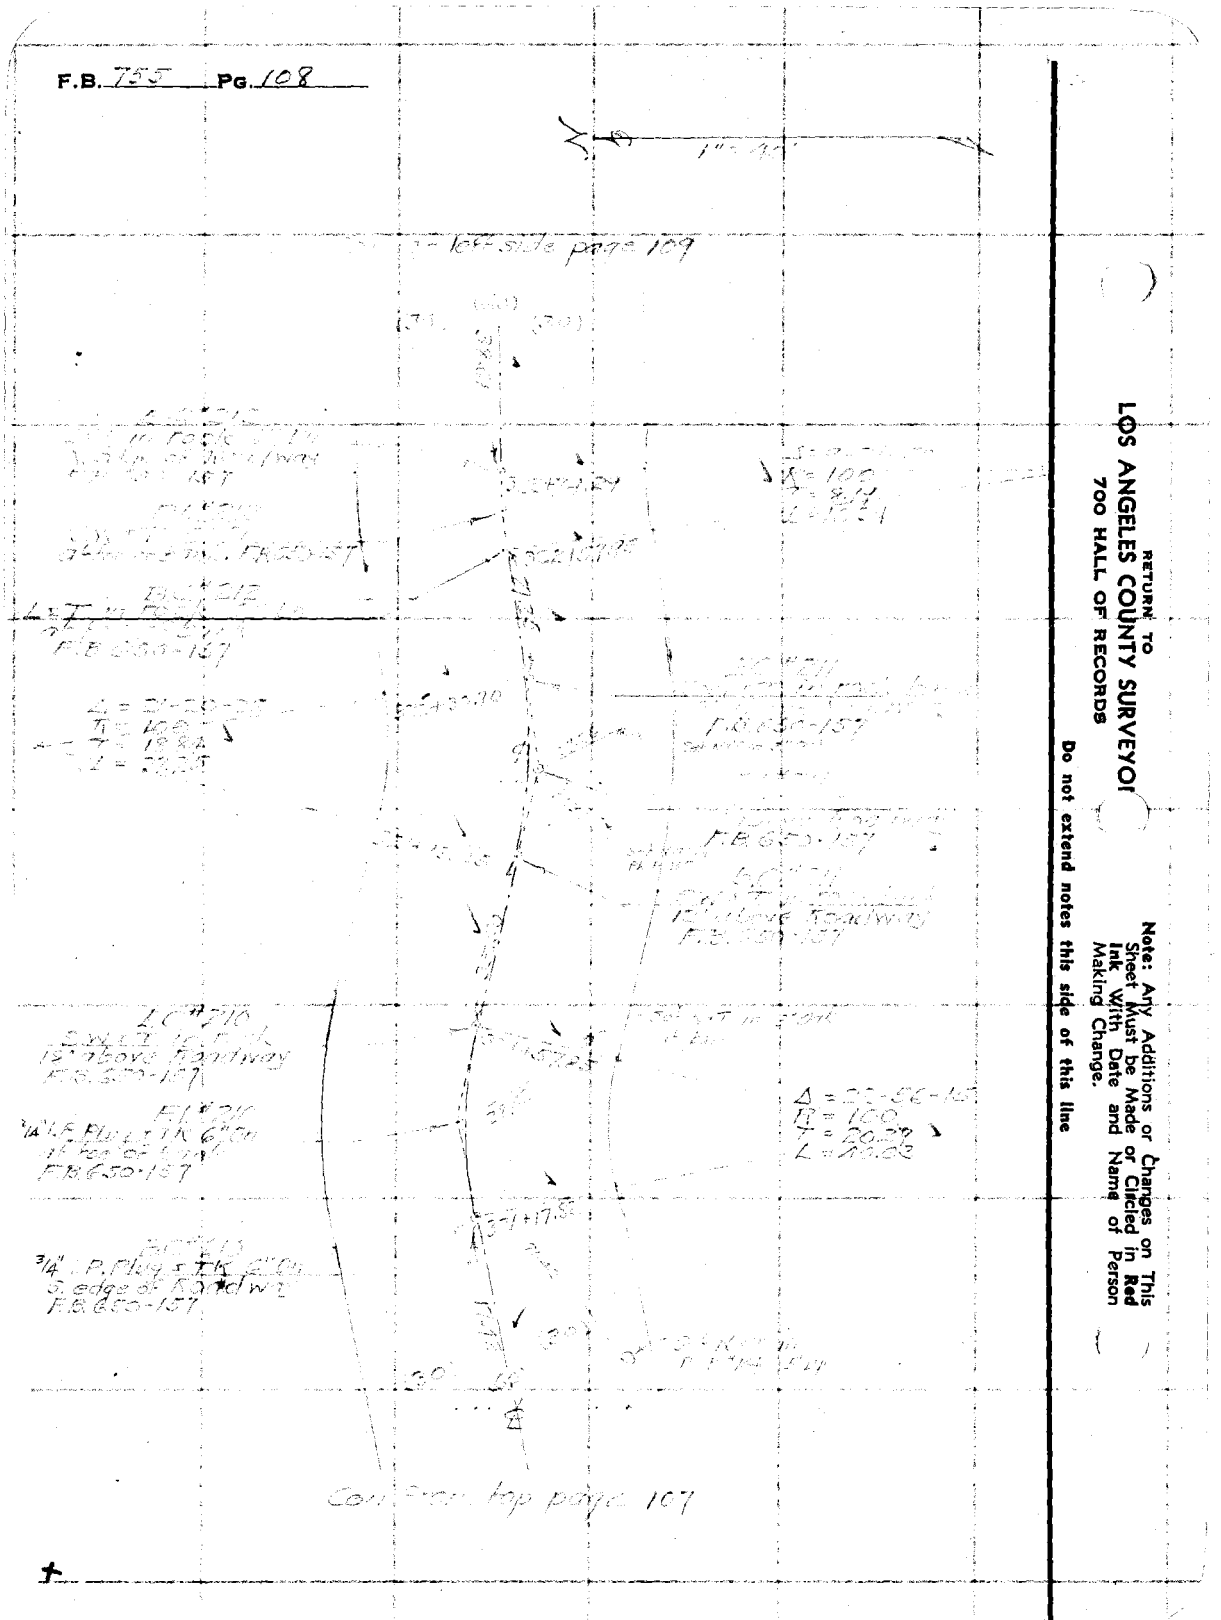

RETURN TO
LOS ANGELES COUNTY SURVEYOR
700 HALL OF RECORDS

Note: Any Additions or Changes on This Sheet Must be Made or Circled in Red Ink With Date and Name of Person Making Change.

Do not extend notes this side of this line

Notes Ck'd by	Survey of
Map No. B-12.7	W. O. 5419 Tape No. St'd °F.
Office Work F. A. W.	Surveyed by
Checked	Notes Date
Date	Indexed

F.B. Pg.

Note: Any Additions or Changes on This Sheet Must be Made or Circled in Red Ink With Date and Name of Person Making Change.

Do not extend notes this side of this line

RETURN TO
LOS ANGELES COUNTY SURVEYOR
7OD HALL OF RECORDS

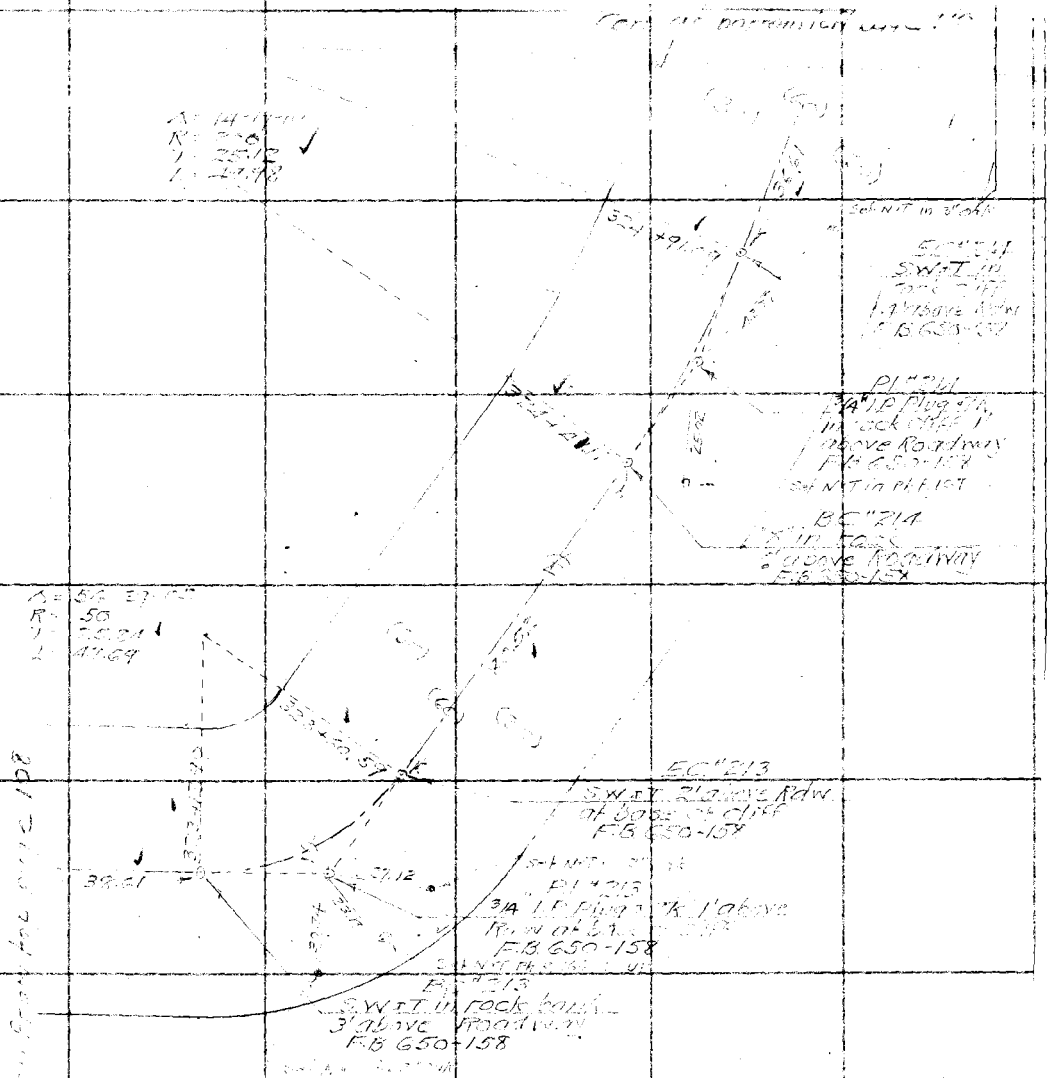

FORM 247 10M 11-38

RETURN TO
LOS ANGELES COUNTY SURVEYOR
700 HALL OF RECORDS

Note: Any Additions or Changes on This Sheet Must be Made or Circled in Red Ink With Date and Name of Person Making Change.

WS AS-A-1

Do not extend notes this side of this line

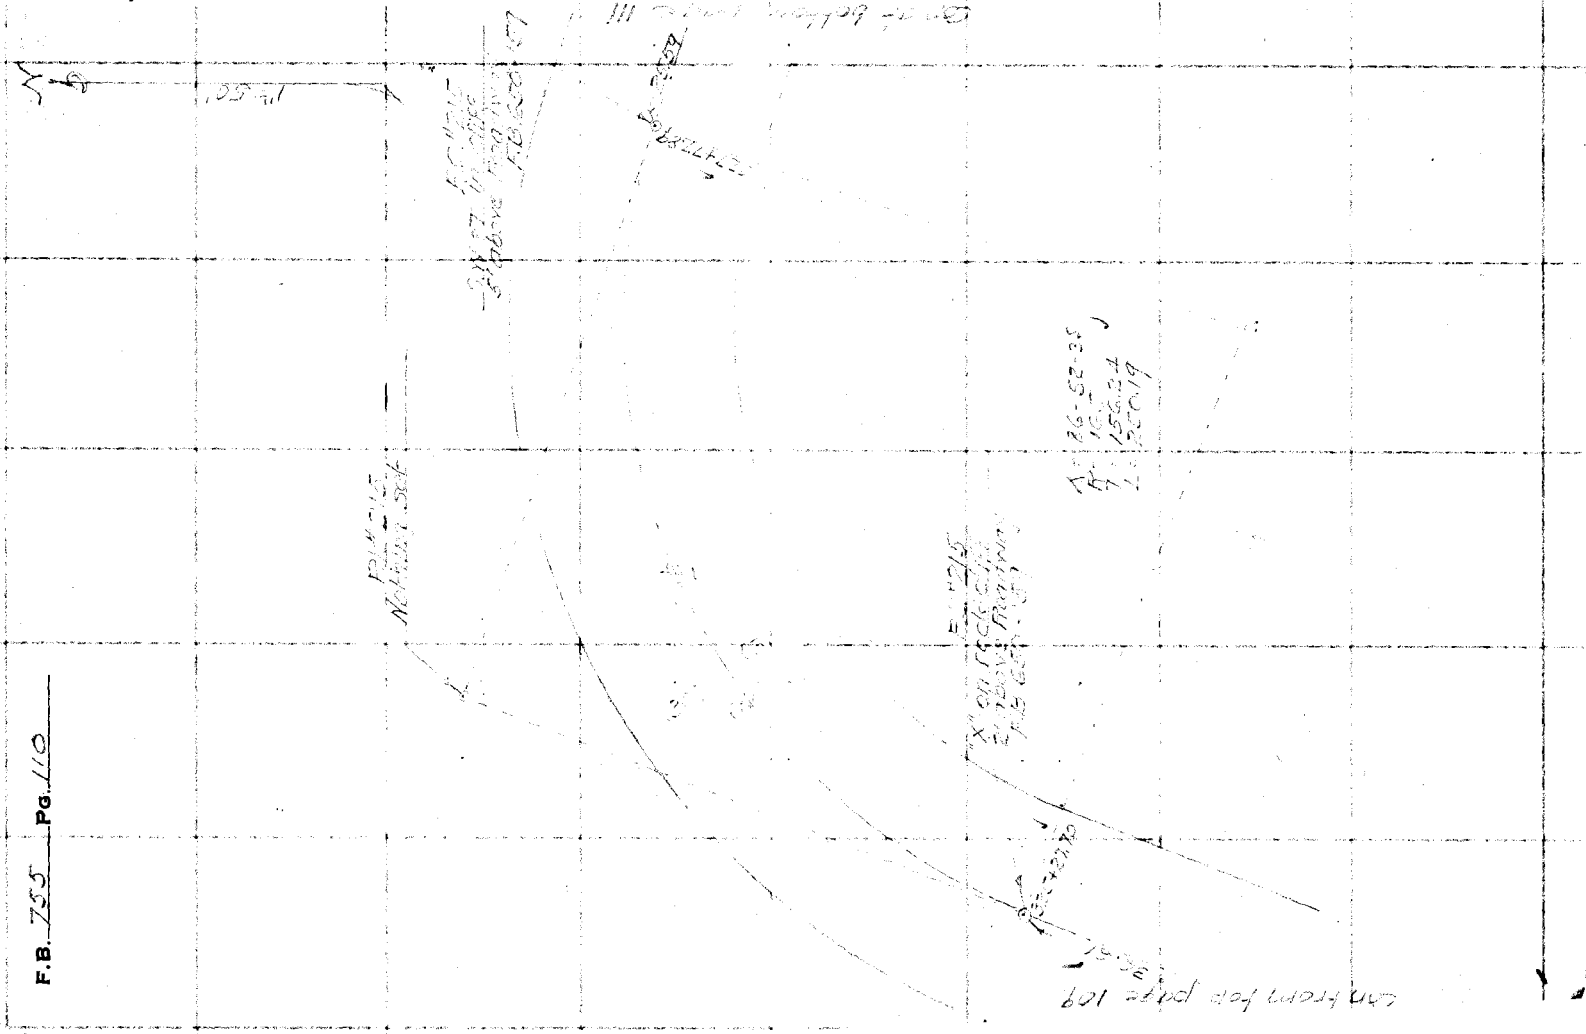

F.B. 755 Pg. 10

Notes Ck'd by	Survey of
Map No. B 12.17-3	W. O. 5019 Tape No. St'd °F.
Office Work F. A. W.	Surveyed by
Checked	Notes Date
Date 12-5-40	Indexed

F.B. -5- PG. 111

Note: Any Additions or Changes on This Sheet Must be Made in Red Ink With Date and Name of Person Making Change.

Do not extend notes this side of this line

RETURN TO
LOS ANGELES COUNTY SURVEYOR
700 HALL OF RECORDS

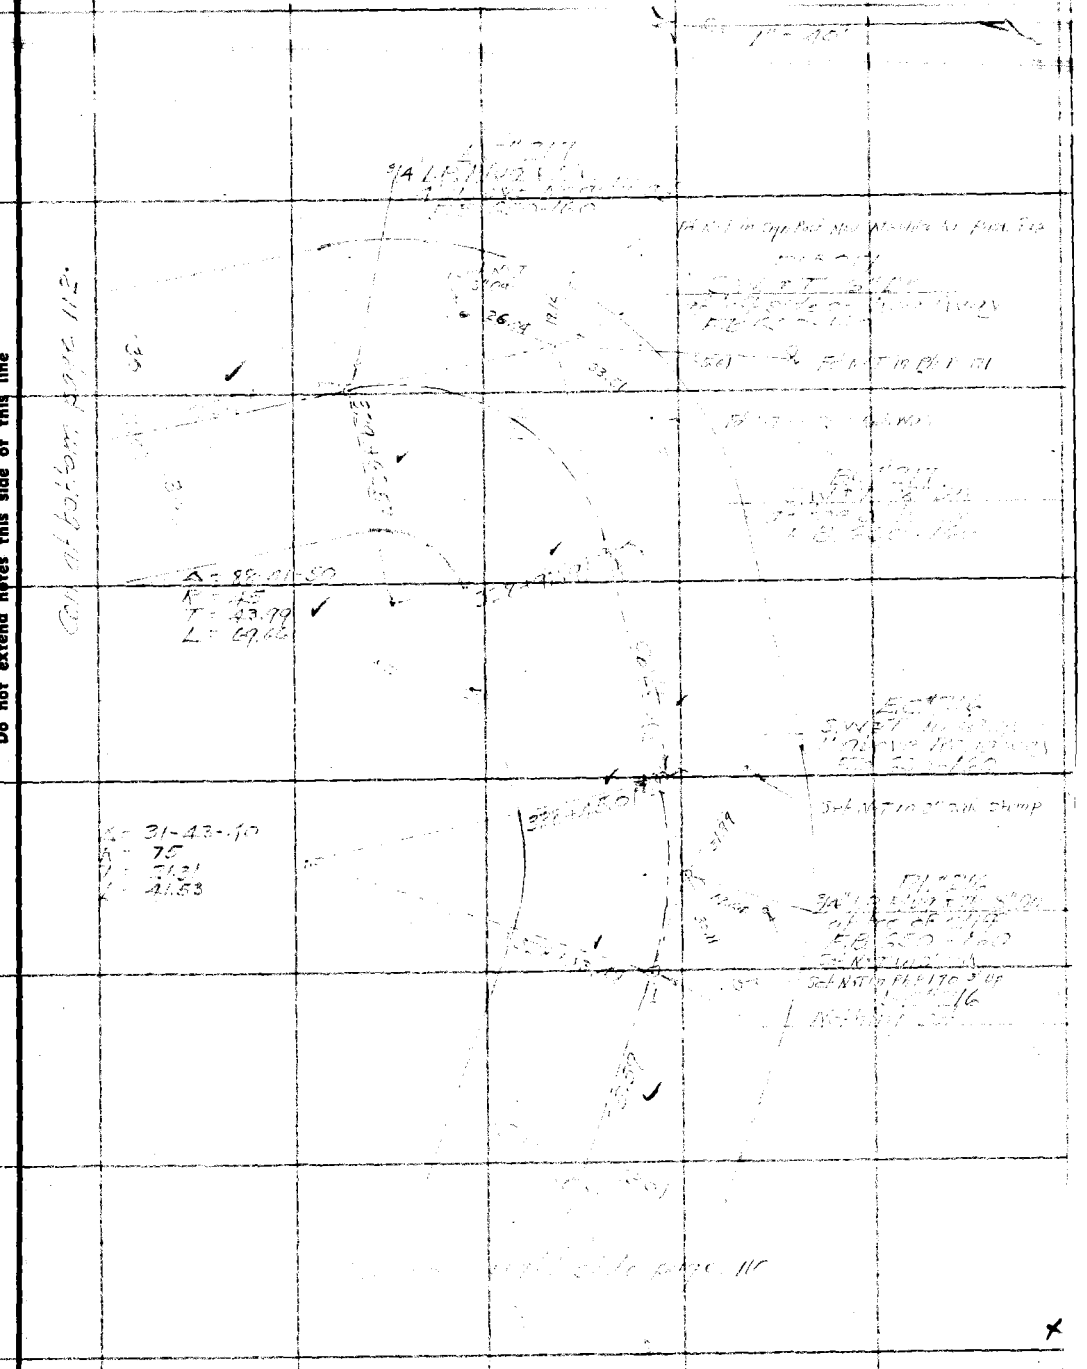

FORM 247 10M 11-35

F.B. 755 PG. 112

RETURN TO
LOS ANGELES COUNTY SURVEYOR
700 HALL OF RECORDS

Note: Any Additions or Changes on This Sheet Must be Made or Circled in Red Ink With Date and Name of Person Making Change.

Do not extend notes this side of this line

EC #218
¾" LP Plug & Tk in back
1' above face of curb

PI #218
¾" LP Plug & Tk, 8" Dp
at left side of roadway
ER 650-161

EC #218
¾" LP Plug & Tk in back
1' above face of curb
ER 650-161

Δ = 31-15-55
R = 100
T = 30.83
L = 59.80

332+36.16

331+76.36

(30)

(30)

Con from left side page 114

Notes Ck'd by	Survey of
Map No. 13-12	W. O. 5107 Tape No. St'd °F.
Office Work F. A. W.	Surveyed by
Checked D.V.	Notes Date
Date	Indexed

F.B. PG.

W. 45'-A-

Note: Any Additions or Changes on This Sheet Must be Made or Circled in Red Ink With Date and Name of Person Making Change.

Do not extend notes this side of this line

RETURN TO
LOS ANGELES COUNTY SURVEYOR
7OD HALL OF RECORDS

FORM 247 10M 11-35

RETURN TO
LOS ANGELES COUNTY SURVEYOR
700 HALL OF RECORDS

Note: Any Additions or Changes on This Sheet Must be Made or Circled in **Red Ink** With Date and Name of Person Making Change.

Do not extend notes this side of this line

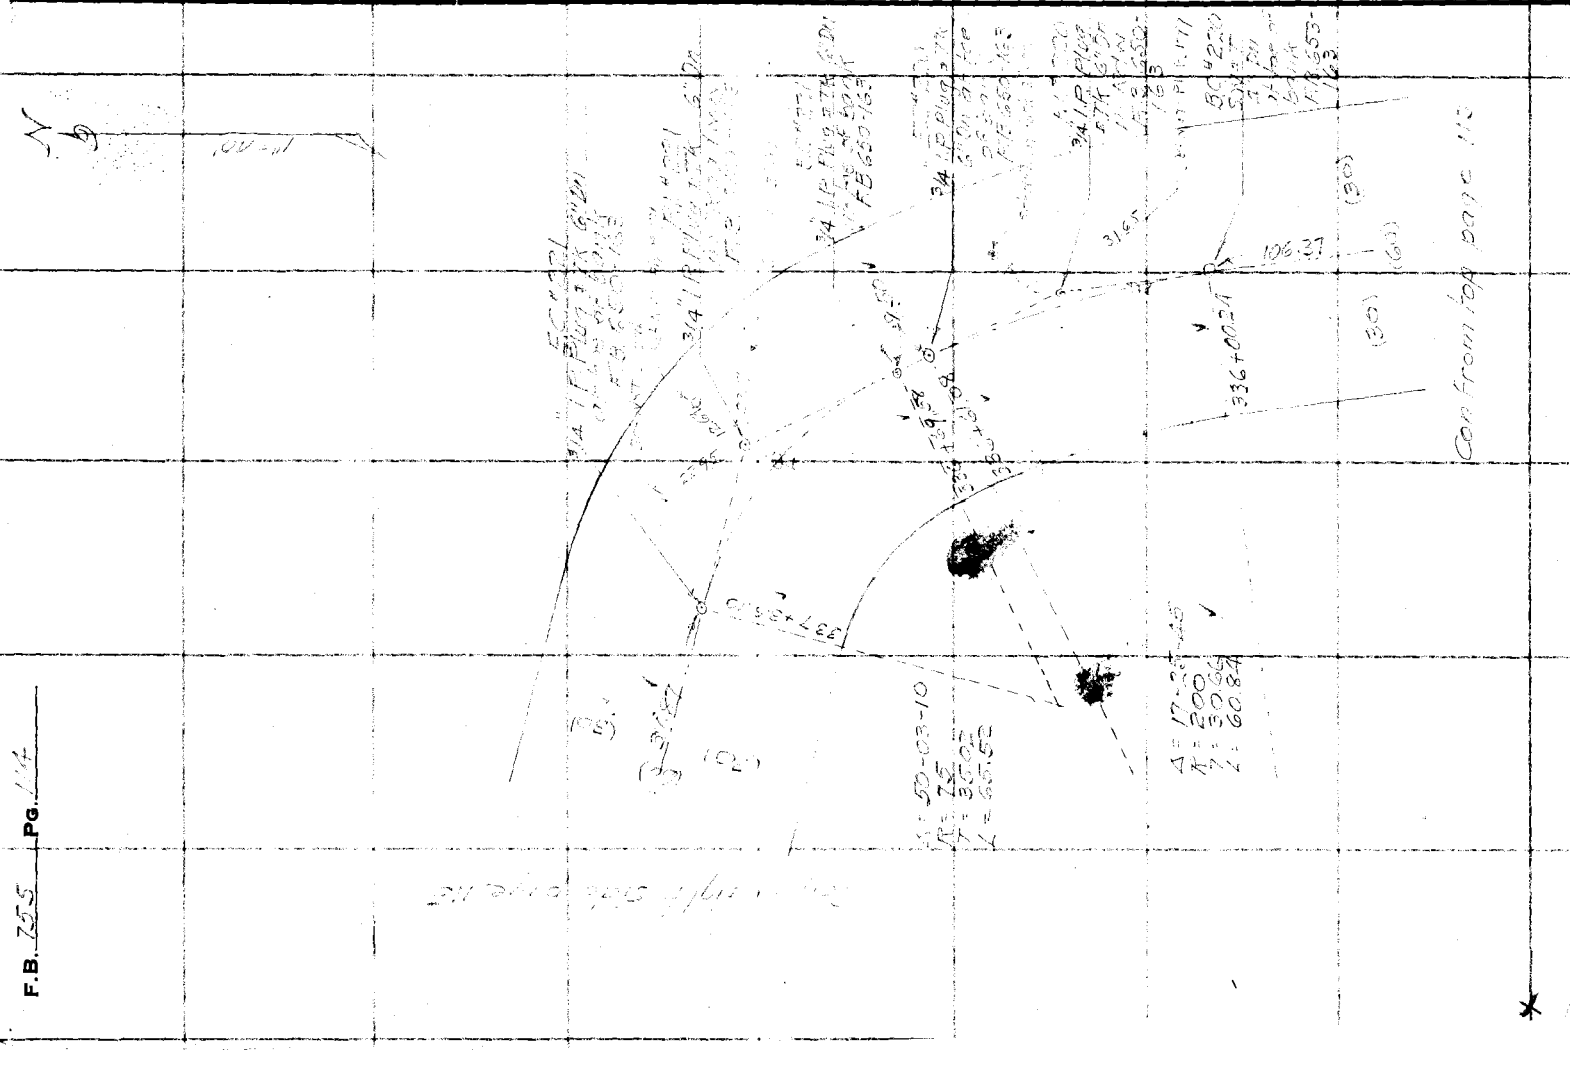
N
100-11
3/4 IP
FB 680 168
34 IP
FB 680 168
34 IP
FB 680 168
3/4 IP
FB 680 168
3/4 IP
FB 680 168
3/4

Notes Ck'd by	Survey of
Map No. B-1217	W. O.	Tape No.	St'd	°F.
Office Work F. A. W.	Surveyed by
Checked	Notes	Date
Date	Indexed

F.B. Pg.

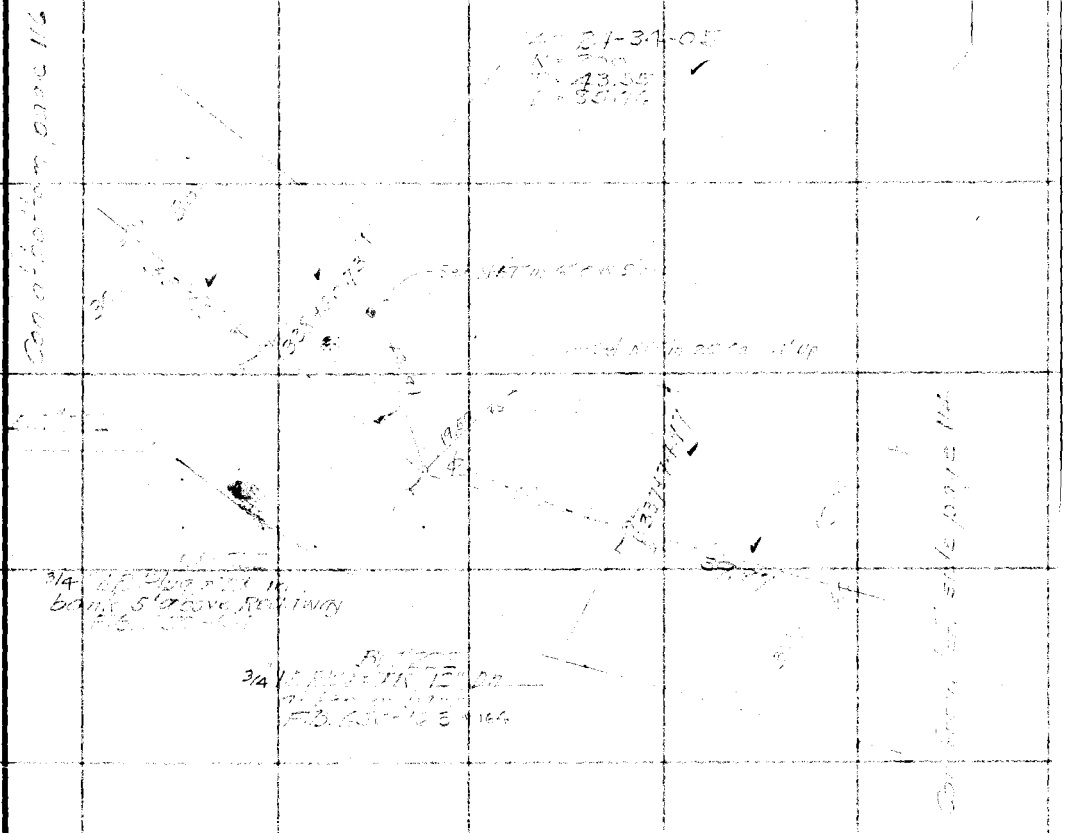

Note: Any Additions or Changes on This Sheet Must be Made or Circled in Red Ink With Date and Name of Person Making Change.

Do not extend notes this side of this line

RETURN TO
LOS ANGELES COUNTY SURVEYOR
7OD HALL OF RECORDS

FORM 247 10M 11-58

RETURN TO
LOS ANGELES COUNTY SURVEYOR
700 HALL OF RECORDS

Note: Any Additions or Changes on This Sheet Must be Made or Circled in **Red Ink** With Date and Name of Person Making Change.

Do not extend notes this side of this line

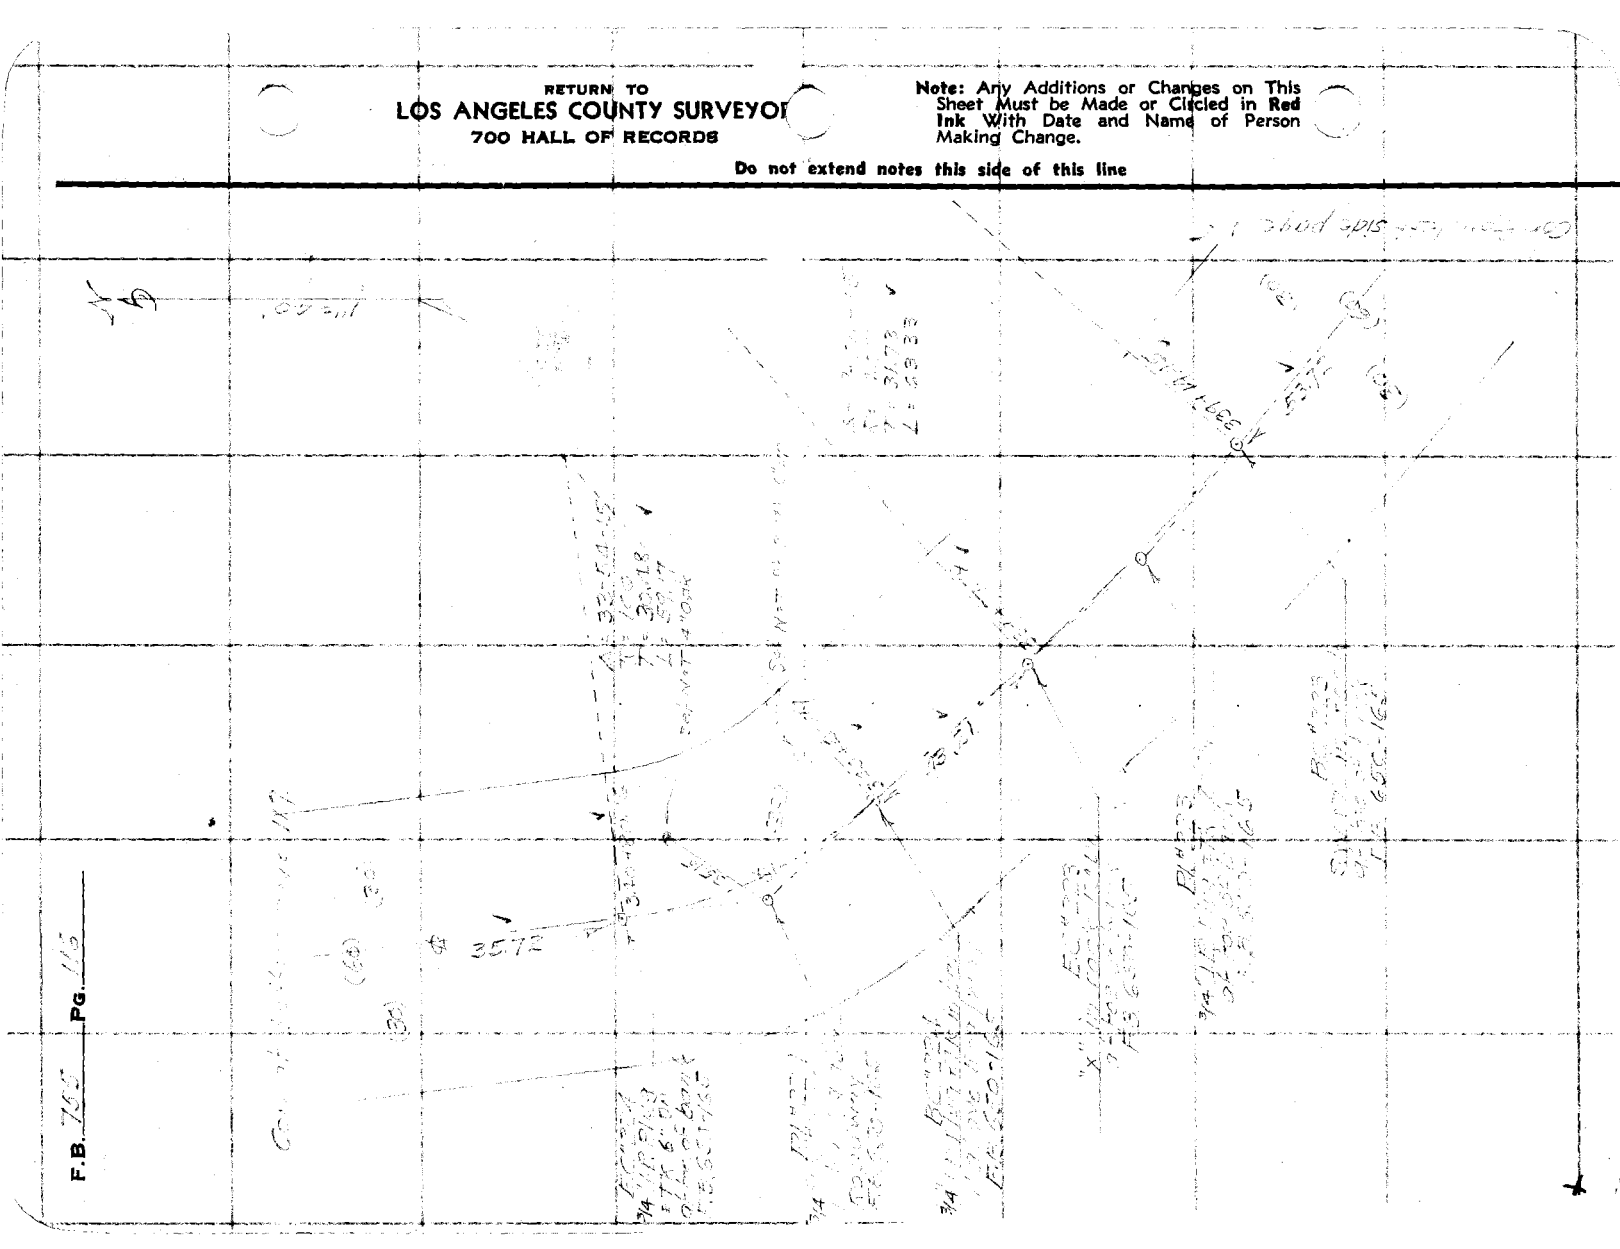

Notes Ck'd by	Survey of
Map No. 6 1217-	W. O.	Tape No.	St'd °F.
Office Work F. A. W.	Surveyed by
Checked	Notes	Date
Date	Indexed

F.B. PG.

W 43 A-1

Note: Any Additions or Changes on This Sheet Must be Made or Circled in Red Ink With Date and Name of Person Making Change.

Do not extend notes this side of this line

RETURN TO
LOS ANGELES COUNTY SURVEYOR
700 HALL OF RECORDS

FORM 247 10M 11-35

F.B. 755 Pg. 118

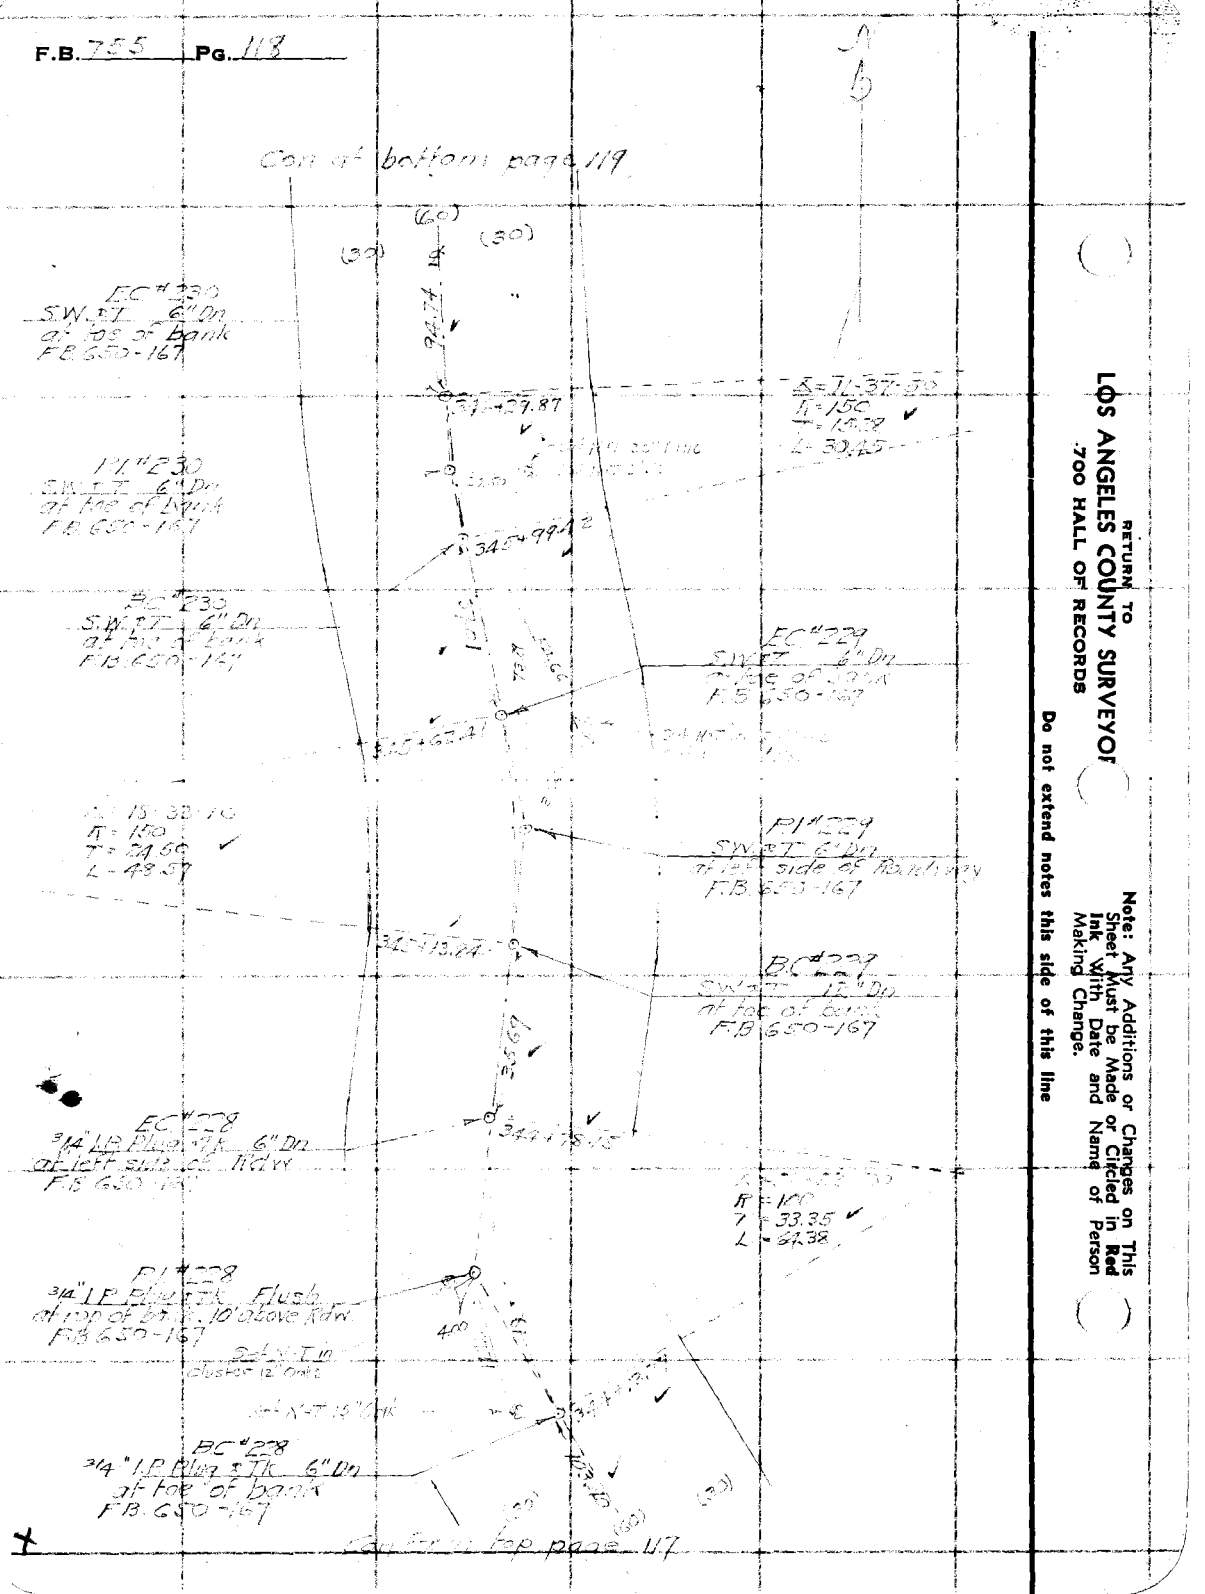

RETURN TO
LOS ANGELES COUNTY SURVEYOR
700 HALL OF RECORDS

Note: Any Additions or Changes on This Sheet Must be Made or Circled in Red Ink With Date and Name of Person Making Change.

Do not extend notes this side of this line

Notes Ck'd by	Survey of
Map No. B 12 T 1	W. O. 8149 Tape No. St'd °F.
Office Work F. A. W.	Surveyed by WAMiller
Checked	Notes Date
Date 11-5-40	Indexed

F.B. Pg.

W.S.4W-A-1

Con at bottom pipe 100

Spl Nail & Tag in 6" oak Stump

P.I. #232
Bk Spk in rock bank
2' above Roadway
F.B. 650-169

349+84.98

Δ = 22-52-50
R = 100
T = 20.22
L = 39.91

P.I. #233
N.T. in rock bank
6' above Roadway
F.B. 650-169

349+45.07

S.C. #233
N.T. in rock bank
8' above Roadway
F.B. 650-169

349+21.55

S.C. #232
N.T. in rock bank
7' above Roadway
F.B. 650-169

P.I. #230
SW 2" 6" Dn
at toe of bank
F.B. 650-169

Δ = 30-36-05
R = 100
T = 27.36
L = 53.41

348+68.11

S.C. #230
N.T. in rock bank
3' above Roadway
F.B. 650-169

SEC 32 T 2N R 11W

SOUTH LINE

SEC 5 T 1N R 11W

173.50

N 79-37-10 W

P.I. #231 Angle Point
SW 2" T 6" Dn
at toe of bank
F.B. 650-168

347+24.61

94.74

Con at pipe

RETURN TO
LOS ANGELES COUNTY SURVEYOR
700 HALL OF RECORDS

Note: Any Additions or Changes on This Sheet Must be Made or Circled in Red Ink With Date and Name of Person Making Change.

Do not extend notes this side of this line

FORM 247 10M 11-38

F.B. 755 Pg. 120

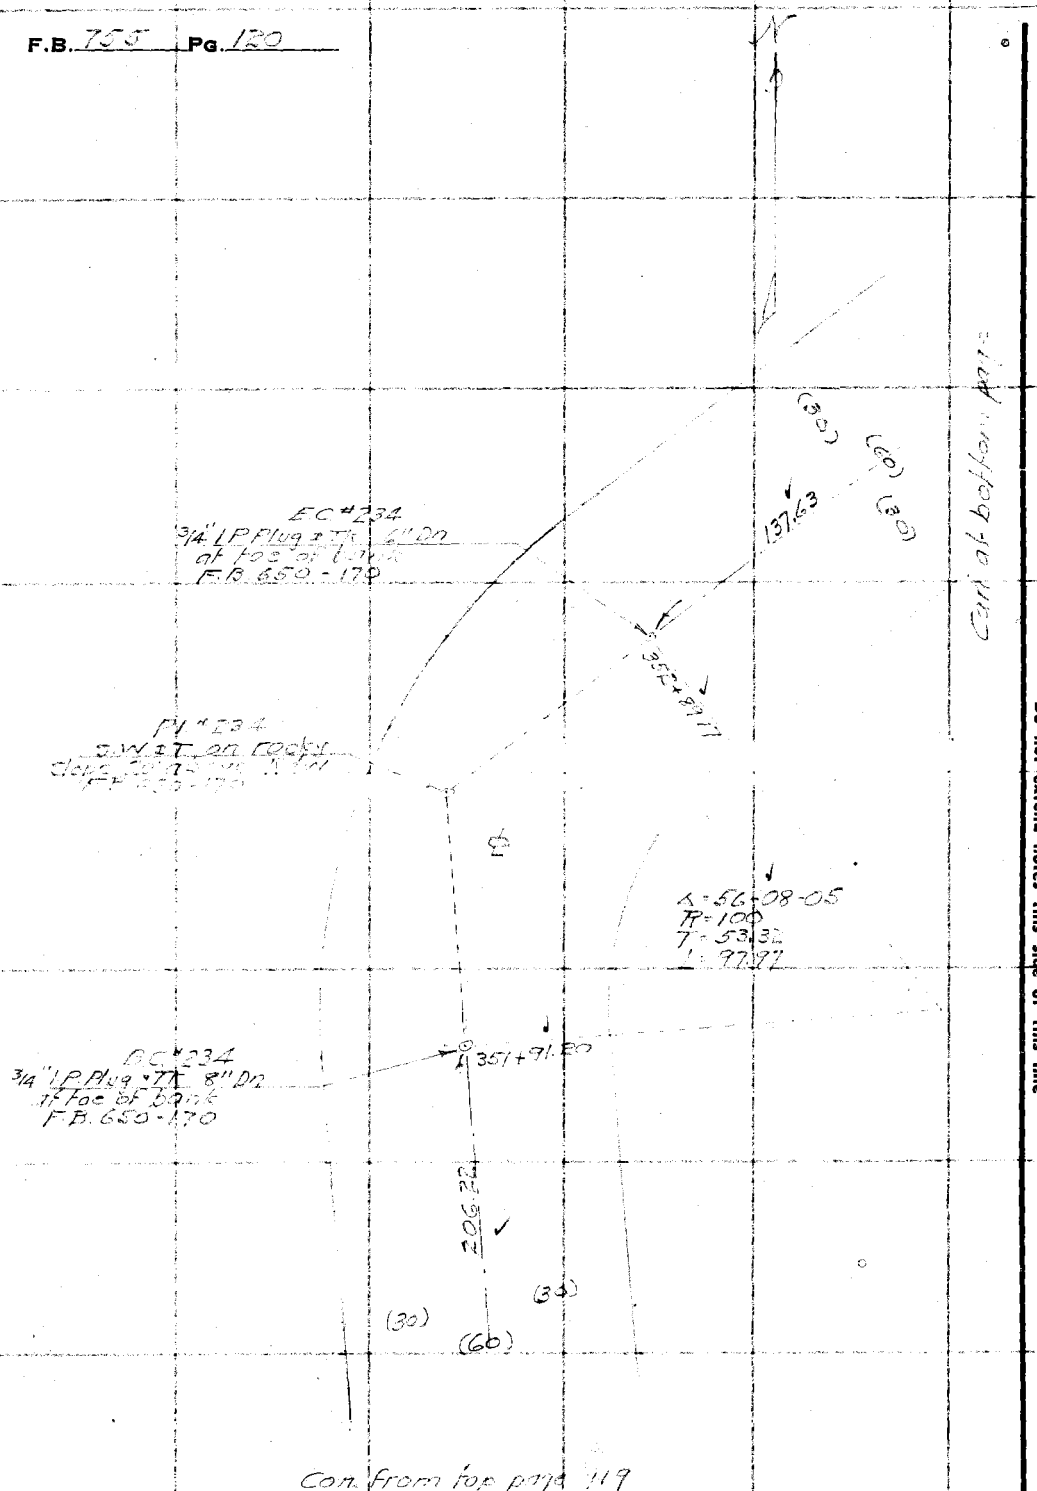

RETURN TO
LOS ANGELES COUNTY SURVEYOR
700 HALL OF RECORDS

Note: Any Additions or Changes on This Sheet Must be Made or Circled in Red Ink With Date and Name of Person Making Change.

Do not extend notes this side of this line

Notes Ck'd by D. Crow	Survey of
Map No. B-12[illegible]	W. O. 21[illegible] Tape No. St'd °F.
Office Work F. A. W.	Surveyed by
Checked D. Crow	Notes Date
Date 12-5-40	Indexed

F.B. [illegible] Pg. 121

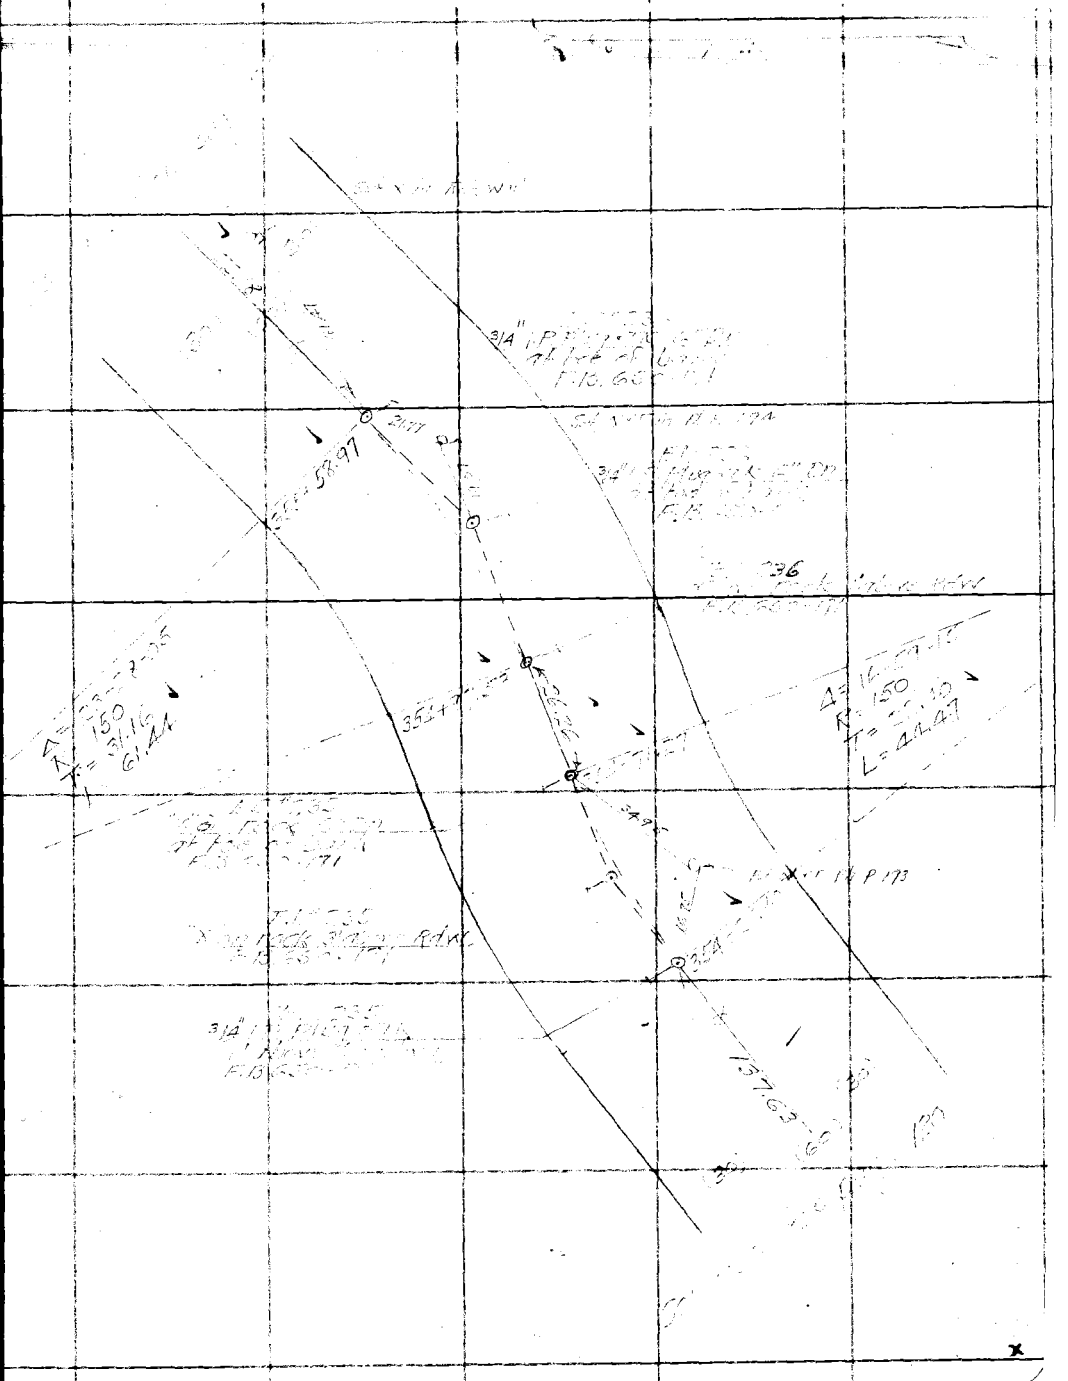

RETURN TO
LOS ANGELES COUNTY SURVEYOR
700 HALL OF RECORDS

Note: Any Additions or Changes on This Sheet Must be Made or Circled in Red Ink With Date and Name of Person Making Change.

Do not extend notes this side of this line

FORM 247 10M 11-38

RETURN TO
LOS ANGELES COUNTY SURVEYOR
700 HALL OF RECORDS

Note: Any Additions or Changes on This Sheet Must be Made or Circled in **Red Ink** With Date and Name of Person Making Change.

WSMS-A-1

Do not extend notes this side of this line

F.B. 755 PG. 122

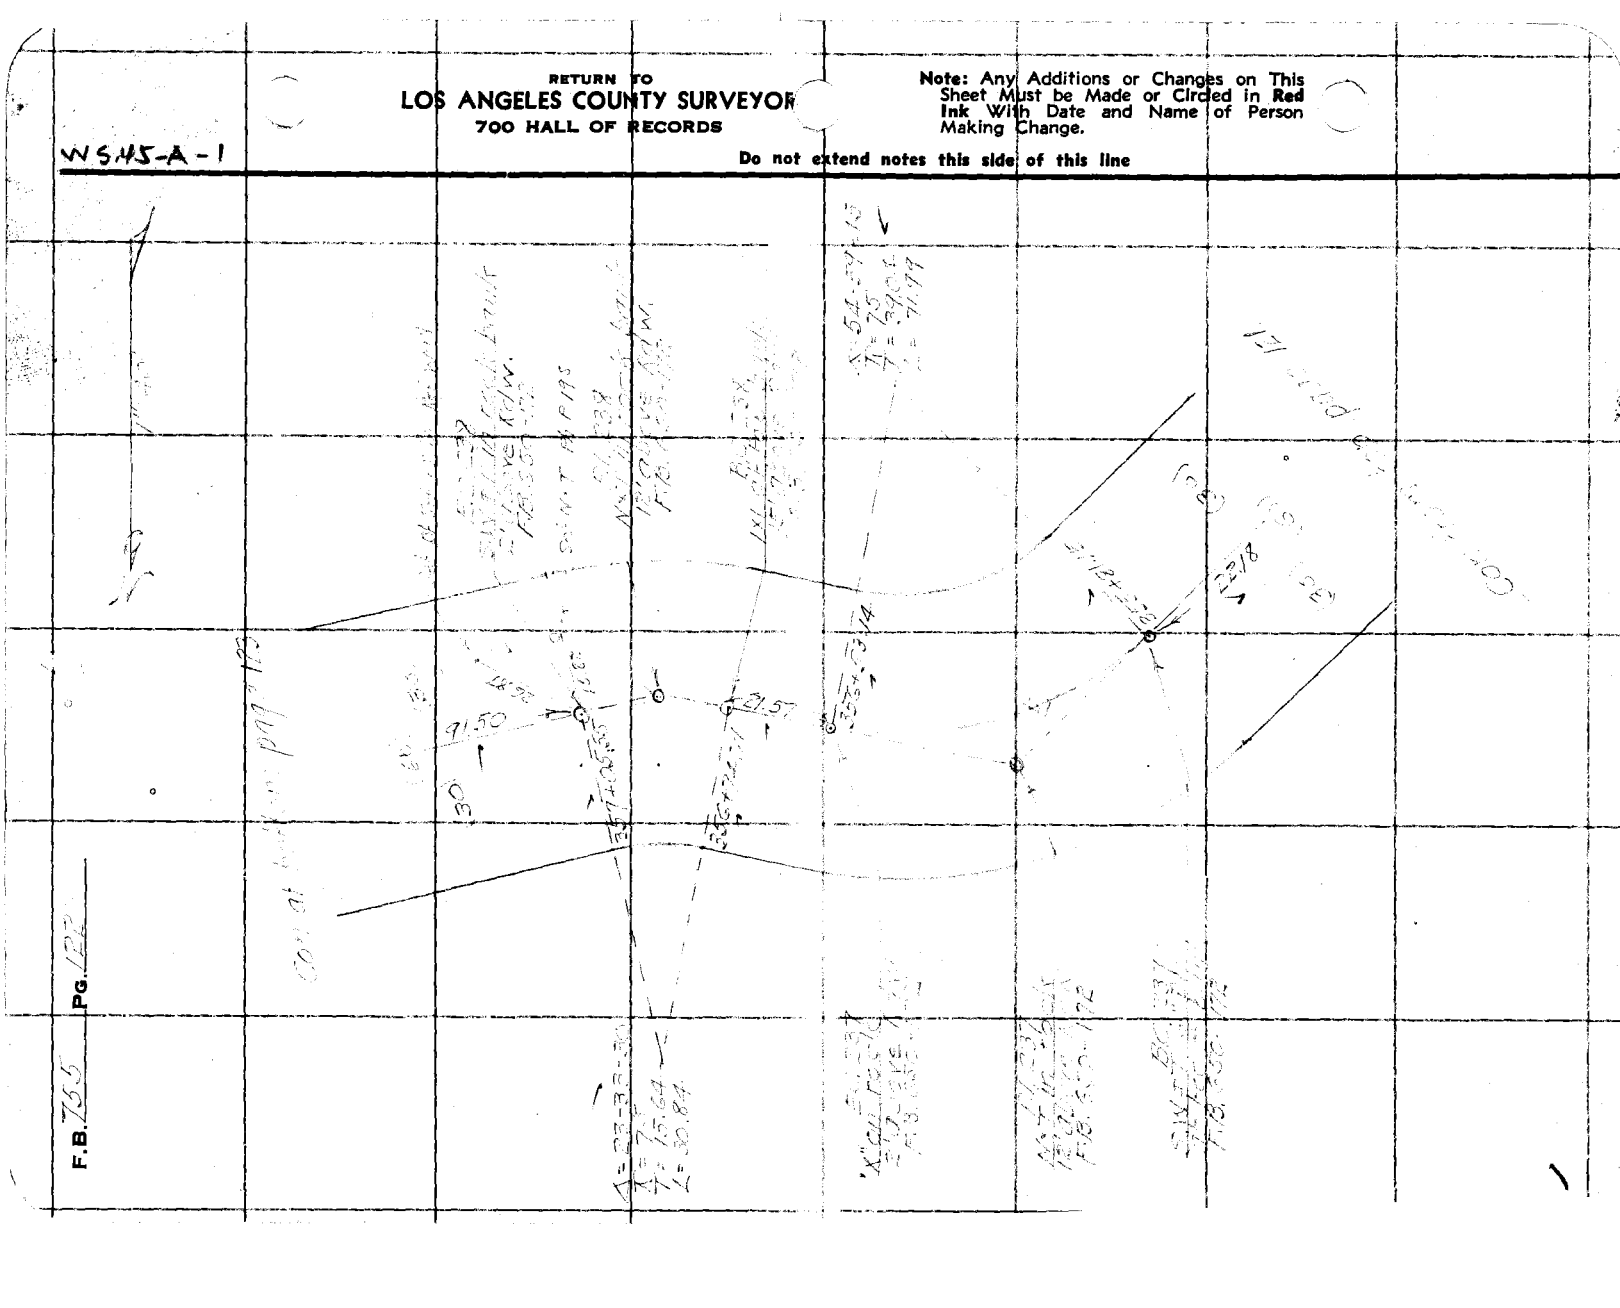

Notes Ck'd by	Survey of
Map No. B-127 #1	W. O.	Tape No.	St'd °F.
Office Work F. A. W.	Surveyed by
Checked	Notes	Date
Date	Indexed

F.B. Pg.

Note: Any Additions or Changes on This Sheet Must be Made in Red Ink or Circled With Date and Name of Person Making Change.

Do not extend notes this side of this line

RETURN TO
LOS ANGELES COUNTY SURVEYOR
700 HALL OF RECORDS

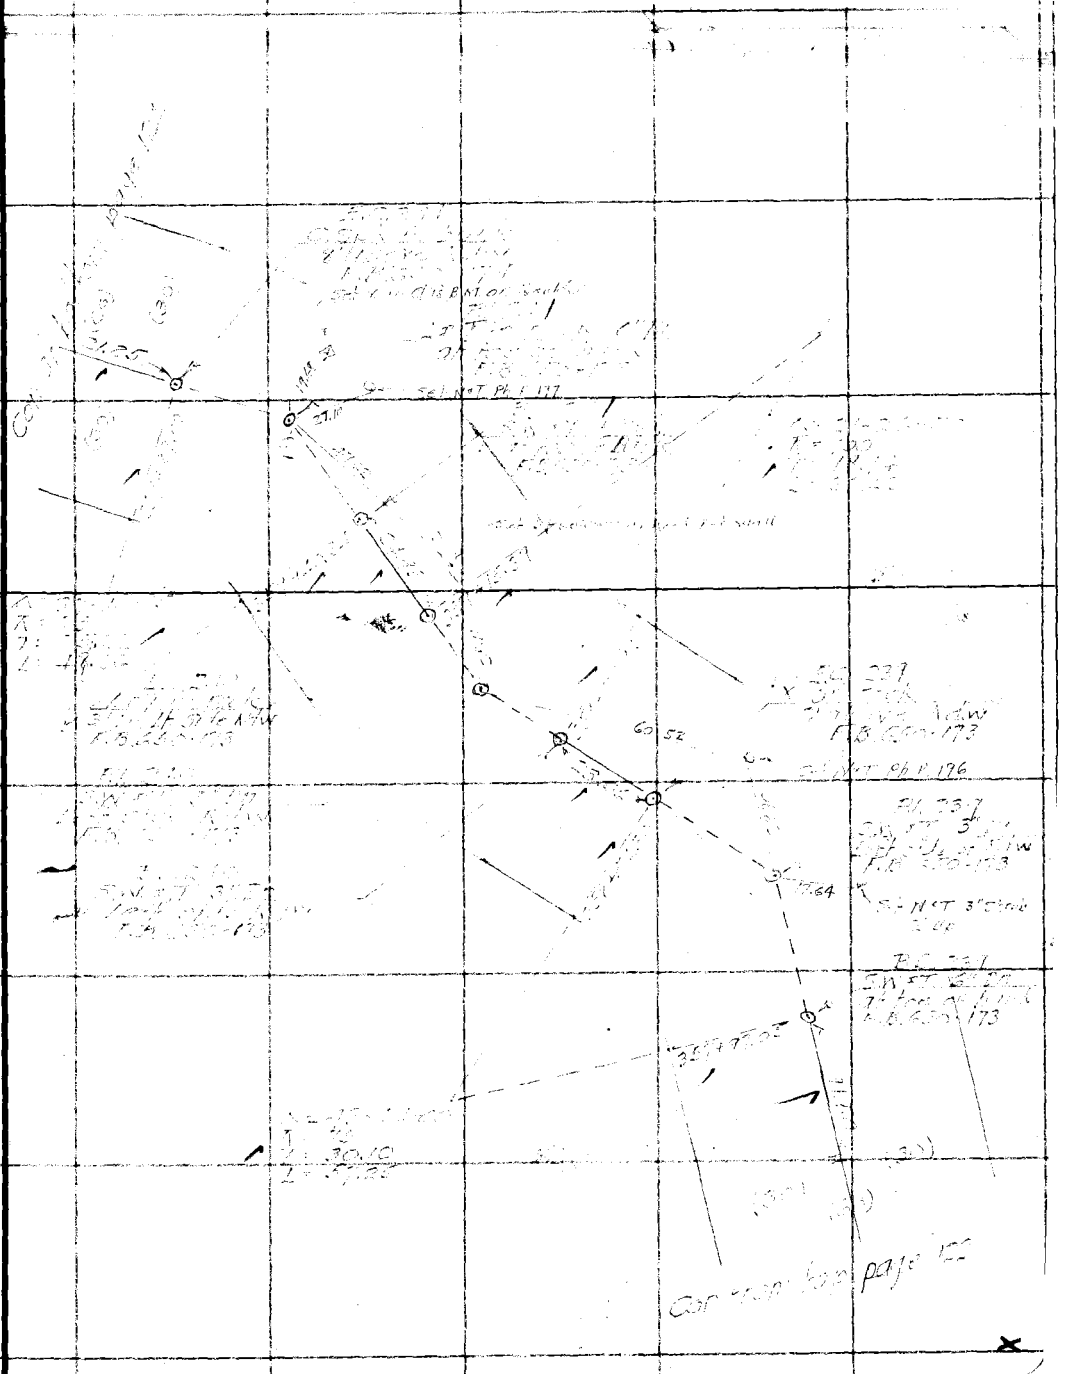

FORM 247 10M 11-38

RETURN TO
LOS ANGELES COUNTY SURVEYOR
700 HALL OF RECORDS

Note: Any Additions or Changes on This Sheet Must be Made or Circled in Red Ink With Date and Name of Person Making Change.

Do not extend notes this side of this line

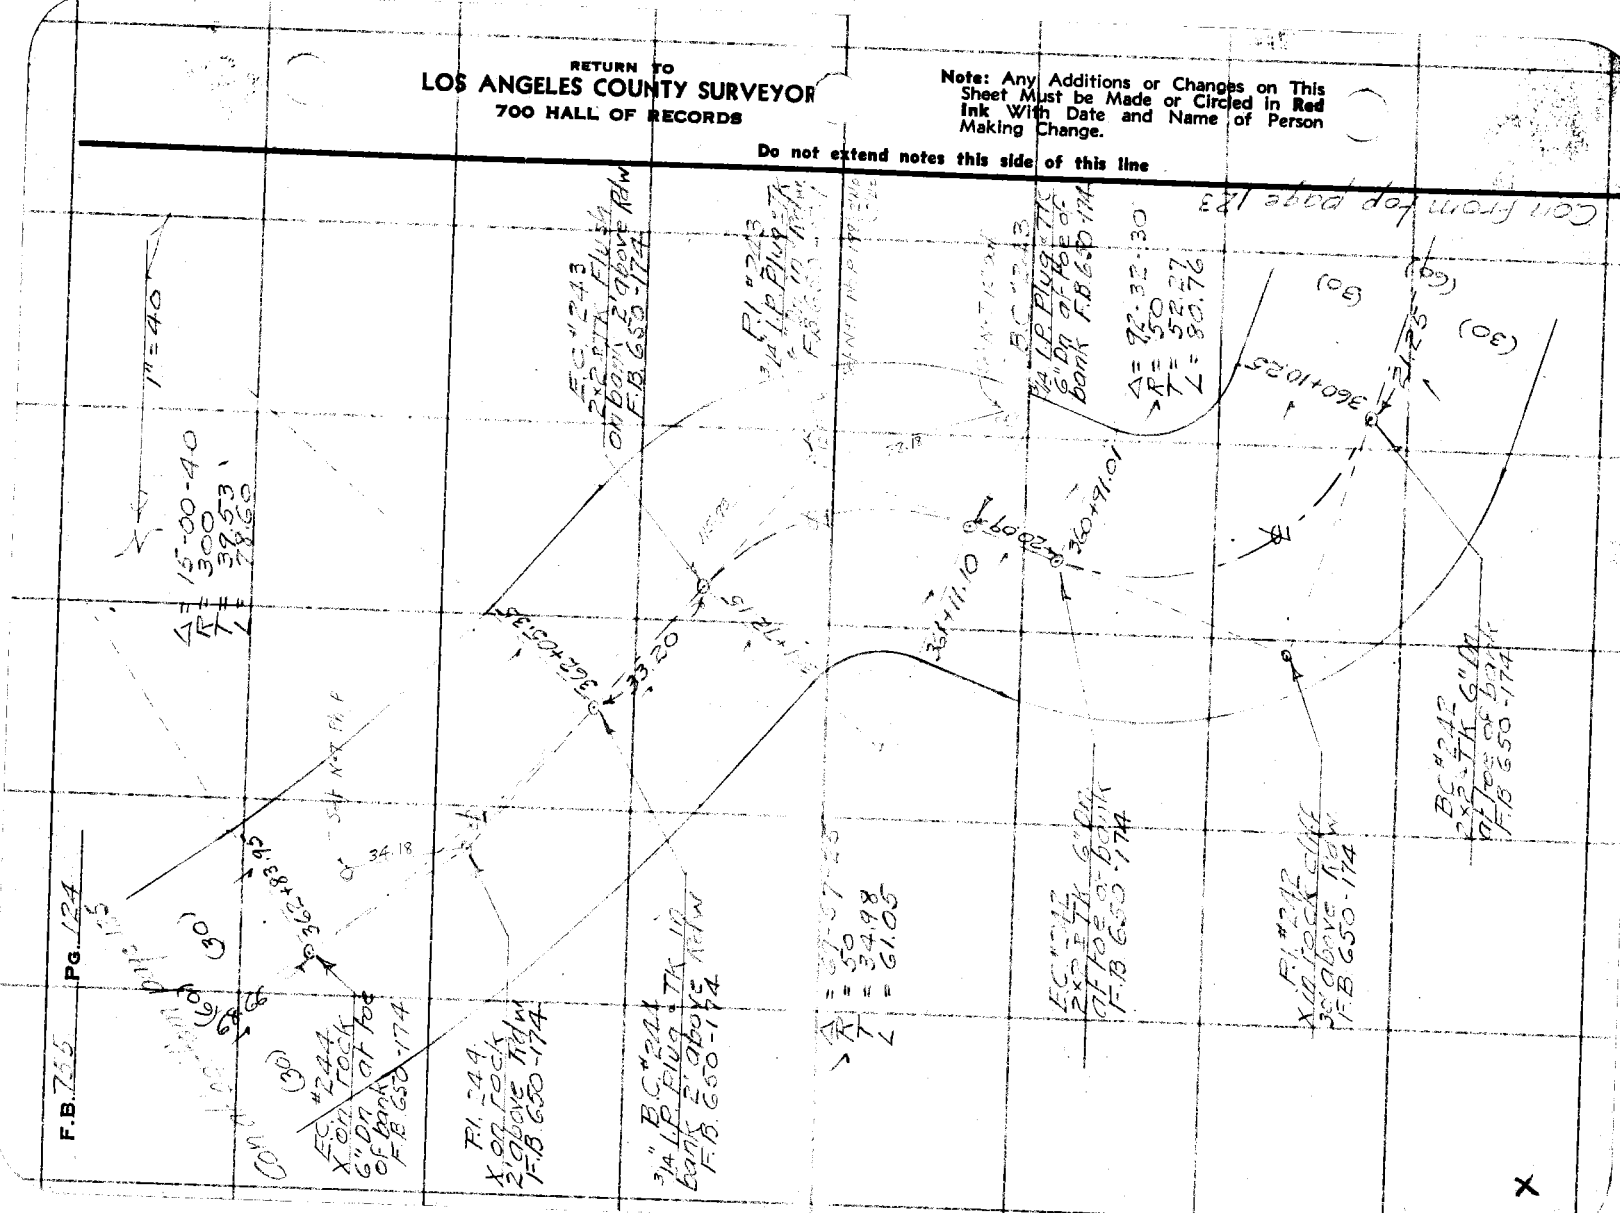
F.B. 755 Pg. 124
1"=40
Δ = 15°-00'-40"
R = 300.53'
L = 78.60'
Δ = 92°32'30"
R = 50.00'
L = 80.76'
Δ = 34°18'
R = 50.00'
L = 29.94'
Δ = 32°40'53"
R = 50.00'
L = 34.98'
Δ = 69°08'
R = 50.00'
L = 61.05'
Con from top page 123
(30)
(30)
(30)

Notes Ck'd by	Survey of
Map No. B-1217-8	W. O. 9149 Tape No. St'd °F.
Office Work F. A. W.	Surveyed by W & M
Checked D. E. W.	Notes Date
Date 12-5-40	Indexed

F.B. 755 Pg. 125

W.O. 9149-A1

1" = 40'

Con at bottom page 126

Δ = 31°-39'-15"
R = 100
T = 28.35
L = 55.25

364+78.67

B.C. #216
S.W.P.T. 6" Dn
at toe of bk
F.B. 650-175

P.I. #216
3/4" I.P. Plug & Tk in
wall 3' Radial N'ly
F.B. 650-175

B.C. #216
3/4" I.P. Plug & Tk 6" Dn
at toe of bank
F.B. 650-175

B.C. #215
S.W.P.T. 6" Dn
at toe of bk
F.B. 650-175

F.B. 175-75
3/4" I.P. Plug & Tk 8" Dn
at toe of bank
F.B. 650-175

B.C. #215
S.W.P.T. in rock
at toe of bk
F.B. 650-175

Δ = 100
R = 25.90
L = 50.68

Con at bottom page 126

RETURN TO
LOS ANGELES COUNTY SURVEYOR
7od HALL OF RECORDS

Note: Any Additions or Changes on This Sheet Must be Made or Circled in Red Ink With Date and Name of Persbn Making Change.

Do not extend notes this side of this line

FORM 247, 10M 11-35

F.B. 755 Pg. 126

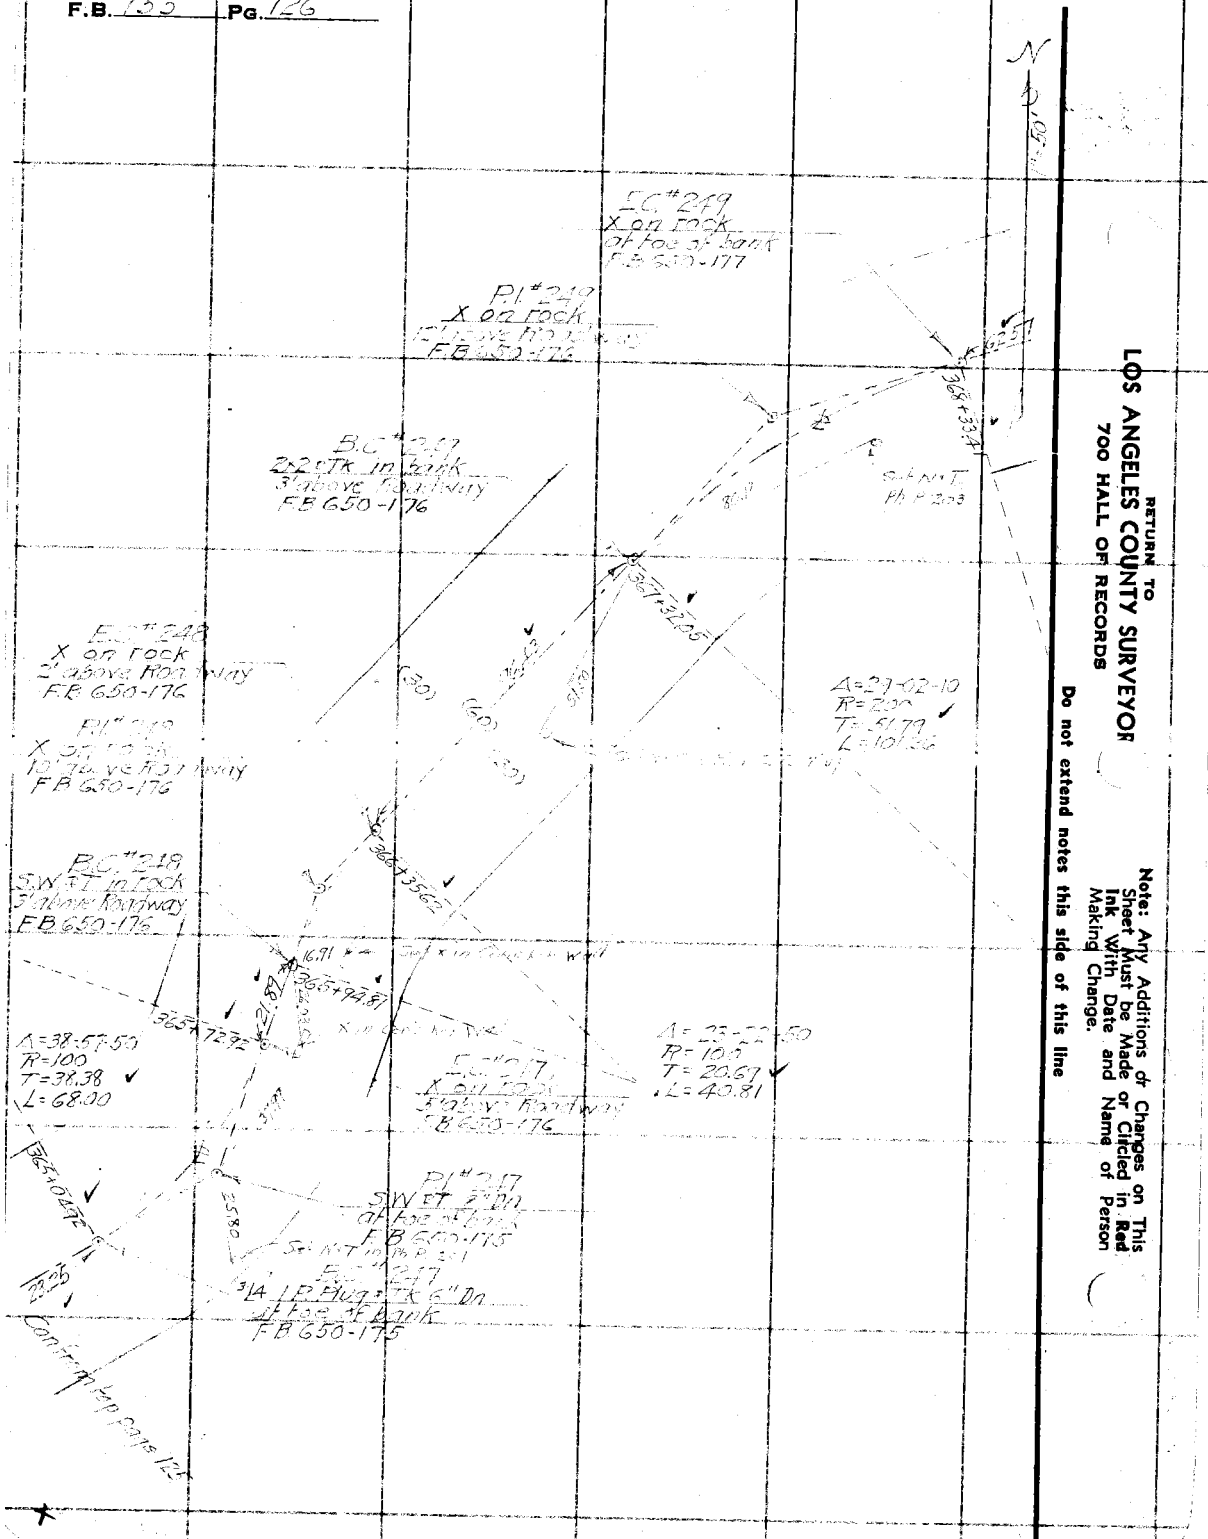

RETURN TO
LOS ANGELES COUNTY SURVEYOR
700 HALL OF RECORDS

Note: Any Additions or Changes on This Sheet Must be Made or Circled in Red Ink With Date and Name of Person Making Change.

Do not extend notes this side of this line

Notes Ck'd by D.	Survey of
Map No. B-1117-A	W. O. 7149 Tape No. St'd °F.
Office Work F. A. W.	Surveyed by W.A.V.
Checked D r e w	Notes Date
Date 12 - 5 - 48	Indexed

F.B. Pg.

1" = 10'

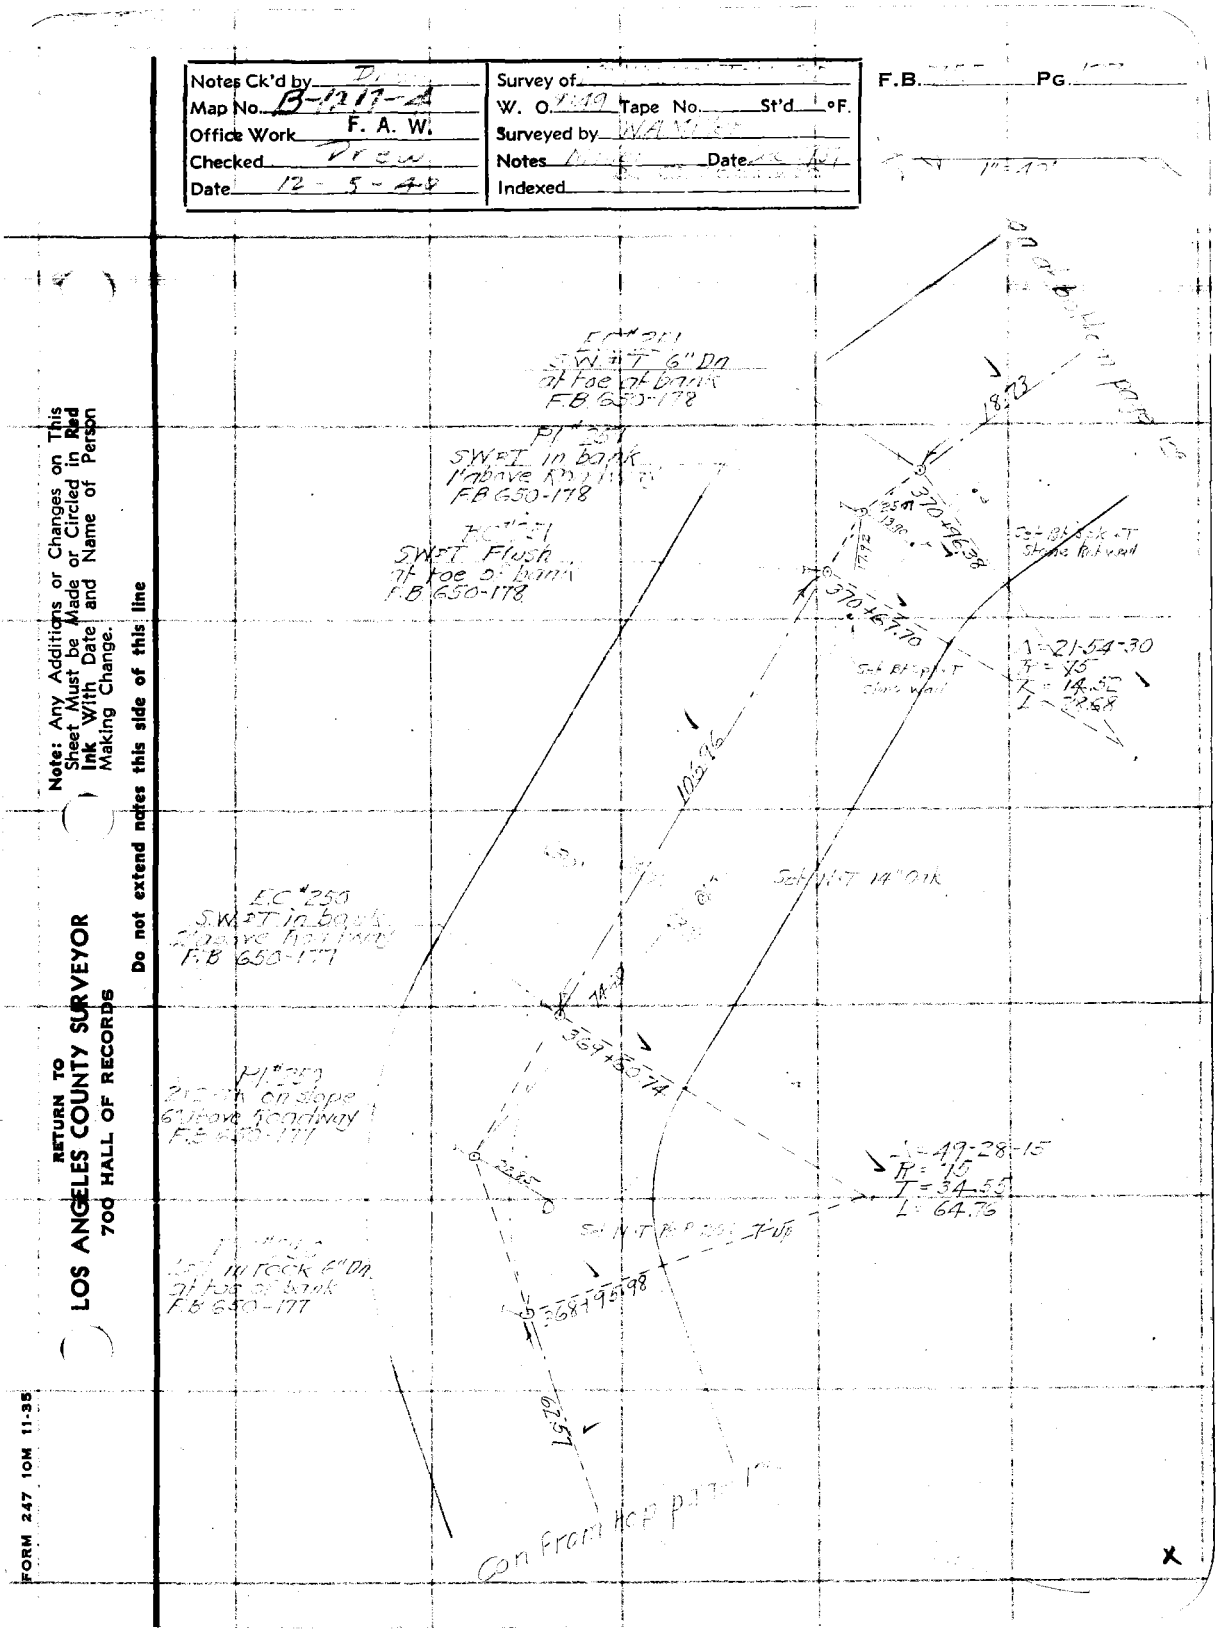
E.C. #250
S.W.P.I. in bank
2' above R.W.L.
F.B. 650-177
P.I. #249
2" C.M. on Slope
6" above Roadway
F.B. 650-177
P.I. #248
1" I.P. in rock 6" Dia.
at toe of bank
F.B. 650-177
Sch. W.T. 14" Oak

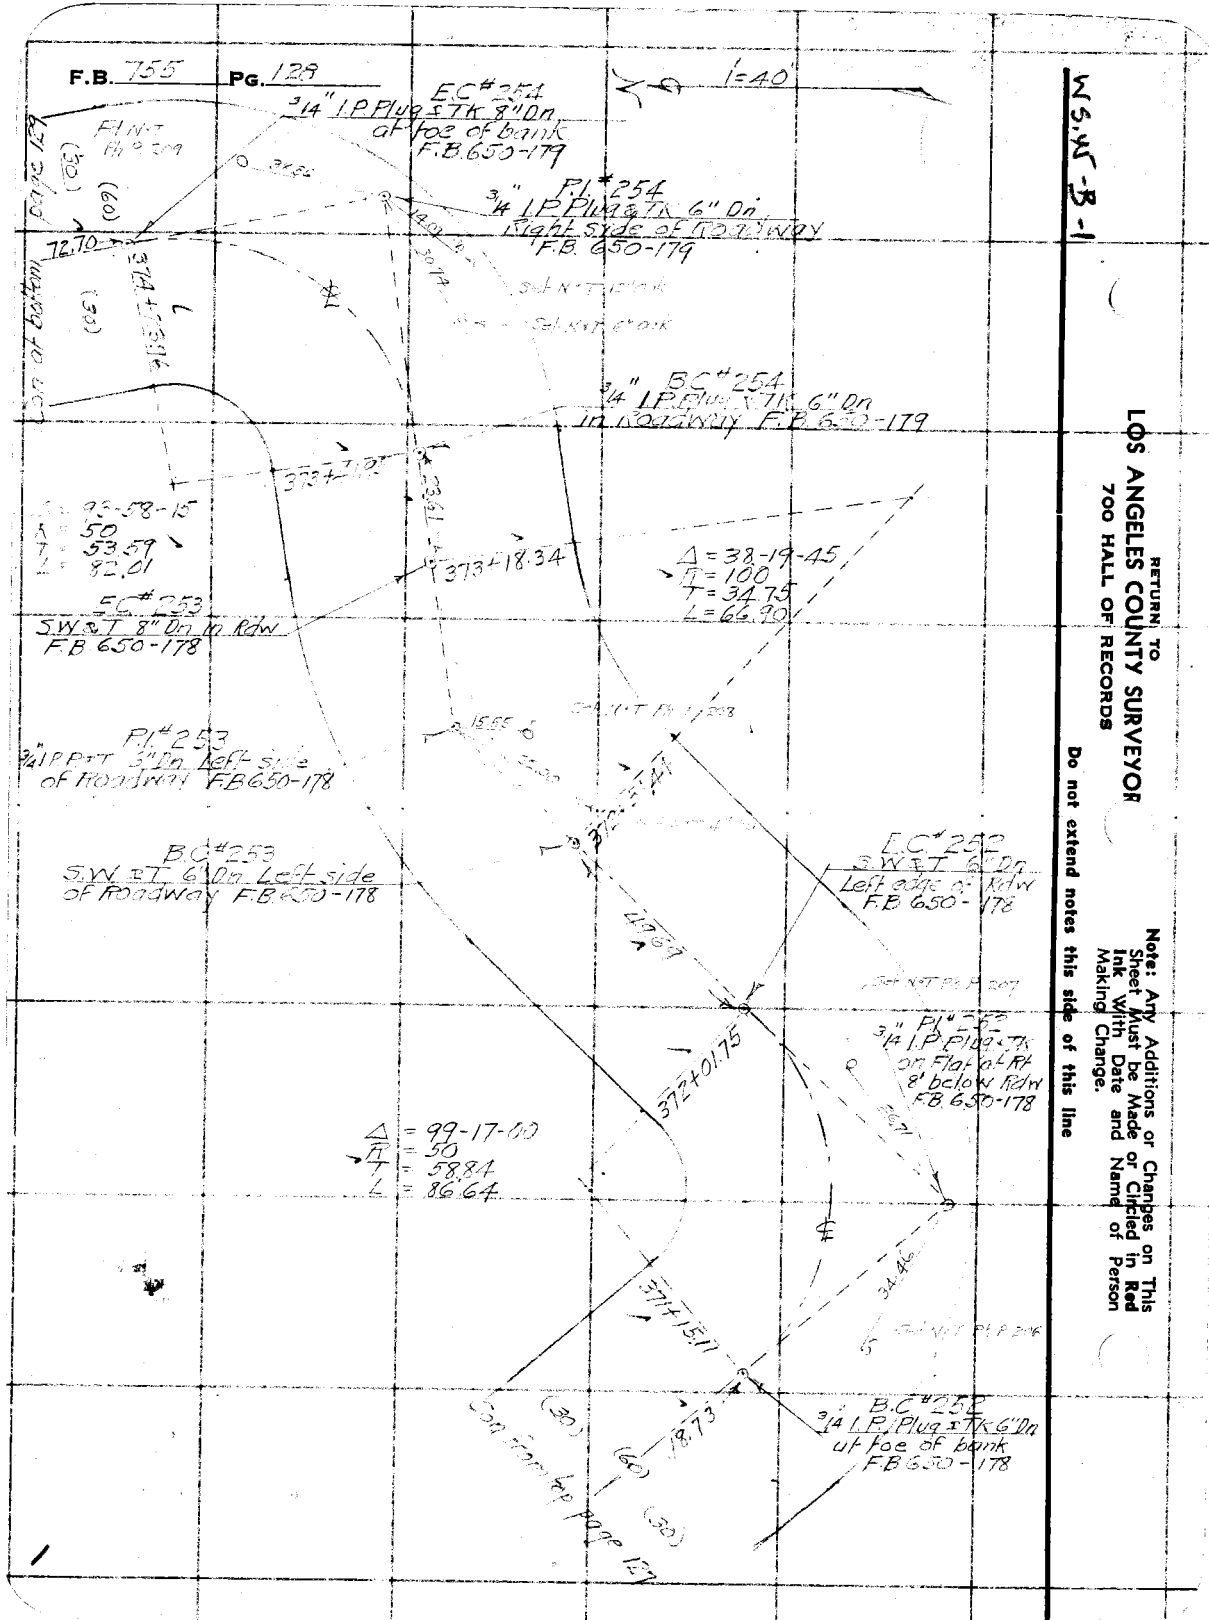
F.B. 755 Pg. 128
1"=40'
EC #254
3/4" I.P. Plug & Tk 8" Dp at toe of bank F.B. 650-179
P.I. #254
3/4" I.P. Plug & Tk 6" Dp Right Side of Roadway F.B. 650-179
BC #254
3/4" I.P. Plug & Tk 6" Dp in Roadway F.B. 650-179
Δ = 95-58-15
R = 50
T = 53.59
L = 82.01
EC #253
S.W. & T. 8" Dp in Rdw F.B. 650-178
P.I. #253
3/4" I.P. P.T.T. 3" Dp. Left Side of Roadway F.B. 650-178
BC #253
S.W. & T. 6" Dp Left side of Roadway F.B. 650-178
Δ = 38-19-45
R = 100
T = 34.75
L = 66.90
EC #252
S.W. & T. 6" Dp Left side of Rdw F.B. 650-178
P.I. #252
3/4" I.P. Plug & Tk on Flat via Pk 8' below Rdw F.B. 650-178
Δ = 99-17-00
R = 50
T = 58.84
L = 86.64
B.C. #252
3/4" I.P. Plug & Tk 6" Dp at toe of bank F.B. 650-178
Toe from top page 127
Top of Bank
Flat N.T.
Pk Nail
Set N.T. P.K. Nail
Set N.T. P.K. Nail & Tag
Set N.T. P.K. Nail & Tag
Set N.T. P.K. Nail & Tag

Notes Ck'd by	Survey of
Map No. B-1217-A	W. O. 8149 Tape No. St'd °F.
Office Work F. A. W.	Surveyed by W A Miller
Checked Drew	Notes Miller Date Dec 1935
Date 12-5-35	Indexed

F.B. 555 Pg. 109

Note: Any Additions or Changes on This Sheet Must be Made or Circled in Red Ink With Date and Name of Person Making Change.

Do not extend notes this side of this line

RETURN TO
LOS ANGELES COUNTY SURVEYOR
700 HALL OF RECORDS

FORM 247 10M 11-35

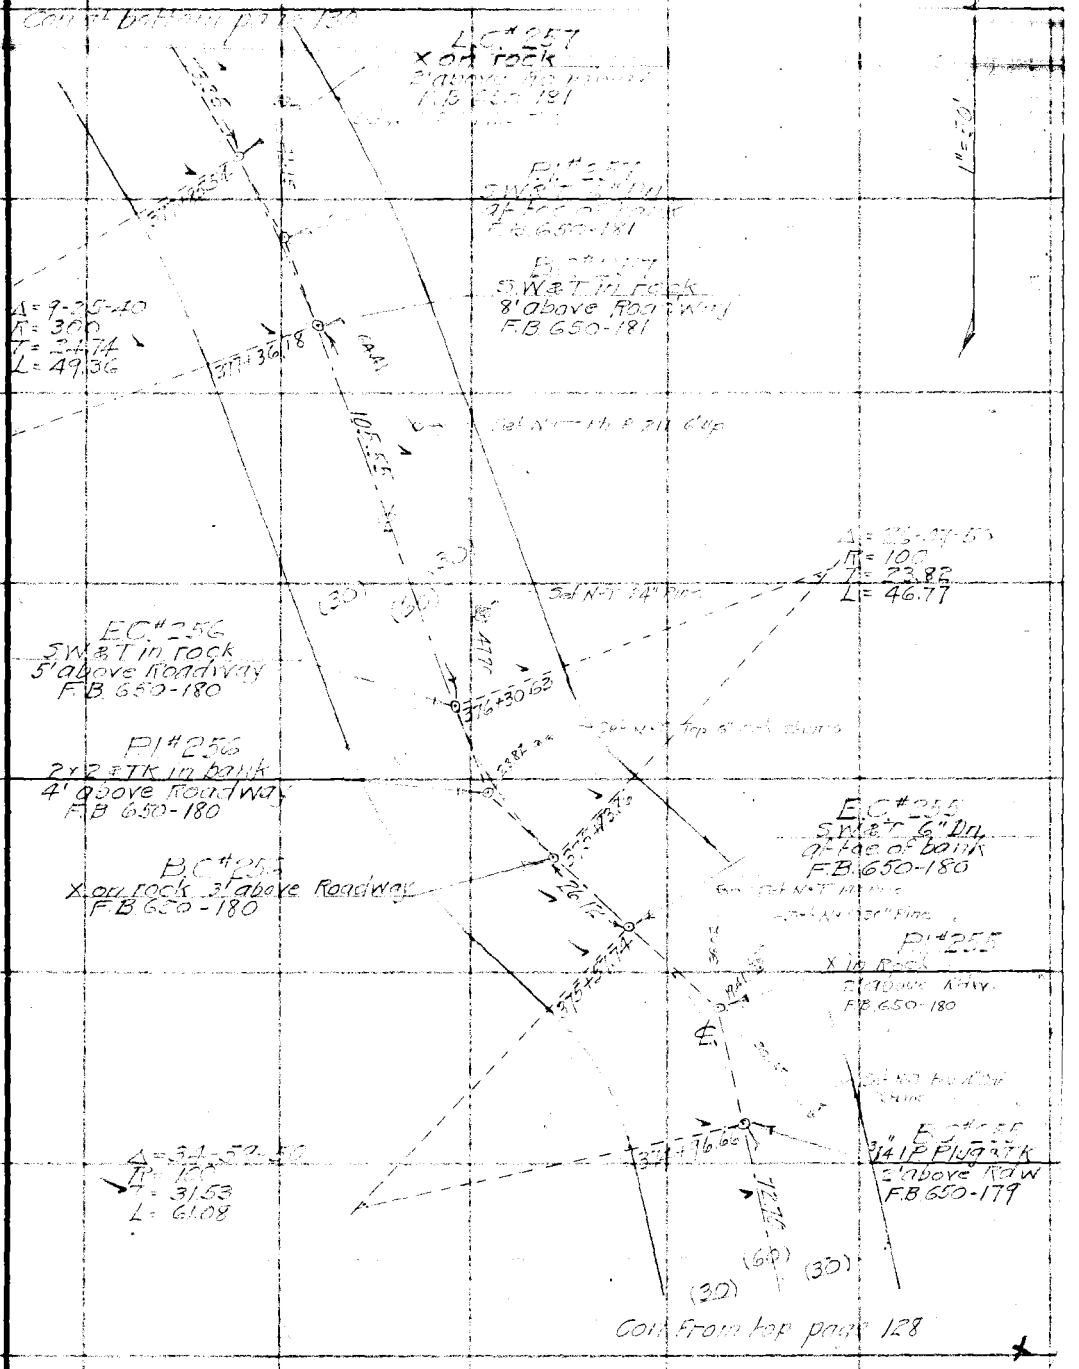

F.B. 755 Pg. 130

W.S. 45-B-1

RETURN TO
LOS ANGELES COUNTY SURVEYOR
700 HALL OF RECORDS

Note: Any Additions or Changes on This Sheet Must be Made or Circled in Red Ink With Date and Name of Person Making Change.

Do not extend notes this side of this line

1" = 40'

EC #261 X on rock 3' above Roadway F.B 650-182

P.I. #261 S.W.F.T. - 5" DR at face of curb F.B 650-182

EC #261 X on rock 3' above Roadway F.B 650-182

Δ = 50-01-40
R = 75
T = 35.12
L = 37.31

Δ = 31-58-10
R = 75
T = 21.48
L = 41.85

380+37.05

380+18.47

EC #260 1 FT 10" rock 3" above Roadway F.B 650-182

P.I. #260 X on rock 3" above Roadway F.B 650-182

379+44.13

379+65.32

F.B. 650-182

F.B. 650-181

379+09.31

Δ = 41-06-15
R = 75
T = 28.13
L = 53.81

379+88.56

Δ = 22-48-40.5
R = 75
T = 15.20
L = 29.67

P.I. #258 X on stone 7' above Roadway F.B 650-181

EC #258 X on stone 3' above Roadway F.B 650-181

(60)

(30)

(30)

(30)

(60)

(30)

Notes Ck'd by	Survey of
Map No. B 121-4	W. O.	Tape No.	St'd °F.
Office Work F. A. W.	Surveyed by
Checked	Notes	Date
Date 12-5-40	Indexed

F.B. Pg.

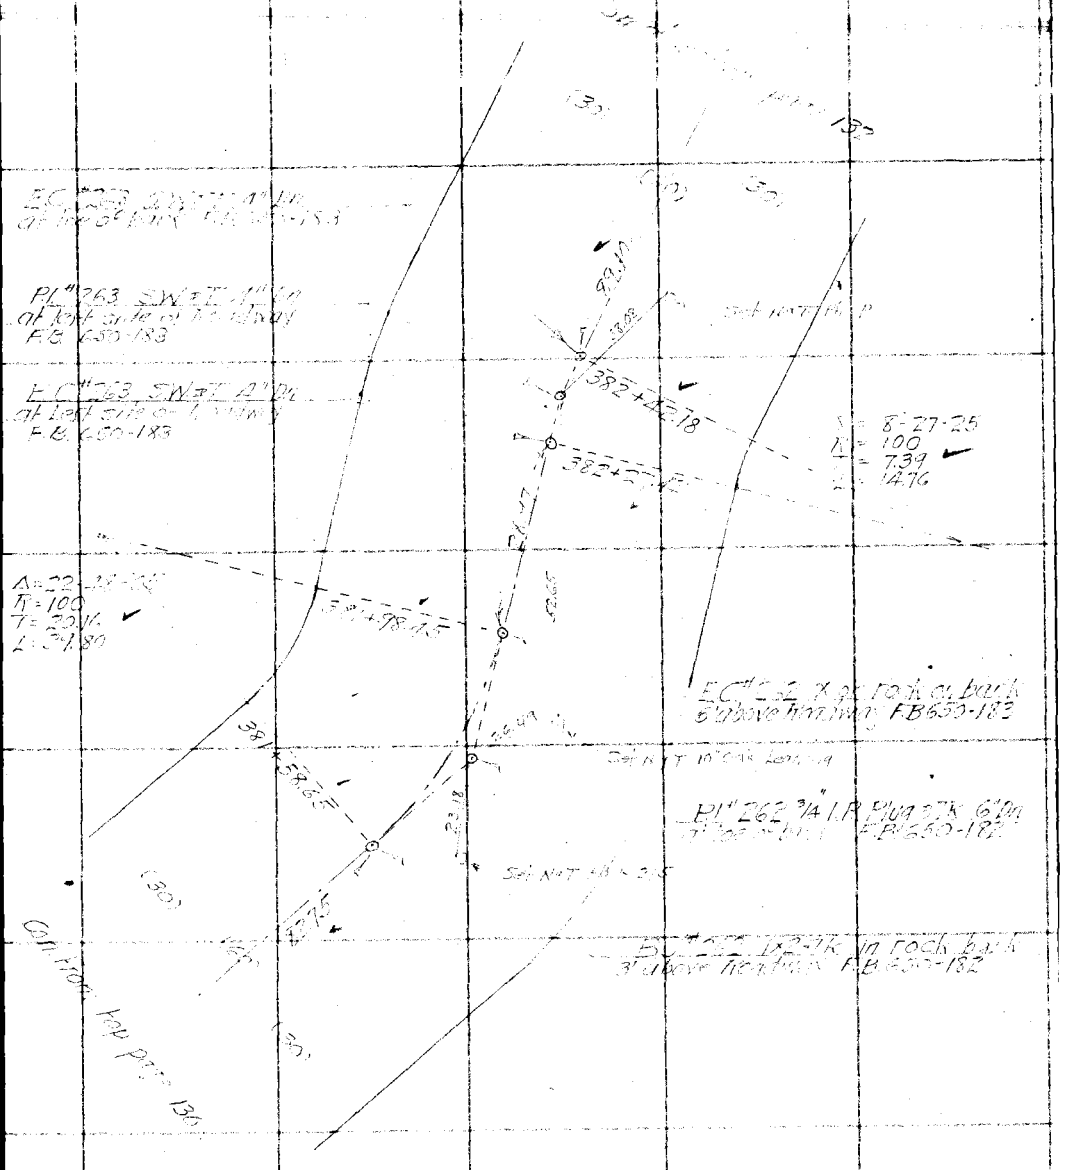

Note: Any Additions or Changes on This Sheet Must be Made or Circled in Red Ink With Date and Name of Person Making Change.

Do not extend notes this side of this line

RETURN TO
LOS ANGELES COUNTY SURVEYOR
700 HALL OF RECORDS

FORM 247 10M 11-38

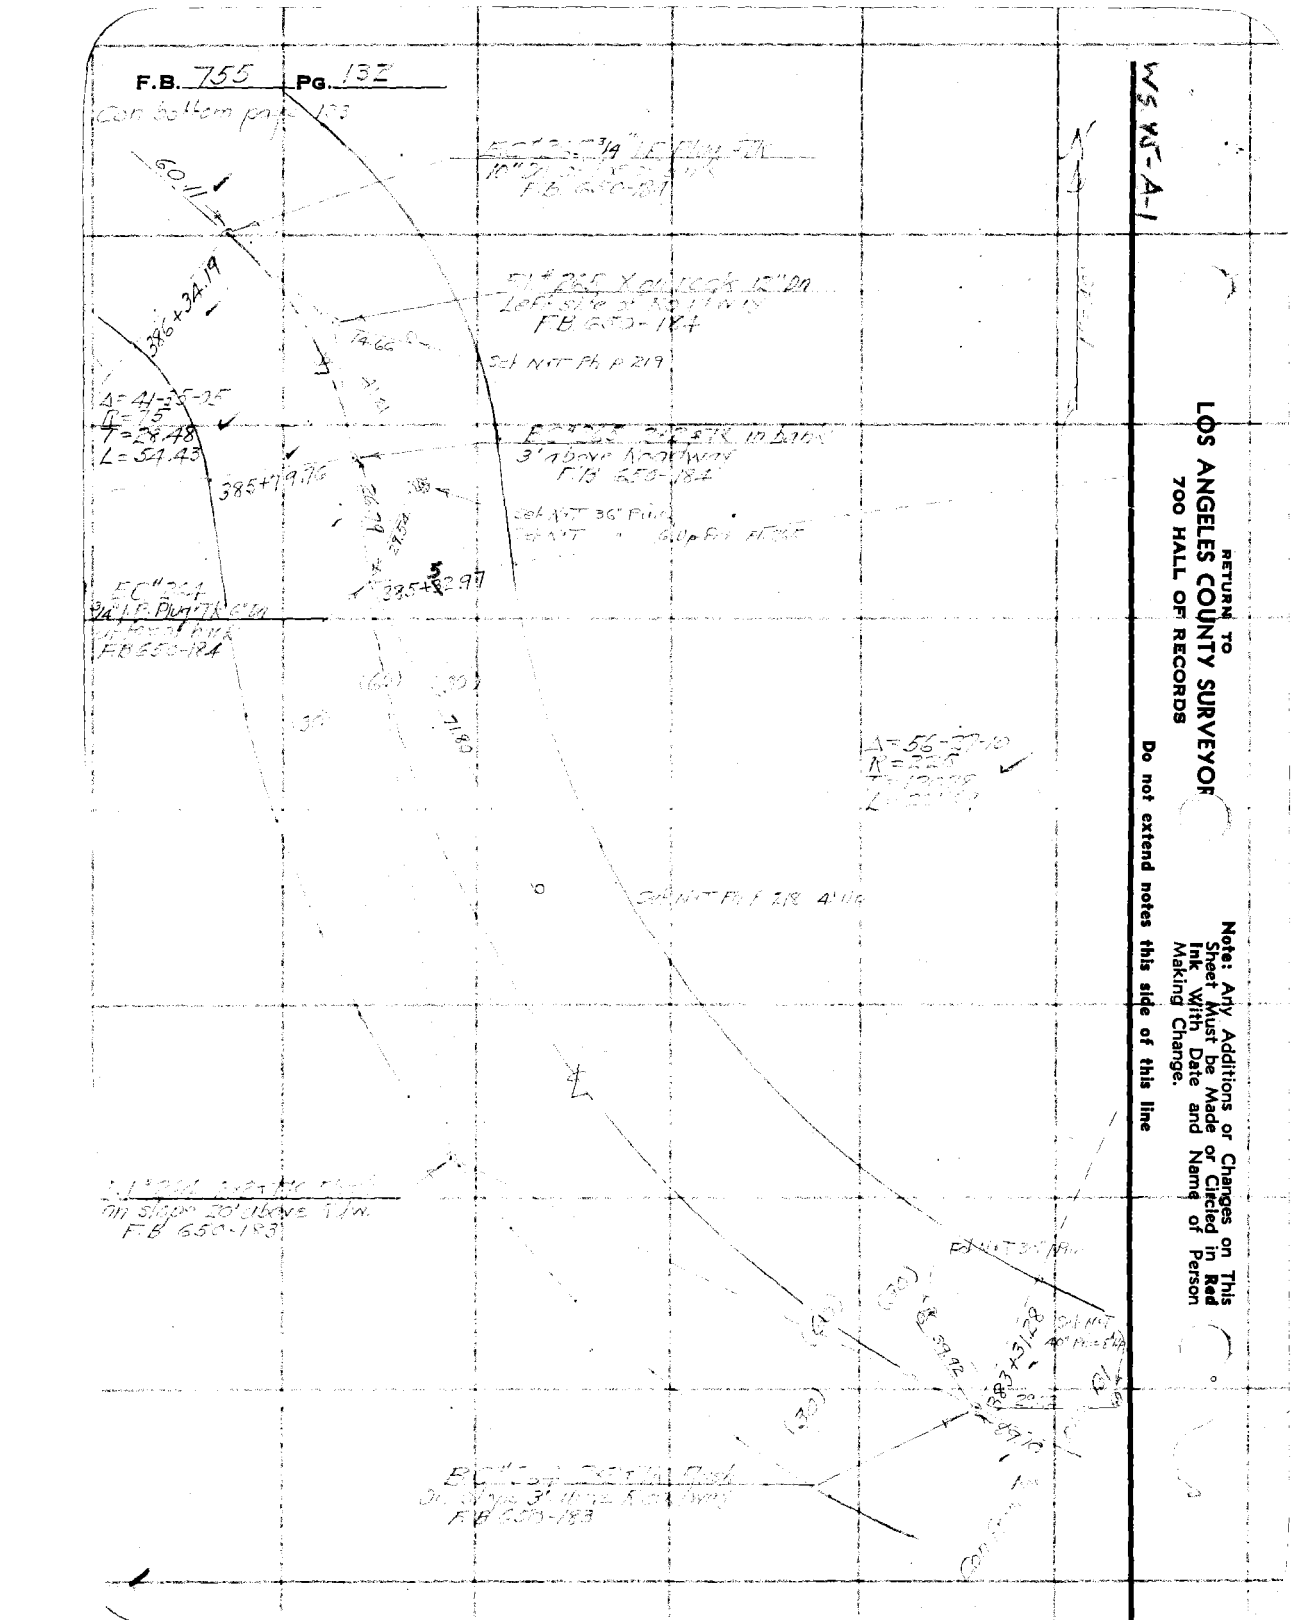
F.B. 755 PG. 132
WS W5-A-1
RETURN TO
LOS ANGELES COUNTY SURVEYOR
700 HALL OF RECORDS
Note: Any Additions or Changes on This Sheet Must be Made or Circled in Red Ink With Date and Name of Person Making Change.
Do not extend notes this side of this line

Notes Ck'd by	Survey of
Map No. 8-1215-4	W. O. 8119 Tape No. St'd °F.
Office Work F. A. W.	Surveyed by
Checked Draw	Notes Date
Date 12-5-	Indexed

F.B. Pg.

Note: Any Additions or Changes on This Sheet Must be Made or Circled in Red Ink With Date and Name of Person Making Change.

Do not extend notes this side of this line

RETURN TO
LOS ANGELES COUNTY SURVEYOR
700 HALL OF RECORDS

FORM 247 10M 11-35

RETURN TO
LOS ANGELES COUNTY SURVEYOR
700 HALL OF RECORDS

Note: Any Additions or Changes on This Sheet Must be Made or Circled in **Red Ink** With Date and Name of Person Making Change.

Do not extend notes this side of this line

W5.15-A-3

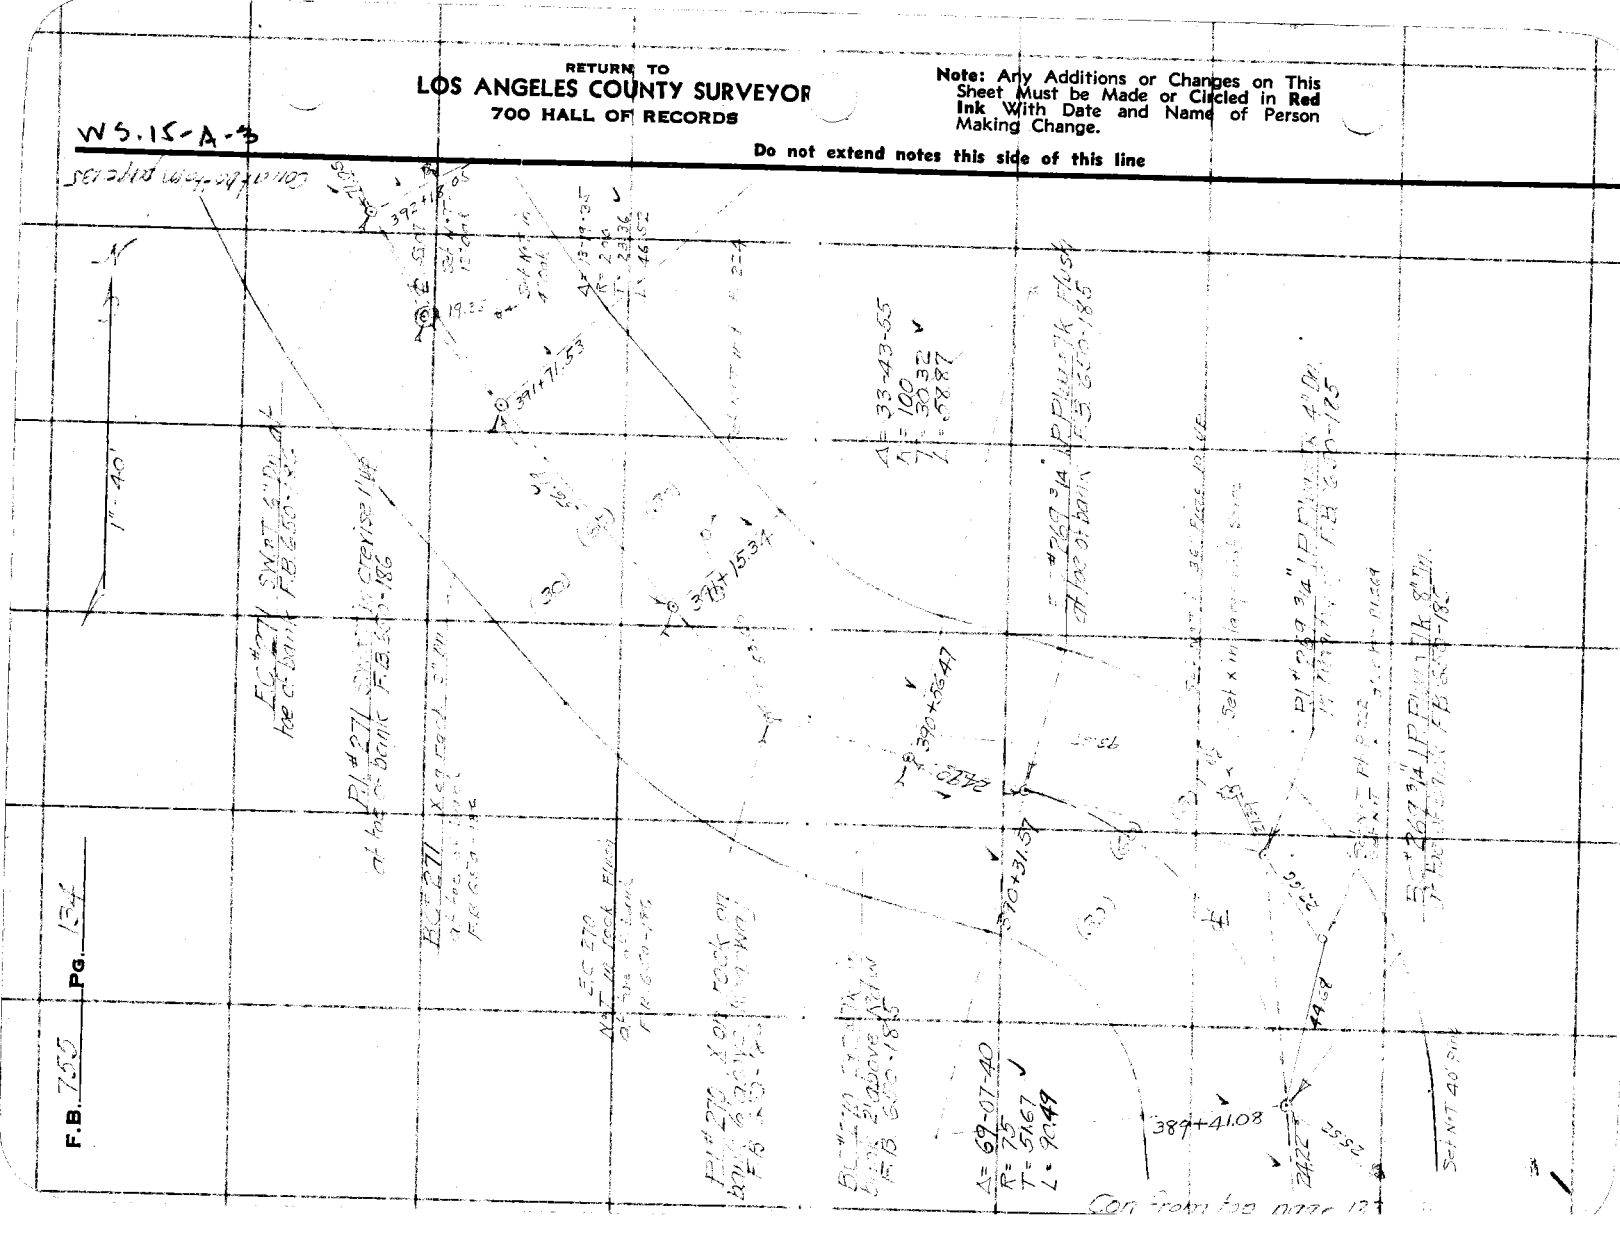

Notes Ck'd by	Survey of
Map No. B-12.17-5	W. O. 7100 Tape No. St'd °F.
Office Work F. A. W.	Surveyed by
Checked	Notes Date
Date 1-7-47	Indexed

F.B. PG.

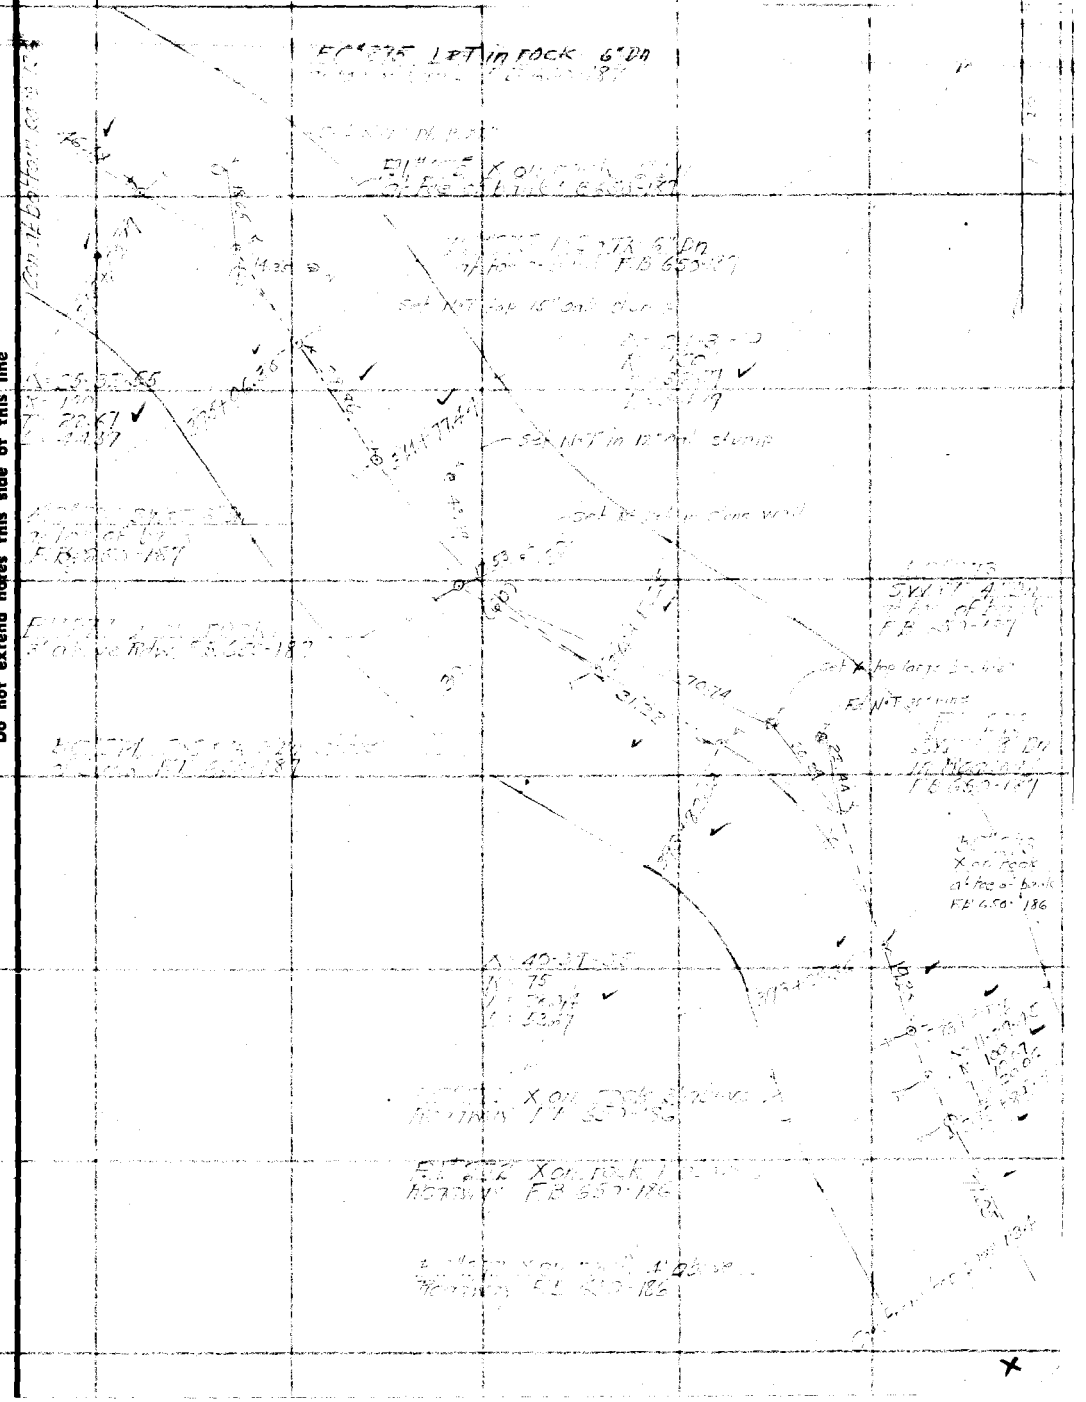

Note: Any Additions or Changes on This Sheet Must be Made or Circled in Red Ink With Date and Name of Person Making Change.

Do not extend notes this side of this line

RETURN TO
LOS ANGELES COUNTY SURVEYOR
700 HALL OF RECORDS

FORM 247 10M 11-38

F.B. 755 Pg. 1:6

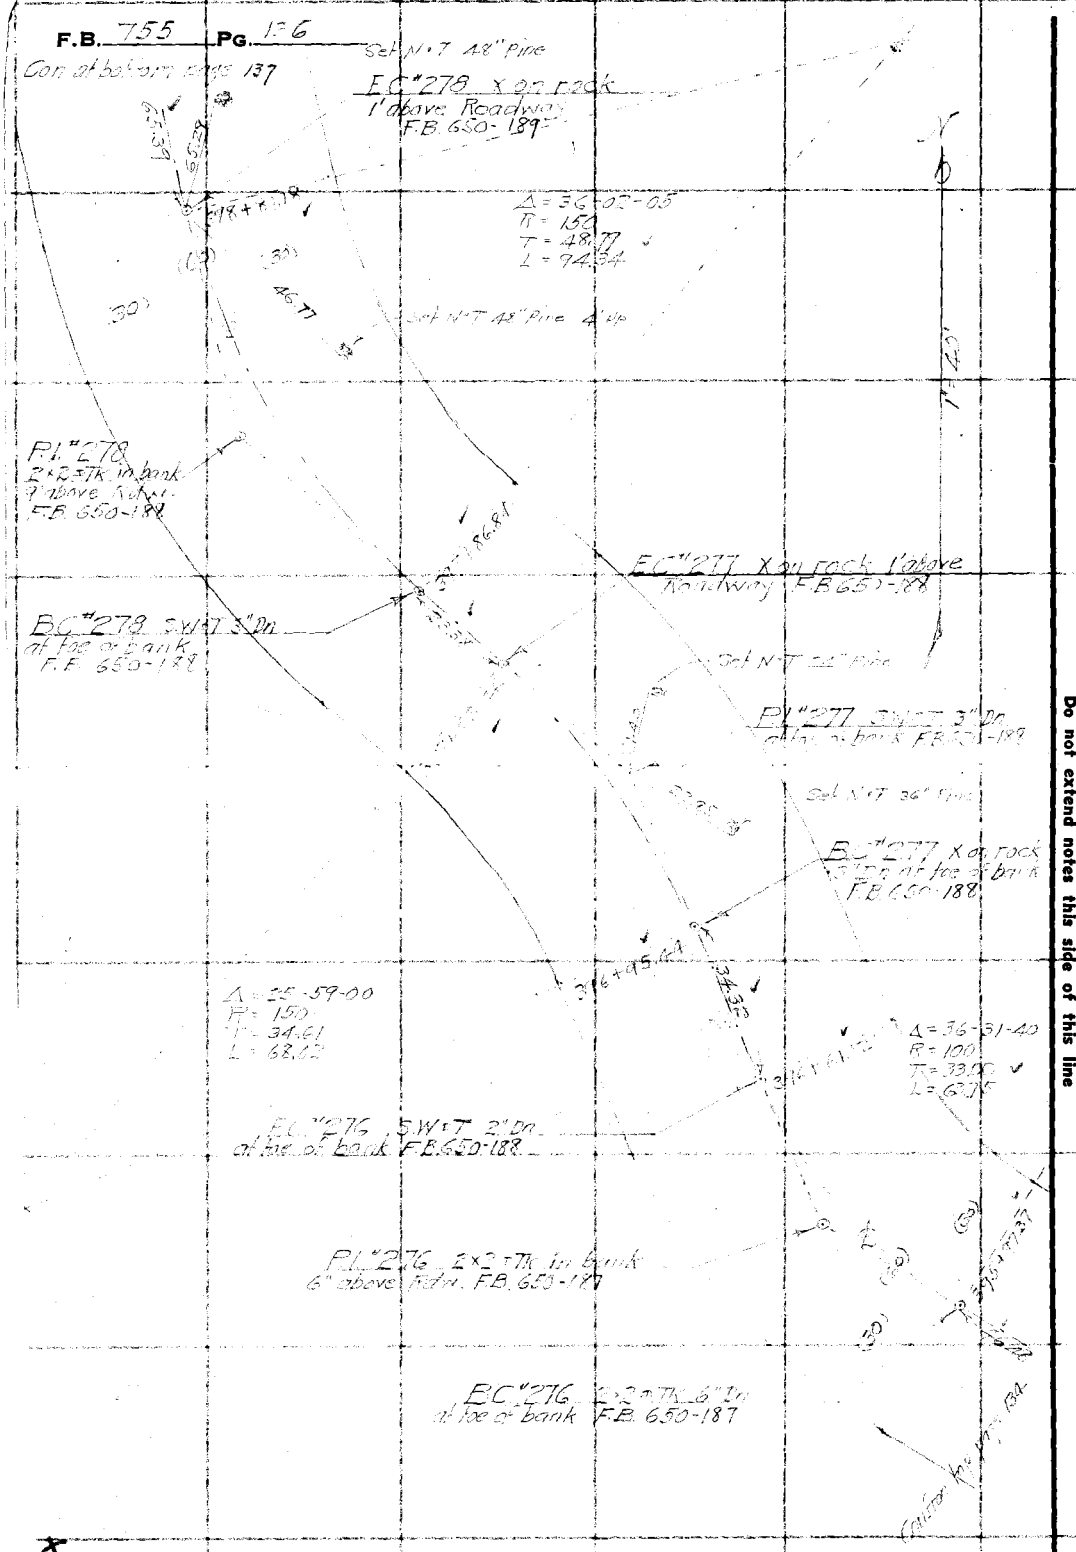

RETURN TO
LOS ANGELES COUNTY SURVEYOR
700 HALL OF RECORDS

Note: Any Additions or Changes on This Sheet Must be Made or Circled in Red Ink With Date and Name of Person Making Change.

Do not extend notes this side of this line

FORM 247 10M 11-35

RETURN TO
LOS ANGELES COUNTY SURVEYOR
700 HALL OF RECORDS

Note: Any Additions or Changes on This Sheet Must be Made or Circled in **Red Ink** With Date and Name of Person Making Change.

Do not extend notes this side of this line

W 15-A-11

Notes Ck'd by
Map No. 63
Office Work F. A. W.
Checked
Date

Survey of
W. O.
Surveyed by
Notes
Indexed

Tape No. St'd °F.
Date

F.B. PG.

F.B. 755 PG. 138

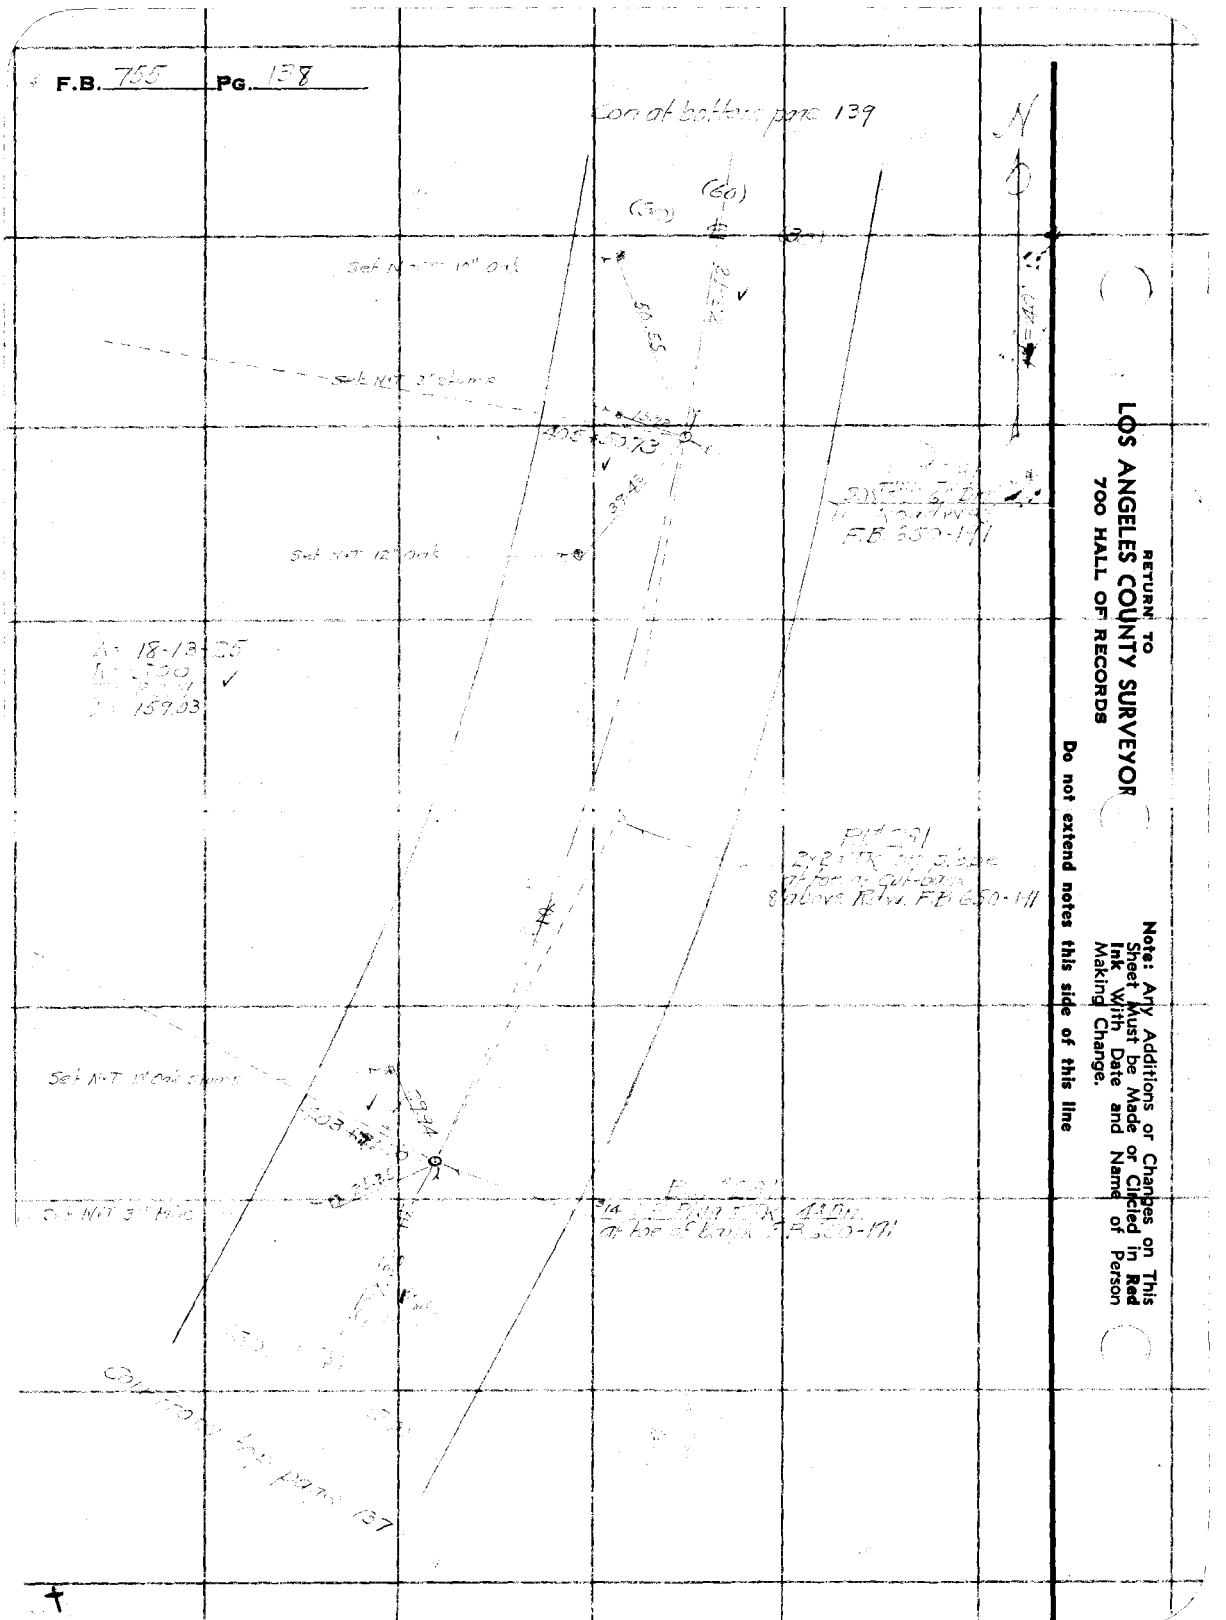
Con at bottom page 139
(60)
Set Nail & tag
Set Nail & tag
Set Nail & tag

Notes Ck'd by	Survey of
Map No. B-210-4	W. O. 8149 Tape No. St'd °F.
Office Work F. A. W.	Surveyed by
Checked D P W	Notes Date
Date 12-5-45	Indexed

F.B. PG.

Note: Any Additions or Changes on This Sheet Must be Made or Circled in Red Ink With Date and Name of Person Making Change.

Do not extend notes this side of this line

RETURN TO
LOS ANGELES COUNTY SURVEYOR
7OO HALL OF RECORDS

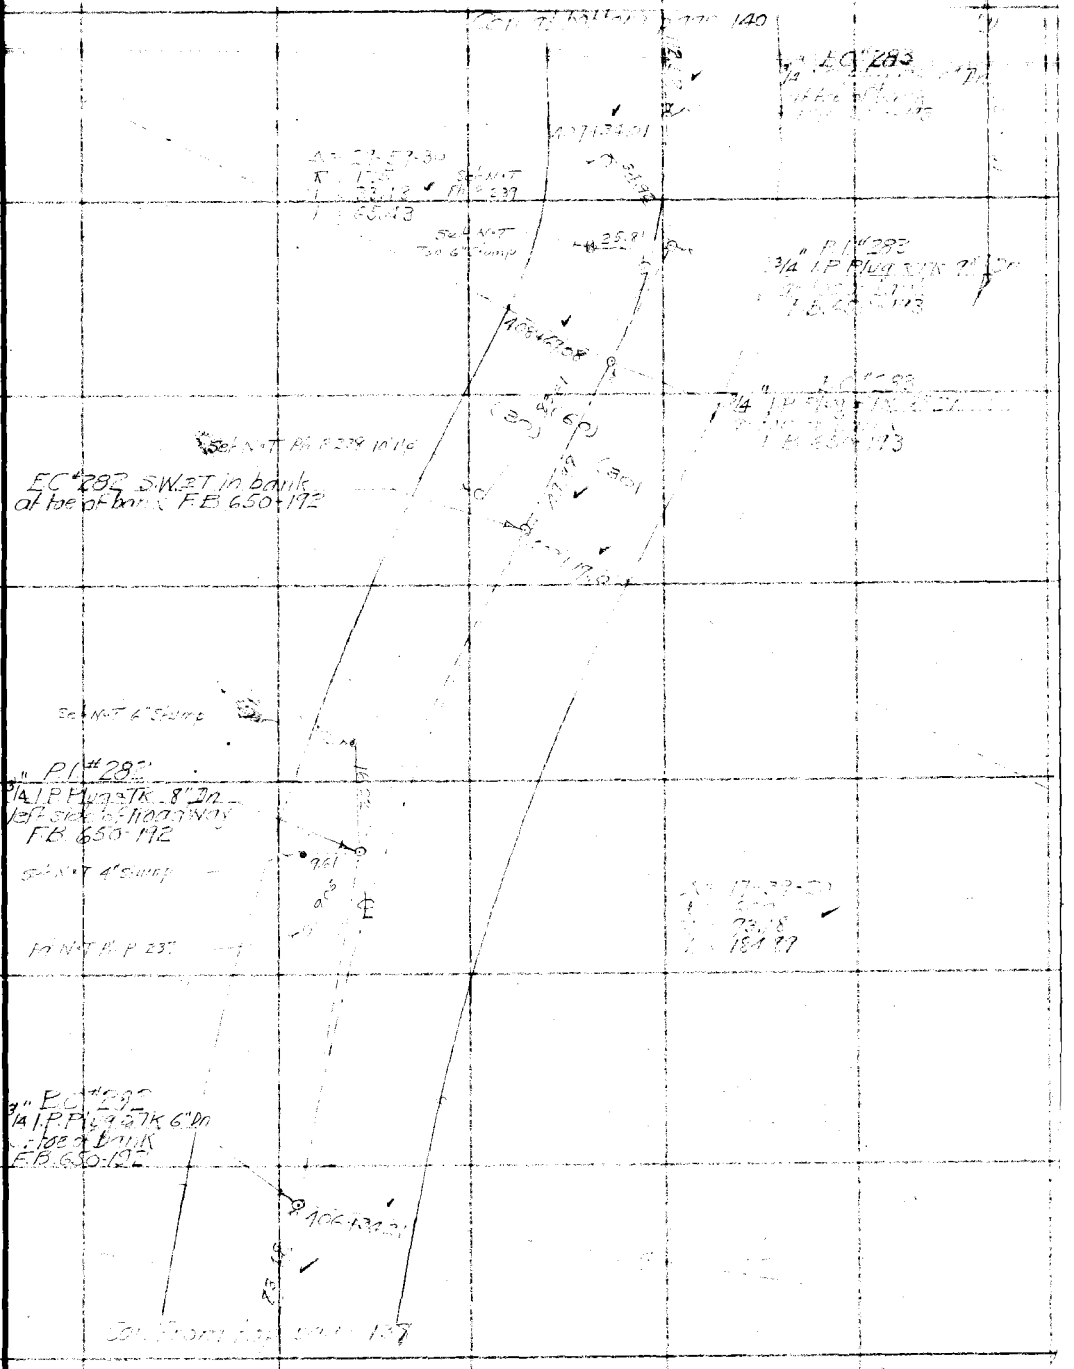

FORM 247 10M 11-38

F.B. 755 Pg. 140

WS.15-A-3

RETURN TO
LOS ANGELES COUNTY SURVEYOR
700 HALL OF RECORDS

Note: Any Additions or Changes on This Sheet Must be Made or Circled in Red Ink With Date and Name of Person Making Change.

Do not extend notes this side of this line

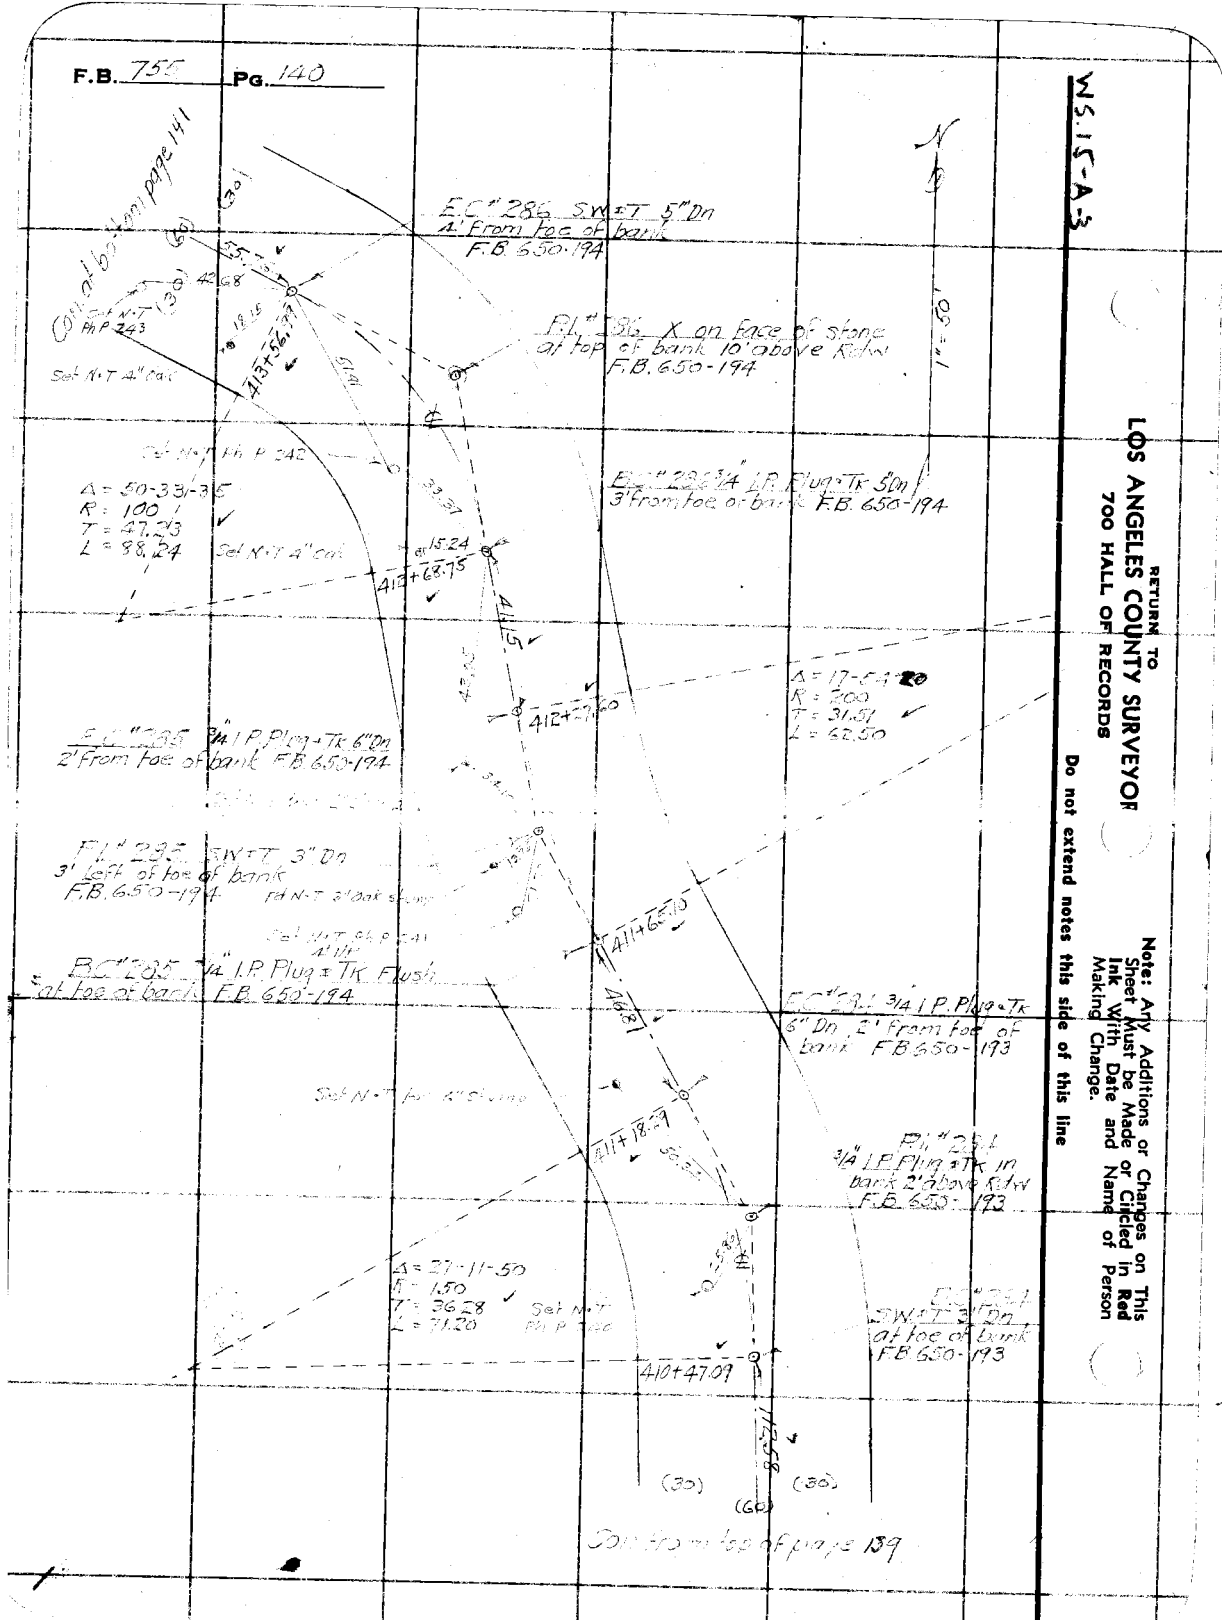
(30)
(60)
(30)
E.C. "286 SW+T 5" Dn
1' From toe of bank
F.B. 650-194
P.I. "286 X on face of stone
at top of bank 10' above R/W
F.B. 650-194
Set N+T 4" Dia
Fd N+T 3/4" Pipe

Notes Ck'd by	Survey of
Map No. B-1217-5	W. O.	Tape No.	St'd °F.
Office Work F. A. W.	Surveyed by
Checked	Notes	Date
Date 12-5-40	Indexed

F.B. ___ PG. ___

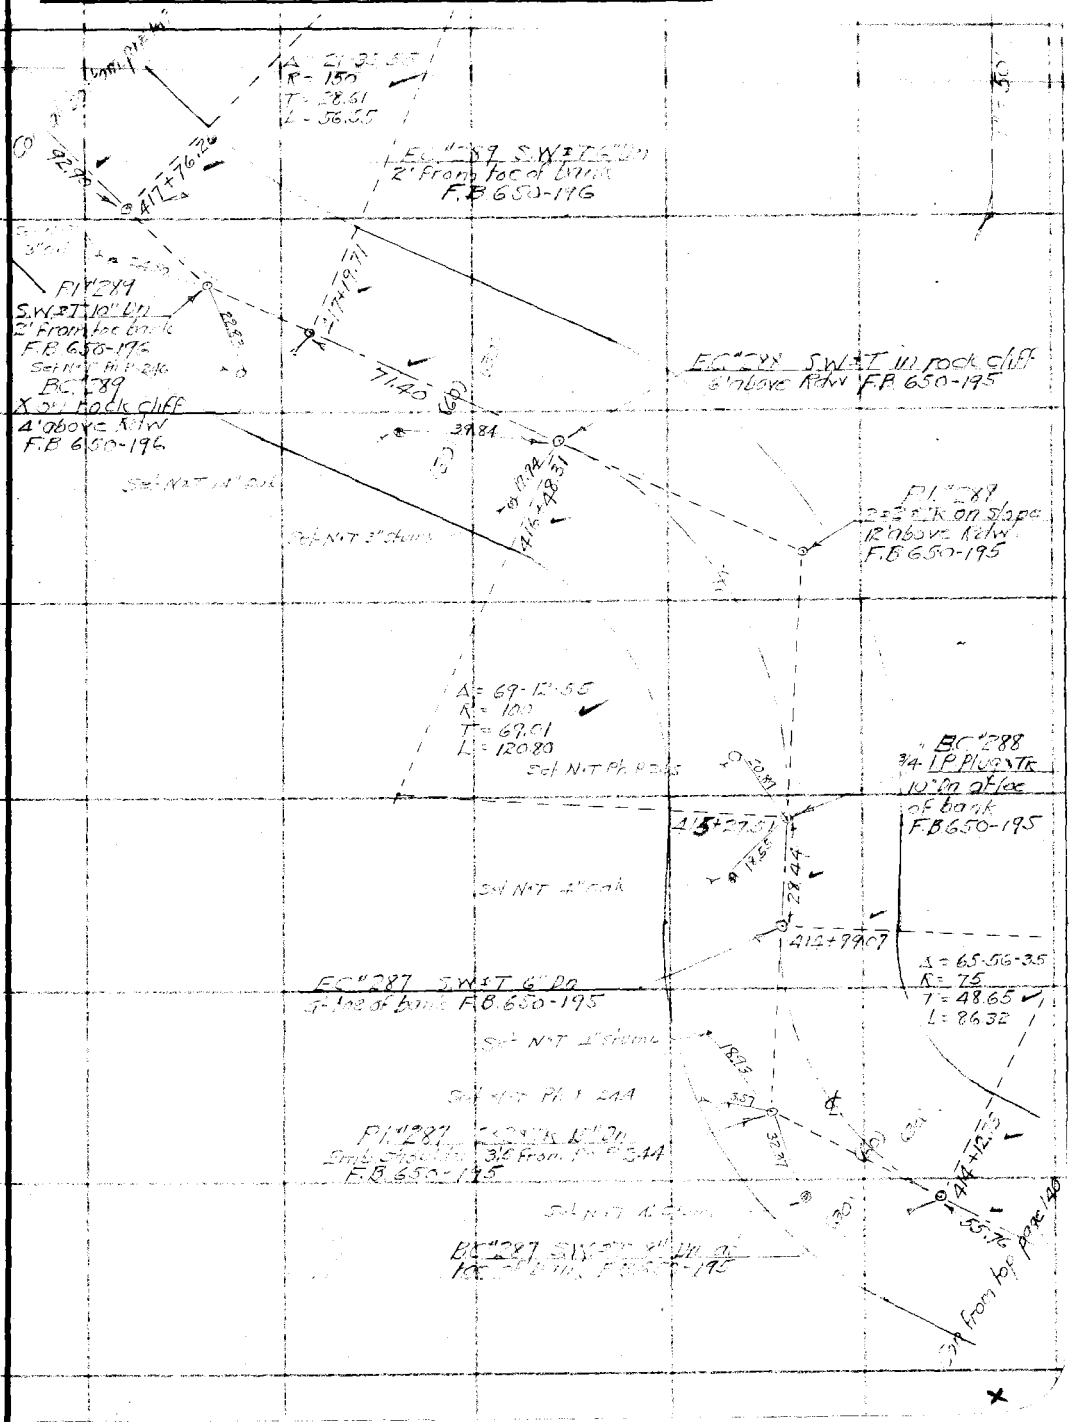
EC "289 S.W.I.P. 2' From face of bank F.B. 650-196
P.I. "289 S.W.I.P. 10" Lip 2' From face of bank F.B. 650-196 Set N.I.T. Ph. 2.6 EC "289 X on Rock Cliff 4' above R/W F.B. 650-196
EC "288 S.W.I.P. in rock cliff 8' above R/W F.B. 650-195
P.I. "289 2" x 2" Tk on slope 12' above R/W F.B. 650-195
EC "288 3/4" I.P. Plug Tk 10' in 2' from face of bank F.B. 650-195
EC "287 S.W.I.P. 6' Do 3' from face of bank F.B. 650-195
P.I. "287 Cross Cut in Stone Step 3.2' From Face of Bank F.B. 650-195
EC "287 S.W.I.P. 10" Lip 2' from face of bank F.B. 650-195
Set N.I.T. 3" Stake
Set N.I.T. Ph. 2.4
Set N.I.T. 4" Stake
Set N.I.T. Ph. 1.2.4
Set N.I.T. 4" Stake
Set N.I.T. Ph. 2.6

F.B. 755 Pg. 142

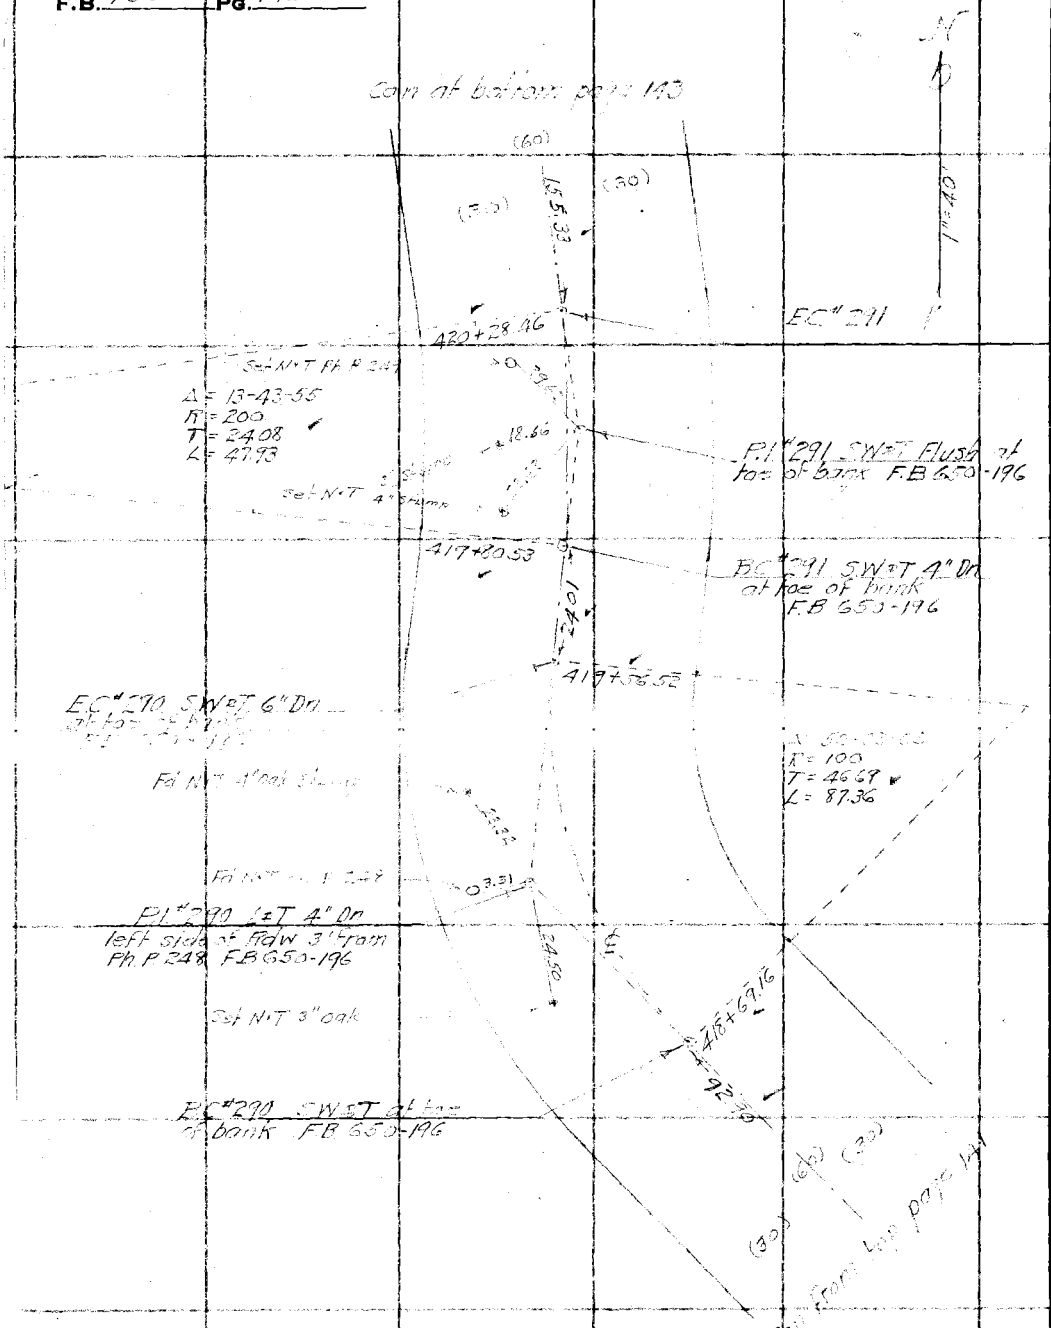

RETURN TO
LOS ANGELES COUNTY SURVEYOR
700 HALL OF RECORDS

Note: Any Additions or Changes on This Sheet Must be Made or Checked in Red Ink With Date and Name of Person Making Change.

Do not extend notes this side of this line

W 3.15-A-3

Notes Ck'd by D. [illegible]	Survey of [illegible]
Map No. 8-12-17 F. A. W.	W. O. 8149 Tape No. St'd °F.
Office Work	Surveyed by W. A. Miller
Checked D. [illegible]	Notes MINE Date Oct 1931
Date 12-5-40	Indexed

F.B. 775 Pg. 143

Con at bottom page 144

(66) (30) (30)

EC # 294 Lt T 6" Dn at toe of cliff F.B. 650-197

Δ = 31-23-35
R = 100
T = 28.10
L = 54.79

31.13

424+22.29

Set N·T 12" Oak

P.I. # 294 Lt T "A" Dn 5' from toe of cliff F.B. 650-197

Set N·T Rh P 251 NCO

423+67.50

B.C. # 294 S.W. Lt T 6" Dn at toe of bank F.B. 650-197

55.39

Δ = 15-35-20
R = 150
T = 20.53
L = 40.81

Set N·T 8" Oak

428+12.11

EC # 293 S.W. Lt T 5" Dn at toe of bank F.B. 650-197

Set N·T 10" Oak

P.I. # 293 Lt T 3" Dn at toe of bank F.B. 650-197

B.C. # 293 3/4" I.P. Flush Tk 6" Dn at toe of bank F.B. 650-197

Set N·T Rh P 251

EC # 292 S.W. Lt T 6" Dn at toe of bank F.B. 650-197

P.I. # 292 2"x2" Tk at top of bank 8' above R/W F.B. 650-197

3/4" I.P. Flush Tk at toe of bank F.B. 650-197

Δ = 94-27-50
R = 75
T = 30.66
L = 58.20

Set N·T 4" stump

Set N·T 3" oak Stump

Set N·T Rh P 250

421+83.79

(60)

(30)

Con from bar page 142

RETURN TO
LOS ANGELES COUNTY SURVEYOR
700 HALL OF RECORDS

Note: Any Additions or Changes on This Sheet Must be Made or Circled in Red Ink With Date and Name of Person Making Change.

Do not extend notes this side of this line

FORM 247 10M 11-35

F.B. 755 Pg. 144

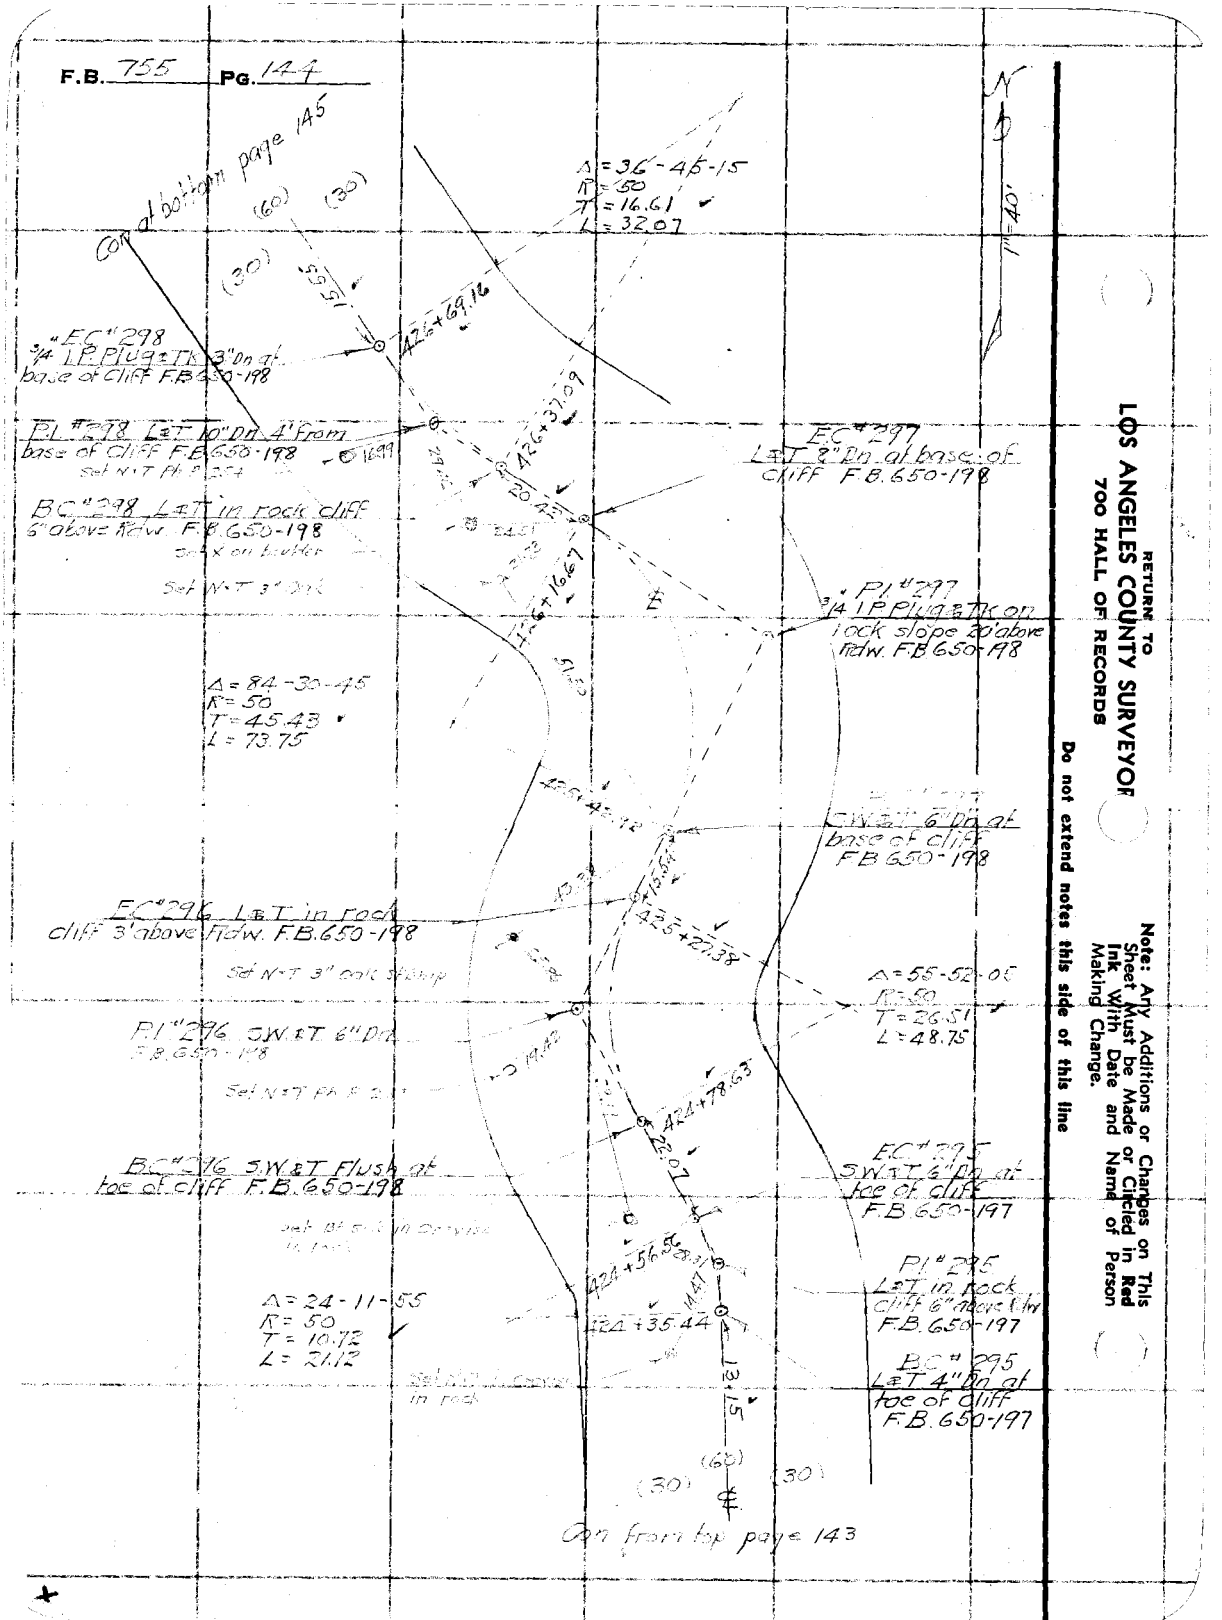

RETURN TO
LOS ANGELES COUNTY SURVEYOR
700 HALL OF RECORDS

Note: Any Additions or Changes on This Sheet Must be Made or Circled in Red Ink With Date and Name of Person Making Change.

Do not extend notes this side of this line

Notes Ck'd by	Survey of
Map No. B-1117	W. O. 8147 Tape No. St'd °F.
Office Work F. A. W.	Surveyed by
Checked	Notes Date
Date	Indexed

F.B. Pg.

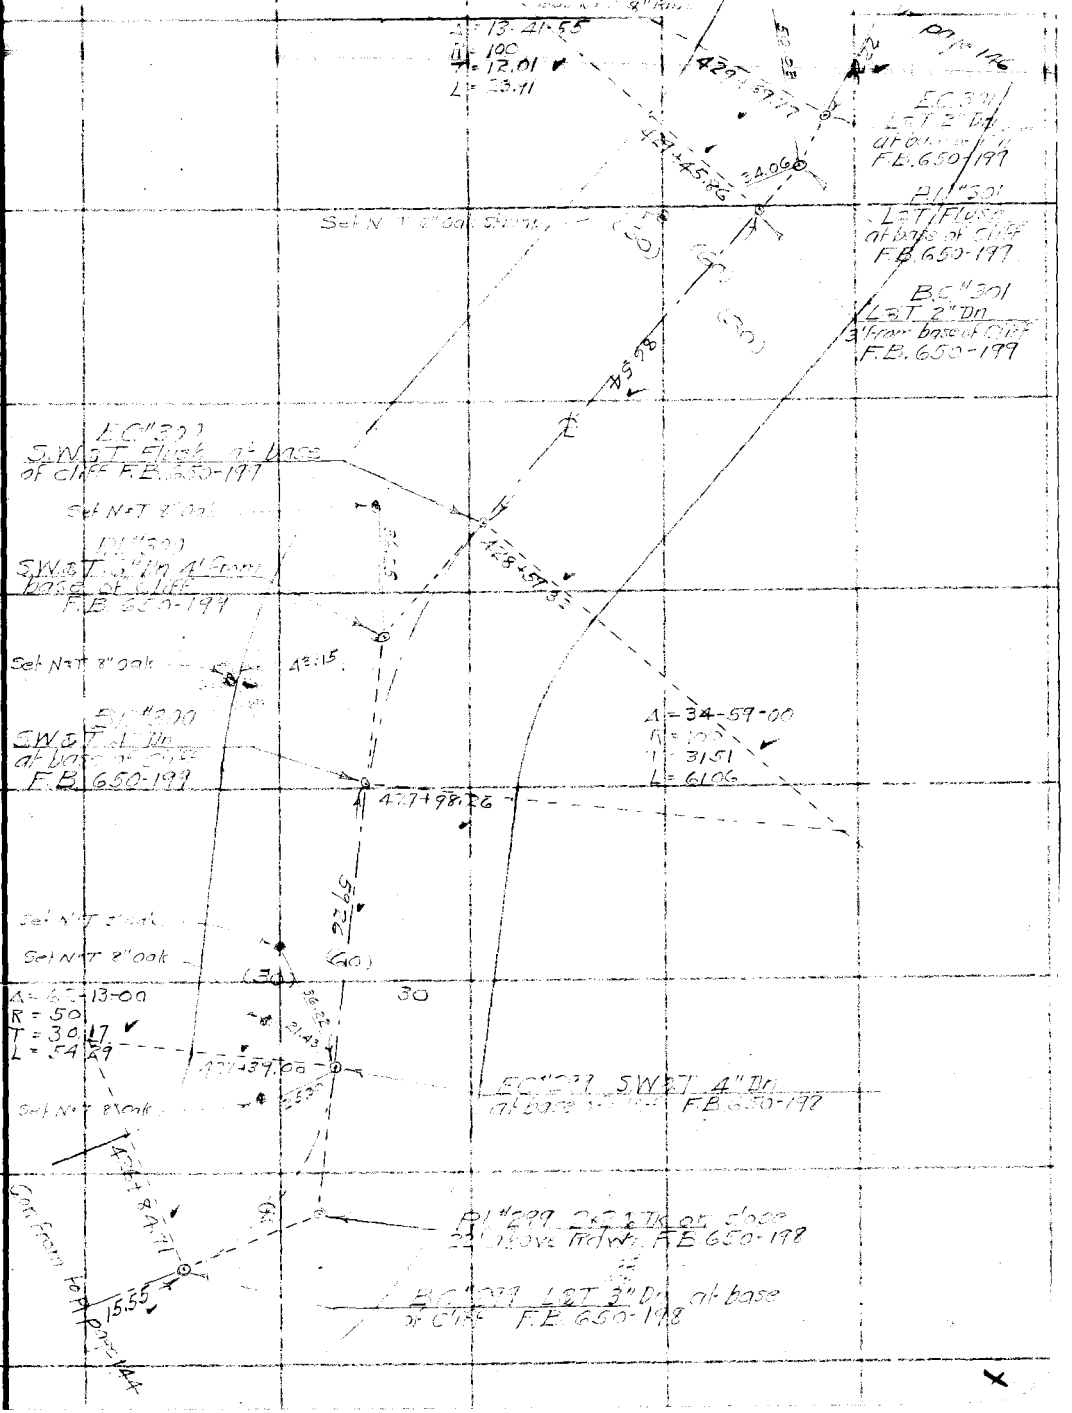

Note: Any Additions or Changes on This Sheet Must be Made in Red Ink With Date and Name of Person Making Change.

Do not extend notes this side of this line

RETURN TO
LOS ANGELES COUNTY SURVEYOR
700 HALL OF RECORDS

FORM 247 10M 11-35

F.B. 755 PG. 146

W5.15-A-5

RETURN TO
LOS ANGELES COUNTY SURVEYOR
700 HALL OF RECORDS

Note: Any Additions or Changes on This Sheet Must be Made or Circled in Red Ink With Date and Name of Person Making Change.

Do not extend notes this side of this line

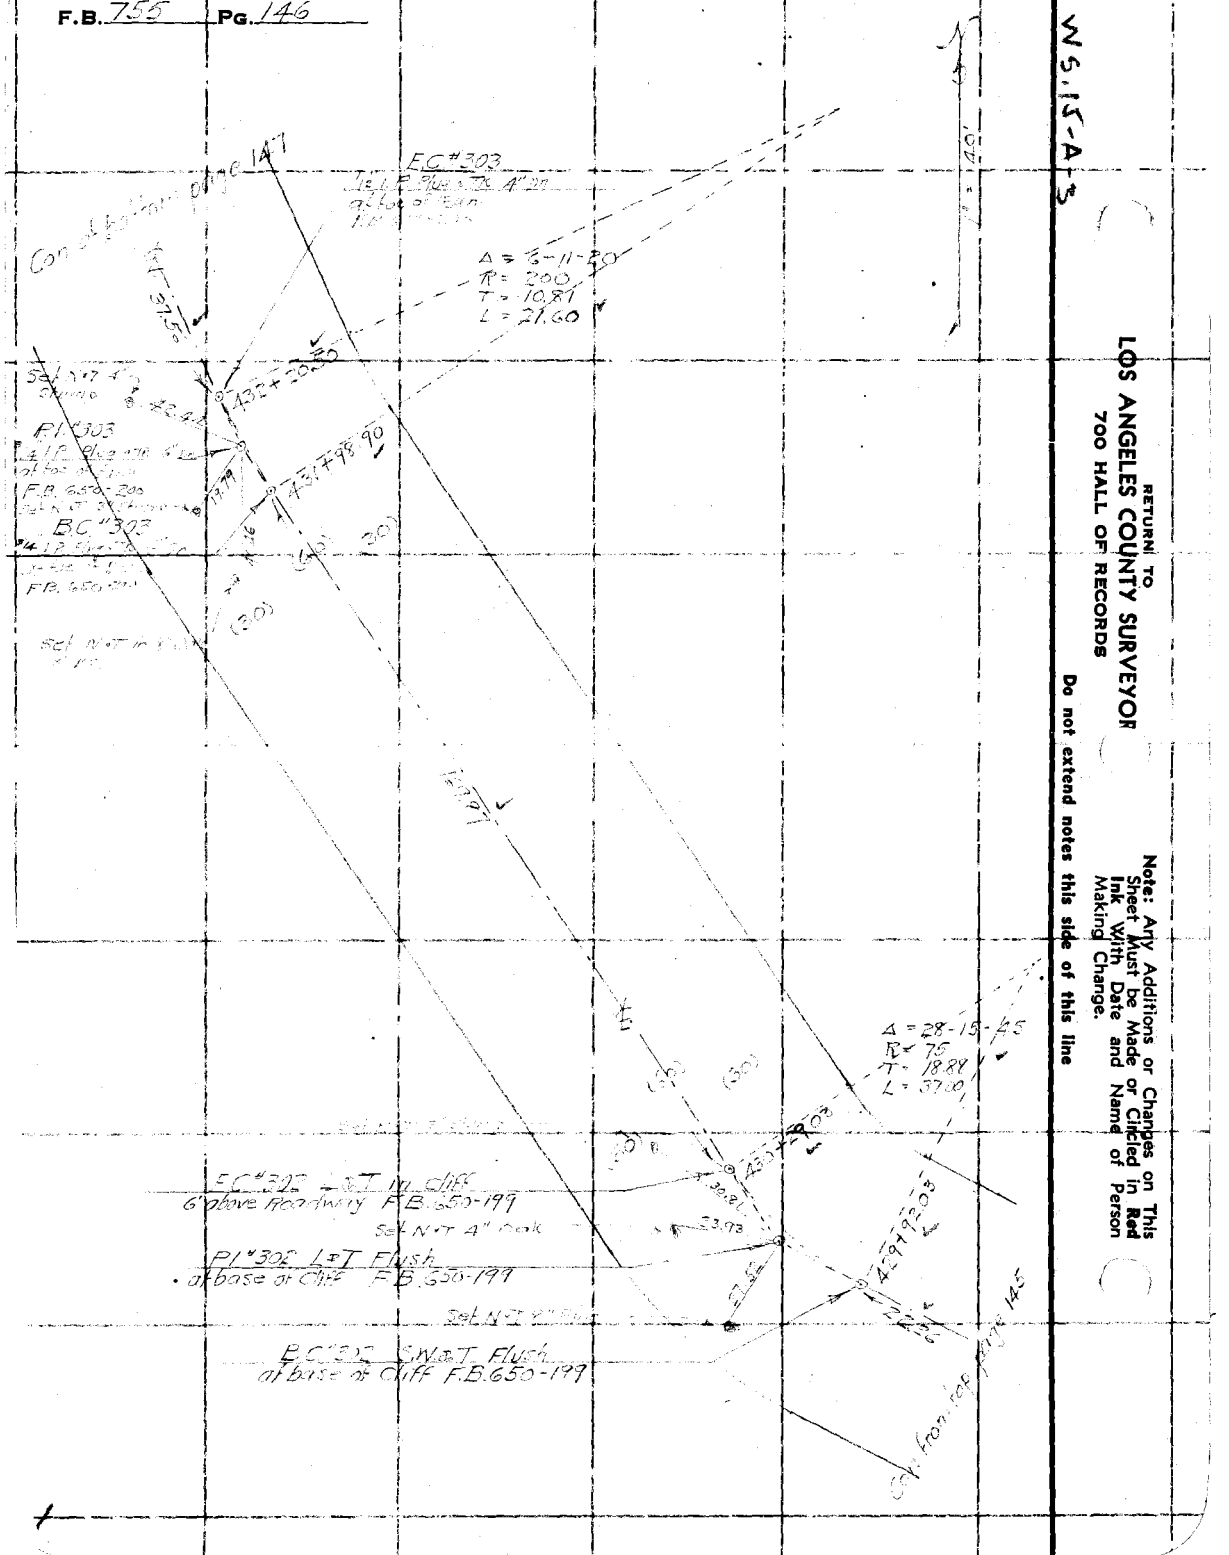
EC #303
Δ = 15-11-50
R = 200
T = 10.81
L = 21.60
Δ = 28-15-45
R = 75
T = 18.88
L = 37.00
EC #302
6' above Roadway F.B. 650-199
Set N-T 4" nail
PI #302 L&T Flush
at base of Cliff F.B. 650-199
BC #302
L&T Flush
at base of Cliff F.B.650-199

Notes Ck'd by	Survey of
Map No. 8-1217 5	W. O. 8177 Tape No. St'd °F.
Office Work F. A. W.	Surveyed by
Checked	Notes Date
Date	Indexed

F.B. Pg.

Note: Any Additions or Changes on This Sheet Must be Made in Red Ink With Date and Name of Person Making Change.

Do not extend notes this side of this line

RETURN TO
LOS ANGELES COUNTY SURVEYOR
7OO HALL OF RECORDS

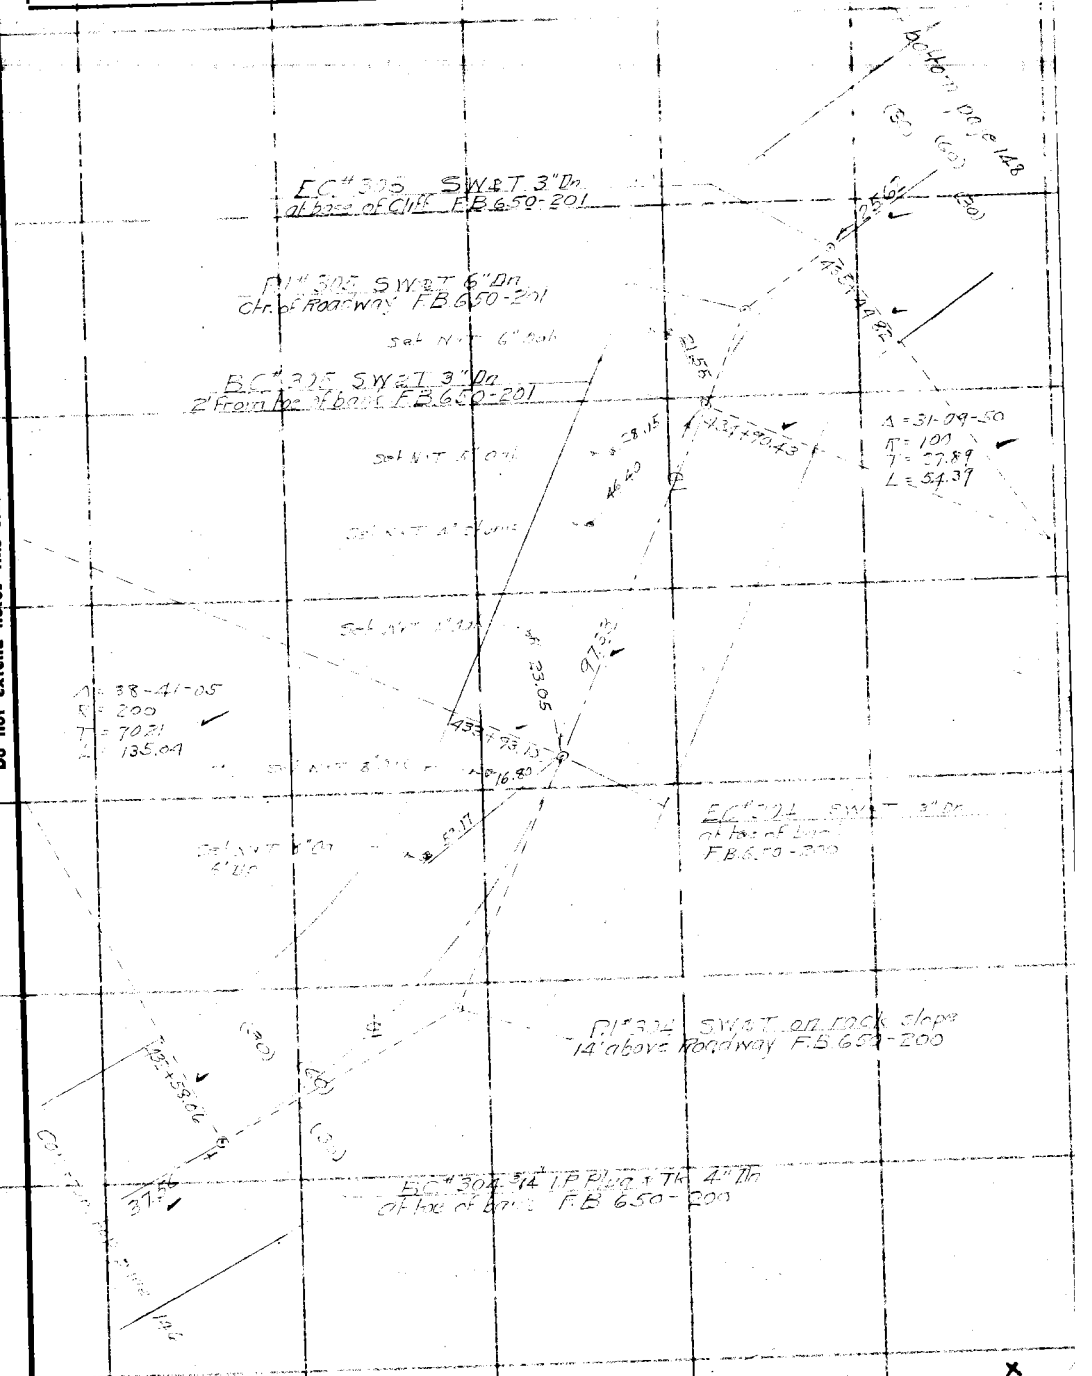

FORM 247 10M 11-38

F.B. 755 Pg. 148

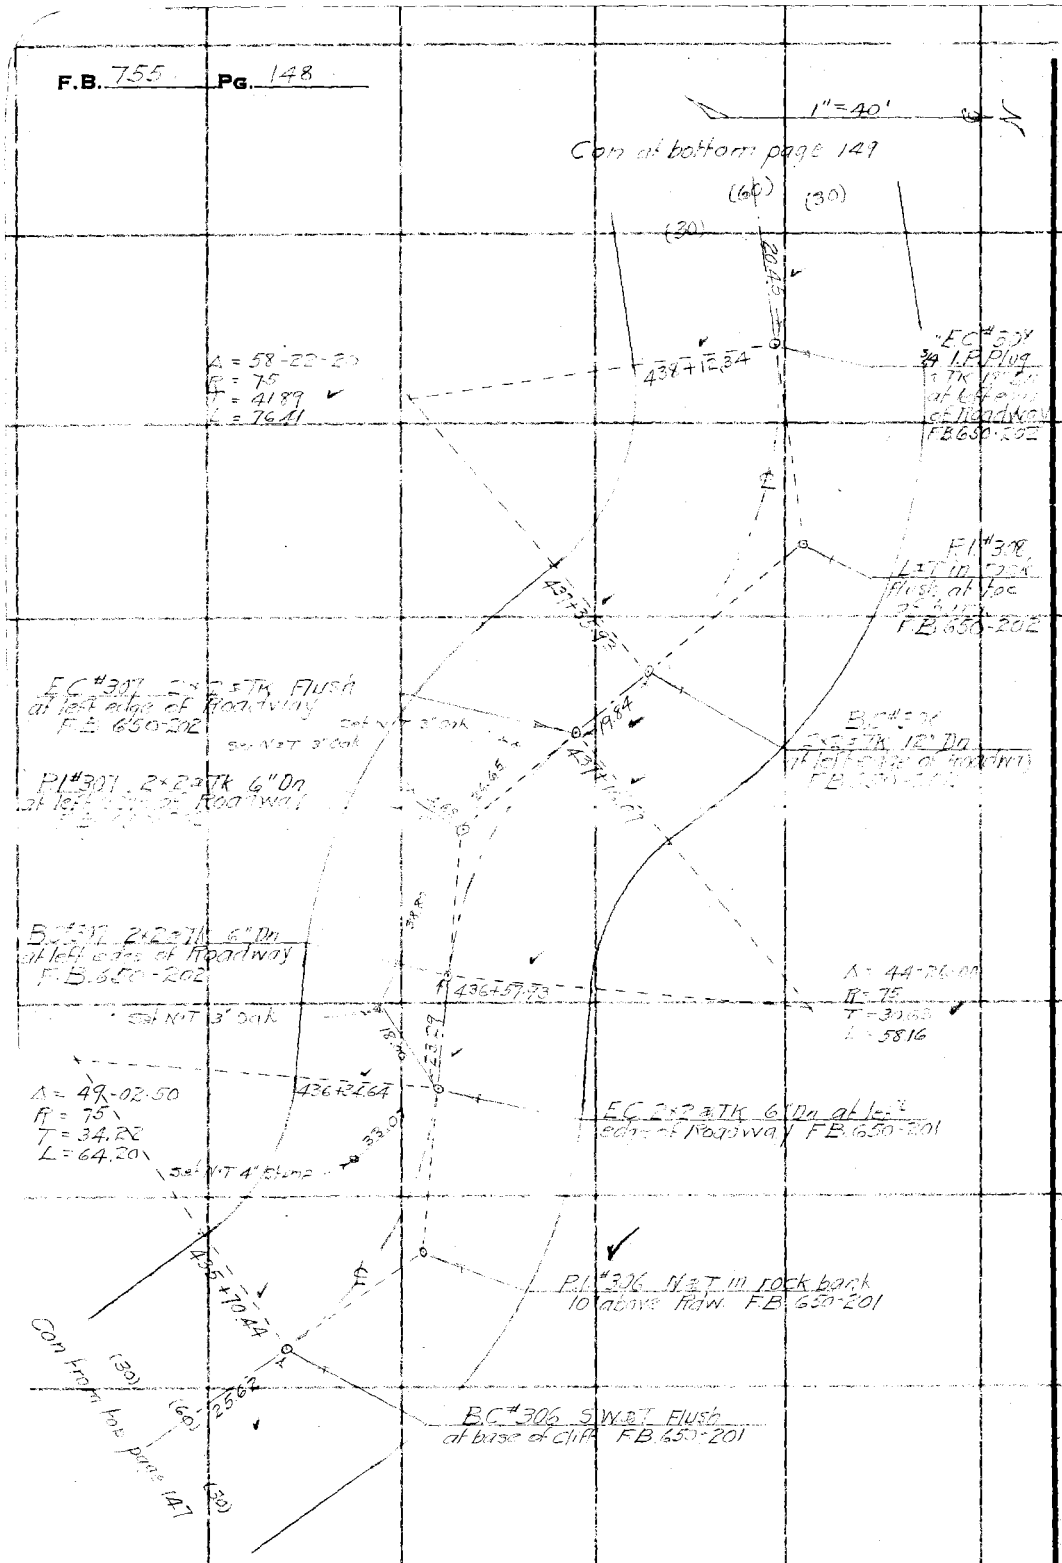

RETURN TO
LOS ANGELES COUNTY SURVEYOR
700 HALL OF RECORDS

Note: Any Additions or Changes on This Sheet Must be Made or Circled in Red Ink With Date and Name of Person Making Change.

Do not extend notes this side of this line

W 15-A-3

Notes Ck'd by	Survey of
Map No. 8-12.17-5	W. O. 8119 Tape No. St'd °F.
Office Work F. A. W.	Surveyed by W.A.M.
Checked	Notes Date
Date 12-5-60	Indexed

F.B. PG. 119

Note: Any Additions or Changes on This Sheet Must be Made or Circled in Red Ink With Date and Name of Person Making Change.

Do not extend notes this side of this line

RETURN TO
LOS ANGELES COUNTY SURVEYOR
700 HALL OF RECORDS

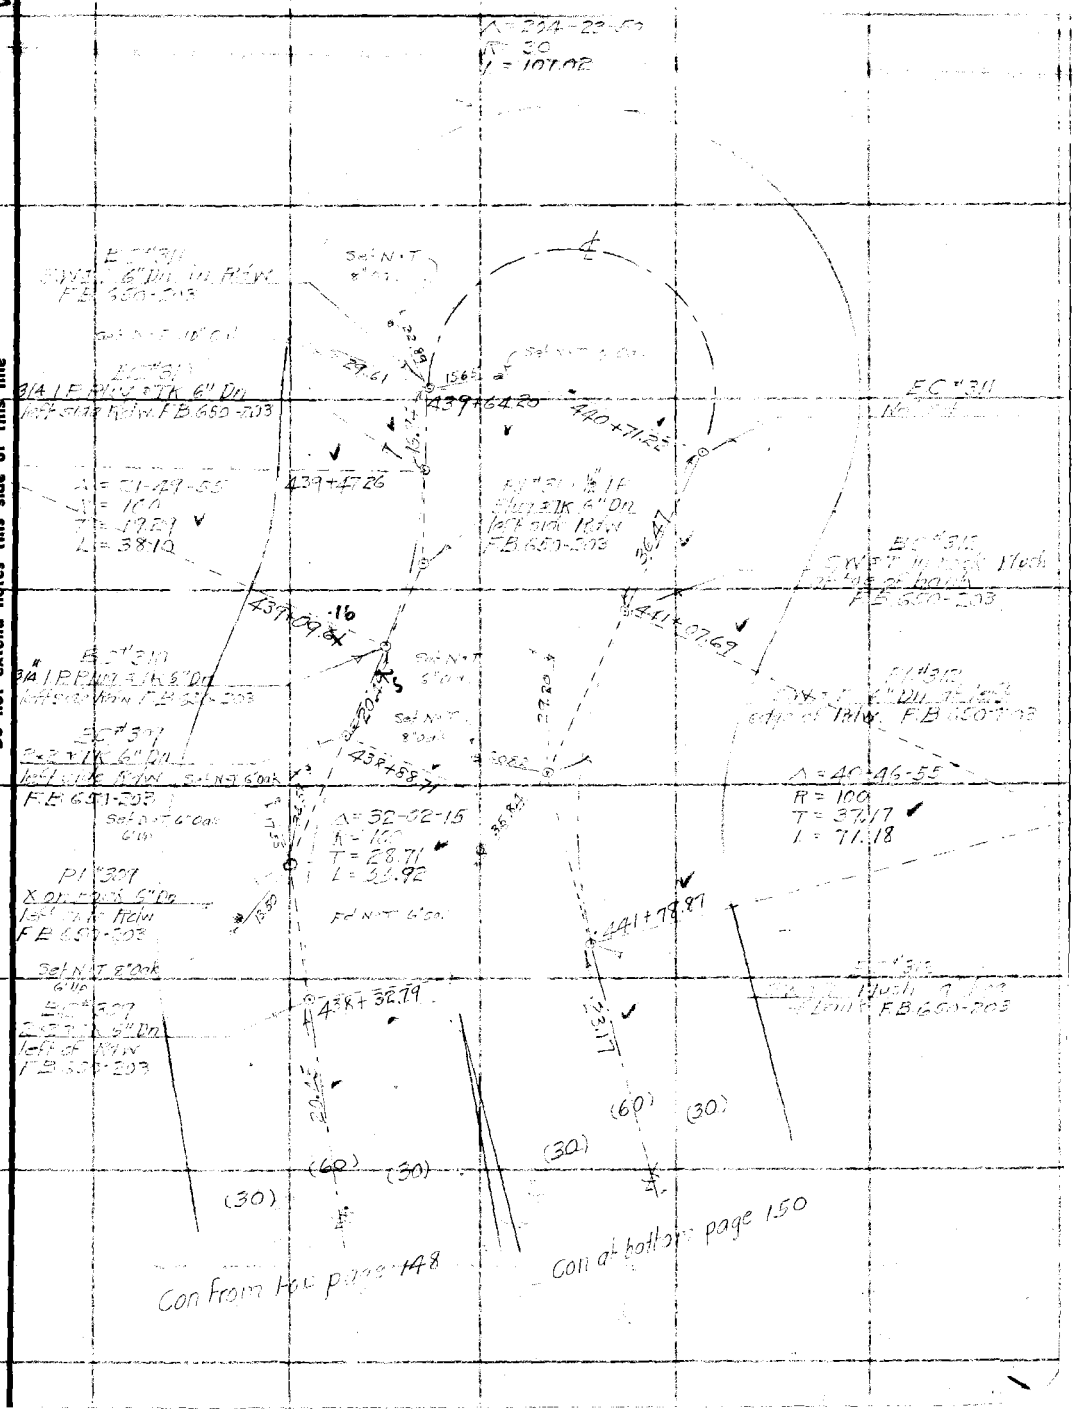

FORM 247 10M 11-58

F.B. 745 Pg. 150

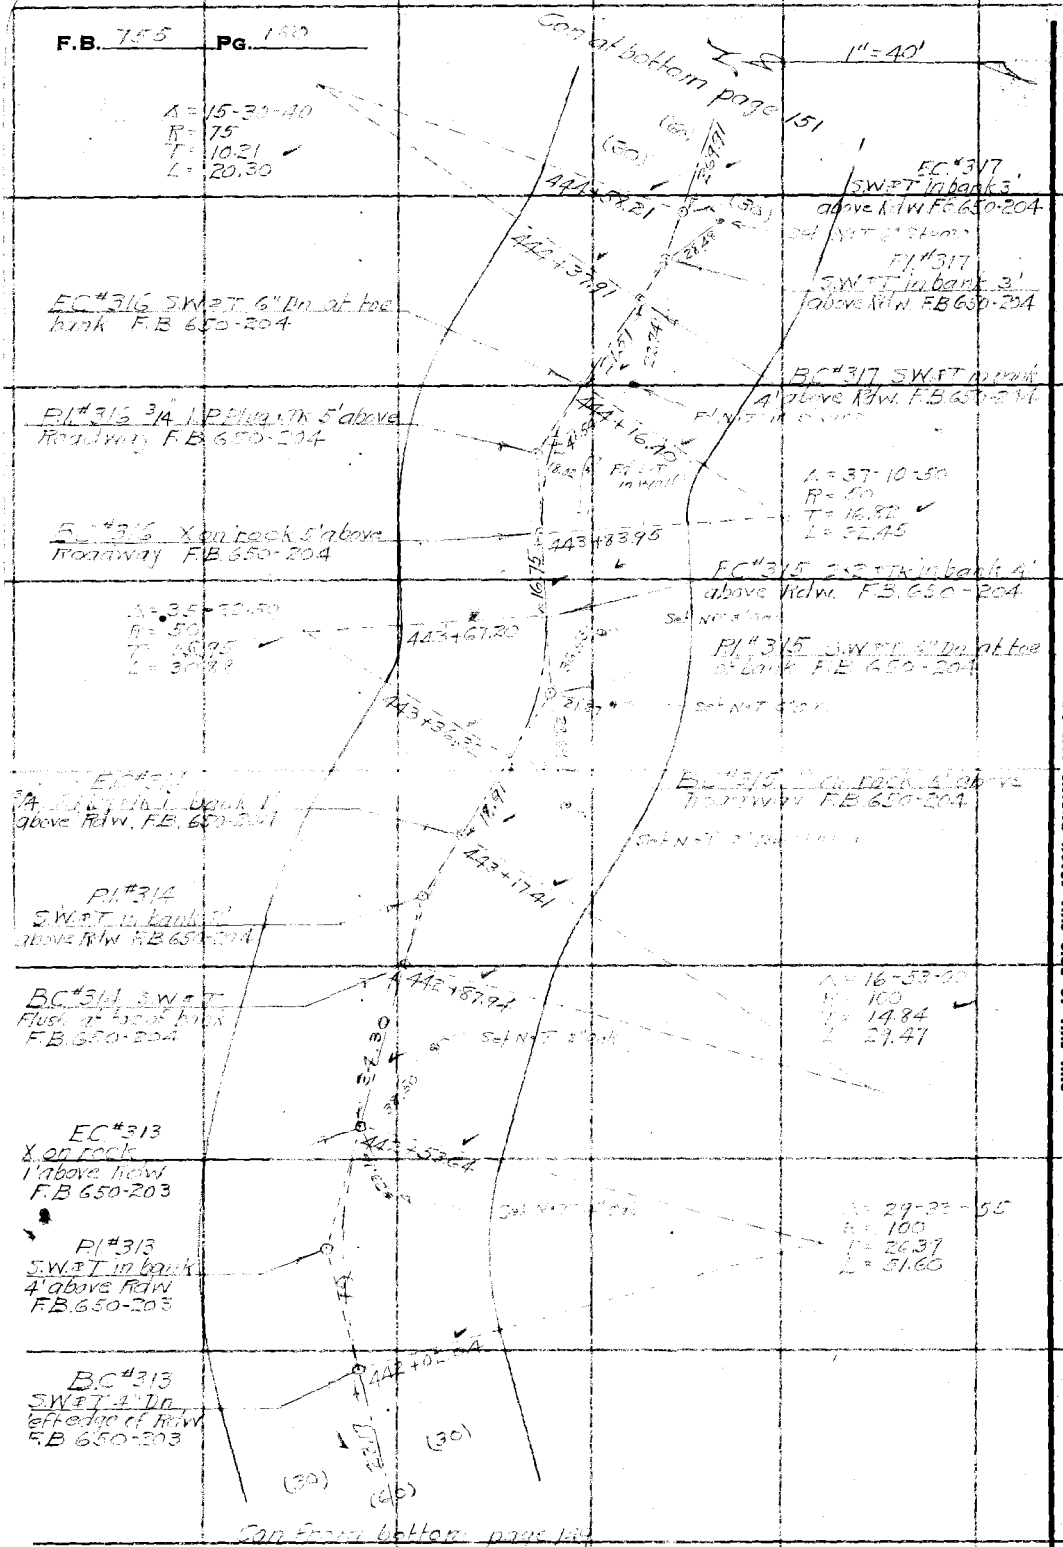

RETURN TO
LOS ANGELES COUNTY SURVEYOR
700 HALL OF RECORDS

Note: Any Additions or Changes on This Sheet Must be Made or Circled in Red Ink with Date and Name of Person Making Change.

Do not extend notes this side of this line

Notes Ck'd by	Survey of
Map No. B-1217-F	W. O. 2111 Tape No. St'd °F.
Office Work F. A. W.	Surveyed by
Checked	Notes Date
Date	Indexed

F.B. PG.

W.1.5-A-4

Note: Any Additions or Changes on This Sheet Must be Made or Circled in Red Ink With Date and Name of Person Making Change.

Do not extend notes this side of this line

RETURN TO
LOS ANGELES COUNTY SURVEYOR
700 HALL OF RECORDS

EC 3/20 SWET 6" Dn
in Roadway F.B.

EC 3/20 SWET 6" Dn
in Roadway F.B. 650-206

B.C. 3/20
L.T.S. in Rock 6" Dn
in Roadway
F.B. 650-206

Set N.T. 6" Dn

Set N.T. in Rock

EC 3/19 3/4" I.P.
Filled w Tk 3 Dn
in Roadway
F.B. 650-206

EC 3/19
SWET 10" Dn in Rdwy
F.B. 650-206

EC 3/19
SWET 10" Dn in Rdwy
F.B. 650-206

EC 3/18
SWET 4" Dn
in Roadway
F.B. 650-205

P.I. 3/19
Xan Rock E
Obsc. Rdwy
F.B. 650-205

B.C. 3/18
SWET 6" Dn
on Rock Mark
F.B. 650-205

Set N.T. in Rock

Set N.T. in Rock

Set N.T. in Rock

F.B. 755 PG. 152

1" = 40'

EC #322 3/4 I.P. Plug & Tk
8' Dn in Roadway
F.B. 650-208

Pl. #322 3/4" I.P. Plug & Tk
Flush with Curb - 10' offset
F.B. 650-208

Δ = 46°-40'-15"
R = 200'
T = 176.35'
L = 163.03'

Pl. #322 3/4" I.P. Plug & Tk
Flush with Curb

Δ = 38°-30'-00"
R = 200'
T = 70.04'
L = 133.80'

Pl. #322 3/4" I.P. Plug & Tk
11' Right of Sta. of Hdwl
F.B. 650-207

Hdwl N 17° 51' 00" W

S 64° 51' 00" W

Pl. #322 3/4" I.P. Plug & Tk
11' Right of Sta. of Hdwl
F.B. 650-207

Hdwl I.P. Post

RETURN TO
LOS ANGELES COUNTY SURVEYOR
700 HALL OF RECORDS

Note: Any Additions or Changes on This Sheet Must be Made or Circled in Red Ink With Date and Name of Person Making Change.

Do not extend notes this side of this line

RETURN TO
LOS ANGELES COUNTY SURVEYOR
700 HALL OF RECORDS

Note: Any Additions or Changes on This Sheet Must be Made or Circled in Red Ink With Date and Name of Person Making Change.

Do not extend notes this side of this line

WS.15-A-3

RETURN TO
LOS ANGELES COUNTY SURVEYOR
700 HALL OF RECORDS

Note: Any Additions or Changes on This Sheet Must be Made in Red Ink With Date and Name of Person Making Change.

Do not extend notes this side of this line

FORM 247 10M 11-38

Notes Ck'd by	Survey of
Map No. B-1217-S	W. O. 8144 Tape No. Sht'd of
Office Work	Surveyed by Notes
Checked	Date Indexed
Date	

W.S. 15-A-3

F.B. 765 Pg. 153

Notes Ck'd by	Survey of
Map No.	W. O. 8149 Tape No. 07 St'd 68°F
Office Work	Surveyed by Moore
Checked	Notes Moore Date 1-16-41
Date	Indexed E. C. Johnson 2-17-41

F.B. 755 Pg. 155

W.S.45-A-7

Note: Any Additions or Changes on This Sheet Must be Made or Circled in Red Ink With Date and Name of Person Making Change.

Do not extend notes this side of this line.

RETURN TO
LOS ANGELES COUNTY SURVEYOR
700 HALL OF RECORDS

FORM 247 5M 10-39

Tie Cor. Pg. 156

Set S.T+W

167.53 @ 58° = 167.50

ROAD

(165°-07'-30"
312-30-00)

P.I. ... Set

246.97 @ 58° = 246.93

Δ = 23°-45'-00"
R = 600
T = 126.17
L = 248.71
D = 246.93

WILSON

P.C. Set S.T+W

46.37 @ 60° = 46.36

22.93 @ 60° = 22.93

168°-07'-30" = Δ

T 48.36

MT

51°-10'-00"

Sec 29 T 2N R 11W

Sec 30 T 2N R 11W

#2 Fd 1x2 F.B. 650-9

50°-08'-00"

Set S.T+W per calc dist

(50°-08'-00"
200-31-20)

22.93

87.74

Set 1x2 Edge Pl

Set S.T+W per calc dist

70.53

79.27

#4 - Fd 1x2 F.B. 650-10

88.34 @ 52° @ 26-10 = 79.27
87.53 @ 52° @ 25-04 = 79.27

144.85

#5 - Fd 1x2 F.B. 650-10

37.38 @ 52° @ 0-00 = 37.37
110.55 @ 52° @ 13-30 = 107.48
144.85

RETURN TO
LOS ANGELES COUNTY SURVEYOR
700 HALL OF RECORDS

Note: Any Additions or Changes on This Sheet Must be Made or Circled in Red Ink With Date and Name of Person Making Change.

Do not extend notes this side of this line.

WS.15-A-3

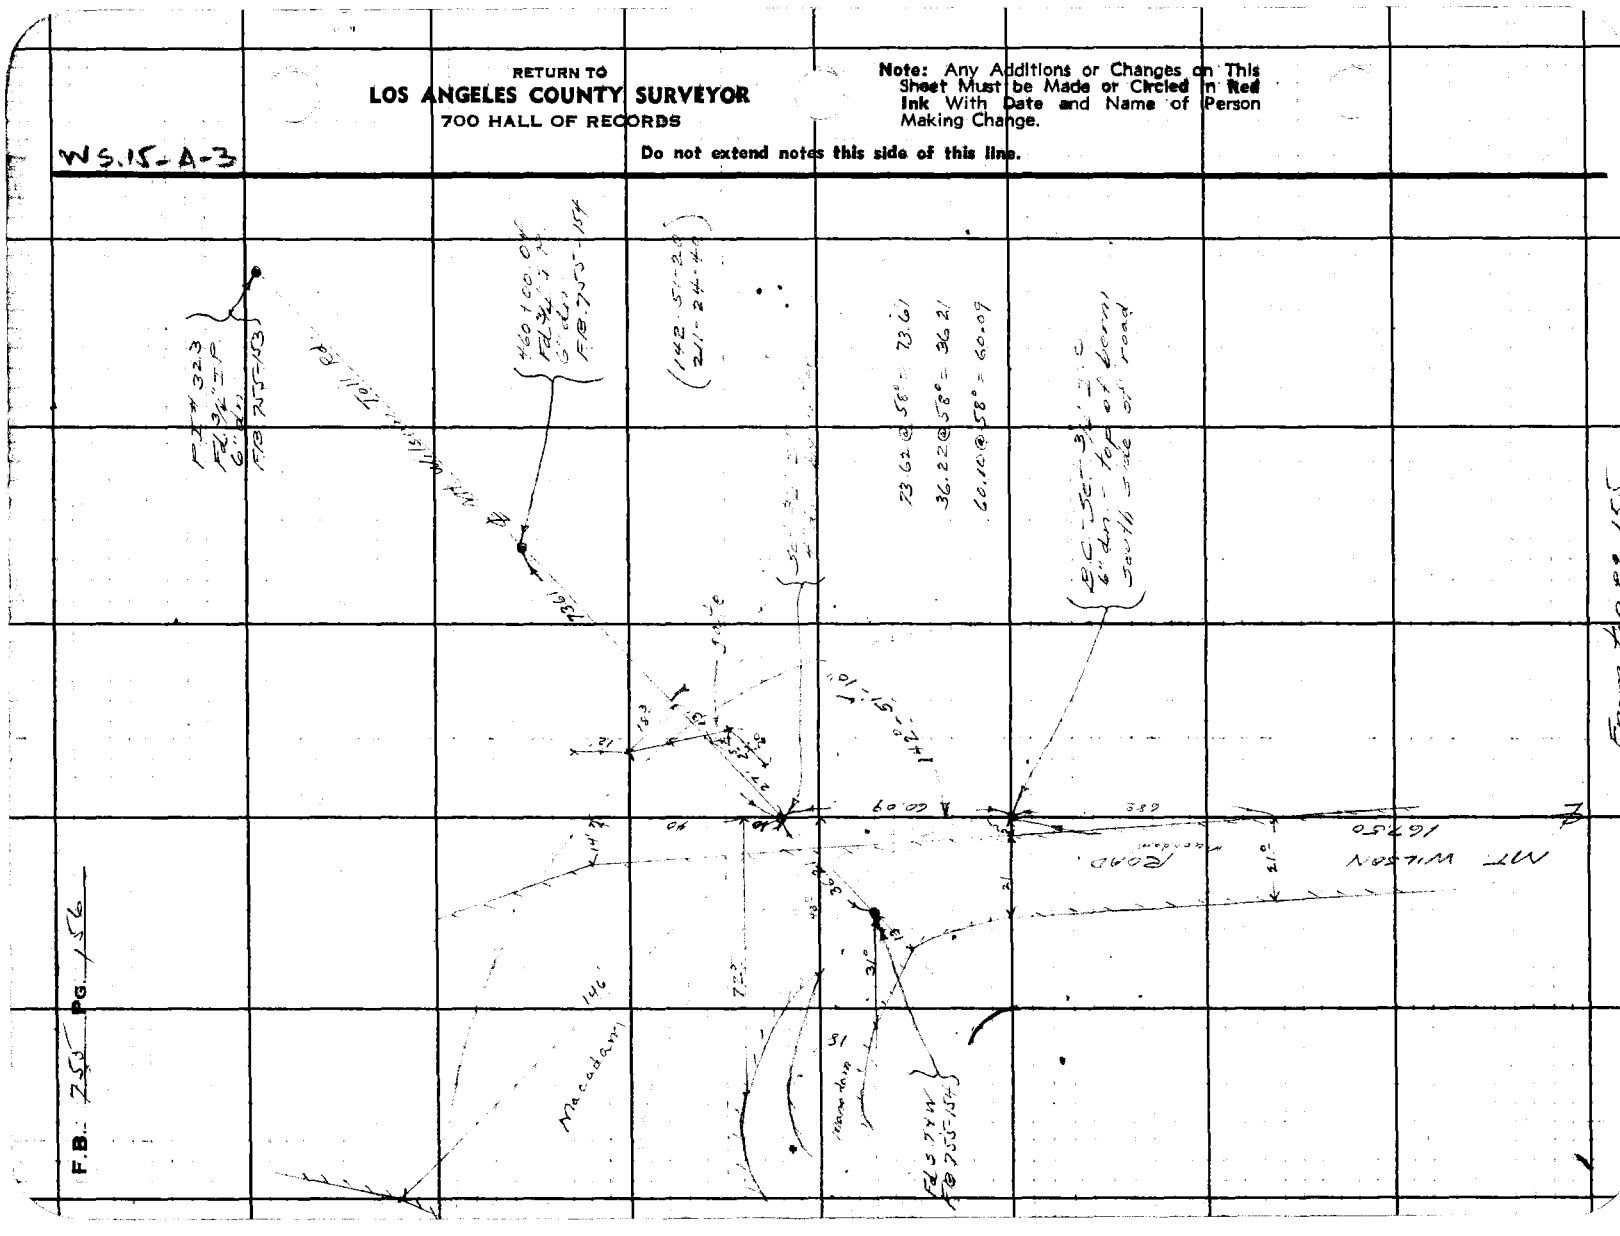

Notes Ck'd by [illegible]	Survey of
Map No. SD 44-51	W. O. Tape No. St'd °F
Office Work [illegible]	Surveyed by
Checked	Notes Date
Date May 1947	Indexed A. C. Johnson 3-21-44

F. B. 755 Pg. 161

HENNINGER FLATS

NEW PROPERTY LINES ON PARCELS RECEIVED FROM THE UNITED STATES GOVT.

NOTE. This survey was made by Hellstrom's party working under the supervision of Wm. Leonard, a surveyor in the employ of the U.S. Forest Service who was sworn in as a Deputy U.S. Surveyor for the purpose of making this survey. The monuments set were furnished by the U.S. Forest Service. Corners were set as directed by Leonard following instructions furnished to him by the U.S. Land Office.

This Survey then has the status of an official U.S. Land Office Survey. Leonard is to send an official set of notes of this survey to the U.S. Land Office. Bearings shown in the field notes were based on a Solar Observation.

Platted on H.C. 44-51

Note: Any Additions or Changes on This Sheet Must be Made or Circled in Red Ink With Date and Name of Person Making Change.

Do not extend notes this side of this line.

RETURN TO
LOS ANGELES COUNTY SURVEYOR
700 HALL OF RECORDS

FORM 247 SM 5-46

RETURN TO
LOS ANGELES COUNTY SURVEYOR
700 HALL OF RECORDS

Note: Any Additions or Changes on This Sheet Must be Made or Circled in Red Ink With Date and Name of Person Making Change.

Do not extend notes this side of this line.

F. B. 755 PG. 162

Notes Ck'd by KRM & LC
Map No. S.D. 44-51
Office Work MM Hunt
Checked
Date May 1947

W. O. 2917 Tape No. 79 St'd 84 °F
Surveyed by HELLSTROM
Notes A.N.H. Date 2-13-47
Indexed A. C. Johnson

F.B. 755 PG. 163

Cont. on Top Pl. pg. 164

W 45-A-2

Cont. on Bottom Pl. pg. 164

BERGER TRANSIT #15051

300' DIETZGEN STEEL TAPE #79 Std 84° F.

PARTY
A. N. HELLSTROM
H. E. FRONK
M. G. SALAZAR
J. C. RIKE
I. J. BOWLES

EXCHANGE SURVEY No. 366

Note: Any Additions or Changes on This Sheet Must be Made or Circled in Red Ink With Date and Name of Person Making Change.

Do not extend notes this side of this line.

RETURN TO
LOS ANGELES COUNTY SURVEYOR
700 HALL OF RECORDS

To ¼ Cor.
To 1½" I.P. Conc.
To Triang. Pt. "A"
by Triang.
19° 21' 20"
20° 08' 50"
20° 40' 01"
0° 47' 30"
2367.99
2317.62
2313.21
2393.71

(1) 0° 47' 30"
(2) 3° 10' 20"
0° 47' 30"

(1) 20° 08' 45"
(2) 20° 35' 15"
20° 08' 60"

Fd. 2" I.P with Brass Cap In Conc. Stamped STA. 16 See F.B. 137 pg. 109

Set Light (X) on Mon. on Line betwn Sec. Cor. and ¼ Cor

0.18

98.51 @ 0° 0' 7.54" = 98.50
150.21 @ 0° 0' 7" = 150.18
248.68 Total

2478.68

SEC. 12
SEC. 1
SEC. 7
SEC. 6

T 1 N R 12 W
T 1 N R 11 W

SECTION CORNER
Fd. 4" x 4" Iron Post Filled with Conc. 18" above Surf. with Lead & Tack in Cntr. mrkd. S.G.F.R. 18 T1N S.6 on N.E., R11W S.7 on S.E., R12W S.12 on S.W. and S.1 on N.W.
Per C.S. B-375
" C.S. B-453 See F.B. 137-62

FORM 247 RM 11-41

F.B. 755 PG 164

W5.50-D-1

RETURN TO
LOS ANGELES COUNTY SURVEYOR
700 HALL OF RECORDS

Do not extend notes this side of this line.

Note: Any Additions or Changes on This Sheet Must be Made or Circled in Red Ink With Date and Name of Person Making Change.

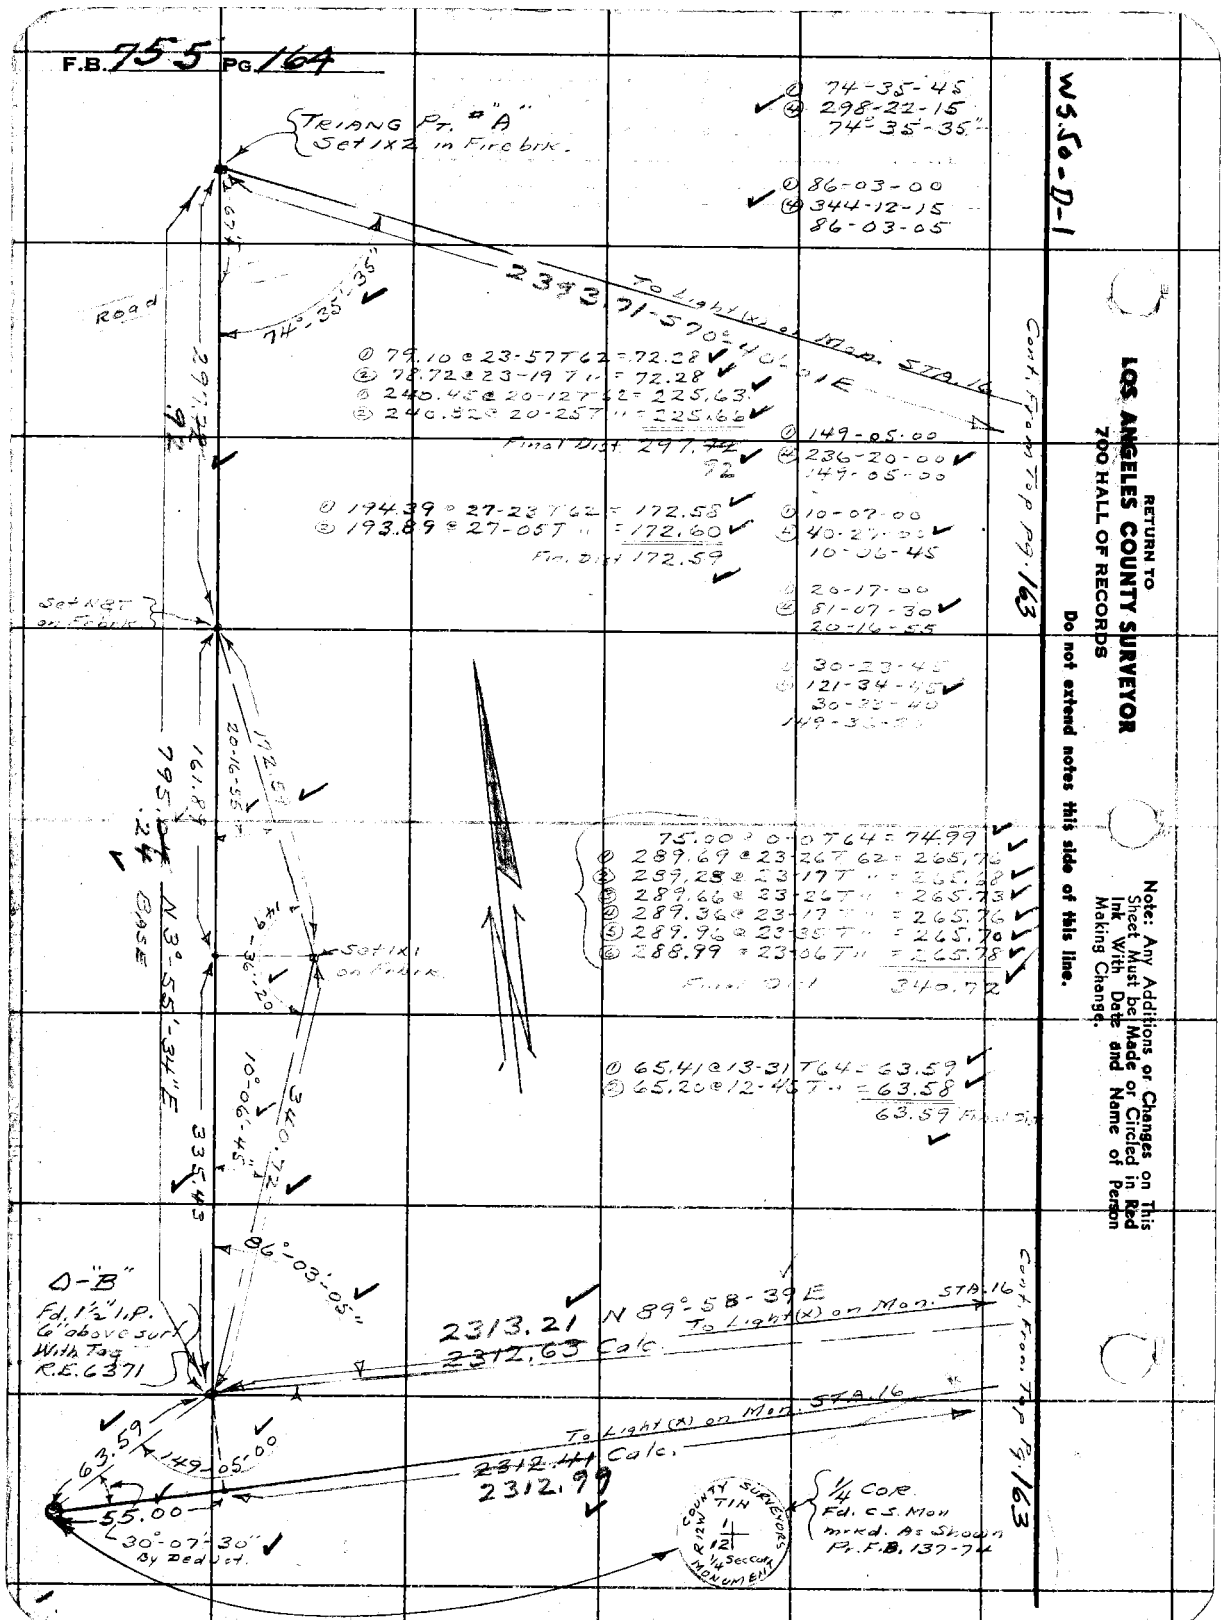

74°-35'-45"
298°-22'-15"
74°-35'-35"

86°-03'-00"
344°-12'-15"
86°-03'-05"

79.10 @ 23-57 T 62 = 72.28
78.72 @ 23-19 T " = 72.28
240.45 @ 20-12 T 62 = 225.63
240.52 @ 20-25 T " = 225.66

149°-05'-00"
236°-20'-00"
149°-05'-00"

194.39 @ 27-28 T 62 = 172.55
193.89 @ 27-05 T " = 172.60
Fin. Dist 172.59

10°-07'-00"
40°-27'-00"
10°-06'-45"

20°-17'-00"
81°-07'-30"
20°-16'-55"

30°-22'-45"
121°-34'-45"
30°-22'-40"
149°-35'-50"

75.00 @ 0-07 T 64 = 74.99
289.69 @ 23-26 T 62 = 265.76
289.28 @ 23-17 T " = 265.28
289.66 @ 23-26 T " = 265.76
289.36 @ 23-17 T " = 265.76
289.96 @ 23-35 T " = 265.78
288.99 @ 23-06 T " = 265.78
Final Dist 340.72

65.41 @ 13-31 T 64 = 63.59
65.20 @ 12-43 T " = 63.58
63.59 Final Dist

FORM 247 5M 11-41

RETURN TO
LOS ANGELES COUNTY SURVEYOR
700 HALL OF RECORDS

Note: Any Additions or Changes on This Sheet Must be Made or Circled in Red Ink With Date and Name of Person Making Change.

Do not extend notes this side of this line.

W.S.50 - D-1
E-1

Notes Ck'd by [illegible]
Map No. S.D. 44-51
Office Work [illegible]
Checked [illegible]
Date May 1947

Survey of W. O. 2917 Tape No. 22 Std. 8# of
Surveyed by [illegible]
Notes [illegible] Date 2-1947
Indexed A. C. Johnson

F.B. 7535 PG. 165

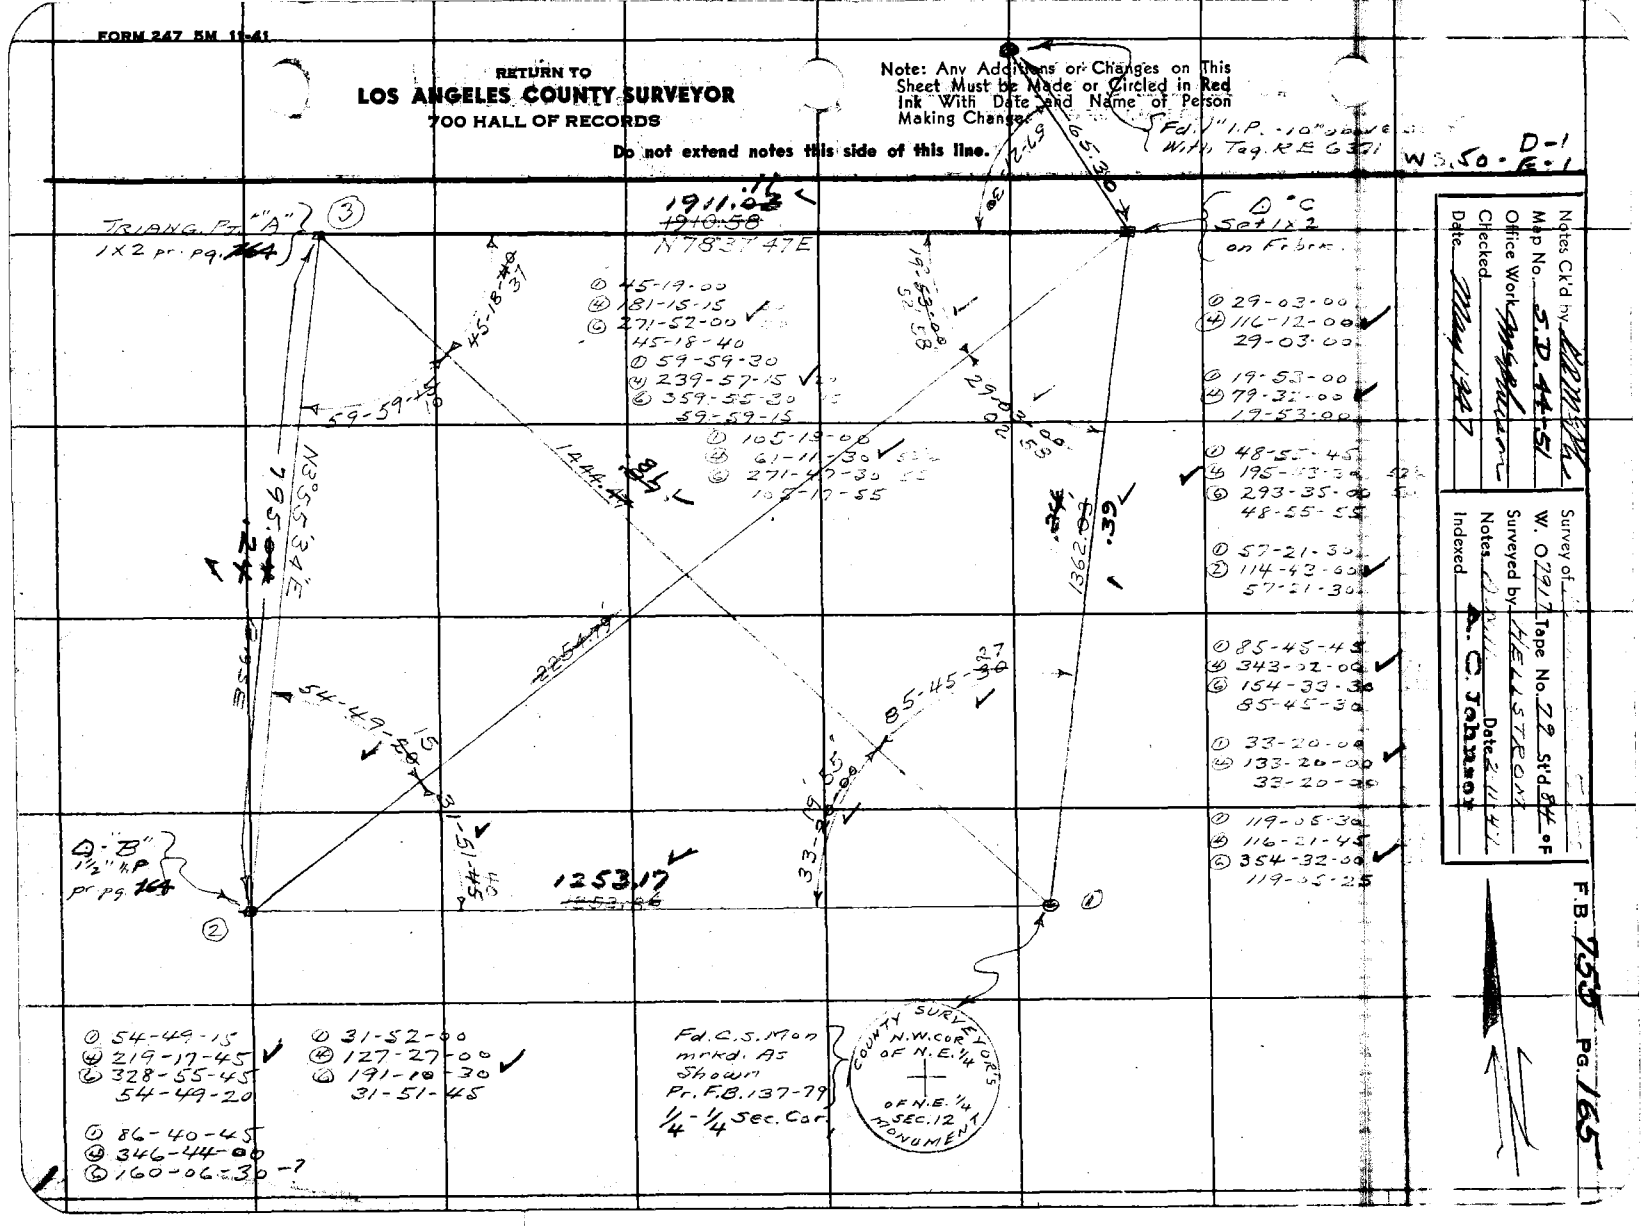

RETURN TO
LOS ANGELES COUNTY SURVEYOR
700 HALL OF RECORDS

Note: Any Additions or Changes on This Sheet Must be Made or Circled in Red Ink With Date and Name of Person Making Change.

Do not extend notes this side of this line.


Notes Ck'd by K.R.M.Sph.
Map No. S.D. 44-51
Office Work
Checked
Date May 1947

Survey of
W. O. 7917 Tape No. 79 St'd 84 °F
Surveyed by Hellstrom
Notes A.N.H. Date 2-17-47
Indexed A. C. Johnson

F.B. 755 Pg. 167

W 50-D-1

Note: Any Additions or Changes on This Sheet Must Be Made or Circled in Red Ink With Date and Name of Person Making Change.

Do not extend notes this side of this line.

RETURN TO
LOS ANGELES COUNTY SURVEYOR
700 HALL OF RECORDS

FORM 247 RM 11-41

16° 27' 30" ✓
16° 27' 32.2

Calc. 56
1962.44
N 88-20-28 E
To Pg. 169

To Cor. #5 Pg. 169

TRACT. COR. 5/4
Set 3" I.P. - 18" in With 1x1 over pipe of Conc. Falls at Toe of cut bank on inner edge of Trav. Rd.

WITNESS COR
Set 2" I.P. with Copy 12 32.5 Conc. in rock mound 10' E. of Top of Cut

T 1N R 12W
S1 E5346
USFS
1947

Set at this position 3-4-47

Identical

Set at ++ 3-4-47

DETAIL

TRACT. COR 5/4

Set 1x2 on N. edg. E. line

Set 1x2 on Top. Edge

Identical

0.045 ✓

0.11

N 12° 31' 58" W 301.54

N 12° 31' 40" W

N 12° 31' 58" W 86.19

N 12° 27' 32" W 84.61

15.73

0.045

0.11

15.73

To Cor. #4 Pg. 169

61-50-00

79-07-34

79-07-52 turned

39° 42' 26"

22.02

24.53

Set 1x2

TRIANG PT. 1x2 pr pg 2

33.76

22.02 ✓
300.18 @ 21-12 T = 54 = 279.53
300.61 @ 21-40 T = 279.51
Total 301.54

90.31 @ 17-18 T 48 = 86.20
90.69 @ 18-06 T = 86.19
86.19 ✓

52.49 @ 0-07-48 = 52.48 ✓
32.14 @ 0-07-48 = 32.13
Total = 84.61 ✓

33.77 @ 0-0 T 46 = 33.76 ✓

N 3° 55' 34" E 795.24 Base ✓

N 12° 31' 58" W 301.54

Adopted Lines shown in red.

1x2 on Hill.

To Cor. #3 Pg. 164

1320.00
N 0° 02' 00" W

1½" I.P. - 6" above With Tag R.E. 6371 pr pg. 164

1/4 Cor

RETURN TO
LOS ANGELES COUNTY SURVEYOR
700 HALL OF RECORDS

Note: Any Additions or Changes on This Sheet Must be Made or Circled in Red Ink With Date and Name of Person Making Change.

Do not extend notes this side of this line.

F.B. 755 Pg 68

Notes Ck'd by LRM Map No. S.D. 44-51 Office Work [illegible] Checked [illegible] Date May 1947

Survey of [illegible] W. O. 29+7 Tape No. 79 St'd 84 °F Surveyed by Hellstrom Notes DN 11 Date 2-15-47 Indexed A. C. Johnson

F.B. 753 PG. 169

N 5.50 - E 1

✓ ① 94-17-45
(4) 17-10-45 ✓

T1N R12W

S1 4 ES.366 USFS 1947

TRACT COR. 4 Set 2" I.P. with Brass Cap - 12" above Surface, Rock Mound On N. Slope 20'± N. of N. edg. of Trav. Rd. Marked As Shown

Adopted Lines in red.

2-03-30W - 175.31 To ⊙C.

N 7° 04' 30" W 175.54 M

OUT

Ø 1x2 in Fr. b. pr 145.3

S 0° 01' 56" E 1348.08' To COR. #2

① 76.20 @ 16-36 T42 = 73.00 ✓
② 76.72 @ 17-52 T " = 73.00 ✓
③ 107.34 @ 21-05 T46 = 100.12 ✓
④ 106.80 @ 20-21 T " = 100.10 ✓
2.43 @ 0-0 T " = 2.43
Final Dist. 175.54 ✓

N 88-20-28E 1962.44 56

N 78°-37'-47" E 1940.68 Calc. 11.42

To COR. #5 79.167

TRANS. PT. ⊙ B N. End Base 1x2 on Fence pr. pg 2.

Note: Any Additions or Changes on This Sheet Must Be Made or Circled in Red Ink With Date and Name of Person Making Change.

Do not extend notes this side of this line.

RETURN TO
LOS ANGELES COUNTY SURVEYOR
700 HALL OF RECORDS

FORM 247 RM 11-41

F.B. 755 Pg. 170

1/4 Cor. Fd. C.S. Mon Flush pr. pg. 2

E.S. "366" Tract Cor "1"

To Cor. #5 - Page 167 →

T1N R2W E.S. 366 1/4 S12 U.S.C.S. 1947

See pg. 2.

Fd. 1x2 - Flush (W.C. to 1/4 cor.) Replaced 1x2 with 2" I.P. with Galv. Cap - 12" above Surf. mrkd. as shown E.S. 366 Tract Cor "2"

① 174-25-30
② 337-44-36
174-26-95

Blazed W. face of 12" Pine and Scribed 1/4 S B.T

B205

42.50 Meas. N12°E S.C.

174°-26'-05" E 30.93

29°-17'-00" E 35.57

30.93 @ 0-0 T66 = 30.93 East

Blazed East Side of 9" Pine Tree and Scribed E.S. 3 B.T.

44.44 @ 29-47 = 38.57

Base Line 795.84 N

"B" 1½" I.P. 6" high Tag RE 6371 pr pg. 2

Turning Pt. "D" 1x2 pr pg. 2

To Cor. #4 - Pg. 169 →

55± at this Position

3-4-44

0.15

USCS 1947 E.S. 366 B.P.3 S1 T1N R12W

① 118.45 @ 20-21 T56 = 111.04
② 118.21 @ 20-00 T" = 111.04 06
Final Dist. 111.04 05

① 240.13 @ 35-50 T54 = 194.63
② 239.19 @ 35-32 T" = 194.59
Final Dist. 194.61

Set 2" I.P. with Galv. Cap - 12" above Surf. in rock mnd. on Side Hill E.S. "366 Cor. "3

Trav. Road

Set 1x2 on W. edg. Trav. Rd.

① 46.00 @ 18-44 T62 = 43.55
② 45.63 @ 17-20 T" = 43.55
③ 67.22 @ 33-19 T54 = 56.16
④ 66.33 @ 32-07 T" = 56.17
Final Dist. - 99.71

111.04

194.61

Set 1x2 on Side Hill

99.71

0.18

Light Chaparral on Hill pr pg.

P.O.T. 2" Iron Pipe With Br. Cp. pr pg. 1

248.68

Sec. 12

Sec. 1

R12W R11W

Sec. 7

Sec. 6

SEC. Cor. 4x4 Iron Post See pg. 163

W 3.45 - A - 7
W 5.50 - D - 1 E-1

RETURN TO
LOS ANGELES COUNTY SURVEYOR
700 HALL OF RECORDS

Do not extend notes this side of this line.

Note: Any Additions or Changes on This Sheet Must be Made or Circled in Red Ink With Date and Name of Person Making Change.

FORM 247 BM 11-41

RETURN TO
LOS ANGELES COUNTY SURVEYOR
700 HALL OF RECORDS

Note: Any Additions or Changes on This Sheet Must be Made or Circled in Red Ink With Date and Name of Person Making Change.

Do not extend notes this side of this line.

W 45-A-1
W 50-E-1

Notes Ck'd by D.L.C.
Map No. S.D. 44451
Office Work
Checked
Date May 1947

Survey of
W. O. 7291 Tape No. 72 Std. Sht. of
Surveyed by
Notes Date 2-24-47
Indexed A. C. Johnson

F.B. 755 PG. 121

① 4-58-00
Ⓜ 19-51-30
4-57-52½"

① 28-42-30
Ⓜ 114-50-30
28-42-37½

① 32-10-45
Ⓜ 128-44-30
32-11-08

① 141-00-00
Ⓜ 55-59-00
13-59-45

① 160-07-00
Ⓜ 40-35-45
100-08-55

① 58-32-30
Ⓜ 234-10-00
58-32-30

① 12-34-45
Ⓜ 50-18-30
12-34-37½

① 31-32-00
Ⓜ 126-08-30
31-32-07½
over all

① 77-38-00
Ⓜ 30-32-30
77-38-07½

① 46-44-15
Ⓜ 186-55-45
46-43-55

See Pg. 172

N 74-08-25 E
1126.66 Base Line

E. end 3" x 3" x 4' Frbk.

"A" Frame Replaced A 2x2 with N.P. in Frbk.

32-11-08

28-42-37½

68-32-30

100-08-55

1/4 COR Fd Br Cp F.B. 137 54-85

12.93 Calc.

621.45 Calc.

S 16-35-12" E

N 15-09-33 E

S 15-09-33 W

1262.80 Calc.

29 Calc.

1847.24

1539.30

120°-22-50"

100.73

18°-57-27½

33°-03-45"

D "Z" Set ¾" I.P. near C/L

① 33-03-00
Ⓜ 132-13-00
33-03-15

① 15-16-00
Ⓜ 61-04-02
15-16-00

2434.80 Calc.

71

N 22°-54-50" E

41°-57-58½"

13°-59-45"

12-34-37½

77-38-07½

Radial Pt. N 43°-38-18" W

46-43-55"

122°-37-47" E

① 60-33-45
Ⓜ 242-15-15
60-33-30

① 120°-22-30
Ⓜ 121-31-45
120-22-30

① 112.48 @ 16-00 T 72 = 108.11
② 112.98 @ 16-54 T 71 = 108.09
Final Dist 108.10

108.10

D "F" - Set 1x2 on Frbk

D "C" = 2x2 in Frbk See Pg. 3

TRIANG. PT. "A"
Pr. Pg 2-3

RETURN TO
LOS ANGELES COUNTY SURVEYOR
700 HALL OF RECORDS

Note: Any Additions or Changes on This Sheet Must be Made or Circled in Red Ink With Date and Name of Person Making Change.

Do not extend notes this side of this line.

WS.45-A-1


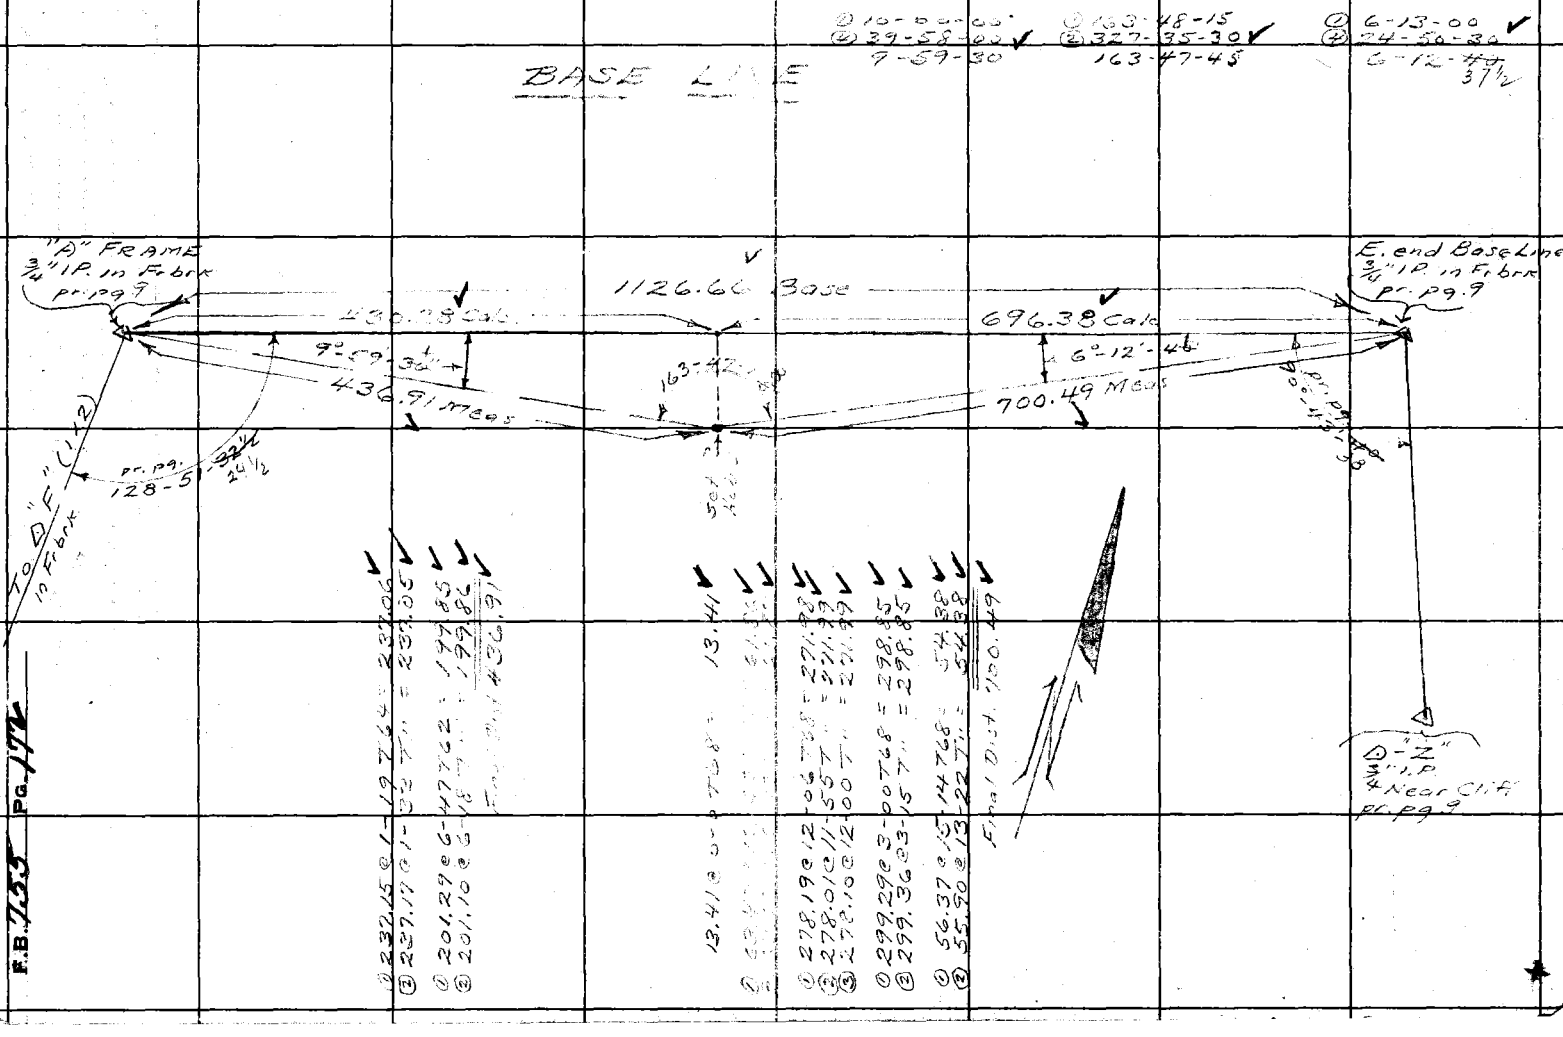

W.S.W.S-A-1

Notes Ck'd by Drew	Survey of
Map No. S.D. 44-51	W. O. 7701 Tape No. 79 St'd 84 °F
Office Work MSP	Surveyed by HELLSTROM
Checked	Notes A.N.H. Date 2-26-47
Date May 1947	Indexed A. C. Johnson

F. B. 752 Pg. 173

Note: Any Additions or Changes on this Sheet Must be Made or Circled in Red Ink With Date and Name of Person Making Change.

Do not extend notes this side of this line.

RETURN TO
LOS ANGELES COUNTY SURVEYOR
700 HALL OF RECORDS

FORM 247 5M 5-46

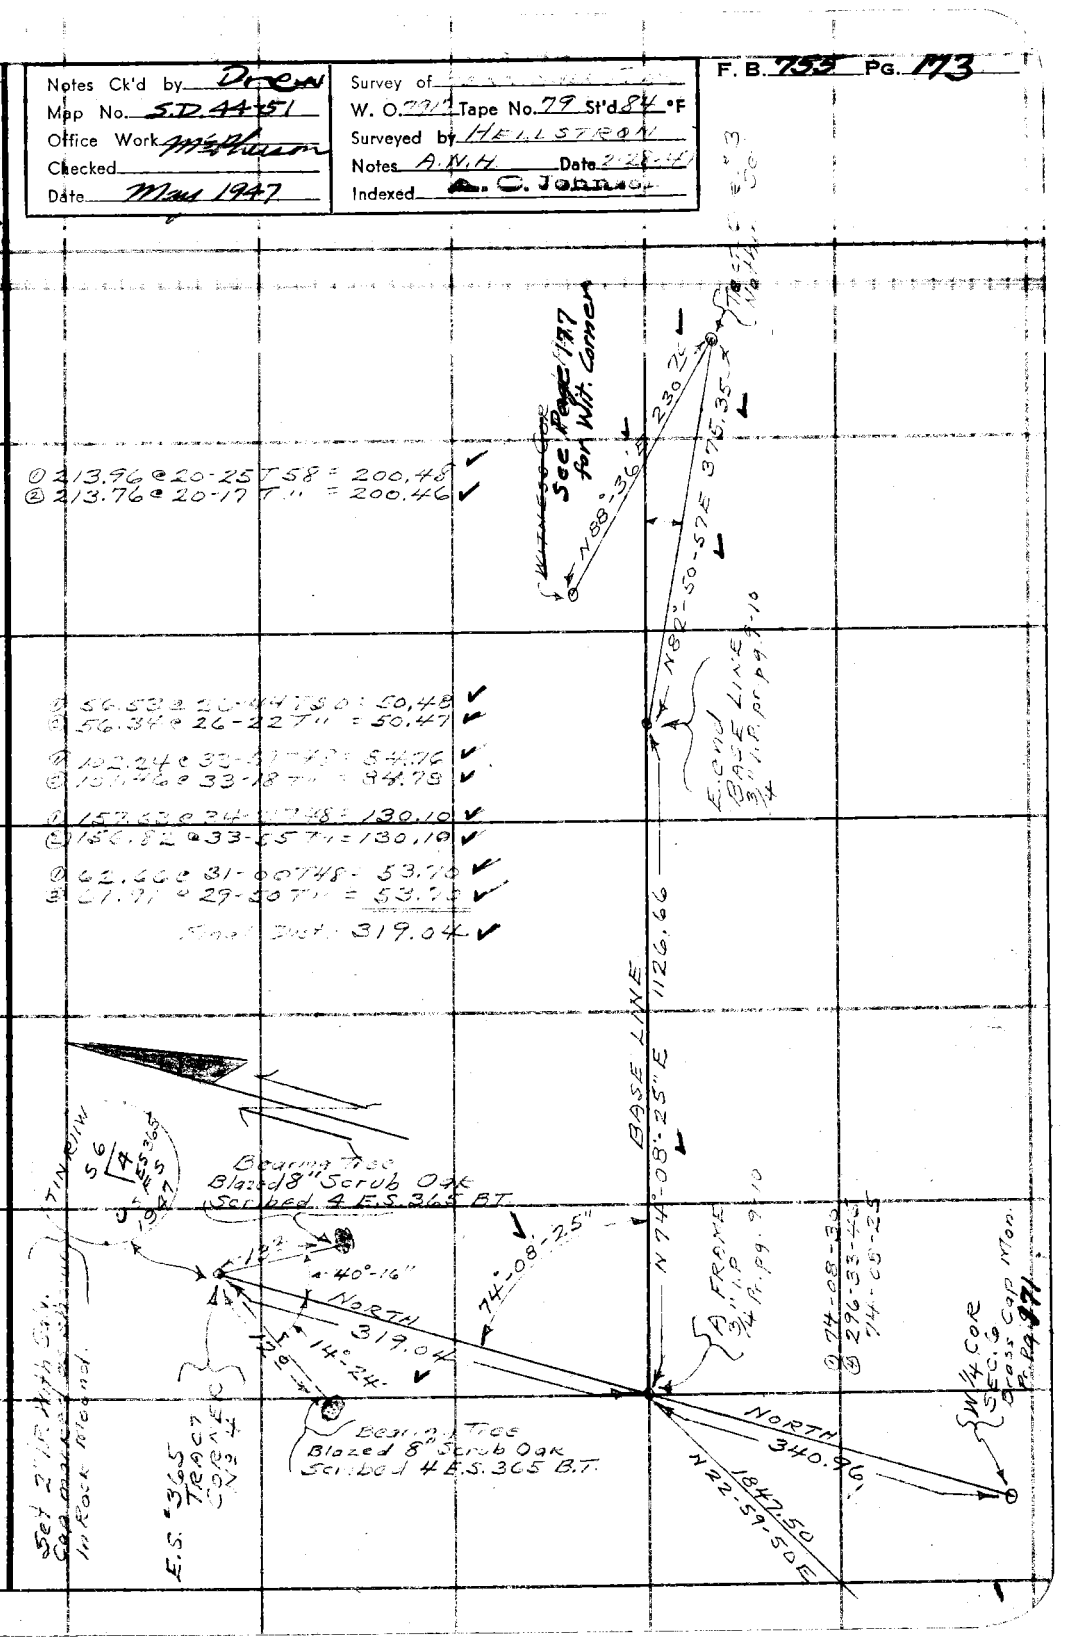

RETURN TO
LOS ANGELES COUNTY SURVEYOR
700 HALL OF RECORDS

Note: Any Additions or Changes on This Sheet Must be Made or Circled in Red Ink With Date and Name of Person Making Change.

Do not extend notes this side of this line.

WS 45-A-1

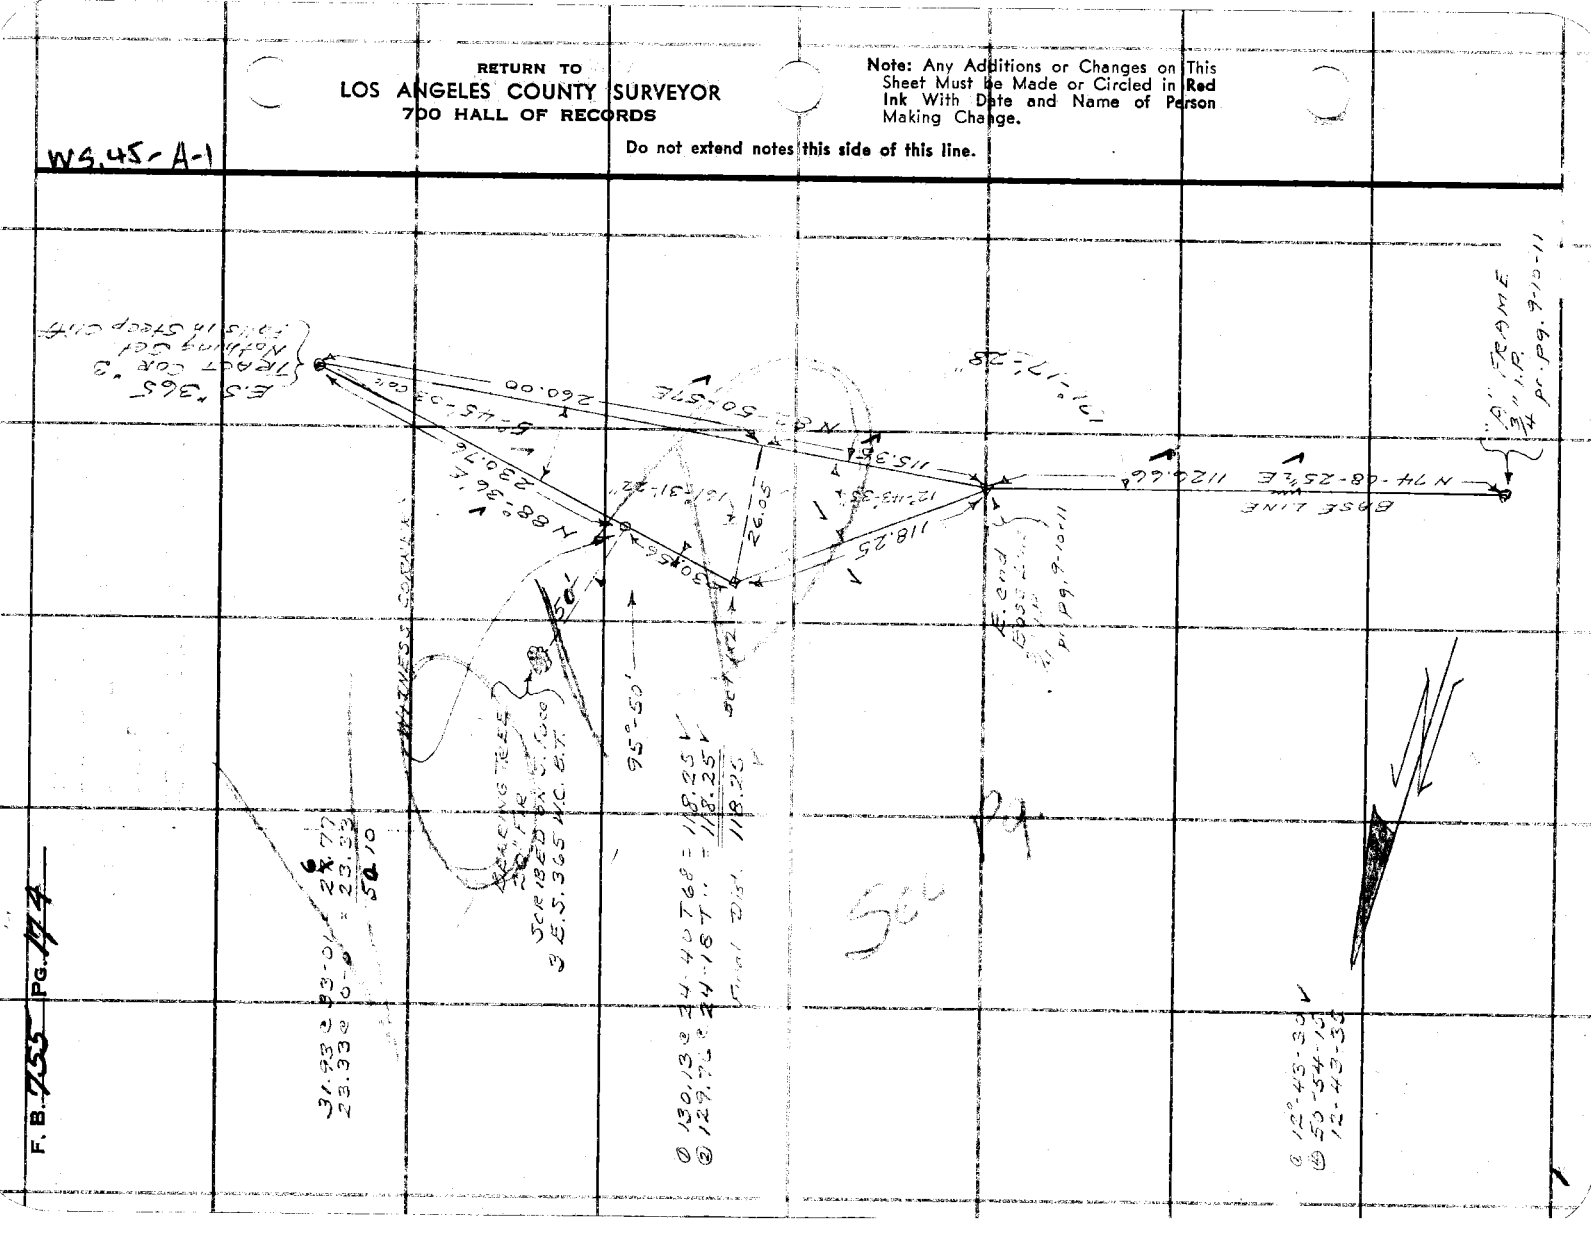

FORM 247 5M 5-46

RETURN TO
LOS ANGELES COUNTY SURVEYOR
700 HALL OF RECORDS

Note: Any Additions or Changes on This Sheet Must be Made or Circled in Red Ink With Date and Name of Person Making Change.

Do not extend notes this side of this line.

W.S. V5-A-1

Notes Ck'd by DMSK
Mpp No. S.D. 44-51
Office Work MSH
Checked MSH
Date MAY 1947

Survey of
W. O. 7321-1 Tape No. 22 Std. 25 °F
Surveyed by HELLSTEAB
Notes D.M.K.
Indexed Date 5-7-47 B. C. Jackson

F. B. 2557 Pg. 176

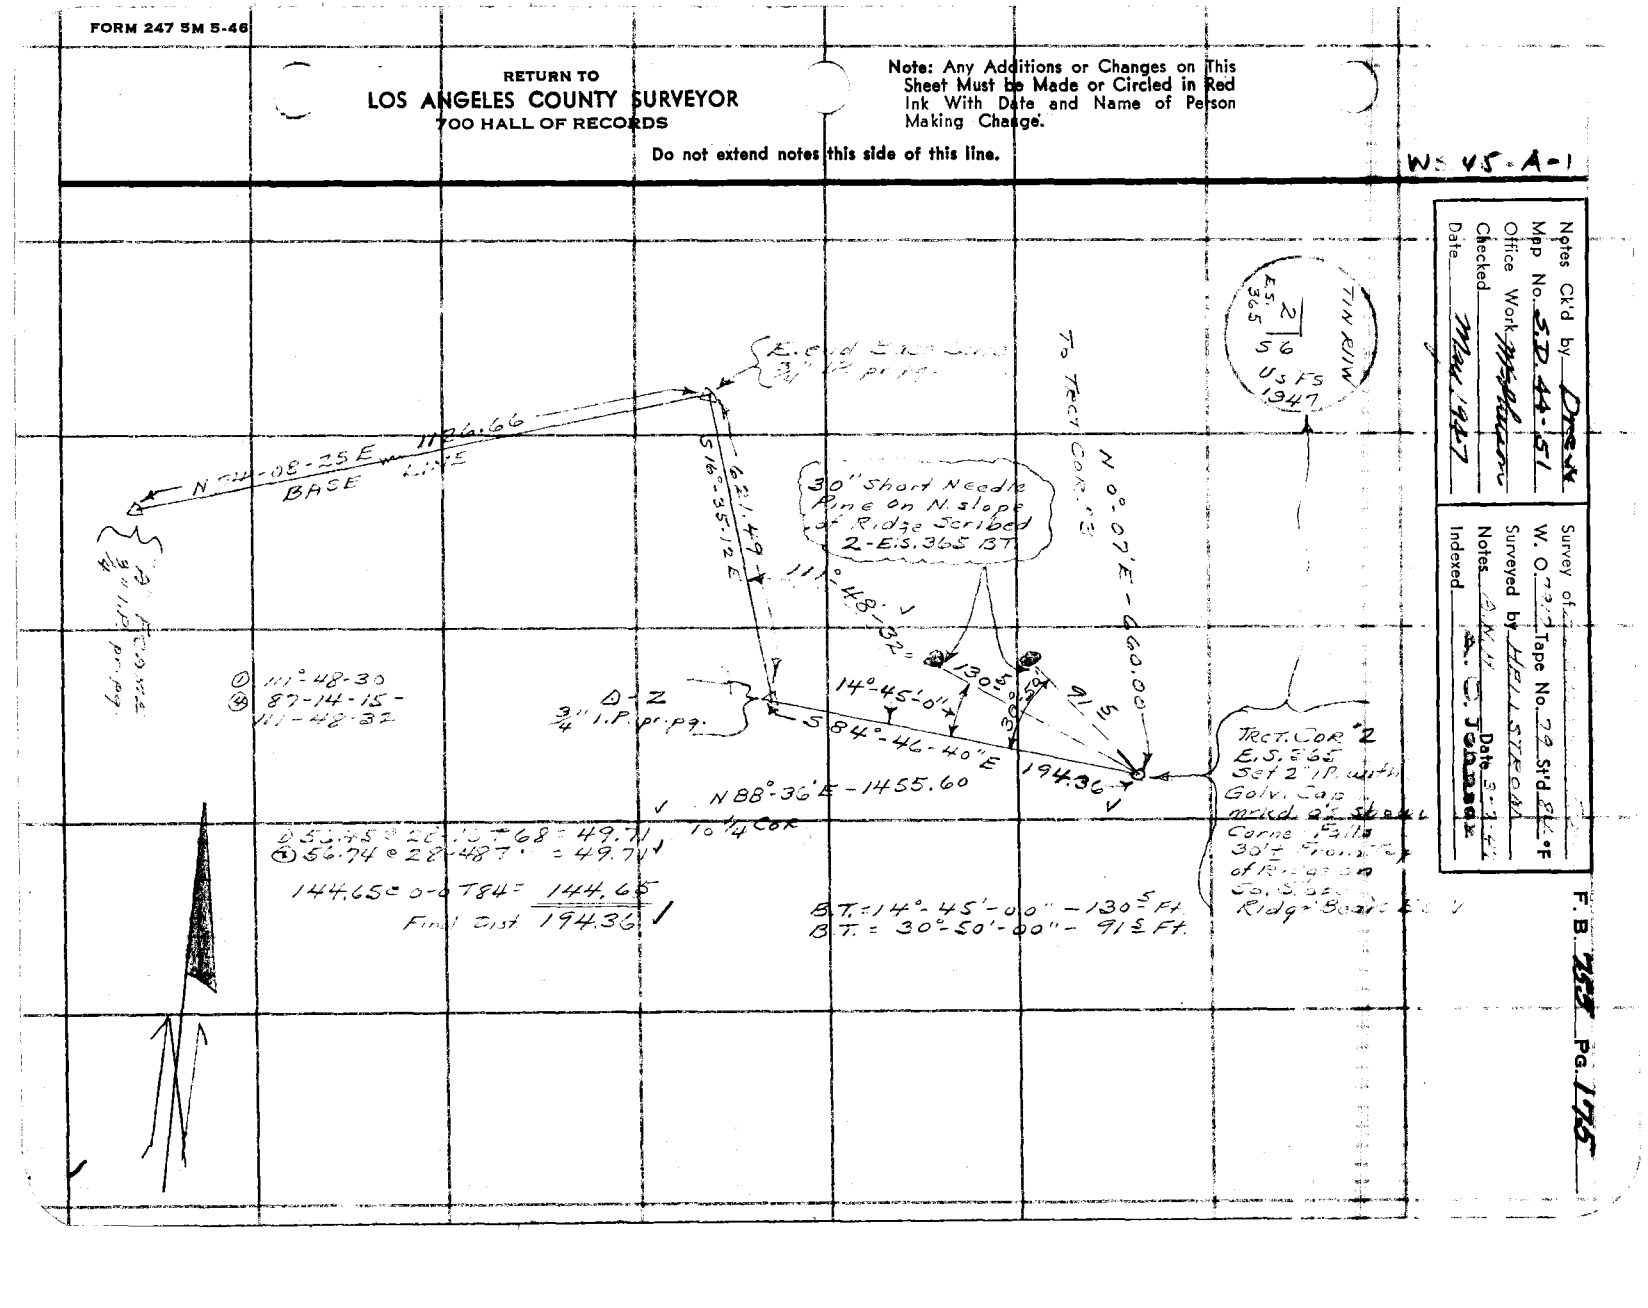

RETURN TO
LOS ANGELES COUNTY SURVEYOR
700 HALL OF RECORDS

Note: Any Additions or Changes on This Sheet Must be Made or Circled in Red Ink With Date and Name of Person Making Change.

Do not extend notes this side of this line.

F. B. 755 PG. 176

W.S.W.S.-A-1

Notes Ck'd by Drew
Map No. S.D. 44-51
Office Work M. K. Duncan
Checked
Date May 1947

Survey of
W. O. 7277 Tape No. 29 St'd 74 °F
Surveyed by HELLSTROM
Notes D.M.H. Date 3-7-47
Indexed A. C. JORDAN

F. B. 755 Pg. 177

① 26-45-00
② [illegible]
26-44-55 ✓

Note: Any Additions or Changes on This Sheet Must Be Made or Circled in Red Ink With Date and Name of Person Making Change.

Do not extend notes this side of this line.

RETURN TO
LOS ANGELES COUNTY SURVEYOR
700 HALL OF RECORDS

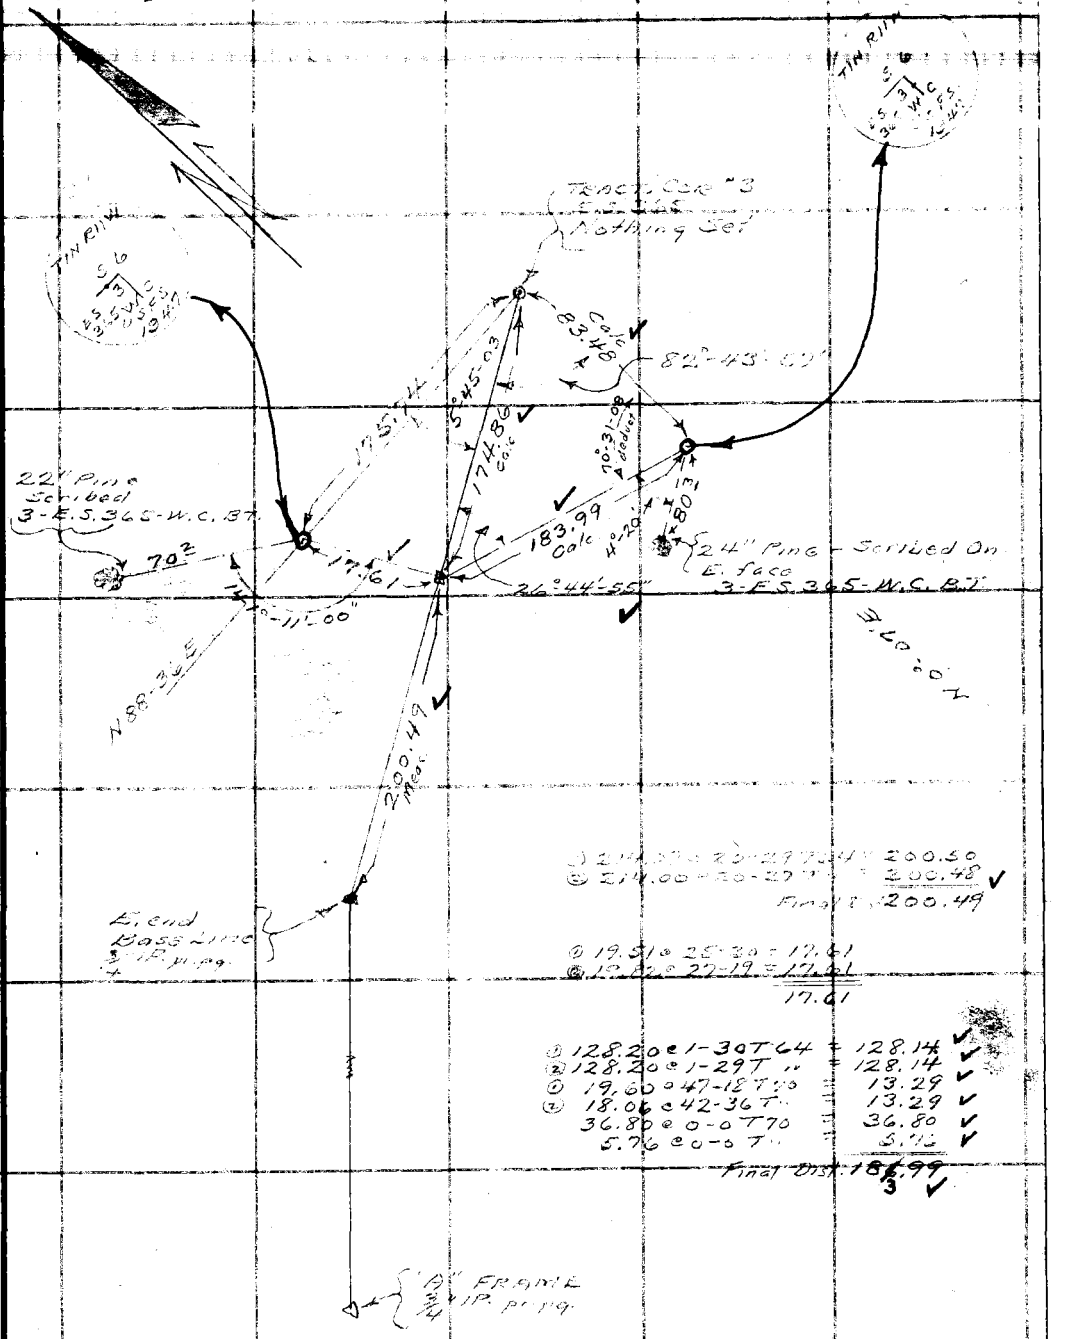

① 214.50 ∠ 20-27 = 200.50
② 214.00 ∠ 20-27 = 200.48
Final: 200.49

① 19.51 ∠ 25-30 = 17.61
② 19.51 ∠ 27-19 = 17.61
17.61

① 128.20 ∠ 1-30 T C4 = 128.14 ✓
② 128.20 ∠ 1-29 T " = 128.14 ✓
③ 19.60 ∠ 47-18 T 70 = 13.29 ✓
④ 18.06 ∠ 42-36 T " = 13.29 ✓
36.80 ∠ 0-0 T 70 = 36.80 ✓
5.72 ∠ 0-0 T " = 5.72 ✓
Final Dist: 183.99 ✓
3 ✓

FORM 247 5M 5-46

RETURN TO
LOS ANGELES COUNTY SURVEYOR
700 HALL OF RECORDS

Note: Any Additions or Changes on This Sheet Must be Made or Circled in Red Ink With Date and Name of Person Making Change.

Do not extend notes this side of this line.

F. B. 755 PG. 178

Notes Ck'd by Drew
Map No. S.D. 44-51
Office Work
Checked
Date May 1947.

Survey of
W. O. Tape No. St'd °F
Surveyed by
Notes Date
Indexed A. C. Johnson

F. B. 755 PG. 179

W.V.S-A-1

T1N R11W
SECTION 6
E.S. 365

(No Arrow)

Tract Cor #4

N88°36'E 1456.65

Witness Corner
See Pg. 177
175.74
230.76

"B" N82°50'57"E
375.35

Tract Cor #3

North 319.04

Base Line
N 74°08'25"E 1126.66

"A" I.P.

N 0°07'E 660.00

S16°35'12"E 621.49

S 77°08'59½"E 1293.70

N27°59'50"E 1847.50

North 340.96

"Z" S84°46'40"E 194.36

Tract Cor #2

W¼ Cor Sec 6

N 88°36'E 1455.60
1455.17 Calc.

N27°57'41"E 1539.40

N 41°57'18"E 2700.78

S 54°31'50" W 2434.97

Copied from Scratch Notes by Wm Leonard of U.S. Forest Service

Copied by A.C. Johnson 3/12/47

Note: Any Additions or Changes on this Sheet Must be Made or Circled in Red Ink With Date and Name of Person Making Change.

Do not extend notes this side of this line.

RETURN TO
LOS ANGELES COUNTY SURVEYOR
700 HALL OF RECORDS

FORM 247 SM 5-46

RETURN TO
LOS ANGELES COUNTY SURVEYOR
700 HALL OF RECORDS

Note: Any Additions or Changes on This Sheet Must be Made or Circled in Red Ink With Date and Name of Person Making Change.

Do not extend notes this side of this line.

F. B. 735 PG. 180

Notes Ck'd by	Survey of Henninger Flats
Map No.	JN 0038.53 Tape 0195 Std. 68 °F
Office Work	Surveyed by R.C. Wilson
Checked	Notes RCW Date 11-7-61
Date	Indexed M. E. OTT NOV 1 1961

F.B. 725 PG. 181

Note: Any Additions or Changes on This Sheet Must be Made or Circled in Red Ink With Date and Name of Person Making Change.

PLEASE RETURN TO
LOS ANGELES COUNTY ENGINEER
700 Los Angeles County Engineering Bldg.

Do not extend this side of this line.

HENNINGER FLATS TREE FARM

△ CONTROL FOR TOPOG

JN 0038.53

11-7-61

T 1 N R 12 W

Note: Control lines & angles have been calc. & adjusted for closeure.

R.C. Wilson
J. Rike ~ T
H. Birlew ~ H.C.
R. Schulthess ~ R.C.
Berger T * 29299

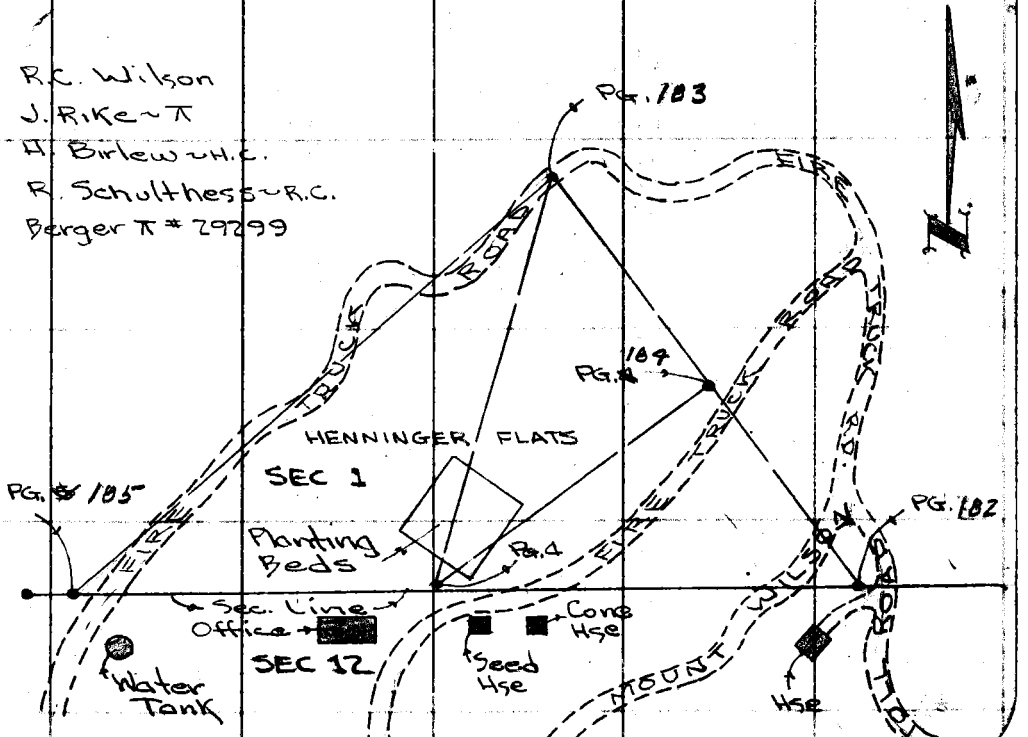

78F309S S&E #247 1-56

F. B. 755 PG. 182

PLEASE RETURN TO
LOS ANGELES COUNTY ENGINEER
700 Los Angeles County Engineering Bldg.

Do not extend this side of this line.

Note: Any Additions or Changes on This Sheet Must be Made or Circled in Red Ink With Date and Name of Person Making Change.

Notes Ck'd by	Survey of Hannrager Flats
Map No.	JN 0038.53 Tape 0175 Std. 68 °F
Office Work	Surveyed by R.C. Wilson
Checked	Notes RCW Date 11-7-61
Date	Indexed H. E. Ott

F. B. 755 PG. 183

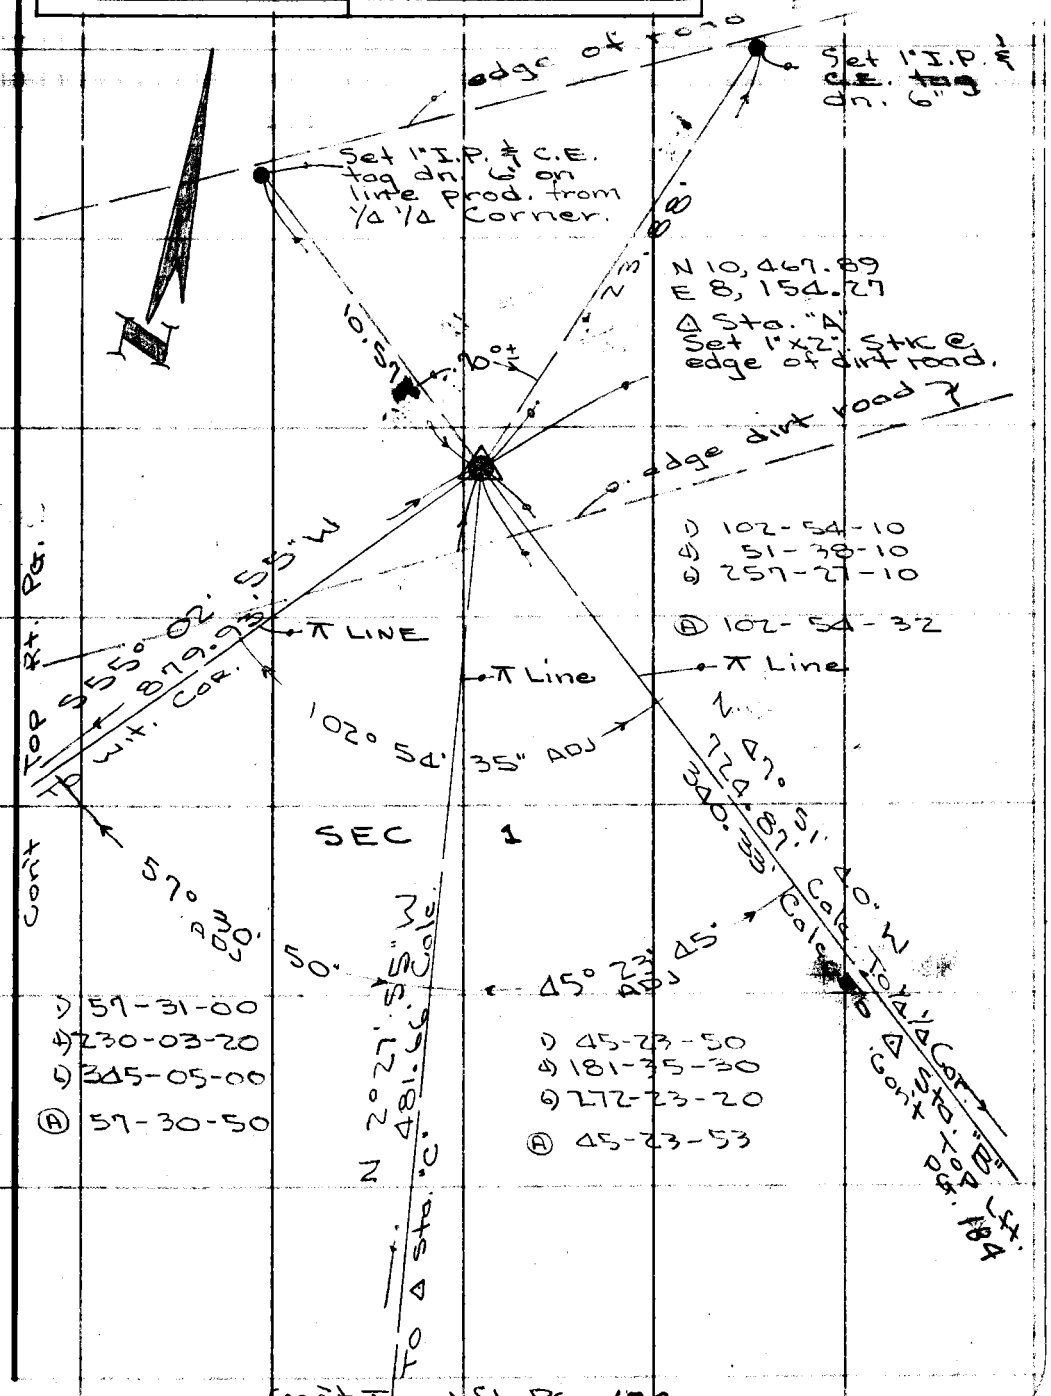

Note: Any Additions or Changes on This Sheet Must be Made or Circled in Red Ink With Date and Name of Person Making Change.

Do not extend this side of this line.

PLEASE RETURN TO
LOS ANGELES COUNTY ENGINEER
700 LOS ANGELES COUNTY ENGINEERING BLDG.

76F309S S&E #247 1-56

PLEASE RETURN TO
LOS ANGELES COUNTY ENGINEER
700 LOS ANGELES COUNTY ENGINEERING BLDG.

Note: Any Additions or Changes on This Sheet Must be Made or Circled in Red Ink With Date and Name of Person Making Change.

~~Do not~~ extend this side of this line.

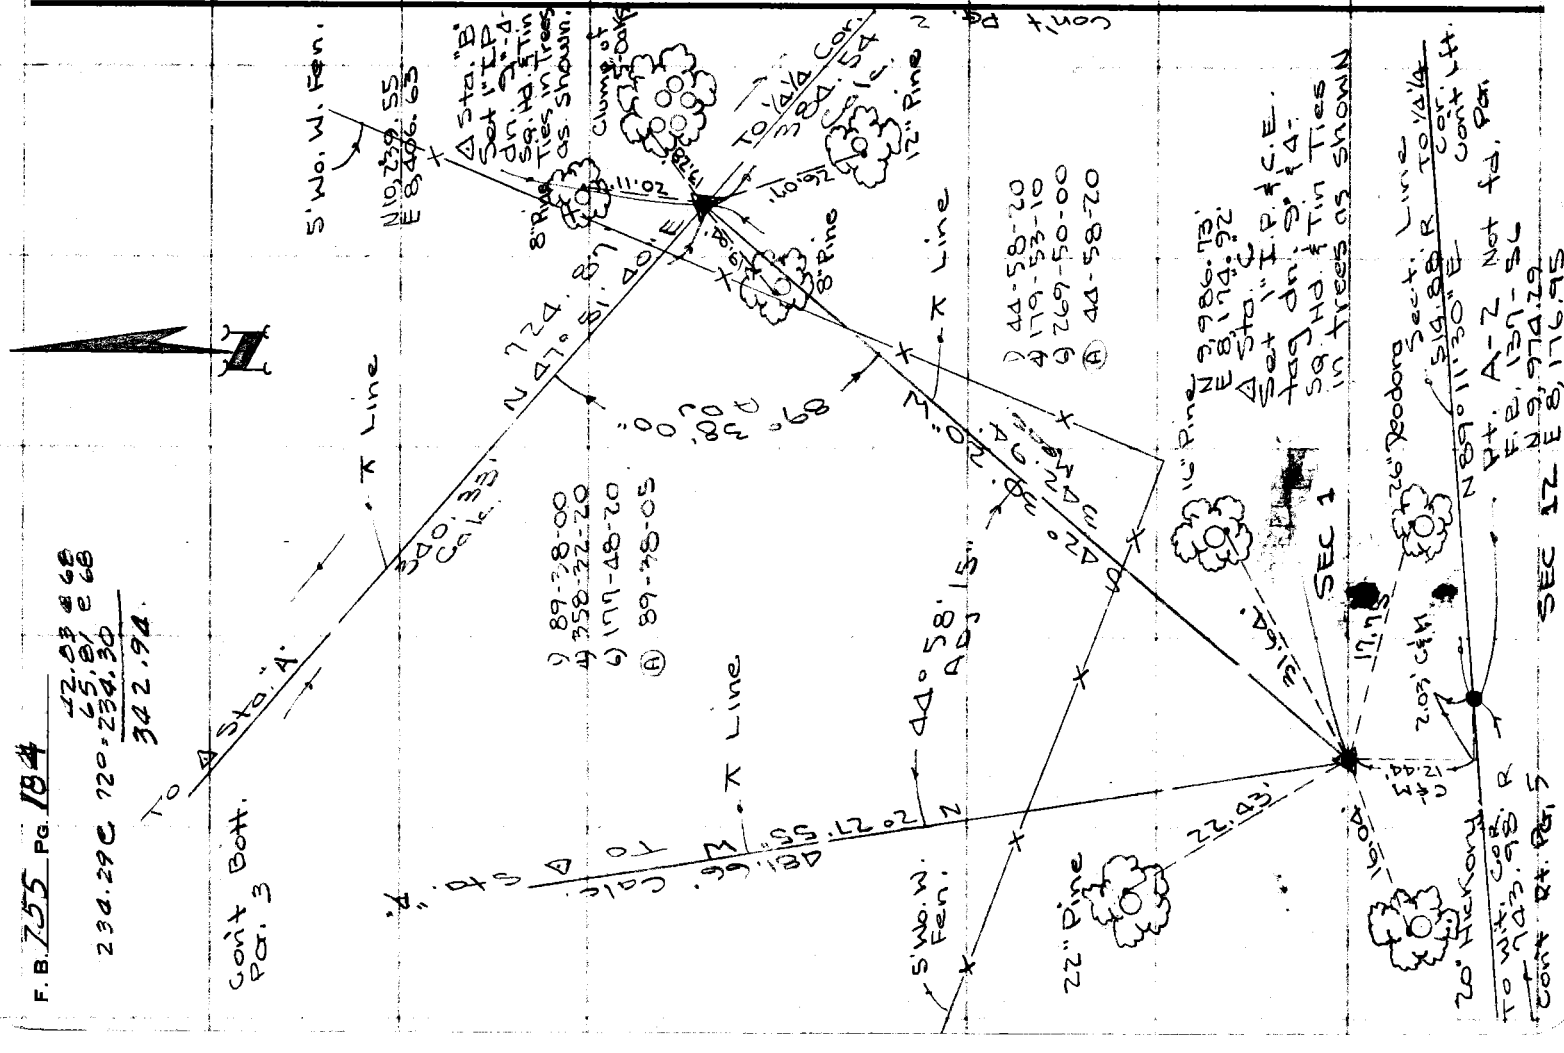

Notes Ck'd by	Survey of Henninger Flats
Map No.	JN 00578.53 Tape 0175 Std 68 °F
Office Work	Surveyed by RC Wilson
Checked	Notes RCW Date 11-7-61
Date	Indexed H. E. Ott

F. B. 155 Pg. 185

Fd. 1½" Capped Pipe up 8" stamped as shown set in position of Sandstone with Cor. per. FB 147-74 By U.S. Forestry Service and accepted same for Wit. Corner.

T1N R12W 2 ES366

1/4 S12

W.C. U.S.F.S. 1947

SEC 1

T Line
1) 34-08-40
2) 136-34-20
3) 204-51-20
A) 34-08-35

Sq. Hd. in Tin

8" Pine

T.P.C. Top of fill slope.

16.5'±

1.51 Rec.
1.55 Meas.

S/L

49.50 R
Δ 7° 53'
53 M

61'±

N 89° 11' 30" E
43.98 R TO "A-2"

N 9,963.80
E 7,433.09

Sq. Hd. in Tin in E. side T.V. Cable pole.

SEC 12

COUNTY SURVEYOR MONUMENT
T1N R12W 1 ES366 12

Stamped as shown - FB 137 pg. 74 "Fd. 4" in 4" slope. Set 4"x4" Post 5' H. 2' North.

Water Tank

E-W

N 55° 02' 55" W 879.83' to "A"

Road

Cont. Both Lft. Pg. 184

Note: Any Additions or Changes on This Sheet Must be Made or Circled in Red Ink With Date and Name of Person Making Change.

Do not extend this side of this line.

PLEASE RETURN TO
LOS ANGELES COUNTY ENGINEER
700 Los Angeles County Engineering Bldg.

76F3095 S&E #247 1-56

PLEASE RETURN TO
LOS ANGELES COUNTY ENGINEER
700 LOS ANGELES COUNTY ENGINEERING BLDG.

Note: Any Additions or Changes on This Sheet Must be Made or Circled in Red Ink With Date and Name of Person Making Change.

Do not extend this side of this line.

F. B. 755 Pg 186

247 10M 11-38

RETURN TO
LOS ANGELES COUNTY SURVEYOR
700 HALL OF RECORDS

Note: Any Additions or Changes on This Sheet Must be Made or Circled in Red Ink With Date and Name of Person Making Change.

Do not extend notes this side of this line

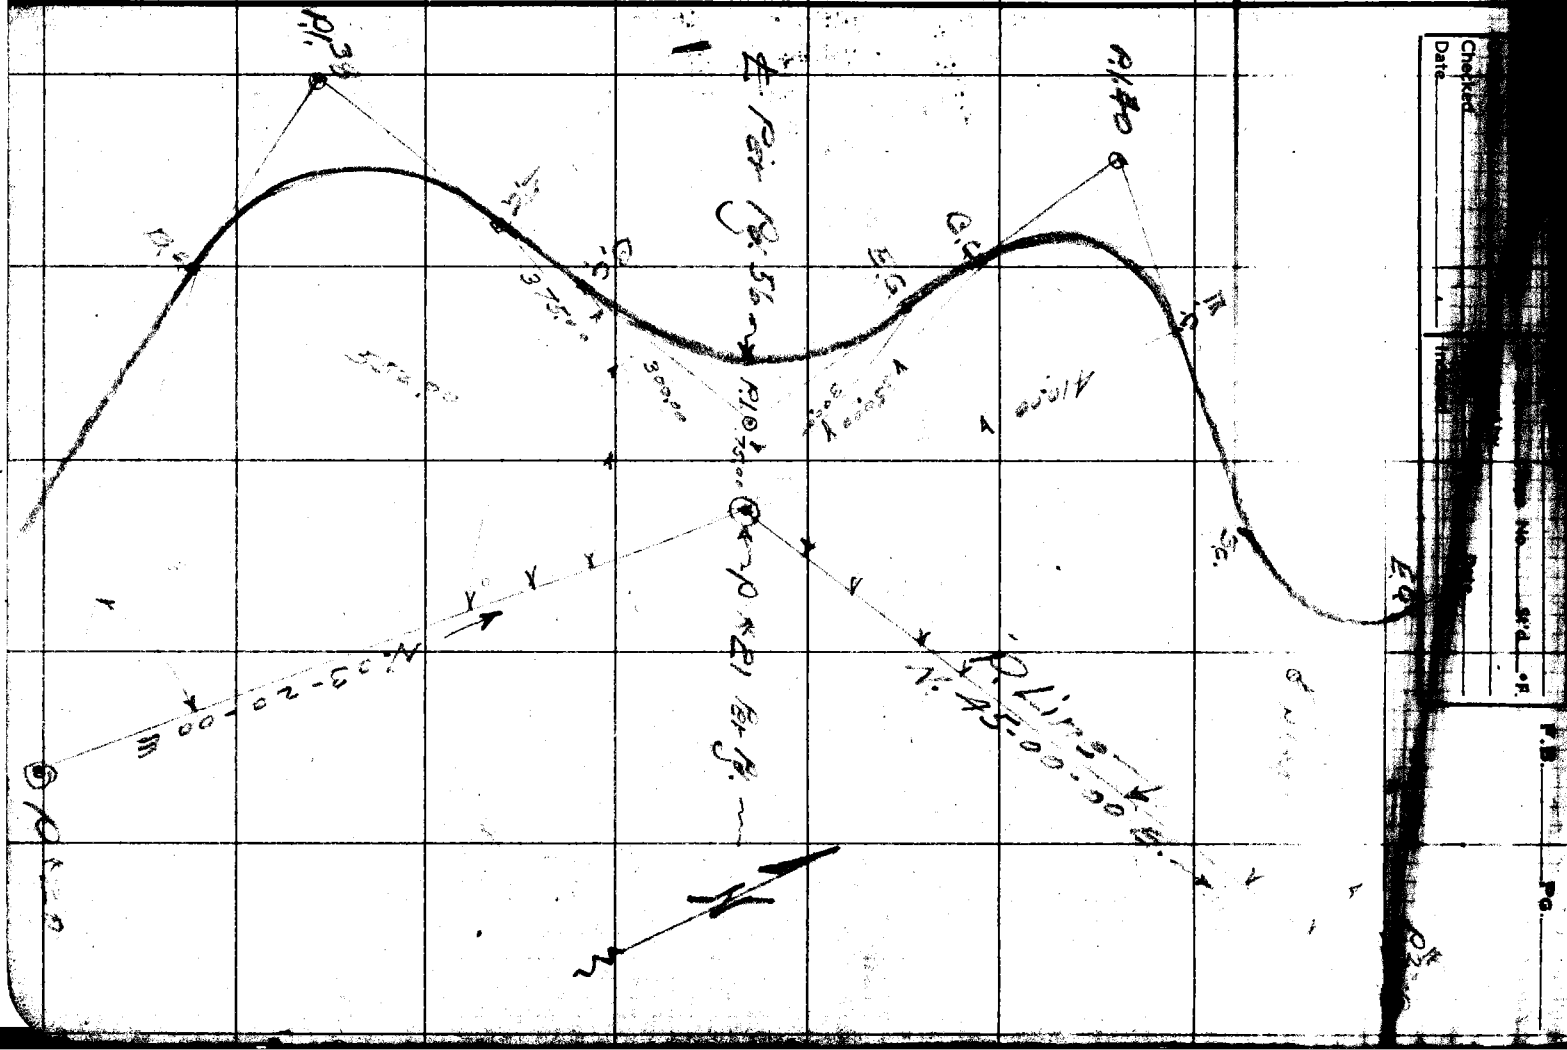

Checked
Date
No.
Sh'd
F.B.
Pg.

LOS ANGELES COUNTY SURVEYOR
700 HALL OF RECORDS

Note: Any Addition or Changes on This Sheet Must Be Signed In Red Ink With Date and Name of Person Making Change.

755

5 10

18

N 59-34-41"W
79-
00