Notes Ck'd by	Survey of	F.B. 772 Pg. 1
Map No.	W. O. Tape No. St'd of	
Office Work	Surveyed by	
Checked	Notes Date	
Date	Indexed	

772

Return to: LOS ANGELES COUNTY [illegible]
[illegible]

Notes Any Additions or Changes on This [illegible] Sent [illegible] Person [illegible]

FORM 247 5M 10-37

RETURN TO
LOS ANGELES COUNTY SURVEYOR
700 HALL OF RECORDS

Note: Any Additions or Changes on This Sheets Must be Made or Circled in **Red Ink** With Date and Name of Person Making Change.

Do not extend notes this side of this line

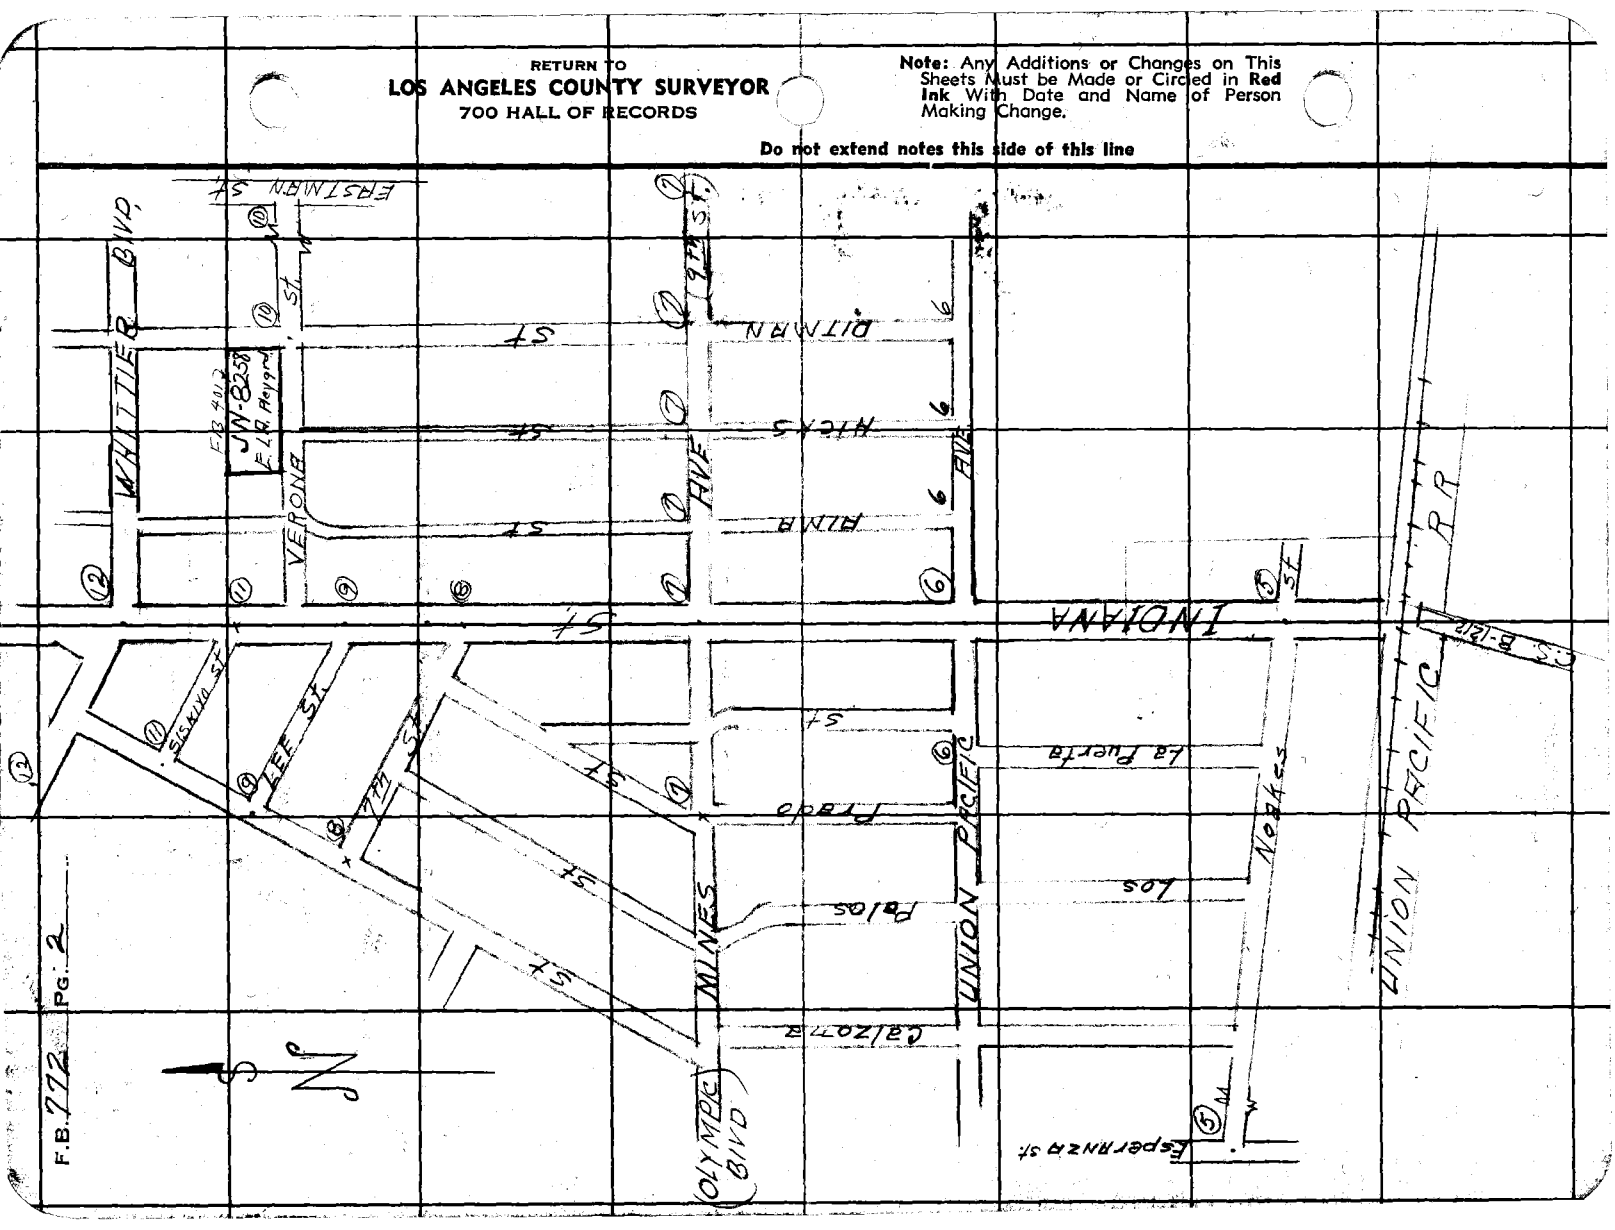

Notes Ck'd by D. M. Finley	Survey of INDIANA ST.	F.B. 772 Pg 2A
Map No. B-1465	W. O. 8226 Tape No. St'd OF	
Office Work F. A. W.	Surveyed by EVANS	
Checked D. M. Finley	Notes OTT Date	
Date Jan 1941	Indexed A. C. Tolson 5-16-39	

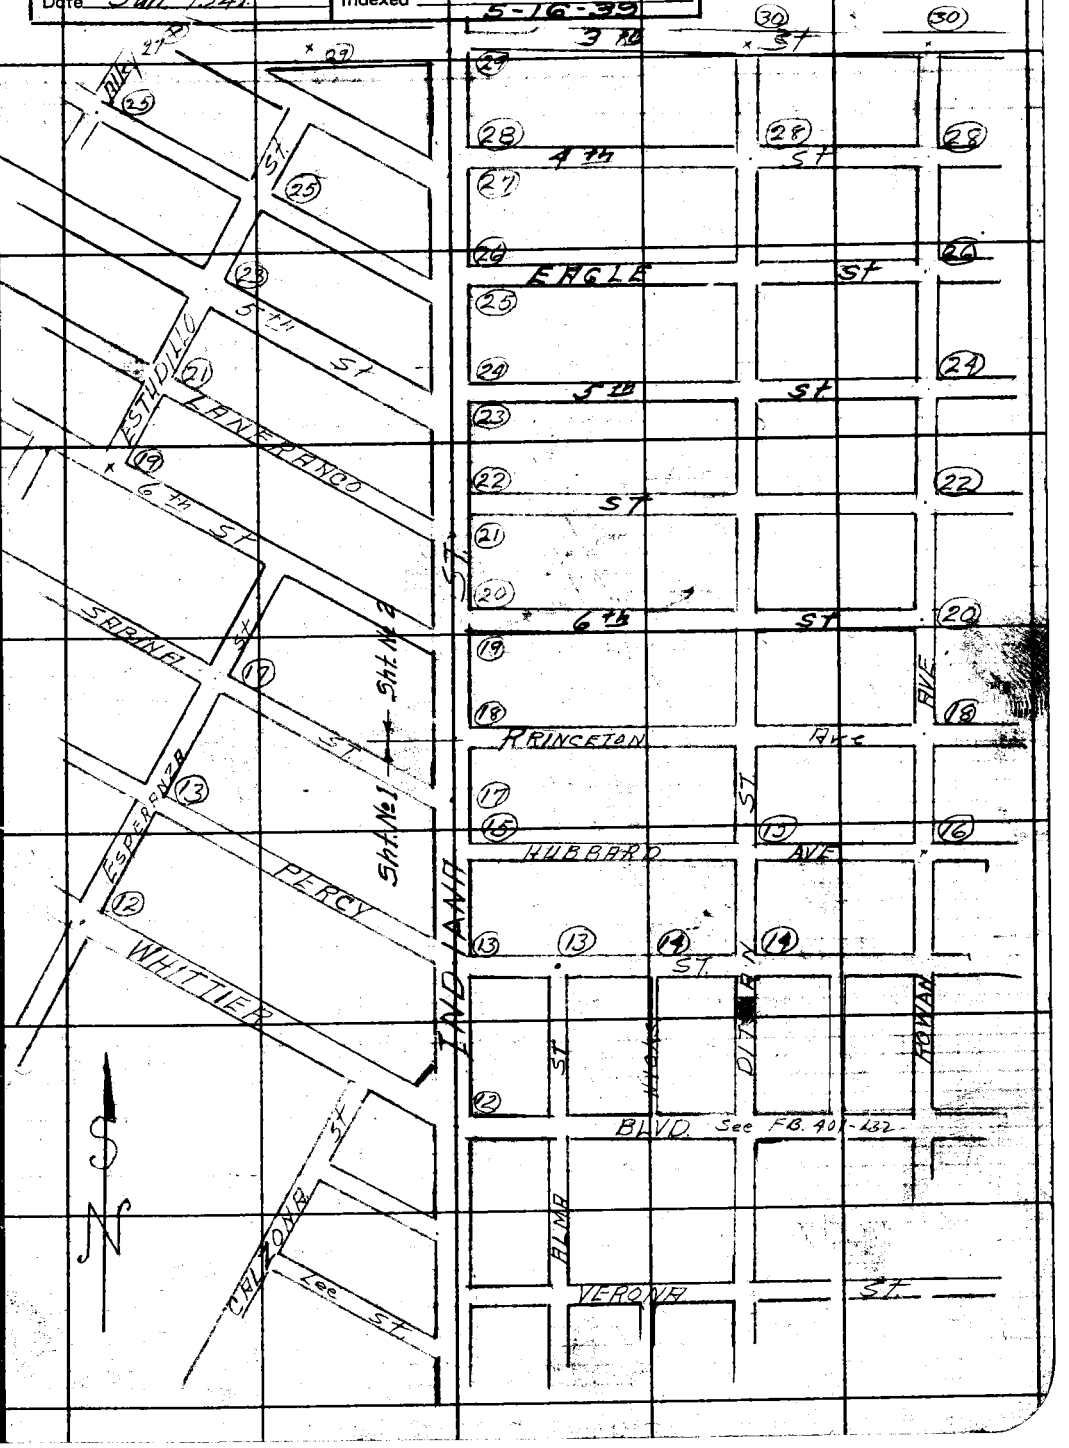

Note: Any Additions or Changes on This Sheets Must be Made or Circled in Red Ink With Date and Name of Person Making Change.

Do not extend notes this side of this line

RETURN TO
LOS ANGELES COUNTY SURVEYOR
700 HALL OF RECORDS

FORM 247 5M 10-37

RETURN TO
LOS ANGELES COUNTY SURVEYOR
700 HALL OF RECORDS

Note: Any Additions or Changes on This Sheets Must be Made or Circled in **Red Ink** With Date and Name of Person Making Change.

Do not extend notes this side of this line

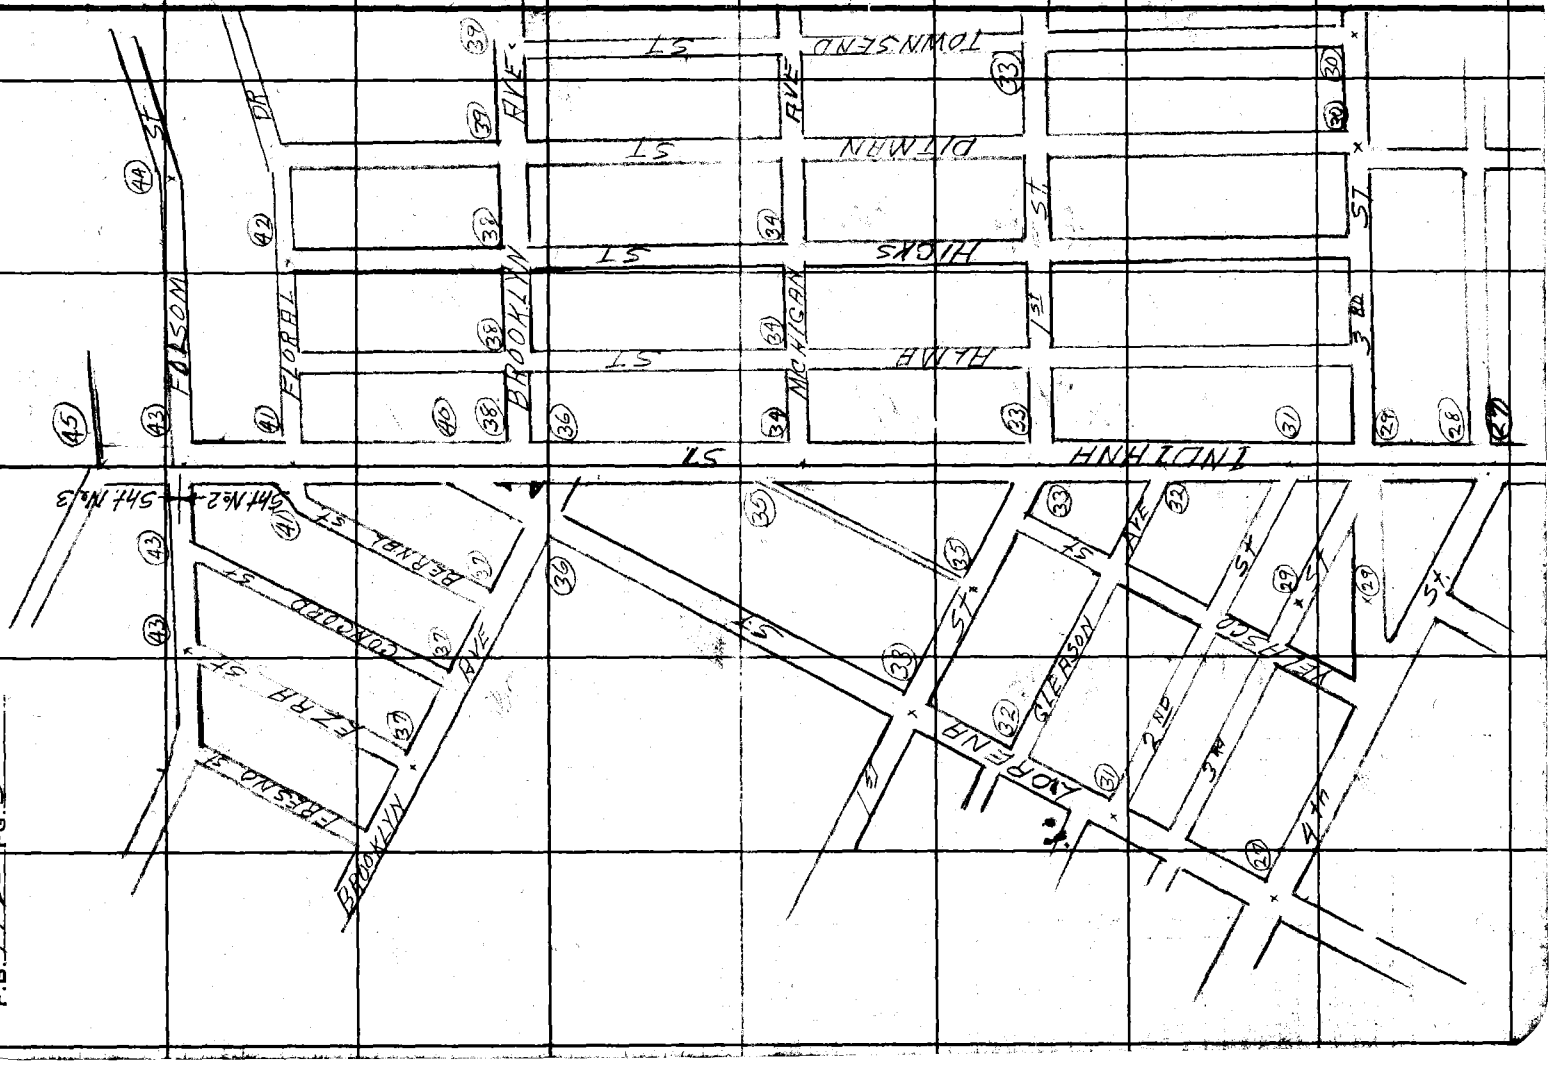

F.B. 772 PG. 3

Notes Ck'd by D. M. Finley	Survey of INDIANA ST	F.B. 772	Pg. 3A
Map No. B-165	W. O. 8214 Tape No.	St'd	of
Office Work F. A. W.	Surveyed by EVANS		
Checked D. M. Finley	Notes O.T.T. Date		
Date Jan 1941	Indexed		

Note: Any Additions or Changes on This Sheets Must be Made or Circled in Red Ink With Date and Name of Person Making Change.

Do not extend notes this side of this line

RETURN TO
LOS ANGELES COUNTY SURVEYOR
700 HALL OF RECORDS

FORM 247 5M 10-37

RETURN TO
LOS ANGELES COUNTY SURVEYOR
700 HALL OF RECORDS

Note: Any Additions or Changes on This Sheets Must be Made or Circled in **Red Ink** With Date and Name of Person Making Change.

Do not extend notes this side of this line

F.B. 772 PG. 4

Notes Ck'd by D. M. Finley	Survey of Indiana St
Map No. B-1465-1	W. O. 8226 Tape No. 036 St'd 64 °F.
Office Work F. A. W.	Surveyed by Evans
Checked D. M. Finley	Notes HE Date 10-21-38
Date Jan. 1941	Indexed 5-16-39

F.B. 778 Pg. 5

W.S. 7D-3

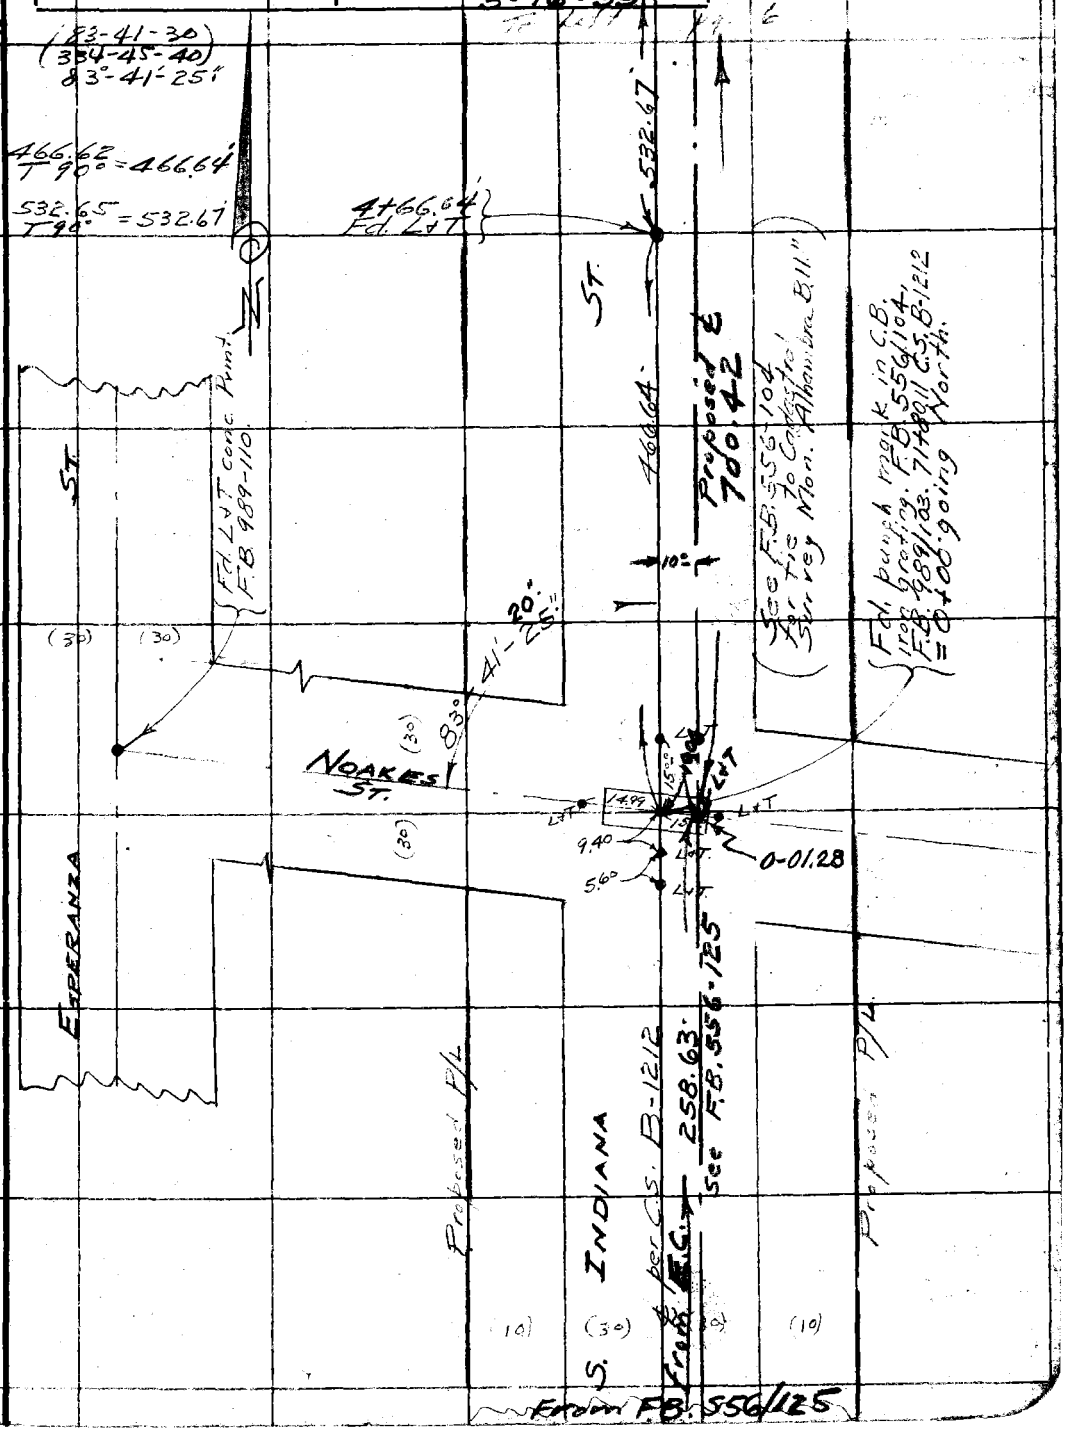

Note: Any Additions or Changes on This Sheet Must be Made or Circled in Red Ink With Date and Name of Person Making Change.

Do not extend notes this side of this line

RETURN TO
LOS ANGELES COUNTY SURVEYOR
700 HALL OF RECORDS

FORM 247 10M 11-35

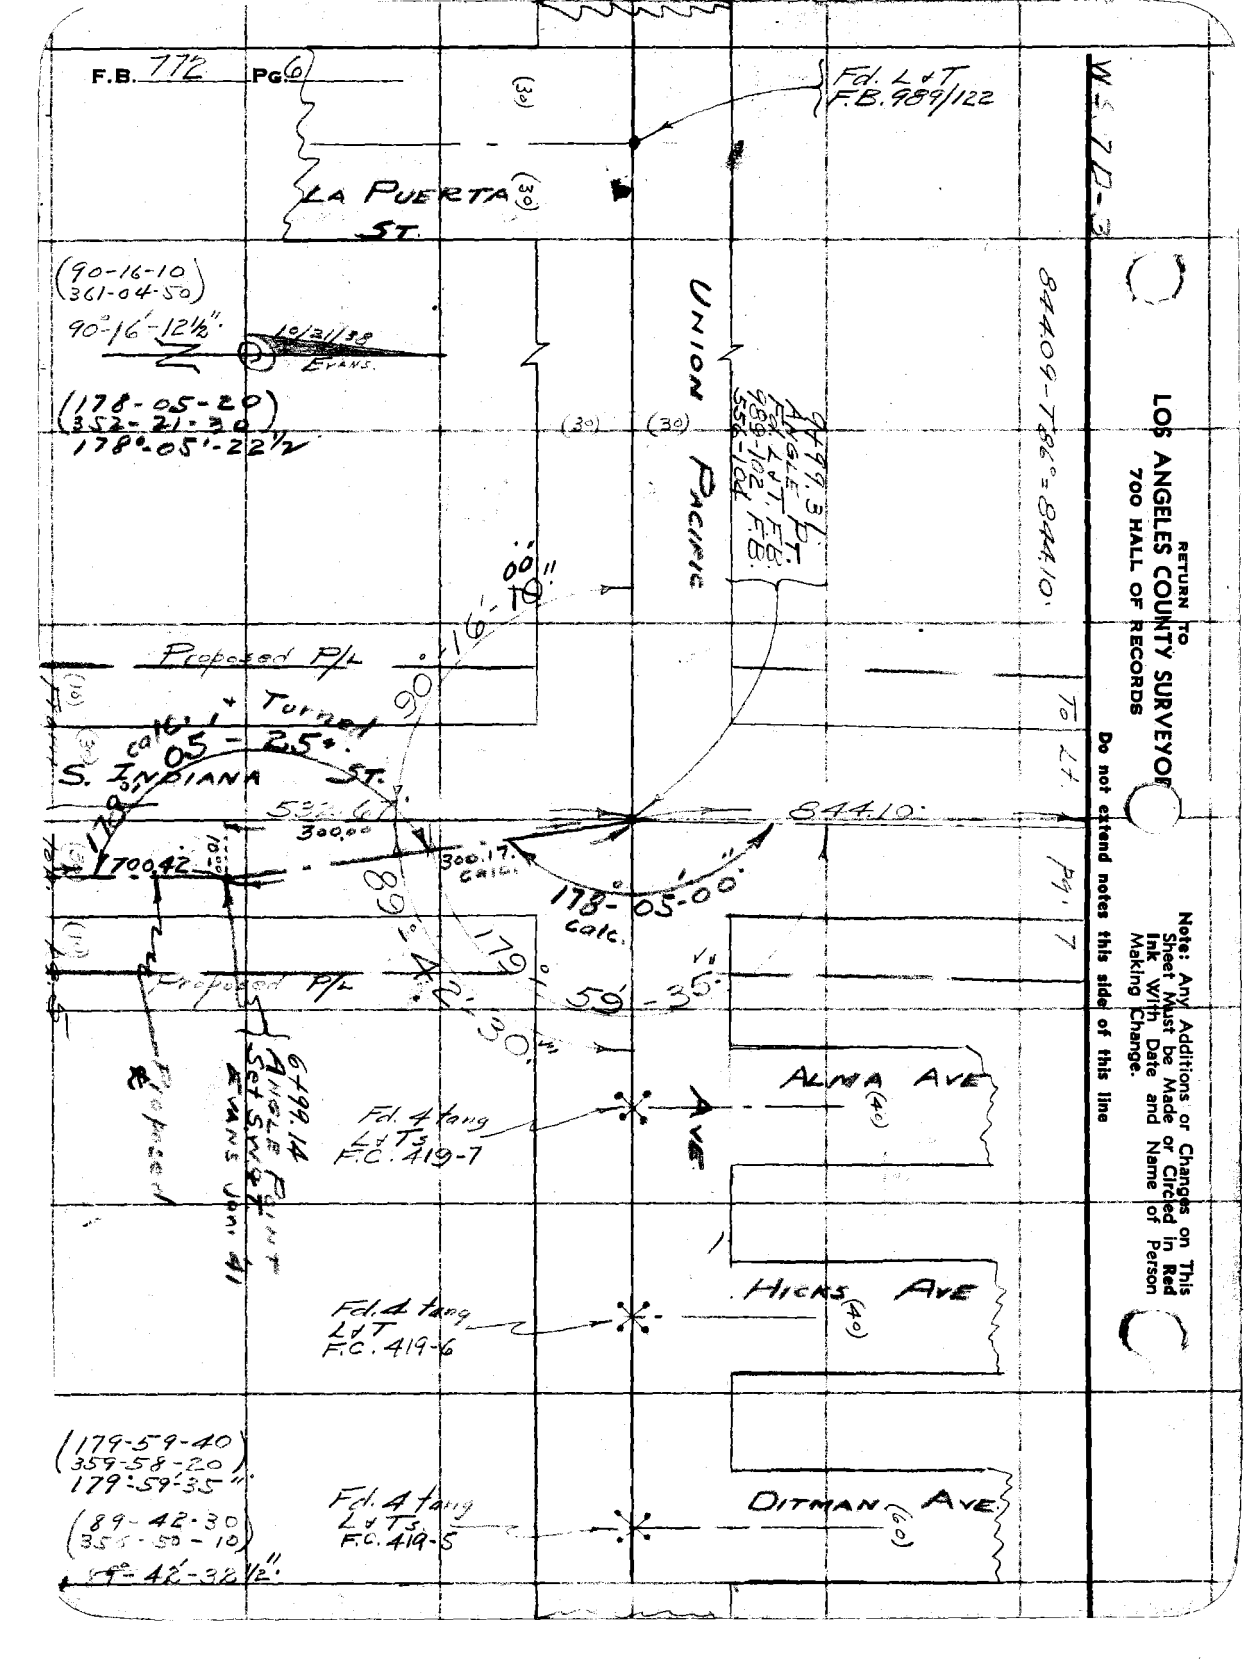
F.B. 772 Pg. 6
Fd. L&T F.B. 989/122
LA PUERTA ST.
(30)
(90-16-10)
(361-04-50)
90°-16'-12½"
10/21/38 EVANS.
(178-05-20)
(352-21-30)
178°-05'-22½"
UNION PACIFIC
(30)
(30)
9499.31 ANGLE PT. Fd. L&T F.B. 989-102 F.B. 556-104
844.09-T86°=844.10'
90°-16'-10"
Proposed P/L
Turned
calc. 1 + 05 - 25 +
S. INDIANA ST.
532.67
300.00
844.10'
700.42
300.17 calc.
178°-05'-00" calc.
89°-42'-30"
179°-59'-35"
Proposed P/L
Proposed
6499.14 ANGLE POINT Set SWGT EVANS Jan. 41
ALMA AVE
(40)
Fd. 4 tang L&Ts F.C. 419-7
HICKS AVE
(40)
Fd. 4 tang L&T F.C. 419-6
(179-59-40)
(359-58-20)
179°-59'-35"
(89-42-30)
(358-50-10)
89°-42'-32½"
Fd. 4 tang L&Ts F.C. 419-5
DITMAN AVE
(60)
To Lt. Pg. 7
W.S. 7D-3
RETURN TO
LOS ANGELES COUNTY SURVEYOR
700 HALL OF RECORDS
Do not extend notes this side of this line
Note: Any Additions or Changes on This Sheet Must be Made or Circled in Red Ink With Date and Name of Person Making Change.

Notes Ck'd by D. M. Finley	Survey of [illegible] St.	F.B. 772 Pg. 7
Map No. B-1465-1	W. O. 8226 Tape No. 036 St'd 84°F.	733.97-T82° = 733.96°
Office Work F. A. W.	Surveyed by EVANS	
Checked D. M. Finley	Notes HE Date 10/21/38	
Date Jan. 1941	Indexed	

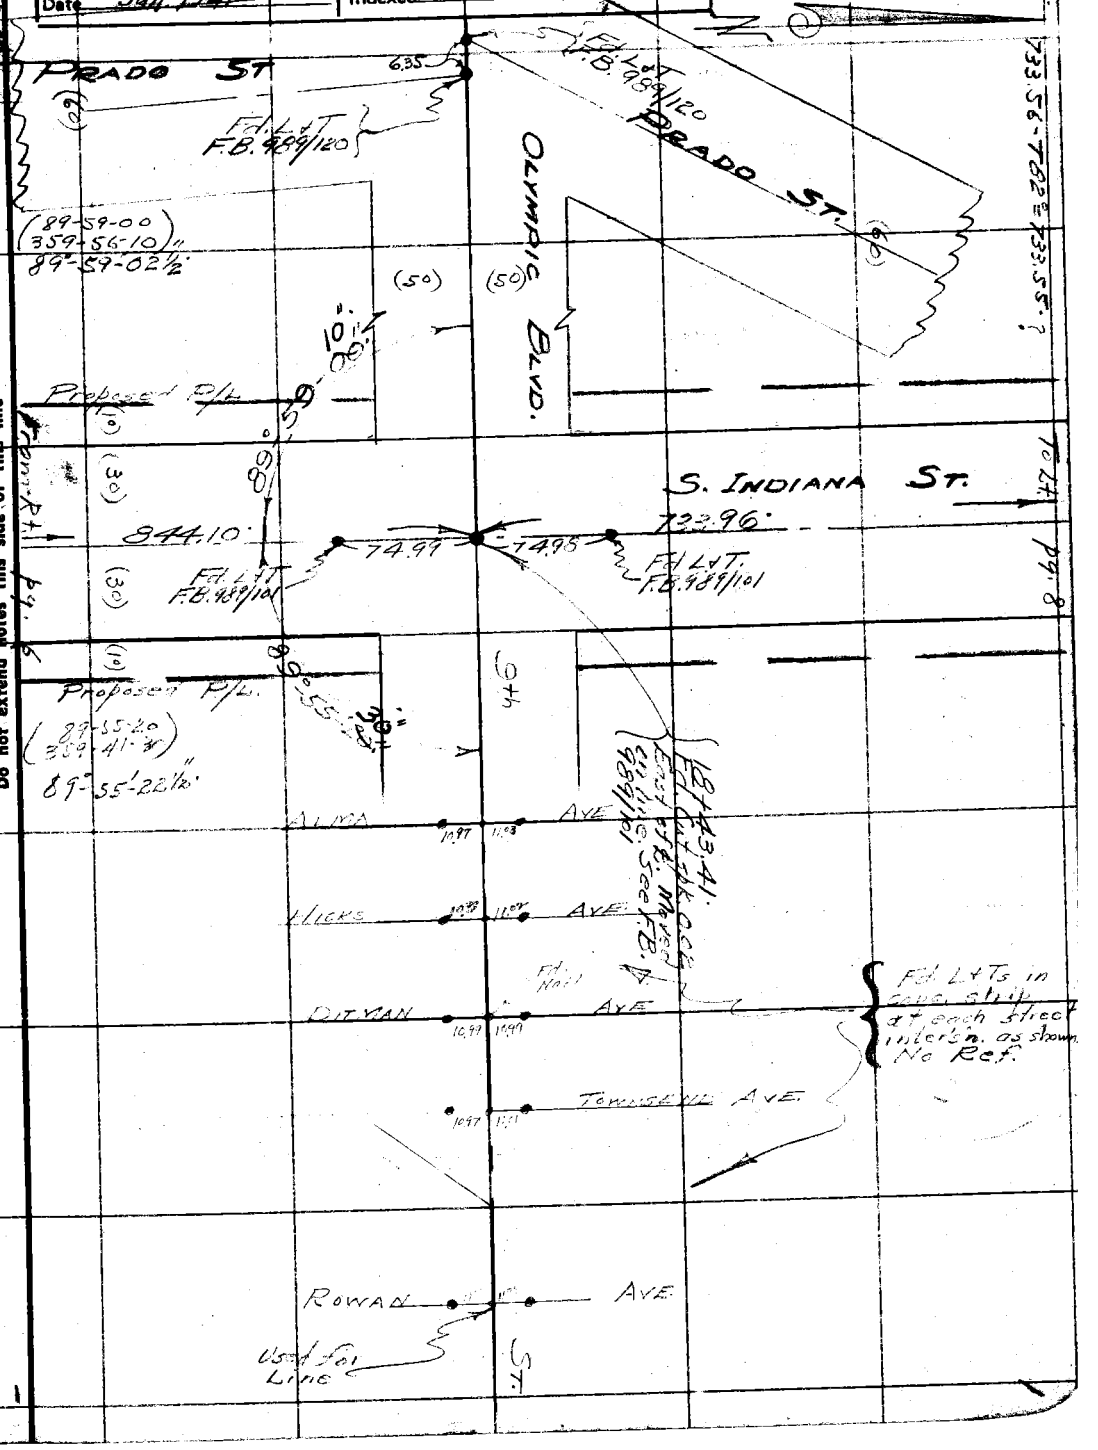

Note: Any Additions or Changes on This Sheet Must be Made or Circled in Red Ink With Date and Name of Person Making Change.

Do not extend notes this side of this line

RETURN TO
LOS ANGELES COUNTY SURVEYOR
700 HALL OF RECORDS

FORM 247 10M 11-35

RETURN TO
LOS ANGELES COUNTY SURVEYOR
700 HALL OF RECORDS

Note: Any Additions or Changes on This Sheet Must be Made or Circled in Red Ink With Date and Name of Person Making Change.

Do not extend notes this side of this line

WS 70-3

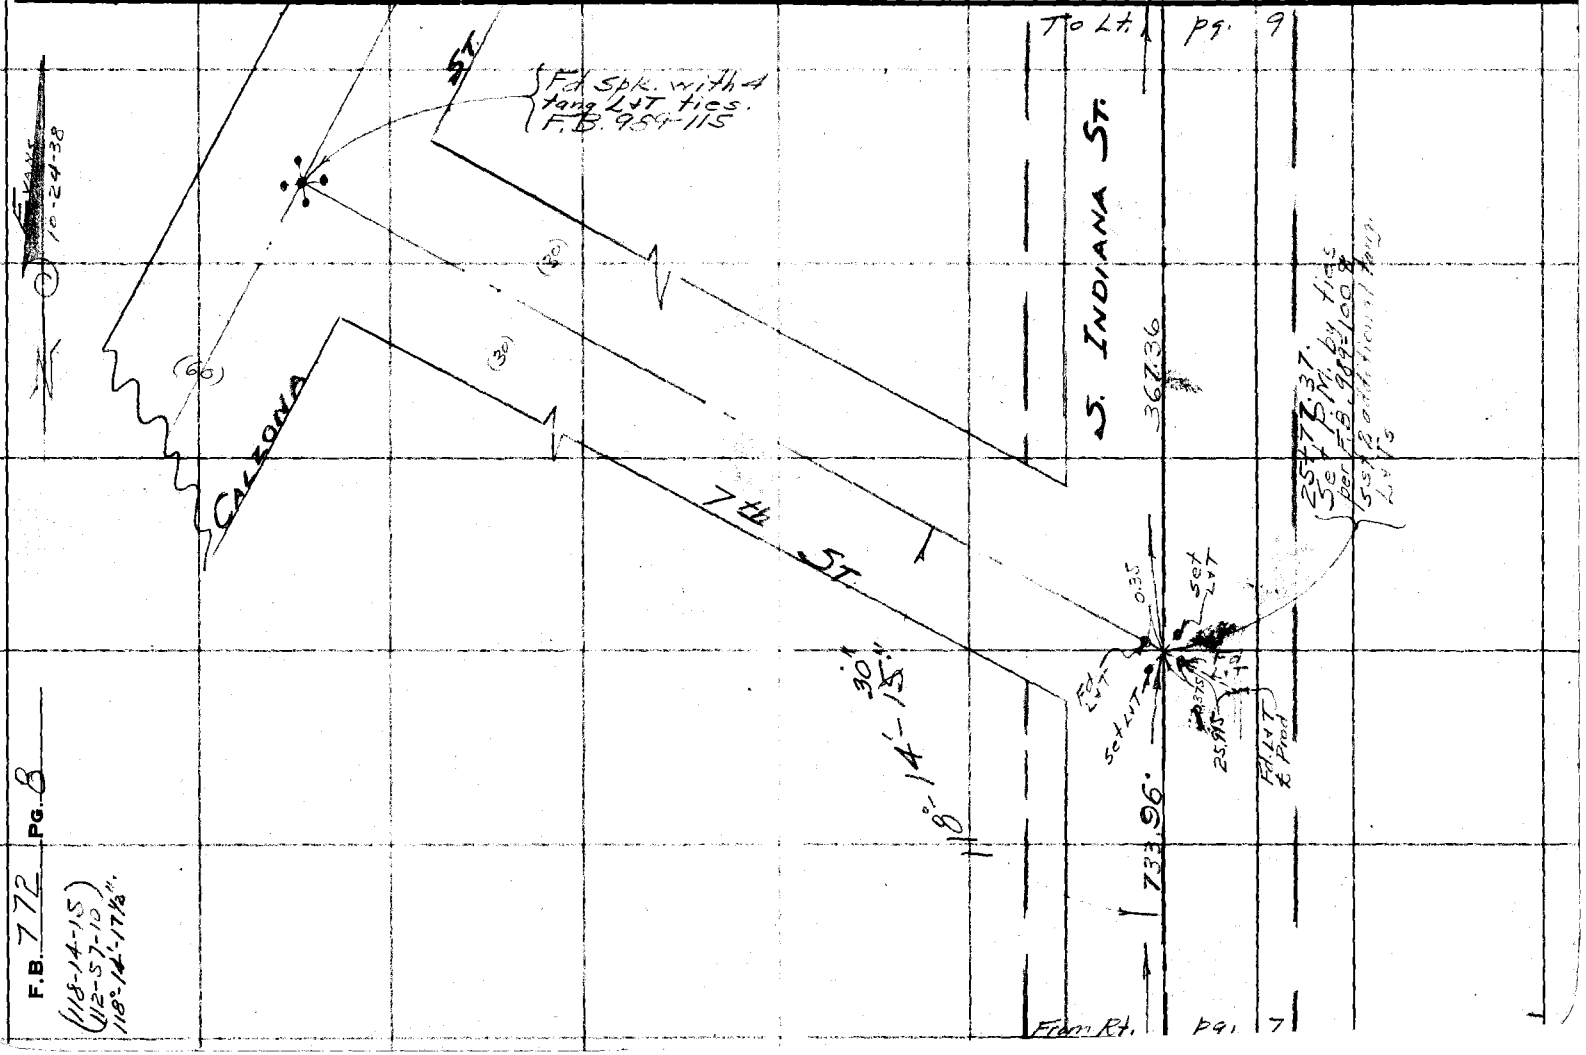

F.B. 772 PG. 8

(118-14-15)
(112-57-10)
118°-14'-17½".

Notes Ck'd by D. M. Finley	Survey of [illegible]
Map No. B-1465-1	W. O. 8226 Tape No. 036 St'd 54°F.
Office Work F. A. W.	Surveyed by Evans
Checked D. M. Finley	Notes HE Date 10/24/38
Date Jan. 1941	Indexed [illegible]

F.B. 772 PG. 9

Fd. spk. & 4 tang L+T's per F.B. 989-113

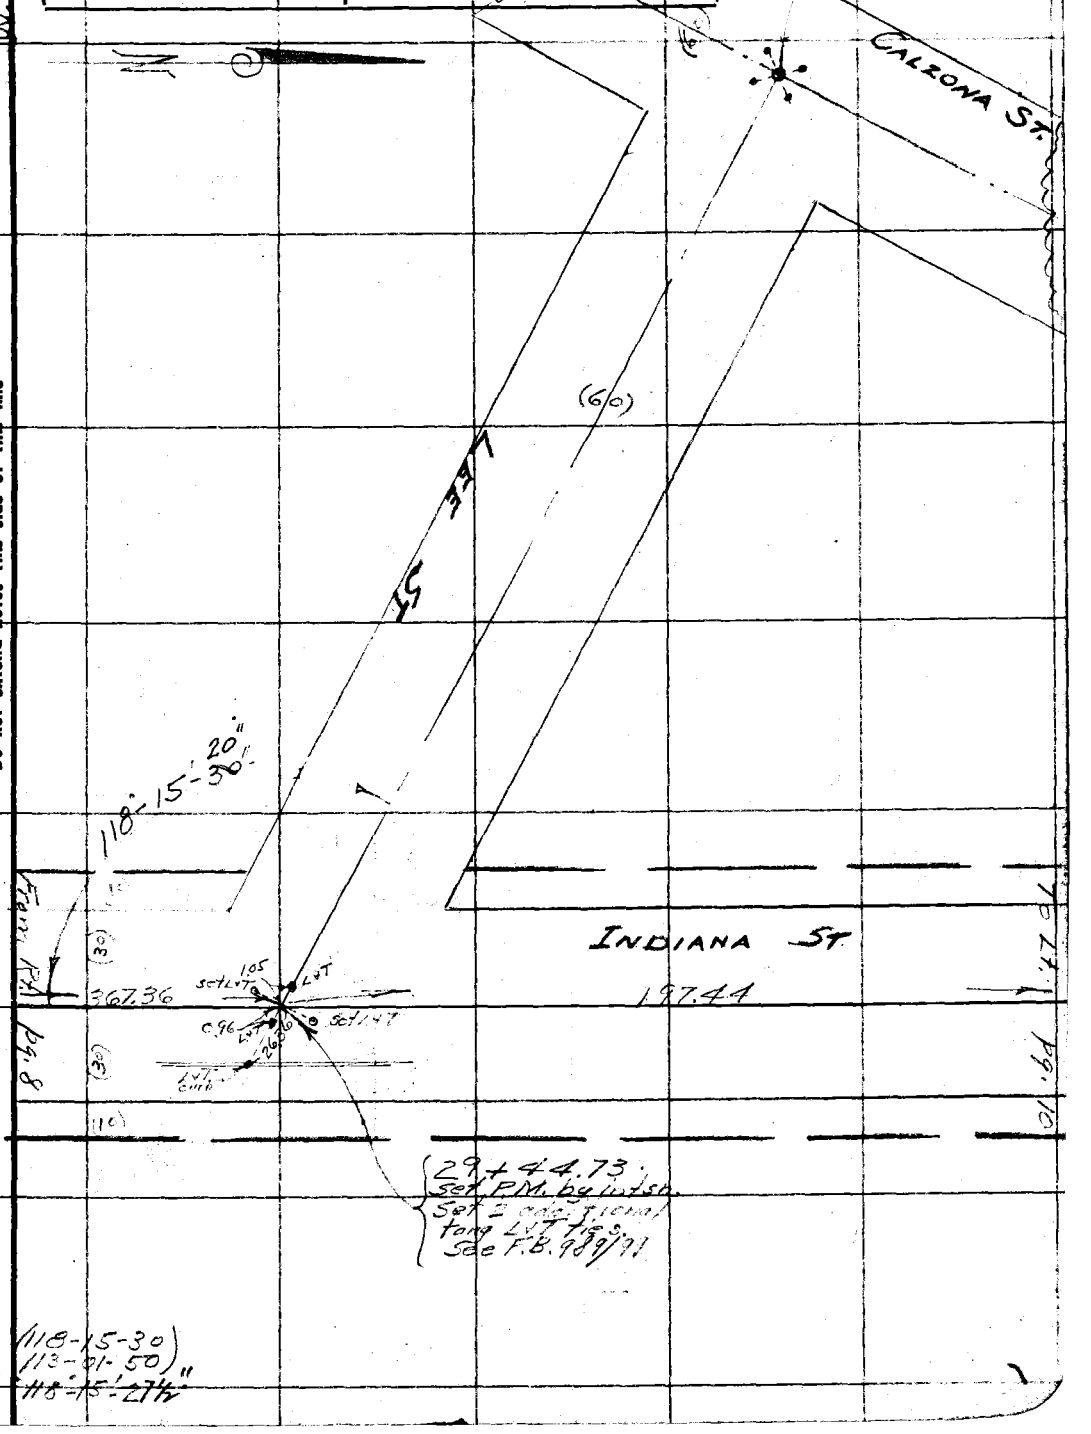

Note: Any Additions or Changes on This Sheet Must be Made or Circled in Red Ink With Date and Name of Person Making Change.

Do not extend notes this side of this line

RETURN TO
LOS ANGELES COUNTY SURVEYOR
700 HALL OF RECORDS

FORM 247 10M 11-35

RETURN TO
LOS ANGELES COUNTY SURVEYOR
700 HALL OF RECORDS

Note: Any Additions or Changes on This Sheet Must be Made or Circled in Red Ink With Date and Name of Person Making Change.

Do not extend notes this side of this line

WS 70-2

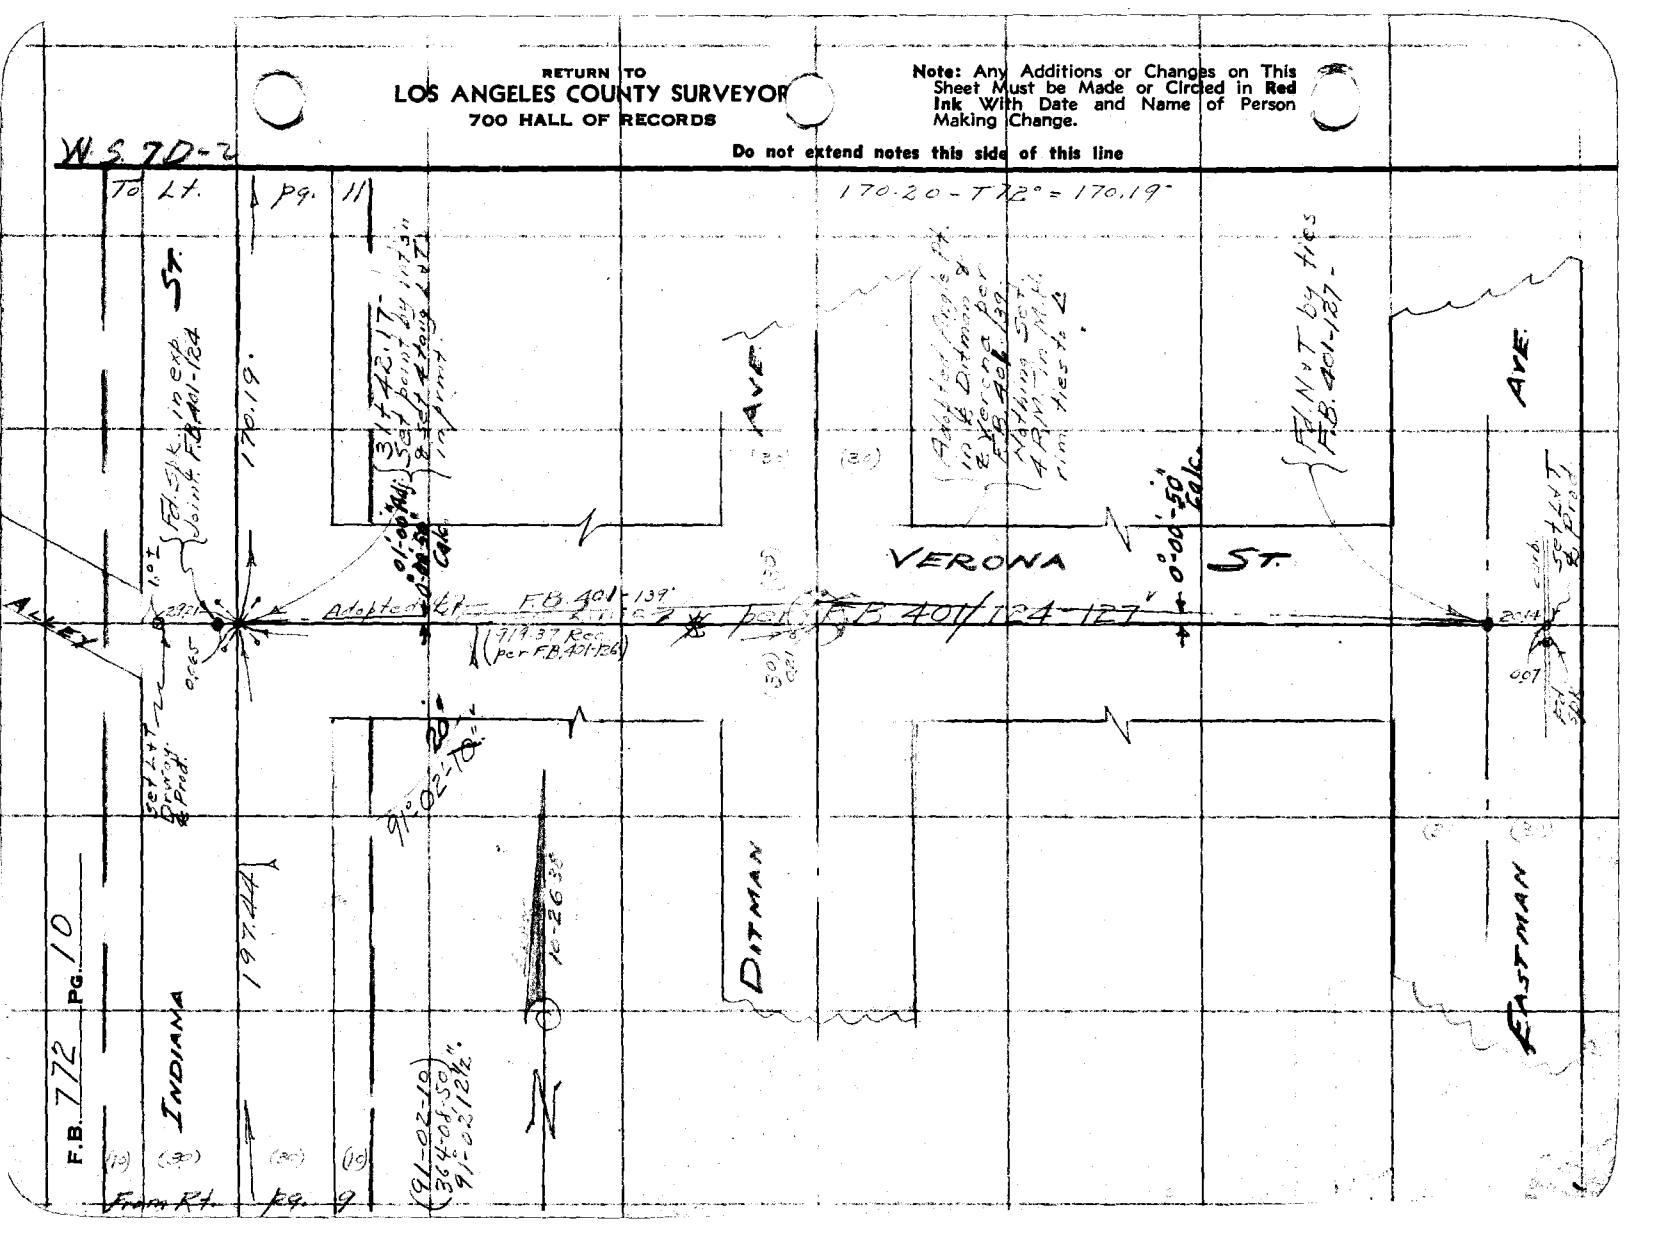

F.B. 772 Pg. 10

Notes Ck'd by D. M. Finley	Survey of [illegible]
Map No. B-1465-1	W. O. 8226 Tape No. 036 St'd 84 °F.
Office Work F. A. W.	Surveyed by EVANS
Checked D. M. Finley	Notes HE Date 10-26-38
Date Jan. 1941	Indexed

F.B. 772 Pg. 11

W.S. 70-2

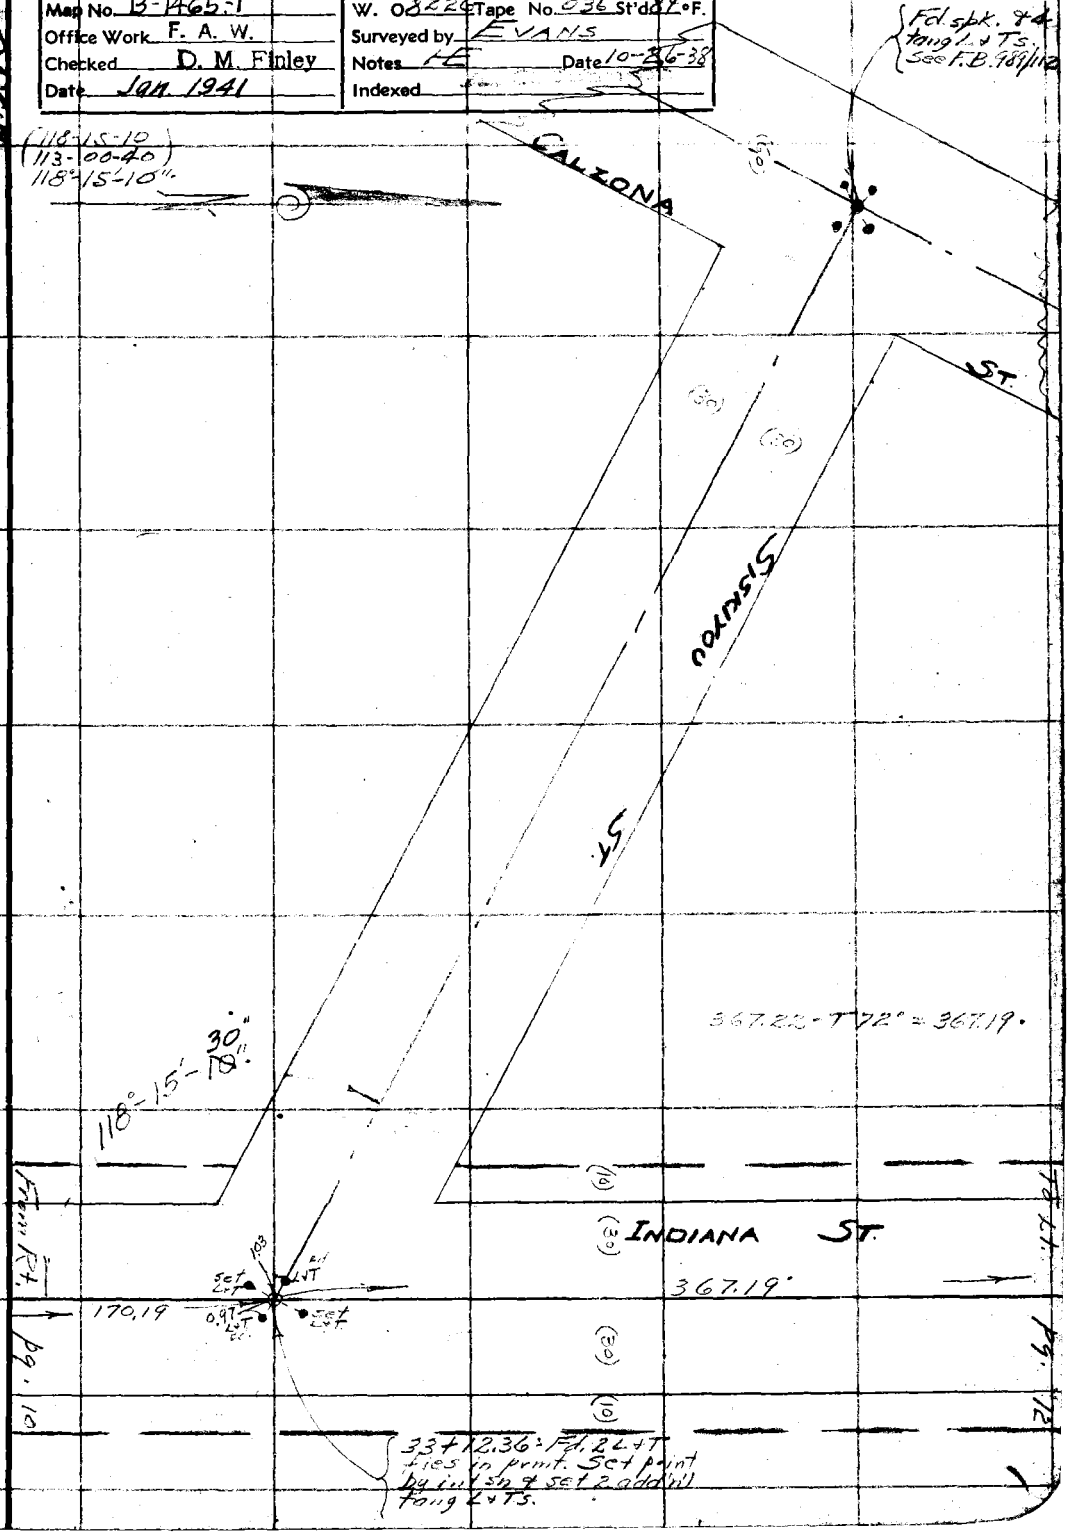

Note: Any Additions or Changes on This Sheet Must be Made or Circled in Red Ink With Date and Name of Person Making Change

Do not extend notes this side of this line

RETURN TO
LOS ANGELES COUNTY SURVEYOR
700 HALL OF RECORDS

FORM 247 10M 11-38

F.B. 772 PG. 12

(118-14-30)
(112-58-00)
118°-14'-30".

Note.
Points referred to as "P.K." nails, are patented masonry nails with "P.K." stamped in top.

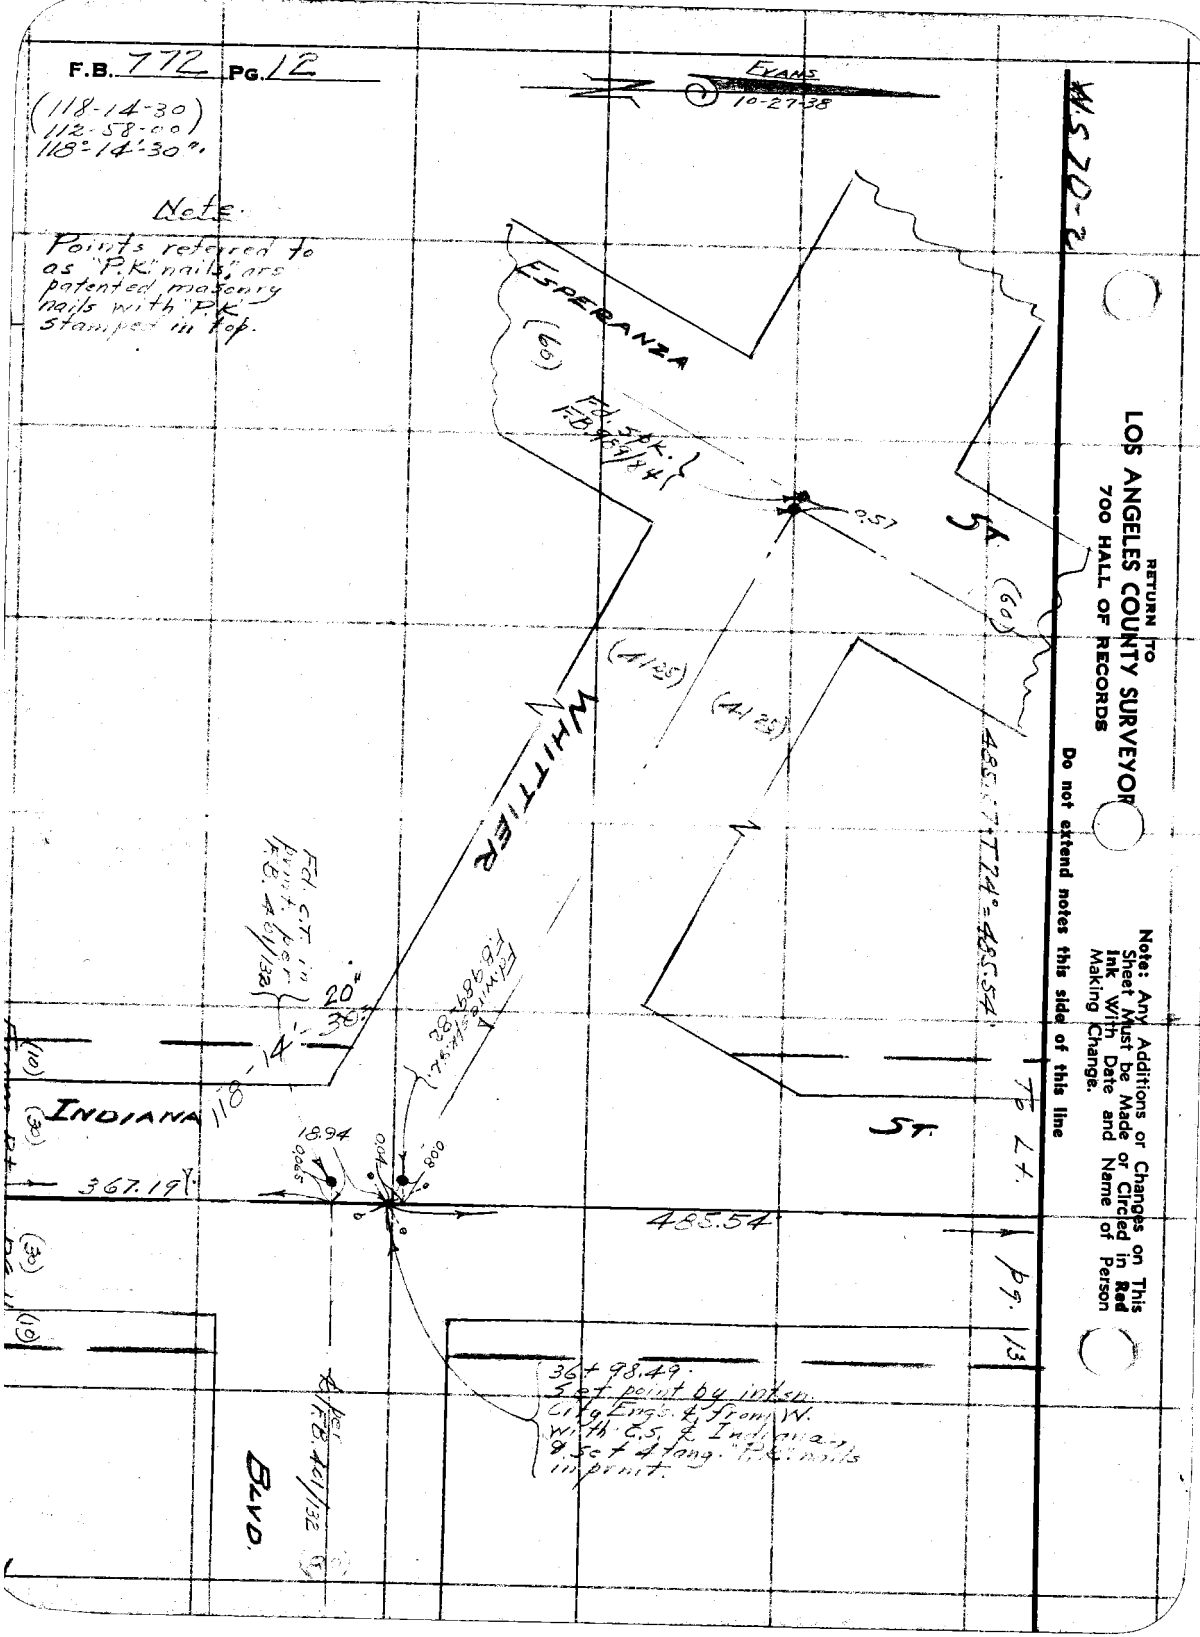

RETURN TO
LOS ANGELES COUNTY SURVEYOR
700 HALL OF RECORDS

Note: Any Additions or Changes on This Sheet Must be Made or Circled in Red Ink With Date and Name of Person Making Change.

Do not extend notes this side of this line

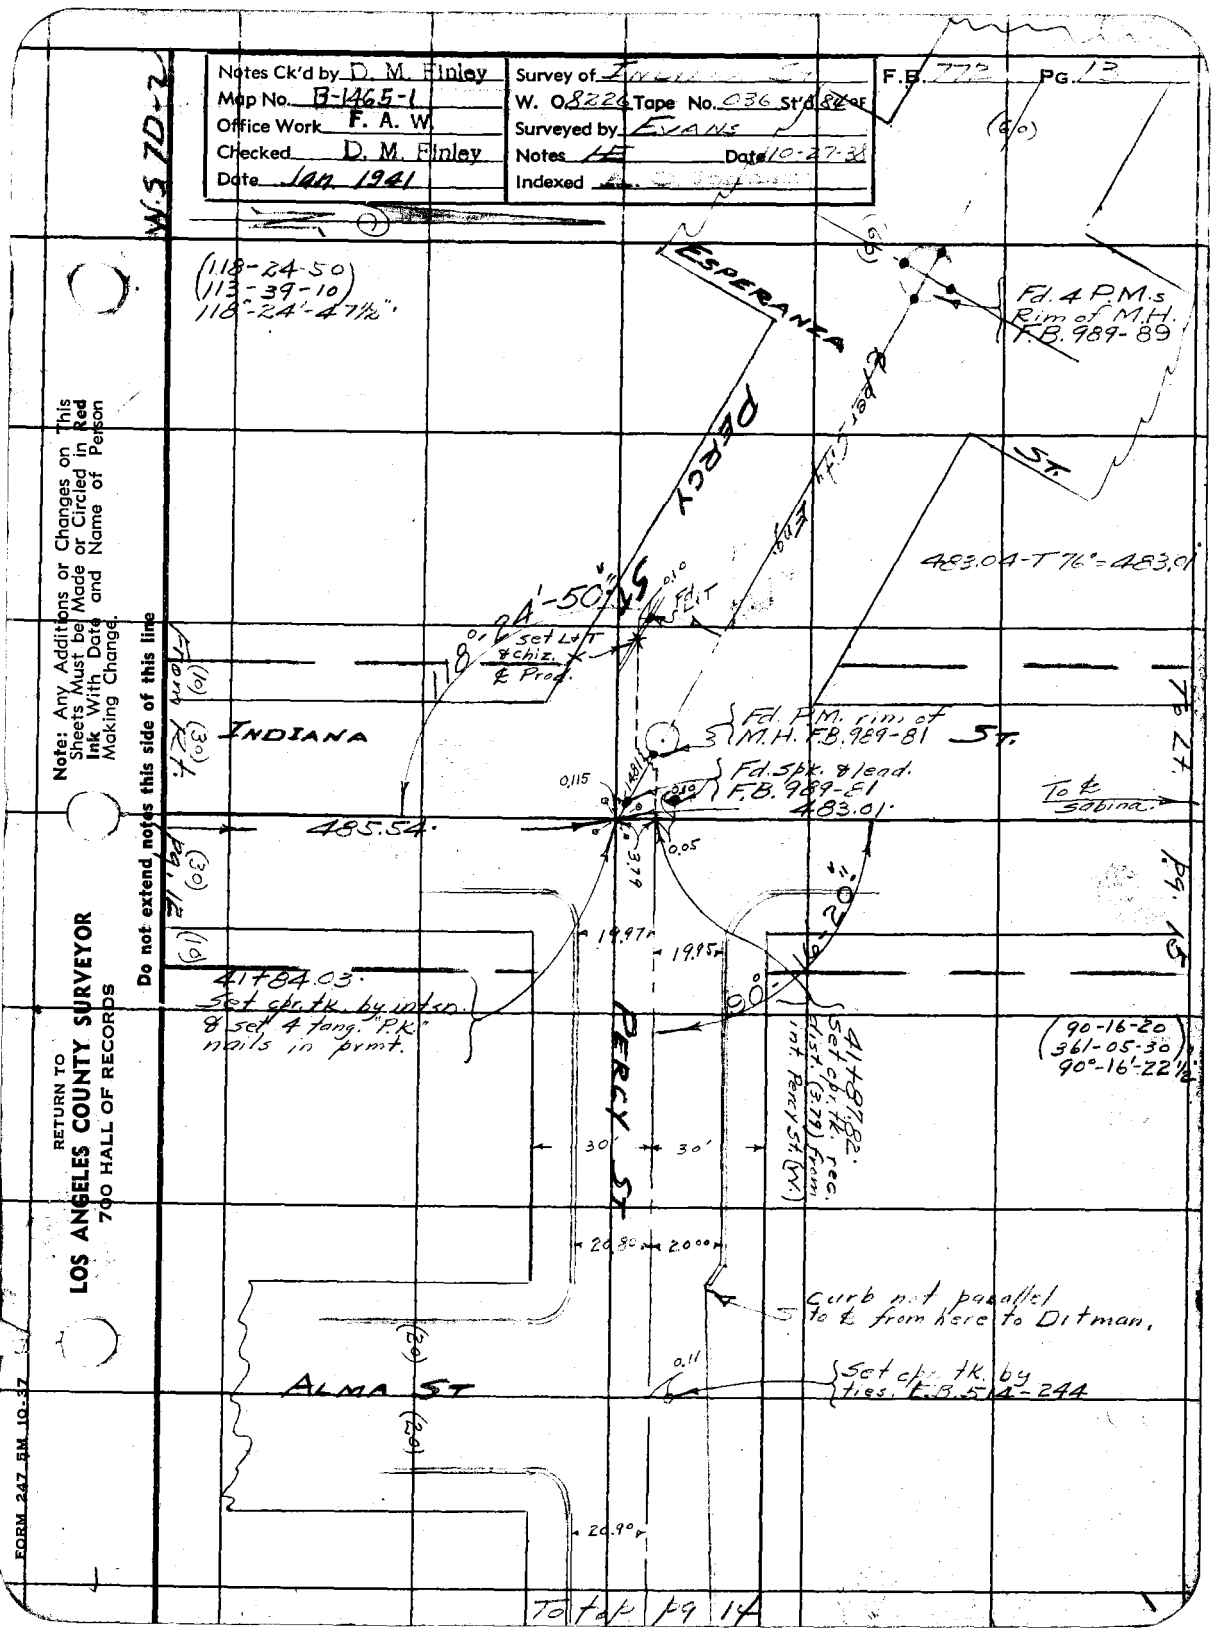

Notes Ck'd by D. M. Finley
Map No. B-1465-1
Office Work F. A. W.
Checked D. M. Finley
Date Jan. 1941
Survey of
W. O. 8226 Tape No. 036 St'd 84°F
Surveyed by Evans
Notes
Date 10-27-38
Indexed
F.B. 772 Pg. 13
W.S. 7D-2
(118-24-50)
(113-39-10)
118°-24'-47½"
ESPERANZA
PERCY
ST.
Fd. 4 P.M.s Rim of M.H. F.B. 989-89
483.04-T 76°=483.01
118°-24'-50"
Set L&T & chiz. ℄ Prod.
INDIANA
Fd. P.M. rim of M.H. F.B. 989-81
Fd. Spk. & lead. F.B. 989-81
483.01
485.54
To ℄ Sabina
To Lt.
Pg. 15
Pg. 12
41+84.03
Set cpr. tk. by intsn. & set 4 tang. "P.K." nails in pvmt.
19.97
19.95
90°-16'-20"
41+87.82
Set cpr. tk. rec. dist. (3.79) from int. Percy St. (W.)
(90-16-20)
(361-05-30)
90°-16'-22½"
30'
30'
PERCY ST
20.80
20.00
Curb not parallel to ℄ from here to Ditman.
ALMA ST
Set cpr. tk. by ties. F.B. 514-244
20.90
To top pg 14
Note: Any Additions or Changes on This Sheets Must be Made or Circled in Red Ink With Date and Name of Person Making Change.
Do not extend notes this side of this line
RETURN TO
LOS ANGELES COUNTY SURVEYOR
700 HALL OF RECORDS
FORM 247 5M 10-37

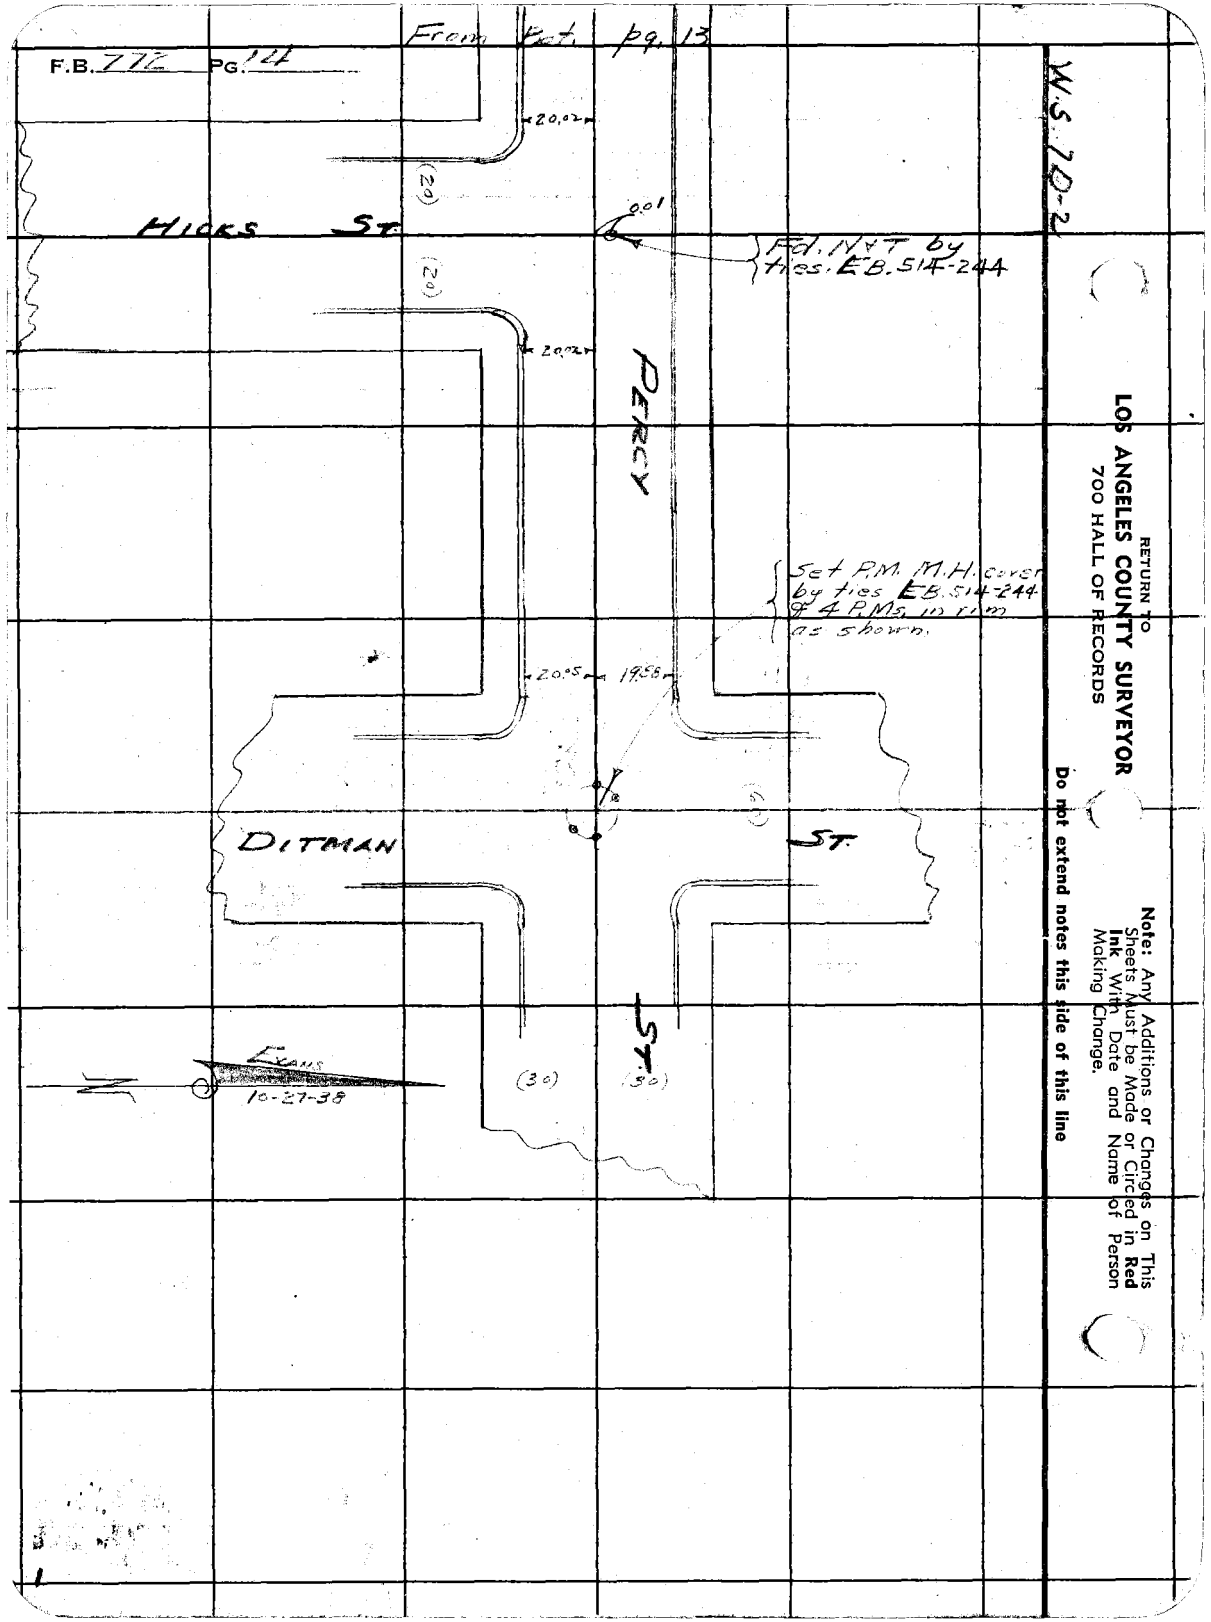

RETURN TO
LOS ANGELES COUNTY SURVEYOR
700 HALL OF RECORDS

Note: Any Additions or Changes on This Sheets Must be Made or Circled in **Red Ink** With Date and Name of Person Making Change.

Do not extend notes this side of this line

Notes Ck'd by D. M. Finley	Survey of [illegible]	F.B. 772 Pg. 15
Map No. B-1465-1	W. O. 8226 Tape No. 036 St'd 84 OF	119.47-T58° = 119.45.
Office Work F. A. W.	Surveyed by Evans	
Checked D. M. Finley	Notes [illegible] Date 11-21-38	
Date Jan 1941	Indexed [illegible]	

W.S. 70-2

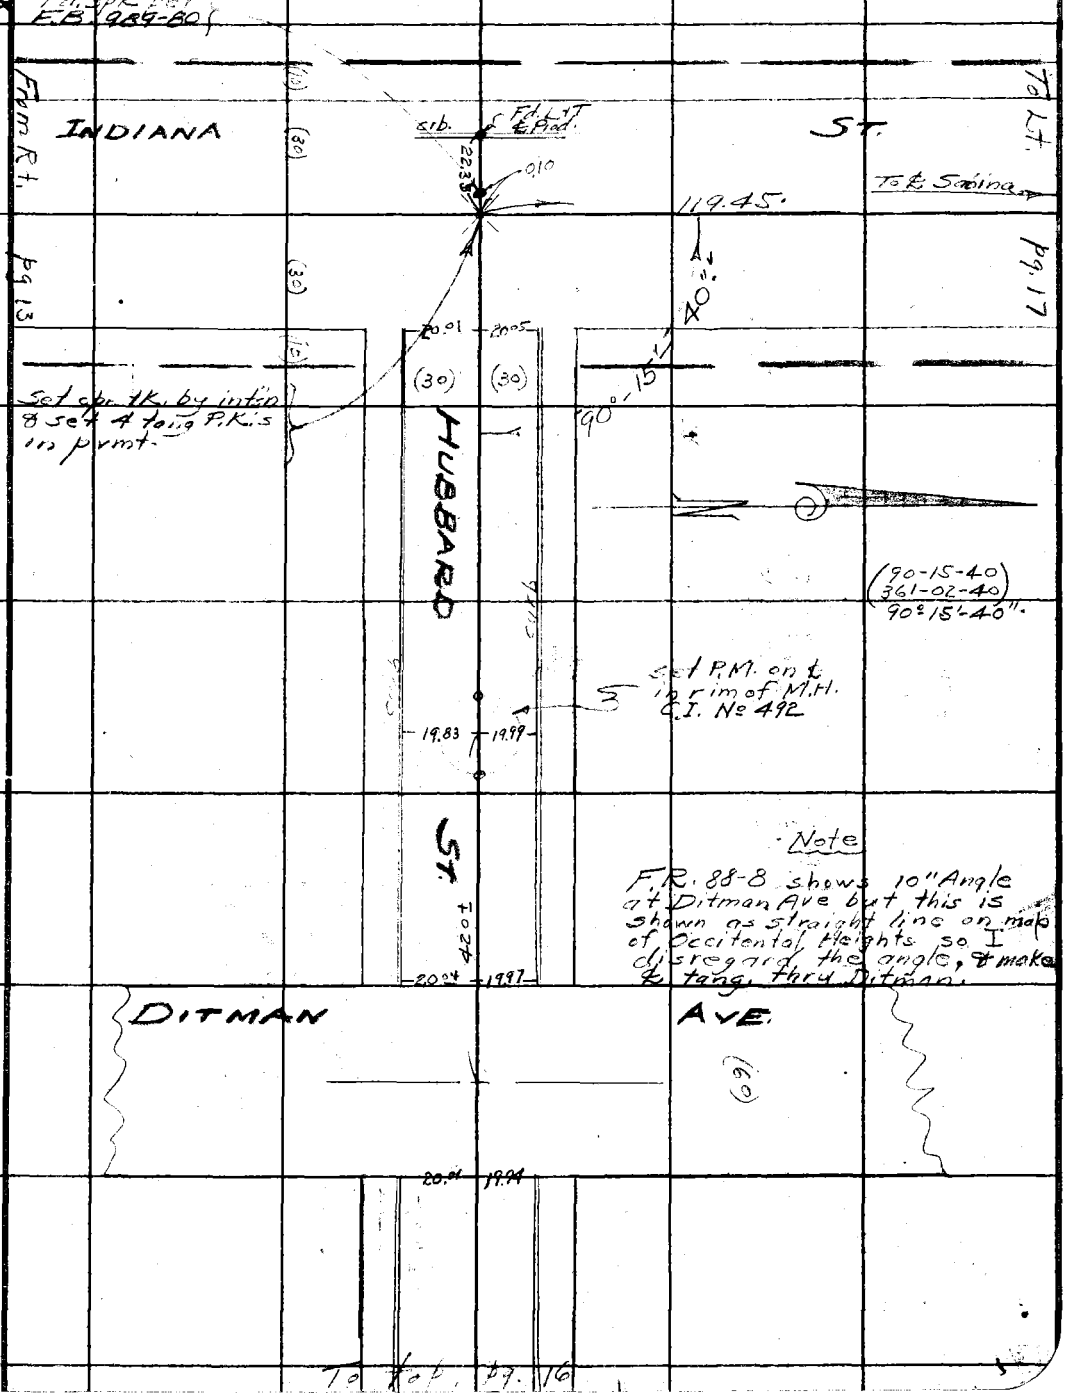

Note: Any Additions or Changes on This Sheets Must Be Made or Circled in Red Ink With Date and Name of Person Making Change.

Do not extend notes this side of this line

RETURN TO
LOS ANGELES COUNTY SURVEYOR
700 HALL OF RECORDS

FORM 247 5M 10-37

F.B. 772 PG 16

W.57E-2

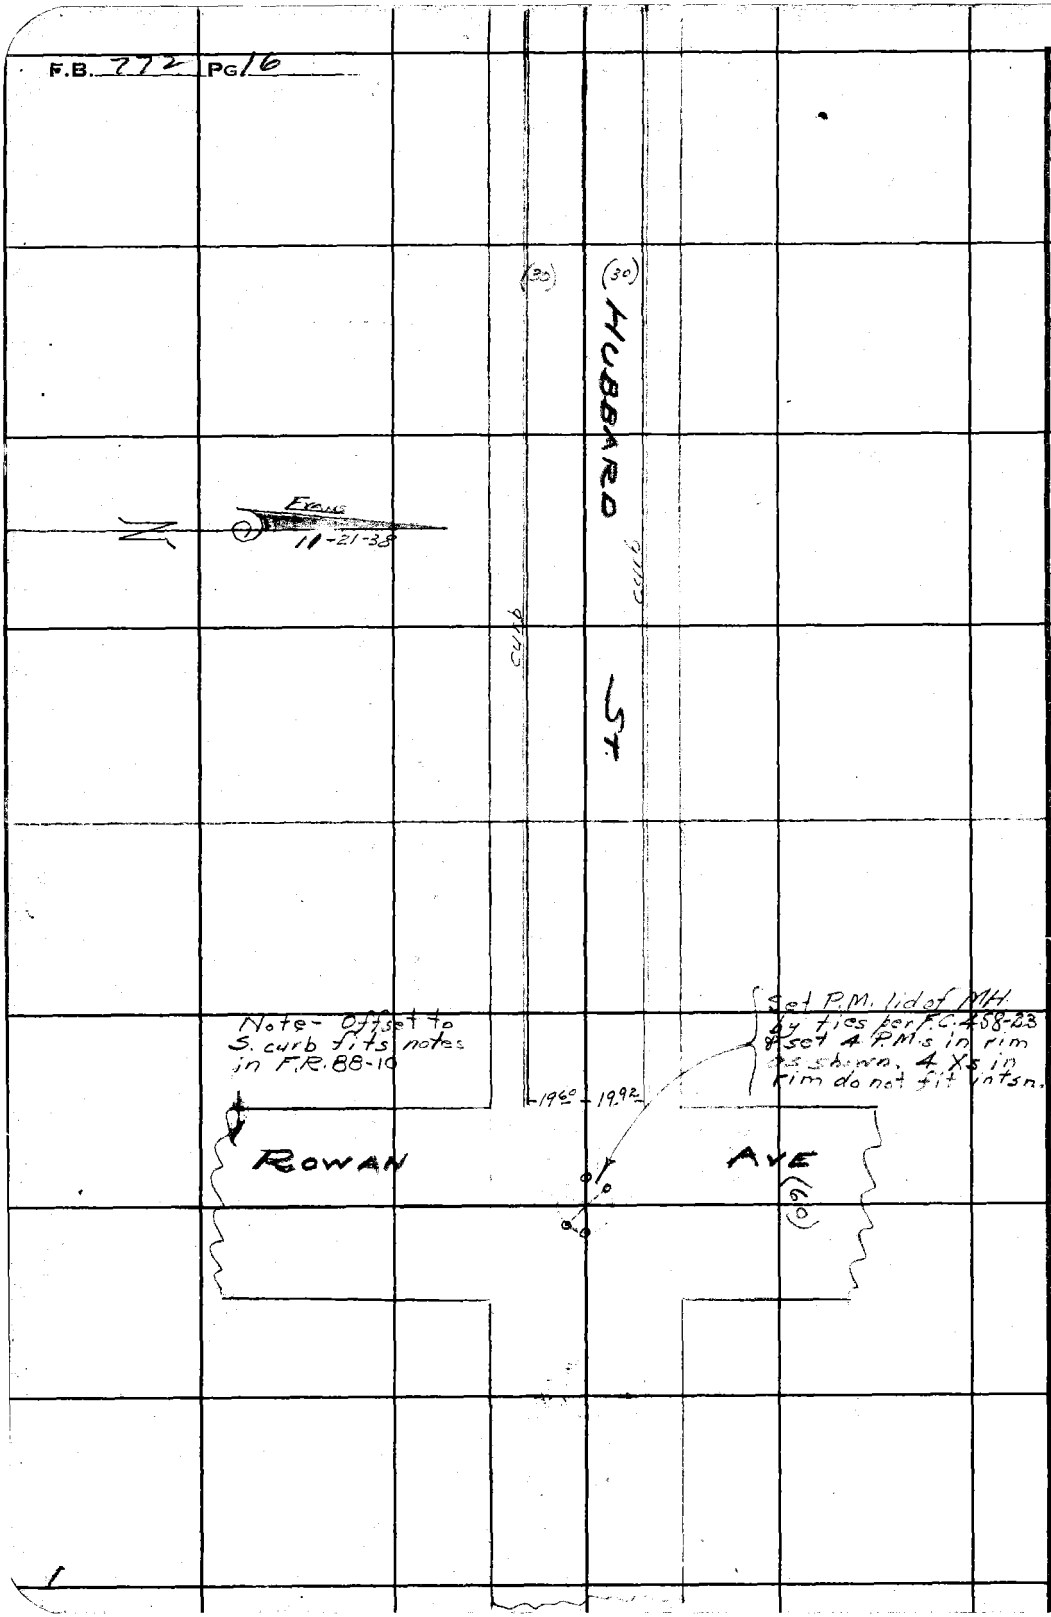

RETURN TO
LOS ANGELES COUNTY SURVEYOR
700 HALL OF RECORDS

Note: Any Additions or Changes on This Sheets Must be Made or Circled in **Red Ink** With Date and Name of Person Making Change.

Do not extend notes this side of this line

Notes Ck'd by D. M. Finley	Survey of [illegible]	F.B. 772 Pg. 17
Map No. B-1465-1	W. O. 8226 Tape No. 036 St'd 84 °F	
Office Work F. A. W.	Surveyed by EVANS	
Checked D. M. Finley	Notes [illegible] Date 10-27-38	
Date Jan. 1941	Indexed [illegible]	

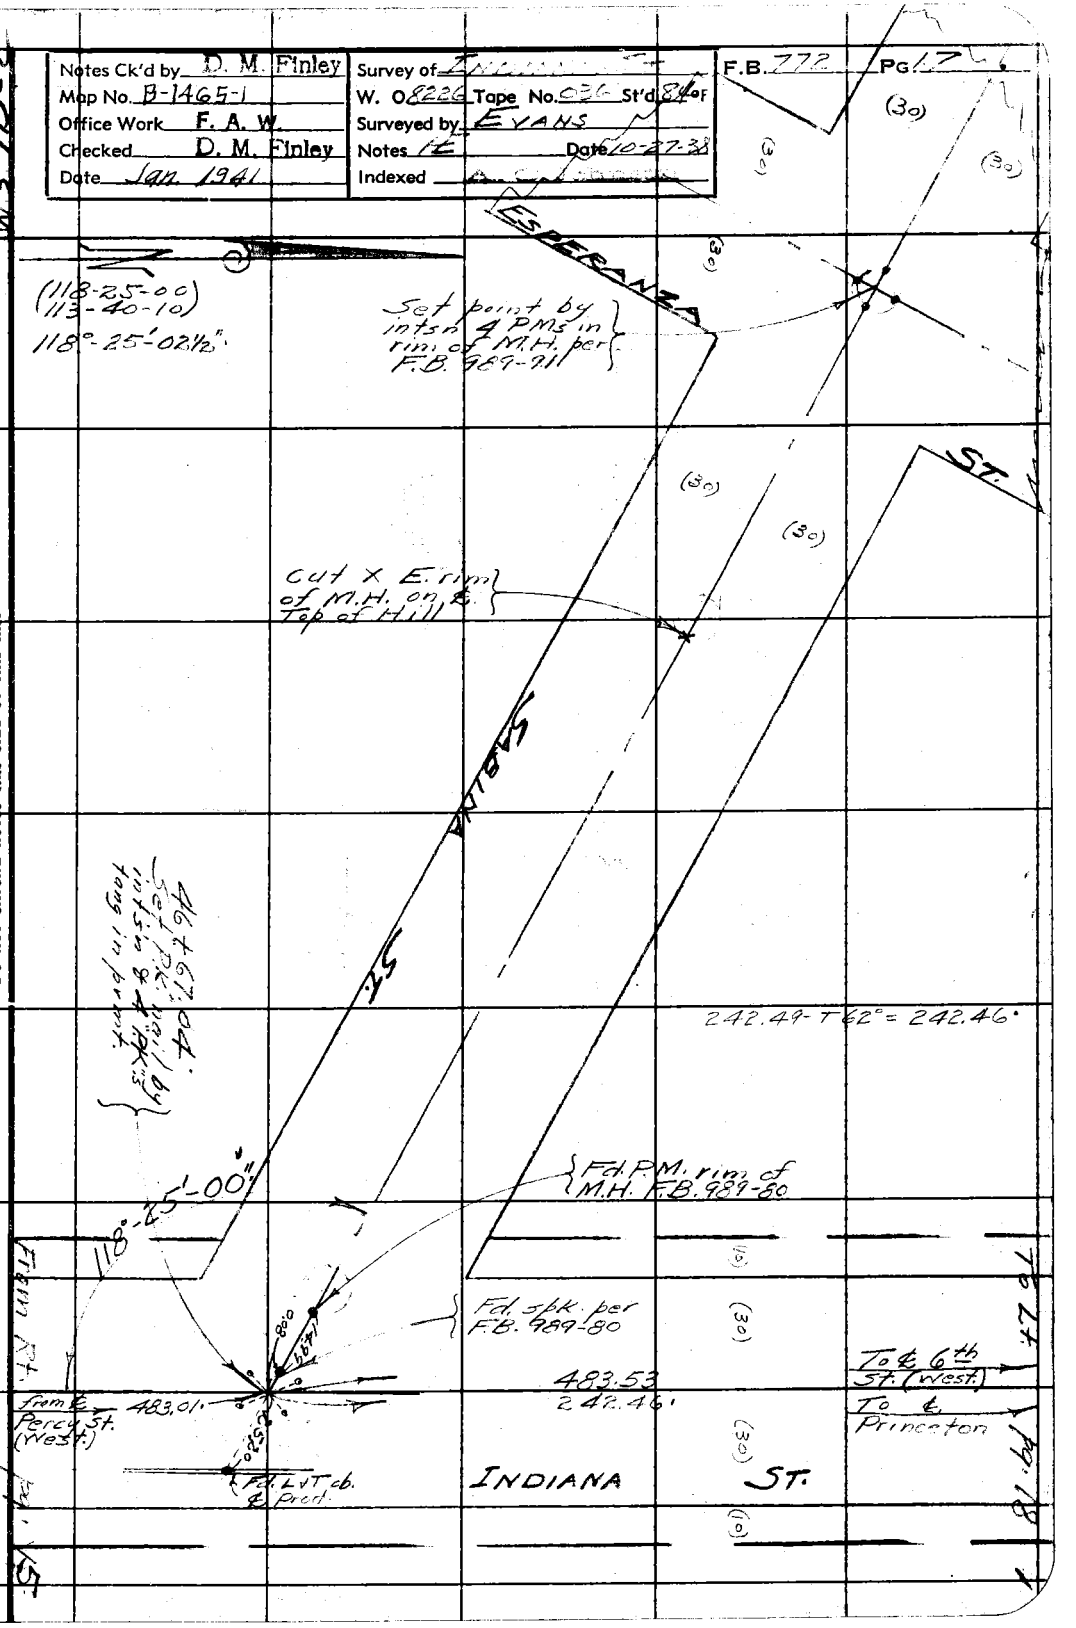

Note: Any Additions or Changes on This Sheets Must be Made or Circled in Red Ink With Date and Name of Person Making Change.

Do not extend notes this side of this line

RETURN TO
LOS ANGELES COUNTY SURVEYOR
700 HALL OF RECORDS

FORM 247 5M 10-37

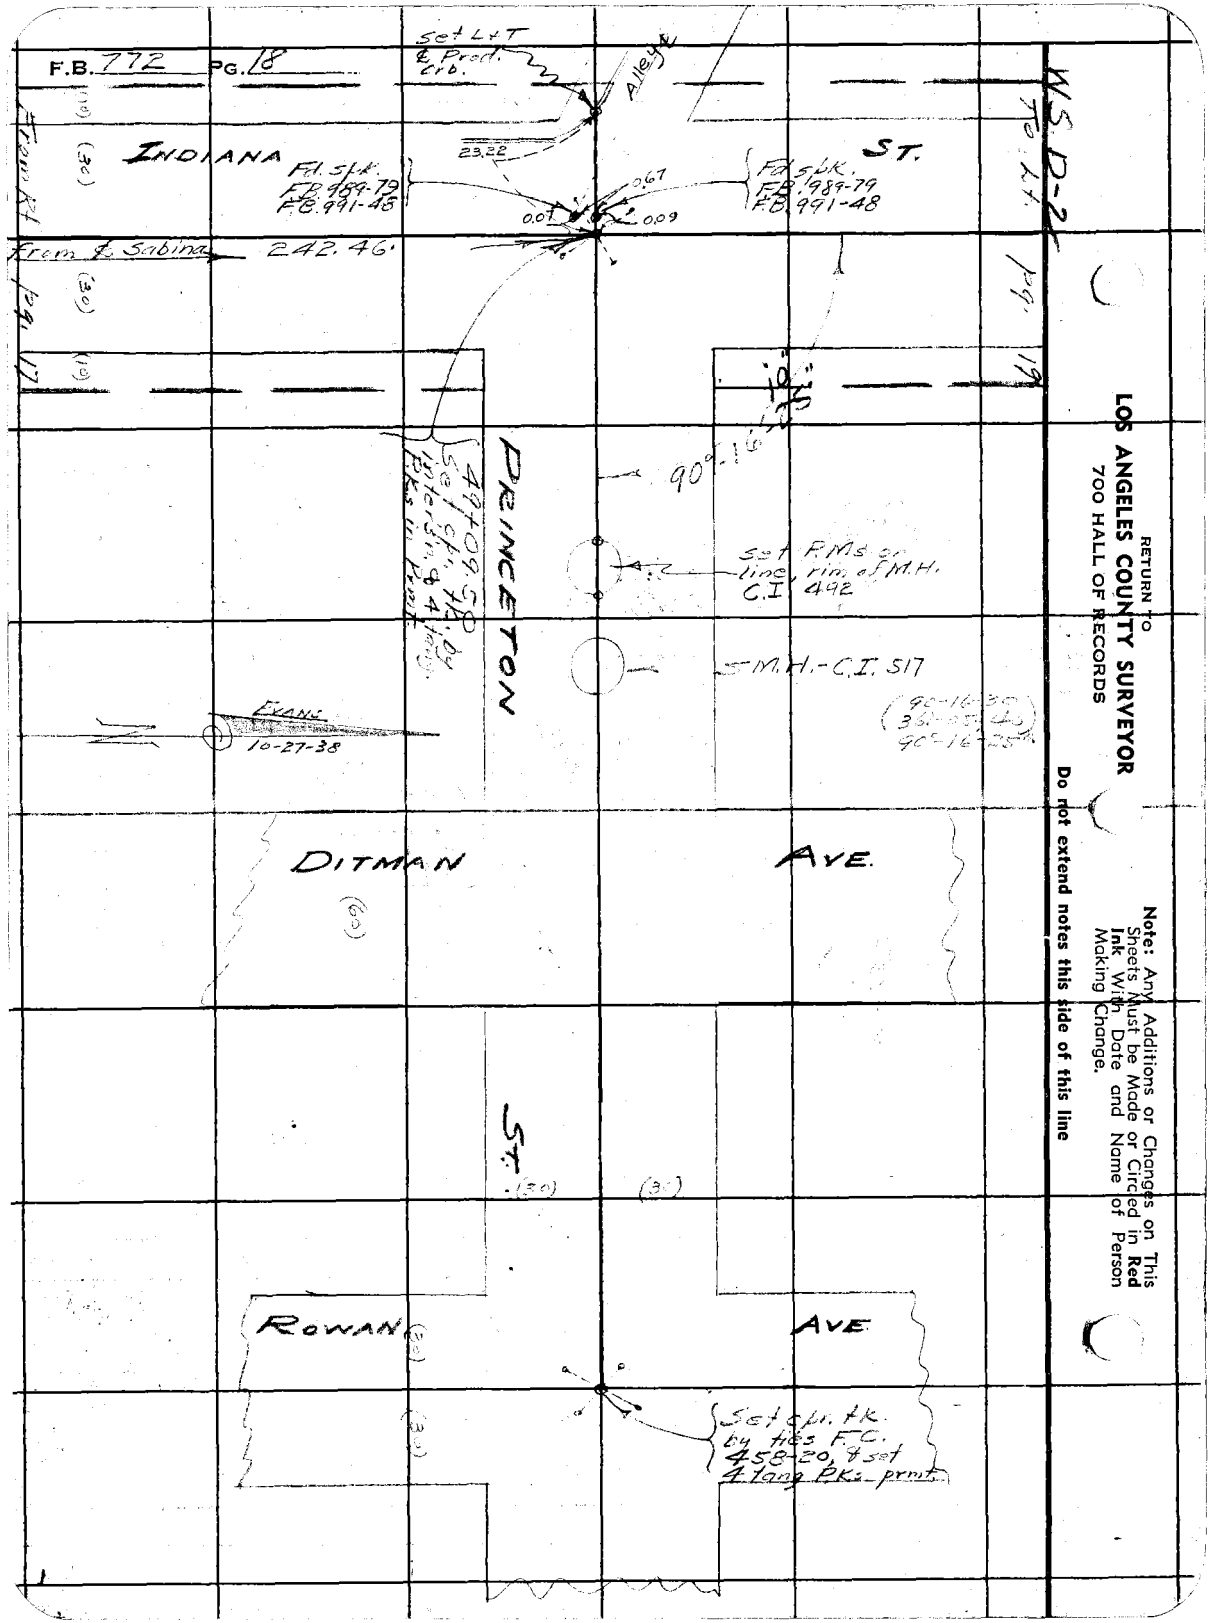

RETURN TO
LOS ANGELES COUNTY SURVEYOR
700 HALL OF RECORDS

Note: Any Additions or Changes on This Sheets Must be Made or Circled in **Red Ink** With Date and Name of Person Making Change.

Do not extend notes this side of this line

Notes Ck'd by D. M. Finley	Survey of INDIANA ST	F.B. 772 PG. 19
Map No. B-1465-2	W. O. 8226 Tape No. 036 St'd 84 °F	
Office Work F. A. W.	Surveyed by EVANS	
Checked D. M. Finley	Notes HE Date 10-27-38	
Date Jan. 1941.	Indexed	

W.S. 7D-2

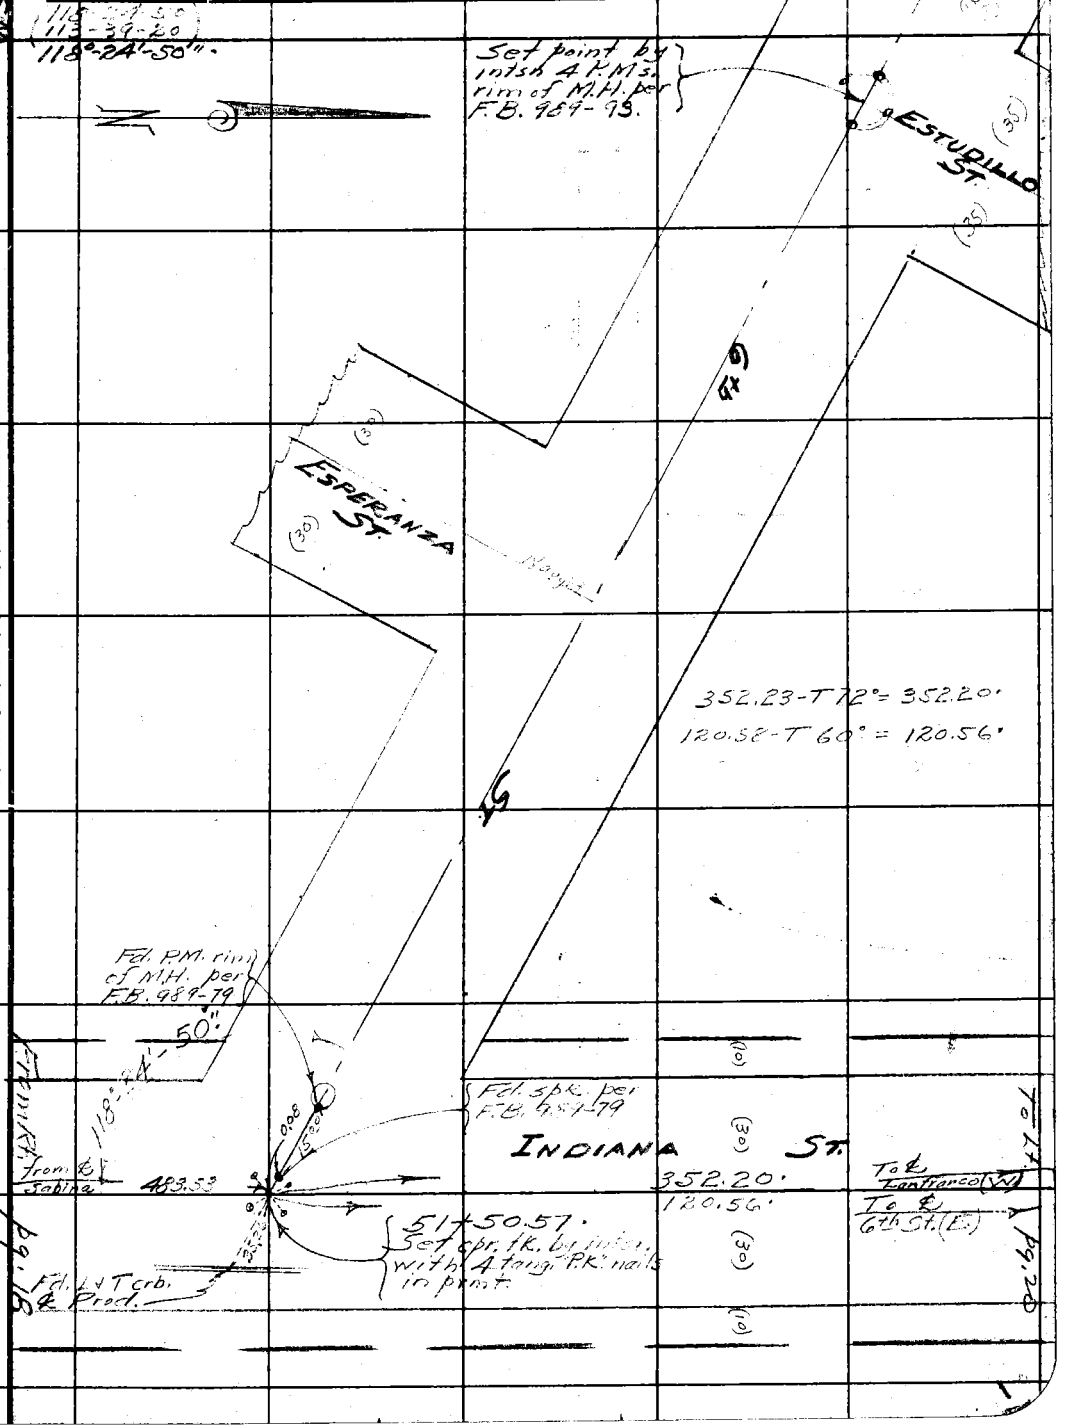

Note: Any Additions or Changes on This Sheets Must be Made or Circled in Red Ink With Date and Name of Person Making Change.

Do not extend notes this side of this line

RETURN TO
LOS ANGELES COUNTY SURVEYOR
700 HALL OF RECORDS

FORM 247 5M 10-37

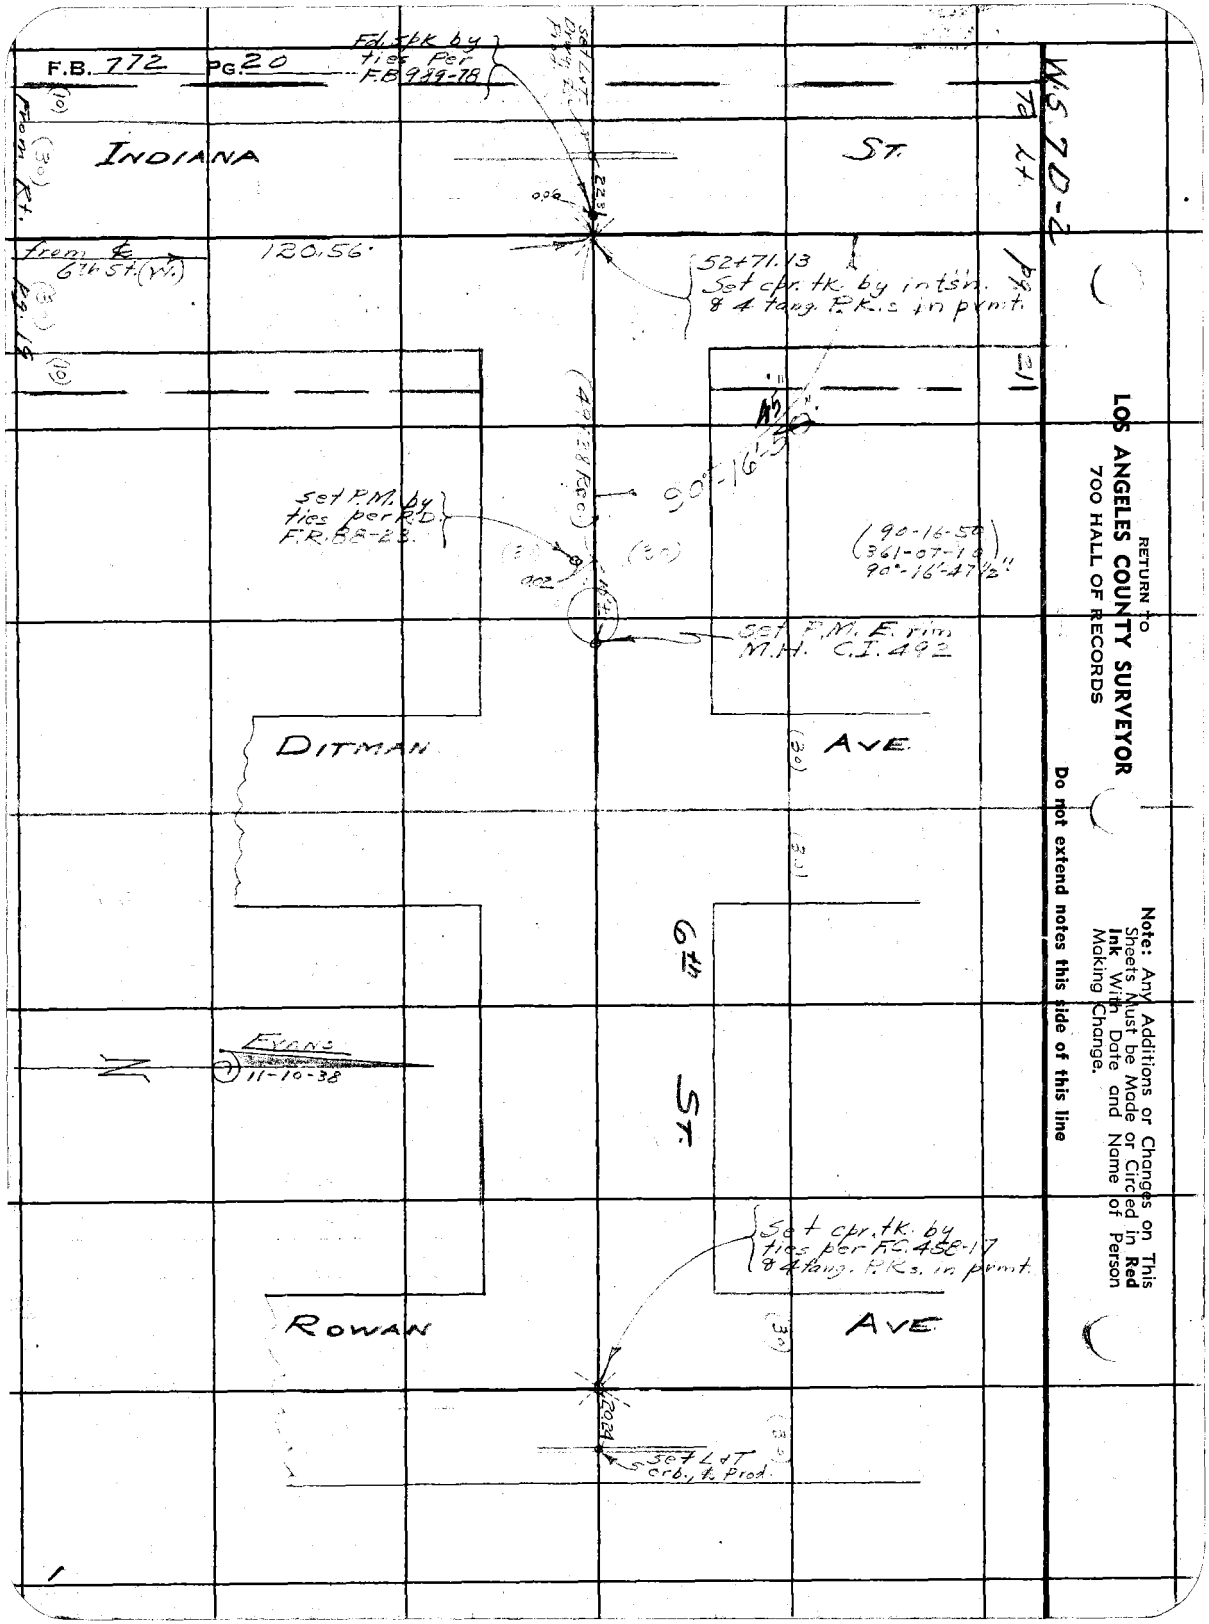

RETURN TO
LOS ANGELES COUNTY SURVEYOR
700 HALL OF RECORDS

Note: Any Additions or Changes on This Sheets Must be Made or Circled in Red Ink With Date and Name of Person Making Change.

Do not extend notes this side of this line

Notes Ck'd by D. M. Finley	Survey of INDIANA ST	F.B. 772 Pg. 21
Map No. B-1465-2	W. O. 8226 Tape No. 036 St'd 84 °F	
Office Work F. A. W.	Surveyed by EVANS	
Checked D. M. Finley	Notes HE Date 10-27-38	
Date Jan. 1941	Indexed	

W.S. 712-2

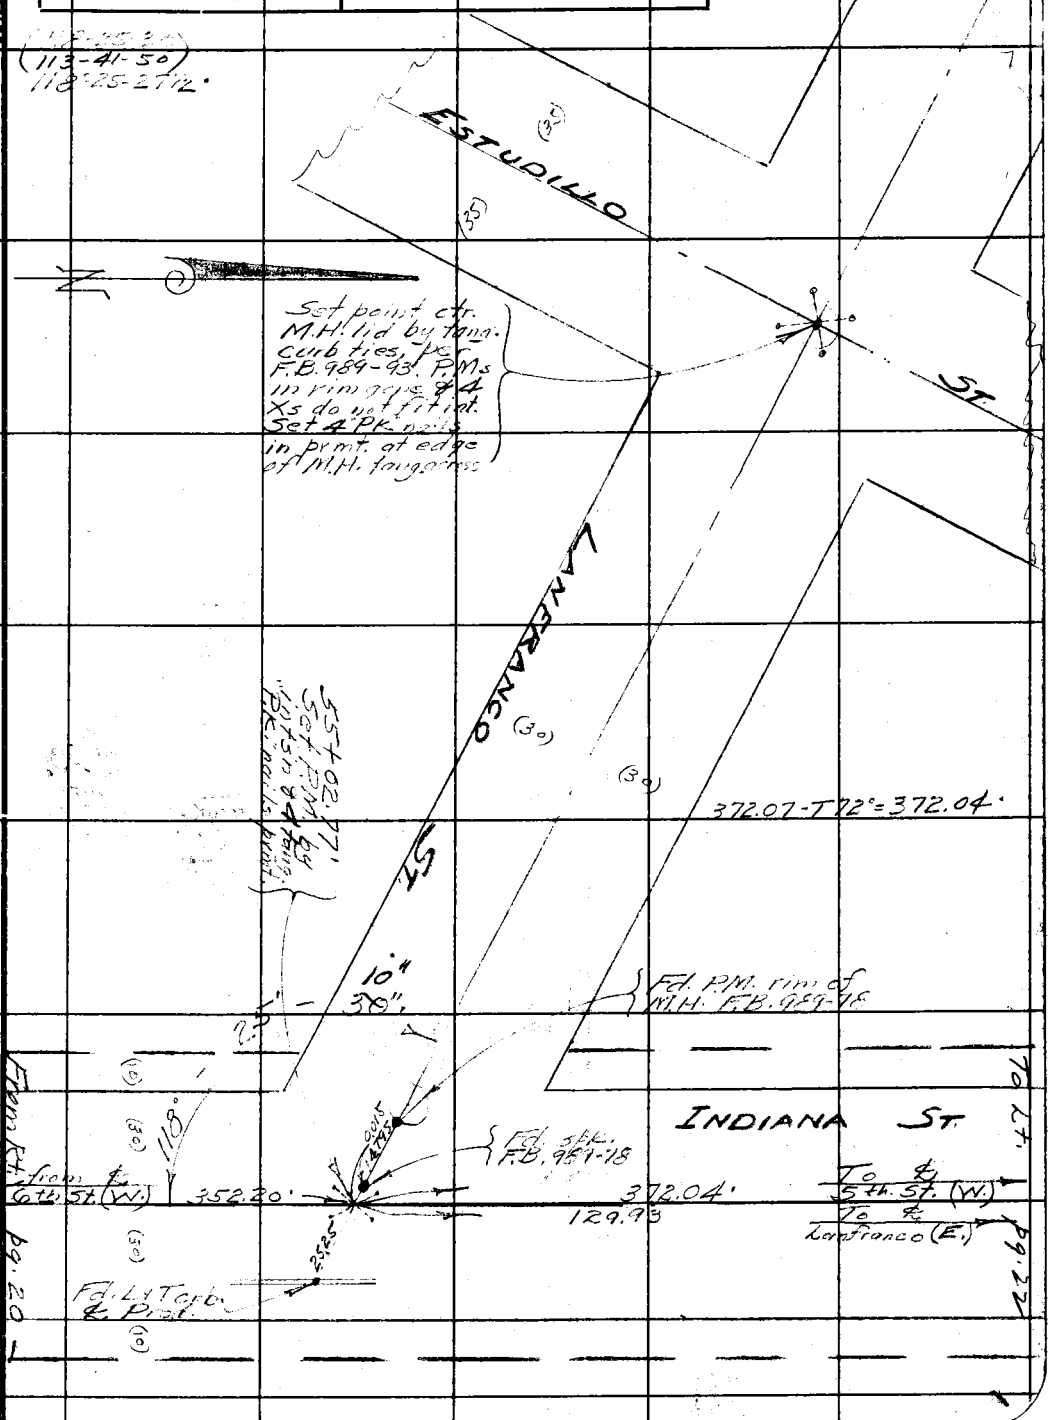

Note: Any Additions or Changes on This Sheets Must be Made or Circled in Red Ink With Date and Name of Person Making Change.

Do not extend notes this side of this line

RETURN TO
LOS ANGELES COUNTY SURVEYOR
700 HALL OF RECORDS

FORM 247 5M 10-37

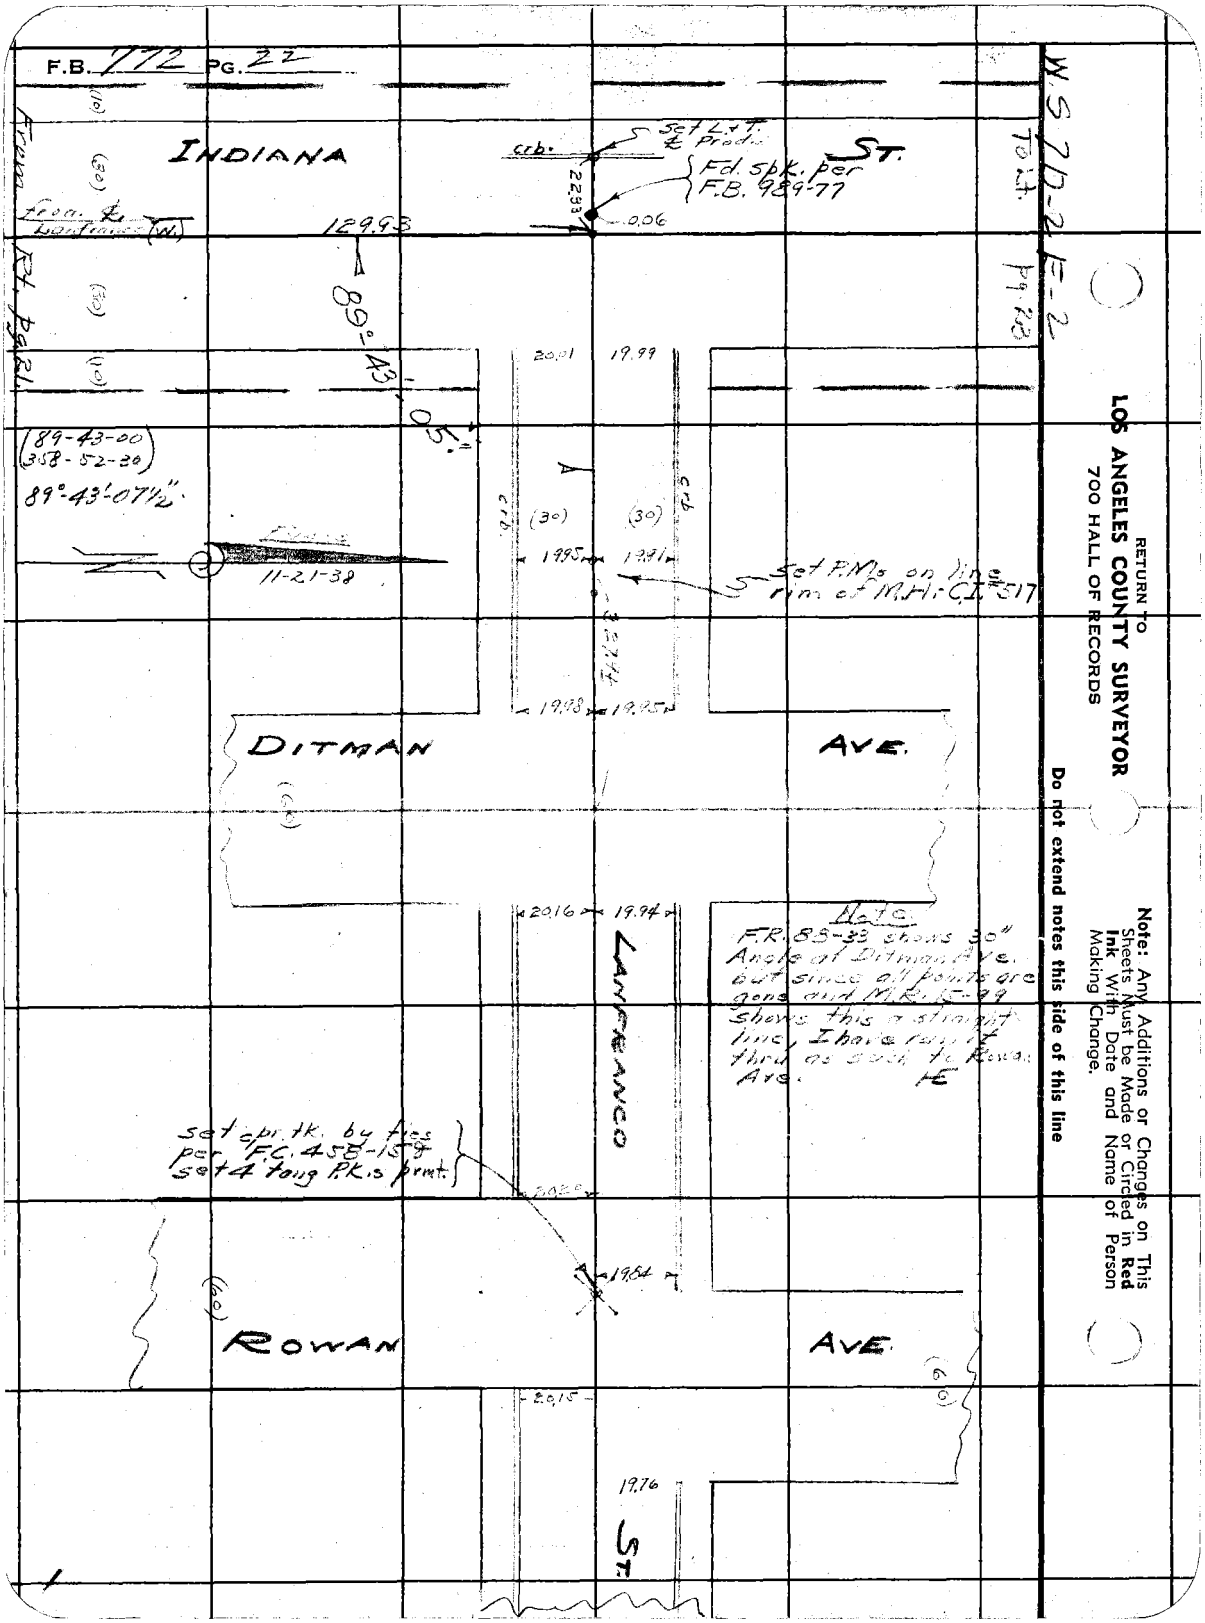
F.B. 772 PG. 22
INDIANA
ST.
crb.
Set L.+T. ℄ Prod.
Fd. spk. per F.B. 989-77
22.93
0.06
From ℄ Lanfranco (W.)
129.93
89°-43'-05"
(89-43-00)
(358-52-30)
89°-43'-07½"
11-21-38
20.01
19.99
(30)
(30)
19.95
19.91
Set P.M.s on line rim of M.H. C.I. #517
19.98
19.95
DITMAN
AVE.
20.16
19.94
LANFRANCO
Note
F.R. 88-33 shows 30" Angle at Ditman Ave. but since all points are gone and M.R. 15-99 shows this a straight line, I have run it thru as such to Rowan Ave.
set cpr. tk. by ties per F.C. 458-158 set 4 tang P.K.s prmt.
19.84
ROWAN
AVE.
20.15
19.76
ST.
W.S. 7D-2 E-2
To L.T.
Pg. 23
RETURN TO
LOS ANGELES COUNTY SURVEYOR
700 HALL OF RECORDS
Note: Any Additions or Changes on This Sheets Must be Made or Circled in Red Ink With Date and Name of Person Making Change.
Do not extend notes this side of this line

Notes Ck'd by D. M. Finley	Survey of Indiana St	F.B. 777 Pg. 2-3
Map No. B-1465-2	W. O. 8226 Tape No. 036 St'd 84°F	
Office Work F. A. W.	Surveyed by Evans	
Checked D. M. Finley	Notes [illegible] Date 10-28-38	
Date Jan 1941	Indexed [illegible]	

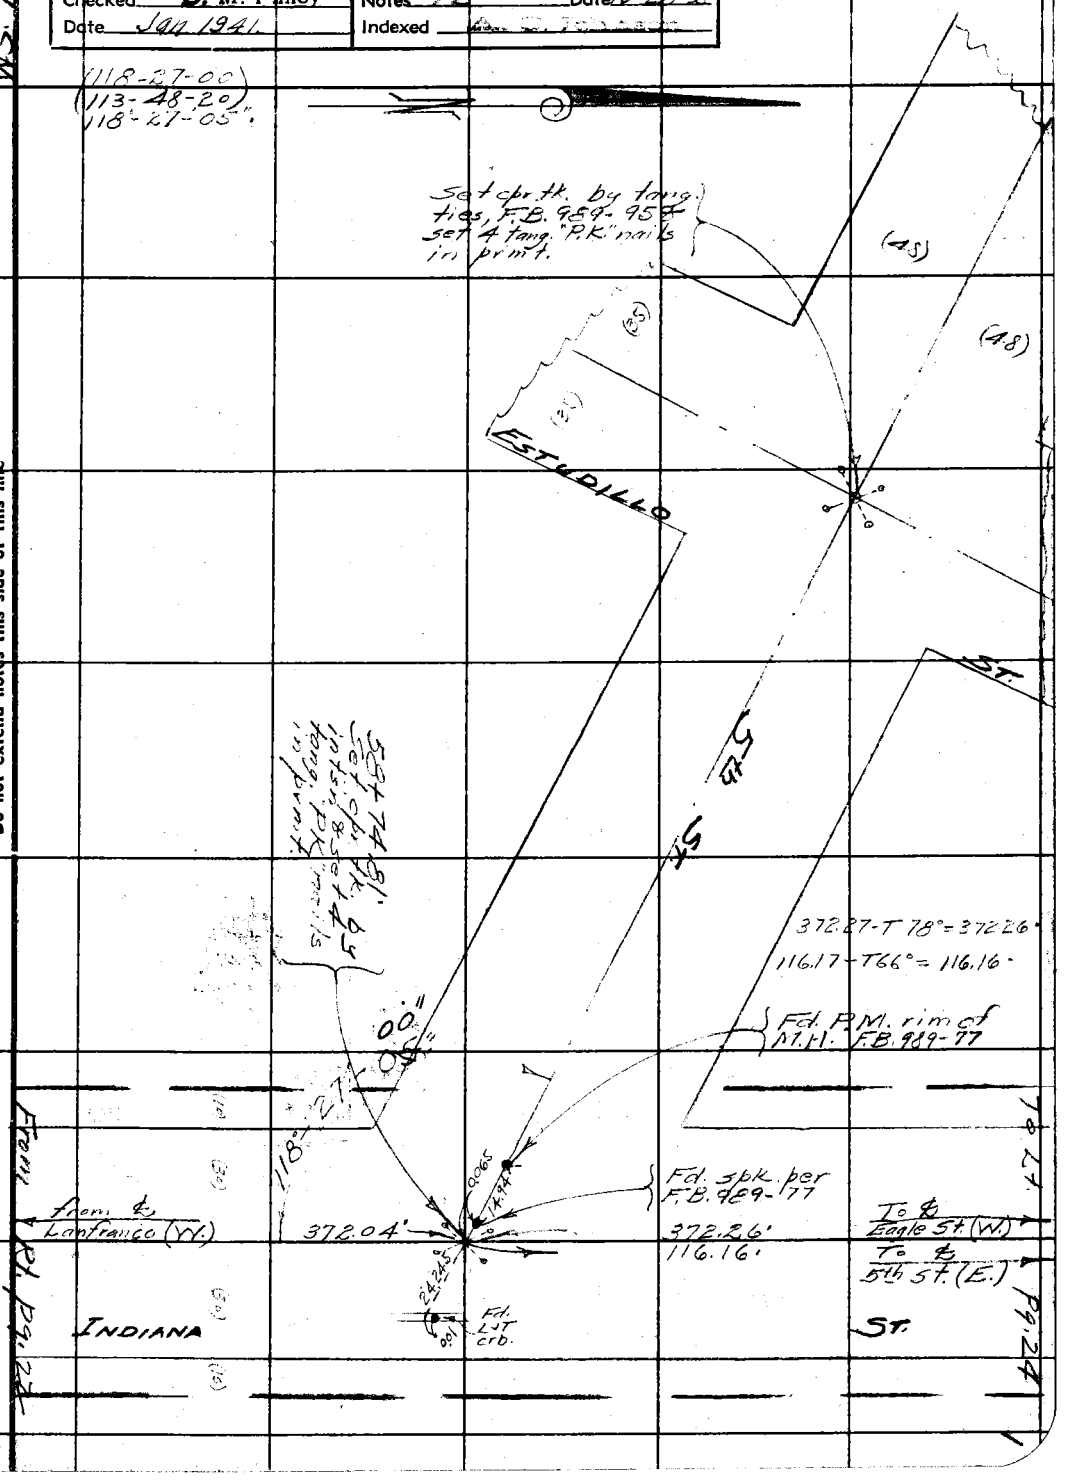

Note: Any Additions or Changes on This Sheets Must be Made or Circled in Red Ink With Date and Name of Person Making Change.

Do not extend notes this side of this line

RETURN TO
LOS ANGELES COUNTY SURVEYOR
700 HALL OF RECORDS

FORM 247 5M 10-37

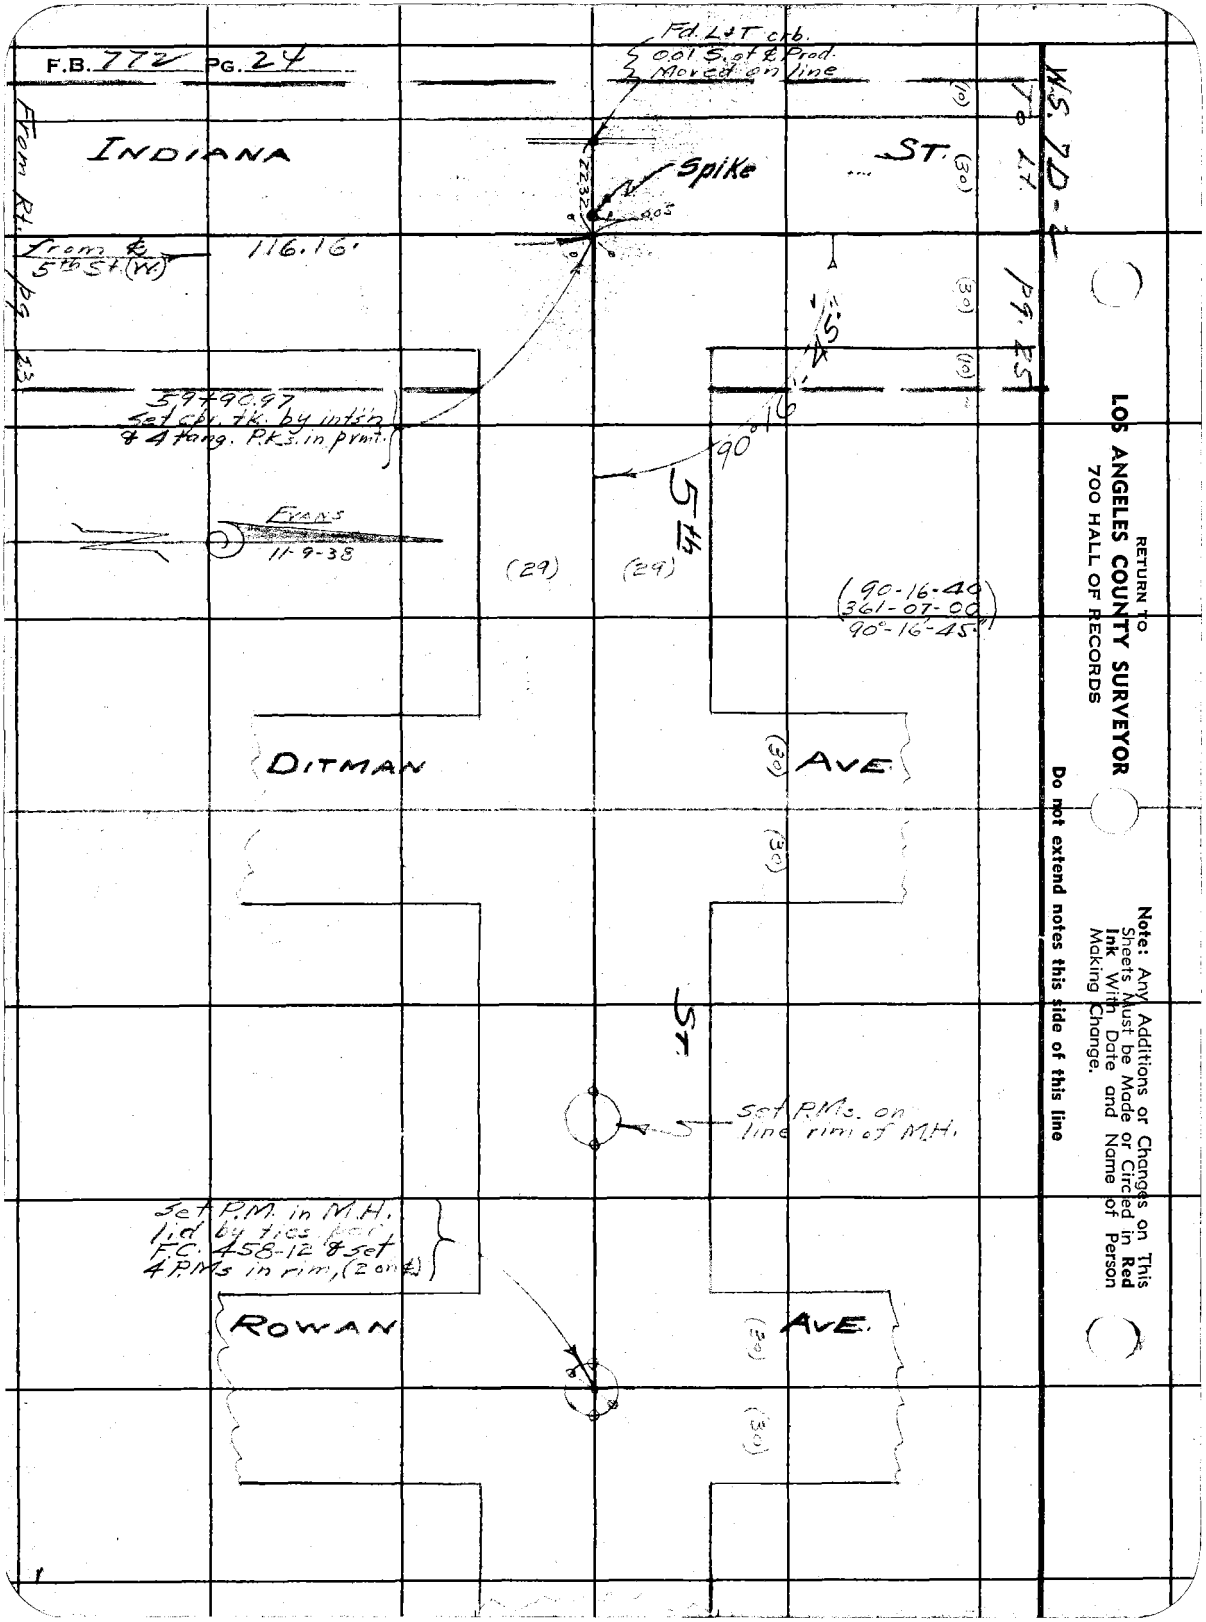
F.B. 772 PG. 24
Fd. L+T crb.
0.01 S. of ℄ Prod.
Moved on line
INDIANA
ST.
Spike
22.32
0.05
From Rt. pg. 23
from ℄ 5th St. (W.)
116.16'
59+90.97
Set cpr. tk. by int'sn
& 4 tang. P.K.s. in pvmt.
Evans
11-9-38
(29)
(29)
5th
90°16'45"
(90-16-40)
361-07-00
90°-16'-45"
DITMAN
AVE.
(30)
(30)
ST.
Set P.M.s. on line rim of M.H.
Set P.M. in M.H. lid by ties per F.C. 458-12 & set 4 P.M.s in rim, (2 on ℄)
ROWAN
AVE.
(30)
(30)
W.S. 7D-2
To Lt.
Pg. 25
(10)
(30)
(30)
(10)
RETURN TO
LOS ANGELES COUNTY SURVEYOR
700 HALL OF RECORDS
Note: Any Additions or Changes on This Sheets Must be Made or Circled in Red Ink With Date and Name of Person Making Change.
Do not extend notes this side of this line

Notes Ck'd by D. M. Finley	Survey of [illegible]
Map No. B-1465-2	W. O. 8226 Tape No. 036 St'd 84 °F
Office Work F. A. W.	Surveyed by EVANS
Checked D. M. Finley	Notes [illegible] Date 10-28-38
Date Jan. 1941	Indexed [illegible]

F.B. 772 Pg. [illegible]

WS. 7D-2

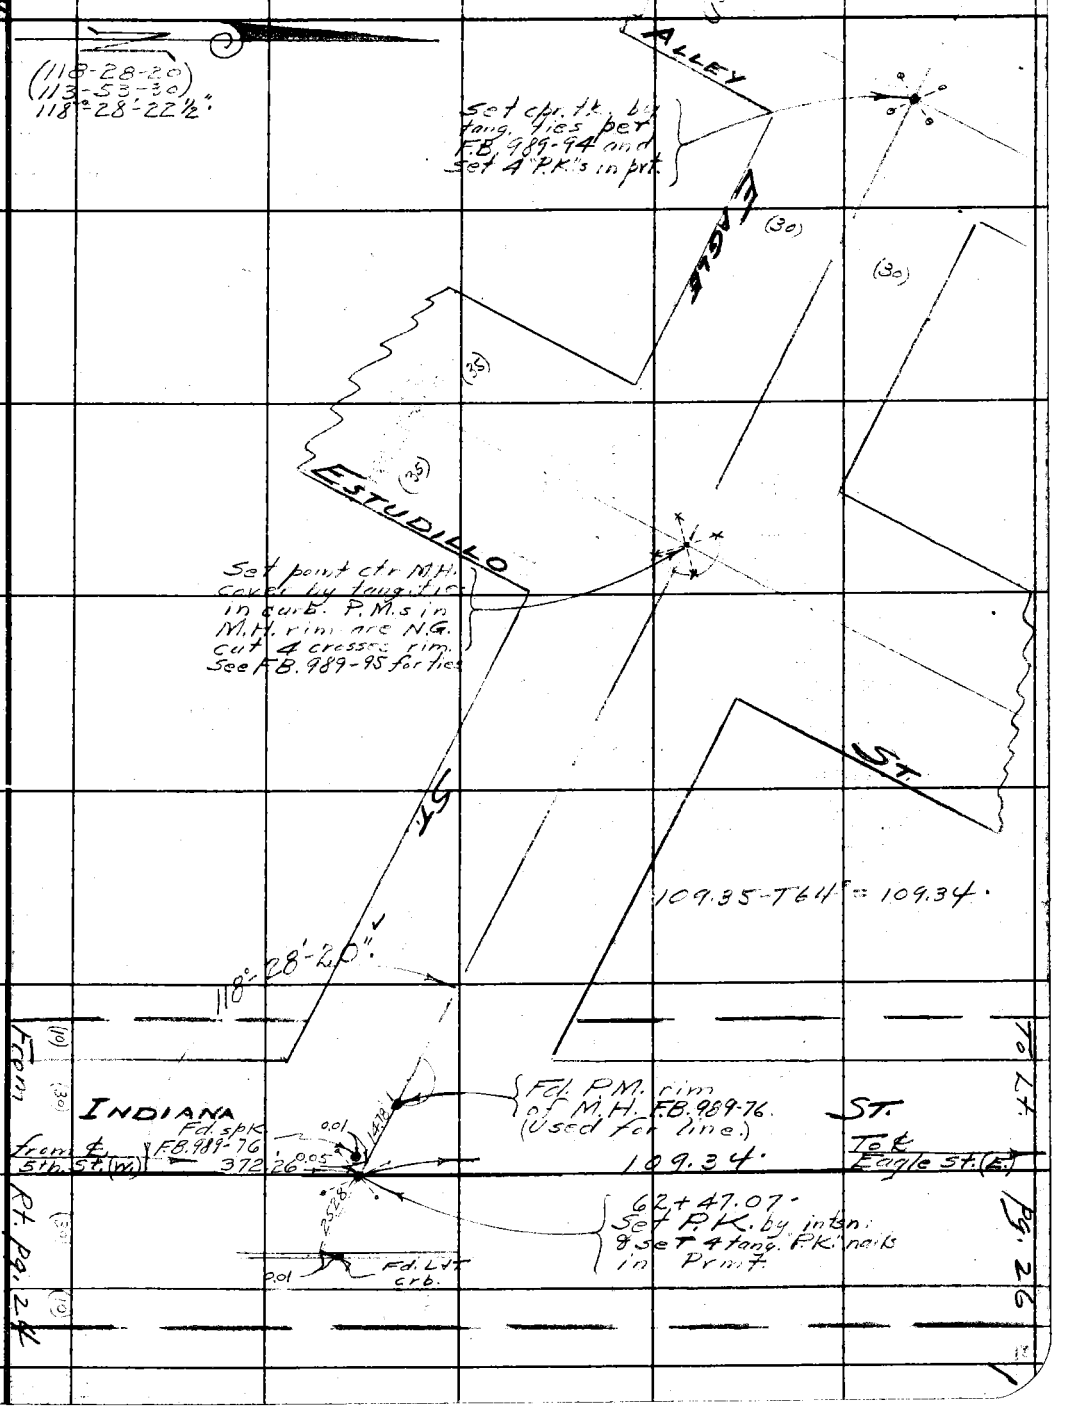

Note: Any Additions or Changes on This Sheets Must be Made or Circled in Red Ink With Date and Name of Person Making Change.

Do not extend notes this side of this line

RETURN TO
LOS ANGELES COUNTY SURVEYOR
700 HALL OF RECORDS

FORM 247 5M 10-37

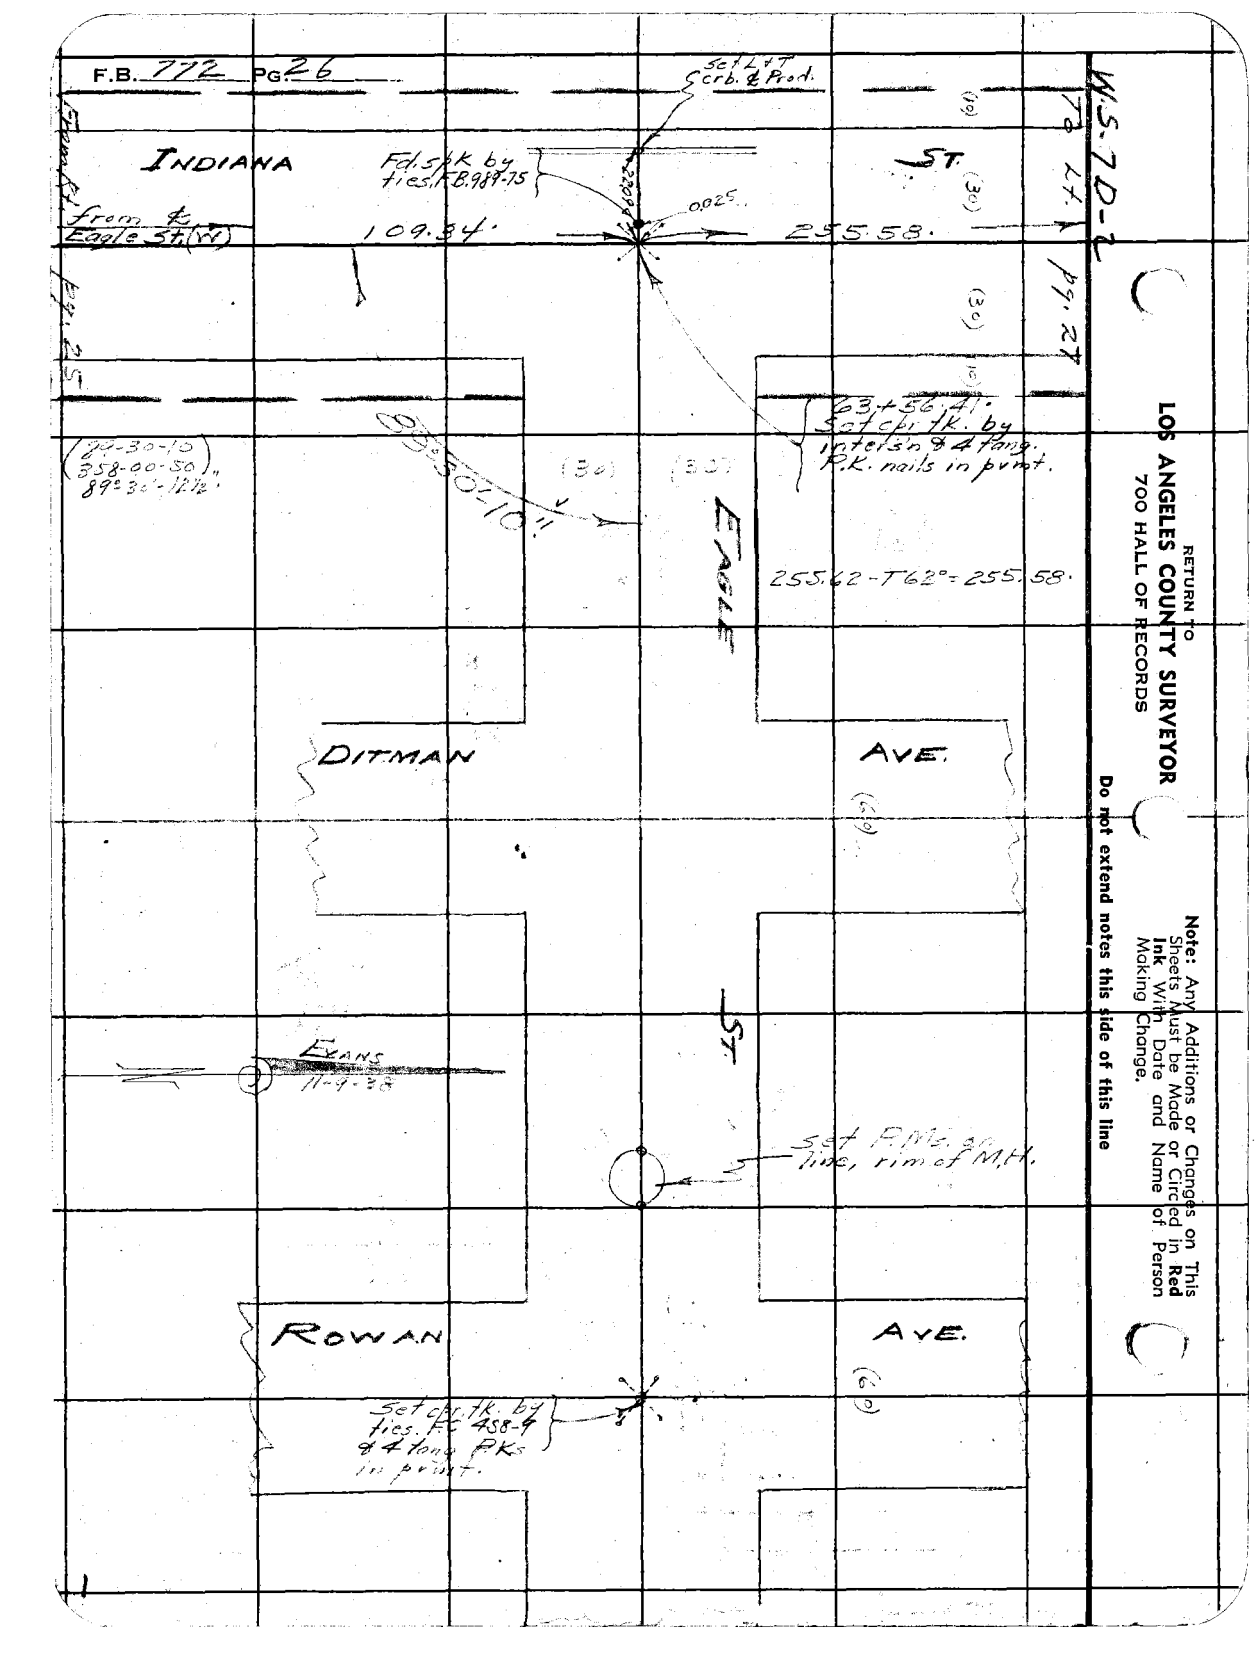

RETURN TO
LOS ANGELES COUNTY SURVEYOR
700 HALL OF RECORDS

Note: Any Additions or Changes on This Sheets Must be Made or Circled in **Red Ink** With Date and Name of Person Making Change.

Do not extend notes this side of this line

Notes Ck'd by D. M. Finley	Survey of Indiana St.	F.B. 772 Pg. 27
Map No. B-1465-2	W. O. 8226 Tape No. 036 St'd 84 of	
Office Work F. A. W.	Surveyed by Evans	
Checked D. M. Finley	Notes HE Date 11-10-38	
Date Jan. 1941	Indexed	

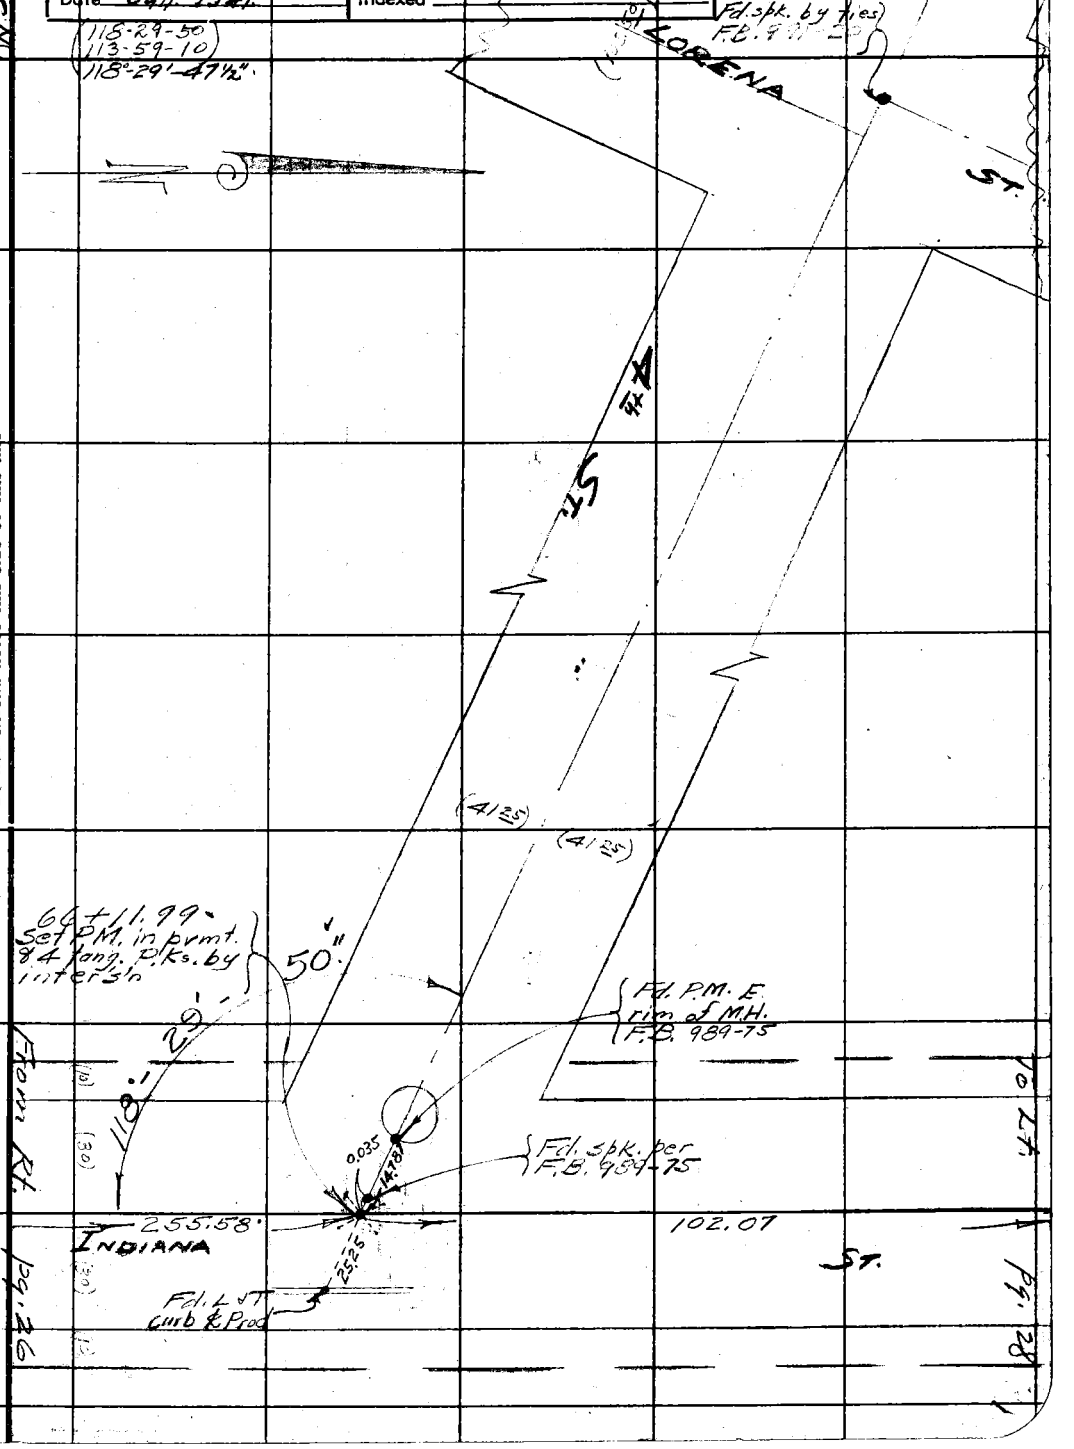

Note: Any Additions or Changes on This Sheets Must be Made or Circled in Red Ink With Date and Name of Person Making Change.

Do not extend notes this side of this line

RETURN TO
LOS ANGELES COUNTY SURVEYOR
700 HALL OF RECORDS

FORM 247 5M 10-37

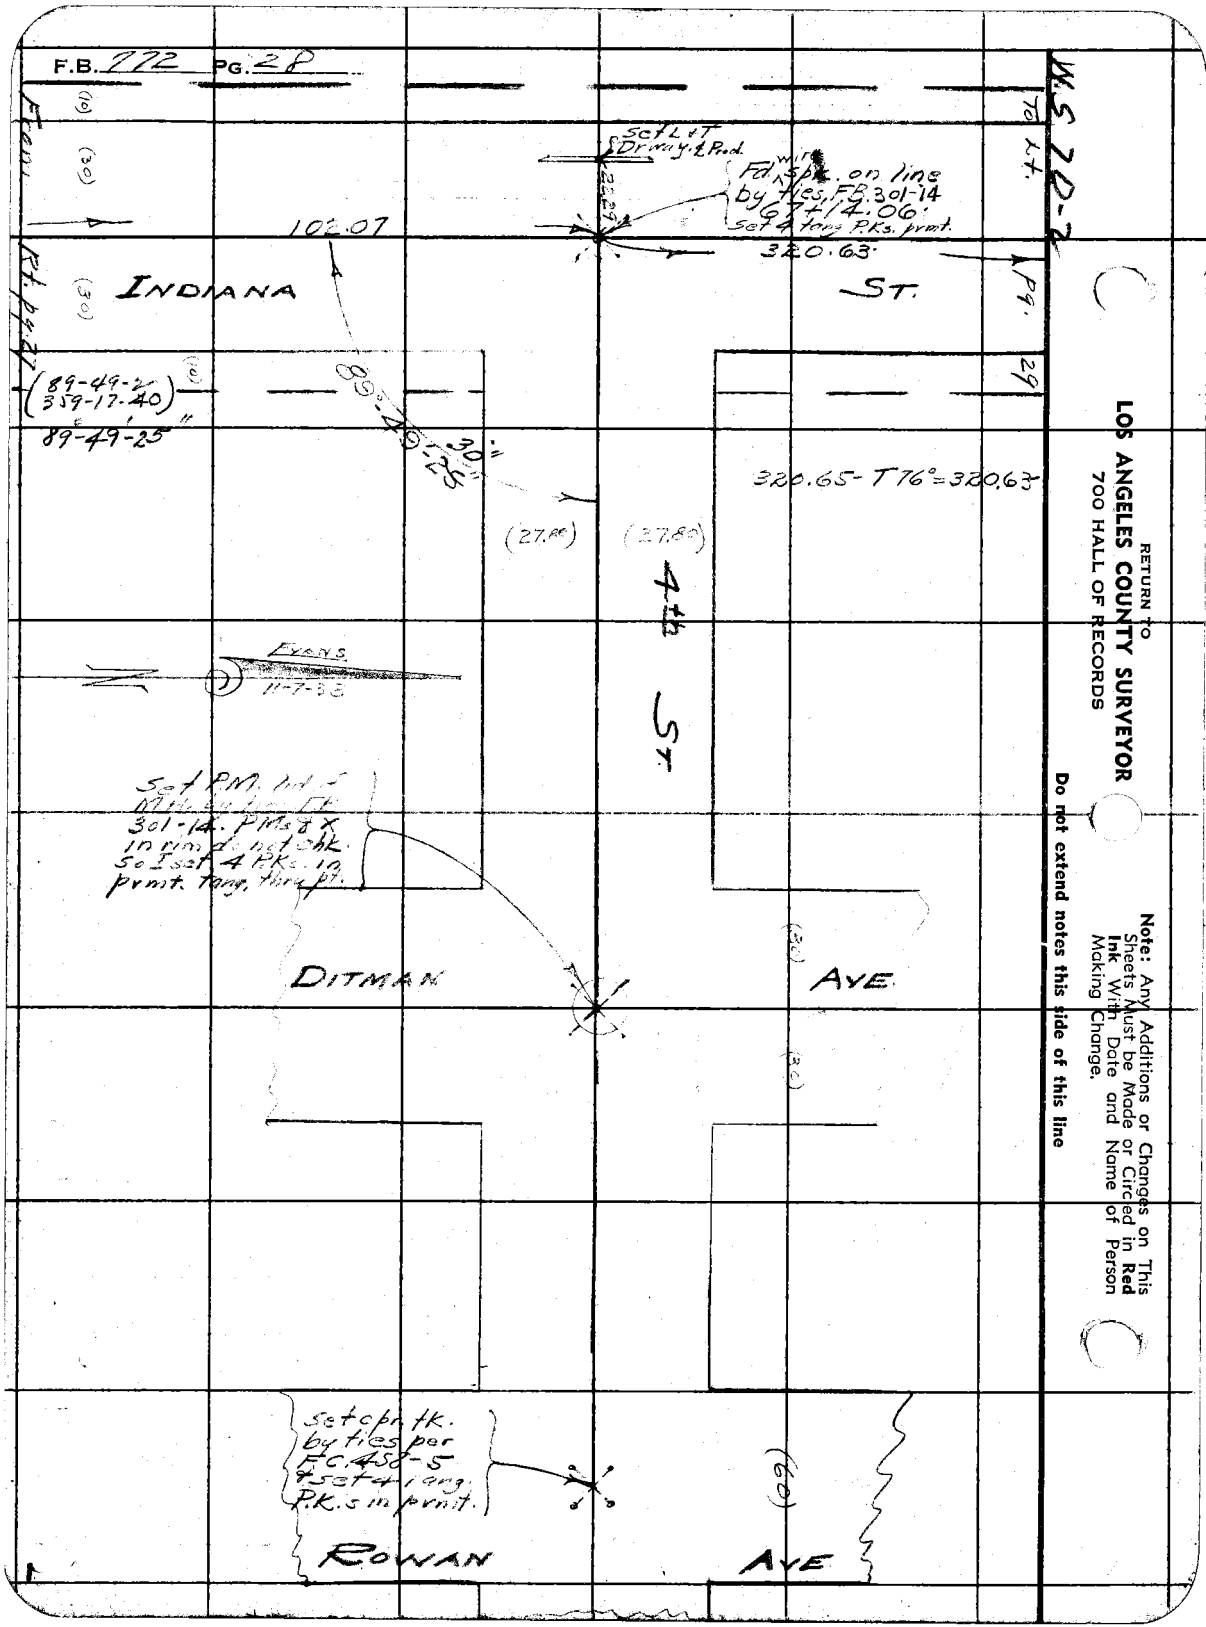

RETURN TO
LOS ANGELES COUNTY SURVEYOR
700 HALL OF RECORDS

Note: Any Additions or Changes on This Sheets Must be Made or Circled in **Red Ink** With Date and Name of Person Making Change.

Do not extend notes this side of this line

Notes Ck'd by D. M. Finley	Survey of Indiana St.	F.B. 772 Pg. 29.
Map No. B-1465-2	W. O. 8226 Tape No. 036 St'd 84 of	
Office Work F. A. W.	Surveyed by Evans	
Checked D. M. Finley	Notes HE Date 11-14-38	
Date Jan. 1941.	Indexed	

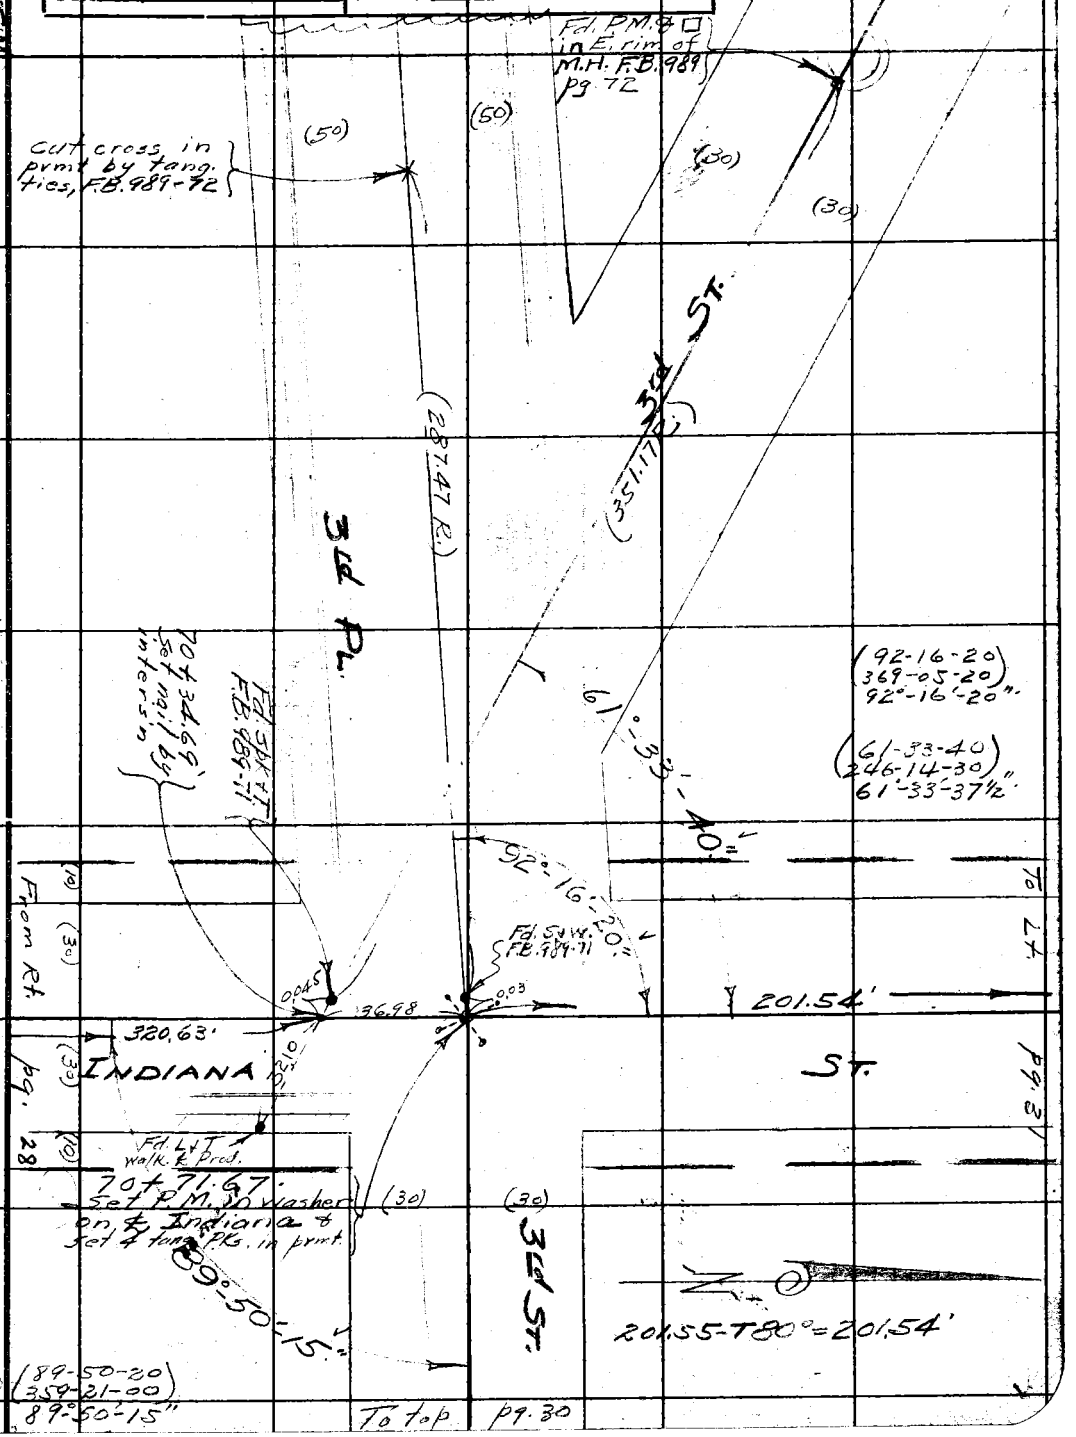

Note: Any Additions or Changes on This Sheets Must be Made or Circled in Red Ink With Date and Name of Person Making Change.

Do not extend notes this side of this line

RETURN TO
LOS ANGELES COUNTY SURVEYOR
700 HALL OF RECORDS

FORM 247 5M 10-37

From Bot. Pg 29

F.B. 772 Pg. 30

ALMA (60) AVE.

(PROPOSED BEVERLY BLVD.)

(30)

(30)

3rd ST.

EVANS 11-12-38

HICKS (60) AVE.

Fd. S.W.I.T. on line

Fd. S.W.I.T. F.B. 301-11

DITMAN AVE.

(60)

(60)

TOWNSEND AVE.

(60)

Set P.M. in cross on line Rim of M.H.

Fd. S.W.I.T. F.B. 301-13

ROWAN AVE.

(60)

RETURN TO
LOS ANGELES COUNTY SURVEYOR
700 HALL OF RECORDS

Note: Any Additions or Changes on This Sheets Must be Made or Circled in Red Ink With Date and Name of Person Making Change.

Do not extend notes this side of this line

Notes Ck'd by D. M. Finley	Survey of INDIANA ST.	F.B. 972	Pg. 31
Map No. B-1465-2	W. 08226 Tape No. 036 St'd 84 of		
Office Work F. A. W.	Surveyed by EVANS		
Checked D. M. Finley	Notes HE Date 11-14-38		
Date Jan 1941	Indexed		

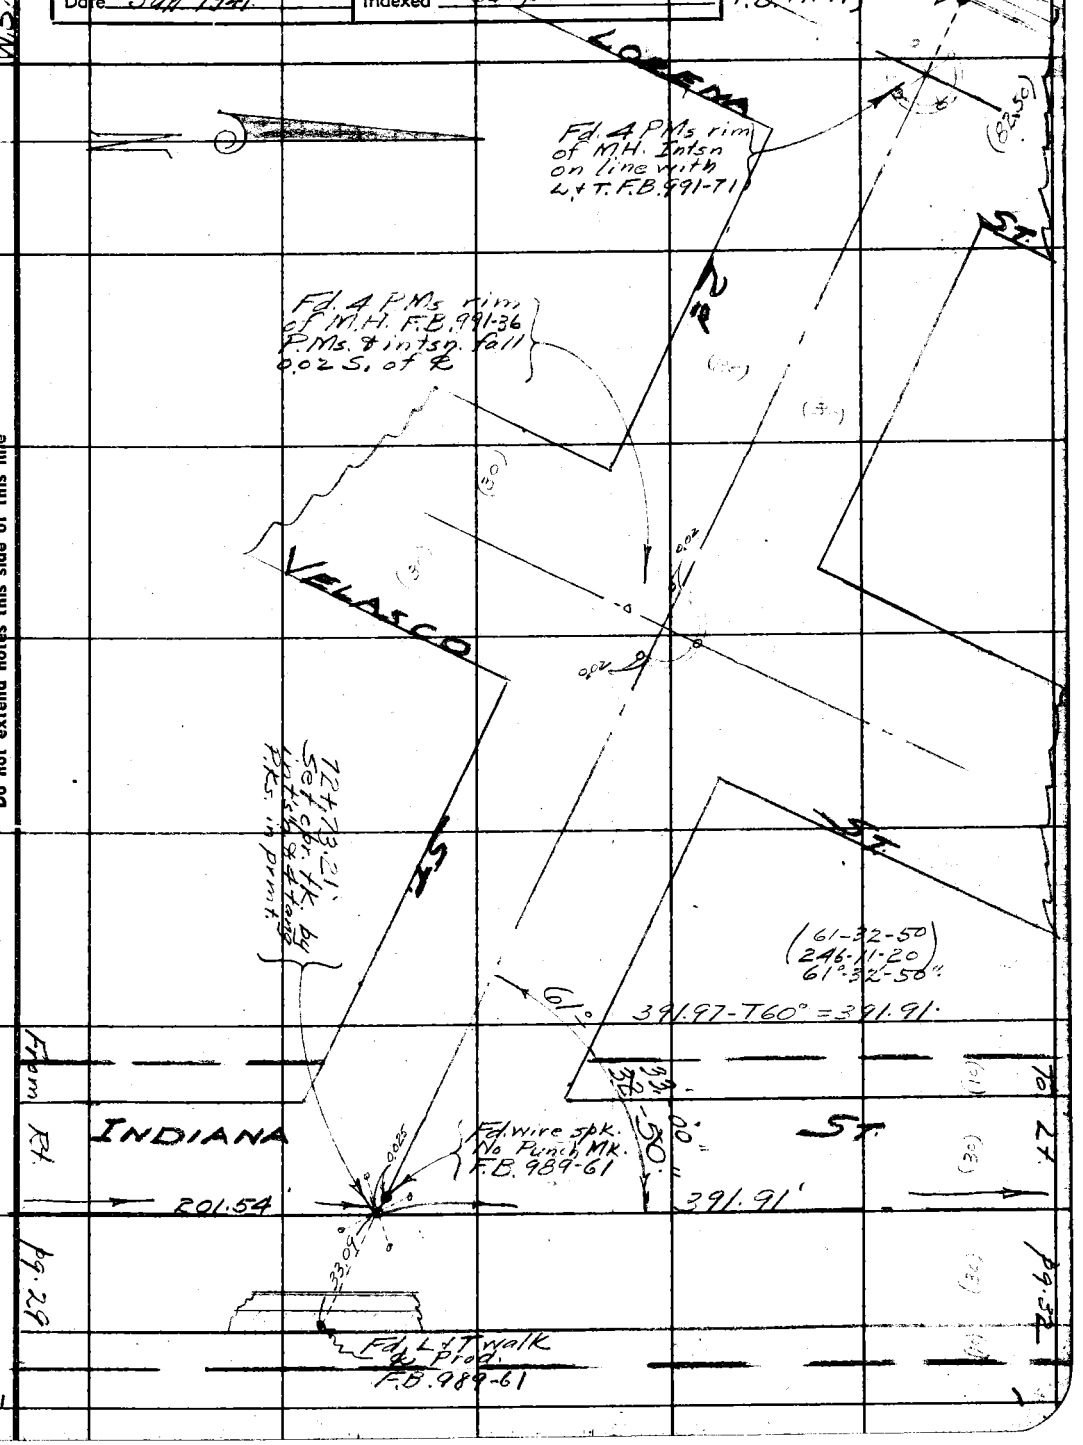

Note: Any Additions or Changes on This Sheets Must be Made or Circled in Red Ink With Date and Name of Person Making Change.

Do not extend notes this side of this line

RETURN TO
LOS ANGELES COUNTY SURVEYOR
700 HALL OF RECORDS

FORM 247 5M 10-37

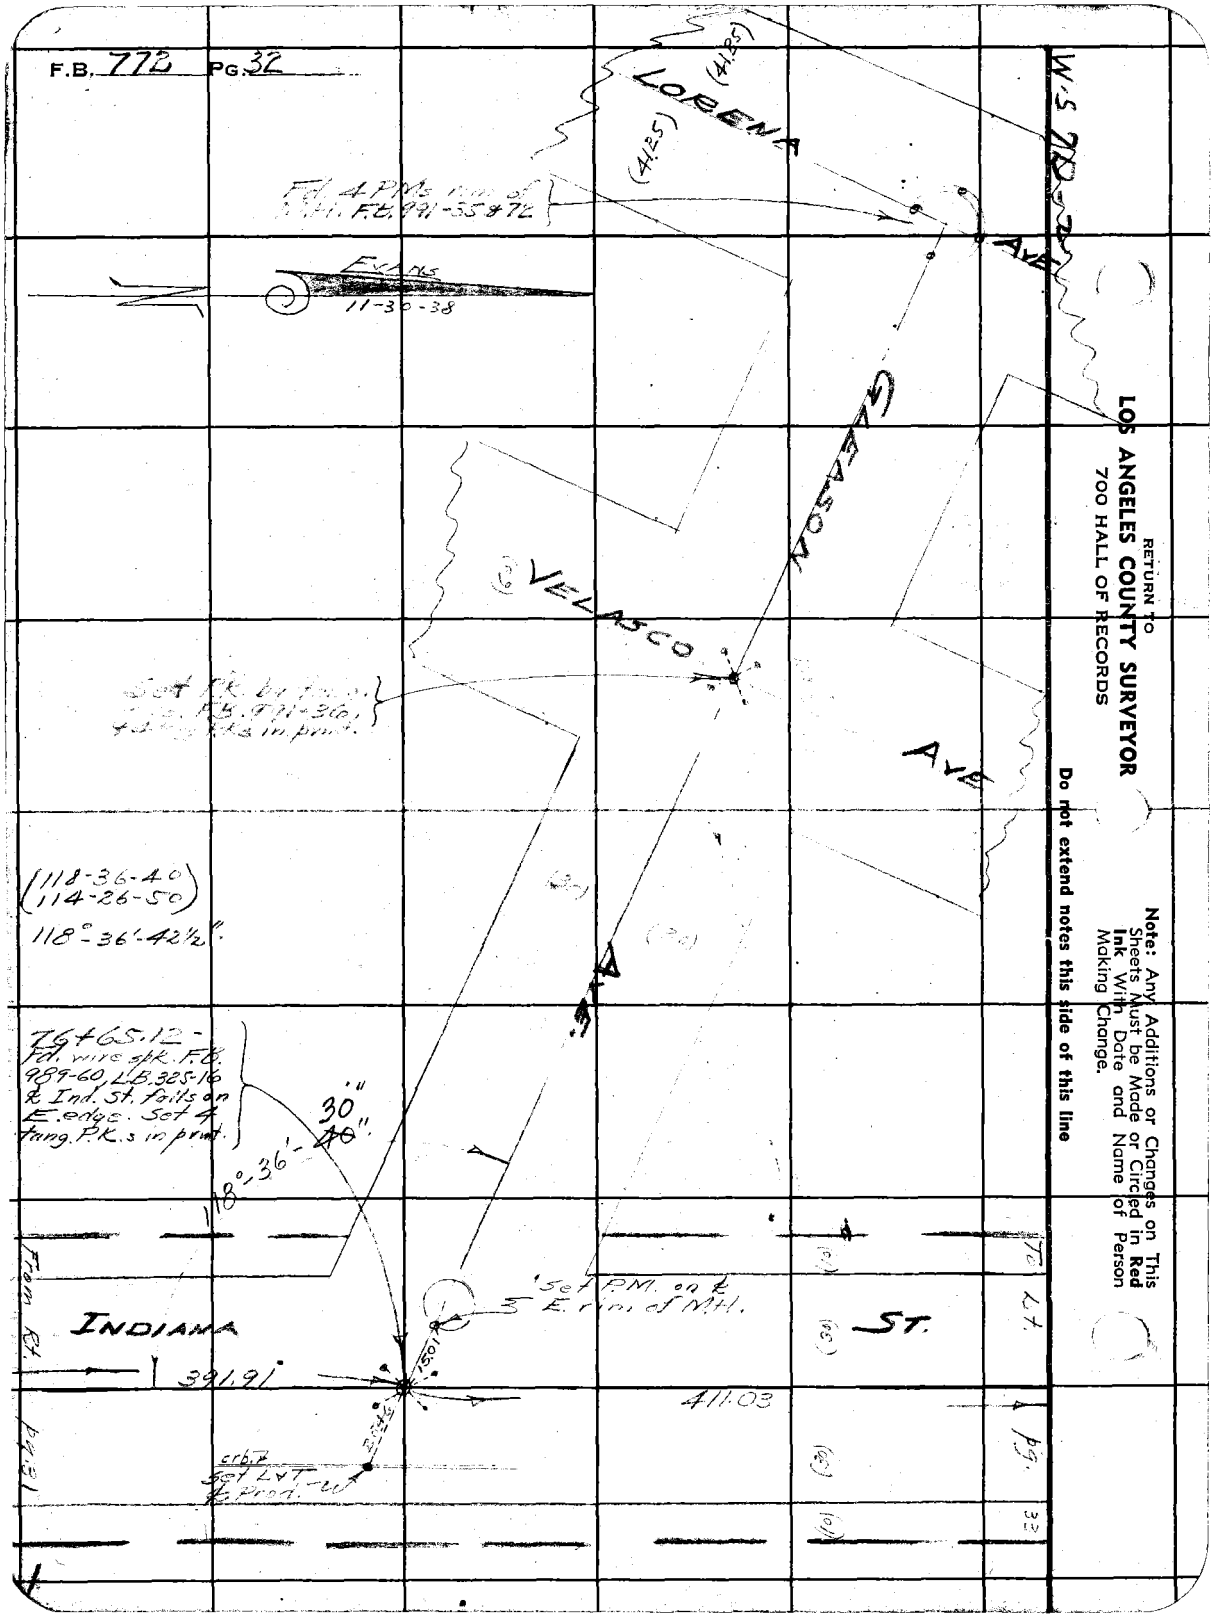
F.B. 772 PG. 32
LORENA
AVE
(41.25)
(41.25)
Fd. 4 PMs rim of M.H. F.B. 991-35 & 72
EVANS
11-30-38
GLEASON
VELASCO
AVE
Set P.K. by tang. F.B. 991-36, & 4 tang. P.K.s in pvmt.
(118-36-40)
(114-26-50)
118°-36'-42½"
76+65.12 - Fd. wire spk. F.B. 989-60, L.B. 325-16 & Ind. St. falls on E. edge. Set 4 tang. P.K.s in pvmt.
118°-36'-30"
INDIANA
ST.
391.91
411.03
Set P.M. on ℄ E. rim of M.H.
crb. Set L&T ℄ Prod.
From Rt.
To Lt.
pg. 31
pg. 33
W.S. 7D-72
RETURN TO
LOS ANGELES COUNTY SURVEYOR
700 HALL OF RECORDS
Note: Any Additions or Changes on This Sheets Must be Made or Circled in Red Ink With Date and Name of Person Making Change.
Do not extend notes this side of this line

Notes Ck'd by D. M. Finley	Survey of [illegible]
Map No. B-1465-2	W. 08226 Tape No. 036 Std. 84 °F
Office Work F. A. W.	Surveyed by EVANS
Checked D. M. Finley	Notes [illegible] Date 11-30-38
Date Jan. 1941	Indexed

F.B. [illegible] PG. 33

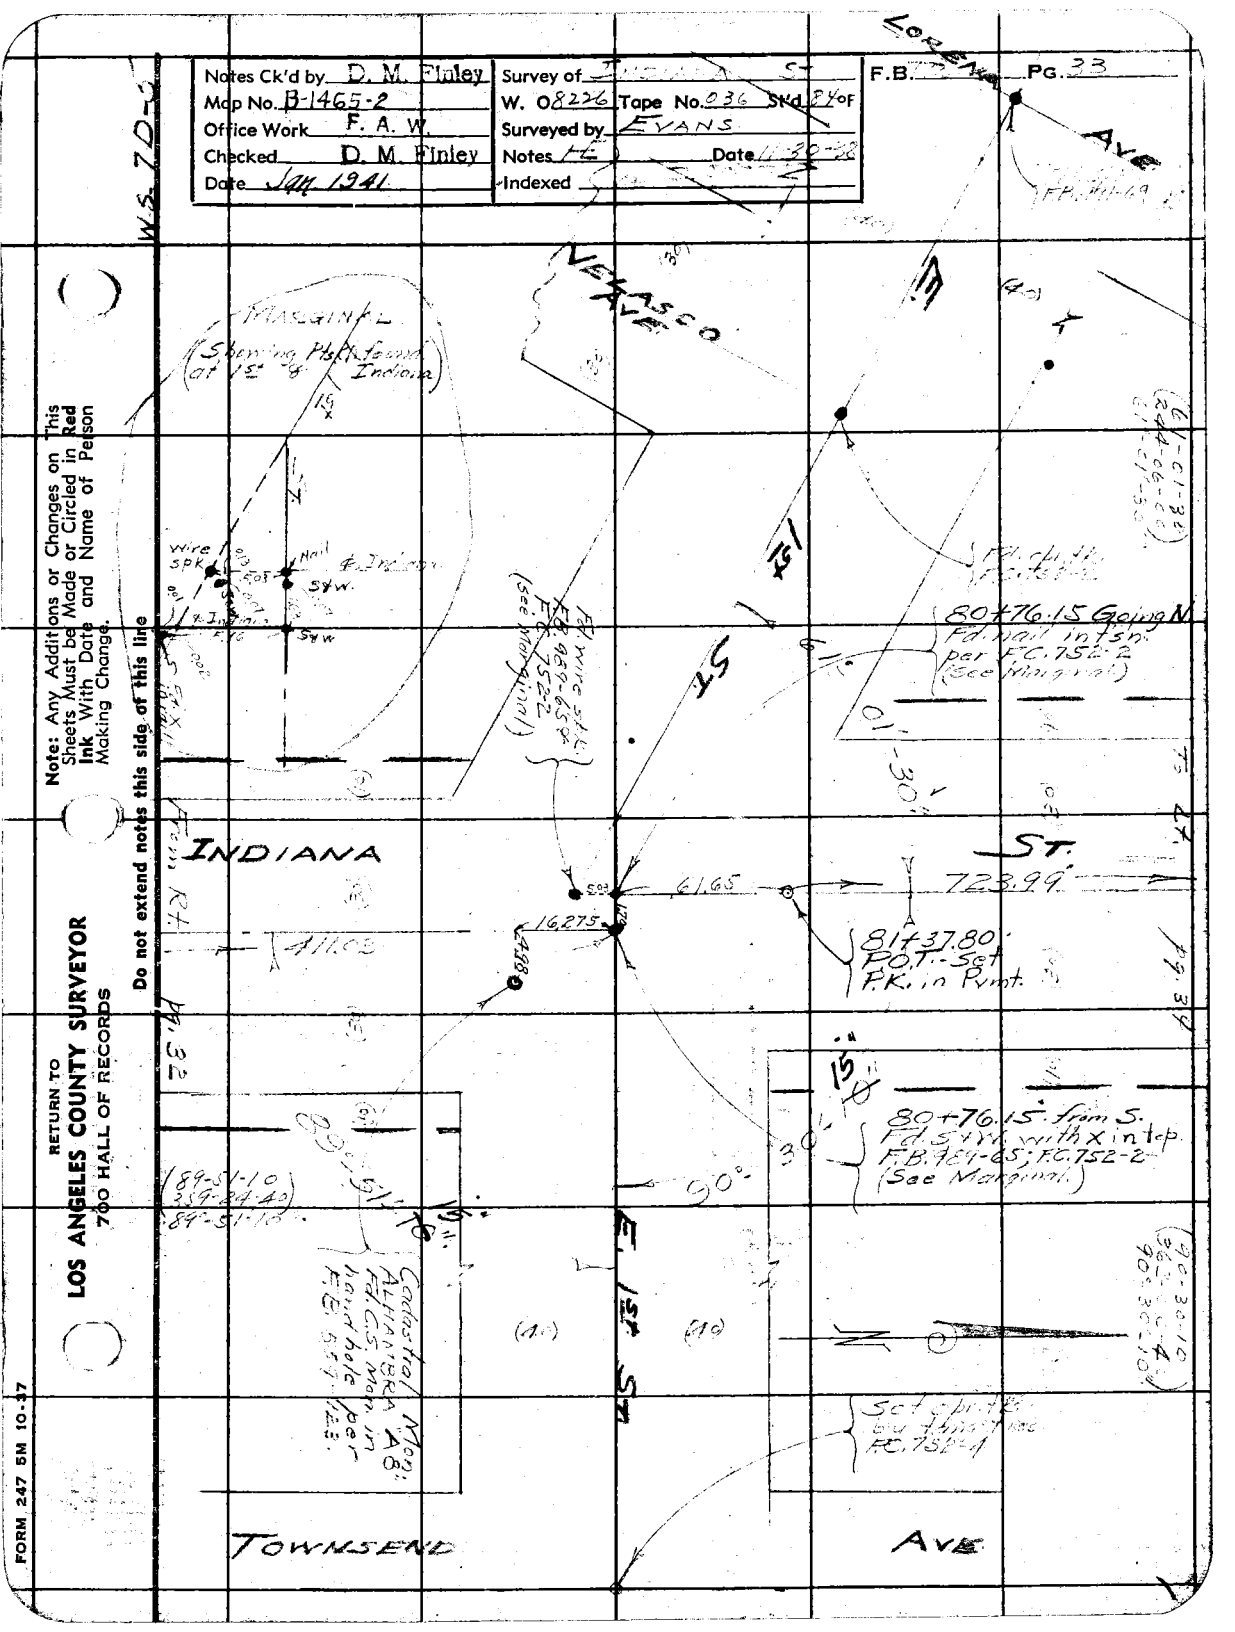

Note: Any Additions or Changes on This Sheets Must be Made or Circled in Red Ink With Date and Name of Person Making Change.

Do not extend notes this side of this line

RETURN TO
LOS ANGELES COUNTY SURVEYOR
700 HALL OF RECORDS

FORM 247 5M 10-37

F.B. 772 PG. 34

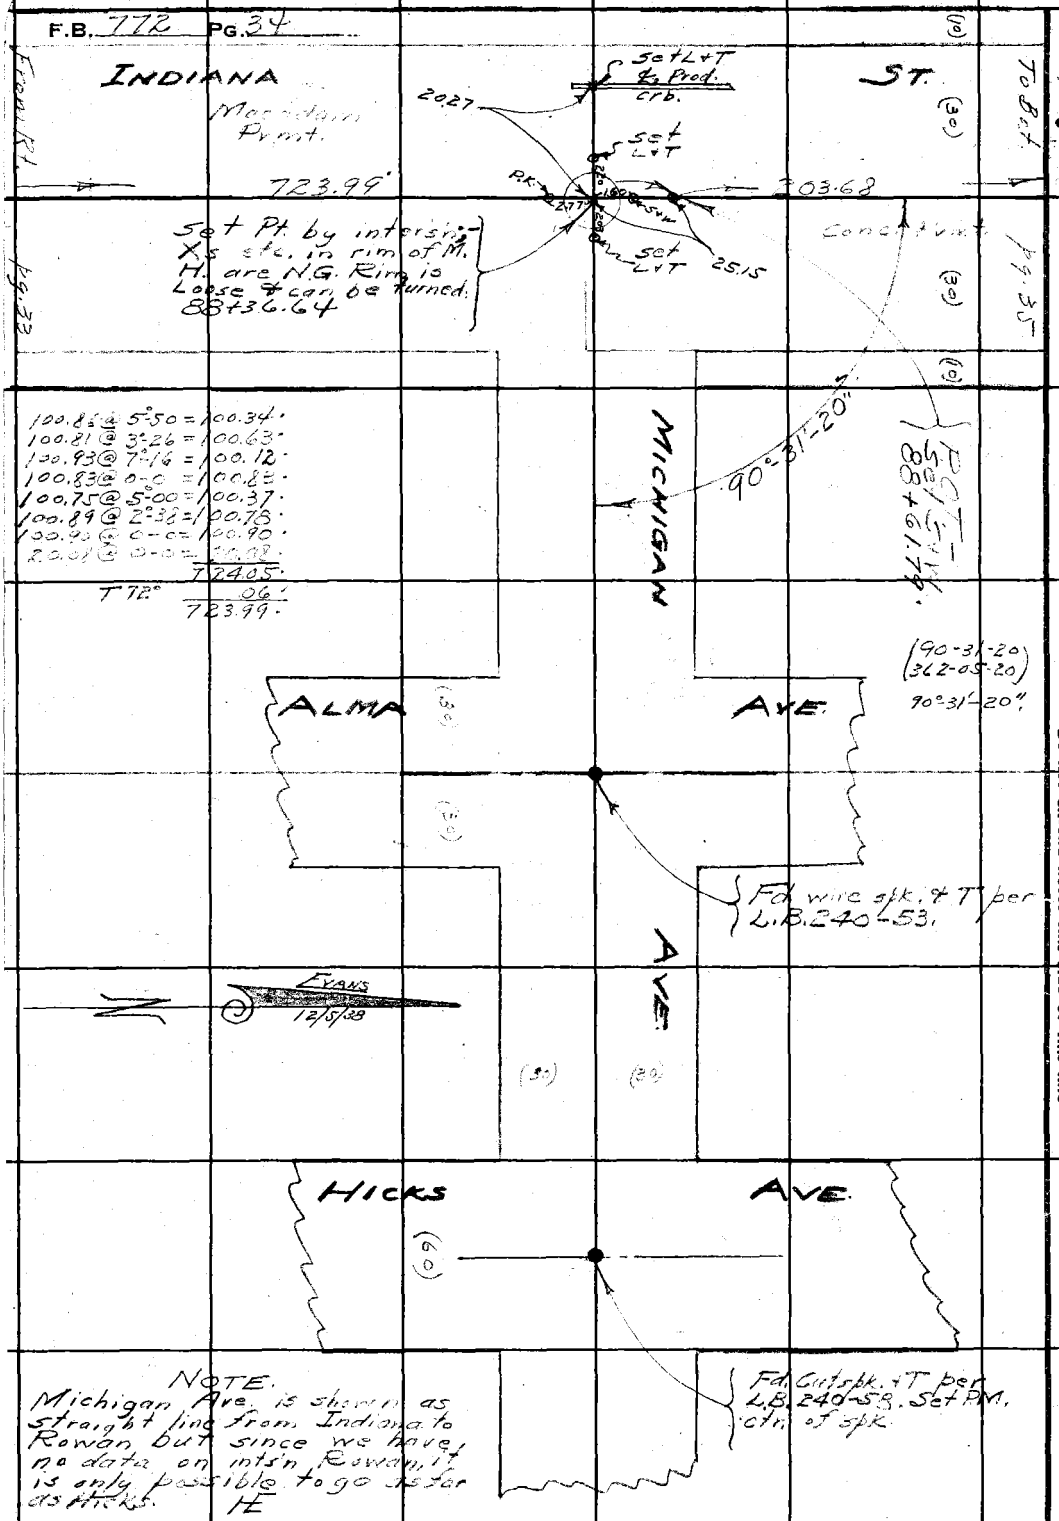

100.86 @ 5°-50 = 100.34
100.81 @ 3°-26 = 100.63
100.93 @ 7°-16 = 100.12
100.83 @ 0-0 = 100.83
100.75 @ 5°-00 = 100.37
100.89 @ 2°-38 = 100.78
100.90 @ 0-0 = 100.90
20.08 @ 0-0 = 20.08
724.05
T 72° .06
723.99

NOTE.
Michigan Ave. is shown as straight line from Indiana to Rowan but since we have no data on intsn Rowan, it is only possible to go as far as Hicks.
HE

WS.7-D-2

RETURN TO
LOS ANGELES COUNTY SURVEYOR
700 HALL OF RECORDS

Note: Any Additions or Changes on This Sheets Must be Made or Circled in Red Ink With Date and Name of Person Making Change.

Do not extend notes this side of this line

(To Lt. pg. 36)

Notes Ck'd by D. M. Finley	Survey of Indiana St.	F.B. 772 Pg. 35
Map No. B-1465-2	W. O. 8226 Tape No. 036 St'd 84 of	
Office Work F. A. W.	Surveyed by Evans	
Checked D. M. Finley	Notes HE Date 12-1-38	
Date Jan. 1941	Indexed	

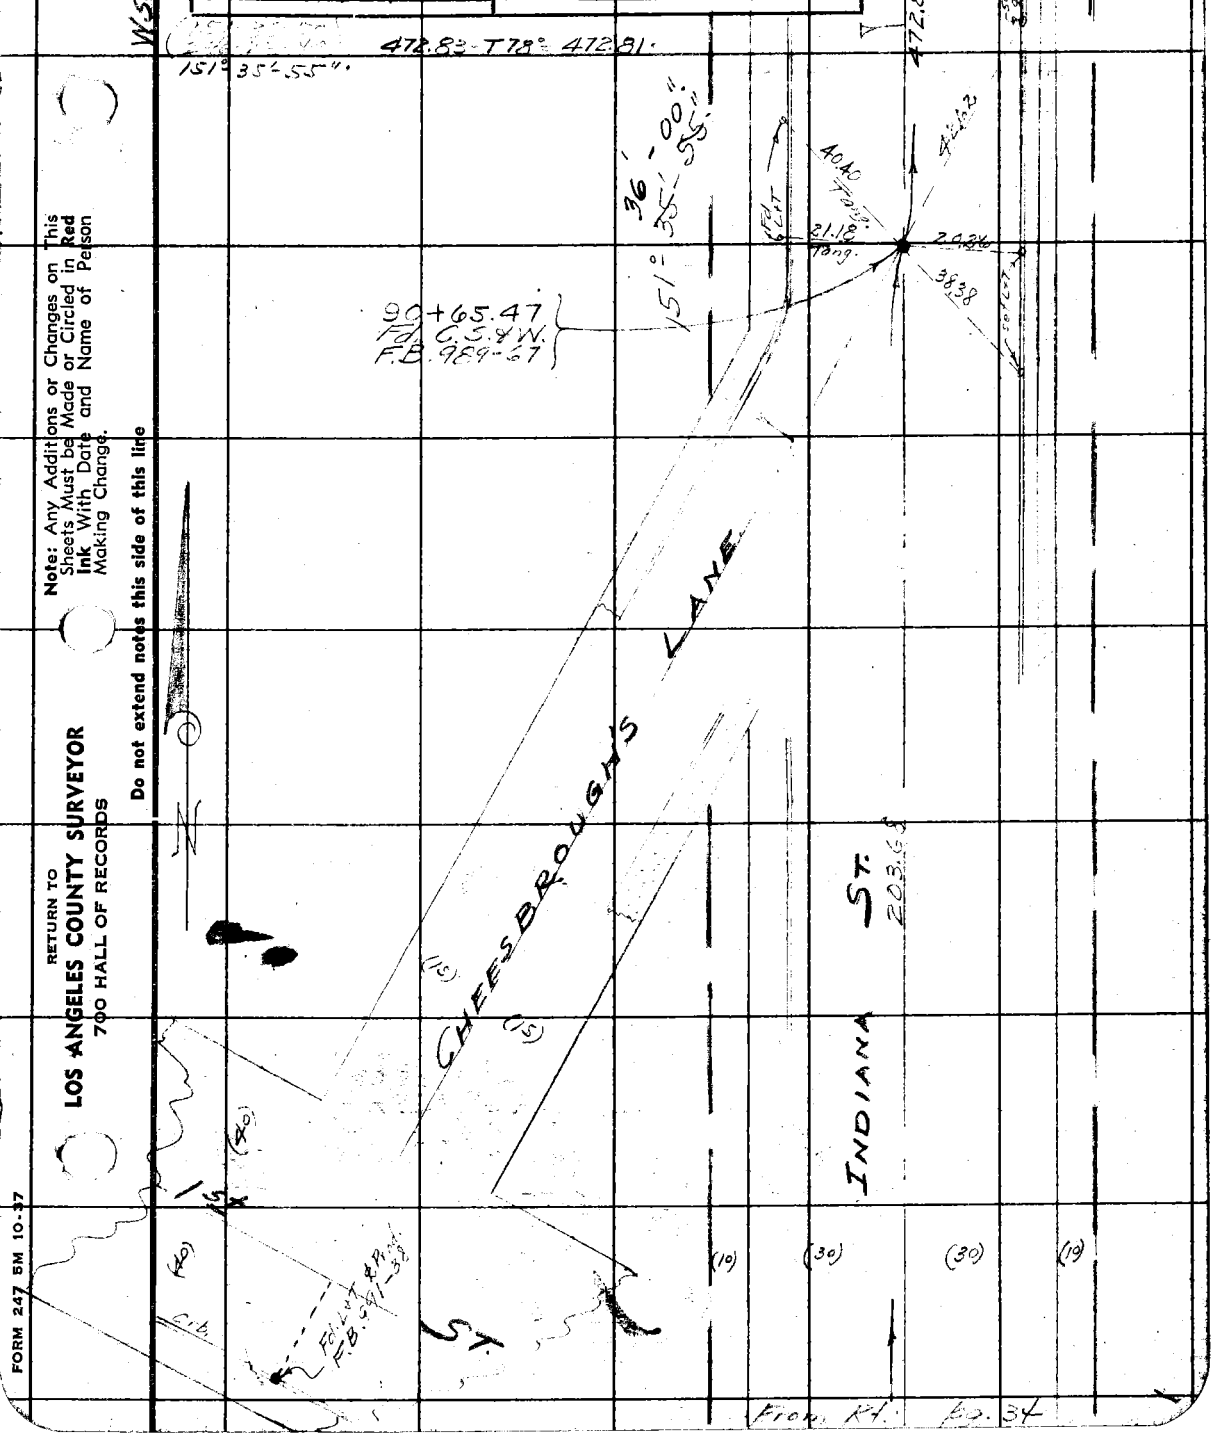

From Rt. pg. 34

Note: Any Additions or Changes on This Sheets Must be Made or Circled in Red Ink With Date and Name of Person Making Change.

Do not extend notes this side of this line

RETURN TO
LOS ANGELES COUNTY SURVEYOR
700 HALL OF RECORDS

FORM 247 5M 10-37

RETURN TO
LOS ANGELES COUNTY SURVEYOR
700 HALL OF RECORDS

Note: Any Additions or Changes on This Sheets Must be Made or Circled in **Red Ink** With Date and Name of Person Making Change.

Do not extend notes this side of this line

WS. 7D-1

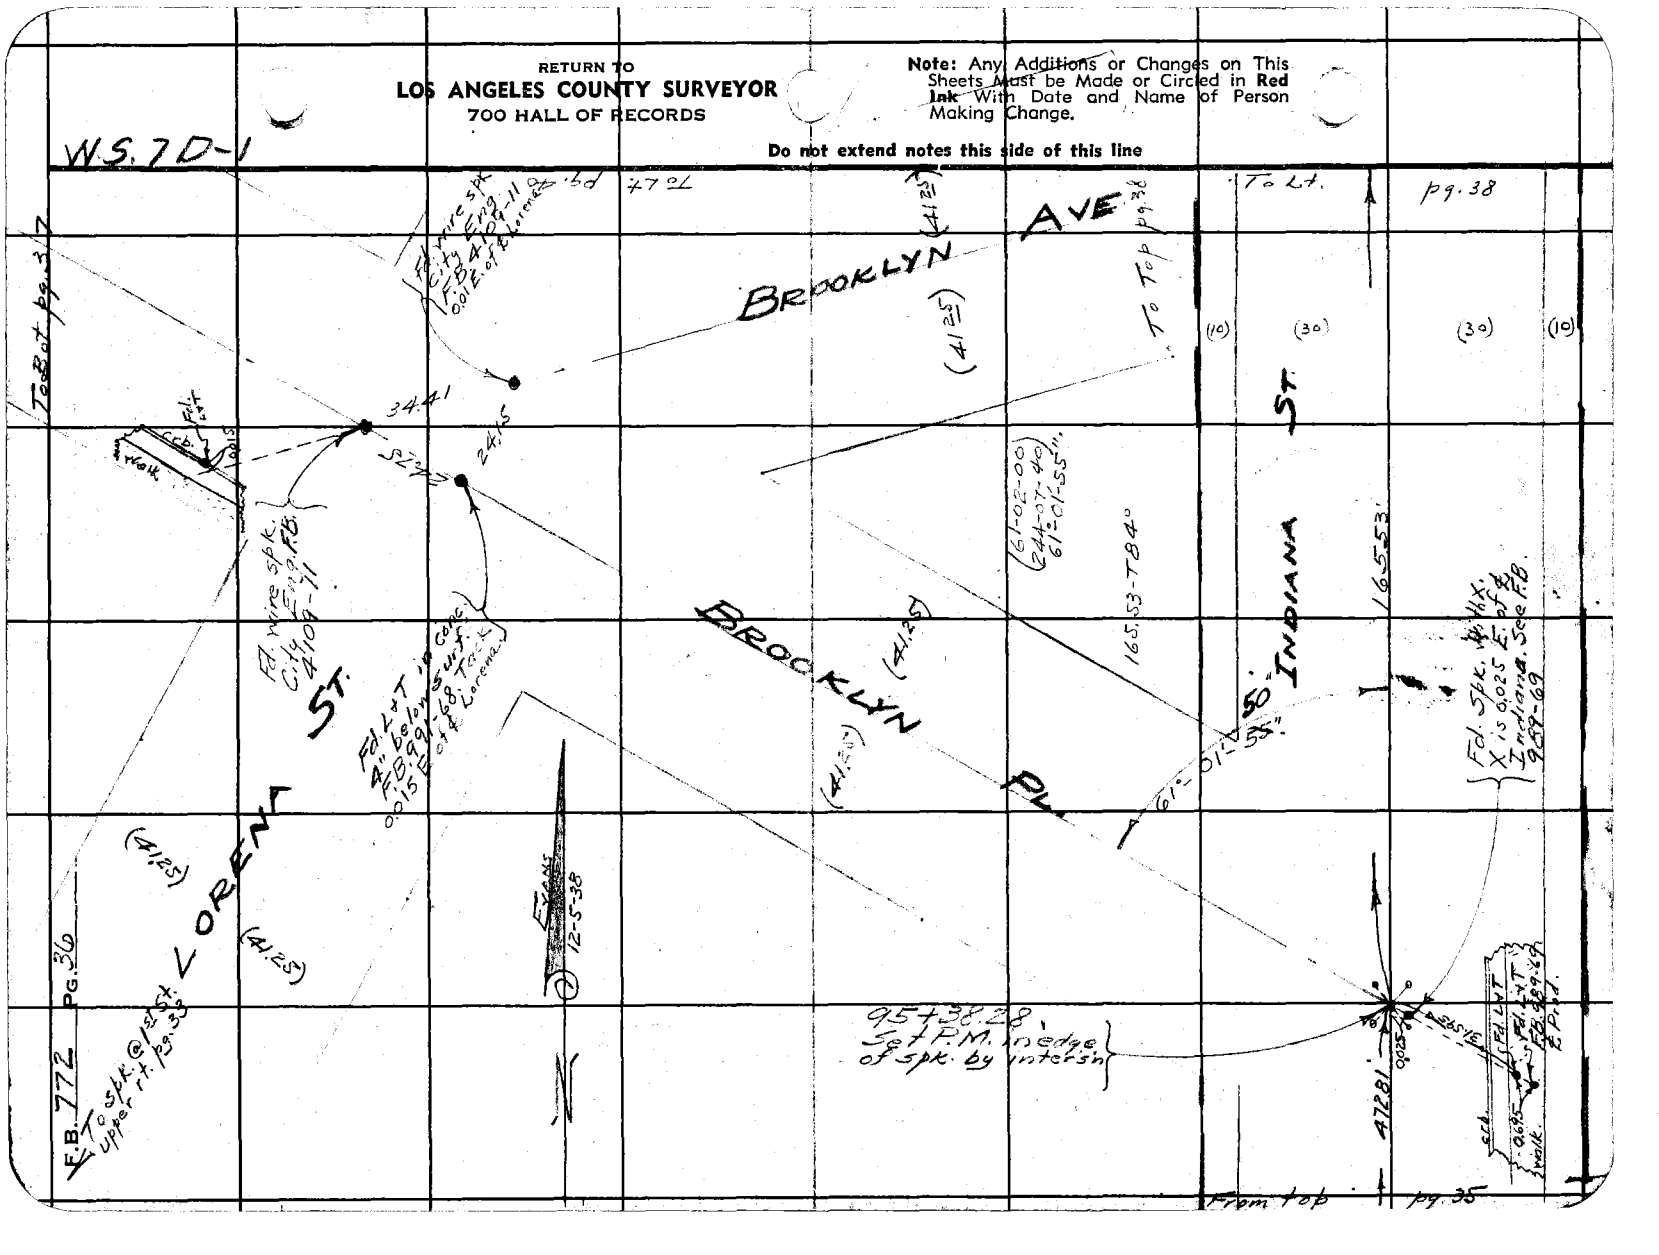

Notes Ck'd by D. M. Finley
Map No. B-1465-2
Office Work F. A. W.
Checked D. M. Finley
Date Jan. 1941

Survey of Indiana St.
W. O. 8226 Tape No. 036 St'd 84 of
Surveyed by EVANS
Notes HE Date 12-5-38
Indexed

F.B. 772 Pg. 37

(41.25) (41.25)

EZRA ST.

Fd. Spk. City Eng. F.B. 4509-74

BROOKLYN AVE.

CONCORD ST.

Fd. Spk. City Eng. F.B. 4509-76

BERNAL AVE.

0.02

Fd. Spk. City Eng. F.B. 4509-76

From top Rt. pg. 36

Note: Any Additions or Changes on This Sheets Must be Made or Circled in Red Ink With Date and Name of Person Making Change.

Do not extend notes this side of this line

RETURN TO
LOS ANGELES COUNTY SURVEYOR
700 HALL OF RECORDS

FORM 247 SM 10-37

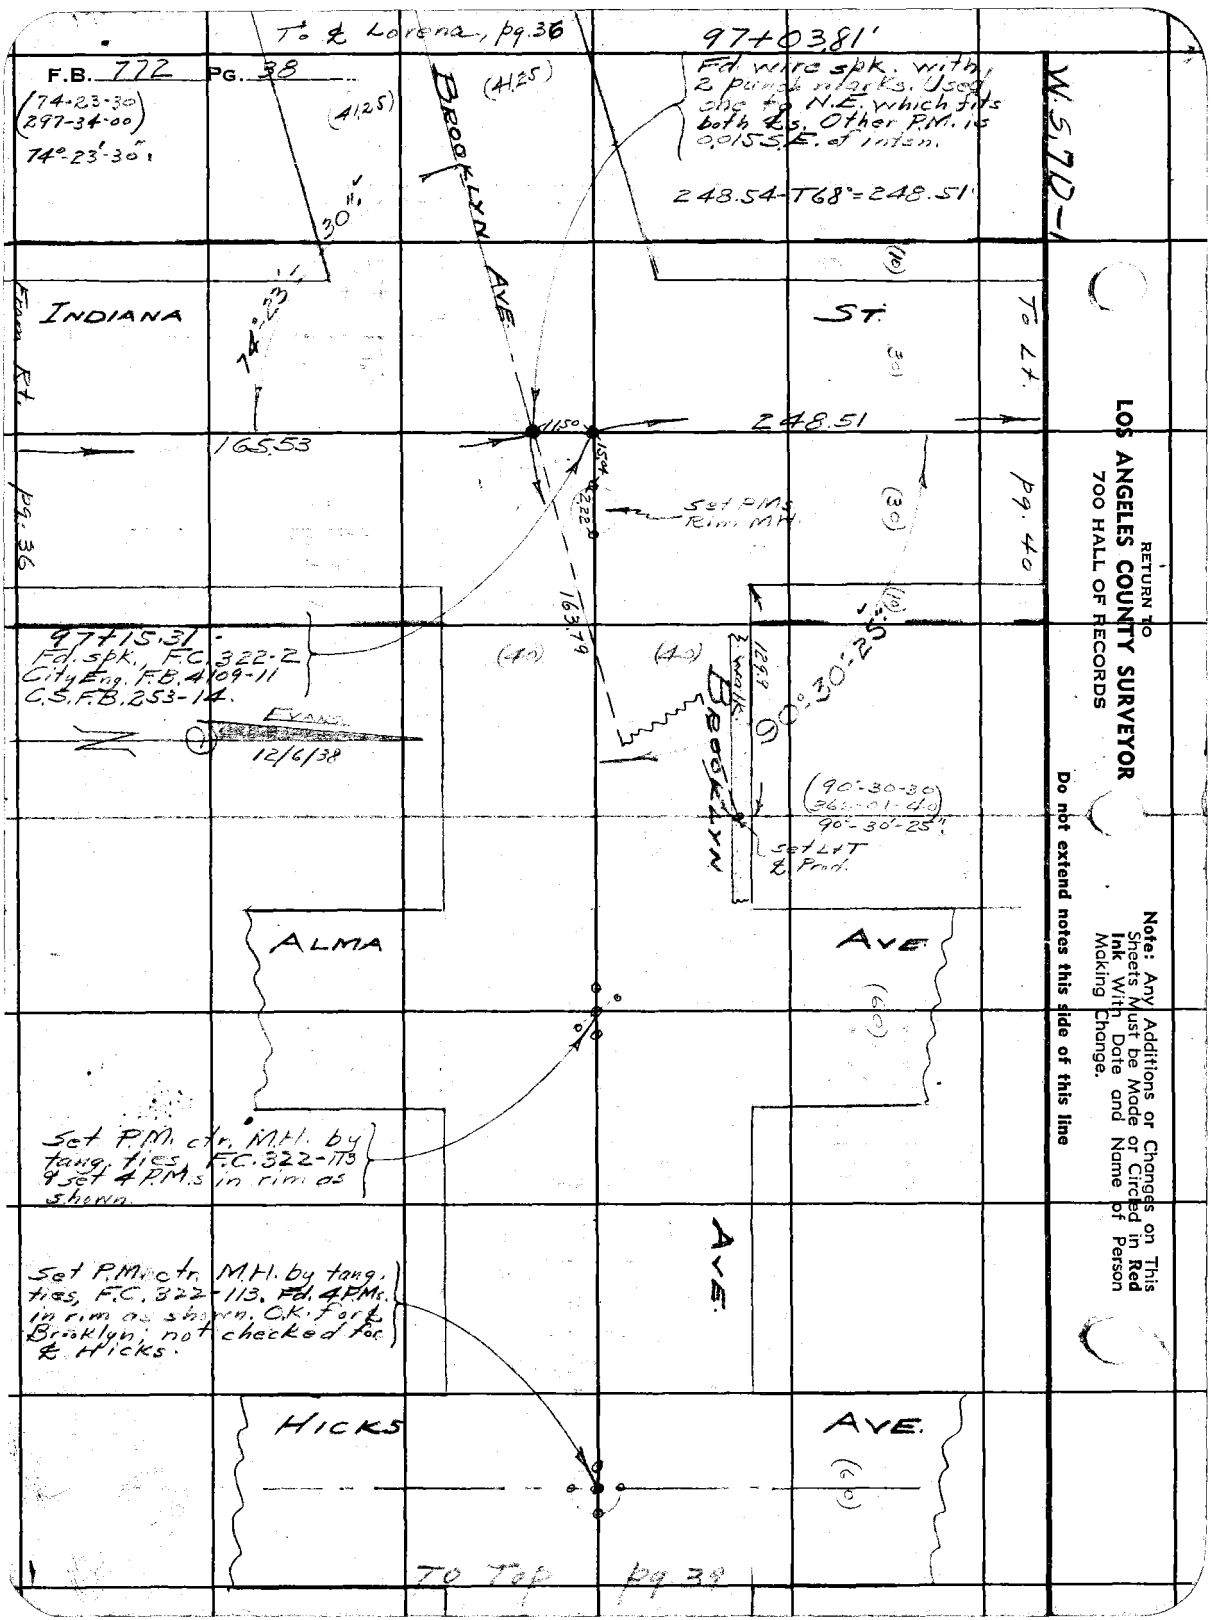

RETURN TO
LOS ANGELES COUNTY SURVEYOR
700 HALL OF RECORDS

Note: Any Additions or Changes on This Sheets Must be Made or Circled in **Red Ink** With Date and Name of Person Making Change.

Do not extend notes this side of this line

Notes Ck'd by D. M. Finley	Survey of Indiana St.	F.B. 272 Pg. 39
Map No. B-1465-2	W. O. 8226 Tape No. 036 St'd 84 °F	
Office Work F. A. W.	Surveyed by Evans.	
Checked D. M. Finley	Notes HE Date 12-6-38	
Date Jan. 1941.	Indexed	

W.S. 7 E.1

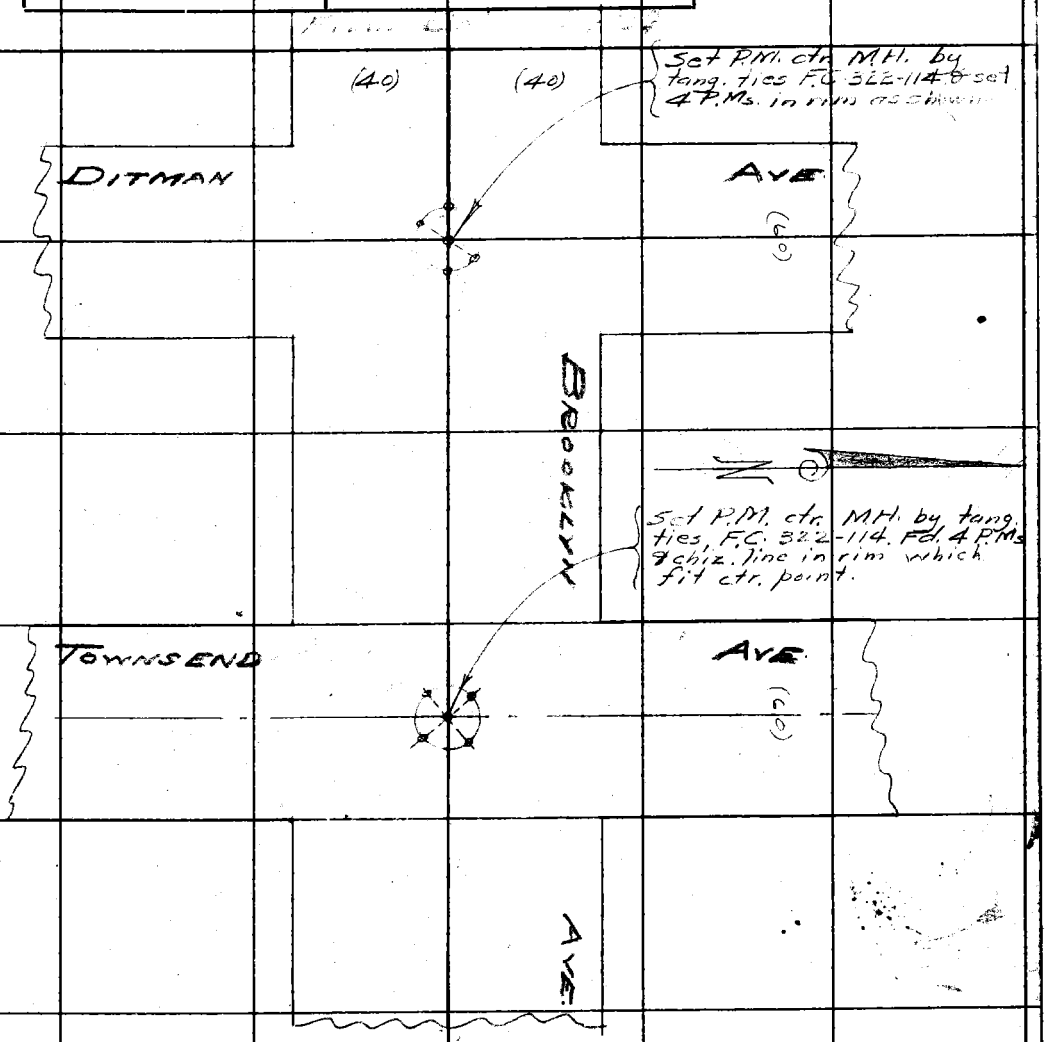

Note: Any Additions or Changes on This Sheets Must be Made or Circled in Red Ink With Date and Name of Person Making Change.

Do not extend notes this side of this line

RETURN TO
LOS ANGELES COUNTY SURVEYOR
700 HALL OF RECORDS

FORM 247 5M 10-37

RETURN TO
LOS ANGELES COUNTY SURVEYOR
700 HALL OF RECORDS

Note: Any Additions or Changes on This Sheets Must be Made or Circled in **Red Ink** With Date and Name of Person Making Change.

Do not extend notes this side of this line

W.S 7D-1

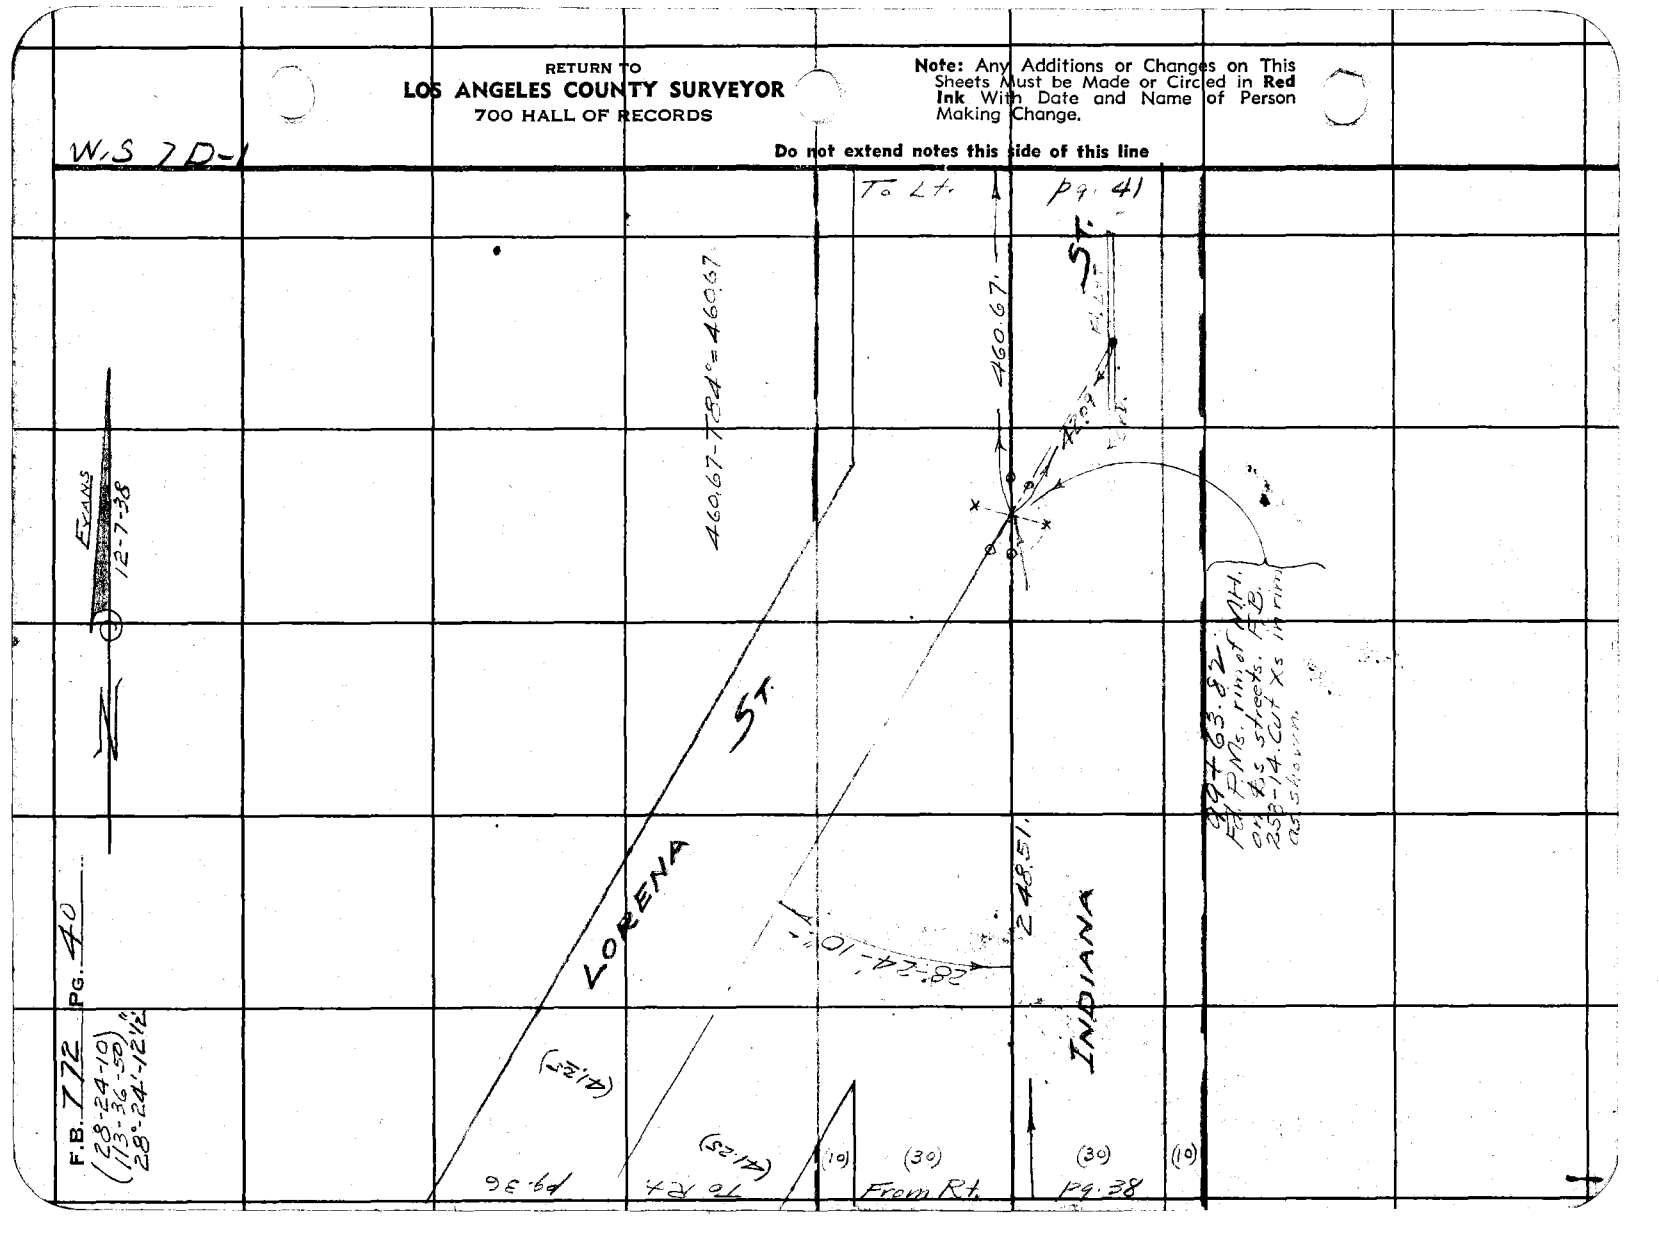

F.B. 772 PG. 40
(28°-24'-10")
113-36-50"
28°-24'-12"

Notes Ck'd by D. M. Finley	Survey of INDIANA ST.	F.B. 772 Pg. 41
Map No. B-1465-2	W. O. 8226 Tape No. 036 St'd 84 °F	
Office Work F. A. W.	Surveyed by EVANS	
Checked D. M. Finley	Notes HE Date 12-7-38	
Date Jan 1941.	Indexed	

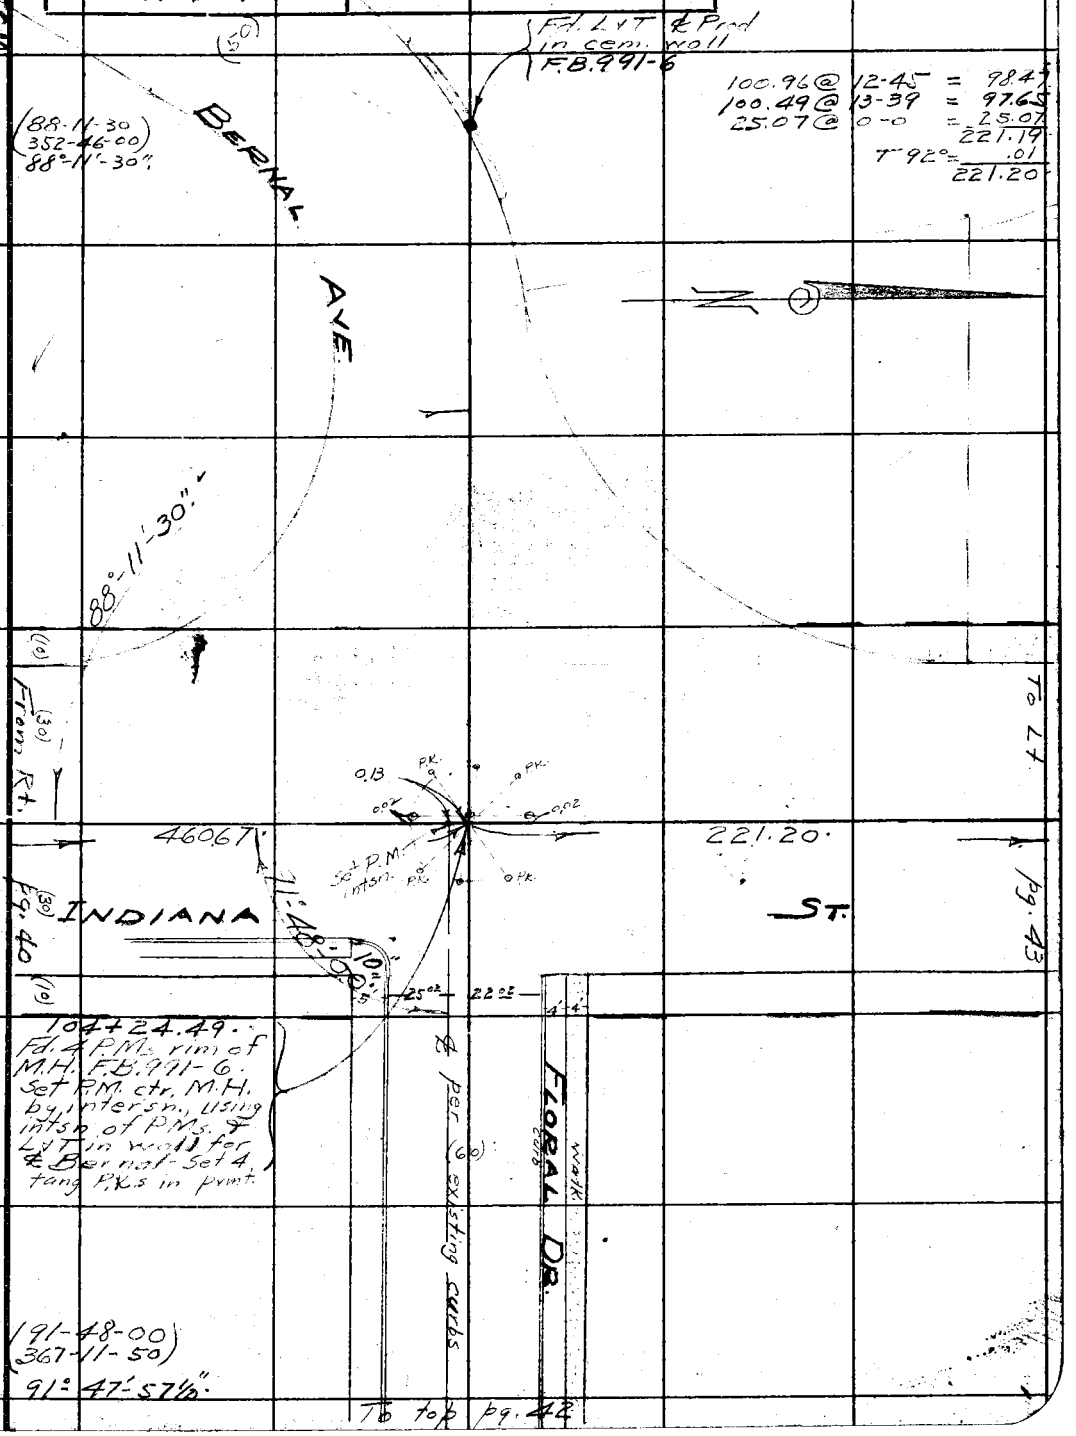

Note: Any Additions or Changes on This Sheets Must be Made or Circled in Red Ink With Date and Name of Person Making Change.

Do not extend notes this side of this line

RETURN TO
LOS ANGELES COUNTY SURVEYOR
700 HALL OF RECORDS

FORM 247 SM 10-37

RETURN TO
LOS ANGELES COUNTY SURVEYOR
700 HALL OF RECORDS

Note: Any Additions or Changes on This Sheets Must be Made or Circled in **Red Ink** With Date and Name of Person Making Change.

Do not extend notes this side of this line

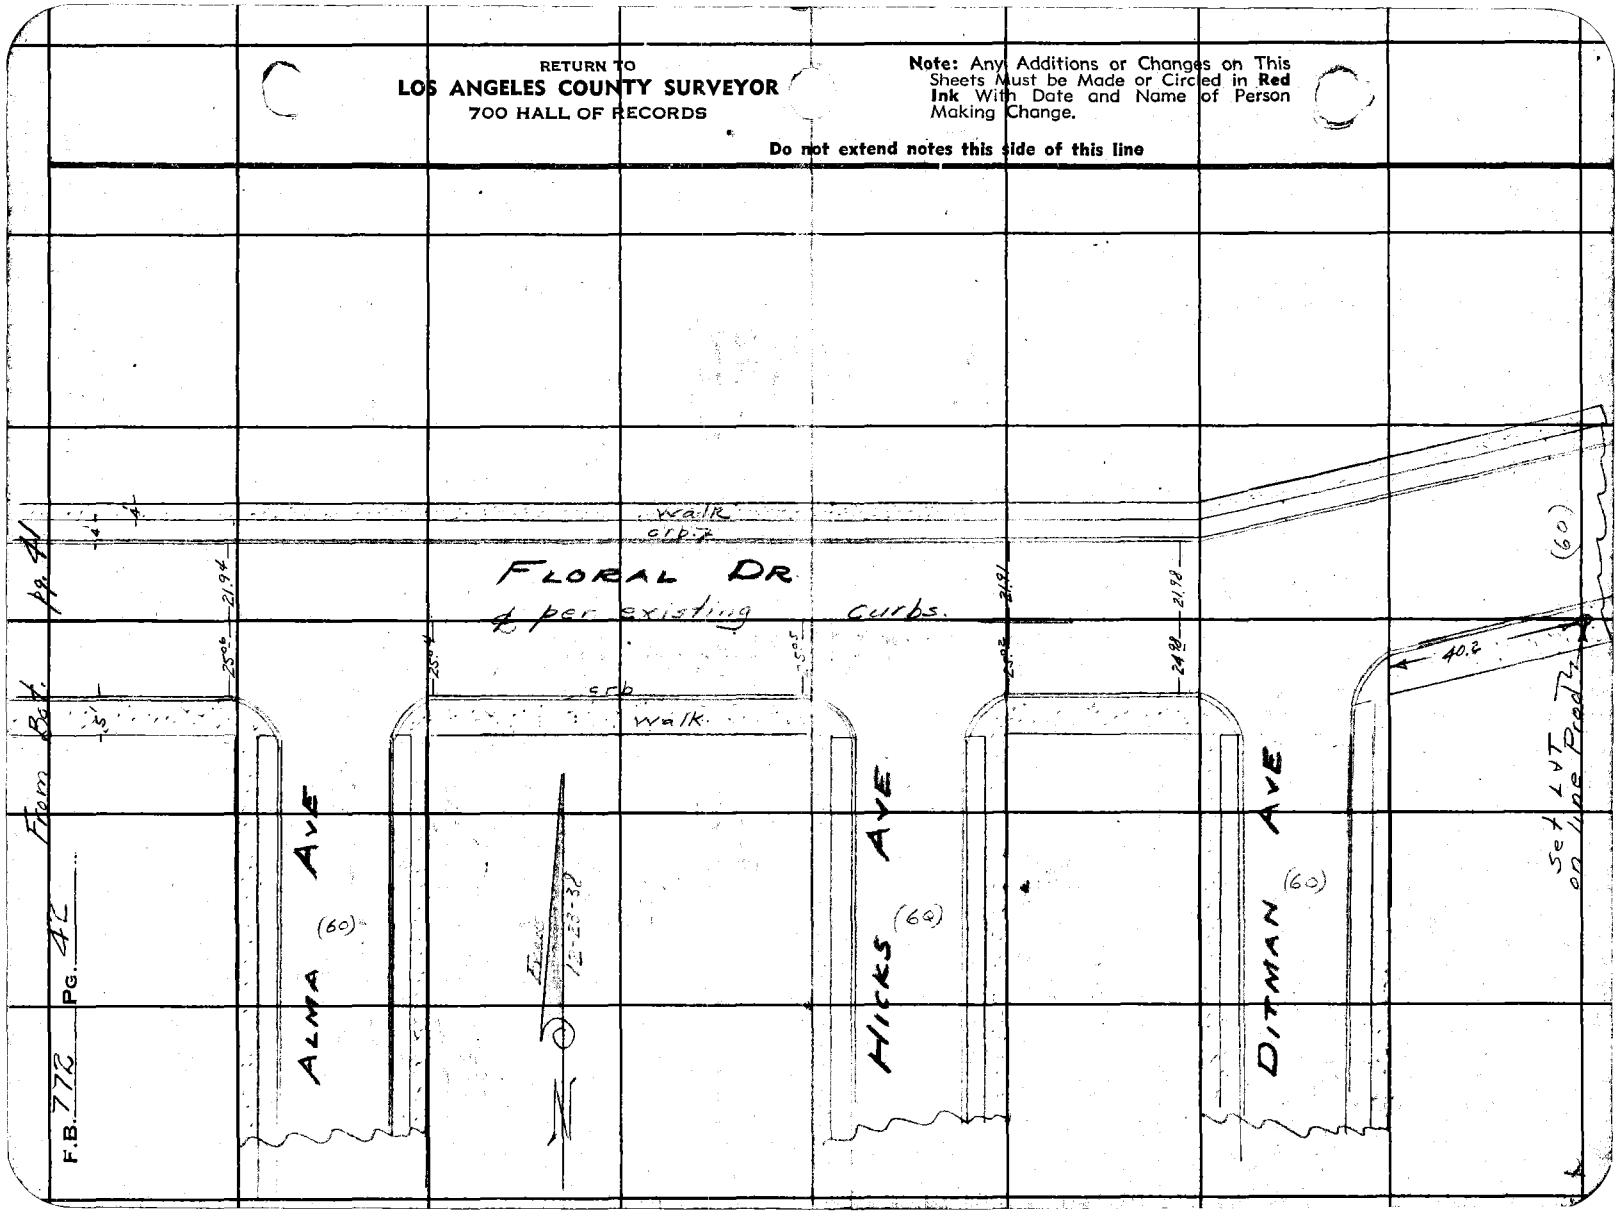

Notes Ck'd by D. M. Finley	Survey of INDIANA ST	F.B. 772	Pg. 43
Map No. B-1465-3	W. O. 8226 Tape No. 036 St'd 84°F		
Office Work F. A. W.	Surveyed by EVANS.		
Checked D. M. Finley	Notes E Date 12-9-38		
Date Jan. 1941.	Indexed		

W.S.7D-1

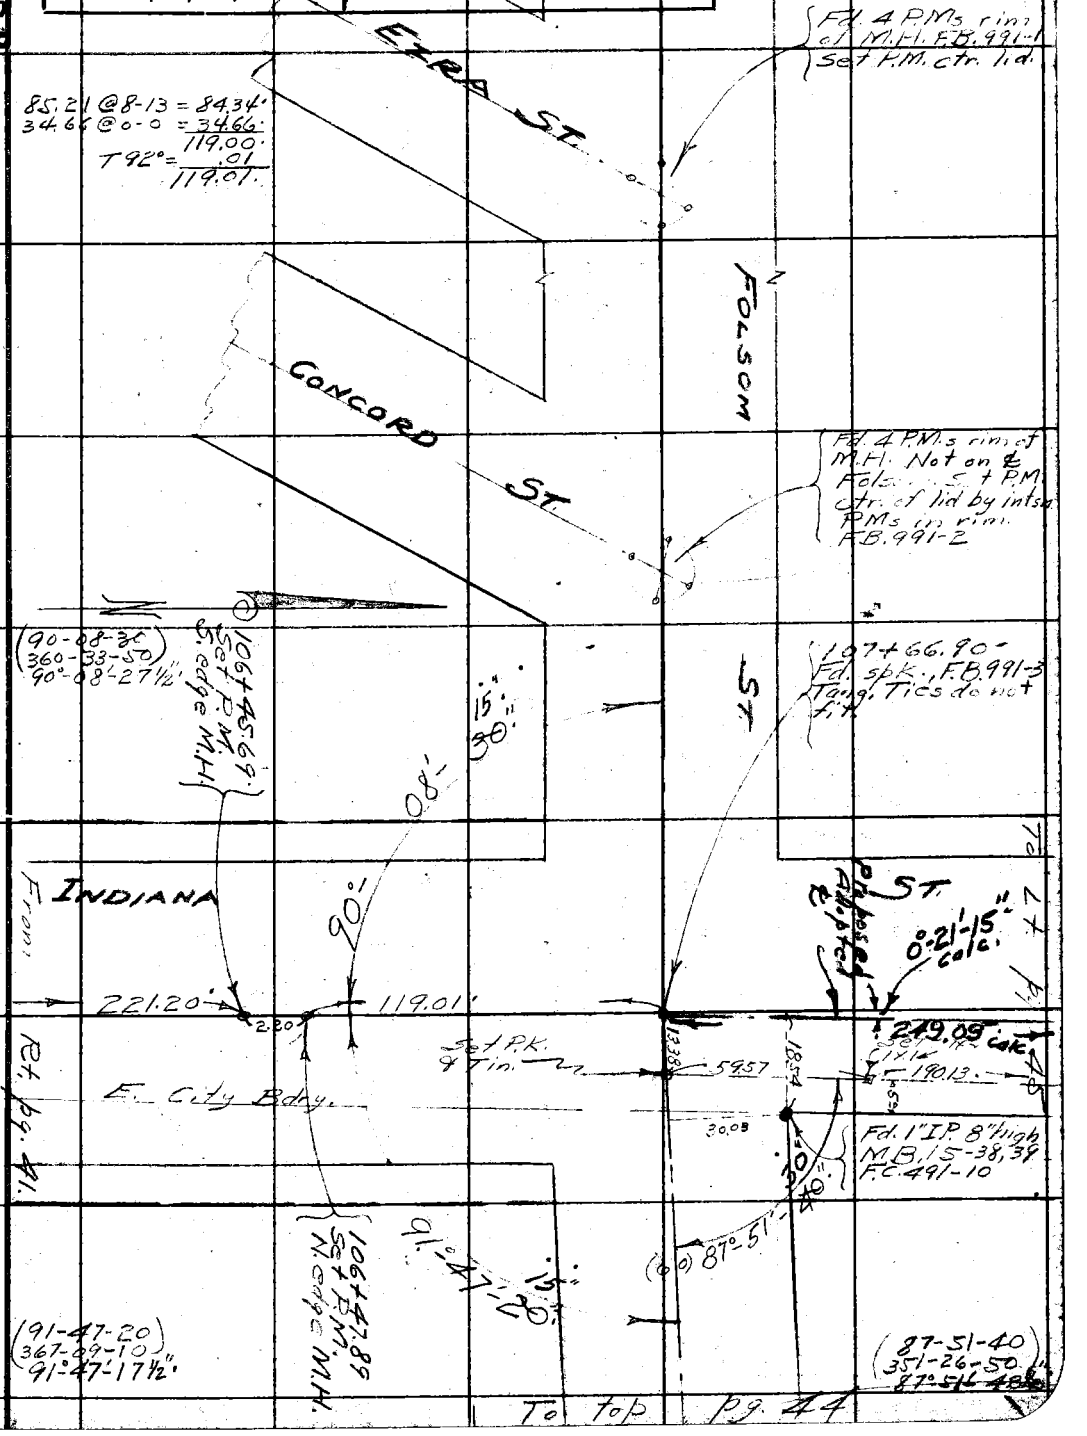

Note: Any Additions or Changes on This Sheets Must be Made or Circled in Red Ink With Date and Name of Person Making Change.

Do not extend notes this side of this line

RETURN TO
LOS ANGELES COUNTY SURVEYOR
700 HALL OF RECORDS

FORM 247 5M 10-37

RETURN TO
LOS ANGELES COUNTY SURVEYOR
700 HALL OF RECORDS

Note: Any Additions or Changes on This Sheets Must be Made or Circled in **Red Ink** With Date and Name of Person Making Change.

Do not extend notes this side of this line

WS-7-E-1

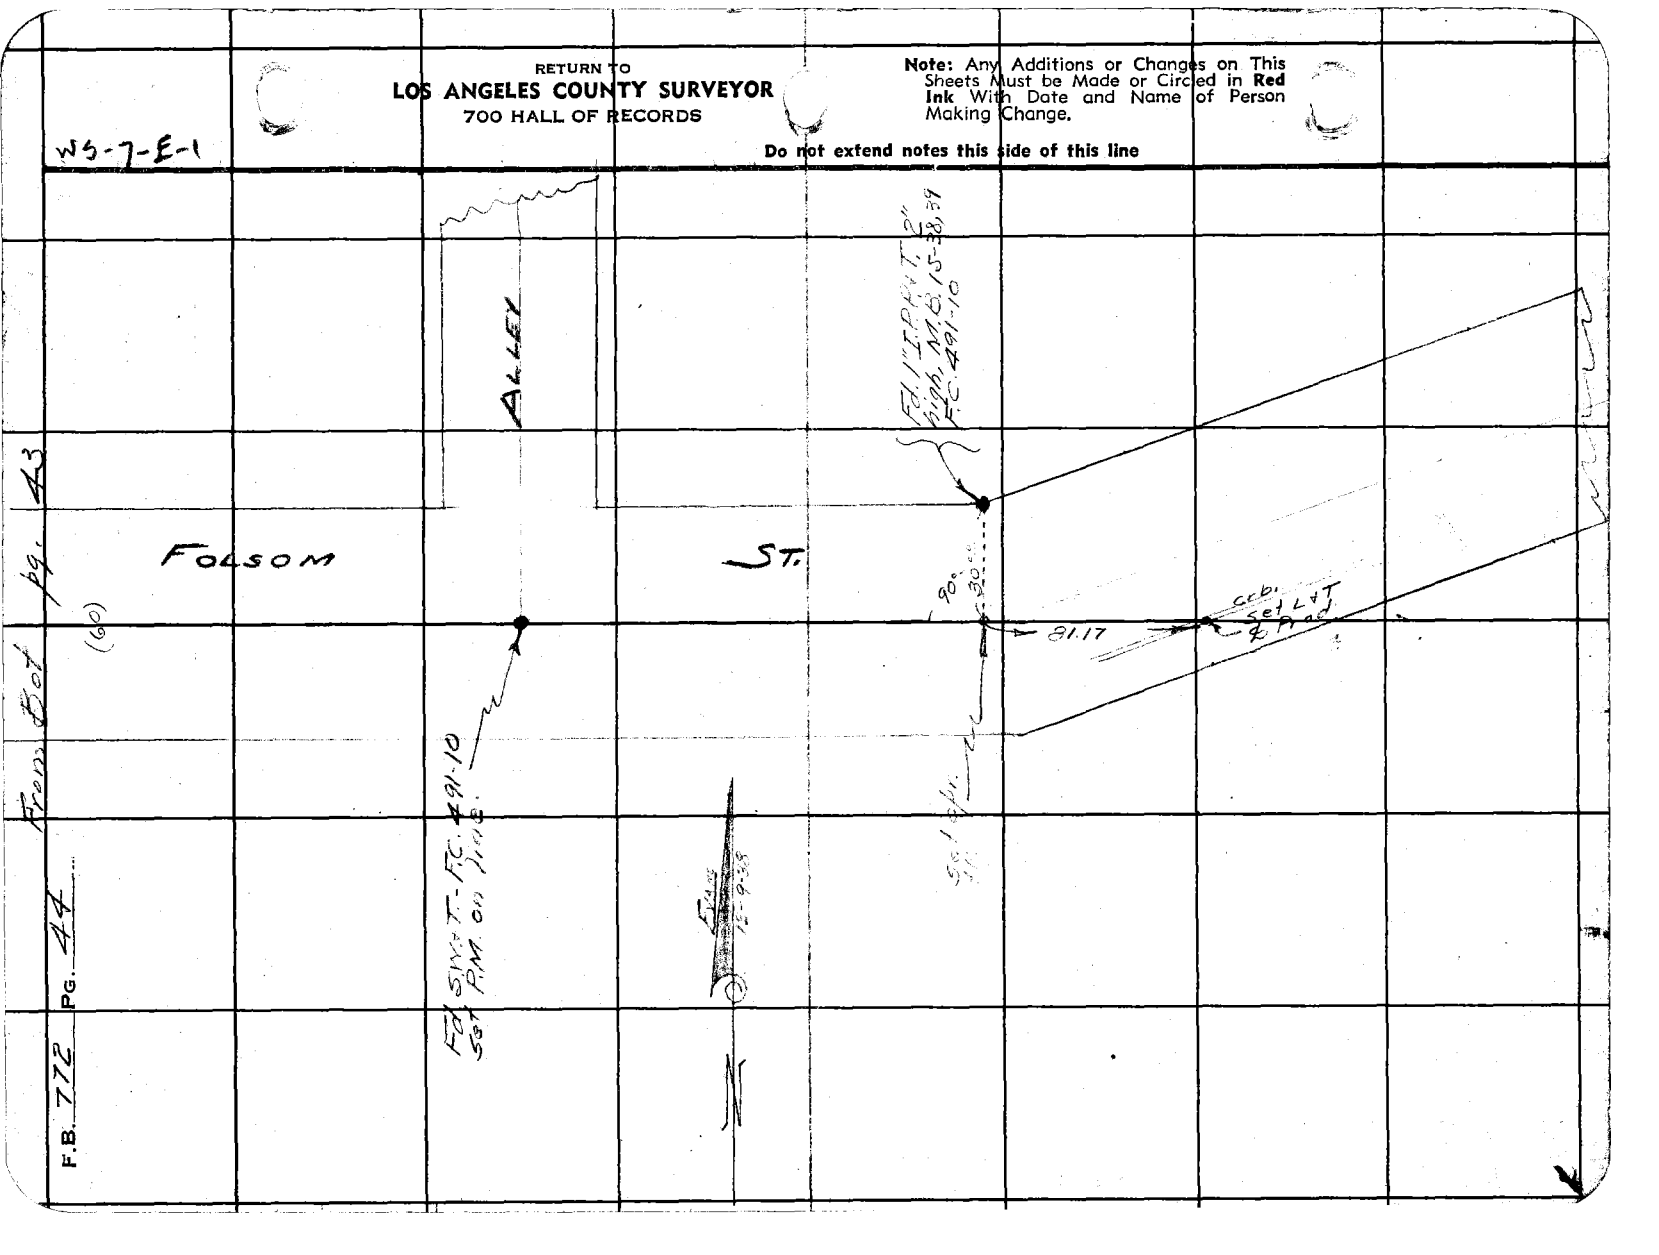


F.B. 772 PG. 44

Notes Ck'd by D. M. Finley	Survey of [illegible]	F.B. 772 Pg. 45
Map No. B-1465:3	W. O. 8226 Tape No. [illegible] Std. of	
Office Work F. A. W.	Surveyed by Evans	
Checked D. M. Finley	Notes HE Date 12-28-38	
Date Jan. 1941	Indexed	

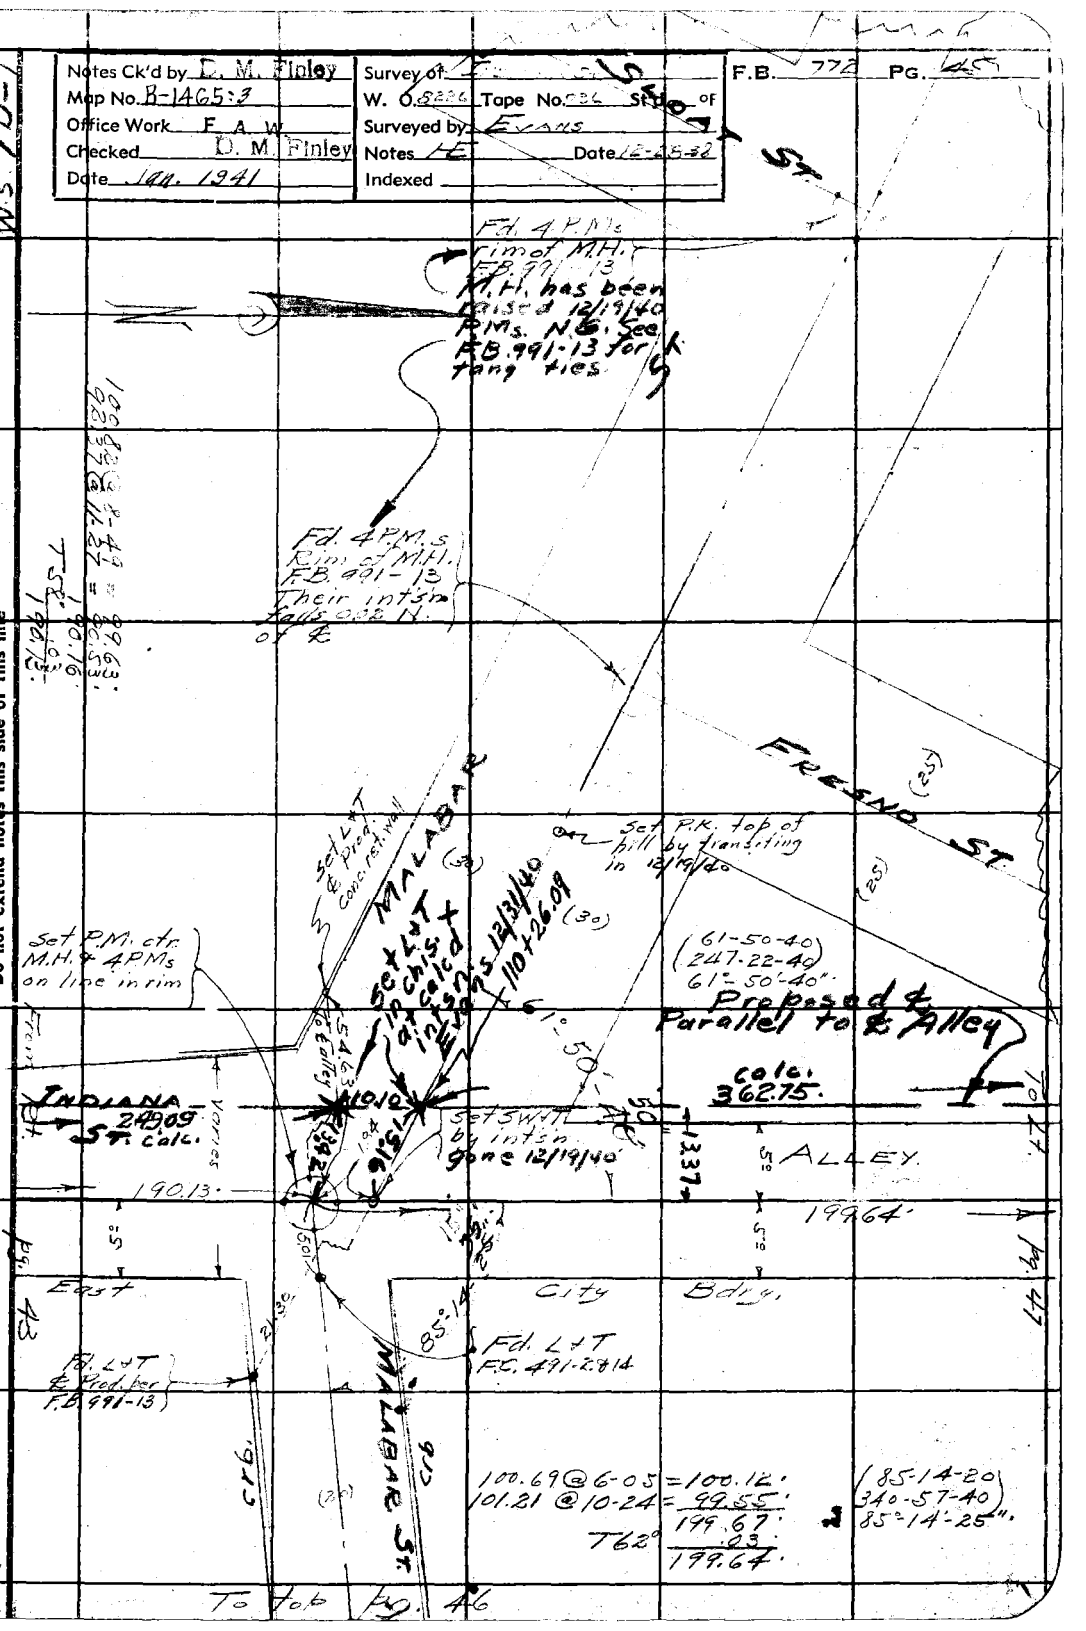

Note: Any Additions or Changes on This Sheets Must be Made or Circled in Red Ink With Date and Name of Person Making Change.

Do not extend notes this side of this line

RETURN TO
LOS ANGELES COUNTY SURVEYOR
700 HALL OF RECORDS

FORM 247 5M 10-37

RETURN TO
LOS ANGELES COUNTY SURVEYOR
700 HALL OF RECORDS

Note: Any Additions or Changes on This Sheets Must be Made or Circled in **Red Ink** With Date and Name of Person Making Change.

Do not extend notes this side of this line

W.S. 70-1

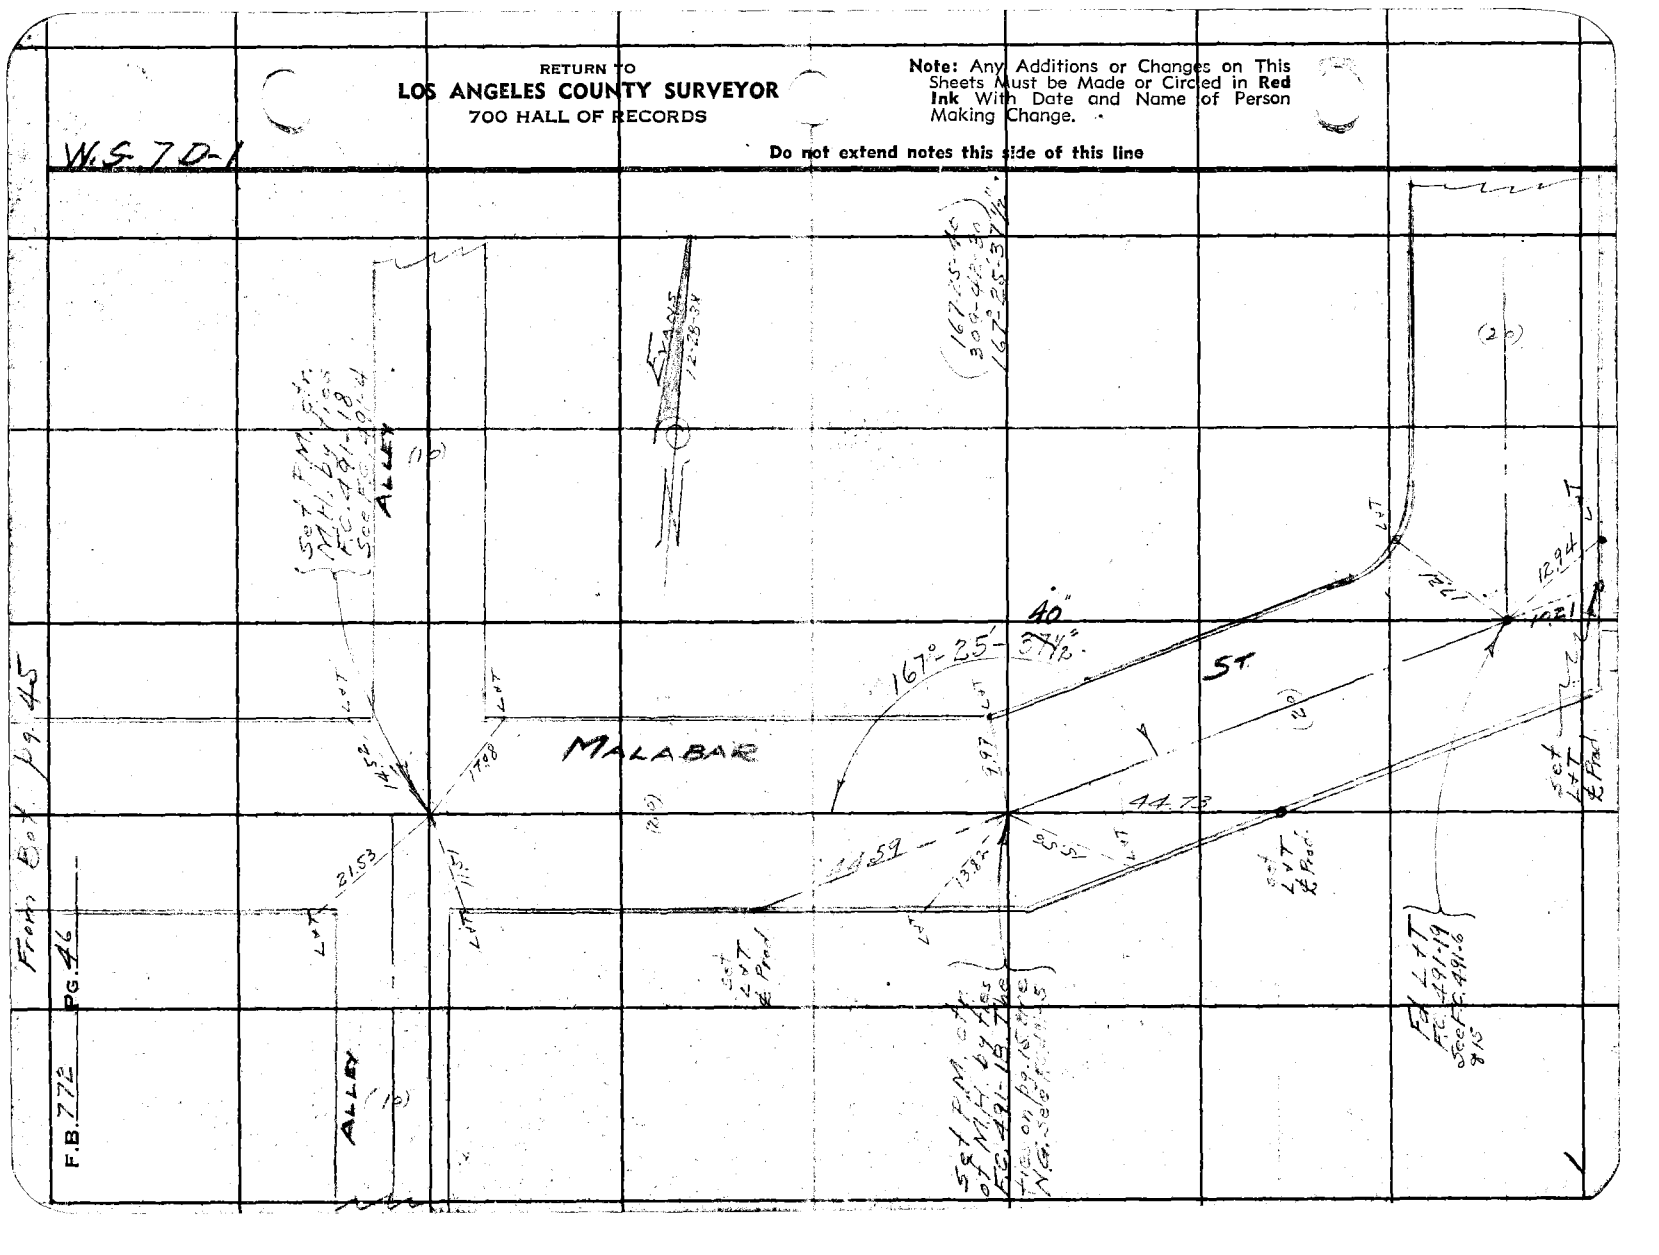

Notes Ck'd by D. M. Finley	Survey of INDIANA ST	F.B. 72 Pg. 47
Map No. B-1465-3	W. O. 8226 Tape No. 036 St'd 84 of	
Office Work F. A. W.	Surveyed by EVANS	
Checked D. M. Finley	Notes HE Date 12-28-38	
Date Jan. 1941.	Indexed	

WS 7-D-1

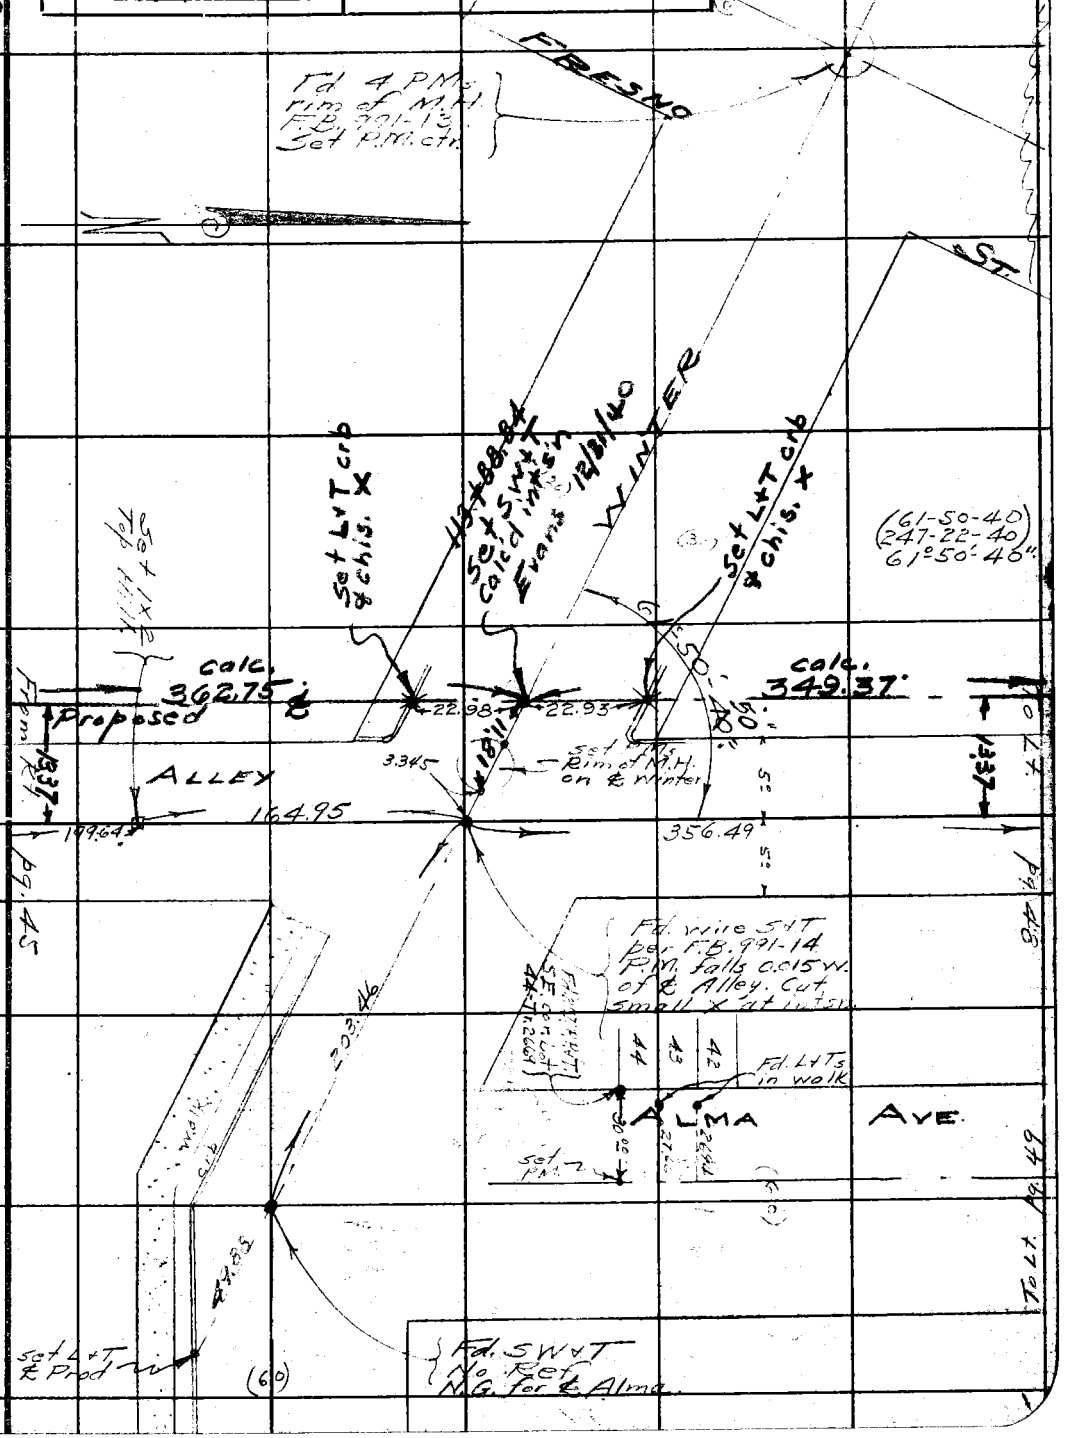

Note: Any Additions or Changes on This Sheets Must be Made or Circled in Red Ink With Date and Name of Person Making Change.

Do not extend notes this side of this line

RETURN TO
LOS ANGELES COUNTY SURVEYOR
700 HALL OF RECORDS

FORM 247 5M 10-37

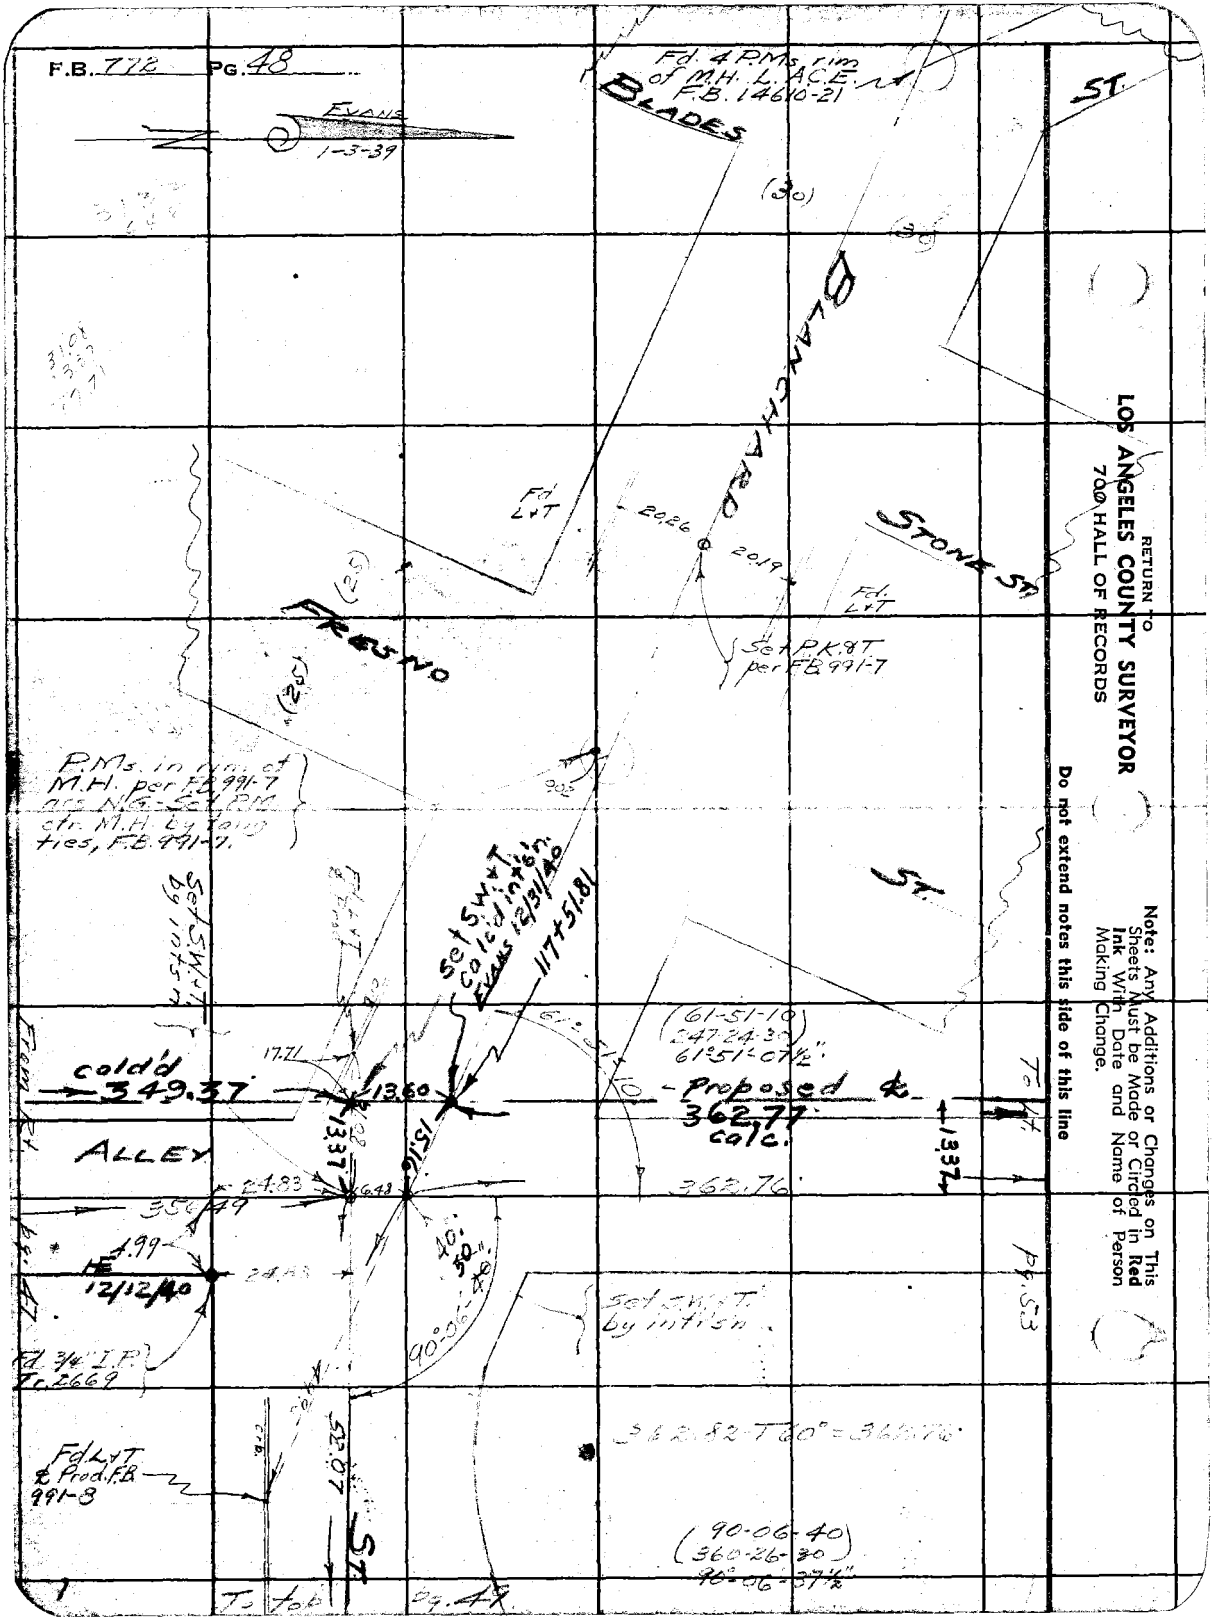

RETURN TO
LOS ANGELES COUNTY SURVEYOR
700 HALL OF RECORDS

Note: Any Additions or Changes on This Sheets Must be Made or Circled in Red Ink With Date and Name of Person Making Change.

Do not extend notes this side of this line

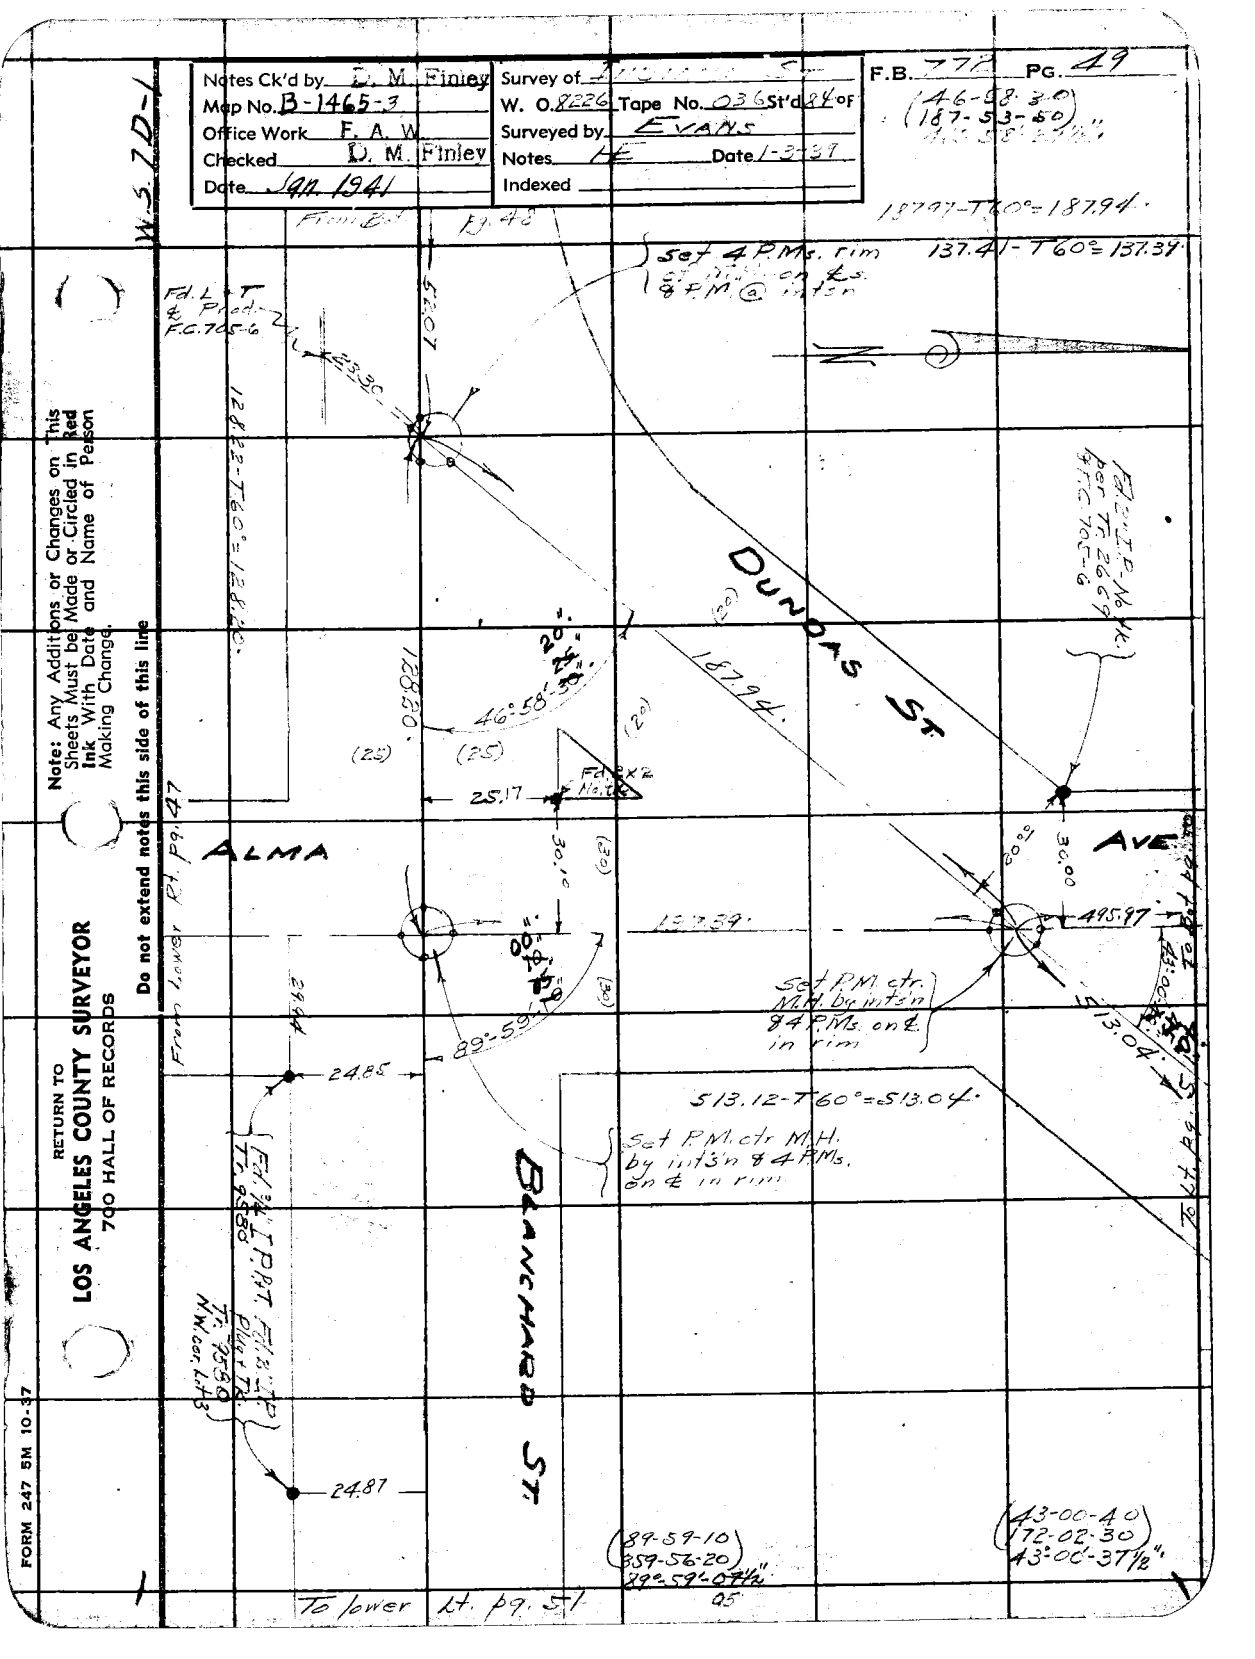

Note: Any Additions or Changes on This Sheets Must be Made or Circled in Red Ink With Date and Name of Person Making Change.

Do not extend notes this side of this line

RETURN TO
LOS ANGELES COUNTY SURVEYOR
700 HALL OF RECORDS

FORM 247 5M 10-37

RETURN TO
LOS ANGELES COUNTY SURVEYOR
700 HALL OF RECORDS

Note: Any Additions or Changes on This Sheets Must be Made or Circled in **Red Ink** With Date and Name of Person Making Change.

Do not extend notes this side of this line

WS 7-D-1

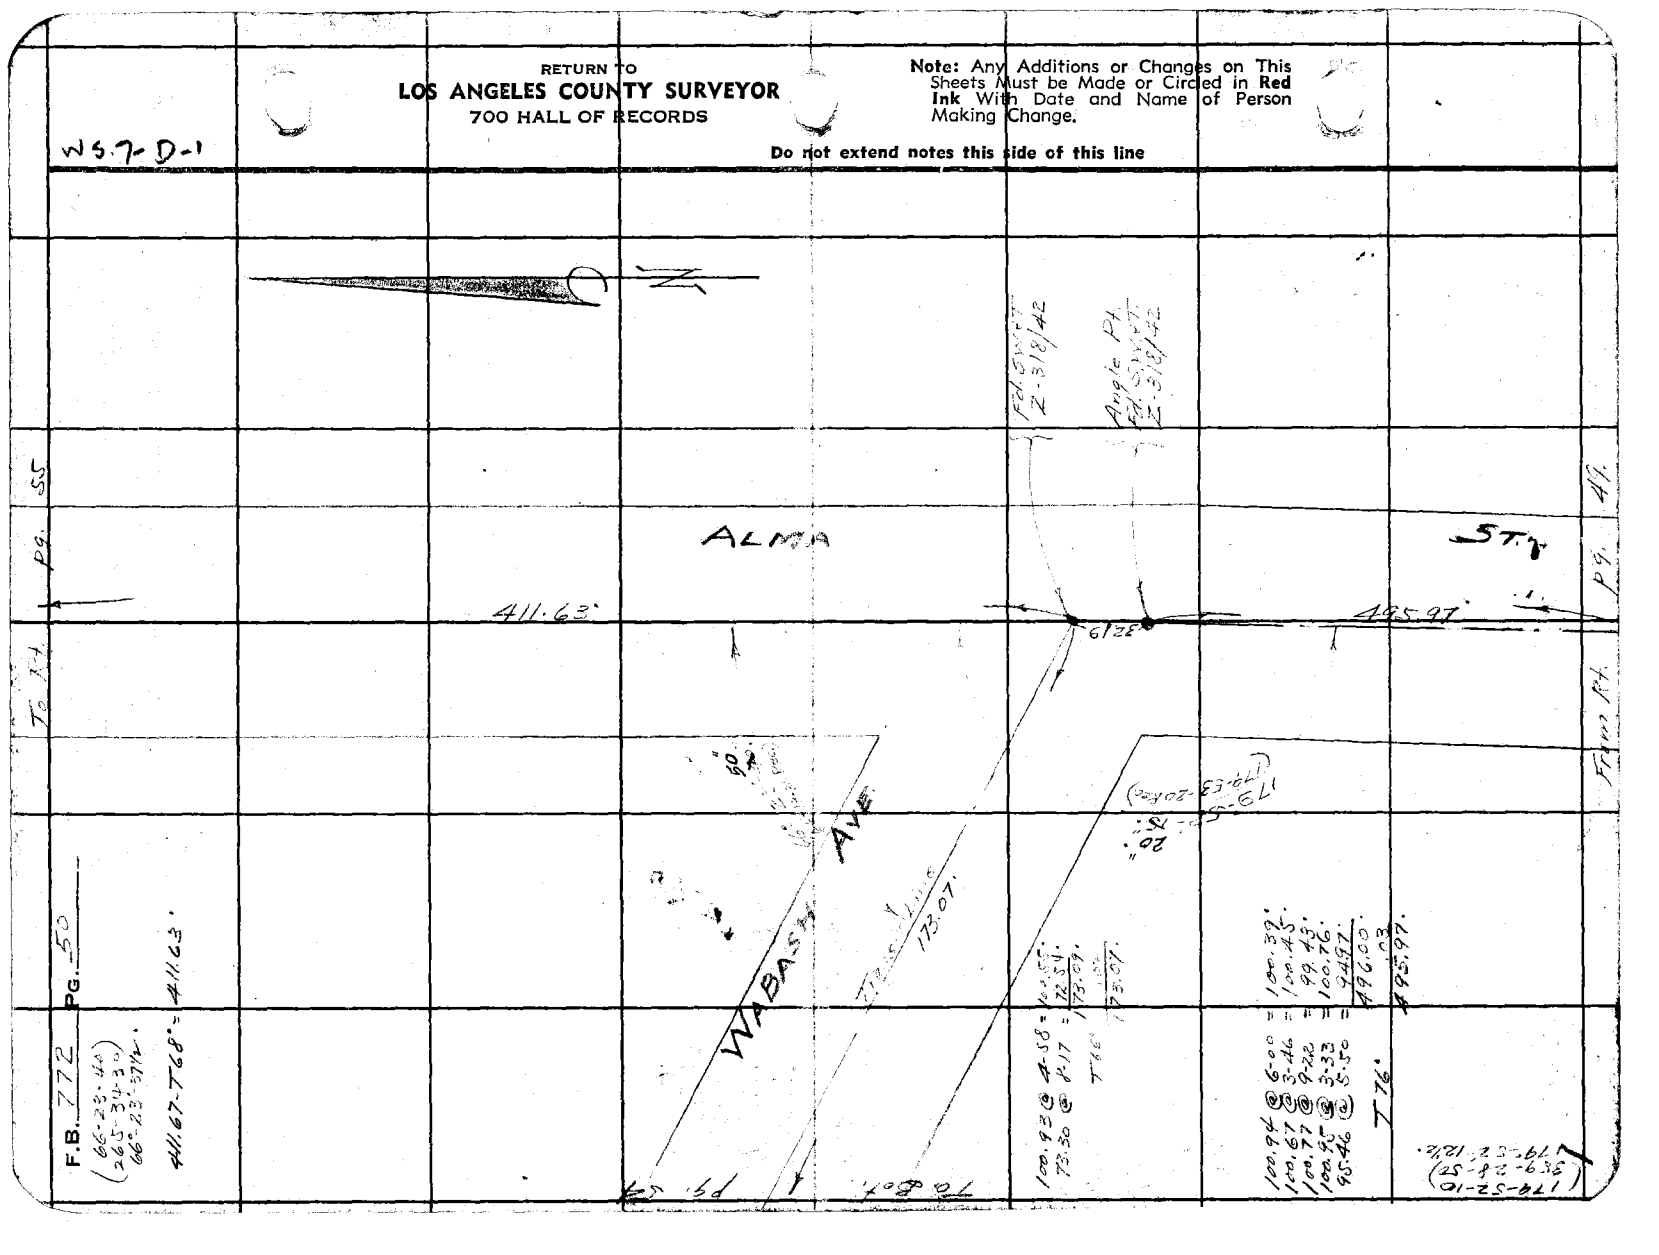

Notes Ck'd by D. M. Finley	Survey of INDIANA ST	F.B. 772 PG. 51
Map No. B-1465-3	W. O. 8226 Tape No. 936 Sta. 8	
Office Work F. A. W.	Surveyed by EVANS	
Checked D. M. Finley	Notes AE Date 1-4-39	
Date Jan. 1941	Indexed	

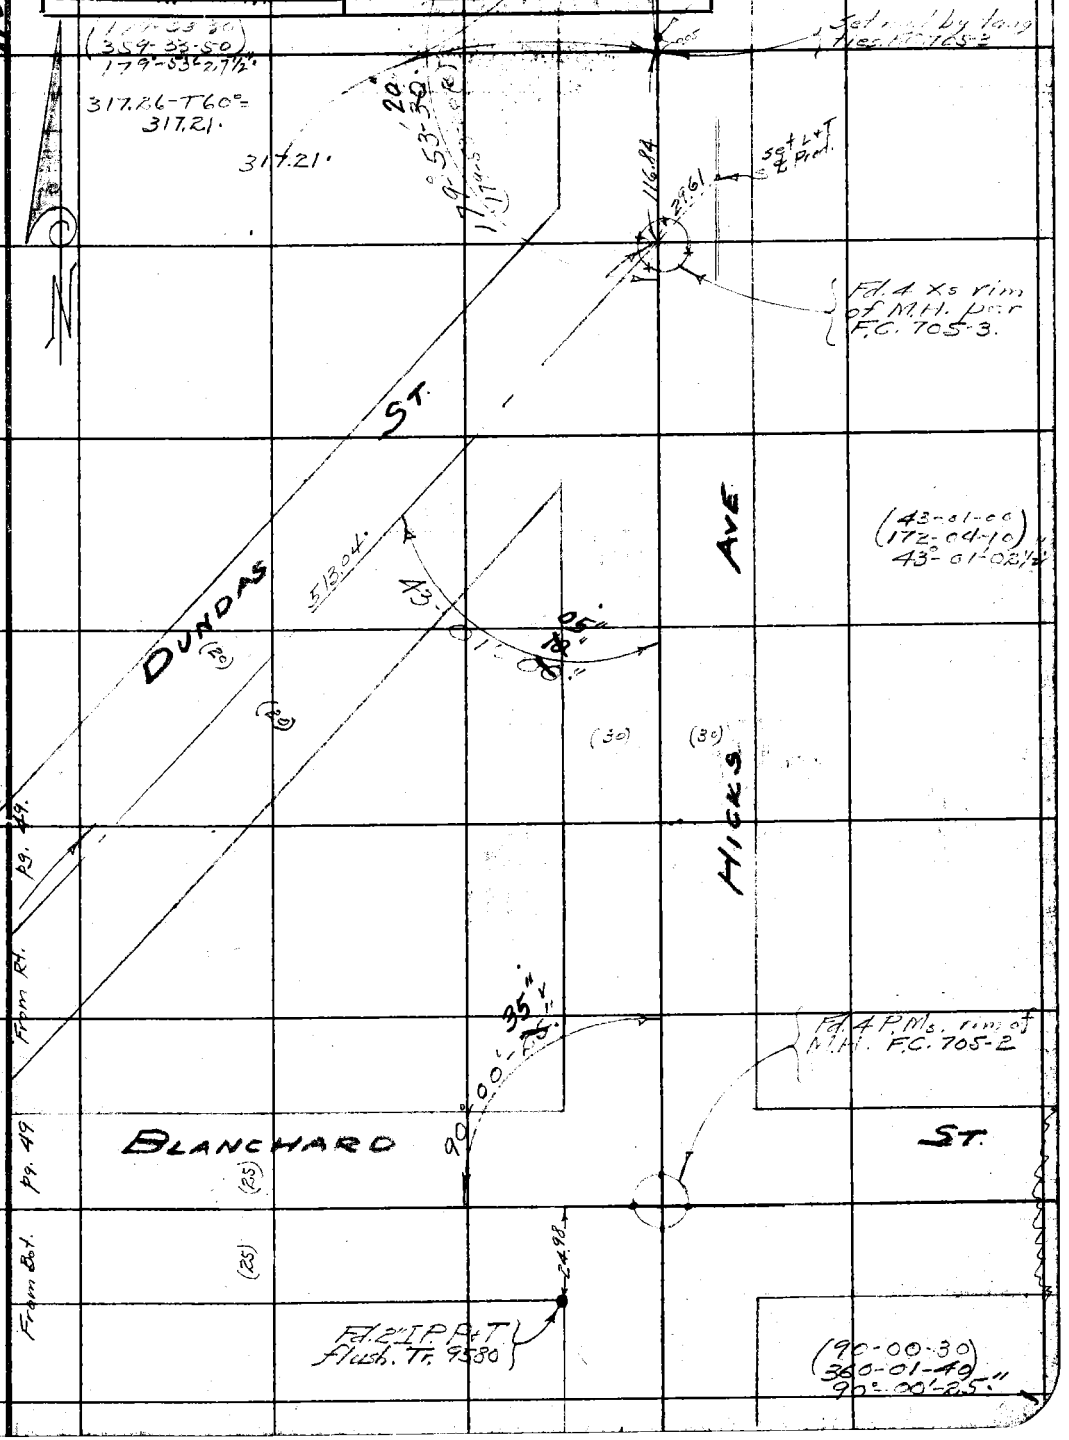

Note: Any Additions or Changes on This Sheets Must be Made or Circled in Red Ink With Date and Name of Person Making Change.

Do not extend notes this side of this line

RETURN TO
LOS ANGELES COUNTY SURVEYOR
700 HALL OF RECORDS

FORM 247 5M 10-37

RETURN TO
LOS ANGELES COUNTY SURVEYOR
700 HALL OF RECORDS

Note: Any Additions or Changes on This Sheets Must be Made or Circled in **Red Ink** With Date and Name of Person Making Change.

Do not extend notes this side of this line

F.B. 772 PG. 52

Notes Ck'd by D. M. Finley	Survey of INDIANA ST
Map No. B-1465-3	W. O. 9286 Tape No. 936 St'd 34 °F.
Office Work F. A. W.	Surveyed by EVANS
Checked D. M. Finley	Notes HE Date 1-16-39
Date Jan. 1941	Indexed

F.B. 114 Pg. 50

Note: Any Additions or Changes on This Sheet Must be Made or Circled in Red Ink With Date and Name of Person Making Change.

Do not extend notes this side of this line

RETURN TO
LOS ANGELES COUNTY SURVEYOR
700 HALL OF RECORDS

FORM 247 10M 11-35

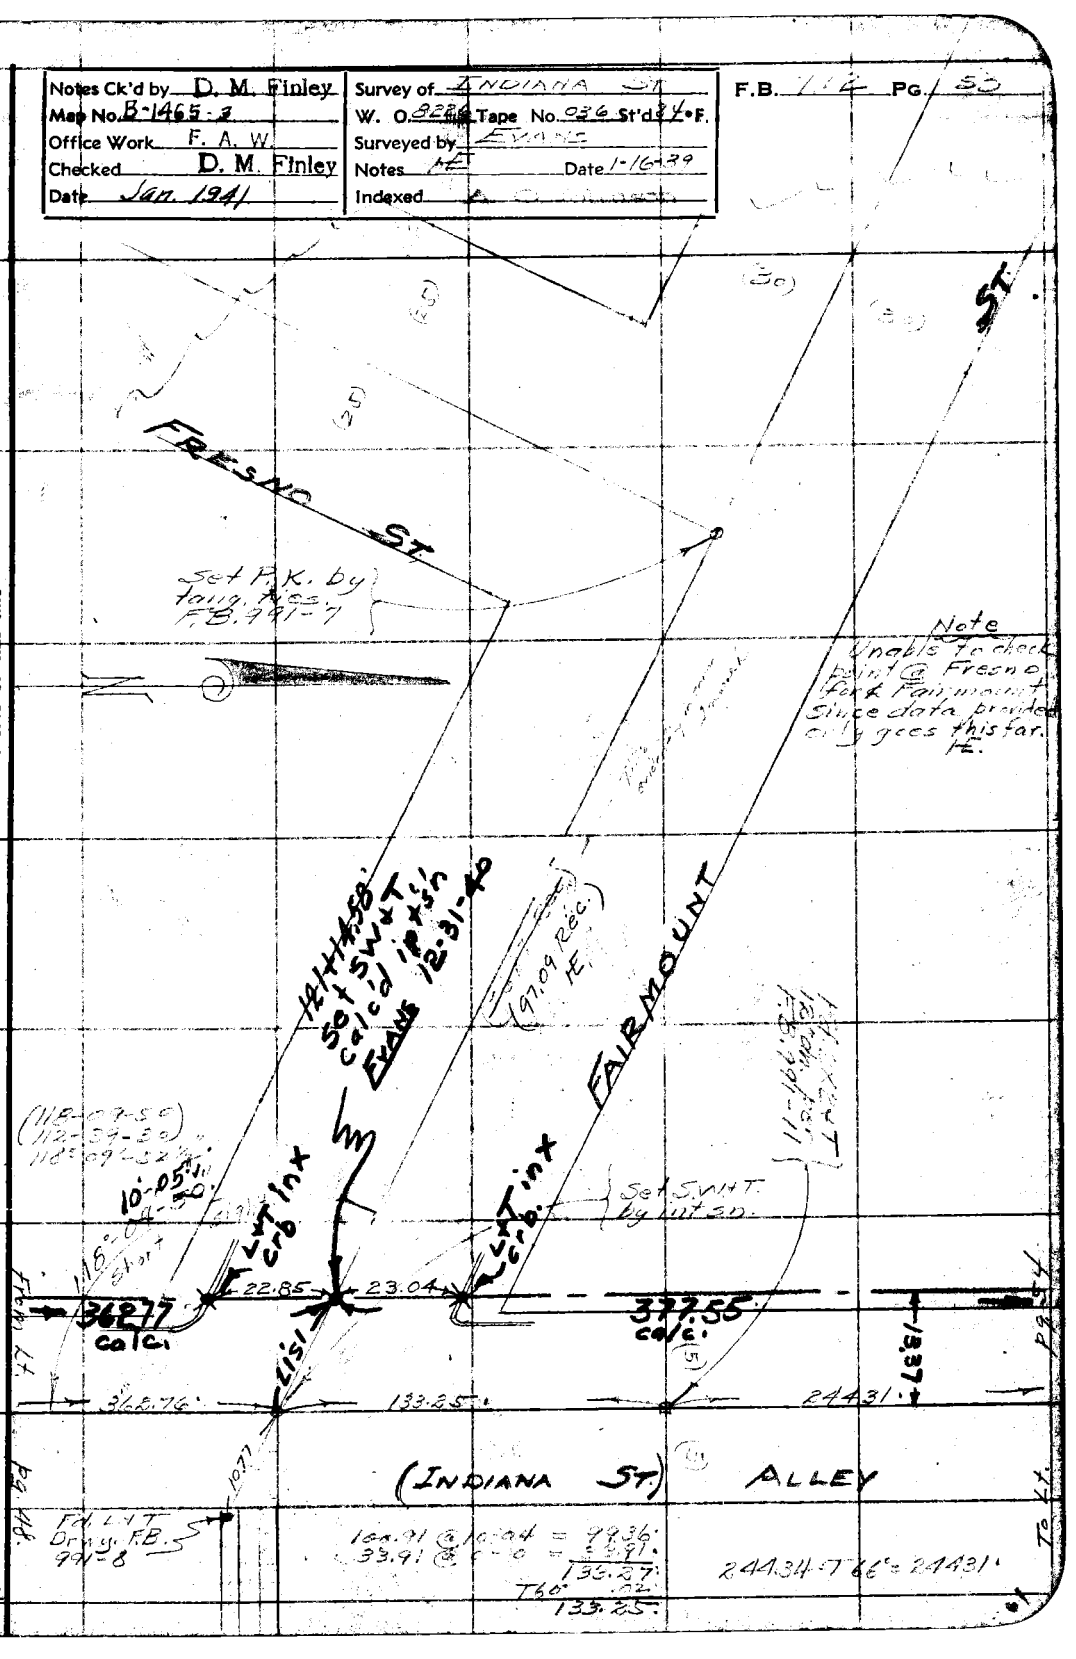

RETURN TO
LOS ANGELES COUNTY SURVEYOR
700 HALL OF RECORDS

Note: Any Additions or Changes on This Sheet Must be Made or Circled in Red Ink With Date and Name of Person Making Change.

Do not extend notes this side of this line

W.S. 70-1

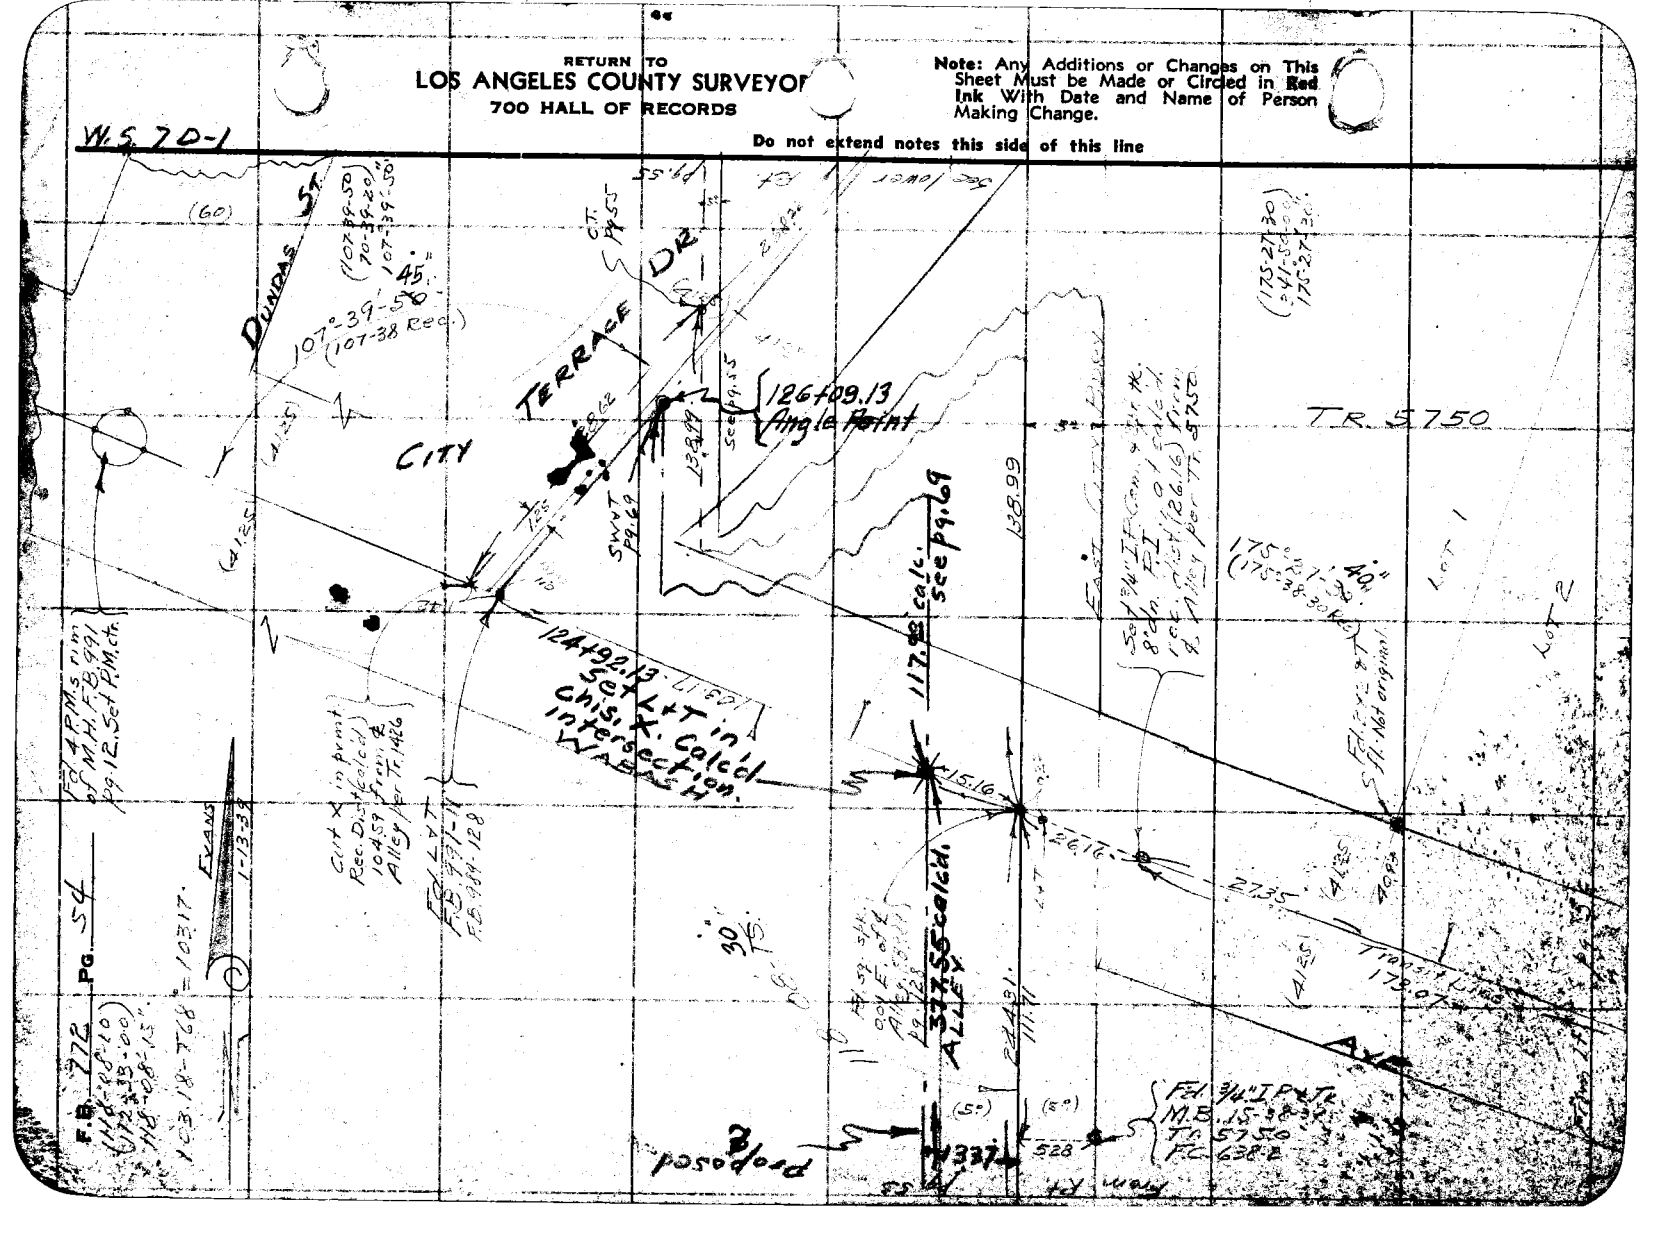

Notes Ck'd by D. M. Finley	Survey of INDIANA ST.
Map No. B-1465-3	W. O. 8226 Tape No. 036 St'd 84°F.
Office Work F. A. W.	Surveyed by EVANS
Checked D. M. Finley	Notes HE Date 1-16-39
Date Jan 1941	Indexed

F.B. 772 PG. 55

421.82 - T 72° = 421.79

(115-14-00)
115°-14'-05"

(62-15-40)
(249-02-30)
62°-15'-37½"

W.S. 70-1

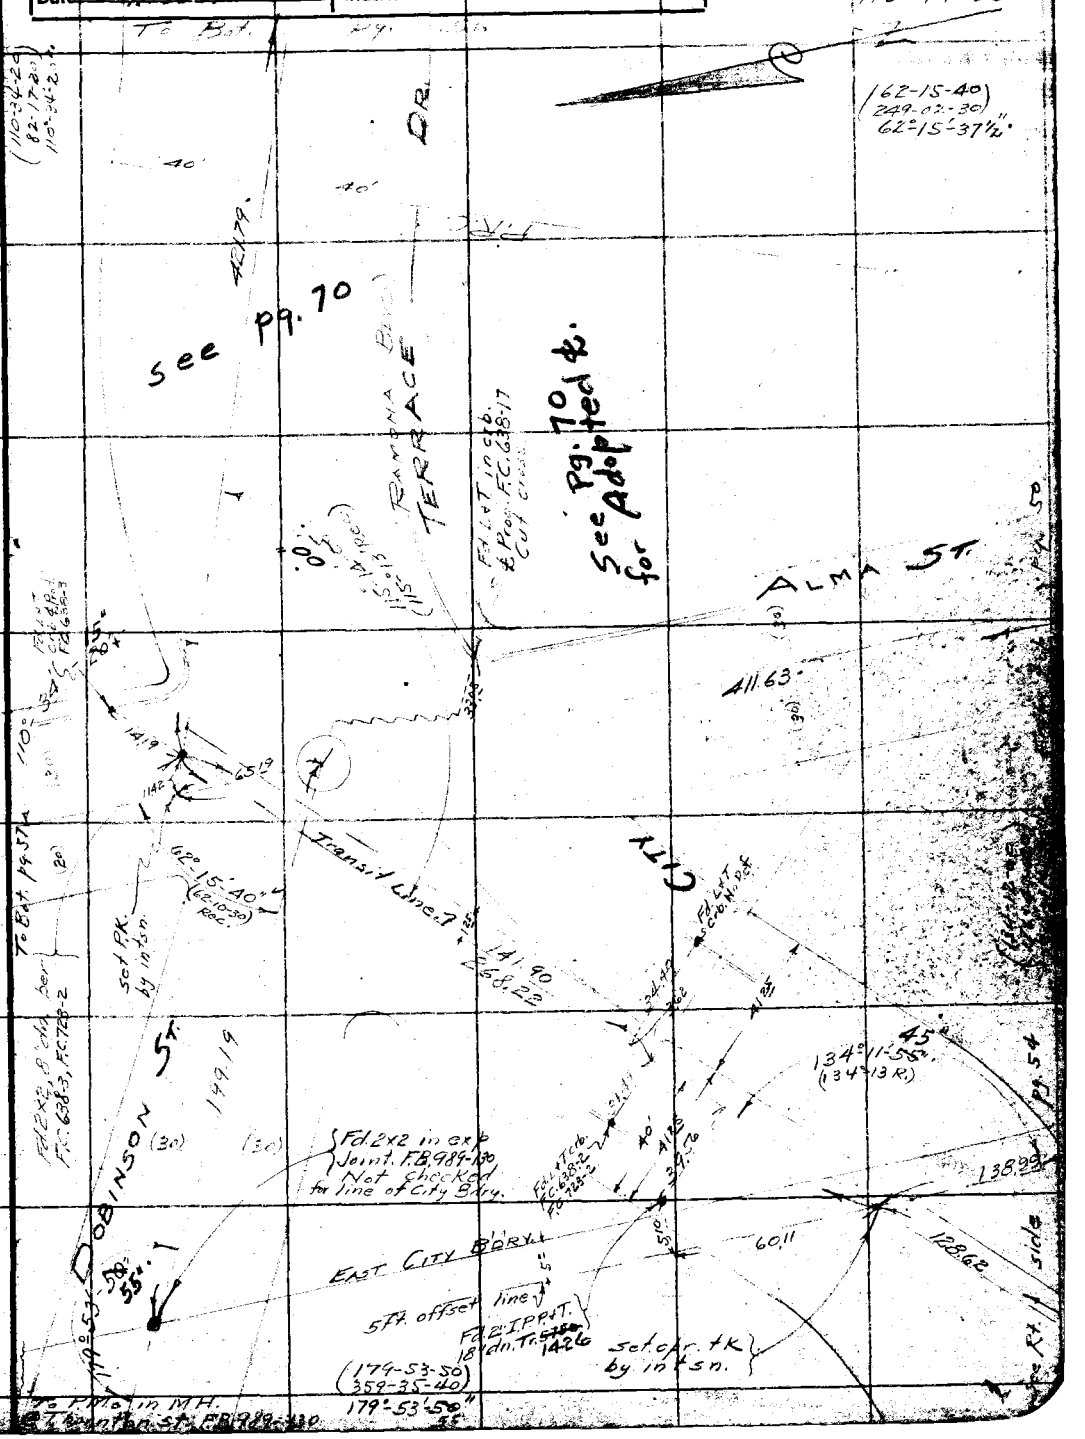

Note: Any Additions or Changes on This Sheet Must be Made or Circled in Red Ink With Date and Name of Person Making Change.

Do not extend notes this side of this line

RETURN TO
LOS ANGELES COUNTY SURVEYOR
700 HALL OF RECORDS

FORM 247 10M 11-35

RETURN TO
LOS ANGELES COUNTY SURVEYOR
700 HALL OF RECORDS

Note: Any Additions or Changes on This Sheet Must be Made or Circled in Red Ink With Date and Name of Person Making Change.

W&S. 7D-1

Do not extend notes this side of this line

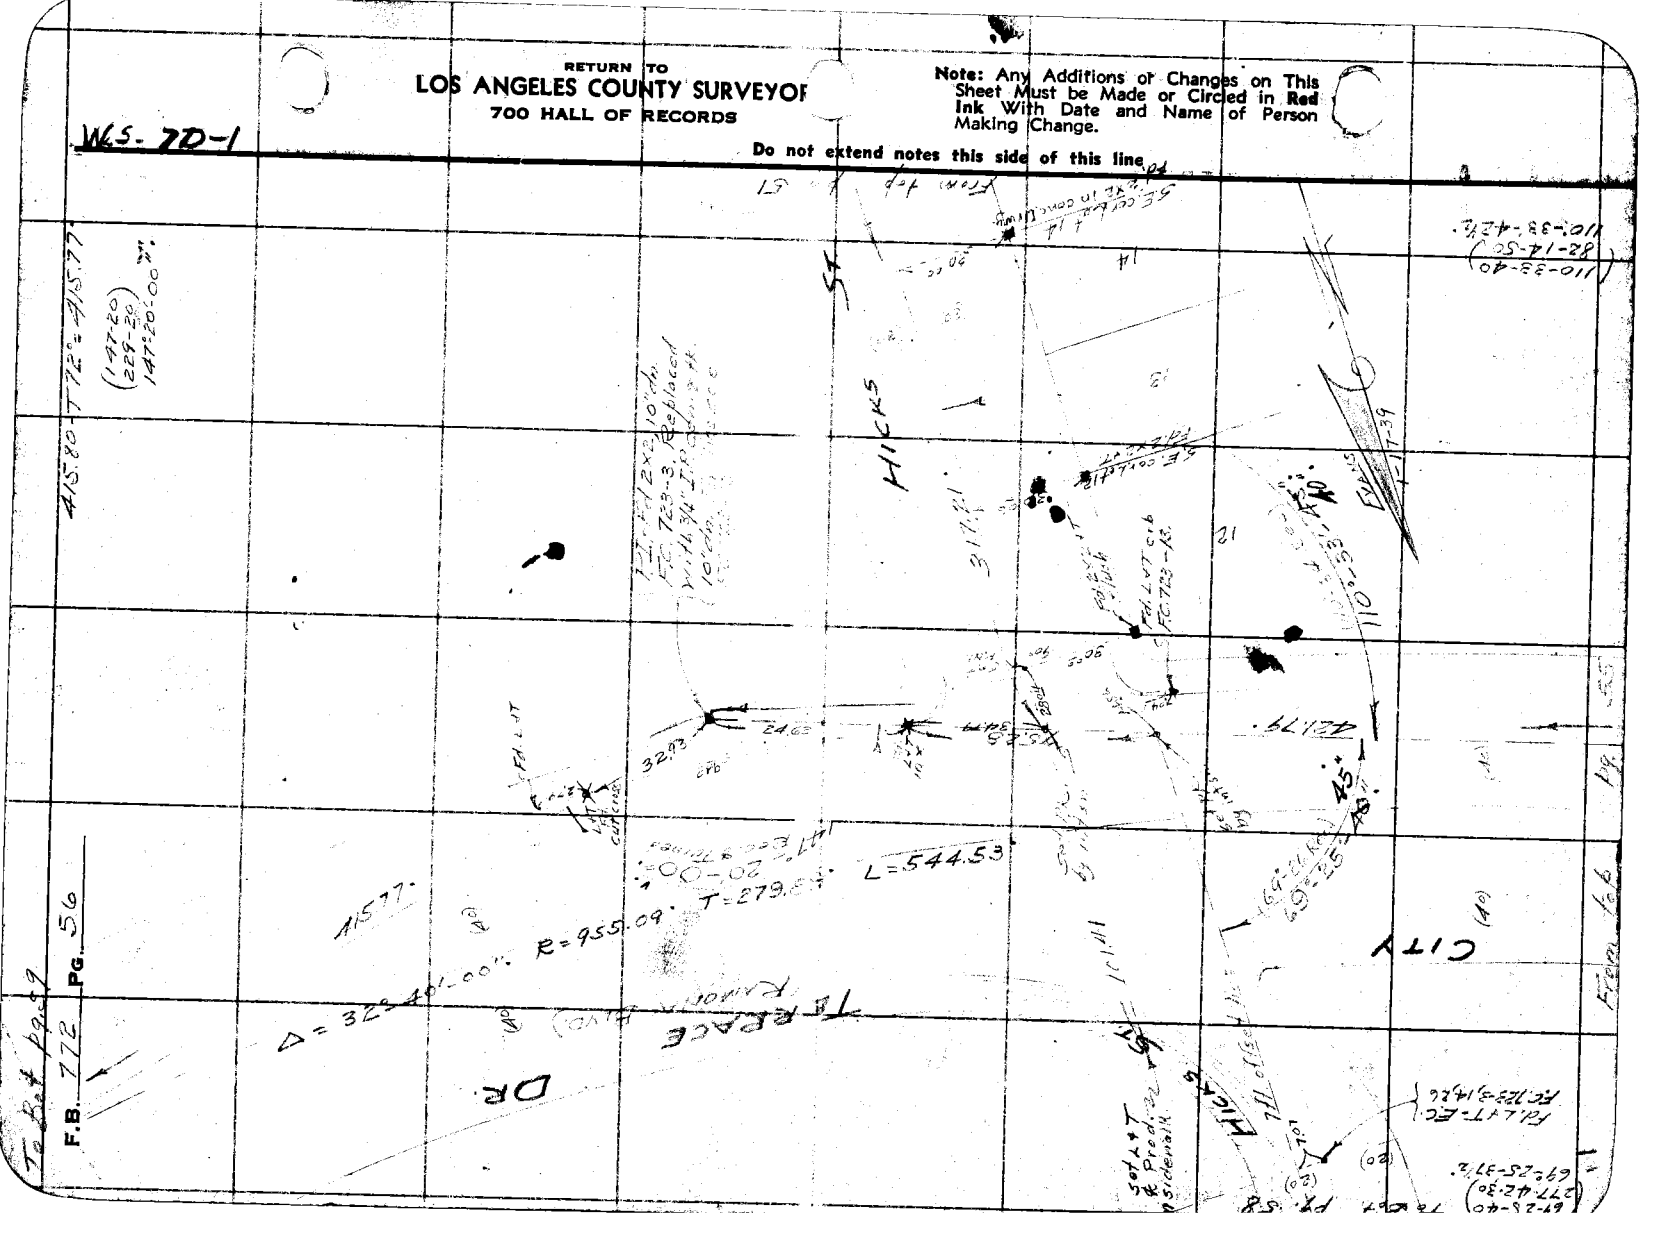

FORM 247 10M 5-31

RETURN TO

LOS ANGELES COUNTY SURVEYOR

700 HALL OF RECORDS

Note: ANY ADDITIONS OR CHANGES ON THIS SHEET MUST BE MADE OR CIRCLED IN **Red Ink.** WITH DATE AND NAME OF PERSON MAKING CHANGE.

Do not extend notes this side of this line

WS.7-D-1

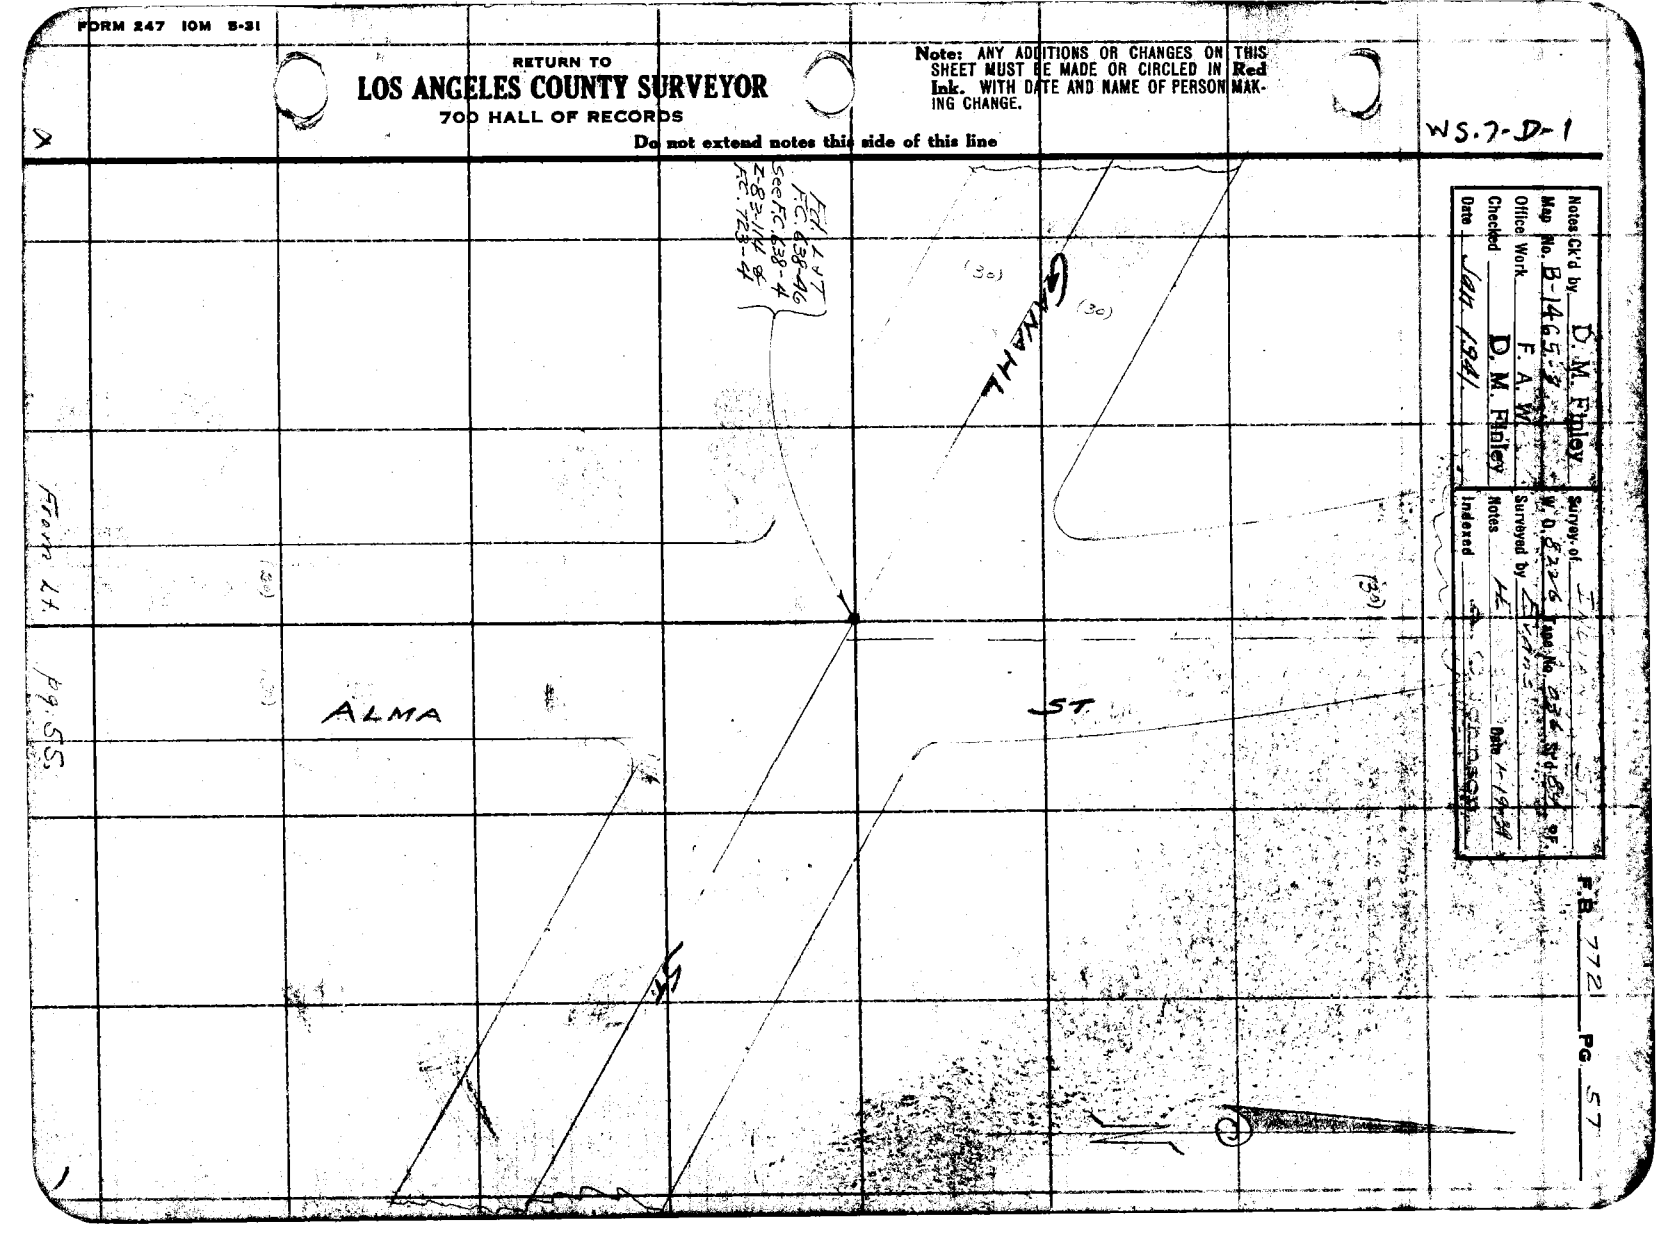

F.B. 772 PG. 58

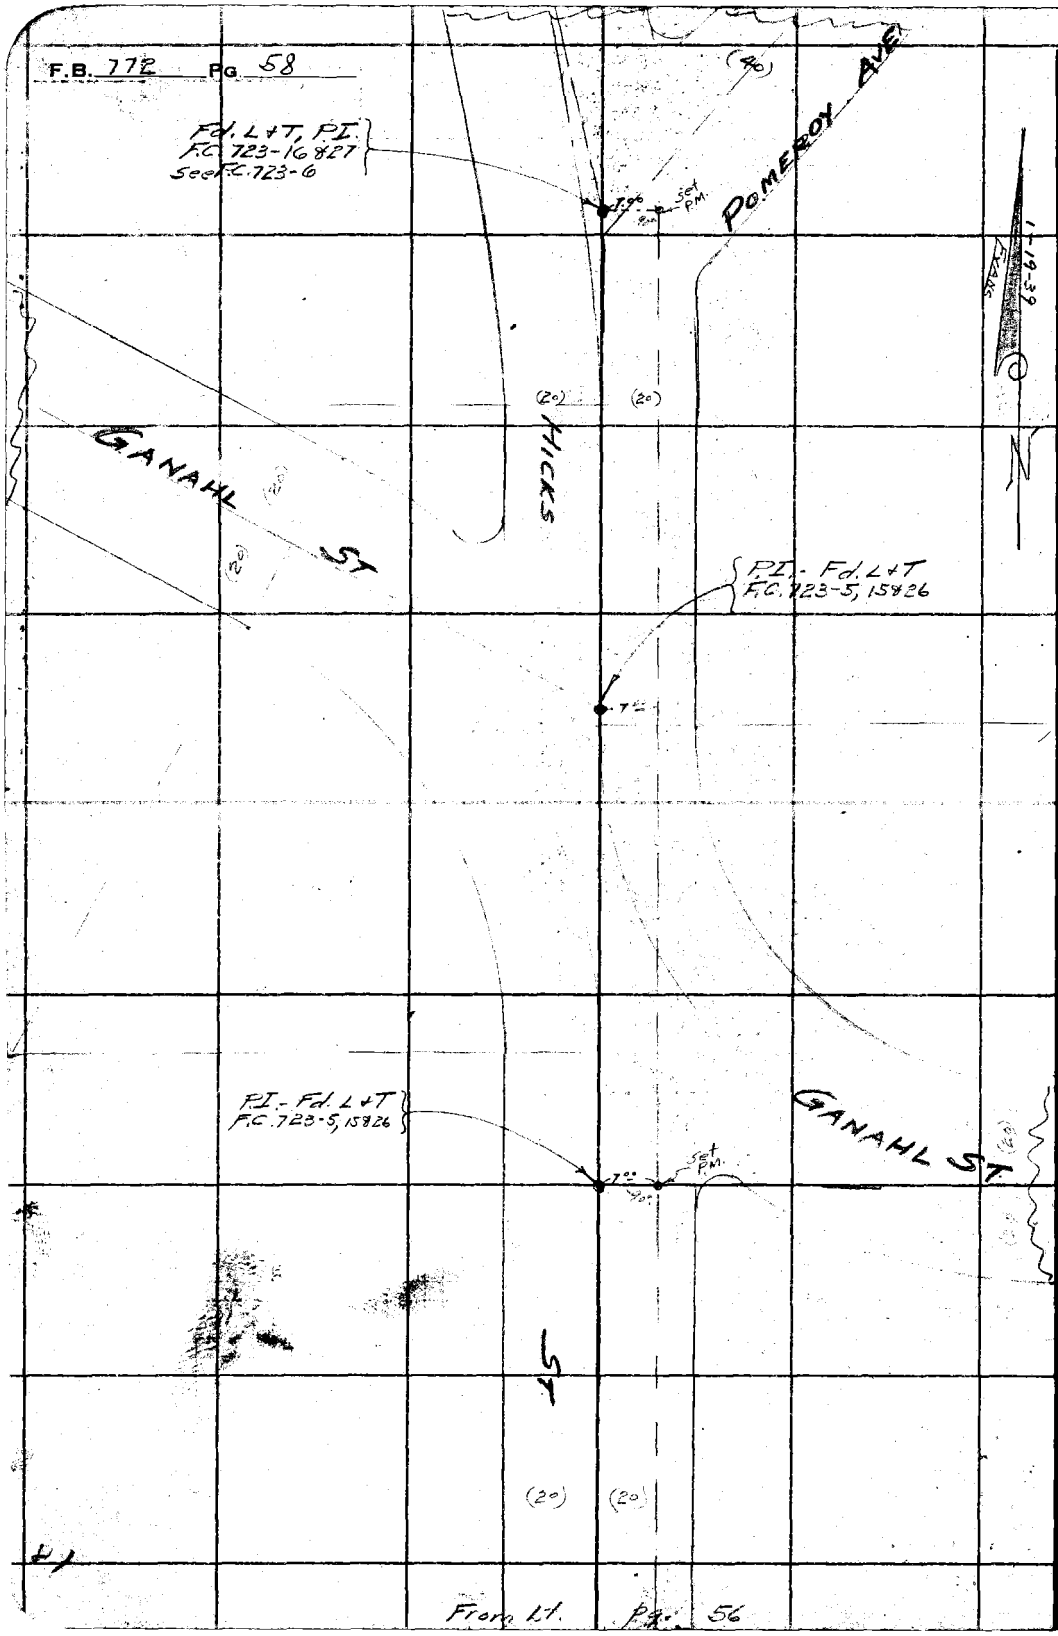

WS-7-D-1

1-19-39

RETURN TO
LOS ANGELES COUNTY SURVEYOR
700 HALL OF RECORDS

Do not extend notes this side of this line

Note: ANY ADDITIONS OR CHANGES ON THIS SHEET MUST BE MADE OR CIRCLED IN Red Ink. WITH DATE AND NAME OF PERSON MAKING CHANGE.

From Lt. Pg. 56

Note: ANY ADDITIONS OR CHANGES ON THIS SHEET MUST BE MADE OR CIRCLED IN Red Ink. WITH DATE AND NAME OF PERSON MAKING CHANGE.

Do not extend notes this side of this line

RETURN TO
LOS ANGELES COUNTY SURVEYOR
700 HALL OF RECORDS

FORM 247 10M 5-31

Ck'd by D. M. Finley	Survey of Indiana St.
No. B-1485-3	W. O. 8226 Tape No. 036
Office Work F. A. W.	Surveyed by Evans
Checked D. M. Finley	Notes ... Date 1-18-39
Date Jan. 1941	Indexed A. C. Johnson

F.B. 772 Pg. 57

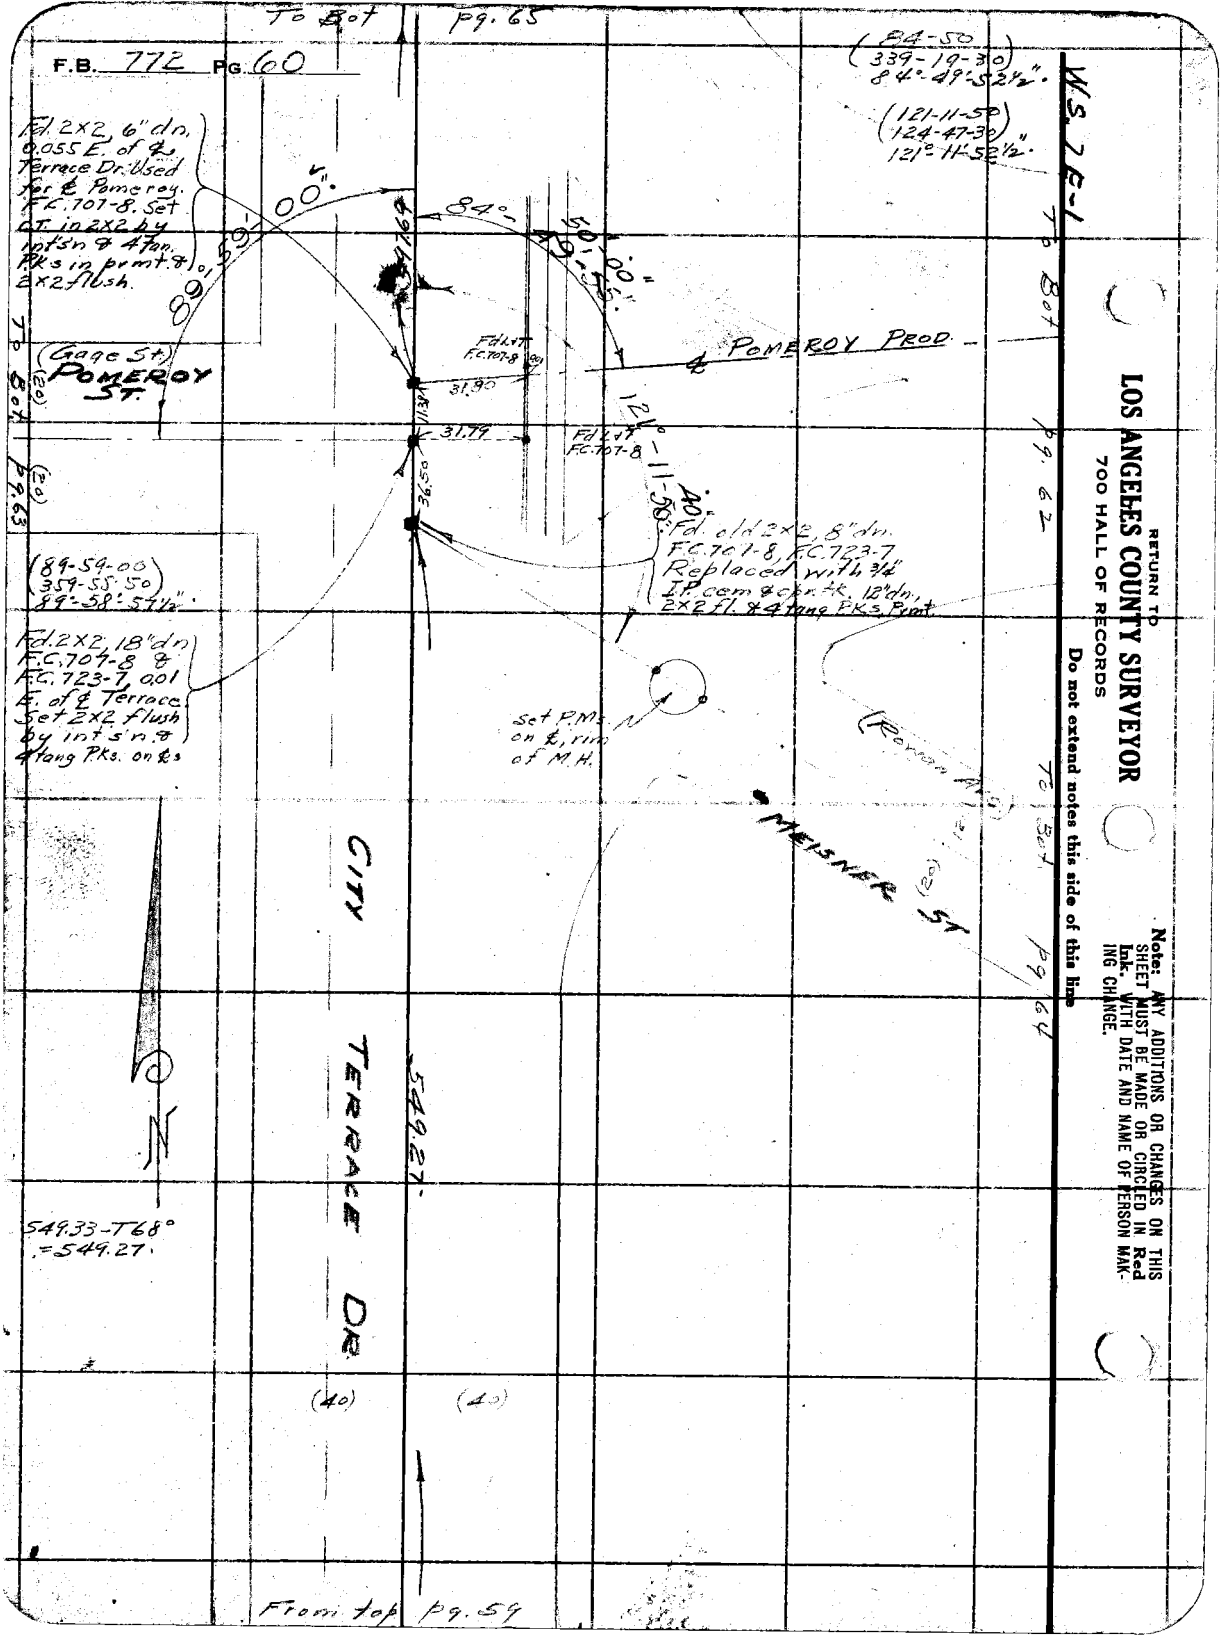

RETURN TO
LOS ANGELES COUNTY SURVEYOR
700 HALL OF RECORDS

Do not extend notes this side of this line

Note: ANY ADDITIONS OR CHANGES ON THIS SHEET MUST BE MADE OR CIRCLED IN Red Ink. WITH DATE AND NAME OF PERSON MAKING CHANGE.

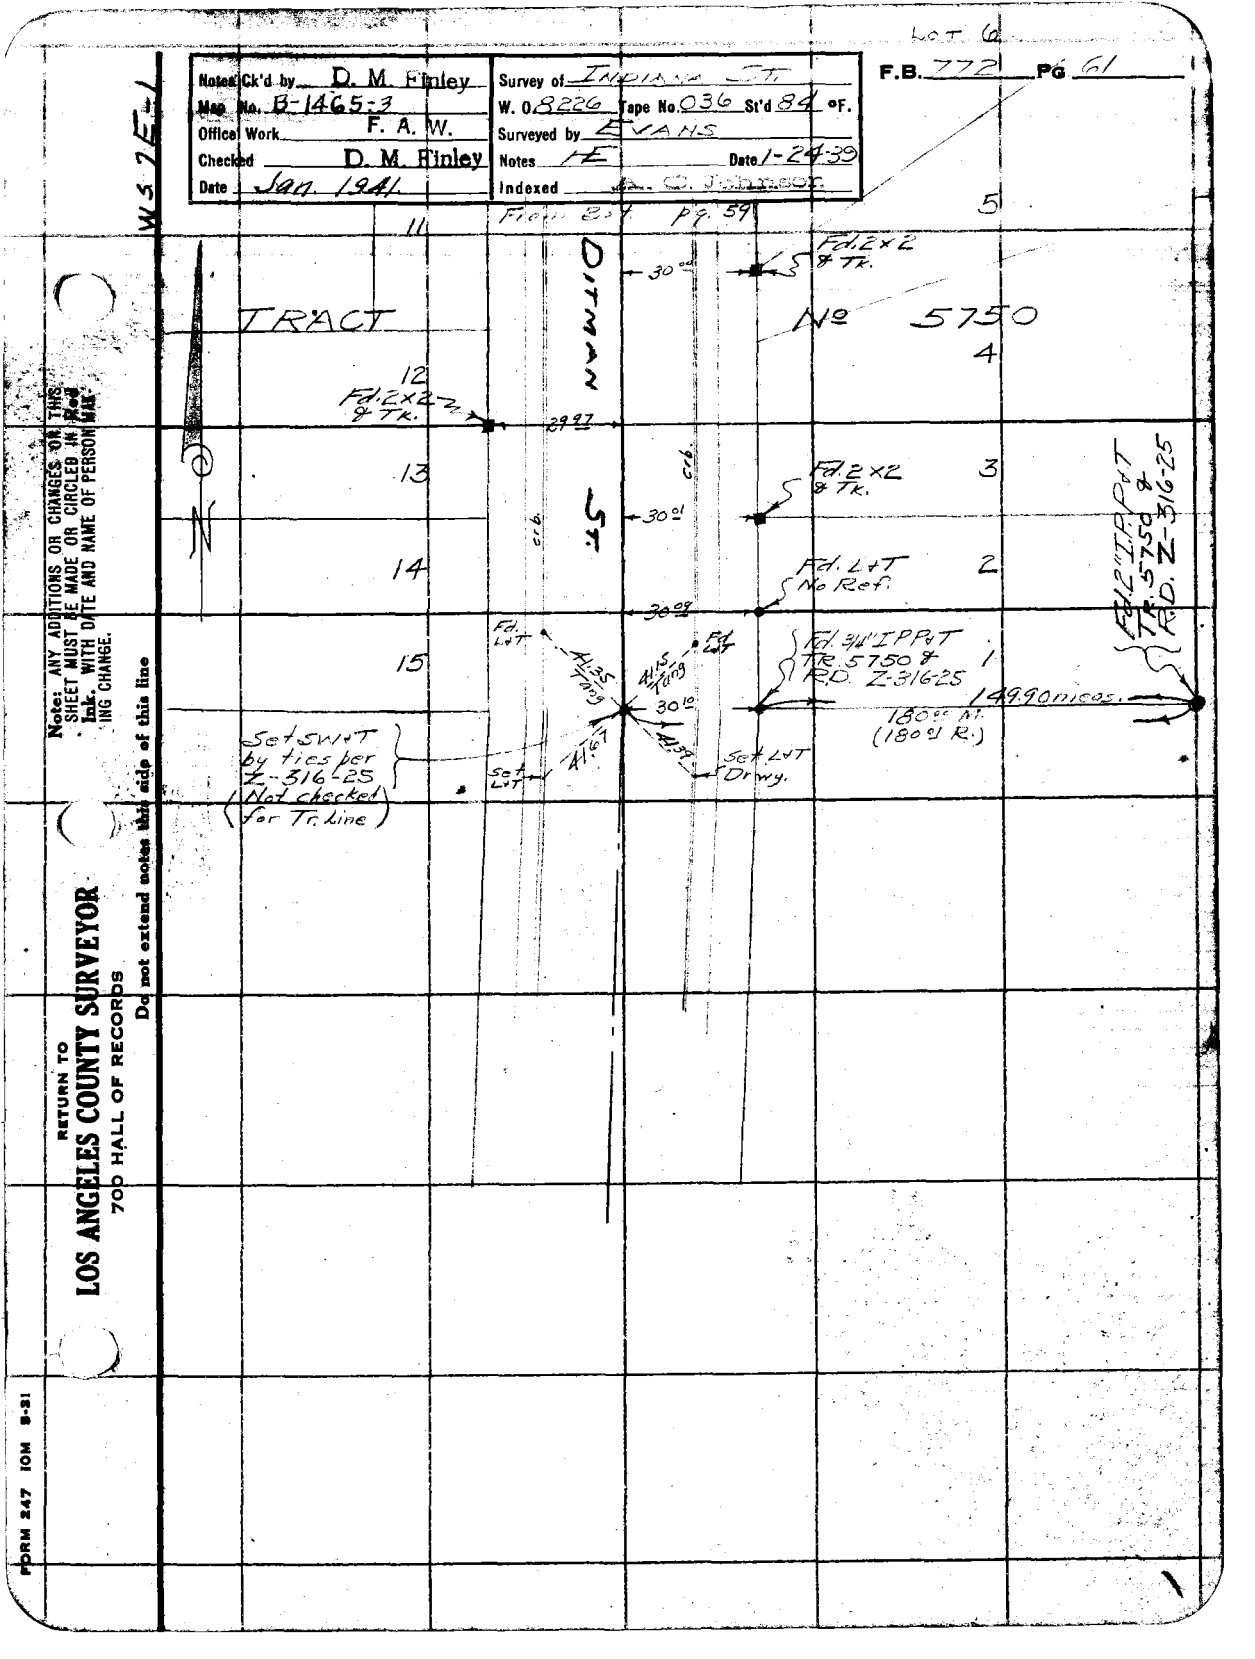

Note: ANY ADDITIONS OR CHANGES TO THIS SHEET MUST BE MADE OR CIRCLED IN Red Ink, WITH DATE AND NAME OF PERSON MAKING CHANGE.

Do not extend notes this side of this line

RETURN TO
LOS ANGELES COUNTY SURVEYOR
700 HALL OF RECORDS

FORM 247 10M 8-31

RETURN TO
LOS ANGELES COUNTY SURVEYOR
700 HALL OF RECORDS

Note: ANY ADDITIONS OR CHANGES ON THIS SHEET MUST BE MADE OR CIRCLED IN Red Ink. WITH DATE AND NAME OF PERSON MAKING CHANGE.

W.S. 7E.1

Do not extend notes this side of this line

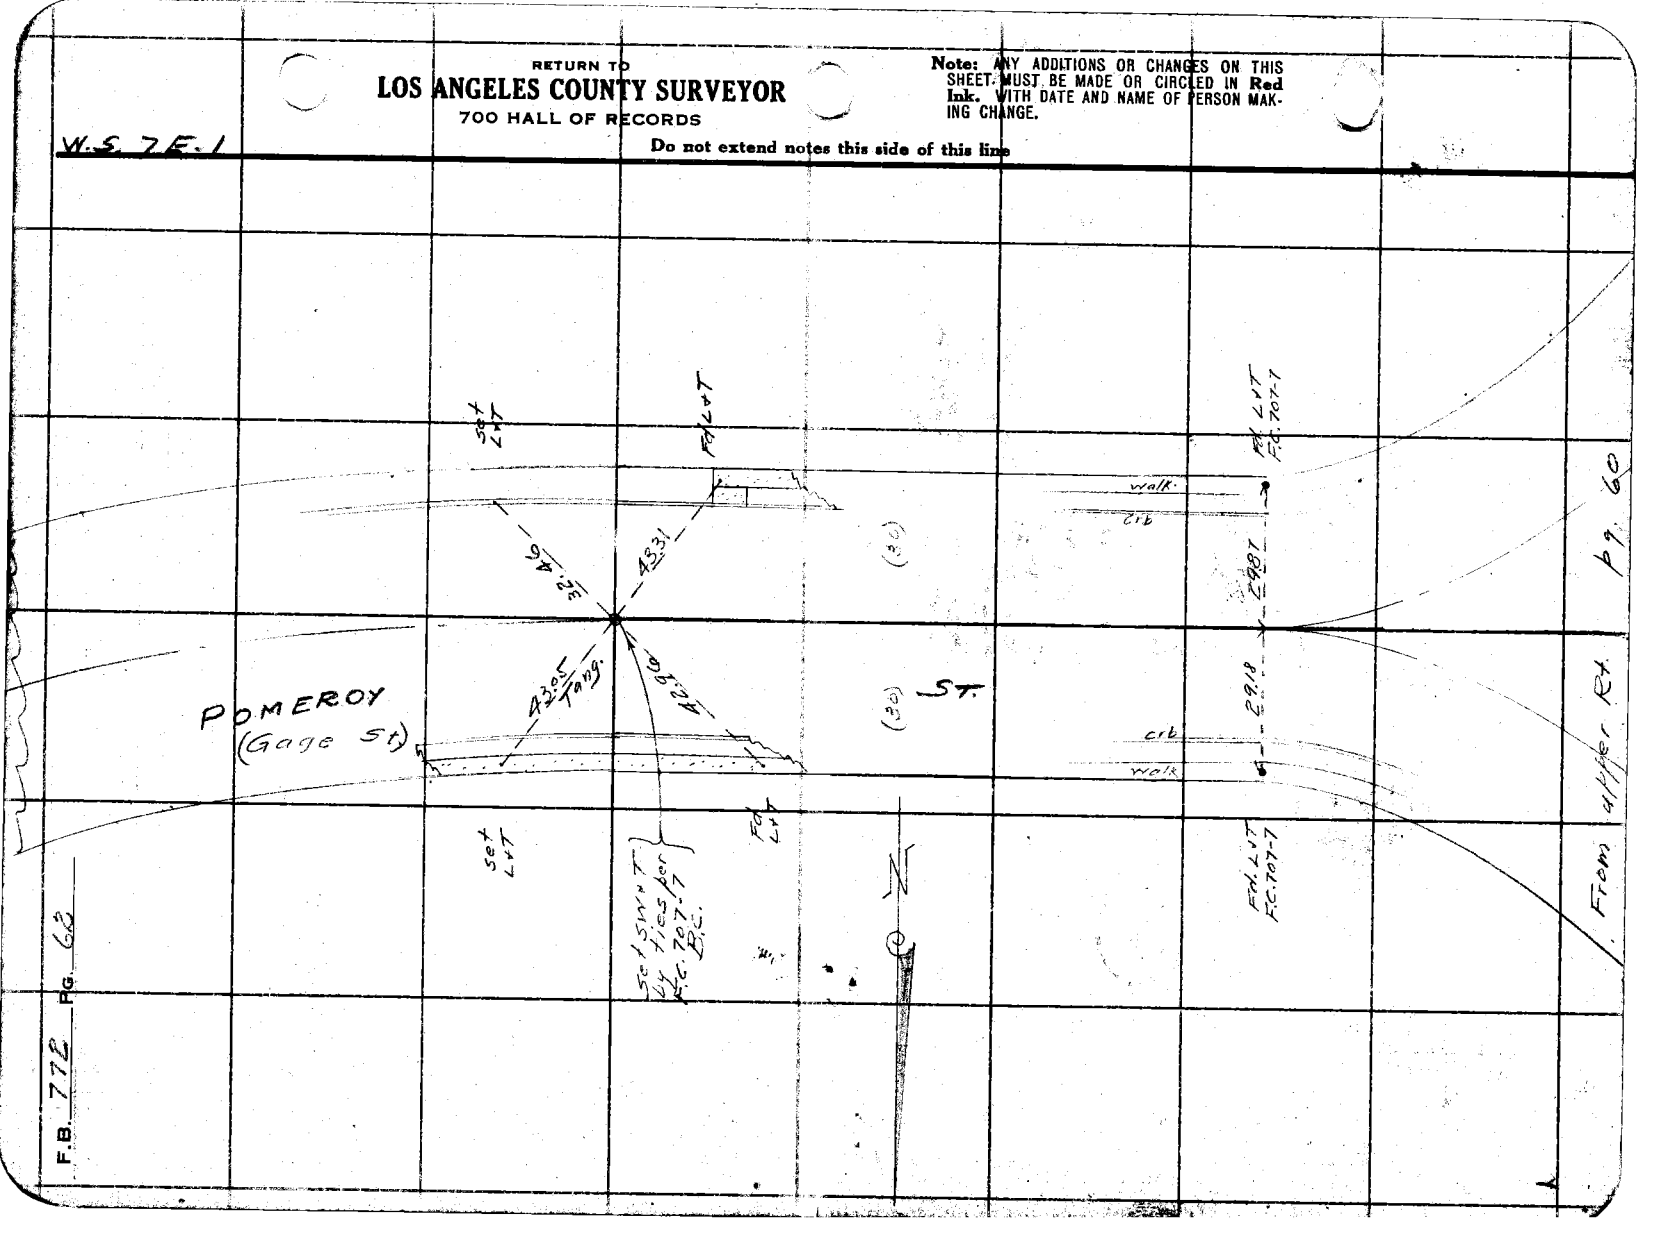

F.B. 772 Pg. 68

Notes Ck'd by D. M. Finley	Survey of INDIANA ST	F.B. 772 PG. 62
Map No. B-1465-3	W. O. 8226 Tape No. 036 St'd 24 of	
Office Work F. A. W.	Surveyed by EVANS	
Checked D. M. Finley	Notes HE Date 1-25-39	
Date Jan 1941	Indexed	

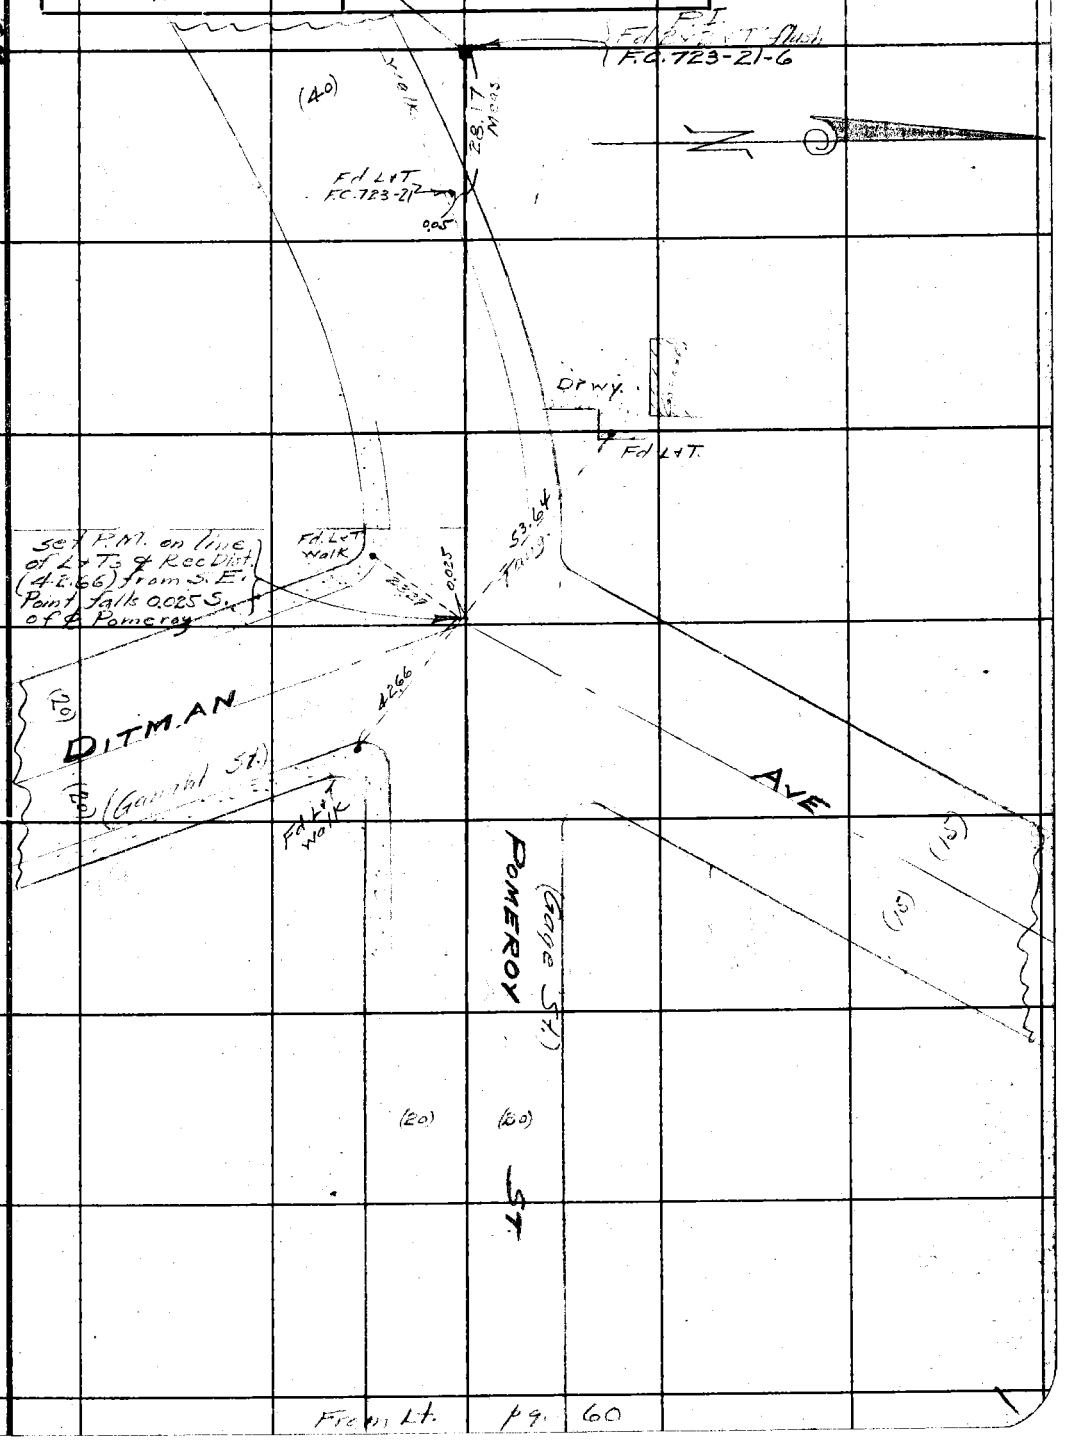

Note: Any Additions or Changes on This Sheets Must be Made or Circled in Red Ink With Date and Name of Person Making Change.

Do not extend notes this side of this line

RETURN TO
LOS ANGELES COUNTY SURVEYOR
700 HALL OF RECORDS

FORM 247 5M 10-37

From Lt. pg. 60

F.B. 772 PG. 64

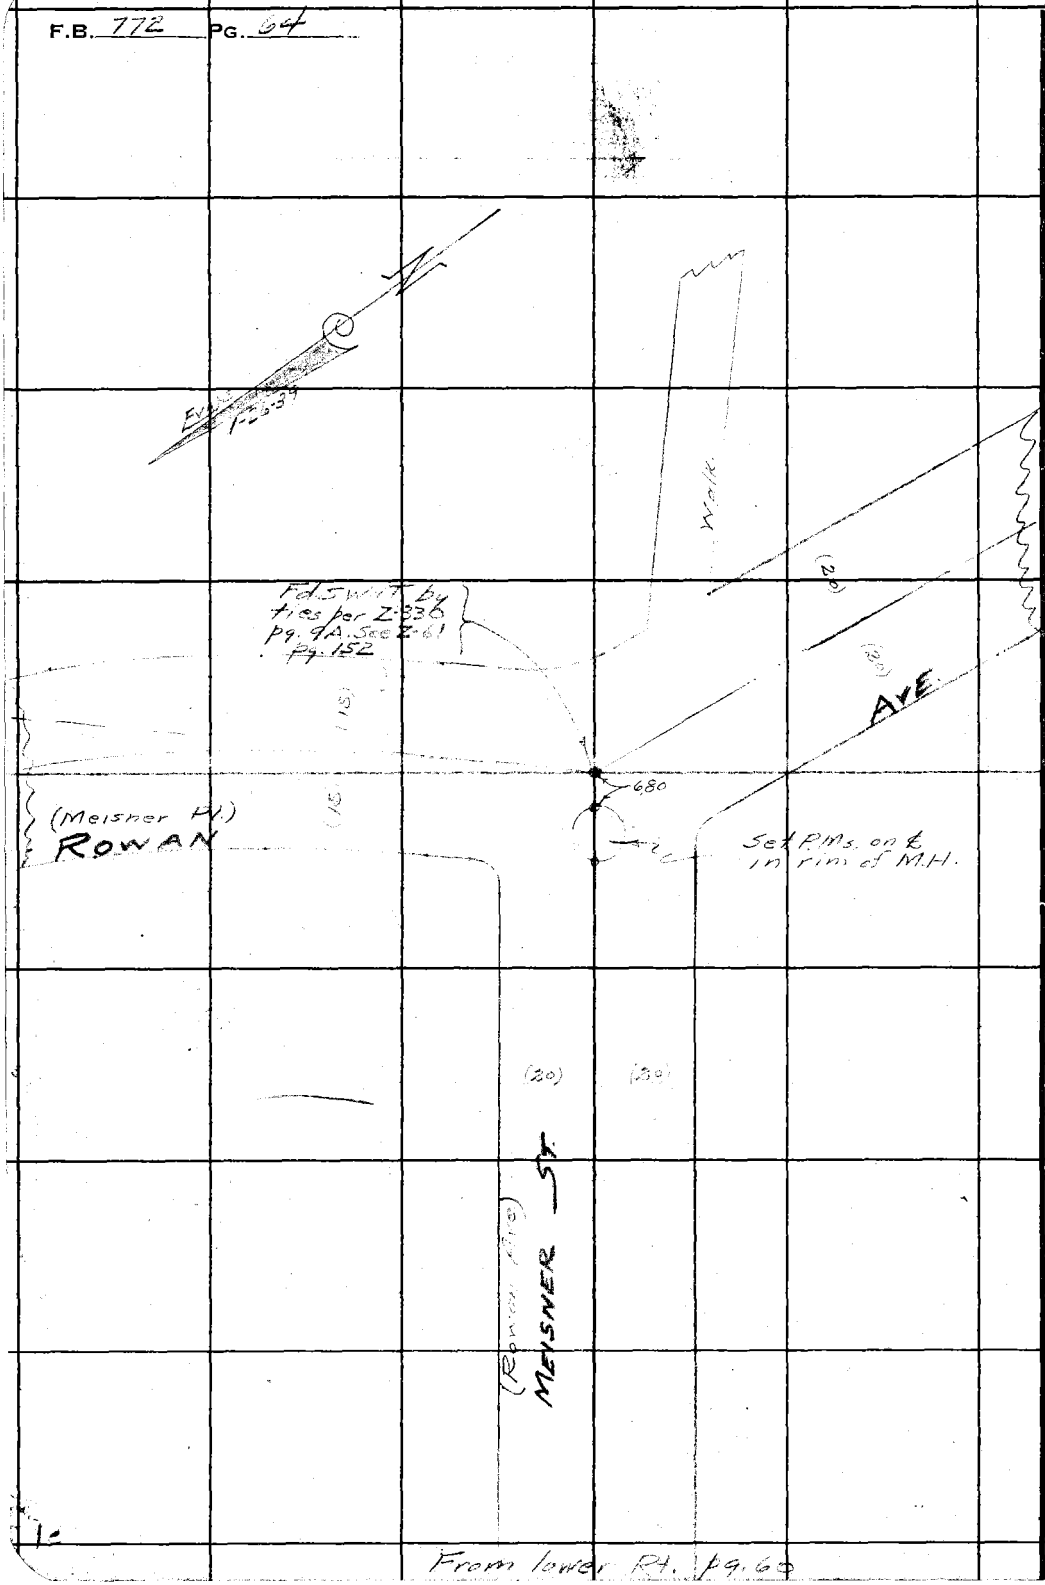

W.S. 7E-1

RETURN TO
LOS ANGELES COUNTY SURVEYOR
700 HALL OF RECORDS

Note: Any Additions or Changes on This Sheets Must be Made or Circled in **Red Ink** With Date and Name of Person Making Change.

Do not extend notes this side of this line

Notes Ck'd by D. M. Finley	Survey of INDIANA ST
Map No. B-1465-3	W. O. 8226 Tape No. 013 St'd 84 °F.
Office Work F. A. W.	Surveyed by EVANS
Checked D. M. Finley	Notes HE Date 5/10/39
Date Jan 1941	Indexed

F.B. 772 Pg. 65

W.S. 7 #1

To Bot. pg. 66

243.02-T 70° = 243°00'

243°00'

(40) (40)

Fd. 2x2, 3" dn. F.X. 345-335

Fd. S.W.&T., 0.03 E. of ℄ City Terr. & on ℄ Ramboz. Removed spk & set 3/4" I.P. cem & c.t. ctr. by intsn. ft. See F.X. 345-335

RAMBOZ DR. (BLAIR ST.) (140.98 Rec.)

(15) (15)

0.515

℄ Prod. 31.36

0.015

0.79

30.55

Fd. L&T S.F.C. 707-9

Set P.K.

0.14

3.86

16°00'

0.04

0.02

40°00'

31.81

Fd. L&T F.C. 707-9

B.C. 150+86.69

Fd. 2" I.P.P.&T. 18" d. F.C. 707-9 F.B. 406-12 & F.X. 345-335 See Tr. 5920

90°-00'-00"

89°-59'-50"

Fd. 2" I.P.P.&T. 12" dn. - F.C. 707-9, F.B. 406-12, F.X. 345-335, & Tr. 5920 Set 2x2 flush above pipe.

Identical

B.C. Set

0.02

37.31

90°

40°00'

2" I.P.

PI - Fd. 2x2 14" dn. Per F.X. 345-335 Tie's same book

Set L&T & X in walk Evans 1-41.

597.74-T 70° = 597.69

597.69

CITY TERRACE DR.

(89-59-50)
(359-59-20)
89°-59'-50"

P-60

Note: ANY ADDITIONS OR CHANGES ON THIS SHEET MUST BE MADE OR CIRCLED IN Red Ink. WITH DATE AND NAME OF PERSON MAKING CHANGE.

Do not extend notes this side of this line

RETURN TO LOS ANGELES COUNTY SURVEYOR 700 HALL OF RECORDS

FORM 247 10M 5-31

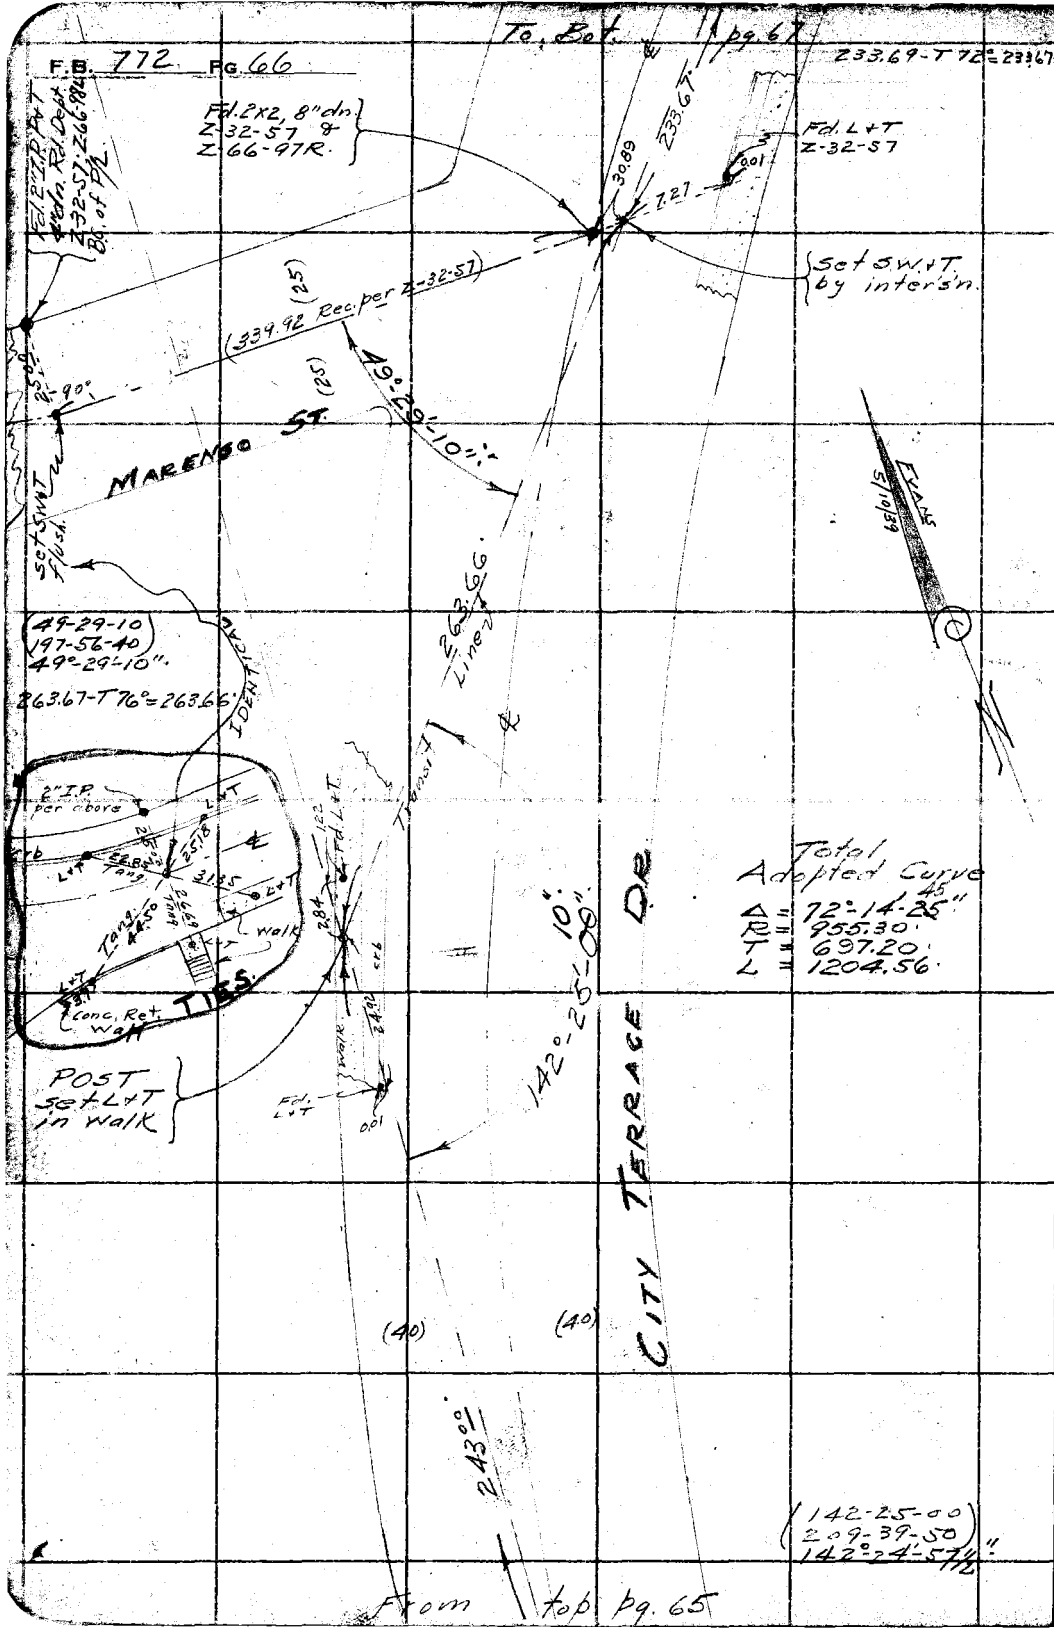

RETURN TO
LOS ANGELES COUNTY SURVEYOR
700 HALL OF RECORDS

Do not extend notes this side of this line

Note: ANY ADDITIONS OR CHANGES ON THIS SHEET MUST BE MADE OR CIRCLED IN **Red Ink.** WITH DATE AND NAME OF PERSON MAKING CHANGE.

Notes Ck'd by D. M. Finley	Survey of INDIANA ST.	F.B. 772 PG. 67
Map No. B-1465-3	W. O. 8226 Tape No. 013 St'd 84 °F	229.60-T 72° = 229.58-
Office Work F. A. W.	Surveyed by EVANS	
Checked D. M. Finley	Notes HE Date 5/10/39	
Date Jan. 1941	Indexed	

W.S. 1D-1

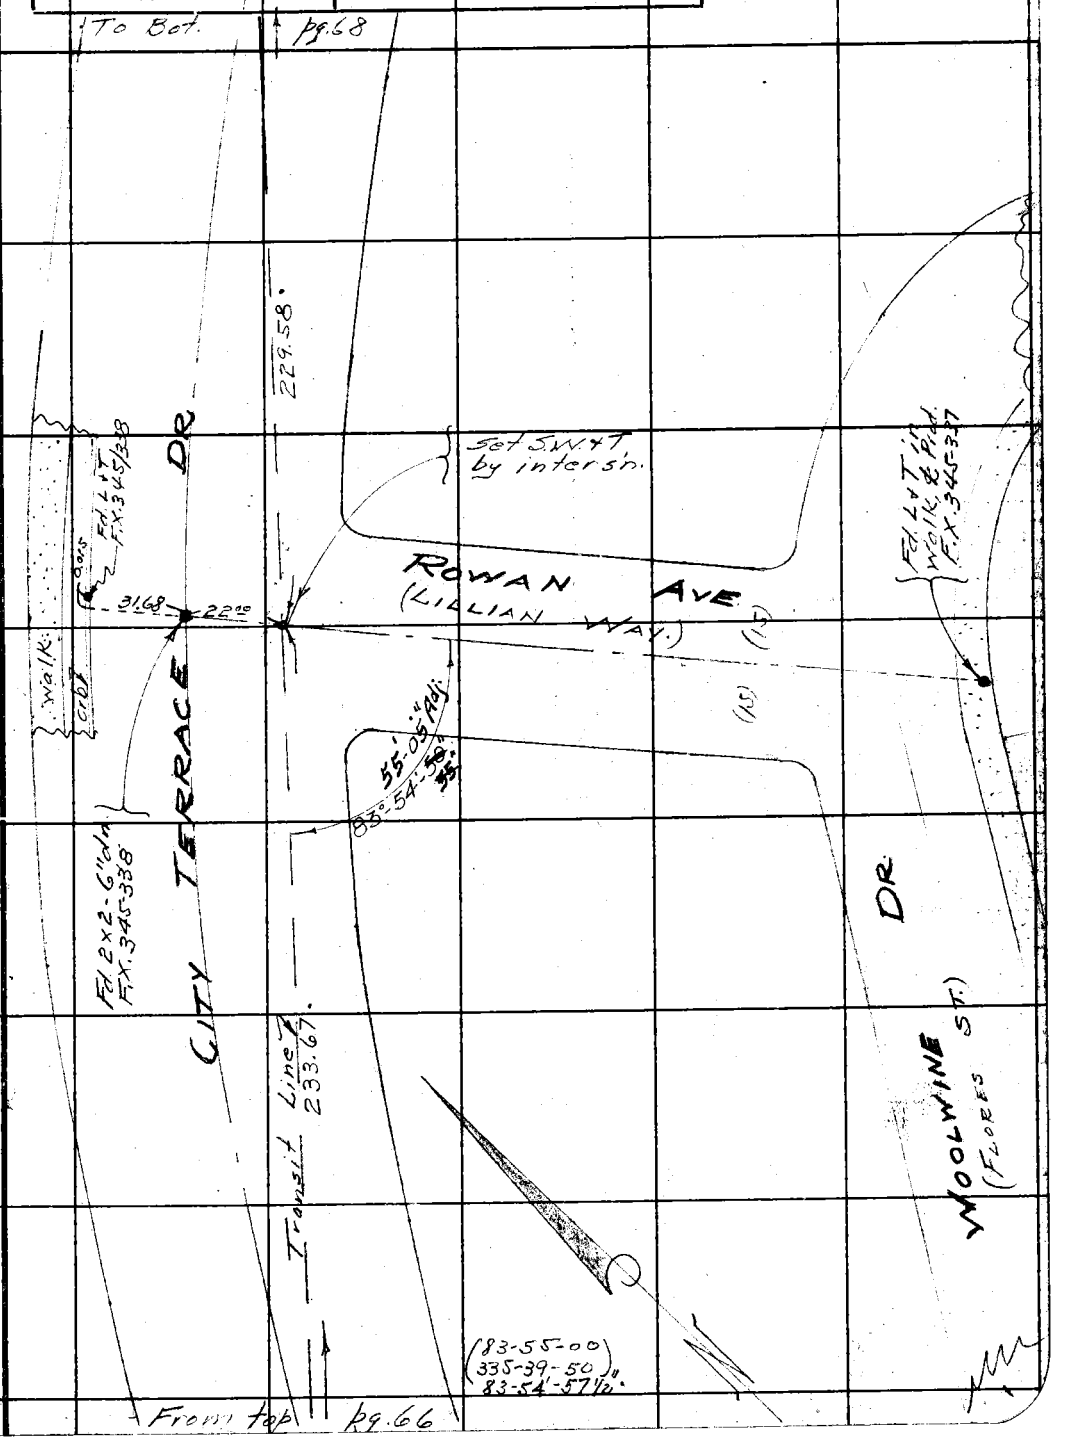

Note: Any Additions or Changes on This Sheets Must be Made or Circled in Red Ink With Date and Name of Person Making Change.

Do not extend notes this side of this line

RETURN TO
LOS ANGELES COUNTY SURVEYOR
700 HALL OF RECORDS

FORM 247 5M 10-37

RETURN TO
LOS ANGELES COUNTY SURVEYOR
700 HALL OF RECORDS

Note: Any Additions or Changes on This Sheets Must be Made or Circled in **Red Ink** With Date and Name of Person Making Change.

W.S. 7D-1

Do not extend notes this side of this line

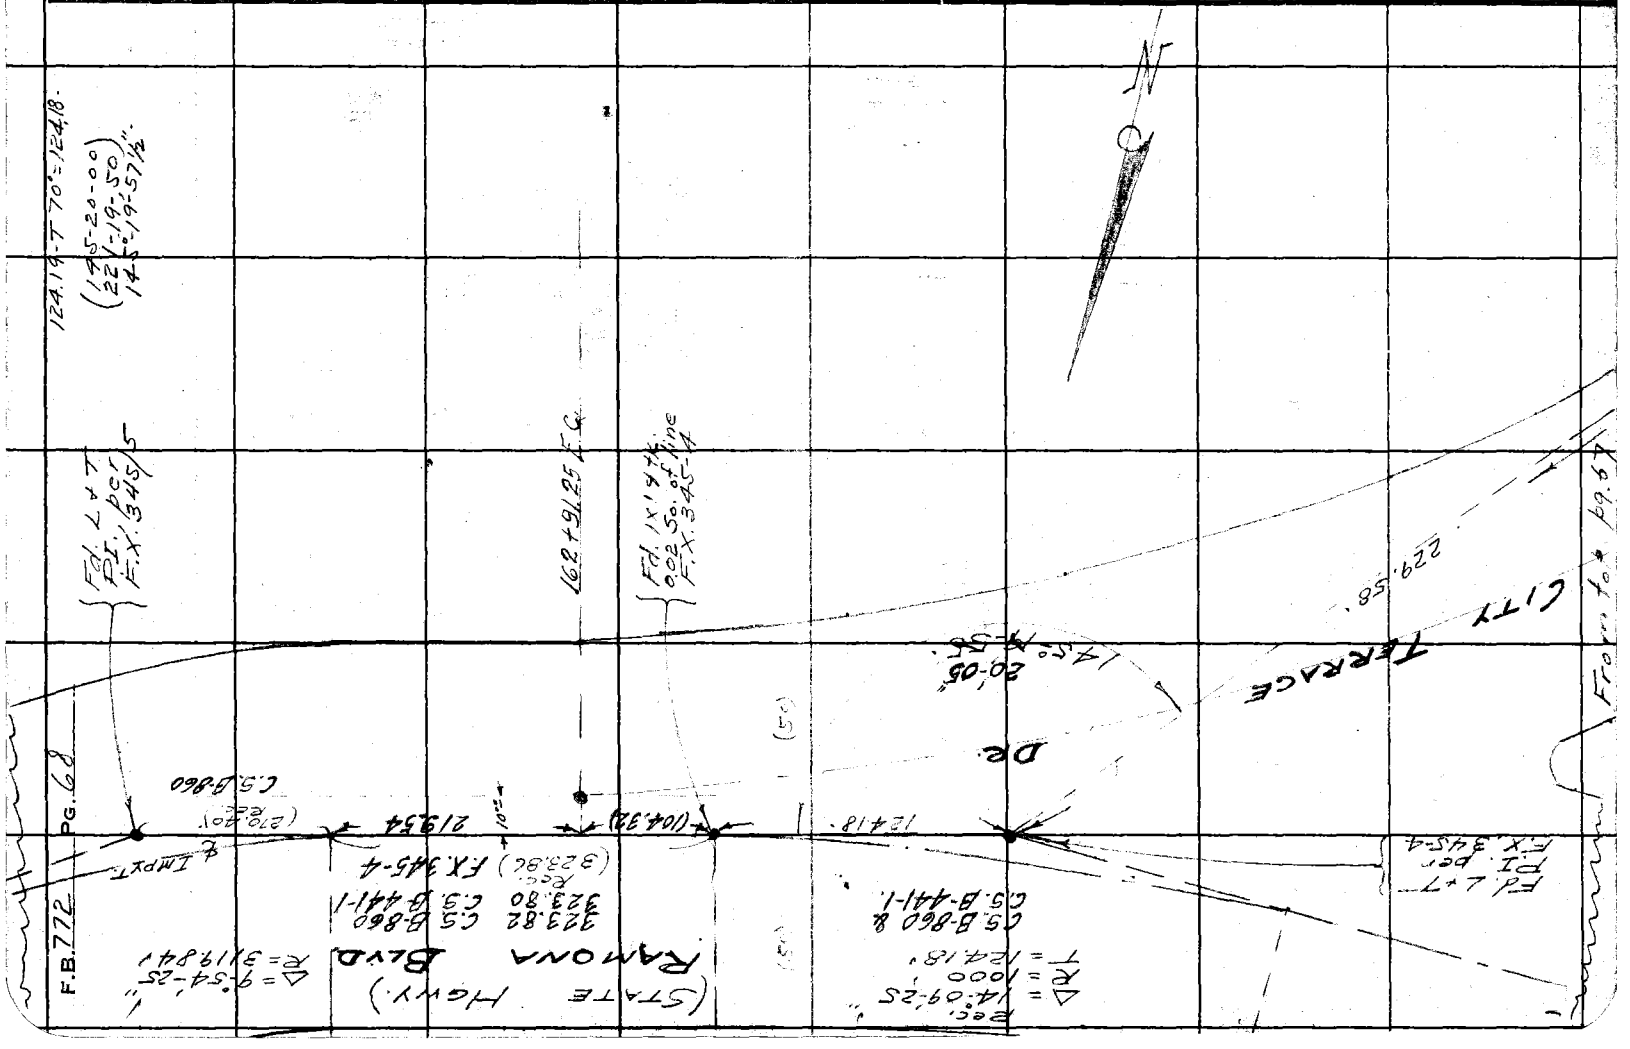

To Bot pg. 70

Notes Ck'd by D. M. Finley	Survey of INDIANA ST
Map No. B-1465-3	W. O. 8226 Tape No. 043 St'd 84°F
Office Work F. A. Wood.	Surveyed by EVANS
Checked D. M. Finley	Notes HE Date 1/2/41
Date Jan. 1941.	Indexed

F.B. 772 PG. 69

(134-12-50)
(176-51-20)
134°-12'-50".

WS.7-D-1

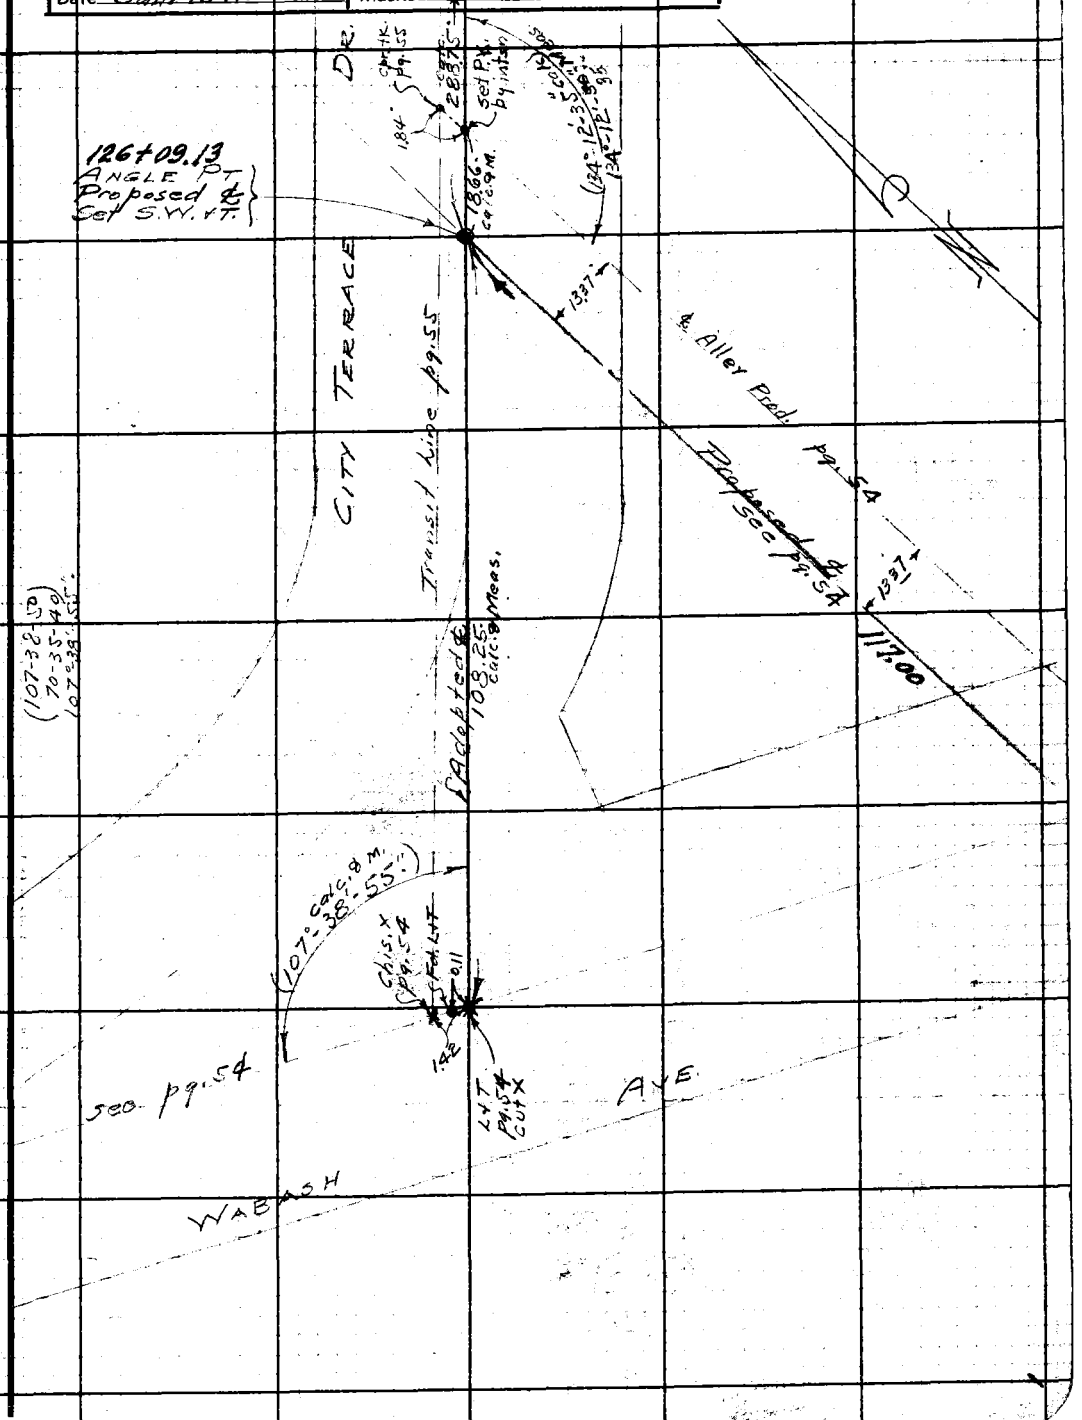

Note: Any Additions or Changes on This Sheet Must be Made or Circled in Red Ink With Date and Name of Person Making Change.

Do not extend notes this side of this line.

RETURN TO
LOS ANGELES COUNTY SURVEYOR
700 HALL OF RECORDS

FORM 247 5M 10-39

F.B. 772 PG. 70

RETURN TO
LOS ANGELES COUNTY SURVEYOR
700 HALL OF RECORDS

Do not extend notes this side of this line.

Note: Any Additions or Changes on This Sheet Must be Made or Circled in **Red** Ink With Date and Name of Person Making Change.

Notes Ck'd by D. M. Finley	Survey of INDIANA ST	F.B. 772 PG. 71
Map No. B-1465-1	W. O 8226 Tape No. ___ St'd ___ OF	
Office Work F. A. W.	Surveyed by Evans	
Checked D. M. Finley	Notes Brook Date 1-39	
Date Jan. 1941.	Indexed 5-16-39	

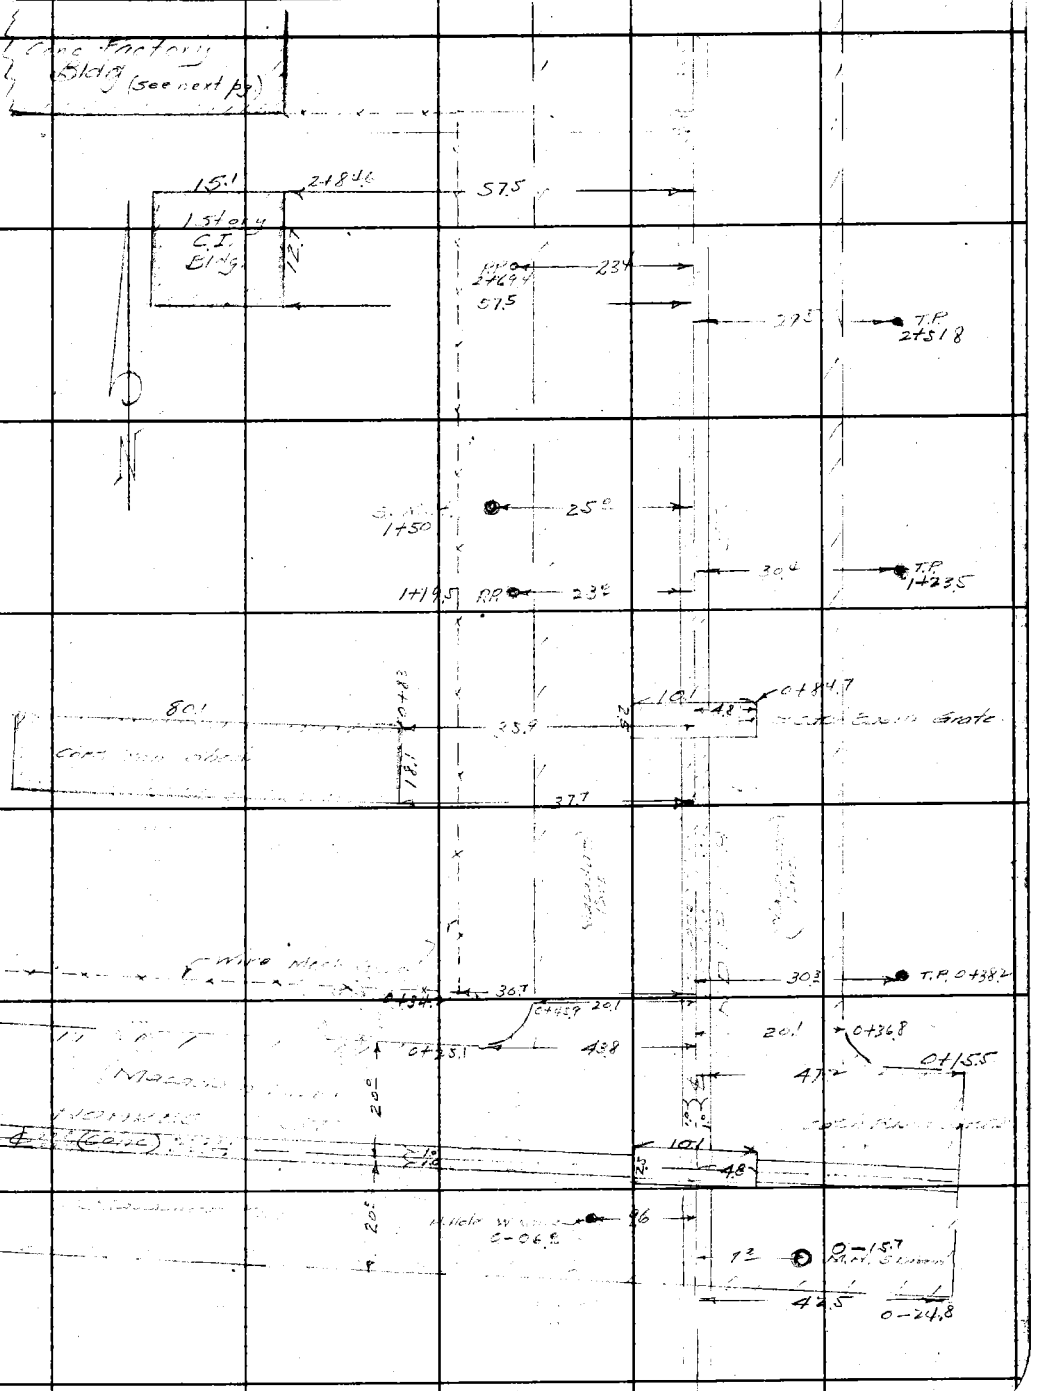

Note: Any Additions or Changes on This Sheets Must be Made or Circled in Red Ink With Date and Name of Person Making Change.

Do not extend notes this side of this line

RETURN TO
LOS ANGELES COUNTY SURVEYOR
700 HALL OF RECORDS

FORM 247 5M 10-37

RETURN TO
LOS ANGELES COUNTY SURVEYOR
700 HALL OF RECORDS

Note: Any Additions or Changes on This Sheets Must be Made or Circled in **Red Ink** With Date and Name of Person Making Change.

Do not extend notes this side of this line

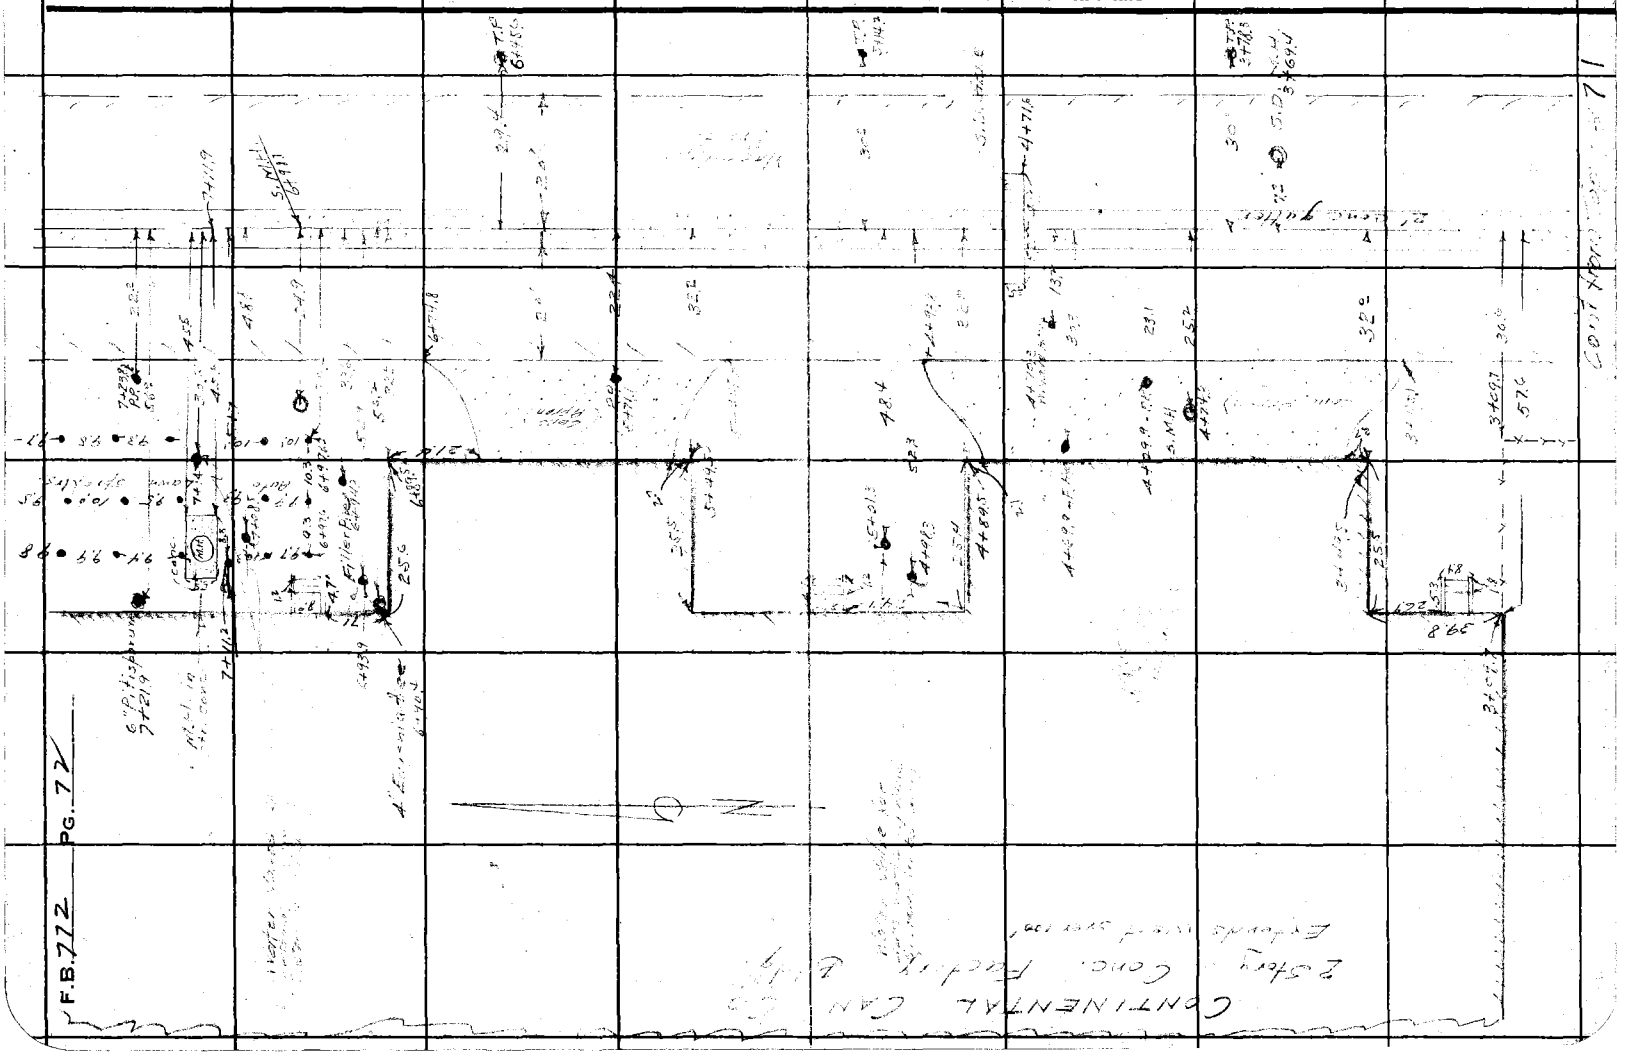

Notes Ck'd by D. M. Finley	Survey of Indiana St	F.B. 772 Pg. 73
Map No. B-1465-1	W. O. 8226 Tape No. ____ St'd ____ of	Cont'd at bot. pg 74
Office Work F. A. W.	Surveyed by Evans	
Checked D. M. Finley	Notes Brock Date 39	
Date Jan. 1941	Indexed	

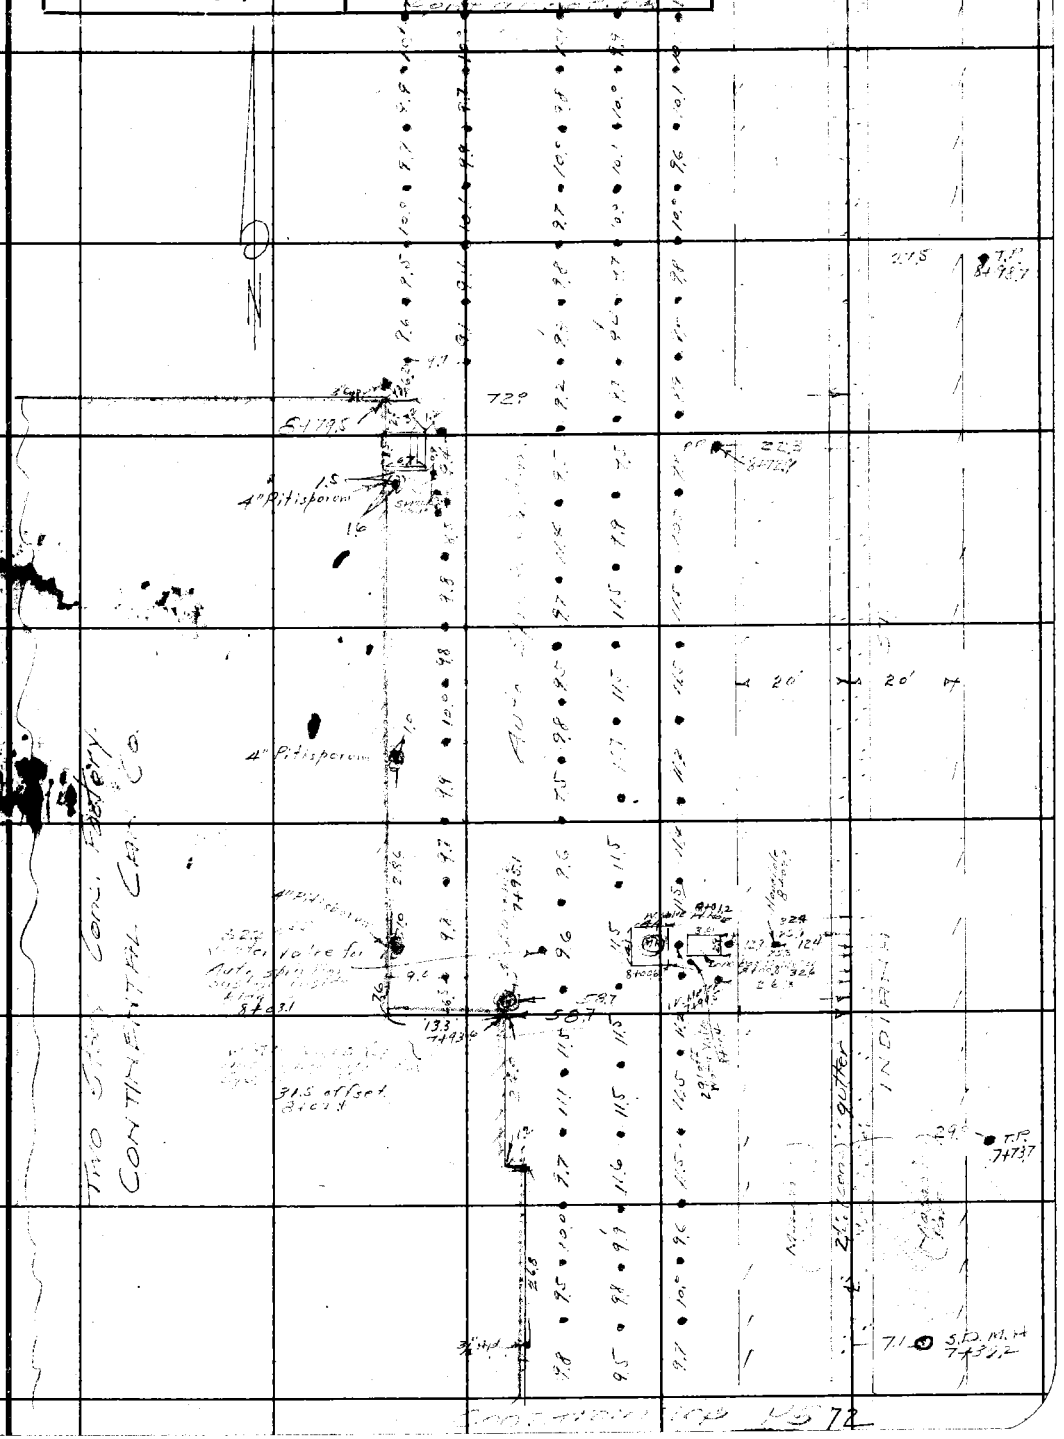

Note: Any Additions or Changes on This Sheets Must be Made or Circled in Red Ink With Date and Name of Person Making Change.

Do not extend notes this side of this line

RETURN TO
LOS ANGELES COUNTY SURVEYOR
700 HALL OF RECORDS

FORM 247 5M 10-37

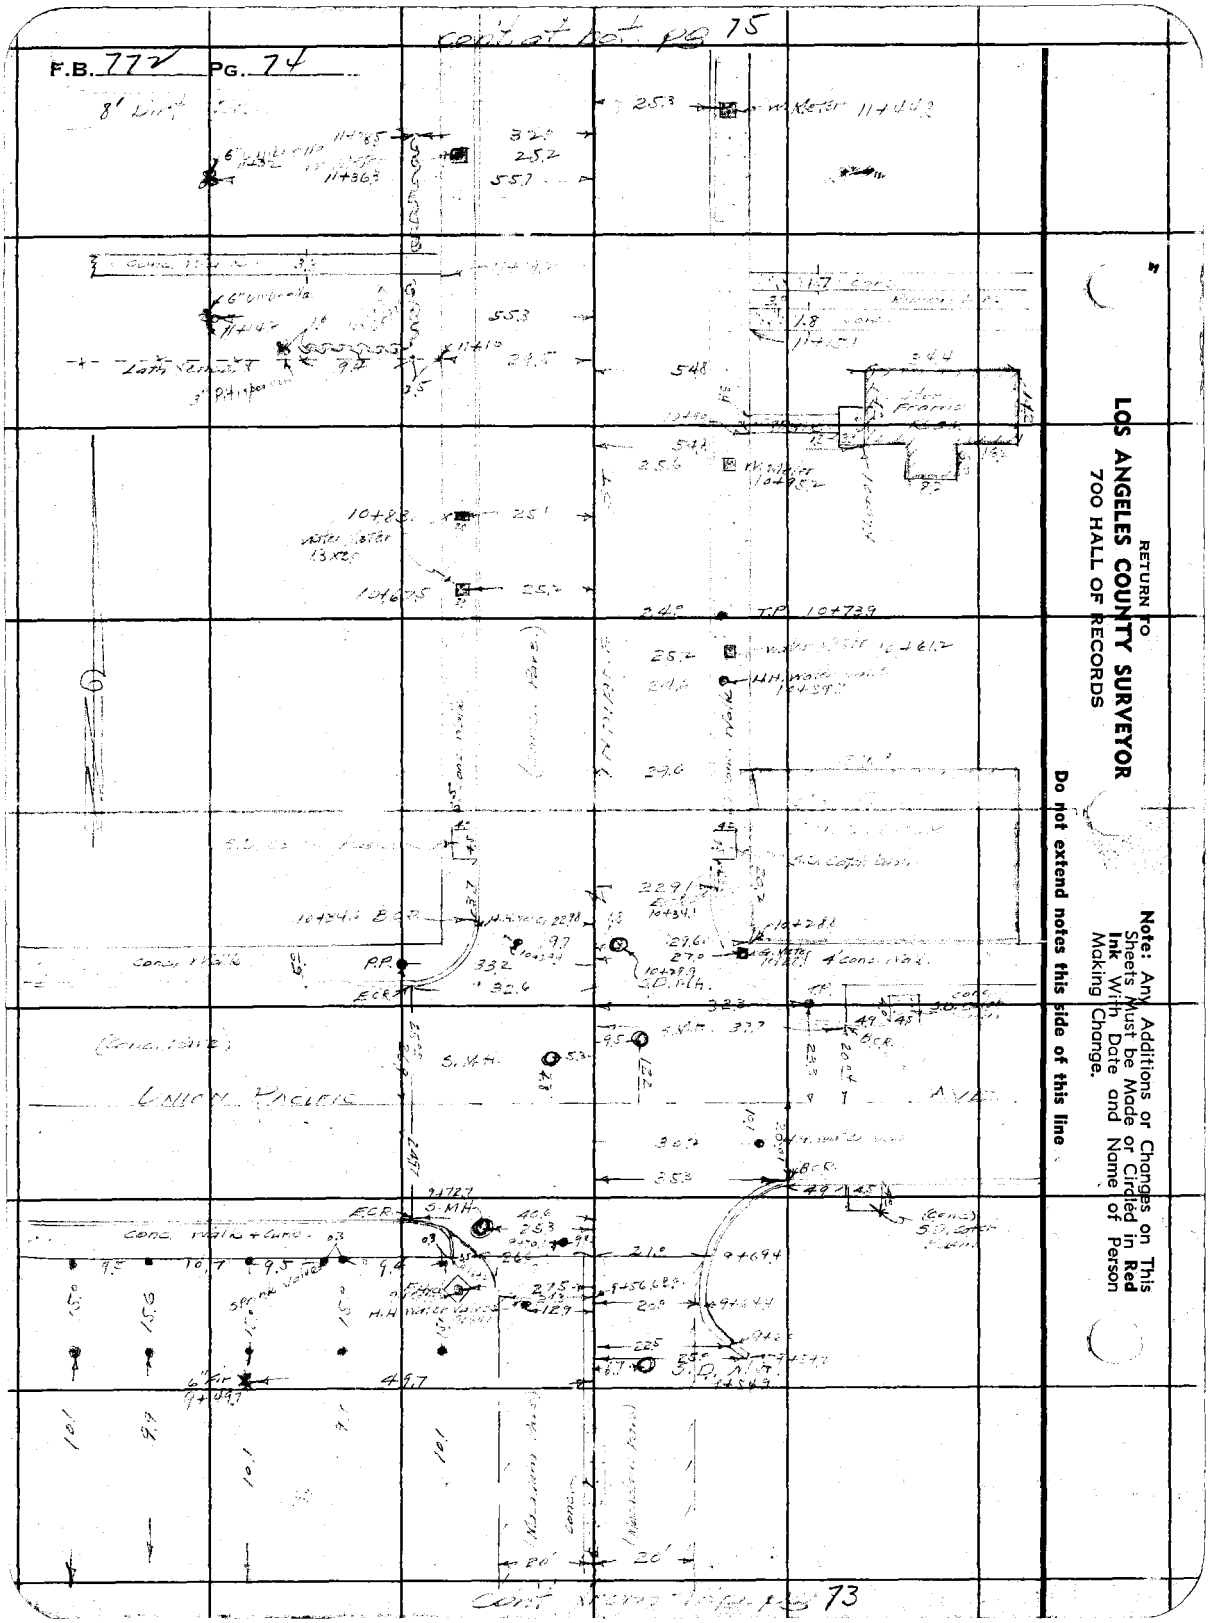

RETURN TO
LOS ANGELES COUNTY SURVEYOR
700 HALL OF RECORDS

Note: Any Additions or Changes on This Sheets Must be Made or Circled in **Red Ink** With Date and Name of Person Making Change.

Do not extend notes this side of this line

Notes Ck'd by D. M. Finley	Survey of [illegible]	F.B. 772 Pg. 75
Map No. B-1465.-1	W. O. 8226 Tape No. ____ St'd ____ °F	
Office Work F. A. W.	Surveyed by Evans	
Checked D. M. Finley	Notes Brock Date 59	
Date Jan. 1941	Indexed [illegible]	

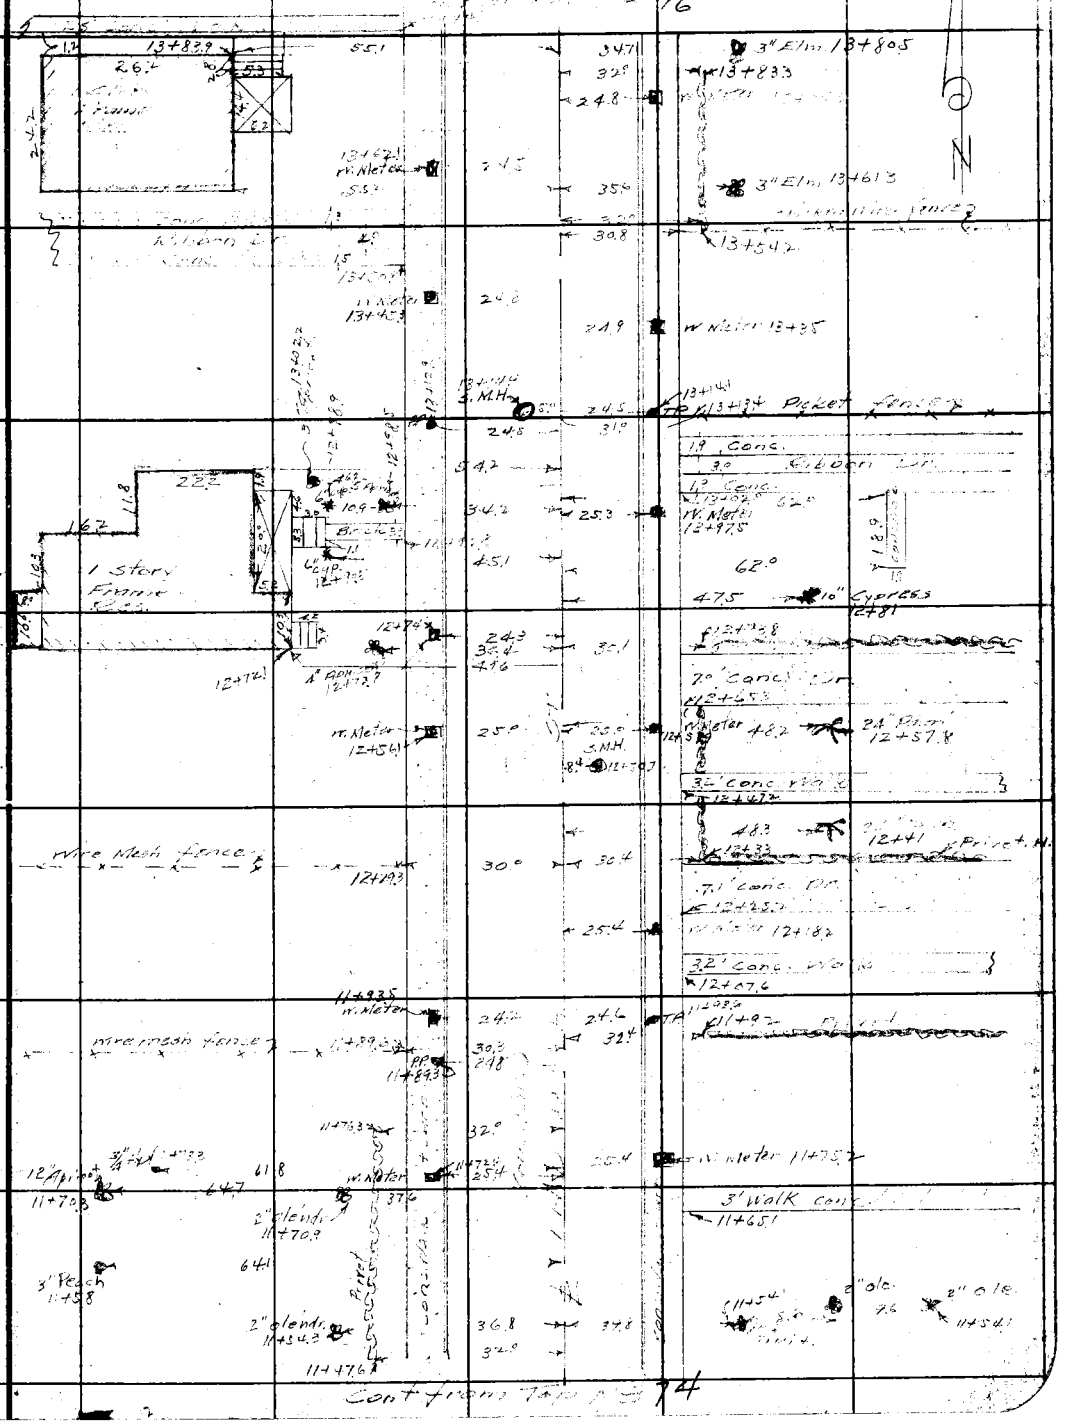

Note: Any Additions or Changes on This Sheets Must be Made or Circled in Red Ink With Date and Name of Person Making Change.

Do not extend notes this side of this line

RETURN TO
LOS ANGELES COUNTY SURVEYOR
700 HALL OF RECORDS

FORM 247 5M 10-37

F.B. 772 PG. 76

RETURN TO
LOS ANGELES COUNTY SURVEYOR
700 HALL OF RECORDS

Note: Any Additions or Changes on This Sheets Must be Made or Circled in **Red** Ink With Date and Name of Person Making Change.

Do not extend notes this side of this line

Notes Ck'd by D. M. Finley	Survey of INDIANA ST	F.B. 772 PG. 77
Map No. B-1465-1	W. O. 8226 Tape No. ____ St'd ____ OF	
Office Work F. A. W.	Surveyed by EVANS	
Checked D. M. Finley	Notes Brock Date '39	
Date Jan. 1941	Indexed [illegible]	

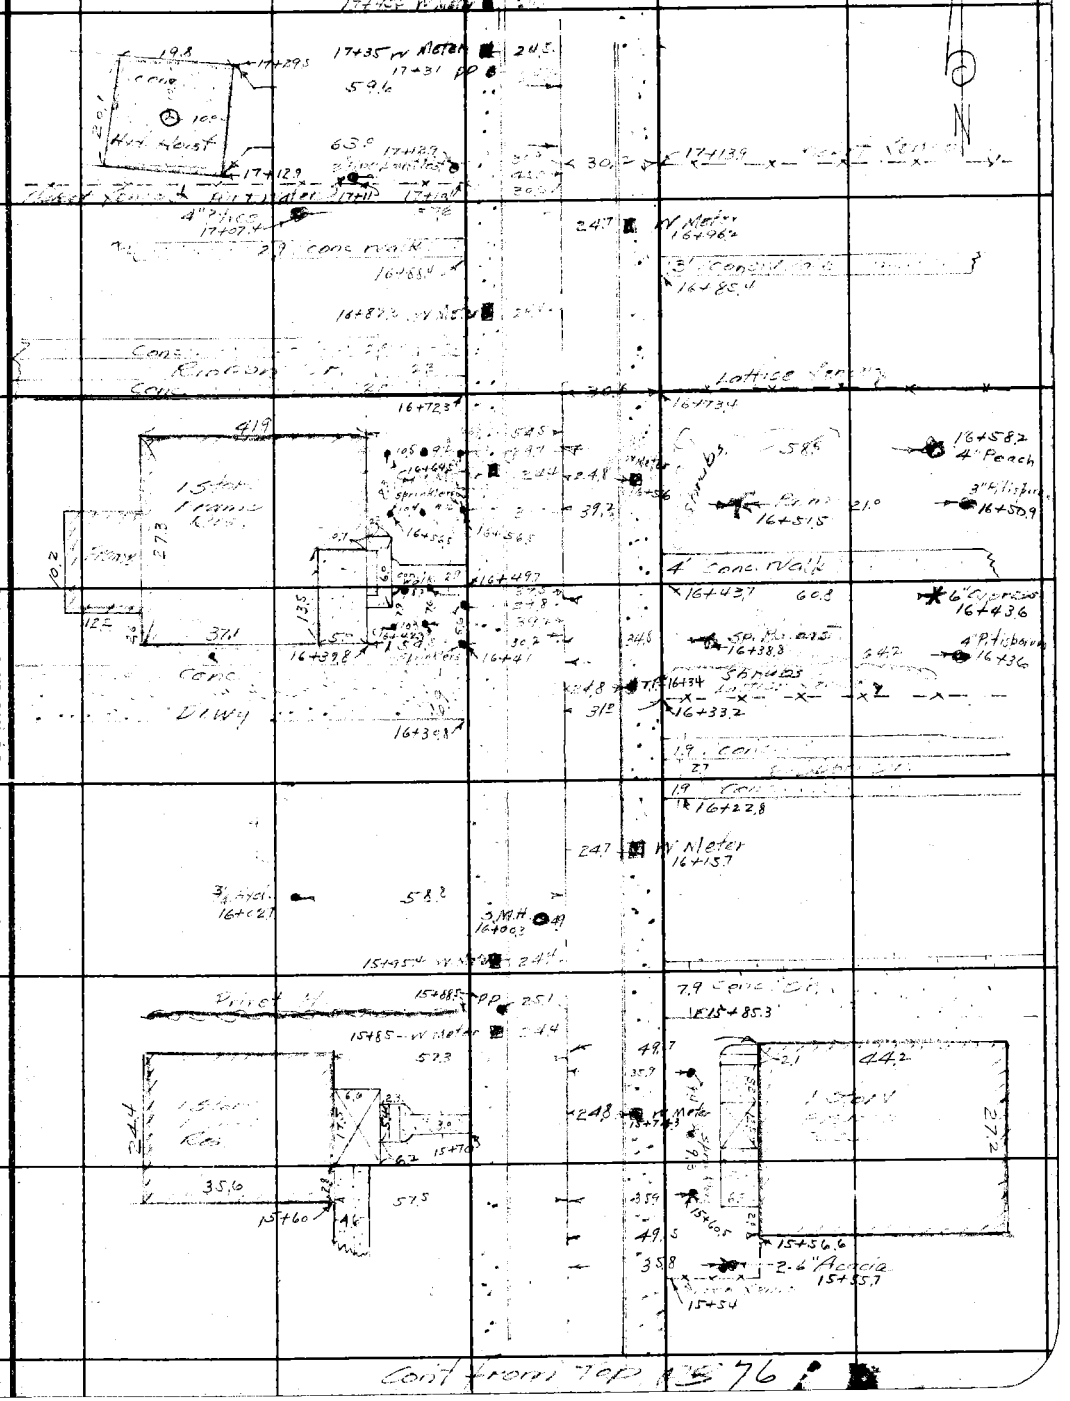

Cont from Top PG 76

Note: Any Additions or Changes on This Sheets Must be Made or Circled in Red Ink With Date and Name of Person Making Change.

Do not extend notes this side of this line

RETURN TO
LOS ANGELES COUNTY SURVEYOR
700 HALL OF RECORDS

FORM 247 5M 10-37

F.B. 772 PG. 78

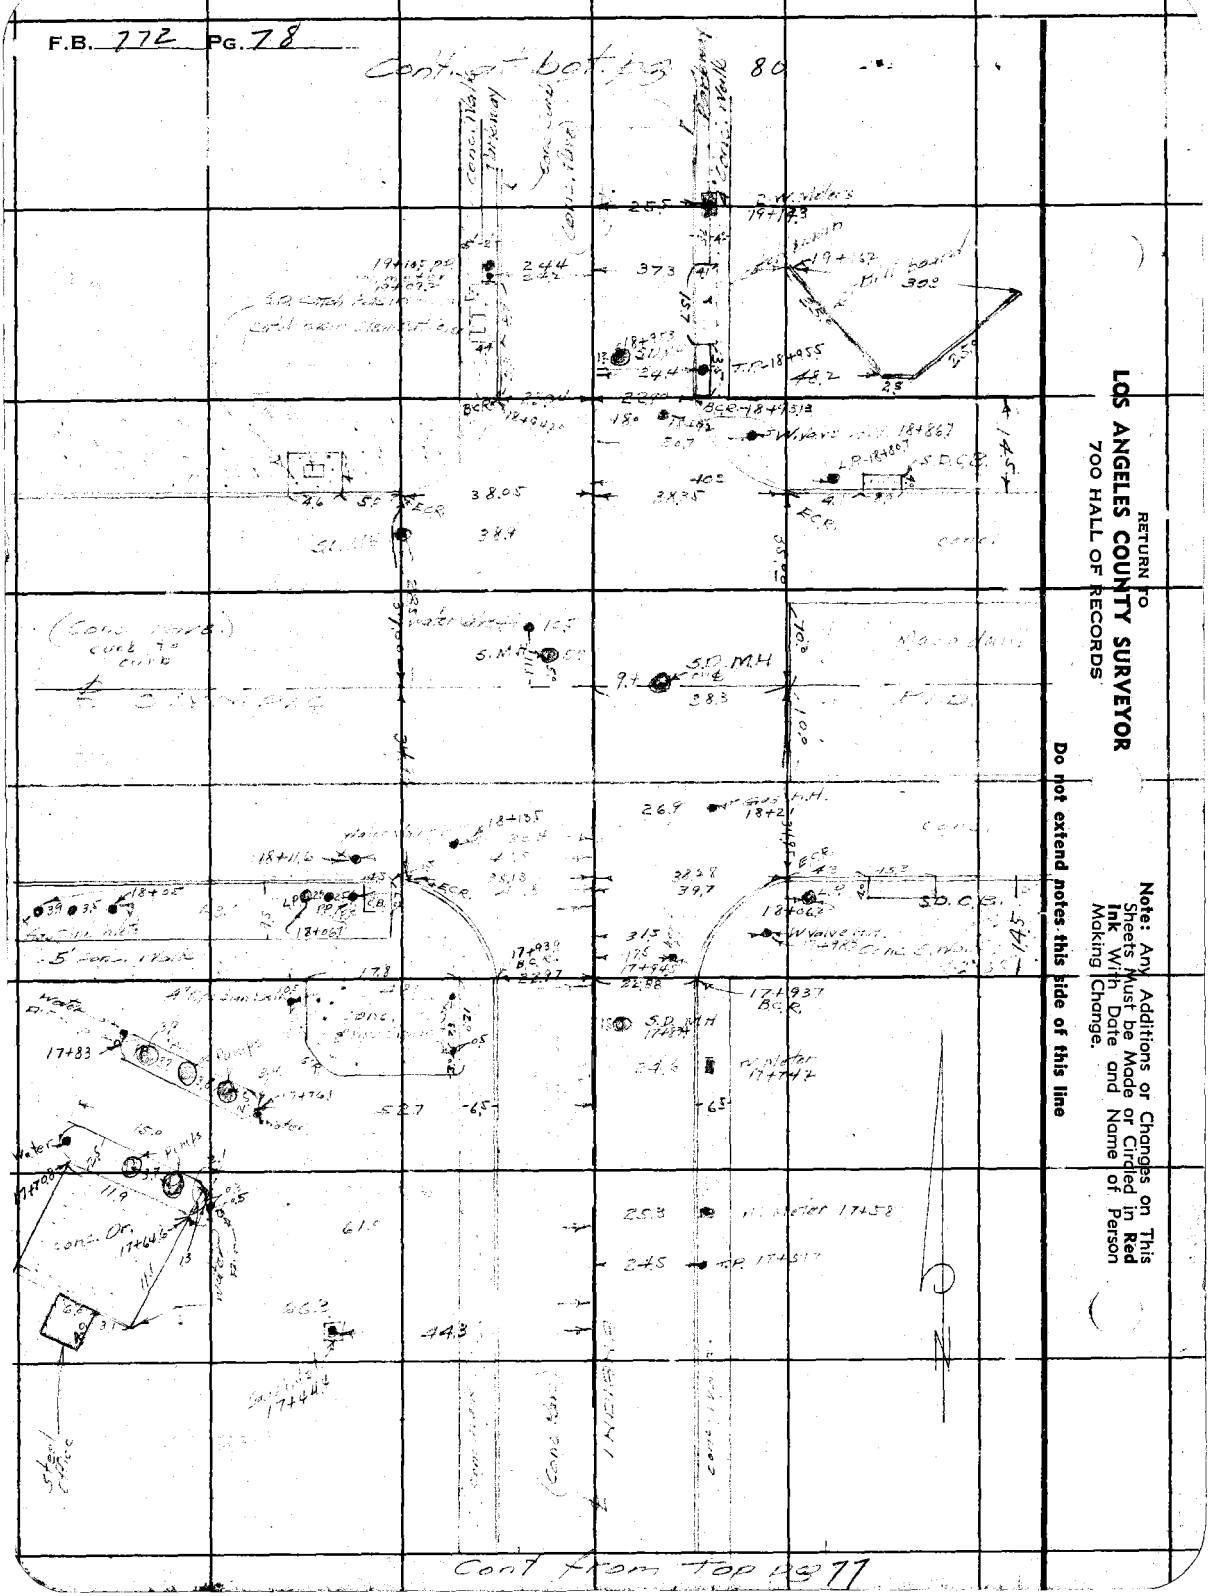

RETURN TO
LOS ANGELES COUNTY SURVEYOR
700 HALL OF RECORDS

Note: Any Additions or Changes on This Sheets Must be Made or Circled in Red Ink With Date and Name of Person Making Change.

Do not extend notes this side of this line

Notes Ck'd by D. M. Finley	Survey of INDIANA ST	F.B. 772 PG. 79
Map No. B-1465-1	W. O. 8226 Tape No. ___ St'd ___ of	
Office Work F. A. W.	Surveyed by Evans	
Checked D. M. Finley	Notes Brock Date '39	
Date Jan. 1941	Indexed A. C. Johnson	

Note: Any Additions or Changes on This Sheets Must be Made or Circled in Red Ink With Date and Name of Person Making Change.

Do not extend notes this side of this line

RETURN TO
LOS ANGELES COUNTY SURVEYOR
700 HALL OF RECORDS

FORM 247 5M 10-37

RETURN TO
LOS ANGELES COUNTY SURVEYOR
700 HALL OF RECORDS

Note: Any Additions or Changes on This Sheets Must be Made or Circled in **Red Ink** With Date and Name of Person Making Change.

Do not extend notes this side of this line

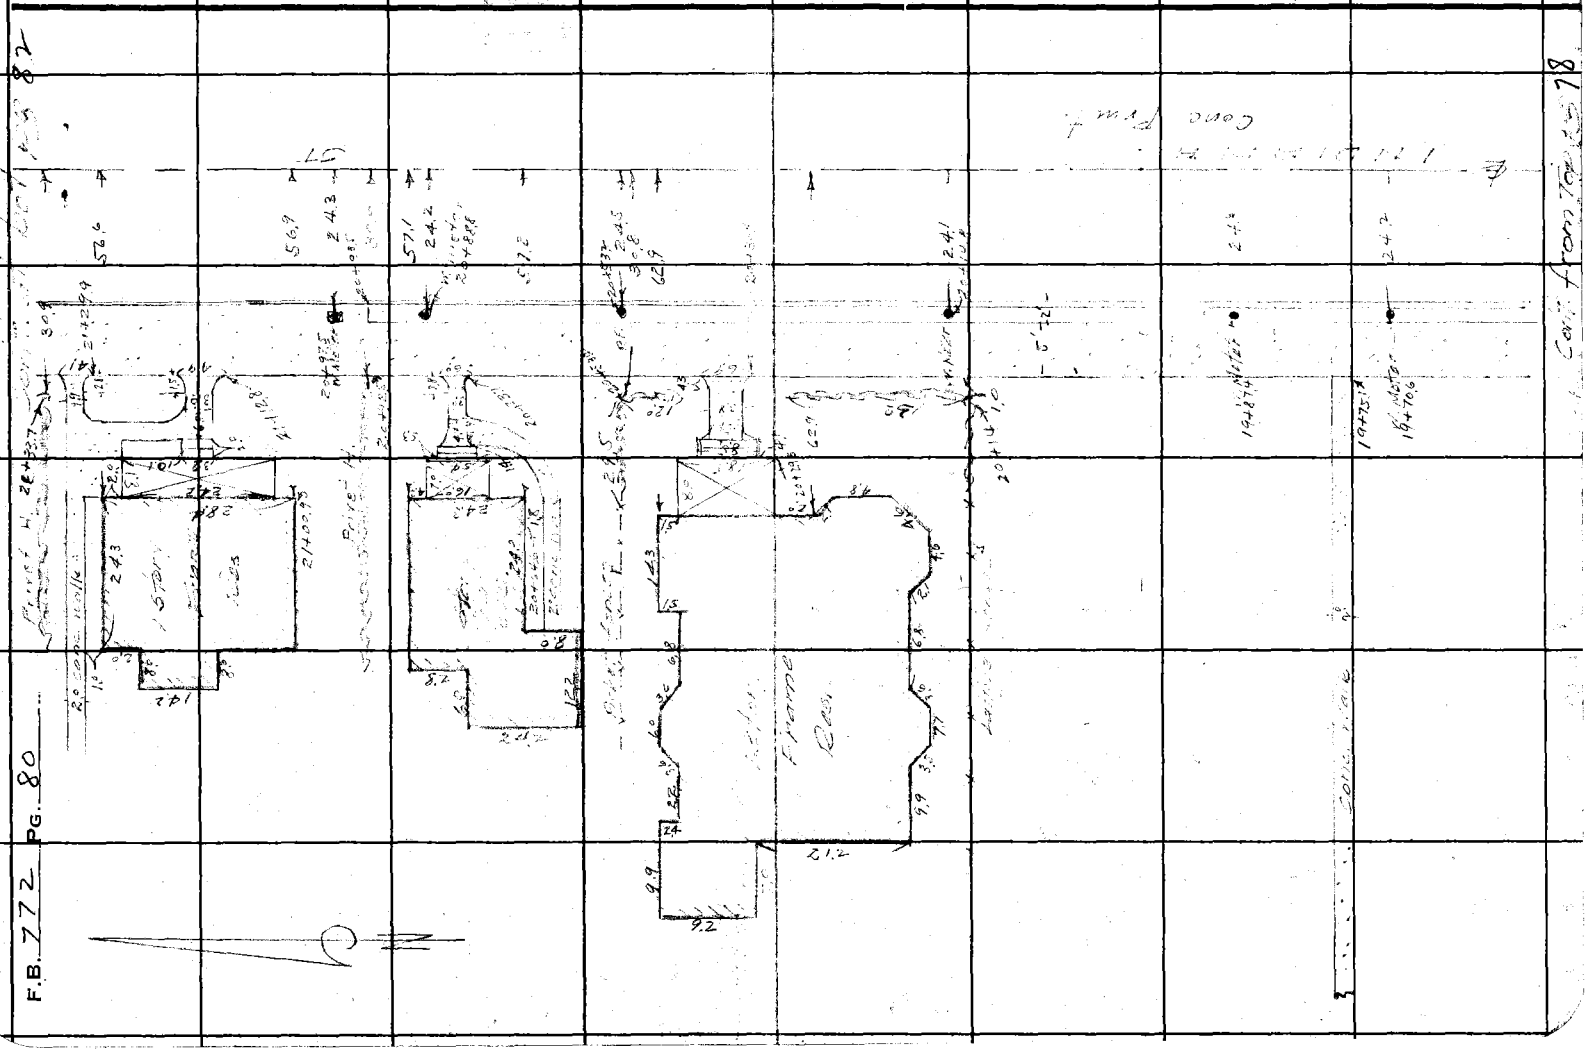

Notes Ck'd by D. M. Finley
Map No. B-1465-1
Office Work F. A. W.
Checked D. M. Finley
Date Jan. 1941

Survey of
W. O. 8226 Tape No. St'd of
Surveyed by Evans
Notes Date
Indexed

F.B. 772 PG. 81

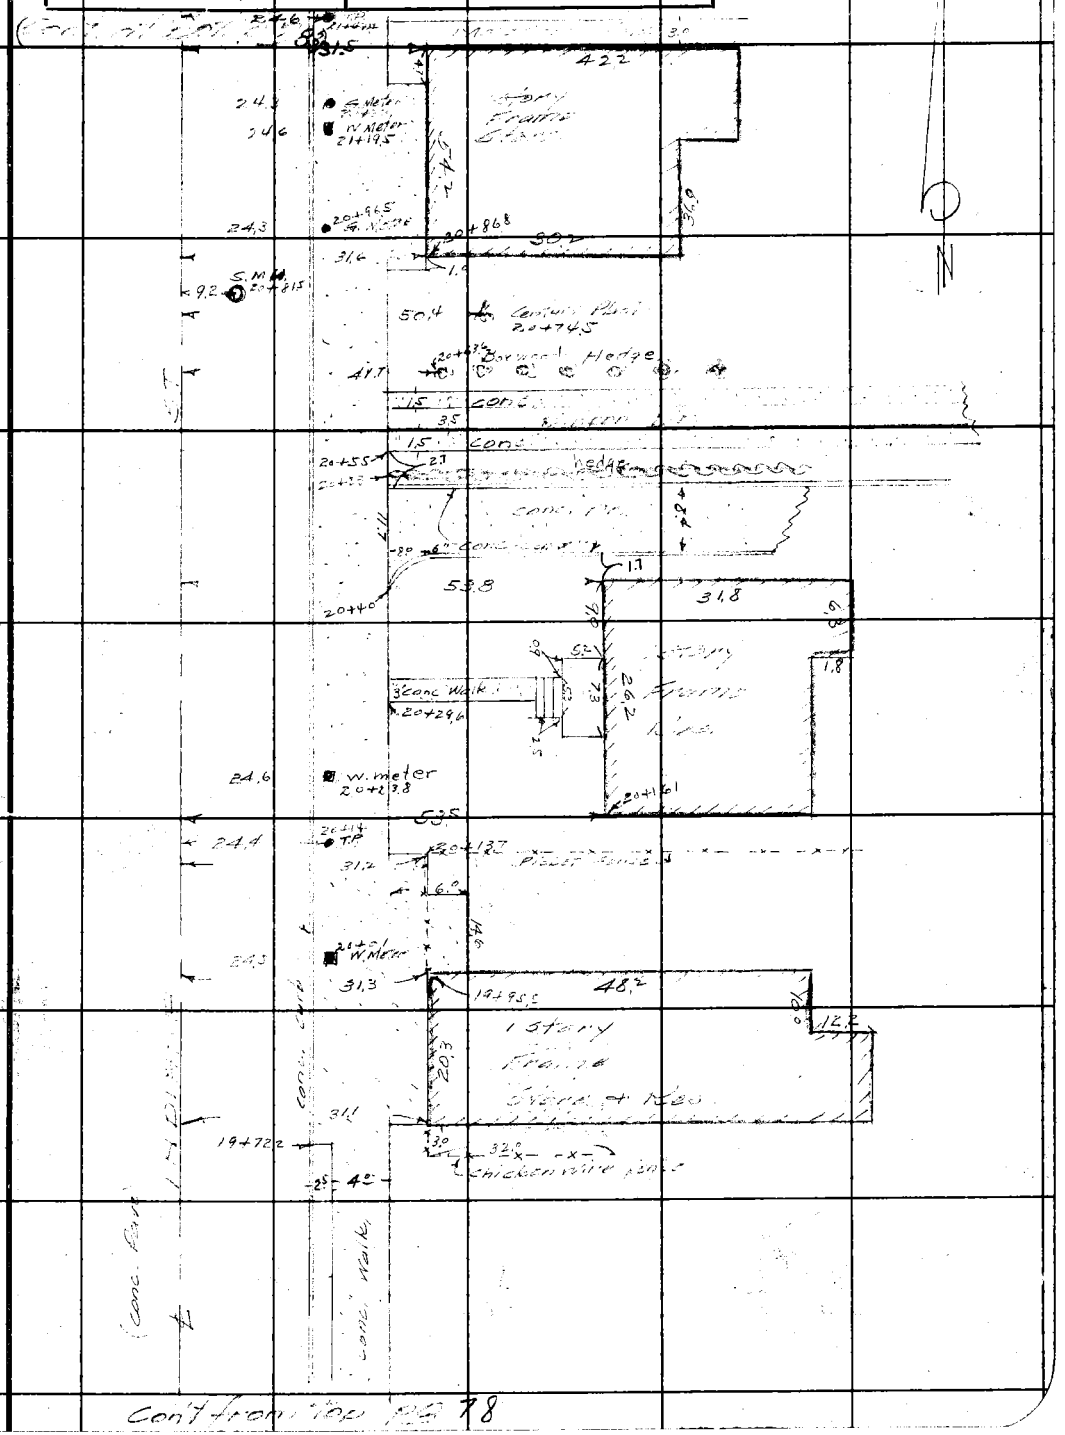

Note: Any Additions or Changes on This Sheets Must be Made or Circled in Red Ink With Date and Name of Person Making Change

Do not extend notes this side of this line

RETURN TO
LOS ANGELES COUNTY SURVEYOR
700 HALL OF RECORDS

FORM 247 SM 10-37

Cont'd on top of 78

F.B. 772 PG. 82

RETURN TO
LOS ANGELES COUNTY SURVEYOR
700 HALL OF RECORDS

Note: Any Additions or Changes on This Sheets Must be Made or Circled in **Red Ink** With Date and Name of Person Making Change.

Do not extend notes this side of this line

Notes Ck'd by D. M. Finley	Survey of [illegible]	F.B. 777 Pg. 82
Map No. B-1465-1	W. O. 8226 Tape No. ____ St'd ____ of	
Office Work F. A. W.	Surveyed by Evans	
Checked D. M. Finley	Notes [illegible] Date '39	
Date Jan. 1941	Indexed	

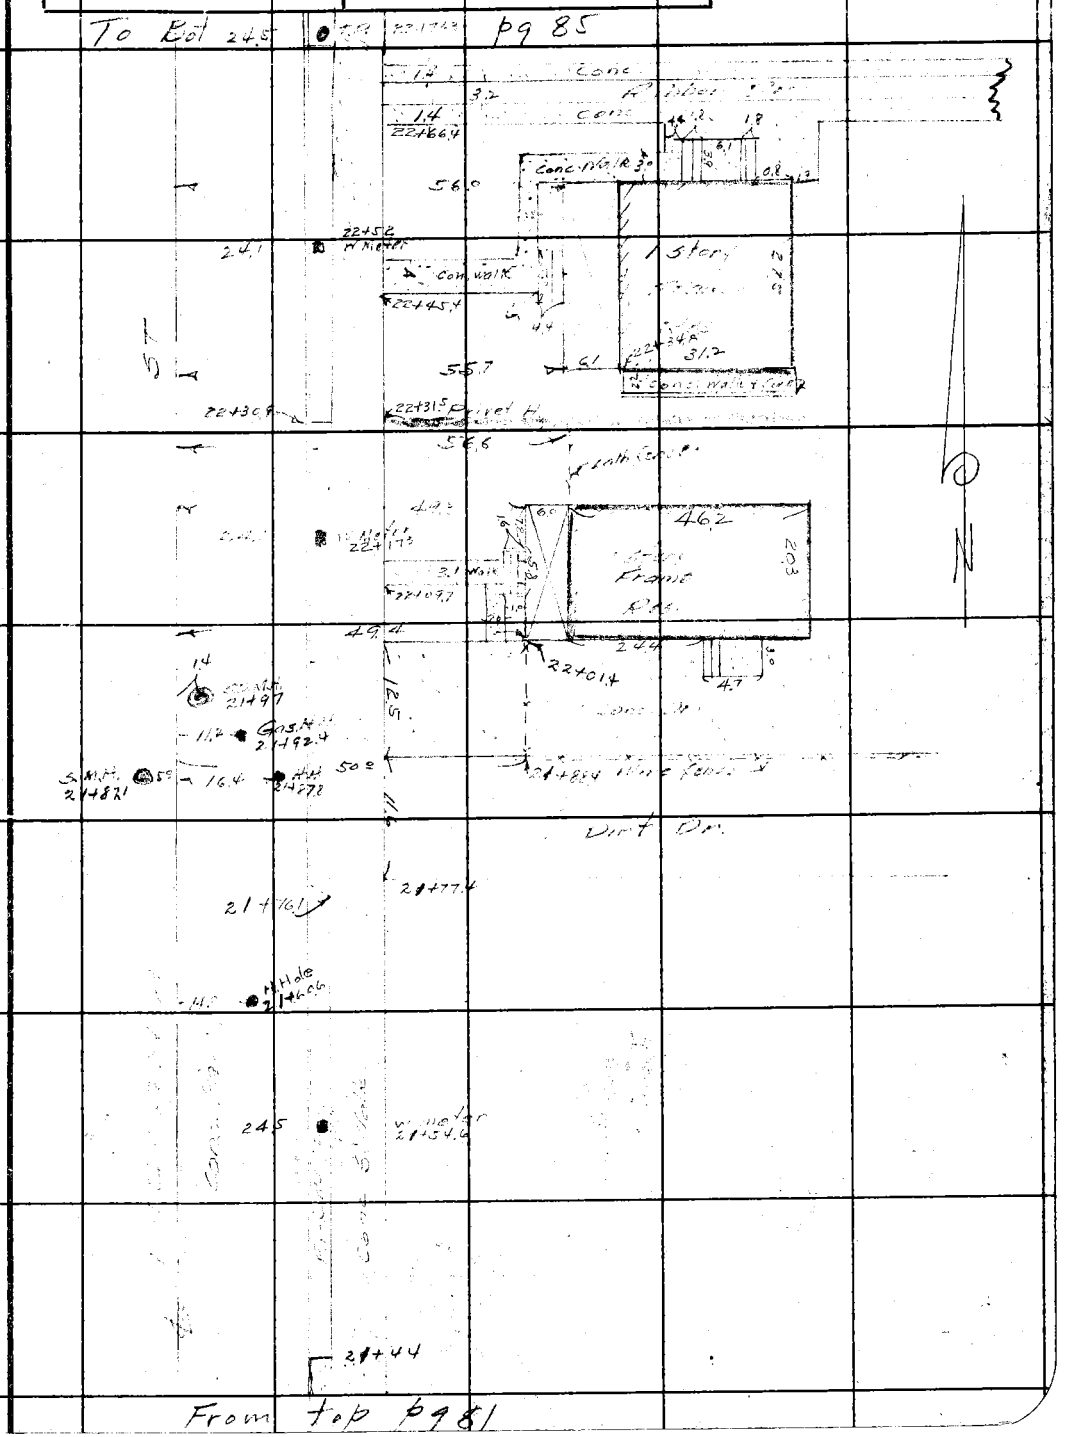

Note: Any Additions or Changes on This Sheets Must be Made or Circled in Red Ink With Date and Name of Person Making Change.

Do not extend notes this side of this line

RETURN TO
LOS ANGELES COUNTY SURVEYOR
700 HALL OF RECORDS

FORM 247 5M 10-37

F.B. 772 PG. 84

cont. at bot. p386

RETURN TO
LOS ANGELES COUNTY SURVEYOR
700 HALL OF RECORDS

Note: Any Additions or Changes on This Sheets Must be Made or Circled in Red Ink With Date and Name of Person Making Change.

Do not extend notes this side of this line

cont. from top p382

Notes Ck'd by D. M. Finley	Survey of [illegible]	F.B. 717 Pg. 85
Map No. B-1465.-1	W. O. 8226 Tape No. ____ St'd ____ of	
Office Work F. A. W.	Surveyed by Evans	
Checked D. M. Finley	Notes Brock Date '39	
Date Jan 1941	Indexed [illegible]	

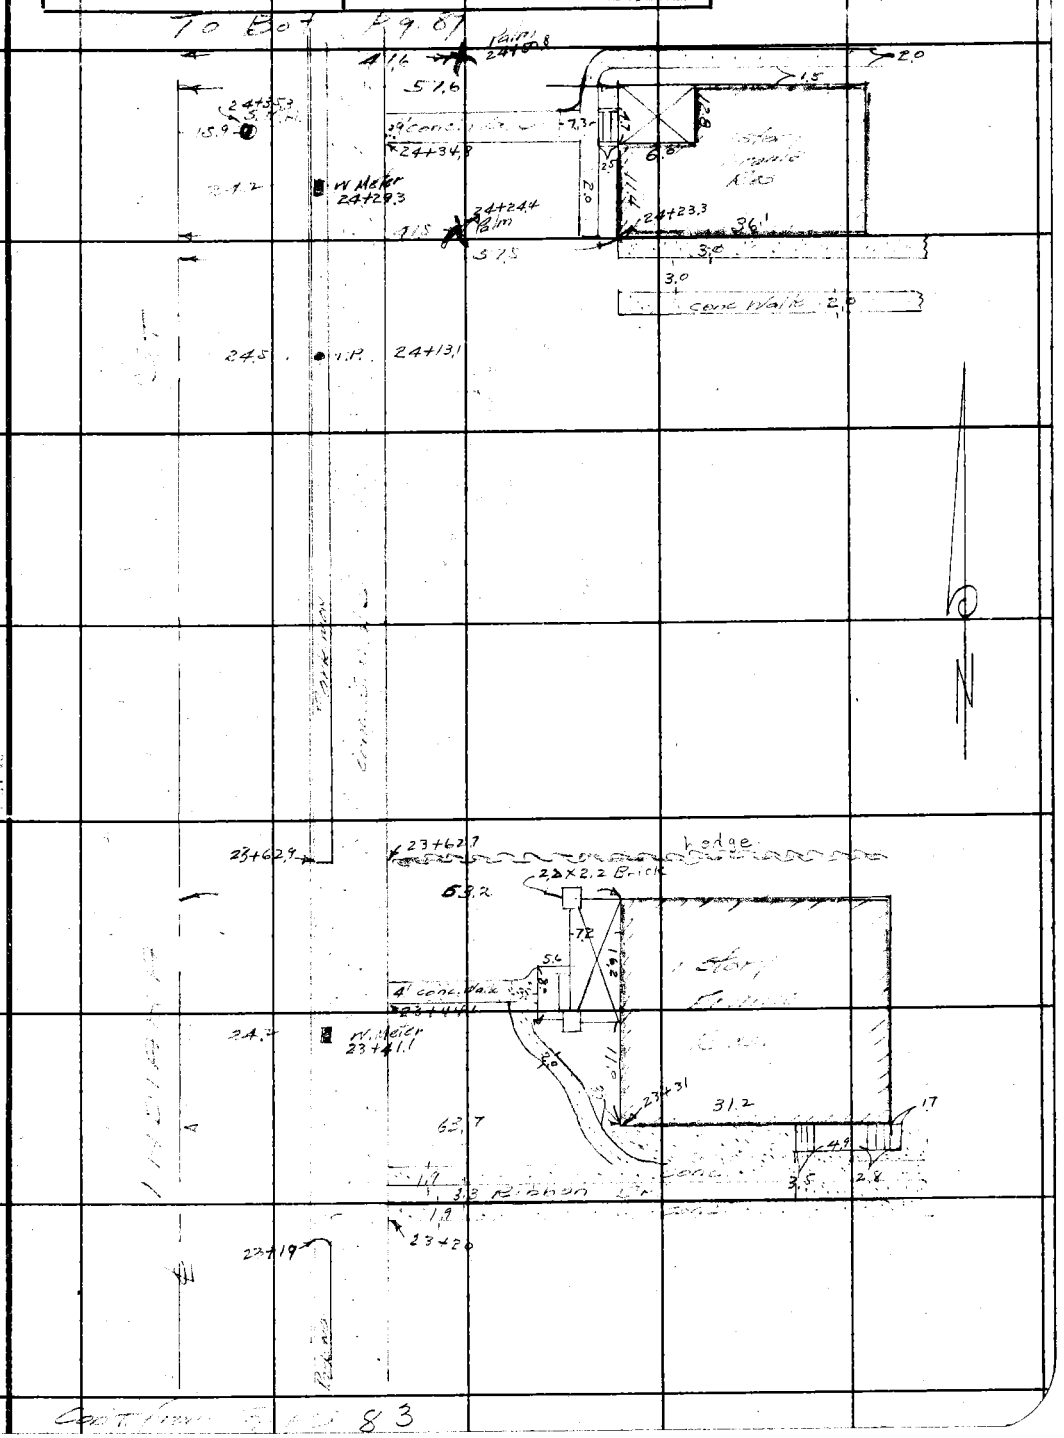

Note: Any Additions or Changes on This Sheets Must be Made or Circled in Red Ink With Date and Name of Person Making Change.

Do not extend notes this side of this line

RETURN TO
LOS ANGELES COUNTY SURVEYOR
700 HALL OF RECORDS

FORM 247 5M 10-37

Cont. from [illegible] 83

To Bat pg 88

F.B. 772 PG. 86

RETURN TO
LOS ANGELES COUNTY SURVEYOR
700 HALL OF RECORDS

Note: Any Additions or Changes on This Sheets Must be Made or Circled in Red Ink With Date and Name of Person Making Change.

Do not extend notes this side of this line

From Bk pg 84

To Bot pg. 89

Notes Ck'd by D. M. Finley	Survey of [illegible]	F.B. 772 Pg. 87
Map No. B-1465-1	W. O. [illegible] Tape No. ____ St'd ____ °F	
Office Work F. A. W.	Surveyed by [illegible]	
Checked D. M. Finley	Notes [illegible] Date 39	
Date Jan. 1941	Indexed [illegible]	

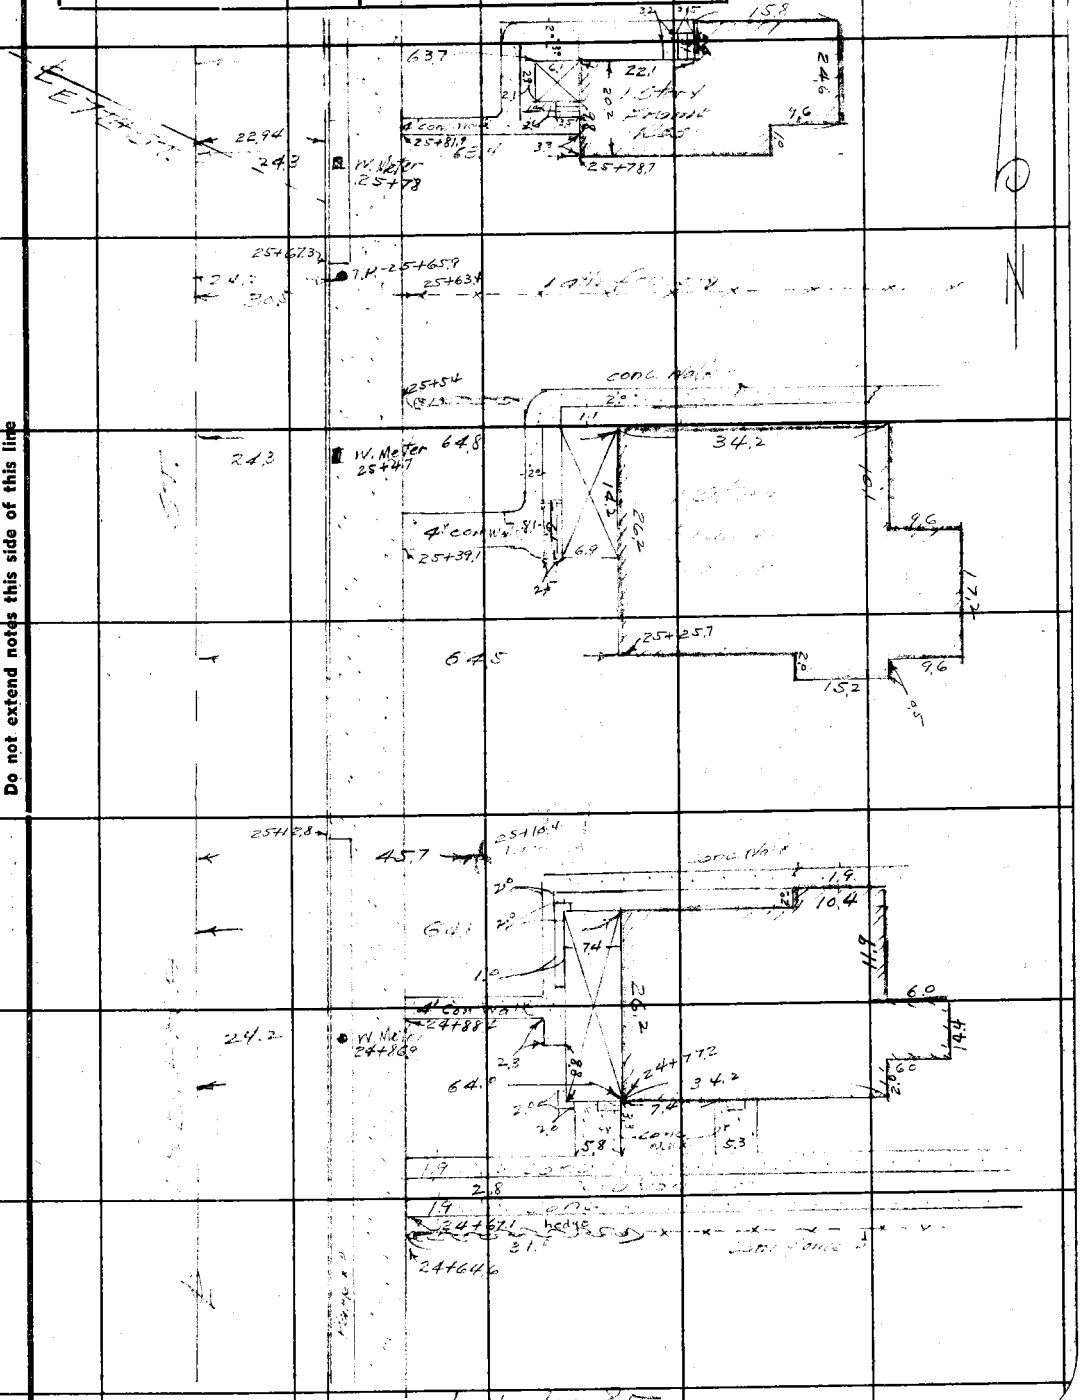

From top pg. 85

Note: Any Additions or Changes on This Sheets Must be Made or Circled in Red Ink With Date and Name of Person Making Change.

Do not extend notes this side of this line

RETURN TO
LOS ANGELES COUNTY SURVEYOR
700 HALL OF RECORDS

FORM 247 5M 10-37

To Bot pg 90

F.B. 772 PG. 88

From top pg 86

RETURN TO
LOS ANGELES COUNTY SURVEYOR
700 HALL OF RECORDS

Note: Any Additions or Changes on This Sheets Must be Made or Circled in Red Ink With Date and Name of Person Making Change.

Do not extend notes this side of this line

To Bk 69, 91

Notes Ck'd by D. M. Finley	Survey of		F.B. 177 Pg. 89
Map No. B-1465-1	W. O. 3221	Tape No.	St'd of
Office Work F. A. W.	Surveyed by Evans		
Checked D. M. Finley	Notes [illegible]	Date 39	
Date Jan. 1941	Indexed		

Note: Any Additions or Changes on This Sheets Must be Made or Circled in Red Ink With Date and Name of Person Making Change.

Do not extend notes this side of this line

RETURN TO
LOS ANGELES COUNTY SURVEYOR
700 HALL OF RECORDS

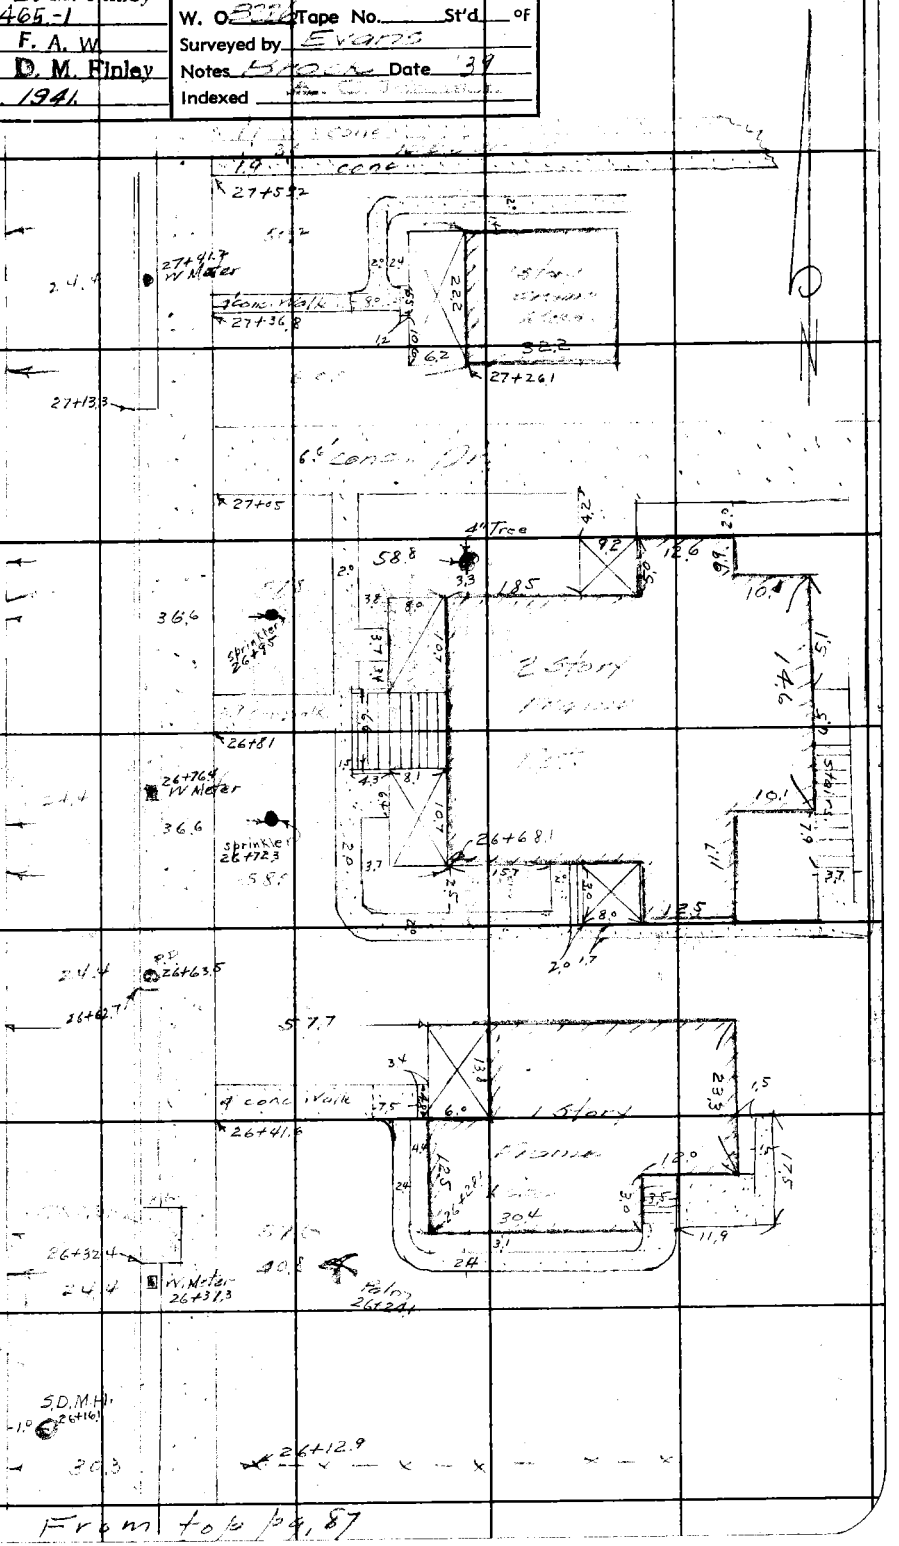

From to bk 87

FORM 247 5M 10-37

To Bot Pg 92

F.B. 772 PG. 90

RETURN TO
LOS ANGELES COUNTY SURVEYOR
700 HALL OF RECORDS

Do not extend notes this side of this line

Note: Any Additions or Changes on This Sheets Must be Made or Circled in **Red Ink** With Date and Name of Person Making Change.

To Bk 1 Pg 93

Notes Ck'd by D. M. Finley	Survey of		F.B. 772 Pg 91
Map No. B-1465-1	W. Q. SC2	Tape No.	St'd OF
Office Work F. A. W.	Surveyed by		
Checked D. M. Finley	Notes	Date 37	
Date Jan. 1941	Indexed		

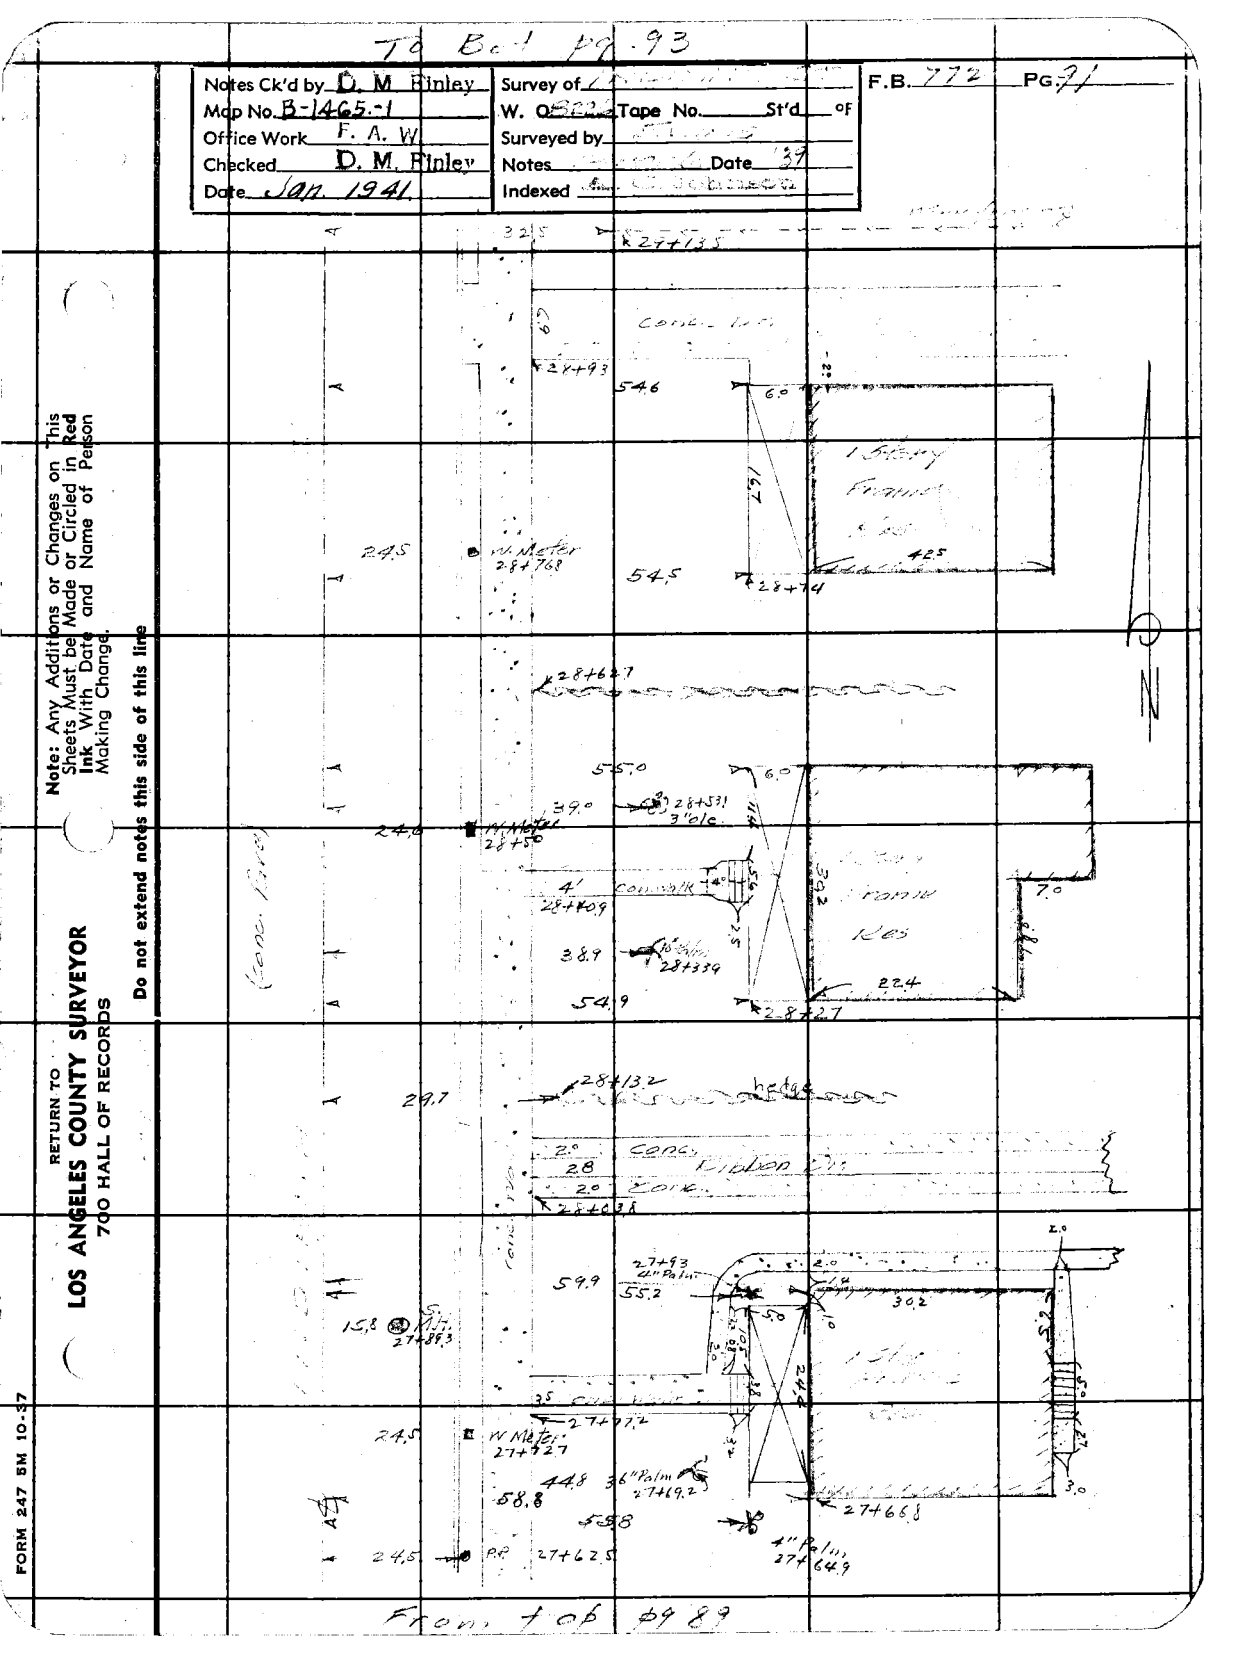

Note: Any Additions or Changes on This Sheets Must be Made or Circled in Red Ink With Date and Name of Person Making Change.

Do not extend notes this side of this line

RETURN TO
LOS ANGELES COUNTY SURVEYOR
700 HALL OF RECORDS

FORM 247 5M 10-37

From 406 4989

RETURN TO
LOS ANGELES COUNTY SURVEYOR
700 HALL OF RECORDS

Note: Any Additions or Changes on This Sheets Must be Made or Circled in **Red Ink** With Date and Name of Person Making Change.

Do not extend notes this side of this line

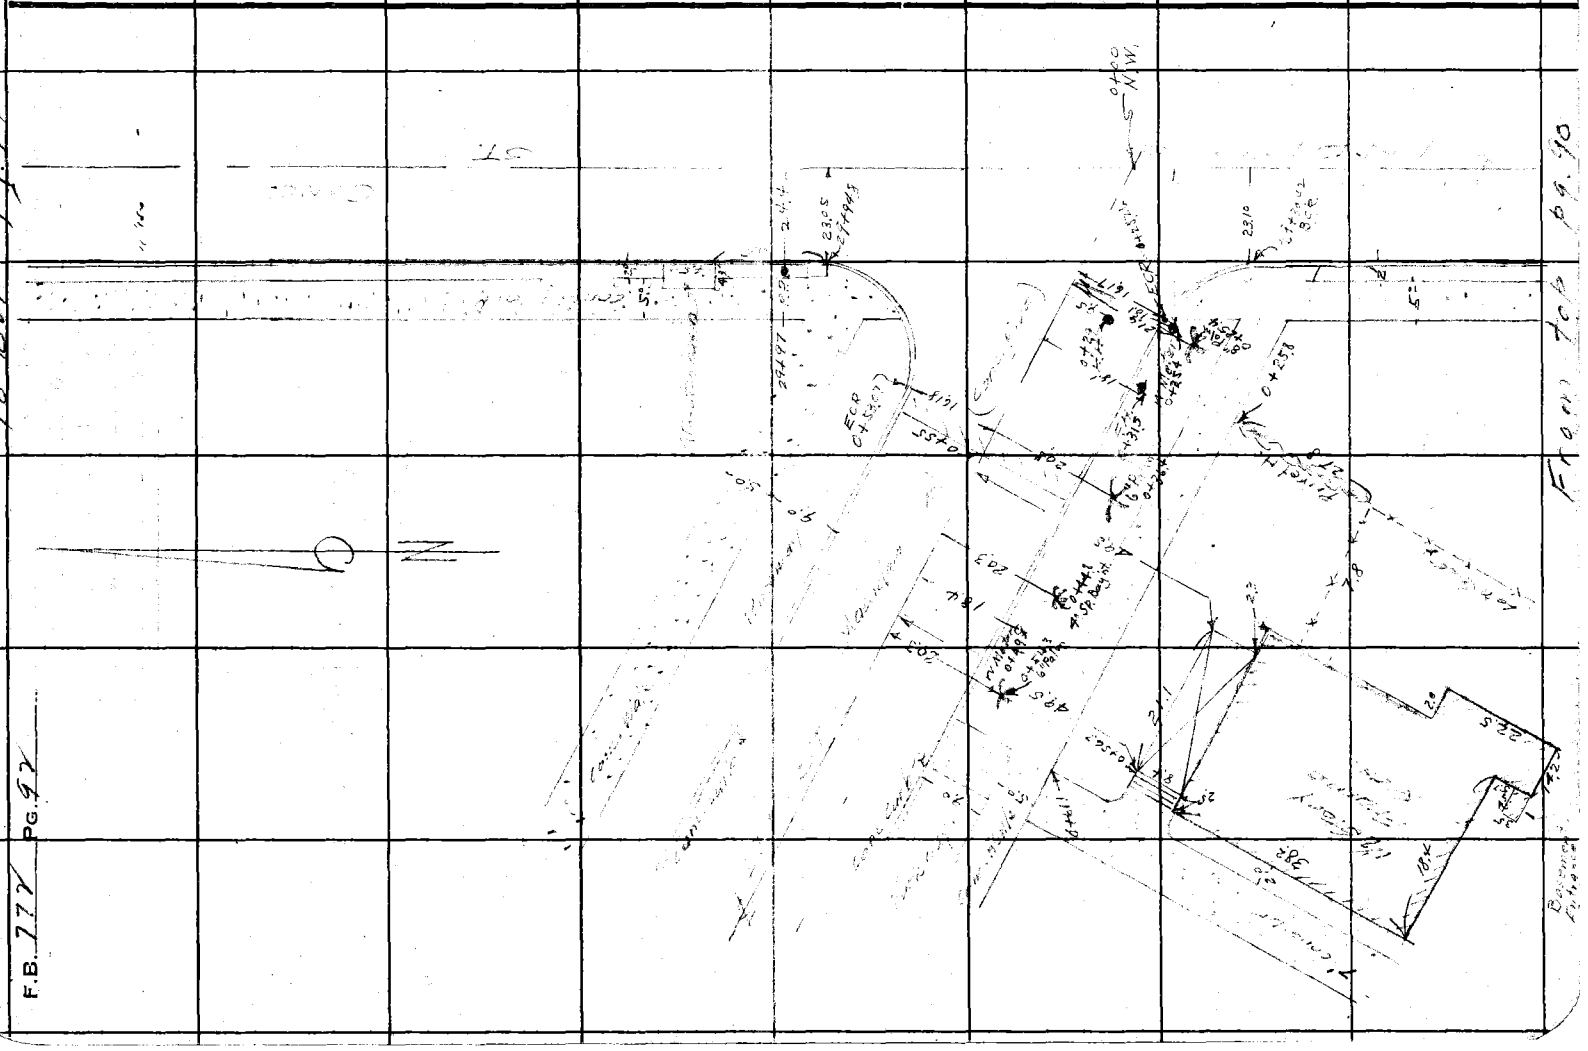

Notes Ck'd by D. M. Finley	Survey of [illegible]	F.B. 272 PG. 93
Map No. B-1465:1	W. O. 8224 Tape No. ____ St'd ____ °F	
Office Work F. A. W.	Surveyed by [illegible]	
Checked D. M. Finley	Notes [illegible] Date '39	
Date Jan. 1941	Indexed [illegible]	

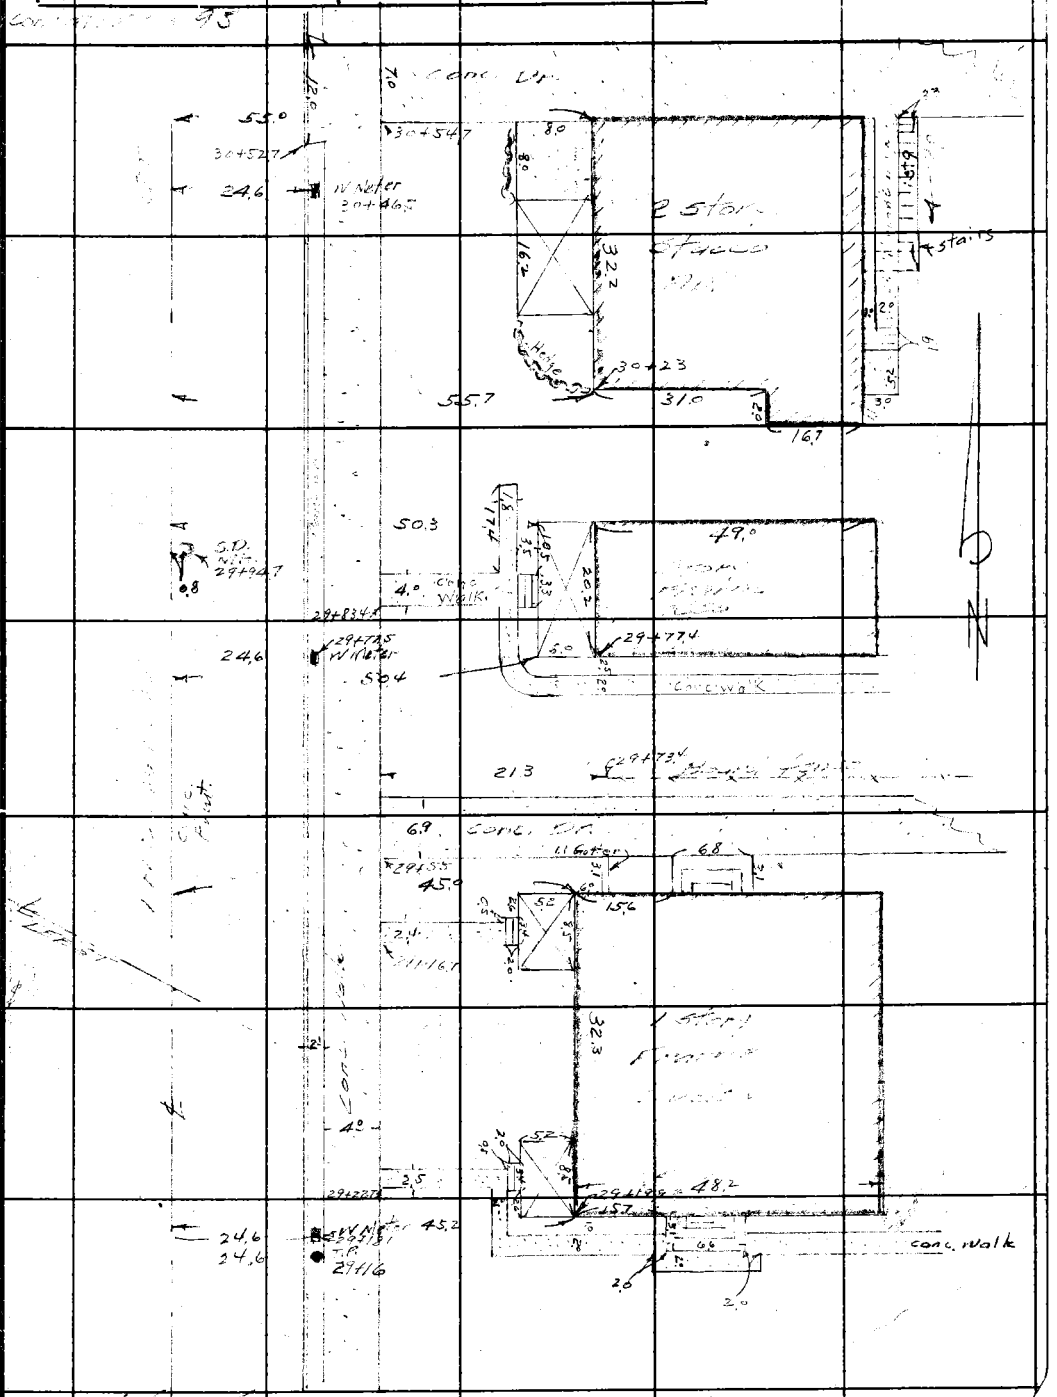

Note: Any Additions or Changes on This Sheets Must be Made or Circled in Red Ink With Date and Name of Person Making Change.

Do not extend notes this side of this line

RETURN TO
LOS ANGELES COUNTY SURVEYOR
700 HALL OF RECORDS

FORM 247 5M 10-37

cont from Top pg 91

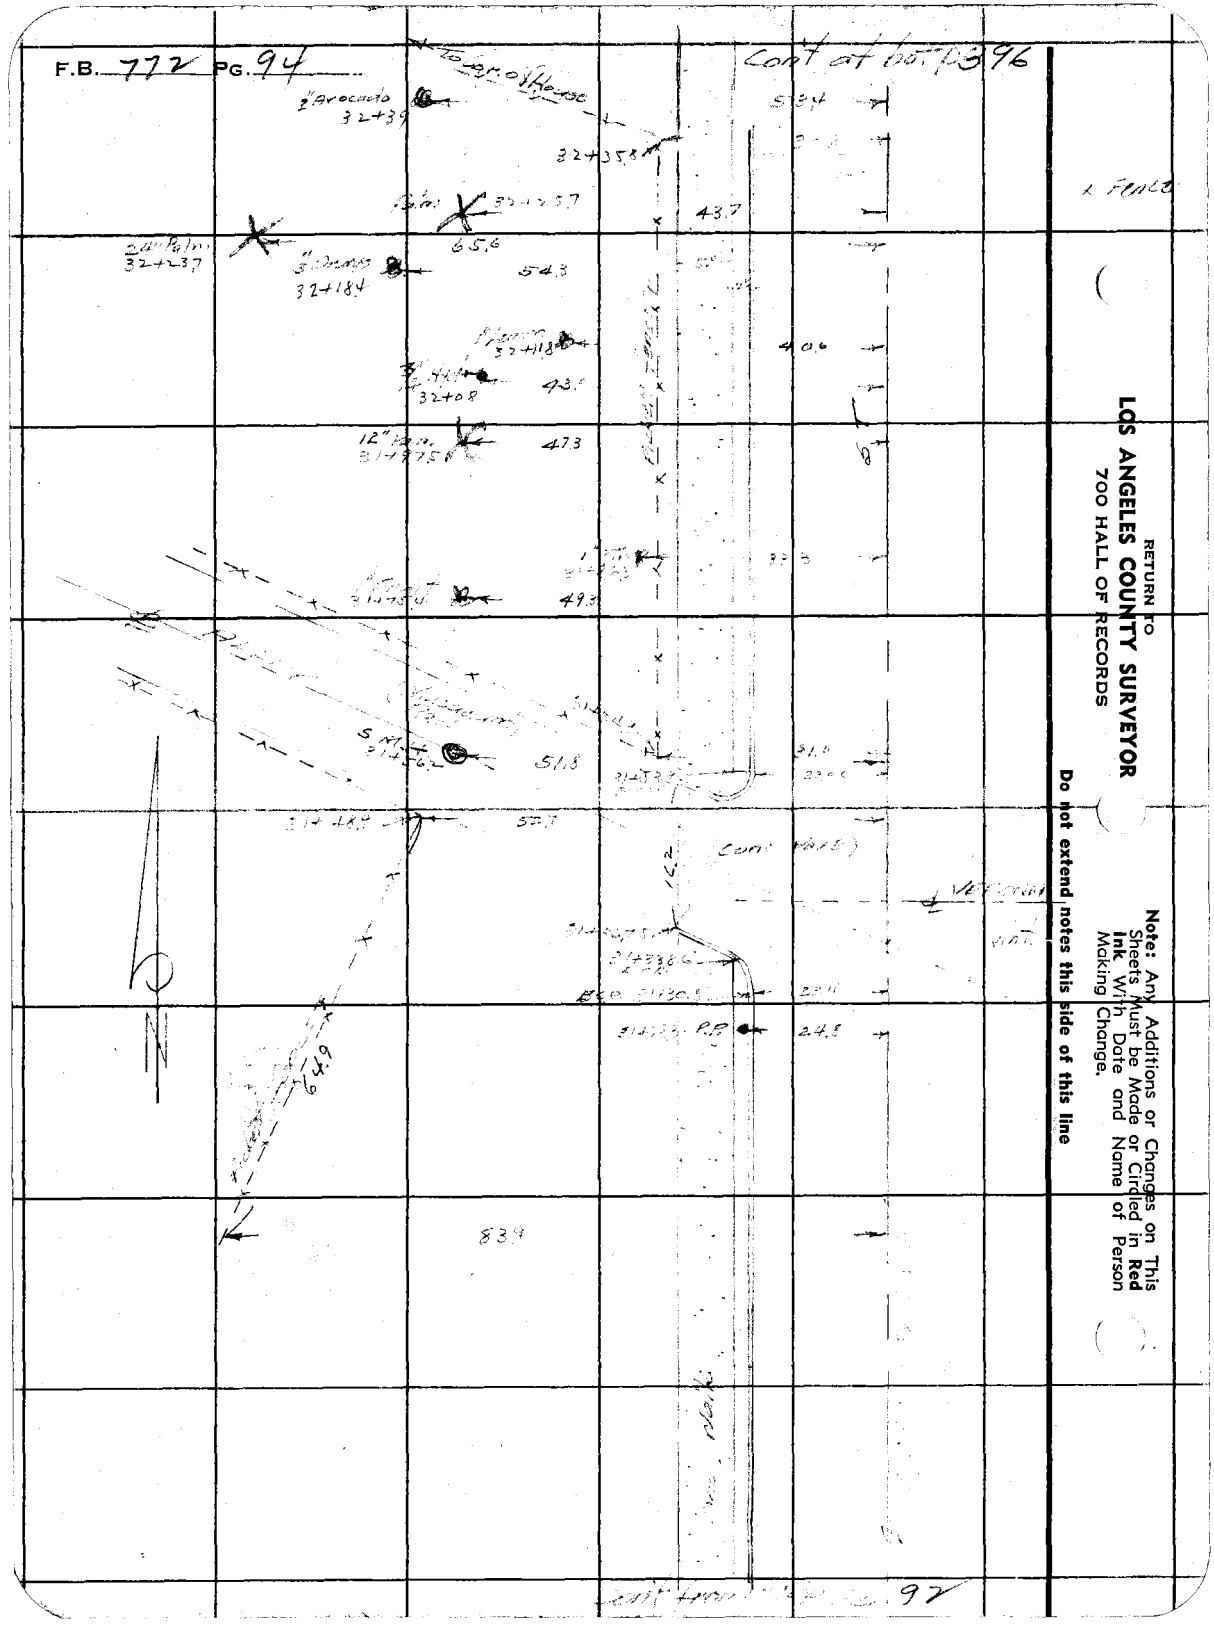

RETURN TO
LOS ANGELES COUNTY SURVEYOR
700 HALL OF RECORDS

Note: Any Additions or Changes on This Sheets Must be Made or Circled in **Red Ink** With Date and Name of Person Making Change.

Do not extend notes this side of this line

Notes Ck'd by D. M. Finley	Survey of [illegible]	F.B. 172 PG. 95
Map No. B-1465-1	W. O. [illegible] Tape No. ____ St'd ____ of	
Office Work F. A. W.	Surveyed by [illegible]	
Checked D. M. Finley	Notes [illegible] Date '39	
Date Jan 1941	Indexed [illegible]	

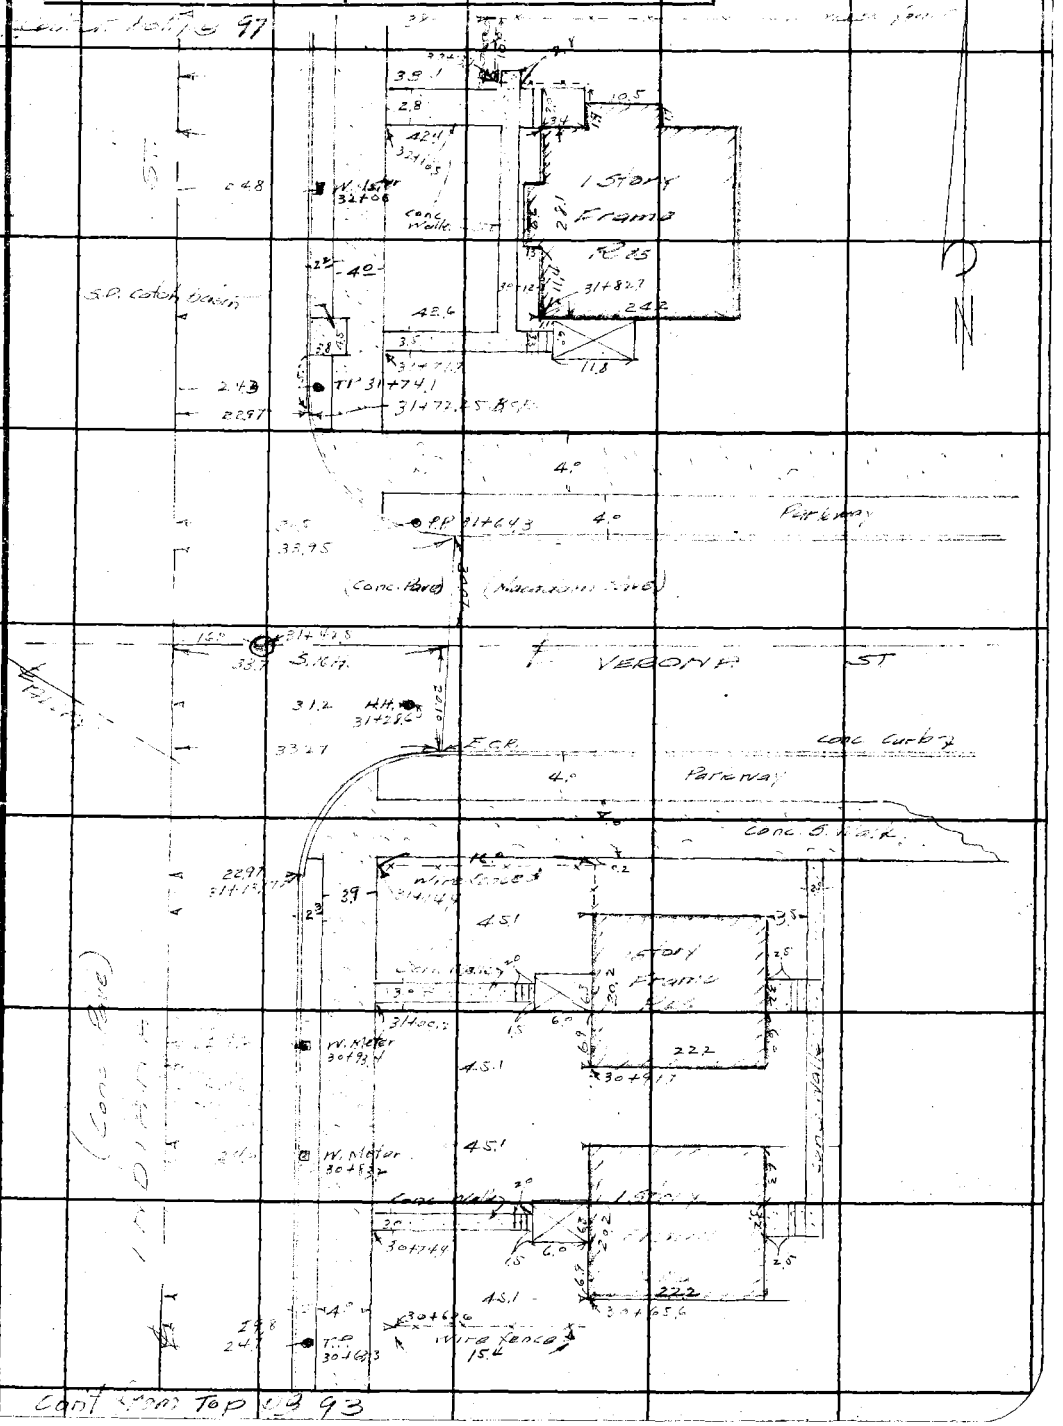

Note: Any Additions or Changes on This Sheets Must be Made or Circled in Red Ink With Date and Name of Person Making Change.

Do not extend notes this side of this line

RETURN TO
LOS ANGELES COUNTY SURVEYOR
700 HALL OF RECORDS

FORM 247 5M 10-37

RETURN TO
LOS ANGELES COUNTY SURVEYOR
700 HALL OF RECORDS

Note: Any Additions or Changes on This Sheets Must be Made or Circled in **Red Ink** With Date and Name of Person Making Change.

Do not extend notes this side of this line

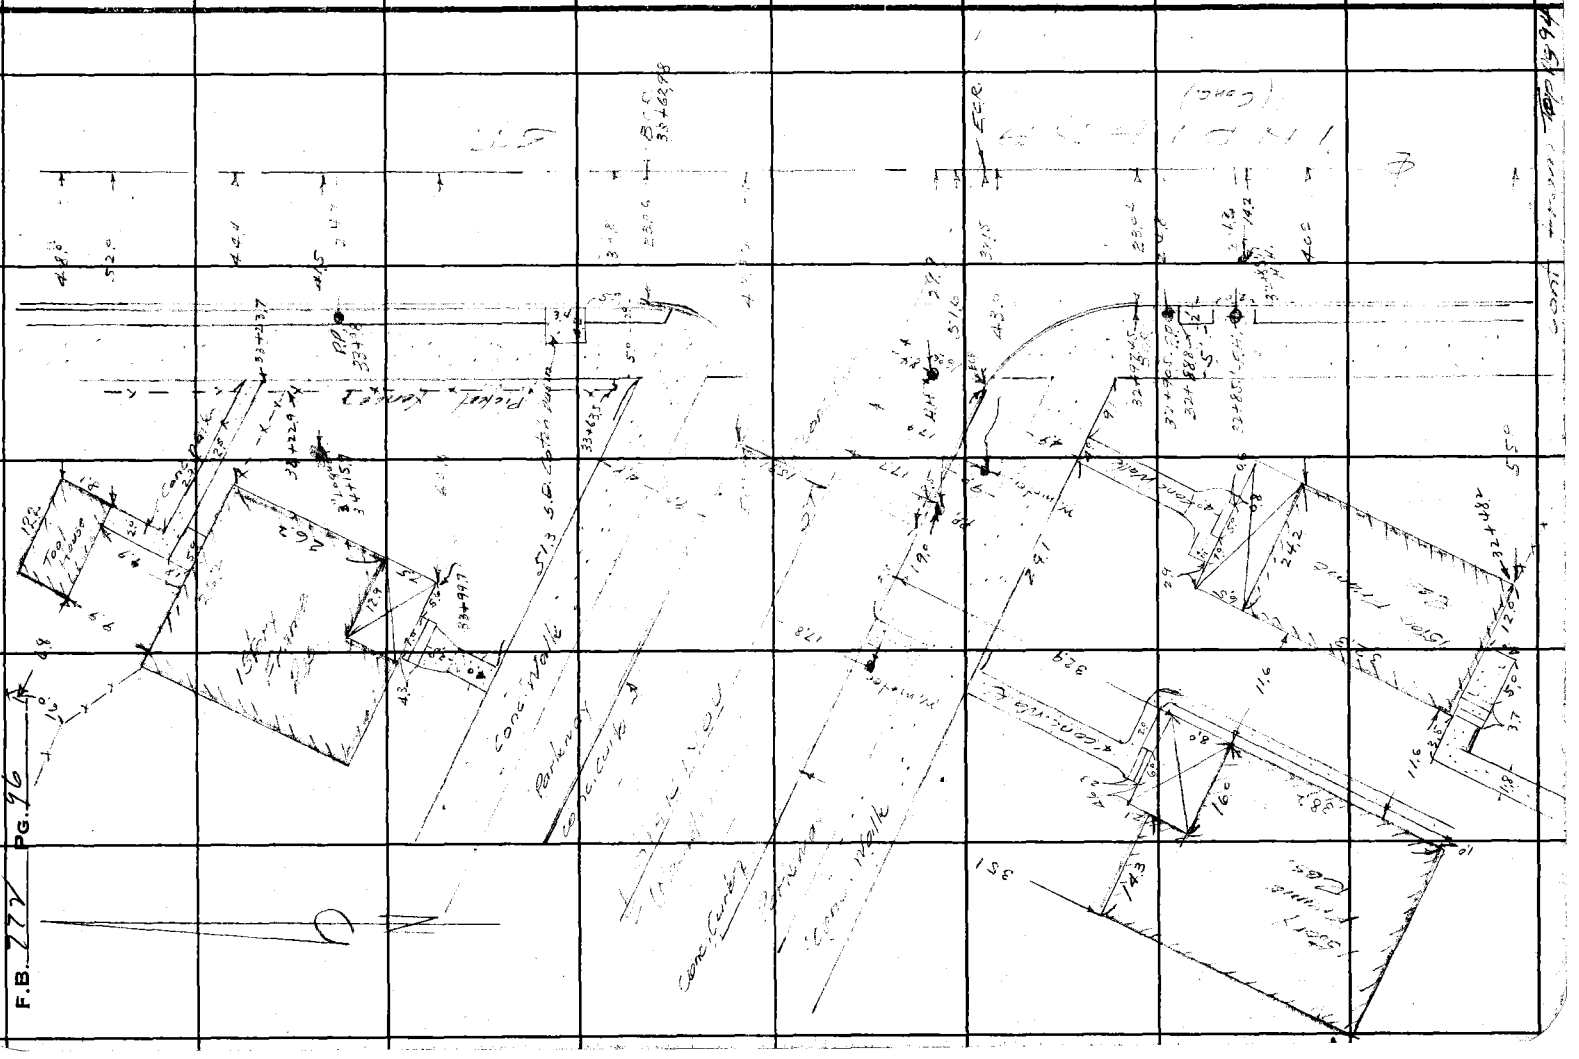

Notes Ck'd by D. M. Finley
Map No. B-1465-1
Office Work F. A. W.
Checked D. M. Finley
Date Jan. 1941

Survey of Indiana St
W. O. 8226 Tape No. St'd of
Surveyed by [illegible]
Notes [illegible] Date '39
Indexed [illegible]

F.B. 772 PG. 97

Note: Any Additions or Changes on This Sheets Must be Made or Circled in Red Ink With Date and Name of Person Making Change.

Do not extend notes this side of this line

RETURN TO
LOS ANGELES COUNTY SURVEYOR
700 HALL OF RECORDS

FORM 247 5M 10-37

RETURN TO
LOS ANGELES COUNTY SURVEYOR
700 HALL OF RECORDS

Note: Any Additions or Changes on This Sheets Must be Made or Circled in **Red Ink** With Date and Name of Person Making Change.

Do not extend notes this side of this line

F.B. 777 PG. 98

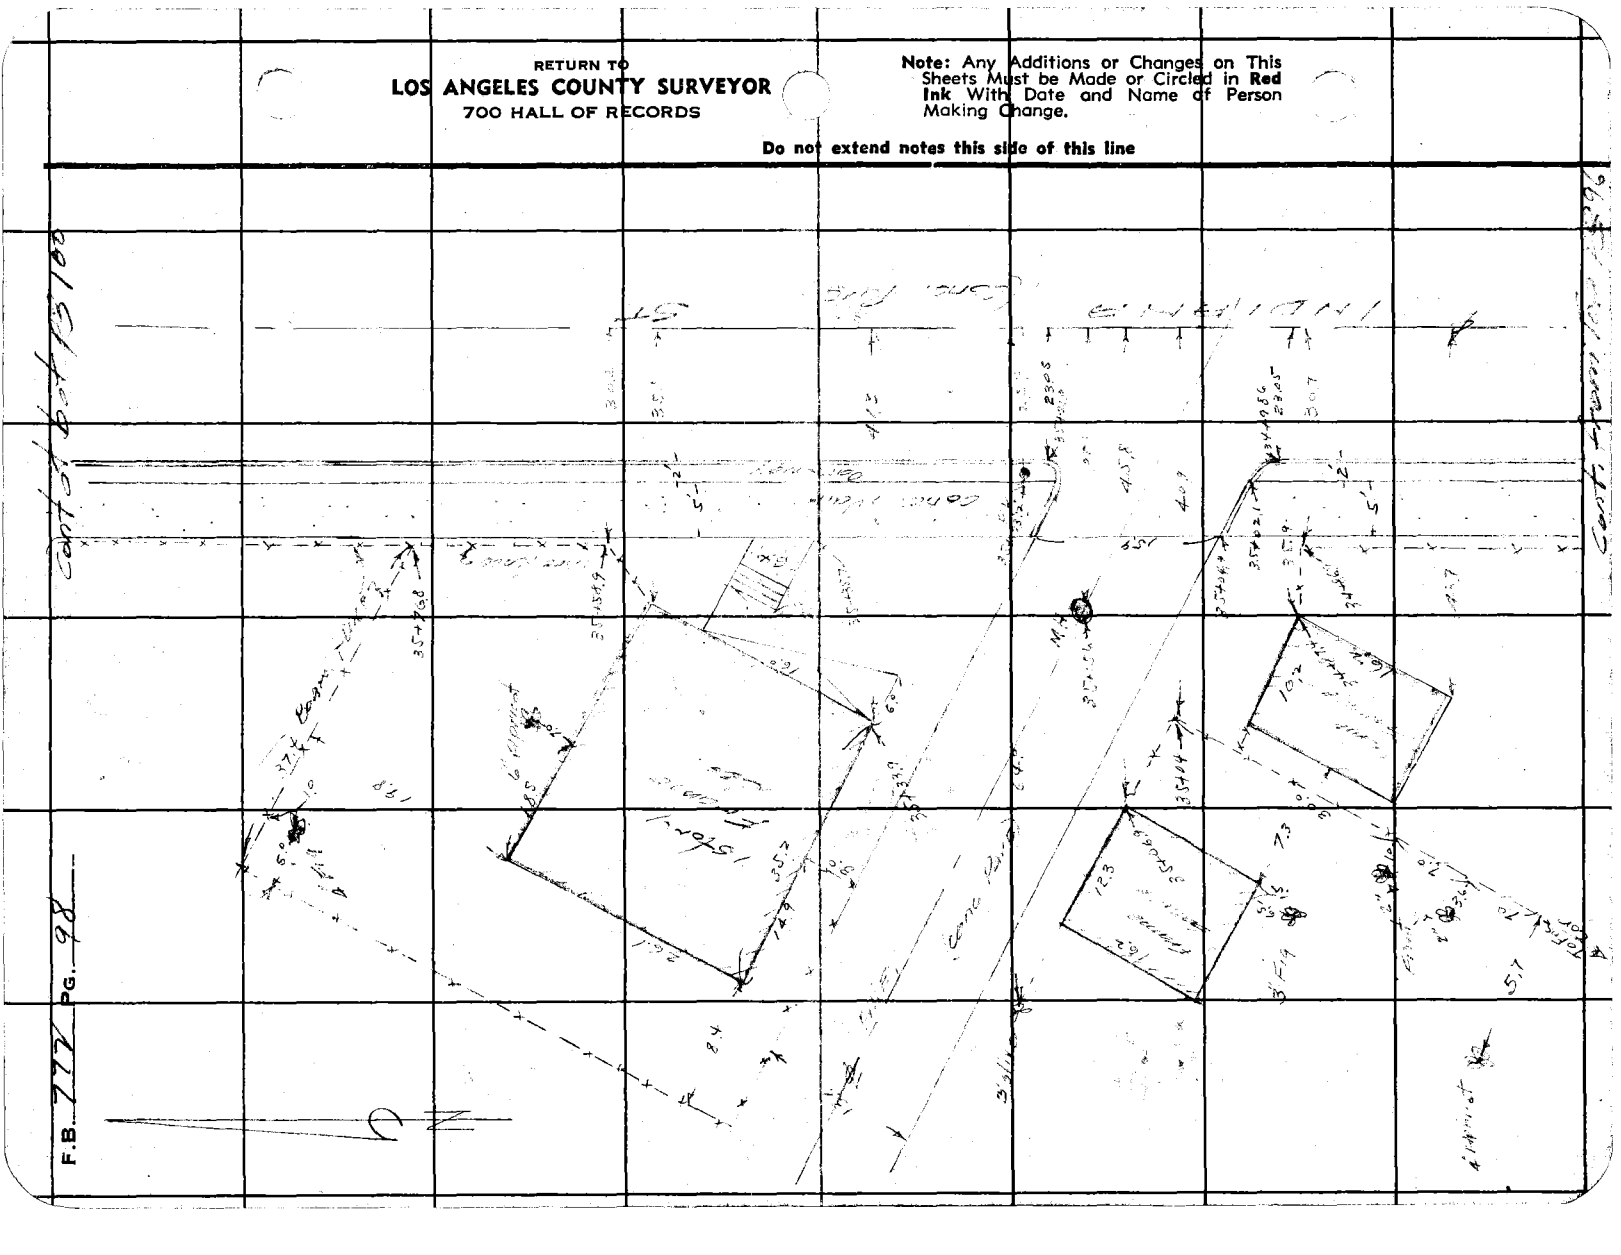

To Bot pg. 101

Notes Ck'd by D. M. Finley	Survey of [illegible]	F.B. 772 Pg. 99
Map No. B-1465-1	W. O. 8226 Tape No. ____ St'd ____ of	
Office Work F. A. W.	Surveyed by Evans	
Checked D. M. Finley	Notes [illegible] Date '39	
Date Jan 1941	Indexed [illegible]	

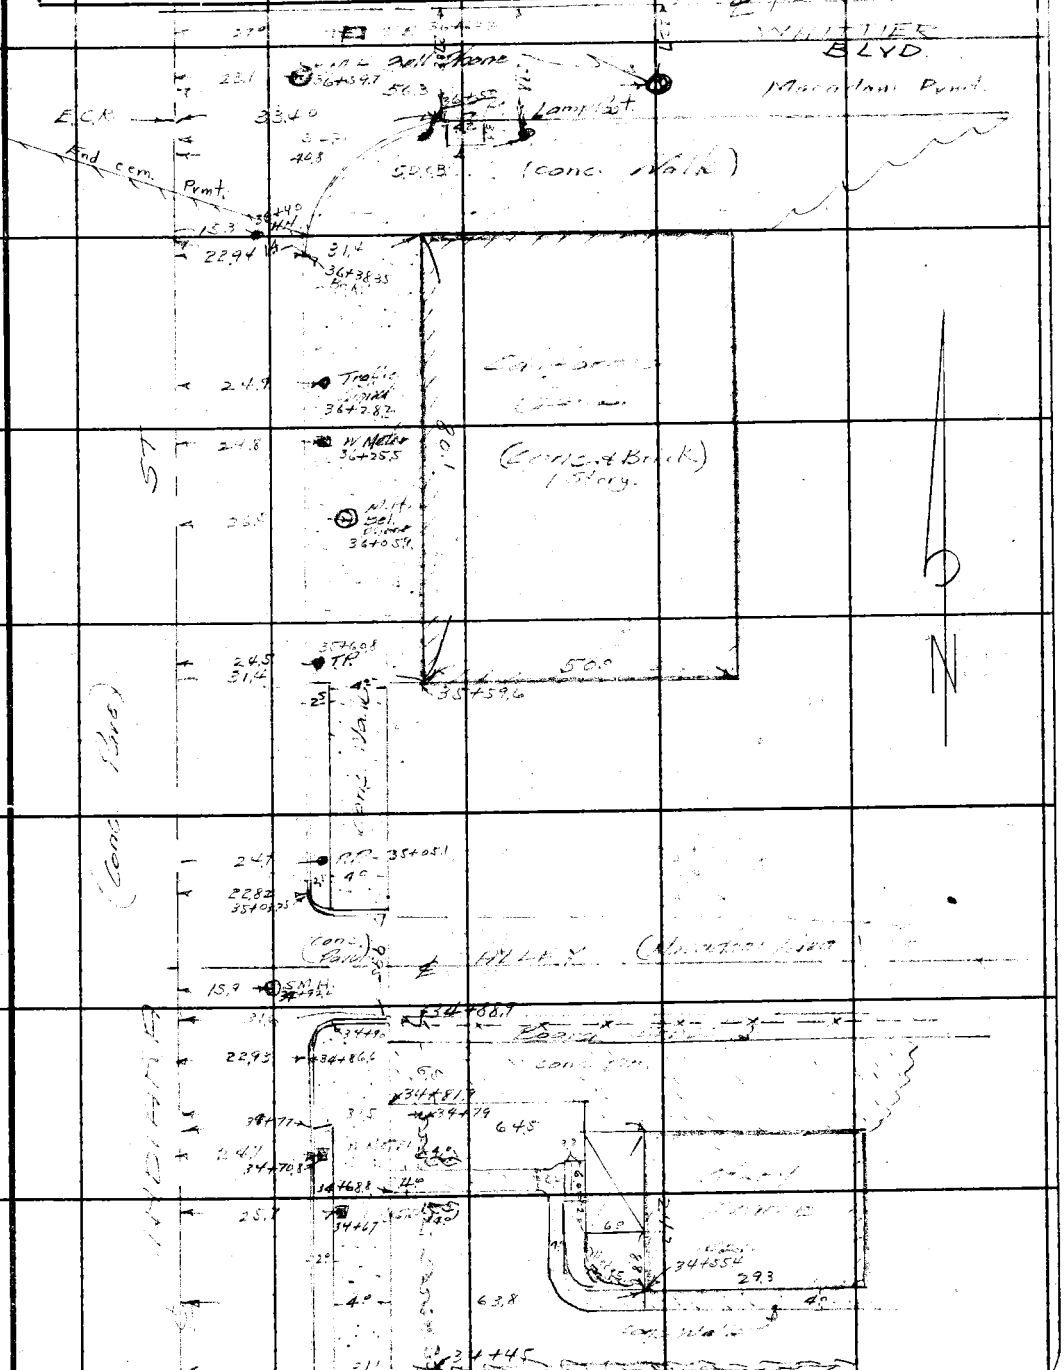

From top pg. 97

Note: Any Additions or Changes on This Sheets Must be Made or Circled in Red Ink With Date and Name of Person Making Change.

Do not extend notes this side of this line

RETURN TO
LOS ANGELES COUNTY SURVEYOR
700 HALL OF RECORDS

FORM 247 5M 10-37

F.B. 772 PG. 100

To Bot. pg 102

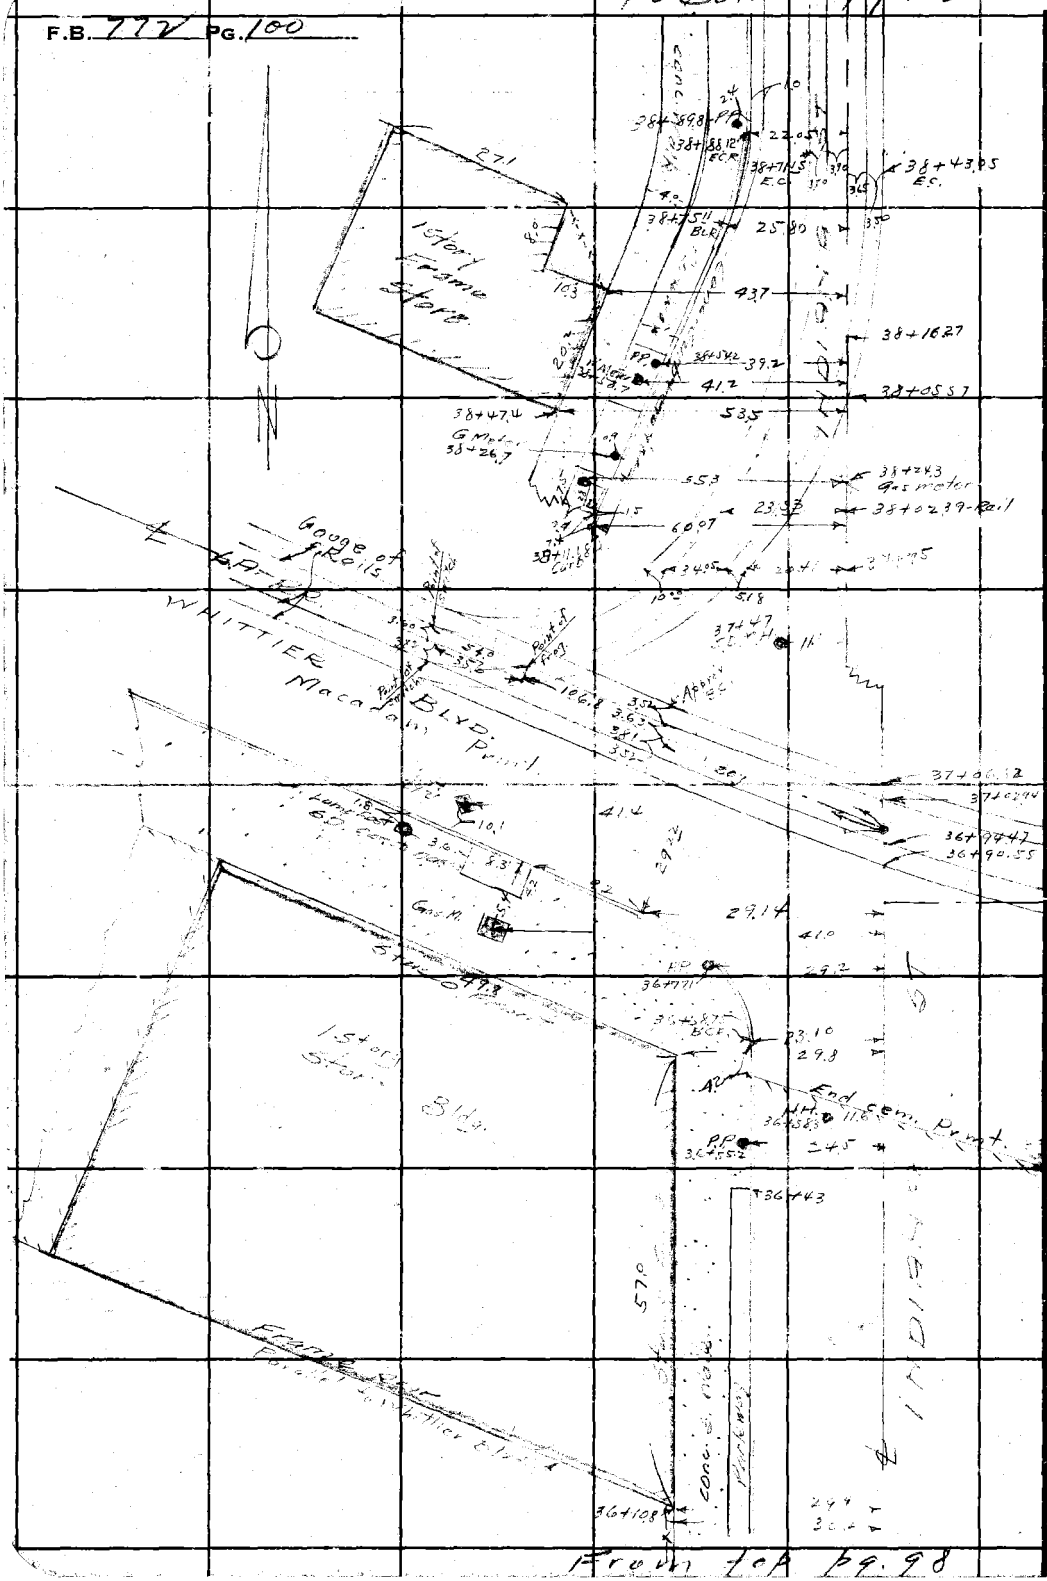

RETURN TO
LOS ANGELES COUNTY SURVEYOR
700 HALL OF RECORDS

Note: Any Additions or Changes on This Sheets Must be Made or Circled in Red Ink With Date and Name of Person Making Change.

Do not extend notes this side of this line

From top pg. 98

To Bd Pg. 103

Notes Ck'd by D. M. Finley	Survey of [illegible]	F.B. 772 Pg. 101
Map No. B-1465-1	W. O. 8226 Tape No. ____ St'd ____ of	
Office Work F. A. W.	Surveyed by Evans	
Checked D. M. Finley	Notes [illegible] Date '39	
Date Jan. 1941	Indexed [illegible]	

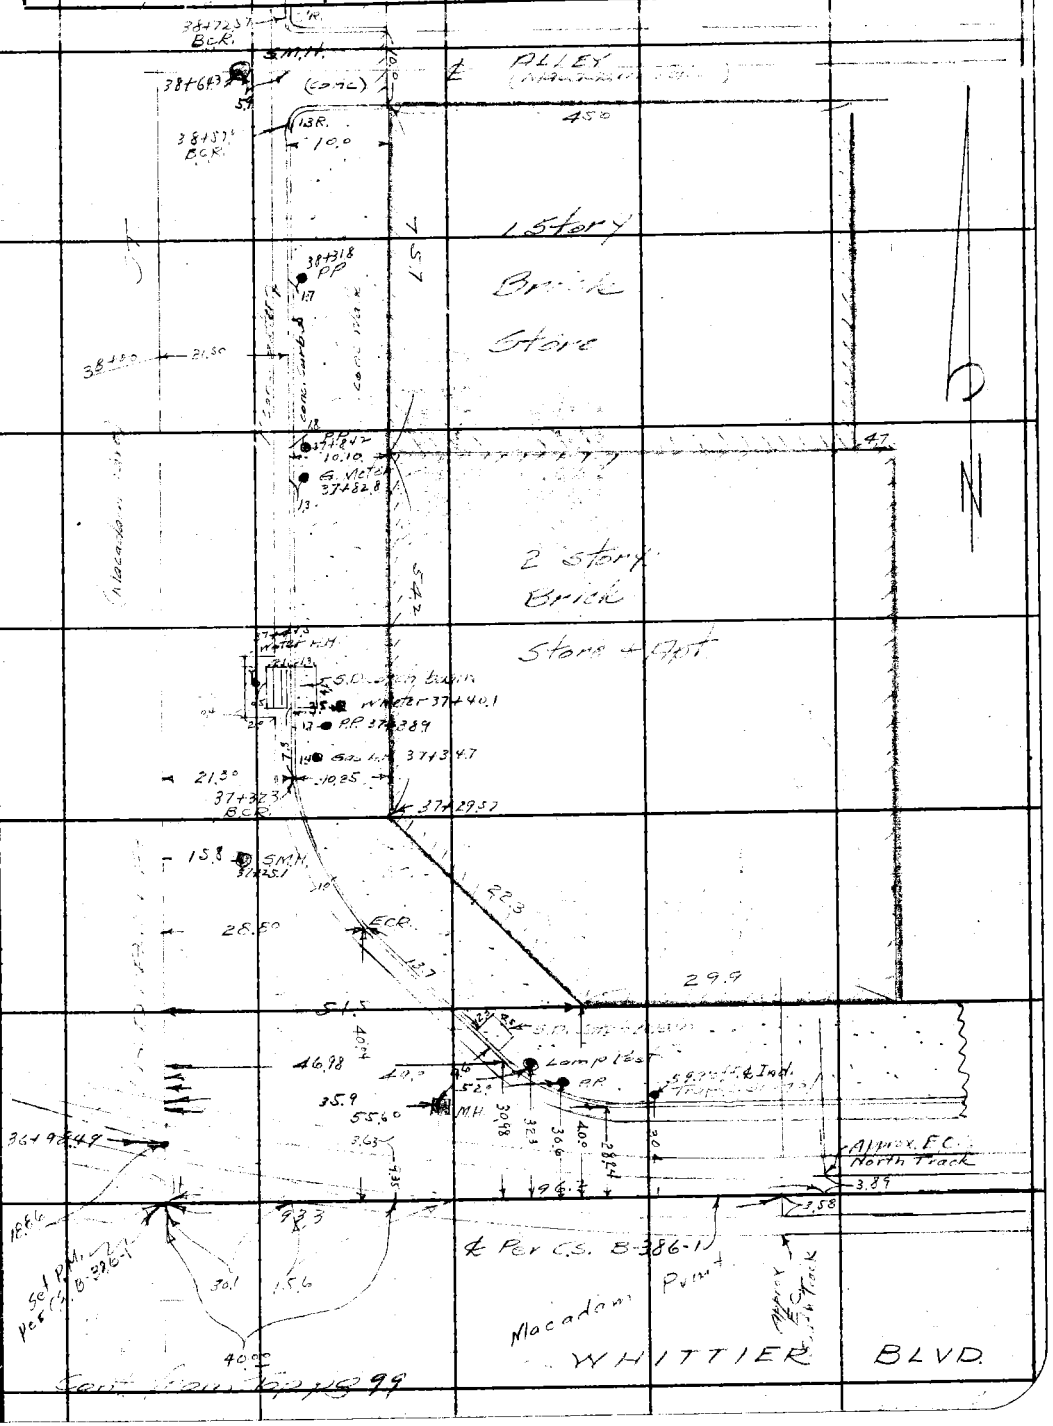

Note: Any Additions or Changes on This Sheets Must be Made or Circled in Red Ink With Date and Name of Person Making Change.

Do not extend notes this side of this line

RETURN TO
LOS ANGELES COUNTY SURVEYOR
700 HALL OF RECORDS

FORM 247 5M 10-37

RETURN TO
LOS ANGELES COUNTY SURVEYOR
700 HALL OF RECORDS

Note: Any Additions or Changes on This Sheets Must be Made or Circled in **Red Ink** With Date and Name of Person Making Change.

Do not extend notes this side of this line

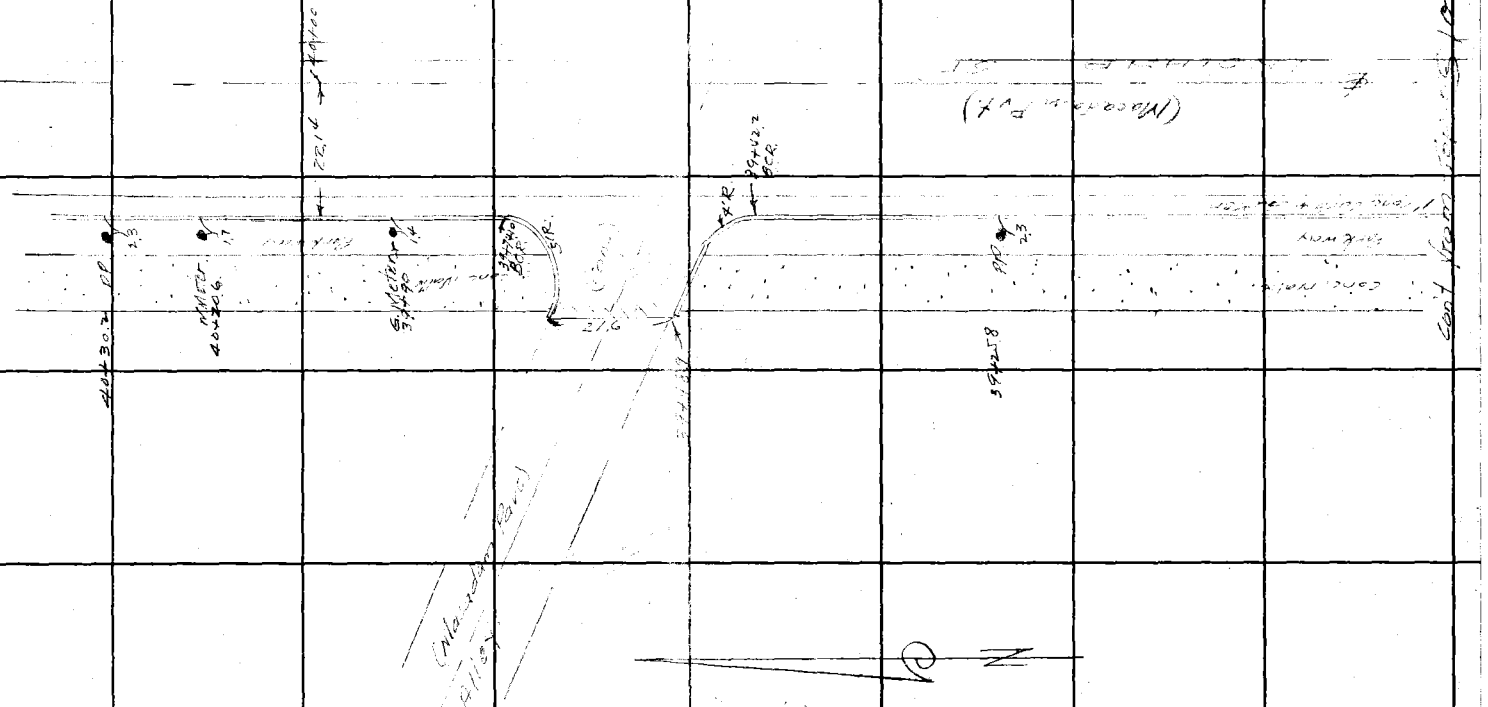

F.B. 777 Pg. 105

Notes Ck'd by D. M. Finley	Survey of			F.B. 772	Pg. 103
Map No. B-1465-1	W. O. 3226	Tape No.	St'd.	of	
Office Work F. A. W.	Surveyed by				
Checked D. M. Finley	Notes	Date 1939			
Date Jan 1941.	Indexed				

105

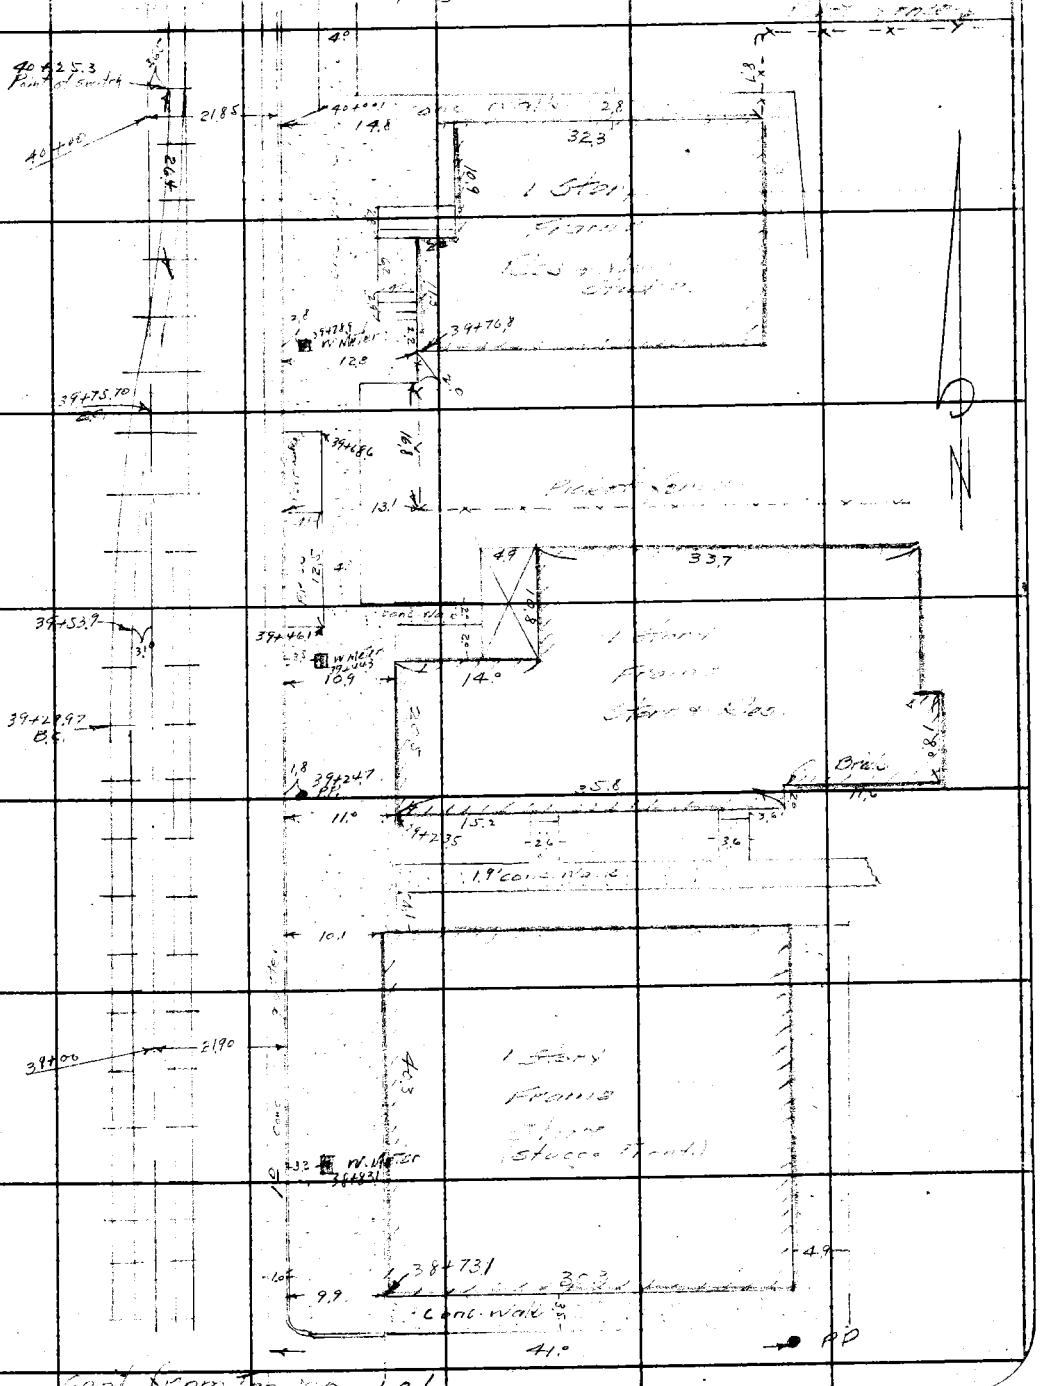

Note: Any Additions or Changes on This Sheets Must be Made or Circled in Red Ink With Date and Name of Person Making Change.

Do not extend notes this side of this line

RETURN TO
LOS ANGELES COUNTY SURVEYOR
700 HALL OF RECORDS

FORM 247 5M 10-37

F.B. 777 PG. 104

cont at bot of pg 106

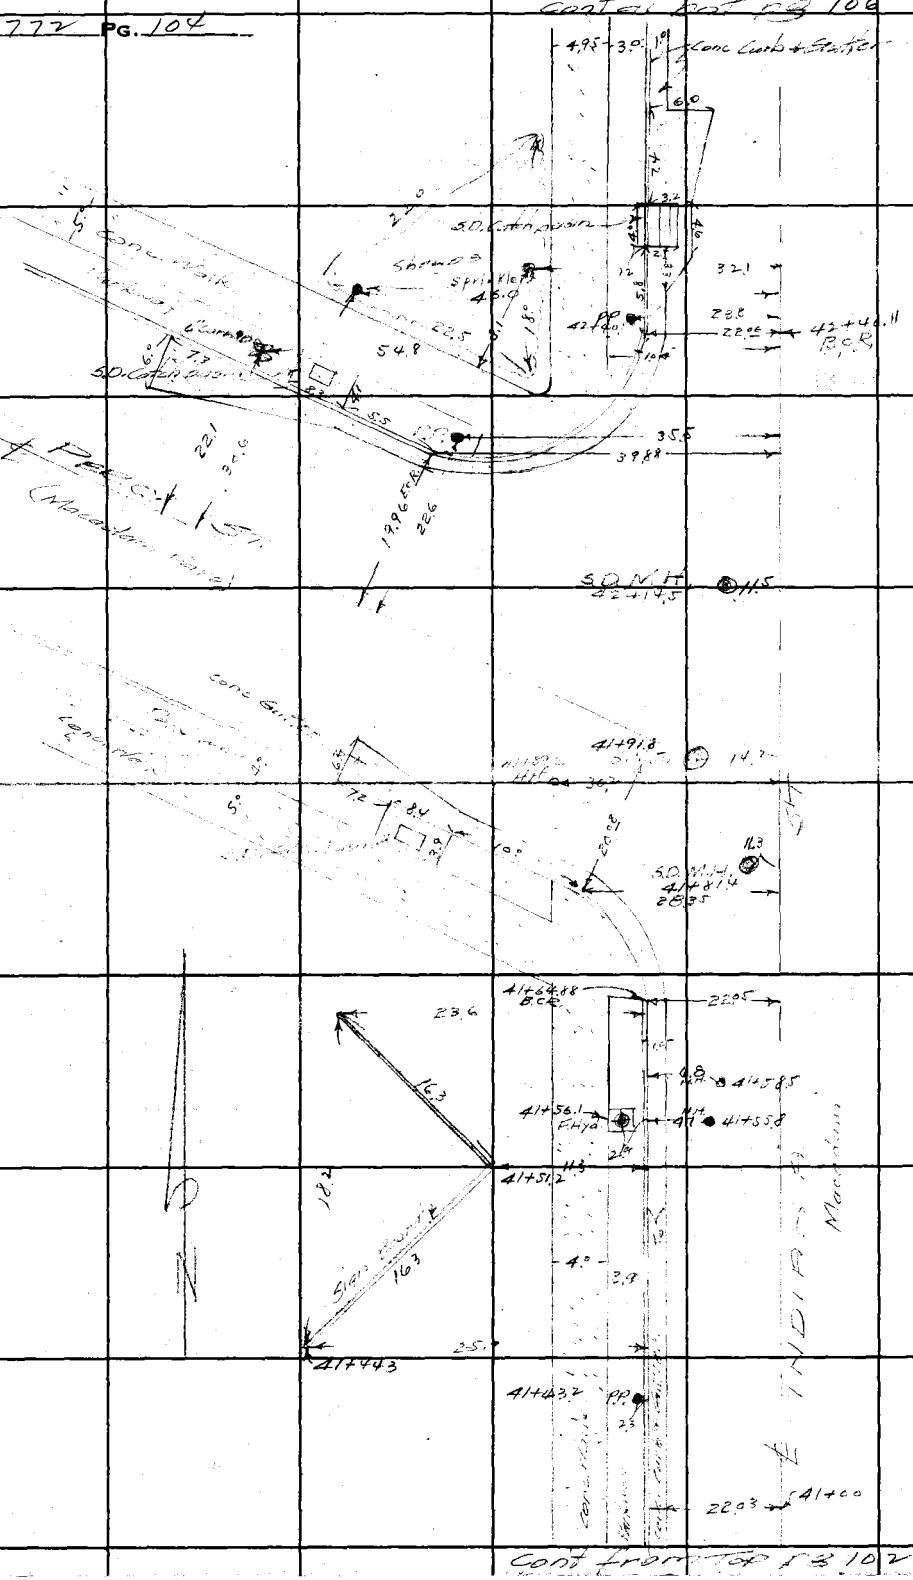

RETURN TO
LOS ANGELES COUNTY SURVEYOR
700 HALL OF RECORDS

Note: Any Additions or Changes on This Sheets Must be Made or Circled in Red Ink With Date and Name of Person Making Change.

Do not extend notes this side of this line

Notes Ck'd by D. M. Finley	Survey of [illegible]	F.B. 772 PG. 105
Map No. B-1465-1	W. O. 8226 Tape No. ____ St'd ____ °F	
Office Work F. A. W.	Surveyed by Evans	
Checked D. M. Finley	Notes [illegible] Date '39	
Date Jan. 1941	Indexed [illegible]	

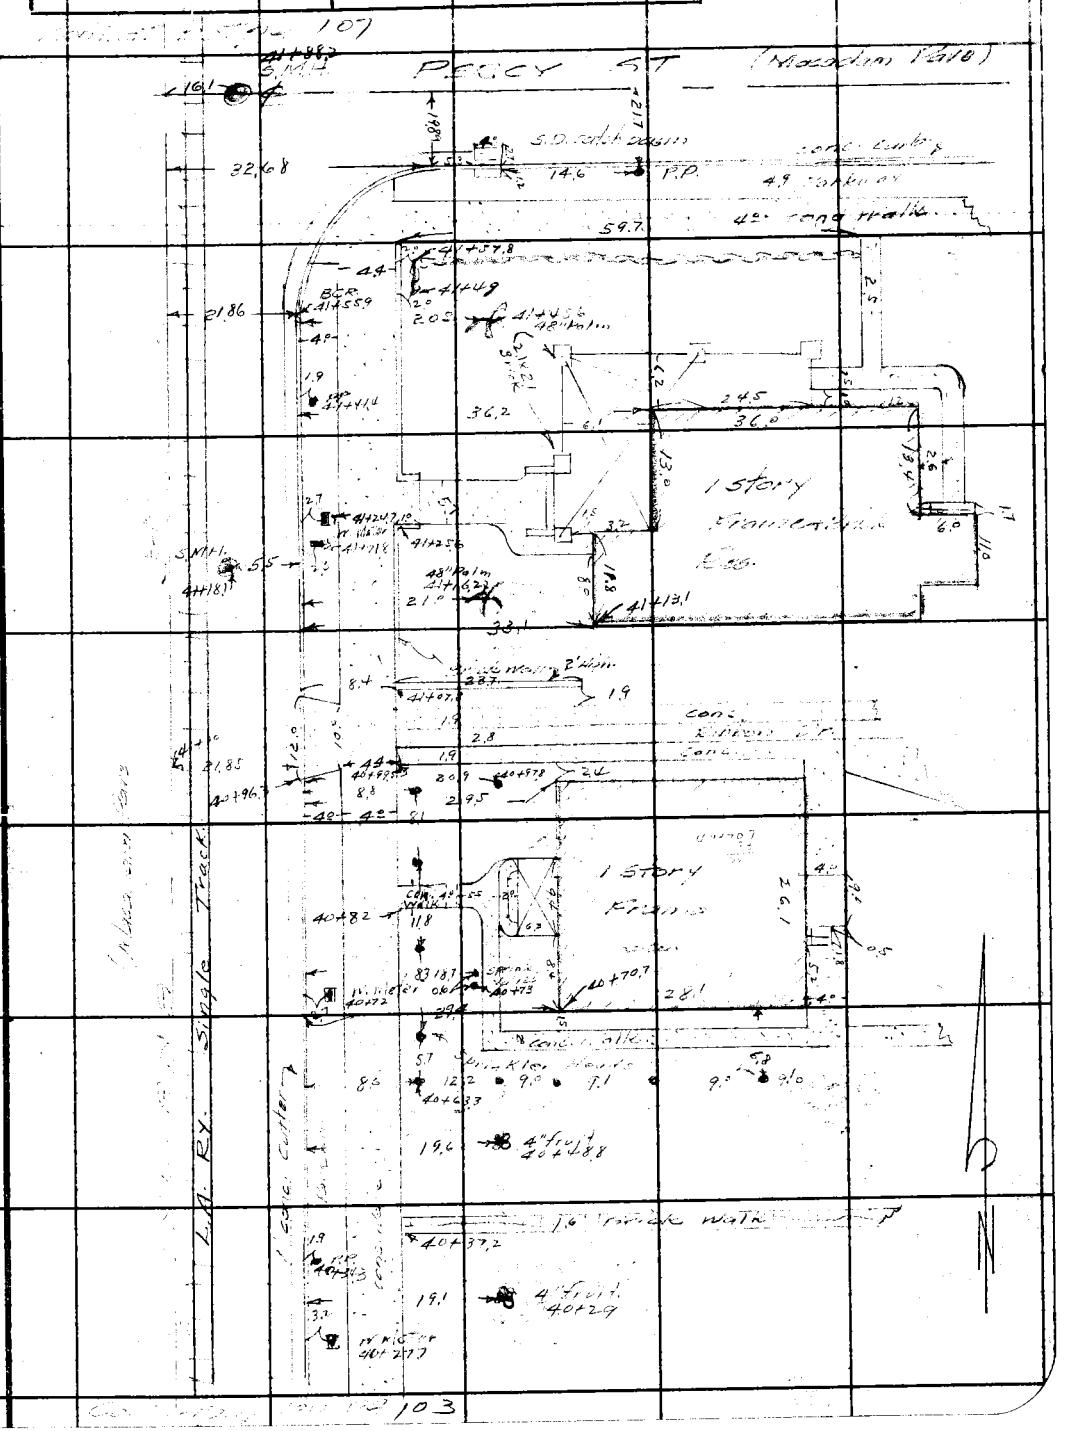

Note: Any Additions or Changes on This Sheets Must be Made or Circled in Red Ink With Date and Name of Person Making Change.

Do not extend notes this side of this line

RETURN TO
LOS ANGELES COUNTY SURVEYOR
700 HALL OF RECORDS

FORM 247.5M 10-37

RETURN TO
LOS ANGELES COUNTY SURVEYOR
700 HALL OF RECORDS

Note: Any Additions or Changes on This Sheets Must be Made or Circled in **Red Ink** With Date and Name of Person Making Change.

Do not extend notes this side of this line

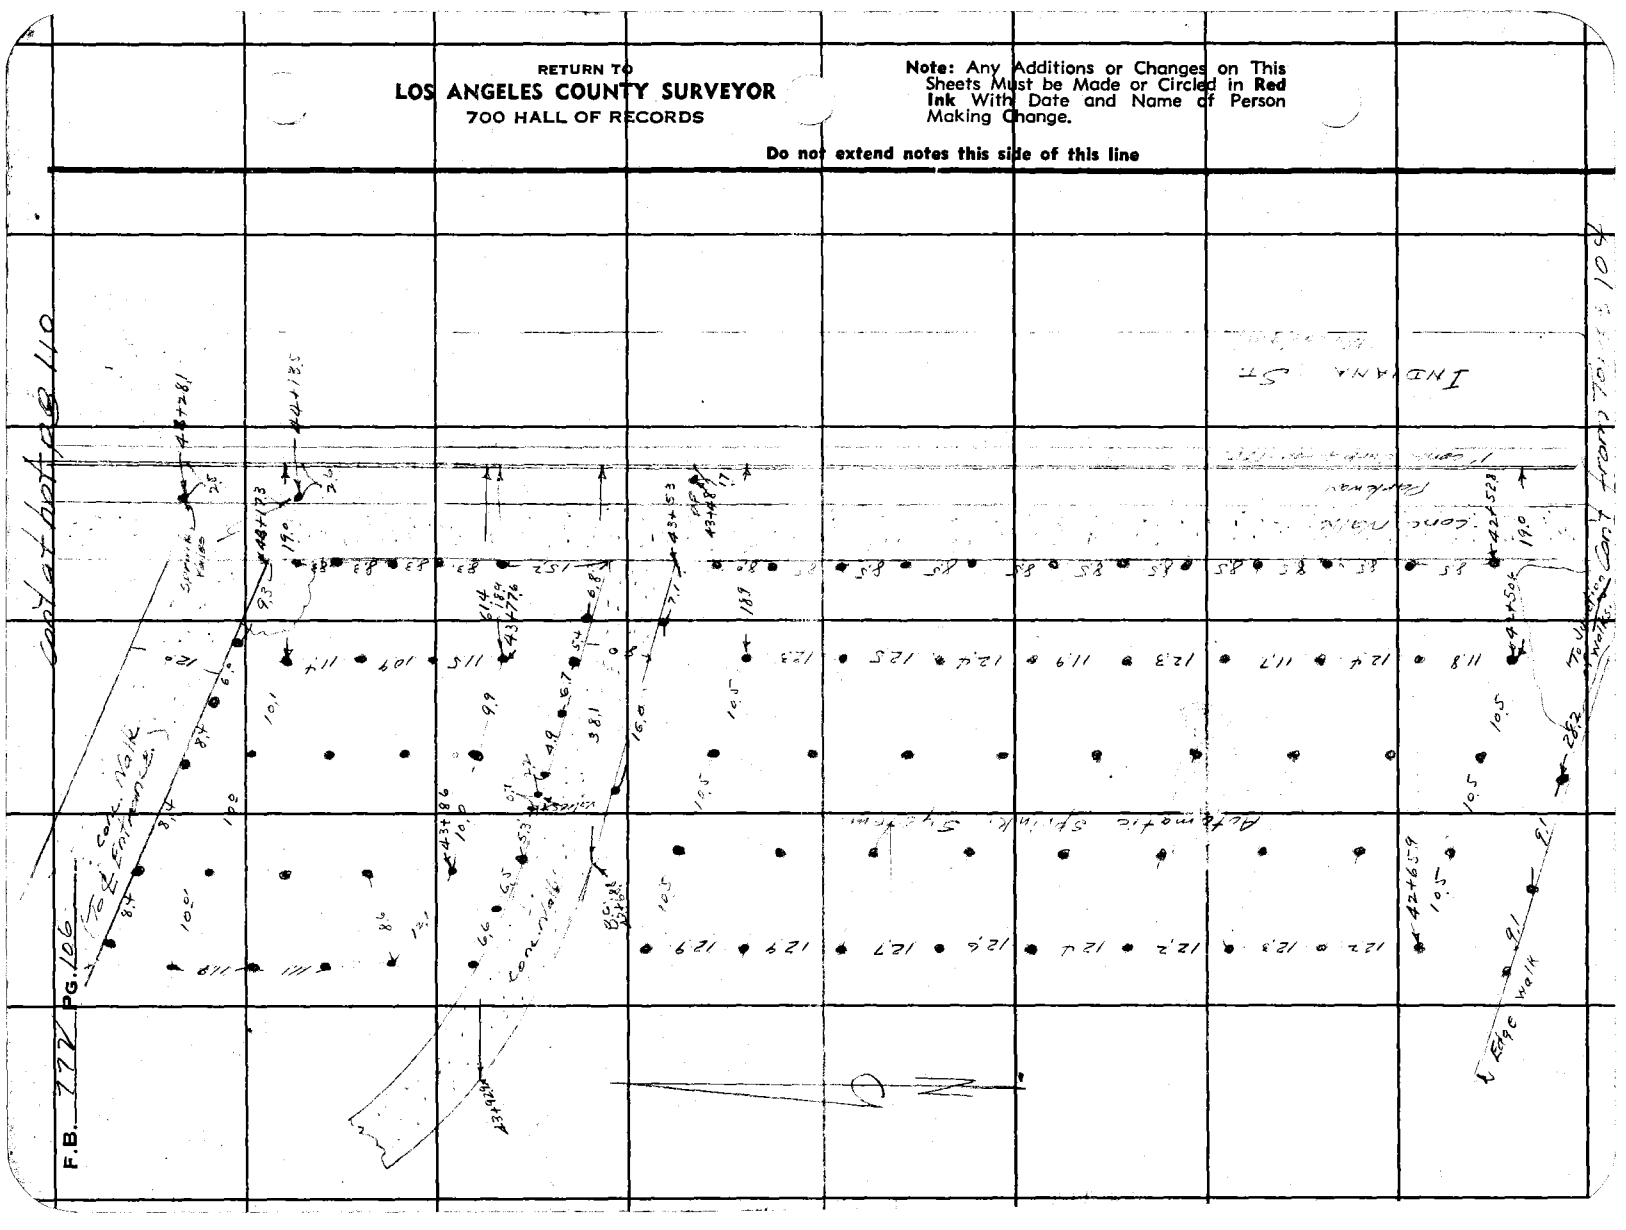

Notes Ck'd by D. M. Finley	Survey of	F.B. 777	PG. 107
Map No. B-1465-1	W. O.	Tape No.	St'd
Office Work F. A. W.	Surveyed by EVANS		
Checked D. M. Finley	Notes	Date 1-24	
Date Jan 1941	Indexed		

Note: Any Additions or Changes on This Sheets Must be Made or Circled in Red Ink With Date and Name of Person Making Change.

Do not extend notes this side of this line

RETURN TO
LOS ANGELES COUNTY SURVEYOR
700 HALL OF RECORDS

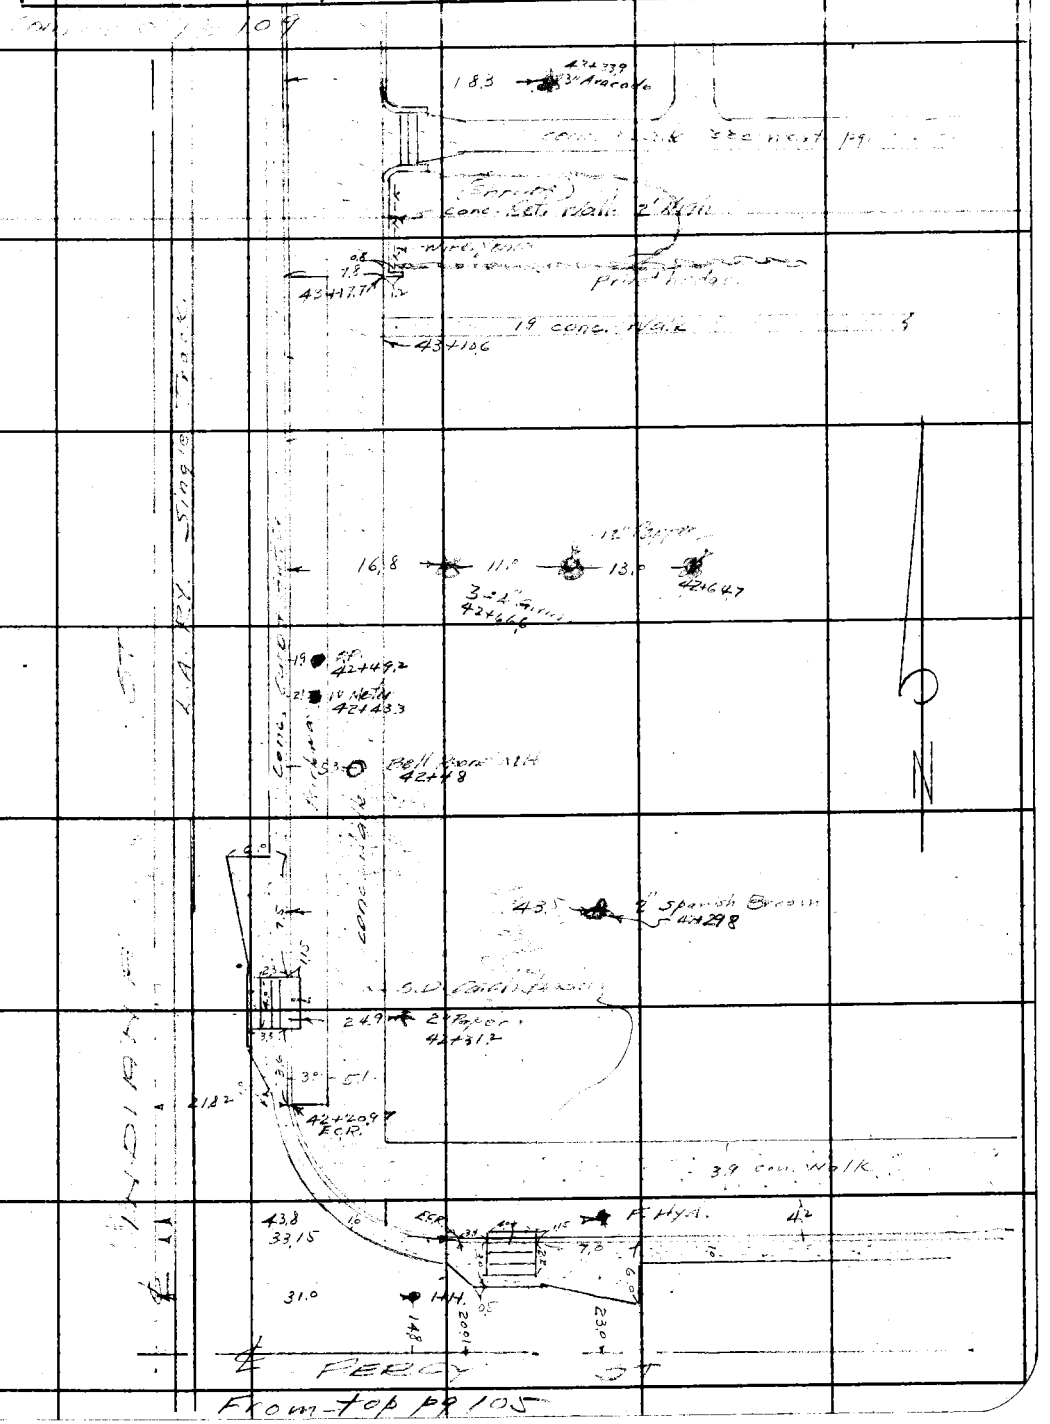

FORM 247 5M 10-37

RETURN TO
LOS ANGELES COUNTY SURVEYOR
700 HALL OF RECORDS

Note: Any Additions or Changes on This Sheets Must be Made or Circled in **Red Ink** With Date and Name of Person Making Change.

Do not extend notes this side of this line

F.B. 777 Pg. 108

To Bot Pg. 111

Notes Ck'd by D. M. Finley	Survey of INDIANA ST	F.B. 772	PG. 109
Map No. B-1465-1	W. O. 8226 Tape No. ____ St'd ____ OF		
Office Work F. A. W.	Surveyed by Evans		
Checked D. M. Finley	Notes Brock Date '33		
Date Jan 1941	Indexed		

Note: Any Additions or Changes on This Sheets Must be Made or Circled in Red Ink With Date and Name of Person Making Change.

Do not extend notes this side of this line

RETURN TO
LOS ANGELES COUNTY SURVEYOR
700 HALL OF RECORDS

FORM 247 5M 10-37

From top pg 107

RETURN TO
LOS ANGELES COUNTY SURVEYOR
700 HALL OF RECORDS

Note: Any Additions or Changes on This Sheets Must be Made or Circled in **Red Ink** With Date and Name of Person Making Change.

Do not extend notes this side of this line

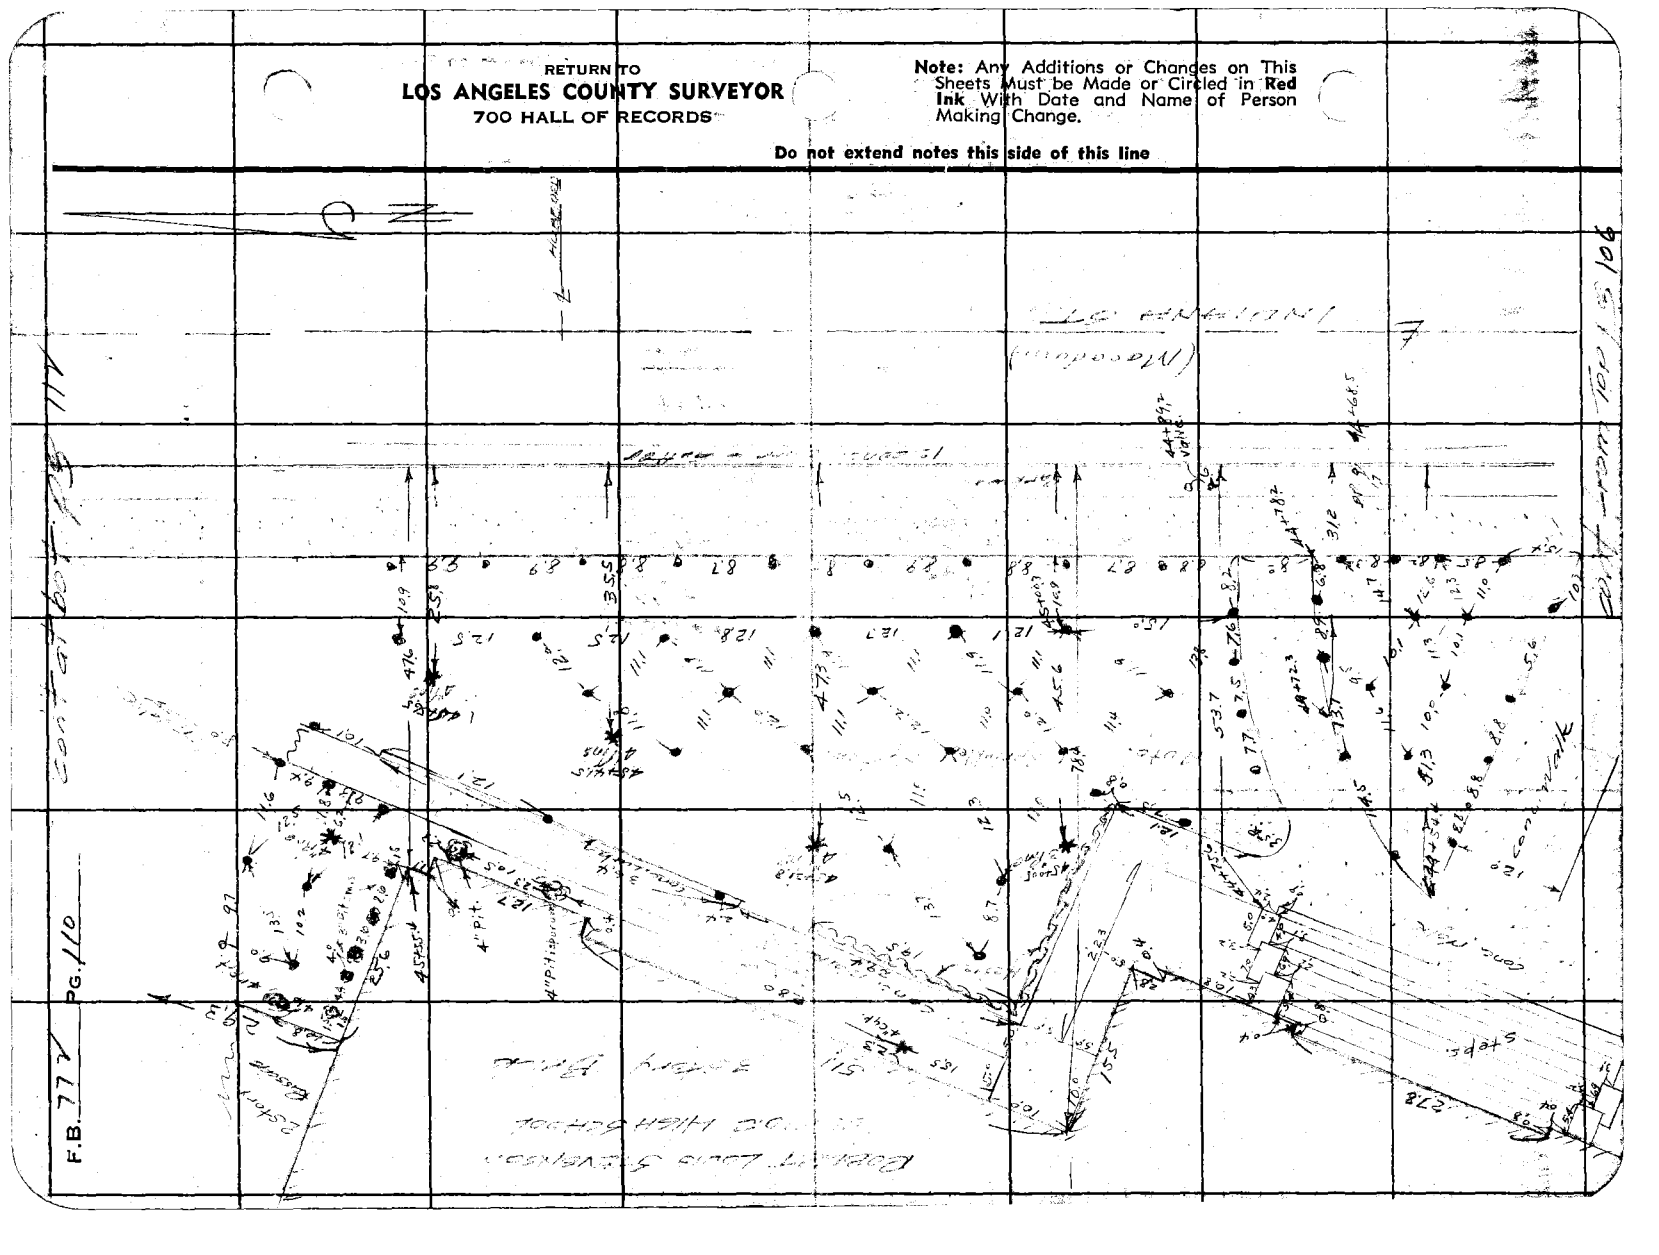

F.B. 777 PG. 110

To Bot pg 113

Notes Ck'd by D. M. Finley	Survey of [illegible]	F.B. 772 PG. 111
Map No. B-1465-1	W. O. 8226 Tape No. ____ St'd ____ OF	
Office Work F. A. W.	Surveyed by Evans	
Checked D. M. Finley	Notes [illegible] Date '39	
Date Jan. 1941	Indexed [illegible]	

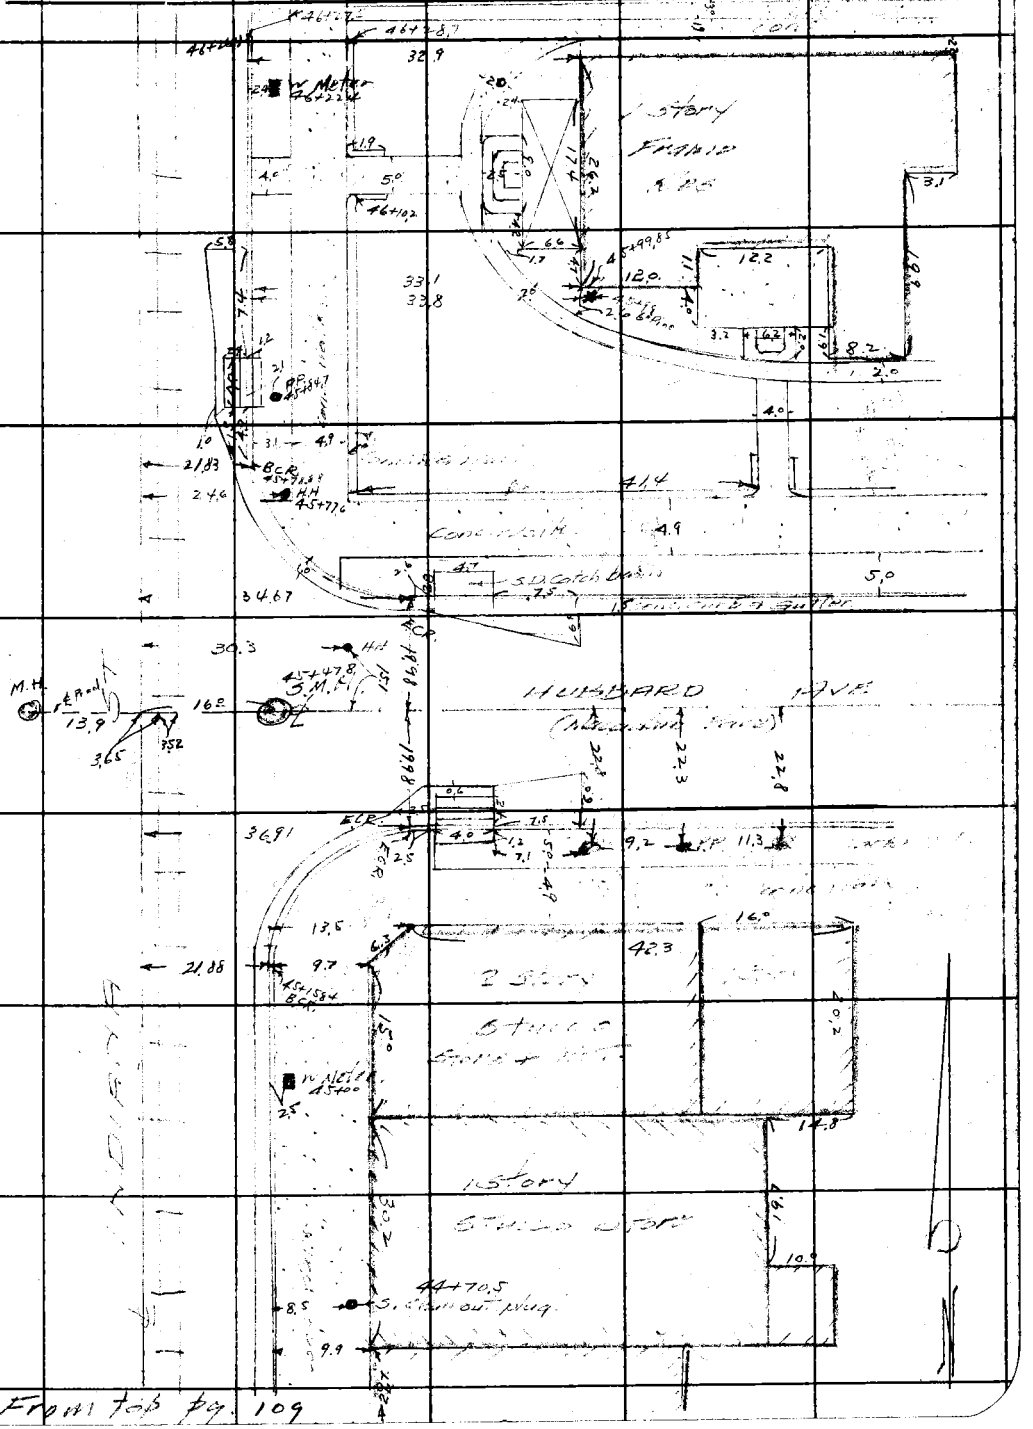

From top pg. 109

Note: Any Additions or Changes on This Sheets Must be Made or Circled in Red Ink With Date and Name of Person Making Change.

Do not extend notes this side of this line

RETURN TO
LOS ANGELES COUNTY SURVEYOR
700 HALL OF RECORDS

FORM 247 5M 10-37

To Bot pg. 114

F.B. 777 PG. 47

RETURN TO
LOS ANGELES COUNTY SURVEYOR
700 HALL OF RECORDS

Note: Any Additions or Changes on This Sheets Must be Made or Circled in Red Ink With Date and Name of Person Making Change.

Do not extend notes this side of this line

From top pg. 110

To Bk 1 pg. 115

Notes Ck'd by D. M. Finley	Survey of INDIANA		F.B. 772 PG. 113
Map No. B-1465-1	W. O. 3826	Tape No.	St'd OF
Office Work F. A. W.	Surveyed by Evans		
Checked D. M. Finley	Notes	Date 1/39	
Date Jan. 1941.	Indexed		

Note: Any Additions or Changes on This Sheets Must be Made or Circled in Red Ink With Date and Name of Person Making Change.

Do not extend notes this side of this line

RETURN TO
LOS ANGELES COUNTY SURVEYOR
700 HALL OF RECORDS

FORM 247 5M 10-37

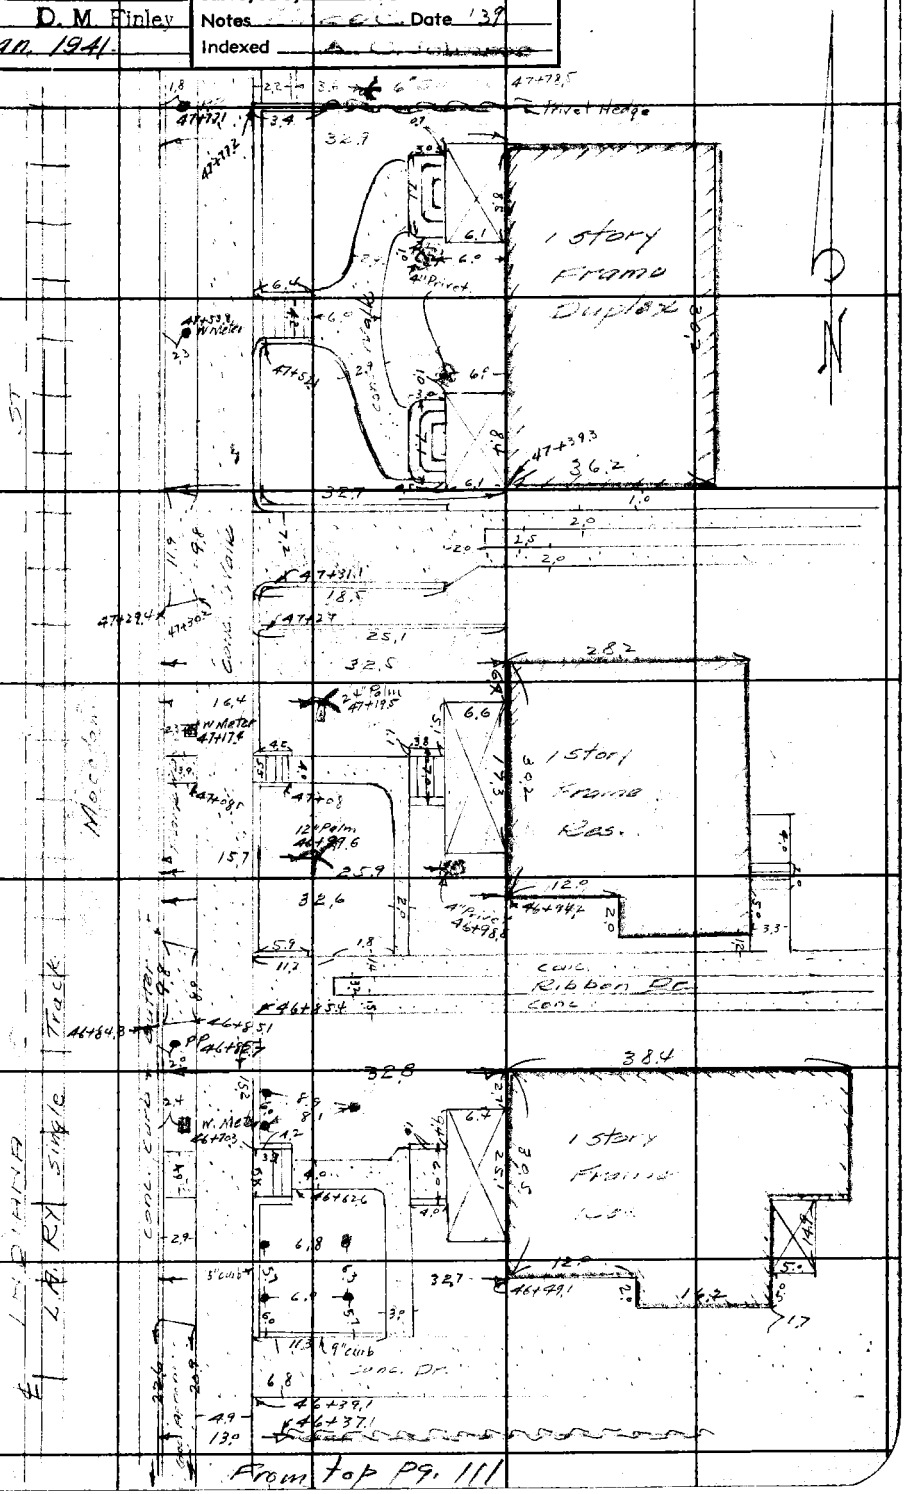

To Bot pg. 116

F.B. 772 PG. 114

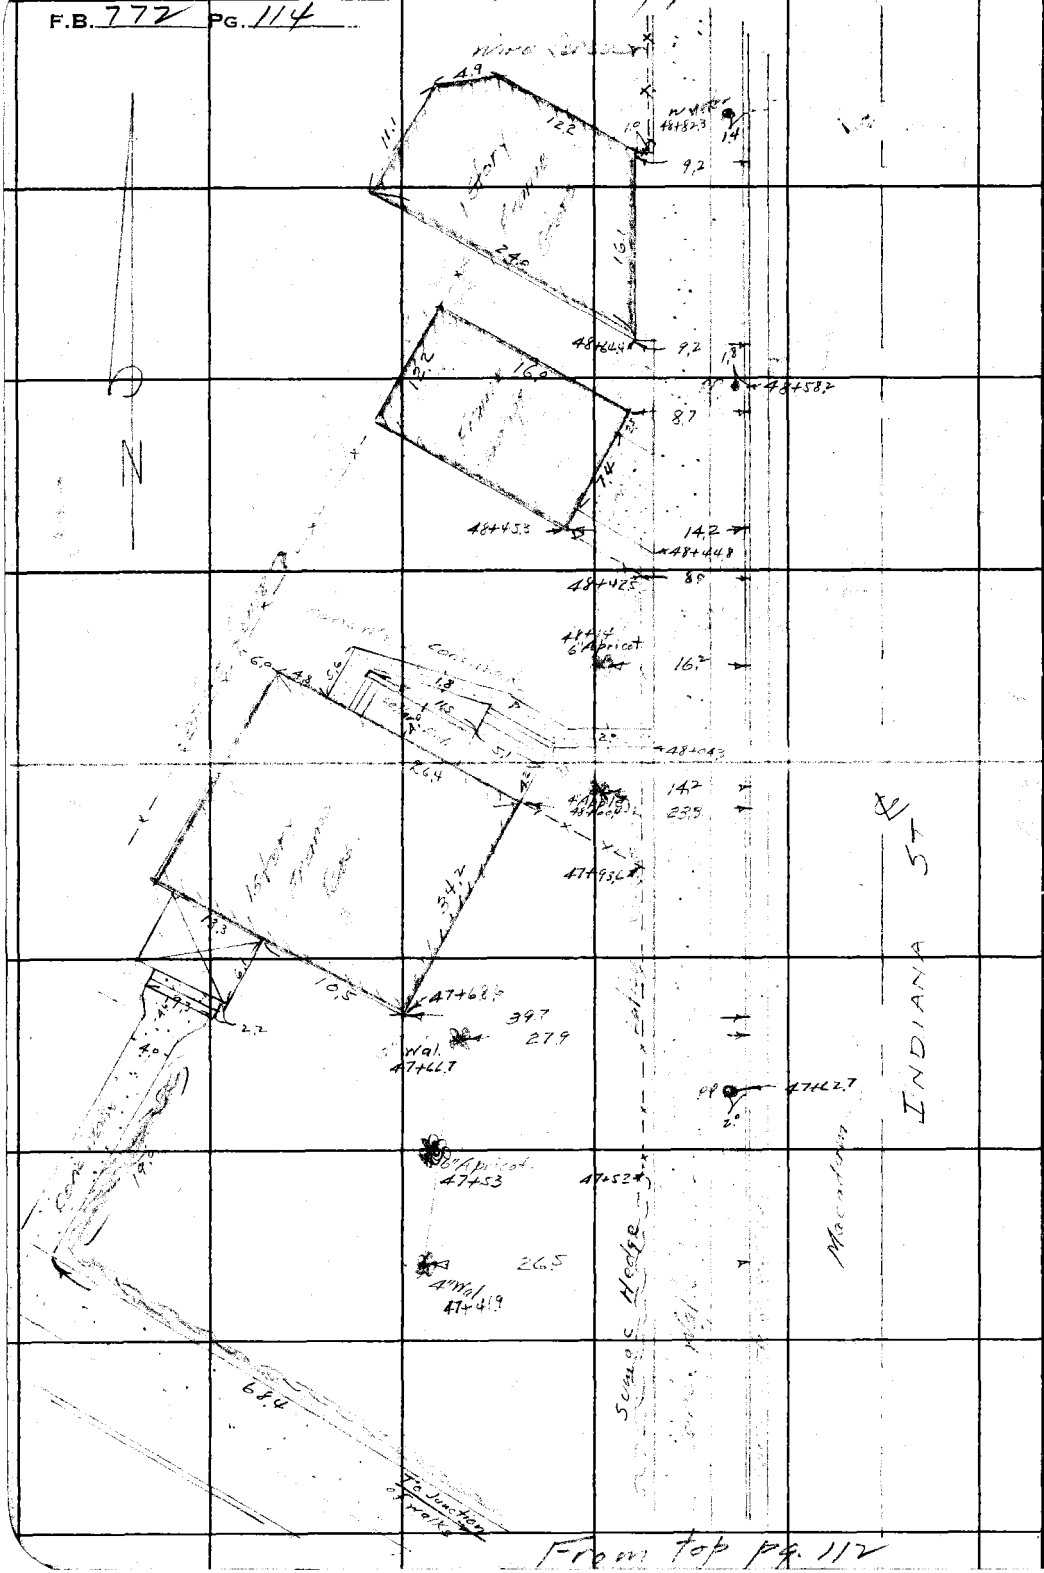

From top pg. 112

RETURN TO
LOS ANGELES COUNTY SURVEYOR
700 HALL OF RECORDS

Note: Any Additions or Changes on This Sheets Must be Made or Circled in **Red Ink** With Date and Name of Person Making Change.

Do not extend notes this side of this line

To Bot pg. 117

Notes Ck'd by D. M. Finley	Survey of INDIANA ST	F.B. 772 Pg 115
Map No. B-1465-1	W. O. [illegible] Tape No. ____ St'd ____ of	
Office Work F. A. W.	Surveyed by Evans	
Checked D. M. Finley	Notes Brock Date '39	
Date Jan. 1941	Indexed [illegible] Johnson	

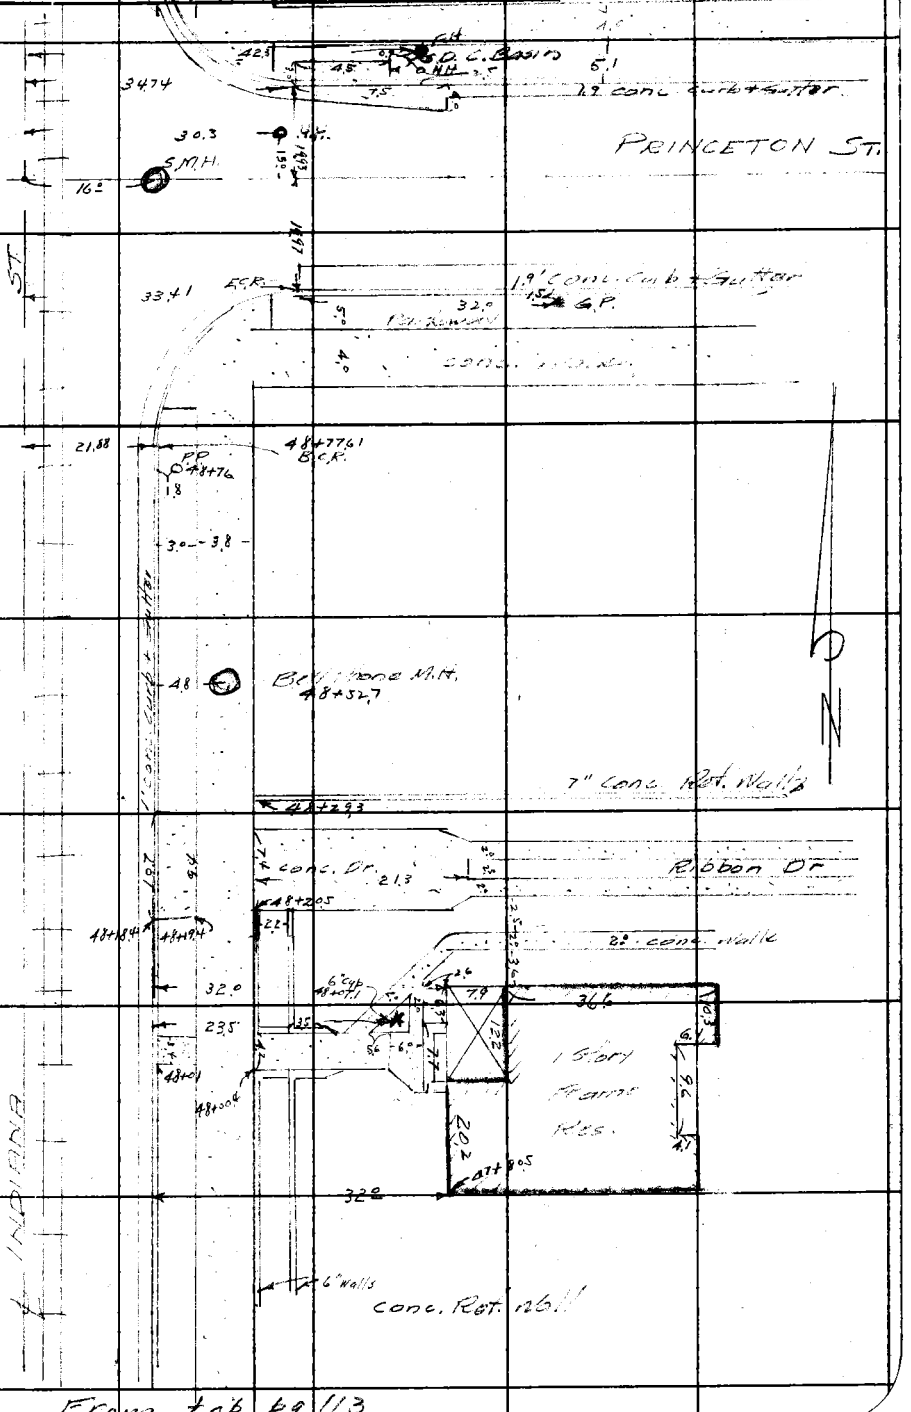

From top pg. 113

Note: Any Additions or Changes on This Sheets Must be Made or Circled in Red Ink With Date and Name of Person Making Change.

Do not extend notes this side of this line

RETURN TO
LOS ANGELES COUNTY SURVEYOR
700 HALL OF RECORDS

FORM 247 5M 10-37

RETURN TO
LOS ANGELES COUNTY SURVEYOR
700 HALL OF RECORDS

Note: Any Additions or Changes on This Sheets Must be Made or Circled in **Red Ink** With Date and Name of Person Making Change.

Do not extend notes this side of this line

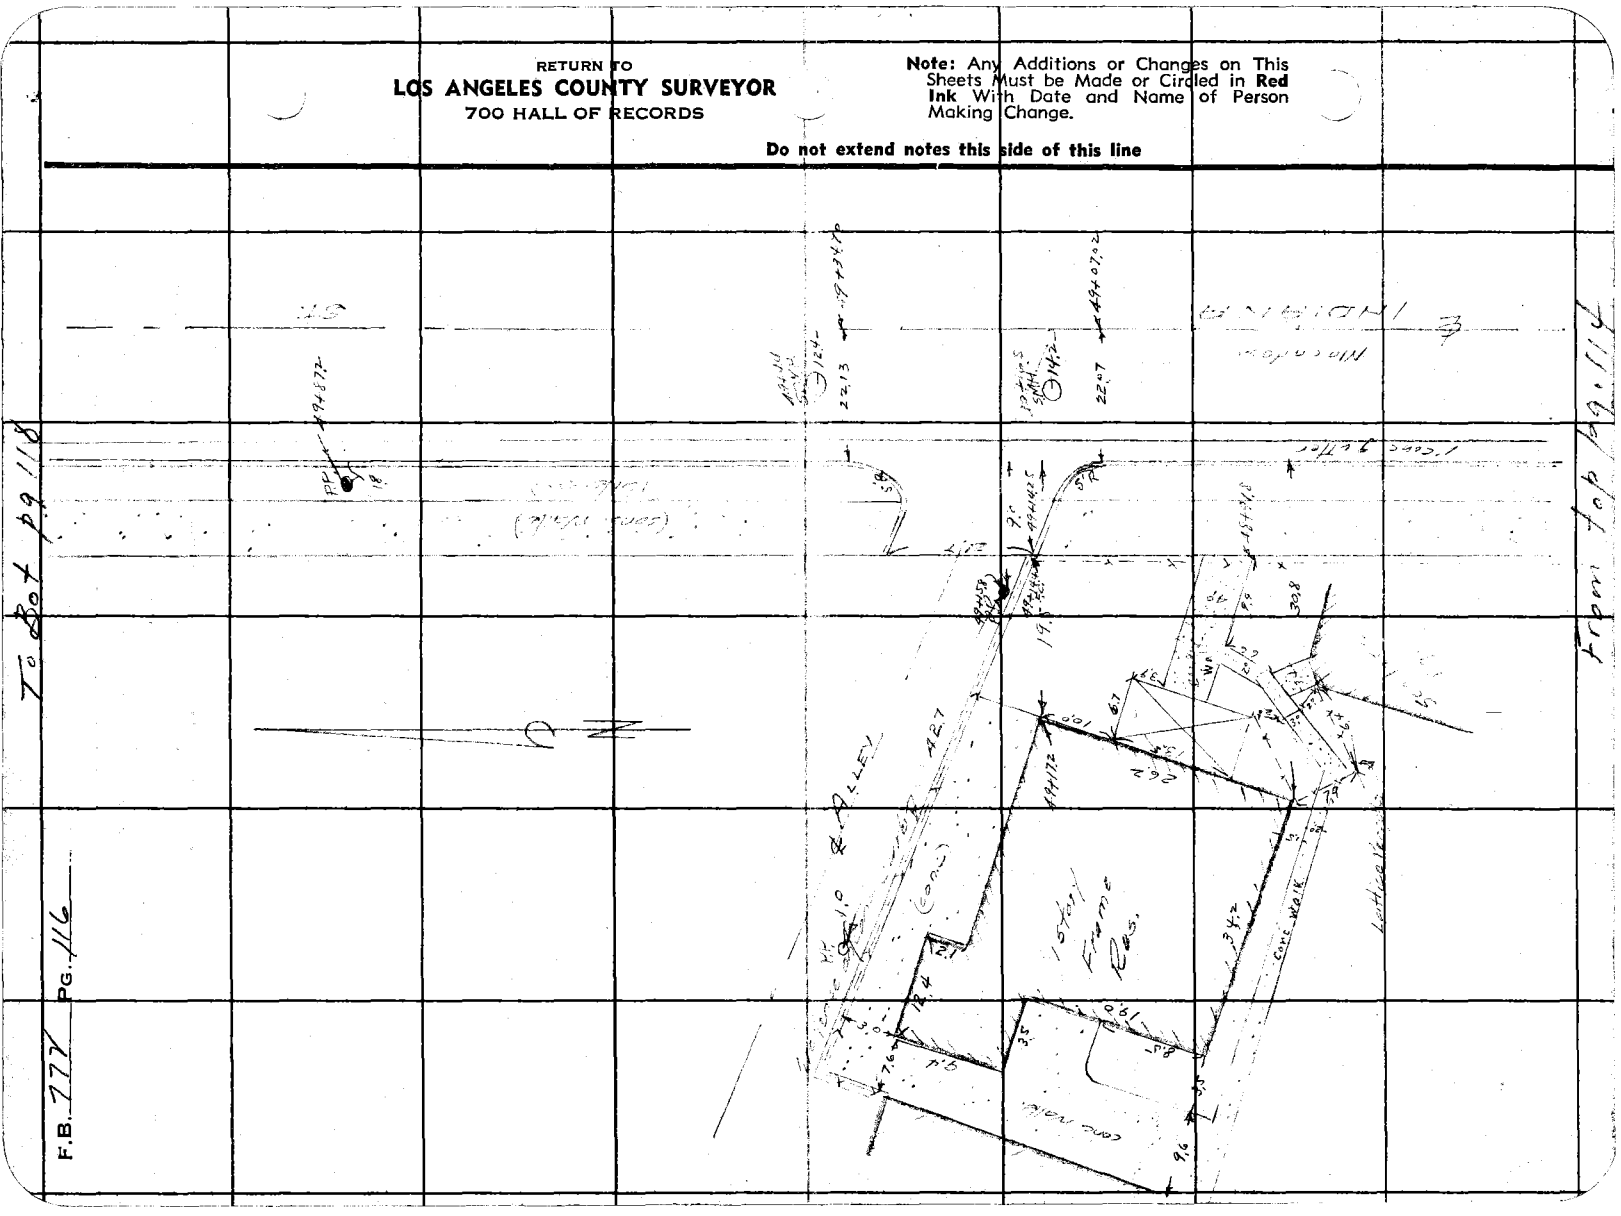

Notes Ck'd by D. M. Finley	Survey of Indiana St	F.B. 772 Pg. 119
Map No. B-1465-2	W. O. [illegible] Tape No. ____ St'd ____ of	
Office Work F. A. W.	Surveyed by Evans	
Checked D. M. Finley	Notes [illegible] Date '39	
Date Jan. 1941	Indexed [illegible]	

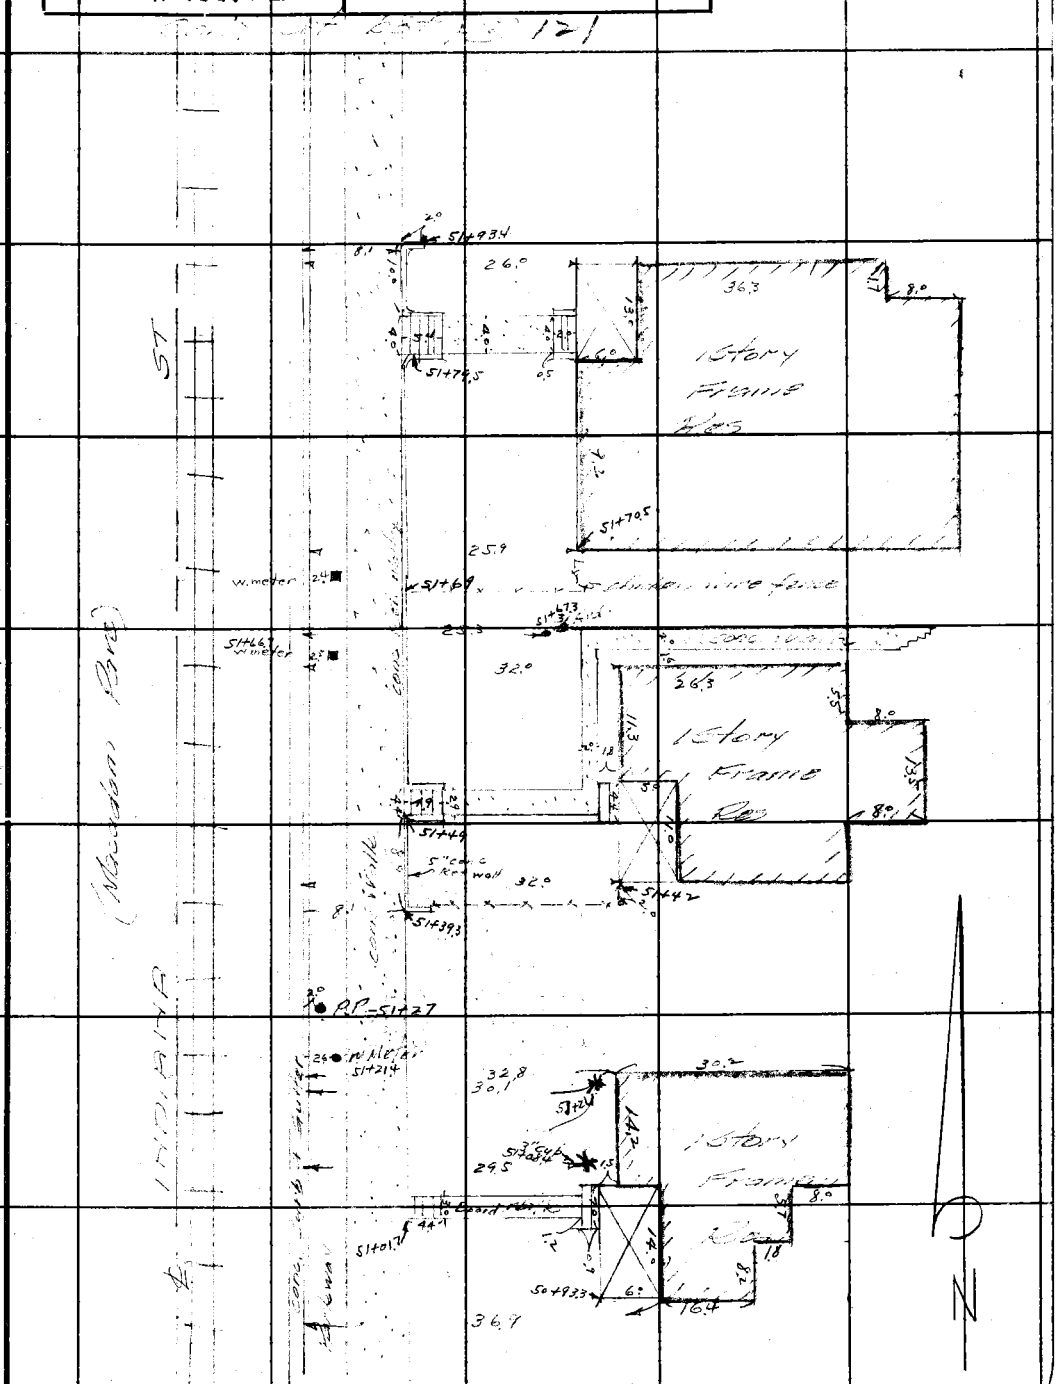

Note: Any Additions or Changes on This Sheets Must be Made or Circled in Red Ink With Date and Name of Person Making Change.

Do not extend notes this side of this line

RETURN TO
LOS ANGELES COUNTY SURVEYOR
700 HALL OF RECORDS

FORM 247 5M 10-37

Cont from top PG 117

RETURN TO
LOS ANGELES COUNTY SURVEYOR
700 HALL OF RECORDS

Note: Any Additions or Changes on This Sheets Must be Made or Circled in **Red Ink** With Date and Name of Person Making Change.

Do not extend notes this side of this line

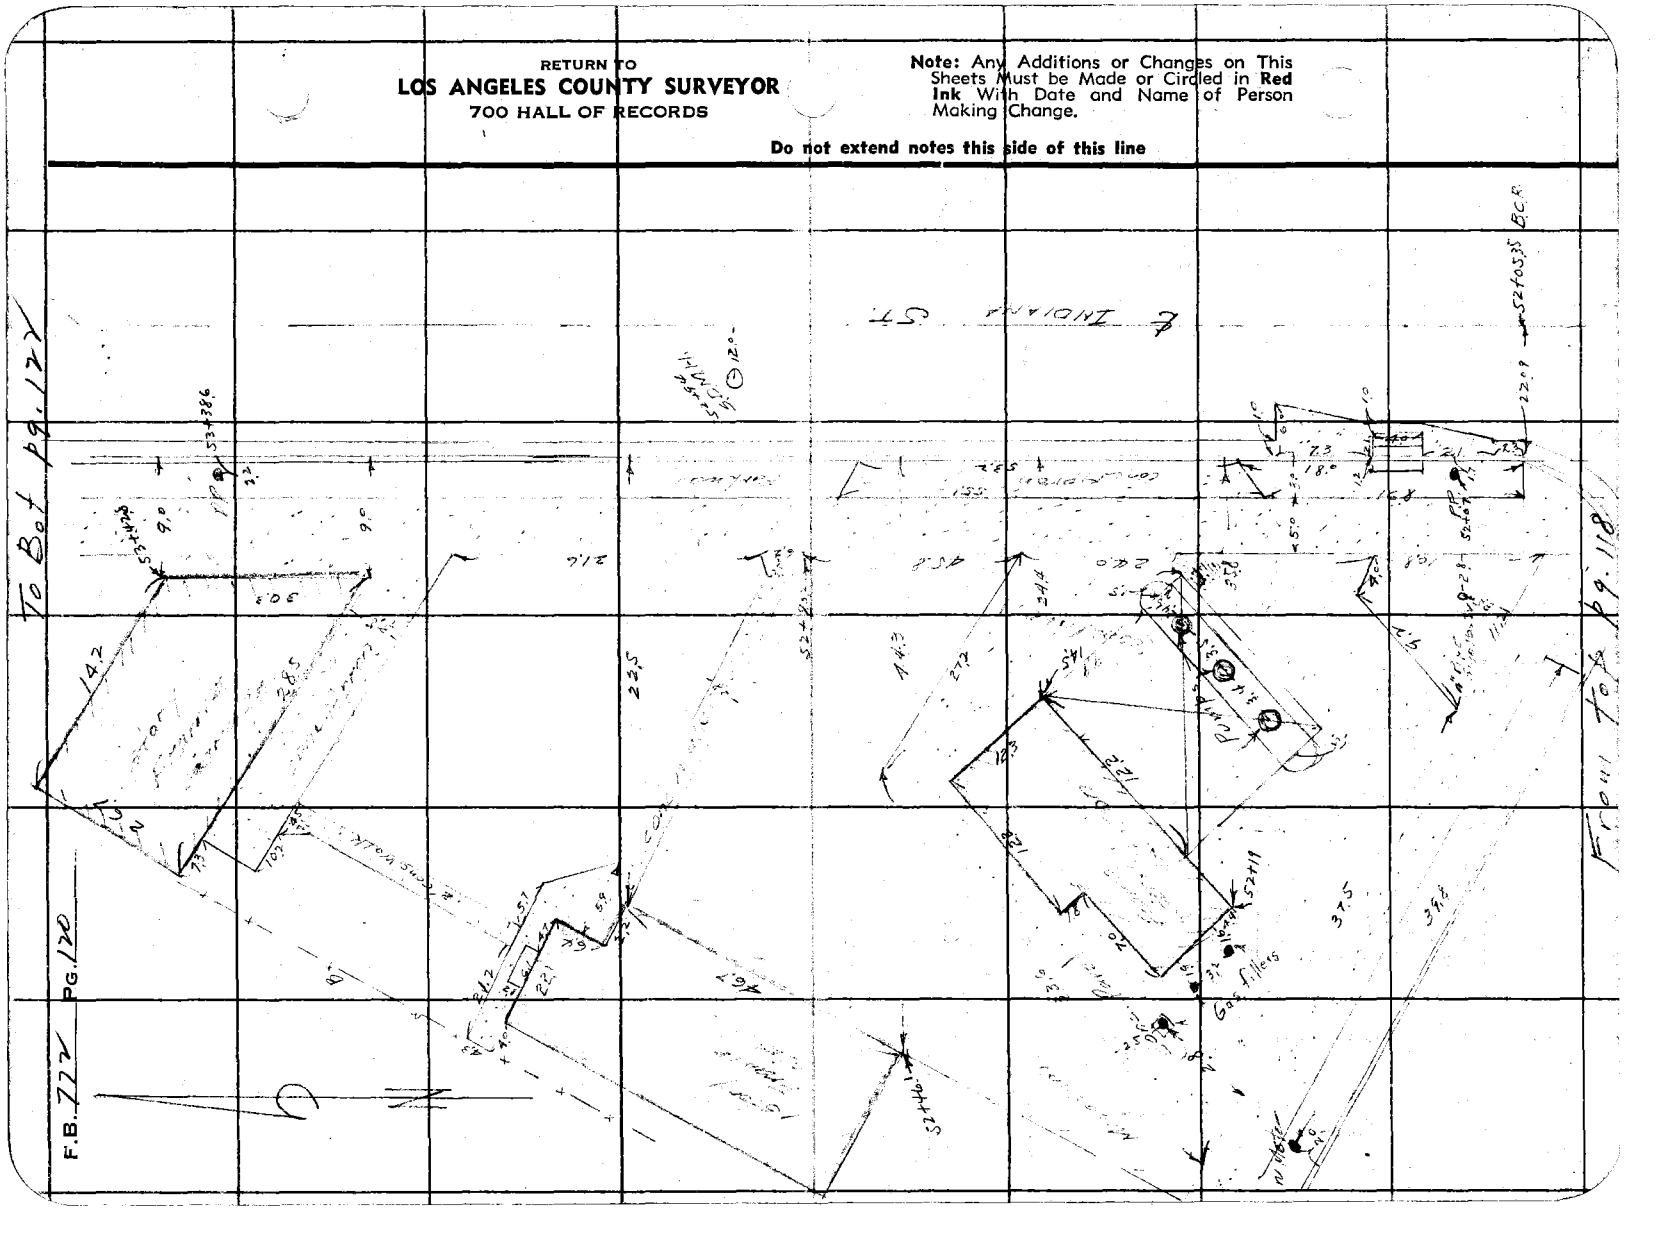

To Bc7 p9.123

Notes Ck'd by D. M. Finley	Survey of INDIANA ST	F.B. 772	PG. 121
Map No. B-1465-2	W. O. 522 Tape No.	St'd	OF
Office Work F. A. W.	Surveyed by EVANS		
Checked D. M. Finley	Notes ROCK Date '39		
Date Jan 1941	Indexed		

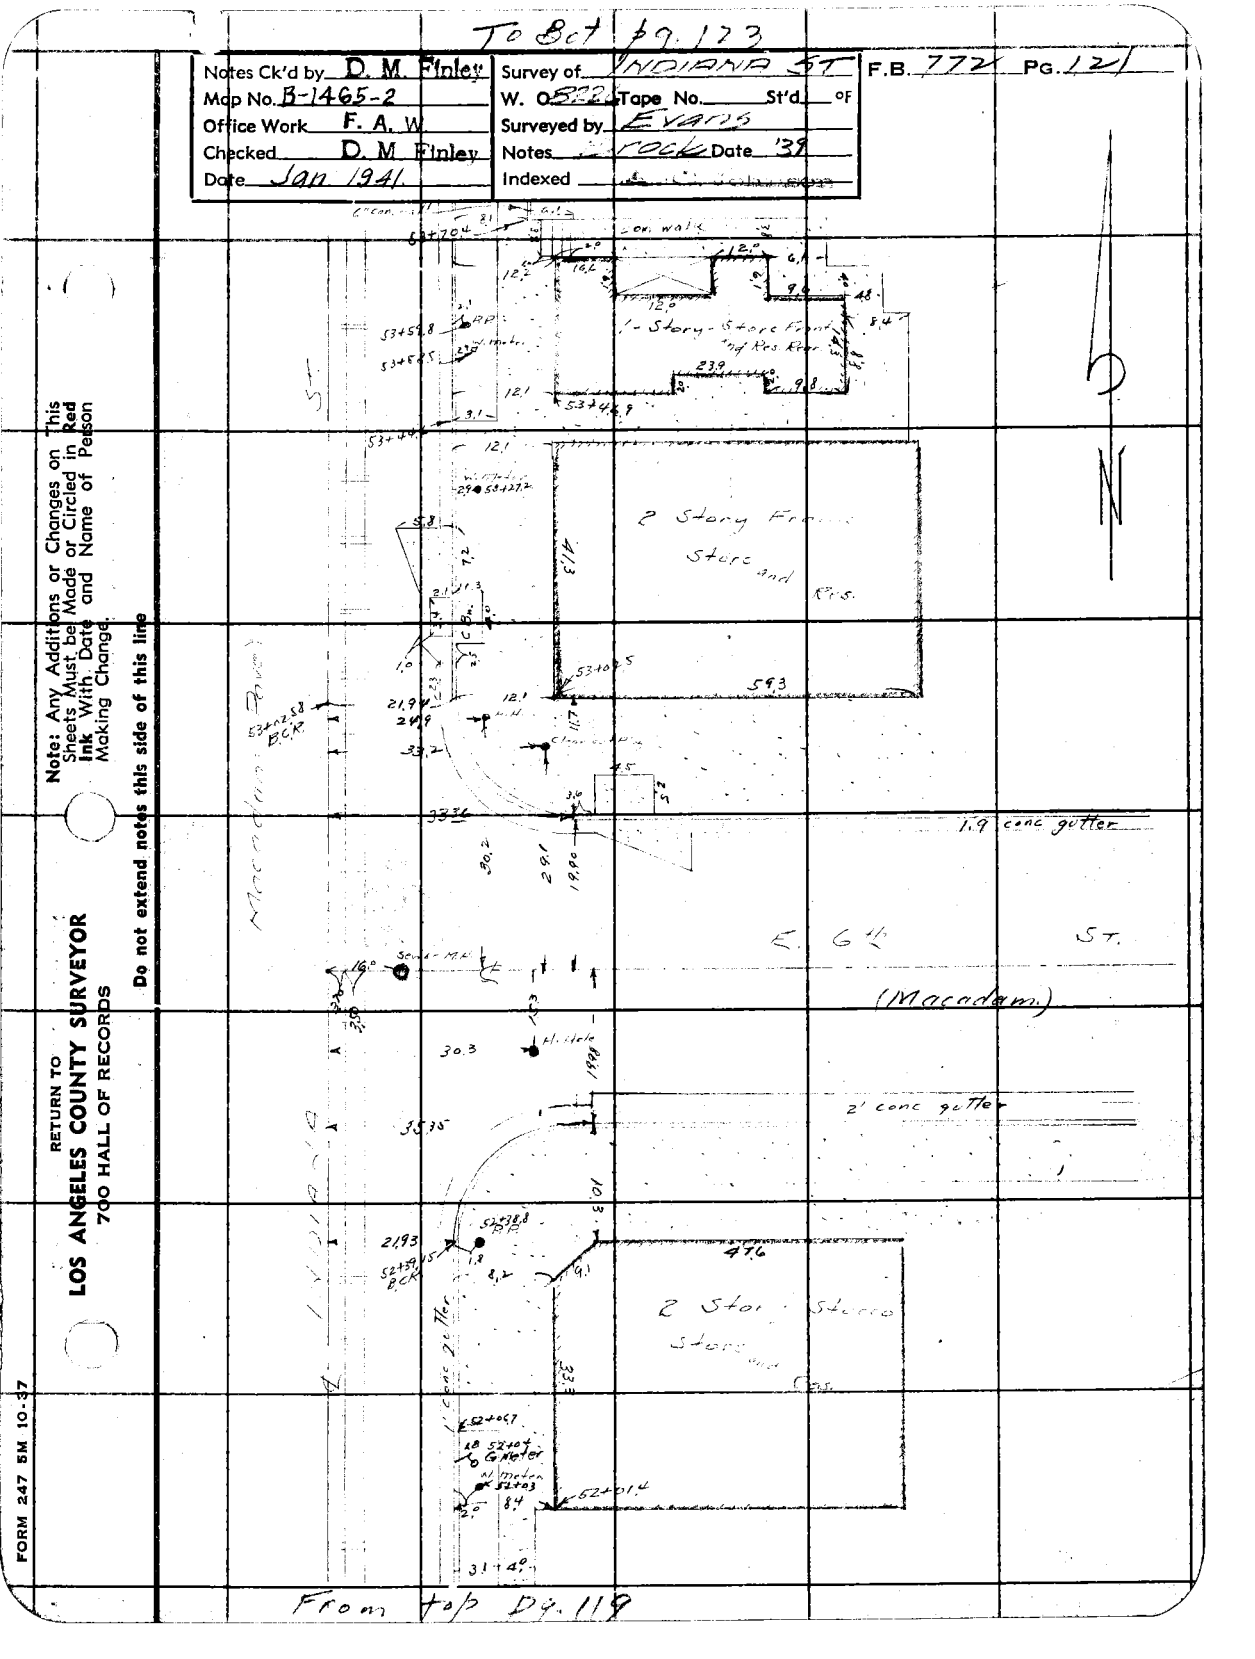

Note: Any Additions or Changes on This Sheets Must be Made or Circled in Red Ink With Date and Name of Person Making Change.

Do not extend notes this side of this line

RETURN TO
LOS ANGELES COUNTY SURVEYOR
700 HALL OF RECORDS

FORM 247 5M 10-37

RETURN TO
LOS ANGELES COUNTY SURVEYOR
700 HALL OF RECORDS

Note: Any Additions or Changes on This Sheets Must be Made or Circled in **Red Ink** With Date and Name of Person Making Change.

Do not extend notes this side of this line

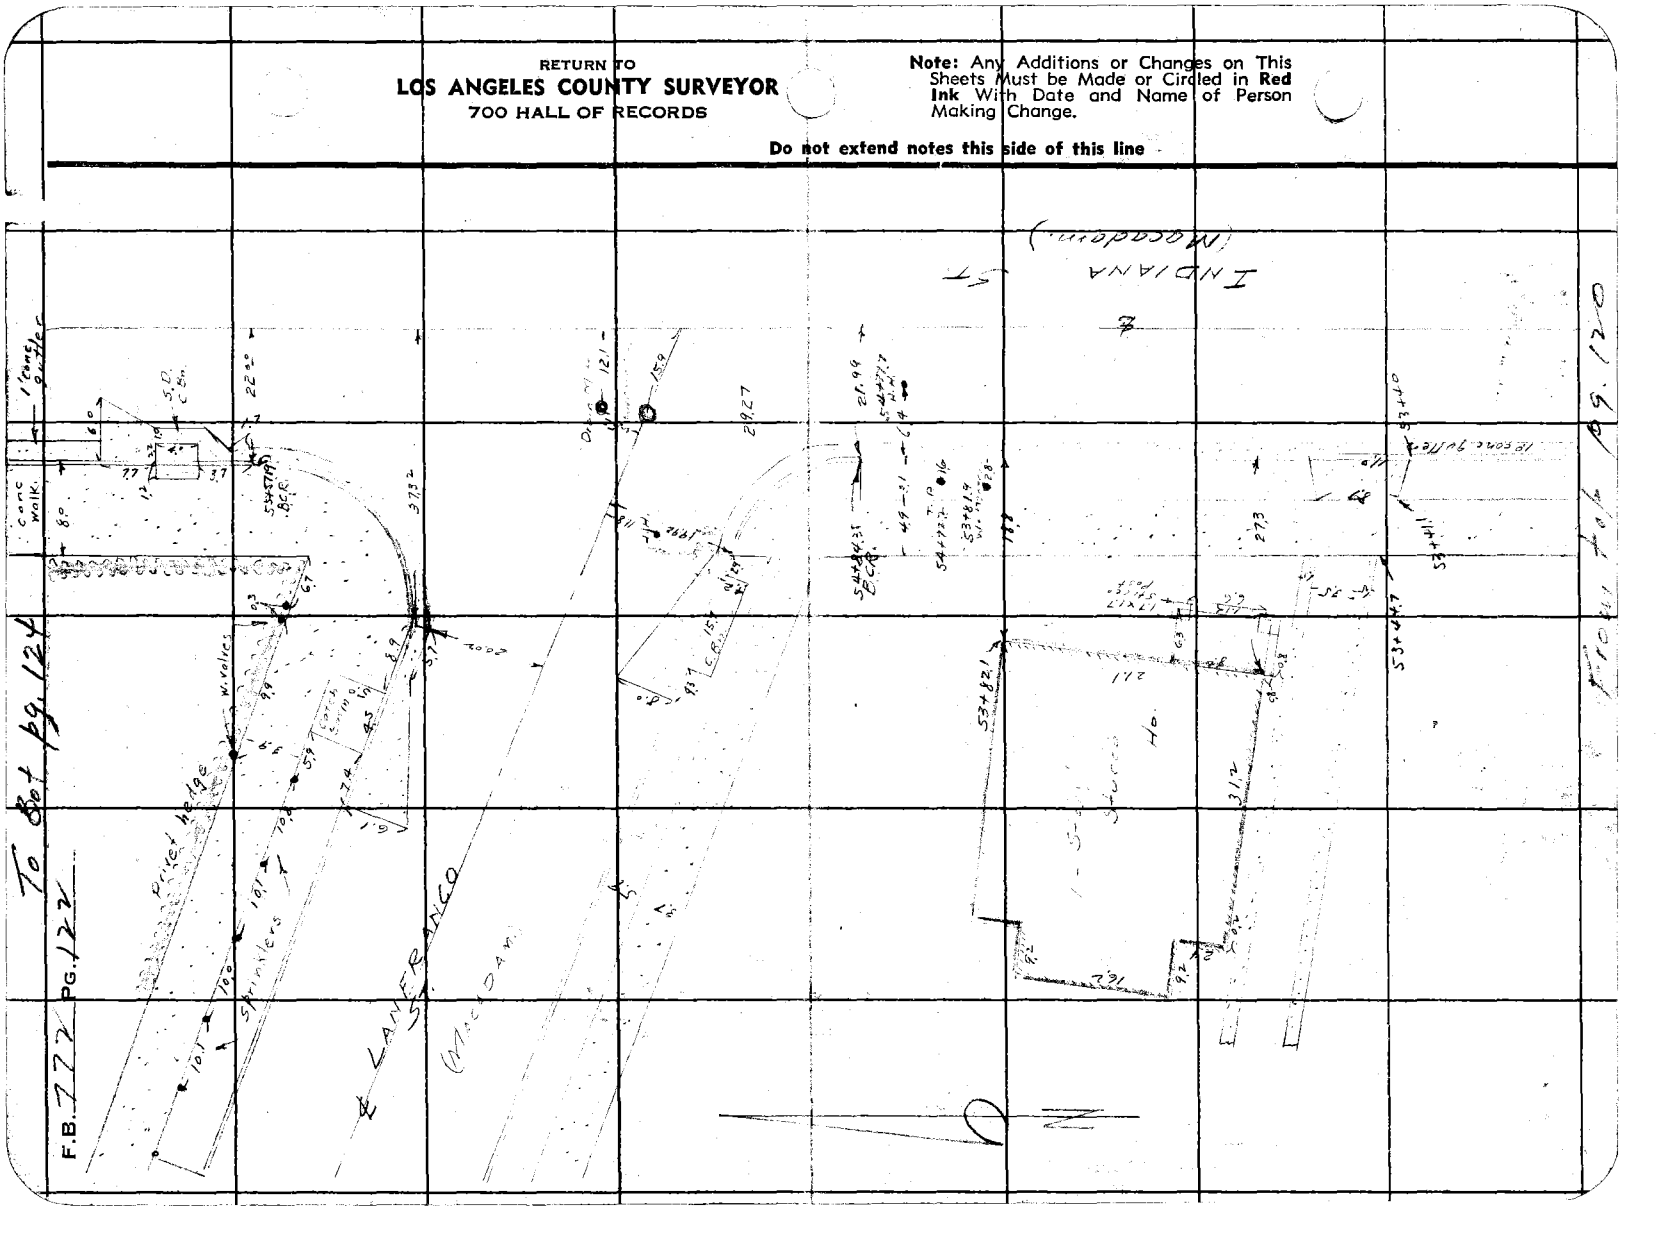

Notes Ck'd by D. M. Finley	Survey of INDIANA ST	F.B. 772	PG. 117
Map No. B-1465-2	W. G. 882 Tape No. St'd OF		
Office Work F. A. W.	Surveyed by EVANS		
Checked D. M. Finley	Notes [illegible] Date '39		
Date Jan. 1941	Indexed		

Note: Any Additions or Changes on This Sheets Must be Made or Circled in Red Ink With Date and Name of Person Making Change.

Do not extend notes this side of this line

RETURN TO
LOS ANGELES COUNTY SURVEYOR
700 HALL OF RECORDS

FORM 247 5M 10-37

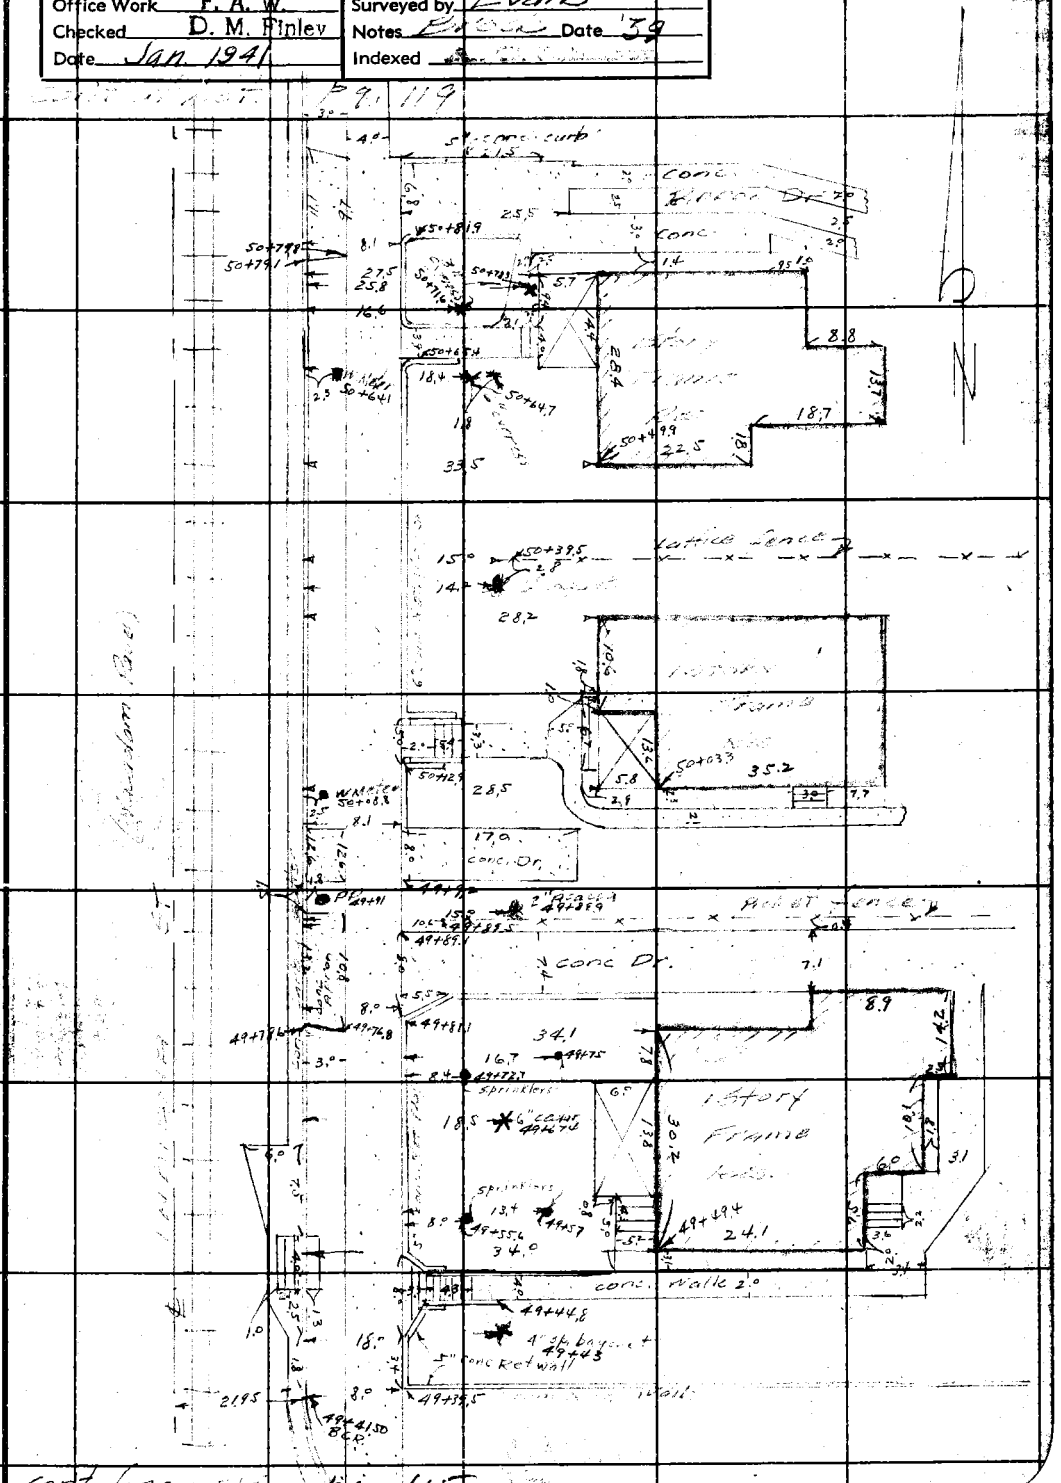

F.B. 777 PG. 118

RETURN TO
LOS ANGELES COUNTY SURVEYOR
700 HALL OF RECORDS

Note: Any Additions or Changes on This Sheets Must be Made or Circled in **Red Ink** With Date and Name of Person Making Change.

Do not extend notes this side of this line

Notes Ck'd by D. M. Finley	Survey of INDIANA ST	F.B. 772 Pg. 123
Map No. B-1465-2	W. O. 8226 Tape No. ____ St'd ____ of	
Office Work F. A. W.	Surveyed by Evans	
Checked D. M. Finley	Notes Brock Date 39	
Date Jan 1941	Indexed	

To Bot pg 125

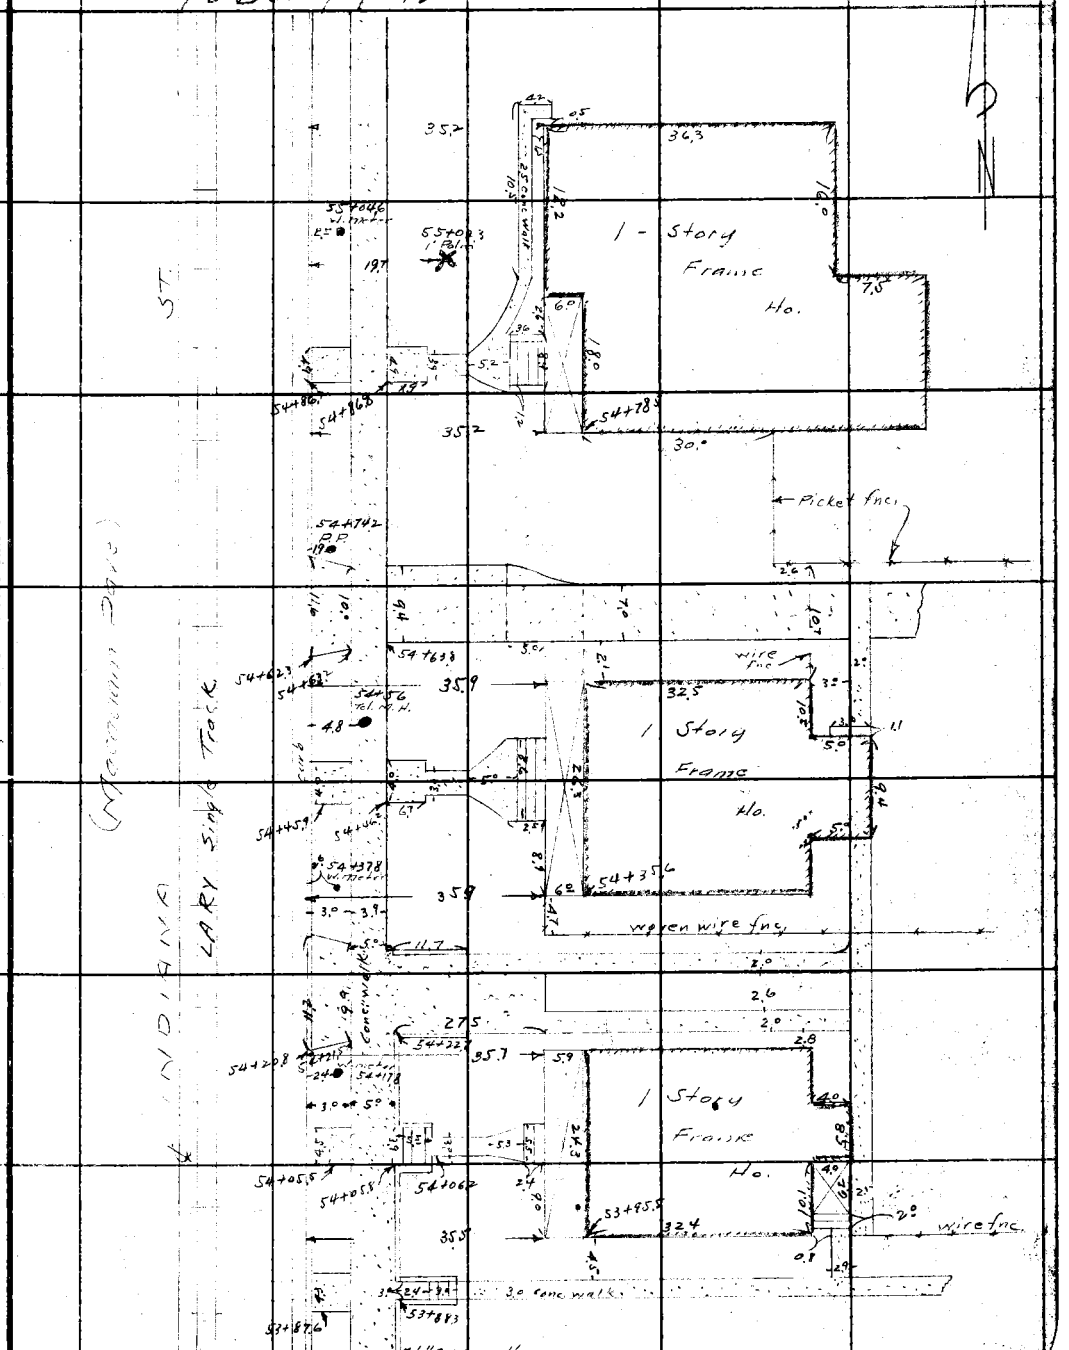

From top pg. 121

Note: Any Additions or Changes on This Sheets Must be Made or Circled in Red Ink With Date and Name of Person Making Change.

Do not extend notes this side of this line

RETURN TO
LOS ANGELES COUNTY SURVEYOR
700 HALL OF RECORDS

FORM 247 5M 10-37

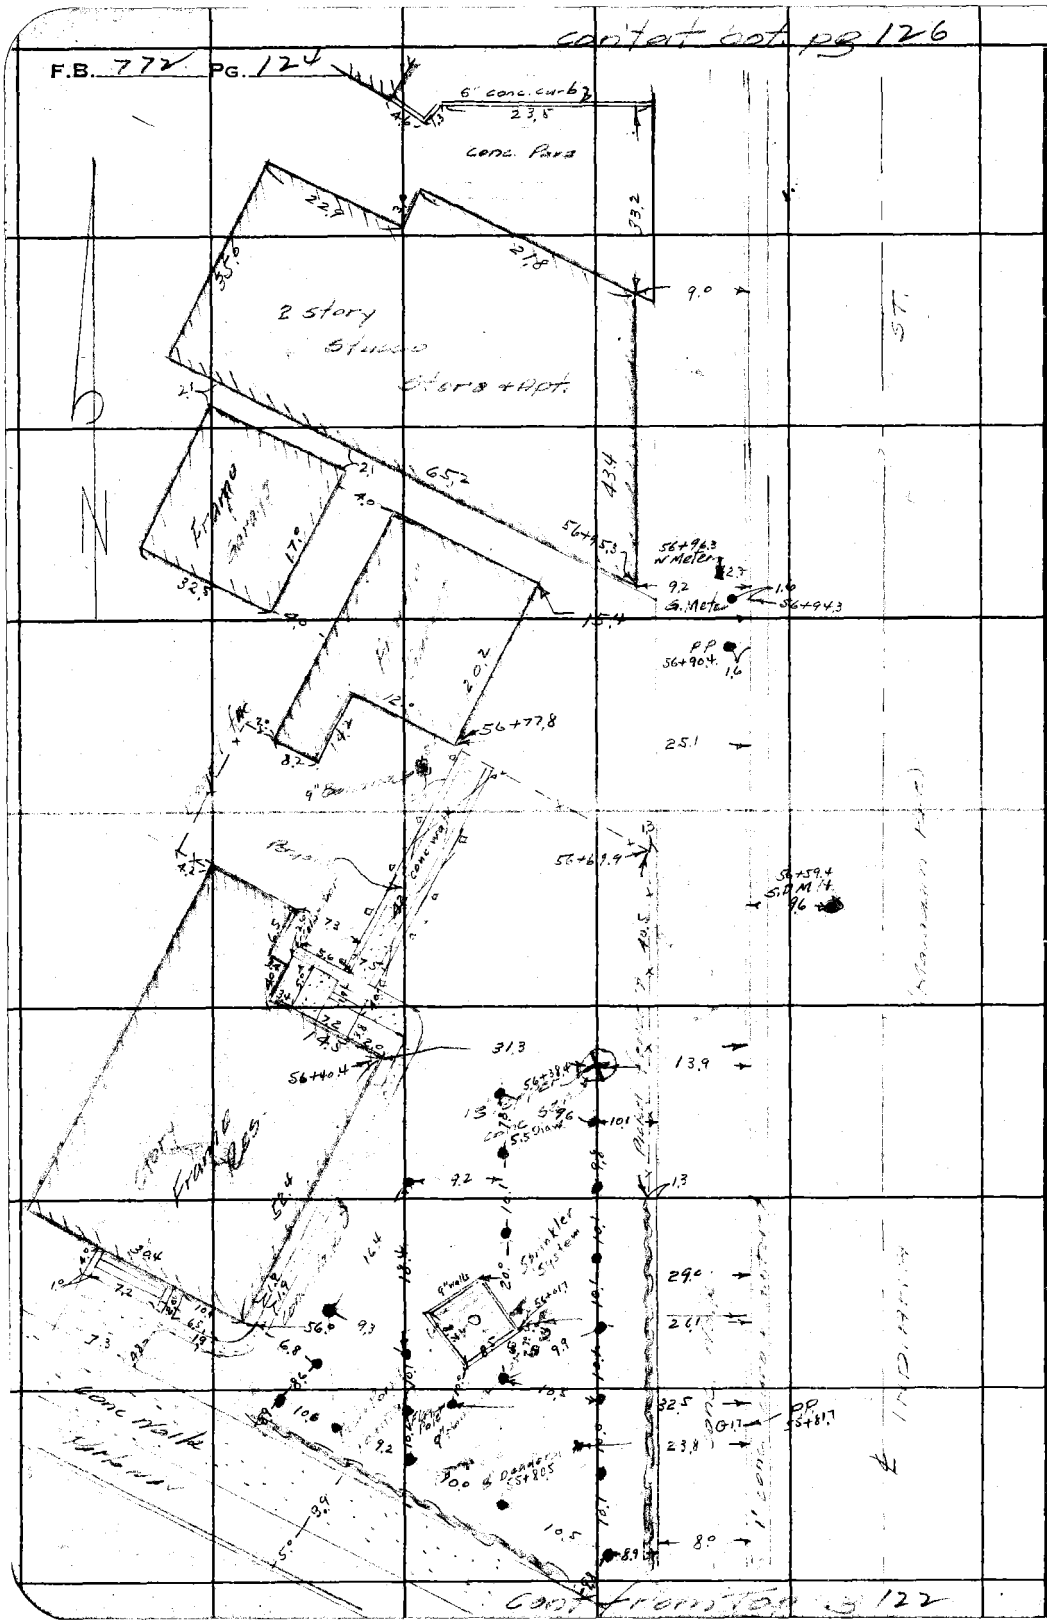

RETURN TO
LOS ANGELES COUNTY SURVEYOR
700 HALL OF RECORDS

Note: Any Additions or Changes on This Sheets Must be Made or Circled in **Red Ink** With Date and Name of Person Making Change.

Do not extend notes this side of this line

Notes Ck'd by D. M. Finley	Survey of INDIANA ST	F.B. 772	Pg. 125
Map No. B-1465-2	W. O. 8224 Tape No.	St'd	OF
Office Work F. A. W.	Surveyed by EVANS		
Checked D. M. Finley	Notes Brick Date '39		
Date Jan. 1941	Indexed		

To Bot Pg 127

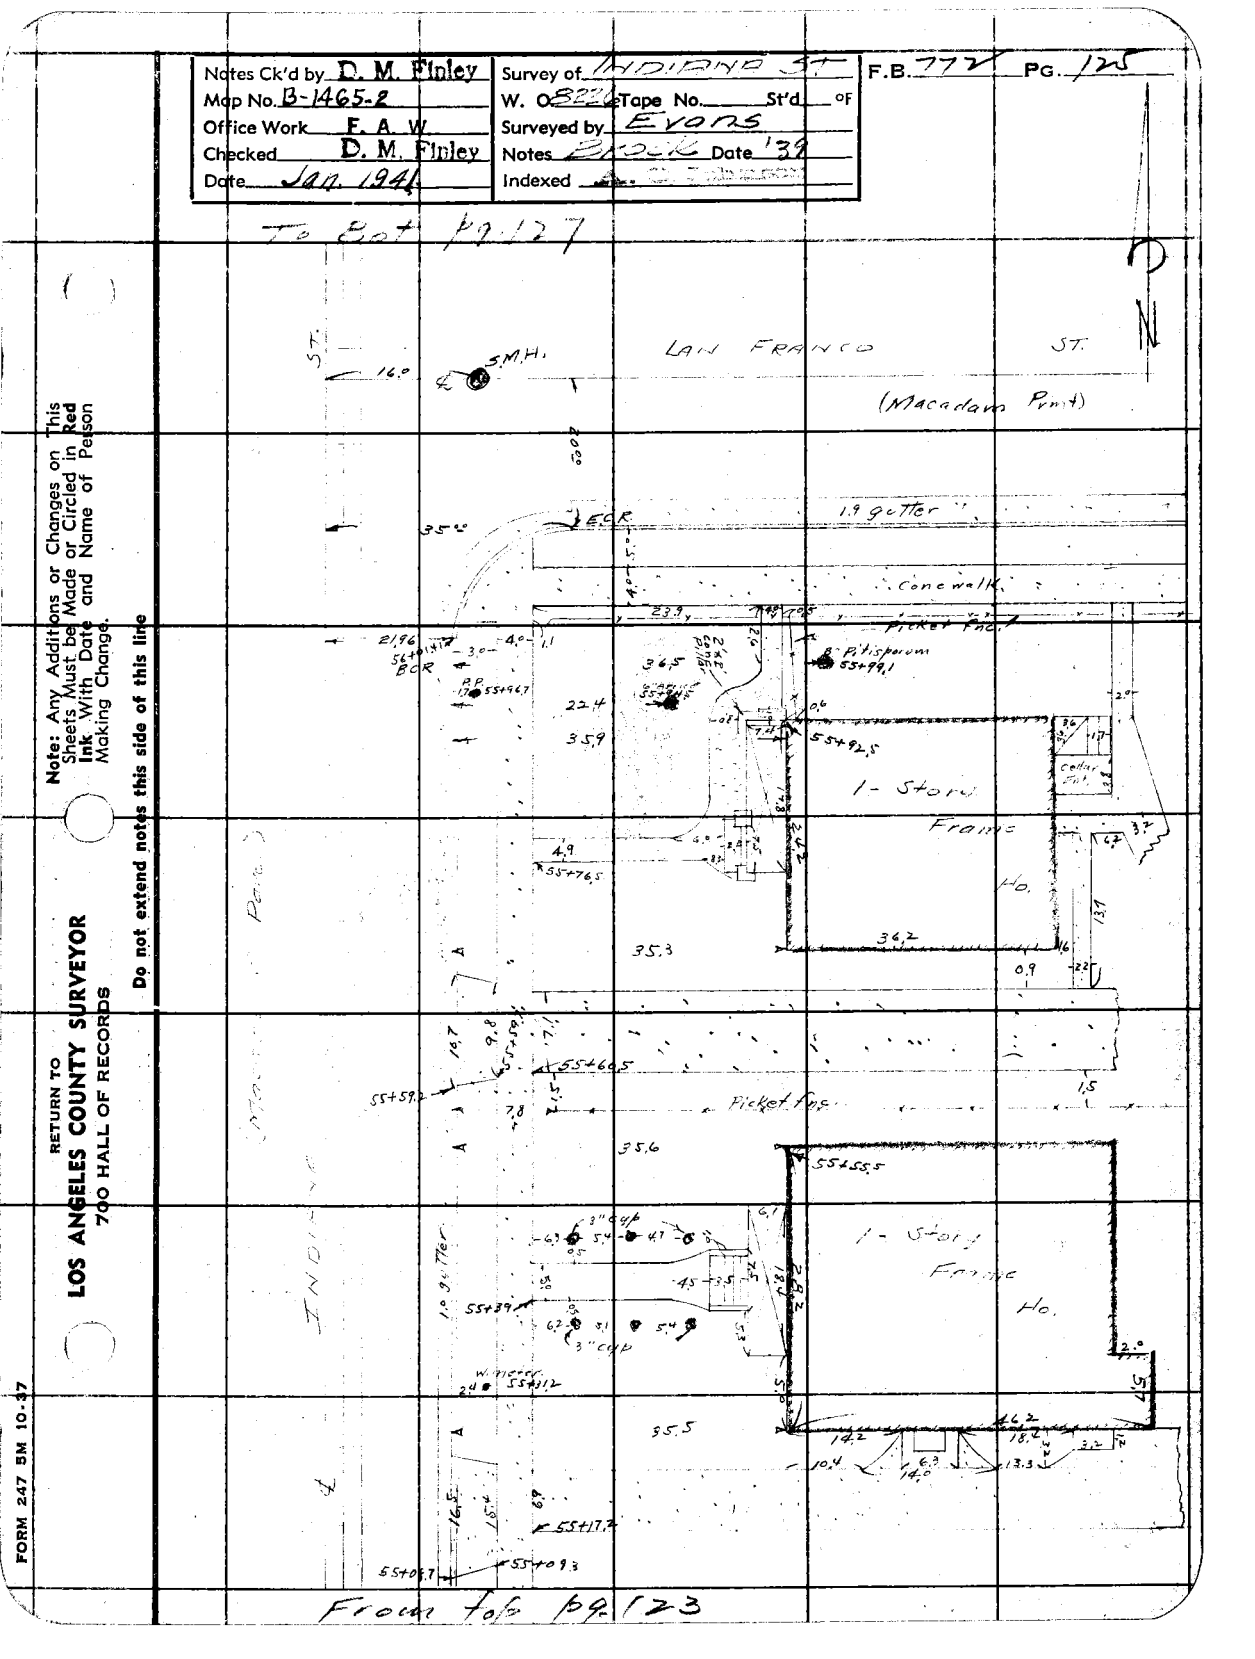

From Bot Pg 123

Note: Any Additions or Changes on This Sheets Must be Made or Circled in Red Ink With Date and Name of Person Making Change.

Do not extend notes this side of this line

RETURN TO
LOS ANGELES COUNTY SURVEYOR
700 HALL OF RECORDS

FORM 247 5M 10-37

F.B. 777 PG. 176

cont. from bot. pg 128

RETURN TO
LOS ANGELES COUNTY SURVEYOR
700 HALL OF RECORDS

Note: Any Additions or Changes on This Sheets Must be Made or Circled in **Red Ink** With Date and Name of Person Making Change.

Do not extend notes this side of this line

cont. to bot. pg 124

Notes Ck'd by D. M. Finley	Survey of INDIANA ST
Map No. B-1465-2	W. O. 8226 Tape No. ____ St'd ____ of
Office Work F. A. W.	Surveyed by Evans
Checked D. M. Finley	Notes [illegible] Date 38
Date Jan. 1941	Indexed [illegible]

F.B. 772 Pg. 127

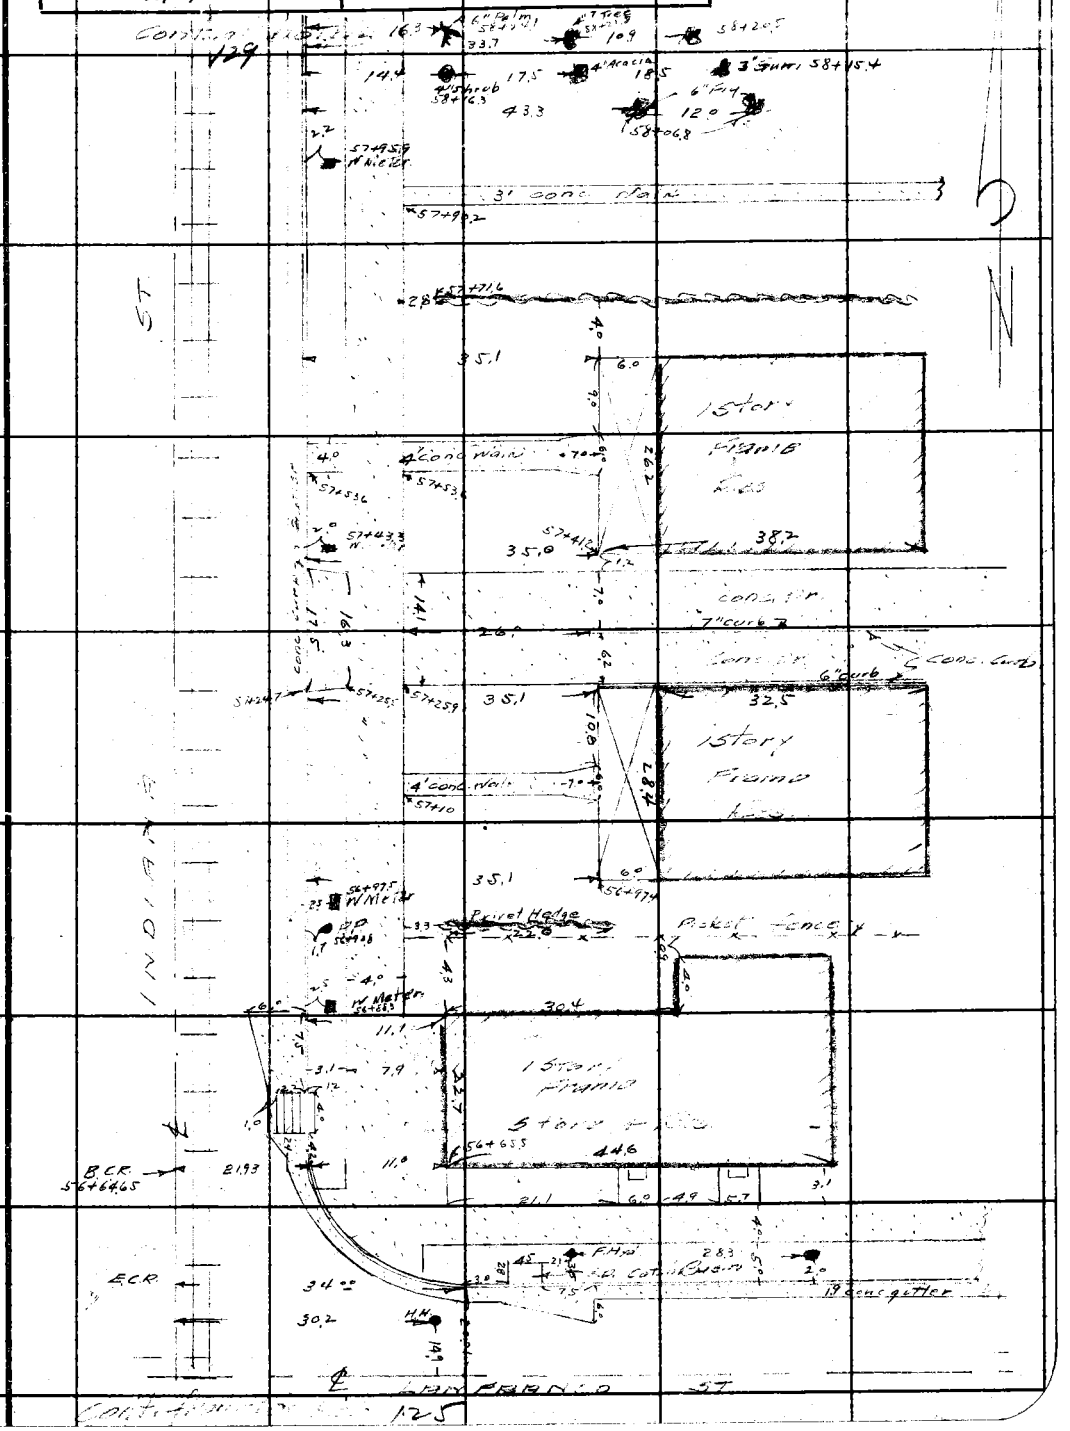

Note: Any Additions or Changes on This Sheets Must be Made or Circled in Red Ink With Date and Name of Person Making Change.

Do not extend notes this side of this line

RETURN TO
LOS ANGELES COUNTY SURVEYOR
700 HALL OF RECORDS

FORM 247 5M 10-37

F.B. 772 PG. 128

Cont at bot PS 130

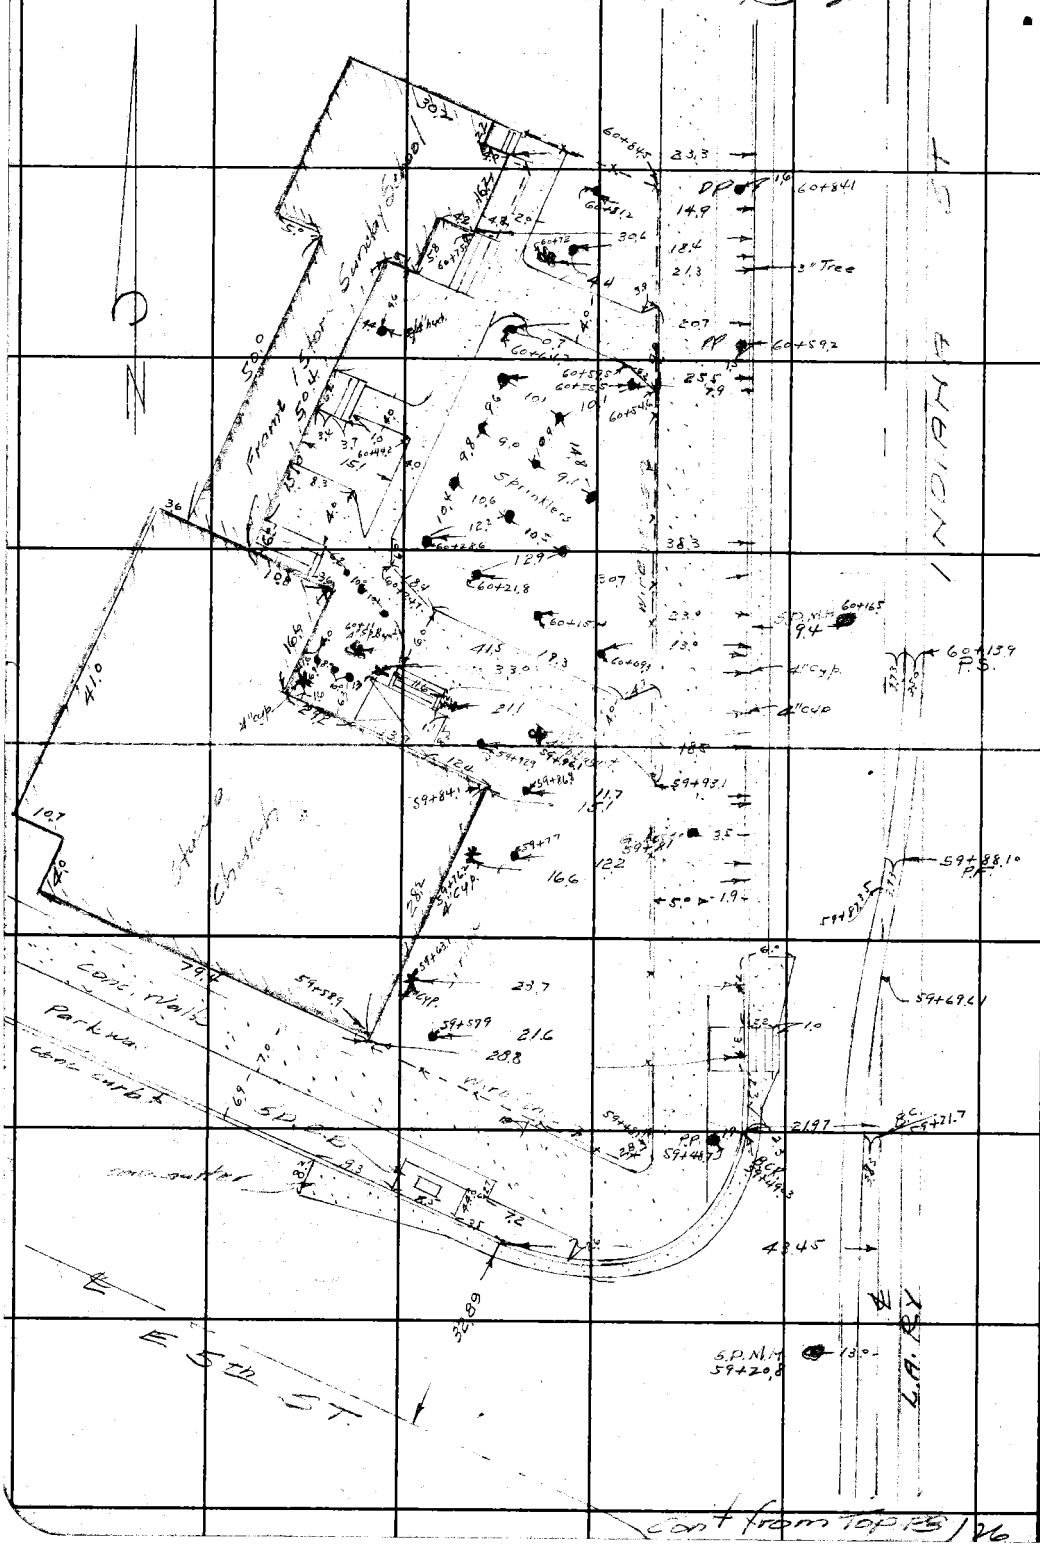

Cont from Top PS 126

RETURN TO
LOS ANGELES COUNTY SURVEYOR
700 HALL OF RECORDS

Note: Any Additions or Changes on This Sheets Must be Made or Circled in Red Ink With Date and Name of Person Making Change.

Do not extend notes this side of this line

Notes Ck'd by D. M. Finley	Survey of INDIANA ST	F.B. 772 PG. 129
Map No. B-1465-2	W. 08226 Tape No. ____ St'd ____ of	
Office Work F. A. W.	Surveyed by Evans	
Checked D. M. Finley	Notes Brock Date '39	
Date Jan. 1941	Indexed [illegible]	

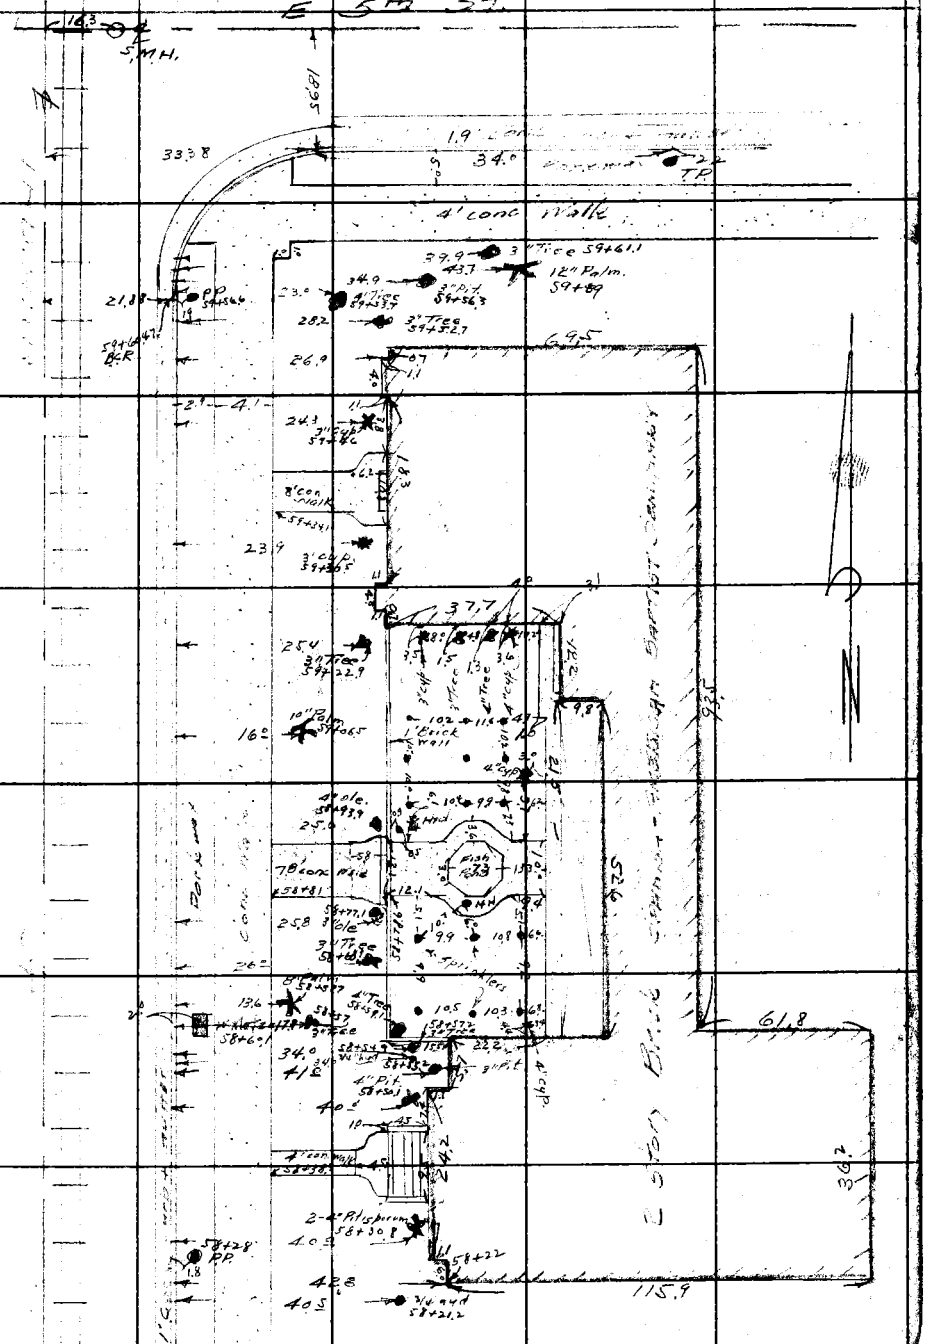

Note: Any Additions or Changes on This Sheets Must be Made or Circled in Red Ink With Date and Name of Person Making Change.

Do not extend notes this side of this line

RETURN TO
LOS ANGELES COUNTY SURVEYOR
700 HALL OF RECORDS

FORM 247 5M 10-37

F.B. 777 PG. 130


To Bot pg. 132

RETURN TO
LOS ANGELES COUNTY SURVEYOR
700 HALL OF RECORDS

Note: Any Additions or Changes on This Sheets Must be Made or Circled in Red Ink With Date and Name of Person Making Change.

Do not extend notes this side of this line

From top pg. 128

To Bk pg. 133

Notes Ck'd by D. M. Finley
Map No. B-1465-2
Office Work F. A. W.
Checked D. M. Finley
Date Jan 1941

W. O. 8226 Tape No. St'd OF
Surveyed by Evans
Notes Brock Date 139
Indexed

F.B. 772 Pg. 131

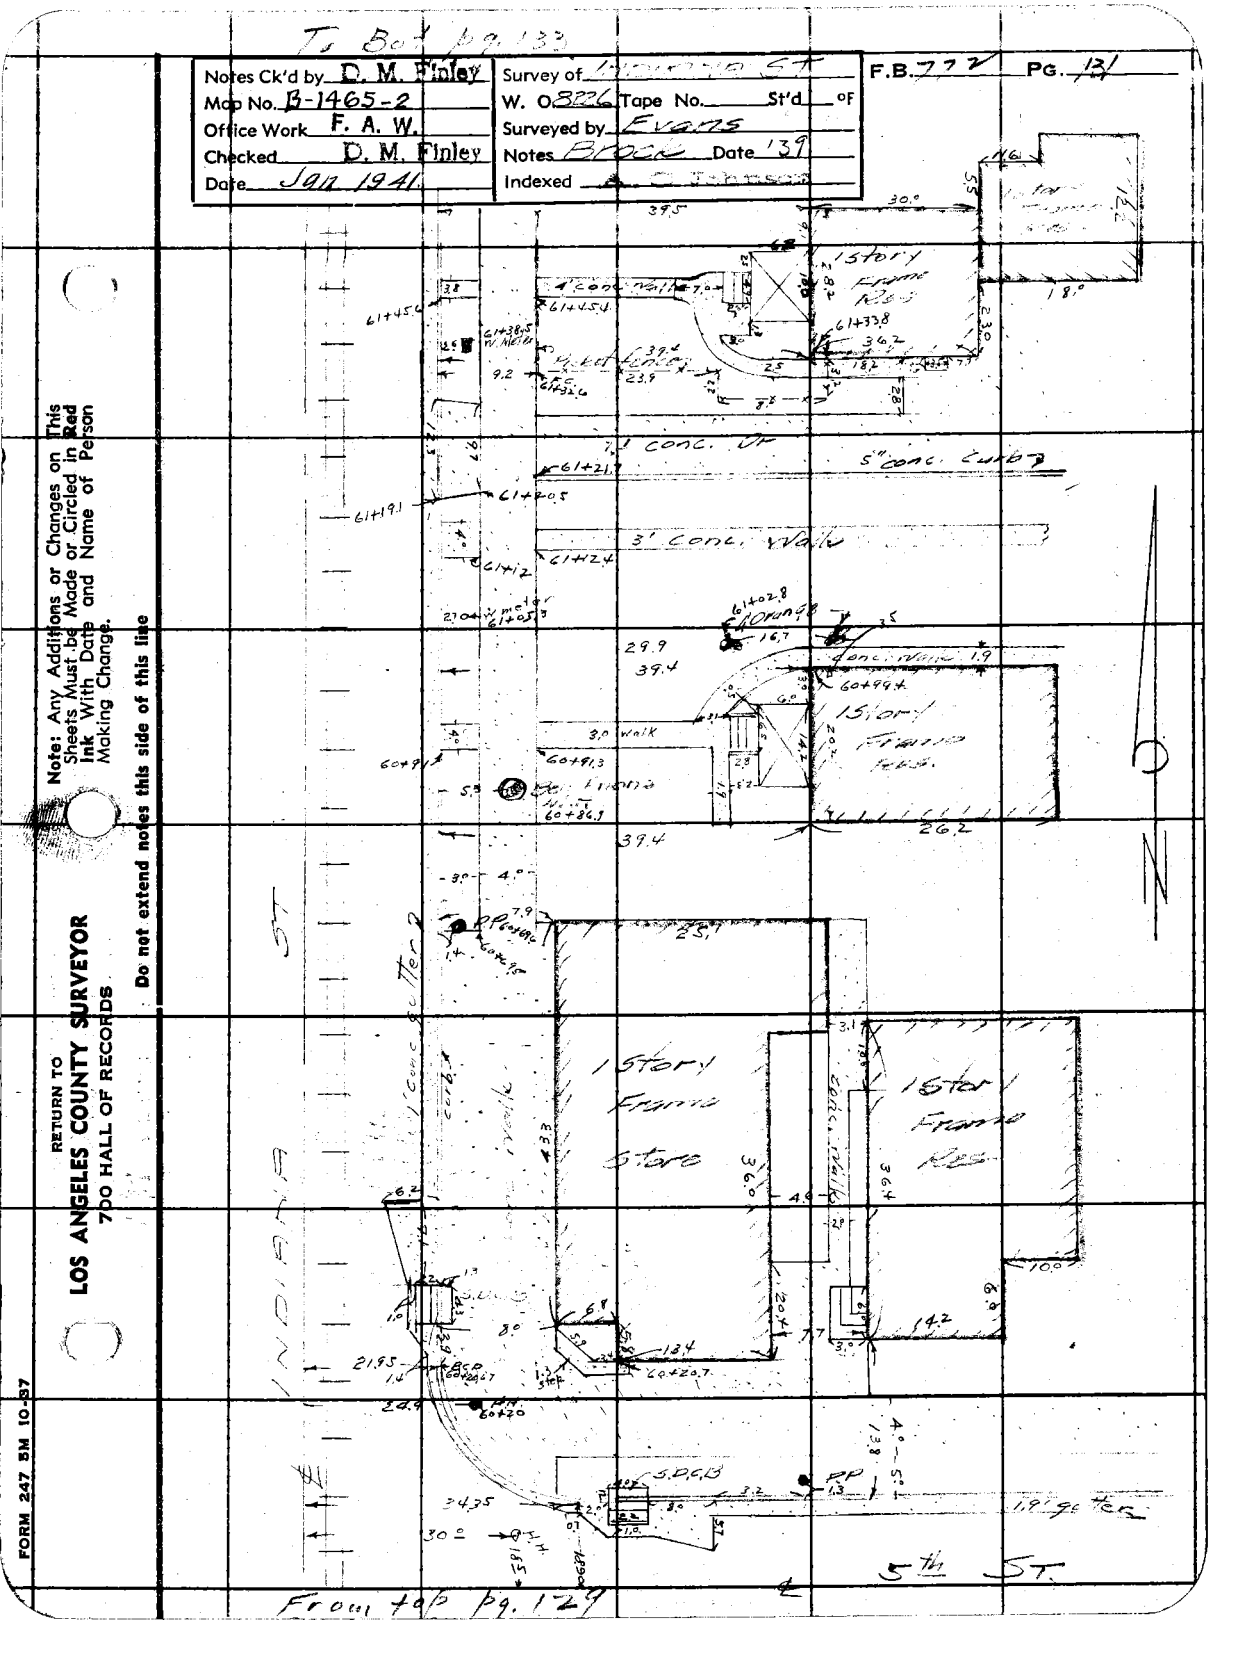

Note: Any Additions or Changes on This Sheets Must be Made or Circled in Red Ink With Date and Name of Person Making Change.

Do not extend notes this side of this line

RETURN TO
LOS ANGELES COUNTY SURVEYOR
700 HALL OF RECORDS

FORM 247 5M 10-37


To Bot pg. 134

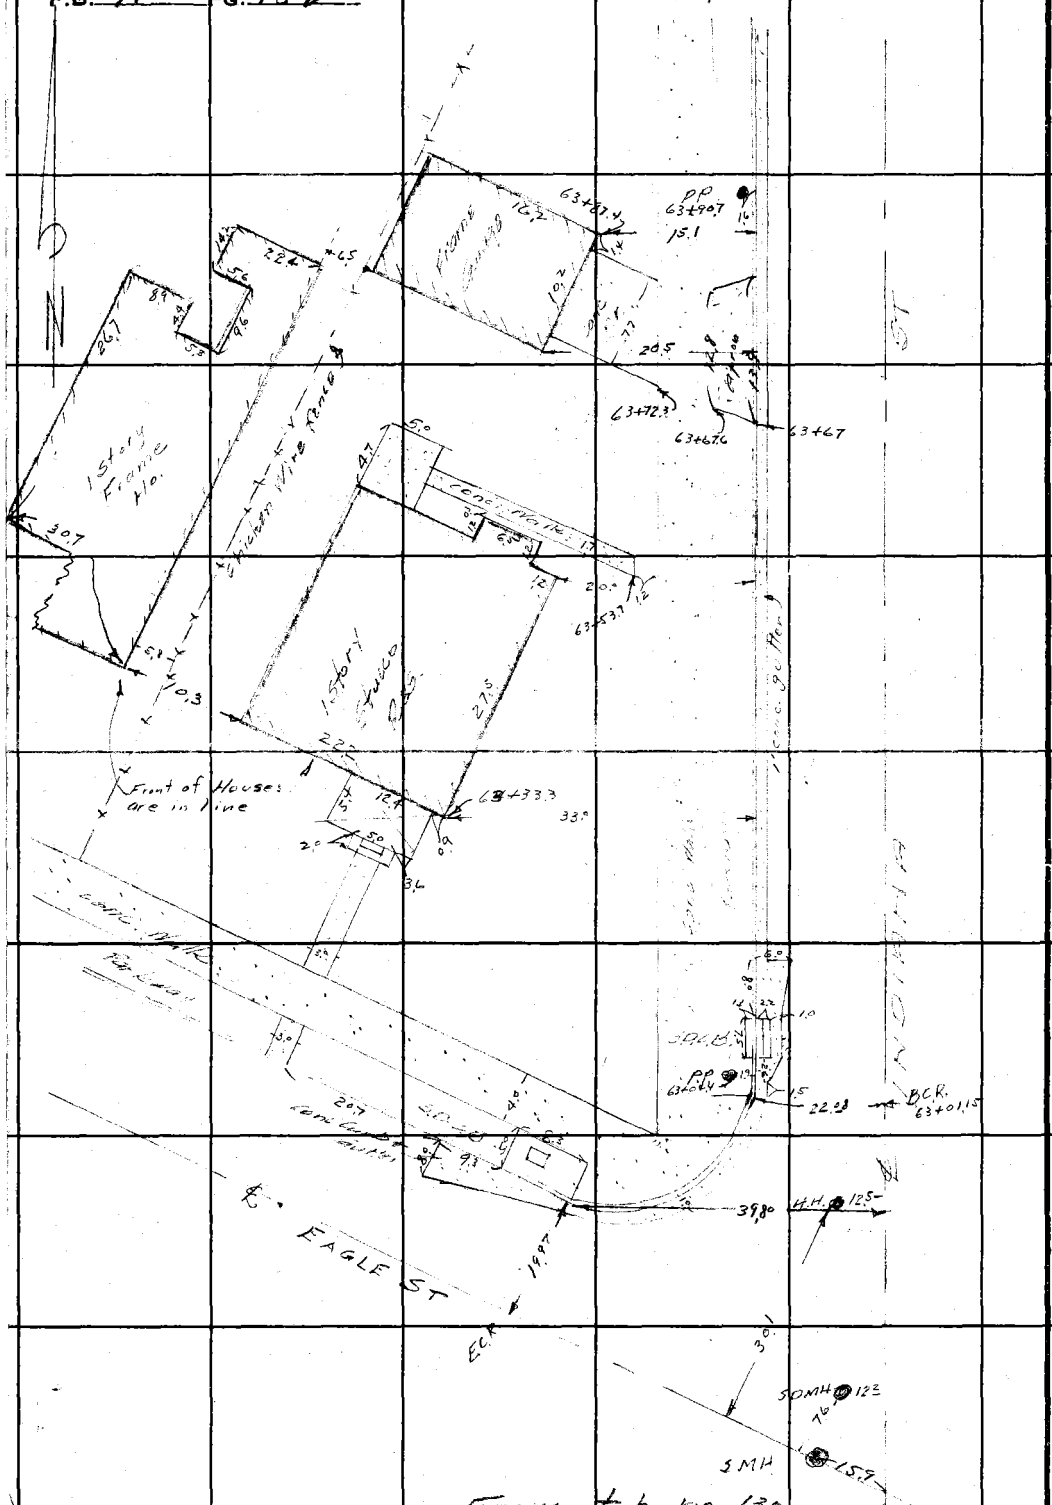

RETURN TO
LOS ANGELES COUNTY SURVEYOR
700 HALL OF RECORDS

Note: Any Additions or Changes on This Sheets Must be Made or Circled in Red Ink With Date and Name of Person Making Change.

Do not extend notes this side of this line

To Bd pg 135

Notes Ck'd by D. M. Finley	Survey of [illegible] ST	F.B. 772 Pg. 133
Map No. B-1465-2	W. O. 8226 Tape No. ____ St'd ____ of	
Office Work F. A. W.	Surveyed by Evans	
Checked D. M. Finley	Notes [illegible] Date '39	
Date Jan. 1941	Indexed [illegible]	

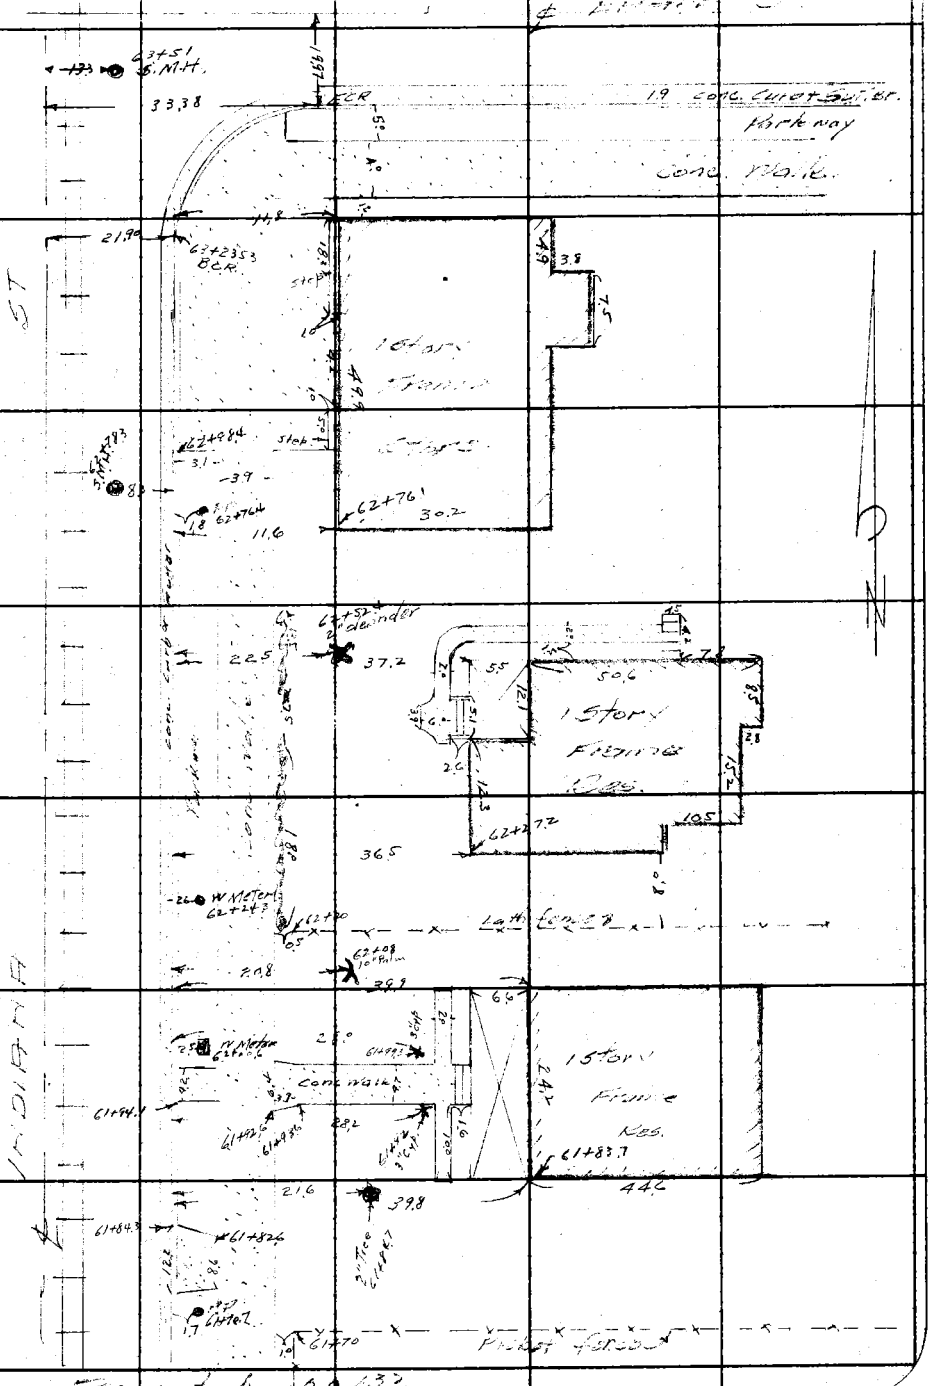

Note: Any Additions or Changes on This Sheets Must be Made or Circled in Red Ink With Date and Name of Person Making Change.

Do not extend notes this side of this line

RETURN TO
LOS ANGELES COUNTY SURVEYOR
700 HALL OF RECORDS

FORM 247 5M 10-37

From top pg 132

RETURN TO
LOS ANGELES COUNTY SURVEYOR
700 HALL OF RECORDS

Note: Any Additions or Changes on This Sheets Must be Made or Circled in **Red Ink** With Date and Name of Person Making Change.

Do not extend notes this side of this line

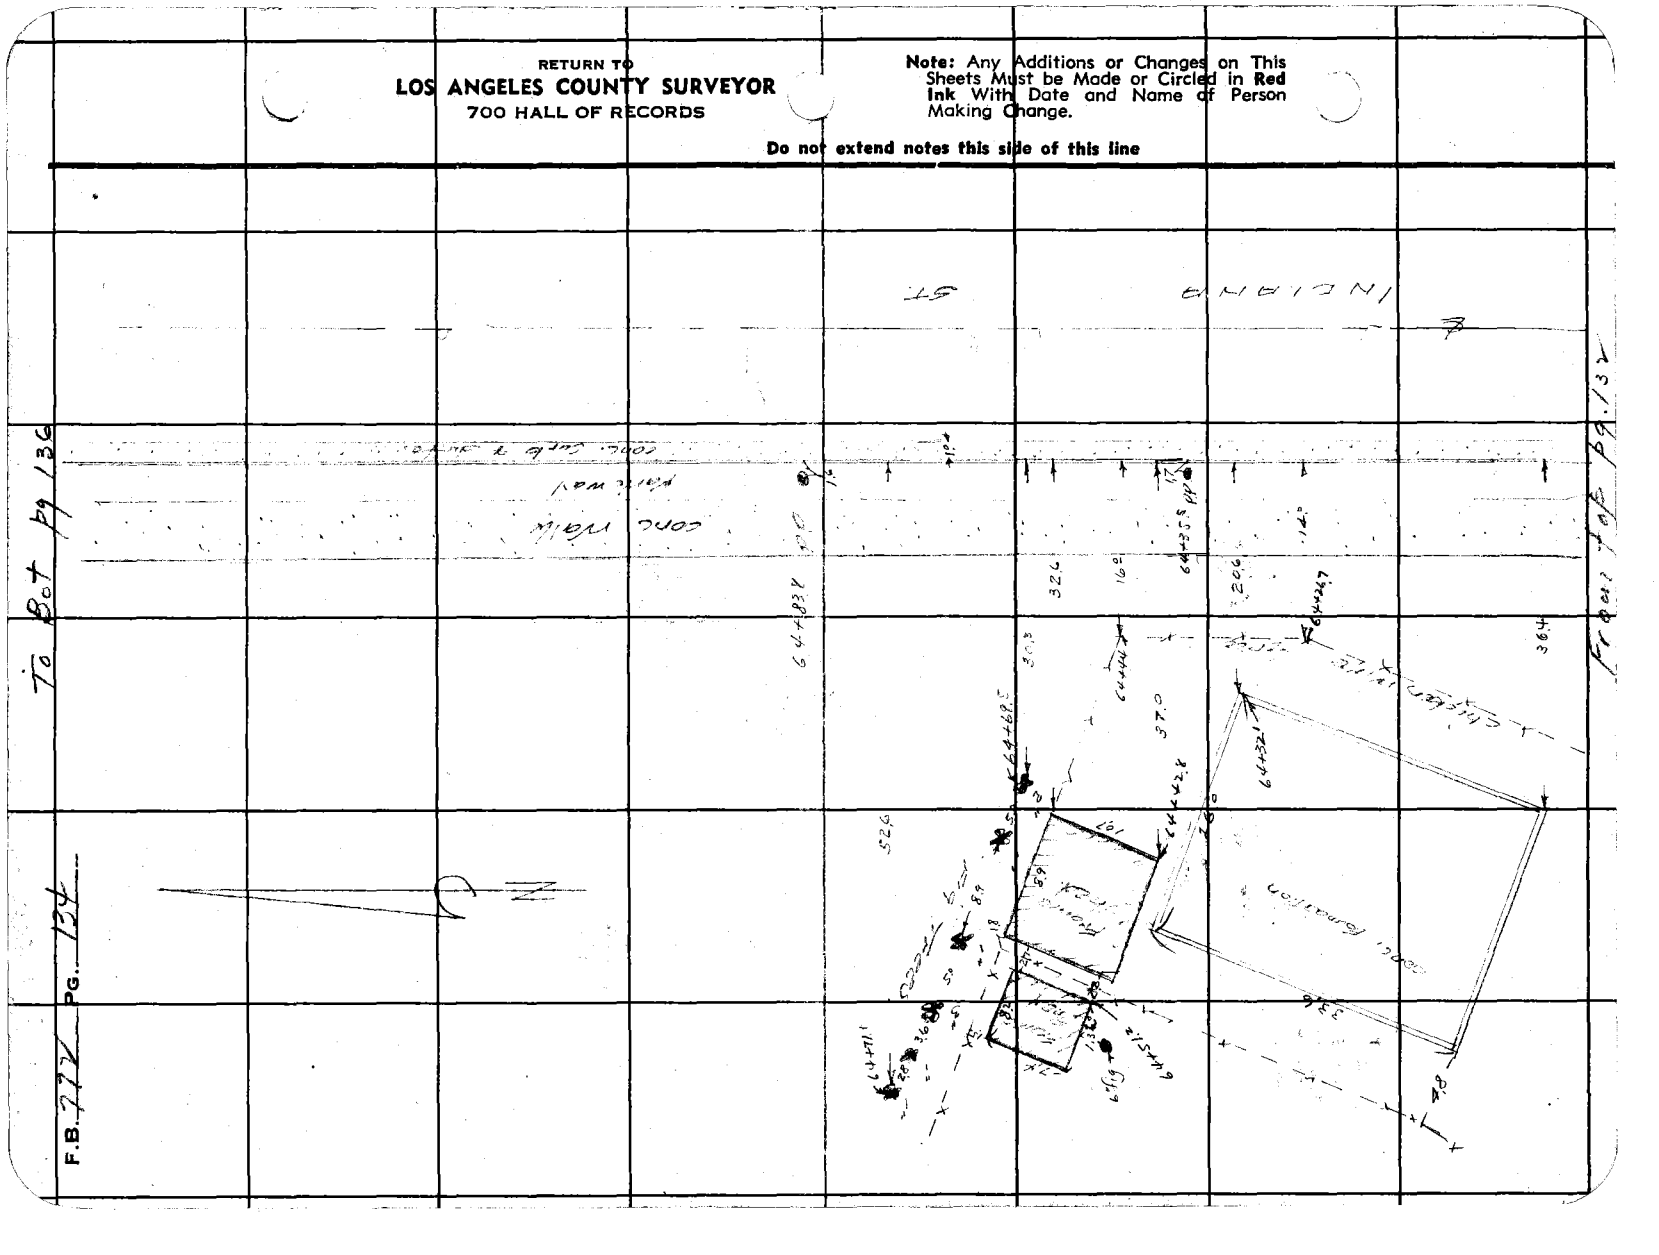

Notes Ck'd by D. M. Finley
Map No. B-1465-2
Office Work F. A. W.
Checked D. M. Finley
Date Jan. 1941

Survey of [illegible] ST
W. O. [illegible] Tape No. [illegible] St'd [illegible] OF
Surveyed by Evans
Notes [illegible] Date '39
Indexed [illegible]

F.B. 772 PG. 135

Note: Any Additions or Changes on This Sheets Must be Made or Circled in Red Ink With Date and Name of Person Making Change.

Do not extend notes this side of this line

RETURN TO
LOS ANGELES COUNTY SURVEYOR
700 HALL OF RECORDS

FORM 247 5M 10-37

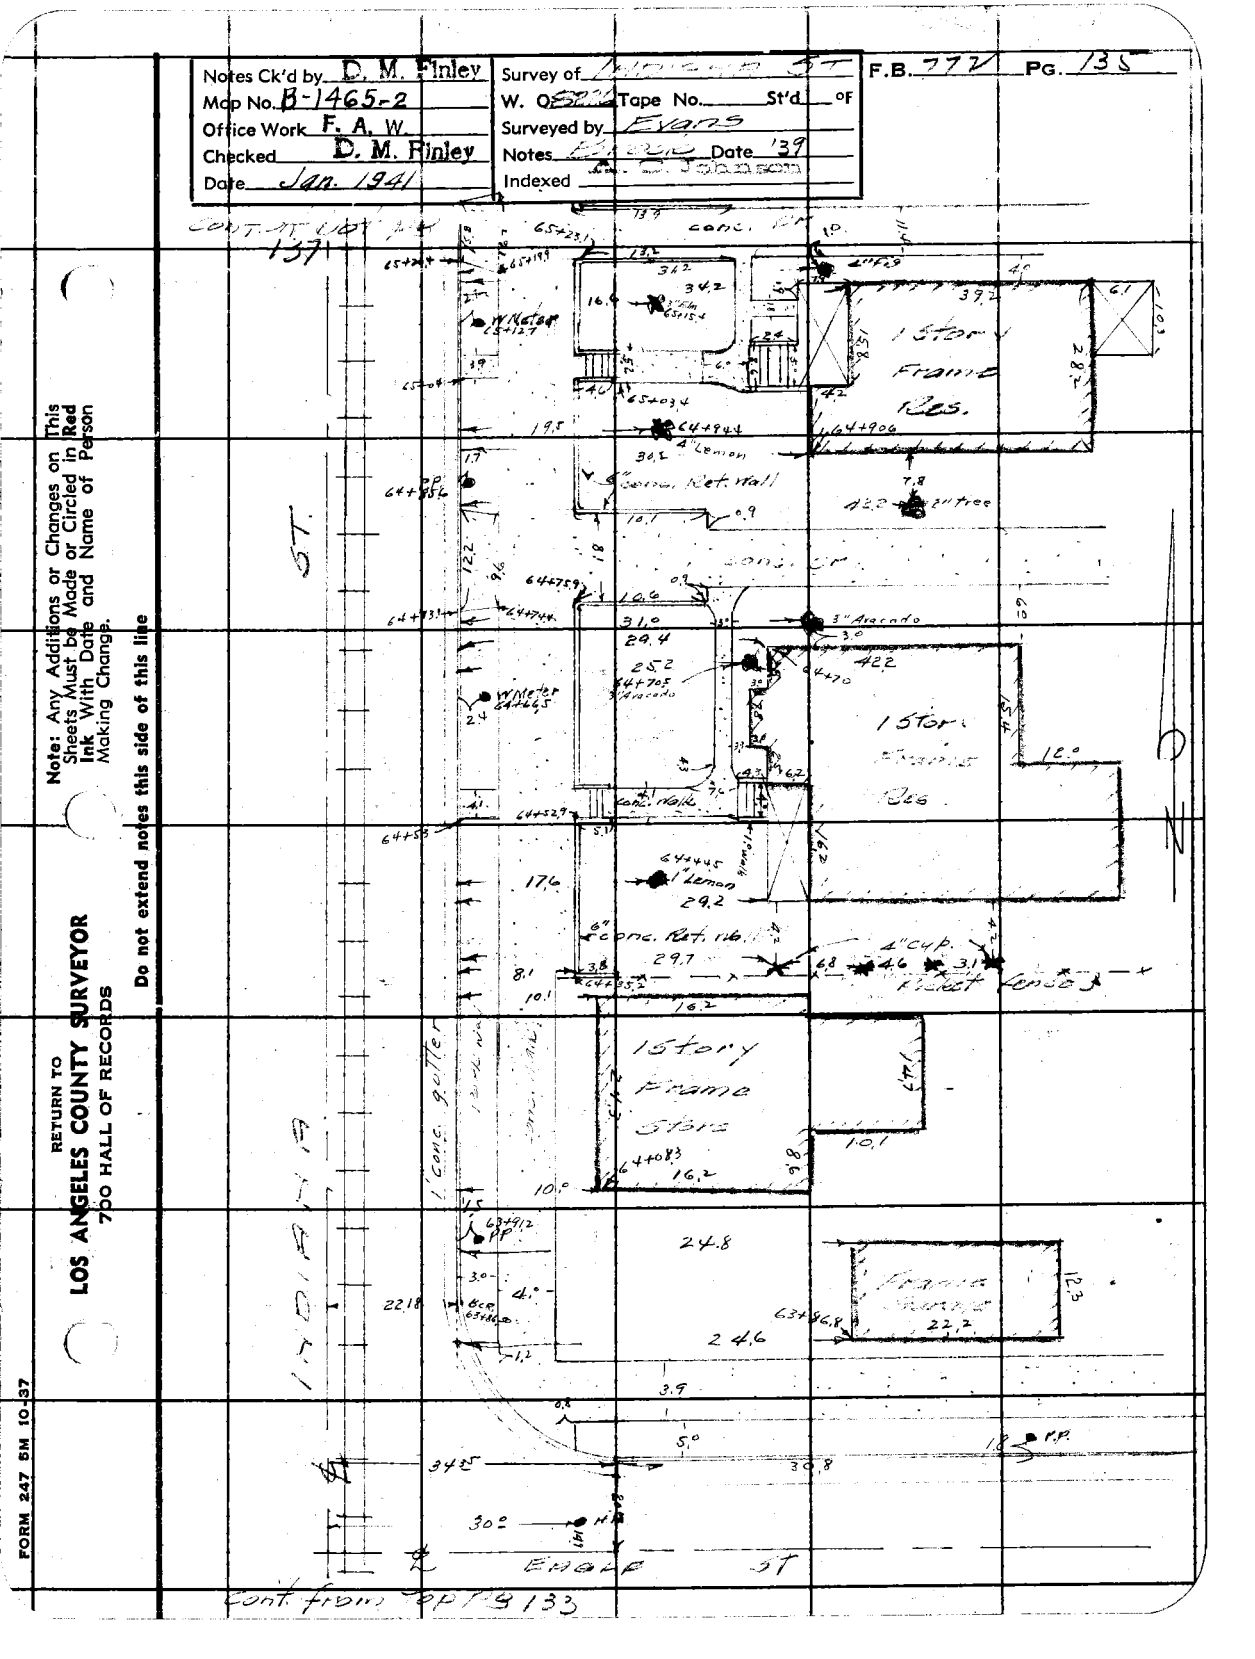

F.B. 772 PG. 136

RETURN TO
LOS ANGELES COUNTY SURVEYOR
700 HALL OF RECORDS

Do not extend notes this side of this line

Note: Any Additions or Changes on This Sheets Must be Made or Circled in Red Ink With Date and Name of Person Making Change.

Notes Ck'd by D. M. Finley	Survey of [illegible] ST	F.B. 772	Pg. 137
Map No. B-1465-2	W. O. [illegible] Tape No. ____ St'd ____ of		
Office Work F. A. W.	Surveyed by Evans		
Checked D. M. Finley	Notes [illegible] Date 139		
Date Jan. 1941	Indexed A. C. Johnson		

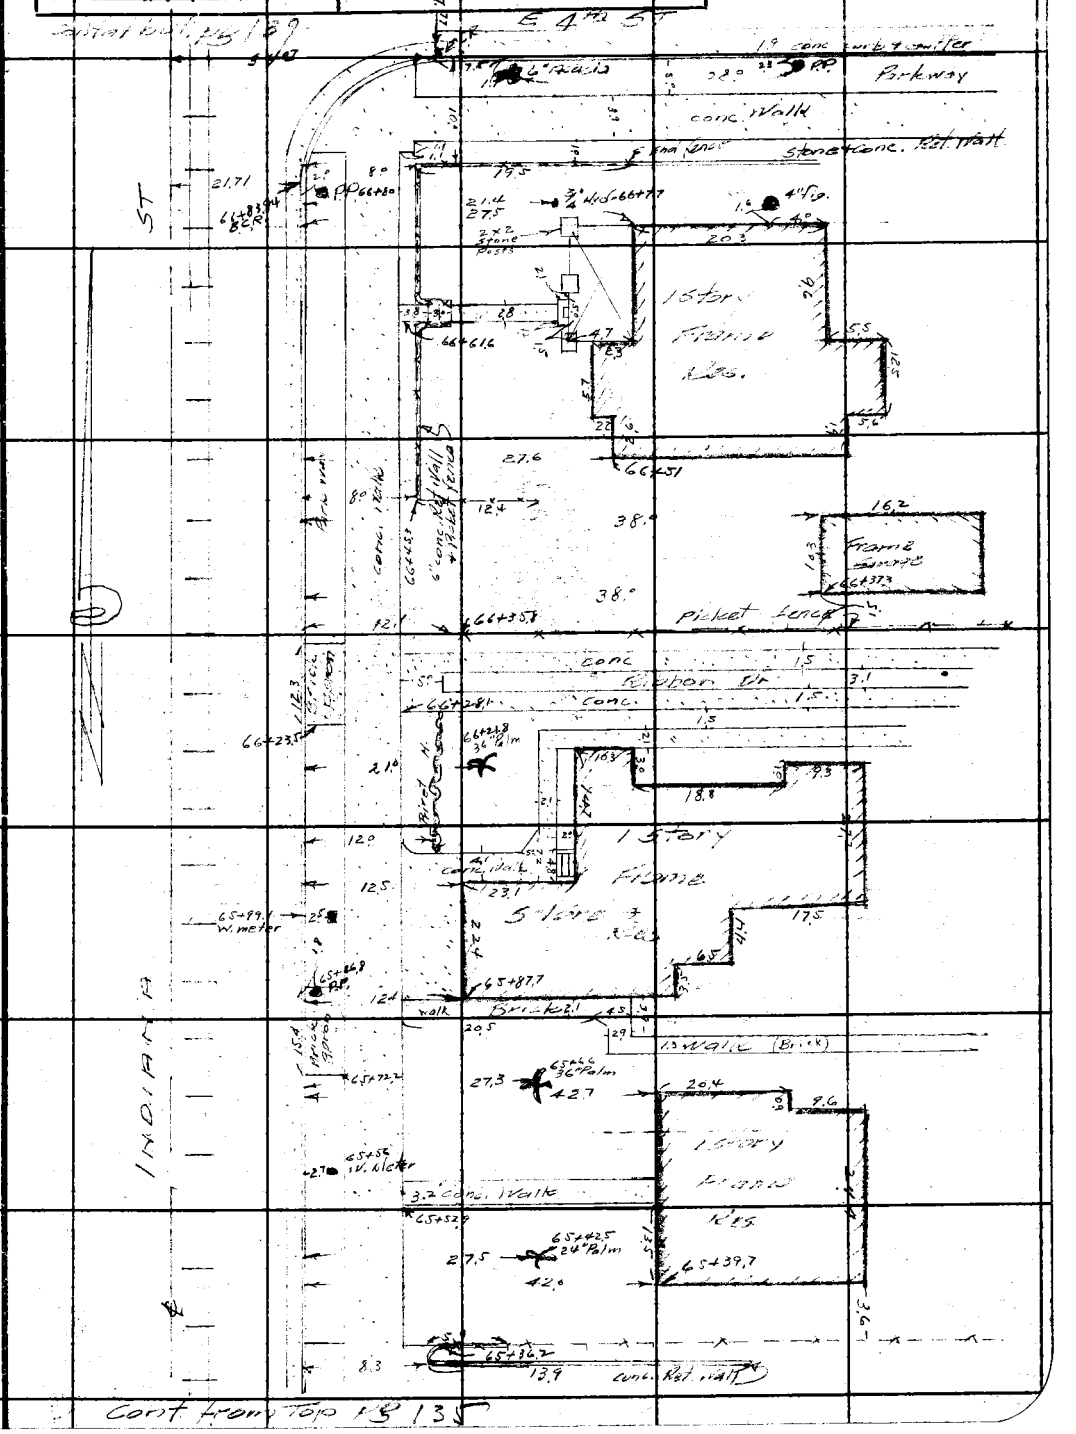

Cont from Top Pg 135

Note: Any Additions or Changes on This Sheets Must be Made or Circled in Red Ink With Date and Name of Person Making Change.

Do not extend notes this side of this line

RETURN TO
LOS ANGELES COUNTY SURVEYOR
700 HALL OF RECORDS

FORM 247 5M 10-37

F.B. 772 PG. 138

To Bot pg. 140

RETURN TO
LOS ANGELES COUNTY SURVEYOR
700 HALL OF RECORDS

Note: Any Additions or Changes on This Sheets Must be Made or Circled in Red Ink With Date and Name of Person Making Change.

Do not extend notes this side of this line

From top pg. 136

Map No. B-1465-2	W. O. 8226 Tape No. St'd OF	
Office Work F. A. W.	Surveyed by Evans	
Checked D. M. Finley	Notes Block Date '39	
Date Jan. 1941.	Indexed	

Cont at Bot. pg 141

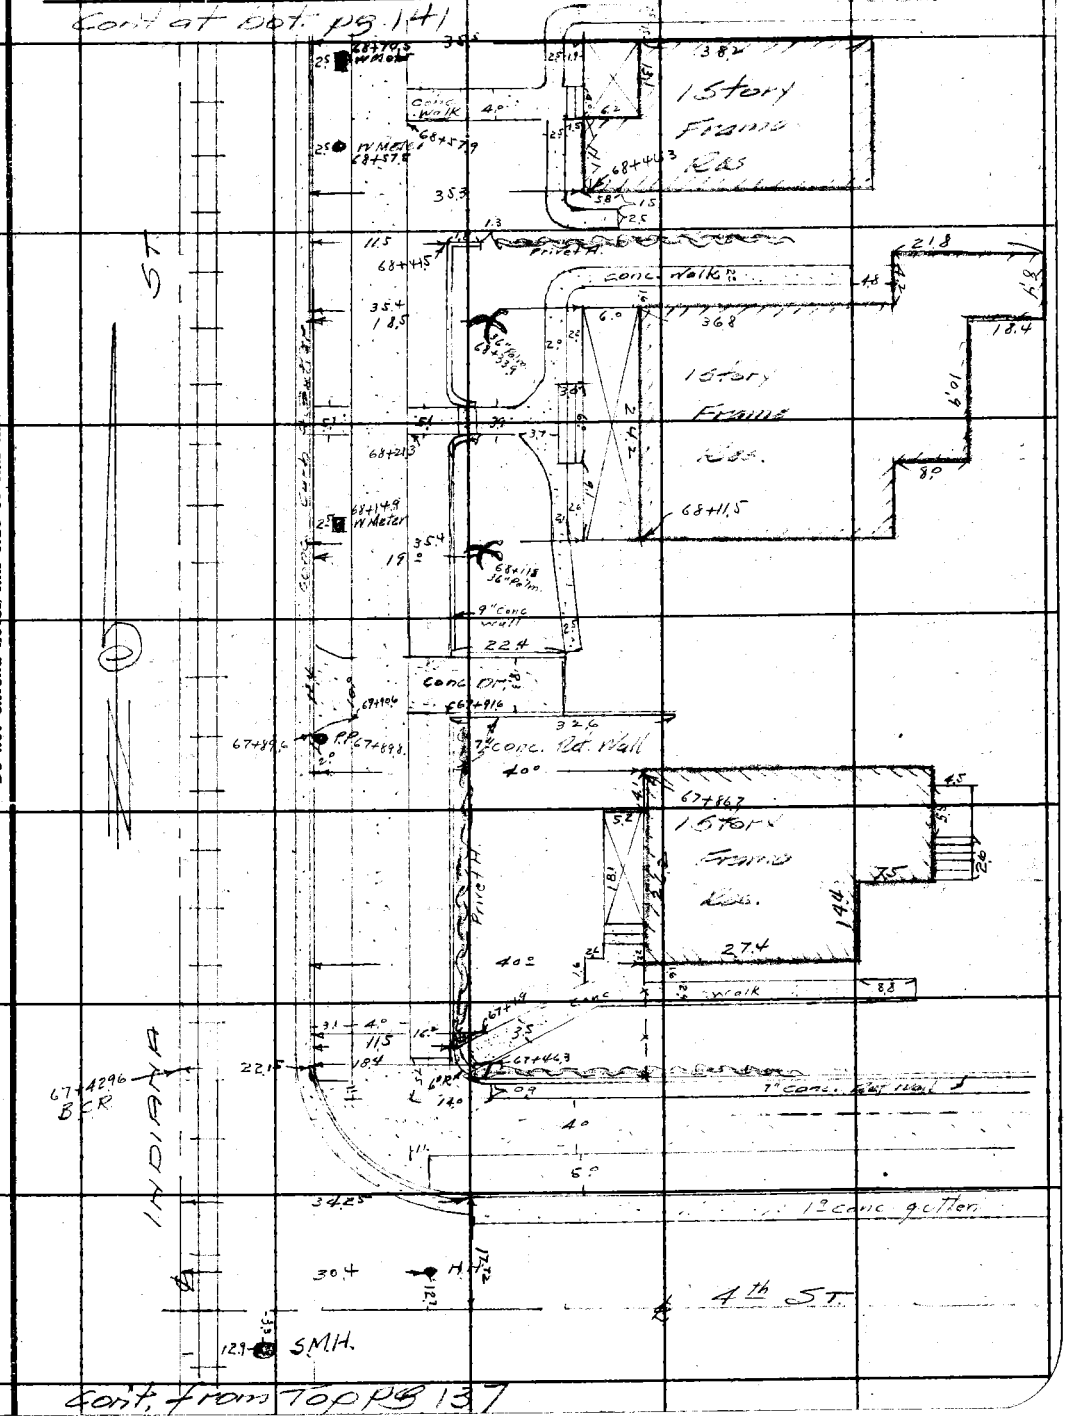

Cont. from Top pg 137

Note: Any Additions or Changes on This Sheets Must be Made or Circled in Red Ink With Date and Name of Person Making Change.

Do not extend notes this side of this line

RETURN TO
LOS ANGELES COUNTY SURVEYOR
700 HALL OF RECORDS

FORM 247 5M. 10-37

RETURN TO
LOS ANGELES COUNTY SURVEYOR
700 HALL OF RECORDS

Note: Any Additions or Changes on This Sheets Must be Made or Circled in **Red Ink** With Date and Name of Person Making Change.

Do not extend notes this side of this line

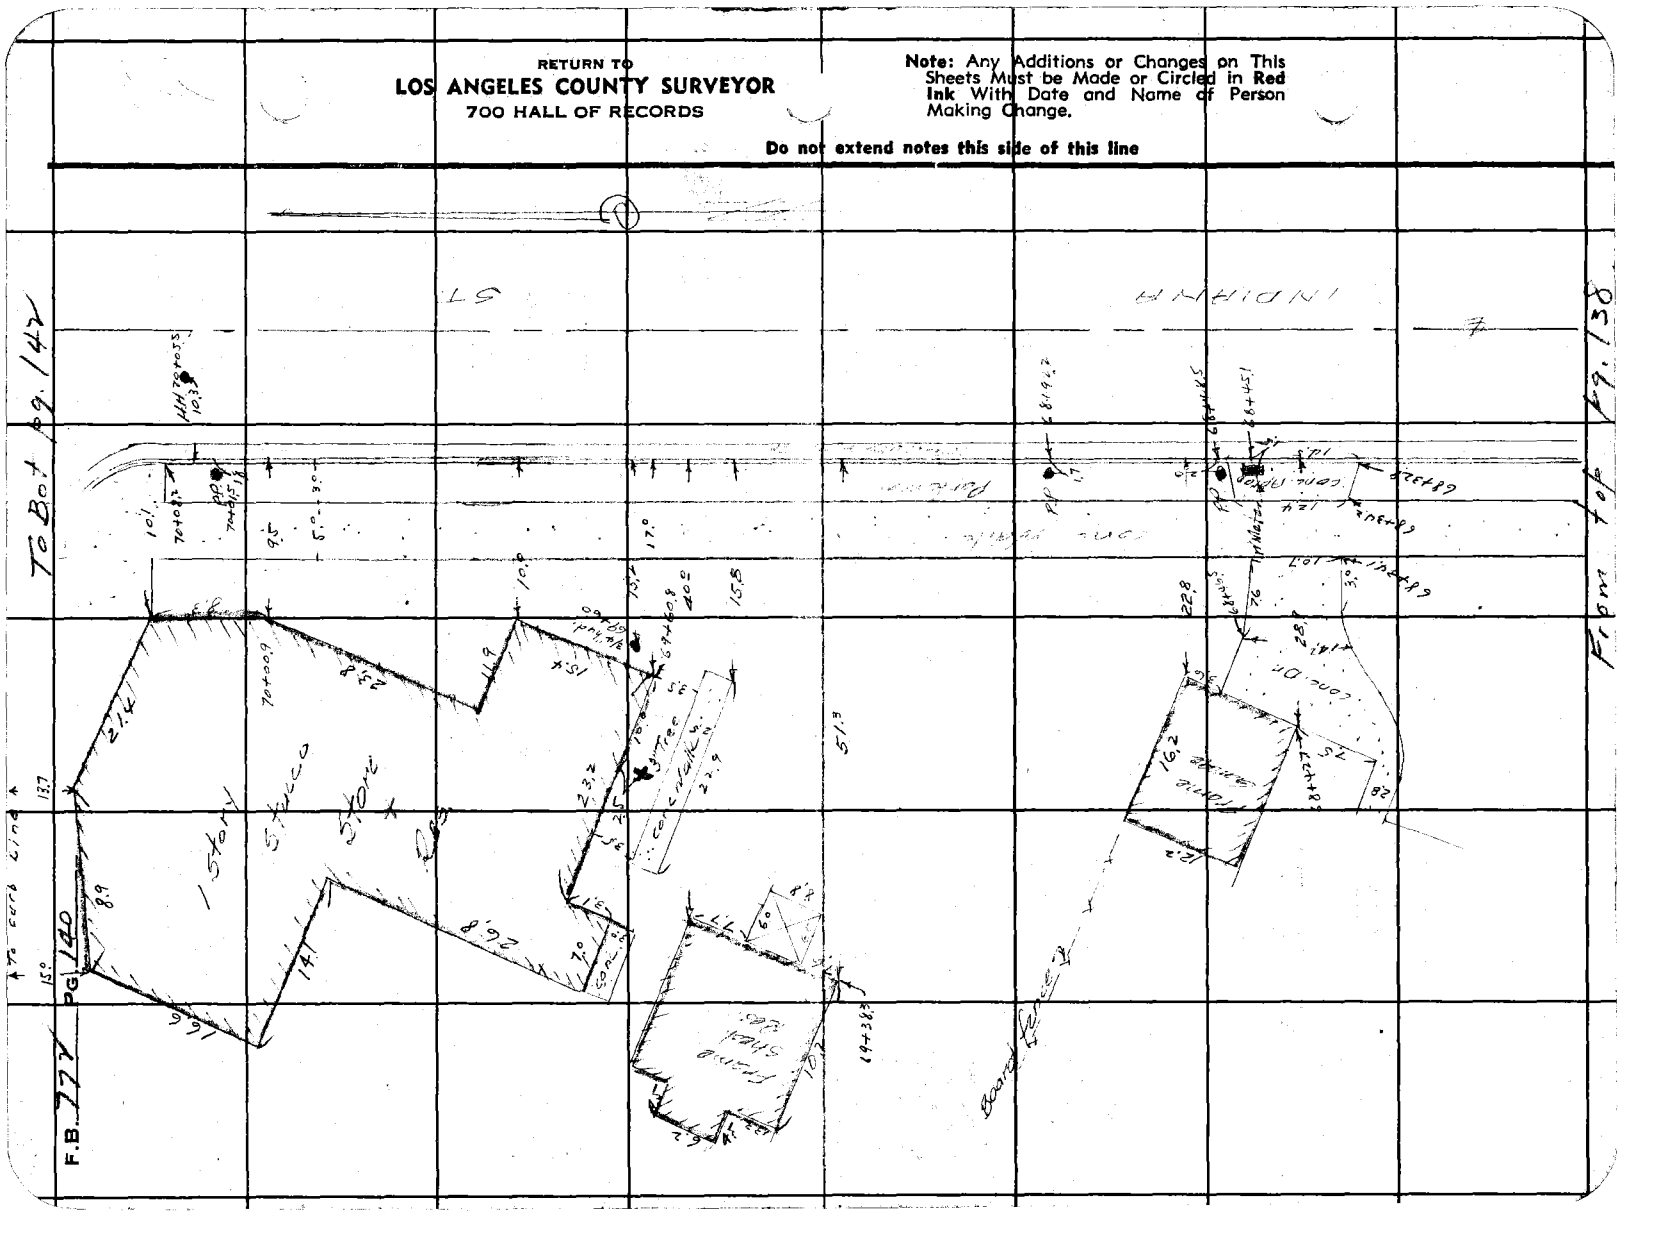

Notes Ck'd by D. M. Finley	Survey of INDIANA ST	F.B. 772	PG. 141
Map No. B-1465-2	W. O. 8226 Tape No. ____ St'd ____ OF		
Office Work F. A. W.	Surveyed by Evans		
Checked D. M. Finley	Notes Brock Date 139		
Date Jan 1941	Indexed		

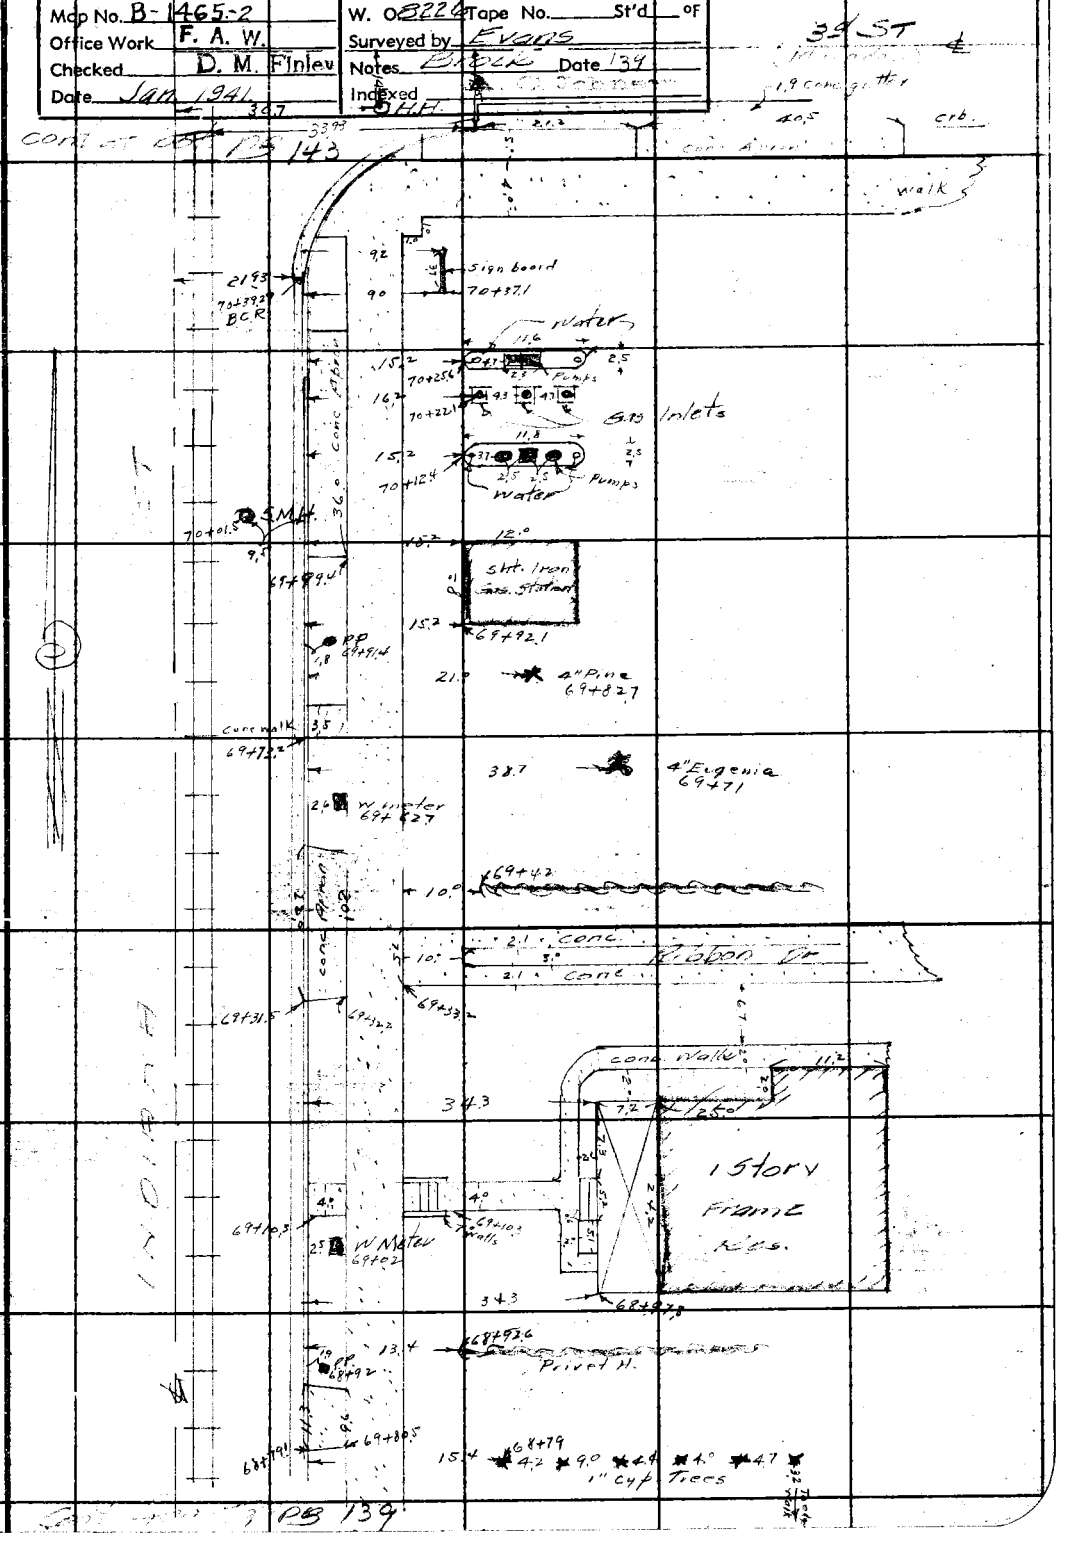

Note: Any Additions or Changes on This Sheets Must be Made or Circled in Red Ink With Date and Name of Person Making Change.

Do not extend notes this side of this line

RETURN TO
LOS ANGELES COUNTY SURVEYOR
700 HALL OF RECORDS

FORM 247 5M 10-37

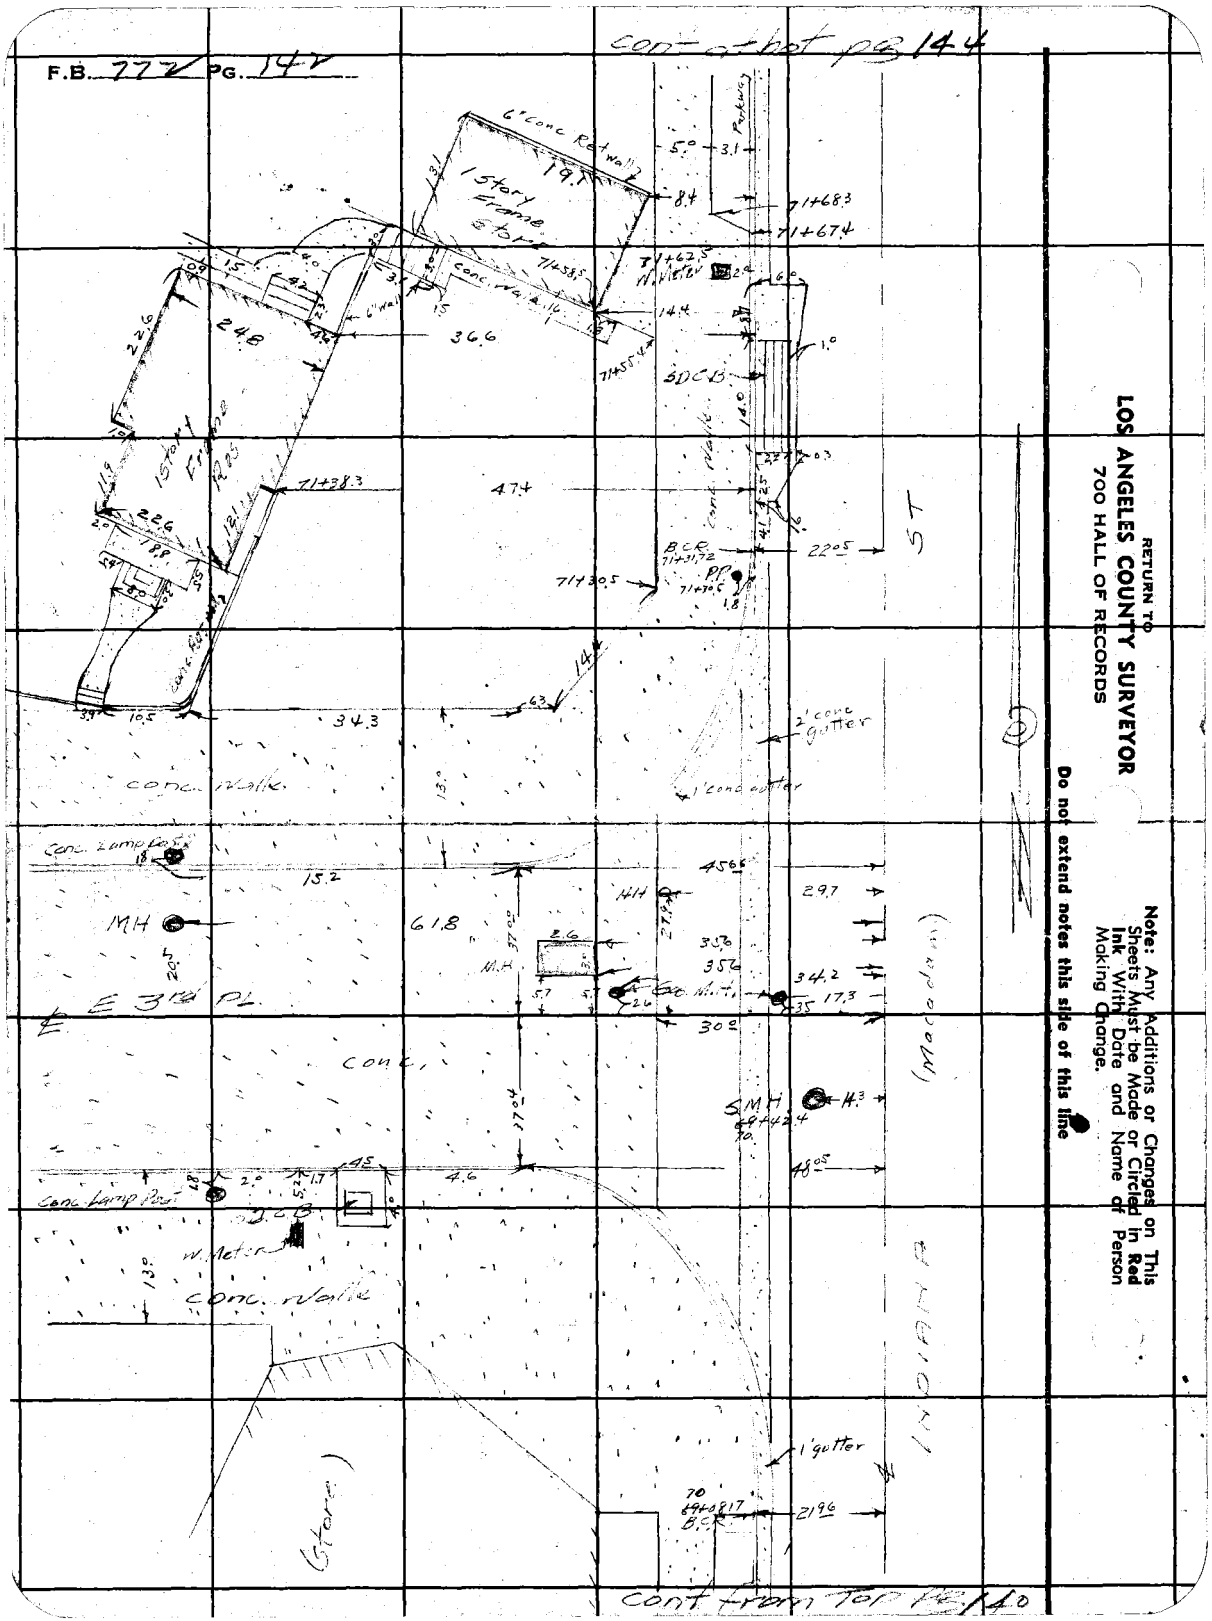

RETURN TO
LOS ANGELES COUNTY SURVEYOR
700 HALL OF RECORDS

Note: Any Additions or Changes on This Sheets Must be Made in Red Ink or Circled With Date and Name of Person Making Change.

Do not extend notes this side of this line

Notes Ck'd by D. M. Finley	Survey of INDIANA ST	F.B. 772 Pg. 143
Map No. B-1465-2	W. O. ____ Tape No. ____ St'd ____ of	
Office Work F. A. W.	Surveyed by Evans	
Checked D. M. Finley	Notes Brock Date '39	
Date Jan. 1941	Indexed To Sys. [illegible]	

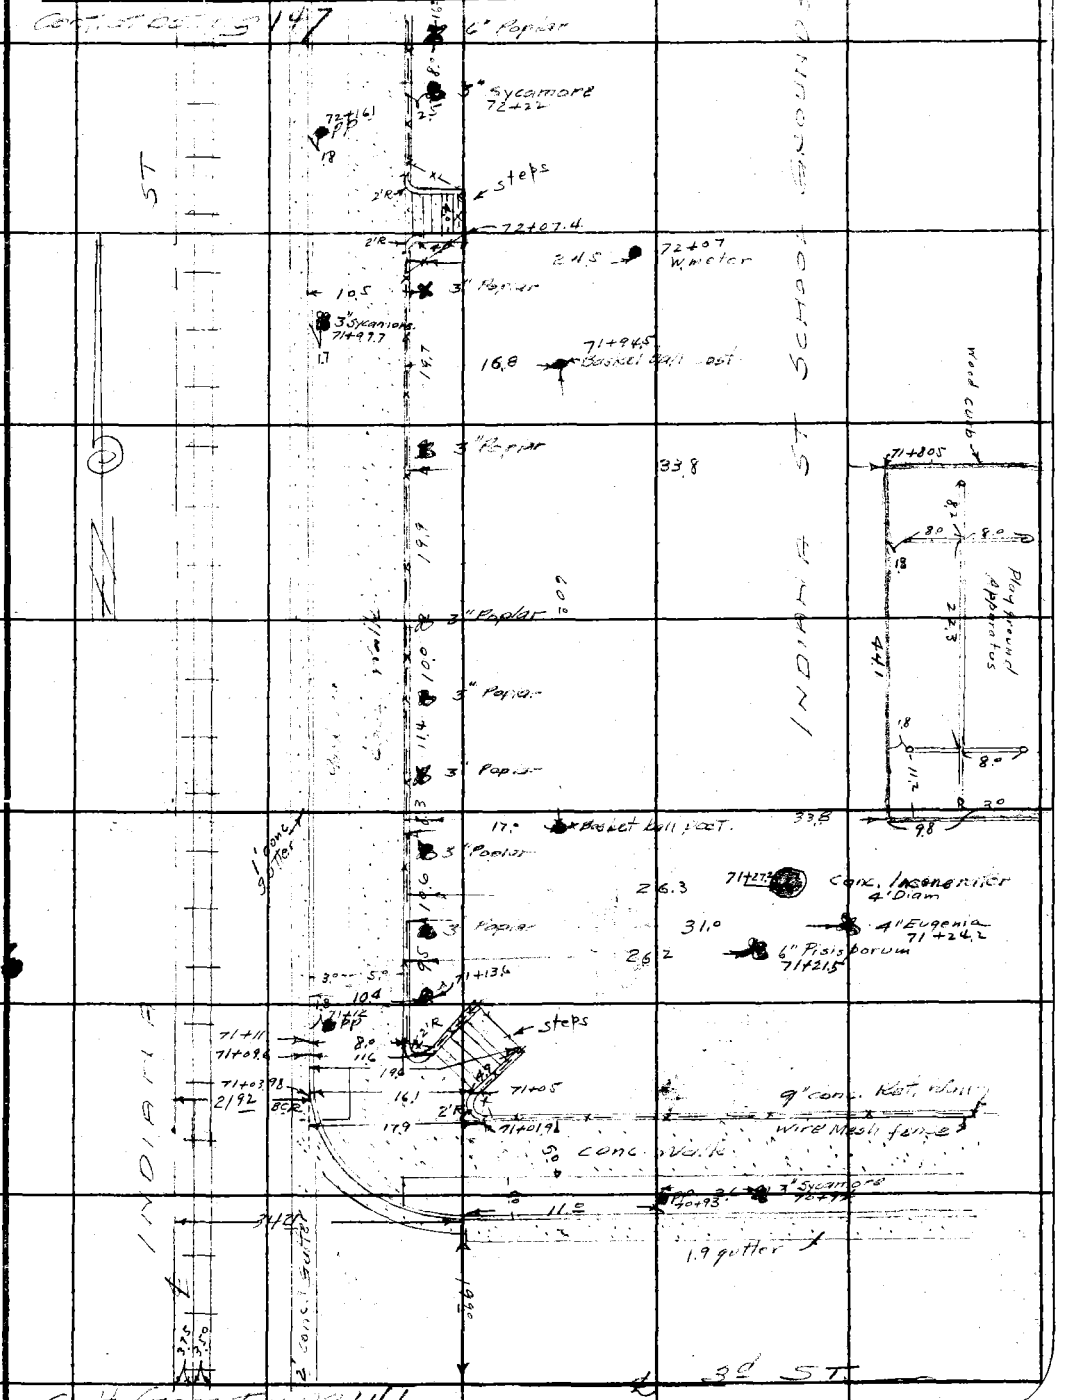

Note: Any Additions or Changes on This Sheets Must be Made or Circled in Red Ink With Date and Name of Person Making Change.

Do not extend notes this side of this line

RETURN TO
LOS ANGELES COUNTY SURVEYOR
700 HALL OF RECORDS

FORM 247 5M 10-37

RETURN TO
LOS ANGELES COUNTY SURVEYOR
700 HALL OF RECORDS

Note: Any Additions or Changes on This Sheets Must be Made or Circled in **Red Ink** With Date and Name of Person Making Change.

Do not extend notes this side of this line

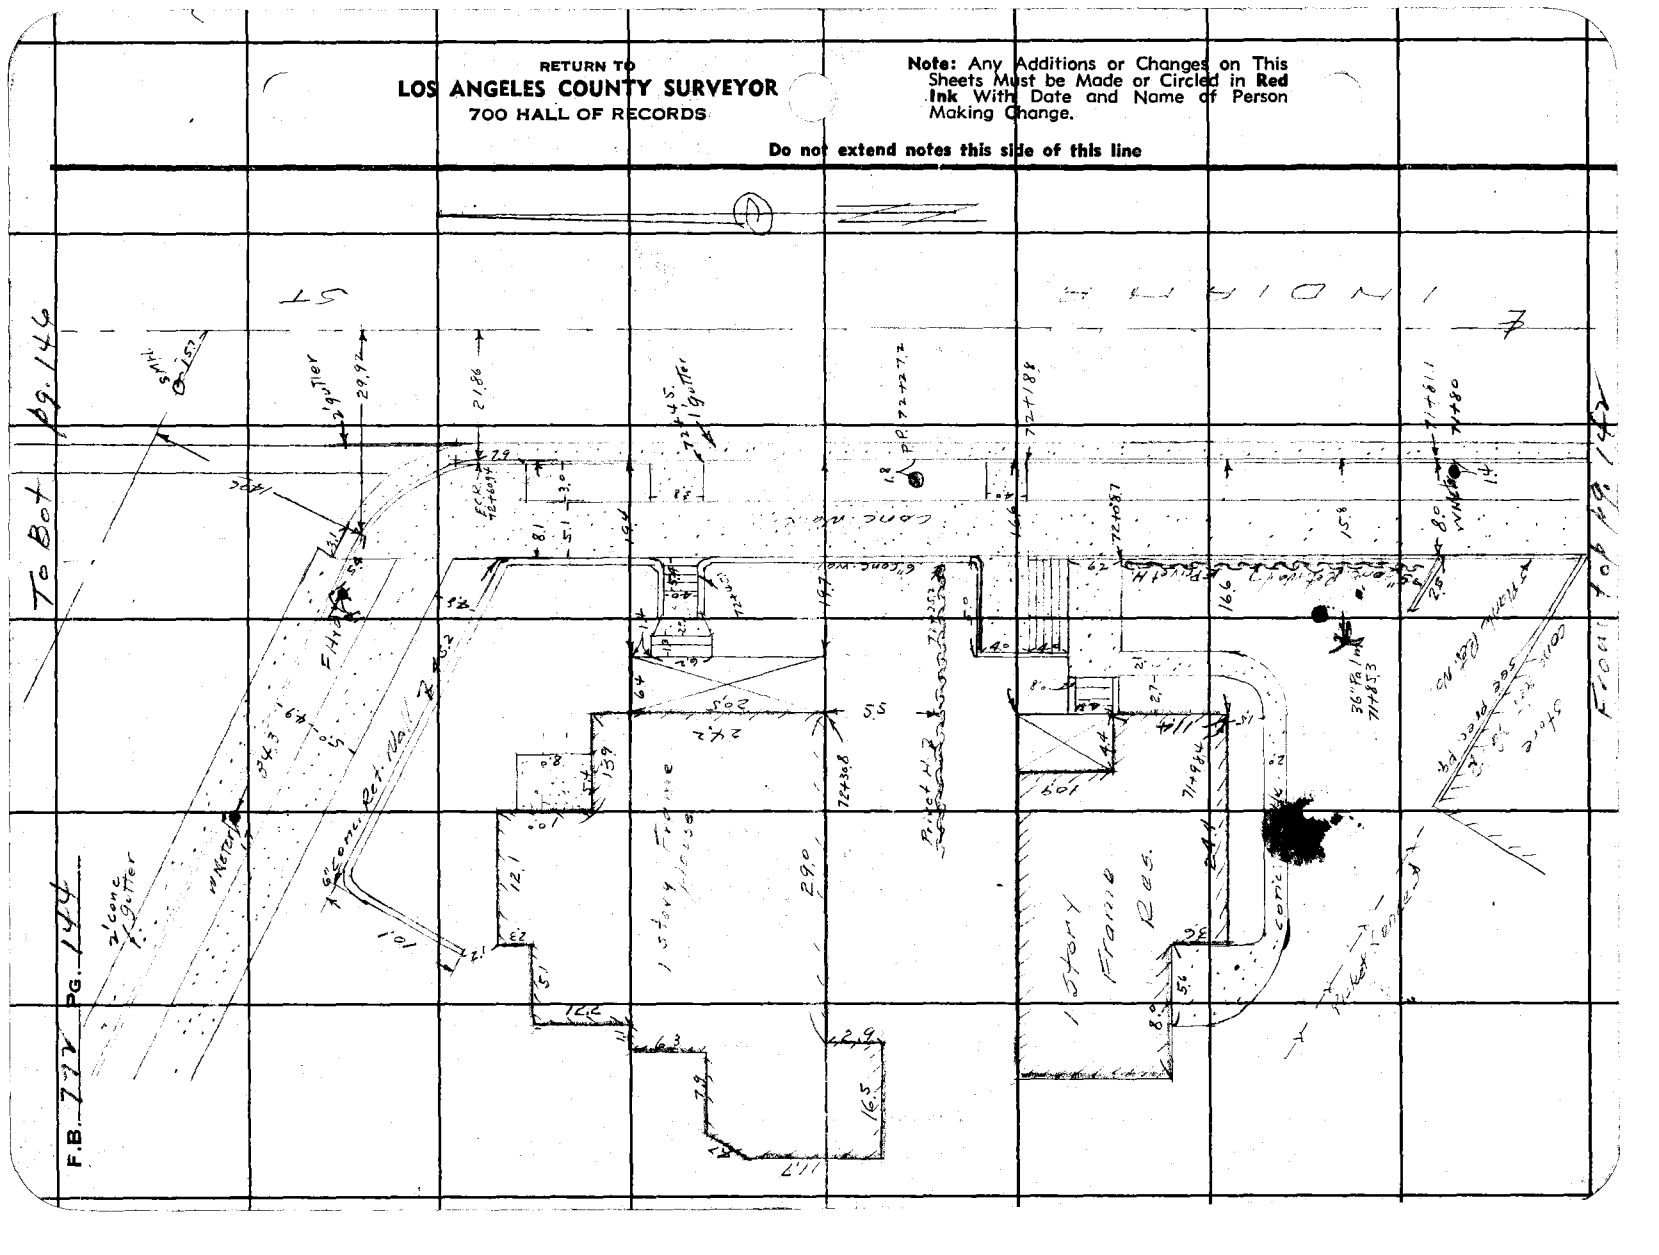

FORM 247 5M 10-37

RETURN TO
LOS ANGELES COUNTY SURVEYOR
700 HALL OF RECORDS

Note: Any Additions or Changes on This Sheets Must be Made or Circled in **Red** Ink With Date and Name of Person Making Change.

Do not extend notes this side of this line

Notes Ck'd by D. M. Finley
Map No. B-1465-2
Office Work F. A. W.
Checked D. M. Finley
Date Jan 1941

Survey of
W. O.
Tape No. Std. of
Surveyed by
Notes Date
Indexed

F.B. Pg.

F.B. 772 PG. 146

cont at bot pg 148

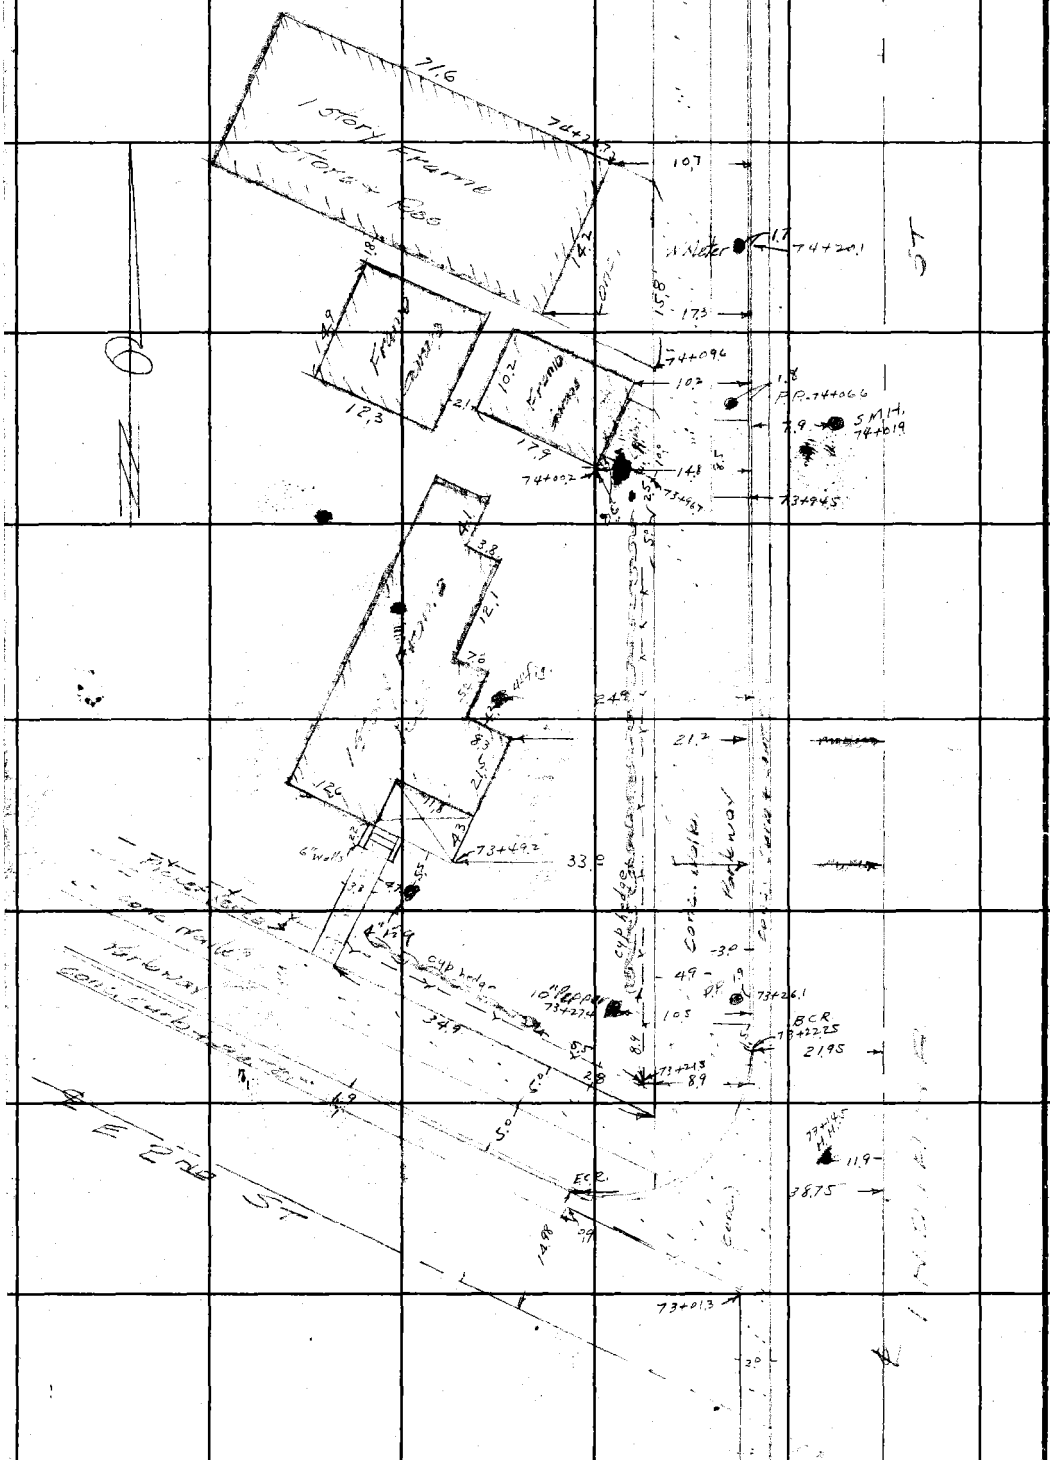

Cont from Top pg 144

RETURN TO
LOS ANGELES COUNTY SURVEYOR
700 HALL OF RECORDS

Note: Any Additions or Changes on This Sheets Must be Made or Circled in Red Ink With Date and Name of Person Making Change.

Do not extend notes this side of this line

Feb 19, 49

Notes Ck'd by D. M. Finley
Map No. B-1465-2
Office Work F. A. W.
Checked D. M. Finley
Date Jan. 1941.

Survey of INDIANA ST
W. O. 8226 Tape No. St'd OF
Surveyed by Evans
Notes Dyck Date '39
Indexed

F.B. 772 PG. 141

Note: Any Additions or Changes on This Sheets Must be Made or Circled in Red Ink With Date and Name of Person Making Change.

Do not extend notes this side of this line

RETURN TO
LOS ANGELES COUNTY SURVEYOR
700 HALL OF RECORDS

FORM 247 5M 10-37

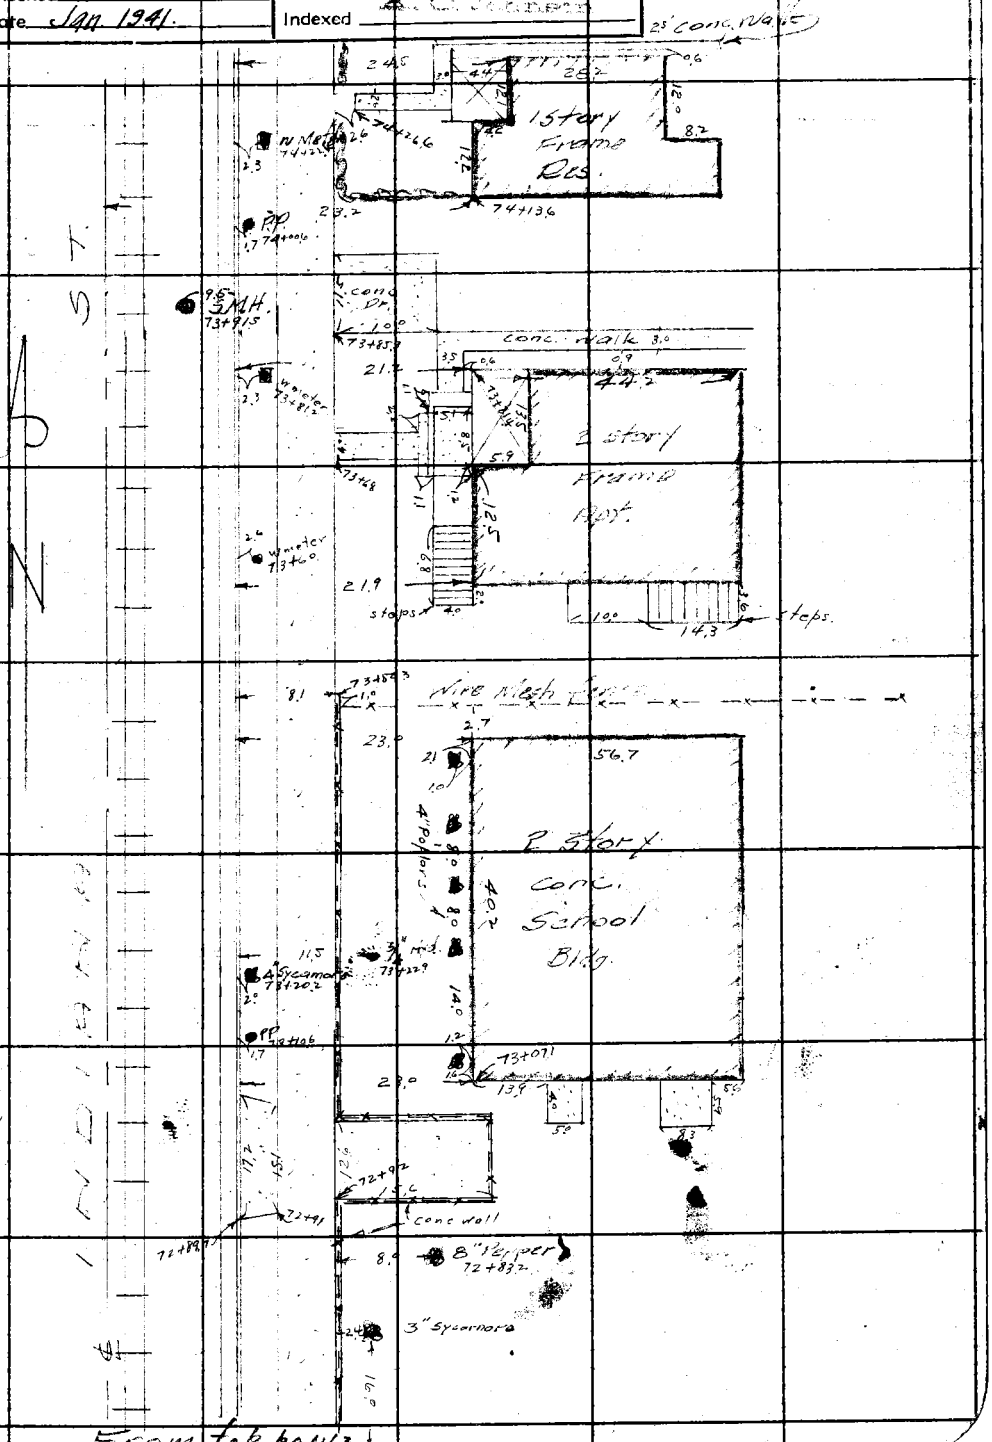

From fob 69143

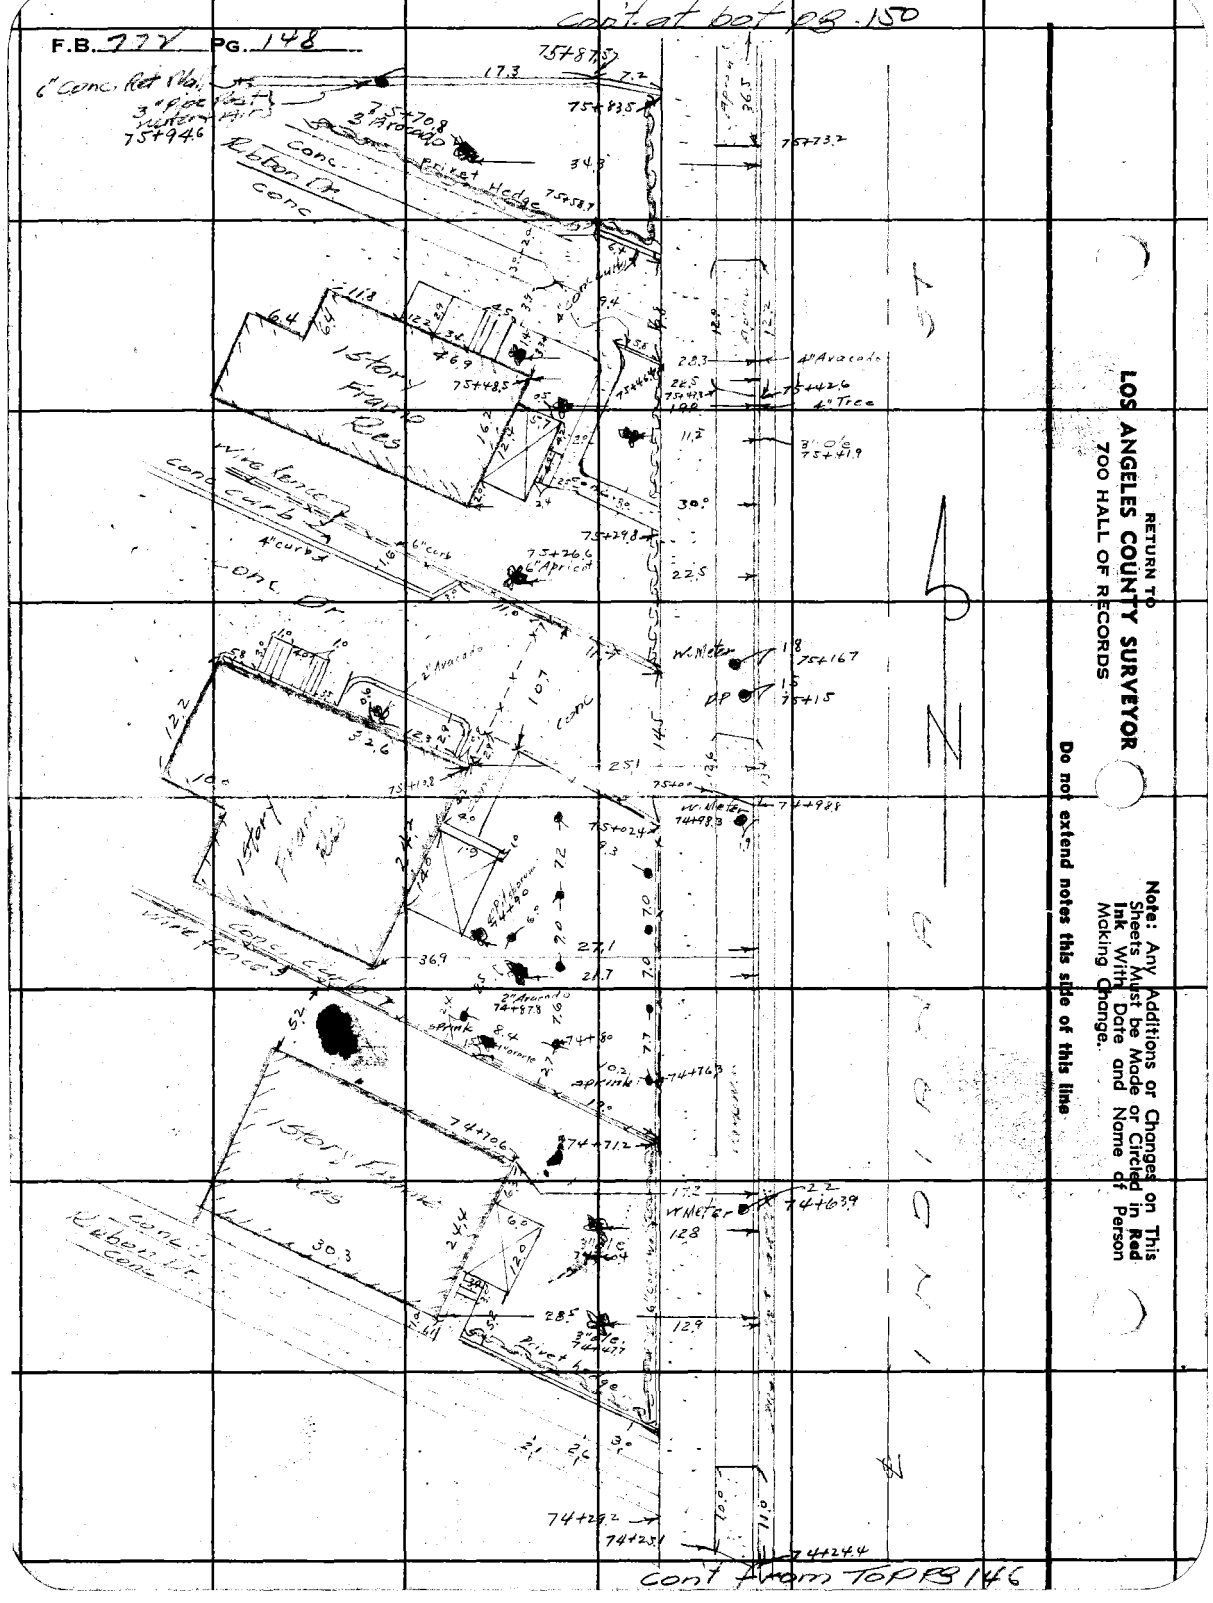

RETURN TO
LOS ANGELES COUNTY SURVEYOR
700 HALL OF RECORDS

Note: Any Additions or Changes on This Sheets Must be Made or Circled in Red Ink With Date and Name of Person Making Change.

Do not extend notes this side of this line

Notes Ck'd by D. M. Finley	Survey of INDIANA ST	F.B. 777	Pg. 149
Map No. B-1465-2	W. O. 5222	Tape No.	St'd	of
Office Work F. A. W.	Surveyed by Evans
Checked D. M. Finley	Notes Date '39
Date Jan 1941.	Indexed

Continued from Pg 150

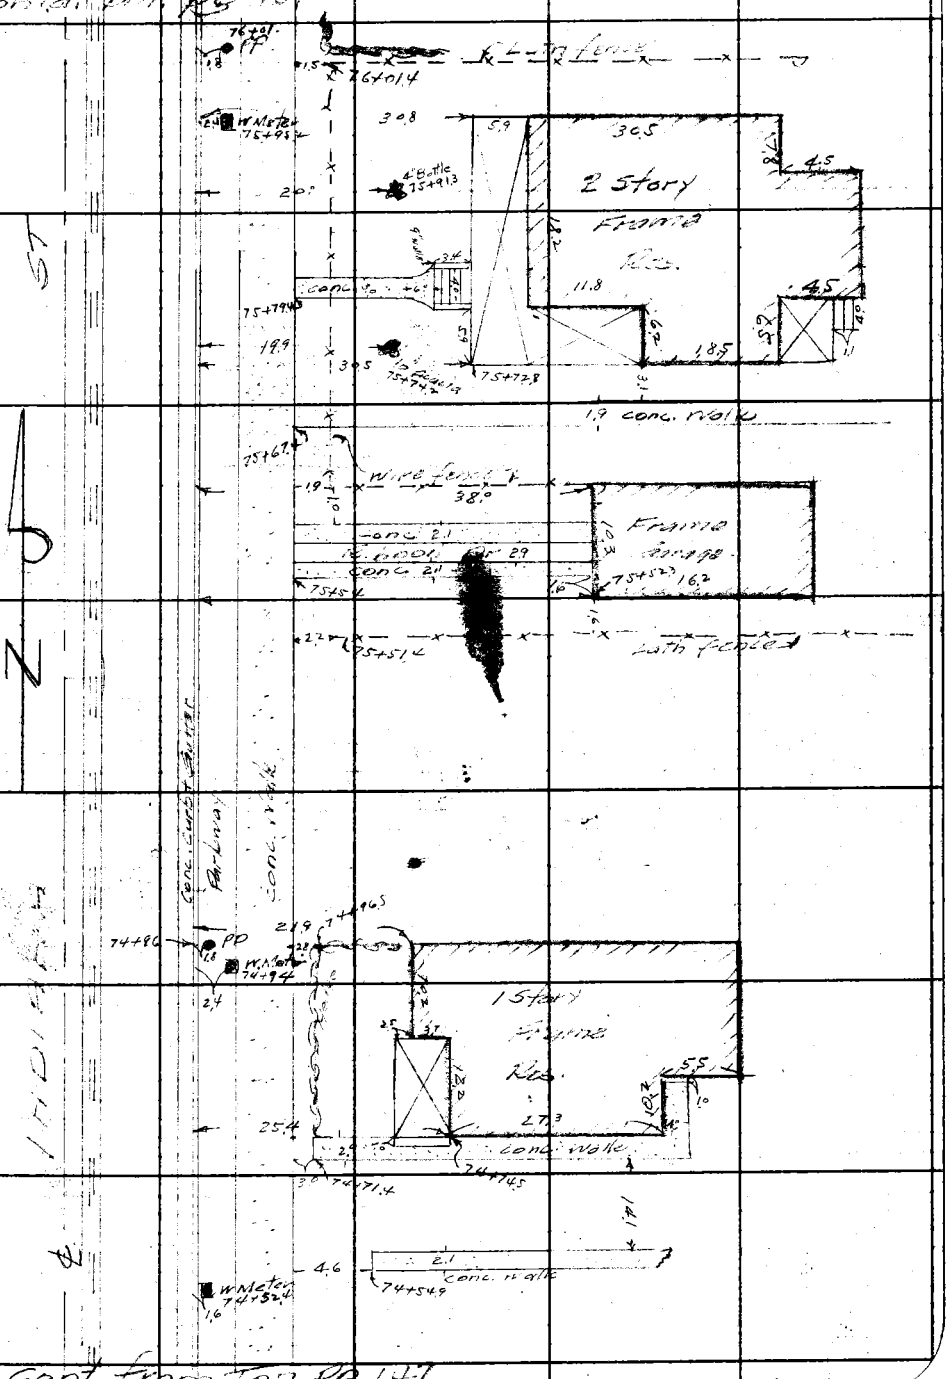

Cont. from Top Pg 149

Note: Any Additions or Changes on This Sheets Must be Made or Circled in Red Ink With Date and Name of Person Making Change.

Do not extend notes this side of this line

RETURN TO
LOS ANGELES COUNTY SURVEYOR
700 HALL OF RECORDS

FORM 247 5M 10-37

F.B. 77Y PG. 150

cont at bot pg 15Y

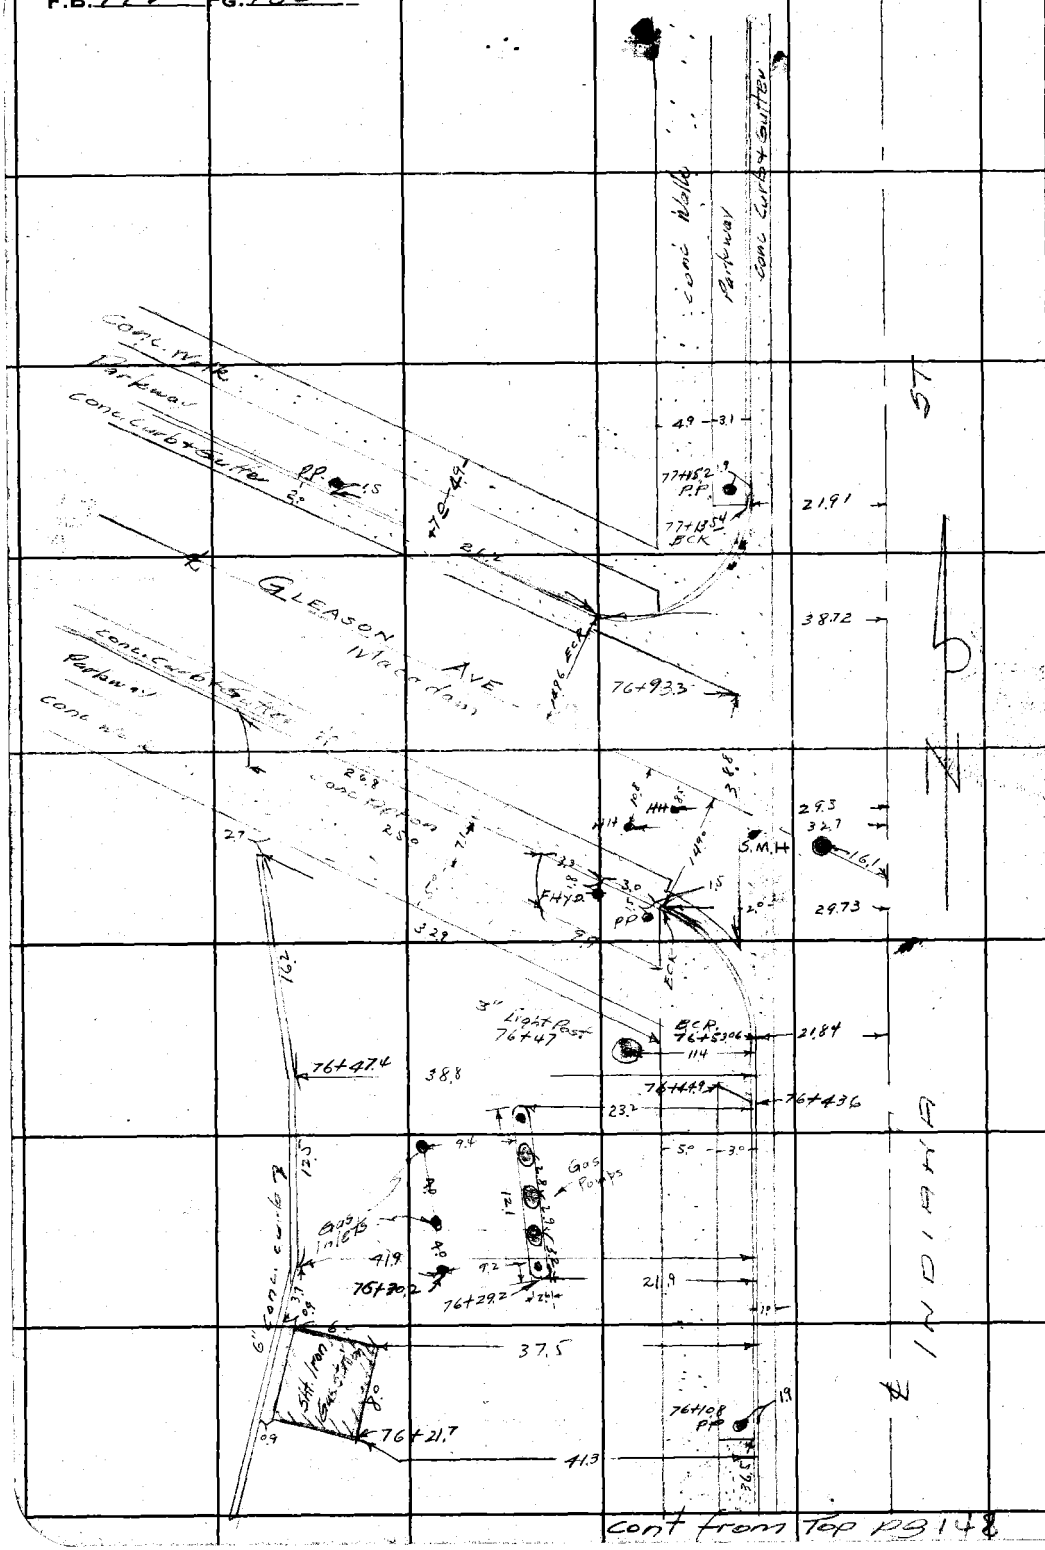

cont from Top pg 148

RETURN TO
LOS ANGELES COUNTY SURVEYOR
700 HALL OF RECORDS

Note: Any Additions or Changes on This Sheets Must be Made or Circled in Red Ink With Date and Name of Person Making Change.

Do not extend notes this side of this line

Notes Ck'd by D. M. Finley	Survey of INDIANA ST	F.B. 772 Pg. 151
Map No. B-1465-2	W. 08226 Tape No. ____ St'd ____ of	
Office Work F. A. W.	Surveyed by Evans	
Checked D. M. Finley	Notes [illegible] Date '39	
Date Jan. 1941	Indexed [illegible]	

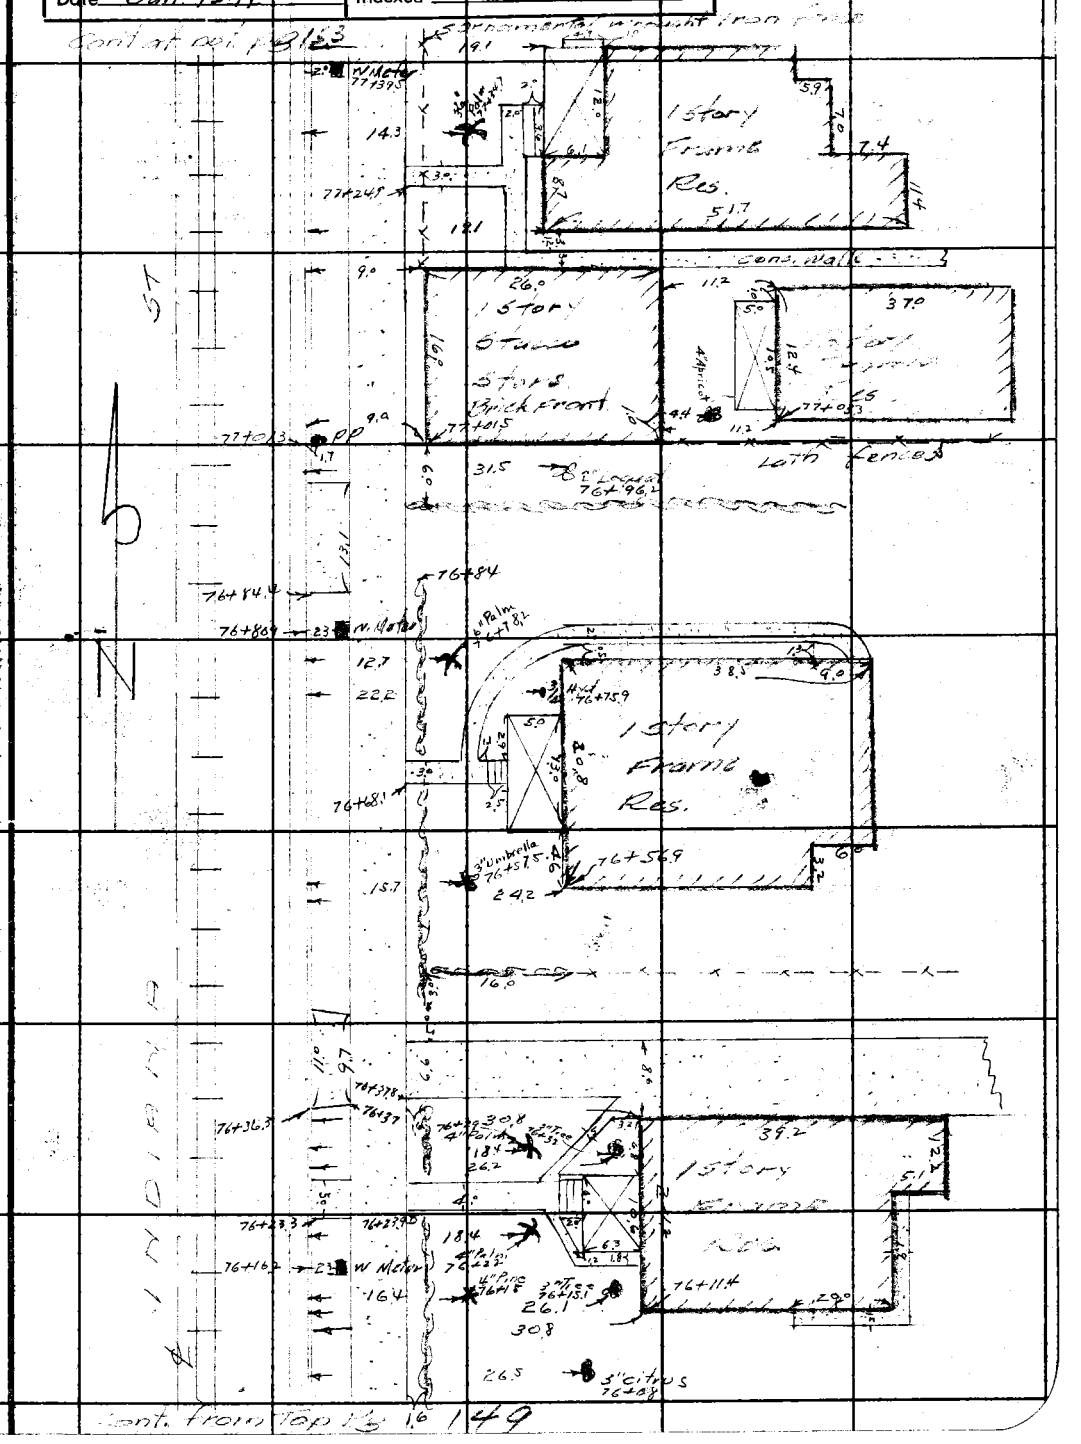

Note: Any Additions or Changes on This Sheets Must be Made or Circled in Red Ink With Date and Name of Person Making Change.

Do not extend notes this side of this line

RETURN TO
LOS ANGELES COUNTY SURVEYOR
700 HALL OF RECORDS

FORM 247 5M 10-37

F.B. 77 PG. 157

Cont at bot. PG 154

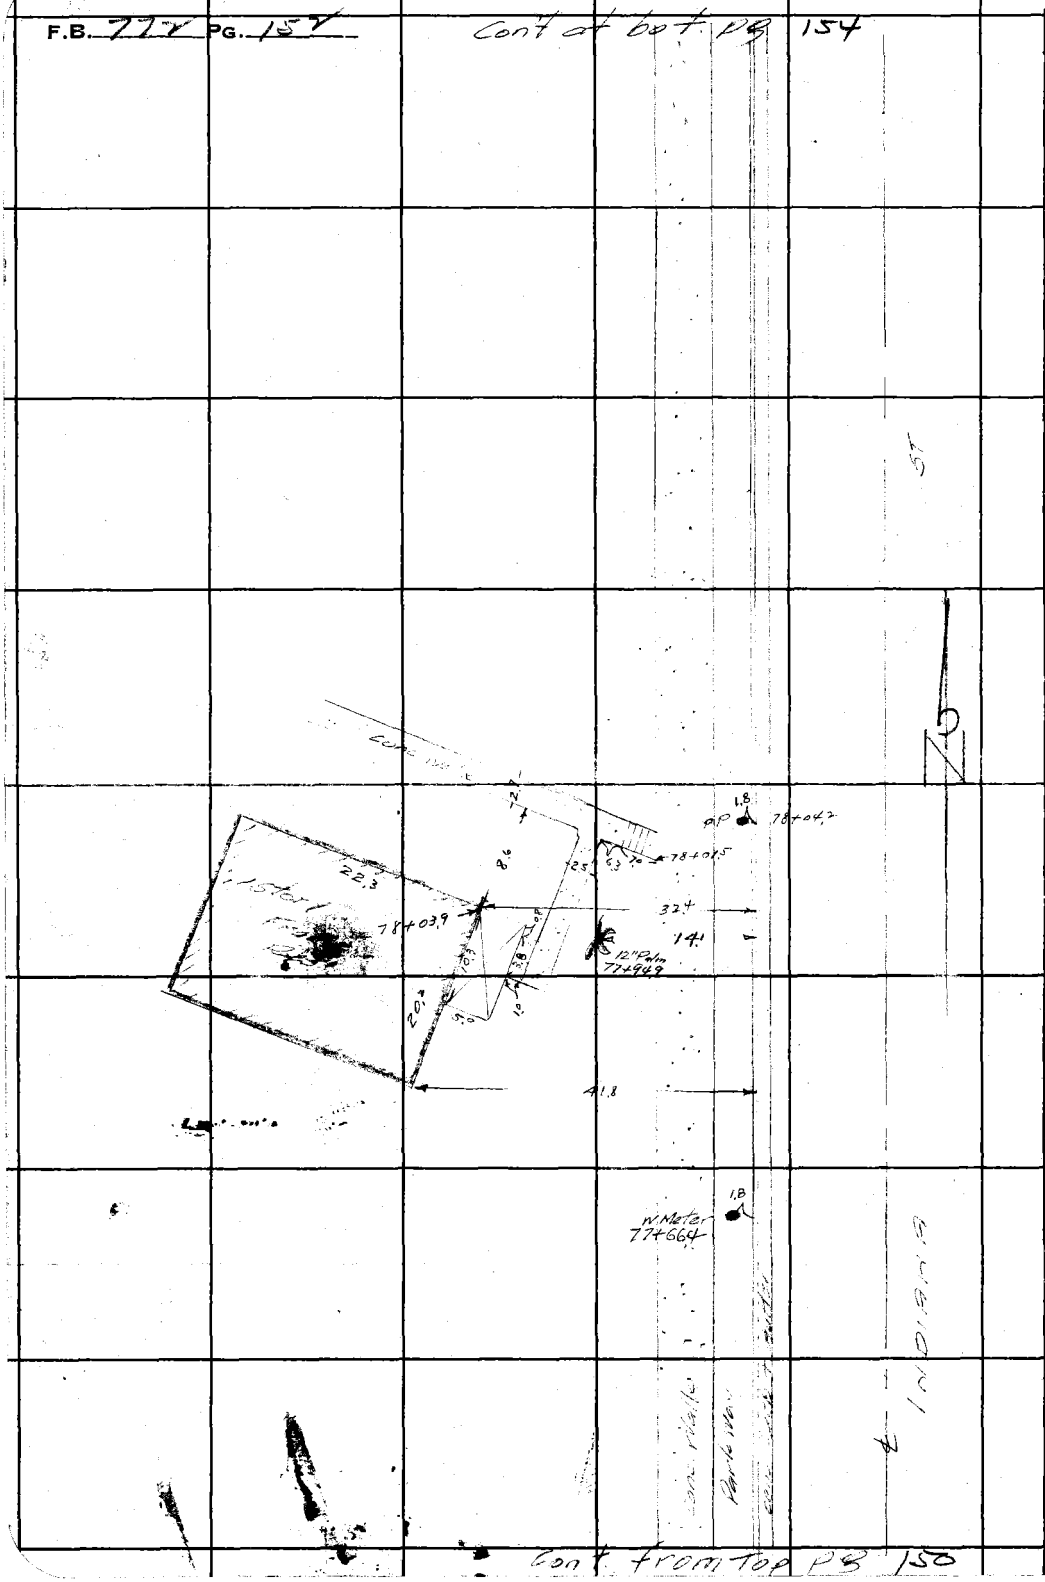

RETURN TO
LOS ANGELES COUNTY SURVEYOR
700 HALL OF RECORDS

Note: Any Additions or Changes on This Sheets Must be Made or Circled in Red Ink With Date and Name of Person Making Change.

Do not extend notes this side of this line

Cont from Top PG 150

Notes Ck'd by D. M. Finley	Survey of [illegible]	F.B. 777	Pg. 153
Map No. B-1465-2	W. O. 8226 Tape No.	St'd	of
Office Work F. A. W.	Surveyed by Evans		
Checked D. M. Finley	Notes Brock Date 1/39		
Date Jan. 1941	Indexed		

cont. from PG 155

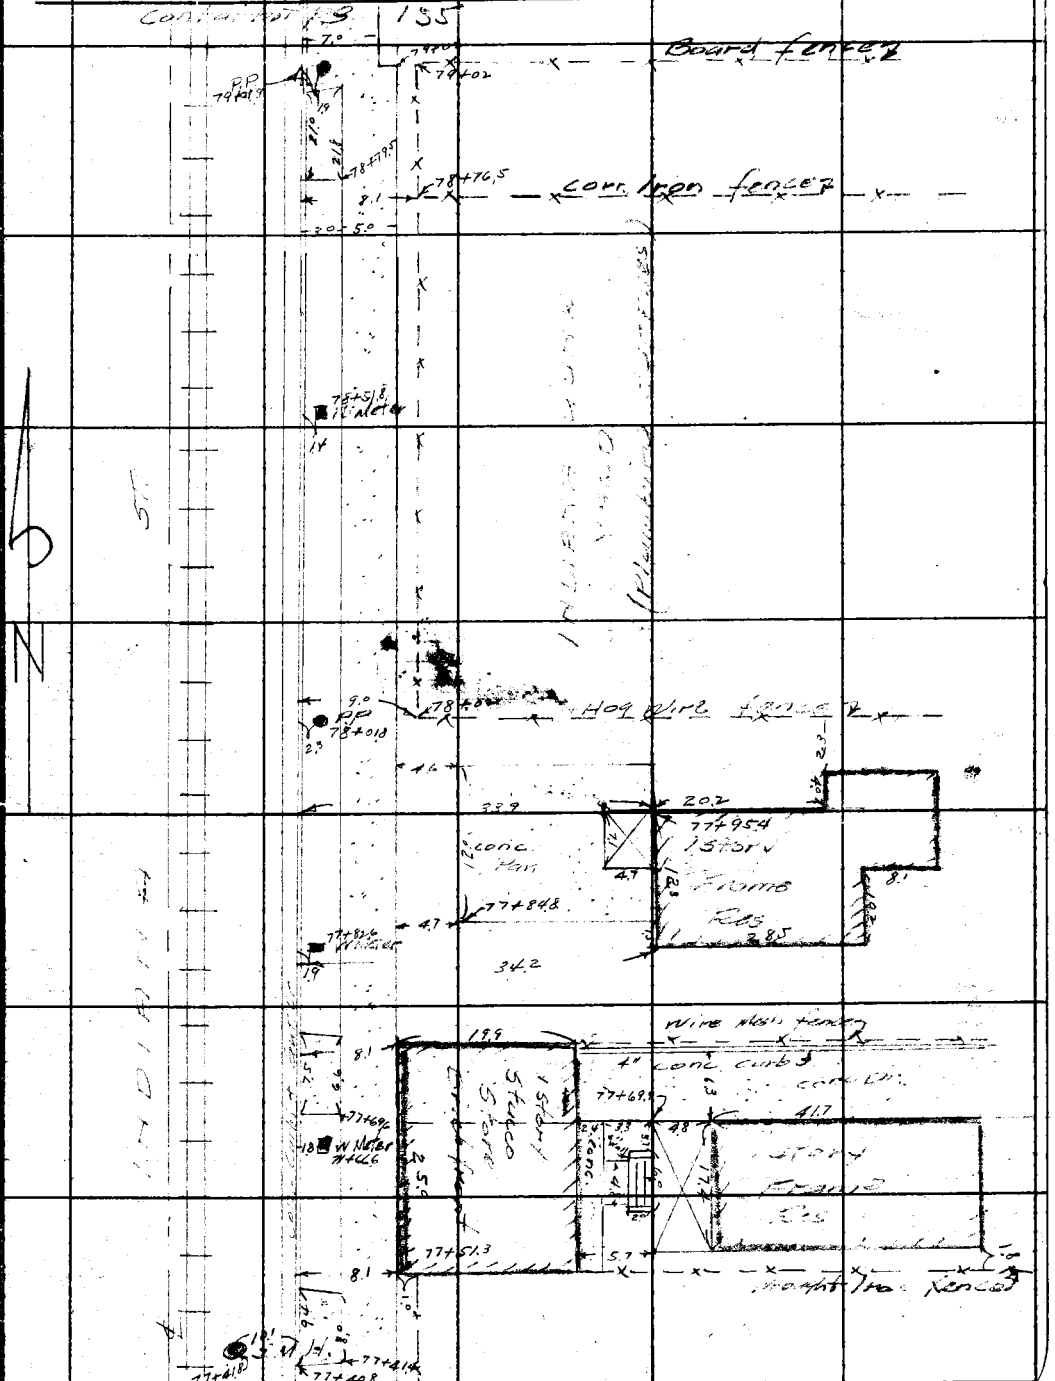

cont. from top PG 151

Notes: Any Additions or Changes on Sheets Must be Made in Red Ink or Circled With Date and Name of Person Making Change.

Do not extend notes this side of this line

RETURN TO
LOS ANGELES COUNTY SURVEYOR
700 HALL OF RECORDS

FORM 247 5M 10-37

F.B. 772 PG. 154

Cont at Rt. pg 156

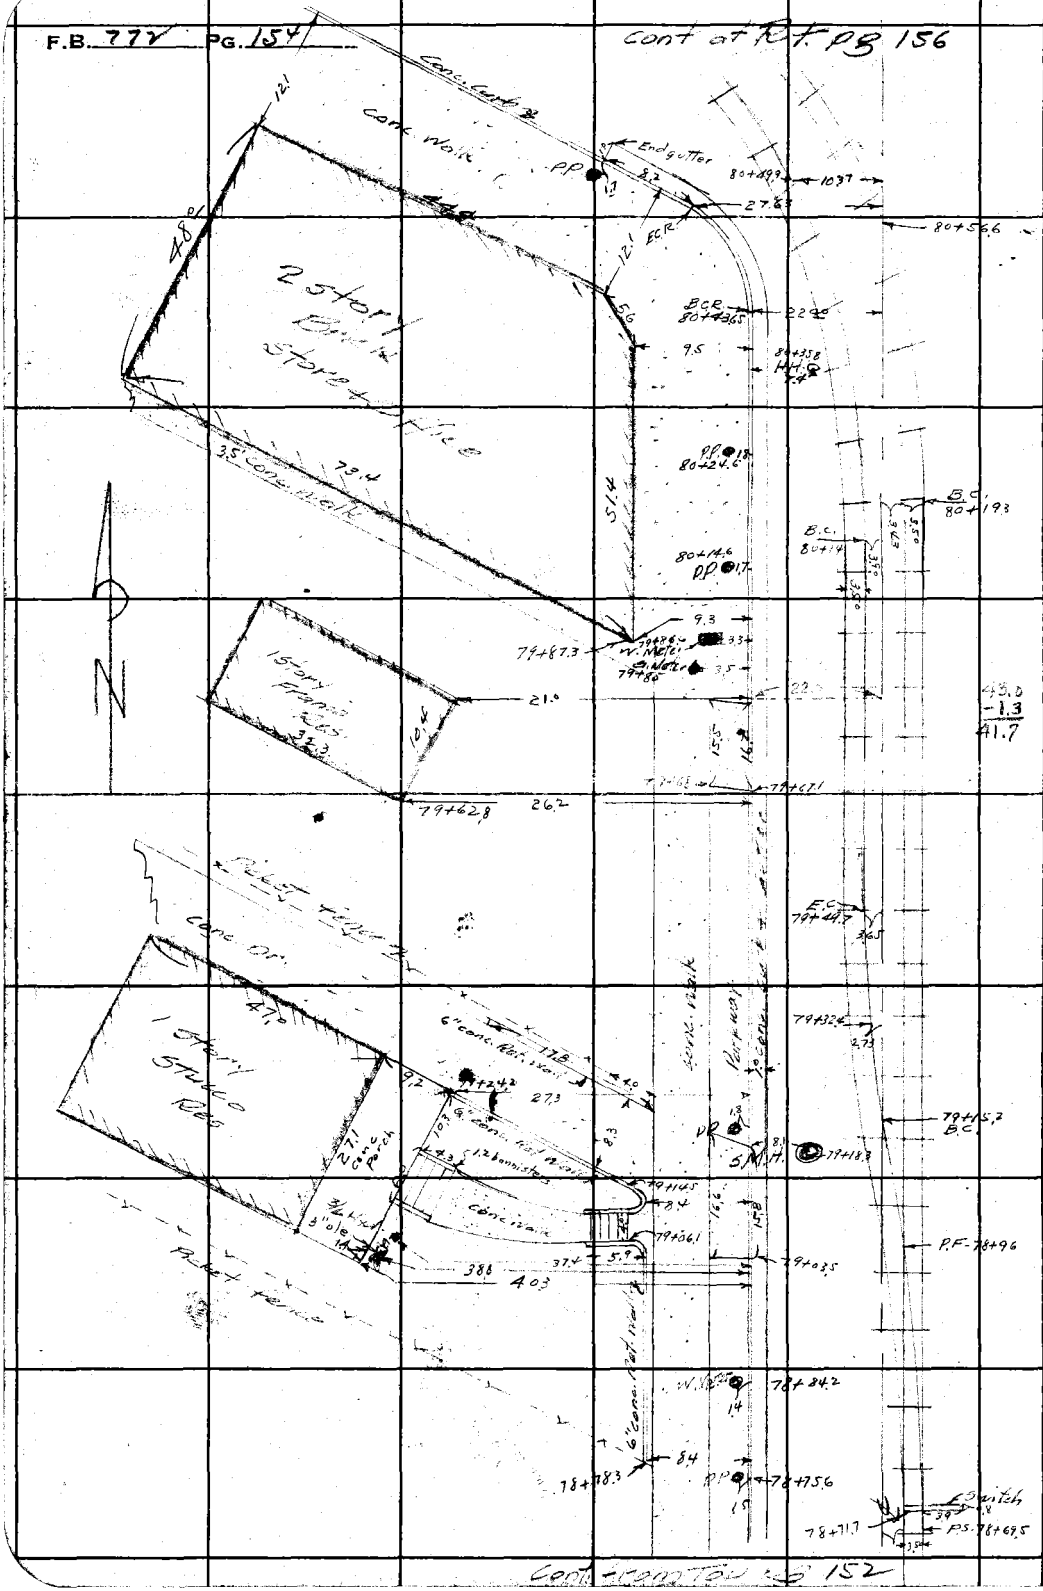

Cont from Top pg 152

RETURN TO
LOS ANGELES COUNTY SURVEYOR
700 HALL OF RECORDS

Note: Any Additions or Changes on This Sheets Must be Made or Circled in Red Ink With Date and Name of Person Making Change.

Do not extend notes this side of this line

Notes Ck'd by D. M. Finley	Survey of Indiana St	F.B. [illegible] Pg. [illegible]
Map No. B-1465-2	W. O. 8226 Tape No. ____ St'd ____ of	
Office Work F. A. W.	Surveyed by Evans	
Checked D. M. Finley	Notes Brock Date '39	
Date Jan. 1941	Indexed	

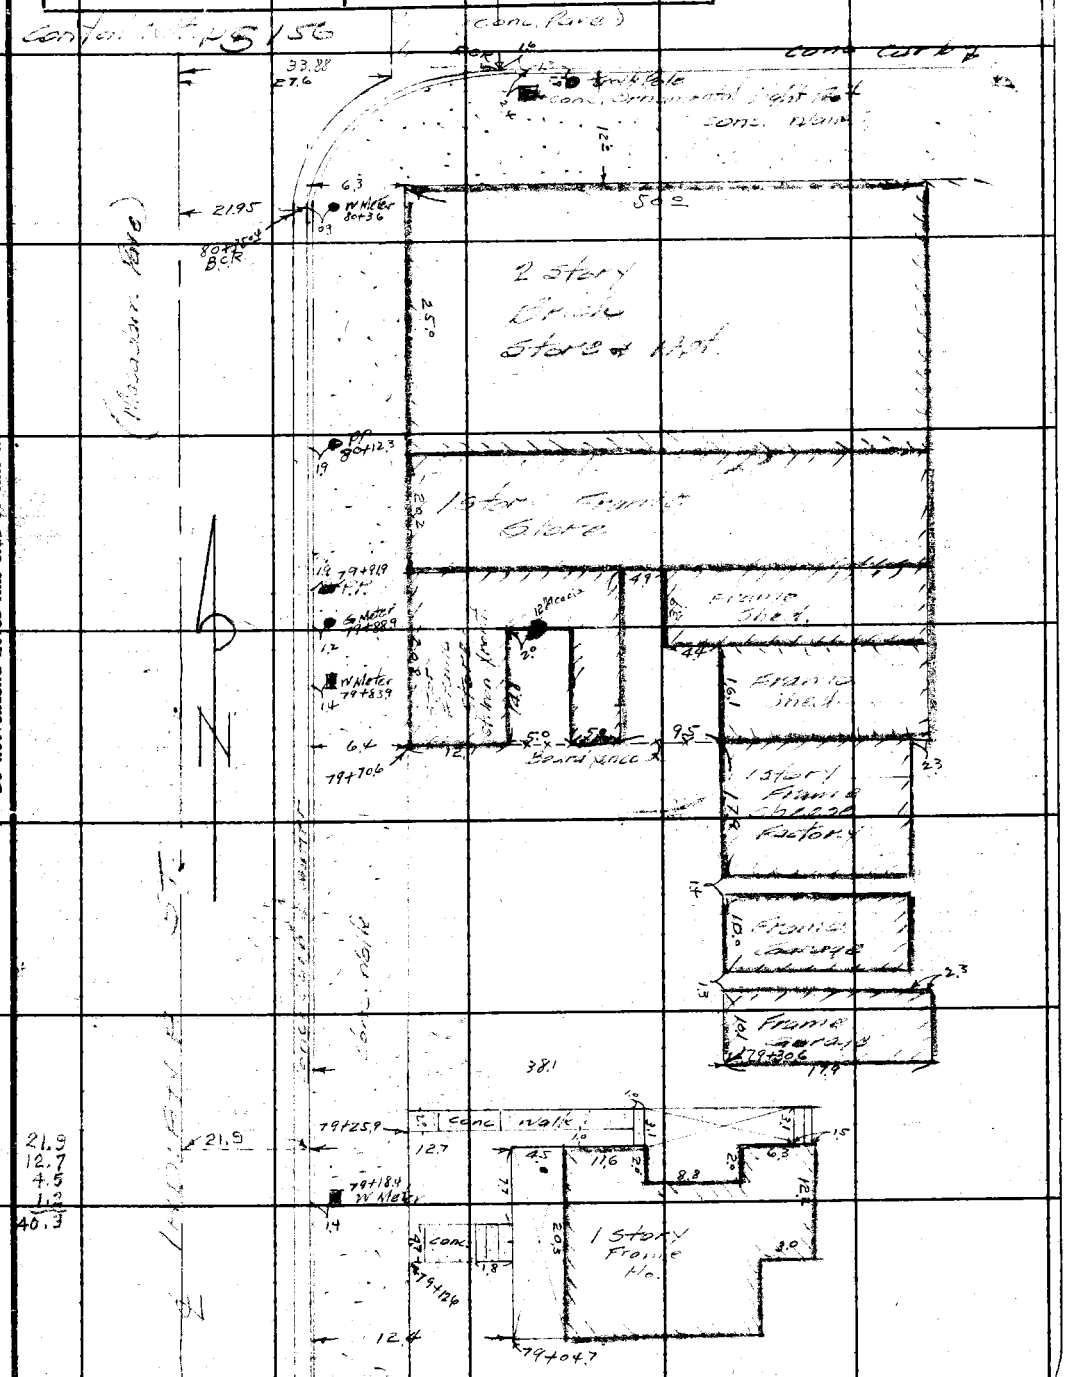

From Top pg. 153

Note: Any Additions or Changes on This Sheets Must be Made or Circled in Red Ink With Date and Name of Person Making Change.

Do not extend notes this side of this line

RETURN TO
LOS ANGELES COUNTY SURVEYOR
700 HALL OF RECORDS

FORM 247 5M 10-37

RETURN TO

LOS ANGELES COUNTY SURVEYOR

700 HALL OF RECORDS

Note: Any Additions or Changes on This Sheets Must be Made or Circled in **Red Ink** With Date and Name of Person Making Change.

Do not extend notes this side of this line

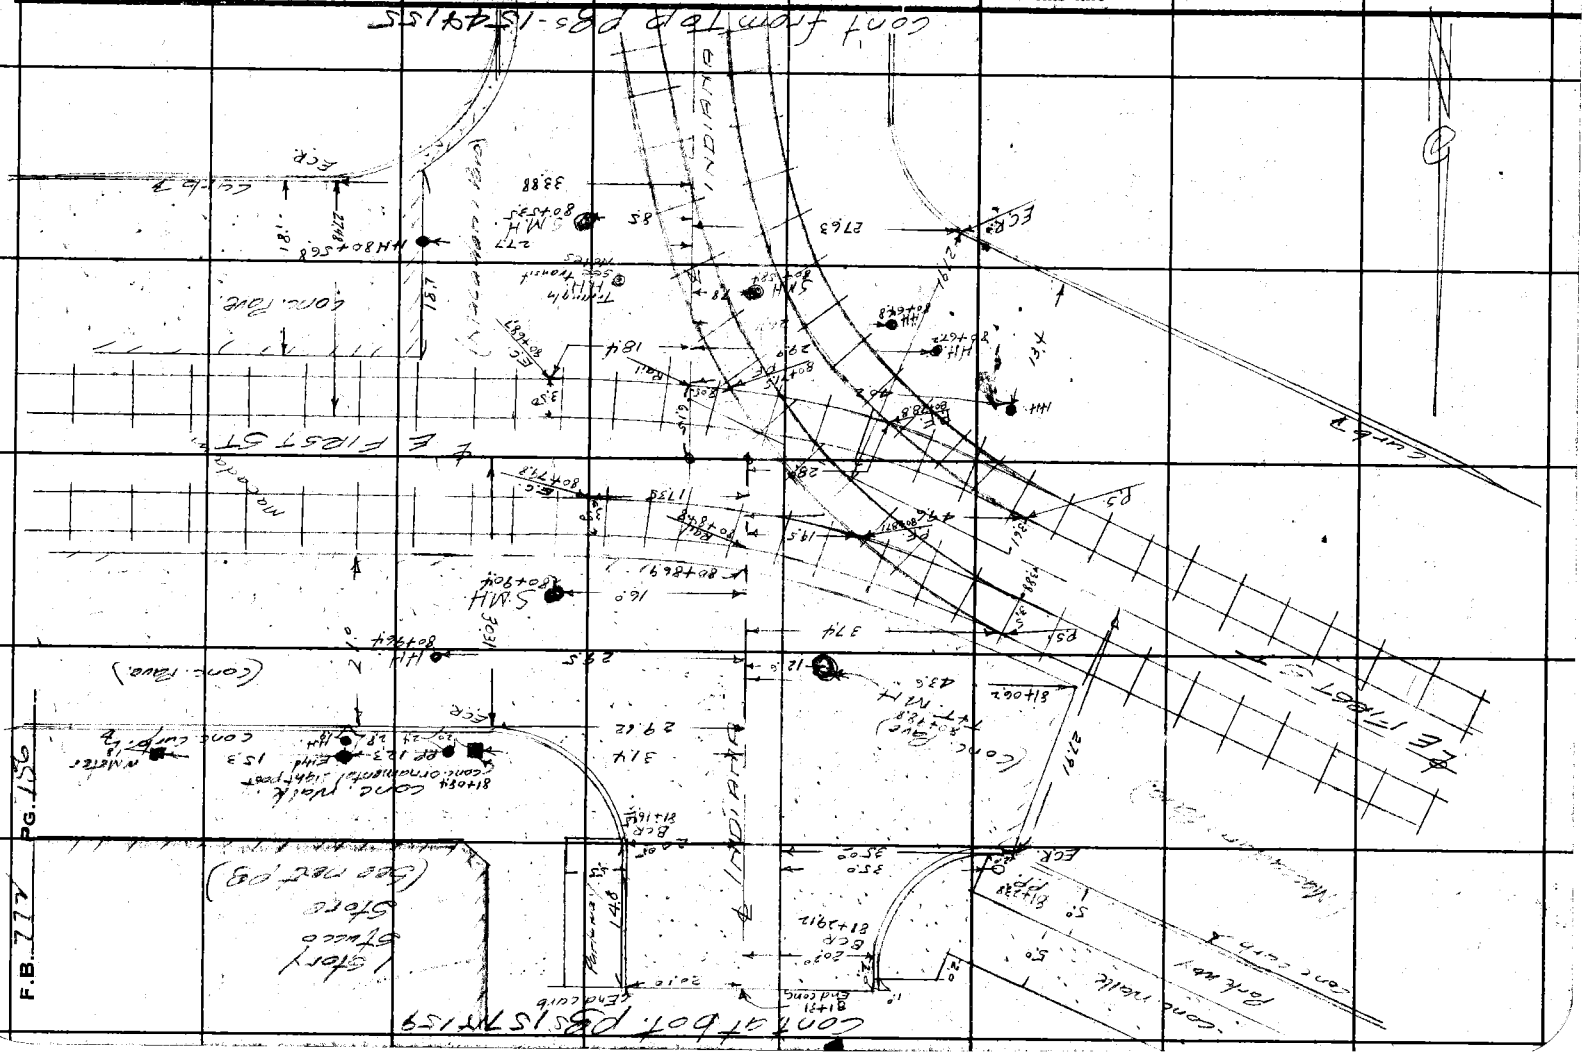
E FIRST ST
Cone. Pave.
Store
Structure
(Case Mct. Cor.)
Cone. Curb
Cone. Walk
Cone. Pave.
Cone. Curb

Notes Ck'd by D. M. Finley	Survey of INDIANA ST	F.B. 772 PG. 157
Map No. B-1465-2	W. O. 8226 Tape No. ____ St'd ____ OF	
Office Work F. A. W.	Surveyed by Evans	
Checked D. M. Finley	Notes Brock Date 139	
Date Jan. 1941	Indexed	

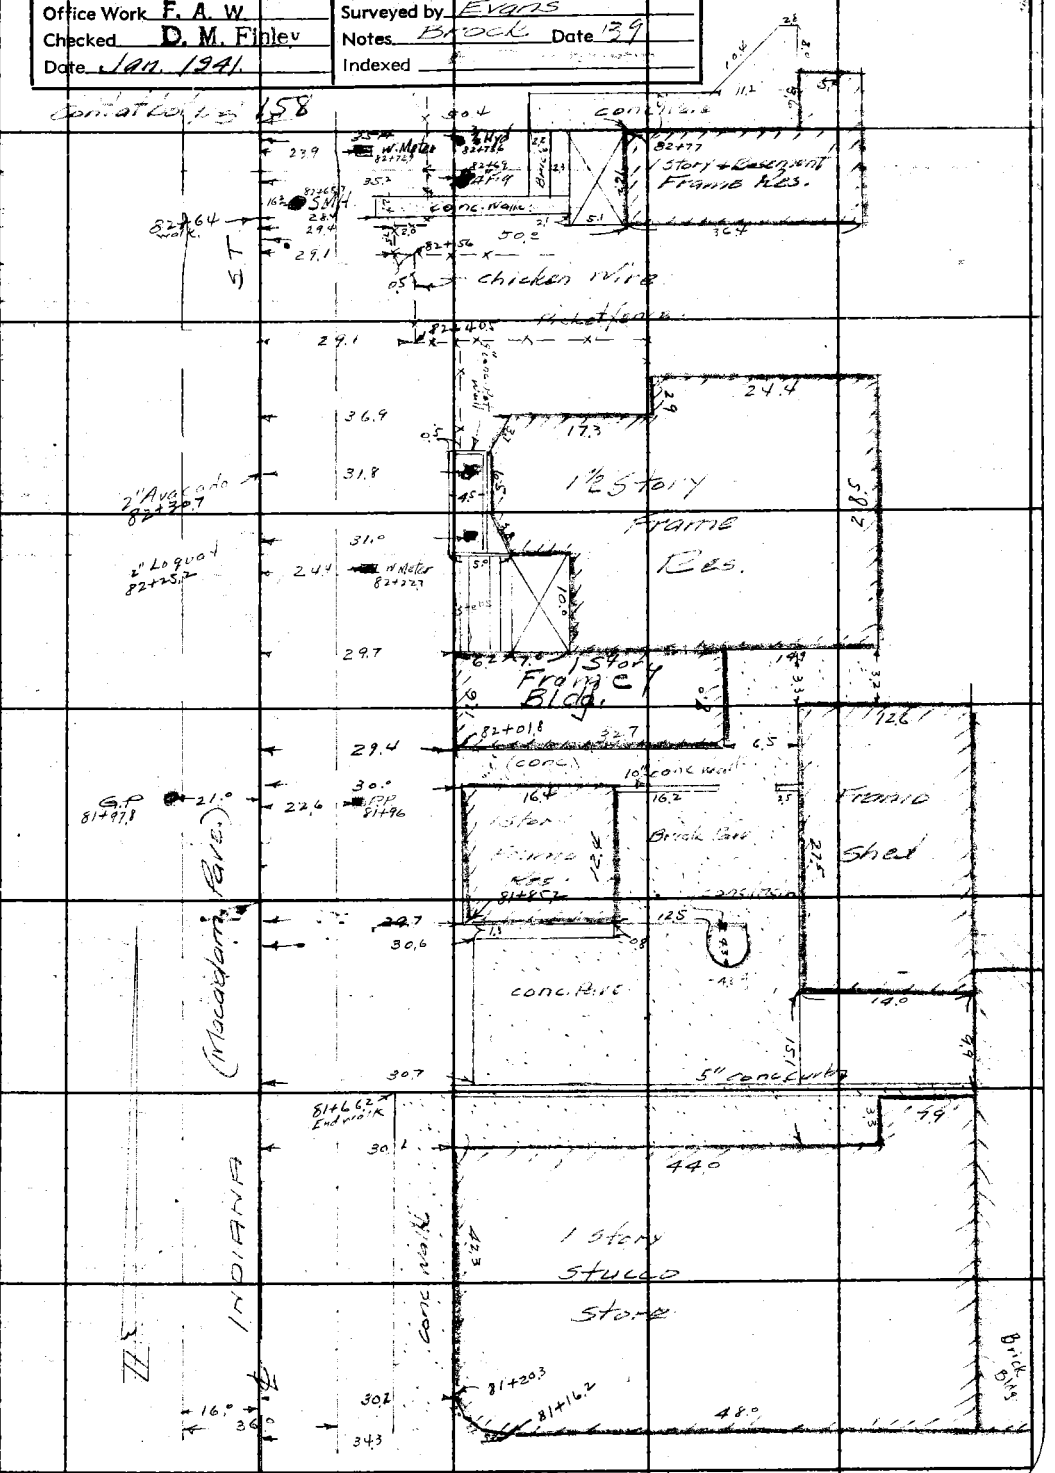

Note: Any Additions or Changes on This Sheets Must be Made or Circled in Red Ink With Date and Name of Person Making Change.

Do not extend notes this side of this line

RETURN TO
LOS ANGELES COUNTY SURVEYOR
700 HALL OF RECORDS

FORM 247 5M 10-37

F.B. 777 PG. 108

Cont at bot PB 161

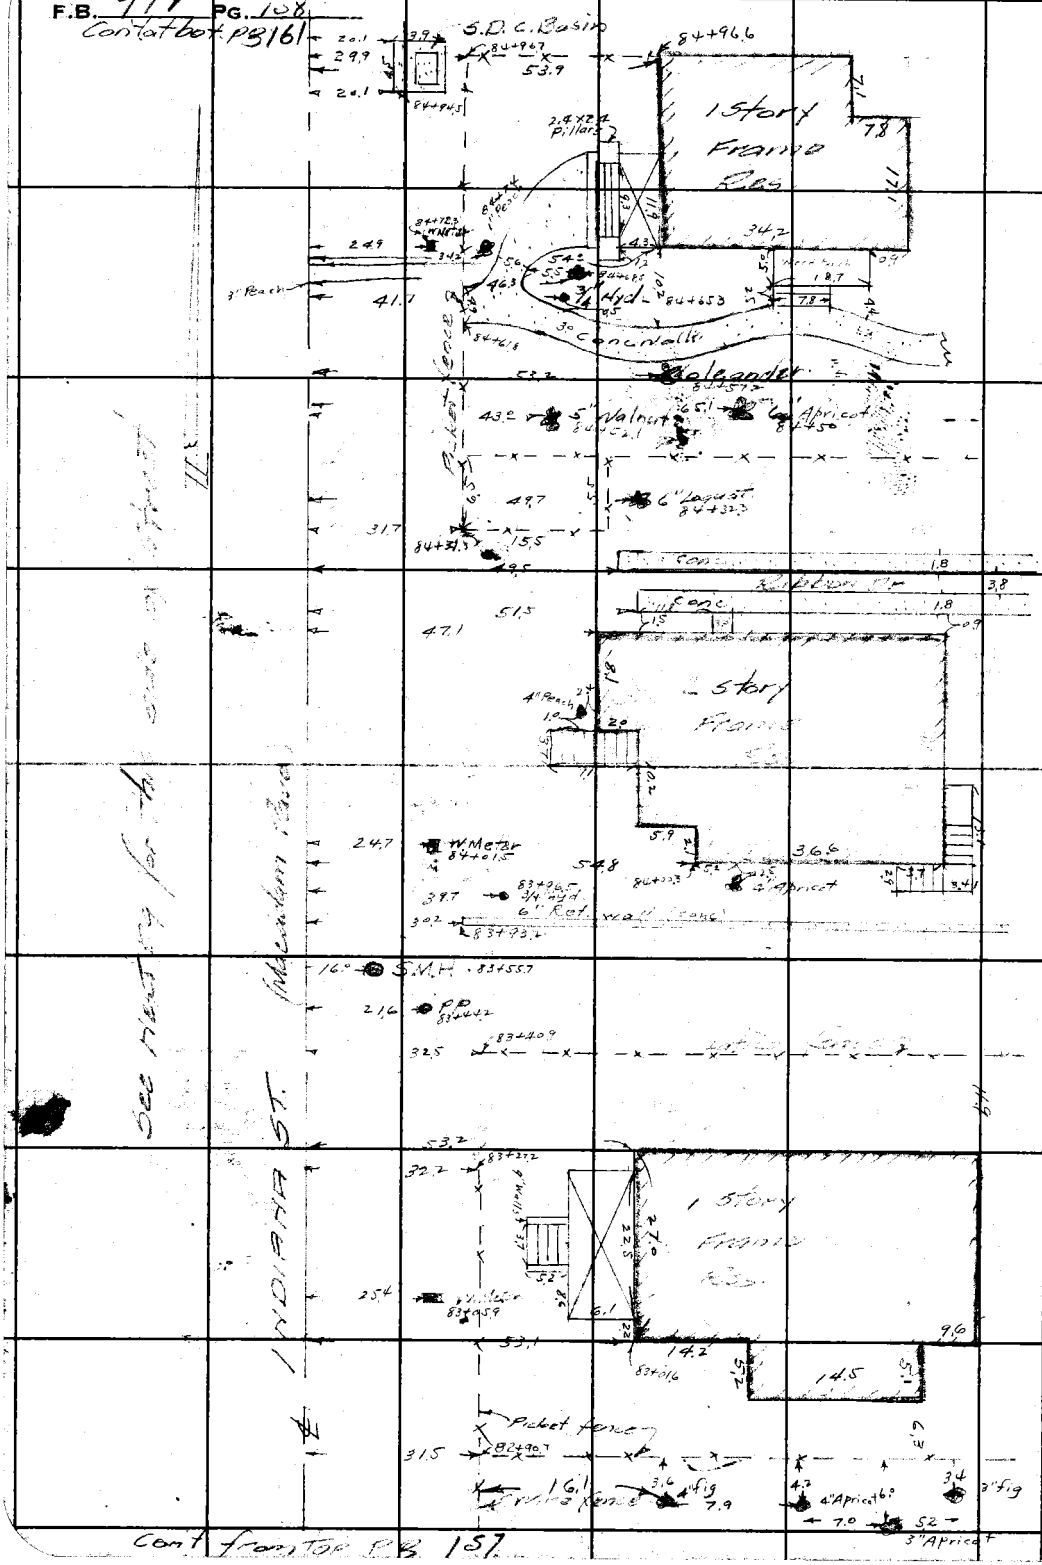

Cont from top PB 157

RETURN TO

LOS ANGELES COUNTY SURVEYOR

700 HALL OF RECORDS

Note: Any Additions or Changes on This Sheets Must be Made or Circled in Red Ink With Date and Name of Person Making Change.

Do not extend notes this side of this line

Notes Ck'd by D. M. Finley	Survey of Indiana St
Map No. B-1465-2	W. O. 8224 Tape No. ____ St'd ____ of
Office Work F. A. W	Surveyed by Evans
Checked D. M. Finley	Notes [illegible] Date 39
Date Jan. 1941	Indexed [illegible]

F.B. [illegible] PG. 159

Cont. at bot. pg 160

Cont from Lt. pg. 156

Note: Any Additions or Changes on This Sheets Must be Made or Circled in Red Ink With Date and Name of Person Making Change.

Do not extend notes this side of this line

RETURN TO
LOS ANGELES COUNTY SURVEYOR
700 HALL OF RECORDS

FORM 247 5M 10-37

F.B. 777 PG. 160

Cont. of bot ps 162

RETURN TO
LOS ANGELES COUNTY SURVEYOR
700 HALL OF RECORDS

Note: Any Additions or Changes on This Sheets Must be Made or Circled in Red Ink With Date and Name of Person Making Change.

Do not extend notes this side of this line

Cont. from bot p 159

Notes Ck'd by D. M. Finley	Survey of INDIANA ST	F.B. 777 Pg. 161
Map No. B-1465-2	W. 08226 Tape No. ____ St'd ____ °F	
Office Work F. A. W.	Surveyed by E. Evans	
Checked D. M. Finley	Notes Brock Date '39	
Date Jan. 1941	Indexed [illegible]	

cont. Rbot pg 163

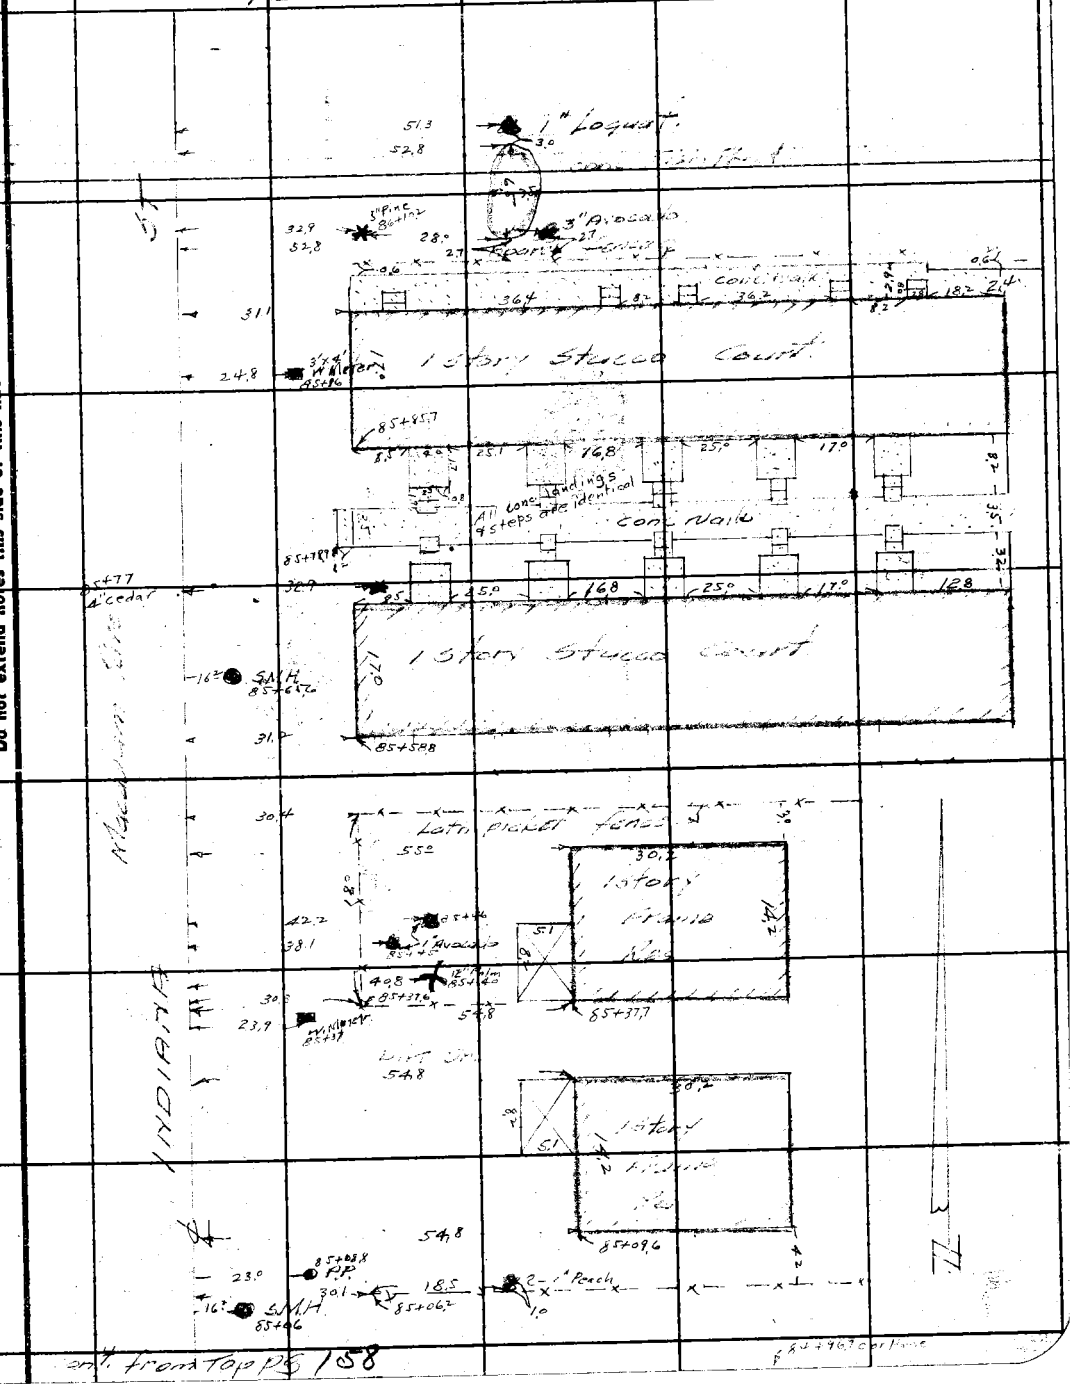

cont. from Top pg 158

Note: Any Additions or Changes on This Sheets Must be Made or Circled in Red Ink With Date and Name of Person Making Change.

Do not extend notes this side of this line

RETURN TO
LOS ANGELES COUNTY SURVEYOR
700 HALL OF RECORDS

FORM 247 5M 10-37

RETURN TO
LOS ANGELES COUNTY SURVEYOR
700 HALL OF RECORDS

Note: Any Additions or Changes on This Sheets Must be Made or Circled in **Red Ink** With Date and Name of Person Making Change.

Do not extend notes this side of this line

F.B. 771 PG. 162

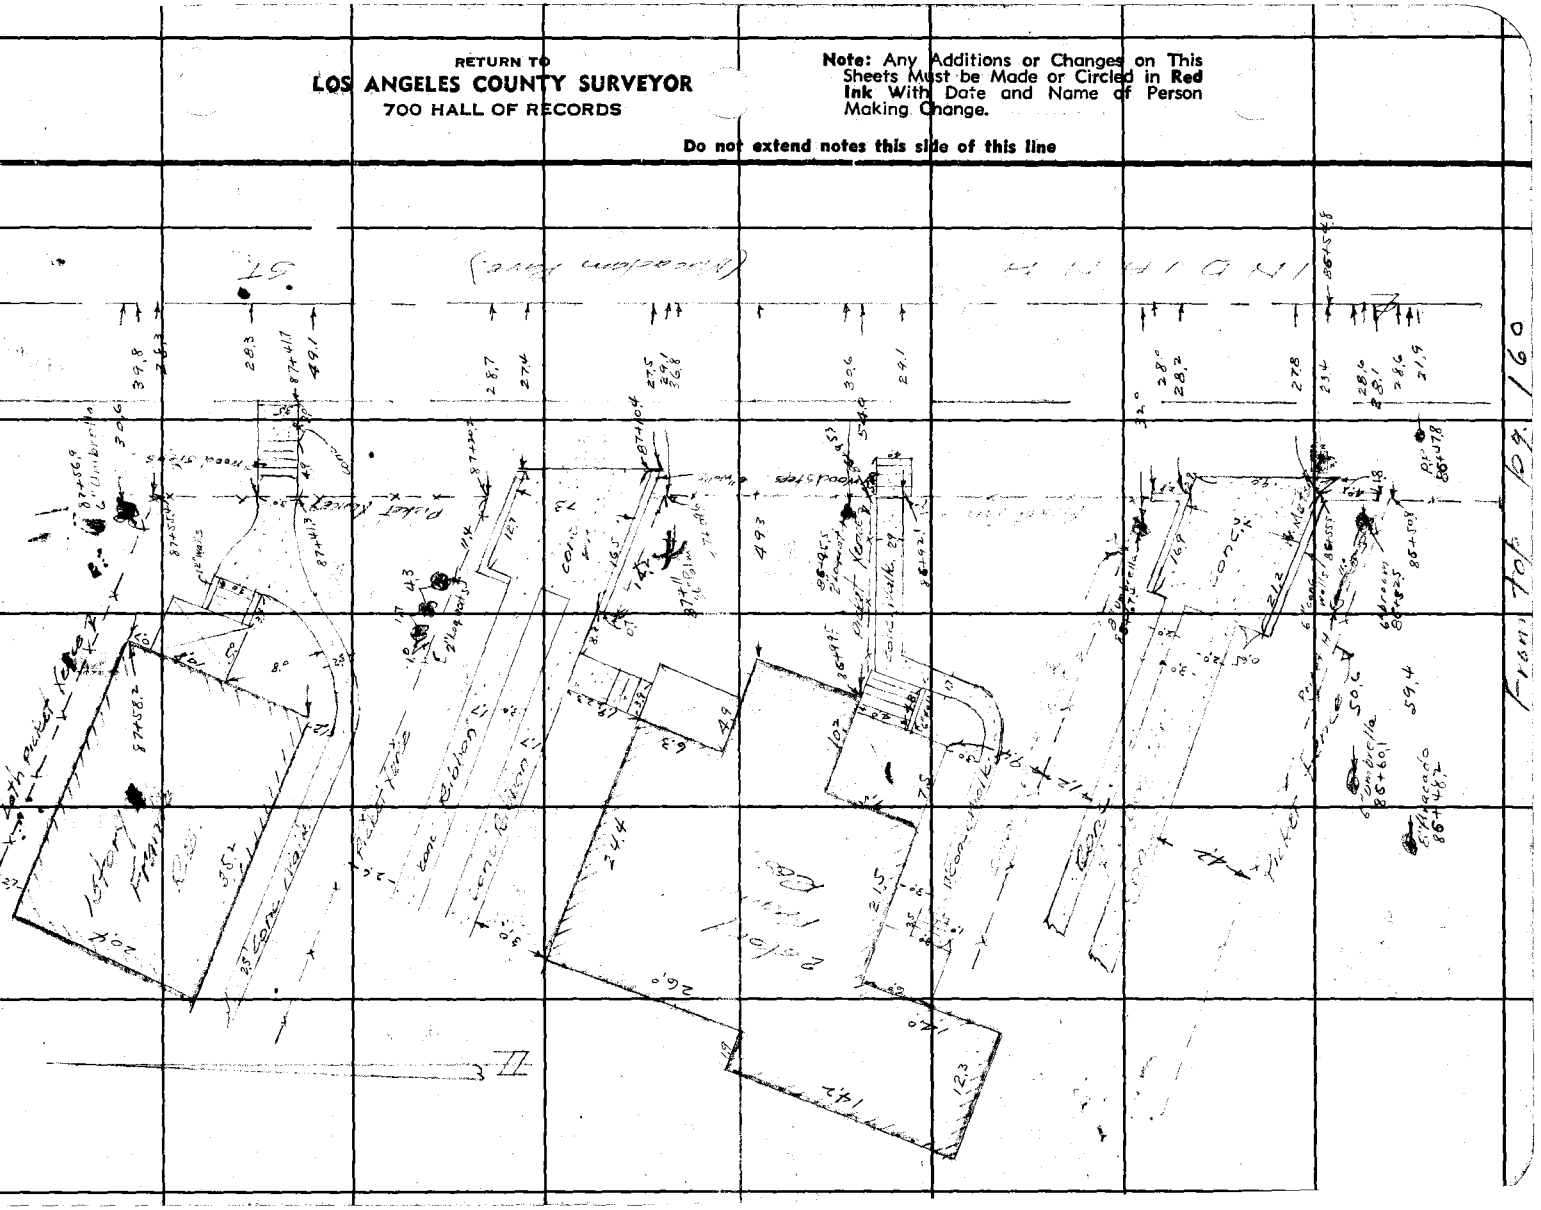

Notes Ck'd by D. M. Finley	Survey of [illegible]	F.B. 777 Pg. 163
Map No. B-1465-2	W. O. 8286 Tape No. ____ St'd ____ °F	
Office Work F. A. W	Surveyed by Evans	
Checked D. M. Finley	Notes [illegible] Date '39	
Date Jan. 1941		

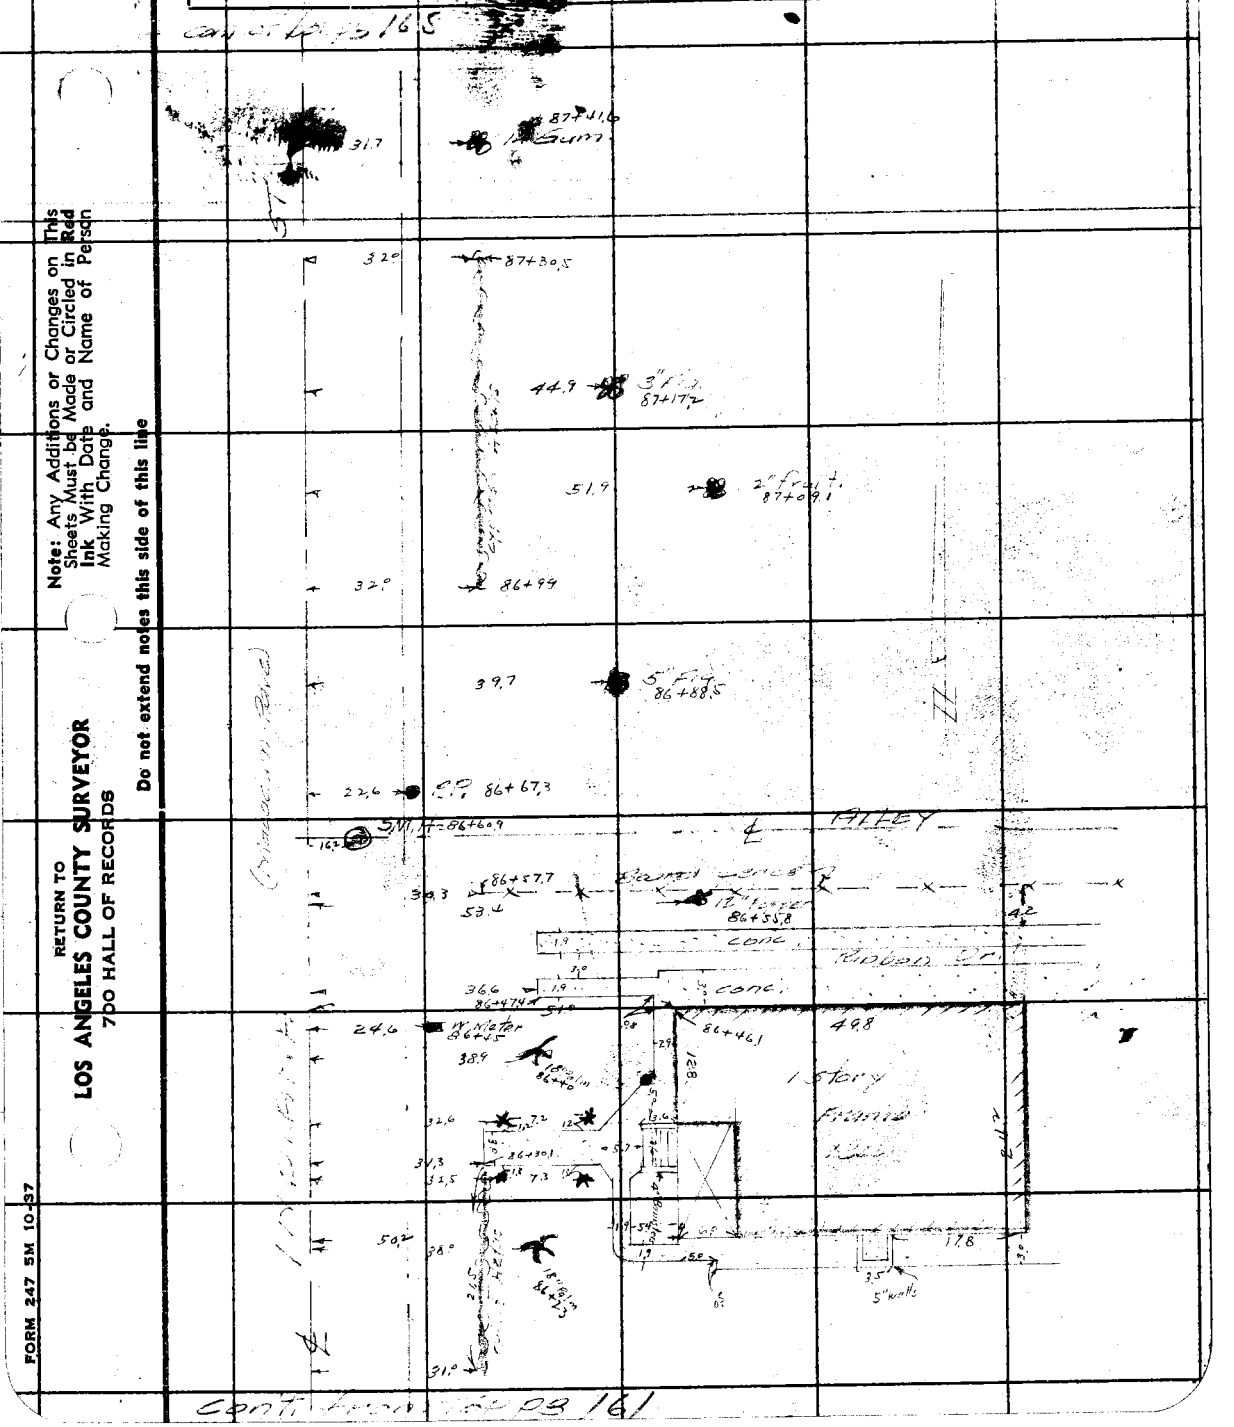

Note: Any Additions or Changes on This Sheets Must be Made or Circled in Red Ink With Date and Name of Person Making Change.

Do not extend notes this side of this line

RETURN TO
LOS ANGELES COUNTY SURVEYOR
700 HALL OF RECORDS

FORM 247 5M 10-37

F.B. 772 PG. 164

166

RETURN TO
LOS ANGELES COUNTY SURVEYOR
700 HALL OF RECORDS

Note: Any Additions or Changes on This Sheets Must be Made or Circled in Red Ink With Date and Name of Person Making Change.

Do not extend notes this side of this line

162

Notes Ck'd by D. M. Finley	Survey of INDIANA ST
Map No. B-1465-2	W. O. 8226 Tape No. ____ St'd ____ °F
Office Work F. A. W.	Surveyed by Evans
Checked D. M. Finley	Notes Brock Date '39
Date Jan 1941	Indexed [illegible]

F.B. 777 PG. 165

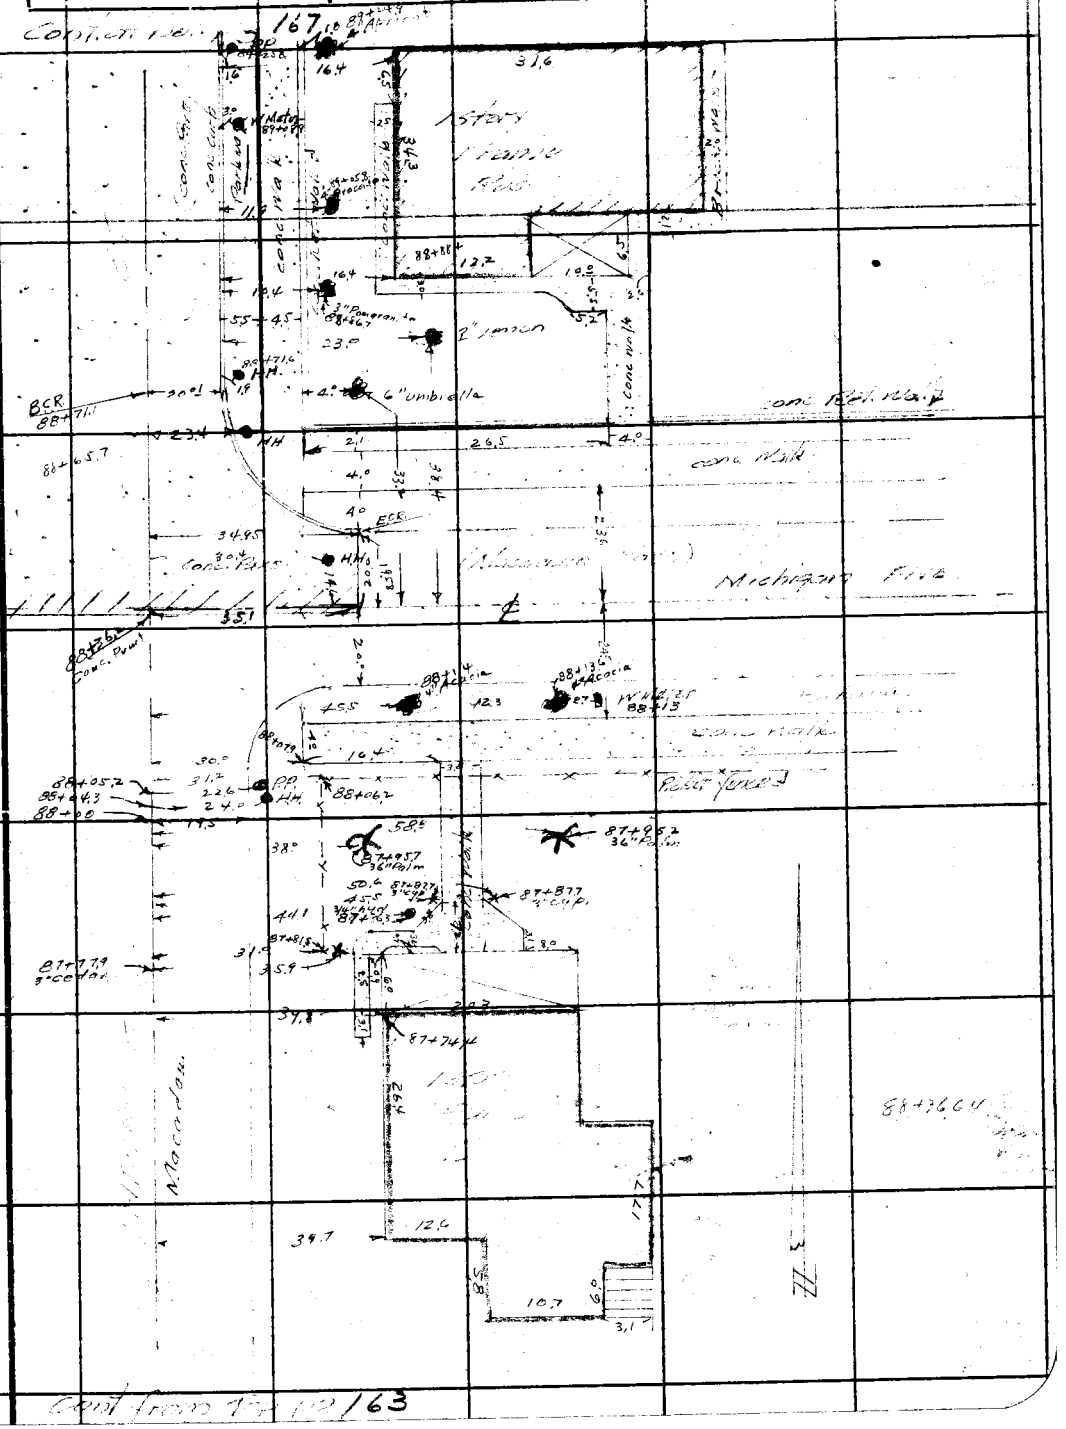

Note: Any Additions or Changes on This Sheets Must be Made or Circled in Red Ink With Date and Name of Person Making Change.

Do not extend notes this side of this line

RETURN TO
LOS ANGELES COUNTY SURVEYOR
700 HALL OF RECORDS

FORM 247 5M 10-37

F.B. 777 PG. 166

cont at bot of 168

RETURN TO
LOS ANGELES COUNTY SURVEYOR
700 HALL OF RECORDS

Note: Any Additions or Changes on This Sheets Must be Made or Circled in Red Ink With Date and Name of Person Making Change.

Do not extend notes this side of this line

cont from top of 164

Notes Ck'd by D. M. Finley	Survey of	F.B. Pg. 167
Map No. B-1465:2	W. O. 822 Tape No. St'd of	
Office Work F. A. W.	Surveyed by Evans	
Checked D. M. Finley	Notes Brock Date '39	
Date Jan. 1941	Indexed	

169

165

Note: Any Additions or Changes on This Sheets Must be Made or Circled in Red Ink With Date and Name of Person Making Change.

Do not extend notes this side of this line

RETURN TO LOS ANGELES COUNTY SURVEYOR 700 HALL OF RECORDS

F.B. 77V PG. 168

cont at bot pg 170

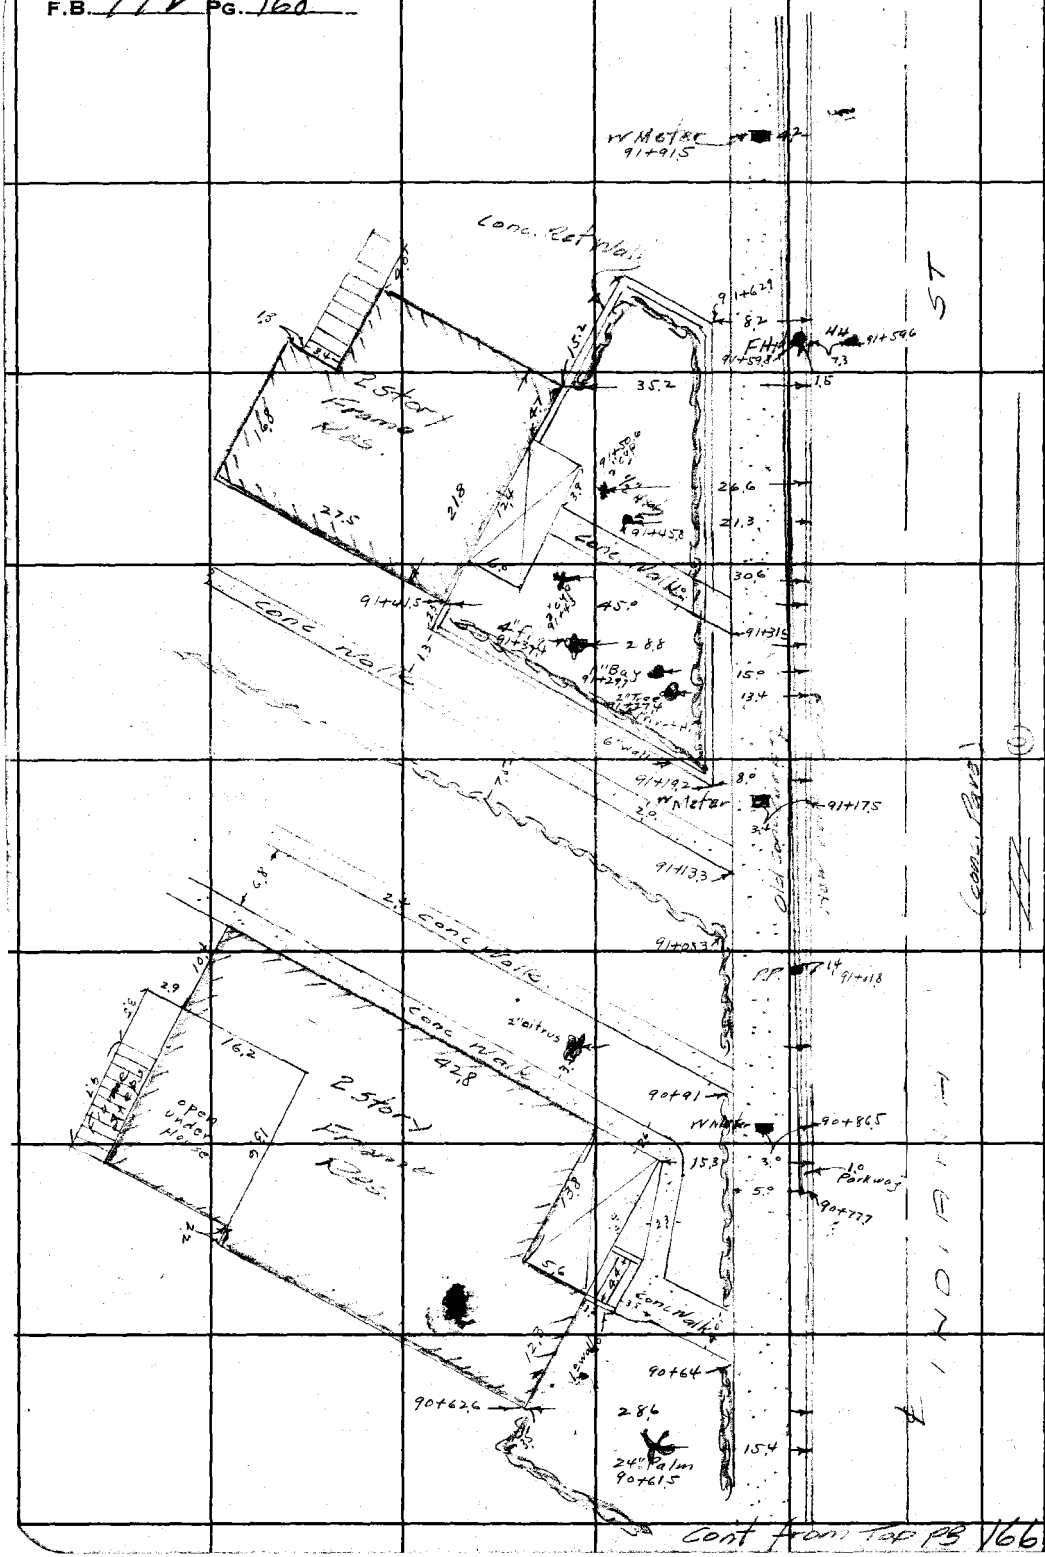

Cont from Top PG 166

RETURN TO
LOS ANGELES COUNTY SURVEYOR
700 HALL OF RECORDS

Note: Any Additions or Changes on This Sheets Must be Made or Circled in Red Ink With Date and Name of Person Making Change.

Do not extend notes this side of this line

Notes Ck'd by D. M. Finley	Survey of	F.B. 772 Pg. 169
Map No. B-1465-2	W. O. Tape No. St'd of	
Office Work F. A. W.	Surveyed by	
Checked D. M. Finley	Notes Date '39	
Date Jan 1941	Indexed	

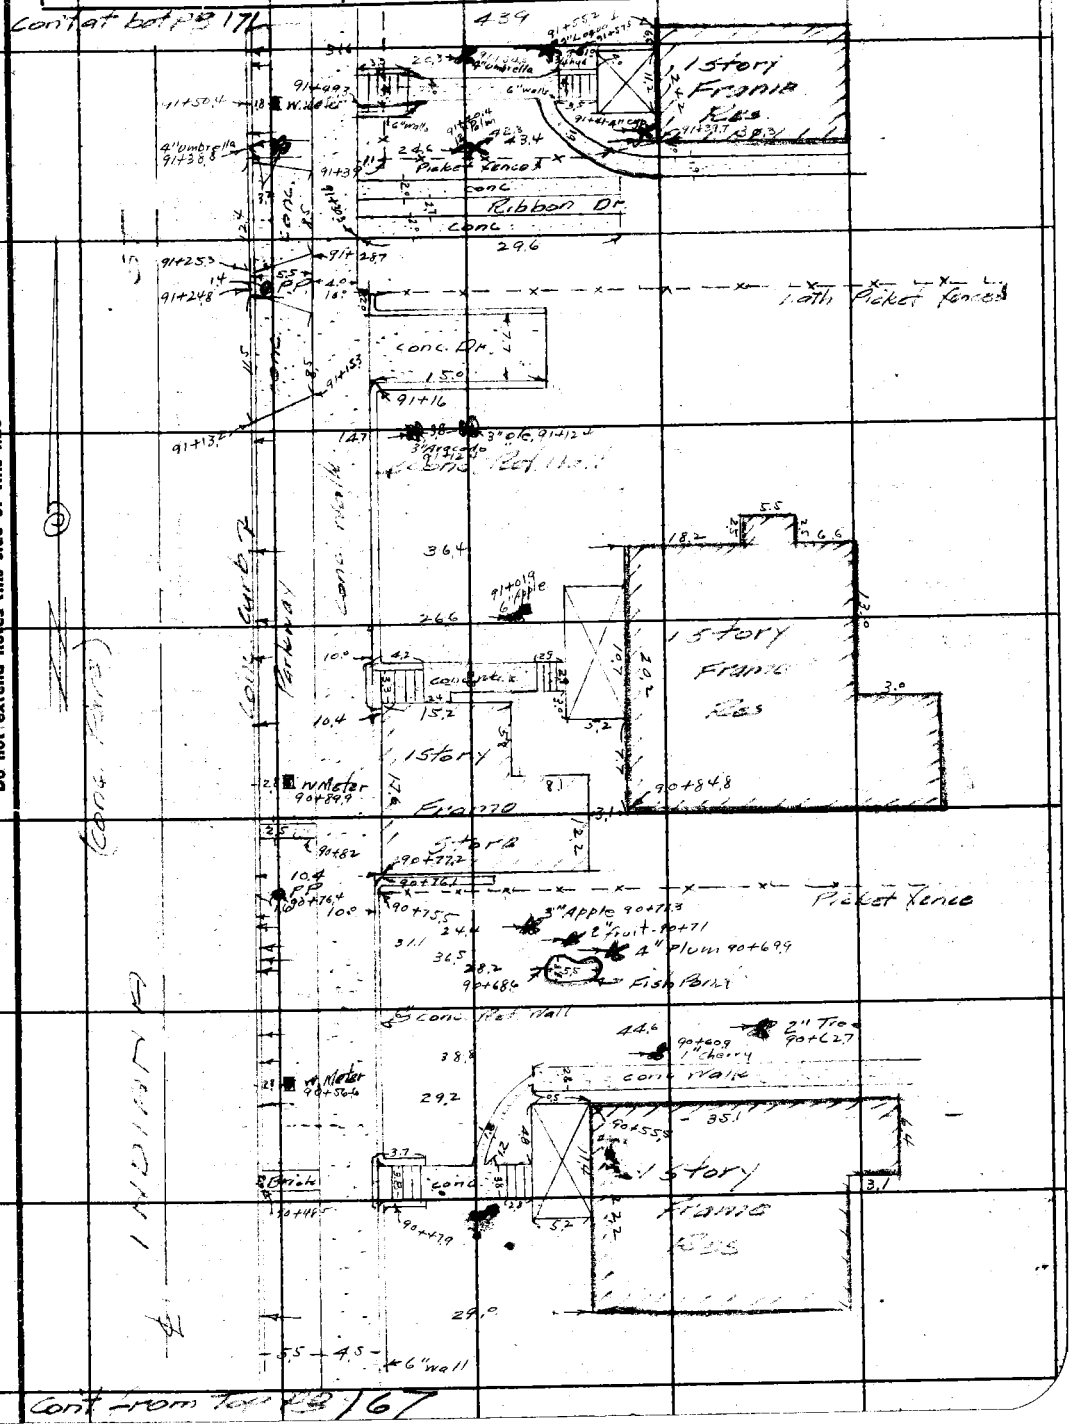

Note: Any Additions or Changes on This Sheets Must be Made or Circled in Red Ink With Date and Name of Person Making Change.

Do not extend notes this side of this line

RETURN TO
LOS ANGELES COUNTY SURVEYOR
700 HALL OF RECORDS

FORM 247 5M 10-37

RETURN TO
LOS ANGELES COUNTY SURVEYOR
700 HALL OF RECORDS

Note: Any Additions or Changes on This Sheets Must be Made or Circled in **Red Ink** With Date and Name of Person Making Change.

Do not extend notes this side of this line

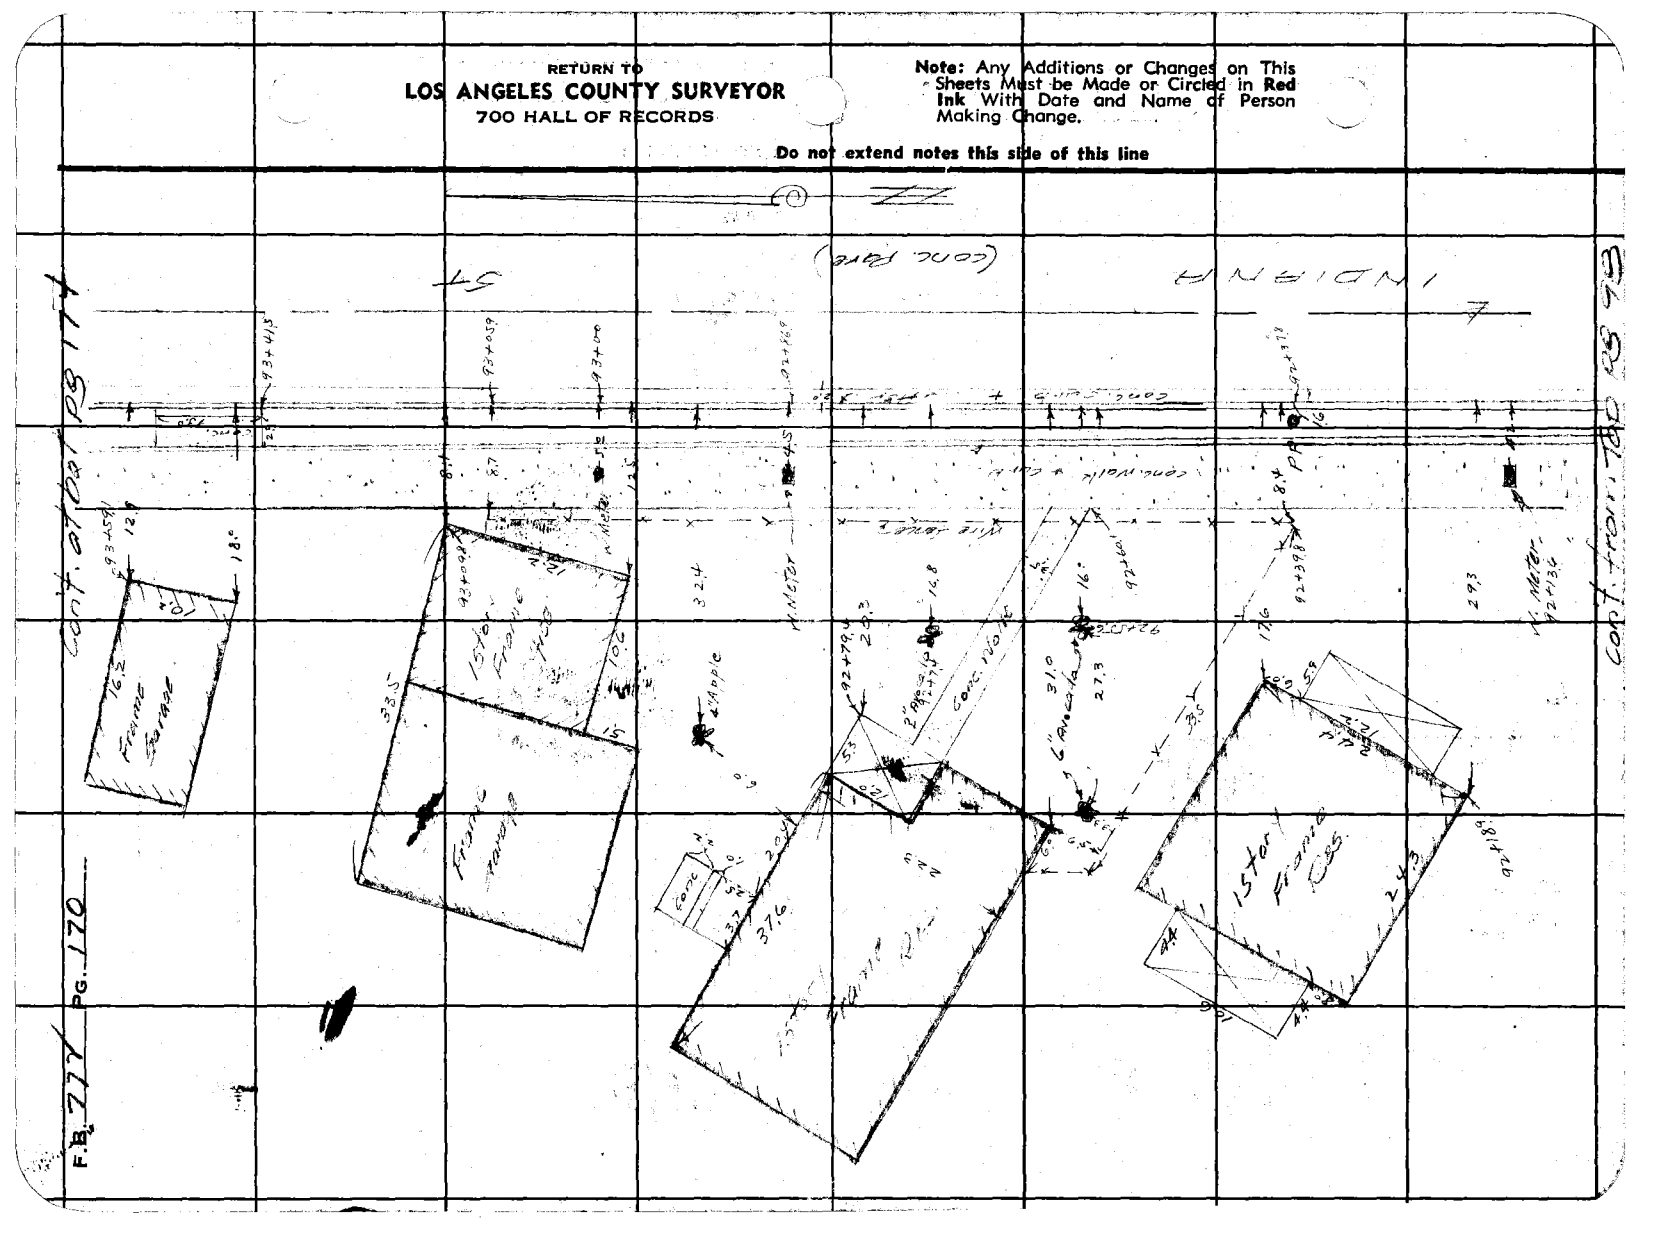

Notes Ck'd by D. M. Finley	Survey of INDIANA ST.	F.B. 77 PG. 171
Map No. B-1465-2	W. O. 8226 Tape No. St'd OF	
Office Work E. A. W.	Surveyed by [illegible]	
Checked D. M. Finley	Notes [illegible] Date '39	
Date Jan. 1941.	Indexed [illegible]	

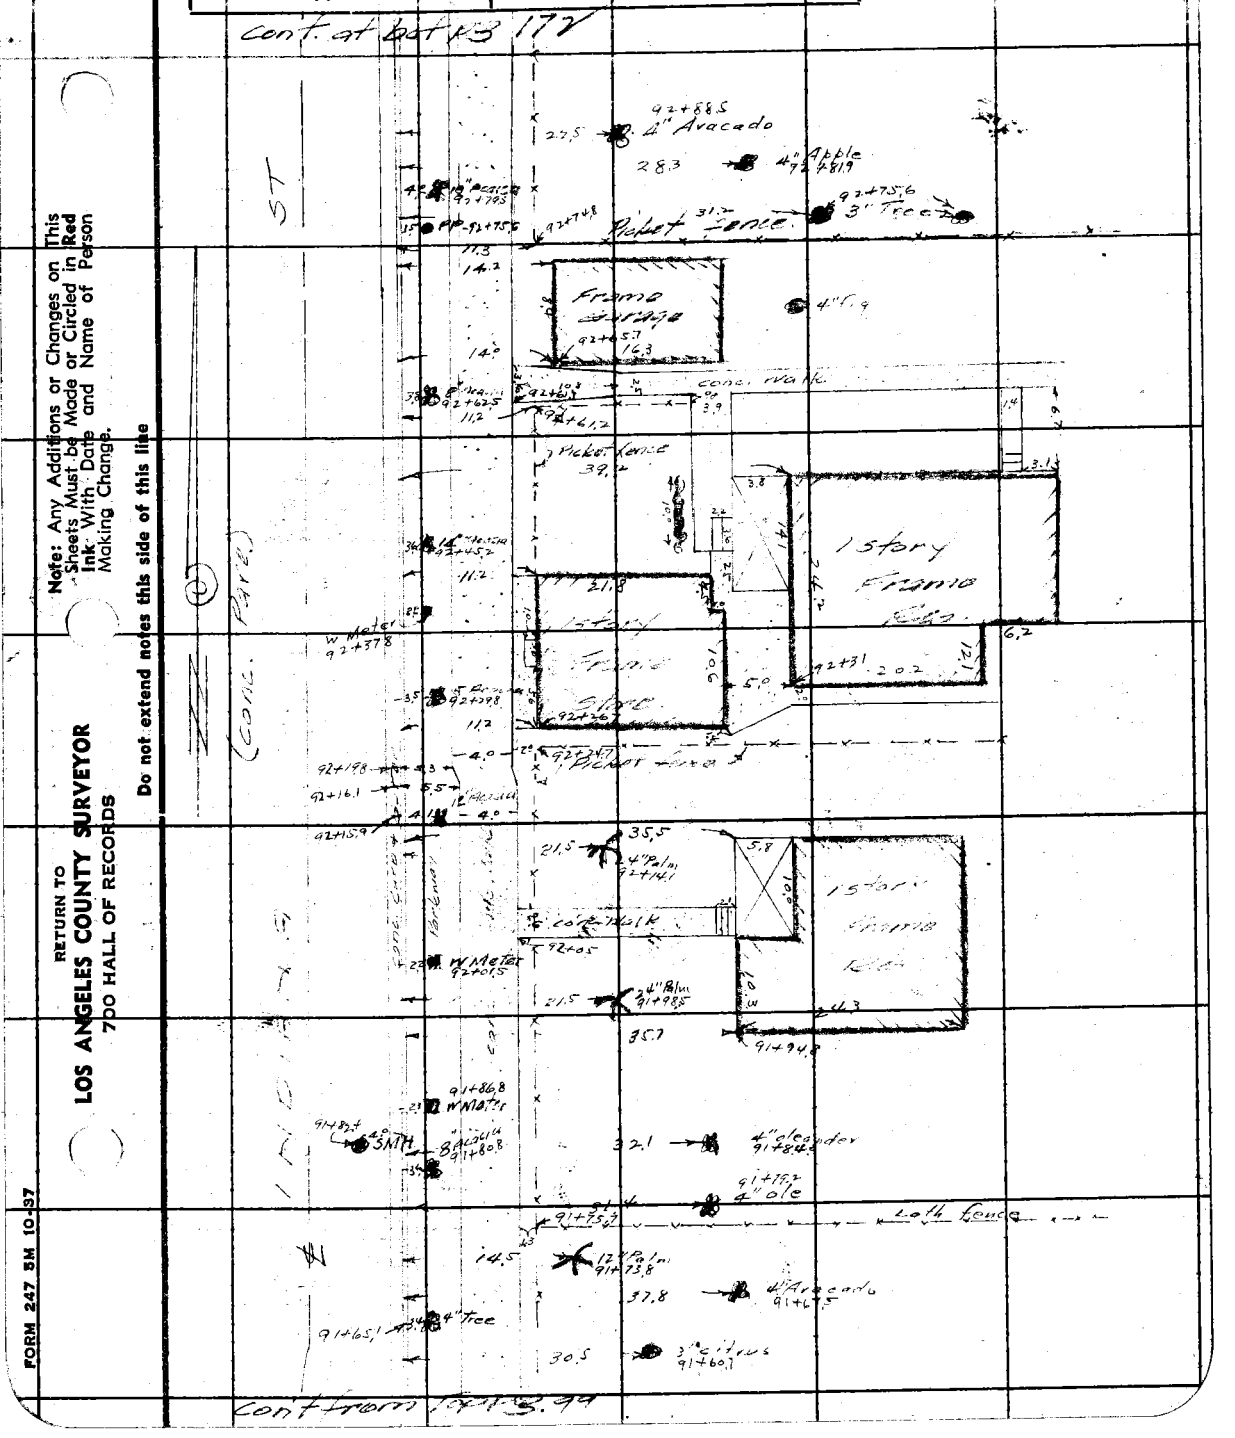

Note: Any Additions or Changes on This Sheets Must be Made or Circled in Red Ink With Date and Name of Person Making Change.

Do not extend notes this side of this line

RETURN TO
LOS ANGELES COUNTY SURVEYOR
700 HALL OF RECORDS

FORM 247 5M 10-37

F.B. 777 PG. 177

cont. at bot pg 173

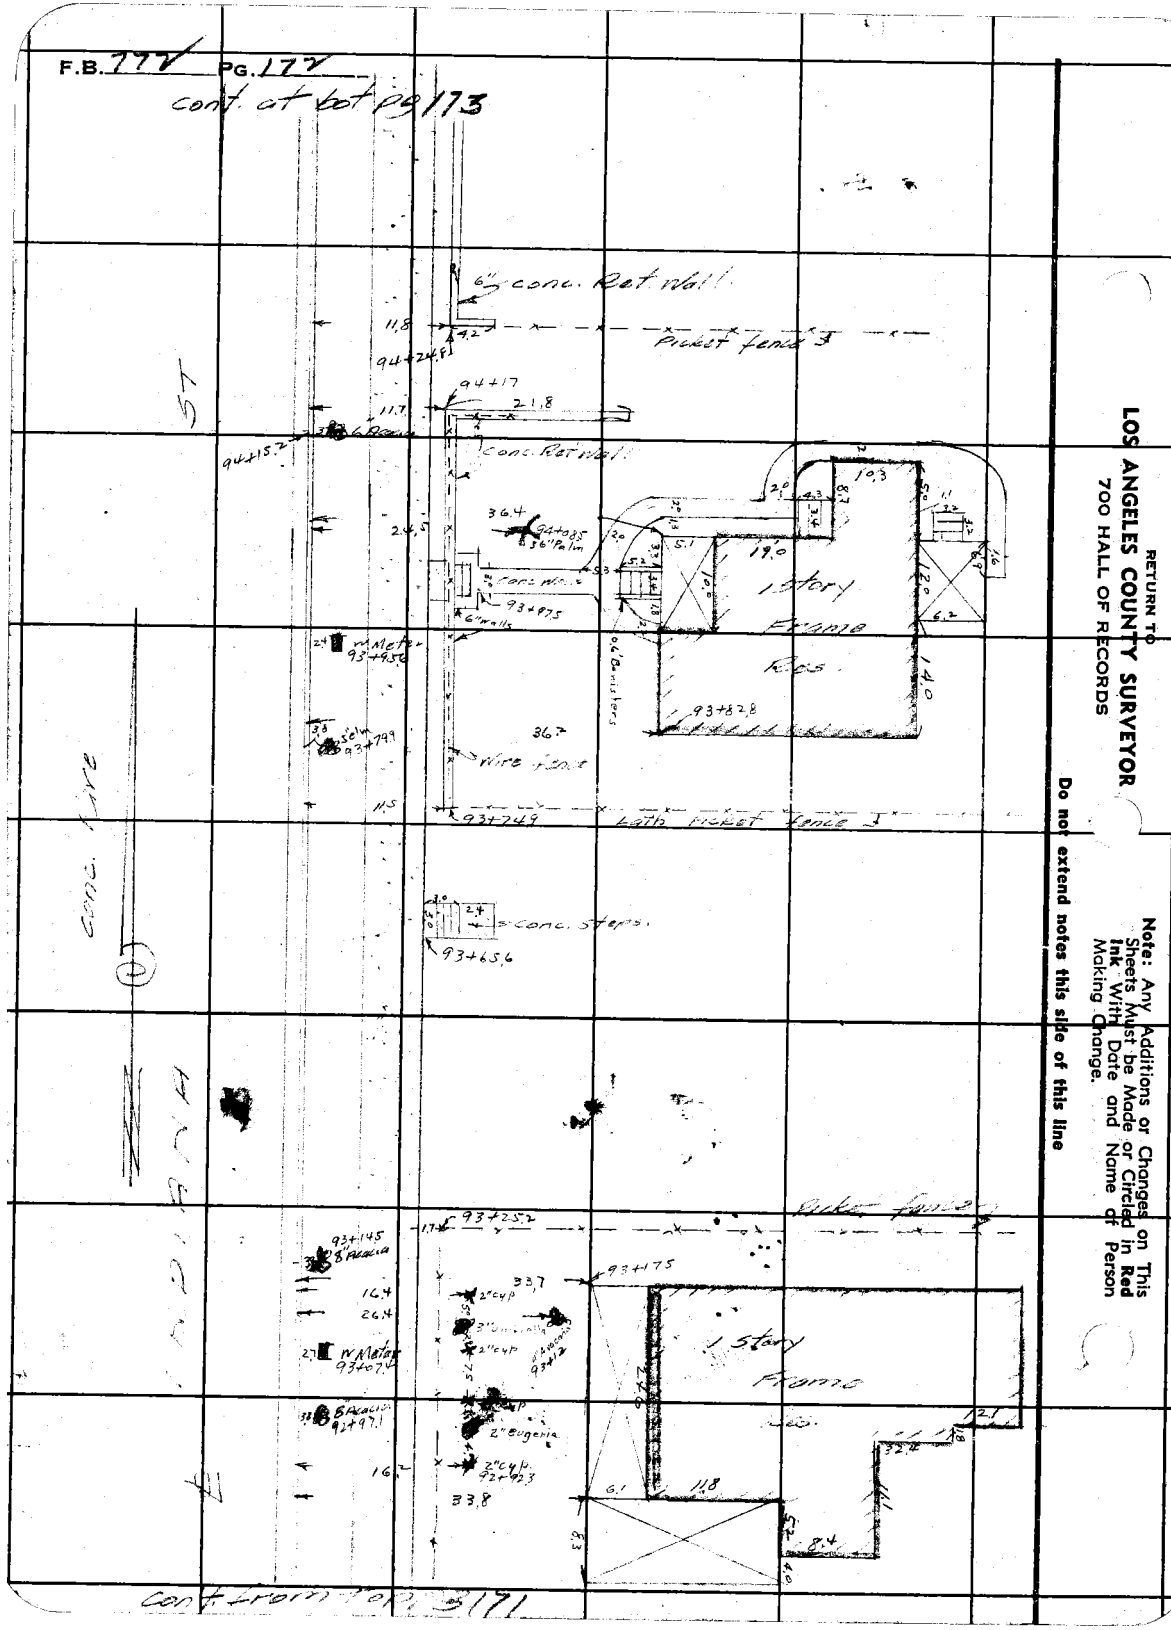

RETURN TO
LOS ANGELES COUNTY SURVEYOR
700 HALL OF RECORDS

Note: Any Additions or Changes on This Sheets Must be Made or Circled in **Red Ink** With Date and Name of Person Making Change.

Do not extend notes this side of this line

Notes Ck'd by D. M. Finley	Survey of		F.B. 772 PG. 173
Map No. B-1465-2	W. O. 8224	Tape No.	St'd OF
Office Work F. A. W.	Surveyed by	EVANS	
Checked D. M. Finley	Notes	BROCK	Date 1939
Date Jan. 1941	Indexed		

Note: Any Additions or Changes on This Sheets Must be Made or Circled in Red Ink With Date and Name of Person Making Change.

Do not extend notes this side of this line

RETURN TO
LOS ANGELES COUNTY SURVEYOR
700 HALL OF RECORDS

FORM 247 SM 10-37

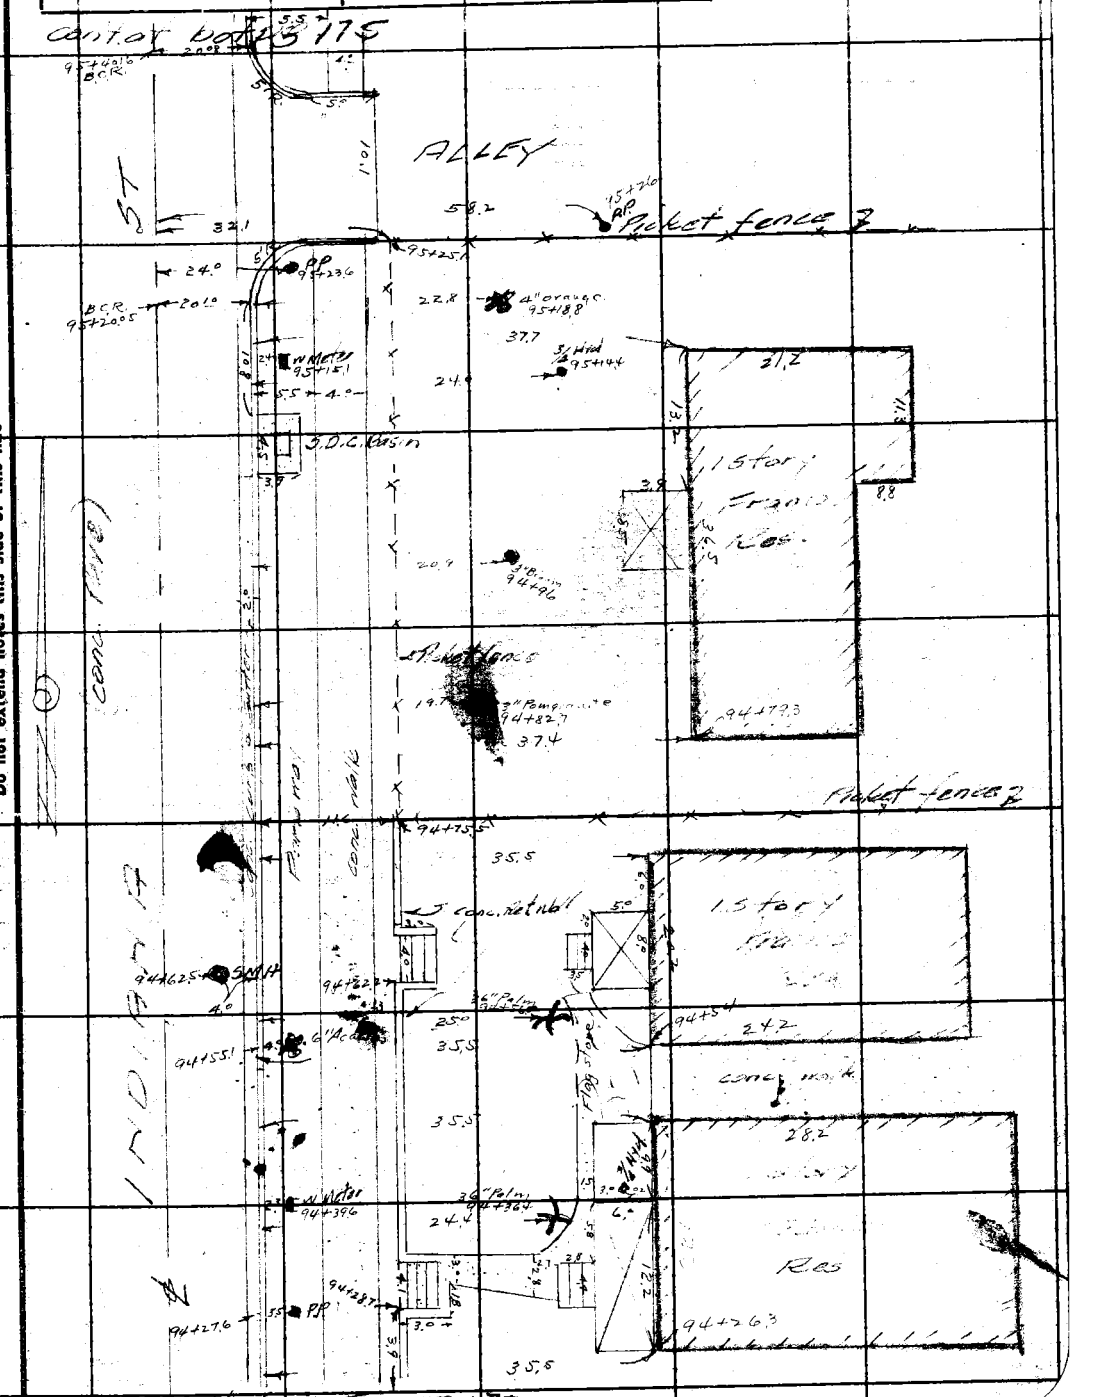

F.B. 772 PG. 174

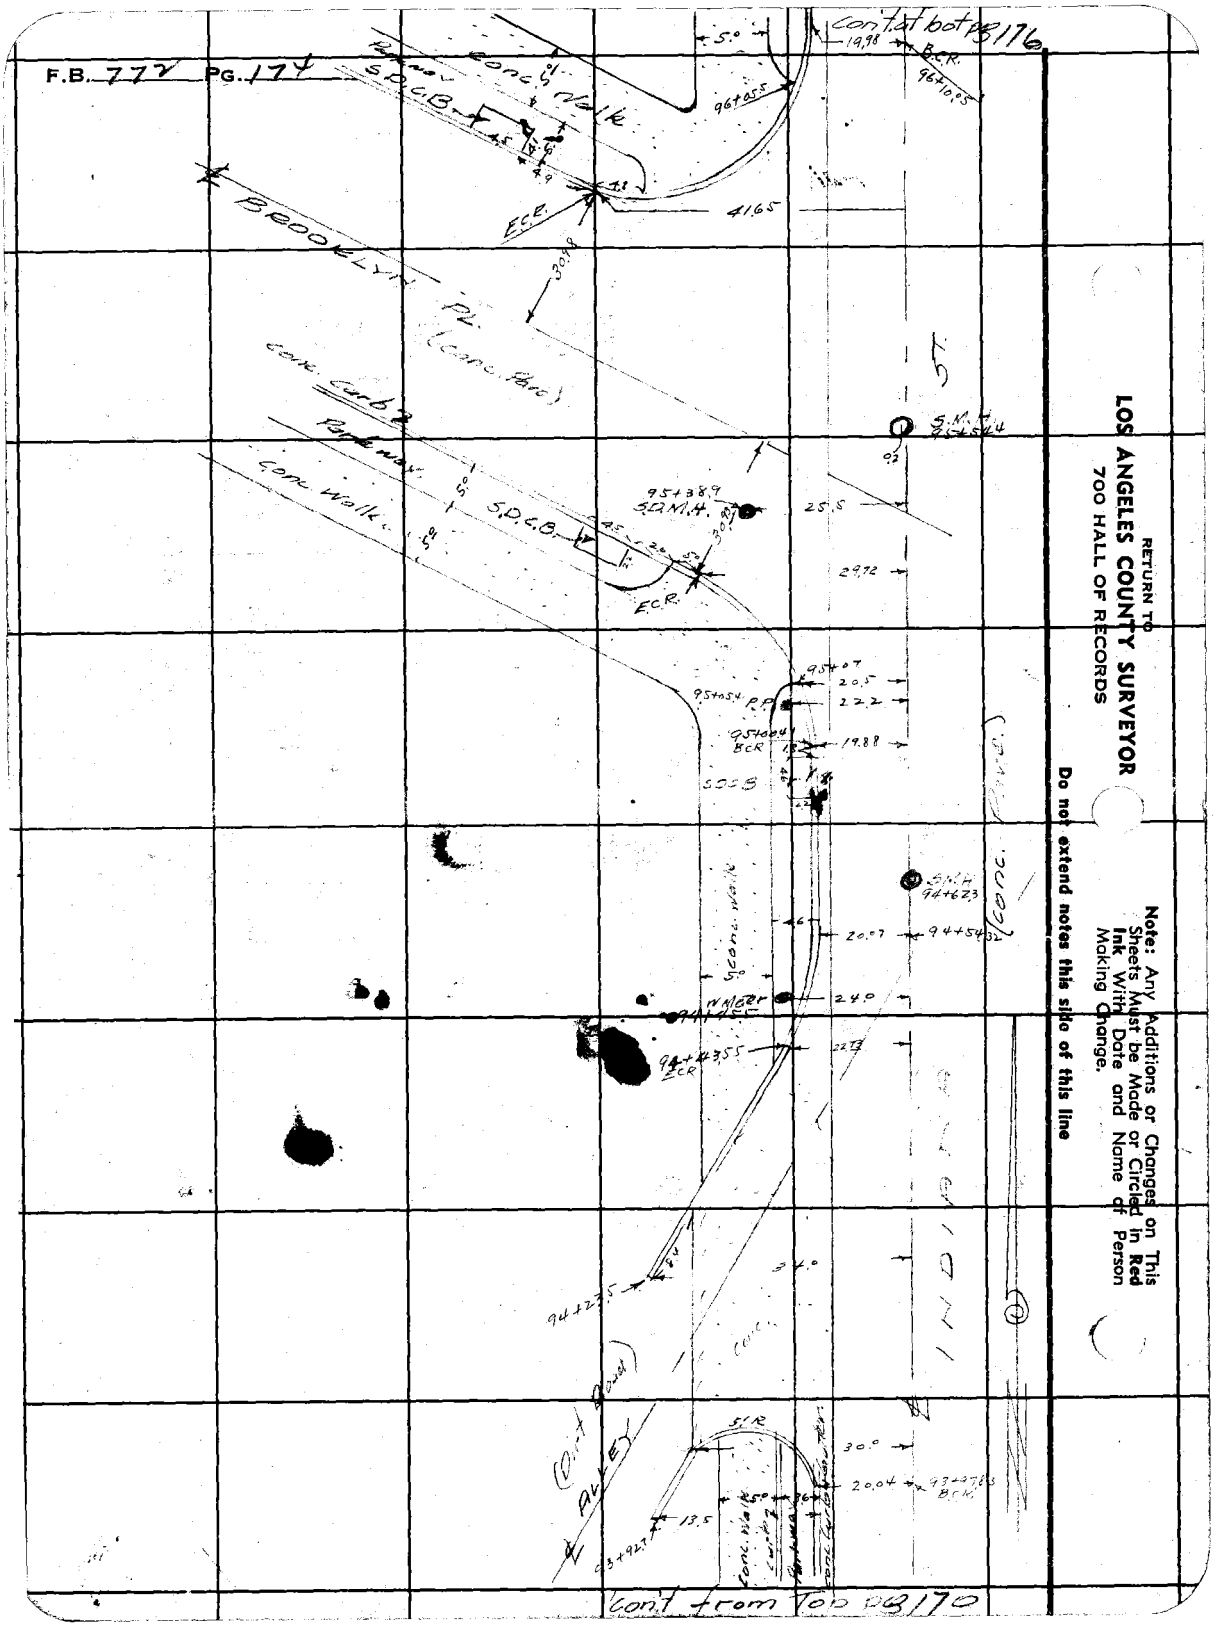

RETURN TO
LOS ANGELES COUNTY SURVEYOR
700 HALL OF RECORDS

Note: Any Additions or Changes on This Sheets Must be Made or Circled in Red Ink With Date and Name of Person Making Change.

Do not extend notes this side of this line

Notes Ck'd by D. M. Finley	Survey of [illegible] ST	F.B. 772	Pg. 175
Map No. B-1465-2	W. [illegible] Tape No.	St'd	of
Office Work F. A. W.	Surveyed by [illegible]		
Checked D. M. Finley	Notes [illegible] Date 39		
Date Jan 1941	Indexed		

Cont from Pg 177

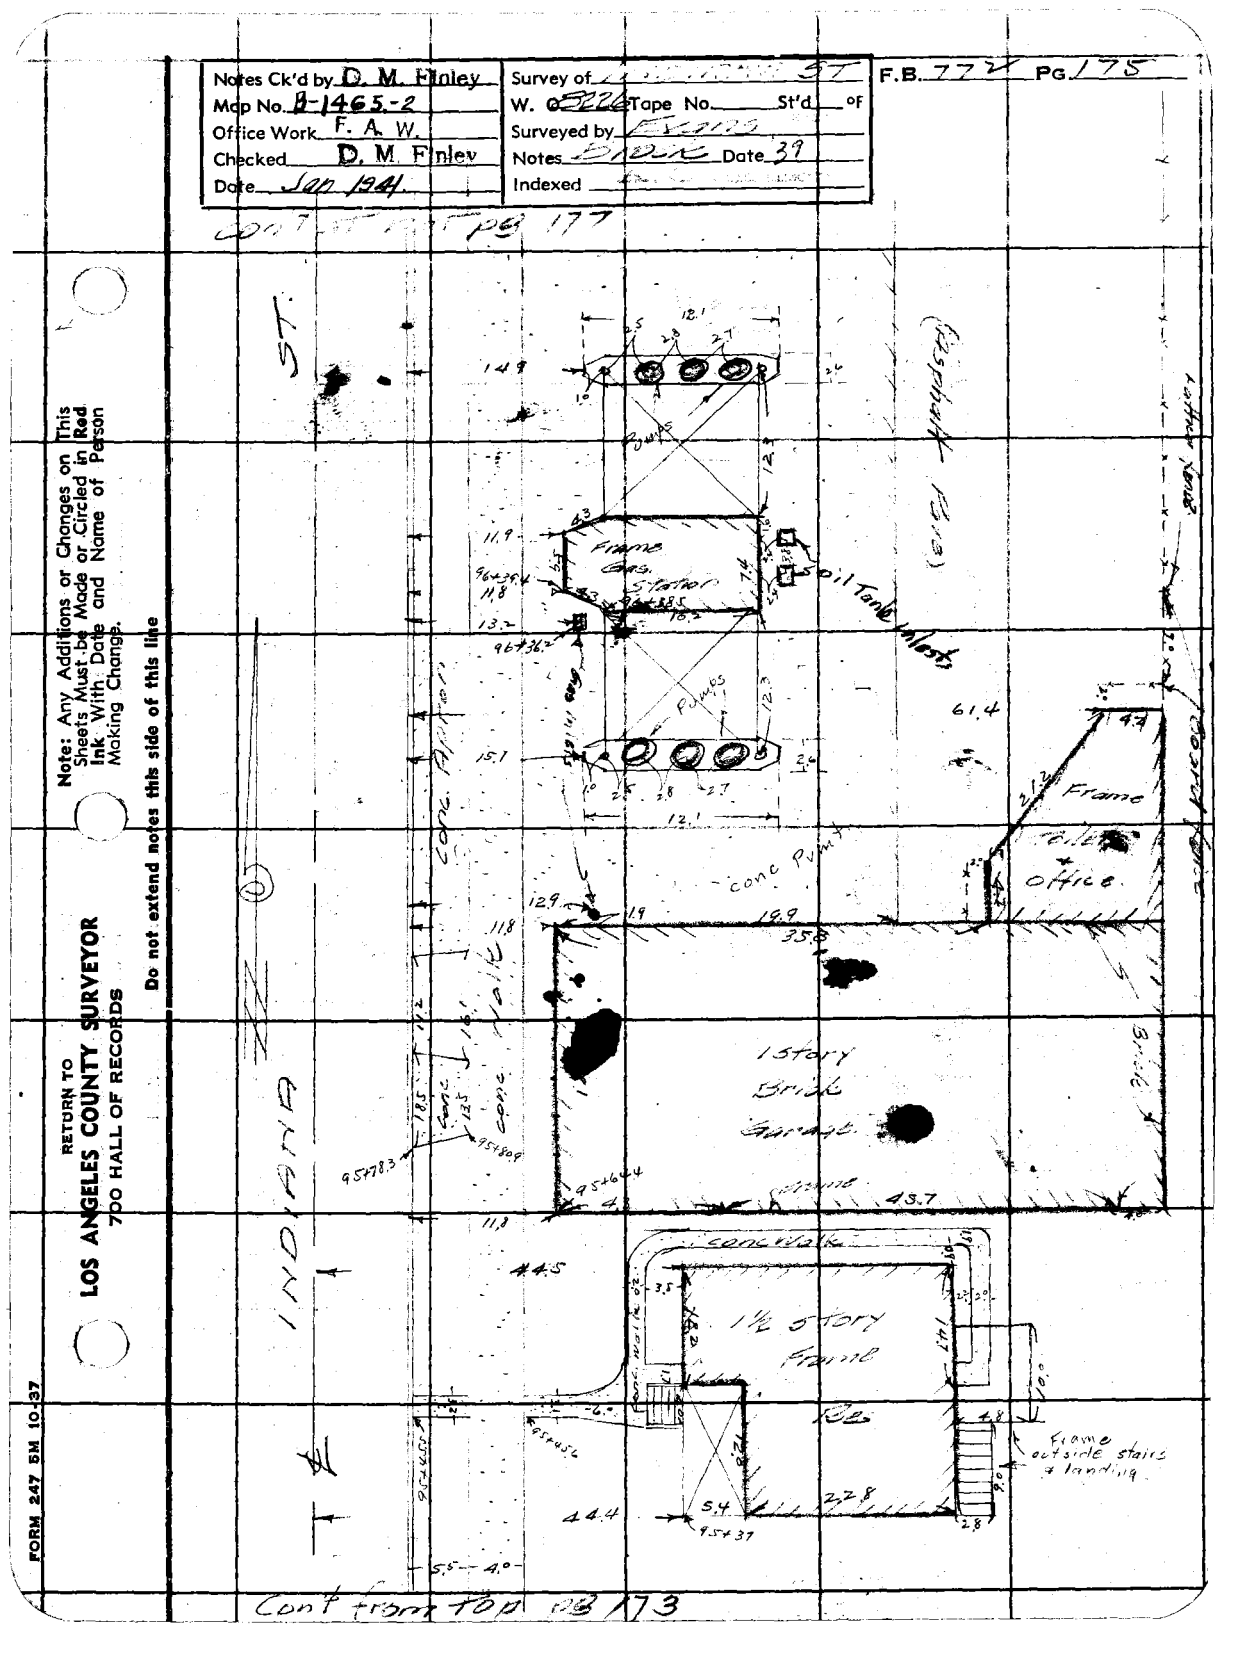

Cont from top Pg 173

RETURN TO
LOS ANGELES COUNTY SURVEYOR
700 HALL OF RECORDS

Note: Any Additions or Changes on This Sheets Must be Made or Circled in Red Ink With Date and Name of Person Making Change.

Do not extend notes this side of this line

FORM 247 5M 10-37

F.B. 777 Pg. 176

cont at bot pg 178

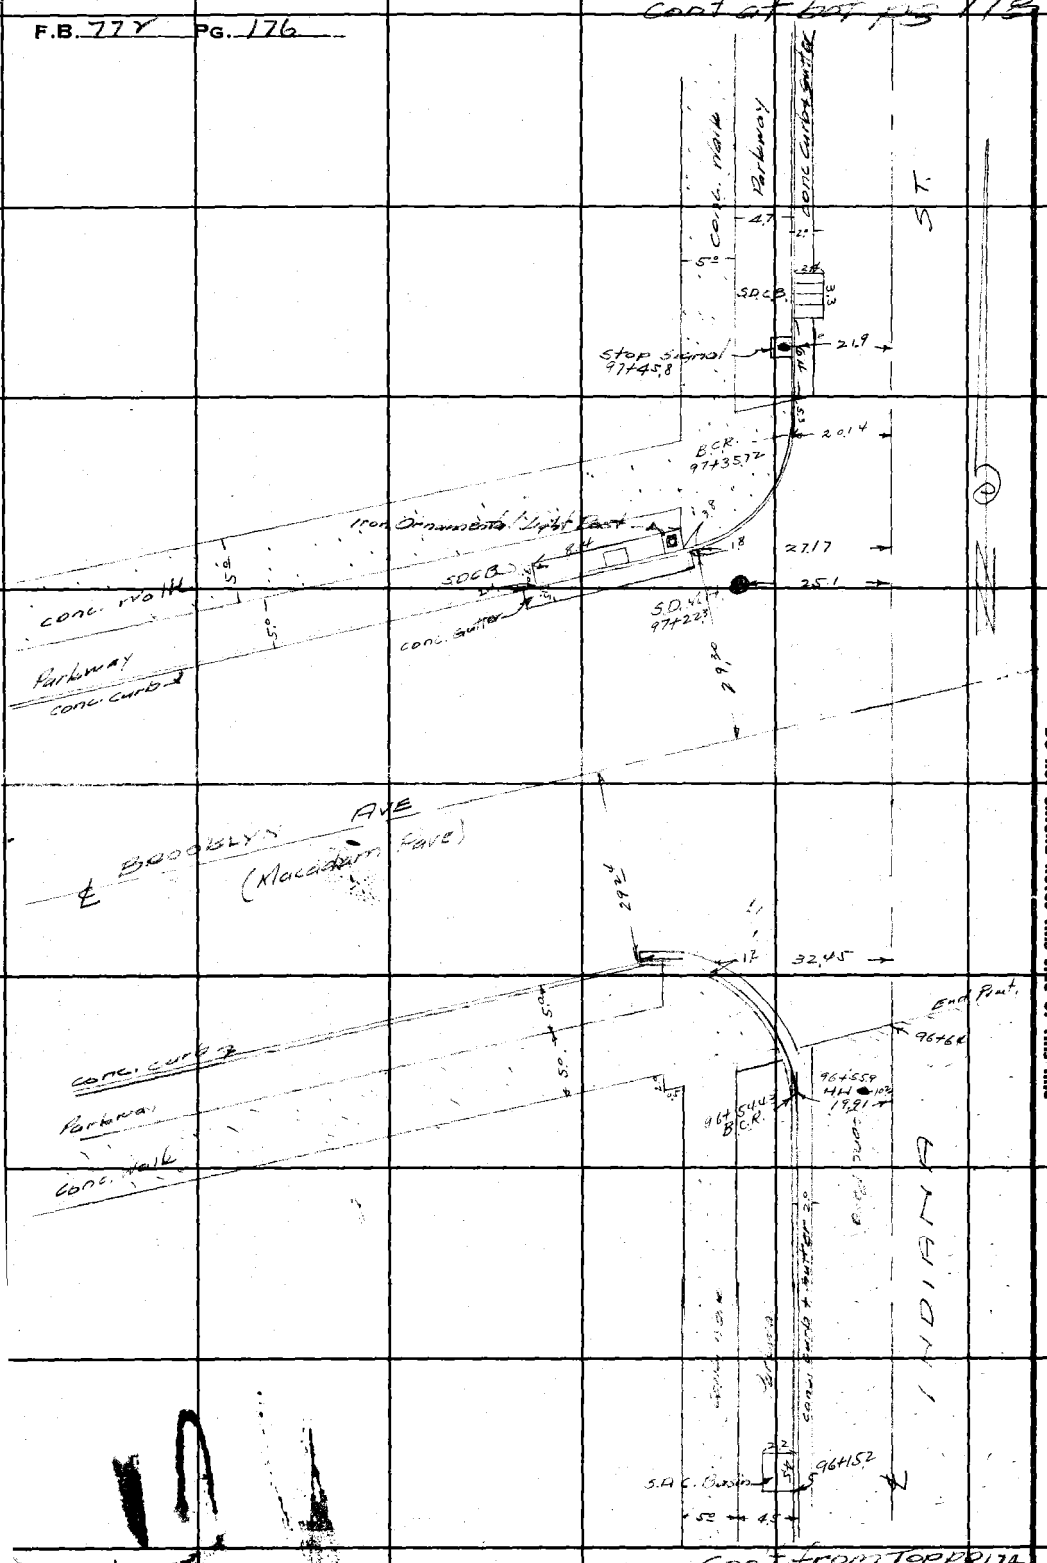

RETURN TO
LOS ANGELES COUNTY SURVEYOR
700 HALL OF RECORDS

Note: Any Additions or Changes on This Sheets Must be Made or Circled in Red Ink With Date and Name of Person Making Change.

Do not extend notes this side of this line

cont from Top pg 174

Notes Ck'd by D. M. Finley	Survey of [illegible]	F.B. [illegible] PG. [illegible]
Map No. B-1465-2	W. O. 8226 Tape No. ____ St'd ____ of	
Office Work F. A. W.	Surveyed by [illegible]	
Checked D. M. Finley	Notes Brock Date 39	
Date Jan 1941	Indexed [illegible]	

cont. at bot. PG 71

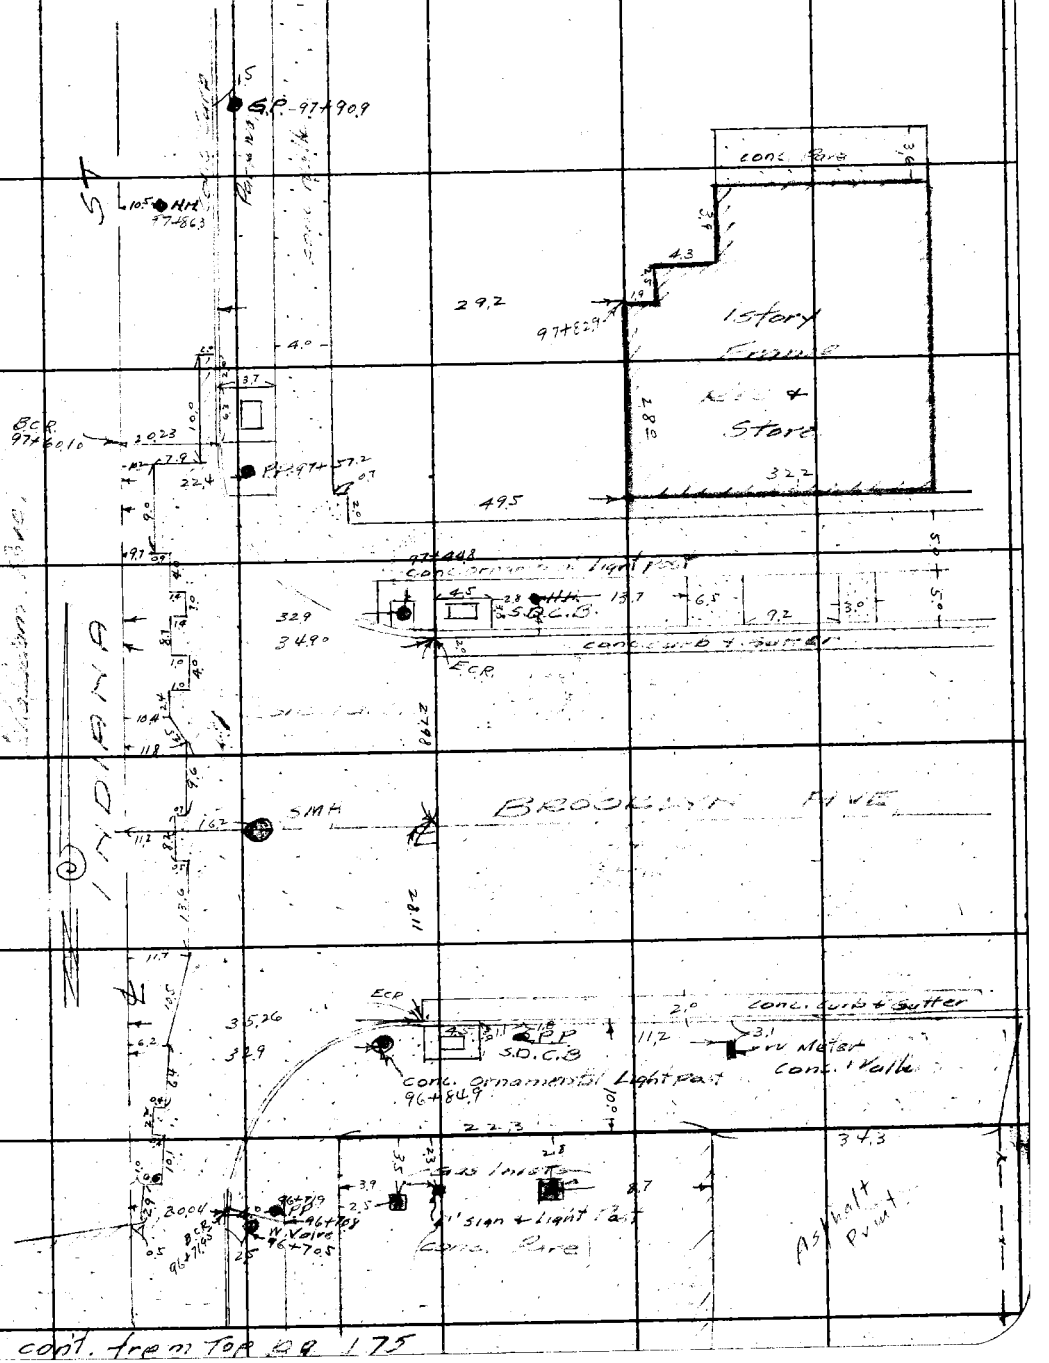

cont. from Top pg 175

Note: Any Additions or Changes on This Sheets Must be Made or Circled in Red Ink With Date and Name of Person Making Change.

Do not extend notes this side of this line

RETURN TO
LOS ANGELES COUNTY SURVEYOR
700 HALL OF RECORDS

FORM 247 5M 10-37

F.B. 772 PG. 178

cont at bot pg 180

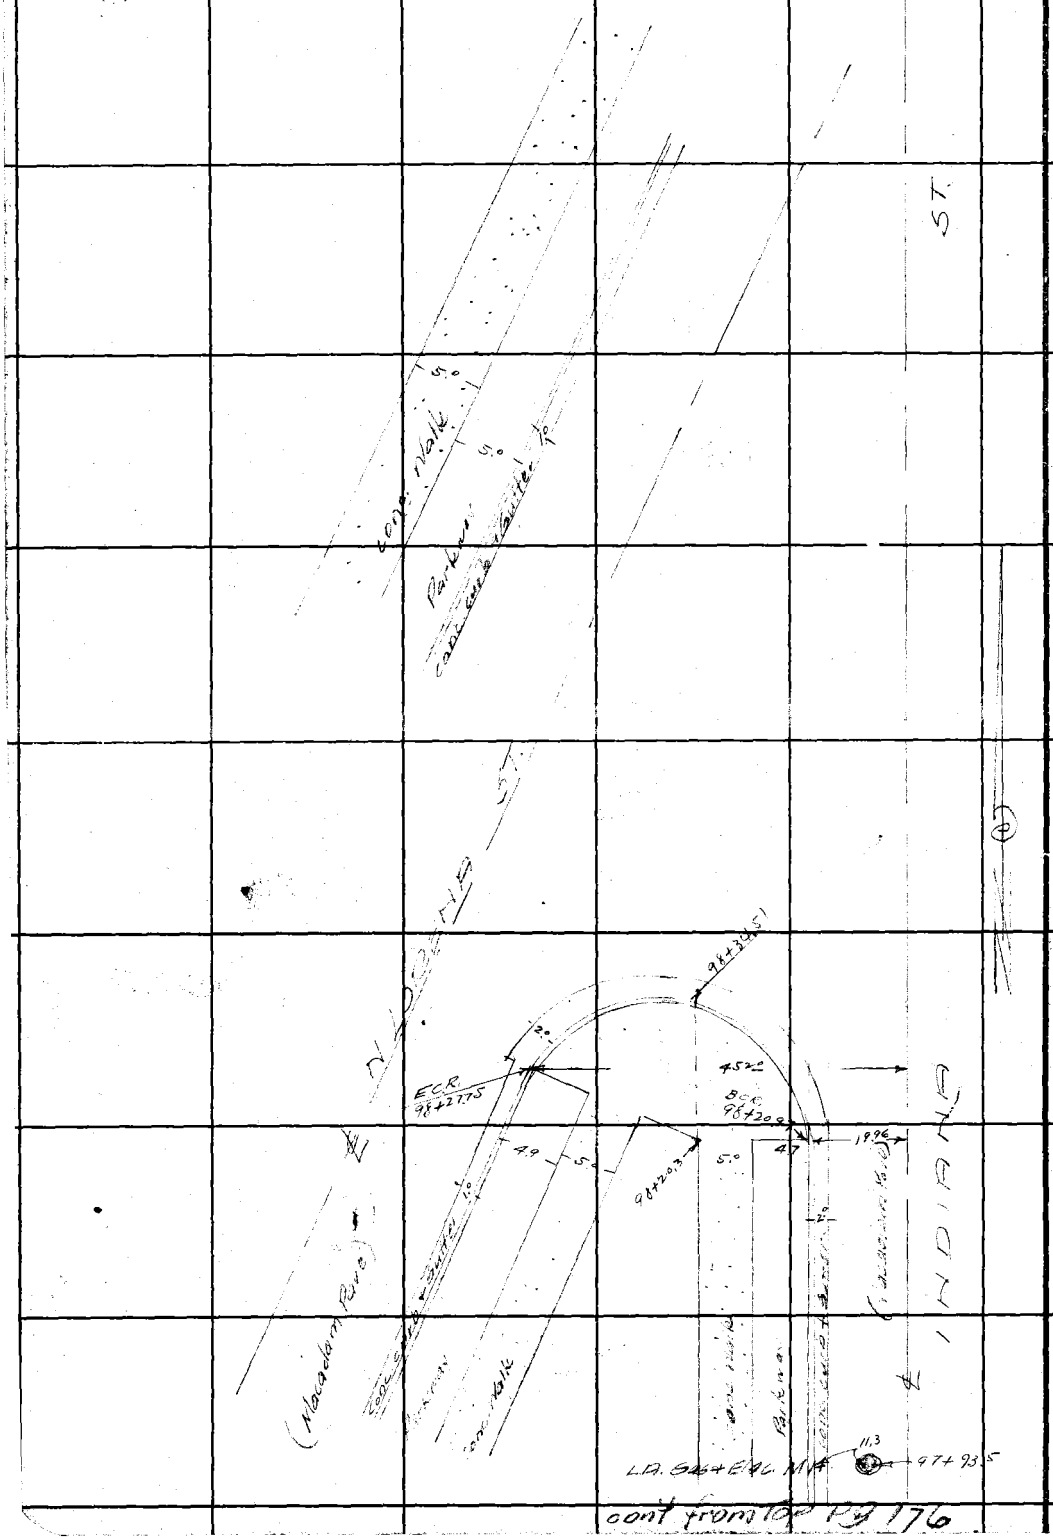

cont from top pg 176

RETURN TO
LOS ANGELES COUNTY SURVEYOR
700 HALL OF RECORDS

Note: Any Additions or Changes on This Sheets Must be Made or Circled in Red Ink With Date and Name of Person Making Change.

Do not extend notes this side of this line

Notes Ck'd by D. M. Finley	Survey of [illegible]	F.B. 276	Pg. 179
Map No. B-1465-2	W. O. 8226 Tape No.	St'd	OF
Office Work F. A. W.	Surveyed by Evans		
Checked D. M. Finley	Notes Block Date 1/39		
Date Jan. 1941	Indexed		

Note: Any Additions or Changes on This Sheets Must be Made or Circled in Red Ink With Date and Name of Person Making Change.

Do not extend notes this side of this line

RETURN TO
LOS ANGELES COUNTY SURVEYOR
700 HALL OF RECORDS

FORM 247 5M 10-37

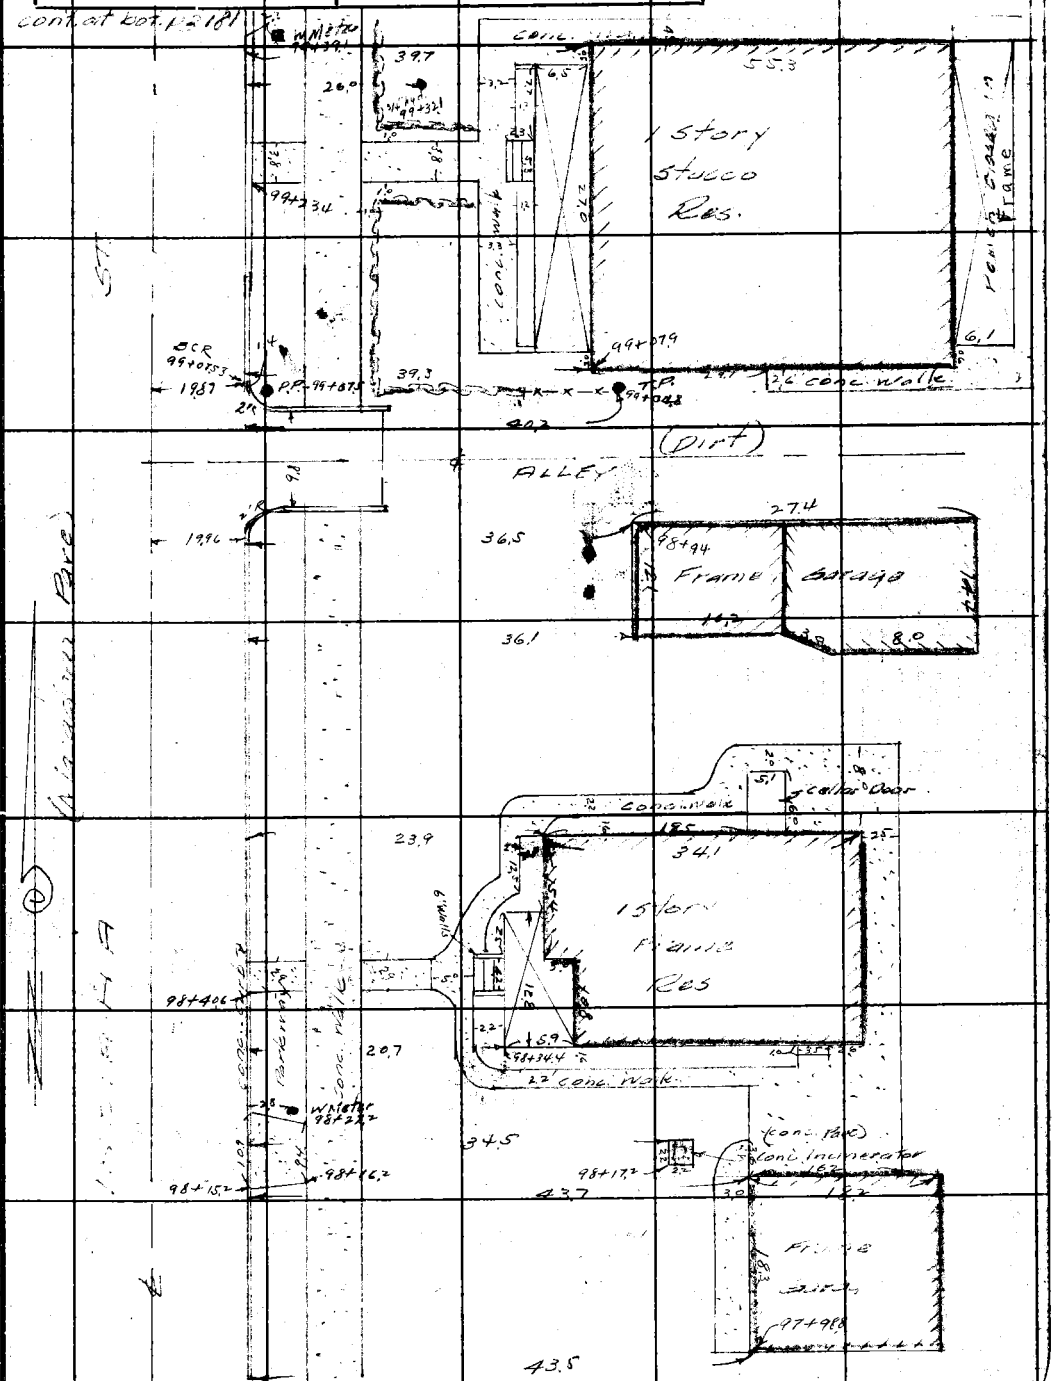

F.B. 777 PG. 180

cont. at bot pg 181

RETURN TO
LOS ANGELES COUNTY SURVEYOR
700 HALL OF RECORDS

Note: Any Additions or Changes on This Sheets Must be Made or Circled in **Red Ink** With Date and Name of Person Making Change.

Do not extend notes this side of this line

Cont. from FB 178

Notes Ck'd by D. M. Finley	Survey of INDIANA ST	F.B. 270	Pg. 161
Map No. B-1465-2	W. O. 8222 Tape No.	St'd	of
Office Work F. A. W.	Surveyed by EVANS		
Checked D. M. Finley	Notes Stock Date '39		
Date Jan. 1941.	Indexed		

Cont. at bot. PG 183.

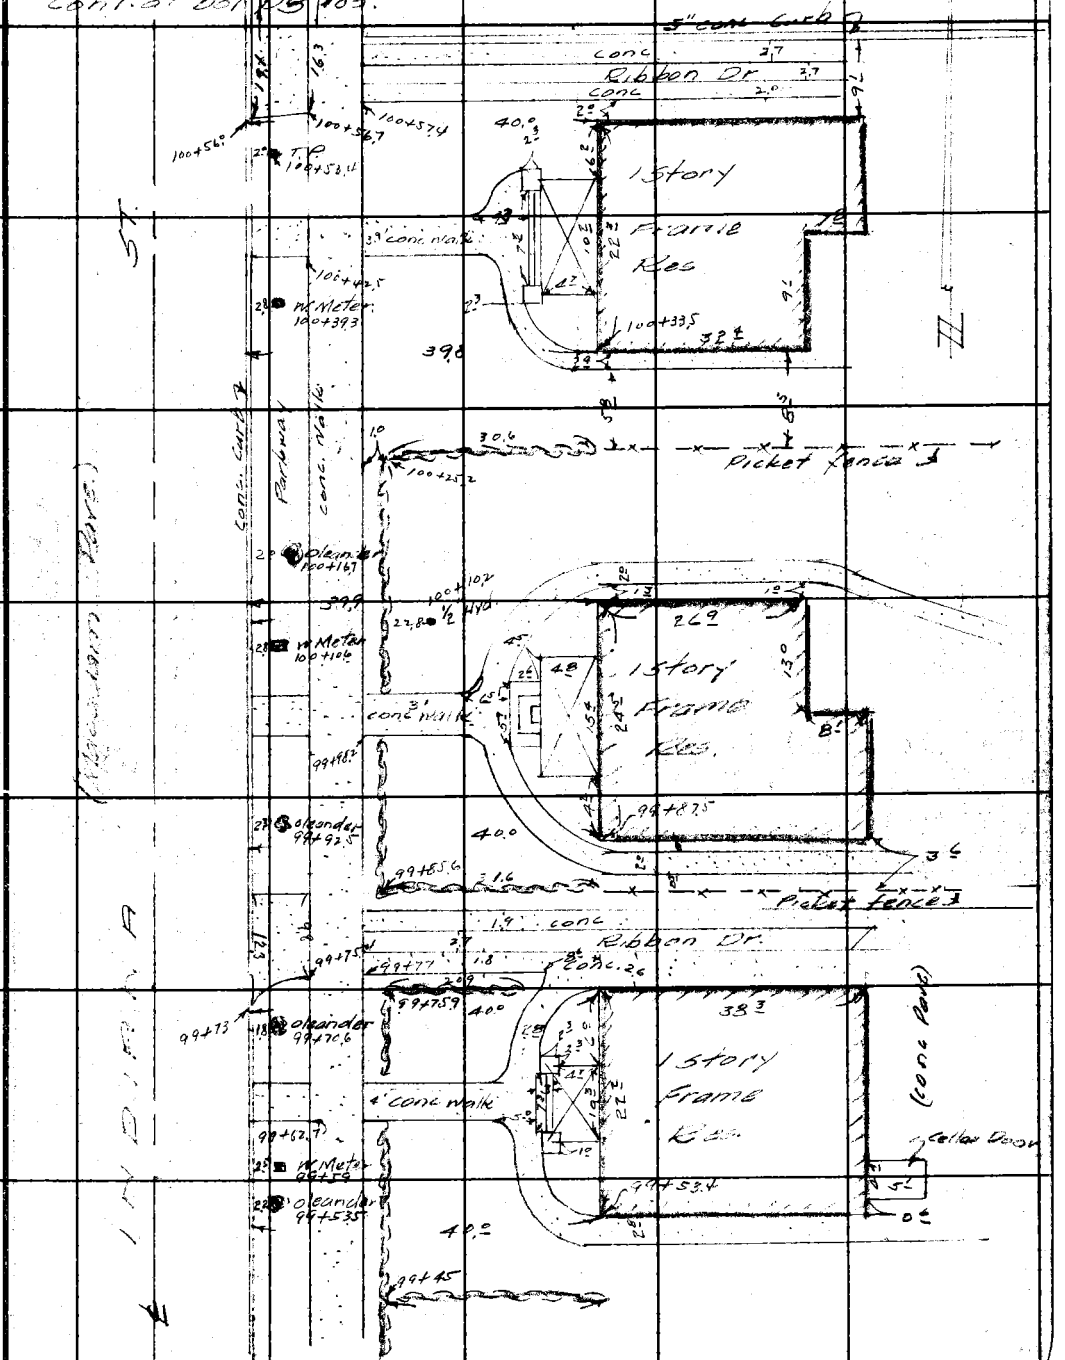

Cont. from Top PG 179

RETURN TO
LOS ANGELES COUNTY SURVEYOR
700 HALL OF RECORDS

Note: Any Additions or Changes on This Sheets Must be Made or Circled in Red Ink With Date and Name of Person Making Change.

Do not extend notes this side of this line

FORM 247 5M 10-37

F.B. 777 PG. 182

cont. at bot. pg 184

con't from TOP pg 180

RETURN TO
LOS ANGELES COUNTY SURVEYOR
700 HALL OF RECORDS

Note: Any Additions or Changes on This Sheets Must be Made or Circled in **Red Ink** With Date and Name of Person Making Change.

Do not extend notes this side of this line

Notes Ck'd by D. M. Finley	Survey of INDIANA ST	F.B. 177 PG. 183
Map No. B-1465-2	W. O. 8226 Tape No. ____ St'd ____ OF	
Office Work F. A. W.	Surveyed by Evans	
Checked D. M. Finley	Notes Brock Date '39	
Date Jan 1941.	Indexed [illegible]	

Cont. at bot. pg 185

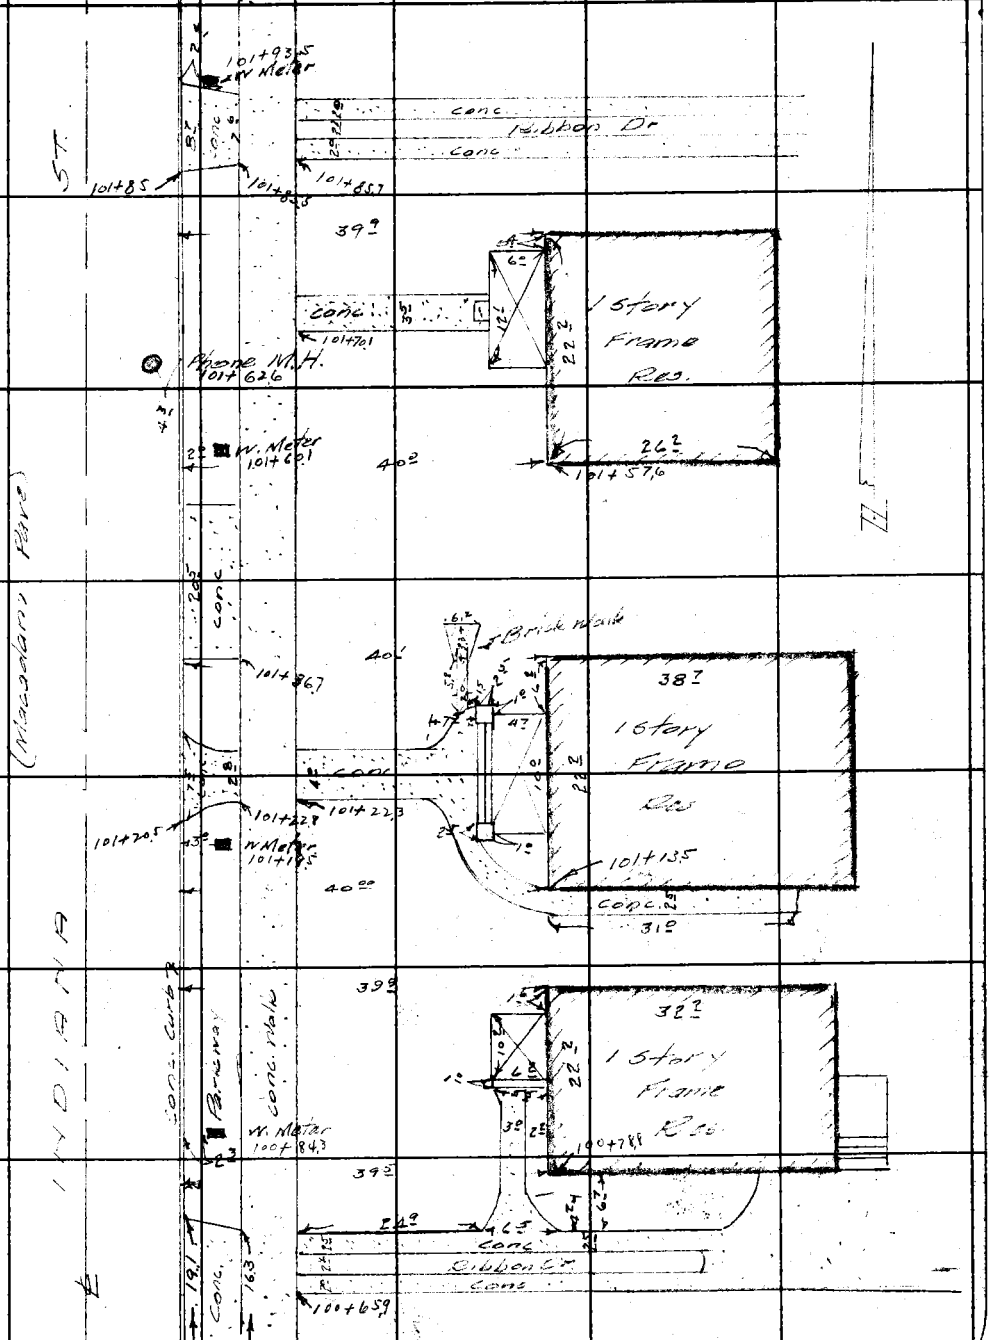

cont. from Top pg 181

Note: Any Additions or Changes on This Sheets Must be Made or Circled in Red Ink With Date and Name of Person Making Change.

Do not extend notes this side of this line

RETURN TO
LOS ANGELES COUNTY SURVEYOR
700 HALL OF RECORDS

FORM 247 5M 10-37

F.B. 772 PG. 184

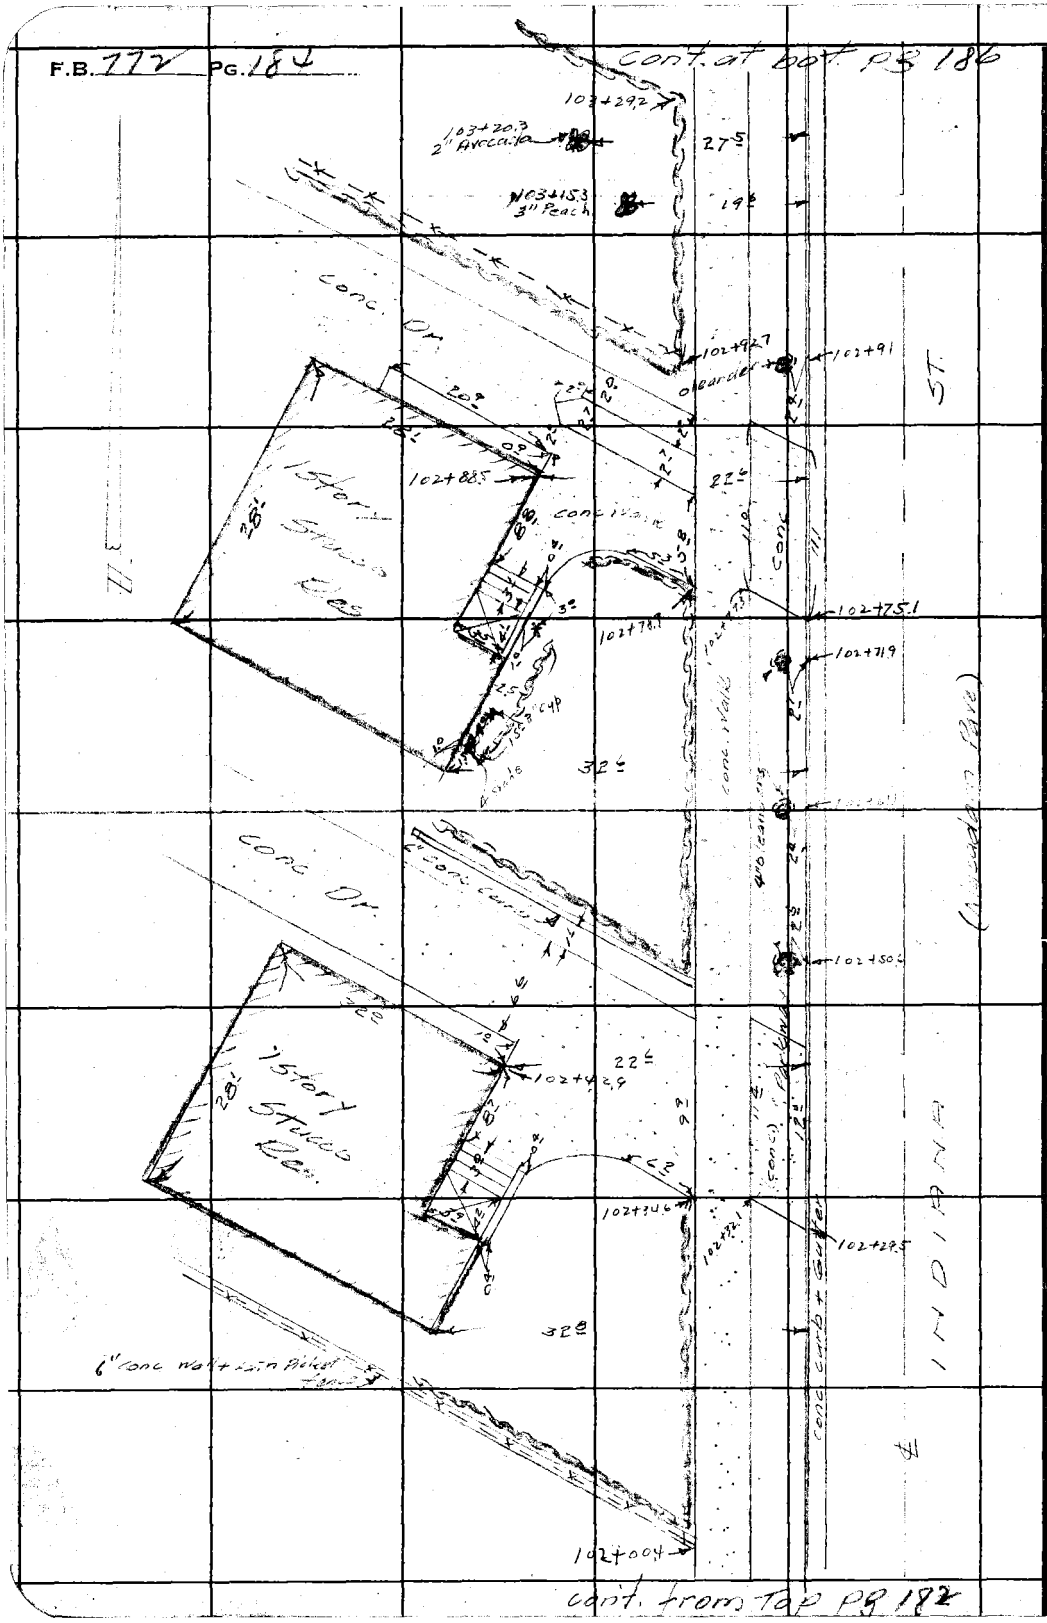

RETURN TO
LOS ANGELES COUNTY SURVEYOR
700 HALL OF RECORDS

Note: Any Additions or Changes on This Sheets Must be Made or Circled in **Red Ink** With Date and Name of Person Making Change.

Do not extend notes this side of this line

To 2-5 by. 187

Map No. B-1465-2	W. O. 5220 Tape No.	St'd	OF
Office Work F. A. W.	Surveyed by Evans		
Checked D. M. Finley	Notes Brock Date 1/39		
Date Jan. 1941	Indexed		

Note: Any Additions or Changes on This Sheets Must be Made or Circled in Red Ink With Date and Name of Person Making Change.

Do not extend notes this side of this line

RETURN TO
LOS ANGELES COUNTY SURVEYOR
700 HALL OF RECORDS

FORM 247 5M 10-37

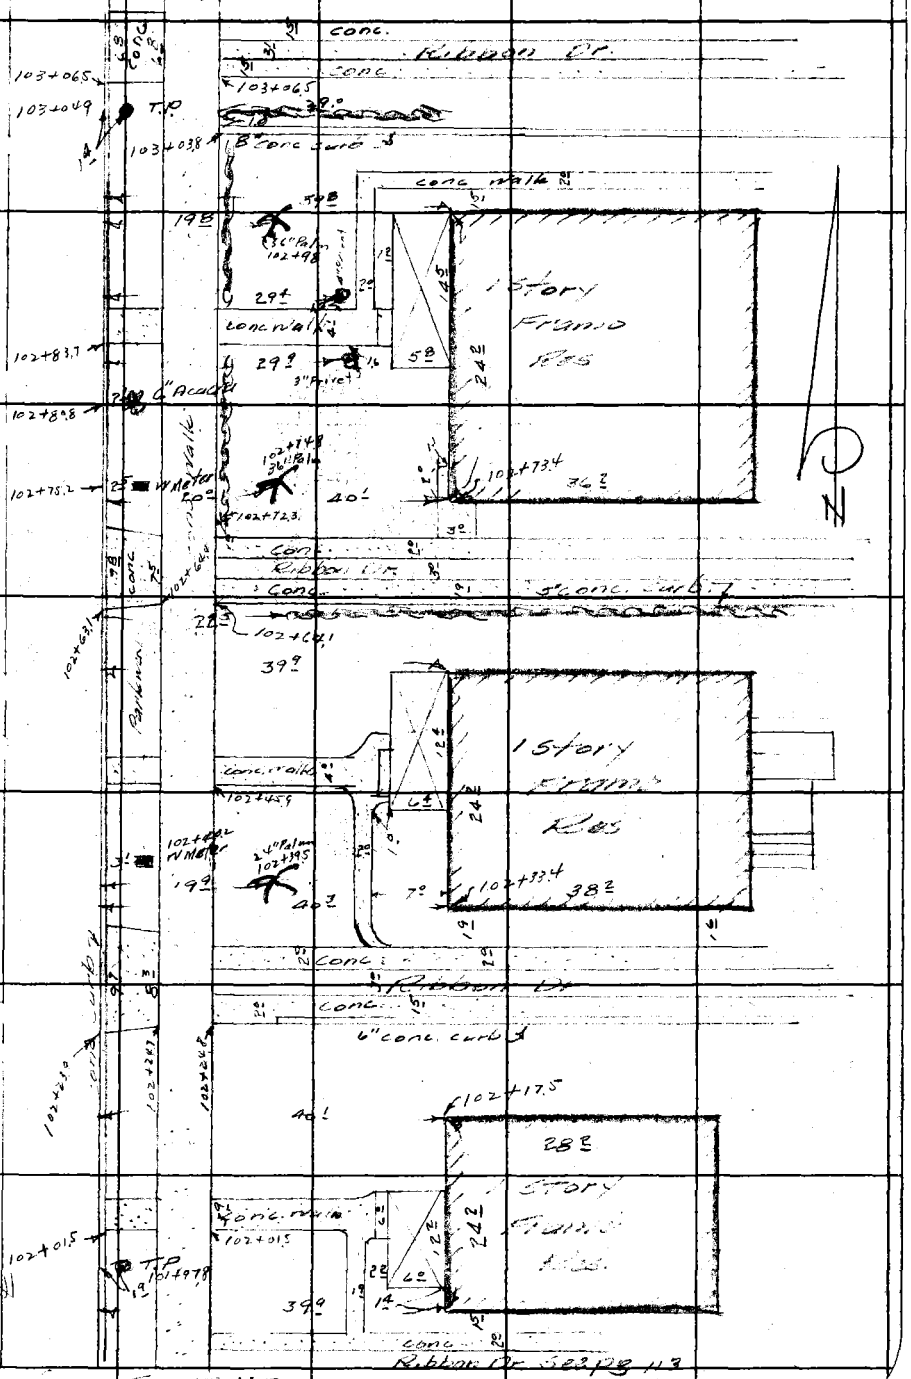

F.B. 777 PG. 186

(See Topog Sheet)

RETURN TO
LOS ANGELES COUNTY SURVEYOR
700 HALL OF RECORDS

Note: Any Additions or Changes on This Sheets Must be Made or Circled in Red Ink With Date and Name of Person Making Change.

Do not extend notes this side of this line

cont. from F.B. 777 PG. 184

Notes Ck'd by [illegible]	Survey of Indiana St.
Map No. B-1465-2	W. O. 8226 Tape No. ___ St'd ___ of
Office Work F. A. W.	Surveyed by Evans
Checked D. M. Finley	Notes Brock Date 39
Date Jan. 1941.	Indexed [illegible]

F.B. 777 Pg. 187

Con't from Top Pg 185

Note: Any Additions or Changes on This Sheets Must be Made or Circled in Red Ink With Date and Name of Person Making Change.

Do not extend notes this side of this line

RETURN TO
LOS ANGELES COUNTY SURVEYOR
700 HALL OF RECORDS

FORM 247 5M 10-37

RETURN TO
LOS ANGELES COUNTY SURVEYOR
700 HALL OF RECORDS

Note: Any Additions or Changes on This Sheets Must be Made or Circled in **Red Ink** With Date and Name of Person Making Change.

Do not extend notes this side of this line

F.B. 772 PG. 188

Notes Ck'd by D. M. Finley	Survey of INDIANA ST.	F.B. 772 PG 189
Map No. B-1465-3	W. O. 8226 Tape No. 043 St'd 84 of	(87-51-20) (351-25-10) 87°-51'-17½"
Office Work F.A. Wood	Surveyed by EVANS	
Checked D. M. Finley	Notes HE Date 12/40	
Date Jan. 1941	Indexed 12-24-40	

W.S. 7D-1

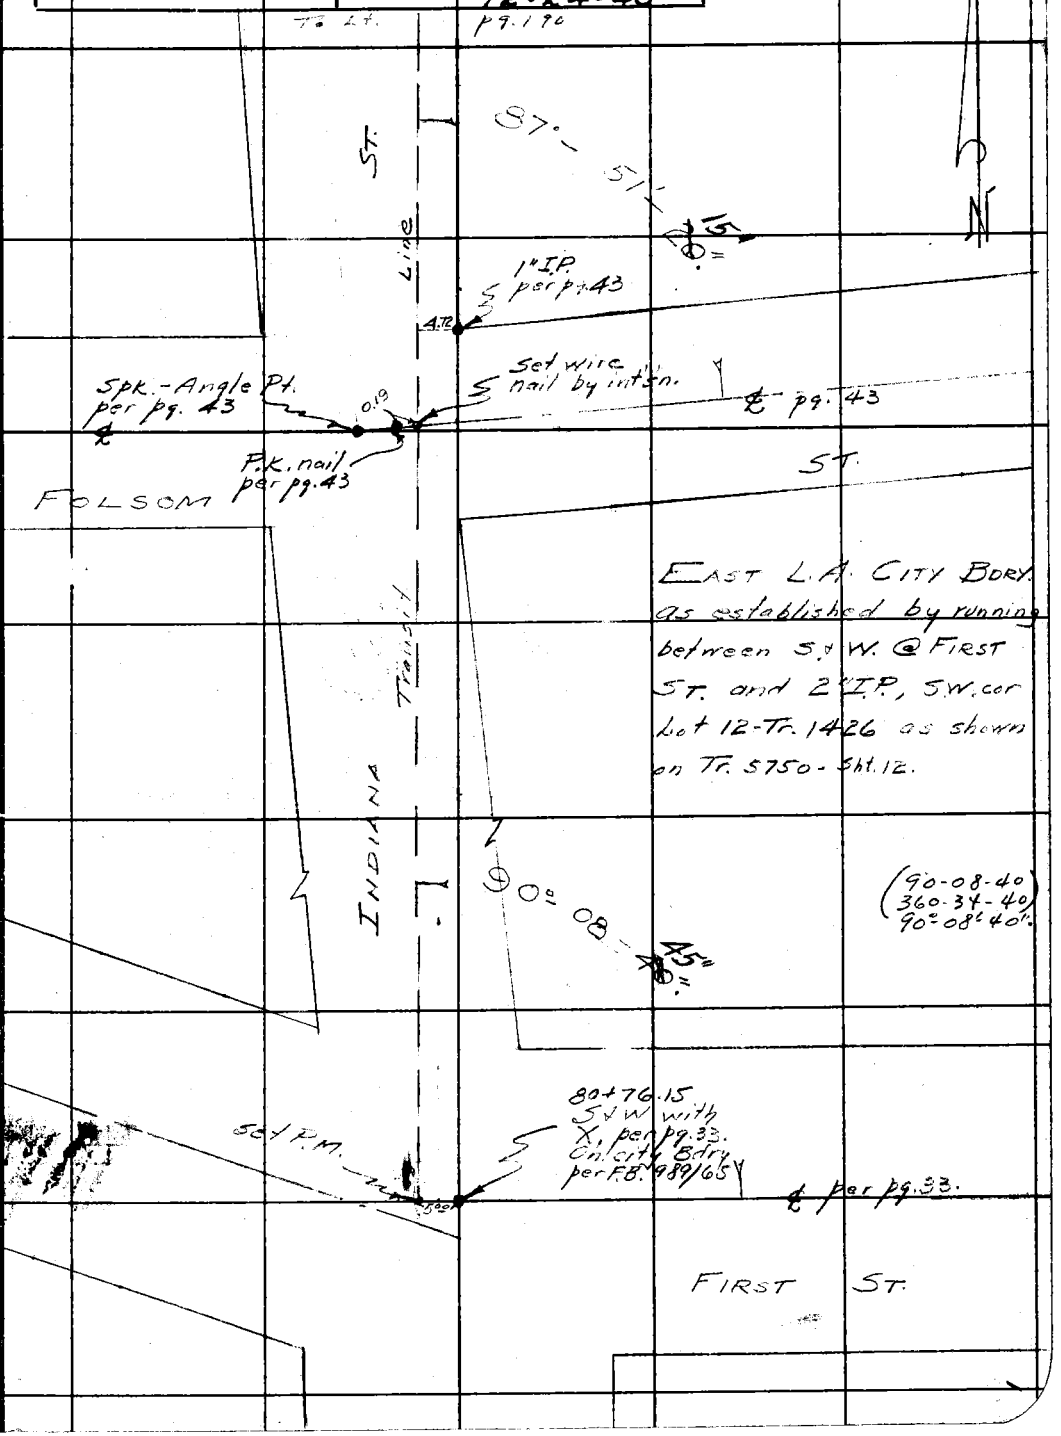

Note: Any Additions or Changes on This Sheets Must be Made or Circled in Red Ink With Date and Name of Person Making Change.

Do not extend notes this side of this line

RETURN TO
LOS ANGELES COUNTY SURVEYOR
700 HALL OF RECORDS

FORM 247 5M 10-37

RETURN TO
LOS ANGELES COUNTY SURVEYOR
700 HALL OF RECORDS

Note: Any Additions or Changes on This Sheets Must be Made or Circled in **Red Ink** With Date and Name of Person Making Change.

Do not extend notes this side of this line

W.S. 7D-1

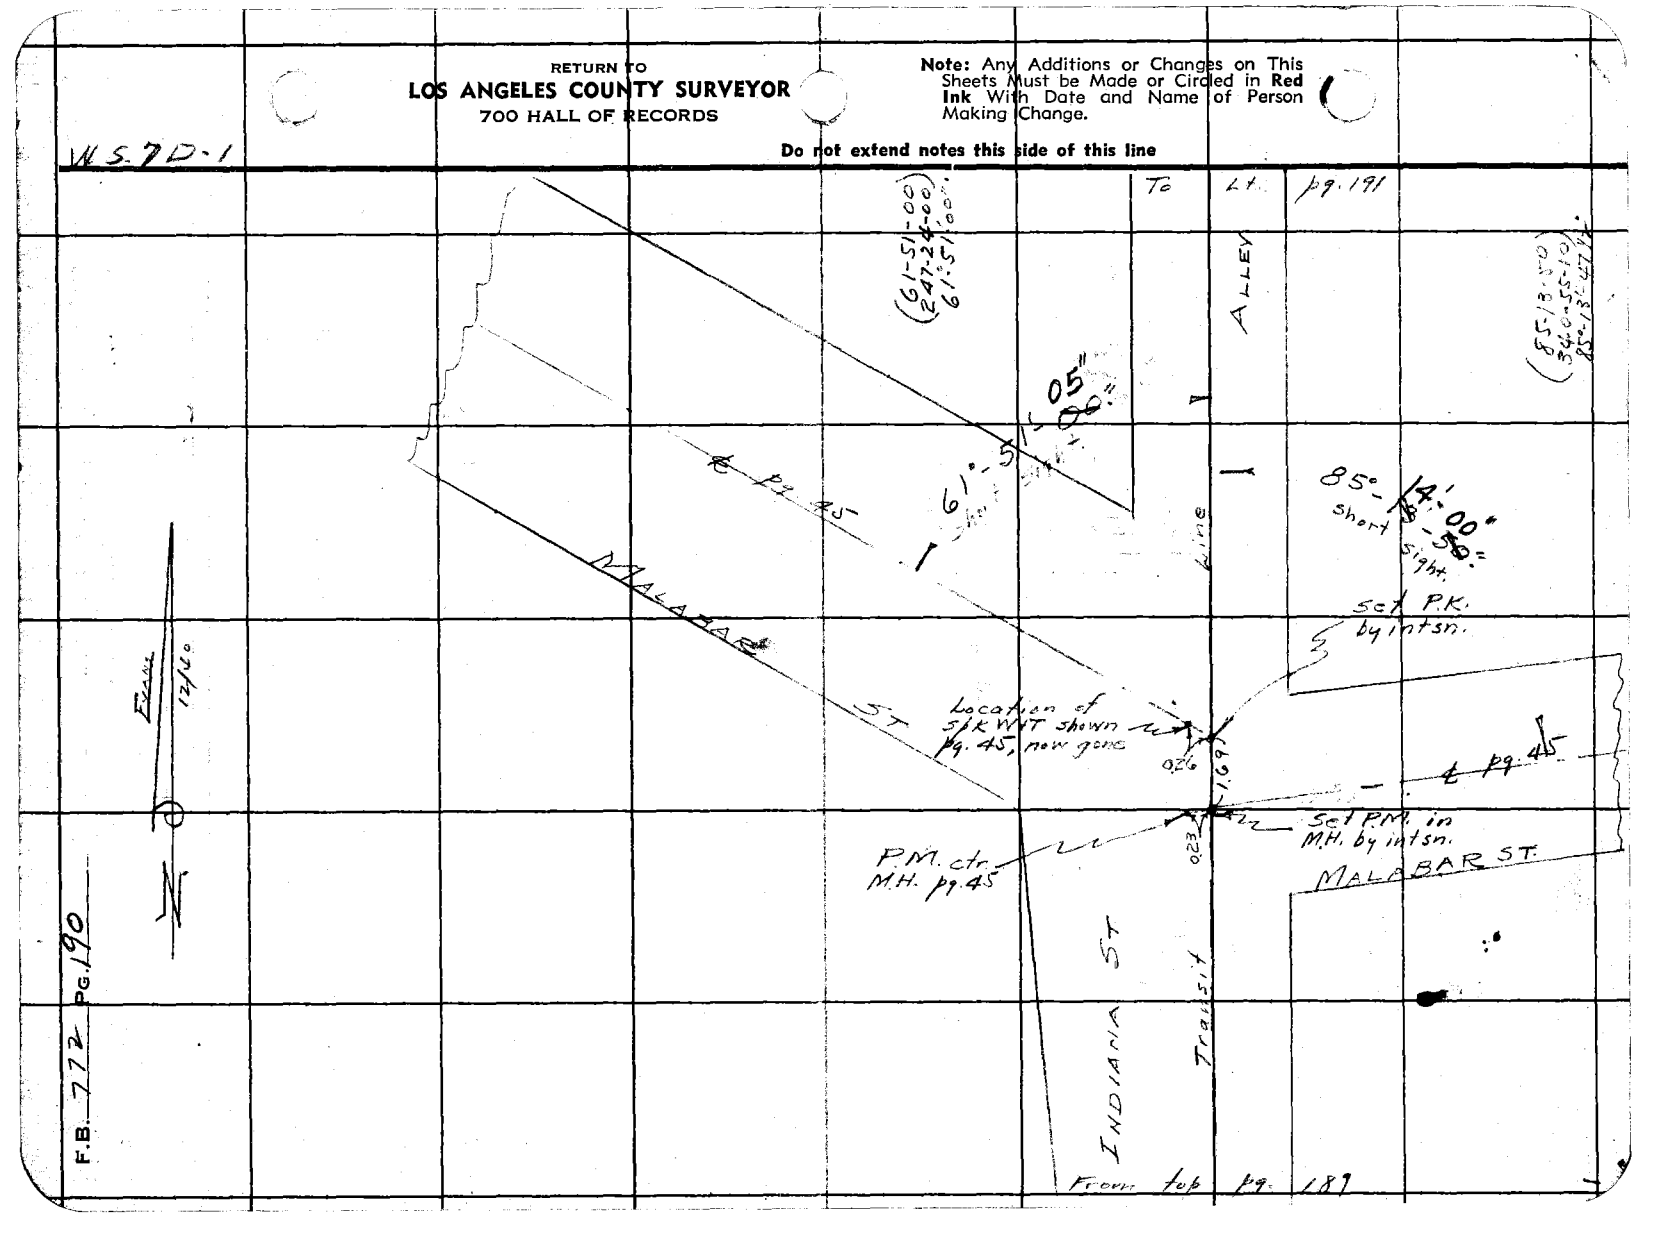

Map No. B-1465-3	W. O. 8226 Tape No. C43 St'd 84°F
Office Work F.A. Wood	Surveyed by EVANS
Checked D. M. Finley	Notes HF Date 12/40
Date Jan. 1941	Indexed

F.B. 772 PG. 191

N 5.7 - D - 1

Note: Any Additions or Changes on This Sheet Must be Made or Circled in Red Ink With Date and Name of Person Making Change

Do not extend notes this side of this line.

RETURN TO
LOS ANGELES COUNTY SURVEYOR
700 HALL OF RECORDS

FORM 247 5M 10-39

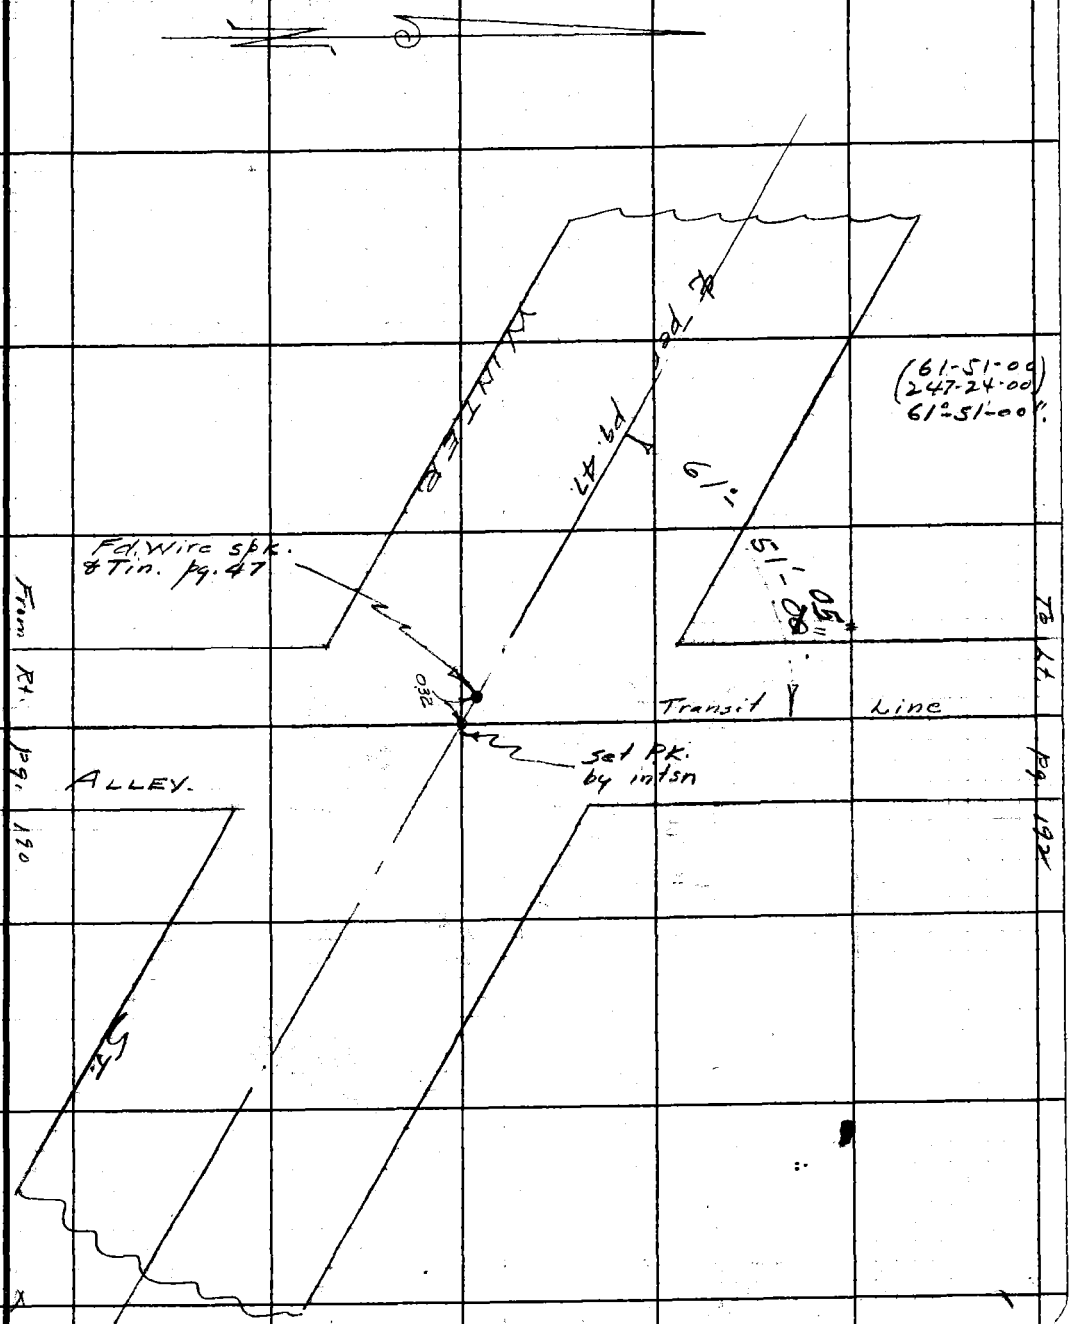

RETURN TO
LOS ANGELES COUNTY SURVEYOR
700 HALL OF RECORDS

Note: Any Additions or Changes on This Sheet Must be Made or Circled in **Red Ink** With Date and Name of Person Making Change.

Do not extend notes this side of this line.

W5.7-D-1

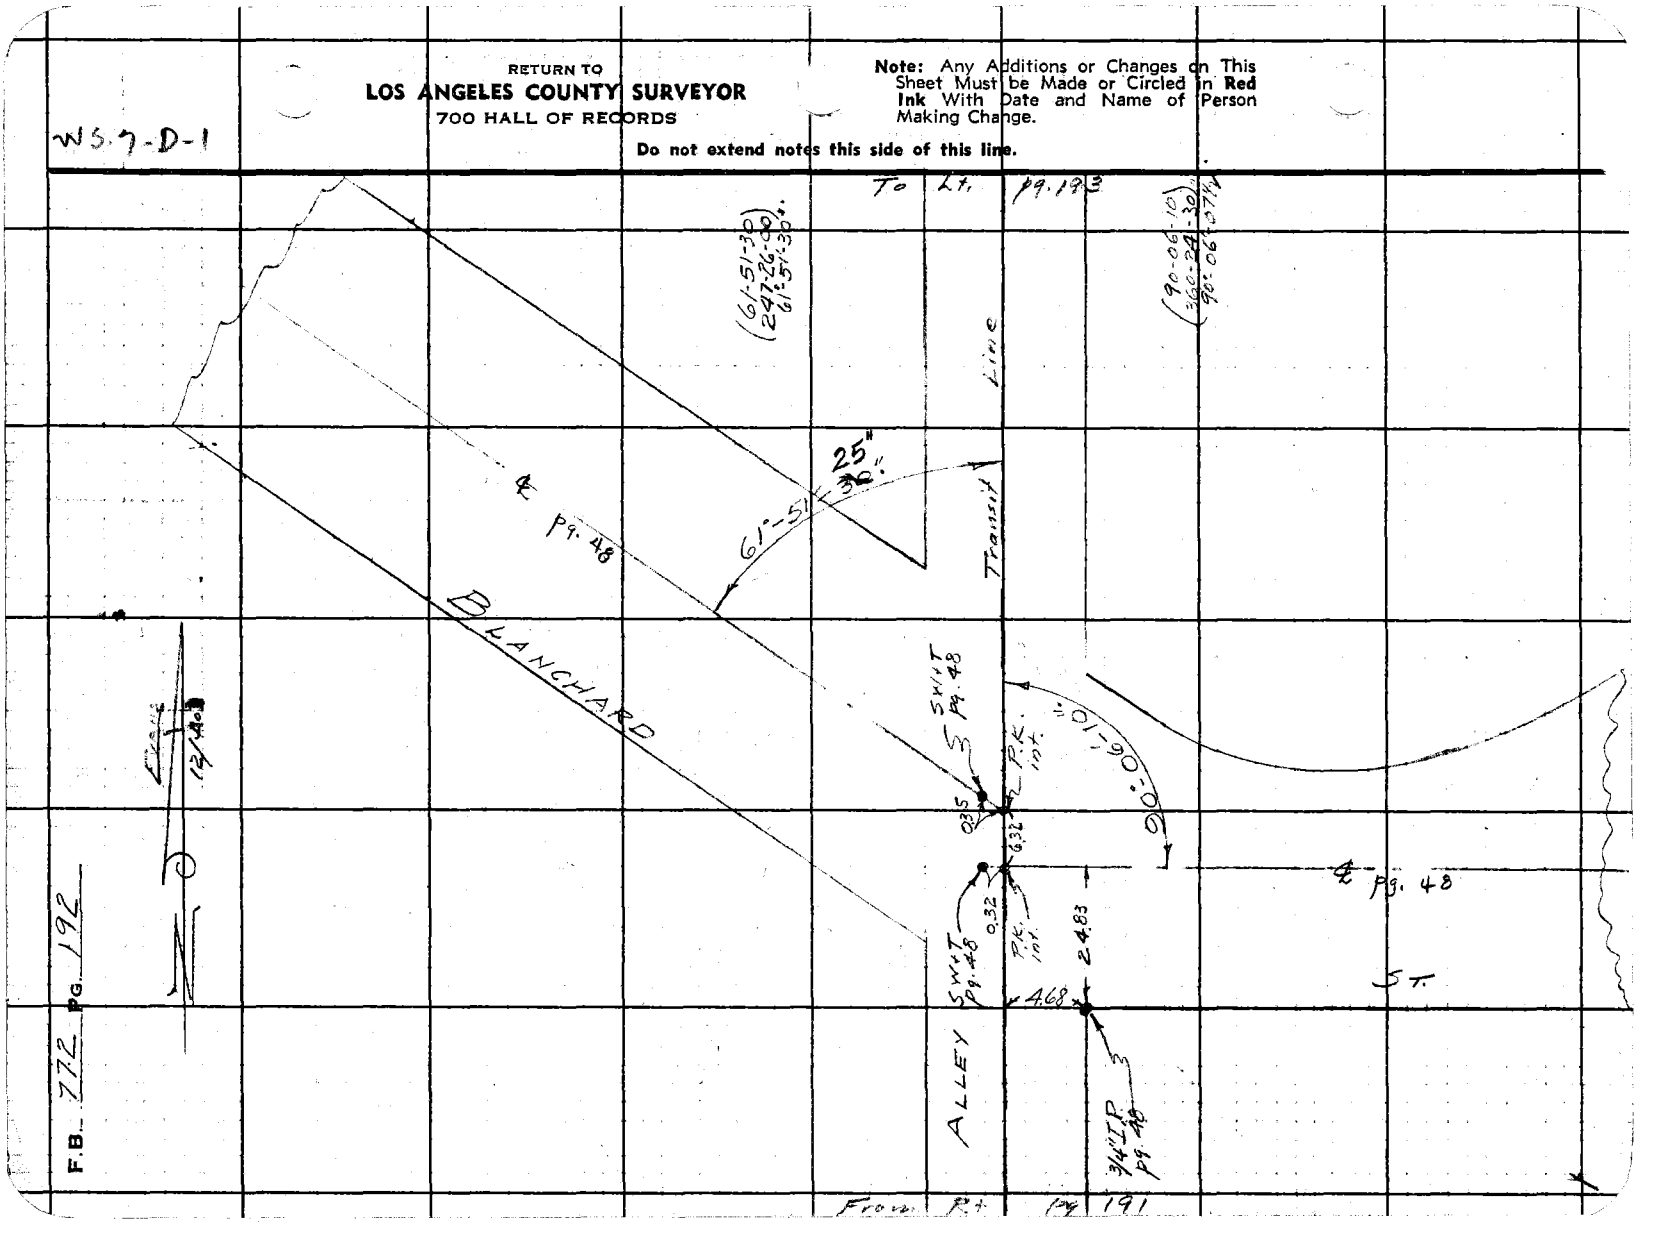

Notes Ck'd by D. M. Finley	Survey of INDIANA ST
Map No. B-1465-3	W. O. B226 Tape No. 043 St'd 84°F
Office Work F.A. Wood	Surveyed by EVANS
Checked D. M. Finley	Notes 1E Date 12/40
Date Jan. 1941.	Indexed A. C. Johnson

F.B. 772 PG. 193

WS 7-D-1

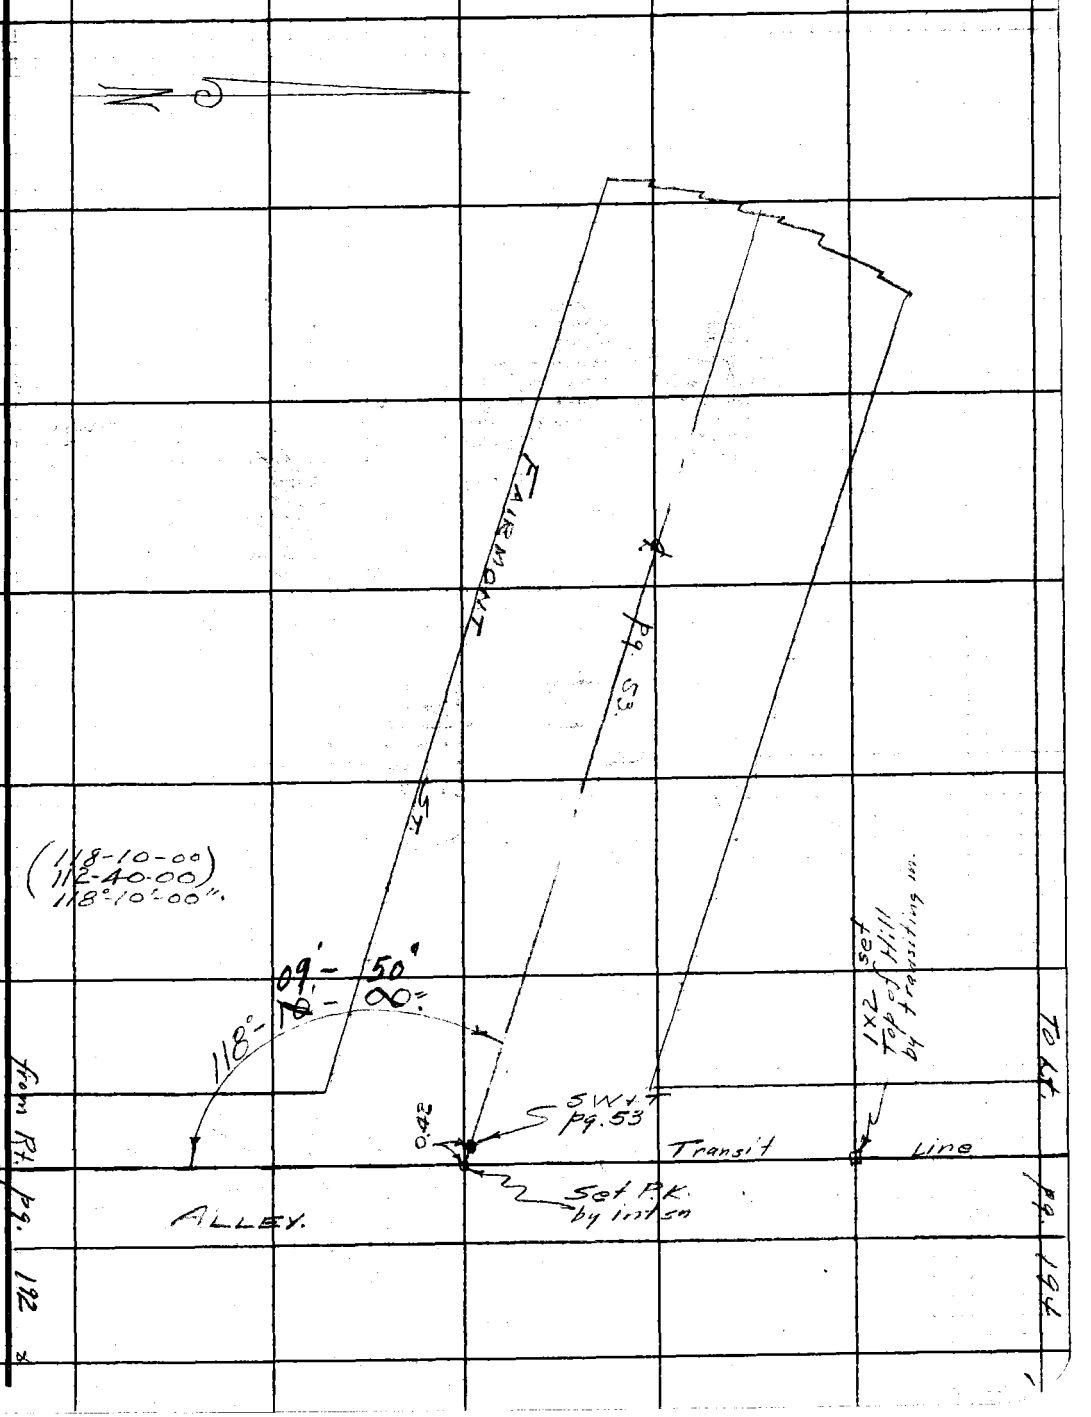

Note: Any Additions or Changes on This Sheet Must be Made or Circled in Red Ink With Date and Name of Person Making Change

Do not extend notes this side of this line.

RETURN TO
LOS ANGELES COUNTY SURVEYOR
700 HALL OF RECORDS

FORM 247 5M 10-39

RETURN TO
LOS ANGELES COUNTY SURVEYOR
700 HALL OF RECORDS

Note: Any Additions or Changes on This Sheet Must be Made or Circled in **Red Ink** With Date and Name of Person Making Change.

Do not extend notes this side of this line.

W5:7-D-1

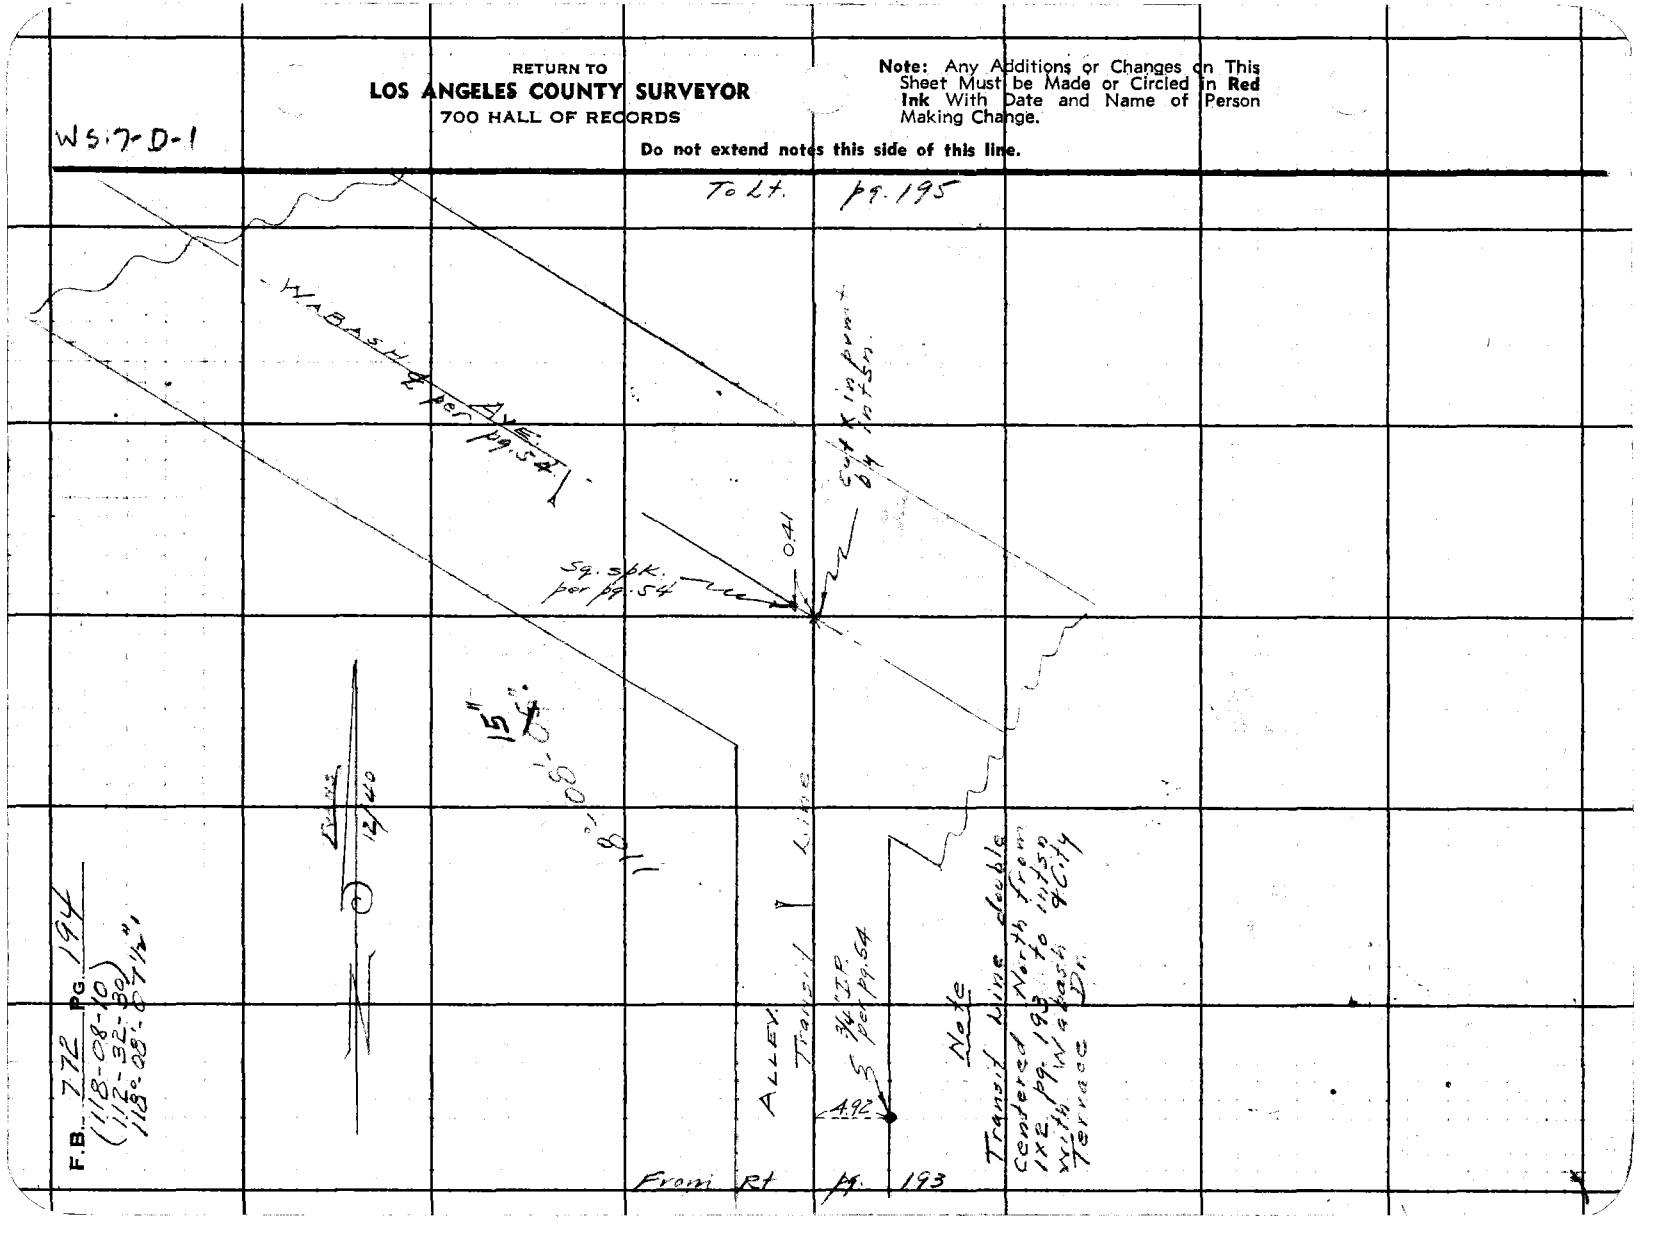

F.B. 772 PG. 194
(118-08-10)
(112-32-50)
118° 28' 57 1/2"

Notes Ck'd by D. M. Finley	Survey of Indiana St
Map No. B-1465-3	W. O. 8226 Tape No. 043 St'd 84°F
Office Work F. A. Wood	Surveyed by Evans
Checked D. M. Finley	Notes HE Date 12/40
Date Jan. 1941	Indexed [illegible]

F.B. 772 Pg. 195

(45-47-50)
(183-11-40)
45° 47' 50"
55"

W.S.7-D-1

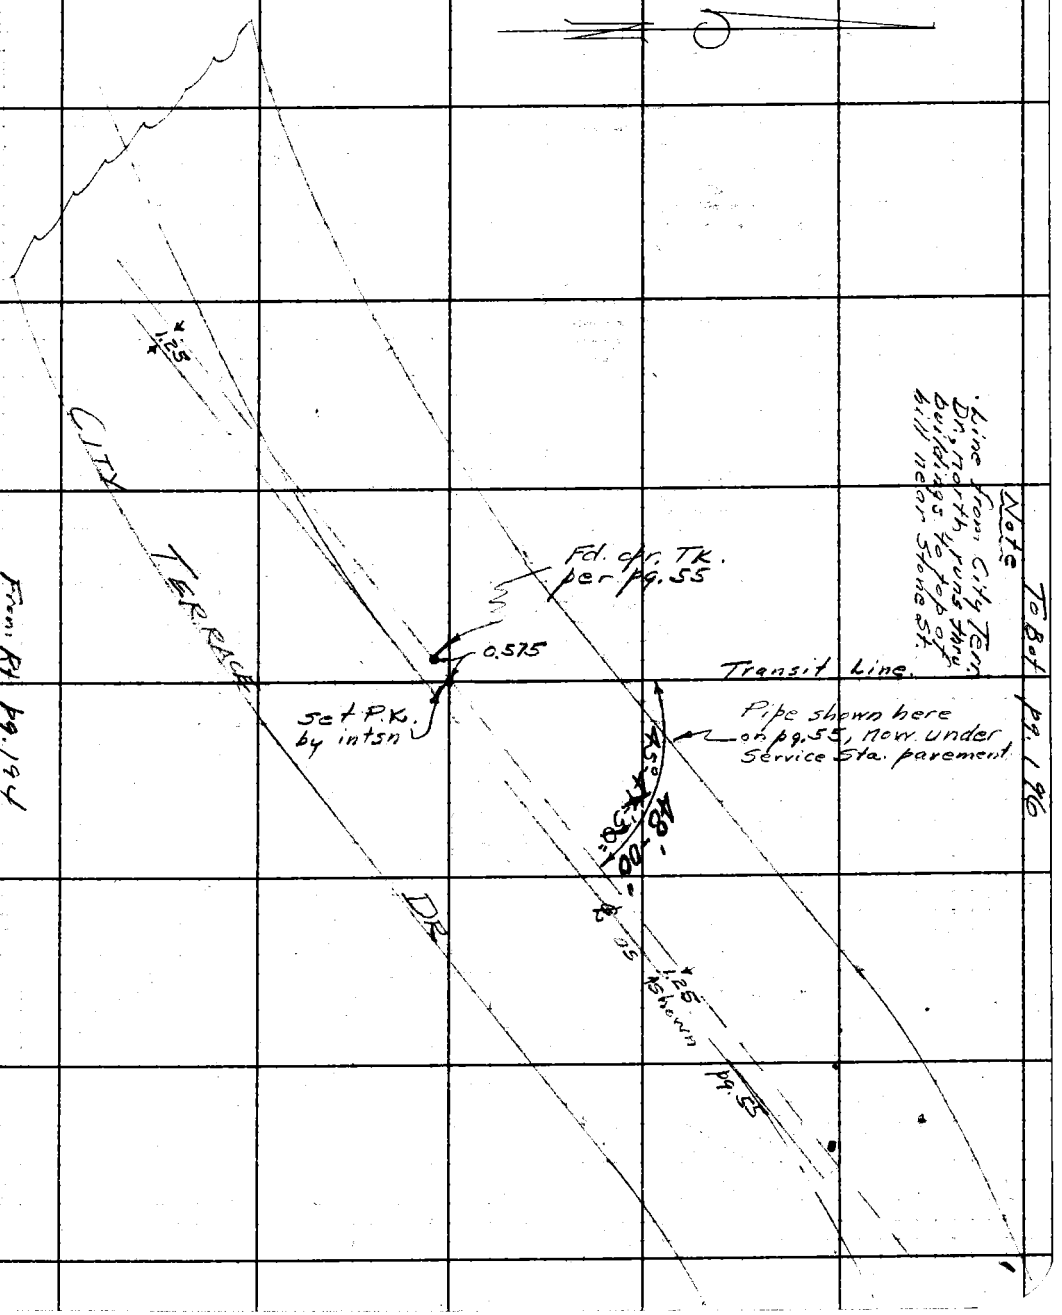

Note: Any Additions or Changes on This Sheet Must be Made or Circled in Red Ink With Date and Name of Person Making Change.

Do not extend notes this side of this line.

RETURN TO
LOS ANGELES COUNTY SURVEYOR
700 HALL OF RECORDS

FORM 247 5M 10-39

F.B. 772 PG. 196

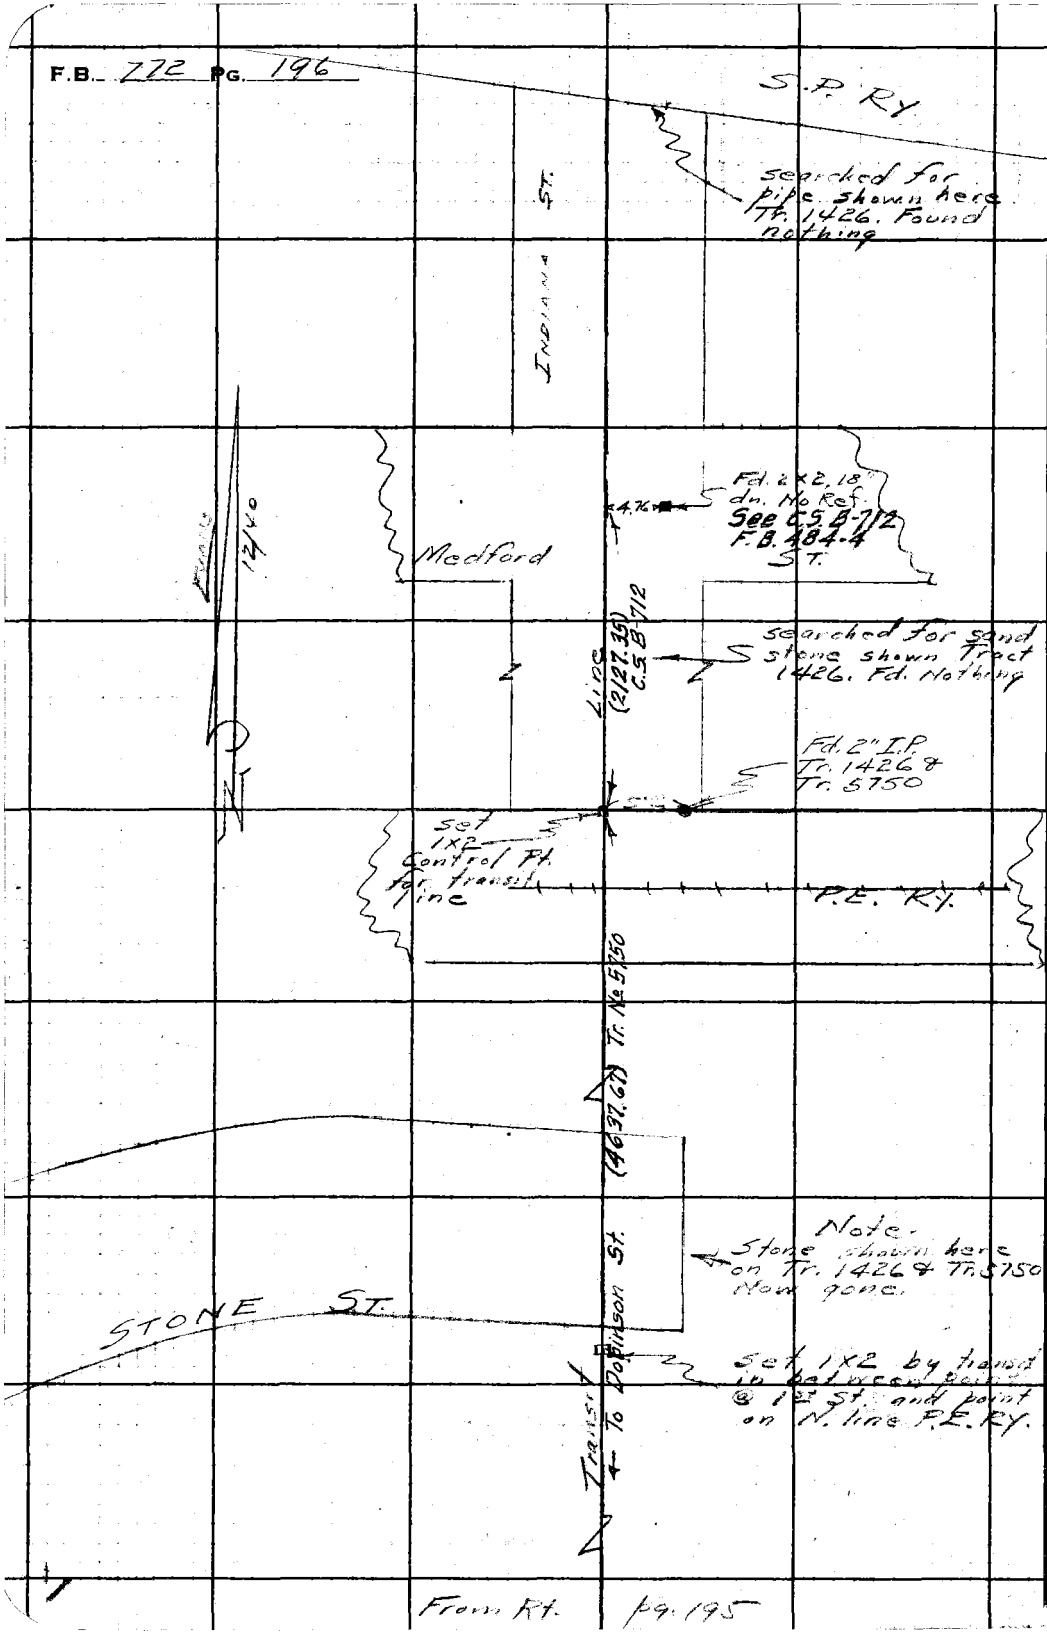

From Rt. pg. 195

WS.7-D-1
WS.8-B-6

RETURN TO
LOS ANGELES COUNTY SURVEYOR
700 HALL OF RECORDS

Do not extend notes this side of this line.

Note: Any Additions or Changes on This Sheet Must be Made or Circled in **Red Ink** With Date and Name of Person Making Change.

FORM 247 5M 10-39

RETURN TO
LOS ANGELES COUNTY SURVEYOR
700 HALL OF RECORDS

Note: Any Additions or Changes on This Sheet Must be Made or Circled in **Red Ink** With Date and Name of Person Making Change.

Do not extend notes this side of this line.

Notes Ck'd by
Map No.
Office Work
Checked
Date

Survey of
W. O. Tape No. Sht'd °F
Surveyed by
Notes Date
Indexed

F. B. Pg.

FORM 247 5M 10-39

RETURN TO
LOS ANGELES COUNTY SURVEYOR
700 HALL OF RECORDS

Note: Any Additions or Changes on This Sheet Must be Made or Circled in **Red Ink** With Date and Name of Person Making Change.

~~Do not extend notes this side of this line.~~

PG.

F. B. 772 Pg. 209

Notes Ck'd by D.M. Finley
Map No. B-2166
Office Work Y.I.
Checked
Date

Survey of CITY TERRACE DIV.
W. O. 8518 Tape No. 665 St'd 68 °F
Surveyed by C.V.C.
Notes Date
Indexed A. C. Johnson 8-10-28

J.N. 8518
CITY TERRACE DR. BOUNDARIES.

BLOCK 2

TRACT 5920
M.B. 65-35
SHEET 3

CENTER LINES.

C.V. CRUMLEY.
A. CARRASCO.
H.E. CULP.
E.K. SMELSER
T.C. LONGSHORE.

Note: Any Additions or Changes on This Sheet Must be Made or Circled in Red Ink With Date and Name of Person Making Change.

Do not extend notes this side of this line.

RETURN TO
LOS ANGELES COUNTY SURVEYOR
700 HALL OF RECORDS

FORM 247 SM 11-46

RETURN TO
LOS ANGELES COUNTY SURVEYOR
700 HALL OF RECORDS

Note: Any Additions or Changes on This Sheet Must be Made or Circled in Red Ink With Date and Name of Person Making Change.

Do not extend notes this side of this line.

W 57E-1

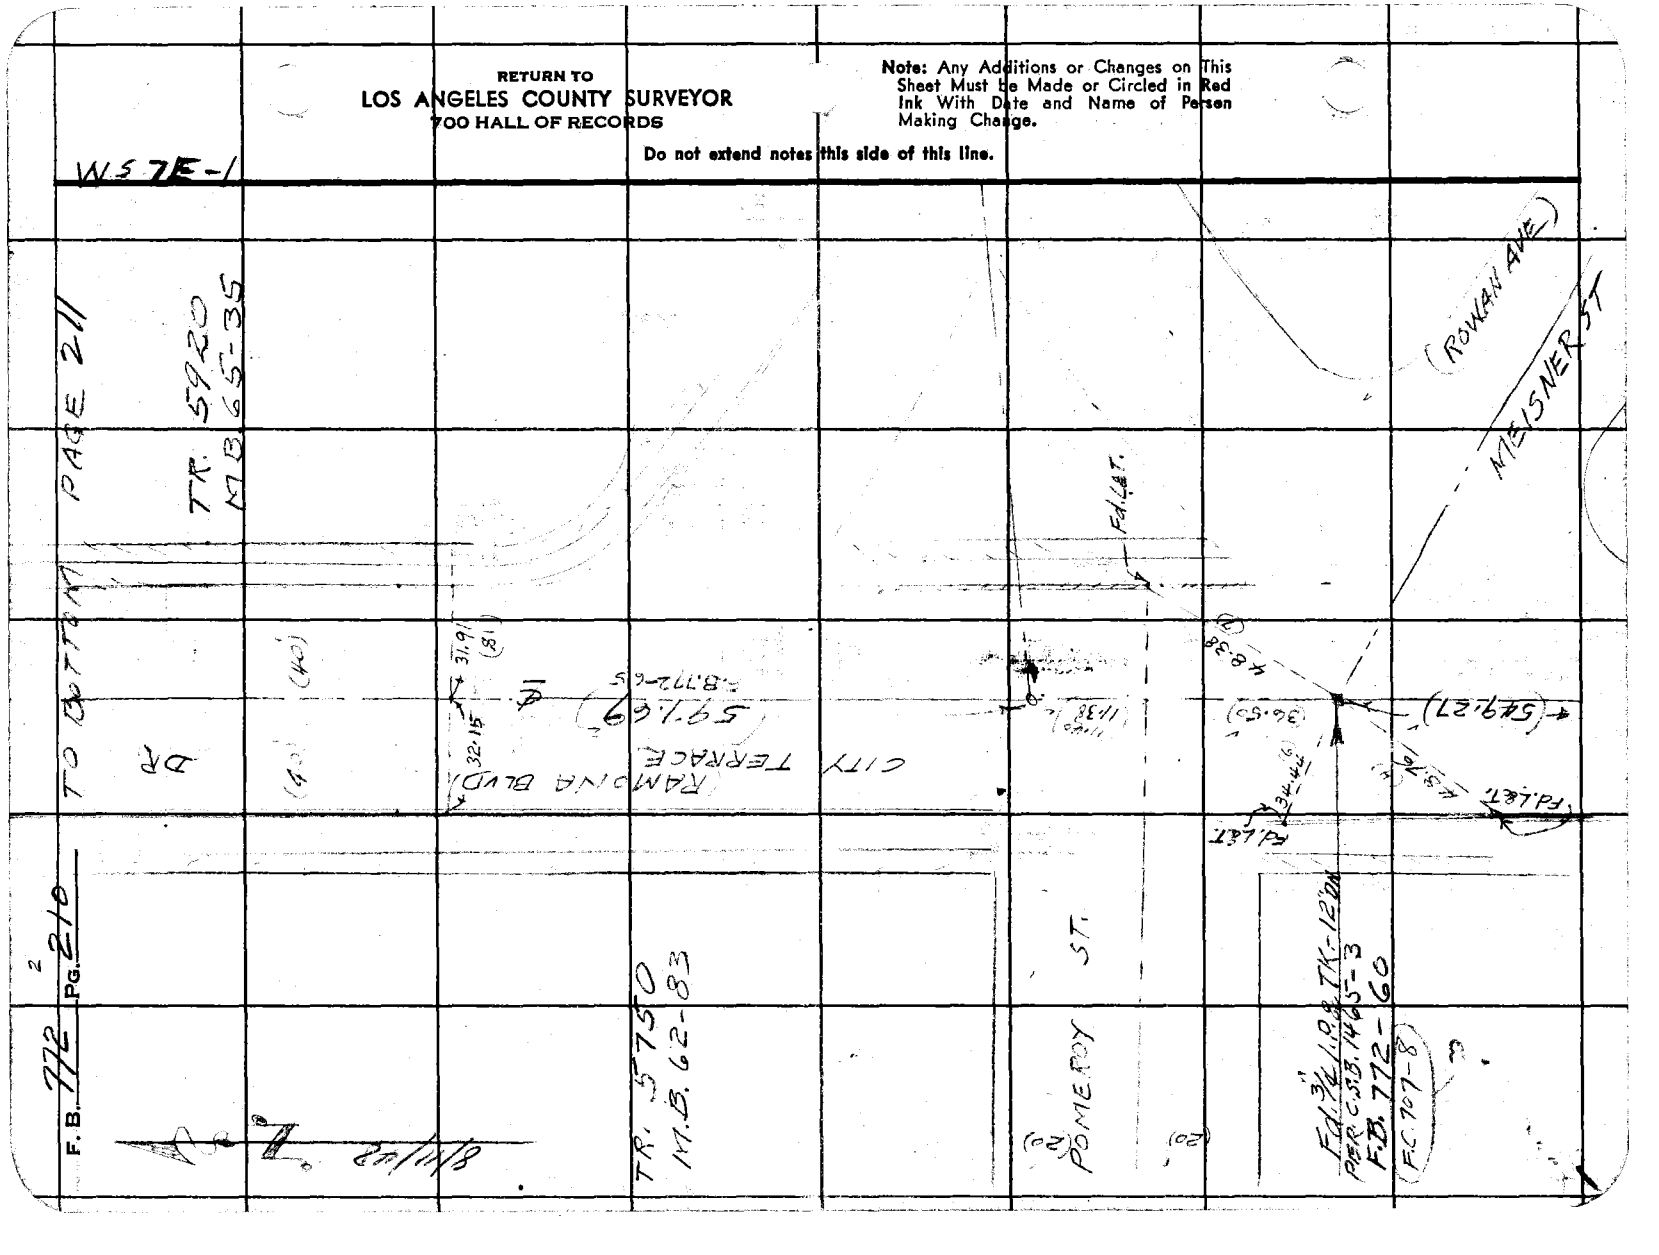

41.73
40.51
1.22

Notes Ck'd by D. M. Finley	Survey of CITY TERRACE DR.
Map No. B-2166	W. O. 8518 Tape No. 65 St'd 68 °F
Office Work Y. I.	Surveyed by C. V. CRUMLEY
Checked	Notes C. V. C. Date 8-11-48
Date	Indexed A. C. Johnson

F. B. 772 PG. 211

TO BOT. PAGE 212

Fd. L&T. - F.B. 772-66

Fd. L&T. IN WALK - P.O.S.T. PER F.B. 772-66

(1.22)

(40) (40) ADOPTED ℄ DR. (PG. 221) TRANS. LINE 498.23

BLOCK 2
TR. 5920
M.B. 65-35

Fd. L&T. IN Cb. 0.01 E. of LINE F.B. 772-66 SHOWS LINE 0.01 W.

(1) 242.94 @ T=72° = 242.95
(2) 242.96 @ T=72° = 242.97
MEAN = 242.96'

CITY TERRACE (RAMONA BLVD)

TR. # 5750
M.B. 62-83

Fd. 2X2 & TK. 3" DN
F.B. 772-65
FX-345-335

Fd. BRAD NAIL IN CURB 243.00 Adj. ~~242.96~~

Fd. 2" I.P. & NAIL - 14" DN
L.B. 473-15

MON. PAGE 221

Fd. 3/4 I.P. & TK. - 3" DN.
F.B. 772-65
SET TANG. BT. SPKS. & T.S. IN PAV.

41.98

0.51

140.99' (15)

Fd. L&T. IN CURB
F.B. 772-65
FX-345-335

(2) 180°-00'-00"
(4) 360-00-00
(6) 180-00-15
90°-00'-00"

0.01 31.37 0.79 40.51 1.03

SET NAIL

(BLAIR ST)
RAMBOZ DR (15)

TO BOTTOM PG. 214

48.21 .57 30.58 30.605 45°

90°

Fd. L&T. IN "X" IN WALK PER F.B. 772-65

(3) 37.28 40.00 0.08

0.025 31.86 0.01 0.01

Fd. 2" I.P. (No Nail) SET Nail - in side edge of SOUTH RIM SEE F.B. 772-65 406-12 & 87

(2) 329-45-30
(4) 299-31-00
(6) 269-16-30
164°-52'-45"

Fd. L&T. Cb. 772-65 F.C. 707-9

SET Nail ON SURFACE

597.69' F.B. 772-65

164°

Fd. 2" I.P. & Nail - 12" DN
TR. 5920-3; C.S.B. 1465-3
C.S.B. 441-1; F.B. 406-12
772-65; FX-345-335

Nail 1.24 2" I.P. .015 .01 W 406

FROM TOP PAGE 210

Note: Any Additions or Changes on This Sheet Must be Made or Circled in Red Ink With Date and Name of Person Making Change.

Do not extend notes this side of this line.

RETURN TO
LOS ANGELES COUNTY SURVEYOR
700 HALL OF RECORDS

FORM 247 5M 11-46

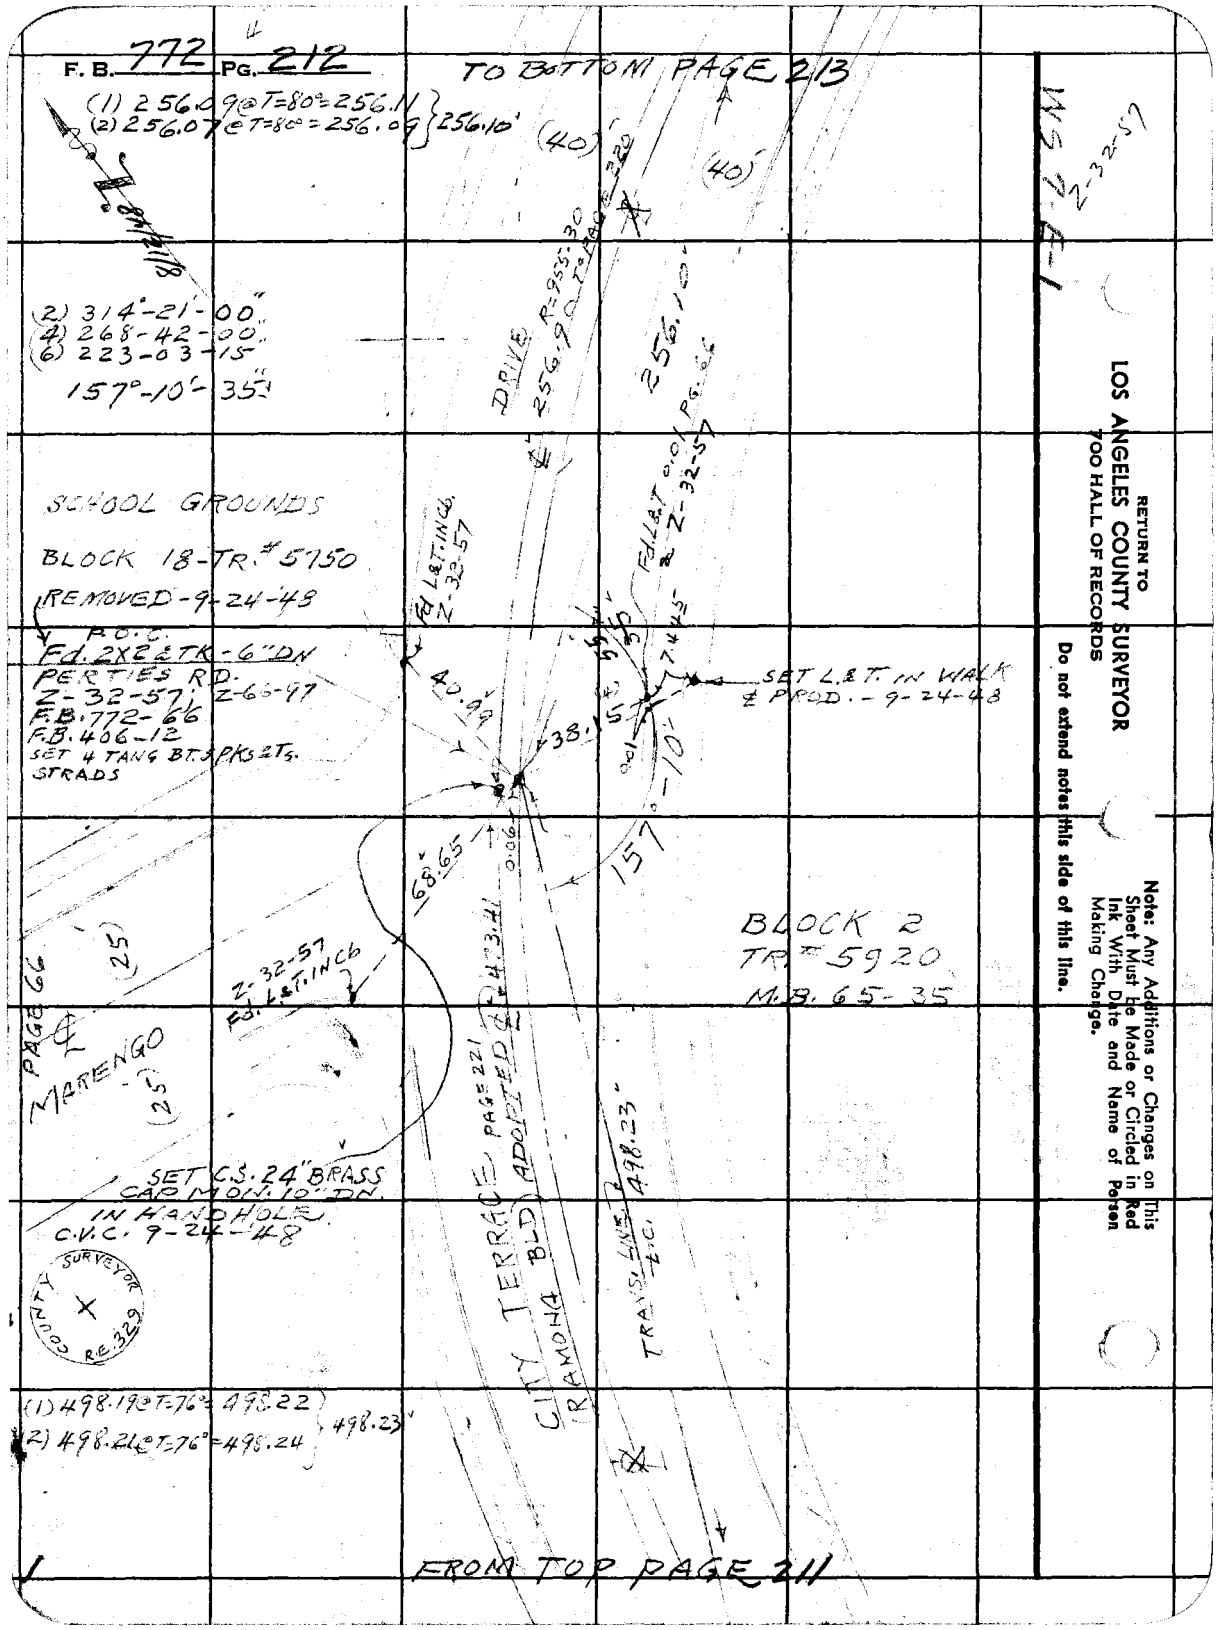
F. B. 772 PG. 212
TO BOTTOM PAGE 213
(1) 256.09 @ T=80° = 256.11
(2) 256.07 @ T=80° = 256.09
256.10'
(40)
(40)
(2) 314°-21'-00"
(4) 268-42-00"
(6) 223-03-15"
157°-10'-35"
DRIVE R=955.30 256.90 TO PAGE 220
256.10'
SCHOOL GROUNDS
BLOCK 18-TR.# 5750
REMOVED-9-24-48
P.O.C.
Fd. 2X2 & TK-6" DN
PERTIES RD.
Z-32-57; Z-66-97
F.B. 772-66
F.B. 406-12
SET 4 TANG BT. 3 PKS & Ts.
STRADS
Fd. L&T. IN Cb. Z-32-57
Fd. L&T 0.01 PG. 66 Z-32-57
40.99
38.15
7.445
SET L.&T. IN WALK & PROD. - 9-24-48
157°-10'
68.65
0.06
BLOCK 2
TR.# 5920
M.B. 65-35
Z-32-57 Fd. L&T. IN Cb
PAGE 66
(25)
MARENGO
(25)
SET C.S. 24" BRASS CAP MON. 10" DN. IN HANDHOLE
C.V.C. 9-24-48
COUNTY SURVEYOR R.E. 329
CITY TERRACE (RAMONA BLD) ADOPTED PAGE 221
TRANS. LINE
498.23'
(1) 498.19 @ T=76° = 498.22
(2) 498.21 @ T=76° = 498.24
498.23'
FROM TOP PAGE 211
WS 7-E-1
Z-32-57
RETURN TO
LOS ANGELES COUNTY SURVEYOR
700 HALL OF RECORDS
Do not extend notes this side of this line.
Note: Any Additions or Changes on This Sheet Must be Made or Circled in Red Ink With Date and Name of Person Making Change.

Notes Ck'd by D. M. Finley	Survey of City Terrace Dr
Map No. B-2166	W. O. 8518 Tape No. 065 St'd 68 °F
Office Work Y. I.	Surveyed by CV Crumley
Checked	Notes CVC Date 8-12-48
Date	Indexed A. C. Johnson

F. B. 772 Pg. 213

5

40.025

WS. 7E-1

BLVD

RAMONA STATE HWY

SEE FX-345-334
F.B. 772-68
F.B. 406-13

DR. (40) 40

BLOCK 3
TR. 5920
M.B. 65-35

SEE PAGE 220

9-23-48
REMOVED-C.V.C.
Fd. 2X2 & TK. 8" DN
PERTIES RD. FX-345-338
F.B. 772-67
C.S.B. 1465-3

PG. 220 ADOPTED

Fd. L.&T. IN Cb FX-345-338

42.78 (9)

0.085

Set Nail Red Head

ROWAN AVE.
(LILLIAN WAY)

TO LEFT SIDE PG. 216

Fd. L.&T. ON ℄ PROD
FX-345-338

31.69 (8)
31.61

40.025

(15)

278.71

P.O.C.
SET C.S. 24" B.C. MON
PAGE 220
C.V.C. 9-23-48

42.15 TAN.

41.94 (2)

24.99

35

SEE PAGE 220 FOR MON.
C.V.C. 9-28-48

T=68°

(1) 100.41 @ 8-10 = 99.392
(2) 100.08 @ 6-42 = 99.397 } 99.40

(1) 100.42 @ 10-46 = 98.64
(2) 100.13 @ 9-53 = 98.64 } 98.64

80.67 Level 80.67
278.71

B.C.
Fd. 2" I.P. PL & Nail Flush

COUNTY SURVEYOR

Fd. L.&T. IN Cb FX-345-338

84°

Fd. L.&T. Cb FX-345-338

CITY TERRACE (RAMONA BLVD.)

256.10

SEE PG. 220 (2) 168°-34'-00"
(4) 337-07-30
(6) 145-40-30
84°-16'-50"
45"

TR. 5750
M.B. 62-83

FROM TOP PAGE 212

Note: Any Additions or Changes on This Sheet Must be Made or Circled in Red Ink With Date and Name of Person Making Change.

Do not extend notes this side of this line.

RETURN TO
LOS ANGELES COUNTY SURVEYOR
700 HALL OF RECORDS

FORM 247 5M 11-46

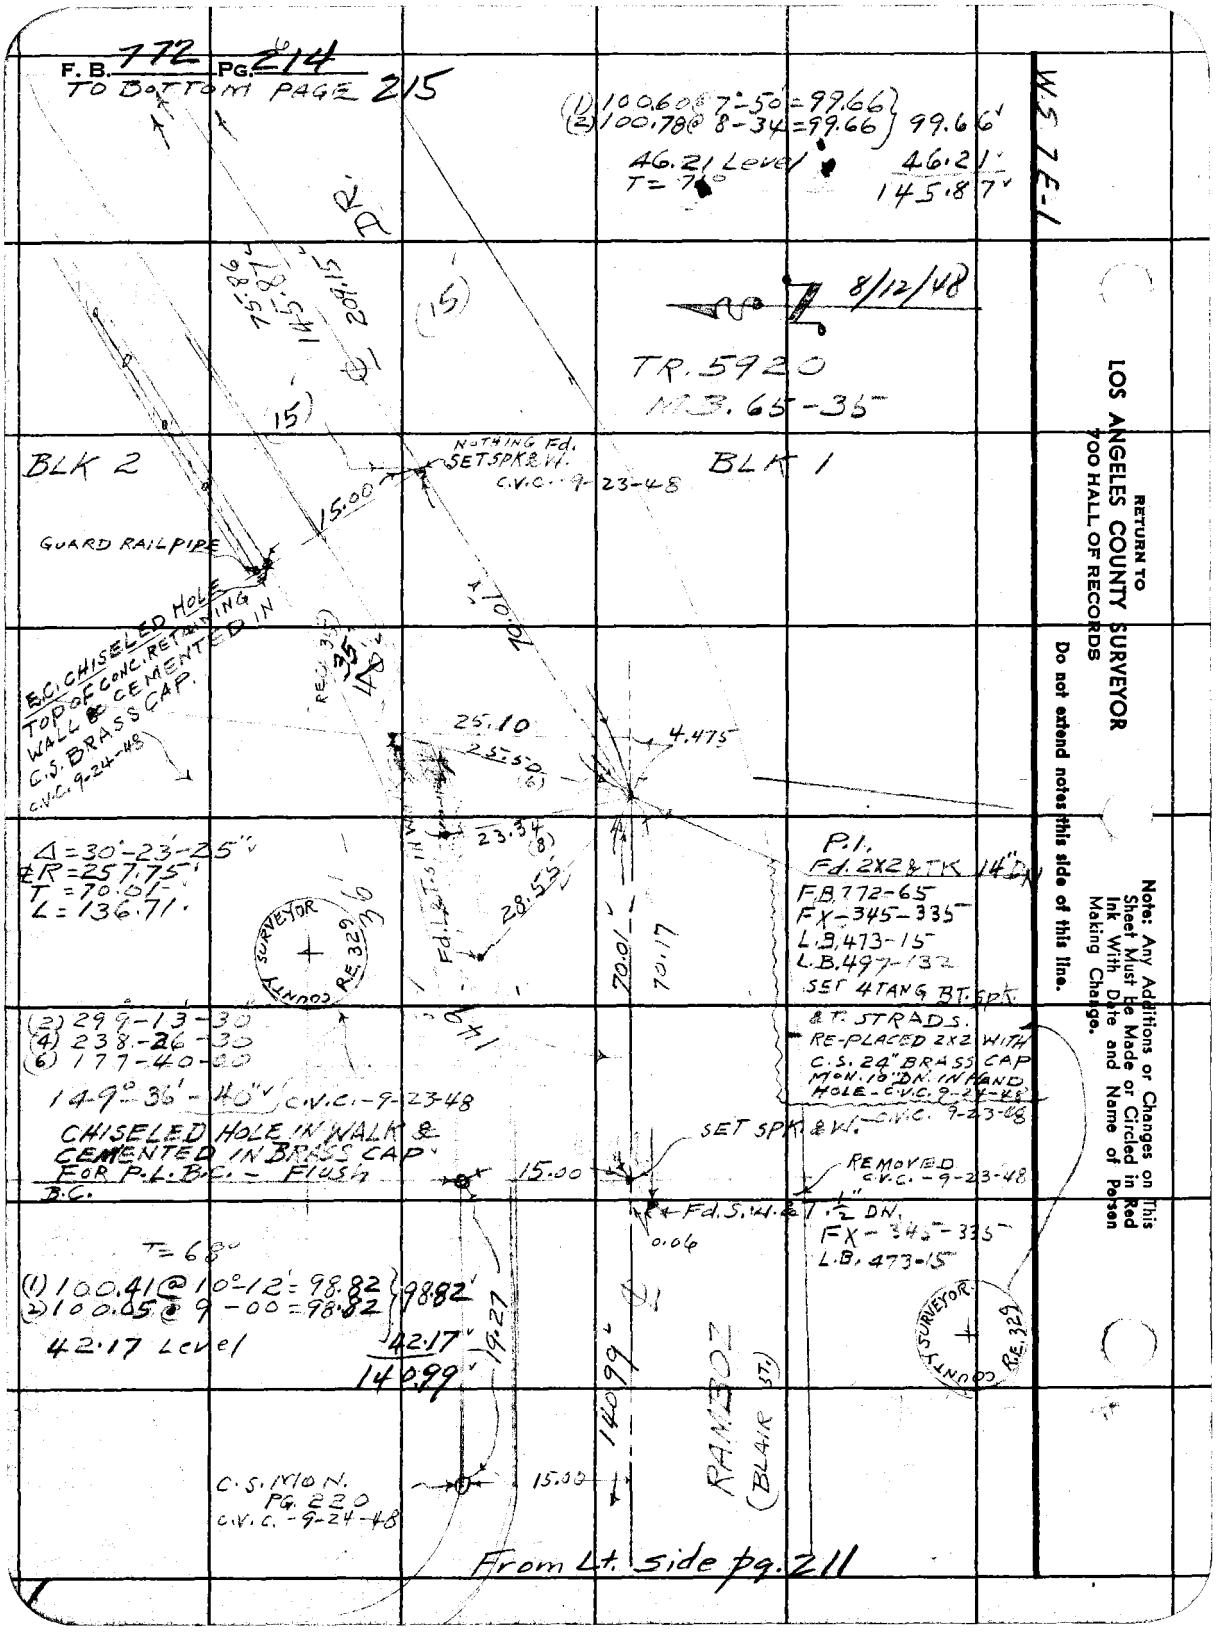
F. B. 772 PG. 214
TO BOTTOM PAGE 215
(1) 100.60 @ 7-50 = 99.66
(2) 100.78 @ 8-34 = 99.66
99.66'
46.21 Level
T = 71°
46.21'
145.87'
W.S. 7E-1
DR.
75.86
145.87
209.15
(15)
8/12/48
TR. 5920
M.B. 65-35
BLK 2
BLK 1
NOTHING Fd.
SET SPK & W.
C.V.C. 9-23-48
15.00
GUARD RAIL PIPE
E.C. CHISELED HOLE
TOP OF CONC. RETAINING
WALL & CEMENTED IN
C.S. BRASS CAP.
C.V.C. 9-24-48
70.01
25.10
25.50
(6)
4.475
23.34
(8)
28.55
Δ = 30°-23'-25"
℄ R = 257.75'
T = 70.01'
L = 136.71'
P.I.
Fd. 2X2 & TK 14" DN
F.B. 772-65
FX-345-335
L.B. 473-15
L.B. 497-132
SET 4 TANG BT. SPK
& T. STRADS.
RE-PLACED 2X2 WITH
C.S. 24" BRASS CAP
MON. 10" DN. IN HAND
HOLE - C.V.C. 9-24-48
C.V.C. 9-23-48
COUNTY SURVEYOR R.E. 329
70.01
70.17
(2) 299-13-30
(4) 238-26-30
(6) 177-40-00
149°-36'-40" C.V.C. - 9-23-48
CHISELED HOLE IN WALK &
CEMENTED IN BRASS CAP
FOR P.L.B.C. - FLUSH
B.C.
15.00
SET SPK & W.
REMOVED
C.V.C. - 9-23-48
Fd. S.W. & 1 1/2" DN.
FX-345-335
L.B. 473-15
0.06
T = 68°
(1) 100.41 @ 10°-12' = 98.82
(2) 100.05 @ 9-00 = 98.82
98.82'
42.17 Level
42.17'
140.99'
19.27
140.99'
RAMBOZ
(BLAIR ST.)
COUNTY SURVEYOR R.E. 329
C.S. MON.
PG. 220
C.V.C. - 9-24-48
15.00
From Lt. side pg. 211
RETURN TO
LOS ANGELES COUNTY SURVEYOR
700 HALL OF RECORDS
Do not extend notes this side of this line.
Note: Any Additions or Changes on This Sheet Must be Made or Circled in Red Ink With Date and Name of Person Making Change.

F. B. 772 Pg. 215

Notes Ck'd by D.M. Finley
Map No. B-2166
Office Work Y.I.
Checked
Date

Survey of CITY TERRACE BDY.
W. O. 8518 Tape No. 465 St'd 68 °F
Surveyed by C.V. CRUMLEY
Notes C.V.C. Date 8-12-48
Indexed C. Johnson

43.17
70.31
75.86

W 537 E-1

To B of pg 16

SET N & T N. EDGE PAV. ON ℄ PROD.

℄ PT. (DID NOT DIG FOR IT)

(2) 68°-34'-00"
(4) 137-07-15
(6) 205-41-30

34°-16'-50" 55'

22½ 15 15 34°-16'-50" 39.18 34.55

ROWAN (FLORES ST.)

40' D.R.

B.C. SET Spk & W.

SURVEYOR KUMMER R.E. 329

C.V.C. 9-27-48

Fd. P.M. ON M. H RIM

0.028

B.C. SET C.S. 30" BRASS CAP MON.-FLUSH

REMOVED-C.V.C.

0.29 0.11

15.00 15.34

Fd. R/D DEPT. CONG. 1904 (BRASS TAG & R.M.) 16'-DP PER EX 345

336 L.B. 473-15, 28
L.B. 491-133
SET 4 TANG. BT. SPK. ET. STRAPS.

Fd. 2X2 & L.S. TAG #1448-

"X" ON TOP SIDE FIRE PLUG

19.5

Δ=34°-16-40"
P.L. R=47.57' - E=62.67'
R.L. T=14.67' - E=19.30'
P.L. L=28.46' - E=37.43'

22.56 19.30

Fd. NEW 2X2 - L.S. TAG #1448
REMOVED-C.V.C. 9-27-48

0.29 3.0 11.7

E.C. SET Spk & W.

0.52 15.00 90°

E.C. SET. C.S. 30" BRASS CAP MON. FLUSH - C.V.C. 9-27-48

SET + WITH P.M. TOP OF R.R. RAIL GUARD POST.

TR. 5920
M.B. 65-35
BLK. 2

BLK 7

43.88 63.28

SET BT. Spk. & T.

RAMBOZ (BLAIR ST.)

ST.

(15) 75.86 145.87 209.15 (15)

BLK 1

FROM TOP PAGE 214

RETURN TO
LOS ANGELES COUNTY SURVEYOR
700 HALL OF RECORDS

Note: Any Additions or Changes on This Sheet Must be Made or Circled in Red Ink With Date and Name of Person Making Change.

Do not extend notes this side of this line.

FORM 247 SM 11-46

F. B. 772 Pg. 216

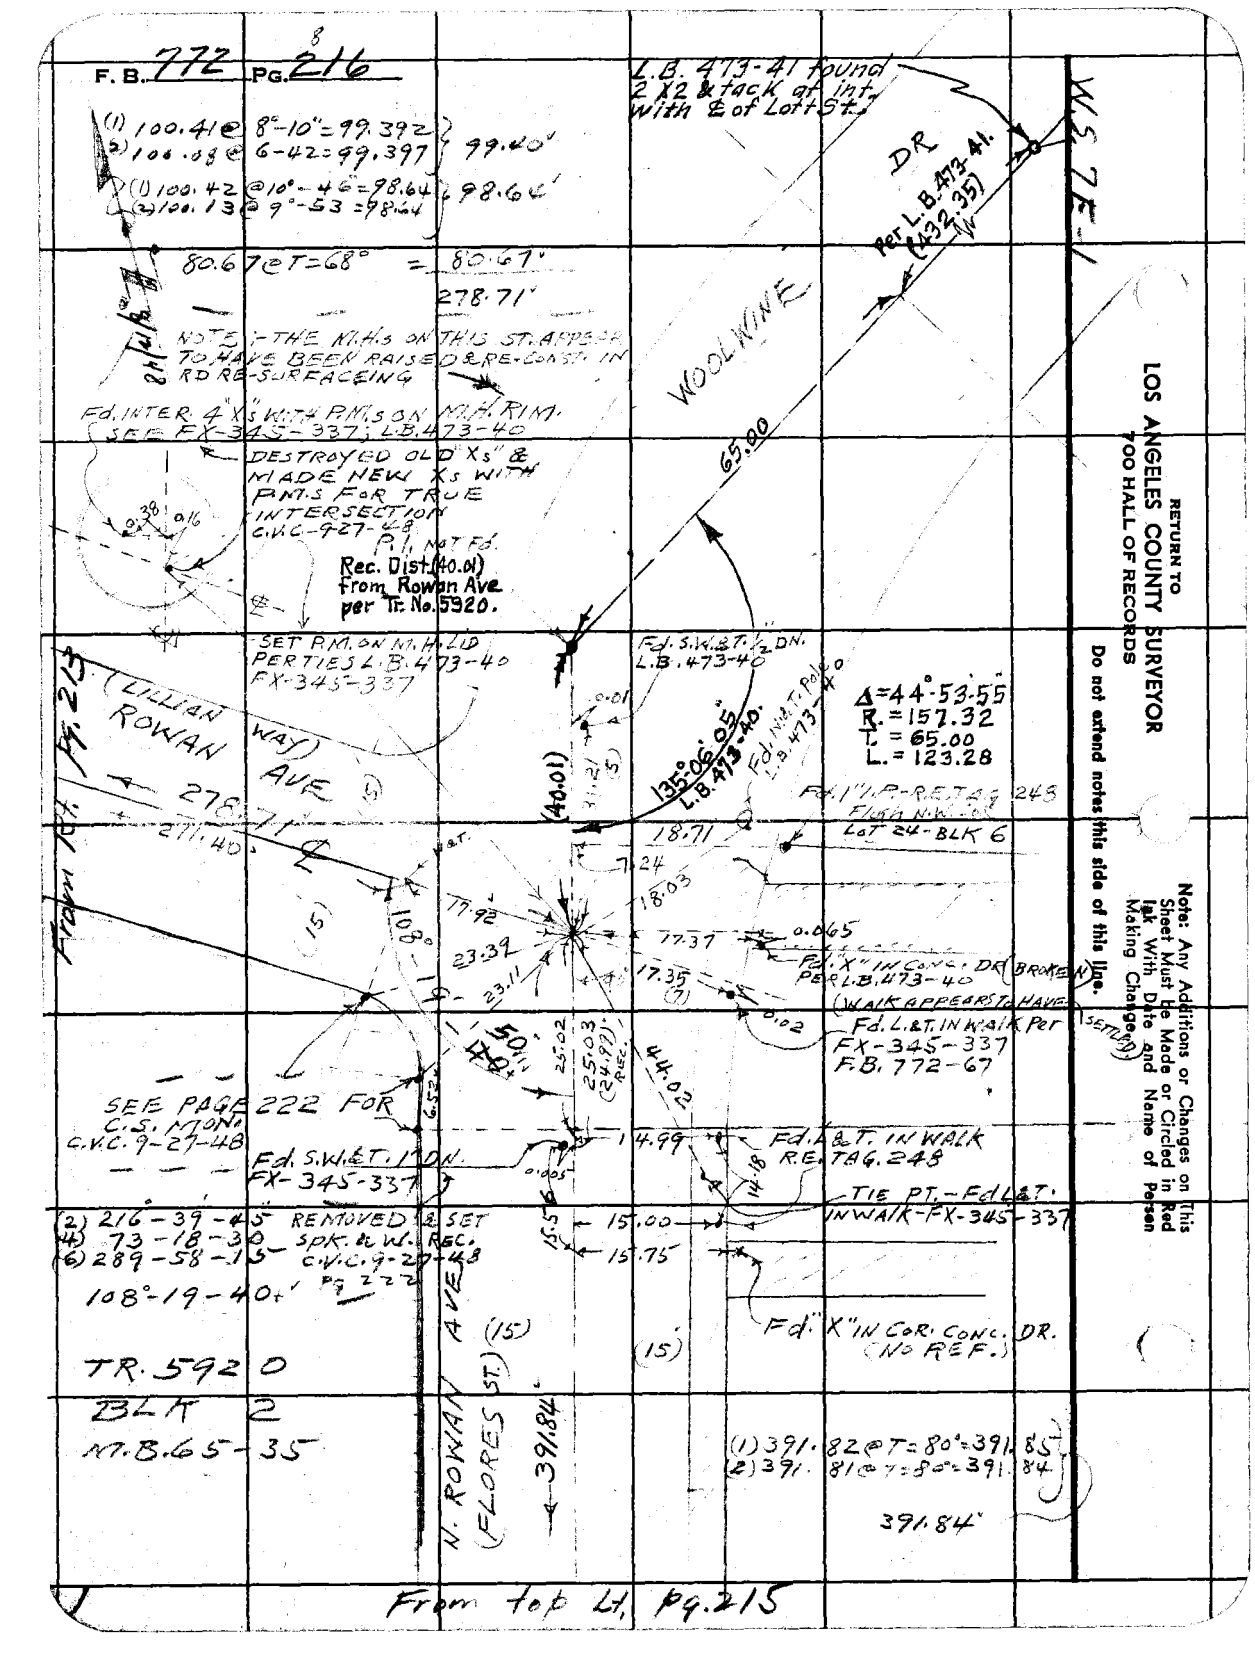

From top Lt. pg. 215

RETURN TO
LOS ANGELES COUNTY SURVEYOR
700 HALL OF RECORDS

Do not extend notes this side of this line.

Note: Any Additions or Changes on This Sheet Must Be Made or Circled in Red Ink With Date and Name of Person Making Change(s)

Notes Ck'd by D.M. Finley	Survey of CITY TERRACE DR. BDY
Map No. B-2166	W. O. 8518 Tape No. 065 St'd 68 °F
Office Work Y.I.	Surveyed by C.V. CRUMLEY
Checked	Notes C.V.C. Date 8-13-16-48
Date	Indexed A. C. Johnson

F. B. 772 PG. 217

TO BOTTOM PAGE 218

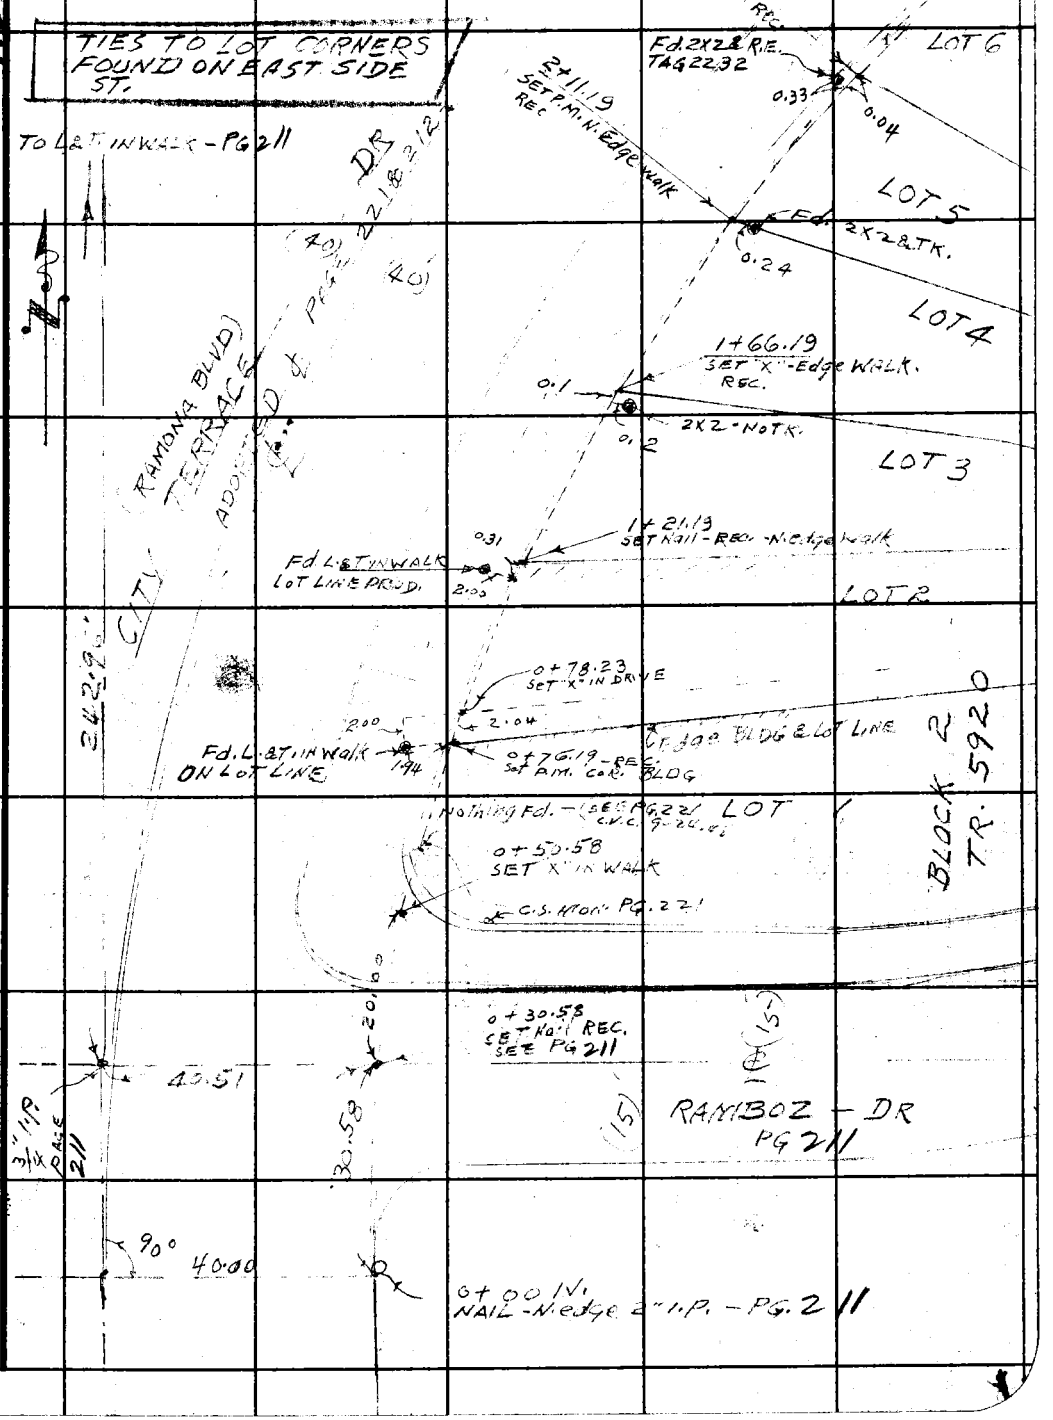

Note: Any Additions or Changes on This Sheet Must be Made or Circled in Red Ink With Date and Name of Person Making Change.

Do not extend notes this side of this line.

RETURN TO
LOS ANGELES COUNTY SURVEYOR
700 HALL OF RECORDS

FORM 247 5M 11-46

F. B. 772 PG. 218

TO BOTTOM PG 219

5+94.98
SET "X" S. EDGE CONC. APRON
REC.
CONC. CK.
Fd NOTHING.

LOT 14

1.62
5+53.40
SET

LOT 13

43.00

LOT 12

5+10.45
SET NAIL REC.

Fd. L & T. IN WALK
OWNER SAYS
2' OFF ON
LOT LINE
1.67
0.06

(BLVD)
DR

LOT 11

4+70.97
SET NAIL REC.
NOTHING. Fd.

(AVE)

LOT 10

4+27.57
SET NAIL REC.
Fd NOTHING

LOT 9

BLOCK 2
TR. 5720

3+86.24
SET NAIL REC.

Fd. OLD 2X2
NO. TK.
0.3

(RAMONA)
TERRACE

LOT 8

3+40.90
SET "X" REC.-IN CONC. WALK
N.W. COR. BLDG.
NOTHING Fd.

CLIX

LOT 7

3+01.19
SET NAIL REC.

Fd. 2X2 & P.E.
TAG 2232
0.20
0.245'

LOT 6

FROM TOP OF PAGE 217

X

RETURN TO
LOS ANGELES COUNTY SURVEYOR
700 HALL OF RECORDS

Do not extend notes this side of this line.

Note: Any Additions or Changes on This Sheet Must Be Made or Circled in Red Ink With Date and Name of Person Making Change.

Notes Ck'd by D. M. Finley	Survey of CITY TERRACE DR. BOUNDARIES	F. B. 772 Pg. 219
Map No. B-2166	W. O. 8518 Tape No. 065 St'd 68° °F	Δ = 45°-45'-22" / 22°-52'-41"
Office Work Y. I.	Surveyed by C. V. CRUMLEY	R. = 915.37 Ch. = 711.74
Checked	Notes C.V.C. Date 8-17-48	Defl. Per 1' of Arc. = 1.877790'
Date	Indexed A. C. Johnson	

W S 7 E 1

DEFLECTION Δs FOR STATIONS SHOWN TO LOCATE LOT CORNERS.

B.C. 0+00.00	0°-00'-00.00"		
0+30.58	0°-57'-25.35"	5+10.45	15°-58'-30.15"
0+50.58	1°-34'-58.68"	5+53.40	17°-19'-09.19"
0+76.19	2°-23'-04.08"	5+94.98	18°-37'-13.88"
0+73.23	2°-26'-53.92"	6+33.93	19°-50'-22.23"
1+21.19	3°-47'-34.09"	6+73.54	21°-04'-44.96"
1+66.19	5°-12'-04.09"	B.C. 7+05.71	22°-05'-09.45"
2+11.19	6°-36'-34.09"	ROWAN AVE 7+31.01 REC. MAP	22°-52'-39.92" (41.00 REC.)
2+56.19	8°-01'-04.09"		
3+01.19	9°-25'-34.09"		
3+40.90	10°-46'-08.09"		
3+86.24	12°-05'-26.11"		
4+27.57	13°-22'-52.32"		
4+70.97	14°-44'-22.06"		

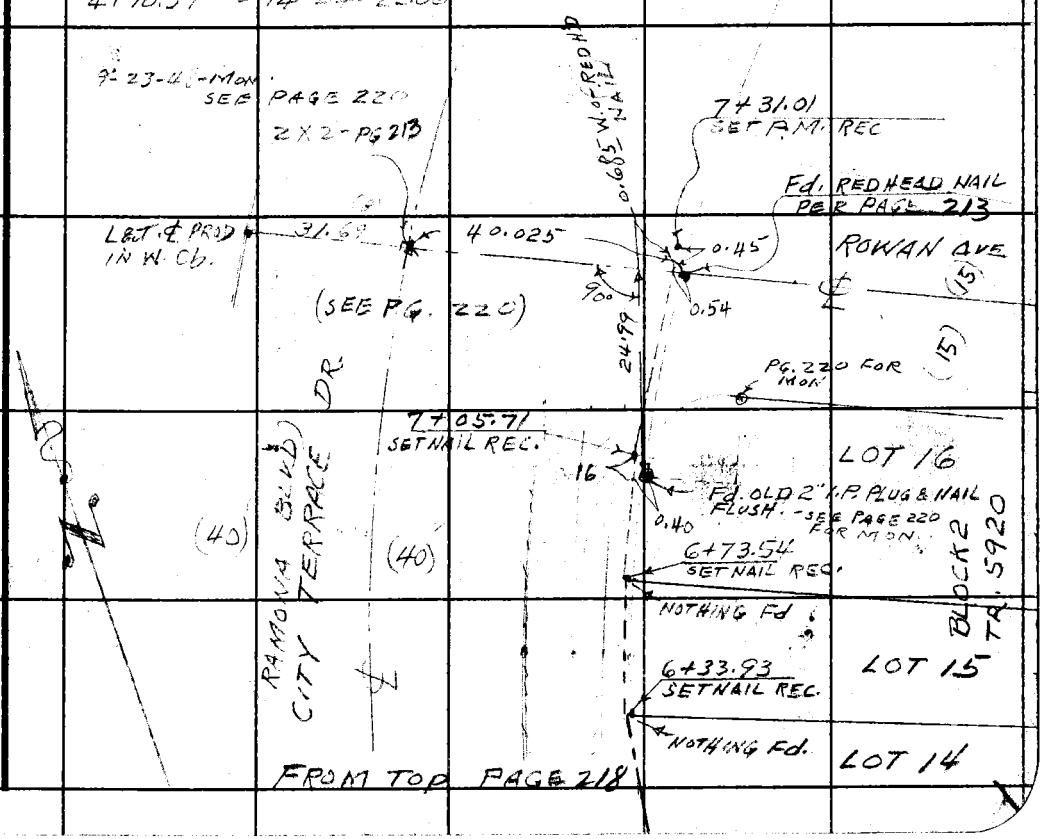

Note: Any Additions or Changes on This Sheet Must Be Made or Circled in Red Ink With Date and Name of Person Making Change.

Do not extend notes this side of this line.

RETURN TO LOS ANGELES COUNTY SURVEYOR 700 HALL OF RECORDS

FORM 247 5M 11-46

F. B. 772 PG. 220

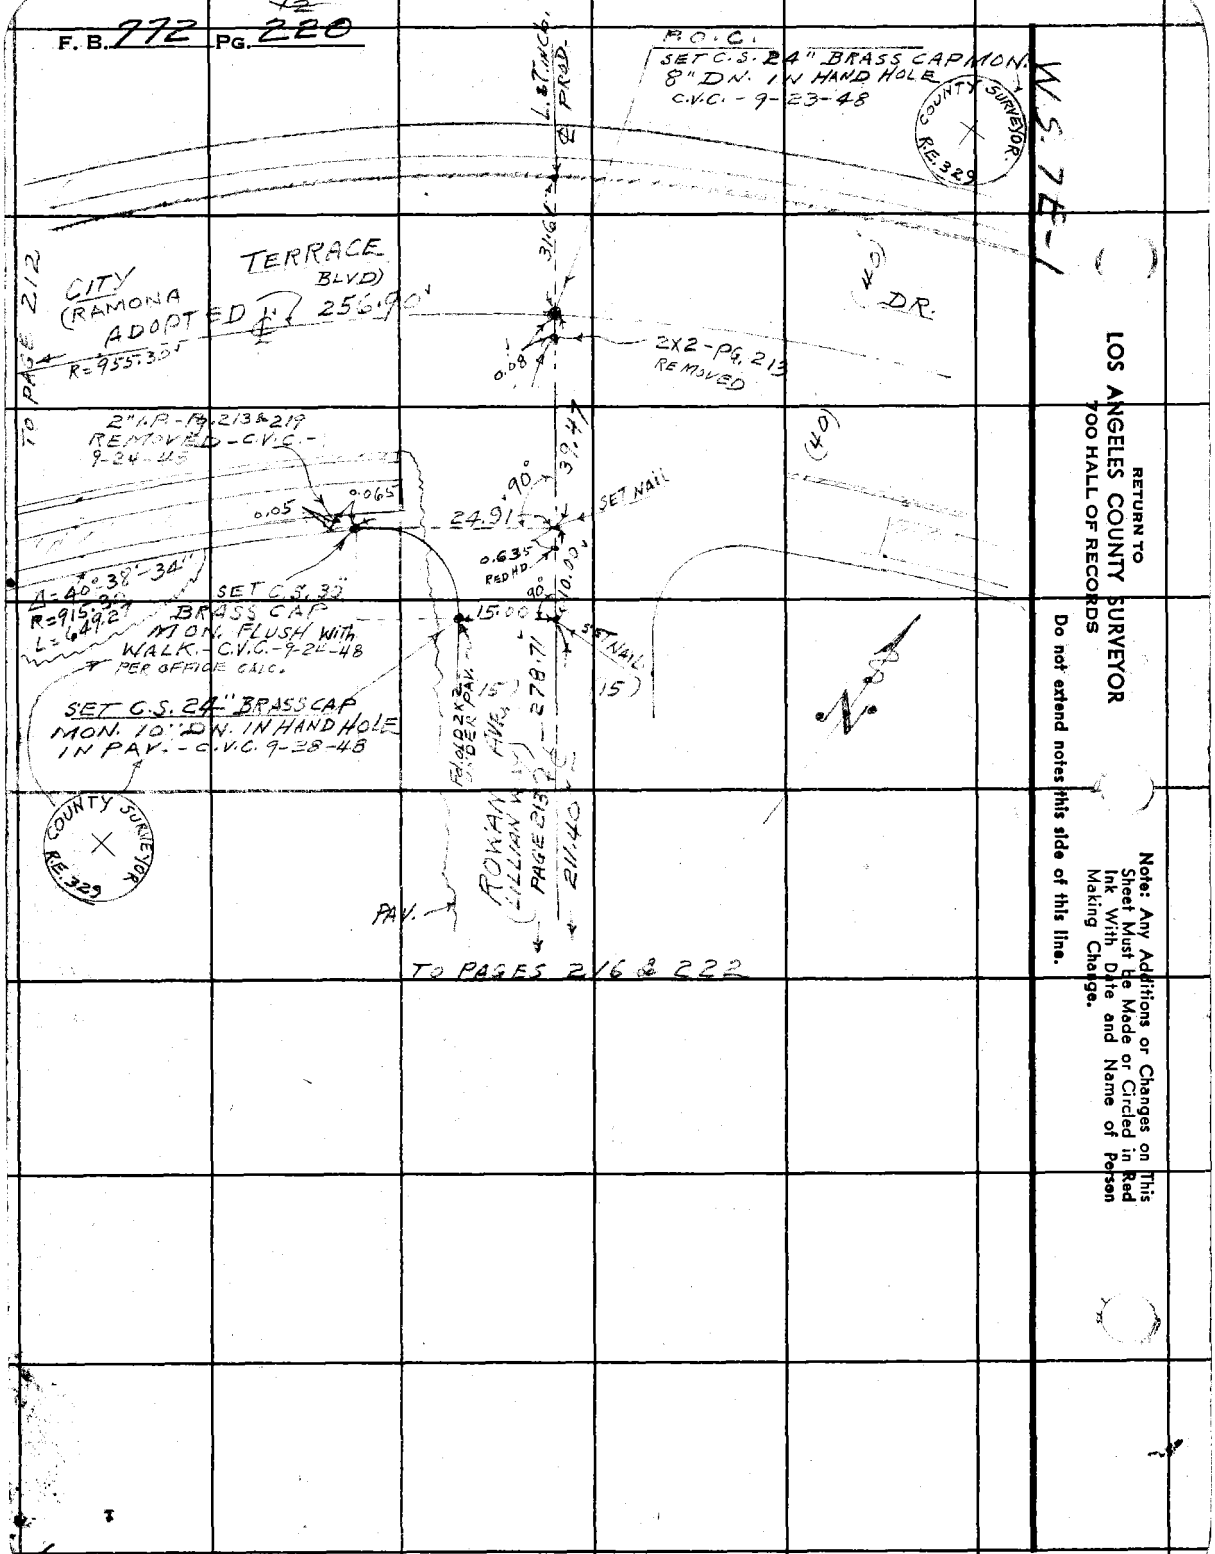

RETURN TO
LOS ANGELES COUNTY SURVEYOR
700 HALL OF RECORDS

Do not extend notes this side of this line.

Note: Any Additions or Changes on This Sheet Must Be Made or Circled in Red Ink With Date and Name of Person Making Change.

Notes Ck'd by D. M. Finley	Survey of CITY TERRACE DR. BOUNDARIES
Map No. B-2166	W. O. 851B Tape No. 065 St'd 68°F
Office Work Y.I.	Surveyed by C.V. CRUMLEY
Checked	Notes C.V.C. Date 9-23, 24, 48
Date	Indexed 9-28-48

F.B. 772 PG. 221

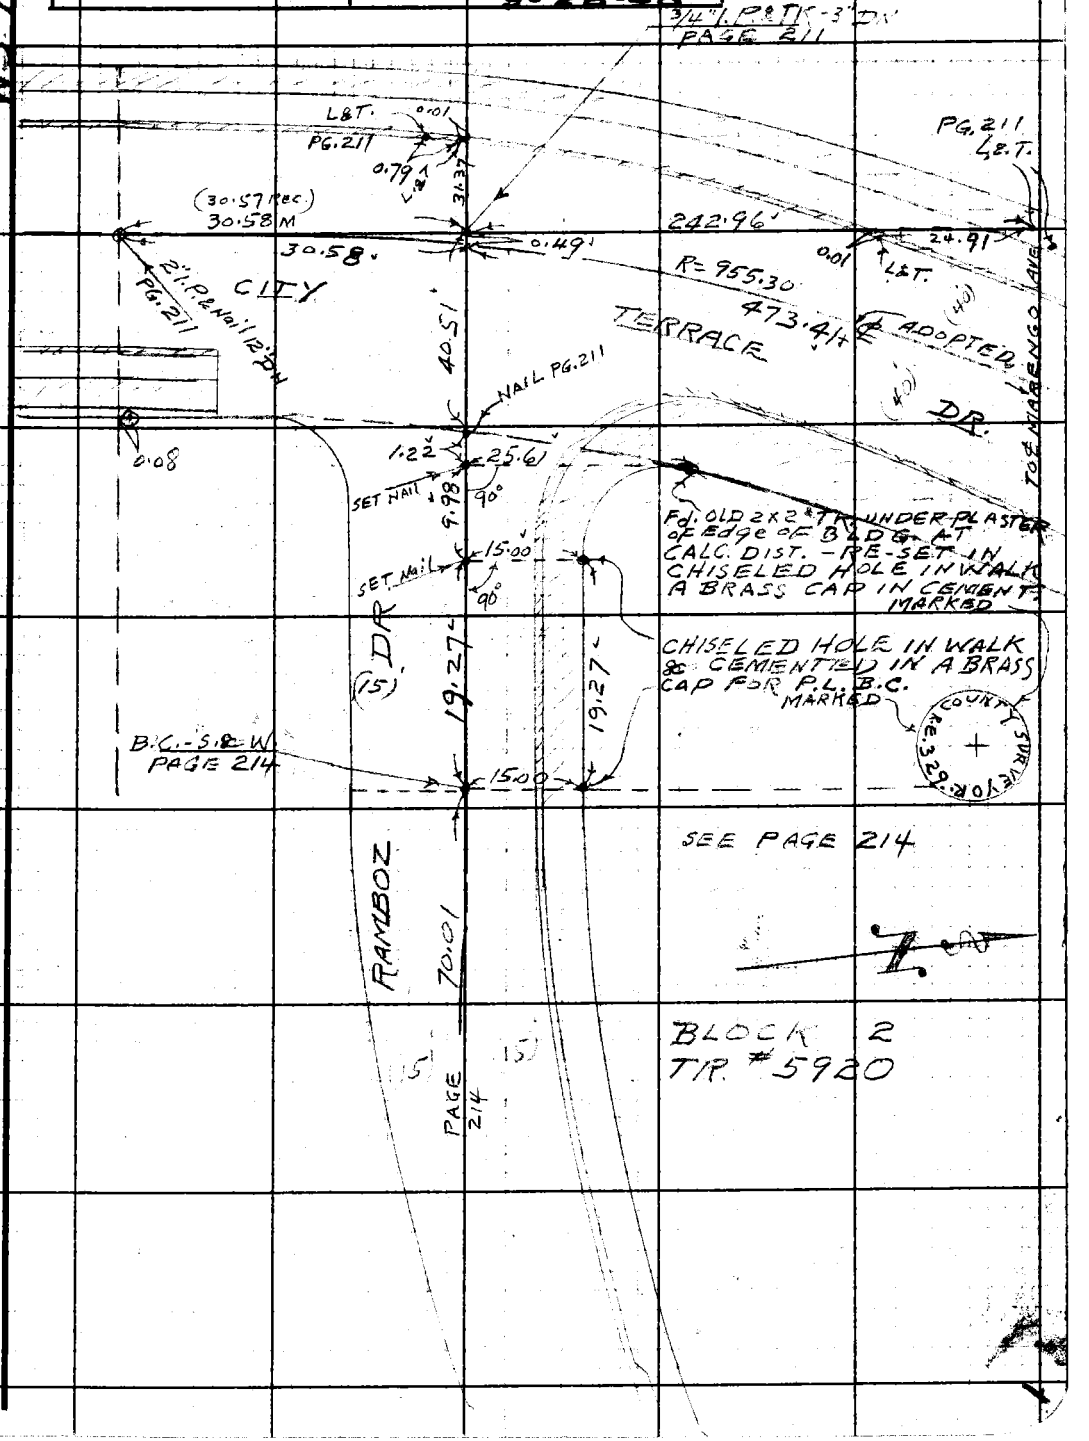

Note: Any Additions or Changes on This Sheet Must be Made or Circled in Red Ink With Date and Name of Person Making Change.

Do not extend notes this side of this line.

RETURN TO
LOS ANGELES COUNTY SURVEYOR
700 HALL OF RECORDS

FORM 247 5M 10-39

RETURN TO
LOS ANGELES COUNTY SURVEYOR
700 HALL OF RECORDS

Note: Any Additions or Changes on This Sheet Must be Made or Circled in **Red Ink** With Date and Name of Person Making Change.

Do not extend notes this side of this line.

WS 7E-1

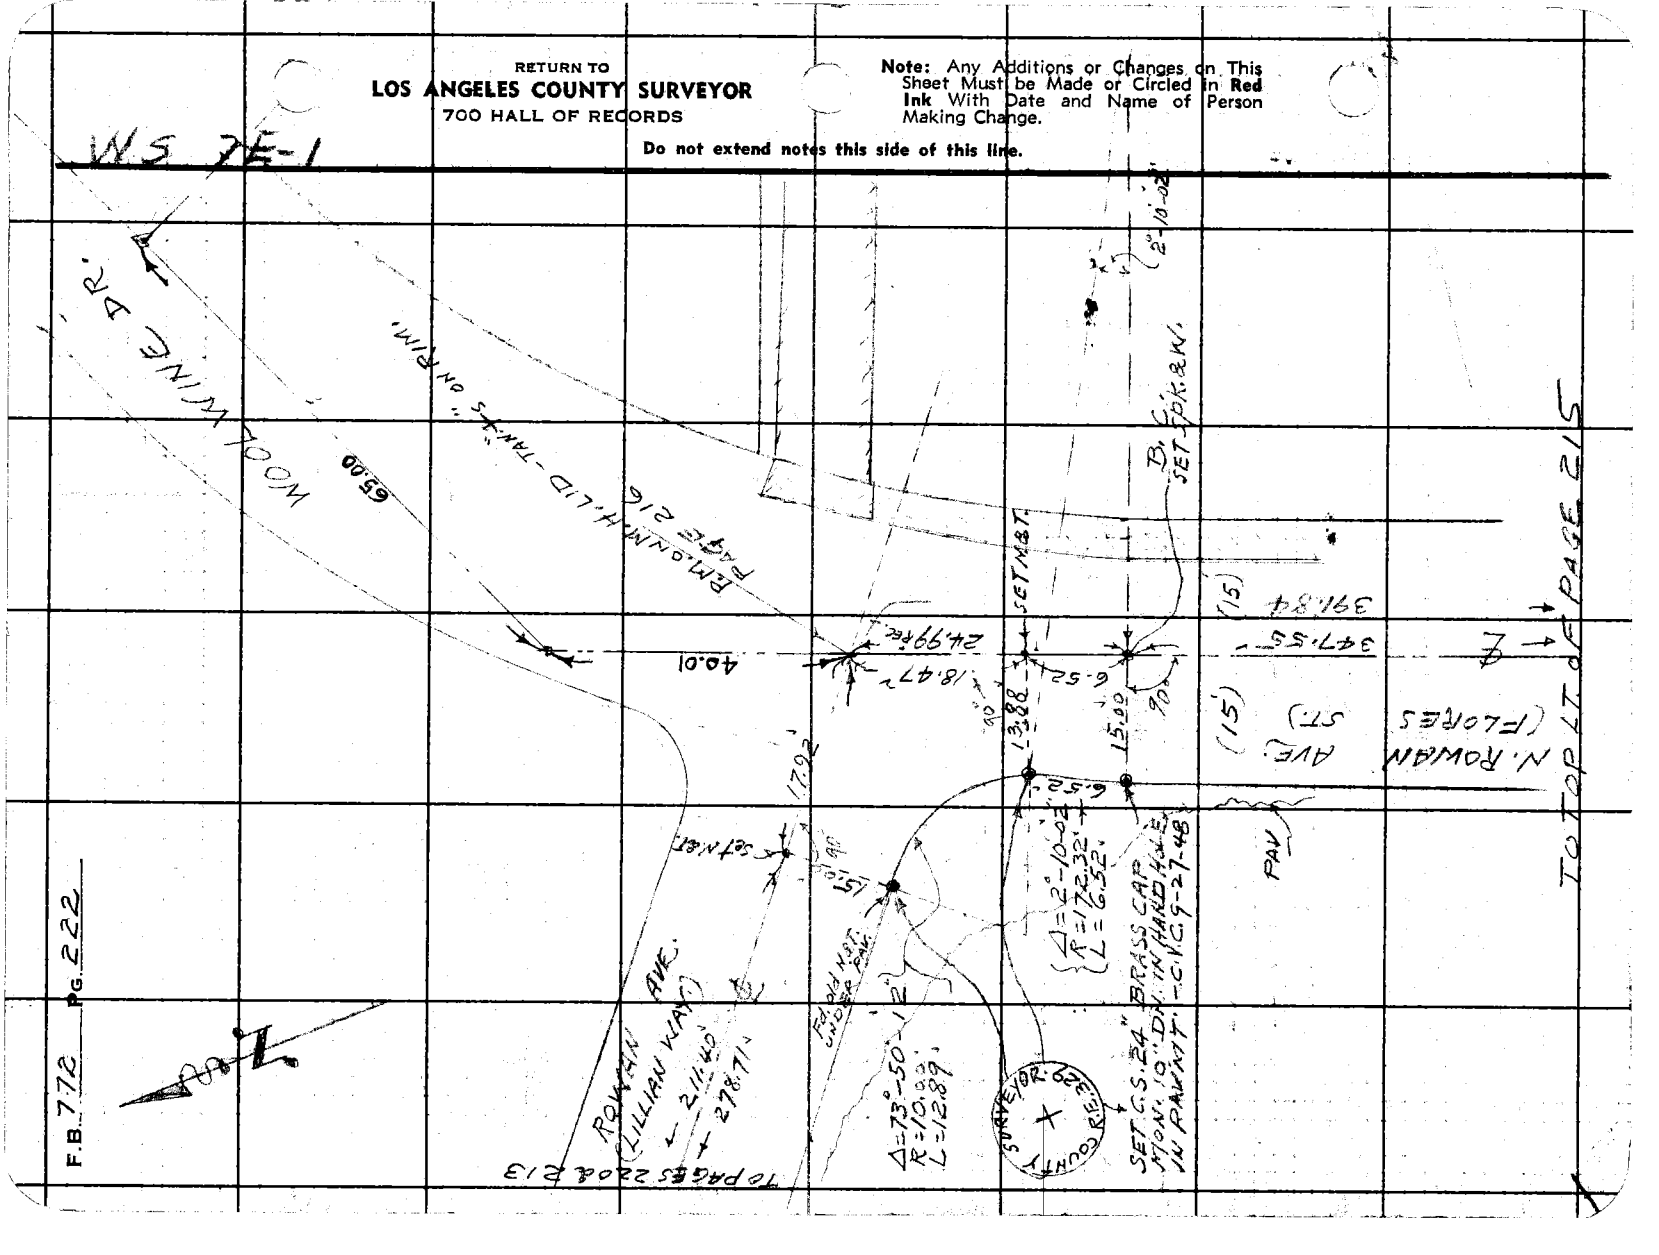

Profile	Notes Red.	Plotted	Job No. 8226	Division No.	F. B. [illegible] PG. 221
No.	Date	Date	Survey of INDIANA STREET		
X-Sec.	Notes Chkd.	Checked	Survey by TWALSH	Notes T. WALSH	Date MAR. 7. 1939
No.	Date	Date	Map No.	Indexed [illegible]	Date 5-16-39

NOTE: ANY ADDITIONS OR CHANGES ON THIS SHEET MUST BE MADE OR CIRCLED IN RED INK, WITH DATE AND NAME OF PERSON MAKING CHANGE

Do not extend notes this side of this line

PLEASE RETURN TO
LOS ANGELES COUNTY SURVEYOR
700 HALL OF RECORDS

Form 307 5M 10-37

INDIANA STREET

BENCH LEVELS

FOR VERTICAL CONTROL

TOPOGRAPHIC MAP

From

FLORAL DRIVE

to

CITY TERRACE DR.

T. Walsh
A. Carrasco ⊼
T. Maxwell ϕ

ELEV.

BASED UPON
A Bench Mark at Lorena & Brooklyn Ave. Per. L.B. 235-2 & B.M. G-65, L.B. 240-34f. Both of which were established in connection with Sewer & Storm Drain Improvements. C.I. 151 & C.I. 716

F. S.

H. I.

B. S.

STATION

F. B. 772 PG. 202 | Job No. | Division No. | Notes Red. | Plotted | Profile

Survey of | Date | Date | No.

Survey by | Notes | Notes Chkd. | Checked | X-Sec.

Indexed | Date | Date | Date | No.

STATION	B. S.	H. I.	F. S.	ELEV.

Form 307 5M 10-37

PLEASE RETURN TO
LOS ANGELES COUNTY SURVEYOR
700 HALL OF RECORDS

NOTE: ANY ADDITIONS OR CHANGES ON THIS SHEET MUST BE MADE OR CIRCLED IN RED INK, WITH DATE AND NAME OF PERSON MAKING CHANGE

Do not extend notes this side of this line

Form 307 5M 10-37

PLEASE RETURN TO
LOS ANGELES COUNTY SURVEYOR
700 HALL OF RECORDS

NOTE: ANY ADDITIONS OR CHANGES ON THIS SHEET MUST BE MADE OR CIRCLED IN RED INK, WITH DATE AND NAME OF PERSON MAKING CHANGE

Do not extend notes this side of this line

STATION	B. S.	H. I.	F. S.	ELEV.		
B.M.				295 777	B.M. Brooklyn Ave. & Lorena St. N.W. Cor.	
	1 585	297 362			C. Spk. in N. Curb of Brooklyn 3' W. of Lorena	
					L.B. 235-2	
B.M. A-1			5765	291 597	Indiana St. & Brooklyn Ave. N.W. Cor. L & T	
	5 19.1	296 778	1 918	291 862	C/n. C.C. L.B. 235-2 El. 291.633	
	5 38.1	297 723	0 269	297 454		
	11 290	308 744	0 452	308 292		
	11 221	310 513	0 101	319 322		
B.M. G-1	5 896	325 218	1 822	320 396	Floral Drive & Indiana St. S.E. Cor. L & T in E. Curb	
	6 249	326 644			of Indiana St., 2' N. of S. line of Floral Drive.	
					L.B. 236-85 El. - 320.370	
B.M. G-2			3 454	323 190	Floral Drive & Alma St. S.W. Cor. C. Spk.	
	3 378	326 568	6 172	320 396	in W. end of C.B. L.B. 236-3 El. 323.16	
	11 198	331 594	0 428	331 166		
	11 804	342 970	0 462	342 508		
	11 733	354 241	0 300	353 941		
T.P.	11 890	365 831	0 522	365 309	C. Spk. R.F. "L 8595 G.	
	11 600	376 909	0 463	376 446		
B.M. G-3	10 990	387 436	0 861	386 575	Indiana & Folsom Sts. S.E. Cor. Wire Spk. So. Cb.	
	1 709	388 284	11 625	376 659	4' E. of E. line Indiana L.B. 236-86	
	0 395	377 054	11 536	365 518	El. 386.500	

Profile No. X-Sec. No.

Notes Red. Date Notes Chkd. Date

Plotted Date Checked Date

Job No. Survey of Survey by Map No.

Division No. F. B. 772 PG. 2 Notes 7-6-39 Date 7-6-39 Indexed Date

Form 507 5M 10-37

PLEASE RETURN TO
LOS ANGELES COUNTY SURVEYOR
700 HALL OF RECORDS

NOTE: ANY ADDITIONS OR CHANGES ON THIS SHEET MUST BE MADE OR CIRCLED IN RED INK, WITH DATE AND NAME OF PERSON MAKING CHANGE

Do not extend notes this side of this line

STATION	B. S.	H. I.	F. S.	ELEV.	
				365 518	
	0 667	366 185	11 616	354 569	
B.M.	2 816	357 385	4 818	352 567	BM. Indiana St. & Malabar St. N.W. Corner
	11 241	363 808	0 710	363 098	Fd. C. Spk. Ctr. C.R.
T.P.	11 334	374 432	0 413	374 019	C. Spk & Tin
	11 621	385 643	1 772	383 871	
B.M. G-5	3 981	387 852	8 548	379 304	Indiana St. & Winter St. N.E. Corner. Cut Spk
	3 320	382 624	4 925	377 699	N. curb Winter 2' E. of E. line Indiana St.
	1 568	379 267			L.B. 236-86 El. 379.097
B.M. G-6			7 845	371 422	Indiana St. & Blanchard St. S.E. Corner. C. Spk.
	4 470	375 892	0 628	375 264	S. Curb Blanchard 2' E. of E line of Indiana.
	11 191	386 455	0 641	385 814	L.B. 236-86 El. 371.460
	11 714	397 526			
B.M.			1 017	396 511	Fairmount & Indiana. S.W. Corner. L&T. in
	6 598	403 109			So. Curb. 8.5 W. of W. end C.R.
T.P.			0 698	402 411	B. Spk in Stairs
	11 272	413 683	0 906	412 777	
T.P.	11 217	423 994	11 186	412 808	C. Spk & Tin
	0 816	413 624	8 591	405 033	
	1 013	406 046			

F. B. 772 PG. 204 | Job No. 8446 | Division No. | Notes Red. | Plotted | Profile
Survey of INDIANA STREET | Date | Date | No.
Survey by T.M. Walsh | Notes T.M.W. | Notes Chkd. | Checked | X-Sec.
Indexed A. [illegible] | Date 3-7-39 | Date | Date | No.

Form 307 5M 10-37

PLEASE RETURN TO
LOS ANGELES COUNTY SURVEYOR
700 HALL OF RECORDS

NOTE: ANY ADDITIONS OR CHANGES ON THIS SHEET MUST BE MADE OR CIRCLED IN RED INK, WITH DATE AND NAME OF PERSON MAKING CHANGE

Do not extend notes this side of this line

Profile No. X-Sec. No. Notes Red. Date Notes Chkd. Date Plotted Date Checked Date Job No. Survey of Survey by Notes Map No. Division No. Date Indexed Data

F. B. PG. 204

STATION	B. S.	H. I.	F. S.	ELEV.		
		106 016				
BM.			7.80	398 237	City Terrace Dr. & Wabash Ave N.E. Corner Fd.	
	10.504	409 281	1605	407 676	L.B. Tan E. Curb of City Terrace Dr, about 20' N. of	
	7272	414 951			Ctr. of Catch Basin	
BM H-1			1 80.3	413 148	BM. H-1. City Terrace Dr. & Alma Ave N.E. Cor.	
					Wire Spk. Ctr. C.R. LB-335-58 El. 413.139	
					Rd Dept 1010-638-3	
BM No 9		(Not Shot)	1502	413 141	BM No 9. City Terrace Dr. & Alma Ave N.E. Cor,	
	6.450	419 598	3305	413 293	L.B. Tan on N. end of Walk L.G. 638-3	
	6.762	423 052	3.155	413 837	El 413.14'	
BM G-65	4.837	428 734	1.555	419 179	BM G-65 City Terrace Dr & Division Ave. S.E. Cor.	
	0.527	419 306	9.955	410 888	C. Spk. Ctr. C.R. L.B 210-34. El 410.19	
BM.	4.10.1	414 999	3047	411 952	BM. Division & First Alley So. of City Terrace Dr.	
	0.653	412 695	8.587	403 715	C. Spk. W. Curb S.W. Corner.	
	0.537	404 285	9.266	395 019		
	10.12	389 033	5.299	393 753		
	2.275	396 033	12.000	383 033		
T.P.	1.780	355 818	9236	376 582	T.P. Sunder Division & Alma S.E. Cor.	C. Spk. in So. W. C. & G. at ... S. Cor. Conc. 371.419 371.132 .003
BM G-6	1.592	378 172	6.755	371 419	See Page.	

RETURN TO BLANCHARD VIA FUNDSS

F. B. 775 PG. 205 6 | Job No. | Division No. | Notes Red. | Plotted | Profile

Survey of | Date | Date | No.

Survey by | Notes | Notes Chkd. | Checked | X-Sec.

Indexed | Date | Date | Date | No.

STATION	B. S.	H. I.	F. S.	ELEV.	

Form 307 5M 10-37

PLEASE RETURN TO
LOS ANGELES COUNTY SURVEYOR
700 HALL OF RECORDS

Do not extend notes this side of this line

NOTE: ANY ADDITIONS OR CHANGES ON THIS SHEET MUST BE MADE OR CIRCLED IN RED INK, WITH DATE AND NAME OF PERSON MAKING CHANGE

FORM 247 5M 10-37

RETURN TO
LOS ANGELES COUNTY SURVEYOR
700 HALL OF RECORDS

Note: Any Additions or Changes on This Sheets Must be Made or Circled in **Red Ink** With Date and Name of Person Making Change.

Do not extend notes this side of this line

Notes Ck'd by
Map No.
Office Work
Checked
Date

Survey of
W. O. Tape No. St'd. OF
Surveyed by
Notes Date
Indexed

F.B. PG.

RETURN TO
LOS ANGELES COUNTY SURVEYOR
700 HALL OF RECORDS

Note: Any Additions or Changes on This Sheets Must be Made or Circled in **Red Ink** With Date and Name of Person Making Change.

Do not extend notes this side of this line

F.B._____ PG._____

76F309S 247 10M 1-49

RETURN TO
LOS ANGELES COUNTY SURVEYOR
726 LOS ANGELES COUNTY
ENGINEERING BLDG.

Note: Any Additions or Changes on This Sheet Must be Made or Circled in Red Ink With Date and Name of Person Making Change.

Do not extend notes this side of this line.

Notes Ck'd by
Map No.
Office Work
Checked
Date

Survey of
W. O. Tape No. St'd °F
Surveyed by
Notes Date
Indexed

F. B. PG.

RETURN TO
LOS ANGELES COUNTY SURVEYOR
726 LOS ANGELES COUNTY
ENGINEERING BLDG.

Note: Any Additions or Changes on This Sheet Must be Made or Circled in Red Ink With Date and Name of Person Making Change.

Do not extend notes this side of this line.

F. B. _____ PG. _____