F.B. 778 PG. 6

LAS VIRGINES F.T.T. SYSTEM INDEX.

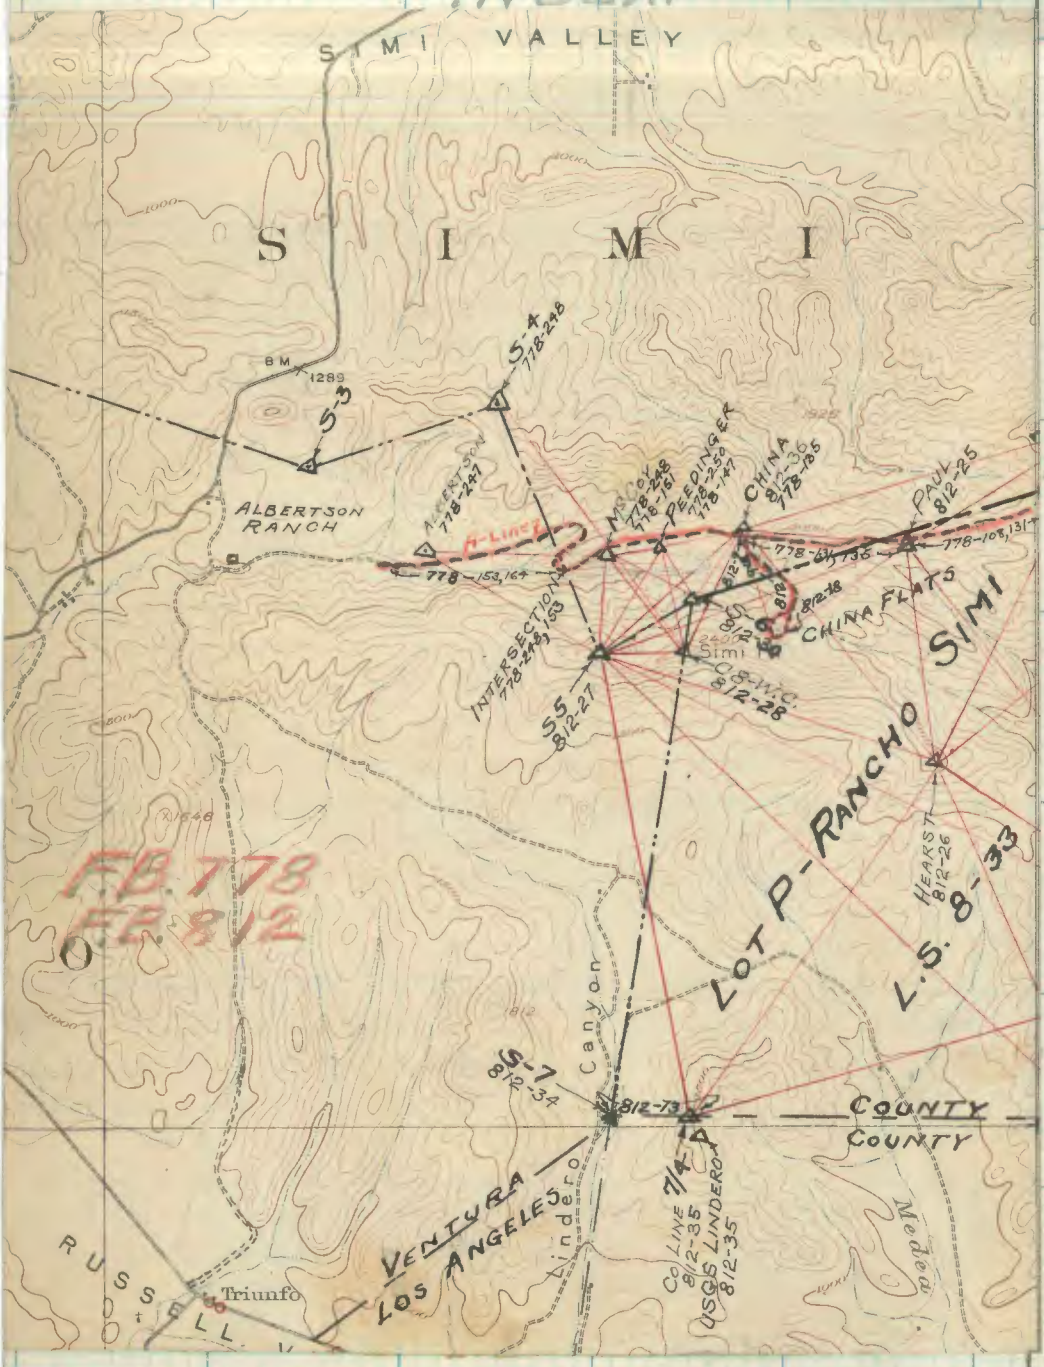

RETURN TO
LOS ANGELES COUNTY SURVEYOR
700 HALL OF RECORDS

Do not extend notes this side of this line.

Note: Any Additions or Changes on This Sheet Must be Made or Circled in Red Ink With Date and Name of Person Making Change.

FORM 247 5M 11-41

RETURN TO
LOS ANGELES COUNTY SURVEYOR
700 HALL OF RECORDS

Note: Any Additions or Changes on This Sheet Must be Made or Circled in Red Ink With Date and Name of Person Making Change.

CO. LINE 7/44
8/2-33
Palo Comado Canyon
U.S.G.S. CHEESEBORO 8/2-23-75
Cheesboro Canyon
LOS ANGELES CO.
VENTURA CO.
Las Virgenes Canyon
East Fork
TURNER 778-249
778-108
778-64
778-64
778-64
ENSIGN 778-251
778-268
778-233
778-58
778-193,200
778-233,245
778-167
778-193
778-18
778-26,44
778-252
778-83
778-74
778-9
778-22
778-44
778-18
778-18
778-18

Notes Ck'd by [illegible]
Map No. B-1830
Office Work
Checked
Date

Survey of Las Virgenes FTT System
W. O. [illegible] Tape No. 69 St'd 24°F
Surveyed by Stevenson
Notes [illegible] Date 1/6
Indexed A. C. Johnson

F.B. 775 Pg. 9

out to end page 10

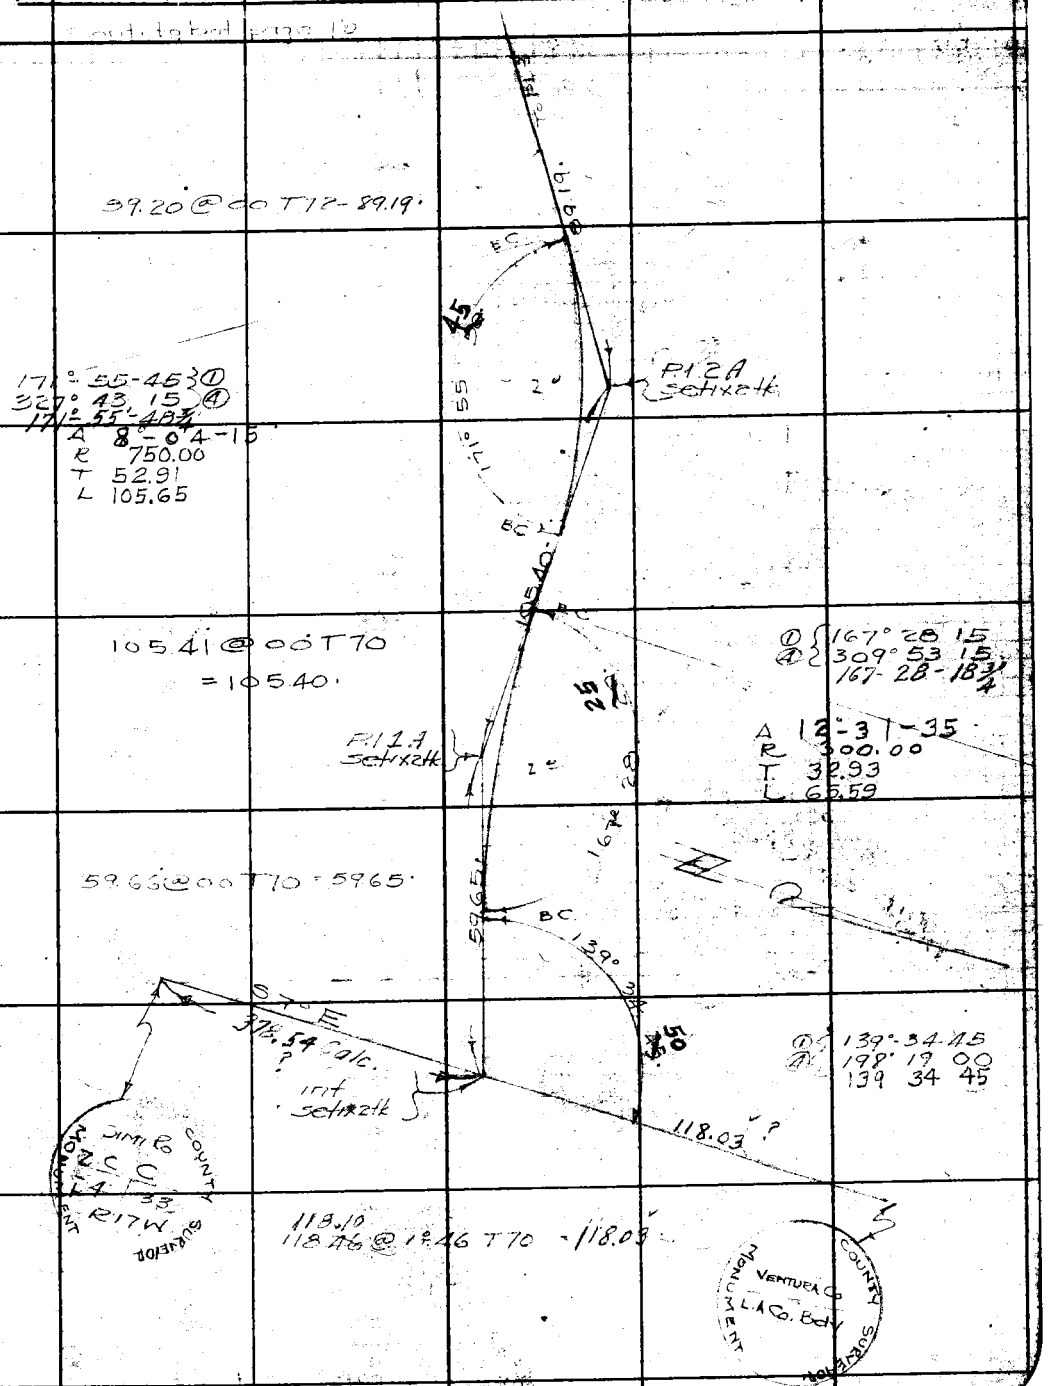

Note: Any Additions or Changes on This Sheets Must be Made or Circled in Red Ink With Date and Name of Person Making Change.

Do not extend notes this side of this line

RETURN TO
LOS ANGELES COUNTY SURVEYOR
700 HALL OF RECORDS

FORM 247 5M 10-37

F.B. 178 PG. 10

Cont to bot page 11

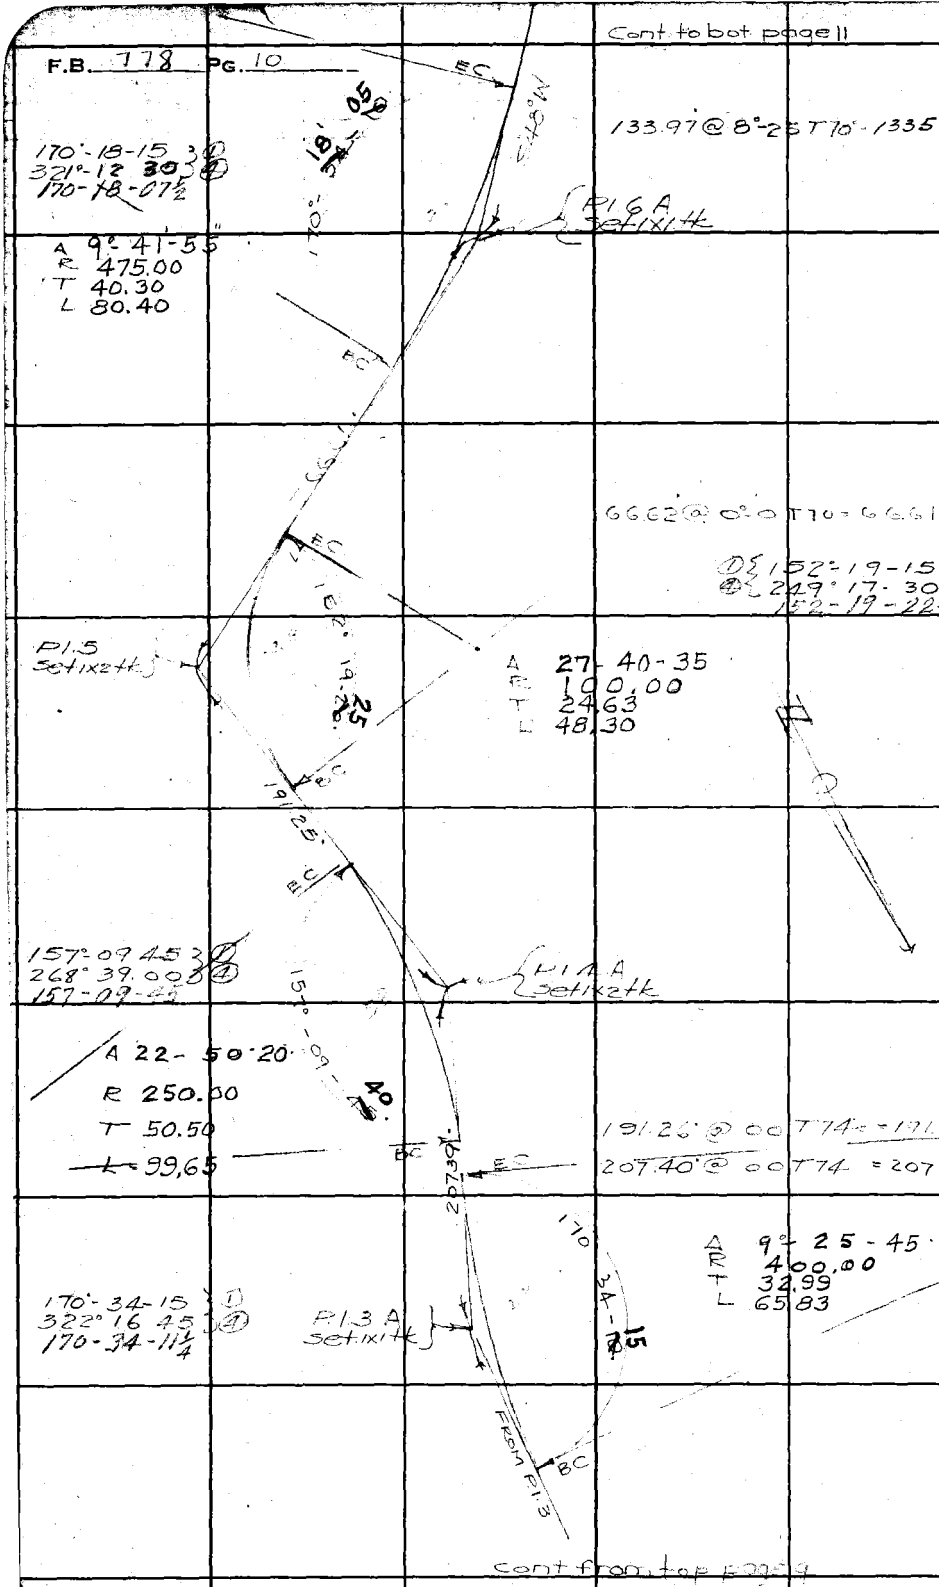

Cont from top page 9

RETURN TO
LOS ANGELES COUNTY SURVEYOR
700 HALL OF RECORDS

Note: Any Additions or Changes on This Sheets Must be Made or Circled in Red Ink With Date and Name of Person Making Change.

Do not extend notes this side of this line

Notes Ck'd by		Survey of	F.B. 778 Pg. 21
Map No. B-1830		W. O. 8243 Tape No.	St'd. of
Office Work		Surveyed by Stevenson	
Checked		Notes	Date 12-1931
Date		Indexed	

Cont to last page 12

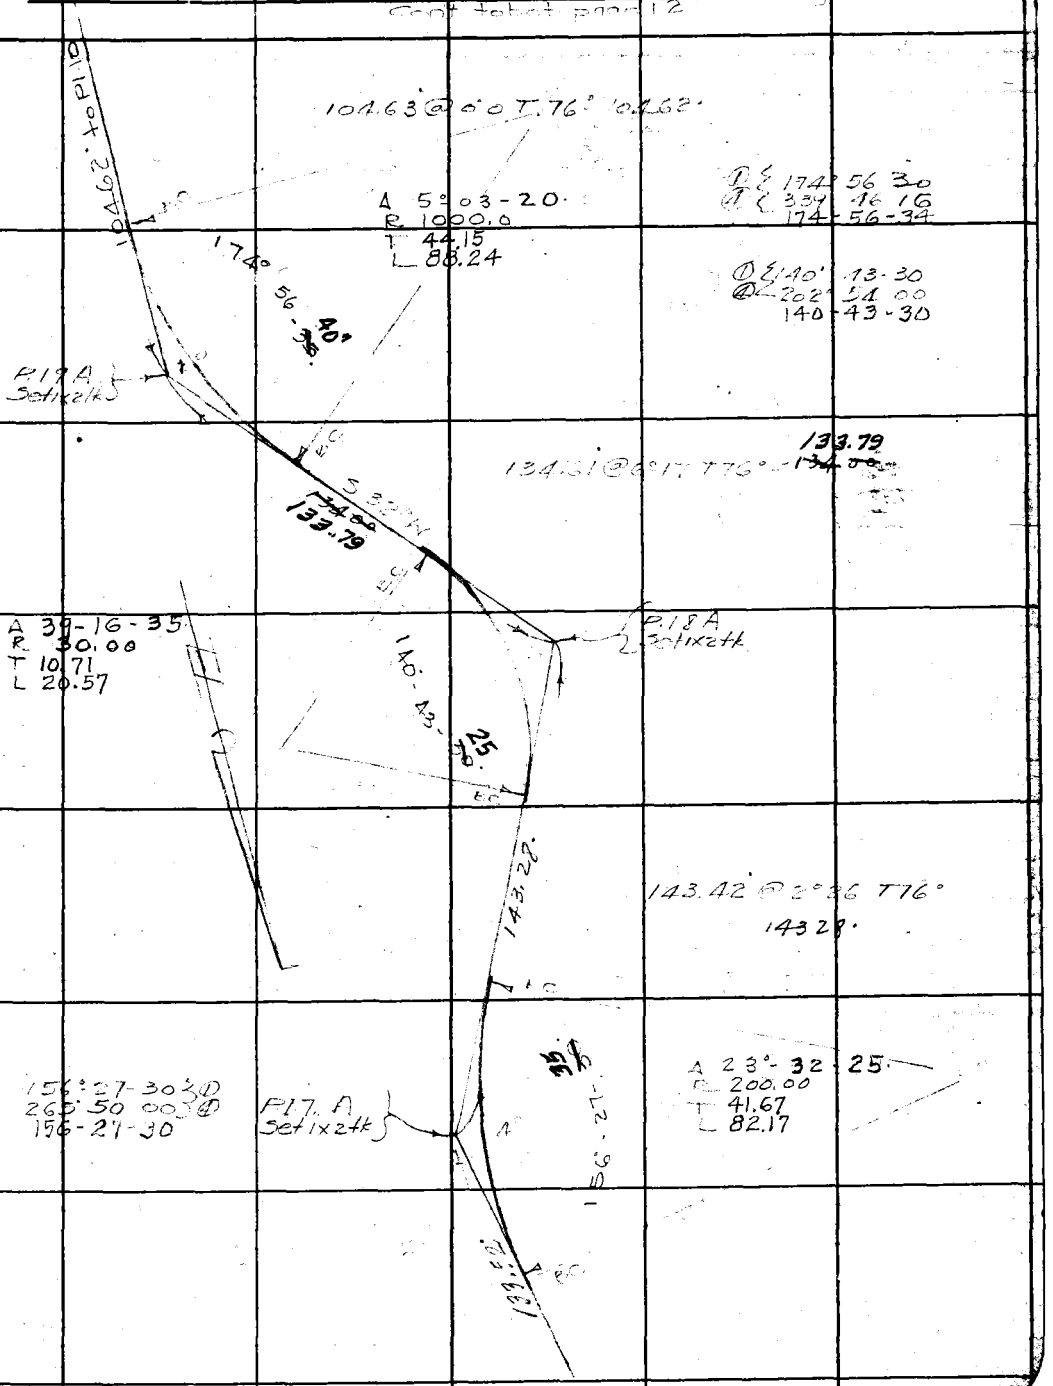

Cont from top page 10

RETURN TO
LOS ANGELES COUNTY SURVEYOR
700 HALL OF RECORDS

Note: Any Additions or Changes on This Sheets Must be Made or Circled in Red Ink With Date and Name of Person Making Change.

Do not extend notes this side of this line

FORM 247 5M 10-37

F.B. 778 PG. 12

Cont. to bot page 13

Δ 23°-25-30
R 100.00
T 20.73
L 40.88

207.99

P.I. 12 A Set 1x1+k

2°

156°

156°-34-30
266°-17-45
156-34-26½

1260°00'716" = 126.06'

148°-34-00
33-30
148-34-03¾
166°-15-30
314°-49-45
166-15-11¼

P.I. 11 A Set 1x1+k

Δ 31°-25-50
R 75.00
T 21.10
L 41.14

105.35

105.35'

13°-47-55
400.00
48.40
96.33

P.I. 10 A Set 1x1+k

Cont. from top page 11

RETURN TO
LOS ANGELES COUNTY SURVEYOR
700 HALL OF RECORDS

Do not extend notes this side of this line

Note: Any Additions or Changes on This Sheets Must be Made or Circled in Red Ink With Date and Name of Person Making Change.

Notes Ck'd by		Survey of	F.B. 778 PG. 13
Map No. B-1830		W. O.	Tape No. St'd. OF
Office Work		Surveyed by	
Checked		Notes	Date
Date		Indexed	

Cont. to bot page 14

14586 @ 00 7 12" 14585.

Vol 4 5-29 25

14-585.

P.14A

New Loc P.14A

P.15A Set 1x2 tk

119°-47 30 30
119° 10 00 34
119-17-30

25'

119.47

A = 60°12 35.
R = 60
T =
L =

201.62 @ 1°15 774 = 201.58

201.67 58

EC

A 11°-24 -30
R 600.00
T 59.93
L 119.47

30'

P.14A Set 1x1 tk

168° 35

Δ 168°-35-30
Δ 57 18 21 45
168-35-26

EC

14176 @ 00 7 12" = 14175'

14175'

25°-05-40
200.00
44.51
87.60

20'

154° 54

Δ 154°-54-30
Δ 257° 5' 1 45
154-54-26

P.13A Set 1x1 tk

EC

Cont. from top page 15

RETURN TO
LOS ANGELES COUNTY SURVEYOR
700 HALL OF RECORDS

Note: Any Additions or Changes on This Sheets Must be Made or Circled in Red Ink With Date and Name of Person Making Change.

Do not extend notes this side of this line

FORM 247 SM 10-37

F.B. 778 Pg. 14

Cont. to bot page 15.

221.03 @ 80 TS2° = 220.98.

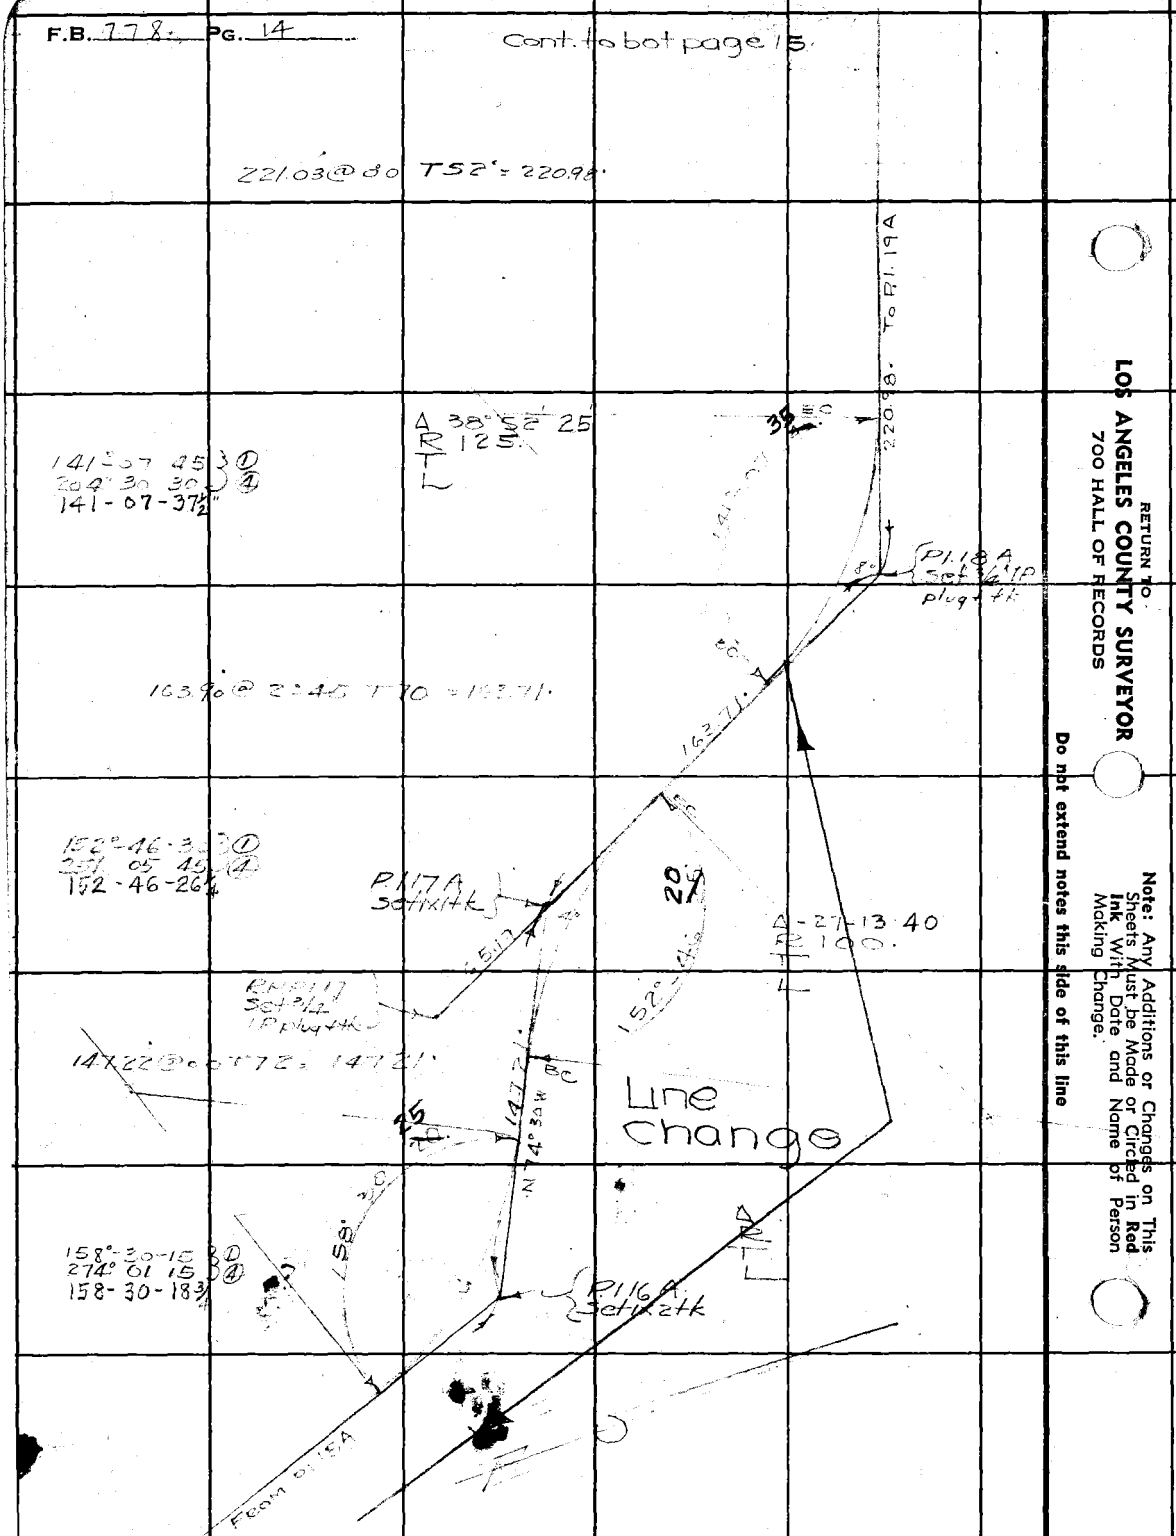

141° 07' 45" (1)
204° 30' 30" (4)
141 - 07 - 37½"

A 38° 52' 25"
R 125.
L

163°-46-30" (1)
337° 05' 45" (4)
152 - 46 - 26½

A - 27 - 13' 40"
R 100.
L

158°-30-15" (1)
274° 01' 15" (4)
158 - 30 - 18½

Cont. from top page 13

RETURN TO
LOS ANGELES COUNTY SURVEYOR
700 HALL OF RECORDS

Note: Any Additions or Changes on This Sheets Must be Made or Circled in Red Ink With Date and Name of Person Making Change.

Do not extend notes this side of this line

Notes Ck'd by		Survey of	
Map No. B-1930		W. O. 824 Tape No. 49 St'd	of
Office Work		Surveyed by Stevenson	
Checked		Notes	Date 5-29-51
Date		Indexed	

F.B. 778 Pg. 14a

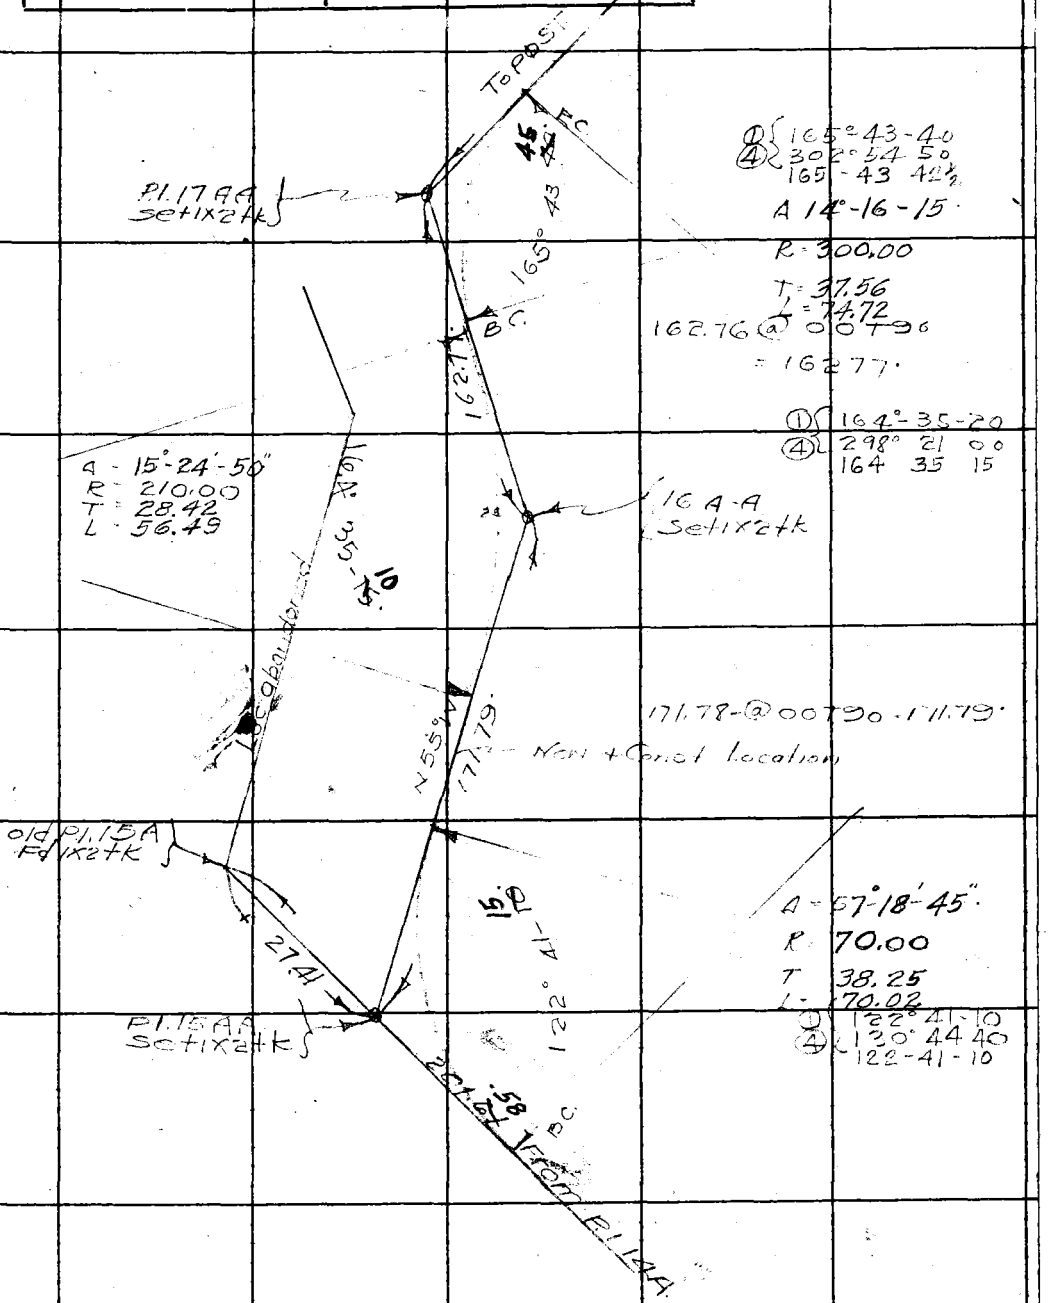

① 165°-43-40
④ 302°-54-50
165-43-42½

Δ 14°-16-15"
R - 300.00
T - 37.56
L - 74.72
162.76 @ 00 T 90
= 162.77'

① 164°-35-20
④ 298° 21 00
164 35 15

171.78 - @ 00 T 90 - 171.79'
Non + Conct location

Δ - 57°-18'-45"
R 70.00
T 38.25
L 70.02

① 122°-41-10
④ 120° 44 40
122-41-10

Note: Any Additions or Changes on This Sheets Must be Made or Circled in Red Ink With Date and Name of Person Making Change.

Do not extend notes this side of this line

RETURN TO
LOS ANGELES COUNTY SURVEYOR
700 HALL OF RECORDS

FORM 247 5M 10-37

F.B. 778 PG. 146

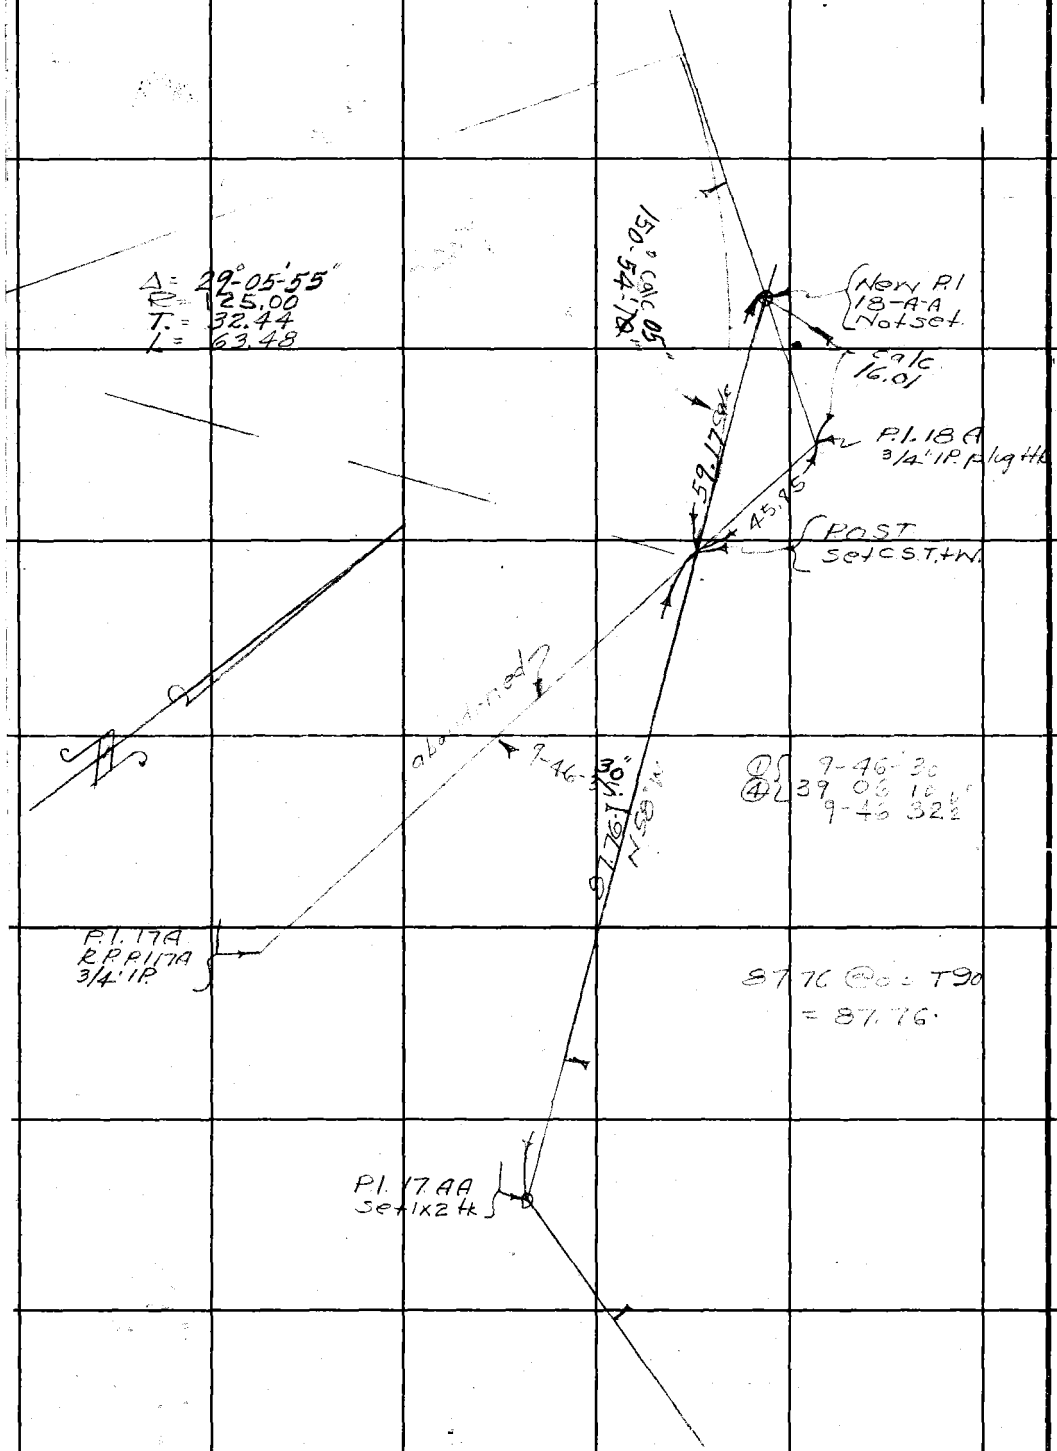

RETURN TO
LOS ANGELES COUNTY SURVEYOR
700 HALL OF RECORDS

Note: Any Additions or Changes on This Sheets Must be Made or Circled in Red Ink With Date and Name of Person Making Change.

Do not extend notes this side of this line

Notes Ck'd by R. V. Finley	Survey of Los Virgenes FTT System	F.B. 778	Pg. 15
Map No. B-1830	W. O. 8248 Tape No. 6° St'd OF		
Office Work	Surveyed by Stevenson		
Checked	Notes T. U. S. Date 12-19-38		
Date	Indexed		

Cont to last line pg 16

T6P1 2A

191.34 @ 0°35' 56" = 191.30'

191.30

E CA

45

1 6° 36

P1 30A
Set 1x1 tk

① 168 36 45
④ 314 27 30
168 36 52½

Δ 11°23'-15"
R 400.00
T 39.88
L 79.50

159.04 @ 1° 44 T52 = 158.94'

EC

N 73° 33' W

158.94'

55

3°

P1 19A
Set 1x1 tk

Δ 14°13'-05"
R 400.00
T 49.89
L 99.26

165°46'

EC

165°46'-45" ①
30°07 15 ④
165 46 48¾

From P1 16

Cont from top page 14

Note: Any Additions or Changes on This Sheets Must be Made or Circled in Red Ink With Date and Name of Person Making Change.

Do not extend notes this side of this line

RETURN TO
LOS ANGELES COUNTY SURVEYOR
700 HALL OF RECORDS

FORM 247 5M 10-37

F.B. 778 PG. 16

cont to bot. page 17

169.28 @ 00°T 60 = 169.25'

COP 122A
Set 3/4" IP Plug
+ Tack

To P1.23A

169.25'

48.11 @ 5°55' T 60

P1.22A
Set 3/4" IP
Plug + tk

160.62'

25 Typ.

74.33'

74.33 @ 00°T 60
= 74.33'

A 69°-07-35"
R 25.00
T 17.22
L 30.16

110°-52-30"
69°-07-35"
110-52-30

POT
Set 1x2 tk

161.02' @ 5°-55' T 60 = 160.25'

111°-03-45"
54°-15-00"
111-03-45

111°-03'-45"

160.25'

29

P1.21A
Set 3/4" IP
Plug + tk

From P1.20A

A 68°-06-10"
R 135.00
T 92.67
L 162.43

Cont. from top page 15

RETURN TO
LOS ANGELES COUNTY SURVEYOR
700 HALL OF RECORDS

Note: Any Additions or Changes on This Sheets Must be Made or Circled in Red Ink With Date and Name of Person Making Change.

Do not extend notes this side of this line

Notes Ck'd by		Survey of Los Angeles FTI System	F.B. 778 Pg. 17
Map No. B-1830		W. O. 8243 Tape No. 69 St'd. 84 OF	
Office Work		Surveyed by Stevenson	
Checked		Notes T.J.S Date 12-14-38	
Date		Indexed	

cont. to sht. page 18

247.33@1°16'TGO° = 247.23

247.23

TO P.125A

EC

37+24.37

158°54'30" ①
275 38 00 ②
158 54 30

P.124A
Set 1x2 tk

Δ = 71°-05'-25"
R = 350.00
T = 651.5
L = 128.83

158.54'

BC

286.83@00°-T60 28679'

=

S84°W
28679'

EC

Δ = 11°42'-05"
R = 500.00
T = 51.24
L = 102.11

17°-55'

160.6'

P.123A
Set 1x2 tk

BC

From P.122A

168-18.00 ①
313 12.00 ②
168 18 00

cont. from/on page 16

RETURN TO
LOS ANGELES COUNTY SURVEYOR
700 HALL OF RECORDS

Note: Any Additions or Changes on This Sheets Must be Made or Circled in Red Ink With Date and Name of Person Making Change.

Do not extend notes this side of this line

FORM 247 SM 10-37

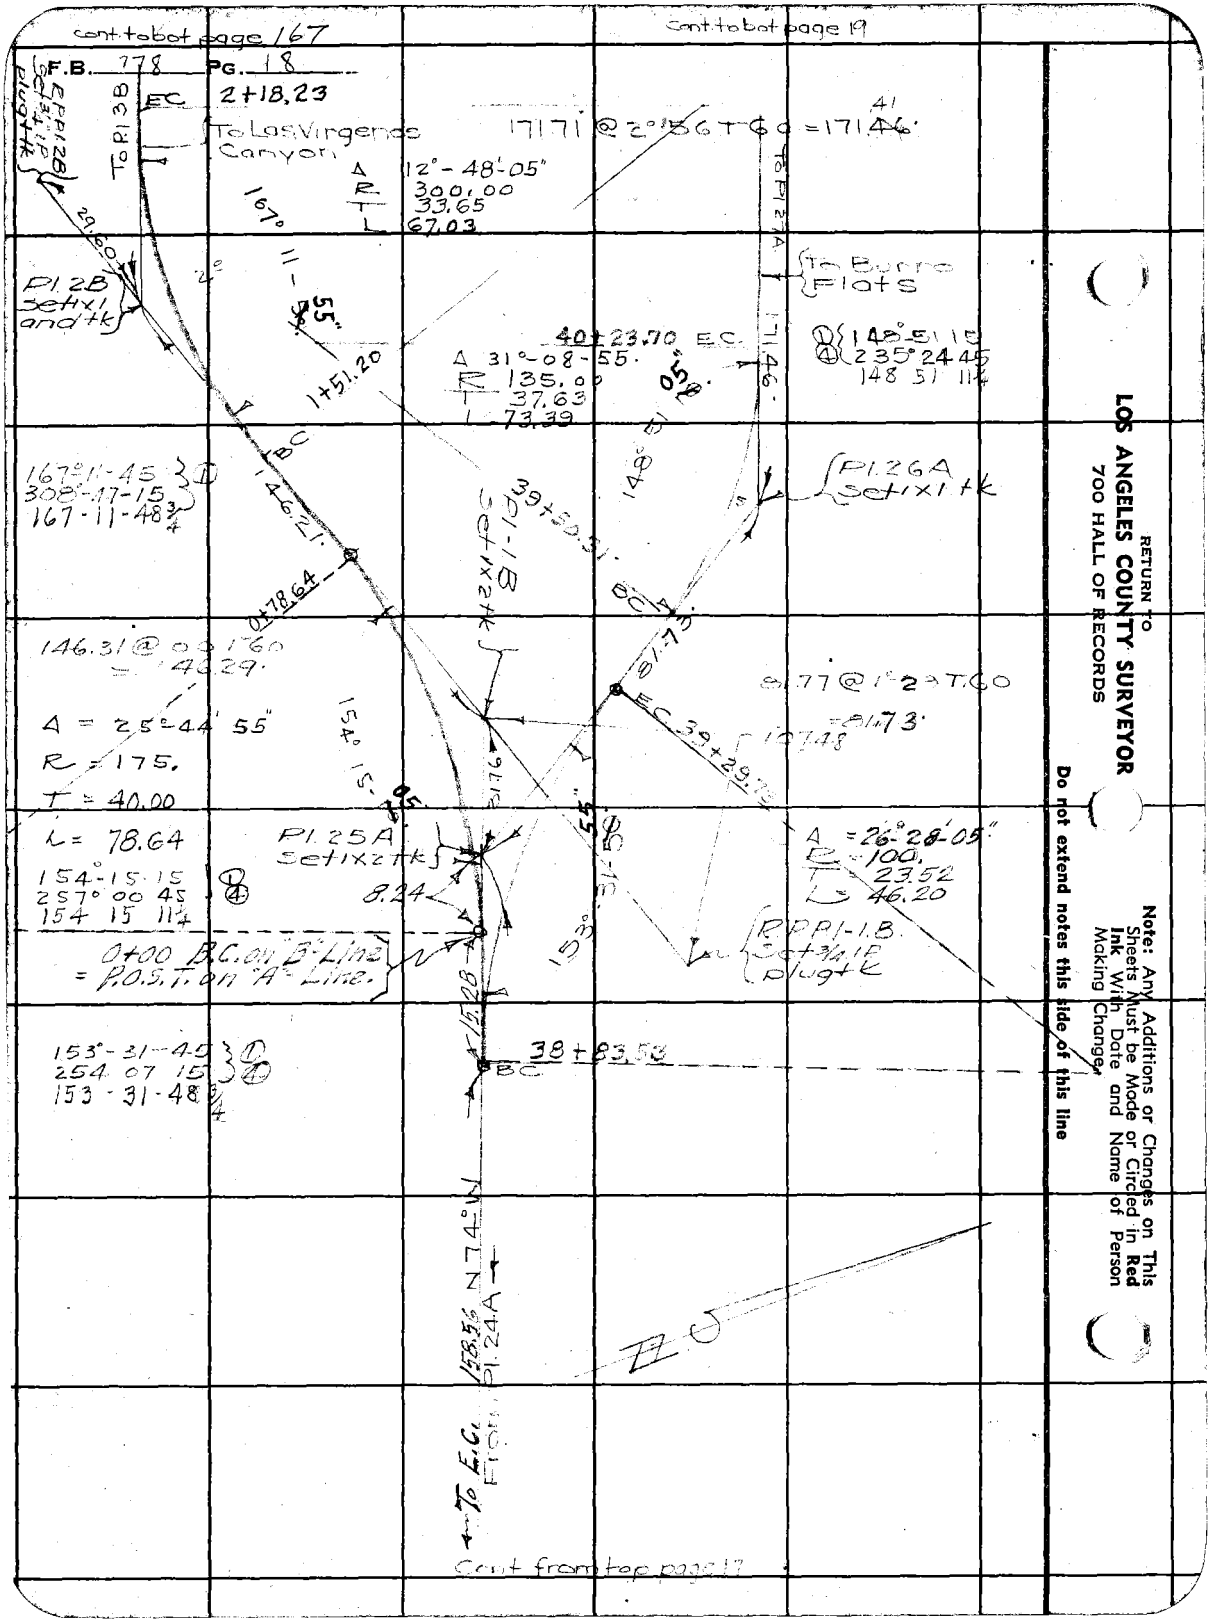

RETURN TO
LOS ANGELES COUNTY SURVEYOR
700 HALL OF RECORDS

Note: Any Additions or Changes on This Sheets Must be Made or Circled in Red Ink With Date and Name of Person Making Change

Do not extend notes this side of this line

Notes Ck'd by
Map No. B-1830
Office Work
Checked
Date

Survey of Las Virgenes Pipeline
W. O. 8243 Tape No. 61 St'd 64 OF
Surveyed by STEVENSON
Notes T.W.C. Date 12-16-37
Indexed


Note: Any Additions or Changes on This Sheets Must be Made in Red Ink With Date and Name of Person Making Change.

Do not extend notes this side of this line

RETURN TO
LOS ANGELES COUNTY SURVEYOR
700 HALL OF RECORDS

FORM 247 5M 10-37

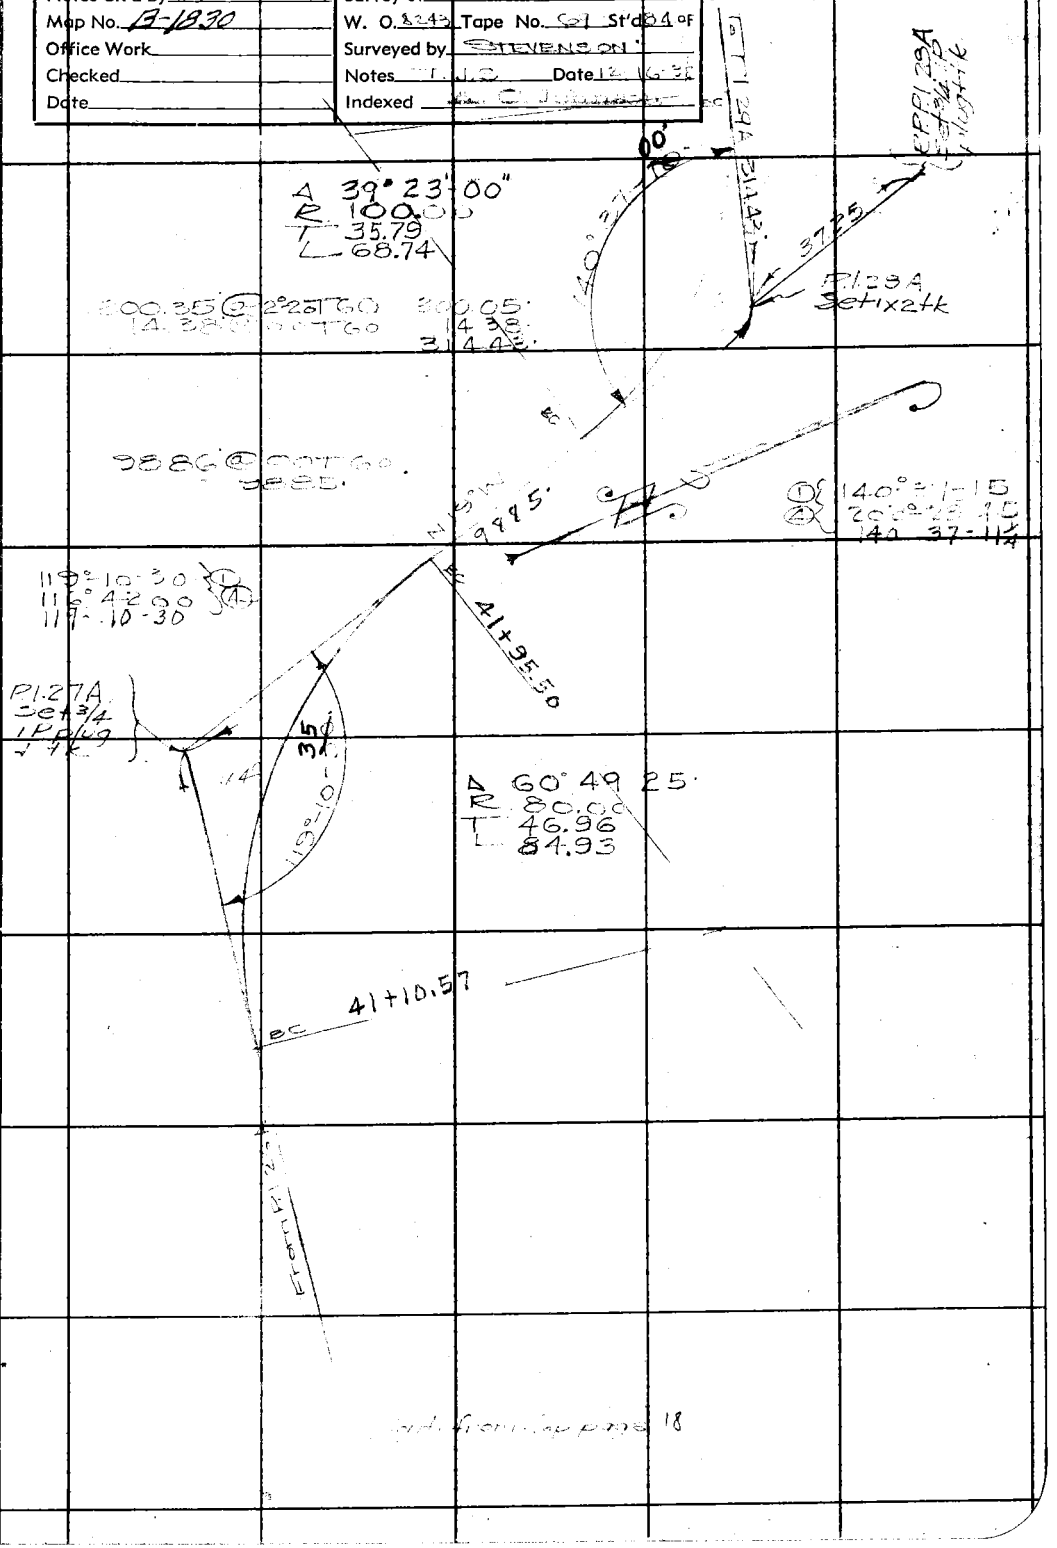

F.B. 778 PG. 20

Cont. to Lot page 21

209.98 @ 3:23 T 70
= 209.59.

125° 23 30 } ①
141° 34 30 } ④
125 23 37½

209.59' To PI 32A

EC

PI 31A
Set 3/4" IP
plug + tk

125° 23' 30"

A 54° 36' 15"
R 90.00
T 46.46
L 85.77

78.01 @ 0:00 T 70
= 78.00.

BC

S83°W

174° 07' 30"

Plug + tk 30A
Set 1x2 tk

174-07 30
336 30 30
174 07 37½

25.39

129.61 @ 4" 55 T 70
= 129.12.

EC 129.12

A 33° 36-40.
R 225.00
T 67.96
L 131.99

146-23 30

PI 29A
Set 1x2 tk

146° 23 30
225 34.00
146 23 30

20.39

BC

From PI 29A

Cont. from Lot page 19

RETURN TO
LOS ANGELES COUNTY SURVEYOR
700 HALL OF RECORDS

Note: Any Additions or Changes on This Sheets Must be Made or Circled in Red Ink With Date and Name of Person Making Change.

Do not extend notes this side of this line

Map No. B-1830	W. O. 8-43 Tape No. 6 St'd 84 of
Office Work	Surveyed by Stevenson
Checked	Notes Date 12-21-38
Date	Indexed

F.B. 779 Pg. 21

Cont from bot page 19

148.26 @ 6°50 T 70 = 147.20'

Δ 28-19-30"
R 275.00
T 69.39
L 135.95

151-40 30
246 41 45
151 40 26½

147.20' to P.I. 33A

P.C.

40'

8°

P.I. 34A Set 1"x2" and tk

211.32 @ 5°58 T 70° = 210.16'

16

210.16'

P.C.

100° 54 00
43 35 30
100 52 52½

P.I. 33A Set 3/4" IP plug + tk

Δ 79-06-15"
R 60.00
T 49.55
L 82.84

45'

N 15°E

227.42'

228.47 @ 5°25 T=70°
= 227.42'

P.C.

Δ 56°-57 25"
R 300.00
L 162.74
298.23

123°-02 30"
136°-10 00"
123 02 30

123°-02

35'

P.I. 32A Set 3/4" IP plug + tk

From P.I. 31A

Cont from top page 20

Note: Any Additions or Changes on This Sheets Must be Made or Circled in Red Ink With Date and Name of Person Making Change

Do not extend notes this side of this line

RETURN TO
LOS ANGELES COUNTY SURVEYOR
700 HALL OF RECORDS

FORM 247 SM 10-37

F.B. 778 PG. 22

Cont. to bot. page 23

130.03 @ 9-18 T 70°
128.32

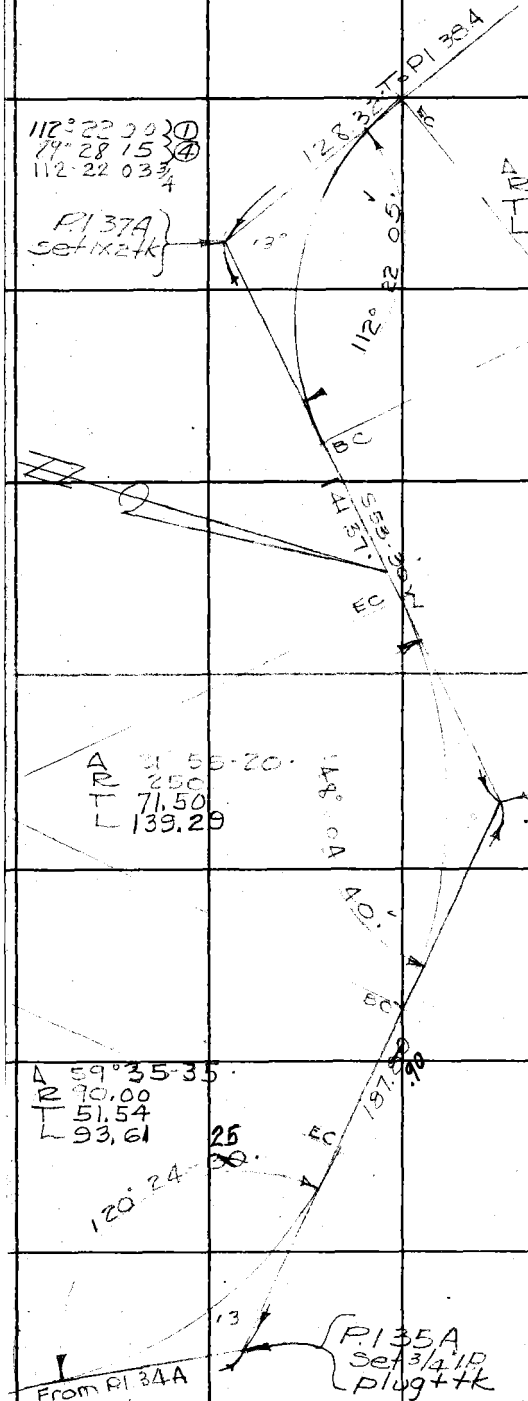

141.63 @ 5°-30 T 70°
141.37

148 0[illegible]

189.83 @ 2-08 T 70°
=187.80

① 120° 21 30
④ 120 24 30

Cont. flow to top page 21

RETURN TO
LOS ANGELES COUNTY SURVEYOR
700 HALL OF RECORDS

Note: Any Additions or Changes on This Sheets Must be Made or Circled in Red Ink With Date and Name of Person Making Change.

Do not extend notes this side of this line

Notes Ck'd by		Survey of Los Virgenes Fit. System	F.B. 778 Pg. 23
Map No. B-1830		W. O. 8243 Tape No. 63 St'd 74°F	
Office Work		Surveyed by Stevenson	
Checked		Notes	Date 12-27-73
Date		Indexed	

Cont from page 22

59.26@3°58 T 70° = 59.11

59 1770 P1.41A

Ang Pt. P1.40A set 1x cut

162°

162° 29 15
289° 57 09
162-29 15

10585@7°41 T70° = 104.89

104.89

141 26 00
205 44 00
141 26 00

P1.39A set 3/4 IP plug + tk

122

141° 26-00"

Δ 39°34-00"
R 508.00
L 314.62

EC

180.27@3°08 T70 = 70.00

Δ 49-03 50
R 125.00
T 57.05
L 107.04

130° 56-10" EC

P1.38A set 3/4 IP plug + tk

130 56 15
163 44 30
130 56 07½

BC

From P1.37A

Cont from top page 22

Note: Any Additions or Changes on This Sheets Must be Made or Circled in Red Ink With Date and Name of Person Making Change.

Do not extend notes this side of this line

RETURN TO
LOS ANGELES COUNTY SURVEYOR
700 HALL OF RECORDS

FORM 247 SM 10-37

Cont Hobol page 25

F.B. 778 PG. 24

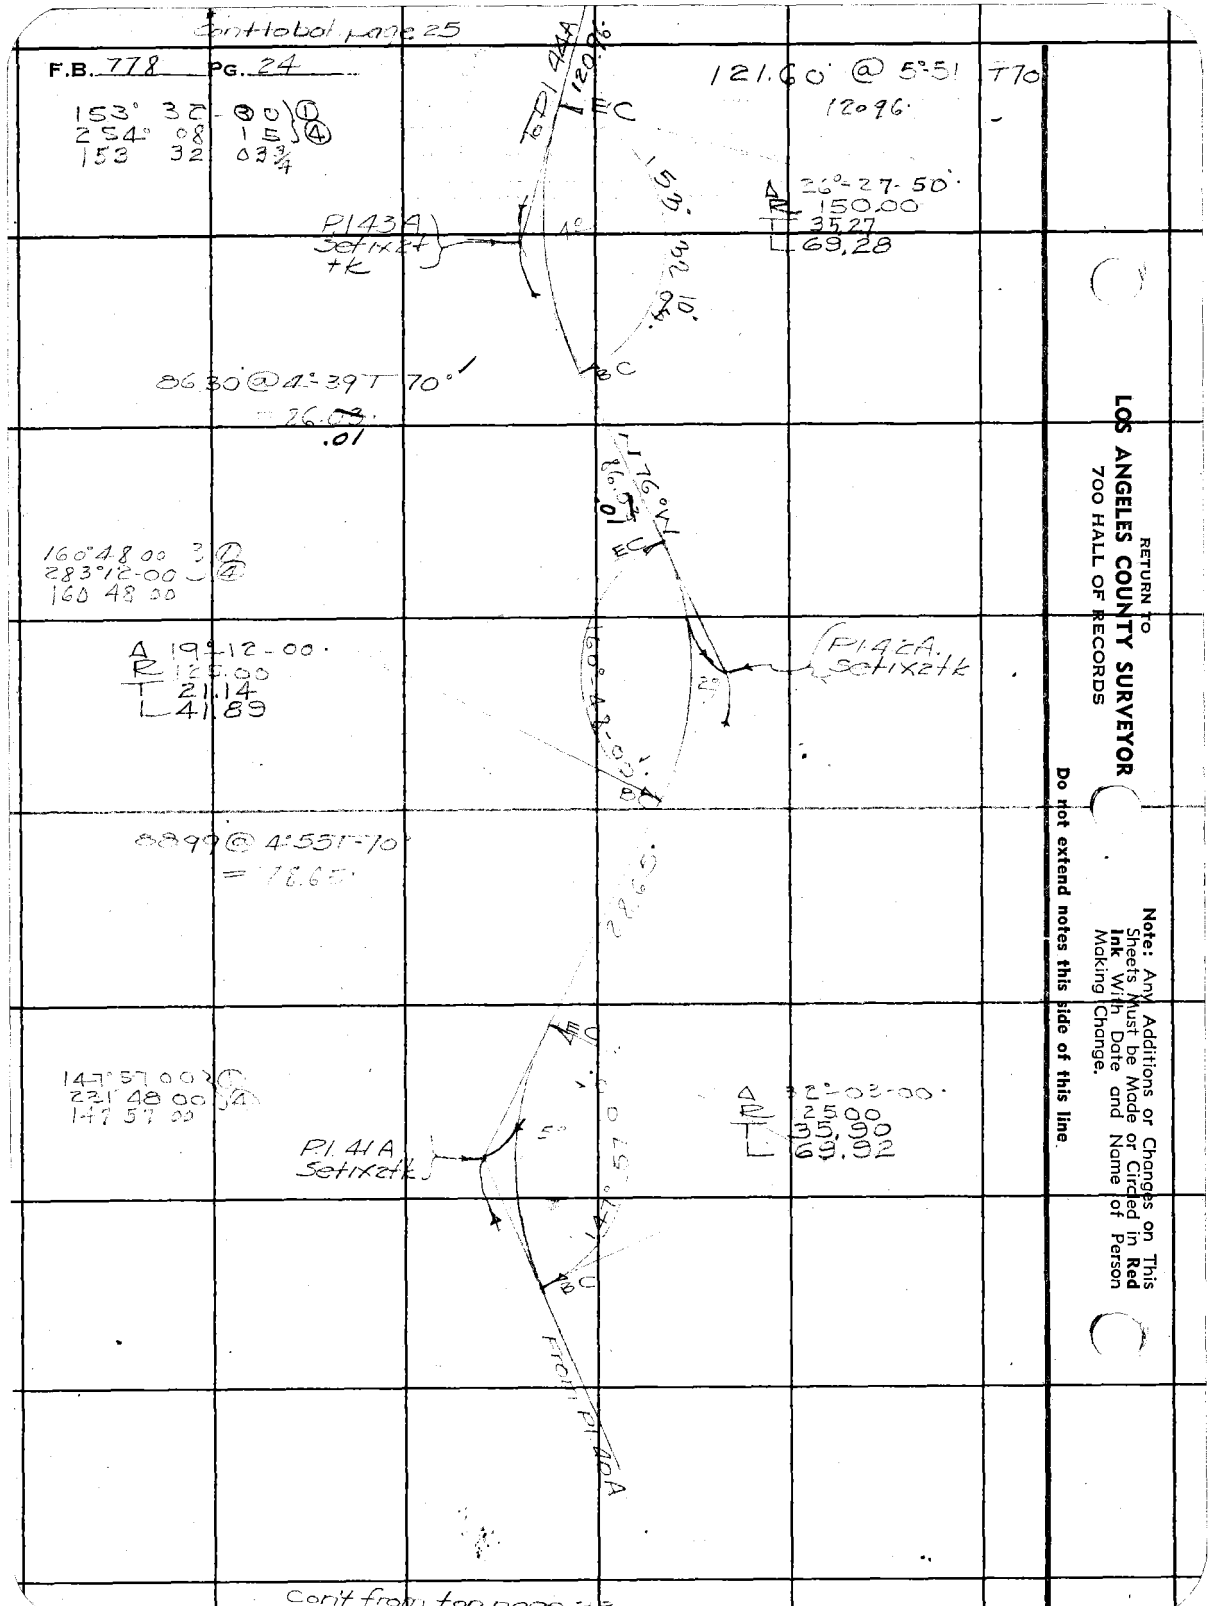

Cont from top page 25

RETURN TO
LOS ANGELES COUNTY SURVEYOR
700 HALL OF RECORDS

Note: Any Additions or Changes on This Sheets Must be Made or Circled in Red Ink With Date and Name of Person Making Change.

Do not extend notes this side of this line.

Notes Ck'd by		Survey of Las Virgenes Fit System	F.B. 778 Pg. 25
Map No. B-1830		W. O. 8243 Tape No. 69 St'd 61 OF	
Office Work		Surveyed by Stevenson	
Checked		Notes Date 12-27-38	
Date		Indexed	

Cont to bot page 26

101.43 @ 4°22 TGO = 101.13'

TO H147A

101.13'

E

0

P146A Set 3/4" IP Plug + tk

Granted east 7/22/41 Hoffmans

153°07'15"
252 31 00
153 07 15

53° 07' 45"

BC

A 72-52-25
R 200.00
T 47.78
L 93.81

225.22 @ 3°16 TGO
= 224.84'

A 95°34'15"
R 25.00
T 27.48
L 41.63

84° 35'

18°

P145A Set 3/4" IP Plug + tk

114.21 @ 7°43 TGO
= 103.23'

112°E

EC

84° 36'
88° 23'45"
84 35 56½

127°42'30" ①
158°50'00" ②
129 12 30

P144A Set 1x24 tk

7°

129°

A 50°17'20"
R 75.00
T 35.20
L 65.83

FROM P143A

BC

Cont from top page 24

Note: Any Additions or Changes on This Sheets Must be Made or Circled in Red Ink With Date and Name of Person Making Change.

Do not extend notes this side of this line

RETURN TO
LOS ANGELES COUNTY SURVEYOR
700 HALL OF RECORDS

FORM 247 SM 10-37

F.B. 778 PG. 26

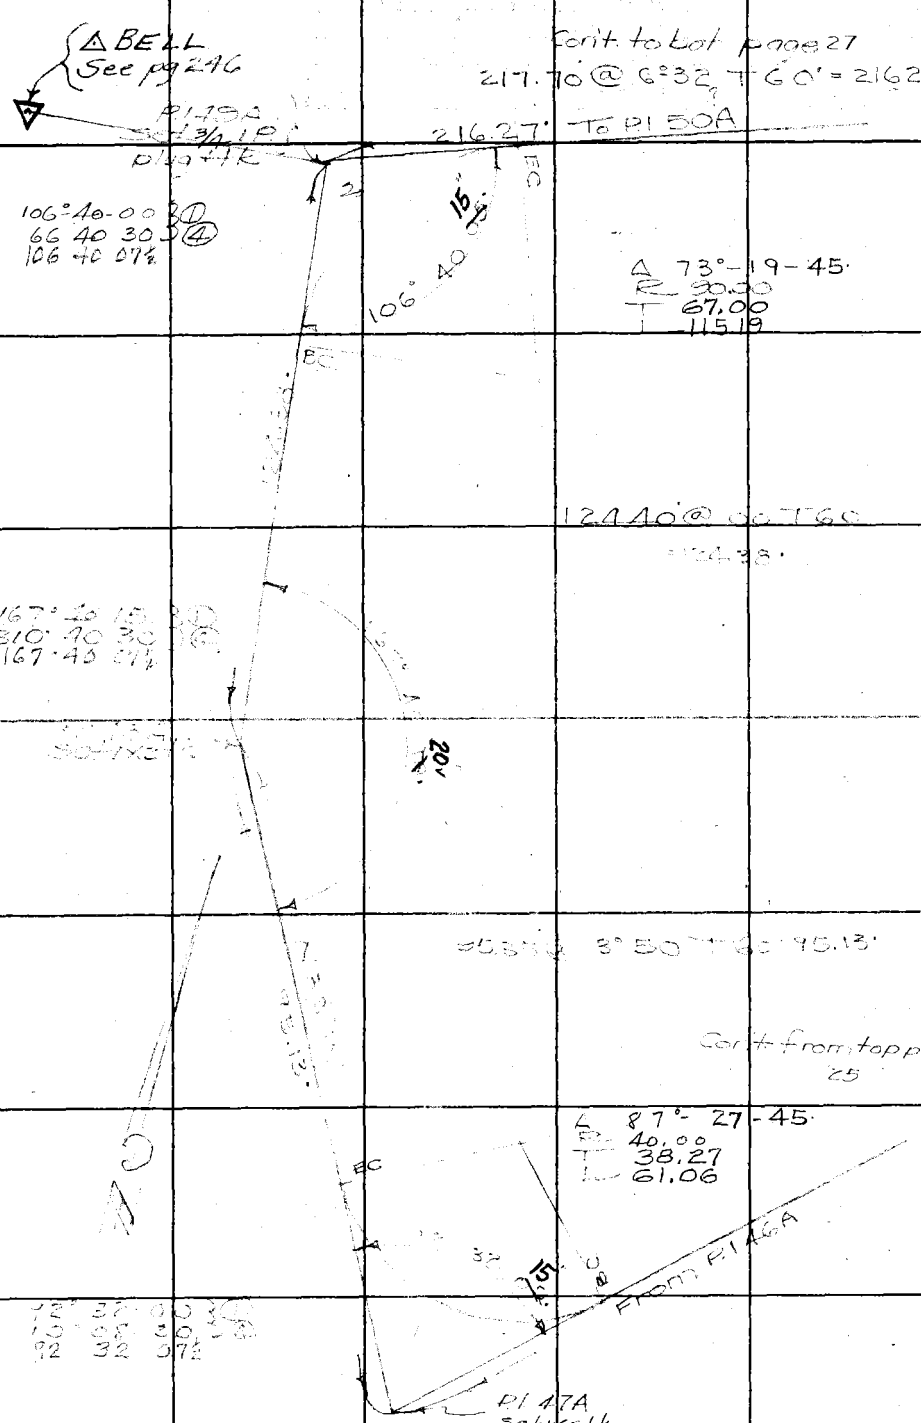

RETURN TO
LOS ANGELES COUNTY SURVEYOR
700 HALL OF RECORDS

Note: Any Additions or Changes on This Sheets Must be Made or Circled in Red Ink With Date and Name of Person Making Change.

Do not extend notes this side of this line

Notes Ck'd by		Survey of	F.B. 778 PG. 21
Map No. B-1830		W. O.	Tape No.	St'd
Office Work		Surveyed by	Stevenson
Checked		Notes	Date 12-28-38
Date		Indexed	

Note: Any Additions or Changes on This Sheets Must be Made or Circled in Red Ink With Date and Name of Person Making Change.

Do not extend notes this side of this line

RETURN TO
LOS ANGELES COUNTY SURVEYOR
700 HALL OF RECORDS

19356 @ 3° 37' T 56 = 193.15'

193.15' T

119° 50 45 ①
119° 22 30 ④
119° 50 37½

P/S IA
Set 3/4 IP
Plug + tk

50.00

151.16 @ 1° 50' T 63 = 151.07'

Δ 60° 09' 10"
R 110.00
T 63.70
L 115.49

N 71° 15' W 151.07'

Con't from top page 26

Δ 155° 05' 00"
R 60.00
T 271.58
L 168.40

105° 58 00 ①
63 52 00 ④
105 58 00

POST ②
Set 3/4 IP
plug + tk

234.53

72° 57' 15 ①
35 48 30 ④
98 57 07½

Curve 50A
Set 3/4 IP plug + tk

100.33 @ 4° 31' T 62°
100.00'

Curve 50A

228.21

FORM 247 5M 10-37

F.B. 778 PG. 28

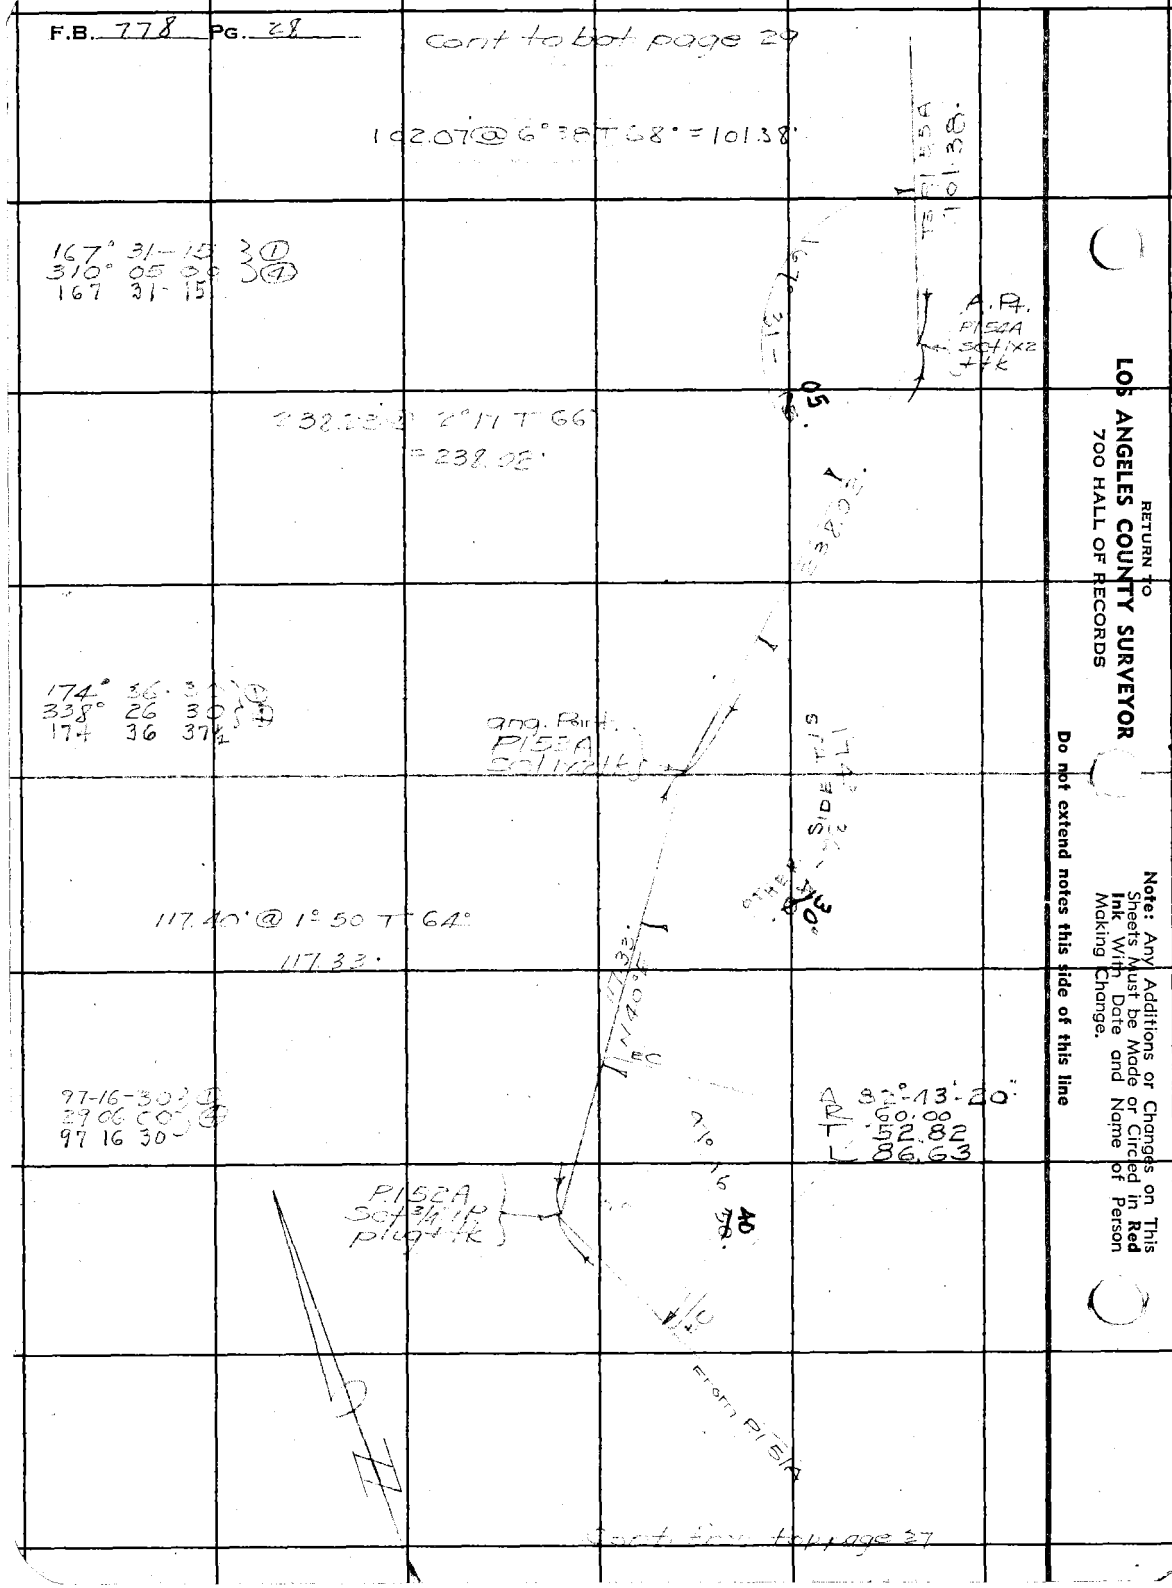

RETURN TO
LOS ANGELES COUNTY SURVEYOR
700 HALL OF RECORDS

Note: Any Additions or Changes on This Sheets Must be Made or Circled in **Red Ink** With Date and Name of Person Making Change.

Do not extend notes this side of this line

Notes Ck'd by	Survey of Las Virgenes FTT System
Map No. 9-1830	W. O. 2243 Tape No. 69 St'd 84 of
Office Work	Surveyed by Stevenson
Checked	Notes Date 12-28-38
Date	Indexed

F.B. 778 PG. 29

Note: Any Additions or Changes on This Sheets Must be Made or Circled in Red Ink With Date and Name of Person Making Change.

Do not extend notes this side of this line

RETURN TO
LOS ANGELES COUNTY SURVEYOR
700 HALL OF RECORDS

FORM 247 5M 10-37

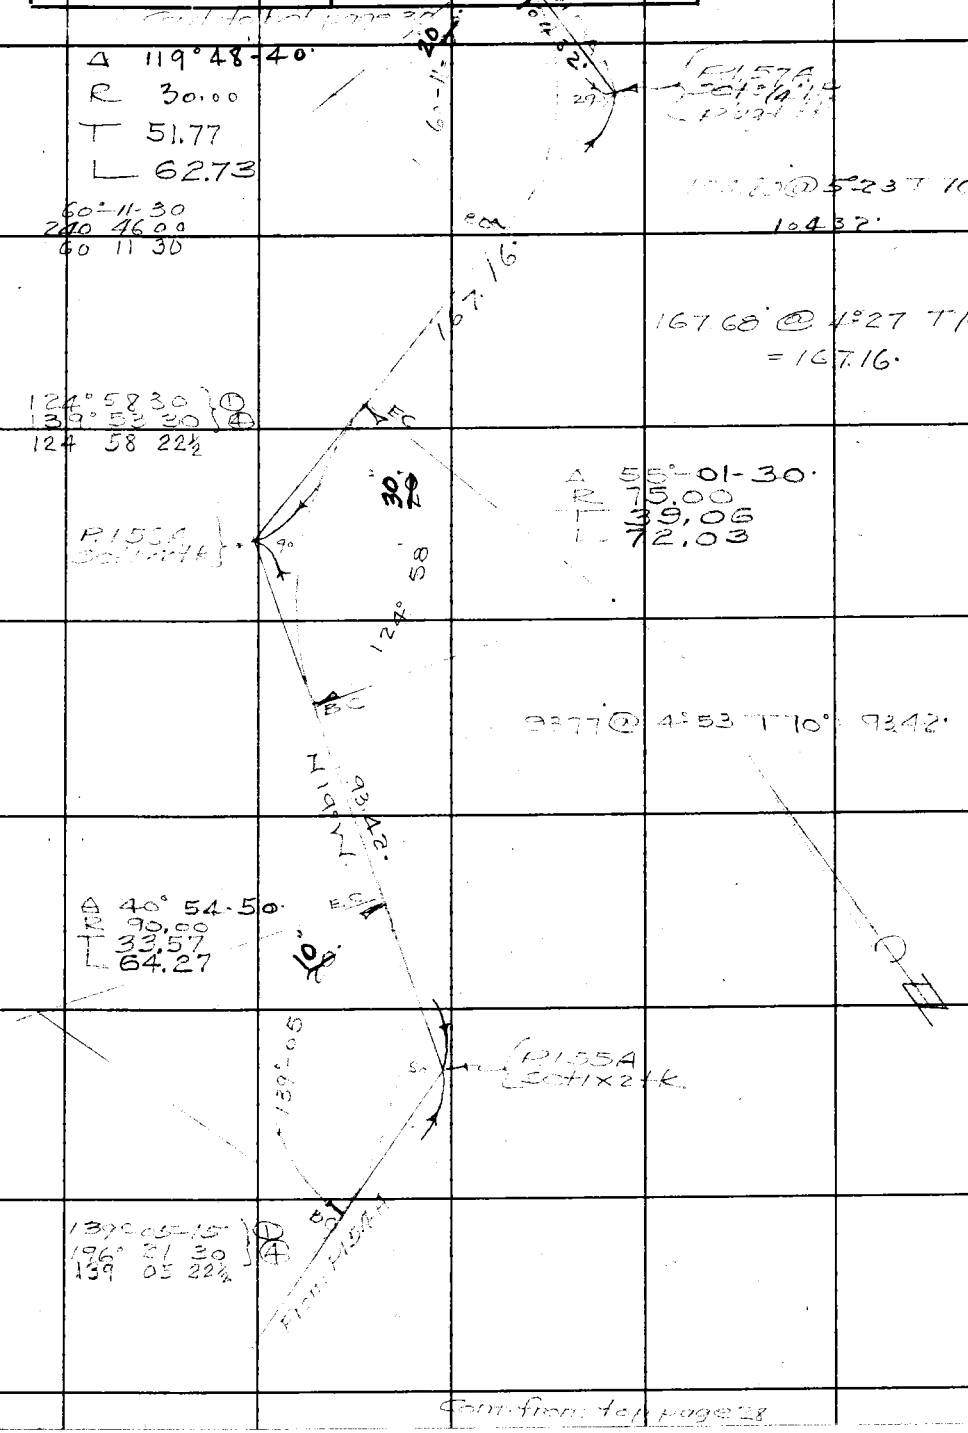

F.B. 778 PG. 30

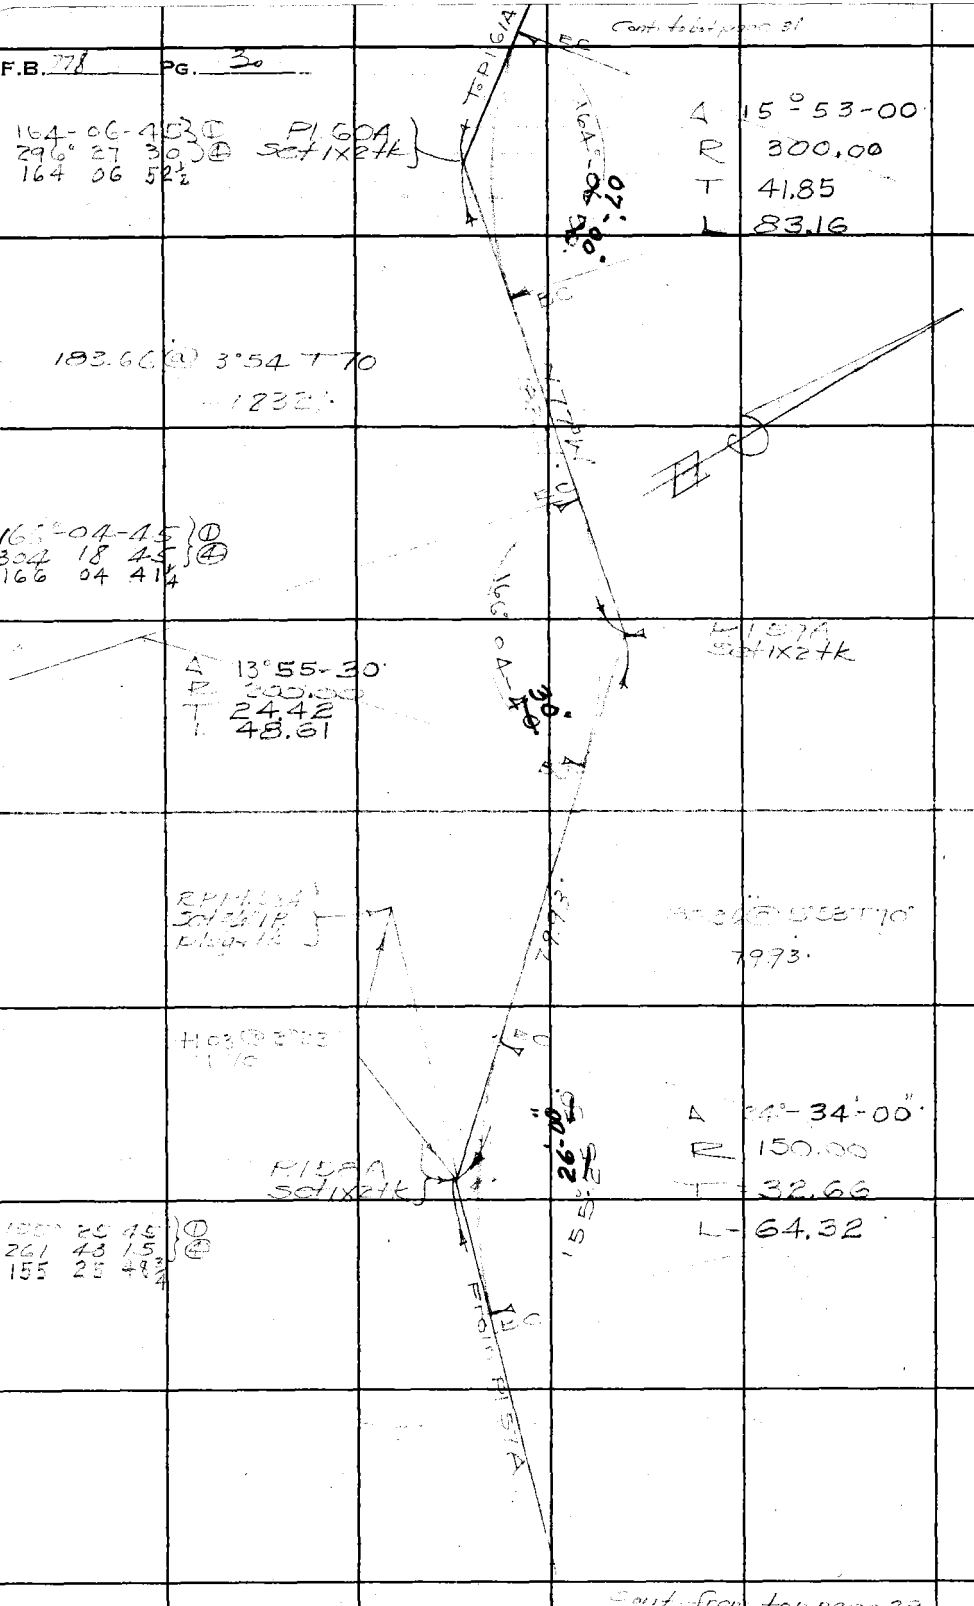

RETURN TO
LOS ANGELES COUNTY SURVEYOR
700 HALL OF RECORDS

Note: Any Additions or Changes on This Sheets Must be Made or Circled in **Red Ink** With Date and Name of Person Making Change.

Do not extend notes this side of this line

Notes Ck'd by		Survey of Los Virgenes FIT System	F.B. 778 Pg. 31
Map No. 9-1830		W. O. 8243 Tape No. 1	St'd 24 OF
Office Work		Surveyed by Stevenson	
Checked		Notes T.N.S.	Date 12-28-38
Date			Indexed

Cont. to bot. of p. 32

113.82 @ 5°44 T 66°
113.24'
Δ 11°37'05"
R 200.00'
T 20.35'
L 40.55'

71.63A
Set 1x24k

168°22'45"D
313 37 00 D
168 22 45

32.45 @ 5°39 T 64
32.39'

Δ 27°47'40"
R 150.00'
T 37.11'
L 72.77'

20'

{ 1.62A
Set 1x2 4k

{ 152°12'30"
248 50 00
152 12 30

14.12 14 @ 3°23'70"
14.14'

{ 172°22'15"
330 08 45
172 22 15

{ 01.61A
Set 1x2 4k

6911 @ 00°76'8"
6910'

Cont. from Vol. page 30

RETURN TO
LOS ANGELES COUNTY SURVEYOR
700 HALL OF RECORDS

Note: Any Additions or Changes on This Sheets Must be Made or Circled in Red Ink With Date and Name of Person Making Change.

Do not extend notes this side of this line

FORM 247 5M 10-37

F.B. 118 PG. 32

Cont. to bot page 33

250.30' @ 4°-23'TC 41'
= 251.52'

E54.52'TG P1.66A

123° 36' 15"

Δ 56°-23-45"
R 75.00
T 40.21
L 73.82

123° 36' 00" (3) (1)
134 24 30 (2) (4)
123 36 07½

E3.72' NE R=50' T 64°
93.76'

E3.72'

103° 02' 15" (3) (1)
103 02 03¾

Δ 76°58-05"
R 50.00
T 39.75
L 67.17

103° 02' 01'-55"

P1.66A
(Bright)

FROM P1.62A

Cont. from top page 31

RETURN TO
LOS ANGELES COUNTY SURVEYOR
700 HALL OF RECORDS

Note: Any Additions or Changes on This Sheets Must be Made or Circled in Red Ink With Date and Name of Person Making Change.

Do not extend notes this side of this line

Notes Ck'd by		Survey of Los Virgenes FTT System	F.B. 778 Pg. 33
Map No. B-1830		W. O. 5243 Tape No. 47 St'd 74 OF	
Office Work		Surveyed by Stevenson	
Checked		Notes JS Date 12-28	
Date		Indexed	

Cont. to Sht. Page 34

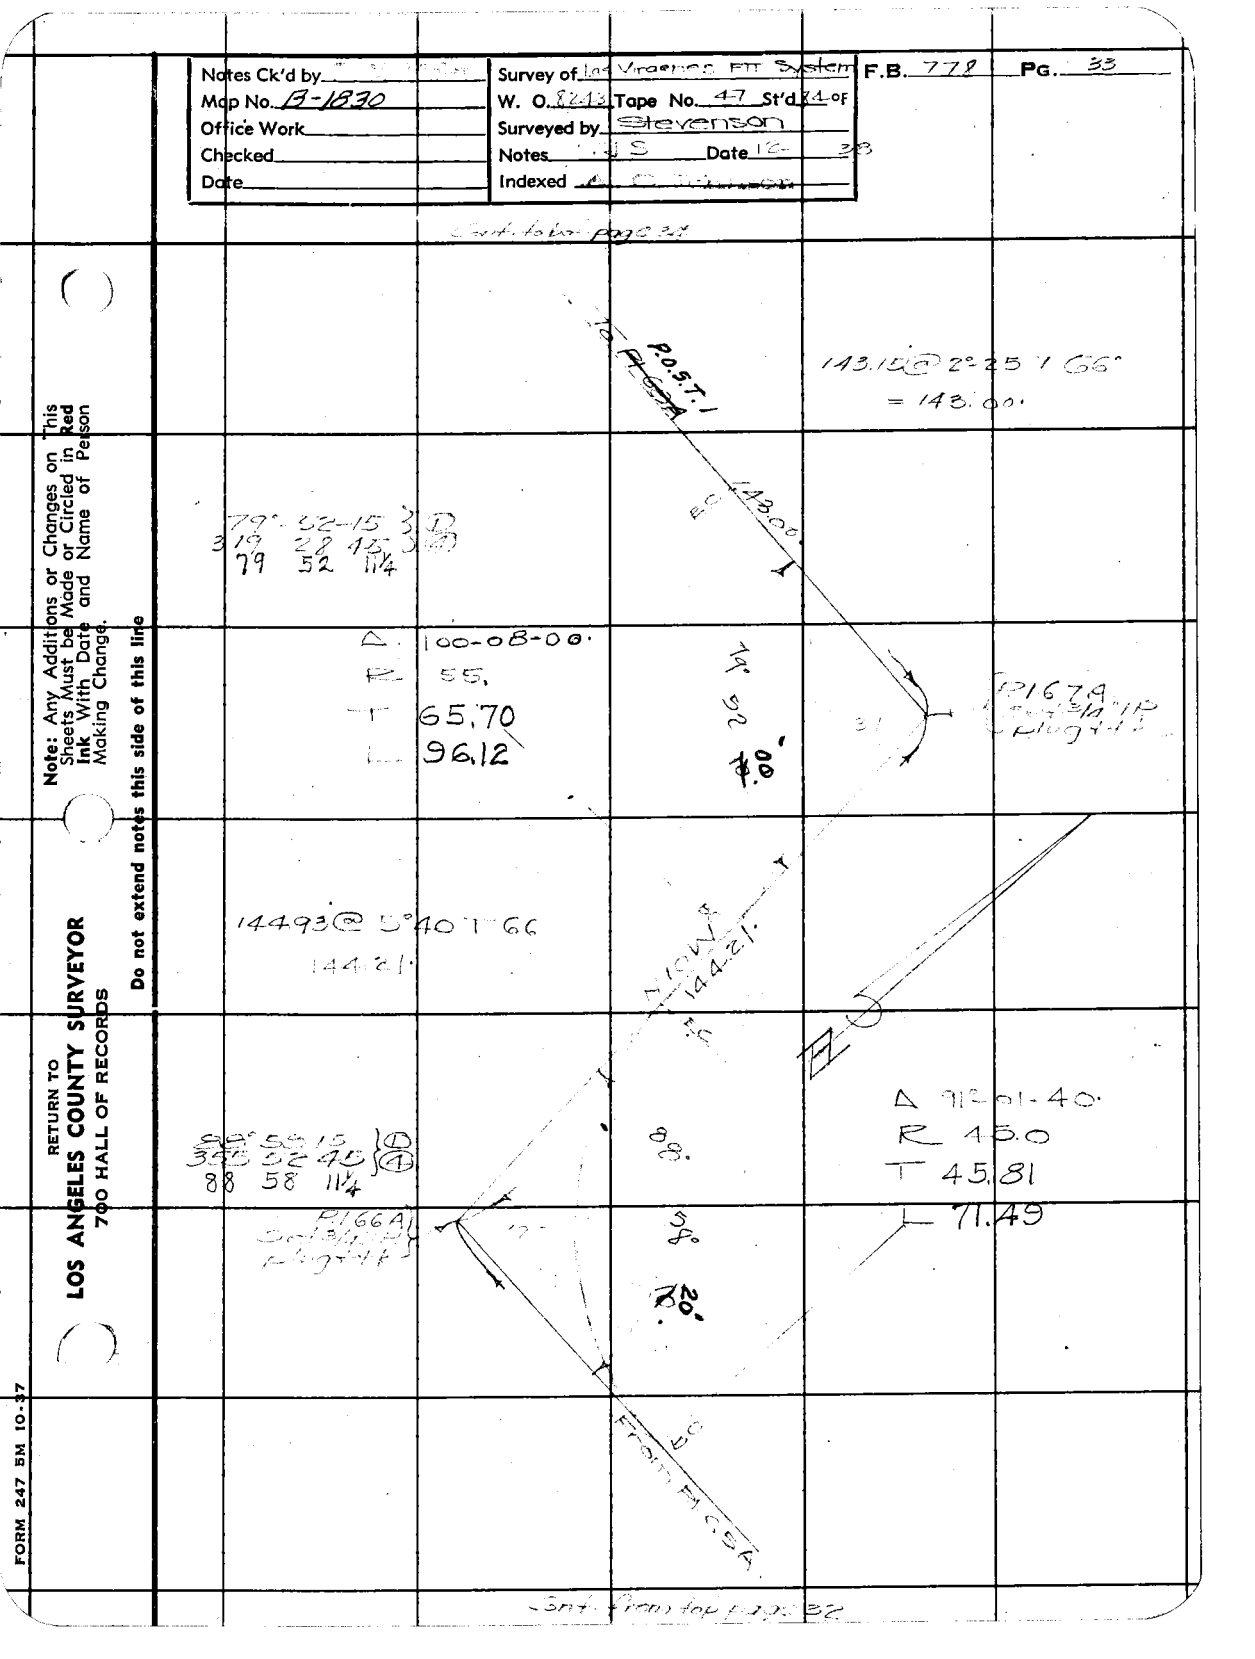

Cont. from Sht. Page 32

RETURN TO
LOS ANGELES COUNTY SURVEYOR
700 HALL OF RECORDS

Note: Any Additions or Changes on This Sheets Must be Made or Circled in Red Ink With Date and Name of Person Making Change.

Do not extend notes this side of this line

FORM 247 5M 10-37

Cont to bot page

F.B. 778 PG. 34

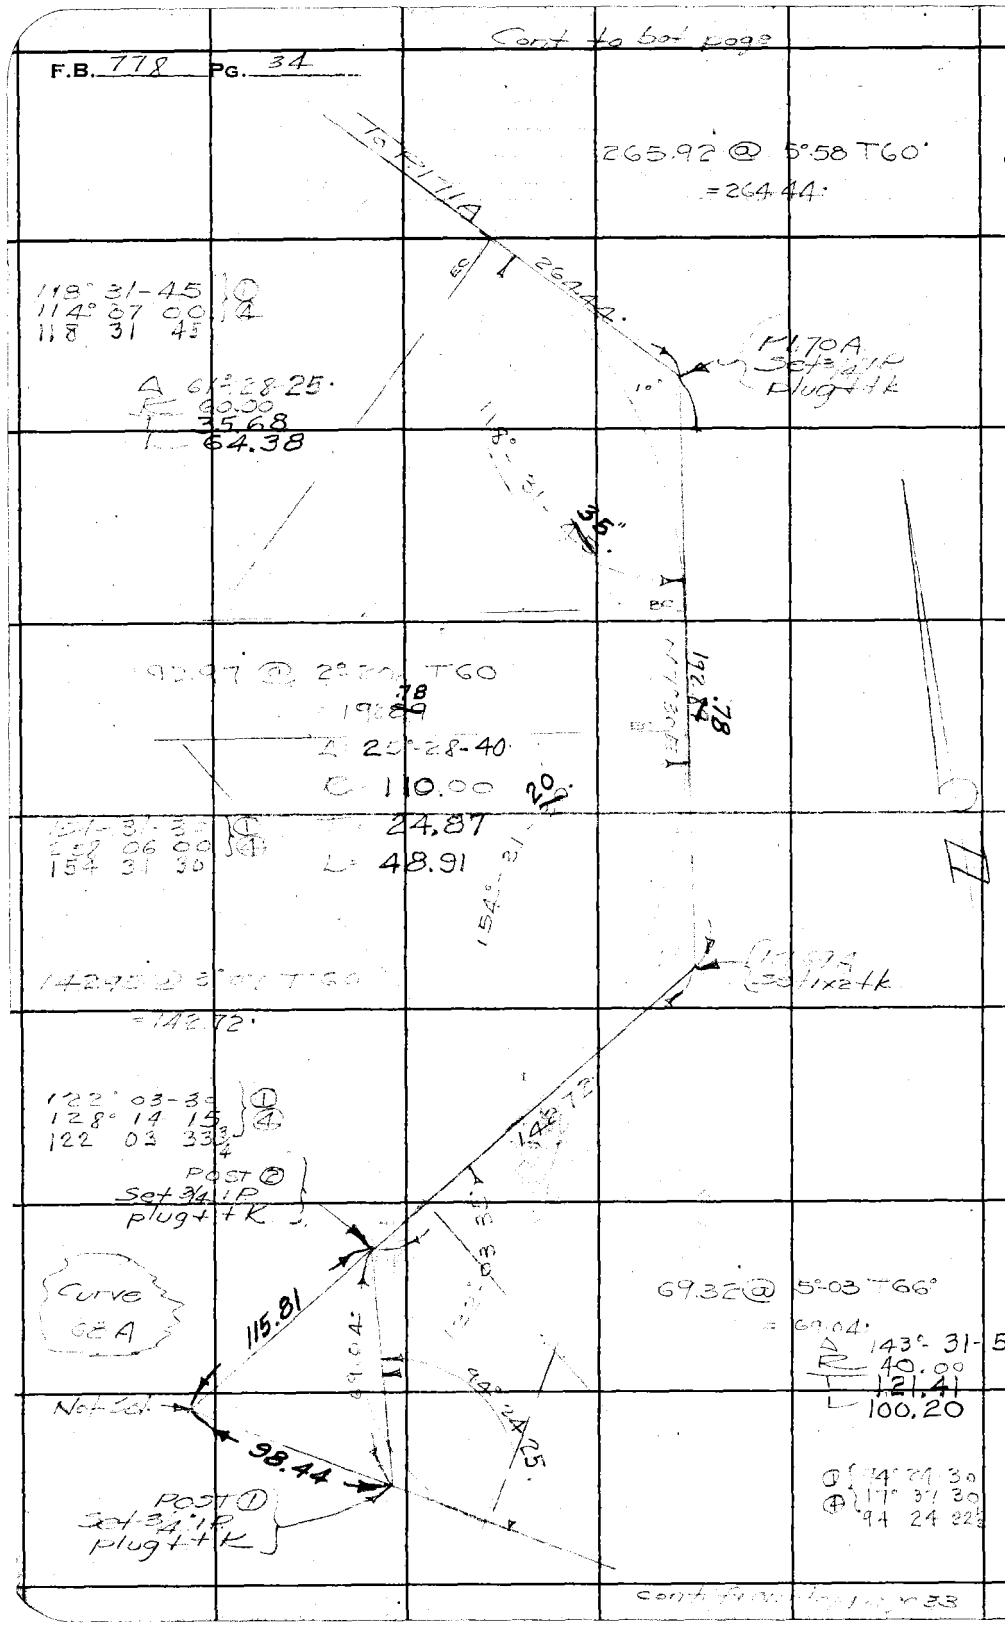

RETURN TO
LOS ANGELES COUNTY SURVEYOR
700 HALL OF RECORDS

Note: Any Additions or Changes on This Sheets Must be Made or Circled in Red Ink With Date and Name of Person Making Change.

Do not extend notes this side of this line

Notes Ck'd by D M Finley	Survey of LOS VIRGENES F/L SYSTEM	F.B. 778	PG. 35
Map No. B-1830	W. O. 3243 Tape No. — St'd 14 OF		
Office Work	Surveyed by STEVENSON		
Checked	Notes T.J.C. Date 12-27-37		
Date	Indexed C. Johnson		

See F.B. 778 Pg. 36

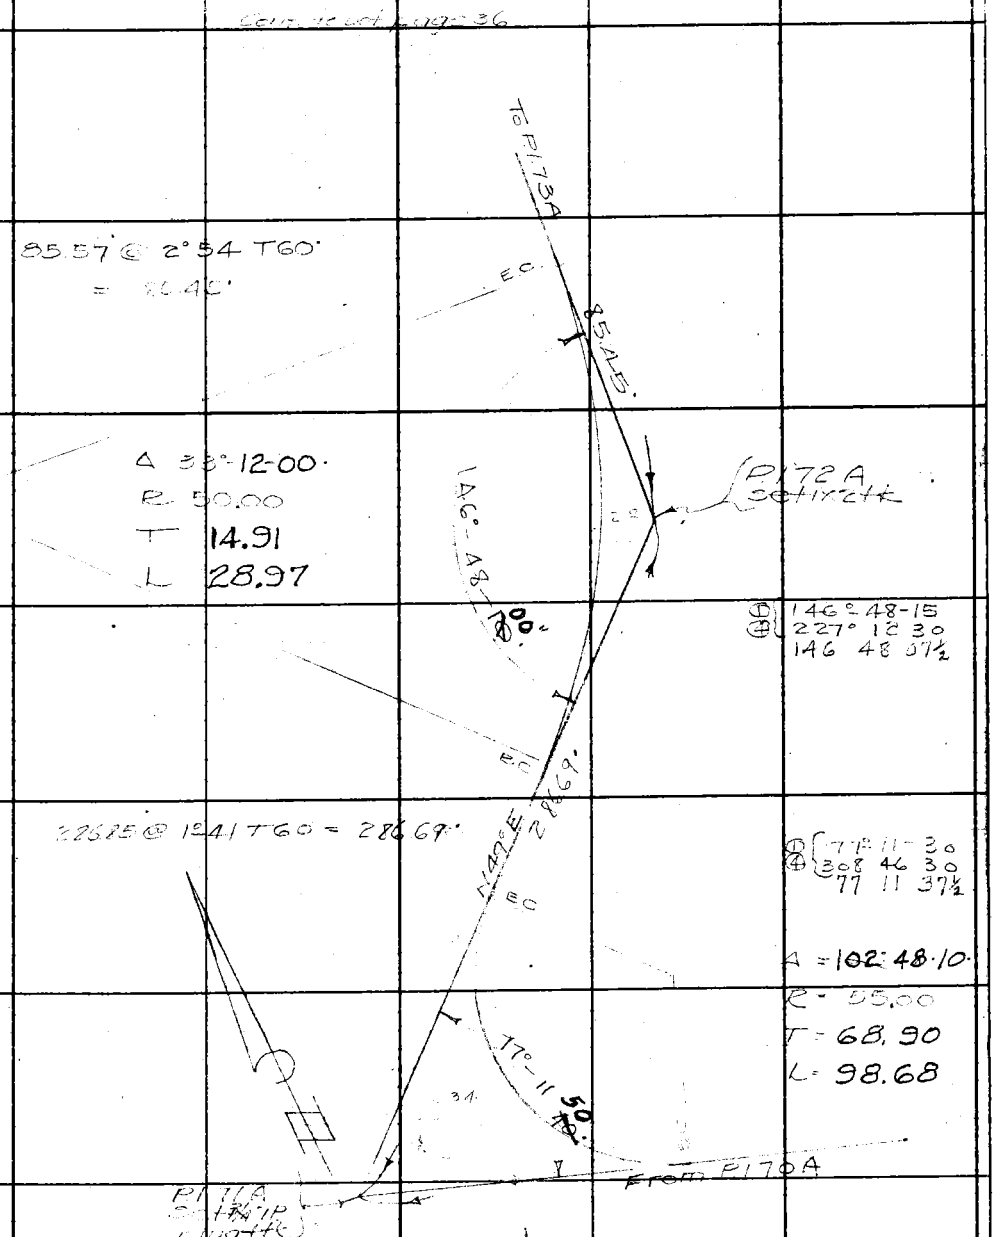

See F.B. 778 Pg. 34

Note: Any Additions or Changes on This Sheets Must be Made or Circled in Red Ink With Date and Name of Person Making Change.

Do not extend notes this side of this line

RETURN TO
LOS ANGELES COUNTY SURVEYOR
700 HALL OF RECORDS

FORM 247 5M 10-37

Cont to bot page 37

F.B. 778 PG. 36

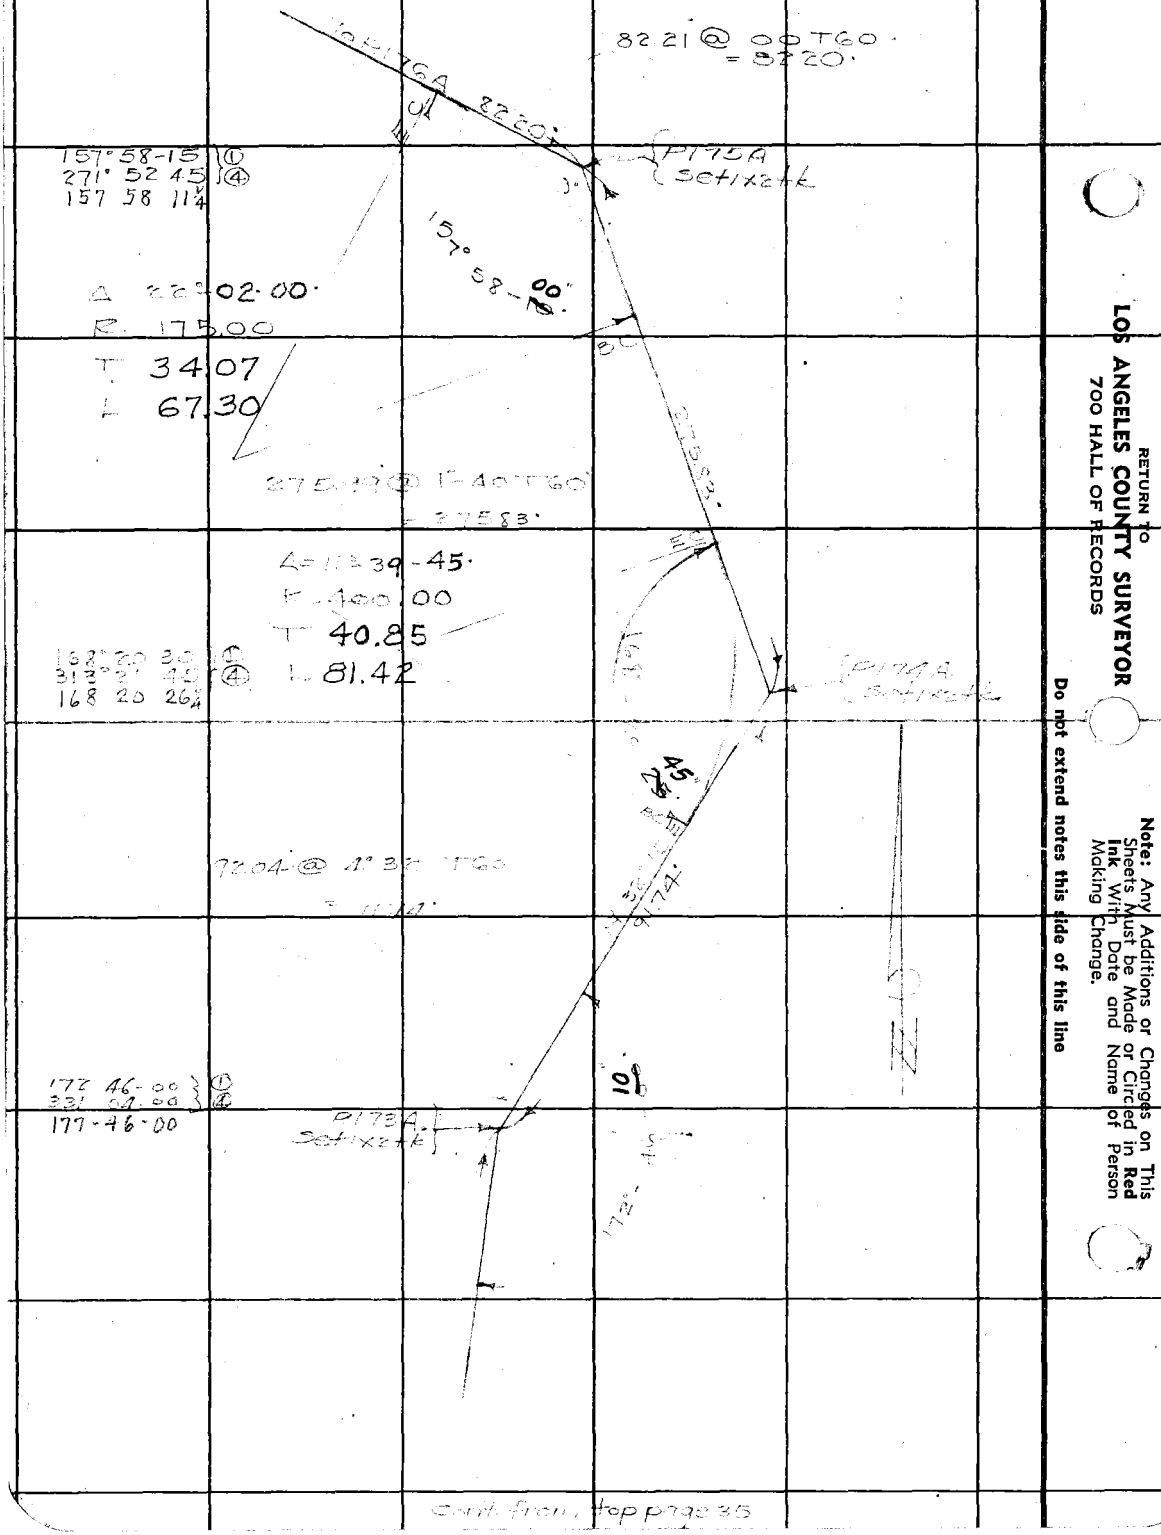

Cont from top page 35

RETURN TO
LOS ANGELES COUNTY SURVEYOR
700 HALL OF RECORDS

Note: Any Additions or Changes on This Sheets Must be Made or Circled in Red Ink With Date and Name of Person Making Change.

Do not extend notes this side of this line

Notes Ck'd by	Survey of Los Virgenes Eff System F.B. 778 Pg. 37
Map No. B-1830	W. O. 824-2 Tape No. 41 St'd 74 of
Office Work	Surveyed by Stevenson
Checked	Notes TVS Date 12-29-28
Date	Indexed A. C. Johnson

cont. to bot. page 38

Note: Any Additions or Changes on This Sheets Must be Made or Circled in Red Ink With Date and Name of Person Making Change.

Do not extend notes this side of this line

RETURN TO
LOS ANGELES COUNTY SURVEYOR
700 HALL OF RECORDS

FORM 247 5M 10-37.

182.01' S 5°-45 T G 2°
182.01'

To P.L. 79A 182.01'

P.L. 79A set 3/4" IP plug + tk

① 130° 48 00
④ 163° 11 45
130 47 56½

30°
47-54'

212.24' @ 2°-08' T 62°
= 211.65'

A 29°-12-15
R 150.00
T 68.68
L 128.82

35°

152° 24'

① 152° 24 15
④ 38 45
152 24 41¼

A 27°-35-25
R 300.00
T 73.66
L 144.46

P.L. 79A set 3/4" IP plug + tk

126.31' @ 2°-07' T 60°
126.20'

126.20'

P.L. 79A set 1x2 tk

A 42°-37-20
R 70.00
T 27.31
L 52.07

137° 22' 30" ①
189° 30 30 ②
137 22 37½

cont. from top page 36

F.B. 778 PG. 38

Cont. to bot page 39

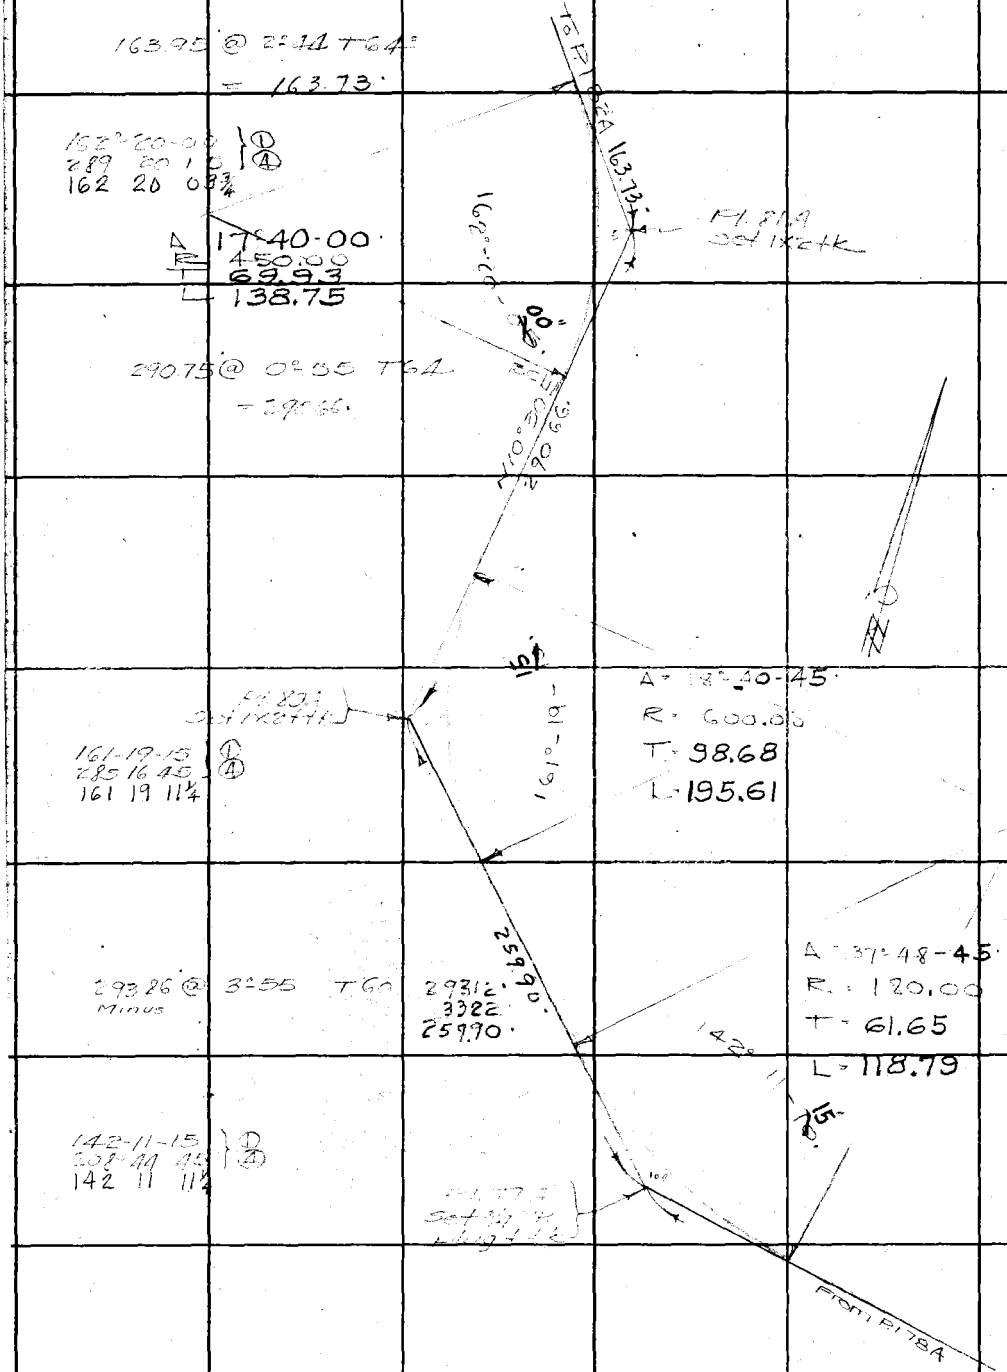

Cont. from top page 37

RETURN TO
LOS ANGELES COUNTY SURVEYOR
700 HALL OF RECORDS

Note: Any Additions or Changes on This Sheets Must be Made or Circled in Red Ink With Date and Name of Person Making Change.

Do not extend notes this side of this line

Notes Ck'd by		Survey of Los Virgenes Pipeline	F.B. 778 Pg. 39
Map No. B-1830		W. O. 2643 Tape No. 41 St'd 84 OF	
Office Work		Surveyed by Stevenson	
Checked		Notes TJS Date 12-29-82	
Date		Indexed	

RETURN TO
LOS ANGELES COUNTY SURVEYOR
700 HALL OF RECORDS

Note: Any Additions or Changes on This Sheets Must be Made or Circled in Red Ink With Date and Name of Person Making Change.

Do not extend notes this side of this line

FORM 247 5M 10-37

83.80 @ 6°05'T64
= 83.54
.32

171° 54' 00" (1)
327 35 45 (4)
171 53 56½

P184A
Set 1x2 tk

A = 8°06'00"
R = 400.00
T = 28.32
L = 56.55

RP P183A
Set 3/4" IP
plug tk

126.95
126.72
37.89
164.61

A = 26°34'45"
R = 100.00
T = 23.62
L = 46.39

P183A
Set 1x2 tk

153° 25' 15" (3)
253 41 15 (4)
153 25 18¾

20666 4° 57' 61" 8033

139° 33' 15" (1)
198° 13' 00" (4)
139 33 15

P182A
Set 1x2 tk

A = 40°26'40"
R = 125.00
T = 46.05
L = 88.24

RP P182A
Set 3/4" IP
plug tk

Cont. from top page 38

F.B. 778 PG. 40

cont to bot page 41

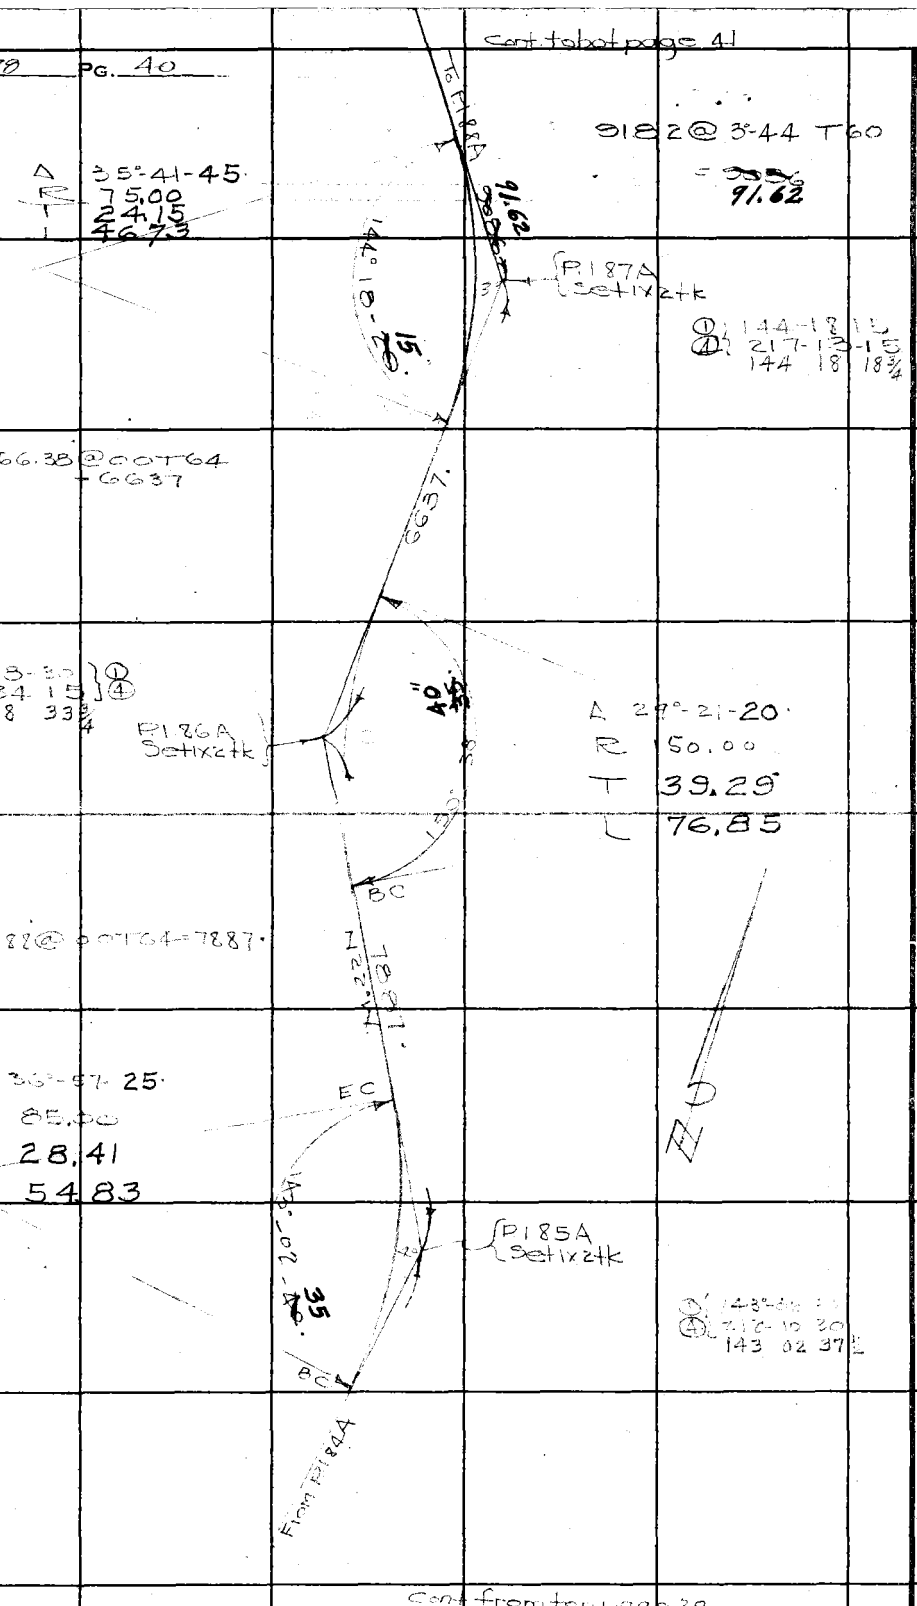

cont from top page 39

RETURN TO
LOS ANGELES COUNTY SURVEYOR
700 HALL OF RECORDS

Note: Any Additions or Changes on This Sheets Must be Made or Circled in Red Ink With Date and Name of Person Making Change.

Do not extend notes this side of this line

Notes Ck'd by		Survey of Los Virgenes MT System	F.B. 770 Pg. 41
Map No. B-1830		W. O. 2242 Tape No. 47 St'd 84 OF	
Office Work		Surveyed by Stevenson	
Checked		Notes T. L. S. Date 12-29-38	
Date		Indexed	

cont from top page 42

300 24 @ 4° 45 T 60
= 299.26'
+ 37.98' (L)
337.24'

337.24' P1 30A

P1 30A
Set 3/4" IP
Plug + tk

159° 11' 30
Δ = 20° 48' 25
R = 400.00
T = 73.44
L = 145.26

159° 11' 30 (1)
276° 46' 00 (4)

117.22'

117 46 @ 3° 39 T 60
= 117.22'

Δ = 13° 37' 45
R = 350.00
T = 41.83
L = 83.26

RP P1 29A
Set 3/4" IP
Plug + tk

47.64'

166° 22' 15 (1)
205 29 15 (4)
166 - 22 18

P1 89A
Set x 2 tk

44.01'

RP P1 89A
Set 3/4" IP
Plug + tk

218.11'

218 73 @ 45 12 T 60
= 218.11'

159° 17' 15 (1)
277 - 09 00 (4)
159 - 17 15

P1 88A
Set x 2 tk

Δ = 20° 42' 40
R = 350.00
T = 63.96
L = 126.52

from P1 91A

cont from top page 40

Note: Any Additions or Changes on This Sheets Must be Made or Circled in Red Ink With Date and Name of Person Making Change.

Do not extend notes this side of this line

RETURN TO
LOS ANGELES COUNTY SURVEYOR
700 HALL OF RECORDS

FORM 247 5M 10-37

Cont. from page 43

F.B. 778 PG. 42

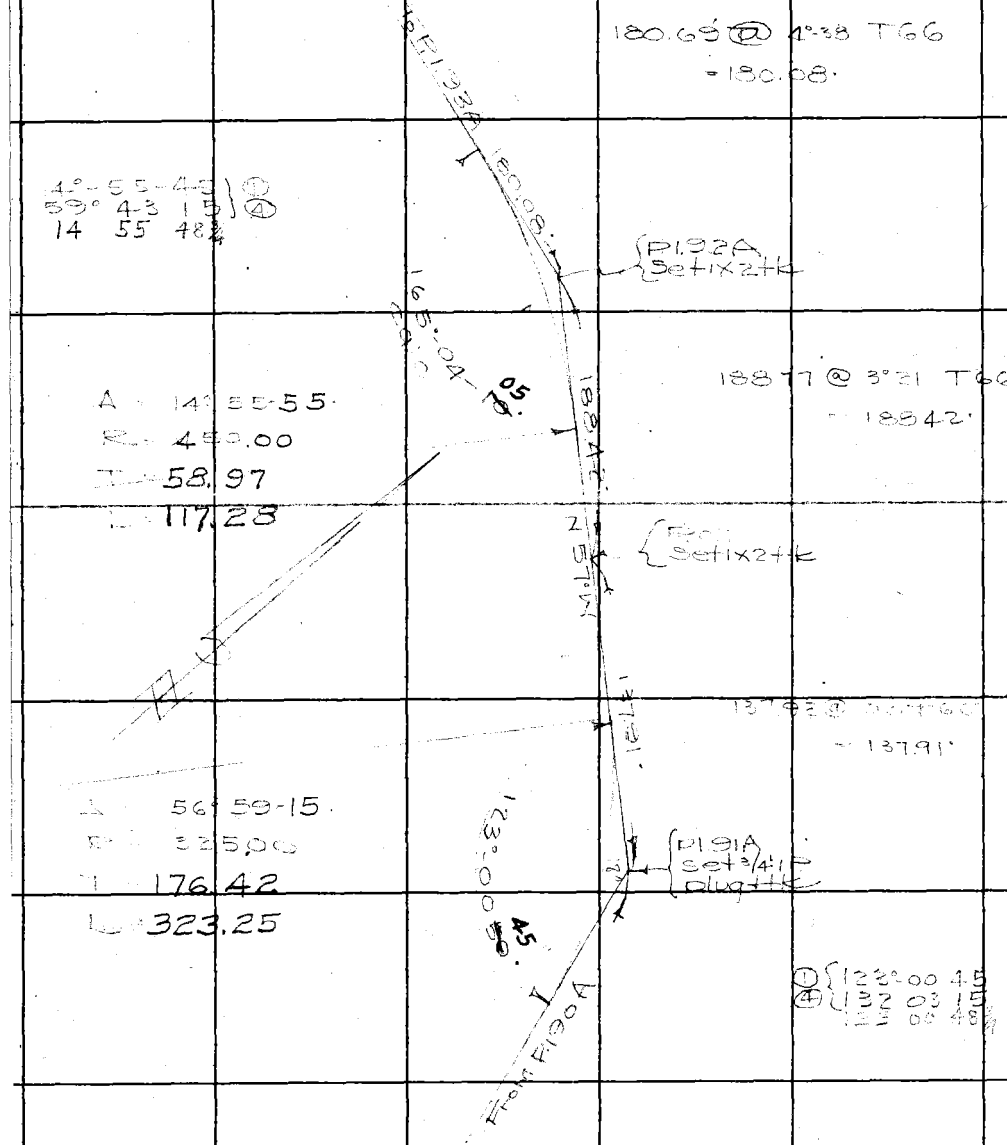

Cont. from page 41

RETURN TO
LOS ANGELES COUNTY SURVEYOR
700 HALL OF RECORDS

Note: Any Additions or Changes on This Sheets Must be Made or Circled in Red Ink With Date and Name of Person Making Change.

Do not extend notes this side of this line

Notes Ck'd by	Survey of Los Angeles Co. Surv. F.B. 778 Pg. 43
Map No. B-1830	W. O. 22-42 Tape No. 47 St'd 34°F
Office Work	Surveyed by Stevenson
Checked	Notes T.S. Date 12-80
Date	Indexed

Cont. from page 44

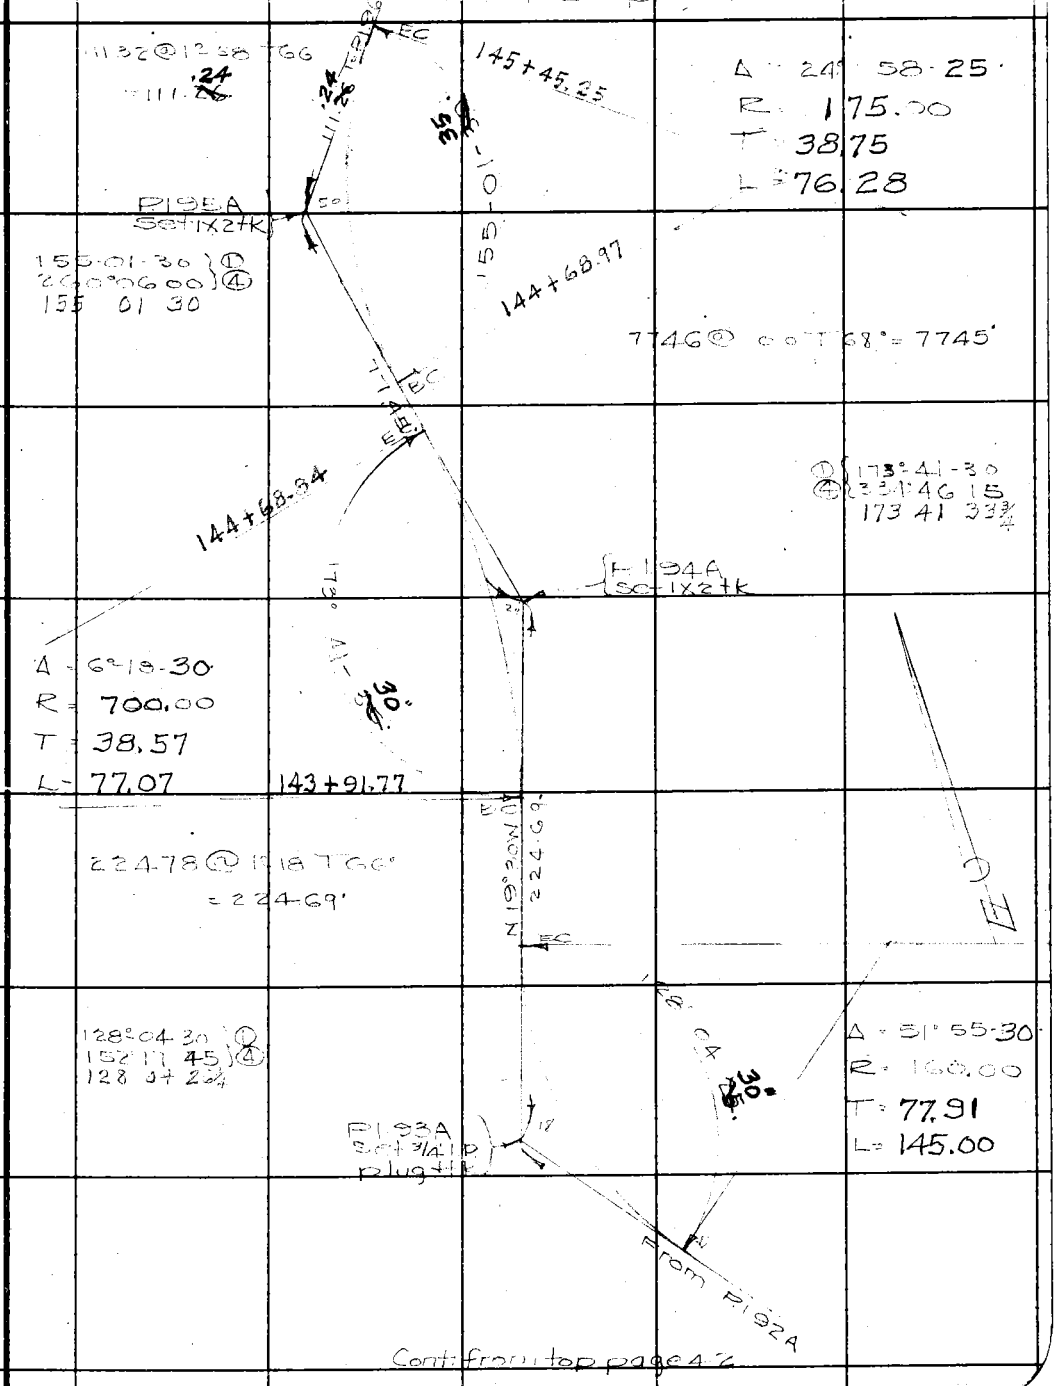

Cont. from top page 46

Note: Any Additions or Changes on This Sheets Must be Made or Circled in Red Ink With Date and Name of Person Making Change.

Do not extend notes this side of this line

RETURN TO
LOS ANGELES COUNTY SURVEYOR
700 HALL OF RECORDS

FORM 247 5M 10-37

Cont. to bot page 45

F.B. 778 Pg. 44

175.35 @ 00 T= 70 - 175.32'

Ang Pt 149+29.26
P198A
set 1x2 tk

To P199A
175.32'

180.28 @ 4° 50 - T70

179.62'

171.62'

172° 58' 30"

172° 58 30
331° 54 00
172 58 30

P197A
set 3/4" P
plug tk

77° 05 00
308° 20 30
77 05 07½

Δ = 102° 54' 45"
R = 35.00
T = 43.93
L = 62.87

147+93.57

147+30.70

Δ 23° 52-20
R = 340.00
T = 71.87
L = 141.66

146+87.53

145+45.91

See F.B. 812 Pg 21
Valley Spur

P196A
set 1x2 tk

20.82

156° 07' 45"
156 07 45

47.69

From P196A

RP P196A
set 3/4" P plug tk

Cont. from top page 43

RETURN TO
LOS ANGELES COUNTY SURVEYOR
700 HALL OF RECORDS

Note: Any Additions or Changes on This Sheets Must be Made or Circled in Red Ink With Date and Name of Person Making Change.

Do not extend notes this side of this line

Notes Ck'd by	Survey of
Map No. B-1830	W. O.	Tape No.	St'd
Office Work	Surveyed by Stevenson
Checked	Notes	Date
Date	Indexed

F.B. 778 Pg. 45

Note: Any Additions or Changes on This Sheets Must be Made or Circled in Red Ink With Date and Name of Person Making Change.

Do not extend notes this side of this line

RETURN TO
LOS ANGELES COUNTY SURVEYOR
700 HALL OF RECORDS

FORM 247 5M 10-37

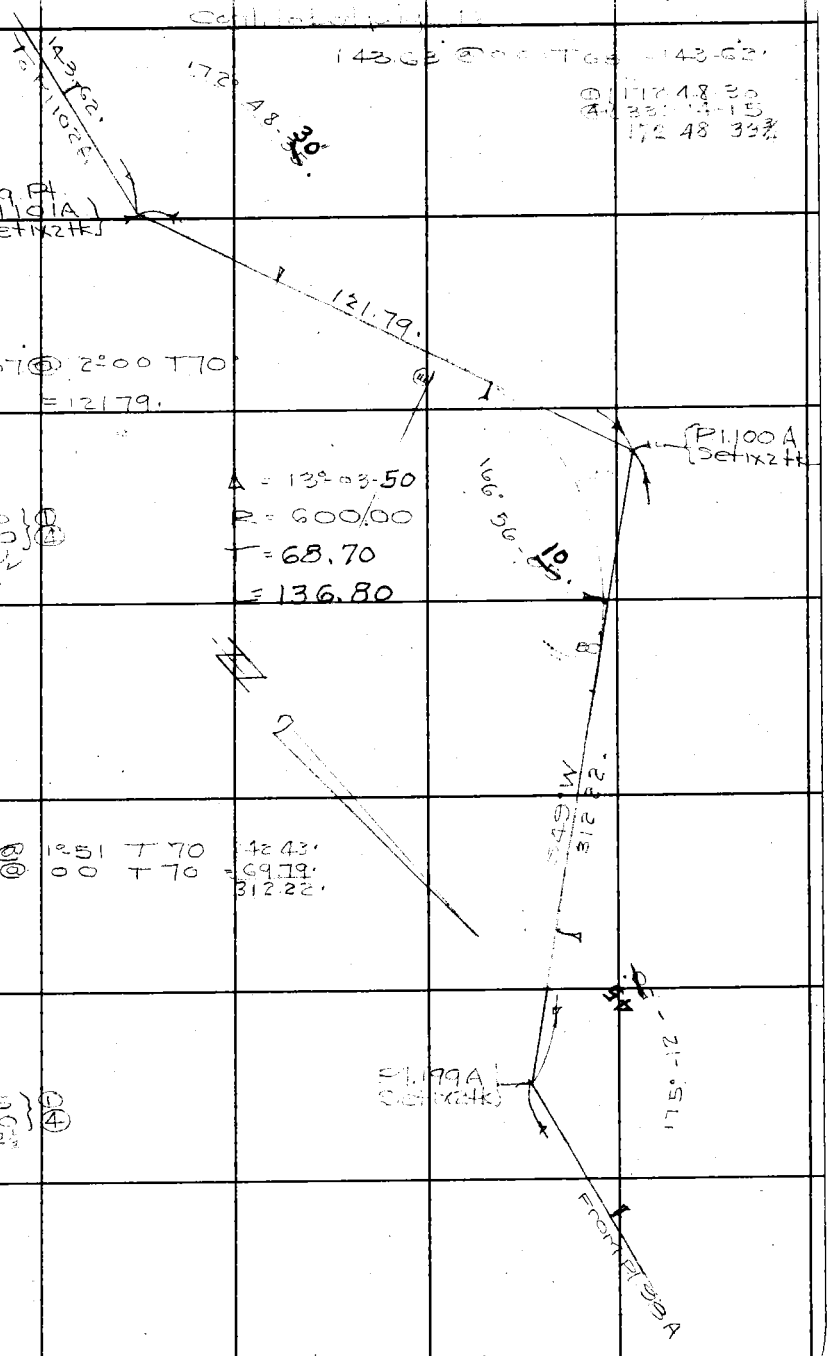

F.B. 778 PG. 46

Cont to bot page

99.84 @ 3+16.70
= 99.72'

172° 20' 30" ④
320° 22' 15" ⑤
172° 20' 33¾"

P/1105A
99.72'

P/1104A
set 3/4" IP
+ tk

172° 20'

40.00'

105.90 @ 00+70
= 105.90'

RP P/1103A
set 3/4" IP
Plug + tk

1931'

P/1103A
set 1x2 tk

5.79'

P/1103A
set 3/4" IP plug + tk

95.00'
169° 58' ±

167.96 @ 00+70
= 167.96'

167.96'

E

147° 42' 45" ①
230° 55' 30" ②
147° 42' 45¼"

Δ 32°17'25"
R 300.00
T 86.85
L 169.07

P/1102A
set 3/4" IP plug
+ tk

From P/1101A

Cont from top page 45

RETURN TO
LOS ANGELES COUNTY SURVEYOR
700 HALL OF RECORDS

Note: Any Additions or Changes on This Sheets Must be Made or Circled in **Red Ink** With Date and Name of Person Making Change.

Do not extend notes this side of this line

Notes Ck'd by		Survey of Las Virgenes EIT System	F.B. 778 PG. 47
Map No. 3-1830		W. O. 3243 Tape No. 49 St'd 24°F	
Office Work		Surveyed by Stevenson	
Checked		Notes T.J.S. Date 12-30-38	
Date		Indexed	

cont to bot page 16

137.22 @ 00 T 54 = 137.30'

Δ = 32° 40' 45"
R = 125.00
T = 37.83
L = 73.48

146°-19'-15" ⓒ
225° 16' 45" ⓑ
146 19 11½

137.30' to P1.106A

15

146°-19'-15"

P1.106A Set ¾" IP Dbl Tk.

119.07 @ 2+18 T 10 = 118.97'

N 59° W 118.97'

P1.105A Set 1"x2" tk

40

139°-57'-45" ⓐ
139° 57' 00" ⓒ
139 57 15

139°-57'-45"

Δ 40°-02-20"
R 110.00
T 40.08
L 76.87

From P1.104A

Cont from top page 16

RETURN TO
LOS ANGELES COUNTY SURVEYOR
700 HALL OF RECORDS

Note: Any Additions or Changes on This Sheets Must be Made or Circled in Red Ink With Date and Name of Person Making Change.

Do not extend notes this side of this line

FORM 247 BM 10-37

Cont to bot page 49

F.B. 778 PG. 48

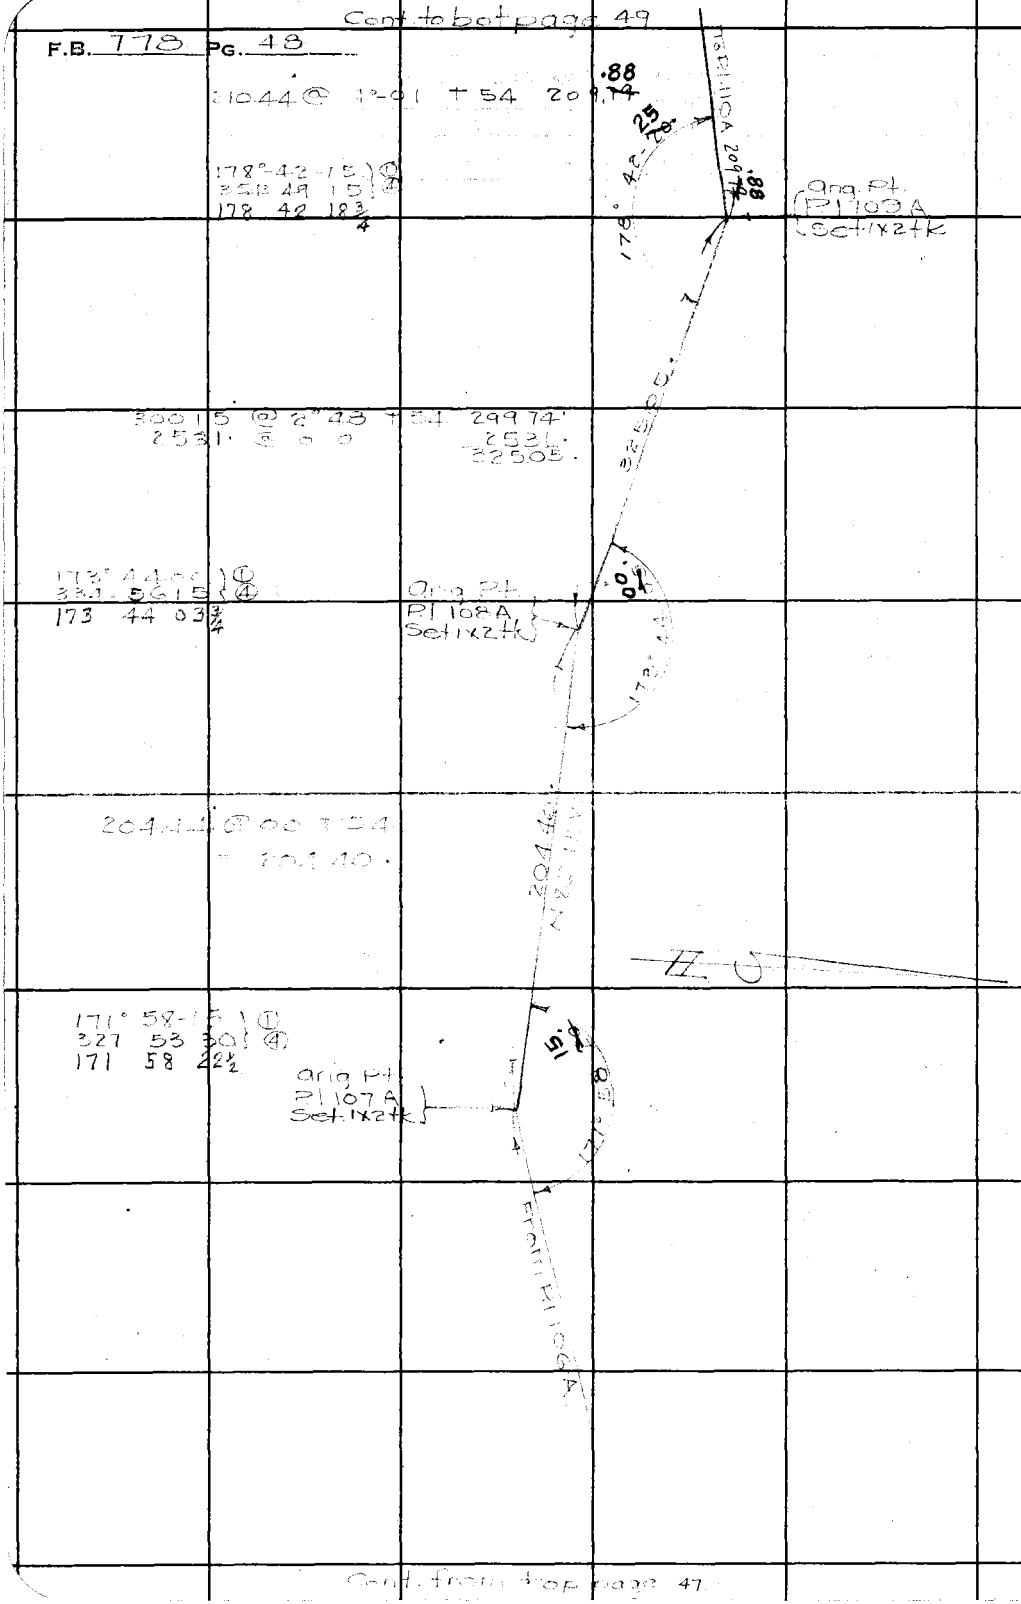

178° 42' 15" ①
2531 49 15 ④
178 42 18¾

30015 @ 2°48 + 54 299.74'
2531. 2526.
32505.

173° 44' 06" ①
3321 56 15 ④
173 44 03¾

204.44 @ 00 + 54
= 100.40.

171° 58' 15" ①
327 53 30 ④
171 58 22½

Cont. from top page 47

RETURN TO
LOS ANGELES COUNTY SURVEYOR
700 HALL OF RECORDS

Note: Any Additions or Changes on This Sheets Must be Made or Circled in Red Ink With Date and Name of Person Making Change.

Do not extend notes this side of this line

Notes Ck'd by		Survey of Las Virgenes Mtr System	F.B. 778 Pg. 49
Map No. 19-1830		W. O. [illegible] Tape No. 1" St'd 1" OF	
Office Work		Surveyed by Stevenson	
Checked		Notes [illegible] Date 1-4-39	
Date		Indexed [illegible] C. Johnson	

Note: Any Additions or Changes on This Sheets Must be Made or Circled in Red Ink With Date and Name of Person Making Change.

Do not extend notes this side of this line

RETURN TO
LOS ANGELES COUNTY SURVEYOR
700 HALL OF RECORDS

FORM 247 5M 10-37

135.77 @ 5° 25 T 54° = 135.13'
7795 @ 6 35 T 54° = 7741'
212.54' 212.54'

167-52-15
21° 29 00
167 52 15

P.I. 12A
Sta 1x21+[illegible]

161.07 @ 4-57 T 54 = 160.45'

A 12-07-50
R 800.00
T 85.01
L 169.37

169 54-15
21 36 30
169 54 07½

P.I. 11A
Sta 1x21+[illegible]

A 10°-05-55"
R 300.00
T 26.51
L 52.88

N 87°W
104.45'

104.40 @ 00 T 54° = 104.45'

173°41-45
33°46 45
173 41 41½

Sta 1x21+[illegible]

From P.I. 10A

Cont'd from top page 48

Cont. to bat page 51

F.B. 778 Pg. 50

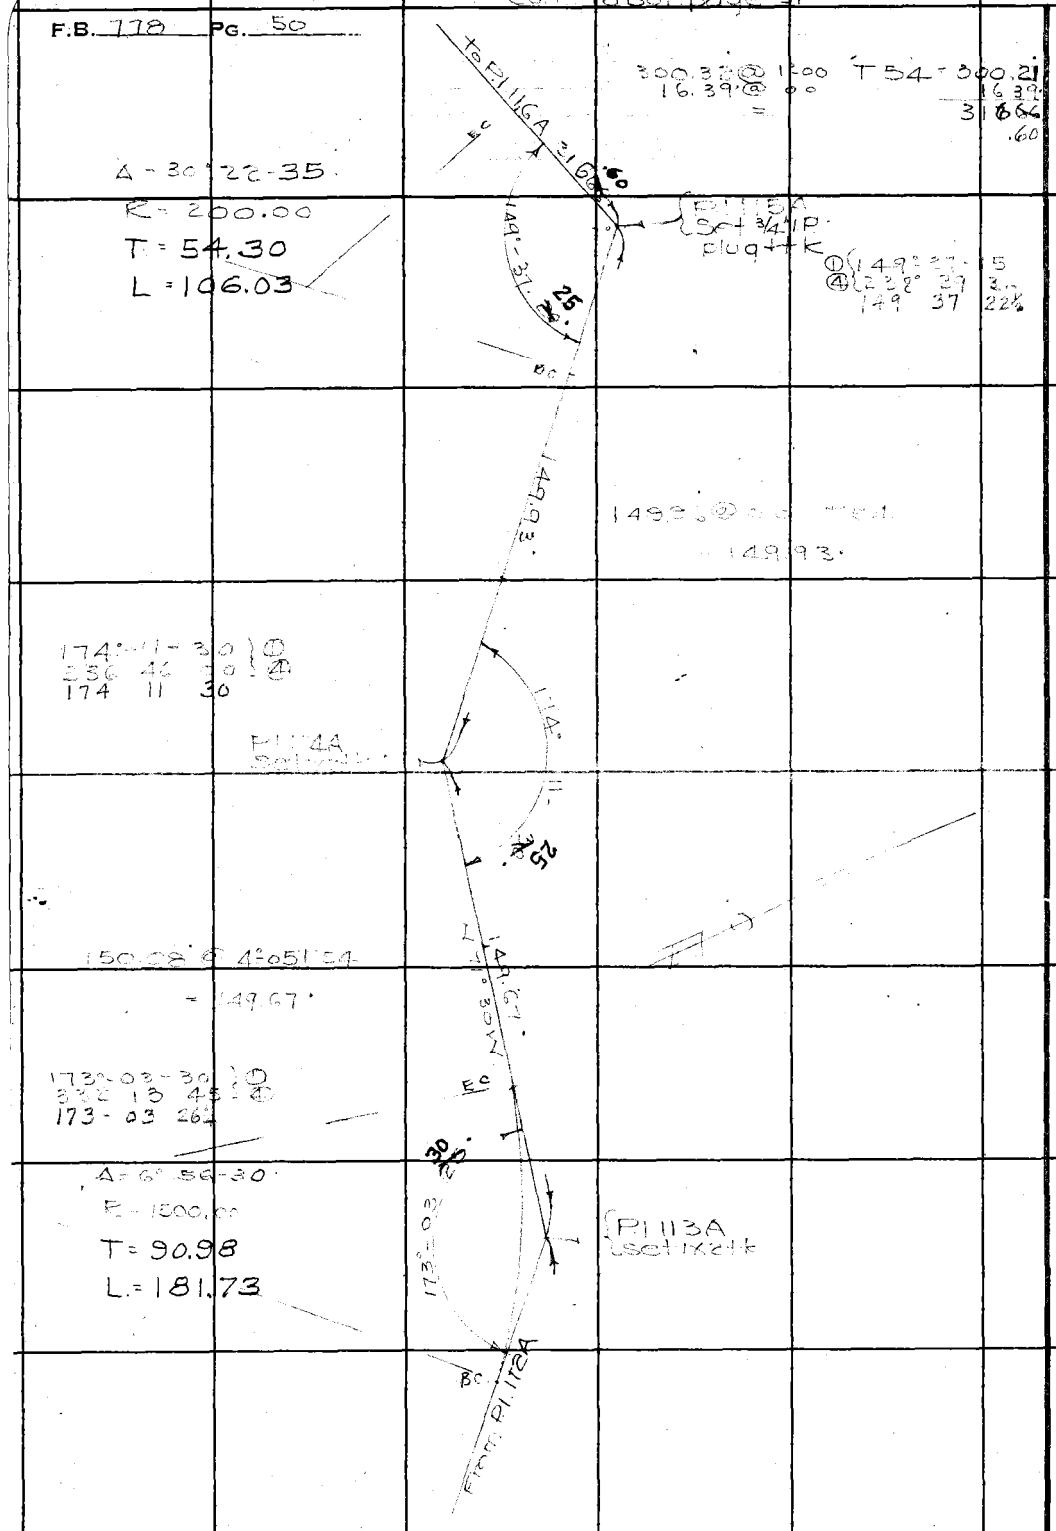

Cont. to bat page 49.

RETURN TO
LOS ANGELES COUNTY SURVEYOR
700 HALL OF RECORDS

Note: Any Additions or Changes on This Sheets Must be Made or Circled in Red Ink With Date and Name of Person Making Change.

Do not extend notes this side of this line

Notes Ck'd by	Survey of Los Virgenes FTS System	F.B. 778	Pg. 51
Map No. B-1830	W. O. 8243 Tape No. 47 St'd 24 OF		
Office Work	Surveyed by Stevenson		
Checked	Notes T.J.S. Date 1-4-37		
Date	Indexed C. Johnson		

Cont to bot page 52

163-01-45 ①
292 07 15 ④
163 01 48½

Δ = 16° 58.-05
R = 100.00
T = 14.92
L = 29.61

248.27 @ 0.0° 54" = 248.24'

163°

P.I. 119A
Set 1x2 tk

163-16-15 ①
293 05 ④
163 16 15

155.13 @ 0.0° 54" = 155.10'

155.10'

EC

P.I. 117A
Set 1x2 tk

10'

163° 16'

Δ 16° 43' 50"
R 400.00
T 58.82
L 116.80

EC

233.71'

N 73° 30' W

233.07 @ 3°-00' 54"
= 233.71'

EC

152° 22' 00" ①
249° 37' 30" ④
152 21 52½

Δ 27° 38' 15"
R 300.00
T 73.79
L 144.71

P.I. 116A
Set 3/4 rebar
Plug + tk

Tgt P.I. 115A

Continued on Page 50

RETURN TO
LOS ANGELES COUNTY SURVEYOR
700 HALL OF RECORDS

Note: Any Additions or Changes on This Sheets Must be Made or Circled in Red Ink With Date and Name of Person Making Change.

Do not extend notes this side of this line

FORM 247 5M 10-37

Cont. from page 53

F.B. 778 PG. 52

106.64 @ 00 T 56 = 106.62'

171 28 15 ① ④
325 53 15
171 28 18 3/4

69.25 @ 00 T 56 69.24'

151 11 45 ① ④
241 47 15
151 11 48 3/4

118.56 @ 5 T 56 = 118.07'

166 14 15 ① ④
3
166 14 52 1/2

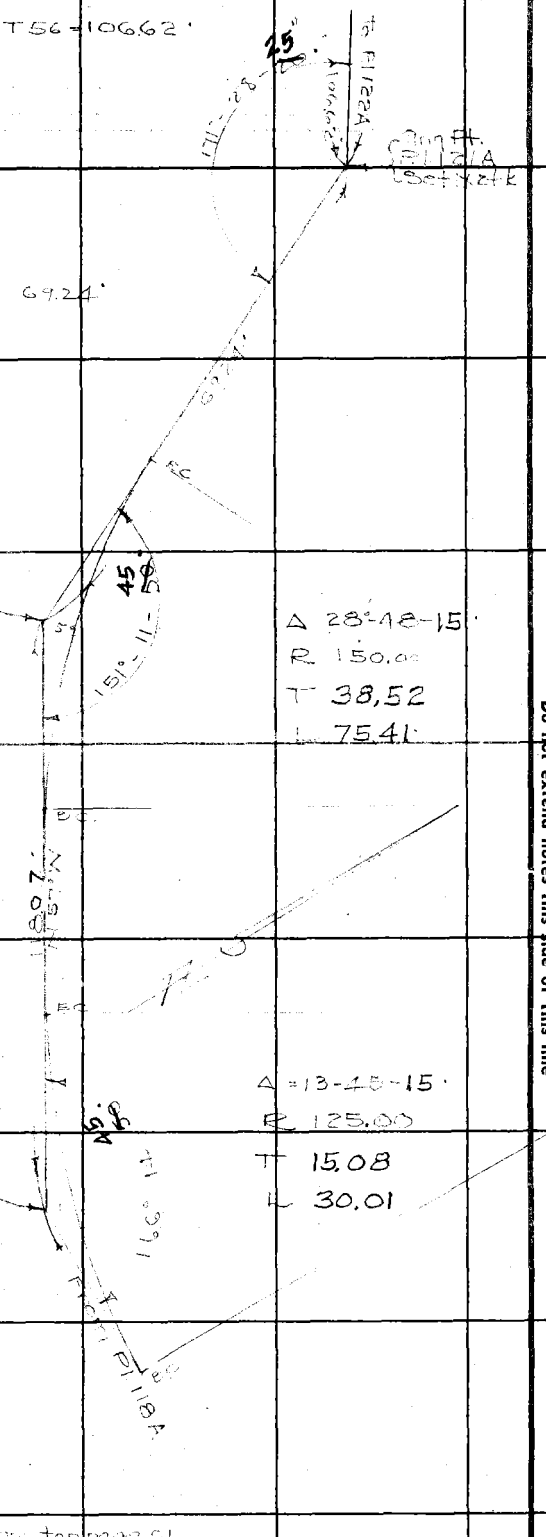

RETURN TO
LOS ANGELES COUNTY SURVEYOR
700 HALL OF RECORDS

Note: Any Additions or Changes on This Sheets Must be Made or Circled in Red Ink With Date and Name of Person Making Change.

Do not extend notes this side of this line

Cont. from top page 51

Notes Ck'd by	Survey of La Verne-Lake FTC System
Map No. B-1830	W. O. 8243 Tape No. 49 St'd 34 OF
Office Work	Surveyed by Stevenson
Checked	Notes Date 1-4-39
Date	Indexed

F.B. 778 Pg. 53

Note: Any Additions or Changes on This Sheets Must be Made or Circled in Red Ink With Date and Name of Person Making Change.

Do not extend notes this side of this line

RETURN TO
LOS ANGELES COUNTY SURVEYOR
700 HALL OF RECORDS

FORM 247 BM 10-37

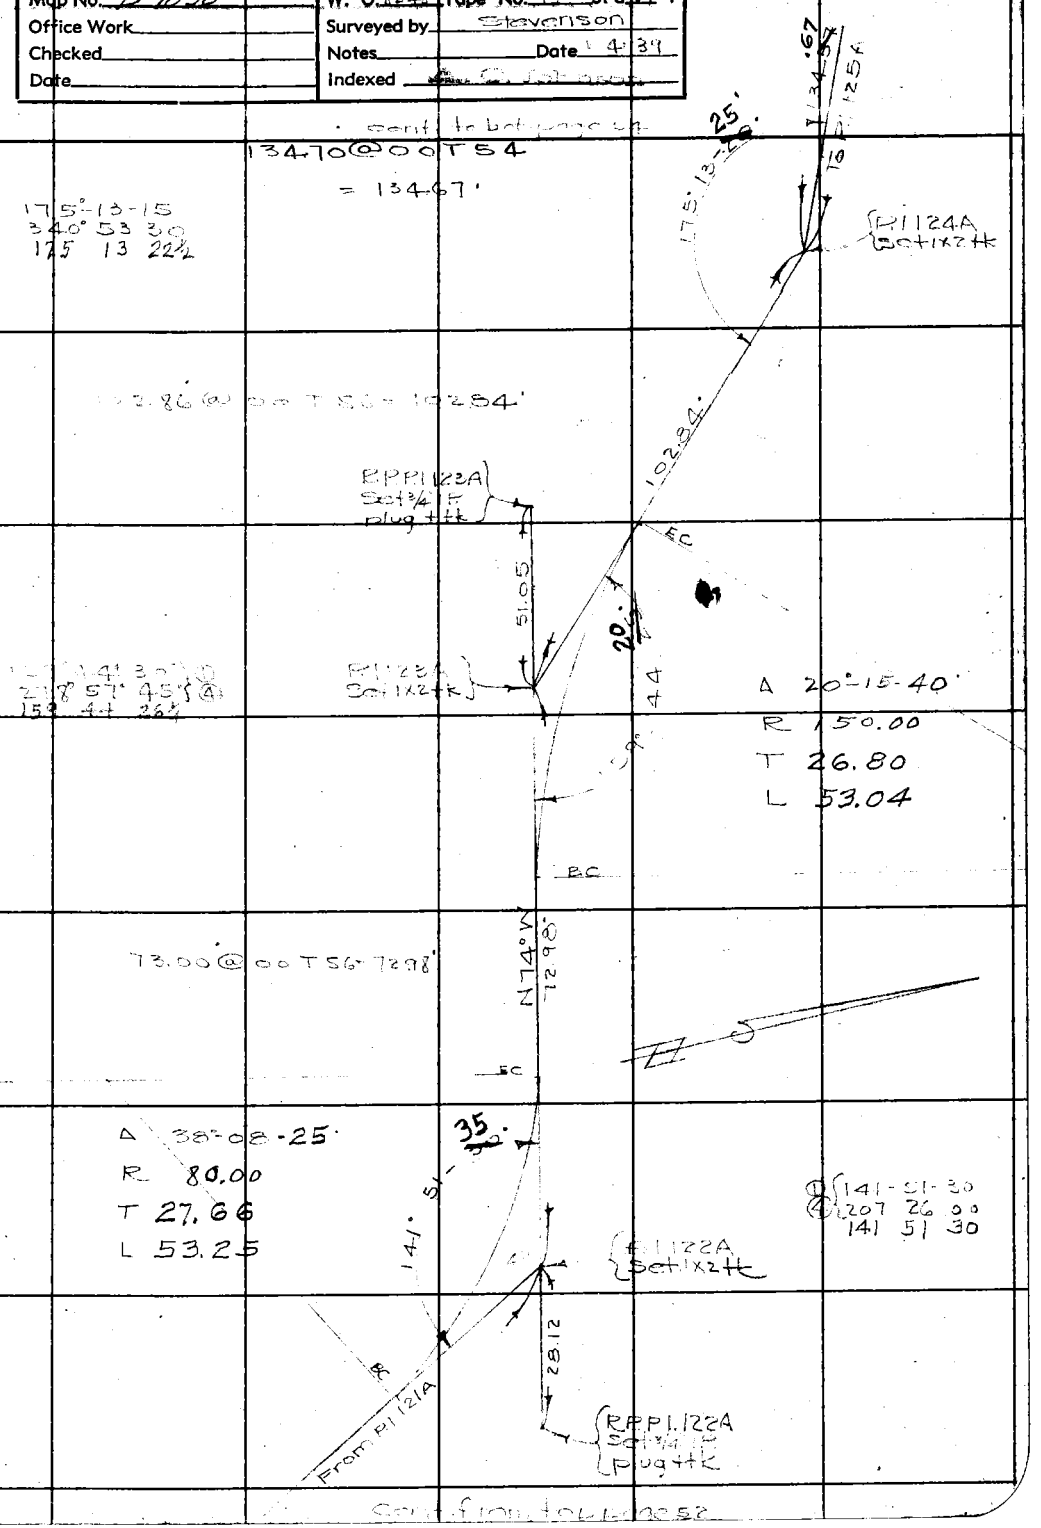

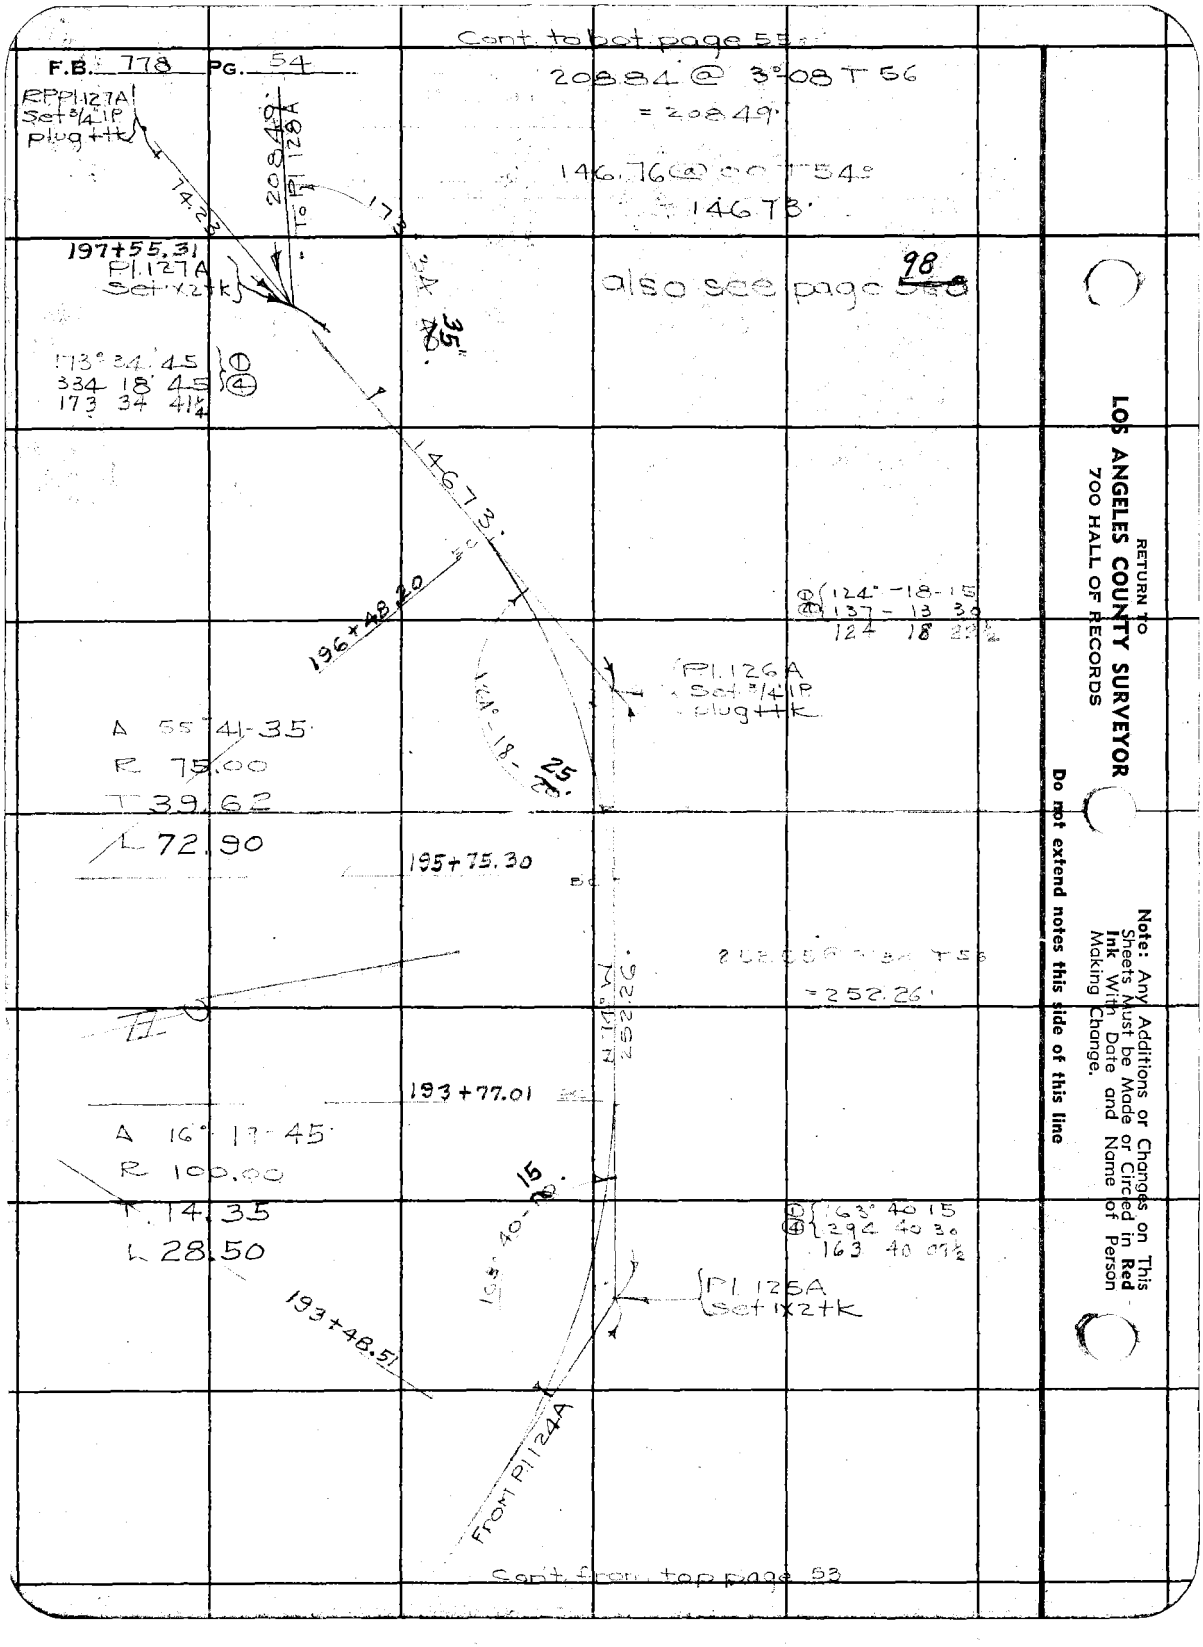
Cont. to bot page 55
F.B. 778 PG. 54
RPP1127A
Set 3/4" IP
plug + tk
14.22
205.48
To PI 128A
173
197+55.31
PI 127A
Set X2 + K
also see page 98
173° 34' 45
334 18' 45
173 34 41½
35"
146.73
196+48.20
PI 126A
Set 3/4" IP
plug + tk
124° 18' 15
137 - 13 30
124 18 22½
A 55° 41' 35"
R 75.00
T 39.62
L 72.90
195+75.30
PC
=252.26'
193+77.01
A 16° 17' 45"
R 100.00
T 14.35
L 28.50
15.00
15° 40' 15"
63° 40 15
292 40 30
163 40 07½
PI 125A
Set 1X2 + K
193+48.51
FROM PI 124A
Cont from top page 53
RETURN TO
LOS ANGELES COUNTY SURVEYOR
700 HALL OF RECORDS
Note: Any Additions or Changes on This Sheets Must be Made or Circled in Red Ink With Date and Name of Person Making Change.
Do not extend notes this side of this line

Notes Ck'd by	Survey of Los Virgenes F.R. System
Map No. B-1830	W. 08243 Tape No. 49 St'd 34 of
Office Work	Surveyed by Stevenson
Checked	Notes T.I.S. Date 1-4-38
Date	Indexed C. Johnson

F.B. 778 PG. 55

Cont. to last page 56

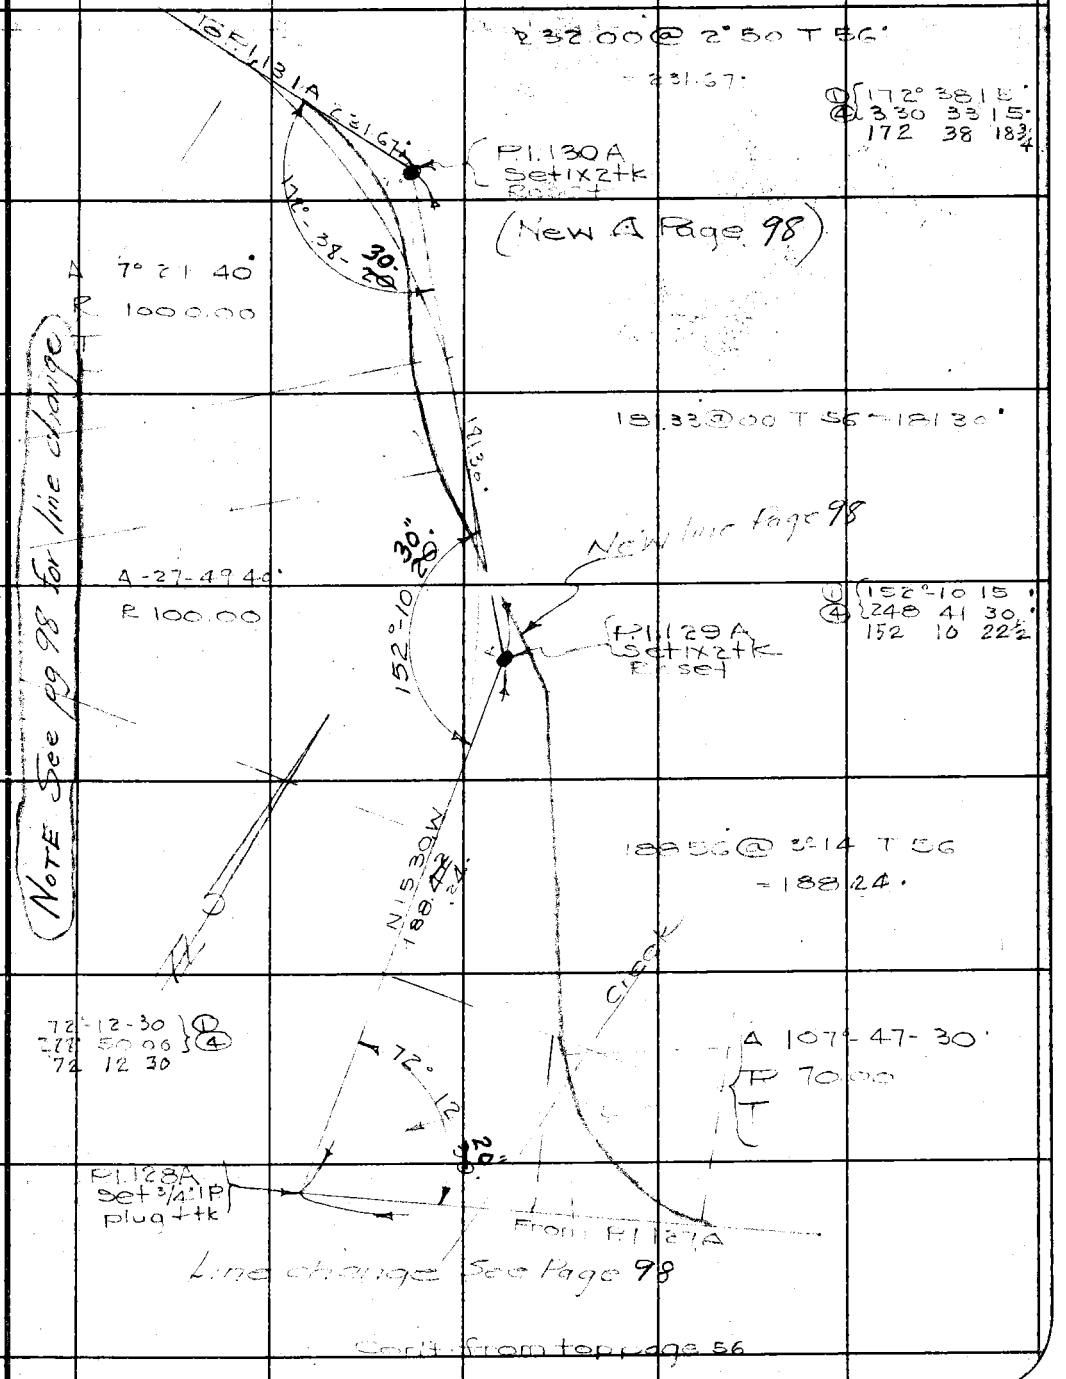

Note: Any Additions or Changes on This Sheets Must be Made or Circled in Red Ink With Date and Name of Person Making Change.

Do not extend notes this side of this line

RETURN TO
LOS ANGELES COUNTY SURVEYOR
700 HALL OF RECORDS

FORM 247 5M 10-37

Cont to bot page 57

F.B. 778 PG. 56

192.65 @ 5°20 T48

= 191.76

176°-02-30 } ①
344° 10 00 } ④
176 02 30

193.31 @ 4°05 T48 = 192.77

125°08 45 } ③
140°35 00 } ④
125 08 45

176°-02-30

191.76

208+19.70
Ang Pt.
{P1133A
Set 1/2" I.P.

192.77

EC

206+73.64

A 54°-51-15
R 90.00
T 46.71
L 86.16

P1132A
Set 3/4 IP
plug + tk

25°08

205+87.48

BC

201.04 @ 6°13 T56

= 199.80

204+67.34 EC

132-34 00 } ②
170 16 30 }
132 34 07½

34°05

A 47°-25 55"
R 75.00
T 32.95
L 62.09

132°

204+05.39 BC

P1131A
Set 3/4" IP
plug + tk

From P1130A

Cont from top page 55

RETURN TO
LOS ANGELES COUNTY SURVEYOR
700 HALL OF RECORDS

Note: Any Additions or Changes on This Sheets Must be Made or Circled in Red Ink With Date and Name of Person Making Change.

Do not extend notes this side of this line

Notes Ck'd by		Survey of Los Virgenes FM System	F.B. 778 Pg. 57
Map No. B-1830		W. O. 8143 Tape No. 47 St'd 84 of	
Office Work		Surveyed by Stevenson	
Checked		Notes T. S. Date 1-9-37	
Date		Indexed	

Note: Any Additions or Changes on This Sheets Must be Made or Circled in Red Ink With Date and Name of Person Making Change.

Do not extend notes this side of this line

RETURN TO
LOS ANGELES COUNTY SURVEYOR
700 HALL OF RECORDS

FORM 247 5M 10-37

Cont to bal Engr Sta

118.48 @ 6°09 T 48
= 118.77.

130-01-15 } (B)
160 05 00 } (A).

212+04.59

118.77

A 19°58'45"
R 50.00
T 23.30
L 43.62

211+60.97

P1 136A
set 1x2 tk

62.37 @ 00 T 48°
= 62.36.

62.36 PC

158° 45' 15" }
275° 03' 15" }.

211+40.66

P1 135A
set 1x2 tk

A 21°-14'-10"
R 100.00
T 18.75
L 37.06

211+03.60

111.87 @ 4° 38' T 48
= 110.99.

N 42° W
110.99

174° 38' 45" } (D)
338° 35' 00" } (A).

210+11.76
P1 134A
set 1x2 tk
orig P1.

174°

Cont from top page 56

F.B. 778 PG. 58

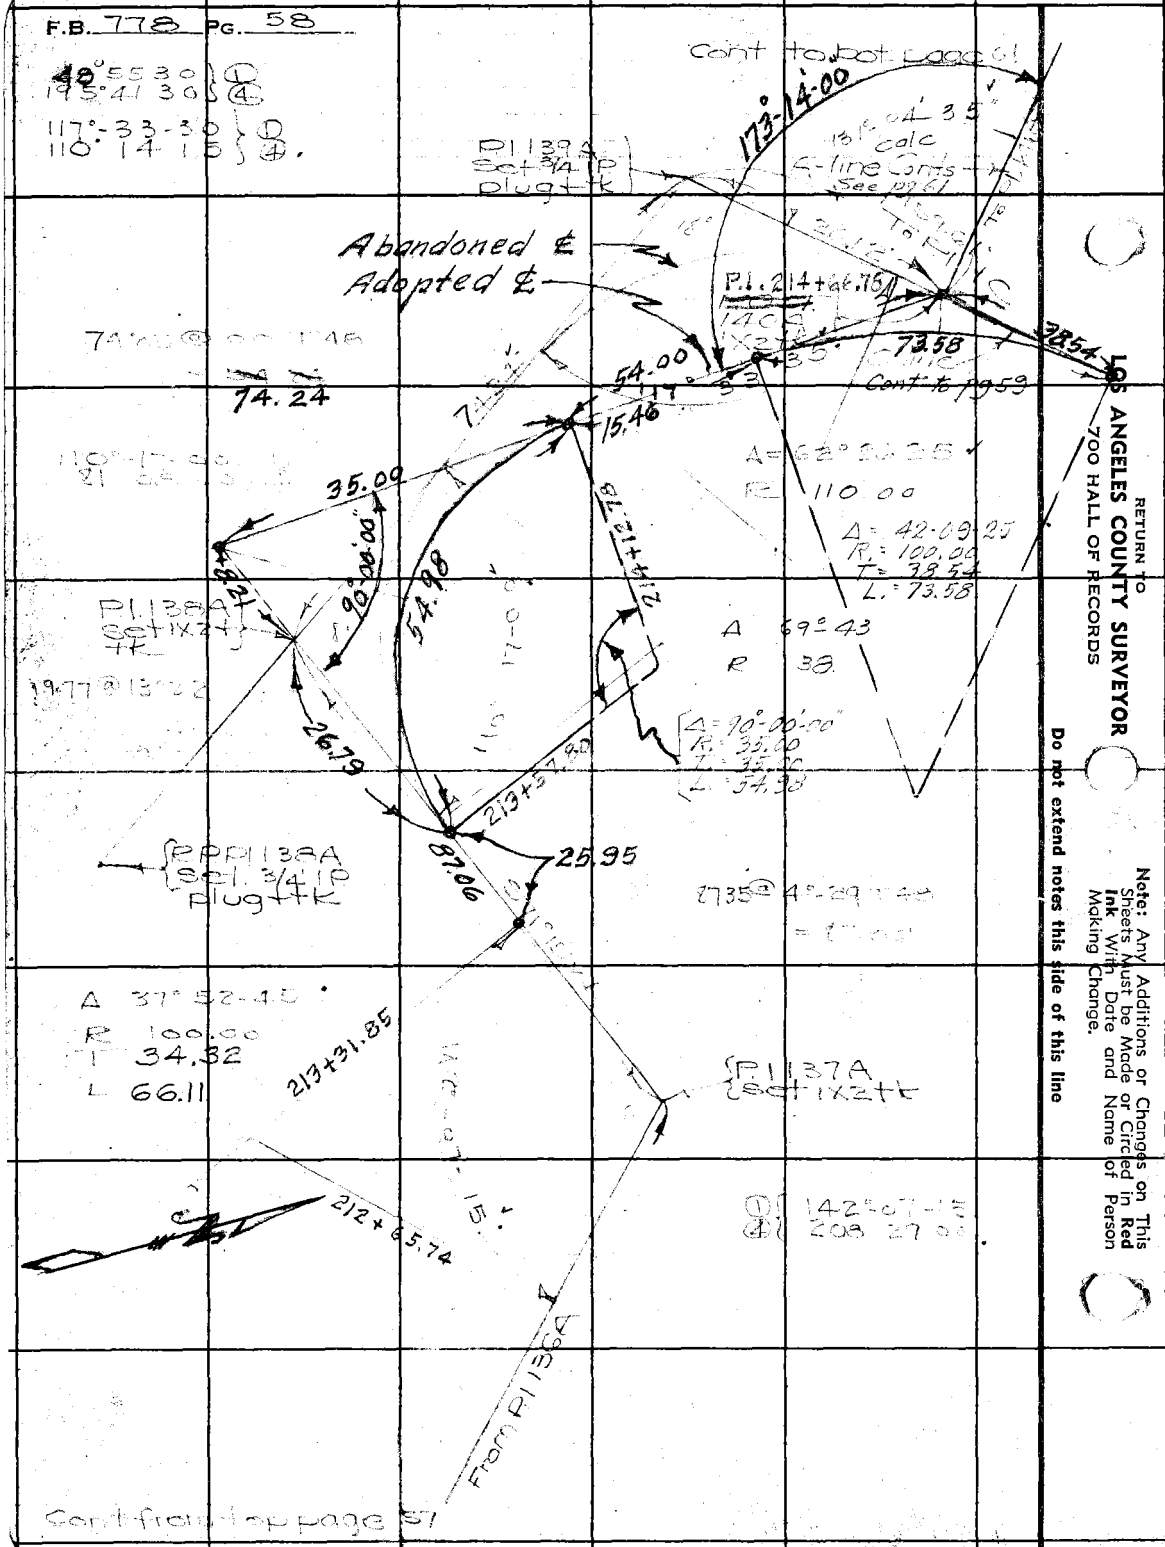

RETURN TO
LOS ANGELES COUNTY SURVEYOR
700 HALL OF RECORDS

Note: Any Additions or Changes on This Sheets Must be Made or Circled in Red Ink With Date and Name of Person Making Change.

Do not extend notes this side of this line

Notes Ck'd by	Survey of Los Virgenes Fill Section
Map No. B-1830	W. O. 8243 Tape No. 63 St'd — OF
Office Work	Surveyed by Stevenson
Checked	Notes Date
Date	Indexed

F.B. 778 PG. 59

Note: Any Additions or Changes on This Sheets Must be Made or Circled in Red Ink With Date and Name of Person Making Change.

Do not extend notes this side of this line

RETURN TO
LOS ANGELES COUNTY SURVEYOR
700 HALL OF RECORDS

FORM 247 5M 10-3

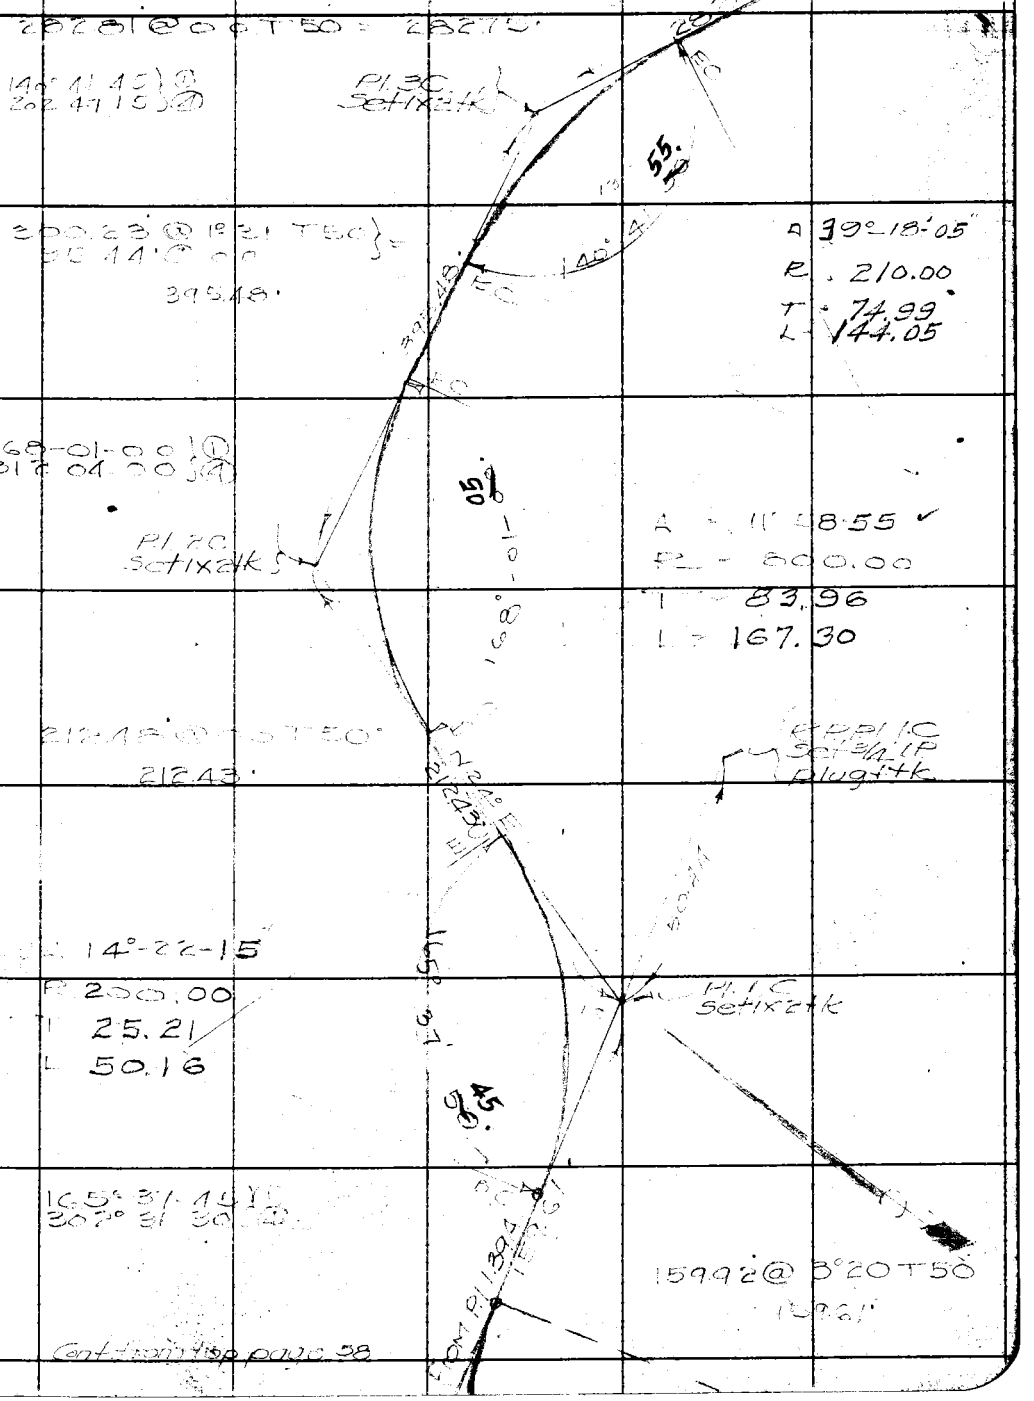

RETURN TO
LOS ANGELES COUNTY SURVEYOR
700 HALL OF RECORDS

Note: Any Additions or Changes on This Sheets Must be Made or Circled in **Red Ink** With Date and Name of Person Making Change.

Do not extend notes this side of this line

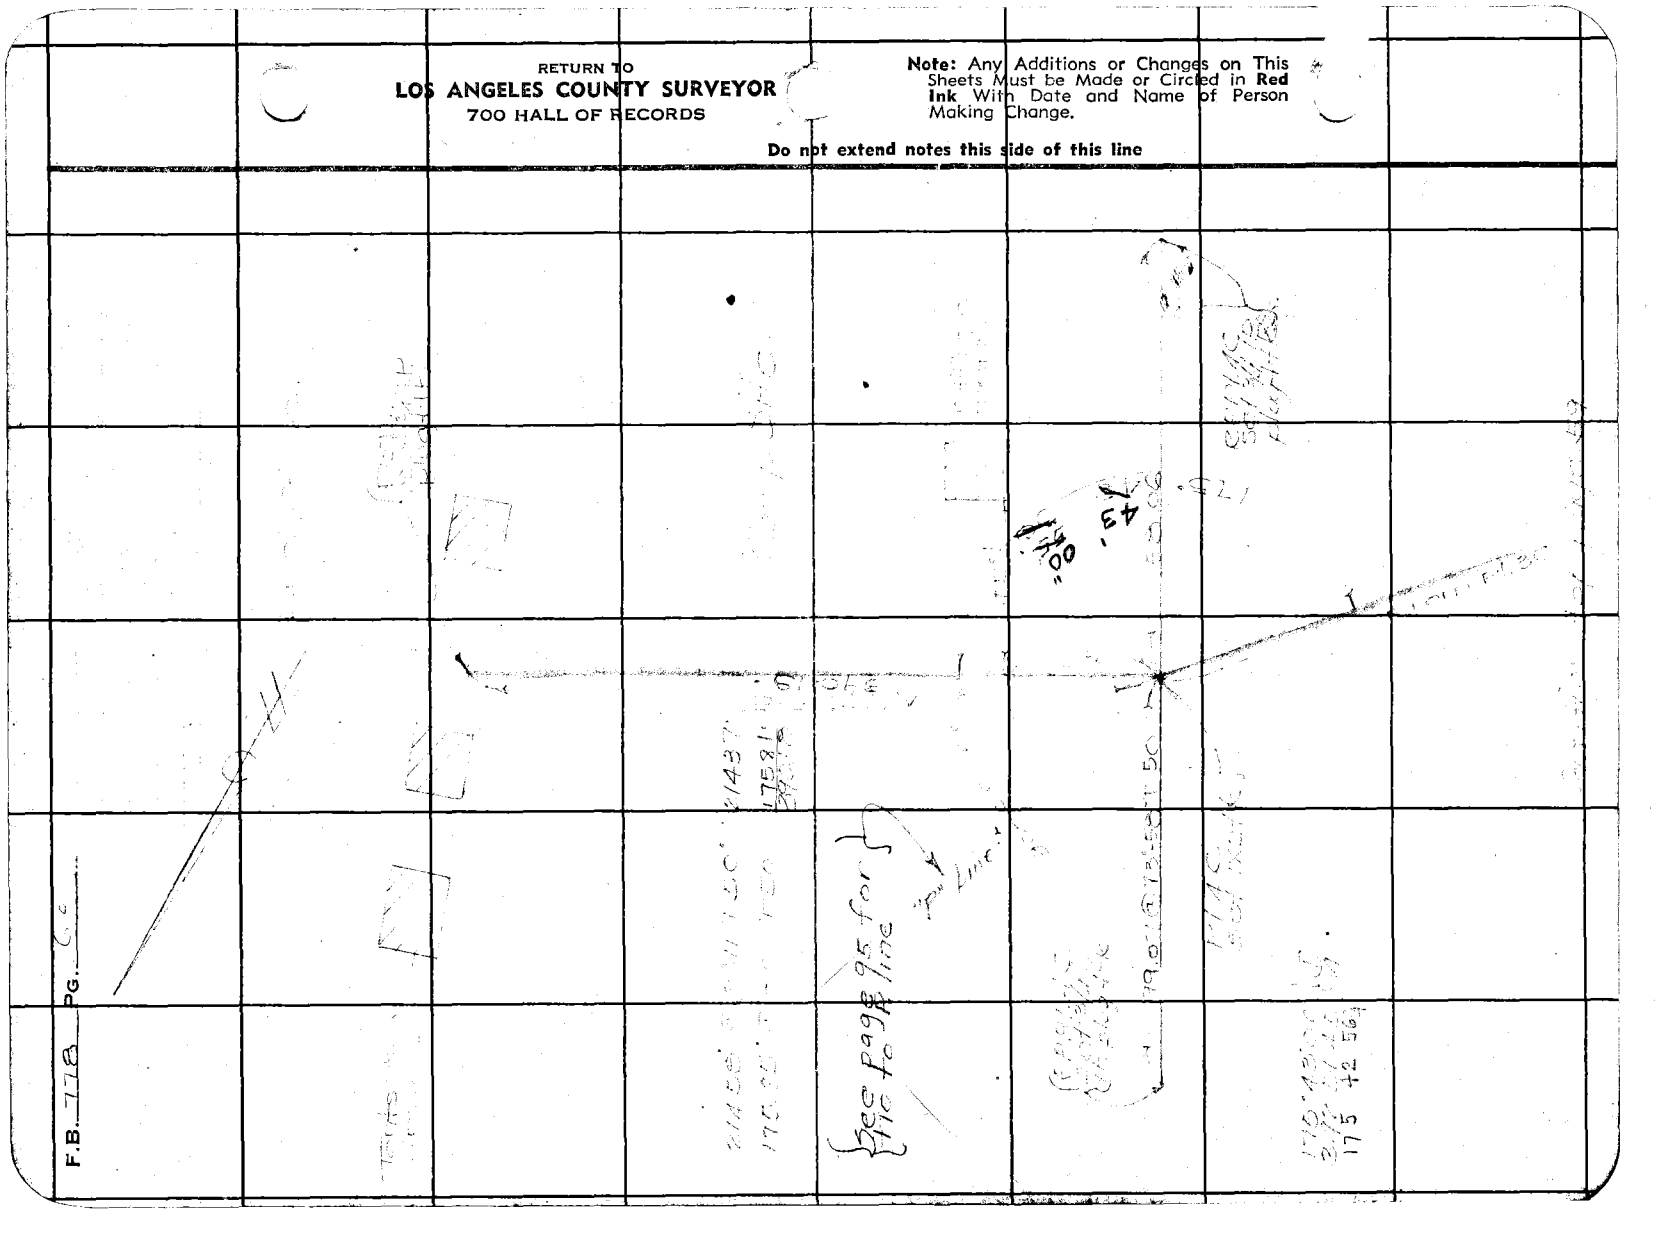

Notes Ck'd by	Survey of Los Virgenes-Triunfo F.B. 778 Pg. 61
Map No. 9-1830	W. O. 1243 Tape No. 63 St'd 84 OF
Office Work	Surveyed by Stevenson
Checked	Notes Date 1-31-37
Date	Indexed

Note: Any Additions or Changes on This Sheets Must be Made or Circled in Red Ink With Date and Name of Person Making Change.

Do not extend notes this side of this line

RETURN TO
LOS ANGELES COUNTY SURVEYOR
700 HALL OF RECORDS

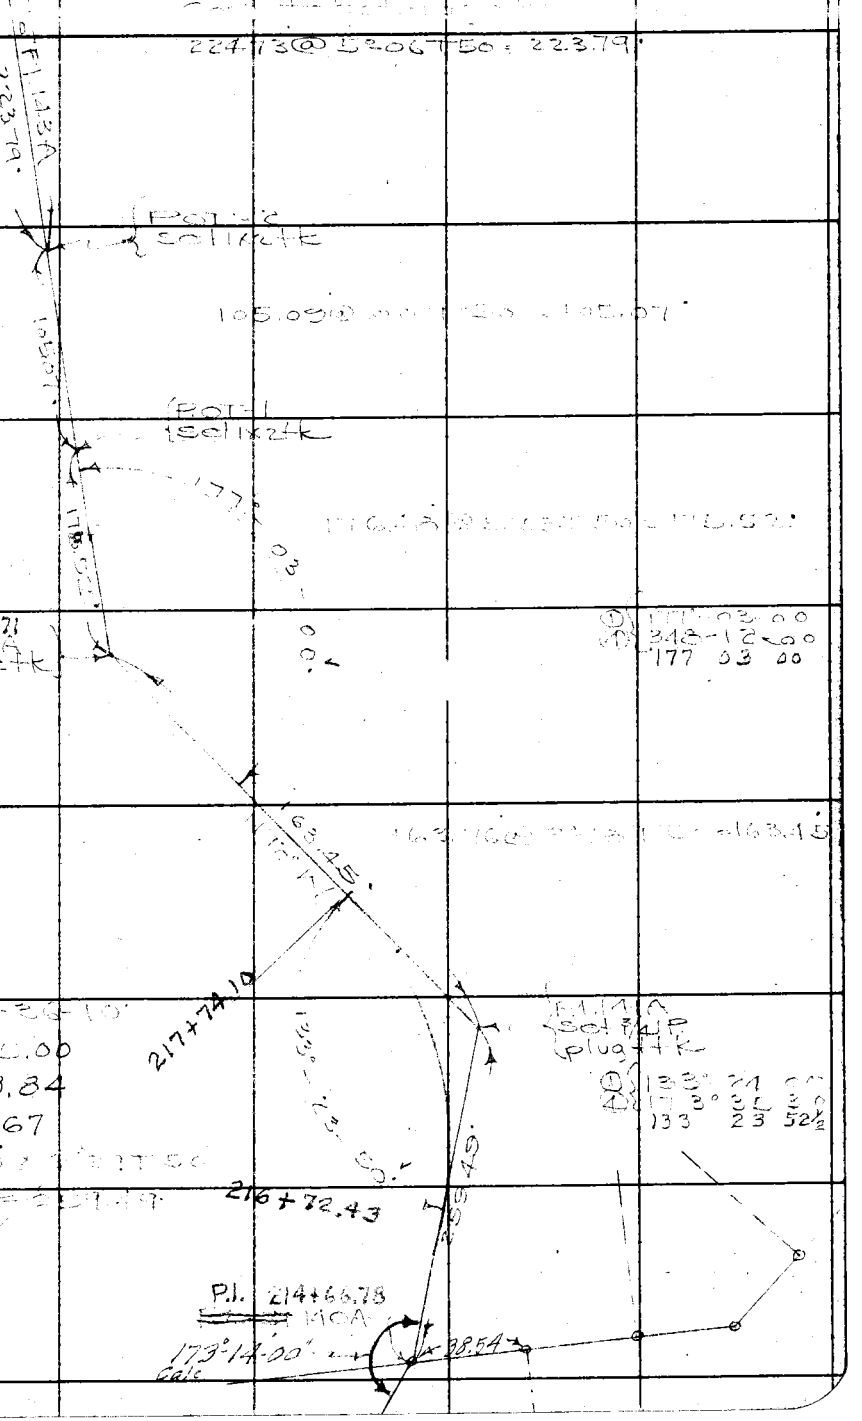

FORM 247 5M 10-37

F.B. 778 Pg. 62

Cont. to bot. page 62

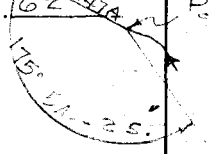

P1146A
set x2 tk

300.53 @ 2°55T48 300.07'
135.26 @ 3°21T49 135.00
435.07'

175°-54-43 ①
3 42 -37-30 ④
175 54 22½

151°-14-00 ①
244°-56-00 ④
151 14 00

Δ = 28°-46'-00"
R = 300.00

T = 76.93
L = 150.62

435.07'

151°-14'-00"

P1145A
set x2 tk

Cont. 7°-05

P1144A
set tk

P1143A
set tk

17.3 00 30

300.37 @ 4°45 T 5
Plus

299.27
300.89
300.53.16
300.24

.16

175°-37-00 ①
3 42 24-15 ④
175 37 0 33¾

Cont. from top page 61

Notes Ck'd by		Survey of Los Virgenes Fit System	F.B. 778 Pg. 63
Map No. B-1830		W. O.	Tape No.	St'd
Office Work		Surveyed by Stevenson	
Checked		Notes	Date
Date		Indexed	

277.88 @ 4°38 - T46
= 276.90.

276.90 TO PT

EC

10°

PI 149+
Set 3/4" IP
Plug tack

156-16-30 ①
265°05 45 ④
156 16 26½

156-16-25

A 23°-43-35
R 500.00
T 105.08
L 207.05

A 47-55 00
R 100.00
T 44.44
L 83.63

132 05 00

PI 148+
Set 3/4" IP

A 26-47-50
R 100.00
T 95.28
L 181.08

EC

100.00

155.50'

PI 147+
Set 3/4"
LF Plug tack

155.50'

Note: Any Additions or Changes on This Sheets Must be Made or Circled in Red Ink With Date and Name of Person Making Change.

Do not extend notes this side of this line

RETURN TO
LOS ANGELES COUNTY SURVEYOR
700 HALL OF RECORDS

FORM 247 5M 10-37

F.B. 778 PG. 64 cont. to bot page 65

186.00 @ 00 T48 = 185.96.

111.79 @ 00 T 46° = 111.76.

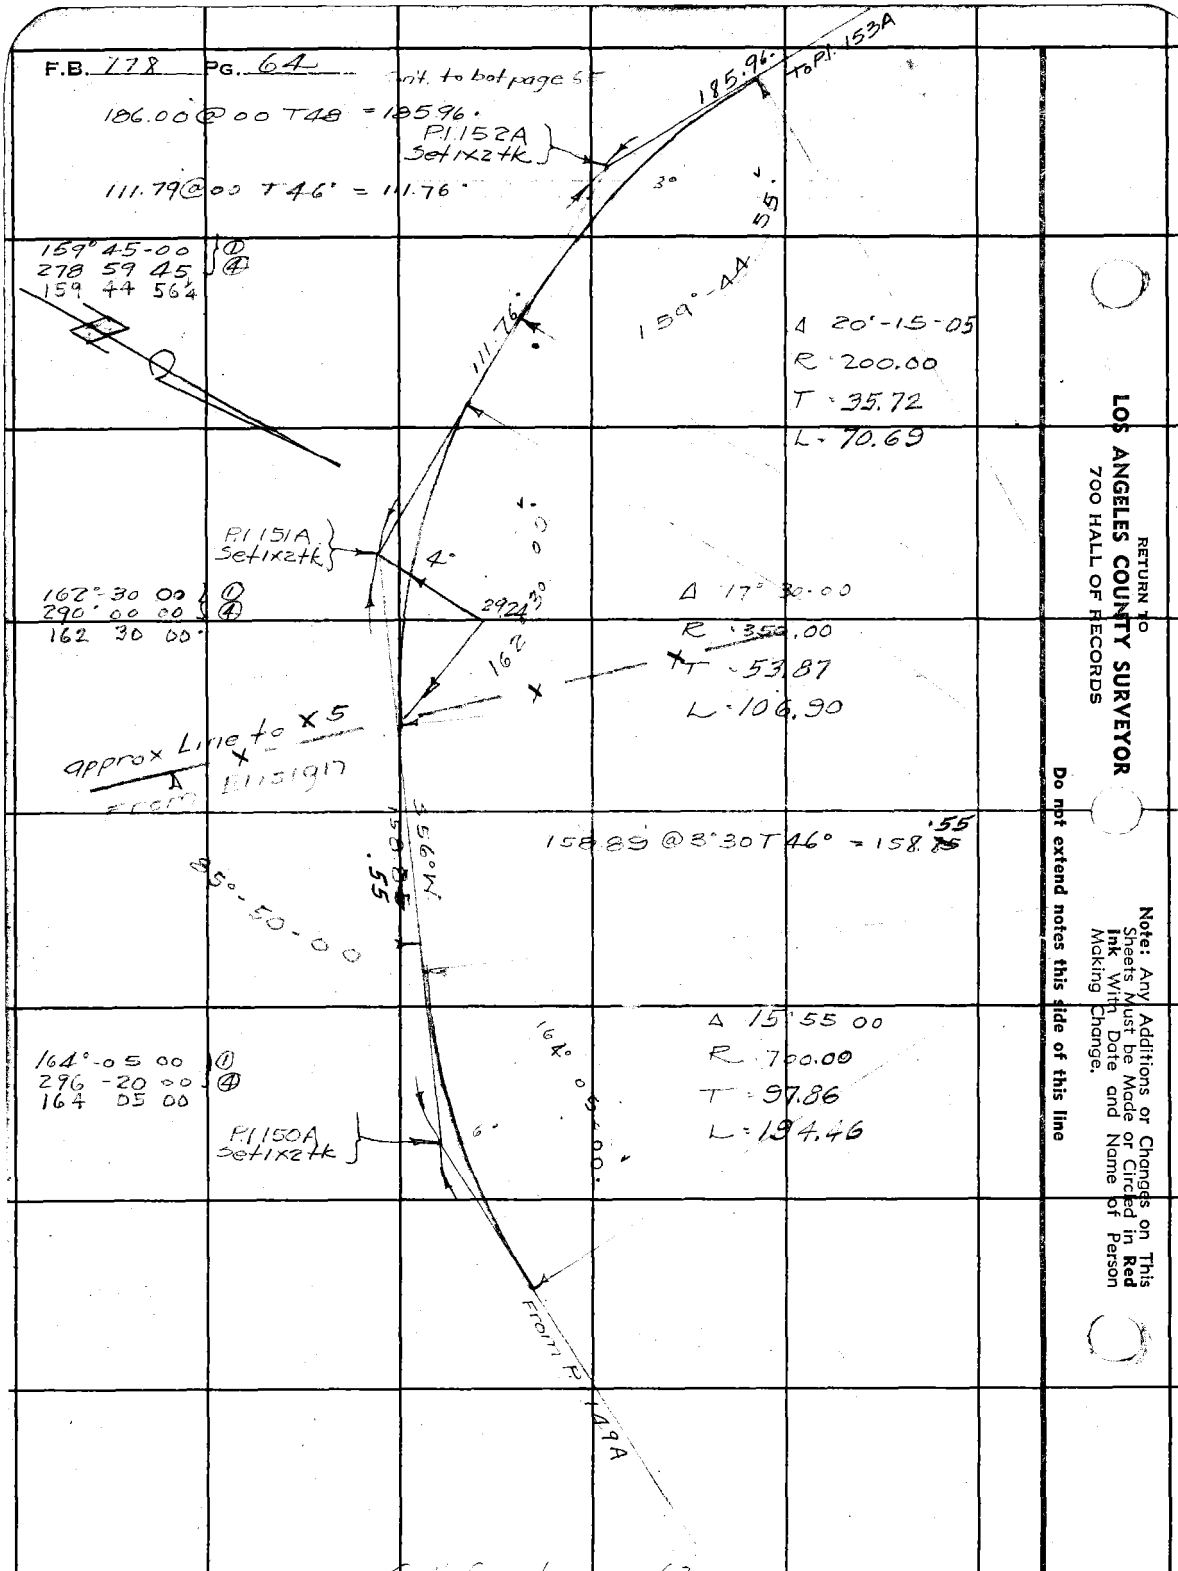

RETURN TO
LOS ANGELES COUNTY SURVEYOR
700 HALL OF RECORDS

Note: Any Additions or Changes on This Sheets Must be Made or Circled in Red Ink With Date and Name of Person Making Change.

Do not extend notes this side of this line

Notes Ck'd by	Survey of Triangle Tie System F.B. 778 Pg. 65
Map No. B-1830	W. O. 8043 Tape No. 49 St'd 11 of
Office Work	Surveyed by Stevenson
Checked	Notes T. J. S Date 3-7-39
Date	Indexed

Survey to be plotted

RETURN TO
LOS ANGELES COUNTY SURVEYOR
700 HALL OF RECORDS

Note: Any Additions or Changes on This Sheets Must be Made or Circled in Red Ink With Date and Name of Person Making Change.

Do not extend notes this side of this line

RP P1155A set 3/4 IP plug + tk

299.34 @ 00 T 48
78.42 @ 00 T 48
299.17'
78.40'
377.57'

T. P1156A

377.57'

763.8

P1155A set 1x2 tk

① 145-16-00
④ 221° 04 15
145 16 03 3/4

145.16.5'

Δ = 34° 43-55
R = 150.00
T = 46.91
L = 90.93

172.67 @ 00 T 46
= 172.63'

S 49° 11' E 172.63'

① 123° 23 00
④ 123 32 00
123 23 00

Δ = 56° 37-00
R = 110.00
T = 59.25
L = 108.70

P1154A set 3/4 IP plug + tk

123° 43-00"

249.47 @ 00 T 46 = 249.41'

249.41'

168° 23-00 ② ④
81 3 31 45
168 22 56 1/4

P1153A set 1x2 tk

From P1152A

168° 22' 56 1/4

Δ 11° 37-05
R 400.00
T 40.70
L 81.11

64

FORM 247 5M 10-37

Cont. to bot. page 67

F.B. 778 PG. 66

94.19 @ 00° T 48 = 94.17

R.P. P.I. 158A set 3/4" I.P. plug + tk

94.17

55.60

P.I. 158A Set 1x2 tk

① 164° 22' 15"
④ 297° 29' 30"
164 22 22½

142.61 @ 1°29 T 48 = 142.53

142.53

164°-22'-20"

Δ - 15° 37' 40"
R - 100.00
T - 13.72
L - 27.28

141° 55' 45" ①④
207° 43' 00"
141 55 45

15.50

P.I. 157A Set 3/4" I.P. plug + tk

12°

14.40

Δ - 38°-04'-15"
R - 200.00
T - 69.00
L - 132.99

S 35° 30" W

155.2 @ 0 0

299.24 @ 3°-09' T 48

155.2

298.72

314.24

314.24

156.

21°-10'

Δ - 23°-38'-40"
R - 300.00
T - 62.79
L - 123.80

156° 21' 15" ①
26° 25' 15" ④
156 21 18¾

R.P. 156A Set 1x2 tk

Cont. from top page 65

RETURN TO
LOS ANGELES COUNTY SURVEYOR
700 HALL OF RECORDS

Note: Any Additions or Changes on This Sheets Must be Made or Circled in Red Ink With Date and Name of Person Making Change.

Do not extend notes this side of this line

Notes Ck'd by	Survey of Los Virgenes 17" System
Map No. B-1830.	W. O. 8243 Tape No. 49 St'd 14°F
Office Work	Surveyed by Stevenson
Checked	Notes T.J.S. Date 3-7-39
Date	Indexed

F.B. 778 PG. 67

Cont. to bot. page 67

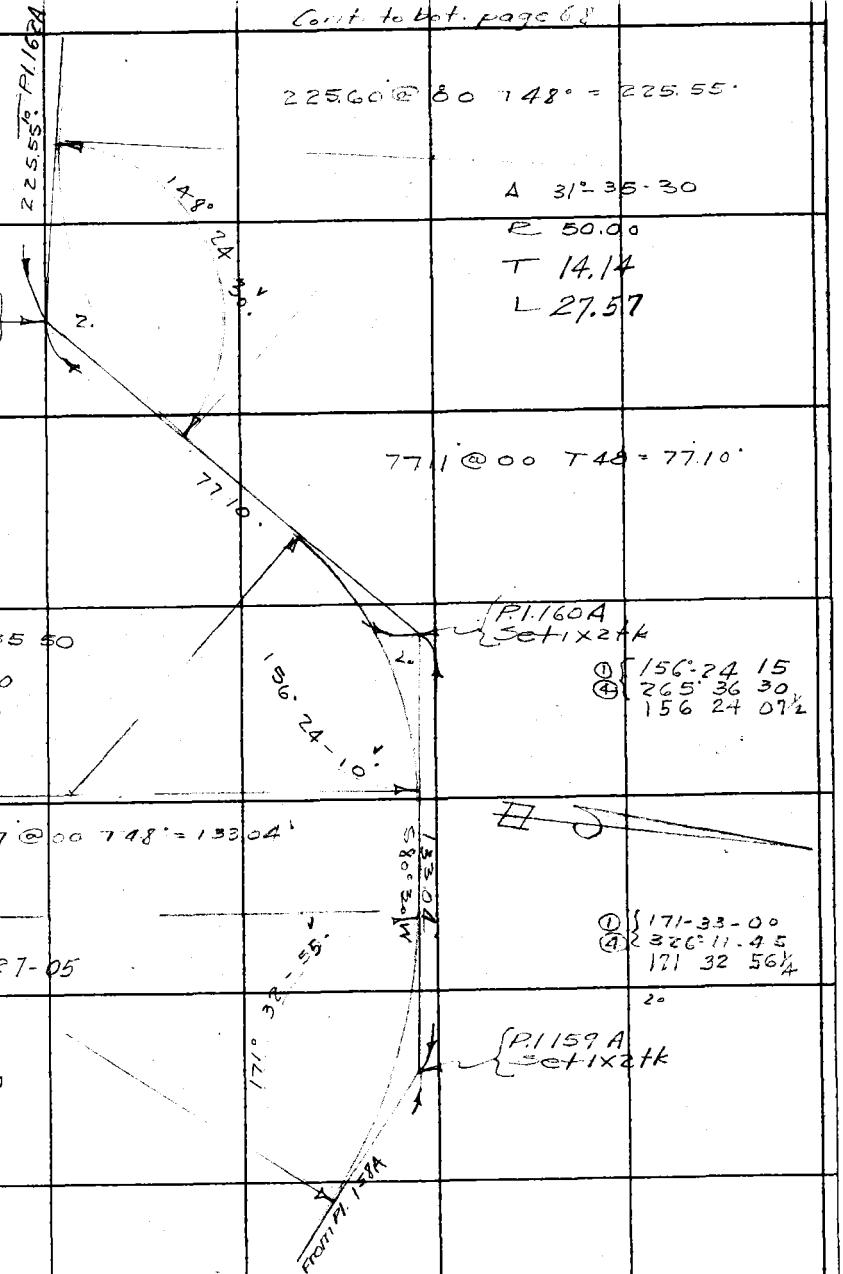

Cont. from top page 66

Note: Any Additions or Changes on This Sheets Must be Made or Circled in Red Ink With Date and Name of Person Making Change.

Do not extend notes this side of this line

RETURN TO
LOS ANGELES COUNTY SURVEYOR
700 HALL OF RECORDS

FORM 247 5M 10-37

Cont. to bot. page 69

F.B. 778 PG. 68

228.60 @ 12 29 T 52 = 228.47'

228.47' To P.1164A

P.1164A Set x ctk

170°-10-00 ①
320 40 00 ④
170 10 00

191.77 @ 1°-18-T 52°
191.68'

170°-10

Δ 9°-50-00
R 300.00
T 25.81
L 51.49

191.62'

P.P. P.1.163A Set 3/4" IP plug + tk

97.49'

167°-55-15 ①
311° 40 45 ④
167 55 15

P.1.163A Set x ctk

167° 55 10"

Δ 12°-04-50
R 500.00
T 52.91
L 105.42

285.94 @ 5°46 T 48 = 284.42'
140.71 @ 5°30 T 48 = 140.00'
424.42'

Δ 13°-11-45"
R 1000.00
T 115.67
L 230.31

166° 48 - 15'

P.1.162A Set x ctk

① 166° 48 15
④ 307° 13 00
166 48 15

65.30'

P.P. P.1.162A Set 3/4" IP plug + tk

From P.1.161

Cont. from top page 67

RETURN TO
LOS ANGELES COUNTY SURVEYOR
700 HALL OF RECORDS

Note: Any Additions or Changes on This Sheets Must be Made or Circled in Red Ink With Date and Name of Person Making Change.

Do not extend notes this side of this line

Notes Ck'd by		Survey of Las Virgenes FT System	F.B. 778 PG. 69
Map No. B-1830		W. O. 8243 Tape No. 49 St'd 84 OF	
Office Work		Surveyed by Stevenson	
Checked		Notes T.J.S Date 3-7-39	
Date		Indexed	

Cont to bot page 70

P1.167A set 1x2+k

178°

157.96'

P1.166A set 1x2+k

Δ = 4-37 30
R = 1000.00
T = 40.38
L = 80.72

175°-22

30'

N 78° W

35059'

201.48 @ 5°43 T 52° = 200.44'
150.50 @ 3°45 T 52 150.15'
35059'

Δ = 20°04-10
R = 800.00
T = 141.56
L = 280.22

159°

P1.165A set ¾" IP plug+tk

Cont from top page 68

Note: Any Additions or Changes on This Sheets Must be Made or Circled in Red Ink With Date and Name of Person Making Change.

Do not extend notes this side of this line

RETURN TO
LOS ANGELES COUNTY SURVEYOR
700 HALL OF RECORDS

FORM 247 5M 10-37

F.B. 778 PG. 70

Cont. to bot. page 71

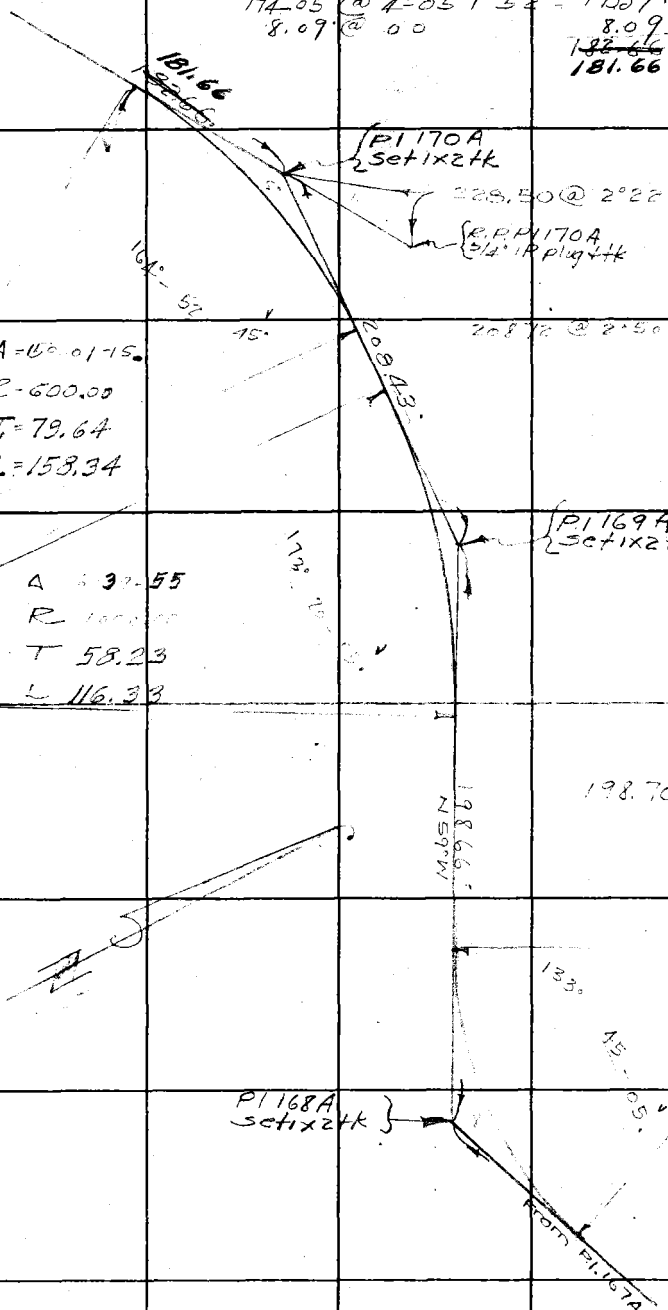

174.05 @ 4°05' T 52° = 173.57'
8.09' @ 0 0
8.09'
181.66

164° 52' 45"
299° 21' 00"
164° 52' 45"

P1170A set 1x2 tk

229.50 @ 2°22' T 56°

R.P. P1170A 3/4" IP plug + tk

164° 52'

45°

208.43 @ 2°50' T 52° = 208.43.

Δ = 15° 01' 15"
R = 600.00
T = 79.64
L = 158.34

Δ = 37° 55'
R =
T 58.23
L 116.33

173° 20'

173° 20' 33"

198.70 @ 0° 7' 52" = 198.63'

133°

Δ = 46°-14' 52"
R = 100.00
T 42.70
L 80.72

15° 05'

133° 45' 0"
173° 00' 37"
133° 45' 07"

Cont from top page 69

RETURN TO
LOS ANGELES COUNTY SURVEYOR
700 HALL OF RECORDS

Note: Any Additions or Changes on This Sheets Must be Made or Circled in Red Ink With Date and Name of Person Making Change.

Do not extend notes this side of this line

Notes Ck'd by	Survey of Los Virgenes FIT System F.B. 778 PG. 71
Map No. B2 1830	W. O. 8242 Tape No. 47 St'd 84 OF
Office Work	Surveyed by Stevenson
Checked	Notes Date 3 7 37
Date	Indexed

Note: Any Additions or Changes on This Sheets Must be Made or Circled in Red Ink With Date and Name of Person Making Change.

Do not extend notes this side of this line

RETURN TO
LOS ANGELES COUNTY SURVEYOR
700 HALL OF RECORDS

FORM 247 5M 10-37

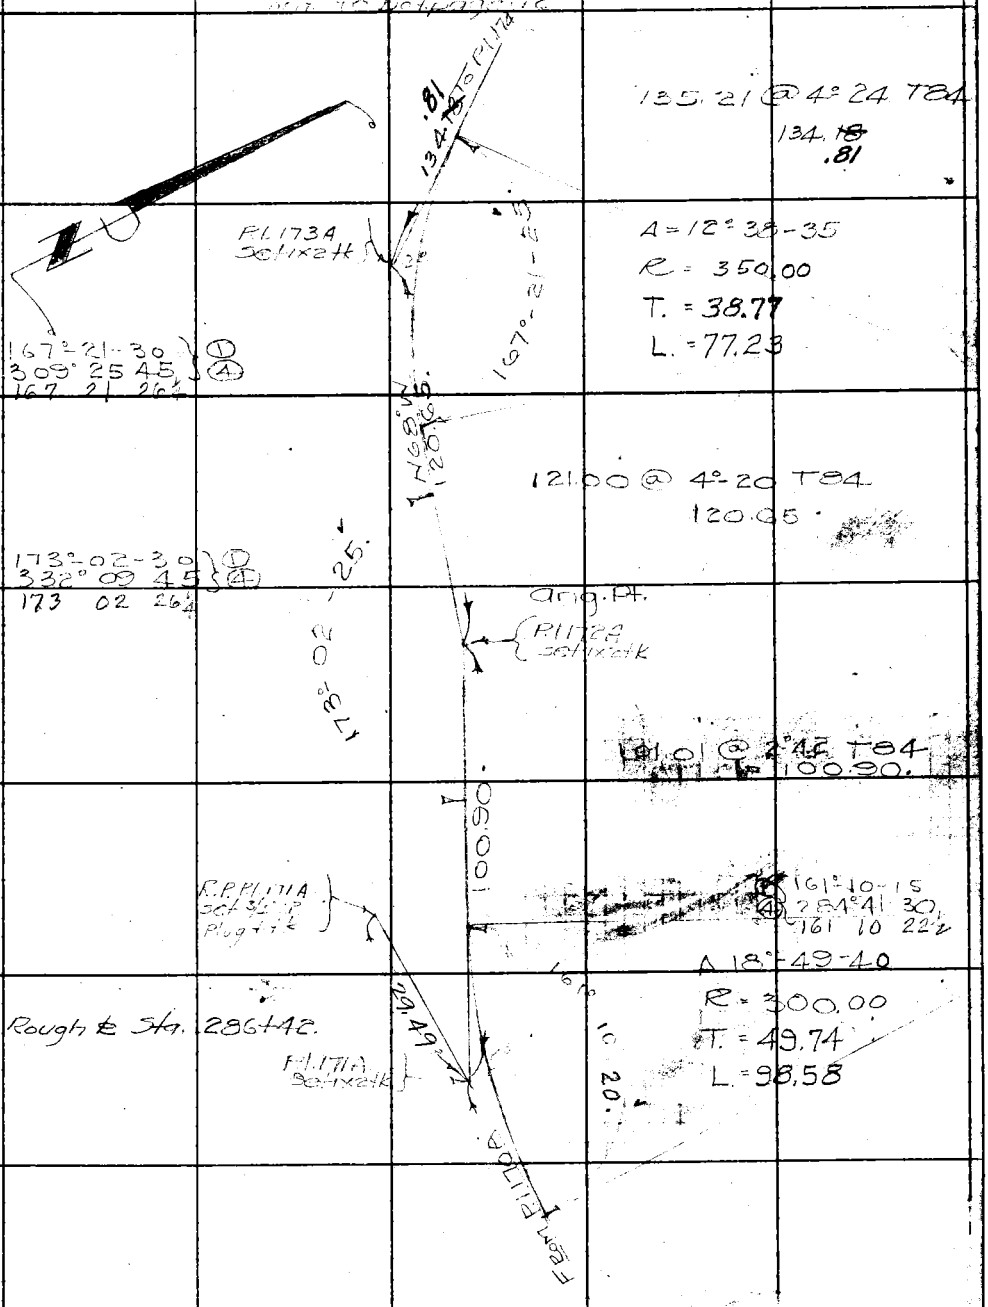

F.B. 778 Pg. 72

Cont. to Lot. page 99.

9403 00 T84°

172° 59 00 ① ④
331 55 45
172 58 56¼

9403 to P.I. 176A

P.I. 176A Set 1x2 tk

172-58 55.5'

175.48 @ 0°41 T84

= 175.48

175.48

173° 49 15 ① ④
335° 19 00
173 49 45

4.5'

173 49

ang. Pt. P.I. 175A Set 1x2 tk

S87°W 117.34

117.50 @ 2°53 T84°
= 117.34

Δ - 15°-44-15
R 100.00
T 42.18
L 79.83

15-44-15

134

① 134 15 45
④ 177 03 00
134 15 45

P.I. 174A Set ¾" IP Plug tk

From P.I. 173A

Cont. from top page 71

RETURN TO
LOS ANGELES COUNTY SURVEYOR
700 HALL OF RECORDS

Note: Any Additions or Changes on This Sheets Must be Made or Circled in Red Ink With Date and Name of Person Making Change.

Do not extend notes this side of this line

Notes Ck'd by		Survey of	F.B. 178 Pg. 73
Map No. A-1830		W. O.	Tape No. St'd of
Office Work		Surveyed by	
Checked		Notes	Date
Date		Indexed	

LAS VIRGENES T.T. SYSTEM

DAYTON CANYON MOTOR WAY-CO.

LINE TO SUMMIT - STADIA LINE.

CONT'S ON P[illegible] TO FUR[illegible]

J.N. 8213

T.J. Stevenson
E. HNISCH
W.F. HOFFIS
R.W. SCOTT

Note: Any Additions or Changes on This Sheets Must be Made or Circled in Red Ink With Date and Name of Person Making Change.

Do not extend notes this side of this line

RETURN TO
LOS ANGELES COUNTY SURVEYOR
700 HALL OF RECORDS

FORM 247 5M 10-57

F.B. 778 PG. 74

Cont. to bot page 75

12491@00 + 56 = 12497

10.8° 34 30 30 ①
74 11 15 - ④

1249.80
To Pt 3 L

Pt #2 D
set 3/4" IP
plug + tk

A 71° 25 30
R 70.00
T 50.32
L 87.26

108°

A

20460 7.16 T 56° 20298

12511 2°20 T 56° 12497

Δ 6°39 19 35

116°22 30 ①
10 02 00 ②

L 135.52

Pt 4 D
set 3/4" IP
(Plug + tk

7459@5°17 15 = 7426

20°44 45 ③
82°58 45 ④

N 0°W

To S 12 3/4 E 490

20298

2650

6715

973.50 L.
N 0°00 40 E
(970.40)

20°44 45

COUNTY
SEMI RD
VENTURA CO
MONUMENT
L.A. CO
SURVEYORS

Pt
Set 1X2 tk

8158

FB 428 p 100

COUNTY
C.S.
Y 99
3360
2.5 Co
LA
MONUMENT
SURVEYORS

FB 428 Pg. 101

RETURN TO
LOS ANGELES COUNTY SURVEYOR
700 HALL OF RECORDS

Note: Any Additions or Changes on This Sheets Must be Made or Circled in Red Ink With Date and Name of Person Making Change.

Do not extend notes this side of this line

Notes Ck'd by	Survey of Los Angeles F.B. 778 Pg. 75
Map No. B-1830	W. O. 2212 Tape No. St'd of
Office Work	Surveyed by Stevenson
Checked	Notes J.S. Date 5-3-27
Date	Indexed C. Jan 11-6-28

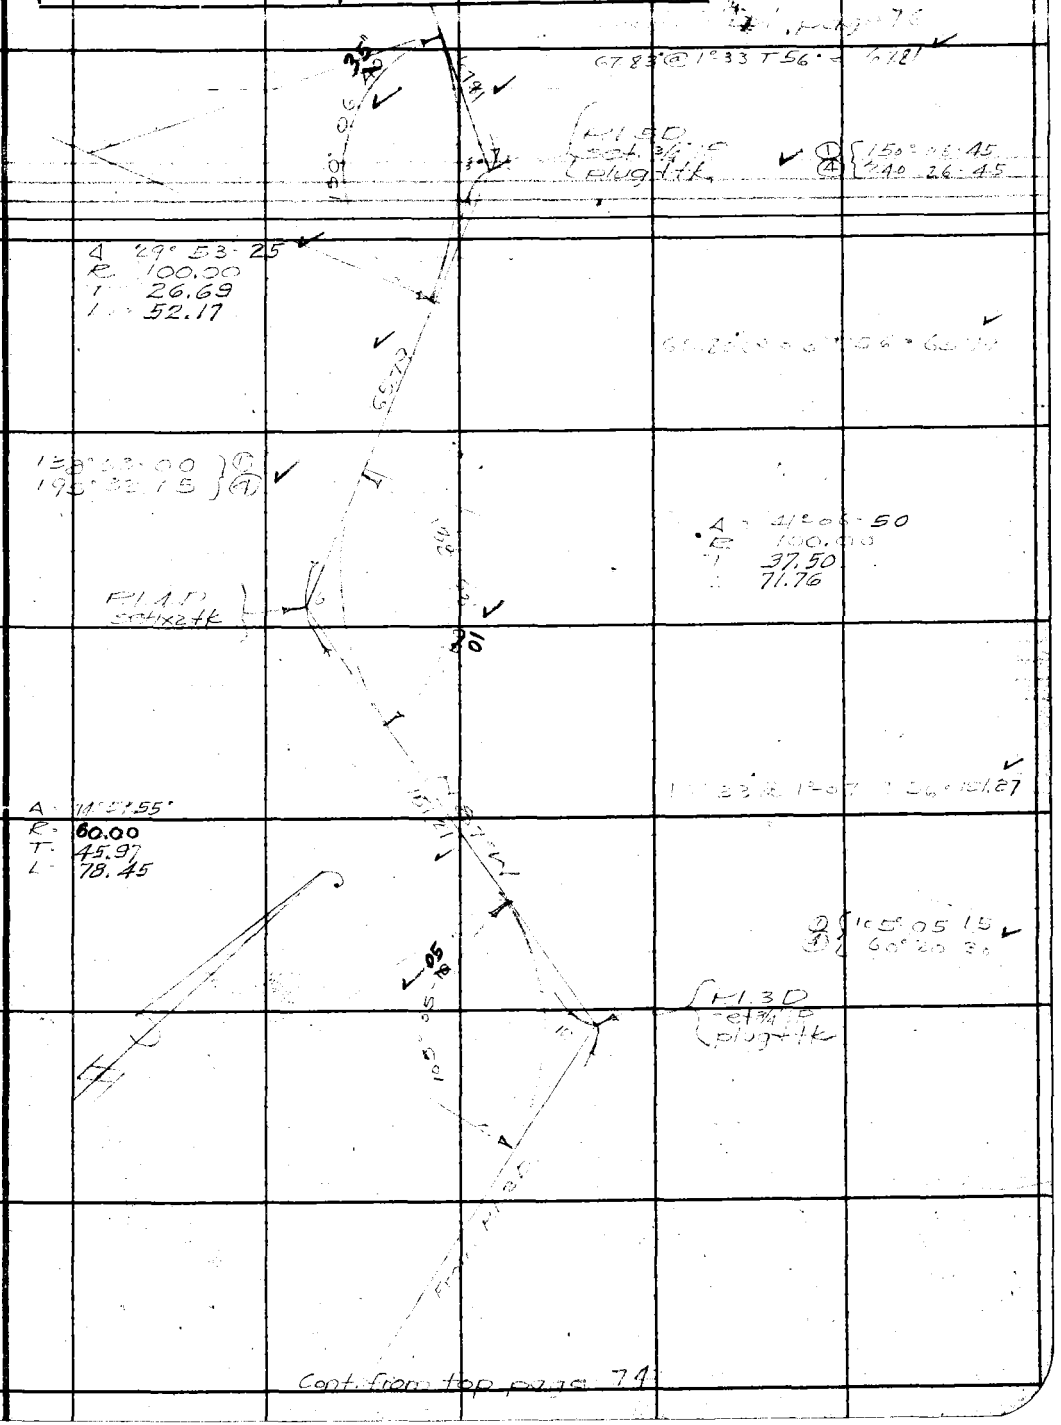

Note: Any Additions or Changes on This Sheets Must be Made or Circled in Red Ink With Date and Name of Person Making Change.

Do not extend notes this side of this line

RETURN TO
LOS ANGELES COUNTY SURVEYOR
700 HALL OF RECORDS

FORM 247 5M 10-37

cont. to bot page 77

F.B. 778 Pg. 76

67.41 @ 4°08 T56 = 67.23

155° 49-15 } D
263° 17 30 } A

67.23

155° 49 25

P.I. 8 D
SCE STAKE

Δ = 12° 10 35
R = 100.00
T = 21.42
L = 42.20

57.27 @ 4°25 T56 = 57.09

57.09

Δ 13° 15-55
R 110.00
T 13.28
L 26.43

P.I. 6 A
SCE STAKE

P.I. 7 A

D 105-19-12
A 35° 26 12

96.73 @ 5°58 T56 = 96.48

N 51° 15 E 96.48

154° 35 15 } D
258° 21 30 } A

P.I. 6 D
SCE STAKE

Δ = 25° 24 35
R = 90.00
T = 20.29
L = 39.91

N 00° 00 E 25.00

Cont. from top page 75

RETURN TO
LOS ANGELES COUNTY SURVEYOR
700 HALL OF RECORDS

Note: Any Additions or Changes on This Sheets Must be Made or Circled in Red Ink With Date and Name of Person Making Change.

Do not extend notes this side of this line

Notes Ck'd by
Map No. B-1830
Office Work
Checked
Date

Survey of
W. O. 8242 Tape No. St'd. °F
Surveyed by
Notes Date 2-3-39
Indexed

F.B. 778 PG. 77

Note: Any Additions or Changes on This Sheets Must be Made or Circled in Red Ink With Date and Name of Person Making Change.

Do not extend notes this side of this line

RETURN TO
LOS ANGELES COUNTY SURVEYOR
700 HALL OF RECORDS

FORM 247 5M 10-37

Peg Notes

.69
.24
.24
.35
60
60
10
20
69

Δ 14°23'45"
R 250.00
T 31.56
L 62.79

Δ 15°53'10"
R 150.00
T 42.33
L 80.09

A 26°03'40"
R 90.00
T 42.03
L 78.64

129°56'30"
157°43'30"

FLAG
set IPK

FLAG
set IPK

FLAG
set 3/4" IP
Flag-11K

Cont. from top page 76

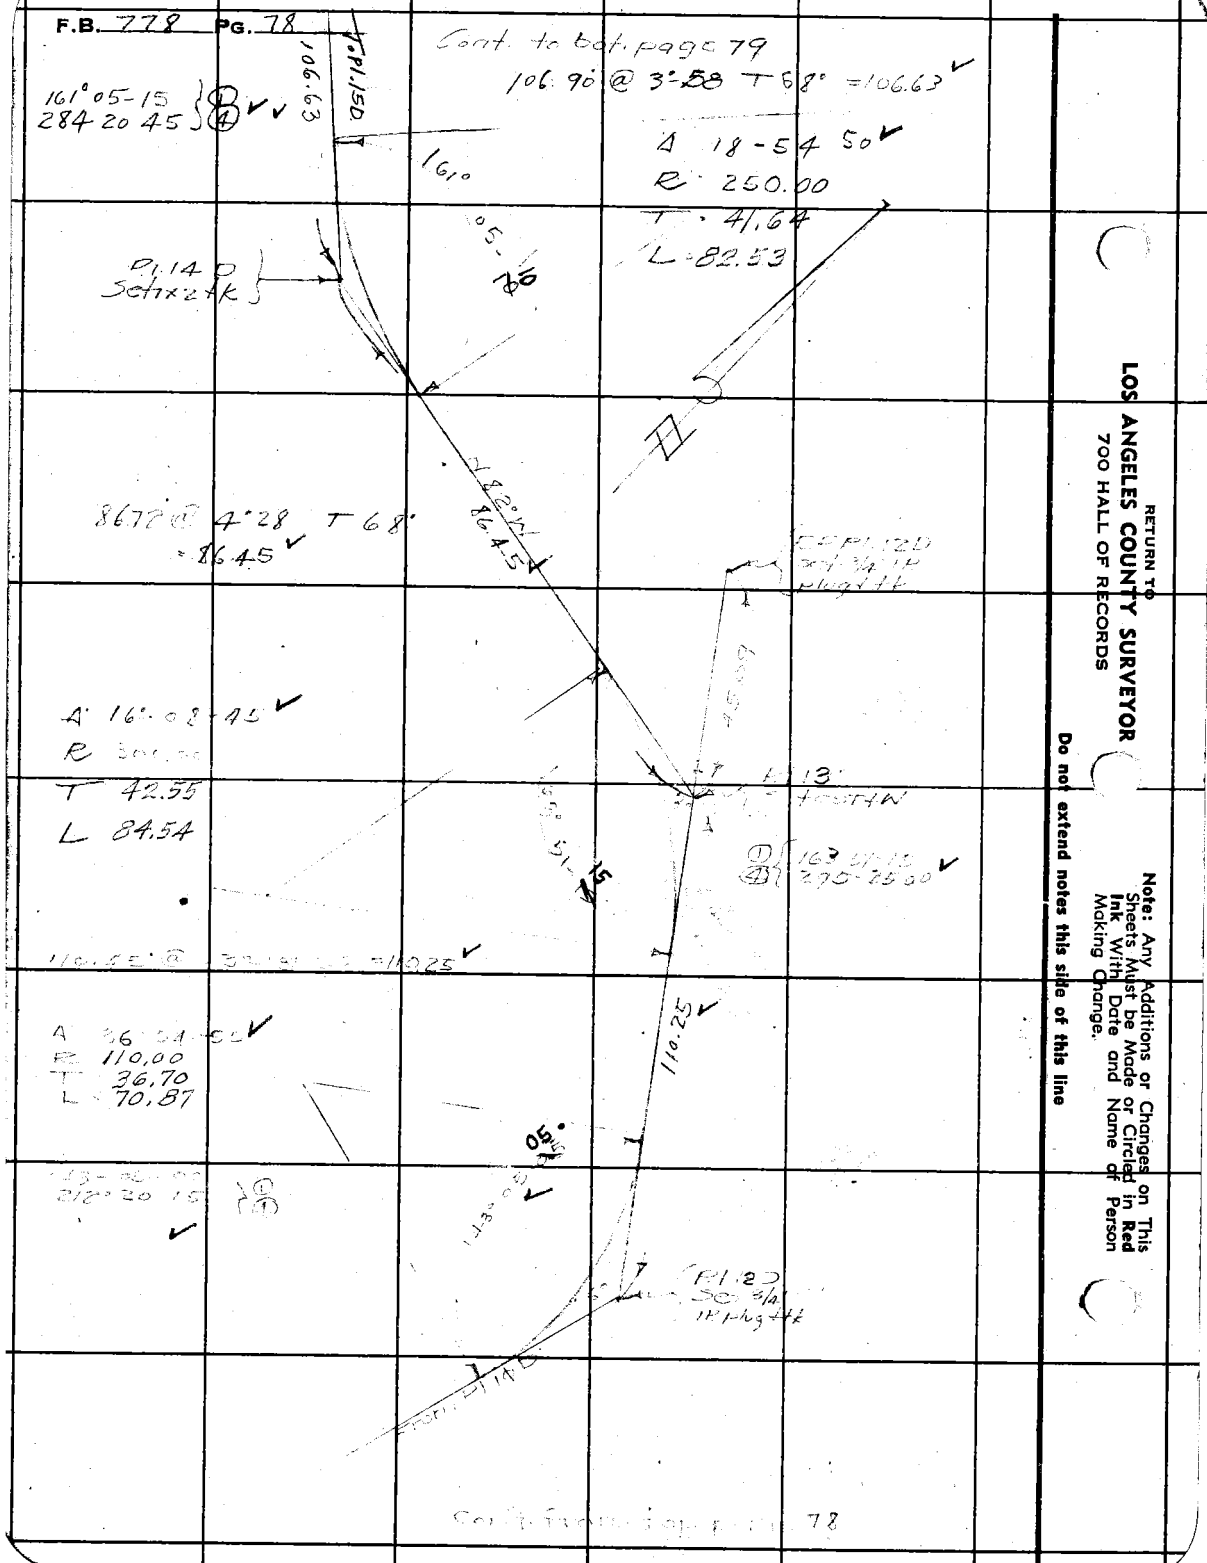

RETURN TO
LOS ANGELES COUNTY SURVEYOR
700 HALL OF RECORDS

Note: Any Additions or Changes on This Sheets Must be Made or Circled in Red Ink With Date and Name of Person Making Change.

Do not extend notes this side of this line

Notes Ck'd by	Survey of Los Virgenes Creek	F.B. 778	Pg. 79
Map No. B-1830	W. O. 8248 Tape No.	St'd.	of
Office Work	Surveyed by Stevenson		
Checked	Notes J S	Date	
Date	Indexed A. C. Johnson		

Cont to dot pag 8

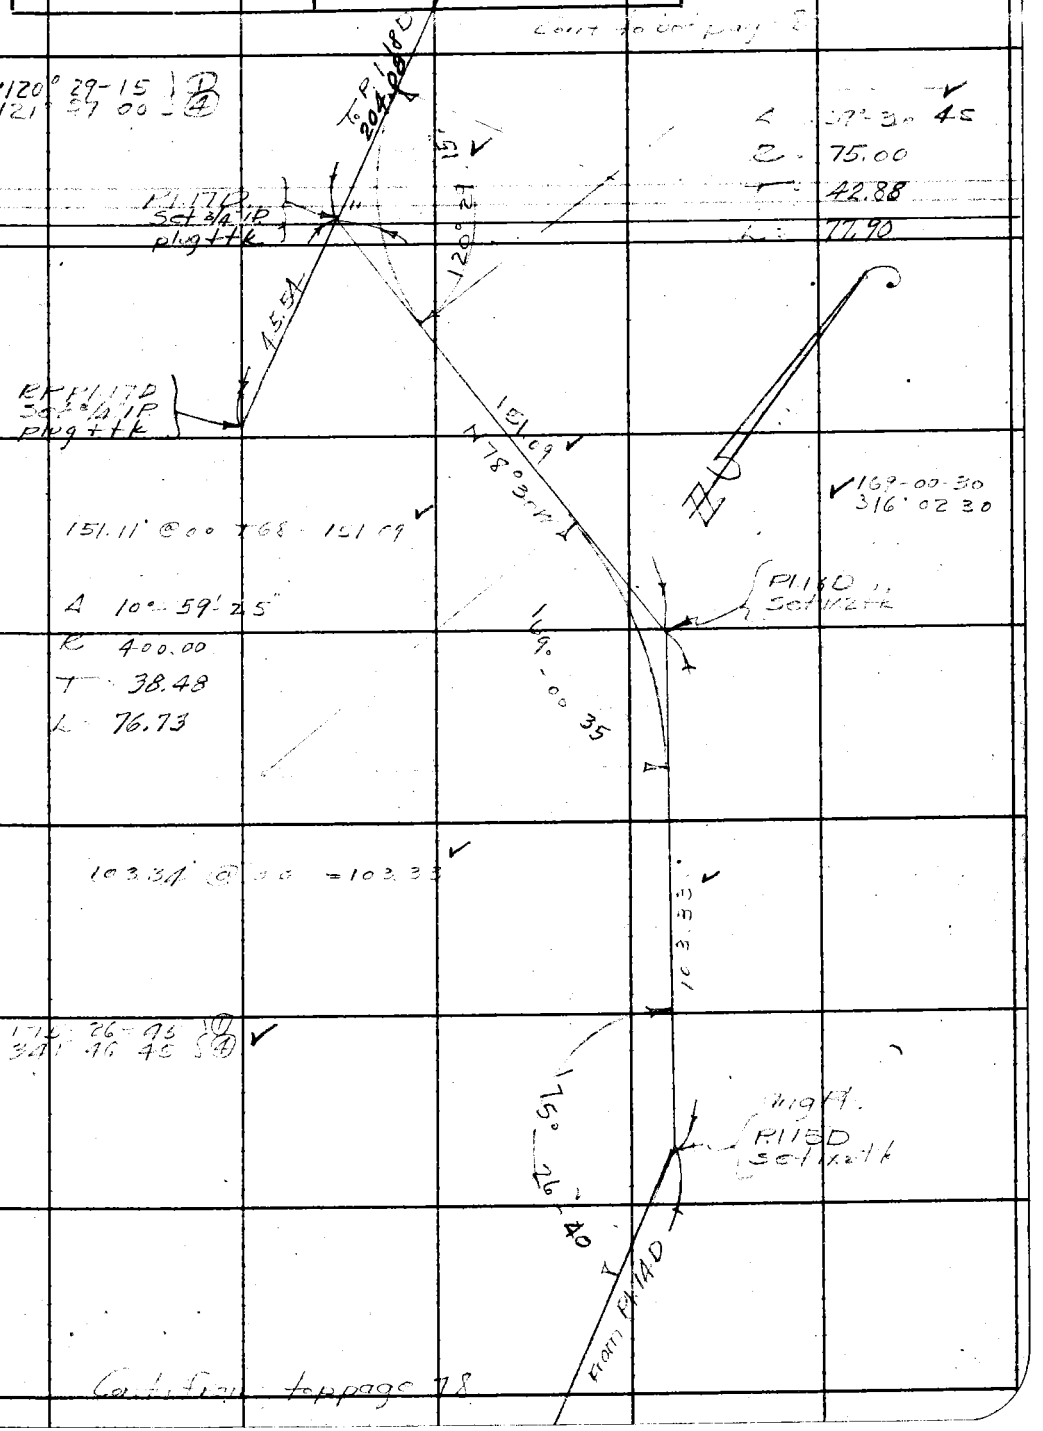

Note: Any Additions or Changes on This Sheets Must be Made or Circled in Ink With Date and Name of Person Making Change.

Do not extend notes this side of this line

RETURN TO
LOS ANGELES COUNTY SURVEYOR
700 HALL OF RECORDS

Continue to page 78

FORM 247 SM 10-37

RETURN TO
LOS ANGELES COUNTY SURVEYOR
700 HALL OF RECORDS

Note: Any Additions or Changes on This Sheets Must be Made or Circled in **Red Ink** With Date and Name of Person Making Change.

Do not extend notes this side of this line

F.B. _____ PG. 80

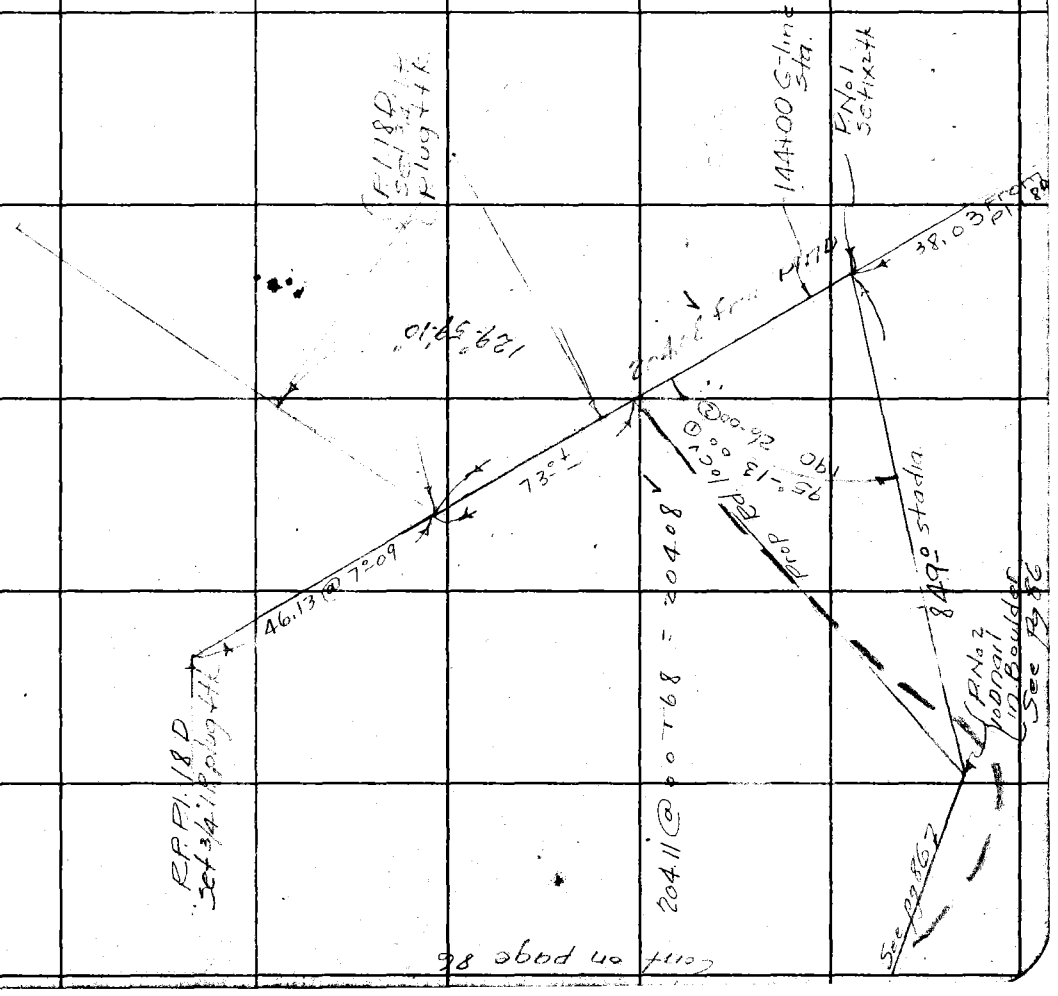

Notes Ck'd by
Map No. E-1890
Office Work
Checked
Date

Survey of Las Virgenes Fit System
W. O. 8243 Tape No. 49 St'd
Surveyed by Stevenson
Notes T.J.S Date 3-13-39
Indexed A. C. Johnson

F.B. 778 PG. 81

Note: Any Additions or Changes on This Sheets Must be Made or Circled in Red Ink With Date and Name of Person Making Change.

Do not extend notes this side of this line

RETURN TO
LOS ANGELES COUNTY SURVEYOR
700 HALL OF RECORDS

FORM 247 SM 10-37

82

115.76 @ 00 7 70 = 115.75'

A - 66°55-30"
R - 50.00
T - 39.66
L - 70.09

186.43 @ 00 7 68 = 186.41'

162°10 30 } (1)(4)
288 48 15

A 17°49 35"
R - 300.00
T - 47.04
L - 93.32

101.35 @ 00 1 68 = 101.34'

170°08-45 } (1)(4)
320°35 15

P.1.19D Set 1x2 tk

136.83 @ 00 7 68 =
= 136.82'

129°59-15 } (1)(4)
159°56 45

P.1.18D Set 3/4" IP Plug & tk

Bo's Corn M.W. 136.82' N30°E

170°-08

A - 9-51-10"
R - 300.00
T - 25.86
L - 51.59

129°59 10"

A 50°-00 50"
R - 90.00
T - 41.98
L - 78.56

P.1.21D Set 3/4" IP Plug & tk

115.75'

113°04-30 } (1)(4)
92°17 45

186.41'

162°10 35"

P.1.20D Set CST & tk

80
79

Cont. from top page

F.B. 778 PG. 82

Cont to bot page 83

262.35 @ 3°21 T 70° = ~~262.89~~ 261.88

171° 20' 15" ①
325° 20' 45" ④

P123D Set ¾" IP plug + tk

261.88 ~~262.89~~ To P1 24 D

171°

Δ 8°39'5"
R 500.00
T 37.88
L 75.61

207.89 @ 4°10 T 70 = ~~206.52~~ 206.52

206.52 ~~206.52~~ N 33° E

103°15'15" ①
53°00'45" ④

P122D Set ¾" IP plug + tk

103°15'15"

Δ 76°44'5"
R 60.00
T 47.51
L 80.37

From P1 21 D

Cont. from top page 81

RETURN TO
LOS ANGELES COUNTY SURVEYOR
700 HALL OF RECORDS

Note: Any Additions or Changes on This Sheets Must be Made or Circled in Red Ink With Date and Name of Person Making Change.

Do not extend notes this side of this line

Notes Ck'd by	Survey of Los Vimenes Fit System
Map No. R-1830	W. O. 824-3 Tape No. 19 St'd 84 OF
Office Work	Surveyed by Stevenson
Checked	Notes F.J.S. Date 3-13-39
Date	Indexed C. Johnson

F.B. 778 Pg. 83

Note: Any Additions or Changes on This Sheets Must be Made in Red Ink With Date and Name of Person Making Change.

Do not extend notes this side of this line

RETURN TO
LOS ANGELES COUNTY SURVEYOR
700 HALL OF RECORDS

FORM 247 5M 10-37

Set PI from ties shown in RB 628 pg. 37-6

5 Peg Notes.

80' Com. M.W. Surv. R.B. 628 P 48

T. Black Cor.

(67+66.87)

(209.63) (Rec.)

(60°26'35")

67.35 @ 4°20 T 7.
67.16.

1199.68 To 5.9+

P125D
Set 1x2 tk

1" PP 125D
Fd 3x2 tks
Inset 3/4" IP
Plug tks
R.P.I. 3.75 pk°
R.B. 628-48.

(65.87)

23.34
Calc. 16°

(43.32)

21°38-00
86°31-45

64.10

21°37-5

85.16

85.61 @ 5°52 T 7.0
= 85.16'

Δ 11°50 55"
R 200.00
T 20.75
L 41.36

168°09'05"

P124D
Set 1x2 tk

168°09'00"
313°36'15"

Cont. from top page 82

RETURN TO
LOS ANGELES COUNTY SURVEYOR
700 HALL OF RECORDS

Note: Any Additions or Changes on This Sheets Must be Made or Circled in **Red Ink** With Date and Name of Person Making Change.

Do not extend notes this side of this line

F.B. _____ PG. 84

Notes Ck'd by		Survey of	F.B. 778 Pg. 85
Map No. A-1830		W. O.	Tape No. St'd of
Office Work		Surveyed by	
Checked		Notes	Date
Date		Indexed	A. C. Johnson

Las Virgenes F F T. System

Burro Flats To Box Can

J N 8245

Stadia Location of P.In.

T. J. Stevenson
G. H. Nichols
W. F. Harris
R. W. Scott

Note: Any Additions or Changes on This Sheets Must be Made or Circled in Red Ink With Date and Name of Person Making Change.

Do not extend notes this side of this line

RETURN TO
LOS ANGELES COUNTY SURVEYOR
700 HALL OF RECORDS

FORM 247 5M 10-37

Cont. to bot page 87

F.B. 778 PG. 86

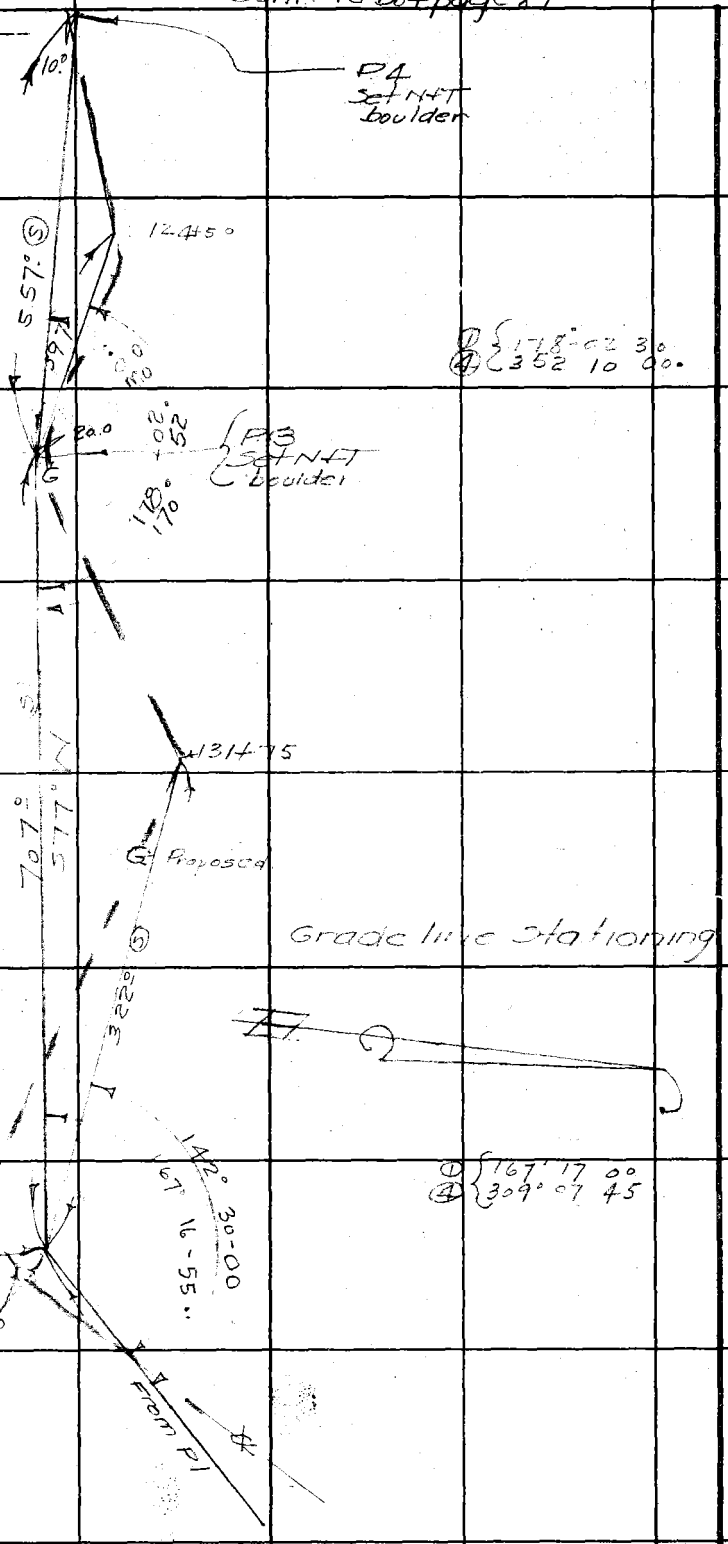

Cont. from bot page 80

RETURN TO
LOS ANGELES COUNTY SURVEYOR
700 HALL OF RECORDS

Note: Any Additions or Changes on This Sheets Must be Made or Circled and Ink With Date and Name of Person Making Change.

Do not extend notes this side of this line

Notes Ck'd by		Survey of	F.B. 778 Pg. 87
Map No. B-1830		W. O. 5243 Tape No. 2 St'd ° F	
Office Work		Surveyed by Stevenson	
Checked		Notes	Date 4-14-39
Date		Indexed	A. C. Johnson

88

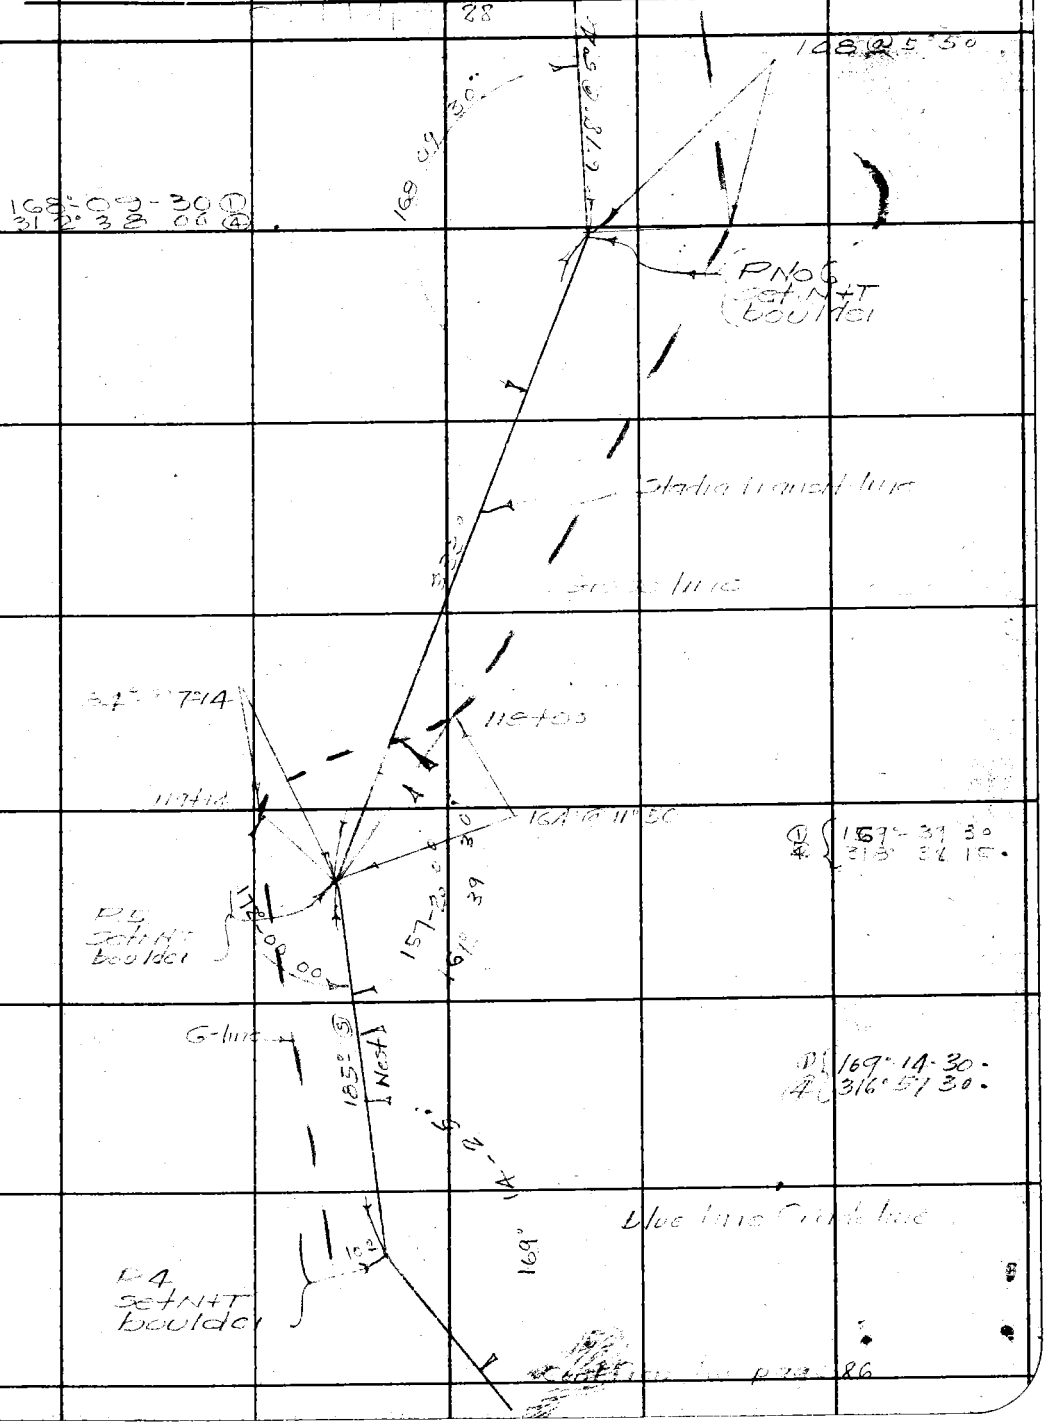

Note: Any Additions or Changes on This Sheets Must be Made in Red Ink With Date and Name of Person Making Change.

Do not extend notes this side of this line

RETURN TO
LOS ANGELES COUNTY SURVEYOR
700 HALL OF RECORDS

FORM 247 5M 10-37

F.B. 778 PG. 88

Cont to bot page 89

This line is [illegible] this [illegible]

157° 42-15 ① ④
270° 49 00

114° @ 9°30

164° 39-15 ① ④
298 36 30

Cont from top page 87

RETURN TO
LOS ANGELES COUNTY SURVEYOR
700 HALL OF RECORDS

Note: Any Additions or Changes on This Sheets Must be Made or Circled in Red Ink With Date and Name of Person Making Change.

Do not extend notes this side of this line

Notes Ck'd by		Survey of		F.B. 778	PG. 89
Map No. 13-1830		W. O. 8263	Tape No. 2	St'd	of
Office Work		Surveyed by	Stevenson		
Checked		Notes	Date		
Date		Indexed	A. C. Johnson		

Cont. to last page 90

Note: Any Additions or Changes on This Sheets Must be Made or Circled in Red Ink With Date and Name of Person Making Change.

Do not extend notes this side of this line

RETURN TO
LOS ANGELES COUNTY SURVEYOR
700 HALL OF RECORDS

162-00-30 (1)
288 01 45 (4).

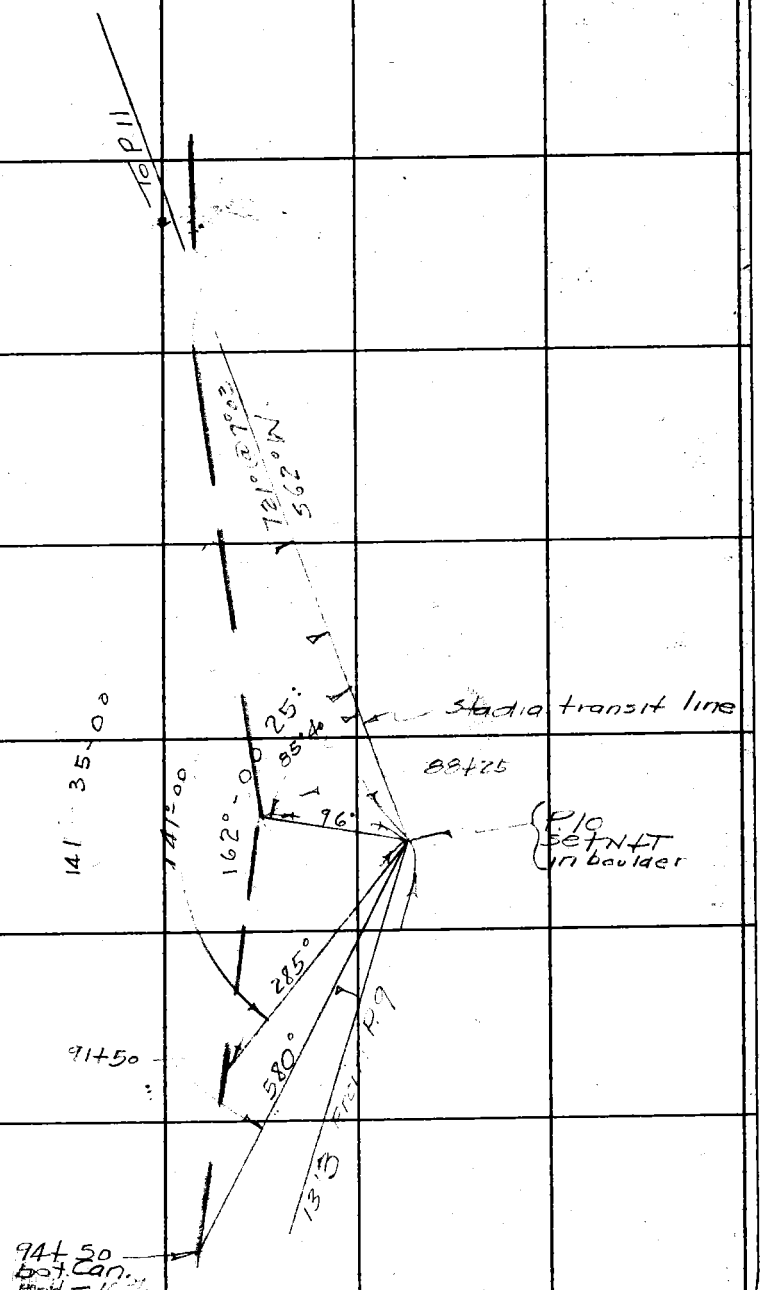

FORM 247 5M 10-37

F.B. 778 PG. 90

Cont. to bot. page 91

To P13

Sour. @ Pt. 68+50

879.01

37½°

139°33'15" 198-13 00.

P No 12 Set N+T boulder

139° 42' 40"

184° 15'

12°-08

73+15

Stadia Distance P line

Stadia traverse line

N66°W

76+00 Summit -16%

899

128°-09-30 152° 38 00

433.9

128°-09-30"

112°-00-00

103°

80+50 Summit -16%

107°

P No 11 Set N+T boulder

22

83+10

Front

P10

7°-40

Cont from top page 89

RETURN TO
LOS ANGELES COUNTY SURVEYOR
700 HALL OF RECORDS

Note: Any Additions or Changes on This Sheets Must be Made or Circled in Red Ink With Date and Name of Person Making Change.

Do not extend notes this side of this line

Notes Ck'd by	Survey of Los Virgines F M System
Map No. B-1830	W. O. 8243 Tape No. ② St'd oF
Office Work	Surveyed by Stevenson
Checked	Notes Date
Date	Indexed A. C. Johnson

F.B. 778 Pg. 91

Cont to bot page 1

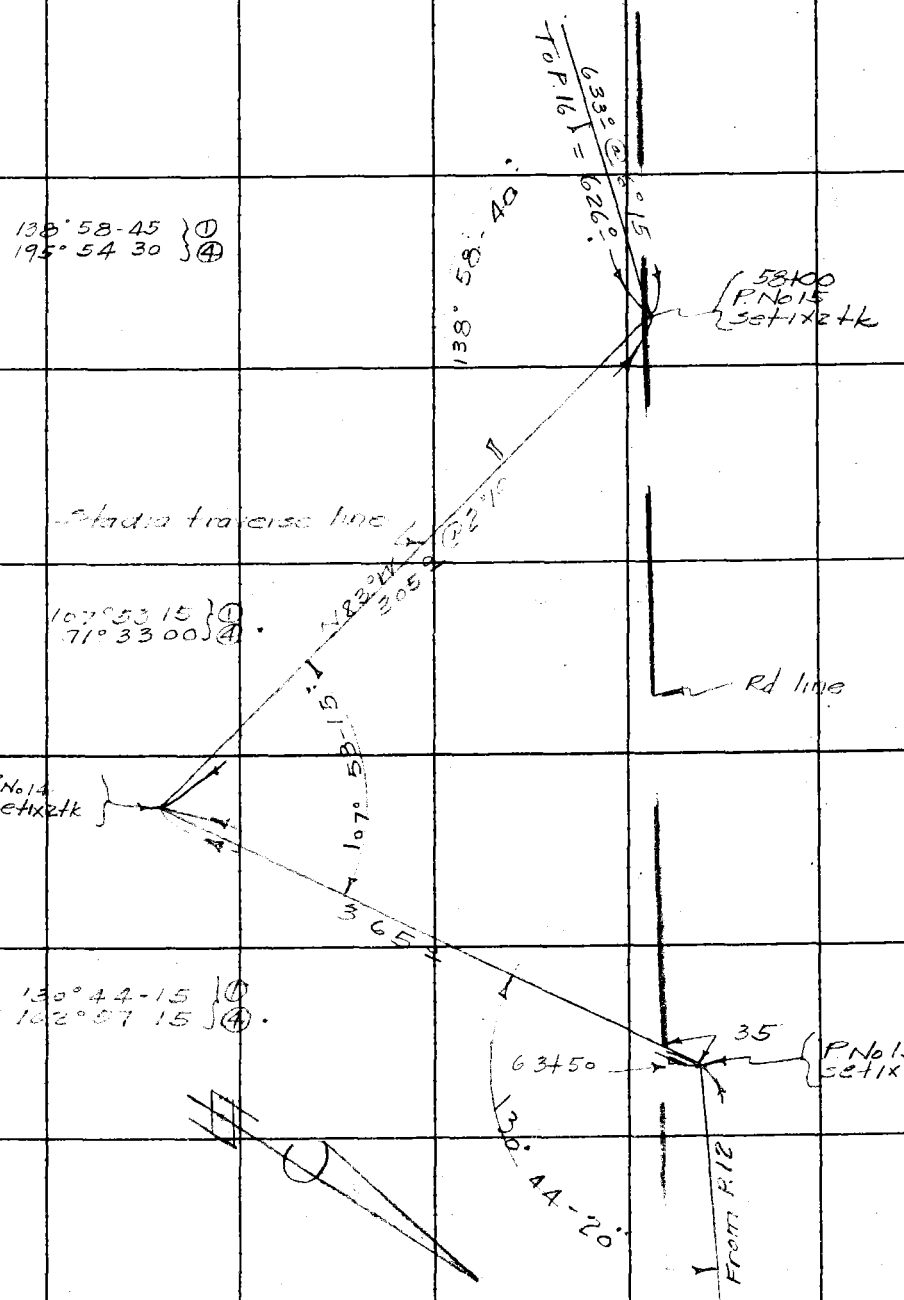

Cont from top page 7

Note: Any Additions or Changes on This Sheets Must be Made or Circled in Red Ink With Date and Name of Person Making Change.

Do not extend notes this side of this line

RETURN TO
LOS ANGELES COUNTY SURVEYOR
700 HALL OF RECORDS

FORM 247 5M 10-37

F.B. 778 PG. 92

Cont. to bot page 93

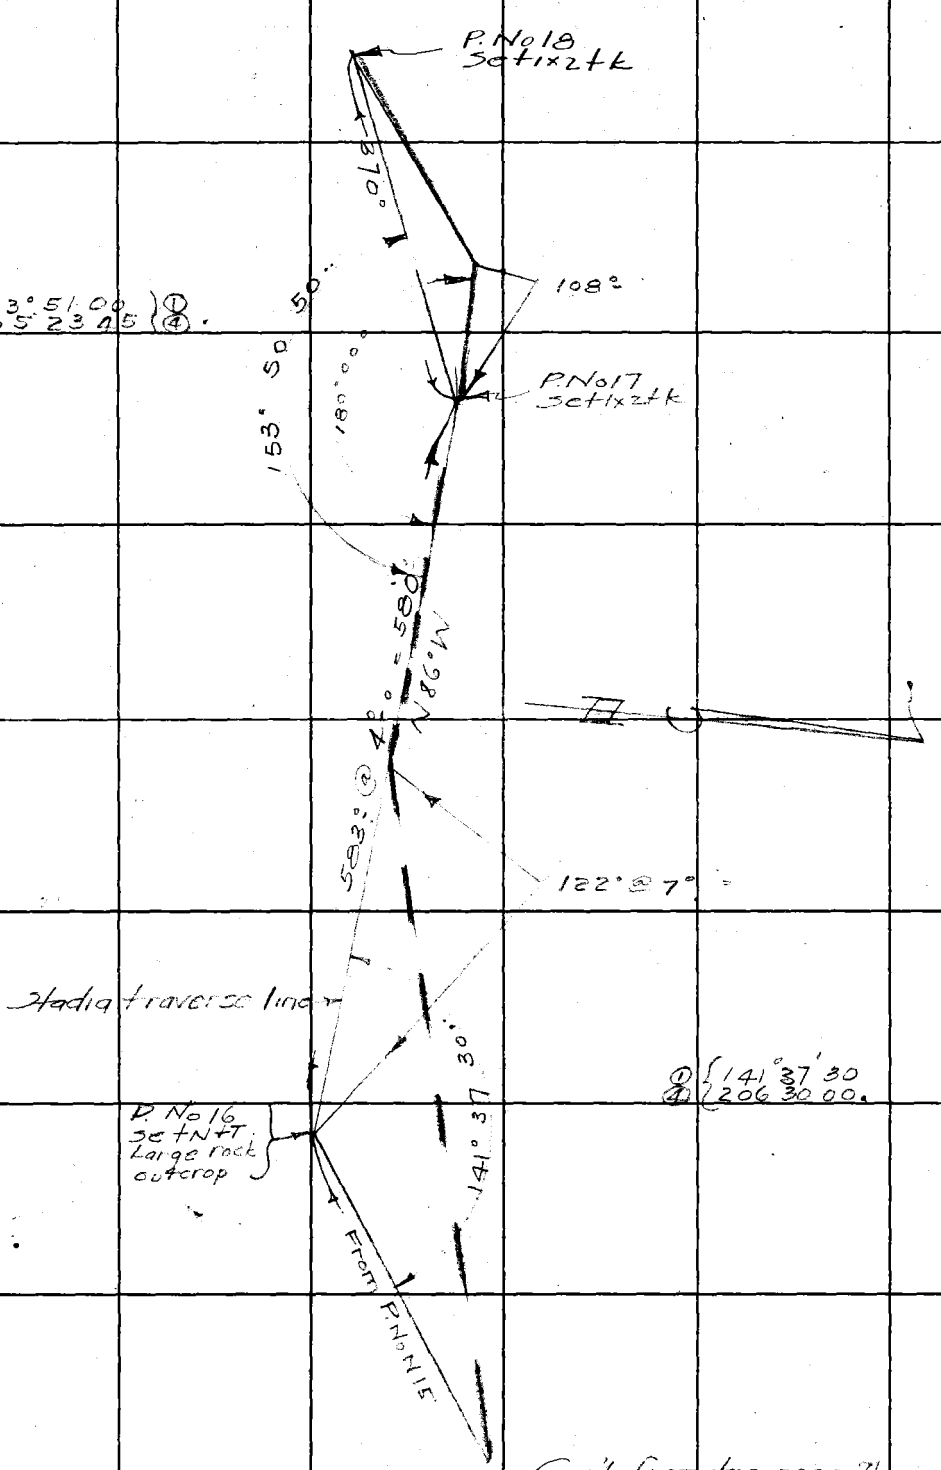

Cont. from top page 11

RETURN TO
LOS ANGELES COUNTY SURVEYOR
700 HALL OF RECORDS

Note: Any Additions or Changes on This Sheets Must be Made or Circled in Red Ink With Date and Name of Person Making Change.

Do not extend notes this side of this line

Notes Ck'd by		Survey of Los Virgenes F.M.	F.B. 778 Pg. 93
Map No. B-1830		W. O. 8243 Tape No.	St'd of
Office Work		Surveyed by Stevenson	
Checked		Notes T.J.S. Date 4-25-39	
Date		Indexed A. C. Johnson	

Note: Any Additions or Changes on This Sheets Must be Made or Circled in Red Ink With Date and Name of Person Making Change.

Do not extend notes this side of this line

RETURN TO
LOS ANGELES COUNTY SURVEYOR
700 HALL OF RECORDS

FORM 247 5M 10-37

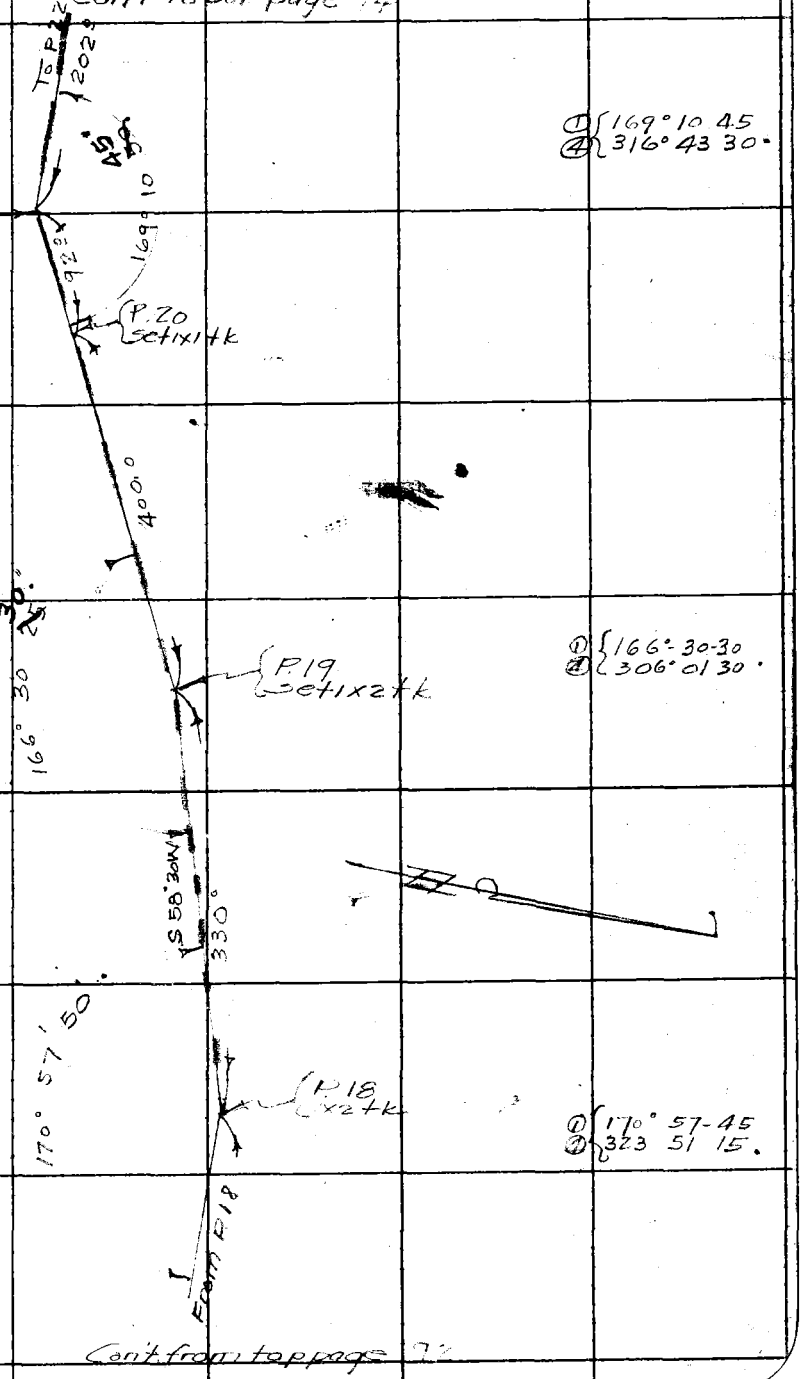

Cont. to bot page 85

F.B. 178 PG. 94

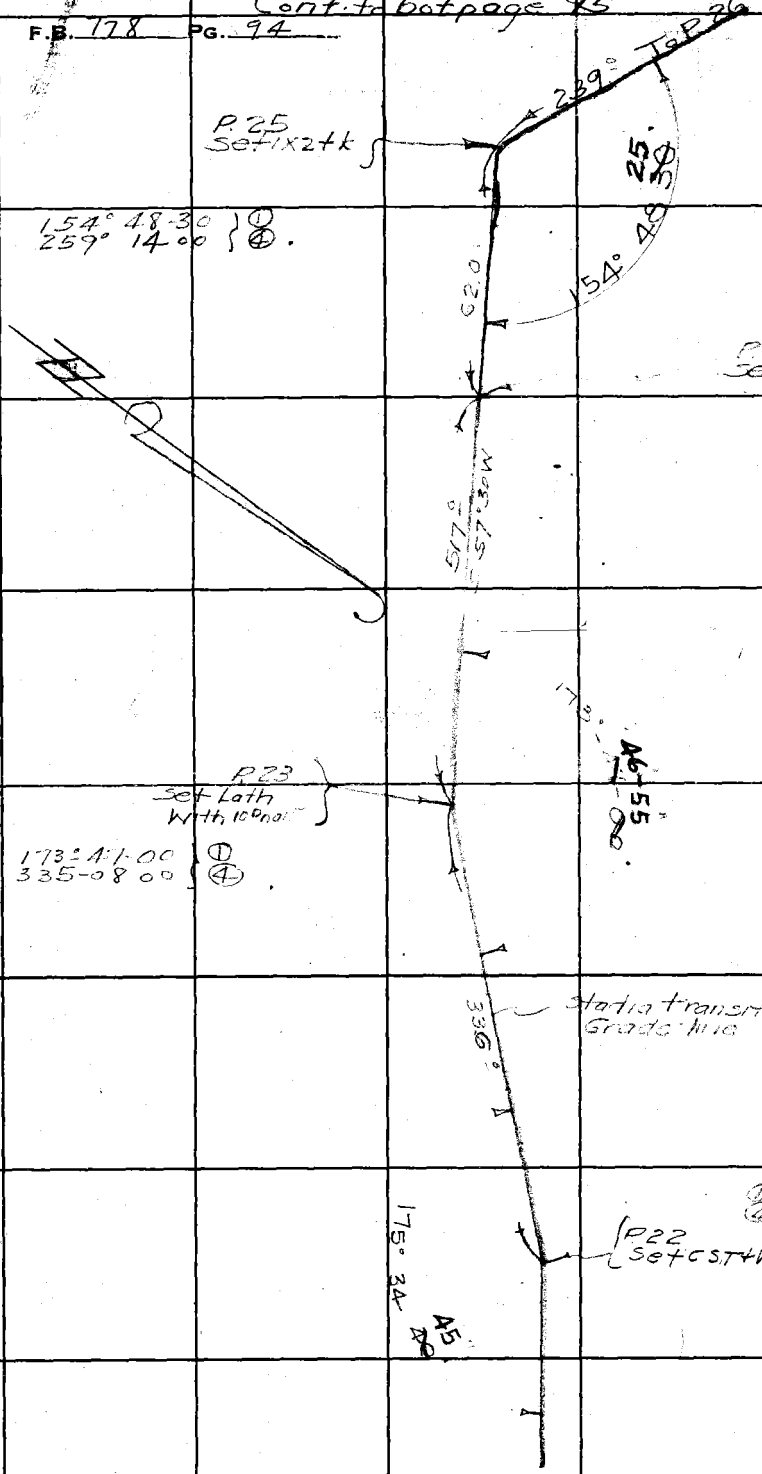

Cont. from top page 93

RETURN TO
LOS ANGELES COUNTY SURVEYOR
700 HALL OF RECORDS

Do not extend notes this side of this line

Note: Any Additions or Changes on This Sheets Must be Made or Circled in Red Ink With Date and Name of Person Making Change.

Notes Ck'd by
Map No. B-1930
Office Work
Checked
Date

Survey of Los Virgenes FTT System F.B. 778 Pg. 95
W. O. 8243 Tape No. 3 St'd OF
Surveyed by Stevenson
Notes J. S. Date 5-9-39
Indexed A. C. Johnson

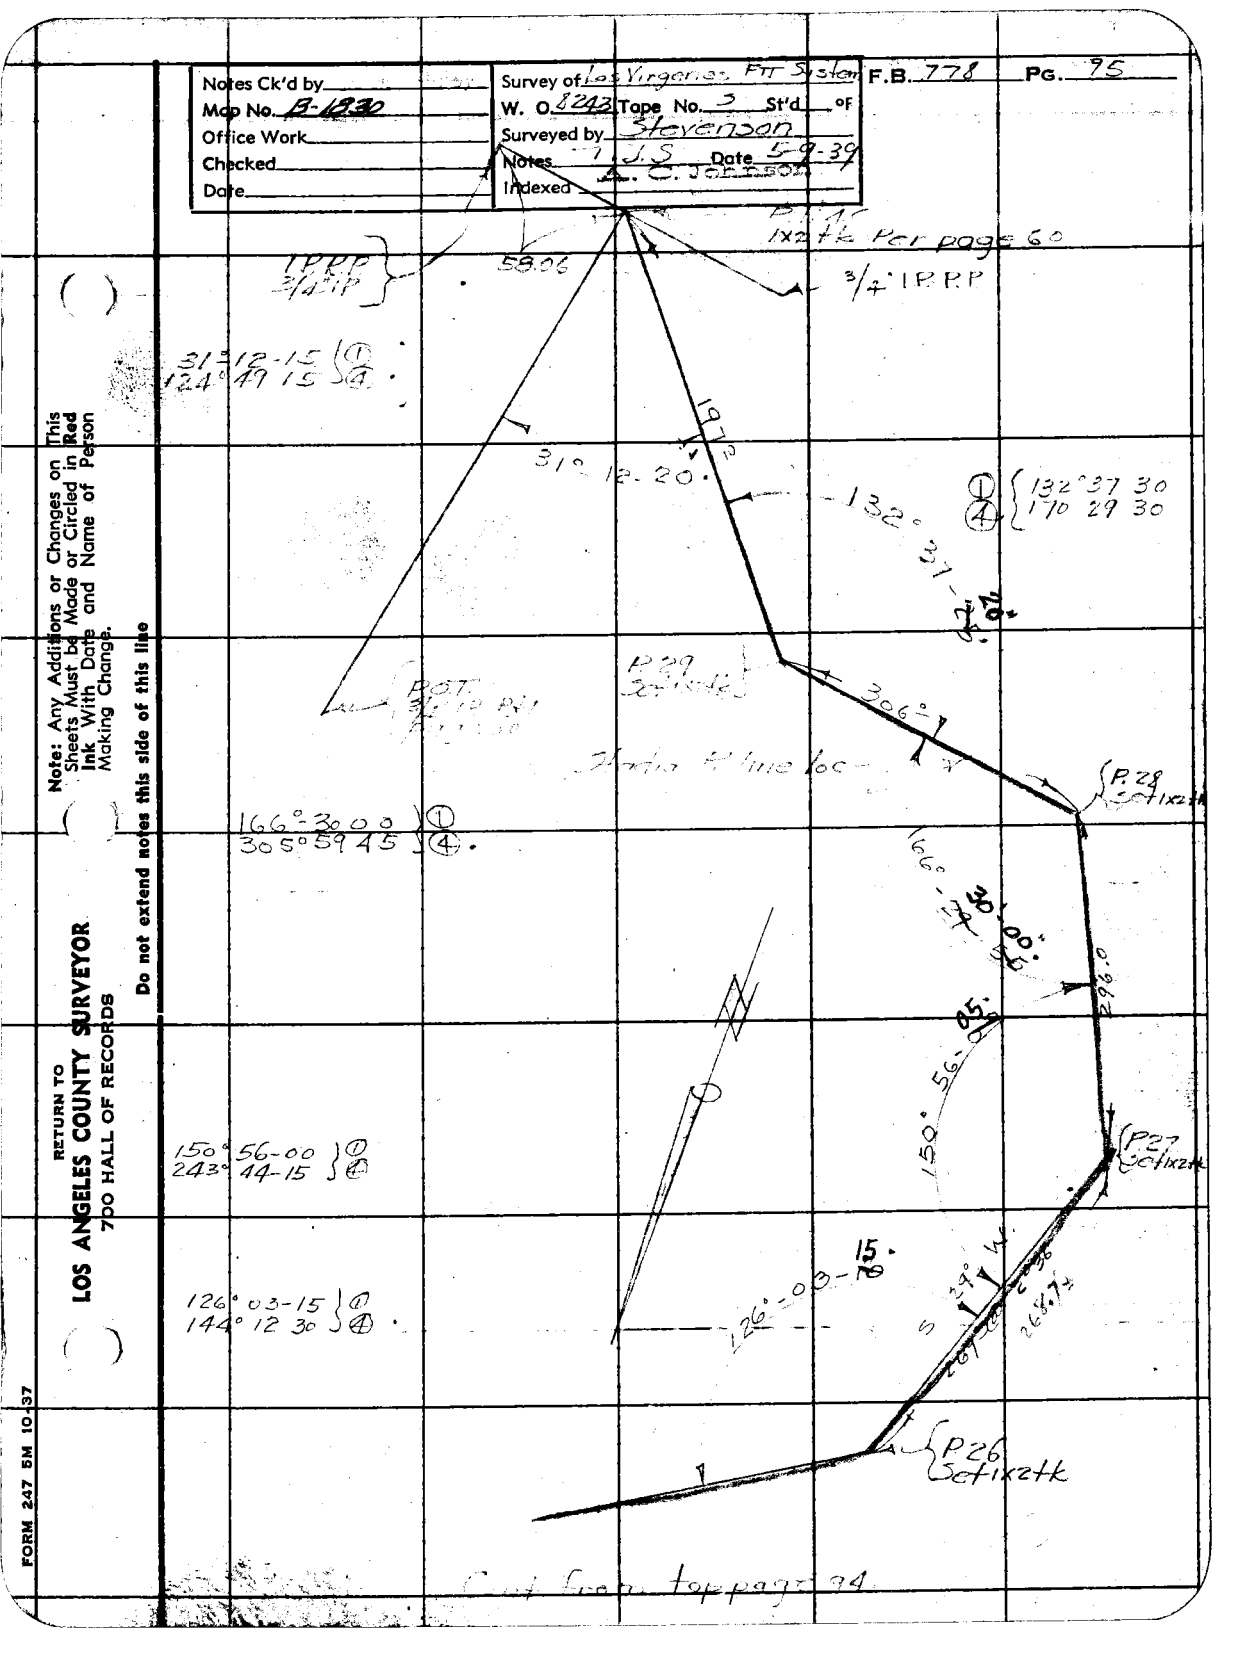

Note: Any Additions or Changes on This Sheets Must be Made or Circled in Red Ink With Date and Name of Person Making Change.

Do not extend notes this side of this line

RETURN TO
LOS ANGELES COUNTY SURVEYOR
700 HALL OF RECORDS

FORM 247 5M 10-37

RETURN TO
LOS ANGELES COUNTY SURVEYOR
700 HALL OF RECORDS

Note: Any Additions or Changes on This Sheets Must be Made or Circled in **Red Ink** With Date and Name of Person Making Change.

Do not extend notes this side of this line

F.B. 778 Pg. 76

Notes Ck'd by		Survey of Las Virgenes MWD System	F.B. 778 Pg. 97
Map No. 8-1830		W. O. 8284 Tape No.	St'd. 84°F
Office Work		Surveyed by J. Stevenson	
Checked		Notes T.J.S.	Date 5-8-39
Date		Indexed	

Note: Any Additions or Changes on This Sheets Must be Made or Circled in Red Ink With Date and Name of Person Making Change.

Do not extend notes this side of this line

RETURN TO
LOS ANGELES COUNTY SURVEYOR
700 HALL OF RECORDS

FORM 247 5M 10-37

AGOURA RANCH

L of B

Bull to Flats

Lot A

Fd 1/2" IP in mound @ Fn corner L.S. 8-33 Rec. Ventura Co. Ensigns 19 Ph

VOID
See Page 25A for Ranch In. and Rd Ent

Fd 1/2" IP in mound Ft. 9 Per Ensigns L.S. 8-33

Not visible - Pipe by crack L.S. 8-33

Pl. 130A Reset 1x2+k Per F.B. 778 P. 55

46° 31' 45" (1) ✓
186° 07' 00" (2) ✓

Doak Tr.

1 CH. Set 3/4" IP 8" down

Pl. 129A Reset 1x2+k Per F.B. 778 P. 55

POT Set 1x2+k

231 @ 00
243.49 @ 1°13' T 70°
231
243.42
245.73

POT Set 1x2+k

17.42 @ 0 0
134.90 @ 1°55' T 70°
17.42
134.81
152.23

117.56 @ 00 T 70° = 117.55

Fd 1/2 Ft. S. per Ensigns L.S. 8-33

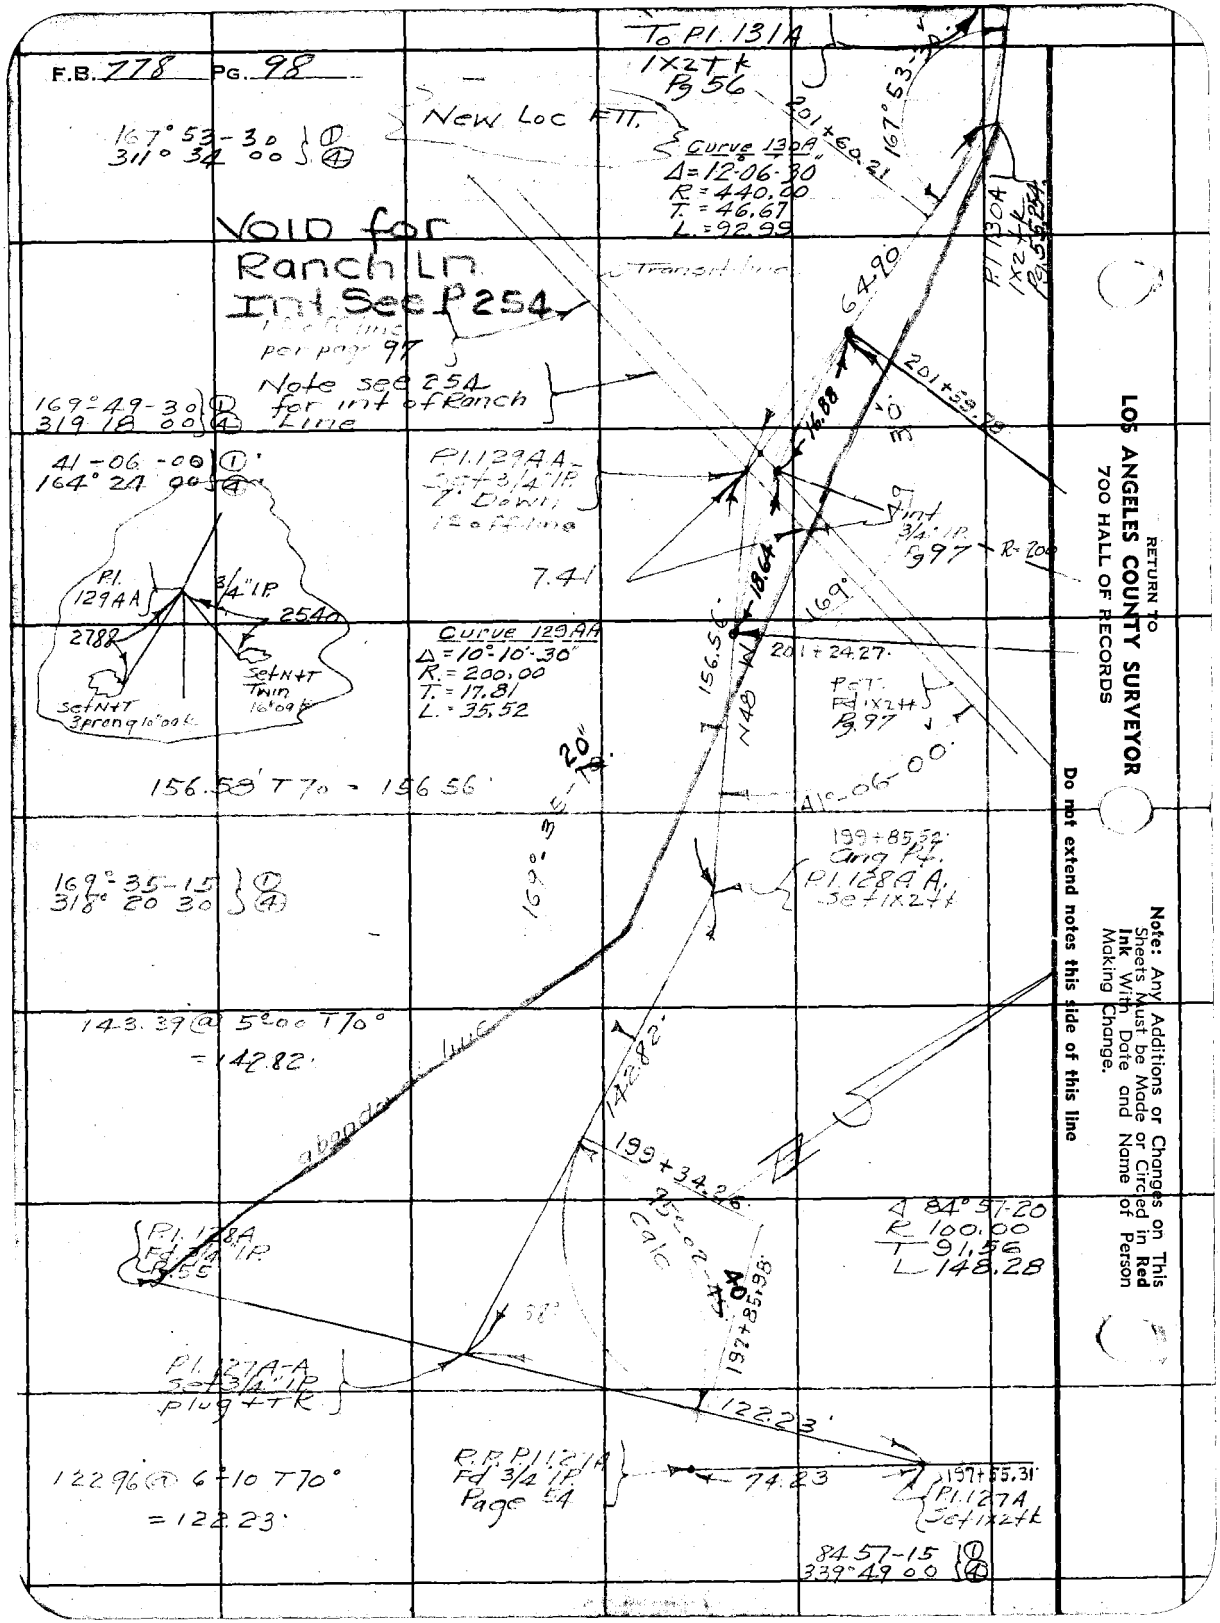
F.B. 778 Pg. 98
To Pl. 131A
1x2+k
Pg 56
New Loc P.T.
Curve 130A
Δ = 12-06-30
R = 440.00
T. = 46.67
L. = 92.39
167° 53-30
311° 34 00
Void for
Ranch Ln
Int See P254
Transit line
per page 97
Note see 254
for int of Ranch
Line
169°49-30
319 18 00
41-06-00
164° 24 00
Pl. 129AA
3/4" I.P.
2540
2782
Set N+T
3 prong 16" coal
Set N+T
Twin
16" coal
Pl. 129AA
Set 3/4" I.P.
7' Down
12 off line
7.41
Curve 129AA
Δ = 10°10'-30"
R. = 200.00
T. = 17.81
L. = 35.52
156.58' T 70 = 156.56'
169°35-15
318° 20 30
143.39 @ 5°00 T 70°
= 142.82'
abandoned line
Pl. 128A
Fd 3/4" I.P.
Pl. 127A-A
Set 3/4" I.P.
plug + tk
122.96 @ 6°10 T 70°
= 122.23'
R.R.P.I. 127A
Fd 3/4" I.P.
Page 54
74.83
197+85.31
Pl. 127A
Set 1x2+k
84.57-15
339°49 00
167°53-30
201+60.21
Pl. 130A
1x2+k
Pg 55
6490
201+39.78
16.88
Int
3/4" I.P.
Pg 97
R. 200
169°
156.58'
N 48 W
1864
201+24.27
P.C.T.
Fd 1x2+k
Pg 97
A 1°-06 00"
20"
199+85.38
Orig P.T.
Pl. 128AA
Set 1x2+k
142.82'
199+34.26
A 84° 51-20
R 100.00
T 91.56
L 148.28
197+85.98
Pl. 127A-A
Set 3/4" I.P.
plug + tk
122.23'
RETURN TO
LOS ANGELES COUNTY SURVEYOR
700 HALL OF RECORDS
Note: Any Additions or Changes on This Sheets Must be Made or Circled in Red Ink With Date and Name of Person Making Change.
Do not extend notes this side of this line

Notes Ck'd by	Survey of Los Virgenes Pit System	F.B. 778	Pg. 99
Map No. 19-1830	W. O. 8268 Tape No. 49 St'd 84°F		
Office Work	Surveyed by Stevenson		
Checked	Notes T.L.S. Date 6-26-39		
Date	Indexed A. C. Johnson 9-31-42		

Cont to bot page 100

147.01 @ 2°51 T 86 = 146.83

RPP P1.178A Set 3/4" IP plug + tk

146.83

32.62

P1.178A Set nx 2 tk

① 160°49-15
④ 283-16 30
160 49 07½

A = 19°-10-50
R = 150.00
T = 25.34
L = 50.21

160.49

N 81° W

160.80 @ 3°-33 T 81
= 160.49

① 147°10-30
④ 228°-41 45
147 10 26½

A = 32°49-35
R 125.00
T 36.82
L 71.62

P1.177A Set 3/4" IP plug + tk

37.04

From P1.176A

Cont from top page 72

RPP 1.177A Set 3/4" IP plug + tk

RETURN TO
LOS ANGELES COUNTY SURVEYOR
700 HALL OF RECORDS

Note: Any Additions or Changes on This Sheets Must be Made or Circled in Red Ink With Date and Name of Person Making Change.

Do not extend notes this side of this line

FORM 247 5M 10-37

Cont. to bot. page 101

F.B. 778 PG. 100

147° 21' 45" ①
229° 27' 00" ④
147 21 45

140.32 @ 4°-34 T86 = 139.70 .87

P.I. 181A
Set 1x2 tk

139.70 .87 To P.I. 182A

EC

7°

45.

154.31 @ 7°-24 T86° = 153.03'

129°-15-15 ①
157° 01 00 ④
129 15 15

153.03

BC 147° 21'

Δ = 32°-38-15
R = 175.00
T = 50.68
L = 99.69

P.I. 180A
Set 3/4" IP
plug + tk

129°-15-15

EC

Δ = 50°-44-45
R = 110.00
T = 52.17
L = 97.43

BC

276.88 @ 3°-00 T86° =
274.18'
Plus 13.30 ④
287.48'

S 10° W.
287.48'

Δ 69°-16-05
R = 85.00
T = 58.71
L = 102.76

55.

EC

110°43

15°

P.I. 179A
Set 3/4" I.P.
plug + tk

① 110°-44-00
④ 82°-55-45
110 43 56¼

BC

From P.I. 178A

Cont. from top page 99

RETURN TO
LOS ANGELES COUNTY SURVEYOR
700 HALL OF RECORDS

Note: Any Additions or Changes on This Sheets Must be Made or Circled in Red Ink With Date and Name of Person Making Change.

Do not extend notes this side of this line

Notes Ck'd by
Map No. B-1830
Office Work
Checked
Date

Survey of Las Virgenes Pipe System F.B. Pg. 101
W. 08243 Tape No. 49 St'd 84°F
Surveyed by Stevenson
Notes T.J.S. Date 6-26-39
Indexed A. C. Johnson

Con't to bot page 102

Ang. Pt.
P.I. 184A
Set 1x2 tk

80.67 to P.I. 184

165°

80.67 @ 0°T84
= 80.67.

168° 52-15
315° 29-15
168 22 18 ① ④

213.03 @ 2°18 T86° = 212.86'

① 166° 50 45
④ 307° 23-00
166 50 45

P.I. 183A
Set 1x2 tk

Δ 13°-09-15
R 900.00
T 103.77
L 206.63

150°

S84° W
244.65

244.87 @ 2°24 T86°
= 244.65.

Δ 8°-59-45
R 600.00
T 47.20
L 94.20

171°-00'

P.I. 182A
Set 1x2 tk

① 171°-00-15
④ 324°-01-00
171-00-15

From P.I. 181A

Con't from top pg

Note: Any Additions or Changes on This Sheets Must be Made or Circled in Red Ink With Date and Name of Person Making Change.

Do not extend notes this side of this line

RETURN TO
LOS ANGELES COUNTY SURVEYOR
700 HALL OF RECORDS

FORM 247 5M 10-37

Con't to bot page 103

F.B. 178 Pg. 102

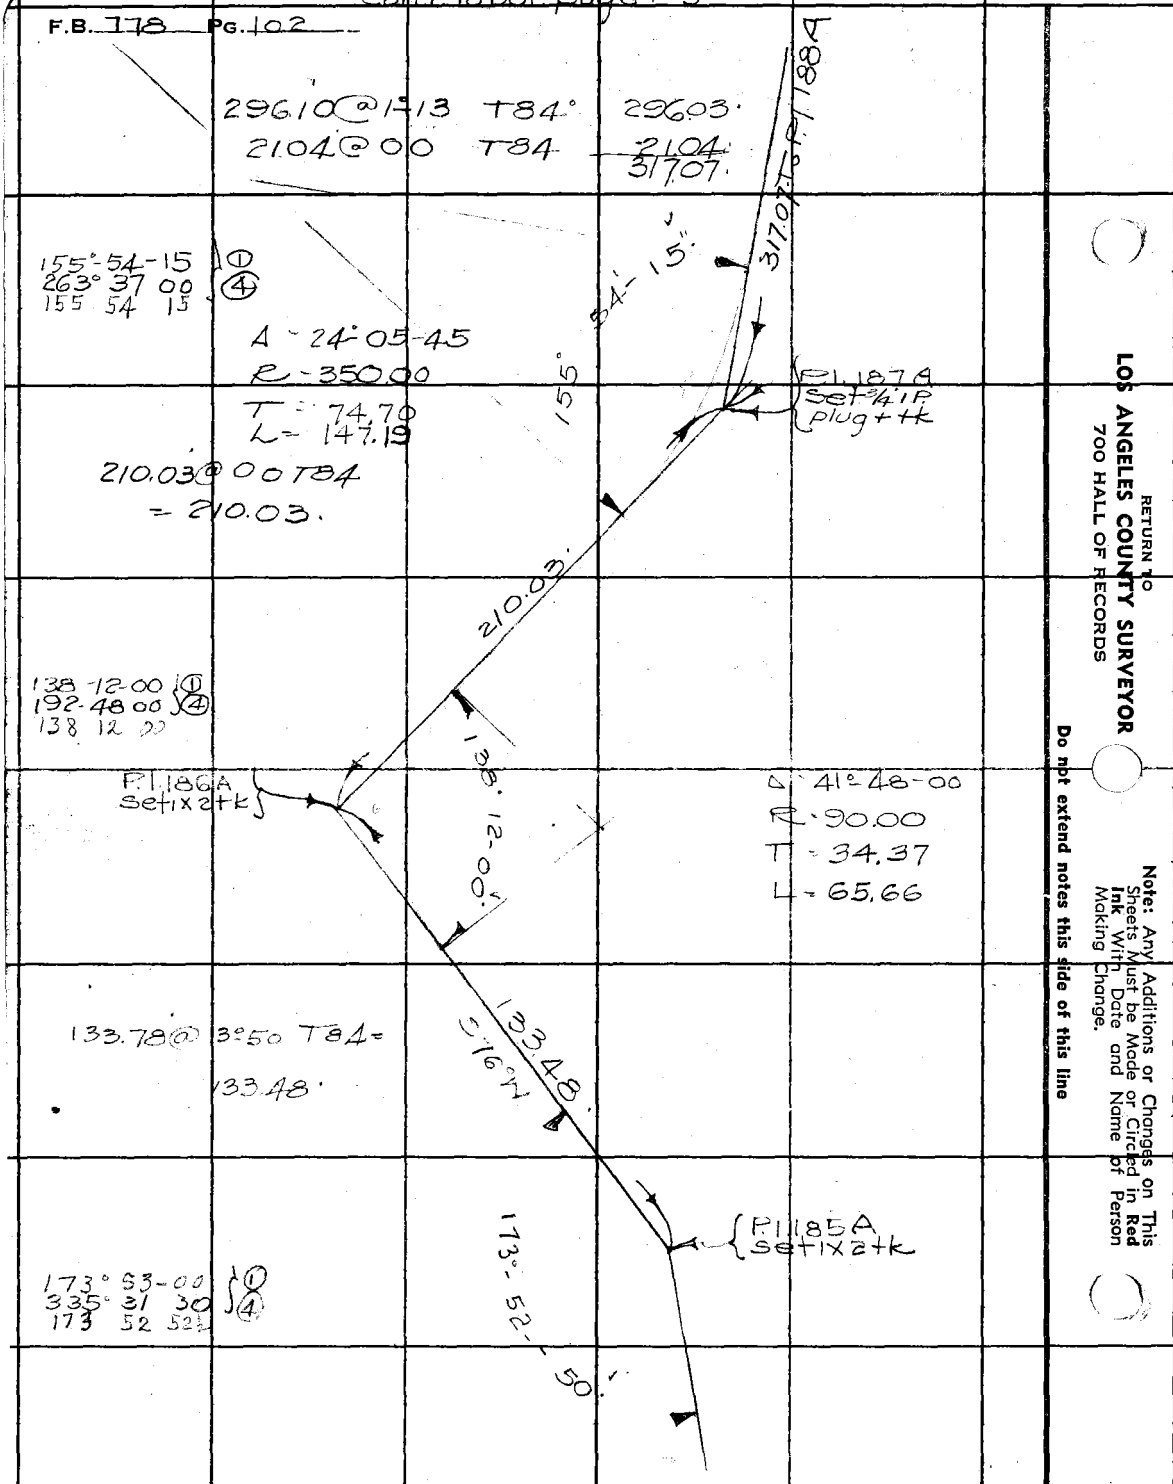

Cont. from top page 101

RETURN TO
LOS ANGELES COUNTY SURVEYOR
700 HALL OF RECORDS

Note: Any Additions or Changes on This Sheets Must be Made or Circled in Red Ink With Date and Name of Person Making Change.

Do not extend notes this side of this line

Notes Ck'd by	Survey of Las Virgenes Fm System
Map No. B-1830	W. O. 8243 Tape No. 42 St'd 34°F
Office Work	Surveyed by Stevenson
Checked	Notes T.J.S Date 6-26-39
Date	Indexed A. C. Johnson

F.B. 778 Pg. 103

Cont. to bot. page 104

157° 27-15 ① / 269° 49 30 ④ / 157 27 22½

103.00 @ 00 T82 = 103.00

103.00 To P.I. 191.A

P.I. 190A Set 1x2 tk

Δ 22° 32.40
R = 250.00
T = 49.83
L = 98.37

129.26 @ 0°0 T82°
= 129.26

129.26 West

168° 50 30 ①
348 15 22 30 ④
168 50 37½

P.I. 189A Set 1x2 tk

Δ 11°-09-25
R = 400.00
T = 39.07
L = 77.89

130.40 @ 0 0 T84
= 130.40

165° 38' 00 ①
302° 31 45 ④
165 37 56½

P.P. P.I. 188A Set 3/4" IP plug + tk

Δ = 14° 22-05
R = 300.00
T = 37.81
L = 75.23

P.I. 188A Set 1x2 + tk

From P.I. 187A

Cont. from top page 102

Note: Any Additions or Changes on This Sheets Must be Made or Circled in Red Ink With Date and Name of Person Making Changh.

Do not extend notes this side of this line

RETURN TO
LOS ANGELES COUNTY SURVEYOR
700 HALL OF RECORDS

FORM 247 BM 10-37

Con't from top page 103

F.B. 778 Pg. 104

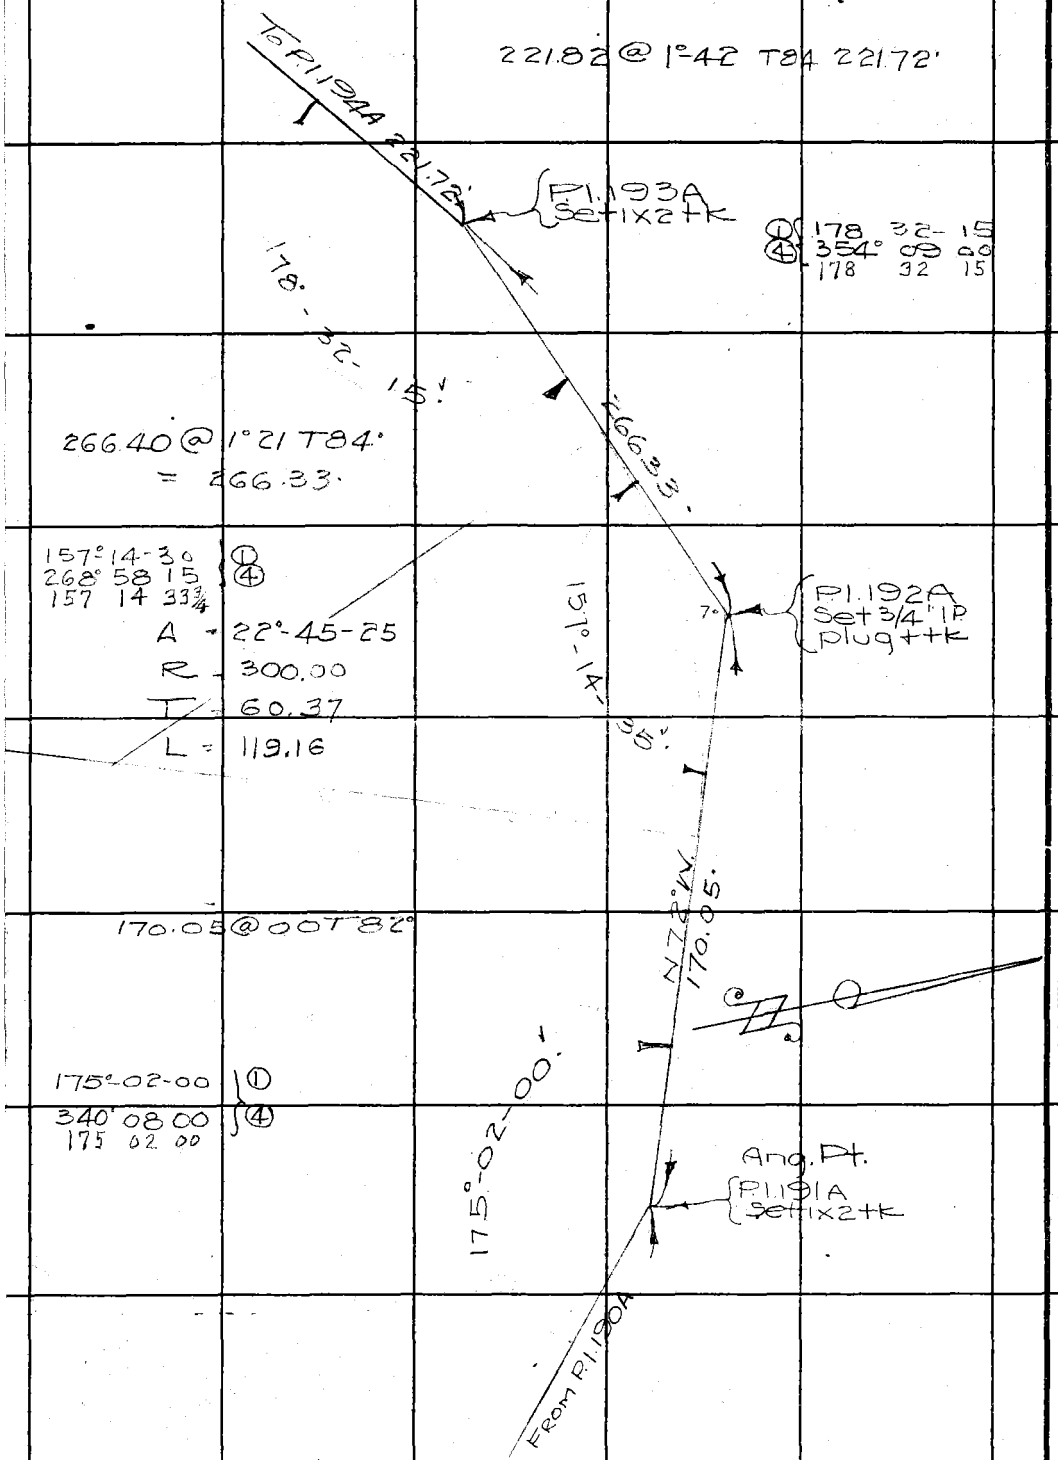

Con't from top page 105

RETURN TO
LOS ANGELES COUNTY SURVEYOR
700 HALL OF RECORDS

Note: Any Additions or Changes on This Sheets Must be Made or Circled in Red Ink With Date and Name of Person Making Change.

Do not extend notes this side of this line

Notes Ck'd by	Survey of Las Virgenes Fnl Sys F.B. 778 Pg. 105
Map No. 9-1830	W. O. 8243 Tape No. 49 St'd 84 of
Office Work	Surveyed by Stevenson
Checked	Notes T.J.S. Date 6-26-35
Date	Indexed A. C. Johnson

Cont. to bot. page 106

155.63 @ 7°10 T86° = 154.42'

154.42' To Pt. 1974

RPP. 196A Set 3/4" IP plug + tk

49.32 @ 6°21

156°-06-15"

Δ - 23°-53-45
R - 400.00
T - 84.64
L - 166.82

92

Pt. 196A Set 1x2 tk

156°-06-15 ① ④
264°-25-00
156 06 15

S 18° W.

252.64'

252.79 @ 2°00 T86
= 252.64'

Δ 69°-35-40
R 75.00

T 52.45
L 91.54

Pt. 195A Set 3/4" IP plug + tk

① ④ 110-04-15
80° 17 15
110 04 18 3/4

110.04-20"

171.04 @ 4°56 T82°
170.41'

170.41'

176°-36-45 ① ④
346 27 00
176 36 45

Pt. 194A Set 1x2 tk

18.13

19.23

Pt. 196A Set 1x2 tk

Pt. 196A Set 1x2 tk

From Pt. 193A

Cont. from top page 104

Note: Any Additions or Changes on This Sheet Must be Made or Circled in Red Ink With Date and Name of Person Making Change.

Do not extend notes this side of this line

RETURN TO
LOS ANGELES COUNTY SURVEYOR
700 HALL OF RECORDS

FORM 247 8M 10-37

F.B. 778 Pg. 106

Cont. to bot page 107

Δ = 15°08-10
R = 200.00
T = 26.42
L = 52.54

96.19 @ 6°28 T84
= 95.58

138.03 @ 4°44 T84° = 137.56

A 56° 47-55
R 100.00
T 54.07
L 99.13

192.87 @ 9-18 T84 = 190.34'

A 72°17-20
R 60.00
T 43.85
L 75.74

① 107° 40 45
④ 70° 42 30
107 40 37½

Cont. from top page 105

RETURN TO
LOS ANGELES COUNTY SURVEYOR
700 HALL OF RECORDS

Note: Any Additions or Changes on This Sheets Must be Made or Circled in Red Ink With Date and Name of Person Making Change.

Do not extend notes this side of this line

Notes Ck'd by L. M. Bailey	Survey of Las Virgenes FM System
Map No. B-1830	W. O. 8243 Tape No. 49 St'd 84°F
Office Work	Surveyed by Stevenson
Checked	Notes T.J.S. Date 6-28-39
Date	Indexed A. C. Johnson

F.B. 778 PG. 107

Cont. from last page 108

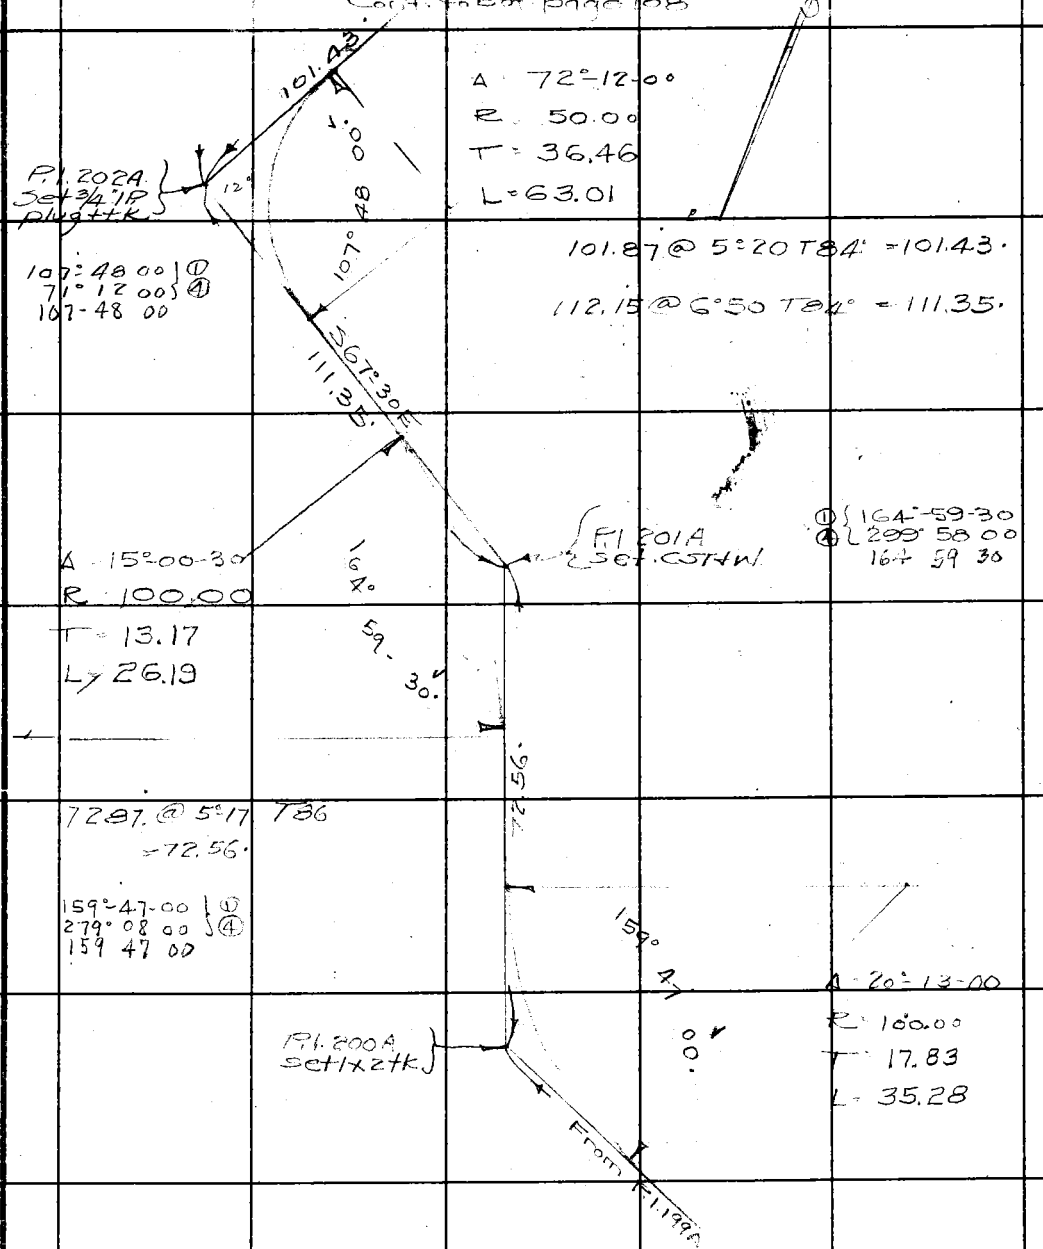

Cont'd from top page 106

Note: Any Additions or Changes on This Sheets Must be Made or Circled in Red Ink With Date and Name of Person Making Change.

Do not extend notes this side of this line

RETURN TO
LOS ANGELES COUNTY SURVEYOR
700 HALL OF RECORDS

FORM 247 SM 10-37

F.B. 778 Pg. 108

Cont'd to bot. page 109

160°-06-15
280° 25 00
160 06 15

To PI 206A

314.15'

340+22.93

PI 205A
Set 1x2+k

A 19°-53-45
R = 200.00
T = 35.09
L = 69.45

299.27 @ 3°-00 T 88 29988'
15.29 @ 0 0 15.29'
314.15'

340+57.38

7485'

75.83 @ 6°-29 T 92° 7485'

PI
Set CST+W.

149°-38 00 ①
238° 31 30 ⑭
149 37 52½

339+57.15

6721'

67.33 @ 2°-28 T 90° 6721'

PI 204A
Set 1x2+k

Δ 30-22-10
R = 150.00
T = 40.71
L = 79.51

49°
37° 50'

TIE TO A. TURNER
Pg 249

338+77.64

MONUMENT LINE

158.48 @ 7°-24 T 84°
= 157.16'

338+10.25

78°-23-15 ①
313 33 00 ⑭
78 23 15

78°-23'

337+39.31

Δ 101°-36-45
R 40.00
T 49.06
L 70.94

PI 203A
Set 3/4" IP
plug + tk

From PI 202A

Cont. from top page 107

RETURN TO
LOS ANGELES COUNTY SURVEYOR
700 HALL OF RECORDS

Note: Any Additions or Changes on This Sheets Must be Made or Circled in Red Ink With Date and Name of Person Making Change.

Do not extend notes this side of this line

Notes Ck'd by
Map No. B-1830
Office Work
Checked
Date

Survey of Las Virgenes Fm System F.B. PG. 109
W. O. 8243 Tape No. 19 St'd 84 °F
Surveyed by Stevenson
Notes T.J.S. Date 6-28-39
Indexed A. C. Johnson

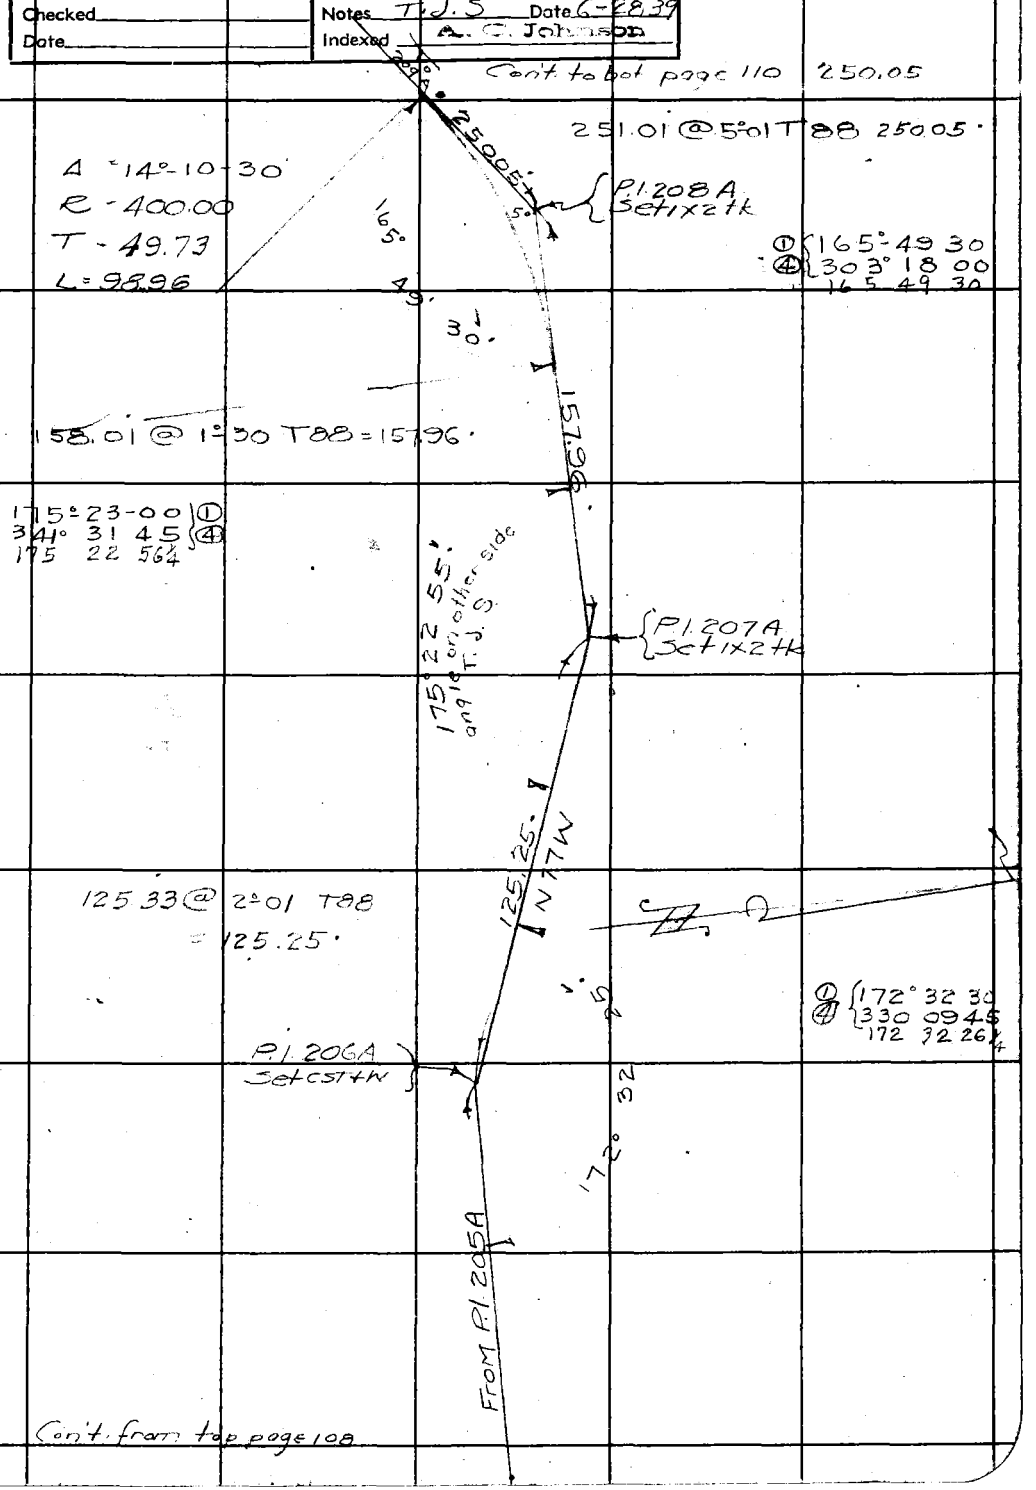

Note: Any Additions or Changes on This Sheets Must be Made or Circled in Red Ink With Date and Name of Person Making Change.

Do not extend notes this side of this line

RETURN TO
LOS ANGELES COUNTY SURVEYOR
700 HALL OF RECORDS

FORM 247 5M 10-37

Cont to bot page 111

F.B. 778 Pg. 110

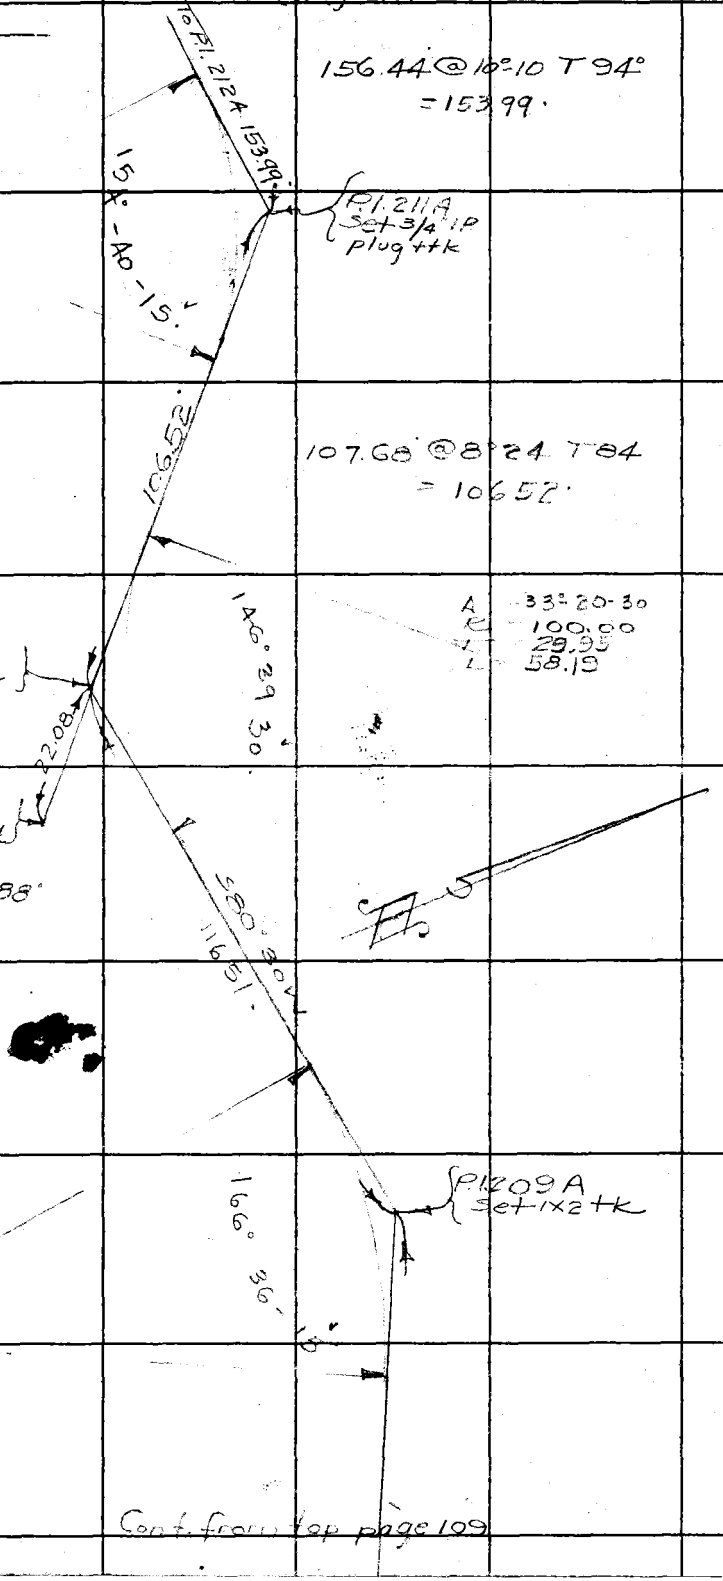

Cont. from top page 109

RETURN TO
LOS ANGELES COUNTY SURVEYOR
700 HALL OF RECORDS

Note: Any Additions or Changes on This Sheet Must be Made or Circled in Red Ink With Date and Name of Person Making Change.

Do not extend notes this side of this line

Notes Ck'd by	Survey of Los Angeles Flt Sys F.B. 778 Pg. 111
Map No. B-1830	W. 0.8248 Tape No. 49 St'd 84 of
Office Work	Surveyed by Stevenson
Checked	Notes T.J.S Date 6-29-39
Date	Indexed

Cont to bot. page 112

143.81 @ 7°10 T 94 = 142.76

To P.I. 215A

142.76

P.I. 214A set 1x2 tk

170° 38' 50" ↙

170.38-45 ①
322 35 15 ④
152 38 48½

178.64 @ 3°03 T 94 = 178.40

Δ = 27°41-10
R = 125.00
T = 30.80
L = 60.40

155°30' N

179.40

EC

152°-18-45 ①
249°-15-30 ④
152 18 52½

152°-18-45" ↙

P.I. 213A set 1x2 tk

110.95 @ 10°34 T 94 = 109.08

109.08

EC

155°-03-45 ①
260°-15-30 ④
155 03 52½

P.I. 212A set 1x2 tk

155°-03-50" ↙

Δ = 24°-56-10
R = 175.00
T = 38.69
L = 76.16

From P.I. 211A

Cont. from top page 110

RETURN TO
LOS ANGELES COUNTY SURVEYOR
700 HALL OF RECORDS

Note: Any Additions or Changes on This Sheets Must be Made or Circled in Red Ink With Date and Name of Person Making Change.

Do not extend notes this side of this line

FORM 247 5M 10-39

Con't. to bot. page 113

F.B. 778 Pg. 112

170° 44 00 ①
322° 55 30 ④
170 43 52½

152.58 to P.I. 2194

153.57 @ 6°34 T92°
= 152.58.

P.I. 217A
Set 1x2 tk

170° 43

160.32 @ .00 T94.
= 160.33.

160.33

135° 39 00 ①
182° 35 30 ④
135° 38 52½

A = 44° 21 10
R = 110.00
T = 44.24
L = 85.15

135° 38' 50"

P.I. 216A
Set 3/4" I.P.
plug + tk

161.57 @ 0°40 T94 = 161.57

N 58° W 161.7

133° 42 00 ①
174° 47 30 ④
133 41 52½

P.I. 215A
Set 3/4" I.P.
plug + tk

133° 41' 50"

Δ = 46° 18 10
R = 100.00
T = 42.76
L = 80.81

From P.I. 214A

Con't. from top page 111

RETURN TO
LOS ANGELES COUNTY SURVEYOR
700 HALL OF RECORDS

Note: Any Additions or Changes on This Sheets Must be Made or Circled in Red Ink With Date and Name of Person Making Change.

Do not extend notes this side of this line

Notes Ck'd by		Survey of Las Virgenes FT System	F.B. 778 Pg. 113
Map No. B-1830		W. O. 8243 Tape No. 49 St'd 44 OF	
Office Work		Surveyed by Stevenson	
Checked		Notes T.L.S. Date 6-29-39	
Date		Indexed A. C. Johnson	

Cont. to bot. page 114

To P.I. 221A

171° 58' 00"

185.29 @ 7°20 T92. = 183.78.

171° 58'

183.78

P.I. 220A Set 3/4" I.P. Plug + Tk

89.77 @ 7°18 T88°

89.04

50° 36' 00" (1)
202° 24' 00" (2)
50° 36' 00" (4)

Δ = 129° 24' 00"
R = 35.00
T = 74.04
L = 79.05

P.I. 219A Set 3/4" I.P. Plug + Tk

S 50° 36' 00" E

129.53 @ 7°14 T92°
= 129.52

N 39° W
128.52

P.I. 218A Set 3/4" I.P. Plug + Tk

126° 39' 00" (1)
126° 39' 00" (4)

126° 39'

Δ = 53° 21' 00"
R = 70.00
T = 35.17
L = 65.18

From P.I. 217A

Cont from top page 112

Note: Any Additions or Changes on This Sheets Must be Made or Circled in Red Ink With Date and Name of Person Making Change.

Do not extend notes this side of this line

RETURN TO
LOS ANGELES COUNTY SURVEYOR
700 HALL OF RECORDS

FORM 247 5M 10-39

F.B. 778 PG. 114

Con't to bot. page 115

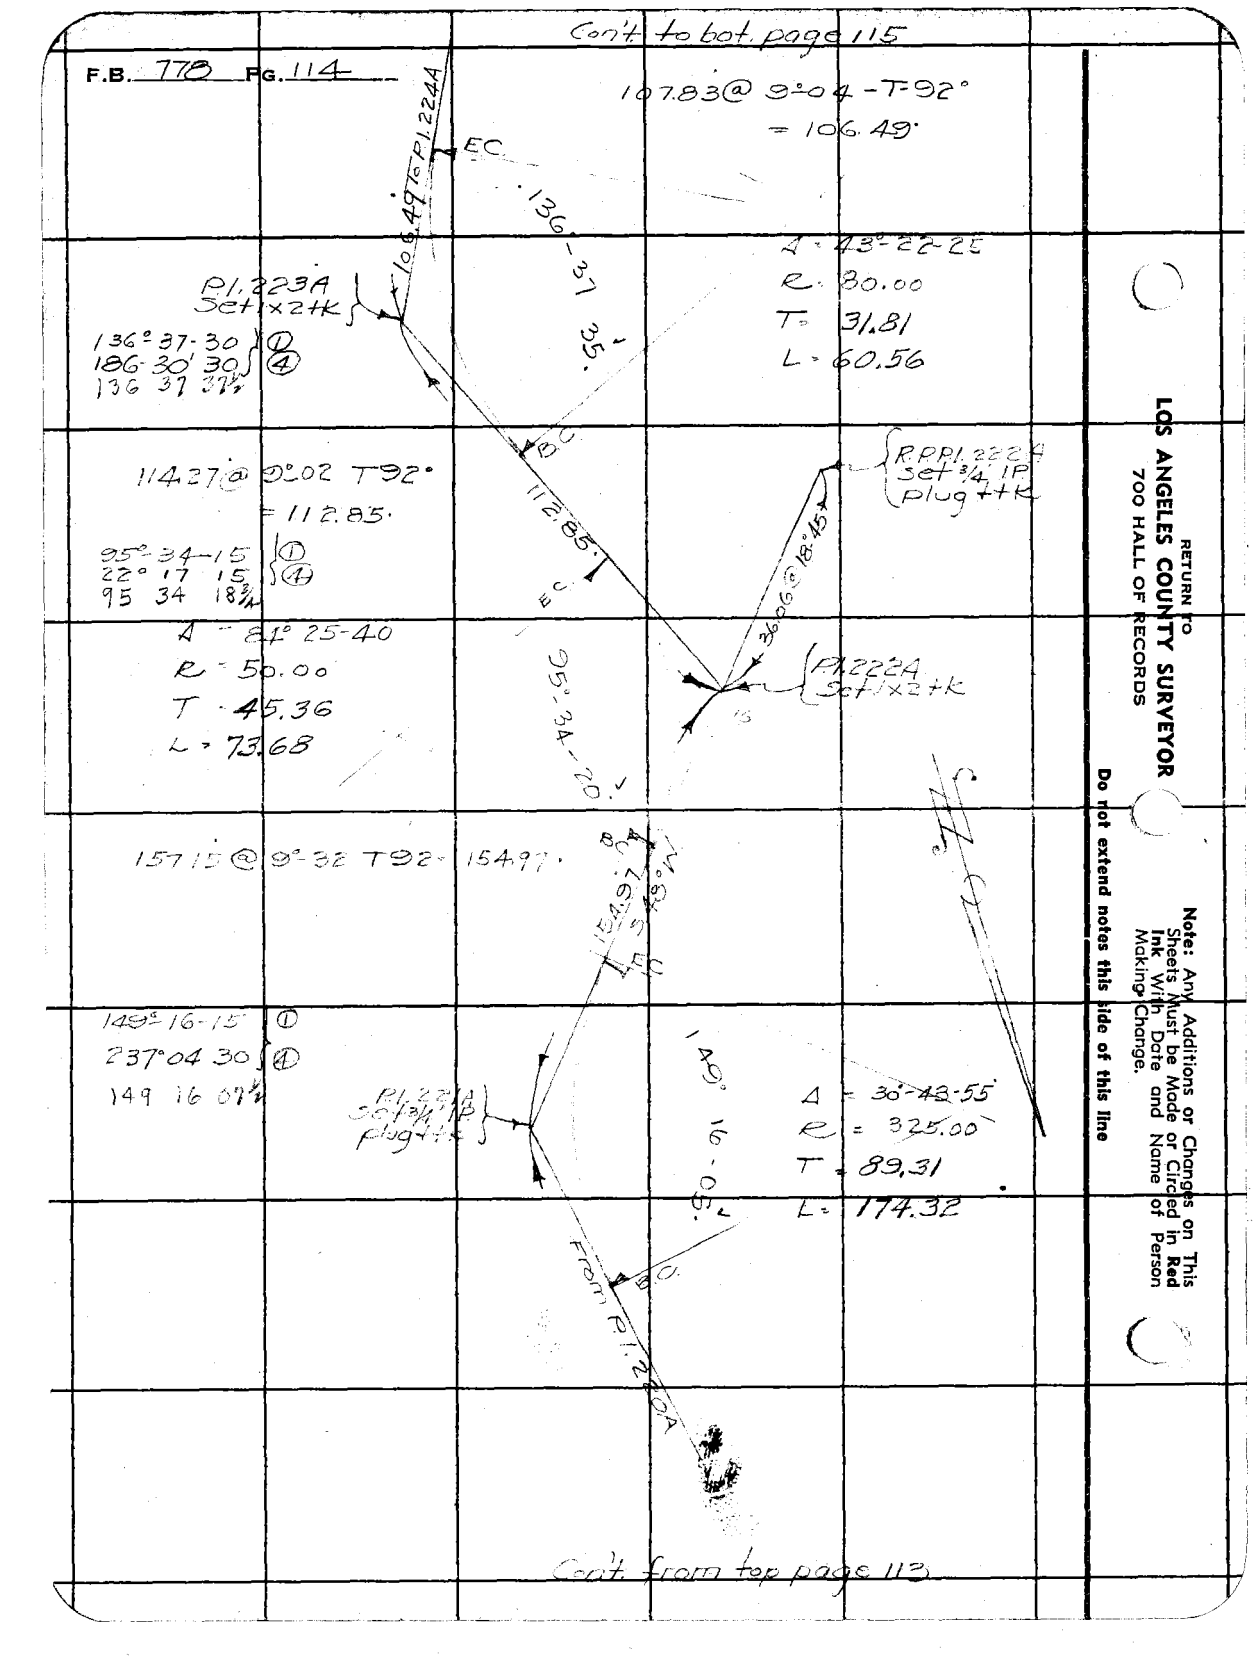

Con't from top page 113

RETURN TO
LOS ANGELES COUNTY SURVEYOR
700 HALL OF RECORDS

Note: Any Additions or Changes on This Sheets Must be Made or Circled in Red Ink With Date and Name of Person Making Change.

Do not extend notes this side of this line

Notes Ck'd by	Survey of Las Virgenes FTT System
Map No. B-1980	W. O. 8243 Tape No. 49 St'd 84 OF
Office Work	Surveyed by Stevenson
Checked	Notes T.J.S Date 6-29-37
Date	Indexed E. E. Johnson

F.B. 778 PG. 115

Cont. to bot. page 116

86.13 @ 8°31 - T96° = 85.18'

151°-15-30 ① 245°-02-00 ④ 151 15 30

85.18'

P.I. 227A Set 1x2 tk

151°-15-30

Δ 28°-44-30
R 100.00
T 25.62
L 50.16

155.38 @ 8°39 T96° = 153.62

172°-14-15

① 172°-14-15 ④ 328°-57-00 172 14 15

P.I. 226A Set 1x2 tk

84.51 @ 9°05 T98° = 83.45

83.45'

161°-24-15 ① 285°-37-00 ④ 161 24 15

P.I. 225A Set 1x2 tk

161°-24-15'

Δ 18°-35-45
R 150.00
T 24.56
L 48.68

150.61 @ 9°05
T91 = 148.73'

S 53°-30-E 148.73'

① 117°-08-30 ④ 108-34-15 117 08 33¾

Δ 62°-51-25
R 100.00
T 36.67
L 65.82

117°-00

35°

10

P.I. 224A Set 1x2 tk

From P.I. 223A

Cont. from top page 114.

RETURN TO
LOS ANGELES COUNTY SURVEYOR
700 HALL OF RECORDS

Note: Any Additions or Changes on This Sheets Must be Made or Circled in Red Ink With Date and Name of Person Making Change.

Do not extend notes this side of this line

FORM 247 5M 10-37

Cont'd on bot. page 117

F.B. 778 Pg. 116

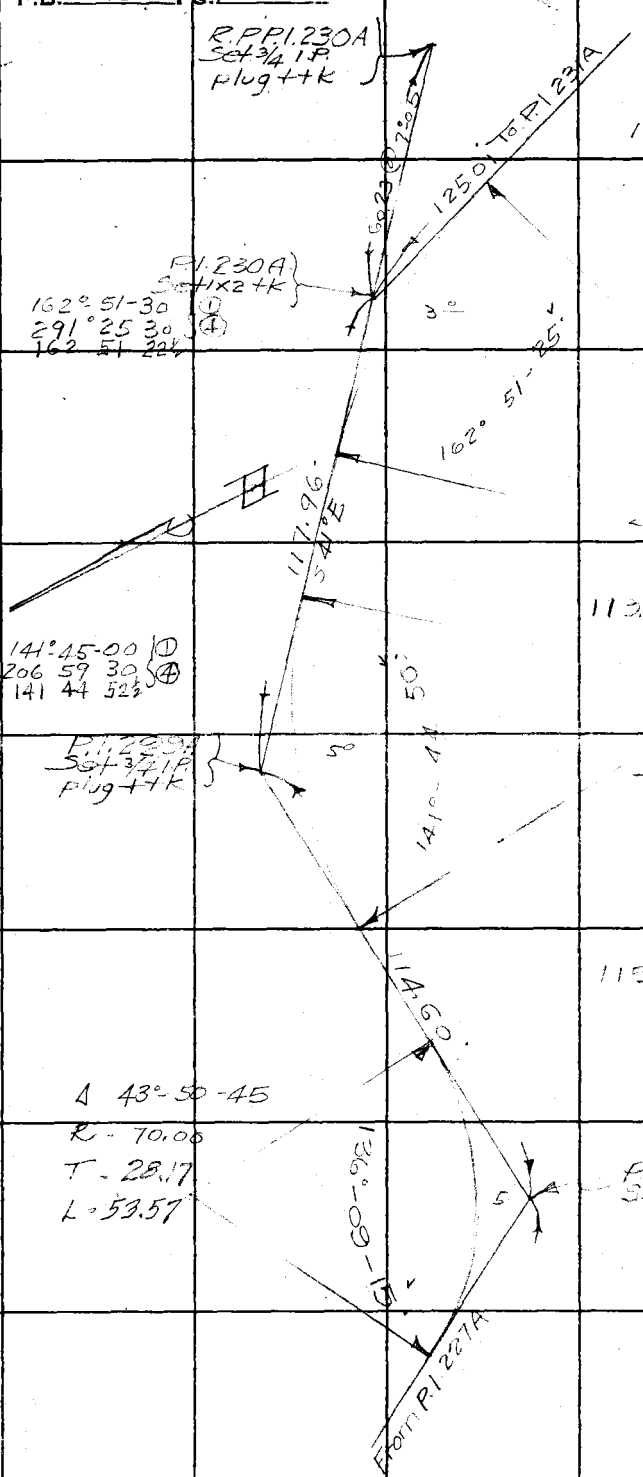

125.60 @ 5° 35' T94°
= 125.01'

Δ = 7° 08' 35"
R = 300.00
T = 45.22
L = 89.76

113.11 @ 8° 00' T94°
= 117.96'

Δ = 38° 15' 10"
R = 100.00
T = 34.68
L = 66.76

115.94 @ 8° 46' T94°
= 114.60'

① 136° 09' 15"
④ 184° 37' 00"
136 09 15

Cont'd from bot. page 115

RETURN TO
LOS ANGELES COUNTY SURVEYOR
700 HALL OF RECORDS

Note: Any Additions or Changes on This Sheets Must be Made or Circled in Red Ink With Date and Name of Person Making Change.

Do not extend notes this side of this line

Notes Ck'd by	Survey of Los Virgenes Fit System
Map No. B-1830	W. O. 8243 Tape No. 49 St'd 84-OF
Office Work	Surveyed by Stevenson
Checked	Notes T. J. S. Date 6-29-33
Date	Indexed

F.B. 718 Pg. 117

Cont. from top page 116

147°03'-11"

147°03'-15" ①
228 12 45 ④
63.10 @ 00 T100 = 63.11'

65.15 @ 00 T 100 65.16'

Δ = 22°18'45"
R = 100.00
T = 19.72
L = 38.94

157°41'-15" ①
270 45 00 ④
157 41 15

62.00 @ 00 T94° = 62.00'

161°08'30" ①
281 51 00 ④
161 08 30

Δ 35°29'-15"
R 110.00
T 35.20
L 68.13

144°30'45" ①
218°03'00" ④
144 30 45

1754 @ 4°19' T76
= 19157'

Δ = 18°51'30"
R = 125.00
T = 20.76
L = 41.14

Δ = 32°56'50"
R = 100.00
T = 29.57
L = 57.50

P.I. 234A
Set 1x2 tk

P.I. 233A
Set 1x2 tk

P.I. 232A
Set 1x2 tk

P.I. 231A
Set 1x2 tk

From P.I. 230A

63.11'
65.16'
62.00'
19457'
46'

RETURN TO
LOS ANGELES COUNTY SURVEYOR
700 HALL OF RECORDS

Note: Any Additions or Changes on This Sheets Must be Made or Circled in Red Ink With Date and Name of Person Making Change

Do not extend notes this side of this line

FORM 247-SM 10-32

Cont. to bot page 119

F.B. 778 Pg. 118

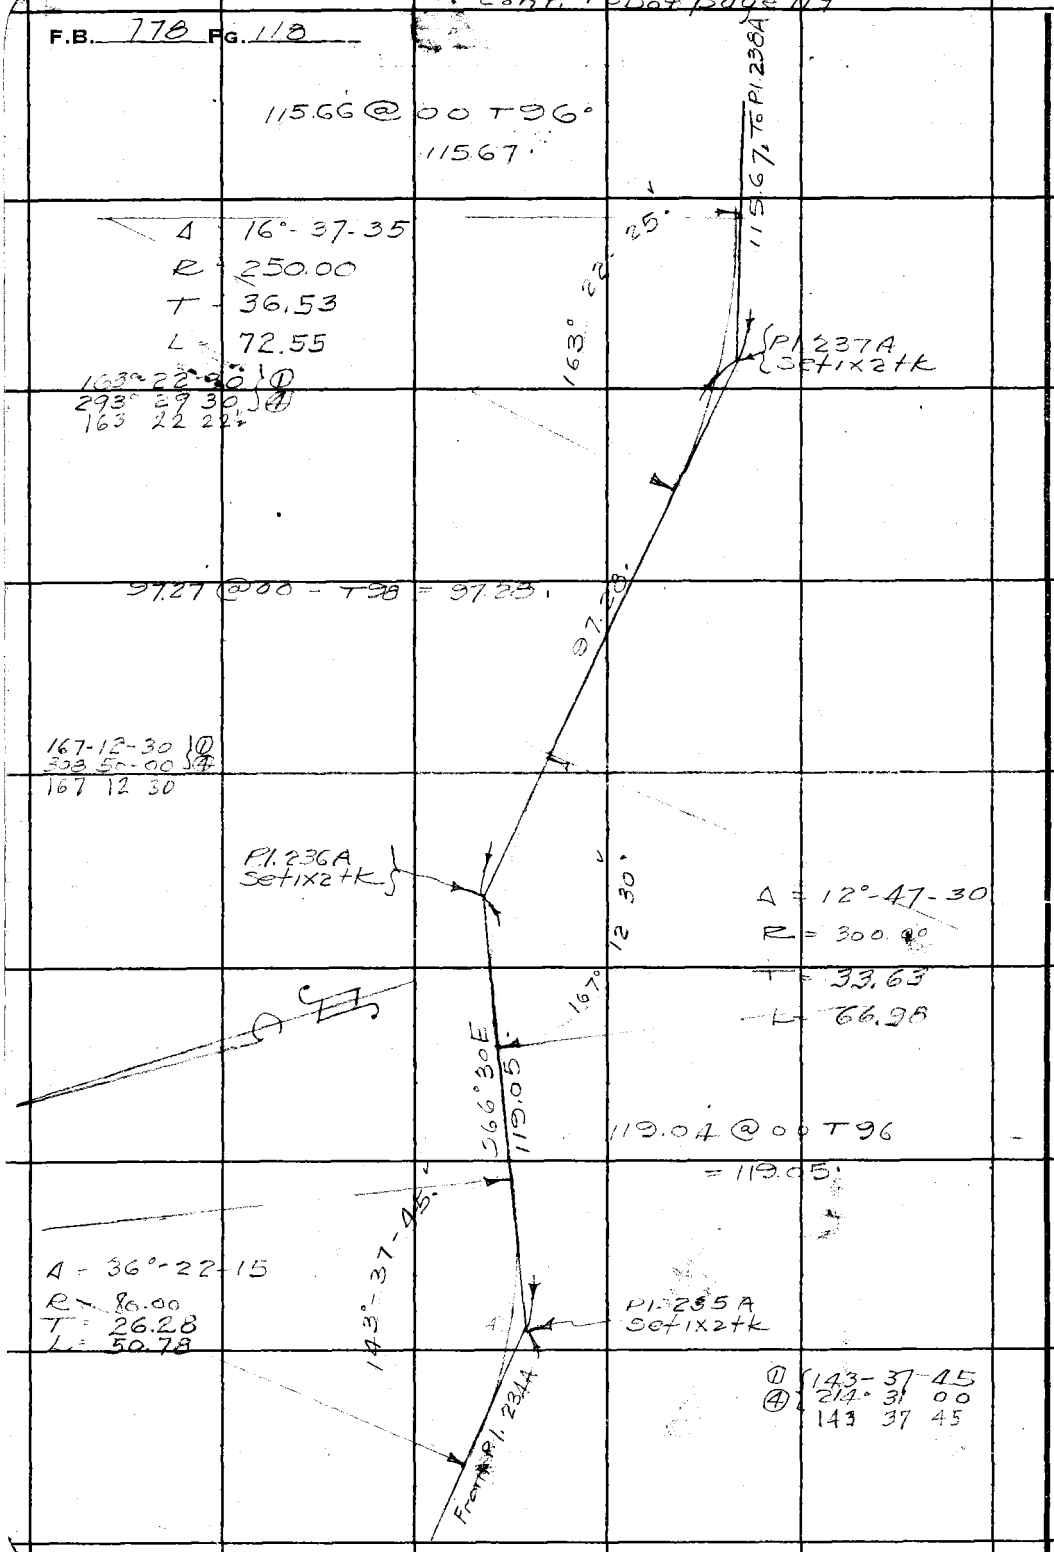

RETURN TO
LOS ANGELES COUNTY SURVEYOR
700 HALL OF RECORDS

Note: Any Additions or Changes on This Sheets Must be Made or Circled in Red Ink With Date and Name of Person Making Change.

Do not extend notes this side of this line

Notes Ck'd by
Map No. B-1830
Office Work
Checked
Date

Survey of Los Virgenes FM System
W. O. 8243 Tape No. 49 St'd 34°F
Surveyed by Stevenson
Notes T.V.S Date 6-30-39
Indexed A. C. John...

F.B. PG. 119

Cont. to bot. page 120

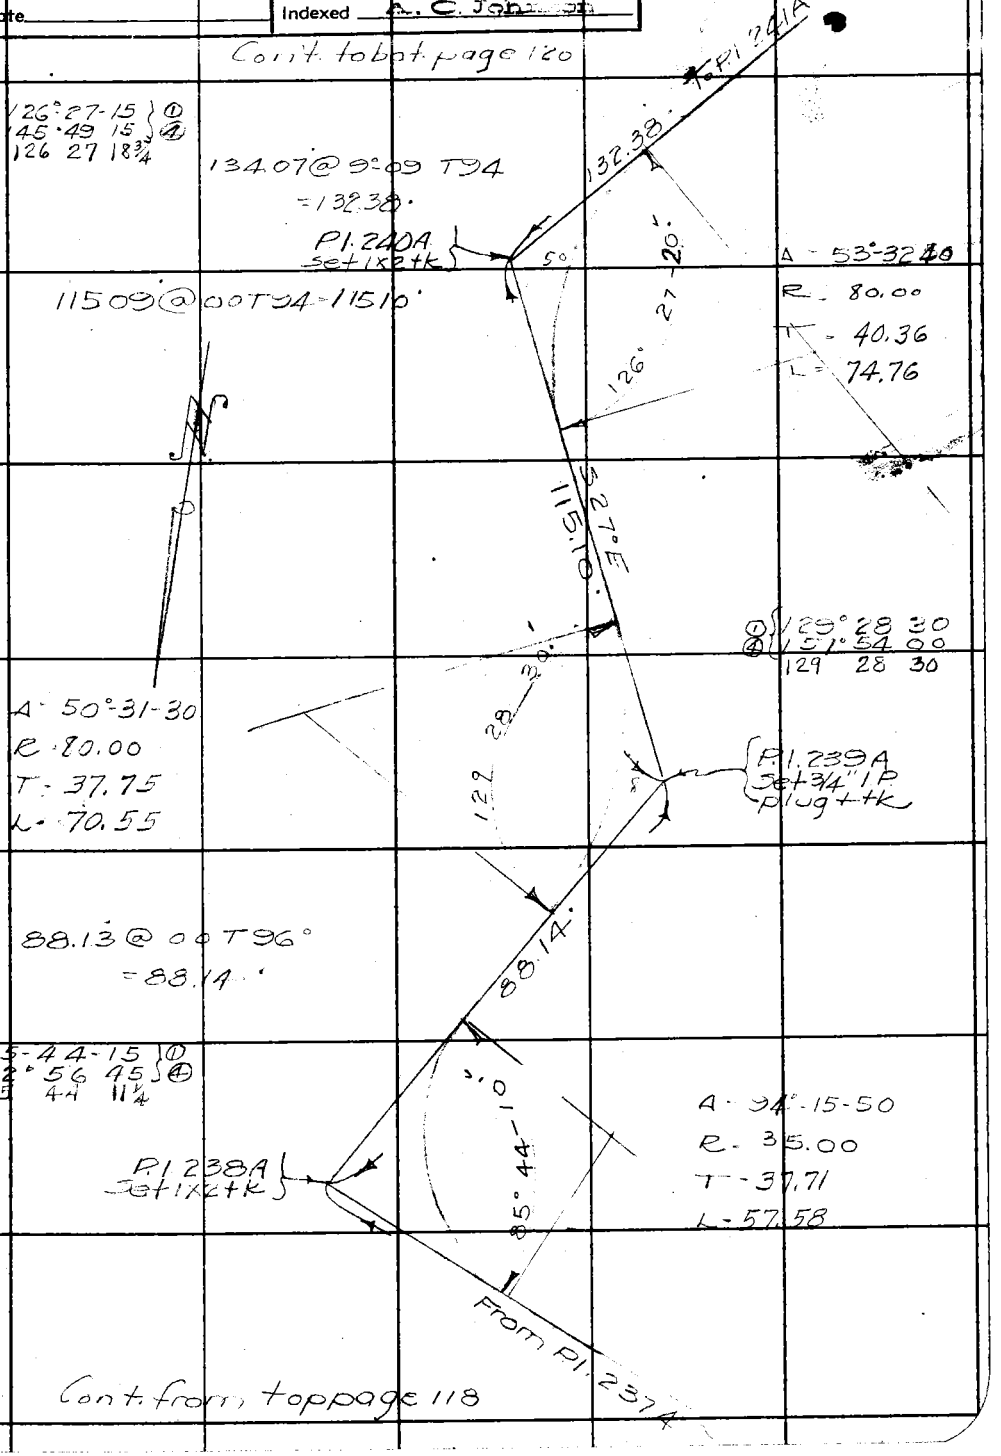

Cont. from top page 118

Note: Any Additions or Changes on This Sheets Must be Made or Circled in Red Ink With Date and Name of Person Making Change.

Do not extend notes this side of this line

RETURN TO
LOS ANGELES COUNTY SURVEYOR
700 HALL OF RECORDS

FORM 247 5M 10-37

Cont'd to bot. page 121

F.B. 778 PG. 120

135.90 @ 4° 20 T 94° = 135.52.

RPP1. 243A Set 3/4" IP plug + tk

To PI 244A

63.68 @ 6° 56 T 94° = 63.58

PI 243A Set 1x2 tk

EC

167° 57 30 ①
311° 50 00 ④
167 57 30

106.93 @ 00 T 94° = 106.84

106.84

16° 57'

BC

POT Set 1x2 tk

Δ = 12° 02' 30"
R = 100.00
T = 10.55
L = 21.02

122.40 @ 5° 00 T 94°
= 121.95

121.95

EC

PI 243A Set 1x2 tk

142° 26 45 ①
209° 47 00 ④
142 26 45

142° 26'

Δ = 37° 33' 15"
R = 300.00
T = 101.93
L = 196.63

156.9

BC

RPP1. 242A Set 3/4" IP plug + tk

150.83'
S 36° W

150.93 @ 2° 08 T 94° = 150.83

PI 241A Set 1x2 tk

170° 16'

① 170° 17' 00"
④ 321 07 45
170 16 56

From PI 240A

Cont. from top page 119

RETURN TO
LOS ANGELES COUNTY SURVEYOR
700 HALL OF RECORDS

Note: Any Additions or Changes on This Sheets Must be Made or Circled in Red Ink With Date and Name of Person Making Change.

Do not extend notes this side of this line

Notes Ck'd by E.D. M. Finley	Survey of Las Virgenes Fit System	F.B.	Pg. 121
Map No. B-1830	W. O. 8243 Tape No. 49 St'd 24 of		
Office Work	Surveyed by Stevenson		
Checked	Notes T. J. S. Date 6-30-37		
Date	Indexed A. C. Johnson		

Con't to bot. page 122

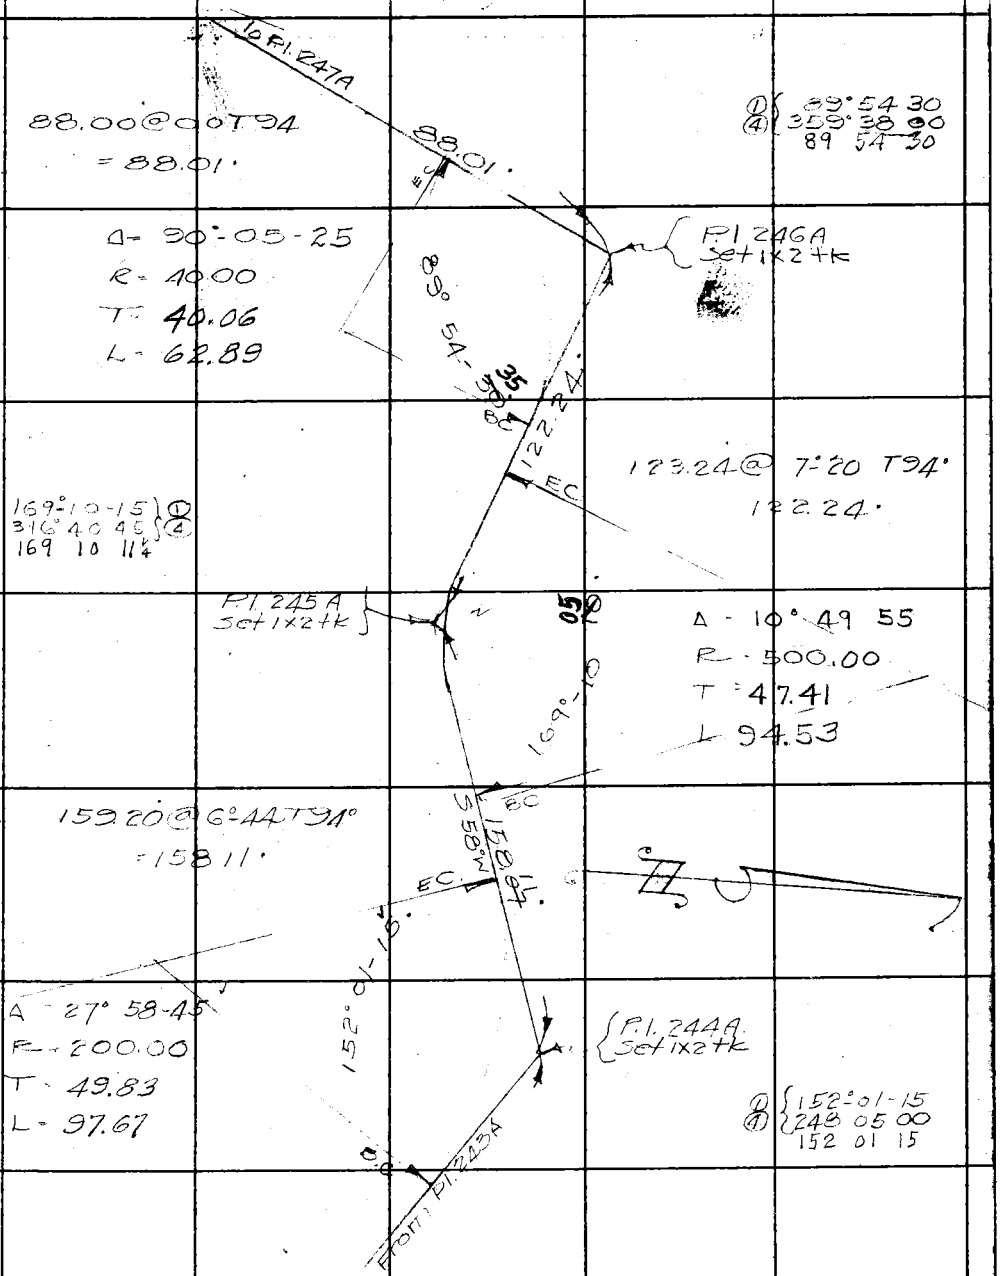

Con't from top page 120

Note: Any Additions or Changes on This Sheets Must be Made or Circled in Red Ink With Date and Name of Person Making Change.

Do not extend notes this side of this line

RETURN TO
LOS ANGELES COUNTY SURVEYOR
700 HALL OF RECORDS

FORM 247 SM 10-37

F.B. 770 Pg. 122

Con't to bot page 123

139°-12-20 ①
192°-49-18 ④
138 12 17½

79.42 @ 6°-20 166 = 78.93'

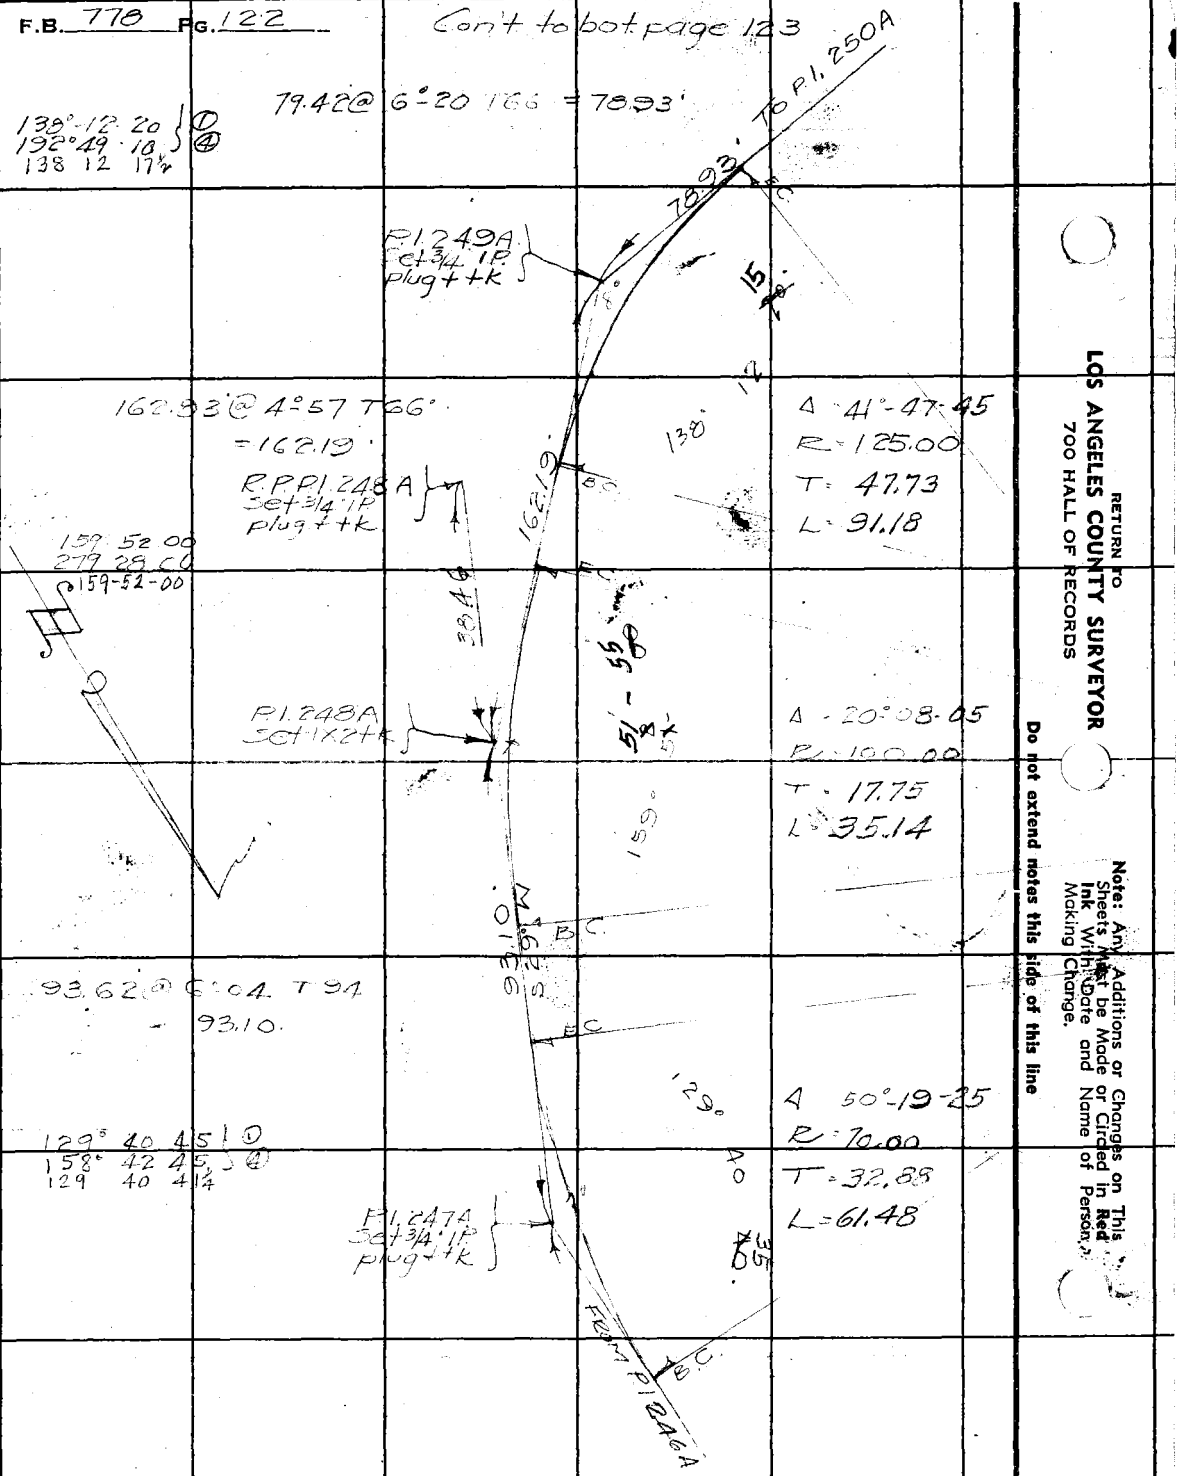

Δ 41°-47-45
R = 125.00
T = 47.73
L = 91.18

Δ 20°-08-05
R = 100.00
T = 17.75
L = 35.14

93.62 @ 6°-04 T 94
= 93.10

Δ 50°-19-25
R = 70.00
T = 32.85
L = 61.48

129° 40 45 ①
158° 42 45½ ④
129 40 41¼

Con't from top page 121

RETURN TO
LOS ANGELES COUNTY SURVEYOR
700 HALL OF RECORDS

Note: Any Additions or Changes on This Sheets Must be Made or Circled in Red Ink With Date and Name of Person Making Change.

Do not extend notes this side of this line

Notes Ck'd by [illegible] Finley	Survey of Los Virgenes Fill System
Map No. B-1830	W. O. 3212 Tape No. 49 St'd 84 OF
Office Work	Surveyed by Sherenson
Checked	Notes N.J.S Date 7-5-39
Date	Indexed A. C. Johnson

F.B. 778 Pg. 123

Cont. from last page 121

6757 @ 5°-36 T68 = 6714.

125°-58-30
143-54-00
125 58 30

Pt. 253A Set 1x2 tk

6714

E.C.

Pt. 253A

A - 54°-01-25
R = 45.00
T = 22.94
L = 42.43

125°

E.C.

10943 @ 5°-38-T68
-10885.

140°-04-20
200 17 00
140 04 15

E.C.

20 T.

A - 39°-55-40
R = 100.00
T = 36.33
L = 69.69

140°-04'

Pt. 251A Set 3/4" I.P. plug + tk

6453 @ 5°-36 T66°
= 54.21'

E.C.

S 63°-30' W 54.21'

A 21°-49-40
R 100.00
T = 19.28
L = 38.10

10

20 T.

E.C.

S 158-10-20
S 2 12 91 00
158 10 15

Pt 250A Set 1x2 tk

B.C.

From Pt. 249A

Cont. from top page 122

Note: Any Additions or Changes on This Sheets Must be Made or Circled in Red Ink With Date and Name of Person Making Change.

Do not extend notes this side of this line

RETURN TO
LOS ANGELES COUNTY SURVEYOR
700 HALL OF RECORDS

FORM 247 5M 10-37

Cont. to bot. page 125

F.B. 778 PG. 124

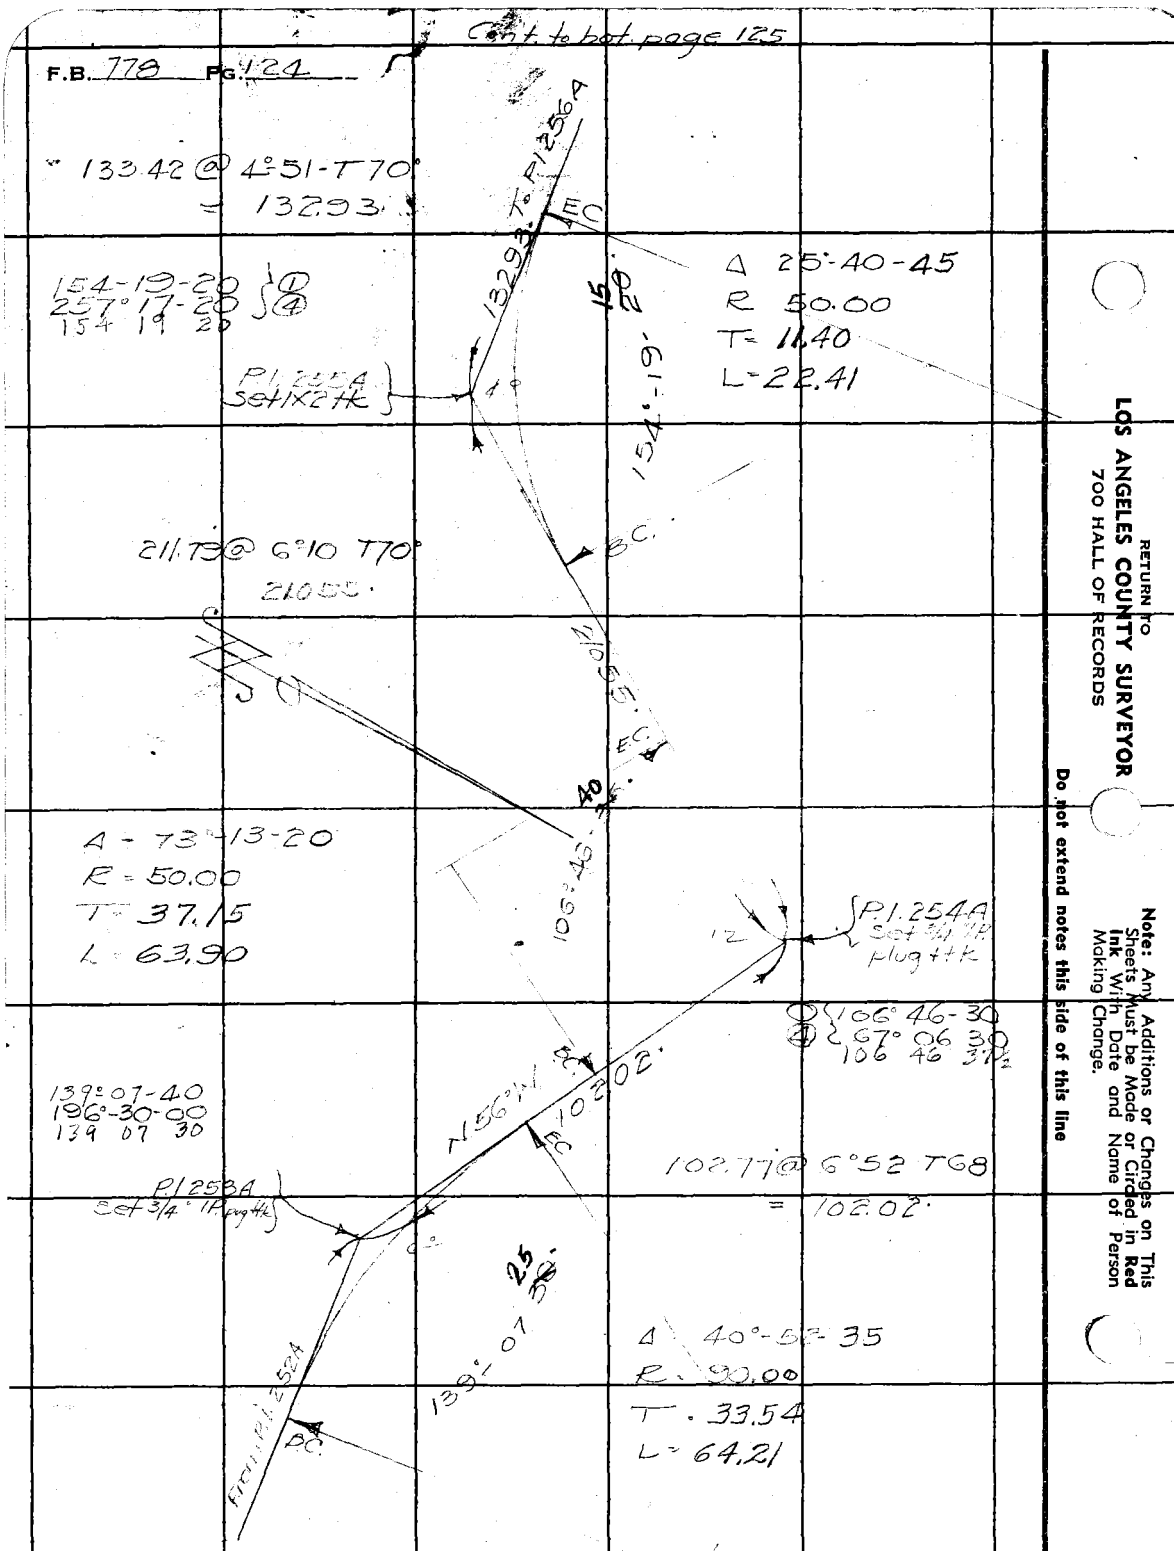

Con't from top page 123

RETURN TO
LOS ANGELES COUNTY SURVEYOR
700 HALL OF RECORDS

Note: Any Additions or Changes on This Sheets Must be Made or Circled in Red Ink With Date and Name of Person Making Change.

Do not extend notes this side of this line

Notes Ck'd by		Survey of Los Virgenes Pipe System	F.B. 775 Pg. 125
Map No. B-1890		W. O. 8743 Tape No. 49 St'd 84 of	
Office Work		Surveyed by Stevenson	
Checked		Notes T.I.S. Date 7-5-39	
Date		Indexed A. C. Johnson	

Cont. to bot. page 126

Note: Any Additions or Changes on Sheets Must be Made or Circled in Red Ink With Date and Name of Person Making Change.

Do not extend notes this side of this line

RETURN TO
LOS ANGELES COUNTY SURVEYOR
700 HALL OF RECORDS

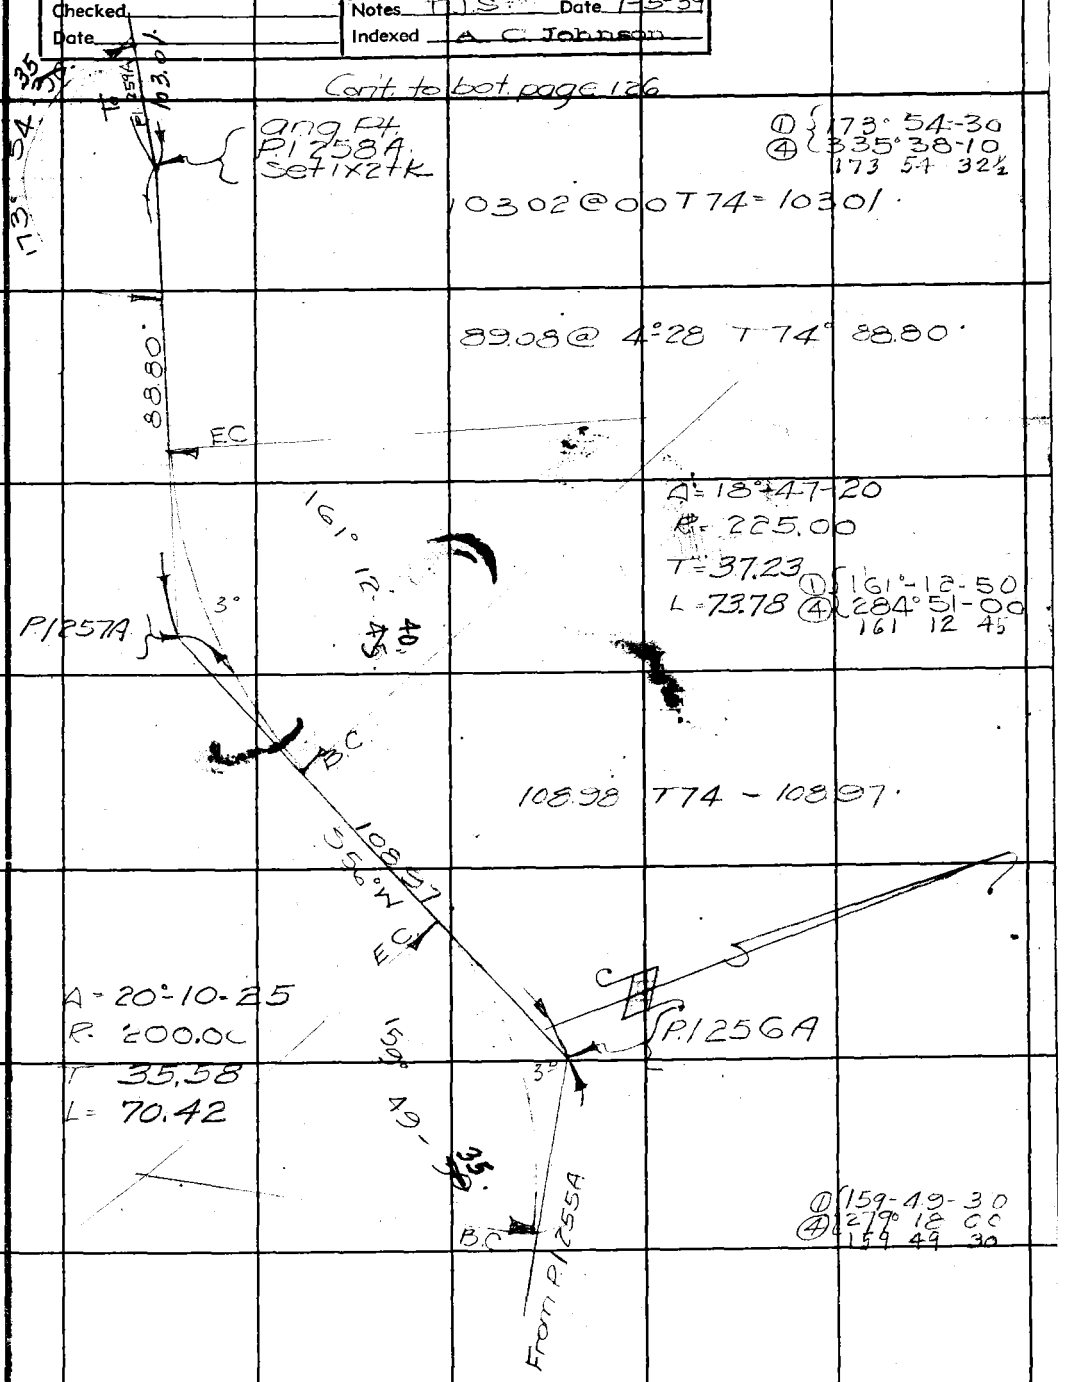

Cont. from top page 124

FORM 247 8M 10-57

Con't to bot. page 127

F.B. 778 Pg. 126

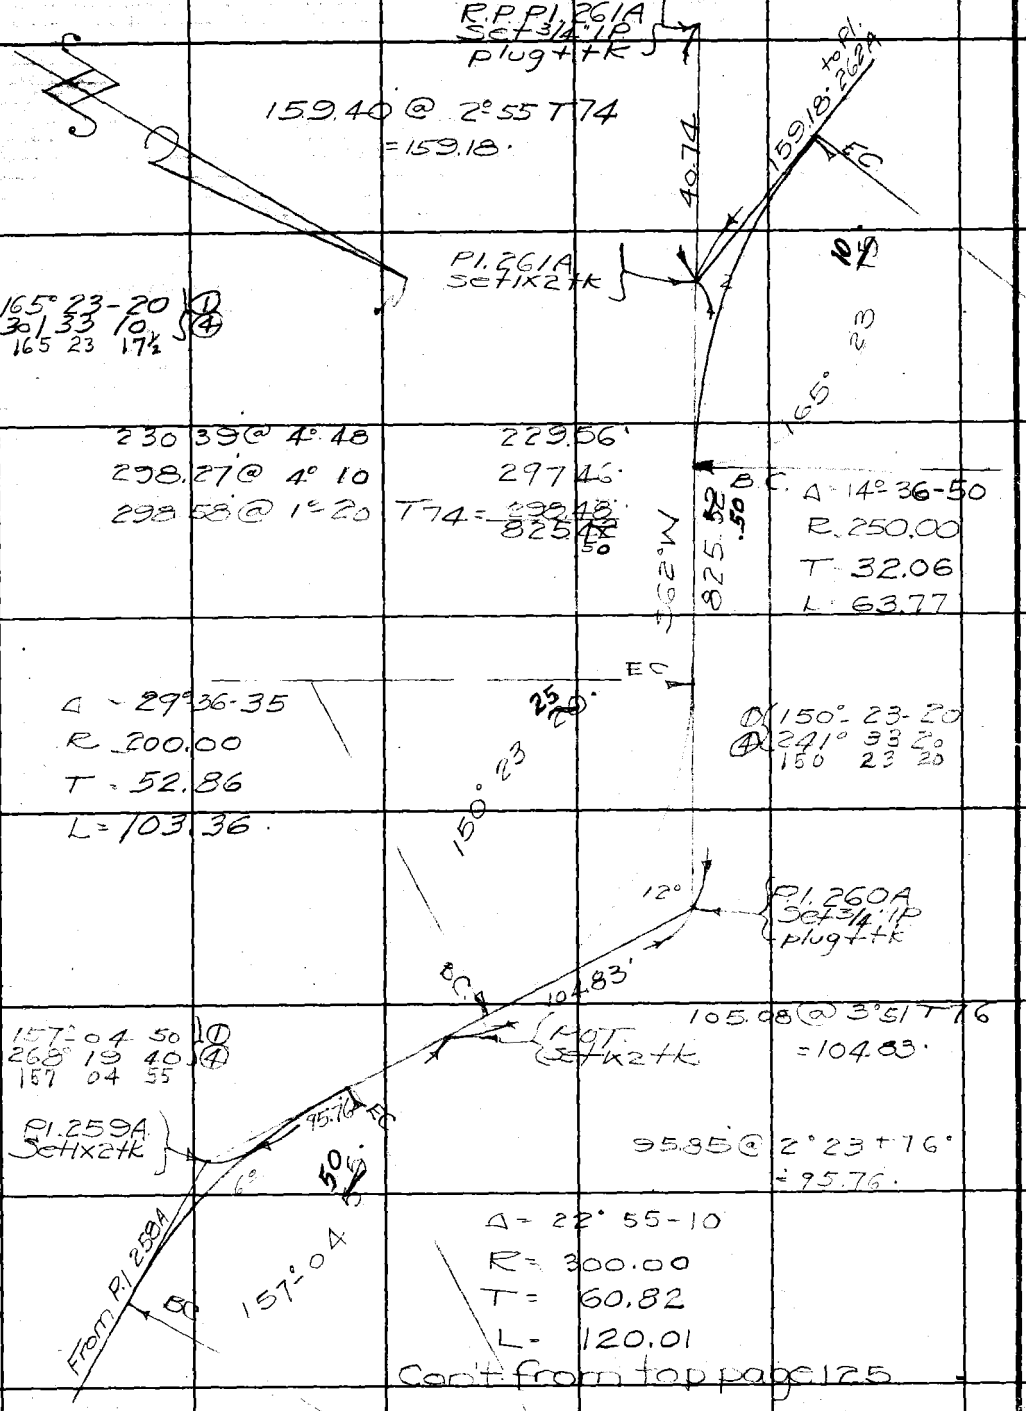

RETURN TO
LOS ANGELES COUNTY SURVEYOR
700 HALL OF RECORDS

Note: Any Additions or Changes on This Sheets Must be Made or Circled in Red Ink With Date and Name of Person Making Change.

Do not extend notes this side of this line

Notes Ck'd by		Survey of Los Virgenes FTT System	F.B. 778 Pg. 127
Map No. B-1830		W. O. 8243 Tape No. 49 St'd 8 OF	
Office Work		Surveyed by Stevenson	
Checked		Notes T.d.S Date 7-5-39	
Date		Indexed A. C. Johnson	

Cont. to Bot. page 128

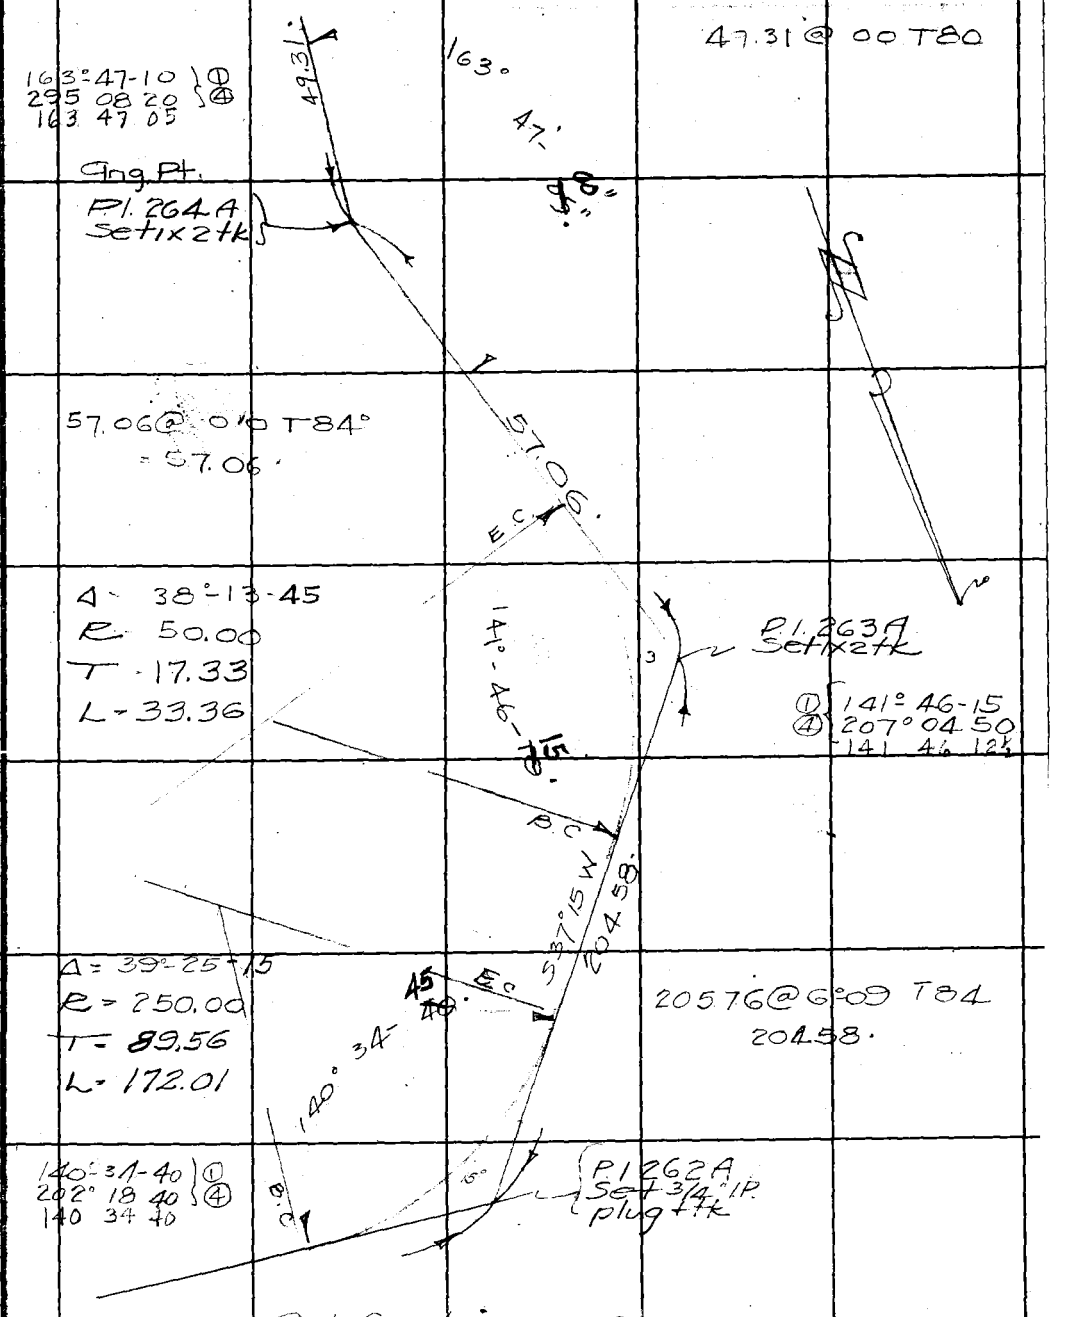

Cont. from top page 126

RETURN TO
LOS ANGELES COUNTY SURVEYOR
700 HALL OF RECORDS

Note: Any Additions or Changes on This Sheets Must be Made or Circled in Red Ink With Date and Name of Person Making Change.

Do not extend notes this side of this line

FORM 247 3M 10-37

F.B. 778 PG. 128

Con't to bot. page 129

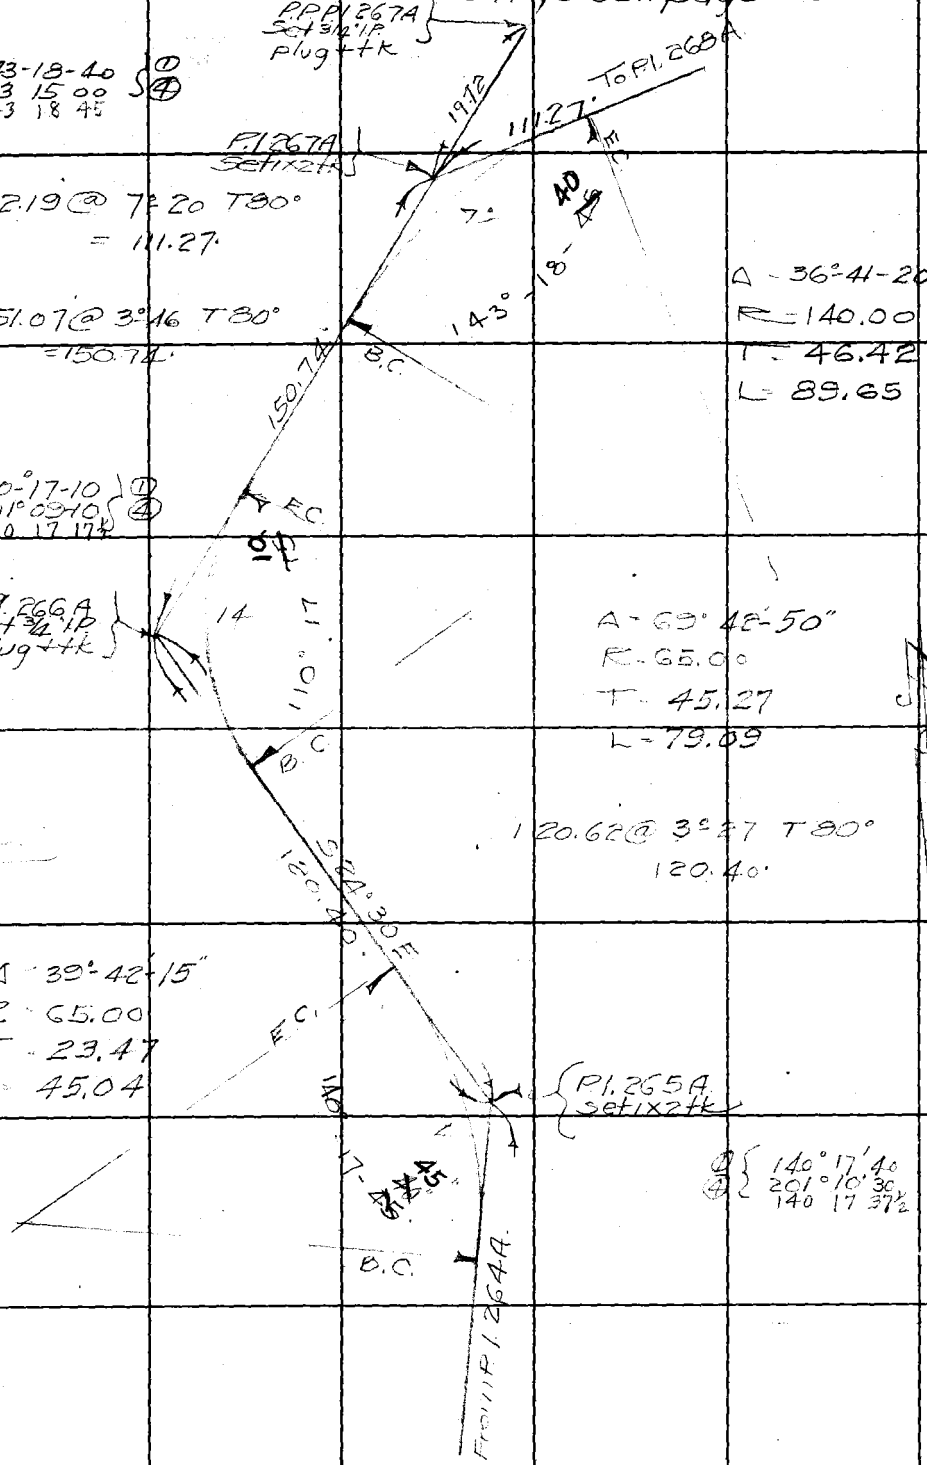

Cont. from top page 127

RETURN TO
LOS ANGELES COUNTY SURVEYOR
700 HALL OF RECORDS

Note: Any Additions or Changes on This Sheets Must be Made or Circled in Red Ink With Date and Name of Person Making Change.

Do not extend notes this side of this line

Notes Ck'd by	Survey of Los Virgenes F.M. System
Map No. B-1830	W. O. 8243 Tape No. 49 St'd 84 OF
Office Work	Surveyed by Stevenson
Checked	Notes T.d.S Date 7-6-39
Date	Indexed

F.B. 778 PG. 129

① 158 52 50
④ 255 30 40
153 52 40

Cont. to bot. page 130

101.98 @ 6°03 T80 = 101.41.

Δ - 26°07-25
R - 150.00
T - 34.80
L - 68.39

101.41 To P.I. 270A

EC

153°

52

25 Ft. Strip

P.I. 270A Set CST+TW.

A

B C

107.23

107.75 @ 5°37 T80
107.23.

150°05 00 ①
240°20 00 ④
150 05 00

Δ - 29°54-50
R - 140.00
T - 37.40
L - 73.09

EC

150°05-00

P.I. 269A Set 1"x4"K

10 Ft.

BC

N 08°22' W

151.46

EC

157.69 @ 3°07 T80°
157.46.

146 21-30 ①
225 26 00 ④
146 21 30

146°21'

A - 33°38-35
R - 125.00
T - 37.79
L - 73.40

P.I. 269A Set 3/4" IP plug + tk

6.

25 Ft. Strip

B.C.

From P.I. 267A

Cont. from top page 128

Note: Any Additions or Changes on This Sheets Must be Made or Circled in Red Ink With Date and Name of Person Making Change.

Do not extend notes this side of this line

RETURN TO
LOS ANGELES COUNTY SURVEYOR
700 HALL OF RECORDS

FORM 257 5M 10-37

Cont. to bot. page 131

F.B. 770 Pg. 130

200.00 @ 7°03 T92 L98.51'

To PI 274A

98.51'

① 140° 43' 50"
④ 202° 55' 50"
140 43 50

EC

PI 273A

140°

43'

55"

132.80 @ 6°34 T92
131.92'

A 39°-16-05
R 125.00
T 44.59
L 85.67

BC

N 50° 39" W

131.92'

EC

141°23'30"
205°34'00"
141 23 30

PI 272A

Δ 53°-36-25
R 110.00
T 38.53
L 74.12

141°-23-30"

35"

B.C.

90.79 @ 2°59 T90 L90.67'

179.98'

EC

R.P.
1X2 tk
Temp

123°41'50"
124°47'20"
123 41 50

123°

Δ 56°18'15"
R - 35.00
T - 18.73
L - 34.39

12.92

PI 271A
set 1x2 tk

45"

B.C.

From PI 274A

Cont. from top page 129

RETURN TO
LOS ANGELES COUNTY SURVEYOR
700 HALL OF RECORDS

Note: Any Additions or Changes on This Sheets Must be Made or Circled in Red Ink With Date and Name of Person Making Change.

Do not extend notes this side of this line

Notes Ck'd by	Survey of Los Virgenes FTT System F.B. 778 Pg. 131
Map No. B-1830	W. O. 8243 Tape No. 49 St'd 84 OF
Office Work	Surveyed by Stevenson
Checked	Notes T.J.S Date 7-10-39
Date	Indexed A. C. John

Cont. to bot. page 132

For closure tie see FB. 812 page 25

To PI 277A

PC 437+01.57

157°

32-55

436+52.59

PI 276A Set 1x24k

38.18

RP PI 276A Set 3/4" IP plug tk

436+28.22 PC

116.28

PI 275A Set 1x24k

A 26°30-20
R 200.00
T 47.10
L 92.52

153°-29

40

435+15.70

S 25°30W

115.42

116.08 @ 6°-07 T 92
- 115.42.

175°

PI 274A Set 1x24k
434+47.38

From PI 273A

A - 27-05
R 125.00
T 24.81
L 48.98

① 157° 33 00
④ 270° 12-00
157 33 00

11645 @ 3°-01-00
11628.

① 153°-29.4°
④ 253 58 20
153 29 35

① 175° 40 40
④ 342° 43 20°
175 40 45

Cont from top page 130

Note: Any Additions or Changes on This Sheets Must be Made or Circled in Red Ink With Date and Name of Person Making Change.

Do not extend notes this side of this line

RETURN TO
LOS ANGELES COUNTY SURVEYOR
7DO HALL OF RECORDS

FORM 247 SW 10-57

RETURN TO
LOS ANGELES COUNTY SURVEYOR
700 HALL OF RECORDS

Note: Any Additions or Changes on This Sheets Must be Made or Circled in Red Ink With Date and Name of Person Making Change.

Do not extend notes this side of this line

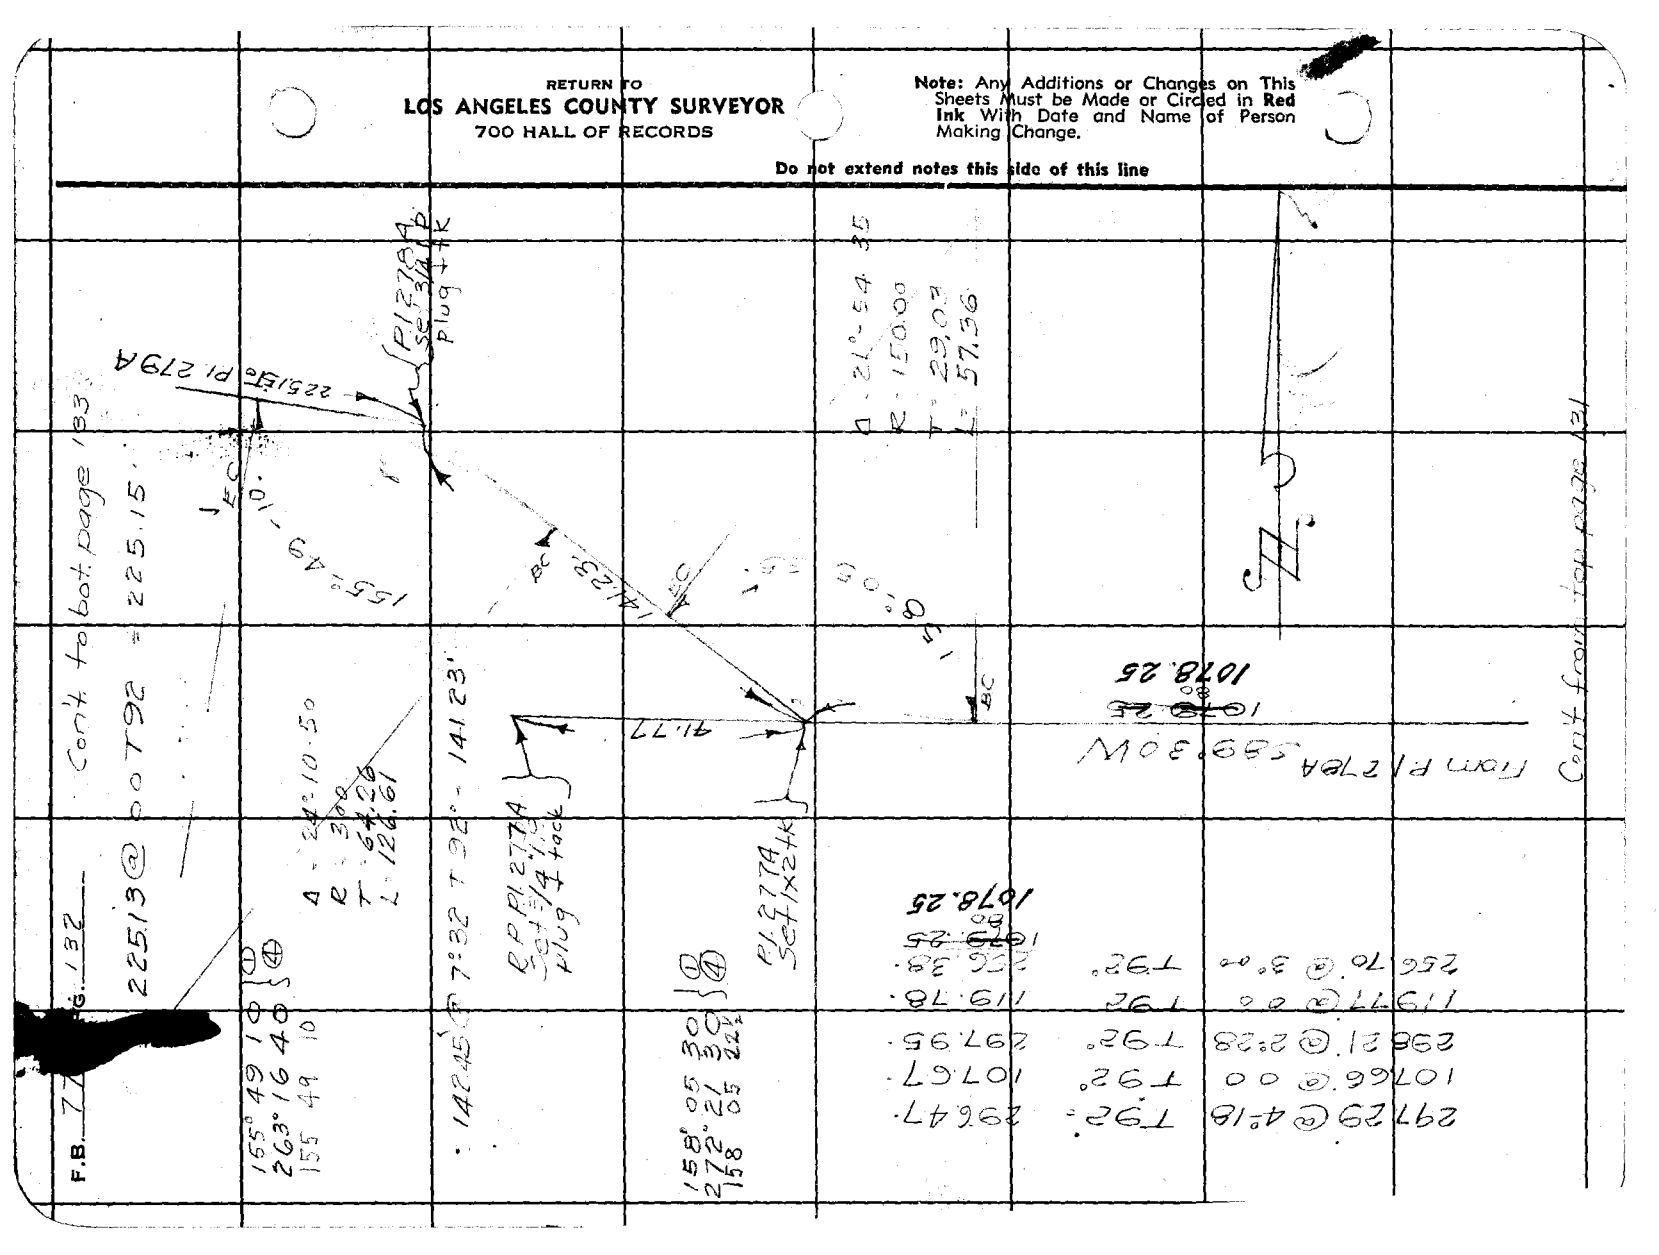

Notes Ck'd by	Survey of Los Virgenes Ext	F.B.	Pg. 133
Map No. B-1830	W. O. 1242 Tape No. 49 St'l 24 of		
Office Work	Surveyed by Stevenson		
Checked	Notes T.J.S. Date 7-10-39		
Date	Indexed C. Jeb		

Cont'd to bot. page 134

167° 27' 40" ⑧
309 50 40 ④
167 27 10

To P.I. 282A

135.9'

EC

P.I. 281A
Set 1x2 ftk

1377.77 @ 9°27 T90° 135.9'

Δ = 12°32-20
R = 350.00
T = 38.45
L = 76.60

167° 27' 40"

118.7'

B.C.

119.83 @ 7°50 T90° 118.71'

EC.

146° 42' 20" ①
226° 42' 20" ④
146 42 20

146° 42' 20"

3

P.I. 250A
Set 1x2 ftk

Δ = 33°17-40
R = 75.00
T = 22.43
L = 43.58

C

Q

S63°W
304.75'

2998.57 @ 0°36 T92
= 2993.57'
plus 618
304.75'

① 54° 52-00
④ 259° 28.00
154 52 20

Δ = 25°08-00
R = 225.00
T = 50.16
L = 98.70

P.I. 279A
Set 1x2 ftk

154° 52' 20"

B.C.

Fr. P.I. 279A

Cont from top page 132

RETURN TO
LOS ANGELES COUNTY SURVEYOR
700 HALL OF RECORDS

Note: Any Additions or Changes on This Sheets Must be Made or Circled in Red Ink With Date and Name of Person Making Change.

Do not extend notes this side of this line

FORM 247 5M 10-37

F.B. 778 PG. 134

Cont. to bot. page 135

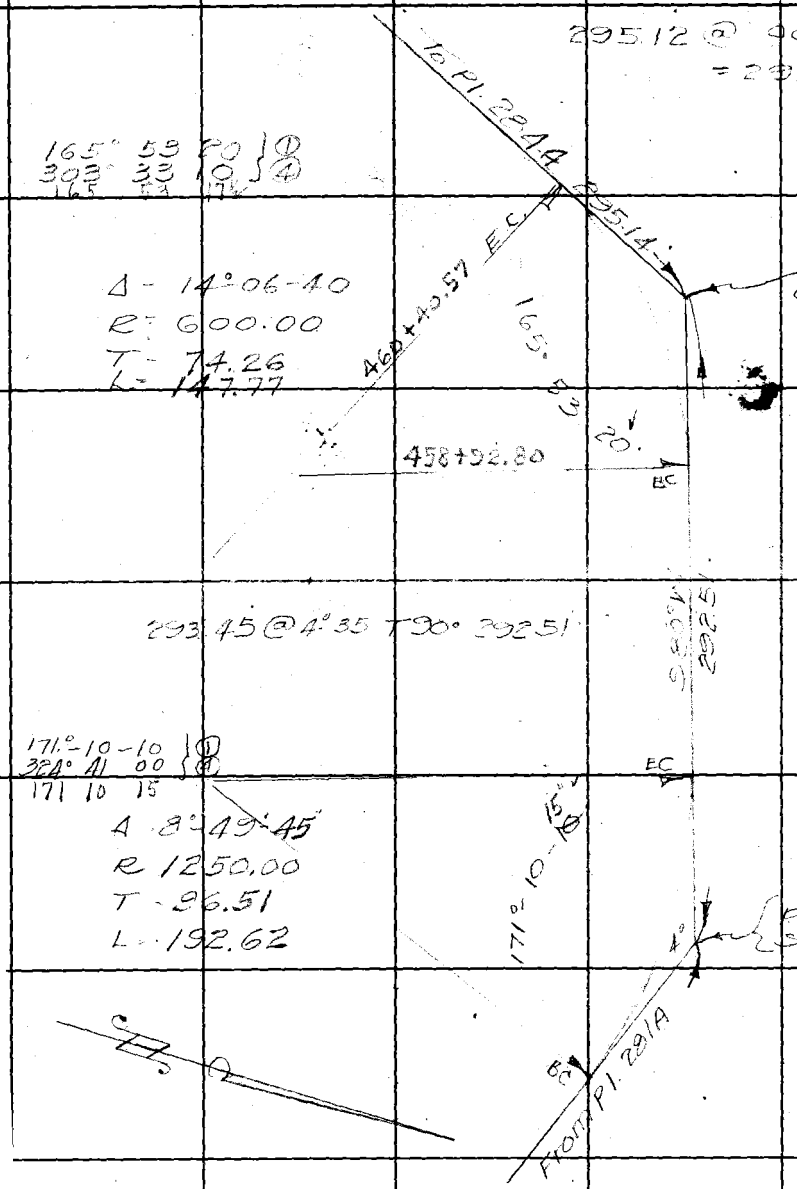

Cont. from top page 133

RETURN TO
LOS ANGELES COUNTY SURVEYOR
700 HALL OF RECORDS

Note: Any Additions or Changes on This Sheets Must be Made or Circled in Red Ink With Date and Name of Person Making Change.

Do not extend notes this side of this line

Notes Ck'd by
Map No. B-1830
Office Work
Checked
Date

Survey of Los Angeles F.C. System
W. O. 8248 Tape No. 49 St'd 84 of
Surveyed by Stevenson
Notes T.J.S Date 7-10-39
Indexed C. Johnson

F.B. PG. 135

Note: Any Additions or Changes on This Sheets Must be Made or Circled in Red Ink With Date and Name of Person Making Change.

Do not extend notes this side of this line

RETURN TO
LOS ANGELES COUNTY SURVEYOR
700 HALL OF RECORDS

FORM 247 8M 10-37

Pl. 287A

Cont. from page 134 44.9

127-16-40 (D)
143°06 40 30 (A)
127 16 40

466+18.92

49.18

465+69.74
Pl. 286 A.

R.P. P.I. D
Set 3/4" I.P
Plug + Tk

Δ=132°00'30
R=35.00
T=78.63
L=80.64

x 28.05

28.14

To China Flat

Cont. to 138.812-9

29.45

27.50

Int. 465+42.24
Set 1x2 + k

25.81

38.41

111.35 @ 00 T90
= 111.35

Δ= 52°48 2.0
R=75.00
T=37.17
L=69.01

127-16-40

13.77

37.16

35.

168°51 50 (D)
315°27 30 (A)
168 51 52½

465+05.07

R.P.INT.
Set 3/4" I.P.
Plug + Tk

1.05

111.35

465+04.02

(See F.B. 812 Pg 36 for tie to Δ China)

Δ-11-08-15
R-750.00
T-73.13
L-145.79

Pl. 285A
Set 1x2 + k

168° 51

463+55.23
B.C.

30.72

R.P. 1x2 + k

170.24 @ 2°09 T90°
= 170.13.

170.13
N86°

172°-08-00 (D)
328° 32-00 (A)
172 08 00

E.C. 463+29.28

Pl. 284A
Set 1x2 + k

05

08

Δ= 7°51'55"
R 1000.00

172°

461+92.70
B.C.

T.= 68.75
L.= 137.28

From Pl. 283A

Cont. from top page 136

F.B. 778 PG. 136

Cont. to bot page 137

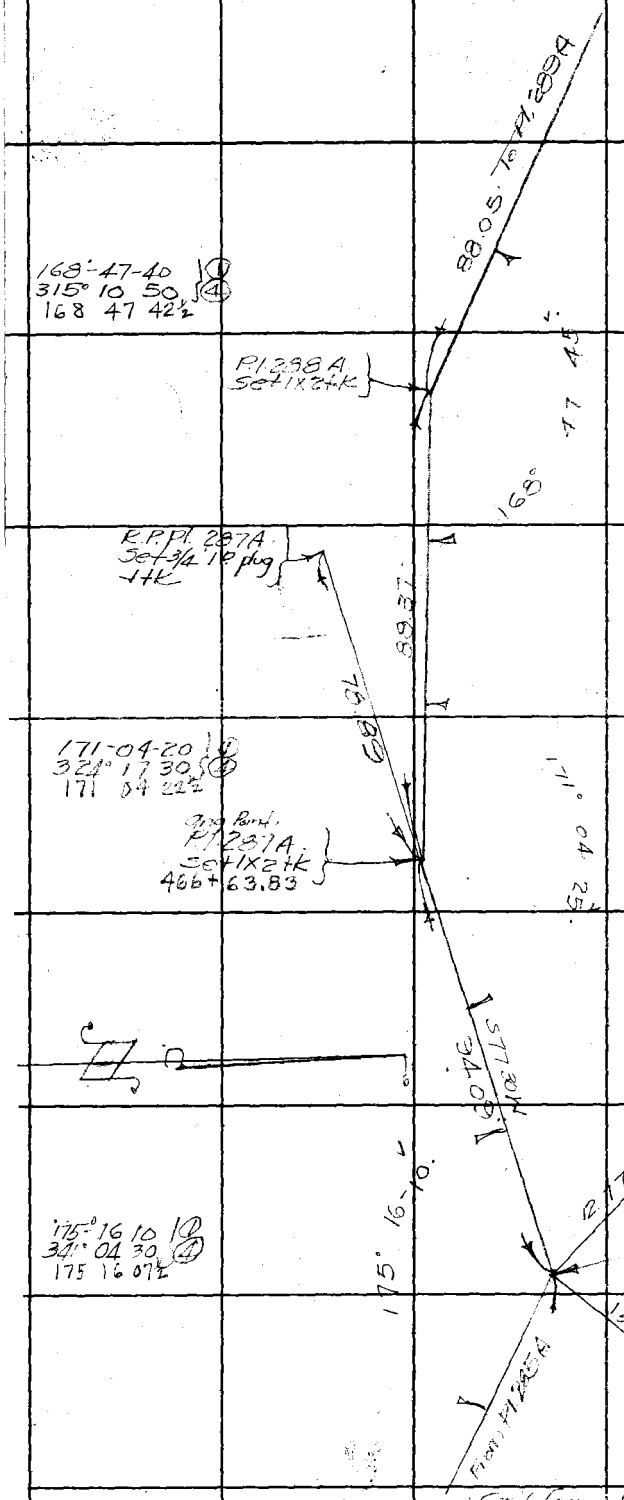

Cont. from top page 136

RETURN TO
LOS ANGELES COUNTY SURVEYOR
700 HALL OF RECORDS

Note: Any Additions or Changes on This Sheets Must be Made or Circled in Red Ink With Date and Name of Person Making Change.

Do not extend notes this side of this line

Notes Ck'd by		Survey of Los Virgenes FM System	F.B. 778 PG. 137
Map No. B-1830		W. O. 8243 Tape No. 49 St'd 84°F	
Office Work		Surveyed by Stevenson	
Checked		Notes T.J.S Date 7-11-39	
Date		Indexed A. C. Johnson	

Cont. to bot. page 135

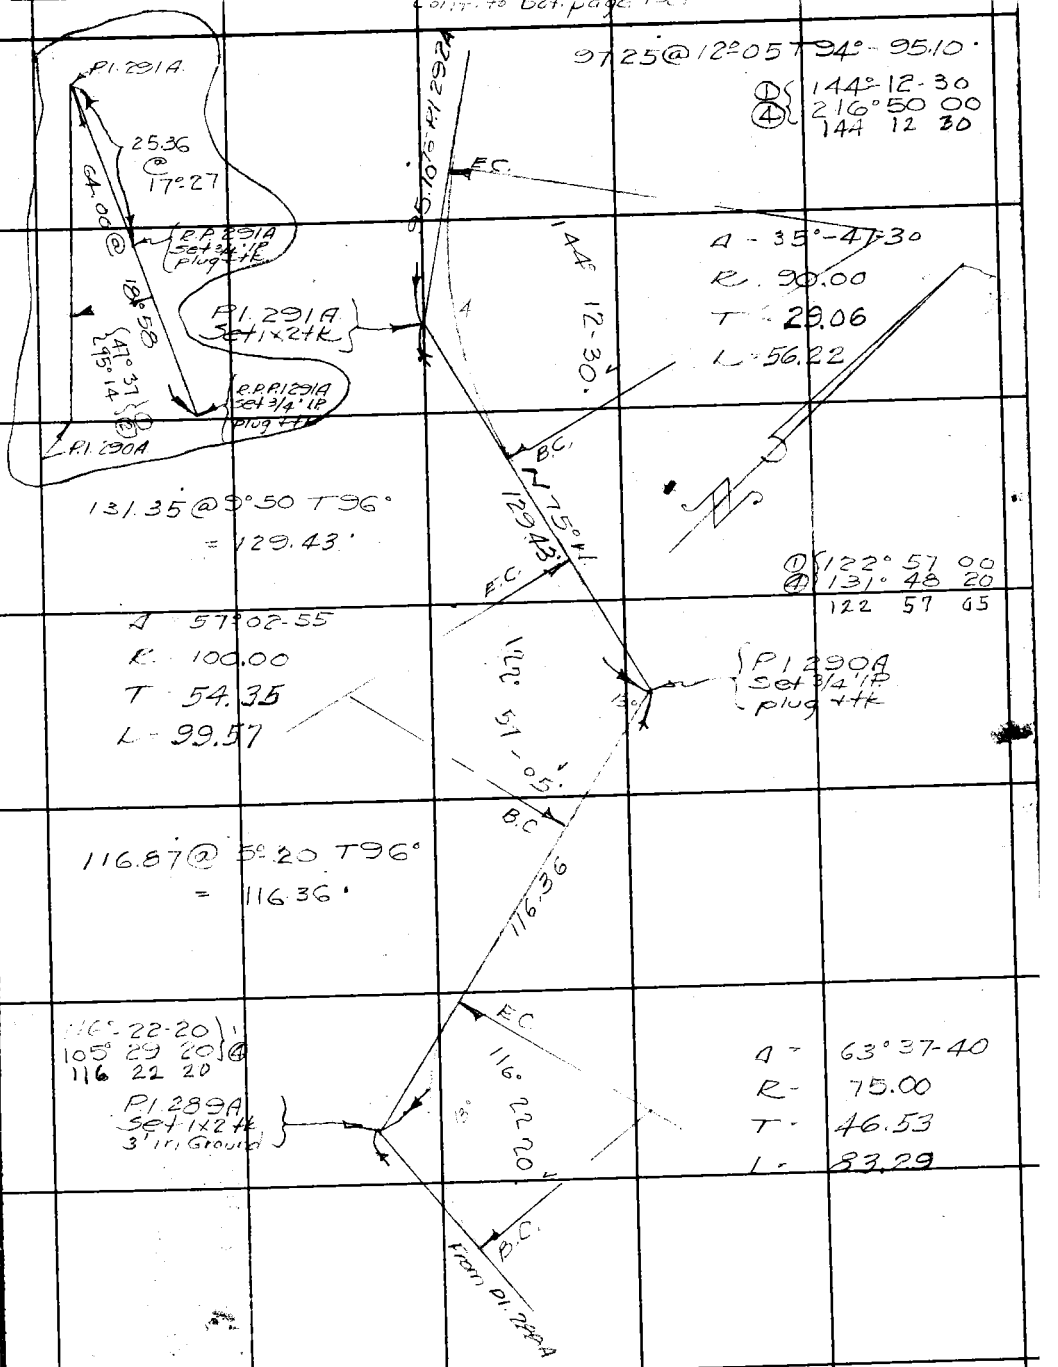

Cont. from top page 136

RETURN TO
LOS ANGELES COUNTY SURVEYOR
700 HALL OF RECORDS

Note: Any Additions or Changes on This Sheets Must be Made or Circled in Red Ink With Date and Name of Person Making Change.

Do not extend notes this side of this line

FORM 247 SM 10-37

F.B. 778 PG. 138

Cont. to bot. page 139

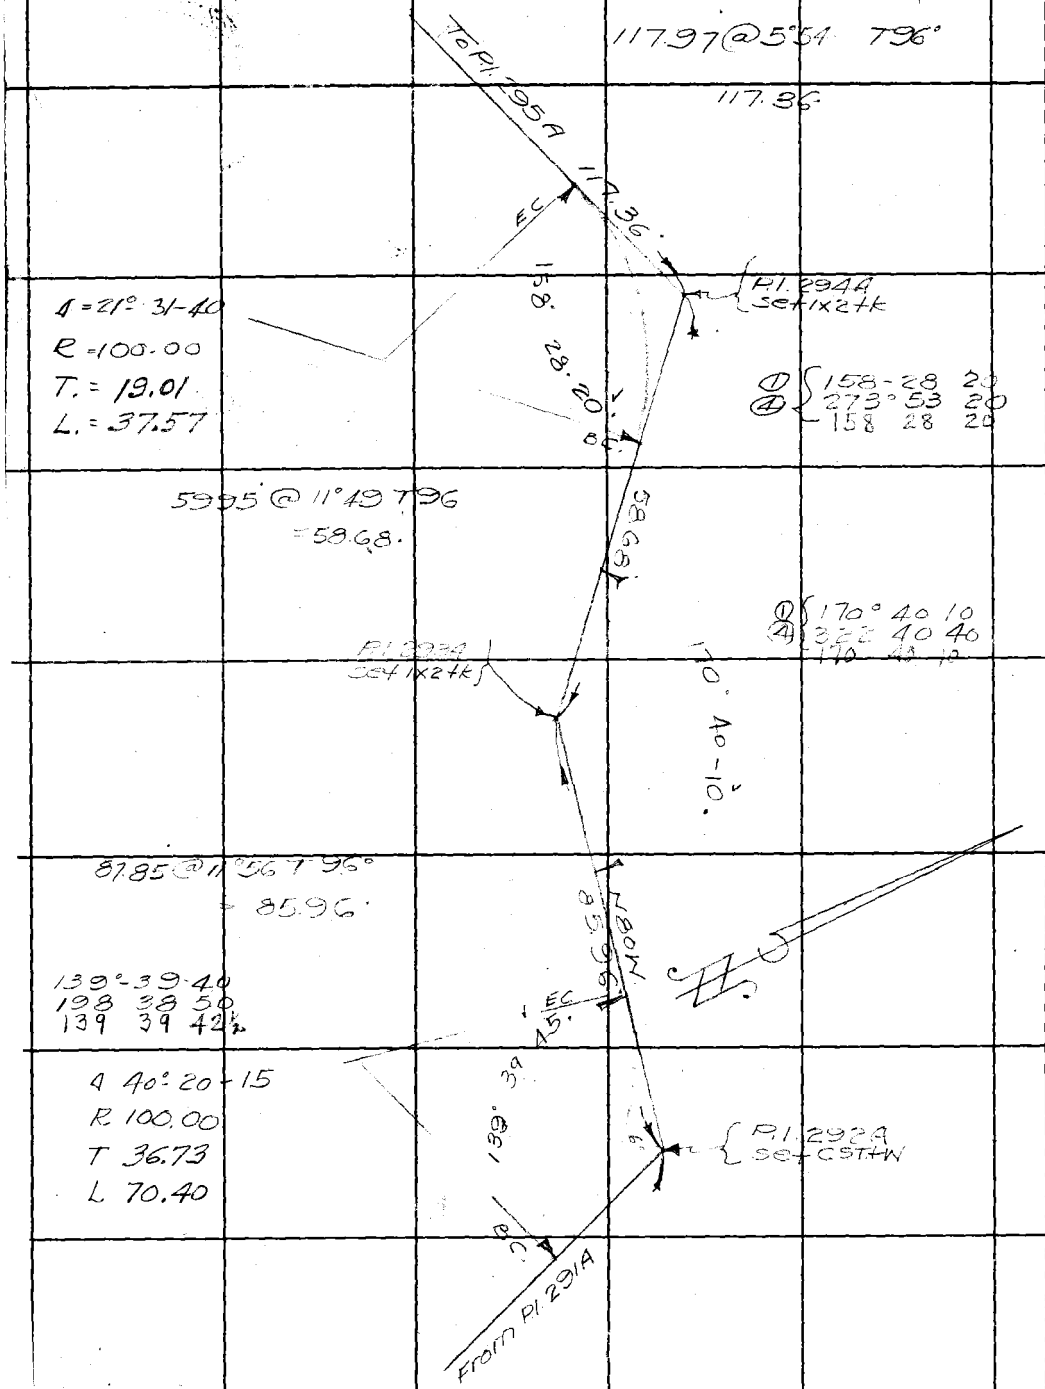

Cont from top page 137

RETURN TO
LOS ANGELES COUNTY SURVEYOR
700 HALL OF RECORDS

Note: Any Additions or Changes on This Sheets Must be Made or Circled in Red Ink With Date and Name of Person Making Change.

Do not extend notes this side of this line

Notes Ck'd by	Survey of Azusa Highways Mtr System
Map No. 19-18.30	W. O. 8248 Tape No. 49 St'd 34 ft
Office Work	Surveyed by Stevenson
Checked	Notes T.J.S Date 7-11-39
Date	Indexed A. C. Johnson

F.B. 778 Pg. 139

Cont. to bot page 140

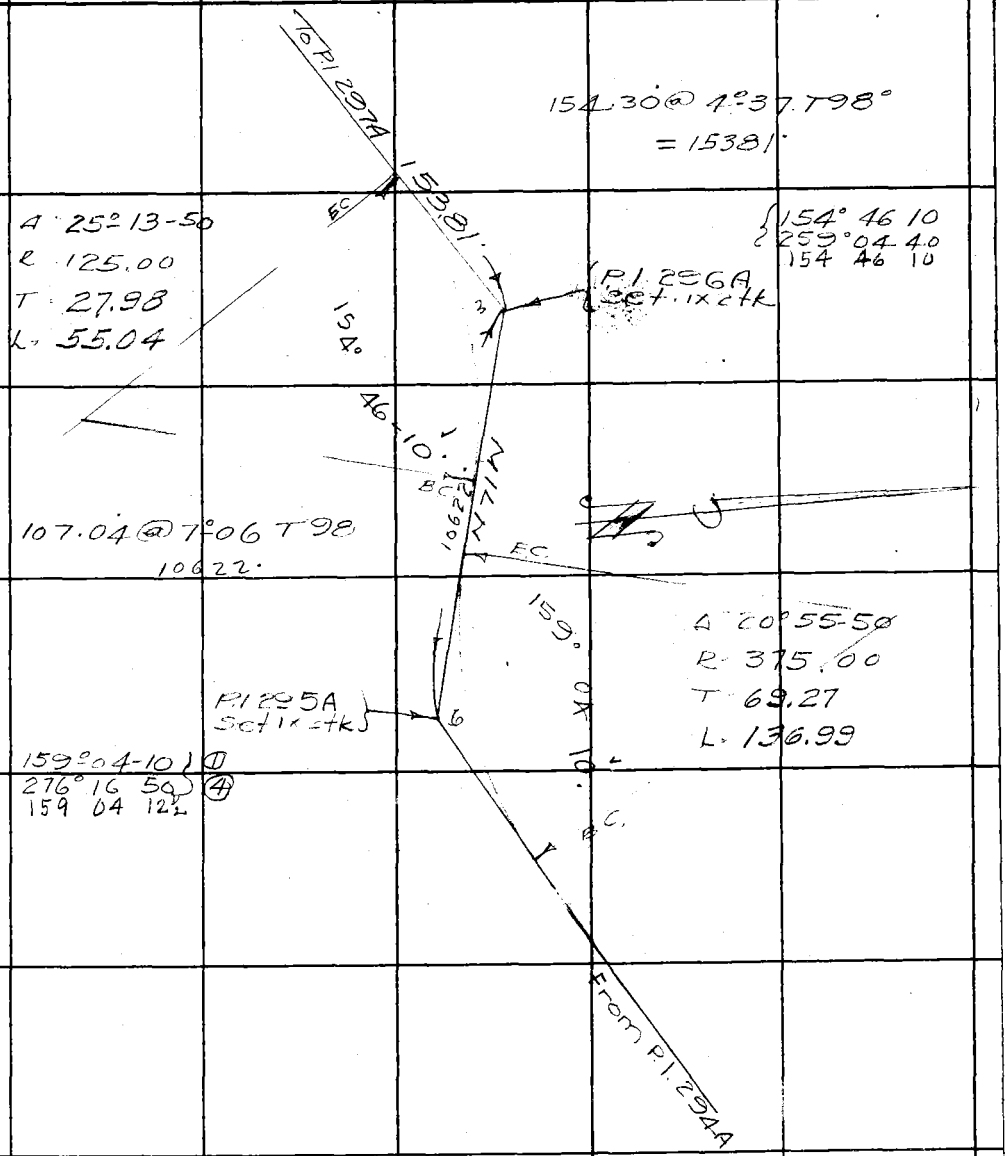

Cont from top page 138

Note: Any Additions or Changes on Sheets Must be Made or Circled in Red Ink With Date and Name of Person Making Change.

Do not extend notes this side of this line

RETURN TO
LOS ANGELES COUNTY SURVEYOR
700 HALL OF RECORDS

FORM 247 SM 10-37

F.B. 778 Pg. 140

Con't to bot. page 141

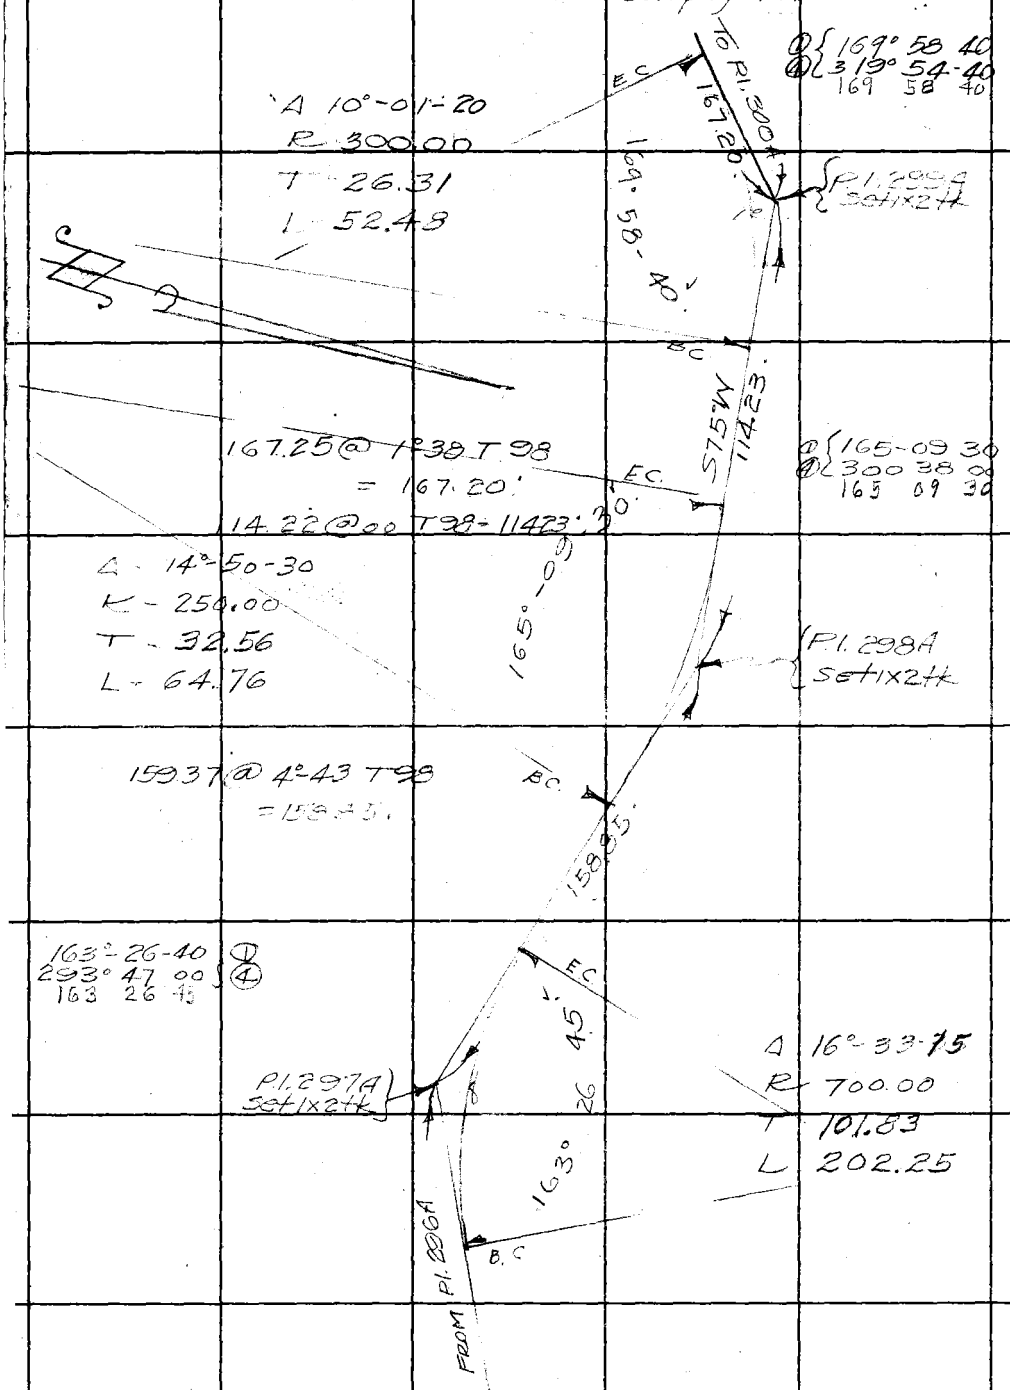

Cont. from top page 139

RETURN TO
LOS ANGELES COUNTY SURVEYOR
700 HALL OF RECORDS

Note: Any Additions or Changes on This Sheets Must be Made or Circled in Red Ink With Date and Name of Person Making Change.

Do not extend notes this side of this line

Notes Ck'd by	Survey of Los Virginios Fill System	F.B. 778	Pg. 141
Map No. B-1830	W. O. 8243 Tape No. 49 St'd 84 oF		
Office Work	Surveyed by Stevenson		
Checked	Notes TJS Date 7-11-39		
Date	Indexed C. Johnson		

Note: Any Additions or Changes on This Sheets Must be Made or Circled in Red Ink With Date and Name of Person Making Change.

Do not extend notes this side of this line

RETURN TO
LOS ANGELES COUNTY SURVEYOR
700 HALL OF RECORDS

FORM 247 SM 10-37

From P.I. 139A

Δ - 43°-43-45
R - 75.00
T - 30.10
L - 57.24

98.46 @ 3°50 T 99° = 97.02'

149.62 @ 4°56 T 98 = 149.08'

145°-46-50 ①
223° 07 10 ④
145 46 47½

278.73 @ 00 T 98
278.76'

165° 24-20 ①
301° 37 10 ④
165 24 17½

P.I. 139A
136°-16 15"
EC
90.75
P.I. 302A Set 1x2 Hk
50'
BC
136°-16-10 ①
L 85 05 00 ④
136 16 15
149.00'
P.P.P.I. 301A Set 3/4" IP pg Hk
16.42
EC
P.I. 301A Set 1x2 Hk
145° 46 50"
278.76'
B.C.
West
EC.
165° 24 15"
Δ 34°-13-10
R 200.00
T 61.57
L 119.45
Δ 14°-35-45
R-500.00
T-64.03
L-127.37
P.I. 300A Set 1x2 Hk
43.56
P.P.P.I. 300A Set 3/4" IP pg Hk
From P.I. 299A

Cont from top page 140

F.B. 778 PG. 142

Cont. to bot page 143

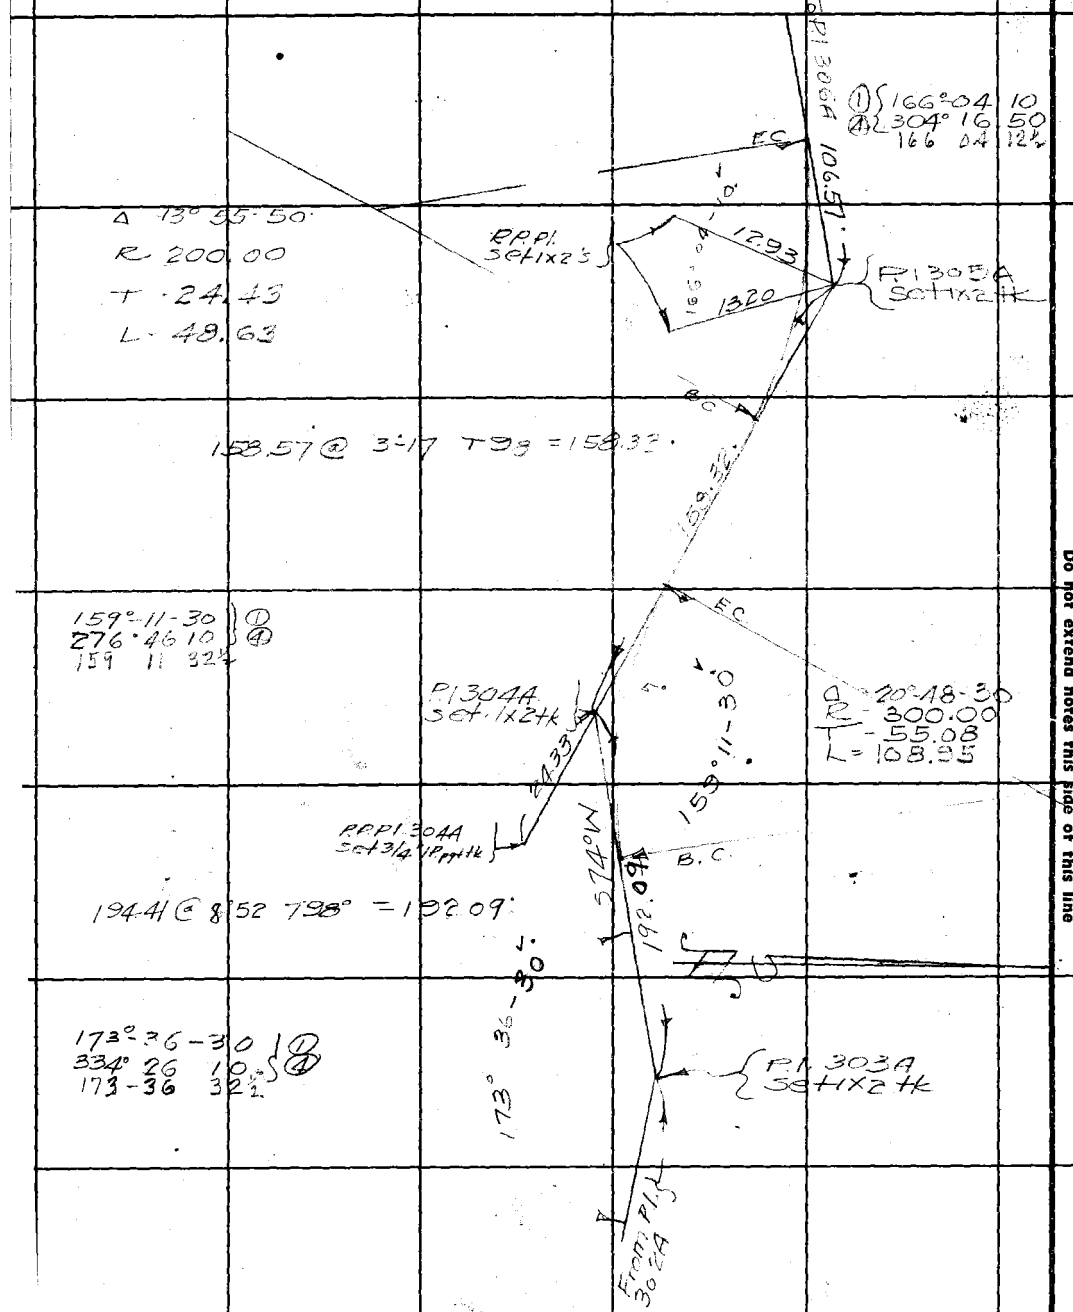

Cont from top page 141

RETURN TO
LOS ANGELES COUNTY SURVEYOR
700 HALL OF RECORDS

Note: Any Additions or Changes on This Sheets Must be Made or Circled in Red Ink With Date and Name of Person Making Change.

Do not extend notes this side of this line

Notes Ck'd by		Survey of Los Angeles FM System	F.B.	Pg. 143
Map No. A-1830		W. O. 1243 Tape No. 49	St'd 84 OF	
Office Work		Surveyed by Stevenson		
Checked		Notes T.d.S Date 7-1839		
Date		Indexed A. C. Johnson		

Note: Any Additions or Changes on Sheets Must be Made or Circled in Red Ink With Date and Name of Person Making Change.

Do not extend notes this side of this line

RETURN TO
LOS ANGELES COUNTY SURVEYOR
700 HALL OF RECORDS

Cont. to bot page 144.

298.68 @ 1°52 T100 = 298.55
15.09 @ 00 = 15.09
313.64

313.64 TO P.I. 308A

173-11-50 ①
332-47-00 ④
173-11-45

P.I. 308A Set 1x24k

45

173°

93.93 @ 6°10 T100
= 93.40.

93.40

EC

39.

71°59

Δ 8°00-25
R 500.00
T 35.00
L 69.87

P.I. 307A Set 1x24k

① 171°59-30
④ 327°58-20
327°59-35

182.85 @ 7°16 T100
= 181.38.

BC

N 82°W

181.39

EC

45

P.I. 306A Set 1x24k

Δ 13°30 45.
R 300.00
T 35.54
L 70.75

166-29-20 ①
305 57 00 ④
166-29-15

166°

BC

P.I. 305A

Cont from top page 142

FORM 247 SM 10-57

Cont to bot page 145

F.B. 778 Pg. 144

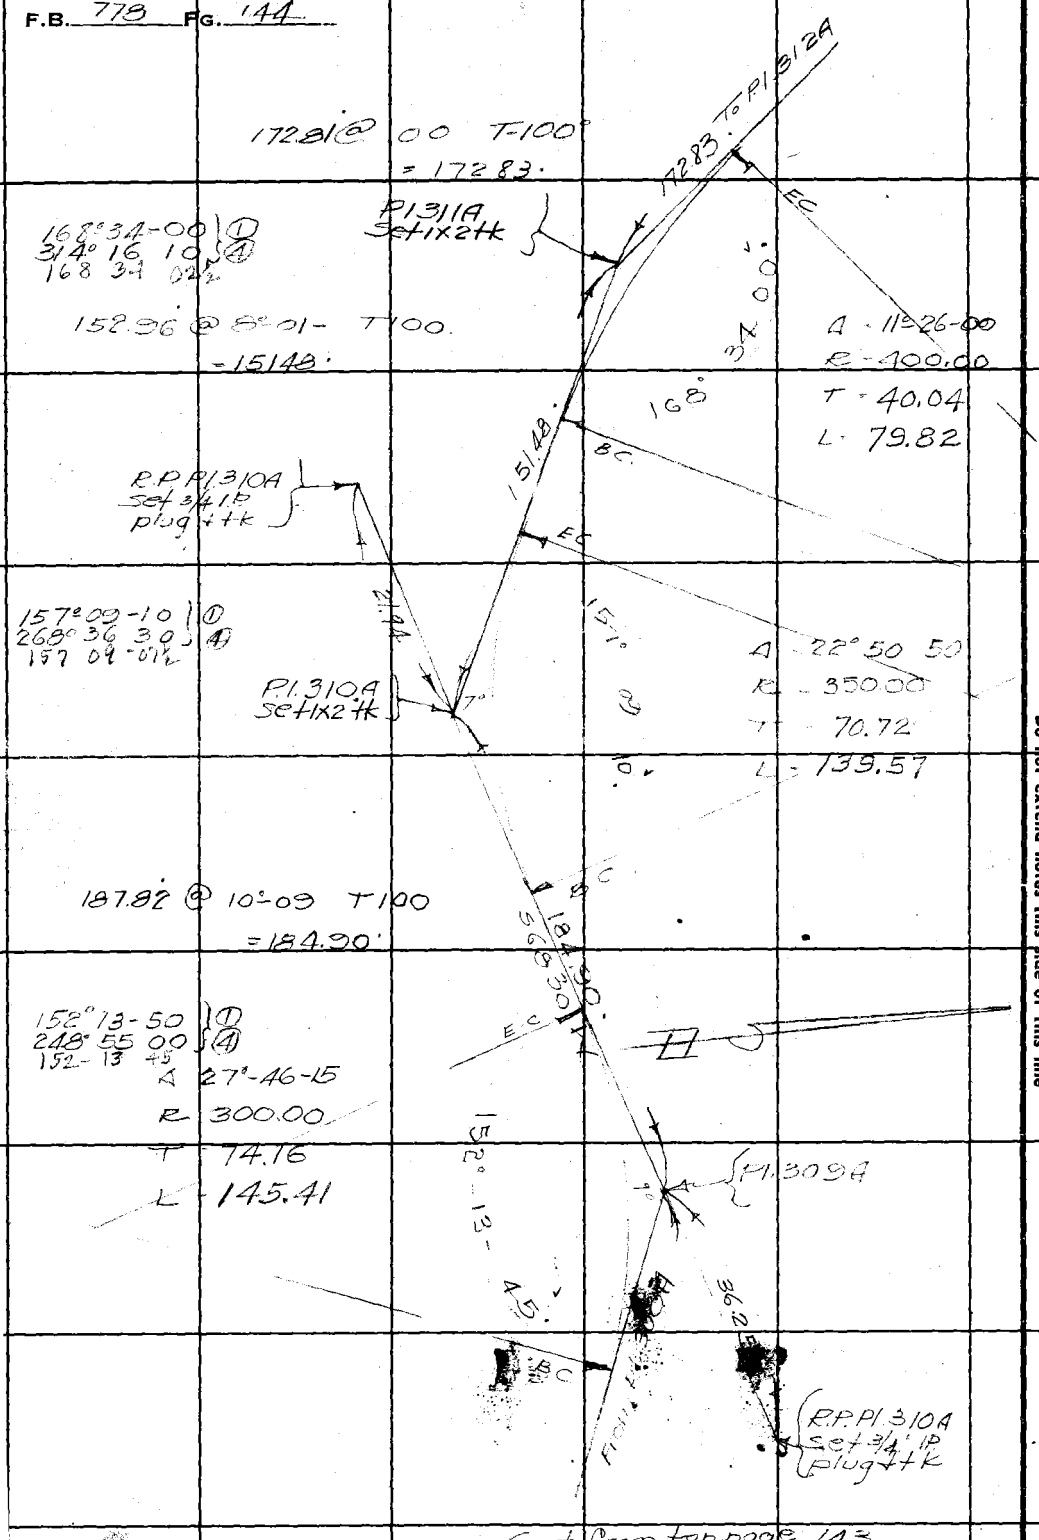

Cont from top page 143

RETURN TO
LOS ANGELES COUNTY SURVEYOR
700 HALL OF RECORDS

Note: Any Additions or Changes on This Sheets Must be Made or Circled in Red Ink With Date and Name of Person Making Change.

Do not extend notes this side of this line

Notes Ck'd by		Survey of Los Virgenes MWD System	F.B. PG. 145
Map No. B-1830		W. O. 8243 Tape No. 49 St'd 84 OF	
Office Work		Surveyed by Stevenson	
Checked		Notes T.J.S. Date 7-12-39	
Date		Indexed A. C. Johnson	

Cont. to bot. page 146

RPPI 314A Set 3/4" IP plug + tk

55.56 @ 6°30'

321.74 PI 315A

EC

296.90 @ 5°05 T100 295.17

25.97 @ 00 25.97

321.74

167°56-00 ①

311°43 50 ④

167°55'57½ PI 314A Set LCSTHW

Δ 12°04-05

R 600.00

T 63.42

L 126.38

167°55

PC

200.10

133°51 50 ⑤

175°27 20 ③

133 51 50

200.34 @ 2°55 T100 = 200.10

A 176°08-10

R 150.00

T 63.88

L 120.78

EC

133°-51-50"

503+40 Ground Station x Sec

PI 313A Set 3/4" IP plug + tk

66.14 D00 T100 66.14

156.23 @ 1°41 T100 156.16

22.30

PC

22.30

176°26-00 ⑩

345 42 40 ④

176 25 55

PI 312A Set 1x2 tk

176°

25 55

From PI 314A

Cont. from top page 144

Note: Any Additions or Changes on This Sheets Must be Made or Circled in Red Ink With Date and Name of Person Making Change.

Do not extend notes this side of this line

RETURN TO
LOS ANGELES COUNTY SURVEYOR
700 HALL OF RECORDS

FORM 247 BM 10-57

F.B. 778 PG. 146

Cont to bot page 147

221.68 @ 5°53 T100
= 220.53

174-14 10 ①
336 56 40 ④
174 14 10

513+32.42
P.I. 318A
Set 1x2 tk

220.53 TO P.I. 319A

174° 14-10"

137.92 @ 00 T98
= 137.93

137.93

EC

Δ 16°-31-5°
R 400.00
T 58.11
L 115.41

163° 28-10"

① 10 2° 28 0
④ 29 3° 57 30
163 28 07½

P.I. 317A
Set 1x2 tk

126.99 @ 2°21 T100 = 176.89

151.81 @ 1°47 T100 = 151.76

57.58

120.00

175°49 25"

175°-49-20 ①
343°-17 30 ④
175 49 22½

P.I. 316A
Set 1x2 tk

151.76

P.I. 315A
Set 1x2 tk

173° 21-20"

① 173 21 20
④ 353° 25 30
173 21 22½

P.I. 314A

Cont. from top page 145

RETURN TO
LOS ANGELES COUNTY SURVEYOR
700 HALL OF RECORDS

Note: Any Additions or Changes on This Sheets Must be Made or Circled in Red Ink With Date and Name of Person Making Change.

Do not extend notes this side of this line

Notes Ck'd by		Survey of Los Angeles County Sisters	F.B. 778 Pg. 147
Map No. B-1830		W. O. 8245 Tape No. 49 St'd 84 °F	
Office Work		Surveyed by Stevens (150)	
Checked		Notes T.J.S Date 1-12-39	
Date		Indexed A. C. Johnson	

Cont. to bot. page 148

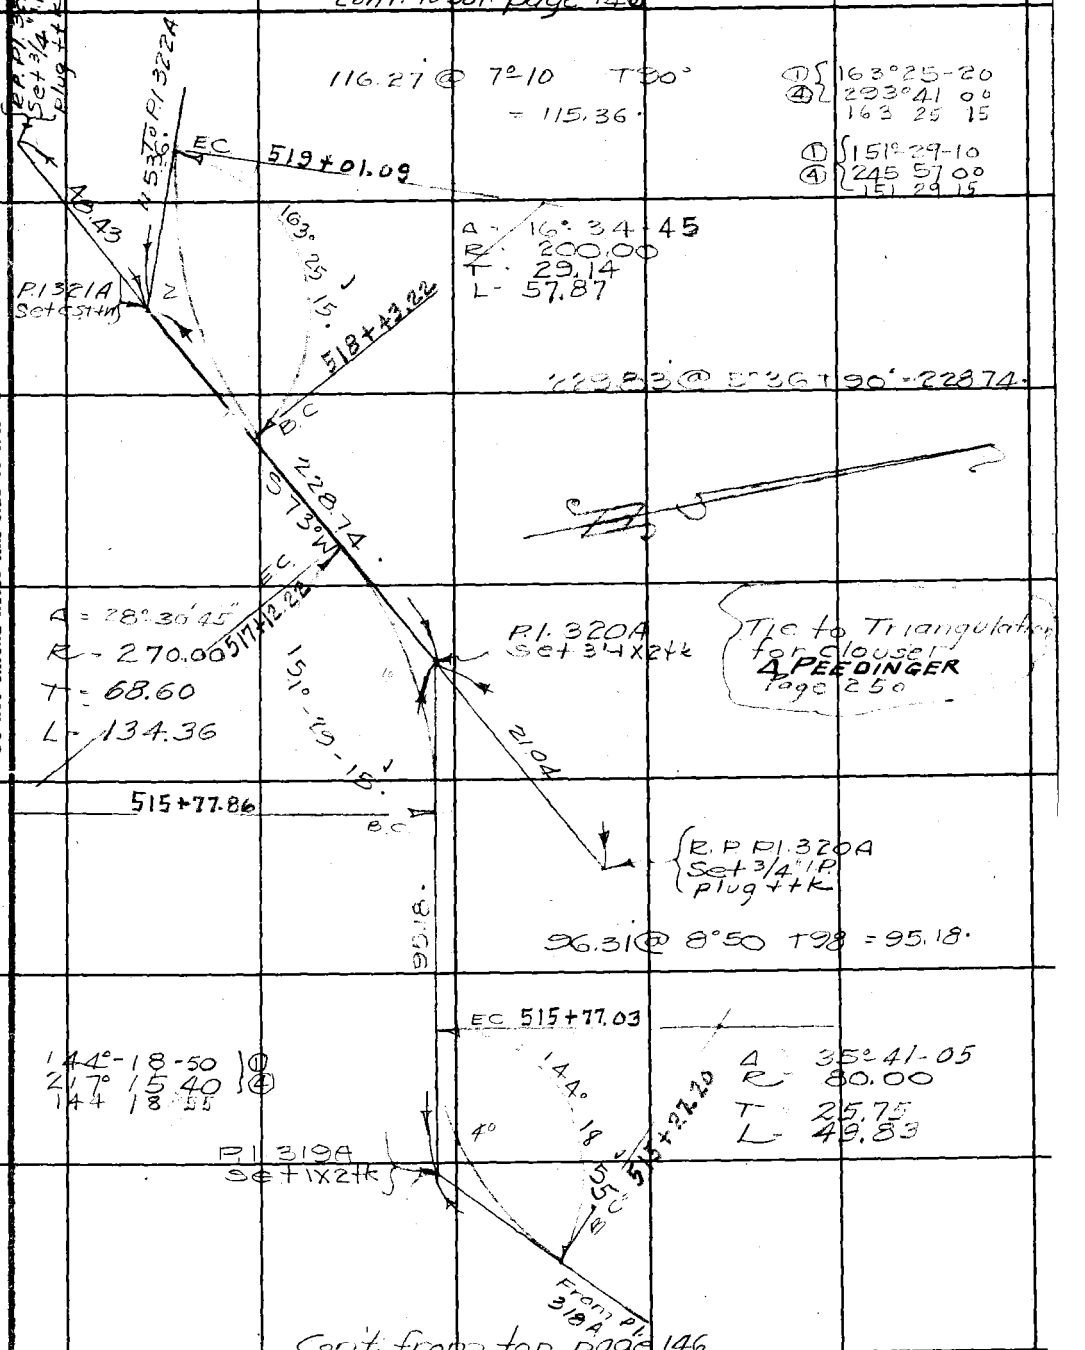

Cont. from top page 146

Note: Any Additions or Changes on This Sheets Must be Made or Circled in Red Ink With Date and Name of Person Making Change.

Do not extend notes this side of this line

RETURN TO
LOS ANGELES COUNTY SURVEYOR
700 HALL OF RECORDS

FORM 247 6M 10-37

Cont. to bot page 149

F.B. 779 Pg. 148

159.10 @ 4°-47 T94 = ~~159.56~~ 158.56

172-39-30 ①
330 38 20 ④
172 39 36½

To P.I. 325A 158.56

172°

39-35-½

523+55
x Sec 340
P.I. 324A
Set 1x24k

273.68 @ 8°-35 T94
= ~~273.39~~
270.63

270.39 270.63

150°-37-24 ①
329 22 10 ④
150 37 11½

P.I. 323A
Set 3/4 I.P.
plug + tk

EC

A 29°-22-40
R 250.00
T 65.53
L 128.18

102.50

S 56°-22-50 E

BC

171.53 @ 8°-53 T90
= ~~171.35~~
169.48

169.48

EC

A 32°-04-45
R 175.00
T 50.31
L 97.98

147°-55-15

P.I. 322A
Set 1x24k

① 147°-55-10
④ 231 41 00
147 55 15

BC

Cont. from top page 147

RETURN TO
LOS ANGELES COUNTY SURVEYOR
700 HALL OF RECORDS

Note: Any Additions or Changes on This Sheets Must be Made or Circled in Red Ink With Date and Name of Person Making Change.

Do not extend notes this side of this line

Notes Ck'd by	Survey of Los Angeles F.T. System
Map No. 19-1830	W. O. 8243 Tape No. 47 St'd 84 of
Office Work	Surveyed by Stevenson
Checked	Notes T.J.S. Date 7-13-39
Date	Indexed A. C. Johnston

F.B. 778 Pg. 149

Cont. to bdy. of Lot 12

To P.I. 32

94 09-40
16° 30 00
94 09 45

Δ = 85°-30'-15"
R = 30.00
T = 27.90
L = 44.94

246.21 @ 7°37 T92°
= 244.05'

P.I. 326A
Set 1x24k

173° 50-00
335° 20 00
173 50 00

108.88 @ 6°49 T 90°
= ~~108.12~~
108.12

157° 33-00
270° 12 10
157 33 02½

P.I. 325A
Set 1x24k

8769 @ 7°38 T 90°
= 86.91

86.91

P.I. 327A
Set 1x24k

N 73° 30' E
244.05'

108.12

EC

Δ 22°27-00
R 200.00
T 39.69
L 78.37

From P.I. 324A

Cont. from top page 148

Note: Any Additions or Changes on This Sheets Must be Made or Circled in Red Ink With Date and Name of Person Making Change.

Do not extend notes this side of this line

RETURN TO
LOS ANGELES COUNTY SURVEYOR
700 HALL OF RECORDS

FORM 247 - 5M 10-37

Cont. to bot. page 151

F.B. 778 Pg. 150

163° 47 40 } ①
295° 10 40 } ④
162 47 40

12957. @ 4°38 T92

plus 129.16
17.74
146.90.

146.90 T. P.I. 3314

EC

P.I. 3304

16° 47 40

A=16-12-20
C 600.00
T.= 85.42
L.=169.70

14994 @ 4°46' T92°
149.44

175° 57 30 } ①
231 49 30 } ④
172 57 22½

BC

149.44

P.I. 3299
Set 1X2 T

124.23 @ 7°51' T92 = 123.84 .07

172° 57 22½

129.77

129° 02 45"

4 - 50° 57 15
R - 65.00
T - 30.97
L - 57.81

129° 02 50
156° 11 00
129 02 15

52.74 K3

P.I. 3288
Set 1X2 T K3

6°

From P.I. 3271

Cont from top page 149

RETURN TO
LOS ANGELES COUNTY SURVEYOR
700 HALL OF RECORDS

Note: Any Additions or Changes on This Sheets Must be Made or Circled in Red Ink With Date and Name of Person Making Change.

Do not extend notes this side of this line

Notes Ck'd by	Survey of Los Angeles FT System
Map No. B-1830.	W. O. 8243 Tape No. 42 St'd 84 oF
Office Work	Surveyed by Stevenson
Checked	Notes T.J.S. Date 7-13-39
Date	Indexed

F.B. 779 Pg. 151

Cont. to Lot map 152

86.78 @ 8°42 T 90° = 85.79'

Δ - 76-59-00
R - 50.00
T - 39.76
L - 67.18

P.I. 334 A.

EC

85.79

① 103-01-00
④ 52°04-10
103 01 02½

103°-01-00

P.I. 333 A
Set 1X2 tk
3' long

174.08 @ 6°59 T 90°
= 172.80

172.80

N 7° W

TIE TO M.C. COY
PAGE 260
248

P.I. 332 A
Set 3/4" IP
plug + tk

EC

① 115° 34-29
④ 102 17 10
115 34 17½

Δ - 64°-25-45
R - 130.00
T - 81.91
L - 146.19

115° 34'

156.01 @ 0°0 T 90° = 156.02

P.I. 331 A
Set 1X2
+ tk

E.P.I. 331 A
Set 3/4" IP
plug + tk

83.06

From P.I. 330

Δ 12° 58-30
R 200.00
T 22.74
L 45.29

① 167°-01-30
④ 308 06 00
167-01-30

Cont. from top page 156

Note: Any Additions or Changes on This Sheets Must be Made or Circled in Red Ink With Date and Name of Person Making Change.

Do not extend notes this side of this line

RETURN TO
LOS ANGELES COUNTY SURVEYOR
700 HALL OF RECORDS

FORM 247 8M 10-37

F.B. 778 PG. 152

Cont. to bot. page 153

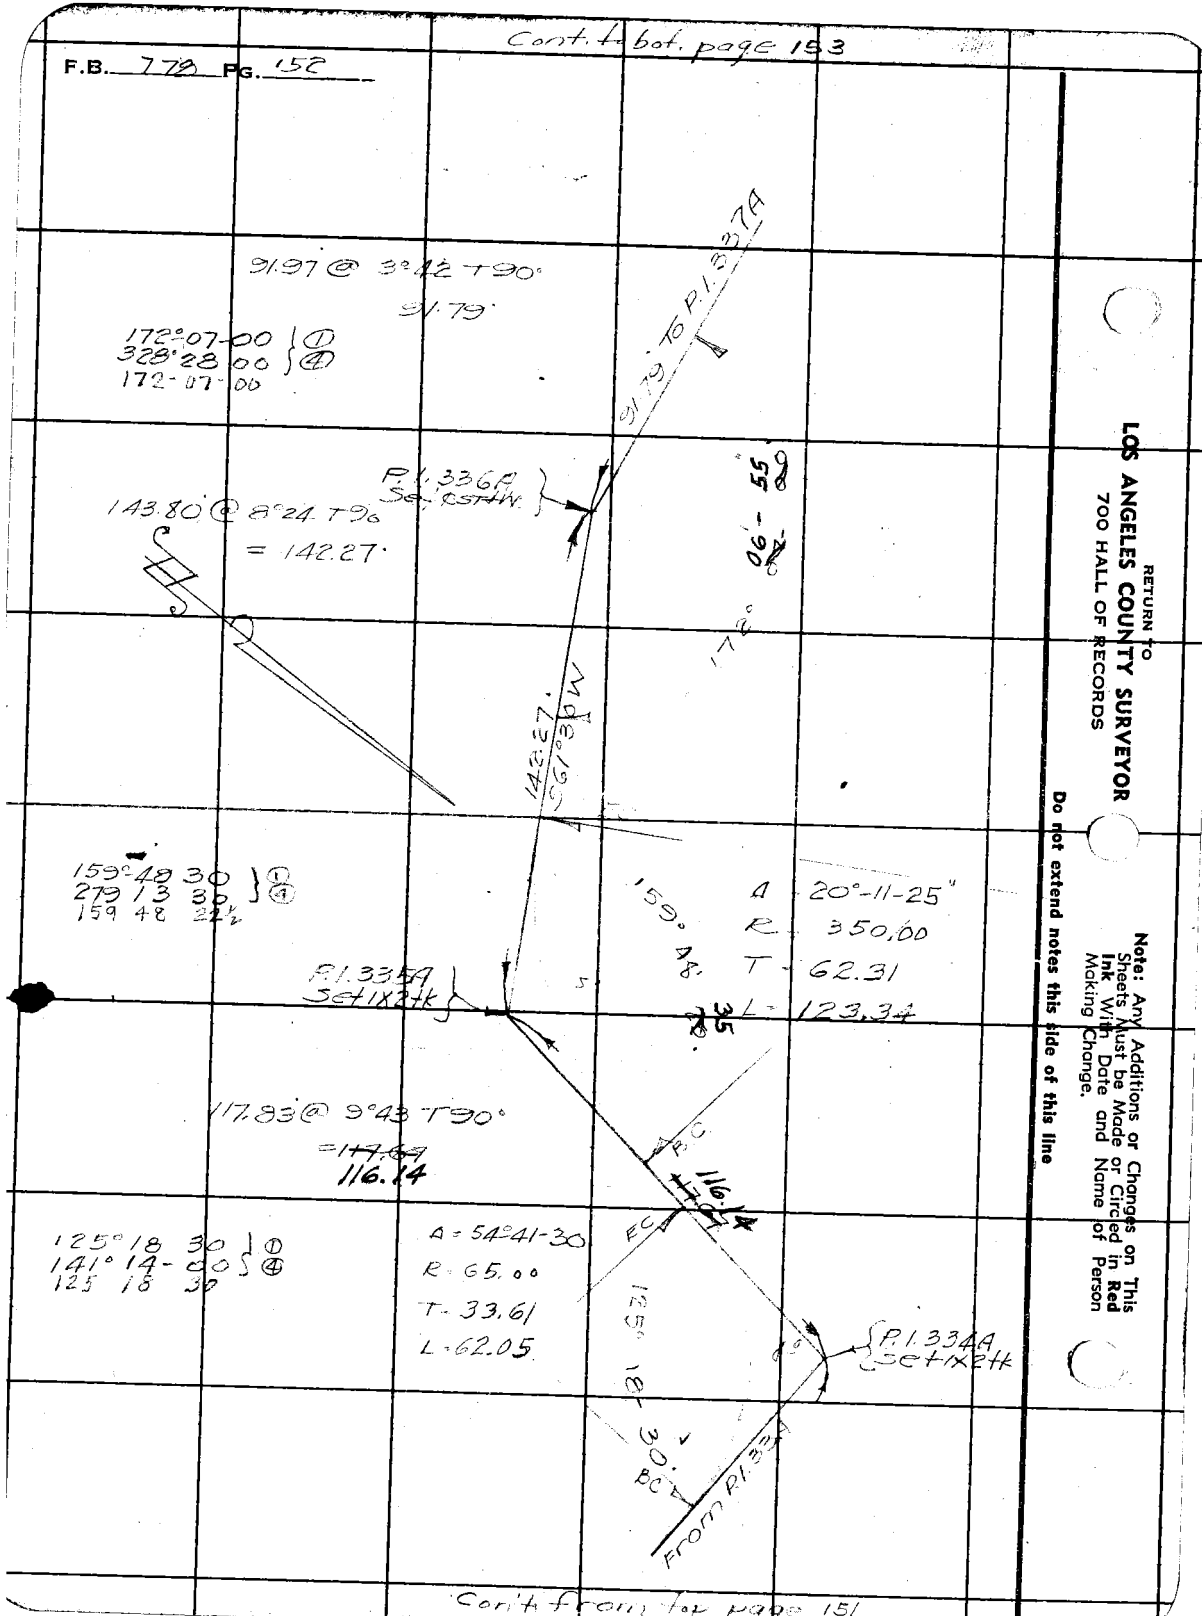

RETURN TO
LOS ANGELES COUNTY SURVEYOR
700 HALL OF RECORDS

Note: Any Additions or Changes on This Sheets Must be Made or Circled in Red Ink With Date and Name of Person Making Change.

Do not extend notes this side of this line

Cont. from top page 151

Notes Ck'd by
Map No. A-1830
Office Work
Checked
Date

Survey of Los Virgenes FM System F.B. 778 Pg. 153
W. O. 8243 Tape No. 49 Sht 84 of
Surveyed by Stevenson
Notes T.J.S Date 7-13-59
Indexed A. C. Johnson

154

Note: Any Additions or Changes on This Sheets Must be Made or Circled in Red Ink With Date and Name of Person Making Change.

Do not extend notes this side of this line

RETURN TO
LOS ANGELES COUNTY SURVEYOR
700 HALL OF RECORDS

FORM 247 5M 10-57

P.I. 339A Set 1x2 tk
86.18 To P.I. 340A
181.43 @ 9°36 T84° = 179.39'
102°20'00"
179.39
BC 544+45.67
87.47 @ 9°50 T86° = 86.18'
Ranch Line
R.P.P.I. 338A Set 1x2 tk
16.57
EC 543+27.84
65.68 @ 14°34 T86
Set 3/4" I.P. plug + tk R.P.P.I. 338A
Alberta soil's
1.43
1.32
Set 1x1 tk
P.I. 338A Set 1x2 tk
Δ 15°45'05"
R 125.00
T 17.29
L 34.36
164°15'00" (3)
196°59'50" (2)
164°14'55"
73°
19.40
164°
542+93.48
Int. tie See page 248
N 25° W.
Gate Posts
160.96
S 69°
162.91 @ 8°53 T86
= 160.96
EC 541+72.88
Δ 13°09'35"
R 200.00
T 23.07
L 45.94
166°50'30" (1)
307°22'00" (4)
166°50'30"
17.83
17.29
P.I. 337A Set 1x2 tk
P.I. 338A
542+97.39 P.O.C.
To 5-4
7495.85
4736.82
541+26.94
From P.I. 336A
0.06
1°43'16"
.375
269°17'
To 5-3
3.74
20.60
Cont. from top page 152

F.B. 778 PG. 154

98.31 @ 8°28 T 86 = 97.24.

Cont. to bot. page 155

86° 27 00 ①
345° 48 00 ④
86 27 09

P.I. 342A
Set 3/4" I.P.
.30 down.

96.10 @ 8°46 T86
94.98.

N21°15W
94.98'

104° 46 40 ①④
59° 06 30
104 46 37½

P.I. 341A
Set 3/4" I.P.
Plug & Tack

To P.I. 342A

EC

86° 27-00"

Δ 33° 33-00"
R-35
T- 37.24
L - 57.15

Δ - 15° 13' 25"
R 60.00
T 46.23
L - 78.77

141.32 @ 9°15 T84
= 139.49.

104° 46' 35"

B.C.

139.49

EC

122° 14 20 ①
122° 57 00 ④
122 14 22½

P.I. 343A
Set 1x24"

Δ - 57° 15' 40"
R 70.00
T - 38.61
L - 70.57

122° 14'

20.'

B.C.

From P.I. 339A

Cont. from top page 153

RETURN TO
LOS ANGELES COUNTY SURVEYOR
700 HALL OF RECORDS

Note: Any Additions or Changes on This Sheets Must be Made or Circled in Red Ink With Date and Name of Person Making Change.

Do not extend notes this side of this line

Notes Ck'd by		Survey of Los Virgenes H.T. System	F.B. 772 PG. 155
Map No. R-1830		W. O. 8243 Tape No. 49 Sht 84 of	
Office Work		Surveyed by Stevenson	
Checked		Notes T.J.S Date 7-14-39	
Date		Indexed A. C. Johnson	

Cont. to top page 155

Ⓓ 133°-31'-00"
Ⓐ 174° 27 50
133 36 57½

93.11 @ 5°-50 T86° = 92.58 .69

P.I. 1347A 92.58 .69

A 46°-23-00" Lt
R 110.00
T 47.13
L 89.05

P.I. 1346A Set 1x24k

97.85 @ 6°12 T86° = 97.28

133° 37.00 96

BC

97.28 EC

A = 20°02-35"
R = 100.00
T = 17.67
L = 34.98

Ⓓ 159°57 30
Ⓐ 339 49 50
159 57 27½

159°-51

P.I. 1345A Set 1x24k

108 @ 7°-39-T86 = 107.41

BC

107.41

EC

A - 32°-08-20"
R = 150.00
T = 43.21
L = 84.14

P.I. 1344A Set 1x24k

Ⓓ 147°-51-40
Ⓐ 231° 26 40
147 51 40

97.26 @ 7°11 T86 = 96.50

BC

EC

158°-21-20 Ⓓ
273° 25 40 Ⓐ
158 21 25

547+97 Sta.

P.I. 1343A Set 1x24k

A - 21°-38-35"
R = 175.00
T = 33.45
L = 66.10

From P.I. 342A

Cont. from top page 154

Note: Any Additions or Changes on This Sheets Must be Made or Circled in Red Ink With Date and Name of Person Making Change.

Do not extend notes this side of this line

RETURN TO
LOS ANGELES COUNTY SURVEYOR
7DO HALL OF RECORDS

FORM 247 SM 10-37

F.B. 778 PG. 156

Cont. to bot page 157

54.23 @ .00 T86
54.23.

R.P.P. 1349A
Set Pla. I.P. plug + tk

To P.I. 350A

21.69

54.23'

EC

P.I. 349A
Set 1x2 tk

88-45-00
355 00 20
88 45 05

Δ = 91°-15-00.
R = 30.00
T = 30.66
L = 47.78

88° 45'

31.32'

32.27 @ 8°15 T86
31.32.

Δ = 61°21'45"
R = 50.00
T = 29.72
L = 53.64

8°-32-15

P.I. 348A
Set 1x2 tk

21.15

118-32 10
14 08 40
118 32 10

Δ = 15°-10-35
R = 100.00
T = 13.32
L = 26.49

BC

R.P.P. 348A
Set 3/4" I.P.
plug + tk

513 00 E
138.36

139.26 @ 0°32 T86
= 139.36

25
49
16°

EC

P.I. 347A
Set cut + tk

From P.I. 346A

164°49'00"
15°30'11.50"
164 49 22½

Cont from top page 155

RETURN TO
LOS ANGELES COUNTY SURVEYOR
700 HALL OF RECORDS

Note: Any Additions or Changes on This Sheets Must be Made or Circled in Red Ink With Date and Name of Person Making Change.

Do not extend notes this side of this line

Notes Ck'd by		Survey of Los Virgenes FM System	F.B. Pg. 157
Map No. B-1830		W. O. 8223 Tape No. 49 St'd 24 OF	
Office Work		Surveyed by Stevenson	
Checked		Notes TJS Date 7-14-39	
Date		Indexed A. C. Johnson	

Con't to Lot, page 156

191.46 @ 2°42 T86° 19125

173°43-00 ①
334 52 00 ④
173 43 00

559+38
P1352A
set c stake

191.25 to P1352A

42-55

173

Δ - 6-17-05
R - 200.00
T - 10.98
L - 21.94

224.19 @ 1°40 T86

~~224.25~~
224.10

S80°W
224.10

Δ - 24° 40 - 20
R - 120.00
T - 26.24
L - 51.67

40
35

155°-19-30

① 155°19 30
④ 261 18 20
155 19 30

P1351A
set 1x2 tk

71.20 @ 6°14 T86

70.78

70.10

117°14-00 ①
108°55 50 ④
117 13 57½

P1350A
set 1x2 tk

50

117°13

Δ - 62°-46-10
R - 30.00
T - 18.30
L - 32.87

From P1352A

EC

Con't from top page 156

RETURN TO
LOS ANGELES COUNTY SURVEYOR
700 HALL OF RECORDS

Note: Any Additions or Changes on This Sheets Must be Made or Circled in Red Ink With Date and Name of Person Making Change.

Do not extend notes this side of this line

FORM 247 SM 10-57

F.B. 778 Pg. 158

Con't. to bot page 159

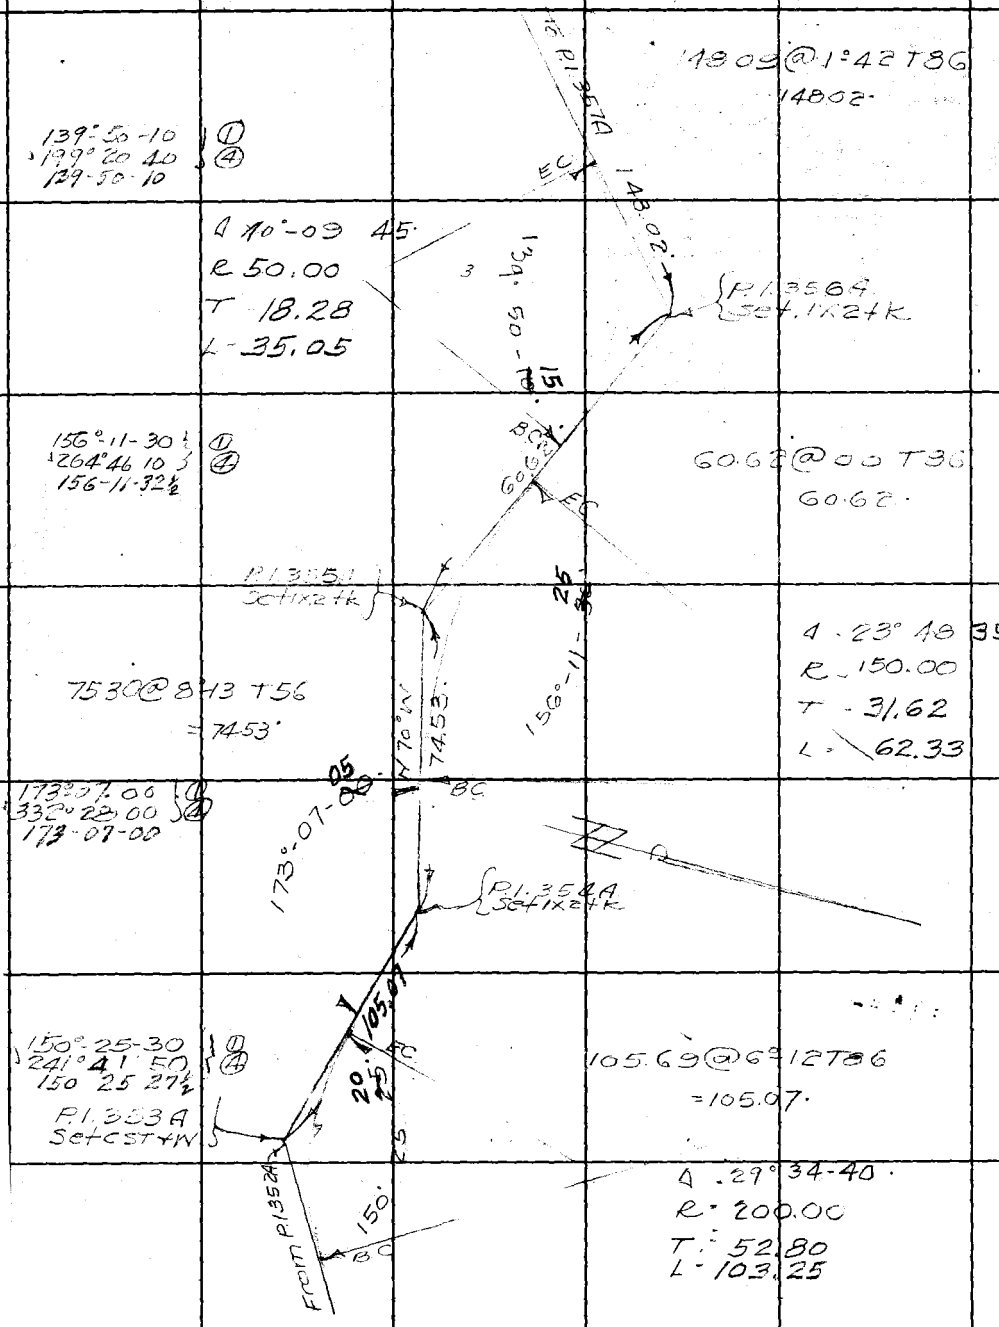

Con't from top page 157

RETURN TO
LOS ANGELES COUNTY SURVEYOR
700 HALL OF RECORDS

Note: Any Additions or Changes on This Sheets Must be Made or Circled in Red Ink With Date and Name of Person Making Change.

Do not extend notes this side of this line

Notes Ck'd by	Survey of Los Virgenes Mtr. System F.B. 778 Pg. 159
Map No. B-1830	W. O. 8243 Tape No. 47 St'd 64 OF
Office Work	Surveyed by Stevenson
Checked	Notes T.J.S Date 7-14-39
Date	Indexed

Note: Any Additions or Changes on This Sheets Must be Made or Circled in Red Ink With Date and Name of Person Making Change.

Do not extend notes this side of this line

RETURN TO
LOS ANGELES COUNTY SURVEYOR
7DO HALL OF RECORDS

FORM 257 3M 10-57

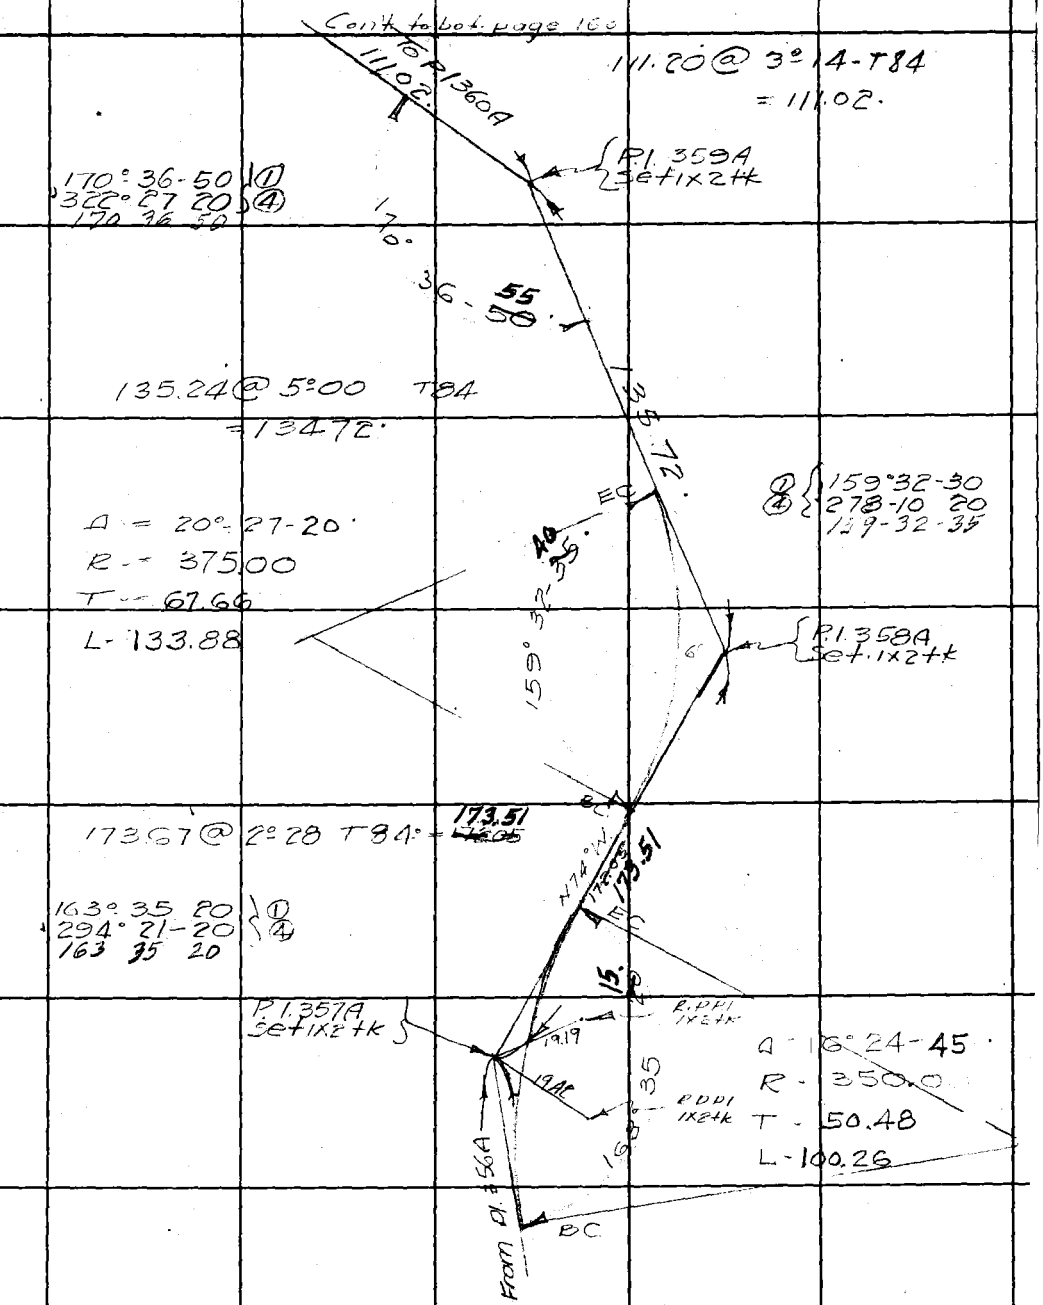

F.B. 778 Pg. 160

Cont. to bot. page 161

167°58'20" ①
311°53'20" ④
167-58-20

90.85 @ 9°32 TB2 ~~90.76~~ 89.60 EC

A - 12°01-35"
R - 100.00
T - 10.53
L - 20.99

RPP1.362A Set 1/4" IP plug + tk

To P1.363A 48.80

P1.362A Set 1X2 tk

127.18 @ 6°38 TB2 = ~~127.05~~ 126.34

EC

152°38'40" ①
250°34'20" ④
152°38'39"

A 27°21-30"
R 300.00
T 48.68
L 95.50

P1.361A Set 1X2 tk

42.44 @ 5°18 TB1

RPP1.361A Set 3/4" IP plug + tk

11.9.20 @ 5°47

BC

McEWEN

EC

A 17°07-45"
R 100.00
T 15.06
L 29.90

162°52'20" ①
291°29'30" ④
162°52'22"

P1.360A Set 1X2 tk

FROM P1.359A

Cont from top page 159

RETURN TO
LOS ANGELES COUNTY SURVEYOR
700 HALL OF RECORDS

Note: Any Additions or Changes on This Sheets Must be Made or Circled in Red Ink With Date and Name of Person Making Change.

Do not extend notes this side of this line

Notes Ck'd by	Survey of Los Virgenes Fit System F.B. 778 Pg. 161
Map No. A-1830	W, O 243 Tape No. 42 St'd 84 OF
Office Work	Surveyed by Stevenson.
Checked	Notes T.J.S Date 7-17-39
Date	Indexed A. C. Jansen

Cont to bot. page 162

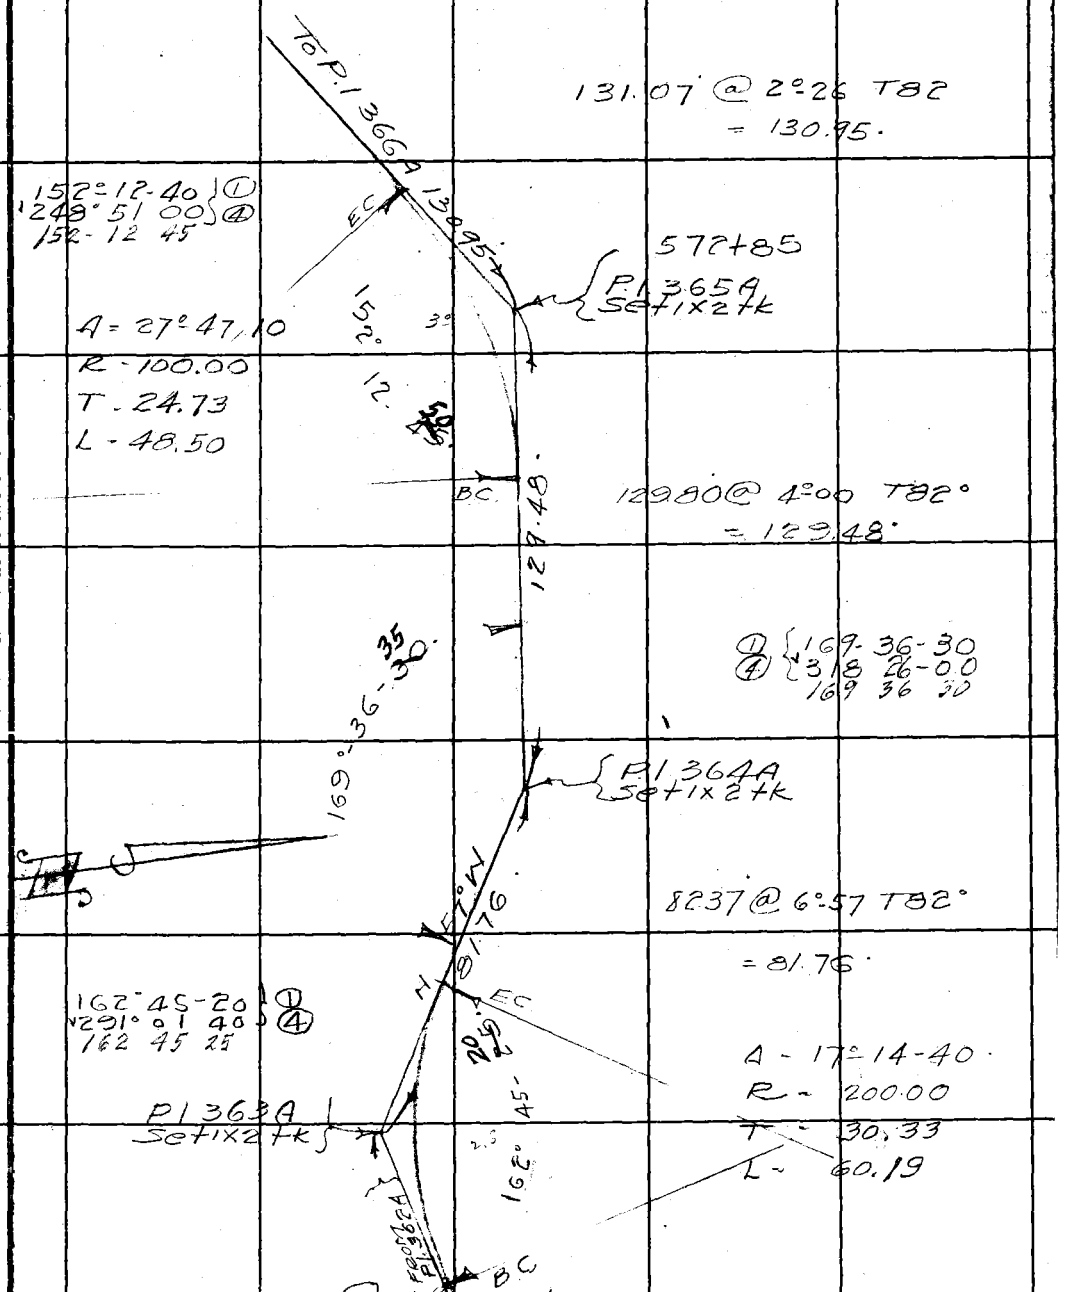

Cont from top page 160

Note: Any Additions or Changes on This Sheets Must be Made or Circled in Red Ink With Date and Name of Person Making Change.

Do not extend notes this side of this line

RETURN TO
LOS ANGELES COUNTY SURVEYOR
700 HALL OF RECORDS

FORM 247 - 8M 10-57

F.B. 778 PG. 162

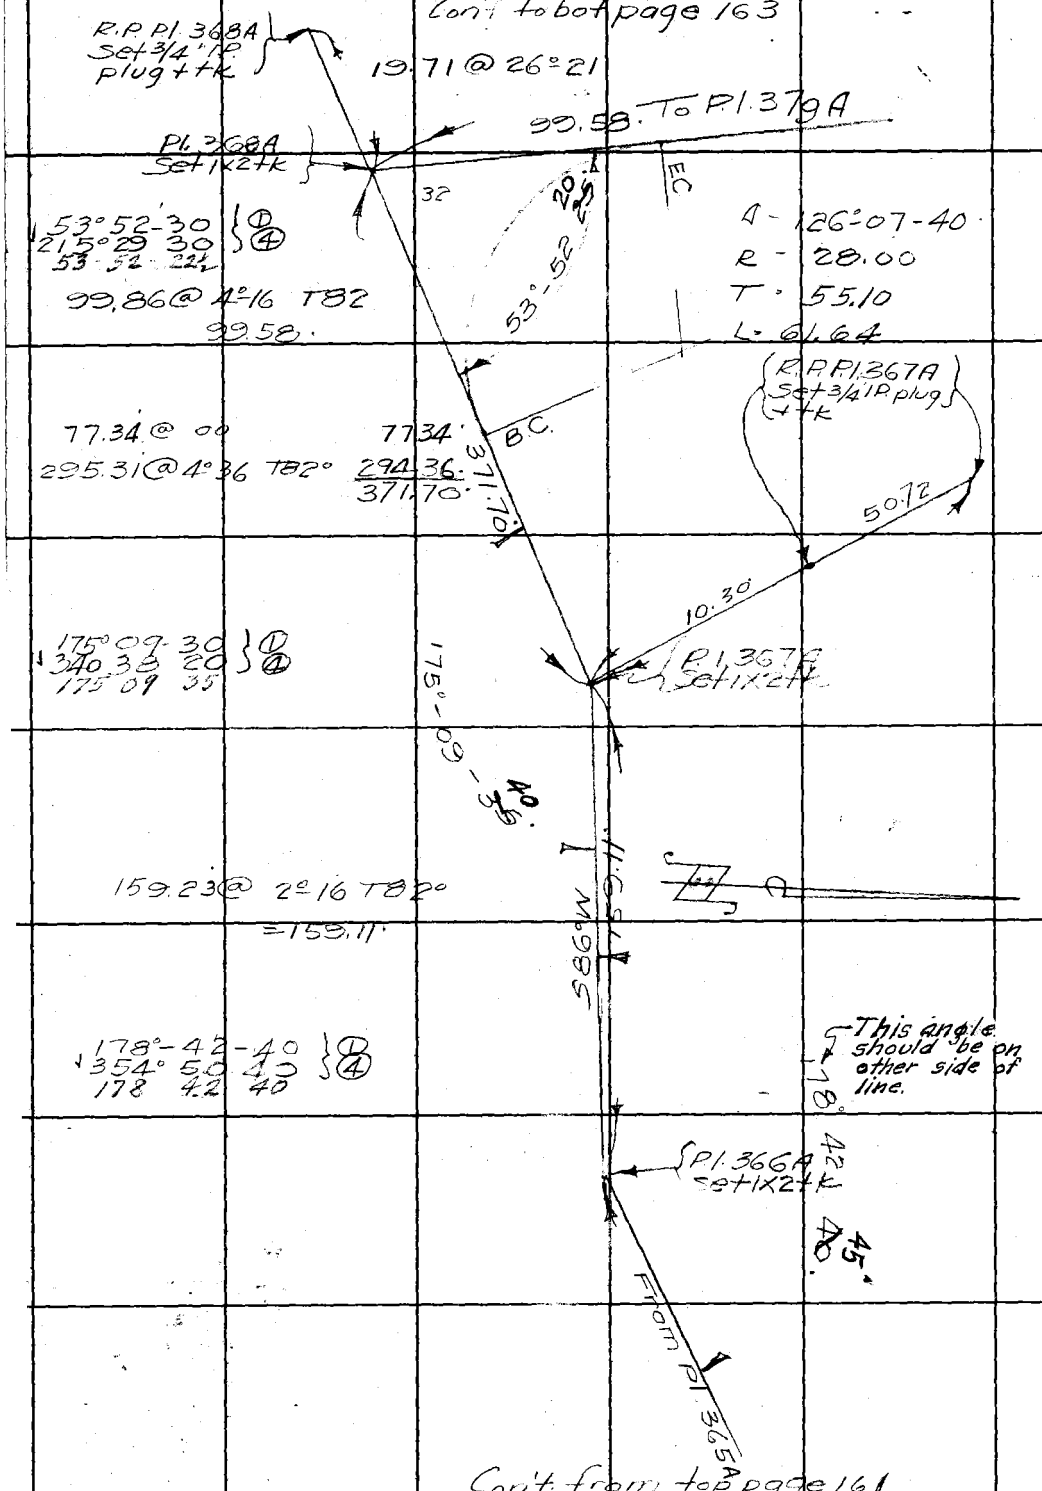

RETURN TO
LOS ANGELES COUNTY SURVEYOR
700 HALL OF RECORDS

Note: Any Additions or Changes on This Sheets Must be Made or Circled in Red Ink With Date and Name of Person Making Change.

Do not extend notes this side of this line

Notes Ck'd by	Survey of Los Virgenes Pipe System F.B. 778 Pg. 163
Map No. 9-1830	W. O. 8243 Tape No. 49 St'd 84 OF
Office Work	Surveyed by Stevenson
Checked	Notes T.J.S Date 7-17-39
Date	Indexed

Cont'd to left side page 164

EC 582+19.52

158°-11-10 ①
272°-44-50 ④
158 11 12½

80.28 @ 8°59 T82°
=79.30
P.I. 371A
Set 1x2 tk

79.30 To P.I. 372

158°-11-30

Δ - 21°-48 55"
R - 150.60
T - 28.91
L - 57.11

581+62.41 B.C.

71.15 @ 7°25 T82
70.50
.65

A 39-48-25
R 65.00
T 23.53
L - 45.16

582+44.30

580+99.14

140°-11-30 ①
200 46-10 ④
140-11-32½

P.I. 370A
Set 1x2 tk

79.59 @ 7°00 T82
=79.00.

163°-20 40 ①
293°-22 58 ④
163 20 42½

P.I. 369A
Set 1x2 tk

From P.I. 369A

163°-20

Δ - 16°-39-20
R - 100.00
T - 14.64
L - 29.07

580+29.24 B.C.

580+58.31 EC

Cont from top page 162

Note: Any Additions or Changes on This Sheets Must be Made or Circled in Red Ink With Date and Name of Person Making Change.

Do not extend notes this side of this line

RETURN TO
LOS ANGELES COUNTY SURVEYOR
700 HALL OF RECORDS

FORM 247 3M 10-37

F.B. 778 Pg. 164

Con't to bot. page 165

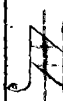

End of line

RP P1.374A
Set 3/4" IP
plug + tk

Tie to Δ ALBERTSON
See Pg 247

Con't from top page 168

584+65

583+36.83
P1.374A
Set 1x2 tk

30.70

195.71 @ 3°15 T82
= 195.46

107°22'00" ①
69°28'00" ④
107-22-00

From P1.371A

Δ 72°37'55"
R 45.00
T 33.08
L 57.04

BC
582+36.83

S 35° W
195.46

81°09'30" ①
324°38'30" ④
81-09

P1.372A
Set 3/4" IP
plug + tk

EC 583+93.87

40'

583+45.75

Δ = 98-50-20
R = 30.00
T = 35.03
L = 51.75

81°09'55"

68.24

68.24 @ 00 T84°
= 68.24'

P1.373A
Set 3/4" IP
plug + tk

RETURN TO
LOS ANGELES COUNTY SURVEYOR
700 HALL OF RECORDS

Note: Any Additions or Changes on This Sheets Must be Made or Circled in Red Ink With Date and Name of Person Making Change.

Do not extend notes this side of this line

Notes Ck'd by E. M. Fisher	Survey of Las Virgenes Fire Trail System	F.B. 778	Pg. 165
Map No. B-1830	W. O. 8243 Tape No. 69 St'd 84 of		
Office Work	Surveyed by Stevenson		
Checked	Notes T.J.S Date 12-14-38		
Date	Indexed A. C. Faulkner 7-31-42		

SURVEY OF
LAS VIRGENES FIRE TRAIL SYSTEM.
JN8243

B-LINE TO LAS VIRGENES CAN

T.J. Stevenson
G.H. Nichols
R.H. Gardner

Note: Any Additions or Changes on This Sheets Must be Made or Circled in Red Ink With Date and Name of Person Making Change.

Do not extend notes this side of this line

RETURN TO
LOS ANGELES COUNTY SURVEYOR
700 HALL OF RECORDS

FORM 247 5M 10-37

F.B. 778 Pg. 166

INDEX TO TRIANGULATION

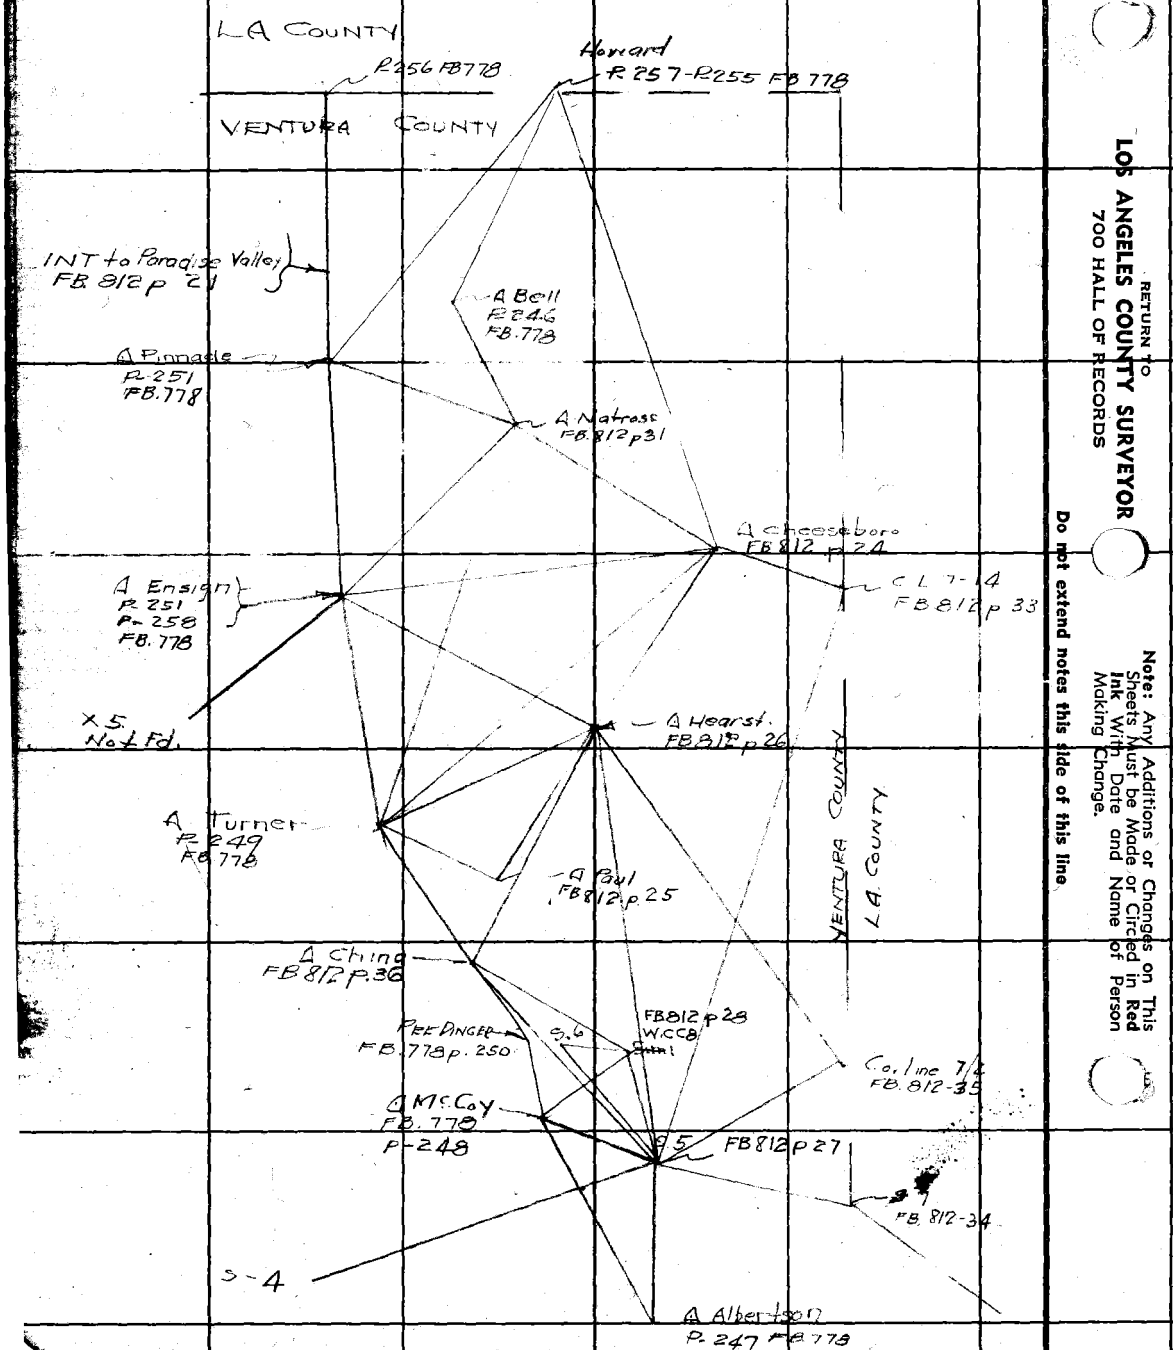

RETURN TO
LOS ANGELES COUNTY SURVEYOR
700 HALL OF RECORDS

Note: Any Additions or Changes on This Sheets Must be Made or Circled in Red Ink With Date and Name of Person Making Change.

Do not extend notes this side of this line

Notes Ck'd by		Survey of Los Virgenes F.H. System	F.B. 778 Pg. 67
Map No. B-1830		W. O. 8243 Tape No. 69 St'd 84 OF	
Office Work		Surveyed by Stevenson	
Checked		Notes T. J. S Date 12-15-36	
Date		Indexed A. C. Johnson	

Cont to bot page

Note: Any Additions or Changes on This Sheets Must be Made or Circled in Red Ink With Date and Name of Person Making Change.

Do not extend notes this side of this line

RETURN TO
LOS ANGELES COUNTY SURVEYOR
700 HALL OF RECORDS

FORM 247 5M 10-37

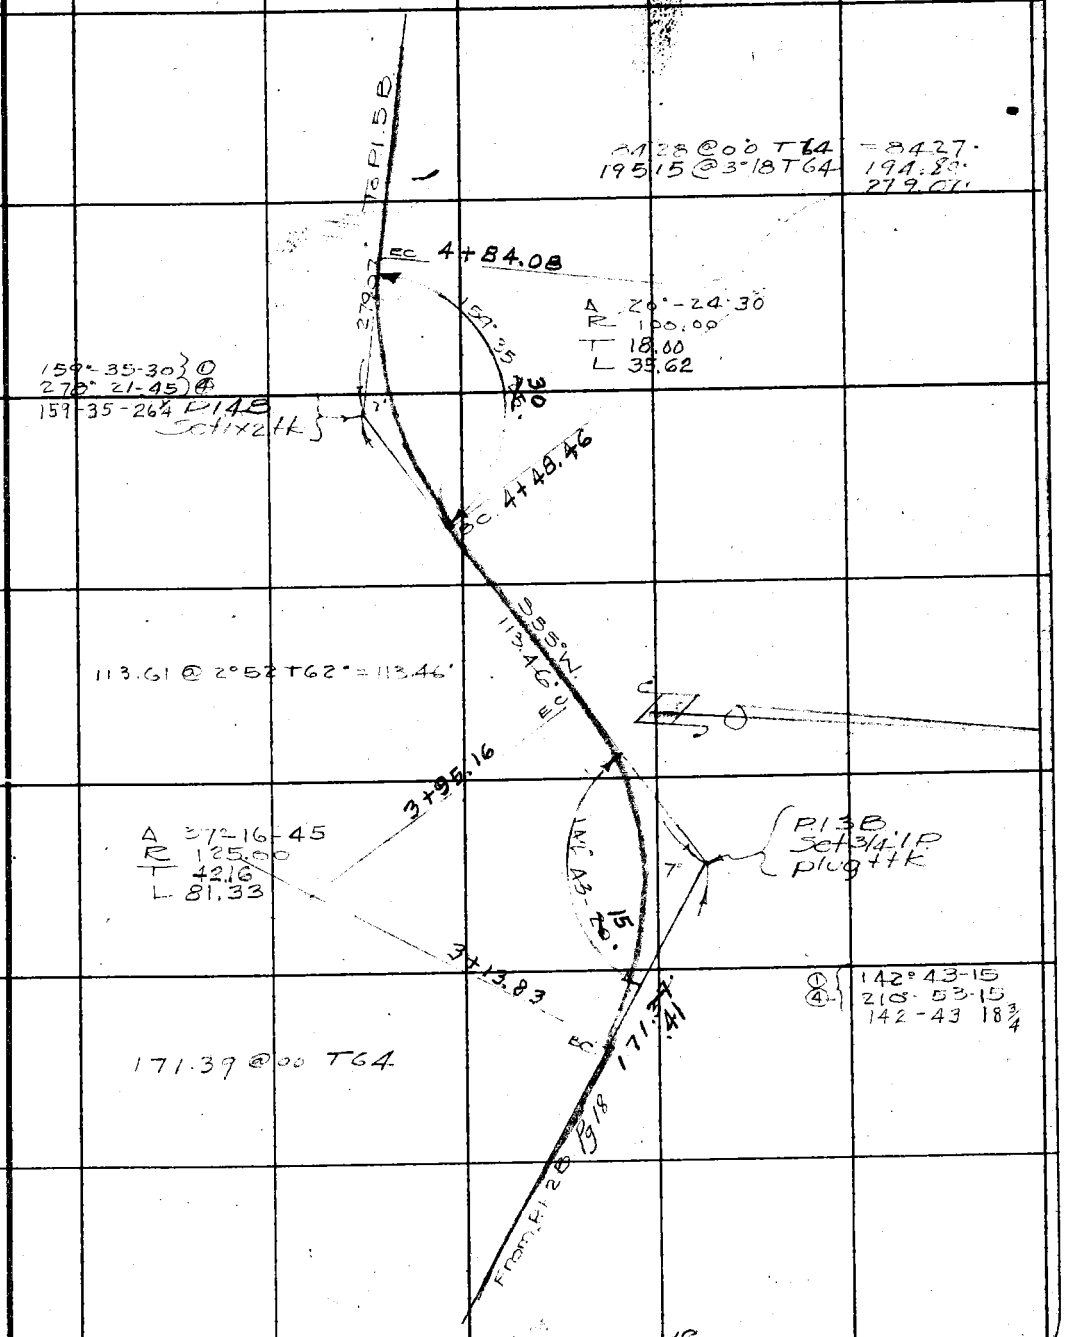

cont. to bot. page

F.B. 778 Pg. 168

133.70 @ 00 T 64 L = 133.66'

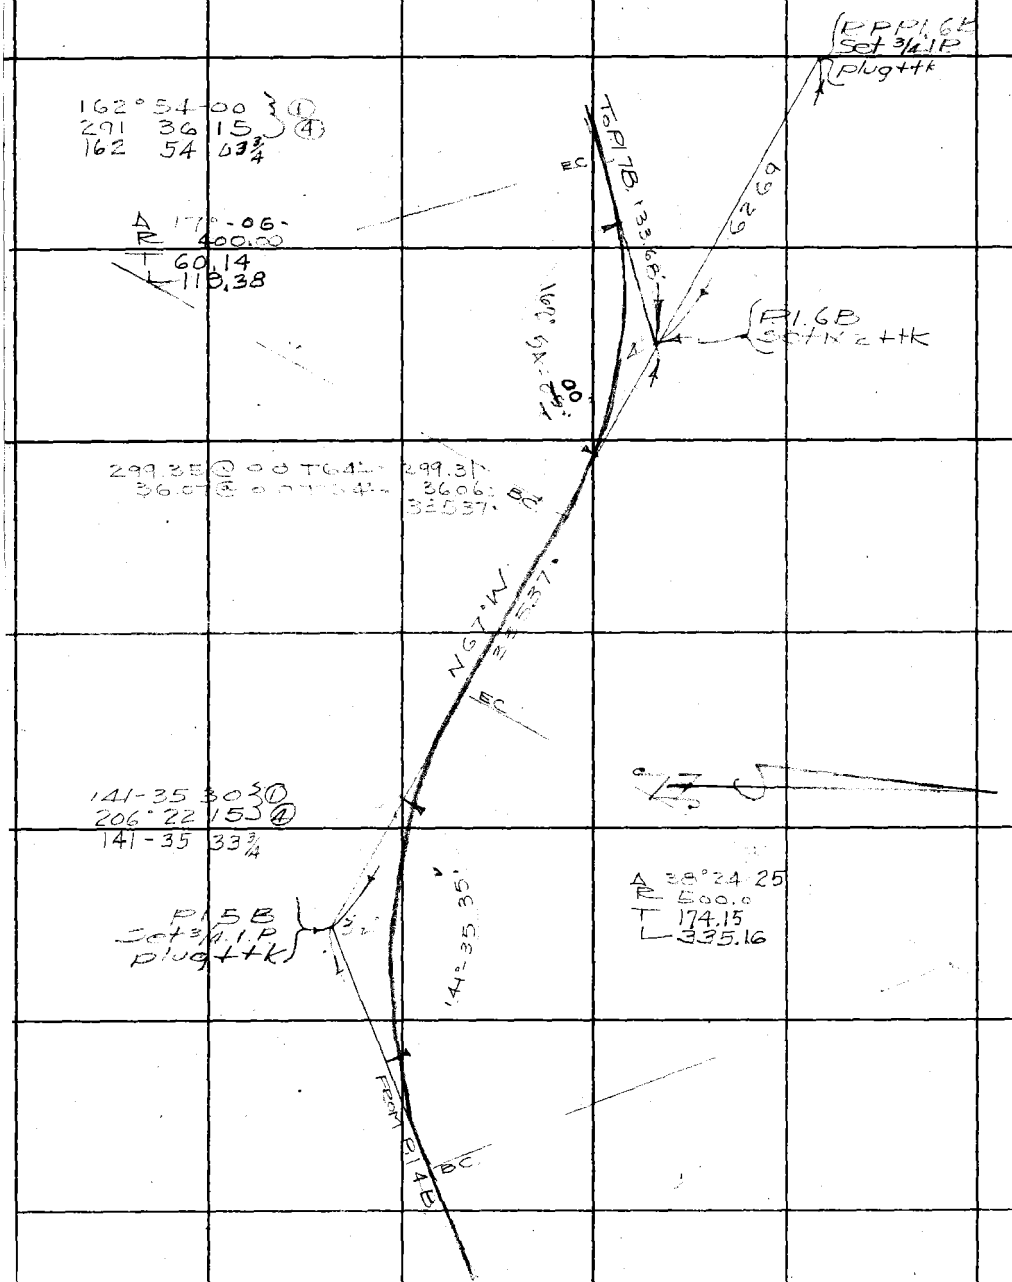

Cont. from top page

RETURN TO
LOS ANGELES COUNTY SURVEYOR
700 HALL OF RECORDS

Note: Any Additions or Changes on This Sheets Must be Made or Circled in Red Ink With Date and Name of Person Making Change.

Do not extend notes this side of this line

Notes Ck'd by		Survey of Las Virgenes Mtn. Eval. M	F.B. 778 Pg. 169
Map No. B-1830.		W. O. 8748 Tape No. 69 St'd 84 °F	
Office Work		Surveyed by Stevenson	
Checked		Notes T. U S Date 12-15-38	
Date		Indexed A. C. Johnson	

Cont. to bot page

74.59 @ 00 T64
= 74.58'

74.58 TO P.I. 8

S 15° E 74.58

P.I. 8B
Set 1x2 tk

3°

155°-07-15
2.60 2.8 1.5
155-07-11¼

Δ 24°-52-45
R 100.00'
T 22.06
L 43.42

155°-07'

87.16 @ 00 T64 = 87.16

87.16 TO P.C.

Δ 29°04-25
R 100.00'
T 26.71
L 52.20

150°-05'

P.I. 8B
Set 1x2 tk

150°-05-45
240°-22-45
150-05-41¼

98.43 @ 00 T64 = 98.42

98.42 TO P.T.

N 71°30' W

EC

170°-36-30
332°-26-00
170-36-30

P.I. 7B
Set 1x2 tk

170°

Δ 9°-46-25
R 200.00'
T 16.43
L 32.78

35°

BC

Cont from top page

Note: Any Additions or Changes on This Sheets Must be Made or Circled in Red Ink With Date and Name of Person Making Change.

Do not extend notes this side of this line

RETURN TO
LOS ANGELES COUNTY SURVEYOR
700 HALL OF RECORDS

FORM 247 5M 10-37

Cont. to bot page

F.B. 778 PG. 170

138.13 @ 1° 20 - T66°
= 138.57

To P1.12B

138.57

147° 57 00 ①
23° 2 30 ④
147-56 52½

P1.12B Set 1x2 tk

A 72-03-15
R 150.00
T 43.09
L 83.92

45.

RP P1.11B Set ¾ IP Plug + tk

116.76 @ 00 T66°
= 116.25

116.25

40.

A 21-41-20
R 50.00
T 28.76
L 56.83

P1.11B Set 1x2 tk

158° 17 30 ③
21-3 15 15 ⑦
158 17 33¾

158.47

67.50

67.51 @ 00 67.50

A 31-09-30
R 100.00
T 27.88
L 54.38

14-8 50 30 ⑨
33-5 22 15 ④
148-50-33¾

148.50

30.

P1.10B Set 1x2 tk

21.41

RP P1.10B Set ¾ IP Plug + tk

From P1.9B

Cont. from top page

Return to
LOS ANGELES COUNTY SURVEYOR
700 HALL OF RECORDS

Note: Any Additions or Changes on This Sheets Must be Made or Circled in Red Ink With Date and Name of Person Making Change.

Do not extend notes this side of this line

Notes Ck'd by		Survey of La Virgenes IW System	F.B. 778 PG. 171
Map No. B-1830		W. O. 9243 Tape No. 69 St'd 11 OF	
Office Work		Surveyed by Stevenson	
Checked		Notes	Date 12-16-36
Date		Indexed A. C. Johnson	

Cont to bot. page

T=2115B

118.68

Ec

118.68

P 1148
5-3/4 X 2 Tk

Δ 2°18'-16"-35
R= 3000.00
T 56.35
L 111.40

158°-43

5

158° 43 30
2°18'-54"-00
158 43 30

29.

BC

118.68

EC

Δ 5° 19 40
R= 200.00
T 27.80
L 55.25

20'

P 1138
5-3/4 X 2 Tk

164°-10-15"-00
296° 41 59 "
164 10 15

BC

Cont. from top page

Note: Any Additions or Changes on This Sheets Must be Made or Circled in Red Ink With Date and Name of Person Making Change.

Do not extend notes this side of this line

RETURN TO
LOS ANGELES COUNTY SURVEYOR
700 HALL OF RECORDS

FORM 247 5M 10-37

F.B. 778 PG. 172

Cont. to bot. page

128.05 @ 00 T 64 = 128.03'

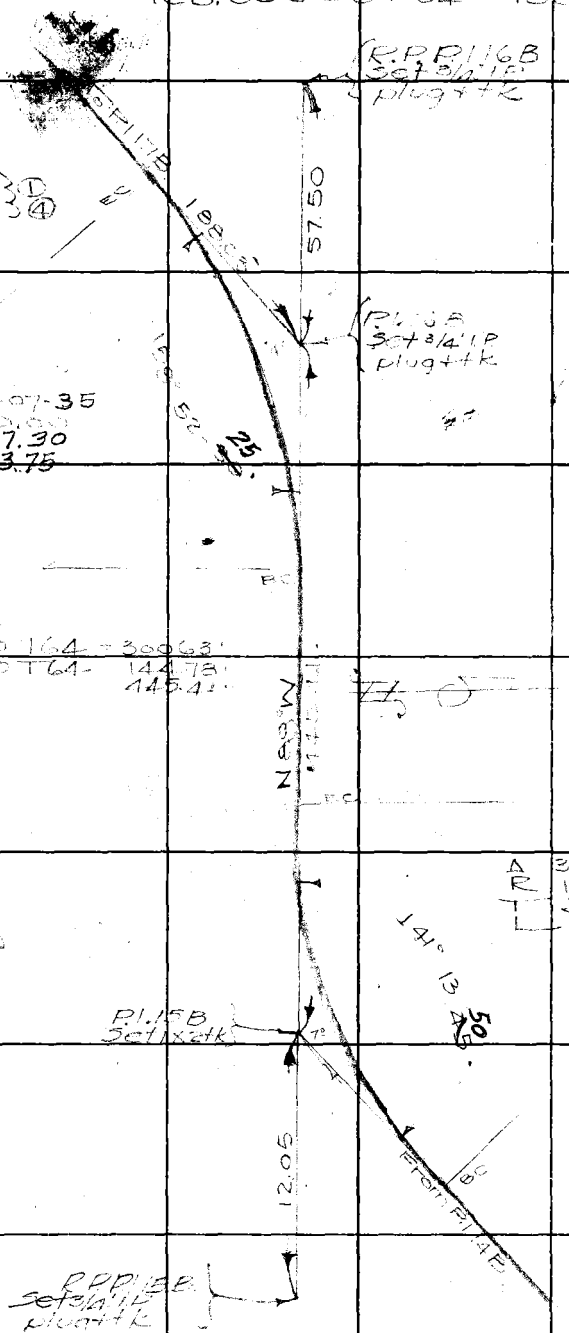

Cont. to top of page

RETURN TO
LOS ANGELES COUNTY SURVEYOR
700 HALL OF RECORDS

Note: Any Additions or Changes on This Sheets Must be Made or Circled in Red Ink With Date and Name of Person Making Change.

Do not extend notes this side of this line

Notes Ck'd by L. W. [illegible]	Survey of Los Angeles Co. System
Map No. B-1830	W. O. 8243 Tape No. 69 St'd 84 OF
Office Work	Surveyed by [illegible]
Checked	Notes [illegible] Date 1/ [illegible]
Date	Indexed A. C. Johnson

F.B. 7[illegible] PG. 173

carried bet pages

Note: Any Additions or Changes on This Sheets Must be Made or Circled in Red Ink With Date and Name of Person Making Change.

Do not extend notes this side of this line

RETURN TO
LOS ANGELES COUNTY SURVEYOR
700 HALL OF RECORDS

FORM 247 5M. 10-37

P.I. 9E
Set 1x2+k

165.05 @ 00°T-64°
= 165.03'

83.22 @ 00°T-64°
= 83.21'

Δ 34° 42' 15"
R 178' 4.8 3"
L 134 42 17½

Δ 45-17-45
R 75.00
T 31.29
L 59.29

169° 20' 45"
21° 20' 00"
169° 20' 45"

P.I. 9B
Set 1x2+k

Δ 10° 39' 10"
R 500.00
T 46.62
L 92.96

S 20° 30' W 221.09

163.29 @ 1°00T-64° 163.24'
57.85 @ 00°T-64° = 57.85'
221.09'

EC

Δ 44°-21-20
R 175.00
T 71.34
L 135.48

Δ 135° 38' 45"
R 180' 35' 00"
135 38 45

P.I. 17B
Set ¾ I.P.
plug + tk

From P.I. 16P

Cont'd from top page

F.B. 778 PG. 174

Cont. to bot. page

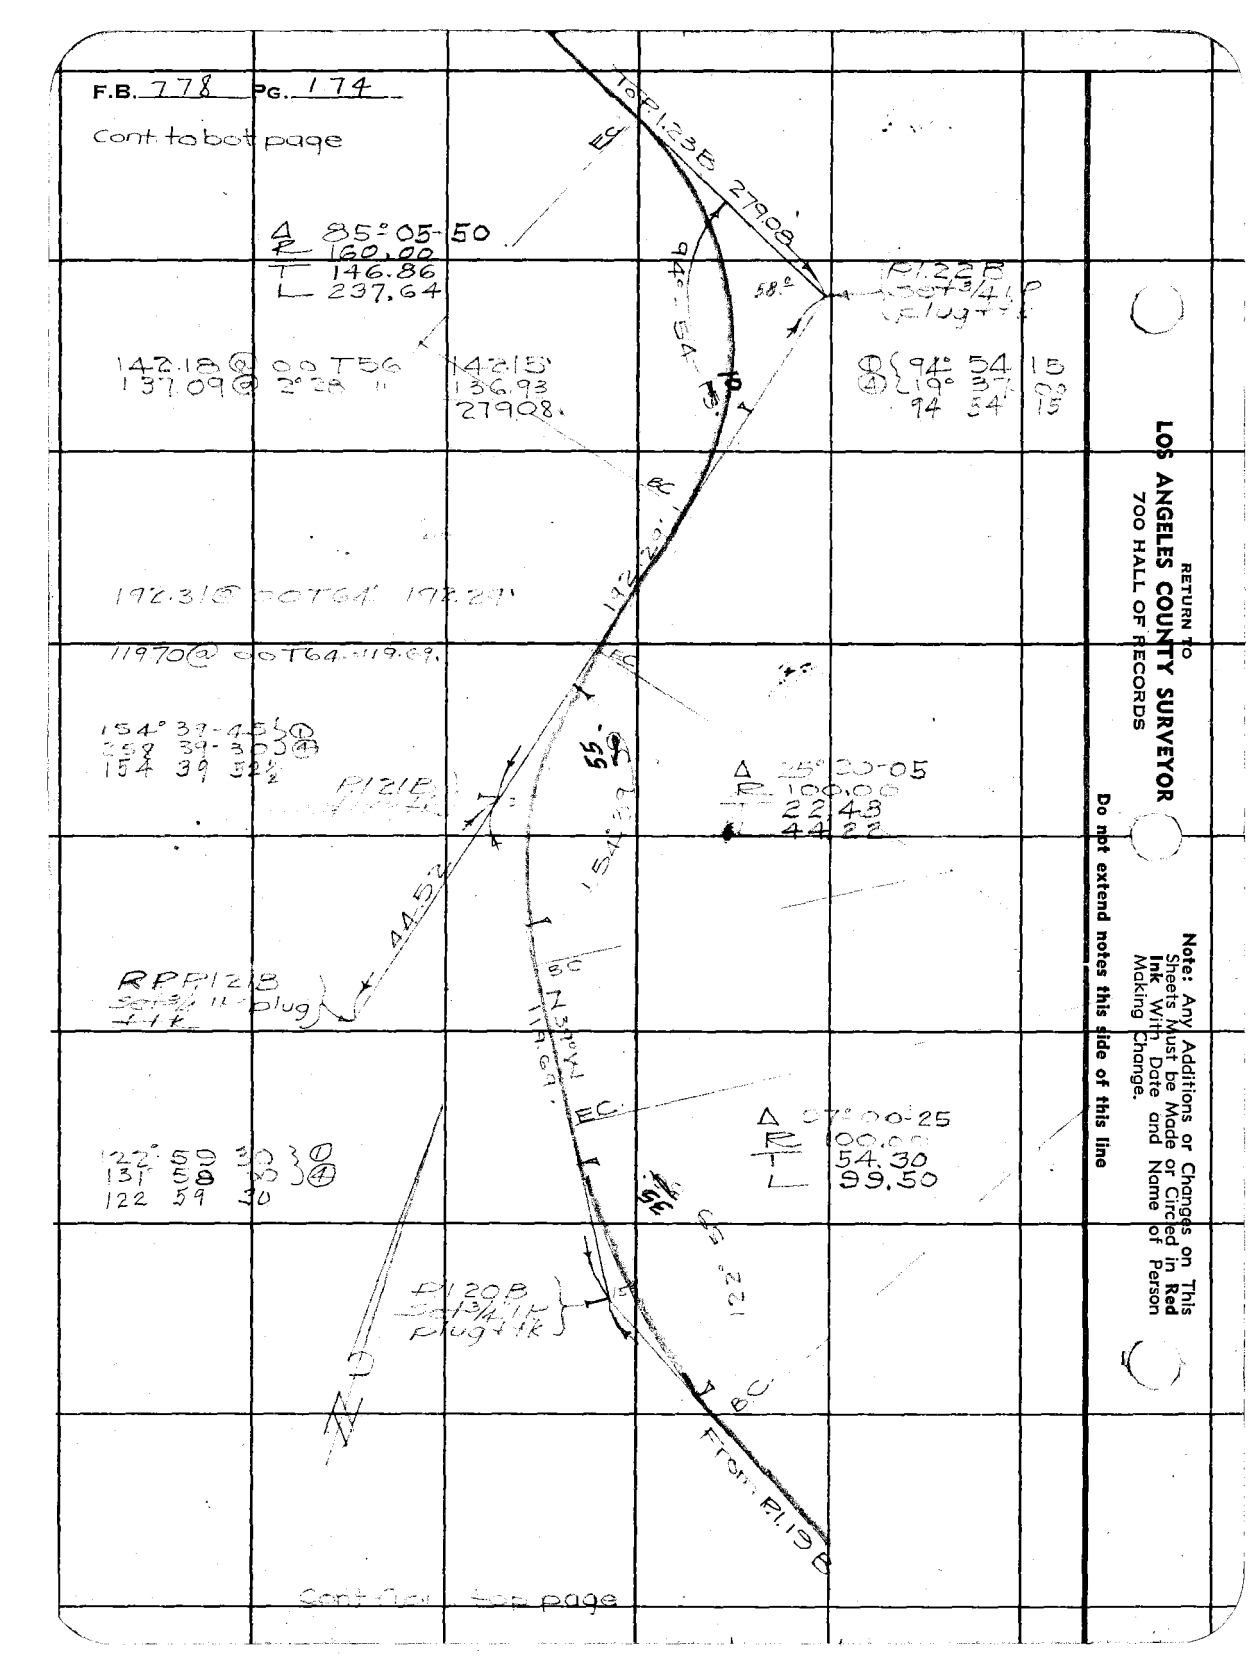

RETURN TO
LOS ANGELES COUNTY SURVEYOR
700 HALL OF RECORDS

Note: Any Additions or Changes on This Sheets Must be Made or Circled in Red Ink With Date and Name of Person Making Change.

Do not extend notes this side of this line

Notes Ck'd by
Map No. B-1830.
Office Work
Checked
Date

Survey of Las Virgenes #11 System
W. O. 1243 Tape No. 49 St'd 84 of
Surveyed by Stevenson
Notes T. J. S. Date 4-9-39
Indexed A. C. Johnson

F.B. 778 PG. 175

Cont. to bot page

137.11 @ 00 + 56 = 137.09'

Δ = 26° 48' 25"
R 250.00
T 59.38
L 116.60

① 153° 16' 30"
④ 25° 30' 06" 00
153 16 30

Pl 25E
Set 3/4" IP
Plug + Tk

116.94 @ 00 + 56
= 116.92'

Δ 68° 27' 20"
R 75.00
T 51.02
L 89.61

Pl 24B
Set 3/4" IP
Plug + Tk

① 111° 32' 45"
④ 86° 11' 00"
111 32 45

130.32 @ 5+11 + 56 = 129.76'

Pl 23B
Set IX 2½

158° 21' 18"
158 21 18

Δ 21° 38' 35"
R 325.00
T 62.12
L 122.77

From Pl 22B

Cont. from top page

Note: Any Additions or Changes on This Sheets Must be Made or Circled in Red Ink With Date and Name of Person Making Change.

Do not extend notes this side of this line

RETURN TO
LOS ANGELES COUNTY SURVEYOR
700 HALL OF RECORDS

FORM 247 5M 10-37

F.B. 778 PG. 176

Cont to bot page

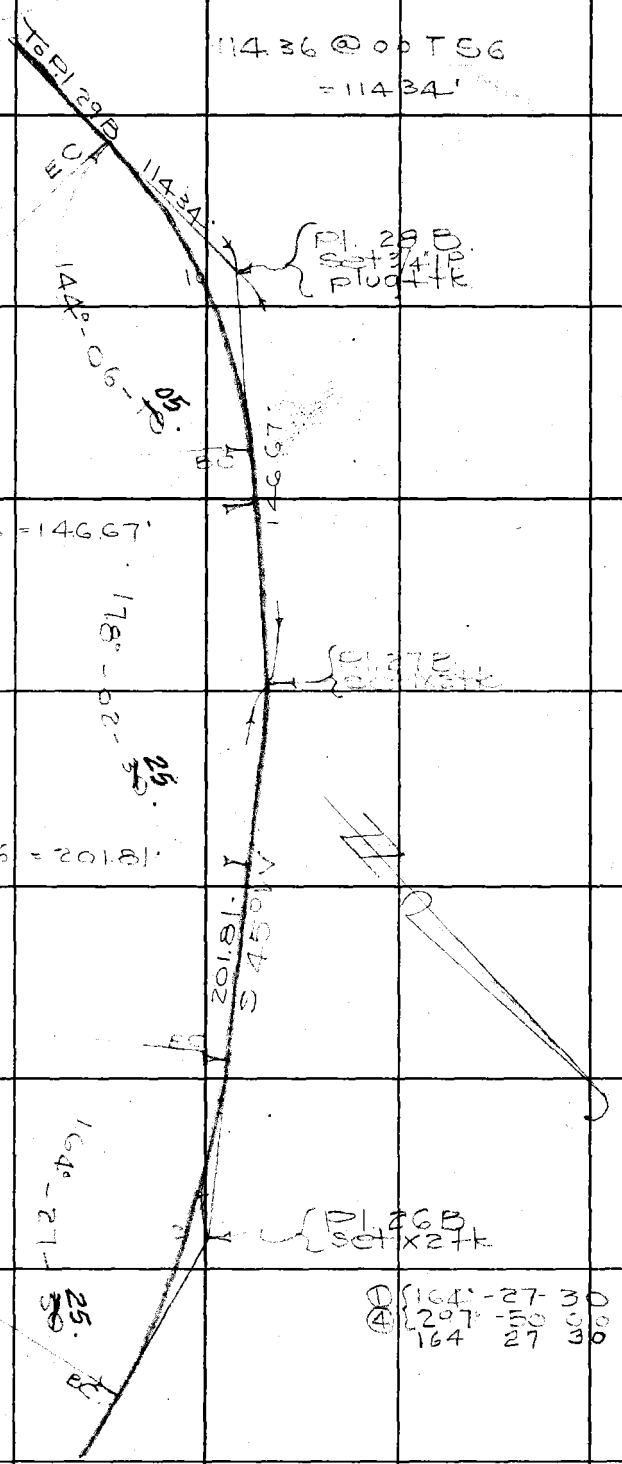

Cont from top page

RETURN TO
LOS ANGELES COUNTY SURVEYOR
700 HALL OF RECORDS

Note: Any Additions or Changes on This Sheets Must be Made or Circled in Red Ink With Date and Name of Person Making Change.

Do not extend notes this side of this line

Notes Ck'd by
Map No. B-1830.
Office Work
Checked
Date

Survey of Los Virgenes Mt System F.B. 77° PG. 177
W. O. 8245 Tape No. 49 St'd 84°F
Surveyed by Stevenson
Notes TJS Date 1-9-39
Indexed

Cont. to bot page

172°33'-30" ①
33°14'00" ④
172 33 30

109.51 @ 1°58' T 54
= 109.43

Pl 31B
Set 1x2 tk
ang Pt

59.97 @ 3°22' T 54 = 59.86

59.86

30

9 N+T

Pl 30B
Set 1x2 tk

168 59 30 ①
31 58 30 ④
16 59 37½

N47 11.77

128.16 @ 0°0' T 56

Pl 29B
Set 3/4" IP
plug + tk

109 59 03¾

Δ = 70-00-50
R = 60.00
T = 42.02
L = 73.32

Cont from top page

RETURN TO
LOS ANGELES COUNTY SURVEYOR
700 HALL OF RECORDS

Note: Any Additions or Changes on This Sheets Must be Made or Circled in Red Ink With Date and Name of Person Making Change.

Do not extend notes this side of this line

FORM 247 5M 10-37

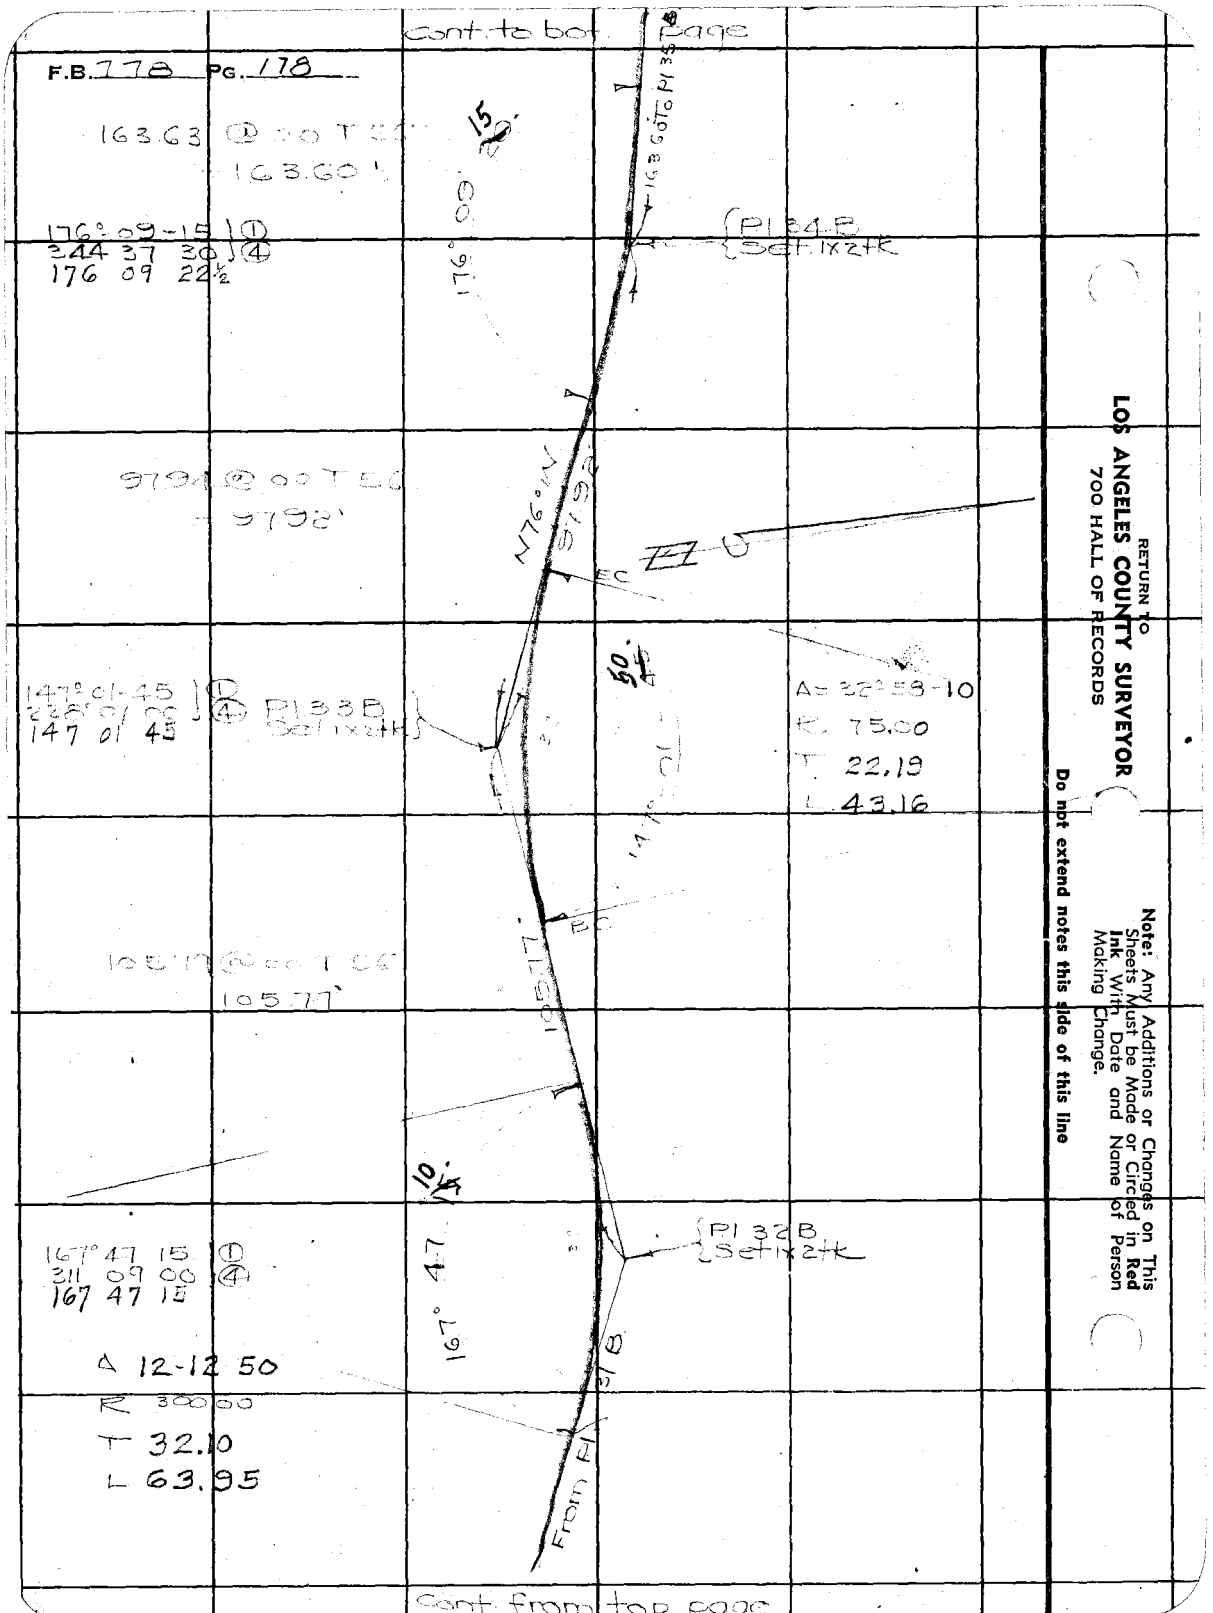
cont. to bot. page
F.B. 178 PG. 178
163.63 ① 00 T 5C
163.60 ①
176° 09' 15" ①
344 37 30 ④
176 09 22½
15.
N 76° 09' E
PI 34 B
Set 1x2 tk
979.1 ① 00 T 5C
979.2'
N 76° 09' E 979.2'
EC
50.
147° 01' 45" ①
328 01 00 ④
147 01 45
PI 33 B
Set 1x2 tk
A = 32° 58' 10"
R 75.00
T 22.19
L 43.16
EC
105.17 ① 00 T 5C
105.17'
105.17'
EC
10.
167° 47' 15" ①
311 09 00 ④
167 47 15
PI 32 B
Set 1x2 tk
Δ 12-12 50
R 300 00
T 32.10
L 63.95
EC
From PI
cont. from top page
RETURN TO
LOS ANGELES COUNTY SURVEYOR
700 HALL OF RECORDS
Note: Any Additions or Changes on This Sheets Must be Made or Circled in Red Ink With Date and Name of Person Making Change.
Do not extend notes this side of this line

Notes Ck'd by		Survey of Los Virgenes Mtn. Street	F.B. 778 PG. 179
Map No. B-1830		W. O. 8243 Tape No. 49 St'd 84 of F	
Office Work		Surveyed by Stevenson	
Checked		Notes T.J.S. Date 1-10-39	
Date		Indexed A. C. Johnson	

Note: Any Additions or Changes on This Sheets Must be Made or Circled in Red Ink With Date and Name of Person Making Change.

Do not extend notes this side of this line

RETURN TO
LOS ANGELES COUNTY SURVEYOR
700 HALL OF RECORDS

Cont: to bal page

124.34 @ 00 T 56 - 124.32'

Δ 9°00-50

R 400.00

T 31.53

L 62.93

PI 27 B Set ¾ I.P. plug & tk

① 170 59 15
④ 323 57 00
170 59 15

205.29 @ 00 T 56 205.25'

165-33-15 ① ④
360-00-00
194-26-45

RPP 36 B Set ¾ I.P. plug & tk

72.15

PI 36 B Set ¾ I.P. plug & tk

Δ 14°-26-40
R 400.00
T 50.69
L 100.84

135.00 @ 00 T 56 - 135.00'
94.85 @ 00 T 56 94.83'

Record B

549.30' N

139°-11-15 ① ④
196 45 00
139 11 15

Δ 40°-48-50
R 135.00
T 46.50
L 89.04

PI 35 B Set ¾ I.P. plug & tk

From

Cont fr last page

FORM 247 5M 10-37

F.B. 778 PG. 180

cont to bot page

168°

120.70 @ 5°03'60"
= 120.21'

169-01-45
312 07 00
168 01 45

120.70'

Δ = 11°58'10"
R = 400.00'
T = 41.93
L = 83.56

50 Rad.

PI 40E
Set 1x2 HT

RETURN TO
LOS ANGELES COUNTY SURVEYOR
700 HALL OF RECORDS

Note: Any Additions or Changes on This Sheets Must be Made or Circled in Red Ink With Date and Name of Person Making Change.

Do not extend notes this side of this line

PI 39
Set 3/4" IP
plug + TK

135.39 @ 2°51'60"
= 135.20'

135.20'

Δ = 42°39'20"
R = 110.00
T = 42.76
L = 81.57

137°30'

40 Rad.

PI 38E
Set 3/4" IP
plug + TK

137 30 00

146.52 @ 2°08'56"
= 146.39'

146.39'

101°50'45"
47°23'00"
101 50 45

101°50'

PI 38E
Set 3/4"
IP plug + HT

50 Rad.

A 78°09'10"
R 100.00
T 81.20
L 136.40

From PI 37E

Cont from top page

Notes Ck'd by	Survey of Los Angeles Co. Surv. F.B. 778 Pg. 181
Map No. B-1830	W. O. 8243 Tape No. 49 St'd 84 OF
Office Work	Surveyed by Stewart Soar
Checked	Notes T.V.S. Date 1-10-39
Date	Indexed A. C. Johnson

Note: Any Additions or Changes on This Sheets Must be Made or Circled in Red Ink With Date and Name of Person Making Change.

Do not extend notes this side of this line

RETURN TO
LOS ANGELES COUNTY SURVEYOR
700 HALL OF RECORDS

Cont. to bot page

A = 22°-12-55
R = 100.00
T = 19.63
L = 38.77

119.07 @ 3°-51 T 60 = 118.78'

11.52 @ 1°-46 T 60
= 71.18'

93.91 @ 00 T 60' 93.90'

160° 08 30 ①
280 33 30 ④
160 08 22½

182° 25 45 ①
169° 43 00 ④
182 - 25 45

P.143B
Set 5/4 IP
plug + tk

P.142B
Set 1x2 tk

P.141B
Set 1x2 tk

157-47 15 ①
271 08 45 ④
157 47 11¼

Δ = 19° 51-30
R = 1175.00
T = 30.63
L = 60.65

Δ 47° 34-10
R 40.00
T 17.63
L 33.21

From P.140B

Cont from top page

FORM 247 5M 10-37

F.B. 778 PG. 182

Cont to tot page

To P147B 110.24'

ang Pt.

P146B
set 1x2 tk

169° 36-00 ①
318° 24 30 ④
169 36 07½

110 25 @ 00 TG 0'
= 110 24'

169° 36' 00"

138.13 @ 2°43 TG 0°
= 137.96'

RP P145B
set 3/4 IP
plug + tk

2994 @ 5°55
=

Δ = 41-22-00
R = 100.00
T = 37.75
L = 72.20

P145B
set 1x2 + tk

138° 38 00
194° 21 15
138 38 33½

89.74 @ 3°50 TG 0 = 89.53'

N 9° W
a 55'

Δ = 38-01-55
R = 100.00
T = 34.46
L = 66.38

① 141° 58 15
④ 207° 52 45
141 - 58 - 11¼

141° 58' 10"

7°

P144B
set 1x2 + tk

40.54 @ 13°52 TG 0°

From P143B

RP P144B
set 3/4 IP
plug + tk

Cont from top page

RETURN TO
LOS ANGELES COUNTY SURVEYOR
700 HALL OF RECORDS

Do not extend notes this side of this line

Note: Any Additions or Changes on This Sheets Must be Made or Circled in Red Ink With Date and Name of Person Making Change.

Notes Ck'd by C. M. Finley	Survey of Los Angeles FM System
Map No. B-1830	W. O. 8243 Tape No. 47 St'd 84 OF
Office Work	Surveyed by Stevenson
Checked	Notes T.J.S. Date 1-10-39
Date	Indexed A. C. Johnson

F.B. 779 Pg. 183

Con't to bot page

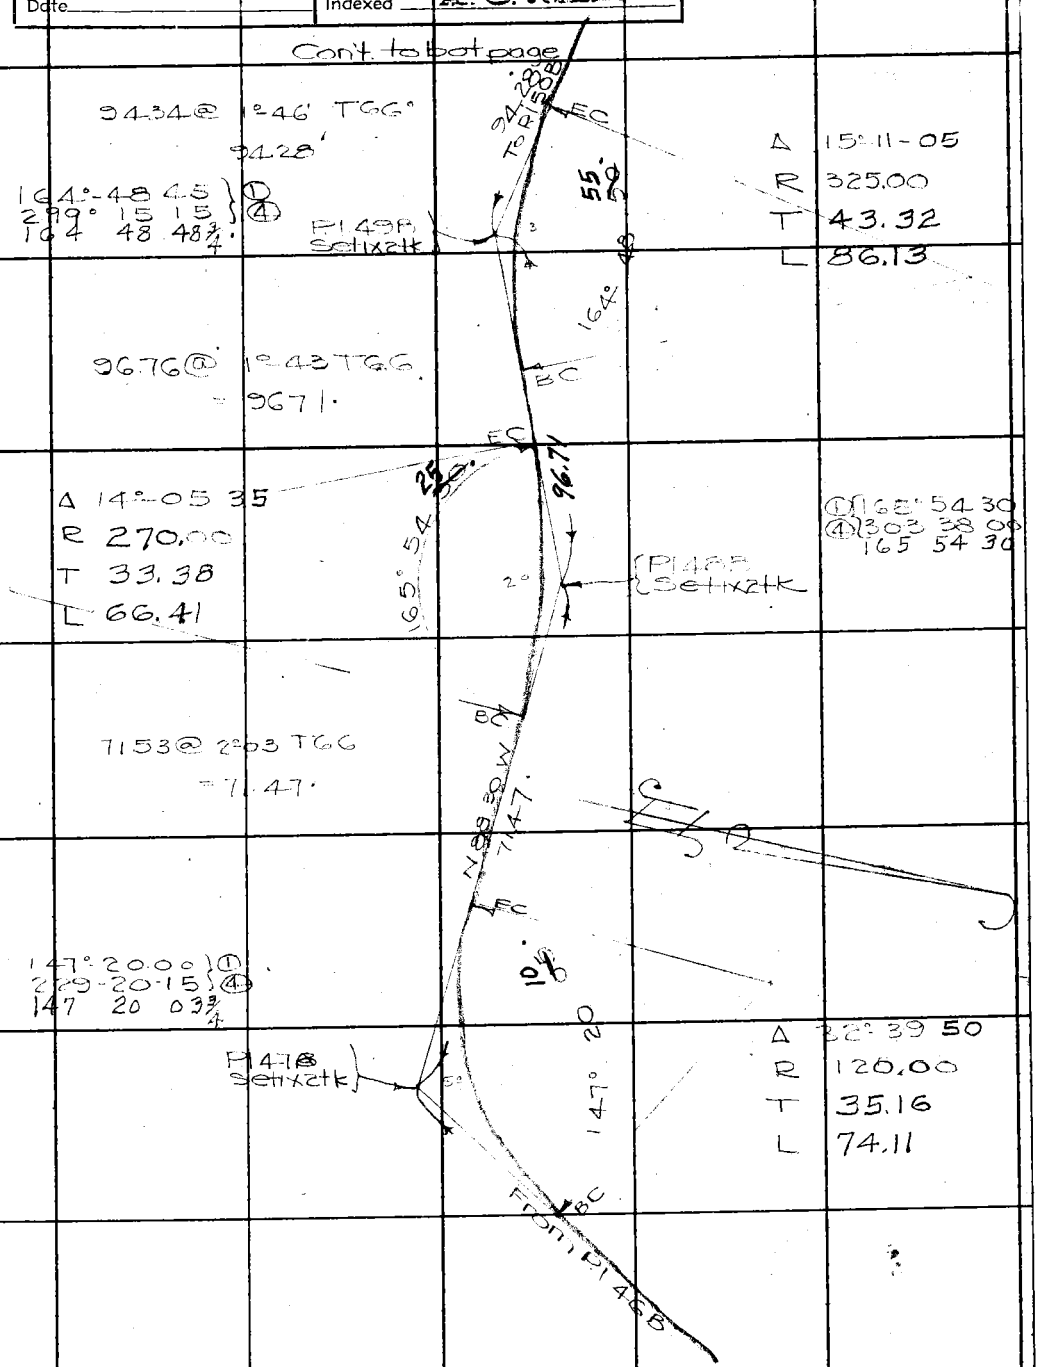

Cont. from top page

RETURN TO
LOS ANGELES COUNTY SURVEYOR
700 HALL OF RECORDS

Do not extend notes this side of this line

Note: Any Additions or Changes on This Sheets Must be Made or Circled in Red Ink With Date and Name of Person Making Change.

FORM 247 SM 10-37

F.B. 778 Pg 184

188.10 @ 5°20 TGA = 187.27'

73.24 @ 3°50 TGA = 73.07'

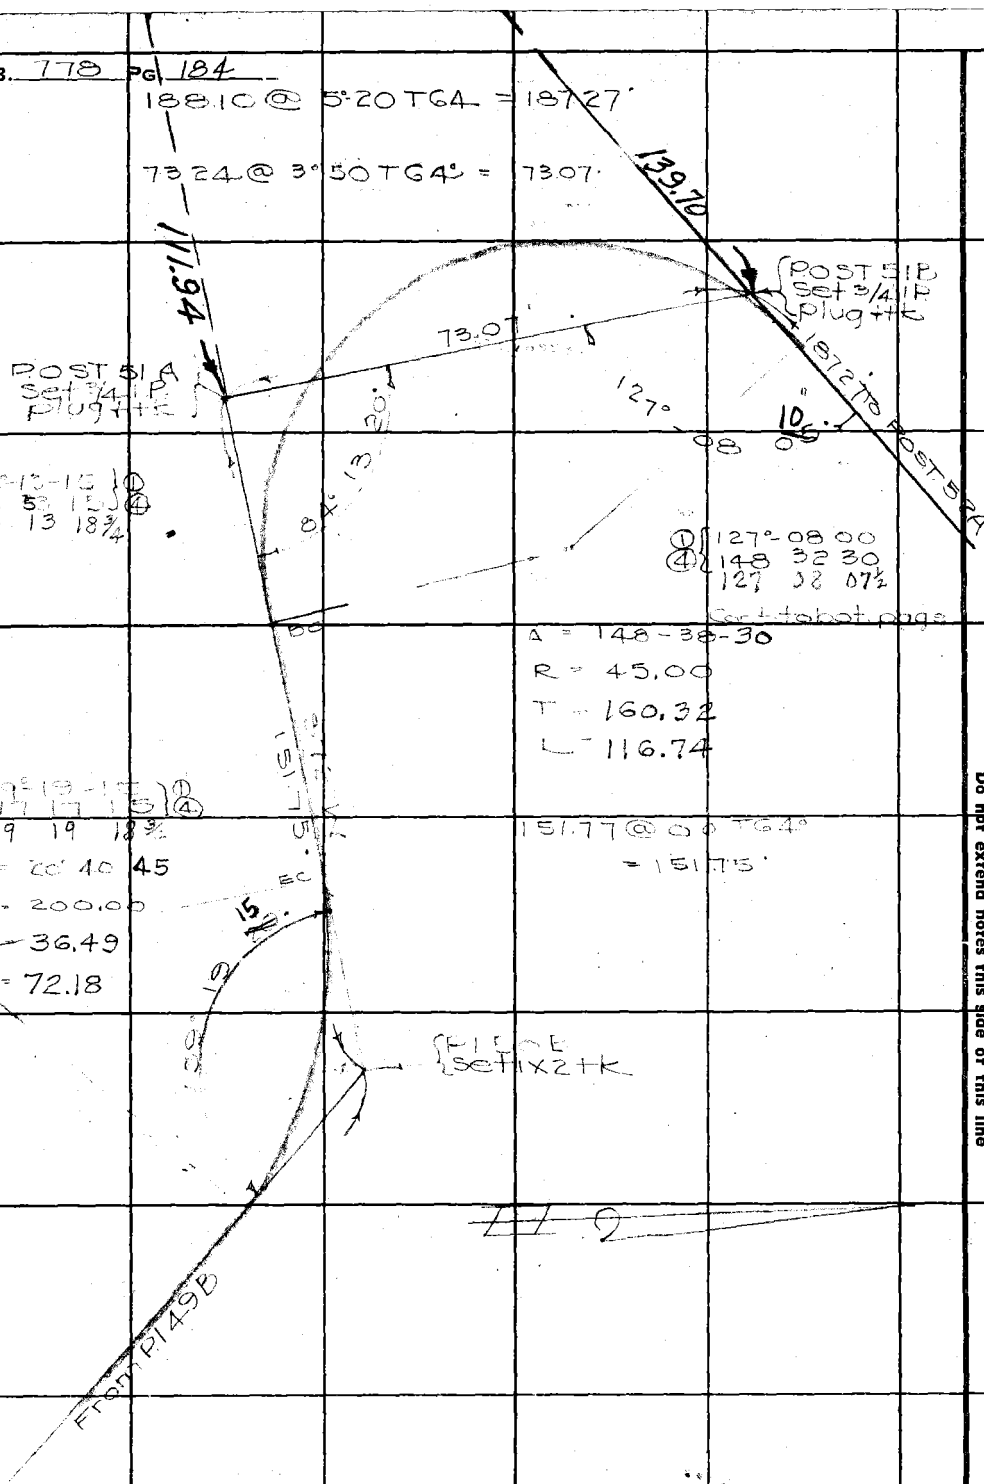

RETURN TO
LOS ANGELES COUNTY SURVEYOR
700 HALL OF RECORDS

Note: Any Additions or Changes on This Sheets Must be Made or Circled in Red Ink With Date and Name of Person Making Change.

Do not extend notes this side of this line

Notes Ck'd by	Survey of
Map No. B-1830	W. O. 8243 Tape No. 49 St'd 50'
Office Work	Surveyed by
Checked	Notes Date
Date	Indexed

F.B. 779 Pg. 185

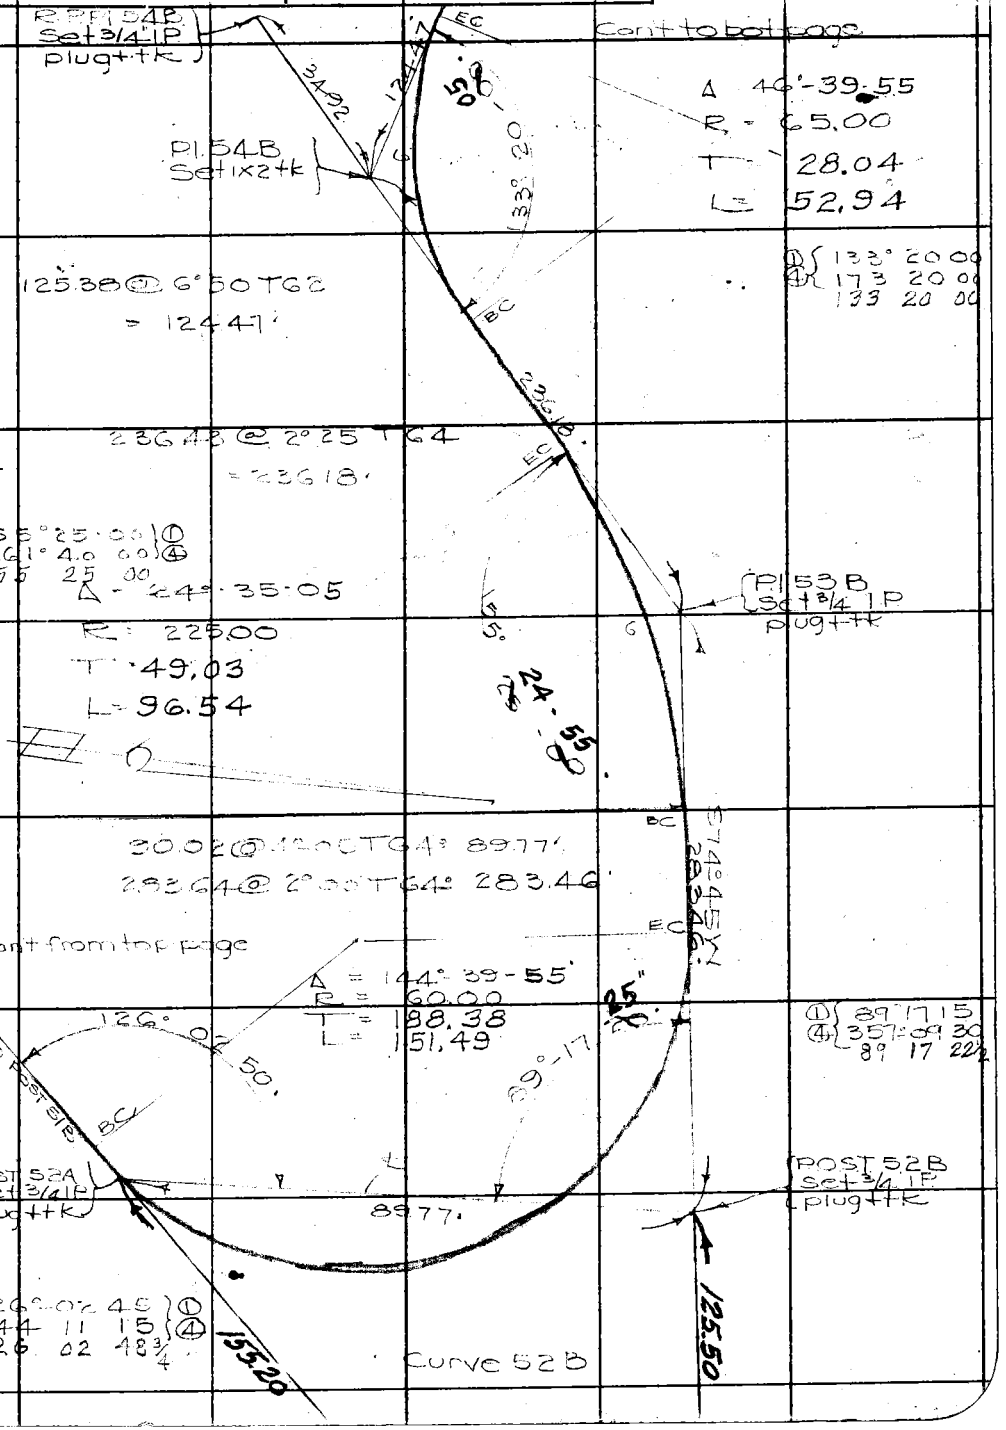

Note: Any Additions or Changes on This Sheets Must be Made or Circled in Red Ink With Date and Name of Person Making Change.

Do not extend notes this side of this line

RETURN TO
LOS ANGELES COUNTY SURVEYOR
700 HALL OF RECORDS

SM 10-37

F.B. 778 Pg. 186

Cont. to bot page 107

To P1 58B

POST 57B Set 1x2 tk

77.86

7824 @ 5°-30 T56

7786.

147.37

Curve 57B

58.52 @ 5°30 T64 = 58.51'

121 43 45
126 54 45

121 42 41

58.51

1 3/10

45 40

126.77

POST 57A Set 3/4 I.P. plug + tk

7834 @ 5° 30 T64

Δ = 156° 53-10

R = 3500

T = 171.16

L = 95.84

81°-23-10

① 81° 23 15
④ 325 38 00
81 23 15

12489 @ 2°05 T62

= 124.29.

124.29.

104° 39 00
58° 36 00
104 39 00

EC

05'

A 75°-20-55

R 60.00

T 46.38

L 78.90

P156B Set 3/4 I.P. plug + tk

16

104°-39

EC

10462 @ 6°15 T62

= 103.51'

103.51'

174°-05 45
336 23 00
174 05 45

40°

Ang Pt.

P155B Set 1x2 tk

174°-05

Cont. from top page

RETURN TO
LOS ANGELES COUNTY SURVEYOR
700 HALL OF RECORDS

Note: Any Additions or Changes on This Sheets Must be Made or Circled in Red Ink With Date and Name of Person Making Change.

Do not extend notes this side of this line

FORM 247

Notes Ck'd by	Survey of Los Virgenes FIT System
Map No. B-1830	W. O. 8243 Tape No. 49 St'd 84-OF
Office Work	Surveyed by Stevenson
Checked	Notes T. S. Date 1-11-39
Date	Indexed A. C. Johnson

F.B. 778 PG. 187

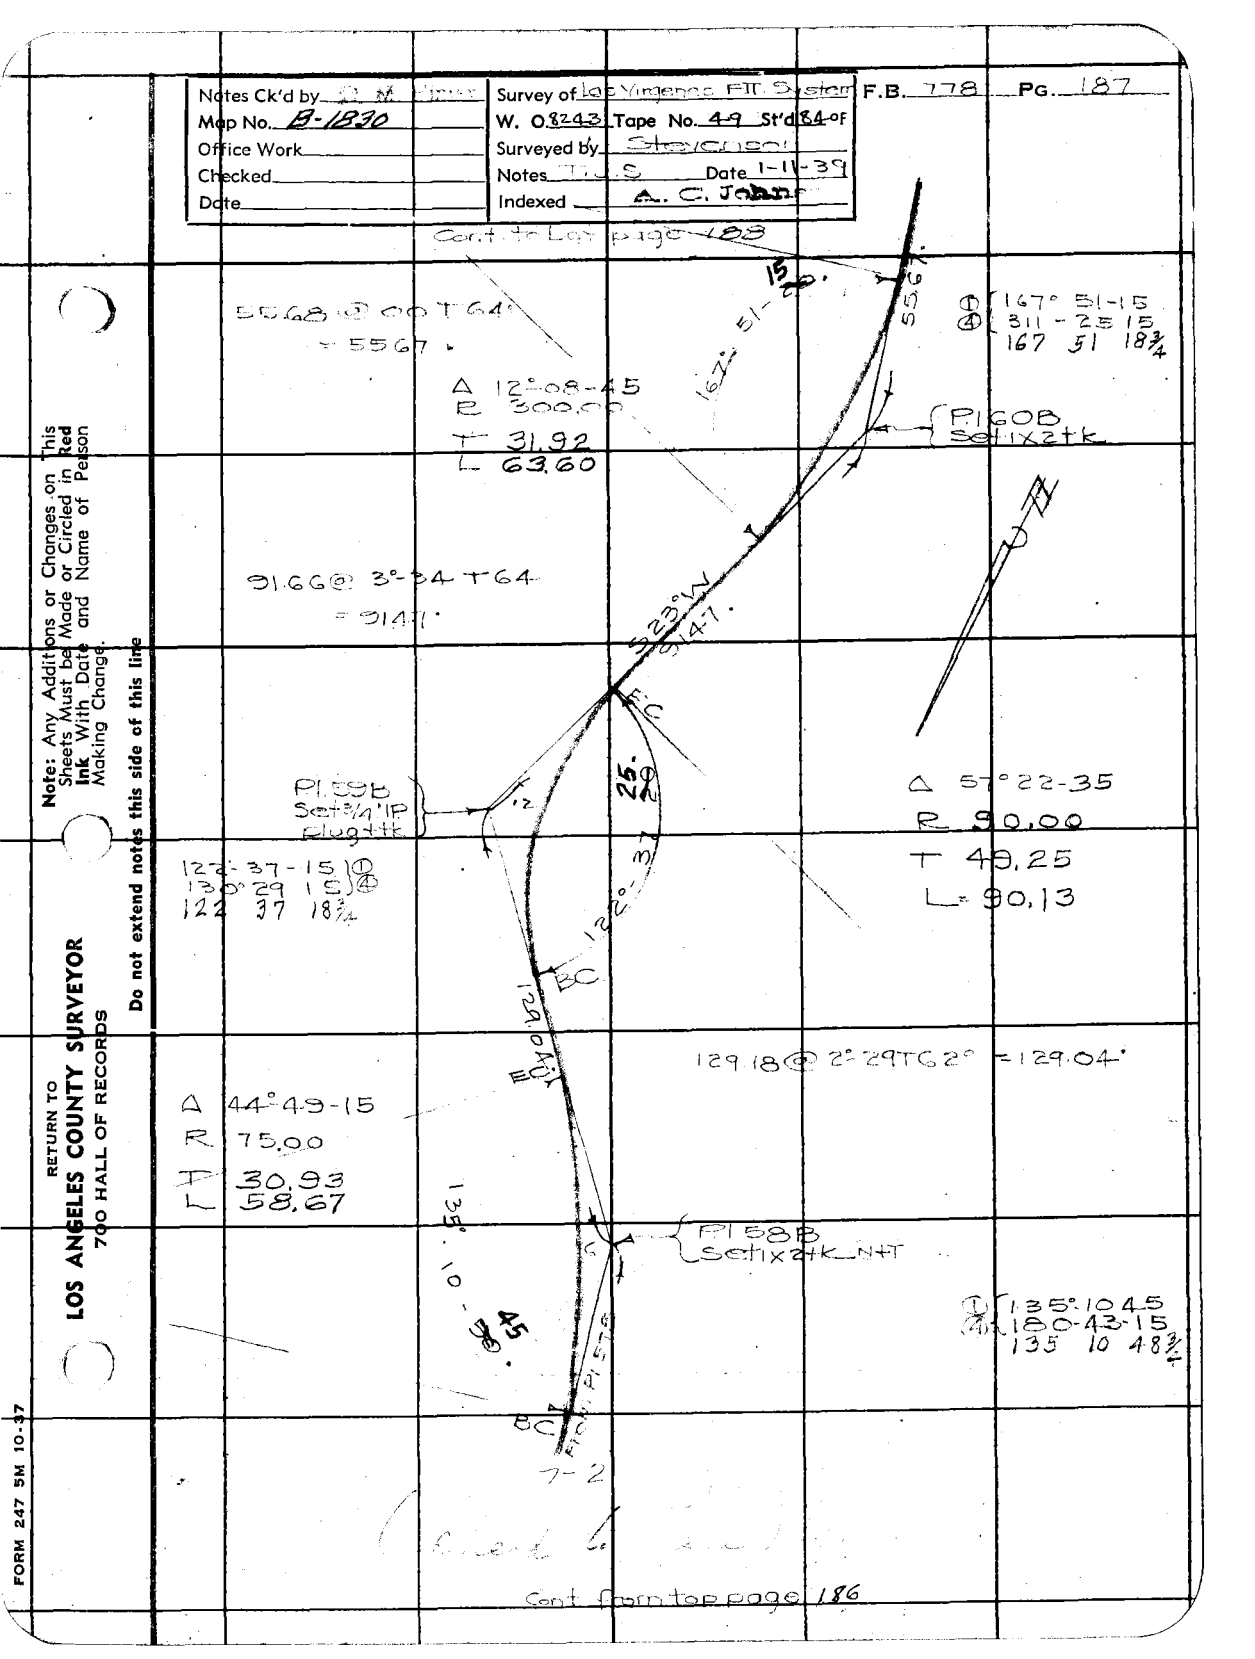

P160B Set 1x2 tk
167° 51-15
311 - 25 15
167 51 18¾

P159B Set ¾" IP Plug tk
122° 37-15
130° 29 15
122 37 18¾

P158B Set 1x2 tk NAT
135° 10 45
180-49-15
135 10 48¾

Note: Any Additions or Changes on This Sheets Must be Made or Circled in Red Ink With Date and Name of Person Making Change.

Do not extend notes this side of this line

RETURN TO
LOS ANGELES COUNTY SURVEYOR
700 HALL OF RECORDS

FORM 247 SM 10-37

cont. to bot. page 189

F.B. 778 PG. 188

110.54 @ 4°-45 T64° 110.55'

Δ = 74°-43-00
R = 40.00
T = 30.54
L = 52.16

105°-17-00 ①
61° 08 30 ④
105 17 07½

To P1.64B 110.55'

P1.63B Set 3/4" P Plug + Tk

86.20 @ 1°-48 T64-86.15'

N79W 86.15'

P1.62B Set 1x2 Tk

114° 40 45 ①
98° 42 45 ④
114 40 41¼

Δ = 65°19-15
R = 60.00
T = 38.46
L = 68.40

87.70 @ 3°-16 T64°
= 87.55

87.55

155°-41-15 ①
26°-18-45 ④
155 41 18¾

Δ 24°-18-35
R 100.00
T 21.54
L 42.43

P1.61B Set 1x2 Tk

From P1.60B

Cont from top page 187

RETURN TO
LOS ANGELES COUNTY SURVEYOR
700 HALL OF RECORDS

Note: Any Additions or Changes on This Sheets Must be Made or Circled in Red Ink With Date and Name of Person Making Change.

Do not extend notes this side of this line

Notes Ck'd by	Survey of Los Virgenes Tr. Sys. #. B. 778 Pg. 189
Map No. B-1830	W. O. 5248 Tape No. 49 St'd 84°F
Office Work	Surveyed by Stevenson
Checked	Notes T.J.S Date 1-11-30
Date	Indexed C. Johnson

Cont to bot page 190

163.4 @ 4°09 T 70 = 162.97

T P1 67B

162.97

P1 66B set 3/4 IP plug + tk

Δ = 111°26-35

R = 32.00

T = 46.95

L = 62.24

103.68

① 68°33-30
④ 274°14-00
68 33 30

103.96 @ 4°11 T 70
103.68

146°03-00 ①
224°12-15 ④
146 03 03¾

Δ = 33°56-50

R = 100.00

T = 30.52

L = 59.25

P1 65B set 1x2 tk

146°03

S 56° W EC

106.12 @ 4°47 T 64
= 105.74

105.74

148.55

Δ 31-04-50
R 100.00
T 27.81
L 54.25

148°55-00 ①
235°40-30 ④
148 55 07½

P1 64B set 1x2 tk

From P1 62B

Cont from top page 188

Note: Any Additions or Changes on This Sheets Must be Made or Circled in Red Ink With Date and Name of Person Making Change.

Do not extend notes this side of this line

RETURN TO
LOS ANGELES COUNTY SURVEYOR
700 HALL OF RECORDS

FORM 247 5M 10-37

F.B. 778 Pg. 190

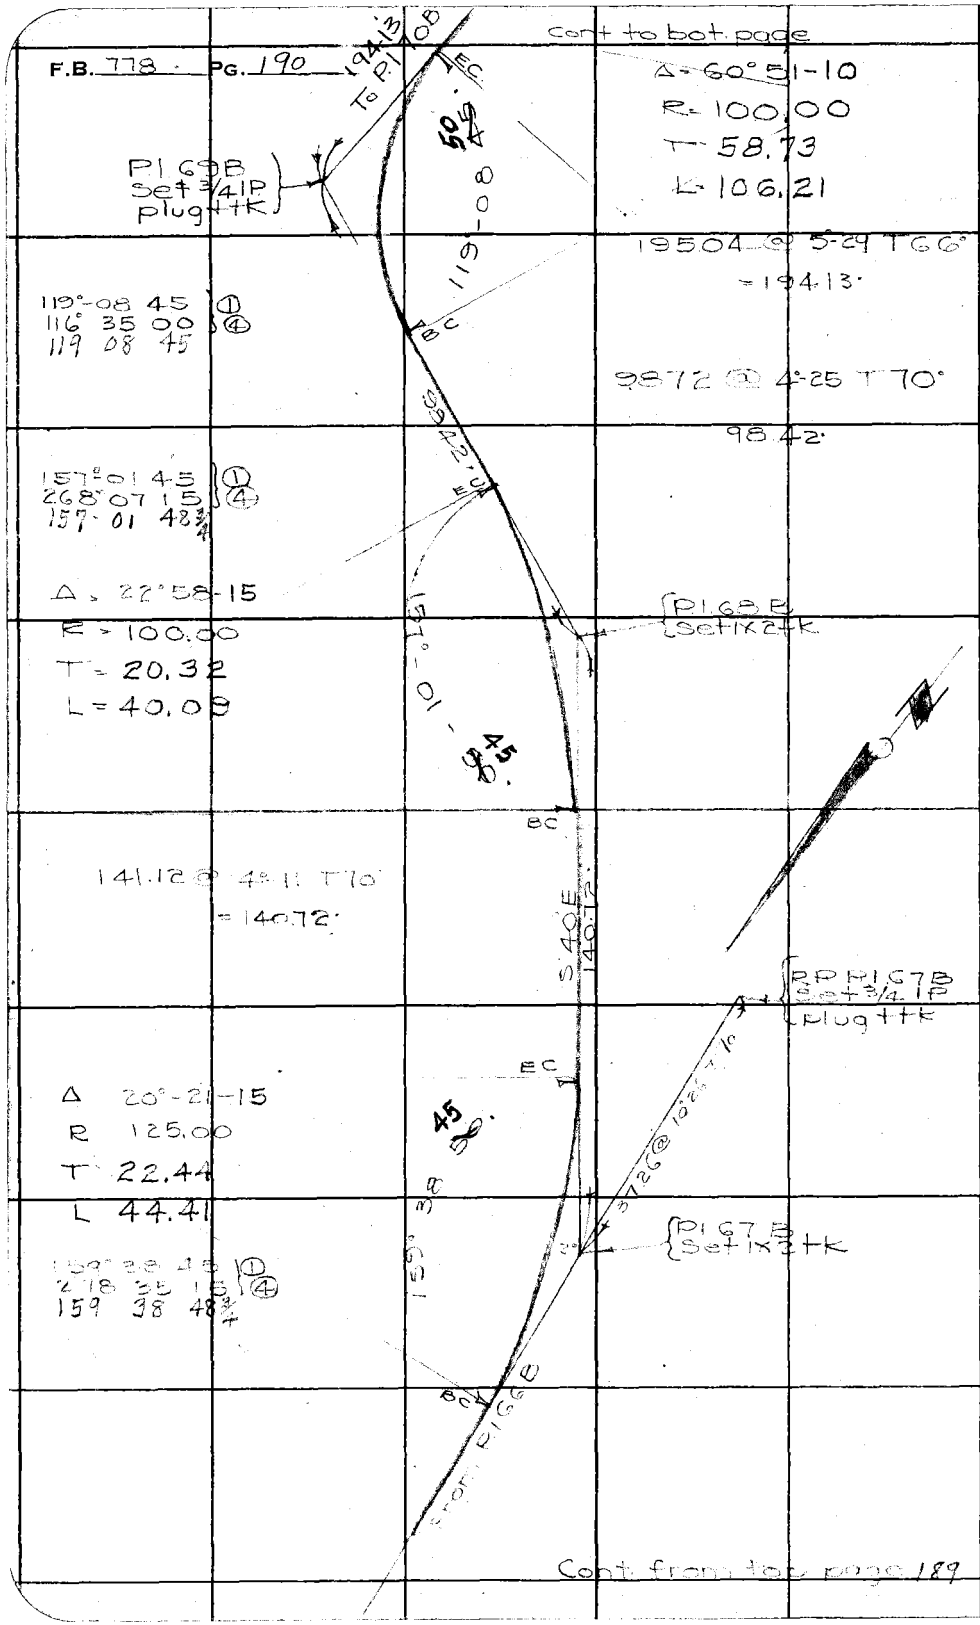

Cont from bot page 189

RETURN TO
LOS ANGELES COUNTY SURVEYOR
700 HALL OF RECORDS

Note: Any Additions or Changes on This Sheets Must be Made or Circled in Red Ink With Date and Name of Person Making Change.

Do not extend notes this side of this line

Notes Ck'd by
Map No. A-1830
Office Work
Checked
Date

Survey of Los Virgenes Fit System F.B. 778 Pg. 191
W. O. 8243 Tape No. 49 St'd 84 of
Surveyed by Stevenson
Notes 1-2 Date 1-11-39
Indexed

Cont. from bot page

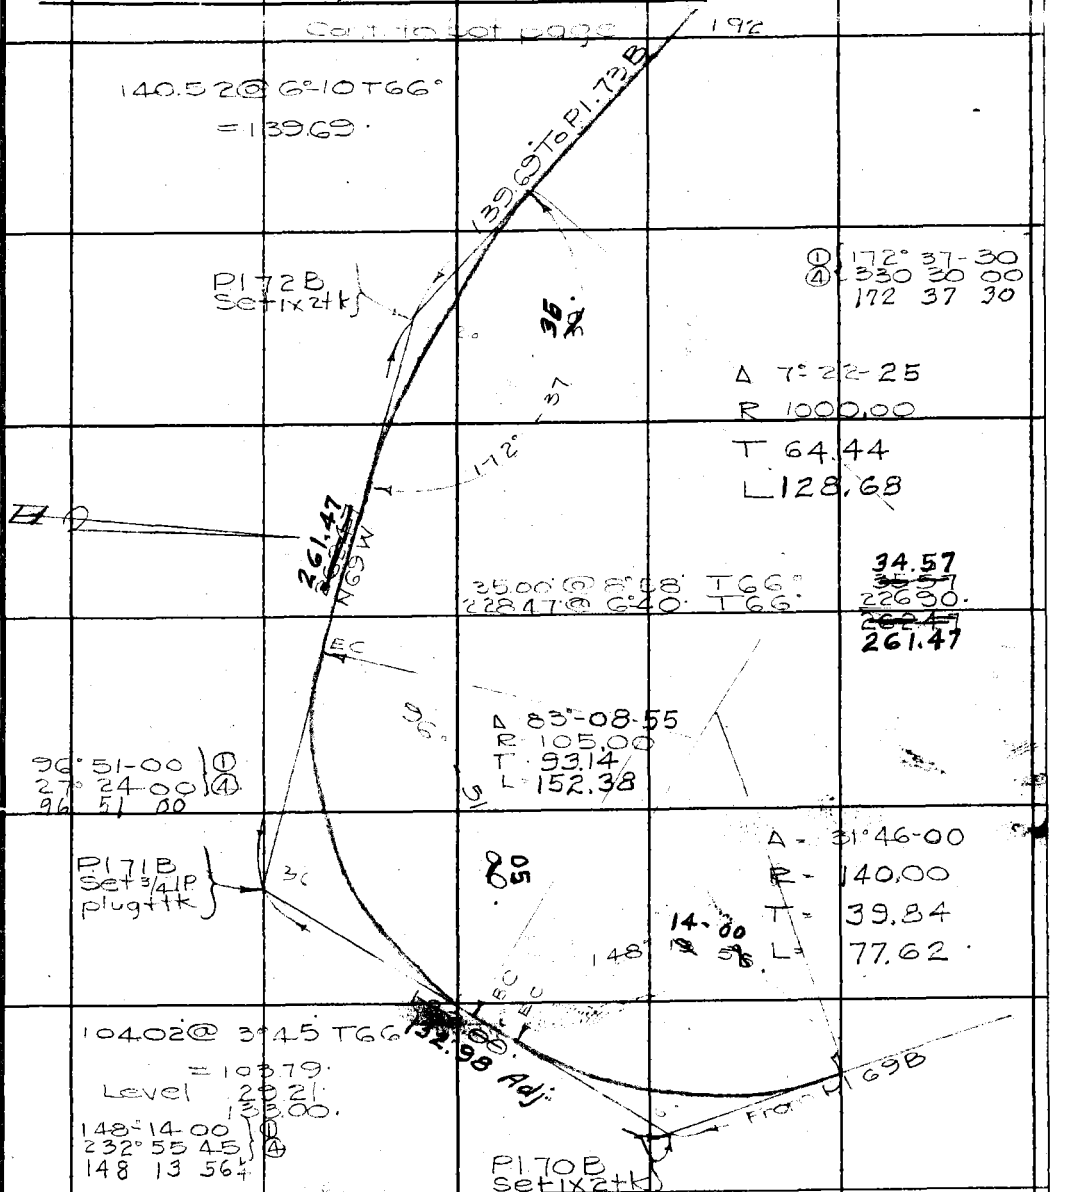

Cont from top page 190

Note: Any Additions or Changes on This Sheets Must be Made or Circled in Red Ink With Date and Name of Person Making Change.

Do not extend notes this side of this line

RETURN TO
LOS ANGELES COUNTY SURVEYOR
700 HALL OF RECORDS

FORM 247 5M 10-37

Cont to bot page 193

F.B. 778 PG. 192

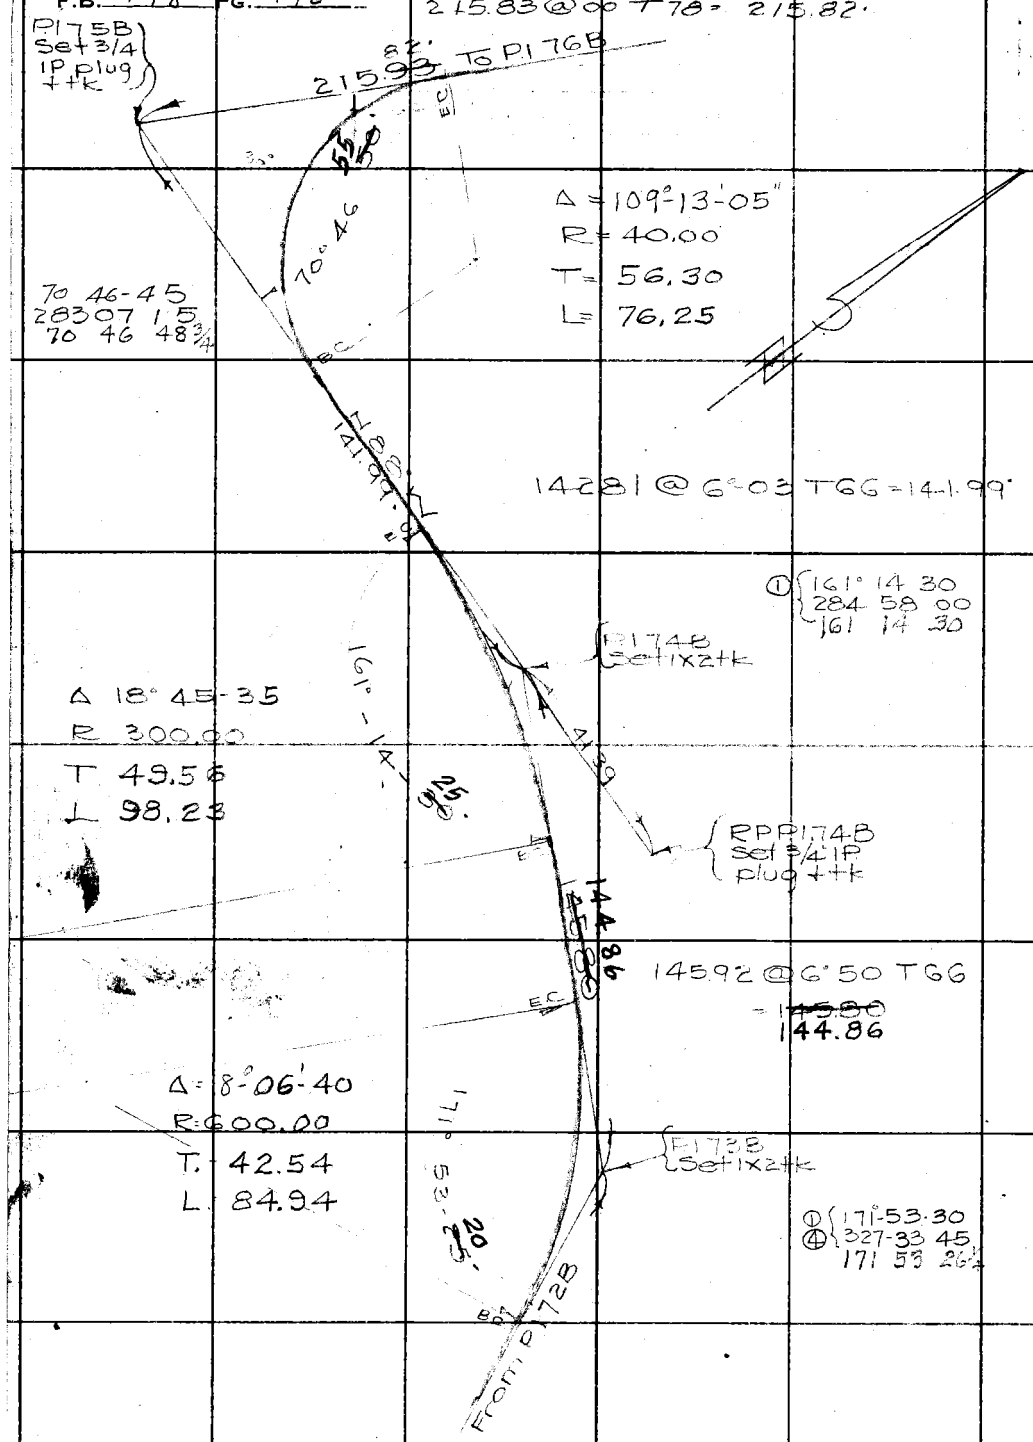

Cont from top page 191

RETURN TO
LOS ANGELES COUNTY SURVEYOR
700 HALL OF RECORDS

Note: Any Additions or Changes on This Sheets Must be Made or Circled in Red Ink With Date and Name of Person Making Change.

Do not extend notes this side of this line

Notes Ck'd by		Survey of Los Angeles Co.	F.B. 778 Pg. 193
Map No. B-1830		W. O. 2243 Tape No. 19 St'd 84 of	
Office Work		Surveyed by Stevenson	
Checked		Notes T. J. S. Date 4-7-39	
Date		Indexed A. C. Johnson	

Cont. to Set P.O.T. 194.

195.10 @ 5°25 T 80 = 194.23.

△ Natross F.B. 812-31-32

To Pl. 78B

118°07-45"
118 33 30
118 07 37½

Tie line F.B. 812 32

194.23.

Pl. 77 B Set ¾ IP Plug + tk

Tie line for Clouser F.B. 812 page 31-32 △ NATROSS

EC

50.

A = 61° 52' 10"
R = 110.00
T = 65.92
L = 118.78

118°-07

BC

310.41.

N 8°-30 E

173.44 @ 00 7' 30" = 173.43.
136.98 @ 00 = 136.98.
310.41.

A 12°32-25
R 300.00
T 32.96
L 65.66

EC

167°-27-45"

① 167°-27-45
④ 309°-51-00
167 27 45

Pl 76B Set 1x2 tk

BC

FOT

Cont from top page 192.

Note: Any Additions or Changes on This Sheets Must be Made or Circled in Red Ink With Date and Name of Person Making Change.

Do not extend notes this side of this line

RETURN TO
LOS ANGELES COUNTY SURVEYOR
700 HALL OF RECORDS

FORM 247 SM 10-37

Cont to bot page 195

F.B. 778 PG. 194

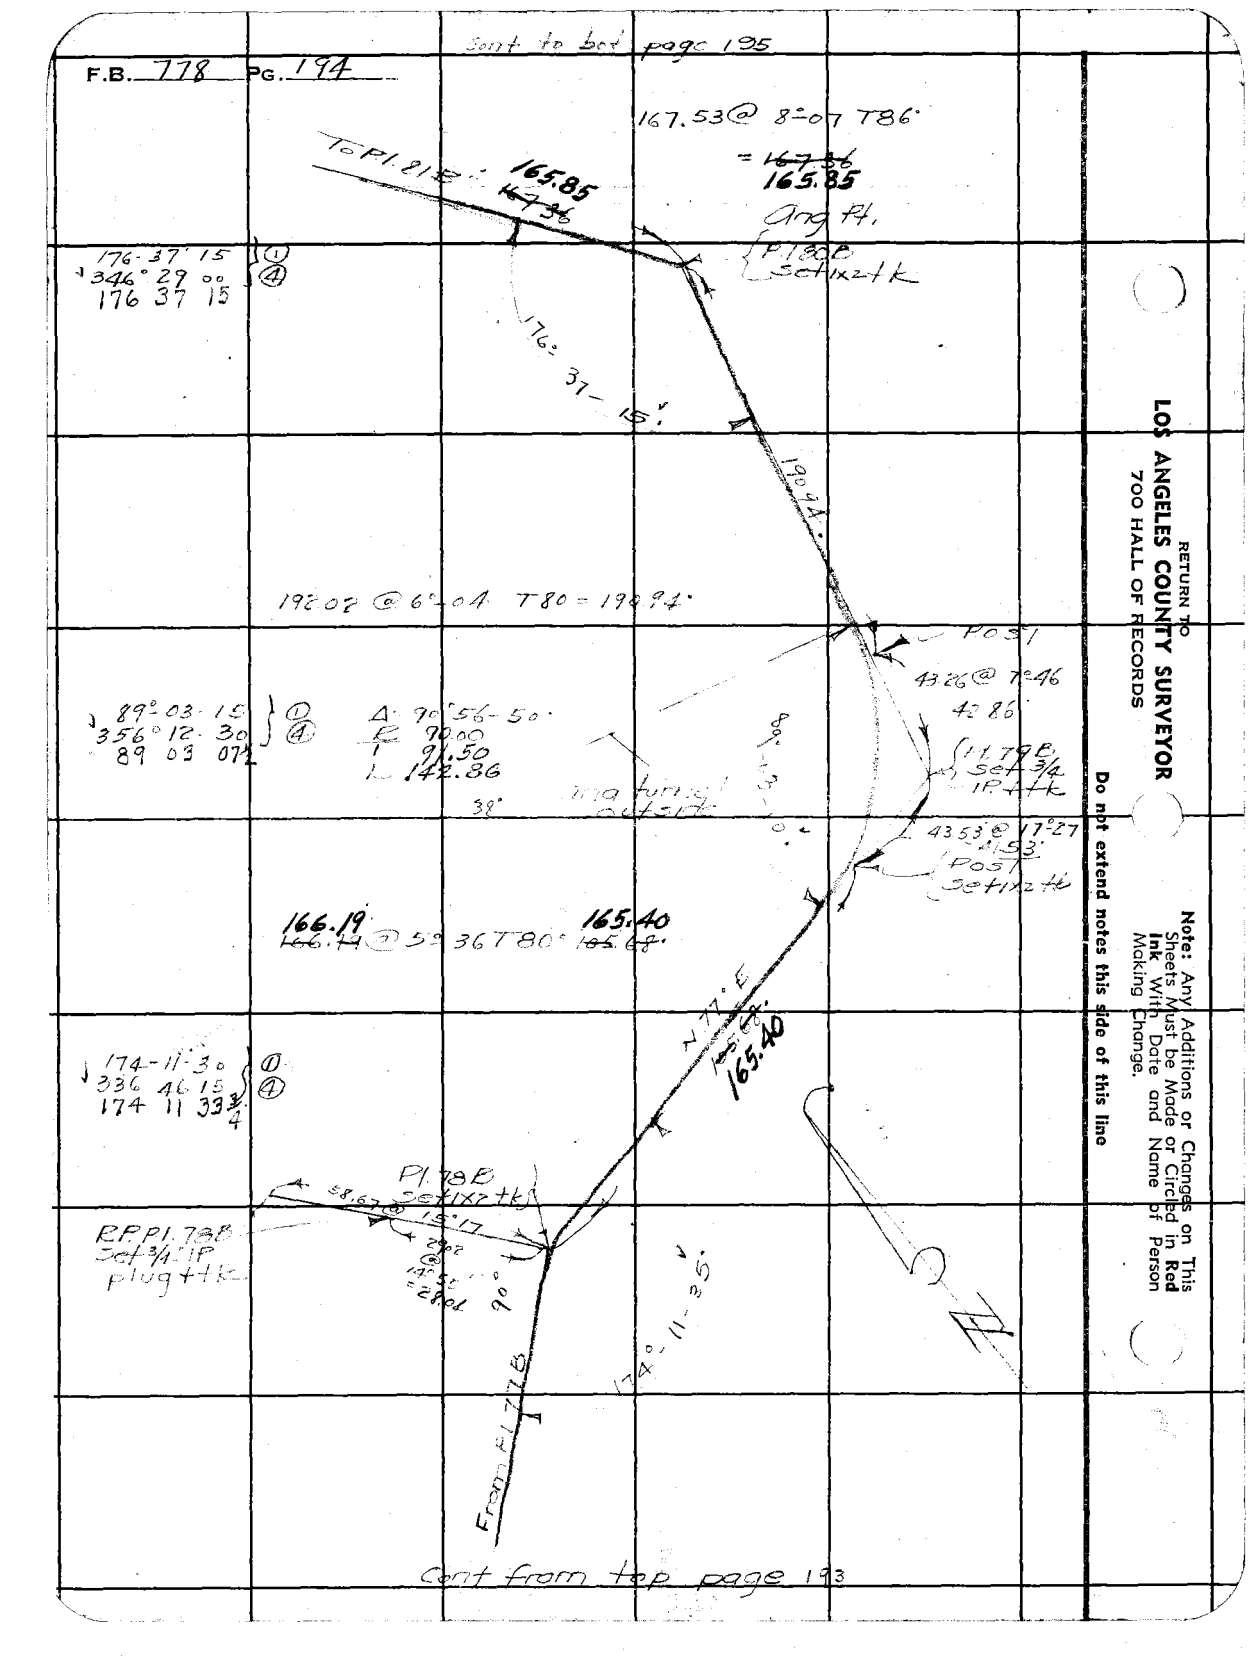

RETURN TO
LOS ANGELES COUNTY SURVEYOR
700 HALL OF RECORDS

Note: Any Additions or Changes on This Sheets Must be Made or Circled in Red Ink With Date and Name of Person Making Change.

Do not extend notes this side of this line

Notes Ck'd by	Survey of La Virgenes Fil System F.B. 778 Pg. 195
Map No. B-1830	W. O. 8265 Tape No. 49 St'd 24 of
Office Work	Surveyed by Stevenson
Checked	Notes Date 4-7-37
Date	Indexed L. C. Johnson

Cont. from L.T. page 196

169°
159° 58-15 ①
319° 58 00 ④
169 58 15

13354 @ 2°-19 T 80°
= 133.43'

P.I. 83 B
Set 1/2" I.P.

To P.I. 84 B

214.96 @ 2°-11 T 80° = 214.96

80°

169°

214.96 T 80°
R 114.6

A = 10°-01-45
R 150.00
T 13.16
L 26.26

122° 51 15 ①
131° 50 30 ④
122 57 37½

P.I. 92 B
Set 3/4" I.P.
Plug + tk.

A 57-02-20
R 90.00
T 48.91
L 89.60

153.95 @ 7°-25 T 84
= ~~154.6~~
152.66

152.66

155°55-15 ①
203° 41 00 ④
155 53 15

A 27°-04-43"
R 125.00
T 26.66
L 52.53

155° 55-15"

P.I. 81 B
Set 1x2 tk.

Cont. from top of page 194

Note: Any Additions or Changes on This Sheets Must be Made or Circled in Red Ink With Date and Name of Person Making Change.

Do not extend notes this side of this line

RETURN TO
LOS ANGELES COUNTY SURVEYOR
700 HALL OF RECORDS

FORM 247 5M 10-37

F.B. 778 PG. 196

Cont. to b.o.t page 197

164.39 @ 5°23 T86°
=163.67'

To P1 88B

163.67'

P1 87B
set 1x2 tk

171°-20-10"

180.52 @ 1°00 T 82°
=180.49'

180.49'
N 76° 45 W

231.79 @ 3°-17 T 86° = 231.42'

Δ = 61°42 00
R = 80.00
T = 47.73
L = 86.15

157°15 00 ④
269° 00 15 ④
157 15 03¾

171°-20 15 ①④
325°20 30 ✓
171 20 07½

118°-18-00 ②④
113 12 15
118 18 03¾

P1 86B
set ¾" IP
plug + tk

P1 84B
set 1x2 tk

117°56-15"

96.31

T 88 = 96.31'

117°56 15 ①④
117°45 00
117 56 15

231.42'

157°-15-05"

Δ = 22°-44 55
R = 325.00
T = 65.38
L = 129.04

P1 85B
set ¾" IP
plug + tk

Δ = 62°03 45
R = 80.00
T = 48.13
L = 86.66

Cont'd from top page 195

RETURN TO
LOS ANGELES COUNTY SURVEYOR
700 HALL OF RECORDS

Note: Any Additions or Changes on This Sheets Must be Made or Circled in Red Ink With Date and Name of Person Making Change.

Do not extend notes this side of this line

Notes Ck'd by		Survey of Los Virgenes FTT System	F.B. 778 Pg. 197
Map No. B-1830		W. O. 8243 Tape No. 49 St'd 84 OF	
Office Work		Surveyed by Stevenson	
Checked		Notes T.J.S. Date 4-7-39	
Date		Indexed C. Johnson	

Cont to bot page 198

8444@ 0 0 T 86°
= 8444.

167°56-15
31° 44 30
167 56 07½

Tan P1 91B

8444.

P1 90B
Set 1½ ztk

167°

56'

10"

146 00 @ 9°56 T84
= 143.81'

143.81'

S 49 W

Δ = 12°03-50"
R. = 180.00
T. = 19.02
L. = 37.90

P1 89B
Set 3/4 IP
- plug + tk

121.

15°

Δ = 58°-18-45"
R. = 100.00
T. = 55.79
L. = 101.77

① 121° 41-15
④ 126° 45 0 0
121 41 15

41

15°

89.79 @ 1°20 T 86 = 89.77'

167 50 00 ①
31 20 15 ③
167 50 03¾ ④

P1 88B
Set ½ ztk

167 50-03

Δ = 12-09-55"
R. = 100.00
T. = 10.66
L. = 21.23

Cont from top page 196

Note: Any Additions or Changes on This Sheets Must be Made or Circled in Red Ink With Date and Name of Person Making Change.

Do not extend notes this side of this line

RETURN TO
LOS ANGELES COUNTY SURVEYOR
700 HALL OF RECORDS

FORM 247 5M 10-37

F.B. 778 Pg. 198

Cont. to bot. page 199

103.28 @ 6°-18 T82
= 102.66.

~~103.46~~ 103.12
~~123.46~~ @ 4° 38 T86 = ~~123.66~~

① 113° 26 40
④ 93° 46 40
113 26 40

Δ = 66°-33'-20"
R = 30.00
T = 19.69
L = 34.85

RP POST 93B
Set 3/4" IP
plug + tk

12.17

POST 92B-2
Set Nail + tk

113° - 26 40

EC P.I. 92B

P.I. 92B
Not Set

34.76

44.17

109°-10-30 ① ④
176° 42 00
109 10 30

103.12
& 123.66'

66.70

25.08
17°55

40.96

109-10-30

POST 92B1

131° 58-30 ① ④
167° 54 15
121 58 33

BC

35.0

131° 58'

P.I. 93B
Set Nail + tk

RP P.I. 93B
Set 3/4" IP
Plug + tk

Δ = 118°-50-55"
R = 30.00
T = 50.78
L = 62.23
113.01 @ 00 T86° = 113.01

113.01

142° 59 15
211° 56 45
142 59 11

42° 59'-10"

Δ 37°-00'-50
R- 75.00
T- 25.15
L- 48.45

P.I. 91B
Set Nail + tk

4.0

RETURN TO
LOS ANGELES COUNTY SURVEYOR
700 HALL OF RECORDS

Note: Any Additions or Changes on This Sheets Must be Made or Circled in Red Ink With Date and Name of Person Making Change.

Do not extend notes this side of this line

Notes Ck'd by	Survey of Los Virgenes FM System
Map No. B-1830	W. O. 3243 Tape No. 47 St'd 34 of
Office Work	Surveyed by Stevenson
Checked	Notes T. U. S. Date 7-12-37
Date	Indexed

F.B. 778 PG. 199

Cont. from bot. page 200

101.65 @ 6°48 T84° = 100.87

Δ = 33°27-10
R = 30.00
T = 9.02
L = 17.52

146° 32-45 ①
226 11 20 ④
146 32 50

43.16 @ 00 T82

167°01-10 ③
308 04 40 ④
167-01-10

54.79 @ 00 T84° = 54.79

142° 53-30 ①
211° 34 00 ④
142 53 30

Δ = 37°-06-30
R = 40.00
T = 13.43
L = 25.91

T-Pl 197.93 100 ft

EC

146°-32-50

Pl. 96 B
Sc 1 x 2 tk

43.16

EC

167°-01-10

Pl. 95 B
Sc 1 x 2 tk

S89°30'W

54.79

BC

EC

142° 53' 30"

A = 12-58-50
R = 75.00
T = 8.53
L = 16.99

Pl 94 B
Sc 1 x 2 tk

BC

From Pl 193.93

Cont. from top page 198

Note: Any Additions or Changes on This Sheets Must be Made or Circled in Red Ink With Date and Name of Person Making Change.

Do not extend notes this side of this line

RETURN TO
LOS ANGELES COUNTY SURVEYOR
700 HALL OF RECORDS

FORM 247 5M 10-37

Cont. to bot. page 239

F.B. 778 Pg. 200

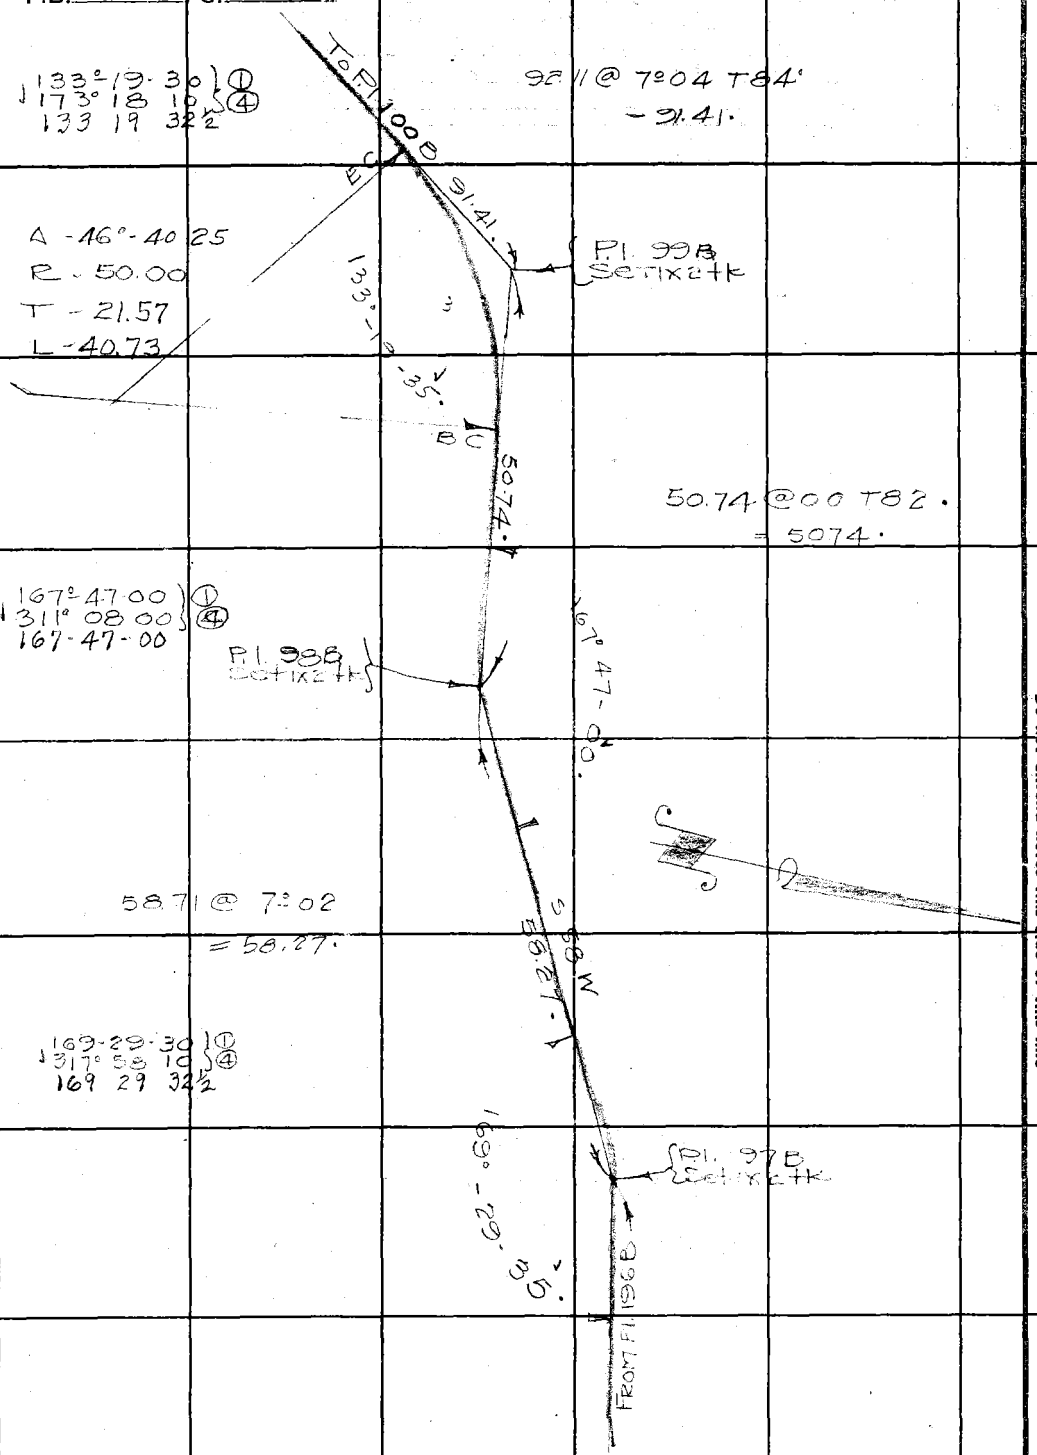

Cont. from bot. page 199

RETURN TO
LOS ANGELES COUNTY SURVEYOR
700 HALL OF RECORDS

Note: Any Additions or Changes on This Sheets Must be Made or Circled in Red Ink With Date and Name of Person Making Change.

Do not extend notes this side of this line

Profile No. ____ X-Sec. No. ____

Notes Red. ____ Date ____ Plotted ____ Date ____ Job No. ____ Division No. ____
Notes Chkd. ____ Date ____ Checked ____ Date ____ Survey of ____ Survey by ____ Map No. ____ Notes ____ Date ____ Indexed ____ Date 3-6-39

F. B. 778 PG. 201

CROSSECTIONS

LAS VIRGENES FTI SYSTEM

LINE (A) TO BURRO FLATS

JAN 1943

STATION	B. S.	H. I.	F. S.	ELEV.

R. J. Stevenson
E. H. Nichols
W. E. Harris
F. W. Scott

NOTE: ANY ADDITIONS OR CHANGES ON THIS SHEET MUST BE MADE OR CIRCLED IN RED INK, WITH DATE AND NAME OF PERSON MAKING CHANGE

Do not extend notes this side of this line

PLEASE RETURN TO
LOS ANGELES COUNTY SURVEYOR
700 HALL OF RECORDS

Form 307 SM 10-37

Form 307 5M 10-37

PLEASE RETURN TO
LOS ANGELES COUNTY SURVEYOR
700 HALL OF RECORDS

NOTE: ANY ADDITIONS OR CHANGES ON THIS SHEET MUST BE MADE OR CIRCLED IN RED INK, WITH DATE AND NAME OF PERSON MAKING CHANGE

Do not extend notes this side of this line

F. B. Pg. 202 | Job No. 8248 Division No. | Notes Red. | Plotted | Profile
Survey of Los Virgenes Fill System | Date | Date | No.
Survey by Arenson Notes T.J.S. | Notes Chkd. | Checked | X-Sec.
Indexed | Date 2-2 39 | Date | Date | No.

STATION	B. S.	H. Dg ~~H/F. S.~~	ELEV.	Stg	Sg Ft
0 x 0		5		5 + 25	15° 0+00 at int Co line and E See pg.
0 + 25		7		+ 50	13°
0 + 50		7		+ 75	20°
0 + 75		7		6 + 00	15°
1 + 00		7		+ 25	9°
+ 25		9		+ 50	6
+ 50		6		+ 75	6
+ 75		8		7 + 00	6
2 + 00		7		+ 25	24°
+ 25		3		+ 50	48°
+ 50		3		+ 75	70°
+ 75		3		8 + 00	44°
3 + 00		10		+ 25	27°
+ 25		12		+ 50	49°
+ 50		8		+ 75	75°
+ 75		7		9 + 00	60°
4 + 00		6		+ 25	50°
+ 25		10		+ 50	17°
+ 50		20		+ 75	12°
+ 75		10	Pl. 8 949.8	10 + 00	20
5 + 00		15		+ 25	36°

Earthwork Calc. ALBERT E. TIMMONS MAR 6 1939

Form 307 5M 10-37

PLEASE RETURN TO
LOS ANGELES COUNTY SURVEYOR
700 HALL OF RECORDS

NOTE: ANY ADDITIONS OR CHANGES ON THIS SHEET MUST BE MADE OR CIRCLED IN RED INK, WITH DATE AND NAME OF PERSON MAKING CHANGE

Sq ft.

Do not extend notes this side of this line

STATION	~~B. S.~~	~~H. I.~~	~~F. S.~~	ELEV.	Sta	Sq ft.
10+50		36°			15+50	6
+75		36			+75	5°
11+00		60°			16+00	20°
+25		36°			+25	7°
+50		40°			+50	7°
+75		40°			+75	5°
12+00		45°			17+00	5°
+25		45°			+25	5°
+50		15°			+50	5
+75		12°			+75	7
13+00		20°			18+00	10°
+25		15°			+25	6
+50		14°			+50	6
+75		9°			+75	6
14+00		5°			+85	5
+25		5°			19+00	10°
+50		27°			+25	4°
+75		36°			+50	6
15+0		10°			+75	4
15+10		6			20+00	20
+25		6			+25	40

Earthwork Calc. ALBERT E. TIMMONS MAR 6 1939

Profile
No.
X-Sec.
No.
Notes Red. Date
Notes Chkd. Date
Date
Plotted Date
Checked Date
Job No. 8243 Division No.
Survey of Los Virgenes F.B. System PG. 203
Survey by Staff Notes Date 3-2-39
Map No. Indexed
Date
Date

Form 307 5M 10-37

PLEASE RETURN TO
LOS ANGELES COUNTY SURVEYOR
700 HALL OF RECORDS

NOTE: ANY ADDITIONS OR CHANGES ON THIS SHEET MUST BE MADE OR CIRCLED IN RED INK, WITH DATE AND NAME OF PERSON MAKING CHANGE

F. B. PG. 204 | Job No. 8243 Division No. Los Virgenes FM System | Notes Red. Date | Plotted Date | Profile No. | X-Sec. No.
Survey of Stevenson | Notes | Notes Chkd. Date | Checked Date
Survey by [illegible] Date 3-2-39
Indexed [illegible]

Do not extend notes this side of this line

STATION	B. S.	H. I. 39 FT	F. S.	ELEV.	Sta	Sq ft
20+40		40			26+75	8°
+50		C			27+00	5°
Fill					+25	5°
22+25		6			+50	5°
+50		7			+75	5°
+75		5			28+00	8°
23+00		3			+25	8°
+25		3			+50	8°
+50		3			+75	5°
+15		3			29+00	6°
24+00		2			+25	6°
24+21.8 P.I. 18 +25		3			+50	5°
+50		6			+75	8°
+75		4			30+00	8°
25+00		5			+25	5°
+25		5			+50	5°
+50		5			+75	5°
+75		5			31+00	5°
26+00		8°			+25	7°
+25		8°			+50	8°
+50		8°			+75	6

Earthwork Cross ALBERT E. TIMMONS MAD 6 1939

Form 307 SM 10-37

PLEASE RETURN TO
LOS ANGELES COUNTY SURVEYOR
700 HALL OF RECORDS

NOTE: ANY ADDITIONS OR CHANGES ON THIS SHEET MUST BE MADE OR CIRCLED IN RED INK, WITH DATE AND NAME OF PERSON MAKING CHANGE

Do not extend notes this side of this line

Profile No. X-Sec. No.

Notes Red. Date Notes Chkd. Date

Plotted Date Checked Date

Job No. 244 Division No. Survey of Los Virgenes F.M. Survey by Notes Map No. Indexed

F.B. 778 Pg. 205

Date 3-2-39

Date

Date

STATION	B. S.	H.I. Sq Ft	F. S.	ELEV.	Sta	Sq ft.
32+00		5°			40+50	3°
+25		5°			41+15 27A 41+00	5°
+50		5°			+50	5°
33+00		3°			42+00	3°
+50		3°			+50	3°
34+00		3°			43+00	3°
+50		3°			+50	7°
35+00		4°			44+00	6°
+50		4°			+50	10°
36+00		3°			45+00	3°
36+30		7°			+50	4°
+50		7°			46+00	6°
37+00		3°			+50	7°
+10		6			47+00	8°
+25		6			+50	3°
+50		10°			48+00	3°
38+00		10°			+50	3°
+50		10°			49+00	5°
39+00		3°			+50	5°
+50		3			50+00	3°
40+00		3°			+50	6

Earthwork Co., ALBERT E. TIMMONS

MAR 6 1939

F. B. 778 PG. 206 | Job No. | Division No. | Notes Red. | Plotted | Profile

Survey of | Date | Date | No.

Survey by | Notes | Notes Chkd. | Checked | X-Sec.

Indexed | Date | Date | Date | No.

Form 367 5M 10-37

PLEASE RETURN TO
LOS ANGELES COUNTY SURVEYOR
700 HALL OF RECORDS

NOTE: ANY ADDITIONS OR CHANGES ON THIS SHEET MUST BE MADE OR CIRCLED IN RED INK, WITH DATE AND NAME OF PERSON MAKING CHANGE

Do not extend notes this side of this line

STATION	B.S.	H.I.	F.S.	ELEV.
51+00				
+50				
52+00				
52+30.5 = 1+80 Ahead		30		
		5°		
		50		
Courts on page 207				
				574
				59 ft.

Earthwork Calc. ALBERT E. TIMMONS MAR 6 1939

Form 307 5M 10-37

PLEASE RETURN TO
LOS ANGELES COUNTY SURVEYOR
700 HALL OF RECORDS

NOTE: ANY ADDITIONS OR CHANGES ON THIS SHEET MUST BE MADE OR CIRCLED IN RED INK, WITH DATE AND NAME OF PERSON MAKING CHANGE

Do not extend notes this side of this line

Profile No. ____ Notes Red. ____ Plotted ____ Job No. 8248 Division No. ____ F. B. 778 PG. 207
X-Sec. No. ____ Date ____ Date ____ Survey of Las Virgenes T.T.S. Date 8/20-38
Notes Chkd. ____ Checked ____ Survey by Howard Notes Howard Date 8/20-38
Date ____ Date ____ Map No. ____ Indexed A. C. Johnson 11-28-38

STATION	B. S.	H. I.	F. S.	ELEV.			
	LAS VIRGENES TRUCK TRAIL SYSTEM - QUAIL CANYON						
	TO PARADISE VALLEY						
							Checked Earthwork Calc. " " NOV 25 1938
1+80					C 02/61	Gr.	00/50
2+10					C 06/63	Gr.	00/35
+40					C 05/63	C01	00/12
+70					C 10/65	C02	00/16
3+00					C 20/70	C04	00/20
+30					C 20/70	C04	00/23
+60					C 22/71	C01	00/30
+90					C 18/69	C02	00/45
4+20					C 10/65	C03	00/25
+50					C 09/65	C04	00/73
+80					00/50	C03	C 06/65
5+10					00/10	C01	C 19/65
+40					00/20	C05	C 14/67
+70					00/30	C13	C 43/82
6+00					00/34	C08	C 47/84
+30					00/46	C17	C 54/87
+60					00/42	C19	C 46/83
+90					00/30	C10	C 33/77

ALBERT E. TIMMONS

Form 307 5M 10-37

PLEASE RETURN TO
LOS ANGELES COUNTY SURVEYOR
700 HALL OF RECORDS

NOTE: ANY ADDITIONS OR CHANGES ON THIS SHEET MUST BE MADE OR CIRCLED IN RED INK, WITH DATE AND NAME OF PERSON MAKING CHANGE

Do not extend notes this side of this line

F. B. 778 Pg. 6 [20 8] Job No. 8243 Division No. Notes Red. Plotted Profile
Survey of Los Virgines T. 5 S. Date Date No.
Survey by Howard Notes Howard Notes Chkd. Checked X-Sec.
Indexed Date Date Date No.

STATION	B. S.	H. I.	F. S.	ELEV.			
7+20					00/28	C 08	C 31/76
+50					00/28	C 08	C 37/72
+75					00/25	C 10	C 37/79
8+00					00/30	C 11	C 55/88
+30					00/48	C 17	C 52/86
+60					00/25	C 13	C 58/89
+90					00/40	C 23	C 88/104
9+20					00/38	C 25	C 72/96
+50					0.0/34	C 17	C 75/98
+80					00/37	C 19	C 64/92
10+10					00/40	C 20	C 61/91
+40					00/42	C 30	C 90/105
+70					00/48	C 34	C 86/103
11+00					00/42	C 25	C 67/94
+25					00/42	C 23	C 104/112
+50					00/50	C 15	C 50/85
+75					00/35	C 17	C 62/91
12+05					00/38	C 22	C 103/112
+35					00/42	C 27	C 104/112
+65					00/30	C 18	C 90/105
+90					00/10	C 42	C 92/106

Earthwork Calc. ALBERT E. TIMMONS NOV 25 1938
Checked " " "
Earthwork

Form 307 5M 10-37

PLEASE RETURN TO
LOS ANGELES COUNTY SURVEYOR
700 HALL OF RECORDS

NOTE: ANY ADDITIONS OR CHANGES ON THIS SHEET MUST BE MADE OR CIRCLED IN RED INK, WITH DATE AND NAME OF PERSON MAKING CHANGE

Do not extend notes this side of this line

STATION	B. S.	H. I.	F. S.	ELEV.			
13+20					00/60	C 27	C 57/88
+50					00/35	C 16	C 44/83
+80					00/45	C 14	C 40/80
14+10					00/25	C 07	C 30/75
+40					00/30	C 09	C 30/75
+70					00/33	C 10	C 34/77
15+00					00/52	C 13	C 37/79
+30					00/15	C 06	C 30/75
+60					00/17	C 05	C 36/78
+80						C 12 00/30	C 21/71
16+00					00/43	C 16	C 70/95
+20					C 17/69	C 38	C 70/95
+50					00/60	C 16	C 41/81
+80					00/30	C 05	C 22/41
17+10					00/15	C 04	C 20/70
+40					00/25	C 11	C 36/78
+70					00/33	C 10	C 28/74
18+00					00/35	C 12	C 54/87
+30					C 0/33	C 20	C 86/103
+65					C 36/78	C 23	C 52/86
+95					00/30	C 06	C 18/69

Checked Earthwork C/C. ALBERT E. TIMMO. NOV 25 1938

Profile Notes Red. Plotted Job No. 8243 Division No. F.B. 776 PG. 4209
No. Date Date Survey of Los Nietos Jct. - Sec.
X-Sec. Notes Chkd. Checked Survey by Howard Notes Howard Date 10/21-38
No. Date Date Map No. Indexed A. C. Johnson Date

Form 307 5M 10-37

PLEASE RETURN TO
LOS ANGELES COUNTY SURVEYOR
700 HALL OF RECORDS

NOTE: ANY ADDITIONS OR CHANGES ON THIS SHEET MUST BE MADE OR CIRCLED IN RED INK, WITH DATE AND NAME OF PERSON MAKING CHANGE

Do not extend notes this side of this line

F. B. 718 Pg. 218 | Job No. 8243 | Division No. | Notes Red. | Plotted | Profile
Survey of Las Virgenes Tr. Sec. 4 | Date | Date | No.
Survey by Howard | Notes Howard | Notes Chkd. | Checked | X-Sec.
Indexed | Date | Date | Date | No.

STATION	B. S.	H. I.	F. S.	ELEV.			
19+25					00/30	C 03	C 15/67
+55					— Grade.		—
+85					0.0/93	C 10	C 25/73
20+05					C 37/79	C 20	C 39/75
+45					00/30	C 05	C 15/68
+65					00/35	C 06	C 21/71
+90					00/30	C 02	C 14/67
21+20					00/40	C 07	C 24/71
+55					C 03/62	Gr.	Gr/60
+80					Gr.	Gr.	Gr.
22+10					00/35	C 07	C 30/75
+40					00/17	Gr.	C 19/65
+65						Gr.	C 25/73
+90						Gr.	C 03/62
23+20					00/20	05	C 09/65
+50						Gr.	C 24/72
+75						Gr.	C 18/69
23+95					00/23	C 17	C 28/74
24+20					00/34	C 11	C 34/71
+45					C 05/62	Gr.	C 14/67
+70					00/30	Gr.	C 09/65

10-28-38
10-31-38
NOV 25 1938
ALBERT E. THOMAS
Earth work calc.
Checked "

Form 307 5M 10-37

PLEASE RETURN TO
LOS ANGELES COUNTY SURVEYOR
700 HALL OF RECORDS

NOTE: ANY ADDITIONS OR CHANGES ON THIS SHEET MUST BE MADE OR CIRCLED IN RED INK, WITH DATE AND NAME OF PERSON MAKING CHANGE

Do not extend notes this side of this line

Profile Notes Red. Plotted Job No. 8493 Division No.
No. Date Date Survey of Los Angeles River F.B. 778 PG. 211
X-Sec. Notes Chkd. Checked Survey by Howard Notes Howard Date 11/21/38
No. Date Date Map No. Indexed A. C. Johnson

Checked

Earthwork Calc. ALBERT E. TIMMONS NOV 25 1938

STATION	B. S.	H. I.	F. S.	ELEV.			
25+00					00/35	C 0 4	C 15/68
+30					00/20	C 0 3	C 14/67
+60					00/30	C 0 5	C 29/75
+90					00/33	C 1 1	C 6 1/9 1
26+15						F 0 8 00/26	C 23/72
+40		26+96 to P1	52 A		00/54	C 1 8	C 47/84
+70					00/35	C 0 7	C 25/73
+95					00/73	C 1 8	C 36/78
27+20					00/40	C 1 1	C 40/80
+50					00/32	C 1 0	C 4 0/8 0
+75					00/12	C 0 2	C 19/70
28+05					C 05/31	Gr	C 05/61
+25						Gr	C 04/62
+60					00/22	C 0 4	C 6 0/9 0
+95						Gr	C 0 2 1/6 2
29+25						Gr	C 05/63
+60						Gr	C 04/62
+85					00/21	Gr	C 1 1/6 1
30+10					00/80	C 1 5	C 32/76
+40					00/30	Gr.	C 10/65
+70					—	—	00/60

Form 307 5M 10-37

PLEASE RETURN TO
LOS ANGELES COUNTY SURVEYOR
700 HALL OF RECORDS

NOTE: ANY ADDITIONS OR CHANGES ON THIS SHEET MUST BE MADE OR CIRCLED IN RED INK, WITH DATE AND NAME OF PERSON MAKING CHANGE

Do not extend notes this side of this line

F.B. 278 Pg. 212 | Job No. 8243 Division No. | Notes Red. | Plotted | Profile
Survey of Los Angeles T.T. Sys. | Date | Date | No.
Survey by Howard | Notes Howard | Notes Chkd. | Checked | X-Sec. No.
Indexed | Date | Date | Date

STATION	B. S.	H. I.	F. S.	ELEV.			
31+05					00/60	C 1°	C 18/69
+35					00/10	C 0° 3	C 29/70
+65						Gr	C 17/69
32+00					00/39	C 0° 7	C 02/61
+30					Gr	Gr	Gr
+60					C 06/63	Gr	00/61
+90					C 05/63	Gr	
33+20					C 09/65	C 0° 1	00/60
+50					00/16	C 0° 2	C 07/61
+70						Gr	Gr
+90					00/19	C 0° 2	C 07/64
34+10					00/29	C 0° 3	C 37/69
+30					00/32	C 1° 7	C 36/66
+50					00/38	C 2°	C 58/69
+70					00/52	C 0° 9	C 27/64
+95					00/22	C 0° 3	C 12/66
35+20					C 12/66	C 1° 1	C 12/66
+45					C 02/61	C 0° 3	00/60
+75					C 12/66	C 0° 4	00/22
36+05					C 11/66	C 0° 6	00/31
+35					C 03/62	C 0° 2	00/30

NOV 25 1938

ALBERT E. TIMMONS
A. W. VAN FLEET

Earthwork Calc. "
Checked " "

Form 307 5M 10-37

PLEASE RETURN TO
LOS ANGELES COUNTY SURVEYOR
700 HALL OF RECORDS

NOTE: ANY ADDITIONS OR CHANGES ON THIS SHEET MUST BE MADE OR CIRCLED IN RED INK, WITH DATE AND NAME OF PERSON MAKING CHANGE

Do not extend notes this side of this line

Profile No. ____ Notes Red. ____ Plotted ____ Job No. 8243 Division No. ____

X-Sec. No. ____ Date ____ Date ____ Survey of Las Virgenes T. Sykes

Notes Chkd. ____ Checked ____ Survey by Howard Notes Howard Date 10/21-28

Date ____ Date ____ Map No. ____ Indexed A. C. Job Order ____

F. B. 776 PG. 14 2/3

Checked Earthwork Calc. ALBERT E. TIMMONS NOV 25 1938

STATION	B. S.	H. I.	F. S.	ELEV.			
36+70					00/30	C.04	C 12/66
37+00					00/30	C 05	C 18/69
+30							
38+80					Gr	Gr	Gr
39+10						Gr	"
+40						Gr	C 06/63
+70						Gr	C 08/67
40+00					00/25	C 02	C 03/62
+30					00/54	C 07	C 05/63
+60					00/32	C 06	C 1/66
+90					00/25	C 05	C 18/69
41+20					00/23	C 04	C 15/68
+50					00/24	C 04	C 15/68
+80					00/26	C 06	C 23/72
42+10					00/40	C 12	C 23/72
+40					00/21	C 06	C 16/68
+70					00/25	C 05	C 20/70
43+00					00/45	C 08	C 25/73
+25					00/42	C 20	C 62/94
+50					00/40	C 21	C 62/94

Form 307 5M 10-37

PLEASE RETURN TO
LOS ANGELES COUNTY SURVEYOR
700 HALL OF RECORDS

NOTE: ANY ADDITIONS OR CHANGES ON THIS SHEET MUST BE MADE OR CIRCLED IN RED INK, WITH DATE AND NAME OF PERSON MAKING CHANGE

Do not extend notes this side of this line

F. B. 778 PG. 214 | Job No. 8213 Division No. | Profile No. | Plotted Date | X-Sec. No. | Checked Date | Notes Red. Date | Notes Chkd. Date | Notes Howard | Tracing Date | Indexed Date

Survey of Los Angeles Co. T.T. Sys.

Survey by Howard

STATION	B. S.	H. I.	F. S.	ELEV.		
43+75					Gr.	C 32/76
44+05					00/33 C 13	C 48/84
+35					00/42 C 20	C 96/108
+65					00/90 C 41	C 57/89
+90					00/67 C 13	C 42/81
45+10					00/43 C 19	C 42/81
+40	= 95+90 S from beg Sec Cont on P215				00/15 C 17	C 30/75 10-21-37
From 45+40 to 68+50. No plugs stamps set						
68+50					Gr	Gr
+80					00/35 C 12	C 32/76
69+10					00/10 C 05	C 35/78
+50					Gr	C 21/71
70+00		Void Page 216			Gr	"
74+00					Gr	C 00/62
+25					00/32 C 08	C 17/62
+55					00/34 C 04	C 25/73
+75					Gr.	C 24/72
+90					F.C. 02	00/30 C 07/63
75+15					00/45 C 15	C 35/78
+35					00/40 C 10	C 24/62

ALBERT E. TIMMONS NOV 25 1938

Earthwork Calc. Checked " "

Form 307 5M 10-37

PLEASE RETURN TO
LOS ANGELES COUNTY SURVEYOR
700 HALL OF RECORDS

NOTE: ANY ADDITIONS OR CHANGES ON THIS SHEET MUST BE MADE OR CIRCLED IN RED INK, WITH DATE AND NAME OF PERSON MAKING CHANGE

Sq ft

Do not extend notes this side of this line

STATION	B. S.	H. I.	F. S.	ELEV.	Sta	Sq ft.
cont. from middle p-214					51+75	7°
45+75		6			52+00	7°
46+00		7°			+25	10°
+25		12°			+50	14°
+50		12°			+75	16°
+75		25°			53+00	12°
47+00		30°			+25	6
+25		14°			+50	4°
+50		15°			+75	3°
+75		20°			54+00	3°
48+00		14°			+50	5°
+25		14°			55+00	3°
+50		14°			+50	6°
+75		12°			56+00	7°
49+00		5°			+50	17°
+25		6			57+00	10°
50+00		3			+50	8°
+50		4°			58+00	4
51+00		6°			+50	3
+25		5°			59+00	3°
+50		6°			+50	3°

Earthwork Co's. ALBERT E. TIMMONS MAR 6 1939

Profile
No. X-Sec.
Notes Red. Date
Notes Chkd. Date
Plotted Date
Checked Date
Job No. 8248 Division No.
Survey of Los Virgenes
Survey by Stevenson Notes T.J.S. Date 3-2-39
Map No.
Indexed by C. Johnson
F. B. PG. 215

Form 307 5M 10-37

PLEASE RETURN TO
LOS ANGELES COUNTY SURVEYOR
700 HALL OF RECORDS

NOTE: ANY ADDITIONS OR CHANGES ON THIS SHEET MUST BE MADE OR CIRCLED IN RED INK, WITH DATE AND NAME OF PERSON MAKING CHANGE

Do not extend notes this side of this line

F. B. PG. 216 | Job No. 8243 Division No. | Notes Red. | Plotted | Profile
Survey of Los Virgenes FT System | Date | Date | No.
Survey by Stevenson | Notes | Notes Chkd. | Checked | X-Sec.
Indexed | Date 3-2-39 | Date | Date | No.

STATION	B. S.	H. I.	F. S.	ELEV.	Sta		Sq ft
60 to		3			67+50		5°
+50		5			+75		7°
61 to		5°			67+95 =	68+50	Howards Sta
+50		3°			P. 214		
62 to		5°			Actual rough sta from beg		
+50		5°			= 118+45.5		
63 to		6°			118+45.5		10°
63+50		2°			+75		10°
64 to		2°			119+00		7°
+25		15°			+25		11°
+50		6°			+50		9°
+75		6°			+75		12°
65 to		6°			120 to		10°
+25		10°			+25		9°
+50		5°			+50		9°
66 to		10°			+75		10°
+25		7°			121 to		18°
+50		7°			+25		10°
+75		7°			+50		6
67 to		7°			+75		6
+25					122 to		5

Earthwork Calc. ALBERT E. TIMMONS MAR 6 1939

Form 307 SM 10-37

PLEASE RETURN TO
LOS ANGELES COUNTY SURVEYOR
700 HALL OF RECORDS

NOTE: ANY ADDITIONS OR CHANGES ON THIS SHEET MUST BE MADE OR CIRCLED IN RED INK, WITH DATE AND NAME OF PERSON MAKING CHANGE

Do not extend notes this side of this line

STATION	~~B. S.~~	~~H. I.~~ Sq ft	~~F. S.~~	~~ELEV.~~	Sta	Sq. ft.
122+25		7			127+50	24°
+50		12°			+75	25
+75		18°			128+00	27°
123+00		18°			+25	20°
+25		12°			+50	12°
+50		18°			+75	32°
+75		18°			129+00	24
124+00		26°			+25	20
+25		15°			+50	14°
+50		6			+75	7°
+75		28°			130+00	5°
125+00		15°			+25	6°
+25		20°			+50	12
+50		0°			+75	4°
+75		30°			131+00	5°
126+00		72°			+25	5°
+25		40			+50	5°
+50		31			+75	4°
+75		28			132+00	6°
127+00		40°			+25	9°
+25		16°			+50	9°

Form Approved
ALBERT E. TIMMONS
MAR 6 1939

Profile
No. Notes Red. Plotted Job No. Division No.
X-Sec. Date Date Survey of
No. Notes Chkd. Checked Survey by Notes
Date Date Map No. Indexed Date Date

F. B. 776 PG. 217

Form 307 5M 10-37

PLEASE RETURN TO
LOS ANGELES COUNTY SURVEYOR
700 HALL OF RECORDS

NOTE: ANY ADDITIONS OR CHANGES ON THIS SHEET MUST BE MADE OR CIRCLED IN RED INK, WITH DATE AND NAME OF PERSON MAKING CHANGE

Do not extend notes this side of this line

F. B. 778 PG. 218 | Job No. ____ Division No. ____ Notes Red. ____ Plotted ____ Profile ____
Survey of Los Virgenes Fill System Date ____ Date ____ No. ____
Survey by Stevenson Notes T.J.S. Notes Chkd. ____ Checked ____ X-Sec. ____
Indexed ____ Date 3-2-39 Date ____ Date ____ No. ____

STATION	~~B. S.~~	~~H. I.~~	~~F. S.~~	ELEV.	Sta	Sq Ft.
132+70 P.I. 90° A					142+50	4
132+75		7			143+00	4
133+00		7			+50	6
+50		10			144+00	6
134+00		8			+50	6
+50		7			145+00	8
135+00		10			+50	12
+50		8			146+	15°
136+00		8			+25	6
+50		6			+50	6
137+0		5			+75	6
+50		6			147+00	12°
138+0		6			+25	12
+50		6			+50	10°
139+00		6°			+75	7°
+50		6			148+00	7°
140+00		6			+50	5
+50		3			149+00	4
141+00		4			+50	6
+50		6			150+0	6
142+00		6			+50	6

Earthwork Co. ALBERT E. TIMMONS MAR 6 1939

Form 307 5M 10-37

PLEASE RETURN TO
LOS ANGELES COUNTY SURVEYOR
700 HALL OF RECORDS

NOTE: ANY ADDITIONS OR CHANGES ON THIS SHEET MUST BE MADE OR CIRCLED IN RED INK, WITH DATE AND NAME OF PERSON MAKING CHANGE

Do not extend notes this side of this line

STATION	B. S.	H. I. 89 ft	F. S.	ELEV.	Sta		Sq ft
151+00		6			161+00		6°
+50		6			+50		8°
152+00		5			162+00		4°
+50		15			+50		5°
153+00		6			163+00		10°
+50		12			+50		10°
154+00		8			164+00		11°
+50		10°			+50		11°
155+00		10°			165+00		9°
+50		8			+50		10°
156+00		7°			166+00		11°
+50		7°			+50		7°
157+00		9°			167+00		10°
+50		9°			+50		12°
158+00		6°			168+00		10°
+50		4°			+50		10°
159+00		3°			169+00		12°
+50		3°			+50		6
160+00		4°			170+00		12°
160+46	PI 106A				+50		12°
160+50		9°			171+00		10°

Earthworks Co.

ALBERT F. TIMMONS

MAR 6 1939

Profile

Notes Red. _____ Plotted _____ Job No. 3243 Division No. _____ F. B. 778 PG. 2 2

No. _____ Date _____ Survey of Earthworks Notes _____

X-Sec. _____ Date _____ Survey by Stevens Date 2-2-39

Notes Chkd. _____ Checked _____

No. _____ Date _____ Map No. _____ Indexed _____ Date _____

Form 307 5M 10-37

PLEASE RETURN TO
LOS ANGELES COUNTY SURVEYOR
700 HALL OF RECORDS

NOTE: ANY ADDITIONS OR CHANGES ON THIS SHEET MUST BE MADE OR CIRCLED IN RED INK, WITH DATE AND NAME OF PERSON MAKING CHANGE

Do not extend notes this side of this line

F. B. 778 Pg. 220 | Job No. 8243 Division No. | Notes Red. | Plotted | Profile
Survey of Eqsy | Date | Date | No.
Survey by | Notes | Notes Chkd. | Checked | X-Sec.
Indexed | Date | Date | Date | No.

STATION	B. S.	H. I. Sq ft	F. S.	ELEV.	Sta		Sq ft
171+50		8°			179+50		6
172+00		8°			180+00		7°
+50		9°			+50		7
173+00		12°			181+00		7°
+25		20°			+50		10°
+50		26°			182+00		8°
+75		18°			+50		8°
174+00		6			183+00		6
+50		6			+50		7°
+75		7°			184+00		7°
175+00		12°			+50		7°
+25		12°			185+00		7°
+50		15°			+50		7°
176+00		7°			186+00		7°
+50		7°			+43	P1.119A	6°
176+99	P1.115A				+50		7°
177+00		8°			187+00		6°
+50		7°			+50		5°
178+00		12°			188+00		8°
+50		12°			+50		7°
179+00					189+00		9

Earthwork Co.

ALBERT E. TIMMONS MAR 6 1939

Form 307 5M 10-37

PLEASE RETURN TO
LOS ANGELES COUNTY SURVEYOR
700 HALL OF RECORDS

NOTE: ANY ADDITIONS OR CHANGES ON THIS SHEET MUST BE MADE OR CIRCLED IN RED INK, WITH DATE AND NAME OF PERSON MAKING CHANGE

Sq ft.

Do not extend notes this side of this line

STATION	B. S.	H. I.	F. S.	ELEV.	Sta.	Sq ft
189+50		7			199+50	7°
190+00		10			200+00	12°
+50		8			+50	7°
191+00		5			201+00	5°
+50		5			+50	5°
192+00		5			202+00	8°
+50		9			+50	10°
193+00		9			203+50	10°
+50		10			204+00	7°
194+00		6			+50	5°
+50		8			205+00	7°
195+00		7			+50	5°
+50		7			206+00	11°
196+00		7			+50	15°
196+30 ℄	P1 12'8				207+00	12°
+50		5			+50	17°
197+00		14			208+00	20
+50		6			+50	12°
198+00		24			209+00	20°
+50		12			+50	17°
199+00		7			210+00	20°

Earthwork Cap

ALBERT E. TIMMONS MAR 6 1939

Profile Notes Red. Plotted Job No. Division No.
No. Date Date Survey of
X-Sec. Notes Chkd. Checked Survey by Notes
No. Date Date Map No. Indexed Date

F.B. 776 PG. 221

Form 307 5M 10-37

PLEASE RETURN TO
LOS ANGELES COUNTY SURVEYOR
700 HALL OF RECORDS

NOTE: ANY ADDITIONS OR CHANGES ON THIS SHEET MUST BE MADE OR CIRCLED IN RED INK, WITH DATE AND NAME OF PERSON MAKING CHANGE

Do not extend notes this side of this line

Profile No. ____ Plotted ____ Date ____ Checked ____ Date ____
X-Sec. No. ____ Notes Red. ____ Date ____ Notes Chkd. ____ Date ____

F. B778 PG. 222 | Job No. 8243 Division No. ____ | Survey of ____ | Survey by ____ | Notes ____ | Indexed ____ Date ____

STATION	B. S.	H. I.	F. S.	ELEV.	Sta	Sq ft
210+25		22°			216+50	7
+50		35°			217+00	10°
+75		32°			217+50	5
211+00		25°			218+00	7
+25		37°			+50	7
+50		35°			219+00	10°
211+75		30°			+50	10°
212+00		30°			220+00	9°
+25		35°			+50	6°
+50		20°			221+00	7°
+75		7°			+50	5°
213+00		17°			222+00	11°
213+20	P.I. 1=9				+50	7°
+25		25°			223+00	7°
+50		17°			+50	7°
+75		10°			224+00	3
214+00		5°			+50	5
+50		7°			225+00	5
215+00		7°			+50	12°
+50		10°			226+00	8°
216+00		7°			+50	8°

Earthwork Co. C. ALBERT E. TIMMONS MAR 6 1939

LOS ANGELES COUNTY SURVEYOR

| Point at | Point on | | |

Form 301 LACM 3-34

PLEASE RETURN TO
LOS ANGELES COUNTY SURVEYOR
700 HALL OF RECORDS

NOTE: ANY ADDITIONS OR CHANGES ON THIS SHEET MUST BE MADE OR CIRCLED IN RED INK. WITH DATE AND NAME OF PERSON MAKING CHANGE

Do not extend notes this side of this line

Transit at	Sight on	Stadia Intercept	Stadia Distance	Stadia Rod→	Horizontal Angle 0° to 360° Right	Horiz. Distance	+ Vertical Angle −	Elevation of Point	+ Back Sight	+ Difference Elevation	Height of Instrument	+ Vertical Distance	REMARKS Station	Left	Right
	Sta				89 ° 57 '		° '	Sta			89 ft				
	247+00				6 ° '		° '	259+00			0				
	248+00				6 ° '		° '	+50			12 °				
	+50				6 ° '		° '	260+00			30 °				
	249+00				6 ° '		° '	+50			30 °				
	+50				3 ° '		° '	261+00			60 °				
	250+00				3 ° '		° '	+25			5 °				
	+50				0 ° '		° '	+50			0				
	251+00				5 ° '		° '	261+75			14 °				
	252+00				6 ° '		° '	262+00			12 °				
	+50				5 ° '		° '	+25			14 °				
	253+00				0 ° '		° '	+50			10 °				
	+50				0 ° '		° '	262+75			5 °				
	254+00				0 ° '		° '	263+00			15 °				
	255+00				0 ° '		° '	+25			23 °				
	+50				7 ° '		° '	+50			20 °				
	256+00				5 ° '		° '	+75			13 °				
	257+00				6 ° '		° '	264+00			10				
	+50				6 ° '		° '	+50			5 °				
	258+00				12 ° '		° '	265+00			5 °				
	+50				15 ° '		° '	+50			5 °				

Earthwork Calc. ALBERT E. TIMMONS MAR 6 1939

Additional Notes

Topography Description Legend:
Side Hill ... S.H. | Bottom Draw B.D. | Bottom Wash B.W. | Top of Ridge T.R. | Top of Slope T.S.
Side of Draw S.D. | Side of Ridge S.R. | Head of Draw H.D.

Intersection of Break to Slope ... B.S. | Top of Cliff ... T.Cl. | Bottom of Cliff ... B.Cl. | Top of Canyon ... T.Cn. | Bottom of Canyon ... B.Cn.

Top of Bank ... T.B. | Bottom of Bank ... B.B. | Top of Cut ... T.Ct. | Bottom of Cut ... B.Ct. | Top of Fill ... T.F. | Bottom of Fill ... B.F.

Top of Curb ... T.C. | Gutter ... G. | Edge of Pavement ... E.P. | Edge of Road ... E.Rd.

Fence ... Fe. | Pile-Pt. ... P.P. | Corner ... Cor. | Ditch ... Dt. | Spreaders ... Sp. | Telephone Pole ... T.P. | Eucalyptus ... Eu. | Power Pole ... P.P. | Pine ... Pi. | Culvert ... Culv. | Trees and all common standard abbreviations

Tree ... Tr. | Shrub ... Shr. | Flat ... Fl. | Stream ... Str. | Trail ... Tr. | Pavement ... Pvt. | Edge of Road ... E.Rd.

LOS ANGELES COUNTY SURVEYOR
700 HALL OF RECORDS

NOTE: ANY ADDITIONS OR CHANGES ON THIS SHEET MUST BE DATED, OR INITIALED IN RED INK, WITH DATE AND NAME OF PERSON MAKING CHANGE

Cont from Pg 224

Do not extend notes this side of this line

S 9 H

Station	Back	Foresight	Distance	Horizontal Angle	Vertical Angle	Rise	Elevation	Height of Instrument	Vertical Distance	Remarks
							1	5+3		
2+a				4			2	279+00	2 0	
26+00				4 0			3	280+	6 0	
+50				0			4	+25	7 0	
26?+				0			5	+50	6 0	
+50				0			6	+75	9 0	
26?+00				0			7	281+00	12 0	
+50				3 0			8	+50	13 0	
269+				2 0			9	282+00	9 0	
+50				4 0			10	+50	0	
27?+				4			11	283+	4	
+50				4			12	+50	10	
271+50				4			13	284+00	13 0	
272+00				5 0			14	+50	15 0	
+50				2 0			15	285+00	15 0	
273+0				2 0			16	+50	10 0	
273+50				2 0			17	286+	15 0	
274+0				2 0			18	+50	11 0	
27?50				2 0			19	287+	12 0	
276+00				2 0			20	+50	14 0	
277+0				0			21	288+00	14 0	
278+				1 0			22	+50	11 0	

Notes Red. Platted Job No. Drawn By Checked By

Plotted T-15 Sht 3-14-39

R.S. 77 Pg. 45

Plotted Oct 4 1939 T.J.S.

Form 301 10M 3-34

PLEASE RETURN TO
LOS ANGELES COUNTY SURVEYOR
700 HALL OF RECORDS

NOTE: ANY ADDITIONS OR CHANGES ON THIS SHEET MUST BE MADE OR CIRCLED IN RED INK, WITH DATE AND NAME OF PERSON MAKING CHANGE

Do not extend notes this side of this line

Transit at	Sight on	Stadia Intercepts	Stadia Distance	Stadia Rod	Horizontal Angle 0° to 360° Right	Horiz. Distance	+ Vertical Angle −	Elevation of Point	+ Back Sight −	+ Difference Elevation −	Height of Instrument	+ Vertical Distance −	REMARKS Station	Left	Right
Sta					Sq. ft.		° '	Sta		0°	ft.				
289+00					15.0		° '	296+25			5.0				
+50					13.0		° '	+50			5.0				
+75					11.0		° '	+75			6.0				
290+00					7.0		° '	297+00			4.0				
+25					11.0		° '	+50			12.0				
+50					9.0		° '	298+00			12.0				
+75					12.0		° '	+50			20.0				
291+00					17.0		° '	299+00			18.0				
+50					11.0		° '	+25			18.0				
292+00					5.0		° '	+50			14.0				
+50					12.0		° '	300+00			12.0				
293+00					12.0		° '	+25			12.0				
+50					4.0		° '	+50			15.0				
+75					4.0		° '	+75			13.0				
294+00					4.0		° '	301+00			12.0				
+50					6.0		° '	+50			9.0				
295+00					5.0		° '	302+00			6.0				
+25					5.0		° '	+50			10.0				
+50					5.0		° '	303+00			7.0				
296+00					13.0		° '	+50			5.0				

Earthwork Calc. A.E. Timmons 3.16.80

Page 226

Topography Description Legend:
Side Hill... S.H. Bottom Draw B.D.
Bot. of Draw B.D. Bottom Wash B.W.
Bot. of Ridge B.R. Top of Ridge T.R.
Head of Draw H.D. Top of Slope T.S.

Cross Sec. Pt. Cross Sec. Pt. Cross Sec. Pt. Cross Sec. Pt.
Sta. Sta. Sta. Sta.
Top of Bank T.B. Bottom of Bank B.B. Edge of Road E.R. Edge of Pavement E.P.
Top of Trail T.T. Bottom of Trail B.T. Edge of Road E.R.
Top of Fill T.F. Cut B.C. Edge of Road E.R.
Bottom of Fill B.F. Fill T.F.
Top of Bank T.B. Bottom of Bank B.B.
Top of Bank T.B. Bottom of Bank B.B.
Top of Bank T.B. Bottom of Bank B.B

FORM 353 1M 8-38

PLEASE RETURN TO
LOS ANGELES COUNTY SURVEYOR
700 HALL OF RECORDS

NOTE: ANY ADDITIONS OR CHANGES ON THIS SHEET MUST BE MADE OR CIRCLED IN RED INK, WITH DATE AND NAME OF PERSON MAKING CHANGE

Do not extend notes this side of this line

NOTES RED. _____ DATE _____
NOTES CHKD. _____ DATE _____
JOB NO. 8243 SURVEY OF Las Virgenes Int Const
SURVEY BY Stevenson DATE 3-14-39
NOTES BY Stevenson DATE _____
INDEXED _____ DATE _____
F. B. 778 PG. 227

Earth work Calc. A E Timms 3-16-39

B.M.	1ST RUN	DIFF.	2ND RUN	3RD RUN	ADJ. ELEV.	DESCRIPTION			
Sta		Sq ft.				Sta		Sq ft.	
304+00		5.0				320+50		2.0	
+50		5.0				321+50		4.0	
305+00		4.0				322+00		2.0	
+50		3.0				323+00		5.0	
306+00		3.0				324+00		5.0	
307+00		4.0				+50		7.0	
+50		7.0				325+00		6.0	
308+00		7.0				+50		3.0	
+50		6.0				+75		3.0	
+75		6.0				326+00		1.0	
309+00		7.0				+25		3.0	
+50		6.0				+50		0	
310+00		5.0				327+00		2.0	
+50		3.0				+50		2.0	
+75		2.0				328+00		2.0	
311+00		1.0				+25		0	
+50		2.0				+50		0	
312+00		3.0				329+00		2.0	
313+00		2.0				+25		6.0	
314+00		1.0				+50		15.0	
315+00		1.0				+75		12.0	
+50		1.0				330+00		15.0	
316+00		2.0				+50		24.0	
+50		2.0				331+00		30.0	
317+00		3.0				+25		30.0	
318+00		2.0				+50		17.0	
+50		3.0				+75		10.0	
319+00		5.0				332+00		35.0	
+50		5.0				+50		40.0	
320+00		4.0				+75		35.0	
						333+00		40.0	

FORM 353 1M 8-38

PLEASE RETURN TO
LOS ANGELES COUNTY SURVEYOR

700 HALL OF RECORDS

NOTE: ANY ADDITIONS OR CHANGES ON THIS SHEET MUST BE MADE OR CIRCLED IN RED INK, WITH DATE AND NAME OF PERSON MAKING CHANGE

Do not extend notes this side of this line

JOB NO. 8243 SURVEY OF Los Virgenes FR System NOTES RED. DATE
SURVEY BY Stevenson NOTES CHKD. DATE
NOTES BY T.L.S. DATE 3-14-39
INDEXED A. C. Johnson DATE

B 278 PG 228

B.M.	1ST RUN	DIFF.	2ND RUN	3RD RUN	ADJ. ELEV.	DESCRIPTION
333 + 25		35.0				+50 20.0
+50		30.0				342 50.0
+75		25.0				+50 25.
334 +00		17.0				343+00 15.0
+25		28.0				+50 Gr
+50		30.0				344+00 17.0
+75		30.0				+50 30.0
335+00		30.0				345+00 35.0
+25		33.0				+50 40.0
+50		40.0				346+00 45.0
+75		25.0				+50 20.0
336+00		25.0				347+00 0
+25		15.0				+50 10.0
+50		10.0				348+00 5.0
+75		5.0				+50 3.0
337+00		5.0				+75 5.0
+50		5.0				349+00 5'0"
338+00		20.0				+50 40
+25		23.00				350+00 35.0
+50		20.0				+50 60.0
+75		10.0				351+00 80.0
339+00		10.0				+25 60.
+25		10.				+50 50.0
+50		5.0				+75 45.0
+75		Gr				352+00 30.0
340+00		Gr				+25 8.0
+25		Gr				+50 0
+50		"				+75 0.
+75		3				353+00 0.
341+00		5				+50 4.0

Earthwork Calc. A.E. Timmons 3-16-39

FORM 353 1M 8-38

PLEASE RETURN TO
LOS ANGELES COUNTY SURVEYOR
700 HALL OF RECORDS

NOTE: ANY ADDITIONS OR CHANGES ON THIS SHEET MUST BE MADE OR CIRCLED IN RED INK, WITH DATE AND NAME OF PERSON MAKING CHANGE

Do not extend notes this side of this line

NOTES RED. DATE
NOTES CHKD. DATE
INDEXED DATE

JOB NO. 8243 SURVEY OF Los Virgenes
SURVEY BY Joyce, Tuls DATE 3-14-
NOTES BY T.L.S. DATE

F.B. 778 PG. 24

Earthwork Calc. AE Timmons 3-16-38

B.M.	1ST RUN	DIFF.	2ND RUN	3RD RUN	ADJ. ELEV.
2+9		39 ft			
354+00		2.0			
+50		3.0			
355+00		4.0			
+50		20.0			
+75		14.0			
356+00		4.0			
+50		0.0			
357+00		0.0			
+25		0.0			
+50		0.0			
358+00		3.0			
+50		4.0			
359+00		25.0			
+25		30.0			
+50		30.0			
360+00		40.0			
+25		60.0			
+50		50.0			
+75		55.0			
361+00		75.0			
+25		75.0			
+50		120.0			
+75		120.0			
362+00		122.0			
+50		90.0			
363+00		73.0			
+25		42.0			
+50		24.0			
+75		24.0			

DESCRIPTION	
2+9	39 ft
364+00	35.0
+25	24.0
+50	0.0
3 +75	12.0
365+00	42.0
+25	42.0
+50	30.0
+75	35.0
3 366+00	35.0
+25	30.0
+50	50.0
+75	57.0
367+00	62.0
+25	70.0
+50	62.0
+75	60.0
368+00	60.
+25	60.0
+50	75.0
+75	60.0
369+00	60.0
+25	60.0
+50	75.0
+75	76.0
370+00	76.0
+25	80.0
+50	90.0
+75	65.0
371+00	75.0

FORM 353 1M 8-38

PLEASE RETURN TO
LOS ANGELES COUNTY SURVEYOR
700 HALL OF RECORDS

NOTE: ANY ADDITIONS OR CHANGES ON THIS SHEET MUST BE MADE OR CIRCLED IN RED INK, WITH DATE AND NAME OF PERSON MAKING CHANGE

Do not extend notes this side of this line

NOTES RED. DATE
NOTES CHKD. DATE

F.B. 778 PG. 230

JOB NO. 8243 SURVEY OF Las Virgenes FIT System
SURVEY BY Stevenson
NOTES BY [illegible] C. Johnson DATE
INDEXED DATE

B.M.	1ST RUN	DIFF.	2ND RUN	3RD RUN	ADJ. ELEV.	DESCRIPTION	
24+		39+1				34+	59+7
371+25		50.				378+50	62.0
+50		60.0				+75	62.0
+75		60.0				379+00	40.0
372+00		42.0				+25	24.0
+25		45.0				+50	15.0
+50		35.0				+75	24.0
+75		12.0				380+00	40.0
373+00		6.				+25	32.0
+25		9.				+50	36.0
+50		15.				+75	32.0
+15		0.				381+00	32.0
374+00		0.				+25	36.0
+25		0				+50	36.0
+50		0				+75	36.0
+15		0.				382+00	36.0
375+00		4.0				+25	32.0
+25		5.				+50	35.0
+50		10.				+75	32.0
+75		0				383+00	32.0
376+00		0				+25	16.0
+25		2.0				+50	25.0
+50		8.0				+75	25.0
+75		19.0				384+00	30.0
377+00		35.0				+25	35.0
+25		40.0				+50	42.0
+50		40.0				+75	42.0
+75		50.0				385+00	36.0
378+00		50.0				+25	20.0
+25		62.0				+50	13.0

Earthwork Calc. A.E. Timmons 3/6/39

FORM 353 1M 8-38

PLEASE RETURN TO
LOS ANGELES COUNTY SURVEYOR

700 HALL OF RECORDS

NOTE: ANY ADDITIONS OR CHANGES ON THIS SHEET MUST BE MADE OR CIRCLED IN RED INK, WITH DATE AND NAME OF PERSON MAKING CHANGE

Do not extend notes this side of this line

NOTES RED. _____ DATE _____

NOTES CHKD. _____ DATE _____

JOB NO. 8243 SURVEY OF Los Angeles Rll System

SURVEY BY Stevenson

NOTES BY T.J.S. DATE 3-14-39

INDEXED _____ DATE _____

F.B. 778 PG 23

Earthwork Calc. AE Timmons 3-16-39

B.M.	1ST RUN	DIFF.	2ND RUN	3RD RUN	ADJ. ELEV.	DESCRIPTION	
2+9		3 ft				2+9	3 ft
386+00		4.0				397+75	15.0
+50		3.0				398+00	22.0
387+00		0.0				+25	25.0
+50		1.0				+50	30.0
388+00		13.0				+75	30.0
+50		0.0				399+00	18.0
389+00		0.0				+25	9.0
+50		12.0				+50	10.0
390+00		3.0				+75	10.0
+50		0.0				400+00	10.0
391+00		0.0				+25	10.0
+50		0.0				+50	12.0
392+00		12.0				+75	12.0
+50		24.0				401+00	20.0
393+00		42.0				+25	12.0
+50		60.0				+50	12.0
+75		90.0				+75	28.0
394+00		50.0				402+00	24.0
+25		50.0				+25	48.0
+50		12.0				+50	50.0
+75		30.0				+75	48.0
395+00		8.0				403+00	36.0
+25		6.0				+25	42.0
+50		5.0				+50	48.0
396+00		0.0				404+00	42.0
+50		7.0				+50	6.0
397+00		11.0				405+00	12.0
+25		15.0				+50	6.0
+50		8.0				406+00	15.0
						+50	12.0

FORM 353 1M 8-38

PLEASE RETURN TO
LOS ANGELES COUNTY SURVEYOR

700 HALL OF RECORDS

NOTE: ANY ADDITIONS OR CHANGES ON THIS SHEET MUST BE MADE OR CIRCLED IN RED INK, WITH DATE AND NAME OF PERSON MAKING CHANGE

Do not extend notes this side of this line

JOB NO. 8243 SURVEY OF Los Virgenes FM System
SURVEY BY Stevenson.
NOTES BY T.J.S. DATE 3-14-39
INDEXED C. Johnson DATE
NOTES RED. DATE
NOTES CHKD. DATE

B.B. 778 PG 232

B.M.	1ST RUN	DIFF.	2ND RUN	3RD RUN	ADJ. ELEV.	DESCRIPTION		
Sta		Sta				420	39 FT	
406+50		12.0				421+50	20.0	
407+00		22.0				+75	20.0	
+50		10.0				422+00	16.0	
408+00		10.0				+25	20.0	
+50		30.0				+50	18.0	
409+00		7.0				+75	14.0	
+50		7.0				423+00	12.0	
410+0		6.0				+25	6.0	
+50		5.0				+50	5.0	
411+00		5.0				+75	10.0	
+50		6.0				424+00	15.0	
412+00		6.0				+25	17.0	
+50		3.0				+50	14.0	
413+00		4.0				+75	8.0	
+50		4.0				425+00	0.0	
414+00		4.0				+25	0.0	
+50		4.0				+50	6.0	
415+00		5.0				+75	6.0	
+50		5.0				426+00	15.0	
416+00		5.0				+25	18.0	
+50		4.0				+50	19.0	
417+00		2.0				+75	5.0	
418+00		4.0				427+00	28.0	
+50		6.0				+25	27.0	
419+00		5.0				+50	22.0	
+50		5.0				+75	25.0	
420+00		6.0				428+00	13.0	
+50		6.0				+25	17.0	
421+00		10.0				+50	13.0	

Earthwork Calc. A.E. Timms 3-16-39

FORM 353 1M 8-38

PLEASE RETURN TO
LOS ANGELES COUNTY SURVEYOR

700 HALL OF RECORDS

NOTE: ANY ADDITIONS OR CHANGES ON THIS SHEET MUST BE MADE OR CIRCLED IN RED INK, WITH DATE AND NAME OF PERSON MAKING CHANGE

Do not extend notes this side of this line

NOTES RED. DATE
NOTES CHKD. DATE
JOB NO. 5443 SURVEY OF Los Angeles County Engineering
SURVEY BY [illegible] DATE 5-15-39 to 5-27-39
NOTES BY [illegible] DATE 6-30-39
INDEXED [illegible] DATE
F.B. 777 PG. 233

Earthwork Calculated - C.L. Keagle 7-5-39
" Checked - L.K. Freeman 7-6-39

B.M.	1ST RUN	DIFF.	2ND RUN	3RD RUN	ADJ. ELEV.	DESCRIPTION	Sq ft
Sta.		3 ft.				Sta	Sq ft
428+75		4.0				446+00	4.0
429+00		17.0				446+50	4.0
+50		13.0				447+00	6.0
+75		6.0				+50	6.0
430+00		0.0				448+00	6.0
+25		12.0				+50	6.0
+50		30.0				449+00	6.0
+75		24.0				450+00	5.0
431+00		11.0				+50	6.0
+50		12.0				451+00	8.0
+75		15.0				+50	7.0
432+00		16.0				452+00	6.0
+50		16.0				+50	6.0
433+00		17.0				453+00	6.0
+50		18.0				+50	5.0
434+00		21.0				454+00	5.0
+50		20.0				+50	6.0
435+00		17.0				455+00	5.0
+50		21.0	458+00 take off to			+50	4.0
436+00		1.0	China Flats. Sta's			456+00	5.0
+50		4.0	continue on Rd			457+00	6.0
437+00		3.0	to Albertson			458+00	5.0
438+00		2.0	Ranch.			459+00	6.0
439+00		4.0				460+00	6.0
440+00		4.0	For continuation			461+00	6.0
441+00		4.0	of Main Line			462+00	6.0
442+00		6.0	See pg.			463+00	6.0
443+00		6.0				464+00	6.0
444+00		4.0				465+00	12.0

To Albertson Ranch

FORM 353 1M 8-38

PLEASE RETURN TO
LOS ANGELES COUNTY SURVEYOR

700 HALL OF RECORDS

NOTE: ANY ADDITIONS OR CHANGES ON THIS SHEET MUST BE MADE OR CIRCLED IN RED INK, WITH DATE AND NAME OF PERSON MAKING CHANGE

Do not extend notes this side of this line

JOB NO. 8243 SURVEY OF Las Virgenes FTT System NOTES RED. DATE

SURVEY BY Stevenson NOTES CHKD. DATE

NOTES BY T.J.S. DATE 5-29-39

INDEXED A. C. Johnson DATE

F.B. 778 PG. 234

B.M.	1ST RUN	DIFF.	2ND RUN	3RD RUN	ADJ. ELEV.	DESCRIPTION	
Sta		3 ft				Sta	3 ft
466+00		14.0				483+50	16.0
467+00		30.0				484+00	10.0
+50		15.0				+50	11.0
468+00		25.0				4 +75	12.0
+50		30.0				485+00	7.0
469+00		27.0				+50	15.0
+50		27.0				486+00	13.0
470+00		27.0				+50	13.0
+50		32.0				487+00	6.0
471+00		44.0				+50	6.0
+50		48.0				488+00	25.0
472+00		35.0				489+00	18.0
+50		50.0				+25	16.0
473+00		45.0				+75	12.0
+50		40.0				490+00	10.0
474+00		40.0				+50	6.0
+50		60.0				491+00	6.0
475+00		30.0				492+00	5.0
+50		18.0				493+00	5.0
476+00		27.0				494+00	6.0
+50		20.0				495+00	6.0
477+00		18.0				495+50	6.0
+50		15.0				496+00	6.0
478+00		18.0				+50	6.0
479+00		12.0				497+00	6.0
480+00		6.0				498+00	6.0
481+00		8.0				+50	25.0
482+00		6.0				499+00	7.0
483+		6.0				+50	5.0

FORM 353 1M 8-38

PLEASE RETURN TO
LOS ANGELES COUNTY SURVEYOR
700 HALL OF RECORDS

NOTE: ANY ADDITIONS OR CHANGES ON THIS SHEET MUST BE MADE OR CIRCLED IN RED INK, WITH DATE AND NAME OF PERSON MAKING CHANGE

Do not extend notes this side of this line

NOTES RED. DATE
NOTES CHKD. DATE
INDEXED

JOB NO. 8243 SURVEY OF Los Virgenes Fill System F.B. 1115 PG. 23
SURVEY BY Sievers Soil
NOTES BY Ind. S DATE 5-29-39
Earthwork Calculated - C.L. Keagle 7-5-39
" Checked - L.K. Freeman 7-6-39

B.M.	1ST RUN	DIFF.	2ND RUN	3RD RUN	ADJ. ELEV.	DESCRIPTION	Sq Ft
Sq Ft		Sq Ft				Sq Ft	
500+00		6.0				520+50	100
+50		6.0				521+00	250
501+00		6.0				+50	240
502+00		6.0				522+00	150
503+00		6.0				+50	270
+50		5.0				523+00	170
504+00		6.0				+50	250
505+00		6.0				524+00	70
+50		6.0				+50	120
506+00		6.0				525+00	170
507+00		6.0				+50	320
508+00		6.0				526+00	280
509+00		6.0				+50	230
510+00		6.0				527+00	350
511+00		6.0				+50	320
512+00		10.0				528+00	220
513+00		6.0				+50	350
+50		13.0				+75	300
514+00		12.0				529+00	350
~~515+00~~ +50		20.0				+25	150
515+00		6.0				+50	120
+50		12.0				530+00	180
516+00		22.0				+50	60
+50		6.0				531+00	60
517+00		6.0				532+00	60
518+00		6.0				533+00	60
519+00		6.0				+50	60
+50		6.0				534+00	60
520+00		10.0					

FORM 353 1M 8-38

PLEASE RETURN TO
LOS ANGELES COUNTY SURVEYOR

700 HALL OF RECORDS

NOTE: ANY ADDITIONS OR CHANGES ON THIS SHEET MUST BE MADE OR CIRCLED IN RED INK, WITH DATE AND NAME OF PERSON MAKING CHANGE

Do not extend notes this side of this line

F.B. 778 PG. 236

JOB NO. 8243 SURVEY OF Los Virgines Flt System NOTES RED. DATE

SURVEY BY Stevenson T.J.S. DATE 5-29-39 NOTES CHKD. DATE

NOTES BY A. C. Johnson DATE

INDEXED DATE

B.M.	1ST RUN	DIFF.	2ND RUN	3RD RUN	ADJ. ELEV.	DESCRIPTION					
		Sq ft				Sta				Sq ft.	
534+50		6.0				545+75				12.0	
535+00		12.0				546+00				6.0	
+50		12.0				+25				7.0	
536+00		14.0				+50				6.0	
+25		18.0				+75				6.0	
+50		22.0				547+00				6.0	
+75		27.0				+25				10.0	
537+00		30.0				548+00				13.0	
+25		32.0				16.				15.0	
+50		32.0				549+00				15.0	
538+00		17.0				+50				18.0	
+50		10.0				550+00				30.0	
539+00		10.0				+50				40.0	
+50		8.0				+75				40.0	
540+00		6.0				551+00				34.0	
+75		18.0				+50				30.0	
541+00		16.0				552+00				40.0	
+50		8.0				Sta to Sta I think T.J.S.					
542+00		10.0				+50				17.0	
+50		10.0				553+00				24.0	
543+00		10.0				+25				60.0	
+50		10.0				+50				60.0	
544+25		6.0				+75				15.0	
~~+50~~		8.0				554+00				Fill	
+50		12.0				+25				10.0	
+75		12.0				+50				15.0	
545+00		12.0				+75				20.0	
+25		16.0				555+00				13.0	
+50		16.0				+25				10.0	

FORM 353 1M 8-38

PLEASE RETURN TO
LOS ANGELES COUNTY SURVEYOR

700 HALL OF RECORDS

NOTE: ANY ADDITIONS OR CHANGES ON THIS SHEET MUST BE MADE OR CIRCLED IN RED INK, WITH DATE AND NAME OF PERSON MAKING CHANGE

Do not extend notes this side of this line

NOTES RED. DATE
NOTES CHKD. DATE
JOB NO. 8243 SURVEY OF Las Virgenes Fil Sub F.B. 738 PG. 22
SURVEY BY Stewart Soto
NOTES BY L. C. Johnson DATE 6-12-39
INDEXED DATE

B.M.	1ST RUN	DIFF.	2ND RUN	3RD RUN	ADJ. ELEV.	DESCRIPTION	
						Sta	Sq Ft
555+50			0			567+50	22.0
+75			27.0			568+00	3.0
556+00			25.0			+50	27.0
+50			12.0			569+00	25.0
557+00			12.0			+50	17.0
+50			15.0			570+00	13.0
558+00			11.0			+50	22.0
+50			9.0			571+00	18.0
559+00			10.0			+50	3.0
+50			7.0			572+00	23.0
+75			8.0			+50	35.0
560+00			8.0			573+00	55.0
+25			7.0			+50	28.0
+50			14.0			574+00	13.0
+75			35.0			575+00	6.0
561+00			50.0			576+00	15.0
+25			50.0			577+00	7.0
+50			40.0			+50	8.0
+75			15.0			578+00	11.0
562+00			25.0			578+75	9.0
563+00			27.0			579+00	10.0
+50			22.0			+25	24.0
564+00			27.0			+50	18.0
+50			40.0			580+00	35.0
565+00			23.0			+25	45.0
+50			30.0			+50	30.0
566+00			22.0			+75	25.0
+25			13.0			581+00	30.0
+75			22.0			+25	50.0
567+00			20.00				

Earthwork Calculated C.L. Kaegle 7-5-39
" Checked L.K. Freeman 7-6-39

FORM 353 1M 8-38

PLEASE RETURN TO
LOS ANGELES COUNTY SURVEYOR

700 HALL OF RECORDS

NOTE: ANY ADDITIONS OR CHANGES ON THIS SHEET MUST BE MADE OR CIRCLED IN RED INK, WITH DATE AND NAME OF PERSON MAKING CHANGE

Do not extend notes this side of this line

NOTES RED. DATE

NOTES CHKD. DATE

JOB NO. SURVEY OF

SURVEY BY

NOTES BY DATE

INDEXED A. O. Johnson DATE

B.M.	1ST RUN	DIFF.	2ND RUN	3RD RUN	ADJ. ELEV.	DESCRIPTION
Sta		3y 11				
581+50		20.0				
+75		20.0				
582+00		20.0				
+25		Grade				
+50		12.0				
+75		5.0				
583+00		12.0				
+25		13.0				
584+00		13.0				
+25		12.0				
+50		12.0				
	End of new Const on Albertson Line					

3778 PG. 238

Notes Ck'd by	Survey of Los Angeles ATT System	F.B. 778	Pg. 239
Map No. B-1830	W. O. 8243 Tape No. 49 St'd 84°F		
Office Work	Surveyed by Stevenson		
Checked	Notes T.J.S Date 7-18-39		
Date	Indexed A. C. Johnson 7-31-42		

Cont. to bot. page 240

RETURN TO
LOS ANGELES COUNTY SURVEYOR
700 HALL OF RECORDS

Note: Any Additions or Changes on This Sheets Must be Made or Circled in Red Ink With Date and Name of Person Making Change.

Do not extend notes this side of this line

FORM 247 SM 10-37

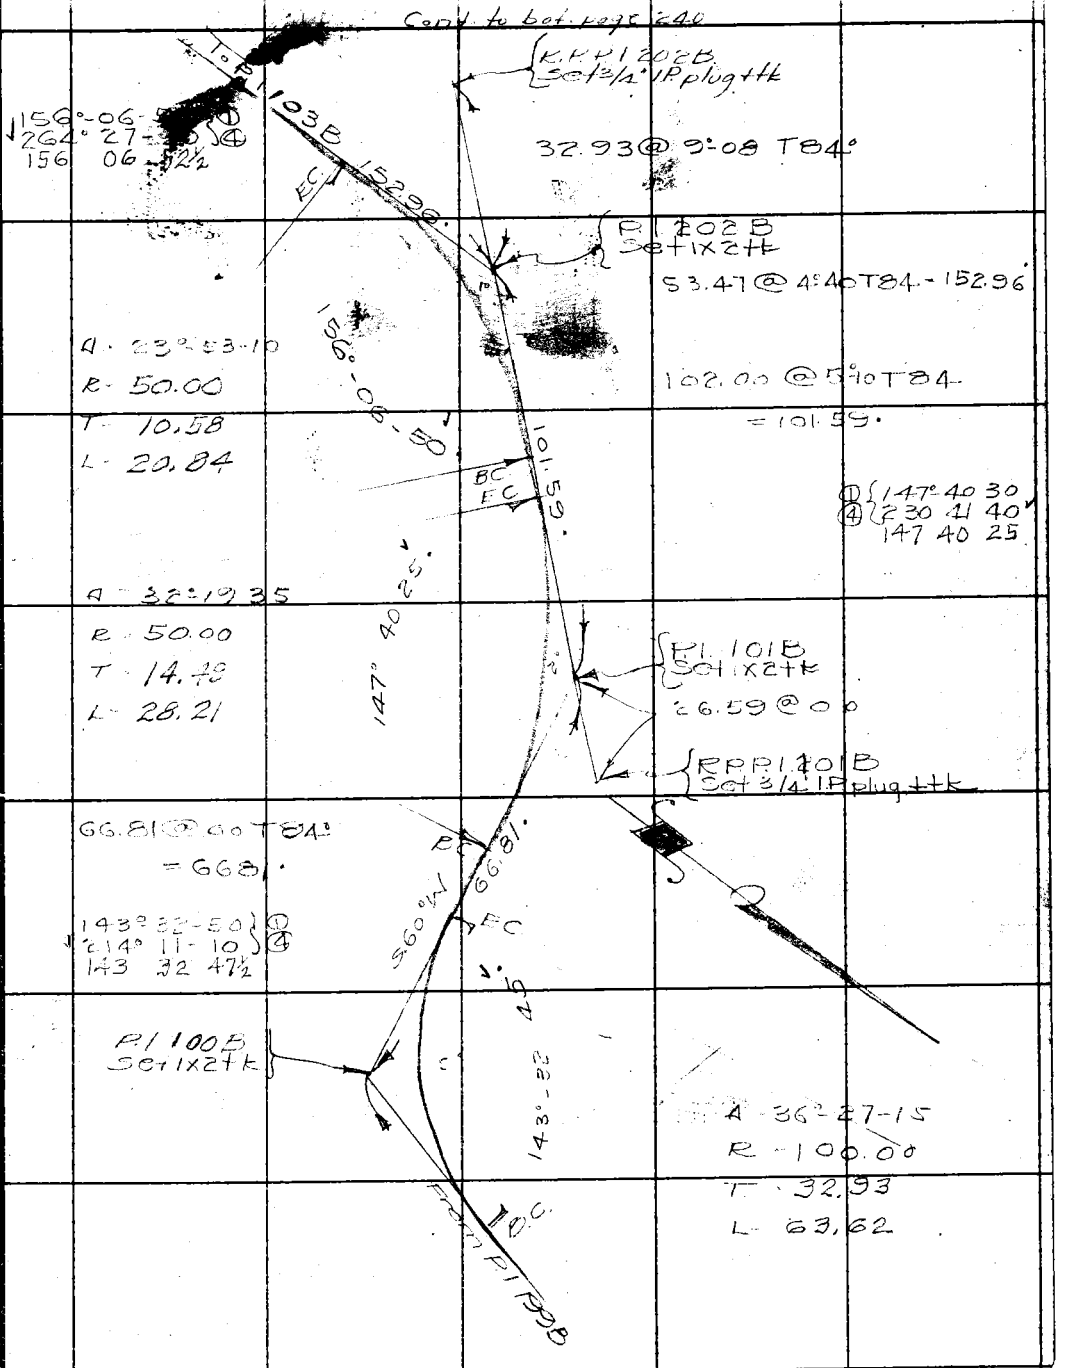

Cont. from top page 200

F.B. 778 PG. 240

Cont. to bot. page 241

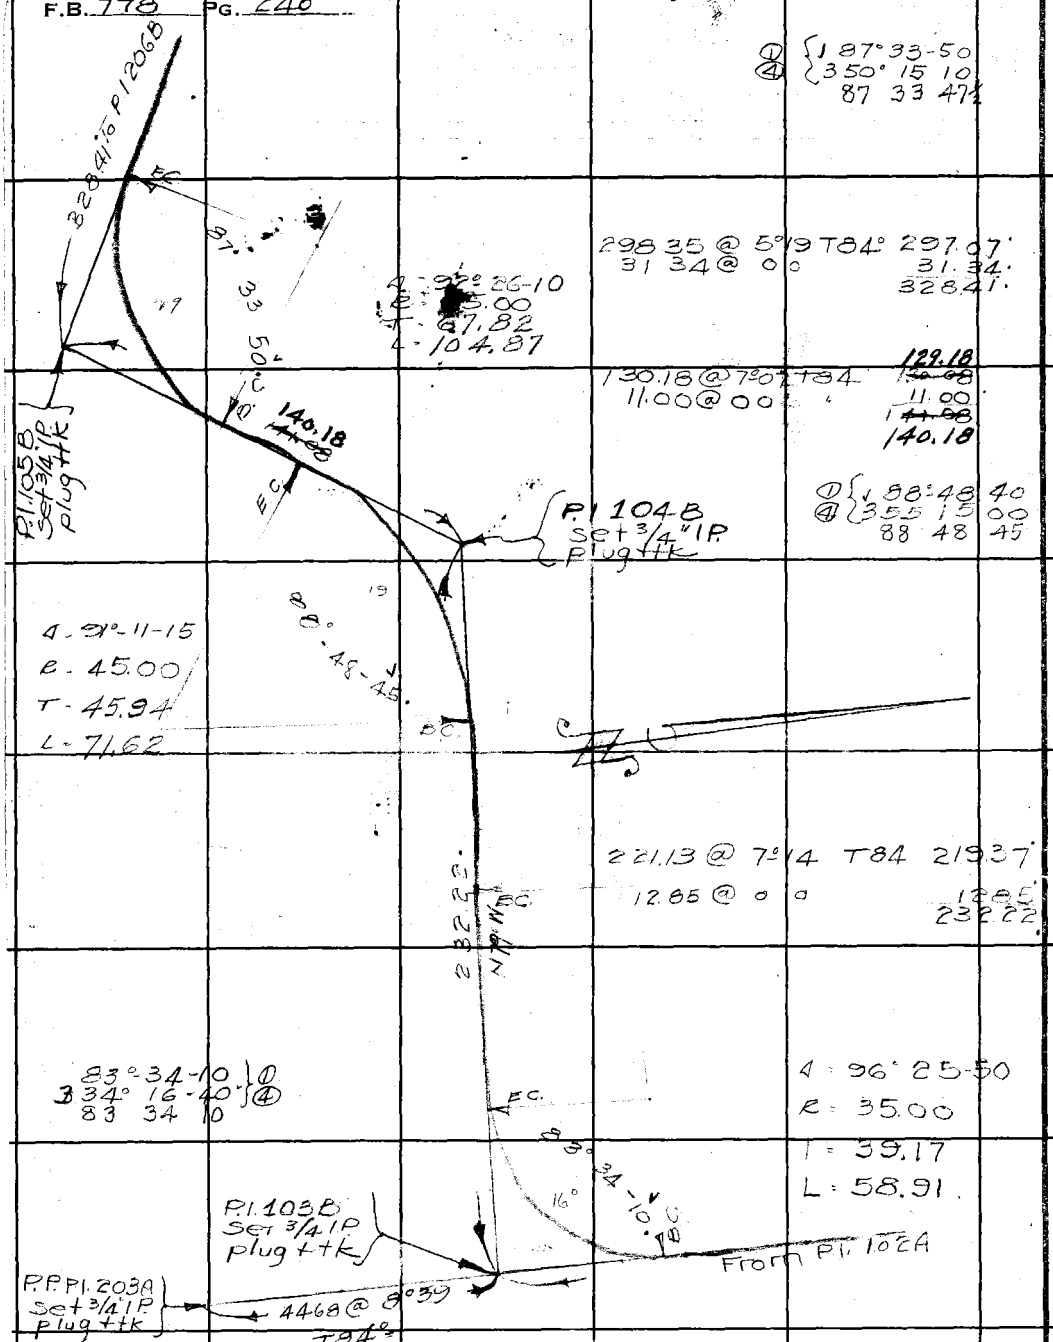

① { 1 87° 33-50
④ { 350° 15 10
87 33 47½

298 35 @ 5°19 T84° 297.07'
31 34 @ 0° 31.34'
328.41'

L - 104.87

130.18 @ 7°02 T84 ~~129.18~~ 129.18
11.00 @ 0° 0' 11.00
~~141.18~~ 140.18

① { 1 88°-48 40
④ { 355 15 00
88 48 45

Δ - 91°-11-15
R - 45.00
T - 45.94
L - 71.62

221.13 @ 7°14 T84 219.37'
12.85 @ 0° 0' 12.85'
232.22'

83°-34-10 ①
3 334° 16-40 ④
83 34 10

Δ - 96° 25-50
R - 35.00
T - 39.17
L - 58.91

RETURN TO
LOS ANGELES COUNTY SURVEYOR
700 HALL OF RECORDS

Note: Any Additions or Changes on This Sheets Must be Made or Circled in Red Ink With Date and Name of Person Making Change.

Do not extend notes this side of this line

Notes Ck'd by		Survey of La Verne Fill System	F.B. 778 Pg. 241
Map No. B-1830		W. 08243 Tape No. 47 St'd 84oF	
Office Work		Surveyed by Stevenson	
Checked		Notes T.J.S Date 7-18-39	
Date		Indexed A. C. Johnson	

Note: Any Additions or Changes on This Sheets Must be Made or Circled in Red Ink With Date and Name of Person Making Change.

Do not extend notes this side of this line

RETURN TO
LOS ANGELES COUNTY SURVEYOR
700 HALL OF RECORDS

FORM 247 SM 10-37

Cont. from top page 240

131.10 @ 6°08 T92° = 130.35.

174°-46-40 ①
339°-06-20 ④
174 46 35

Pl 108B Set ix2tk

58.12 @ 00°196" = 58.12

58.12

Pl 107B Set ix2tk

175°-09-00 ①
340 36 00 ④
175 09 00

184.65 @ 5°30 T92 = 182.82.

137°-41-30 ①
190°-46-30 ④
137 41 37½

Δ 42°-18-25
R = 225.00
T = 87.06
L = 166.14

Pl 106B Set

From Pl 105B

Cont to bot page 243

F.B. 778 PG. 242

8843 @ 4-14 = 88.19

Δ - 31° 50 40

R - 90.00

T - 25.67

L - 50.02

64.84 @ 0 0 T 92

- 64.84

131° 28 50 ①
165° 55 30 ④
131 28 52½

RP Pl.111B
Set 3/4 IP
plug + tk

To Pl.112B 88.19

20.47

Pl.111B
set ix2 tk

148° 09 10 ① ④
232° 37 00
148 09 15

148-09-15

64.84

Pl.110B
set ix2 tk

137.2 @ 8.40

RP Pl.110B
set 3/4" IP
plug + tk

131.17 @ 6.05 T 92°

130.44

Δ - 48° - 31-15

R - 70.00

T - 31.55

L - 59.28

131.08

130.44

133° 30 50 ①
174° 03 10 ④
133 30 47½

Δ - 46° 29-05

R - 85.00

T - 36.51

L - 68.96

133°30'55"

Pl.109B
set ix2 tk

10.98

From

Cont. from top page 241

RETURN TO
LOS ANGELES COUNTY SURVEYOR
700 HALL OF RECORDS

Do not extend notes this side of this line

Note: Any Additions or Changes on This Sheets Must be Made or Circled in Red Ink With Date and Name of Person Making Change.

Notes Ck'd by		Survey of Las Virgenes Fil 2 Section	F.B. 778 PG. 243
Map No. B-1830		W. 08243 Tape No. 42 St'd 24 OF	
Office Work		Surveyed by Stevenson	
Checked		Notes T.J.S Date 7-18	
Date		Indexed A. C. Johnson	

Cont to bot. page 244

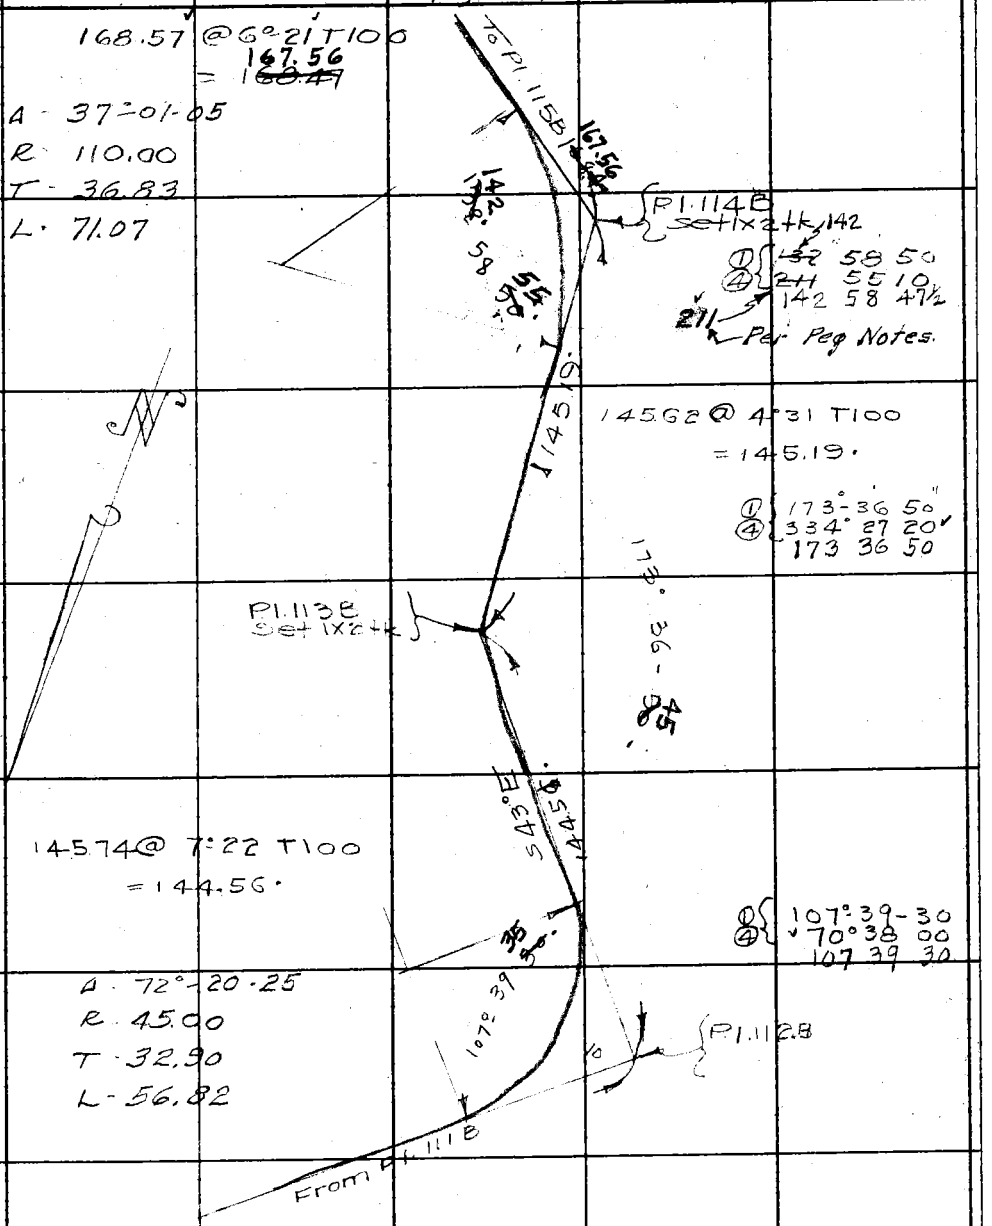

Cont from top page 242

Note: Any Additions or Changes on This Sheets Must be Made or Circled in Red Ink With Date and Name of Person Making Change.

Do not extend notes this side of this line

RETURN TO
LOS ANGELES COUNTY SURVEYOR
700 HALL OF RECORDS

FORM 247 5M 10-87

F.B. 778 PG. 244

93.40 @ 5°16' + 10p Cont to bot. page 245

~~93.42~~
93.02

101° 56-30 ①
47° 45 50 ④
101 56 27½

① 168°-37-30
④ 314° 29 40
168 37 25

P1.117B Set 3/4 W+T.

93.02 To P 1188 ~~93.42~~

10 @ 11 @ 6°-38 T 98
= 99 45

99.45

BC

168°-37

20.

A - 11°-22-40
R - 300.00
T - 29.98
L - 59.57

EC

P1.116B Set 3/4 IP Plug + tk

A = 78-03-40
R - 50.00
T - 40.53
L - 68.12

101°

116.39

BC

116 39 @ 0 0 T 98

S 2° 30' W

EC

103° 56-50 ①
55° 47 30 ④
103 56 52½

A - 16°-03 15
R - 60.00
T - 46.92
L - 79.64

P1.115B Set 3/4 P plug + tk

From P1.115B

Cont. from top page 243

RETURN TO
LOS ANGELES COUNTY SURVEYOR
7007 ALL OF RECORDS

Note: Any Additions or Changes on This Sheets Must be Made or Circled in Red Ink With Date and Name of Person Making Change.

Do not extend notes this side of this line

Notes Ck'd by		Survey of: Los Angeles City System	F.B. 778 Pg. 249
Map No. B-1830		W. O. 8246 Tape No. 19 St'd 84 OF	
Office Work		Surveyed by Stevenson	
Checked		Notes T.J.S. Date 7-21-39	
Date		Indexed A. C. Jot	

78.42 @ 5°28 TB6 = 78.06'
293.03 @ 4°04' 1.86 292.29'
58.68 @ 0 0 1.86 58.68'
129.03'
(at half on of P.I.)

R.P.P.I. 1198
Set 1/2" IP plug + tk

160.80 @ 1°08 1.38 = 160.29'

① 5° 54 00
④ 53° 35 40
⑧ 147° 11 30
5° 53 56

N 84° W
160.39'
6° 53' 55"

P.I. 1188
Set 1x2 tk

93.02

175.26'

① 145° 24 20
④ 221° 37 10
⑧ 83° 14 30
⑫ 145 - 24 20

① 175° 52 30
④ 343° 29 40
175 52 30

9.92 @ 3°25

R.P.P.I. 1188
Set 3/4 IP
plug + tk

From P.I. 117.8

20"

145° - 24 -

Set 3/4 IP
Plug + tk

42.20'

To A Nail in Post
FB 812-32

Cont'd from top of page 249

Note: Any Additions or Changes on This Sheets Must be Made or Circled in Red Ink With Date and Name of Person Making Change.

Do not extend notes this side of this line

RETURN TO
LOS ANGELES COUNTY SURVEYOR
700 HALL OF RECORDS

FORM 247 5M 10-37

F.B. 778 PG. 246

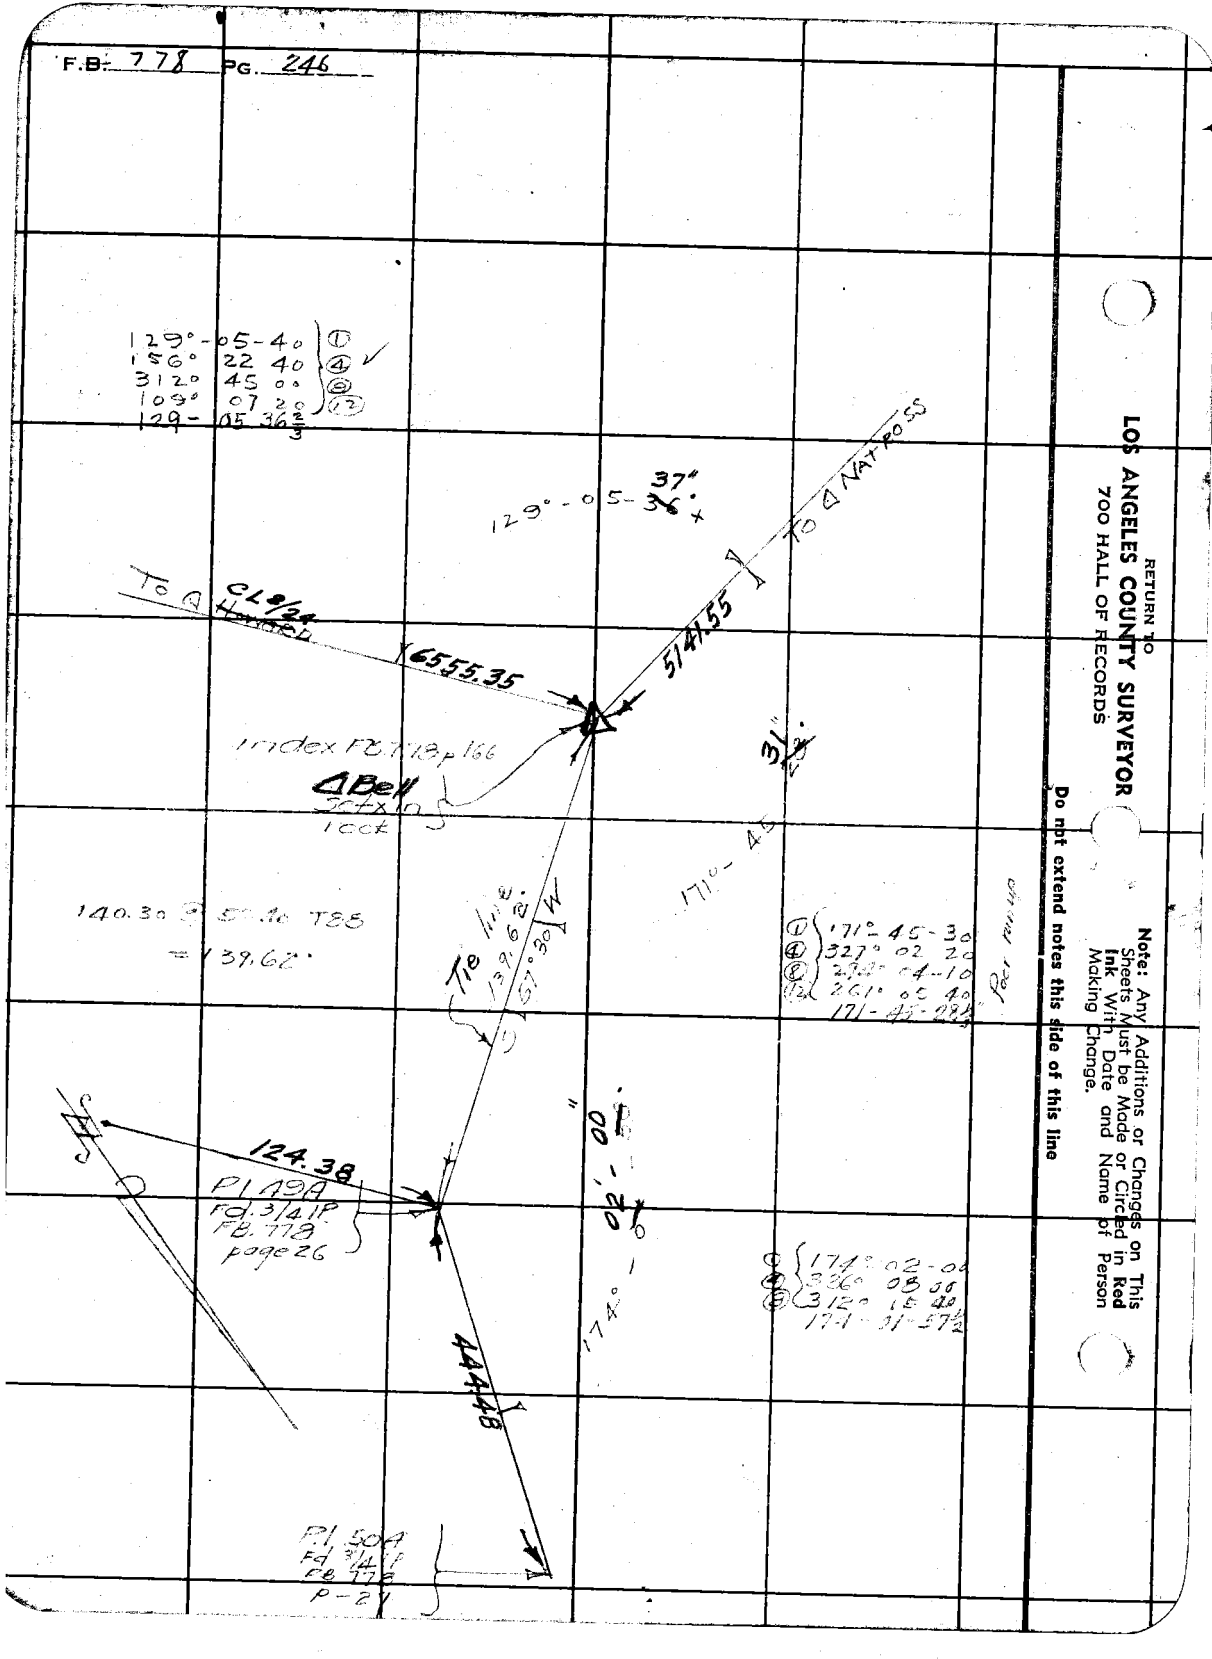

RETURN TO
LOS ANGELES COUNTY SURVEYOR
700 HALL OF RECORDS

Note: Any Additions or Changes on This Sheets Must be Made or Circled in Red Ink With Date and Name of Person Making Change.

Do not extend notes this side of this line

Notes Ck'd by
Map No. B-1830
Office Work
Checked
Date

Survey of Los Virgenes FIT System F.B. 718 Pg. 247
W. O. 8242 Tape No. 49 St'd 84 °F
Surveyed by Stevenson
Notes T.J.S. Date 8-1-39
Indexed A. C. Johnson 5-31-42

Note: Any Additions or Changes on This Sheets Must be Made or Circled in Red Ink With Date and Name of Person Making Change.

Do not extend notes this side of this line

RETURN TO
LOS ANGELES COUNTY SURVEYOR
700 HALL OF RECORDS

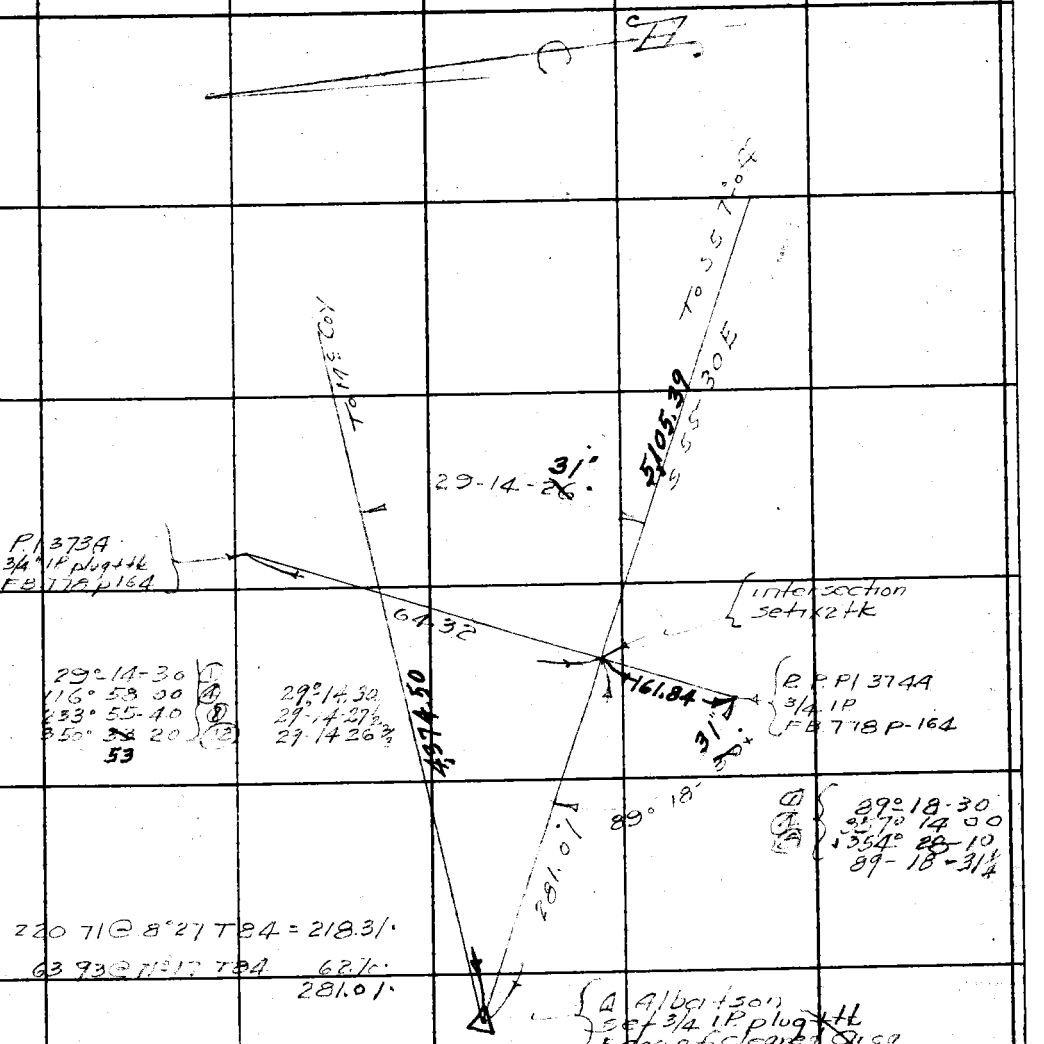

FORM 247 5M 10-37

F.B. 778 Pg. 248

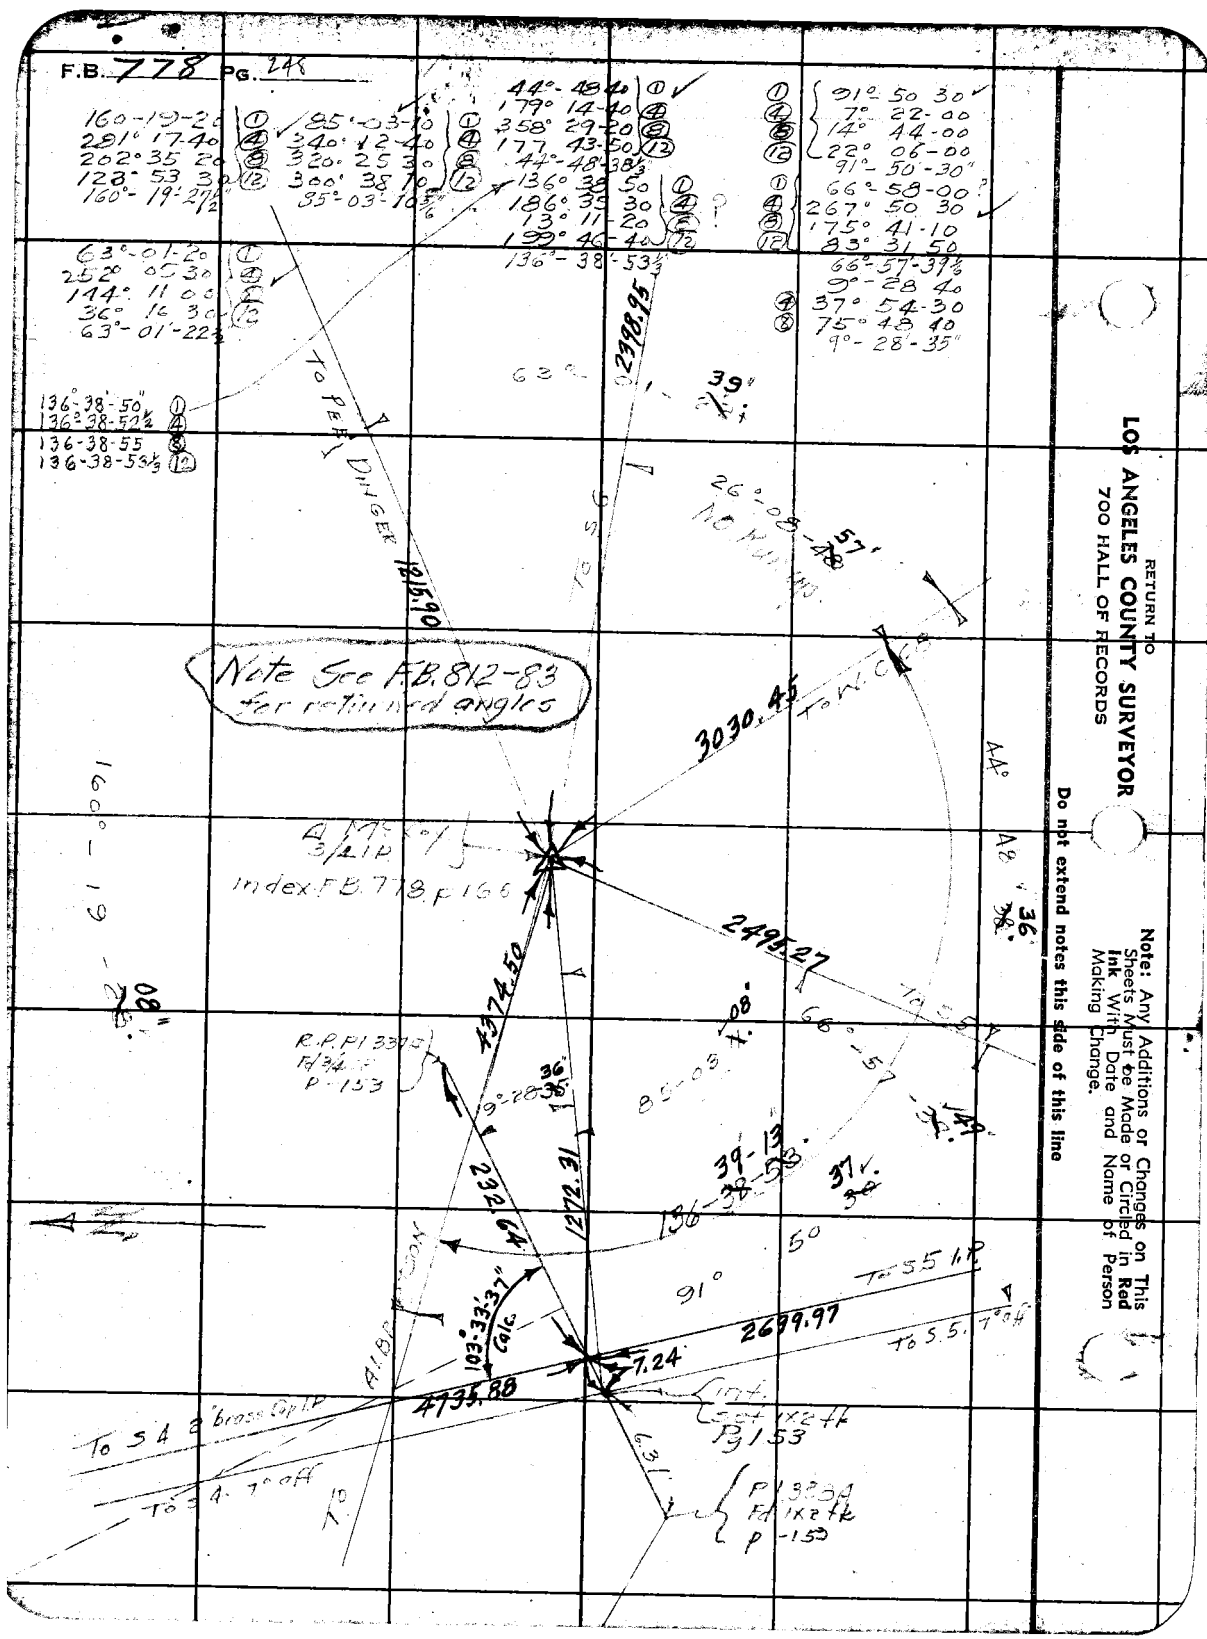

RETURN TO
LOS ANGELES COUNTY SURVEYOR
700 HALL OF RECORDS

Note: Any Additions or Changes on This Sheets Must be Made or Circled in **Red Ink** With Date and Name of Person Making Change.

Do not extend notes this side of this line

Notes Ck'd by
Map No. A-1830
Office Work
Checked
Date

Survey of Las Virgenes Fit System
W. O. 8243 Tape No. St'd. OF
Surveyed by Stevenson
Notes T & S. Date 8-2-39
Indexed A. C. Johnson

F.B. 778 PG. 243

Note: Any Additions or Changes on This Sheets Must be Made or Circled in Red Ink With Date and Name of Person Making Change.

Do not extend notes this side of this line

RETURN TO
LOS ANGELES COUNTY SURVEYOR
700 HALL OF RECORDS

FORM 247 5M 10-37

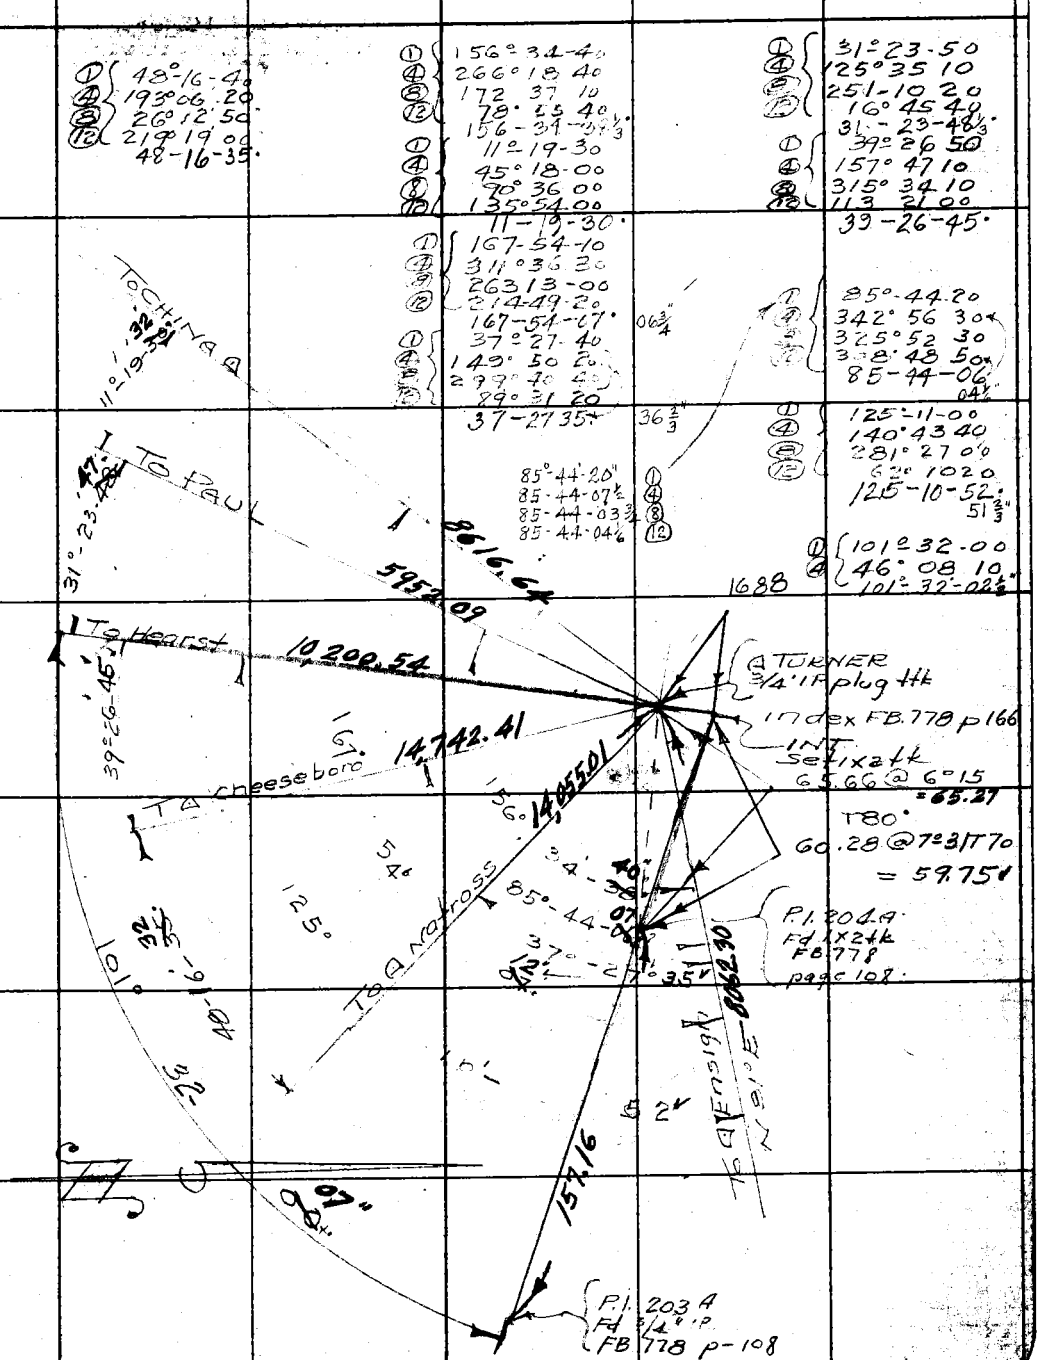

F.B. 778 PG. 250

22° 40 30 ①
90° 43 00 ④
181° 25 50 ⑨
272° 06 00 ⑫
43°-10 40
172° 42 20
345° 24 30
158° 06 50
43°-10-34½"
50°-11 20
200° 41 40
41° 29 20
242° 13 30
50°-11-07½"
49°-39'15"
138° 37' 00
37°-14 00
49°-39'-15"

Var 1

189°-48-20 ①
39° 13 20 ④
78 27 00 ⑨
117-46 30 ⑫
189°-48-22½"

22°-40-30 ①
90° 43 00 ④
181° 25 20 ⑨
272° 07 50 ⑫
2° 50 30 ⑬

123°-16-20 ①
133° 05 40 ⑨
256° 11-20 ⑫
123°-16-25"

22°-40'-30"
22°-40-45"
22-40-40
22-40-39½
22-40-39½

① 116° 02 20
④ 104-09-20
⑨ 208 19 20
⑫ 312 29 50
116°-02'-24½"

OK

① 54°-09'-15"
④ 216° 37' 00"
⑨ 73° 13-30"
⑫ 289° 50 10"
54°-09'-10½"

RETURN TO
LOS ANGELES COUNTY SURVEYOR
700 HALL OF RECORDS

Note: Any Additions or Changes on This Sheets Must be Made or Circled in Red Ink With Date and Name of Person Making Change.

Do not extend notes this side of this line

54°-09'-15"

To China 1659.34

See F.B. 812-85 for retracing angles

1602.36

To WC 1229

22°-40'-30"

2705.50

Index FB 778 page 166
Pos Finger
Pos Flagpole

180°

Tie line

88.47

3092.49

43°-10'-45"

RP PI 3 1A
3/4 IP
page 147

48

25'

49°-39'16"

1215.90

To Cone 1241

58.4

50.

123°

298.21

90.33 @ 11-38 T84.
~~88.48~~
88.47

RP PI 32 1A
3/4 IP
page 147

Notes Ck'd by
Map No. B-1830
Office Work
Checked
Date

Survey of Los Virgenes F.H. System
W. O. 8243 Tape No. 49 St'd 84°F
Surveyed by Stevenson
Notes T.J.S. Date
Indexed A. C. Johnson

F.B. 778 Pg. 251

Note: Any Additions or Changes on This Sheets Must be Made or Circled in Red Ink With Date and Name of Person Making Change.

Do not extend notes this side of this line

RETURN TO
LOS ANGELES COUNTY SURVEYOR
700 HALL OF RECORDS

FORM 247 5M 10-87

To C.L. 8/24

12,505.23

4942.22 to Holmes

4907.80 to Holmes

45°

Index FB 173 pg 163

See pg 259

Pinnacle Saddle Trail

50.13

35.73

Rel. 1/2 I.P.

11.07

35.73

INT Setback

179°-14-40
356°-58-50
353°-57-20
350°-55-40
179°-14-38½
45°-02-40
180°-10-40
360°-22-20
180°-33-50
45°-02-49½"
45-02-54

78.15 @ 28°-41 = 68.57

MINUS 18.44

50.13

134°-12-00
176°-47-50
358°-35-20
170°-23-00
139°-11-55"

8254.53 to Natross

0°-20-30
1°-22-00
2°-44-10
4°-06-20
0°-20-31½"

2°-28-32

cale. 2°-28-32

0°-20-30

134°

17°-51-30-56

47-53

4754.19

5991.01

I.P. See Pg. 253

31°-24-22

18967.99 to USGS Cheese boro

To C.L. 8/24

76°-17-10
305°-08-20
250°-16-40
195°-25-00
76°-17-05"

Transit line

31°-03-50
124°-15-20
248°-30-40
12°-46-00
31°-03-50"

1236.71 East

600.97

Detail Transit line page 253

31°-03-52

0°-09-51" West Pg. 257

77°-31-00
310°-04-00
260°-08-00
210°-12-00
77°-31-00"

31°-14-30
124°-58-00
249°-55-40
14°-54-00
31°-14-30"

107°-41-20

17,274.32

16,268.43

TOUSGS A Cheese boro

54°-48-00
219°-12-30
78-24-20
297°-36-00
54°-48-00"
54-47-56

A Ensign
Rd 1/2" IP per Cor to Lots
P.B. A
L.S. B-33

Cont page 258

31-24-20
125°-37-20
251°-14-40
16°-52-20
31°-24-21½"
107°-41-20
70°-45-40
141°-31-20
212°-16-40
107°-41-20

F.B. _____ PG. 252

INDEX F.B. 778 pg 166

205+41.98

Random Transit LINE
F.B. 428 Pg. 93 & 99
Los Angeles County

Ventura County

c. line
A 8-24
1X2+K
Pg 255

E 0E+91.11

A Scott
S.W+T.
See pg 256

3935.99'

89° 38' pg 256

45°00'

Set 1X2 & TK
(50' east of Pt 42)
Per LS 8-32

Transit Line

0.56

A Holmes
Fd ½" IP in cement
No tacks or X
LS 8-33

12,555.36

17,274.32

Transit N.G.
1-0°25'00"
1-1°10'00"
3°20'00"
Holmes

4942.29'

14969.05'

4907.00'

East

From a Pinnacle

From a Ensign

Pinnacle
Pt 42

0-29-51
Calc

To Ensign

RETURN TO
LOS ANGELES COUNTY SURVEYOR
700 HALL OF RECORDS

Note: Any Additions or Changes on This Sheets Must be Made or Circled in Red Ink With Date and Name of Person Making Change.

Do not extend notes this side of this line

Notes Ck'd by		Survey of Los Angeles City System	F.B. Pg. 253
Map No. B-1830		W. O. 8243 Tape No. 43 St'd 84 OF	
Office Work		Surveyed by Stevenson	
Checked		Notes T.J.S Date 4-20-39	
Date		Indexed	

Note: Any Additions or Changes on This Sheets Must be Made or Circled in Red Ink With Date and Name of Person Making Change.

Do not extend notes this side of this line

RETURN TO
LOS ANGELES COUNTY SURVEYOR
700 HALL OF RECORDS

FORM 247 BM 10-37

Cont. to tab page 251

37.23 @ 14 19 T84 36.07'
26 51 @ 14° 51 T84 25.63'
300.91 @ 5° 24 T84 299.57'
95.67 @ 31° 15 T94 81.80'
86.05 @ 19° 51 T94° 80.94'
522.01'

R No 4 Set 1x24k

285.88 13°28 T94 278.04'
226.84 @ 14°32 T94 219.60'
497.64'

R No 3 Set 1x24k

73.13'

R No 2 Set 1x24k

70.33 @ 13°55 T94 73.13'
64.61 @ 10°33 T94 63.53'

63.53'

245.34 @ 19°35 T94° 231.17'
251.08 @ 3°34 T94° 250.61'
481.78'

Fd 1/2 I.P. on line

29.55

481.78'

A Set 1x24k

R No 1 Set 1x24k

East

65°-48-30
263°-13-50
166°-27-30
65°-48-26½

87°-08-10
349-32-50
337°-06-00
87-08-15

Transit Line
Page 251-252

21°-19-50
85°-19-20
70°-38-20
21°-19-47½

1203.16

21°-19-50

A Ensign 1/2" I.P.

F.B. 778 PG. 254

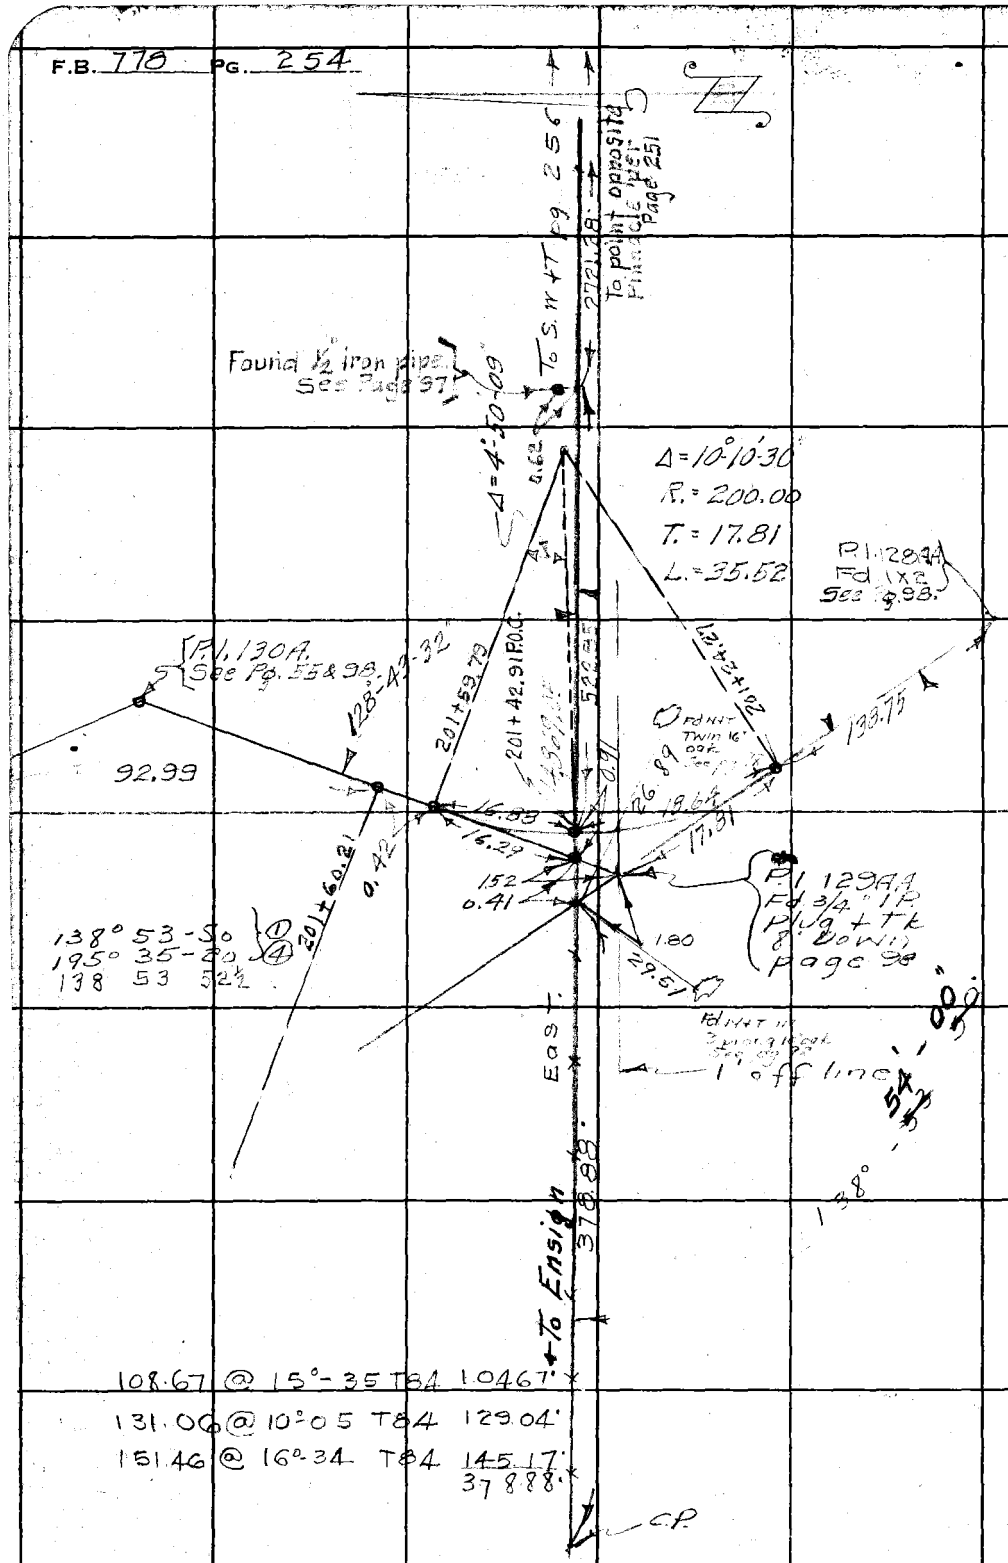

Con't from top page 253

RETURN TO
LOS ANGELES COUNTY SURVEYOR
700 HALL OF RECORDS

Do not extend notes this side of this line

Note: Any Additions or Changes on This Sheets Must be Made or Circled in Red Ink With Date and Name of Person Making Change.

Notes Ck'd by	Survey of Los Angeles Fire Sys F.B. 778 Pg. 255
Map No. A-1830	W. O. 8243 Tape No. 6 & 6 St'd 84 of
Office Work	Surveyed by F.C. HOWARD
Checked	Notes F.C.H. Date 7-19-39
Date	Indexed A. C. Johnson

Note: Any Additions or Changes on This Sheets Must be Made or Circled in Red Ink With Date and Name of Person Making Change.

Do not extend notes this side of this line

RETURN TO
LOS ANGELES COUNTY SURVEYOR
700 HALL OF RECORDS

FORM 247 SM 10-37

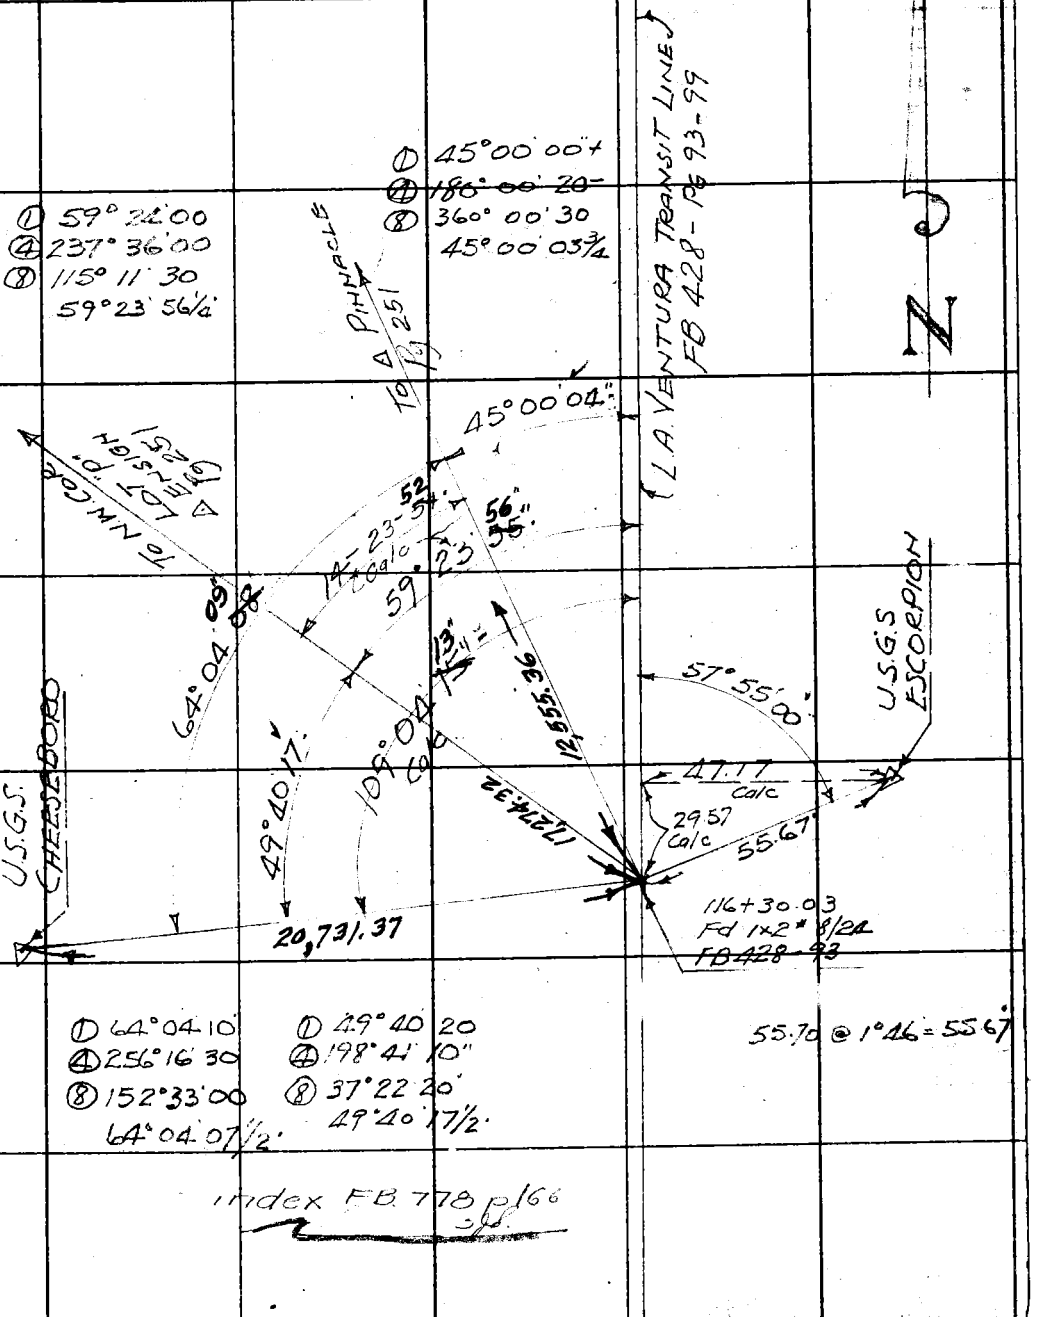

F.B. 778 Pg. 256

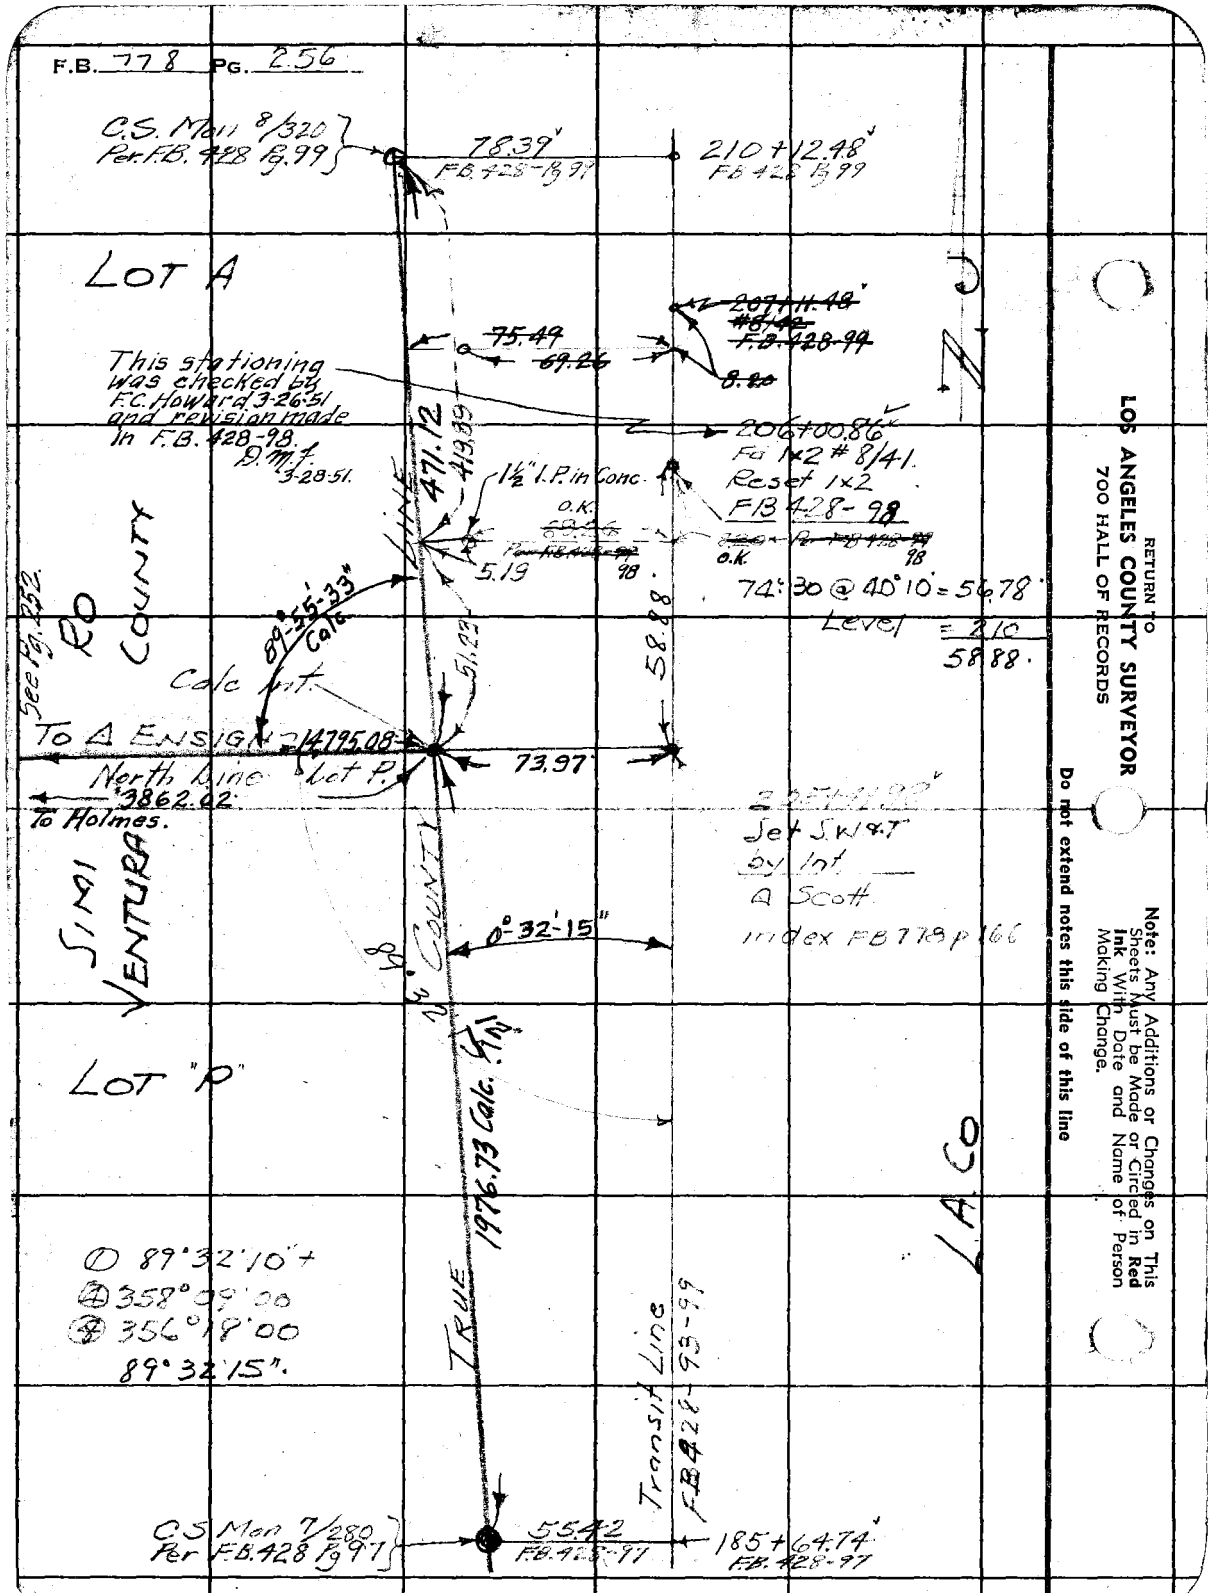

RETURN TO
LOS ANGELES COUNTY SURVEYOR
700 HALL OF RECORDS

Note: Any Additions or Changes on This Sheets Must be Made or Circled in Red Ink With Date and Name of Person Making Change.

Do not extend notes this side of this line

Notes Ck'd by	Survey of LAS VIRGENES T.T.S.S. F.B. 778 Pg. 257
Map No. B-1830	W. O. 8243 Tape No. 66 St'd 89°F
Office Work	Surveyed by F.C. HOWARD
Checked	Notes Date 7-19-39
Date	Indexed

RETURN TO
LOS ANGELES COUNTY SURVEYOR
700 HALL OF RECORDS

Note: Any Additions or Changes on This Sheets Must be Made or Circled in Red Ink With Date and Name of Person Making Change.

Do not extend notes this side of this line

FORM 247 5M 10-37

F.B. 778 PG. 258

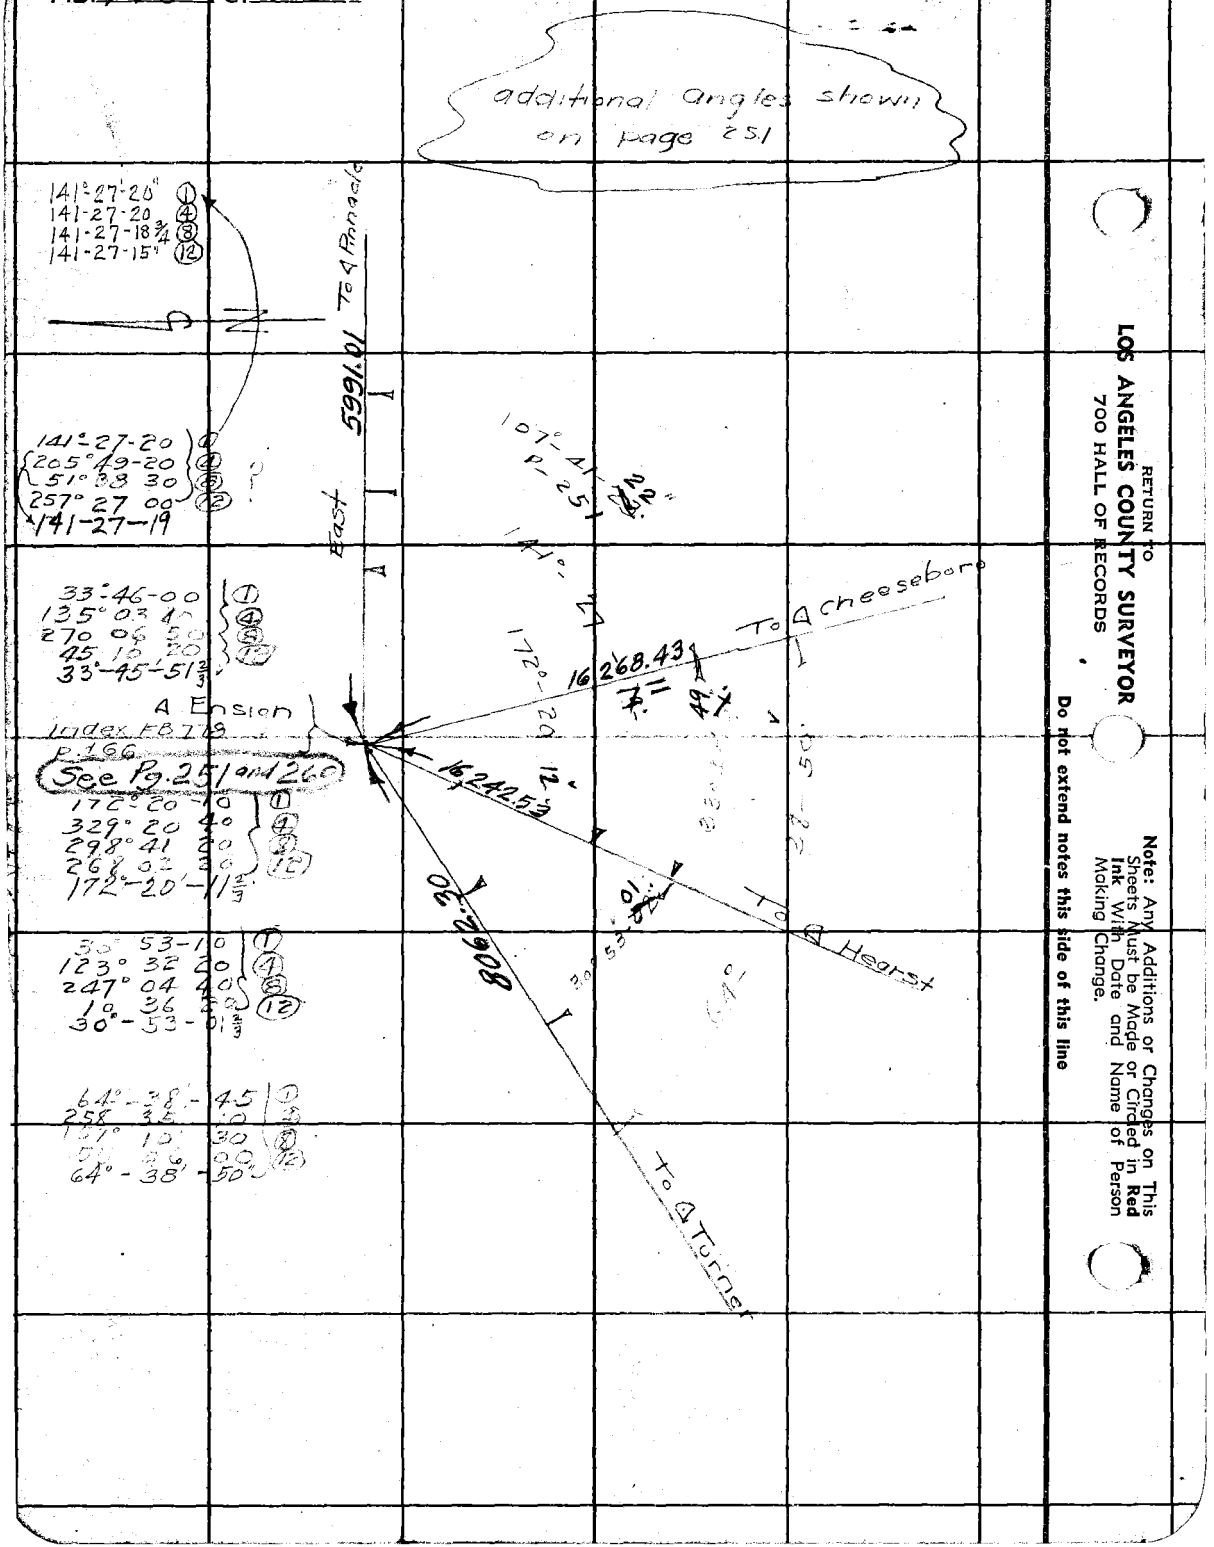

RETURN TO
LOS ANGELES COUNTY SURVEYOR
700 HALL OF RECORDS

Note: Any Additions or Changes on This Sheets Must be Made or Circled in **Red** Ink With Date and Name of Person Making Change.

Do not extend notes this side of this line

Notes Ck'd by	Survey of Los Angeles Co. System F.B. 775 Pg. 259
Map No. B-1830	W. O. 8243 Tape No. St'd °F
Office Work	Surveyed by Harrison
Checked	Notes T. J. S Date 10-16-39
Date	Indexed E. C. Johnson

Moderate wind from west Good visability

317°-35-30 ④
275°-11-00 ⑤
232°-46-10 ⑫
79°-23-53½
79° 23 53 ① ✓

5°-01-40 ④
65°-03-30 ⑤
9°-25-20 ⑫
180°-45-26⅔" ①

176°-47-00 ④
353°-34-20 ⑤
170°-21-30 ⑫
134°-11-47½
134°-11'-47½" ①

Cheesboro

54°-47-53" ✓

5991.01

30°-52'-10 ④
181°-44-10 ⑤
272°-36-10 ⑫
22°-43-00" ①

219°-11-30 ④
79°-23-10 ⑤
297°-34-40 ⑫
54°-47-53½" ①

Ensign

18967.99

10,933.06

22°-43-03" ✓

53°

134°

Z U

Notross

8254.58

Annacle
See pg. 251

180°-11-00 ④
360°-22-00 ⑤
180°-33-00 ⑫
45°-02'-45" ① ✓

12555.36

226°-43-50 ④
93°-26-10 ⑤
320°-10-00 ⑫
56°-40-50" ① ✓

4942.39

Colin

Holmes

Note: Any Additions or Changes on This Sheets Must be Made or Circled in Red Ink With Date and Name of Person Making Change.

Do not extend notes this side of this line

RETURN TO
LOS ANGELES COUNTY SURVEYOR
700 HALL OF RECORDS

FORM 247 5M 10-37

F.B. 778 PG. 260

Visibility very good.
No wind.

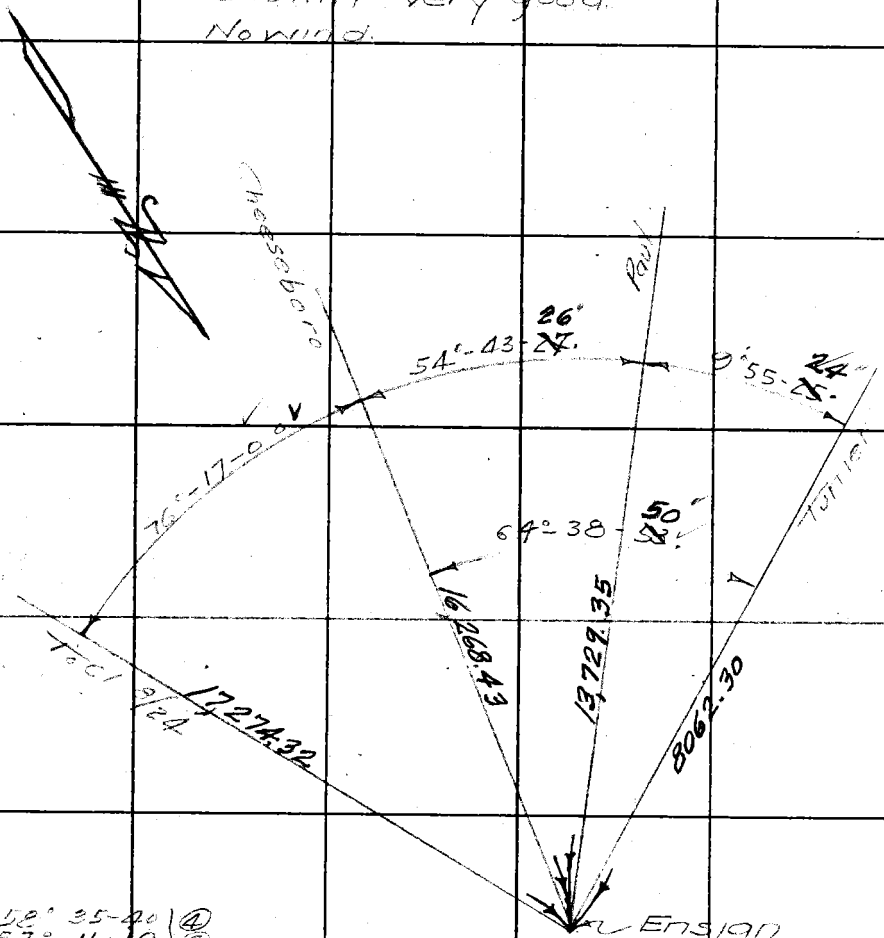

218° 53-40 | 4
77° 47 30 | 9
296° 41 30 | 12

54°-43-26 2/3"

39° 41-40 | 4
79° 23 30 | 9
119° 05-00 | 12

9°-55-25"

156° 35-40 | 4
157° 11-10 | 9
64°-38-33 1/3 | 12 ✓

305° 08 00 | 4
250° 16 00 | 9
195° 24 00 | 12

76° 17-00" (1) ✓

RETURN TO
LOS ANGELES COUNTY SURVEYOR
700 HALL OF RECORDS

Note: Any Additions or Changes on This Sheets Must be Made or Circled in Red Ink With Date and Name of Person Making Change.

Do not extend notes this side of this line

76F3095 247 10M 1-49

RETURN TO
LOS ANGELES COUNTY SURVEYOR
726 LOS ANGELES COUNTY
ENGINEERING BLDG.

Note: Any Additions or Changes on This Sheet Must be Made or Circled in Red Ink With Date and Name of Person Making Change.

Do not extend notes this side of this line.

Notes Ck'd by
Map No.
Office Work
Checked
Date

Survey of
W. O. Tape No. St'd. °F
Surveyed by
Notes
Date
Indexed

F. B. 778 Pg. 261

RETURN TO
LOS ANGELES COUNTY SURVEYOR
725 LOS ANGELES
ENGINEERING

Note: Any

Do not

Note: this

F. B. _____ PG. _____