Notes Ck'd by O. M. Finley	Survey of Alameda St	F.B. 807 PG.
Map No. B-1498.	W. O. 8270 Tape No. 063 St'd 76 of	
Office Work	Surveyed by Moore	
Checked	Notes	Date 10/79
Date	Indexed	

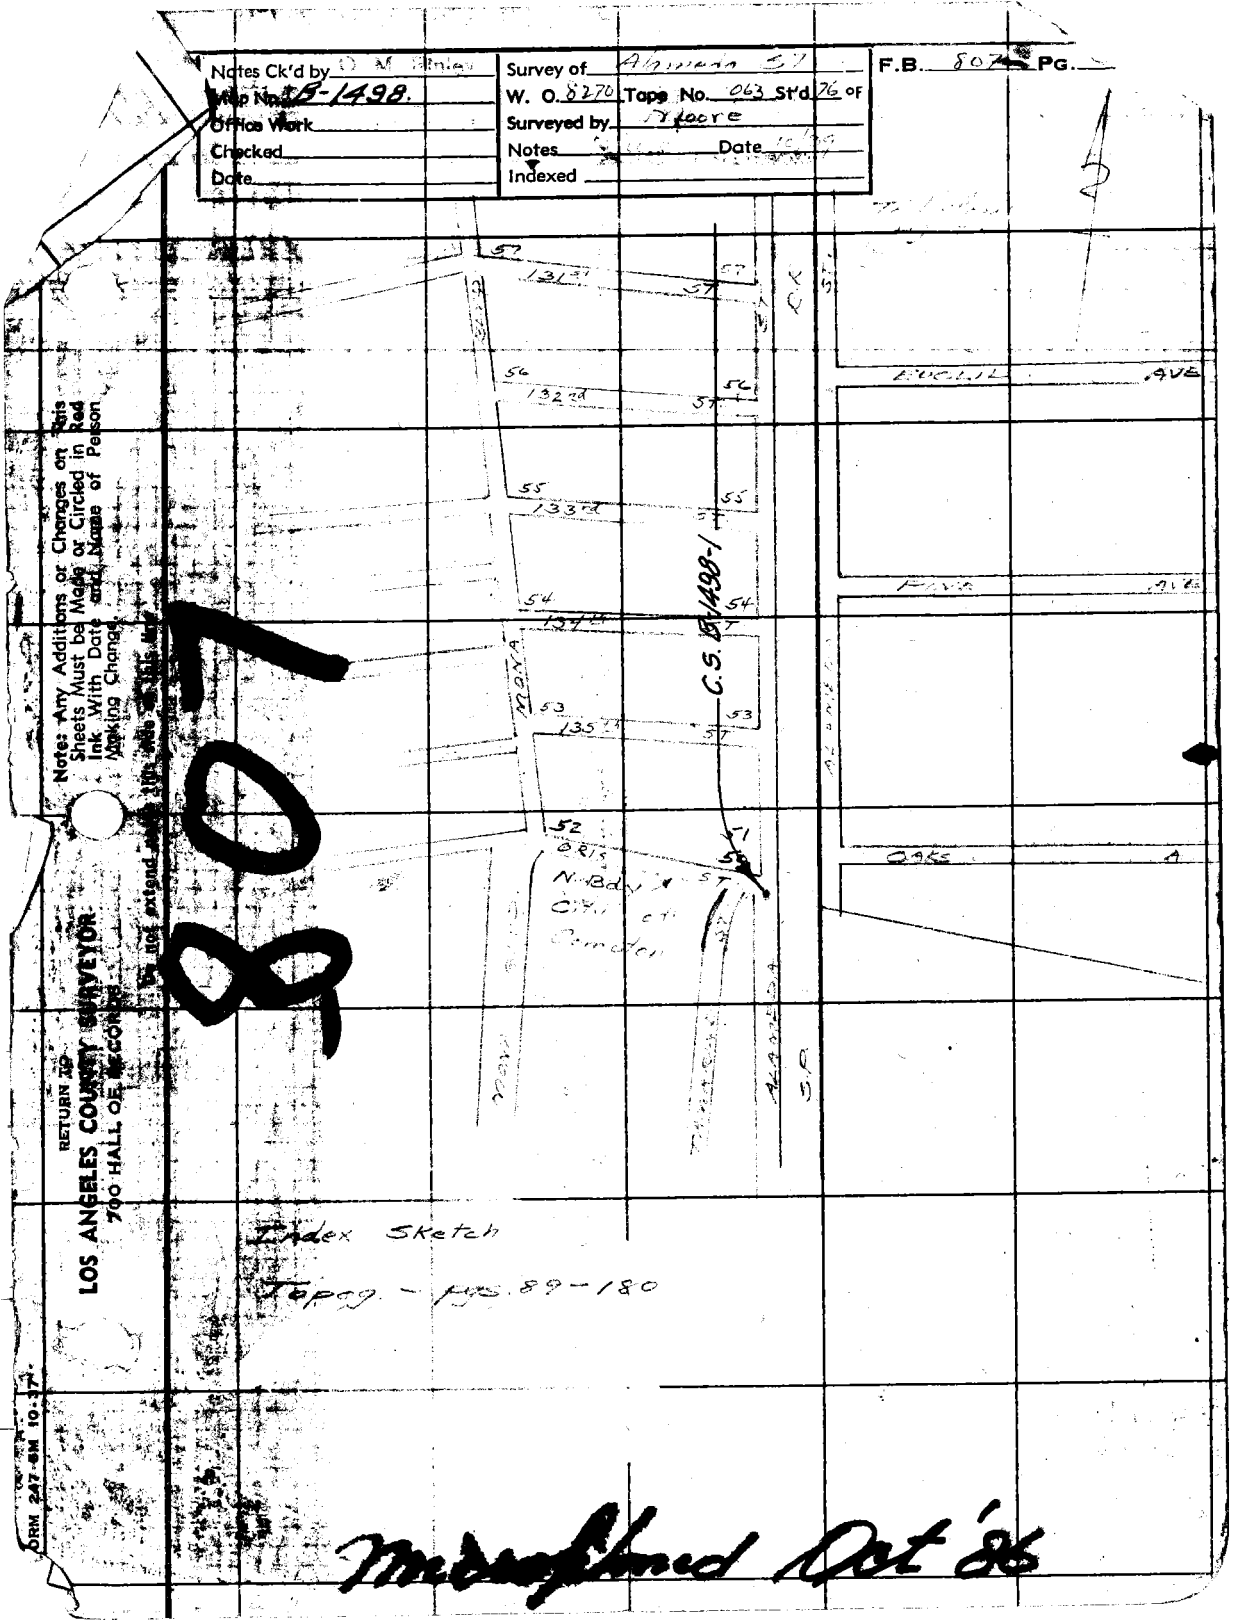

Note: Any Additions or Changes on This Sheets Must be Made or Circled in Red Ink With Date and Name of Person Making Change.

Do not extend [illegible] this line

RETURN TO
LOS ANGELES COUNTY SURVEYOR
700 HALL OF RECORDS

807

FORM 247-6M 10-37

RETURN TO
LOS ANGELES COUNTY SURVEYOR
700 HALL OF RECORDS

Note: Any Additions or Changes on This Sheets Must be Made or Circled in **Red Ink** With Date and Name of Person Making Change.

Do not extend notes this side of this line

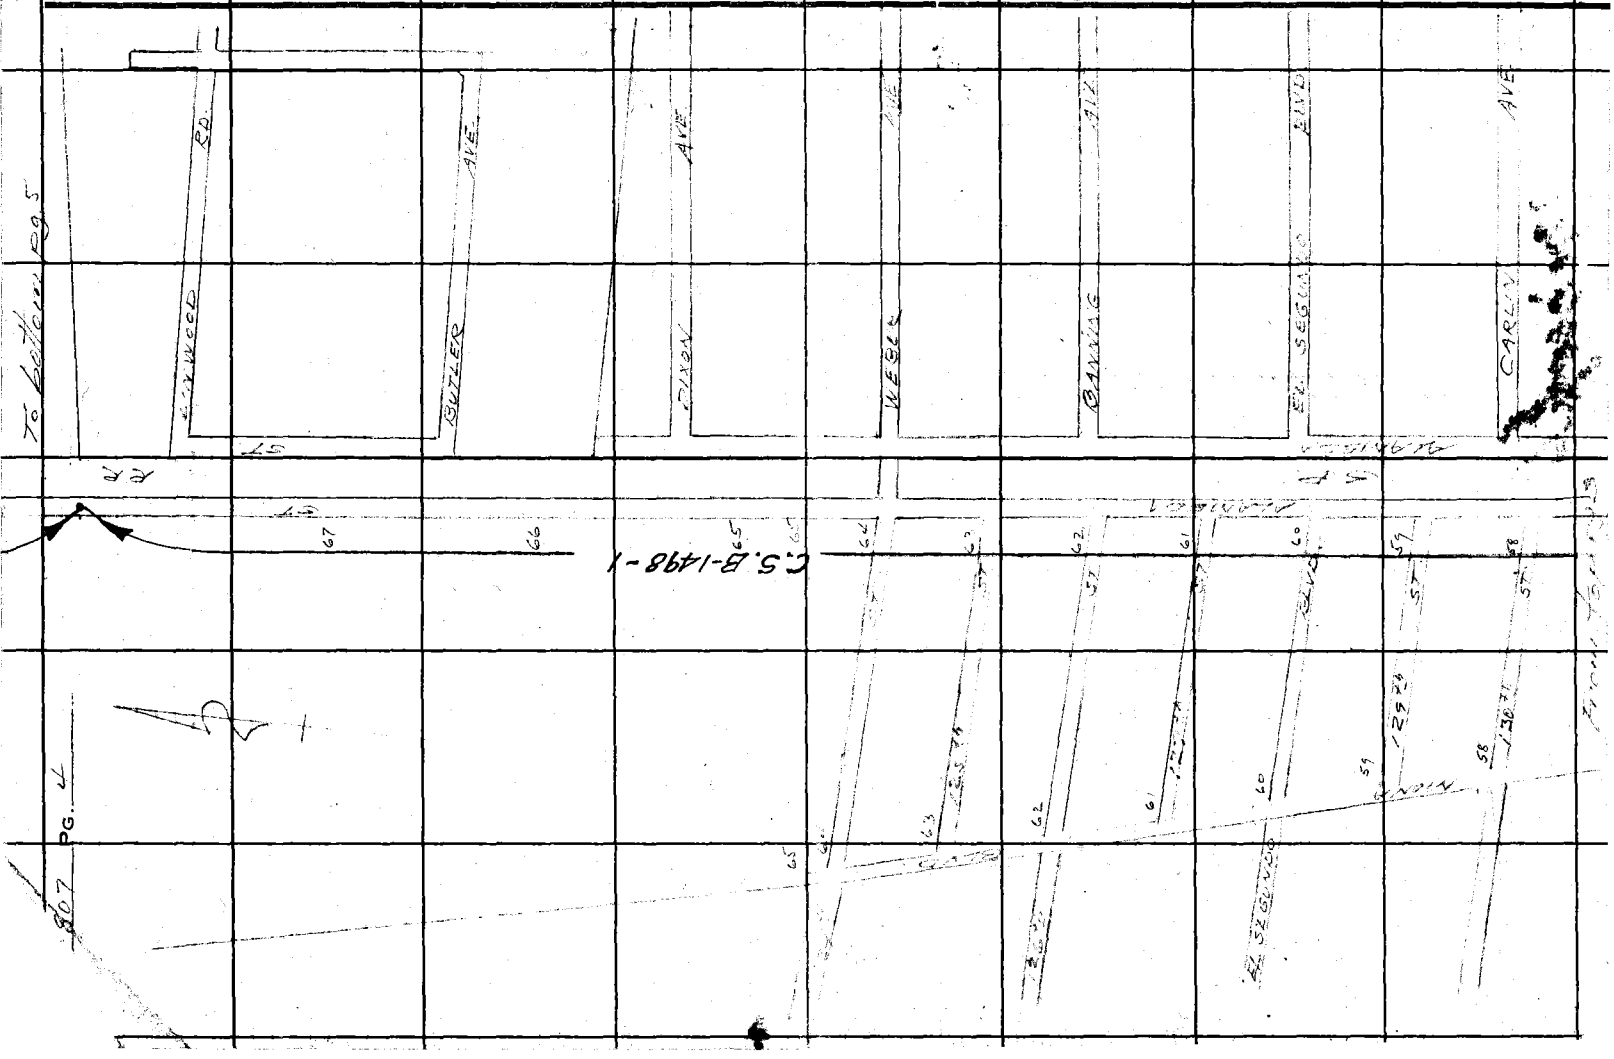

Notes Ck'd by D. M. Finley
Map No. B-1498
Office Work
Checked
Date

Survey of Alameda St
W. O. 8270 Tape No. 063 St'd 76 of
Surveyed by Moore
Notes Date 7-39
Indexed Wm. H. Blackmer

F.B. 807 PG. 5

To Left on Pg. 6

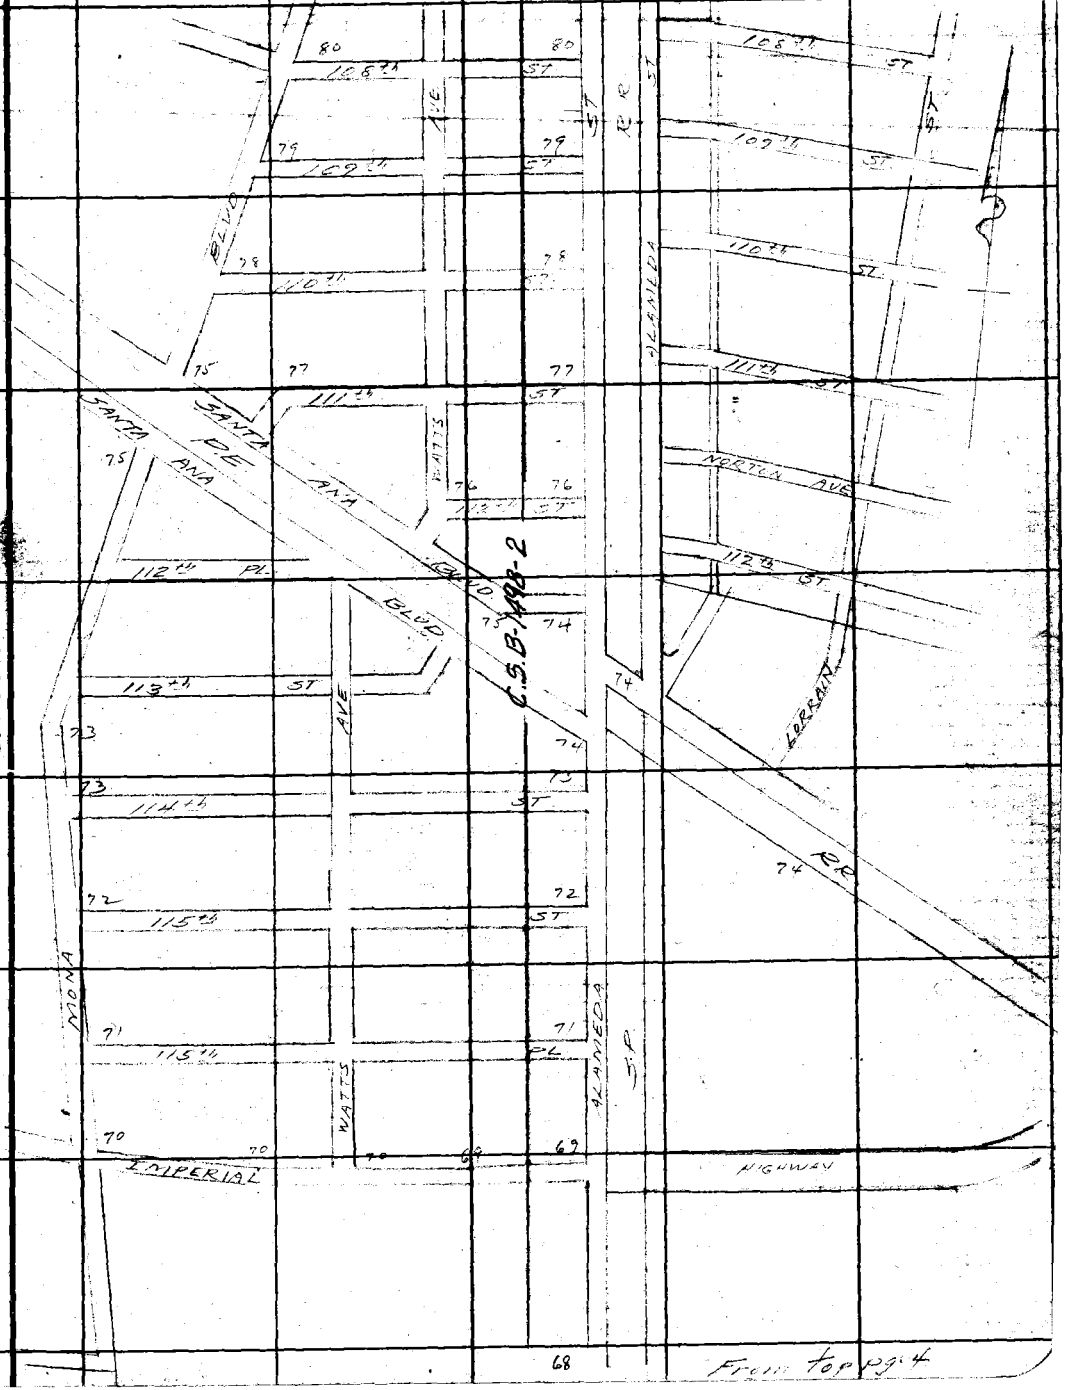

From top pg. 4

Note: Any Additions or Changes on This Sheets Must be Made or Circled in Red Ink With Date and Name of Person Making Change.

Do not extend notes this side of this line

RETURN TO
LOS ANGELES COUNTY SURVEYOR
700 HALL OF RECORDS

FORM 247 5M 10-37

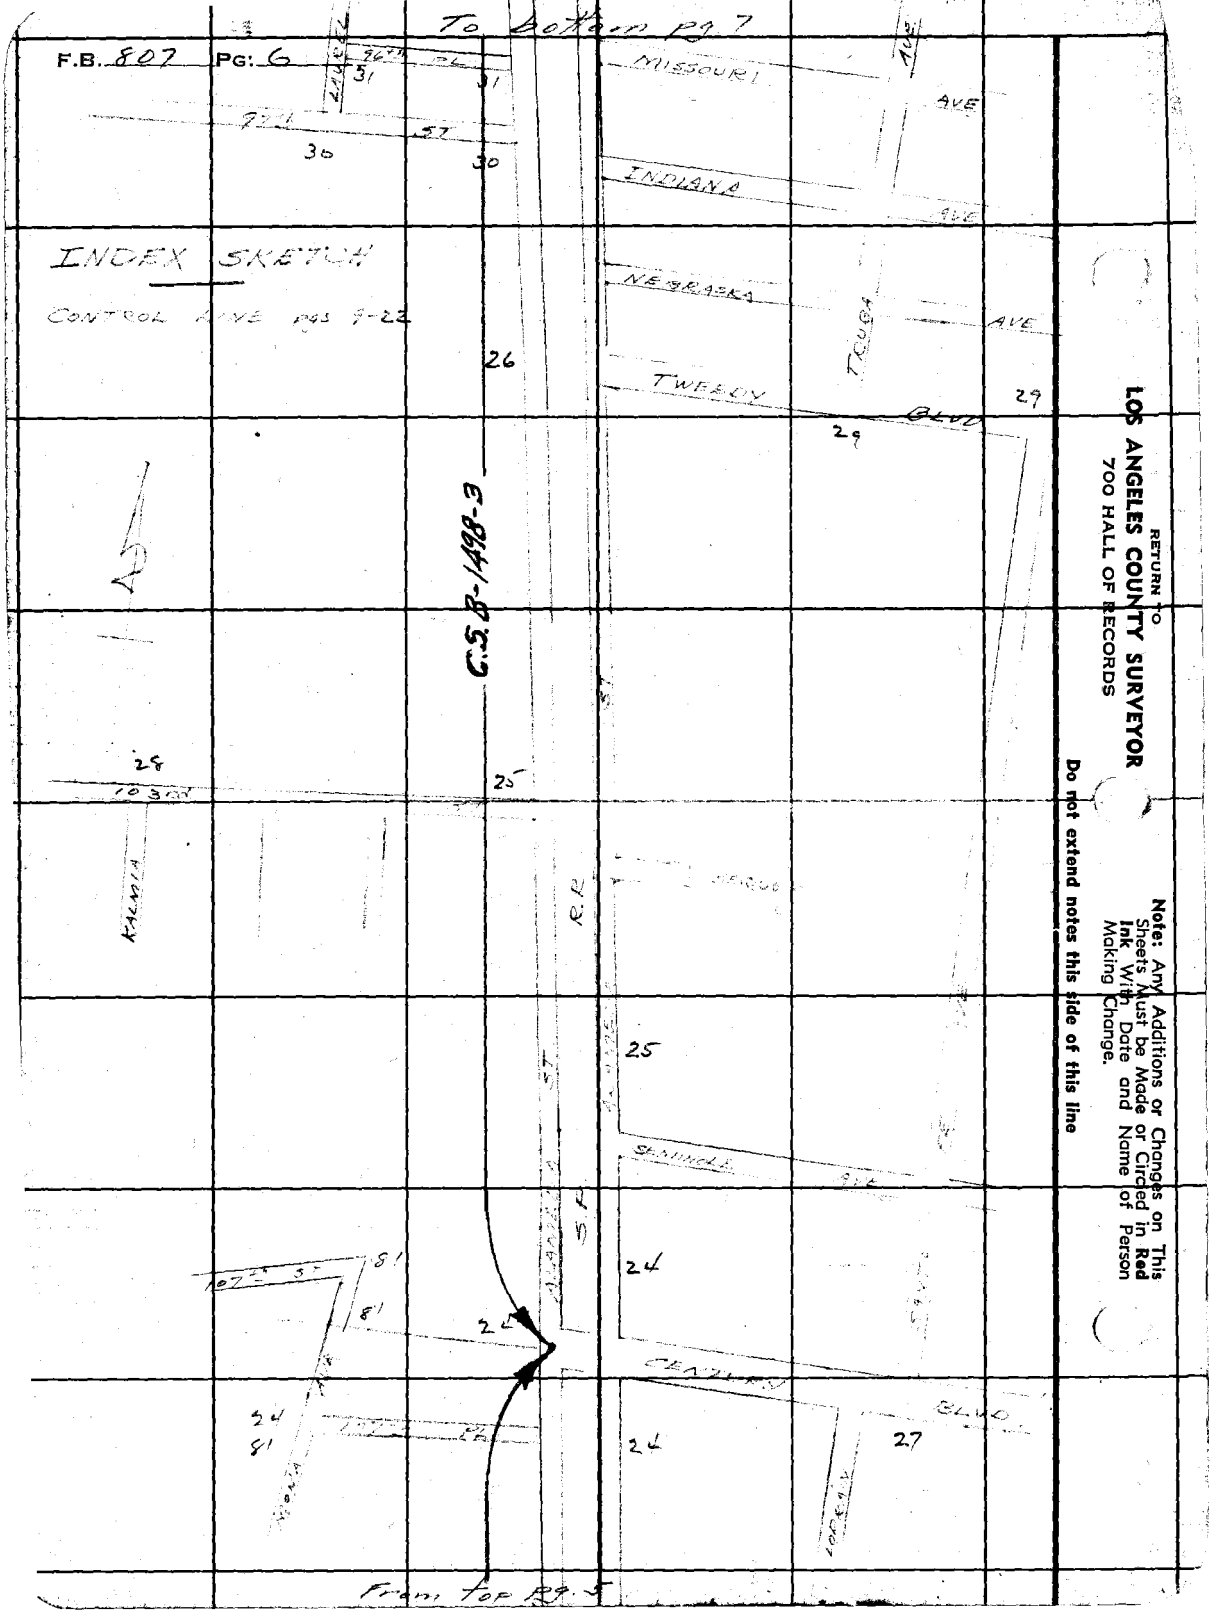
To bottom pg 7
F.B. 807 PG: 6
INDEX SKETCH
CONTROL LINE pgs 9-22
MISSOURI AVE
INDIANA AVE
NEBRASKA AVE
TWEEDY BLVD
TRUBA
C.S.B-1498-3
KALMIA
SEMINOLE AVE
CENTURY BLVD
LORRAIN
From top pg. 5
RETURN TO
LOS ANGELES COUNTY SURVEYOR
700 HALL OF RECORDS
Note: Any Additions or Changes on This Sheets Must be Made or Circled in Red Ink With Date and Name of Person Making Change.
Do not extend notes this side of this line

Notes Ck'd by D. M. Finley	Survey of Alameda St.	F.B. 807 PG. 7
Map No. B-1498	W. O. 8270 Tape No. 063 St'd 76 °F	
Office Work	Surveyed by Moore	
Checked	Notes Moore Date 7/39	
Date	Indexed Wm. H. Blackmer	

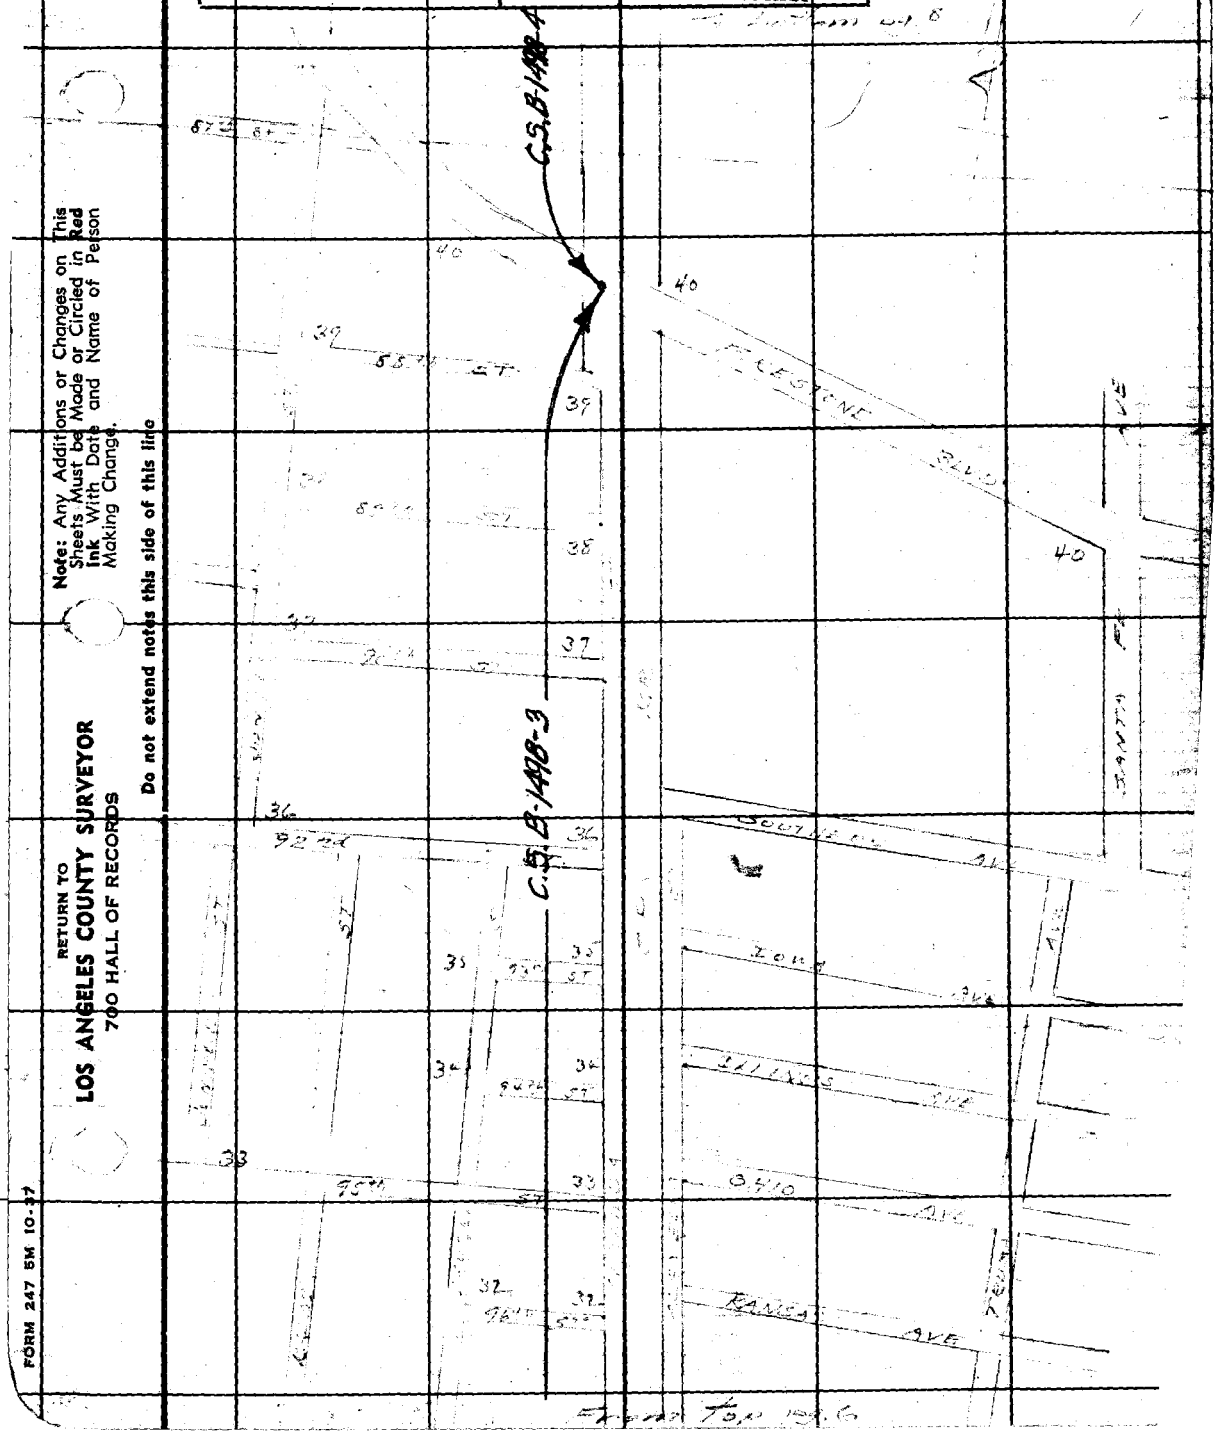

Note: Any Additions or Changes on This Sheets Must be Made or Circled in Red Ink With Date and Name of Person Making Change.

Do not extend notes this side of this line

RETURN TO
LOS ANGELES COUNTY SURVEYOR
700 HALL OF RECORDS

FORM 247 5M 10-37

RETURN TO
LOS ANGELES COUNTY SURVEYOR
700 HALL OF RECORDS

Note: Any Additions or Changes on This Sheets Must be Made or Circled in **Red Ink** With Date and Name of Person Making Change.

Do not extend notes this side of this line

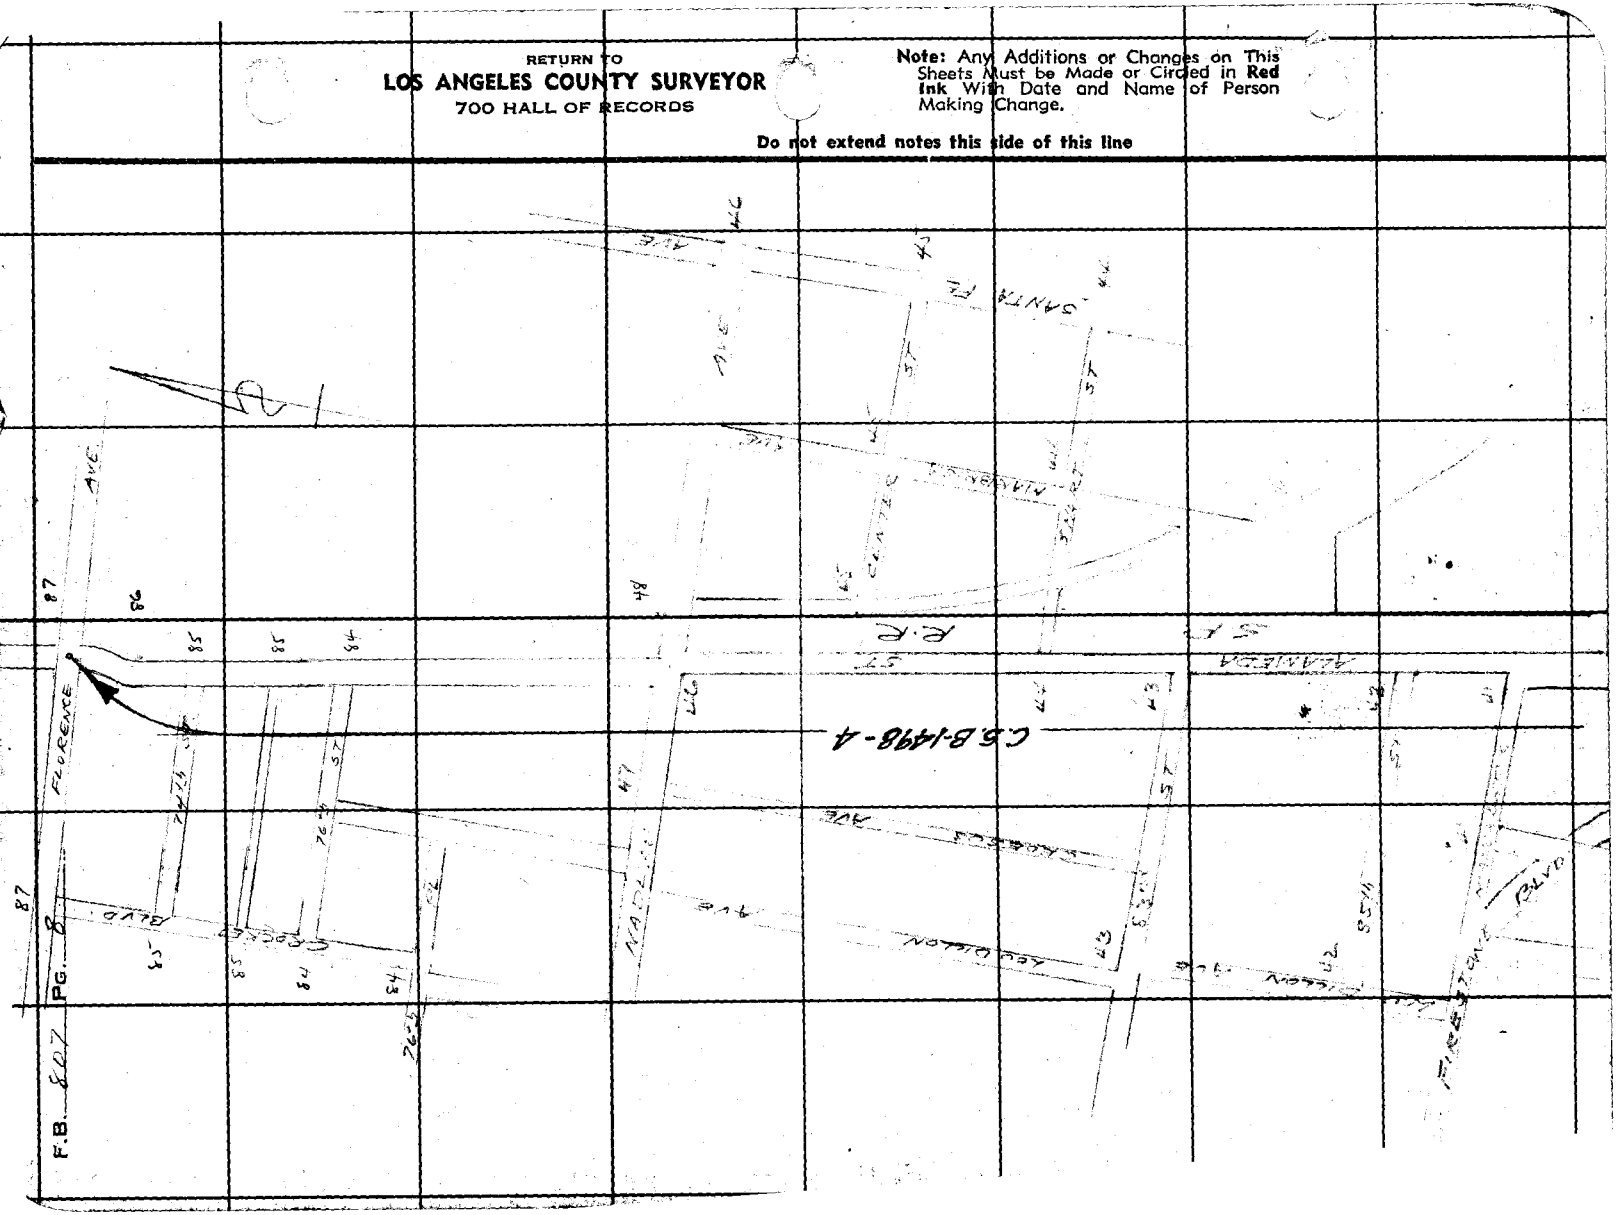

Date _____ Notes by _____ Chief Party _____ F.B. _____ PG. _____

Platted by _____	W. O. No. _____ D. S. O. No. _____
Date _____	Location _____
Map No. _____	Surveyed by _____
Platting C'k'd by _____	Date _____
Date _____	Indexed _____

Notes: ANY ADDITIONS OR CHANGES ON THIS SHEET MUST BE MADE OR CIRCLED IN Red. WITH DATE AND NAME OF PERSON MAKING CHANGE.

Do not extend notes this side of this line

RETURN TO
LOS ANGELES COUNTY SURVEYOR

F.B._____ PG._____ _____ Chief Party Notes by_____ Date_____

RETURN TO

LOS ANGELES COUNTY SURVEYOR

Do not extend notes this side of this line

Notes: ANY ADDITIONS OR CHANGES ON THIS SHEET MUST BE MADE OR CIRCLED IN Red. WITH DATE AND NAME OF PERSON MAKING CHANGE.

Notes Ck'd by D. M. Finley	Survey of Alameda St.	F.B. 607	Pg. 1
Map No. B-1498-2	W. O. 8270 Tape No. 063 St'd 76 of		
Office Work D. A. WHITE	Surveyed by [illegible]		
Checked D. M. Finley	Notes D. Moore Date 7-10-39		
Date Feb. 1940	Indexed A. G. Johnson 7-17-39		

CONTROL LINE
ON
ALAMEDA ST
BETWEEN
N. COMPTON BLV
TO
FLORENCE AVE
Job # 8270

Moore
Farmer
Lawson
Waterman

Note: Any Additions or Changes on This Sheets Must be Made or Circled in Red Ink With Date and Name of Person Making Change.

Do not extend notes this side of this line

RETURN TO
LOS ANGELES COUNTY SURVEYOR
700 HALL OF RECORDS

FORM 247 5M 10-37

F.B. 807 PG. 10

To bottom pg. 11

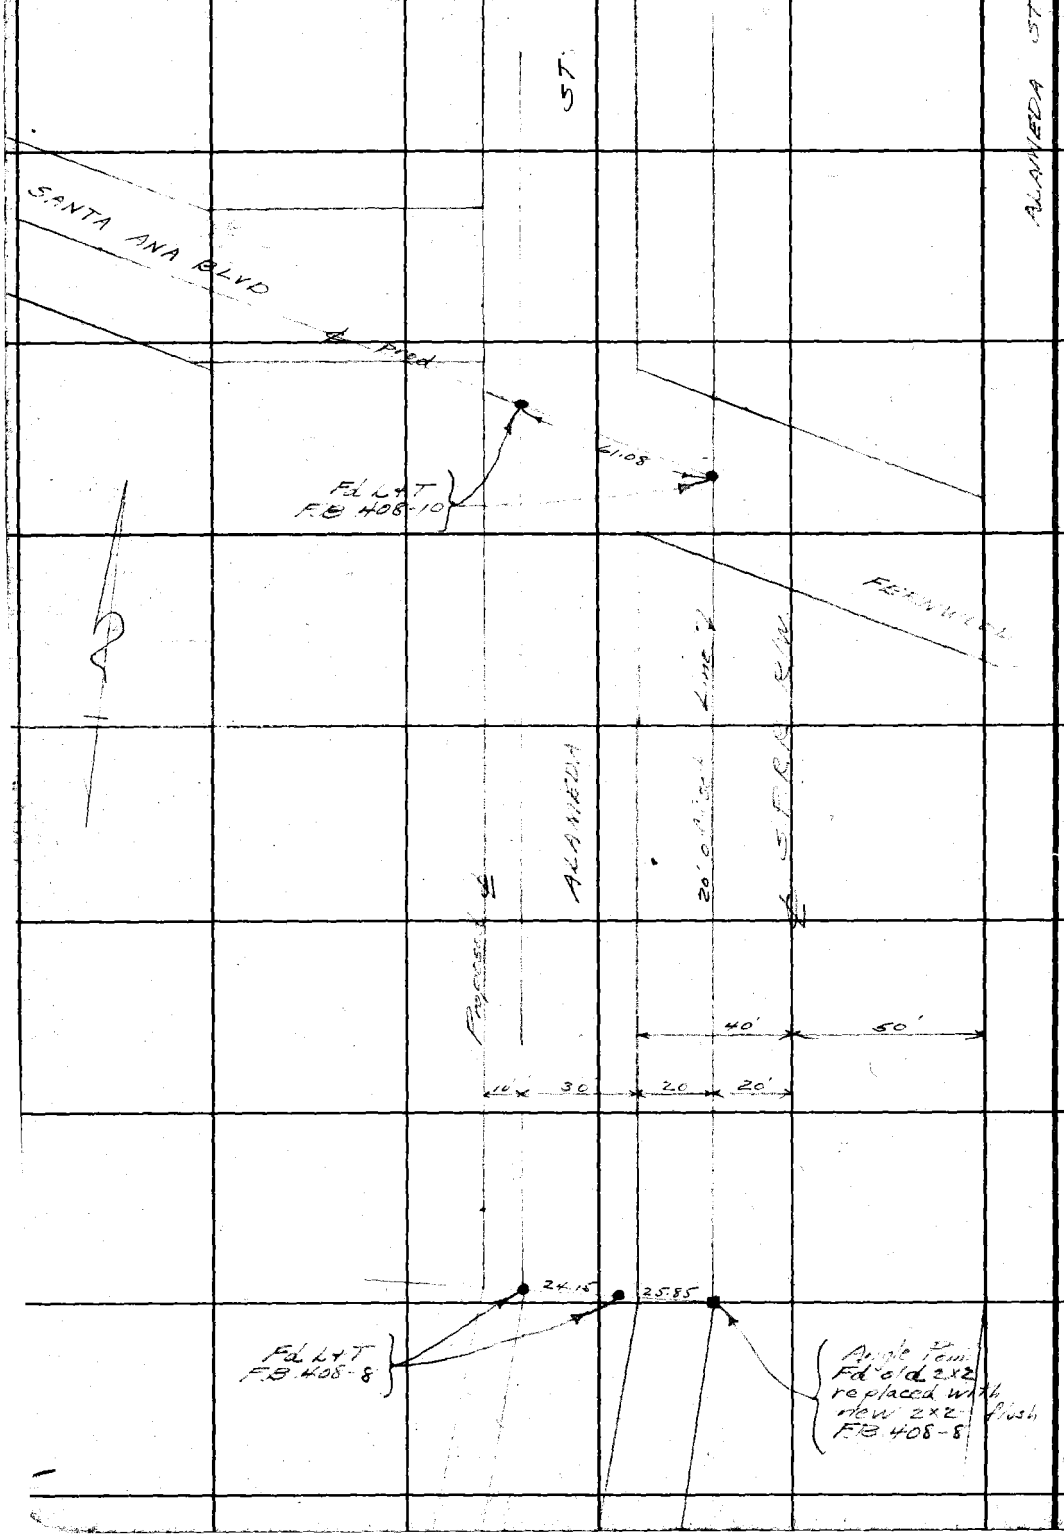

RETURN TO
LOS ANGELES COUNTY SURVEYOR
700 HALL OF RECORDS

Note: Any Additions or Changes on This Sheets Must be Made or Circled in **Red Ink** With Date and Name of Person Making Change.

Do not extend notes this side of this line

Notes Ck'd by D. M. Finley	Survey of Alameda ST	F.B. 807 PG. 11
Map No. B-1498-2	W. O. 8270 Tape No. 063 St'd 76 OF	
Office Work D. A. WHITE	Surveyed by Moore	
Checked D. M. Finley	Notes Moore Date 7-11-39	
Date Feb. 1940	Indexed A. C. Johnson	

To bottom pg. 12

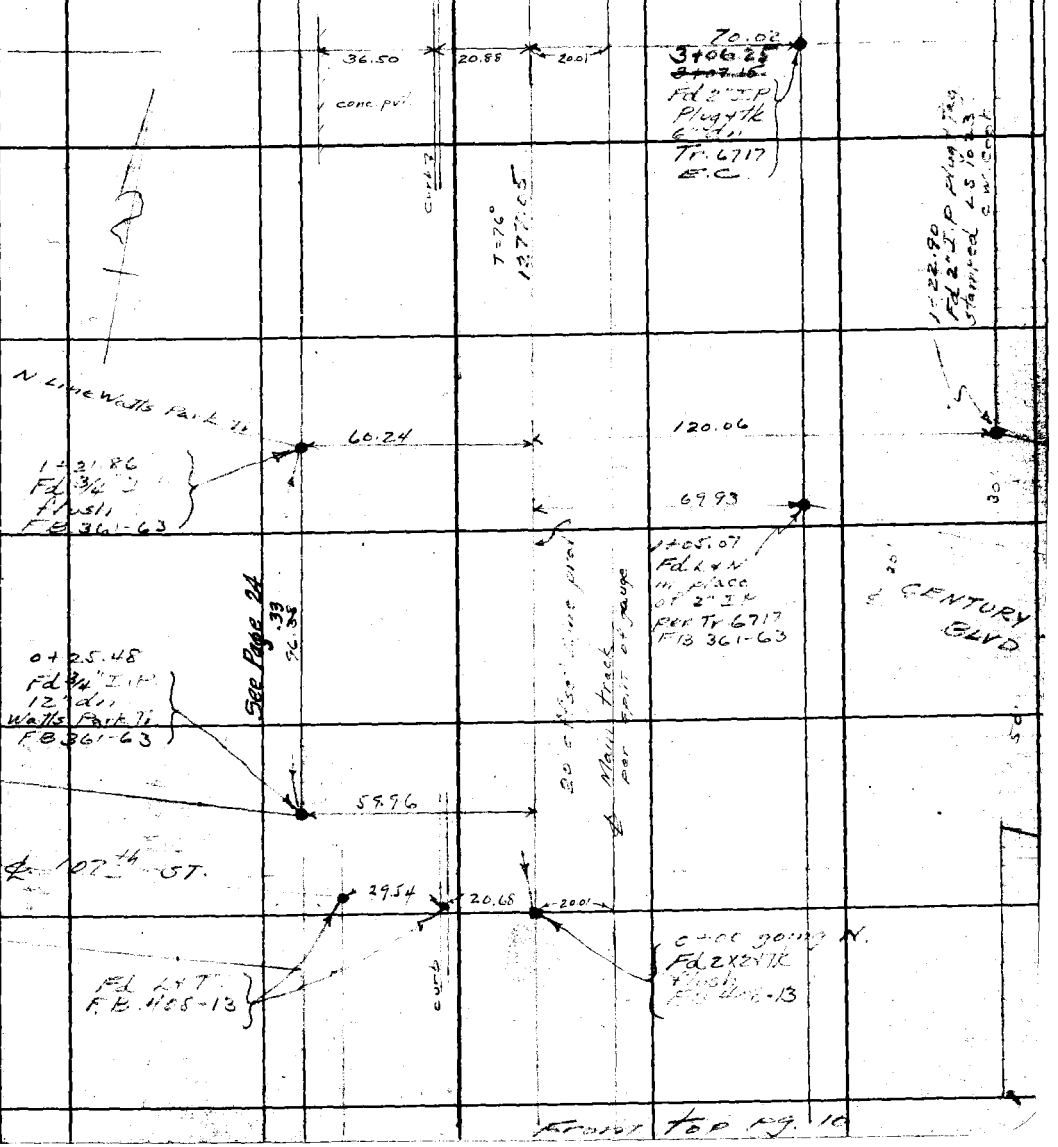

From top pg. 10

Note: Any Additions or Changes on This Sheets Must be Made or Circled in Red Ink With Date and Name of Person Making Change.

Do not extend notes this side of this line

RETURN TO
LOS ANGELES COUNTY SURVEYOR
700 HALL OF RECORDS

FORM 247 5M 10-37

F.B. 807 PG. 12

To bottom pg

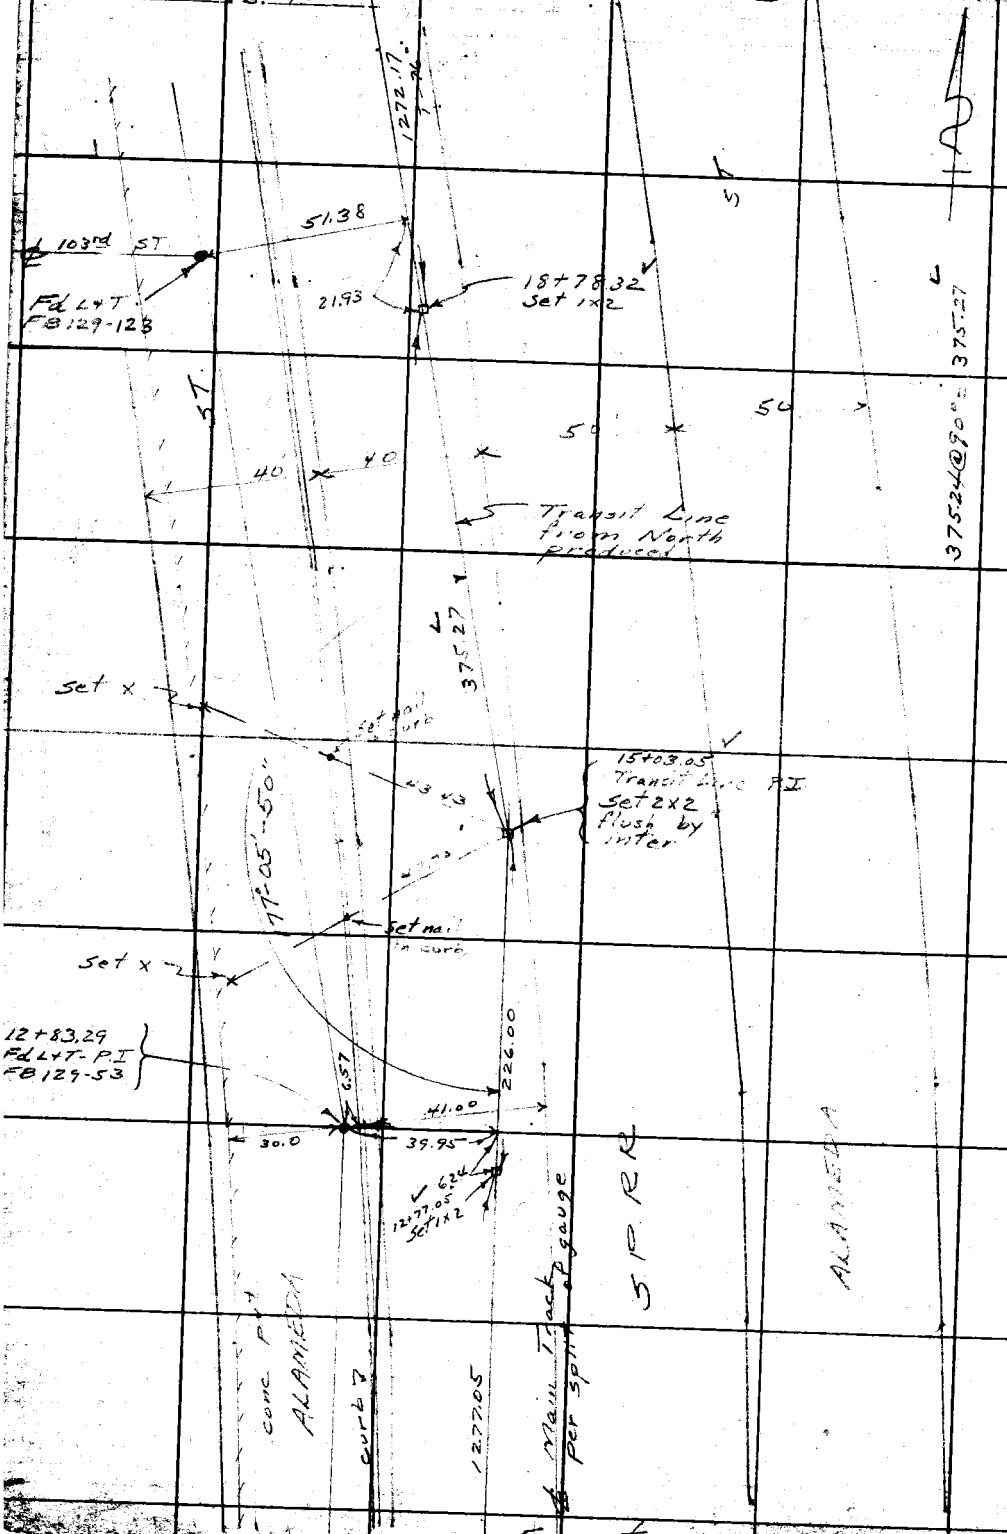

From top pg. 11

RETURN TO
LOS ANGELES COUNTY SURVEYOR
700 HALL OF RECORDS

Note: Any Additions or Changes on This Sheets Must be Made or Circled in Red Ink With Date and Name of Person Making Change.

Do not extend notes this side of this line

Notes Ck'd by D. M. Finley	Survey of Annual 57
Map No. B-1498-3	W. O. 8270 Tape No. 063 St'd 76 °F.
Office Work D. A. WHITE	Surveyed by [illegible]
Checked D. M. Finley	Notes [illegible] Date 7-12-39
Date Feb. 1940	Indexed A. C. Johnson

F.B. 807 PG. 13

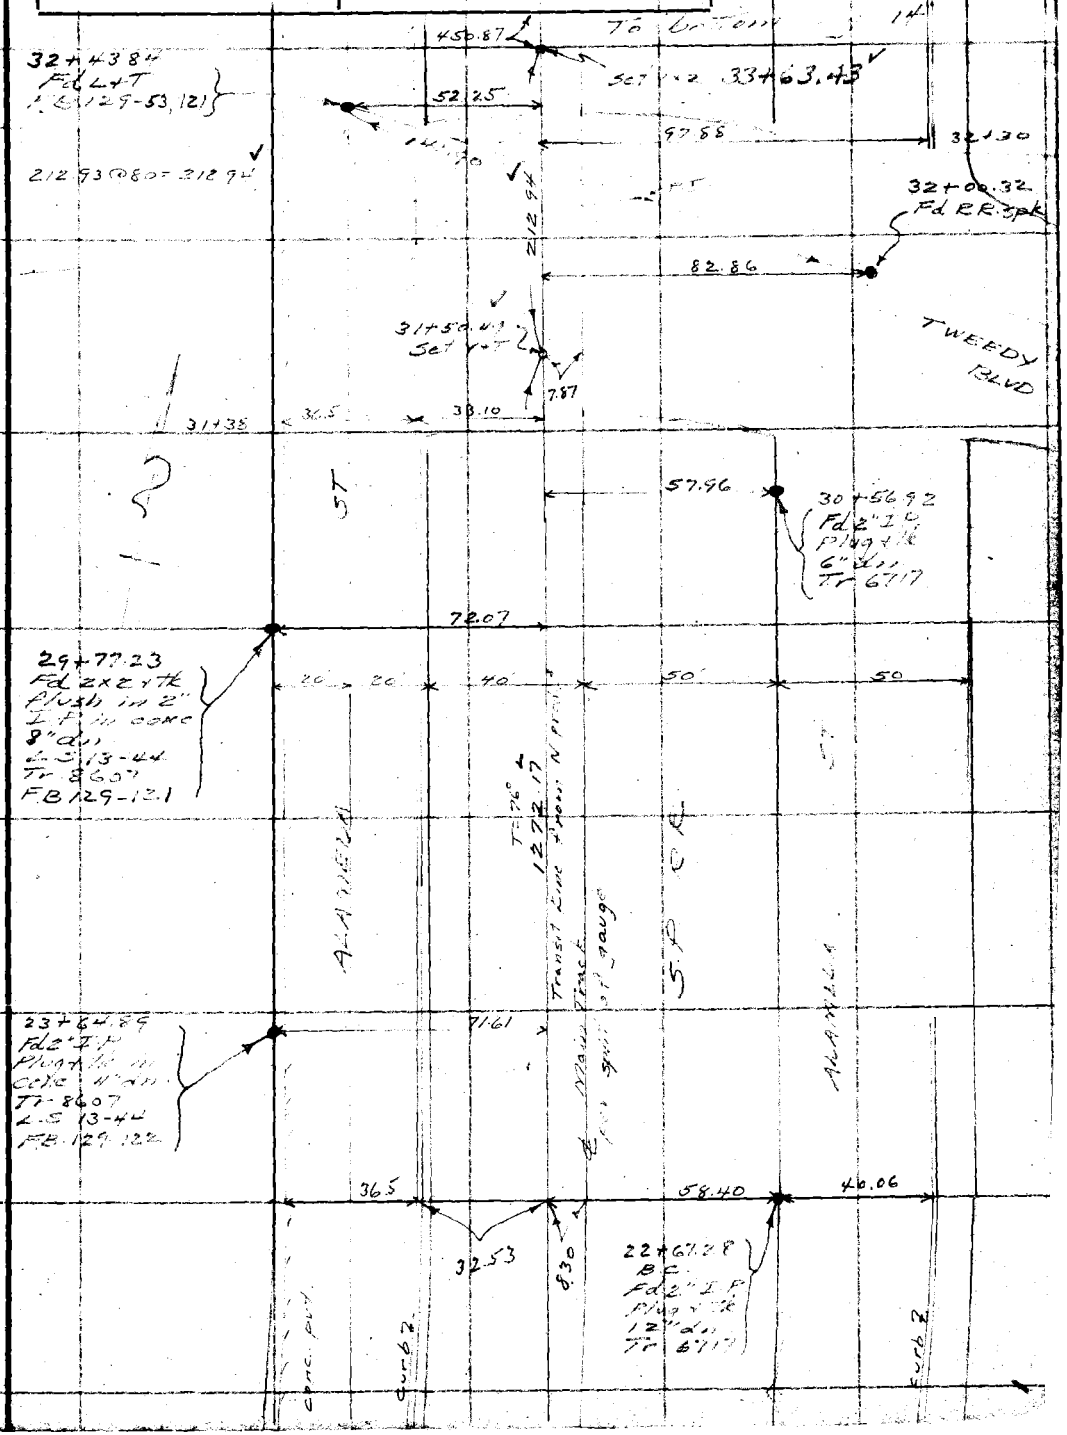

Note: Any Additions or Changes on This Sheet Must be Made or Circled in Red Ink With Date and Name of Person Making Change.

Do not extend notes this side of this line

RETURN TO
LOS ANGELES COUNTY SURVEYOR
700 HALL OF RECORDS

FORM 247 10M 11-35

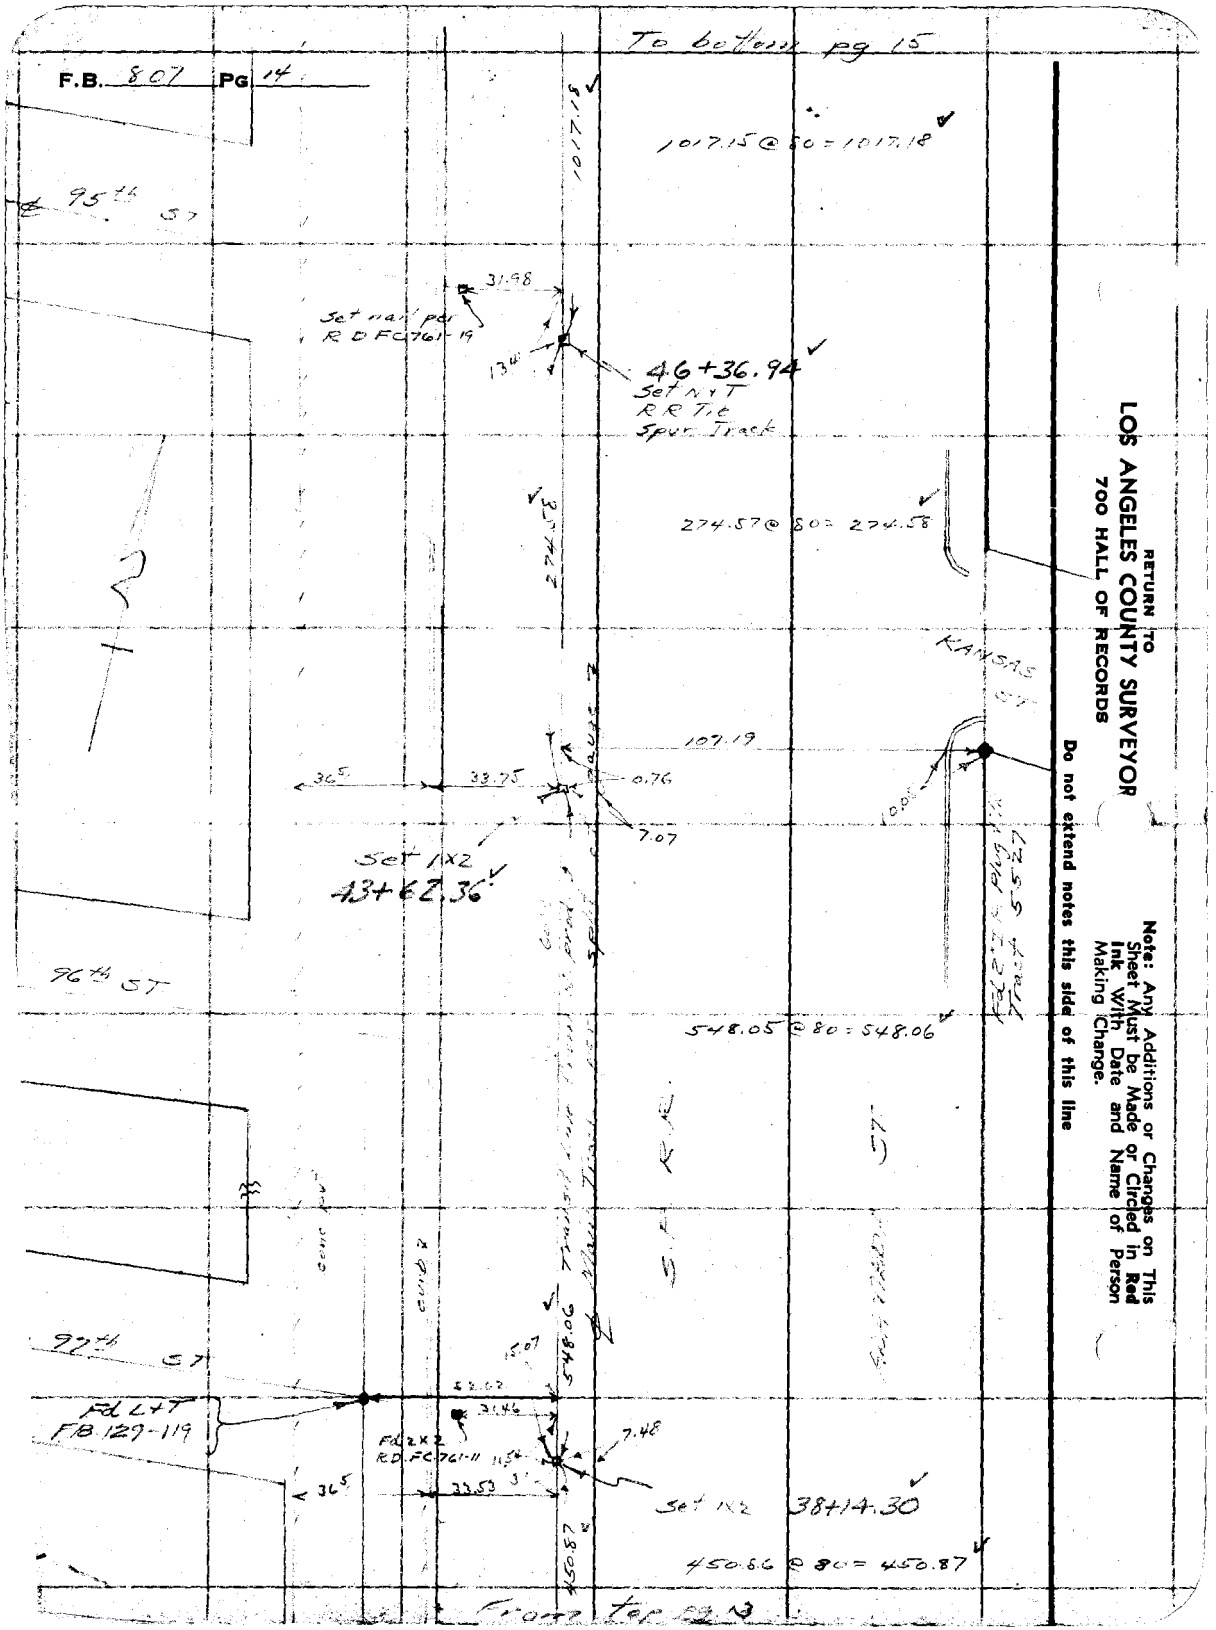

RETURN TO
LOS ANGELES COUNTY SURVEYOR
700 HALL OF RECORDS

Do not extend notes this side of this line

Note: Any Additions or Changes on This Sheet Must be Made or Circled in Red Ink With Date and Name of Person Making Change.

Notes Ck'd by D. M. Finley	Survey of Alameda ST.
Map No. B-1494-4	W. 08370 Tape No. 863 St'd 76-8
Office Work D. A. WHITE	Surveyed by Moore
Checked D. M. Finley	Notes Moore Date 7-12-39
Date Feb. 1940	Indexed A. C. Johnson

F.B. 807 Pg. 15

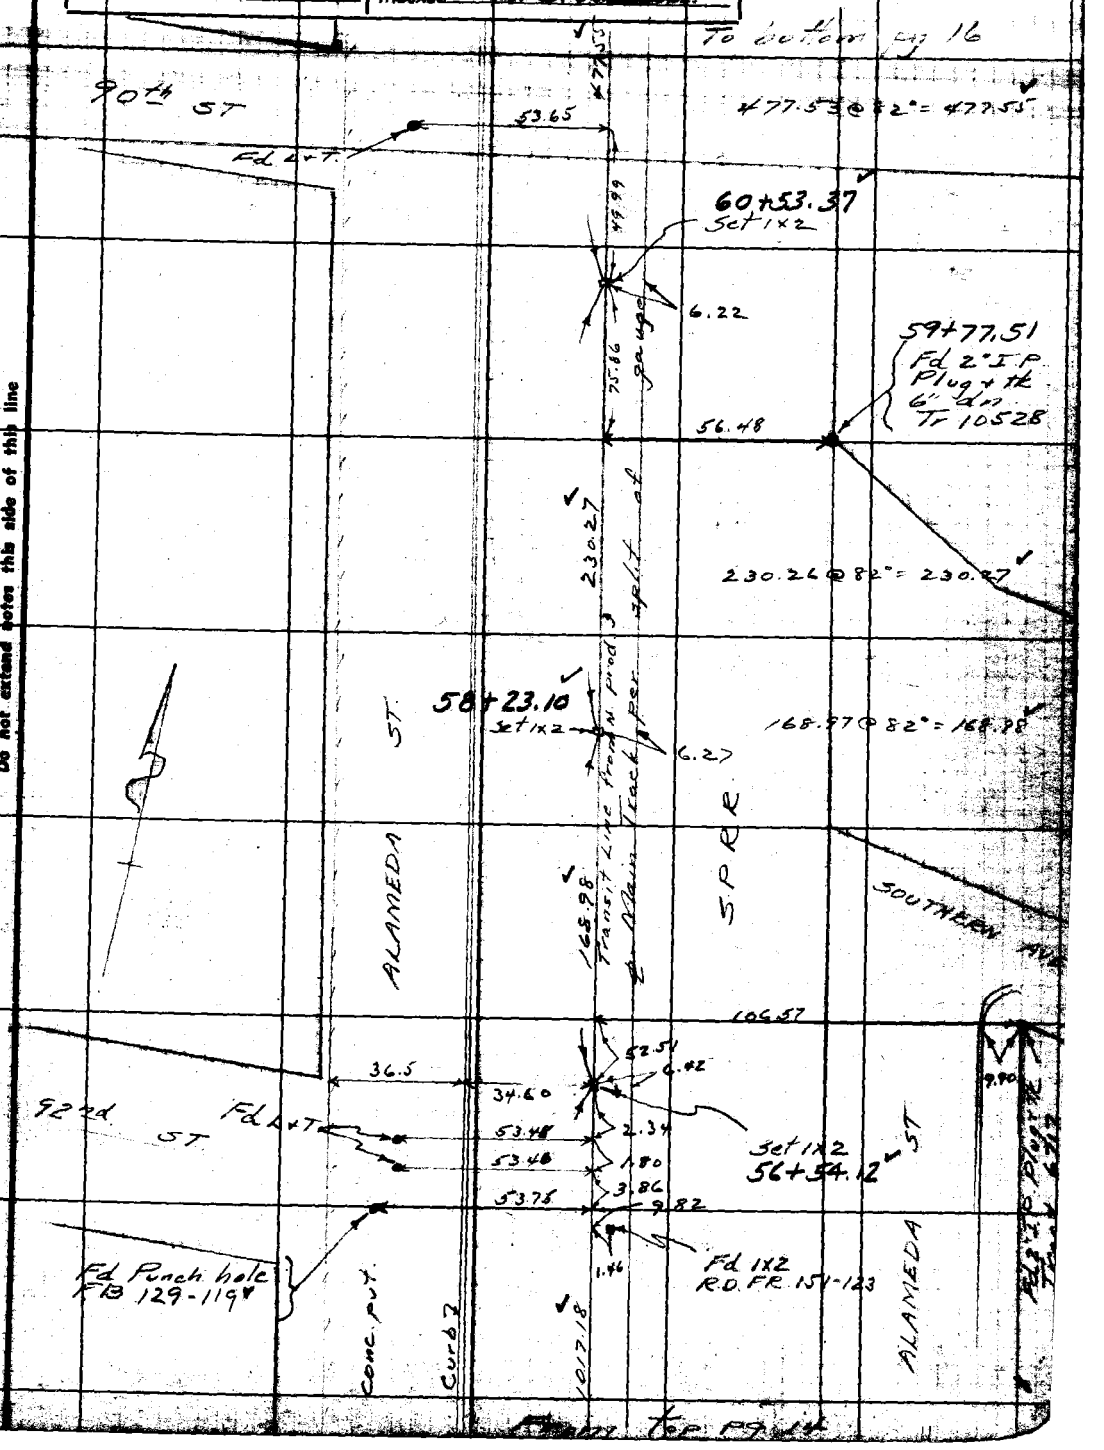

Note: Any Additions or Changes on This Sheet Must be Made or Circled in Red Ink With Date and Name of Person Making Change.

Do not extend notes this side of this line

LOS ANGELES COUNTY SURVEYOR
700 HALL OF RECORDS

FORM 247 10M 11-35

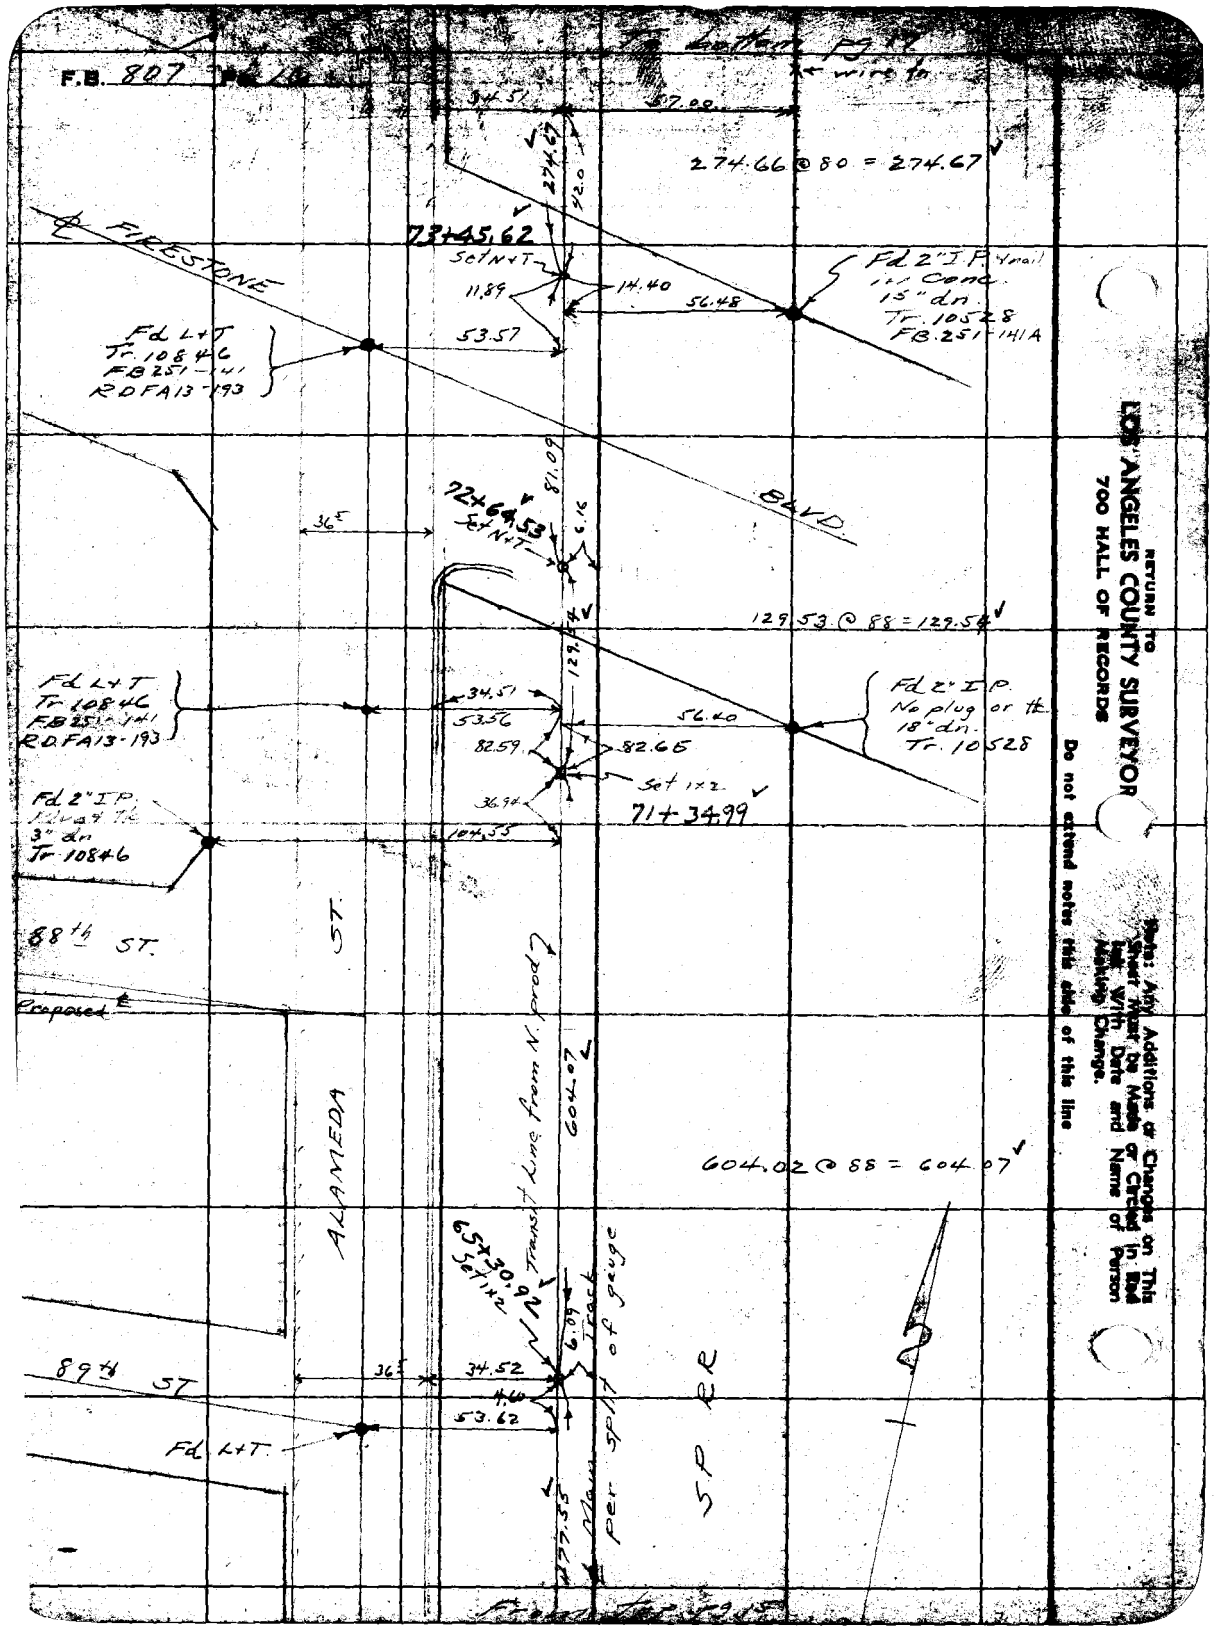

RETURN TO
LOS ANGELES COUNTY SURVEYOR
700 HALL OF RECORDS

Note: Any Additions or Changes on This Sheet Must be Made or Circled in Red Ink With Date and Name of Person Making Change.

Do not extend notes this side of this line

Notes Ck'd by D. M. Finley | Change of Alameda ST | F.B. 807 | PG 17
Map No. B-1490-4 | Wt. 0.82 | Rate 0.63 | Grid Zone
Office Work H. H. REYNOLDS | Surveyed by Moore
Checked D. M. Finley | Notes Moore | Date 7-13-39
Date Feb 1940 | Indexed A. C. Johnson

To bottom pg 18

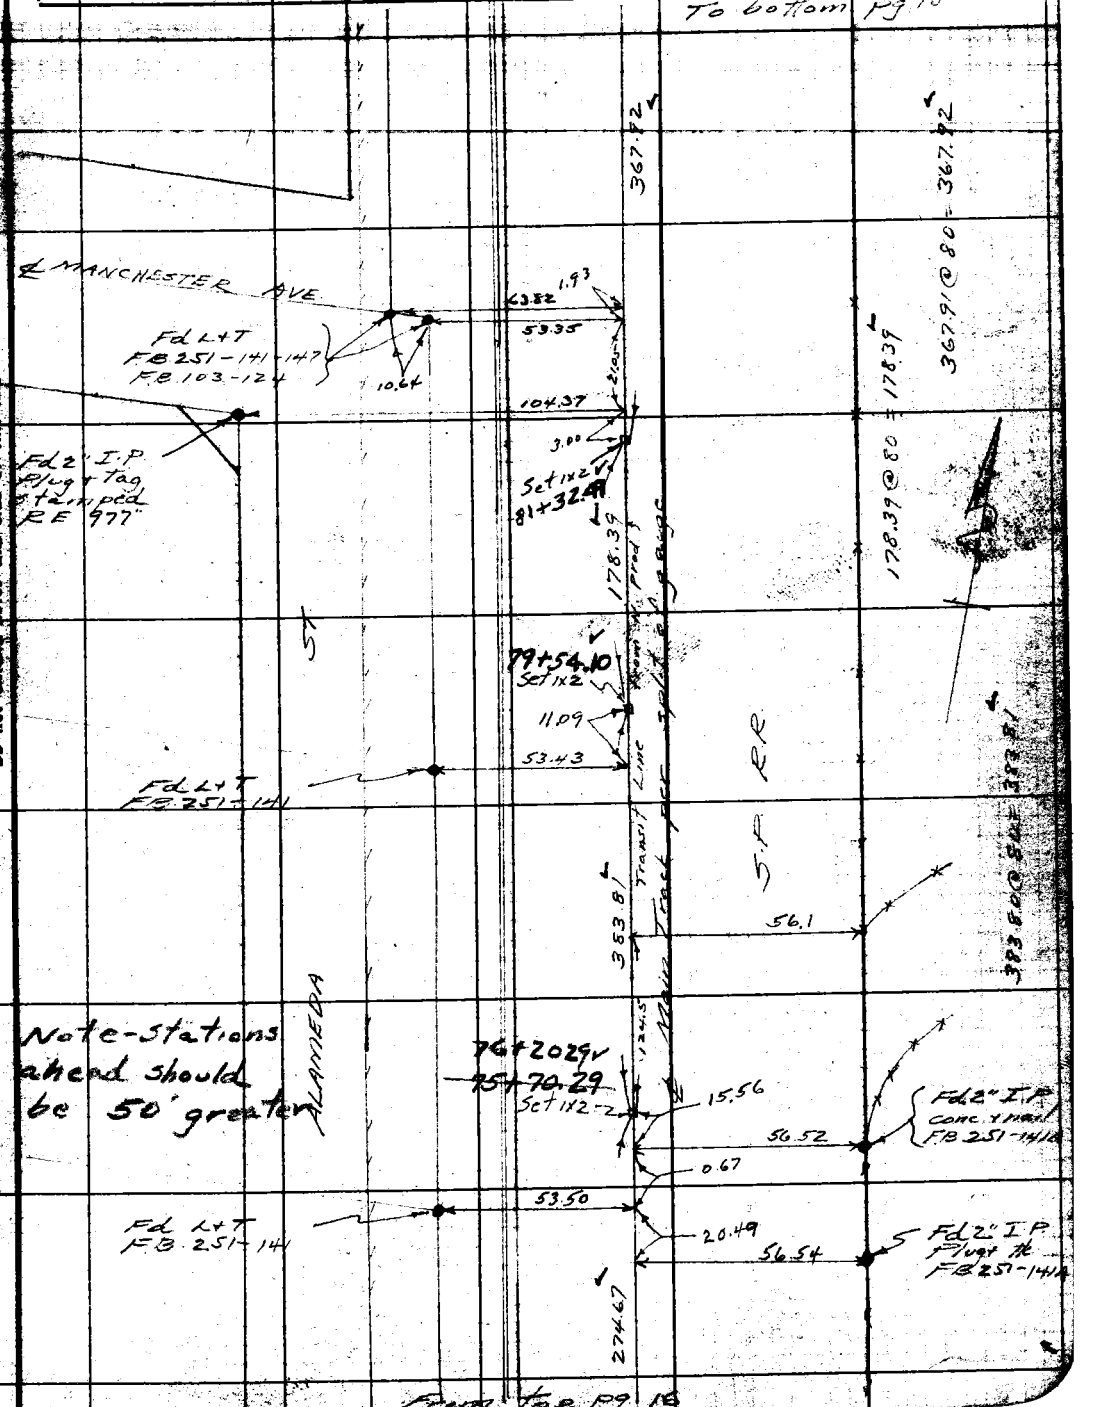

From top pg 16

Note: Any Additions or Changes on Sheet Must be Made or Circled in Ink With Date and Name of Making Change
Do not extend notes this side of this line
RETURN TO
LOS ANGELES COUNTY SURVEYOR
700 HALL OF RECORDS
FORM 247 10M 11-35

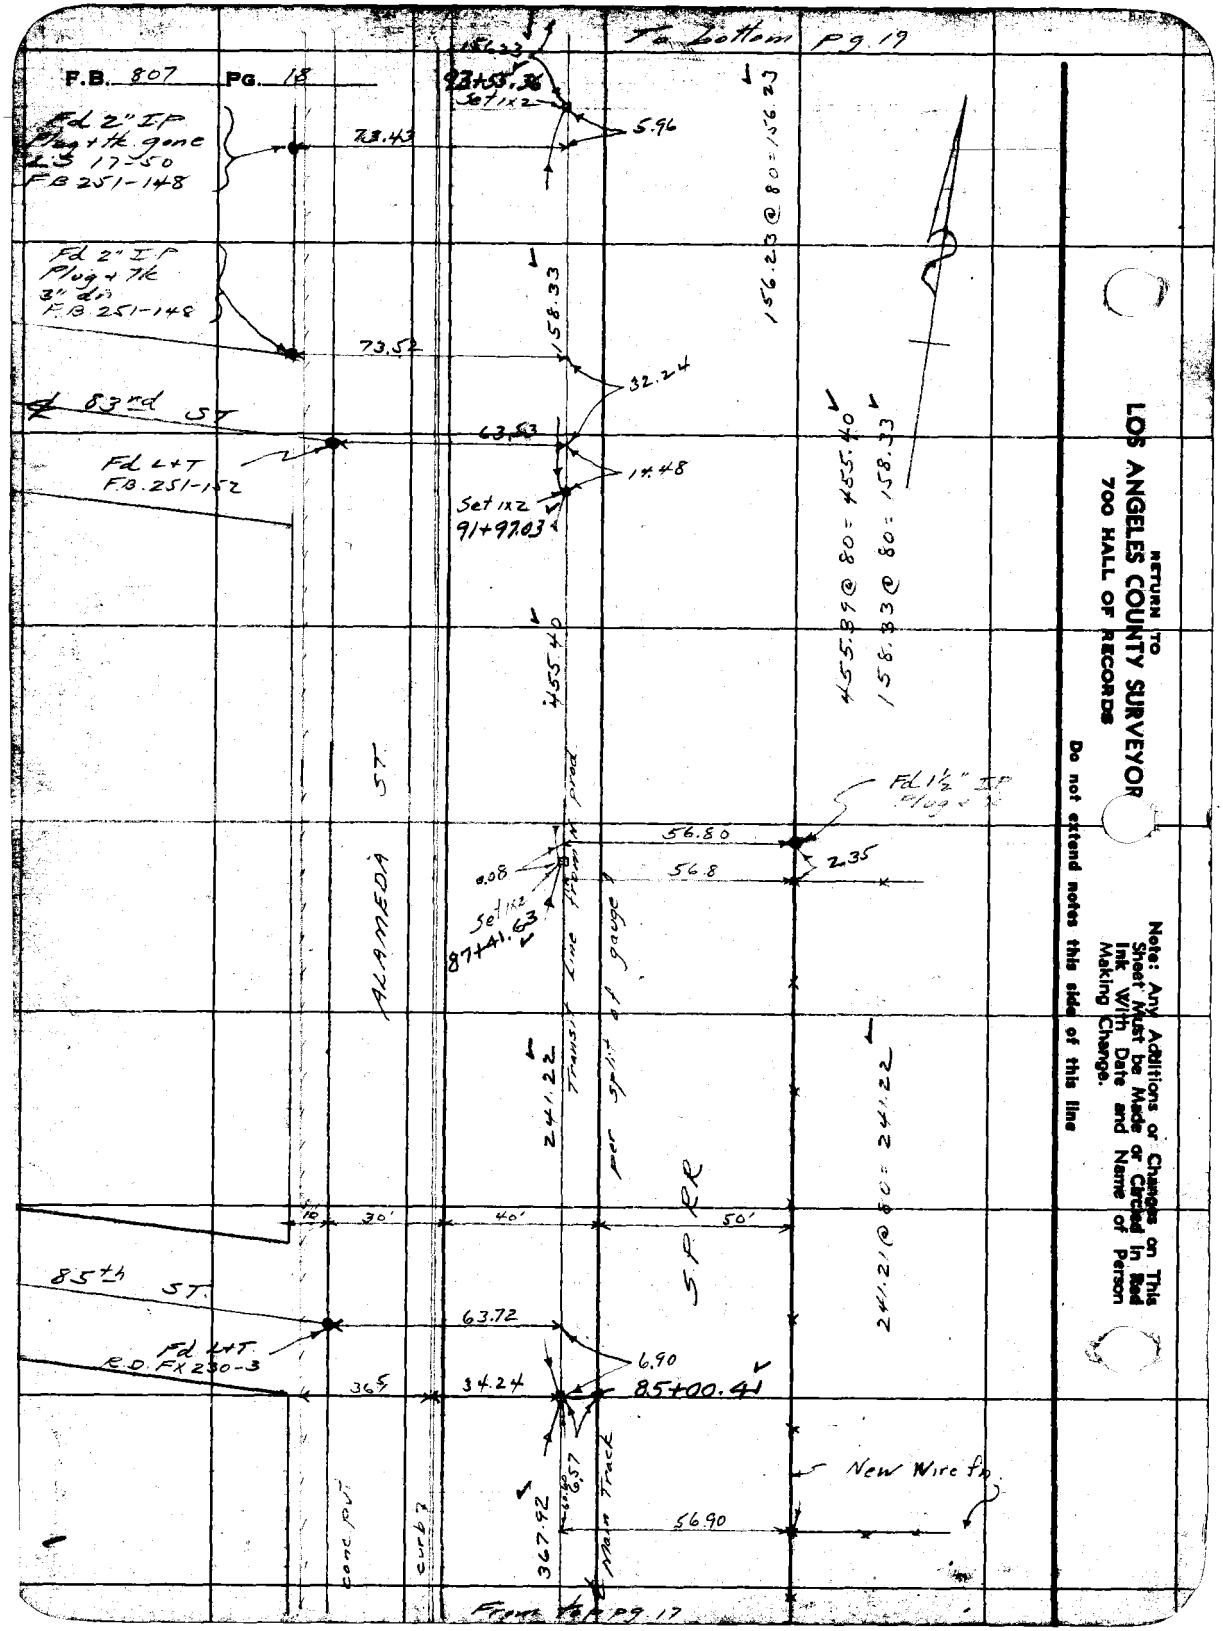

RETURN TO
LOS ANGELES COUNTY SURVEYOR
700 HALL OF RECORDS

Do not extend notes this side of this line

Note: Any Additions or Changes on This Sheet Must be Made or Circled in Red Ink With Date and Name of Person Making Change.

Notes Circled by D. M. Finley	Survey of Alameda ST		F.B. 807 PG. 19
Map No. B-1499-4	Ref. 08220	Tape No. 063 St 4.76 F.	
Office Work H. H. REYNOLDS	Surveyed by Moore		
Checked D. M. Finley	Notes Moore	Date 7-13-39	
Date Feb 1940.	Indexed A. C. Johnson		

To bottom pg 20

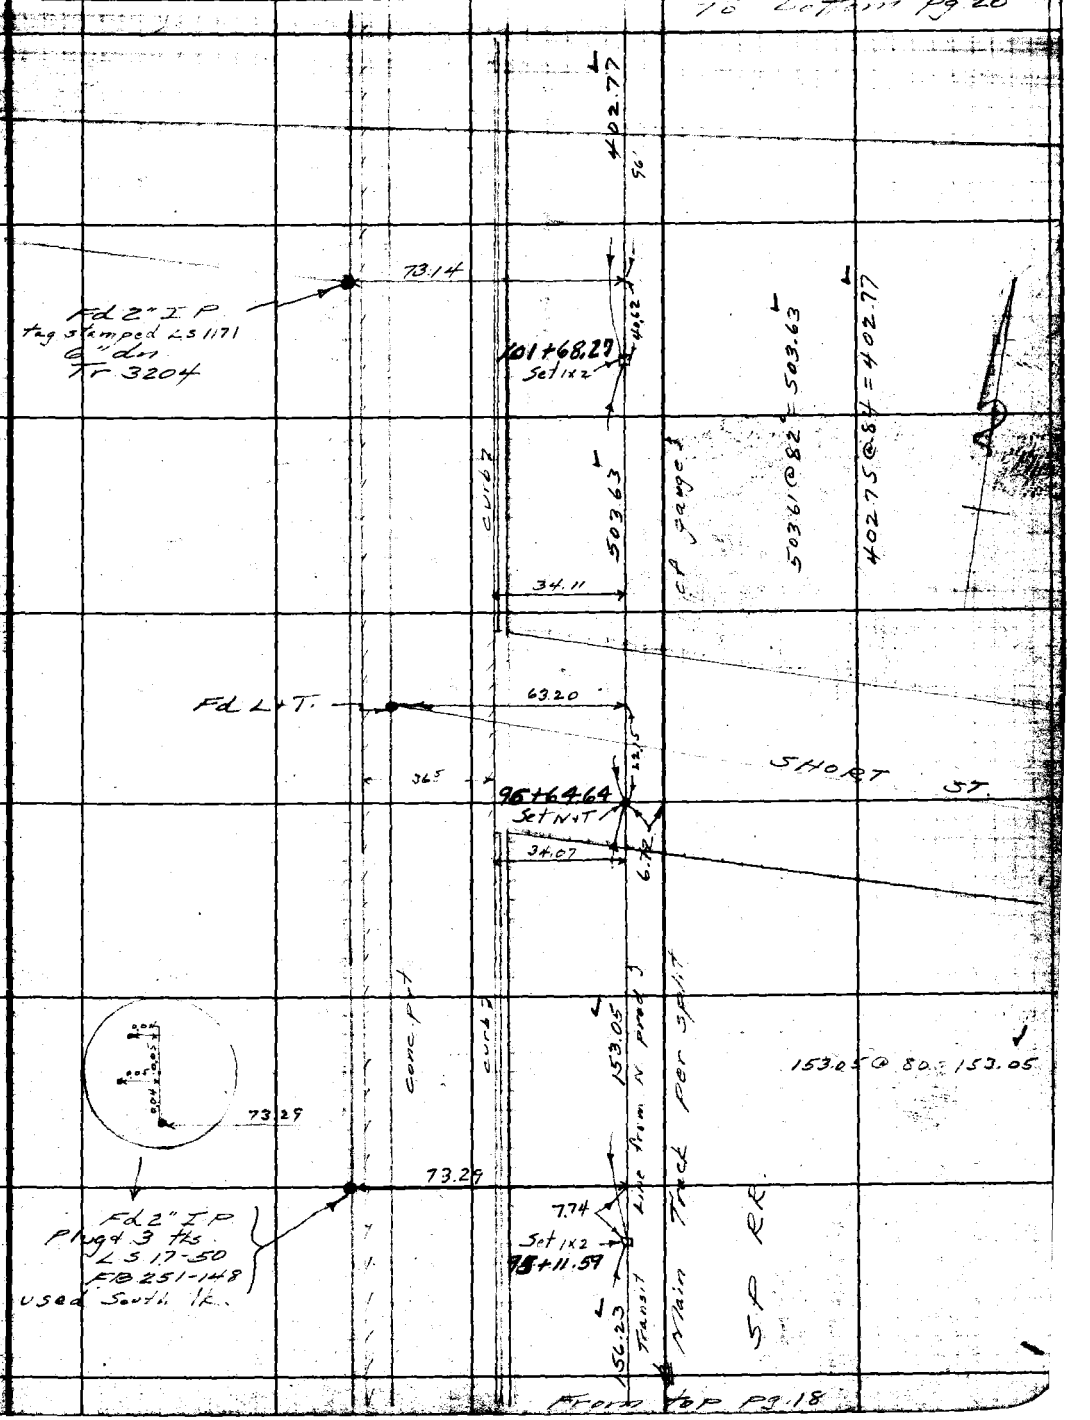

From top pg 18

Note: Any Additions or Changes on This Sheet Must be Made or Circled in Red Ink With Date and Name of Person Making Change.

Do not extend notes this side of this line

RETURN TO
LOS ANGELES COUNTY SURVEYOR
700 HALL OF RECORDS

FORM 247 10M 11-38

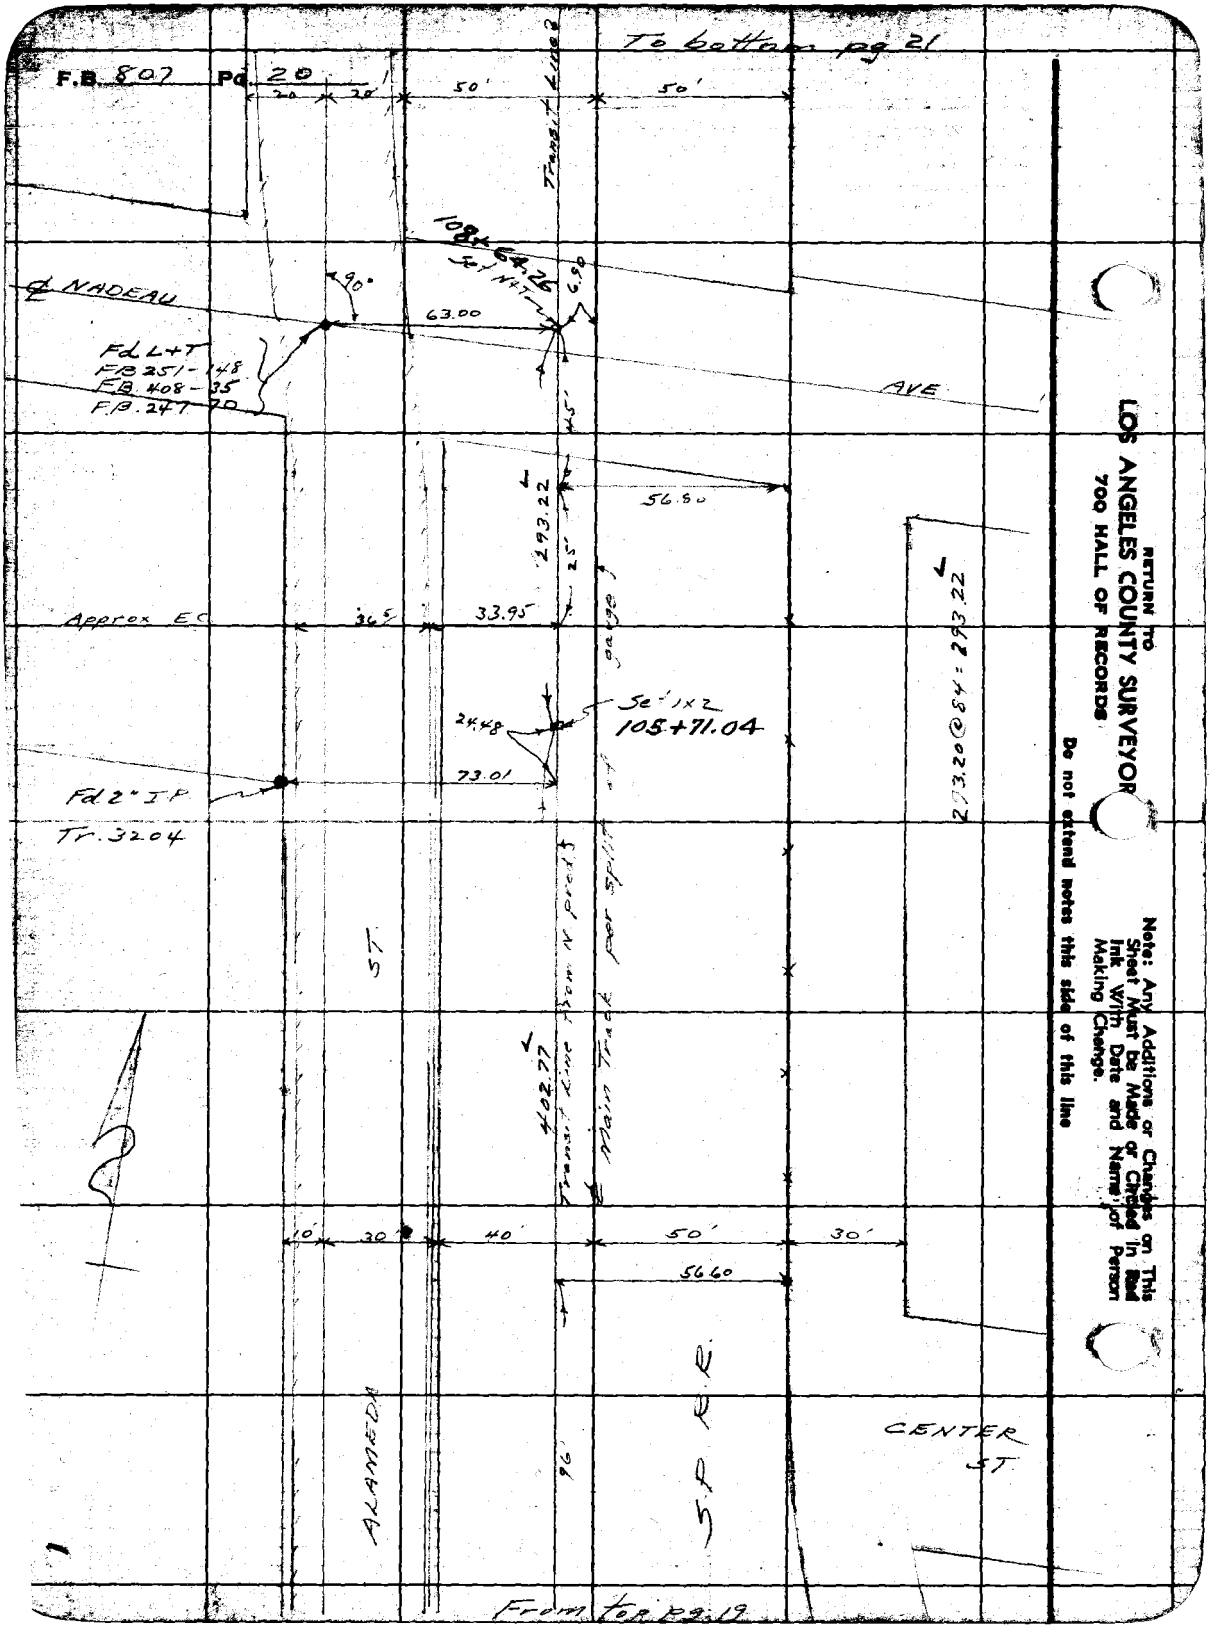

RETURN TO
LOS ANGELES COUNTY SURVEYOR
700 HALL OF RECORDS

Do not extend notes this side of this line

Note: Any Additions or Changes on This Sheet Must be Made or Circled in Red Ink With Date and Name of Person Making Change.

Notes Ck'd by D. M. Finley	Survey of Alameda ST.	F.B. 307	Pg. 21
Map No. B-1496	W. O. 8270 Tape No. 063 St'd 76		
Office Work H. H. REYNOLDS	Surveyed by Moore		
Checked D. M. Finley	Notes Moore Date 7-14-39		
Date Feb 1940	Indexed A. C. Johnson		

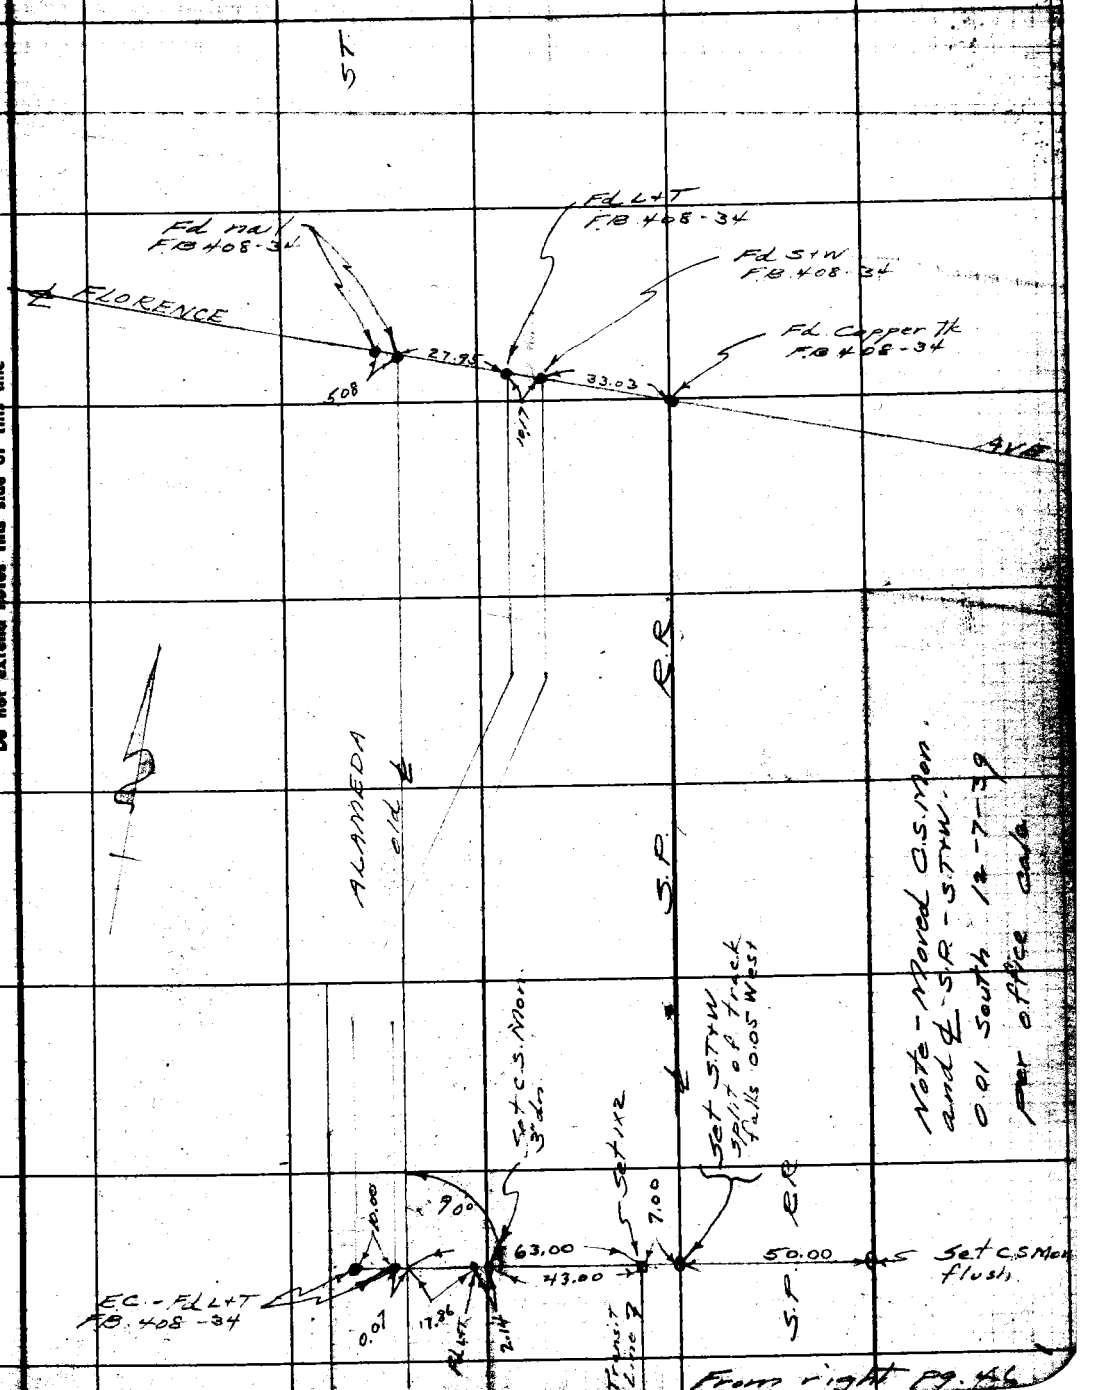

From right Pg. 46

Note: Any Additions or Changes on This Sheet Must be Made or Circled in Red Ink With Date and Name of Person Making Change

Do not extend notes this side of this line

RETURN TO
LOS ANGELES COUNTY SURVEYOR
700 HALL OF RECORDS

FORM 247 10M 11-38

RETURN TO
LOS ANGELES COUNTY SURVEYOR
700 HALL OF RECORDS

Note: Any Additions or Changes on This Sheet Must be Made or Circled in Red Ink With Date and Name of Person Making Change.

Do not extend notes this side of this line

F.B. 807 Pg. 22

[illegible] D. M. Finley	Survey of Alameda St	F.B. 807	PG. 23
[illegible]	W. 8270 Tape No. 063 Std. % of		
Office Work D. A. WHITE	Surveyed by L. B. Moore		
Checked D. M. Finley	Notes Moore Date 8-2-39		
Date Feb. [illegible]	Indexed Wm. H. Blackmer 9-7-39		

SURVEY
OF
ALAMEDA ST
FROM
107th ST
NORTH TO
NADEAU ST
Job # 8270

Note - All C.S. Mon[illegible]
4 B.C. [illegible]
as shown

COUNTY SURVEYOR

Note: Any Additions or Changes on This Sheets Must be Made or Curled in Red Ink With Date and Name of Person Making Change.

Do not extend notes this side of this line

REVIEW TO
LOS ANGELES COUNTY SURVEYOR
700 HALL OF RECORDS

FORM 247 5M 10-37

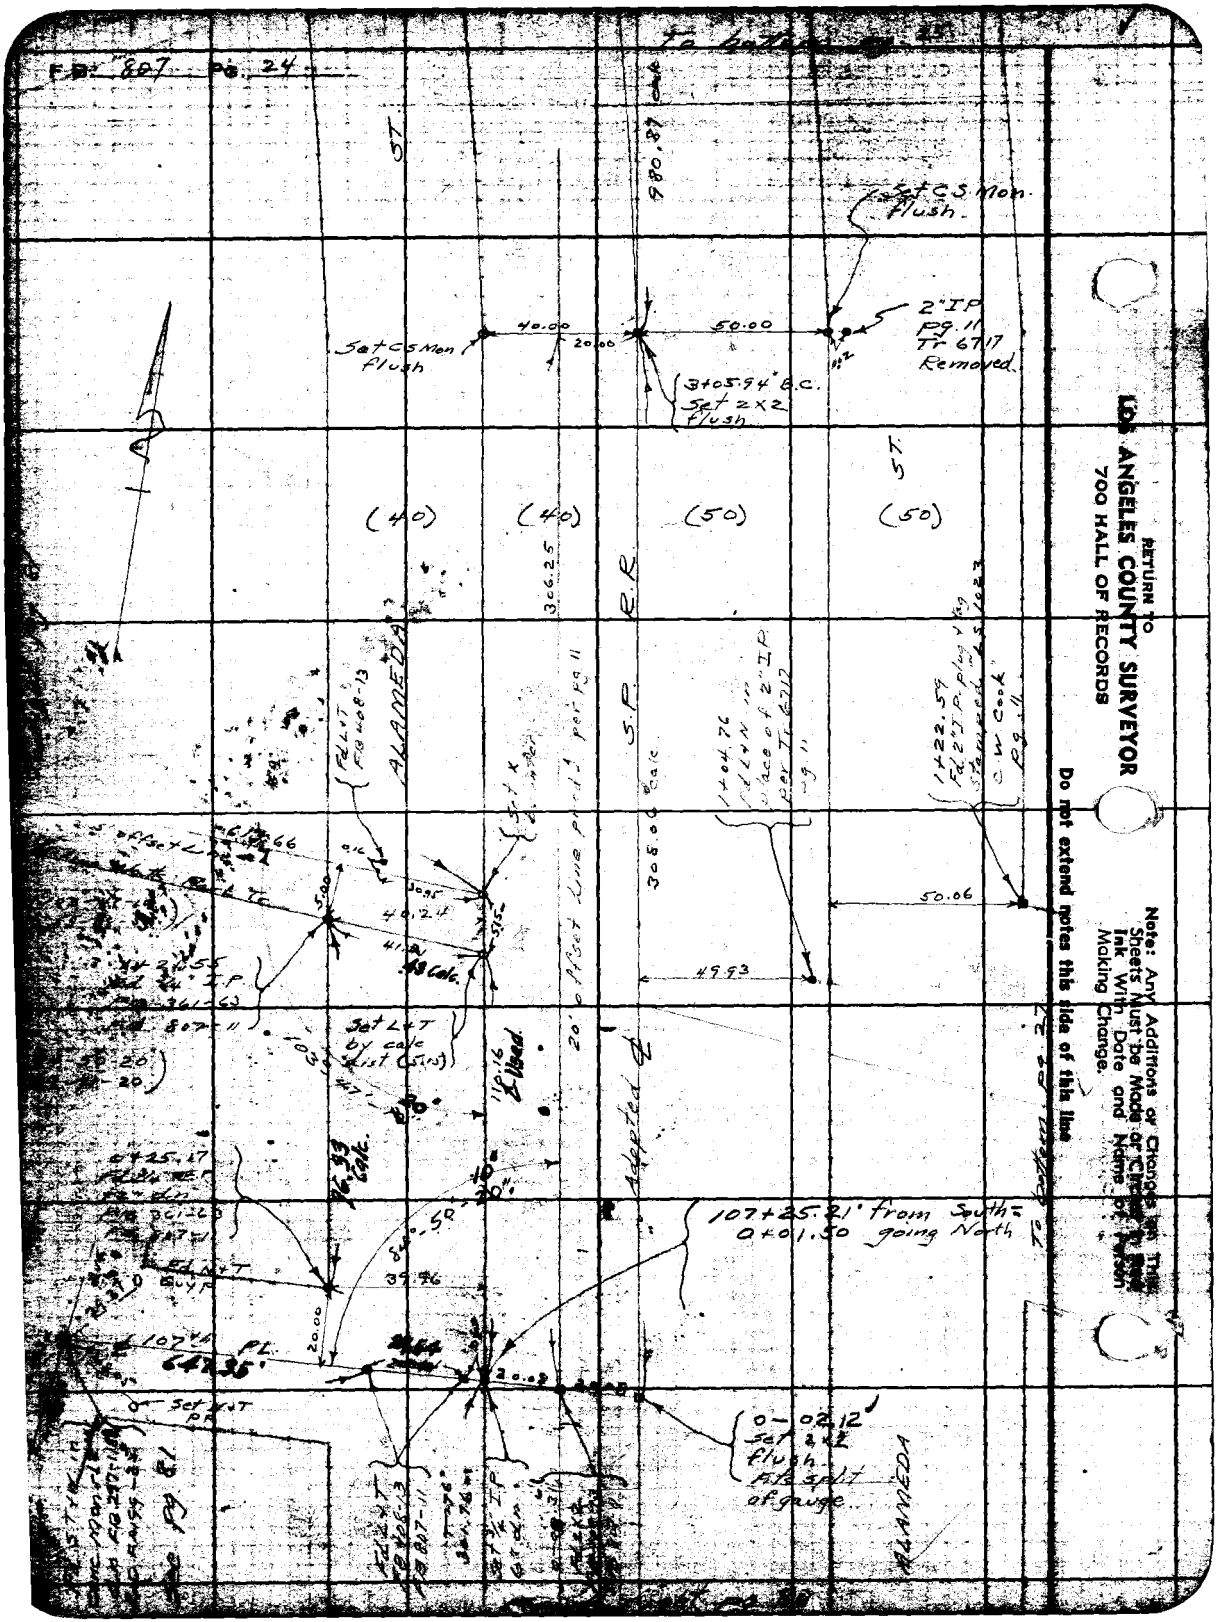

RETURN TO
LOS ANGELES COUNTY SURVEYOR
700 HALL OF RECORDS

Note: Any Additions or Changes on This Sheets Must be Made or Circled in Red Ink With Date and Name of Person Making Change.

Do not extend notes this side of this line

Notes Ck'd by D. M. Finley	Survey of Alameda ST	F.B. 807	Pg. 25
Map No. B-1498-3	W. 0.8270 Tape No. 063 St'd 76 of		
Office Work D. A. WHITE	Surveyed by Moore		
Checked D. M. Finley	Notes	Date 8-3-39	
Date Feb. 1940.	Indexed Wm. H. Blackmer 9-7-39		

Note: Any Additions or Changes on This Sheets Must be Made or Circled in Red Ink With Date and Name of Person Making Change.

Do not extend notes this side of this line

RETURN TO
LOS ANGELES COUNTY SURVEYOR
700 HALL OF RECORDS

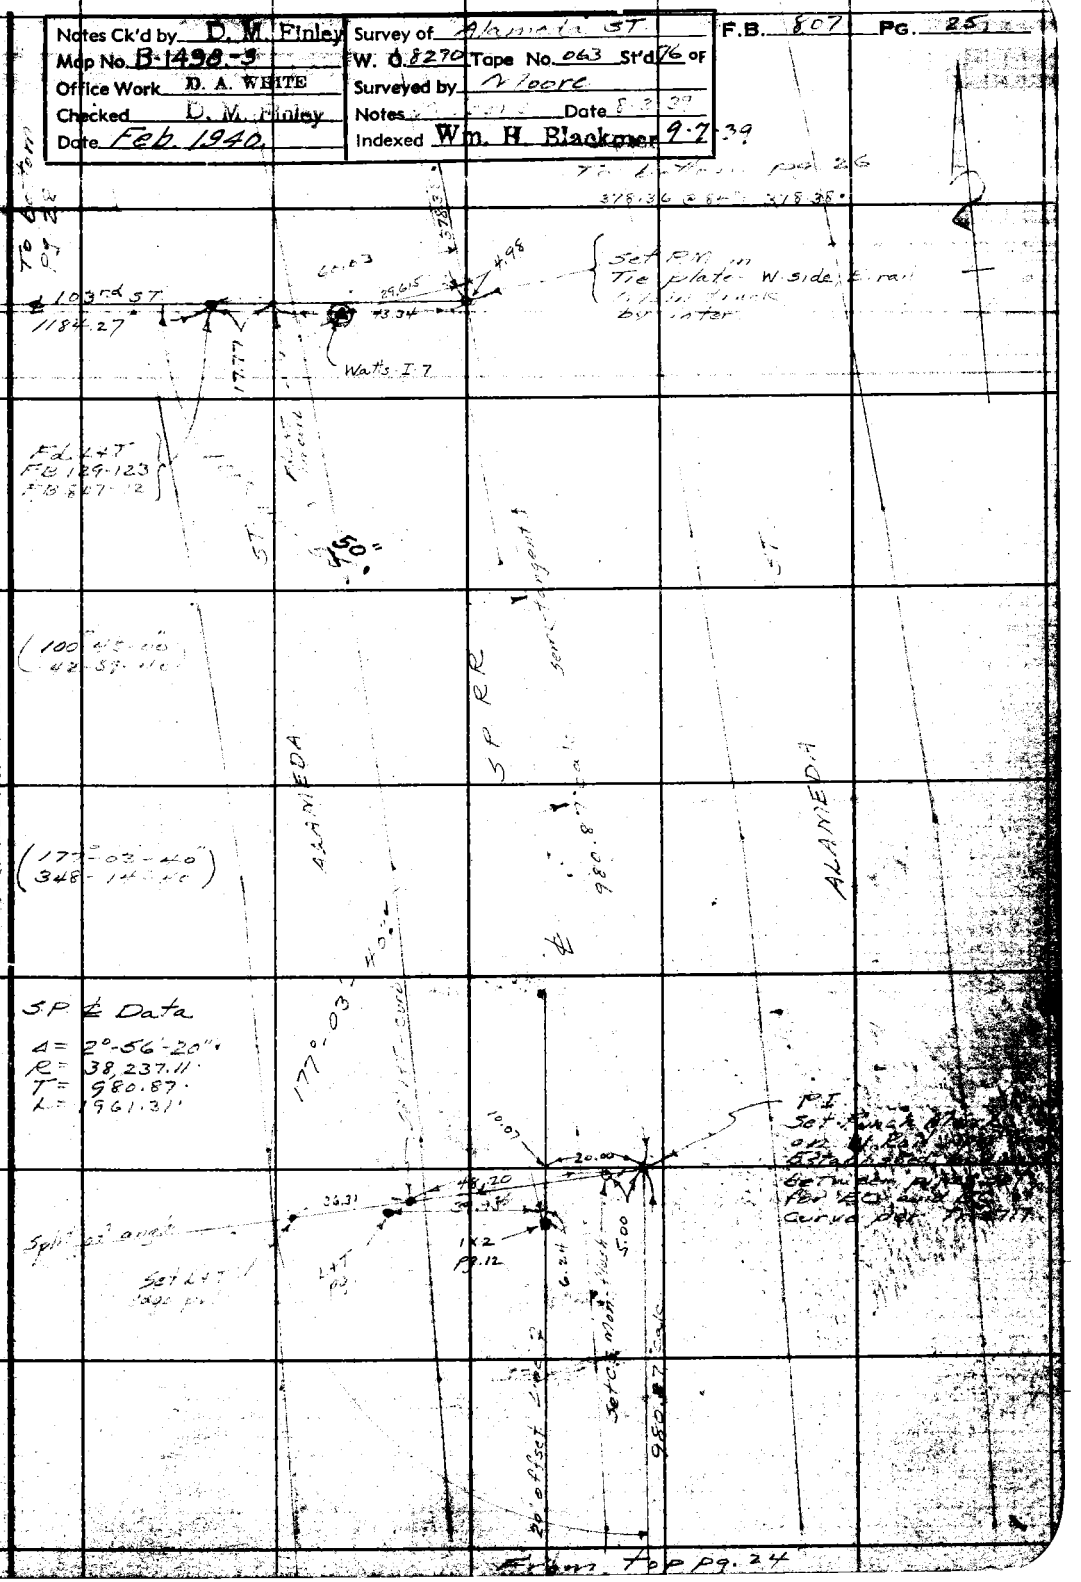

FORM 247 BM 10-37

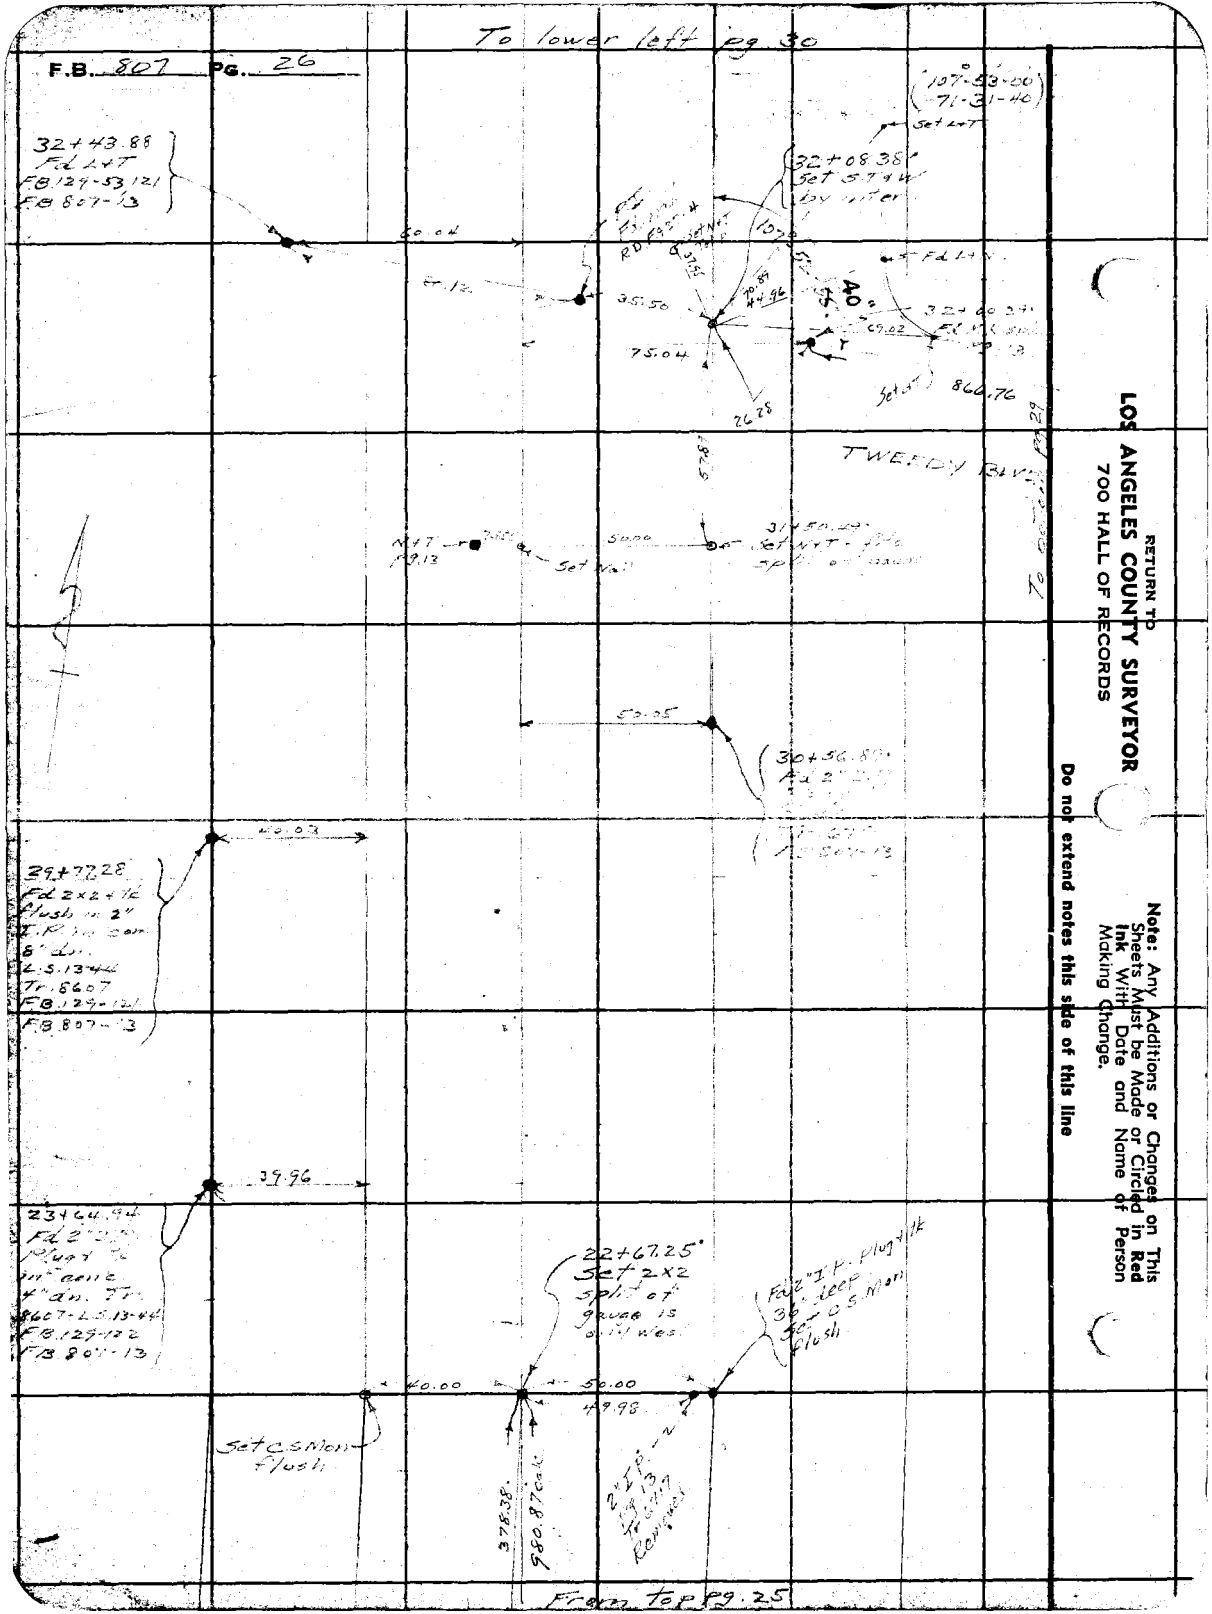

RETURN TO
LOS ANGELES COUNTY SURVEYOR
700 HALL OF RECORDS

Note: Any Additions or Changes on This Sheets Must be Made or Circled in Red Ink With Date and Name of Person Making Change.

Do not extend notes this side of this line

Notes Ck'd by D. M. Finley	Survey of Alameda St	F.B. 807 Pg. 27
Map No. B-1498-1	W. O. 8270 Tape No. 063 Sta. 9	
Office Work D. A. WHITE	Surveyed by Moore	
Checked D. M. Finley	Notes Moore Date	
Date Feb 1940	Indexed Wm. H. Blackmer 9-7-39	

Century Blvd

Note: Any Additions or Changes on This Sheets Must be Made or Circled in Red Ink With Date and Name of Person Making Change.

Do not extend notes this side of this line

RETURN TO
LOS ANGELES COUNTY SURVEYOR
700 HALL OF RECORDS

FORM 247 5M 10-37

Frame right pg. 2K

F.B. 807 Pg. 28

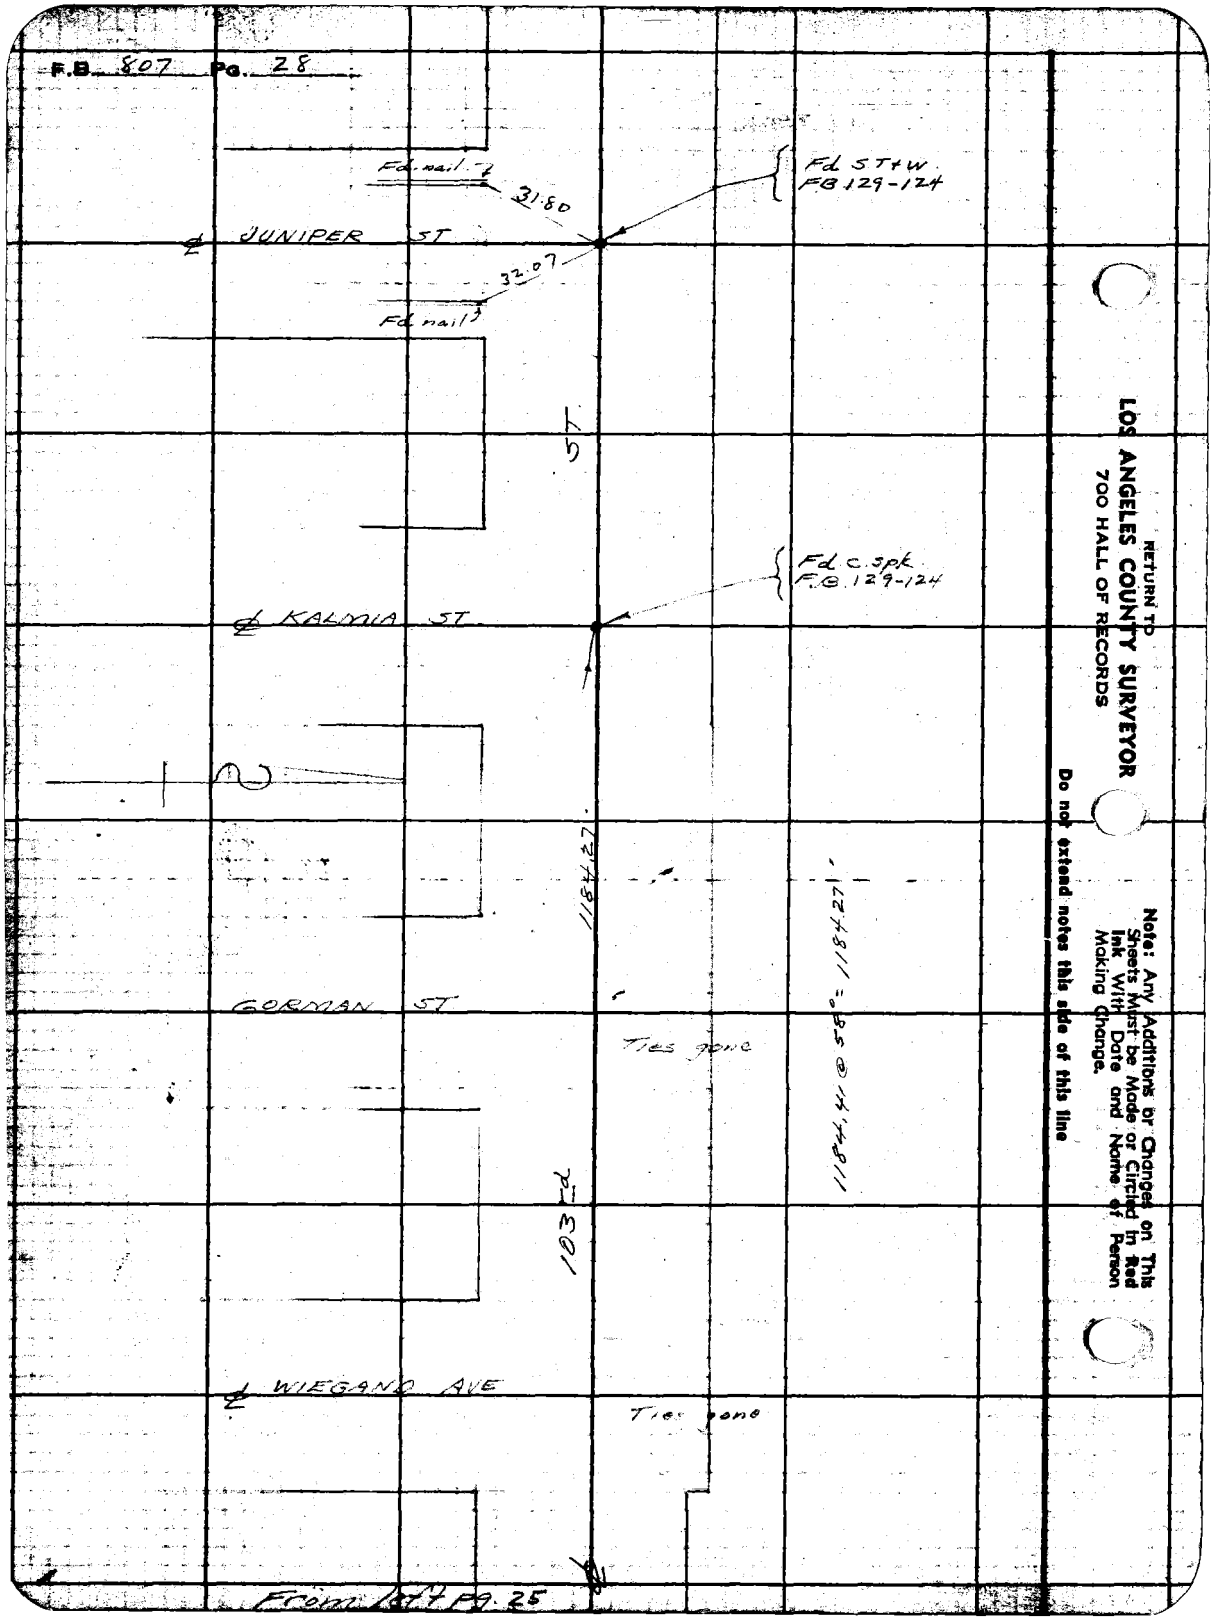

RETURN TO
LOS ANGELES COUNTY SURVEYOR
700 HALL OF RECORDS

Note: Any Additions or Changes on This Sheets Must be Made or Circled in Red Ink With Date and Name of Person Making Change.

Do not extend notes this side of this line

Notes Ck'd by D. M. Finley	Survey of Alameda St	F.B. 807 Pg. 29
Map No. B-1491-3	W. O. 8270 Tape No. 063 St'd 76 ct	
Office Work D. A. WHITE	Surveyed by Moore	
Checked D. M. Finley	Notes: Moore Date 8-4-39	
Date Feb. 1940	Indexed Wm. H. Blackmer 9-7-39	

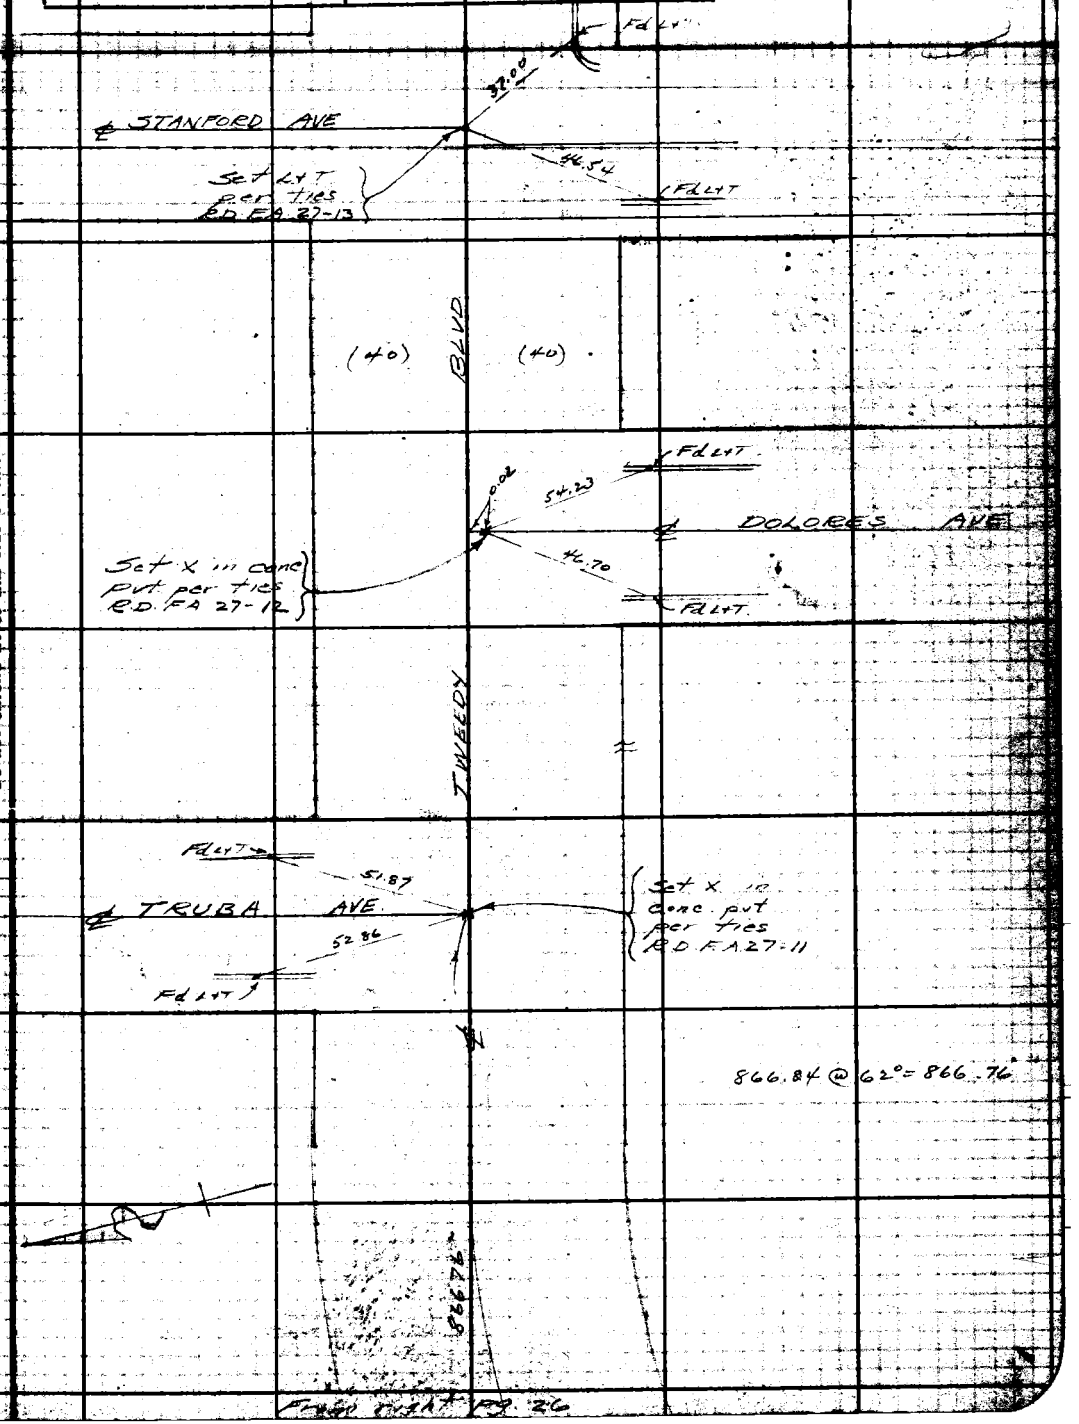

Note: Any Additions or Changes on This Sheets Must be Made or Circled in Red Ink With Date and Name of Person Making Change.

Do not extend notes this side of this line

RETURN TO
LOS ANGELES COUNTY SURVEYOR
700 HALL OF RECORDS

FORM 247 5M 10-37

F.B. 807 Pg. 30

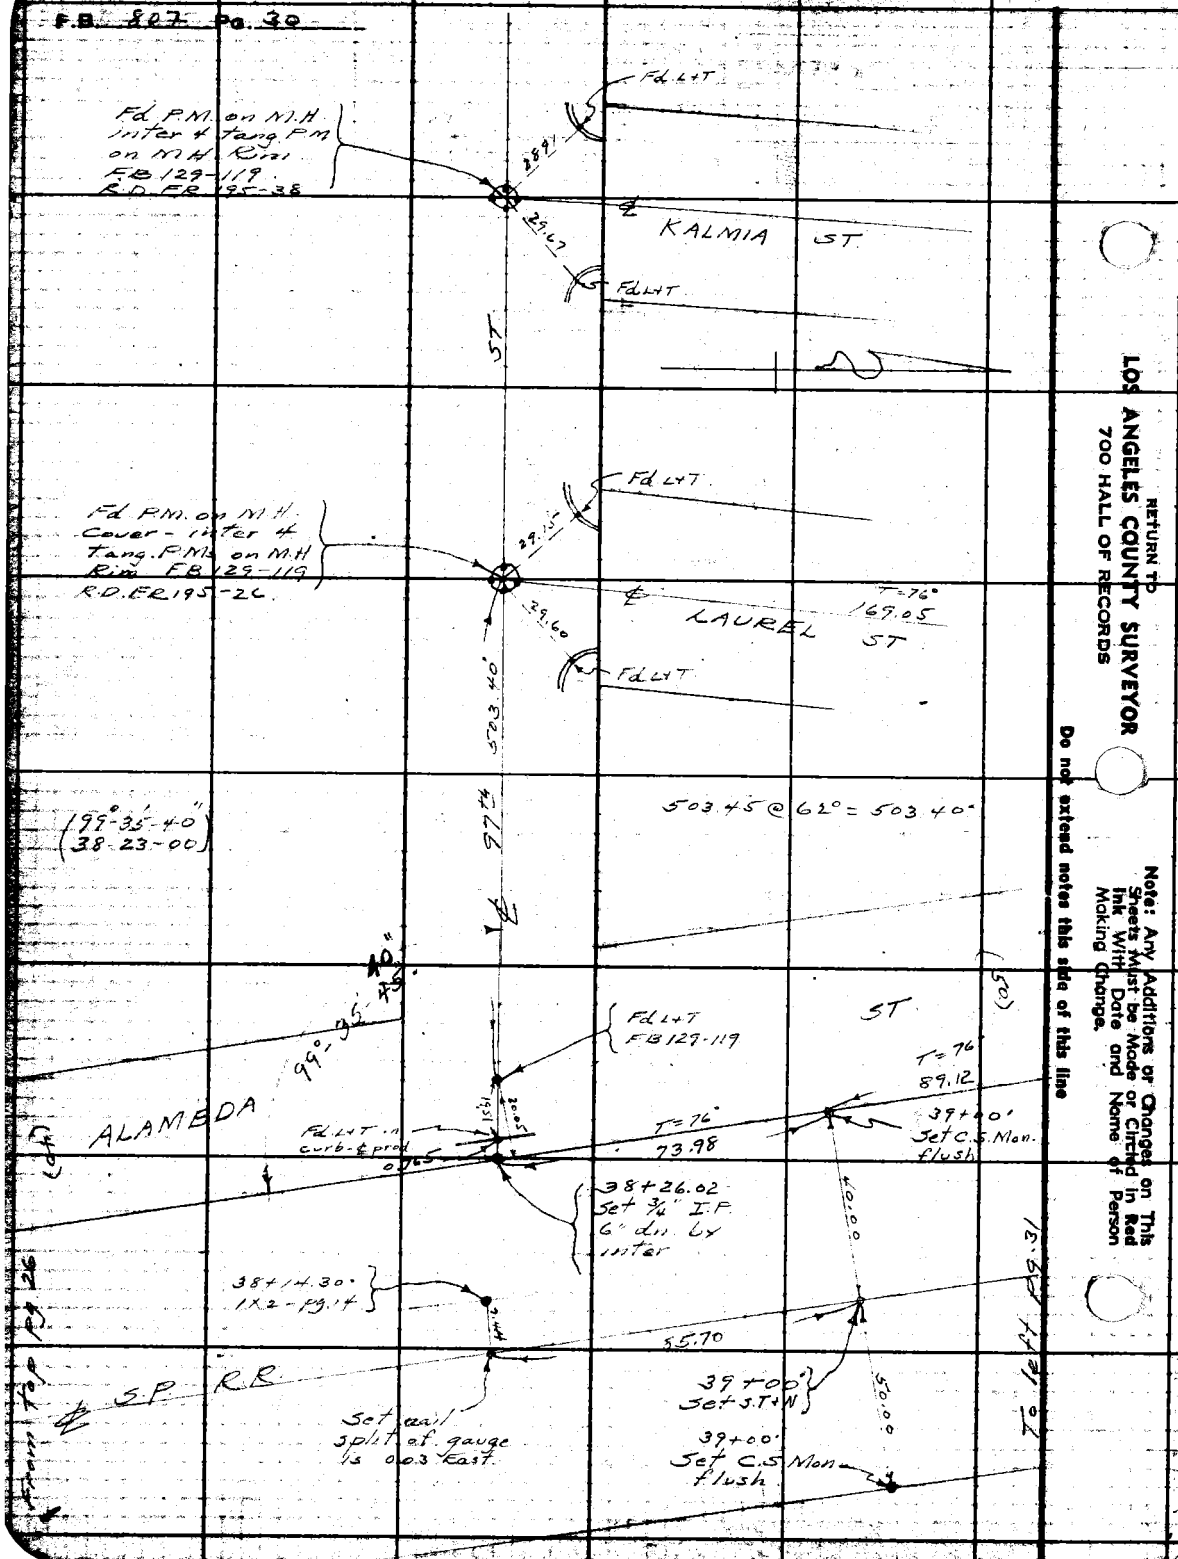

RETURN TO
LOS ANGELES COUNTY SURVEYOR
700 HALL OF RECORDS

Do not extend notes this side of this line

Note: Any Additions or Changes on This Sheets Must be Made or Circled in Red Ink With Date and Name of Person Making Change.

Notes Ck'd by D. M. Finley	Survey of Alameda ST	F.B. 807 Pg. 31
Map No. B-1498-3	W. O. 8270 Tape No. 063 Sta. 76 of	
Office Work D. A. WHITE	Surveyed by Moore	
Checked D. M. Finley	Notes Moore Date 8-22-39	
Date Feb. 1940	Indexed Wm. H. Blackmer 9-7-39	

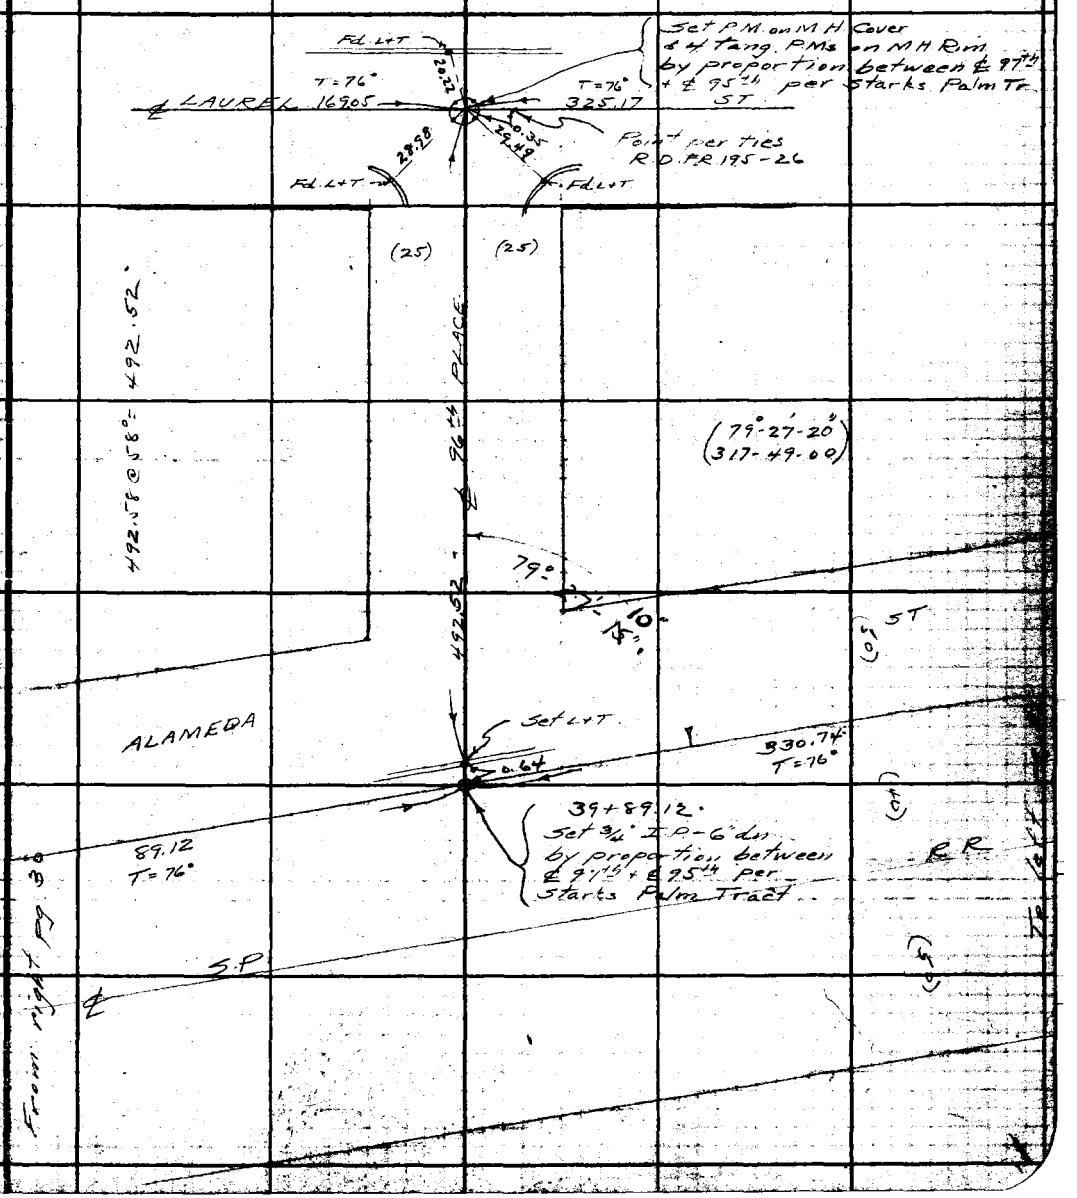

Note: Any Additions or Changes on This Sheets Must be Made or Circled in Red Ink With Date and Name of Person Making Change.

Do not extend notes this side of this line

RETURN TO
LOS ANGELES COUNTY SURVEYOR
700 HALL OF RECORDS

FORM 347 5M 10-37

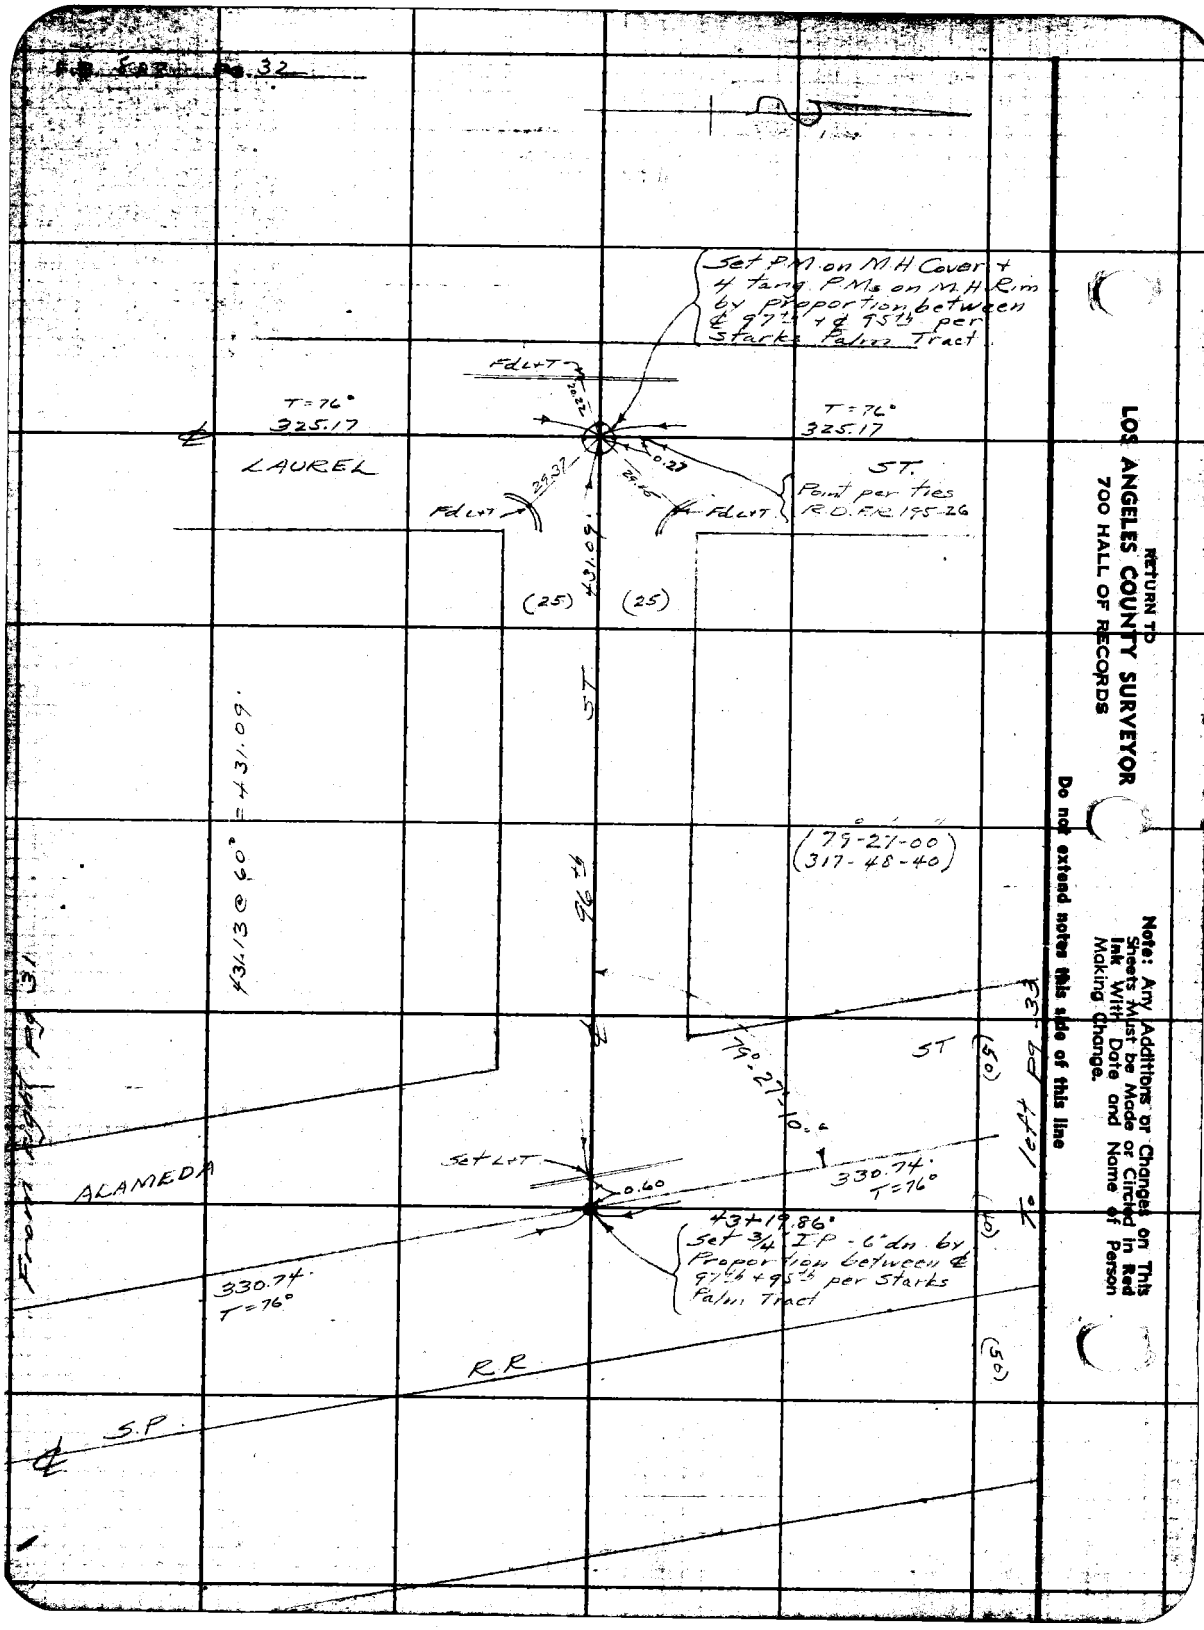

RETURN TO
LOS ANGELES COUNTY SURVEYOR
700 HALL OF RECORDS

Note: Any Additions or Changes on This Sheets Must be Made or Circled in Red Ink With Date and Name of Person Making Change.

Do not extend notes this side of this line

Notes Ck'd by D. M. Finley	Survey of Alameda St.	F.B. 807	Pg. 33
Map No. B-1498-3	W. D. 8270 Tape No. 063 Std 76 of		
Office Work D. A. WHITE	Surveyed by Moore		
Checked D. M. Finley	Notes Moore Date 8-22-39		
Date Feb 1940.	Indexed Wm. H. Blackmer 9-7-39		

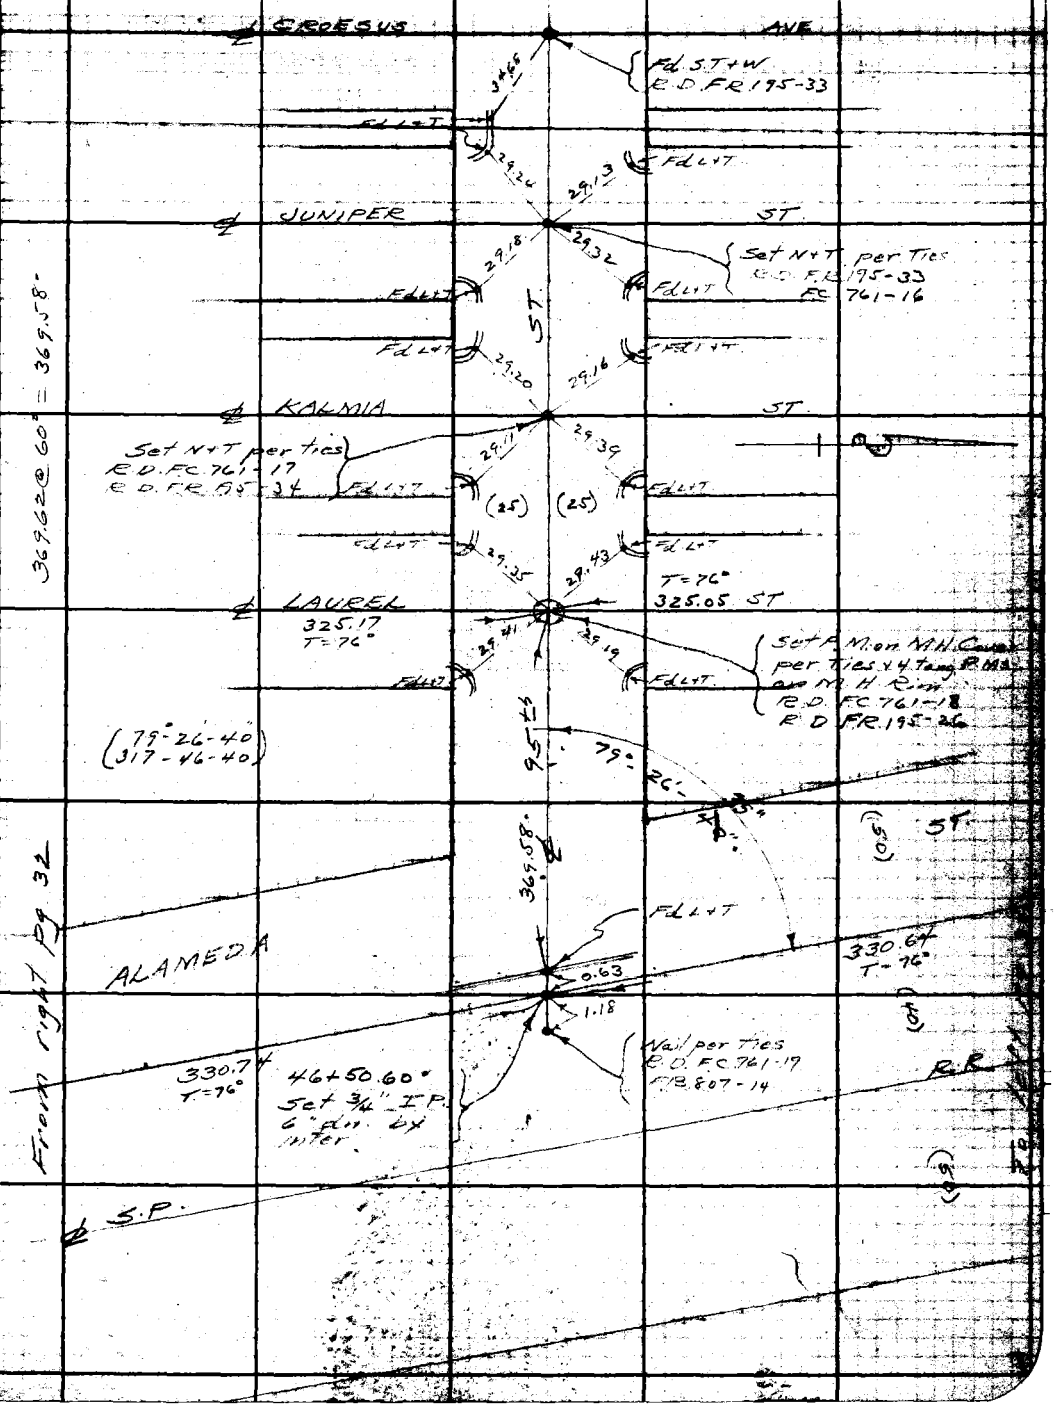

Note: Any Additions or Changes on This Sheets Must be Made or Circled in Red Ink With Date and Name of Person Making Change.

Do not extend notes this side of this line

RETURN TO
LOS ANGELES COUNTY SURVEYOR
700 HALL OF RECORDS

FORM 247 5M 10-37

F.B. 807 Pg. 34

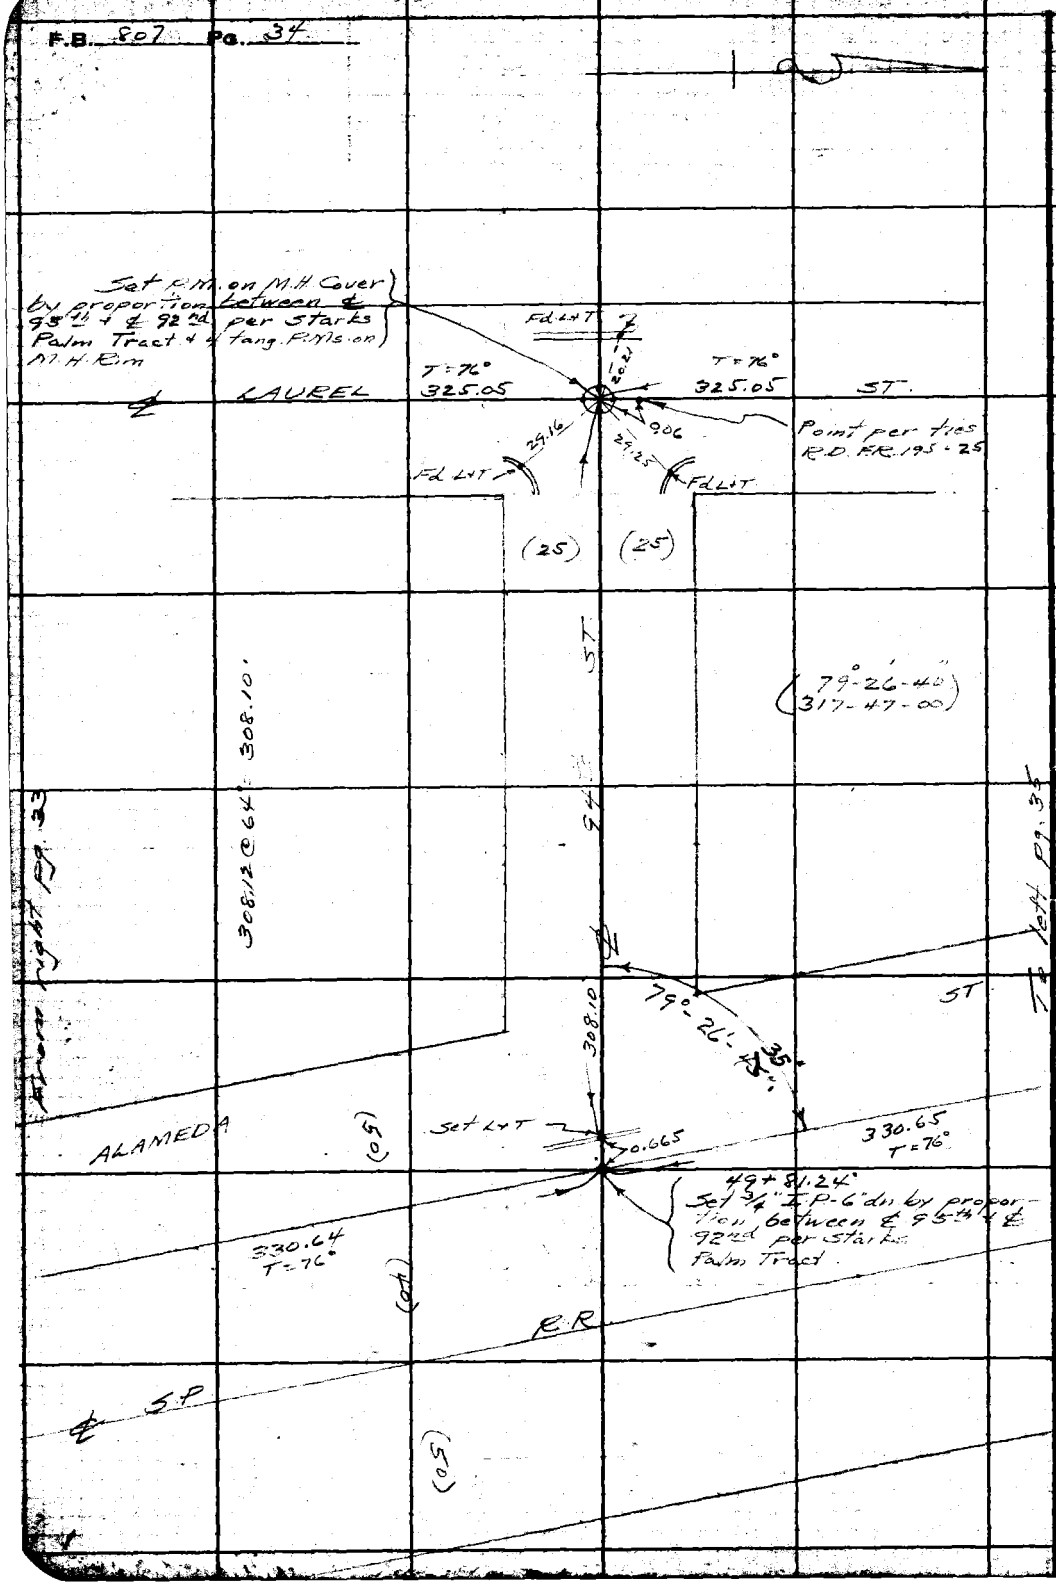

RETURN TO
LOS ANGELES COUNTY SURVEYOR
700 HALL OF RECORDS

Do not extend notes this side of this line

Notes: Any Additions or Changes on This Sheets Must be Made or Circled in Red Ink With Date and Name of Person Making Change.

Notes Ck'd by D. M. Finley	Survey of Alameda St.	F.B. 807 Pg. 35
Map No. B-1438-3	W. O. 8270 Tape No. 563 Sh'd 76 of	
Office Work D. A. WHITE	Surveyed by Moore	
Checked D. M. Finley	Notes Moore Date 8-23-39	
Date Feb 1940.	Indexed Wm. H. Blackmer 9-7-39	

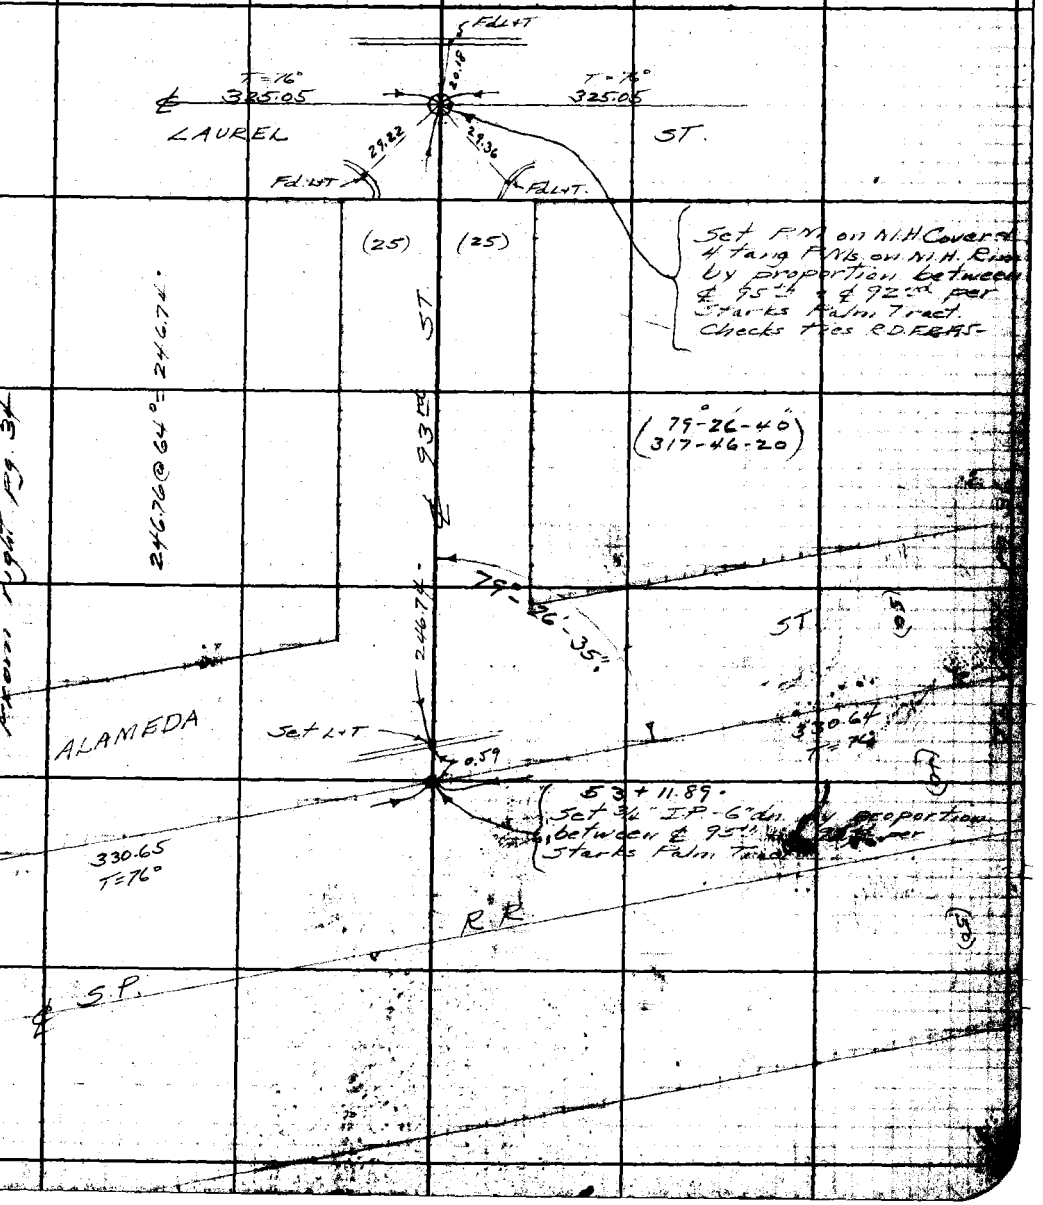

Note: Any Additions or Changes on This Sheets Must be Made or Circled in Red Ink With Date and Name of Person Making Change.

Do not extend notes this side of this line

RETURN TO
LOS ANGELES COUNTY SURVEYOR
700 HALL OF RECORDS

FORM 247 5M 10-37

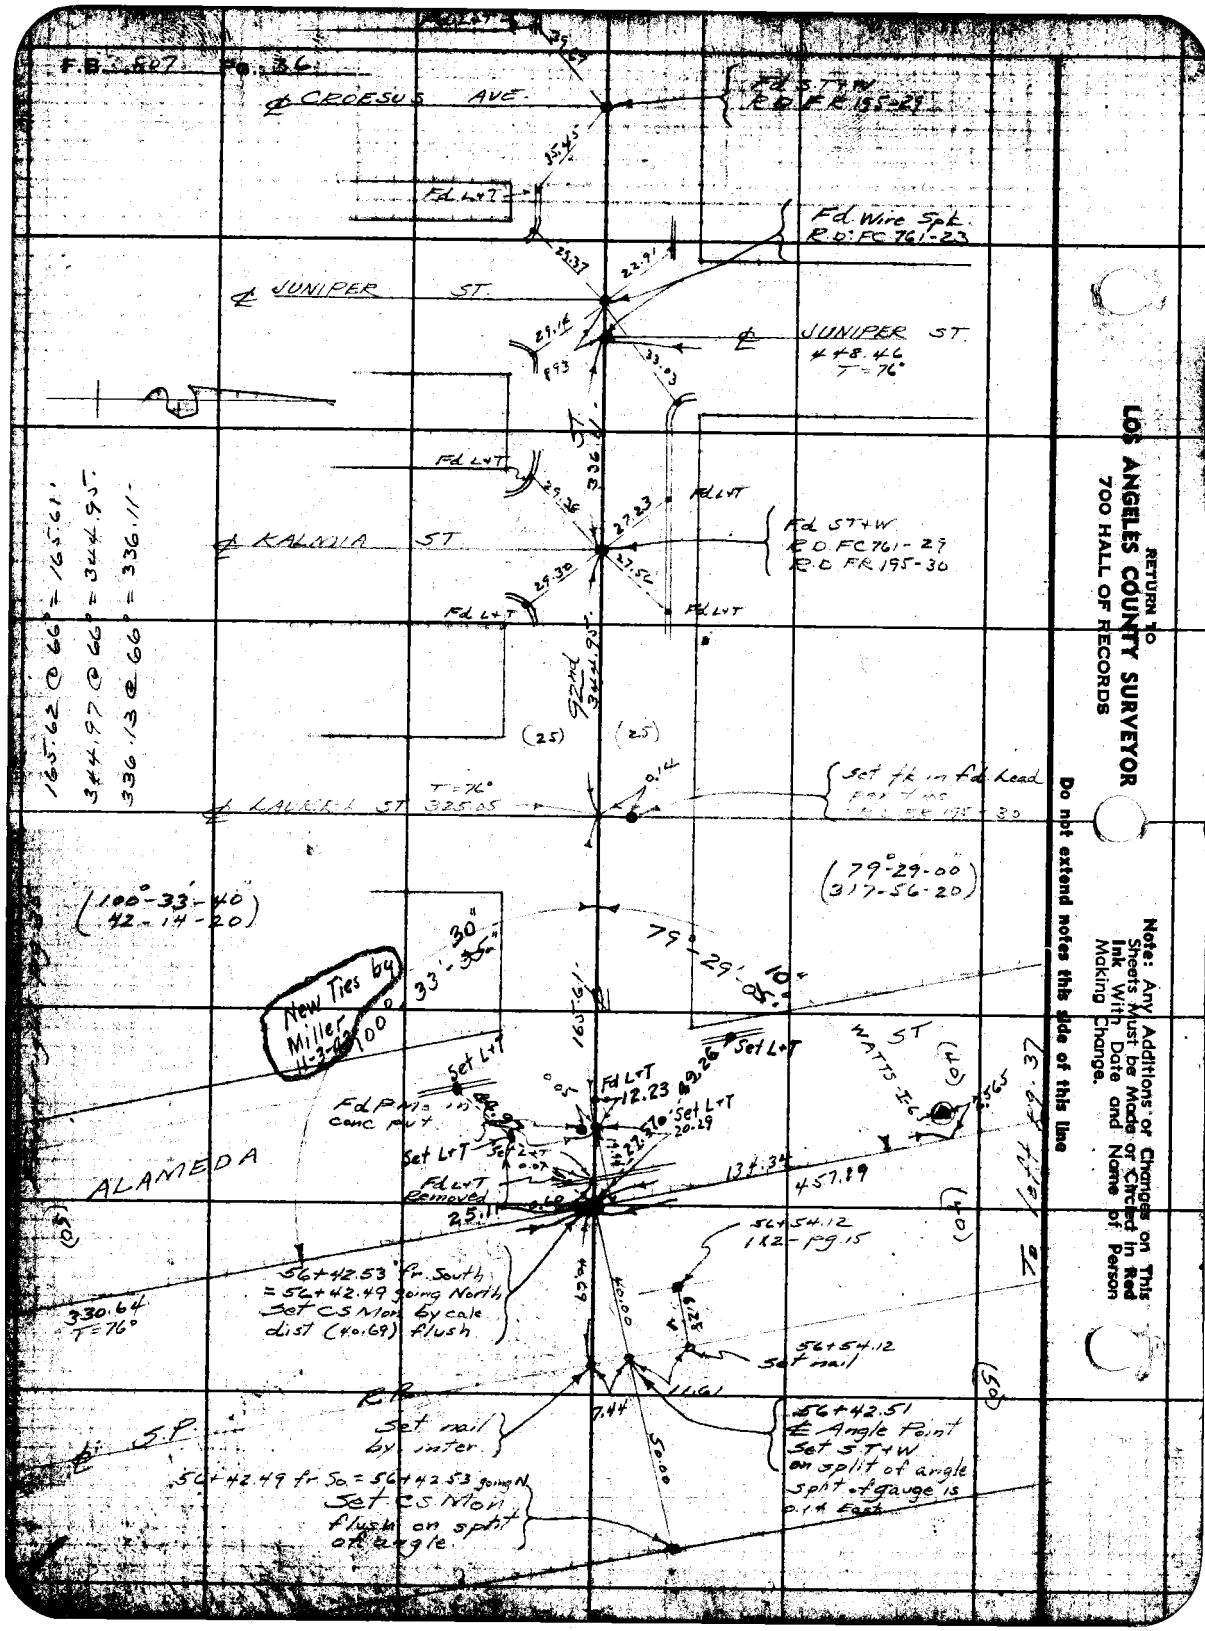

RETURN TO
LOS ANGELES COUNTY SURVEYOR
700 HALL OF RECORDS

Note: Any Additions or Changes on This Sheets Must be Made or Circled in Red Ink With Date and Name of Person Making Change.

Do not extend notes this side of this line

Notes Ck'd by D. M. Finley	Survey of Alameda St	F.B. 807 Pg. 37
Map No. [illegible]	W. O. [illegible] Tape No. [illegible]	
Office Work D. A. WHITE	Surveyed by Moore	
Checked D. M. Finley	Notes Moore Date 8-24-39	
Date Feb. 1940	Indexed [illegible] 9-7-39	

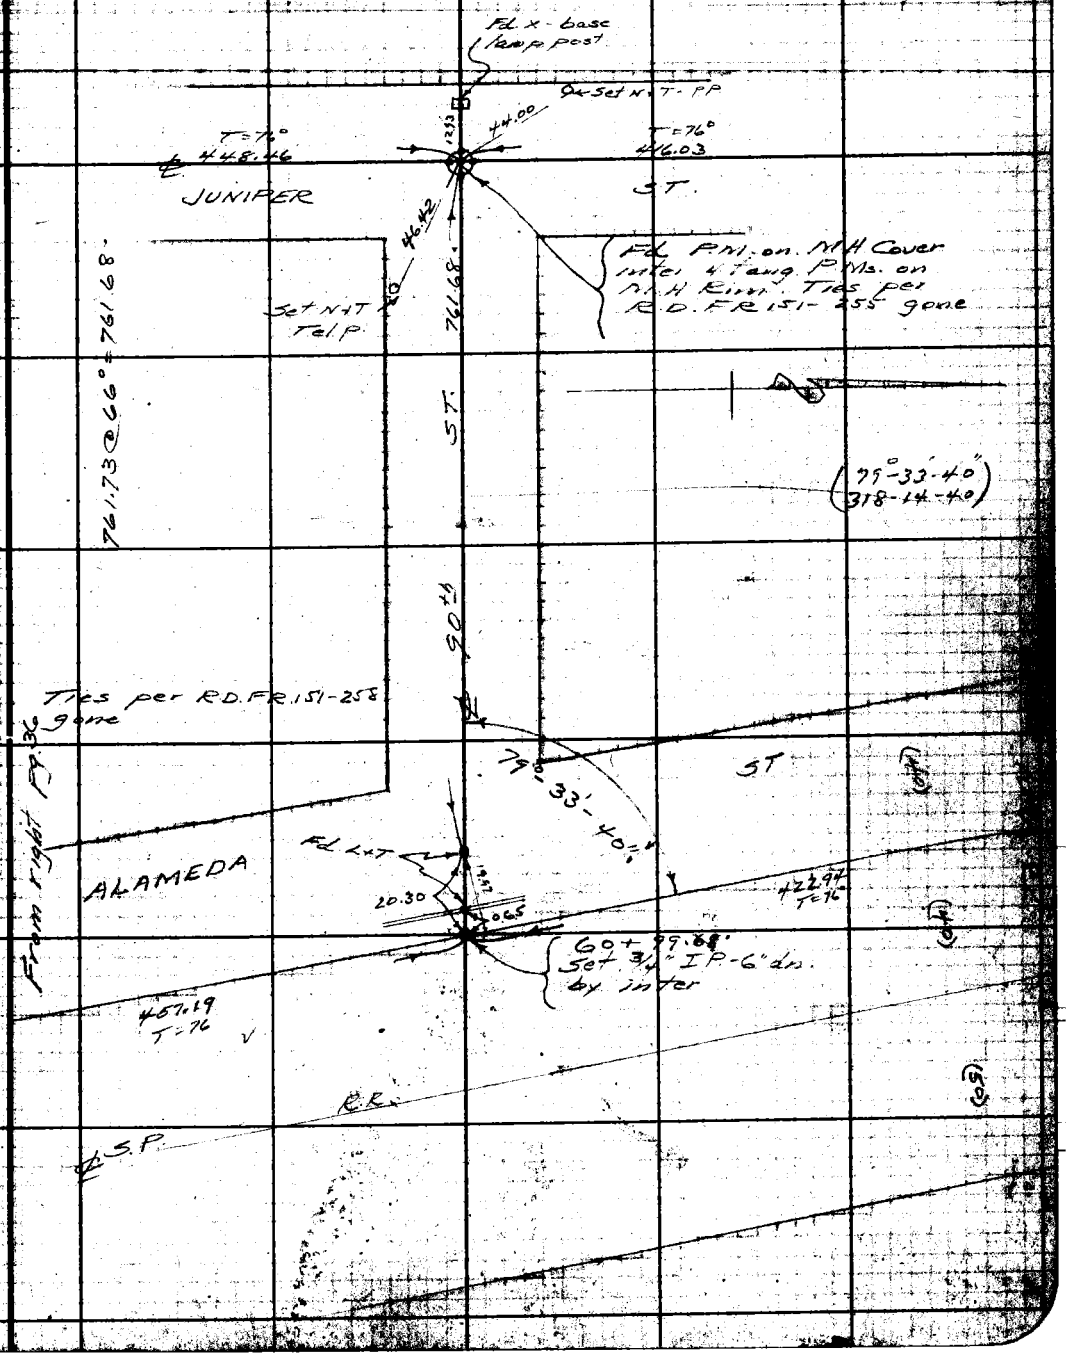

Note: Any Additions or Changes on This Sheets Must be Made or Circled in Red Ink With Date and Name of Person Making Change.

Do not extend notes this side of this line

RETURN TO
LOS ANGELES COUNTY SURVEYOR
700 HALL OF RECORDS

FORM 247 5M 10-37

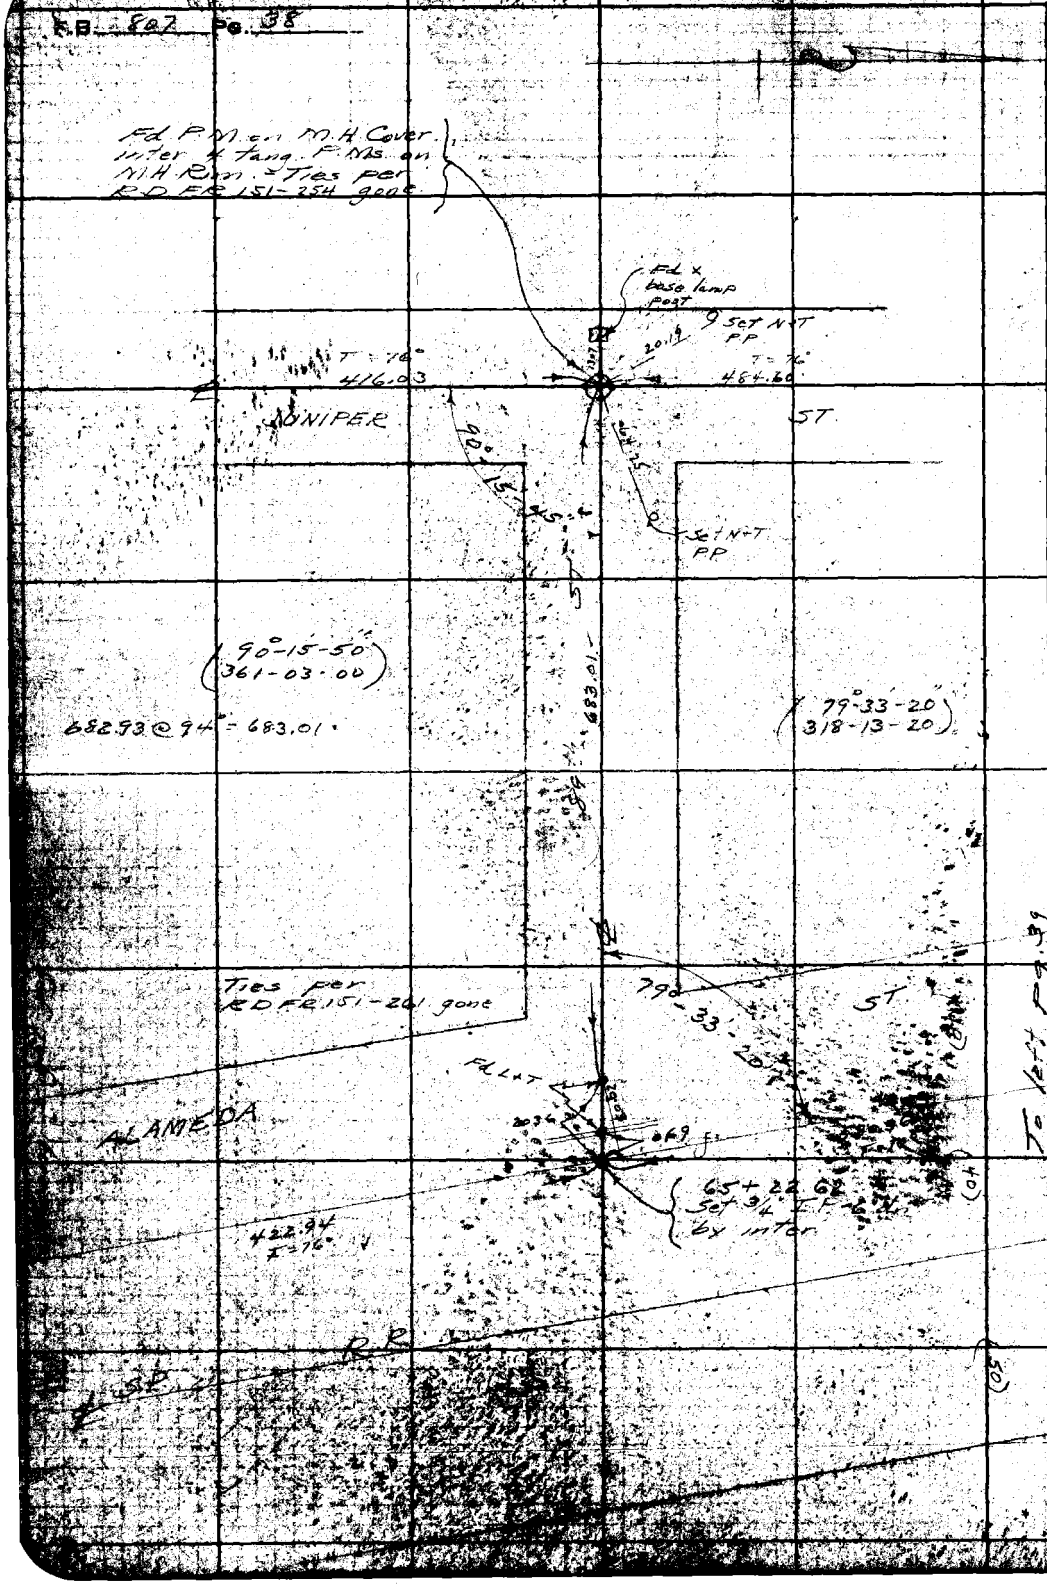

RETURN TO
LOS ANGELES COUNTY SURVEYOR
700 HALL OF RECORDS

Note: Any Additions or Changes on This Sheets Must be Made or Circled in Red Ink With Date and Name of Person Making Change.

Do not extend notes this side of this line

Notes Chk'd by D. M. Finley	Survey of Alameda St.	F.B. 807 Pg. 39
[illegible]	[illegible] No. 563 Std 76 of	
Office Work D. A. WHITE	Surveyed by Moore	
Checked D. M. Finley	Notes Moore Date 8-24-39	
Date Feb. 1940.	Indexed Wm. H. Blackmer 9-7-39	

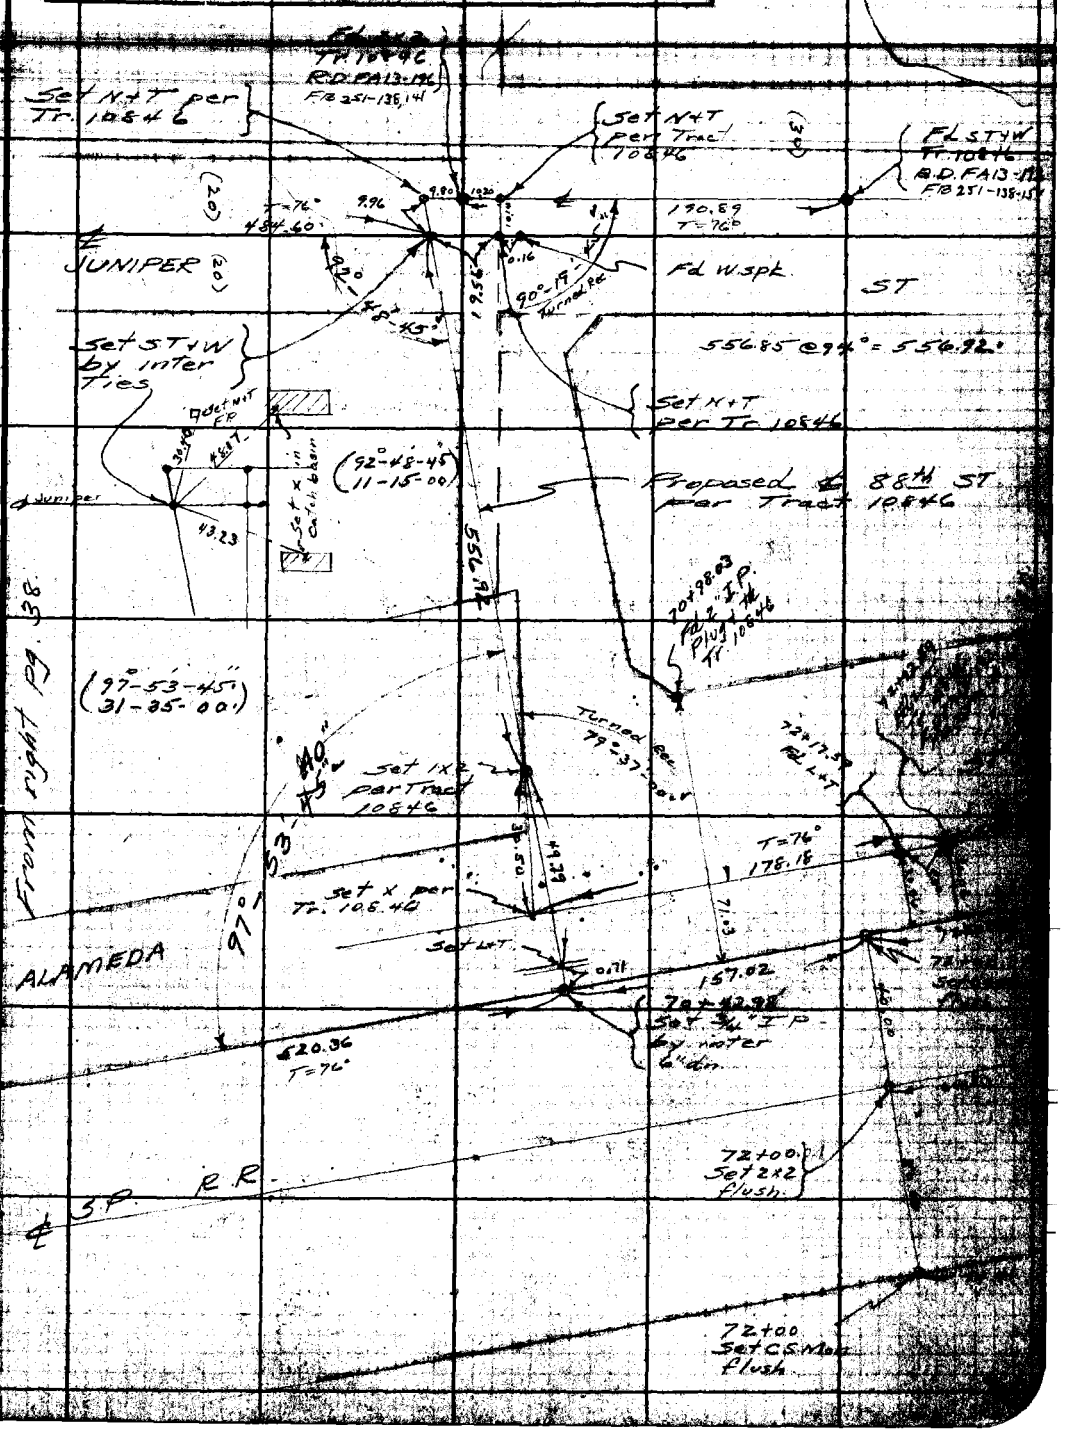

Note: Any Additions or Changes on This Sheets Must be Made or Circled in Red Ink With Date and Name of Person Making Change.

Do not extend notes this side of this line

RETURN TO LOS ANGELES COUNTY SURVEYOR 700 HALL OF RECORDS

FORM 247 SM 10-37

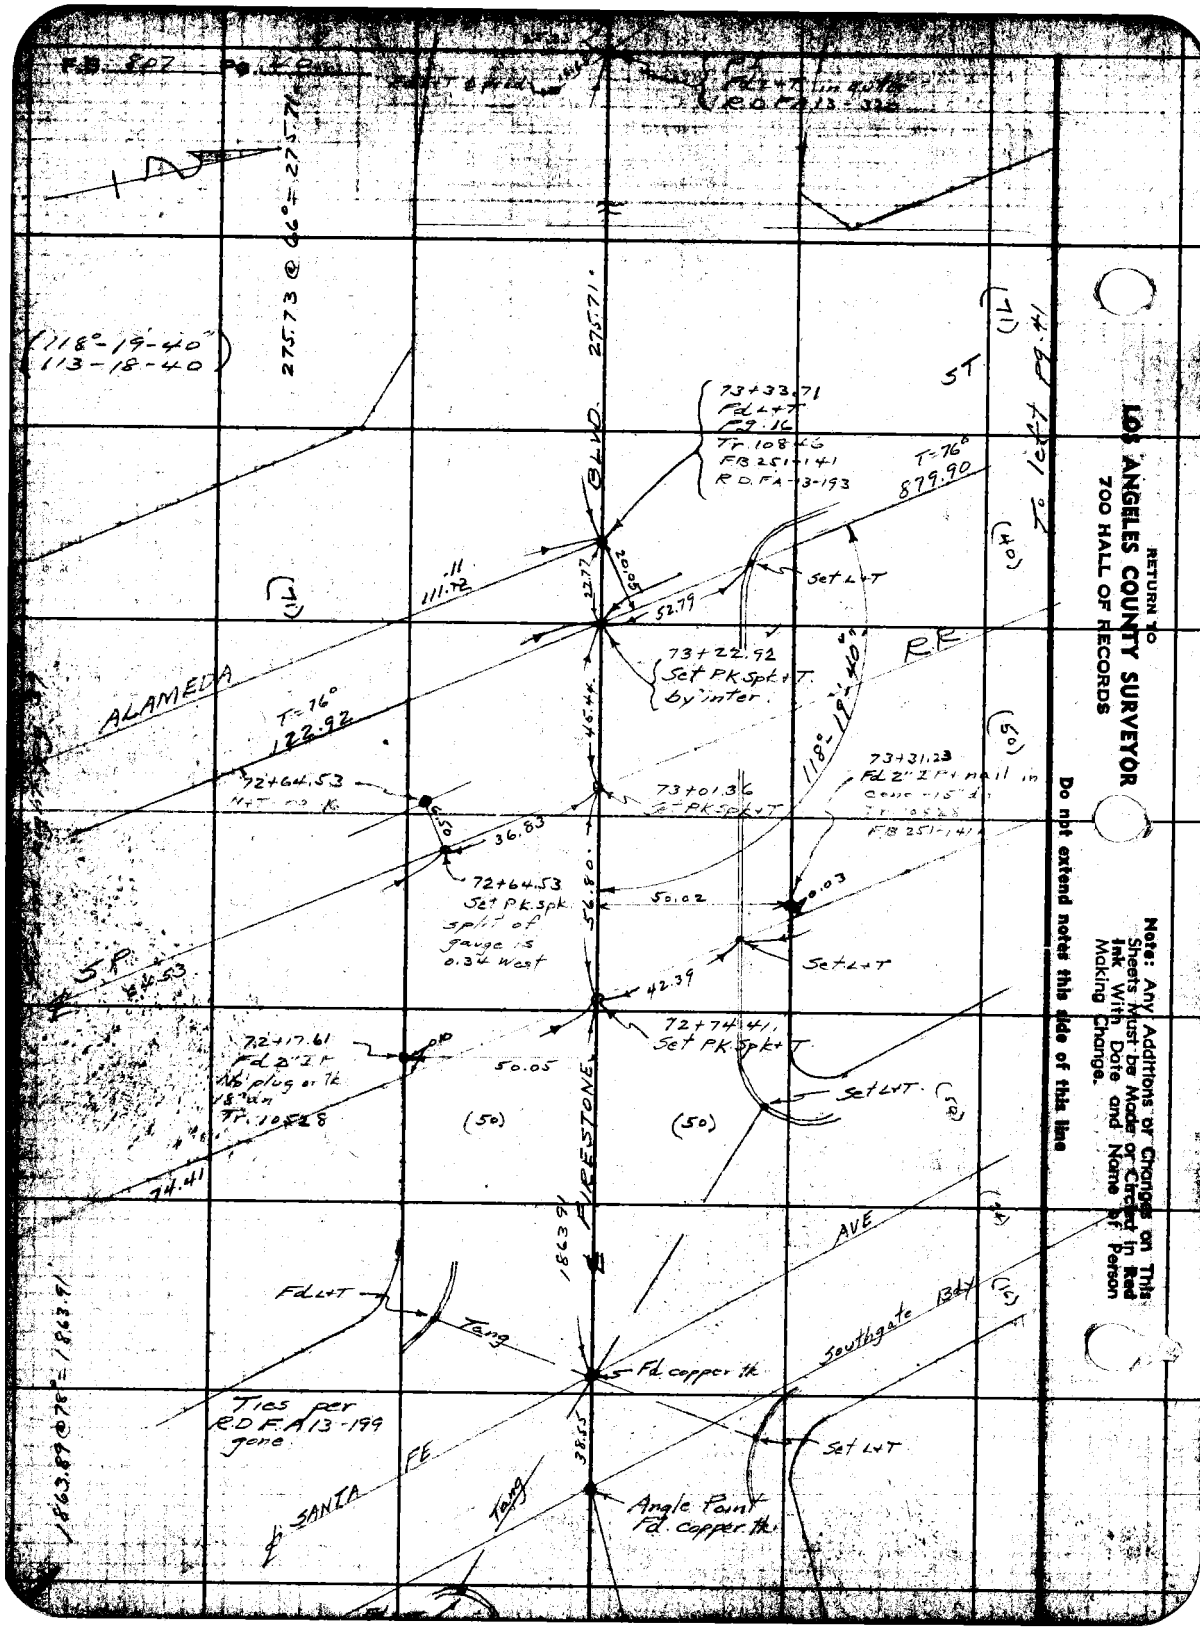
RETURN TO
LOS ANGELES COUNTY SURVEYOR
700 HALL OF RECORDS
Note: Any Additions or Changes on This Sheets Must be Made or Checked in Red Ink With Date and Name of Person Making Change.
Do not extend notes this side of this line
ALAMEDA
FIRESTONE
BLVD.
ST
AVE
Southgate
SANTA FE
R.R.
S.P.
(118°-19'-40")
(113-18-40)
275.73 @ 66° = 275.71
1863.89 @ 76° = 1863.91
73+33.71
Fd L+T
F9.16
Tr. 108.46
FB 251-141
R.D. FA 13-193
T=76°
879.90
Set L+T
73+22.92
Set Pk Spk+T.
by inter.
T=76°
122.92
72+64.53
Set Pk.spk.
split of
gauge is
0.34 west
73+31.23
Fd 2" IP nail in
cone
FB 251-141
73+01.36
Set Pk.spk+T
72+74.41
Set Pk.spk+T
72+17.61
Fd 2" IP
No plug or tk
18" dia
Tr. 10 F28
Set L+T
Fd L+T
Tang
Fd. copper tk
Angle Point
Fd. copper tk.
Ties per
R.D. F.A 13-199
gone
(50)
(40)
(7)
(1)
(5)
(14)
(15)
(18)
(19)
Notes Ch'd by D. M. Finley	Survey of Alameda ST	F.B. 807 Pg. 41
[illegible]	W. [illegible] Tract No. [illegible]	
Office Work H. H. REYNOLDS	Surveyed by Moore	
Checked D. M. Finley	Notes Moore Date 8-21-39	
Date Feb 1940	Indexed Wm. H. Blackmer 9-7-39	

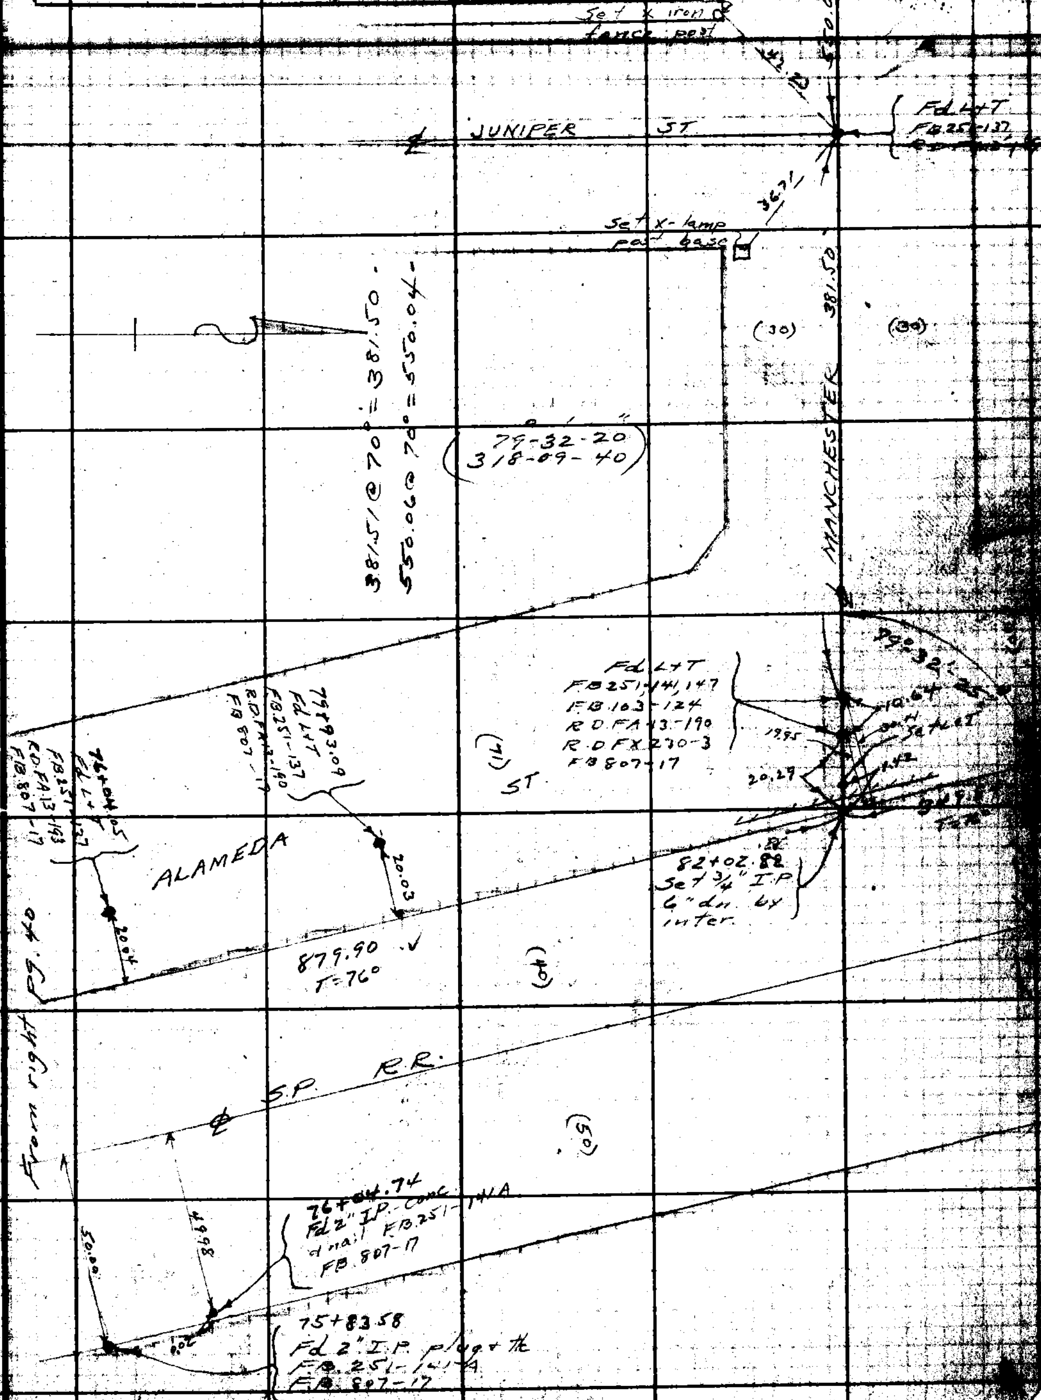

Note: Any Additions or Changes on This Sheets Must be Made or Circled in Red Ink With Date and Name of Person Making Change.

Do not extend notes this side of this line

RETURN TO LOS ANGELES COUNTY SURVEYOR 700 HALL OF RECORDS

FORM 247 5M 10-37

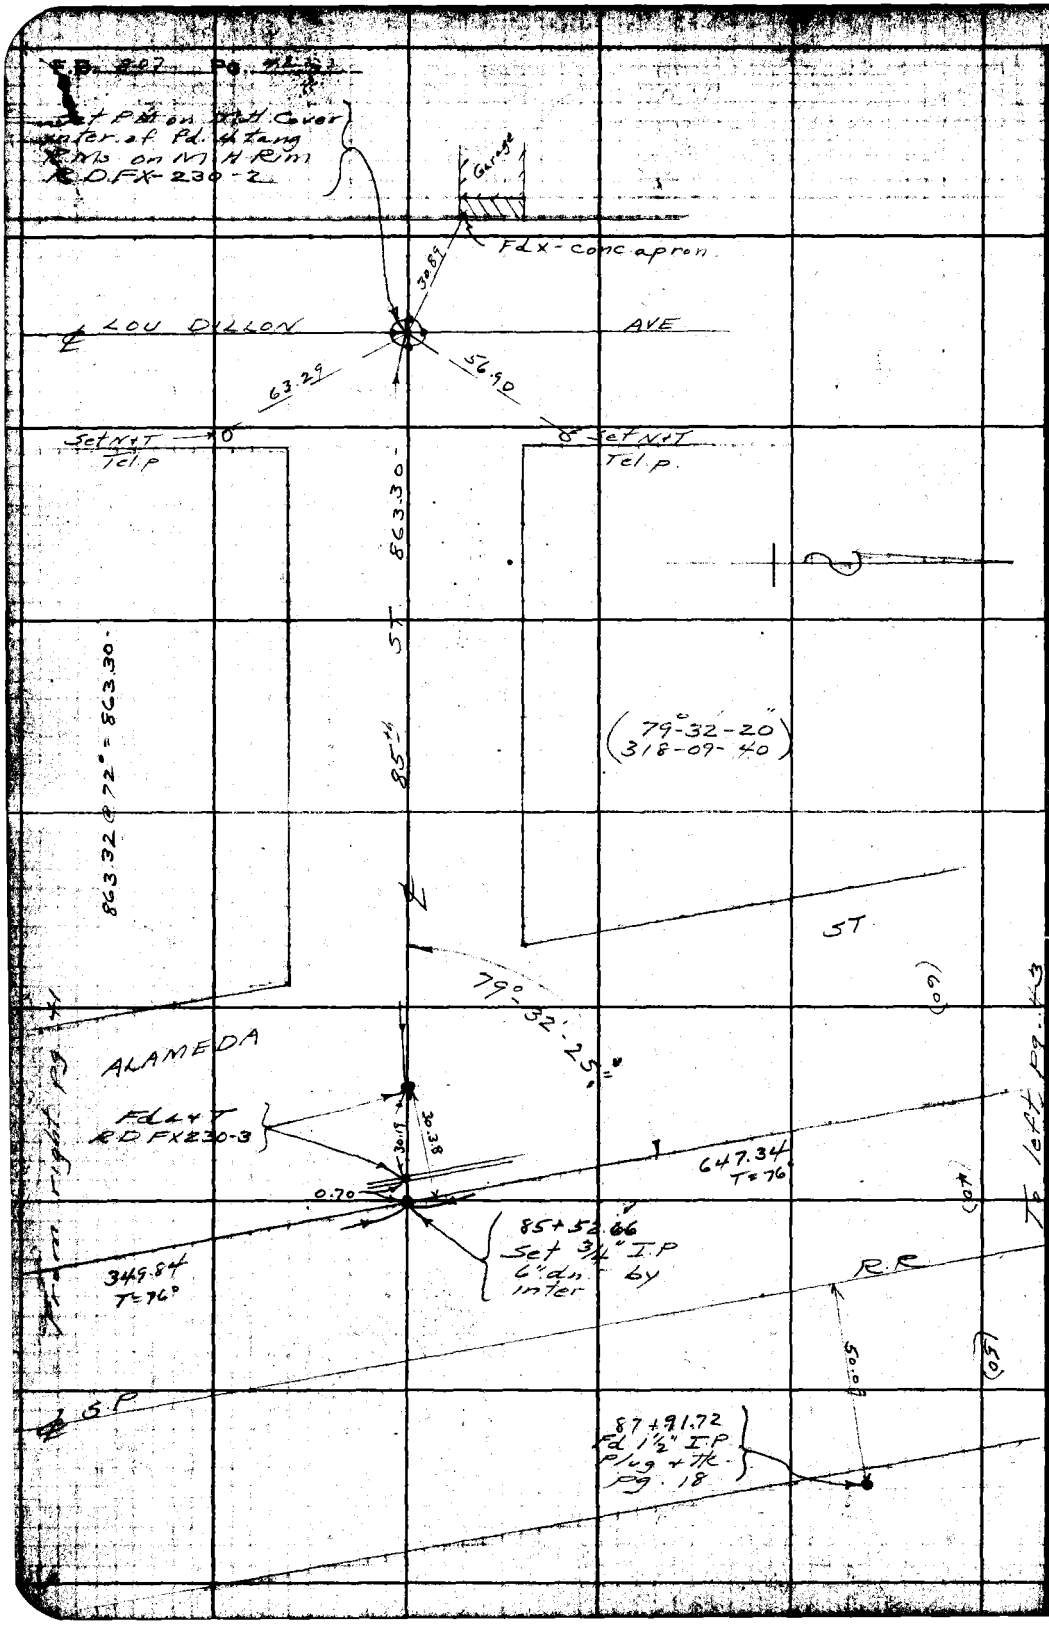

RETURN TO
LOS ANGELES COUNTY SURVEYOR
700 HALL OF RECORDS

Note: Any Additions or Changes on This Sheets Must be Made or Circled in Red Ink With Date and Name of Person Making Change.

Do not extend notes this side of this line

Notes Ck'd by D. M. Finley	Survey of Alameda St	F.B. 807 Pg. 43
Map No. [illegible]	W. O. [illegible] Tape No. [illegible]	
Office Work H. H. REYNOLDS	Surveyed by Moore	
Checked D. M. Finley	Notes Moore Date 8-28-39	
Date Feb. 1940	Indexed Wm. H. Blackman 9-7-39	

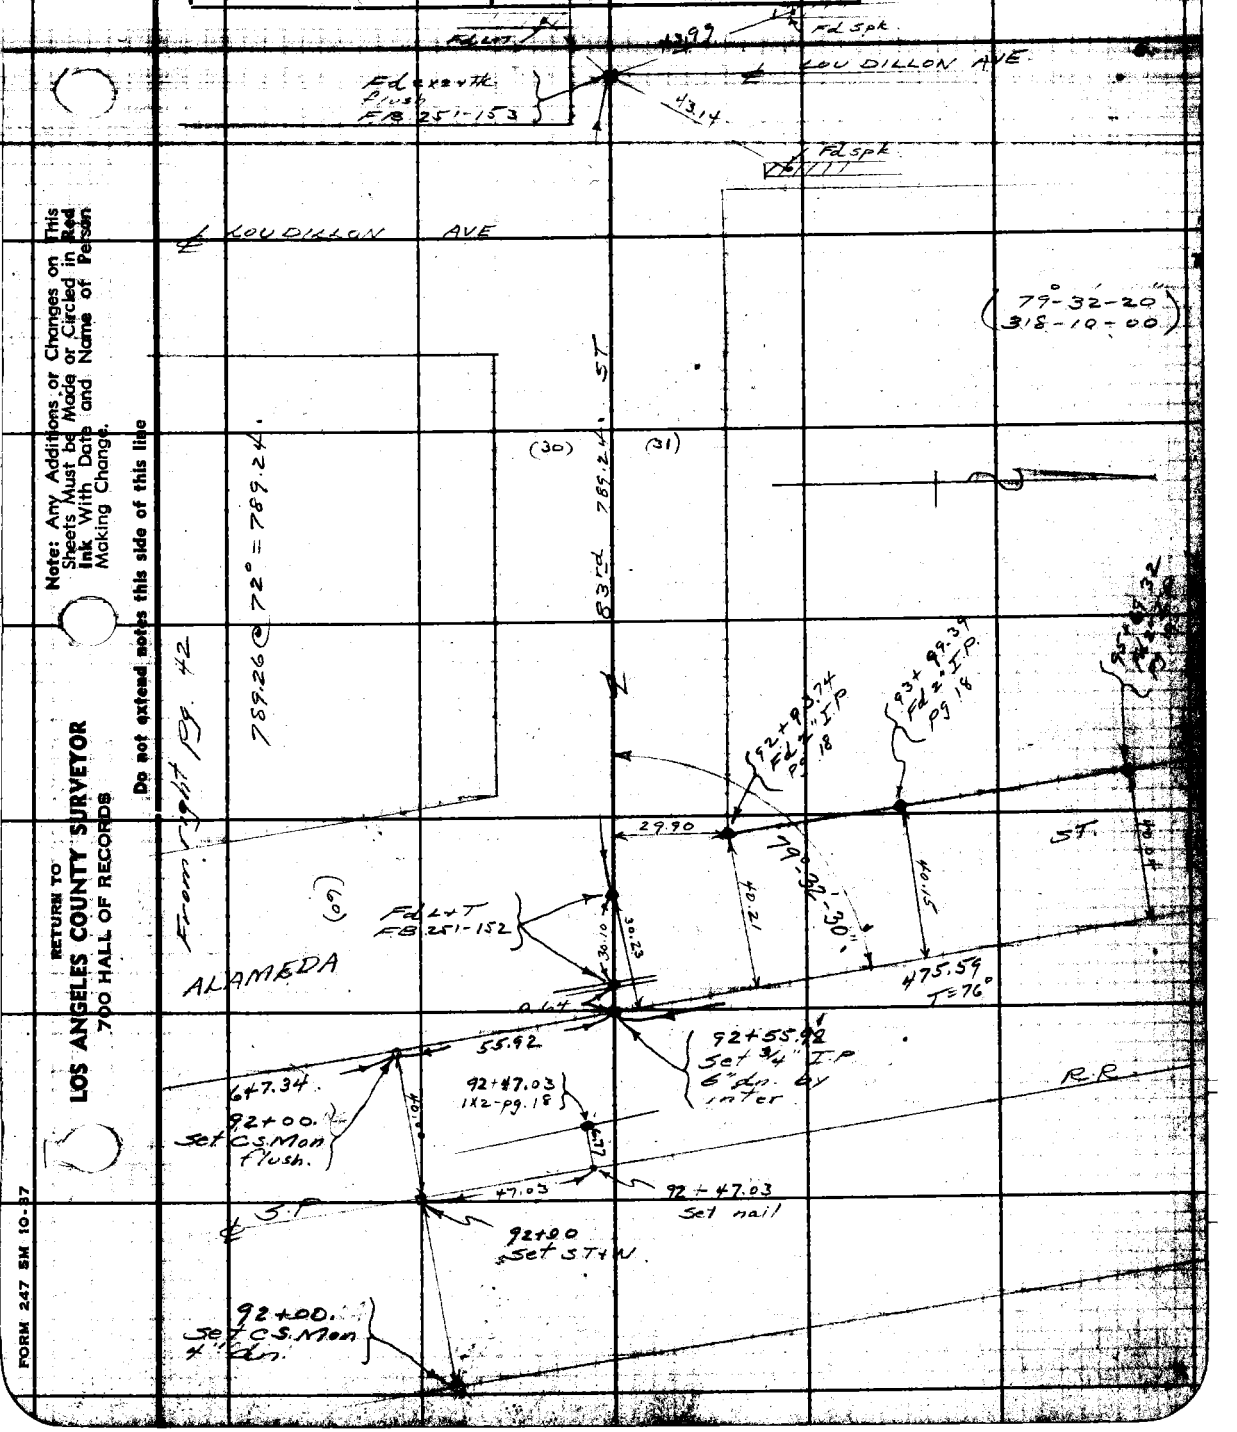

Note: Any Additions or Changes on This Sheets Must be Made or Circled in Red Ink With Date and Name of Person Making Change.

Do not extend notes this side of this line

RETURN TO
LOS ANGELES COUNTY SURVEYOR
700 HALL OF RECORDS

FORM 247 5M 10-37

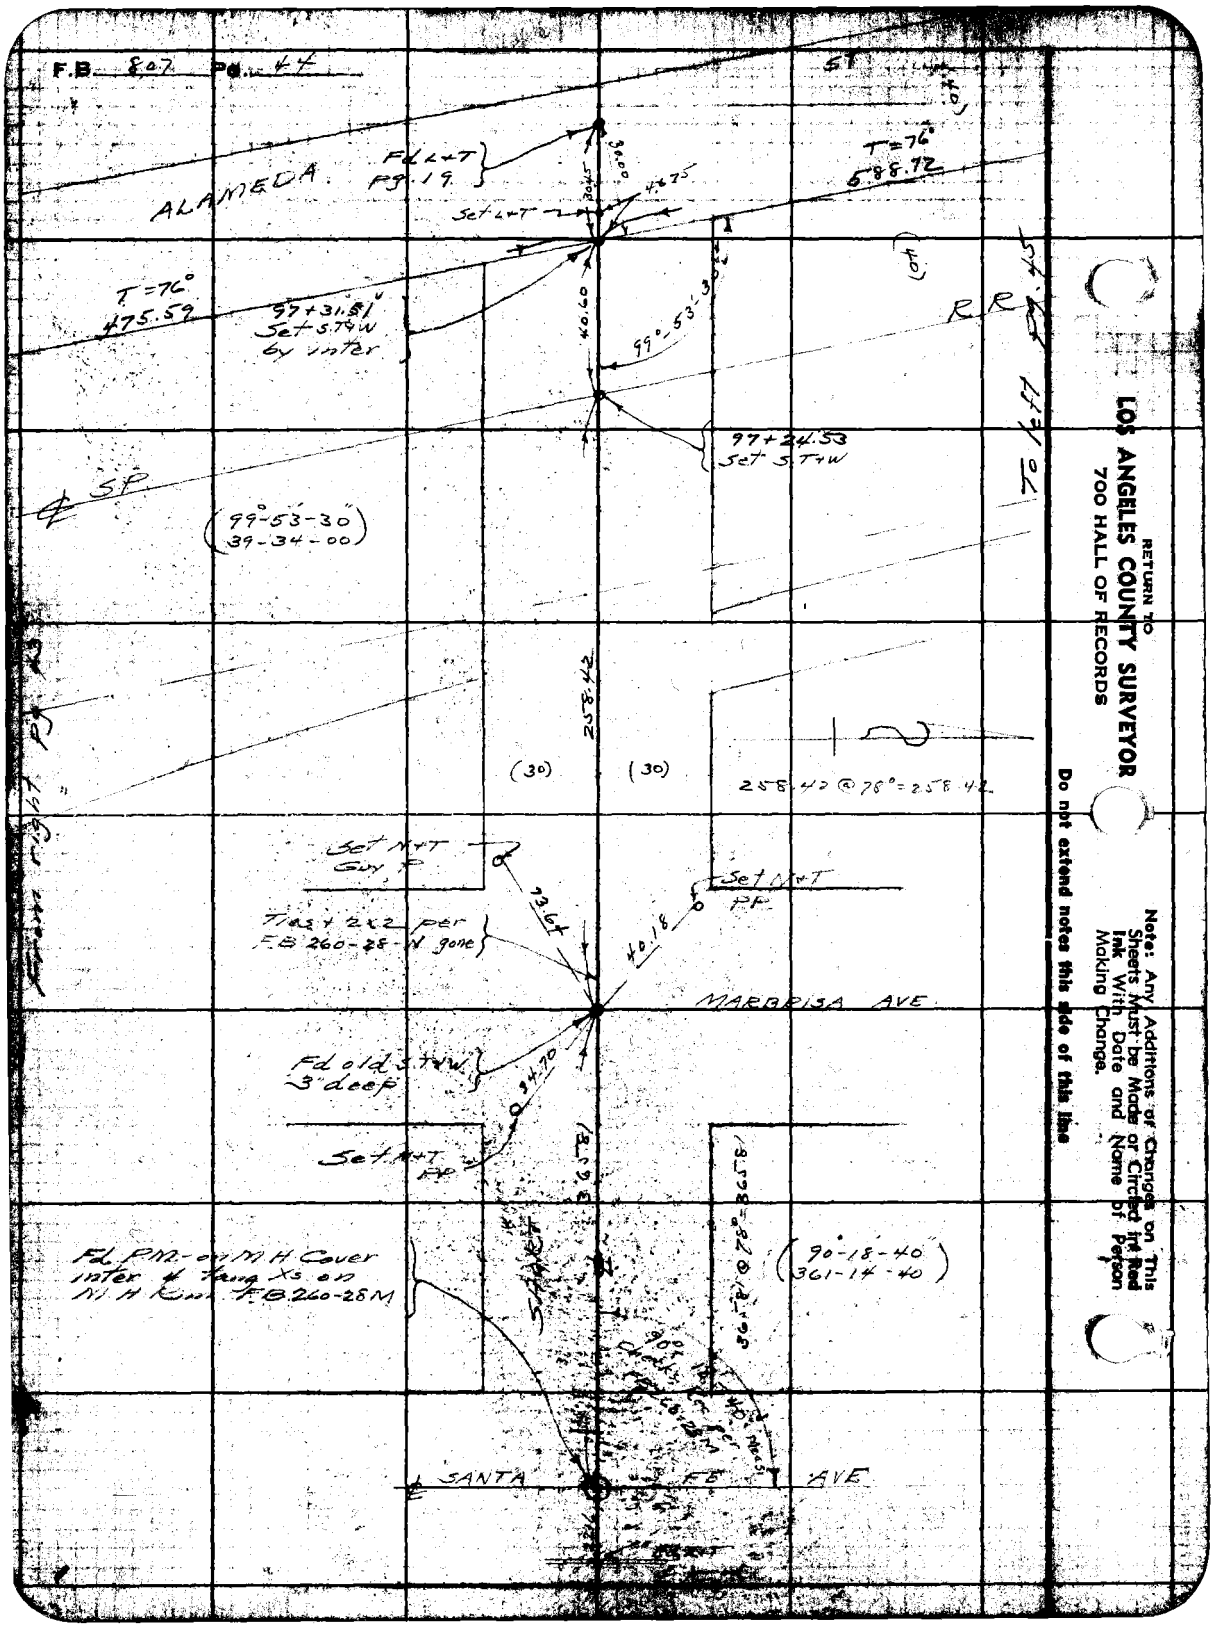

RETURN TO
LOS ANGELES COUNTY SURVEYOR
700 HALL OF RECORDS
Note: Any Additions or Changes on This Sheets Must be Made or Circled in Red Ink With Date and Name of Person Making Change.
Do not extend notes this side of this line

Notes Ck'd by D. M. Finley | Survey of Alameda St | F.B. 807 | Pg. 45

Office Work P. H. REYNOLDS | Surveyed by Moore

Checked D. M. Finley | Notes Moore | Date 9-1-39

Date Feb 1940 | Indexed Wm. H. Blackmer 9-7-39

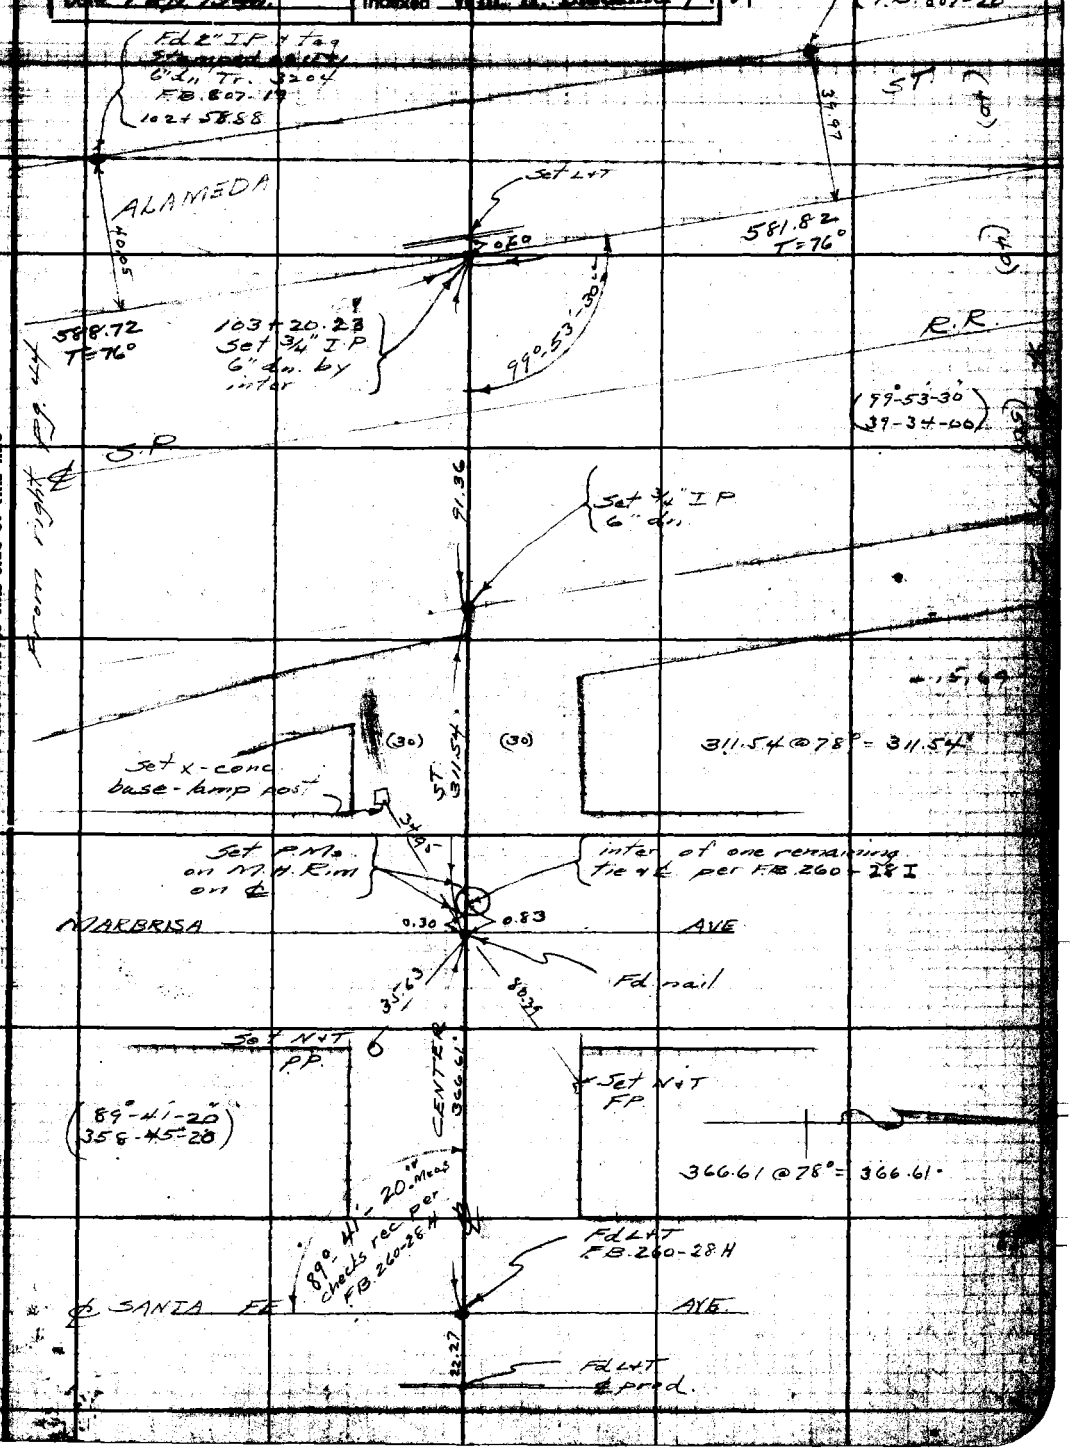

Note: Any Additions or Changes on This Sheets Must be Made or Circled in Red Ink With Date and Name of Person Making Change.

Do not extend notes this side of this line

RETURN TO
LOS ANGELES COUNTY SURVEYOR
700 HALL OF RECORDS

FORM 247 BM 10-37

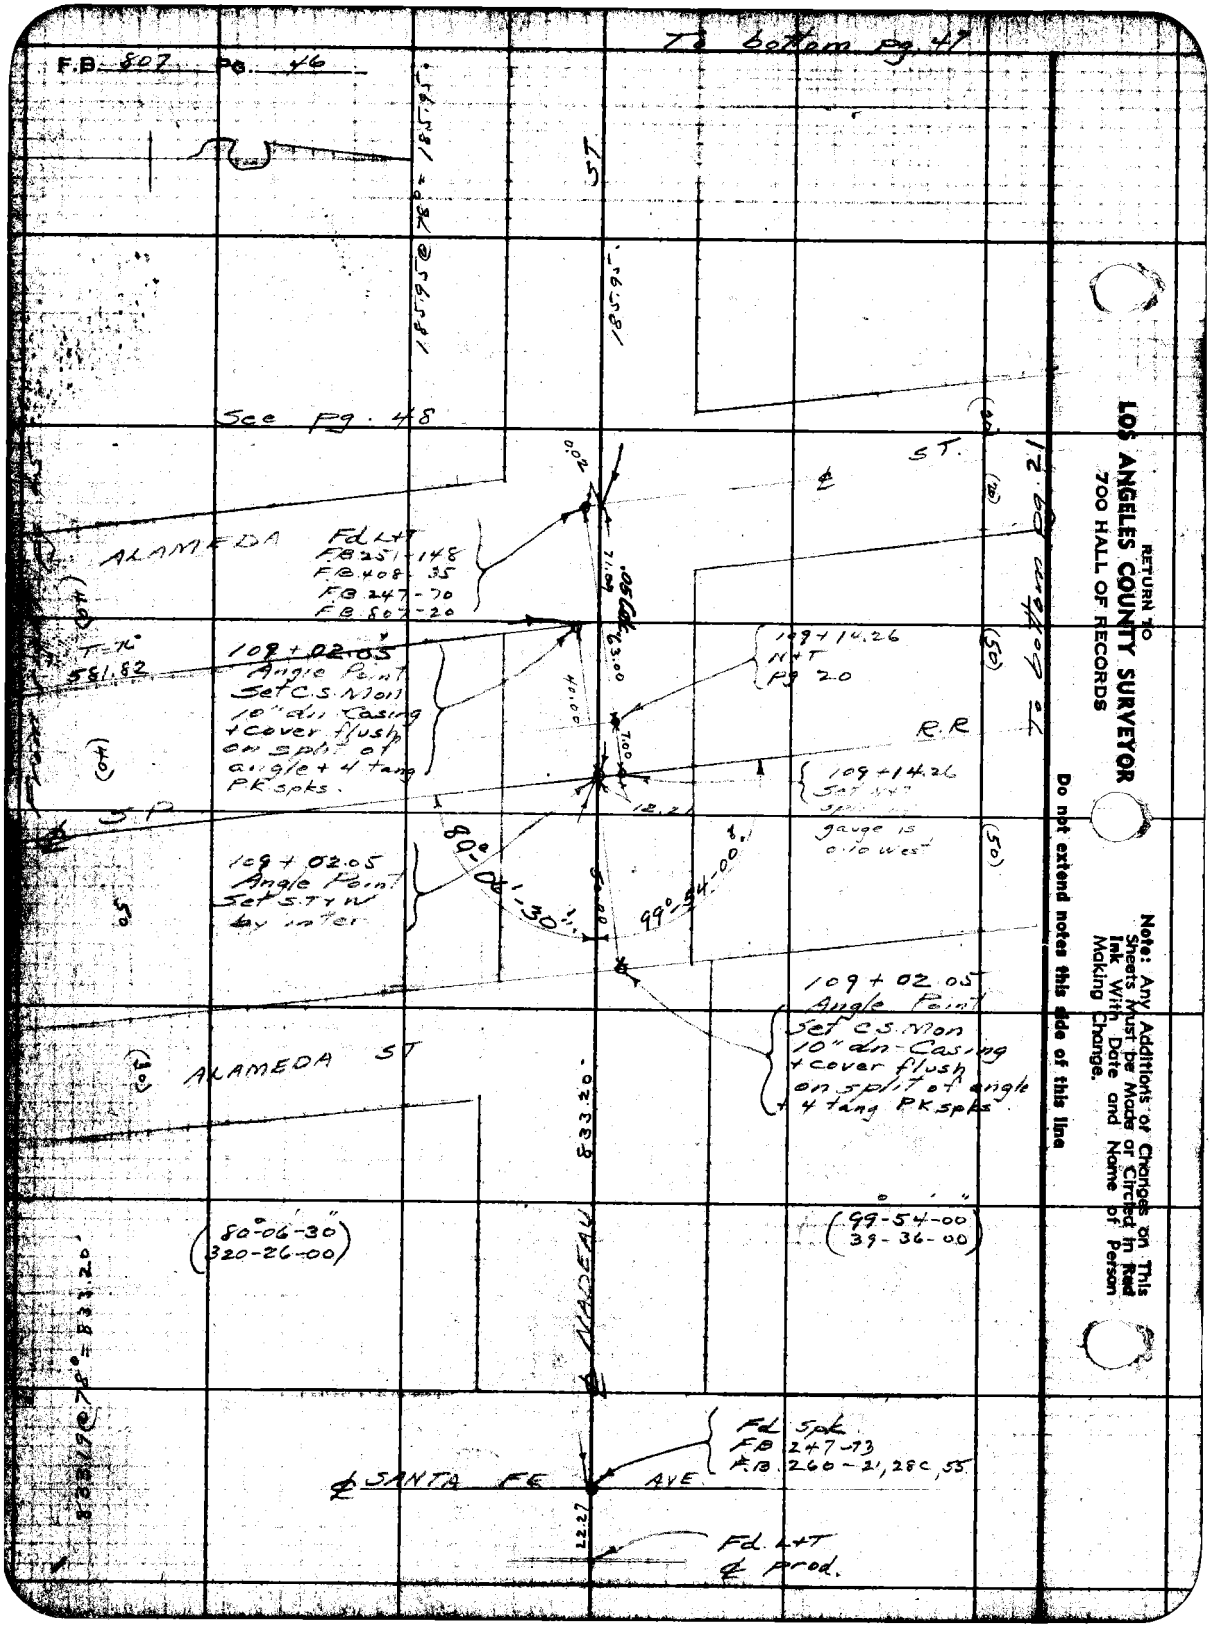

RETURN TO
LOS ANGELES COUNTY SURVEYOR
700 HALL OF RECORDS

Note: Any Additions or Changes on This Sheets Must be Made or Circled in Red Ink With Date and Name of Person Making Change.

Do not extend notes this side of this line

Notes Cold by D. M. Finley	Survey of Alameda St	F.B. 807 Pg. 47
[illegible]	W. O. 8270 Tape No. 063 Std 76 of	
Office Work H. H. REYNOLDS	Surveyed by Moore	
Checked D. M. Finley	Notes Moore Date 9-1-39	
Date Feb. 1940.	Indexed Wm. H. Blackmer 9-7-39	

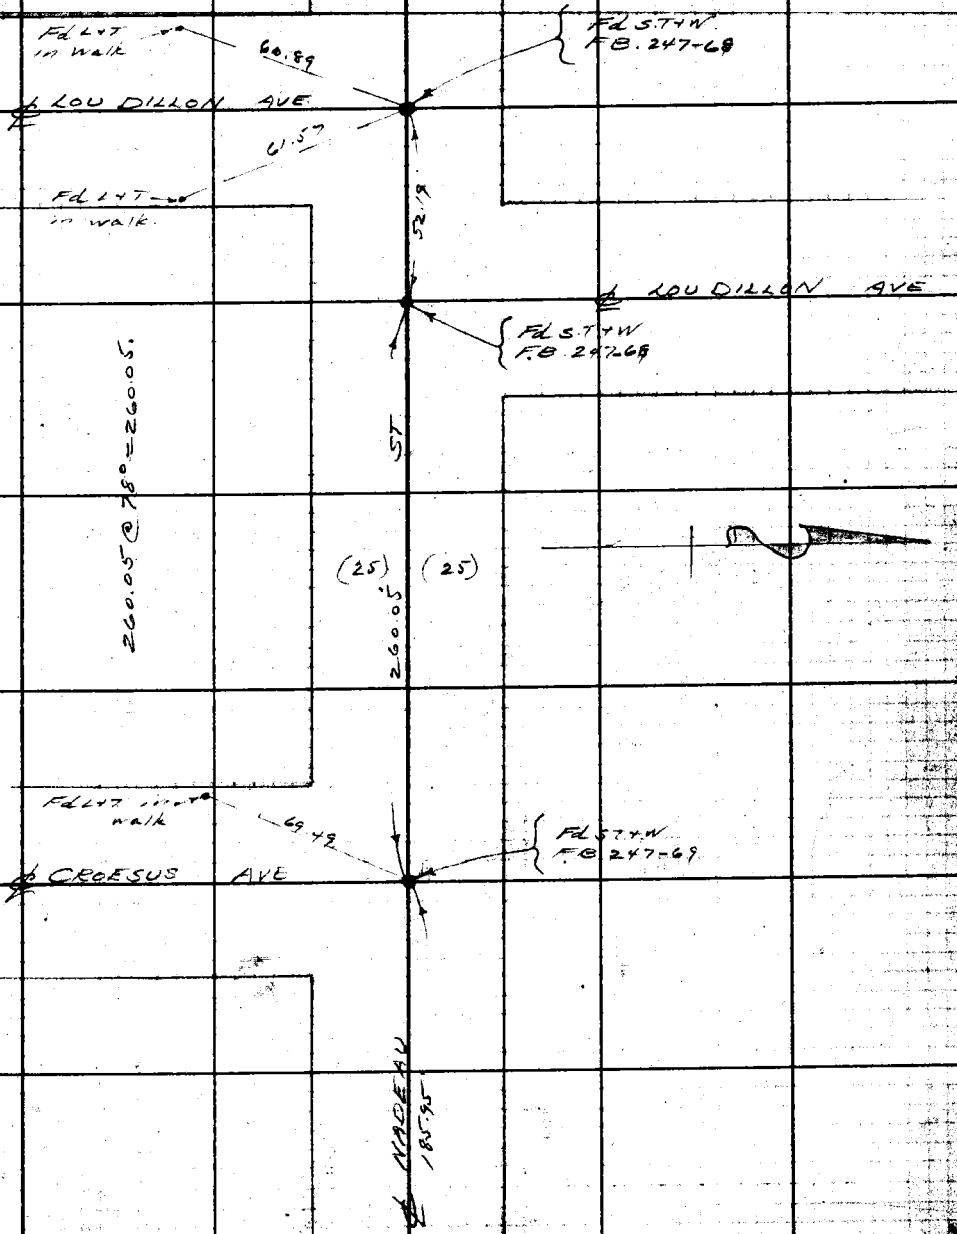

Note: Any Additions or Changes on This Sheets Must be Made or Circled in Red Ink With Date and Name of Person Making Change.

Do not extend notes this side of this line

RETURN TO
LOS ANGELES COUNTY SURVEYOR
700 HALL OF RECORDS

FORM 247 5M 10-37

F.B. 807 Pg. 48

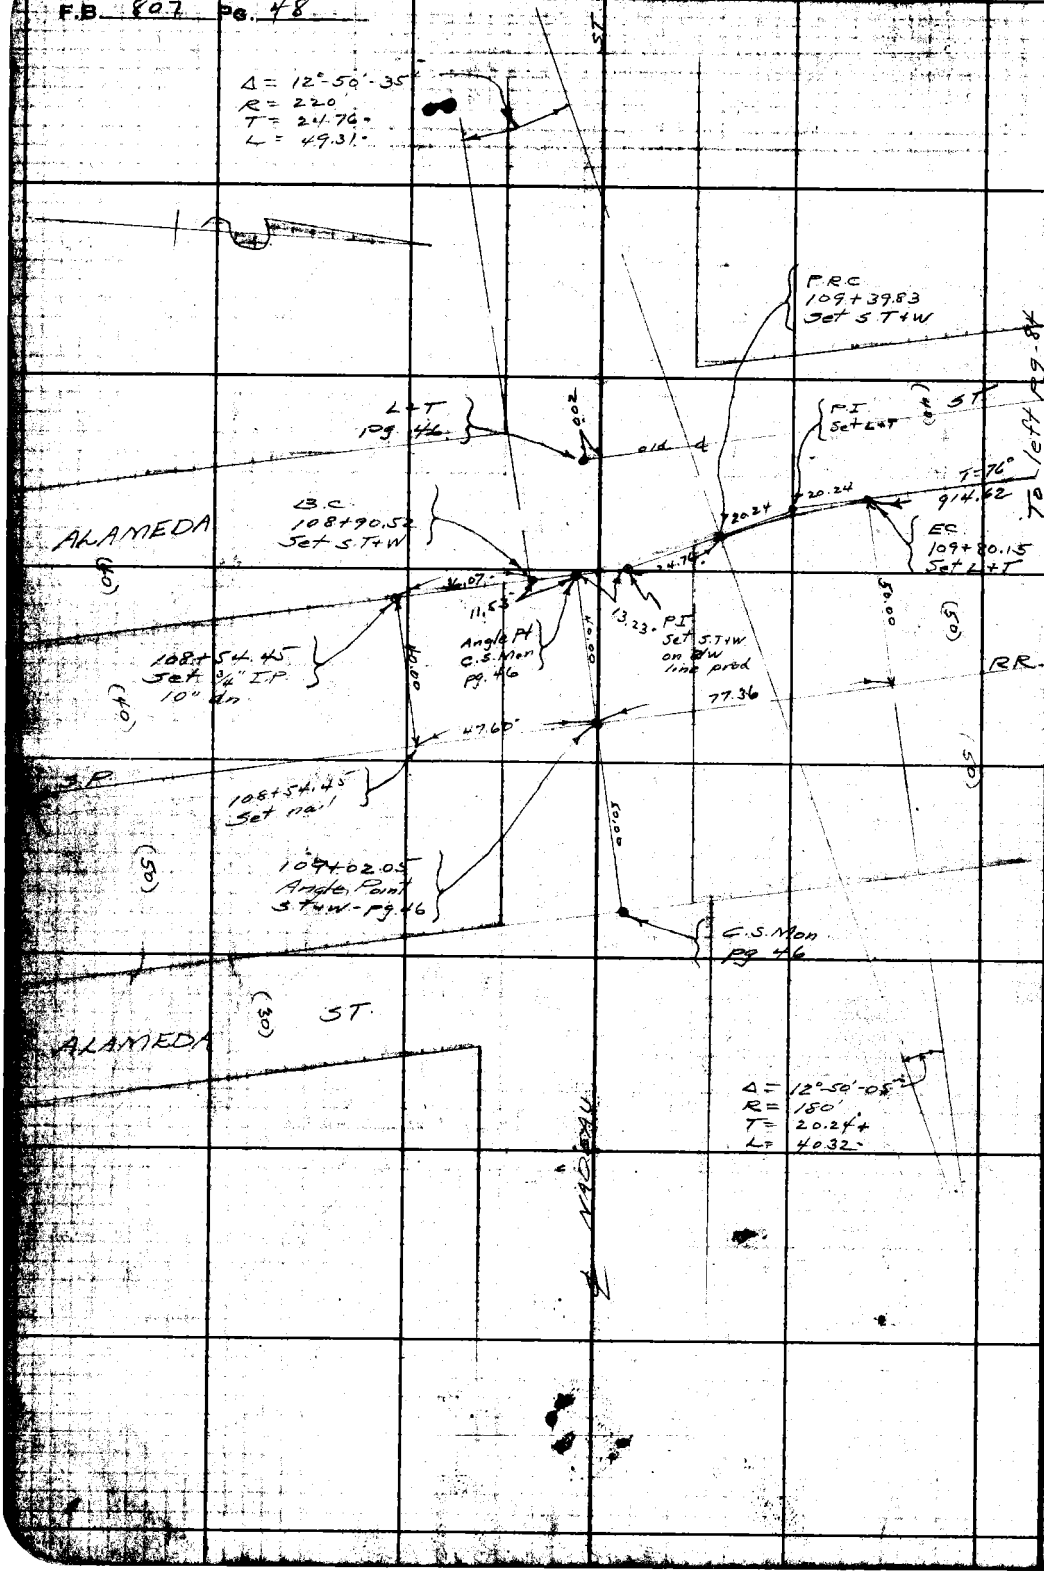

RETURN TO
LOS ANGELES COUNTY SURVEYOR
700 HALL OF RECORDS

Note: Any Additions or Changes on This Sheets Must be Made or Circled in Red Ink With Date and Name of Person Making Change.

Do not extend notes this side of this line

Notes Ck'd by D. M. Finley	Survey of Alameda St	F.B. 807 PG. 49
Map No. [illegible]	W. [illegible] Tape No. 063 Sp'd 76 of	
Office Work D. A. WHITE	Surveyed by Moore	
Checked D. M. Finley	Notes Moore Date 10-10-39	
Date Feb 1940	Indexed A. C. Johnson 11-6-39	

SURVEY
OF
ALAMEDA ST
FROM
NORTH BOUNDARY
CITY OF COMPTON
NORTH TO
107th ST
Job # 8270

Moore
Fenner
Lawson
Waltermire

Note- All C.S. Mons are 2" I.P. + B.C. in conc. and marked as shown

COUNTY SURVEYOR
R.E. 2197

Note: Any Additions or Changes on This Sheets Must be Made or Circled in Red Ink With Date and Name of Person Making Change.

Do not extend notes this side of this line

RETURN TO
LOS ANGELES COUNTY SURVEYOR
700 HALL OF RECORDS

FORM 247 5M 10-37

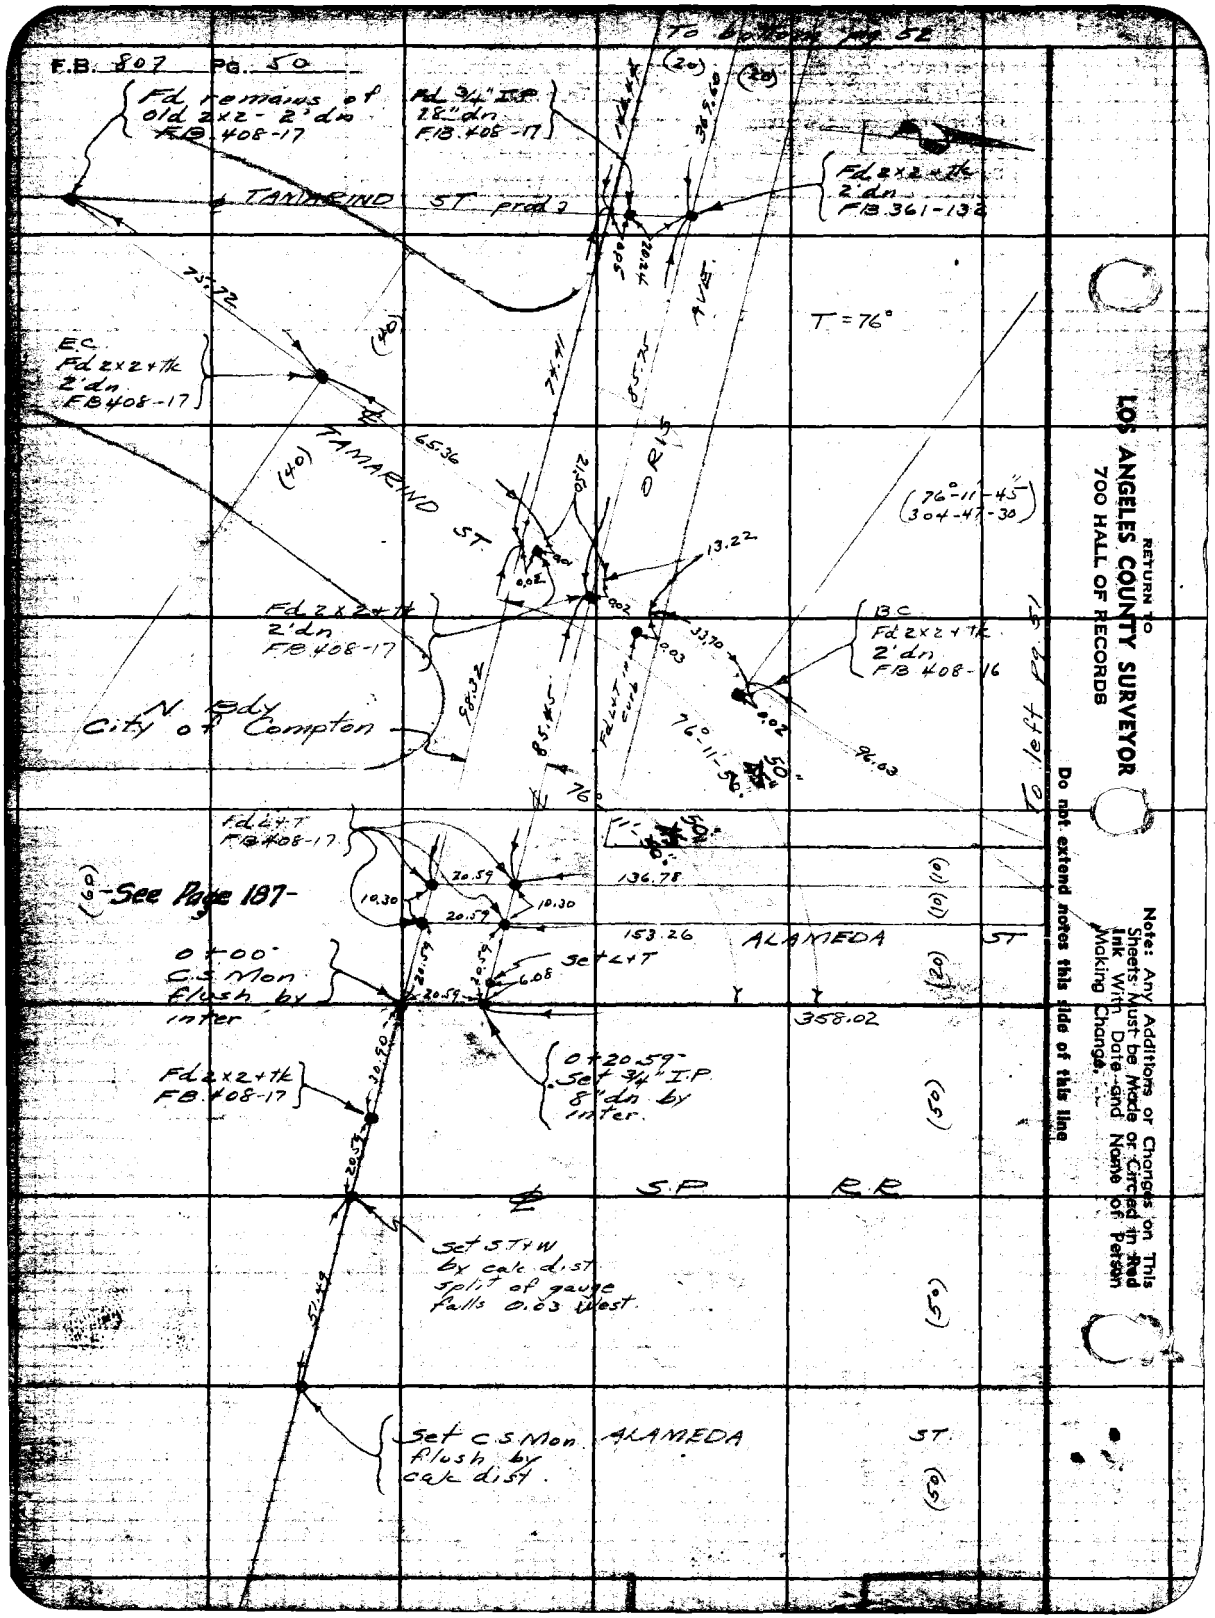

RETURN TO
LOS ANGELES COUNTY SURVEYOR
700 HALL OF RECORDS

Note: Any Additions or Changes on This Sheets Must be Made or Circled in Red Ink With Date and Name of Person Making Change.

Do not extend notes this side of this line

Notes Ck'd by D. M. Finley	Survey of Alameda St	F.B. 807	PG. 51
[illegible]	W. [illegible] Tab No. [illegible]		
Office Work [illegible] WHITE	Surveyed by L. B. Moore		
Checked D. M. Finley	Notes T. Moore Date 10-10-39		
Date Feb 1940	Indexed A. C. Johnson		

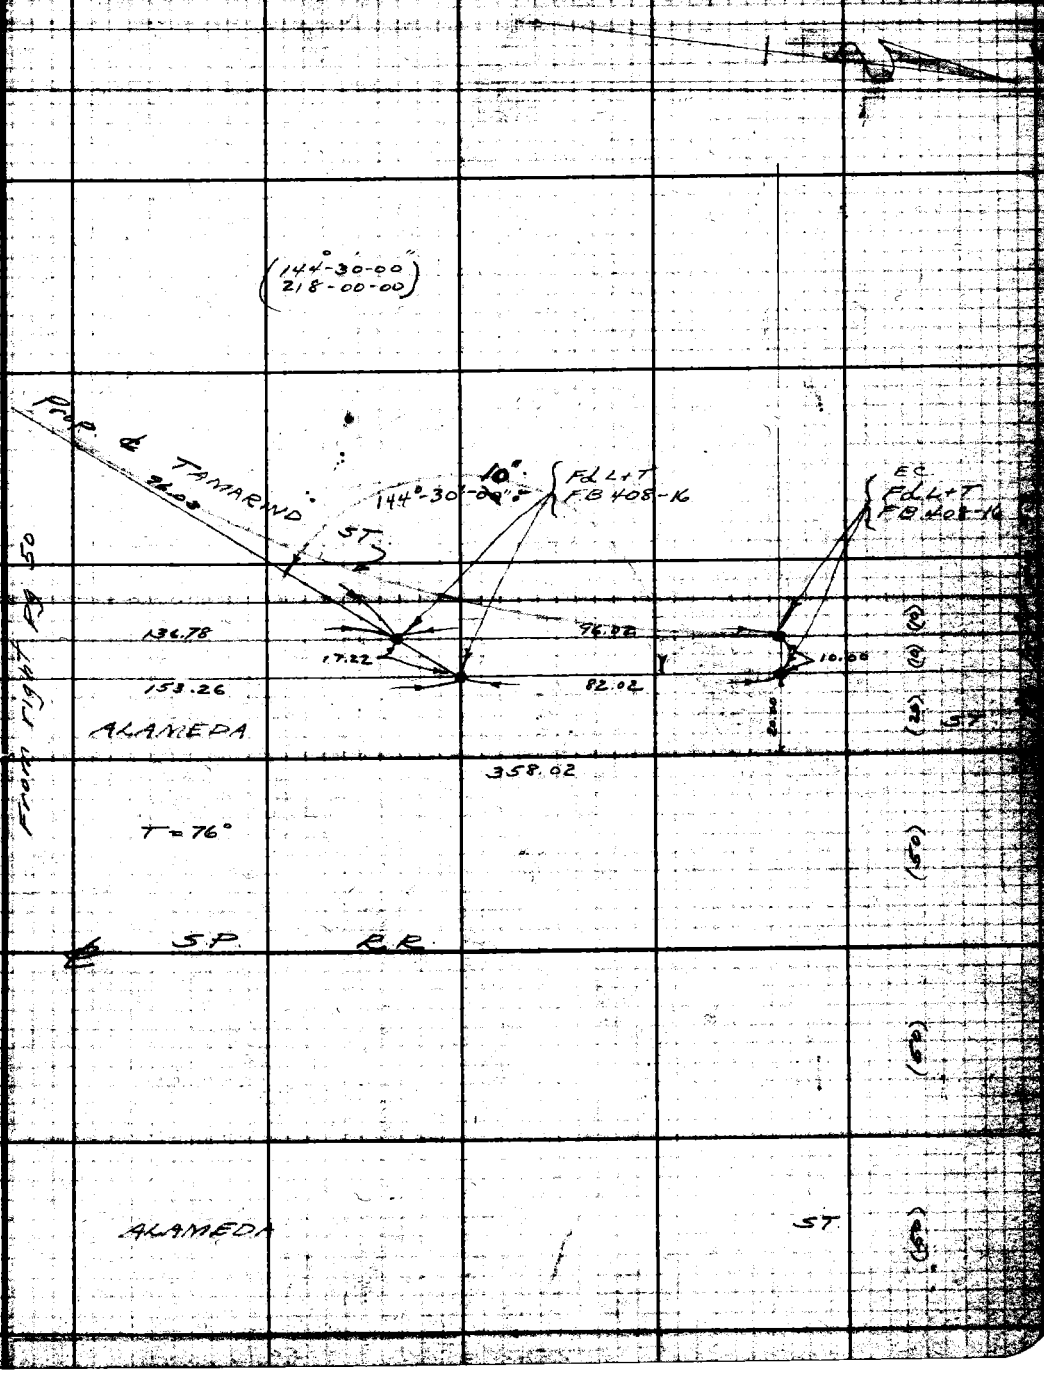

From right Pg 50

Note: Any Additions or Changes on This Sheets Must be Made or Circled in Red Ink With Date and Name of Person Making Change.

Do not extend notes this side of this line

RETURN TO
LOS ANGELES COUNTY SURVEYOR
700 HALL OF RECORDS

FORM 247 5M 10-37

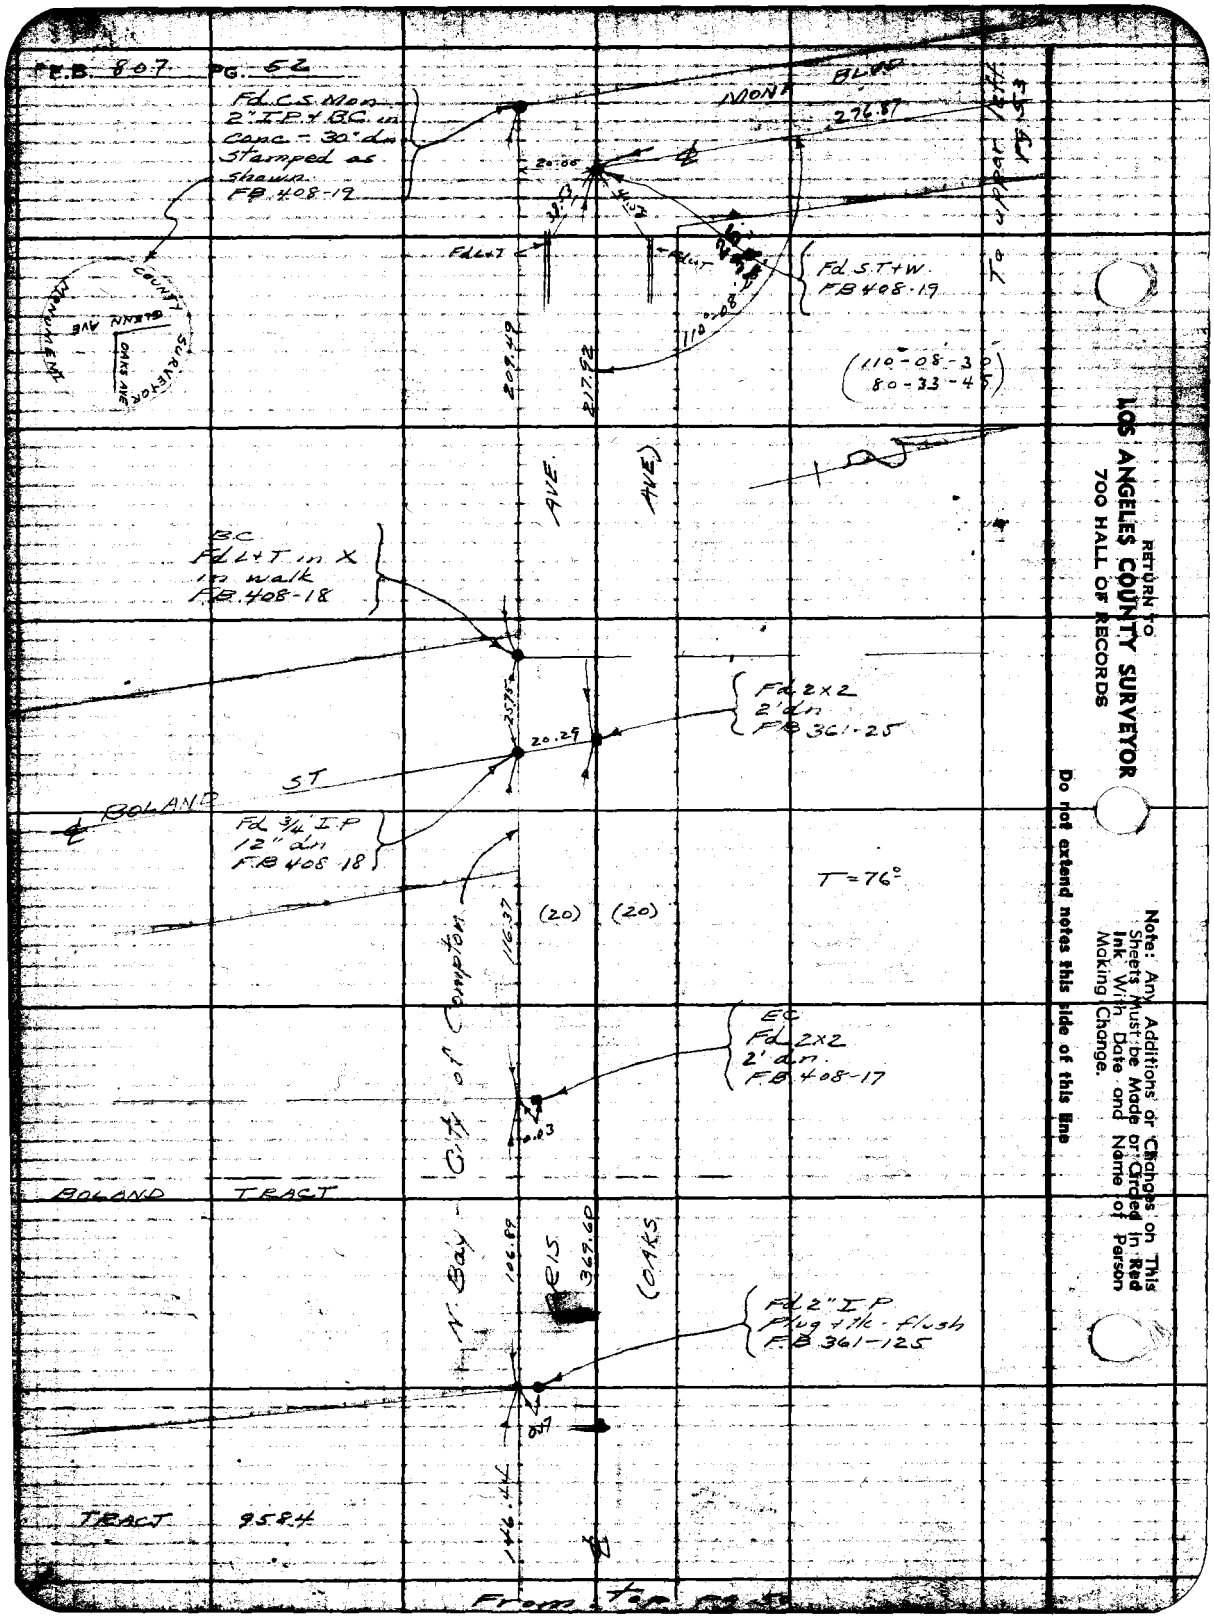

RETURN TO
LOS ANGELES COUNTY SURVEYOR
700 HALL OF RECORDS
Note: Any Additions or Changes on This Sheets Must be Made or Graded in Red Ink With Date and Name of Person Making Change.
Do not extend notes this side of this line

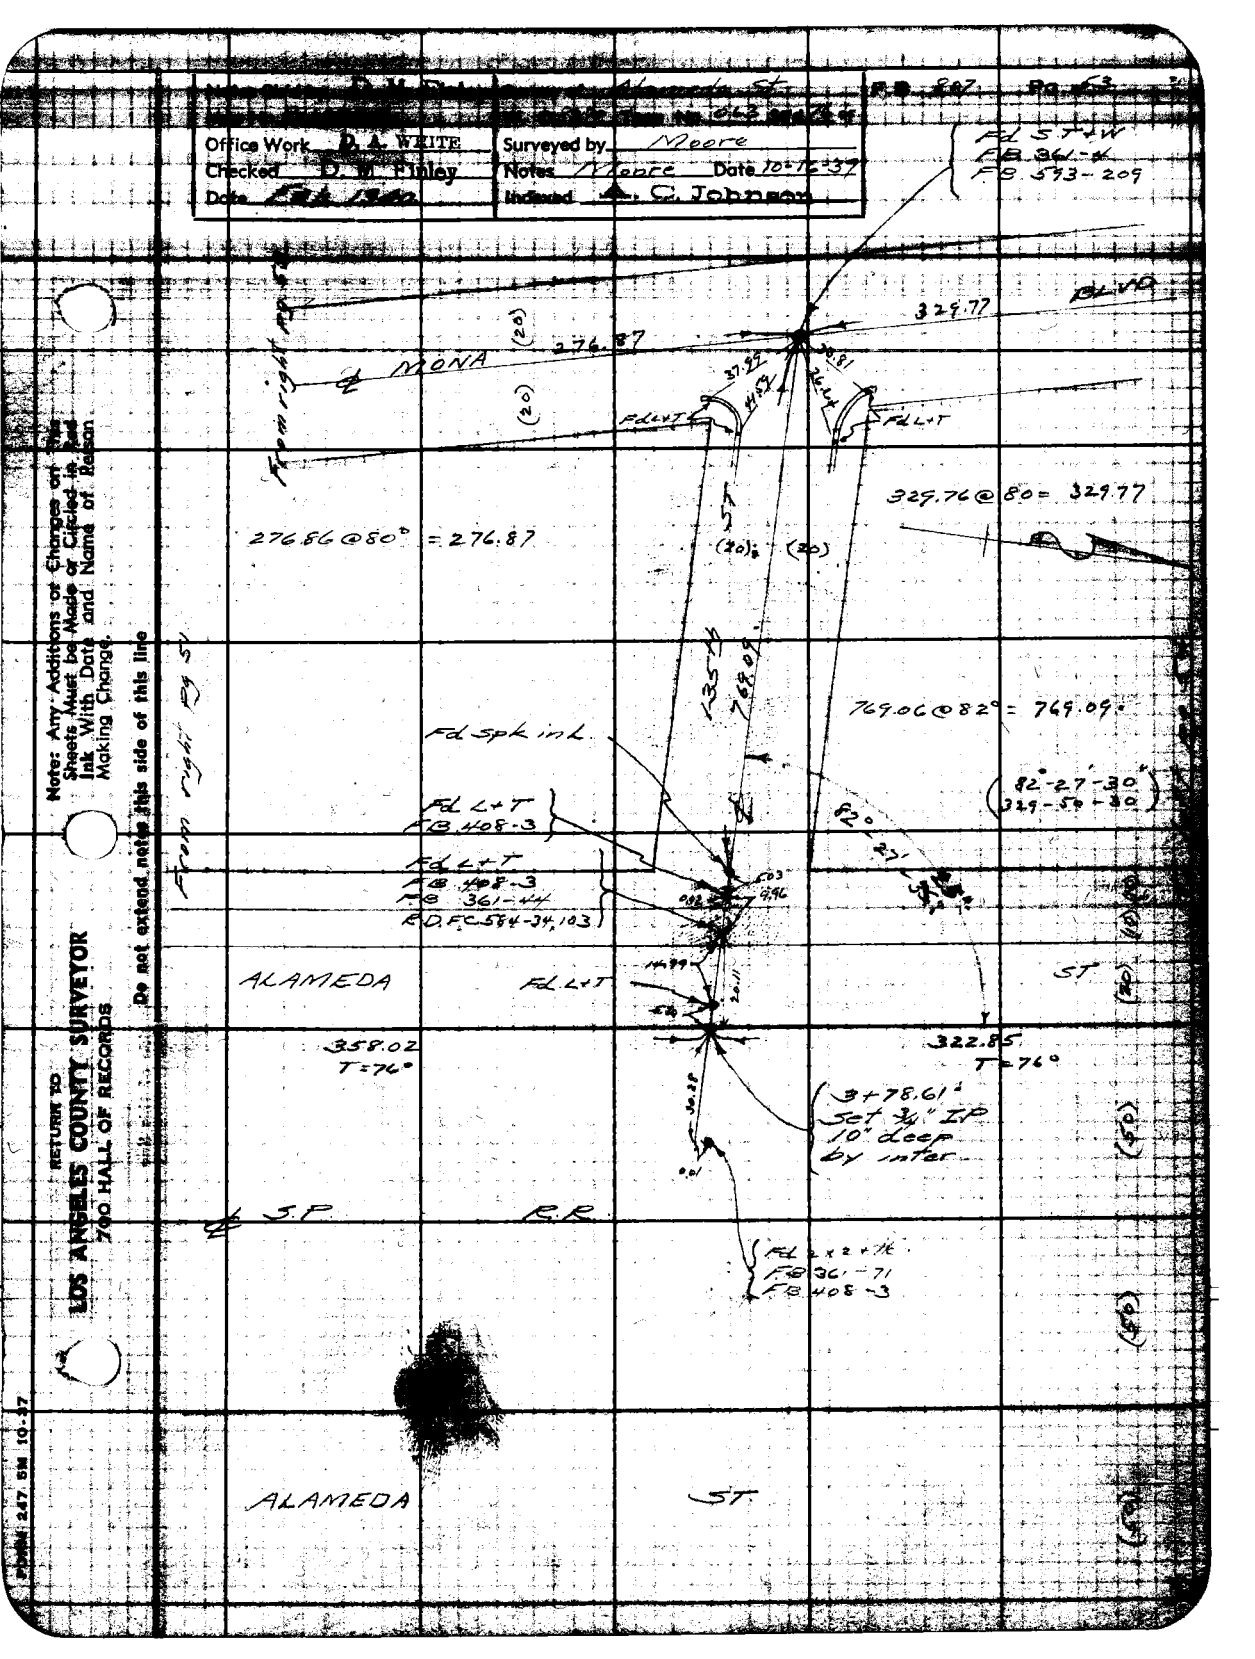

Office Work D. A. WHITE
Checked D. M. Finley
Date
Surveyed by Moore
Notes Moore Date 10-16-37
Indexed A. C. Johnson
F.B. 807
Fd S.T.+W
F.B. 361-4
F.B. 593-209
BLVD
329.77
276.87
MONA
(20)
From right Pg 51
Fd L+T
329.76 @ 80 = 329.77
276.86 @ 80° = 276.87
(20)
769.06 @ 82° = 769.09
Fd spk in L
Fd L+T
F.B. 408-3
Fd L+T
F.B. 408-3
F.B. 361-44
R.D. F.C. 584-34, 103
82°-27'-30"
329-50-30
ALAMEDA
Fd L+T
ST
358.02
T=76°
322.85
T=76°
3+78.61'
Set 3/4" I.P.
10" deep
by inter.
S.P.
R.R.
Fd 2x2+1/2
F.B. 361-71
F.B. 408-3
ALAMEDA
ST
Note: Any Additions or Changes on this Sheets Must be Made or Circled in Red Ink With Date and Name of Person Making Change.
Do not extend notes this side of this line
RETURN TO
LOS ANGELES COUNTY SURVEYOR
700 HALL OF RECORDS
FORM 247 5M 10-37

F.B. 807 PG. 54

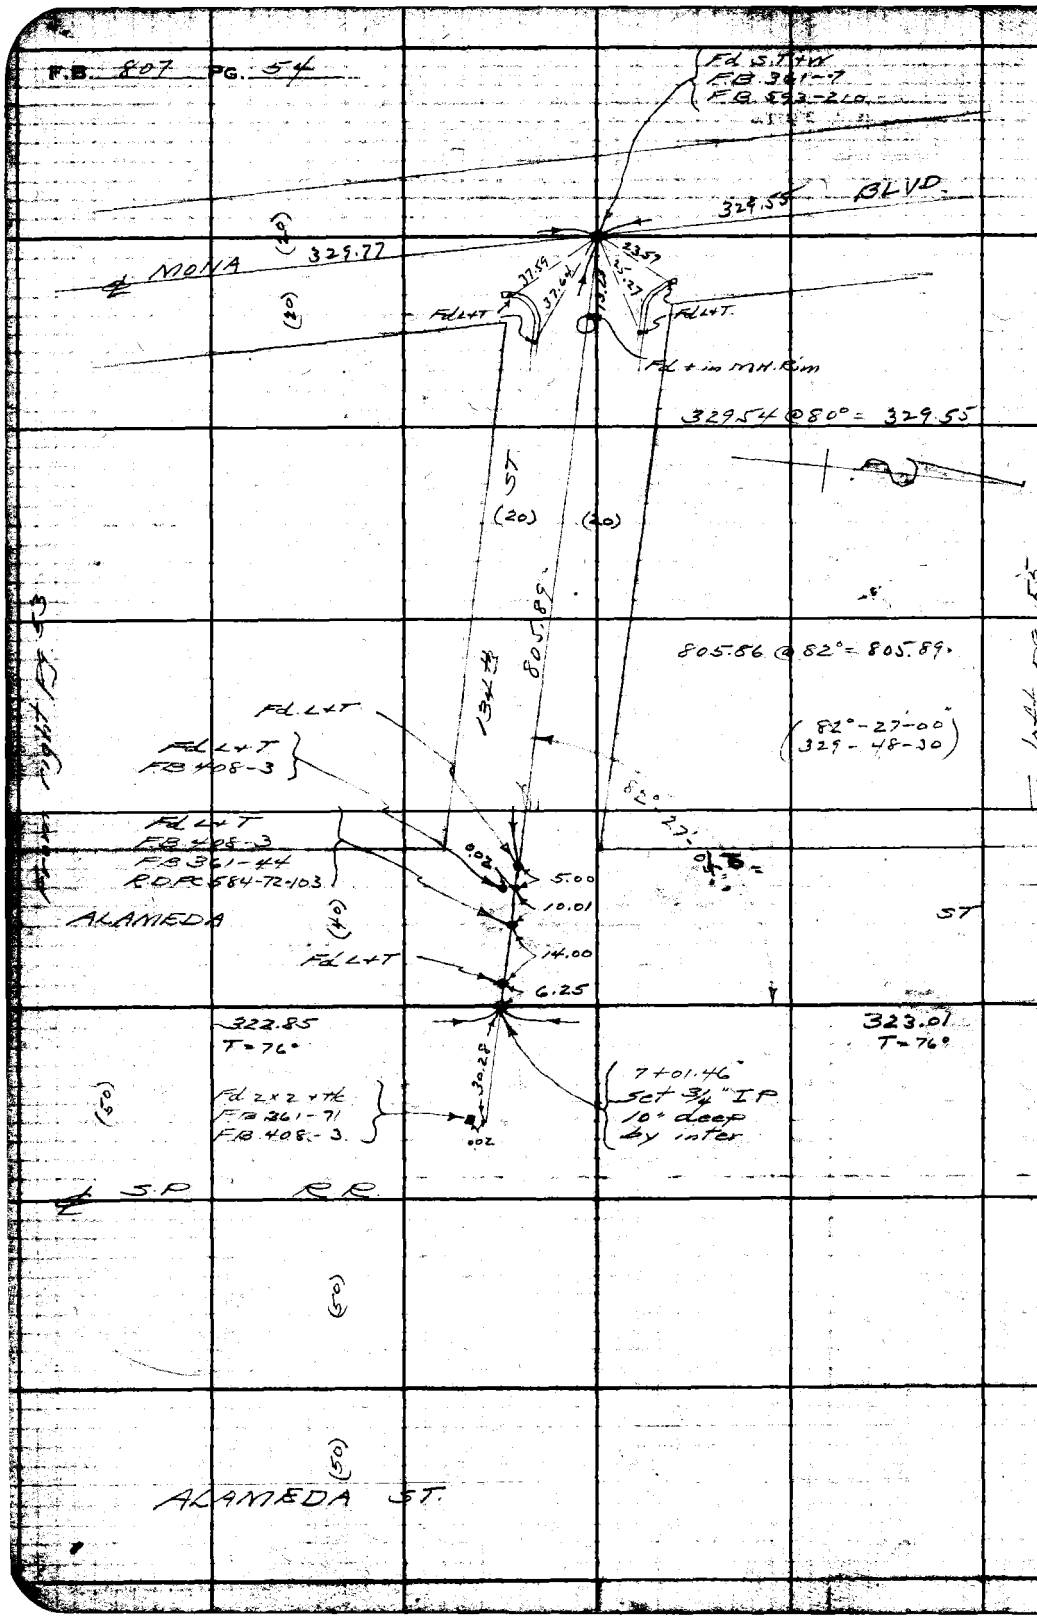

RETURN TO
LOS ANGELES COUNTY SURVEYOR
700 HALL OF RECORDS

Note: Any Additions or Changes on This Sheets Must be Made or Circled In Red Ink With Date and Name of Person Making Change.

Do not extend notes this side of this line.

Notes Circled by D. M. Finley	Survey of Alameda St.		P.B. 807 Pg. 55
Map No. [illegible]	[illegible] Tract No. 6-1 [illegible] 76 of		
Office Work D. A. WHITE	Surveyed by Moore		
Checked D. M. Finley	Notes Moore Date 10-16-39		
Date Feb 1940	Indexed A. C. Johnson		

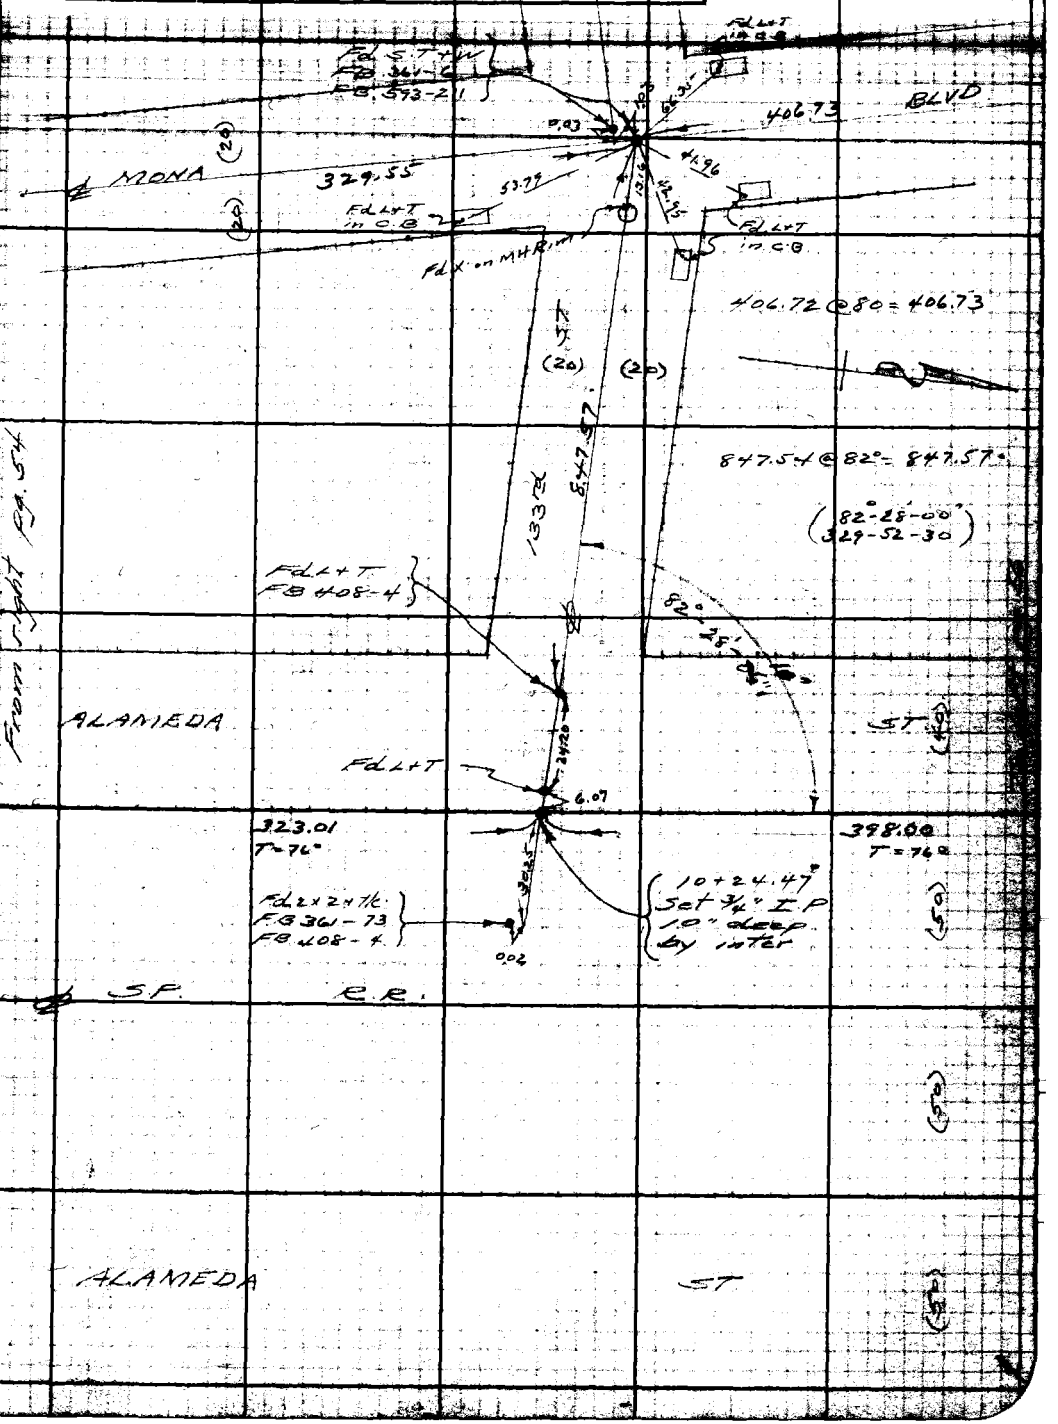

Note: Any Additions or Changes on This Sheets Must be Made or Circled in Red Ink With Date and Name of Person Making Change.

Do not extend notes this side of this line

RETURN TO
LOS ANGELES COUNTY SURVEYOR
700 HALL OF RECORDS

FORM 247 5M 10-37

F.B. 807 PG. 56

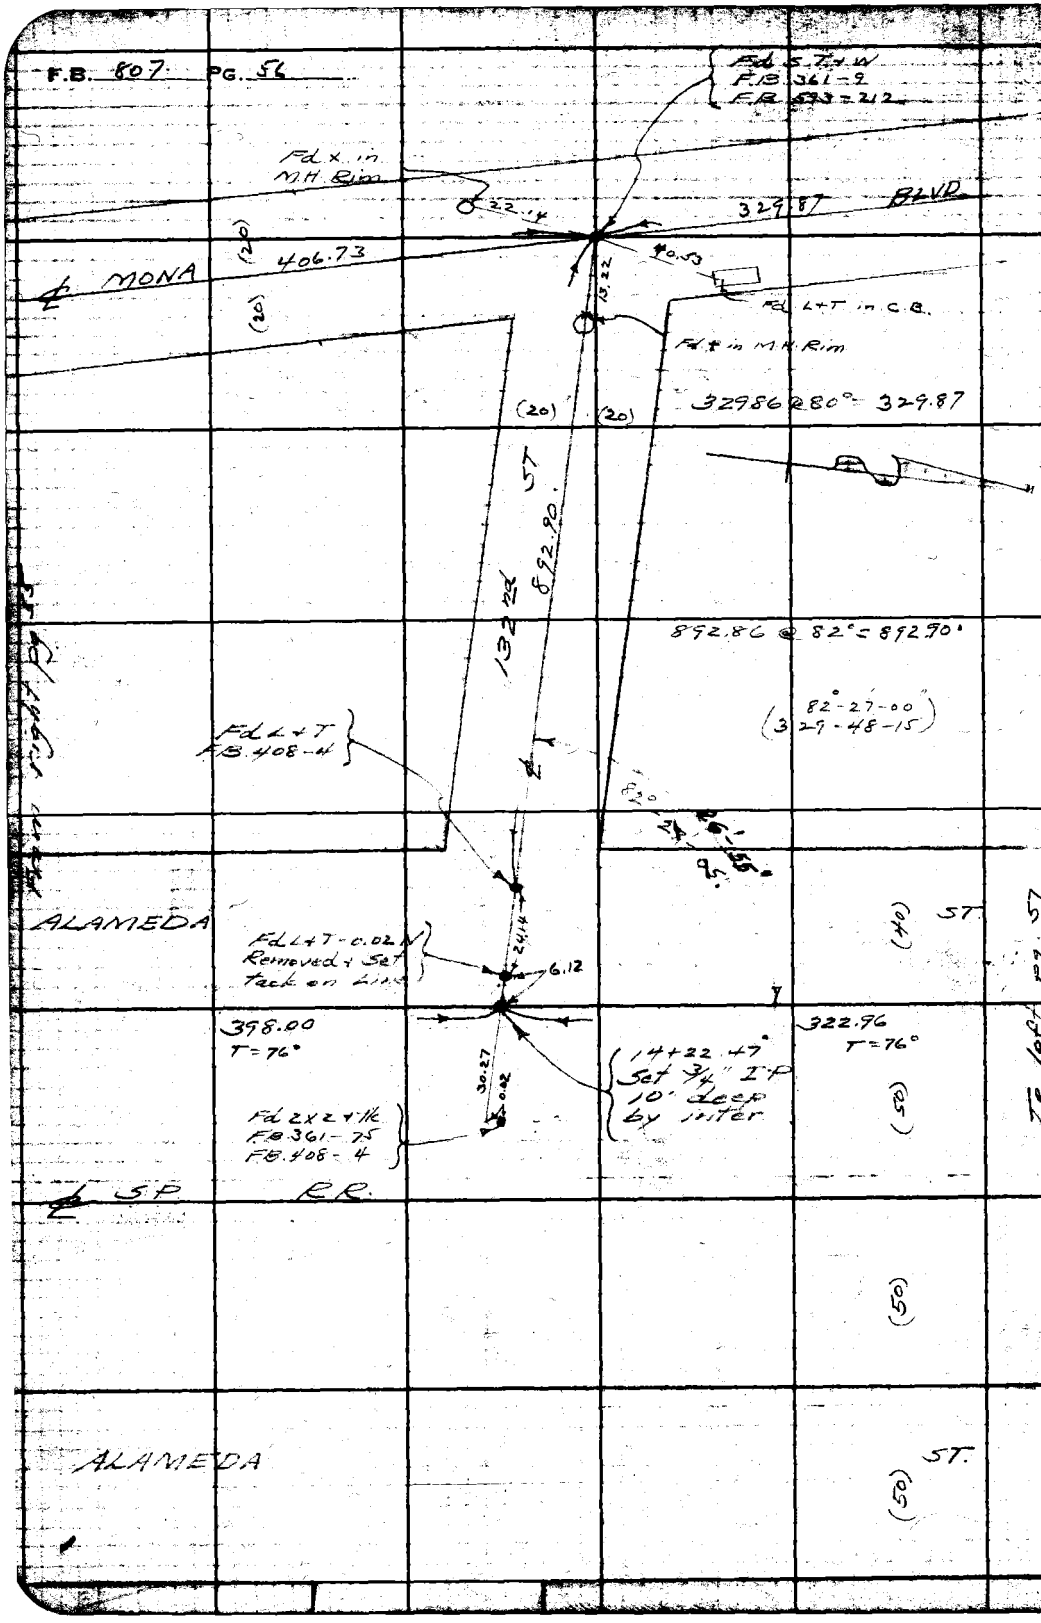

RETURN TO
LOS ANGELES COUNTY SURVEYOR
700 HALL OF RECORDS

Note: Any Additions or Changes on This Sheets Must be Made or Circled In Red Ink, With Date and Name of Person Making Change.

Do not extend notes this side of this line

Notes Ck'd by D. M. Finley	Survey of Alameda ST	F.B. 807 PG. 57
Map No. [illegible]	[illegible] Tape No. 063 Std 76 of	
Office Work D. A. WHITE	Surveyed by Moore	
Checked D. M. Finley	Notes Moore Date 10-11-39	
Date Feb 1940	Indexed A. C. Johnson	

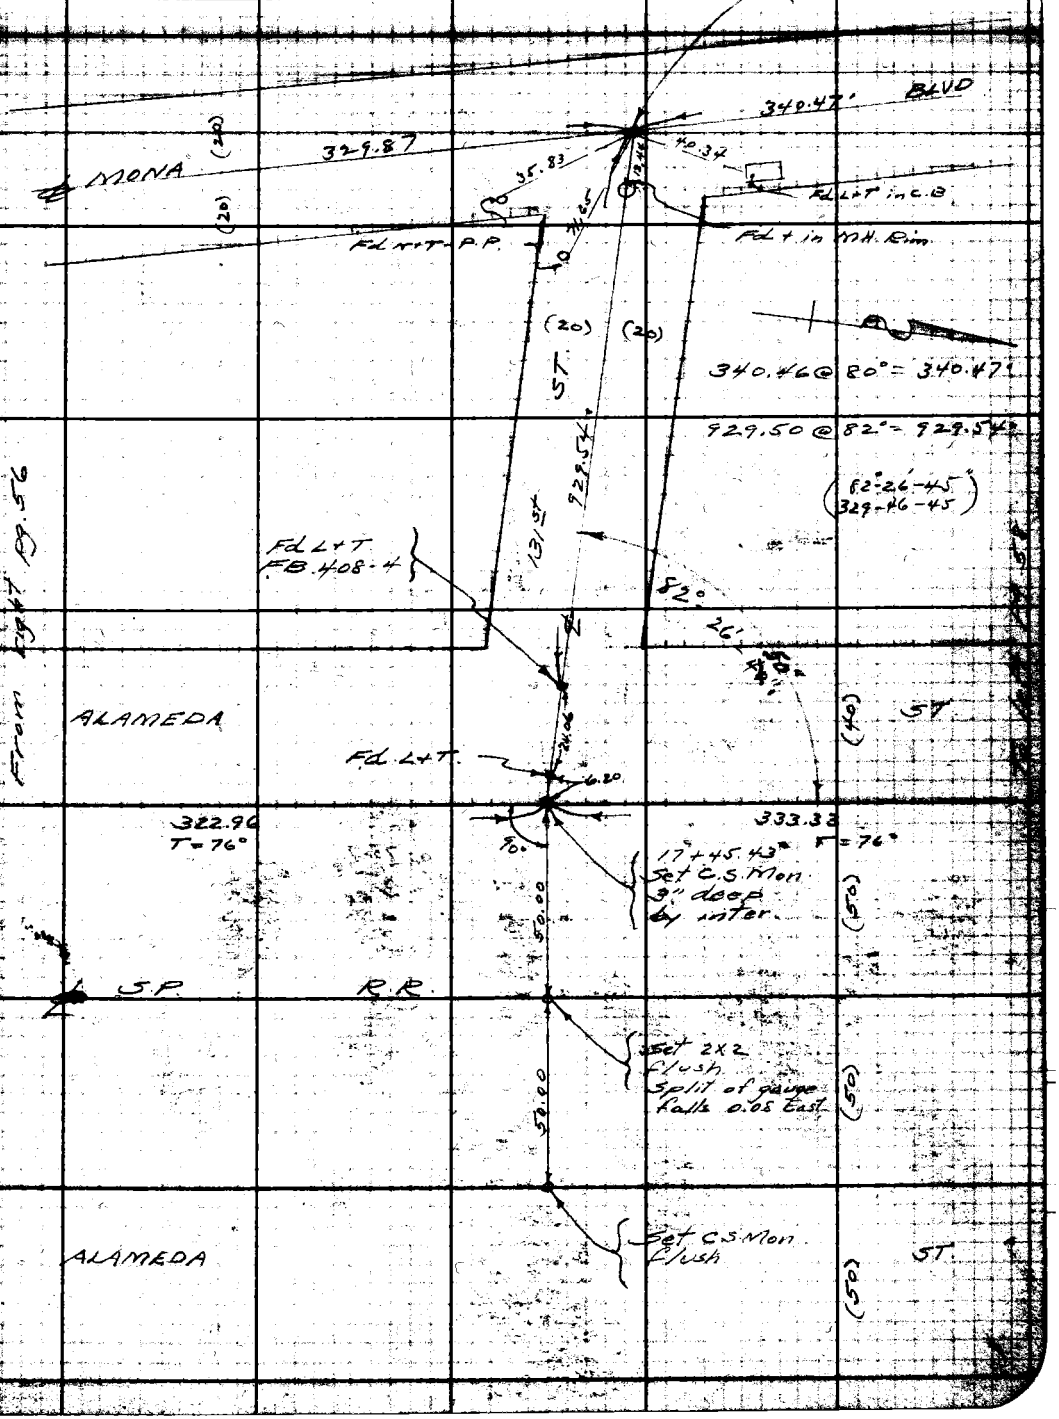

Note: Any Additions or Changes on This Sheets Must be Made or Circled in Red Ink With Date and Name of Person Making Change.

Do not extend notes this side of this line

RETURN TO
LOS ANGELES COUNTY SURVEYOR
700 HALL OF RECORDS

FORM 247 5M 10-37

F.B. 807 PG. 58

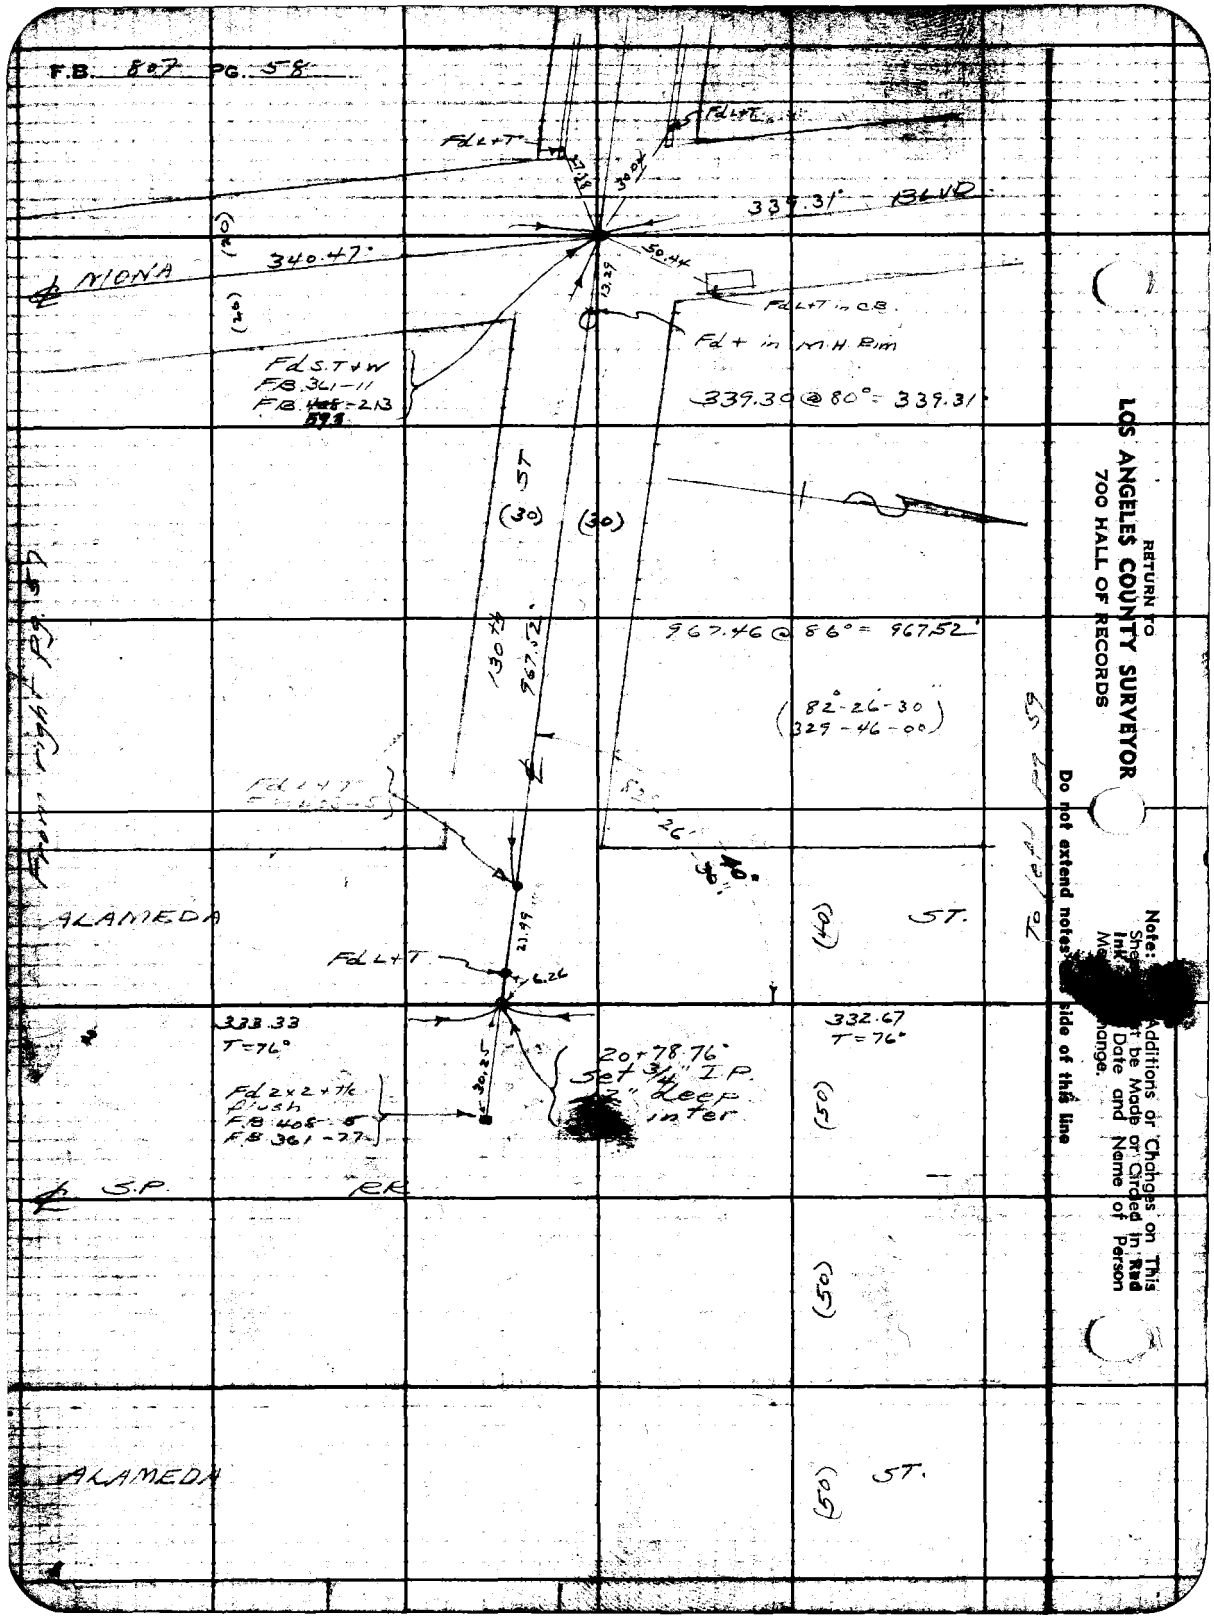

RETURN TO
LOS ANGELES COUNTY SURVEYOR
700 HALL OF RECORDS

Note: Additions or Changes on This Sheet be Made or Circled in Red Ink. Date and Name of Person Making Change.

Do not extend notes [redacted] side of this line

Notes Ckd by D. M. Finley	Survey of Alameda St	F.B. 807	Pg. 59
Map No. [illegible]	W. O. [illegible] Tom. No. [illegible] Std. [illegible]		
Office Work D. A. WHITE	Surveyed by Moore		
Checked D. M. Finley	Notes Moore Date 10-17-39		
Date Feb. 1940	Indexed A. C. Johnson		

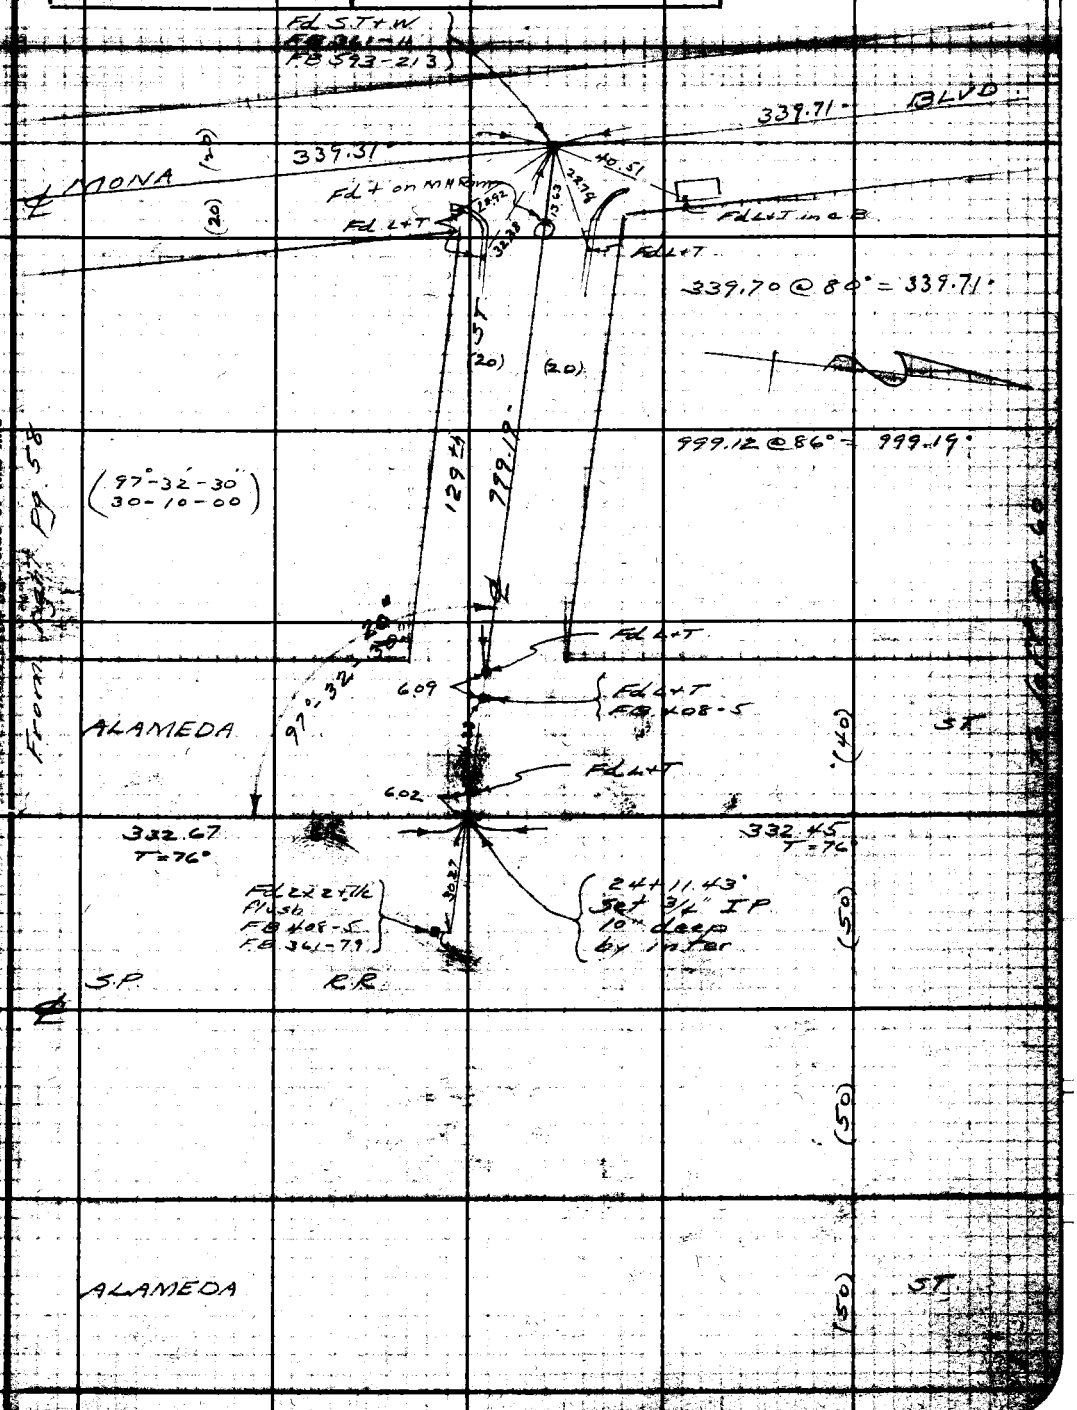

Note: Any Additions or Changes on This Sheets Must be Made or Circled in Red Ink With Date and Name of Person Making Change.

Do not extend notes this side of this line

RETURN TO
LOS ANGELES COUNTY SURVEYOR
700 HALL OF RECORDS

FORM 247 5M 10-37

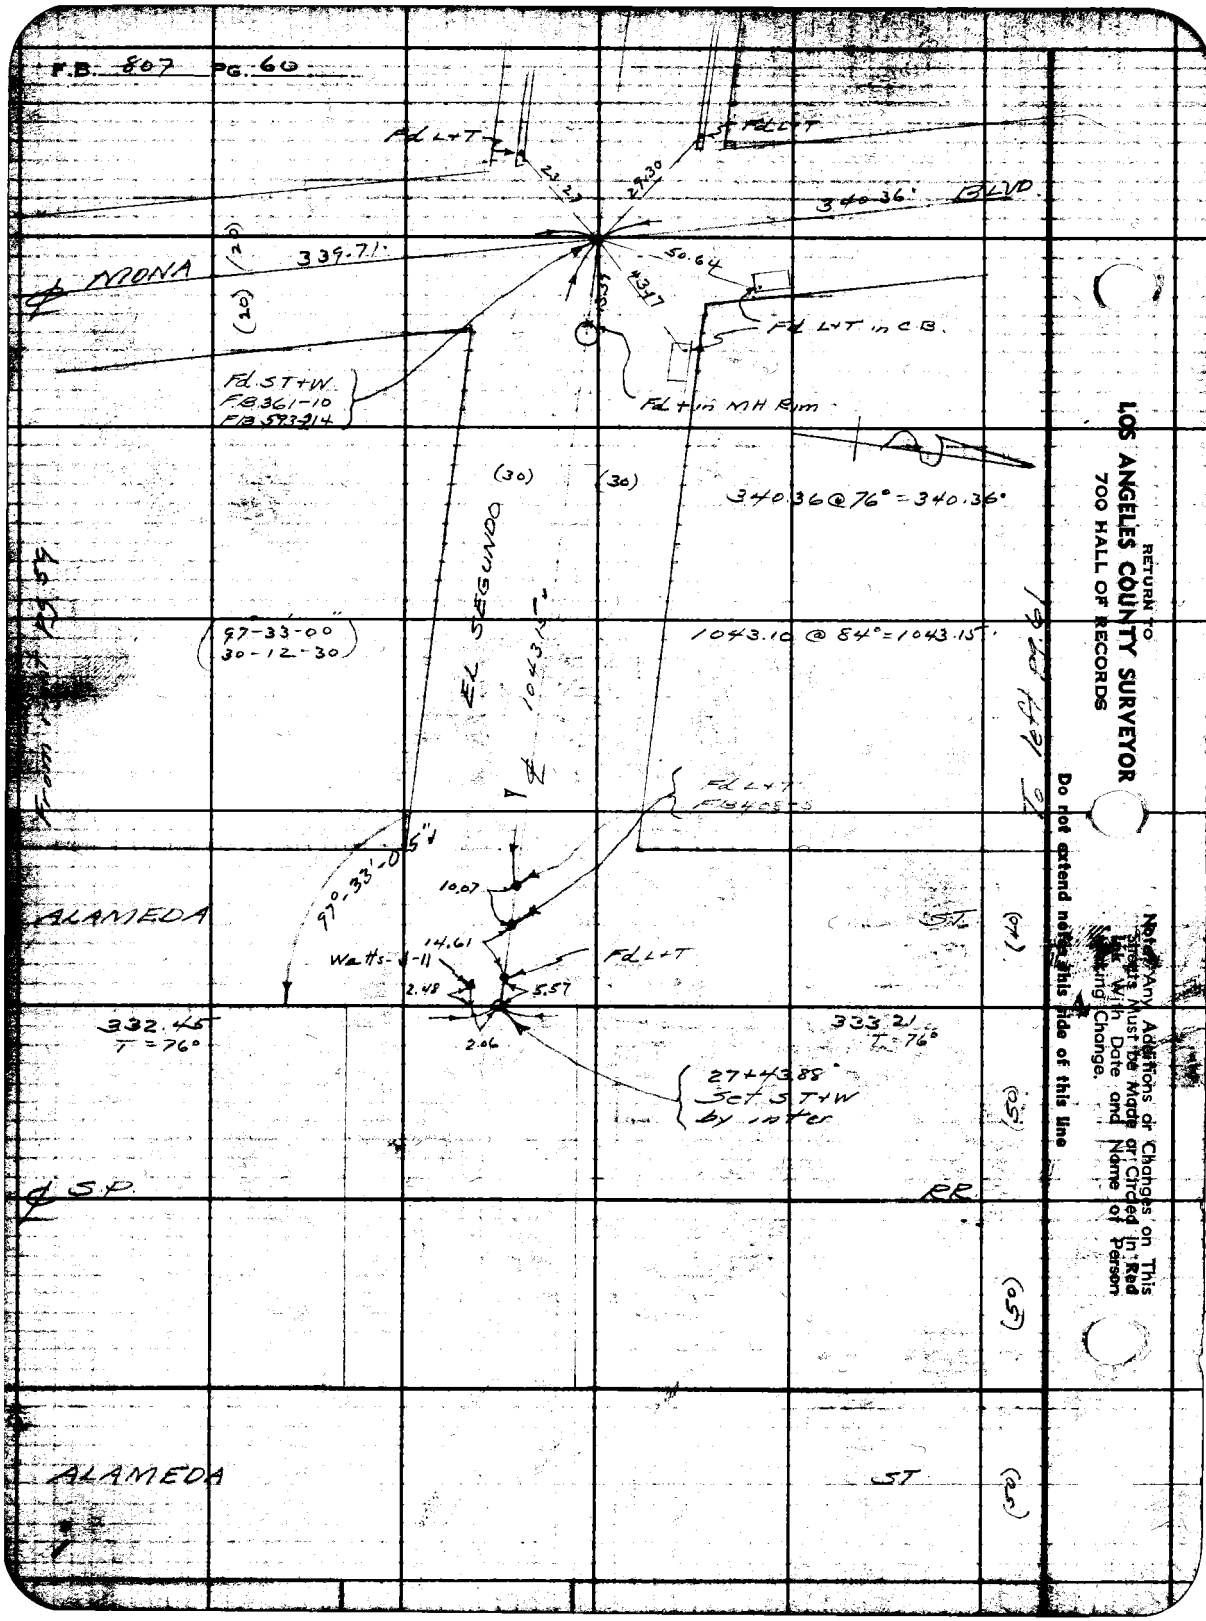

RETURN TO
LOS ANGELES COUNTY SURVEYOR
700 HALL OF RECORDS
Note: Any Additions or Changes on This Sheets Must be Made or Circled in Red Ink With Date and Name of Person Making Change.
Do not extend notes this side of this line

[illegible] D. M. Finley	[illegible] Alameda St	F.B. 807	Pg. 61
[illegible]	W. [illegible] Tom [illegible]		
Office Work D. A. WHITE	Surveyed by Moore		
Checked D. M. Finley	Notes Moore Date 10-17-39		
Date Feb 1940	Indexed A. C. Johnson		

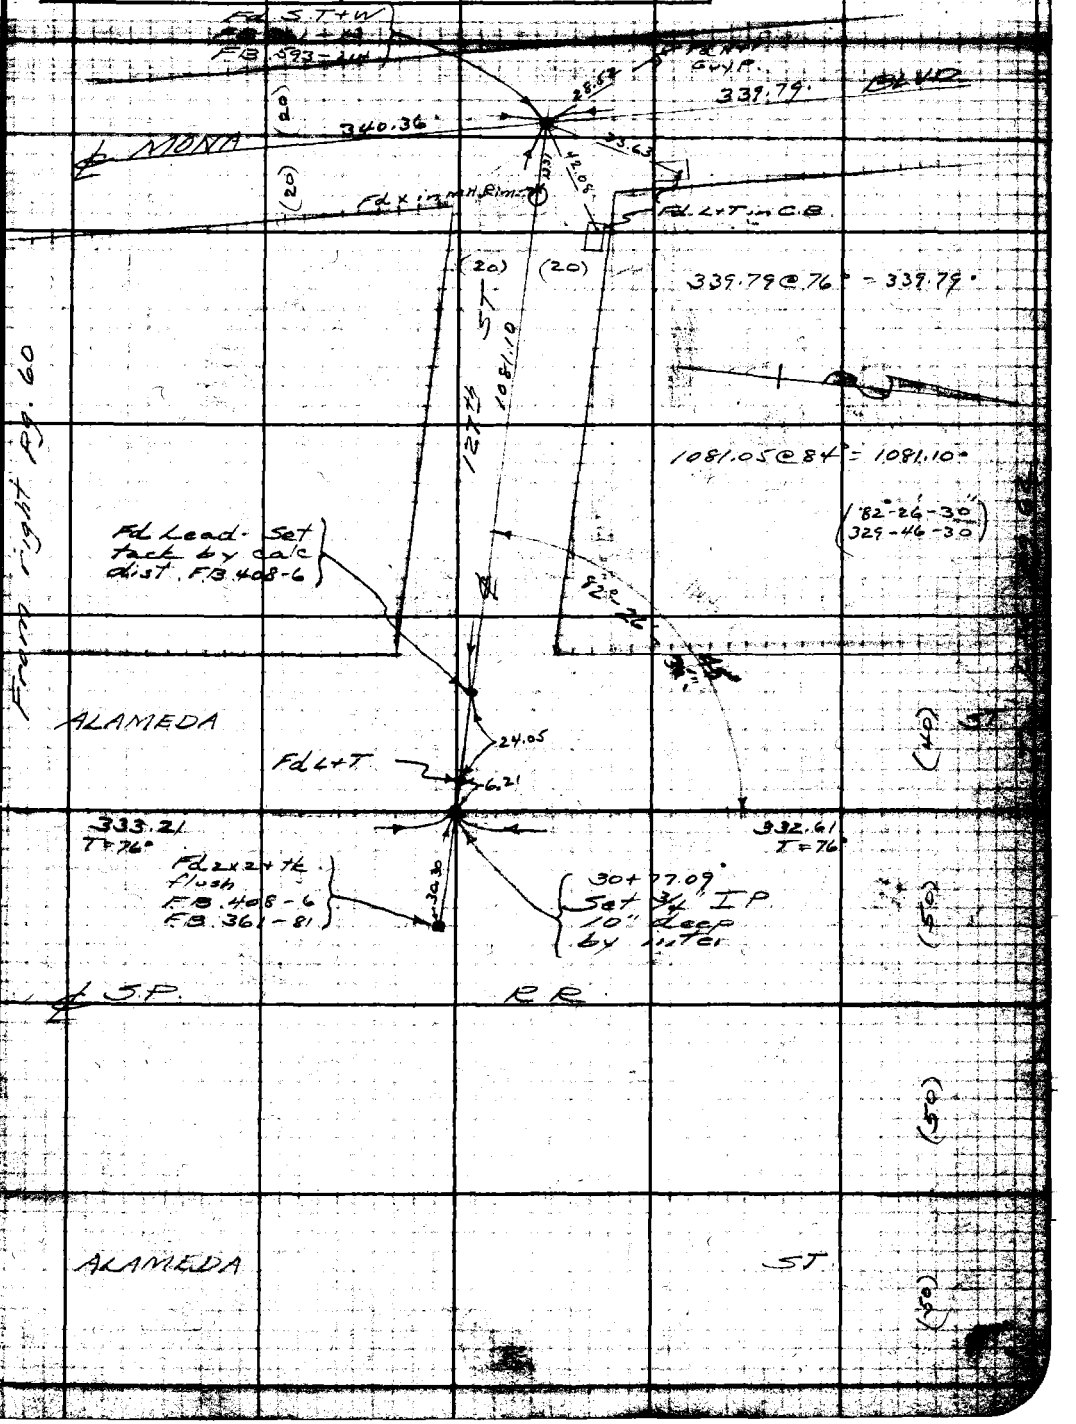

Note: Any Additions or Changes on This Sheets Must be Made or Circled in Red Ink With Date and Name of Person Making Change.

Do not extend notes this side of this line

RETURN TO
LOS ANGELES COUNTY SURVEYOR
700 HALL OF RECORDS

FORM 247 5M 10-47

F.B. 807 PG. 62

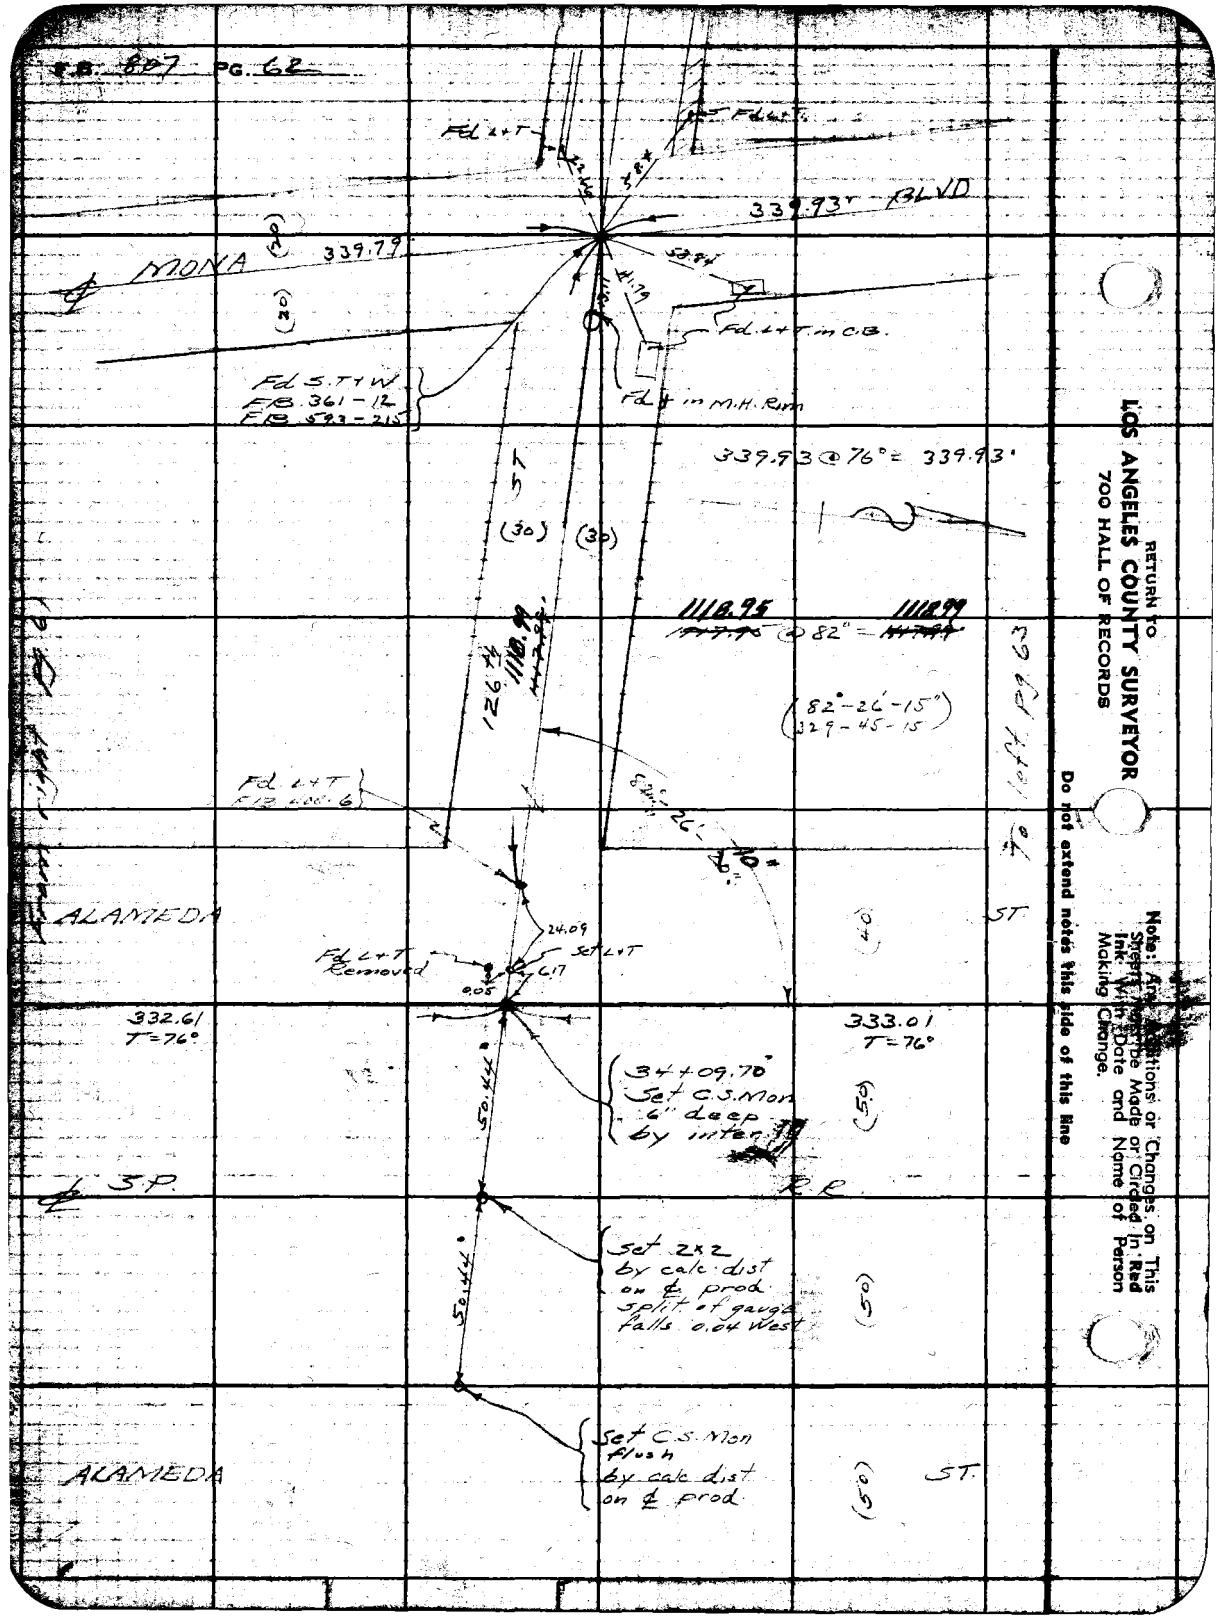

RETURN TO
LOS ANGELES COUNTY SURVEYOR
700 HALL OF RECORDS

Do not extend notes this side of this line

Note: Any Additions or Changes on This Sheet Must Be Made or Circled In Red Ink With Date and Name of Person Making Change.

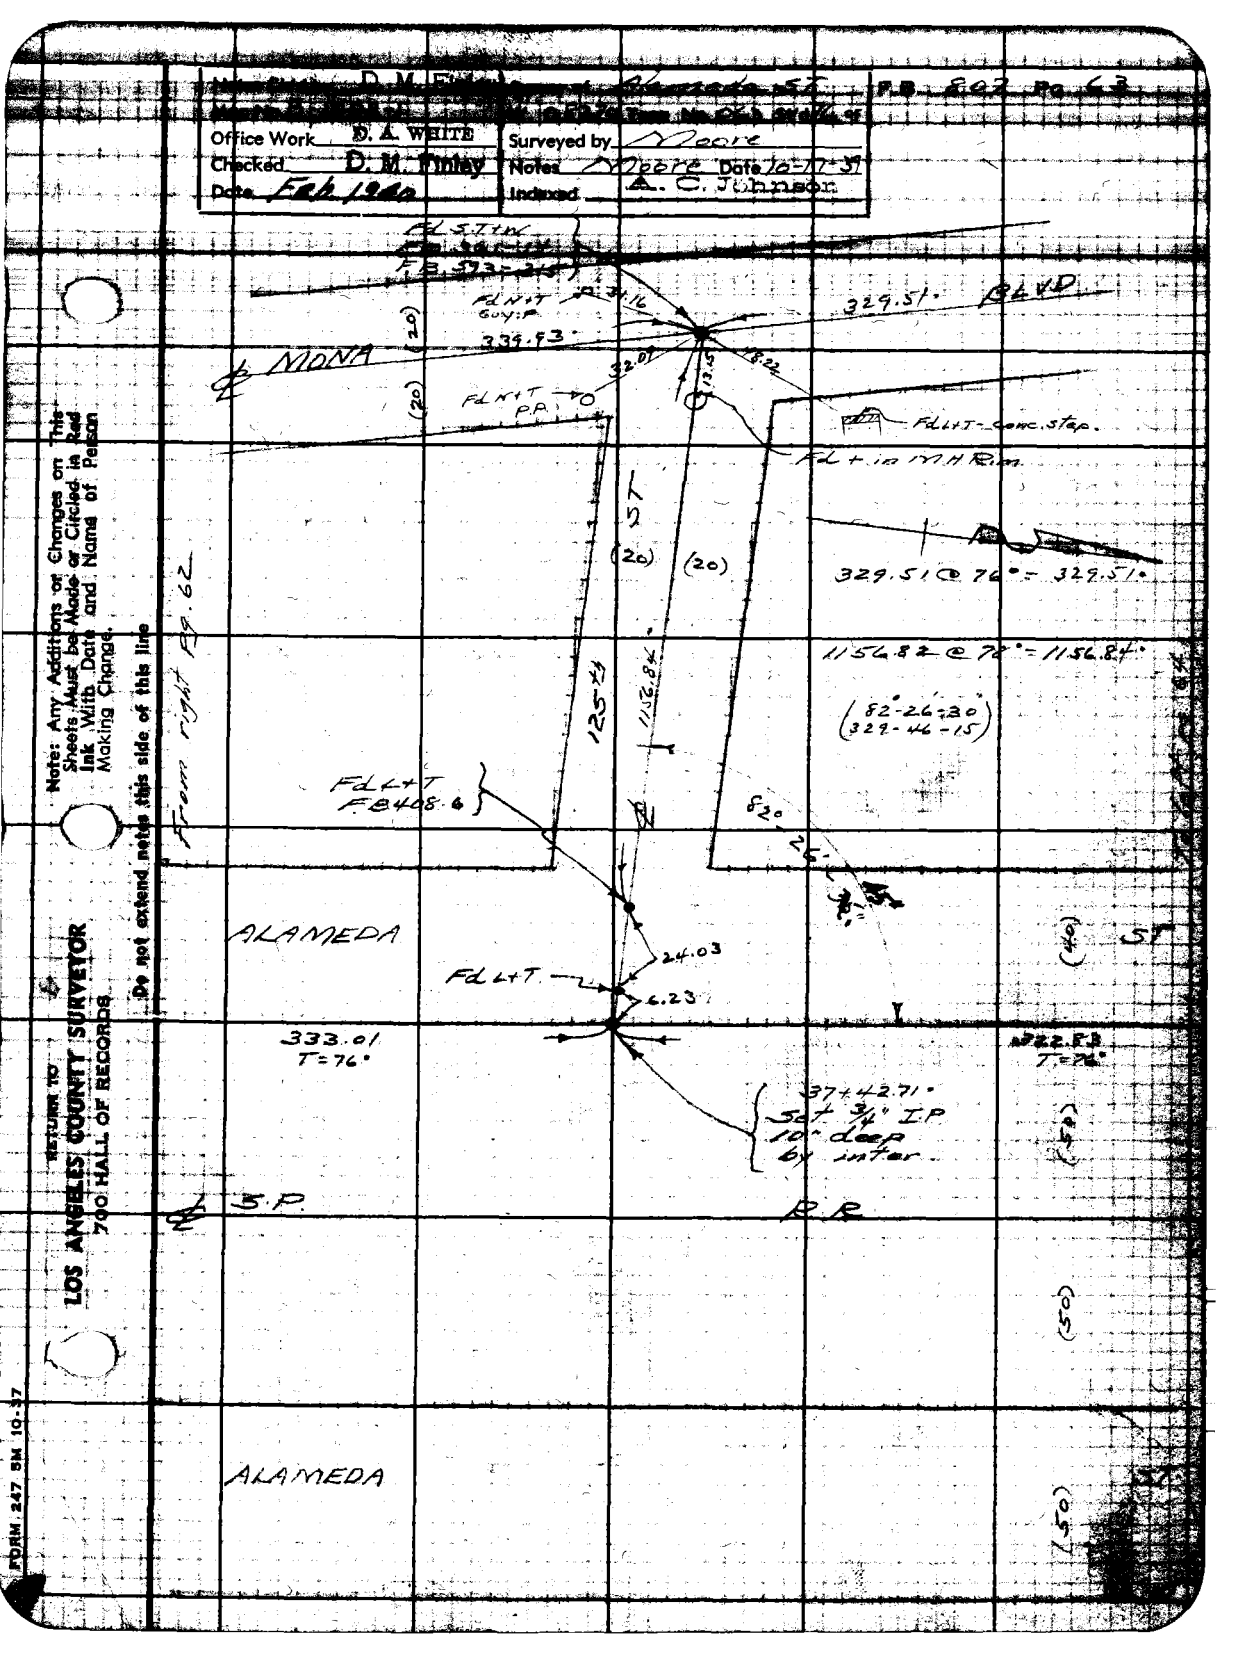

D. M. Finley
Alameda ST
F.B. 802 Pg. 63
Office Work D. A. WHITE
Checked D. M. Finley
Date Feb 1940
Surveyed by Moore
Notes Moore Date 10-17-39
Indexed A. C. Johnson
Fd S.T+W
F.B. 593-215
Fd N+T Guy: P
329.51
BLVD
339.93
MONA
32.07
13.15
18.22
Fd N+T P.P.
Fd L+T - conc. step.
Fd + in M.H. Rim
ST
(20)
(20)
329.51 @ 76° = 329.51
1156.82 @ 78° = 1156.84
(82°-26'-30")
(329-46-15)
From right Pg. 62
125±
1156.84
Fd L+T F.B. 408.6
820
26
ALAMEDA
ST
(40)
24.03
Fd L+T
6.23
333.01
T=76°
322.83
T=76°
37+42.71
Set 3/4" I.P.
10" deep
by inter.
(50)
S.P.
R.R.
(50)
ALAMEDA
(50)
Note: Any Additions or Changes on This Sheets Must be Made or Circled in Red Ink With Date and Name of Person Making Change.
Do not extend notes this side of this line
RETURN TO
LOS ANGELES COUNTY SURVEYOR
700 HALL OF RECORDS
FORM 247 5M 10-37

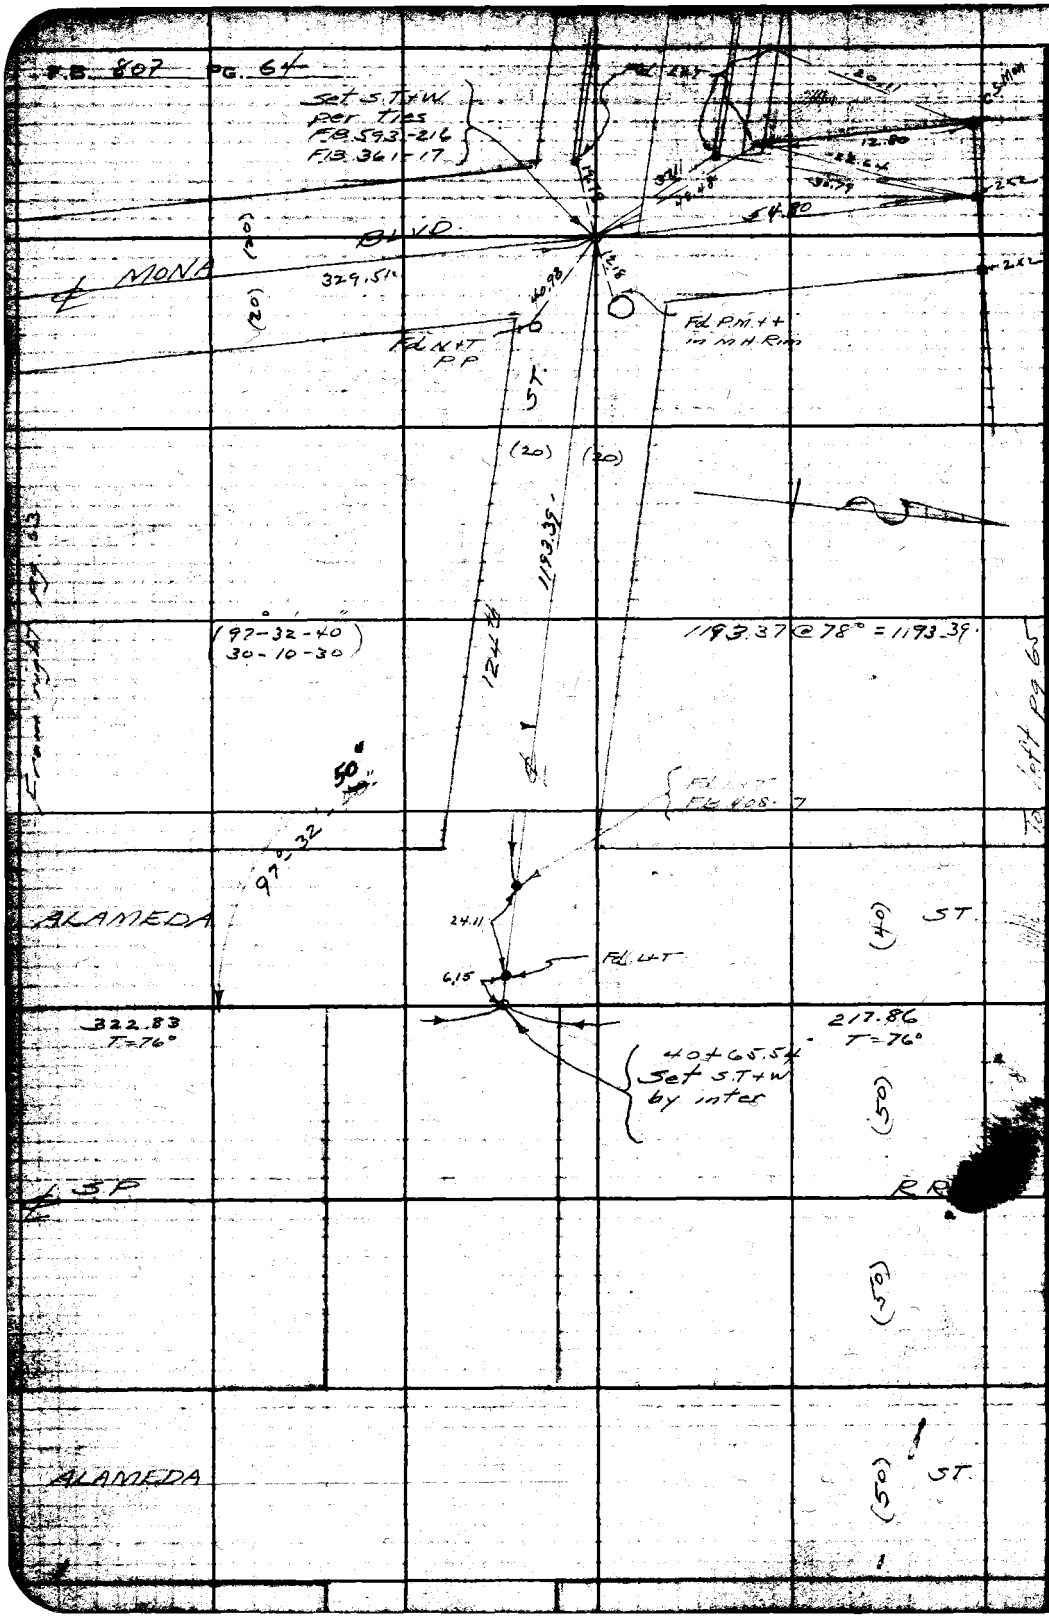

RETURN TO
LOS ANGELES COUNTY SURVEYOR
700 HALL OF RECORDS
Do not extend notes this side of this line
Note: Any Additions or Changes on This Sheets Must be Made or Circled in Red Ink With Date and Name of Person Making Change.

Notes Ck'd by D. M. Finley	Survey of [illegible]
Office Work [illegible]	Surveyed by [illegible]
Checked D. M. Finley	Notes Moore Date 10-18-39
Date Feb 1940	Indexed A. C. Johnson

F.B. [illegible] PG. [illegible]

Note: Any Additions or Changes on This Sheets Must be Made or Circled in Red Ink With Date and Name of Person Making Change.

Do not extend notes this side of this line

RETURN TO LOS ANGELES COUNTY SURVEYOR 700 HALL OF RECORDS

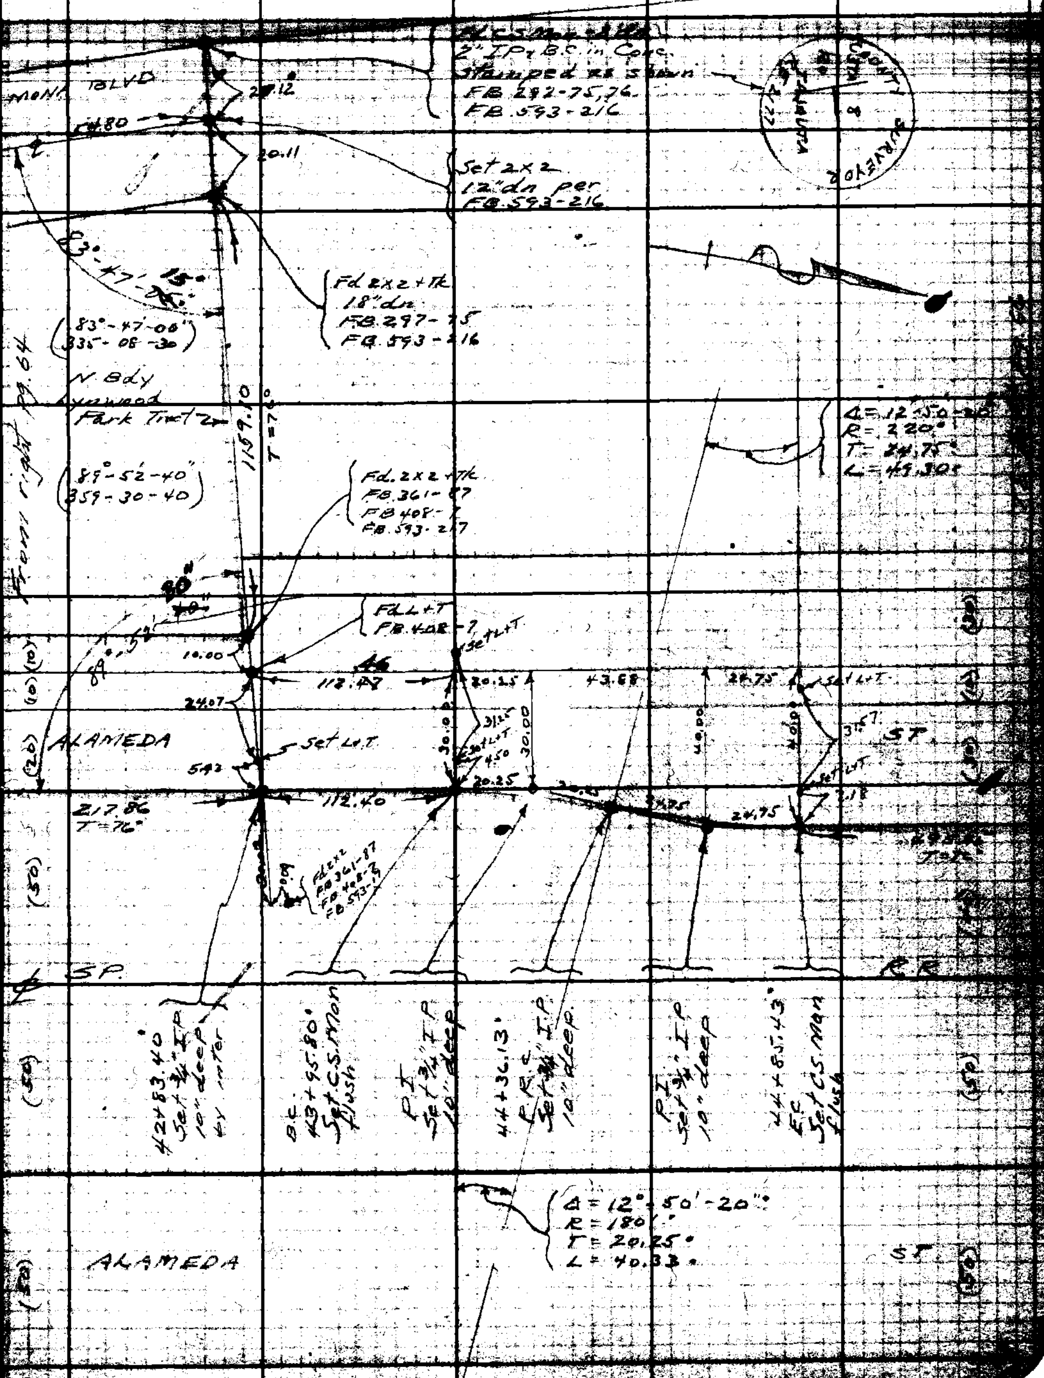

FORM 247 5M 10-37

F.B. 807 PG. 66

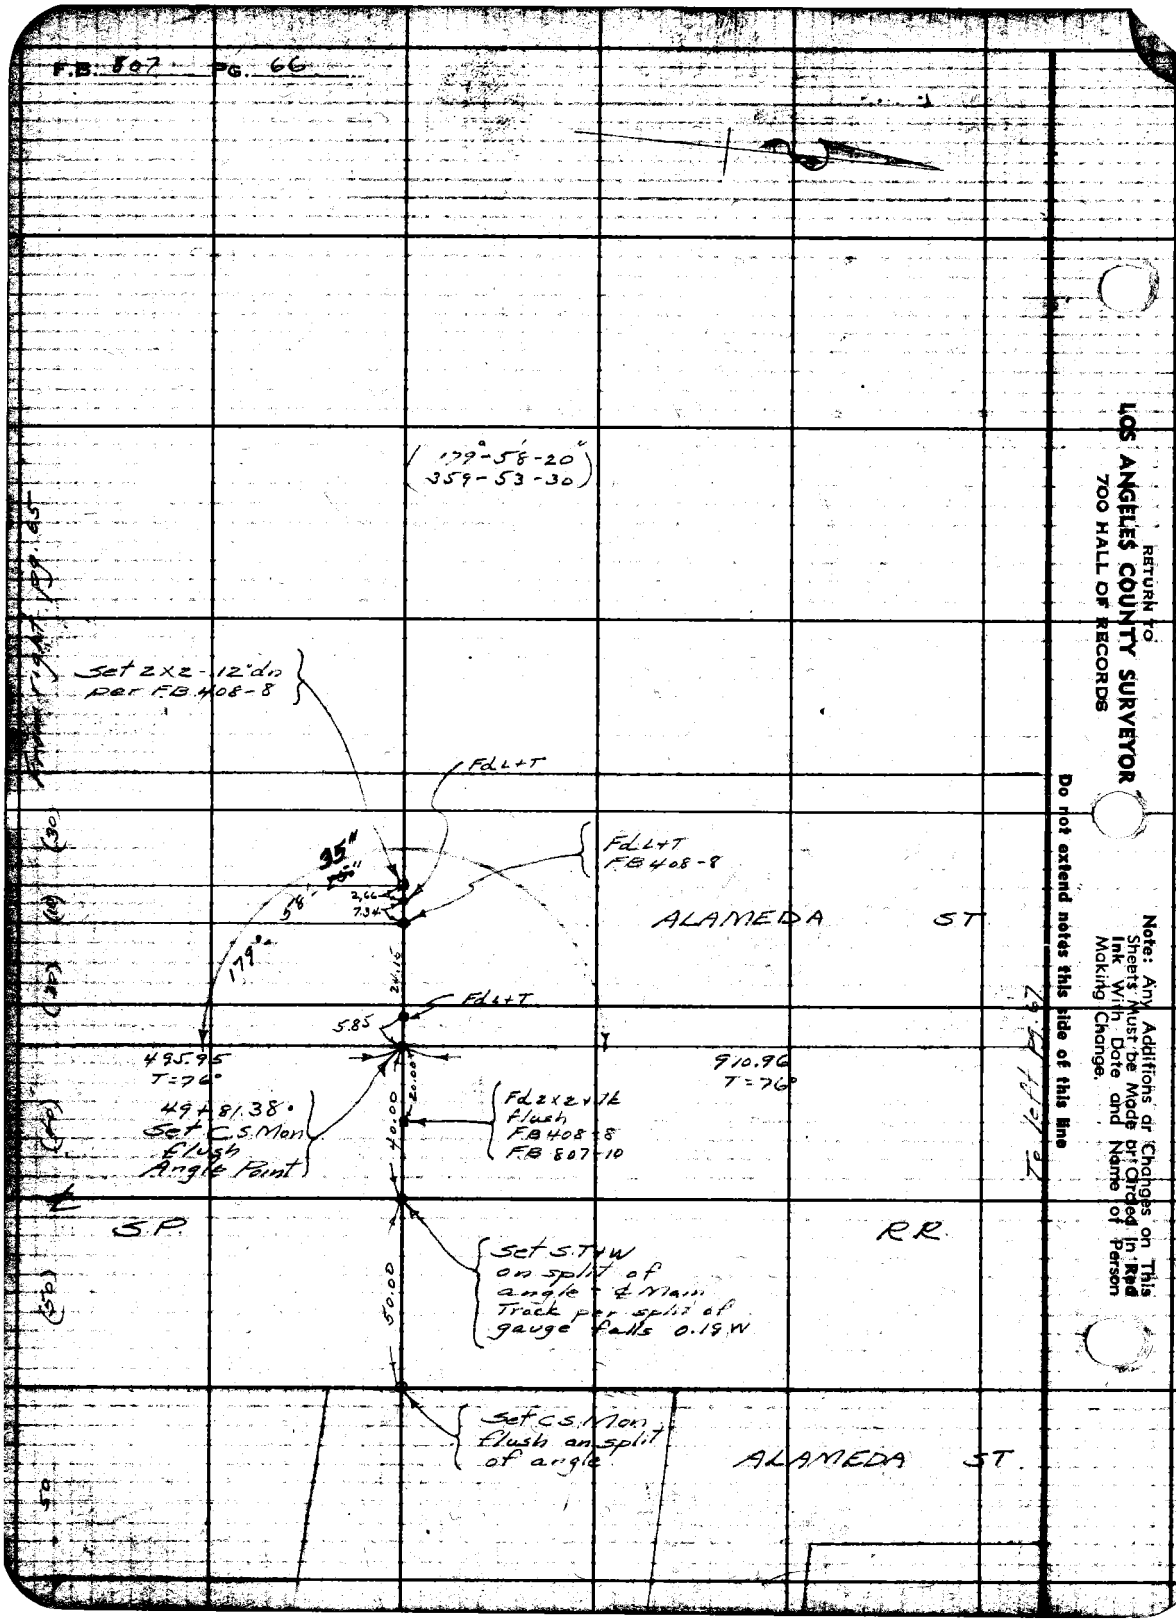

RETURN TO
LOS ANGELES COUNTY SURVEYOR
700 HALL OF RECORDS

Do not extend notes this side of this line

Note: Any Additions or Changes on This Sheets Must be Made or Circled in Red Ink With Date and Name of Person Making Change.

Notes Ck'd by D. M. Finley	Survey of Alameda St	F.B. 807 Pg. [illegible]
[illegible]	[illegible]	
Office Work [illegible]	Surveyed by [illegible]	
Checked D. M. Finley	Notes Moore Date 10-20-39	
Date Feb 1940	Indexed A. C. Johnson	

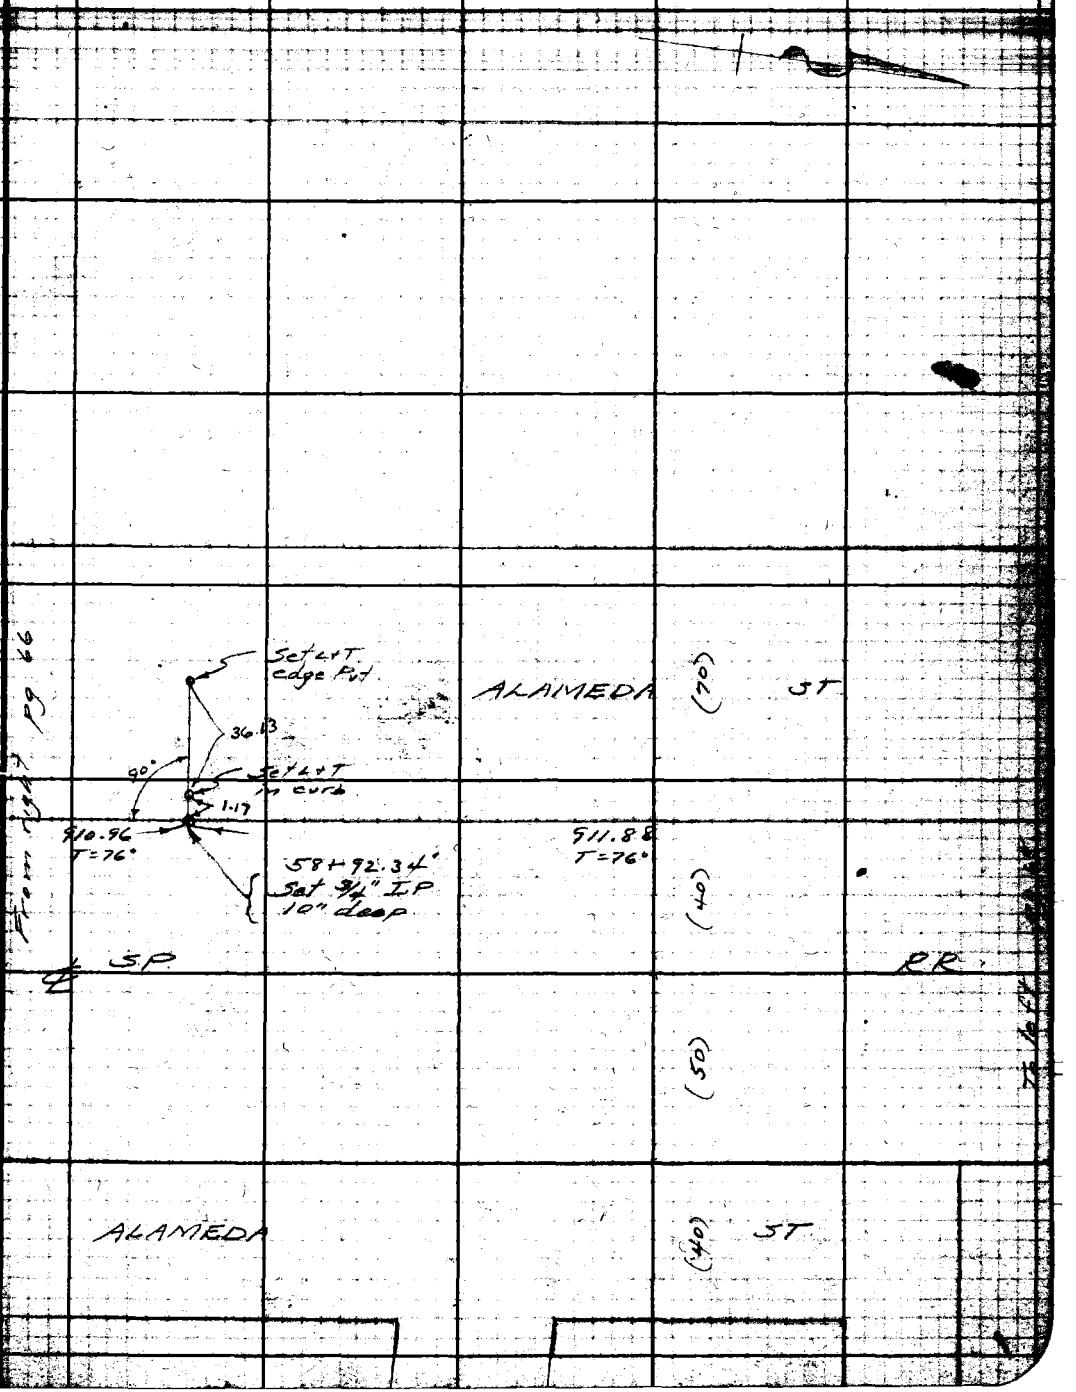

Note: Any Additions or Changes on This Sheets Must be Made or Circled in Red Ink With Date and Name of Person Making Change.

Do not extend notes this side of this line

RETURN TO
LOS ANGELES COUNTY SURVEYOR
700 HALL OF RECORDS

FORM 247 BM 10-37

F.B. 807 PG. 68

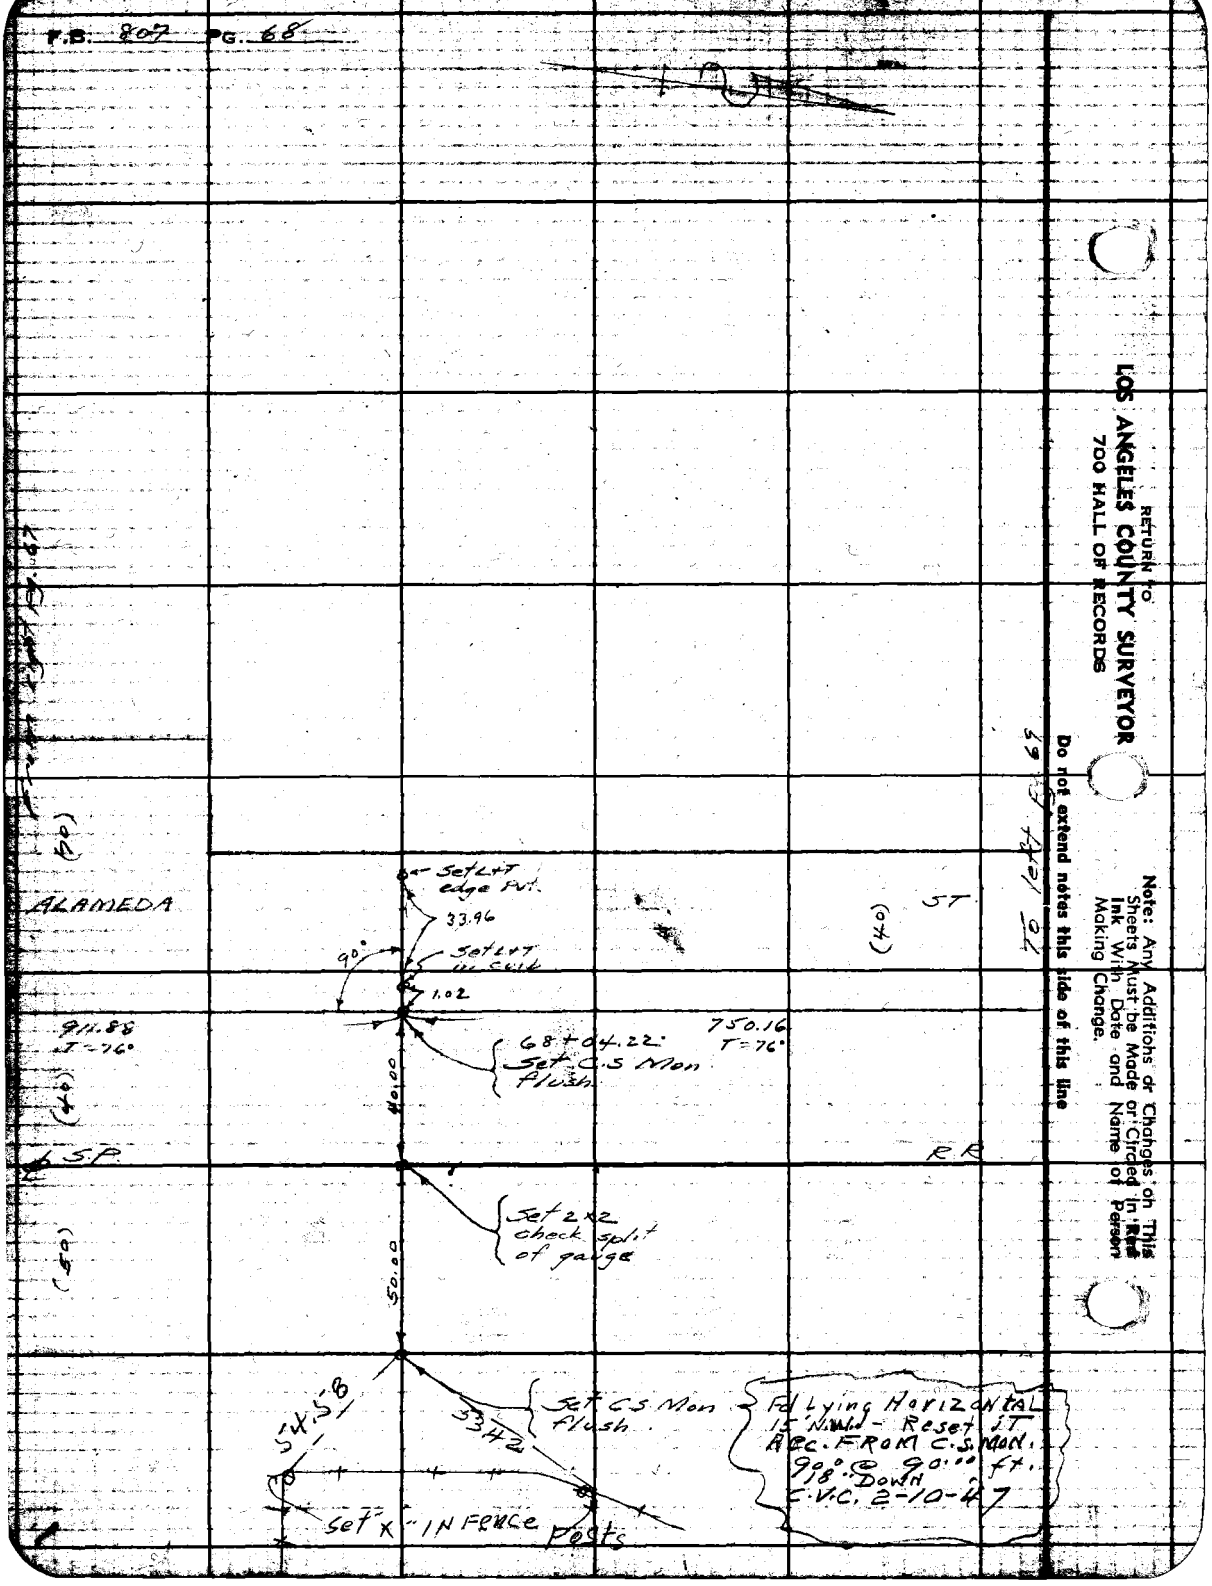

RETURN TO
LOS ANGELES COUNTY SURVEYOR
700 HALL OF RECORDS

Note: Any Additions or Changes on This Sheets Must be Made or Circled in Red Ink With Date and Name of Person Making Change.

Do not extend notes this side of this line

Notes Ck'd by D. M. Finley	Survey of Alameda St	F.B. 807 Pg. 69
[illegible]	[illegible]	
[illegible]	Surveyed by [illegible]	
Checked D. M. Finley	Notes Moore Date 10-23-39	
Date Feb 1940	Indexed A. C. Johnson	

90.04

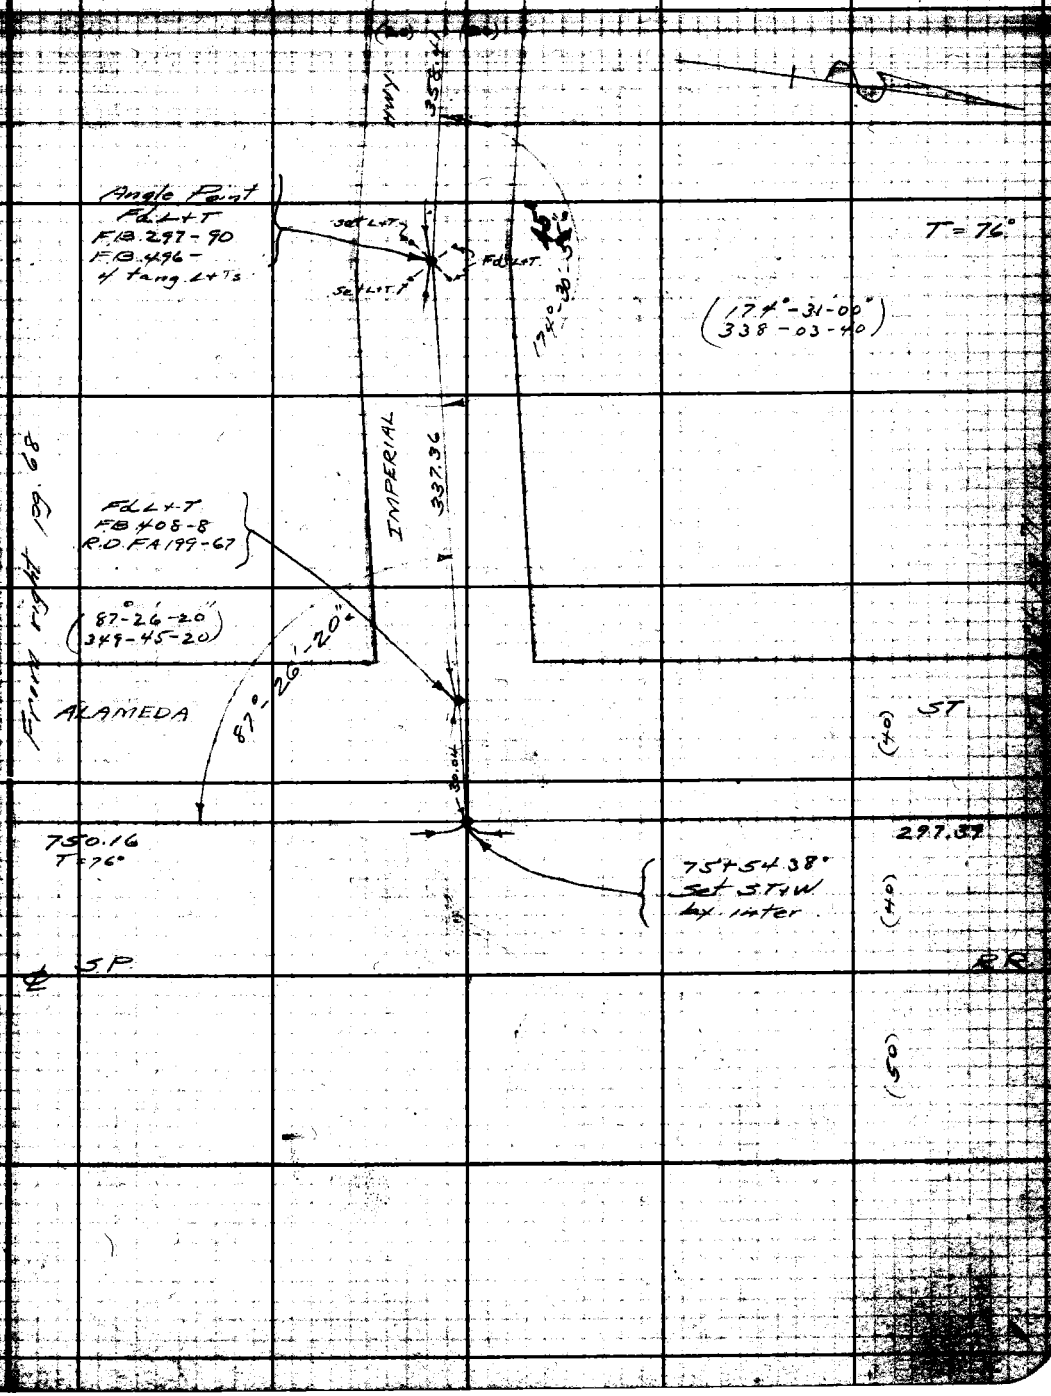

Note: Any Additions or Changes on This Sheets Must be Made or Circled in Red Ink With Date and Name of Person Making Change.

Do not extend notes this side of this line

RETURN TO
LOS ANGELES COUNTY SURVEYOR
700 HALL OF RECORDS

FORM 247 5M 10-37

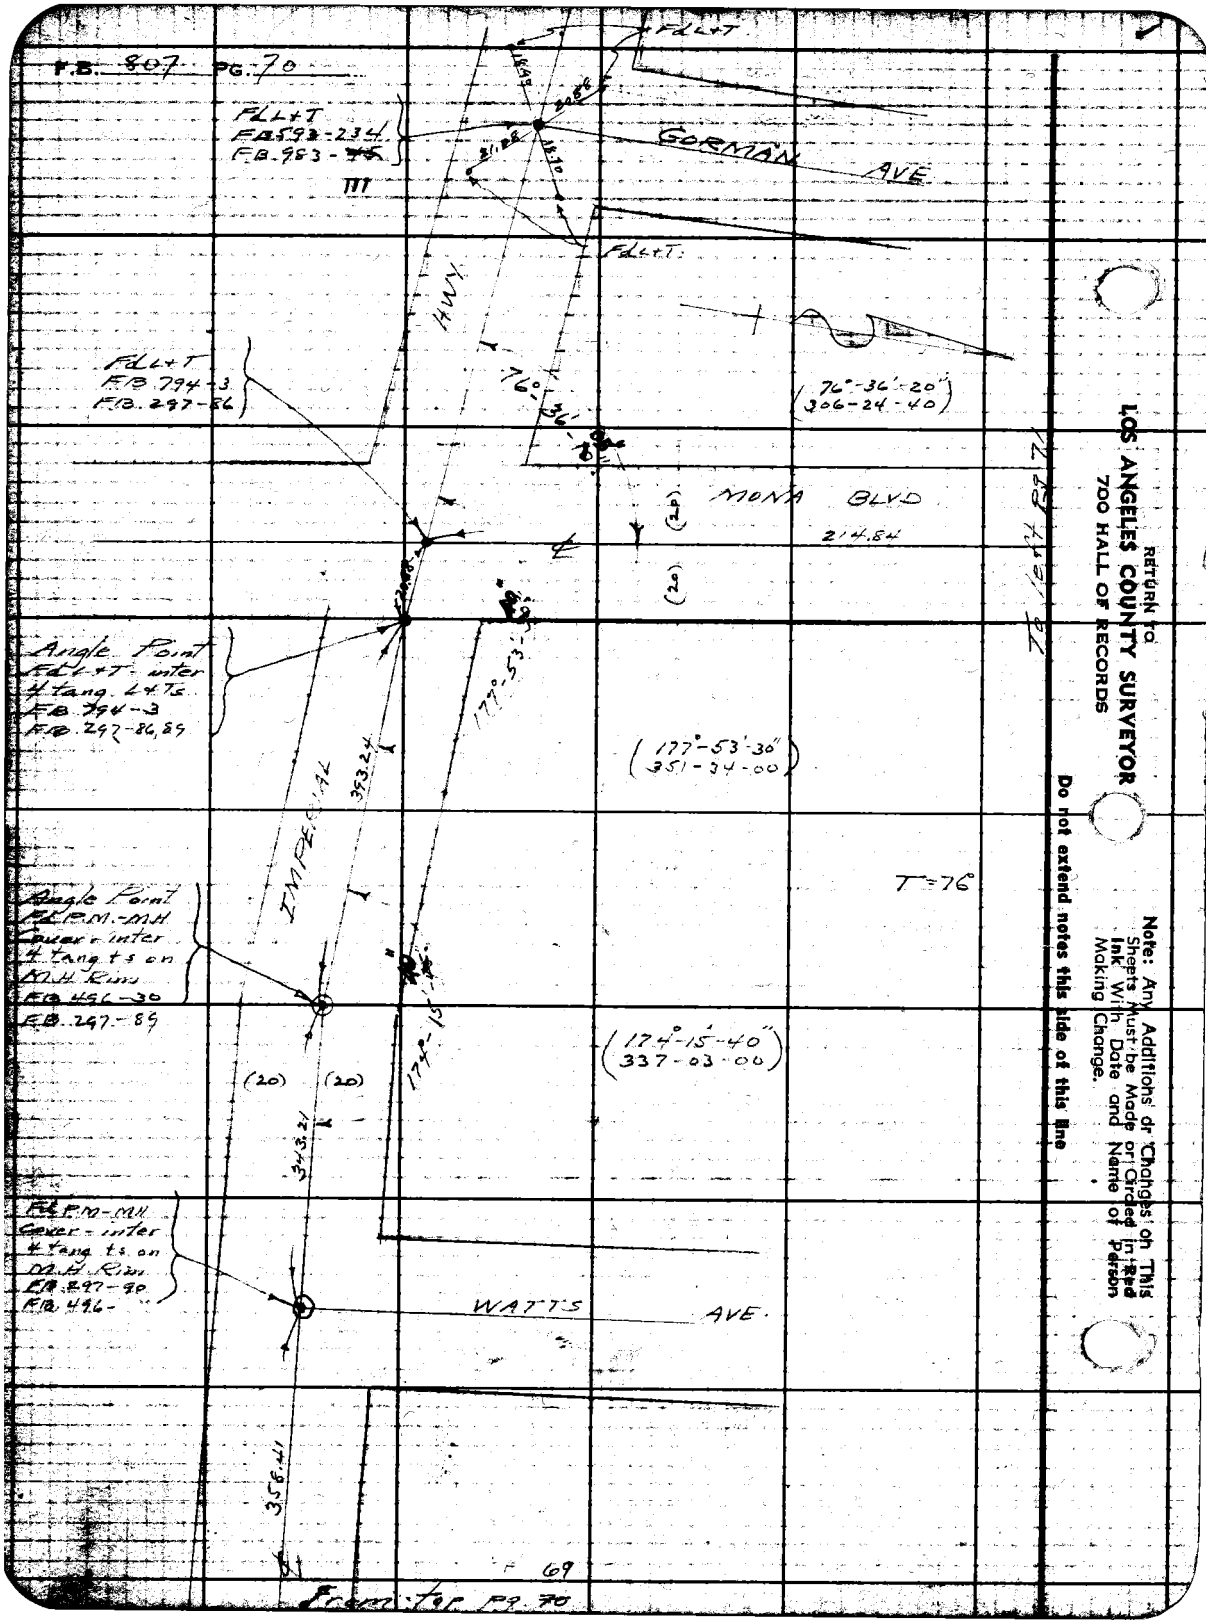

RETURN TO
LOS ANGELES COUNTY SURVEYOR
700 HALL OF RECORDS

Note: Any Additions or Changes on This Sheets Must be Made or Circled in Red Ink With Date and Name of Person Making Change.

Do not extend notes this side of this line

Notes Ck'd by D. M. Finley
Checked D. M. Finley
Date Feb. 1940

Survey of [illegible]
Surveyed by [illegible]
Notes [illegible] Date 10-23-39
Indexed A. C. Johnson

F.B. 807 Pg. [illegible]

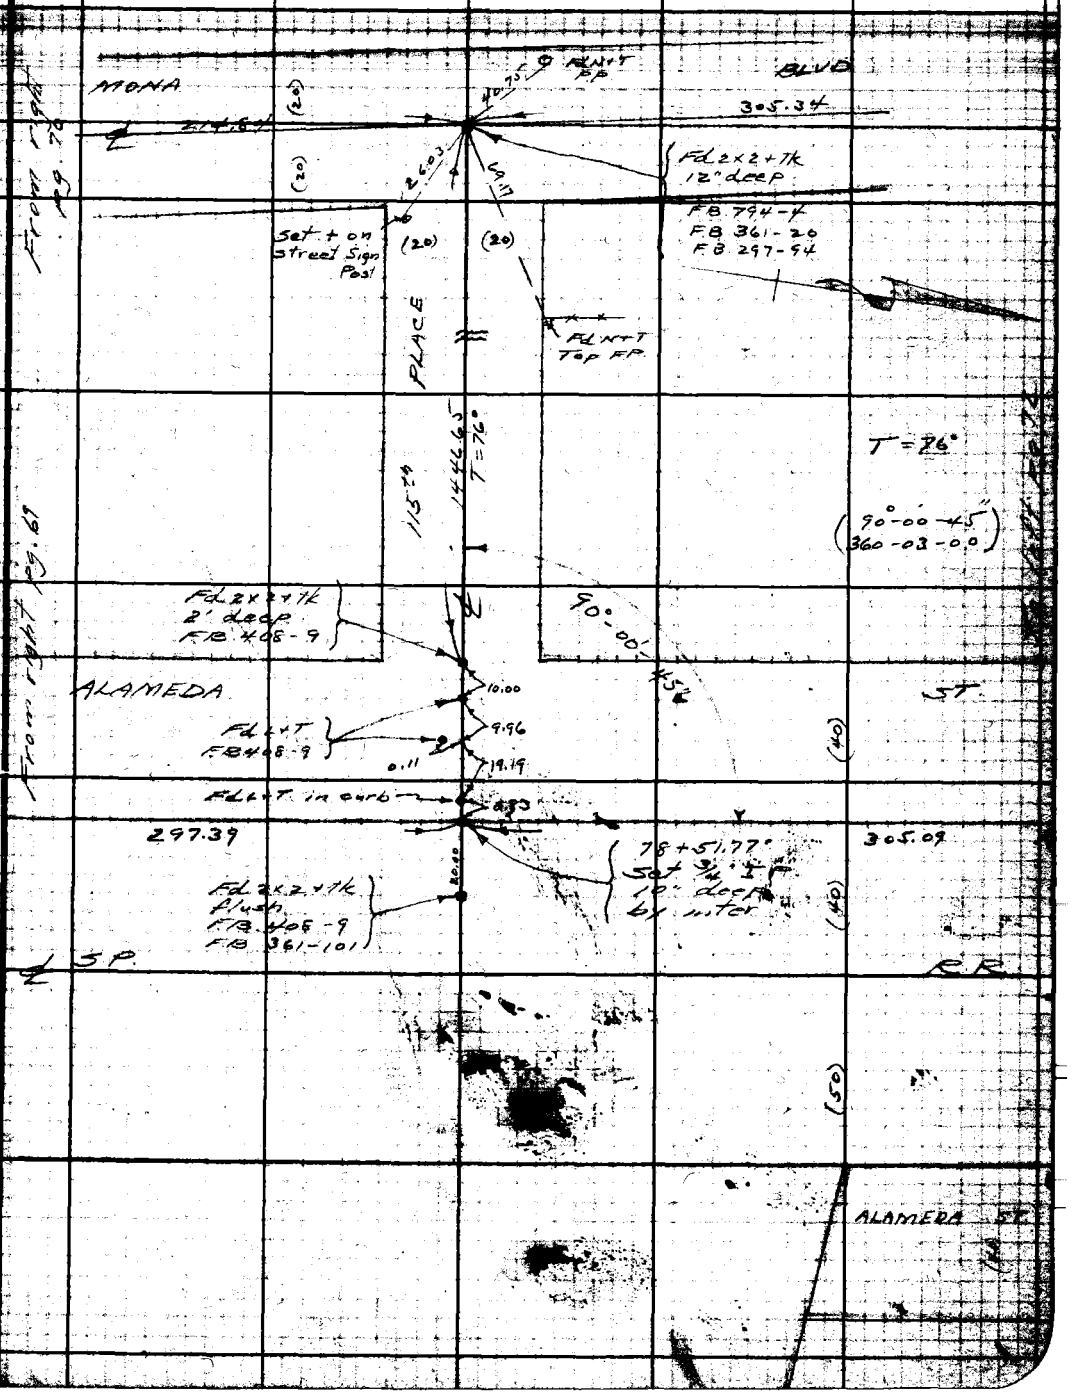

Note: Any Additions or Changes on This Sheets Must be Made or Circled in Red Ink With Date and Name of Person Making Change.

Do not extend notes this side of this line

RETURN TO
LOS ANGELES COUNTY SURVEYOR
700 HALL OF RECORDS

FORM 247 SM 10-37

F.B. 807 PG. 72

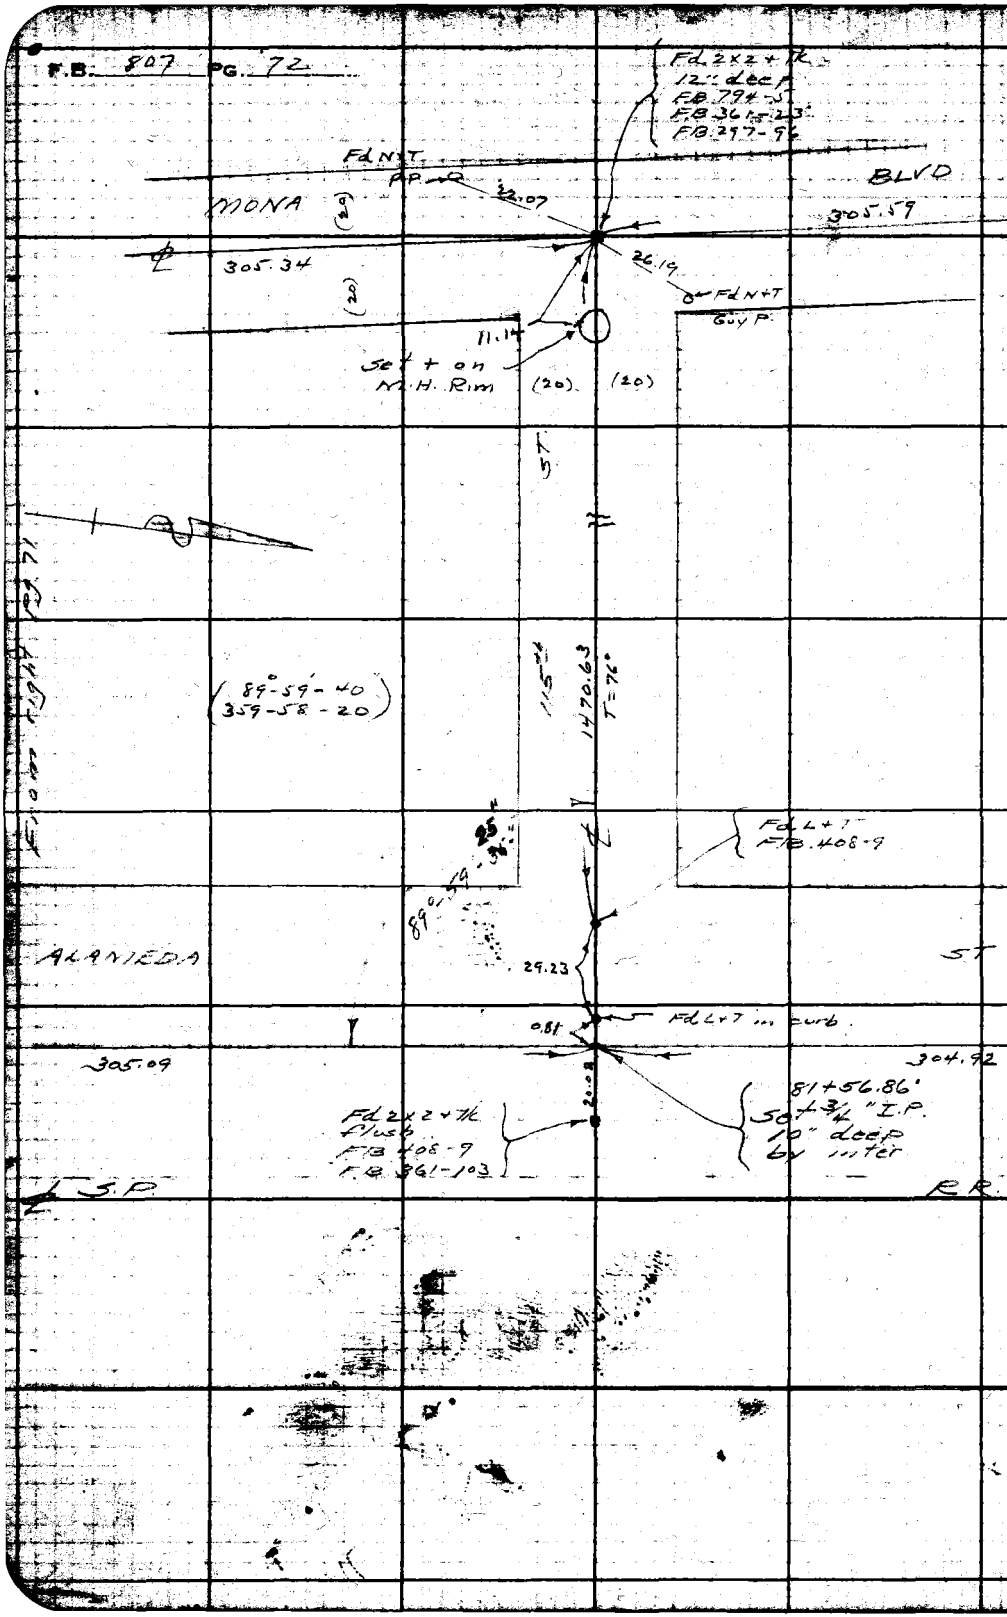

RETURN TO
LOS ANGELES COUNTY SURVEYOR
700 HALL OF RECORDS

Note: Any Additions or Changes on This Sheets Must be Made or Circled in Red Ink With Date and Name of Person Making Change.

Do not extend notes this side of this line

Notes Ck'd by D. M. Finley	Survey of Alameda St	F.B. 807 PG. 73
Map No. [illegible]	W. O. [illegible] Tab No. [illegible]	
Office Work D. A. Wilms	Surveyed by [illegible]	
Checked D. M. Finley	Notes [illegible] Date 10-24-39	
Date Feb 1940	Indexed A. C. Johnson	

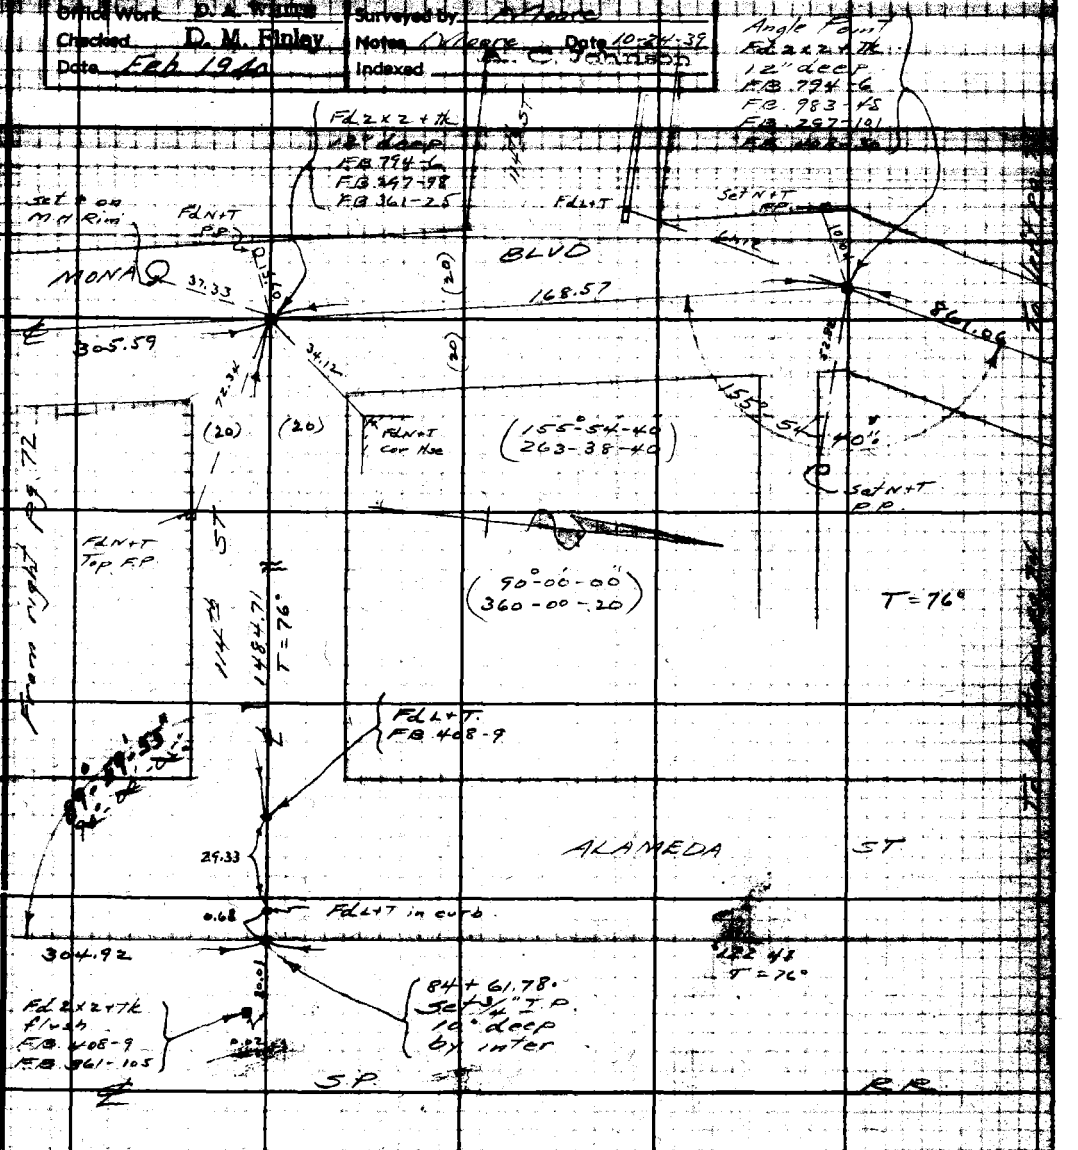

Note: Any Additions or Changes on This Sheets Must be Made or Circled in Red Ink With Date and Name of Person Making Change.

Do not extend notes this side of this line

RETURN TO
LOS ANGELES COUNTY SURVEYOR
700 HALL OF RECORDS

FORM 247 5M 10-37

RETURN TO
LOS ANGELES COUNTY SURVEYOR
700 HALL OF RECORDS

Do not extend notes this side of this line

Note: Any Additions or Changes on This Sheets Must be Made or Checked in Ink With Date and Name of Person Making Change.

Notes Ck'd by D. M. Finley | Survey of [illegible] | F.B. 807 | Pg. 75

Office Work [illegible] | Surveyed by [illegible]

Checked D. M. Finley | Notes Moore | Date 12-27-39

Date Feb 1940 | Indexed A. C. Johnson

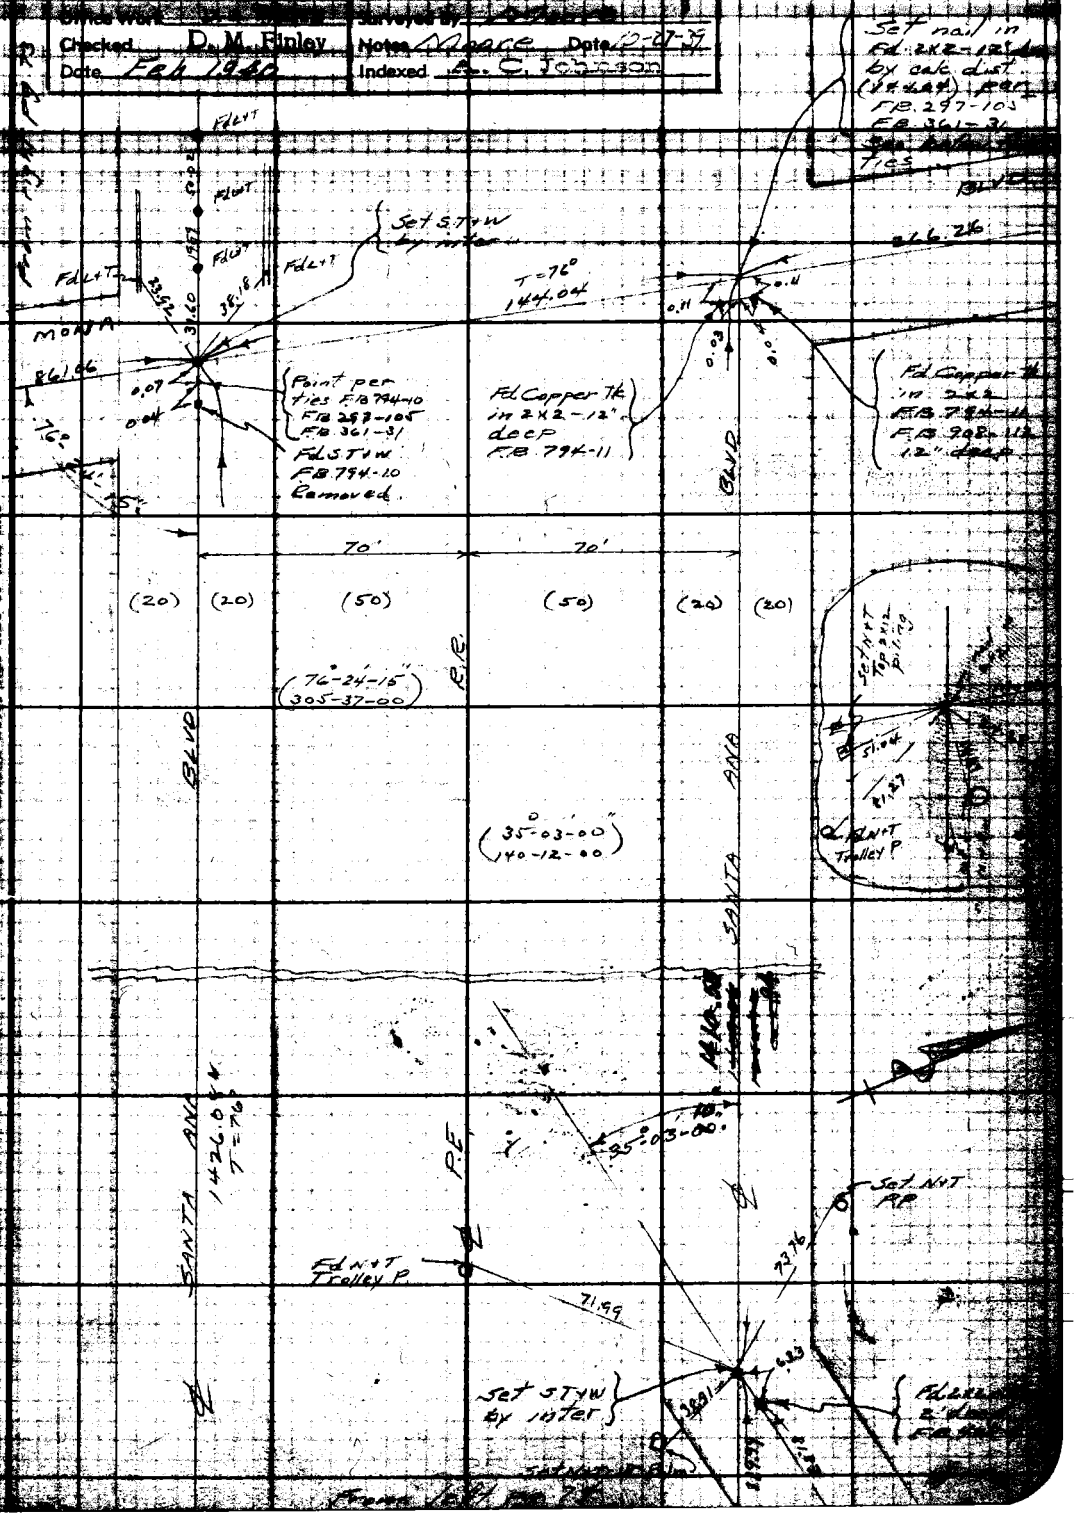

Note: Any Additions or Changes on This Sheets Must be Made or Circled in Red Ink With Date and Name of Person Making Change.

Do not extend notes this side of this line

RETURN TO
LOS ANGELES COUNTY SURVEYOR
700 HALL OF RECORDS

FORM 247 5M 10-37

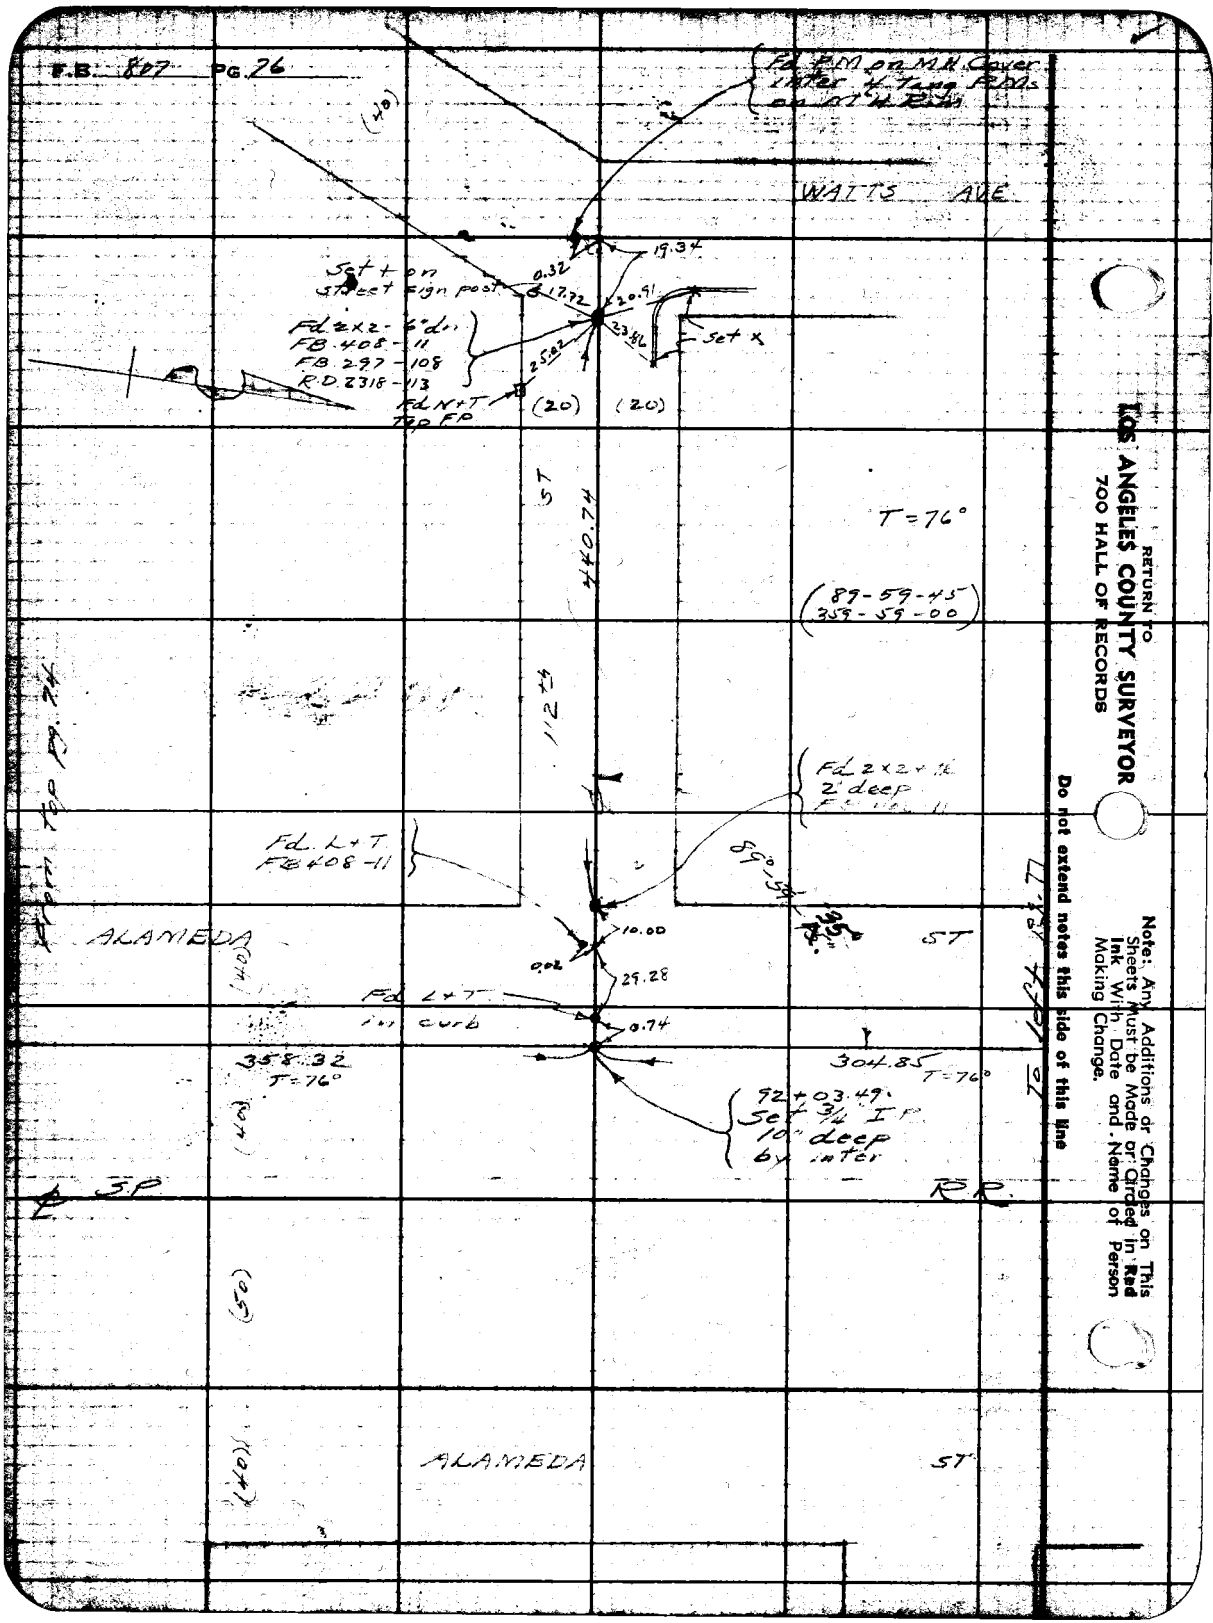

RETURN TO
LOS ANGELES COUNTY SURVEYOR
700 HALL OF RECORDS

Note: Any Additions or Changes on This Sheets Must be Made or Circled in Red Ink With Date and Name of Person Making Change.

Do not extend notes this side of this line

Notes Ck'd by D. M. Finley	Survey of Alameda St	F.B. 807	Pg. 77
[illegible]	W. [illegible] Type No. [illegible]		
Office Work [illegible]	Surveyed by [illegible]		
Checked D. M. Finley	Notes Moore Date 10-[illegible]-39		
Date Feb 1940	Indexed A. C. Johnson		

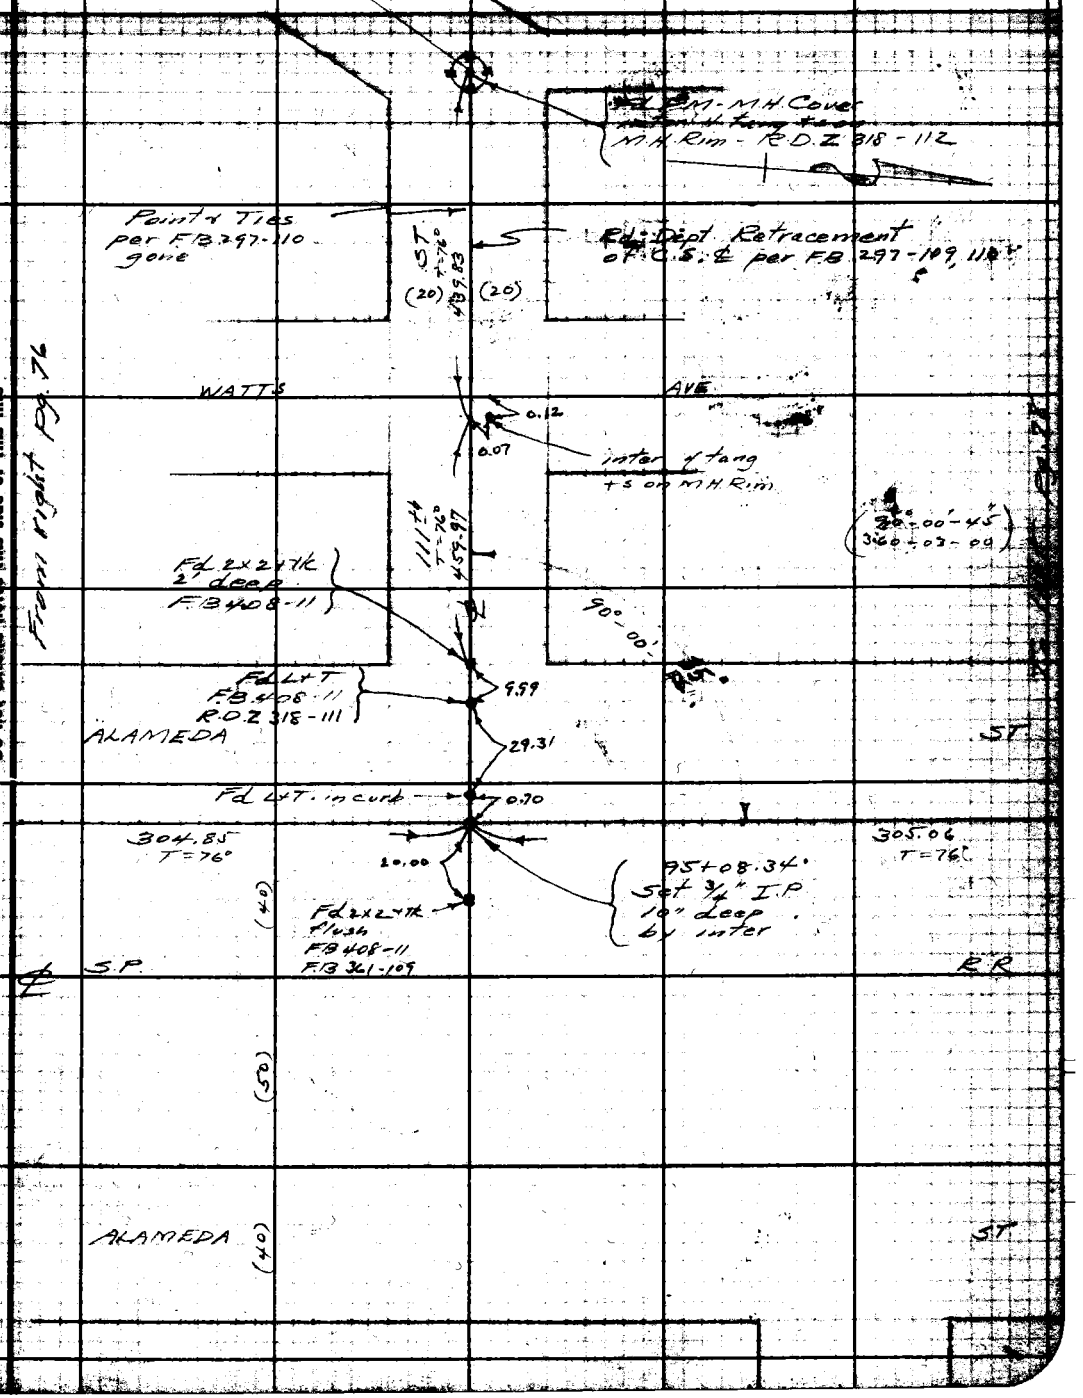

Note: Any Additions or Changes on This Sheets Must be Made or Circled in Red Ink With Date and Name of Person Making Change.

Do not extend notes this side of this line

RETURN TO
LOS ANGELES COUNTY SURVEYOR
700 HALL OF RECORDS

FORM 247 5M 10-37

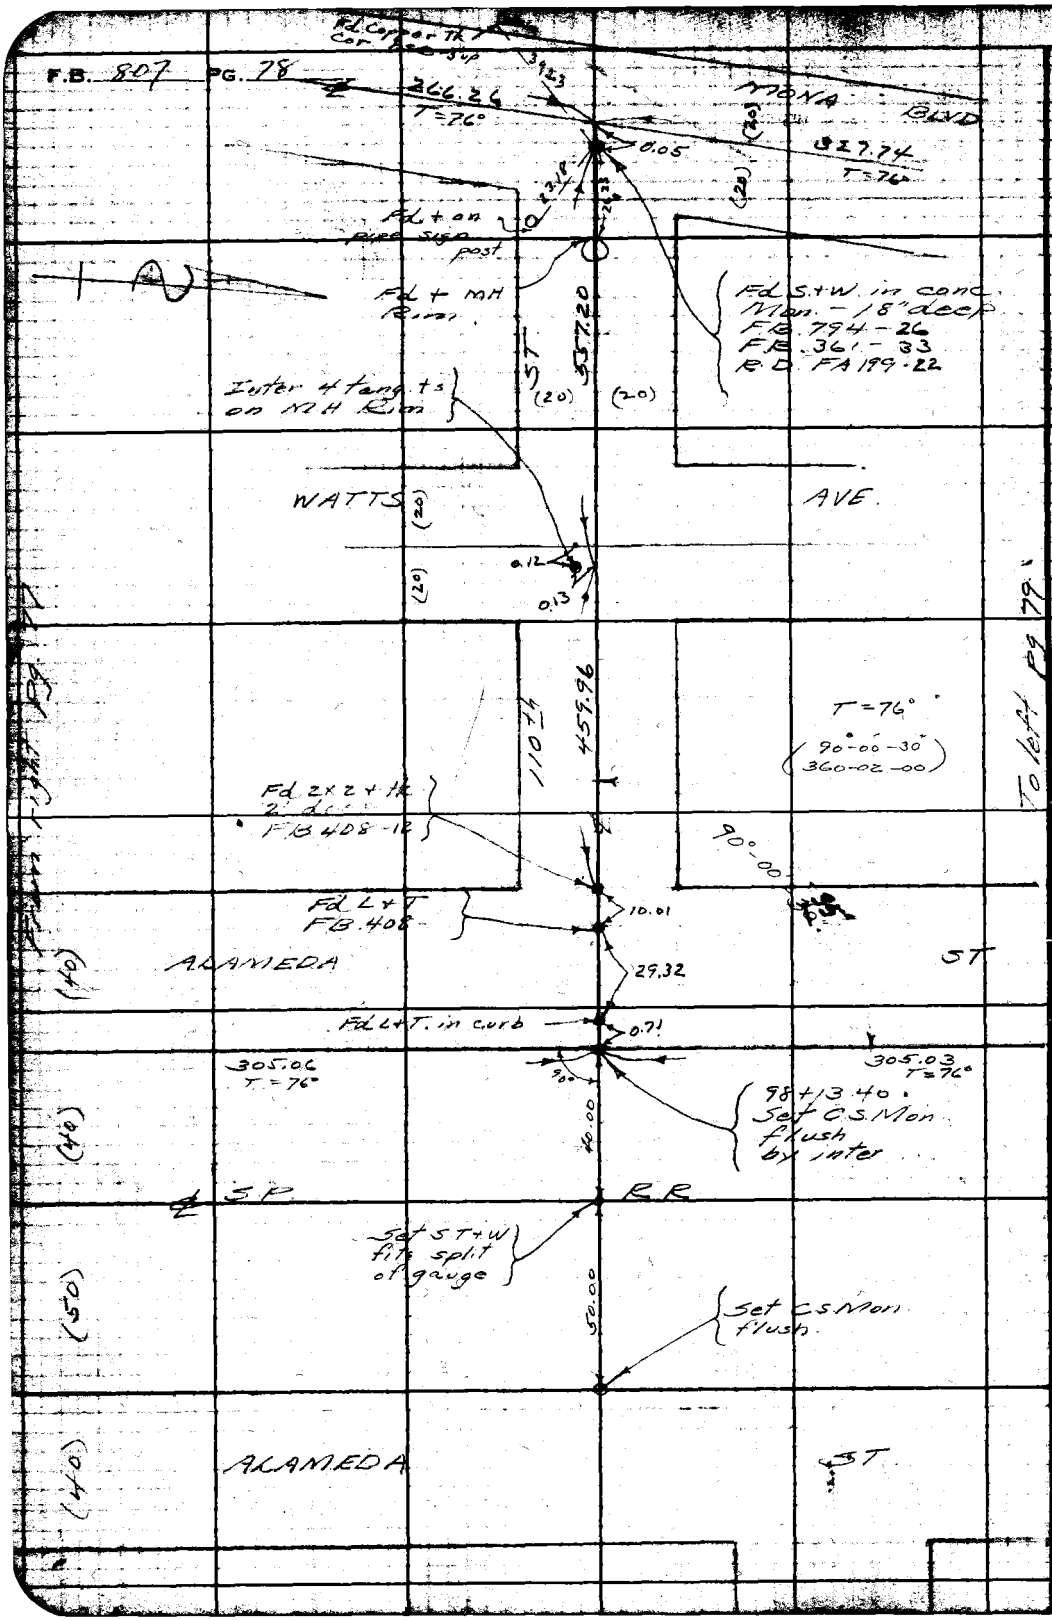

RETURN TO
LOS ANGELES COUNTY SURVEYOR
700 HALL OF RECORDS

Note: Any Additions or Changes on This Sheets Must be Made or Circled in Red Ink With Date and Name of Person Making Change.

Do not extend notes this side of this line

Notes Ck'd by D. M. Finley	Survey of Alameda St.	F.B. 807	Pg. 79
[illegible]	[illegible]		
Office Work [illegible]	Surveyed by Moore		
Checked D. M. Finley	Notes Moore	Date 10-31-39	
Date Feb. 1940.	Indexed A. C. Johnson		

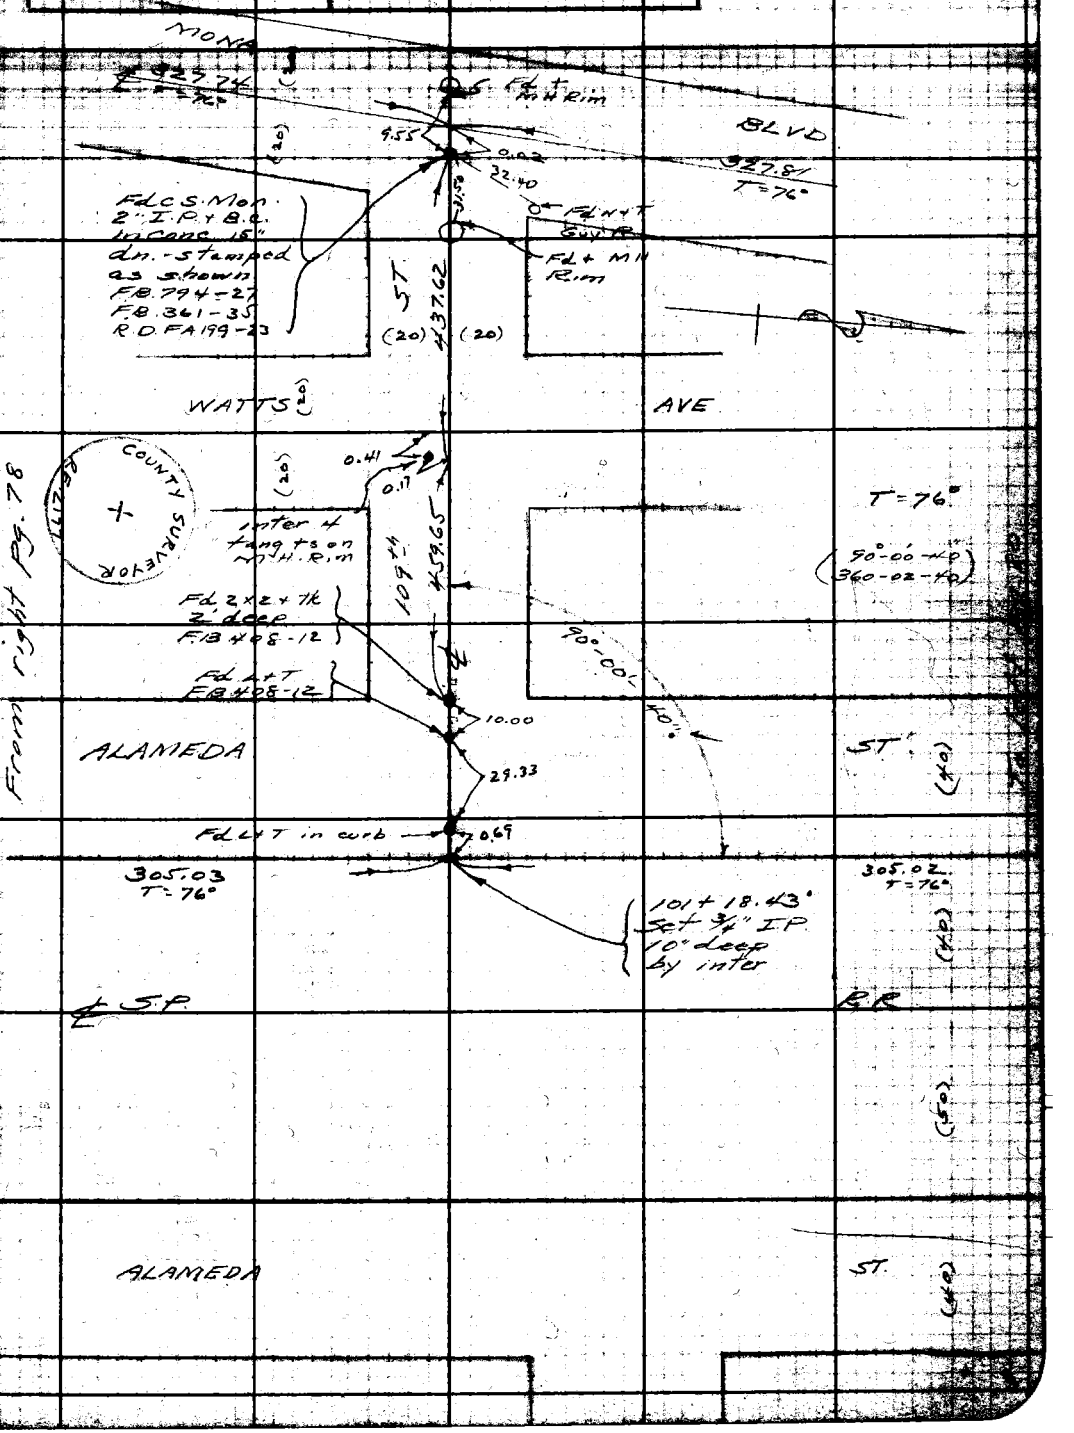

Note: Any Additions or Changes on This Sheets Must be Made or Circled in Red Ink With Date and Name of Person Making Change.

Do not extend notes this side of this line

RETURN TO
LOS ANGELES COUNTY SURVEYOR
700 HALL OF RECORDS

FORM 247 5M 10-37

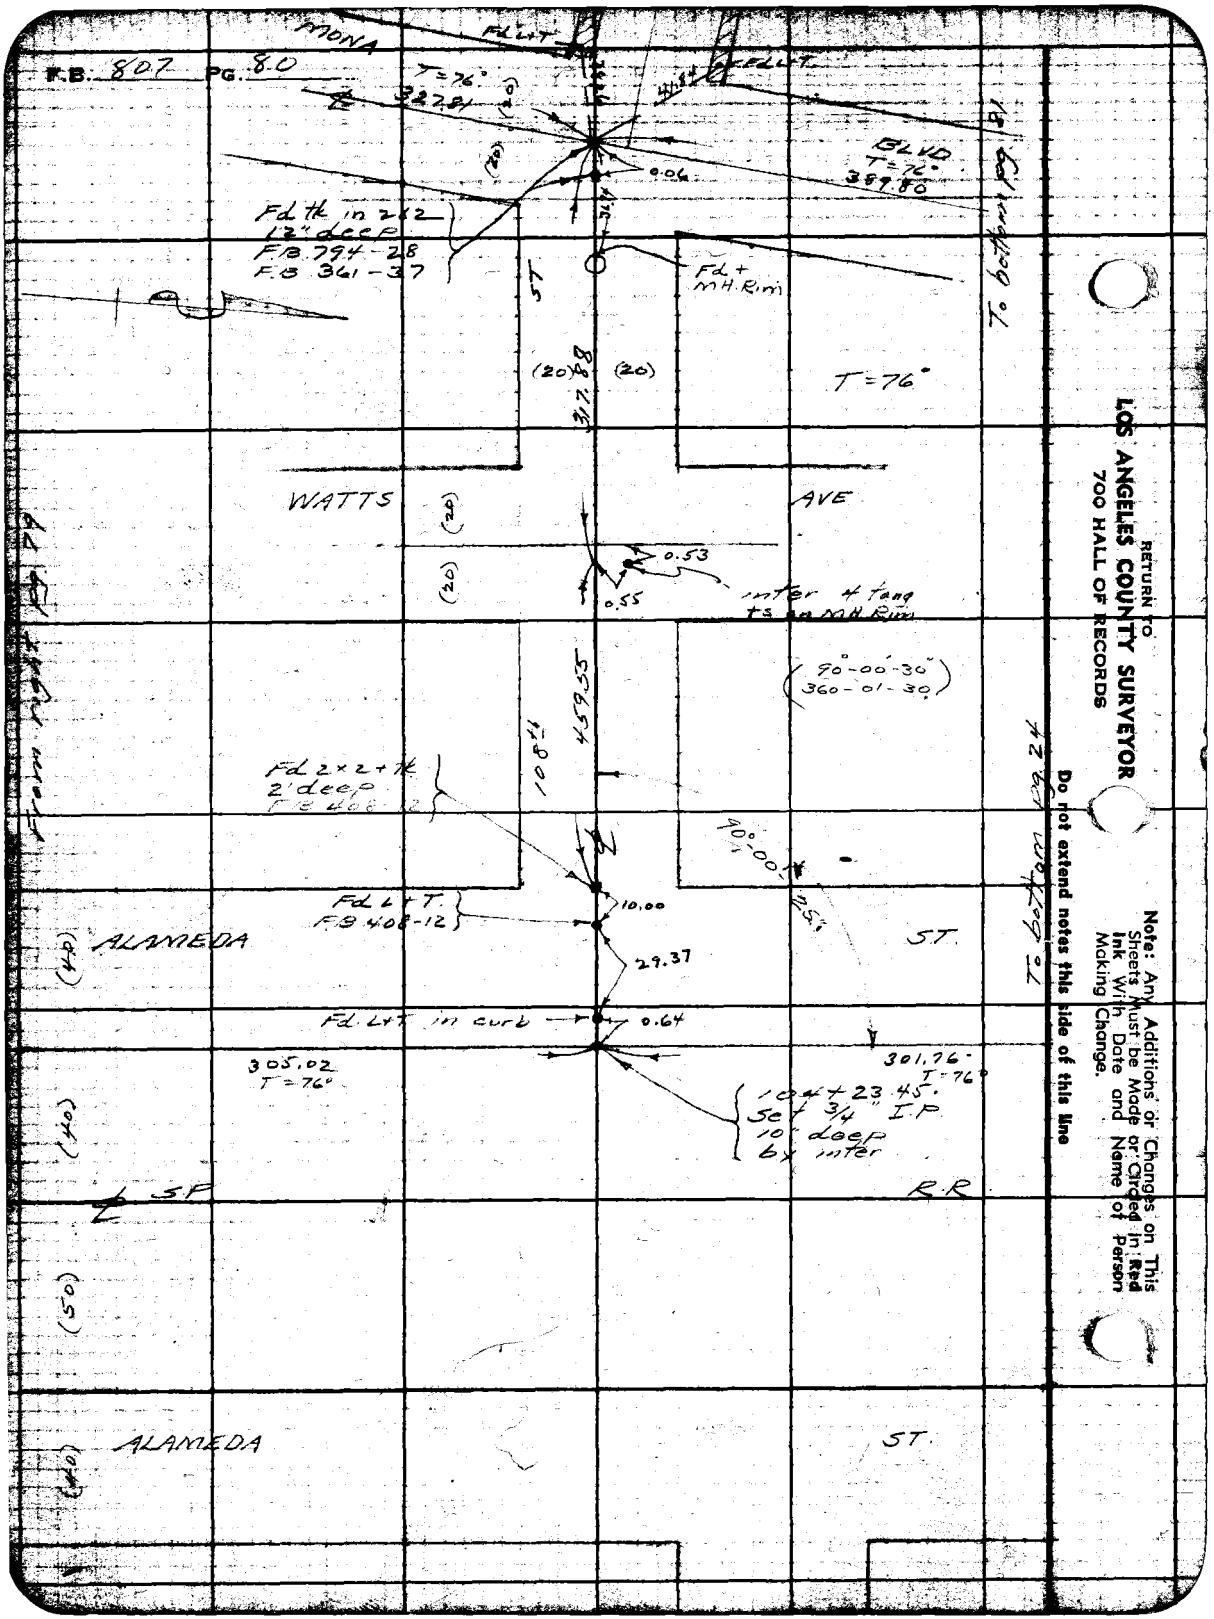

RETURN TO
LOS ANGELES COUNTY SURVEYOR
700 HALL OF RECORDS

Note: Any Additions or Changes on This Sheets Must be Made or Circled in Red Ink With Date and Name of Person Making Change.

Do not extend notes this side of this line

Notes Ck'd by D. M. Finley	Survey of Alameda St	F.B. 807 Pg. 81
Map No. [illegible]	W. O. [illegible]	
Office Work D. A. [illegible]	Surveyed by [illegible]	
Checked D. M. Finley	Notes Moore Date 10-31-39	
Date Feb. 1940	Indexed A. S. Johnson	

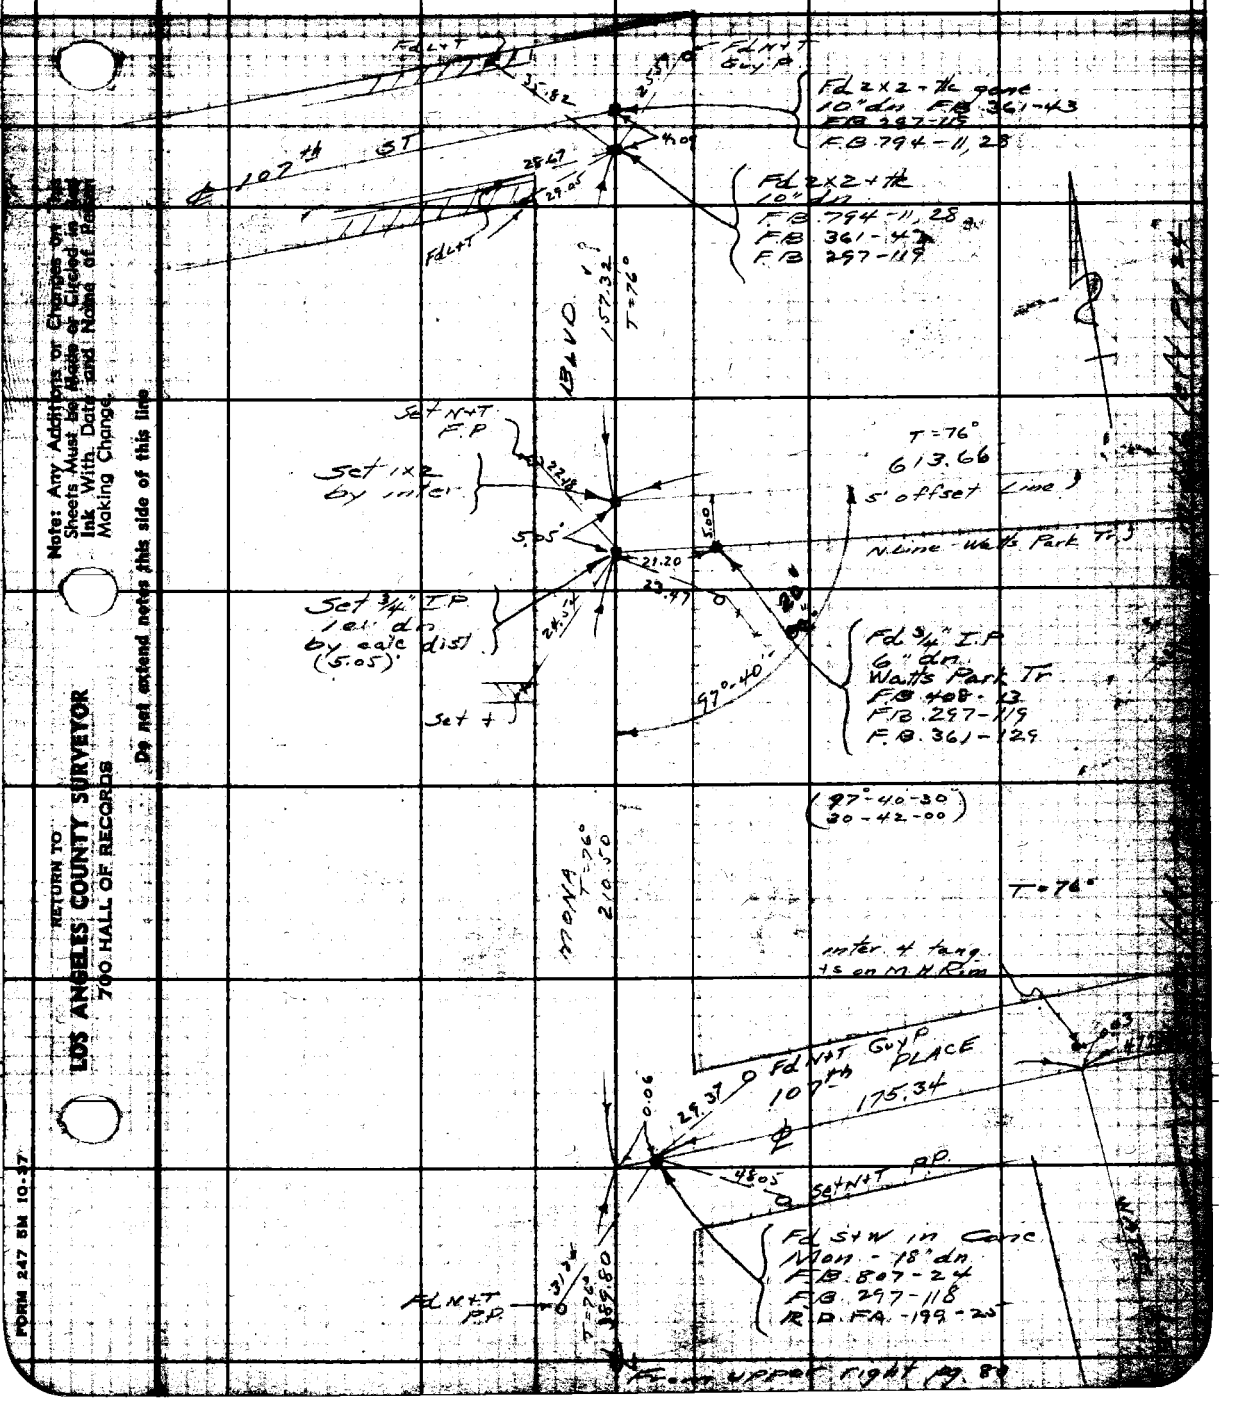

Note: Any Additions or Changes on this Sheets Must be Made or Circled in Ink With Date and Name of Person Making Change.

Do not extend notes this side of this line

RETURN TO
LOS ANGELES COUNTY SURVEYOR
700 HALL OF RECORDS

FORM 247 5M 10-37

RETURN TO
LOS ANGELES COUNTY SURVEYOR
700 HALL OF RECORDS

Note: Any Additions or Changes on This Sheets Must be Made or Circled in Red Ink With Date and Name of Person Making Change.

Do not extend notes this side of this line

F.B. 807 PG. 82

Notes Ck'd by D. M. Finley	Survey of Alameda St	F.B. 807 Pg. 83
Map No. [illegible]	W. O. [illegible] Time No. [illegible]	
Office Work N. H. REYNOLDS	Surveyed by Moore	
Checked D. M. Finley	Notes Moore Date 11-3-39	
Date Feb 1940	Indexed A. C. Johnson 11-16-39	

SURVEY
OF
ALAMEDA ST
FROM
NADEAU ST
NORTH TO
FLORENCE AVE

Note: Any Additions or Changes on This Sheets Must be Made or Circled in Red Ink With Date and Name of Person Making Change.

Do not extend notes this side of this line

RETURN TO
LOS ANGELES COUNTY SURVEYOR
700 HALL OF RECORDS

FORM [illegible] 10-37

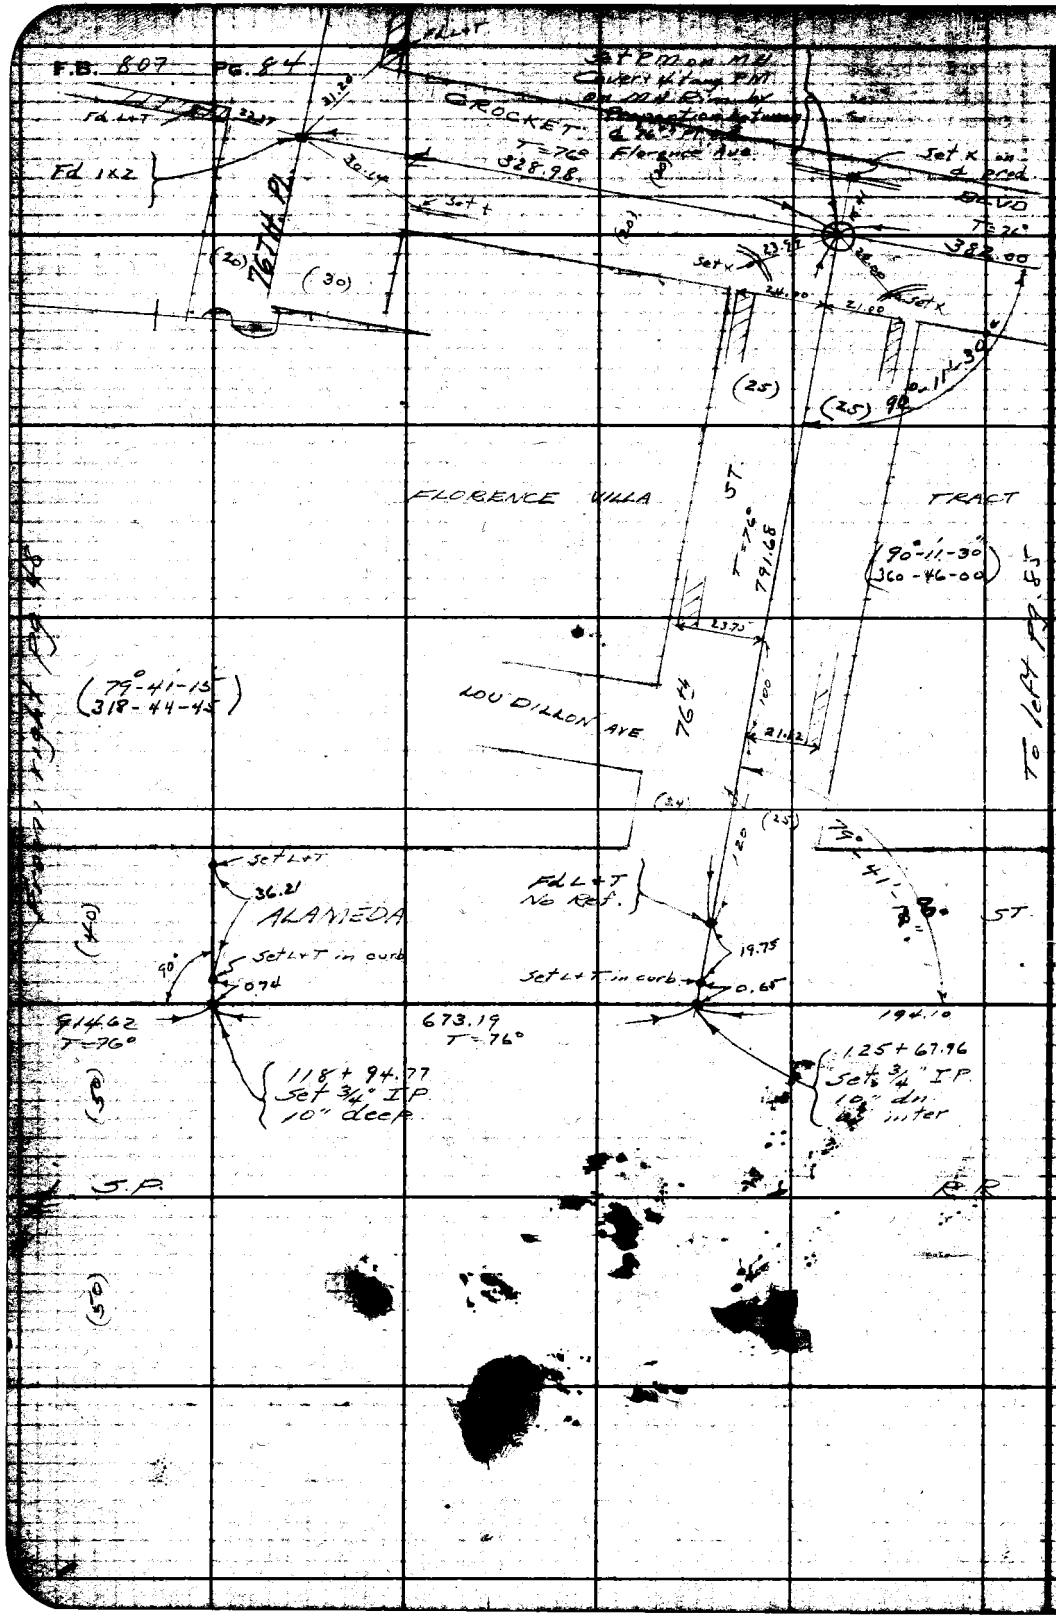

RETURN TO:
LOS ANGELES COUNTY SURVEYOR
700 HALL OF RECORDS

Do not extend notes this side of this line

Note: Any Additions or Changes on This Sheets Must be Made or Circled in Red Ink With Date and Name of Person Making Change.

Notes Ck'd by D. M. Finley | Survey of Alameda ST | F.B. 807 Pg. 86

[illegible] | Time No. 063 [illegible]

[illegible] | Surveyed by [illegible]

Checked D. M. Finley | Notes Moore Date 11-14

Date Feb 1940 | Indexed [illegible]

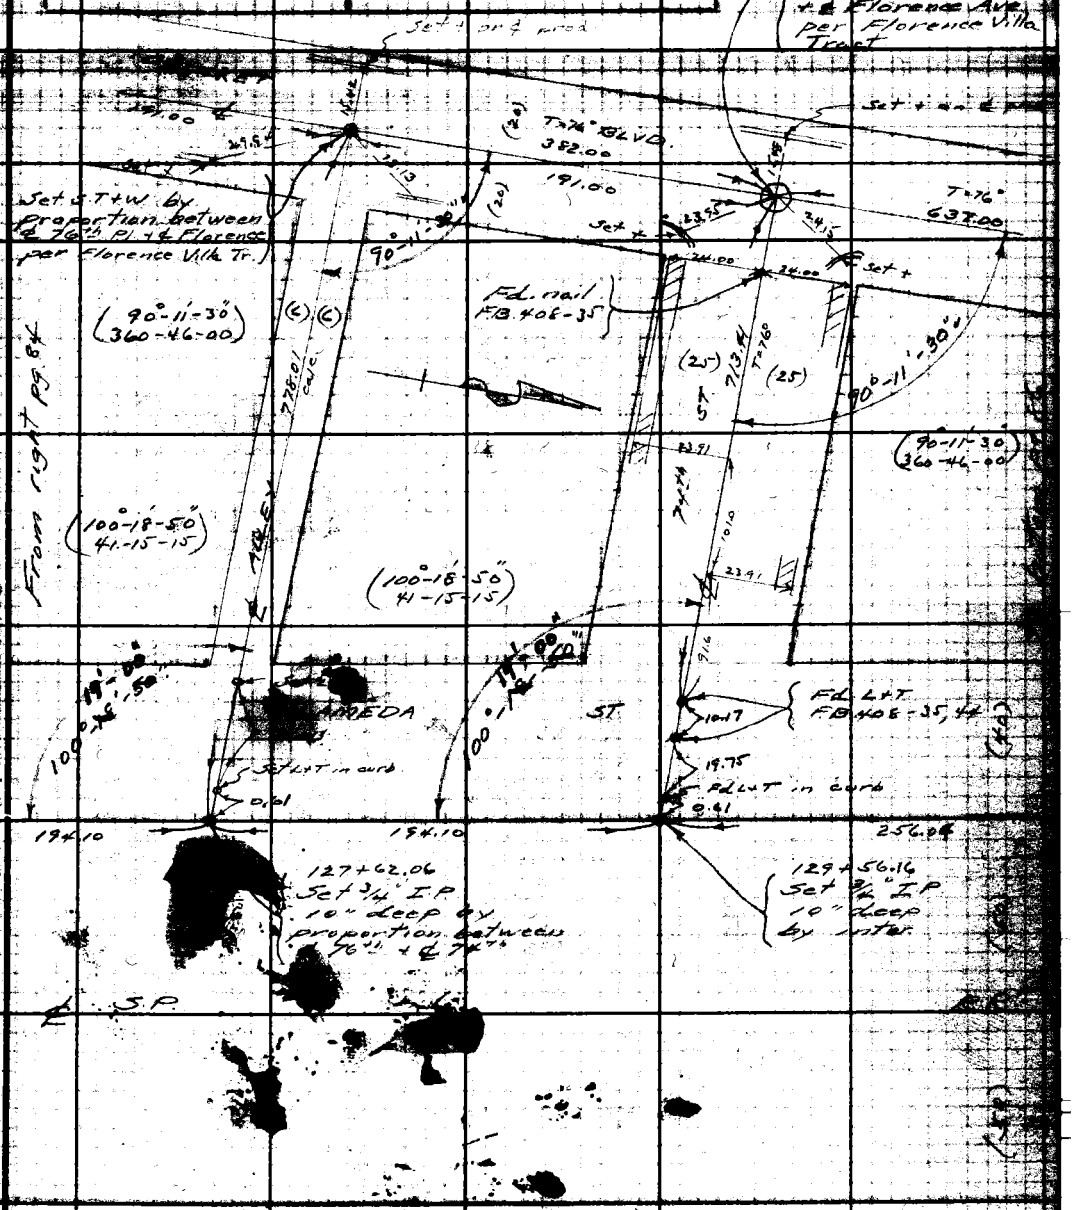

Note: Any Additions or Changes on this Sheets Must be Made or Circled in Red Ink With Date and Name of Person Making Change.

Do not extend notes this side of this line

RETURN TO
LOS ANGELES COUNTY SURVEYOR
700 HALL OF RECORDS

FORM 247 5M 10-37

RETURN TO
LOS ANGELES COUNTY SURVEYOR
700 HALL OF RECORDS

Note: Any Additions or Changes on This Sheets Must be Made or Circled in Red Ink With Date and Name of Person Making Change.

Do not extend notes this side of this line

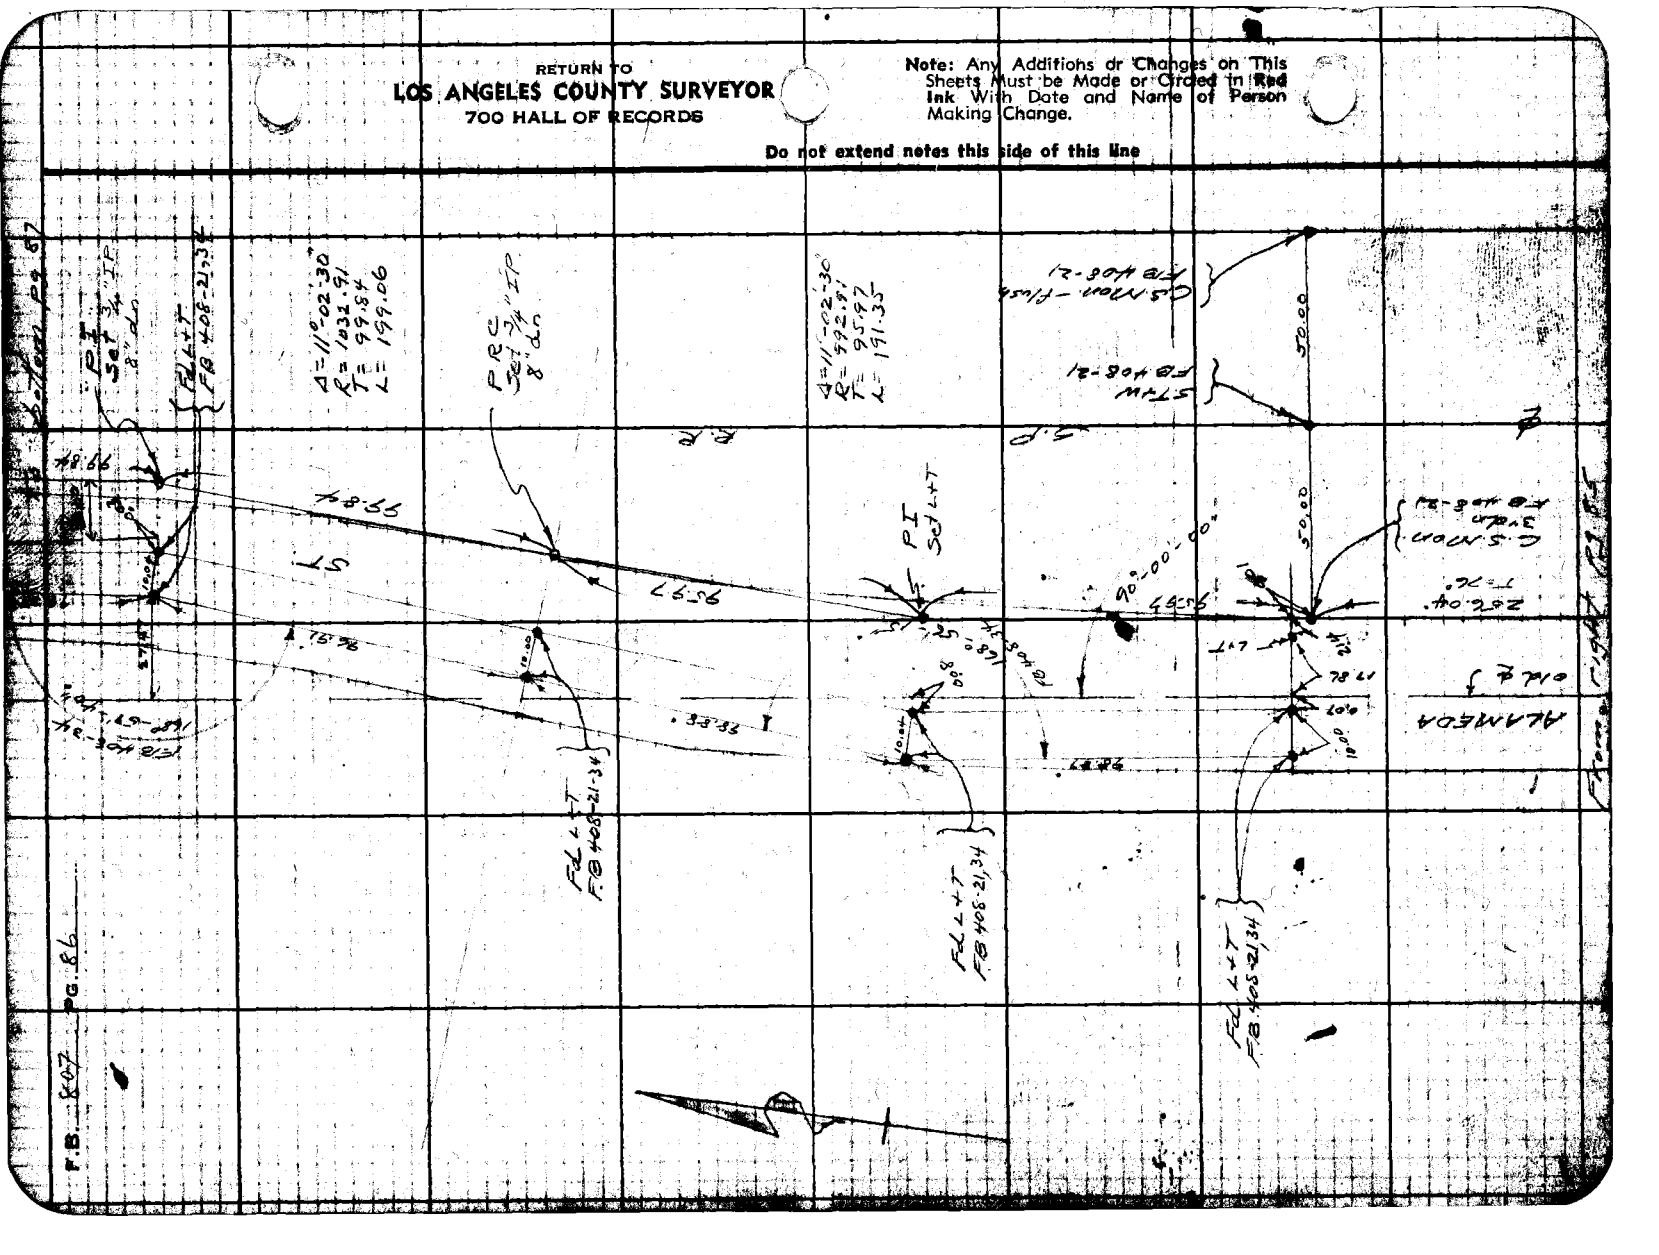

Notes Ck'd by D. M. Finley	Survey of Alameda St	F.B. 807 Pg. 87
Map No. [illegible]	W. O. [illegible] Tape No. 063 Std. [illegible]	
Office Work H. H. REYNOLDS	Surveyed by Moore	
Checked D. M. Finley	Notes Moore Date 11-15-39	
Date Feb 1940	Indexed G. C. Johnson	

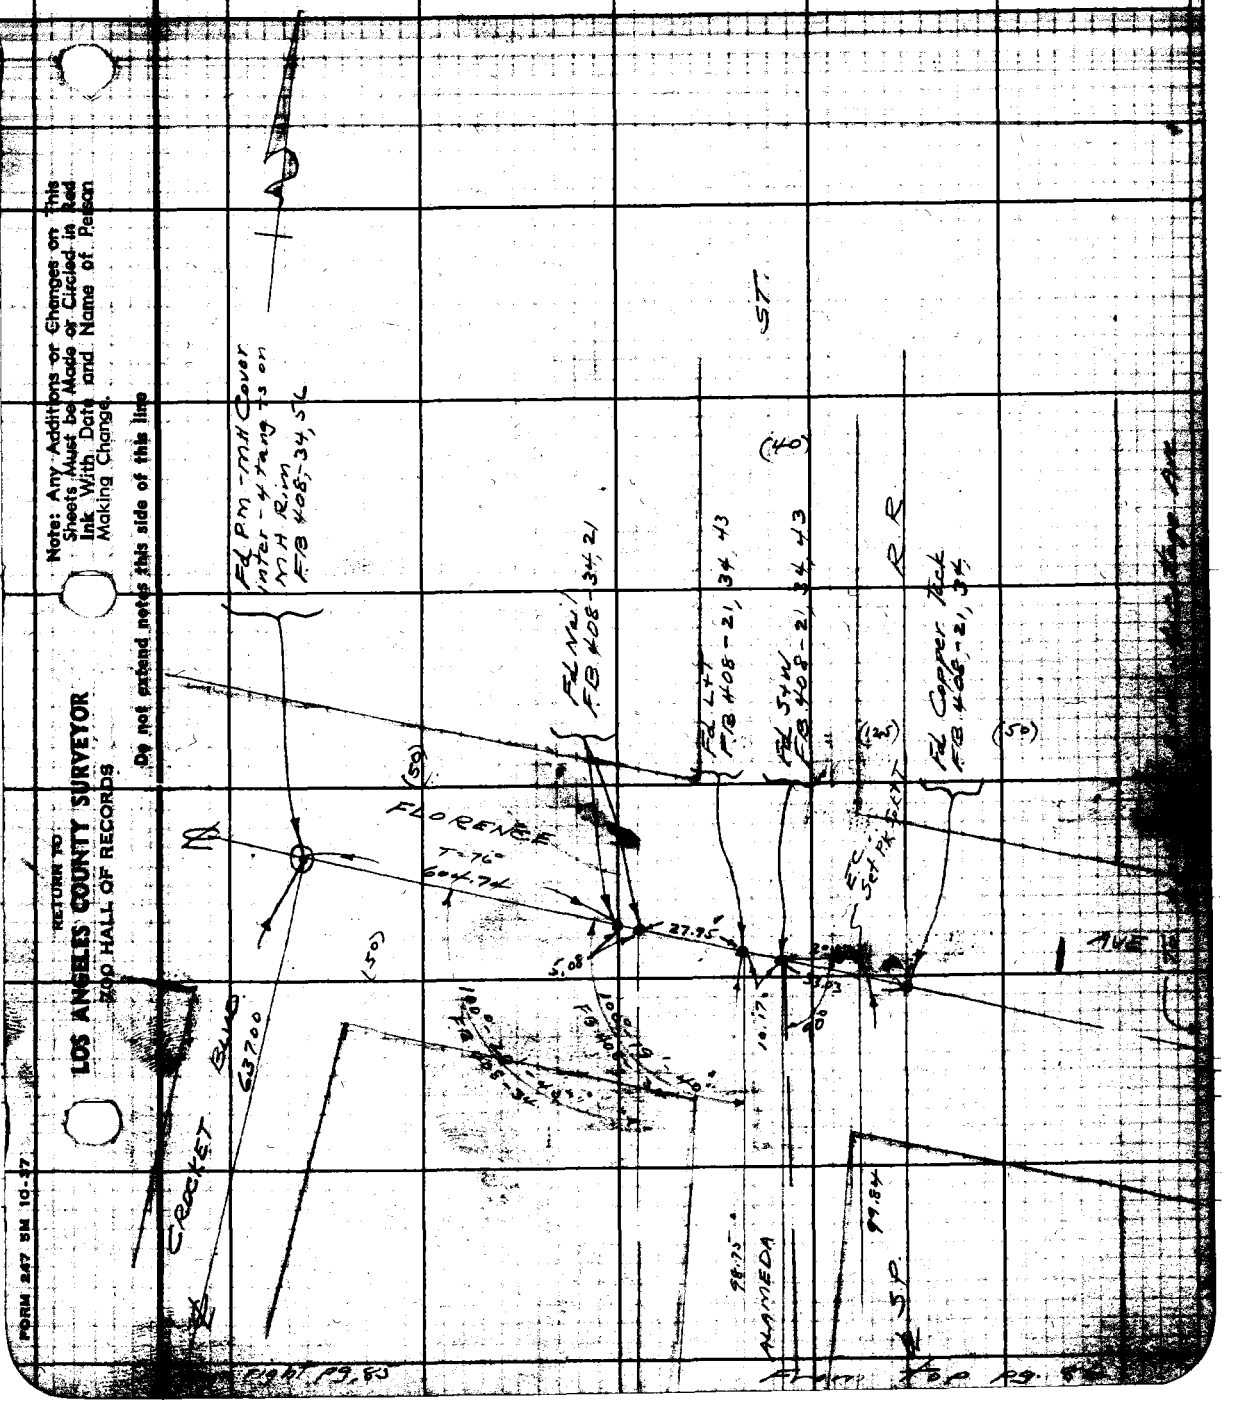

Note: Any Additions or Changes on This Sheets Must be Made or Circled in Red Ink With Date and Name of Person Making Change.

Do not extend notes this side of this line

RETURN TO
LOS ANGELES COUNTY SURVEYOR
700 HALL OF RECORDS

FORM 247 5M 10-37

Right Pg. 85

From Top Pg. 86

RETURN TO
LOS ANGELES COUNTY SURVEYOR
700 HALL OF RECORDS

Note: Any Additions or Changes on This Sheets Must be Made or Circled in **Red Ink** With Date and Name of Person Making Change.

Do not extend notes this side of this line

F.B. 807 Pg. 58

Notes Ck'd by D. M. Finley	Survey of Alameda St	F.B. 807 PG. 89
[illegible]	W. O. [illegible] Topo No. [illegible] Sh'd [illegible]	
Office Work [illegible]	Surveyed by [illegible]	
Checked D. M. Finley	Notes Moore Date 11-15-39	
Date Feb. 1940	Indexed [illegible]	

TOPOGRAPHY
ON
WEST SIDE OF
ALAMEDA ST.
FROM
NORTH BOUNDARY
CITY OF COMPTON
TO
FLORENCE AVE
Job # 8270

Note: Any Additions or Changes on This Sheets Must be Made or Circled in Red Ink With Date and Name of Person Making Change.

Do not extend notes this side of this line

RETURN TO
LOS ANGELES COUNTY SURVEYOR
700 HALL OF RECORDS

FORM 247 5M 10-37

RETURN TO
LOS ANGELES COUNTY SURVEYOR
700 HALL OF RECORDS

Note: Any Additions or Changes on This Sheets Must be Made or Circled in **Red Ink** With Date and Name of Person Making Change.

Do not extend notes this side of this line

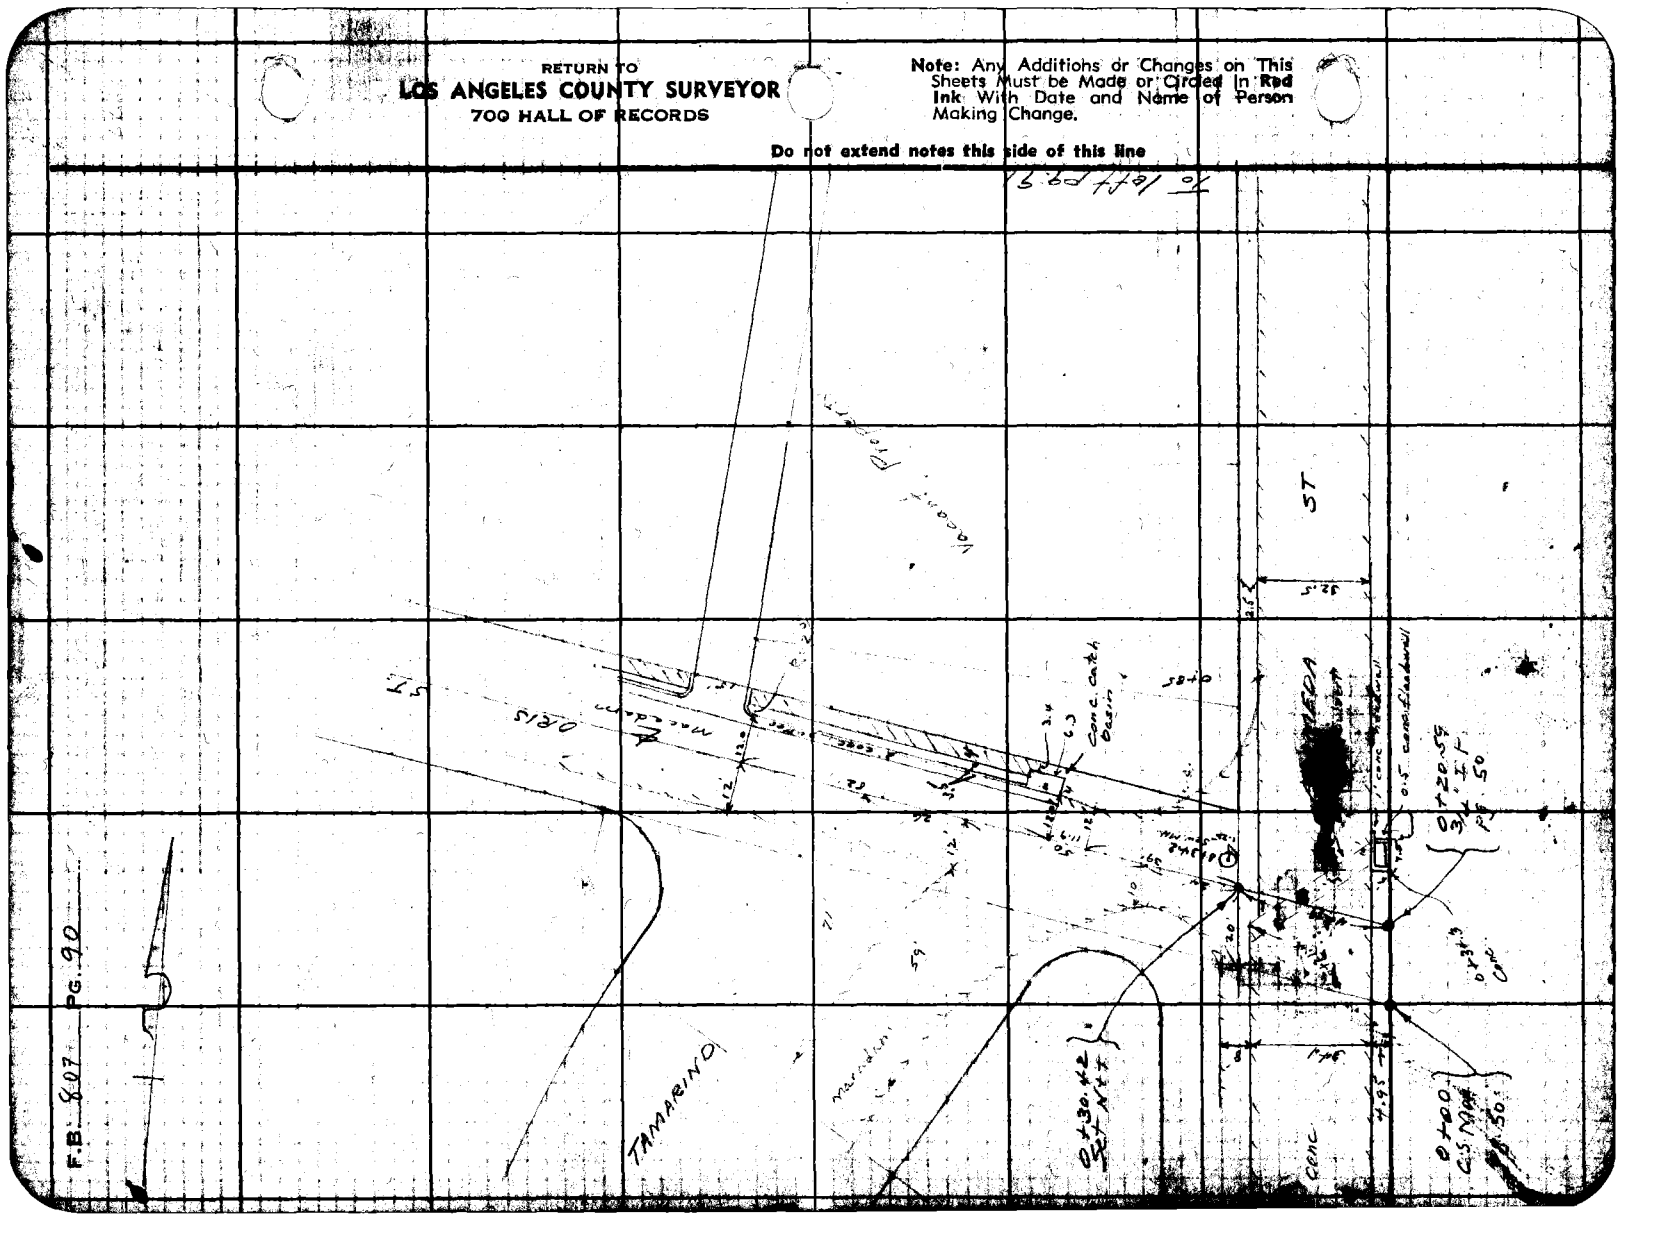

Notes Ck'd by D. M. Finley	Survey of Alameda St	F.B. 807 Pg. 91
Map No. [illegible]	W. [illegible] Tape No. [illegible]	
Office Work [illegible]	Surveyed by D. Moore	
Checked D. M. Finley	Notes D. Moore Date 11-15-39	
Date Feb. 1940	Indexed C. Johnson	

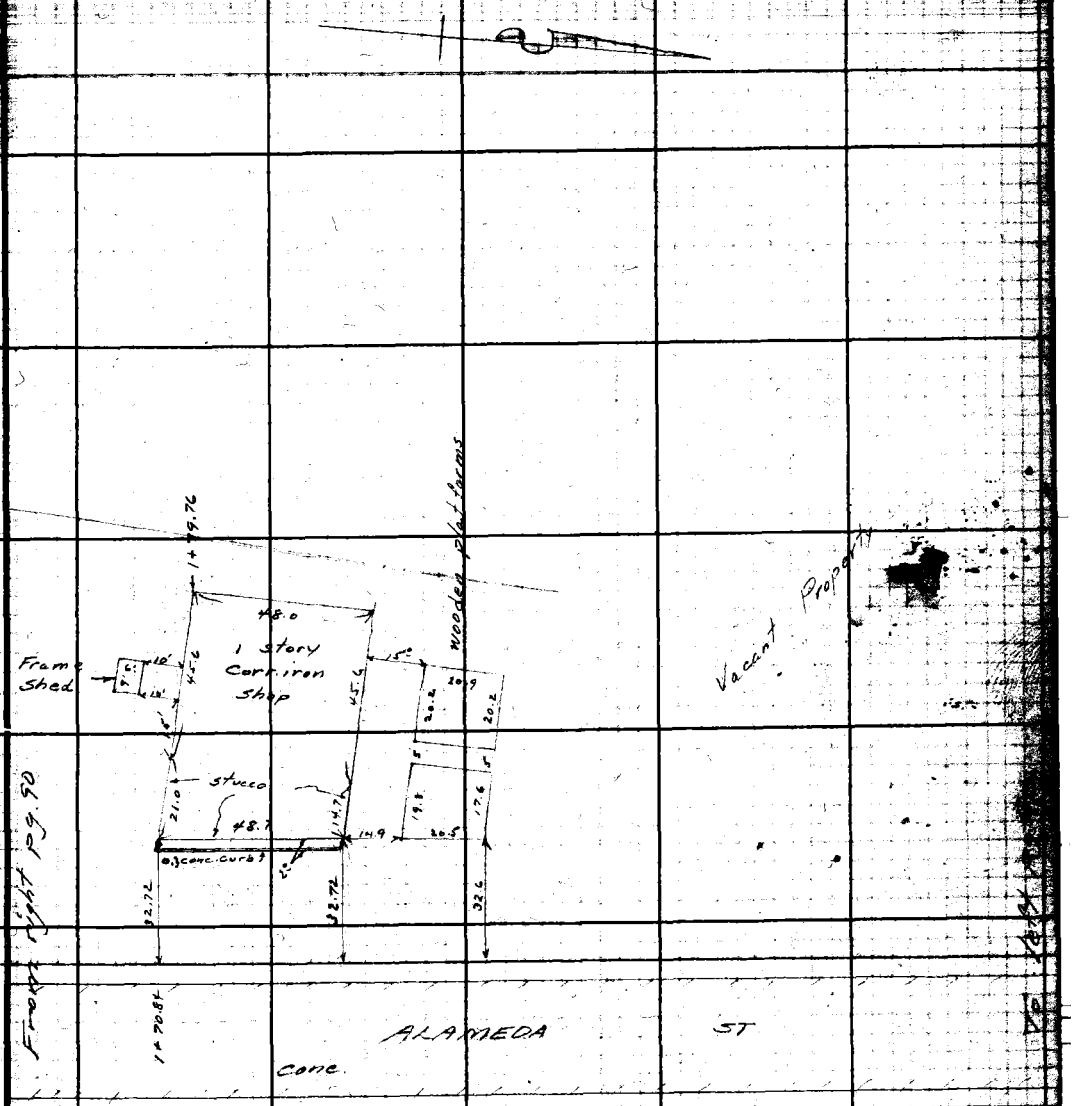

Note: Any Additions or Changes on Sheets Must be Made or Circled in Ink With Date and Name of Making Change.

Do not extend notes this side of this line

RETURN TO
LOS ANGELES COUNTY SURVEYOR
700 HALL OF RECORDS

FORM 247 5M 10-37

RETURN TO
LOS ANGELES COUNTY SURVEYOR
700 HALL OF RECORDS

Note: Any Additions or Changes on This Sheets Must be Made or Circled, In **Red Ink** With Date and Name of Person Making Change.

Do not extend notes this side of this line

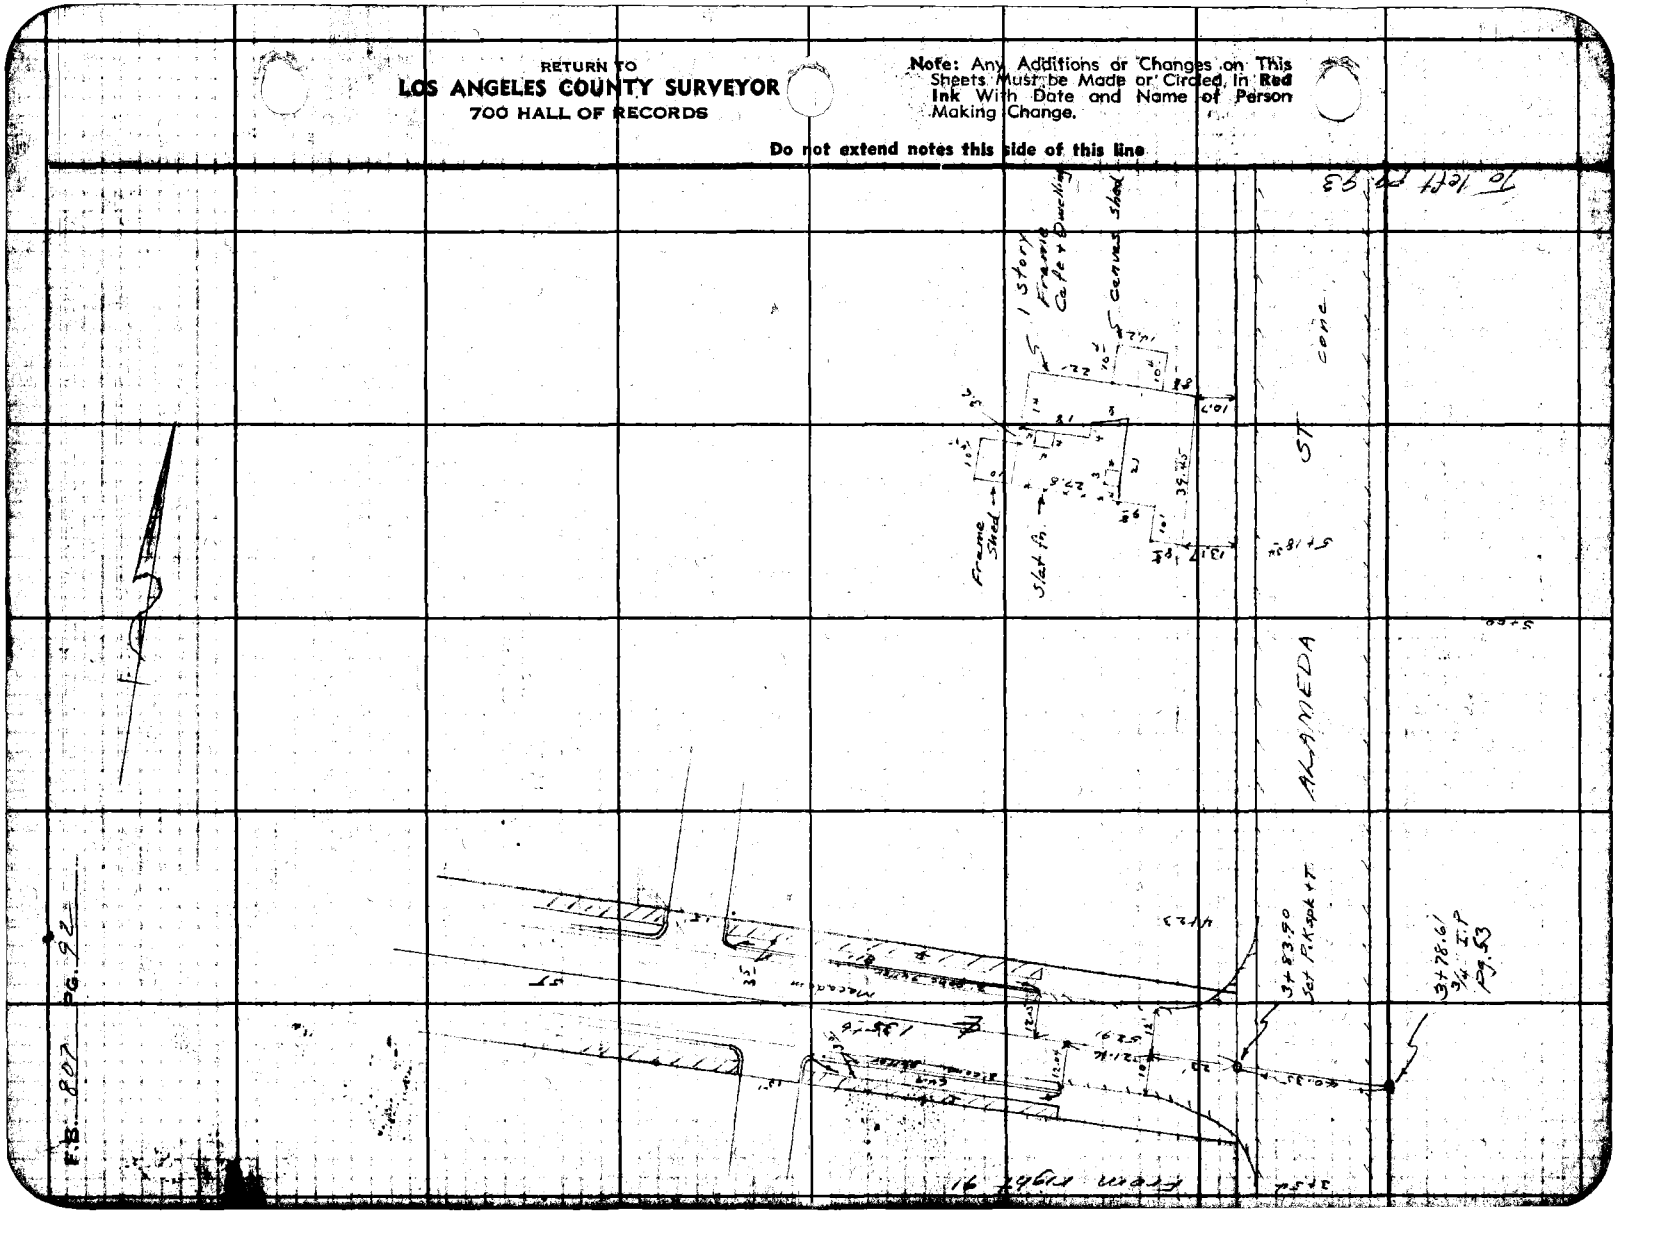

Notes Ck'd by [illegible]	Survey of Alameda St	F.B. 807 Pg. [illegible]
[illegible]	[illegible]	
Office Work [illegible]	Surveyed by [illegible]	
Checked D. M. Finley	Notes [illegible] Date 11-15-39	
Date Feb. 1940	Indexed A. C. Johnson	

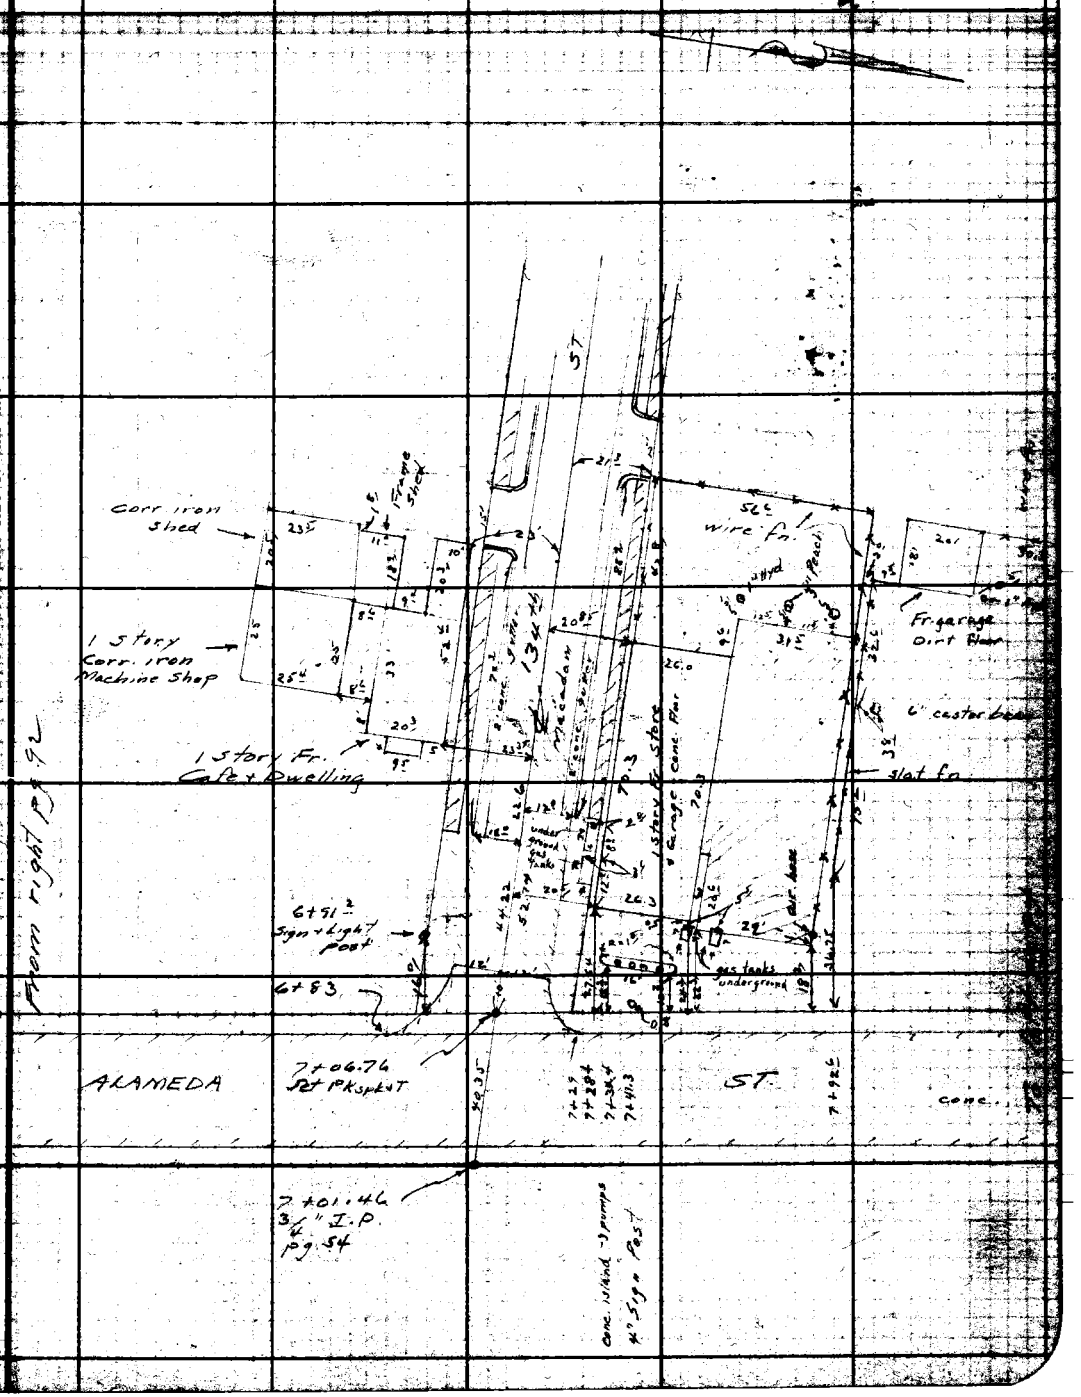

Note: Any Additions or Changes on This Sheets Must be Made or Circled in Ink With Date and Name of Person Making Change.

Do not extend notes this side of this line

RETURN TO
LOS ANGELES COUNTY SURVEYOR
700 HALL OF RECORDS

FORM 247 5M 10-37

F.B. 807 PG. 94

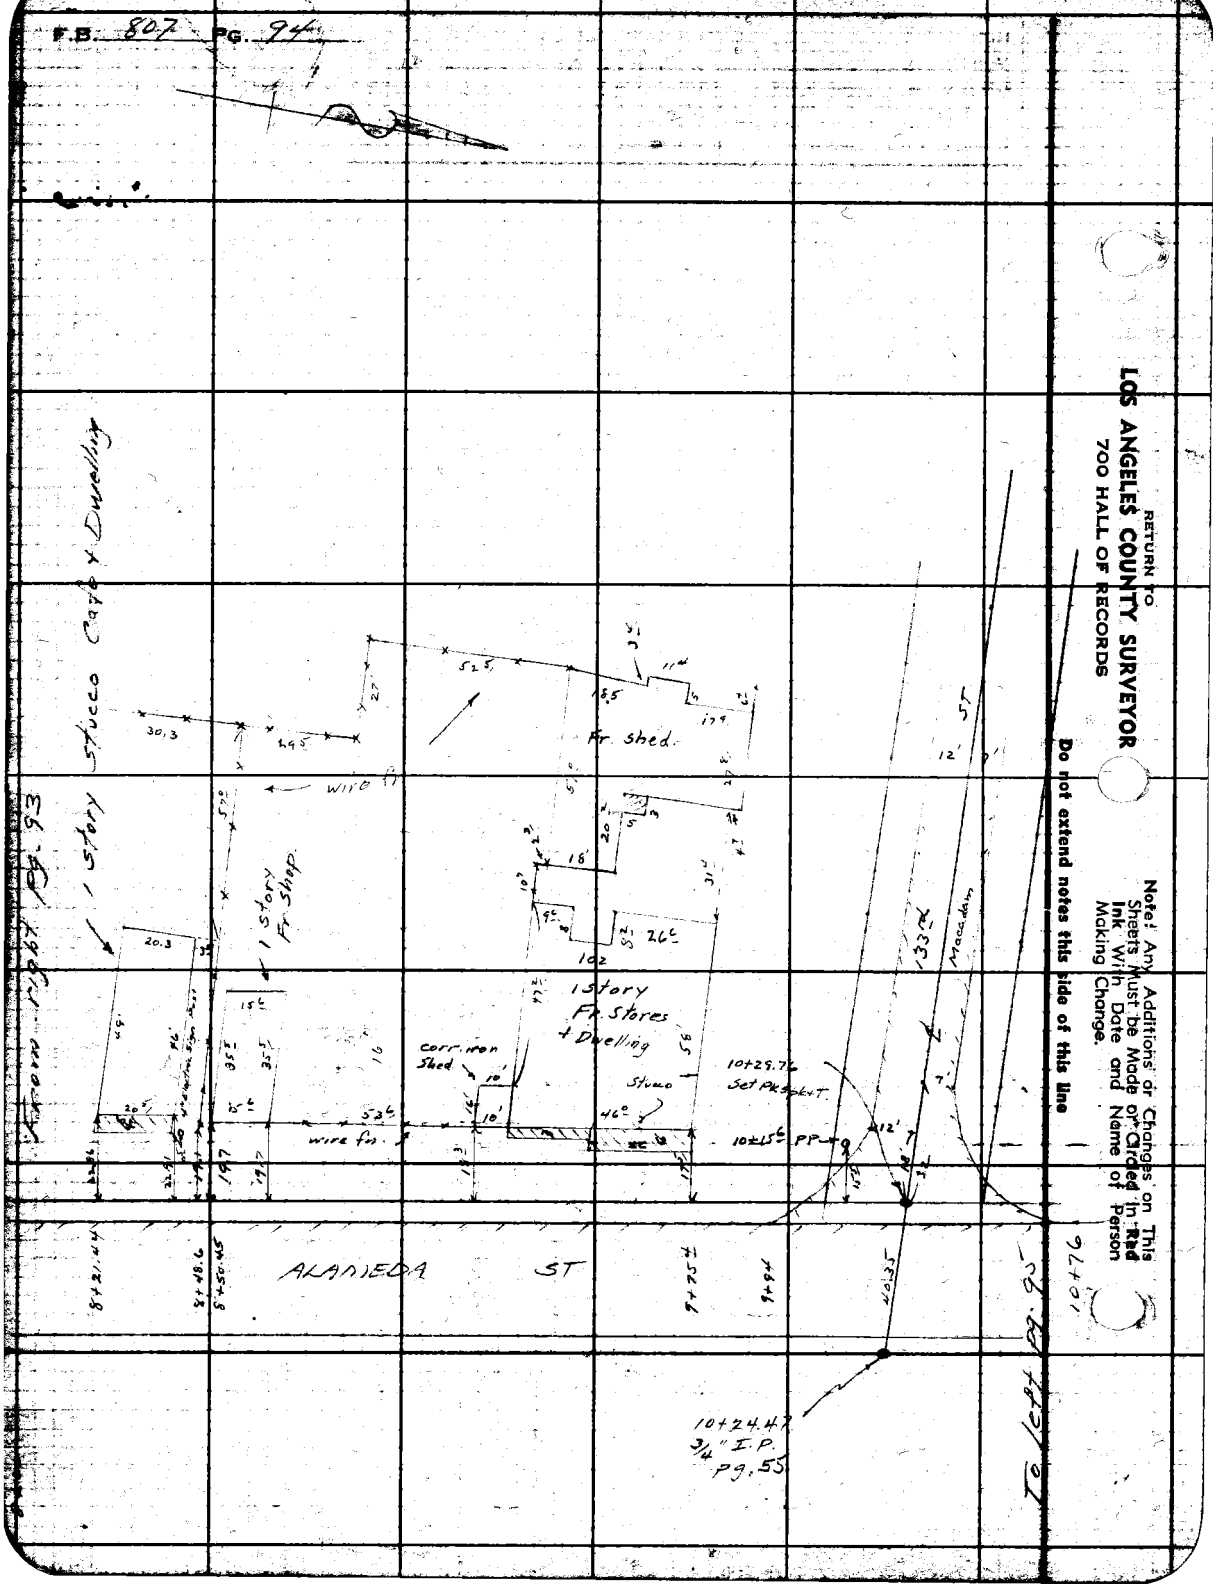

RETURN TO
LOS ANGELES COUNTY SURVEYOR
700 HALL OF RECORDS

Note: Any Additions or Changes on This Sheets Must be Made or Circled in Red Ink With Date and Name of Person Making Change.

Do not extend notes this side of this line

[illegible]	Survey of Alameda St.	F.B. 807 Pg. 95
[illegible]	[illegible] Tree No. [illegible]	
Office Work [illegible]	Surveyed by Moore	
Checked D. M. Finley	Notes Moore Date 11-16-39	
Date Feb. 1940	Indexed A. C. Johnson	

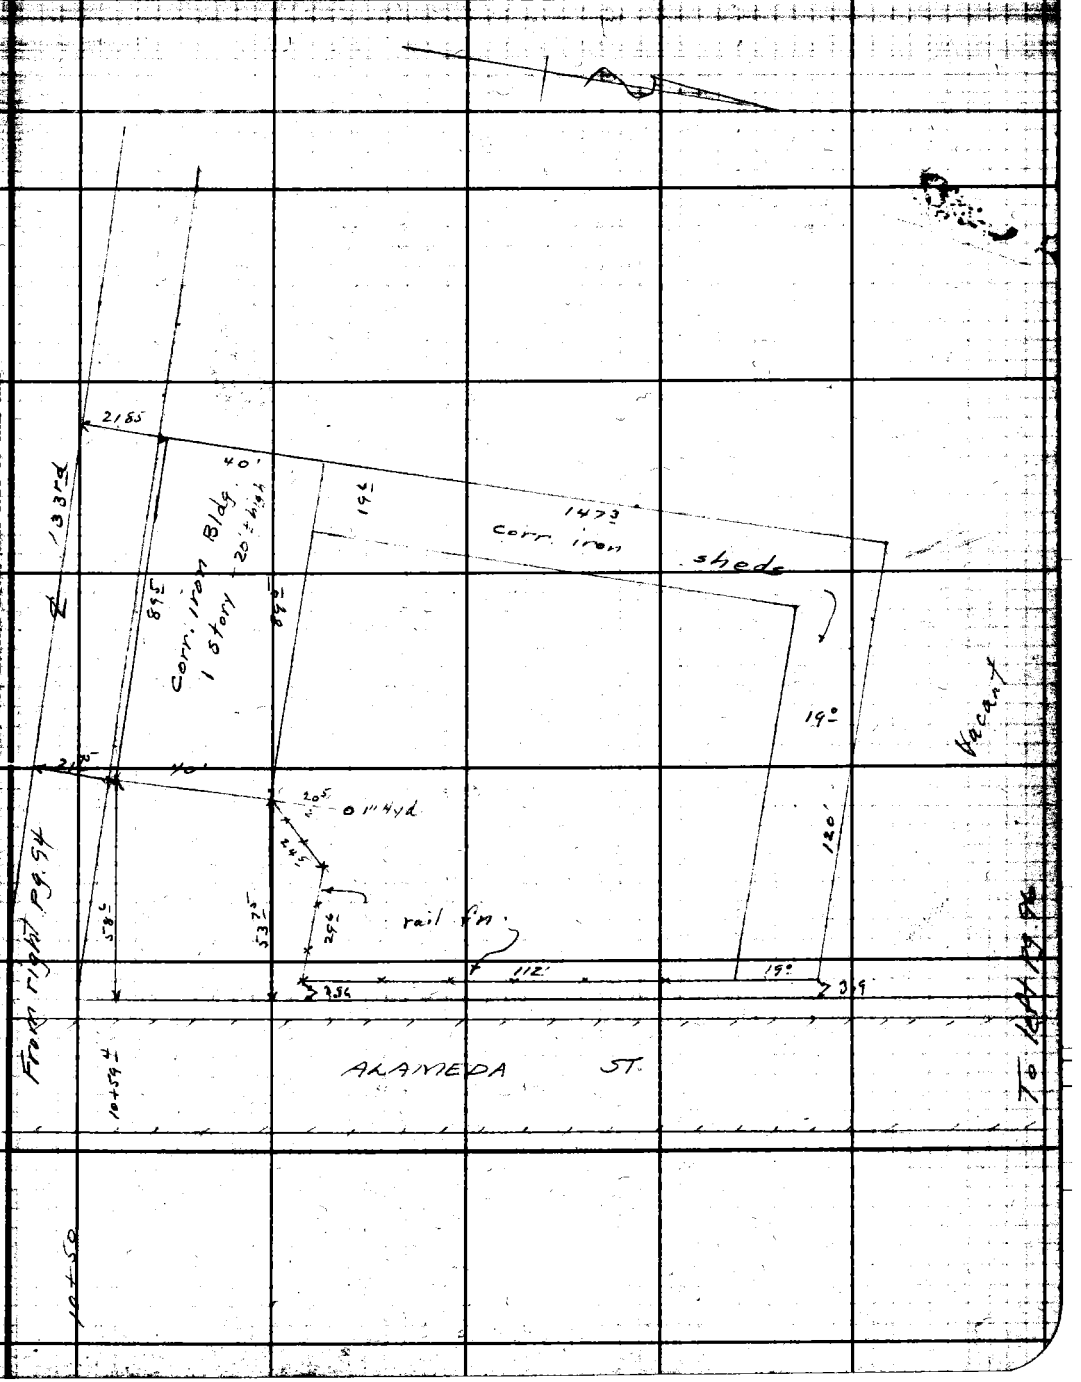

Note: Any Additions or Changes on This Sheets Must be Made or Circled in Red Ink With Date and Name of Person Making Change.

Do not extend notes this side of this line

RETURN TO
LOS ANGELES COUNTY SURVEYOR
700 HALL OF RECORDS

FORM 247 5M 10-37

F.B. 807 PG. 96

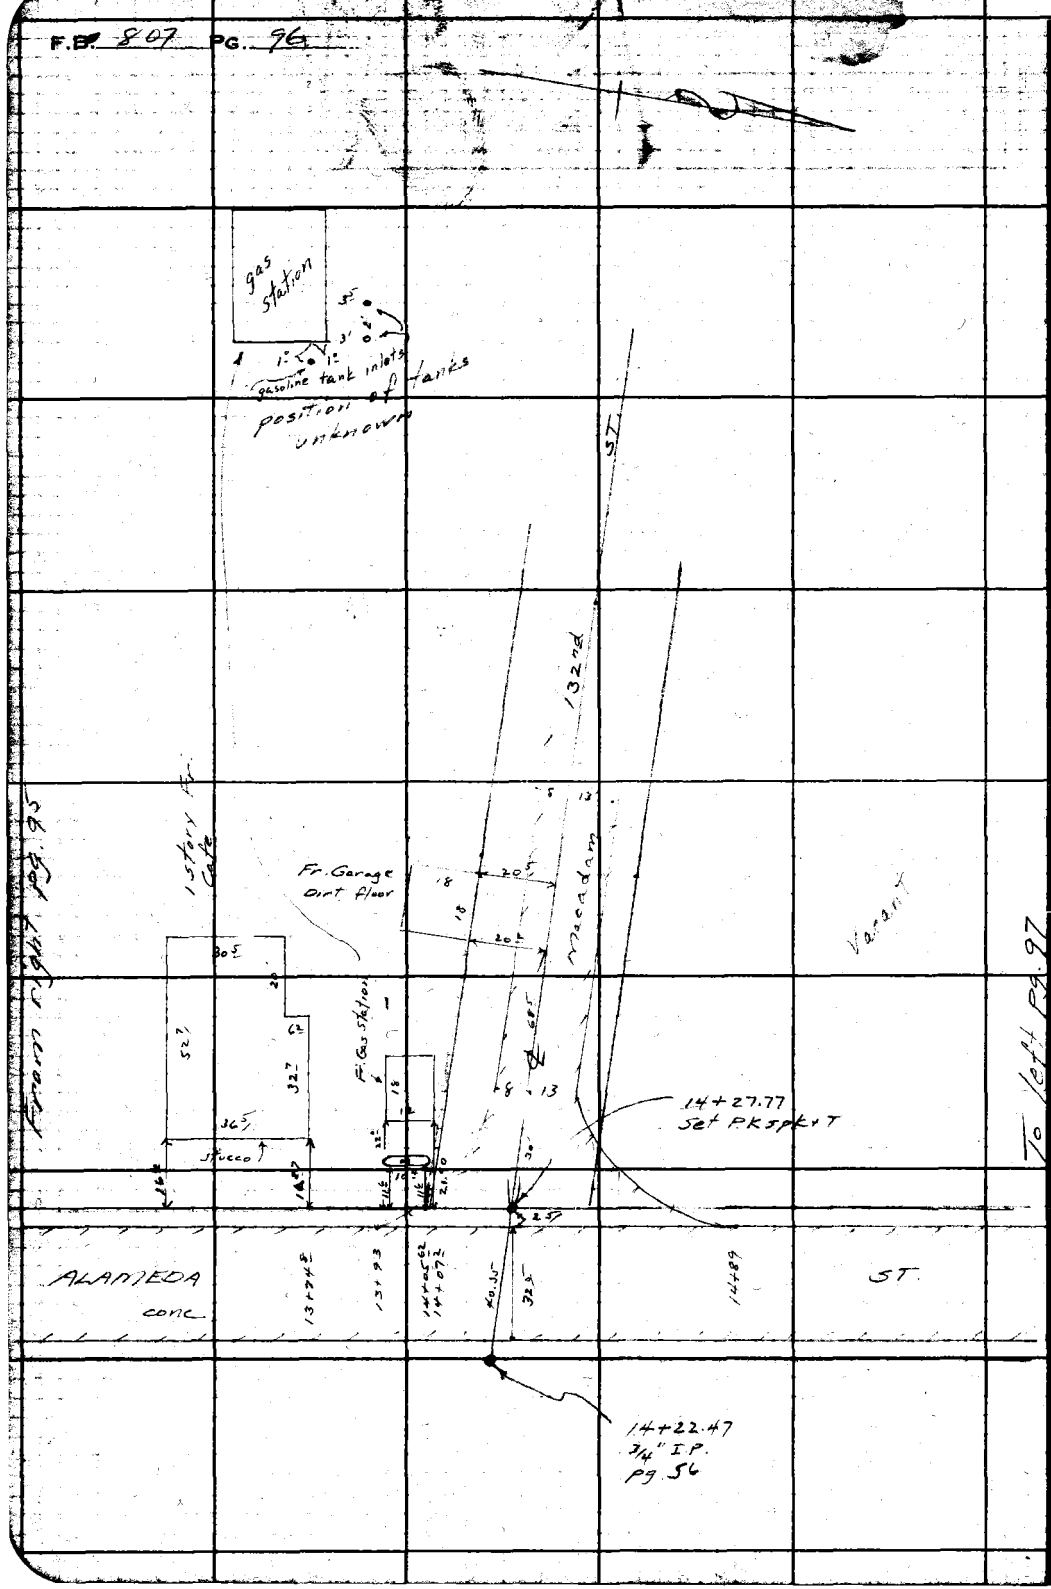

RETURN TO
LOS ANGELES COUNTY SURVEYOR
700 HALL OF RECORDS

Do not extend notes this side of this line

Note: Any Additions or Changes on This Sheets Must be Made or Circled in Red Ink With Date and Name of Person Making Change.

Notes Ck'd by [illegible]	Surveyed [illegible]	F.B. 807	Pg. 97
Map No. [illegible]	[illegible]		
Office Work [illegible]	Surveyed by [illegible]		
Checked D. M. Finley	Notes Moore	Date 11-16-39	
Date Feb 1940	Indexed A. C. Johnson		

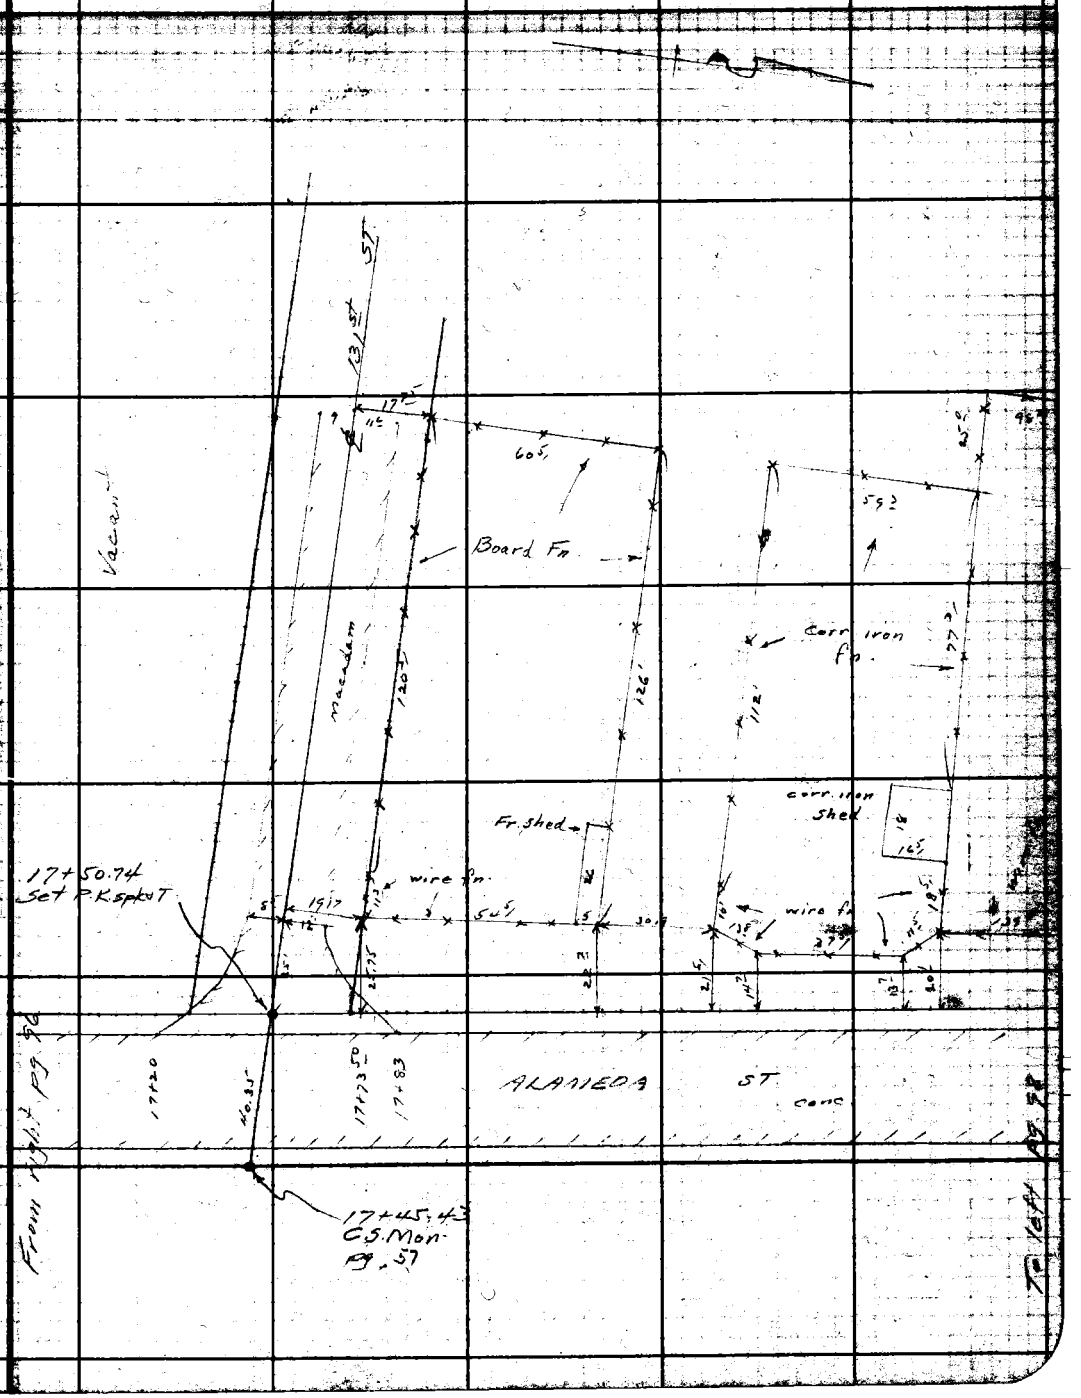

Note: Any Additions or Changes on This Sheets Must be Made or Circled in Red Ink With Date and Name of Person Making Change.

Do not extend notes this side of this line

RETURN TO
LOS ANGELES COUNTY SURVEYOR
700 HALL OF RECORDS

FORM 247 5M 10-37

RETURN TO
LOS ANGELES COUNTY SURVEYOR
700 HALL OF RECORDS

Note: Any Additions or Changes on This Sheets Must be Made or Circled in **Red Ink** With Date and Name of Person Making Change.

Do not extend notes this side of this line

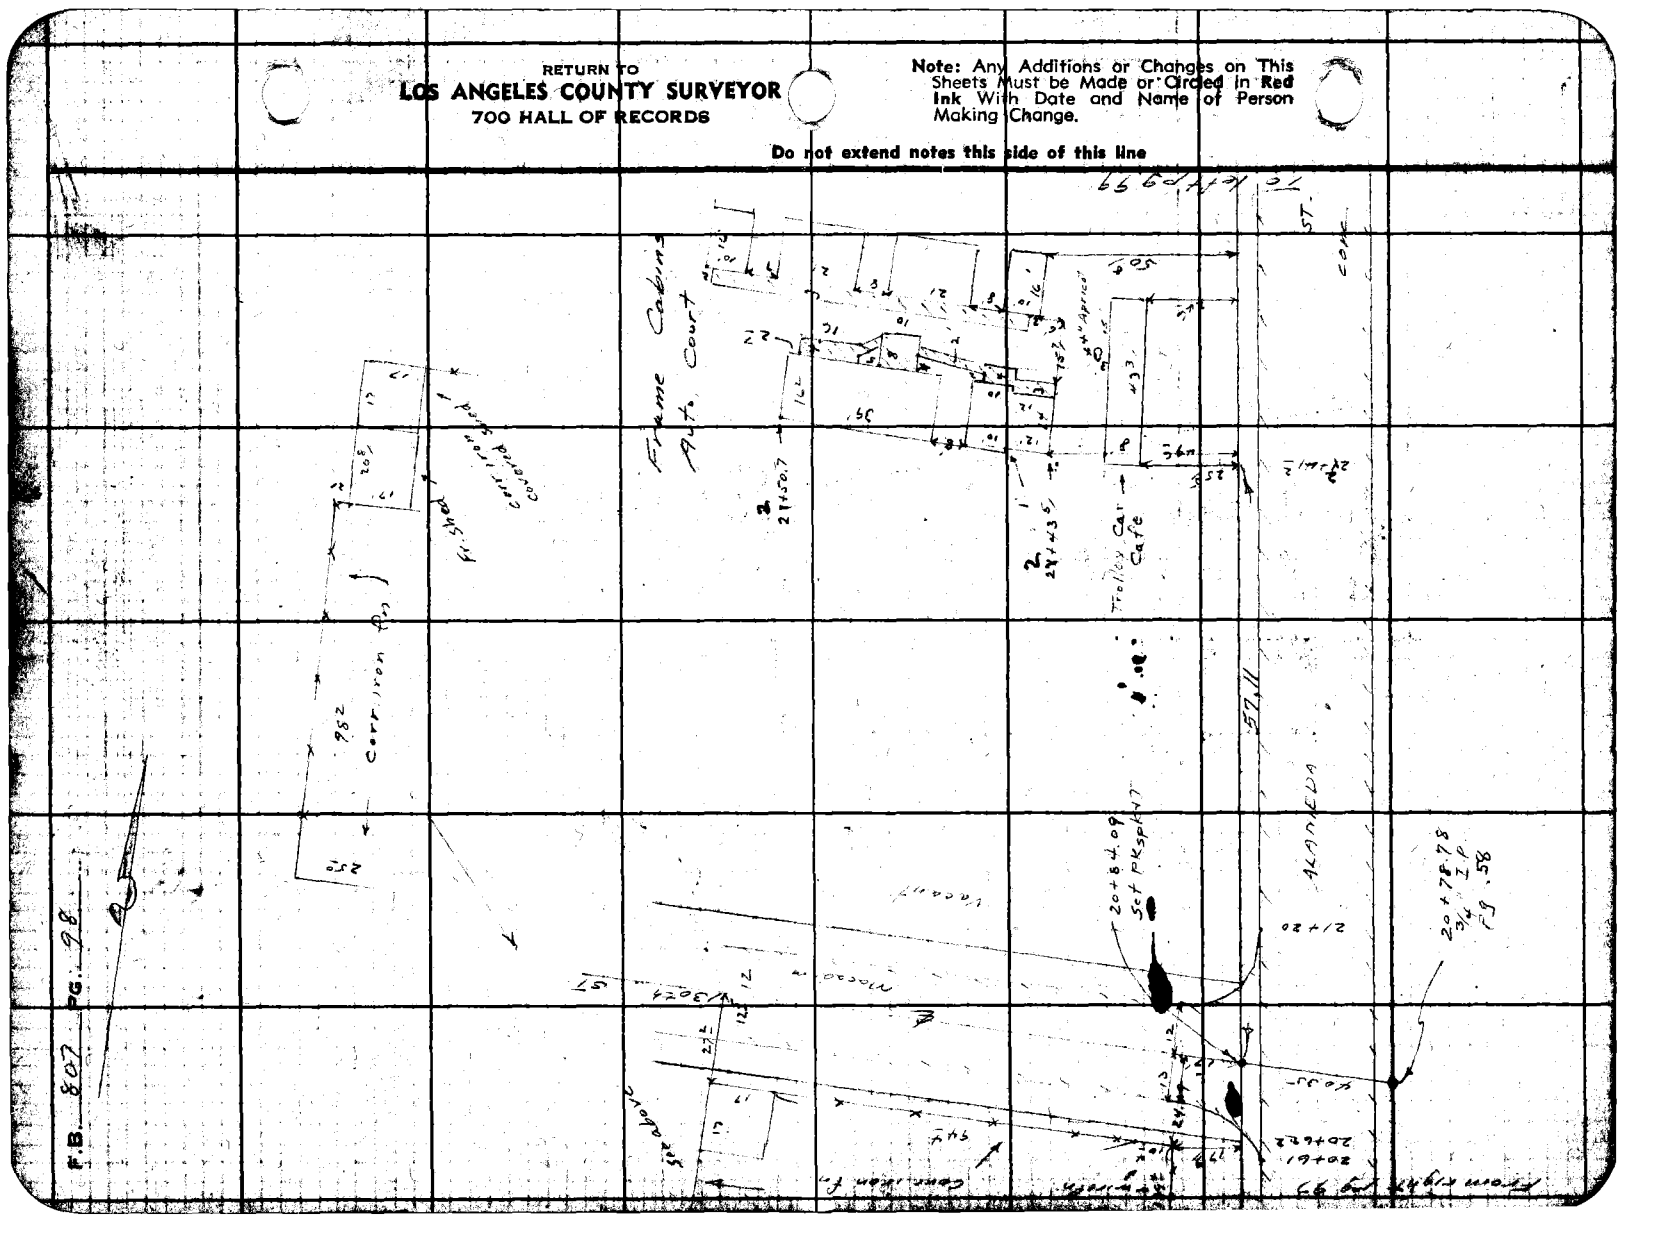

Notes Ck'd by [illegible]	Survey of Alameda St	F.B. 807	Pg. [illegible]
Map No. [illegible]	[illegible]		
Office Work [illegible]	Surveyed by [illegible]		
Checked D. M. Finley	Notes Moore Date 11-16-39		
Date Feb 1940	Indexed A. C. Johnson		

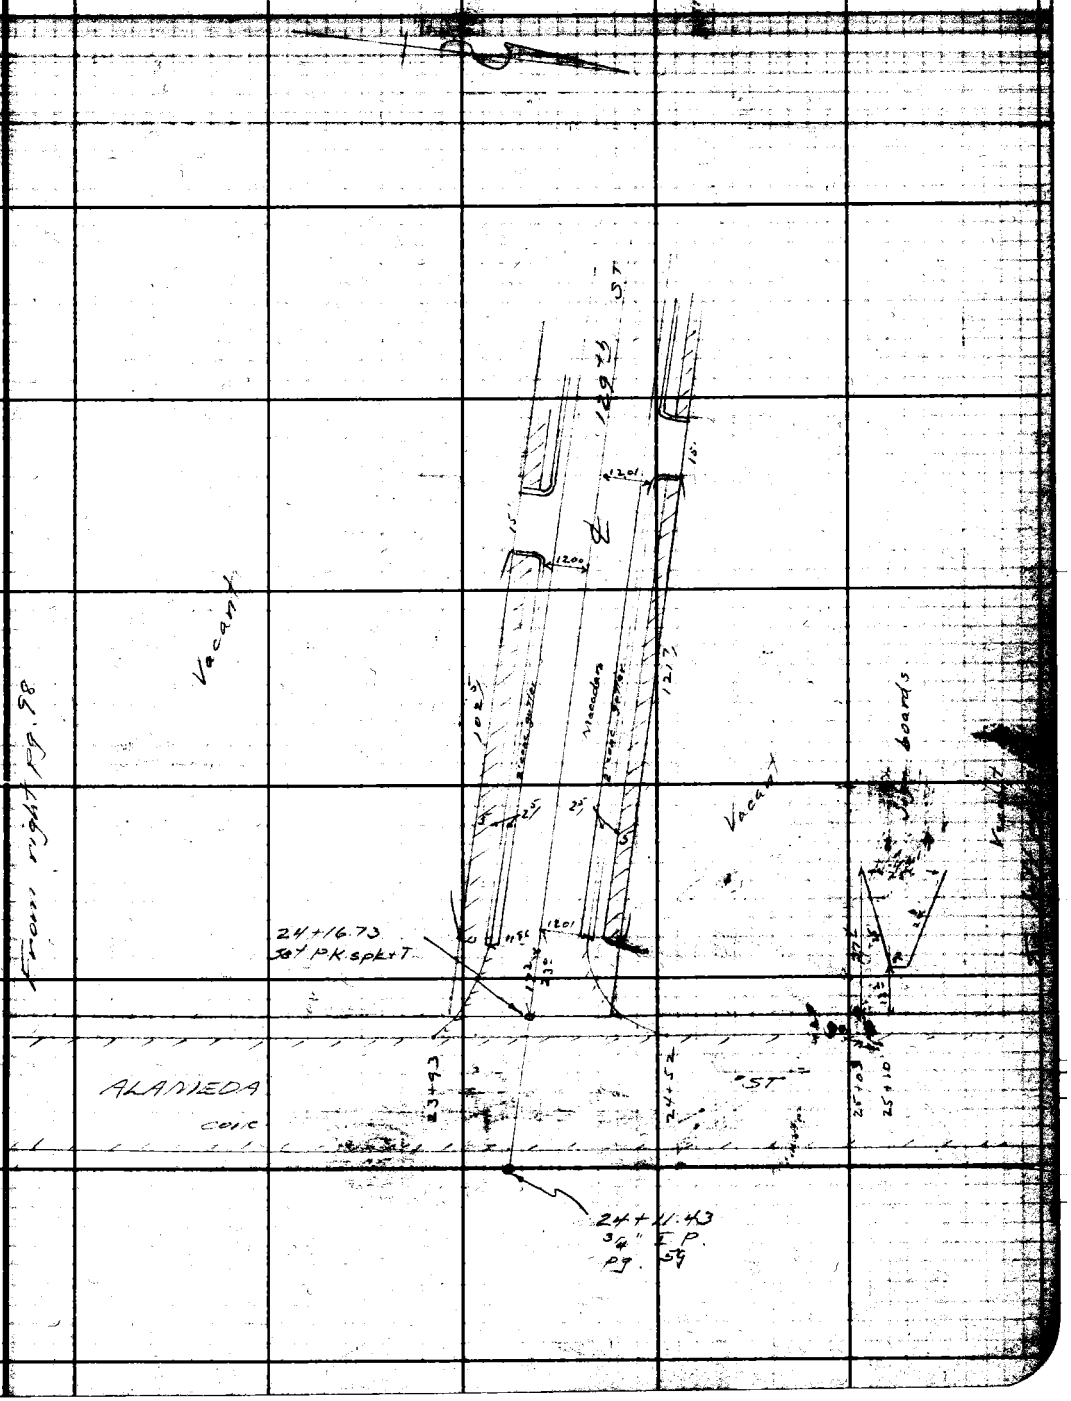

Note: Any Additions or Changes on Sheets Must be Made or Circled in Ink With Date and Name of Person Making Change.

Do not extend notes this side of this line

RETURN TO
LOS ANGELES COUNTY SURVEYOR
700 HALL OF RECORDS

FORM 247 5M 10-37

F.B. 807 PG. 100

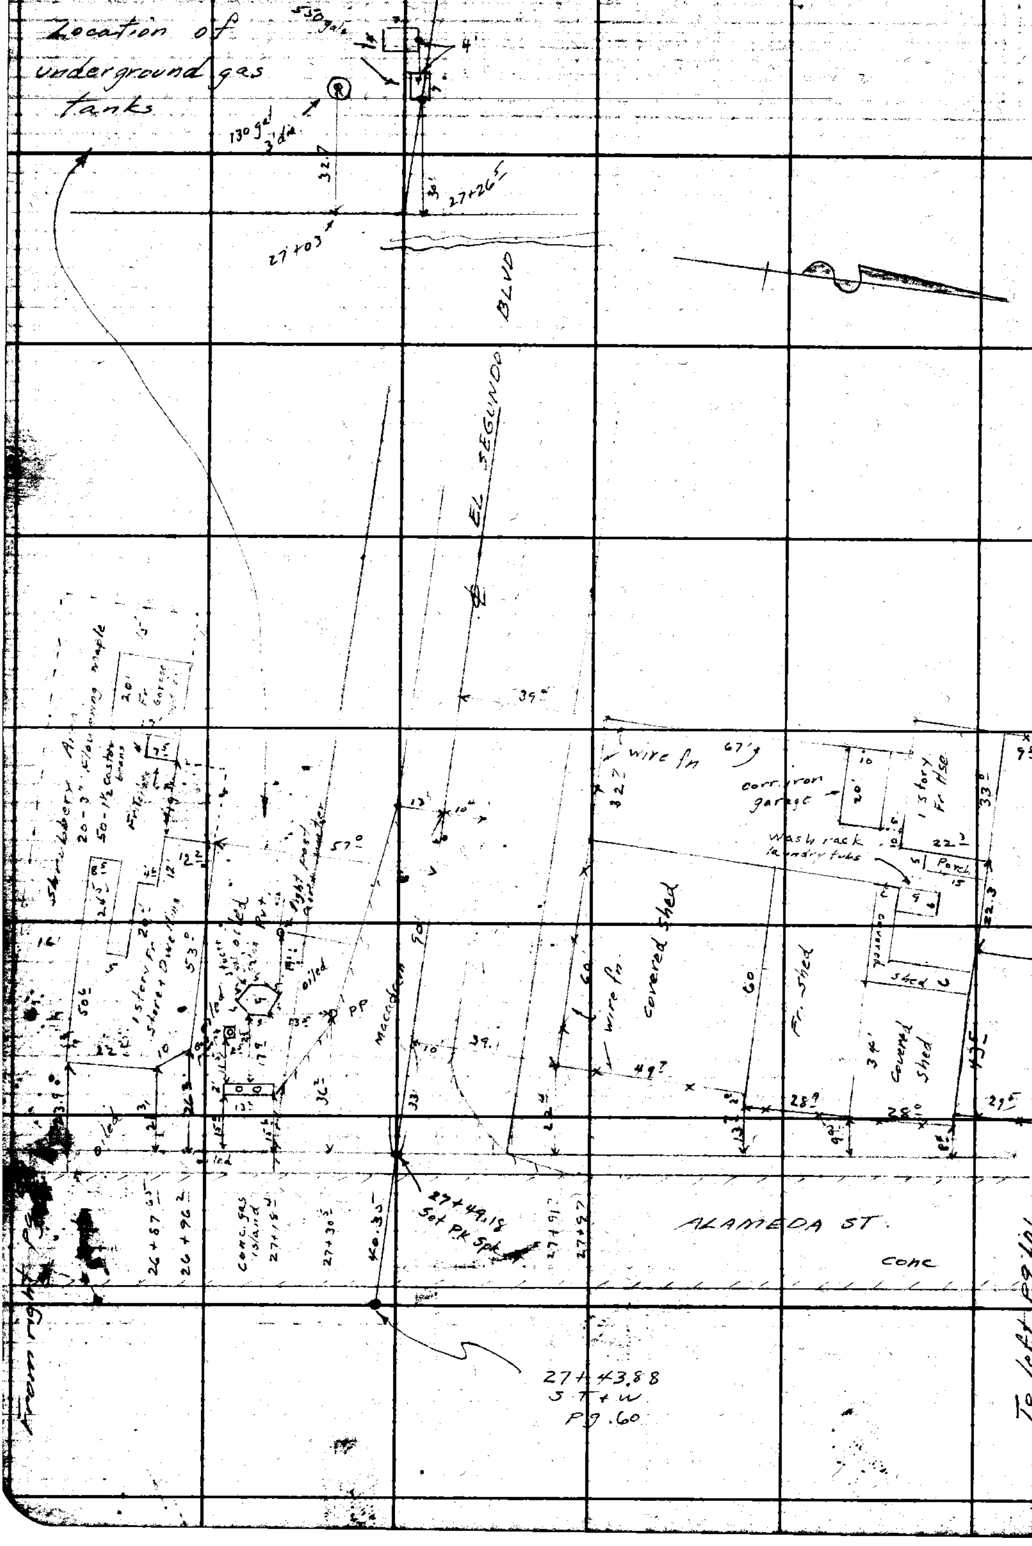

RETURN TO
LOS ANGELES COUNTY SURVEYOR
700 HALL OF RECORDS

Note: Any Additions or Changes on This Sheets Must be Made or Circled In Red Ink With Date and Name of Person Making Change.

Do not extend notes this side of this line

FORM 247 SM 10-37

RETURN TO
LOS ANGELES COUNTY SURVEYOR
700 HALL OF RECORDS

Note: Any Additions or Changes on These Sheets Must be Made or Circled in Red Ink With Date and Name of Person Making Change.

Do not extend notes this side of this line

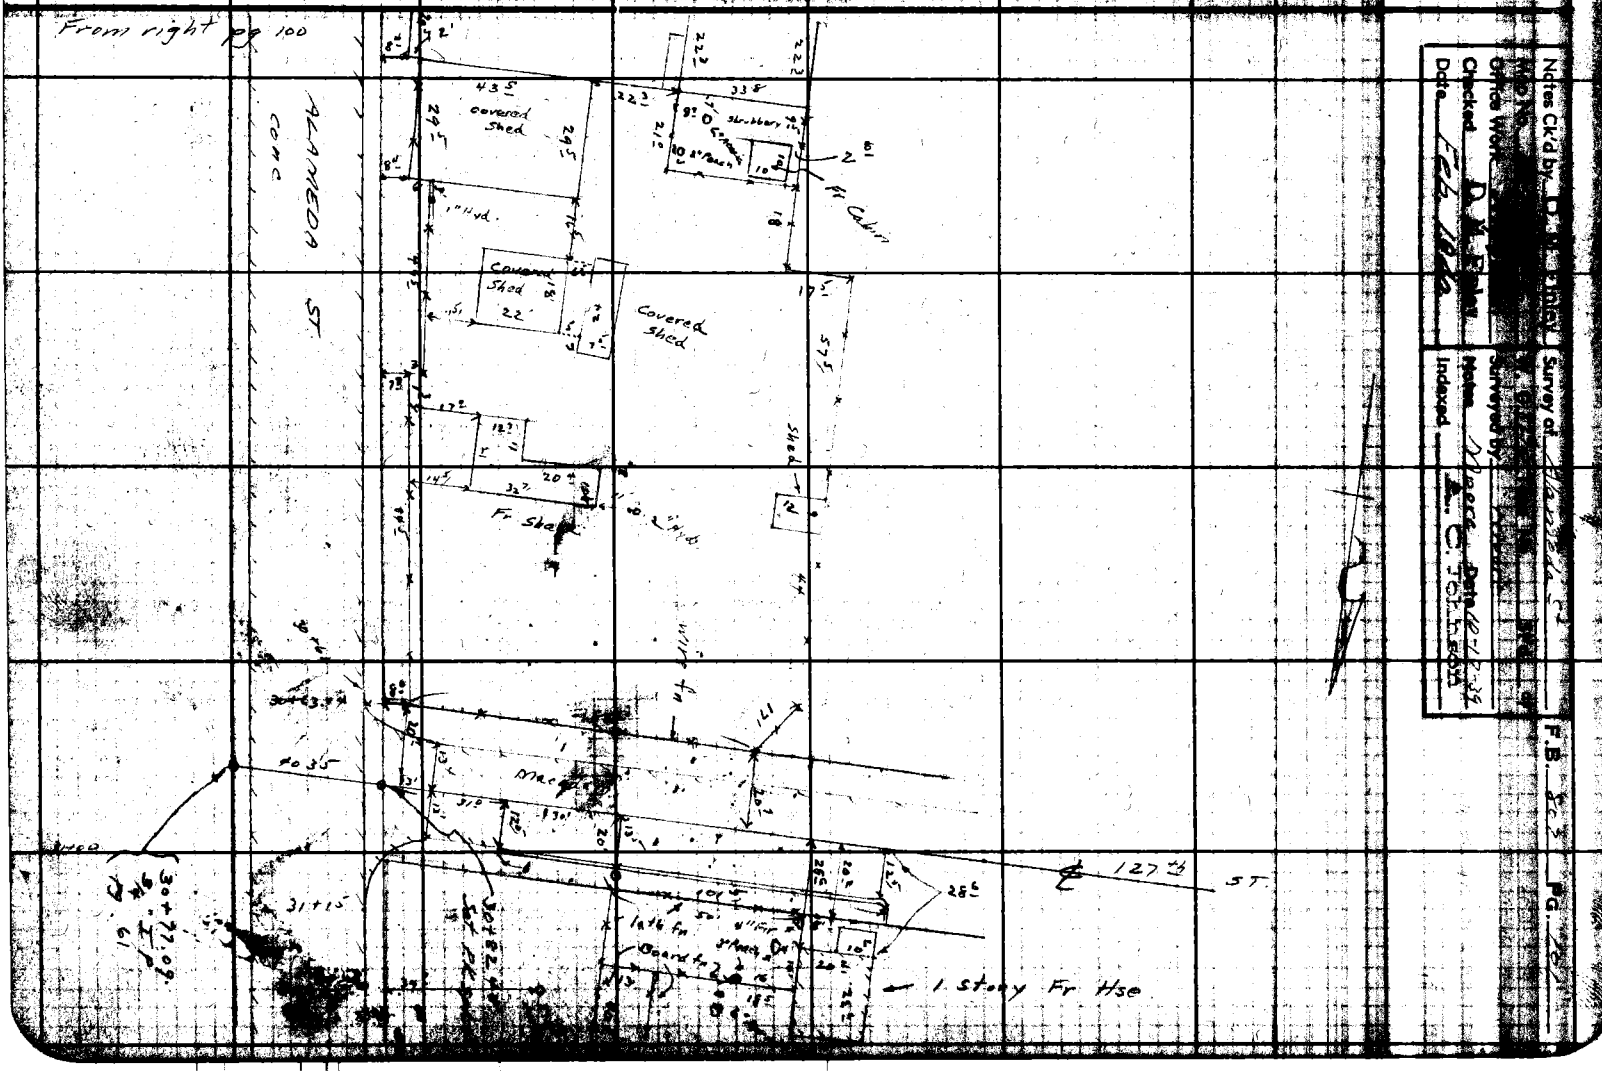

RETURN TO
LOS ANGELES COUNTY SURVEYOR
700 HALL OF RECORDS

Note: Any Additions or Changes on This Sheets Must be Made or Circled in **Red Ink** With Date and Name of Person Making Change.

Do not extend notes this side of this line

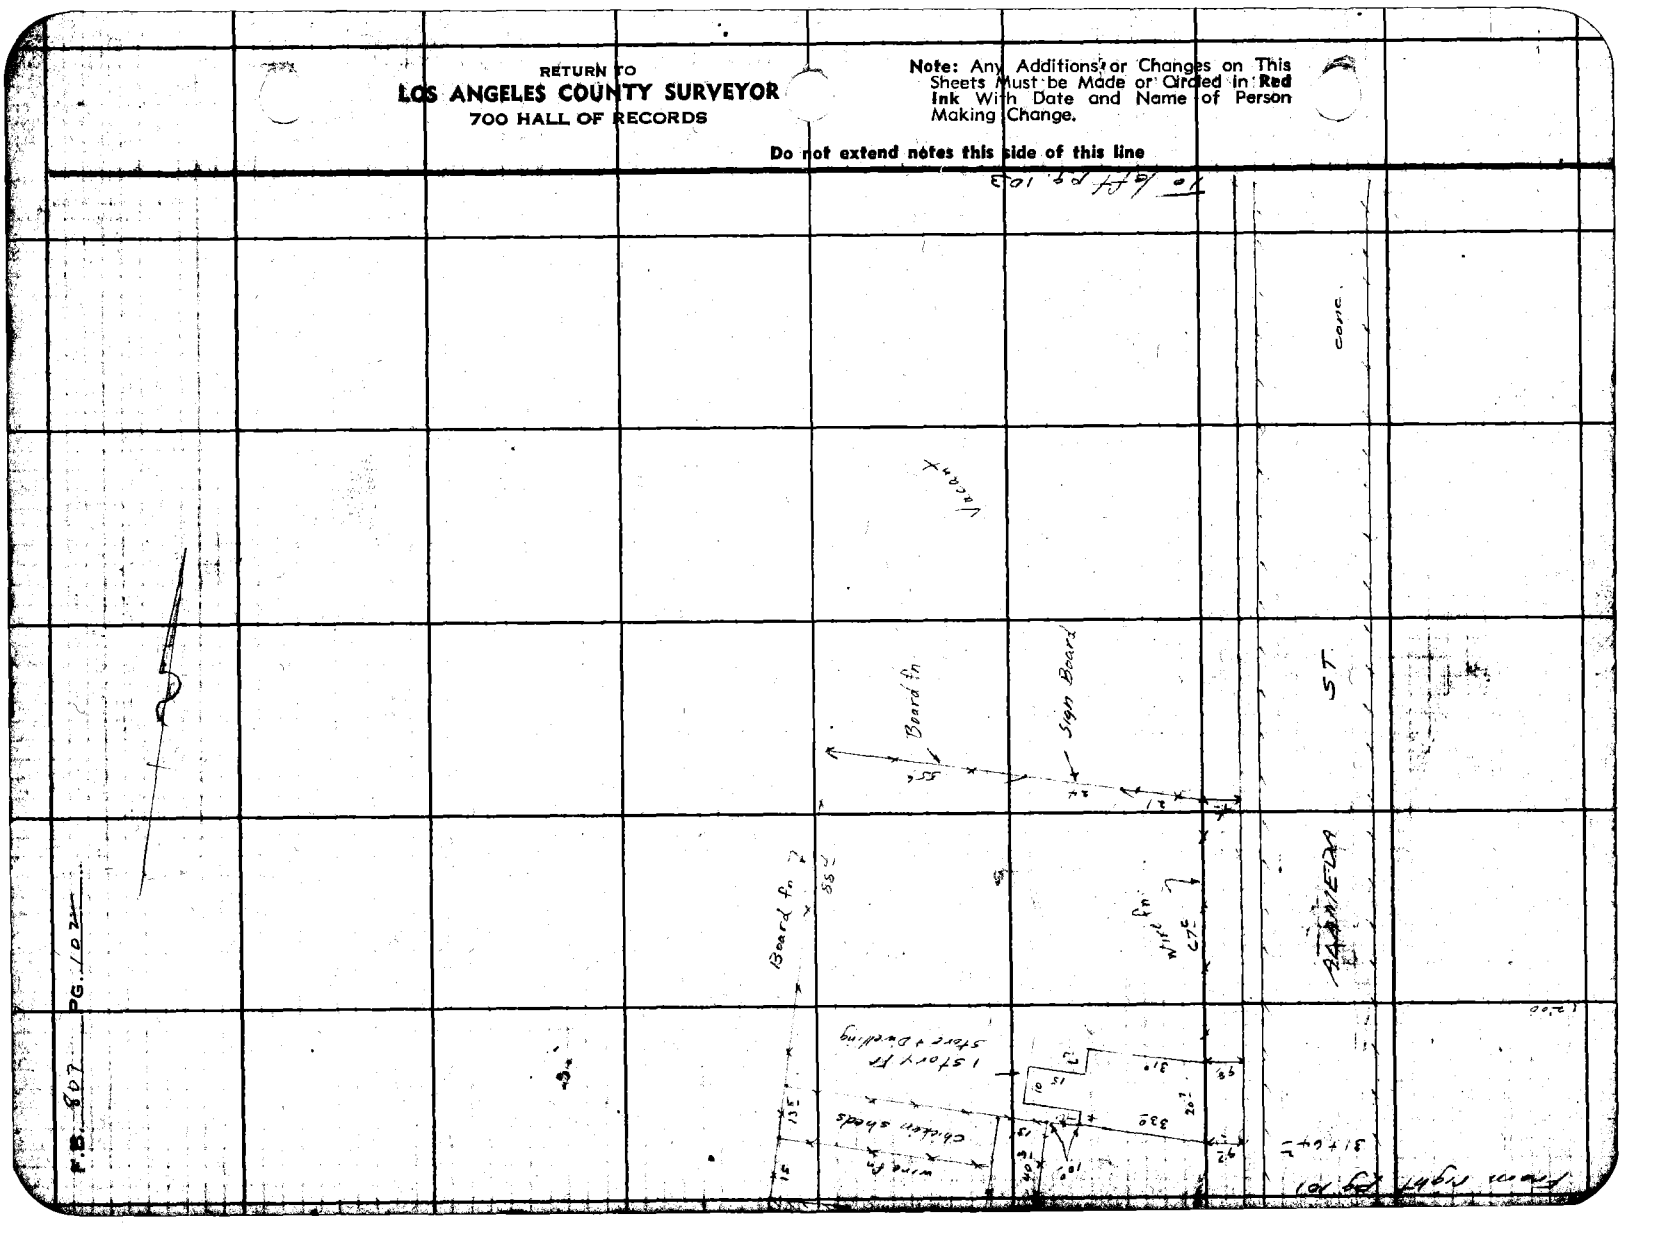

F.B. 807 PG. 102

Notes Ck'd by D. M. Finley	Survey of Alameda St	F.B. 807 Pg. 103
Map No. [illegible]	W. OR-70 Tape No. Std. of	
Office Work [illegible]	Surveyed by Moore	
Checked D. M. Finley	Notes Moore Date 11-17-39	
Date Feb. 1940	Indexed A. C. Johnson	

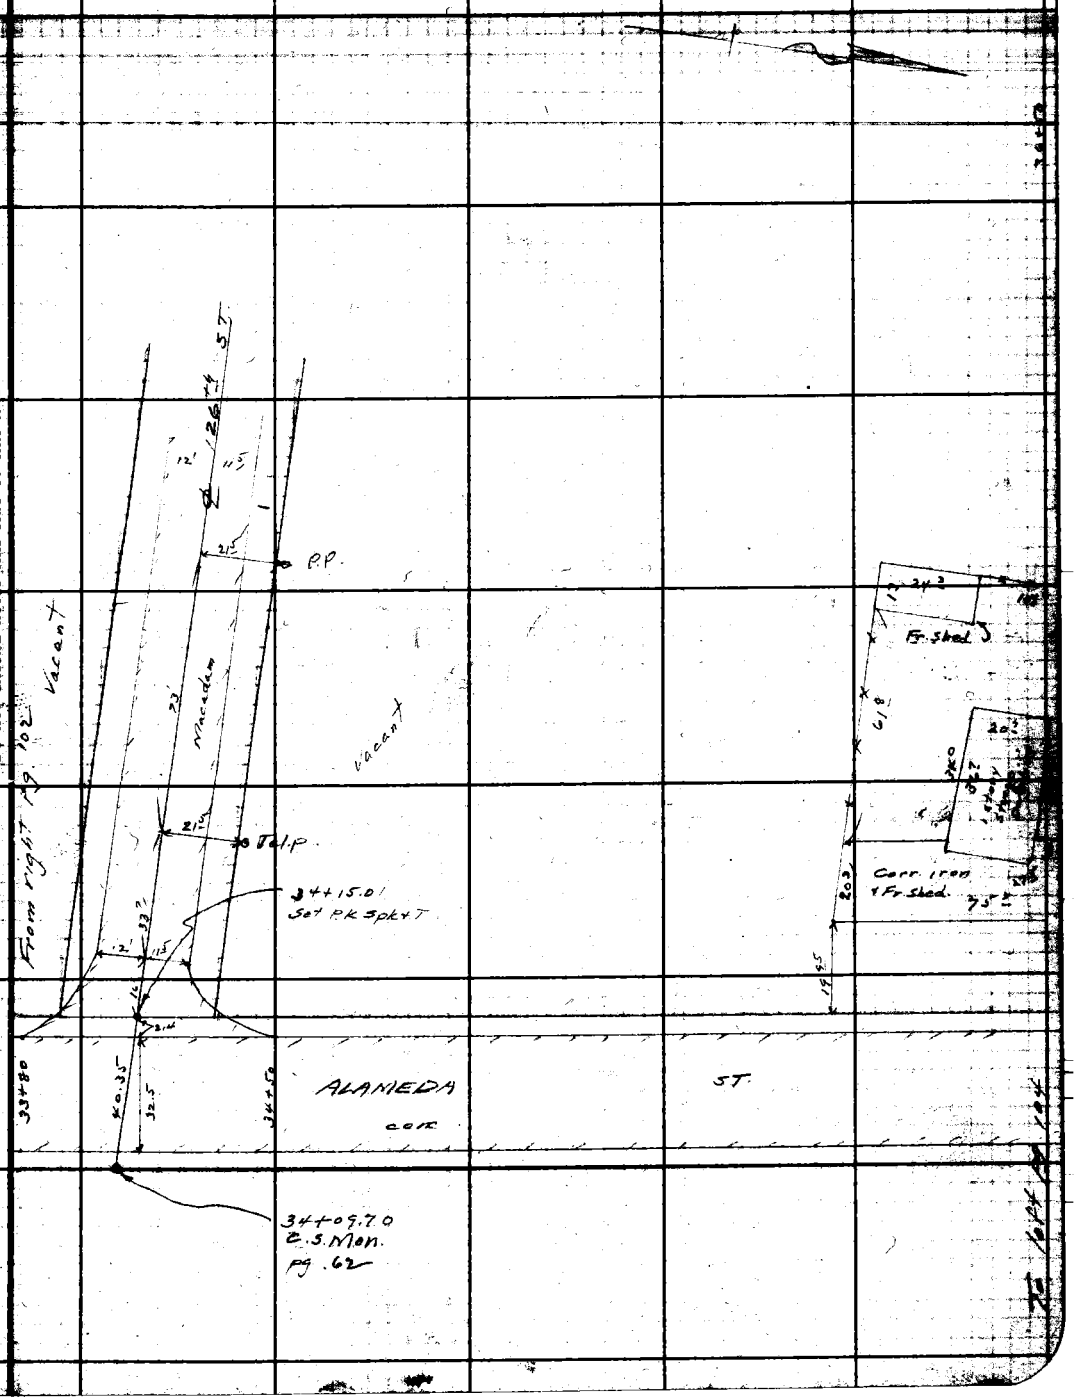

Note: Any Additions or Changes on This Sheets Must be Made or Circled in Ink With Date and Name of Person Making Change.

Do not extend notes this side of this line

RETURN TO
LOS ANGELES COUNTY SURVEYOR
700 HALL OF RECORDS

FORM 247 5M 10-37

RETURN TO
LOS ANGELES COUNTY SURVEYOR
700 HALL OF RECORDS

Note: Any Additions or Changes on This Sheets Must be Made or Circled in **Red Ink** With Date and Name of Person Making Change.

Do not extend notes this side of this line

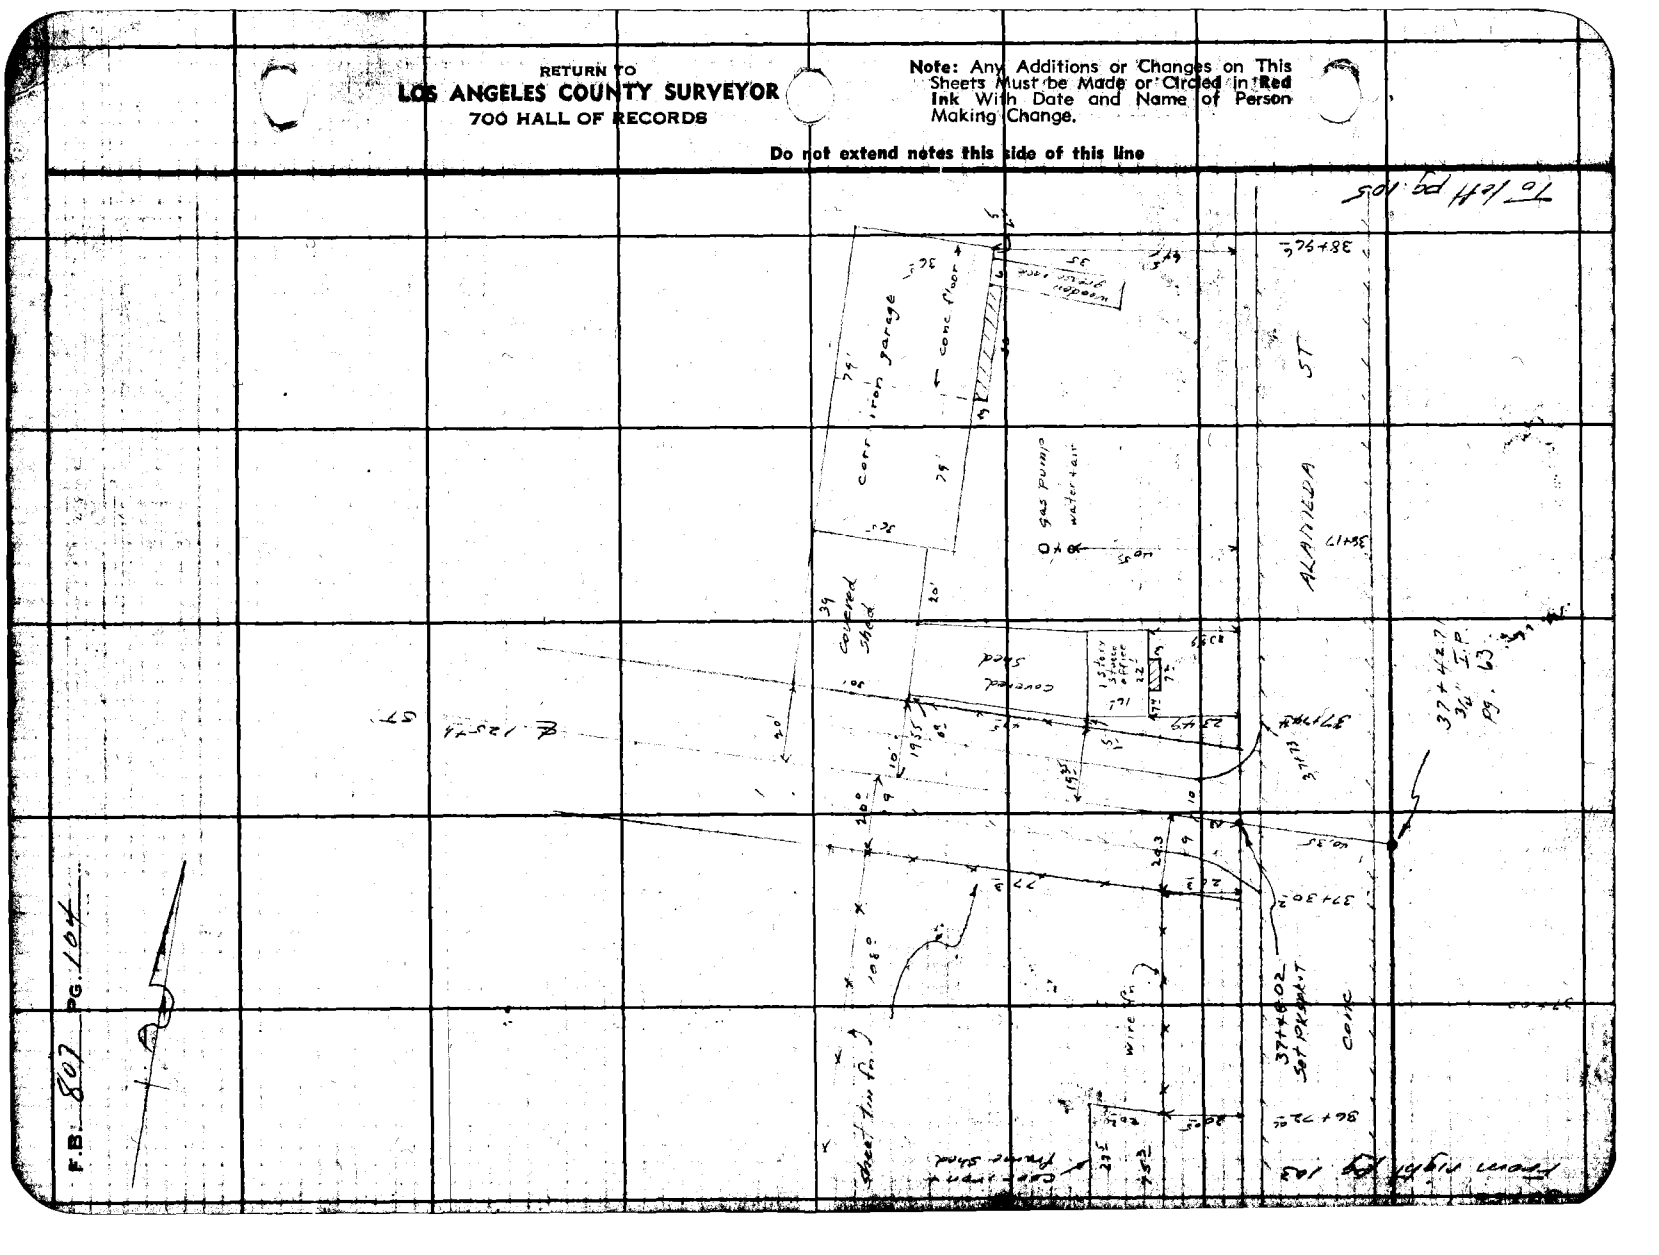

Notes Ck'd by D. M. Finley	Survey of Alameda St.	F.B. 807	Pg. 105
[illegible]	[illegible]		
Office Work [illegible]	Surveyed by Moore		
Checked D. M. Finley	Notes Moore Date 11-17-39		
Date Feb 1940	Indexed A. C. Johnson		

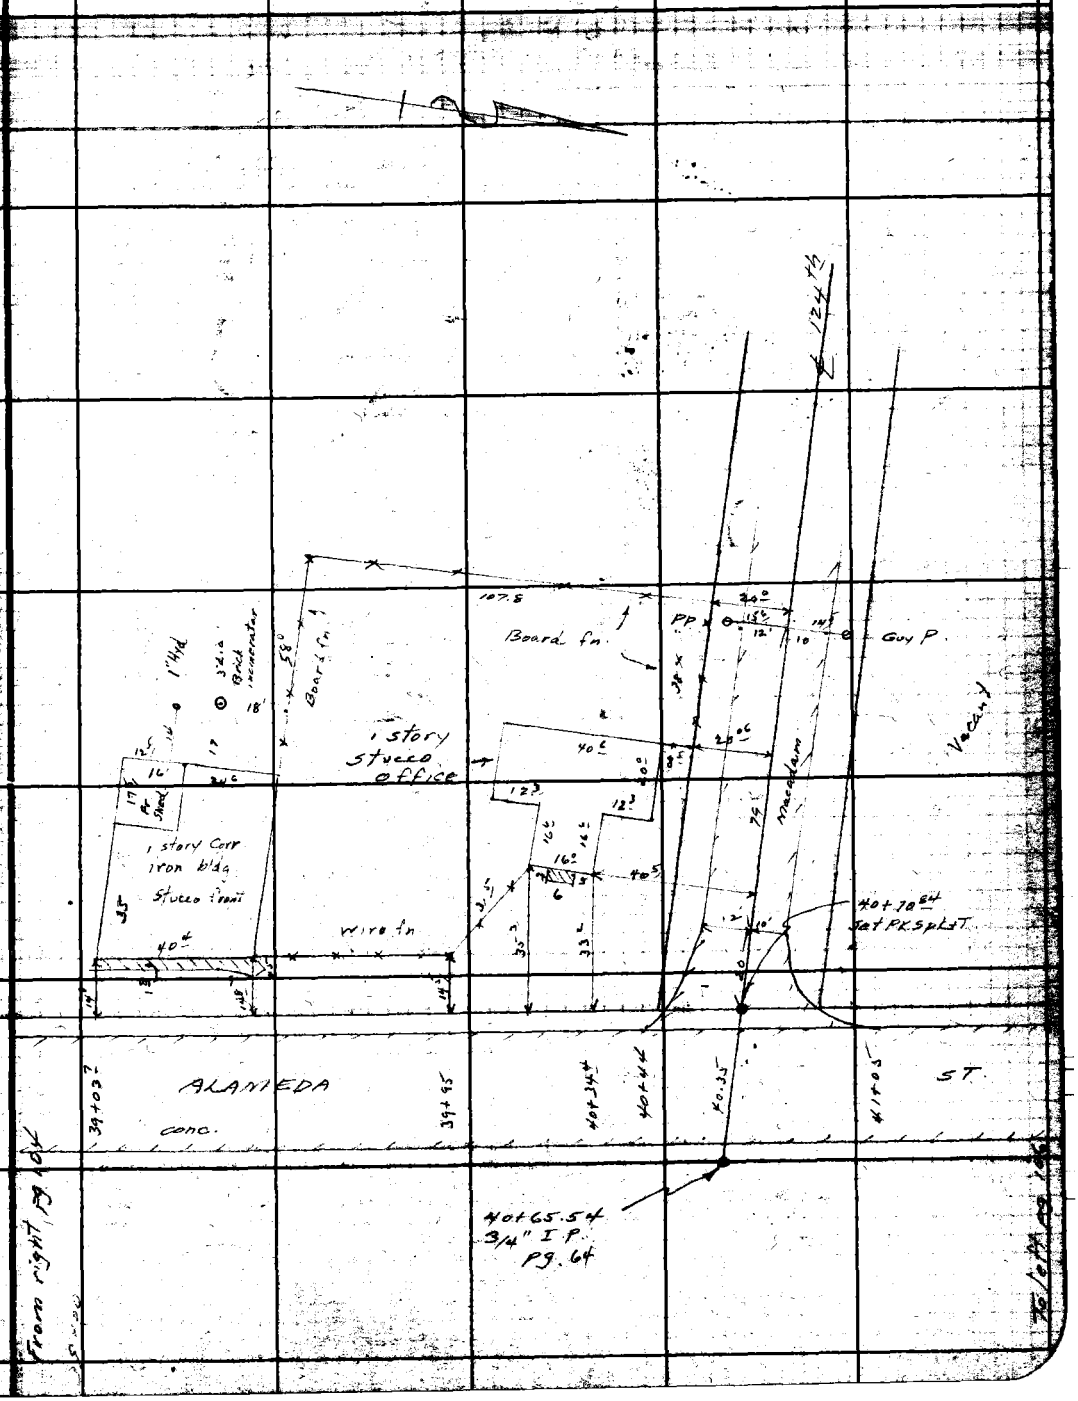

Note: Any Additions or Changes on Sheets Must be Made or Circled in Ink With Date and Name of Person Making Change.

Do not extend notes this side of this line

RETURN TO
LOS ANGELES COUNTY SURVEYOR
700 HALL OF RECORDS

FORM 247 5M 10-37

RETURN TO
LOS ANGELES COUNTY SURVEYOR
700 HALL OF RECORDS

Note: Any Additions or Changes on This Sheets Must be Made or Circled in **Red** Ink With Date and Name of Person Making Change.

Do not extend notes this side of this line

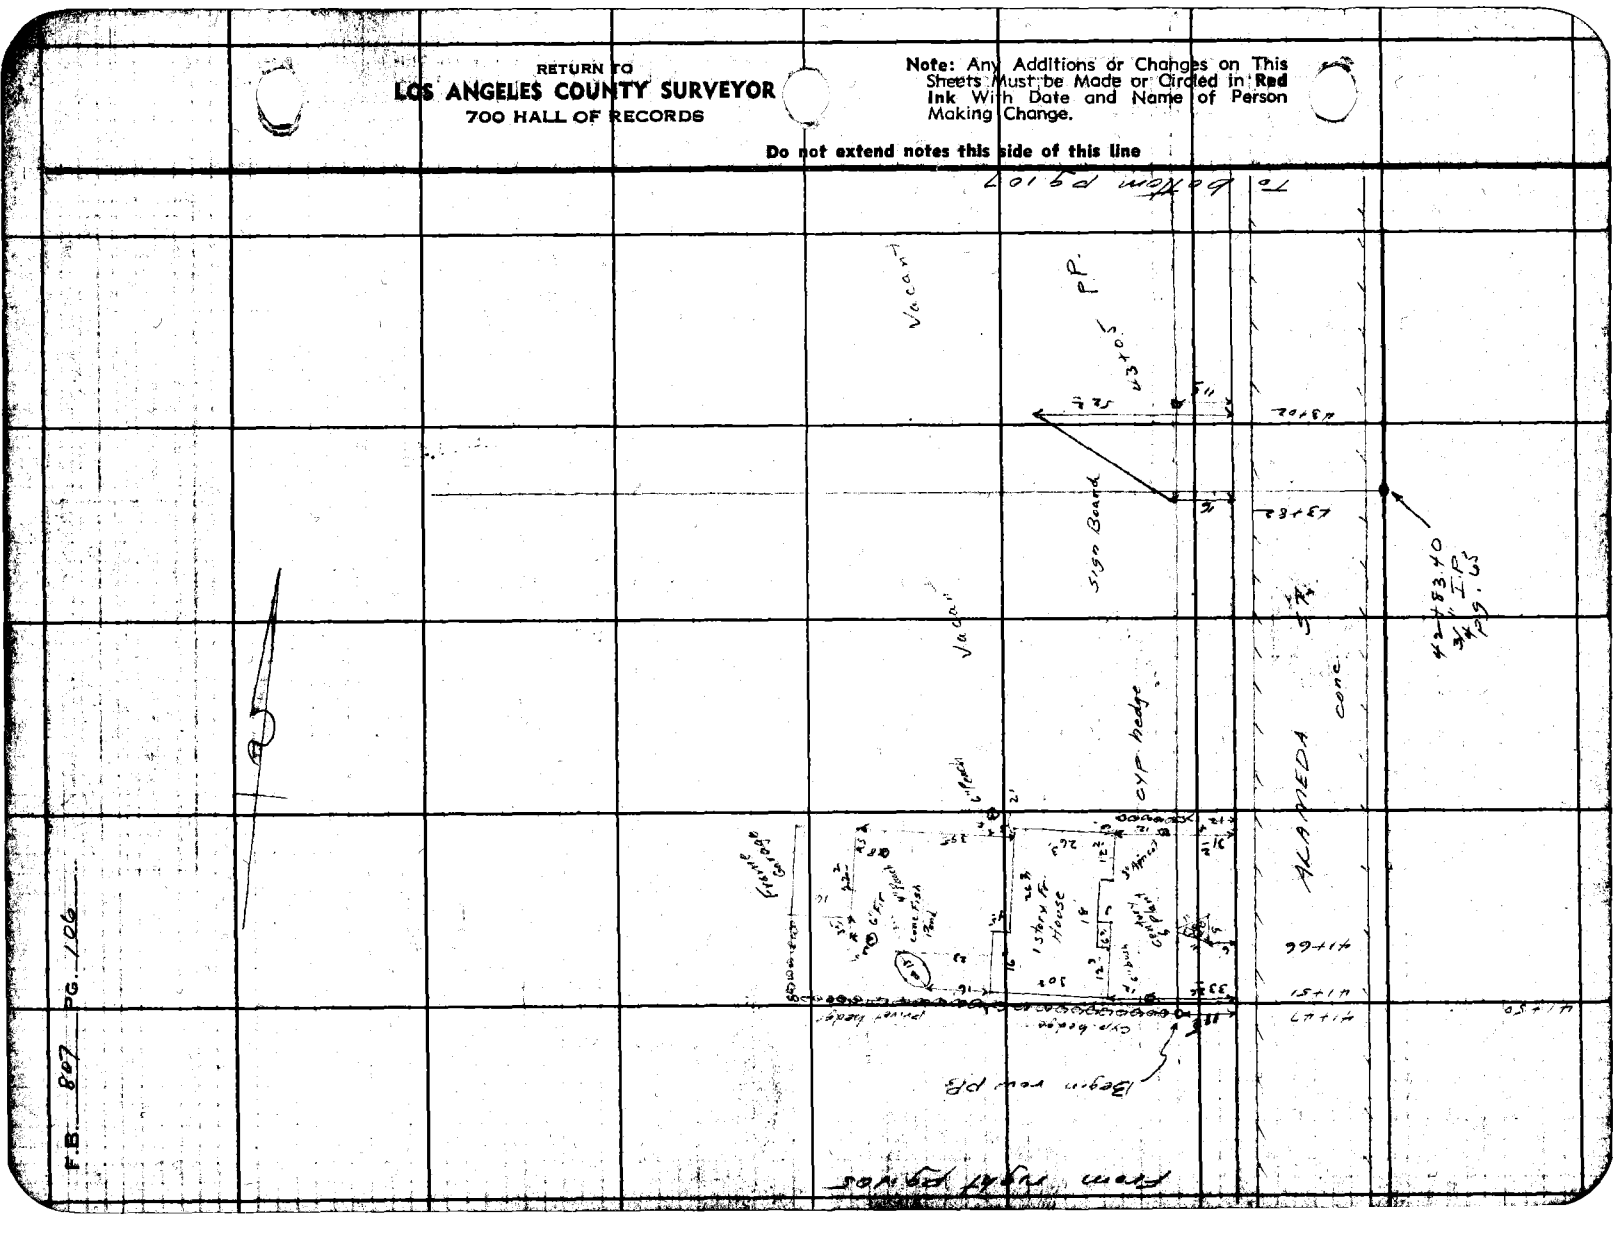


Notes Ck'd by D. M. Finley | Survey of Alameda St | F.B. 807 | Pg. 109
Map No. [illegible] | [illegible] | Type No. [illegible]
Office Work [illegible] | Surveyed by Moore
Checked D. M. Finley | Notes Moore | Date 11-17-39
Date Feb 1940 | Indexed A. C. Johnson

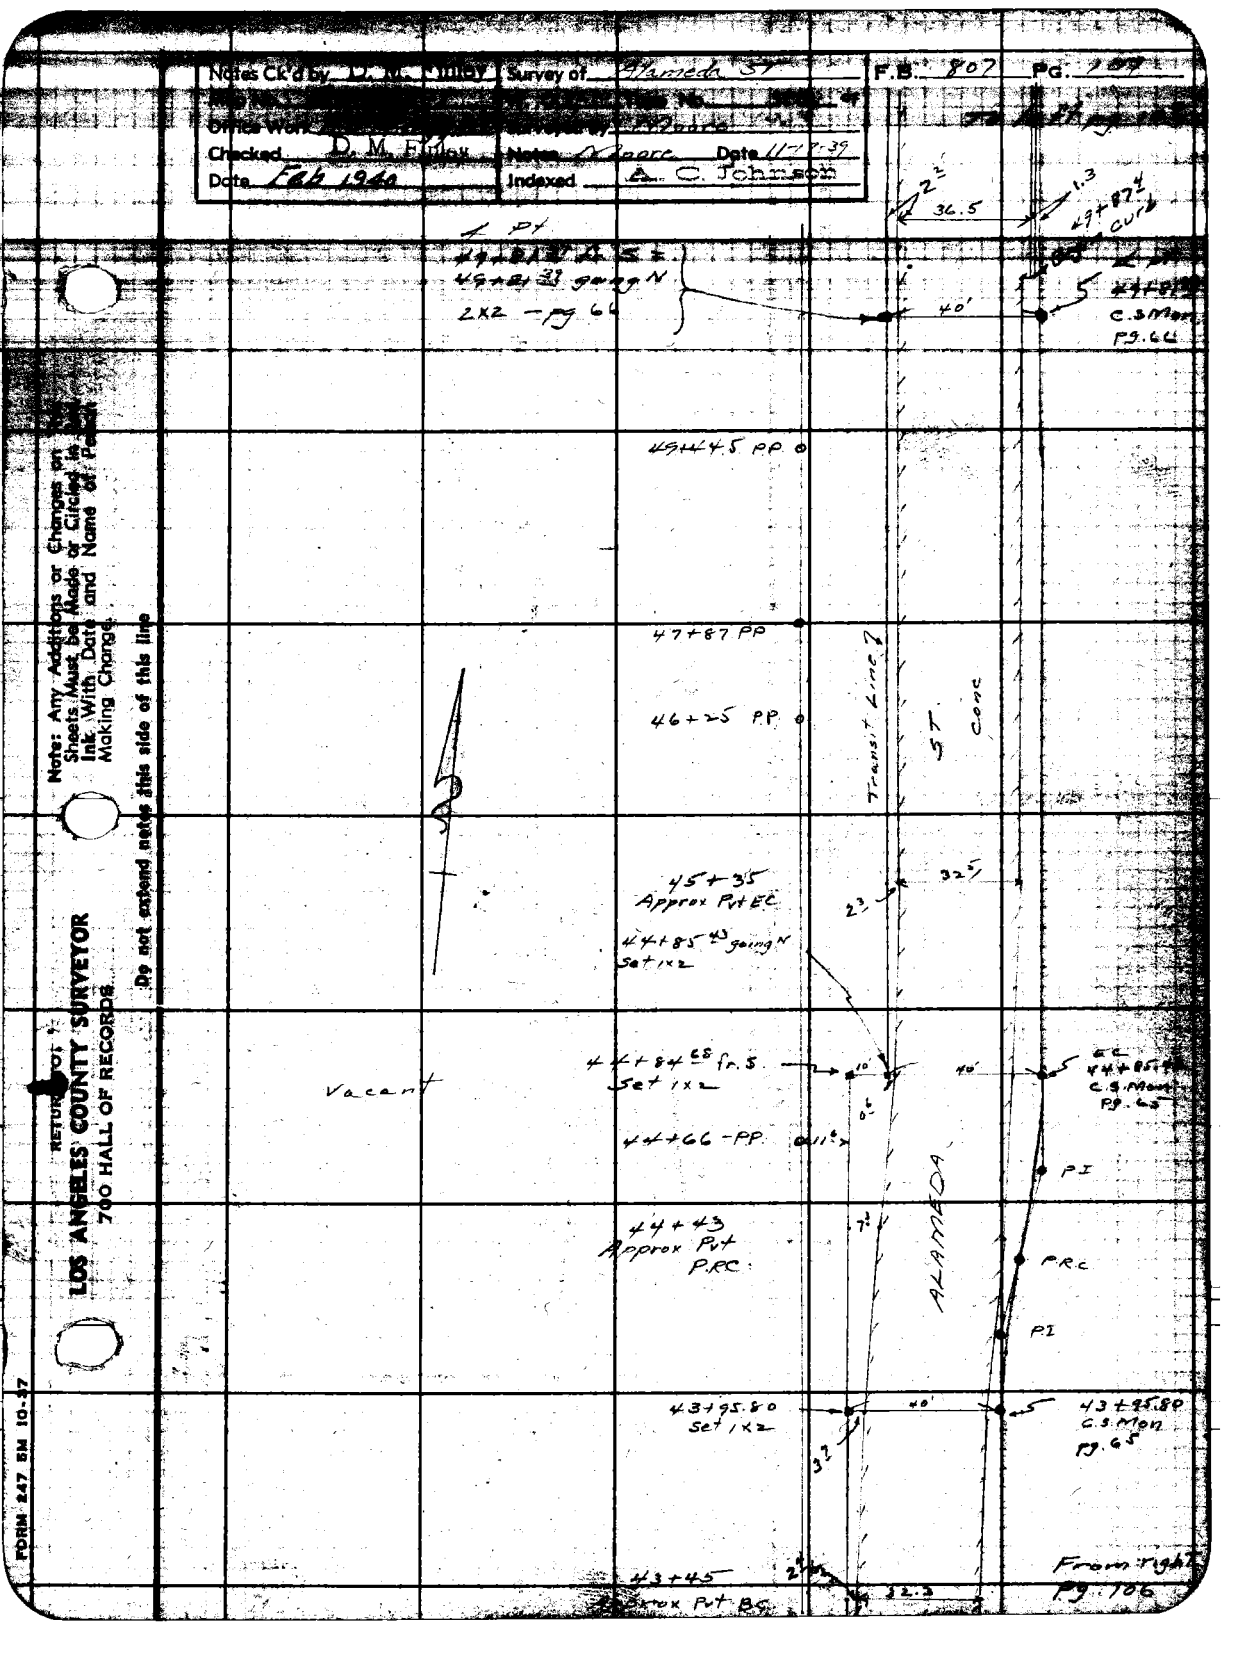

Note: Any Additions or Changes on Sheets Must be Made or Circled in Ink With Date and Name of Person Making Change.

Do not extend notes this side of this line

RETURN TO:
LOS ANGELES COUNTY SURVEYOR
700 HALL OF RECORDS

FORM 247 5M 10-37

RETURN TO
LOS ANGELES COUNTY SURVEYOR
700 HALL OF RECORDS

Note: Any Additions or Changes on This Sheets Must be Made or Circled in **Red Ink** With Date and Name of Person Making Change.

Do not extend notes this side of this line

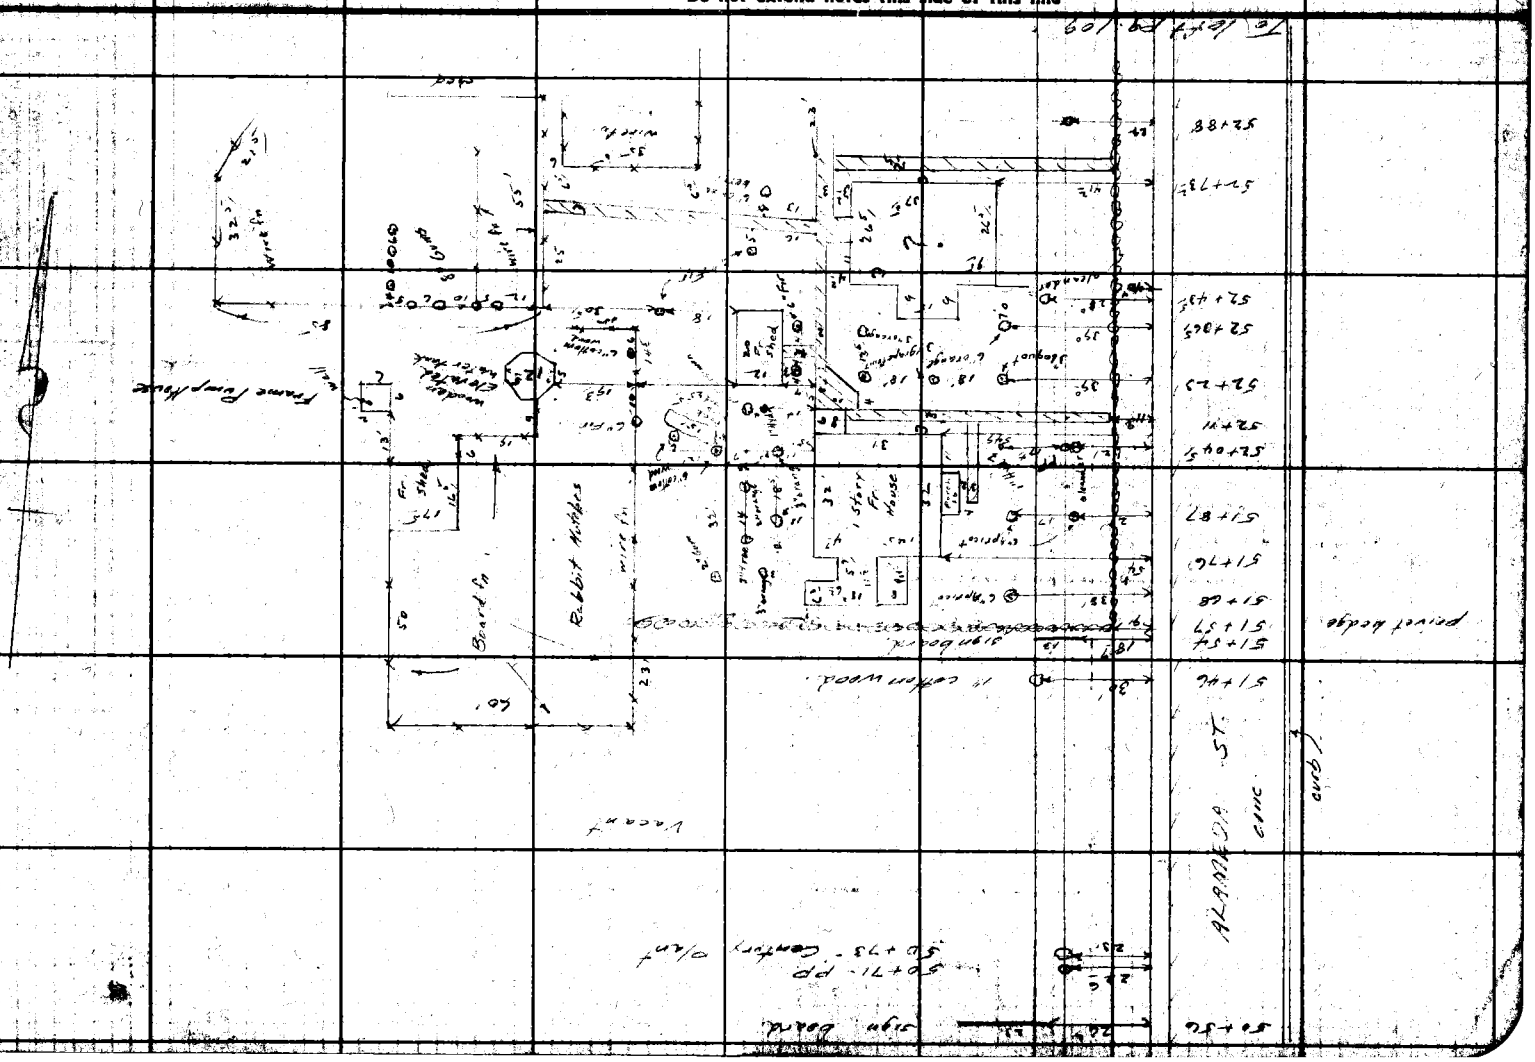

F.B. 887 PG. 108

FORM 247 5M 10-37

RETURN TO
LOS ANGELES COUNTY SURVEYOR
700 HALL OF RECORDS

Note: Any Additions or Changes Sheets Must be Made or Circled Ink With Date and Name of Making Change

Do not extend notes this side of this line

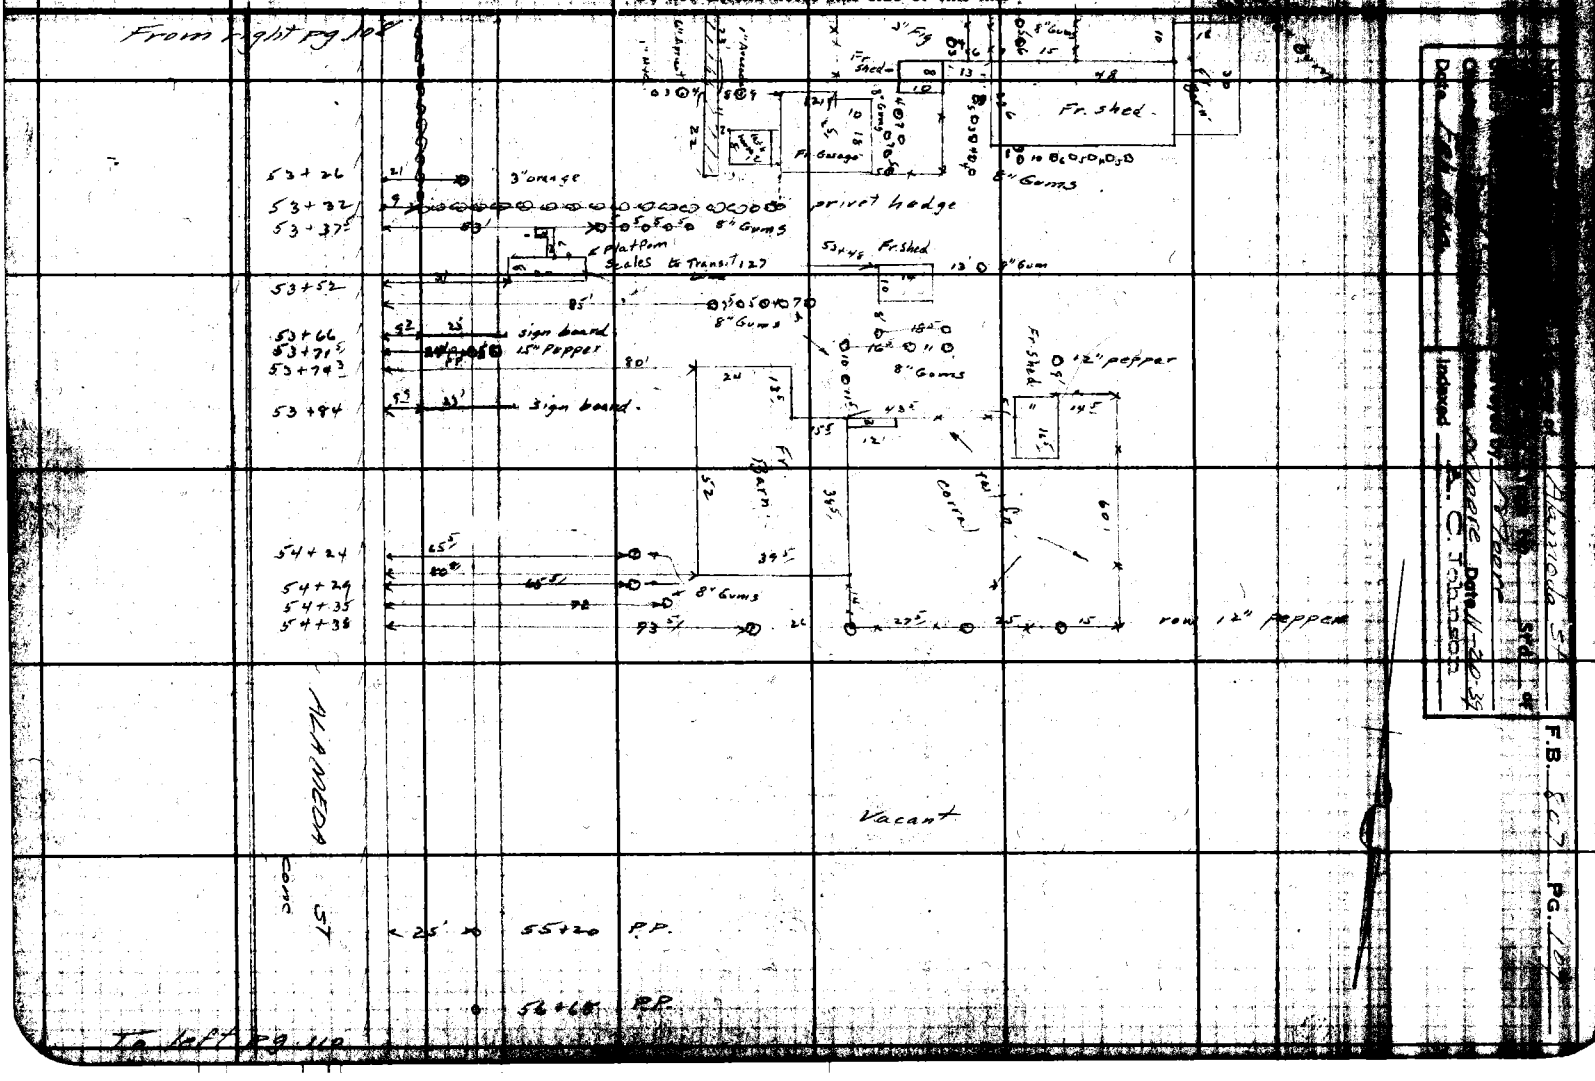

RETURN TO
LOS ANGELES COUNTY SURVEYOR
700 HALL OF RECORDS

Note: Any Additions or Changes on This Sheets Must be Made or Circled In **Red Ink** With Date and Name of Person Making Change.

Do not extend notes this side of this line

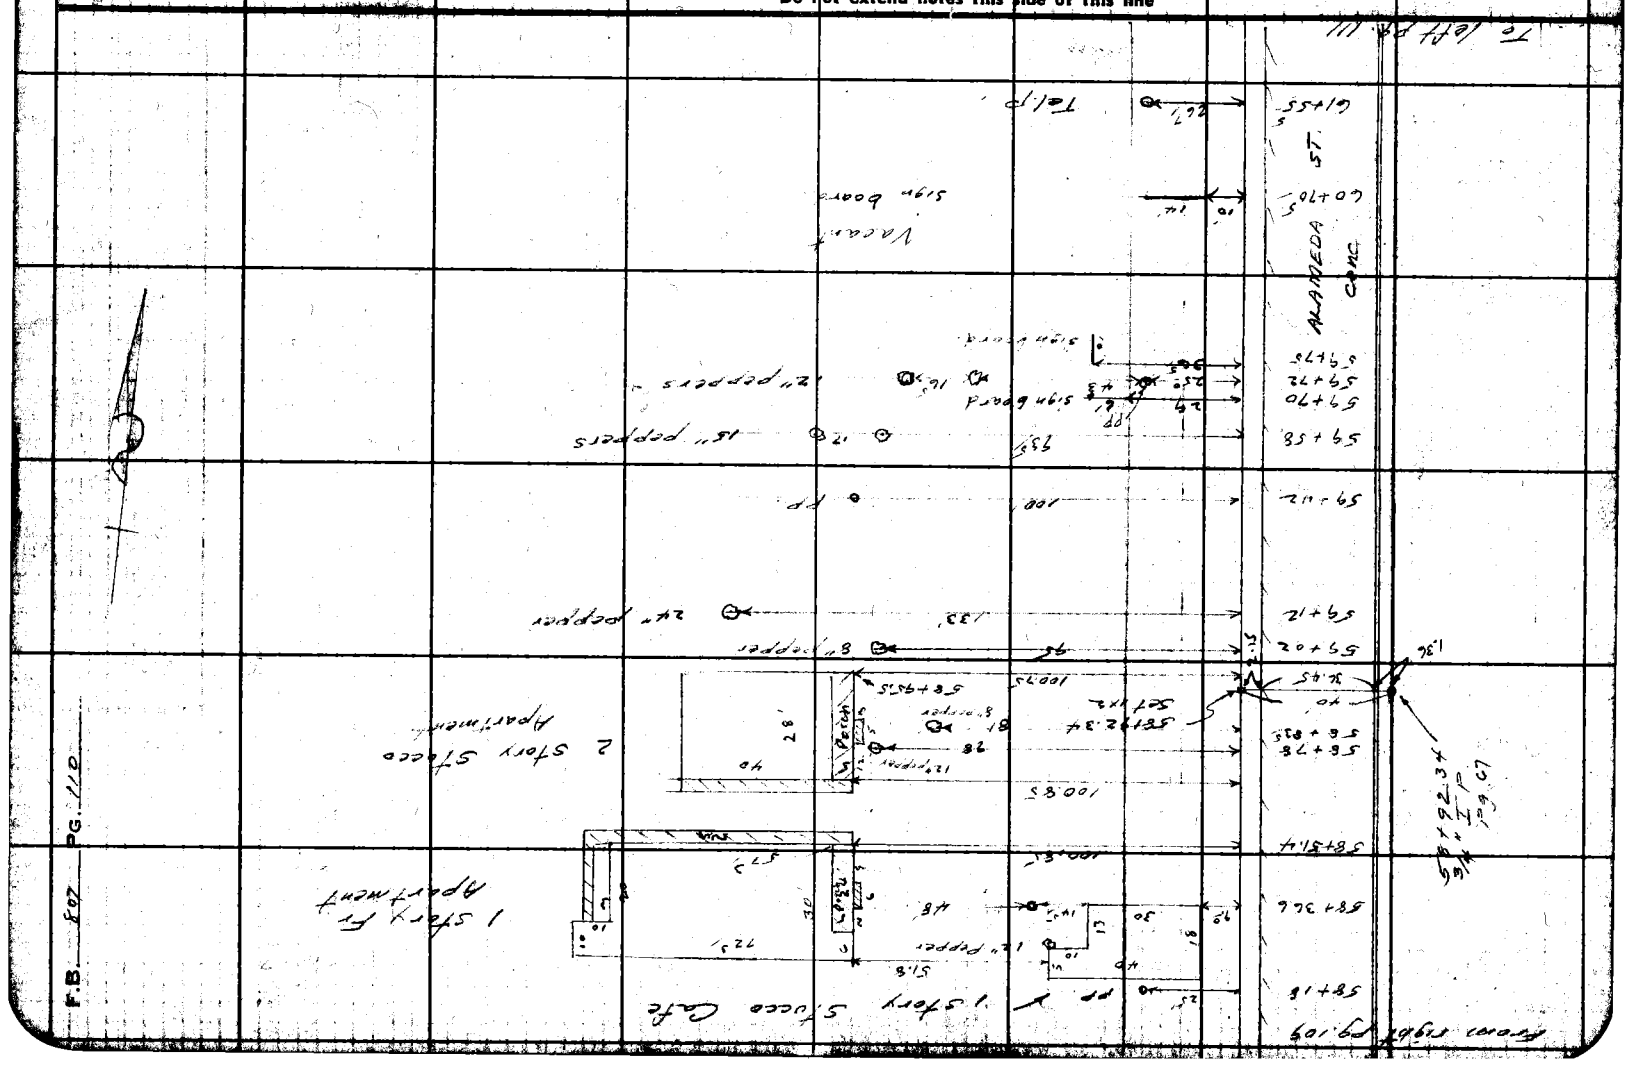

RETURN TO
LOS ANGELES COUNTY SURVEYOR
700 HALL OF RECORDS

Note: Any Additions or Changes on Sheets Must be Made or Circled in Ink With Date and Name of Person Making Change.

Do not extend notes this side of this line

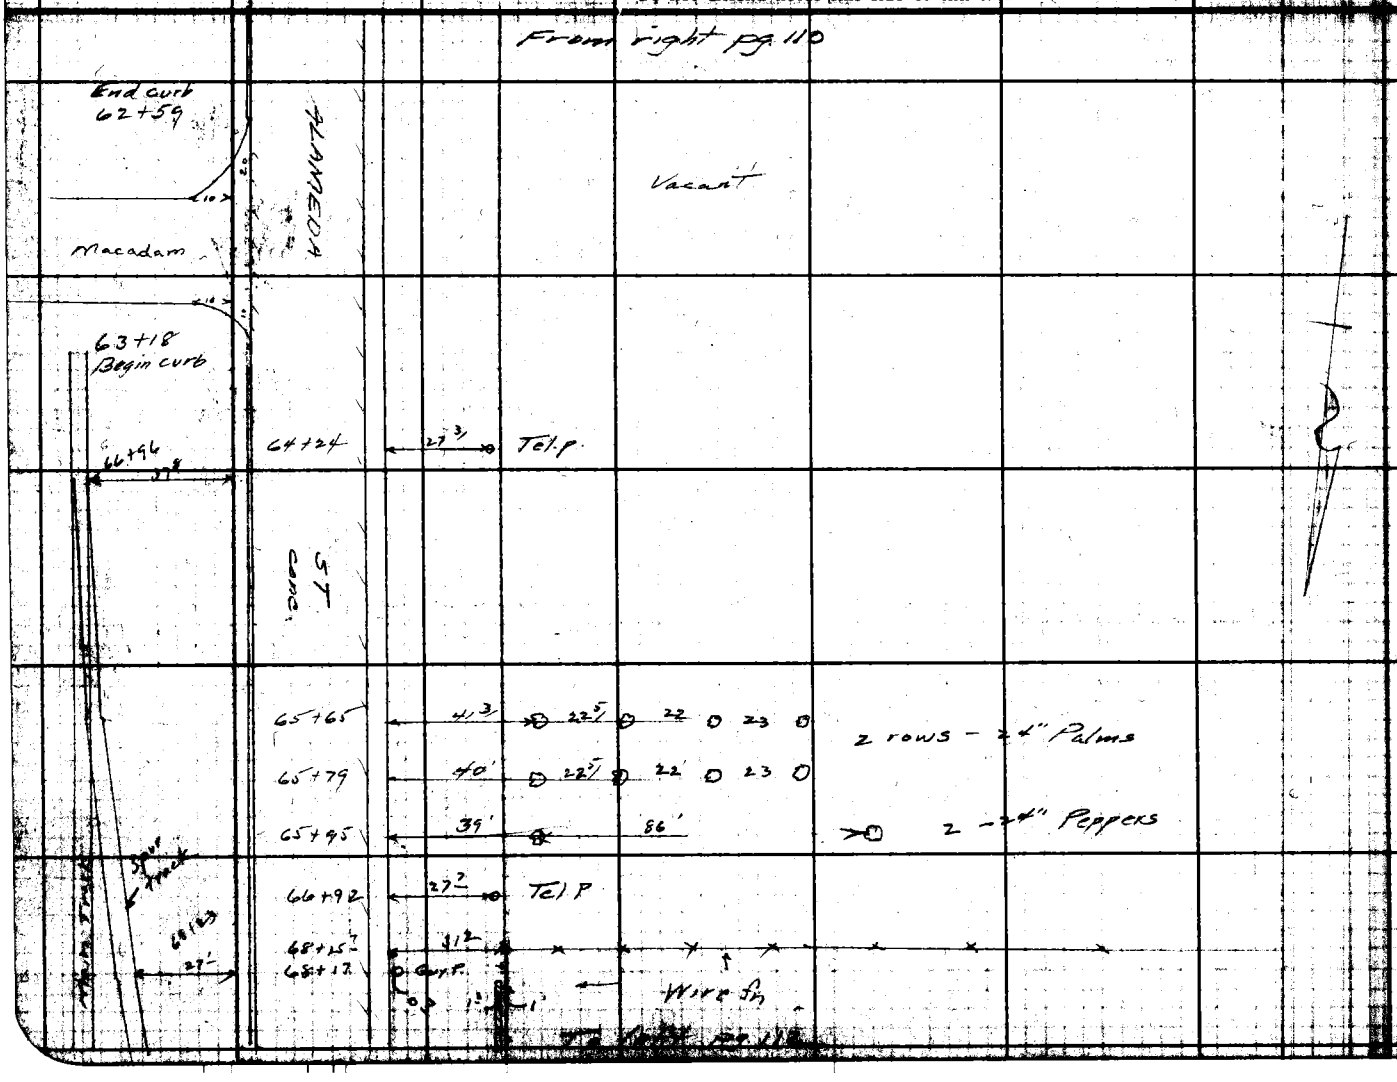

Notes Ck'd by
Map No.
Office Work
Checked
Date Feb 1946
Survey of Alameda St
Tech No. Std. of
Surveyed by Moore
Notes Moore Date 11-20-39
Indexed C. Johnson

F.B. 807 PG. 111

F.B. 807 PG. 112

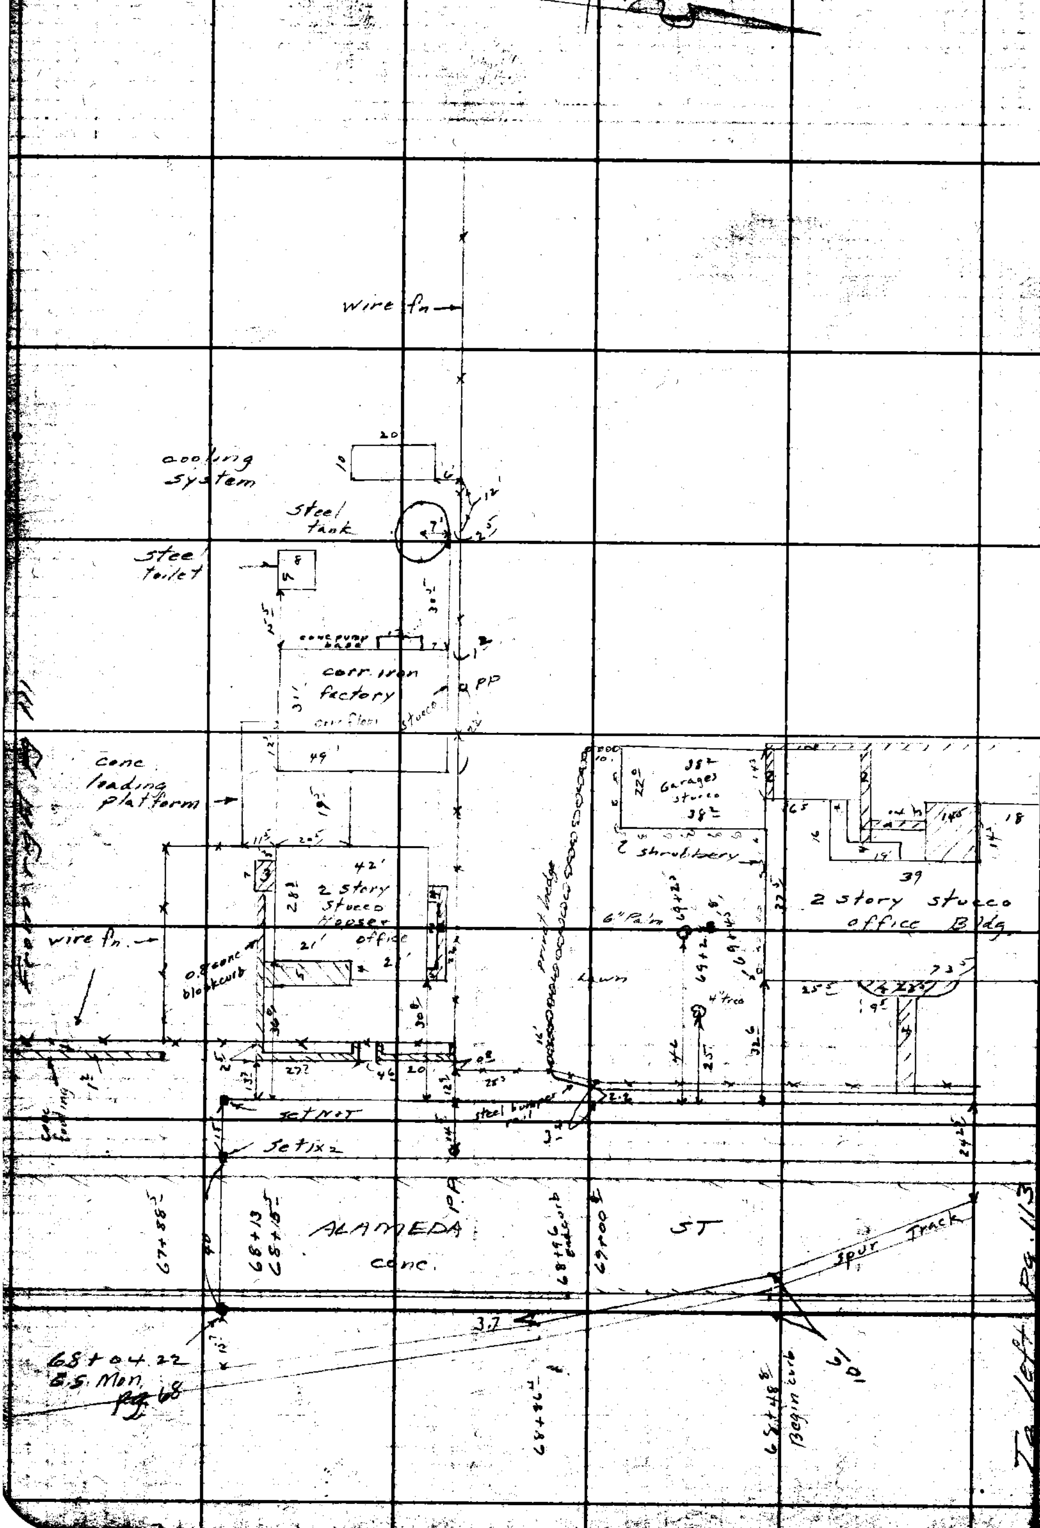

RETURN TO
LOS ANGELES COUNTY SURVEYOR
700 HALL OF RECORDS

Note: Any Additions or Changes on This Sheet Must be Made or Circled in Red Ink With Date and Name of Person Making Change.

Do not extend notes this side of this line

Form 247 SM 10-37

RETURN TO
LOS ANGELES COUNTY SURVEYOR
700 HALL OF RECORDS

Note: Any Additions or Changes on Sheets Must be Made or Circled in Ink With Date and Name of Making Change.

Do not extend notes this side of this line

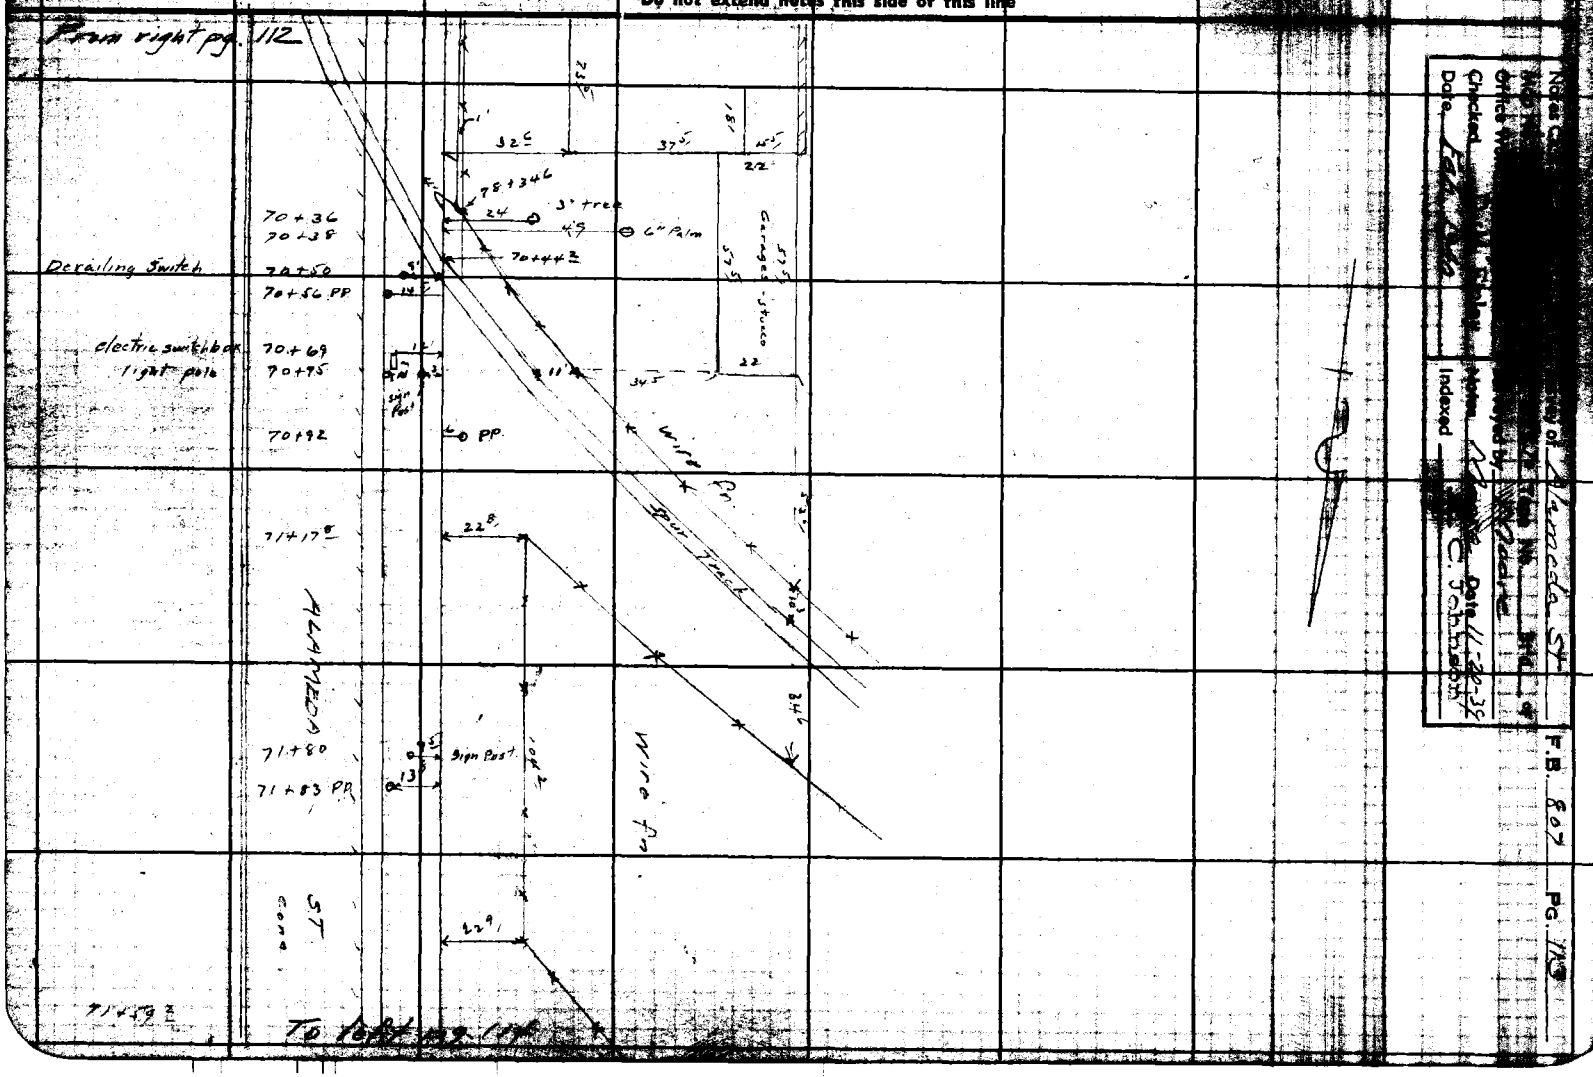

RETURN TO
LOS ANGELES COUNTY SURVEYOR
700 HALL OF RECORDS

Note: Any Additions or Changes on This Sheets Must be Made or Circled in **Red Ink** With Date and Name of Person Making Change.

Do not extend notes this side of this line

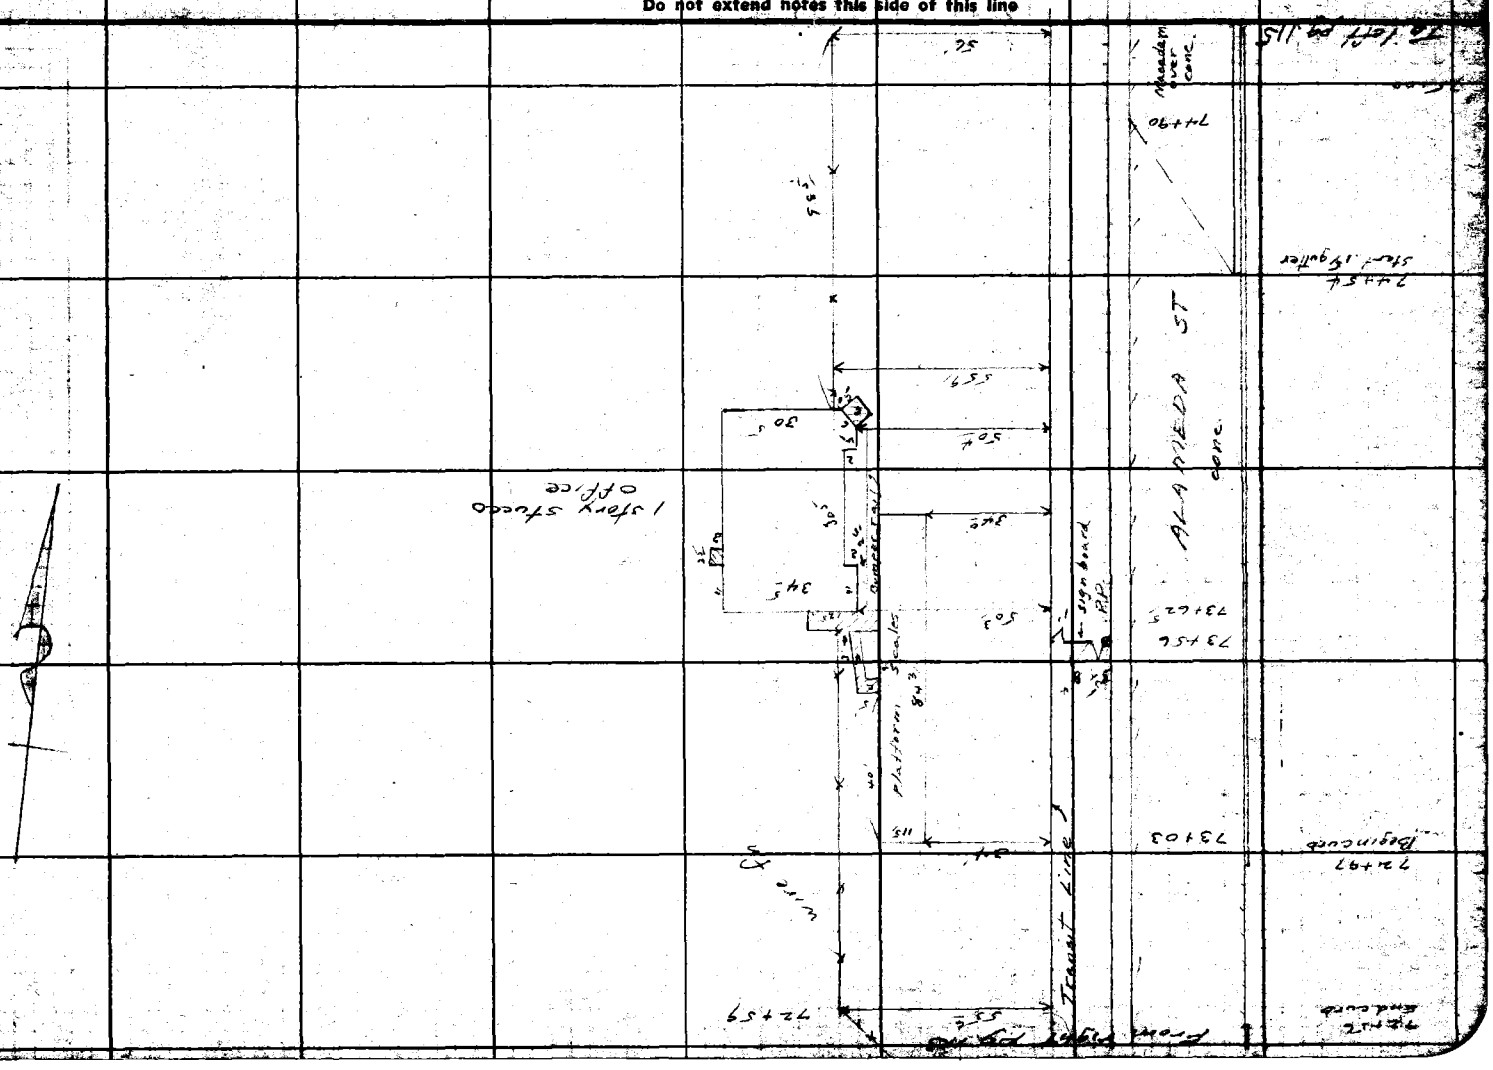

FORM 247 5M 10-37

RETURN TO
LOS ANGELES COUNTY SURVEYOR
700 HALL OF RECORDS

Note: Any Additions or Changes on Sheets Must be Made or Circled in Ink With Date and Name of Making Change.

Do not extend notes this side of this line

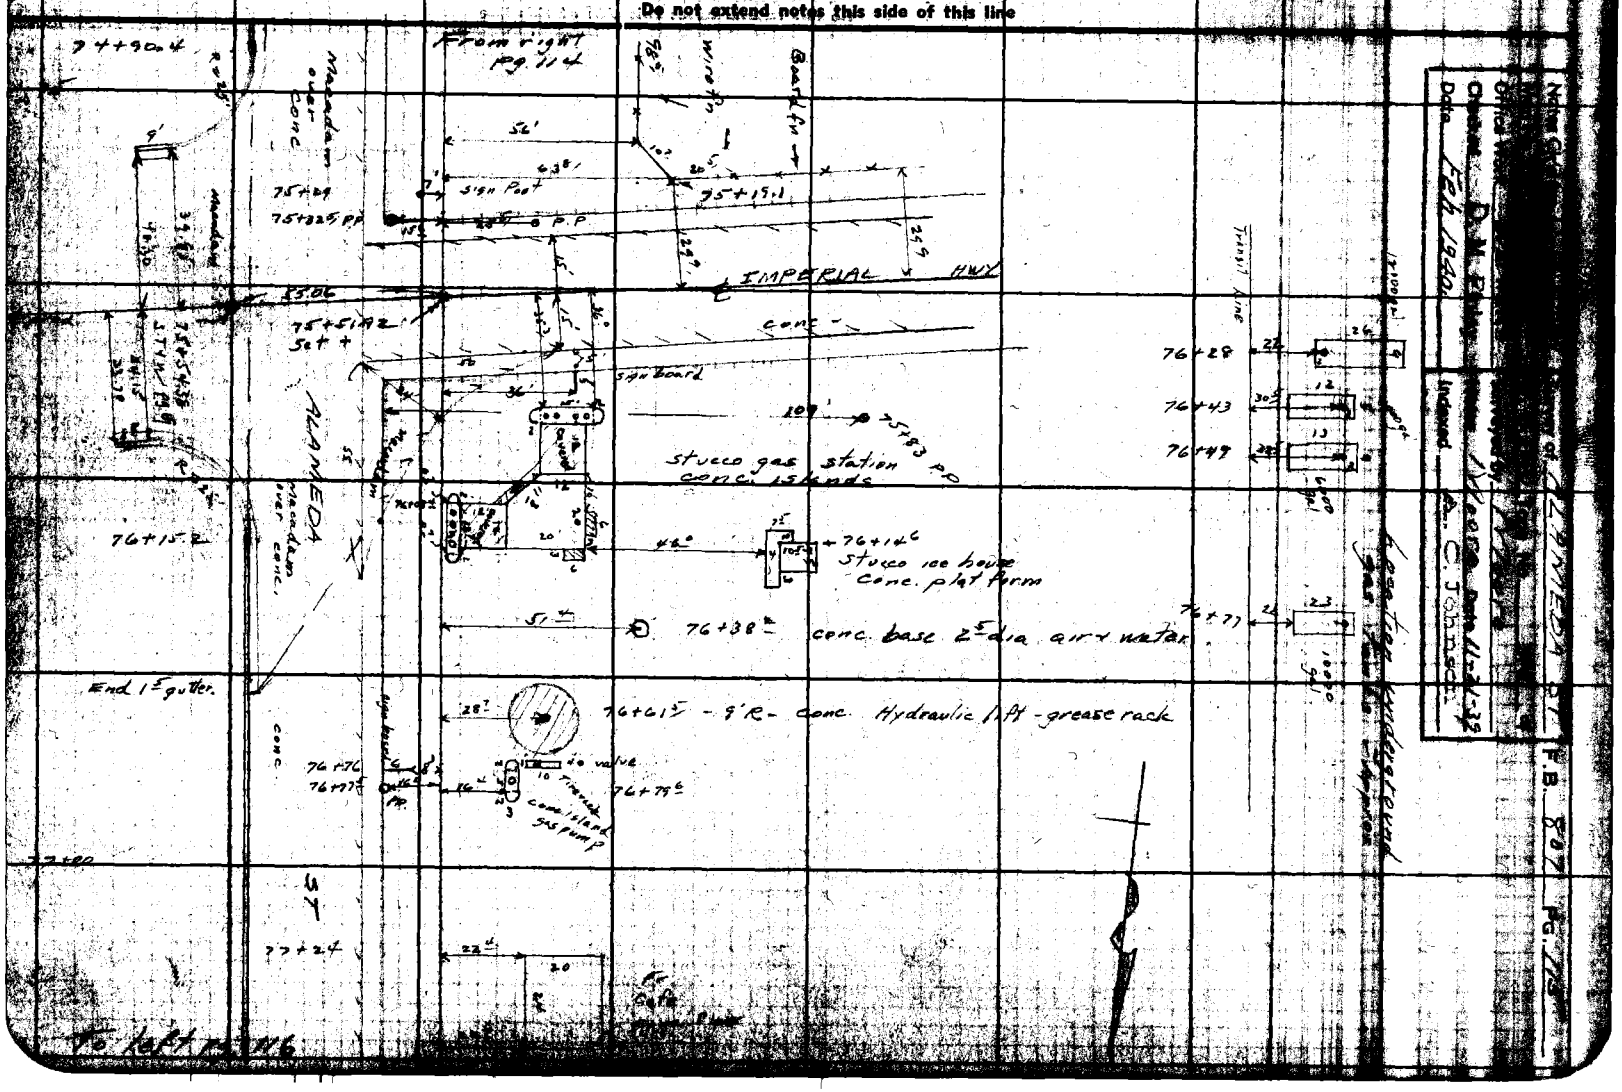

RETURN TO
LOS ANGELES COUNTY SURVEYOR
700 HALL OF RECORDS

Note: Any Additions or Changes on This Sheets Must be Made or Circled In **Red Ink** With Date and Name of Person Making Change.

Do not extend notes this side of this line

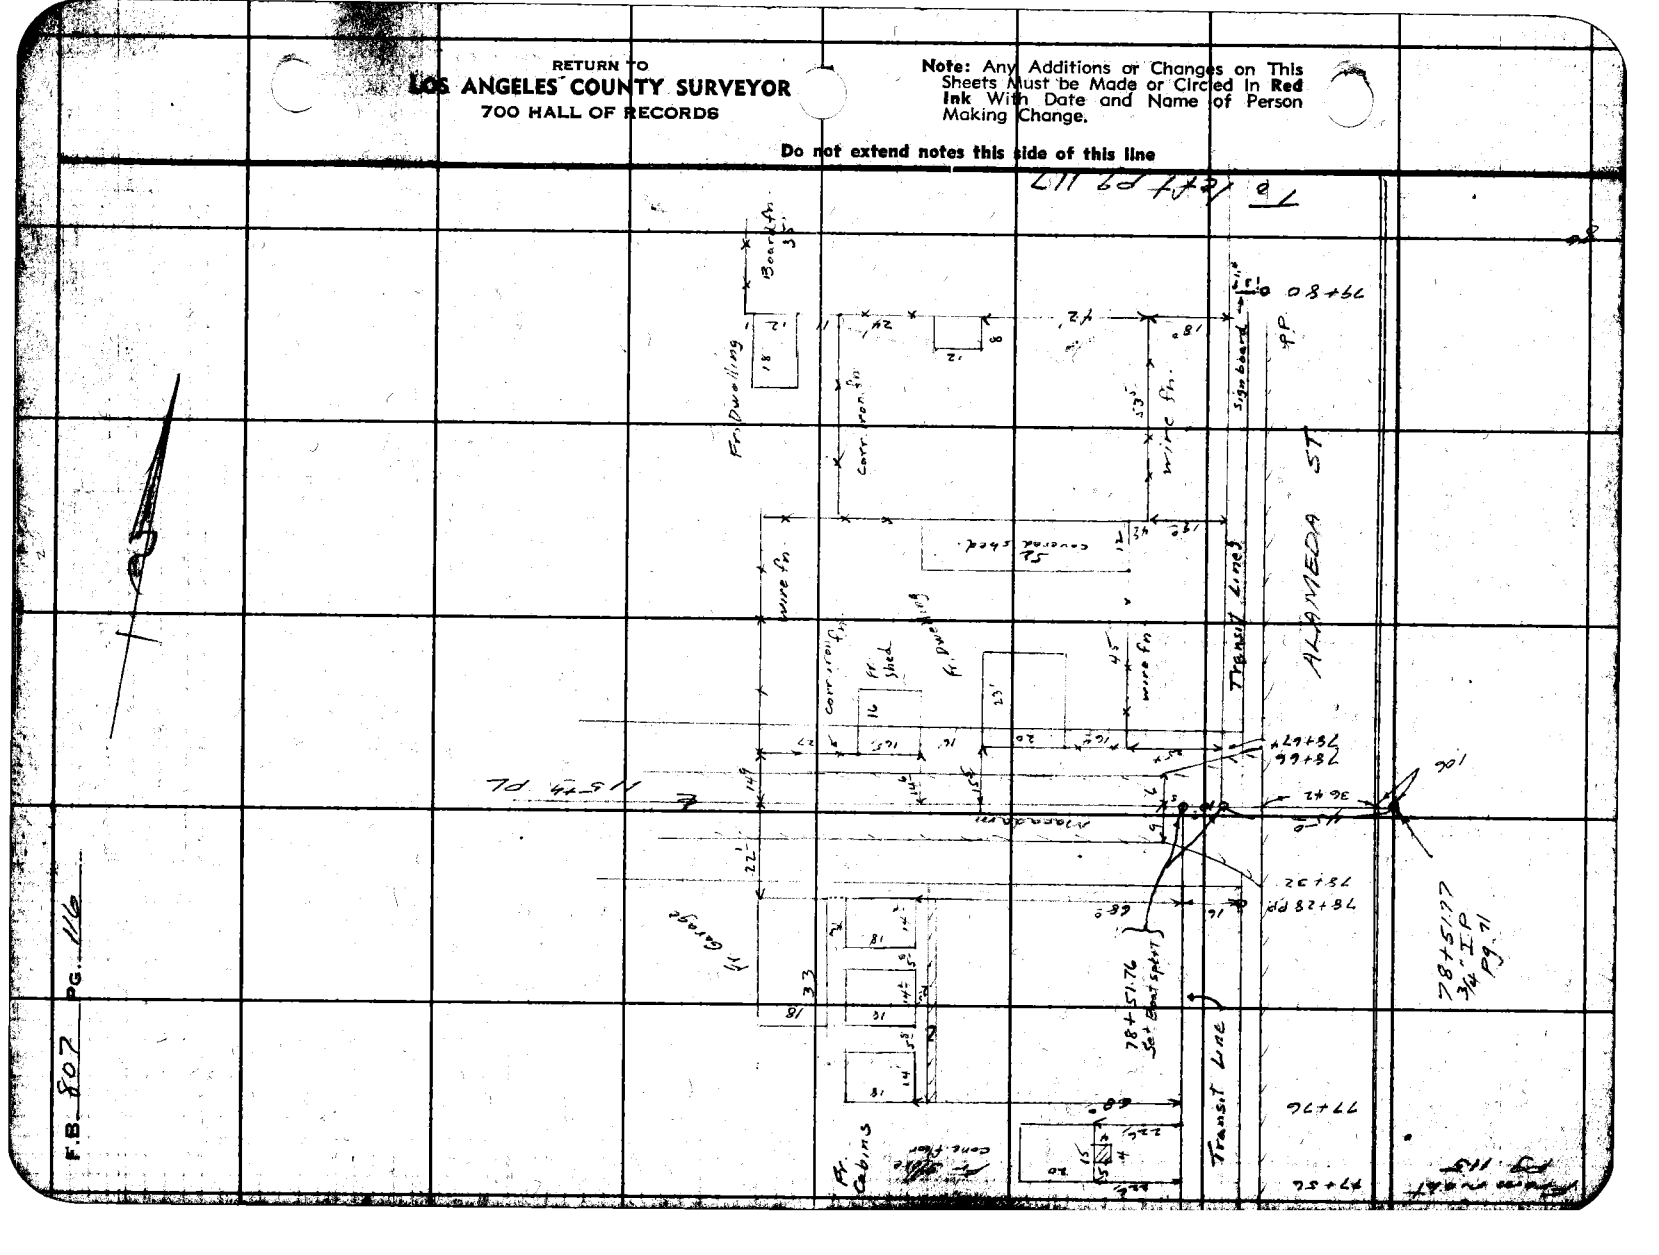

F.B. 807 PG. 116

FORM 247 5M 10-37

RETURN TO
LOS ANGELES COUNTY SURVEYOR
700 HALL OF RECORDS

Note: Any Additions or Changes on This Sheets Must be Made or Circled in Ink With Date and Name of Person Making Change.

Do not extend notes this side of this line

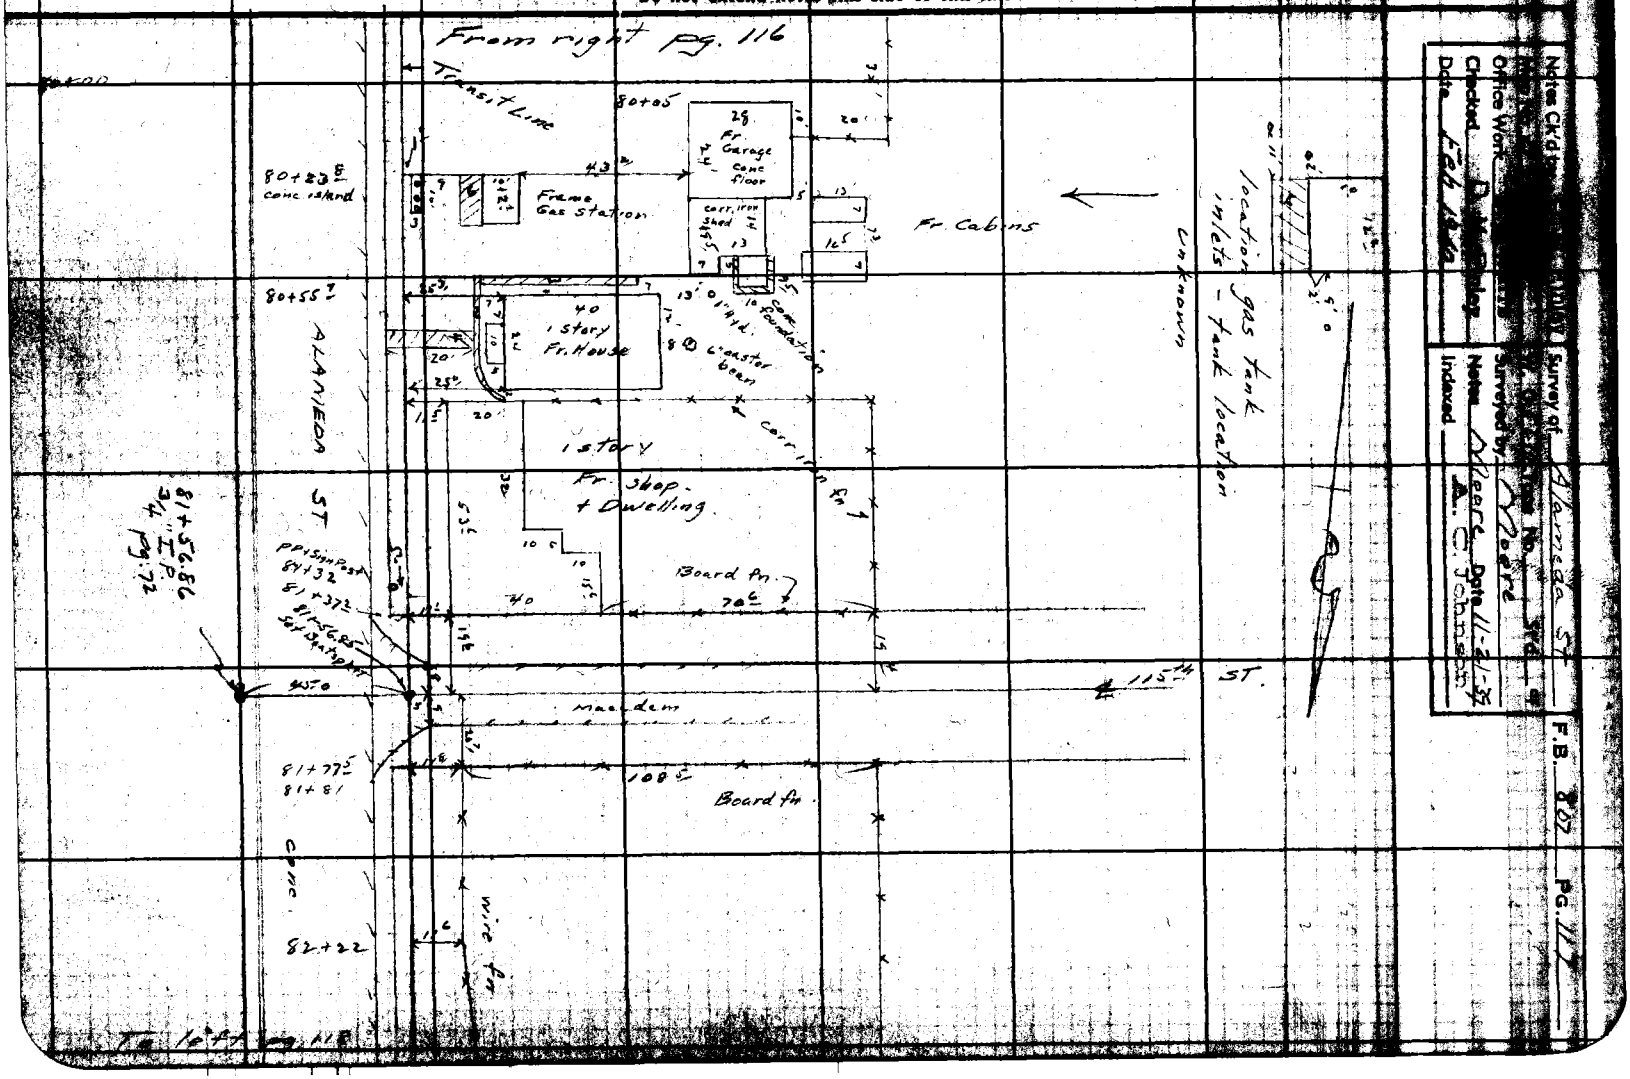

RETURN TO
LOS ANGELES COUNTY SURVEYOR
700 HALL OF RECORDS

Note: Any Additions or Changes on This Sheets Must be Made or Circled in **Red Ink** With Date and Name of Person Making Change.

Do not extend notes this side of this line

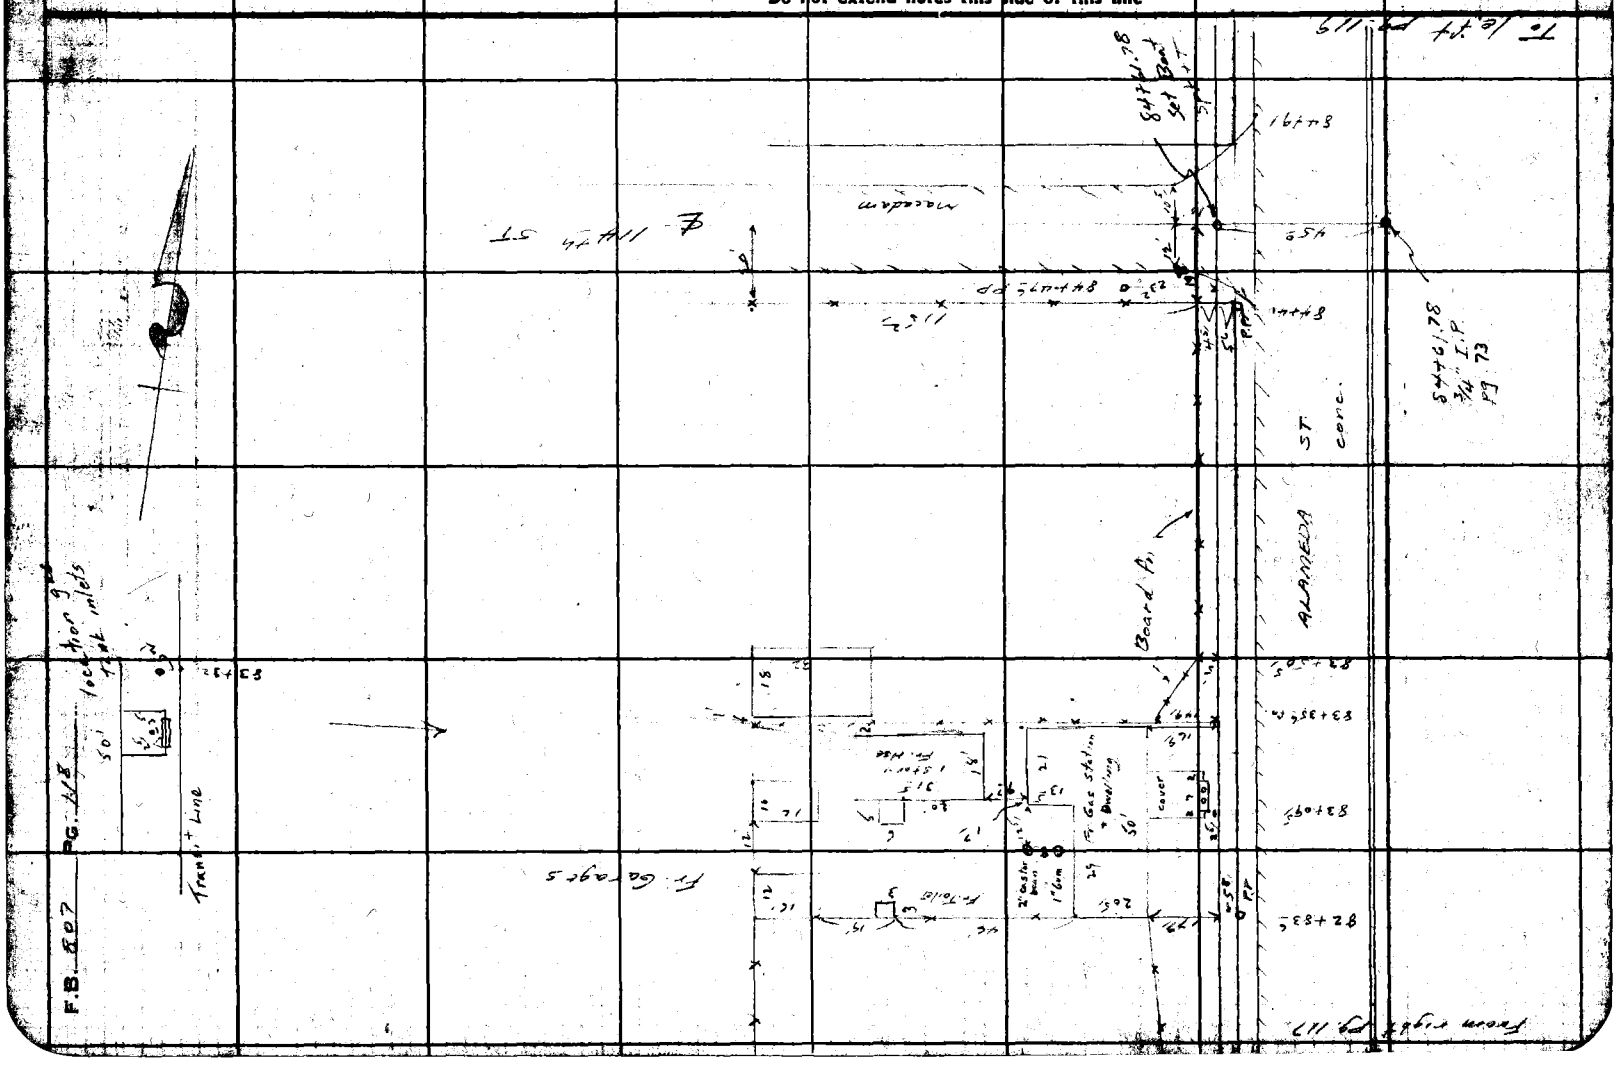

Notes Ch'd by D. M. Finley	Survey of Alameda St	F.B. 807	Pg. 119
Map No.	W. O. 1270 Tape No. Std. of		
Office Work D. A. WHITE	Surveyed by Moore		
Checked D. M. Finley	Notes Moore Date 11-21-39		
Date Feb 1940	Indexed A. C. Johnson		

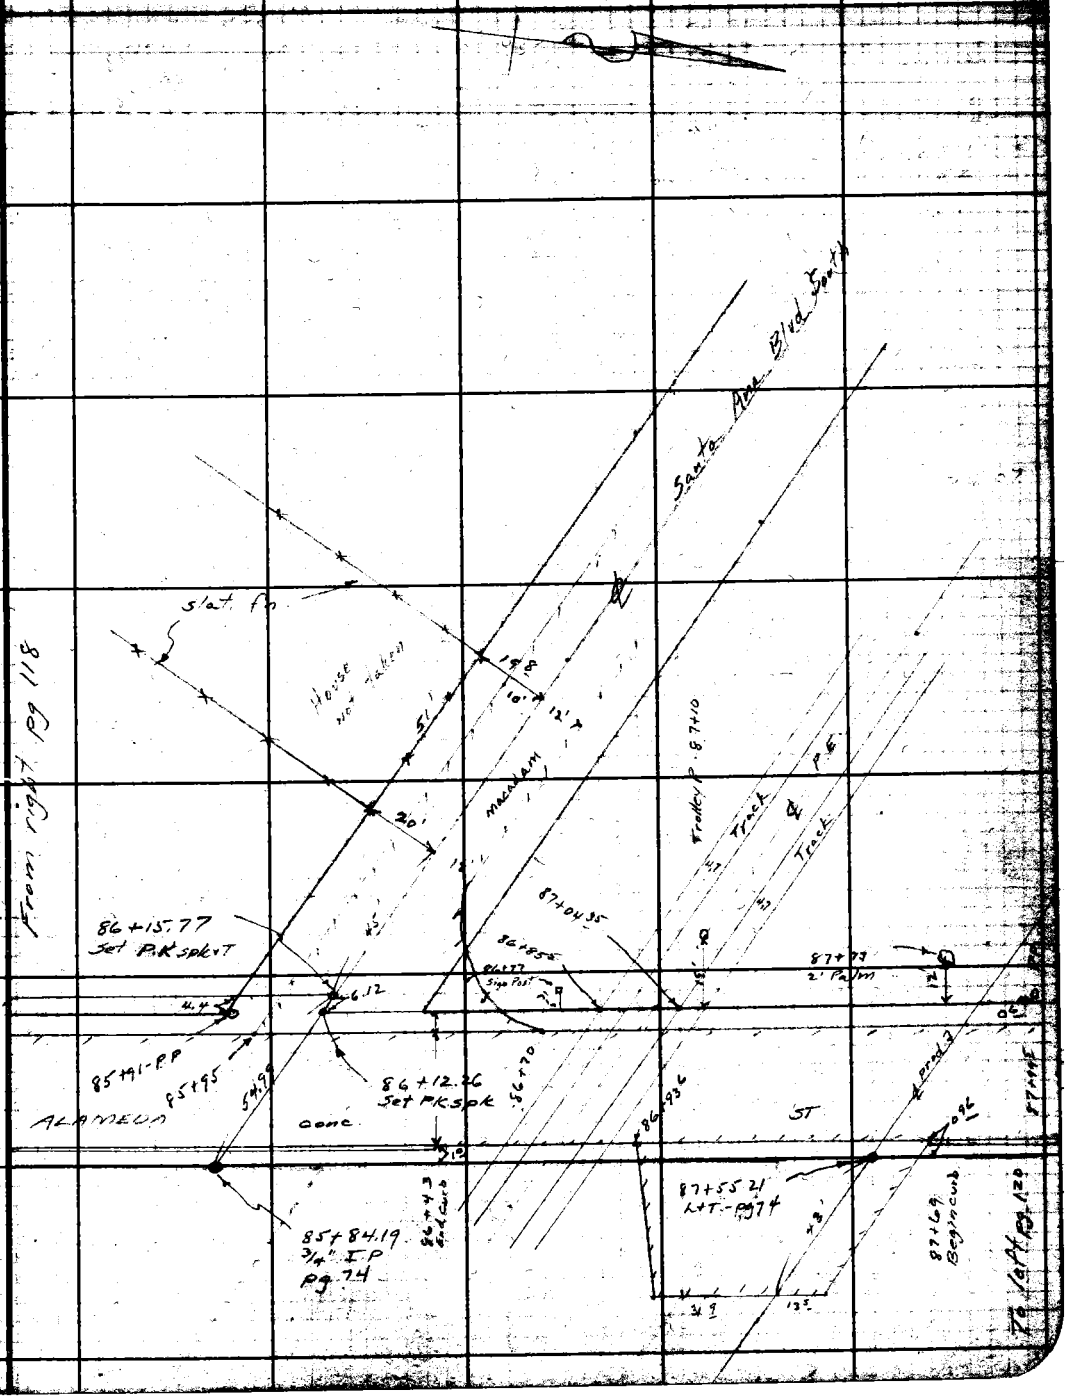

Note: Any Additions or Changes on This Sheets Must be Made or Circled in Red Ink With Date and Name of Person Making Change.

Do not extend notes this side of this line

RETURN TO
LOS ANGELES COUNTY SURVEYOR
700 HALL OF RECORDS

FORM 247 5M 10-37

RETURN TO
LOS ANGELES COUNTY SURVEYOR
700 HALL OF RECORDS

Note: Any Additions or Changes on This Sheets Must be Made or Circled In **Red Ink** With Date and Name of Person Making Change.

Do not extend notes this side of this line

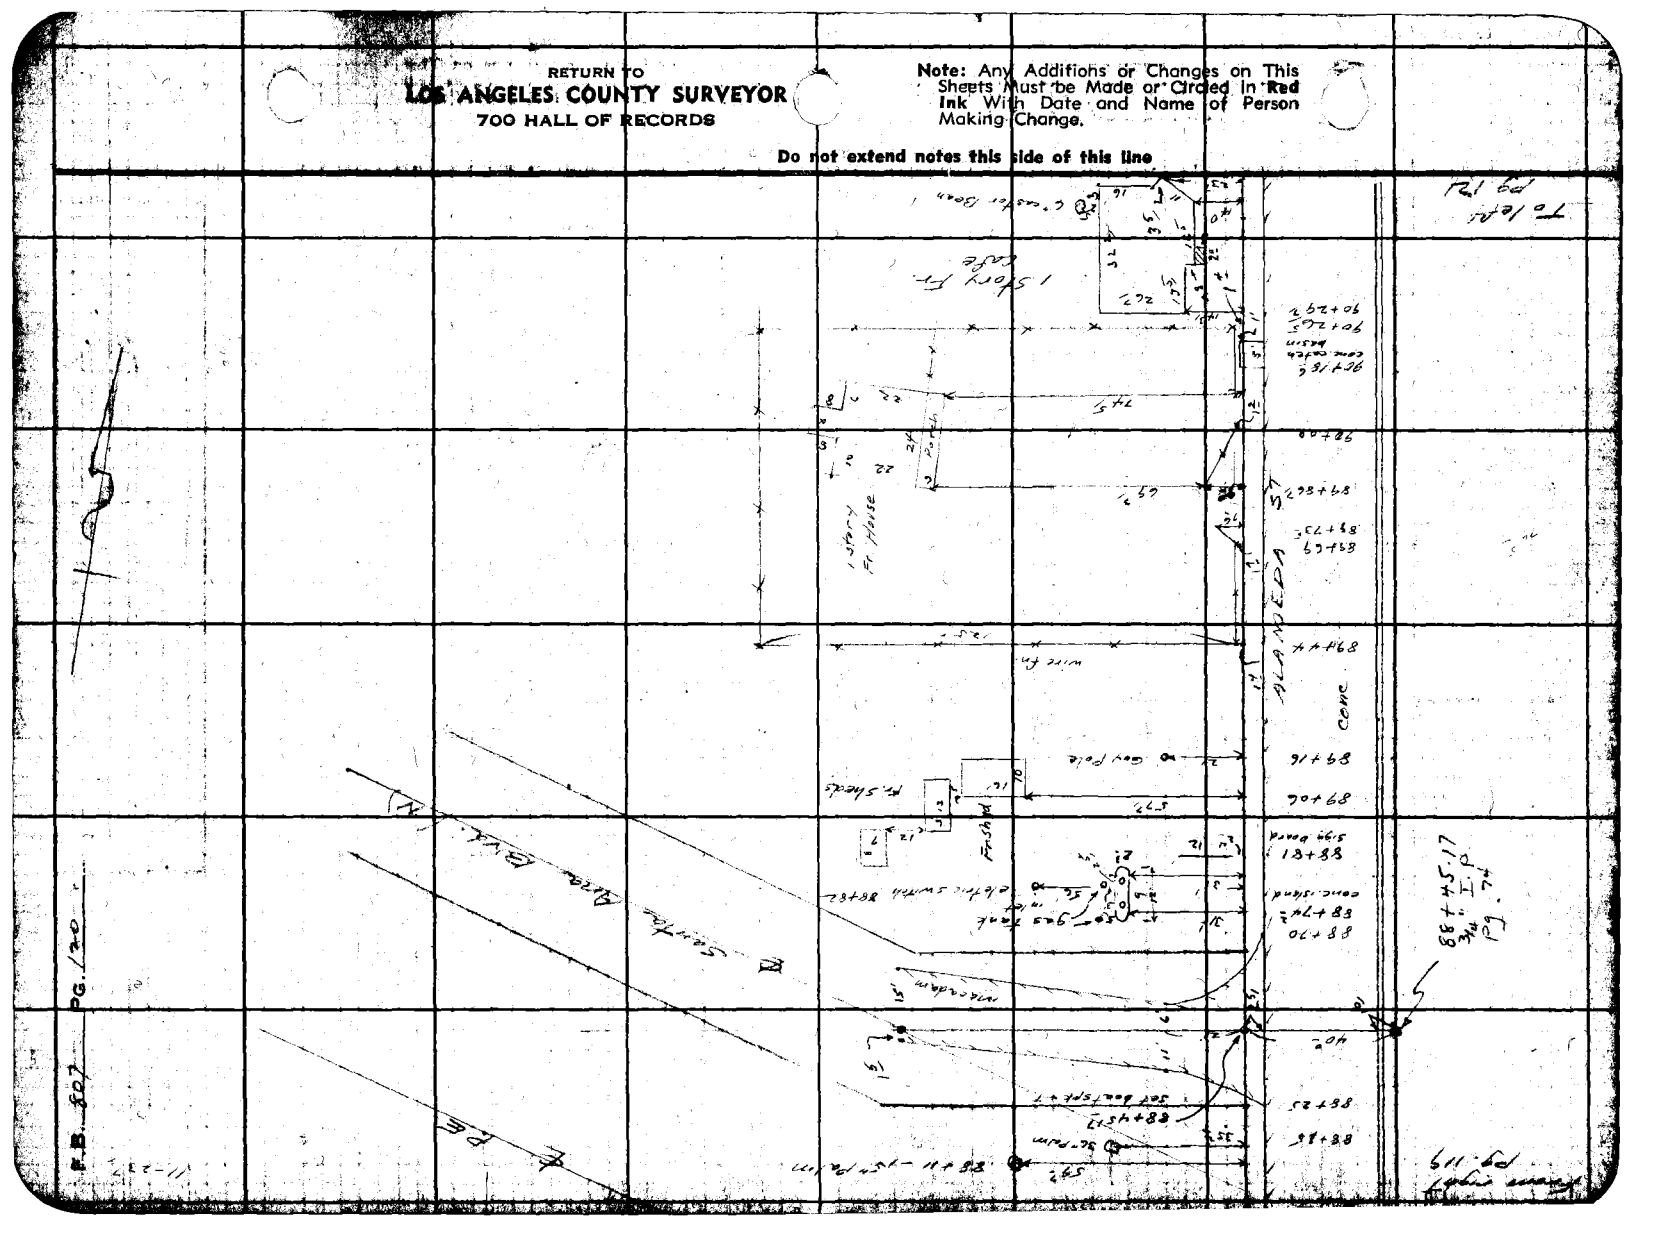

Notes Ck'd by D. M. Finley	Survey of Alameda St	F.B. 807	PG. 121
Map No. [illegible]	W. O. 8270 Tape No. St'd °F.		
Office Work D. A. WHITE	Surveyed by Moore		
Checked D. M. Finley	Notes Moore Date 11-[illegible]-39		
Date Feb 1940	Indexed A. C. Johnson		

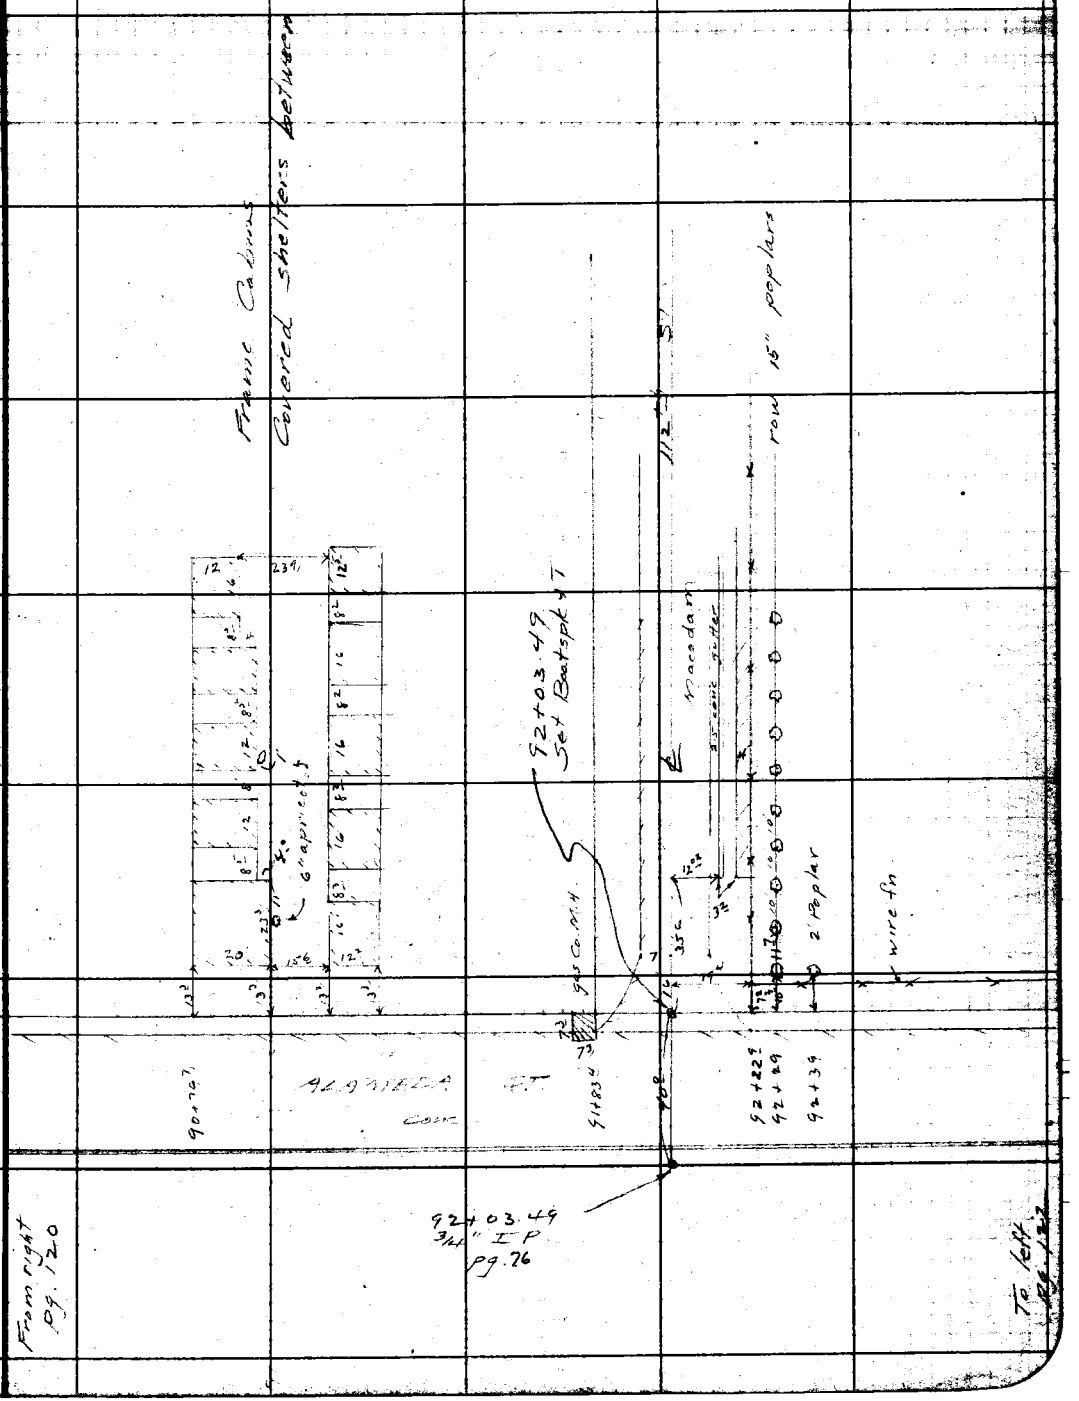

Note: Any Additions or Changes on This Sheet Must be Made or Circled in Red Ink With Date and Name of Person Making Change.

Do not extend notes this side of this line

RETURN TO
LOS ANGELES COUNTY SURVEYOR
700 HALL OF RECORDS

FORM 247 10M 11-35

RETURN TO
LOS ANGELES COUNTY SURVEYOR
700 HALL OF RECORDS

Note: Any Additions or Changes on This Sheet Must be Made or Circled in Red Ink With Date and Name of Person Making Change.

Do not extend notes this side of this line

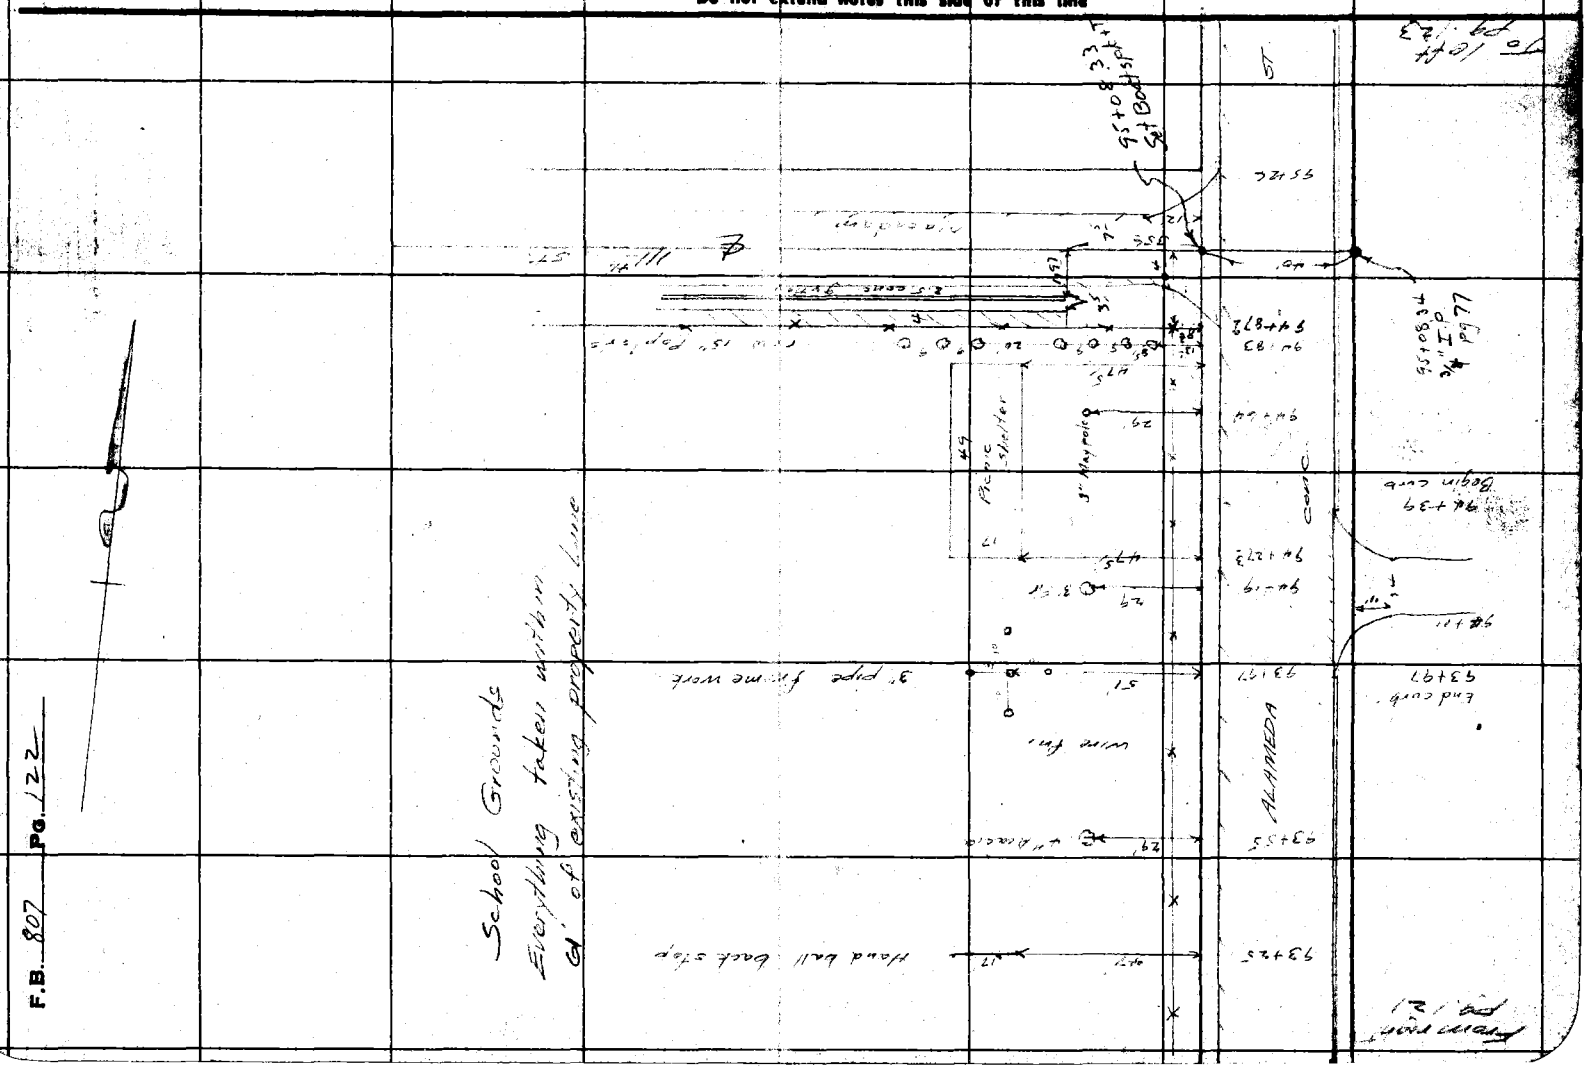

F.B. 807 Pg. 122

School Grounds
Everything taken within 10' of existing property line

Notes Ck'd by D. M. Finley	Survey of Alameda St	F.B. 867	Pg. 123
Map No. [illegible]	W. O. [illegible]		
Office Work B. A. WHITE	Surveyed by Moore		
Checked D. M. Finley	Notes Moore Date 11-24-39		
Date Feb 1940	Indexed A. C. Johnson		

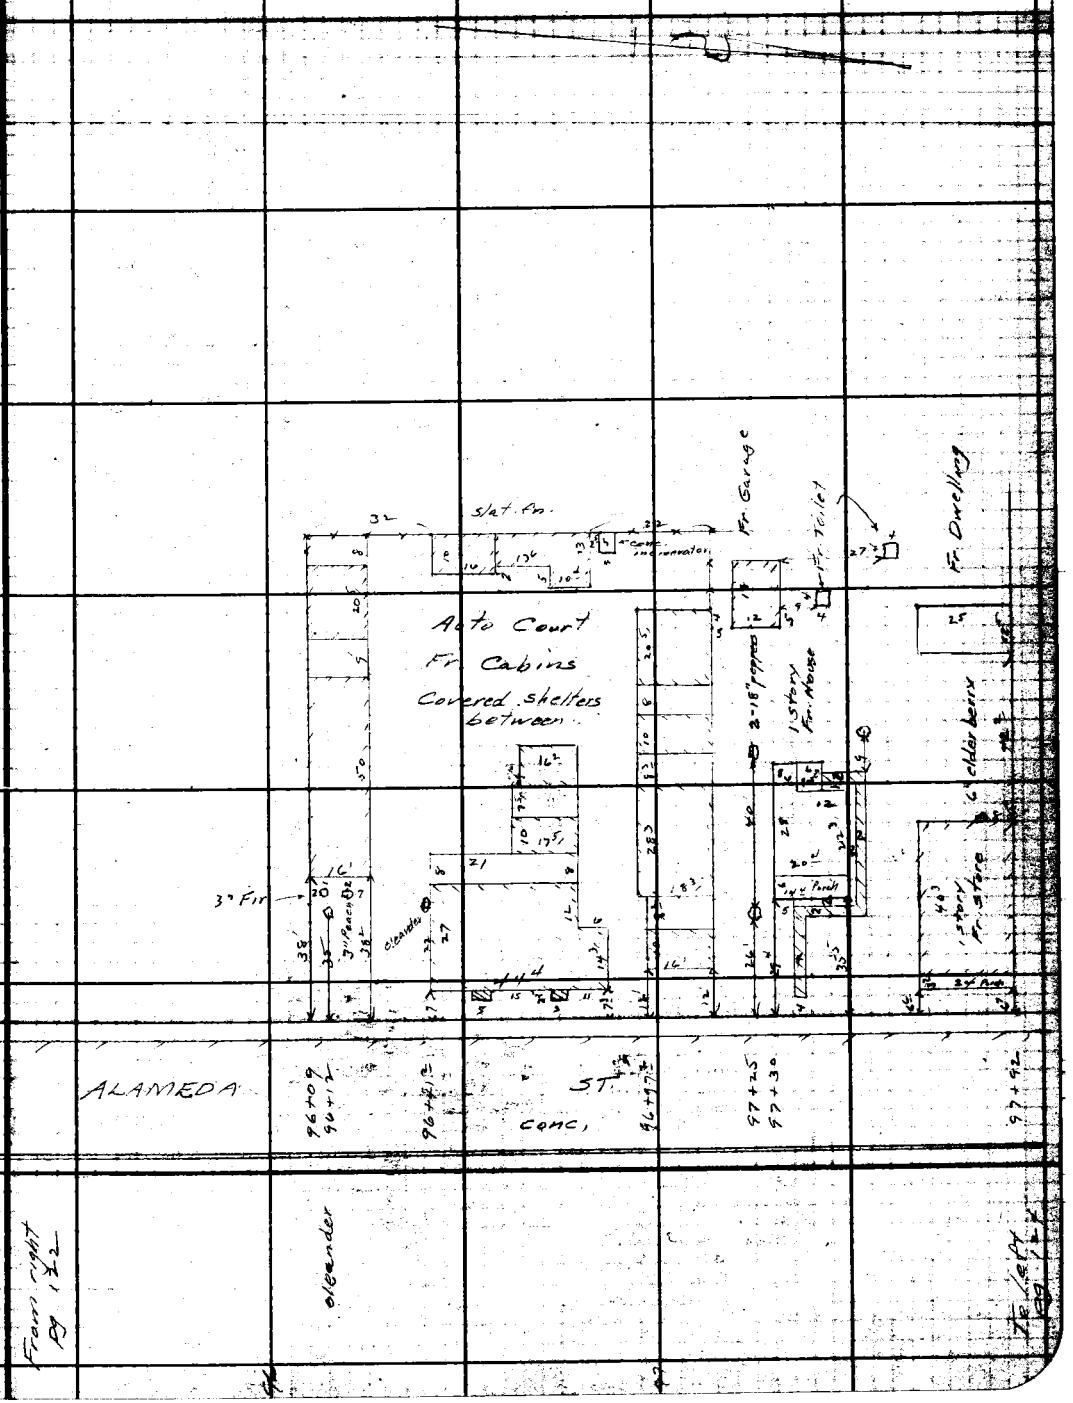

Note: Any Additions or Changes on This Sheets Must be Made or Circled in Red Ink With Date and Name of Person Making Change.

Do not extend notes this side of this line

RETURN TO
LOS ANGELES COUNTY SURVEYOR
700 HALL OF RECORDS

FORM 247 5M 10-37

RETURN TO
LOS ANGELES COUNTY SURVEYOR
700 HALL OF RECORDS

Note: Any Additions or Changes on This Sheets Must be Made or Circled in **Red Ink** With Date and Name of Person Making Change.

Do not extend notes this side of this line

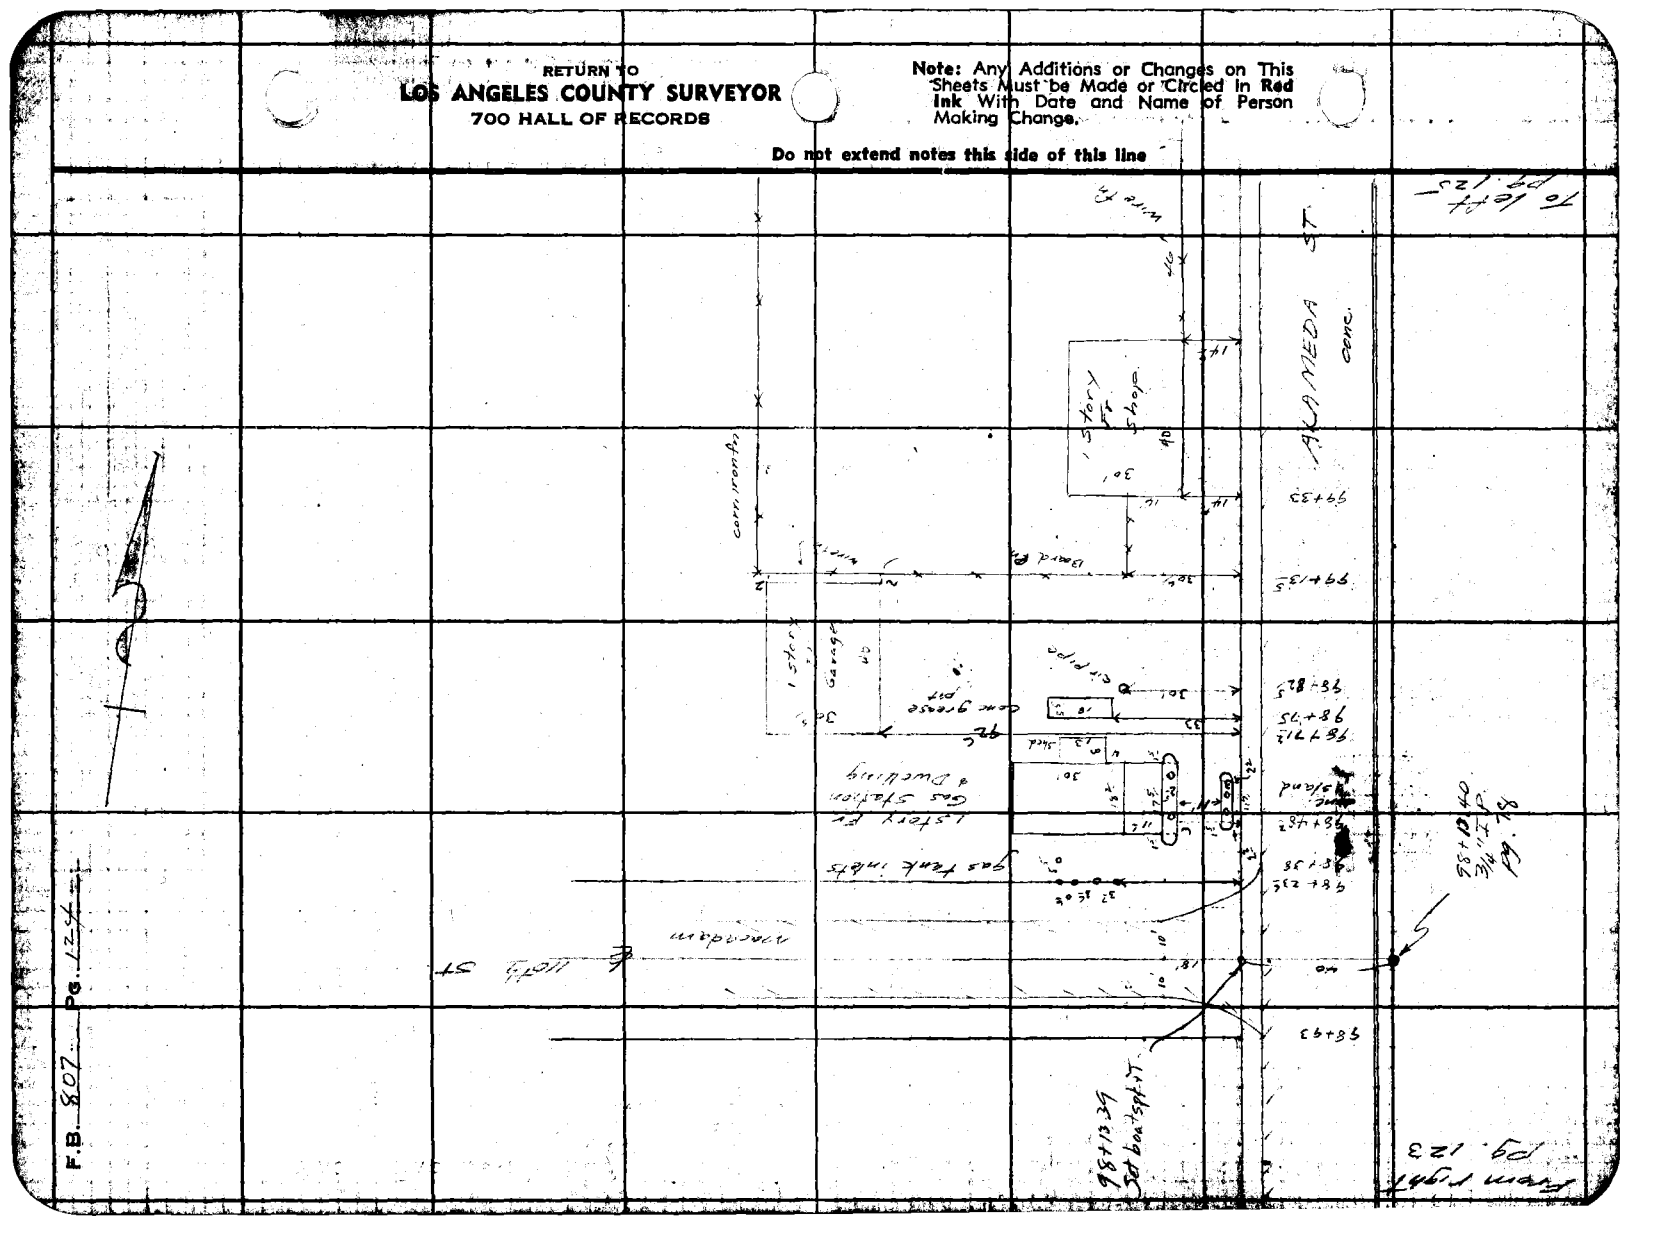

F.B. 807 Pg. 124

Notes Ck'd by D. M. Finley	Survey of Alameda St
Map No. [illegible]	W. O. 8270 Tape No. St'd °F.
Office Work D. A. WHITE	Surveyed by Moore
Checked D. M. Finley	Notes Moore Date 11-24-39
Date Feb. 1940.	Indexed A. C. Johnson

F.B. 807 PG. 125

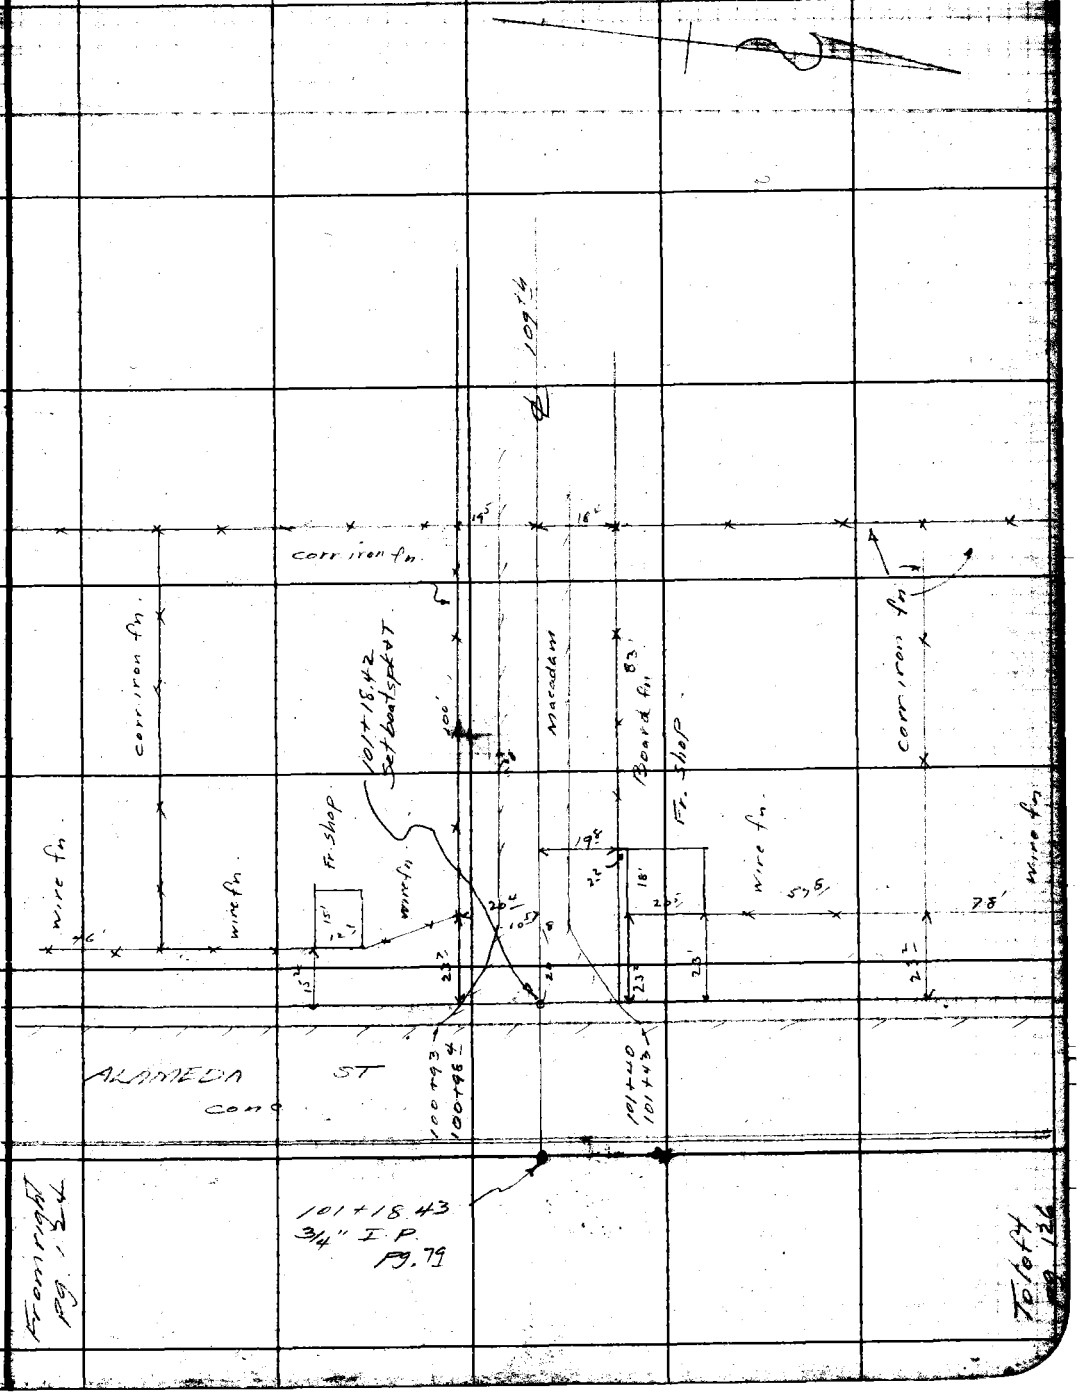

Note: Any Additions or Changes on This Sheet Must be Made or Circled in Red Ink With Date and Name of Person Making Change.

Do not extend notes this side of this line

RETURN TO
LOS ANGELES COUNTY SURVEYOR
700 HALL OF RECORDS

FORM 247 10M 11-35

F.B. 807 PG. 126

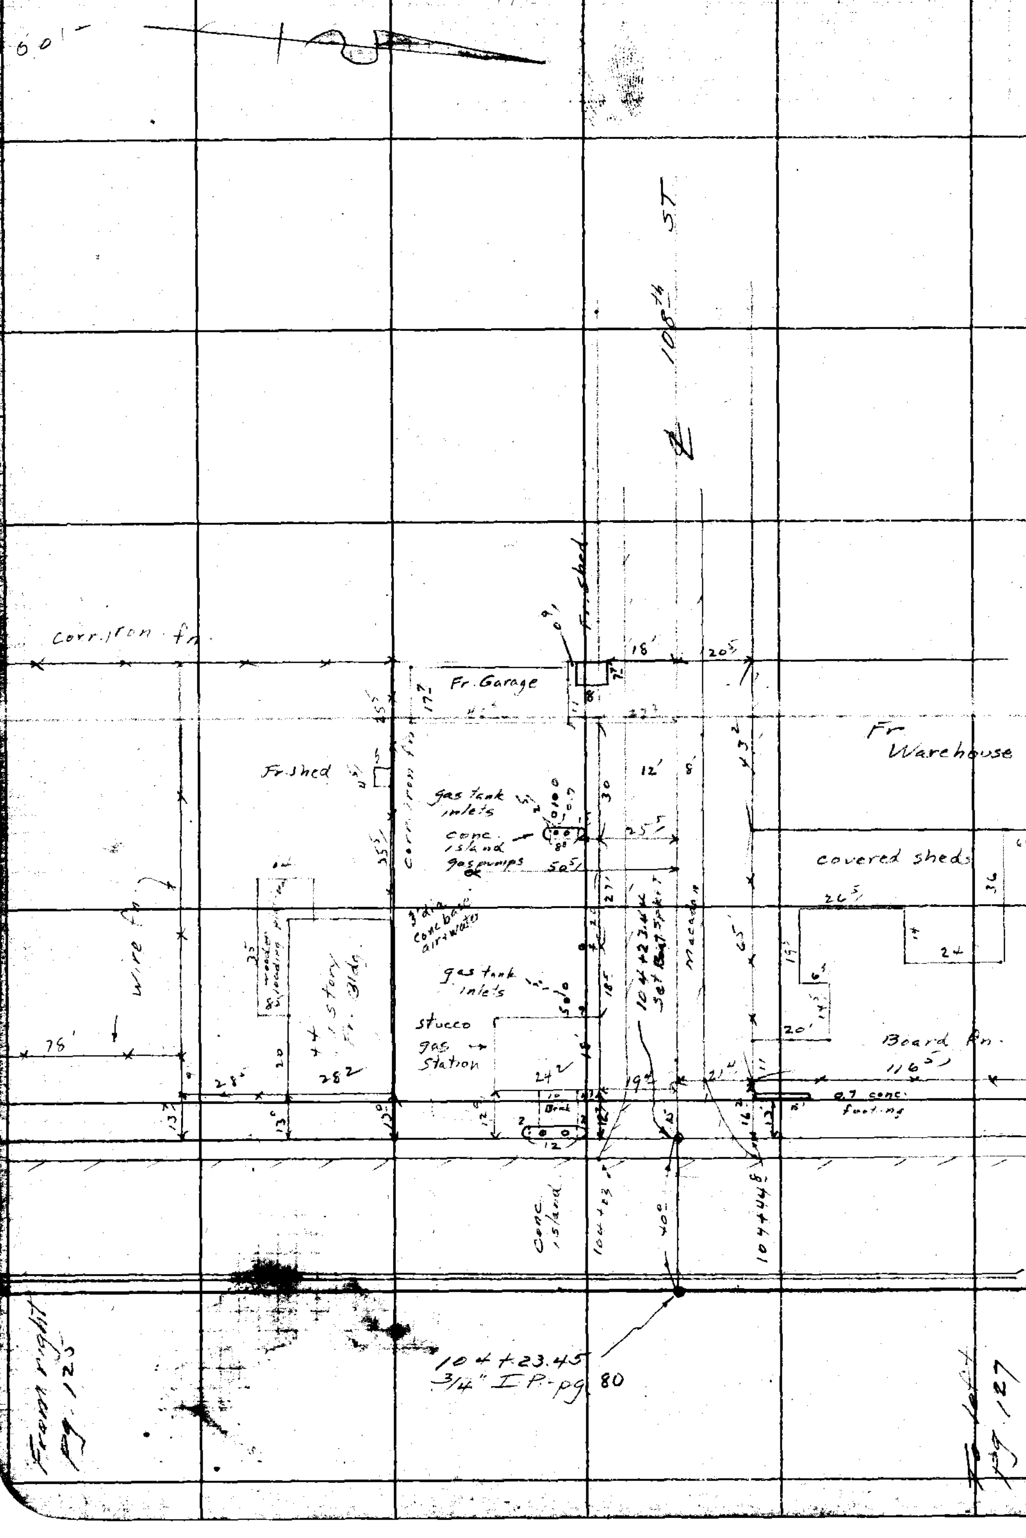

RETURN TO
LOS ANGELES COUNTY SURVEYOR
700 HALL OF RECORDS

Do not extend notes this side of this line

Note: Any Additions or Changes on This Sheet Must be Made or Circled in Red Ink With Date and Name of Person Making Change.

Notes Ck'd by [illegible] Finley	Survey of Alameda St	F.B. 807 Pg. 127
[illegible]	[illegible] Tape No. [illegible] Std. of	
Office Work [illegible]	Surveyed by Moore	
Checked D. M. Finley	Notes Moore Date 11-24-39	
Date Feb 1940	Indexed A. C. Johnson	

107+28.82 F
0+5.11

Note: Any Additions or Changes on [illegible] Sheets Must be Made or Circled in Ink With Date and Name of Person Making Change.

Do not extend notes this side of this line

RETURN TO
LOS ANGELES COUNTY SURVEYOR
700 HALL OF RECORDS

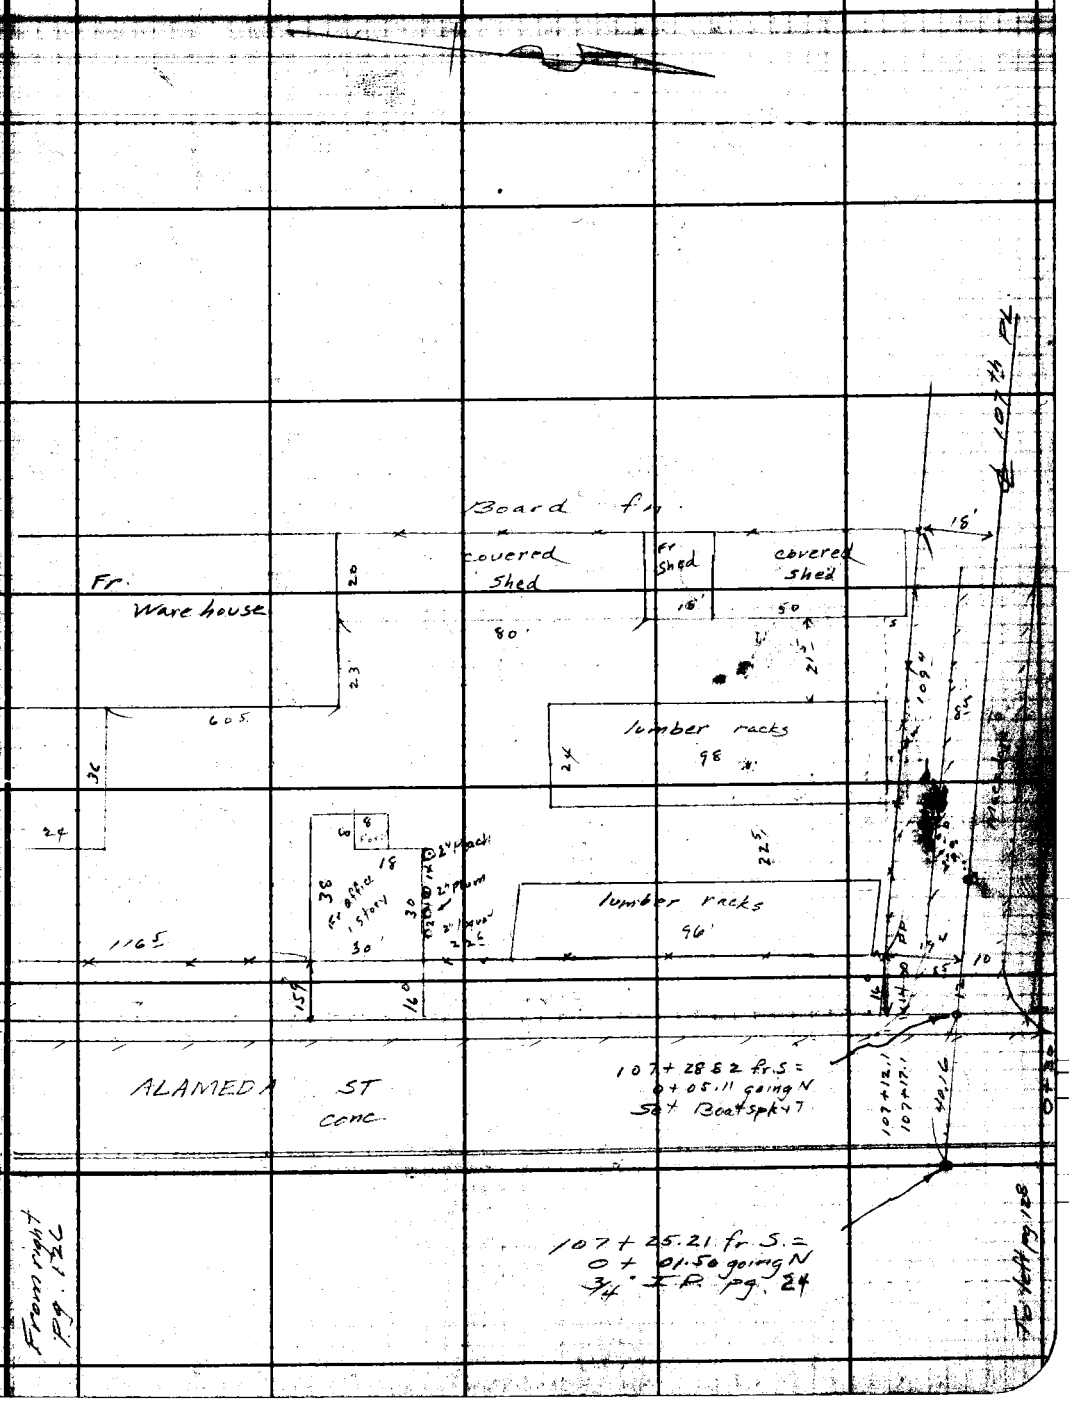

FORM 247 5M 10-37

RETURN TO
LOS ANGELES COUNTY SURVEYOR
700 HALL OF RECORDS

Note: Any Additions or Changes on This Sheets Must be Made or Circled in **Red Ink** With Date and Name of Person Making Change.

Do not extend notes this side of this line

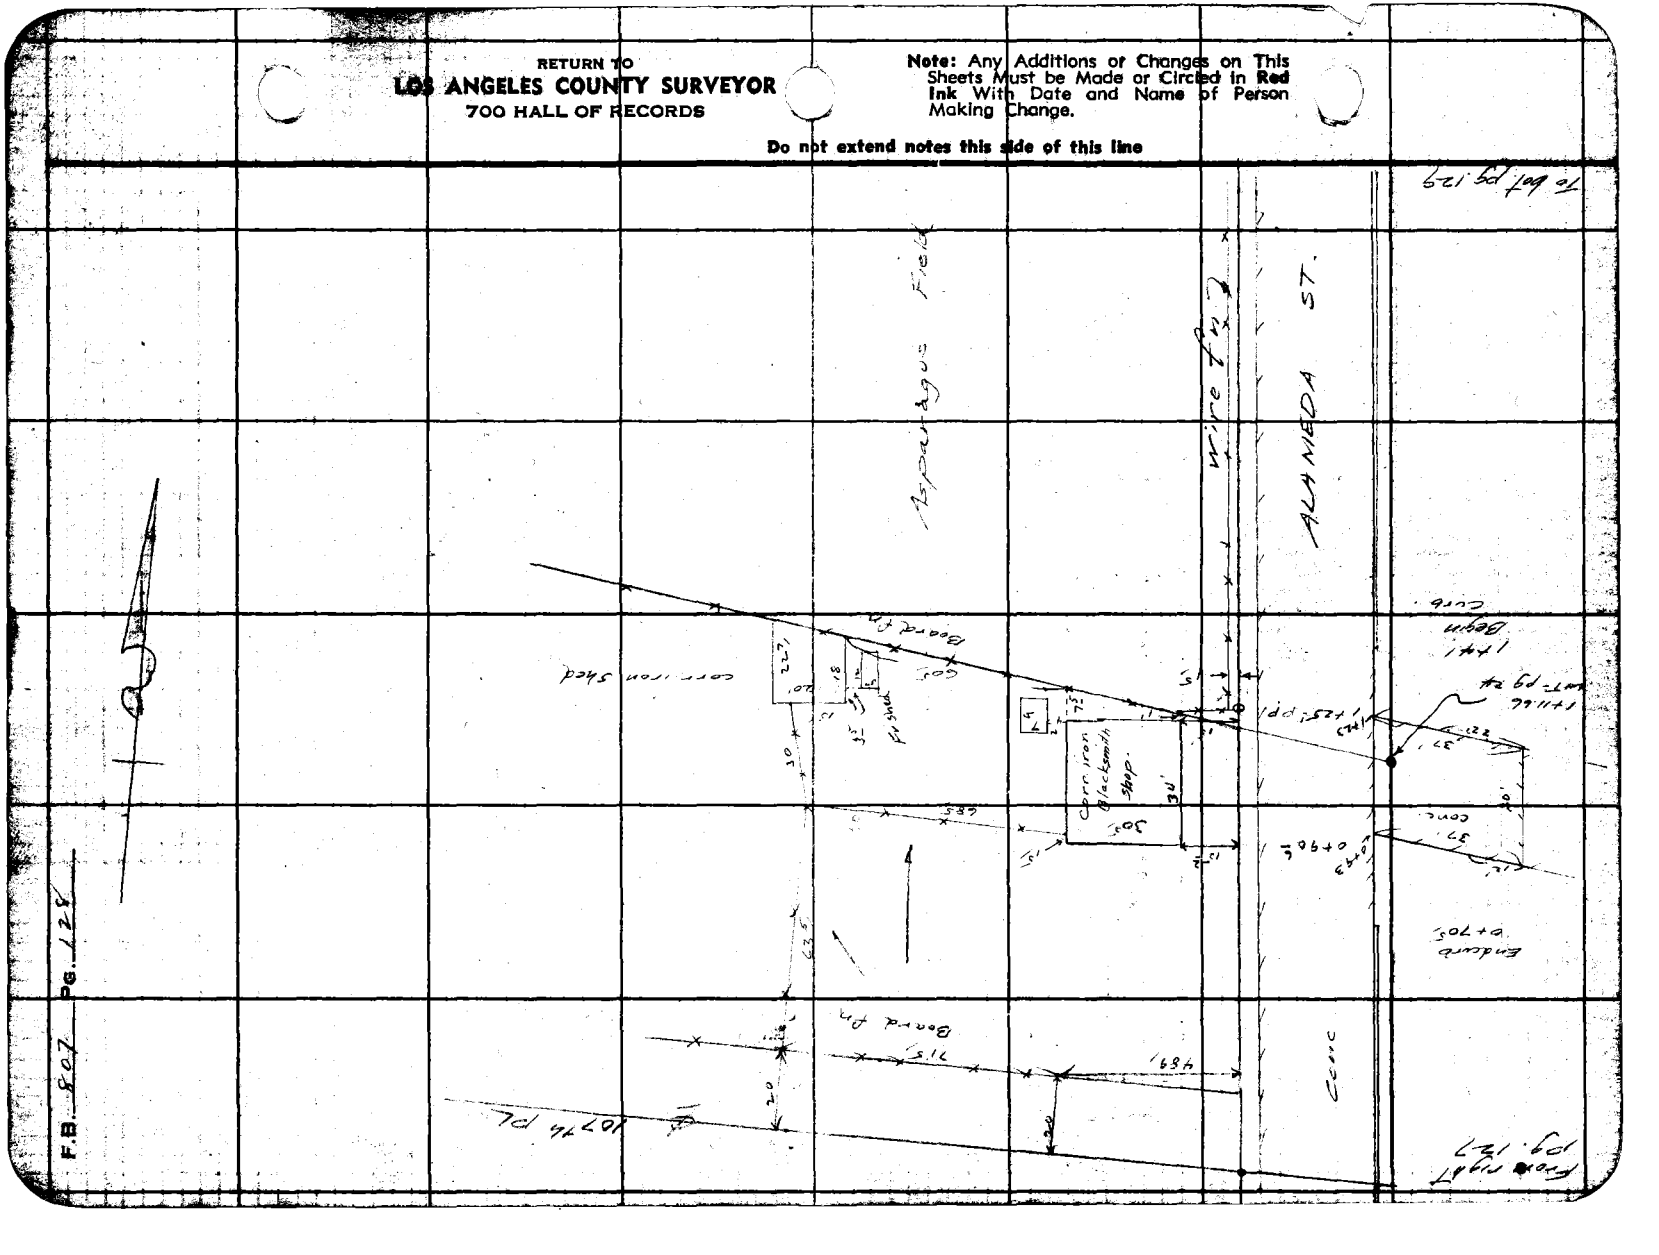

Notes Ck'd by D. M. Finley	Survey of Alameda St	F.B. 107 Pg. 129
Map No. [illegible]	W. O. 1210 Tape No. ___ St'd ___ of	To bot pg 130
Office Work [illegible]	Surveyed by Moore	
Checked D. M. Finley	Notes Moore Date 11-24-39	
Date Feb. 1940	Indexed A. C. Johnson	

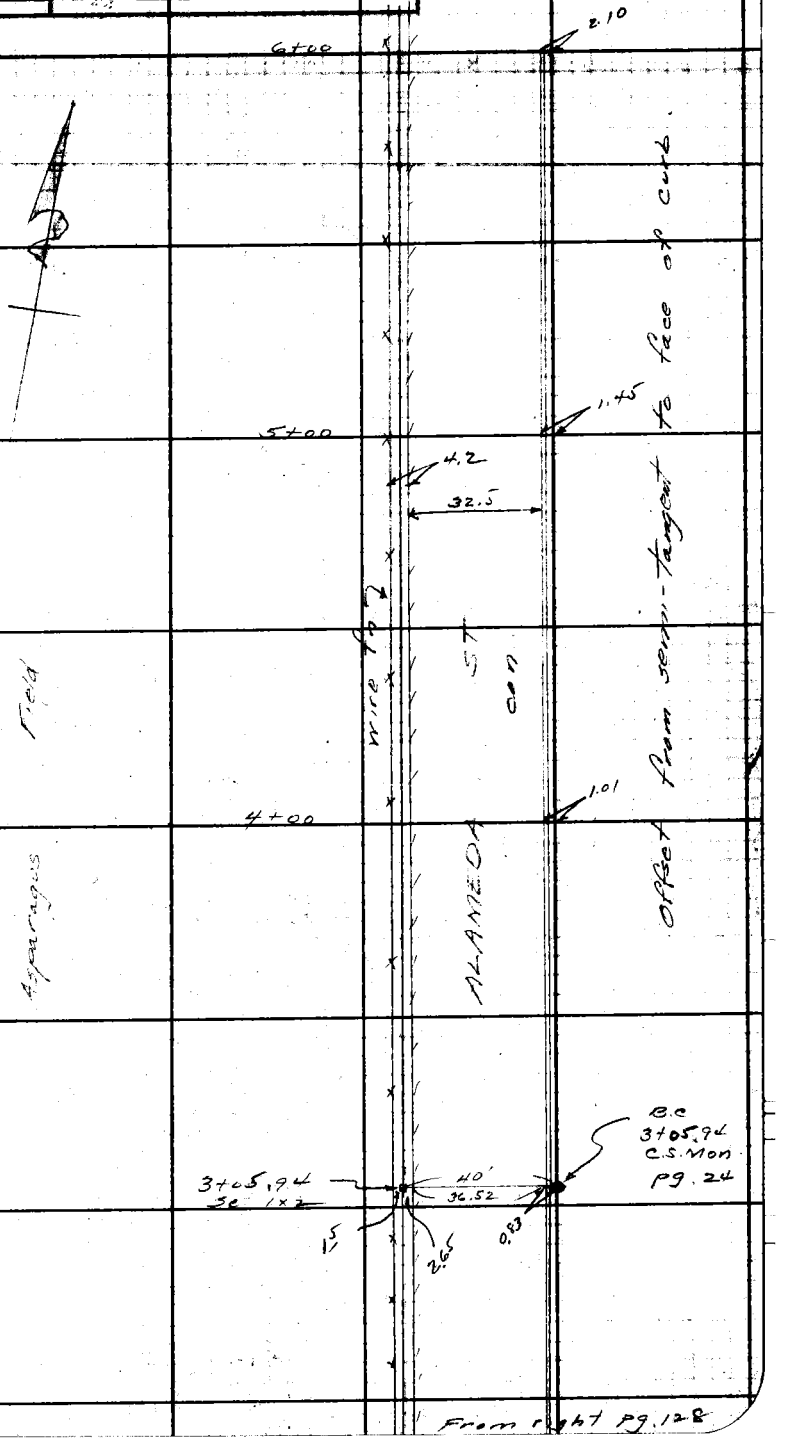

From right pg. 128

Note: Any Additions or Changes on This Sheets Must be Made or Circled in Red Ink With Date and Name of Person Making Change.

Do not extend notes this side of this line

RETURN TO
LOS ANGELES COUNTY SURVEYOR
700 HALL OF RECORDS

FORM 247 5M 10-37

F.B. 807 Pg. 130

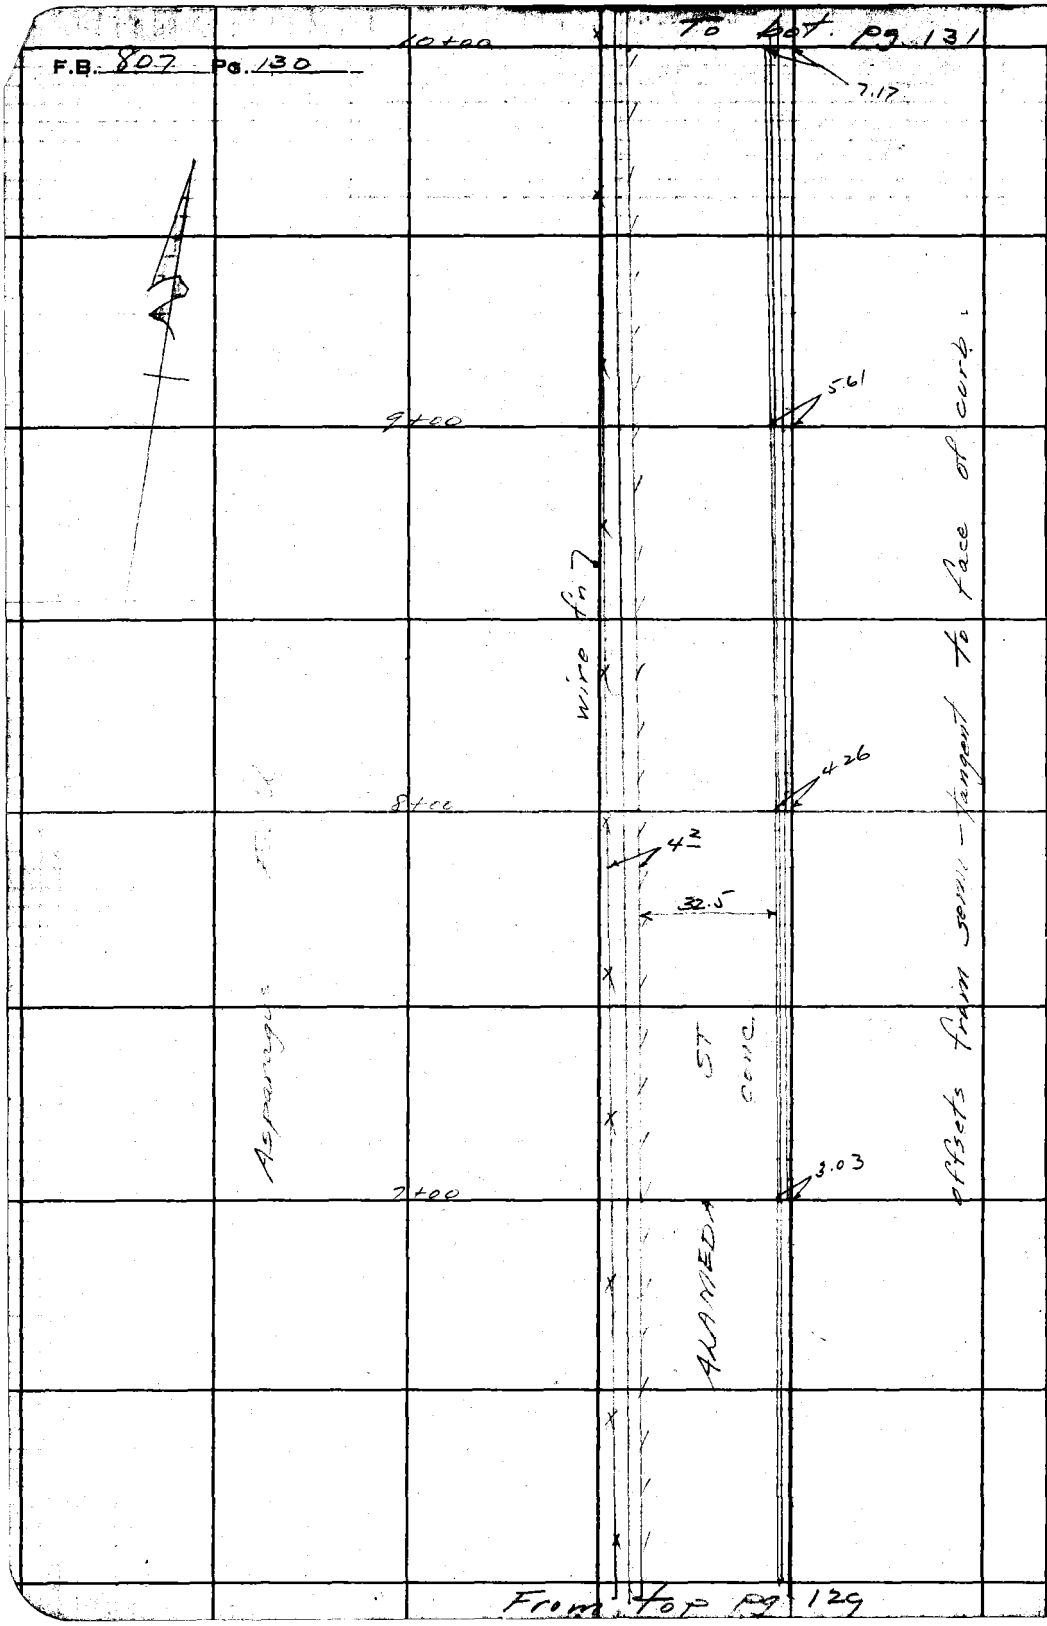

RETURN TO
LOS ANGELES COUNTY SURVEYOR
700 HALL OF RECORDS

Note: Any Additions or Changes on This Sheets Must be Made or Circled in Red Ink With Date and Name of Person Making Change.

Do not extend notes this side of this line

Notes Ck'd by D. M. Finley	Survey of Alameda St	F.B. 807 Pg. 131
Map No. 9-1497-2	W. O. 5272 Tape No. St'd of	
Office Work D. A. WHITE	Surveyed by Moore	
Checked D. M. Finley	Notes Moore Date 11-27-39	
Date Feb. 1940	Indexed A. C. Johnson	

To Cont. pg. 132

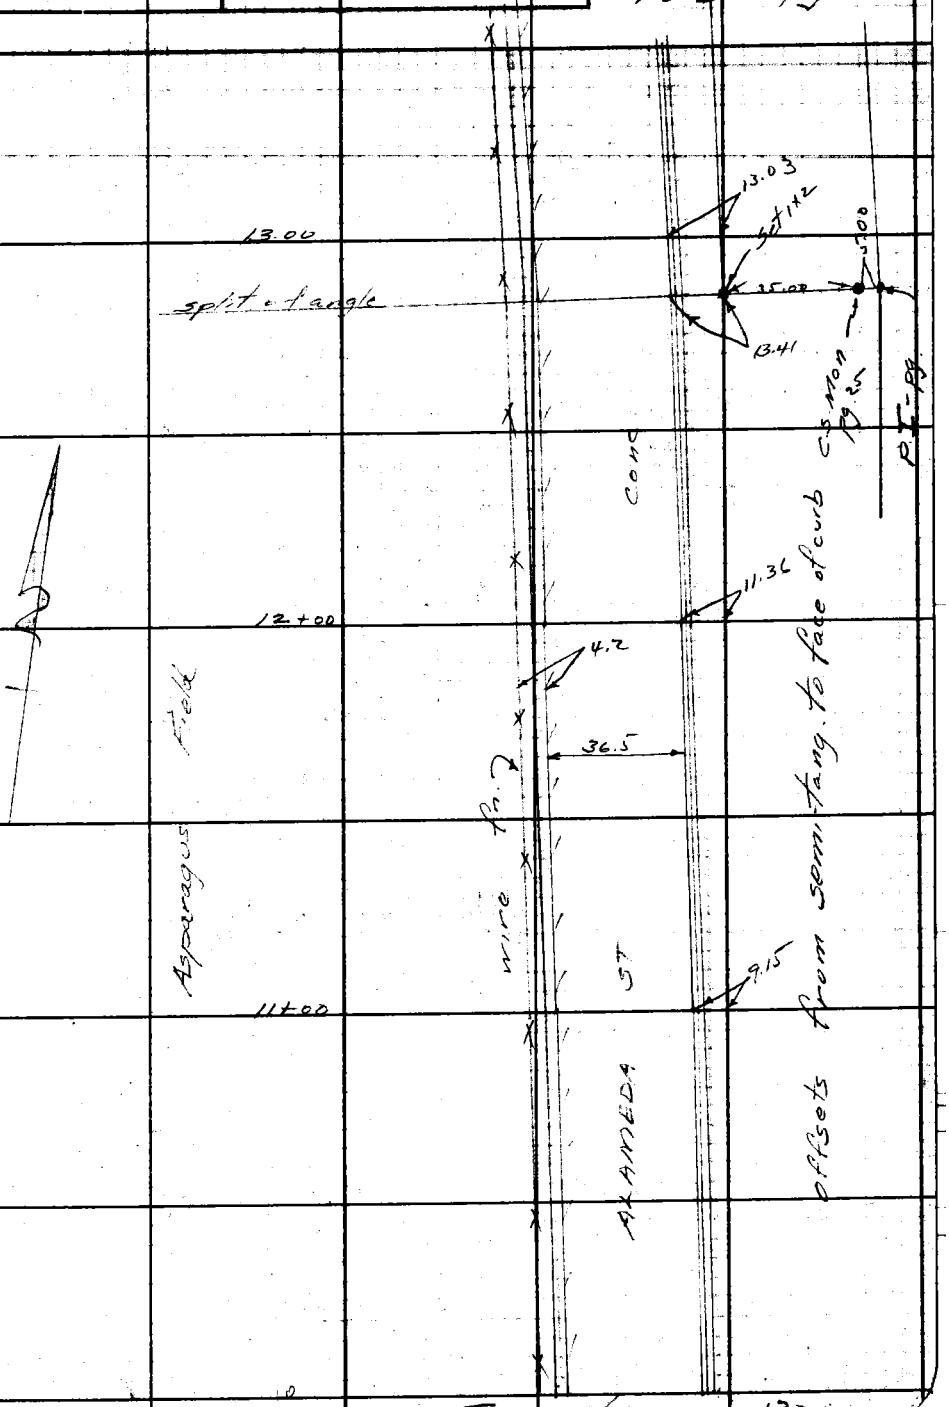

From top pg. 130

Note: Any Additions or Changes on This Sheets Must be Made or Circled in Red Ink With Date and Name of Person Making Change.

Do not extend notes this side of this line

RETURN TO
LOS ANGELES COUNTY SURVEYOR
700 HALL OF RECORDS

FORM 247 5M 10-57

F.B. 807 PG. 132

To left pg 133

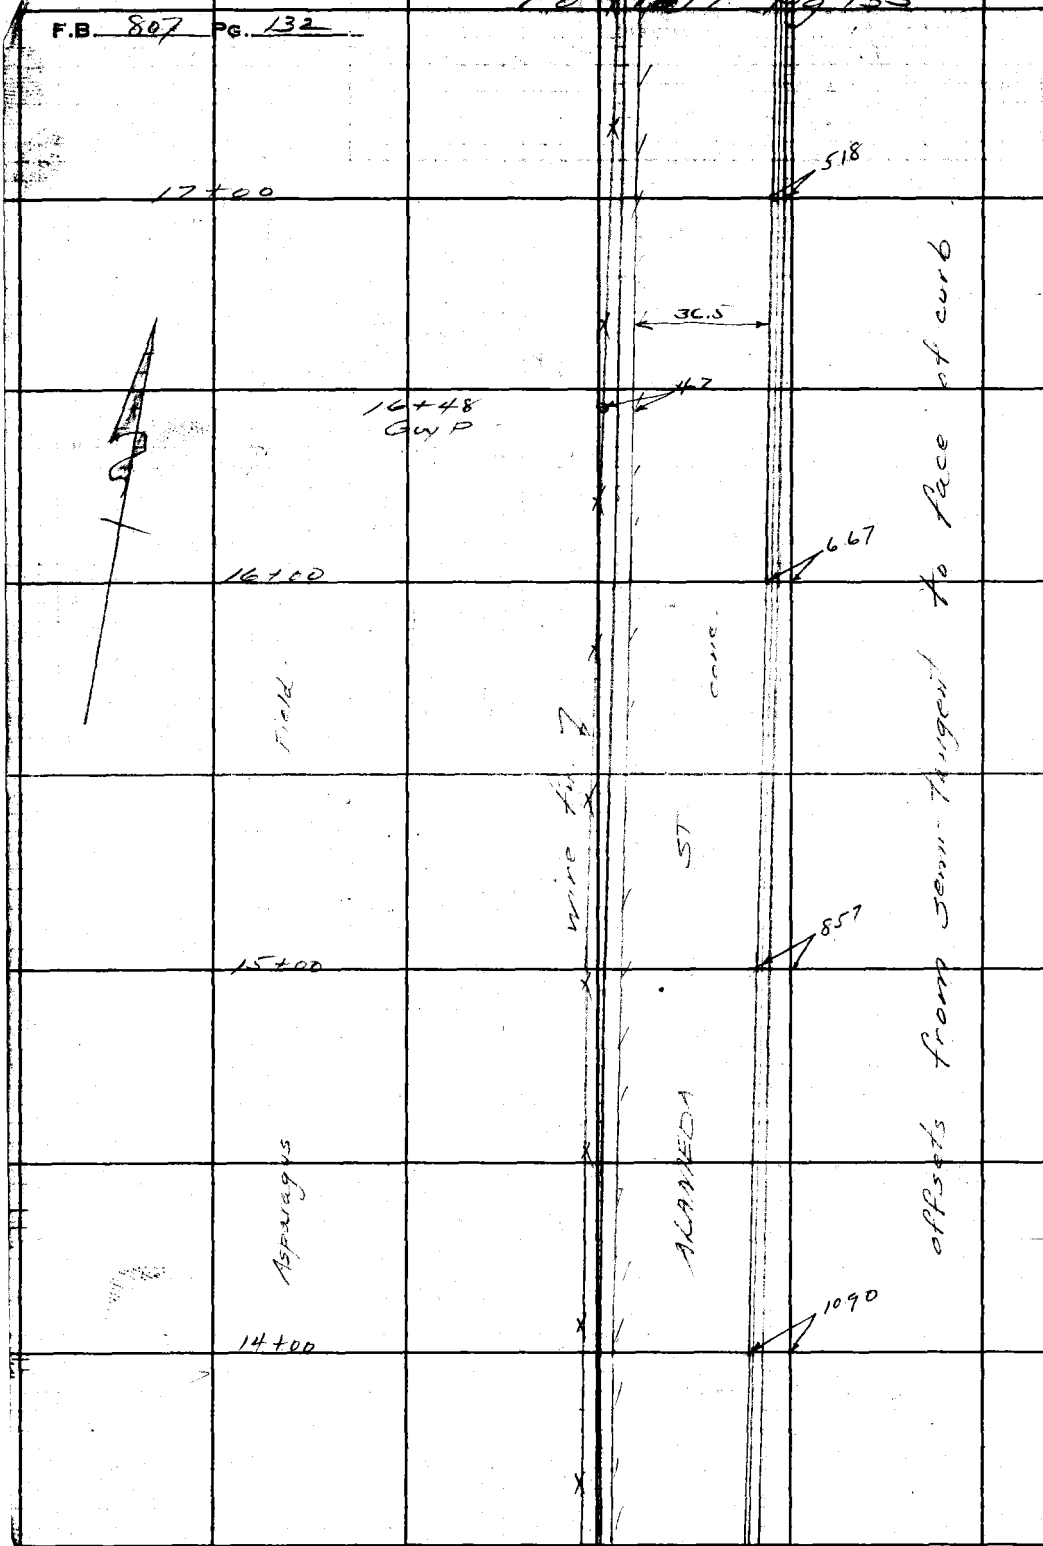

From top pg. 131

RETURN TO
LOS ANGELES COUNTY SURVEYOR
700 HALL OF RECORDS

Note: Any Additions or Changes on This Sheets Must be Made or Circled in Red Ink With Date and Name of Person Making Change.

Do not extend notes this side of this line

FORM 247 5M 10-37

RETURN TO
LOS ANGELES COUNTY SURVEYOR
700 HALL OF RECORDS

Note: Any Additions or Changes on This Sheets Must be Made or Circled in Red Ink With Date and Name of Person Making Change.

Do not extend notes this side of this line

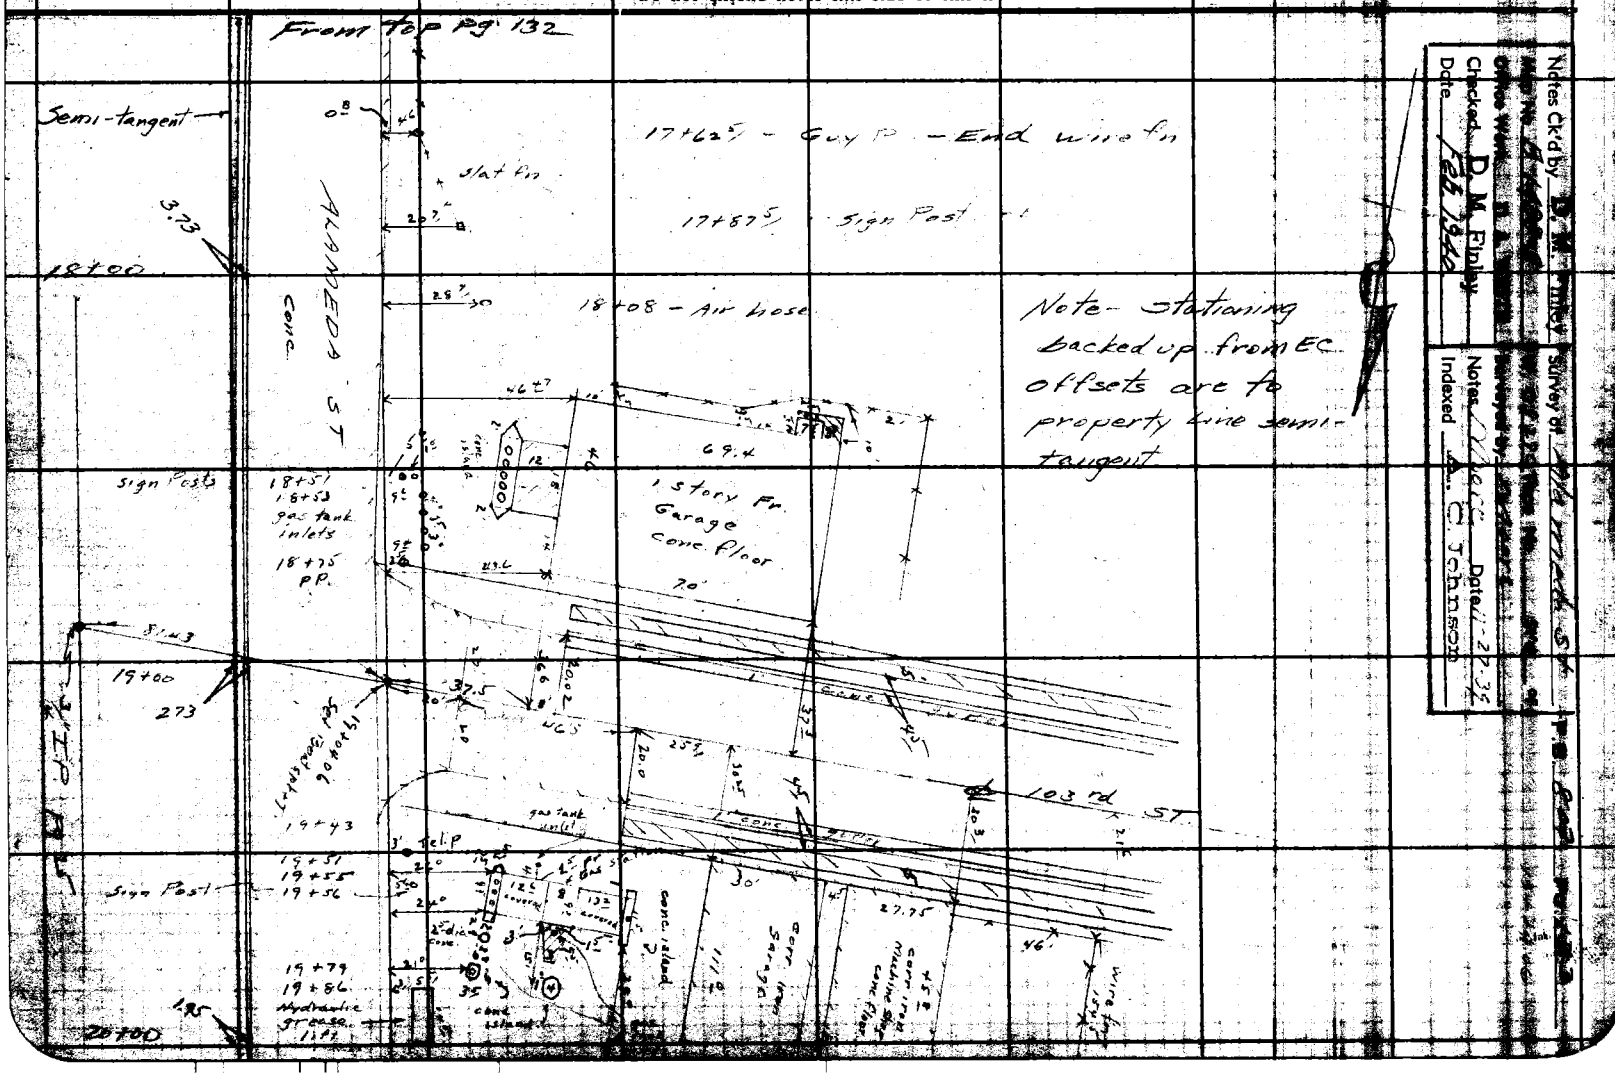

RETURN TO
LOS ANGELES COUNTY SURVEYOR
700 HALL OF RECORDS

Note: Any Additions or Changes on This Sheets Must be Made or Circled in Red Ink With Date and Name of Person Making Change.

Do not extend notes this side of this line

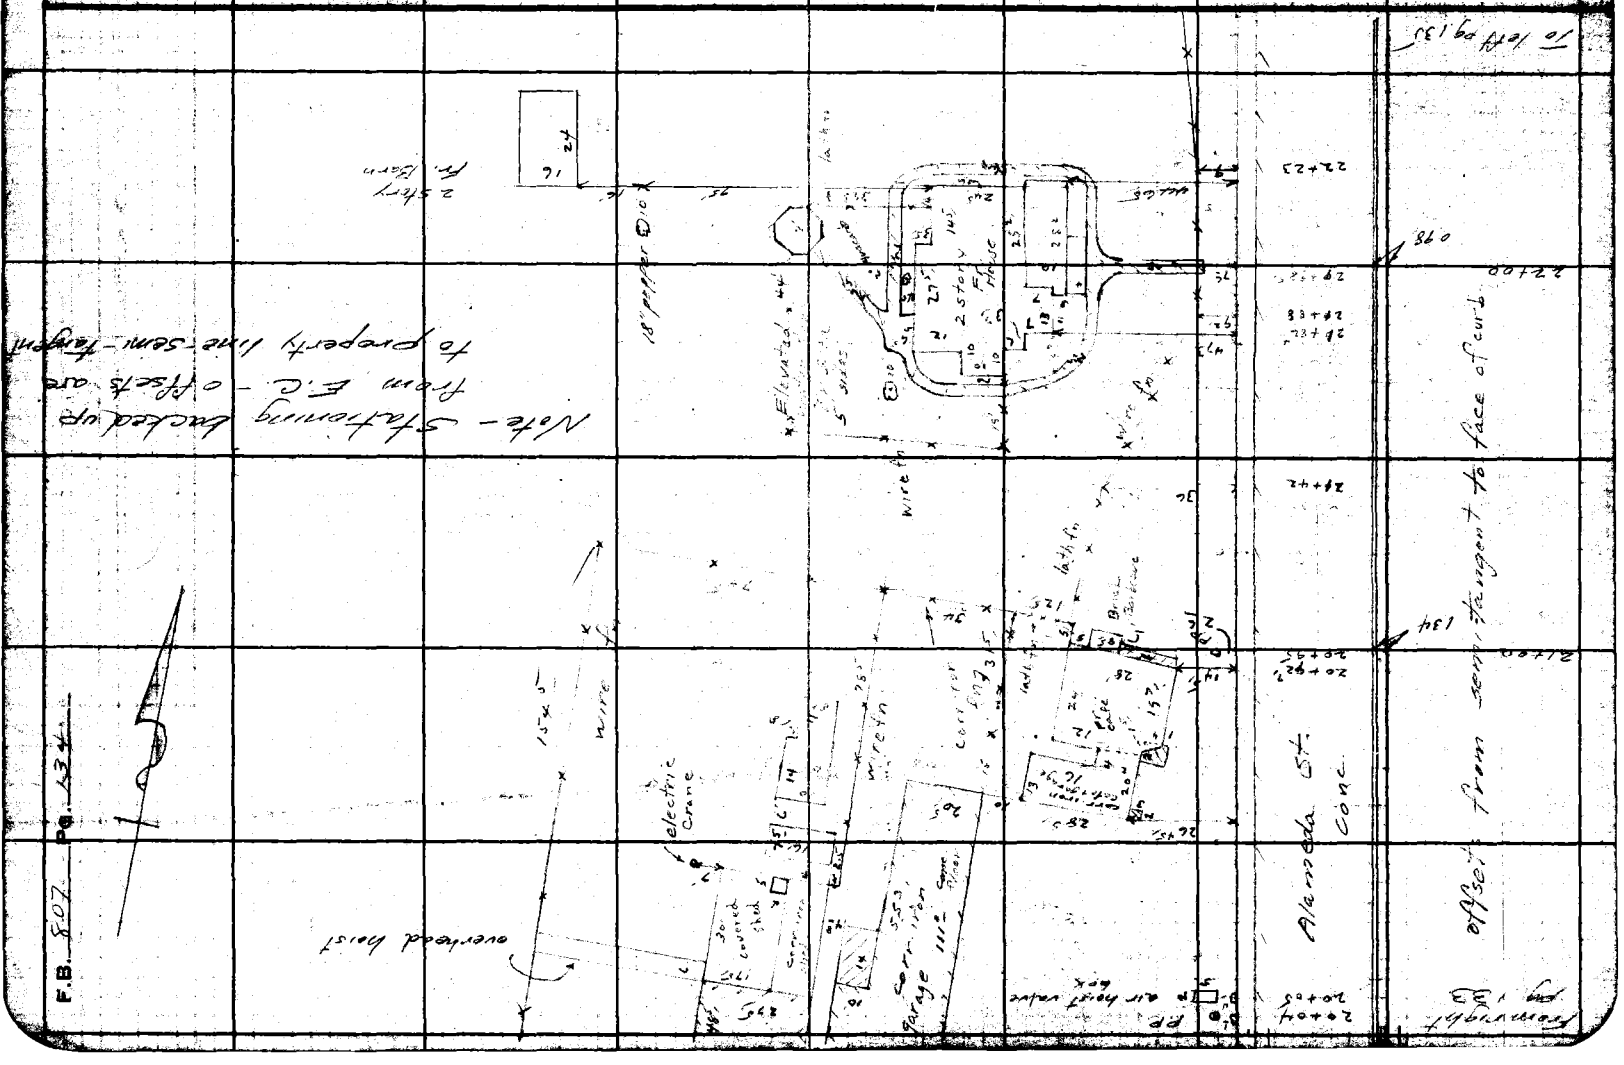

F.B. 807 Pg. 134

Notes Ck'd by D. M. Finley	Survey of [illegible]	F.B. 807 Pg. 135
Map No. [illegible]	W. [illegible] Tape No. ____ Std. ____	
Office Work B. A. WHITE	Surveyed by Moore	
Checked D. M. Finley	Notes Moore Date 11-27-37	
Date Feb. 1940.	Indexed A. C. Johnson	

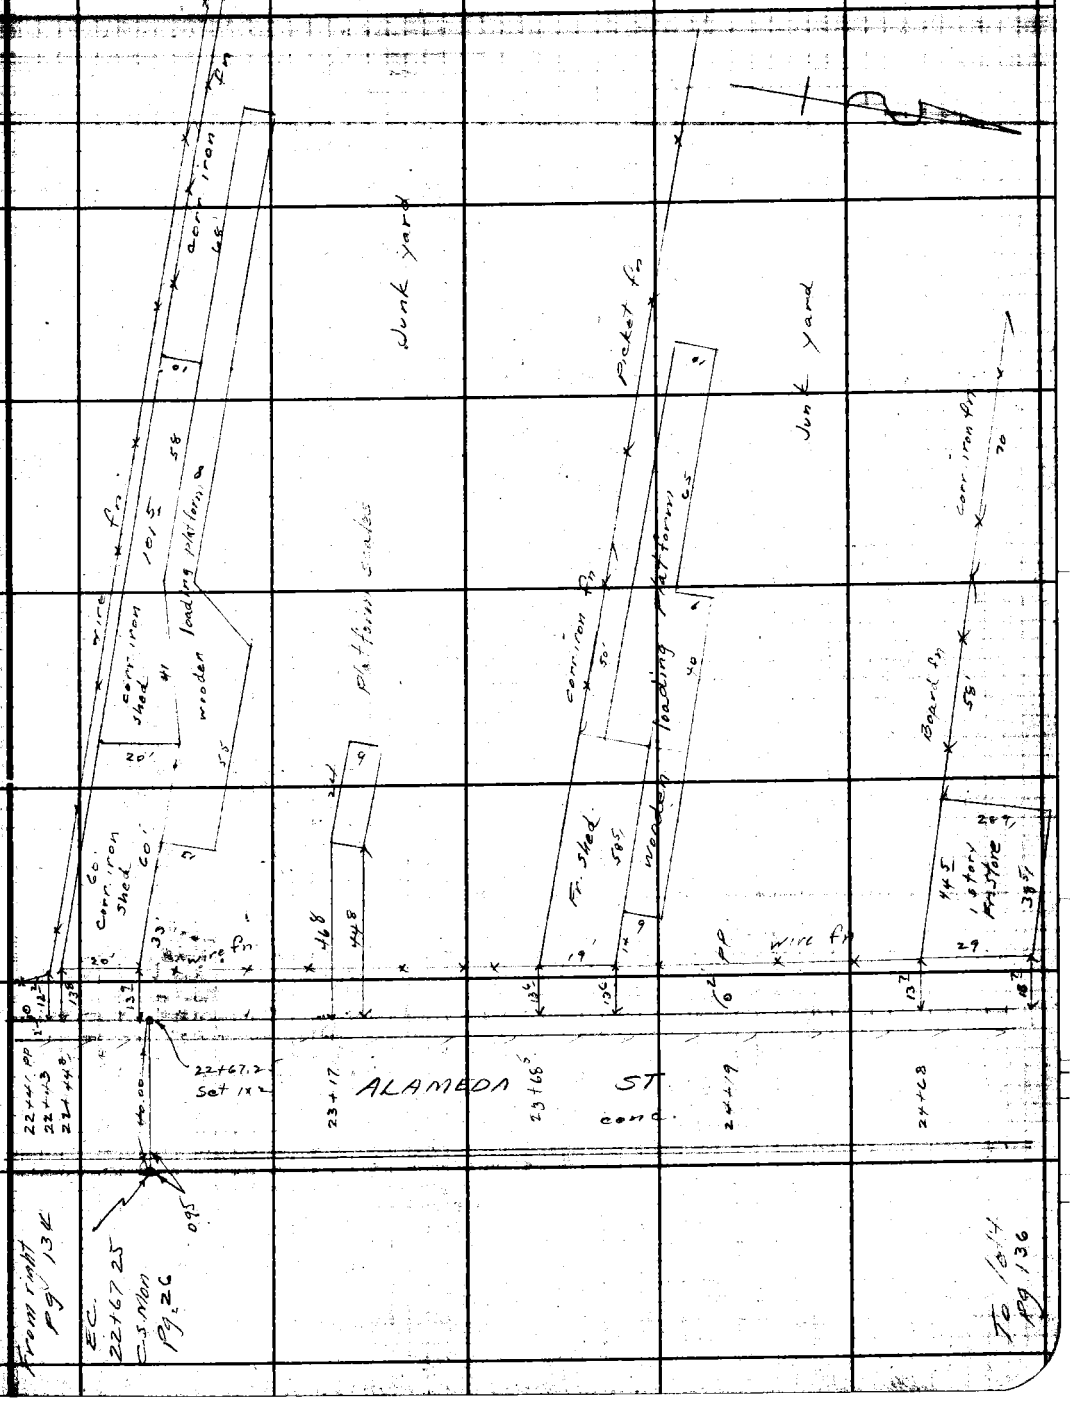

RETURN TO
LOS ANGELES COUNTY SURVEYOR
700 HALL OF RECORDS

Note: Any Additions or Changes on This Sheets Must be Made or Circled in Red Ink With Date and Name of Person Making Change.

Do not extend notes this side of this line

FORM 247 5M 10-37

RETURN TO
LOS ANGELES COUNTY SURVEYOR
700 HALL OF RECORDS

Note: Any Additions or Changes on This Sheets Must be Made or Circled in **Red Ink** With Date and Name of Person Making Change.

Do not extend notes this side of this line

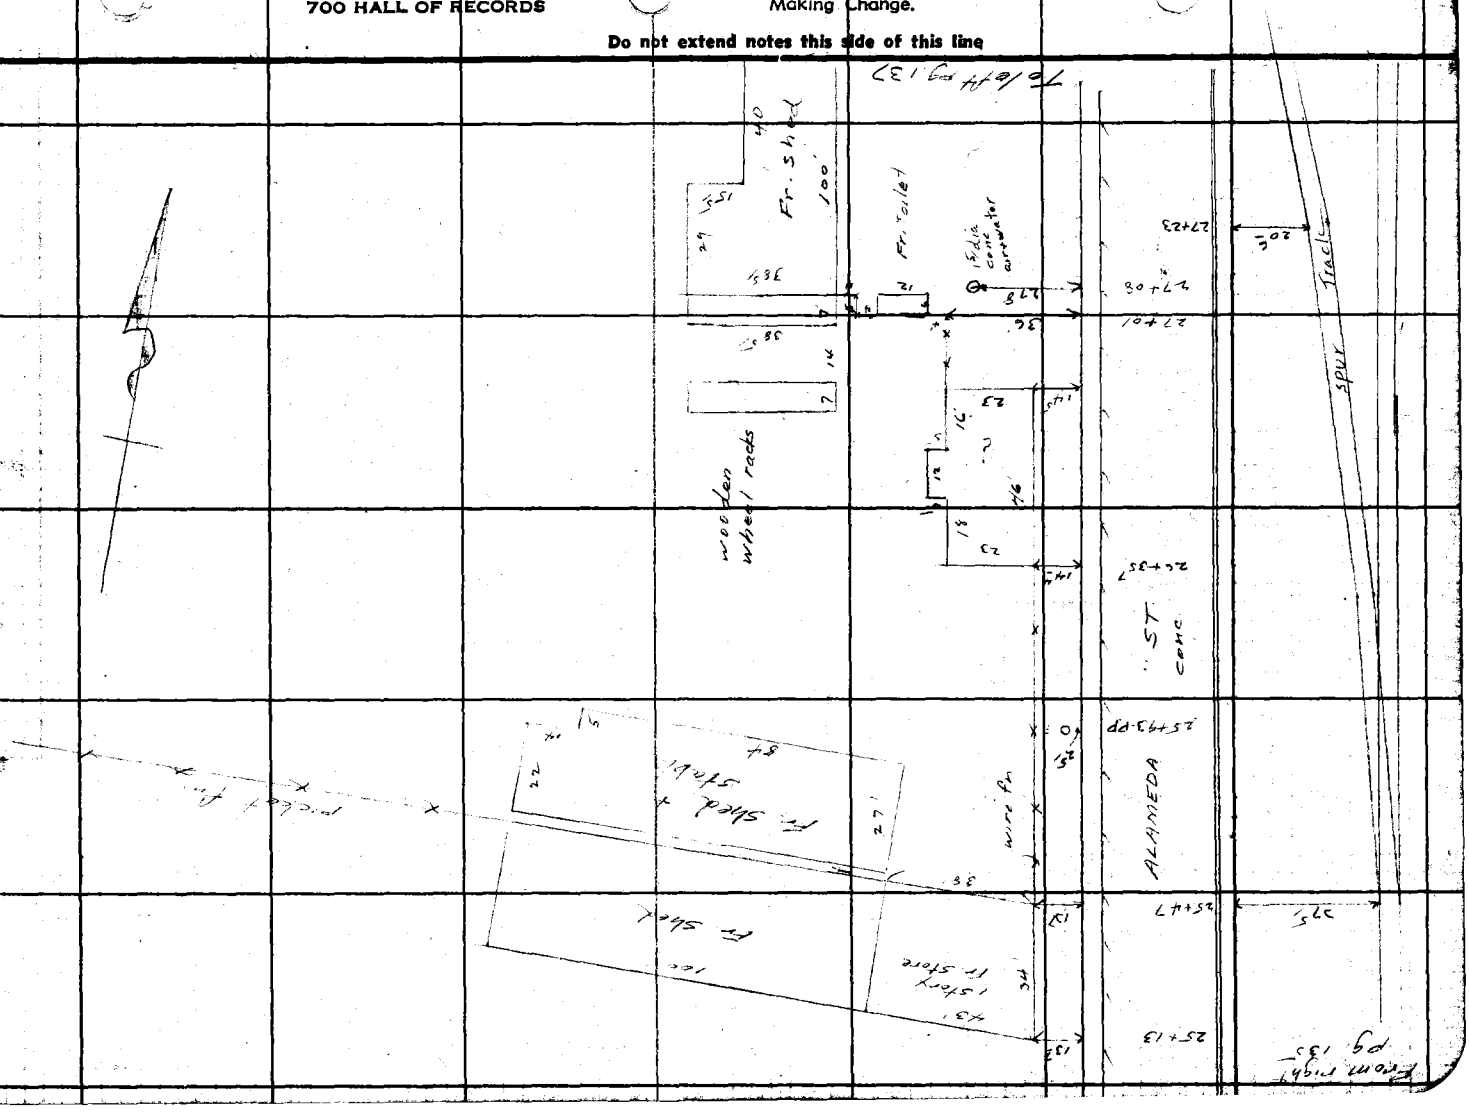

F.B. 807 Pg. 136

Notes Ck'd by D. M. Finley	Survey of Alameda St	F.B. 807 Pg. 137
Map No. [illegible]	W. O. 82[illegible] Map No. [illegible]	
Office Work [illegible] WHITE	Surveyed by [illegible]	
Checked D. M. Finley	Notes Moore Date 11-28-39	
Date Feb 1940.	Indexed R. C. Johnson	

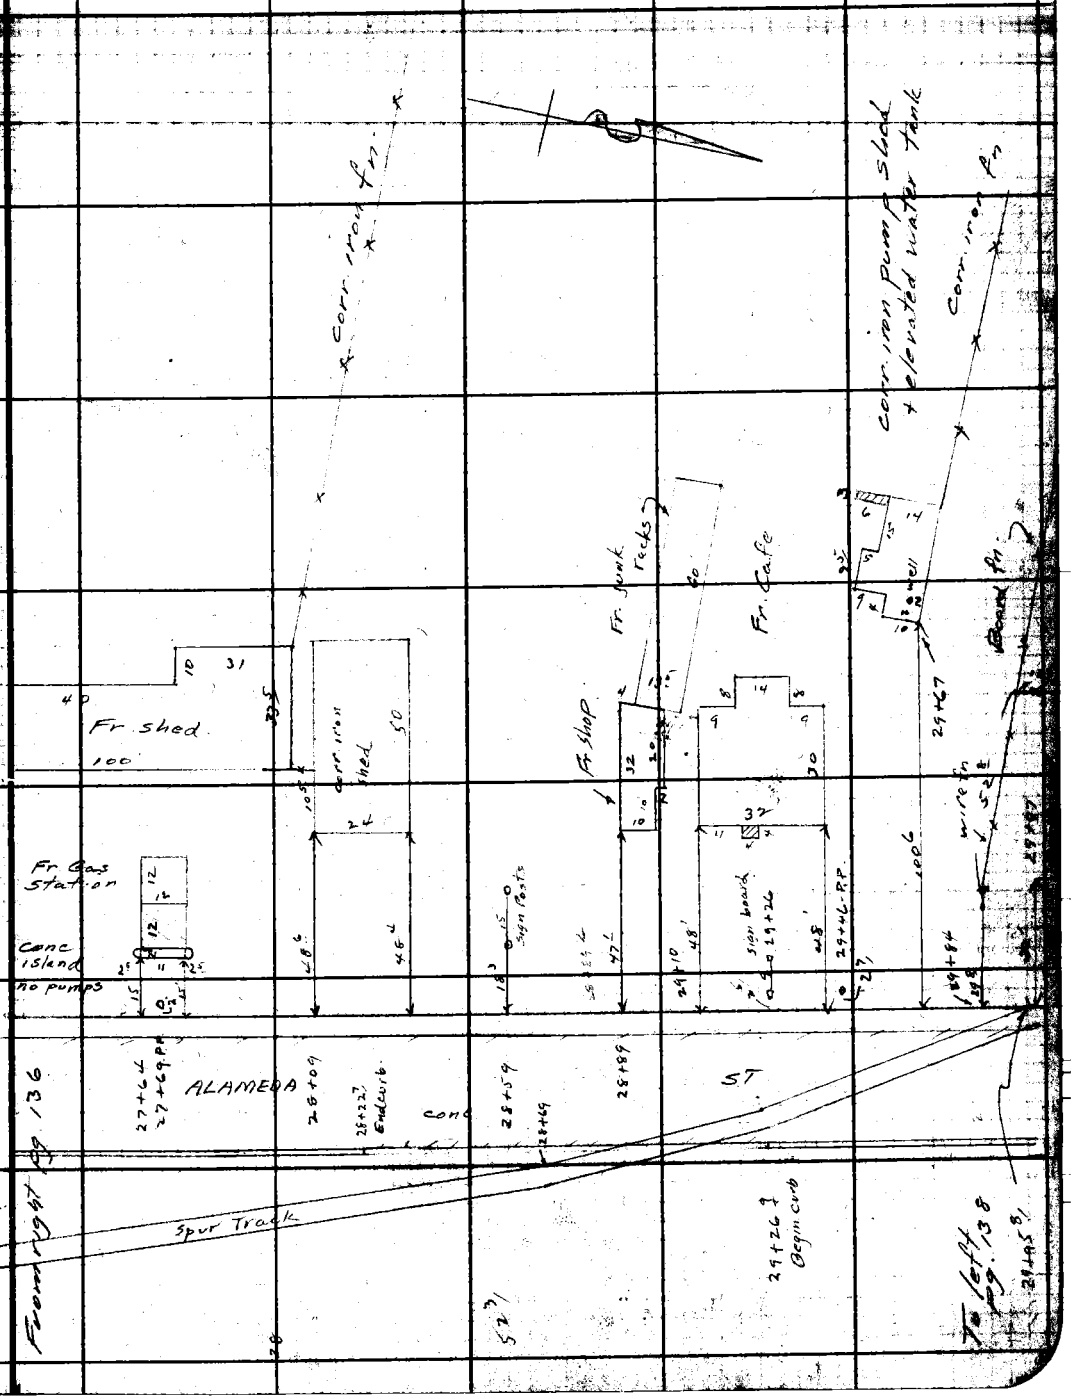

Note: Any Additions or Changes on This Sheets Must be Made or Circled in Red Ink With Date and Name of Person Making Change.

Do not extend notes this side of this line

RETURN TO
LOS ANGELES COUNTY SURVEYOR
700 HALL OF RECORDS

FORM 247 5M 10-37

RETURN TO
LOS ANGELES COUNTY SURVEYOR
700 HALL OF RECORDS

Note: Any Additions or Changes on This Sheets Must be Made or Circled in **Red Ink** With Date and Name of Person Making Change.

Do not extend notes this side of this line

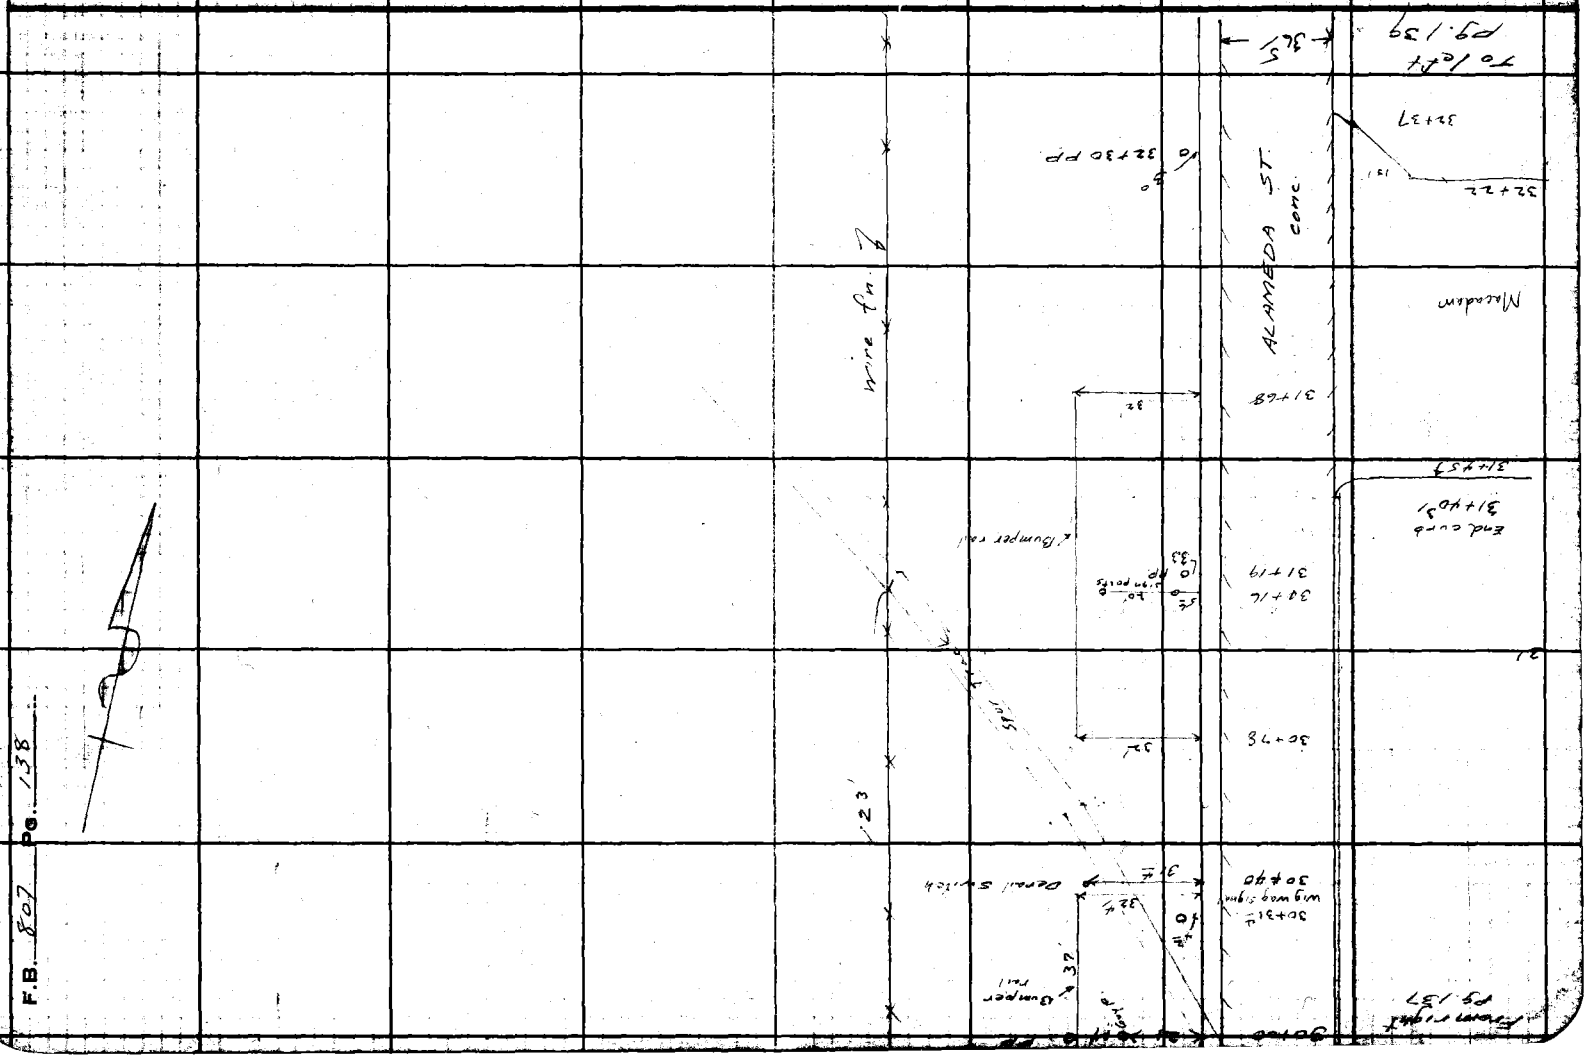

F.B. 807 PG. 138

Notes Ck'd by D. M. Finley	Survey of Alameda St	F.B. 807 Pg. 139
Map No. [illegible]	W. O. 8270 Tape No. ___ Std ___ of	
Office Work D. A. WHITE	Surveyed by Moore	
Checked D. M. Finley	Notes Moore Date 11-28-39	
Date Feb. 1940	Indexed A. C. Johnson	

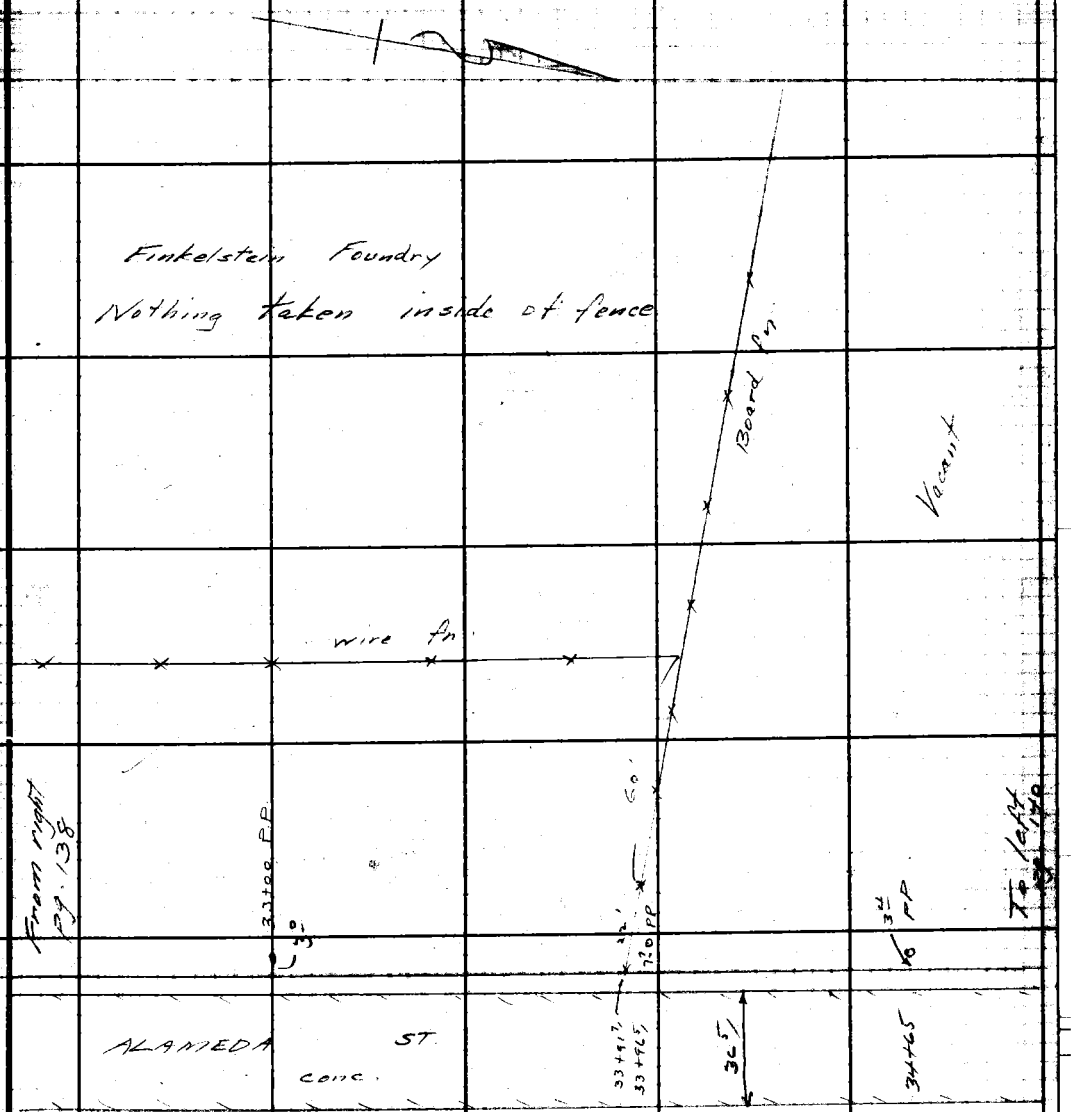

Note: Any Additions or Changes on This Sheets Must be Made or Circled in Red Ink With Date and Name of Person Making Change.

Do not extend notes this side of this line

RETURN TO
LOS ANGELES COUNTY SURVEYOR
700 HALL OF RECORDS

FORM 247 BM 10-37

F.B. 807 Pg. 140

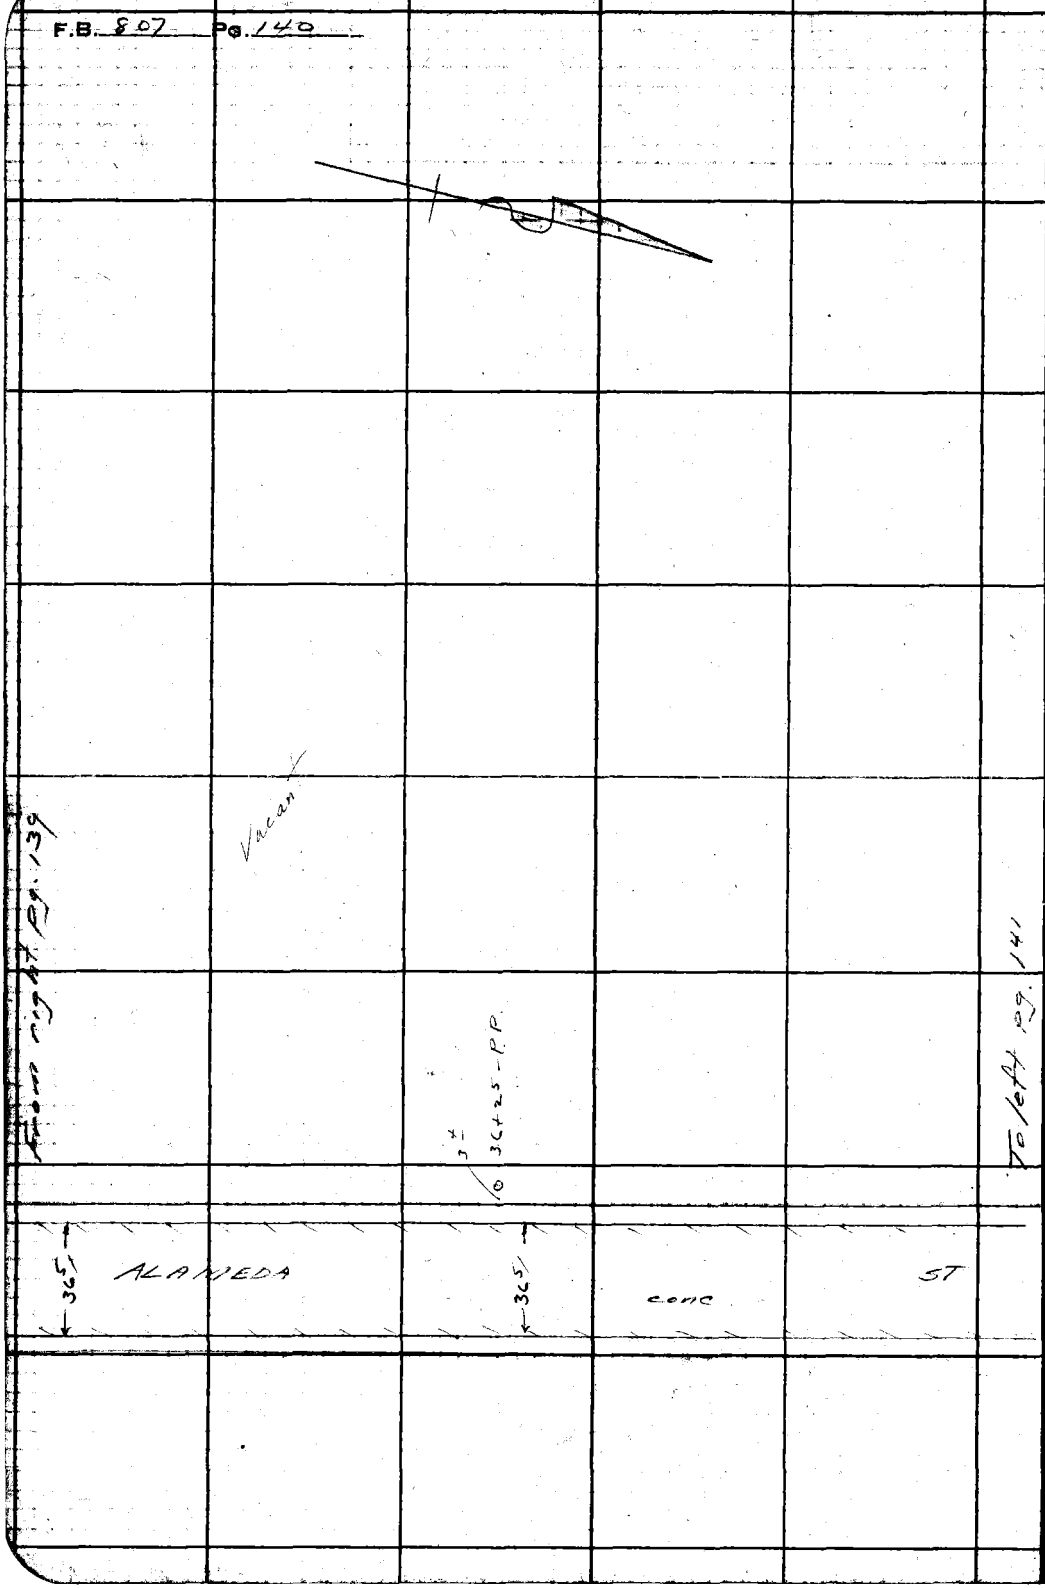

RETURN TO
LOS ANGELES COUNTY SURVEYOR
700 HALL OF RECORDS

Note: Any Additions or Changes on This Sheets Must be Made or Circled in Red Ink With Date and Name of Person Making Change.

Do not extend notes this side of this line

Notes Ck'd by D. M. Finley	Survey of Alameda St	F.B. 807 Pg. 144
Map No. B-1498-A	W. O. 8270 Tape No. ___ St'd ___ of	
Office Work D. A. WHITE	Surveyed by Moore	
Checked D. M. Finley	Notes Moore Date 11-28-39	
Date Feb. 1940	Indexed A. C. Johnson	

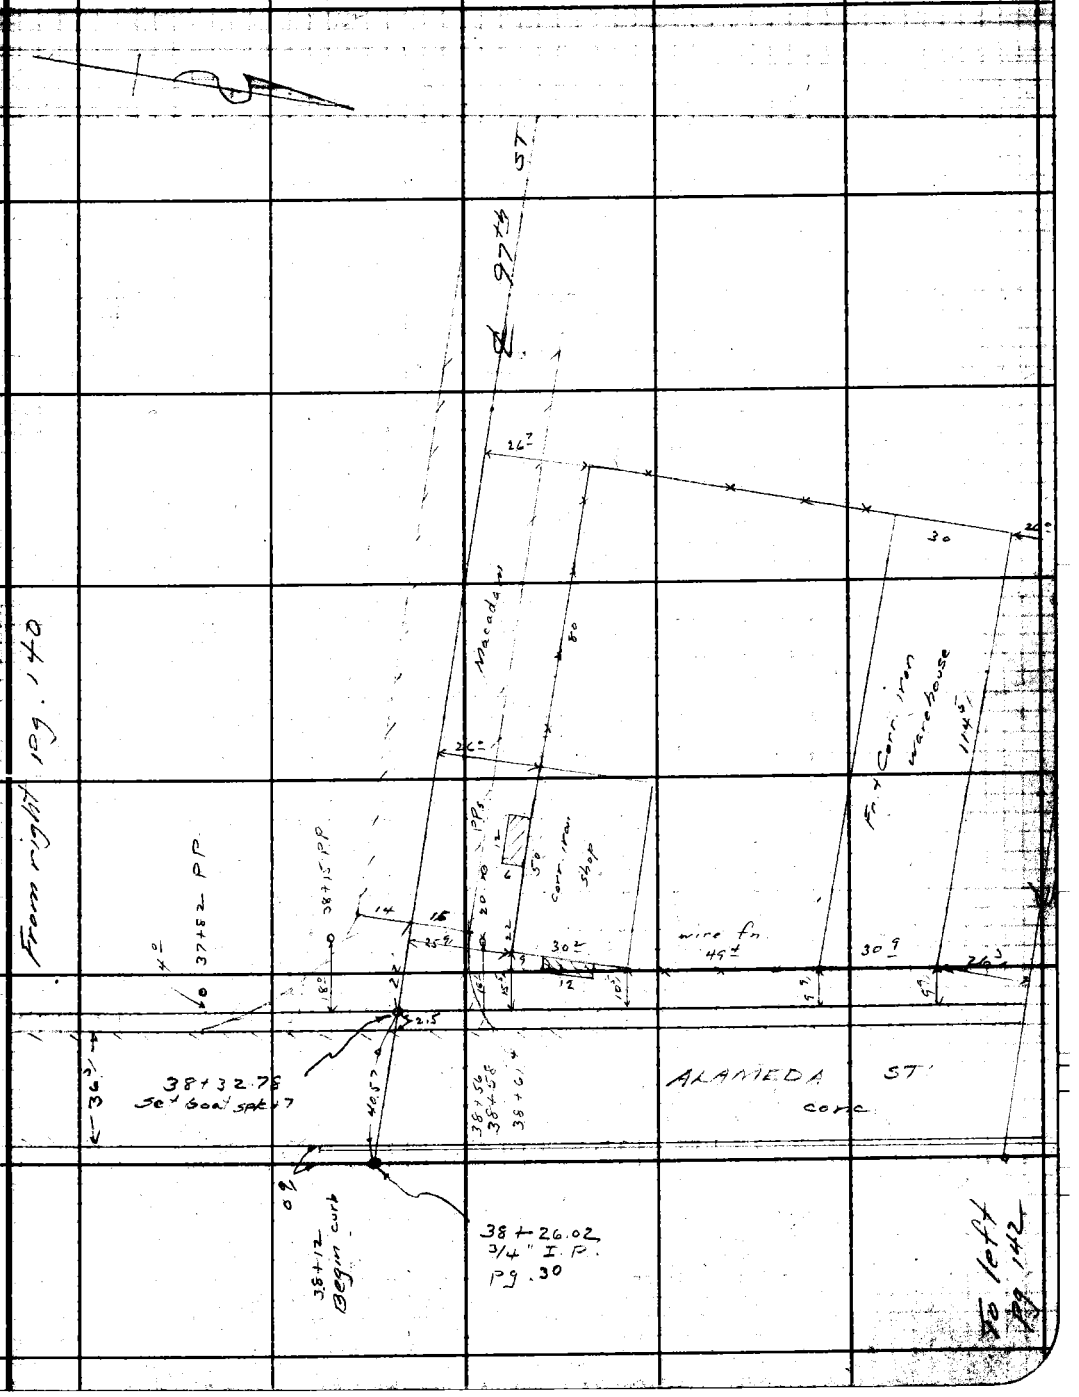

RETURN TO
LOS ANGELES COUNTY SURVEYOR
700 HALL OF RECORDS

Note: Any Additions or Changes on This Sheets Must be Made or Circled in Red Ink With Date and Name of Person Making Change.

Do not extend notes this side of this line

FORM 247 5M 10-37

RETURN TO
LOS ANGELES COUNTY SURVEYOR
700 HALL OF RECORDS

Note: Any Additions or Changes on This Sheets Must be Made or Circled in Red Ink With Date and Name of Person Making Change.

Do not extend notes this side of this line

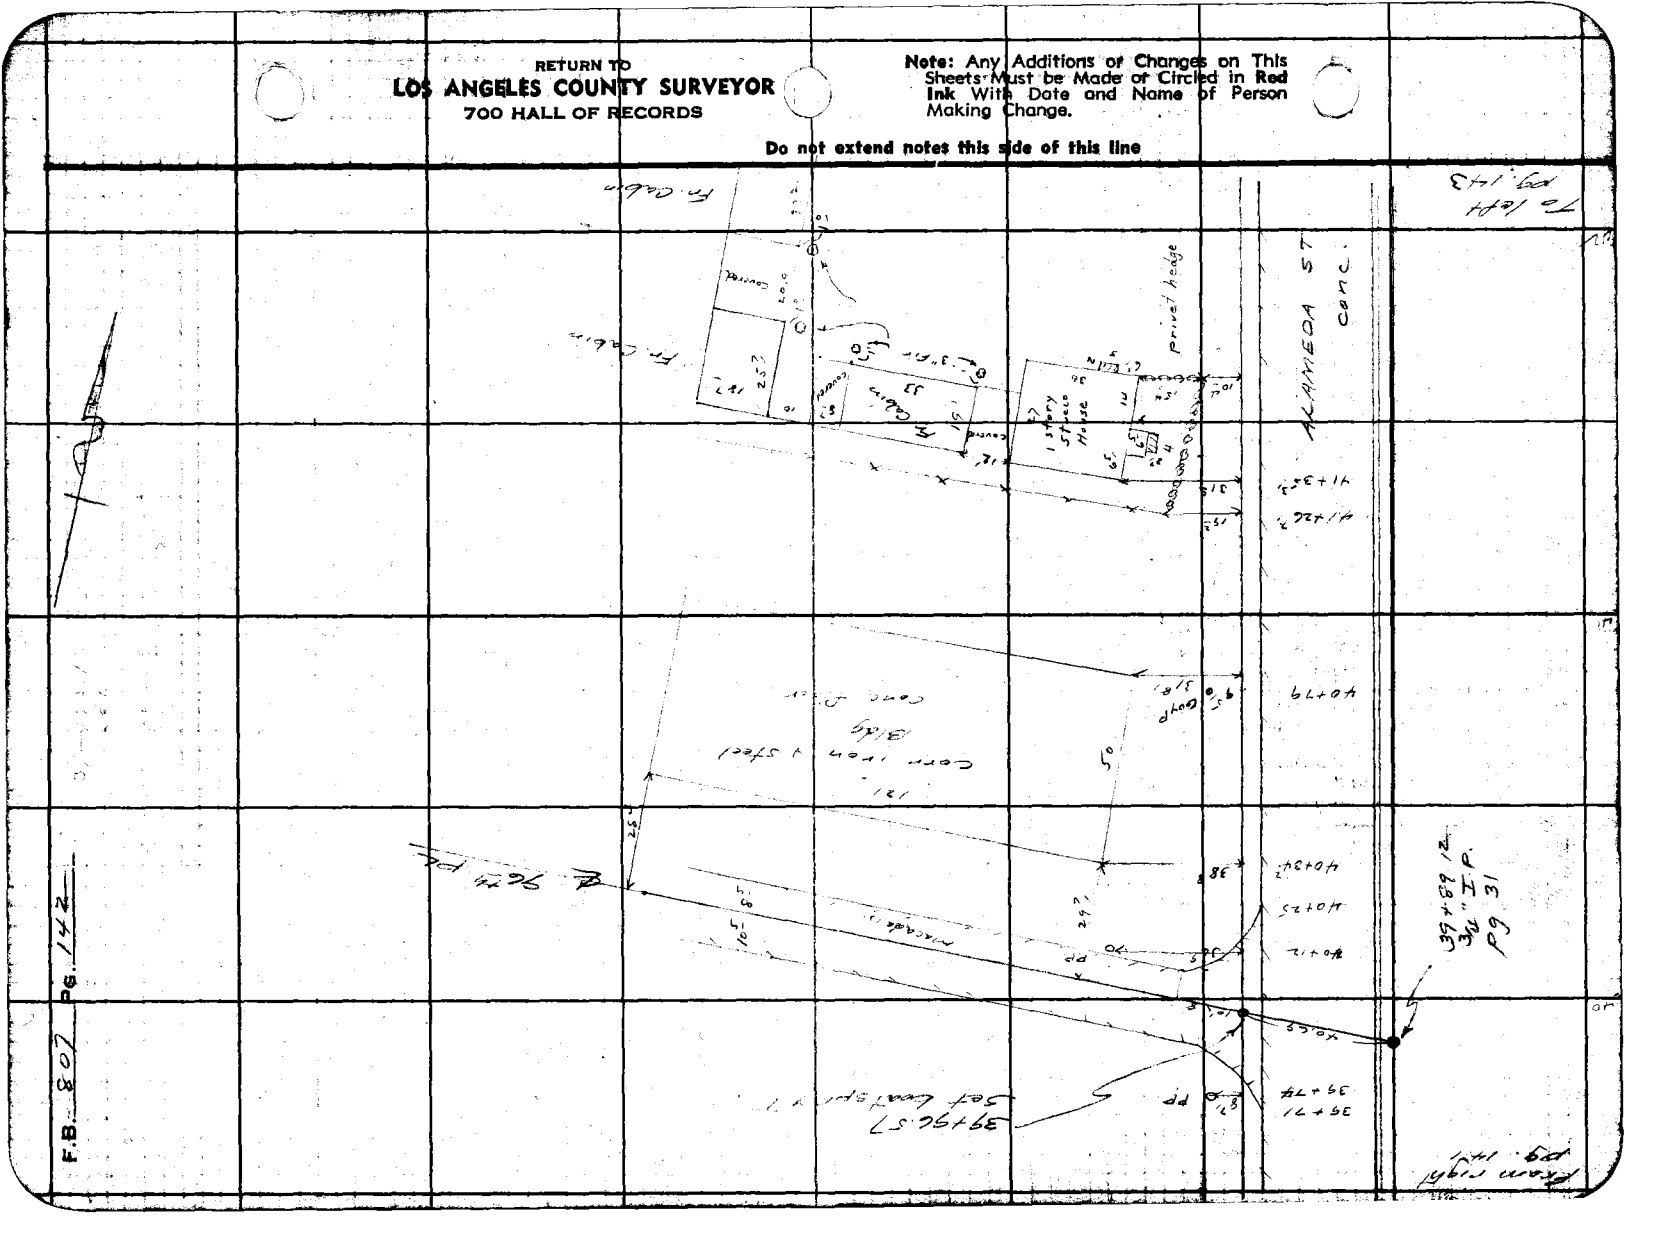

Notes Ck'd by D. M. Finley	Survey of Alameda St	P.B. 807 Pg. 143
Map No. [illegible]	W. O. [illegible] Tape No. St'd of	
Office Work [illegible]	Surveyed by [illegible]	
Checked D. M. Finley	Notes [illegible] Date 11-28-39	
Date Feb. 1940	Indexed A. C. Johnson	

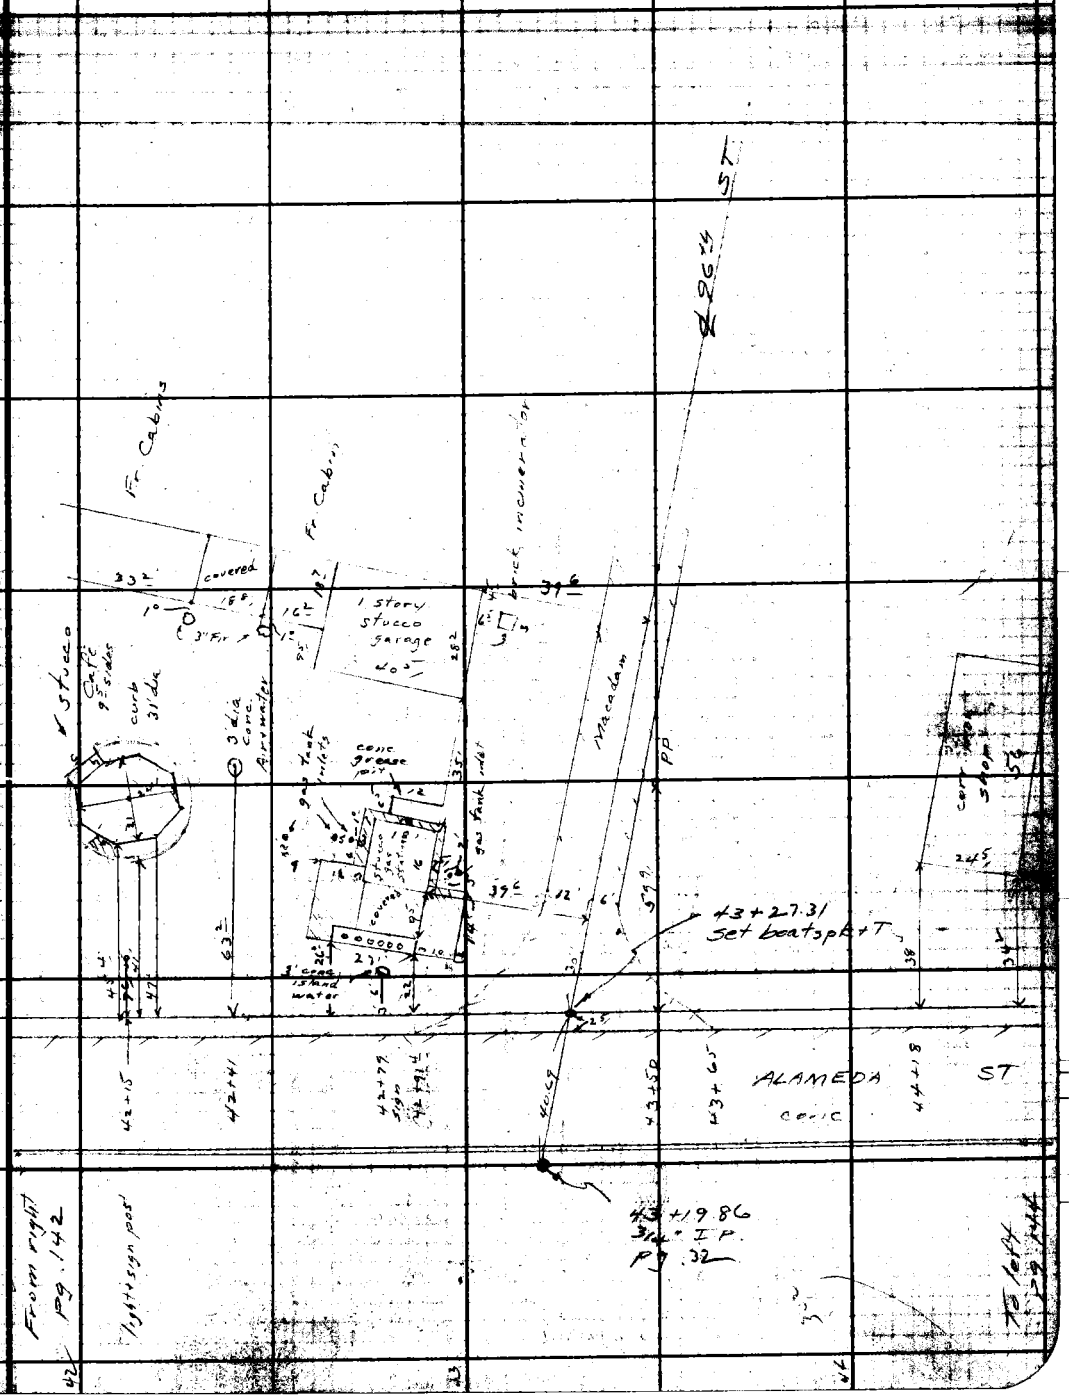

RETURN TO
LOS ANGELES COUNTY SURVEYOR
700 HALL OF RECORDS

Note: Any Additions or Changes on This Sheets Must be Made or Circled in Red Ink With Date and Name of Person Making Change.

Do not extend notes this side of this line

FORM 247 5M 10-37

RETURN TO
LOS ANGELES COUNTY SURVEYOR
700 HALL OF RECORDS

Note: Any Additions or Changes on This Sheets Must be Made or Circled in **Red Ink** With Date and Name of Person Making Change.

Do not extend notes this side of this line

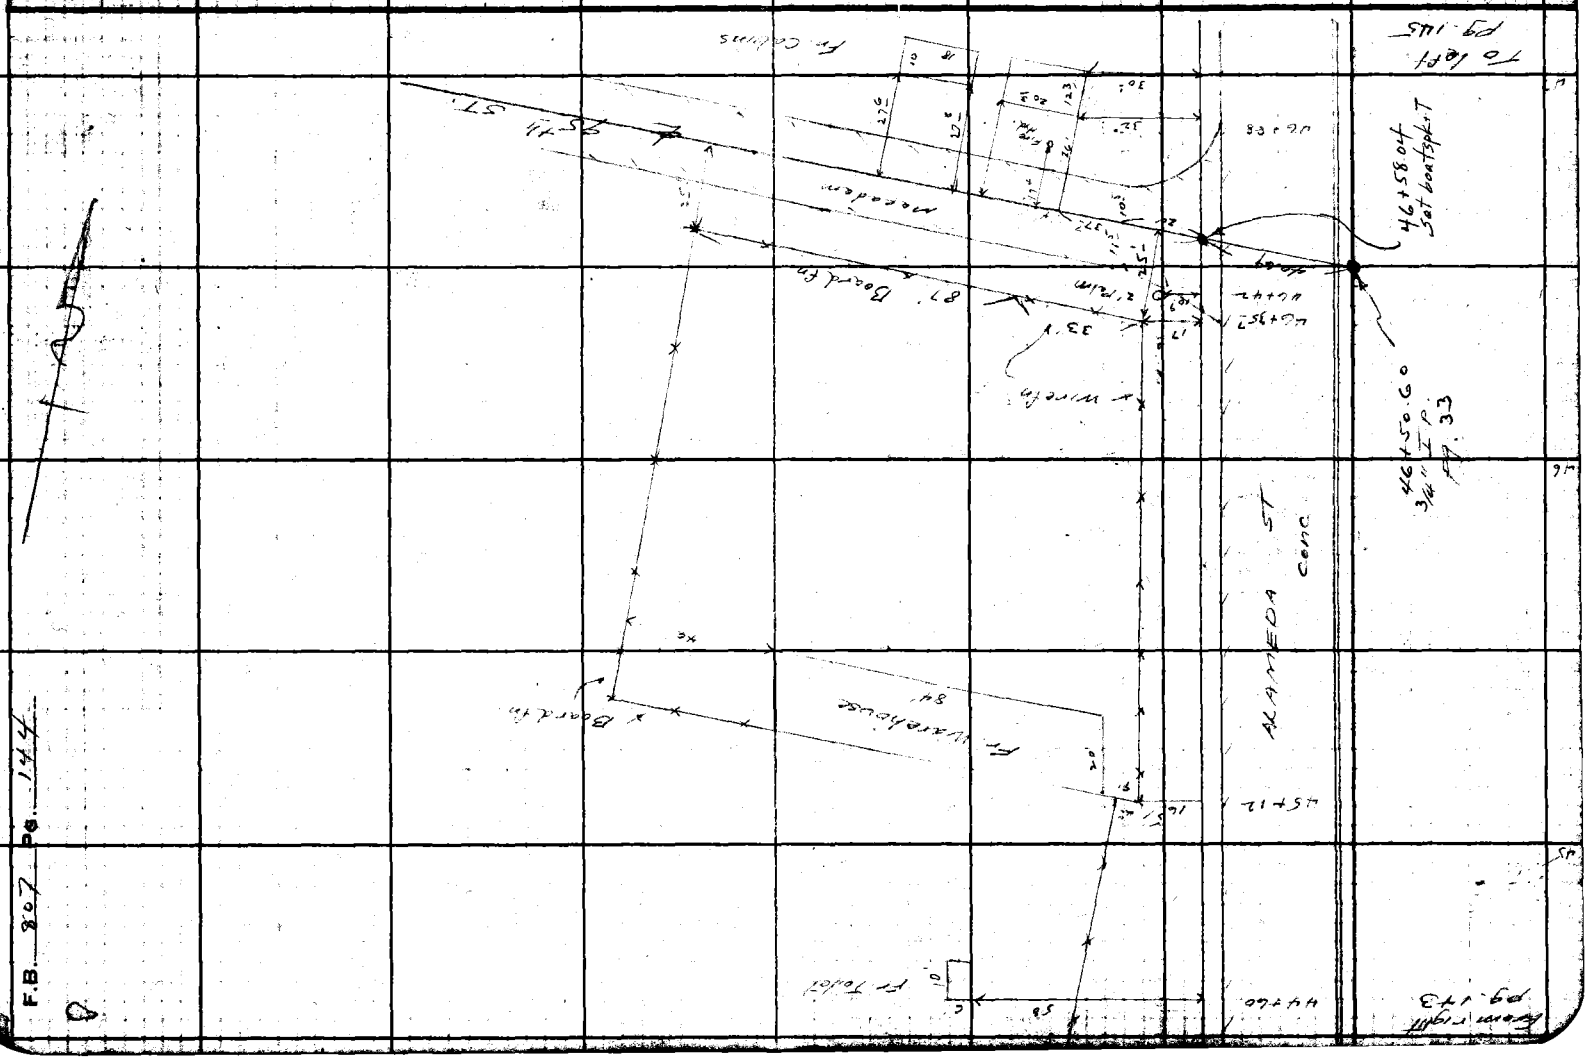

Notes Ck'd by D. M. Finley	Survey of Alameda St	F.B. 807 Pg. 145
Map No. [illegible]	W. 08220 Tape No. ___ Std ___ of	
Office Work [illegible]	Surveyed by Moore	
Checked D. M. Finley	Notes Moore Date 11-39	
Date Feb 1940	Indexed A. C. Johnson	

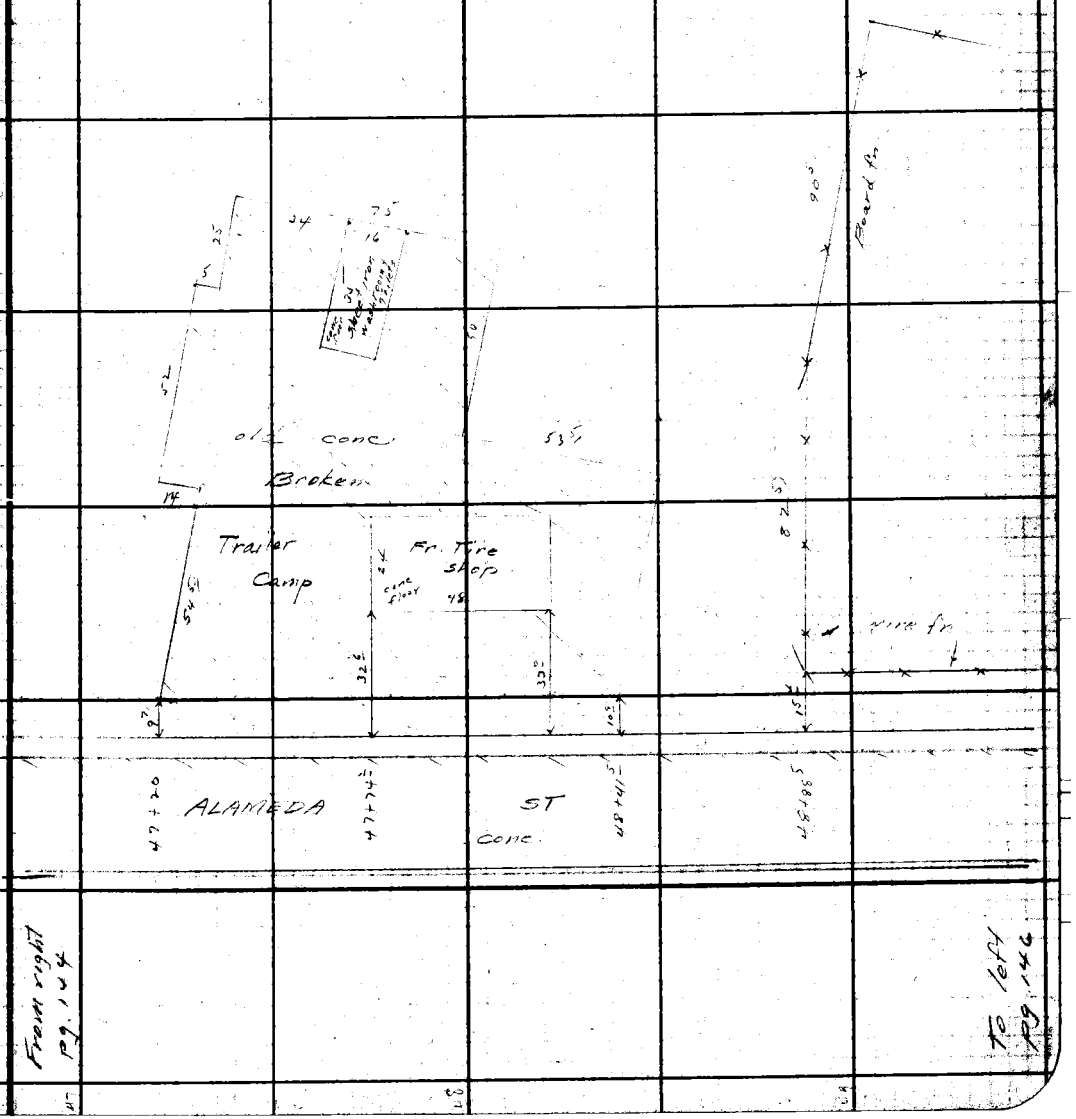

Note: Any Additions or Changes on This Sheets Must be Made or Circled in Red Ink With Date and Name of Person Making Change.

Do not extend notes this side of this line

RETURN TO
LOS ANGELES COUNTY SURVEYOR
700 HALL OF RECORDS

FORM 247 5M 10-37

RETURN TO
LOS ANGELES COUNTY SURVEYOR
700 HALL OF RECORDS

Note: Any Additions or Changes on This Sheets Must be Made or Circled in **Red Ink** With Date and Name of Person Making Change.

Do not extend notes this side of this line

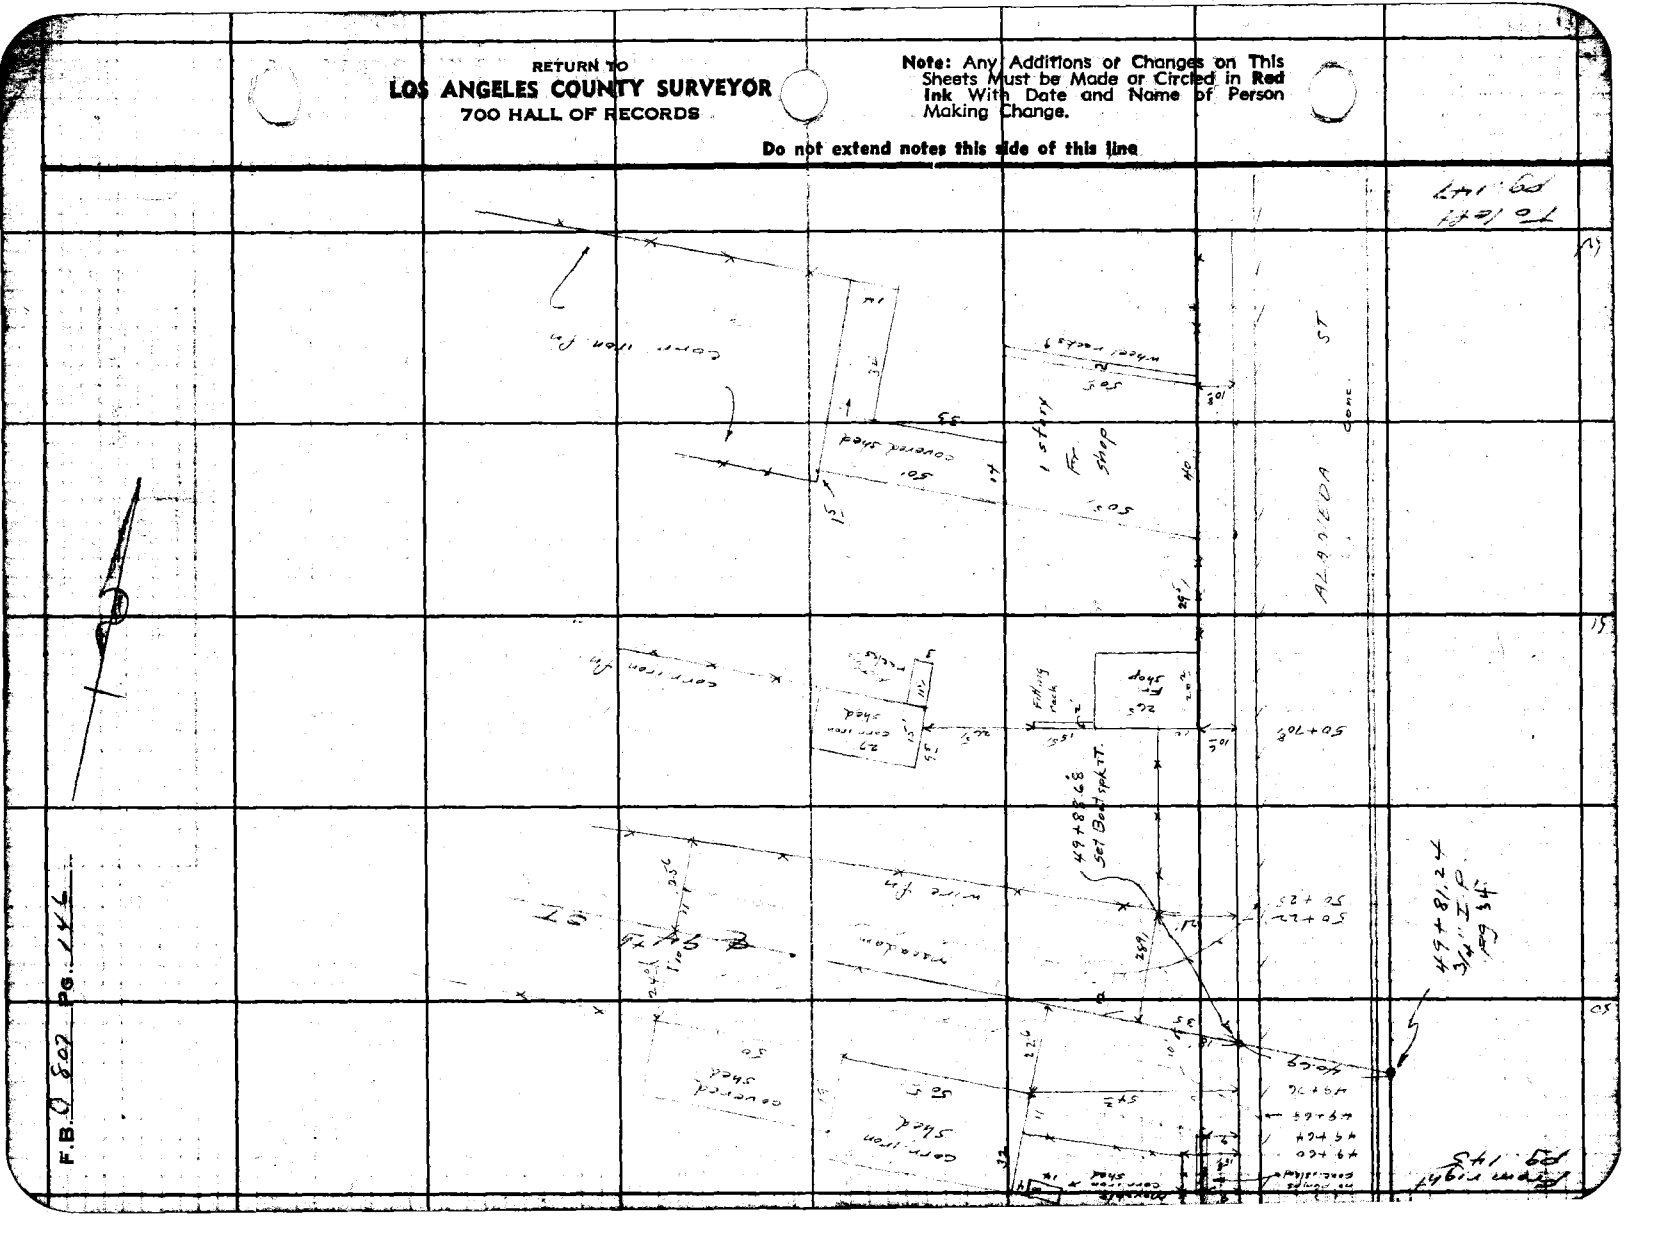

Notes Ck'd by D. M. Finley	Survey of Alameda St.	F.B. 807 Pg. 147
Map No. [illegible]	W. O. 7274 Tape No. [illegible]	
Office Work [illegible]	Surveyed by Moore	
Checked D. M. Finley	Notes Moore Date 11-39	
Date Feb. 1940	Indexed A. C. Johnson	

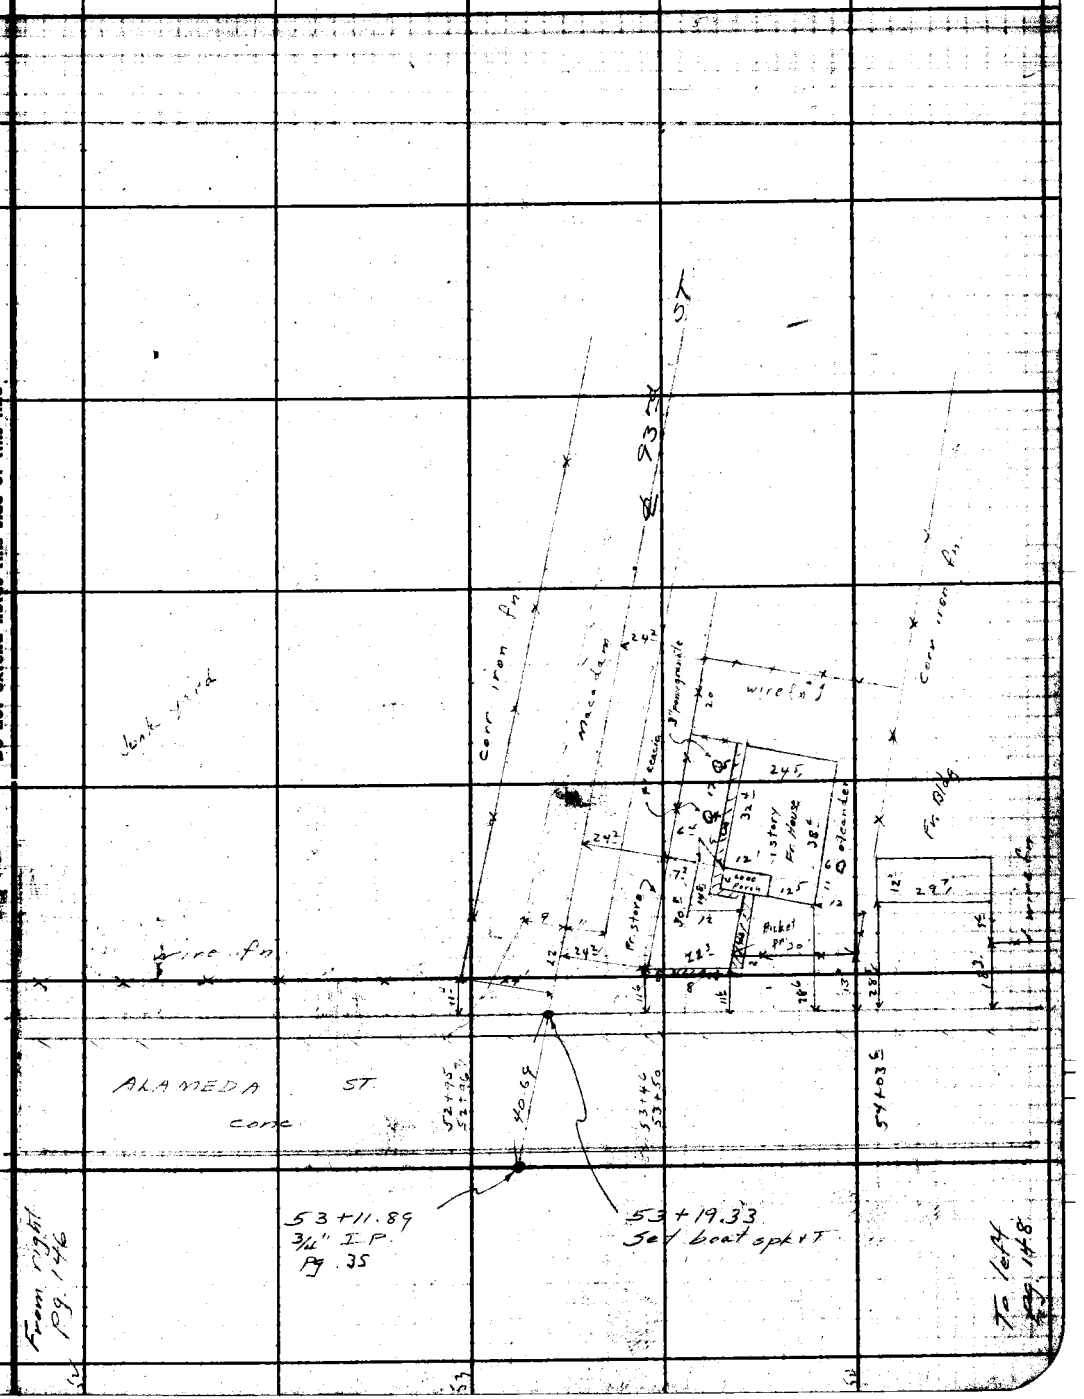

Note: Any Additions or Changes on This Sheets Must be Made or Circled in Red Ink With Date and Name of Person Making Change.

Do not extend notes this side of this line.

RETURN TO
LOS ANGELES COUNTY SURVEYOR
700 HALL OF RECORDS

FORM 247 5M 10-37

F.B. 807 Pg. 148

RETURN TO
LOS ANGELES COUNTY SURVEYOR
700 HALL OF RECORDS

Note: Any Additions or Changes on This Sheets Must be Made or Circled in Red Ink With Date and Name of Person Making Change.

Do not extend notes this side of this line

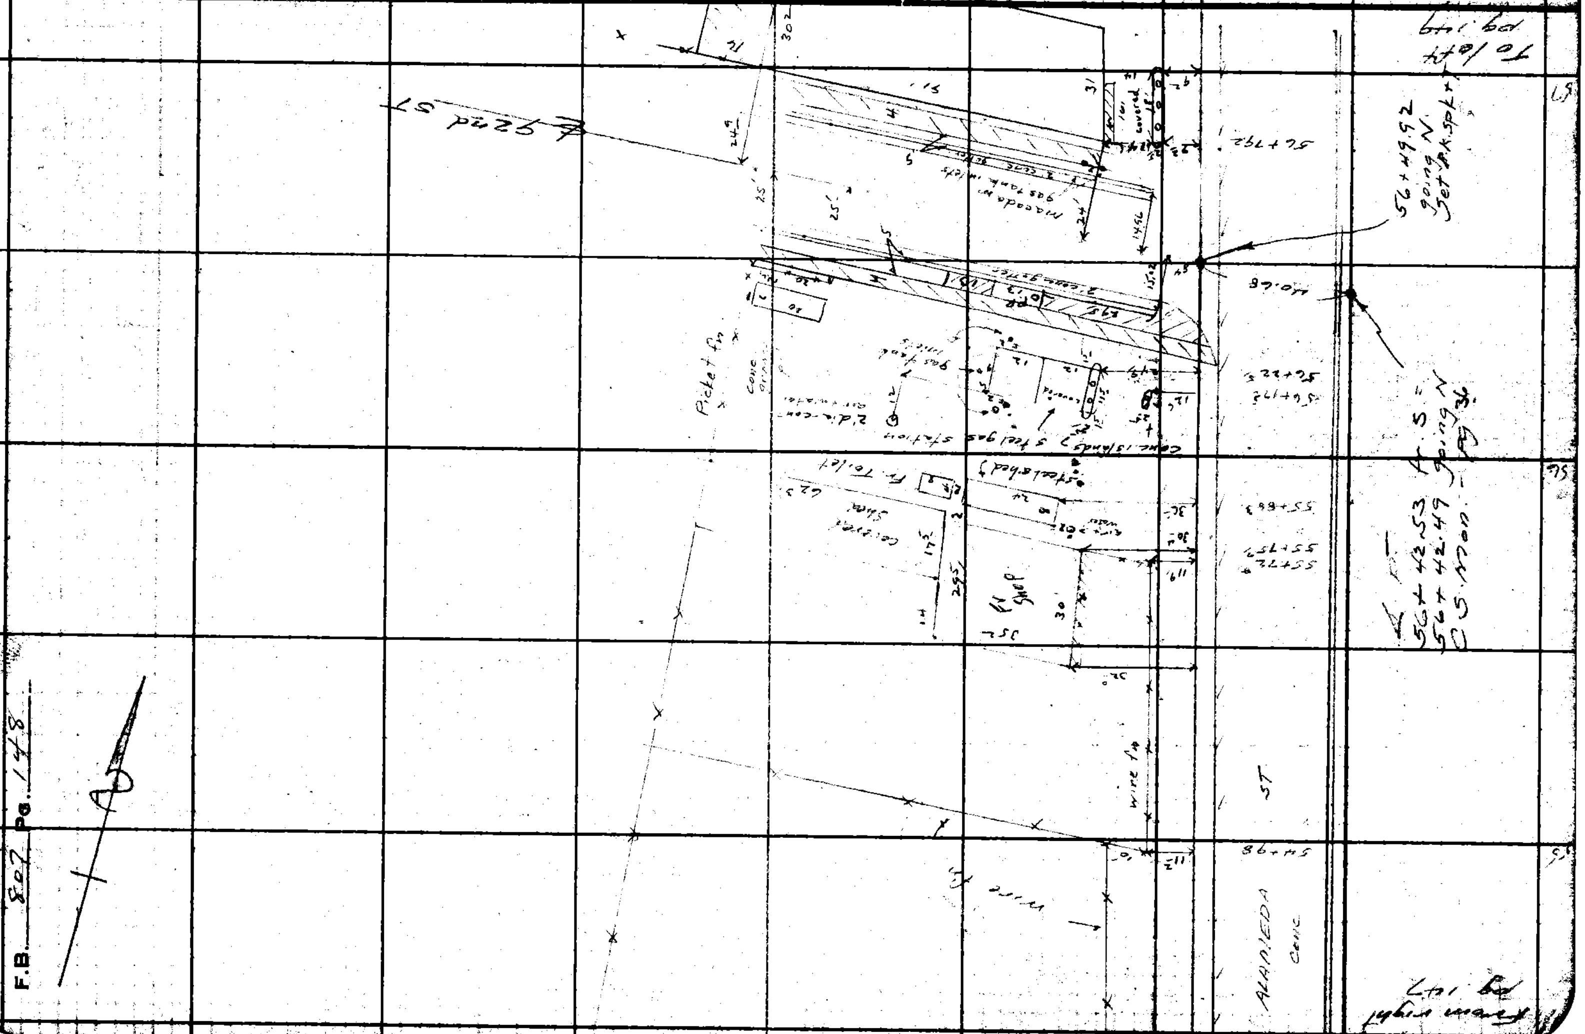

Notes Ck'd by D. M. Finley	Survey of Alameda St	F.B. 807 Pg. 149
Map No. [illegible]	W. O. [illegible] Title No. ___ Std. ___ of	
Office Work [illegible]	Surveyed By N. Moore	
Checked D. M. Finley	Notes N. Moore Date 11-29-39	
Date Feb. 1940	Indexed A. C. Johnson	

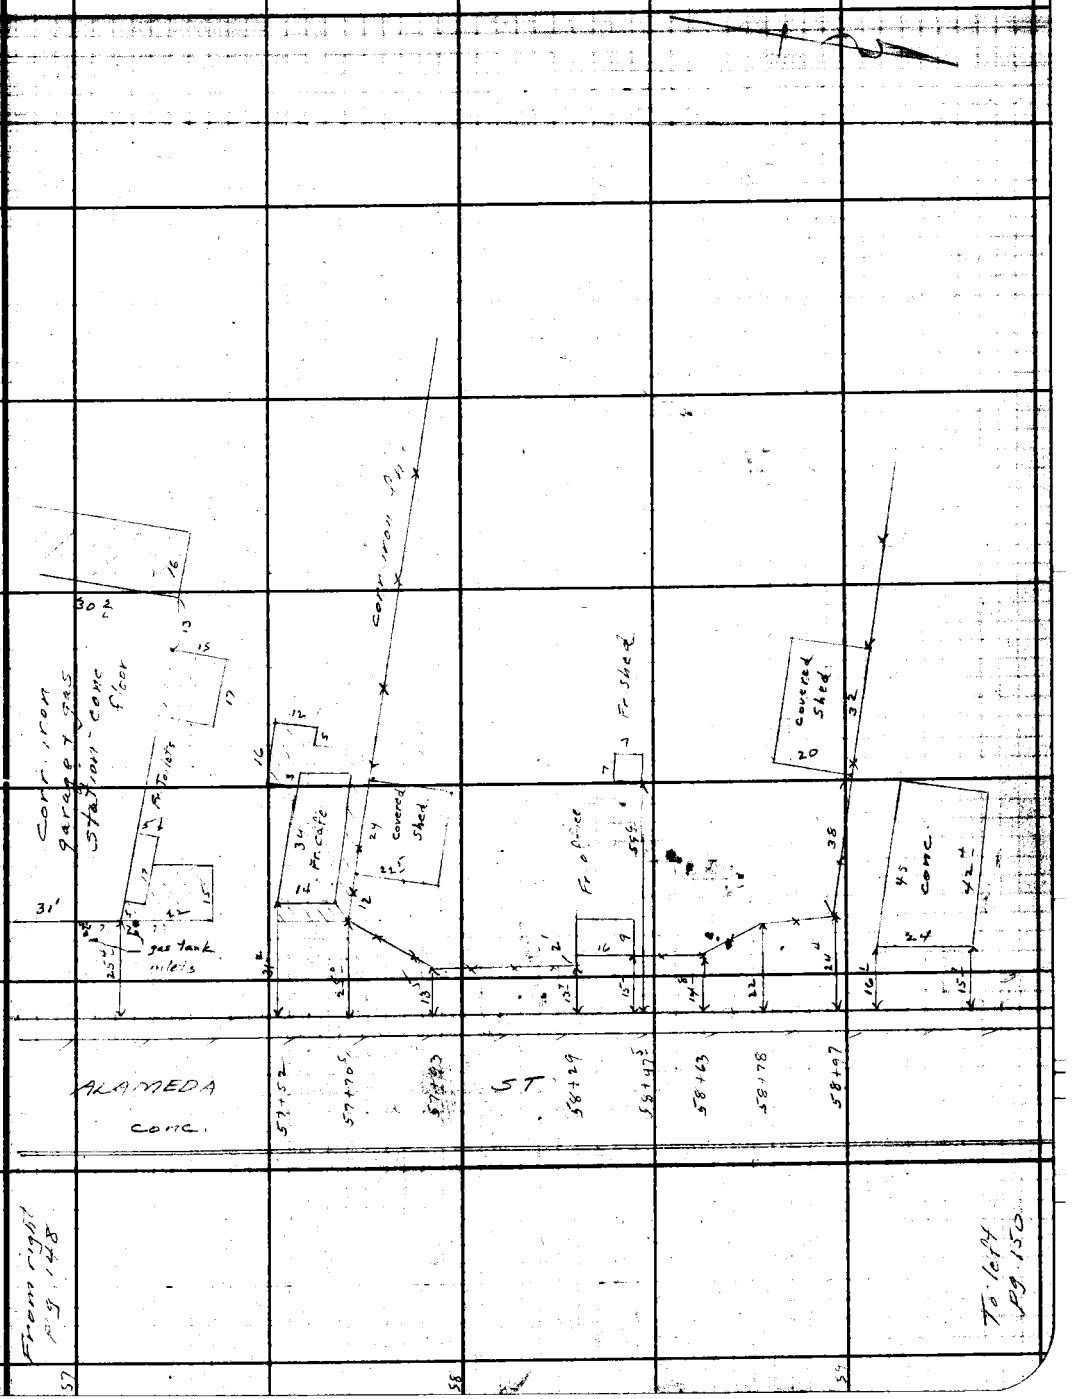

Note: Any Additions or Changes on Sheets Must be Made or Circled in Ink With Date and Name of Person Making Change.

Do not extend notes this side of this line

RETURN TO
LOS ANGELES COUNTY SURVEYOR
700 HALL OF RECORDS

FORM 247 BM 10-37

RETURN TO
LOS ANGELES COUNTY SURVEYOR
700 HALL OF RECORDS

Note: Any Additions or Changes on This Sheets Must be Made or Circled in **Red Ink** With Date and Name of Person Making Change.

Do not extend notes this side of this line

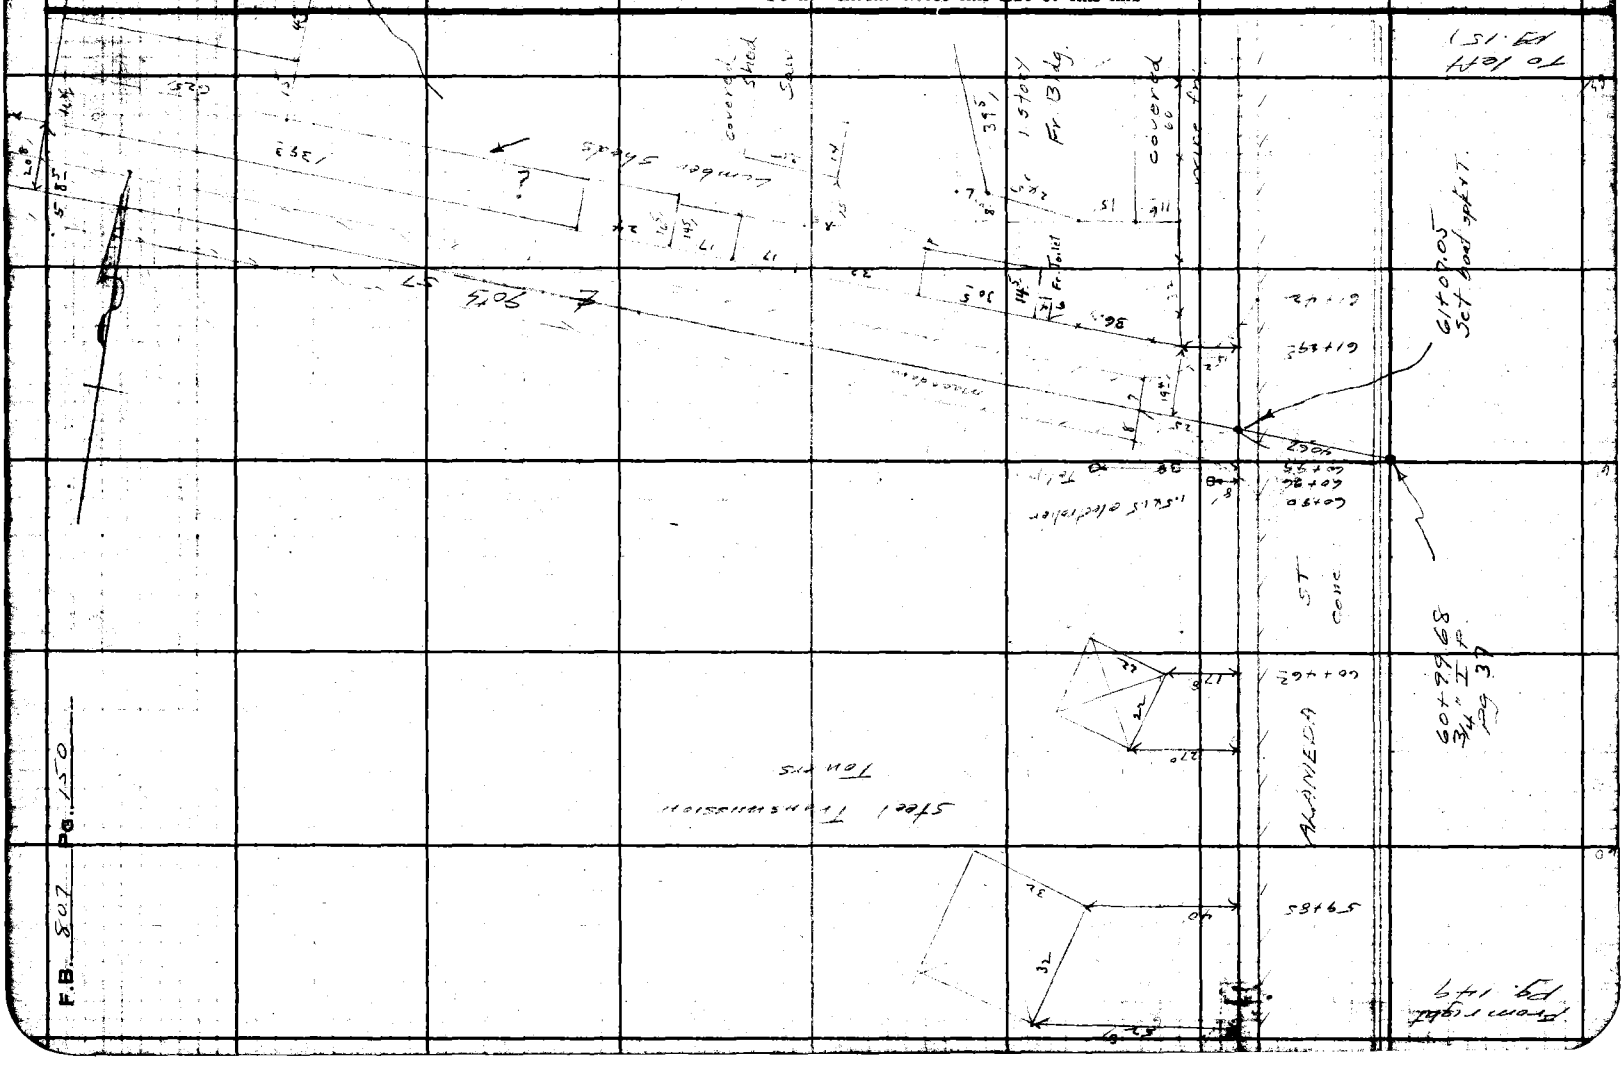

F.B. 807 PG. 150

Notes Ck'd by D. M. Finley	Survey of Alameda St	F.B. 807 Pg. 15[illegible]
[illegible]	[illegible] No. [illegible] Sta. [illegible] of	
Office Work [illegible]	[illegible] by Moore	
Checked D. M. Finley	Notes Moore Date 11-29-39	
Date Feb. 1940.	Indexed A. C. Johnson	

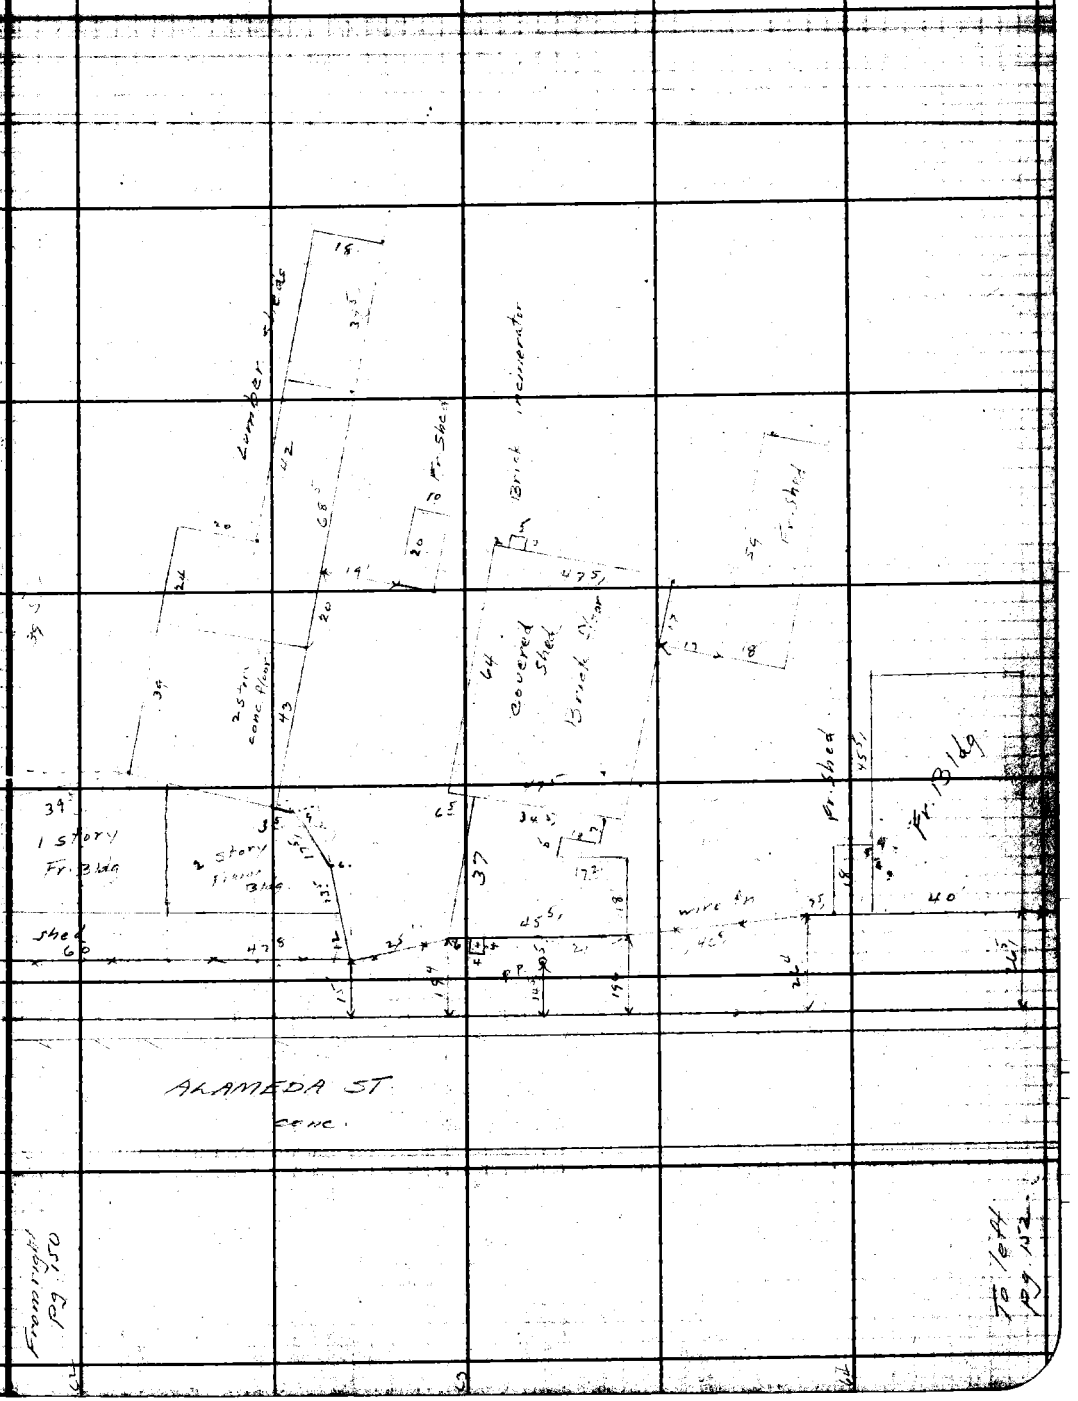

Note: Any Additions or Changes on [illegible] Sheets Must be Made or Circled in [illegible] Ink With Date and Name of Person Making Change.

Do not extend notes this side of this line

RETURN TO
LOS ANGELES COUNTY SURVEYOR
700 HALL OF RECORDS

FORM 247 5M 10-37

RETURN TO
LOS ANGELES COUNTY SURVEYOR
700 HALL OF RECORDS

Note: Any Additions or Changes on This Sheets Must be Made or Circled in **Red Ink** With Date and Name of Person Making Change.

Do not extend notes this side of this line

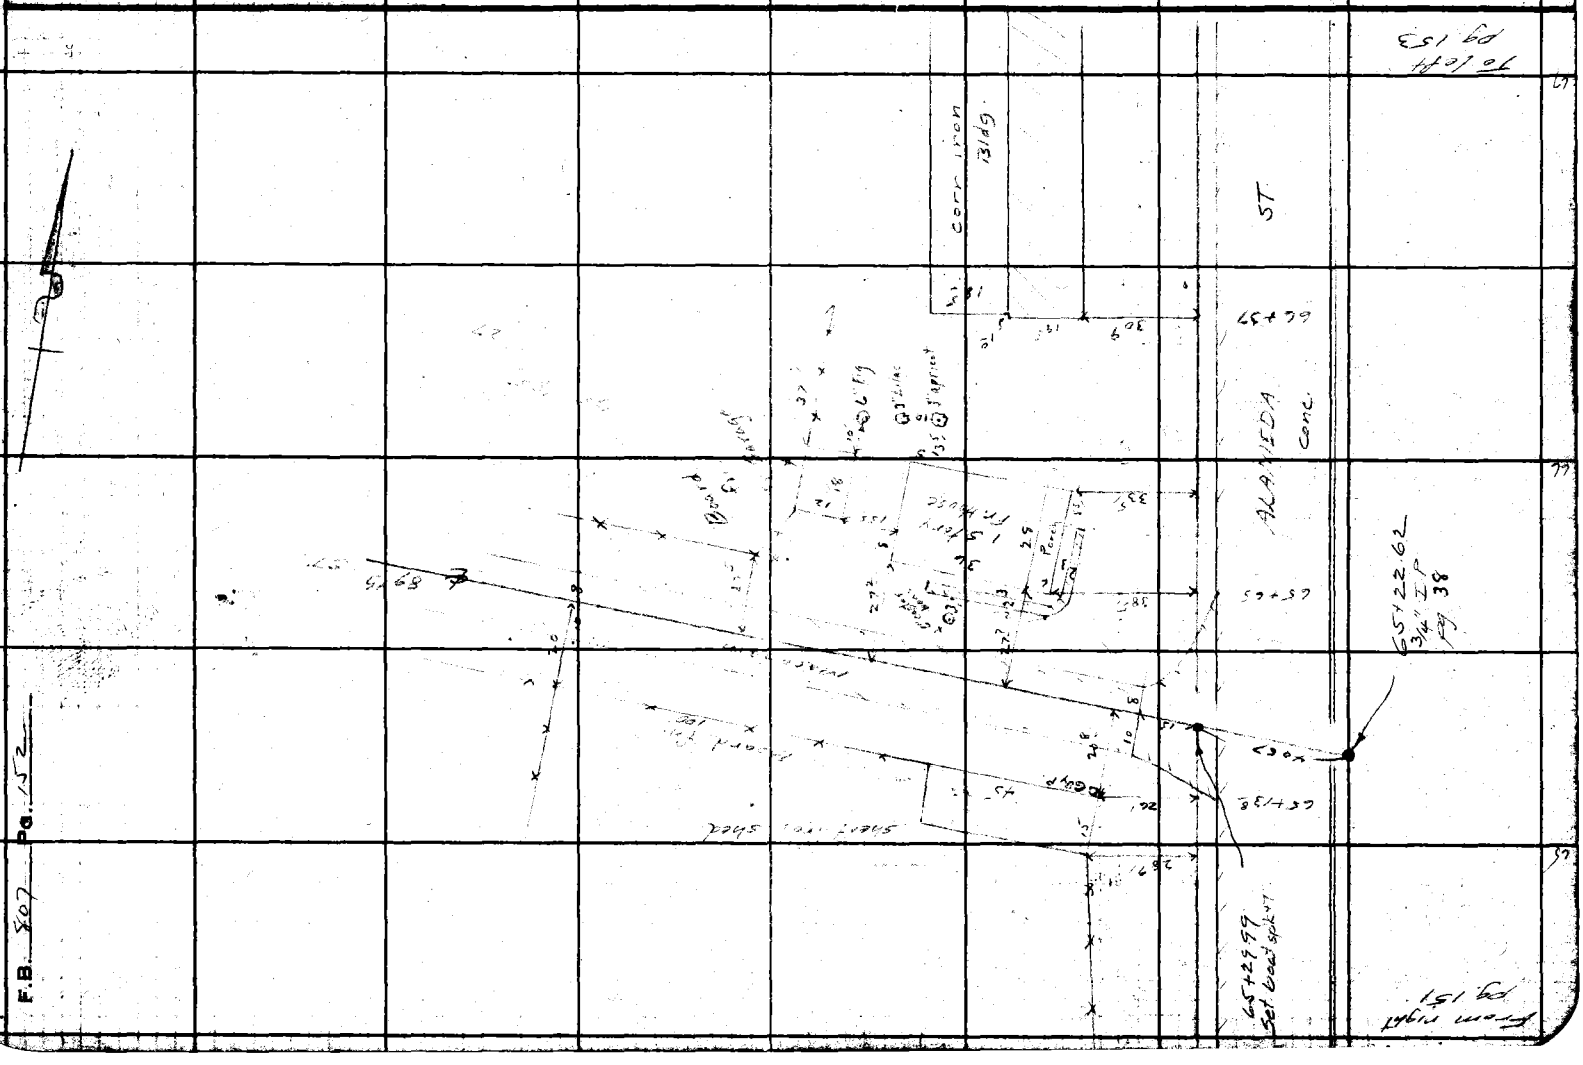

F.B. 807 Pg. 152

Notes Ck'd by D. M. Finley	Survey of Alameda St	F.B. 847 Pg. 152
Map No. [illegible]	W. O. 8270 Type No. [illegible]	
Office Work B. A. WHITE	Surveyed by [illegible]	
Checked D. M. Finley	Notes [illegible] Date 11-29-37	
Date Feb 1940	Indexed A. C. Johnson	

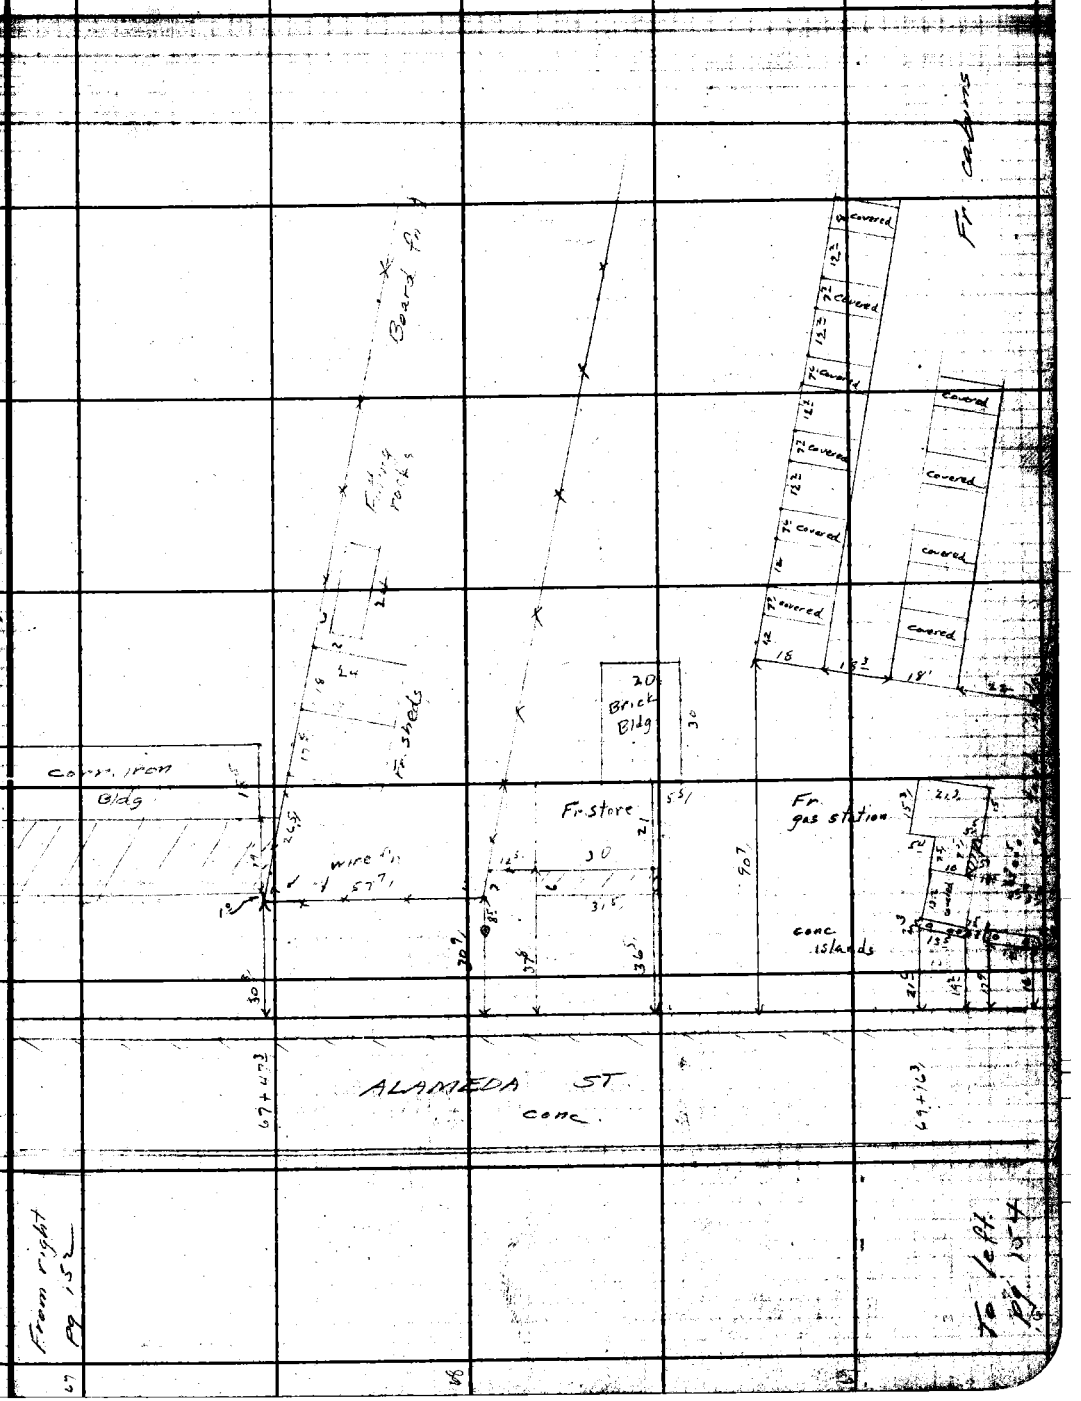

Note: Any Additions or Changes on This Sheets Must be Made or Circled in Red Ink With Date and Name of Person Making Change.

Do not extend notes this side of this line

RETURN TO
LOS ANGELES COUNTY SURVEYOR
700 HALL OF RECORDS

FORM 247 5M 10-37

RETURN TO
LOS ANGELES COUNTY SURVEYOR
700 HALL OF RECORDS

Note: Any Additions or Changes on This Sheets Must be Made or Circled in **Red Ink** With Date and Name of Person Making Change.

Do not extend notes this side of this line

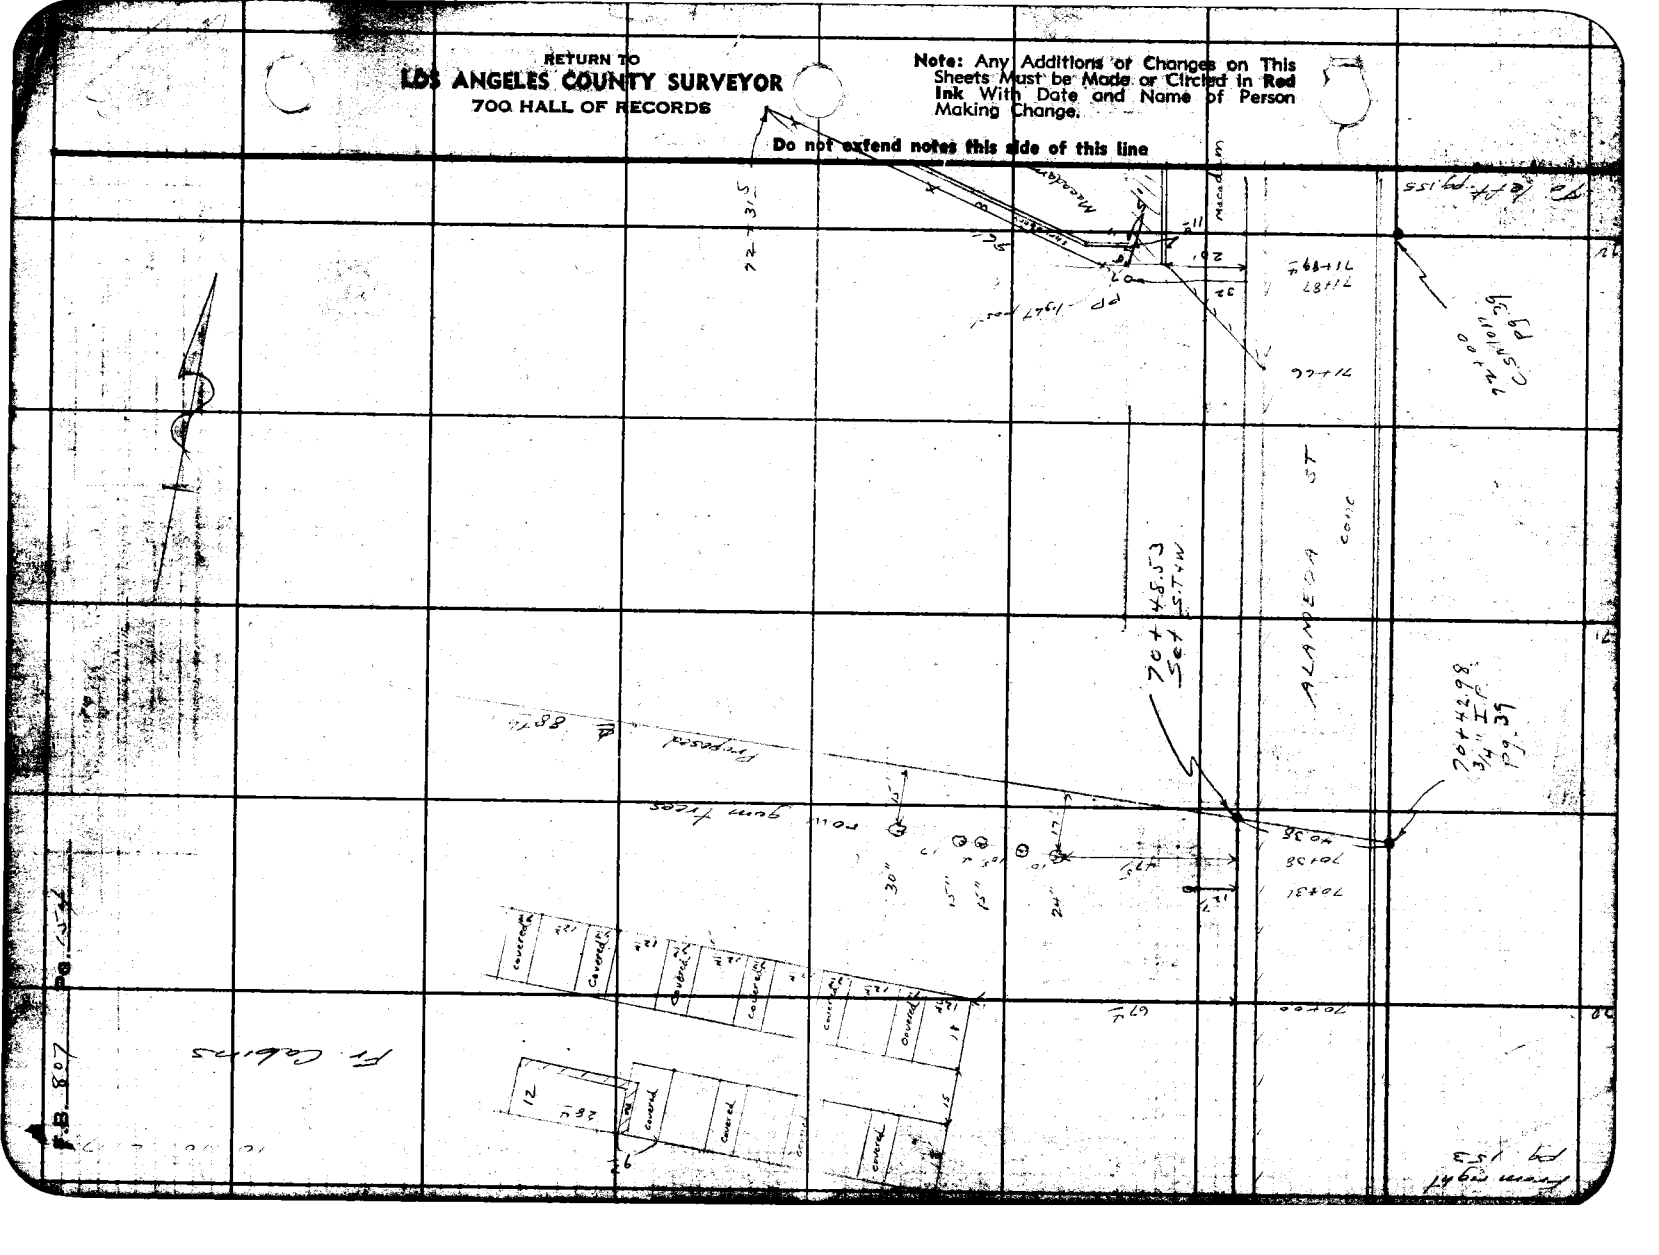

FORM 247 5M 10-37

RETURN TO
LOS ANGELES COUNTY SURVEYOR
700 HALL OF RECORDS

Note: Any Additions or Changes on this Sheets Must be Made or Circled in Red Ink With Date and Name of Person Making Change.

Do not extend notes this side of this line

1693

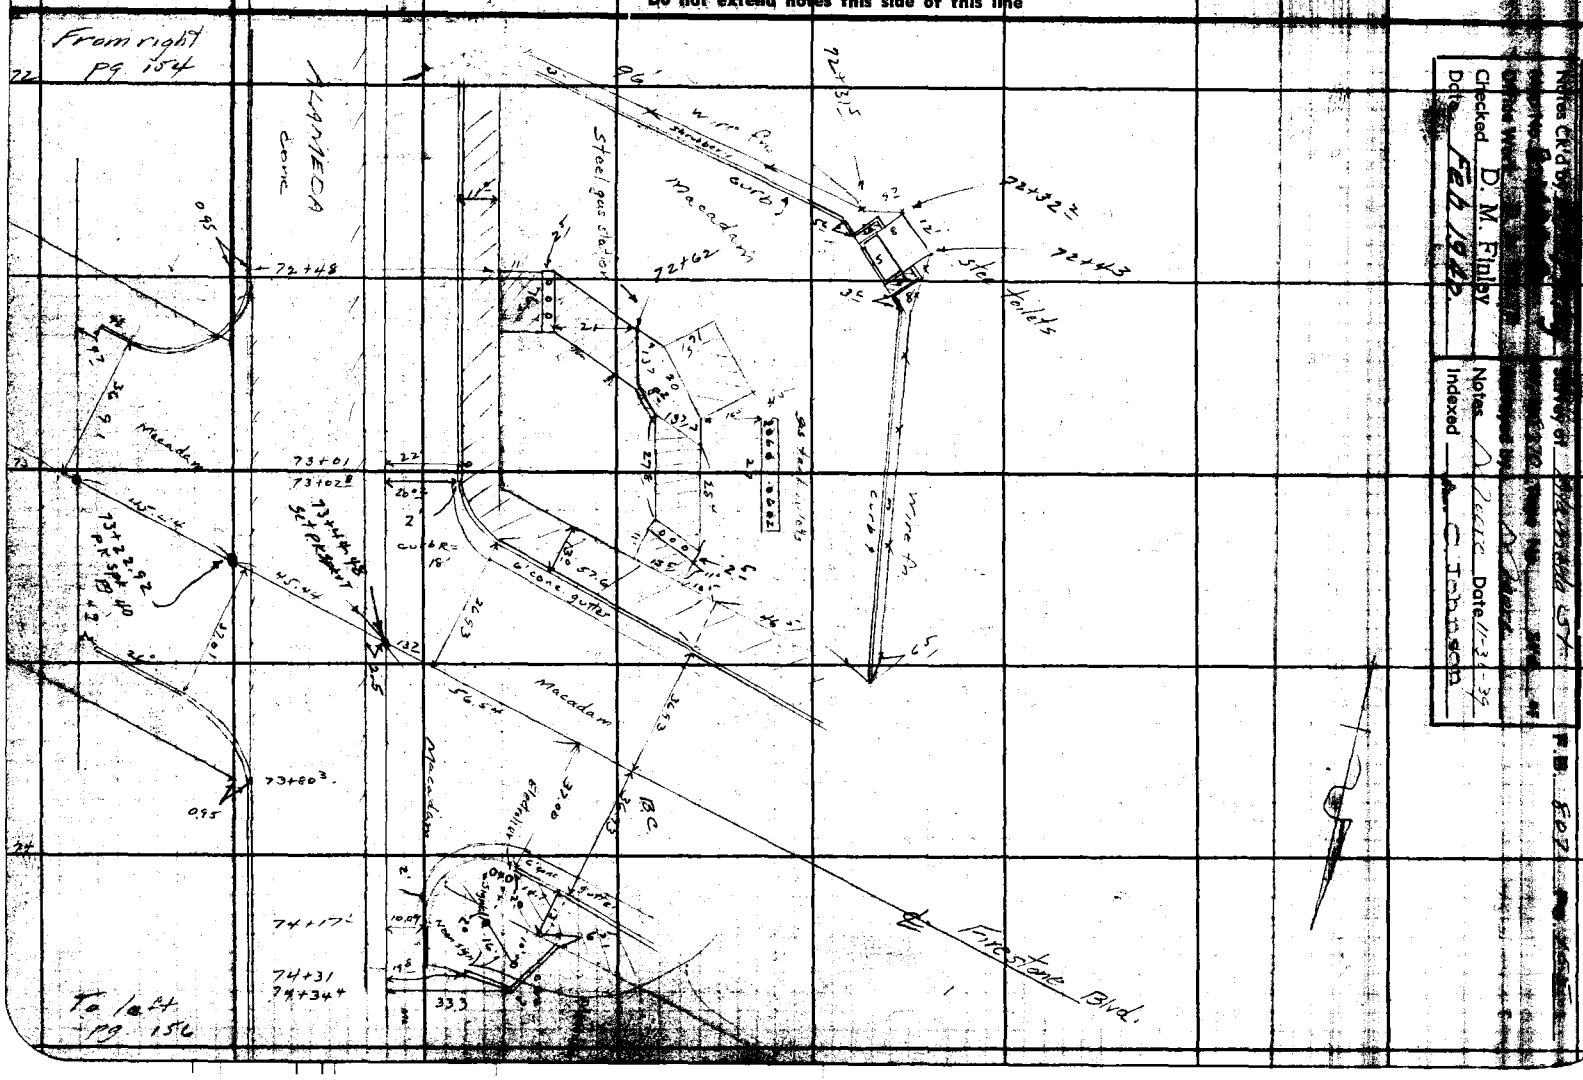

Notes Ck'd by
Checked D. M. Finley
Notes
Indexed
Date 11-3-39
A. C. Johnson


RETURN TO
LOS ANGELES COUNTY SURVEYOR
700 HALL OF RECORDS

Note: Any Additions or Changes on This Sheets Must be Made or Circled in Red Ink With Date and Name of Person Making Change.

Do not extend notes this side of this line

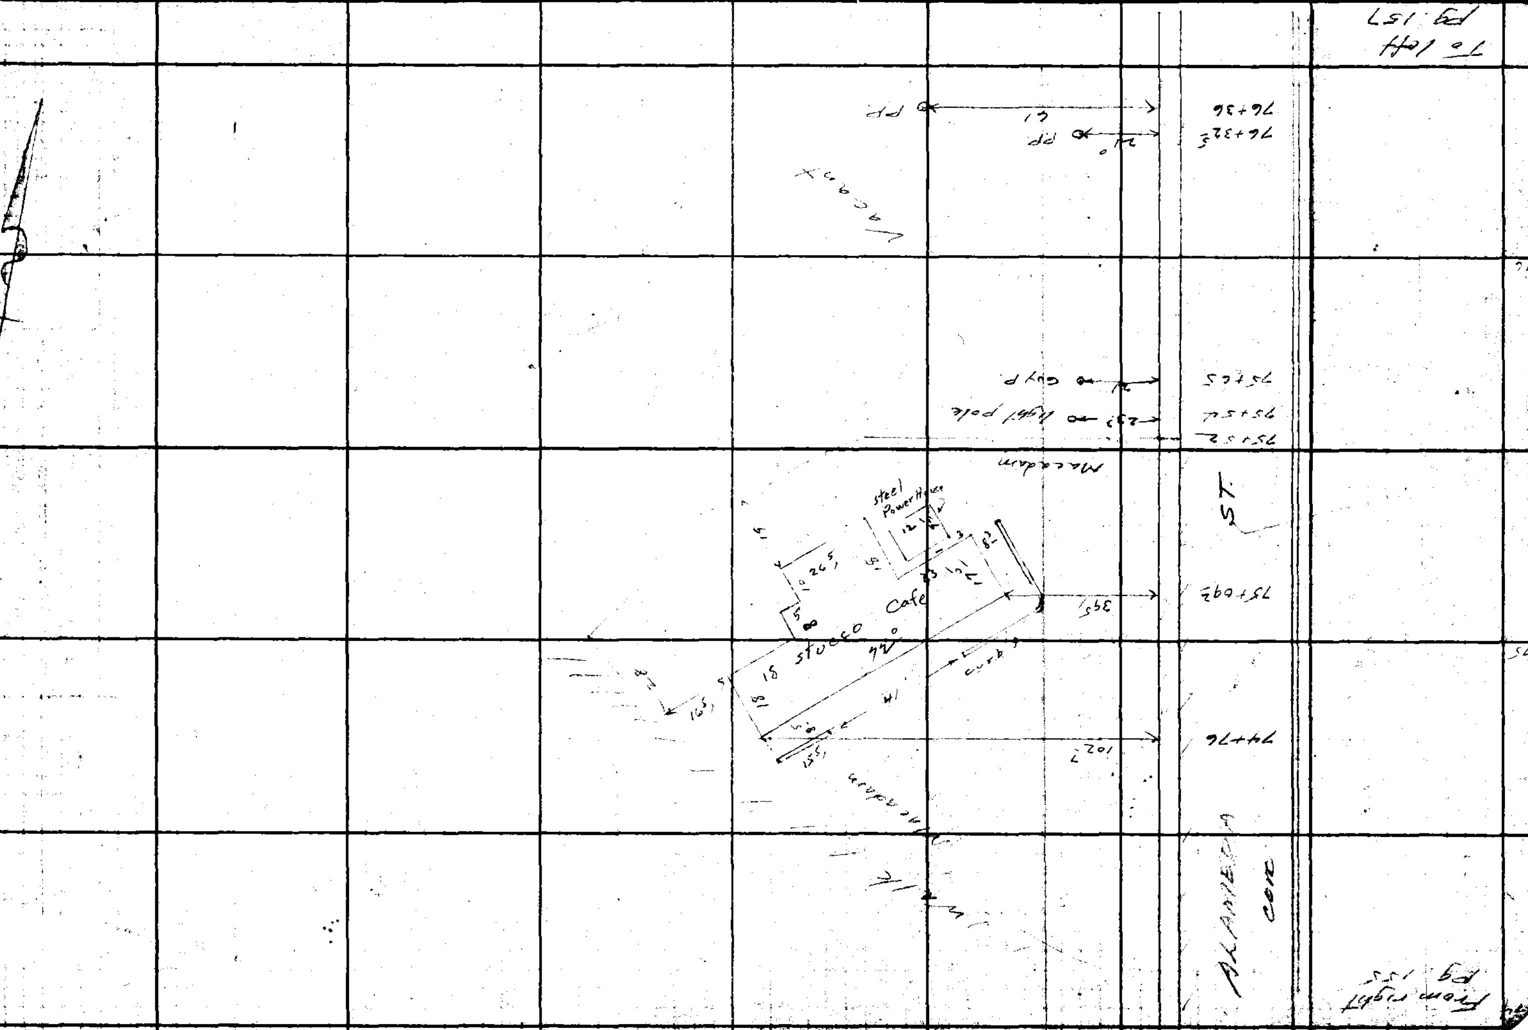

Notes Cut by D. M. Finley	Survey of Alameda St	F.B. 807	Pg. 157
[illegible]	W. O. 5270 Tape No. Std of		
Office Work H. H. REYNOLDS	Surveyed by Moore		
Checked D. M. Finley	Notes Moore Date 11-30-39		
Date Feb. 1940	Indexed A. C. Johnson		

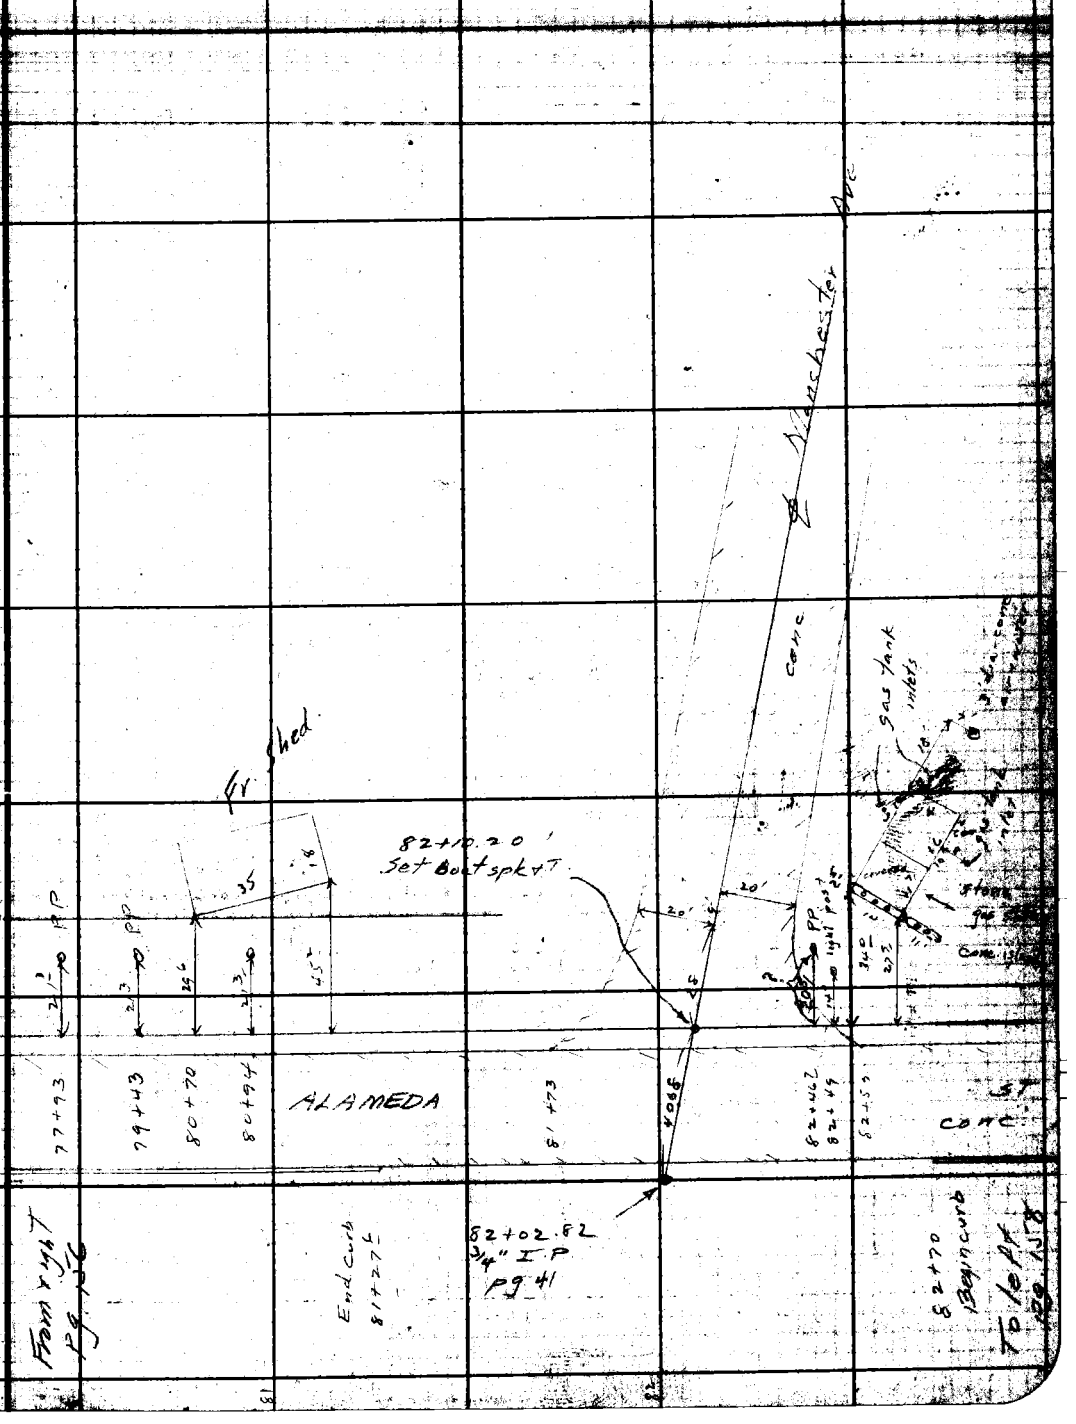

RETURN TO
LOS ANGELES COUNTY SURVEYOR
700 HALL OF RECORDS

Note: Any Additions or Changes on This Sheets Must be Made or Circled in Red Ink With Date and Name of Person Making Change.

Do not extend notes this side of this line

FORM 247 5M 10-37

F.B. 807 Pg. 156

RETURN TO
LOS ANGELES COUNTY SURVEYOR
700 HALL OF RECORDS

Note: Any Additions or Changes on This Sheets Must be Made or Circled in Red Ink With Date and Name of Person Making Change.

Do not extend notes this side of this line

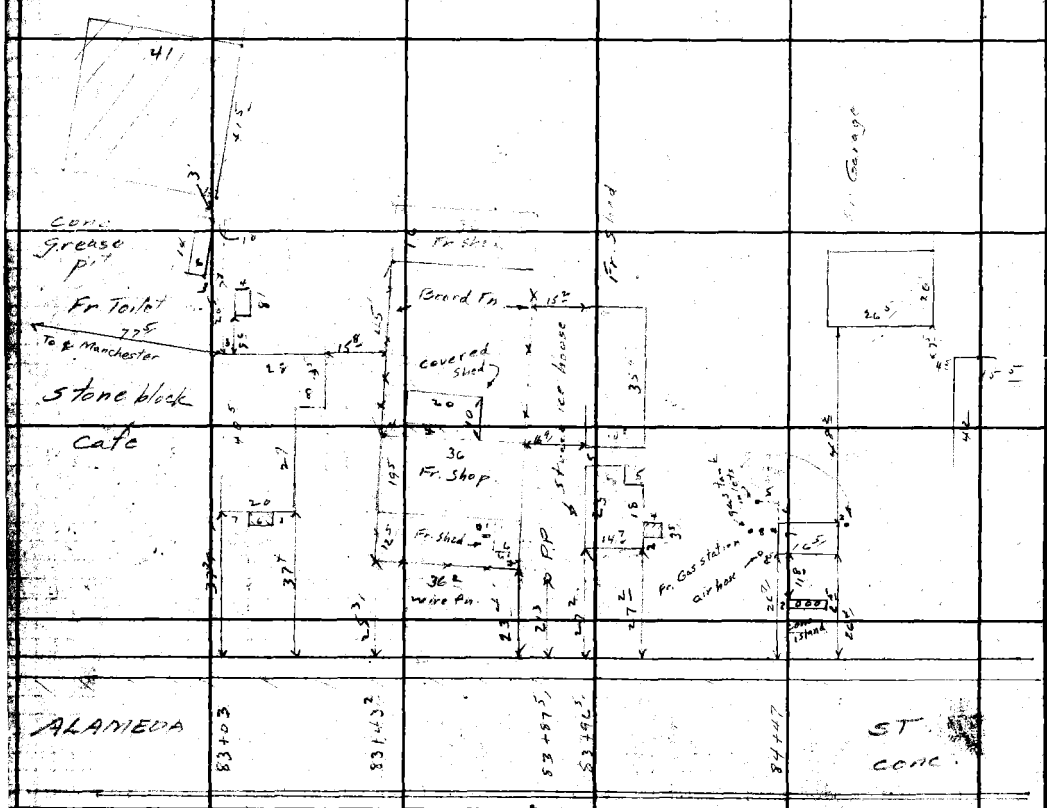

See Page 181
For Later Survey

From right pg 157

To left pg 159

FORM 247 5M 10-37

RETURN TO
LOS ANGELES COUNTY SURVEYOR
700 HALL OF RECORDS

Note: Any Additions or Changes on This Sheets Must be Made or Circled in Red Ink With Date and Name of Person Making Change.

Do not extend notes this side of this line

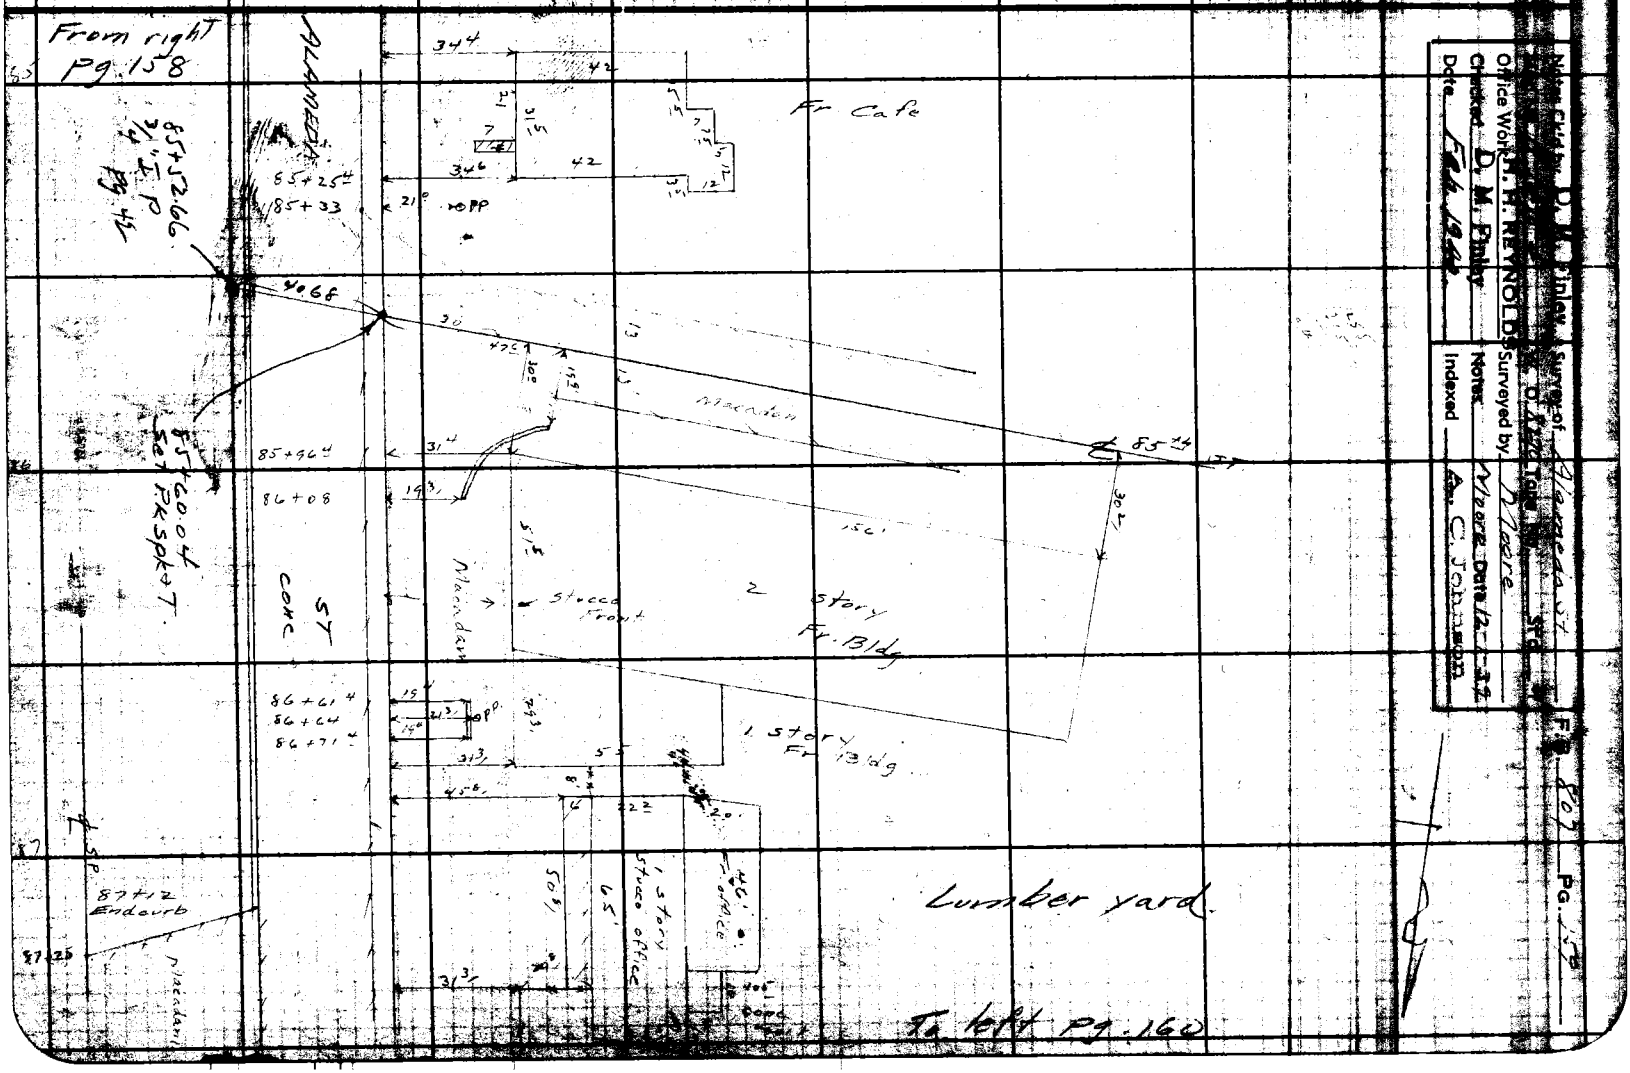

RETURN TO
LOS ANGELES COUNTY SURVEYOR
700 HALL OF RECORDS

Note: Any Additions or Changes on This Sheets Must be Made or Circled in Red Ink With Date and Name of Person Making Change.

Do not extend notes this side of this line

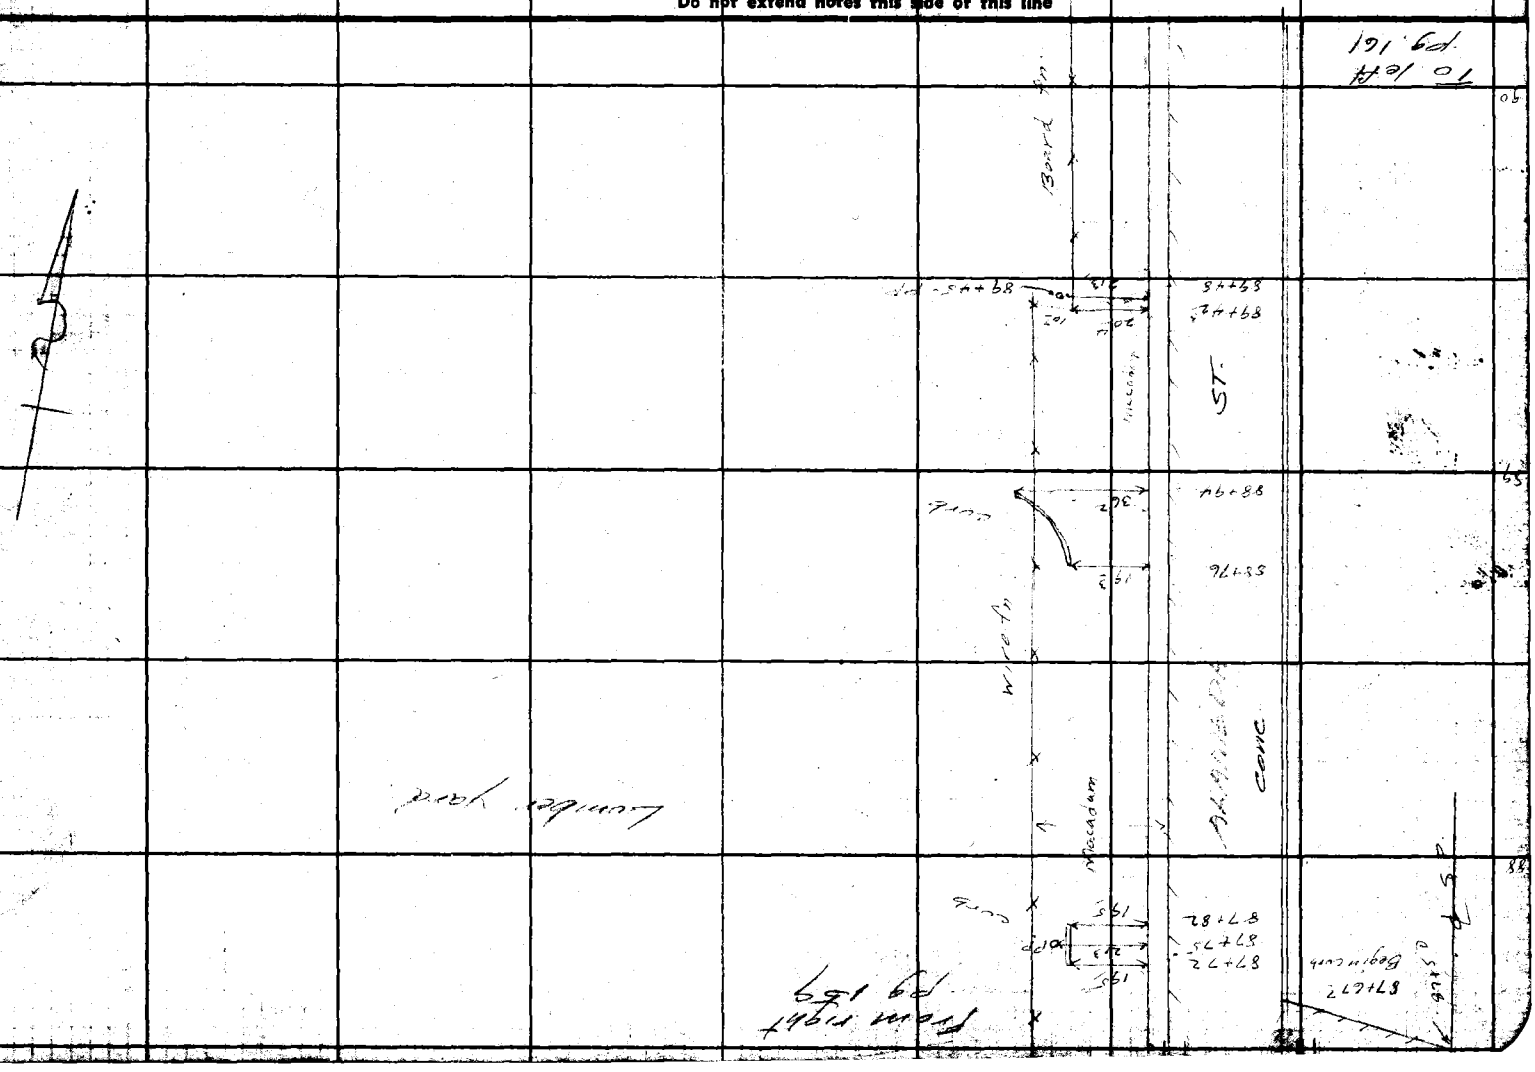

Notes Ck'd by D. M. Finley	Survey of Alameda St	F.B. 807 Pg. 161
Map No. [illegible]	W. O. [illegible] Title No. [illegible] Sht. [illegible] of	
Office Work H. H. REYNOLDS	Surveyed by [illegible] Moore	
Checked D. M. Finley	Notes [illegible] Date 11-30-39	
Date Feb 1940	Indexed A. C. Johnson	

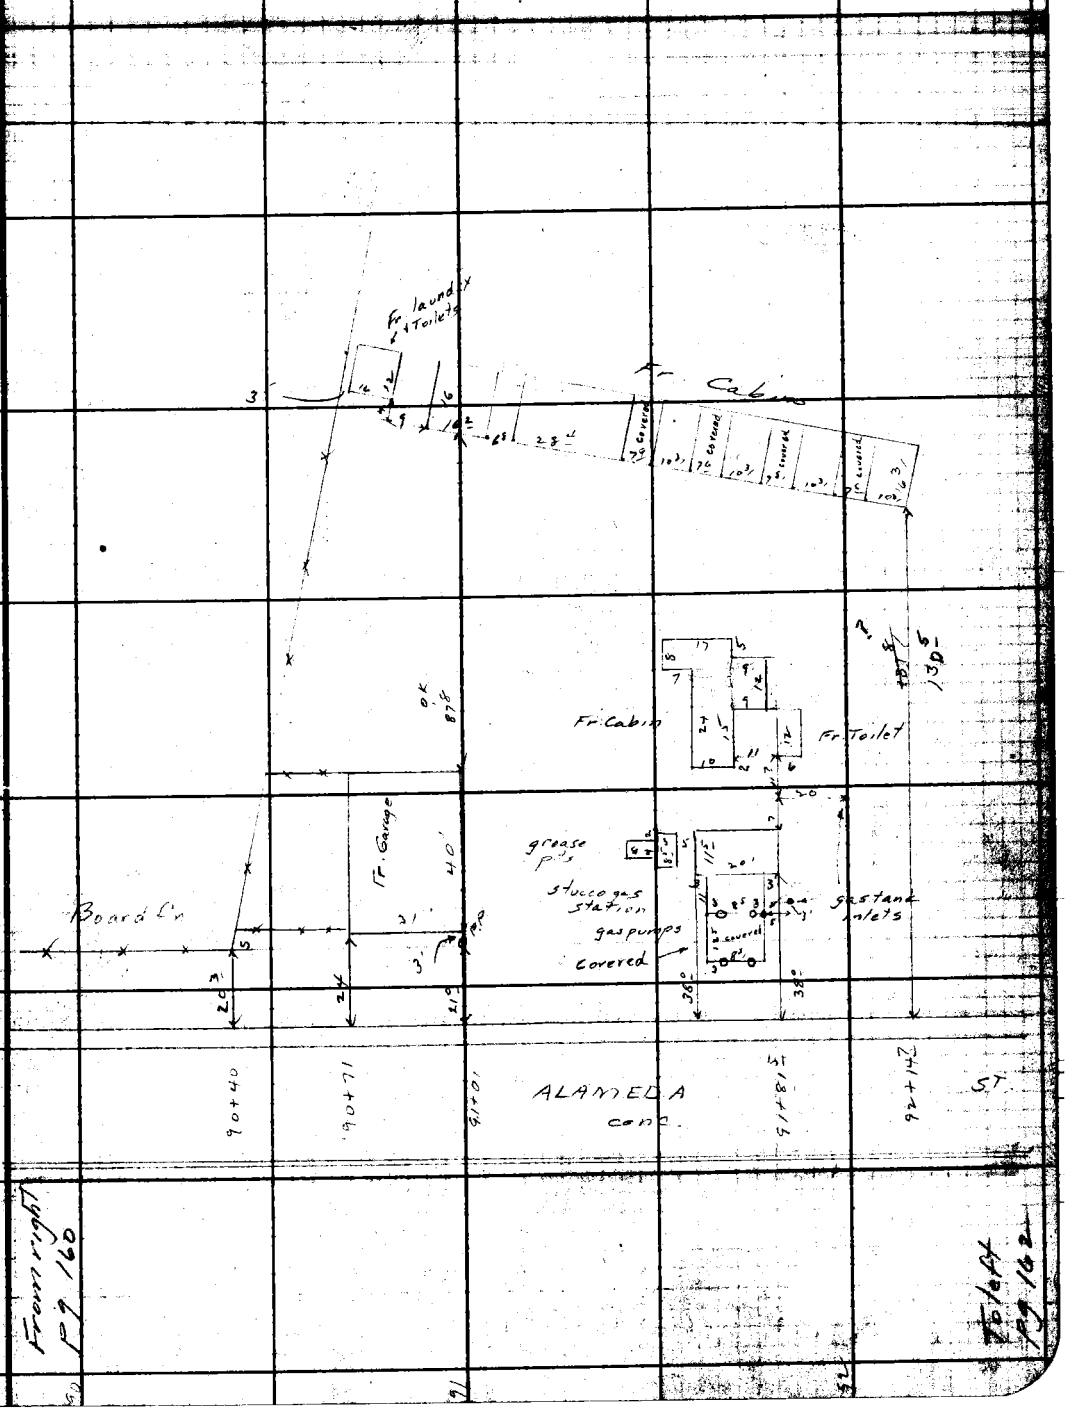

Note: Any Additions or Changes on This Sheets Must be Made or Circled in Red Ink With Date and Name of Person Making Change.

Do not extend notes this side of this line

RETURN TO
LOS ANGELES COUNTY SURVEYOR
700 HALL OF RECORDS

FORM 247 5M 10-37

RETURN TO
LOS ANGELES COUNTY SURVEYOR
700 HALL OF RECORDS

Note: Any Additions or Changes on This Sheets Must be Made or Circled in **Red Ink** With Date and Name of Person Making Change.

Do not extend notes this side of this line

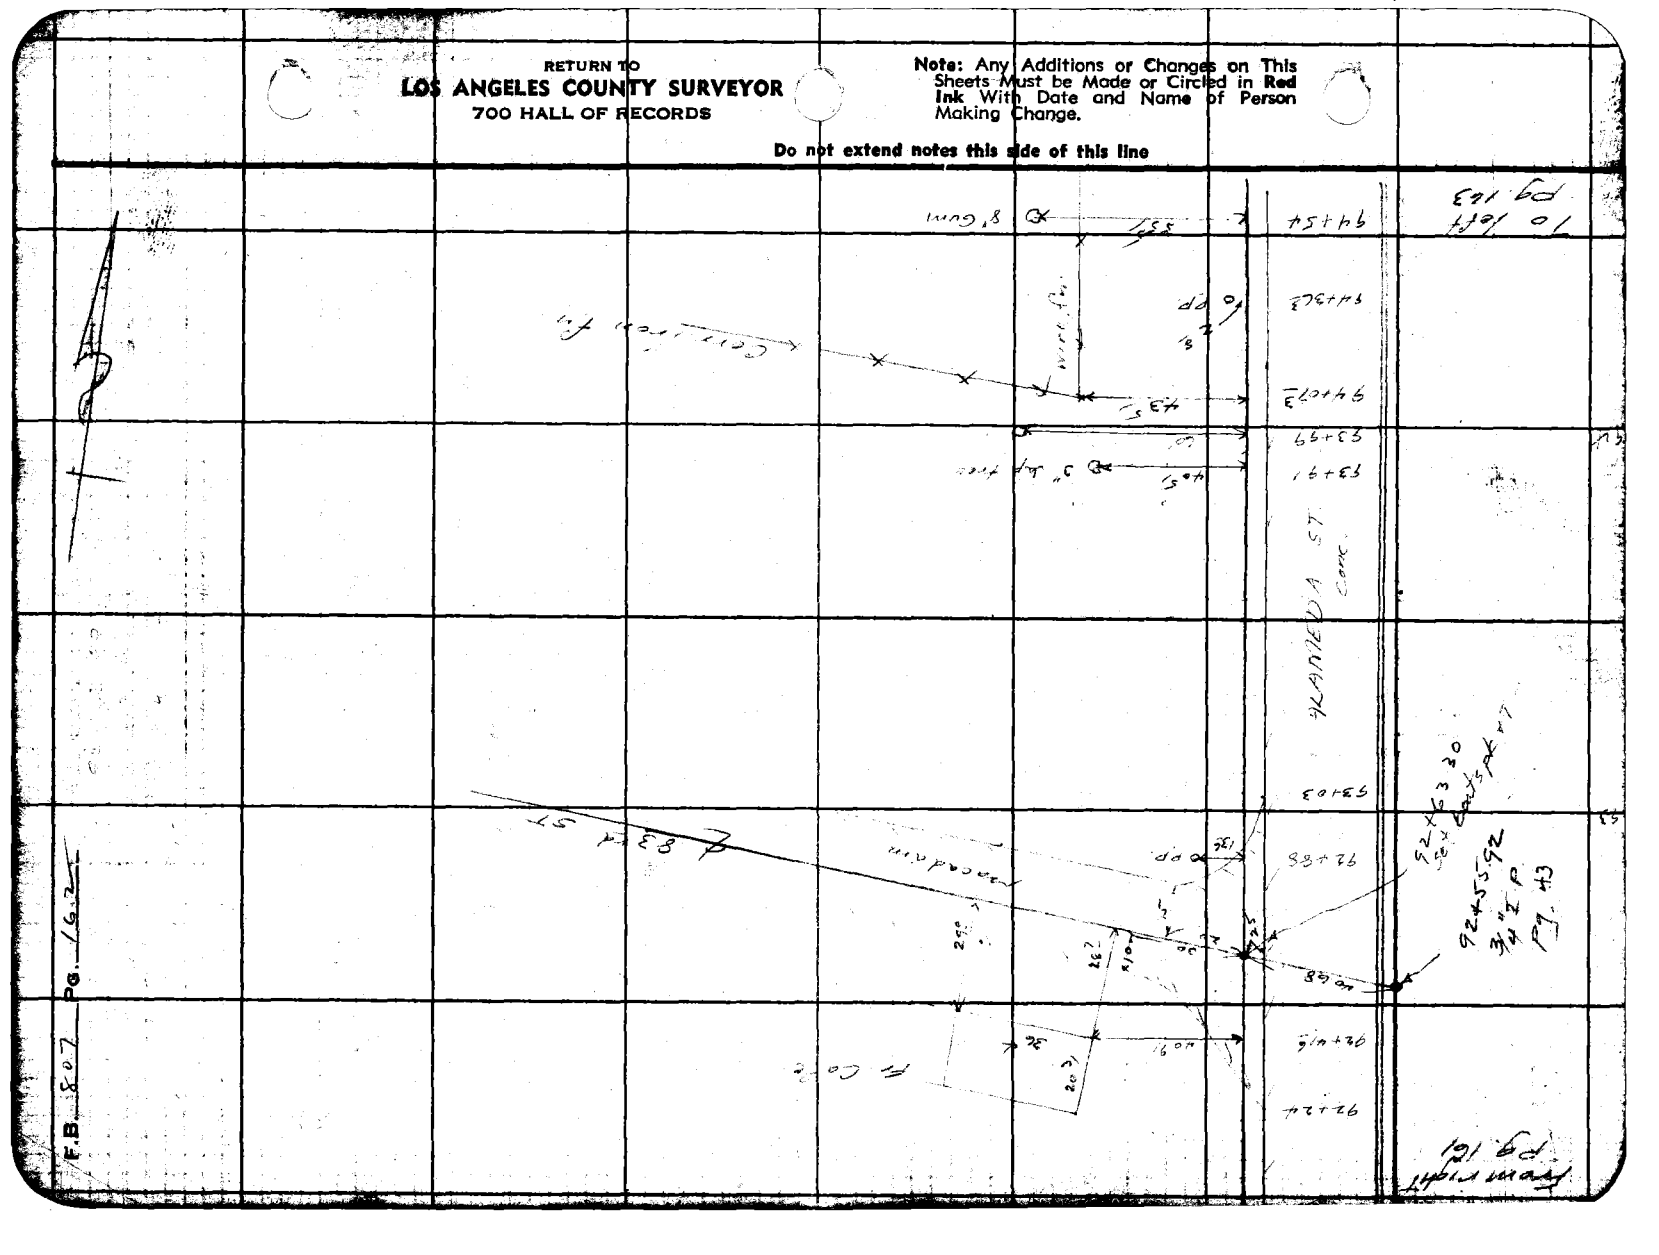

FORM 247 5M 10-37

RETURN TO
LOS ANGELES COUNTY SURVEYOR
700 HALL OF RECORDS

Note: Any Additions or Changes on Sheets Must be Made or Circled in Ink With Date and Name of Person Making Change.

Do not extend notes this side of this line

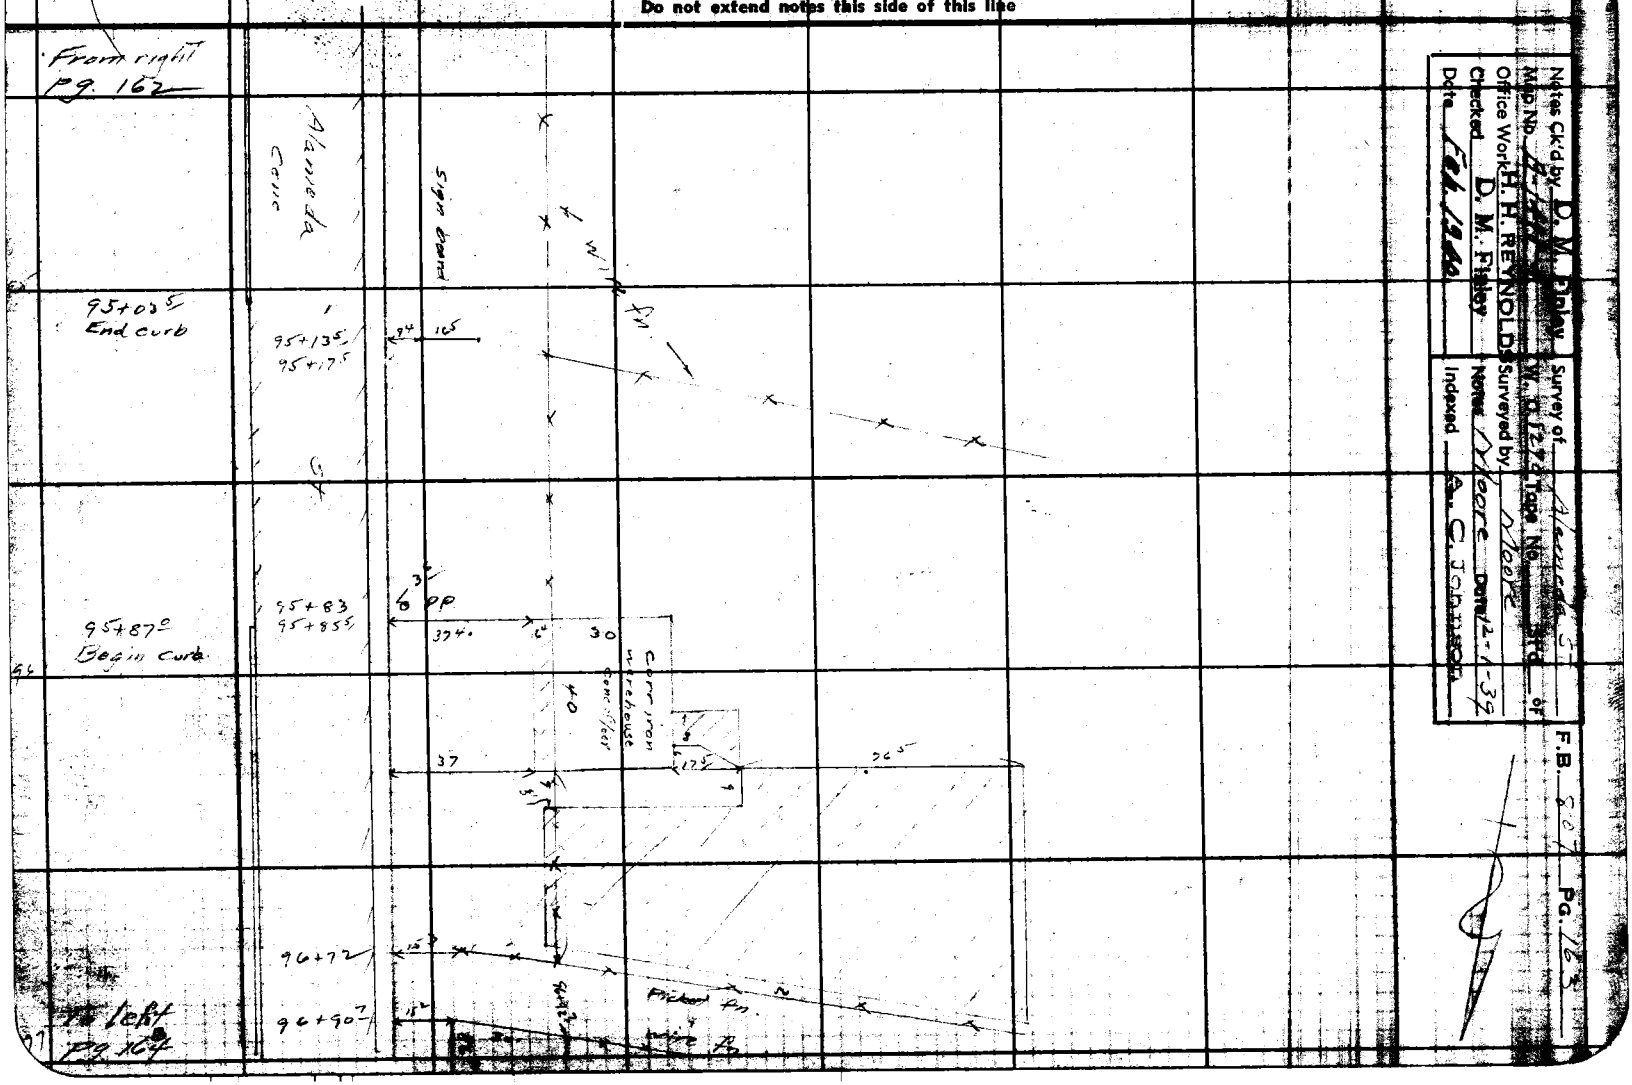

RETURN TO
LOS ANGELES COUNTY SURVEYOR
700 HALL OF RECORDS

Note: Any Additions or Changes on This Sheets Must be Made or Circled in **Red** Ink With Date and Name of Person Making Change.

Do not extend notes this side of this line

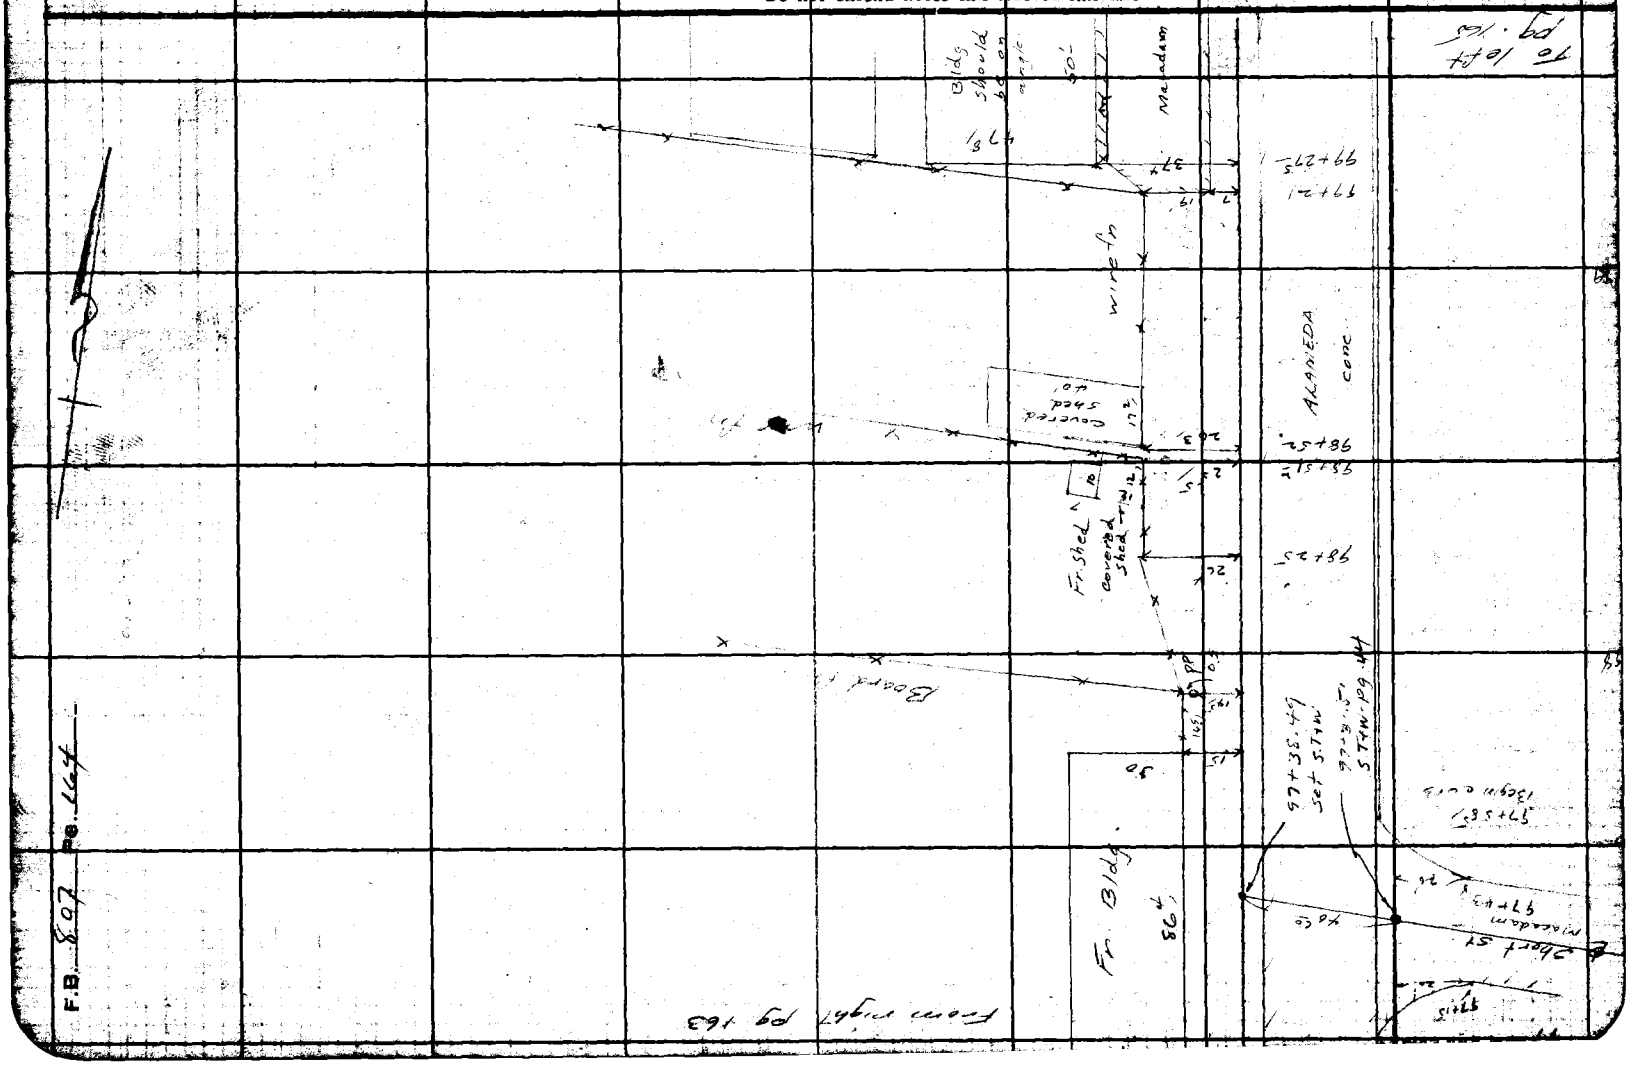

F.B. 807 Pg. 164

FORM 247 5M 10-57

RETURN TO
LOS ANGELES COUNTY SURVEYOR
700 HALL OF RECORDS

Note: Any Additions or Changes on This Sheets Must be Made or Circled in Red Ink With Date and Name of Person Making Change.

Do not extend notes this side of this line

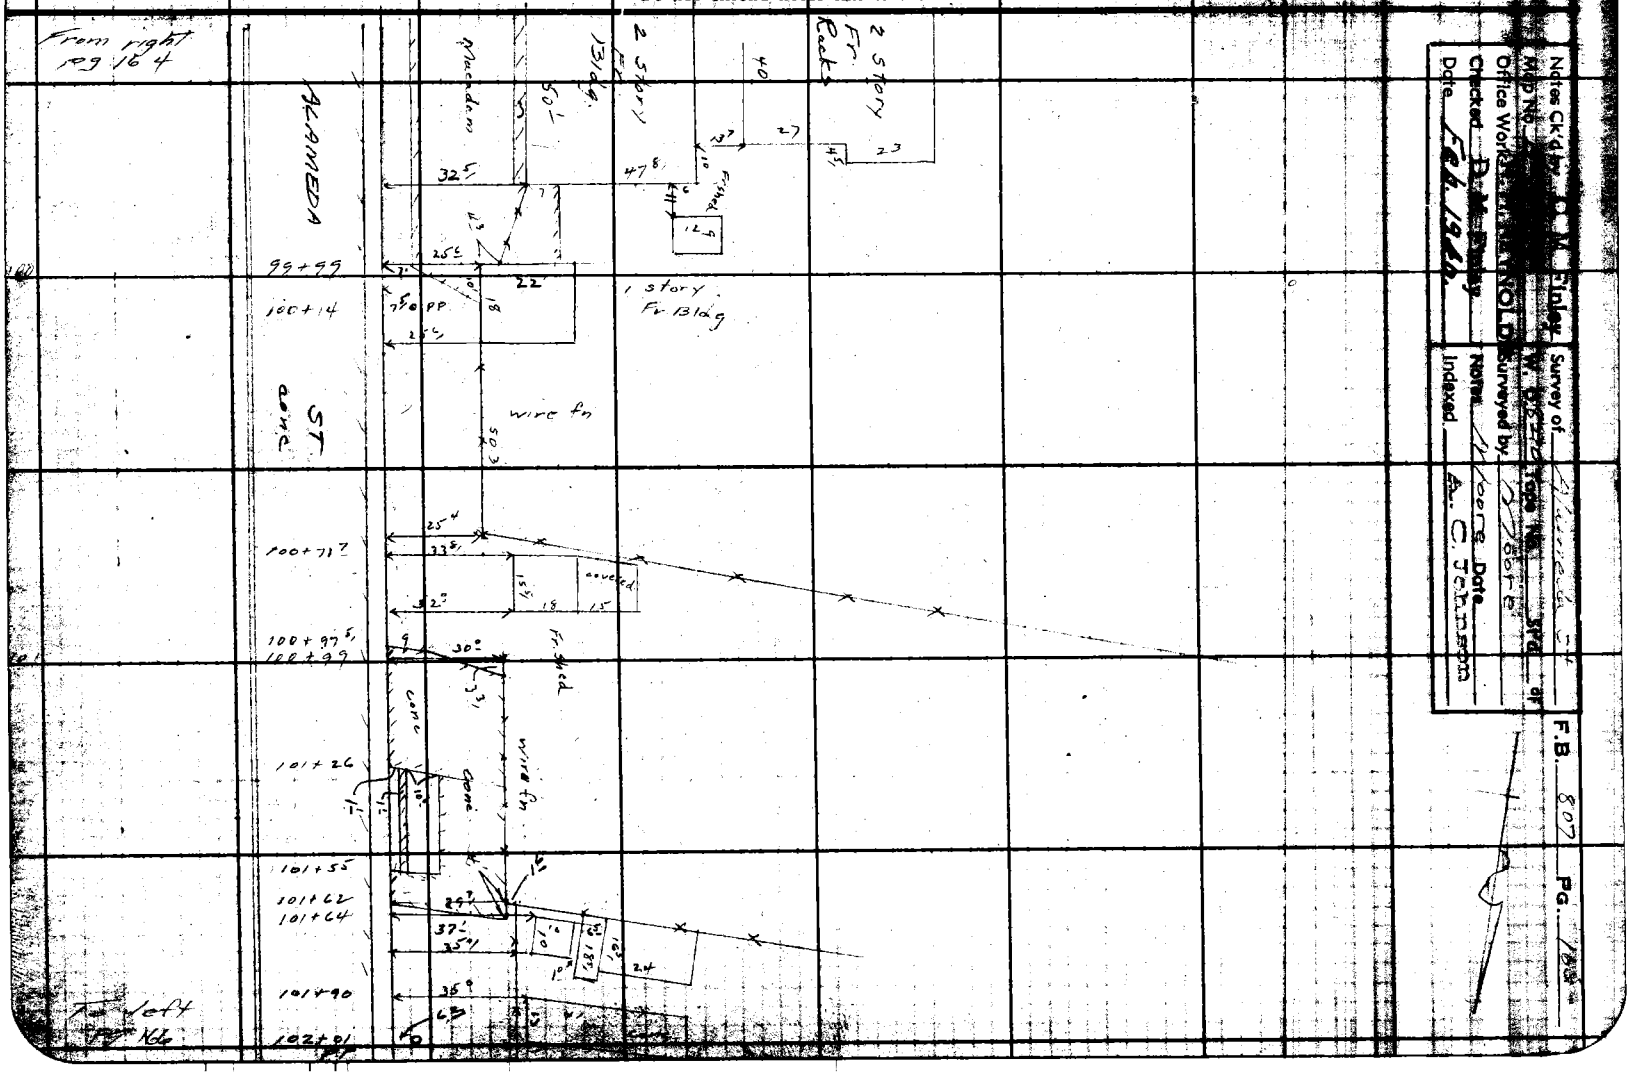

RETURN TO
LOS ANGELES COUNTY SURVEYOR
700 HALL OF RECORDS

Note: Any Additions or Changes on This Sheets Must be Made or Circled in Red Ink With Date and Name of Person Making Change.

Do not extend notes this side of this line

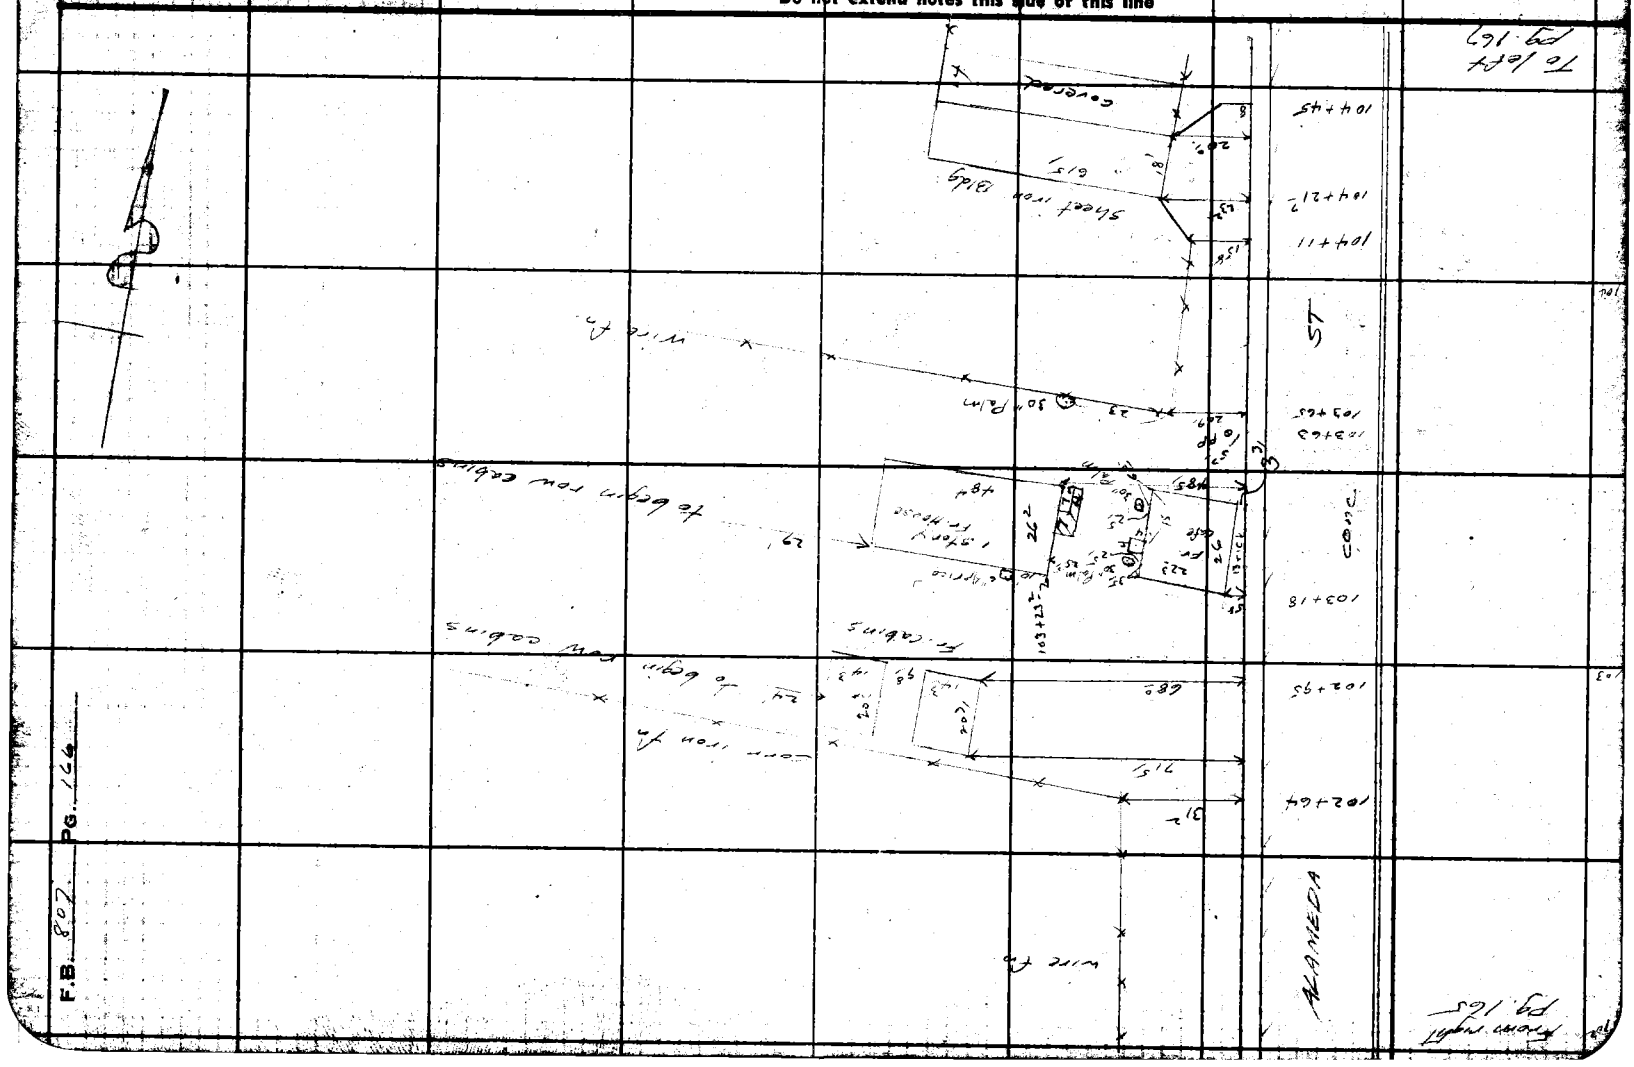

Map No. [illegible]	W. [illegible] Tape No. 3rd of	
Office Work H. H. REYNOLDS	Surveyed by Moore	
Checked D. M. Finley	Notes Moore Date 12-5-39	
Date Feb. 1940	Indexed [illegible] C. Johnson	

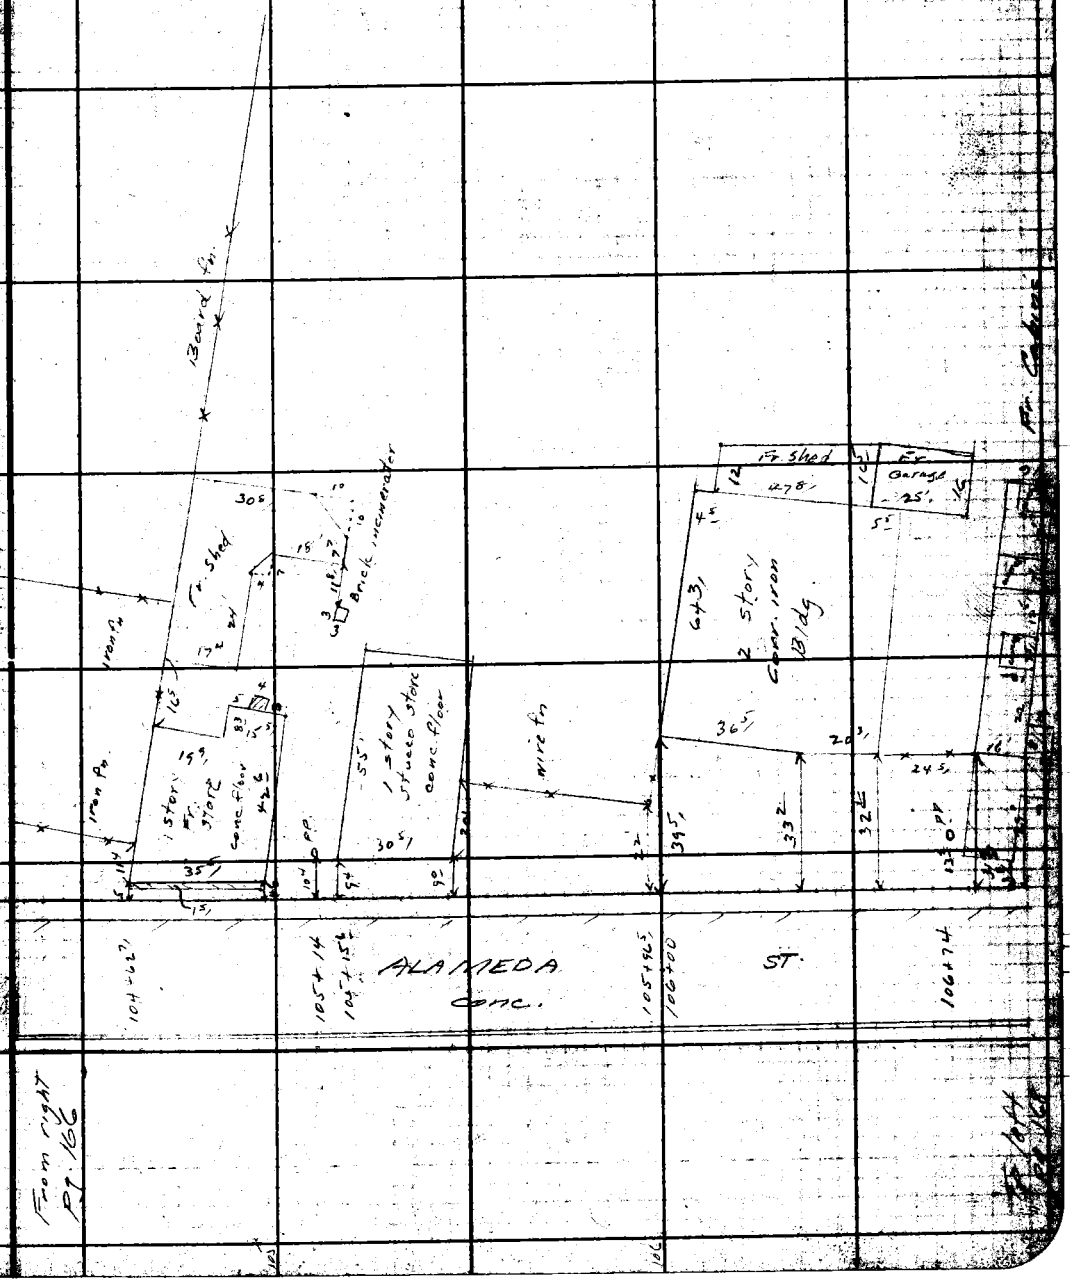

Note: Any Additions or Changes on Sheets Must be Made or Circled in Ink With Date and Name of Person Making Change.

Do not extend notes this side of this line

RETURN TO
LOS ANGELES COUNTY SURVEYOR
700 HALL OF RECORDS

FORM 247 5M 10-37


RETURN TO
LOS ANGELES COUNTY SURVEYOR
700 HALL OF RECORDS

Note: Any Additions or Changes on This Sheets Must be Made or Circled in Red Ink With Date and Name of Person Making Change.

Do not extend notes this side of this line

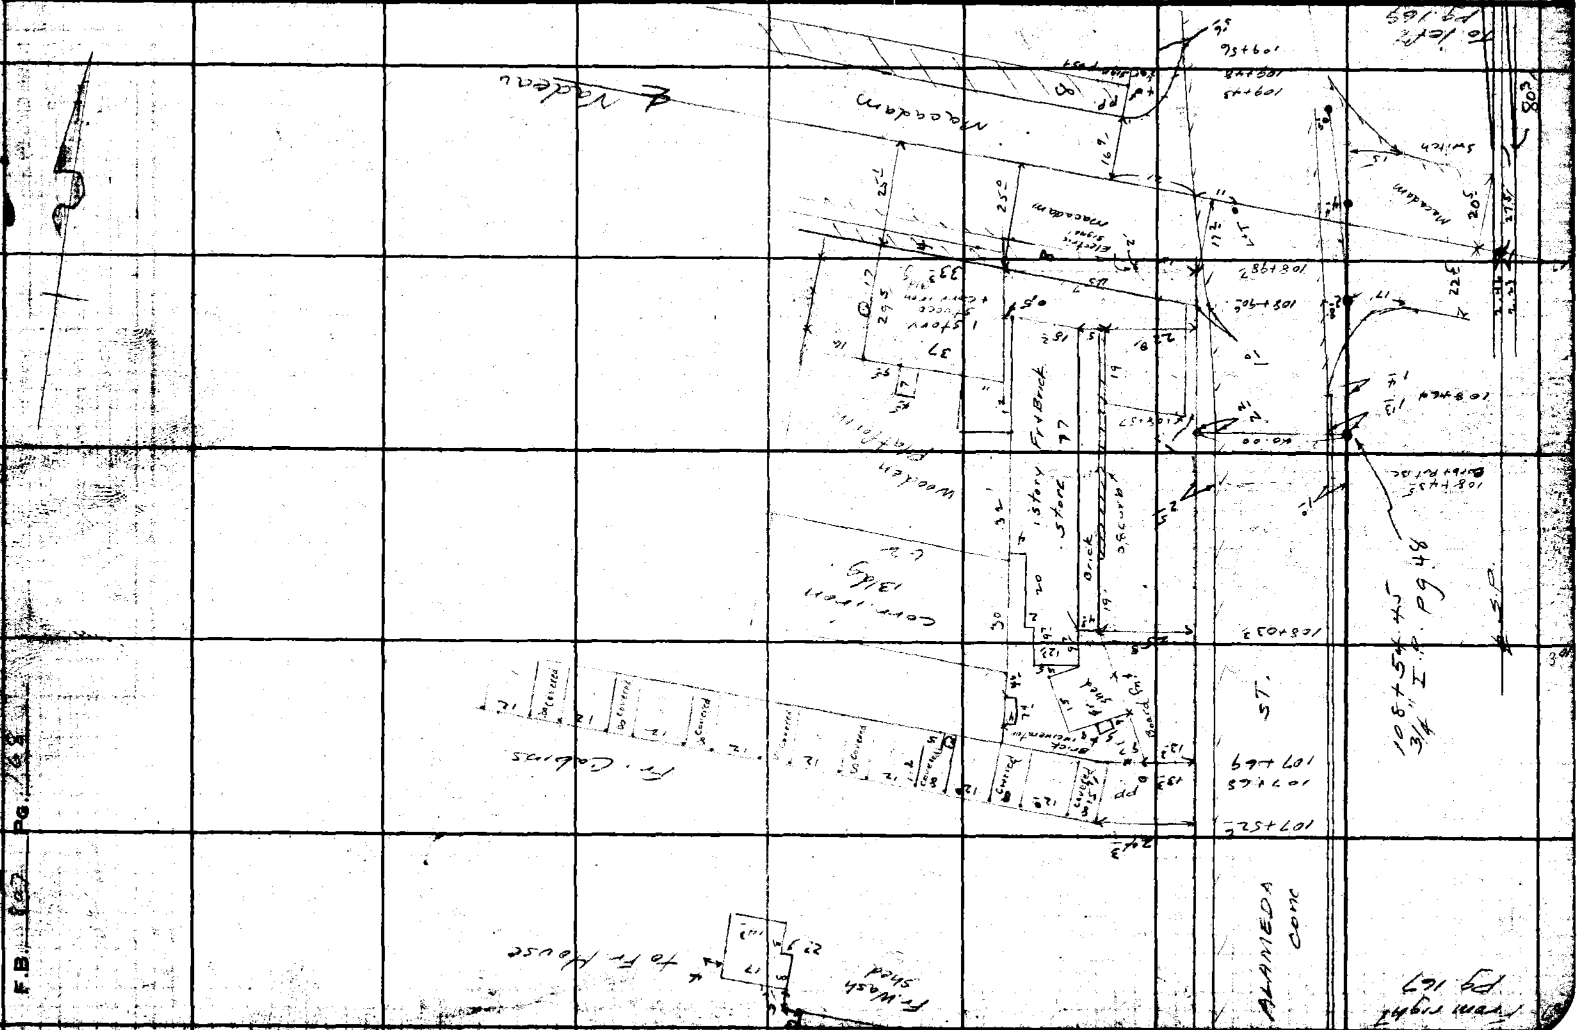

Notes Ck'd by [illegible]	Survey of [illegible]	F.B. 807 Pg. 167
[illegible]	[illegible] Tape No. ___ Sta ___ of	
Office Work [illegible]	Surveyed by [illegible] Moore	
Checked D. M. [illegible]	[illegible] Moore Date 12-6-39	
Date Feb. 19[illegible]	Indexed A. C. Johnson	

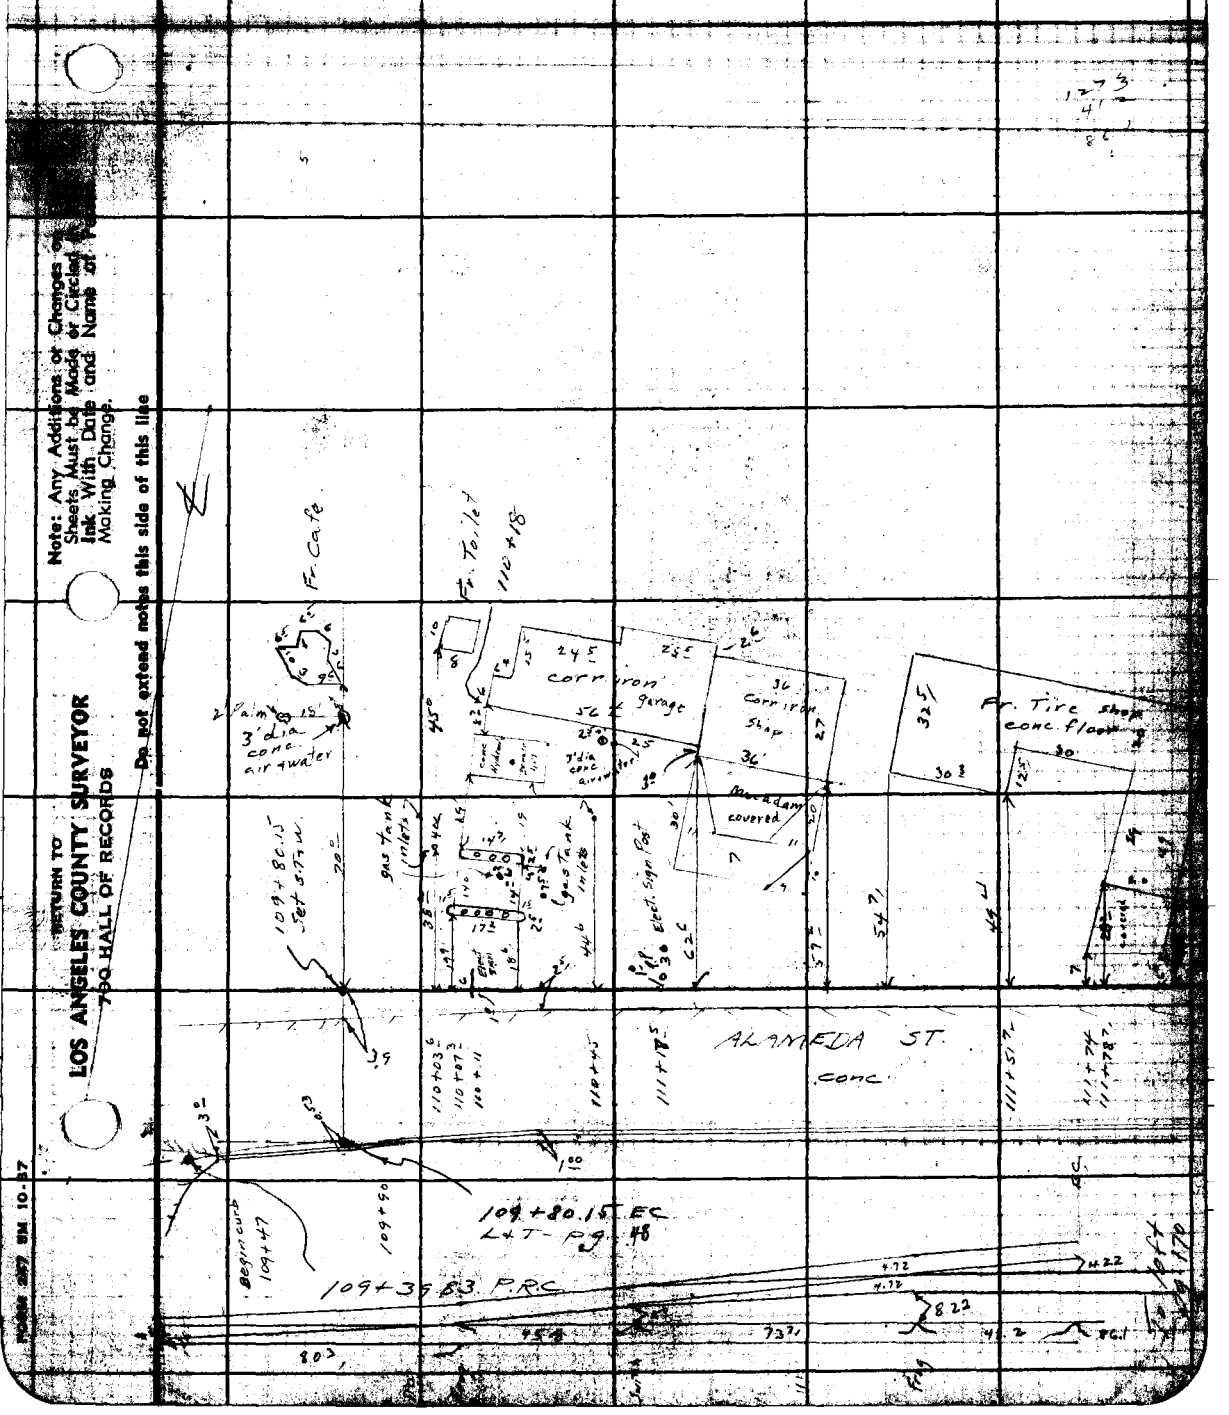

Note: Any Additions or Changes on Sheets Must be Made or Circled in Ink With Date and Name of Person Making Change.

Do not extend notes this side of this line

RETURN TO
LOS ANGELES COUNTY SURVEYOR
700 HALL OF RECORDS

FORM 2-47 5M 10-37

RETURN TO
LOS ANGELES COUNTY SURVEYOR
700 HALL OF RECORDS

Note: Any Additions or Changes on This Sheets Must be Made or Circled in Red Ink With Date and Name of Person Making Change.

Do not extend notes this side of this line

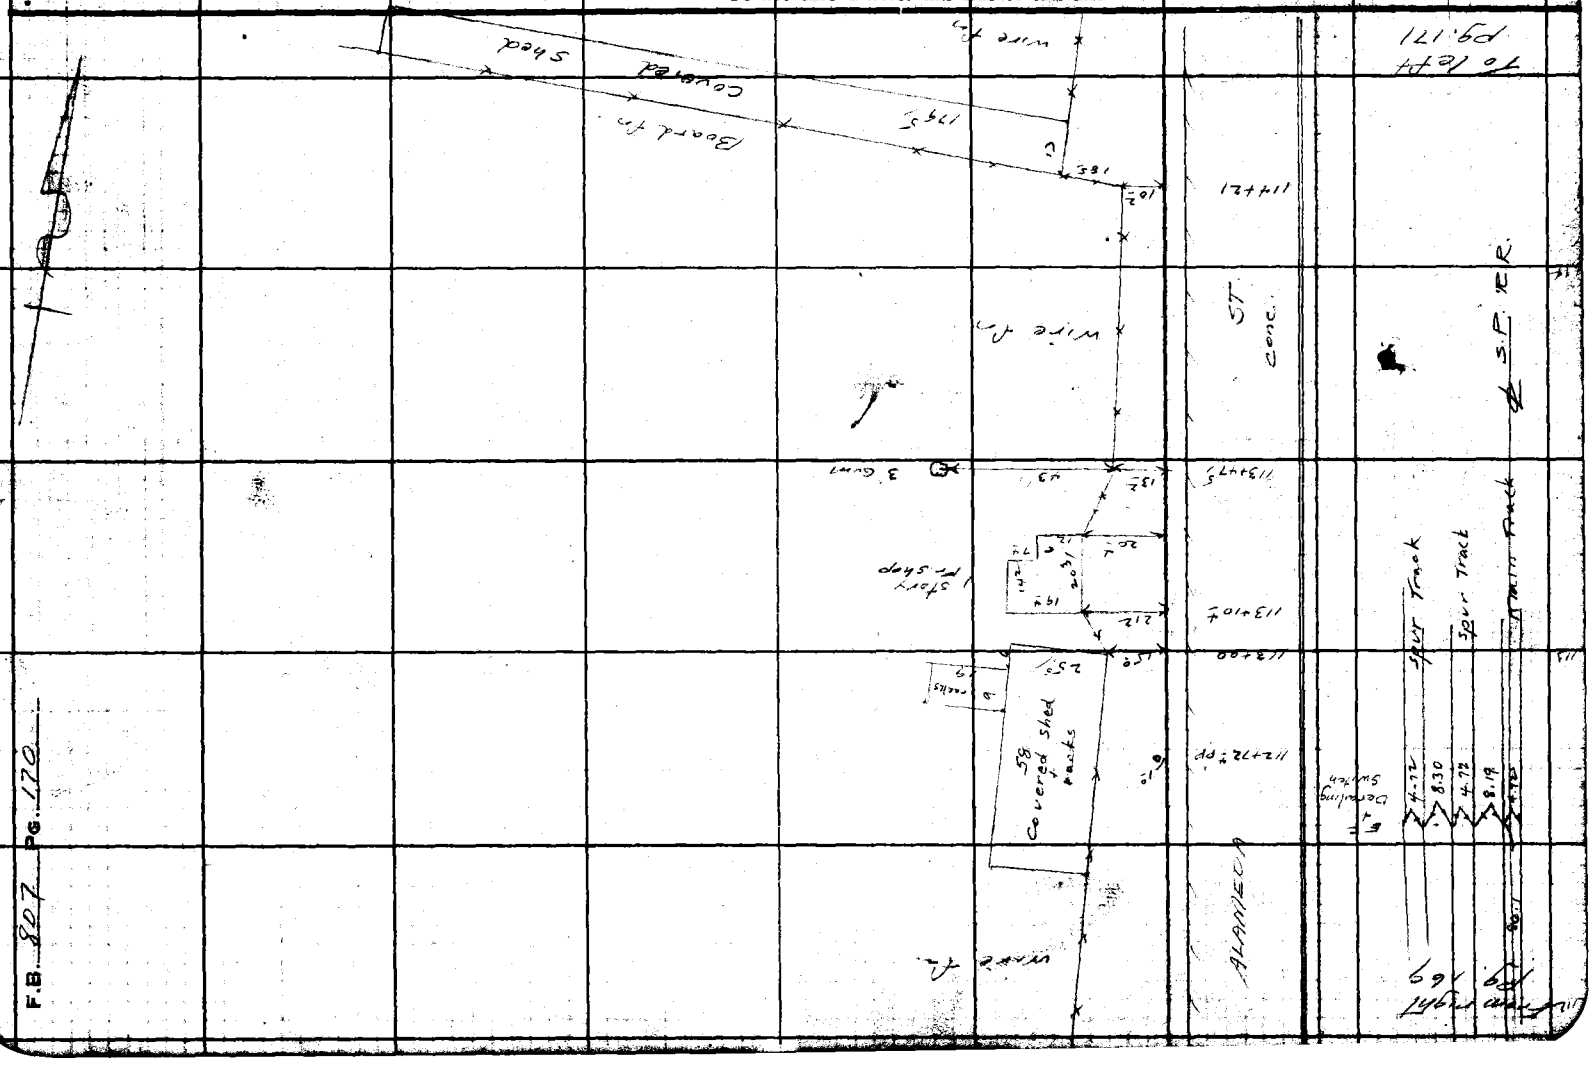

F.B. 807 Pg. 170

Notes Ck'd by D. M. Finley	Survey of Alameda St	F.B. 807	Pg. 177
Map No. [illegible]	[illegible] Tape No.	Std.	of
Office Work H. H. REYNOLDS	Surveyed by [illegible]		
Checked D. M. Finley	Notes [illegible] Date 12-6-39		
Date Feb. 1940	Indexed A. C. Johnson		

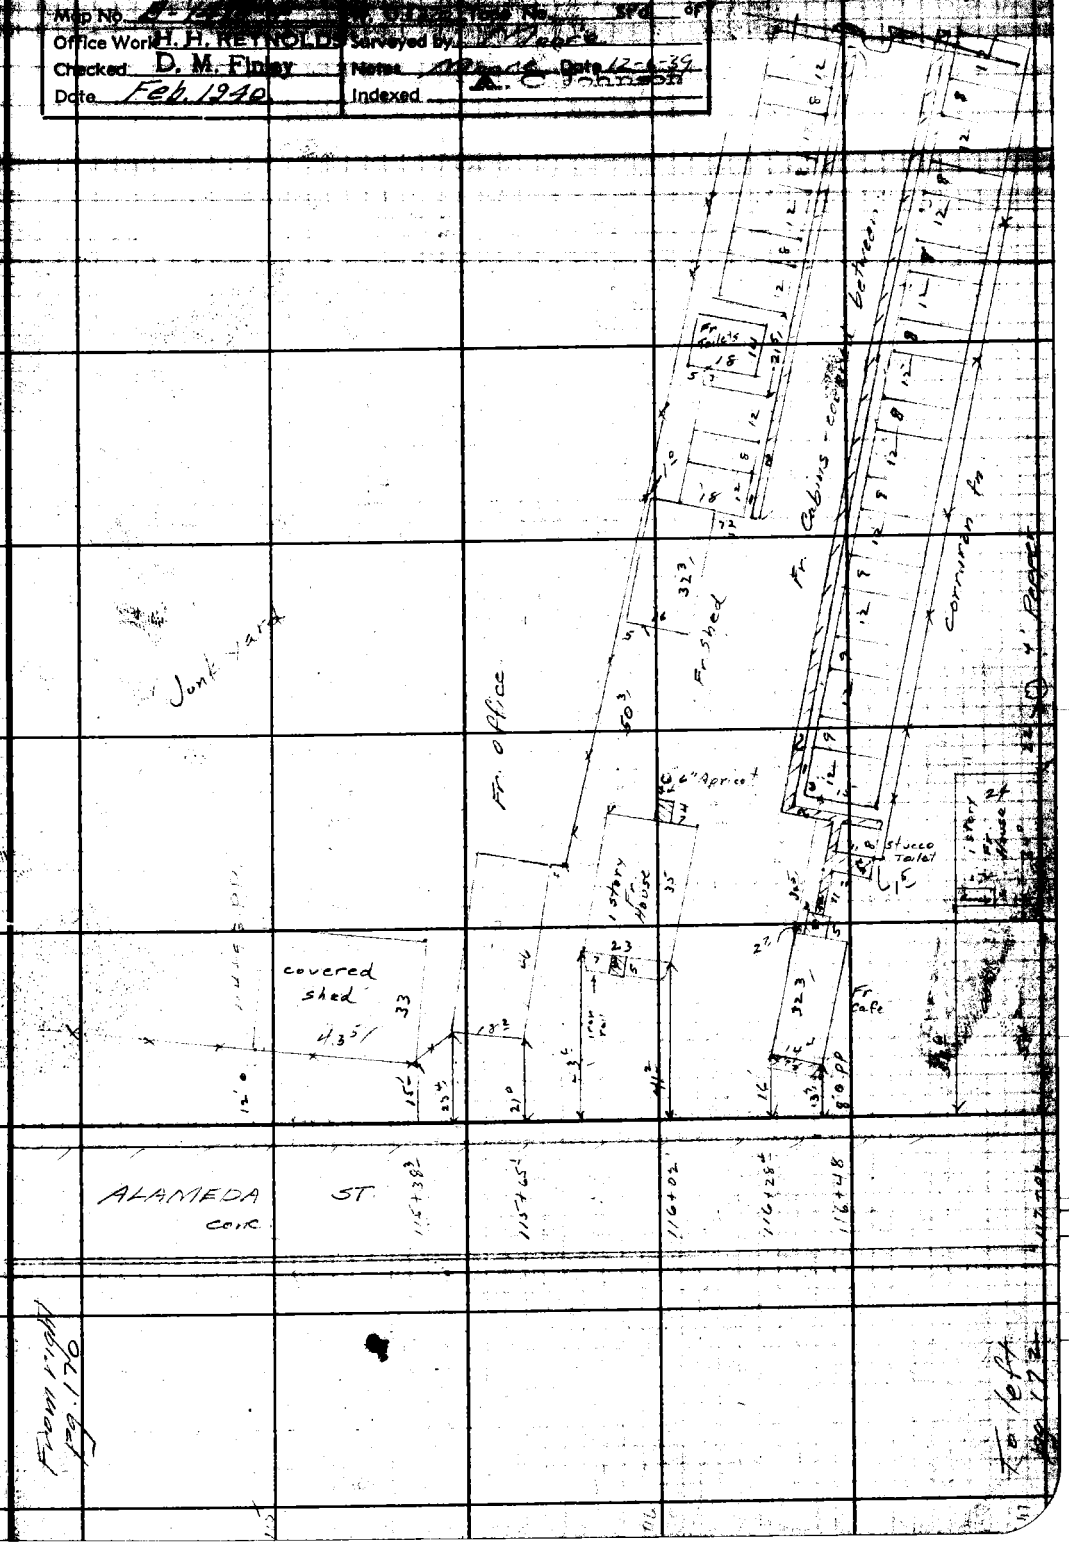

Note: Any Additions or Changes on This Sheets Must be Made or Circled in Red Ink With Date and Name of Person Making Change.

Do not extend notes this side of this line

RETURN TO
LOS ANGELES COUNTY SURVEYOR
700 HALL OF RECORDS

FORM 247 5M 10-37

F.B. 807 Pg. 172

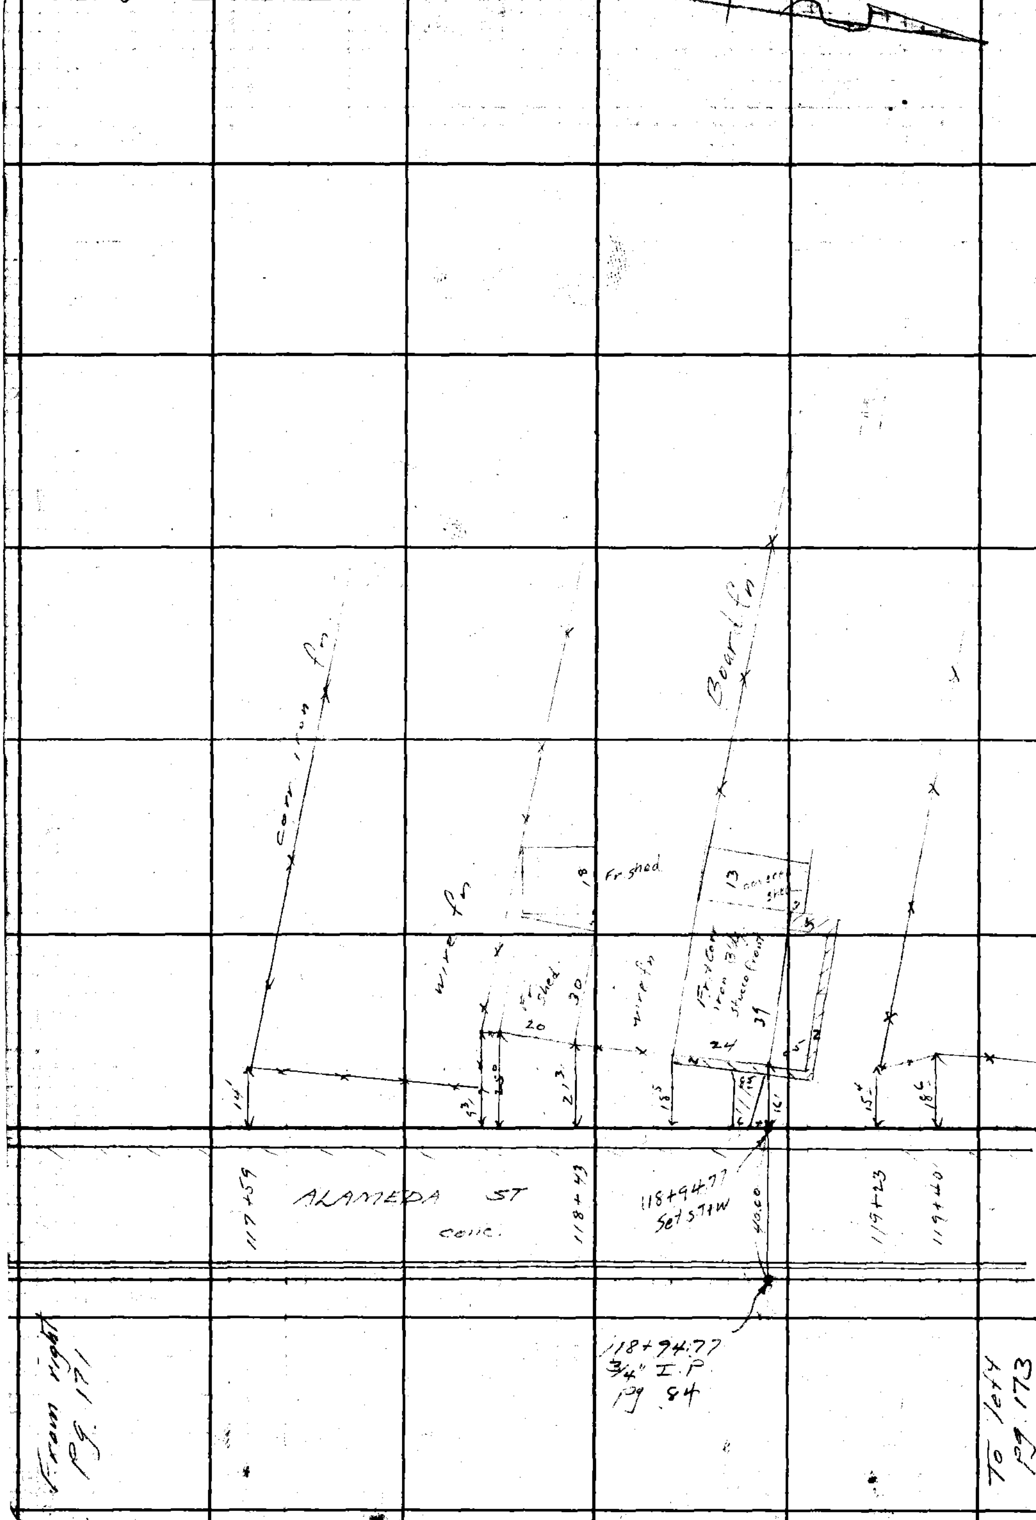

RETURN TO
LOS ANGELES COUNTY SURVEYOR
700 HALL OF RECORDS

Note: Any Additions or Changes on This Sheets Must be Made or Circled in Red Ink With Date and Name of Person Making Change.

Do not extend notes this side of this line

FORM 247 5M 10-37

RETURN TO
LOS ANGELES COUNTY SURVEYOR
700 HALL OF RECORDS

Note: Any Additions or Changes on This Sheets Must be Made or Circled in Red Ink With Date and Name of Person Making Change.

Do not extend notes this side of this line

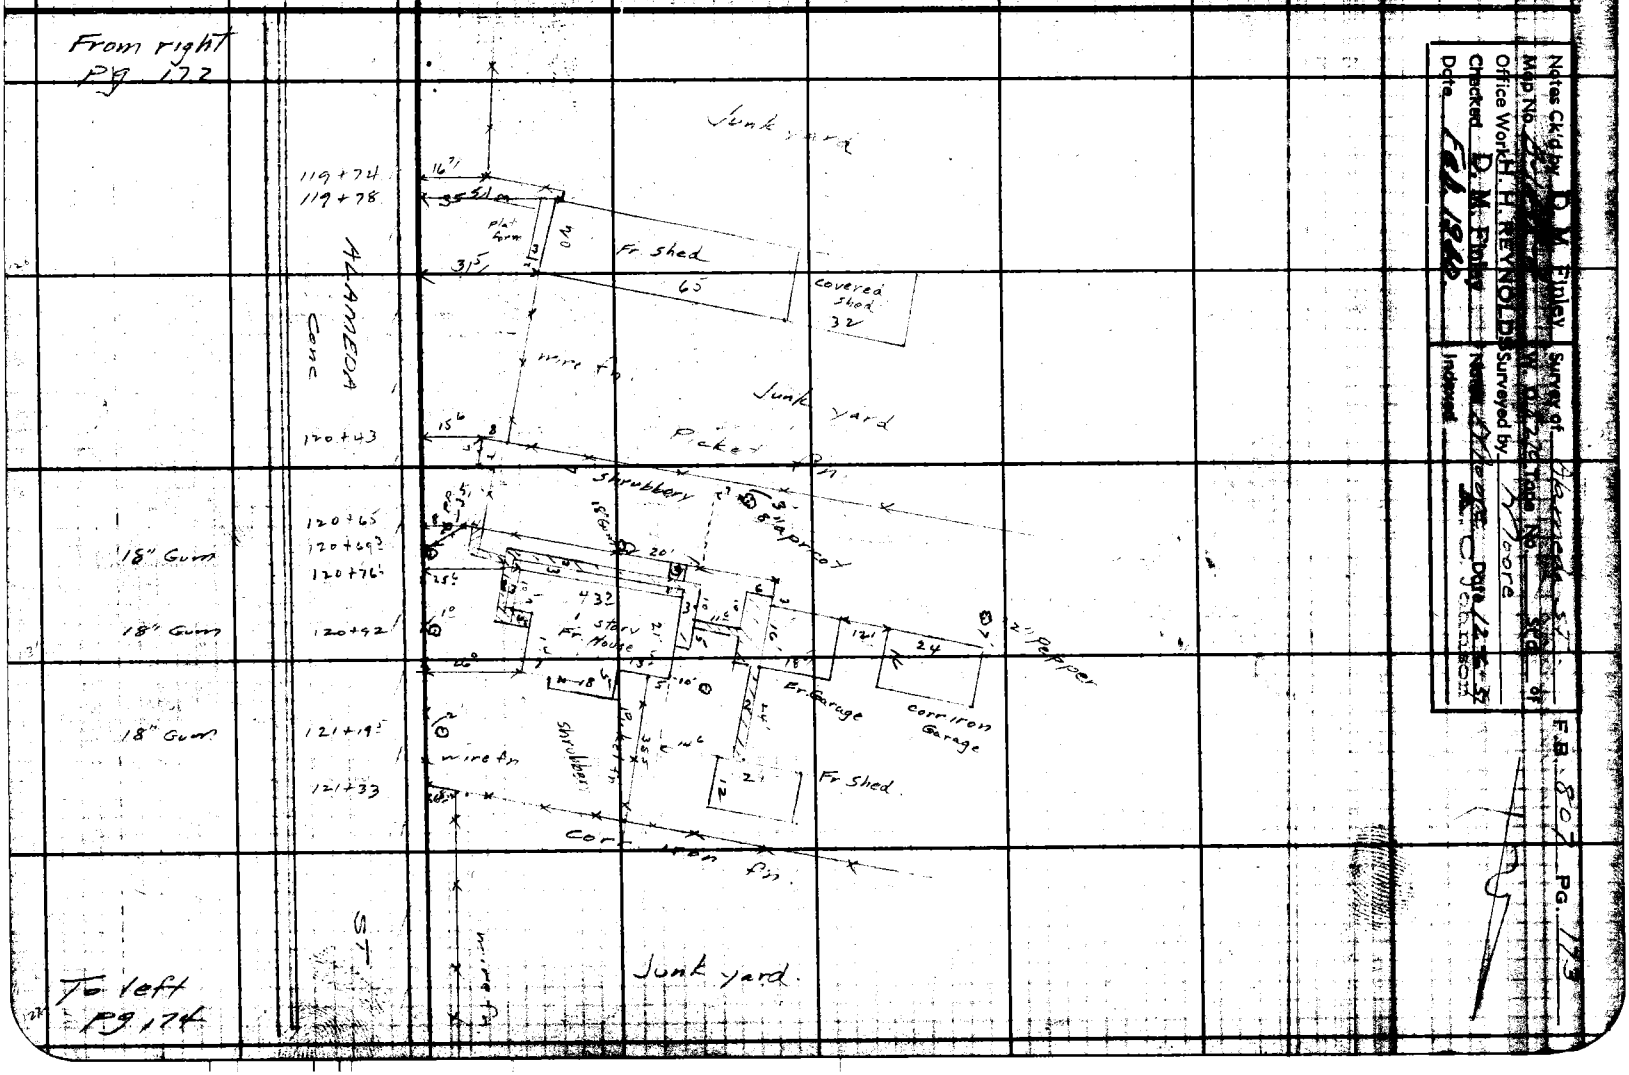

F.B. 807 Pg. 174

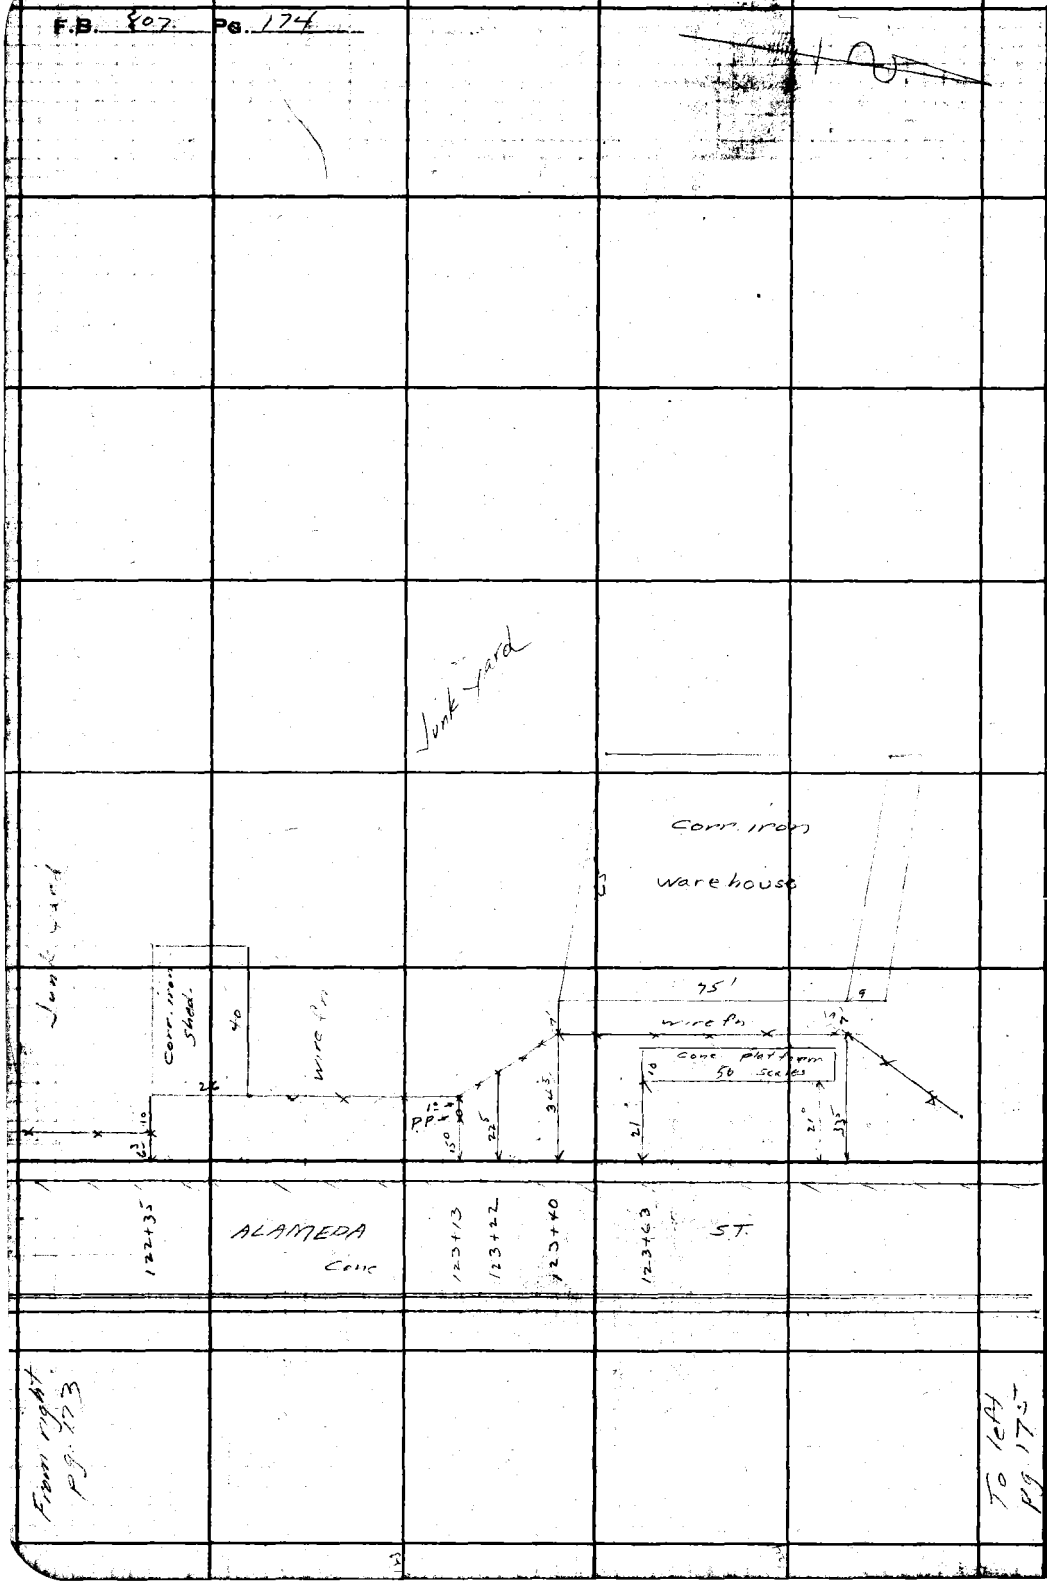

RETURN TO
LOS ANGELES COUNTY SURVEYOR
700 HALL OF RECORDS

Note: Any Additions or Changes on This Sheets Must be Made or Circled in Red Ink With Date and Name of Person Making Change.

Do not extend notes this side of this line

Notes Ck'd by D. M. Finley | F.B. 887 | PG. 175
Map No. [illegible]
Office Work H. H. REYNOLDS | Surveyed by [illegible]
Checked D. M. Finley | Name [illegible] Date 12-[illegible]-39
Date Feb. 1940 | Indexed A. C. Johnson

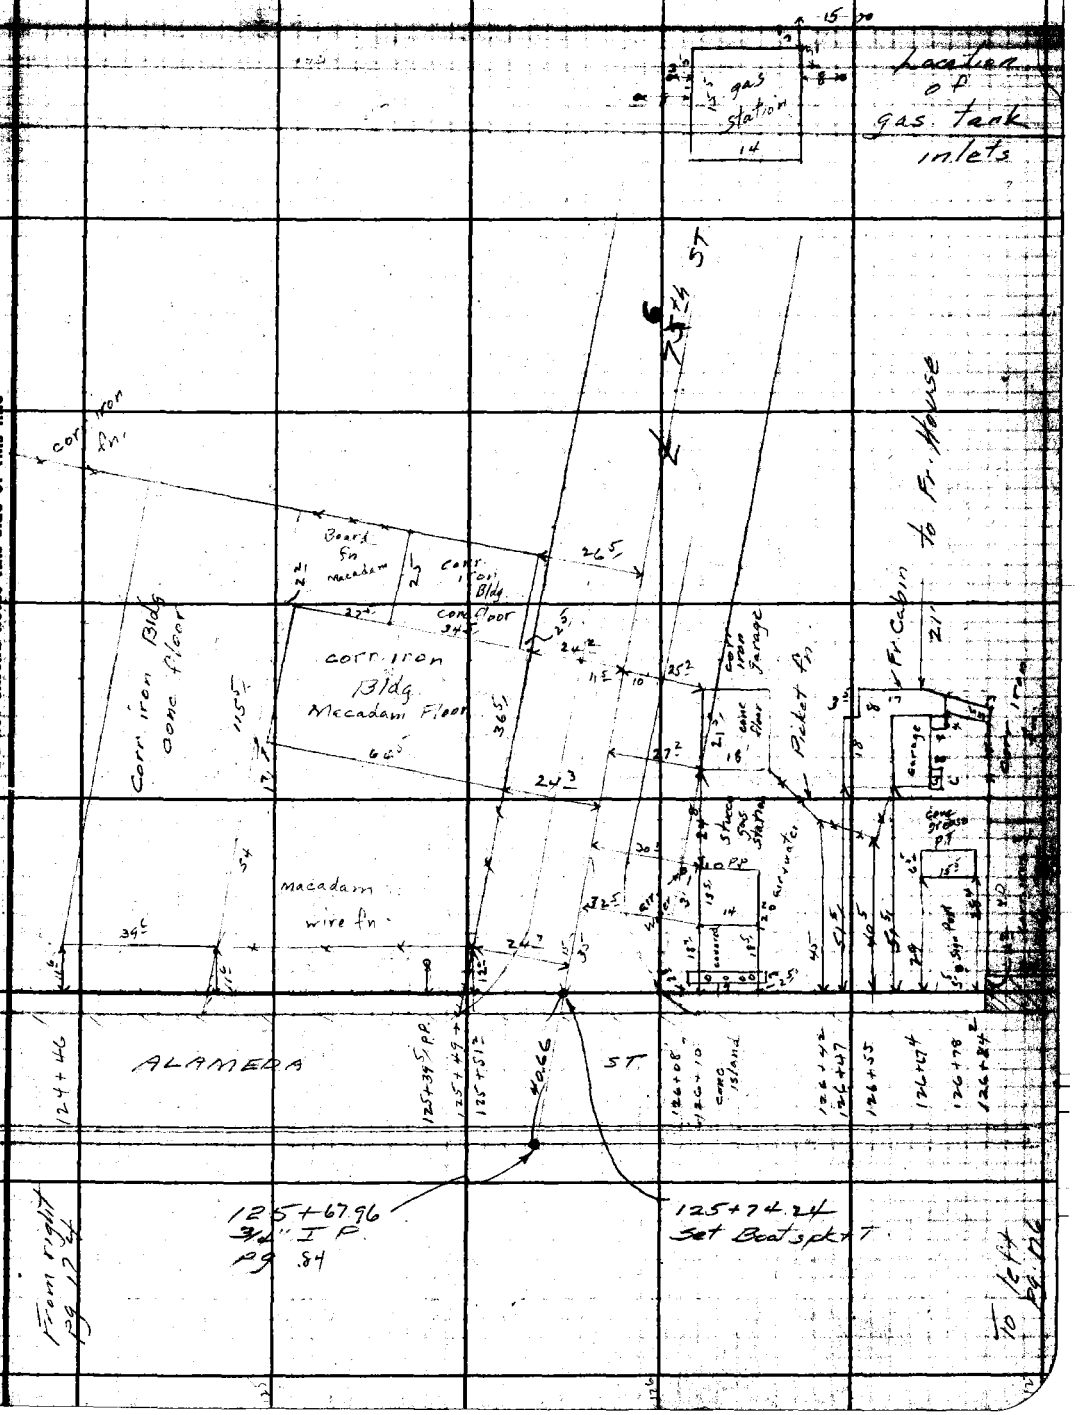

Note: Any Additions or Changes on This Sheets Must be Made or Circled in Red Ink With Date and Name of Person Making Change.

Do not extend notes this side of this line

RETURN TO
LOS ANGELES COUNTY SURVEYOR
700 HALL OF RECORDS

FORM 247 5M 10-37

RETURN TO
LOS ANGELES COUNTY SURVEYOR
700 HALL OF RECORDS

Note: Any Additions or Changes on This Sheets Must be Made or Circled in Red Ink With Date and Name of Person Making Change.

Do not extend notes this side of this line

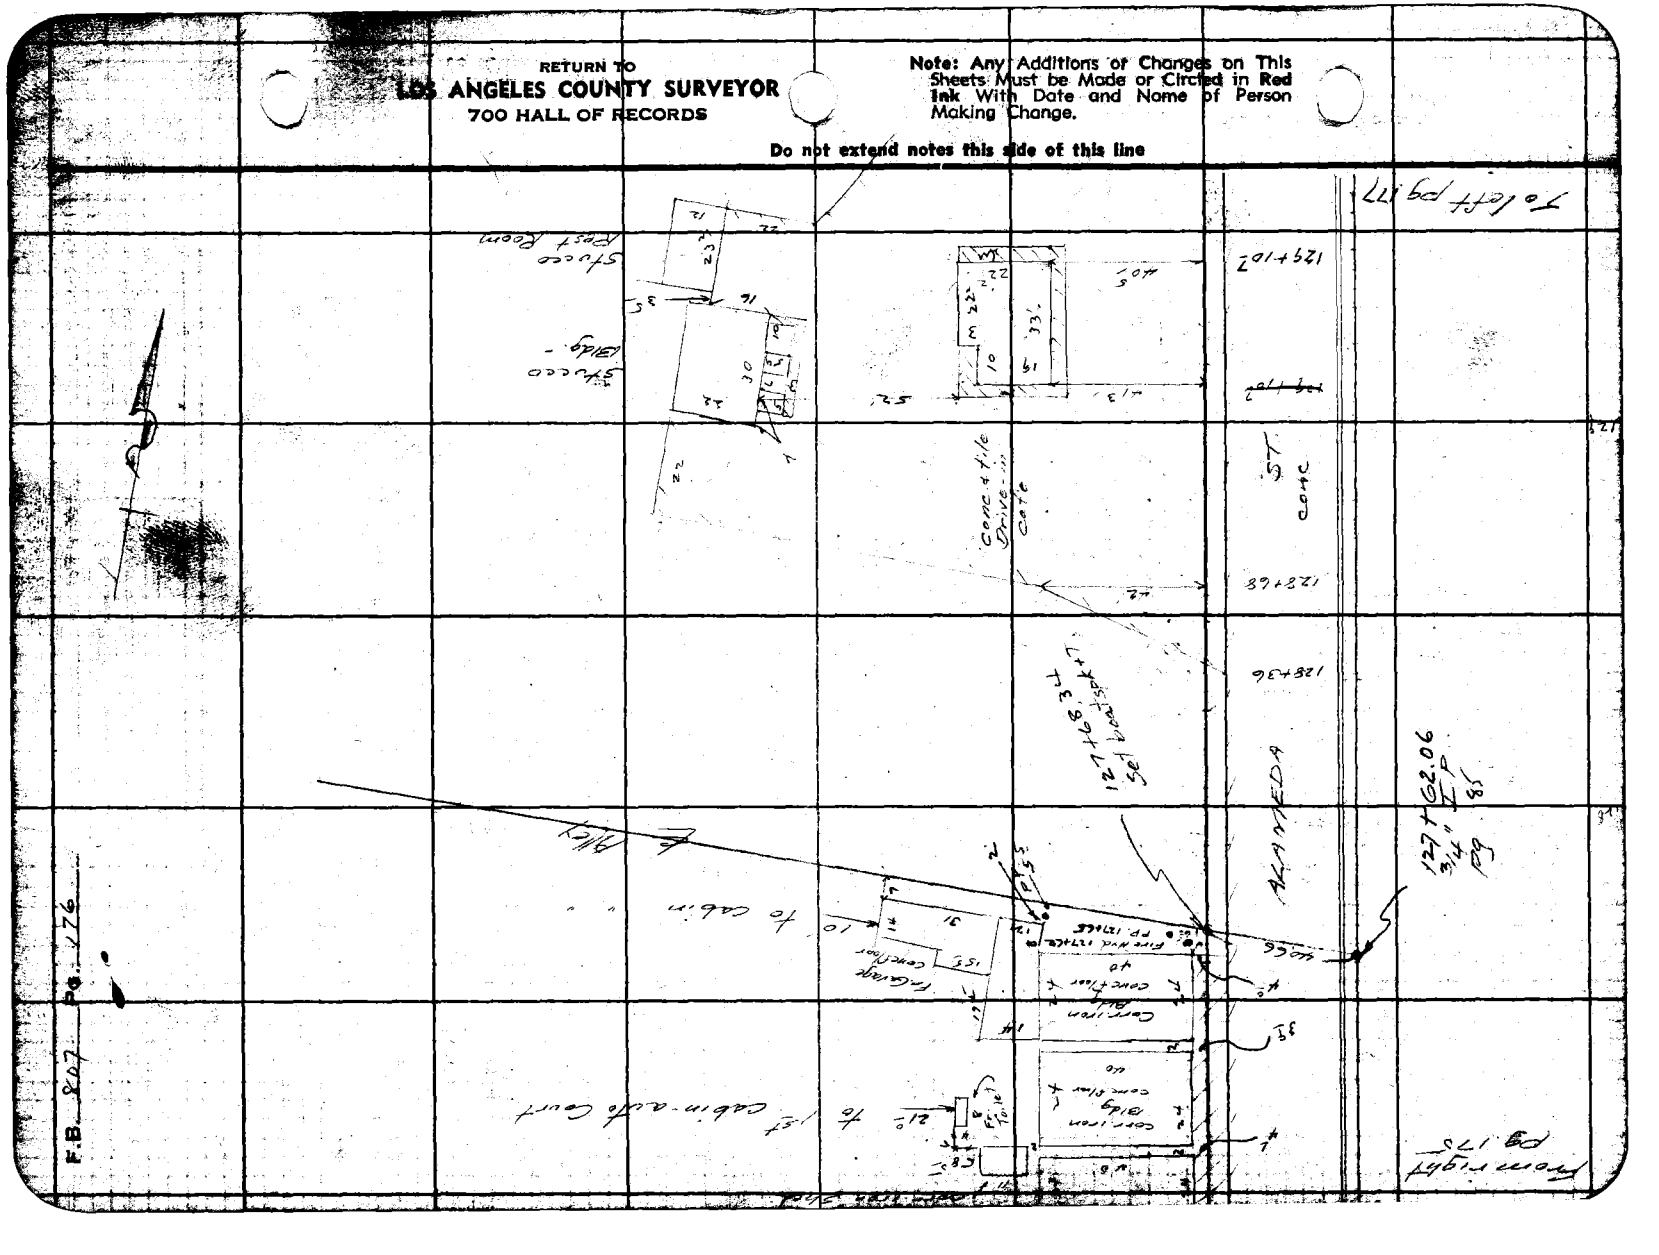

Notes Ck'd by D. M. Finley | Survey of Alameda St. | F.B. 807 Pg. 177
Map No. | Tape No. | of
Office Work H. H. REYNOLDS | Surveyed by Moore
Checked D. M. Finley | Notes Moore Date 12-7-39
Date Feb 1940 | Indexed A. C. Johns

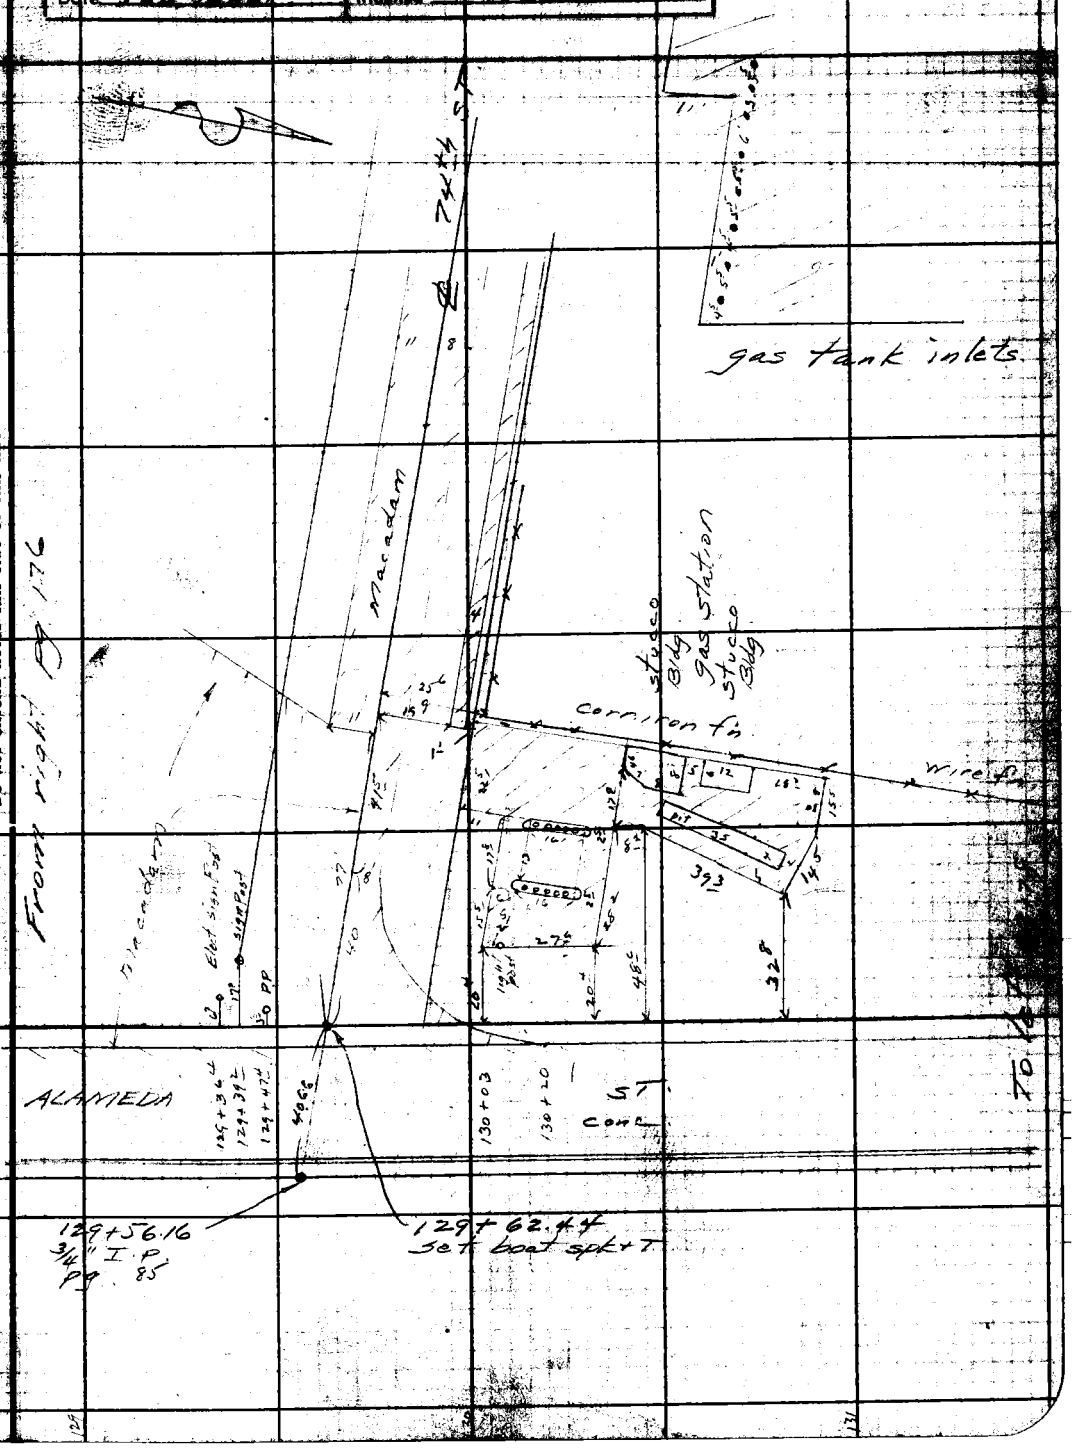

Note: Any Additions or Changes on Sheets Must be Made or Circled in Ink With Date and Name of Person Making Change.

Do not extend notes this side of this line

RETURN TO
LOS ANGELES COUNTY SURVEYOR
700 HALL OF RECORDS

FORM 247 5M 10-37

F.B. 807 Pg. 178

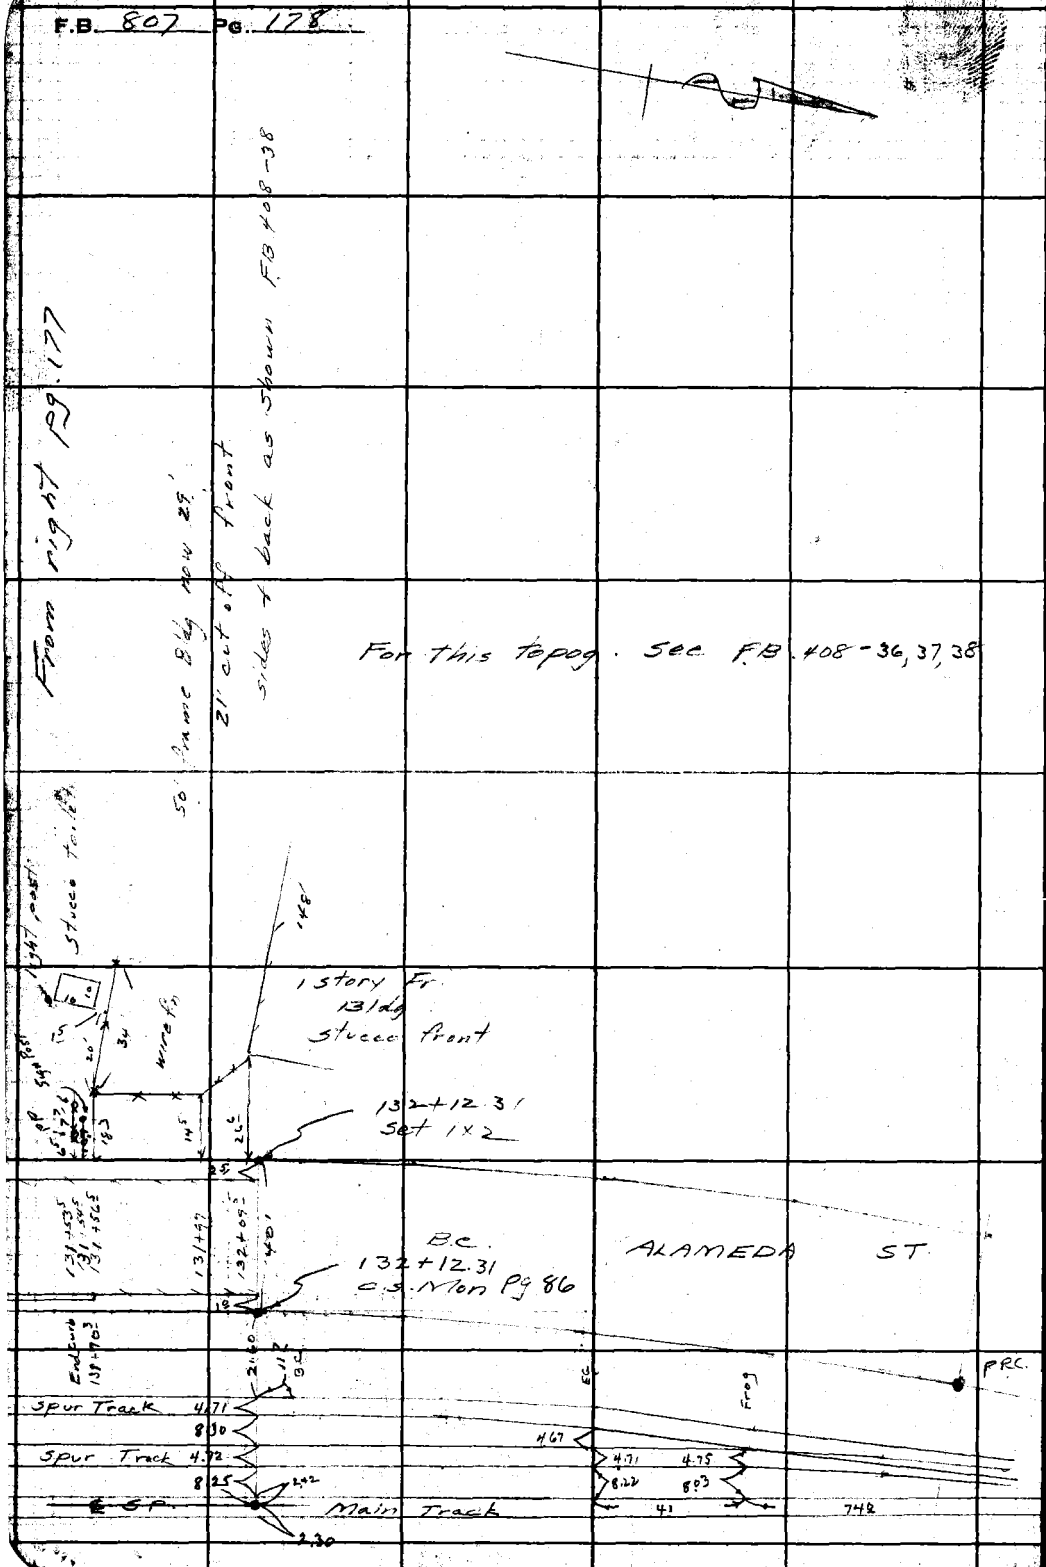

RETURN TO
LOS ANGELES COUNTY SURVEYOR
700 HALL OF RECORDS

Note: Any Additions or Changes on This Sheets Must be Made or Circled in Red Ink With Date and Name of Person Making Change.

Do not extend notes this side of this line

Notes Ck'd by D. M. Finley	Survey of Alameda ST	F.B. 807 Pg. 179
Map No. [illegible]	W. O. 270 Tape No. St'd dF	
Office Work H. H. REYNOLDS	Surveyed by Moore	
Checked D. M. Finley	Notes Moore Date 12-1-59	
Date Feb. 1960.	Indexed A. C. Johnson	

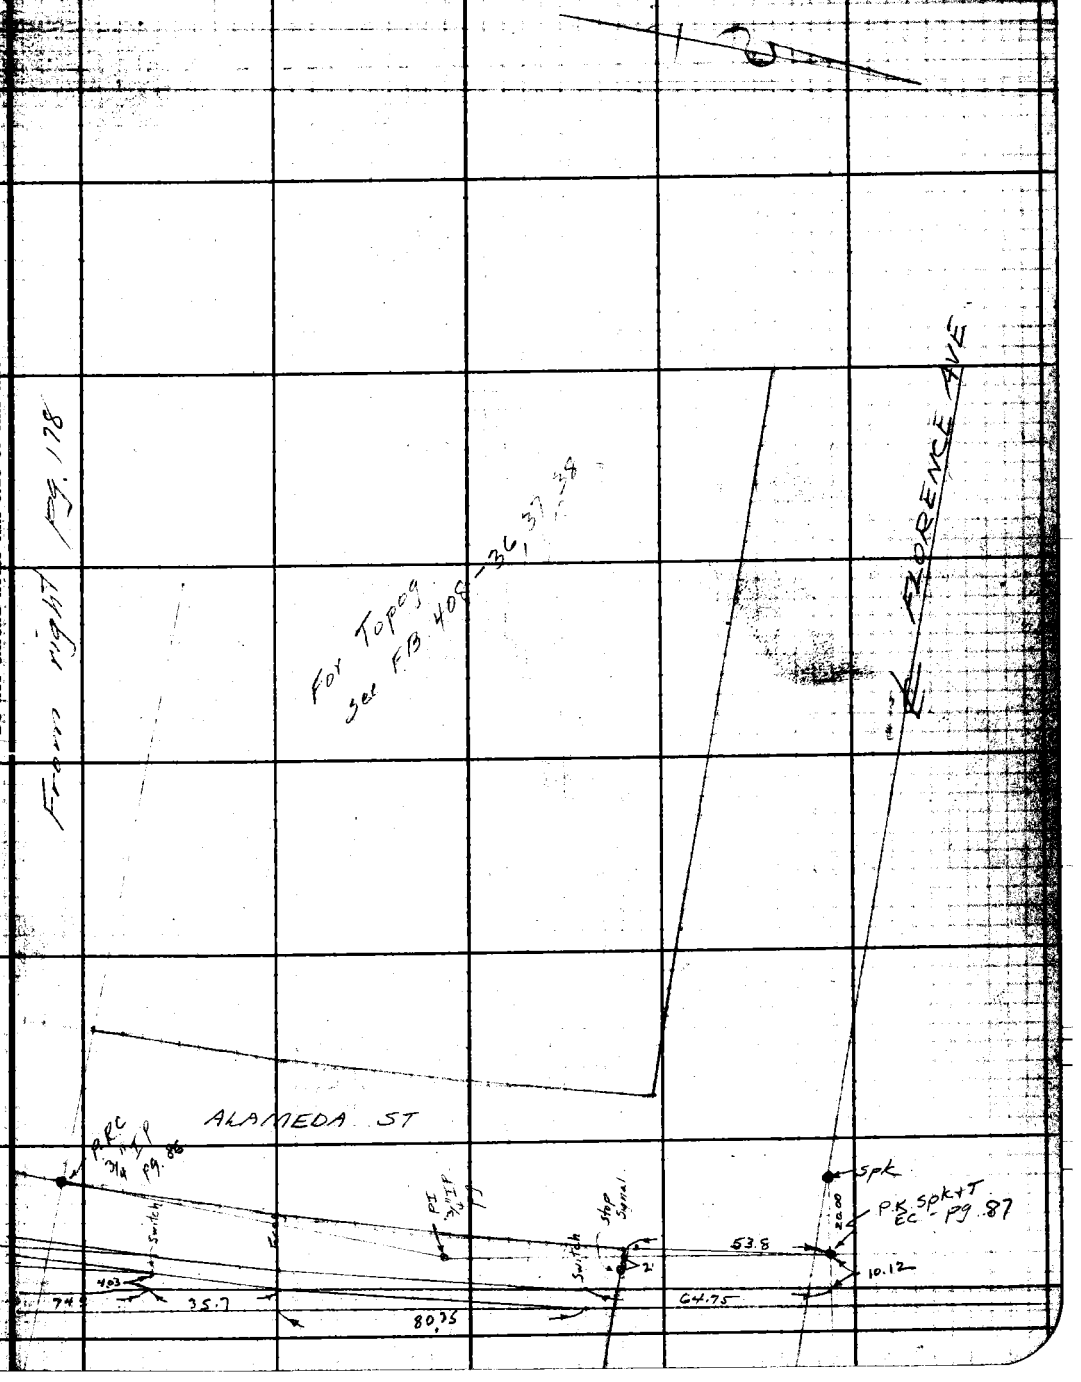

Note: Any Additions or Changes on This Sheets Must be Made or Circled in Red Ink With Date and Name of Person Making Change.

Do not extend notes this side of this line

RETURN TO
LOS ANGELES COUNTY SURVEYOR
700 HALL OF RECORDS

FORM 247 5M 10-37

RETURN TO
LOS ANGELES COUNTY SURVEYOR
700 HALL OF RECORDS

Note: Any Additions or Changes on This Sheets Must be Made or Circled in **Red Ink** With Date and Name of Person Making Change.

Do not extend notes this side of this line

F.B. 807 Pg. 180

Notes Ck'd by D. M. Finley	Survey of Alameda St	F.B. 807	Pg. 181
Map No. [illegible]	W. O. 127[illegible] Tape No.	Std.	
Office Work H. H. REYNOLDS	Surveyed by Mobie		
Checked D. M. Finley	Notes ℄ 85th	Date 1-24-40	
Date Feb. 1940	Indexed A. C. Johnson		

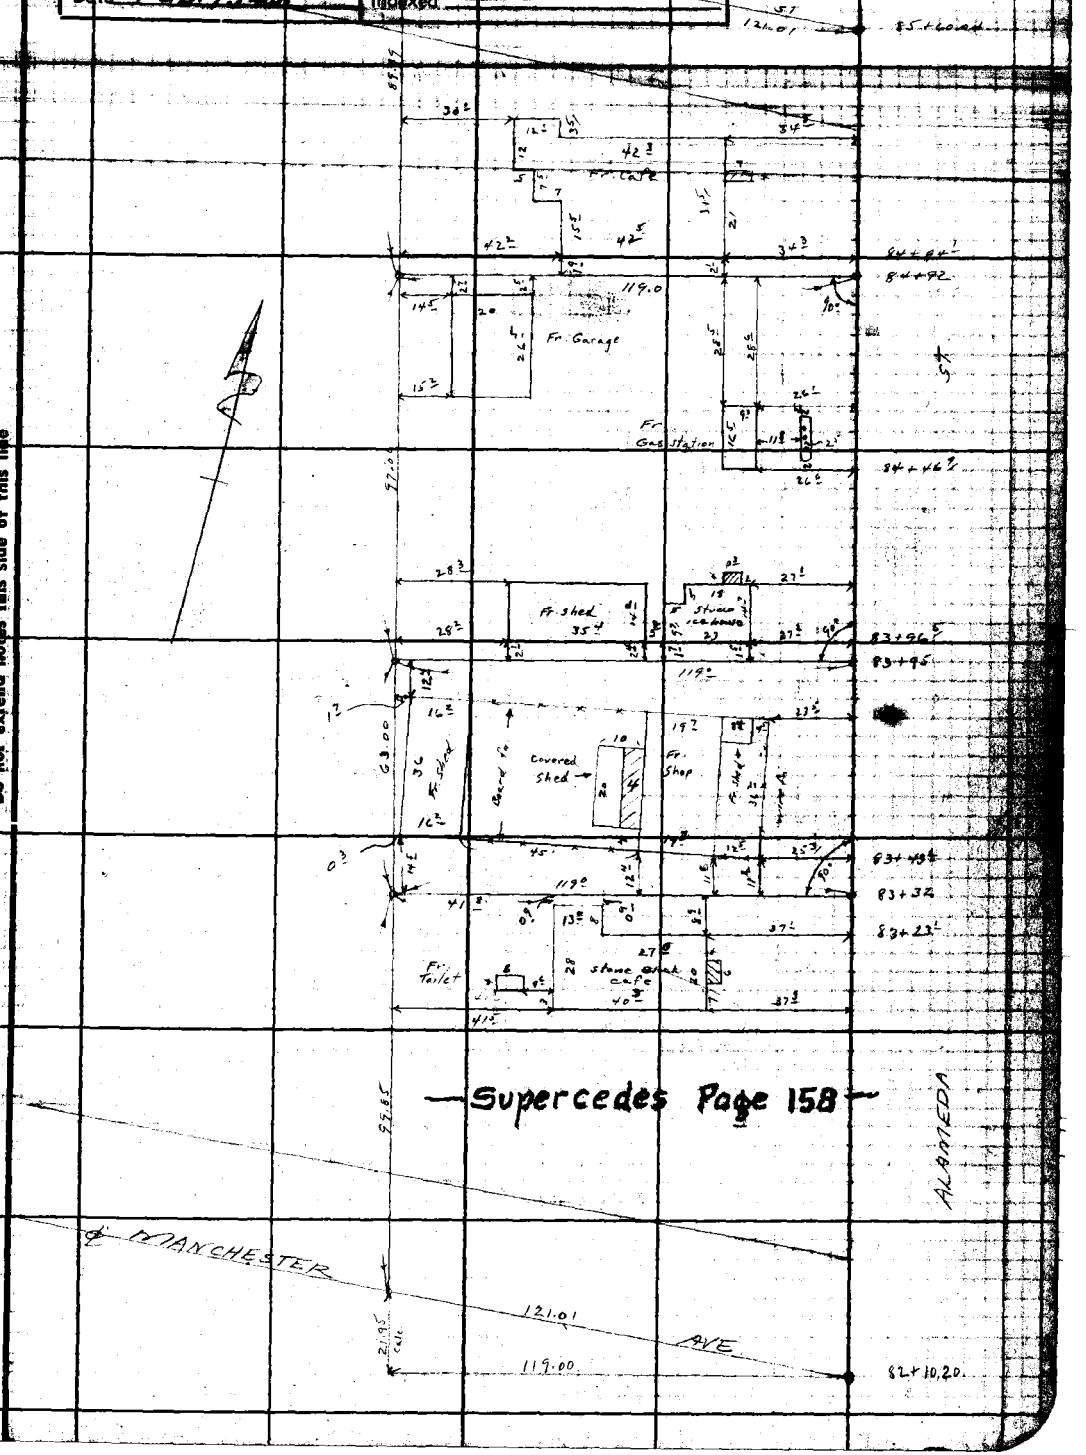

Note: Any Additions or Changes on This Sheets Must be Made or Circled in Red Ink With Date and Name of Person Making Change.

Do not extend notes this side of this line

RETURN TO
LOS ANGELES COUNTY SURVEYOR
700 HALL OF RECORDS

FORM 247 5M 10-37

RETURN TO
LOS ANGELES COUNTY SURVEYOR
700 HALL OF RECORDS

Note: Any Additions or Changes on This Sheets Must be Made or Circled in Red Ink With Date and Name of Person Making Change.

Do not extend notes this side of this line

FEB 1983

Notes Ck'd by D. M. Finley	Survey of Alameda St		F.B. 807
Map No. [illegible]	W. O. 8270	Tape No. 27	
Office Work D.A. White	Surveyed by Moore		
Checked D. M. Finley	Notes Moore	Date 7/40	
Date March 1945	Indexed A. C. Johnson		

SURVEY
OF
ALAMEDA ST
FROM
NORTH BOUNDARY
CITY OF COMPTON
SOUTH TO
DOMINGUEZ JUNCTION
JOB # 8270

Moore
Fenner
Lawson
Clinite

Note - All C.S. Mons are 2" I.P. in conc. - marked as shown

COUNTY SURVEYOR
R.E. 2177

Note: Any Additions or Changes on This Sheet Must be Made or Circled in Red Ink With Date and Name of Person Making Change.

Do not extend notes this side of this line.

RETURN TO
LOS ANGELES COUNTY SURVEYOR
700 HALL OF RECORDS

FORM 247 5M 10-39

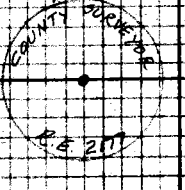

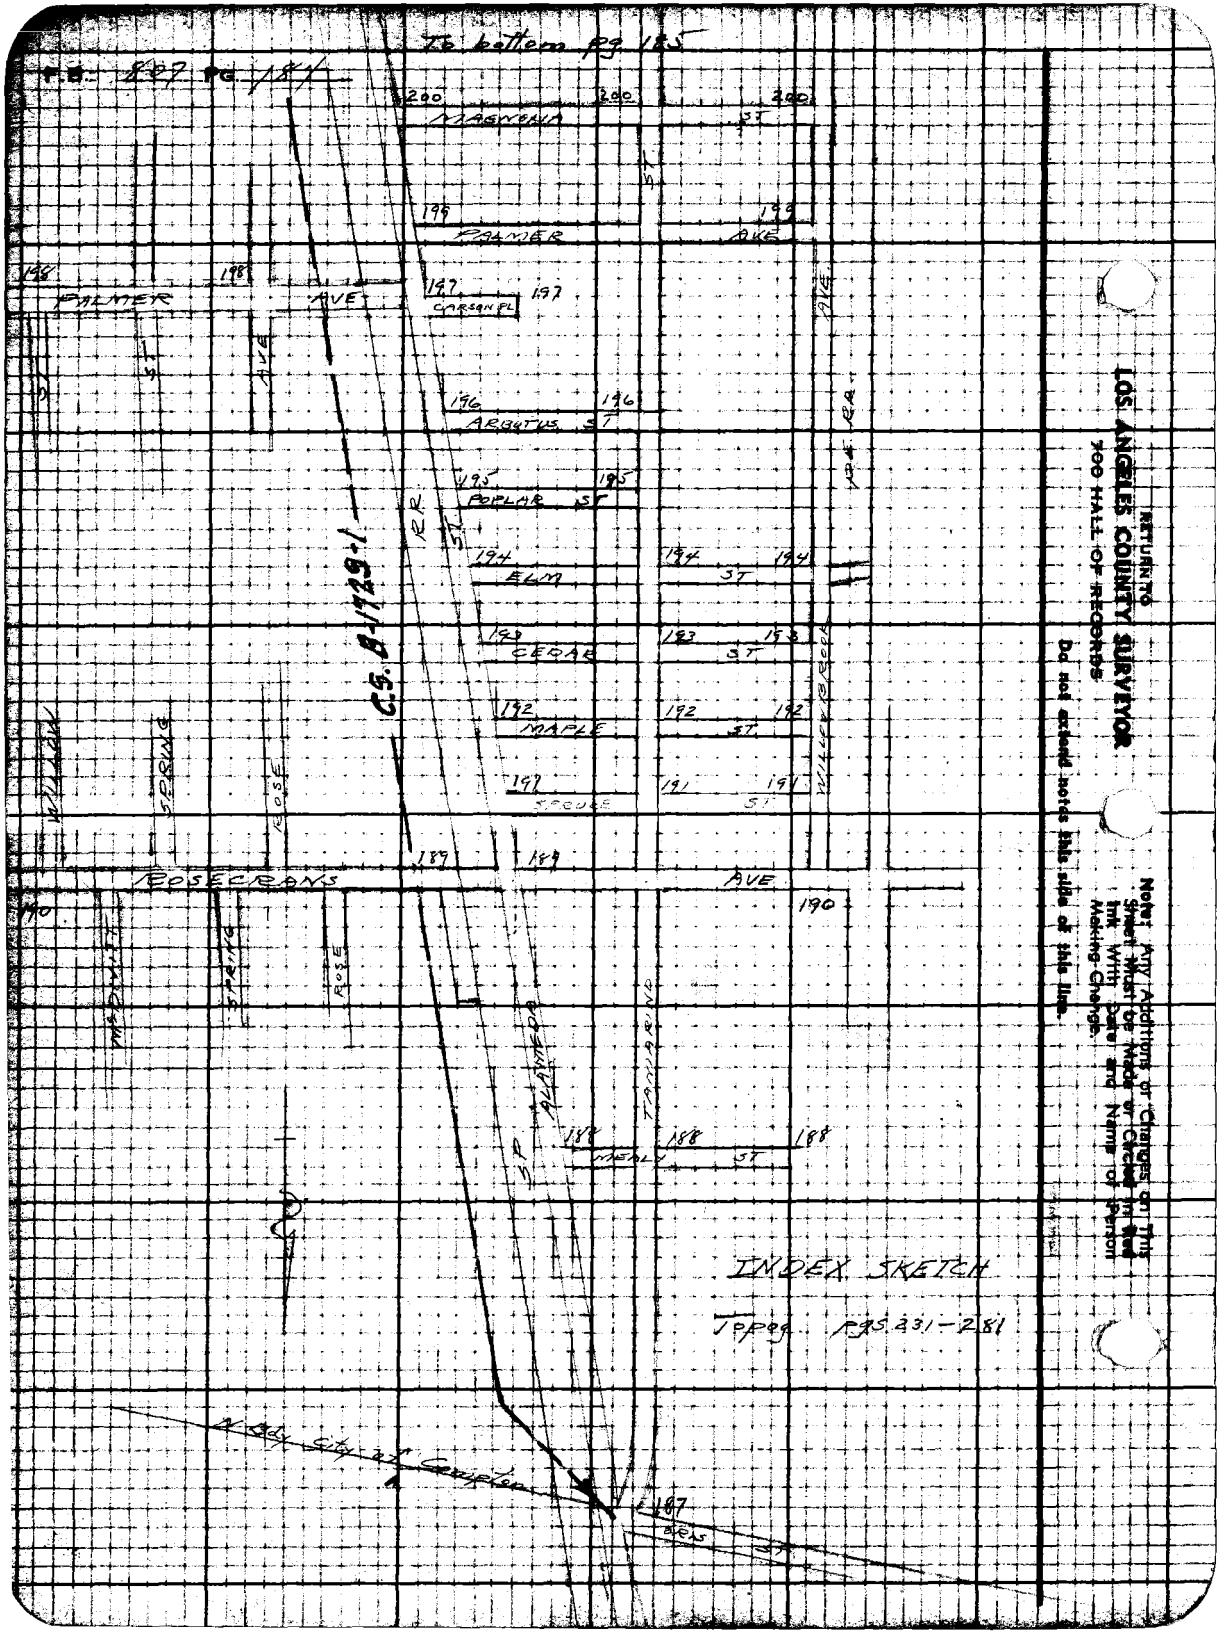
To bottom pg 185
F.B. 807 PG. 184
200
MAGNOLIA ST
199
PALMER AVE
198
PALMER AVE
197
CARSON PL
196
ARBUTUS ST
195
POPLAR ST
194
ELM ST
193
CEDAR ST
192
MAPLE ST
191
SPRUCE ST
189
ROSECRANS AVE
190
188
MEALY ST
187
ORIS ST
C.S. B-1729-1
RR
ST
WILLOW
SPRING
ROSE
McDIVITT
ALAMEDA
TAMARIND
WILLOWBROOK
PE RR
N Bdy City of Compton
INDEX SKETCH
Topog. pgs 231-281
RETURN TO
LOS ANGELES COUNTY SURVEYOR
700 HALL OF RECORDS
Do not extend notes this side of this line.
Note: Any Additions or Changes on This Sheet Must be Made or Circled in Red Ink With Date and Name of Person Making Change.

Notes Ck'd by D. M. Finley	Survey of Alameda St
Map No. [illegible]	W. O. 8270 Tape No. [illegible]
Office Work D. A. White	Surveyed by Moore
Checked D. M. Finley	Notes Moore Date 7/40
Date Mar. 1949	Indexed R. C. Johnson

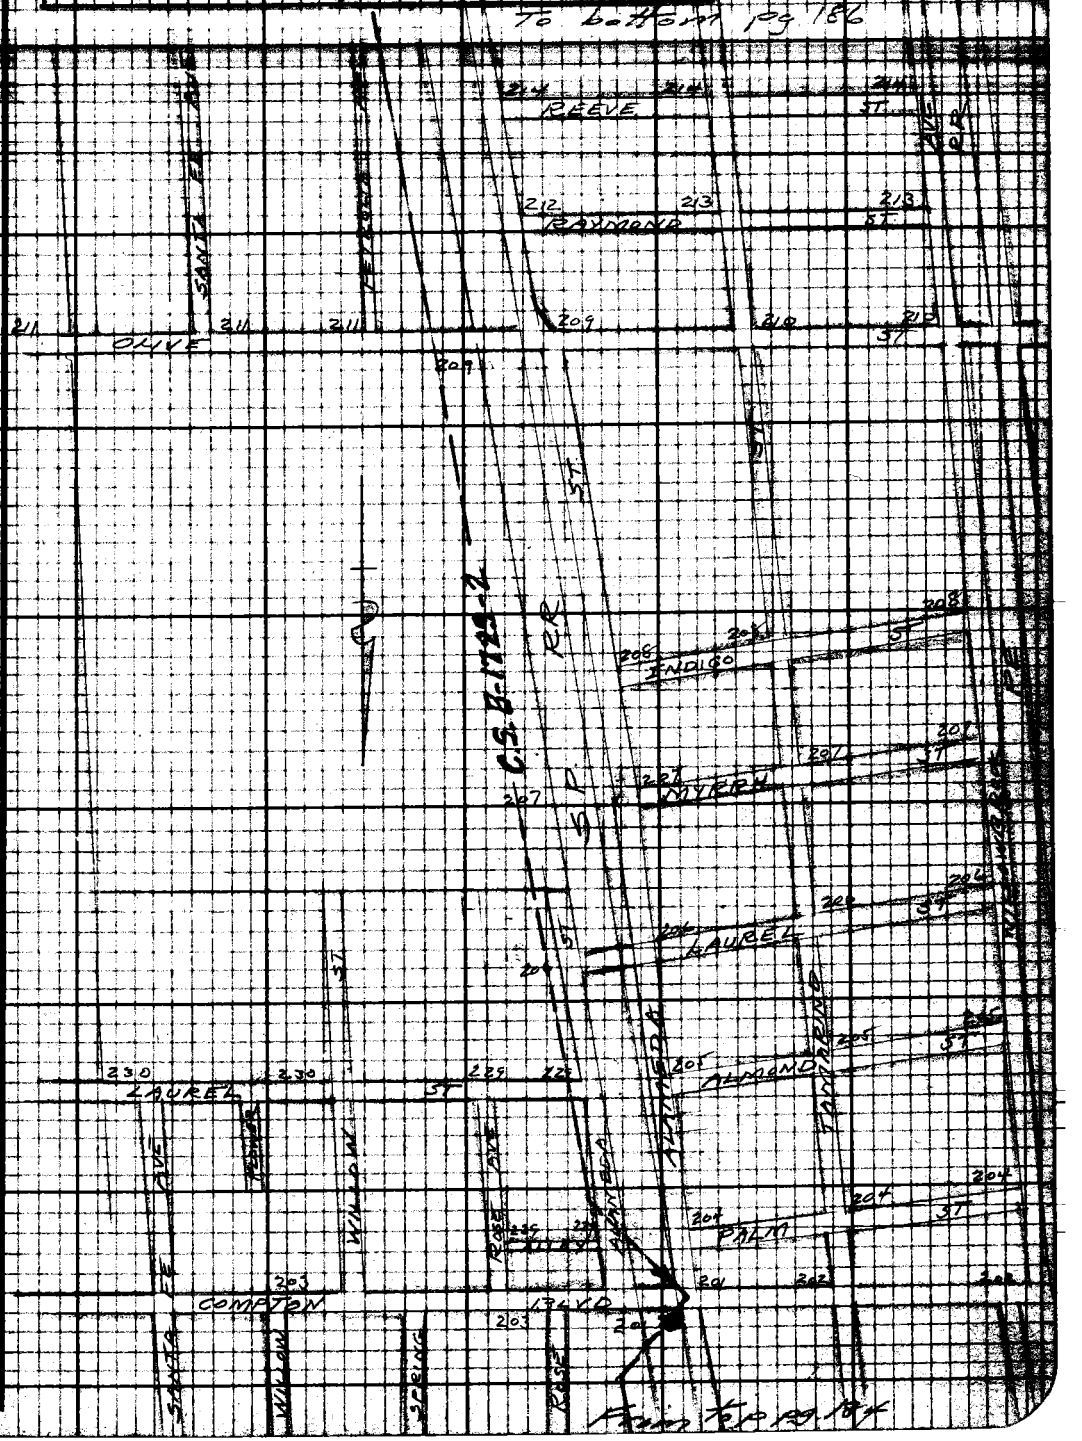

Note: Any Additions or Changes on This Sheet Must be Made or Circled in Red Ink With Date and Name of Person Making Change.

Do not extend notes this side of this line.

RETURN TO
LOS ANGELES COUNTY SURVEYOR
700 HALL OF RECORDS

FORM 247 5M 10-39

RETURN TO
LOS ANGELES COUNTY SURVEYOR
700 HALL OF RECORDS

Note: Any Additions or Changes on This Sheet Must be Made or Circled in Red Ink With Date and Name of Person Making Change.

Do not extend notes this side of this line.

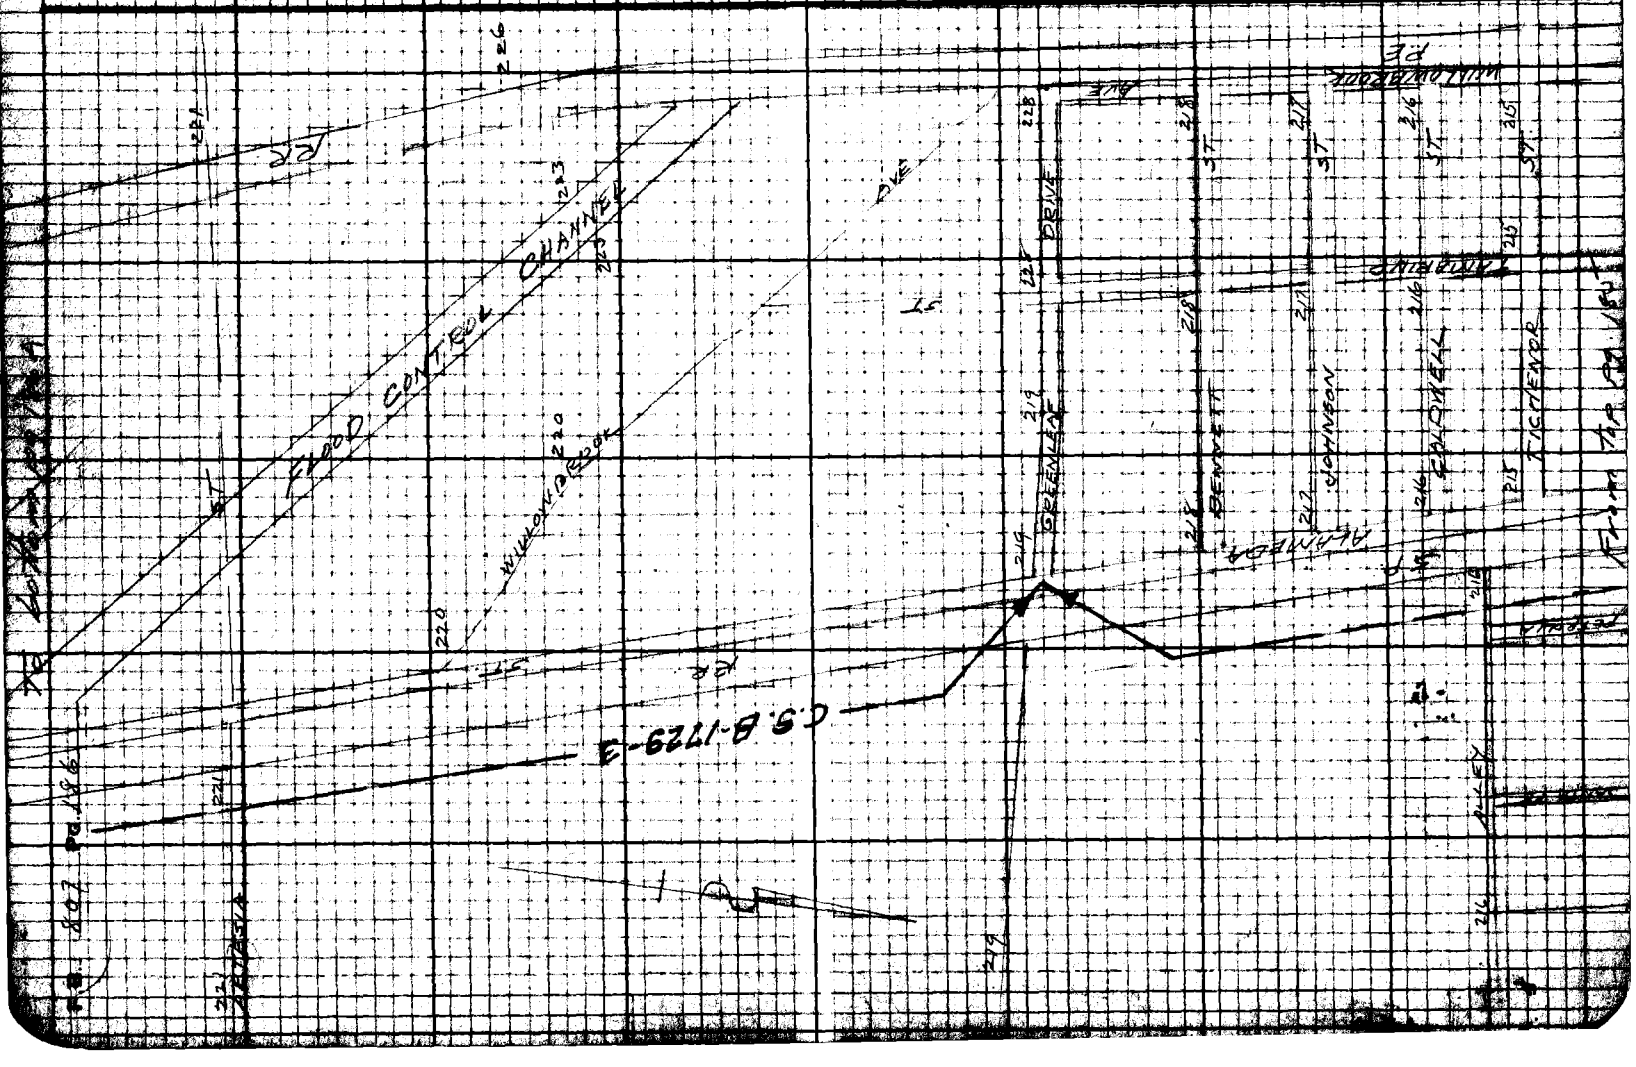

Notes Ck'd by D. M. Finley	Survey of Alameda St
Map No. [illegible]	W. O. 8220 Tape No. Std.
Office Work	Surveyed by N. Moore
Checked D. M. Finley	Notes N. Moore Date 7/40
Date Mar. 1945	Indexed A. C. Johnson

F.B. 807 Pg. [illegible]

To bottom pg. 186 B

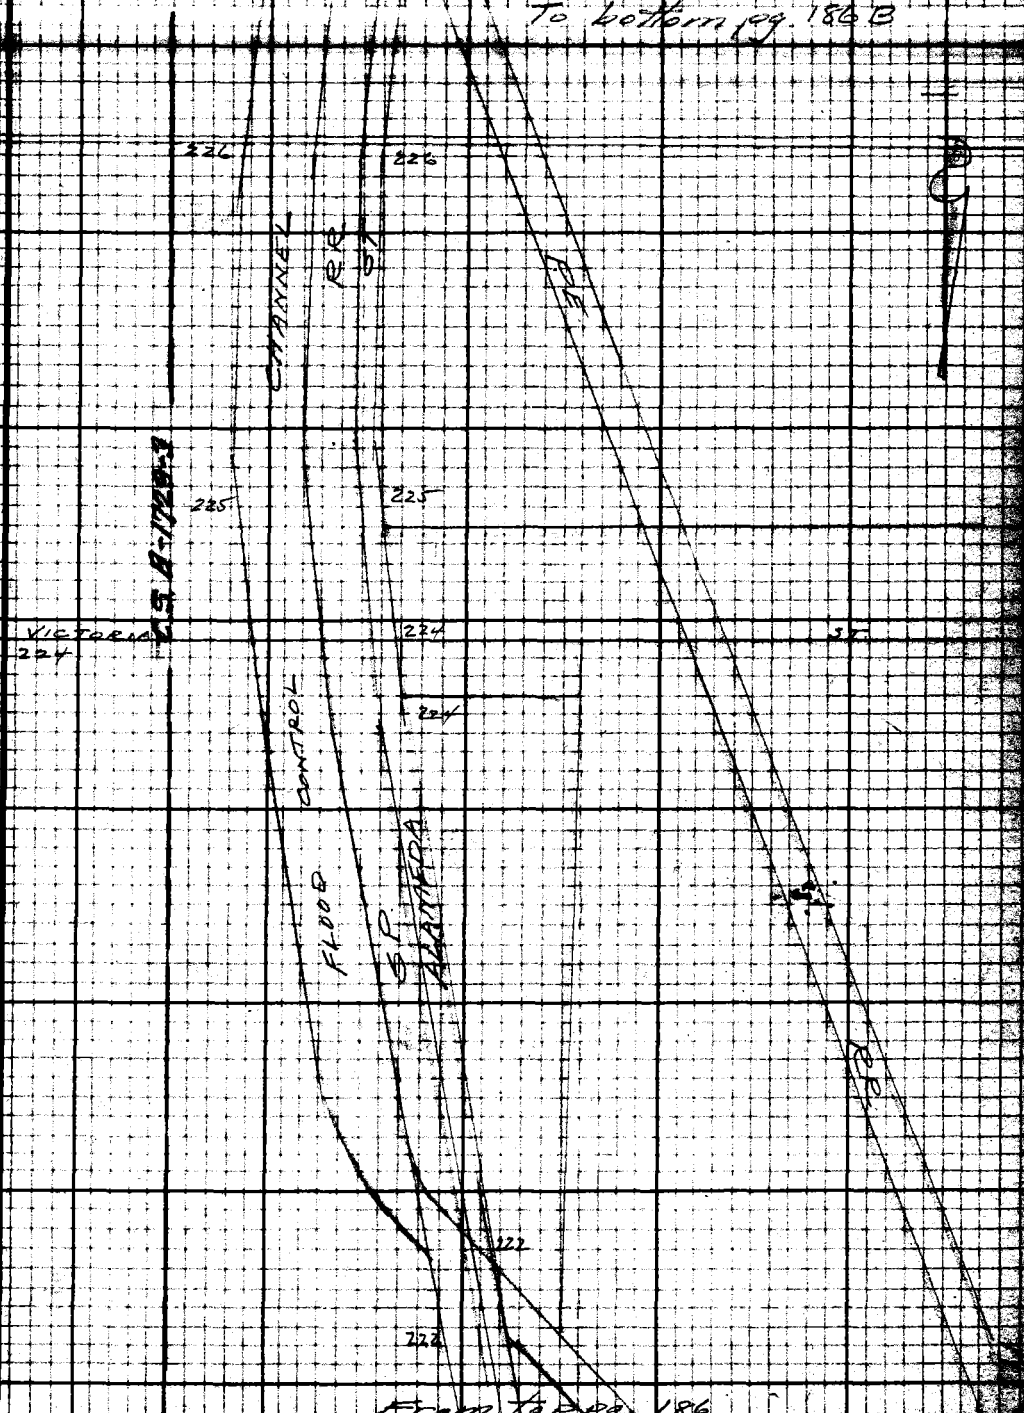

From top pg. 186

RETURN TO
LOS ANGELES COUNTY SURVEYOR
700 HALL OF RECORDS
Note: Any Additions or Changes on This Sheet Must be Made or Circled in Red Ink With Date and Name of Person Making Change.
Do not extend notes this side of this line.
FORM 247 5M 10-39

RETURN TO
LOS ANGELES COUNTY SURVEYOR
700 HALL OF RECORDS

Note: Any Additions or Changes on This Sheet Must be Made or Checked in Red Ink With Date and Name of Person Making Change.

Do not extend notes this side of this line

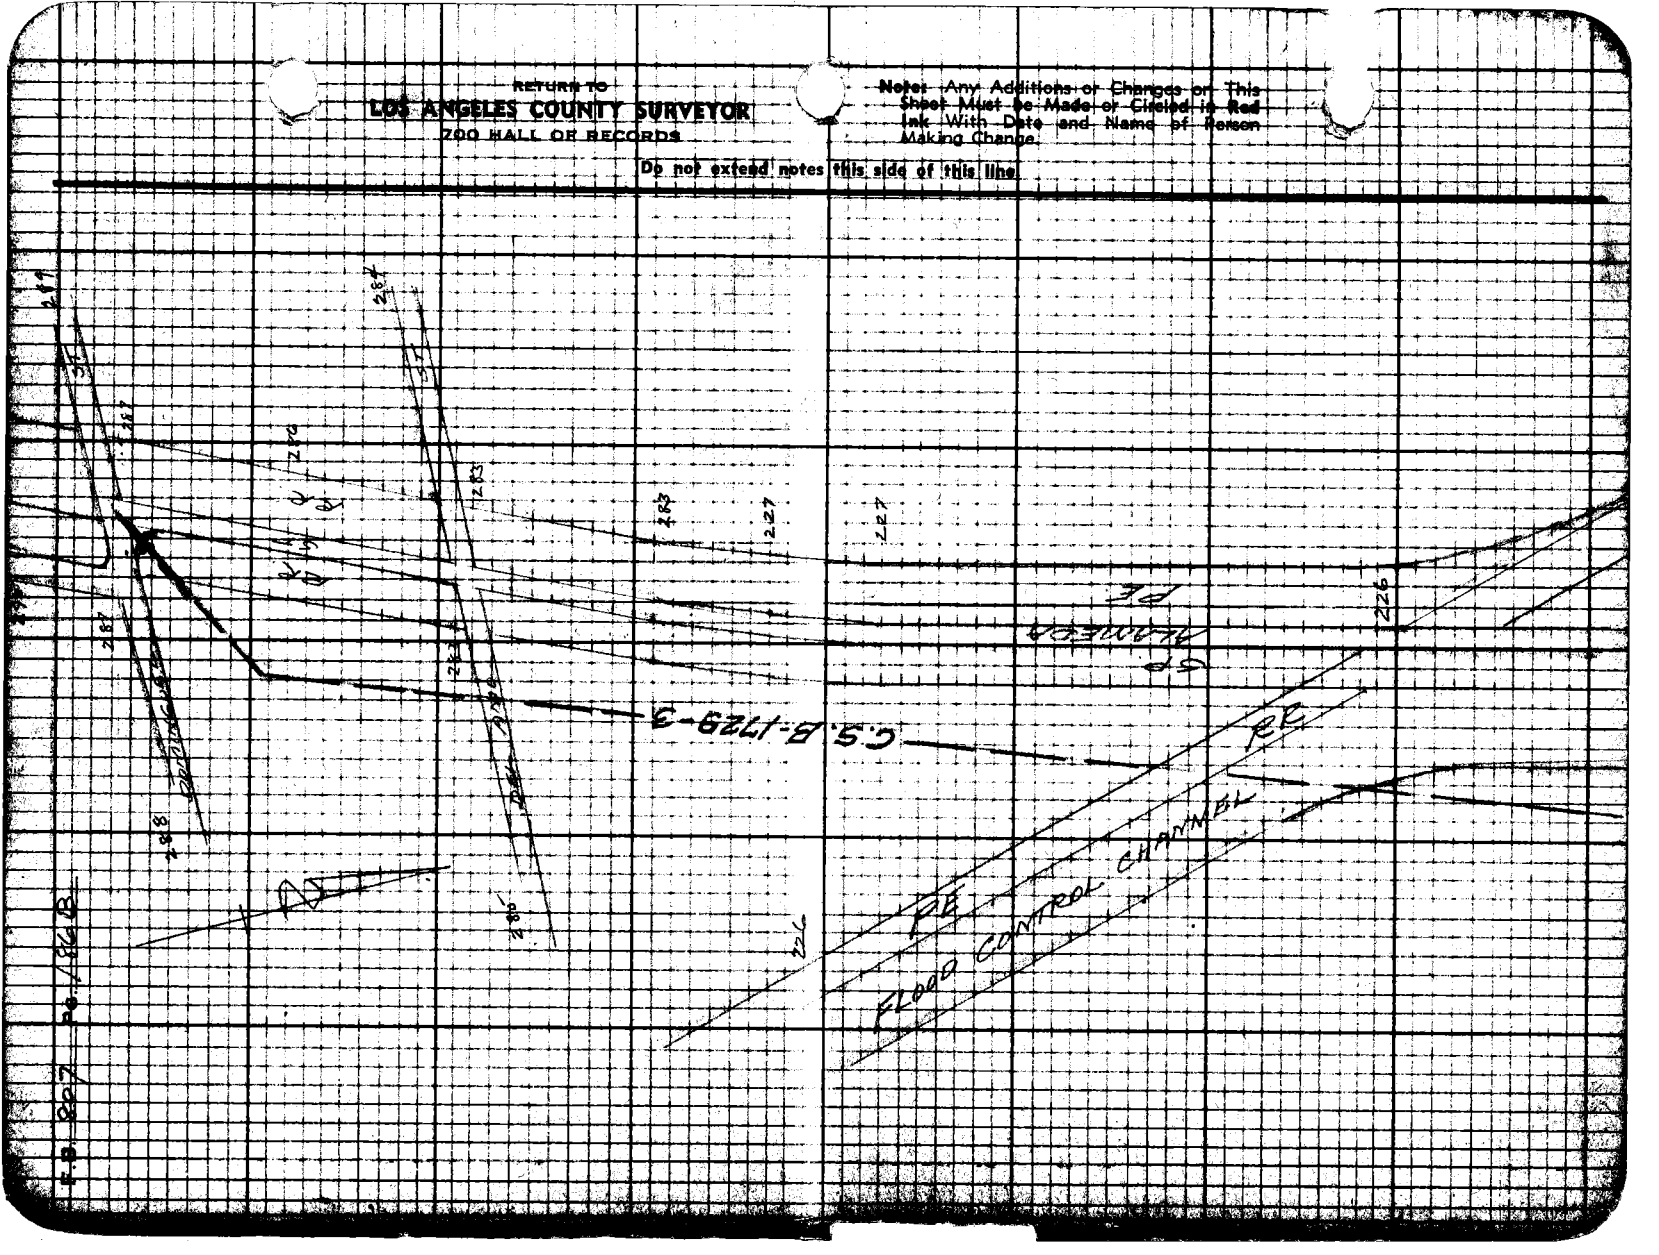

Notes Ck'd by	D. M. Finley	Survey of	Alameda St
Map No.	[redacted]	[redacted]	
Office Work		Surveyed by	
Checked	D. M. Finley	Notes	Moore Date 7-1-40
Date	Mar. 1945	Indexed	A. C. Johnson

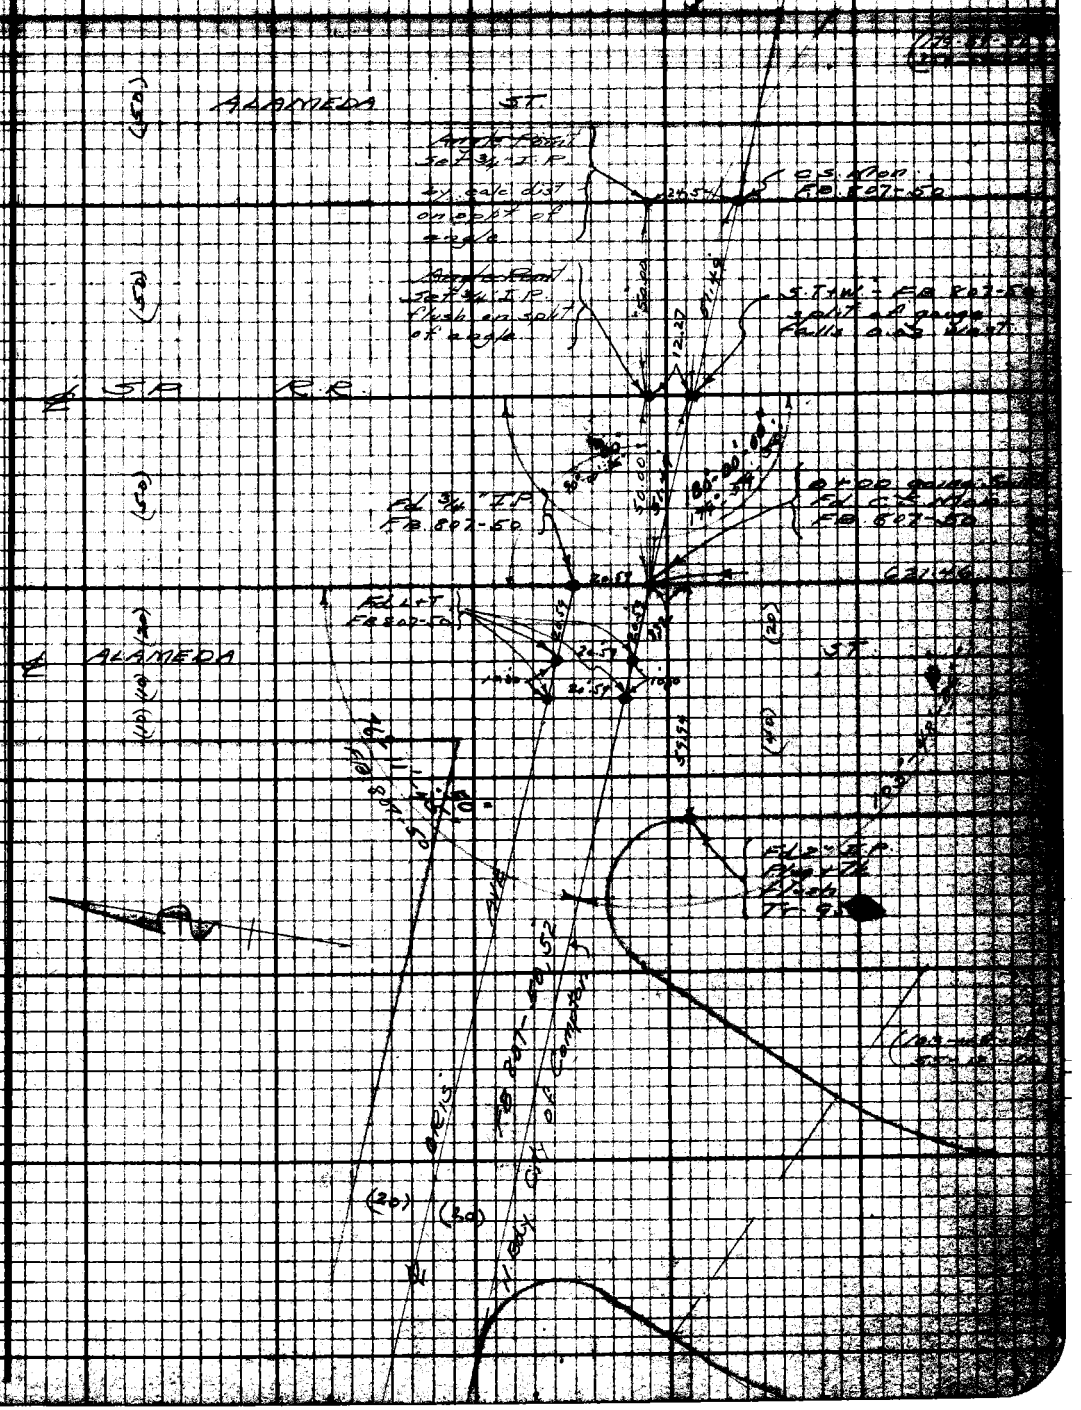

Note: Any Additions or Changes on This Sheet Must be Made or Circled in Red Ink With Date and Name of Person Making Change.

Do not extend notes this side of this line.

RETURN TO
LOS ANGELES COUNTY SURVEYOR
700 HALL OF RECORDS

FORM 247 5M 10-39

Bk. 807 Pg. 188

621.52 @ 68° = 621.46

535.14 @ 68° = 535.08

781.73 @ 68° = 781.65

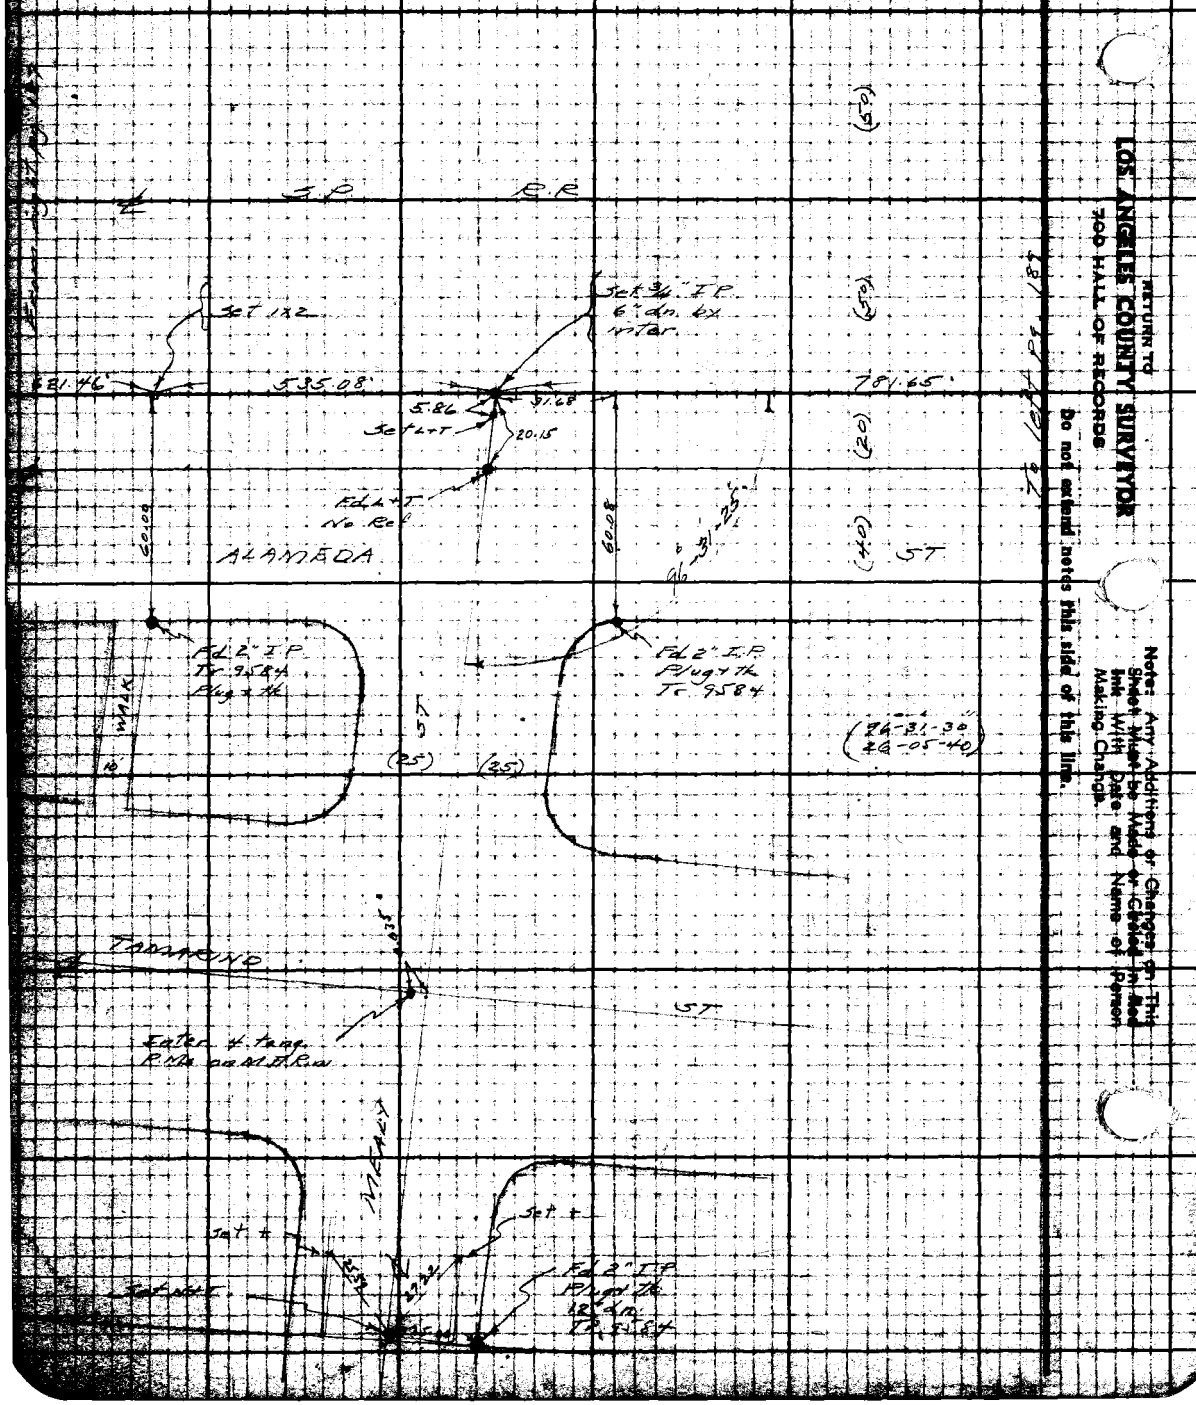

RETURN TO
LOS ANGELES COUNTY SURVEYOR
700 HALL OF RECORDS

Do not extend notes this side of this line.

Note: Any Additions or Changes on This Sheet Must be Made or Checked in Red Ink With Date and Name of Person Making Change.

FORM 247 5M 10-59

RETURN TO
LOS ANGELES COUNTY SURVEYOR
760 HALL OF RECORDS

Note: Any Additions or Changes on This Sheet Must be Made or Circled in Red Ink With Date and Name of Person Making Change.

Do not extend notes this side of this line.

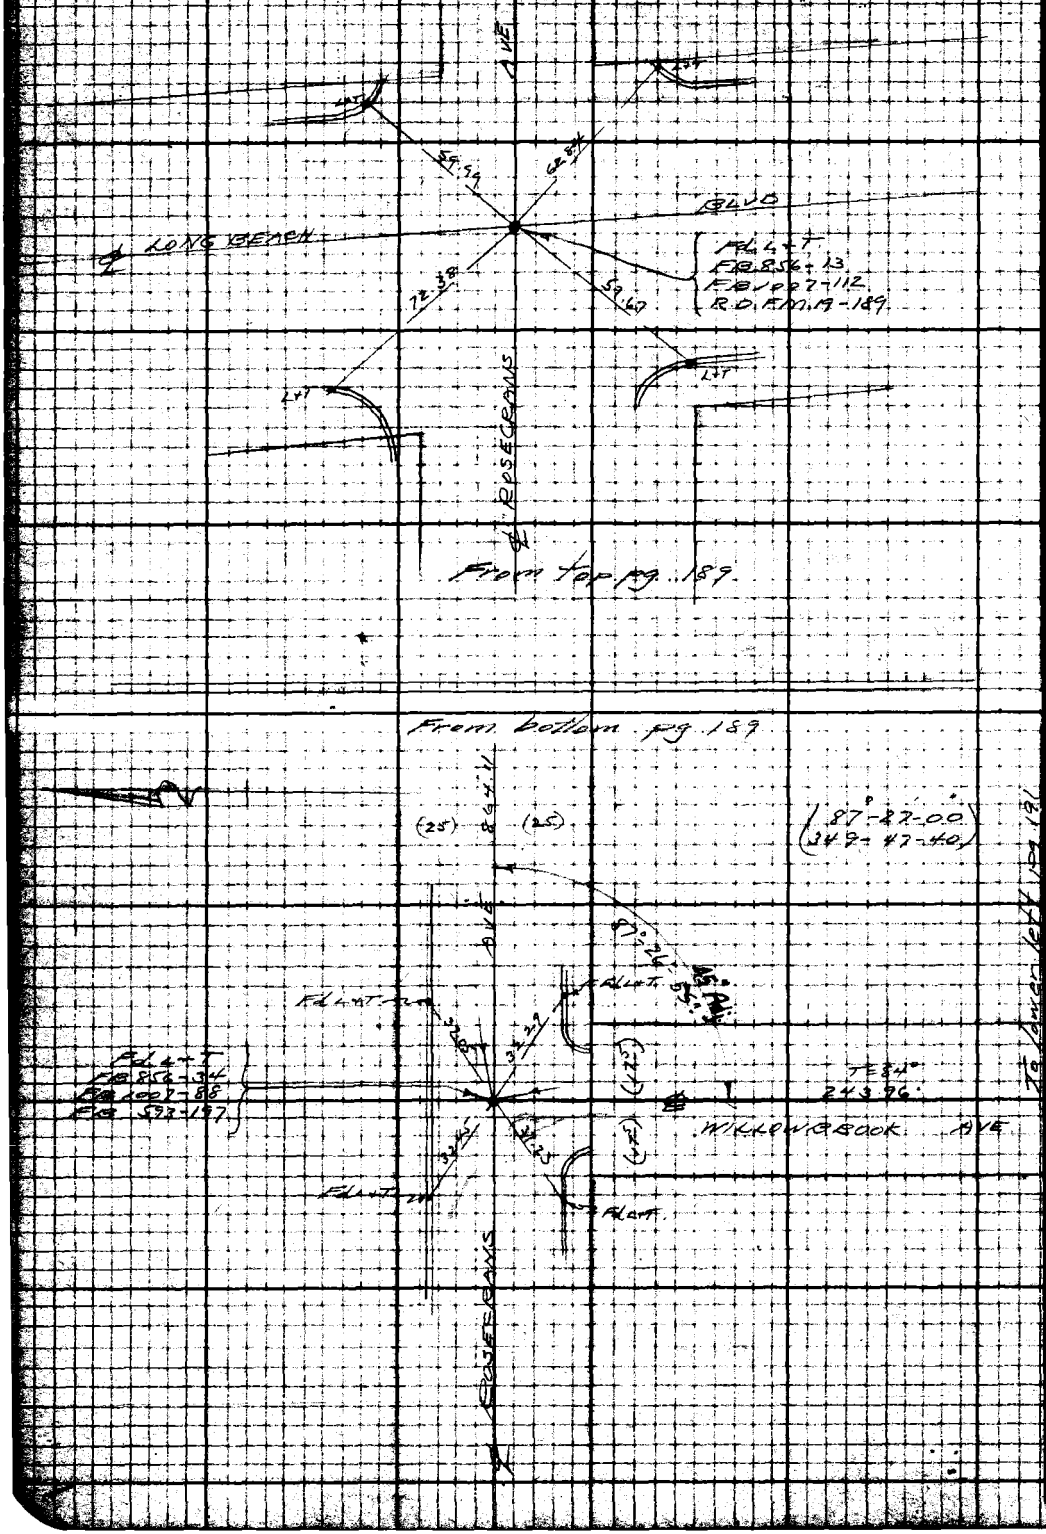

RETURN TO
LOS ANGELES COUNTY SURVEYOR
700 HALL OF RECORDS
Do not extend notes this side of this line.
Note: Any Additions or Changes on This Sheet Must be Made or Coded in Red Ink With Date and Name of Person Making Change.

Notes Ck'd by D. M. Finley	Survey of Alameda St.
Map No. [illegible]	W. O. [illegible] Tape No. [illegible]
Office Work	Surveyed by Moore
Checked D. M. Finley	Notes Moore Date 7-2-40
Date Mar 1945	Indexed A. C. Johnson

F.B. [illegible] Pg. [illegible]

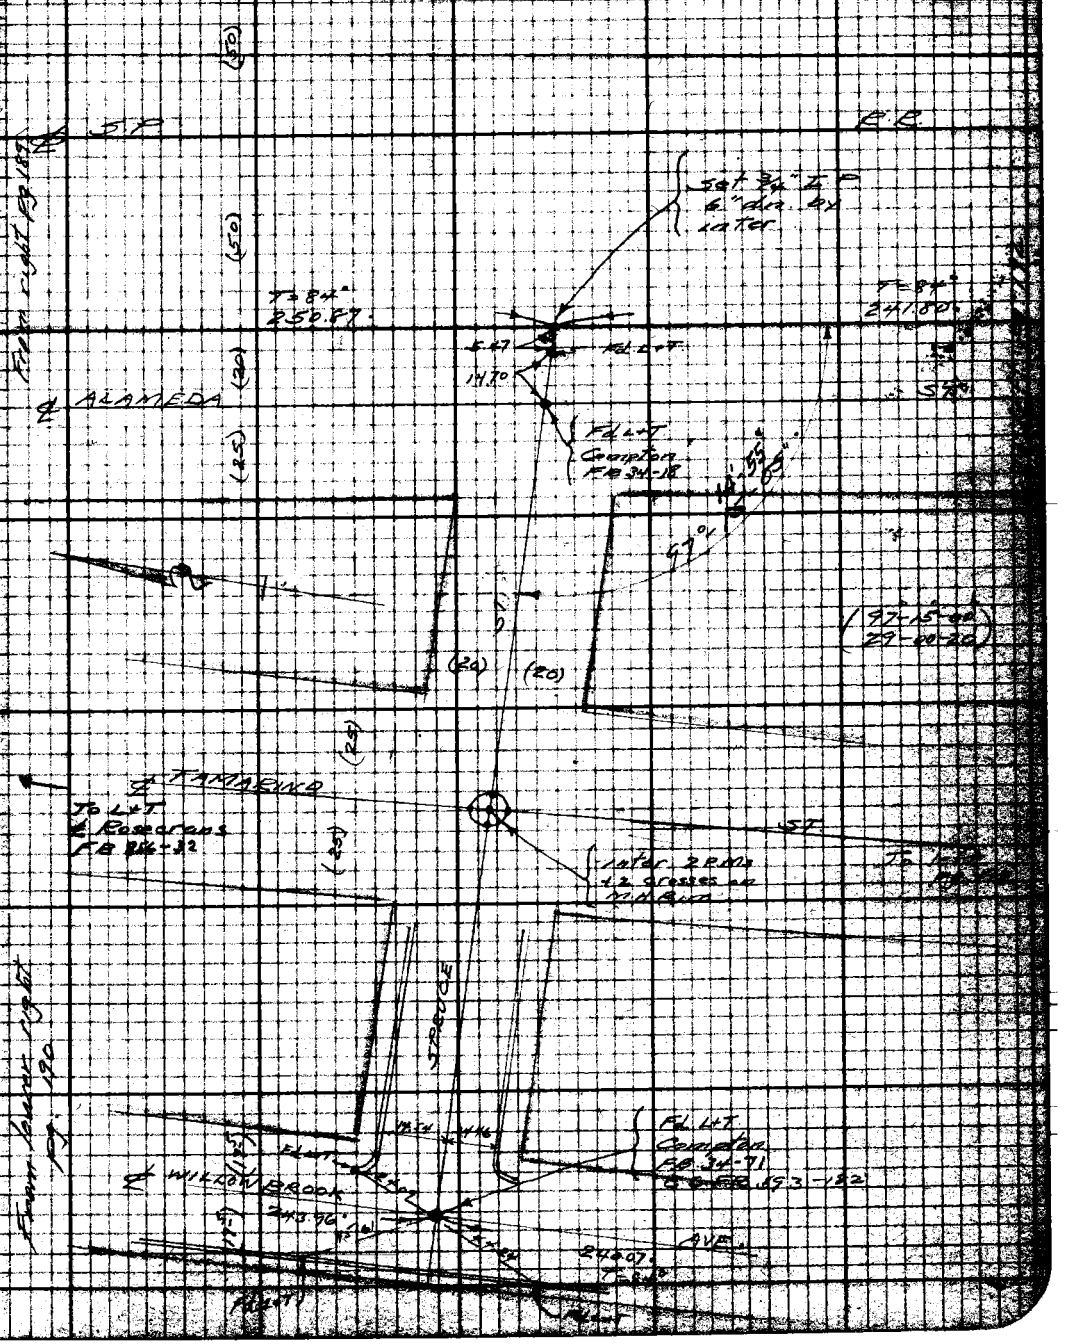

Notes: Any Additions or Changes on this Sheet Must be Made or Circled in Red Ink With Date and Name of Person Making Change.

Do not extend notes this side of this line.

RETURN TO
LOS ANGELES COUNTY SURVEYOR
700 HALL OF RECORDS

FORM 247 5M 10-39

F.B. 807 Pg. 192

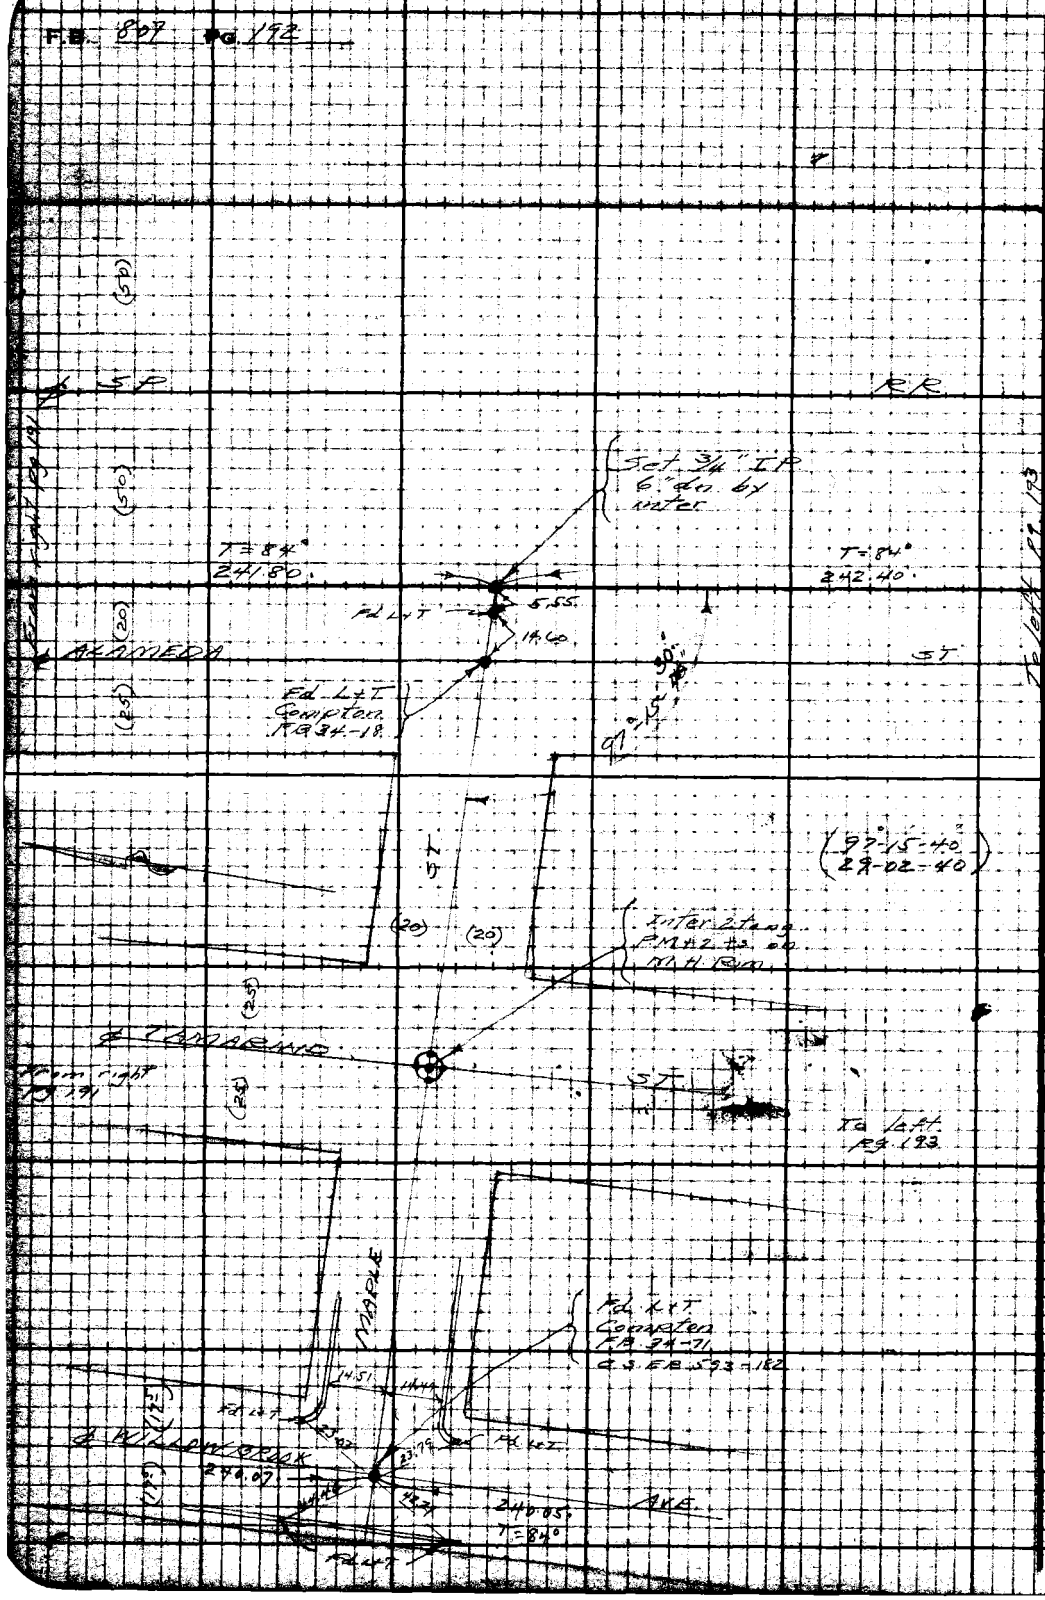

RETURN TO
LOS ANGELES COUNTY SURVEYOR
700 HALL OF RECORDS

Do not extend notes this side of this line.

Note: Any Additions or Changes on This Sheet Must be Made or Cleared in Red Ink With Date and Name of Person Making Change.

Notes Ck'd by D. M. Finley	Survey of Alameda St		F.B. 807 Pg. 192
Map No. [illegible]	W. O. 8270	Tape No. 07	
Office Work	Surveyed by Moore		
Checked D. M. Finley	Notes Moore	Date 7-2-40	
Date Mar. 1945	Indexed A. C. Johnson		

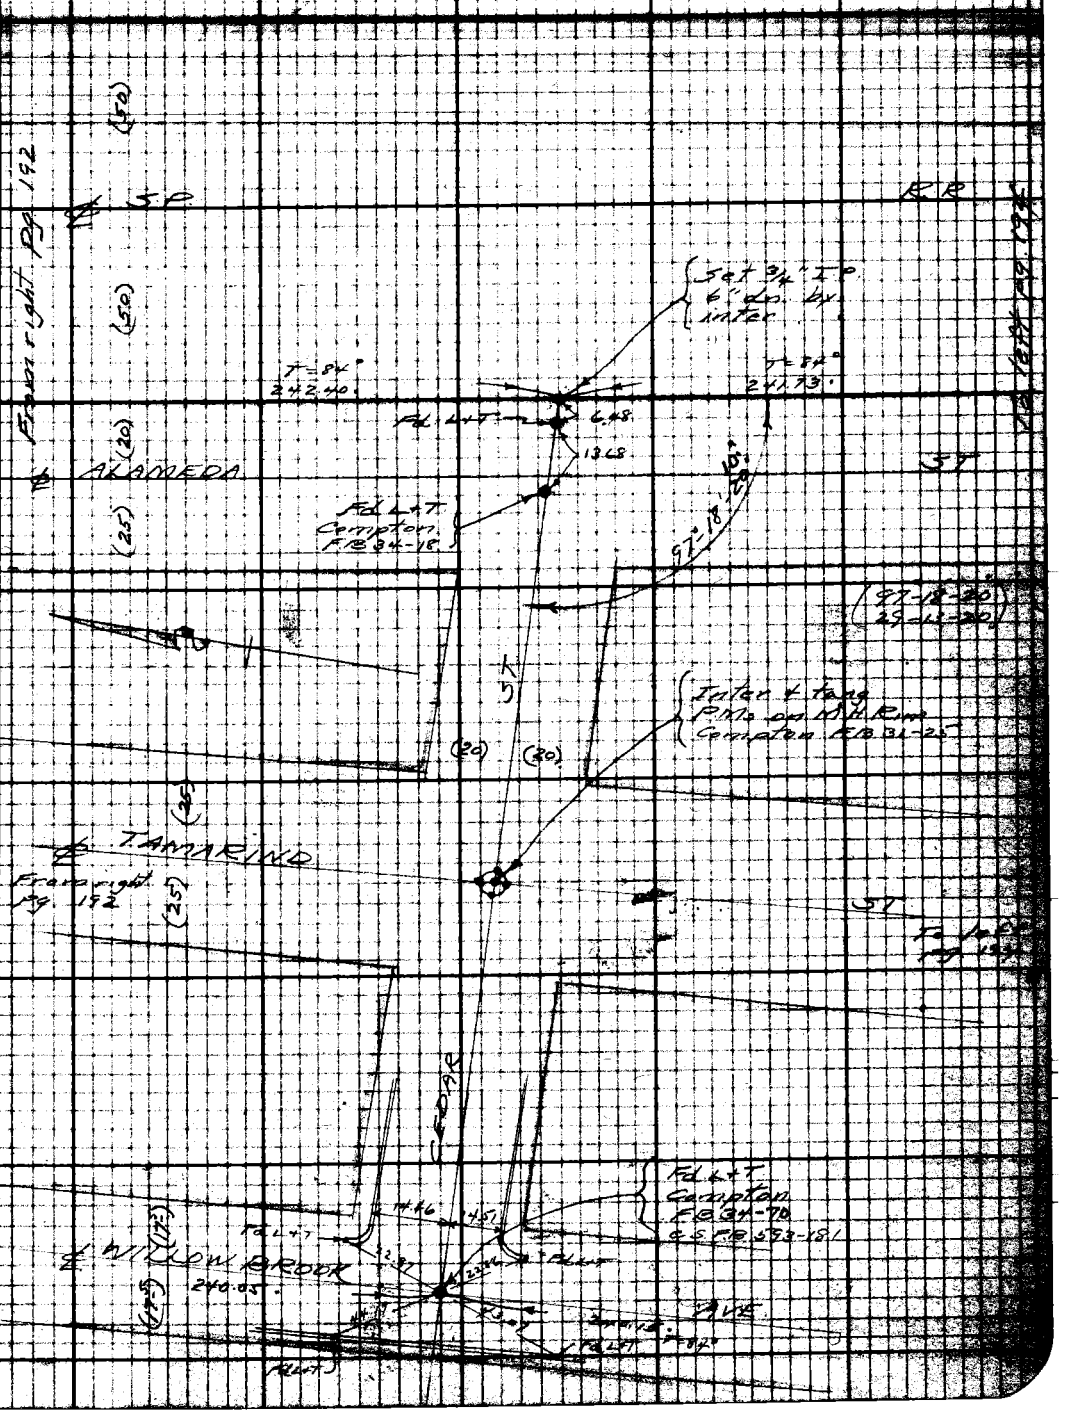

Note: Any Additions or Changes on This Sheet Must be Made or Circled in Red Ink With Date and Name of Person Making Change.

Do not extend notes this side of this line.

RETURN TO
LOS ANGELES COUNTY SURVEYOR
700 HALL OF RECORDS

FORM 247 5M 10-39

F.B. 807 PG. 194

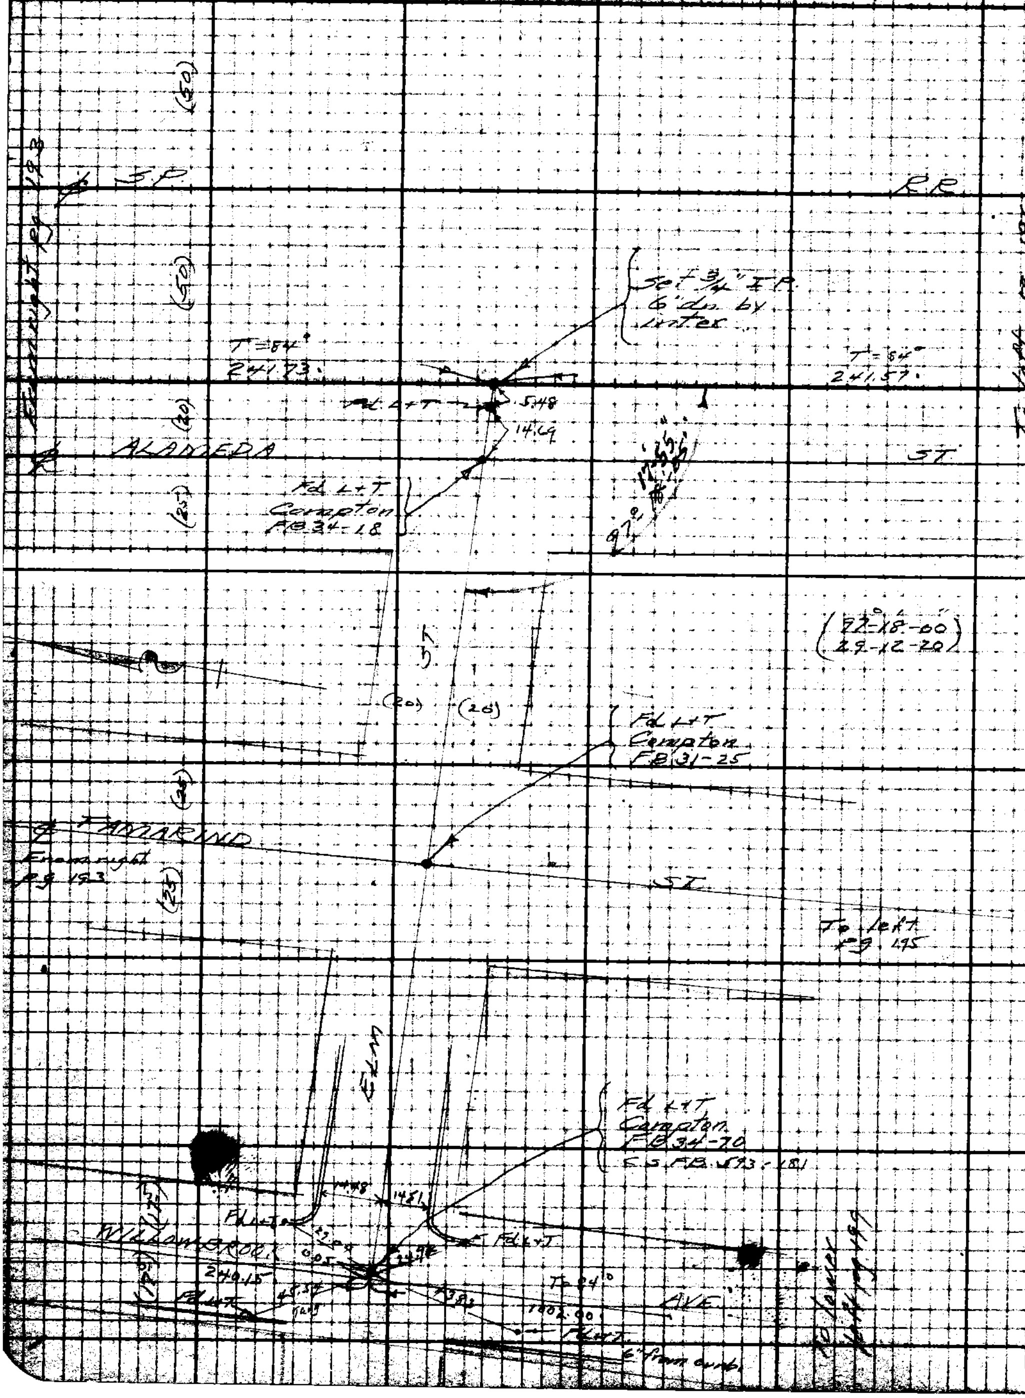

RETURN TO
LOS ANGELES COUNTY SURVEYOR
700 HALL OF RECORDS
Do not extend notes this side of this line.

Note: Any Additions or Changes on This Sheet Must be Made or Circled in Red Ink with Date and Name of Person Making Change.

Notes Ck'd by D. M. Finley	Survey of Alameda St	F.B. 807	Pg. 195
Map No. [illegible]	Tap No. 07		
Office Work	Surveyed by Moore		
Checked D. M. Finley	Notes Moore	Date 7-2-40	
Date Mar. 1946	Indexed A. C. Johnson		

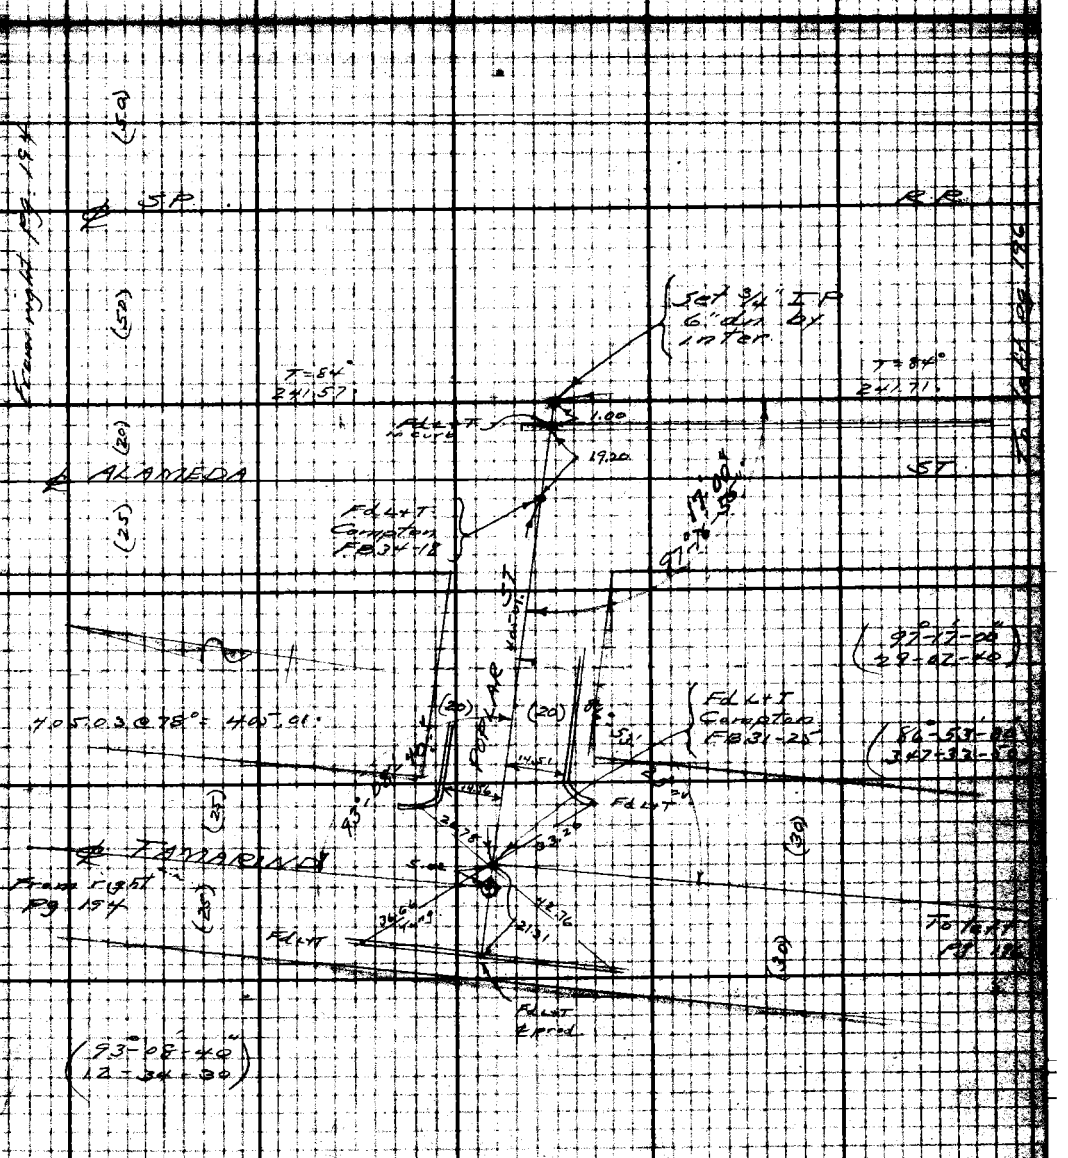

Note: Any Additions or Changes on This Sheet Must be Made or Circled in Red Ink With Date and Name of Person Making Change.

Do not extend notes this side of this line.

RETURN TO
LOS ANGELES COUNTY SURVEYOR
700 HALL OF RECORDS

FORM 247 5M 10-39

F.B. 807 PG. 196

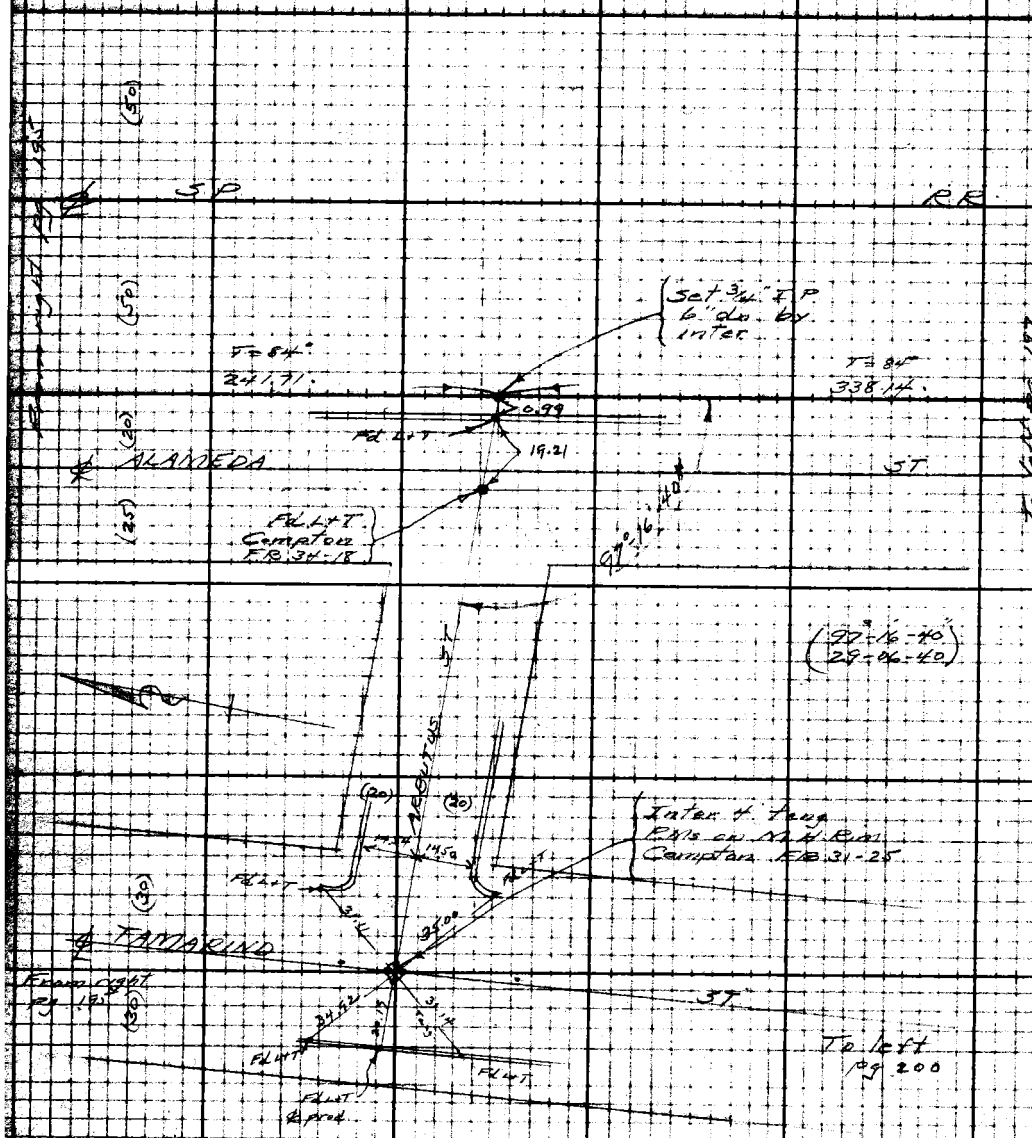

RETURN TO
LOS ANGELES COUNTY SURVEYOR
700 HALL OF RECORDS

Do not extend notes this side of this line.

Note: Any Additions or Changes on This Sheet Must be Made or Circled in Red Ink With Date and Name of Person Making Change.

Notes Ckd by D. M. Finley | Survey of Alameda St
Map No. [redacted] W. 08210 Tract No. of Sp [redacted]
Office Work D. [redacted] | Surveyed by Wood
Checked D. M. Finley | Notes Wood | Date 7-3-48
Date Mar 1945 | Indexed A. C. Johnson

F.B. [redacted]

To bottom Pg. 198

Set S.T.W. by oak dist

(82°-46-20)
331-05-20

PALMETTE AVE

Set S.T.W. by oak dist. falls one foot of split of page

(40)

(40)

(50)

(50)

(25)

(25)

Frame Right 182

℄ ST

℄ E.B.

Set 3/4 I.P. 6 dia. ex. inter.

Set 1-T. by inter.

7-84
7-84
7-84

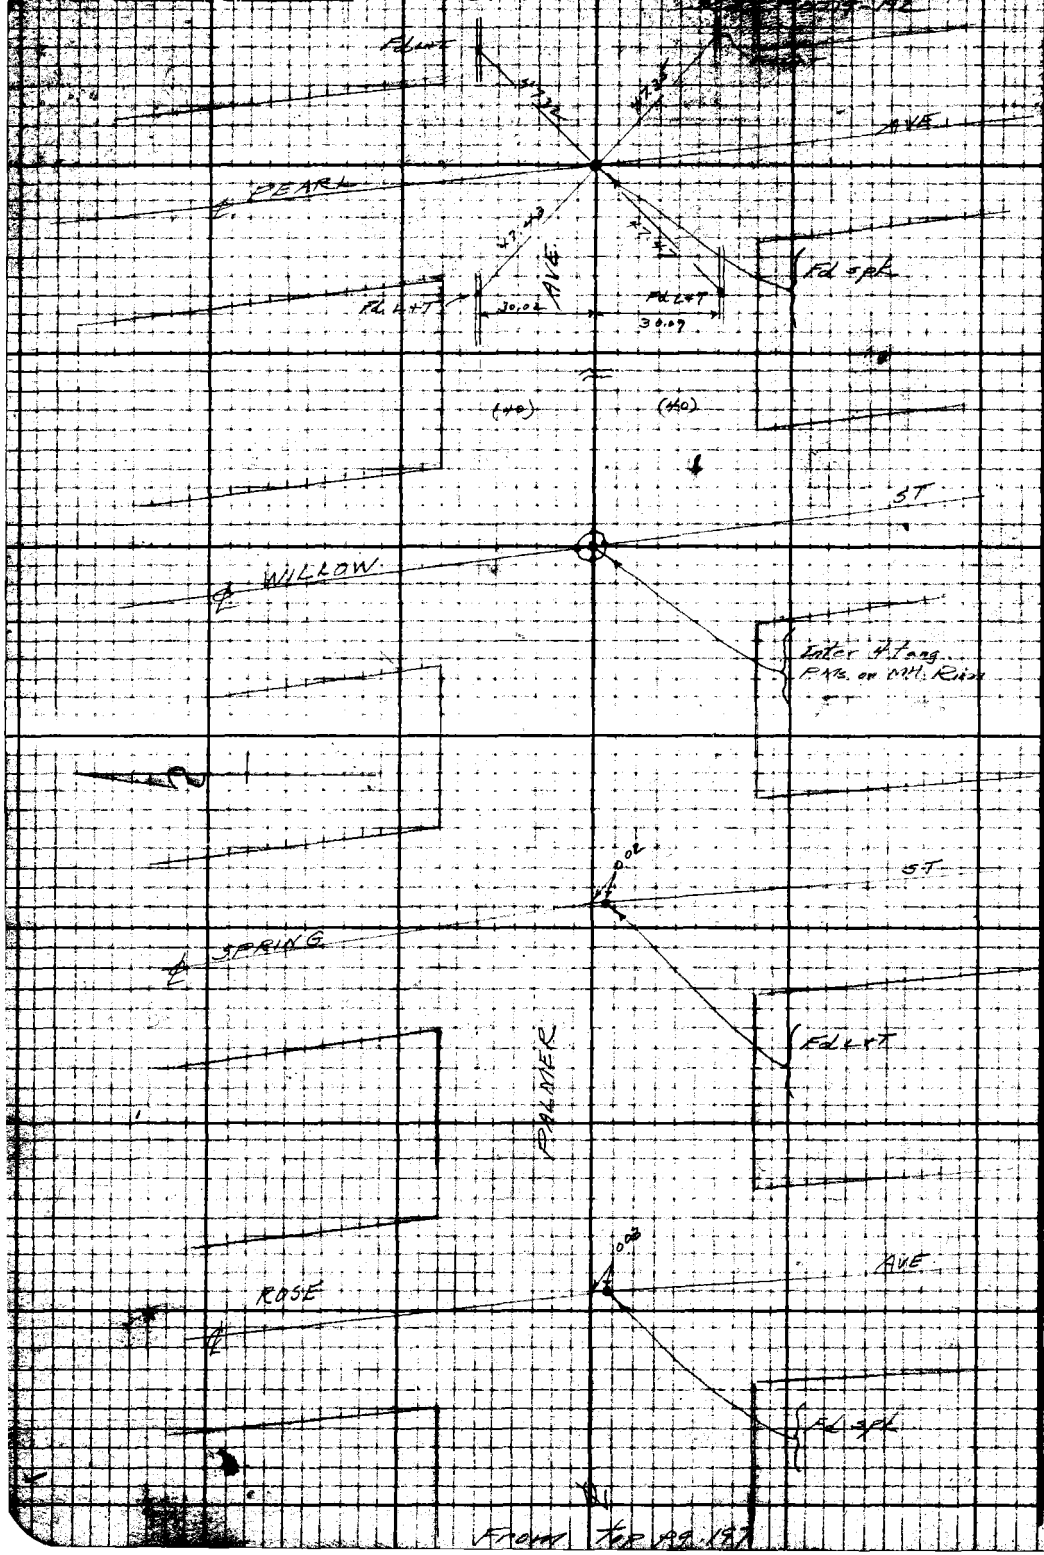

RETURN TO
LOS ANGELES COUNTY SURVEYOR
700 HALL OF RECORDS
Do not extend notes this side of this line.
Note: Any Additions or Changes on This Sheet Must be Made or Circled in Red Ink With Date and Name of Person Making Change.

From top pg. 197

F.B. 867 Pg. 199

Office Work
Checked
Date Mar 1965

Surveyed by Moore
Notes Moore Date 7-3-40
Indexed A. C. Johnson

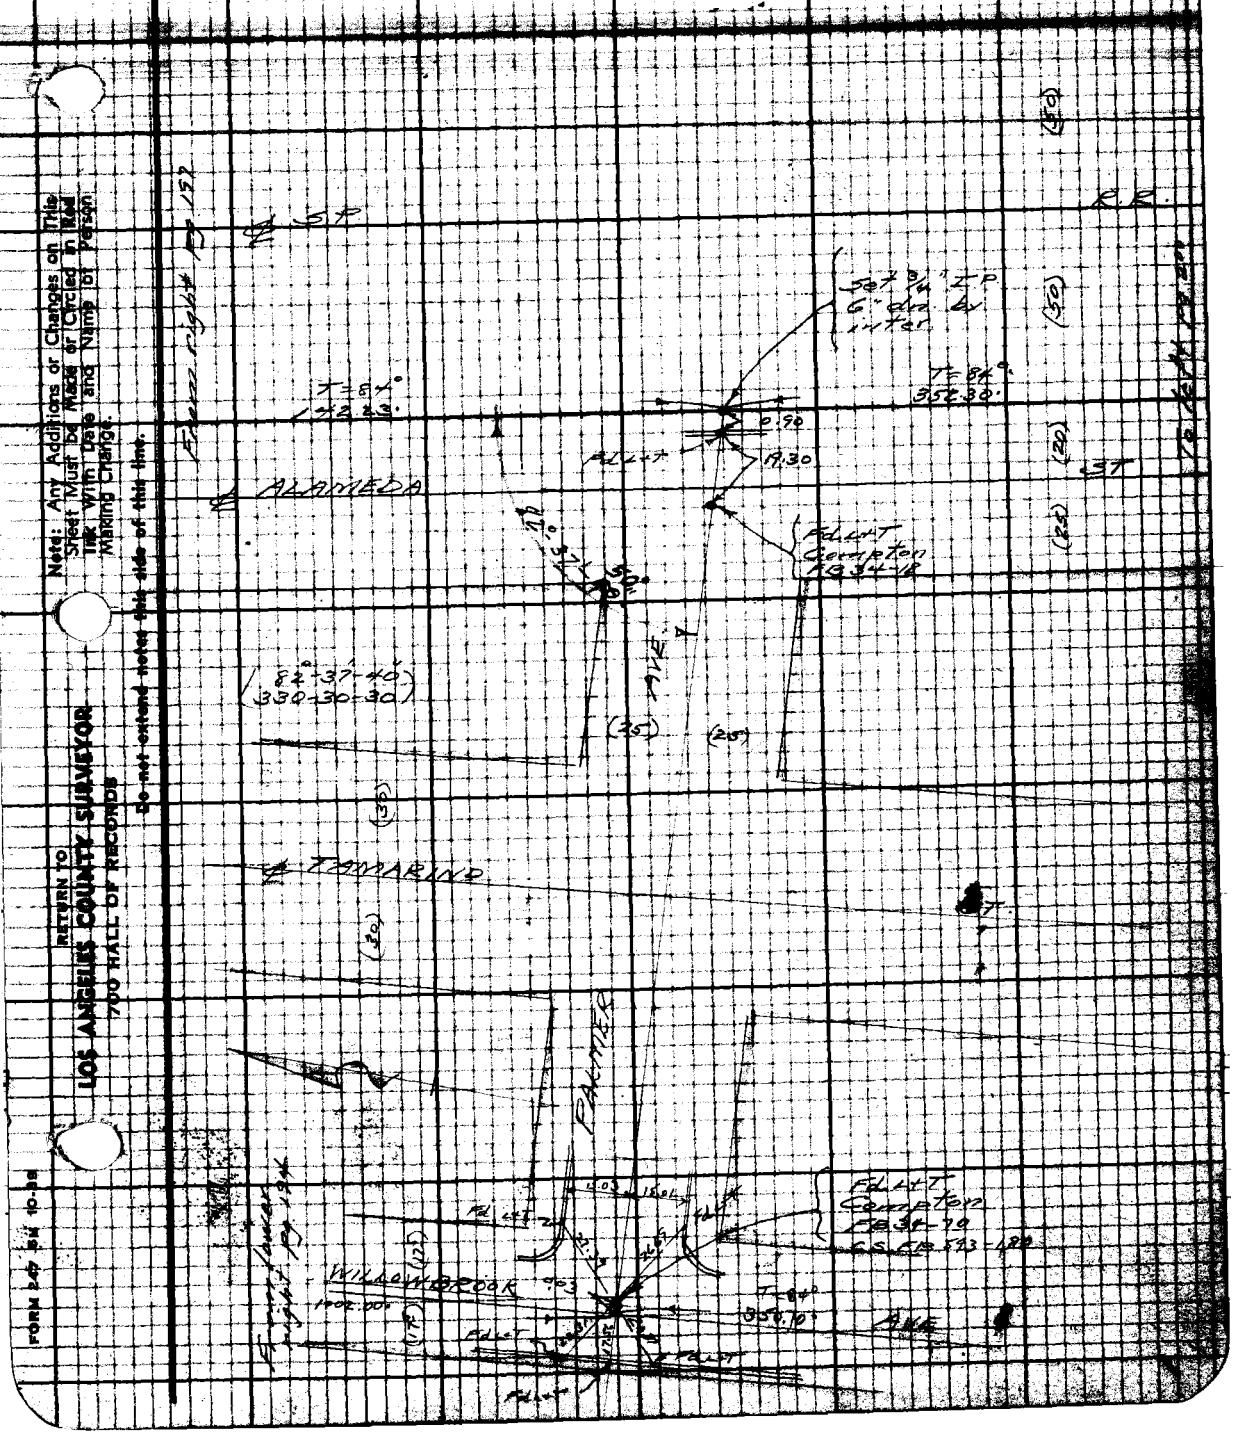

Note: Any Additions or Changes on This Sheet Must be Made or Circled in Red Ink With Date and Name of Person Making Change.

Do not extend notes this side of this line.

RETURN TO
LOS ANGELES COUNTY SURVEYOR
700 HALL OF RECORDS

FORM 247 5M 10-38

F.B. 807 PG. 200

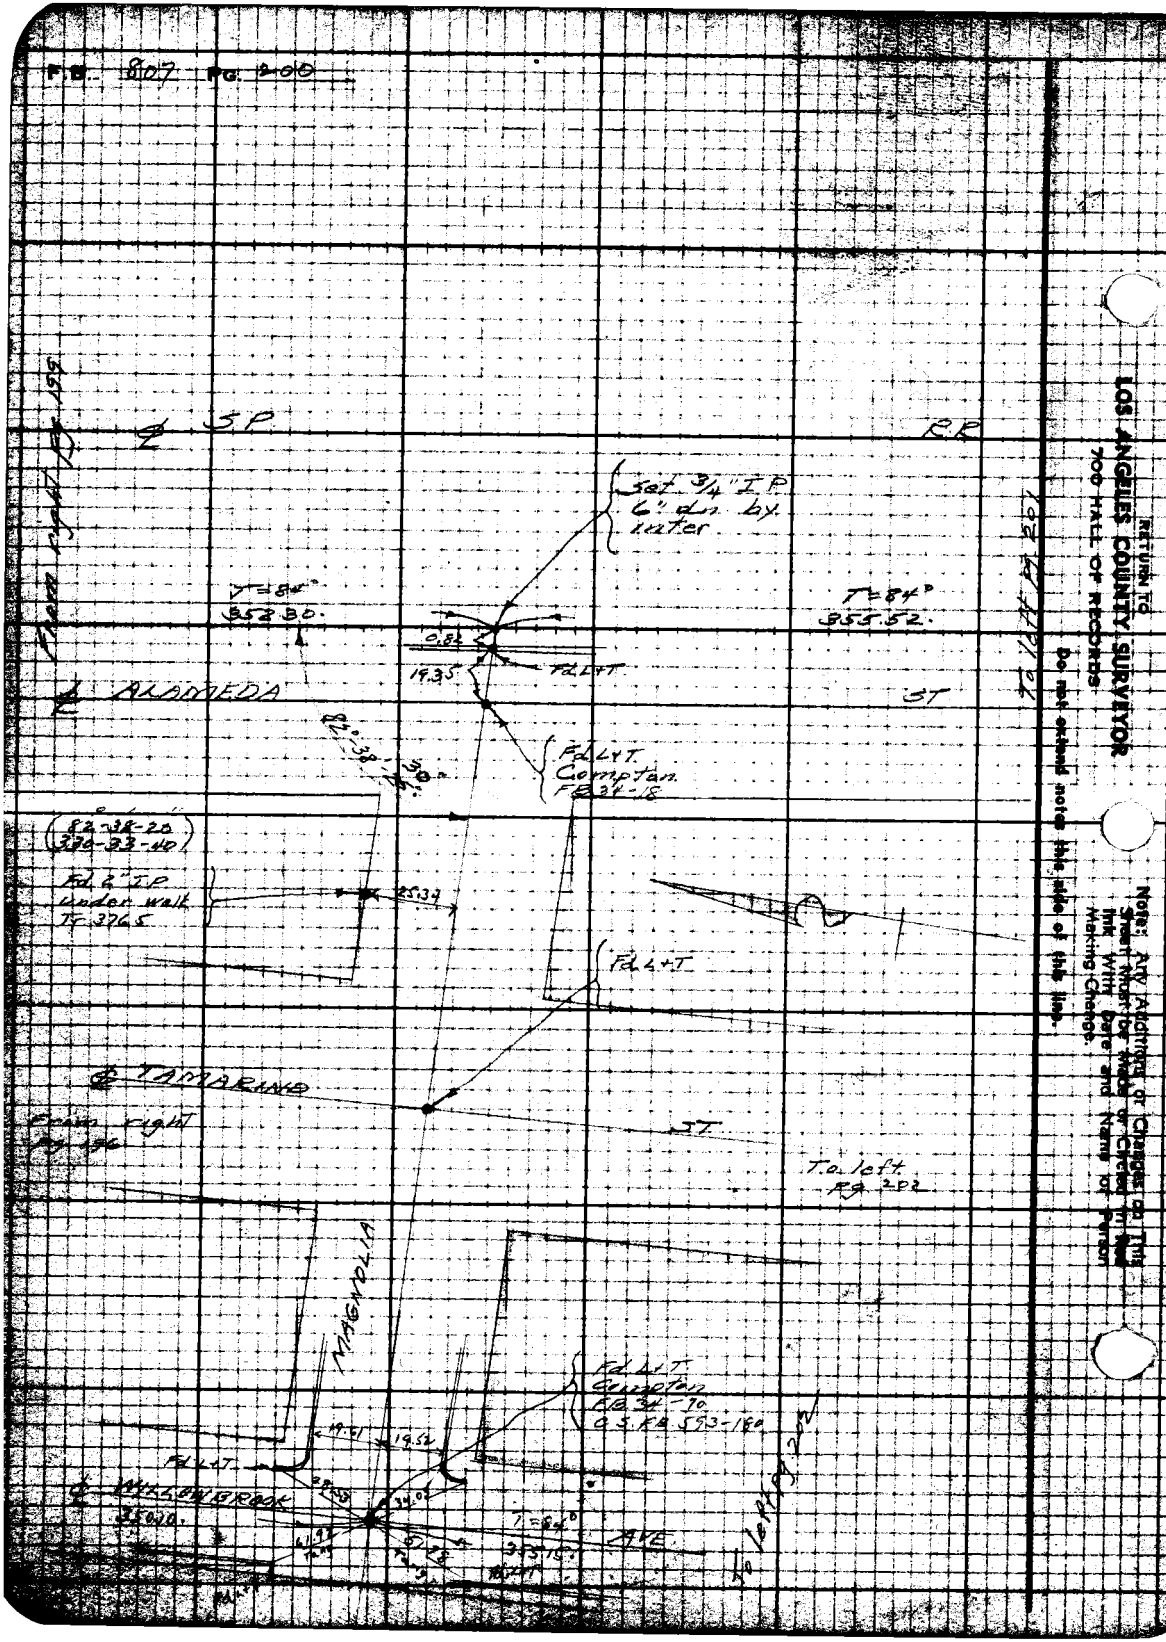

RETURN TO
LOS ANGELES COUNTY SURVEYOR
700 HALL OF RECORDS

Do not extend notes this side of this line.

Note: Any Additions or Changes on This Sheet Must be Made or Circled in Red Ink With Date and Name of Person Making Change.

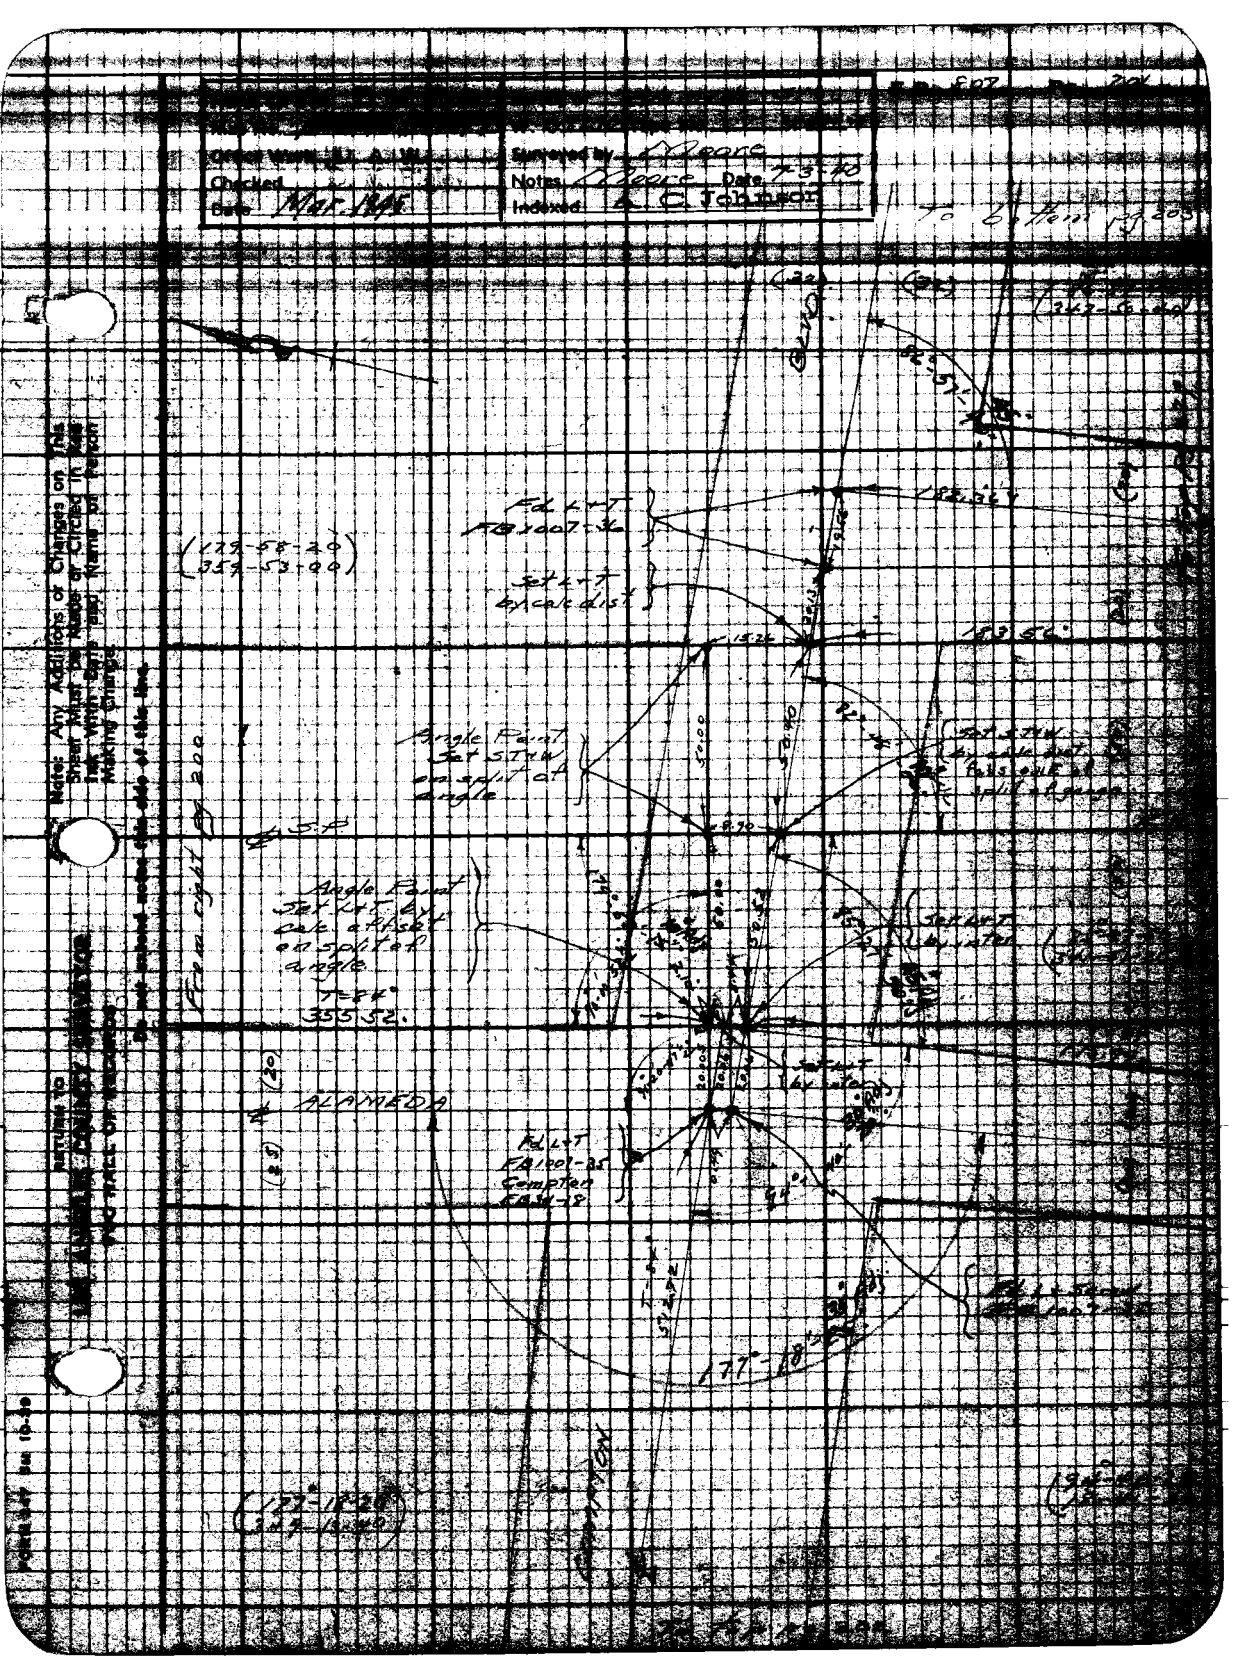

Surveyed by Moore
Notes Moore Date 7-3-40
Indexed A. C. Johnson
Checked
Date Mar. 1945
To bottom pg 203
Fd L+T
FB1007-36
Set L+T
by calc dist
(179-58-20)
(359-53-00)
183.56
Angle Point
Set STW
on split of
angle
Set STW
by calc dist
Angle Point
Set L+T by
calc offset
on split of
angle
T=84°
355.52
Set L+T
by inter
ALAMEDA
Fd L+T
FB1007-35
Compton
FB34-18
177°-18'
From right pg 200
Note: Any Additions or Changes on This Sheet Must be Made or Circled in Red Ink With Date and Name of Person Making Change.
Do not submit notes this side of this line.
RETURN TO
LOS ANGELES COUNTY SURVEYOR
FOOT HALL OF RECORDS

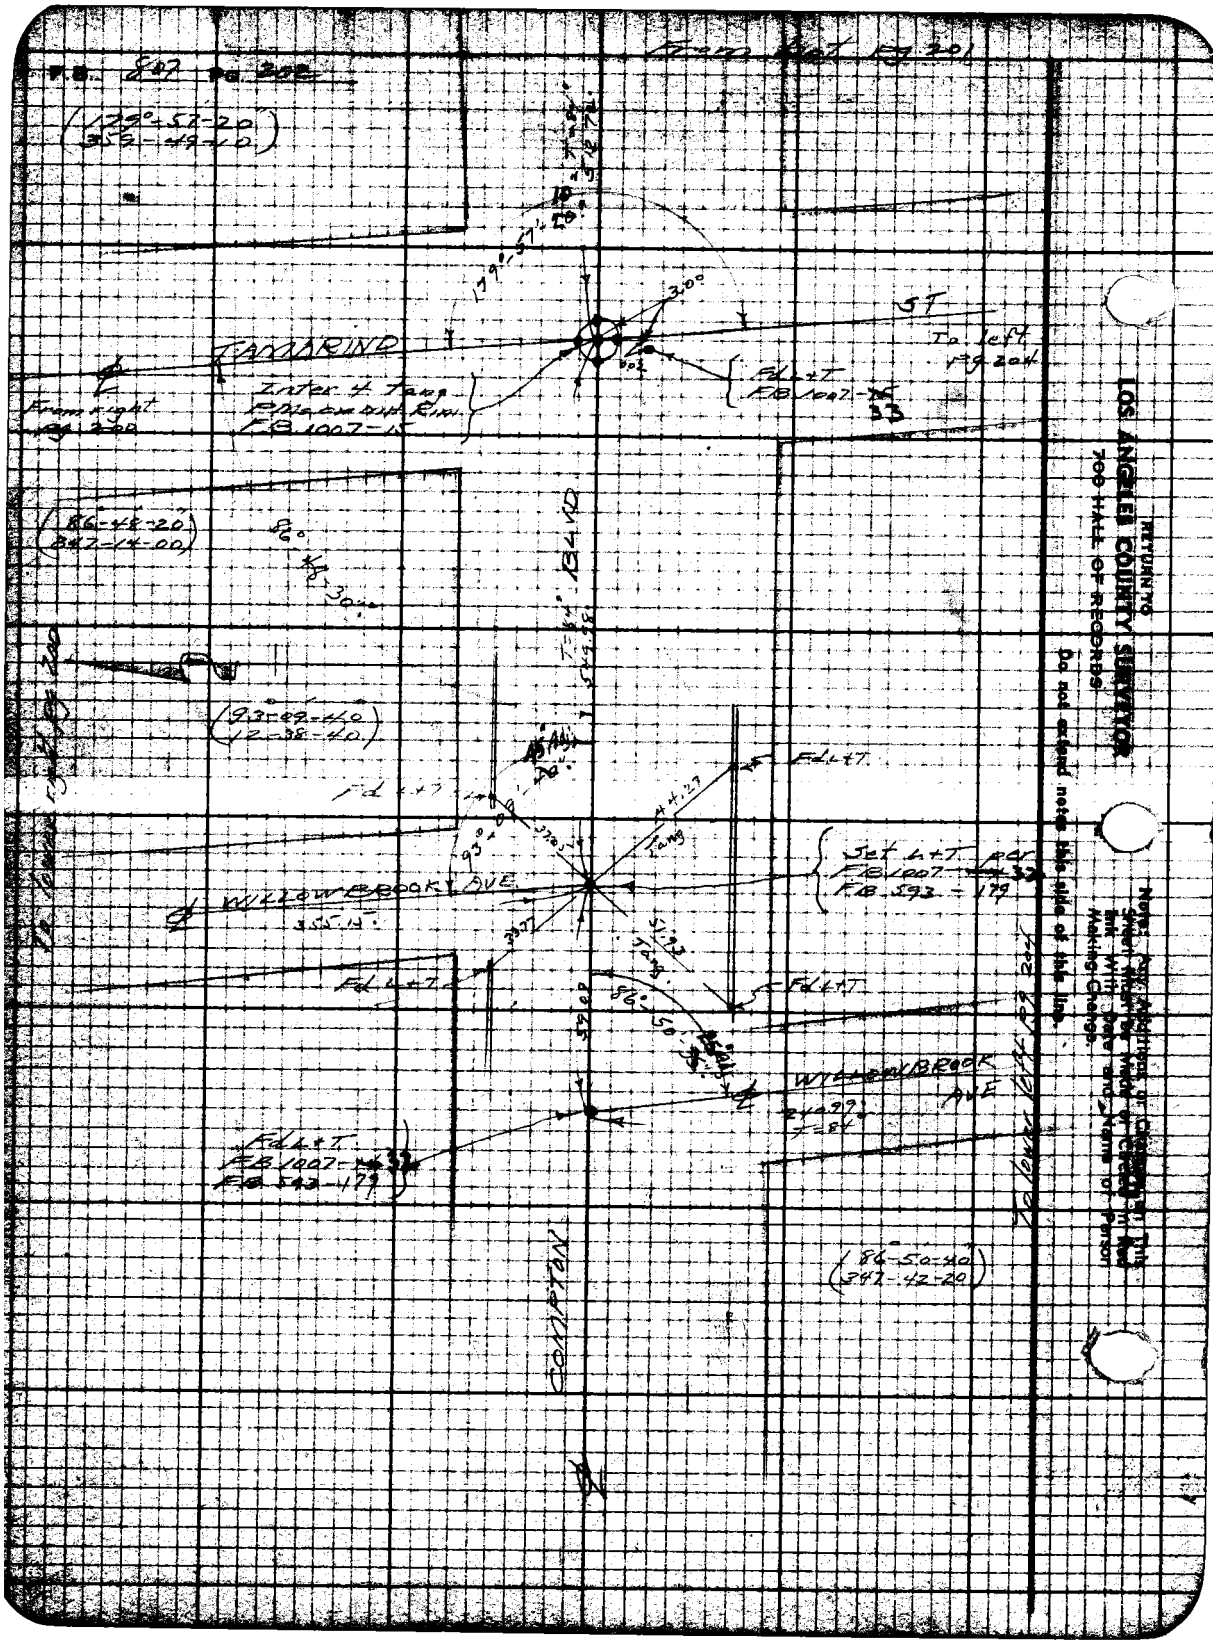

F.B. 807 Pg. 202
From Bot Pg 201
(179°-57-20)
(359-49-10)
TAMARIND
ST
To left Pg 204
From right Pg 200
Inter 4 Tang
P.Marcus Rim
F.B. 1007-15
Fd L+T
F.B. 1007-33
(86-48-20)
(347-14-00)
BLVD
(93-09-40)
(12-38-40)
Fd L+T
Set L+T per
F.B. 1007-32
F.B. 593-179
WILLOWBROOK AVE
Fd L+T
Fd L+T
WILLOWBROOK AVE
Fd L+T
F.B. 1007-32
F.B. 593-179
COMPTON
To lower left Pg 204
(86-50-40)
(347-42-20)
RETURN TO
LOS ANGELES COUNTY SURVEYOR
700 HALL OF RECORDS
Do not extend notes this side of this line.
Note: Any Additions or Changes in This Sheet Must be Made or Circled in Red Ink With Date and Name of Person Making Change.

Notes Ck'd by: D. M. Finley	Survey of: Alameda St
Map No. [illegible]	W. O. [illegible] Map No. [illegible]
Office Work: D. A. W.	Surveyed by: Moore
Checked: D. M. Finley	Notes: Moore Date: 7-3-40
Date: Mar 1945	Indexed: A. C. Johnson

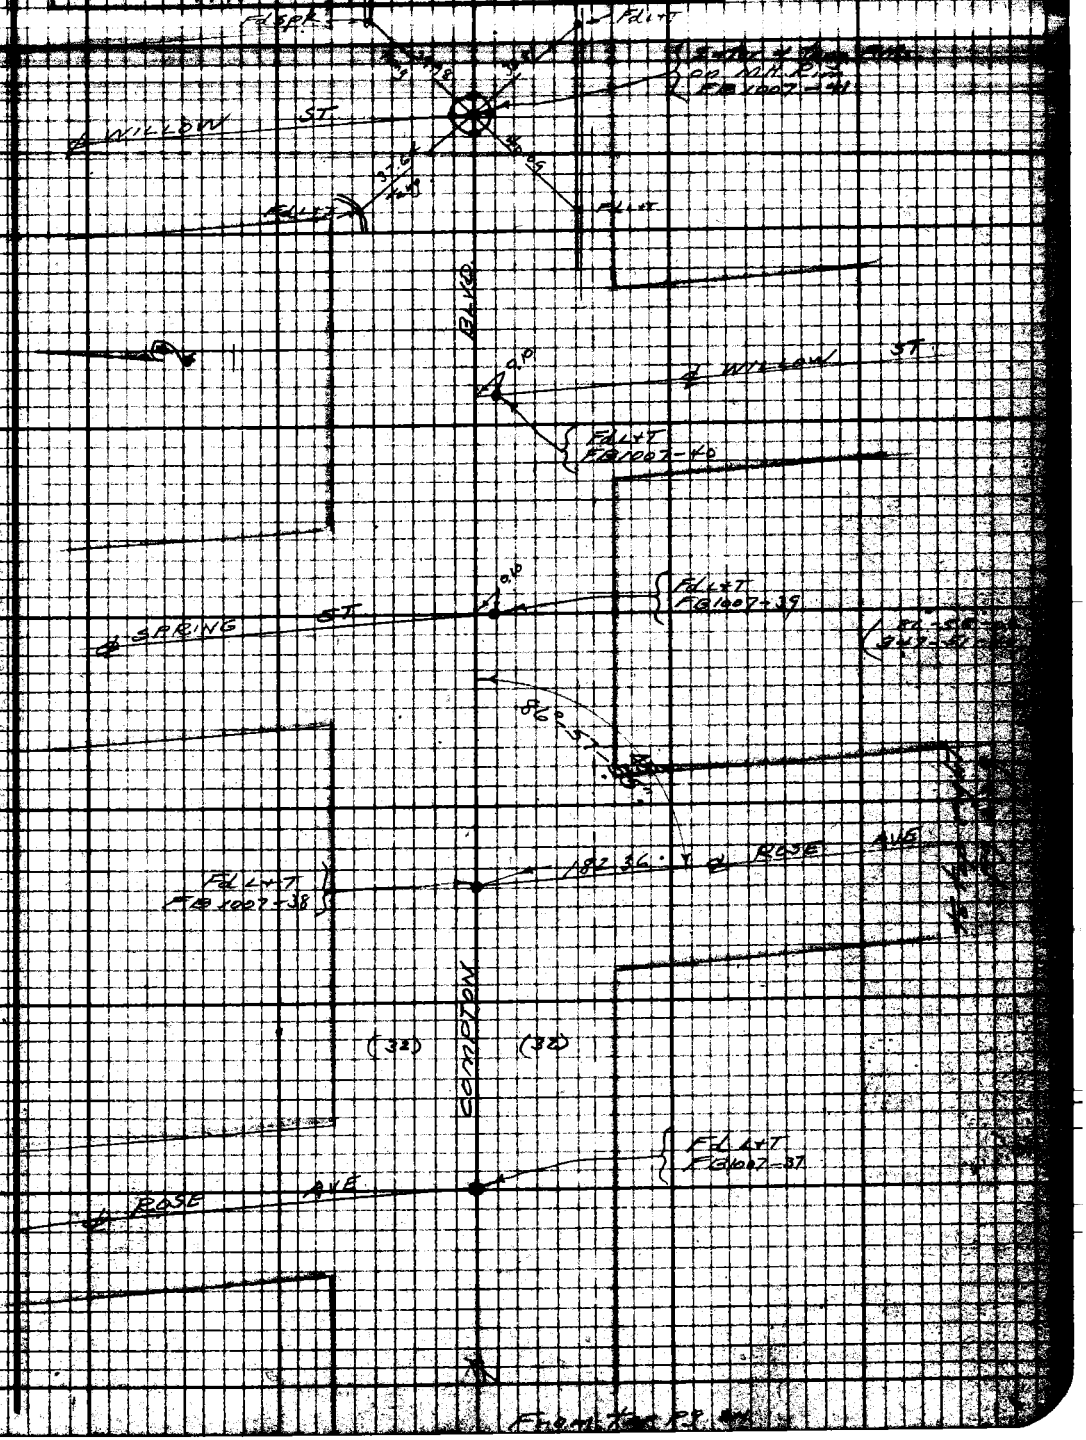

Note: Any Additions or Changes on This Sheet Must be Made or Circled in Red Ink With Data and Name of Person Making Change.

Do not extend notes this side of this line.

RETURN TO
LOS ANGELES COUNTY SURVEYOR
700 HALL OF RECORDS

FORM 247 5M 10-39

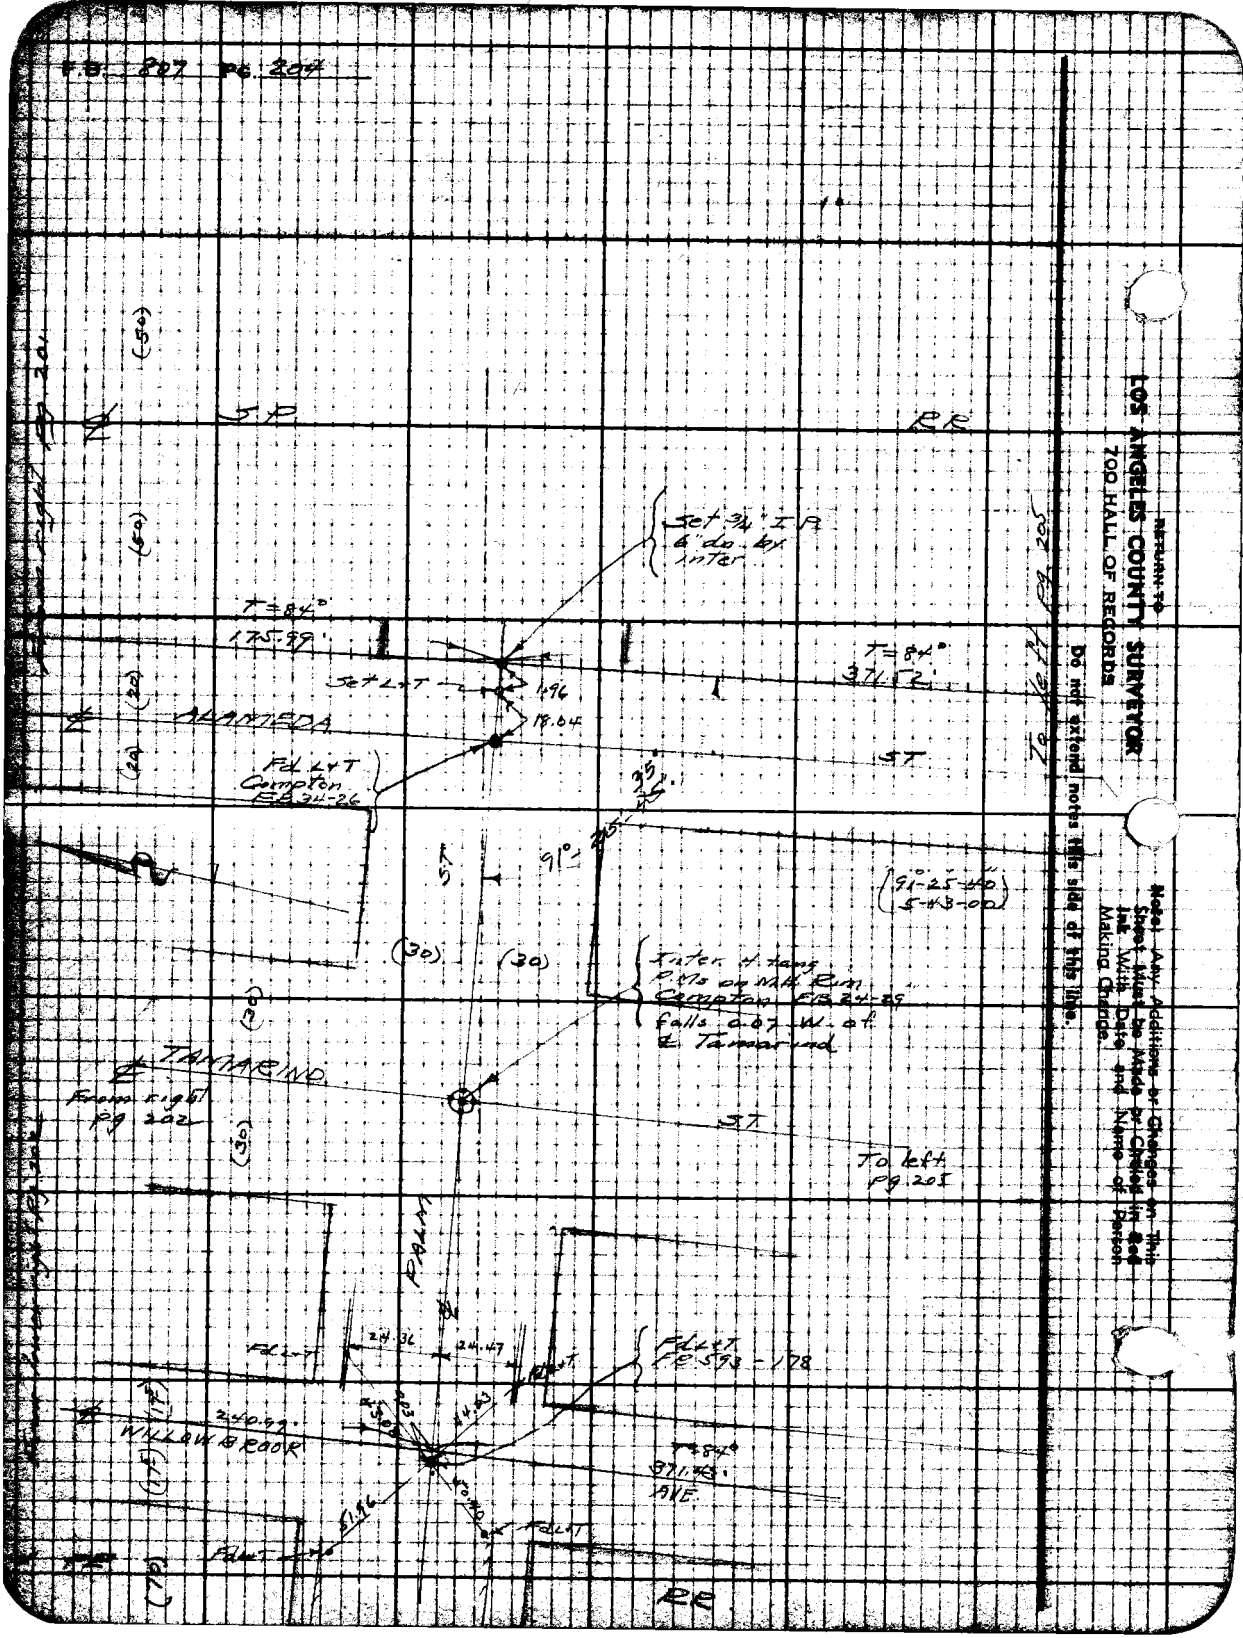
F.B. 807 Pg. 204
S.P.
RR
Set 3/4" I.P. 6" dn. by inter.
T=84°
175.99'
T=84°
371.52'
Set L+T
1.96
18.04
ALAMEDA
ST
Fd L+T Compton F.B. 34-26
91°-25-40
5-43-00
Inter. 4 tang P.M's on M.H. Rim Compton F.B. 24-29 falls 0.07 W. of ℄ Tamarind
TAMARIND
From right pg 202
To left pg 205
PALM
Fd L+T
24.36
24.47
Fd L+T F.B. 593-178
240.99'
WILLOW BROOK
T=84°
371.43'
AVE.
51.96
Fd L+T
RR
To left pg 205
RETURN TO
LOS ANGELES COUNTY SURVEYOR
700 HALL OF RECORDS
Do not extend notes this side of this line.
Note: Any Additions or Changes on this Sheet Must be Made or Circled in Red Ink With Date and Name of Person Making Change.

FORM 247 5M 10-39

RETURN TO
LOS ANGELES COUNTY SURVEYOR
700 HALL OF RECORDS

Note: Any Additions or Changes on This Sheet Must be Made or Circled in Red Ink With Date and Name of Person Making Change

Do not extend notes this side of this line.

From Eight Pg 204

Notes Checked D. M. Kinley
Office Work D. M. Kinley
Date May 1945

Survey of
Surveyed by
Notes Roberts Dated 7-15 49
Indexed A. C. Johnson

(20) (20) (54) (54a)





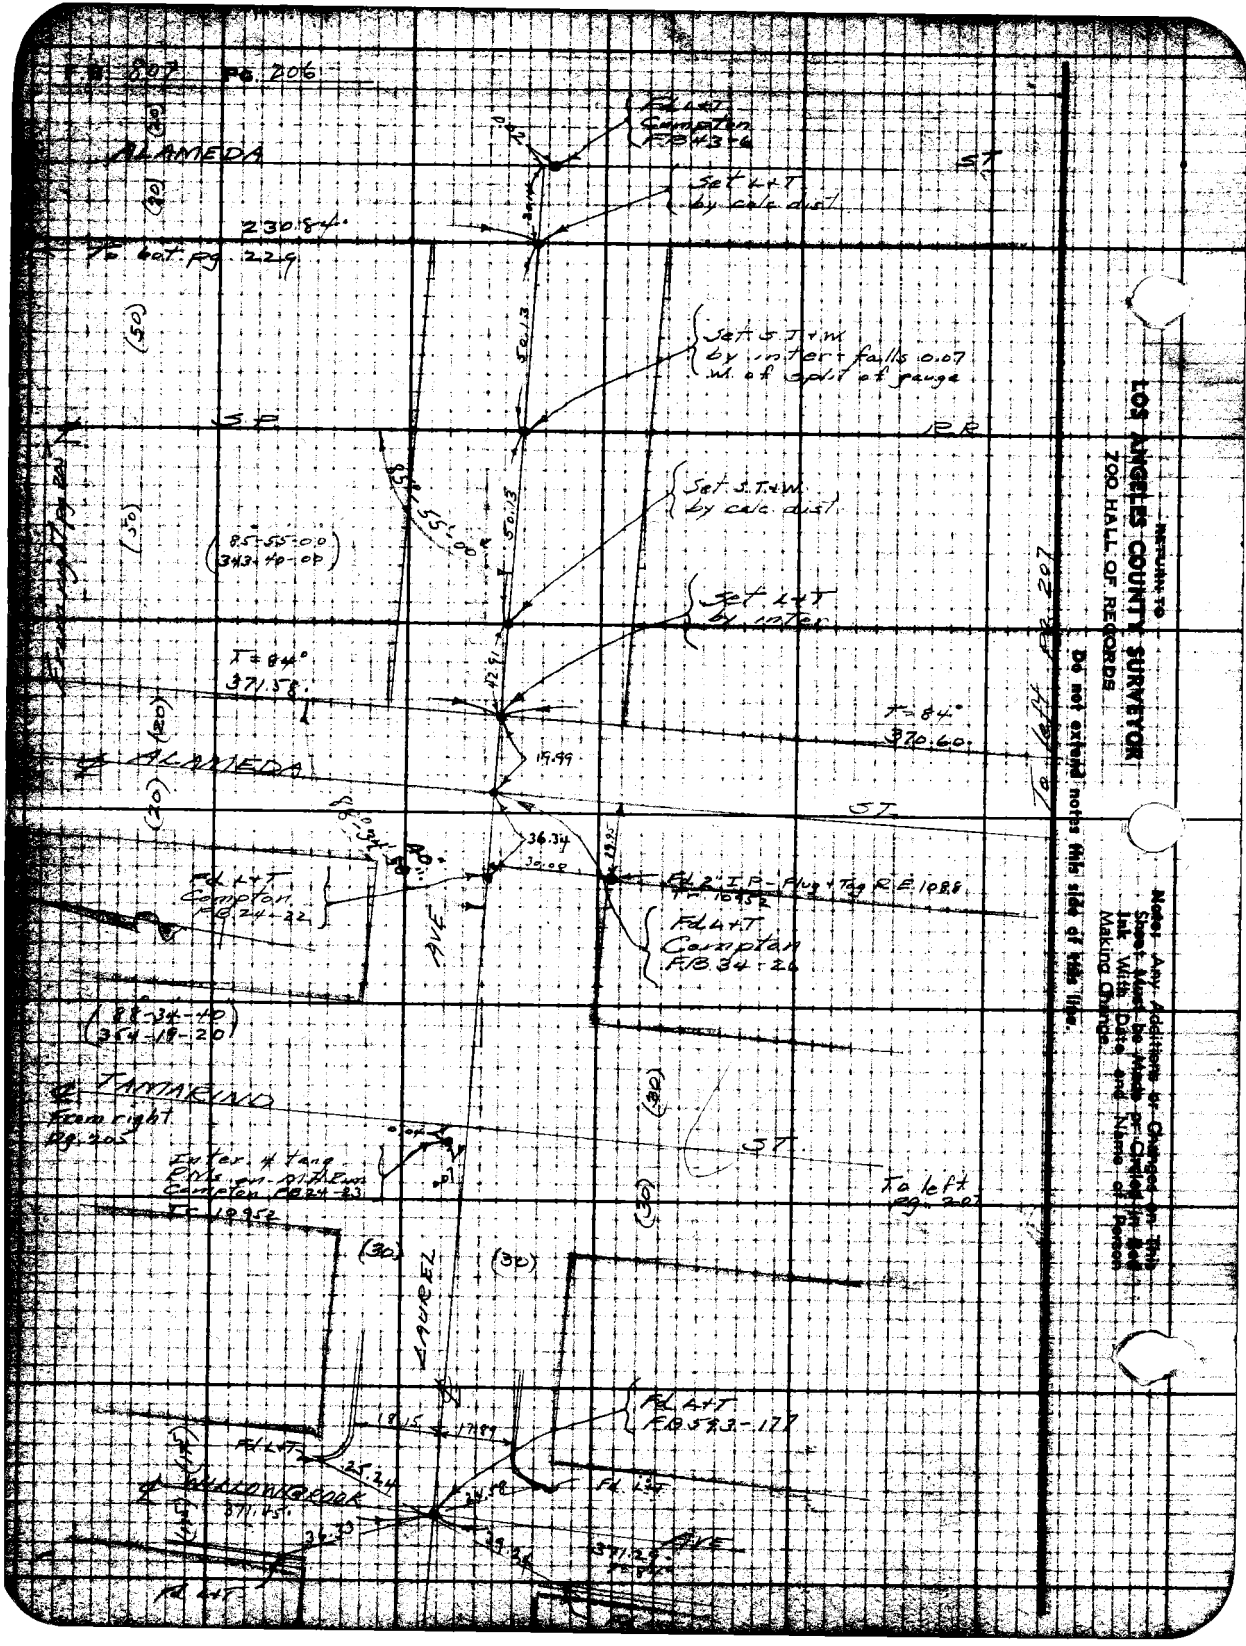
F.B. 807 Pg. 206
ALAMEDA
ST
Fd L+T Compton FB 43-6
Set L+T by calc dist
230.84
To bot pg. 229
Set S.T.+W. by inter + falls 0.07 W. of split of gauge
S.P.
R.R.
Set S.T.+W. by calc dist
85°-55'-00"
(85-55-00)
(343-40-00)
Set L+T by inter
T=84°
371.58
T=84°
370.60
ALAMEDA
ST
19.99
36.34
30.00
Fd L+T Compton FB 24-22
Fd 2" I.P. - Plug + Tag R.E. 1088
Fd L+T Compton FB 34-26
AVE
(88-34-40)
(354-18-20)
TAMARIND
From right pg. 205
Inter. + tang RMs on M.H. Rim Compton FB 24-23
To left pg. 207
LAUREL
Fd L+T FB 593-177
Fd L+T
25.24
WILLOWBROOK
371.45
AVE
371.29
To left pg. 207
RETURN TO
LOS ANGELES COUNTY SURVEYOR
ZOO HALL OF RECORDS
Do not extend notes this side of this line.
Note: Any Additions or Changes on This Sheet Must be Made or Circled in Red Ink With Date and Name of Person Making Change.

Notes Ck'd by D. M. Finlay | Survey of Alameda St.
Office Work D. A. W. | Surveyed by Moore
Checked D. M. Finlay | Notes Moore | Date 7-8-40
Date Mar. 1949 | Indexed A. C. Johnson

F.B. 807 Pg. 207

(359-56-40)

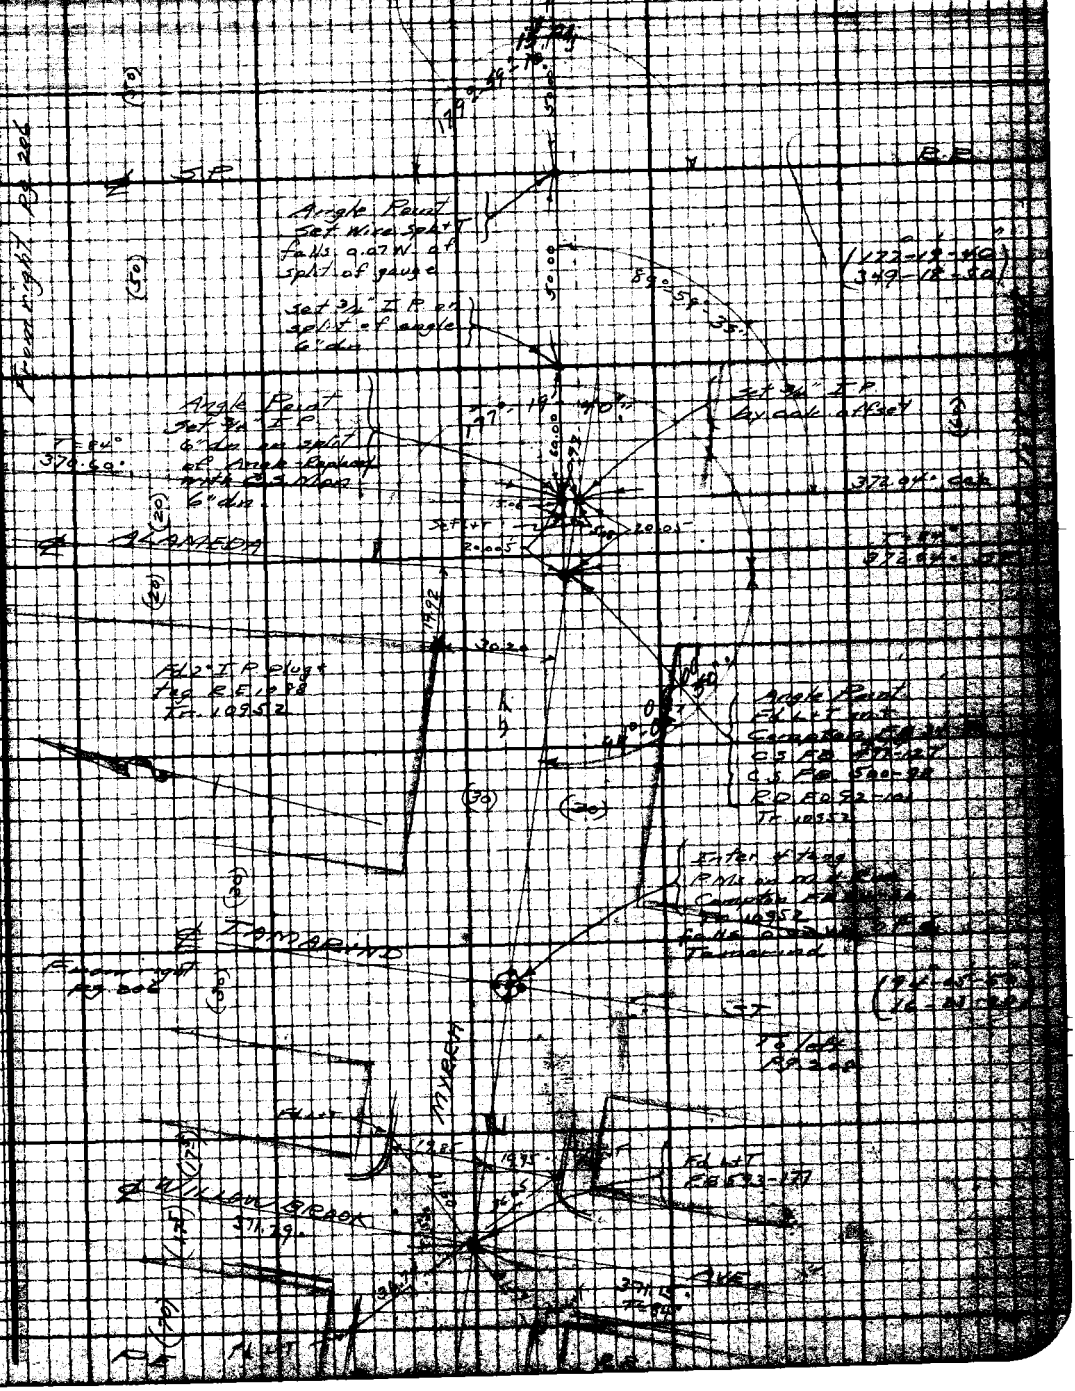

Note: Any Additions or Changes on This Sheet Must be Made or Circled in Red Ink With Date and Name of Person Making Change.

Do not extend notes this side of this line.

RETURN TO
LOS ANGELES COUNTY SURVEYOR
700 HALL OF RECORDS

FORM 247 SM 10-39

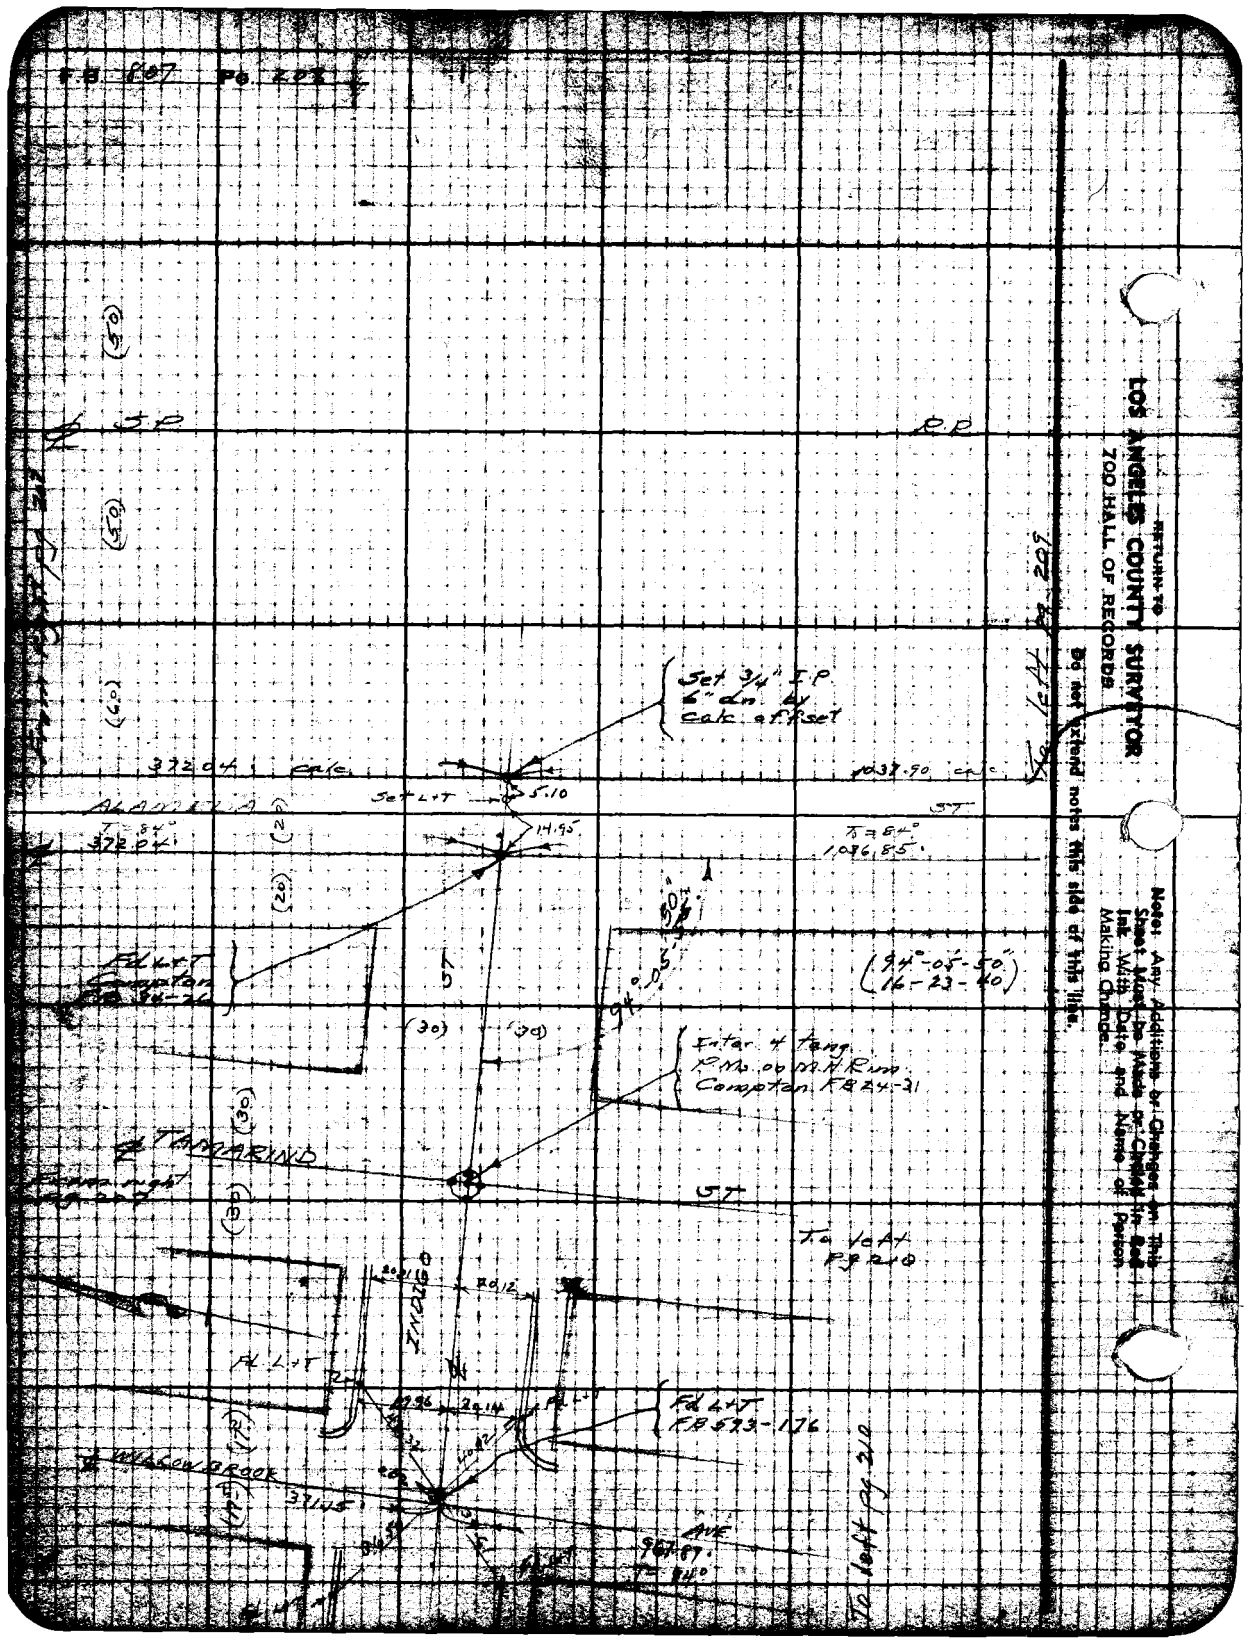

RETURN TO
LOS ANGELES COUNTY SURVEYOR
700 HALL OF RECORDS

Do not extend notes this side of this line.

Note: Any Additions or Changes on This Sheet Must be Made or Circled in Red Ink With Date and Name of Person Making Change.

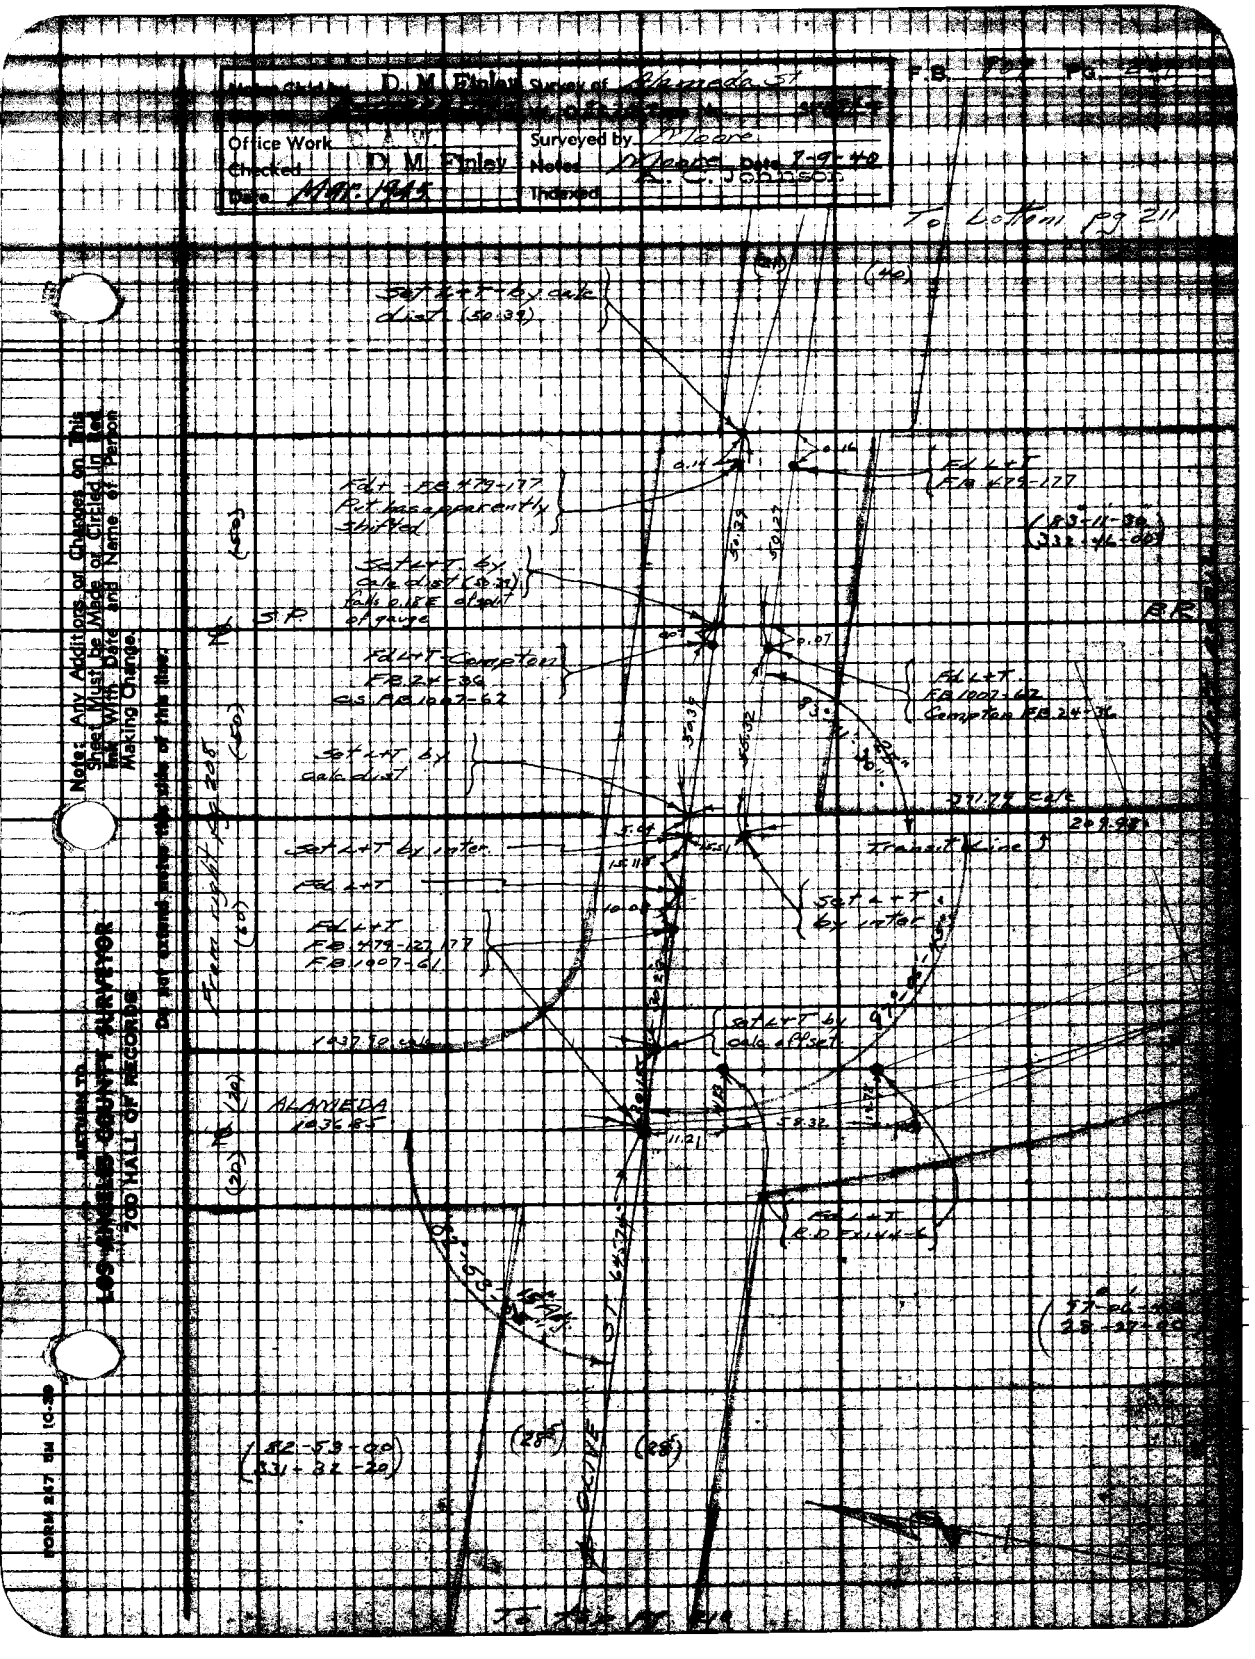

Notes Chk'd by D. M. Finley
Survey of Alameda St
Office Work
Checked D. M. Finley
Date Mar. 1945
Surveyed by Moore
Notes Moore Date 7-9-40
Indexed A. C. Johnson
F.B.
To Lottom pg 211
Set L+T by calc dist (50.39)
Fd L+T FB 479-177
Fd+ FB 479-177 Put has apparently shifted
Set L+T by calc dist (50.39) falls 0.18E of split of gauge
S.P.
B.R.
Fd L+T Compton FB 24-36 as FB 1007-62
Fd L+T FB 1007-62 Compton FB 24-36
Set L+T by calc dist
371.79 calc
209.98
Transit Line
Set L+T by inter.
Fd L+T
Set L+T by inter
Fd L+T FB 479-127 177 FB 1007-61
Set L+T by calc offset
1037.90 calc
ALAMEDA 1036.85
Fd L+T R.D. FX144-6
From right pg 208
To Top pg 210
Note: Any Additions or Changes on This Sheet Must be Made or Circled in Red Ink With Date and Name of Person Making Change.
Do not extend notes this side of this line.
RETURN TO LOS ANGELES COUNTY SURVEYOR 700 HALL OF RECORDS
FORM 247 5M 10-39

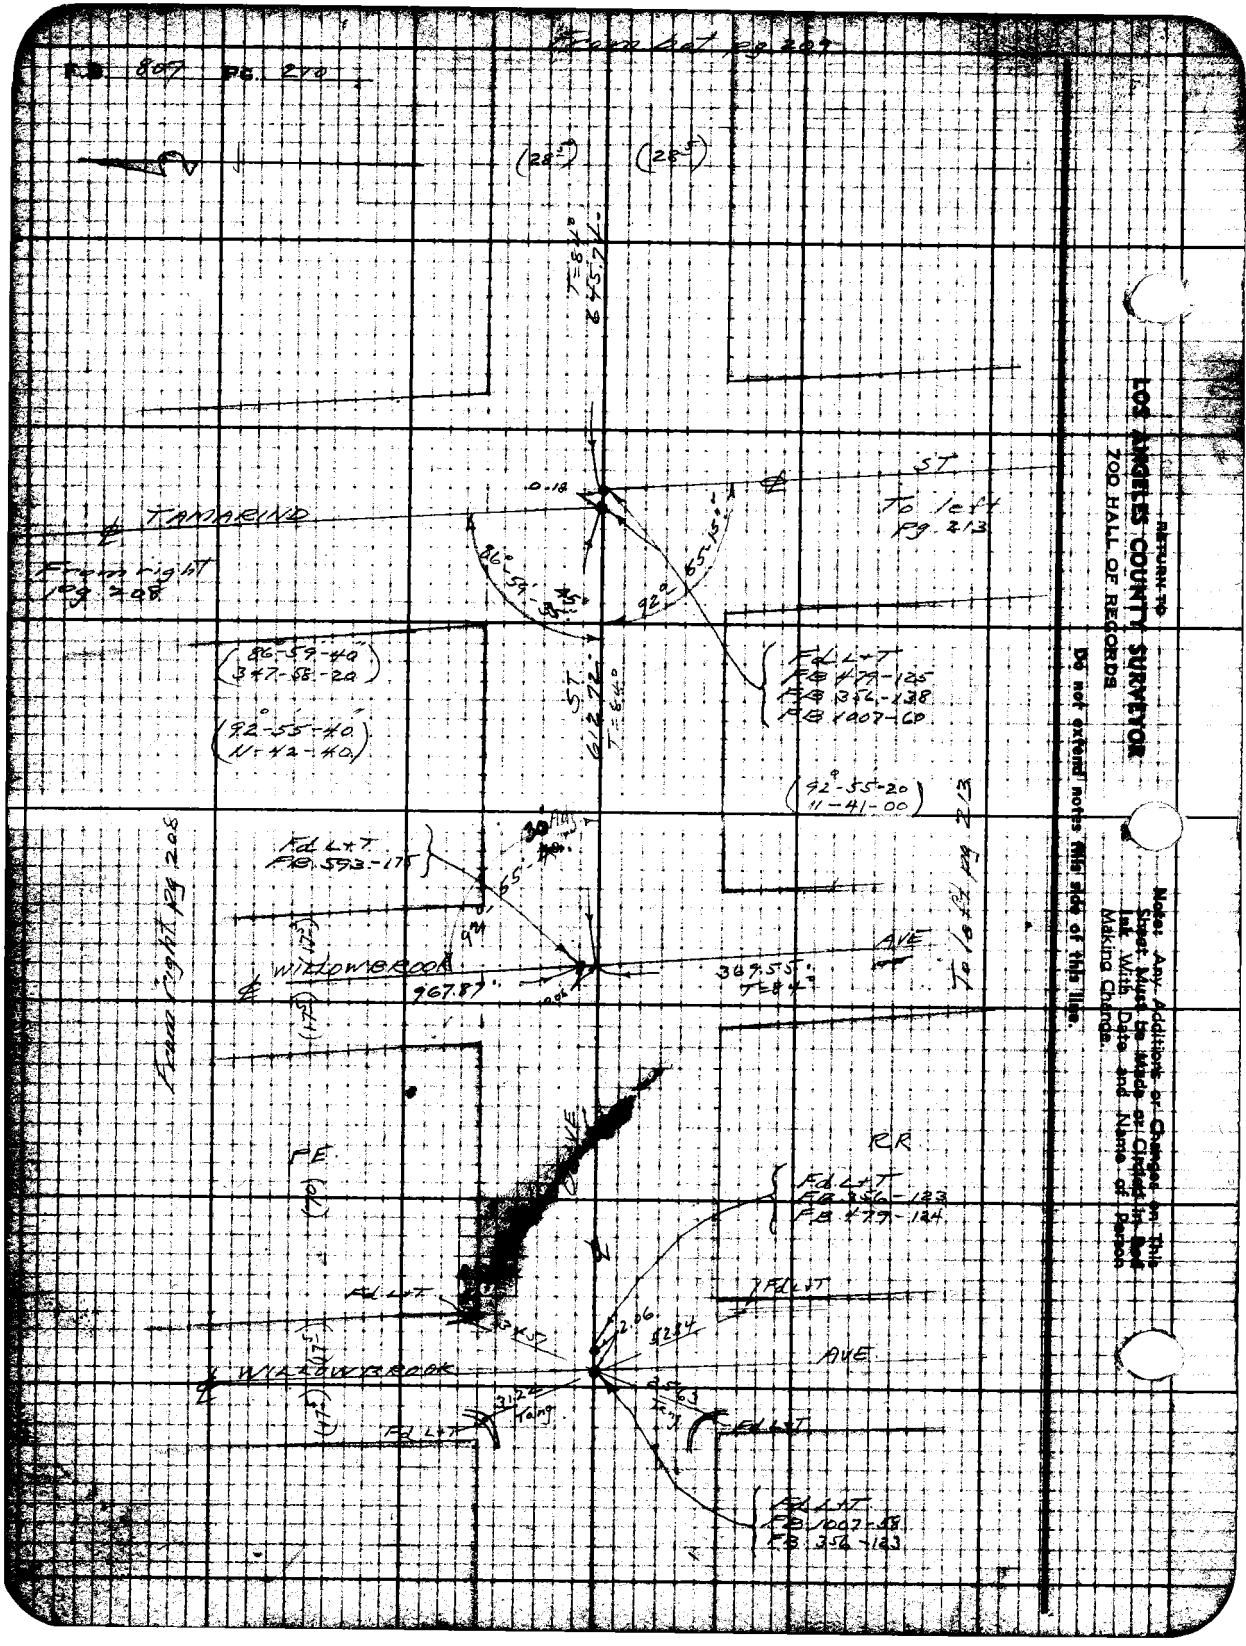

RETURN TO
LOS ANGELES COUNTY SURVEYOR
700 HALL OF RECORDS

Do not extend notes this side of this line.

Note: Any Additions or Changes on This Sheet Must be Made or Circled in Red Ink With Date and Name of Person Making Change.

Notes Ck'd by D. M. Finley	Survey of Alameda ST		F.B. 807 Pg. 24
[illegible]	W. O. [illegible]	Tape No.	[illegible]
Office Work		Surveyed by Moore	
Checked D. M. Finley		Notes Moore	Date 7-9-40
Date Mar 1945		Indexed A. C. Johnson	

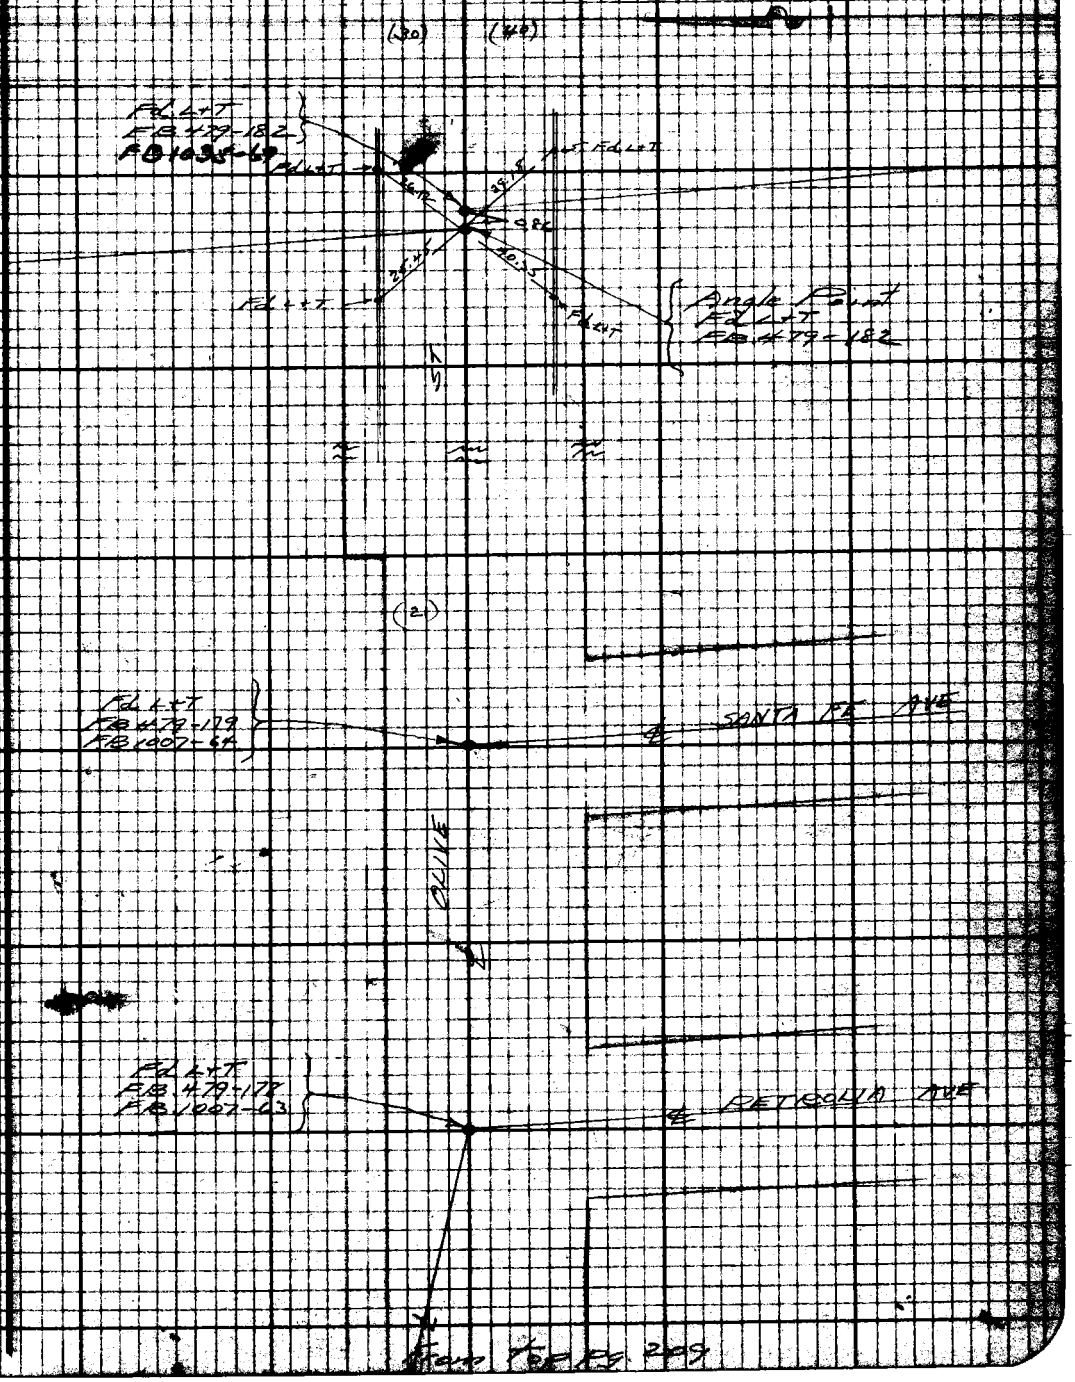

From Top Pg 209

Note: Any Additions or Changes on This Sheet Must be Made or Circled in Red Ink With Date and Name of Person Making Change

Do not extend notes this side of this line.

RETURN TO
LOS ANGELES COUNTY SURVEYOR
700 HALL OF RECORDS

FORM 247 SM 10-39

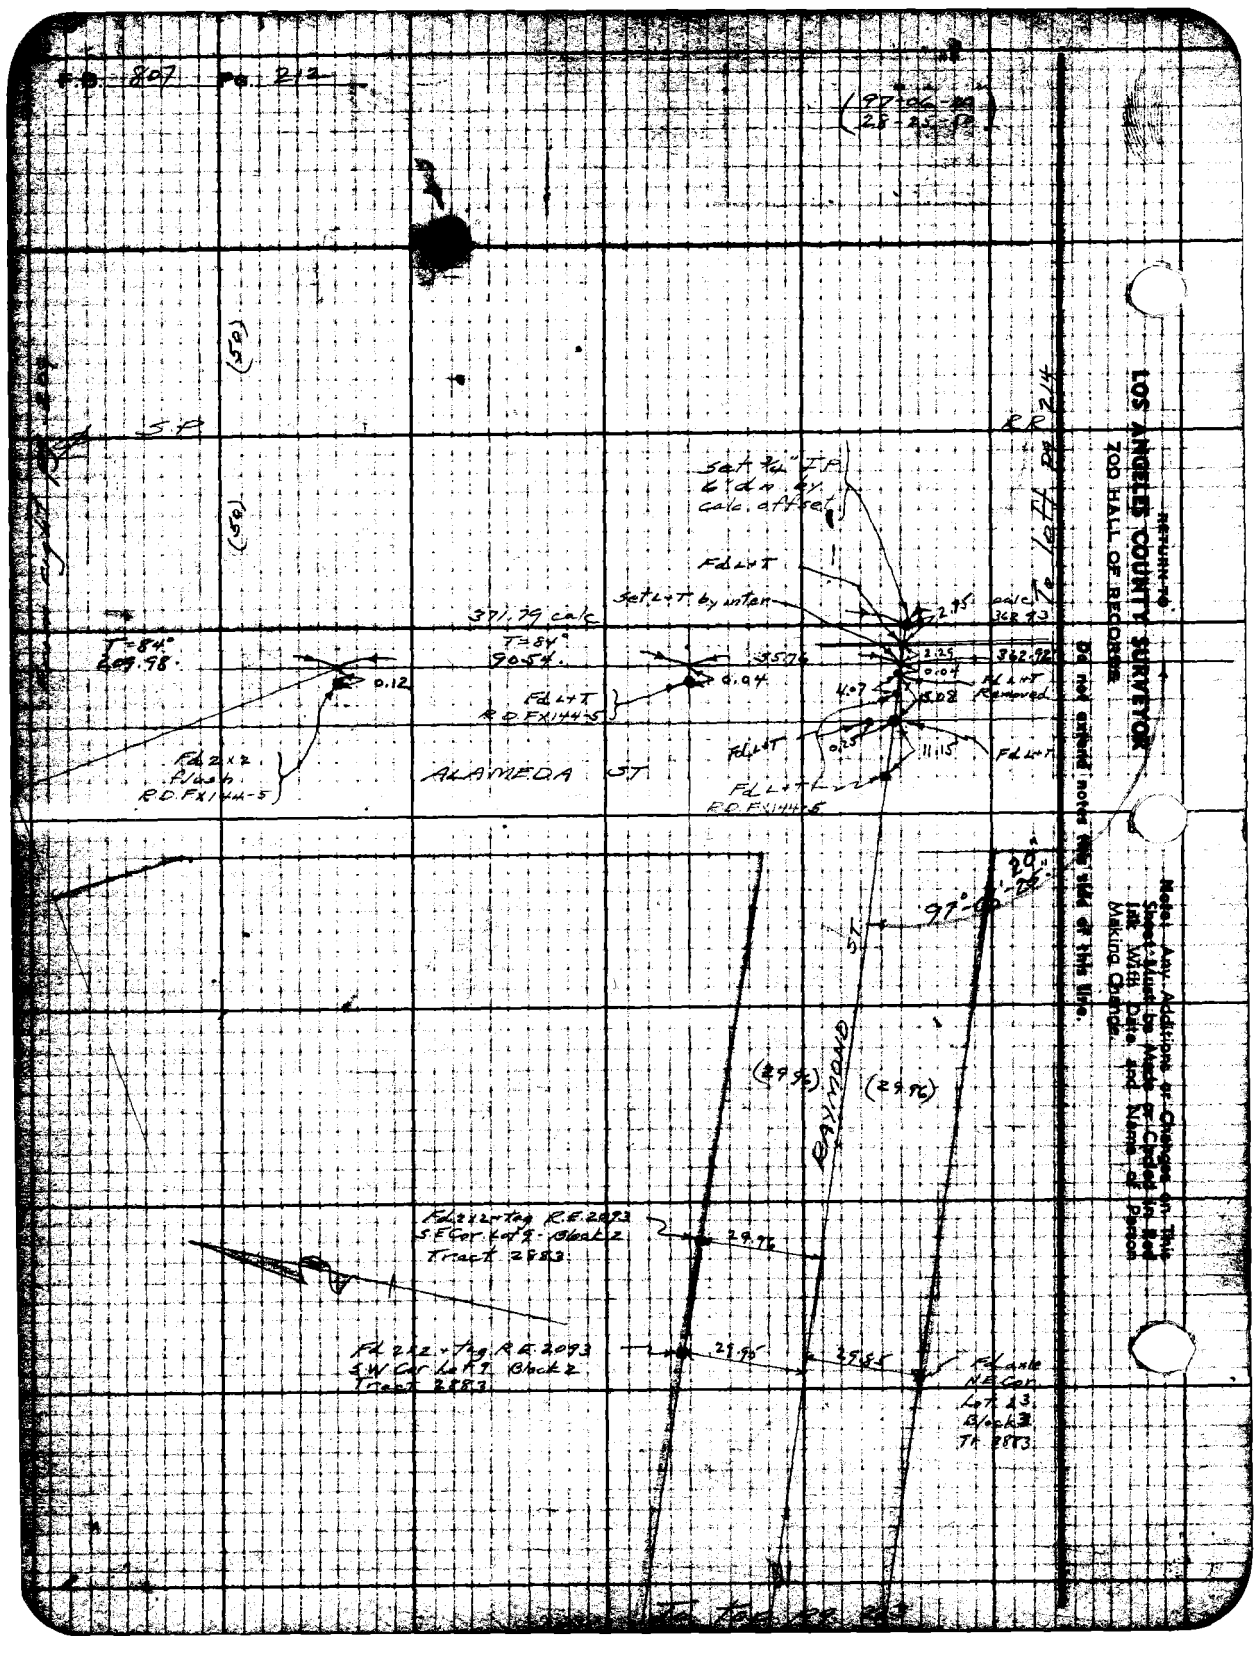
F.B. 807 Pg. 212
(97°-06'-20")
(28-25-18)
(50)
S.P.
R.R.
To left Pg. 214
Set 3/4" I.P. 6' dn by calc. offset
Fd L+T
Set L+T by inter
371.79 calc
T=84°
209.98
T=84°
90.54
0.12
0.04
35.76
2.95
calc 362.93
2.25
0.04
362.92
4.07
5.08
Fd L+T Removed
Fd L+T R.D. FX144-5
Fd L+T
0.25
11.15
Fd L+T
Fd 2x2 flush R.D. FX144-5
ALAMEDA ST
Fd L+T R.D. FX144-5
97°-06'-20"
RAYMOND ST
(29.96)
(29.96)
Fd 2x2 + Tag R.E. 2093 S.E. Cor. Lot 9 - Block 2 Tract 2883
29.96
Fd 2x2 + Tag R.E. 2093 S.W. Cor. Lot 9 Block 2 Tract 2883
29.95
29.85
Fd axle N.E. Cor. Lot 23 Block 3 Tr. 2883
To top Pg. 203
RETURN TO
LOS ANGELES COUNTY SURVEYOR
700 HALL OF RECORDS
Do not extend notes this side of this line.
Note: Any Additions or Changes on This Sheet Must be Made or Coded in Red Ink With Date and Name of Person Making Change.

Notes Compiled by D. M. Finley | Survey of Alameda St | F.B. 807 | Pg.
Office Work By [redacted] | Surveyed by Moore
Office Work By [redacted] | Notes Moore Date 7/10/40
Checked D. M. Finley | Indexed A. C. Johnson
Date Mar 1945

From book pg. 212

Note: Any Additions or Changes on This Sheet Must be Made of Circled in Red Ink with Date and Name of Person Making Change

LOS ANGELES COUNTY SURVEYOR
TO HALL OF RECORDS

Do not cover upper 1/3 of this sheet

FORM 247 Rev 10-39

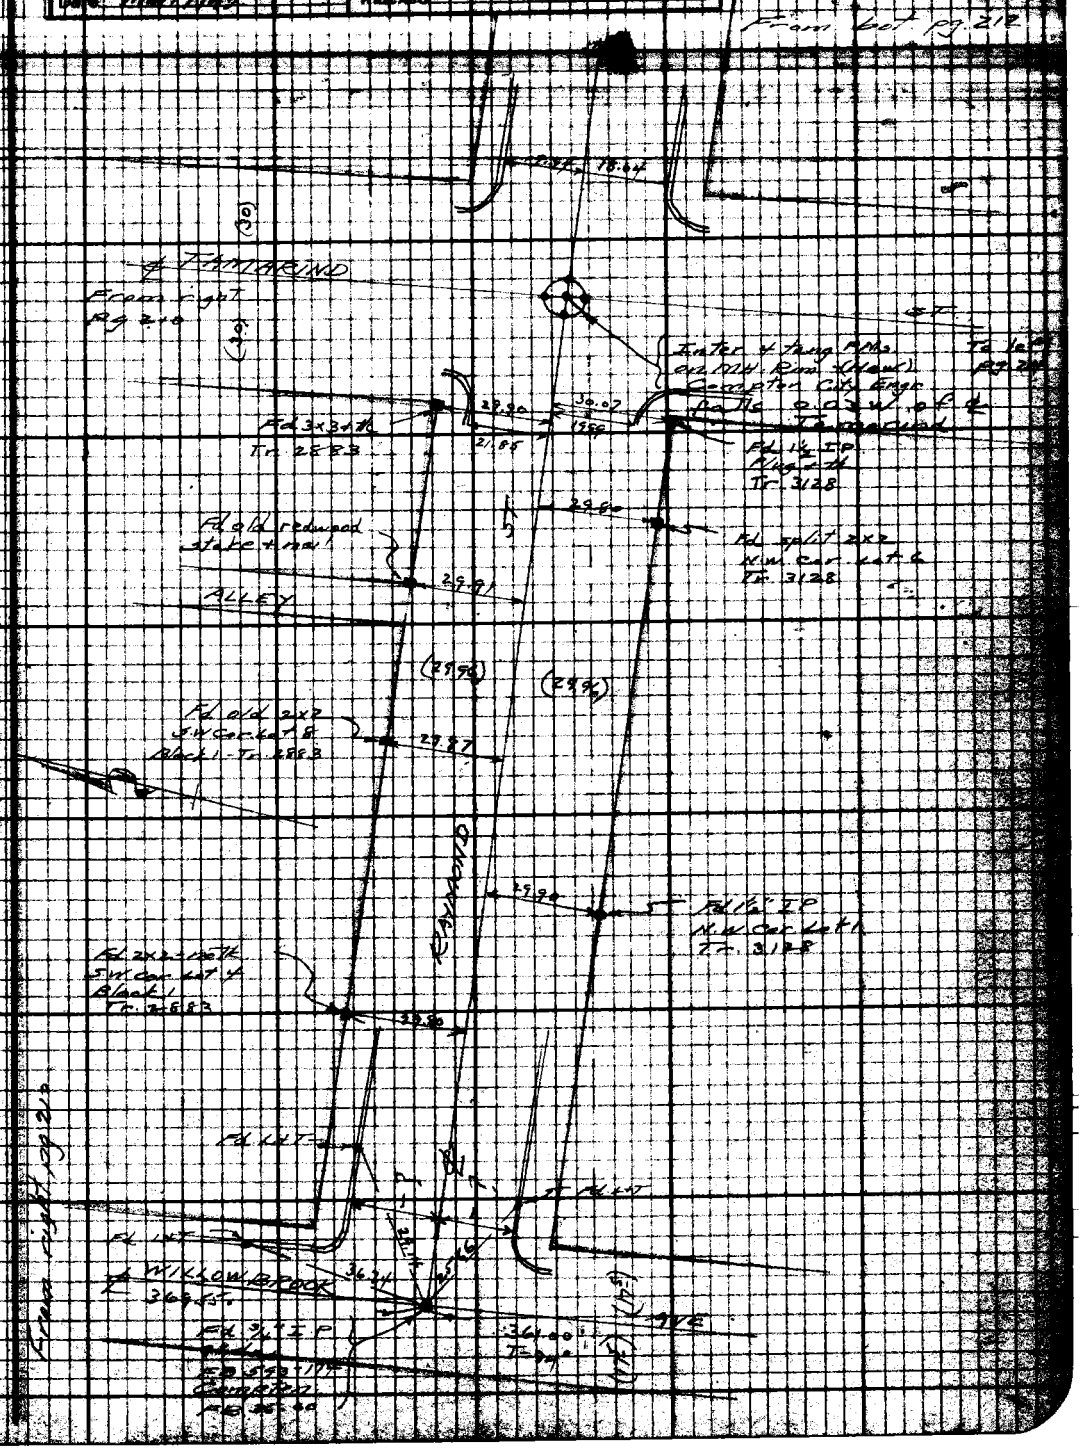
Curve 78.64
(30)
Fence
From right pg 210
(30)
Fd 3x3 pk
Tr. 2883
29.90
30.07
21.85
Fd 1½ IP
Flush
Tr. 3128
29.60
Fd old redwood stake + nail
29.91
Fd 2x2 pk
N.W. Cor. Lot 6
Tr. 3128
ALLEY
(29.96)
(29.96)
Fd old 2x2
S.W. Cor. Lot 8
Block 1 Tr. 2883
29.87
29.90
Fd 1½ IP
N.W. Cor. Lot 1
Tr. 3128
Fd 2x2 pk
S.W. Cor. Lot 4
Block 1
Tr. 2883
29.90
Fd Lot
Fd Lot
Fence
Fence
Fence

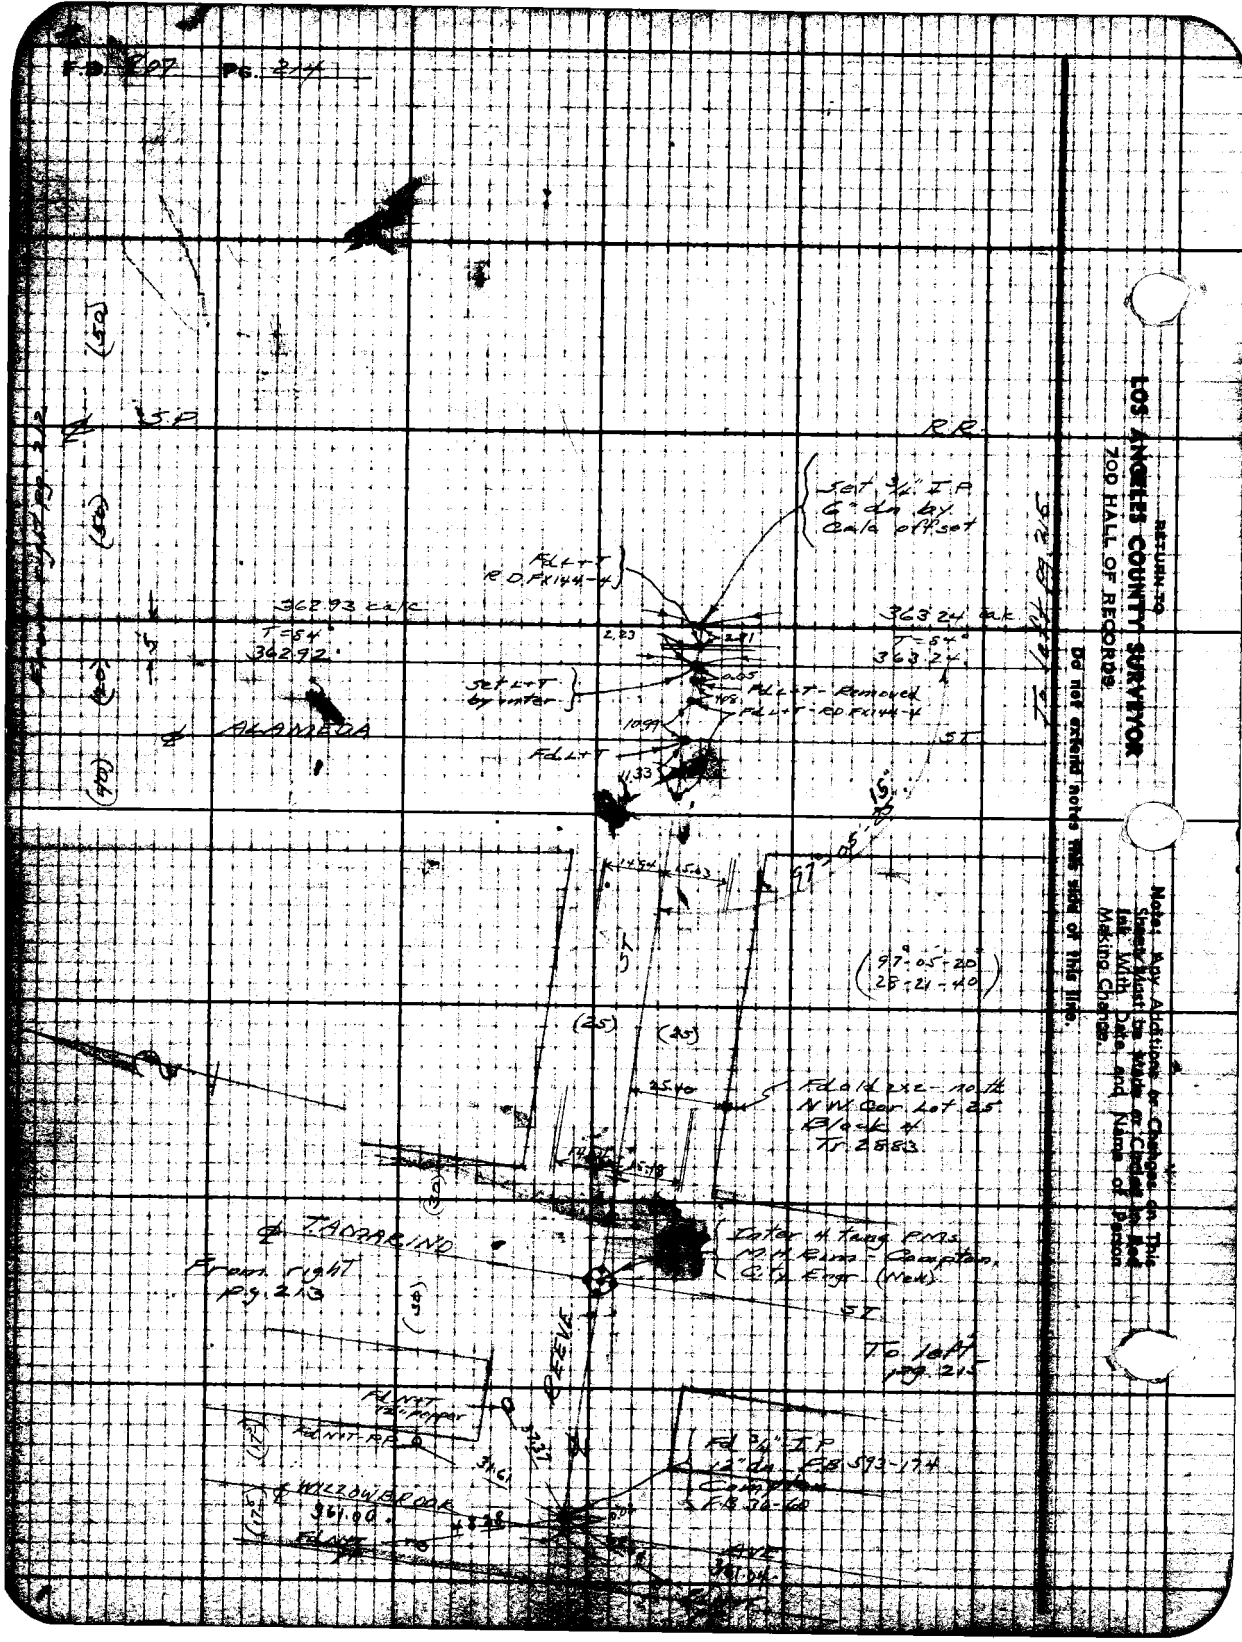

RETURN TO
LOS ANGELES COUNTY SURVEYOR
700 HALL OF RECORDS

Do not extend notes this side of this line.

Note: Any Additions or Changes on This Sheet Must be Made or Circled in Red Ink With Date and Name of Person Making Change.

Notes Ck'd by	D. M. Finley	Survey of	Alameda St
Map No.	[illegible]	W. O.	[illegible]
Office Work	D. A. W.	Surveyed by	[illegible]
Checked	D. M. Finley	Notes	Moore Date 7-11-40
Date	Mar 1945	Indexed	A. C. Johnson

F.B. 807 Pg. [illegible]

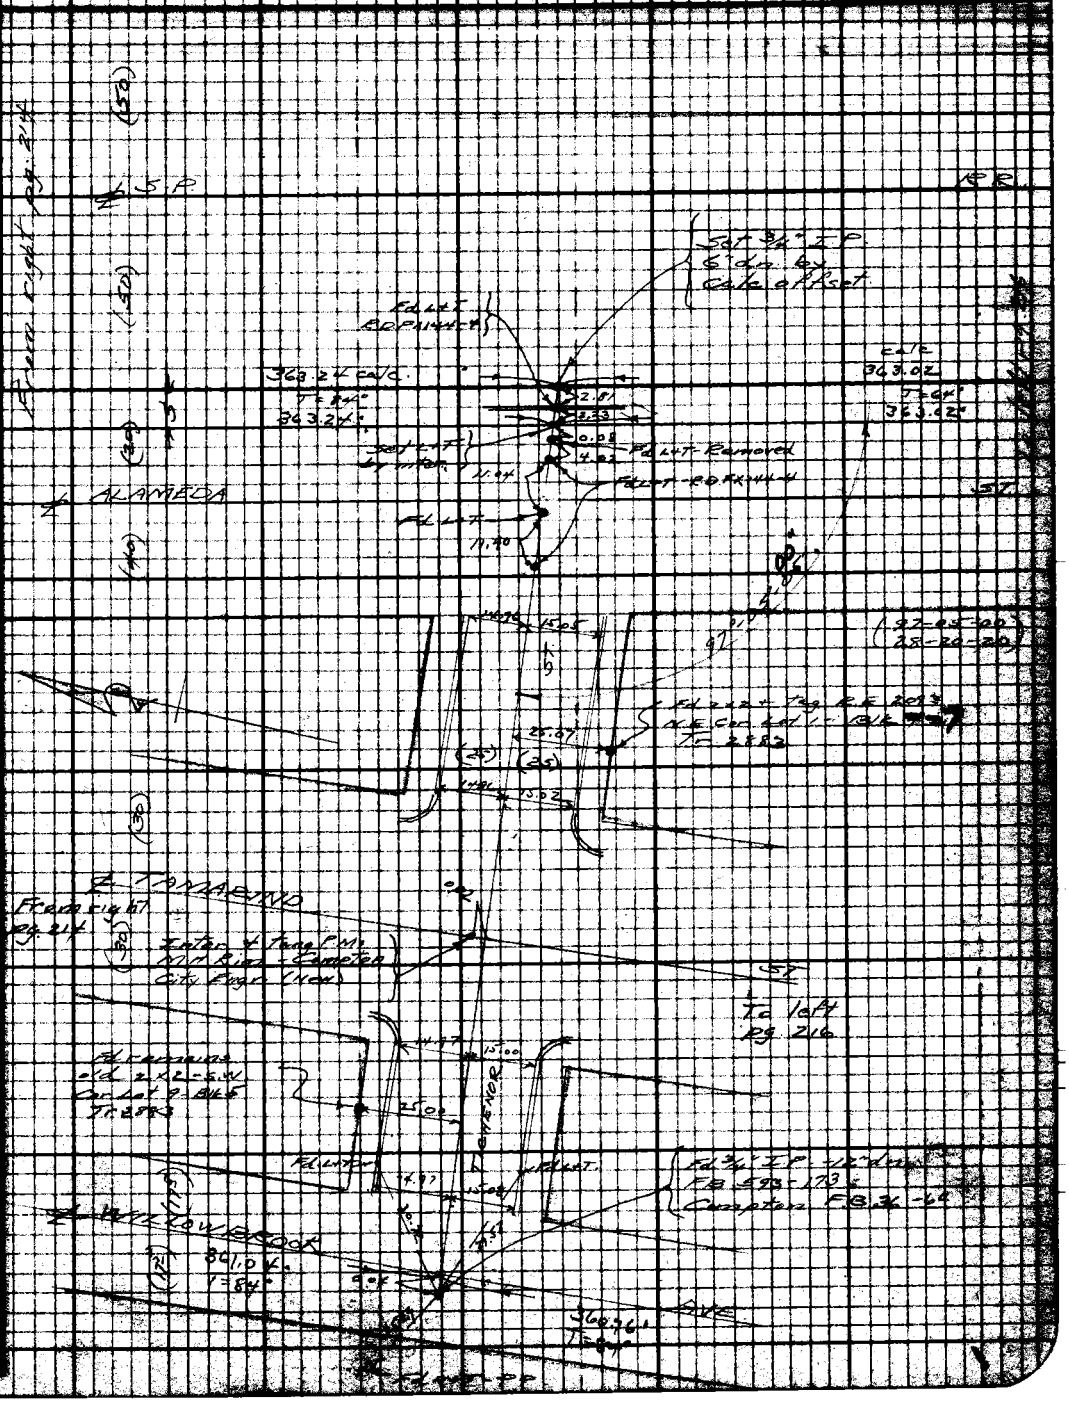

Note: Any Additions or Changes on This Sheet Must be Made or Circled in Red Ink With Date and Name of Person Making Change.

Do not extend notes this side of this line.

RETURN TO
LOS ANGELES COUNTY SURVEYOR
700 HALL OF RECORDS

FORM 247 5M 10-39

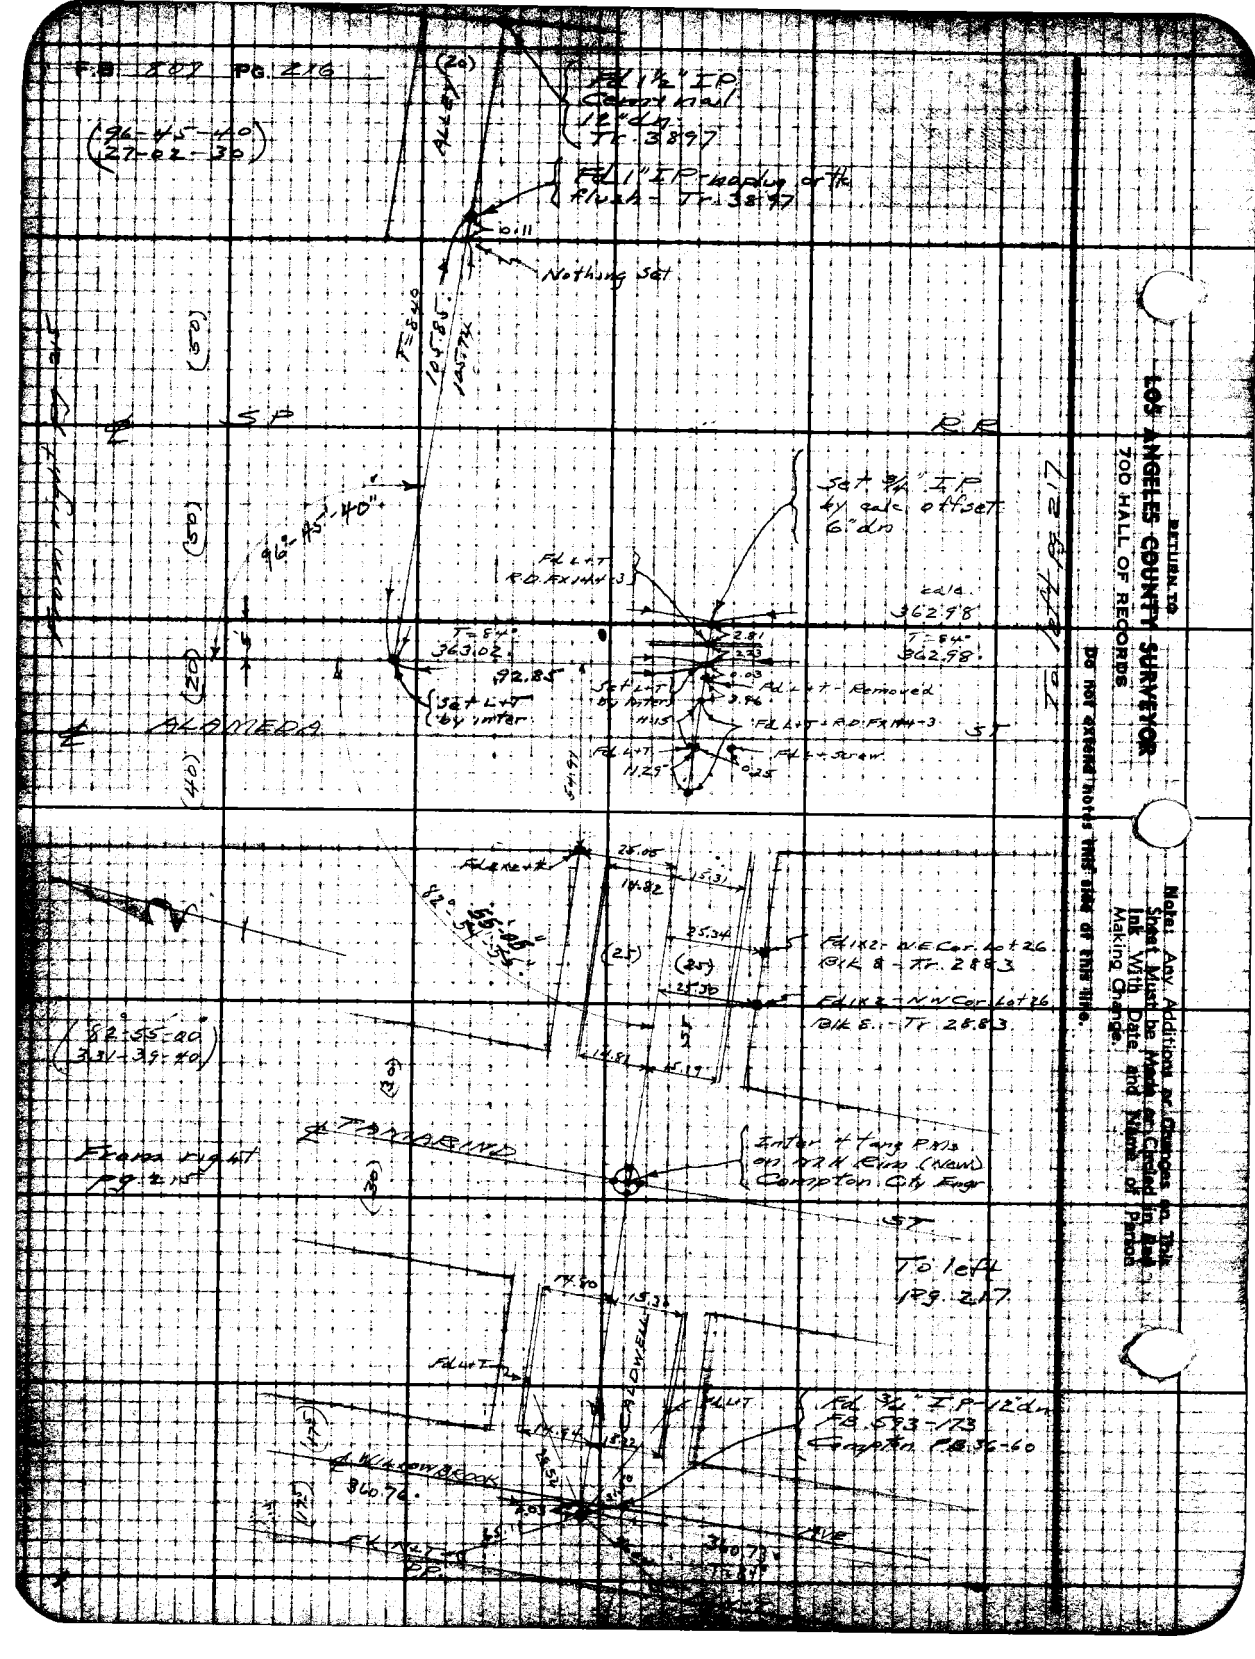
F.B. 807 PG. 216
(96-45-40)
(27-02-30)
ALLEY
Fd 1½" IP Cement nail 12" dn Tr. 3897
Fd 1" IP - no plug or tk flush - Tr. 3897
Nothing set
T=840
105.85
105.74
SP
RR
Set ¾" IP by calc offset 6" dn
96°-45'-40"
Fd L+T R.D. FX 144-3
calc. 362.98
T=84° 363.02
T=84° 362.98
92.85
Set L+T by inter
Set L+T by inter
Fd L+T - Removed
Fd L+T - R.D. FX 144-3
Fd L+T
Fd L+ screw
ALAMEDA
ST
To left pg. 217
Fd 1x2 - N.E. Cor. Lot 26 Blk 8 - Tr. 2883
Fd 1x2 - N.W. Cor. Lot 26 Blk 8 - Tr. 2883
(82°-55'-00")
(331-39-40)
TAMARIND
From right pg. 215
Inter 4 tang PMs on M.H. Rim (New) Compton City Engr
ST
To left pg. 217
CALDWELL
Fd L+T
Fd ¾" IP - 12" dn FB 593-173 Compton FB 36-60
WILLOWBROOK
360.76
360.73
AVE
DR.
RETURN TO
LOS ANGELES COUNTY SURVEYOR
700 HALL OF RECORDS
Do not extend notes this side of this line.
Note: Any Additions or Changes on This Sheet Must be Made or Circled in Red Ink With Date and Name of Person Making Change.

Notes Ck'd by D. M. Finley	Survey of [illegible] ST
Map No. [illegible]	W. O. 8270 Tape No. St'd 34°F
Office Work	Surveyed by Moore
Checked	Notes Moore Date 7-23-46
Date Mar. 1945	Indexed A. C. Johnson

F.B. 807 Pg. 217

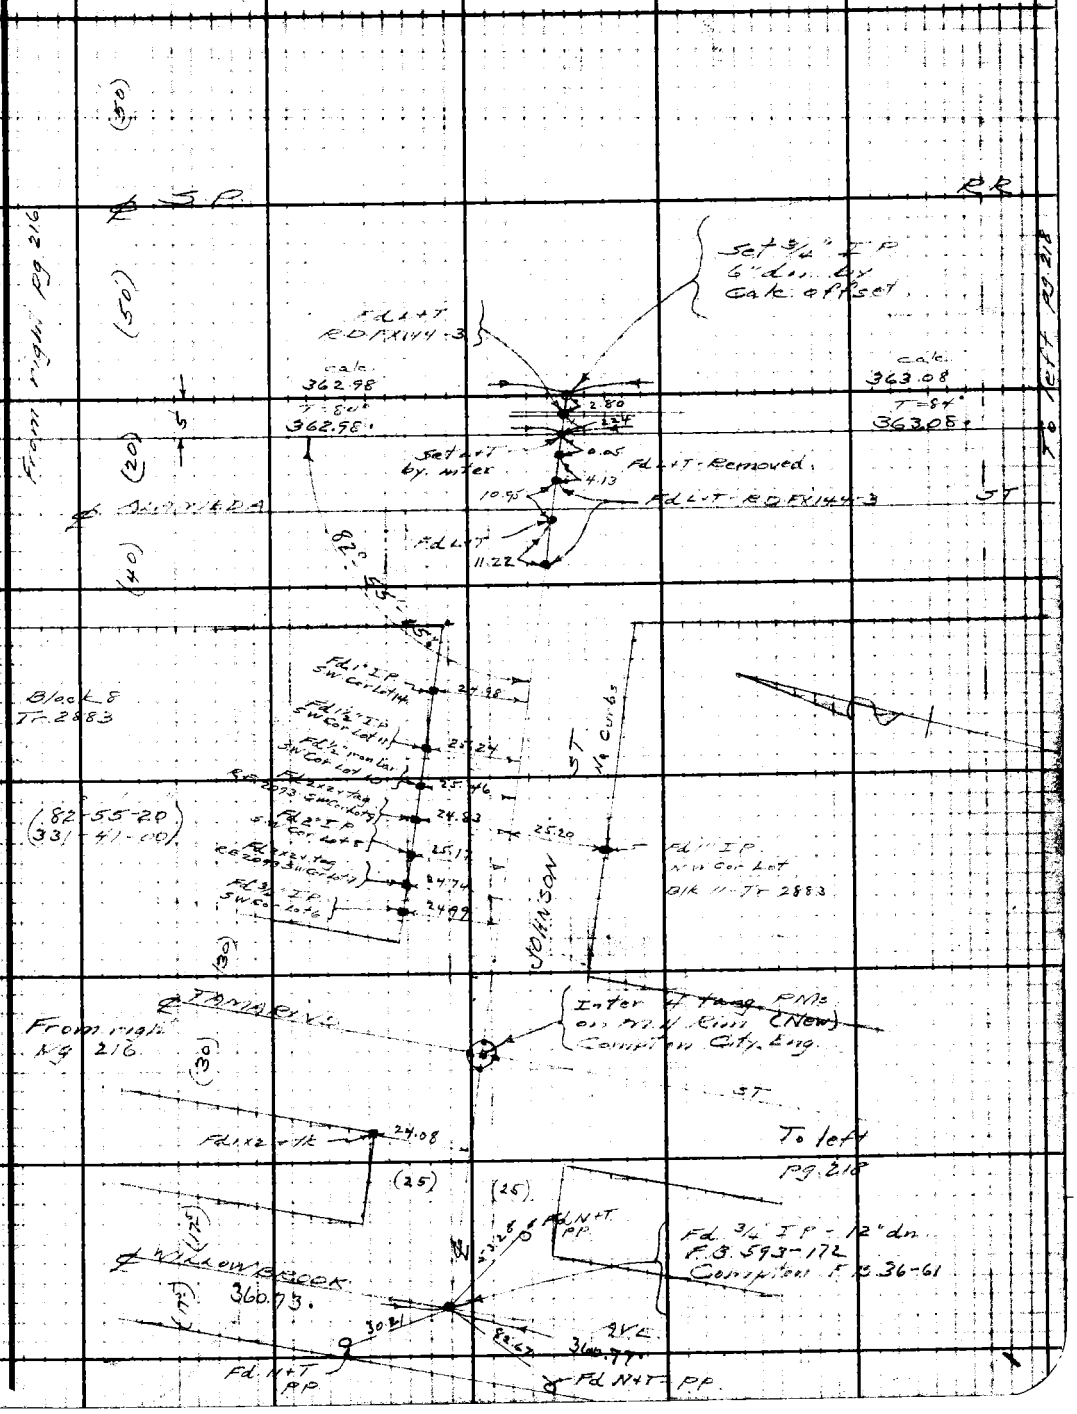

Note: Any Additions or Changes on This Sheet Must be Made or Circled in Red Ink With Date and Name of Person Making Change.

Do not extend notes this side of this line.

RETURN TO
LOS ANGELES COUNTY SURVEYOR
700 HALL OF RECORDS

FORM 247 5M 10-39

F.B. 807 PG. 218

RETURN TO
LOS ANGELES COUNTY SURVEYOR
700 HALL OF RECORDS

Do not extend notes this side of this line.

Note: Any Additions or Changes on This Sheet Must be Made or Circled in **Red Ink** With Date and Name of Person Making Change.

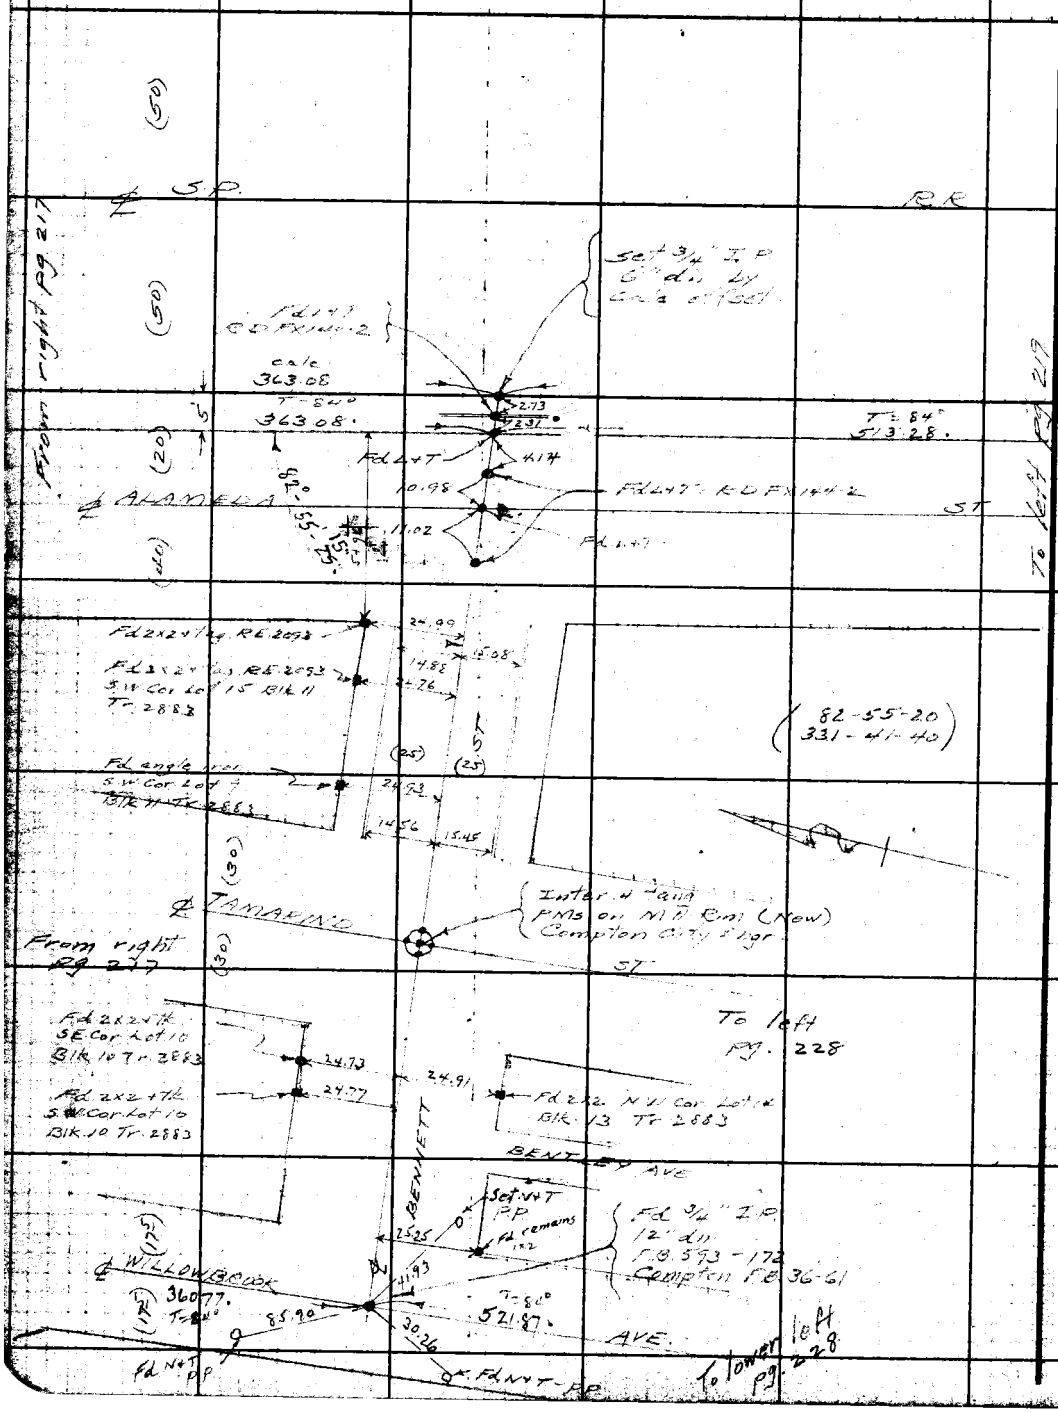

Notes Ck'd by D. M. Finlay	Survey of Florence St
Map No. [illegible]	W. O. 8270 Tape No. 5 Std 84°F
Office Work	Surveyed by Moore
Checked	Notes Moore Date 7-24-40
Date Mar. 1945	Indexed A. D. Jones

F.B. 807 PG. 129

Note: Any Additions or Changes on This Sheet Must be Made of Circled in Red Ink With Date and Name of Person Making Change

Do not extend notes this side of this line.

RETURN TO
LOS ANGELES COUNTY SURVEYOR
700 HALL OF RECORDS

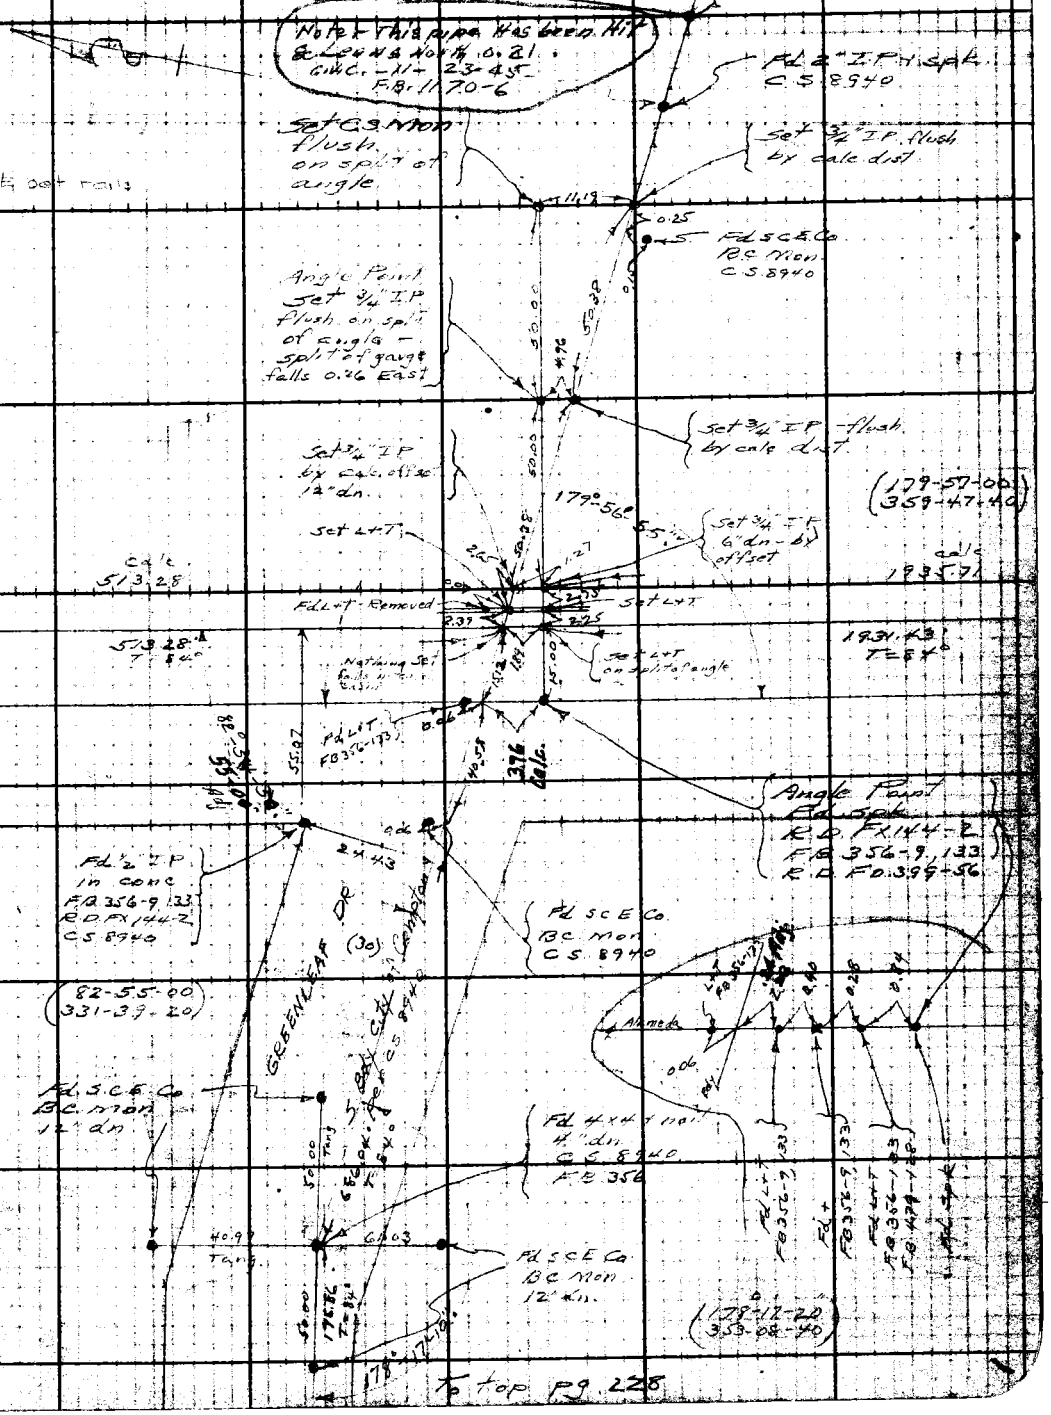

FORM 247 5M 10-38

RETURN TO
LOS ANGELES COUNTY SURVEYOR
700 HALL OF RECORDS

Note: Any Additions or Changes on This Sheet Must be Made or Circled in Red Ink With Date and Name of Person Making Change.

Do not extend notes this side of this line.

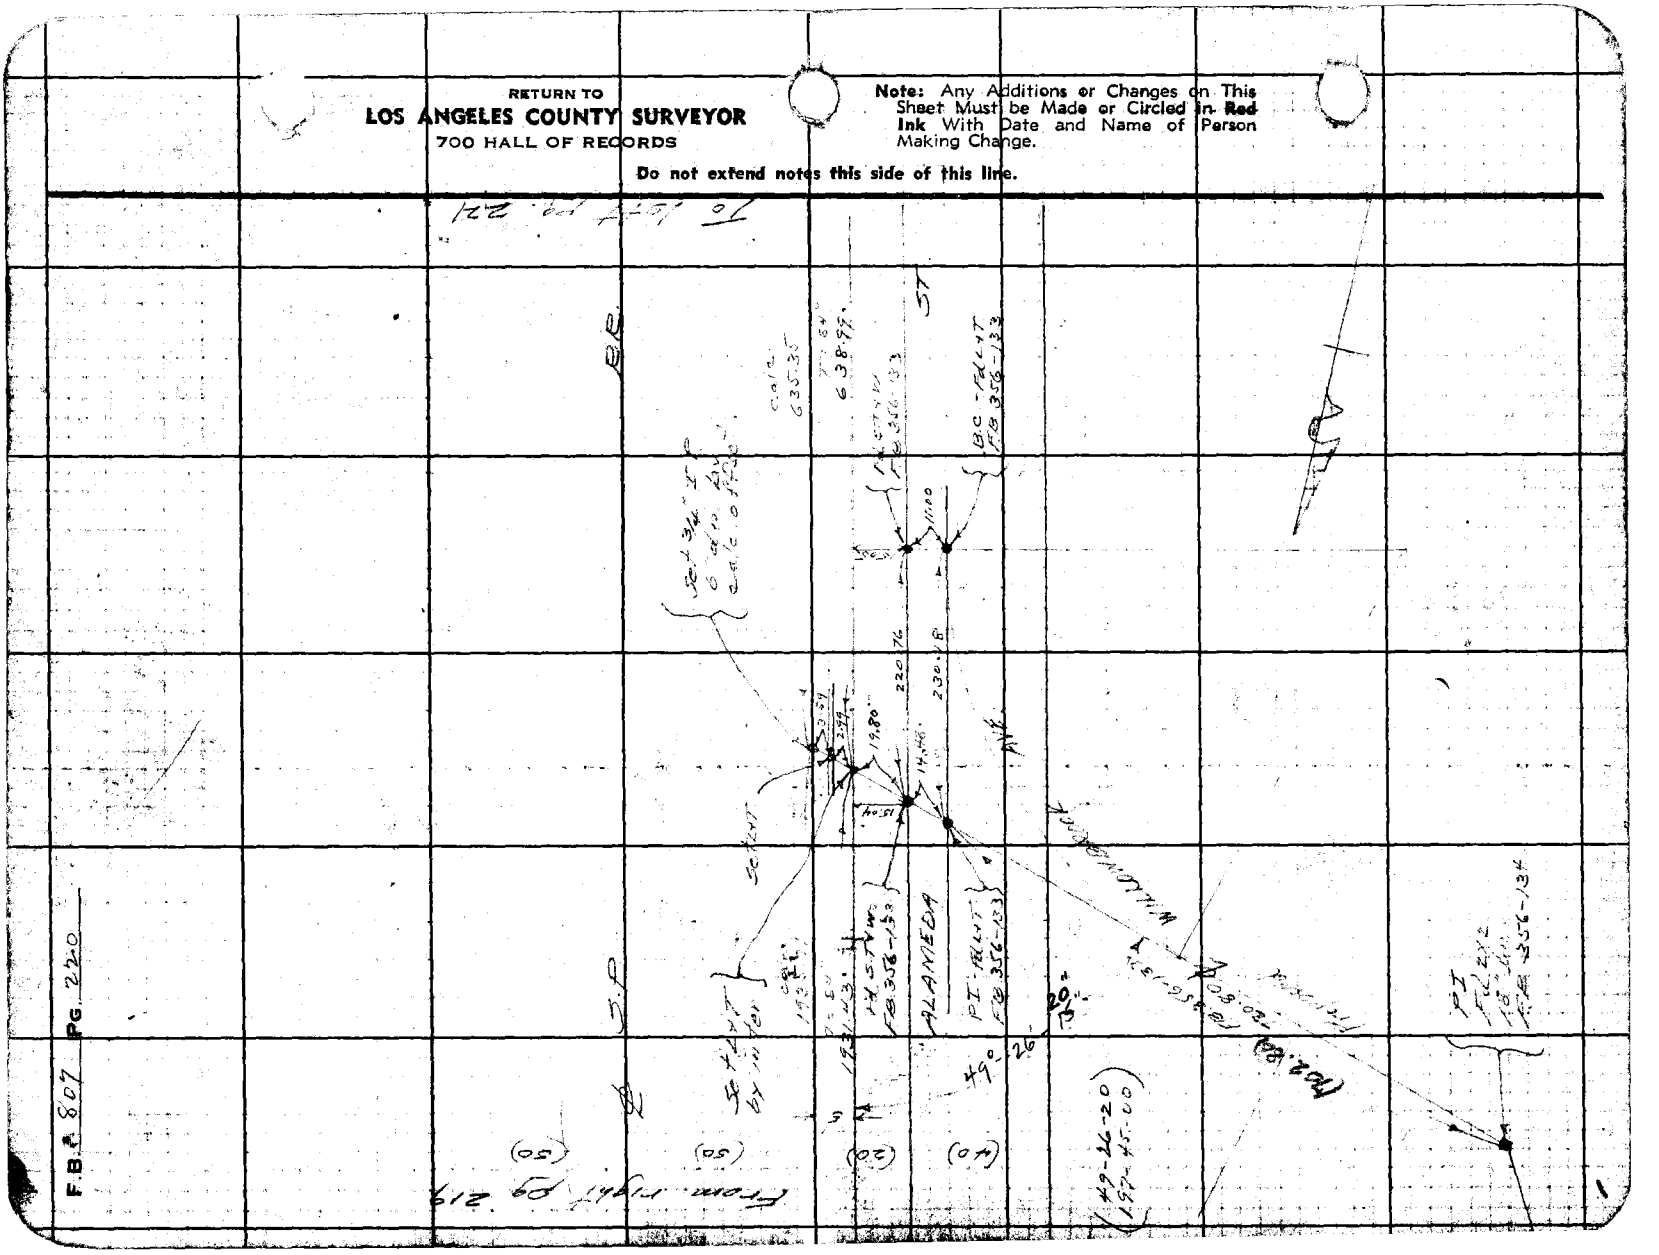

F.B. 807 Pg. 220

Notes Ck'd by D. M. Finley	Survey of Alameda St.
Map No. [illegible]	W. O. 8270 Tape No. 54 84 °F
Office Work	Surveyed by Moore
Checked	Notes Moore Date 7-25-40
Date Mar. 1945	Indexed 1-6-40

F.B. 807 PG. 221

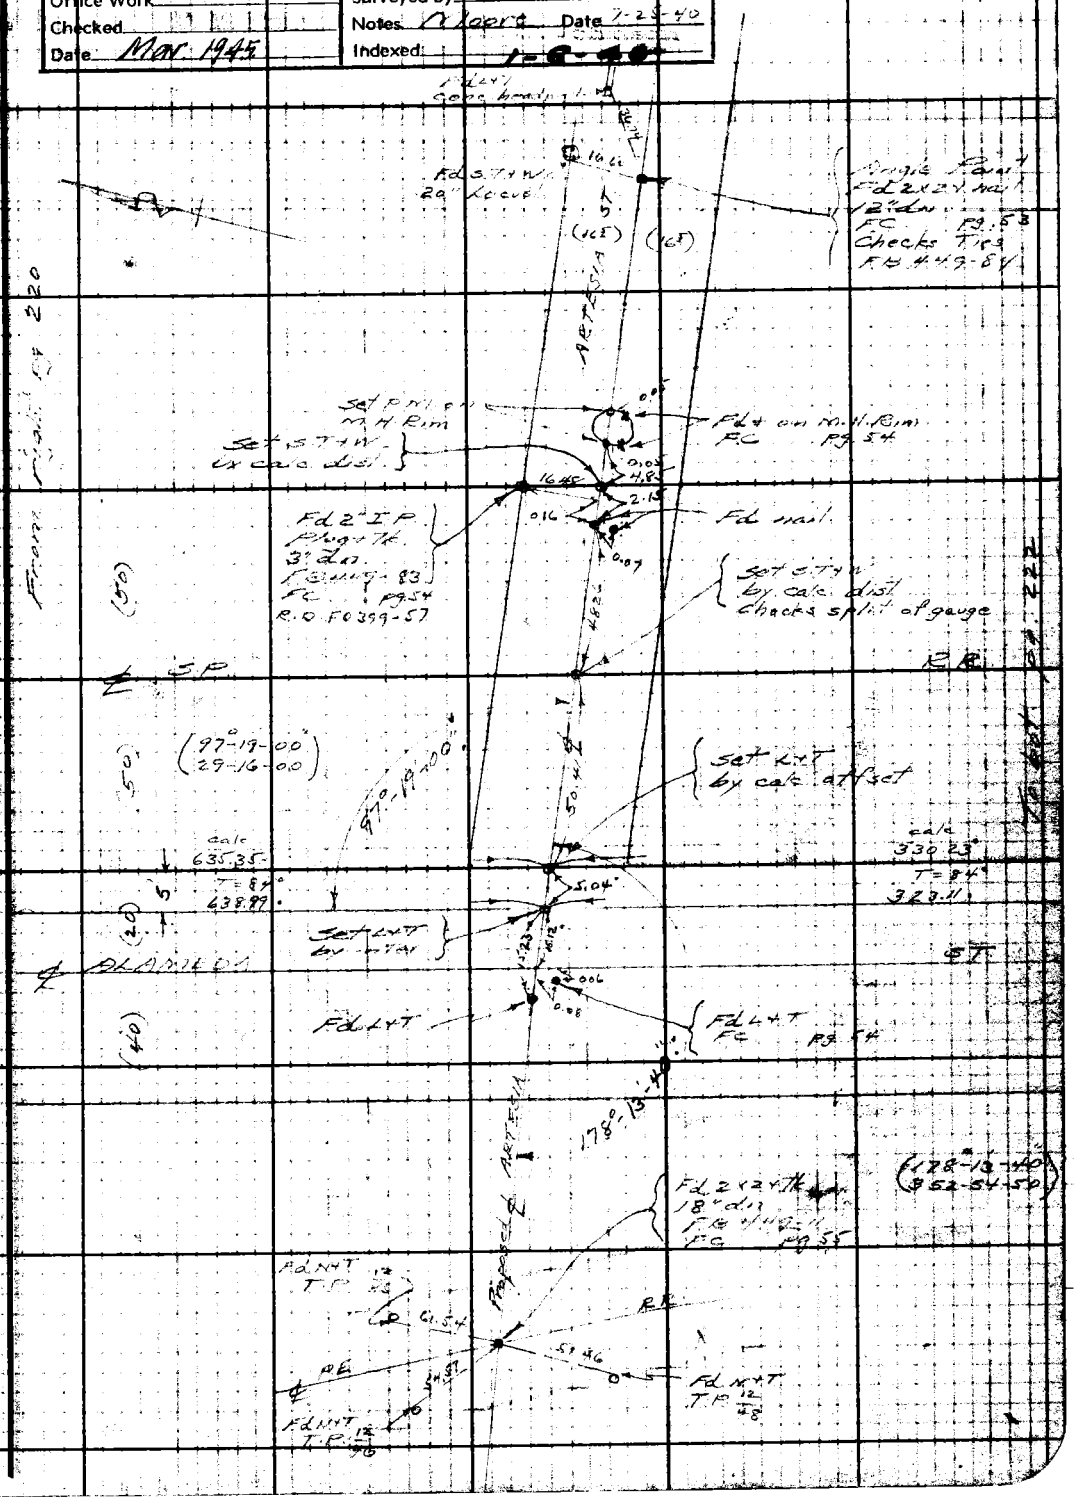

Note: Any Additions or Changes on This Sheet Must be Made or Circled in Red Ink With Date and Name of Person Making Change

Do not extend notes this side of this line.

RETURN TO
LOS ANGELES COUNTY SURVEYOR
700 HALL OF RECORDS

FORM 247 5M 10-39

RETURN TO
LOS ANGELES COUNTY SURVEYOR
700 HALL OF RECORDS

Note: Any Additions or Changes on This Sheet Must be Made or Circled in **Red Ink** With Date and Name of Person Making Change.

Do not extend notes this side of this line.

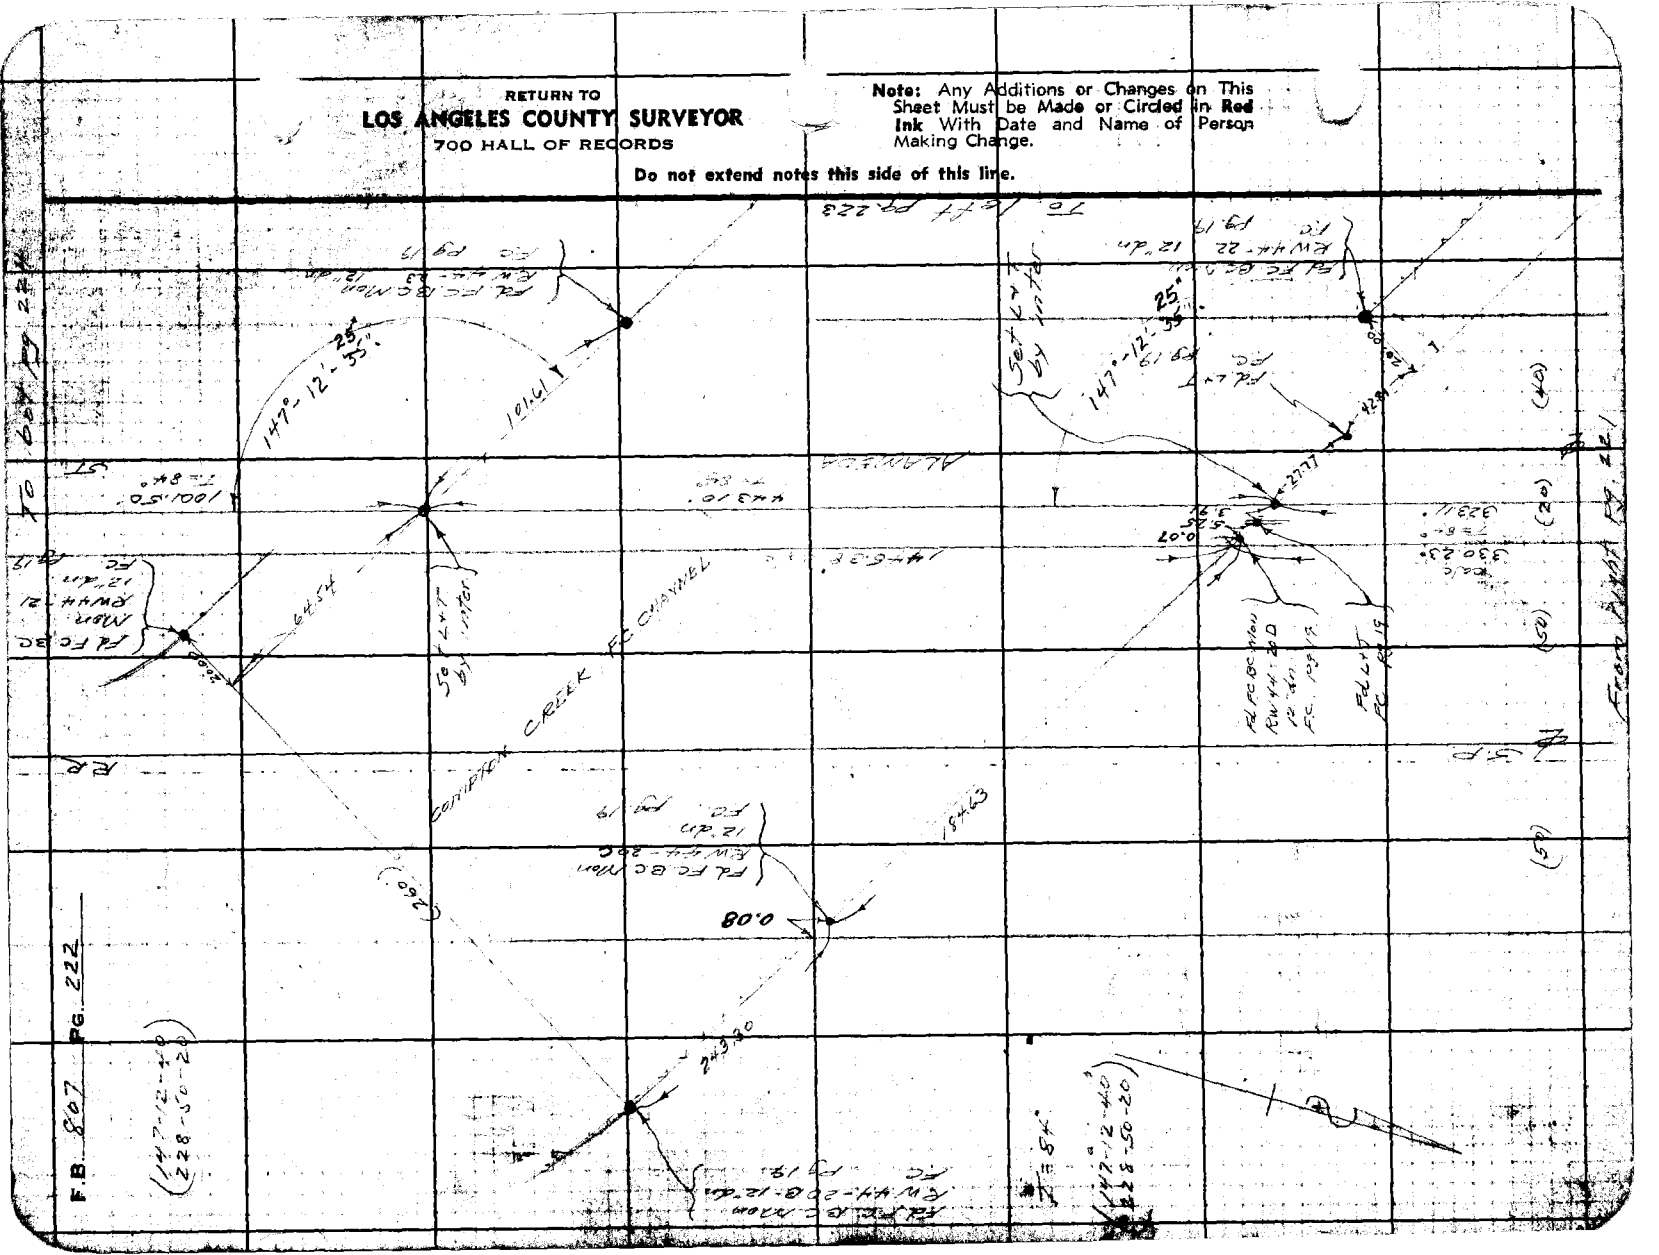

Notes Ck'd by D. M. Finley	Survey of Alameda St
Map No. [illegible]	W. D. 8270 Tape No. St'd 84 °F
Office Work	Surveyed by Moore
Checked	Notes Moore Date 7-26-40
Date Mar. 1945	Indexed

F.B. 807 Pg. 223

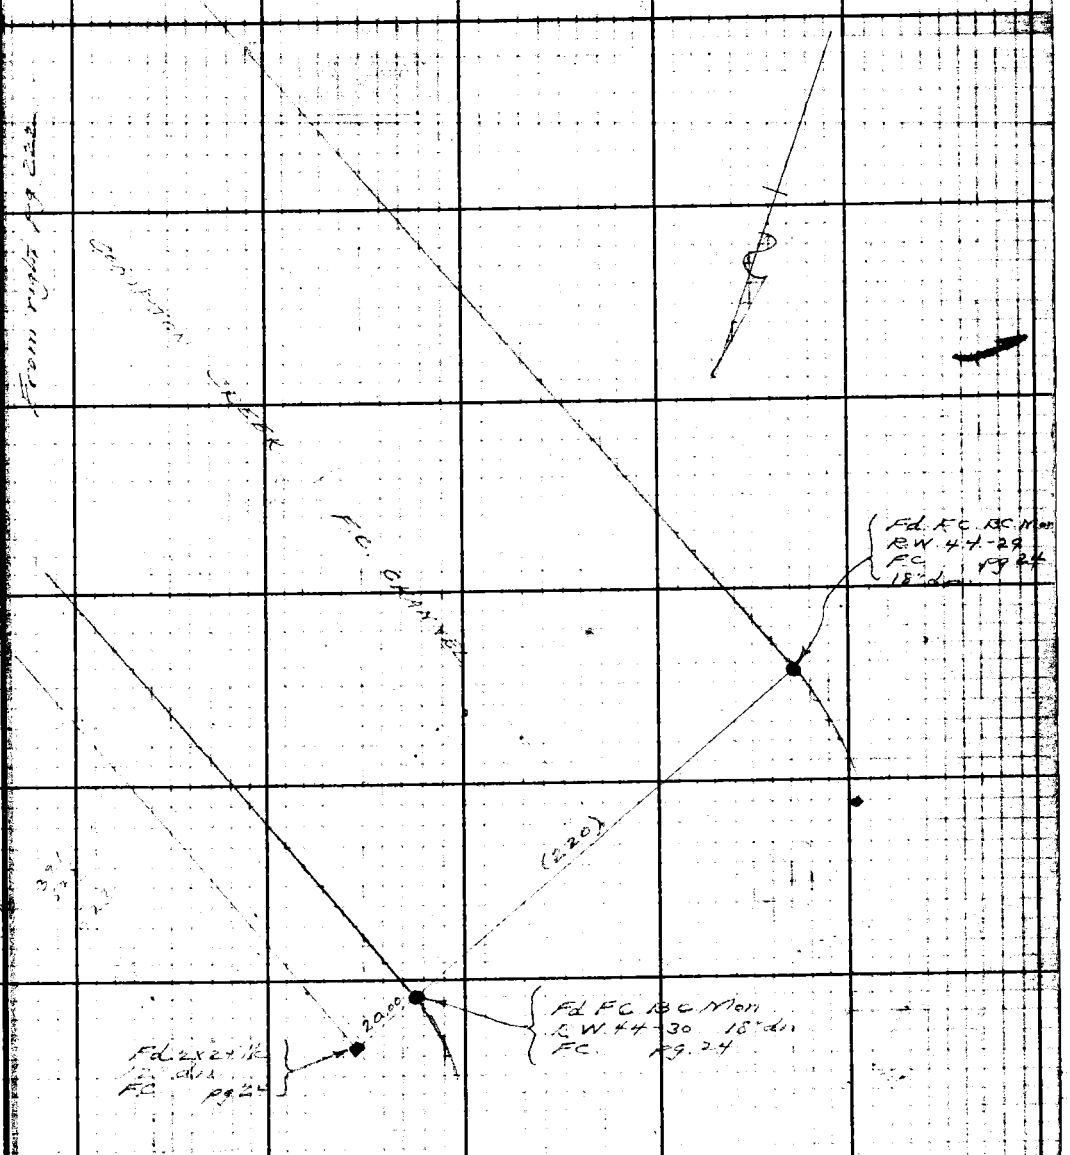

Note: Any Additions or Changes on This Sheet Must be Made or Circled in Red Ink With Date and Name of Person Making Change

RETURN TO
LOS ANGELES COUNTY SURVEYOR
700 HALL OF RECORDS

Do not extend notes this side of this line.

FORM 247 5M 10-39

RETURN TO
LOS ANGELES COUNTY SURVEYOR
700 HALL OF RECORDS

Note: Any Additions or Changes on This Sheet Must be Made or Circled in **Red Ink** With Date and Name of Person Making Change.

Do not extend notes this side of this line.

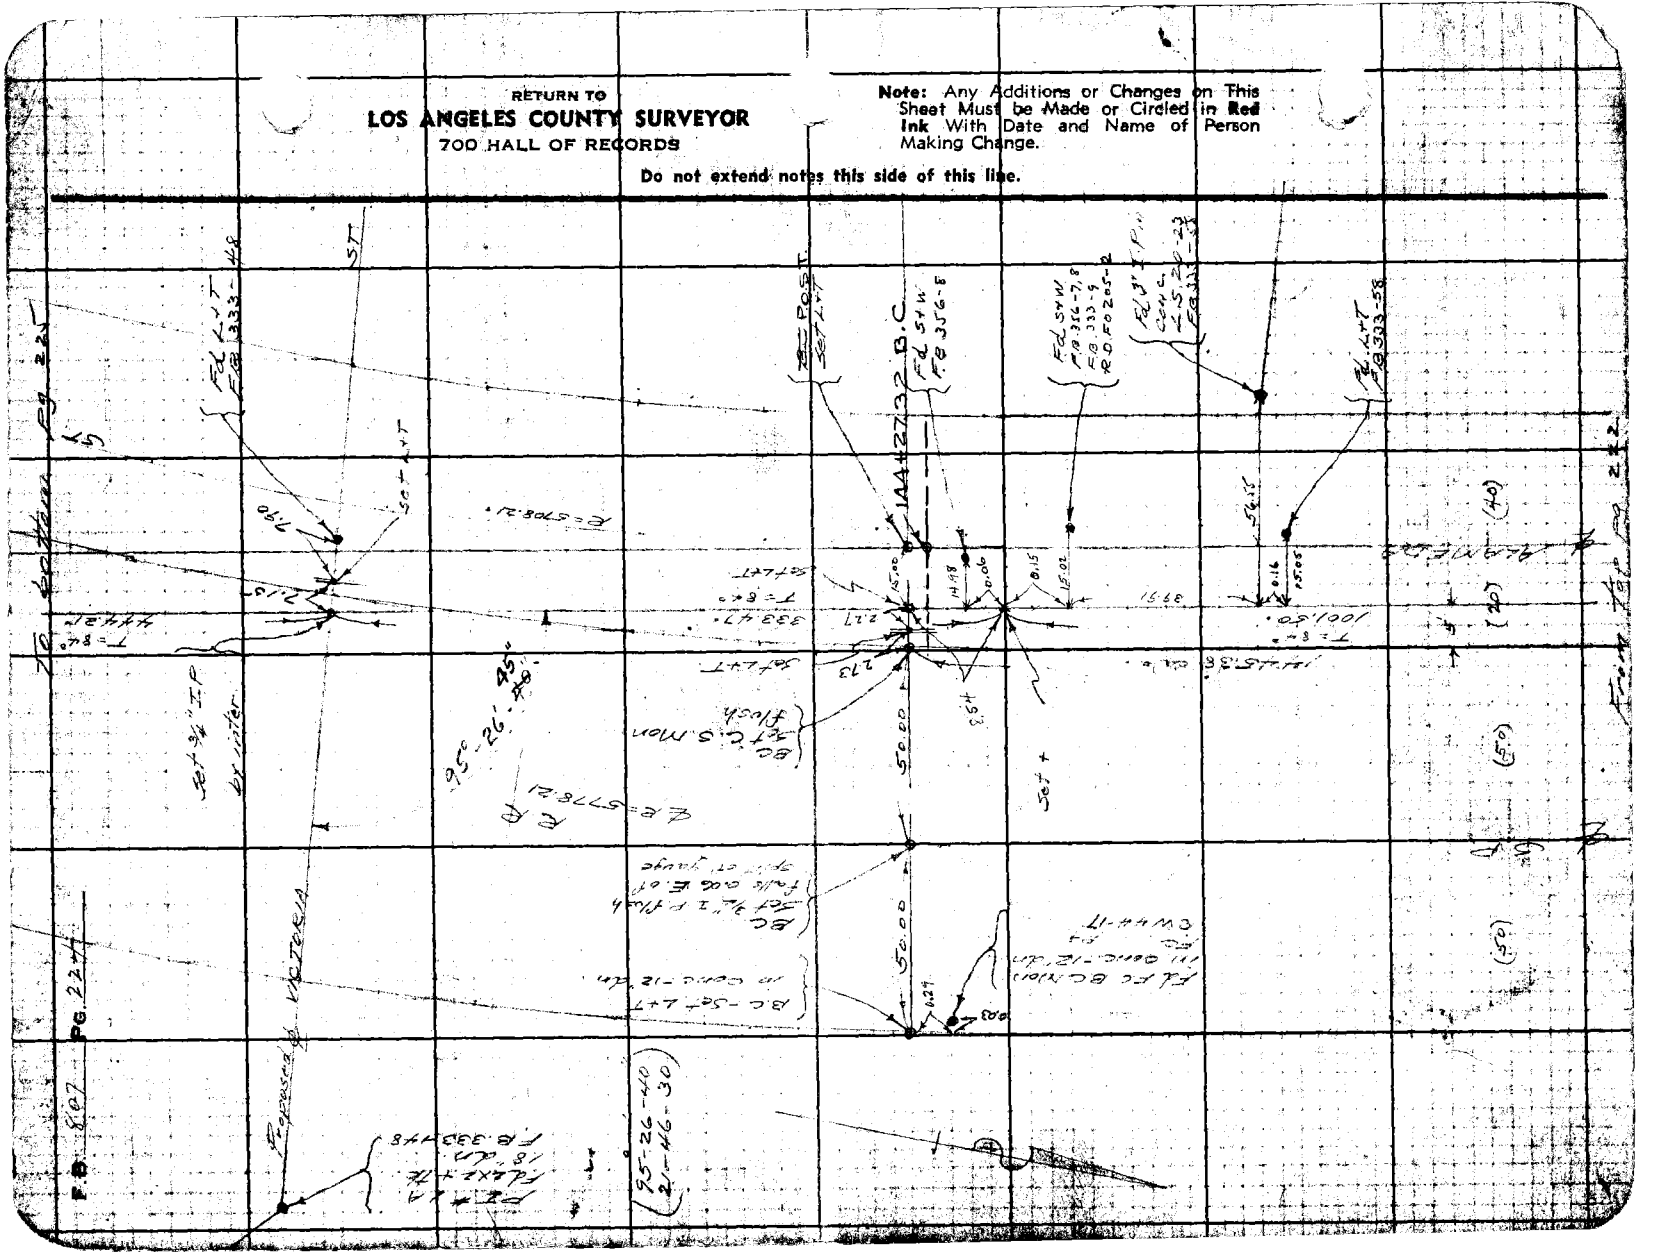
To Brother Pg 225
From Top Pg 222
Pg 224
Pg 227
F.B. 867
Fd. 5+W
F.B. 356-7,8
F.B. 333-5
R.D. F0 265-2
Fd. 5+W
F.B. 356-8

Notes Ck'd by M. Finley	Survey of Alameda St	F.B. 807	Pg. 225
Map No. [illegible]	W. O. [illegible] Tape No. St'd 84°F		
Office Work	Surveyed by D. Moore		
Checked	Notes D. Moore Date 7-29-40		
Date Mar. 1945	Indexed		

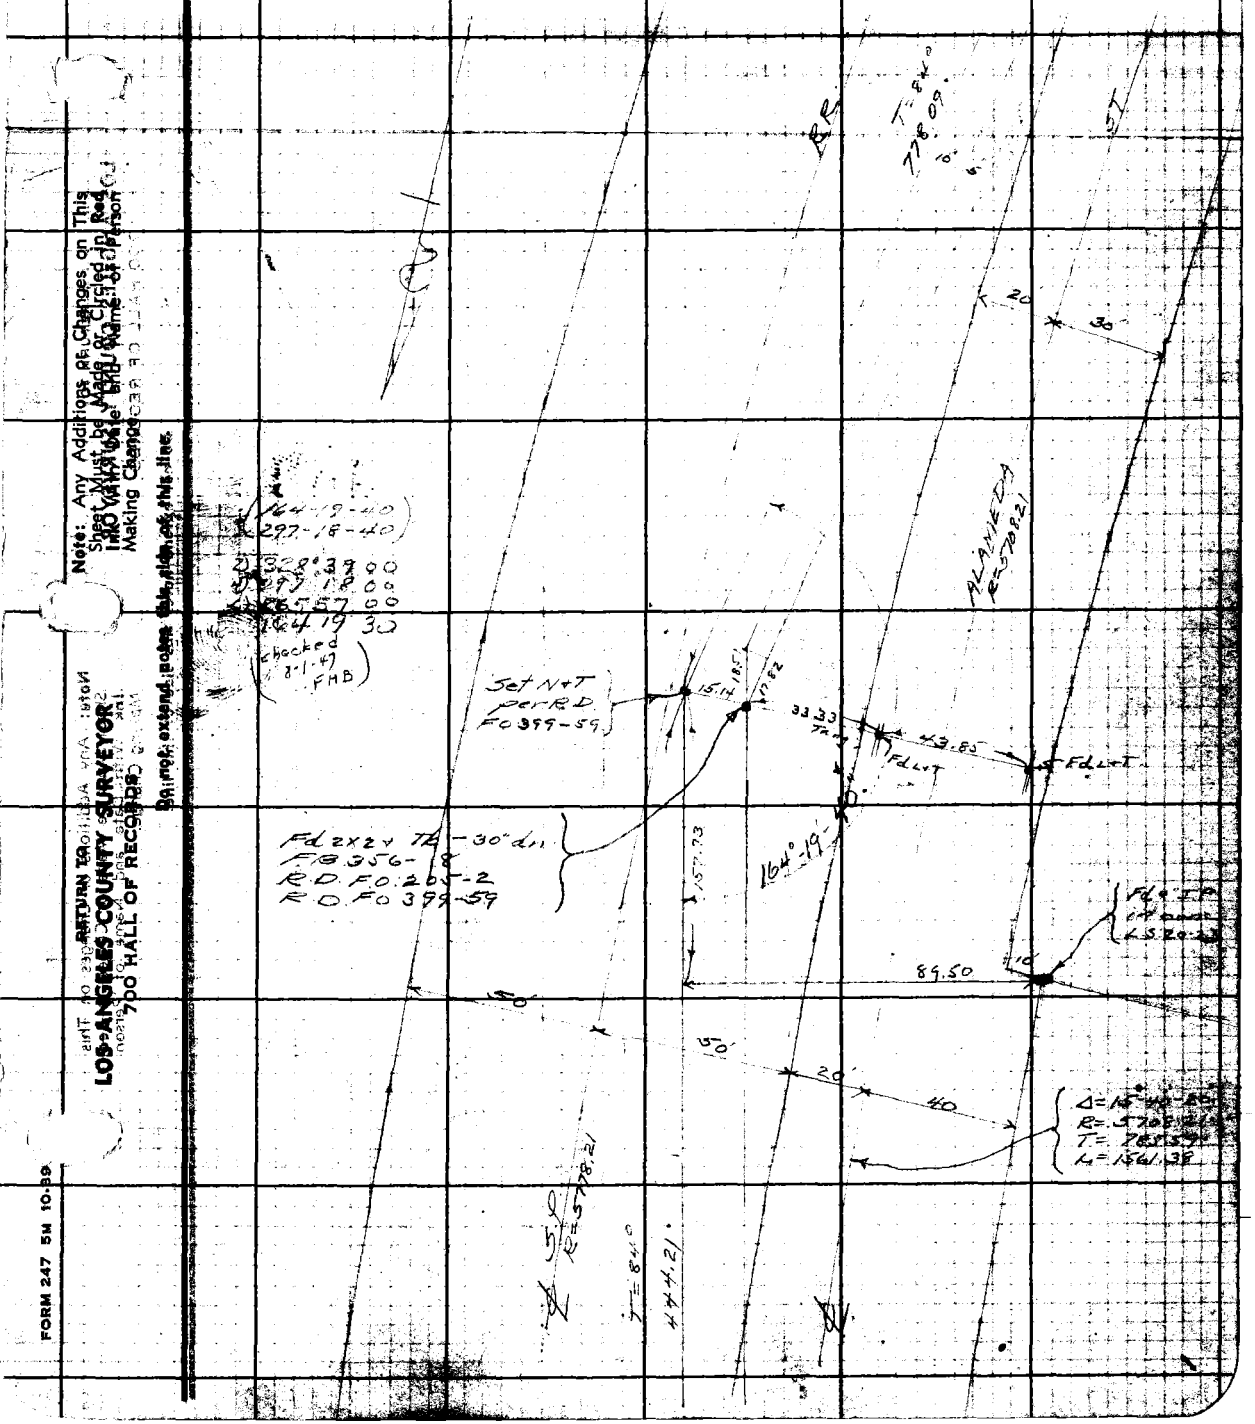

Note: Any Additions or Changes on This Sheet Must be Made or Circled in Red Ink With Date and Name of Person Making Change

RETURN TO
LOS ANGELES COUNTY SURVEYOR
700 HALL OF RECORDS

Do not extend notes this side of this line.

FORM 247 5M 10-39

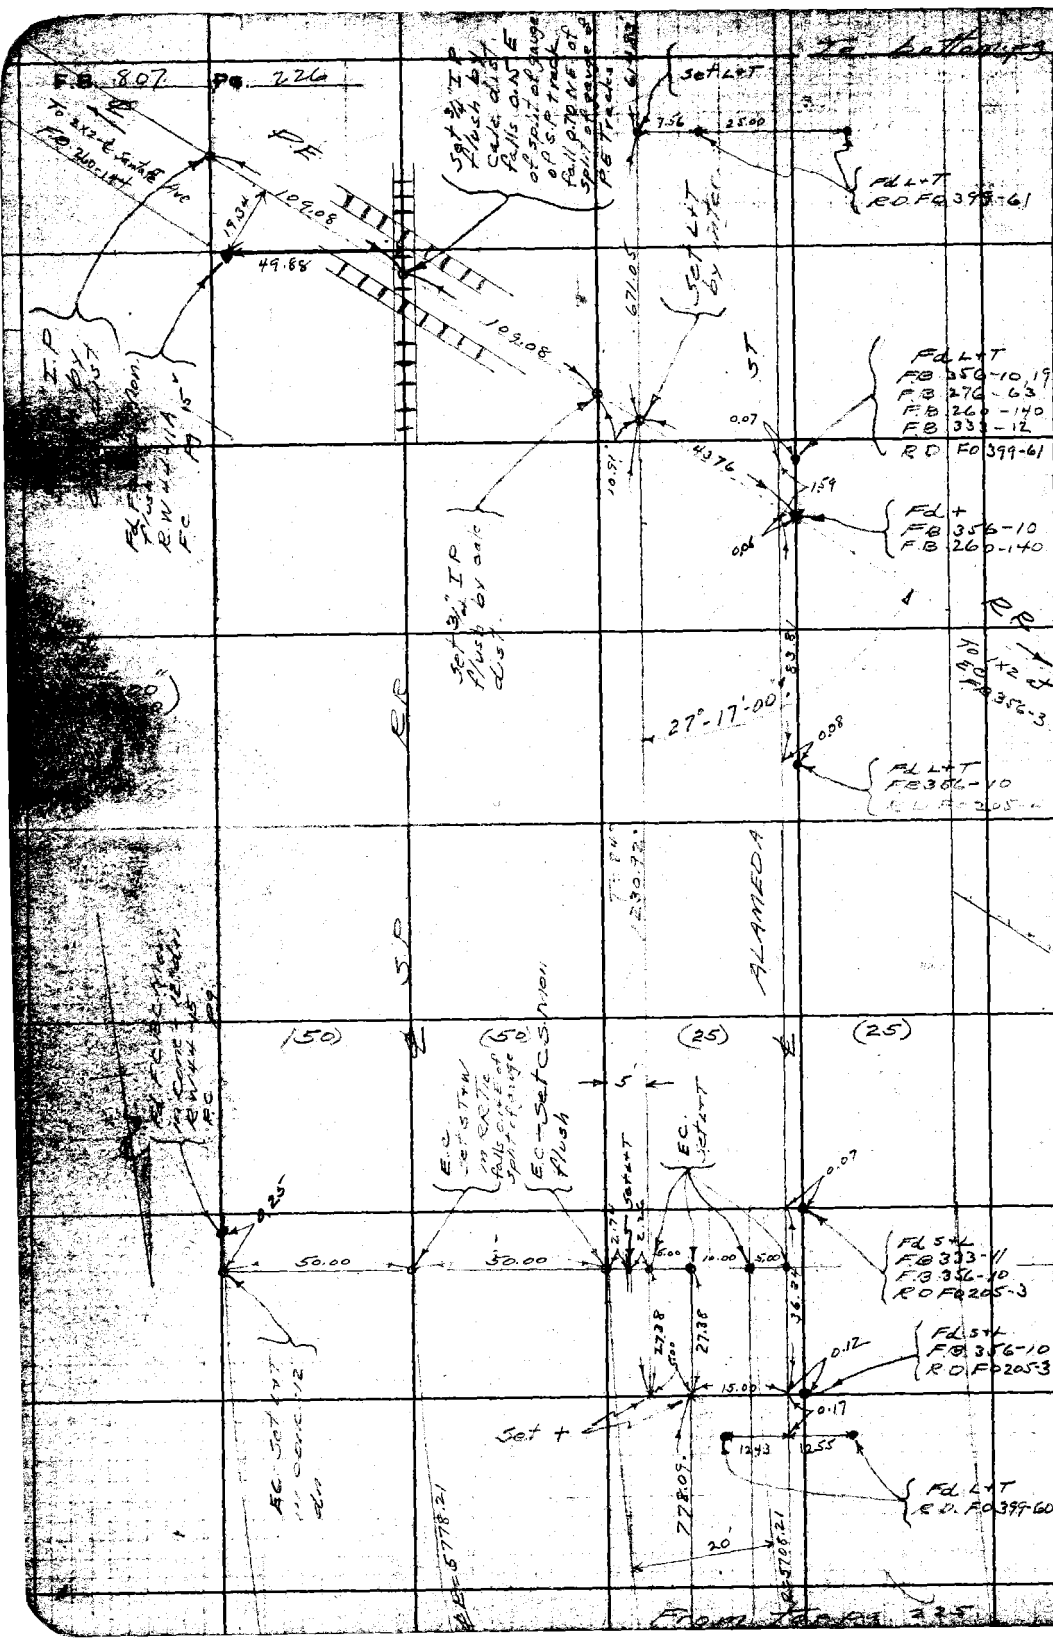

Return to
LOS ANGELES COUNTY SURVEYOR
700 HALL OF RECORDS

Do not extend notes this side of this line.

Note: Any Additions or Changes on This Sheet Must be Made or Circled in Red Ink With Date and Name of Person Making Change.

Notes Ck'd by D. M. Finley	Survey of Alameda St
Map No. [illegible]	W. O. 8270 Tape No. St'd 84°F
Office Work	Surveyed by Moore
Checked	Notes Moore Date 7-31-40
Date Mar. 1945.	Indexed

F.B. 807 PG. 227

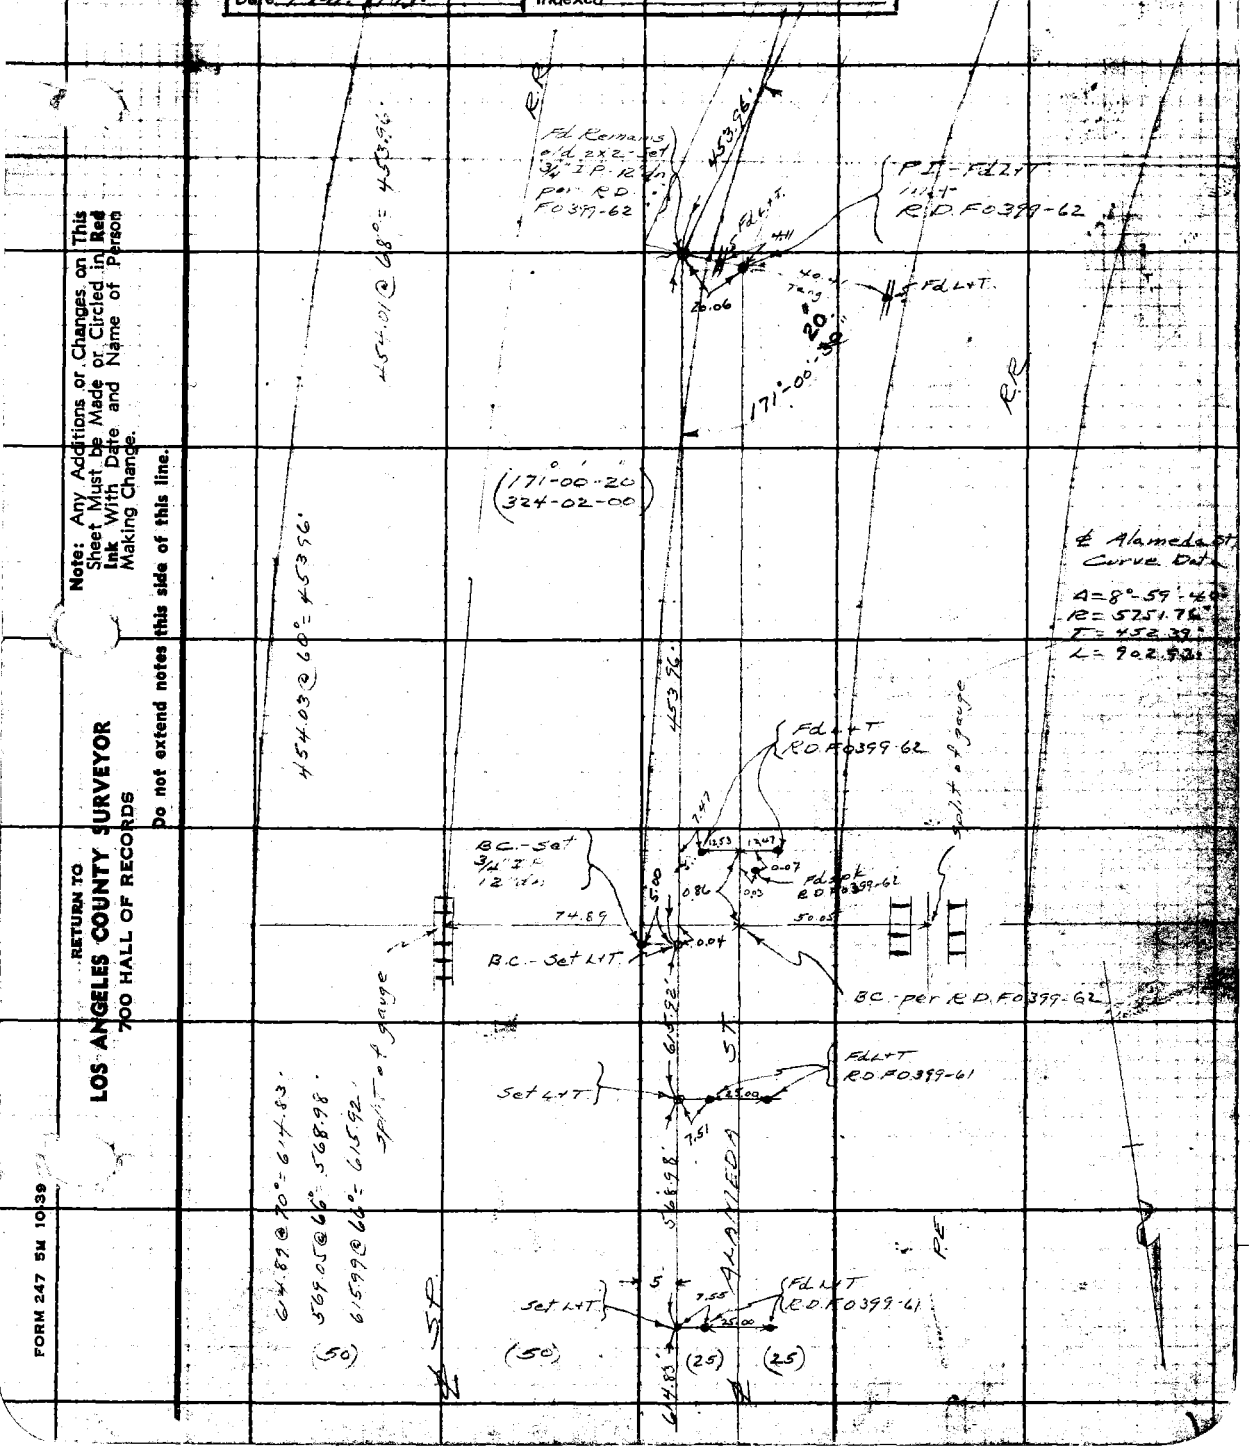

Note: Any Additions or Changes on This Sheet Must be Made or Circled in Red Ink With Date and Name of Person Making Change.

Do not extend notes this side of this line.

RETURN TO
LOS ANGELES COUNTY SURVEYOR
700 HALL OF RECORDS

FORM 247 5M 10-39

RETURN TO
LOS ANGELES COUNTY SURVEYOR
700 HALL OF RECORDS

Note: Any Additions or Changes on This Sheet Must be Made or Circled in Red Ink With Date and Name of Person Making Change.

Do not extend notes this side of this line.

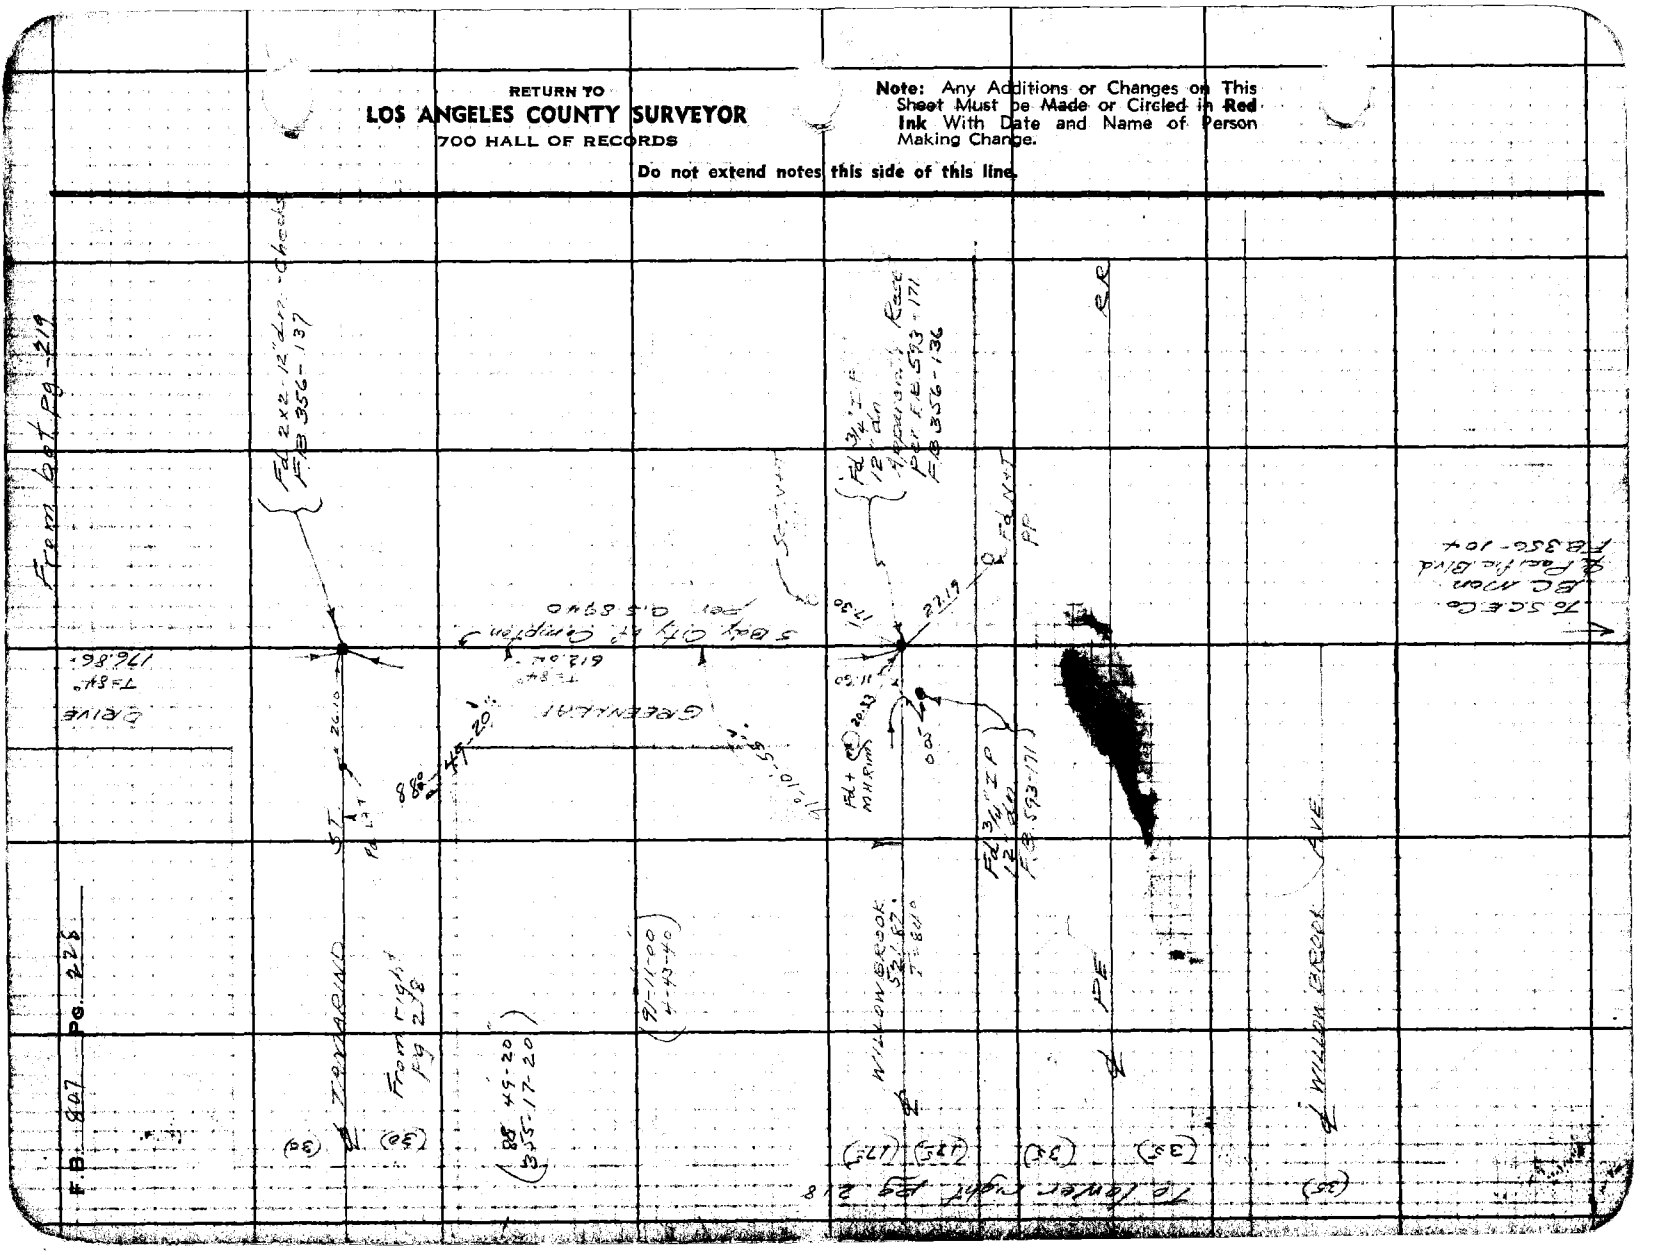

Notes Ck'd by D. M. Finley	Survey of Alameda St
Map No. [illegible] 1729-3	W. O. 8270 Tape No. 07 St'd 84°F
Office Work [illegible]	Surveyed by Moore
Checked [illegible]	Notes Moore Date 8-6-40
Date Mar. 1945	Indexed [illegible]

F.B. 507 PG. 229

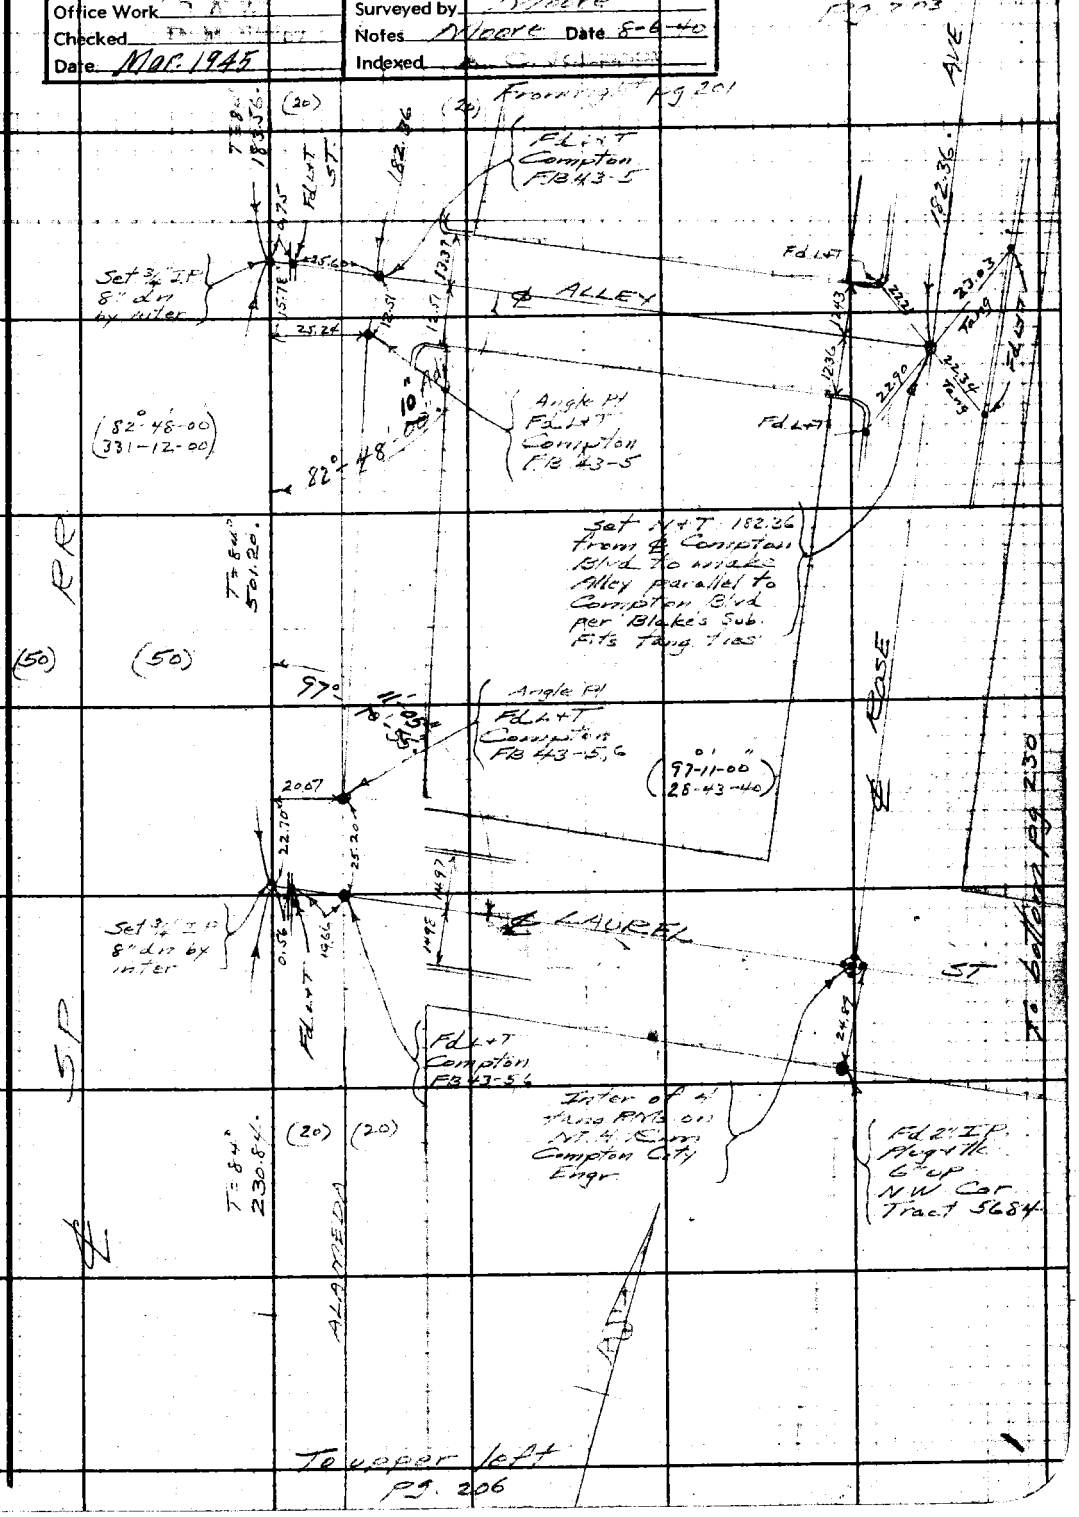

Note: Any Additions or Changes on This Sheet Must be Made or Circled in Red Ink With Date and Name of Person Making Change.

Do not extend notes this side of this line.

RETURN TO
LOS ANGELES COUNTY SURVEYOR
700 HALL OF RECORDS

FORM 247 5M 10-39

F.B. 807 Pg. 230

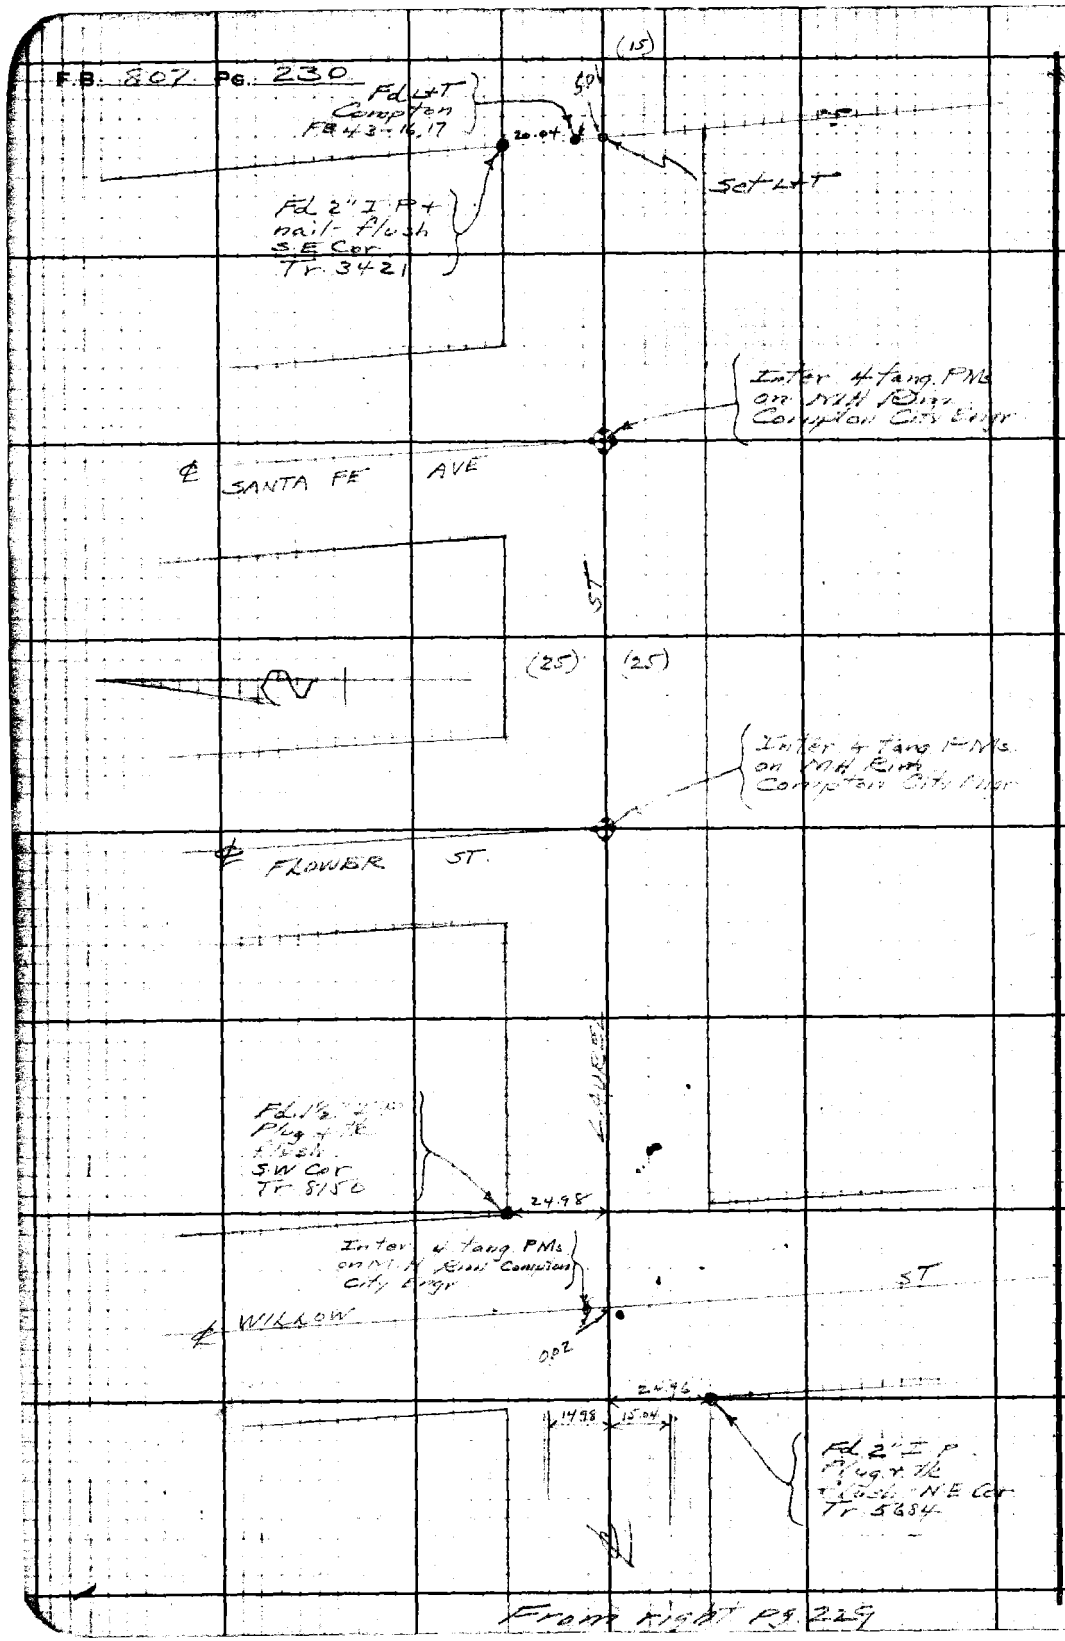

From Right Pg. 229

RETURN TO
LOS ANGELES COUNTY SURVEYOR
700 HALL OF RECORDS

Do not extend notes this side of this line

Note: Any Additions or Changes on This Sheet Must be Made or Circled in Red Ink With Date and Name of Person Making Change.

Notes Ck'd by D. M. Finley	Survey of Alameda St
Map No. [illegible] 1749-1	W. O. 8270 Tape No. ____ St'd ____ °F
Office Work ____	Surveyed by D Moore
Checked ____	Notes D Moore Date 9-25-40
Date MAY 1945	Indexed [illegible]

F.B. 807 PG. 231

LOCATION OF IMPROVEMENTS
ON
ALAMEDA ST
FROM
N. BOY. - CITY OF COMPTON
SOUTH 70

Job # 8270

[illegible]

Note: Any Additions or Changes on This Sheet Must be Made or Circled in Red Ink With Date and Name of Person Making Change.

Do not extend notes this side of this line.

RETURN TO
LOS ANGELES COUNTY SURVEYOR
700 HALL OF RECORDS

FORM 247 5M 10-39

RETURN TO
LOS ANGELES COUNTY SURVEYOR
700 HALL OF RECORDS

Note: Any Additions or Changes on This Sheet Must be Made or Circled in Red Ink With Date and Name of Person Making Change.

Do not extend notes this side of this line.

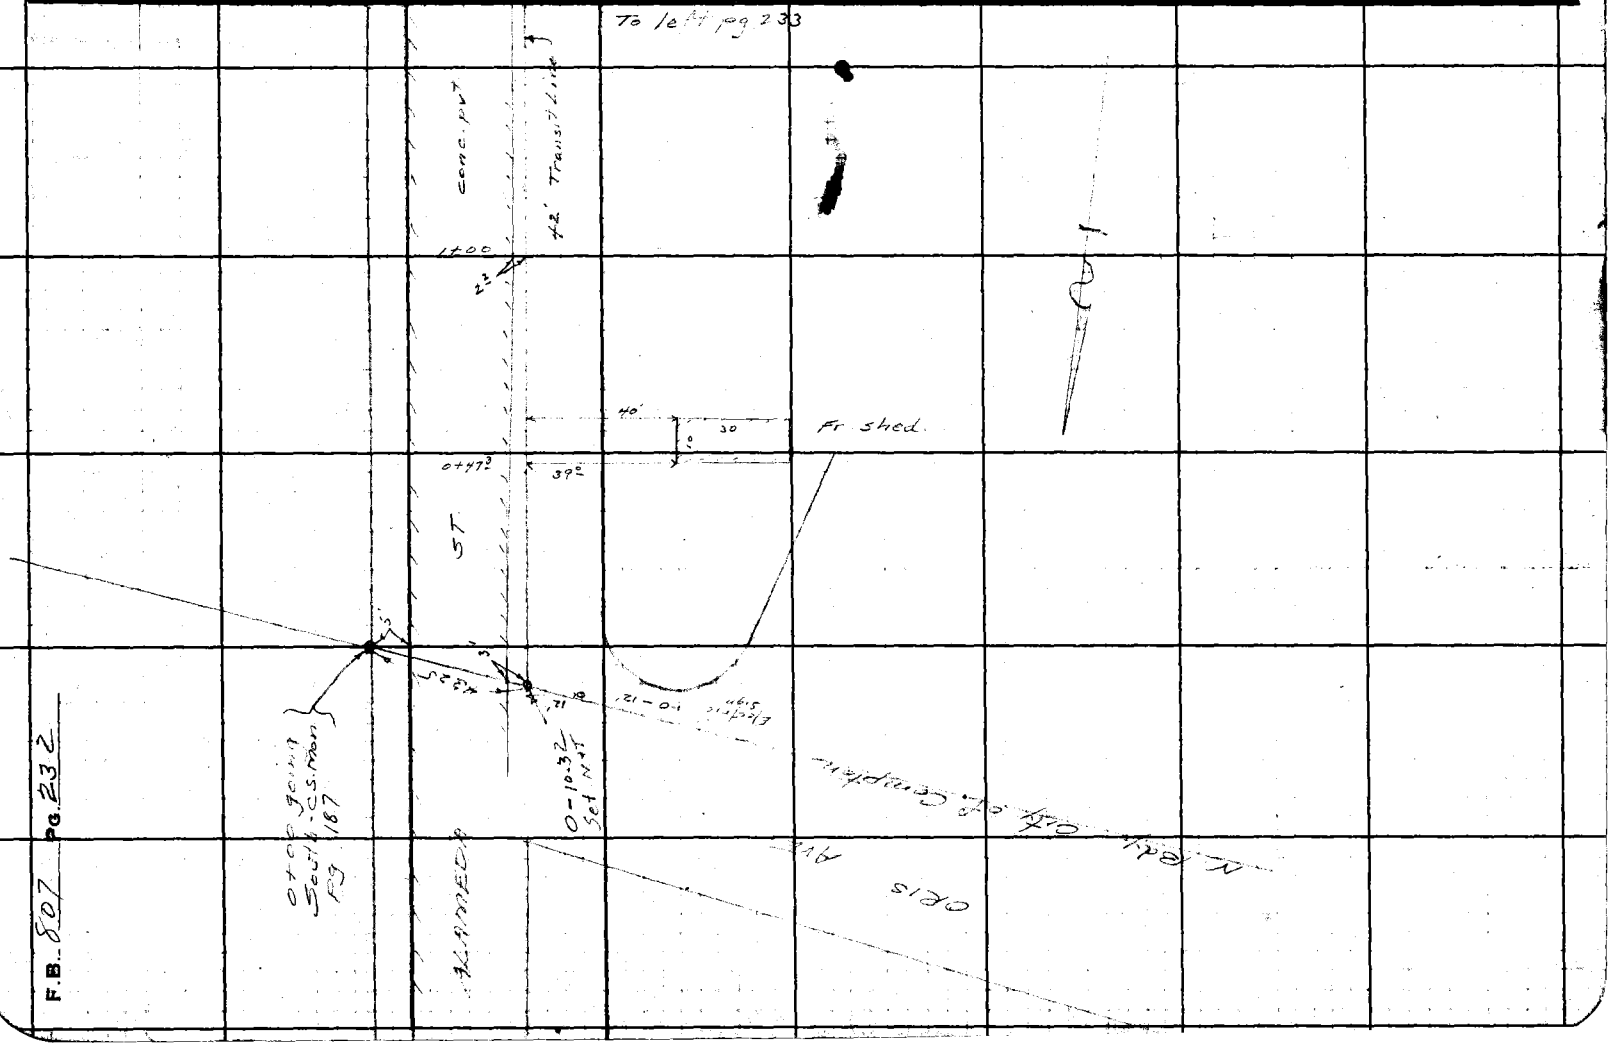

F.B. 807 PG. 232

F.B. 807 PG. 233

Notes Ck'd by D. M. Finley	Survey of [illegible]
Map No. [illegible]	W. O. 82-70 Tape No. Std. °F
Office Work	Surveyed by Moore
Checked	Notes Moore Date 7-25-42
Date Mar. 1945	Indexed

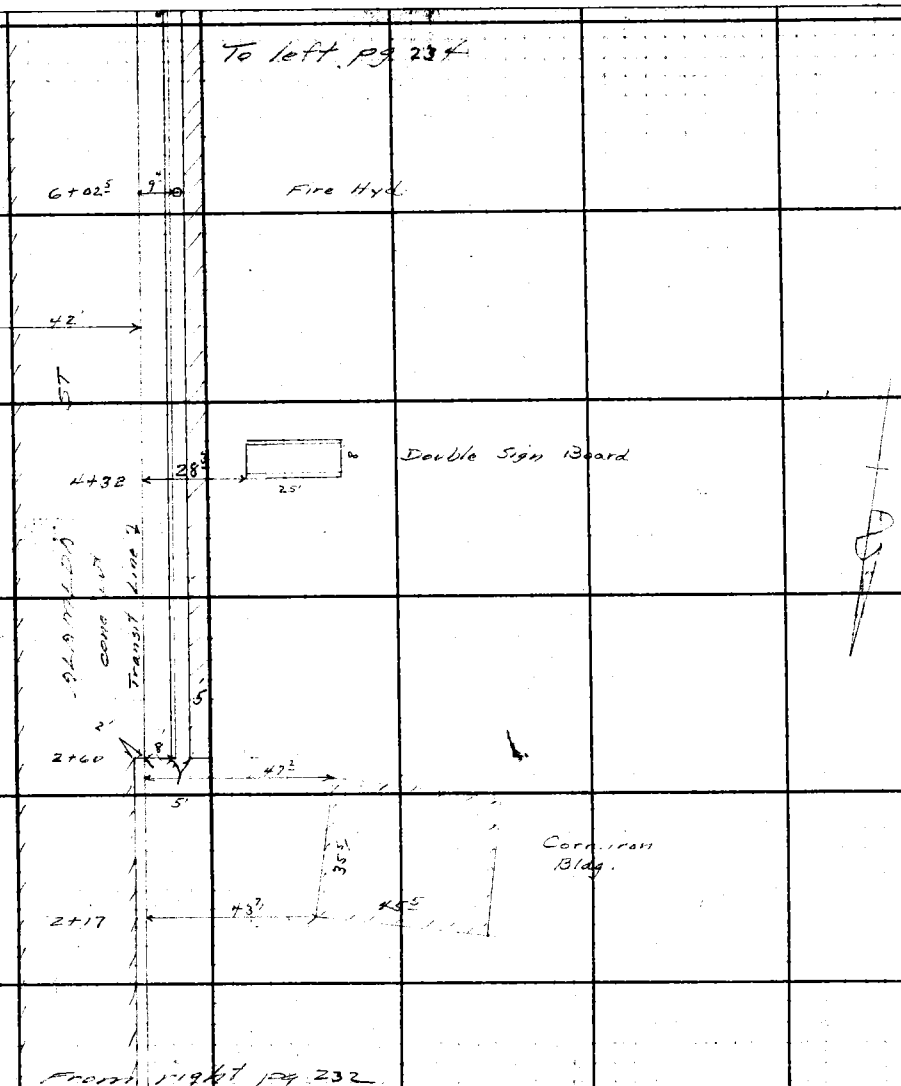

RETURN TO
LOS ANGELES COUNTY SURVEYOR
700 HALL OF RECORDS

Do not extend notes a side of this line.

Note: Any Additions or Changes on This Sheet Must be Made or Circled in Red Ink With Date and Name of Person Making Change

RETURN TO
LOS ANGELES COUNTY SURVEYOR
700 HALL OF RECORDS

Note: Any Additions or Changes on This Sheet Must be Made or Circled in **Red Ink** With Date and Name of Person Making Change.

Do not extend notes this side of this line.

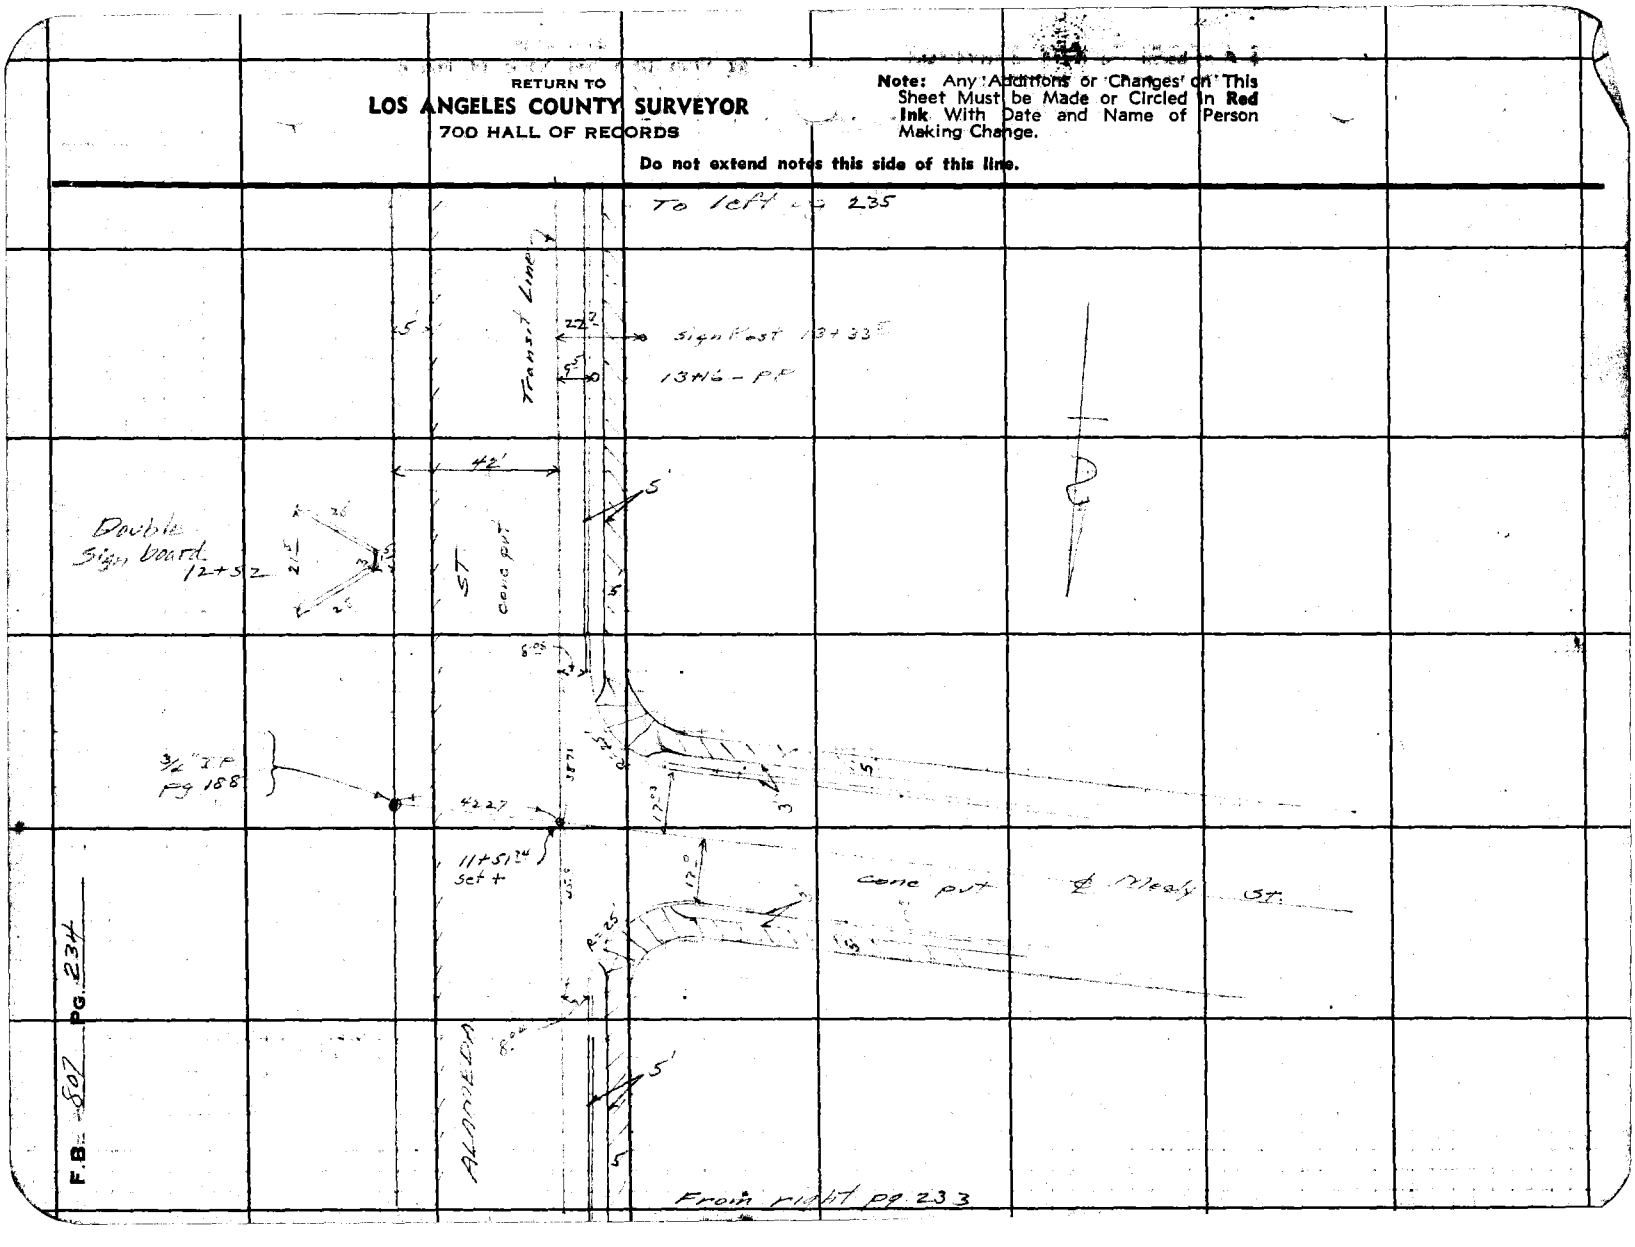

F.B. 807 PG. 234

Notes Ck'd by D. M. Finley	Survey of Alameda St	F.B. 807 PG. 235
Map No. ~~B-1729~~ B-1729-1	W. O. 8270 Tape No. ____ St'd ____ °F	
Office Work	Surveyed by Moore	
Checked	Notes Moore Date 9-25-40	
Date Mar. 1945.	Indexed	

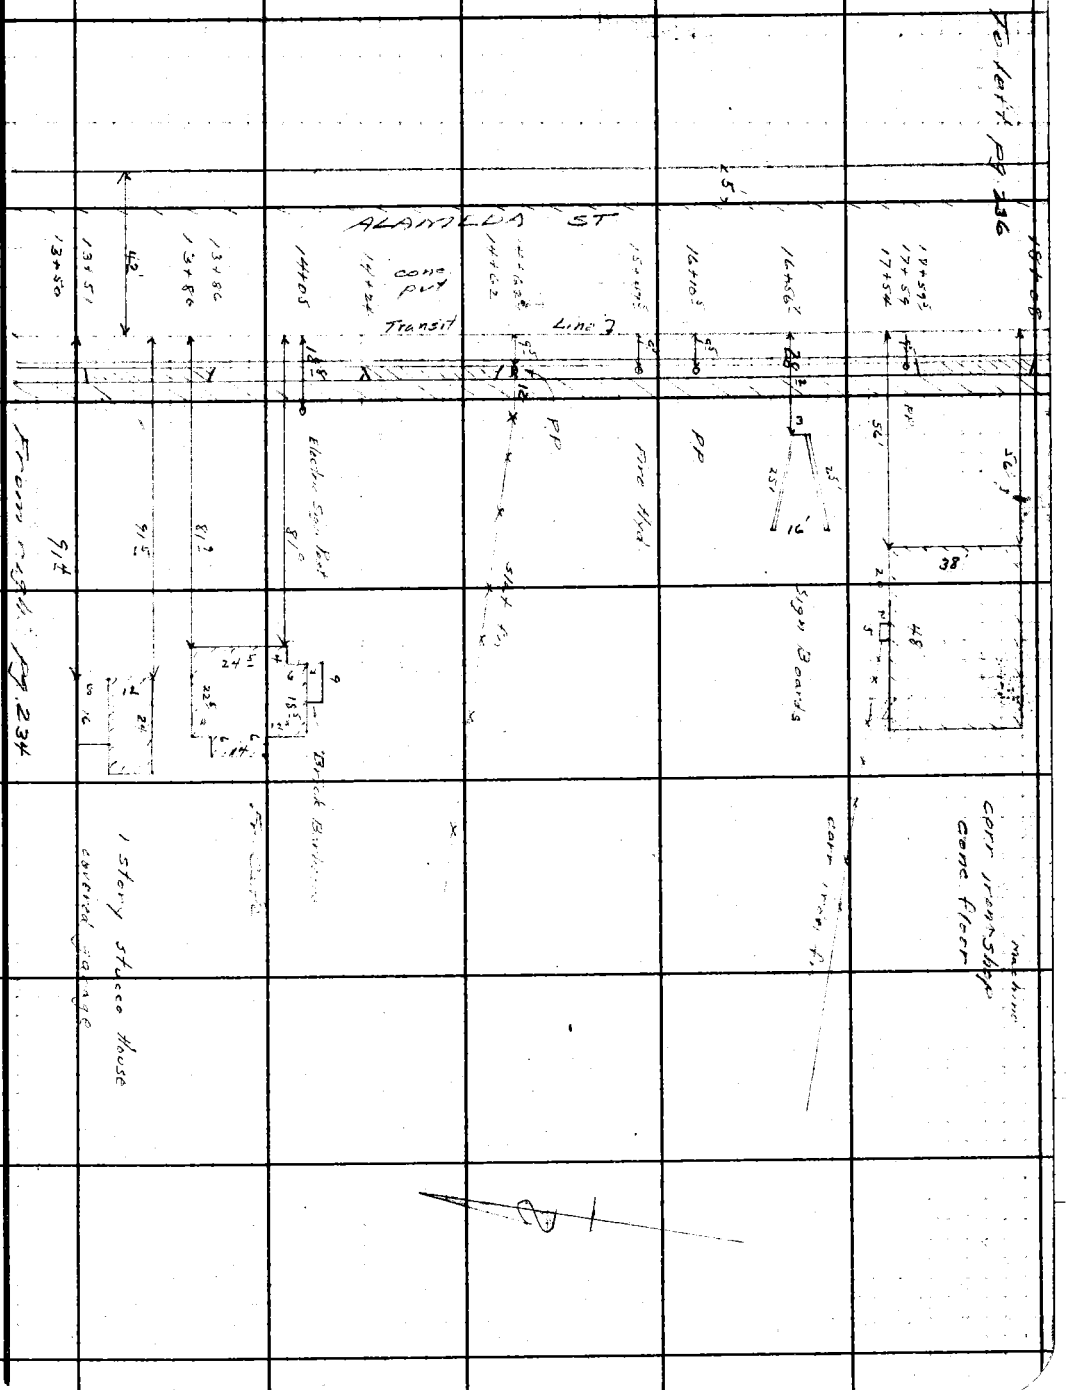

Note: Any Additions or Changes on This Sheet Must be Made or Circled in Red Ink With Date and Name of Person Making Change.

Do not extend notes this side of this line.

RETURN TO
LOS ANGELES COUNTY SURVEYOR
700 HALL OF RECORDS

FORM 247 5M 10-39

RETURN TO
LOS ANGELES COUNTY SURVEYOR
700 HALL OF RECORDS

Note: Any Additions or Changes on This Sheet Must be Made or Circled in Red Ink With Date and Name of Person Making Change.

Do not extend notes this side of this line.

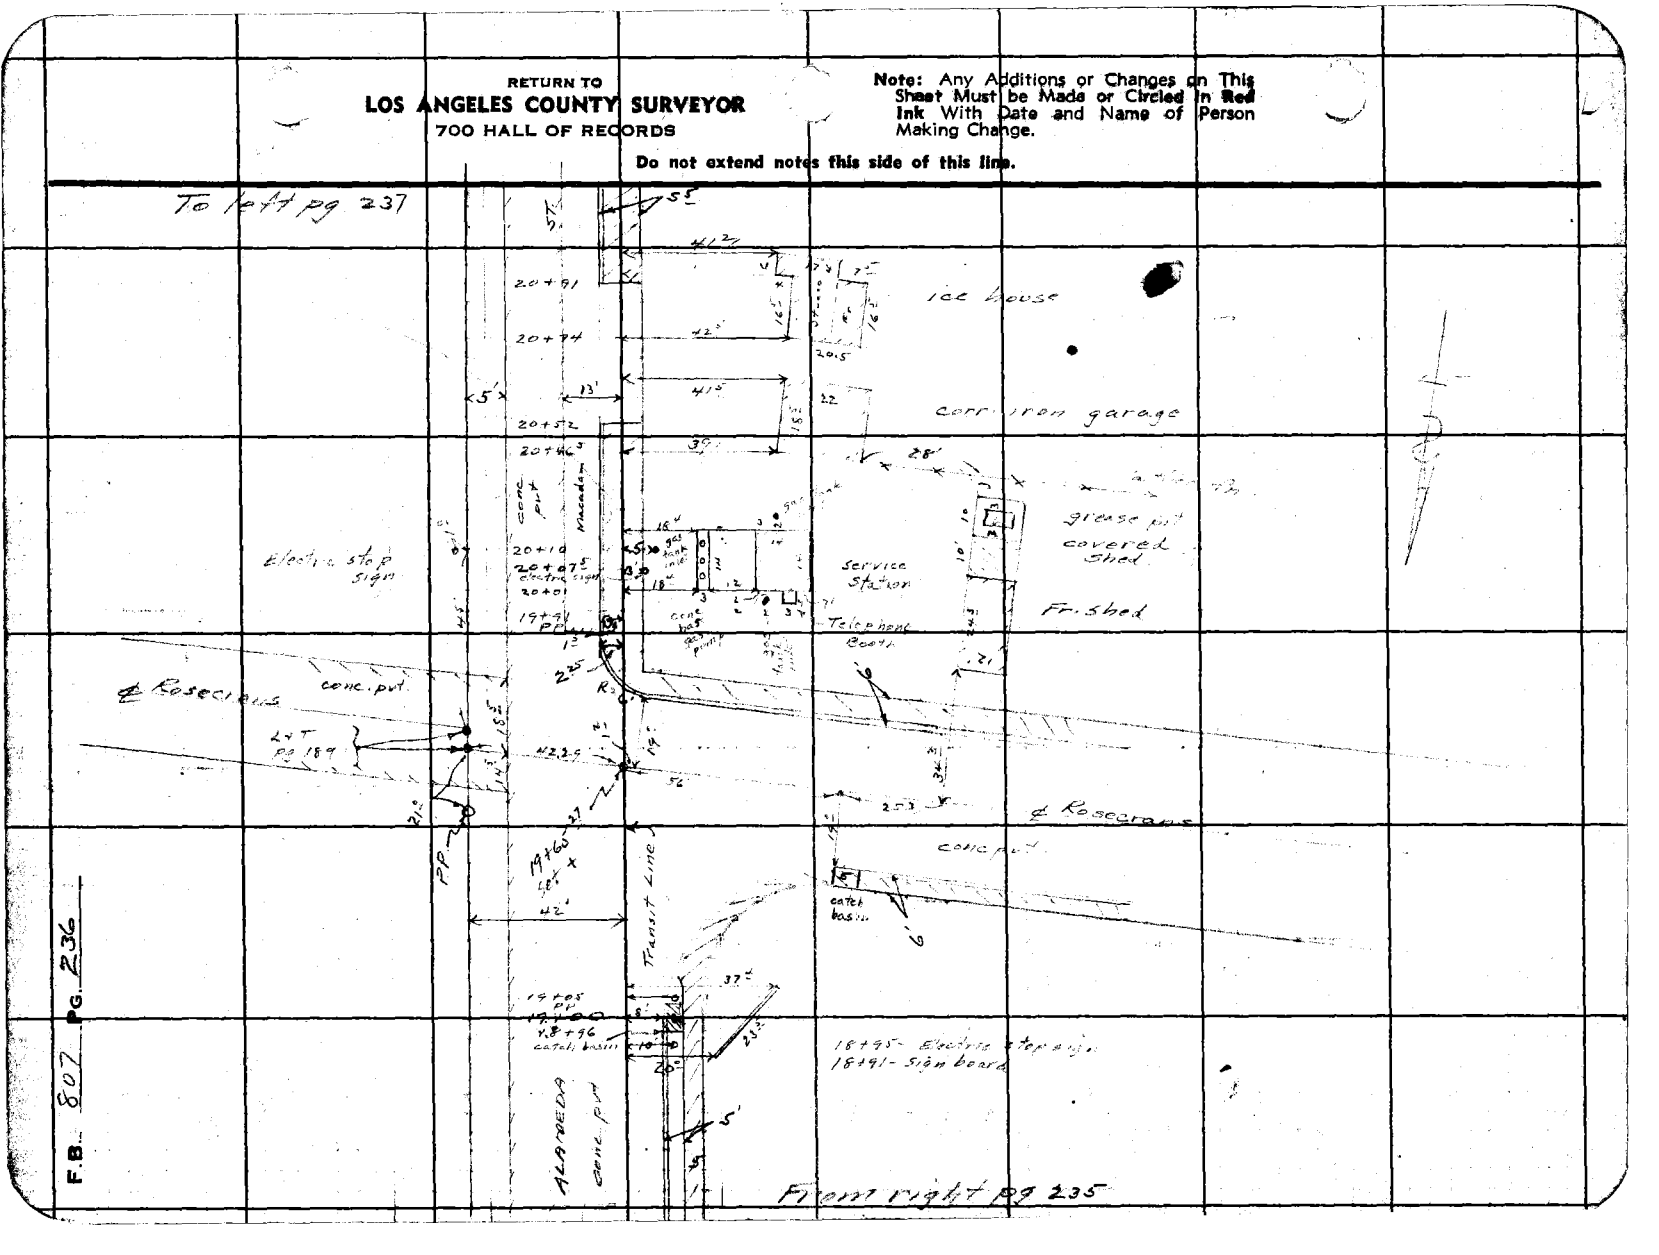

F.B. 807 PG. 236

Notes Ck'd by D. M. Finley	Survey of Alameda ST
Map No. ~~B-1496~~ B-1729-1	W. O. 8270 Tape No. St'd. °F
Office Work	Surveyed by Moore
Checked	Notes Moore Date 9-25-40
Date Mar. 1945.	Indexed

F.B. 807 Pg. 237

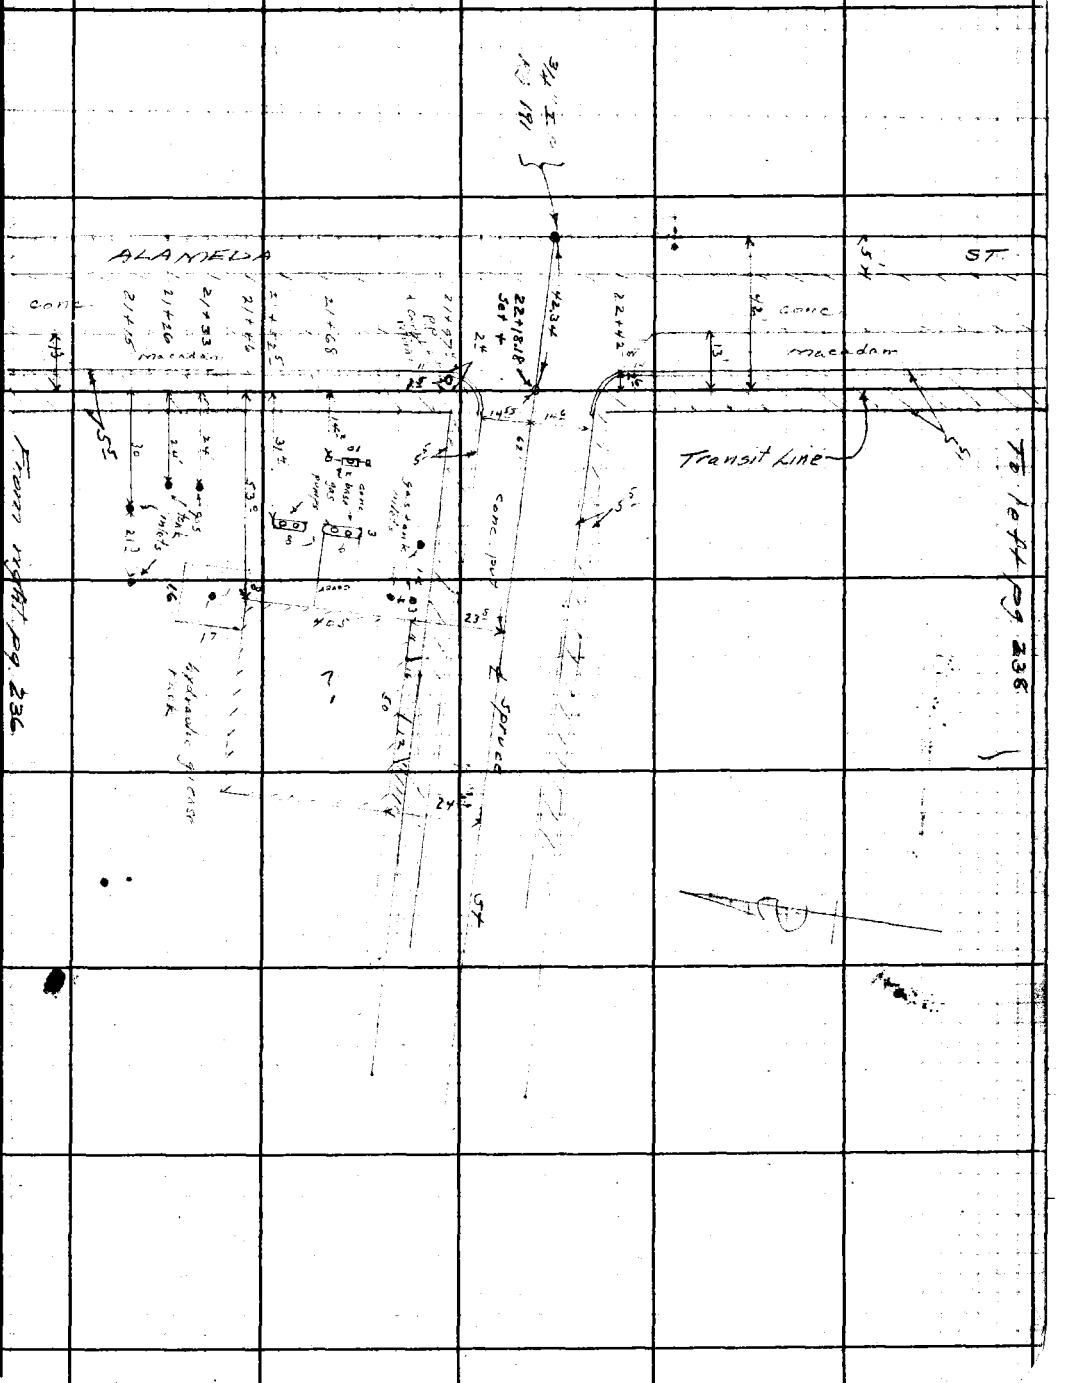

Note: Any Additions or Changes on This Sheet Must be Made or Circled in Red Ink With Date and Name of Person Making Change

Do not extend notes this side of this line.

RETURN TO
LOS ANGELES COUNTY SURVEYOR
700 HALL OF RECORDS

FORM 247 5M 10-59

RETURN TO
LOS ANGELES COUNTY SURVEYOR
700 HALL OF RECORDS

Note: Any Additions or Changes on This Sheet Must be Made or Circled in Red Ink With Date and Name of Person Making Change.

Do not extend notes this side of this line.

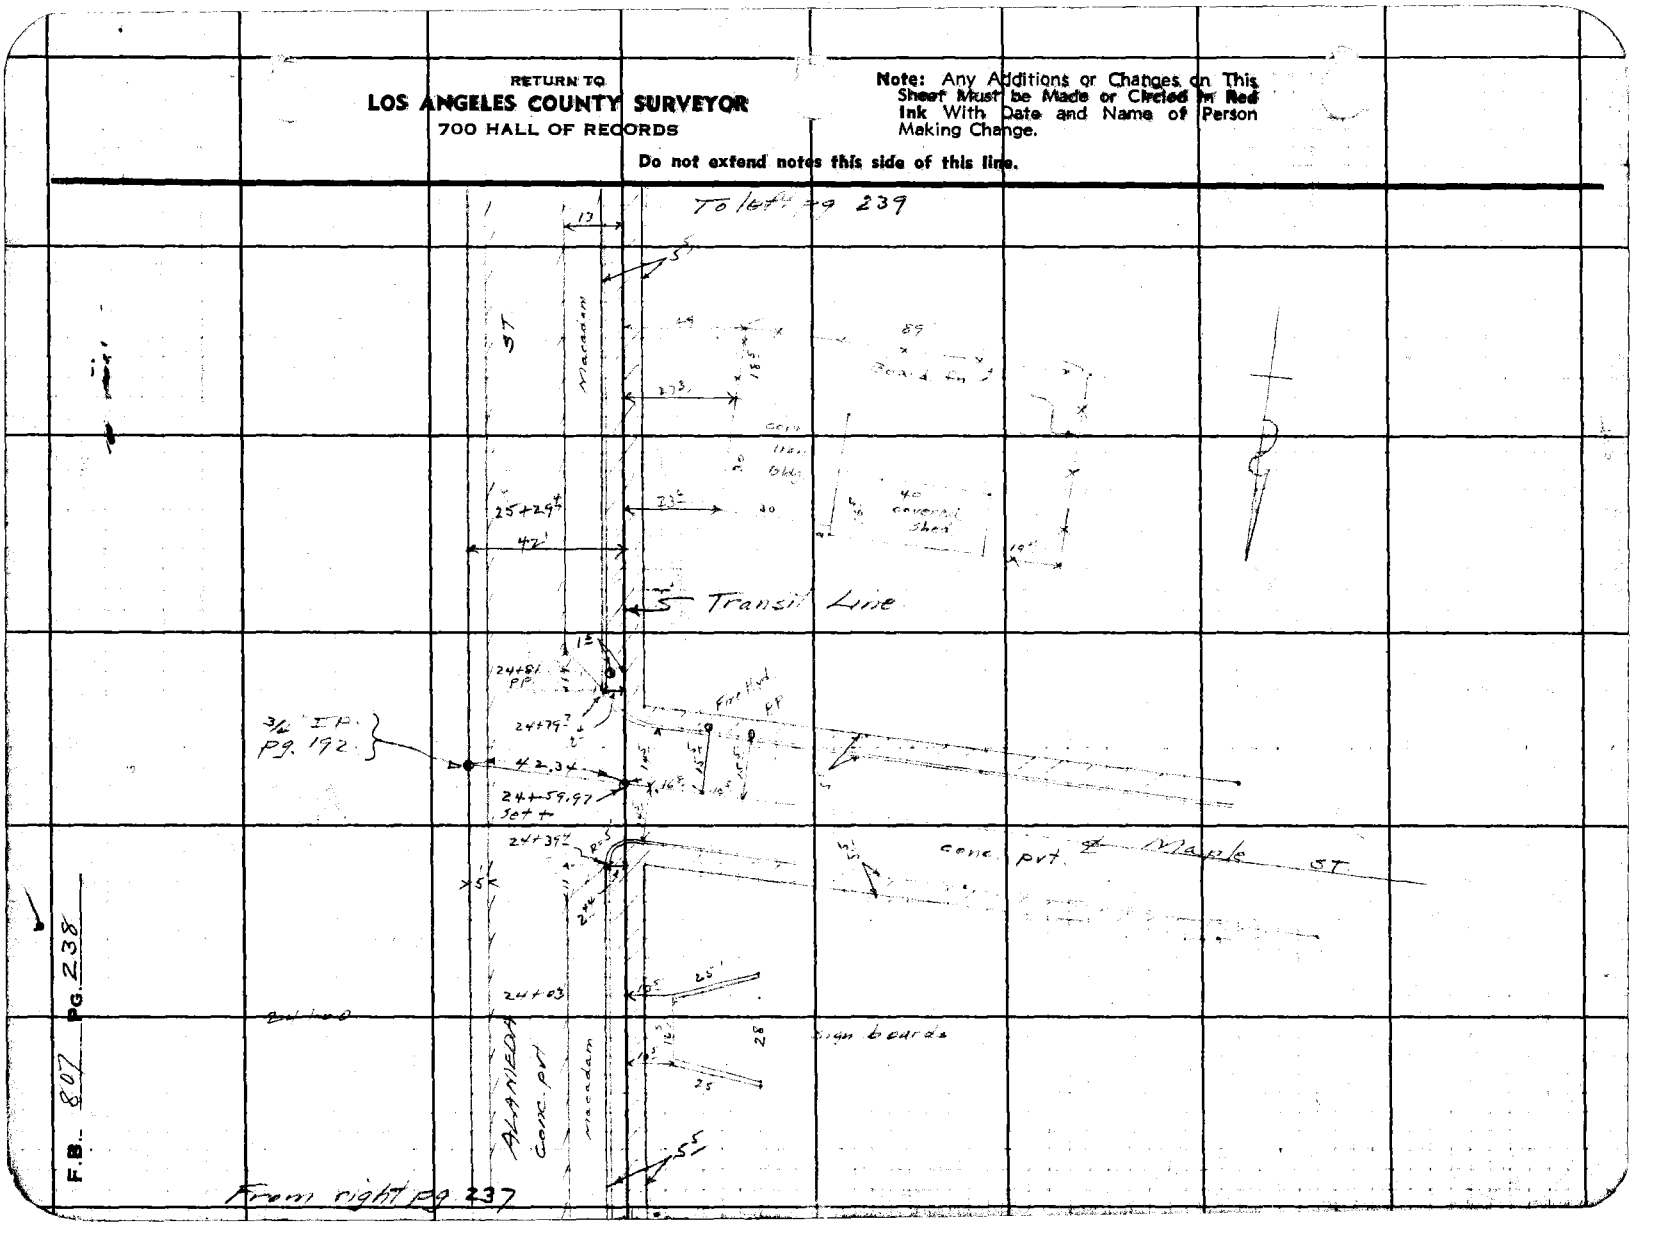

F.B. 807 PG. 238

FORM 247 5M 10-39

RETURN TO
LOS ANGELES COUNTY SURVEYOR
700 HALL OF RECORDS

Note: Any Additions or Changes on This Sheet Must be Made or Circled in **Red Ink** With Date and Name of Person Making Change.

Do not extend notes this side of this line.

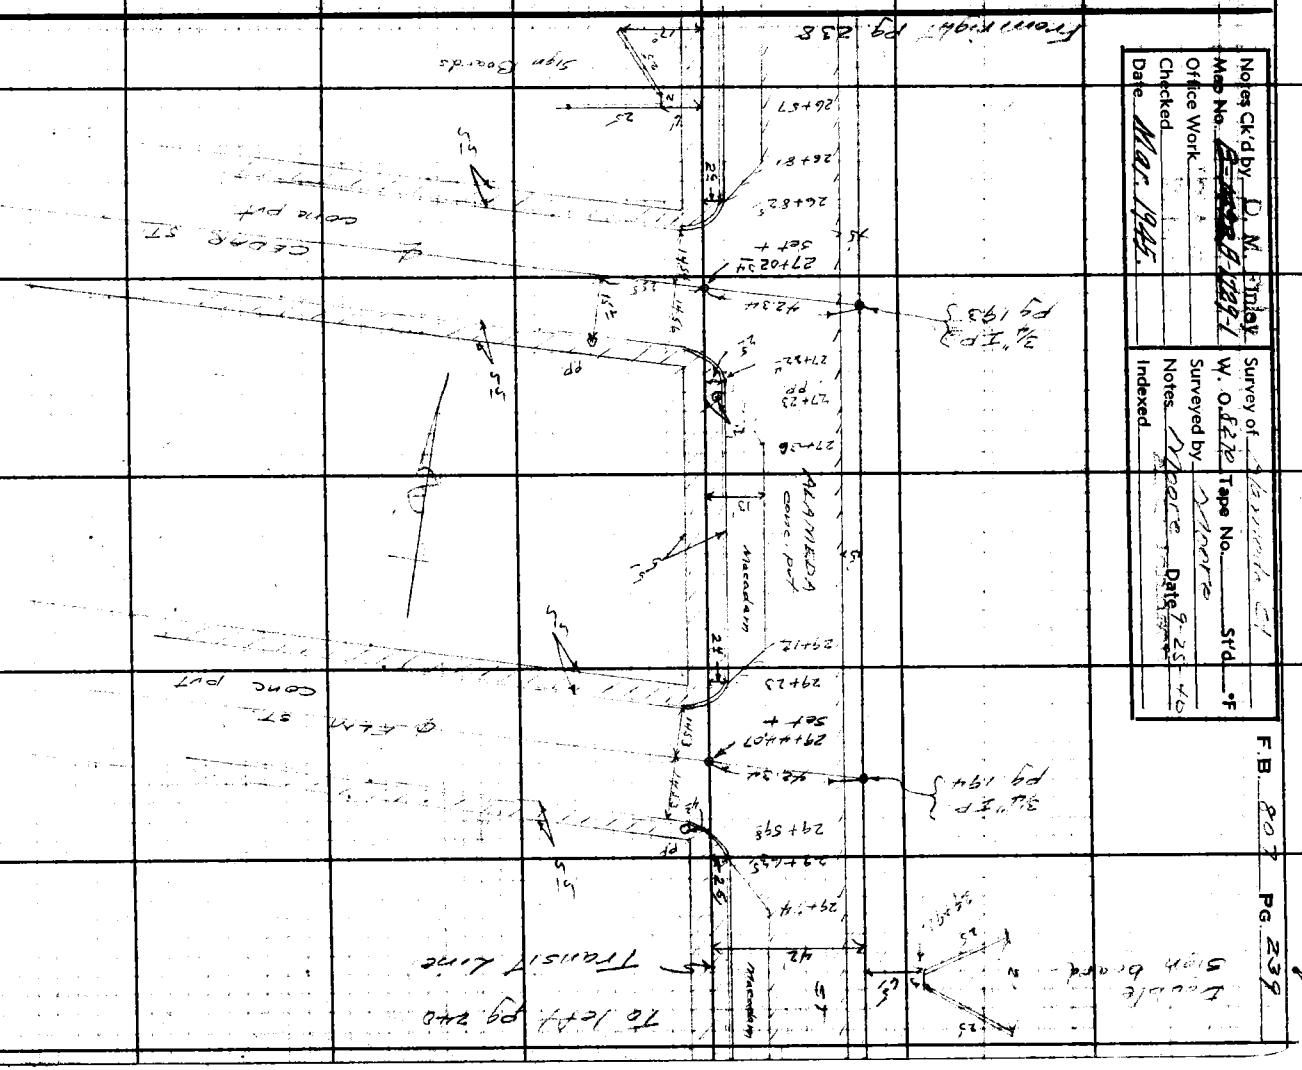
From right pg. 238
Sign Boards
To left pg. 240
Transit Line
Alameda St
Conc. pvt
Alameda Conc. pvt
Alameda St
Conc pvt
3¼" I.P.
pg 193
3¼" I.P.
pg 194
Alameda
Alameda
26+57
26+81
26+82½
27+02½
27+25
27+48
29+12
29+23
29+44.07
29+59
29+65
29+74
42
42.34
42.34
42.34

RETURN TO
LOS ANGELES COUNTY SURVEYOR
700 HALL OF RECORDS

Note: Any Additions or Changes on This Sheet Must be Made or Circled in Red Ink With Date and Name of Person Making Change.

Do not extend notes this side of this line.

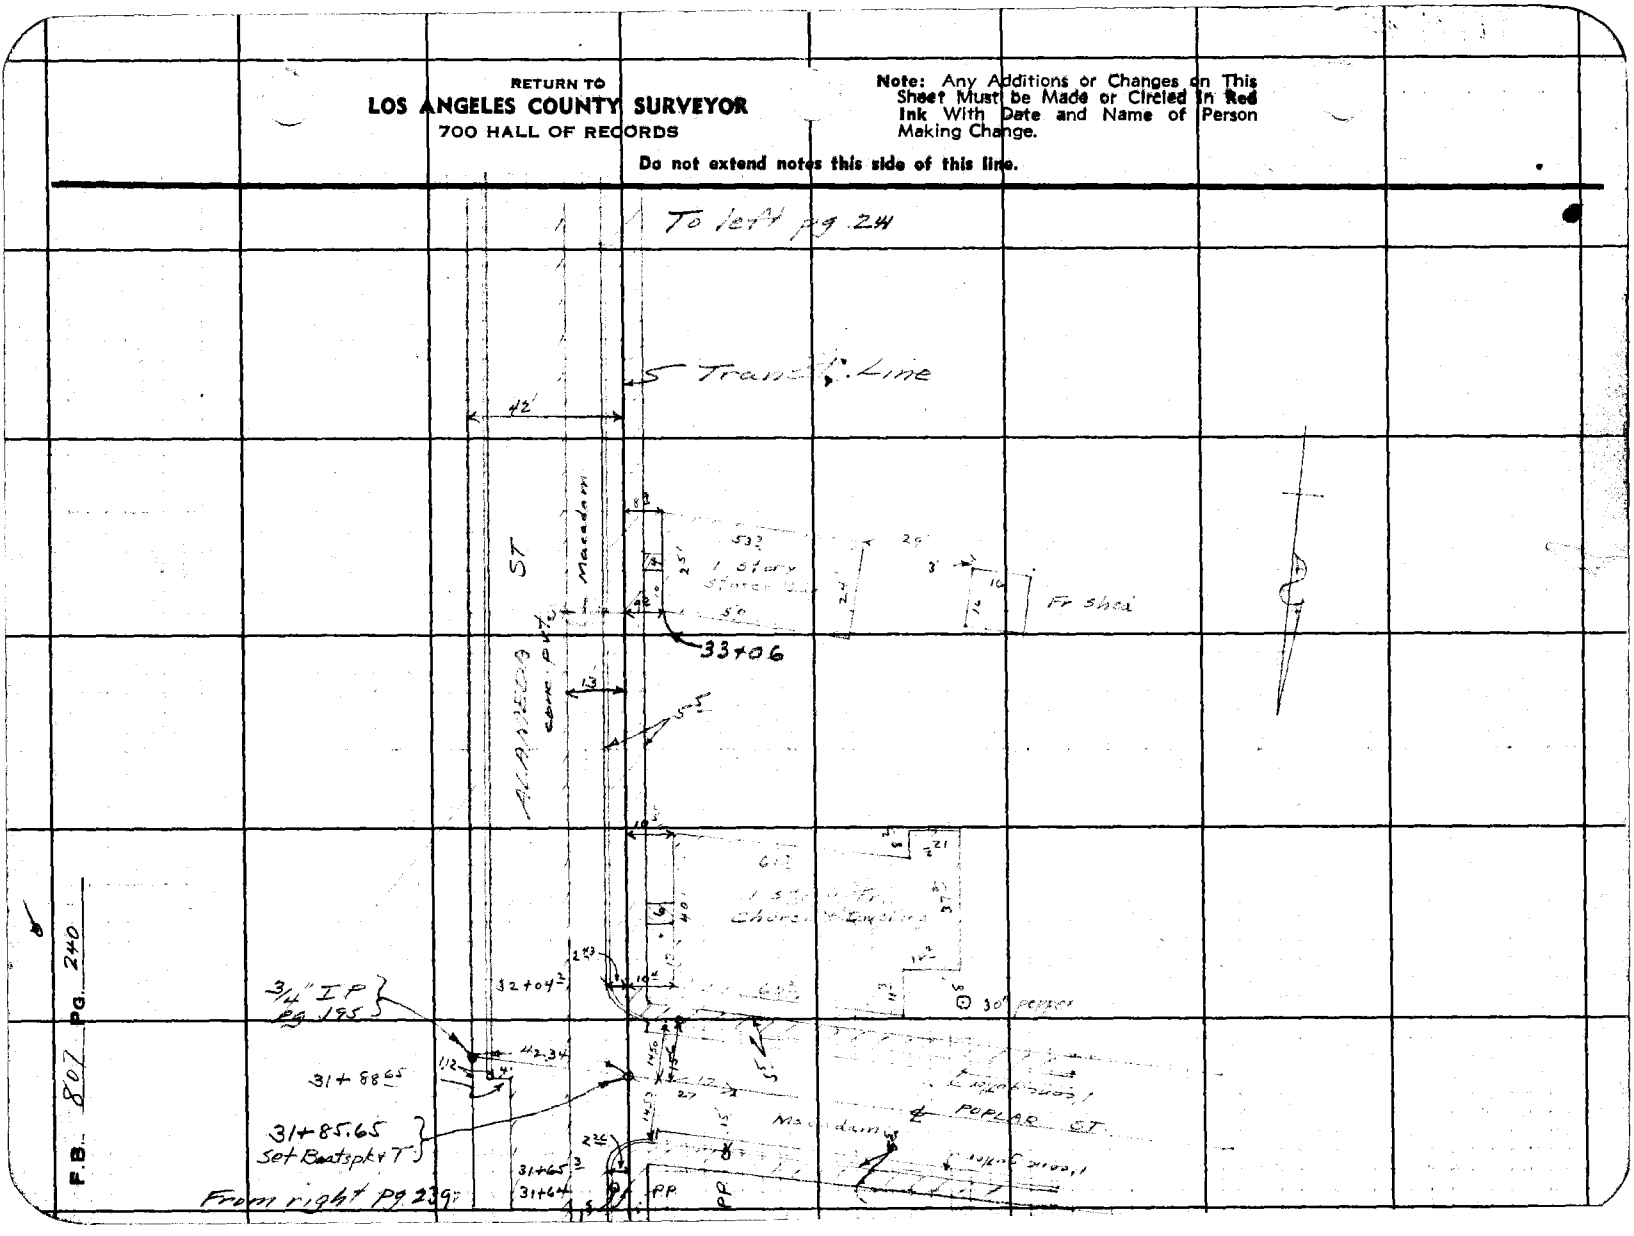

Notes Ck'd by D. M. Finley	Survey of Alameda St.	F.B. 807 PG. 241
Map No. ~~B-1498~~ B-1729-1	W. O. 8270 Tape No. ____ St'd ____ °F	
Office Work	Surveyed by Moore	
Checked	Notes Moore Date 9-26-40	
Date Mar. 1945.	Indexed	

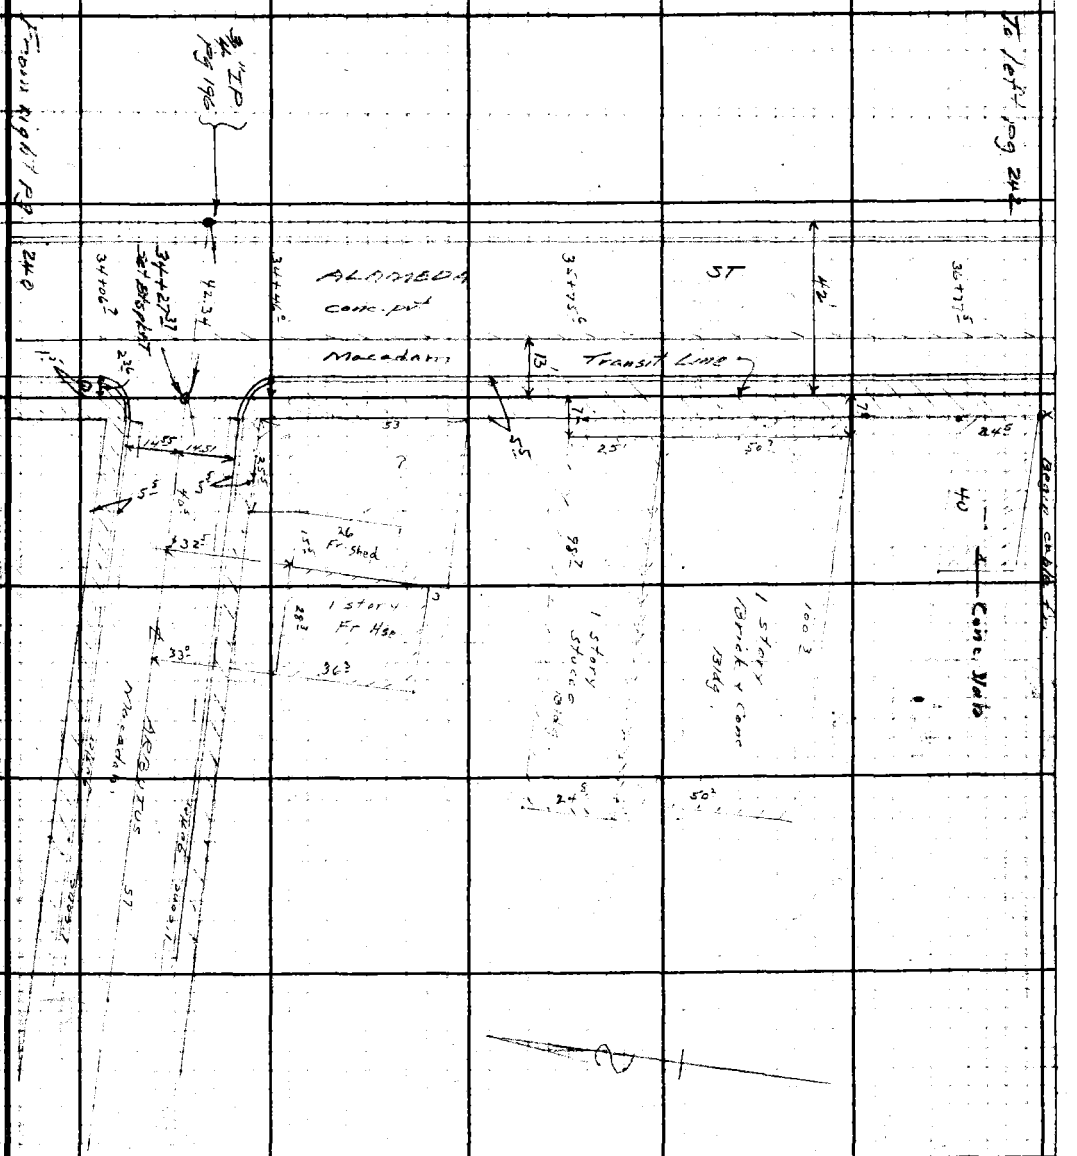

Note: Any Additions or Changes on This Sheet Must be Made or Circled in Red Ink With Date and Name of Person Making Change.

Do not extend notes this side of this line.

RETURN TO
LOS ANGELES COUNTY SURVEYOR
700 HALL OF RECORDS

FORM 247 5M 10-39

RETURN TO
LOS ANGELES COUNTY SURVEYOR
700 HALL OF RECORDS

Note: Any Additions or Changes on This Sheet Must be Made or Circled in Red Ink With Date and Name of Person Making Change.

Do not extend notes this side of this line.

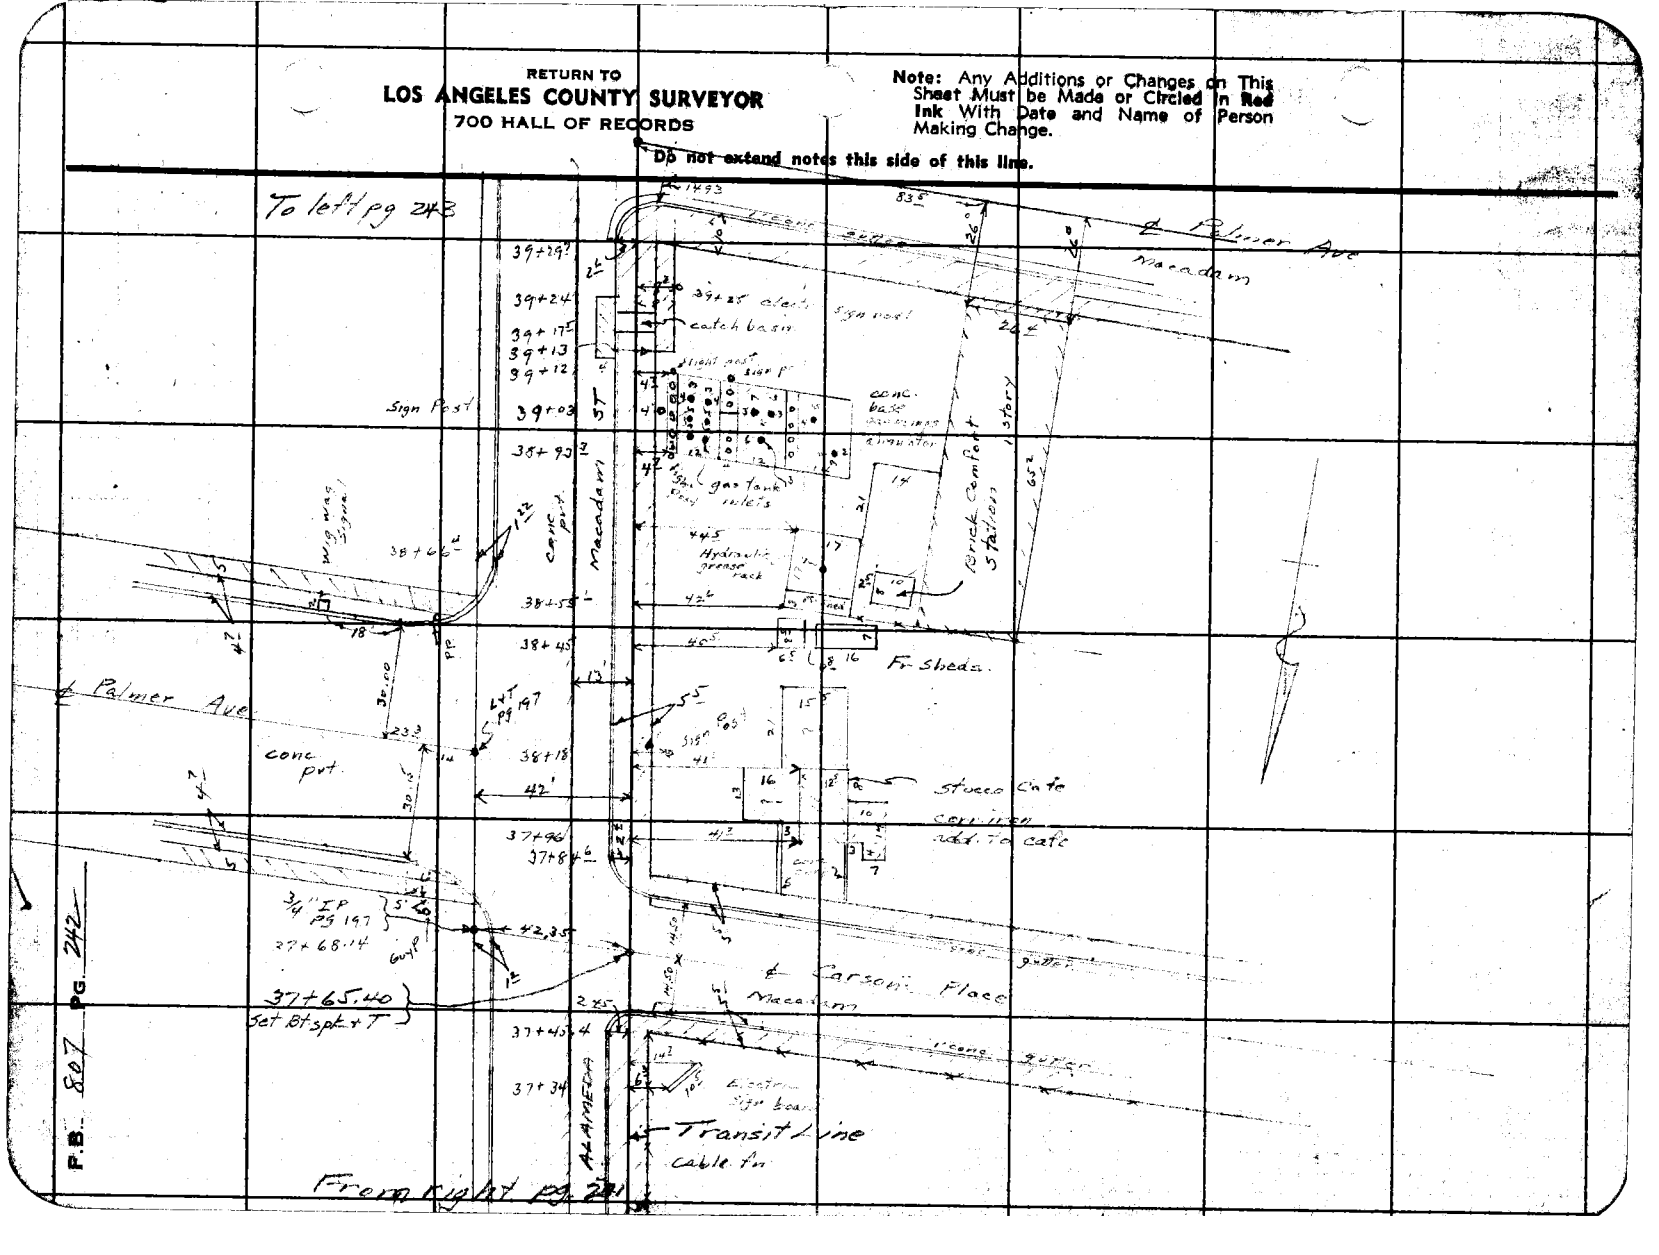

Notes Ck'd by D. M. Finley	Survey of Alameda St
Map No. ~~B-1498~~ B-1729-1	W. O. 8270 Tape No. ____ St'd ____ °F
Office Work ____	Surveyed by Moore
Checked ____	Notes Moore Date 9-26-40
Date Mar. 1945	Indexed E. O. Johnson

F.B. 807 PG. 243

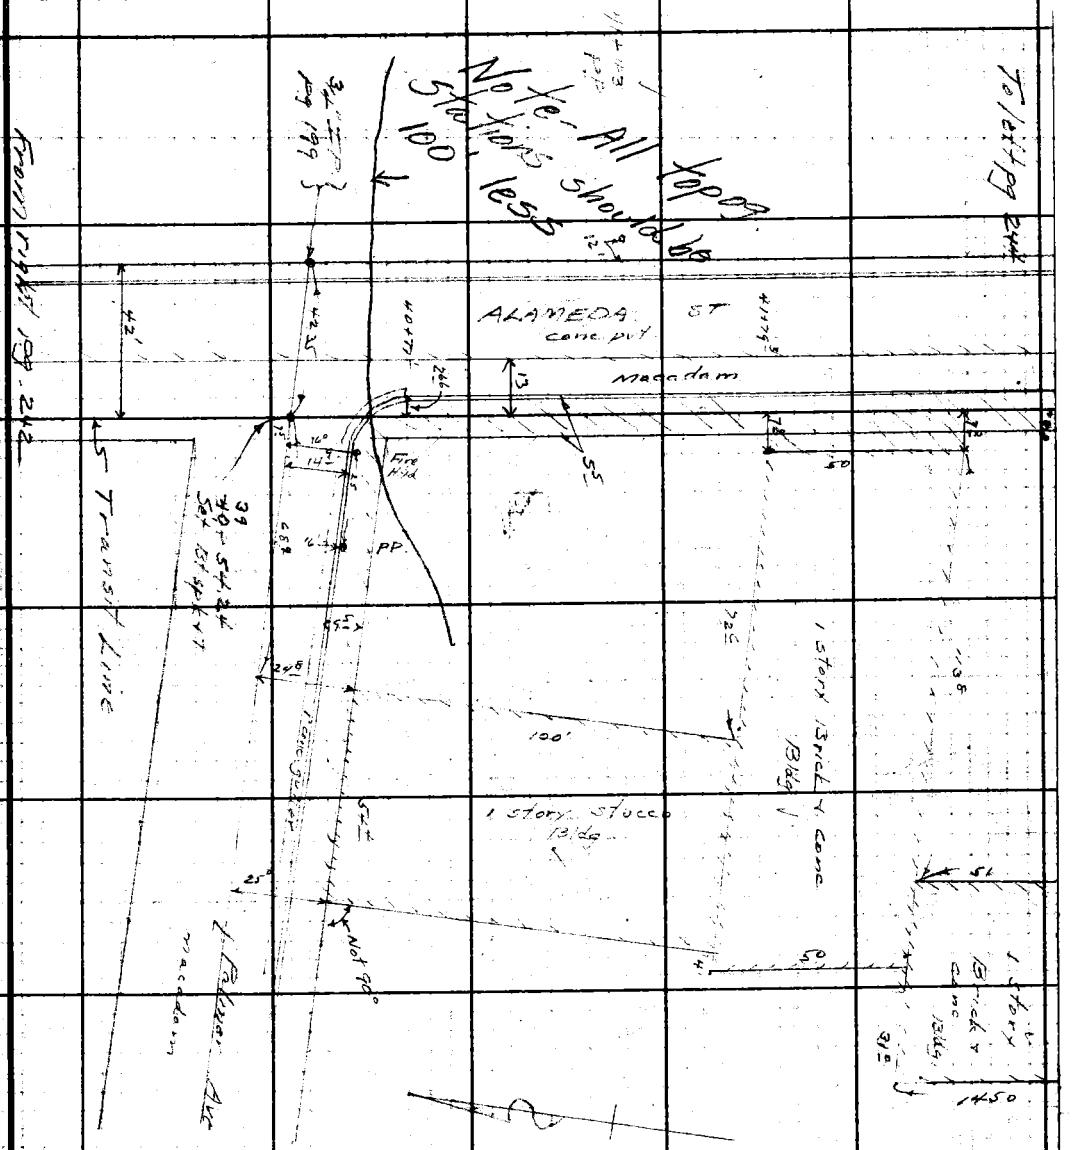

Note: Any Additions or Changes on This Sheet Must be Made or Circled in Red Ink With Date and Name of Person Making Change.

Do not extend notes this side of this line.

RETURN TO
LOS ANGELES COUNTY SURVEYOR
700 HALL OF RECORDS

FORM 247 5M 10-39

F.B. 807 PG. 244

Topog. stations should be 100' less

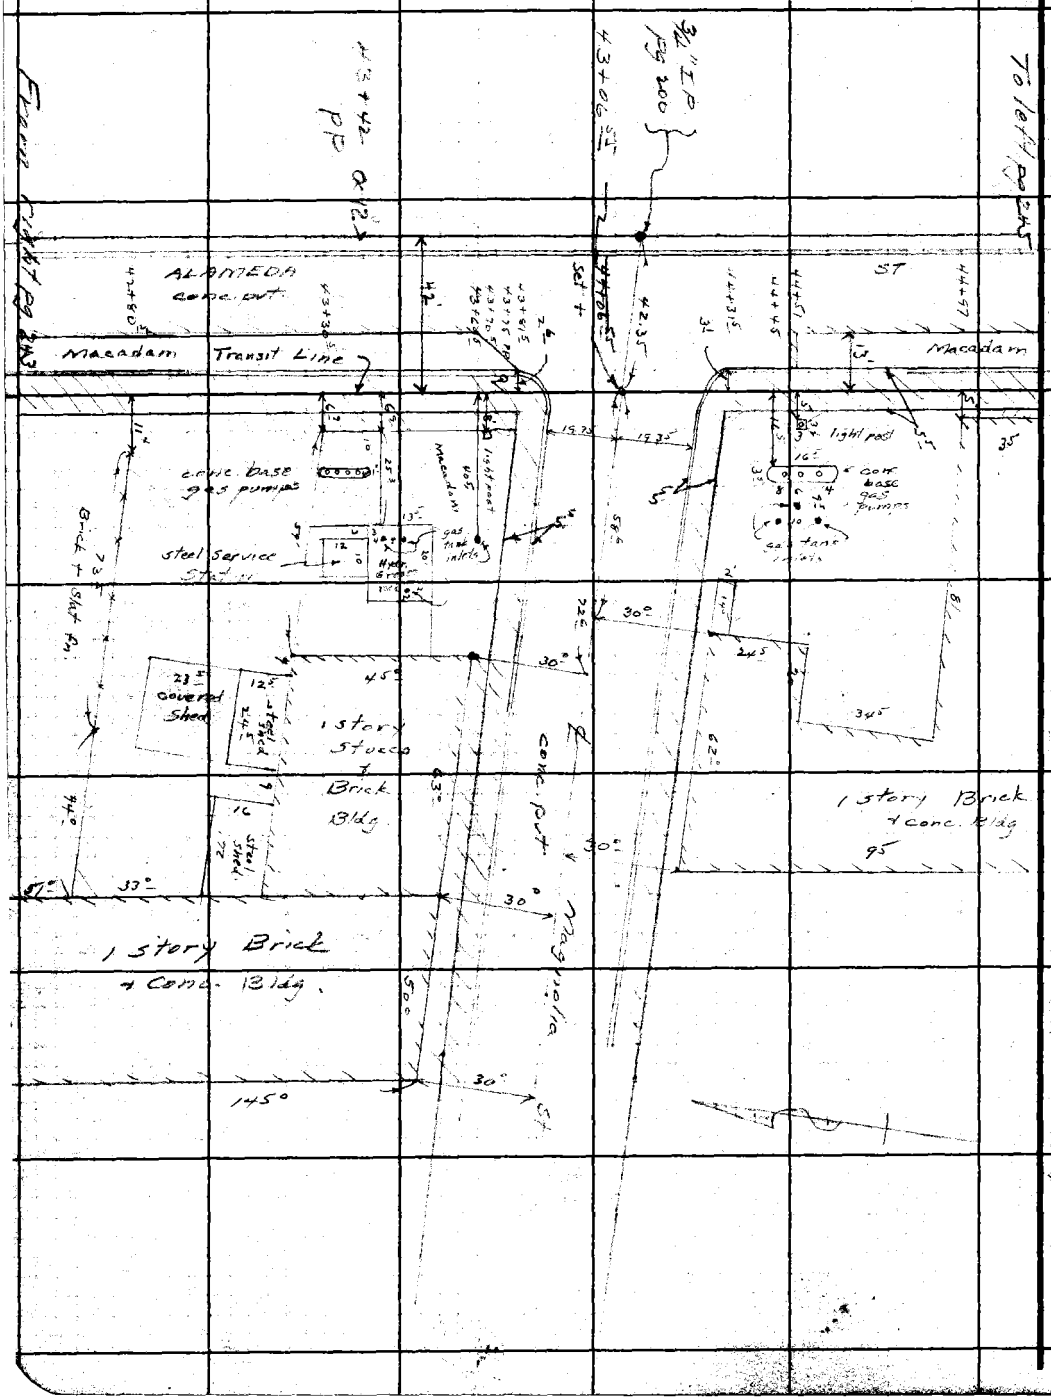

RETURN TO
LOS ANGELES COUNTY SURVEYOR
700 HALL OF RECORDS

Do not extend notes this side of this line.

Note: Any Additions or Changes on This Sheet Must be Made or Created in Red Ink With Date and Name of Person Making Change.

81

Notes Ck'd by D. M. Finley	Survey of Alameda St	F.B. 807 Pg. 245
Map No. ~~B-1498~~ B-1729-1	W. O. 8270 Tape No. ____ St'd ____ °F	
Office Work	Surveyed by Moore	
Checked	Notes Moore Date 9-26-40	
Date Mar. 1945.	Indexed A. C. Johnson	

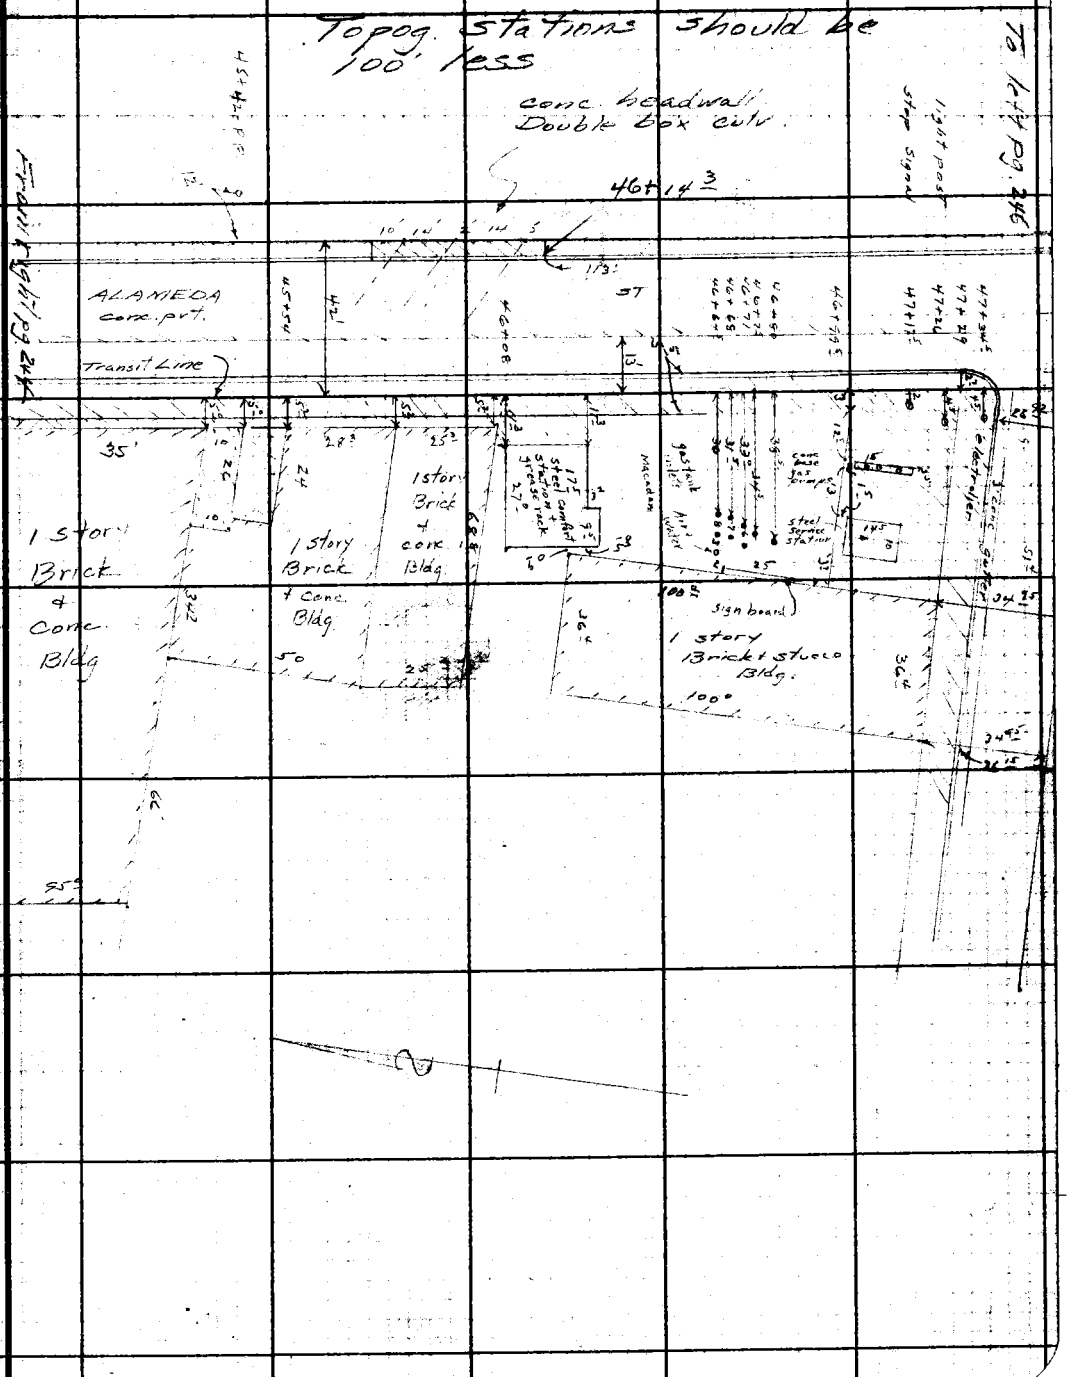

Note: Any Additions or Changes on This Sheet Must be Made or Circled in Red Ink With Date and Name of Person Making Change.

Do not extend notes this side of this line.

RETURN TO
LOS ANGELES COUNTY SURVEYOR
700 HALL OF RECORDS

FORM 247 5M 10-39

RETURN TO
LOS ANGELES COUNTY SURVEYOR
700 HALL OF RECORDS

Note: Any Additions or Changes on This Sheet Must be Made or Circled in Red Ink With Date and Name of Person Making Change.

Do not extend notes this side of this line.

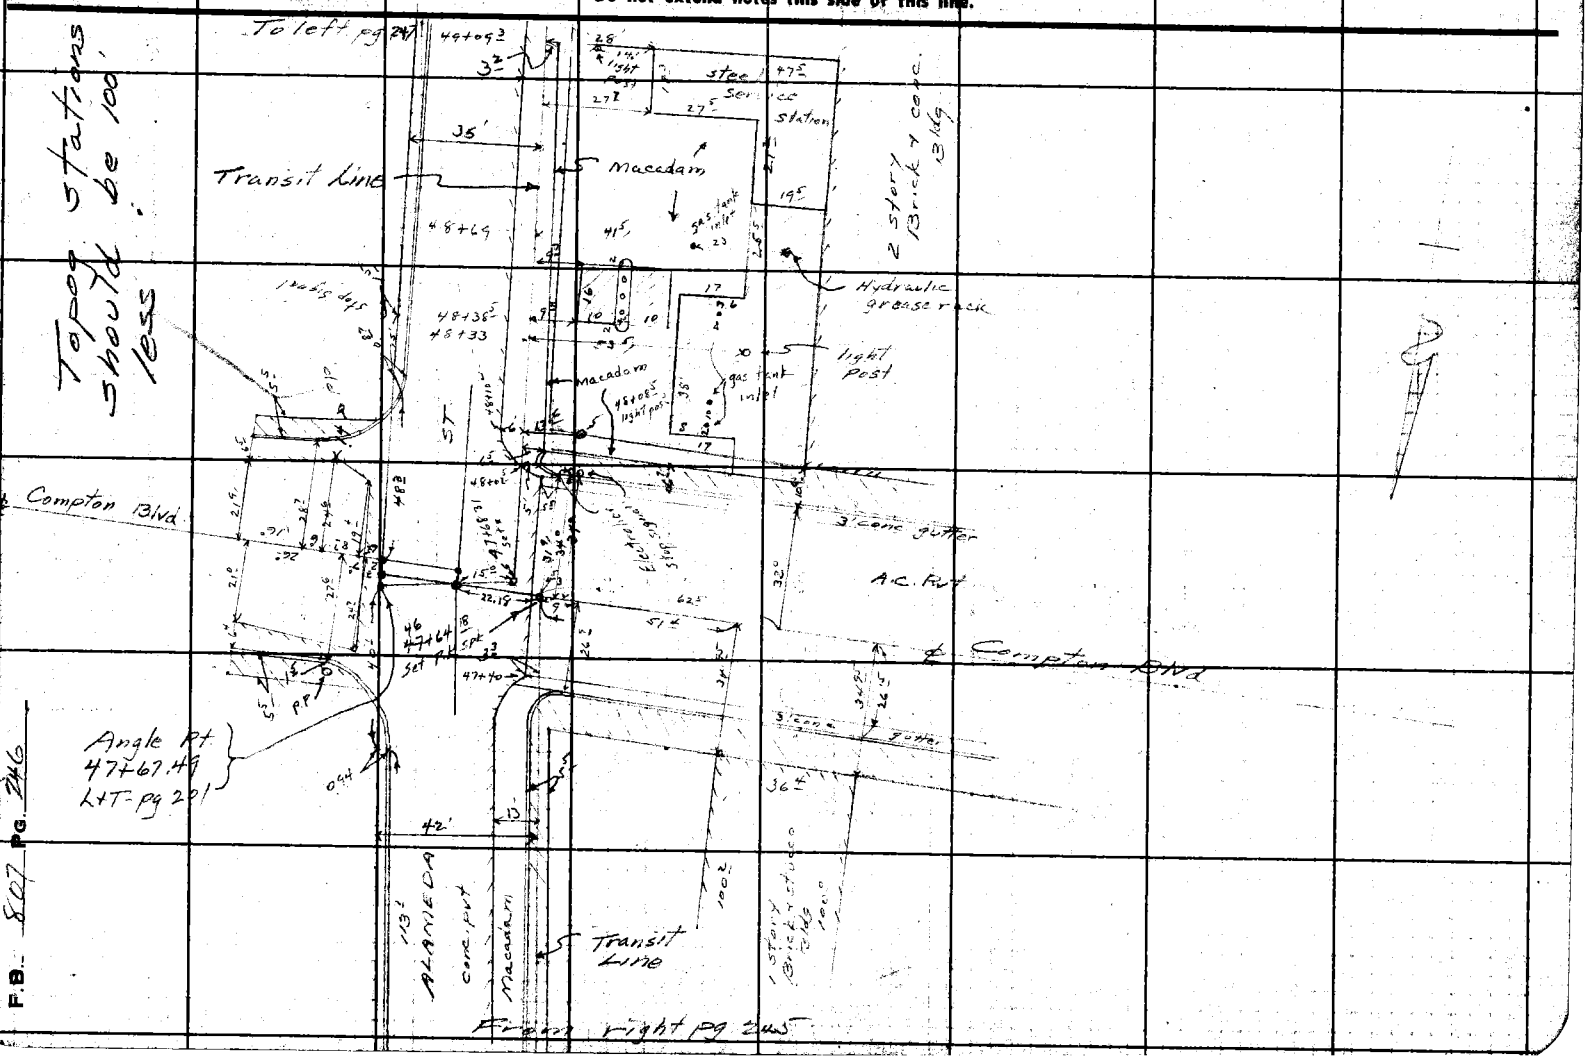

F.B. 807 PG. 246

Notes Ck'd by D. M. Hinley	Survey of Alameda St
Map No. [illegible]	W. O. 8270 Tape No. St'd °F
Office Work	Surveyed by Moore
Checked	Notes Moore Date 10-3-40
Date Mar. 1945.	Indexed

F.B. 807 PG. 242

Topog. Stations should be 100' less

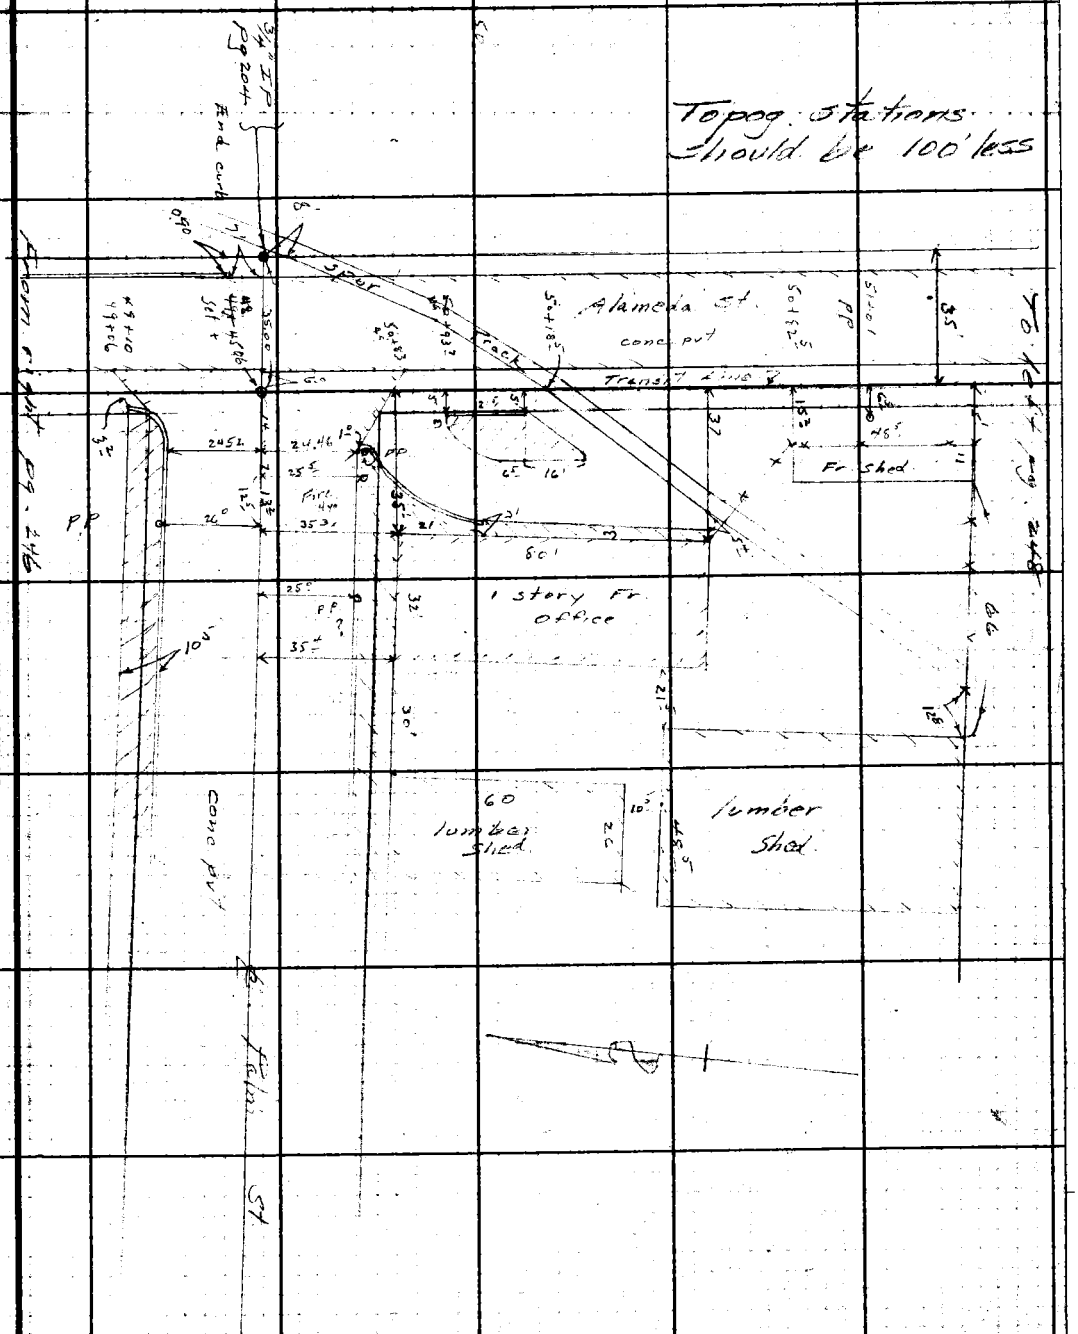
Alameda St.
conc pvt
Transit Line
Fr. Shed
1 story Fr. office
60 lumber shed
lumber shed
conc pvt

RETURN TO
LOS ANGELES COUNTY SURVEYOR
700 HALL OF RECORDS

Note: Any Additions or Changes on This Sheet Must be Made or Circled in Red Ink With Date and Name of Person Making Change.

Do not extend notes this side of this line.

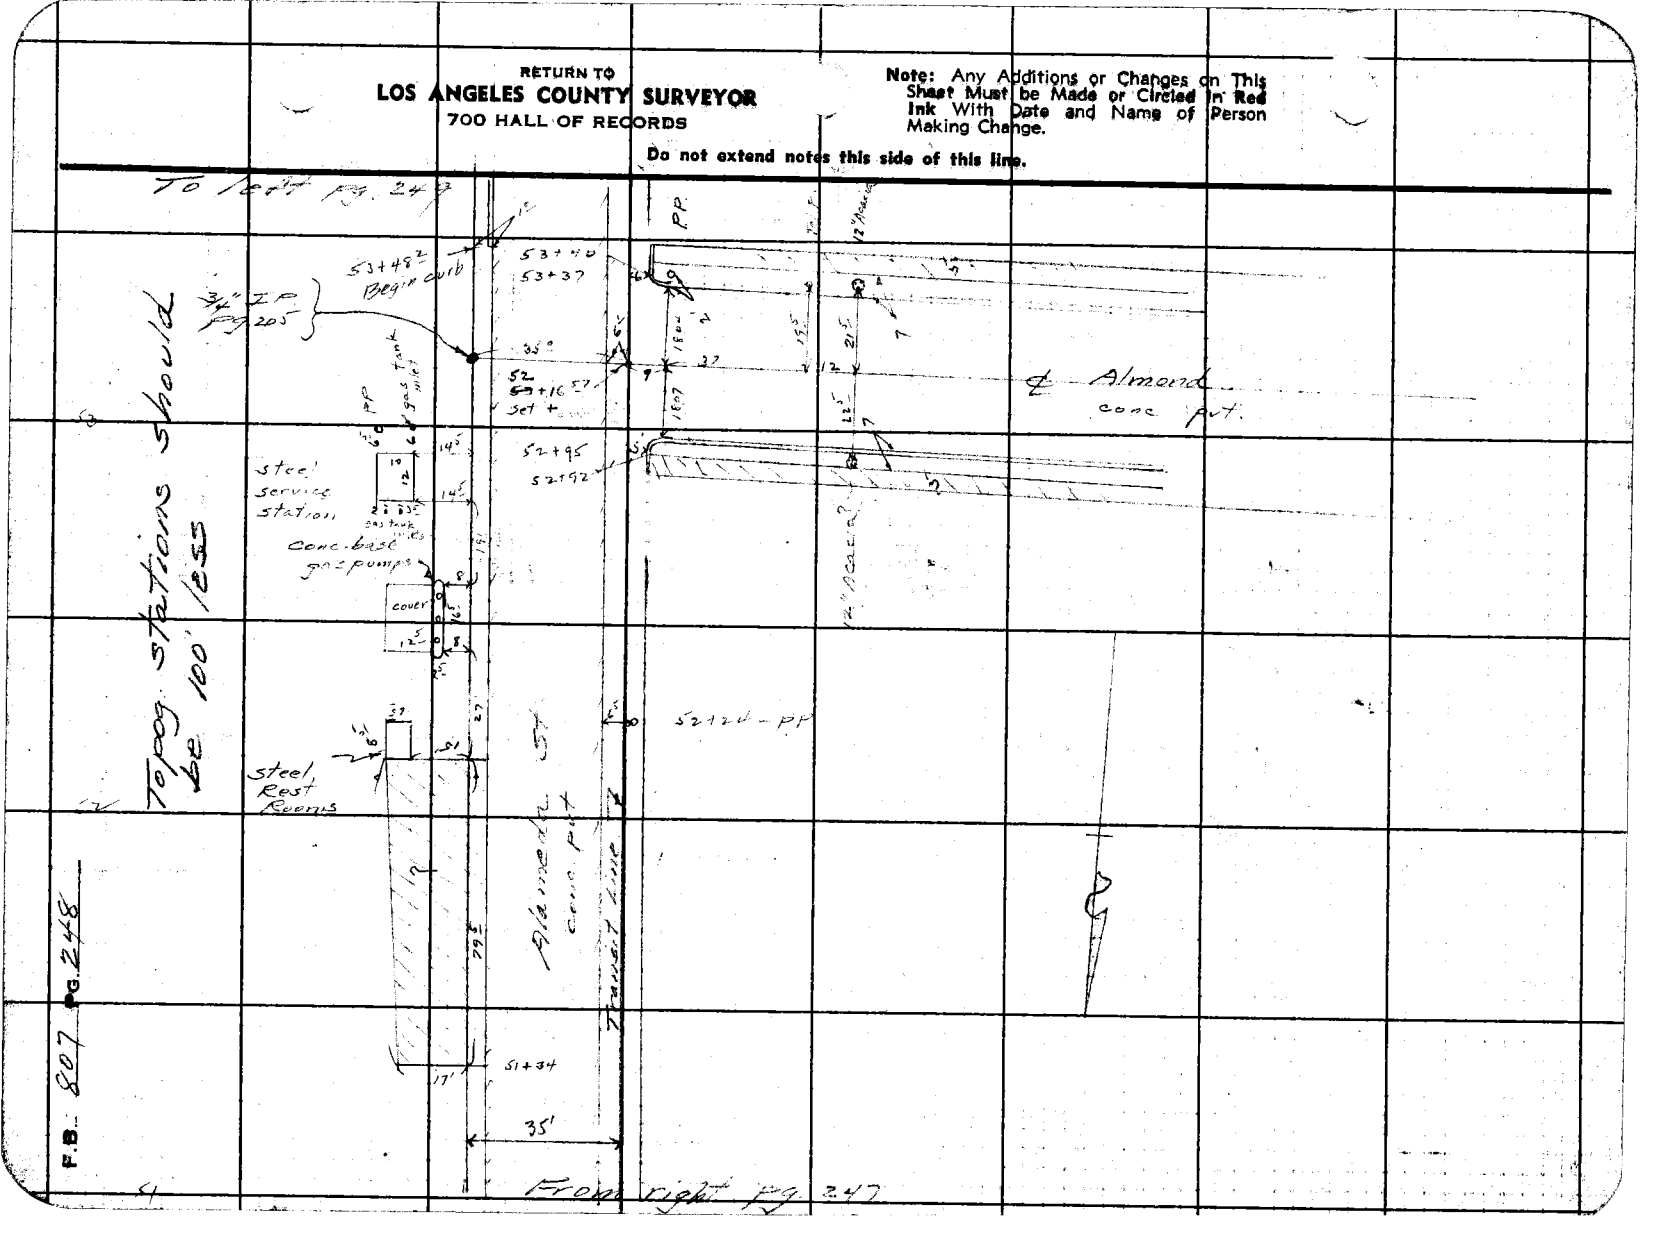

Notes Ck'd by D. M. Finley	Survey of Alameda St
Map No. ~~B-1493~~ B-1729-2	W. O. 8270 Tape No. ____ St'd ____ °F
Office Work	Surveyed by Moore
Checked	Notes Moore Date 10-3-40
Date Mar. 1945	Indexed

F.B. 807 Pg. 249

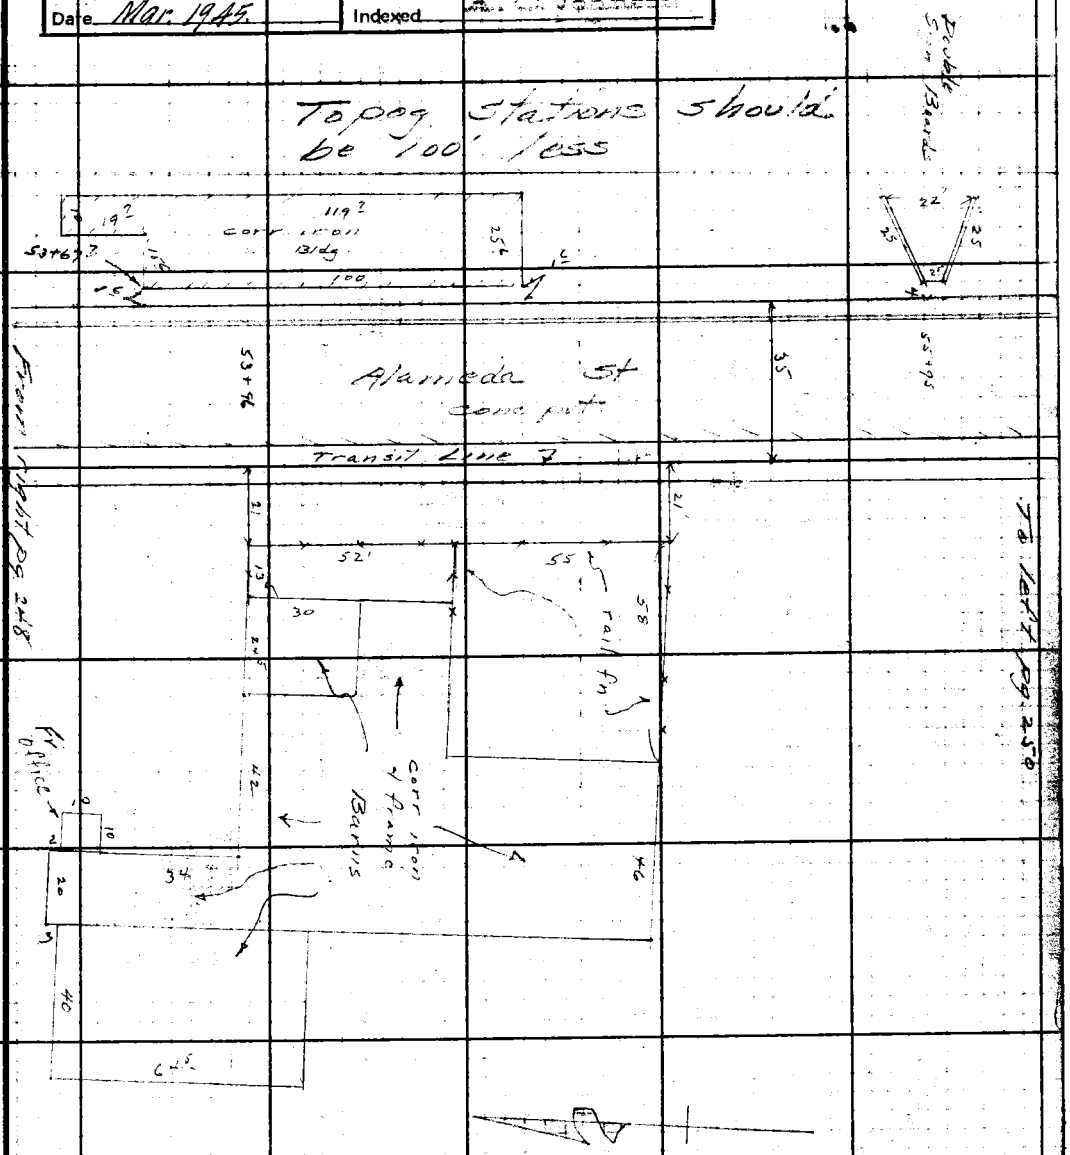

Note: Any Additions or Changes on This Sheet Must be Made or Circled in Red Ink With Date and Name of Person Making Change.

Do not extend notes this side of this line.

RETURN TO
LOS ANGELES COUNTY SURVEYOR
700 HALL OF RECORDS

FORM 247 5M 10-39

RETURN TO
LOS ANGELES COUNTY SURVEYOR
700 HALL OF RECORDS

Note: Any Additions or Changes on This Sheet Must be Made or Circled in **Red Ink** With Date and Name of Person Making Change.

Do not extend notes this side of this line.

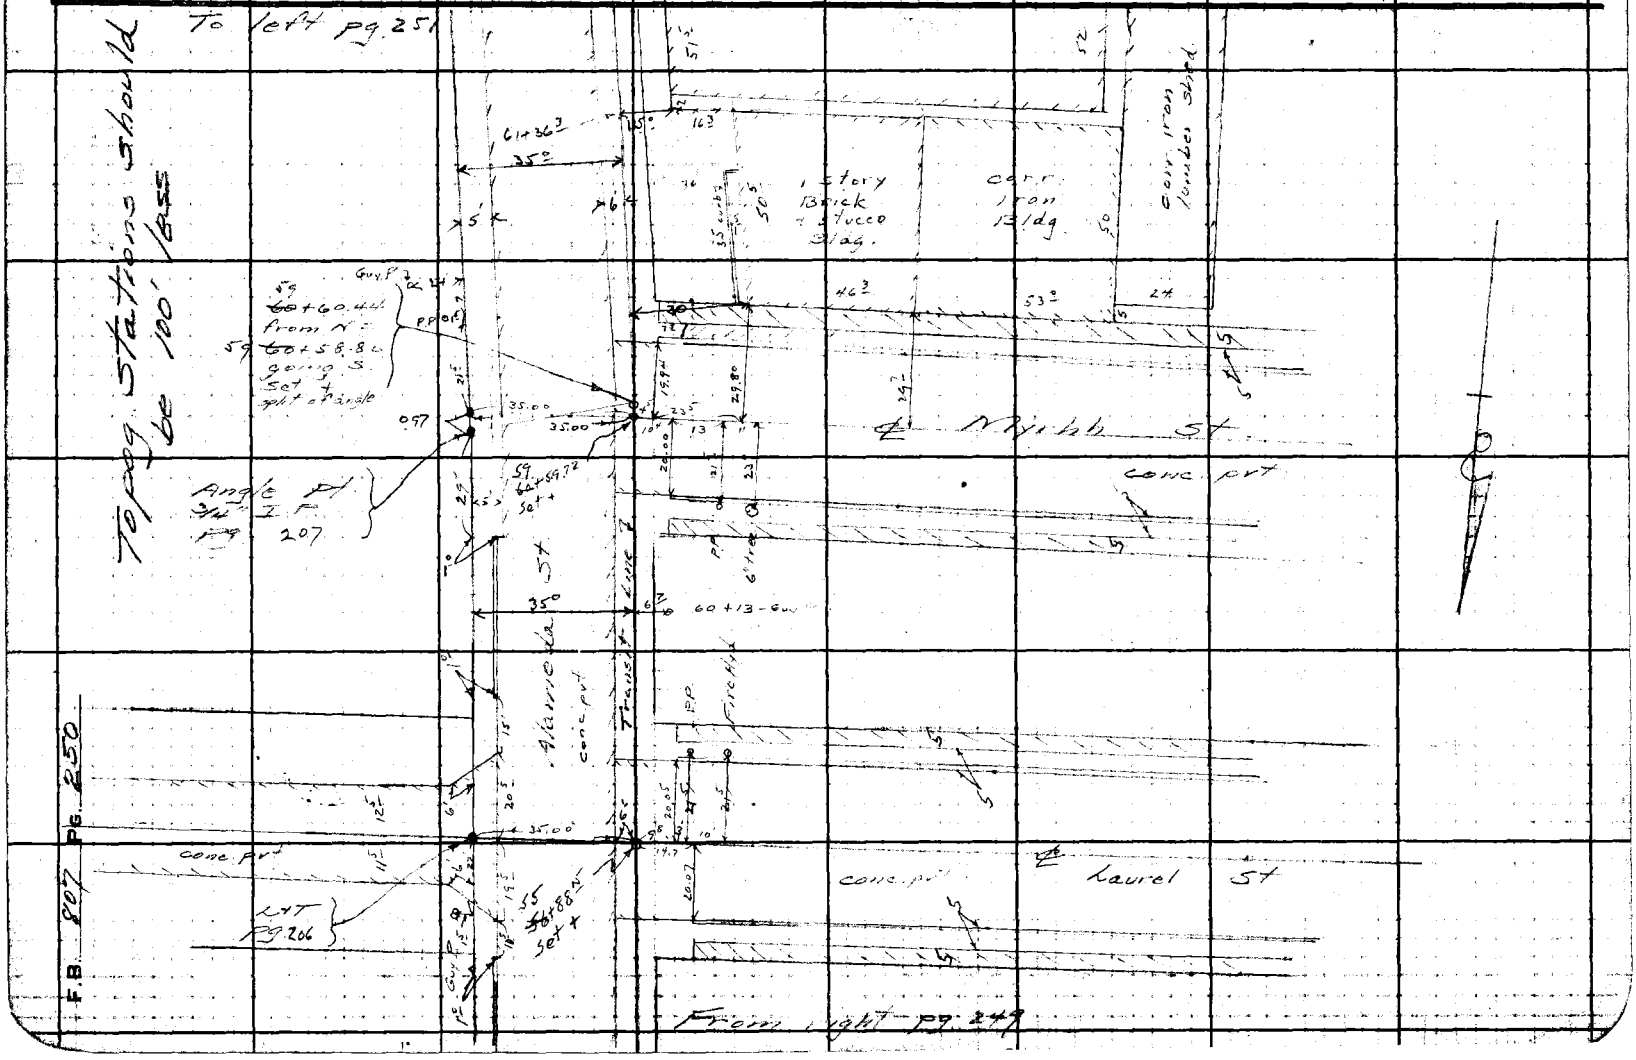

Notes Ck'd by D. M. Finley	Survey of Alameda St
Map No. ~~[illegible]~~ P-1729-2	W. O. 8270 Tape No. ____ St'd ____ °F
Office Work ____	Surveyed by Moore
Checked ____	Notes Moore Date 10-4-40
Date Mar. 1945	Indexed A. C. Johnson

F.B. 807 PG. 251

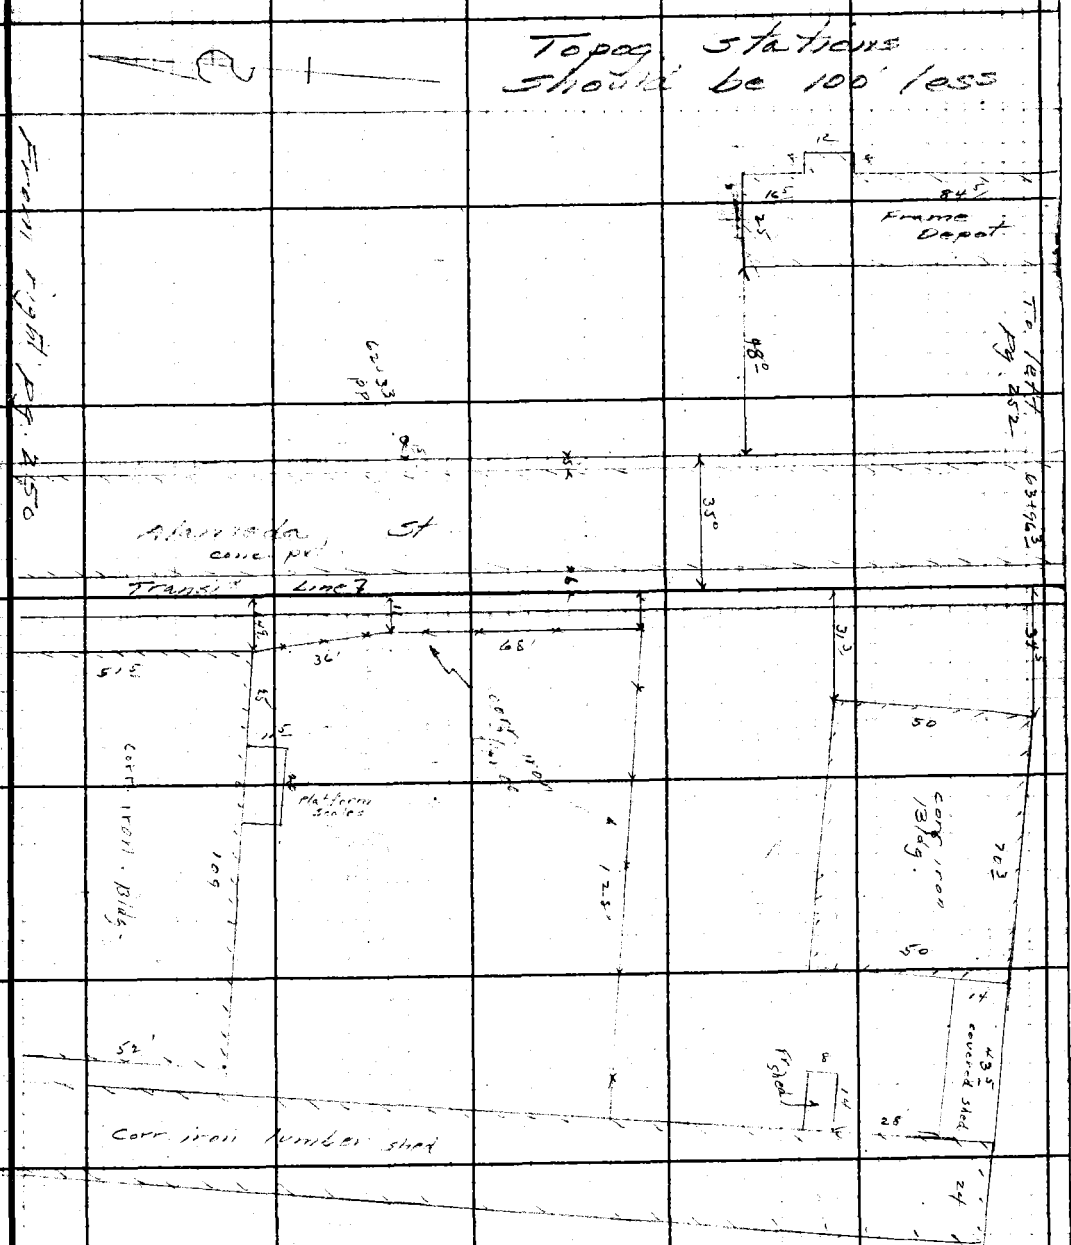

Note: Any Additions or Changes on This Sheet Must be Made or Circled in Red Ink With Date and Name of Person Making Change.

Do not extend notes this side of this line.

RETURN TO
LOS ANGELES COUNTY SURVEYOR
700 HALL OF RECORDS

M 10-39

RETURN TO
LOS ANGELES COUNTY SURVEYOR
700 HALL OF RECORDS

Note: Any Additions or Changes on This Sheet Must be Made or Circled in **Red Ink** With Date and Name of Person Making Change.

Do not extend notes this side of this line.

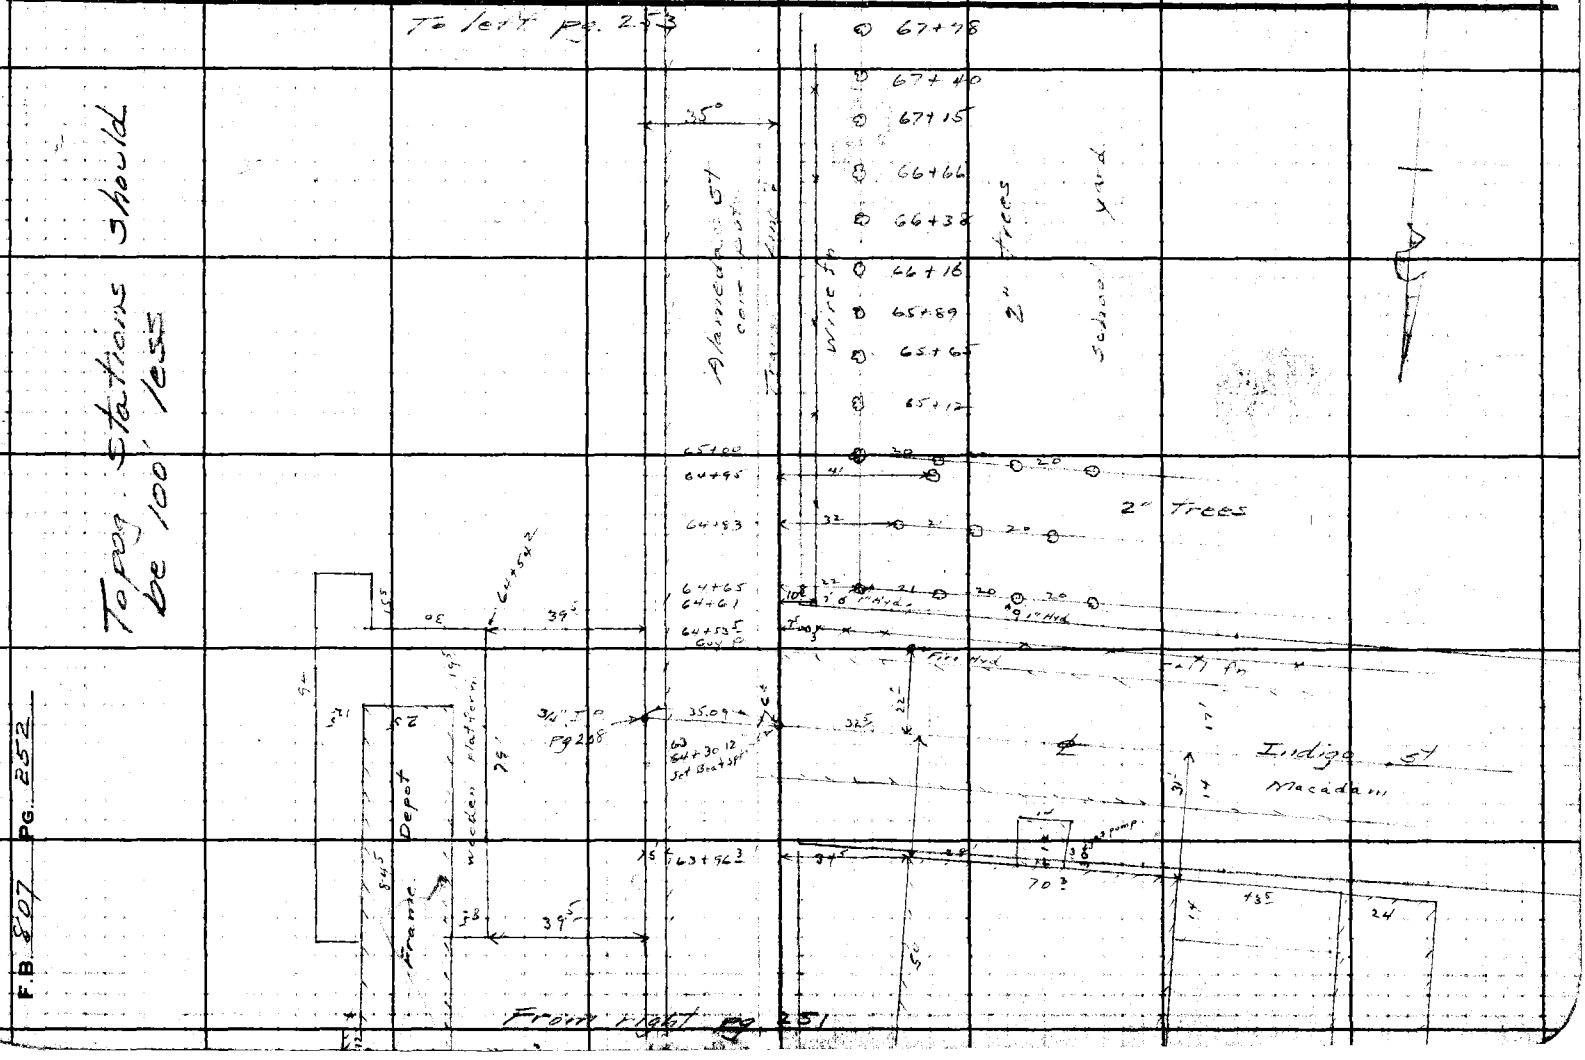

FORM 247 5M 10-39

RETURN TO
LOS ANGELES COUNTY SURVEYOR
700 HALL OF RECORDS

Note: Any Additions or Changes on This Sheet Must be Made or Circled in **Red Ink** With Date and Name of Person Making Change.

Do not extend notes this side of this line.

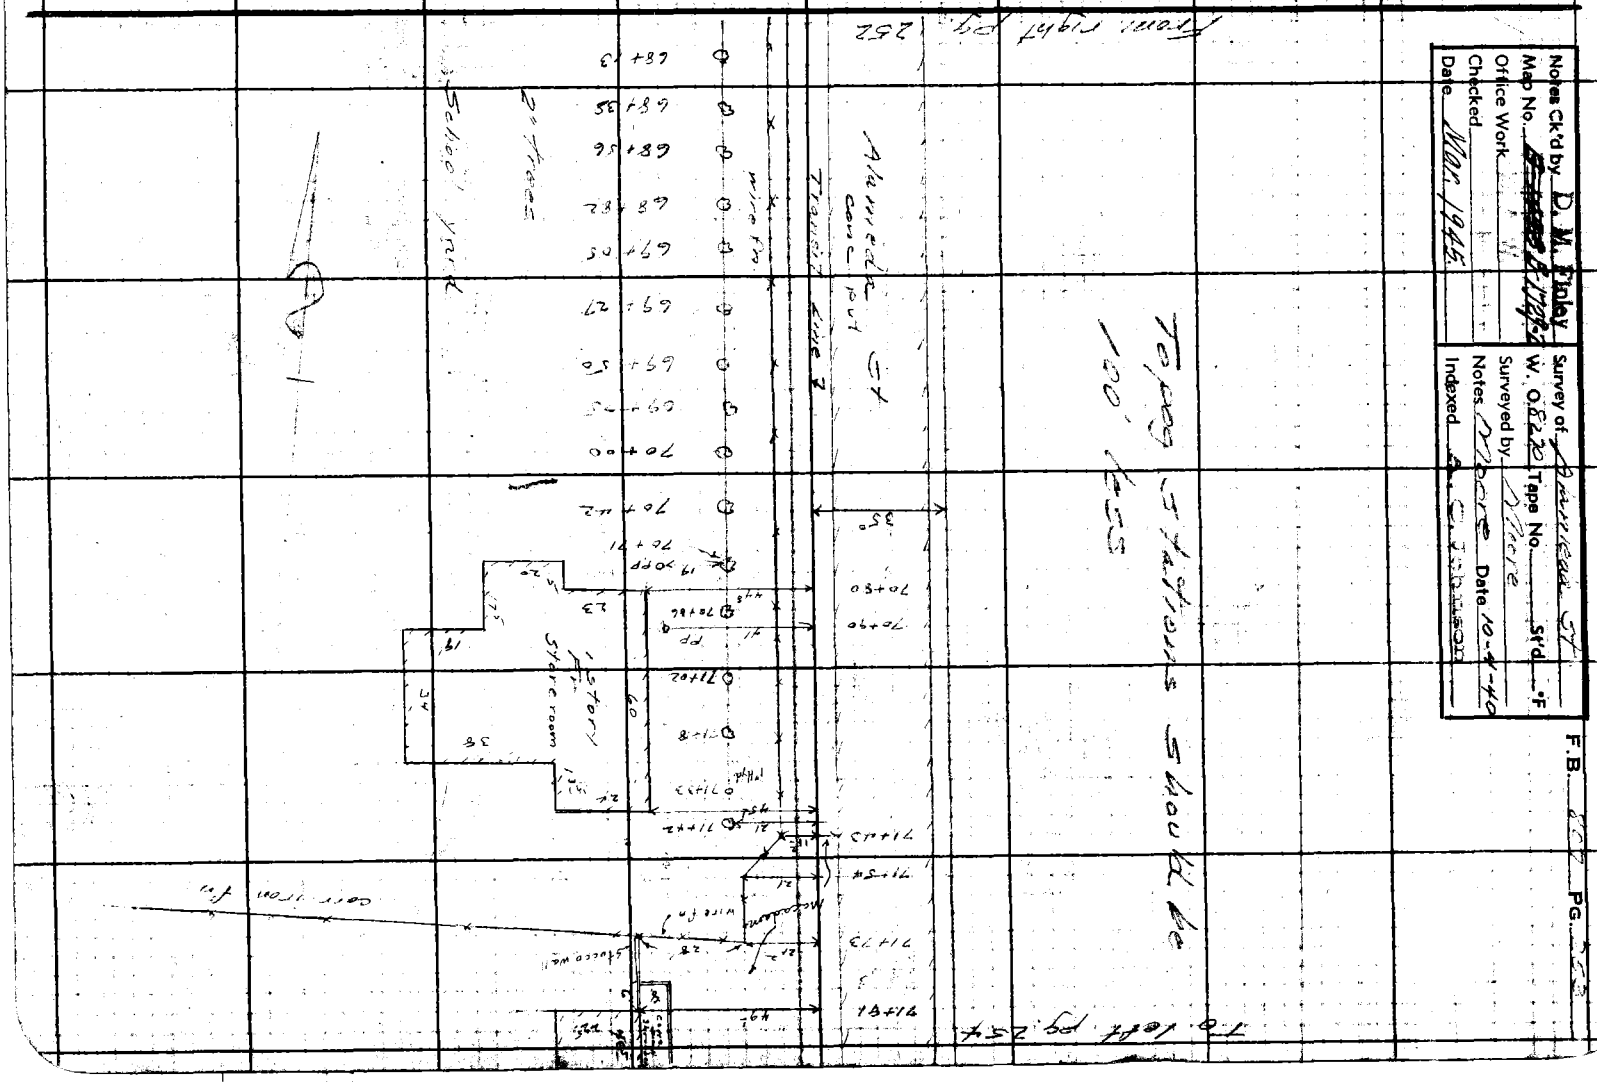

RETURN TO
LOS ANGELES COUNTY SURVEYOR
700 HALL OF RECORDS

Note: Any Additions or Changes on This Sheet Must be Made or Circled in **Red Ink** With Date and Name of Person Making Change.

Do not extend notes this side of this line

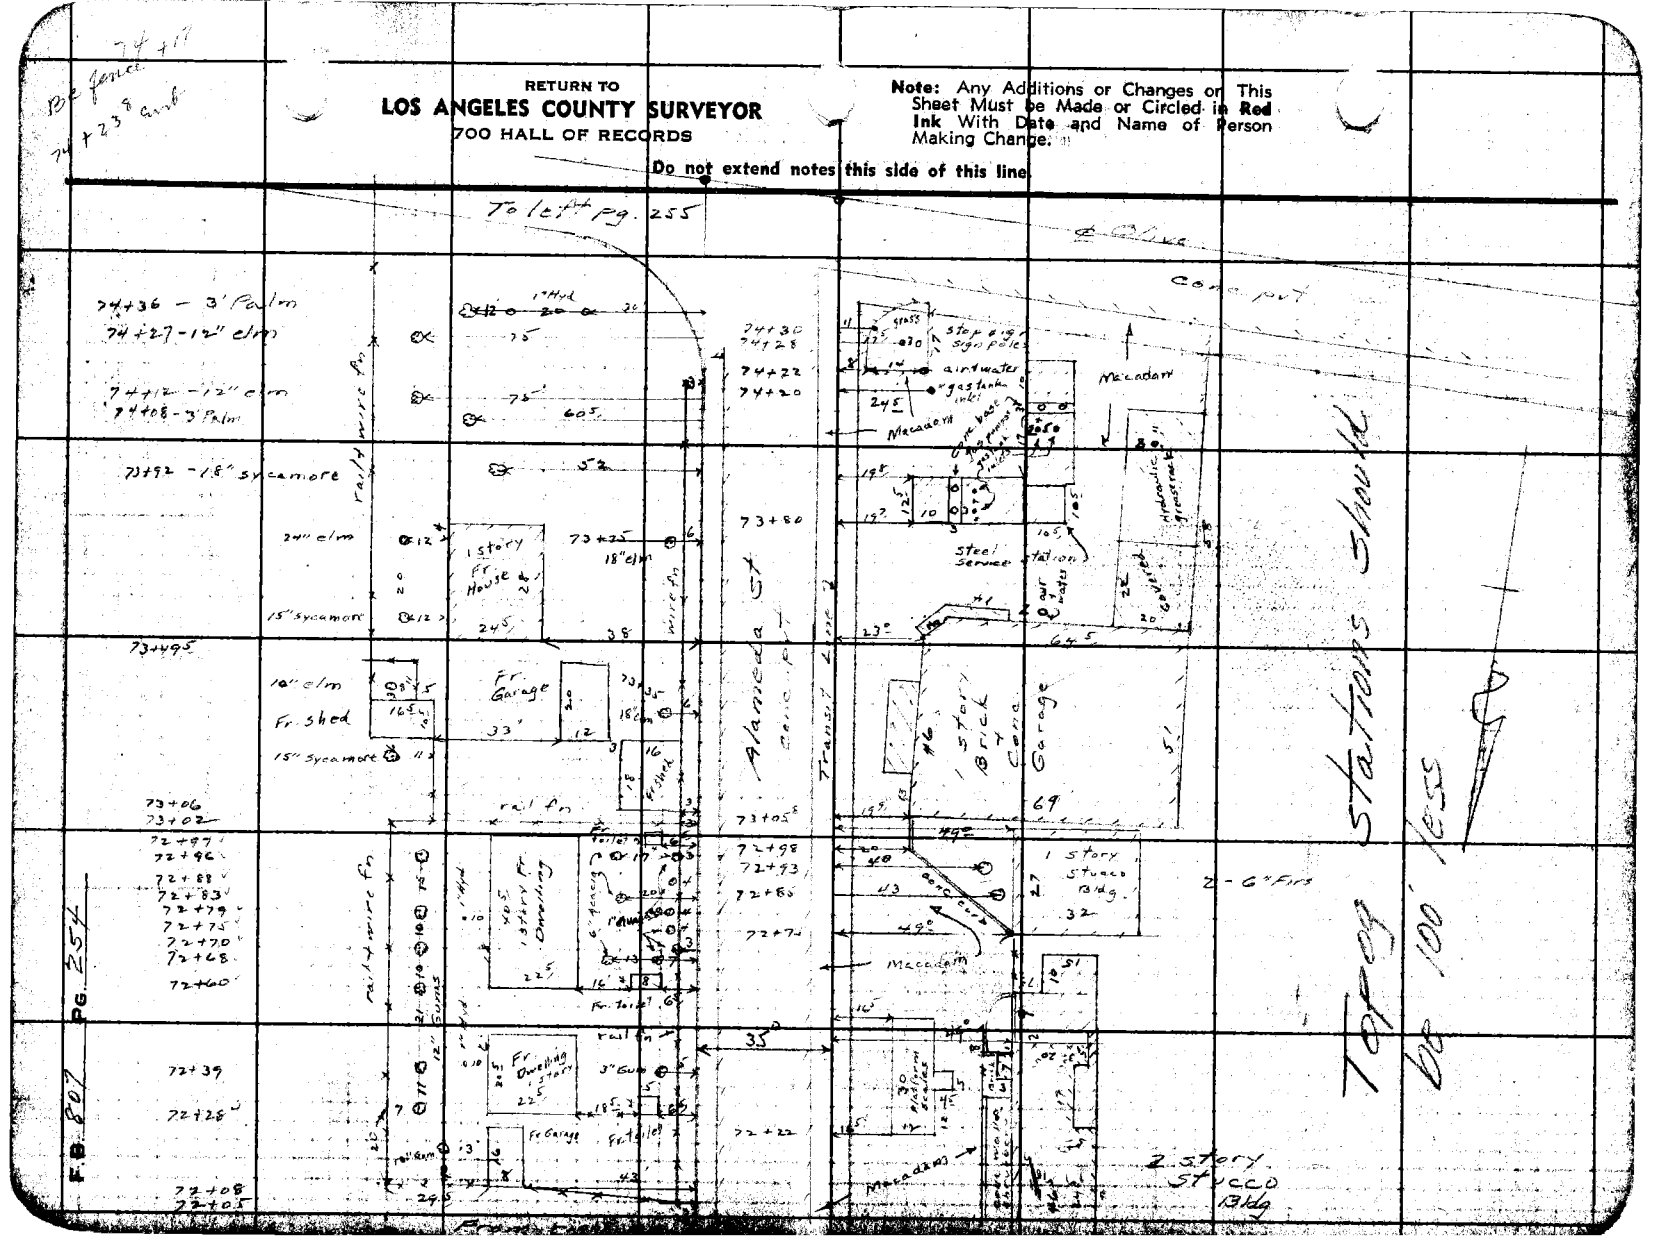

Notes Ck'd by D. M. Finley	Survey of [illegible]
Map No. [illegible]	W. O. 8220 Tape No. ____ St'd ____ °F
Office Work [illegible]	Surveyed by Moore
Checked [illegible]	Notes Moore Date 10-4-40
Date Mar. 1945	Indexed [illegible]

F.B. 807 Pg. 255

Topog Stations should be 100' less

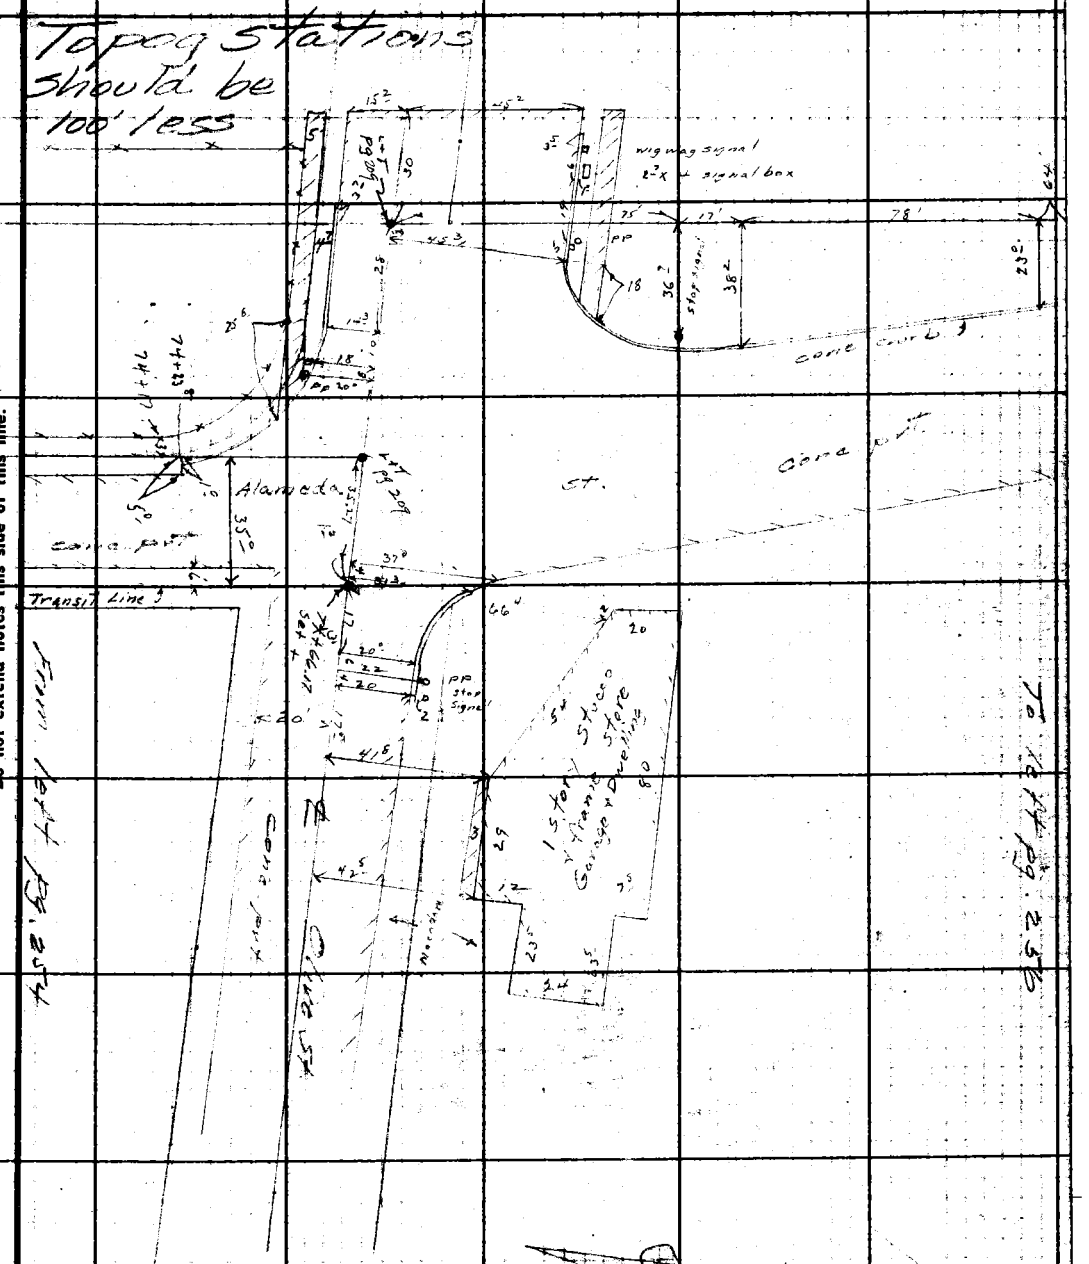

Note: Any Additions or Changes on This Sheet Must be Made or Circled in Red Ink With Date and Name of Person Making Change.

Do not extend notes this side of this line.

RETURN TO
LOS ANGELES COUNTY SURVEYOR
700 HALL OF RECORDS

FORM 247 5M 10-39

RETURN TO
LOS ANGELES COUNTY SURVEYOR
700 HALL OF RECORDS

Note: Any Additions or Changes on This Sheet Must be Made or Circled in **Red Ink** With Date and Name of Person Making Change.

Do not extend notes this side of this line.

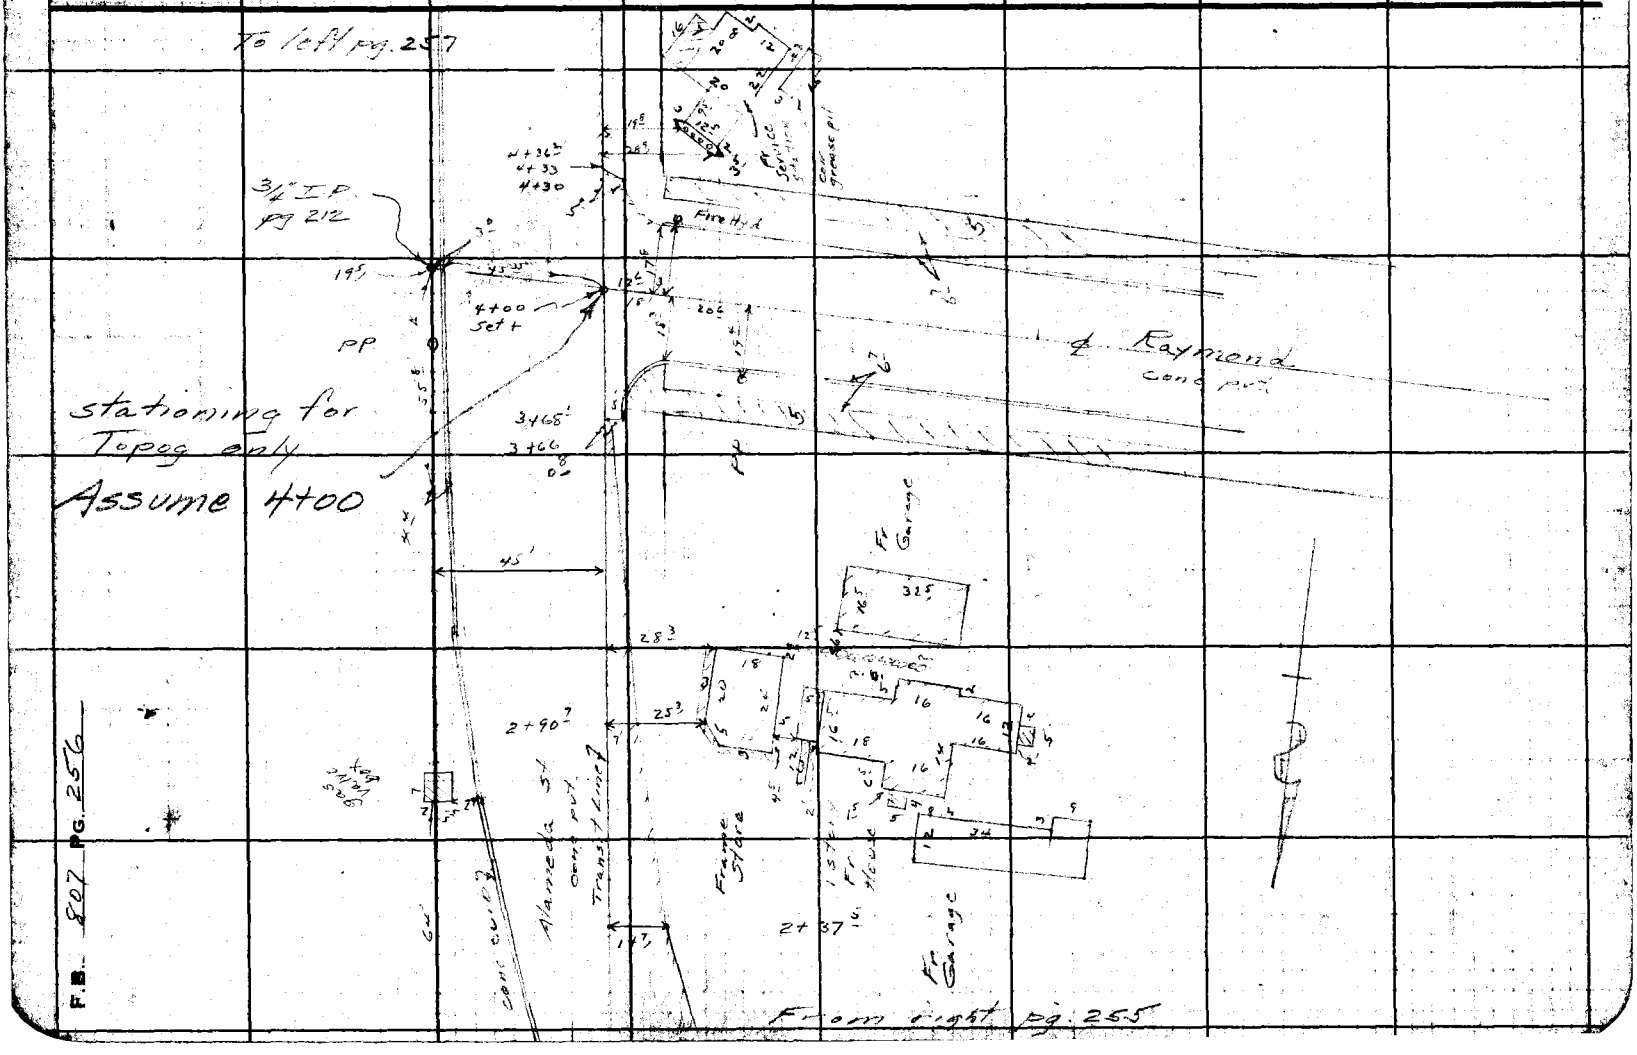

F.B. 807 PG. 256

Notes Ck'd by D. M. Finley	Survey of [illegible]
Map No. ~~[illegible]~~ B-1729-2	W. O. 8270 Tape No. ____ St'd ____ °F
Office Work [illegible]	Surveyed by [illegible]
Checked D. M. [illegible]	Notes Moore Date 10-7-40
Date Mar. 1945.	Indexed A. C. Johnson

F.B. 807 PG. 257

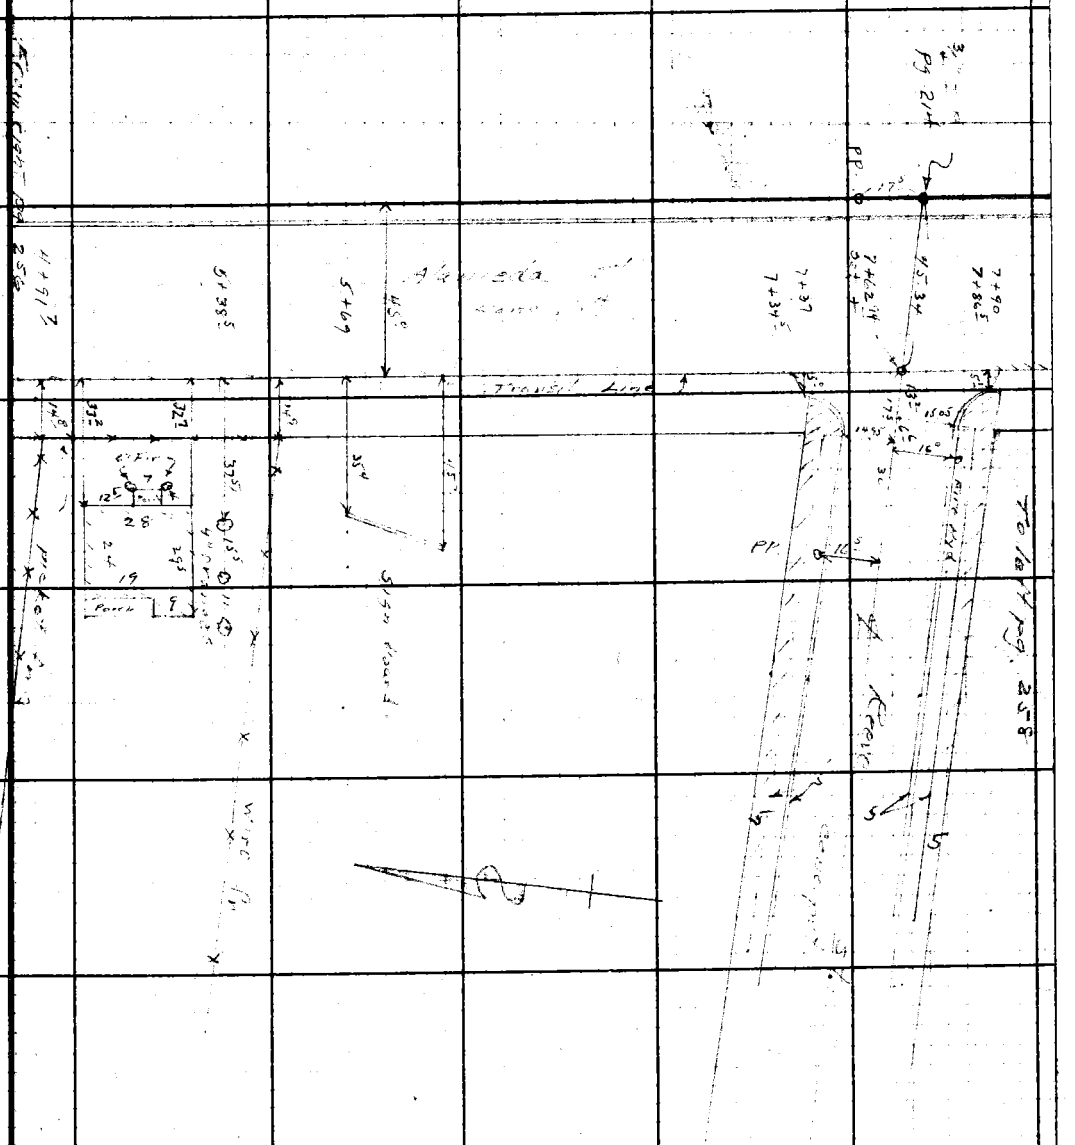

Note: Any Additions or Changes on This Sheet Must be Made or Circled in Red Ink With Date and Name of Person Making Change.

Do not extend notes this side of this line.

RETURN TO
LOS ANGELES COUNTY SURVEYOR
700 HALL OF RECORDS

FORM 247 5M 10-39

RETURN TO
LOS ANGELES COUNTY SURVEYOR
700 HALL OF RECORDS

Note: Any Additions or Changes on This Sheet Must be Made or Circled in **Red Ink** With Date and Name of Person Making Change.

Do not extend notes this side of this line.

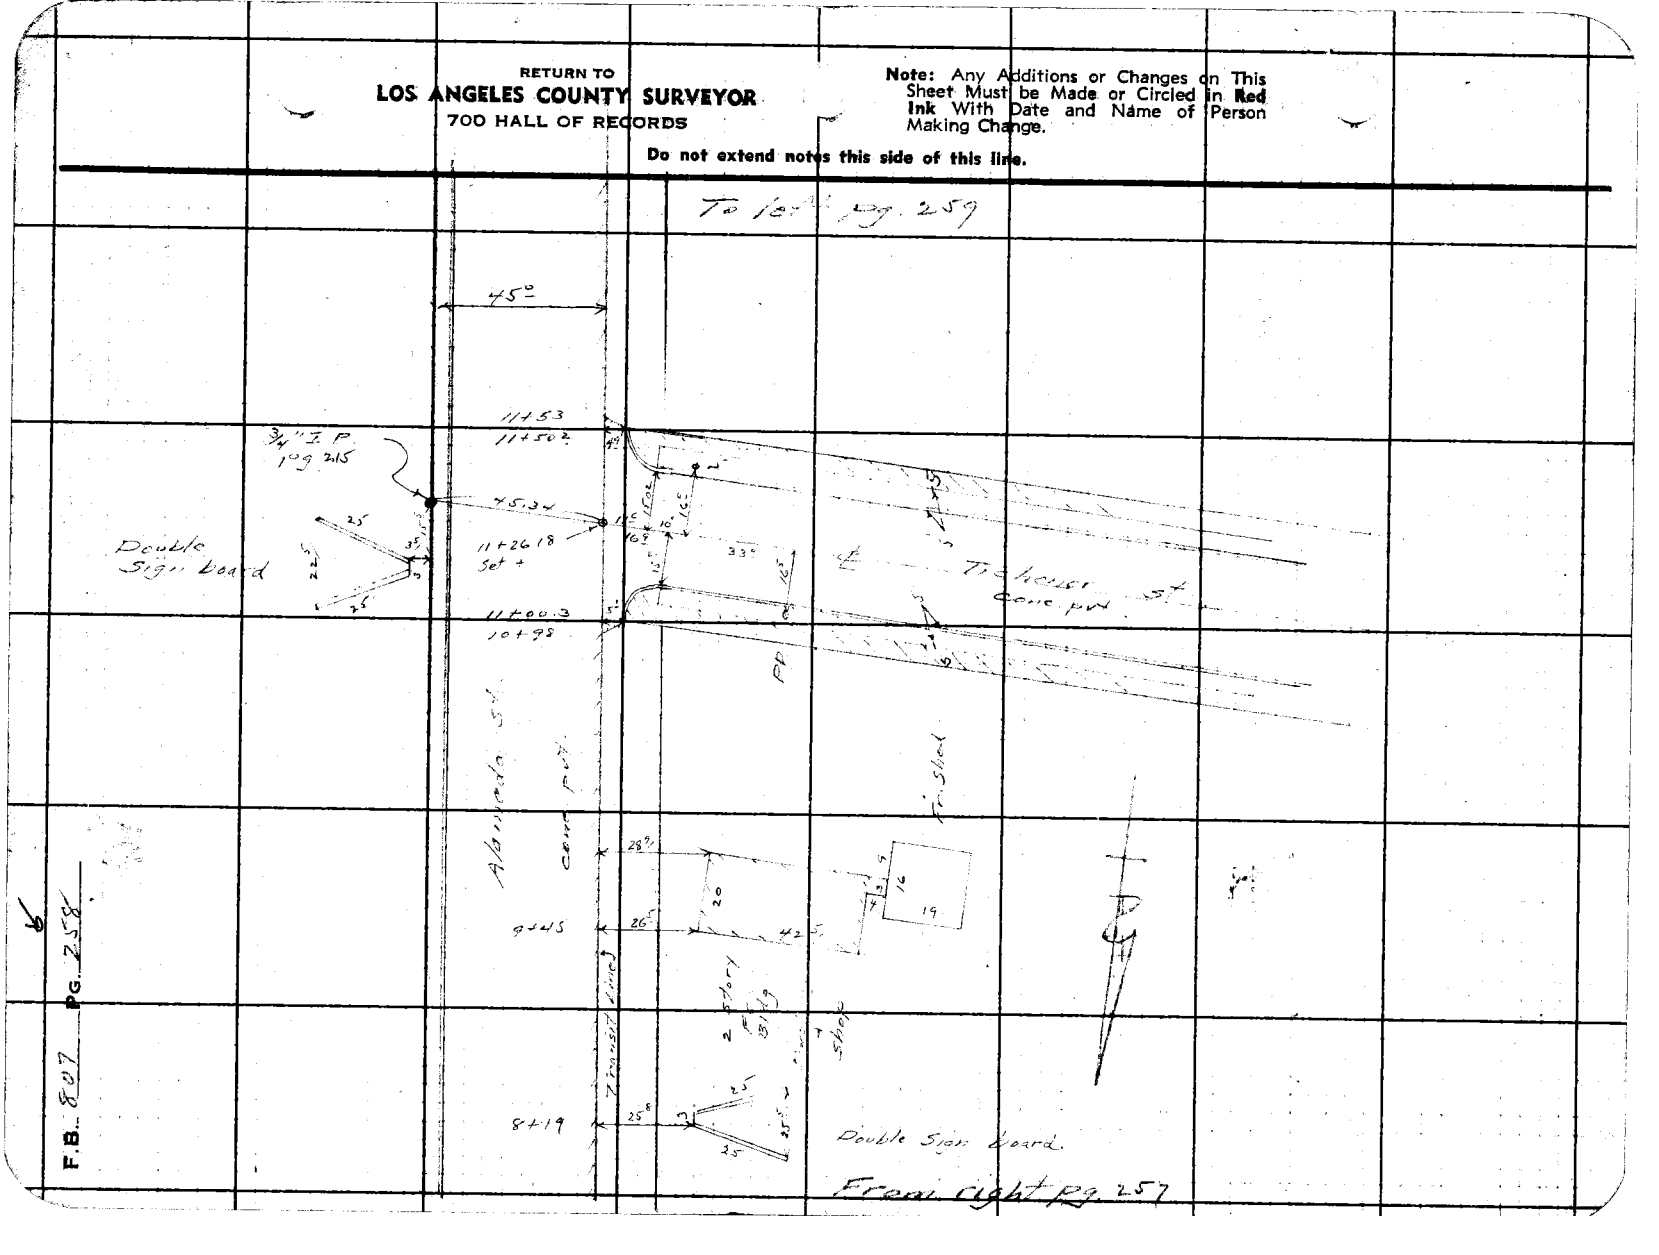

F.B. 807 PG. 258

Notes Ck'd by D. M. Finley	Survey of Alameda St
Map No. ~~B-1492~~ B-1729-2	W. O. 8270 Tape No. ____ St'd ____ °F
Office Work	Surveyed by Moore
Checked	Notes Moore Date 10-7-40
Date Mar. 1945.	Indexed A. C. Johnson

F.B. 807 PG. 259

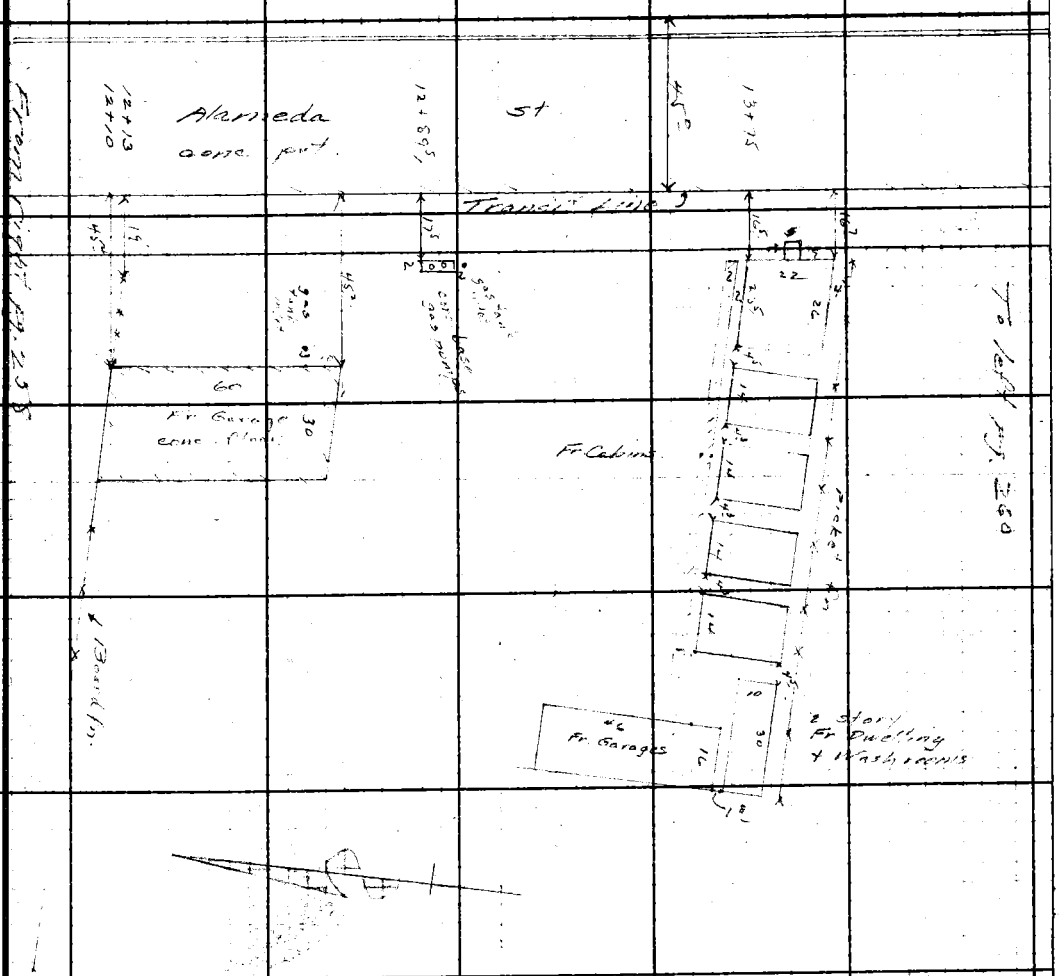

Note: Any Additions or Changes on This Sheet Must be Made or Circled in Red Ink With Date and Name of Person Making Change

Do not extend notes this side of this line.

RETURN TO
LOS ANGELES COUNTY SURVEYOR
700 HALL OF RECORDS

FORM 247 5M 10-39

RETURN TO
LOS ANGELES COUNTY SURVEYOR
700 HALL OF RECORDS

Note: Any Additions or Changes on This Sheet Must be Made or Circled in **Red Ink** With Date and Name of Person Making Change.

Do not extend notes this side of this line.

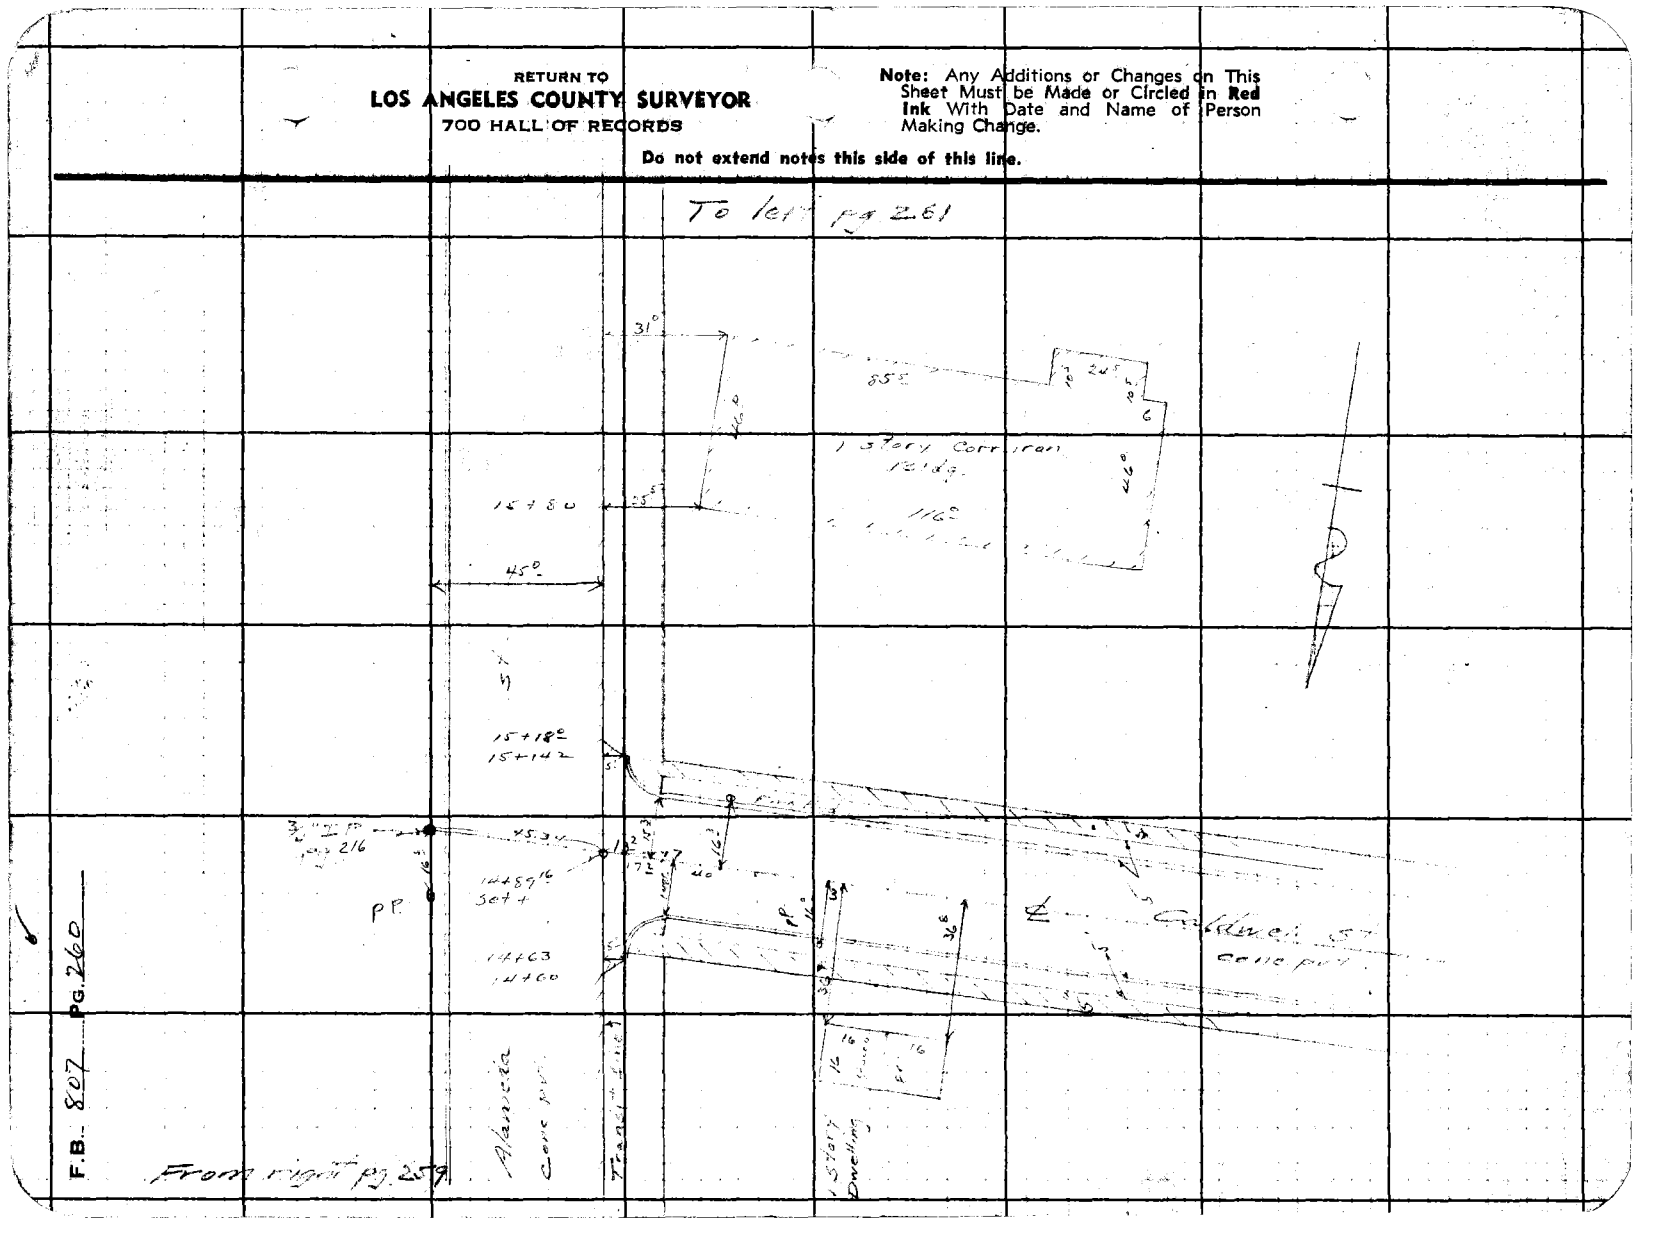

F.B. 807 PG. 260

Notes Ck'd by D. M. Finley	Survey of [illegible]
Map No. ~~B-1498~~ B-1729-2	W. O. 8270 Tape No. ____ St'd ____ °F
Office Work ____	Surveyed by Moore
Checked ____	Notes Moore Date 10-7-40
Date Mar. 1945.	Indexed A. C. Johnson

F.B. 807 PG. 261

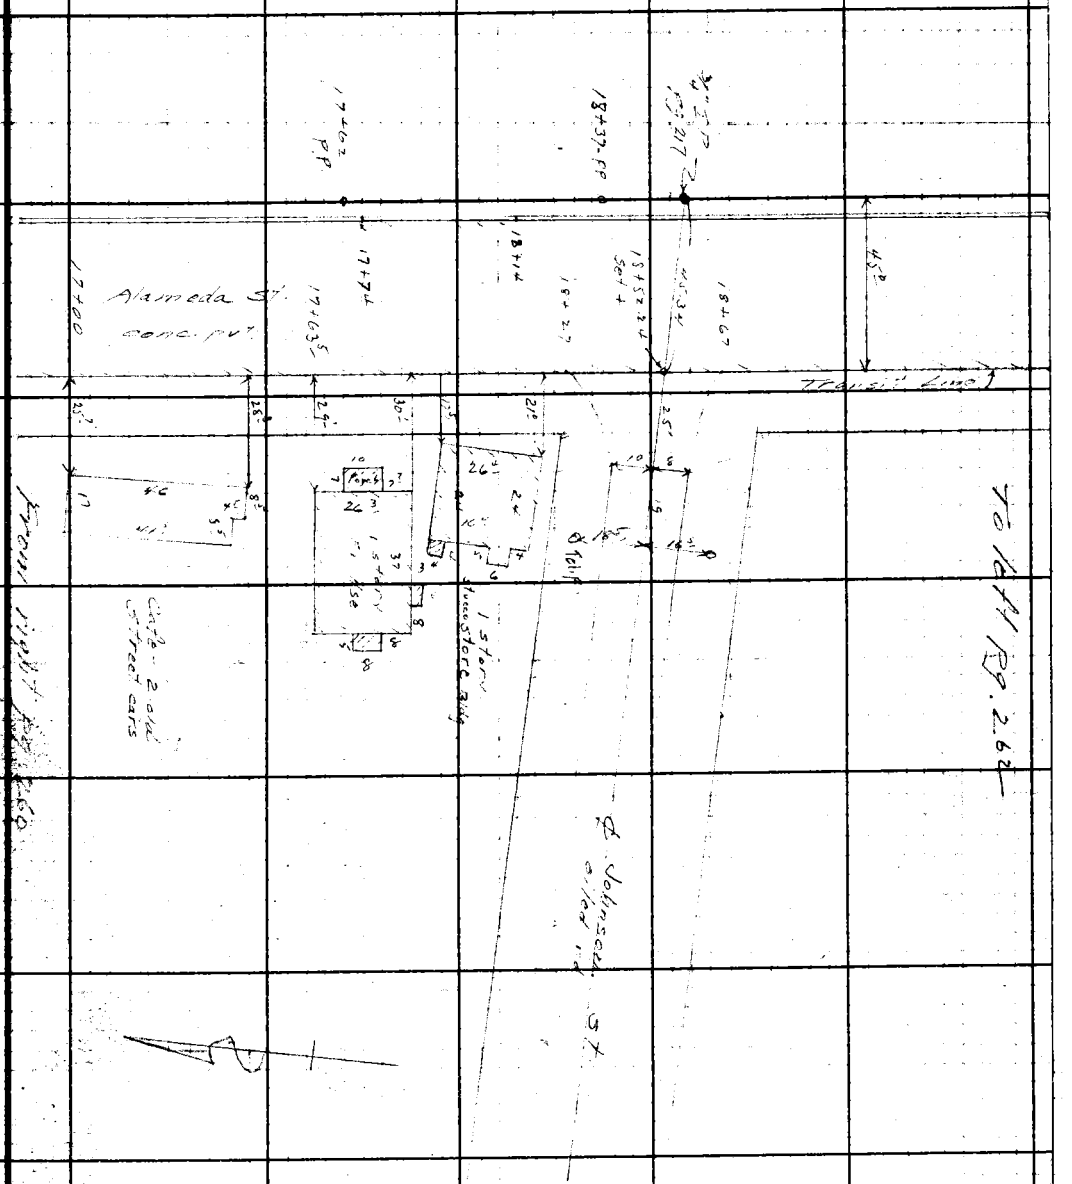

Note: Any Additions or Changes on This Sheet Must be Made or Circled in Red Ink With Date and Name of Person Making Change

Do not extend notes this side of this line.

RETURN TO
LOS ANGELES COUNTY SURVEYOR
700 HALL OF RECORDS

FORM 247 5M 10-39

RETURN TO
LOS ANGELES COUNTY SURVEYOR
700 HALL OF RECORDS

Note: Any Additions or Changes on This Sheet Must be Made or Circled in **Red Ink** With Date and Name of Person Making Change.

Do not extend notes this side of this line.

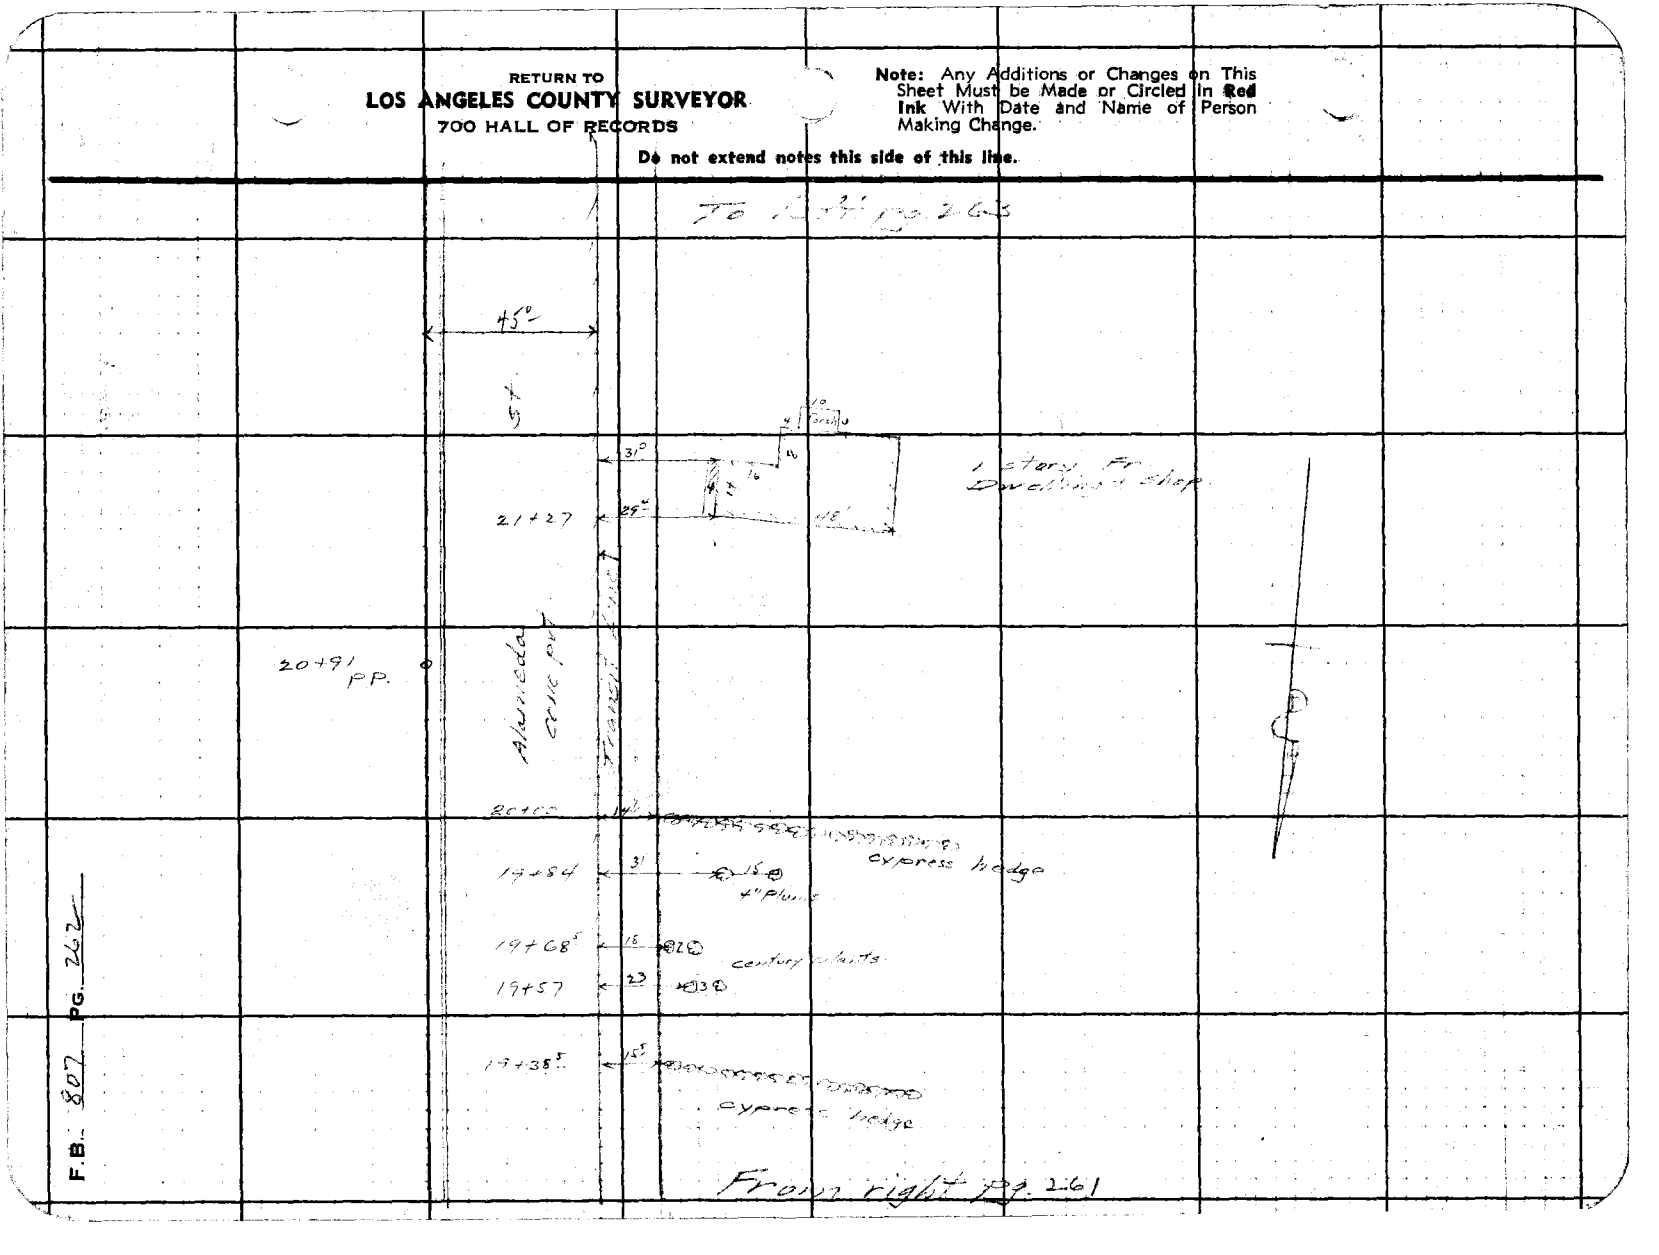

F.B. 807 PG. 262

FORM 247 5M 10-39

RETURN TO
LOS ANGELES COUNTY SURVEYOR
700 HALL OF RECORDS

Note: Any Additions or Changes on This Sheet Must be Made or Circled in **Red Ink** With Date and Name of Person Making Change.

Do not extend notes this side of this line.

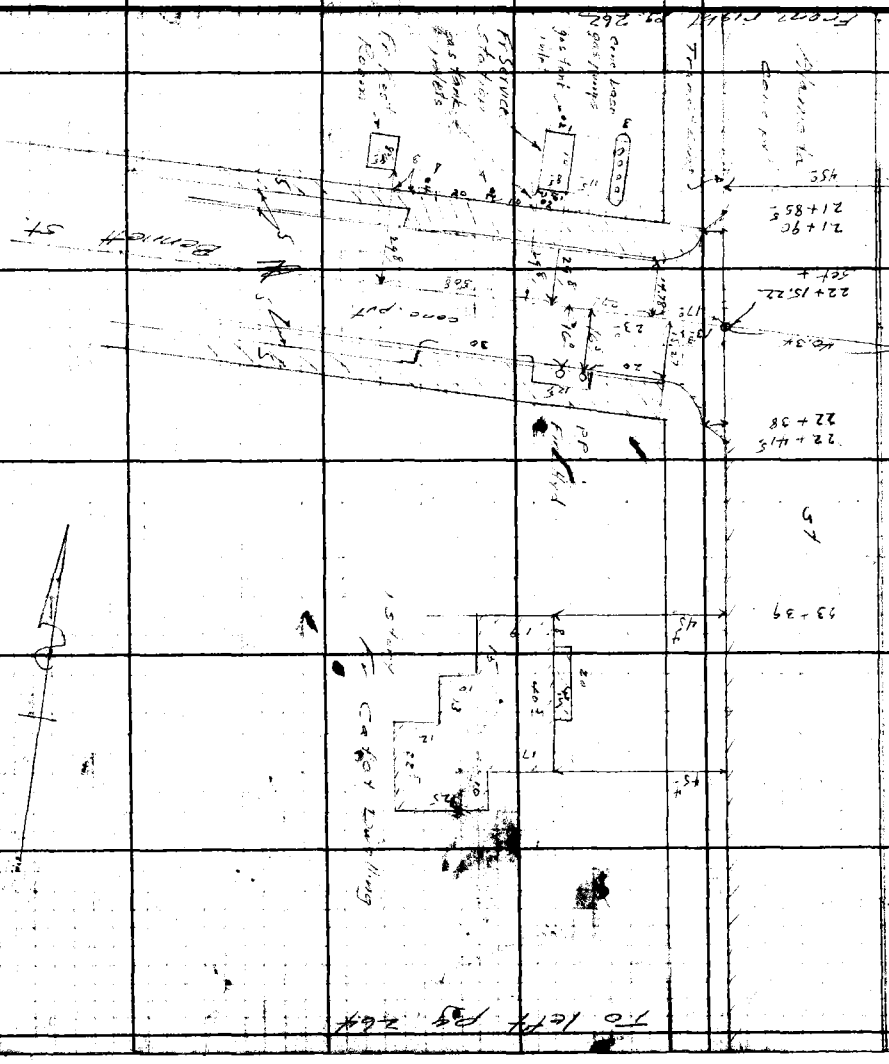
Bonnell St
Cone put
To left Pg 264
Pg 262
21+85
21+90
22+15.22
22+38
22+41.5
45°
45°
45°

RETURN TO
LOS ANGELES COUNTY SURVEYOR
700 HALL OF RECORDS

Note: Any Additions or Changes on This Sheet Must be Made or Circled in **Red Ink** With Date and Name of Person Making Change.

Do not extend notes this side of this line.

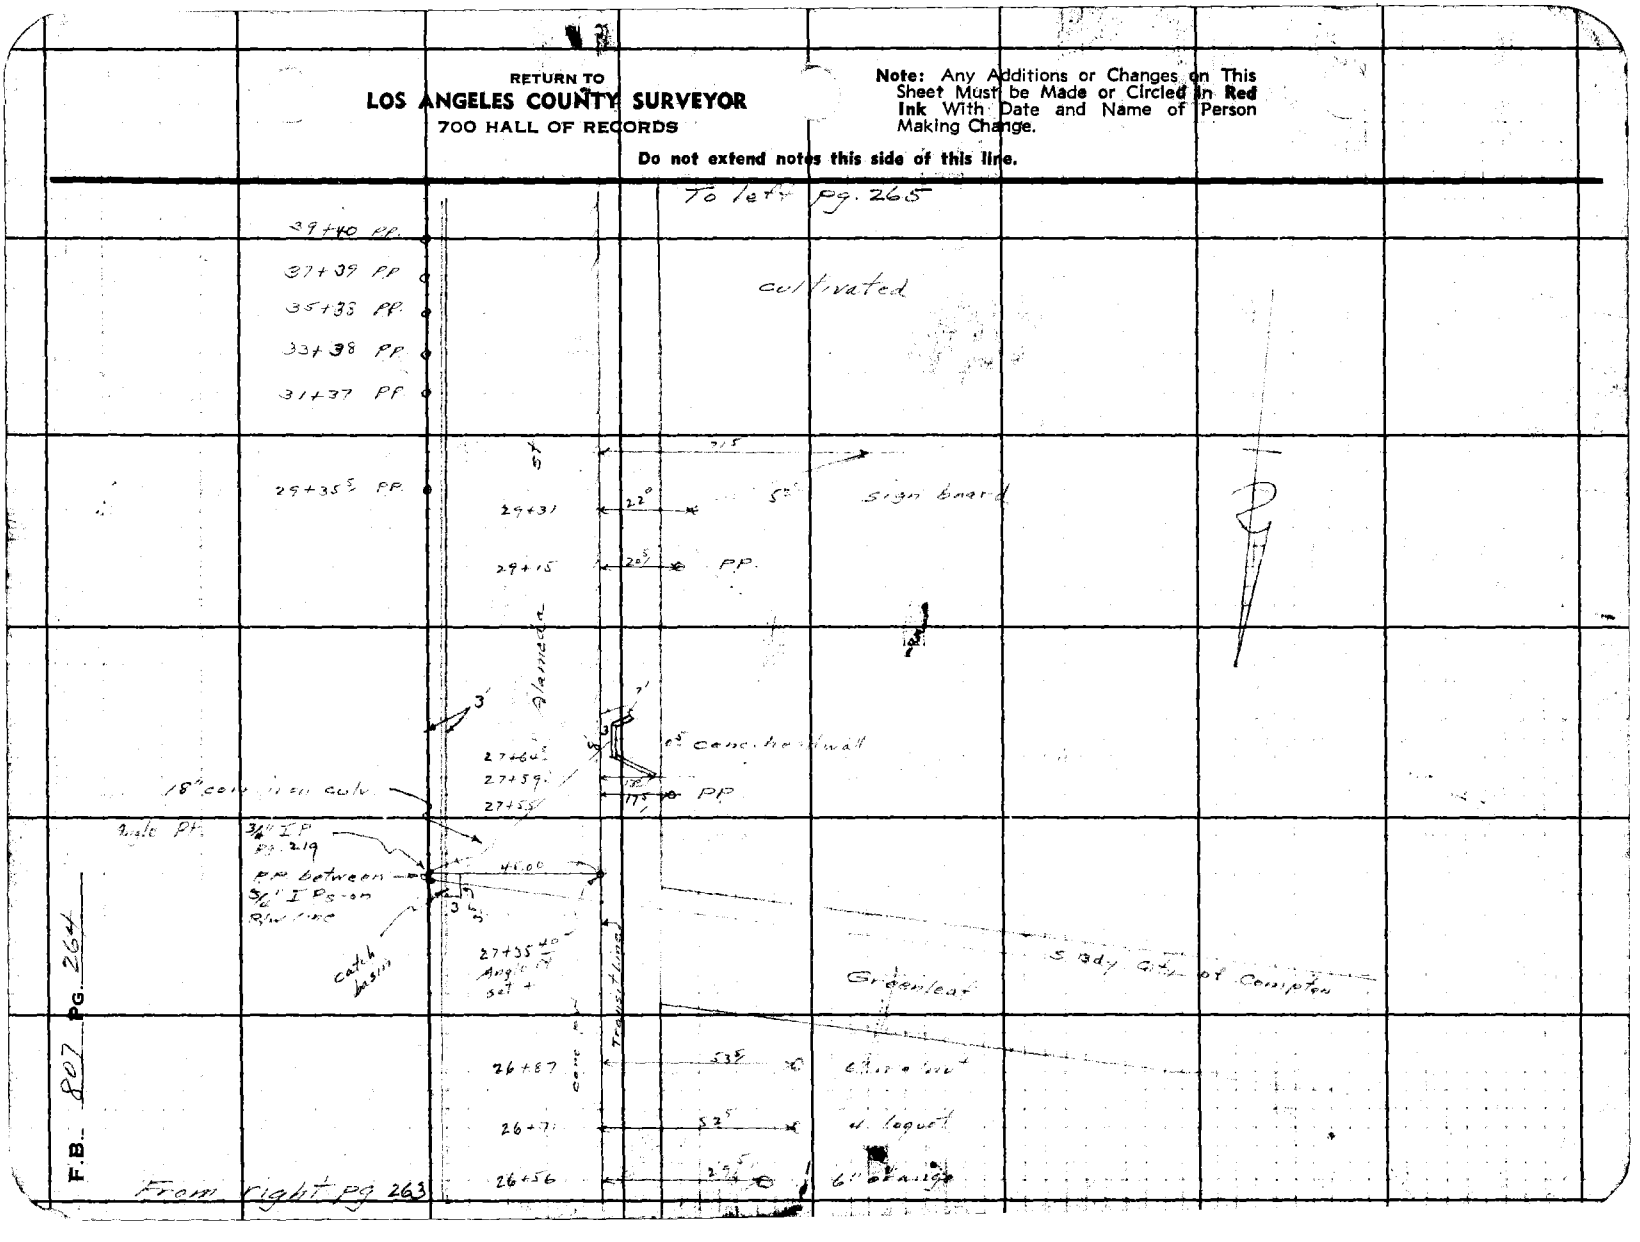

Notes Ck'd by D. M. Finley	Survey of Alameda St
Map No. ~~B-1498 B-1729~~	W. O. 8270 Tape No. St'd °F
Office Work	Surveyed by Moore
Checked	Notes Moore Date 10-9-40
Date Mar. 1945	Indexed C. Johnson


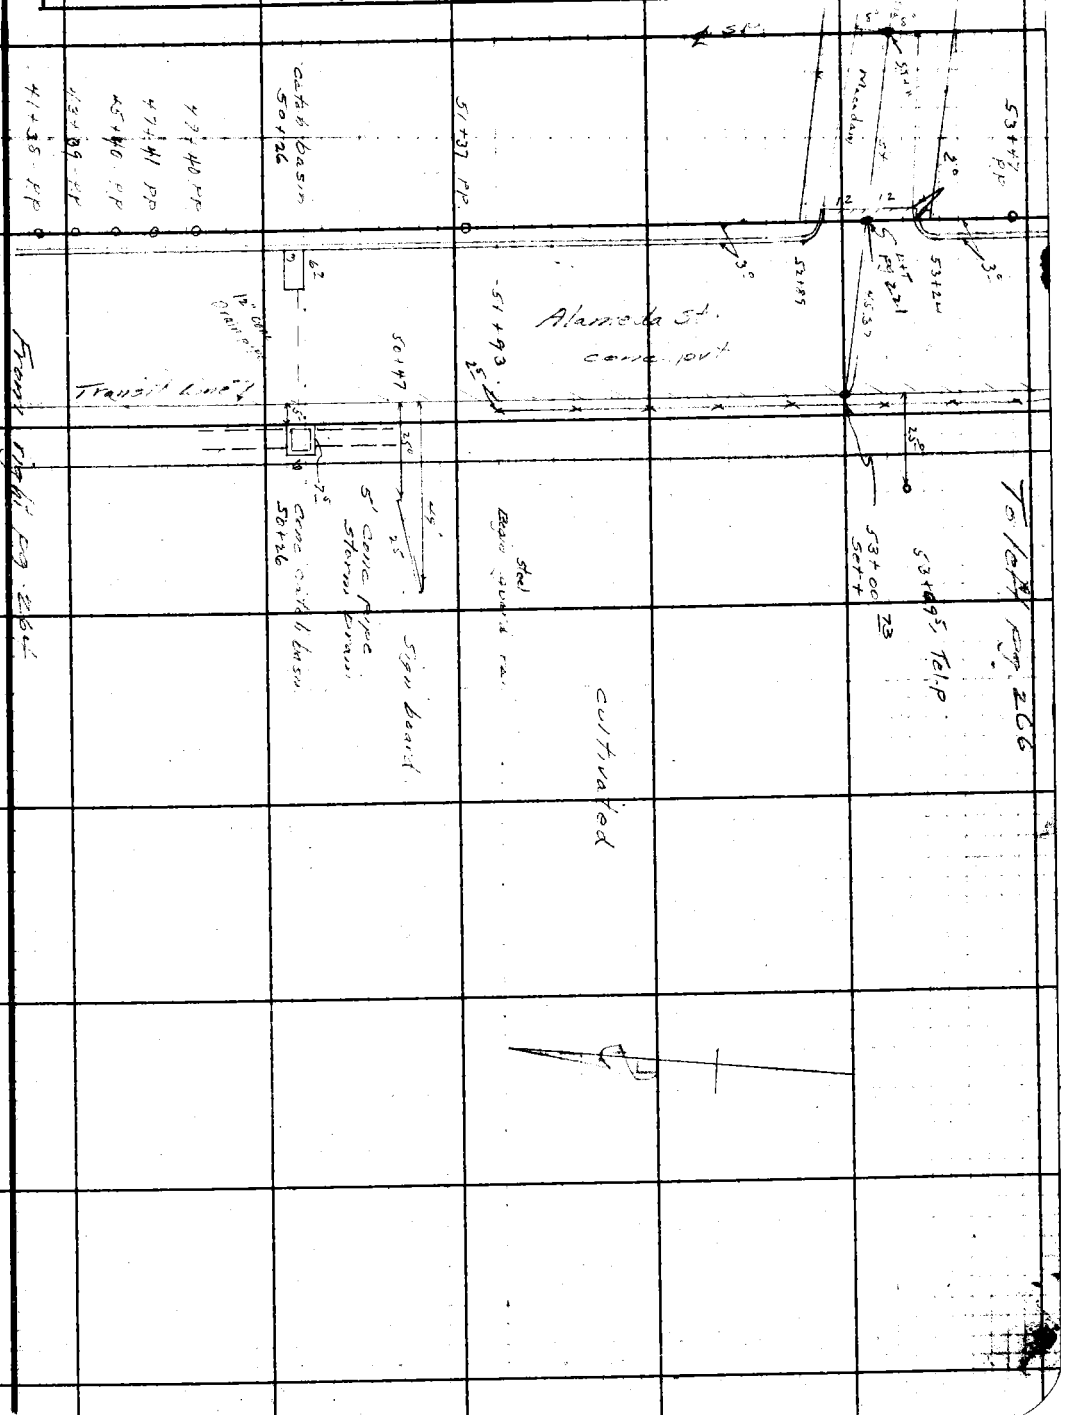

Note: Any Additions or Changes on This Sheet Must be Made or Circled in Red Ink With Date and Name of Person Making Change

Do not extend notes this side of this line.

RETURN TO
LOS ANGELES COUNTY SURVEYOR
700 HALL OF RECORDS

FORM 247 5M 10-39

RETURN TO
LOS ANGELES COUNTY SURVEYOR
700 HALL OF RECORDS

Note: Any Additions or Changes on This Sheet Must be Made or Circled in **Red Ink** With Date and Name of Person Making Change.

Do not extend notes this side of this line.

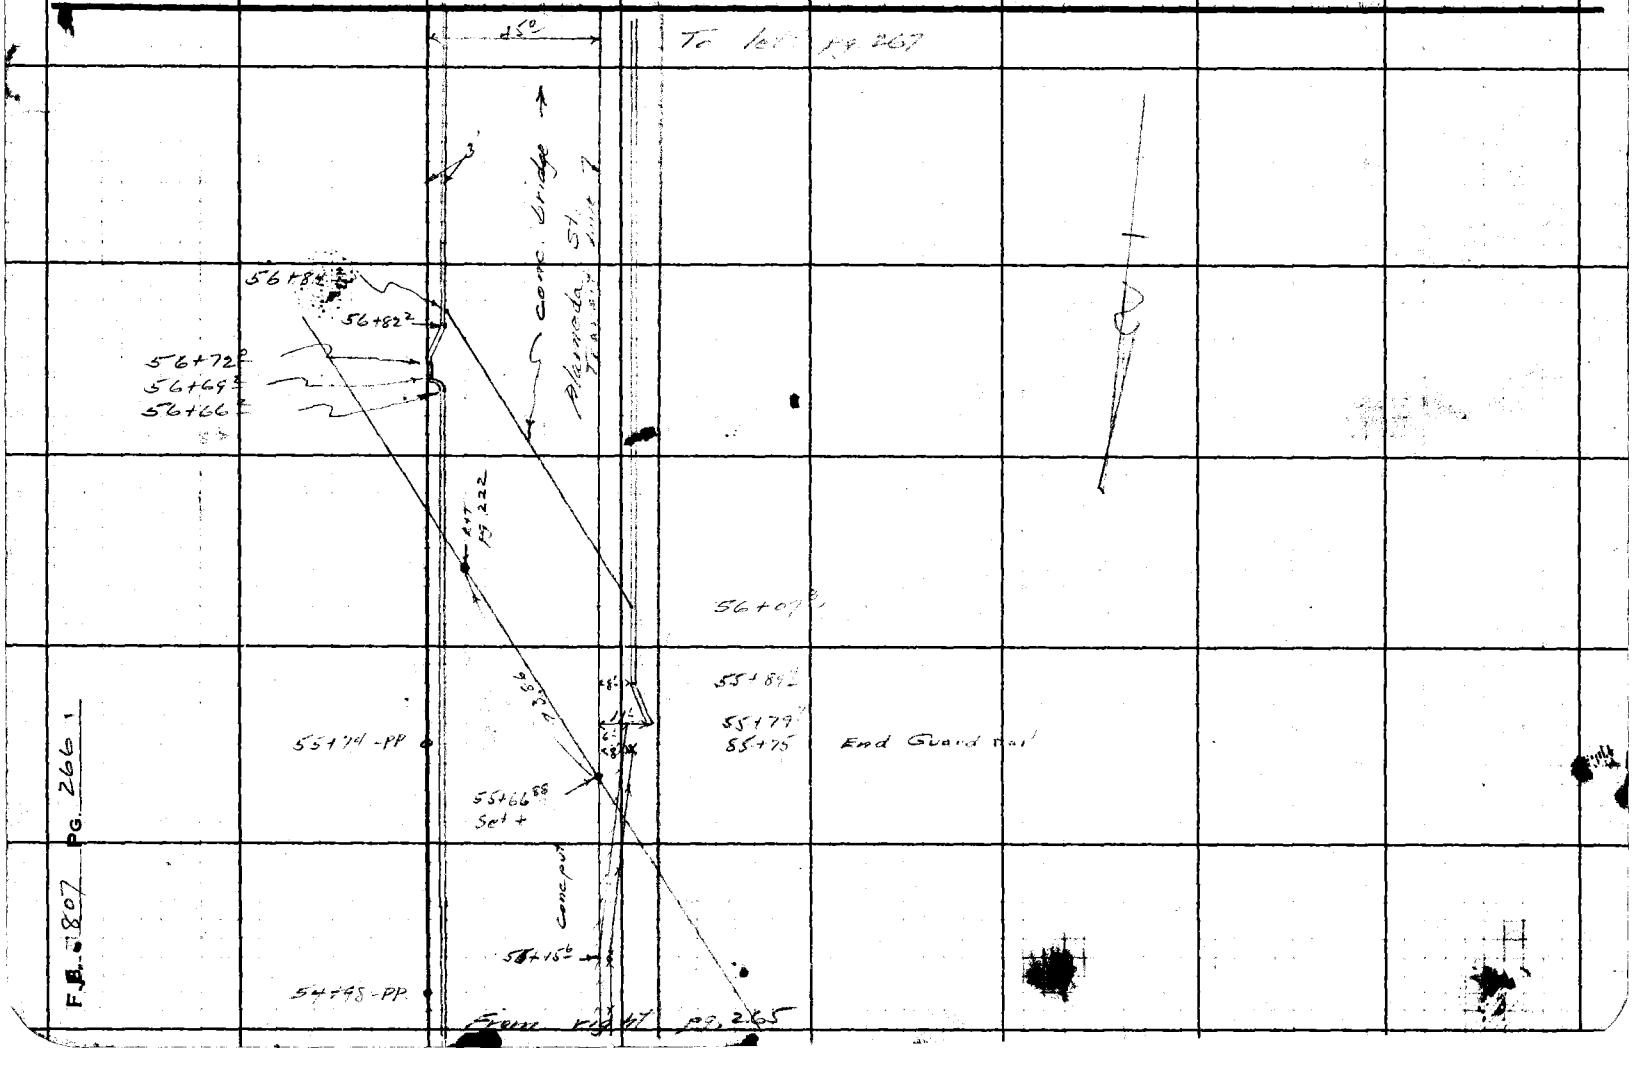

F.B. 807 PG. 266

Notes Ck'd by D. M. Finley	Survey of Alameda St
Map No. ~~B-1498~~ B-1729-3	W. O. 8270 Tape No. St'd °F
Office Work	Surveyed by [illegible]
Checked	Notes [illegible] Date 10-9-40
Date Mar. 1945	Indexed A. C. Johnson


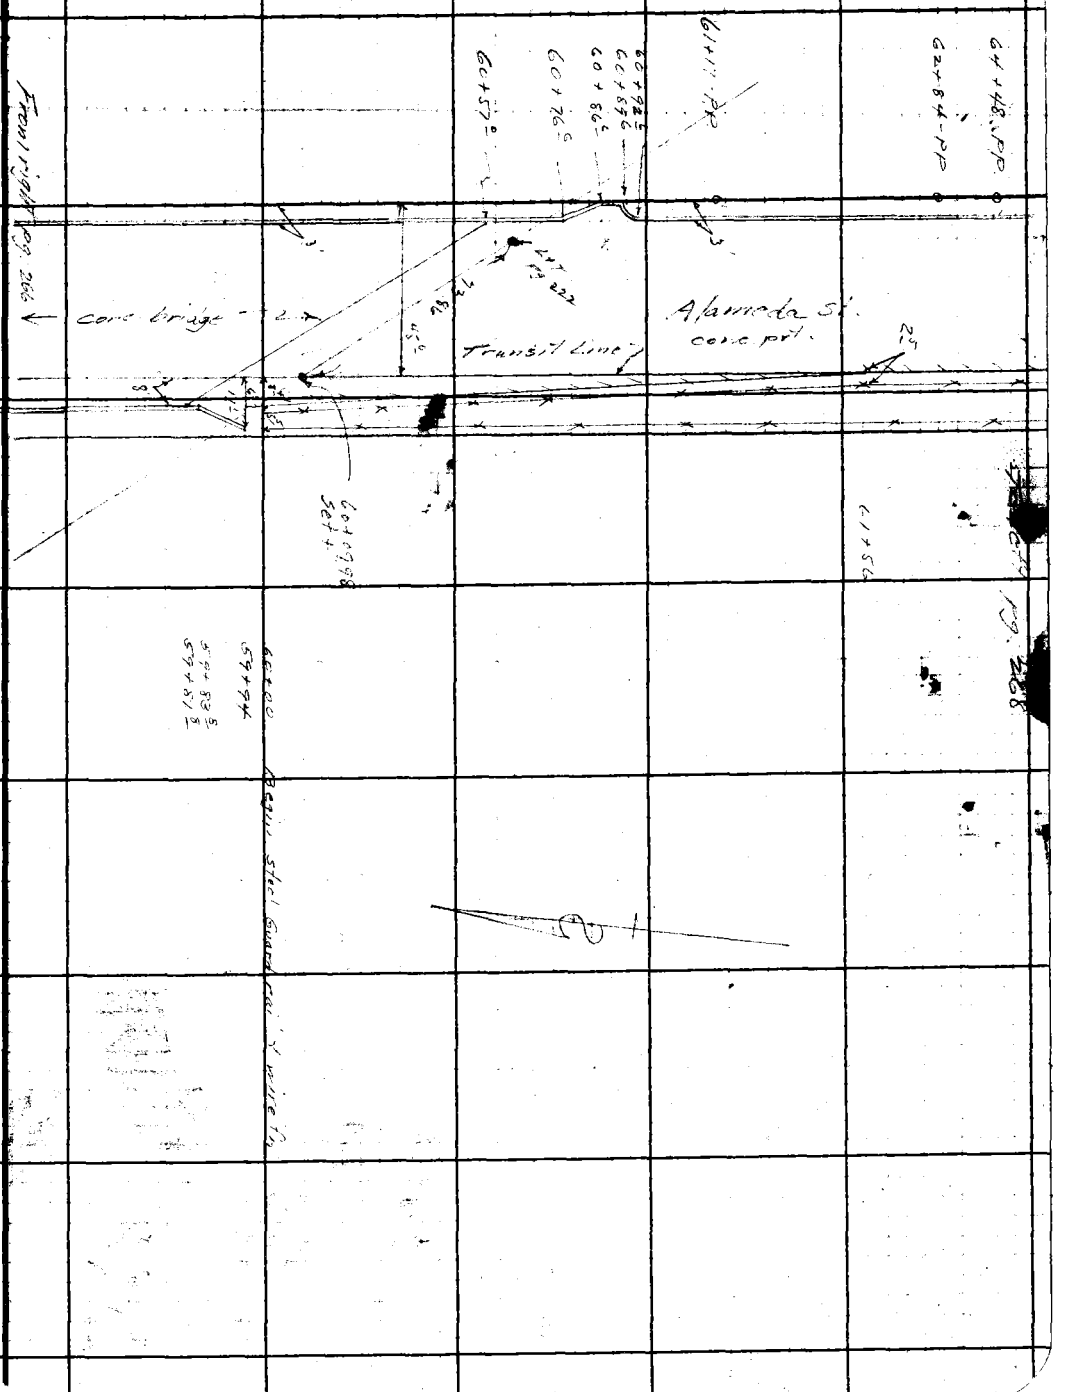

Note: Any Additions or Changes on This Sheet Must be Made or Circled in Red Ink With Date and Name of Person Making Change

Do not extend notes this side of this line.

RETURN TO
LOS ANGELES COUNTY SURVEYOR
700 HALL OF RECORDS

FORM 247 5M 10-39

RETURN TO
LOS ANGELES COUNTY SURVEYOR
700 HALL OF RECORDS

Note: Any Additions or Changes on This Sheet Must be Made or Circled in **Red Ink** With Date and Name of Person Making Change.

Do not extend notes this side of this line.

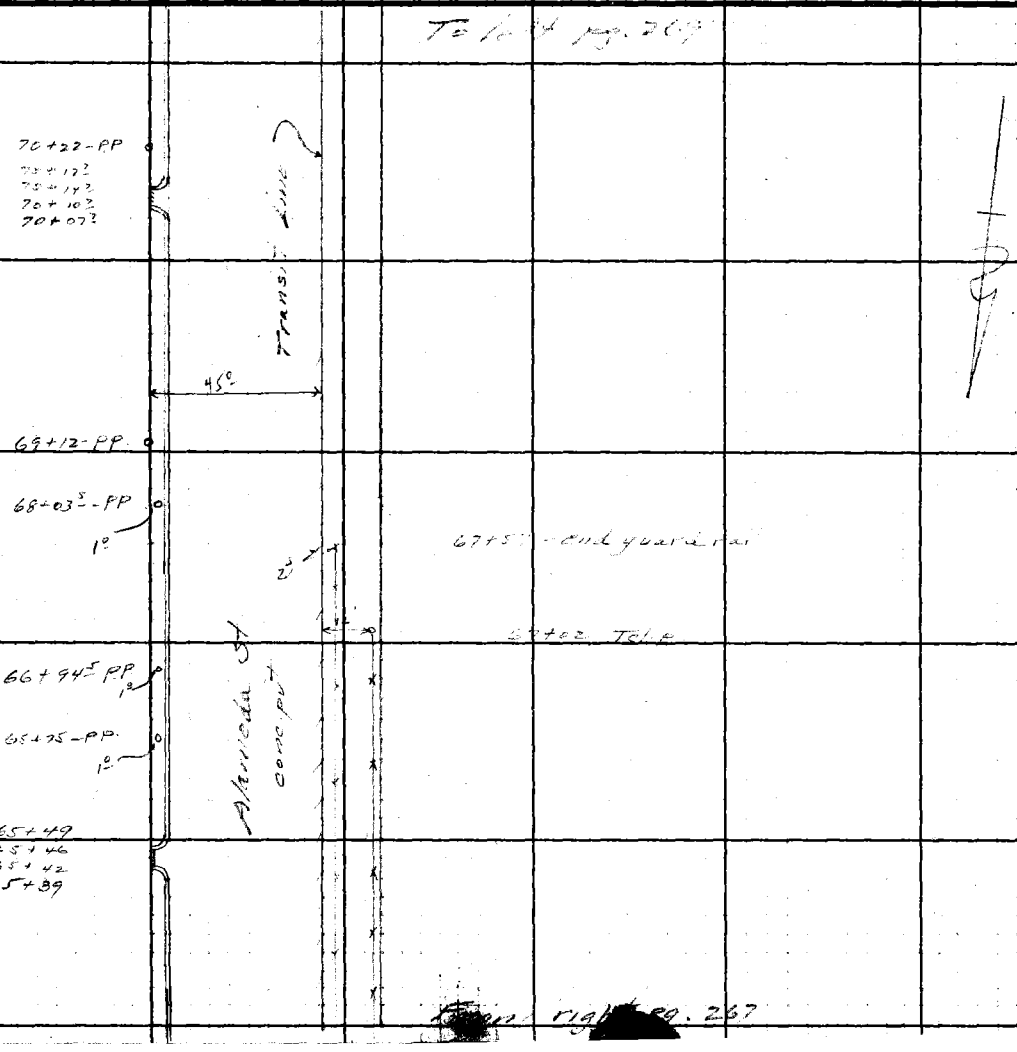

F.B. 807 PG. 268

Notes Ck'd by D. M. Finley	Survey of Alameda St	F.B. 807 Pg. 269
Map No. ~~B-1498~~ B-1729-3	W. O. 8270 Tape No. Std. °F	
Office Work D. A. W.	Surveyed by Moore	
Checked	Notes Moore Date 10-9-40	
Date Mar. 1945.	Indexed A. C. Johnson	

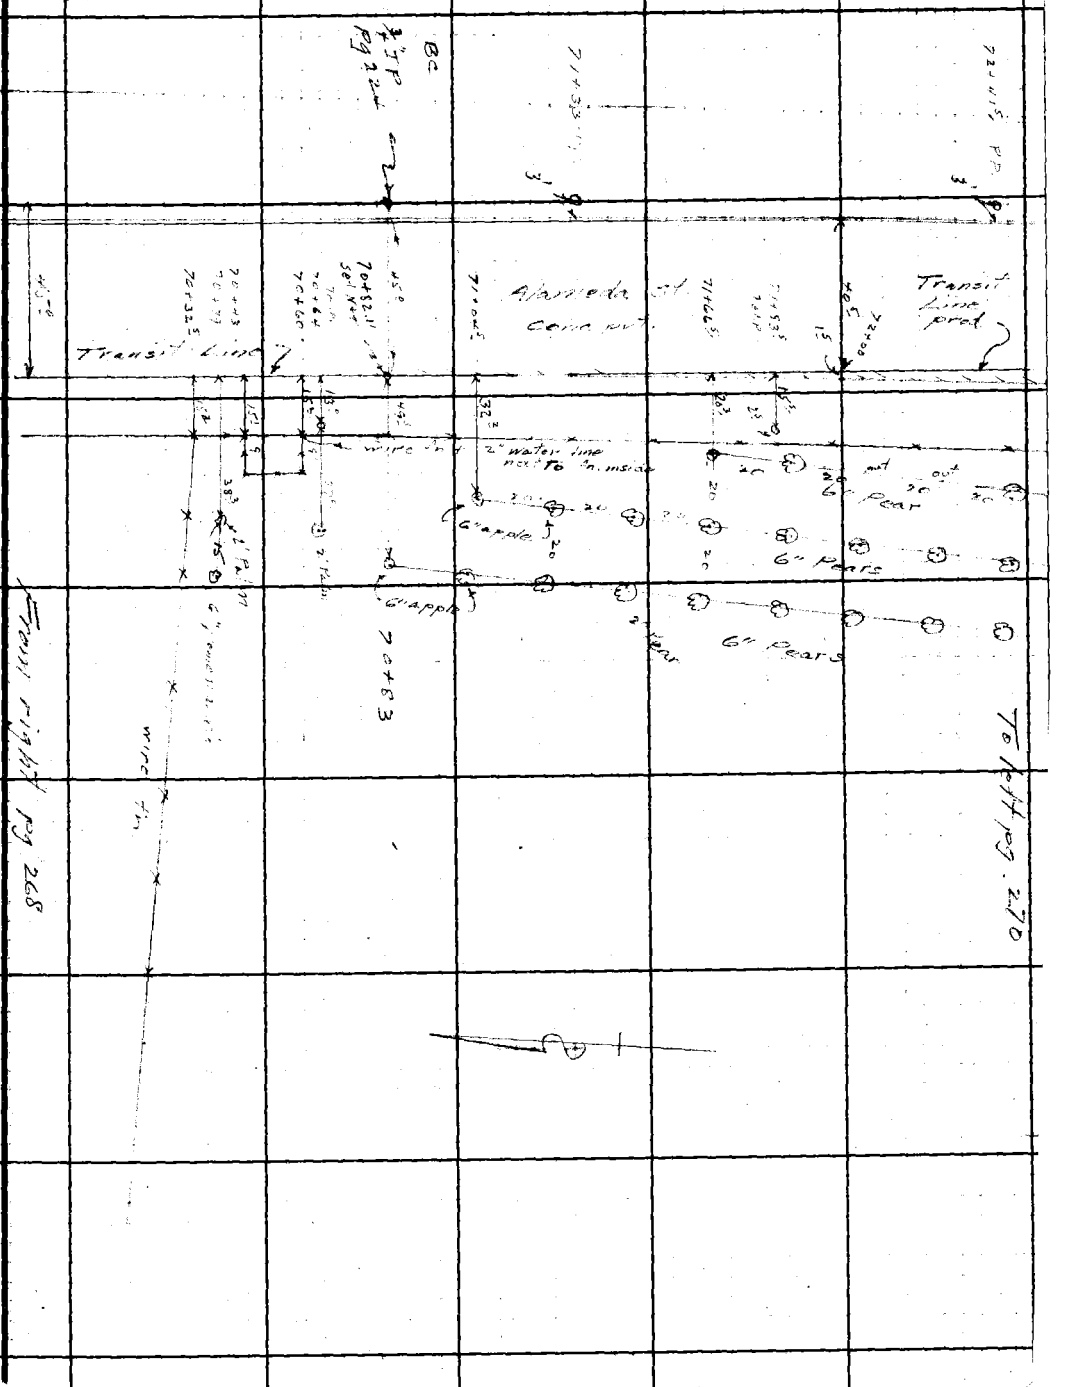

Note: Any Additions or Changes on This Sheet Must be Made or Circled in Red Ink With Date and Name of Person Making Change.

Do not extend notes this side of this line.

RETURN TO
LOS ANGELES COUNTY SURVEYOR
700 HALL OF RECORDS

FORM 247 5M 10-39

RETURN TO
LOS ANGELES COUNTY SURVEYOR
700 HALL OF RECORDS

Note: Any Additions or Changes on This Sheet Must be Made or Circled in **Red Ink** With Date and Name of Person Making Change.

Do not extend notes this side of this line.

To left pg. 271

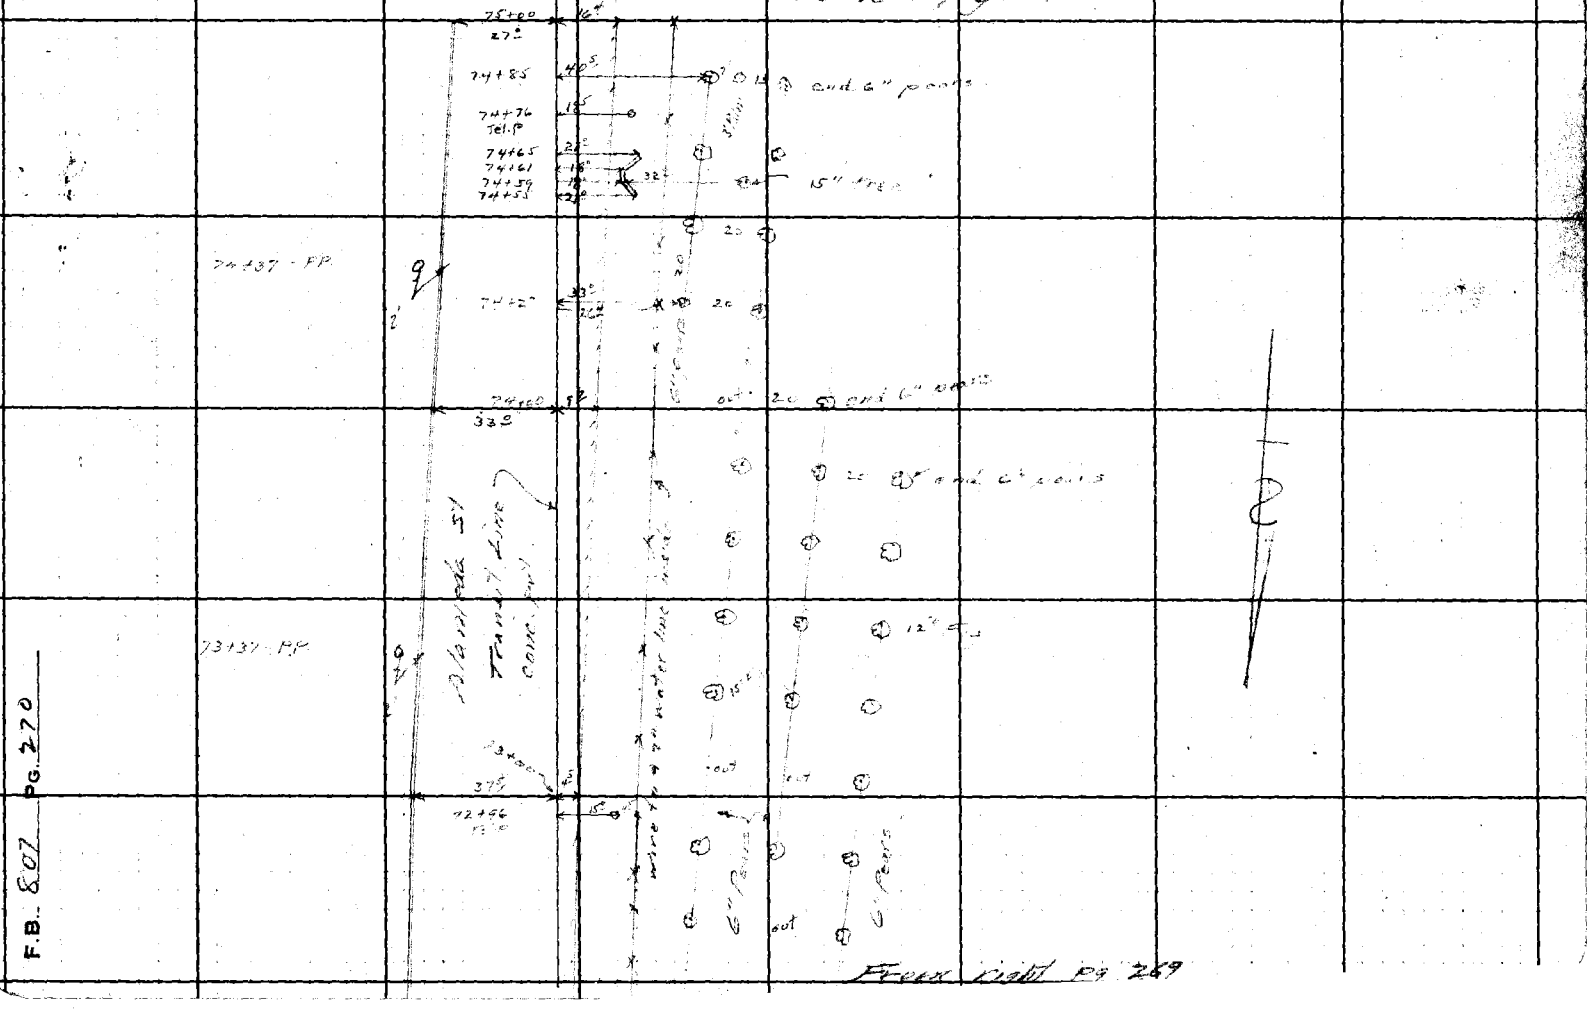

Fence left pg. 269

F.B. 807 PG. 270

Notes Ck'd by D. M. Finley	Survey of Alameda St
Map No. ~~[illegible]~~ B-1729-3	W. O. 8270 Tape No. St'd °F
Office Work	Surveyed by Moore
Checked	Notes Moore Date 10-10-40
Date Mar. 1945	Indexed A. C. Johnson

F.B. 807 Pg. 271

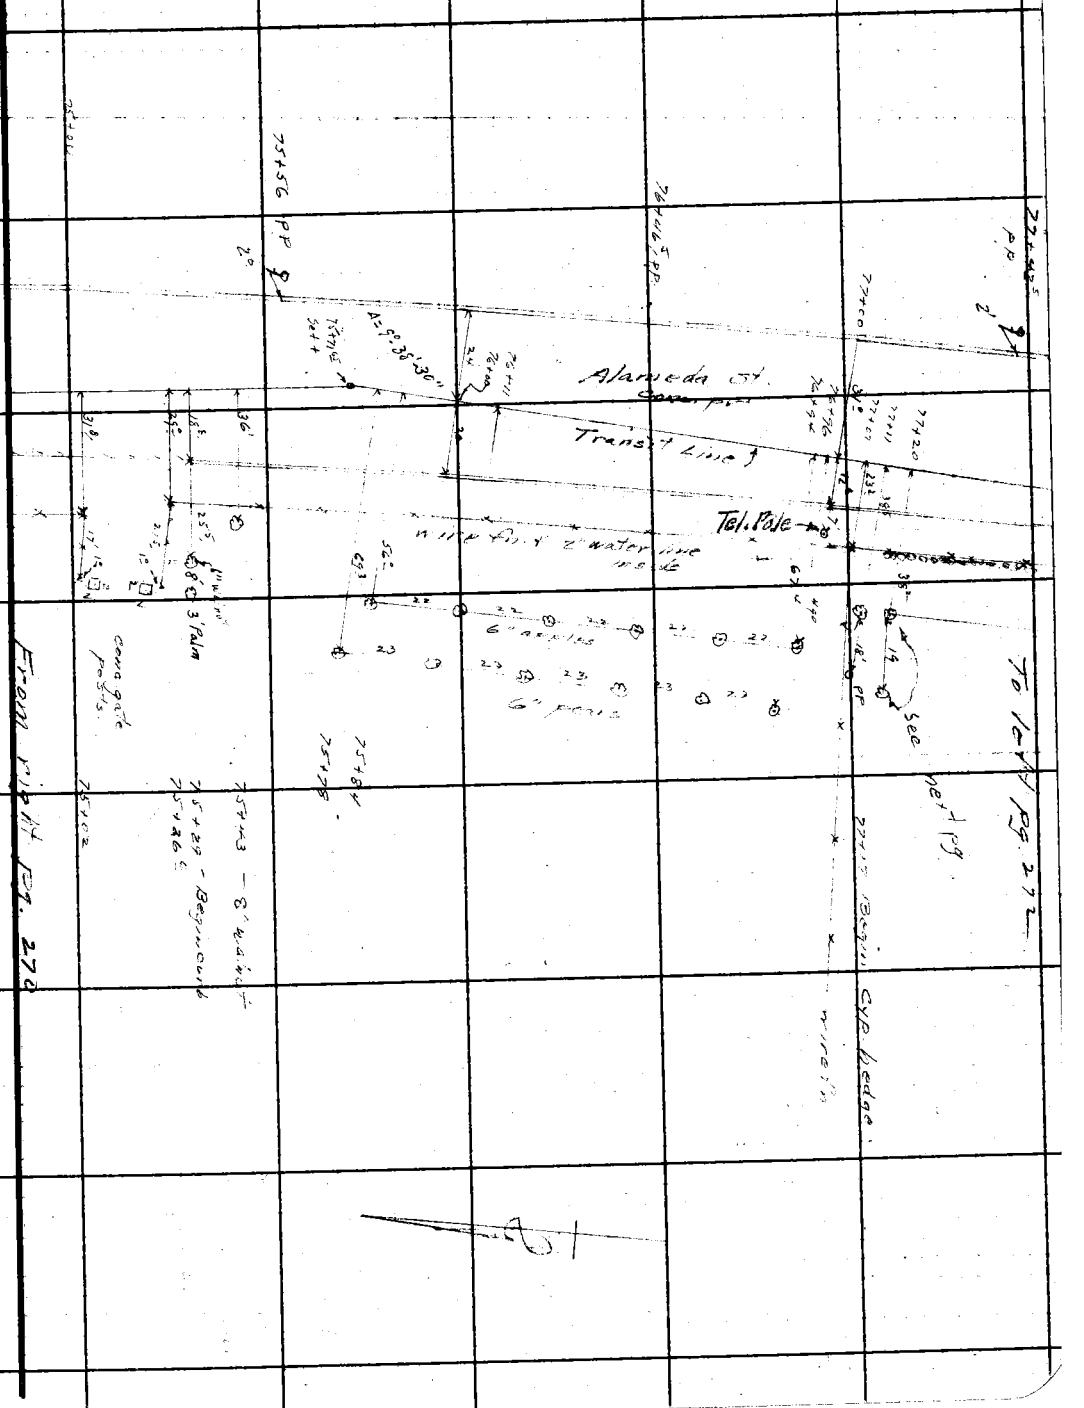

Note: Any Additions or Changes on This Sheet Must be Made or Circled in Red Ink With Date and Name of Person Making Change.

Do not extend notes this side of this line.

RETURN TO
LOS ANGELES COUNTY SURVEYOR
700 HALL OF RECORDS

FORM 247 5M 10-39

RETURN TO
LOS ANGELES COUNTY SURVEYOR
700 HALL OF RECORDS

Note: Any Additions or Changes on This Sheet Must be Made or Circled in **Red Ink** With Date and Name of Person Making Change.

Do not extend notes this side of this line.

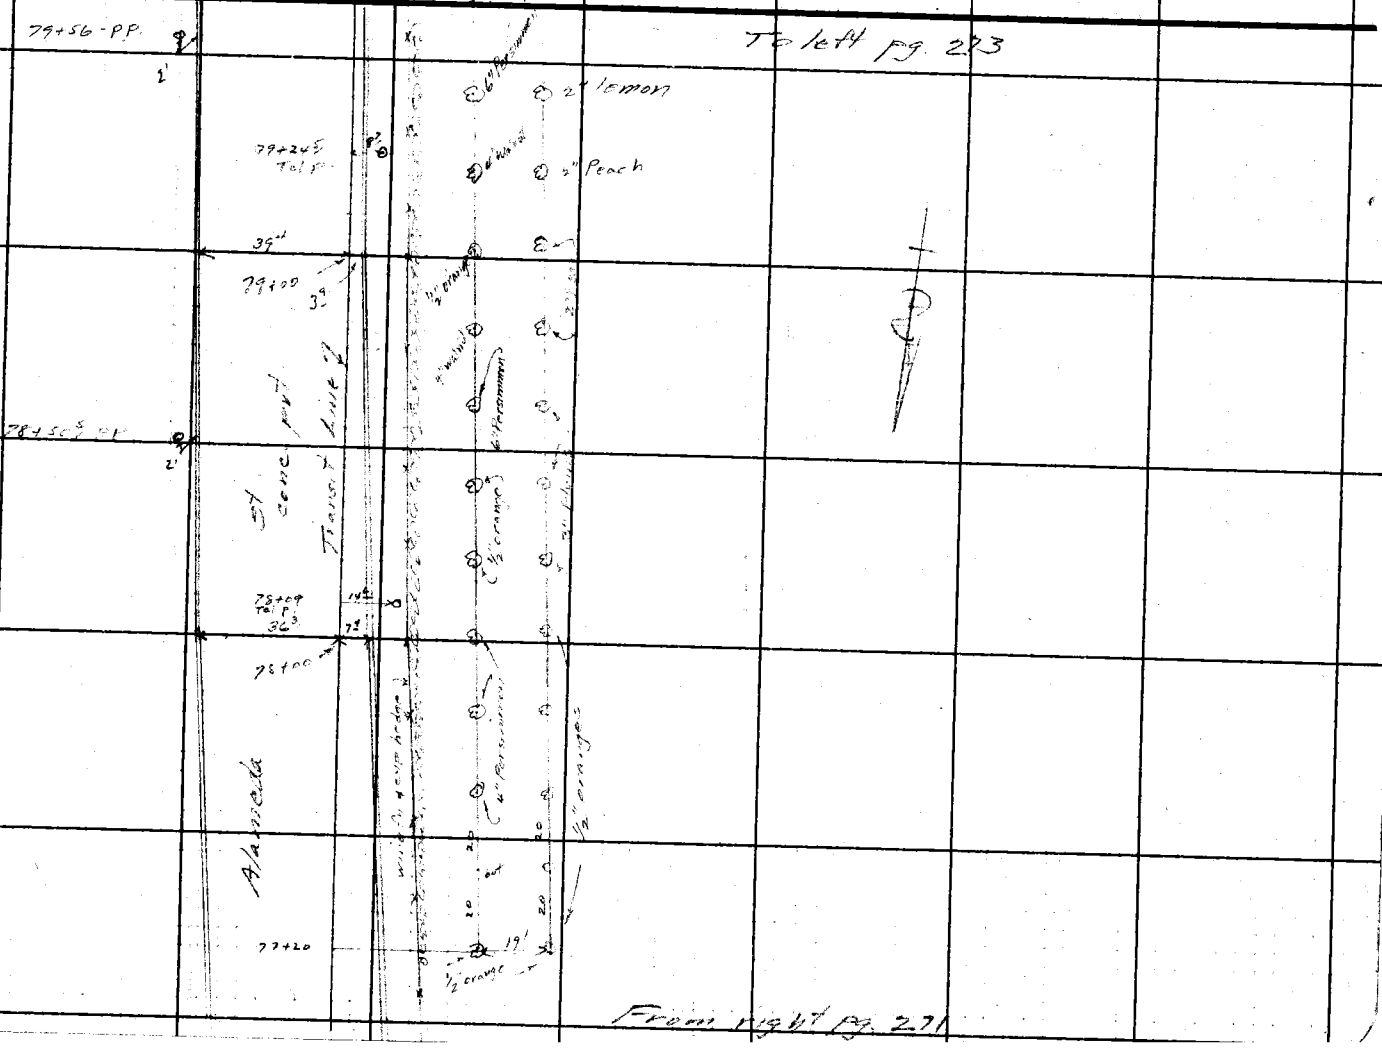

F.B. 807 PG. 272

Notes Ck'd by D. M. Finley	Survey of Alameda St
Map No. [illegible]	W. O. 8270 Tape No: Std °F
Office Work	Surveyed by Alone
Checked	Notes Alone Date 10-10-40
Date Mar. 1945.	Indexed [illegible]

F.B. 867 PG. 273

Note: Any Additions or Changes on This Sheet Must be Made or Circled in Red Ink With Date and Name of Person Making Change.

Do not extend notes this side of this line.

RETURN TO
LOS ANGELES COUNTY SURVEYOR
700 HALL OF RECORDS

FORM 247 3M 10-39

RETURN TO
LOS ANGELES COUNTY SURVEYOR
700 HALL OF RECORDS

Note: Any Additions or Changes on This Sheet Must be Made or Circled in **Red Ink** With Date and Name of Person Making Change.

Do not extend notes this side of this line.

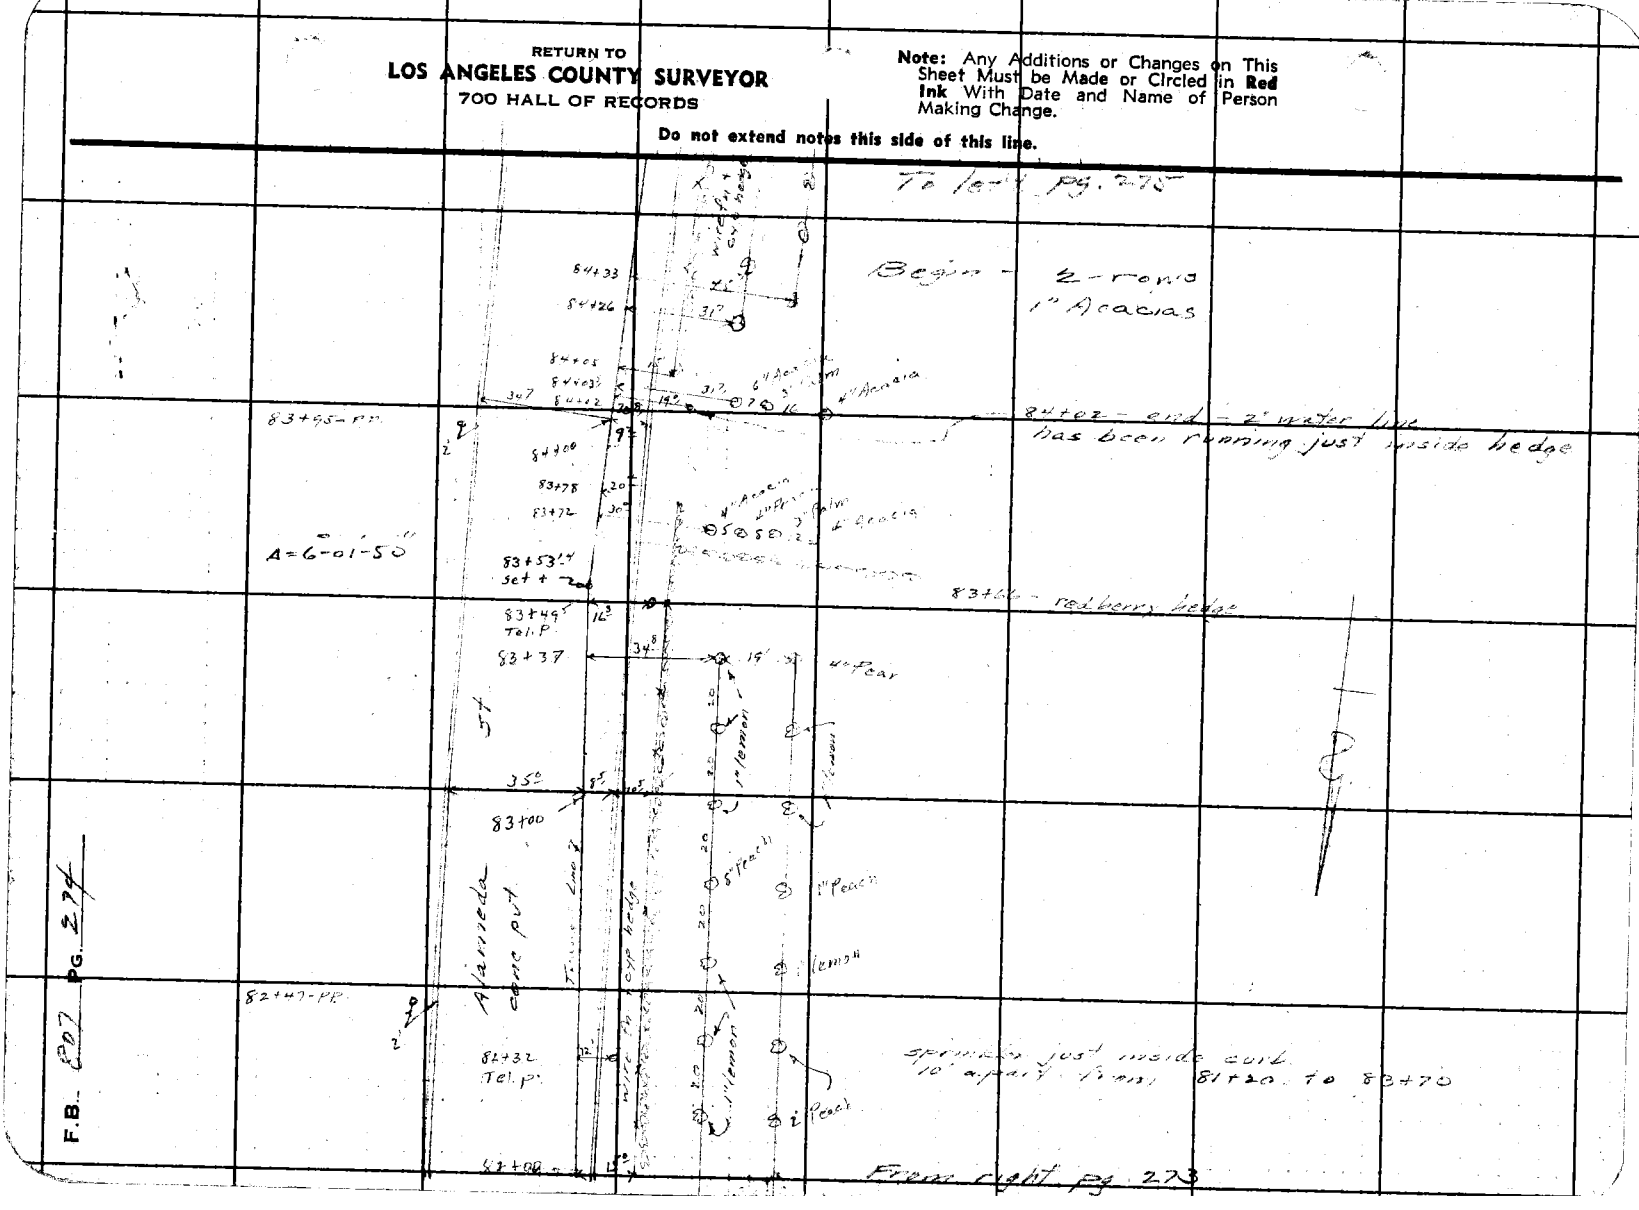

F.B. 807 PG. 274

Notes Ck'd by D. M. Finley	Survey of Alameda St
Map No. ~~[illegible]~~ B-1729-3	W. O. 8270 Tape No. St'd. °F
Office Work	Surveyed by [illegible]
Checked	Notes [illegible] Date 12-10-45
Date Mar. 1945	Indexed ~~[illegible]~~ C. Johnson

F.B. 8[illegible] PG. 275

Note: Any Additions or Changes on This Sheet Must be Made or Circled in Red Ink With Date and Name of Person Making Change

Do not extend notes this side of this line.

RETURN TO
LOS ANGELES COUNTY SURVEYOR
700 HALL OF RECORDS

FORM 247 5M 10-59

RETURN TO
LOS ANGELES COUNTY SURVEYOR
700 HALL OF RECORDS

Note: Any Additions or Changes on This Sheet Must be Made or Circled in **Red Ink** With Date and Name of Person Making Change.

Do not extend notes this side of this line.

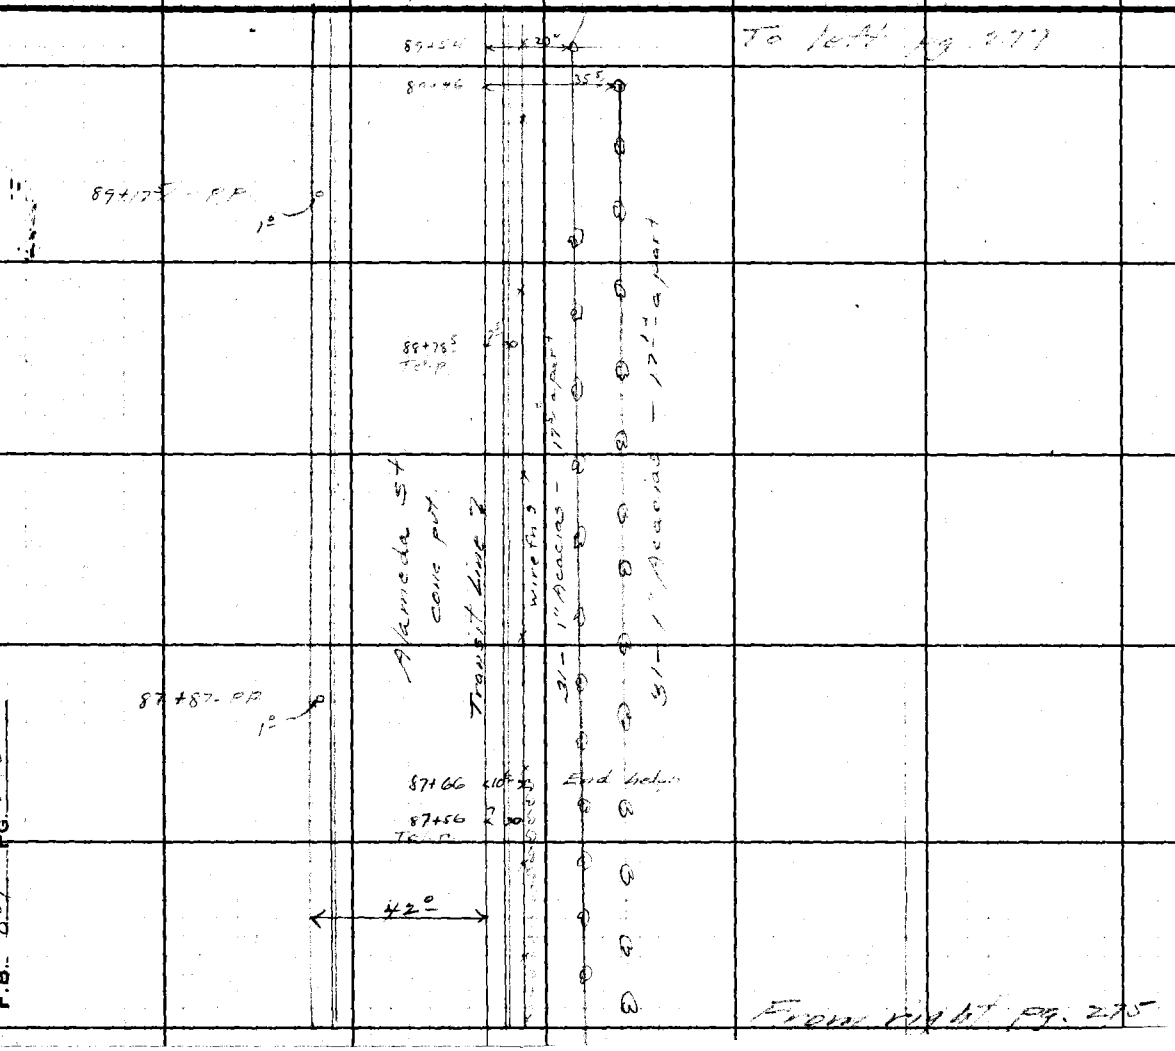

F.B. 807 PG. 276

Notes Ck'd by D. M. Finley	Survey of Alameda St
Map No. ~~[illegible]~~ B-1729-3	W. O. 8270 Tape No: St'd °F
Office Work	Surveyed by Moore
Checked	Notes Moore Date 10-10-40
Date Mar 1945.	Indexed [illegible] C. Johnson

F.B. 8[illegible] PG. 27[illegible]

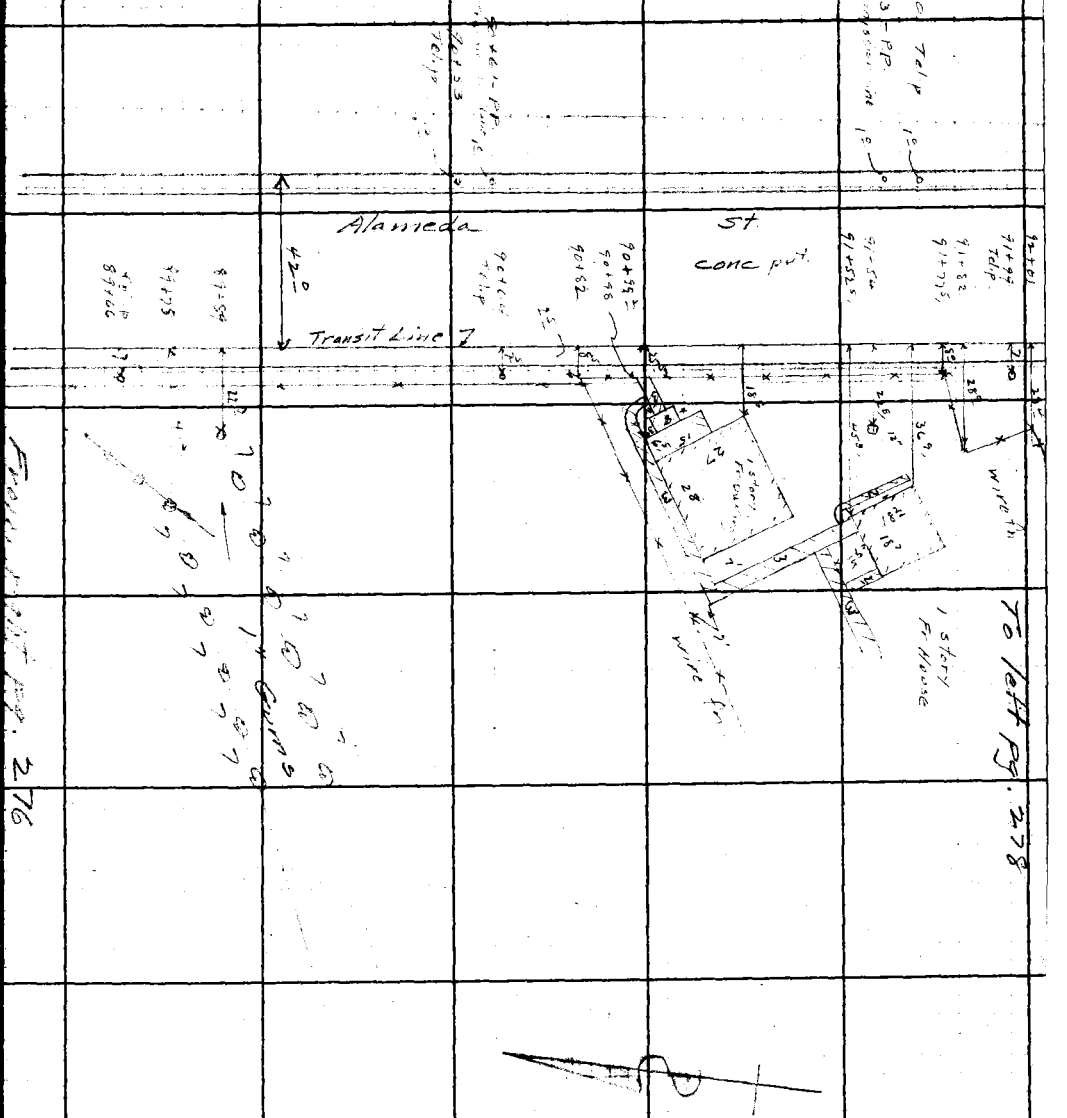

Note: Any Additions or Changes on This Sheet Must be Made or Circled in Red Ink With Date and Name of Person Making Change

Do not extend notes this side of this line.

RETURN TO
LOS ANGELES COUNTY SURVEYOR
700 HALL OF RECORDS

FORM 247 5M 10-39

RETURN TO
LOS ANGELES COUNTY SURVEYOR
700 HALL OF RECORDS

Note: Any Additions or Changes on This Sheet Must Be Made or Circled in **Red Ink** With Date and Name of Person Making Change.

Do not extend notes this side of this line.

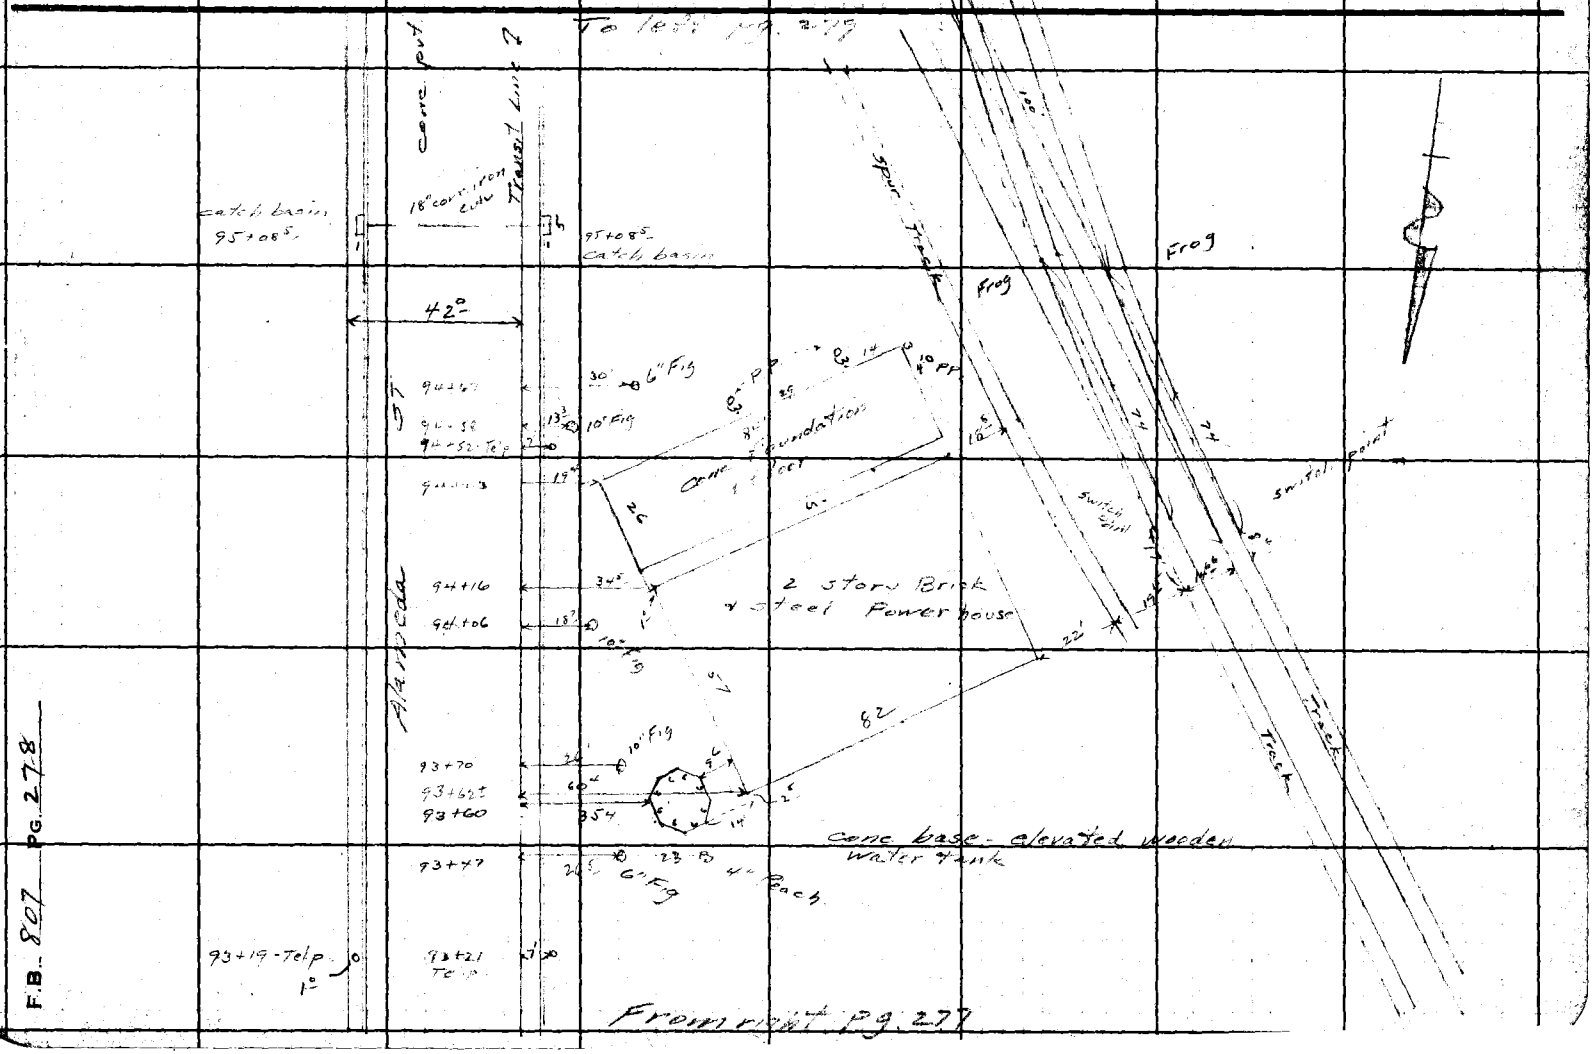

Notes Ck'd by D. M. Finley
Map No. [illegible] 8/7/45
Office Work
Checked
Date Mar. 1945.

Survey of Alameda St.
W. O. 8270 Tape No. St'd °F
Surveyed by [illegible]
Notes [illegible] Date [illegible]
Indexed [illegible]

F.B. 807 PG. 277

Alameda St
Conc pvt
Transit Line 2
From Left Pg. 278
To left Pg. 280
Left Pg 226
Trees
Gate
Pp
Gate
Pp
Gate
Pp

RETURN TO
LOS ANGELES COUNTY SURVEYOR
700 HALL OF RECORDS

Note: Any Additions or Changes on This Sheet Must be Made or Circled in **Red Ink** With Date and Name of Person Making Change.

Do not extend notes this side of this line.

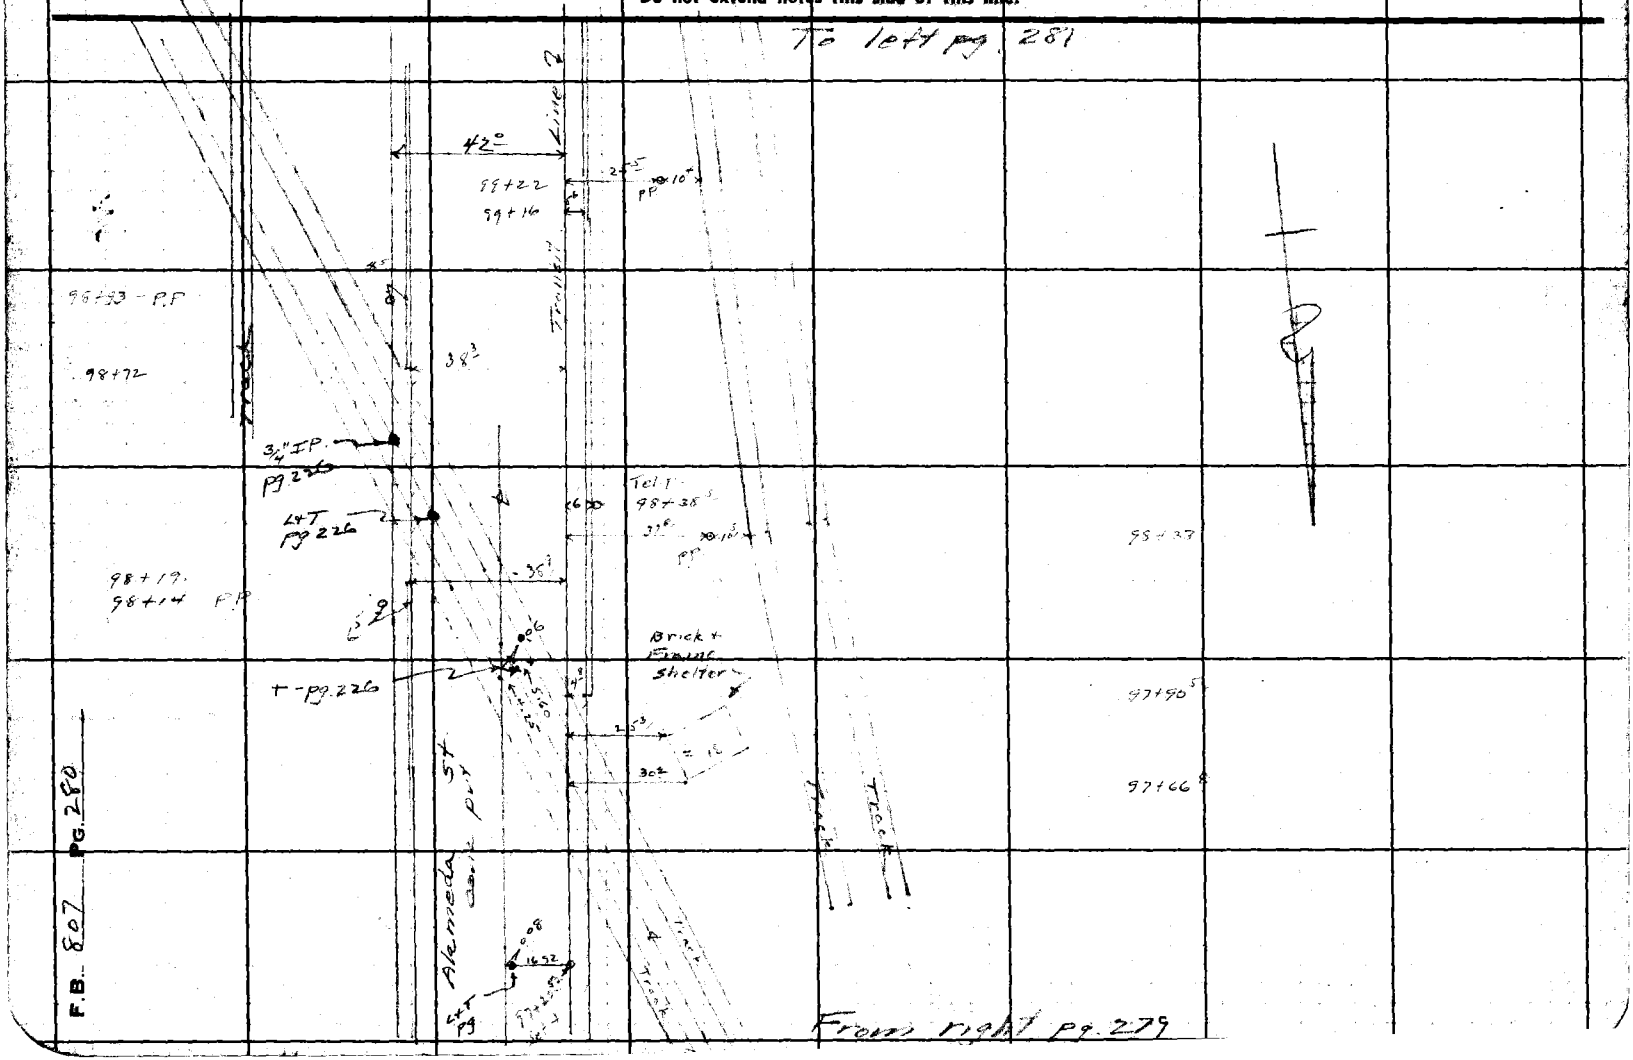

Notes Ck'd by D. M. Finley	Survey of Alameda St	F.B. 807 Pg. 281
Map No. [illegible] A-17293	W. O. 8270 Tape No. ____ St'd ____ °F	
Office Work [illegible]	Surveyed by [illegible]	
Checked	Notes [illegible] Date 10-11-40	
Date Mar. 1945	Indexed A. C. Johnson	

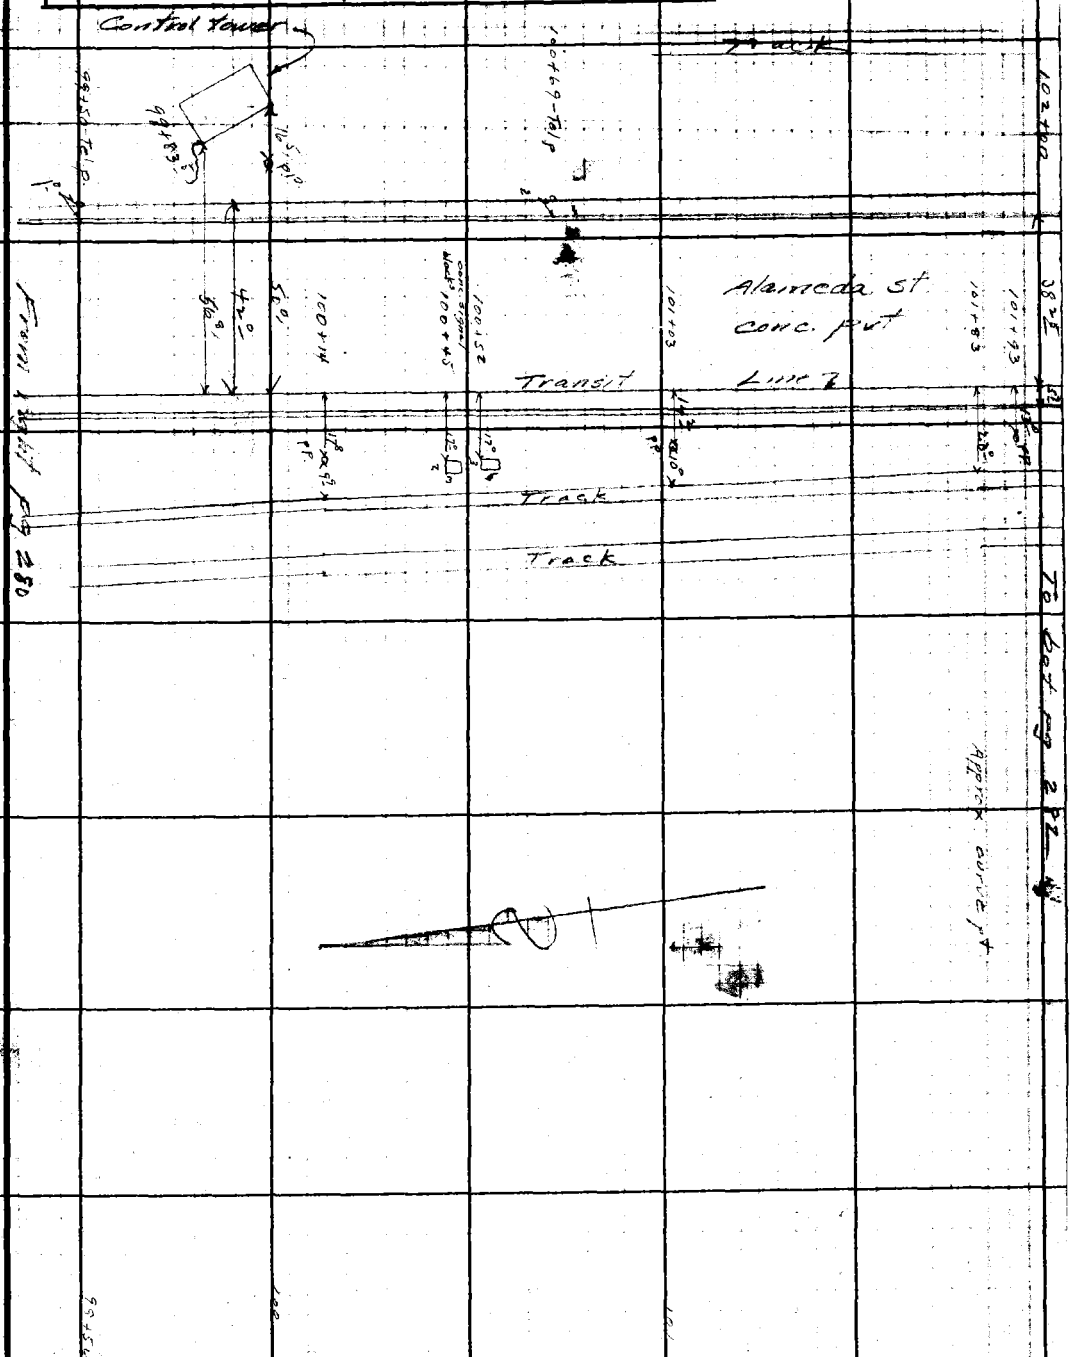

Note: Any Additions or Changes on This Sheet Must be Made or Circled in Red Ink With Date and Name of Person Making Change.

Do not extend notes this side of this line.

RETURN TO
LOS ANGELES COUNTY SURVEYOR
700 HALL OF RECORDS

FORM 247 5M 10-39

F.B. 807 PG. 282

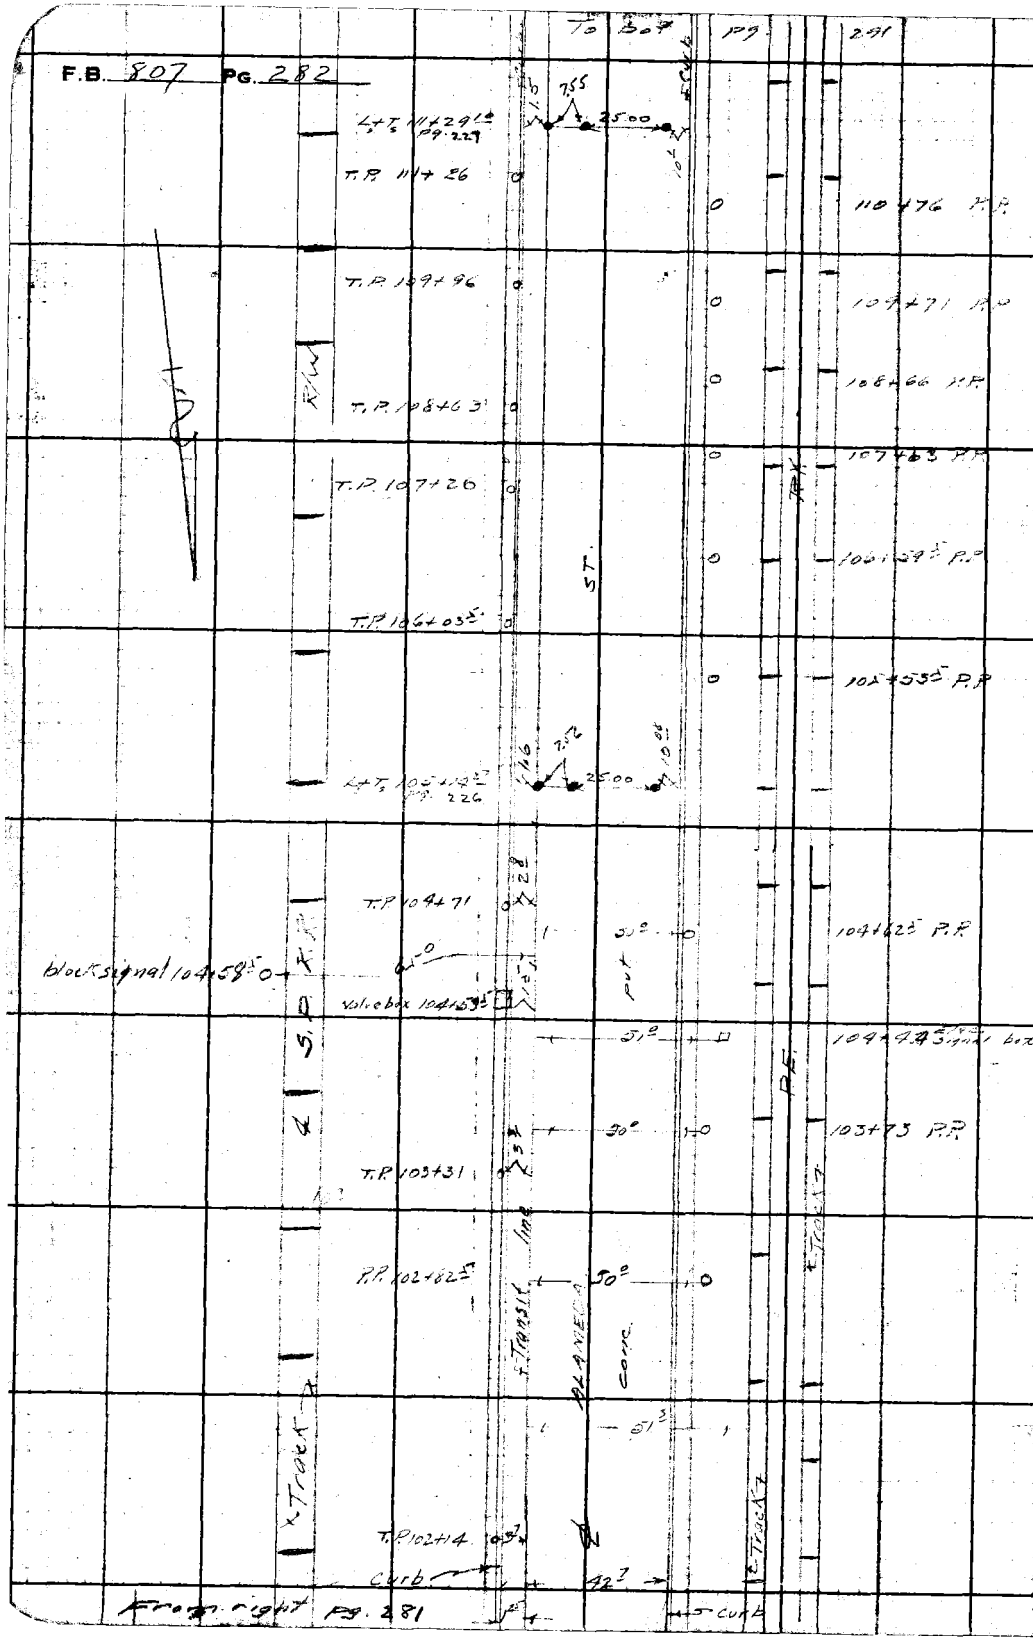

RETURN TO
LOS ANGELES COUNTY SURVEYOR
700 HALL OF RECORDS

Do not extend notes this side of this line.

Note: Any Additions or Changes on This Sheet Must be Made or Circled in Red Ink With Date and Name of Person Making Change.

Notes Ck'd by D. M. Finley	Survey of Alameda St
Map No. [illegible]	W. O. 8270 Tape No. 07 Std 84 °F
Office Work	Surveyed by Moore
Checked	Notes Moore Date 12-31-40
Date Mar. 1945	Indexed [illegible]

F.B. 801 PG. 283

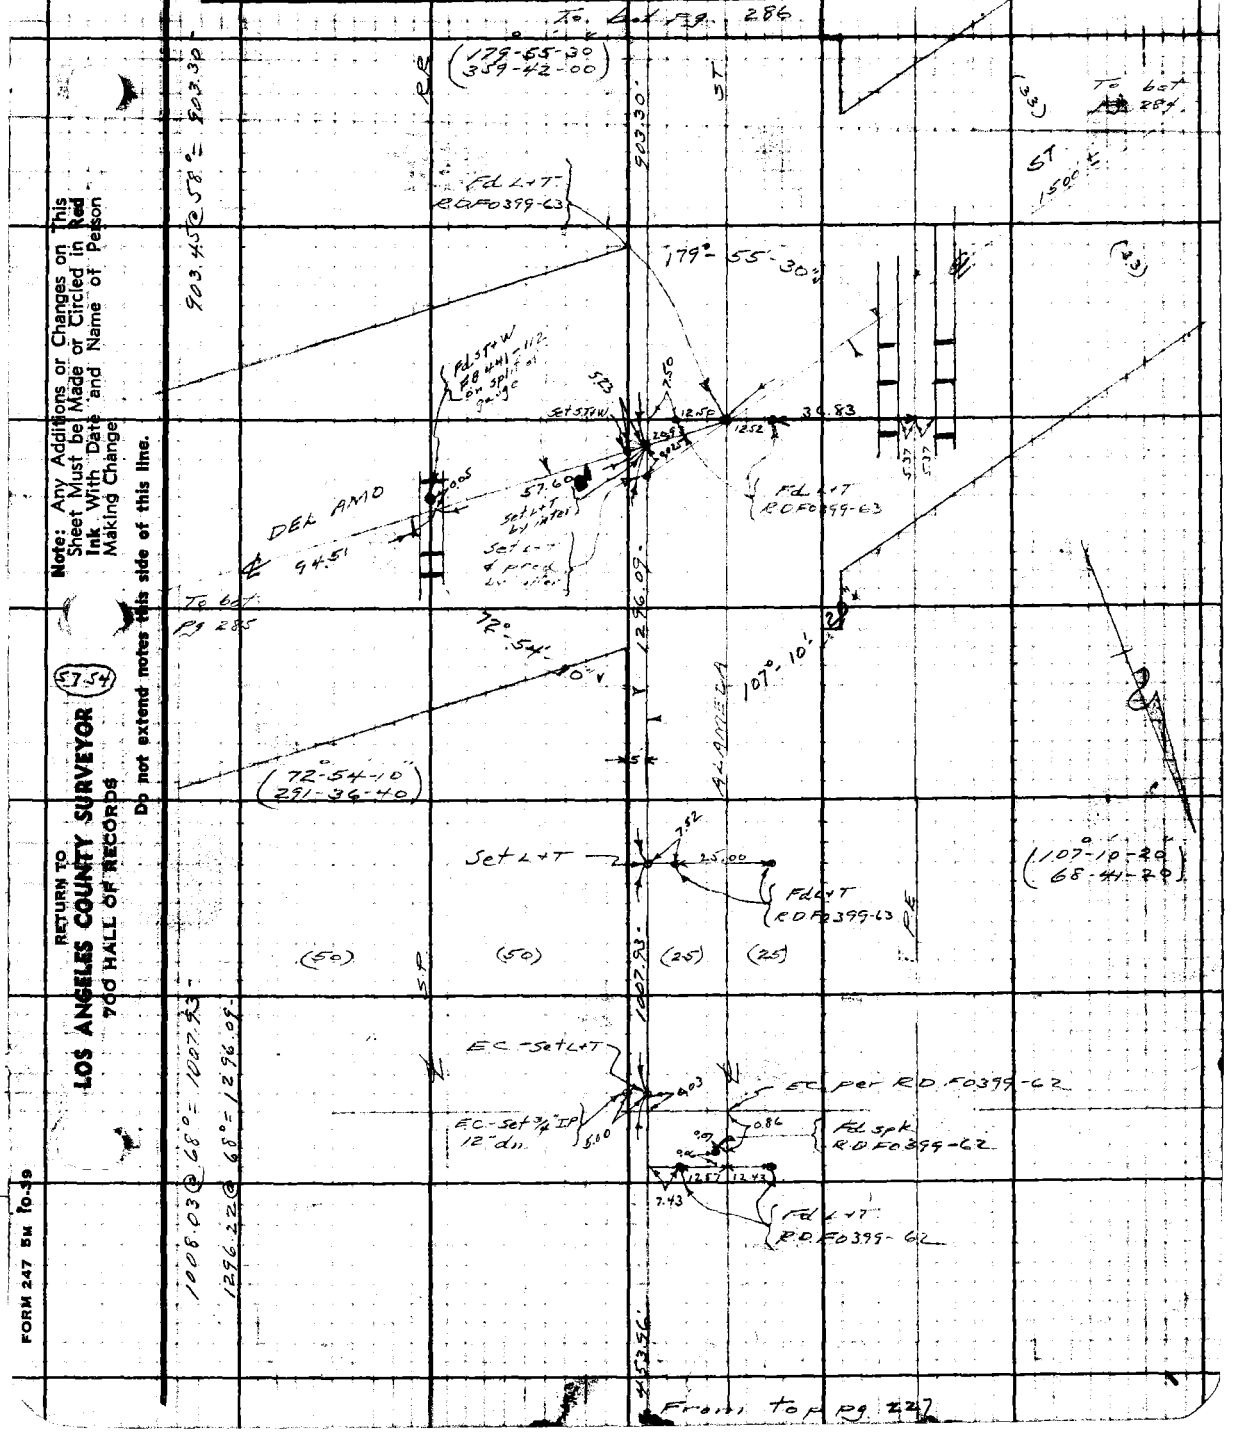

Note: Any Additions or Changes on This Sheet Must be Made or Circled in Red Ink With Date and Name of Person Making Change

Do not extend notes this side of this line.

RETURN TO
LOS ANGELES COUNTY SURVEYOR
700 HALL OF RECORDS

57.54

FORM 247 5M 10-39

F.B. 807 PG. 284

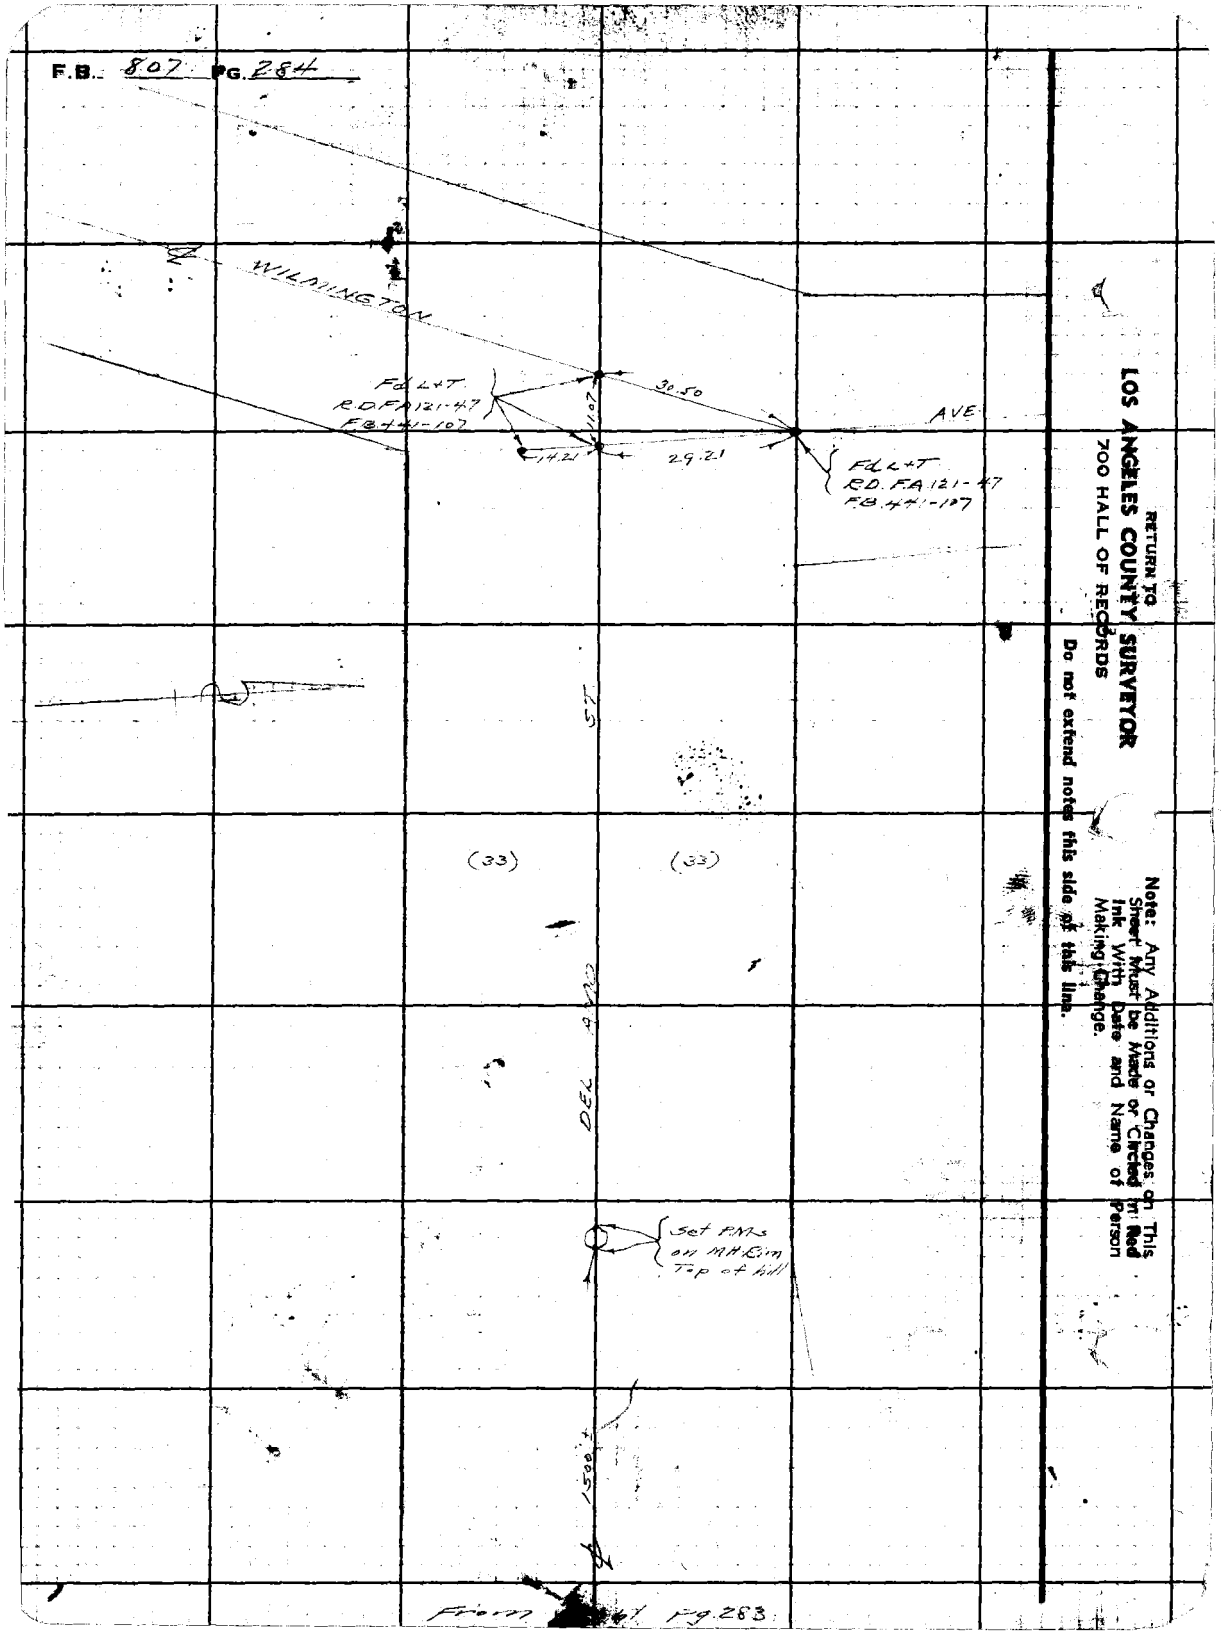

RETURN TO
LOS ANGELES COUNTY SURVEYOR
700 HALL OF RECORDS

Do not extend notes this side of this line.

Note: Any Additions or Changes on This Sheet Must be Made or Checked in Red Ink With Date and Name of Person Making Change.

Notes Ck'd by D. M. Finley	Survey of Alameda St	F.B. 807 PG. 285
Map No. [illegible]	W. O. 8270 Tape No. 01 St'd 84°F	
Office Work	Surveyed by D. Moore	
Checked	Notes D. Moore Date 12-30-40	
Date Mar. 1945	Indexed	

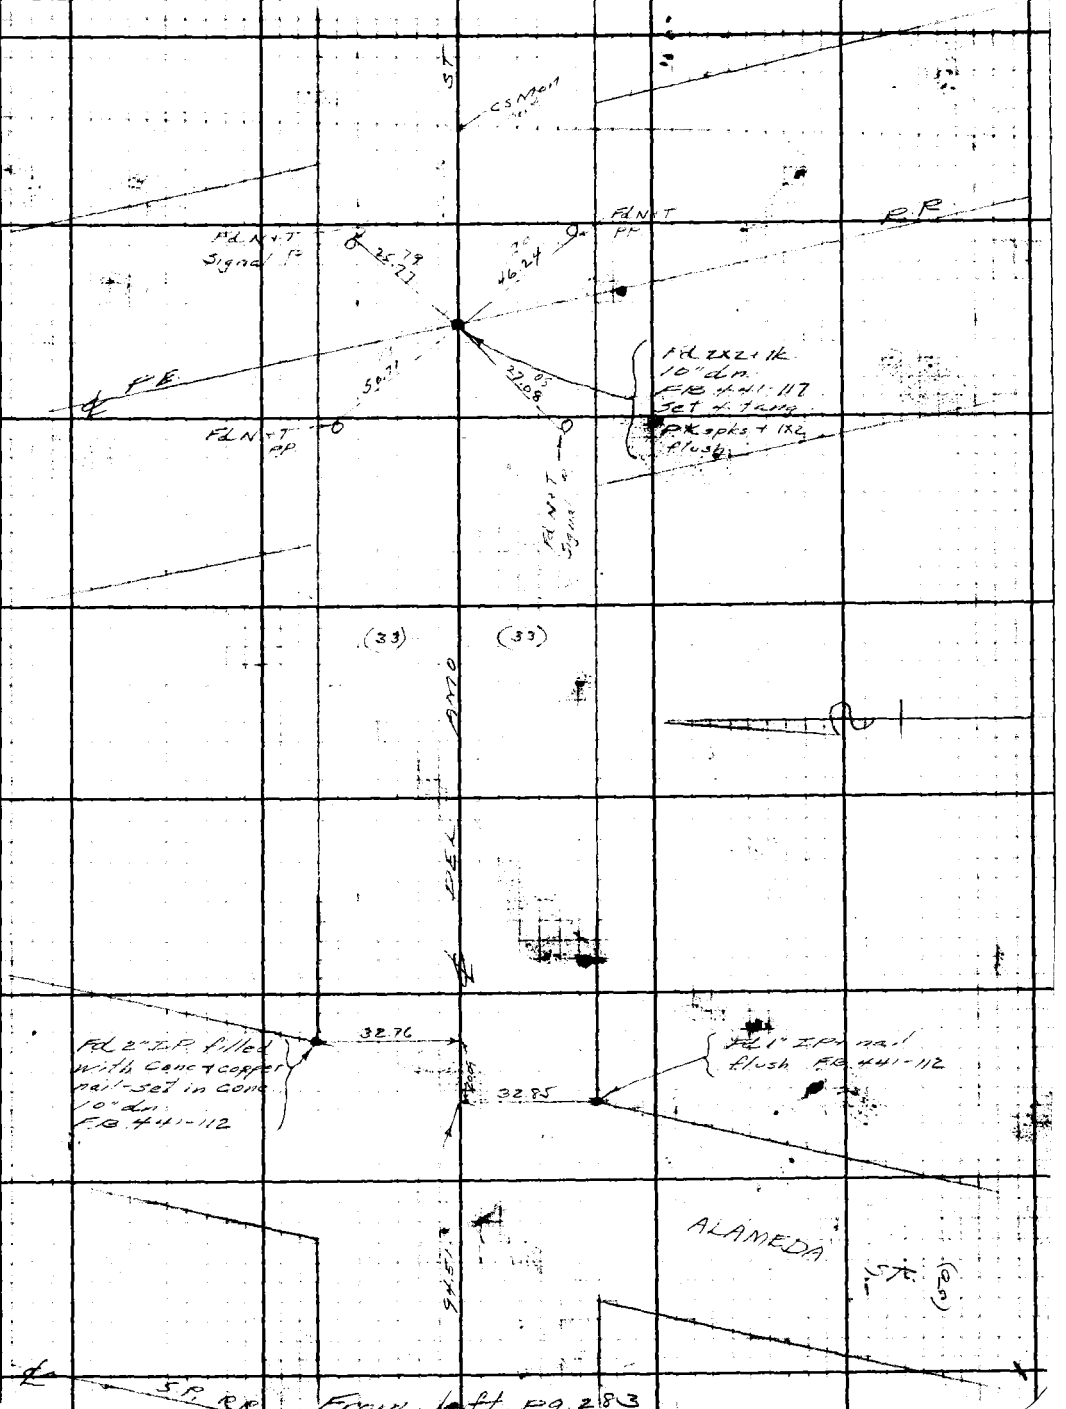

Note: Any Additions or Changes on This Sheet Must be Made or Circled in Red Ink With Date and Name of Person Making Change.

Do not extend notes this side of this line.

RETURN TO
LOS ANGELES COUNTY SURVEYOR
700 HALL OF RECORDS

FORM 247 5M 10-39

RETURN TO
LOS ANGELES COUNTY SURVEYOR
700 HALL OF RECORDS

Note: Any Additions or Changes on This Sheet Must be Made or Circled in Red Ink With Date and Name of Person Making Change.

Do not extend notes this side of this line.

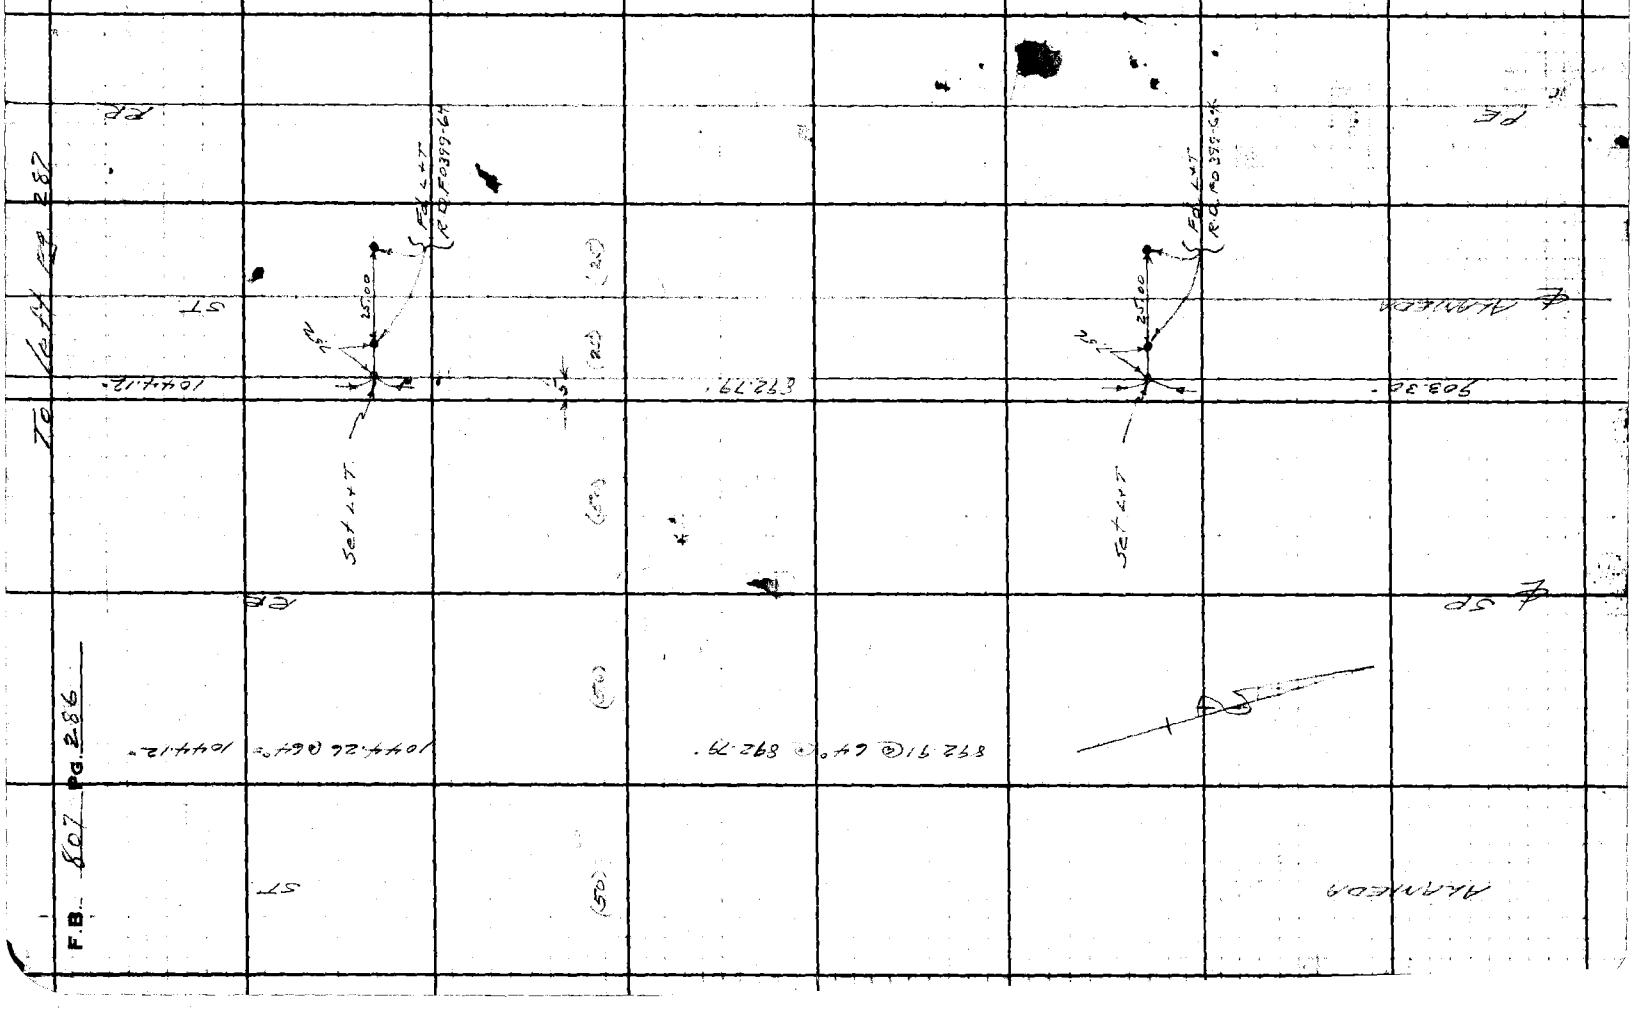

Notes Ck'd by D. M. Finley	Survey of Alameda St	F.B. 307 Pg. 287
Map No. ~~[illegible]~~ 1729-3	W. O. 8270 Tape No. 07 St'd 84°F	
Office Work	Surveyed by Moore	
Checked	Notes Moore Date 12-31-40	
Date Mar. 1945	Indexed [illegible]	

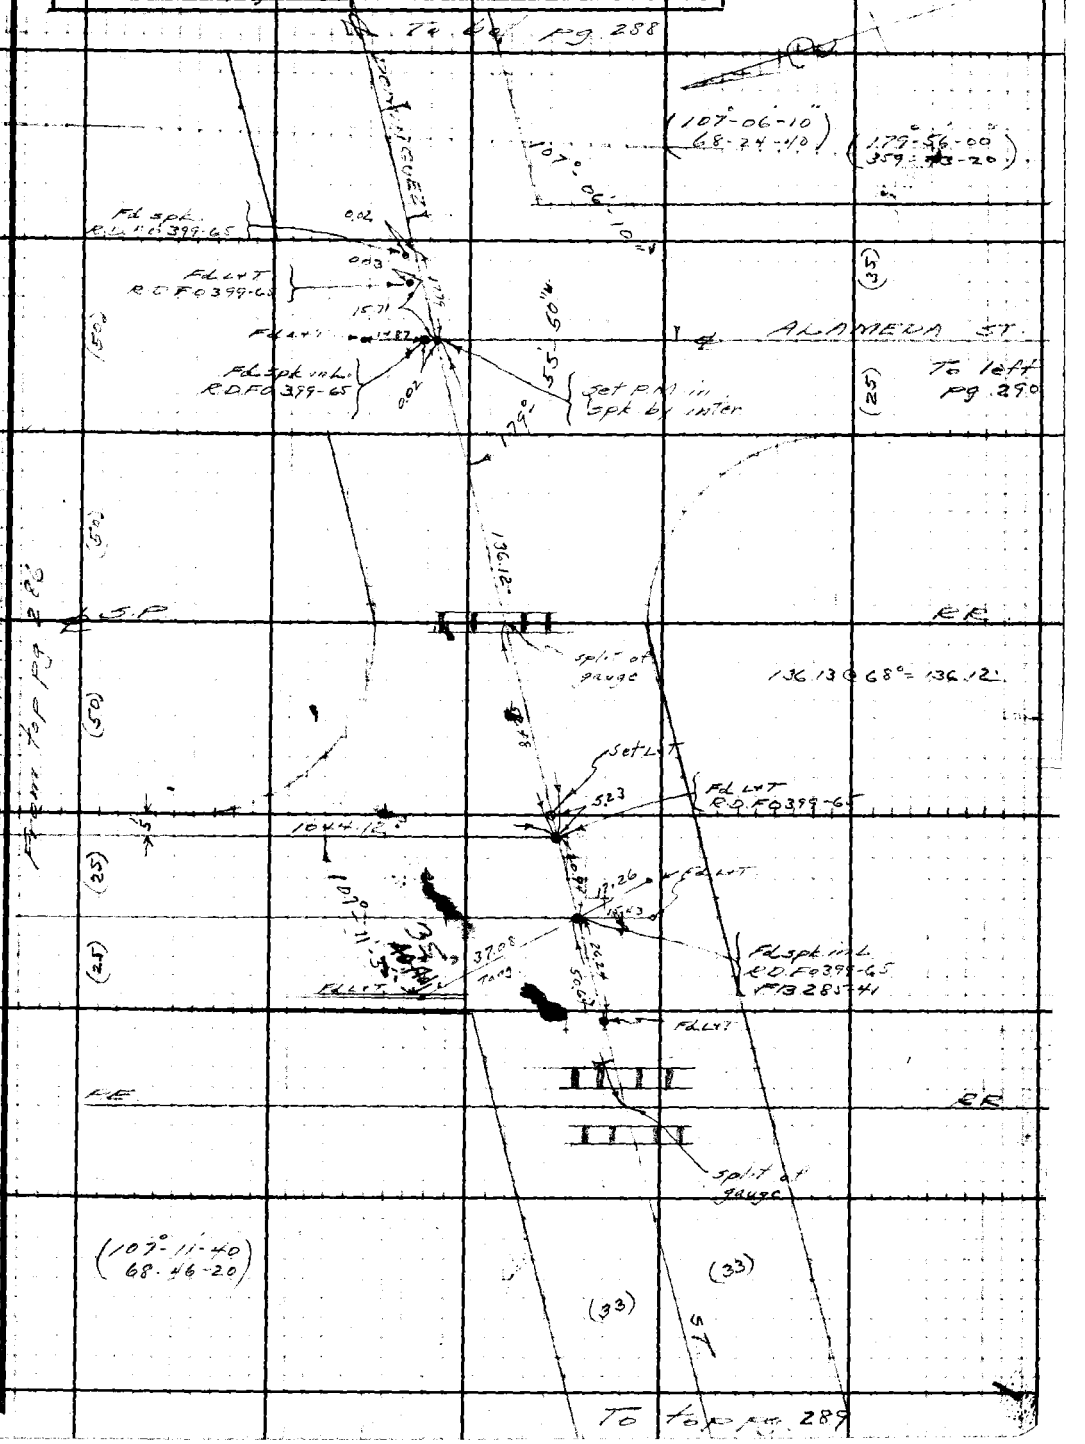

Note: Any Additions or Changes on This Sheet Must be Made or Circled in Red Ink With Date and Name of Person Making Change.

Do not extend notes this side of this line.

RETURN TO
LOS ANGELES COUNTY SURVEYOR
700 HALL OF RECORDS

FORM 247 5M 10-39

F.B. 807 PG. 288

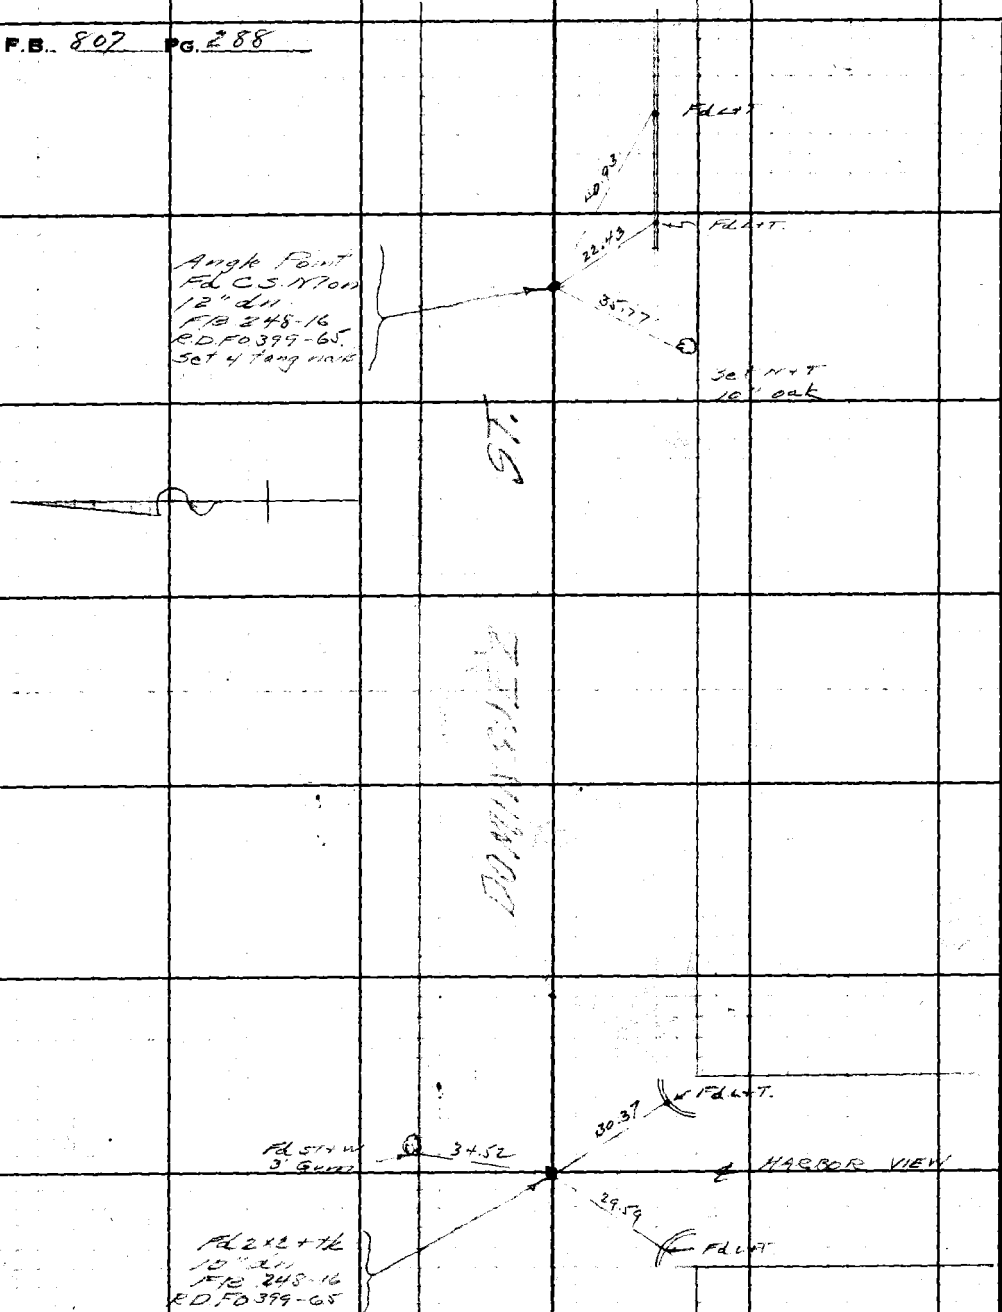

RETURN TO
LOS ANGELES COUNTY SURVEYOR
700 HALL OF RECORDS

Do not extend notes this side of this line.

Note: Any Additions or Changes on This Sheet Must be Made or Circled in Red Ink With Date and Name of Person Making Change.

Notes Ck'd by D. M. Finley	Survey of Alameda St.
Map No. ~~B-1498~~ B-1729-3	W. O. 8270 Tape No. 07 St'd 84°F
Office Work	Surveyed by Moore
Checked	Notes Moore Date 12-31-40
Date Mar. 1945	Indexed [illegible]

F.B. 807 PG. 287

From bot pg. 287

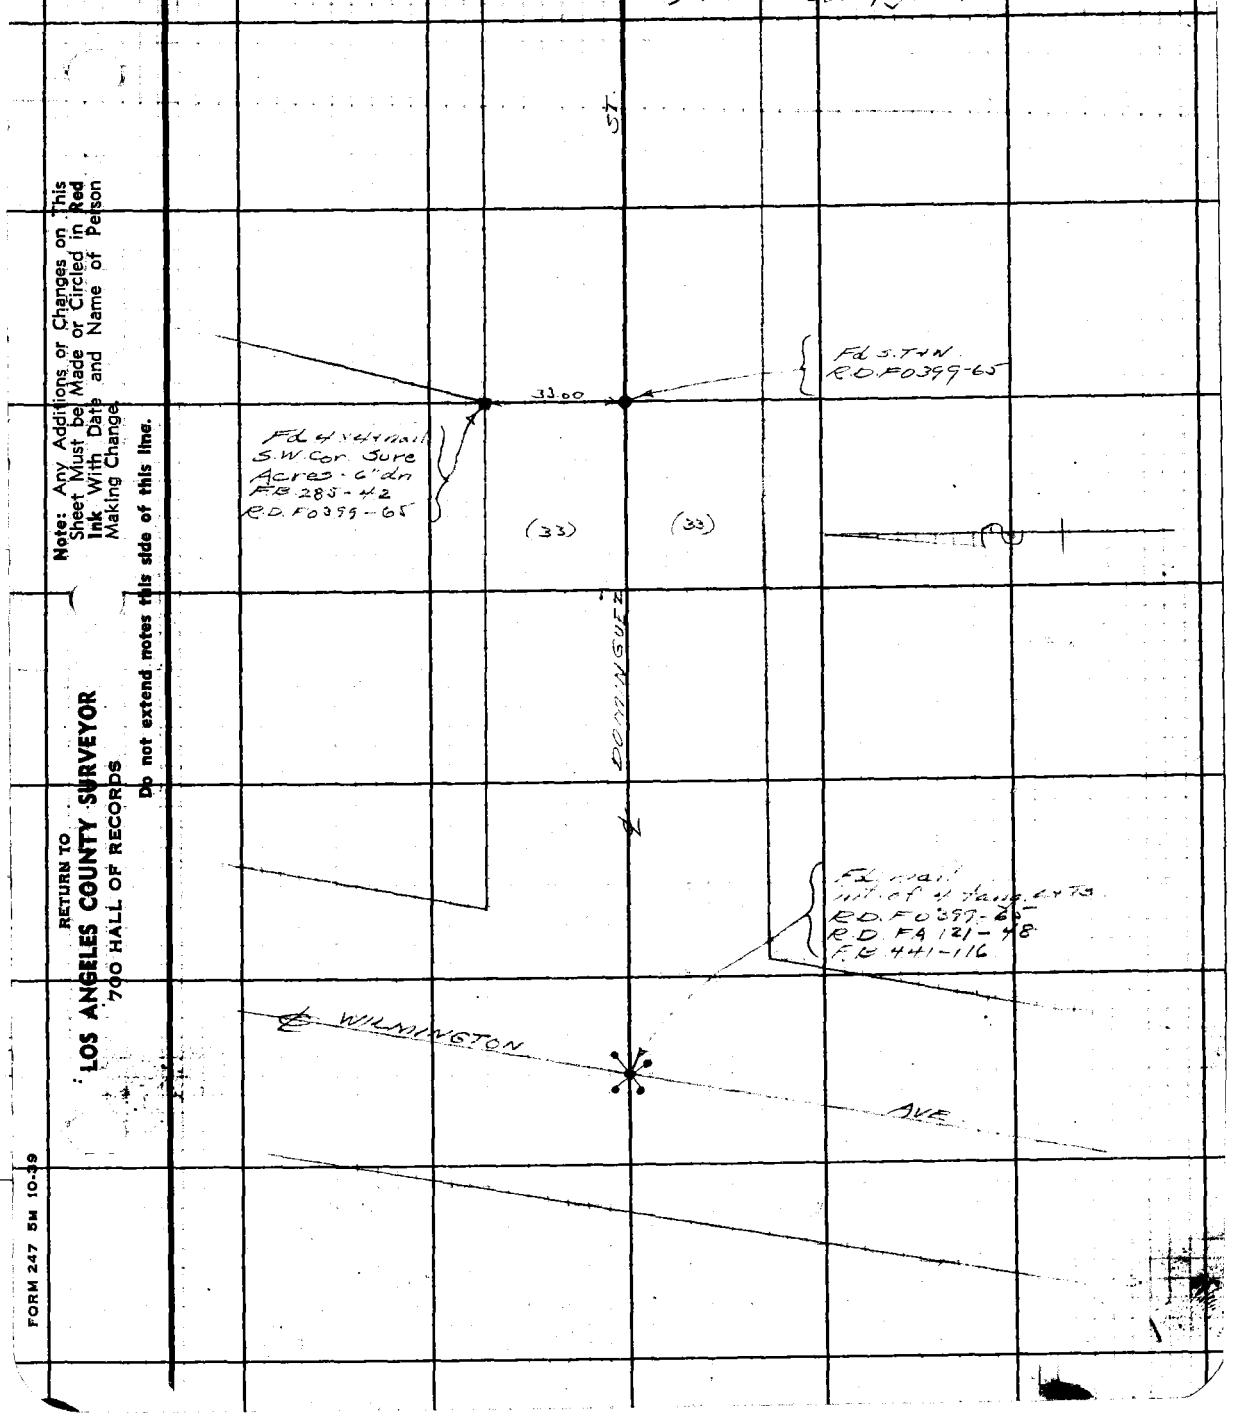

Note: Any Additions or Changes on This Sheet Must be Made or Circled in Red Ink With Date and Name of Person Making Change.

Do not extend notes this side of this line.

RETURN TO
LOS ANGELES COUNTY SURVEYOR
700 HALL OF RECORDS

FORM 247 5M 10-39

RETURN TO
LOS ANGELES COUNTY SURVEYOR
700 HALL OF RECORDS

Note: Any Additions or Changes on This Sheet Must be Made or Circled in Red Ink With Date and Name of Person Making Change.

Do not extend notes this side of this line.

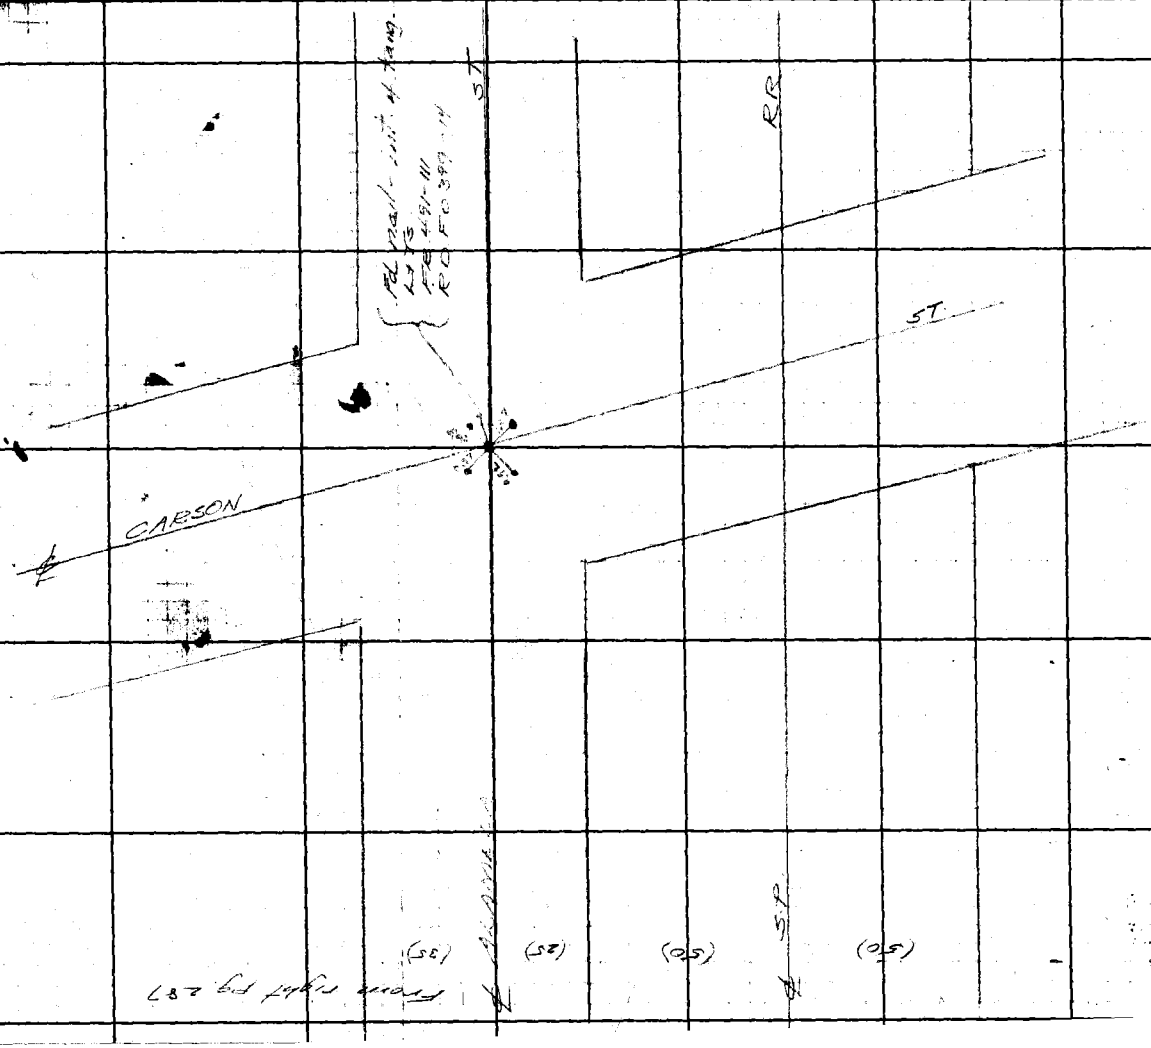

F.B. 807 PG. 290

Notes Ck'd by D. M. Finley	Survey of Alameda St	F.B. 807 Pg. 291
Map No. ~~[illegible]~~ B-1729-3	W. O. 8270 Tape No. ____ St'd ____ °F	
Office Work ____	Surveyed by Moore	
Checked ____	Notes Fawler Date 1-2-41	
Date Mar. 1945	Indexed A. C. Johnson 1-6-41	

To bot pg 292

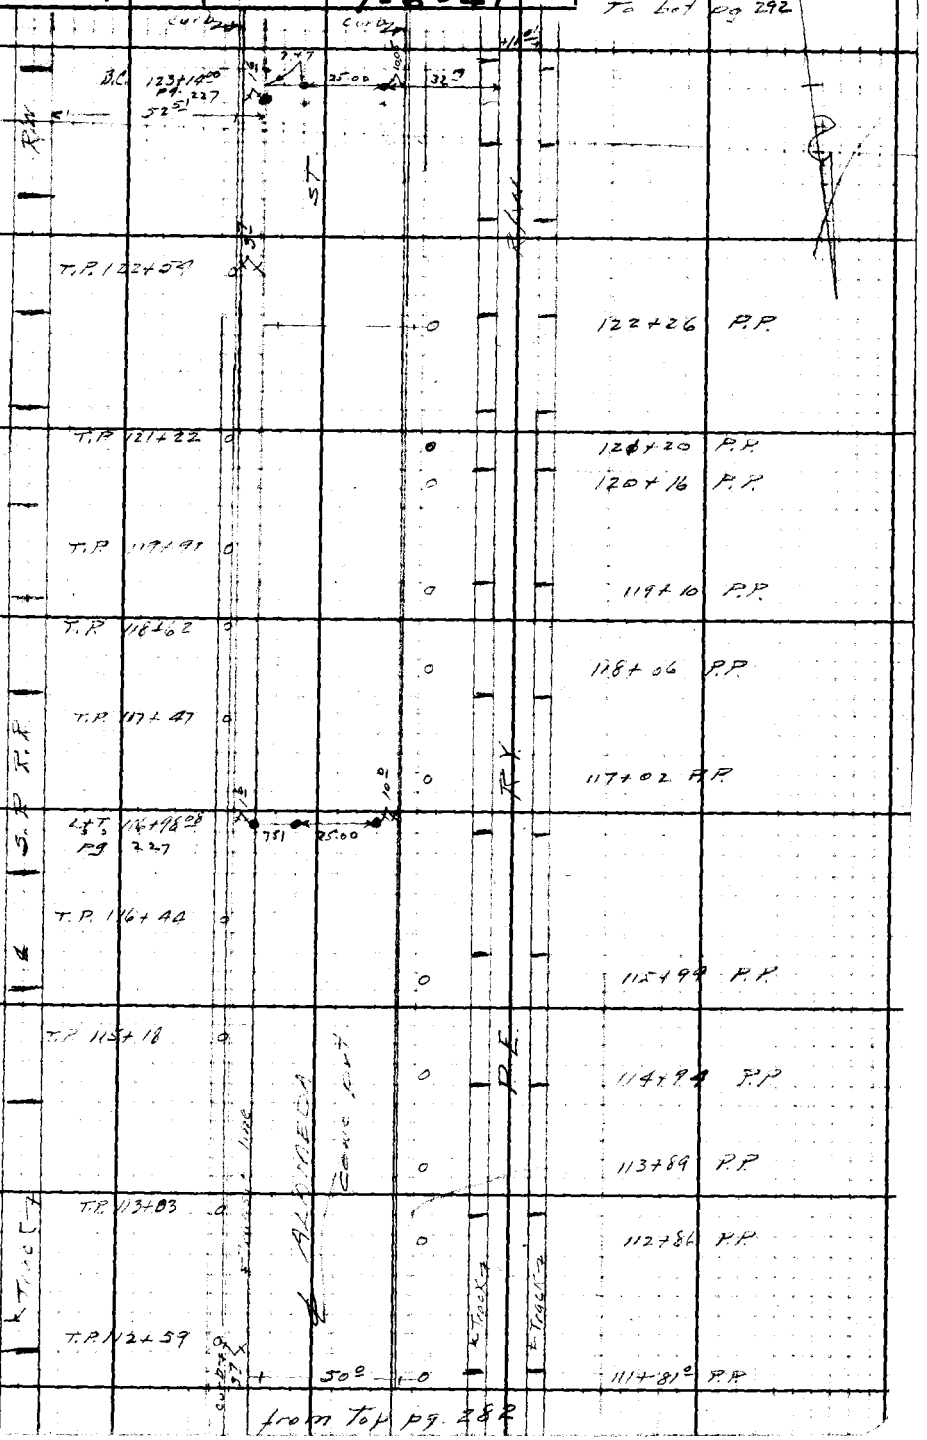

from top pg. 282

Note: Any Additions or Changes on This Sheet Must be Made or Circled in Red Ink With Date and Name of Person Making Change.

Do not extend notes this side of this line.

RETURN TO
LOS ANGELES COUNTY SURVEYOR
700 HALL OF RECORDS

FORM 247 5M 10-39

F.B. 807 PG. 292

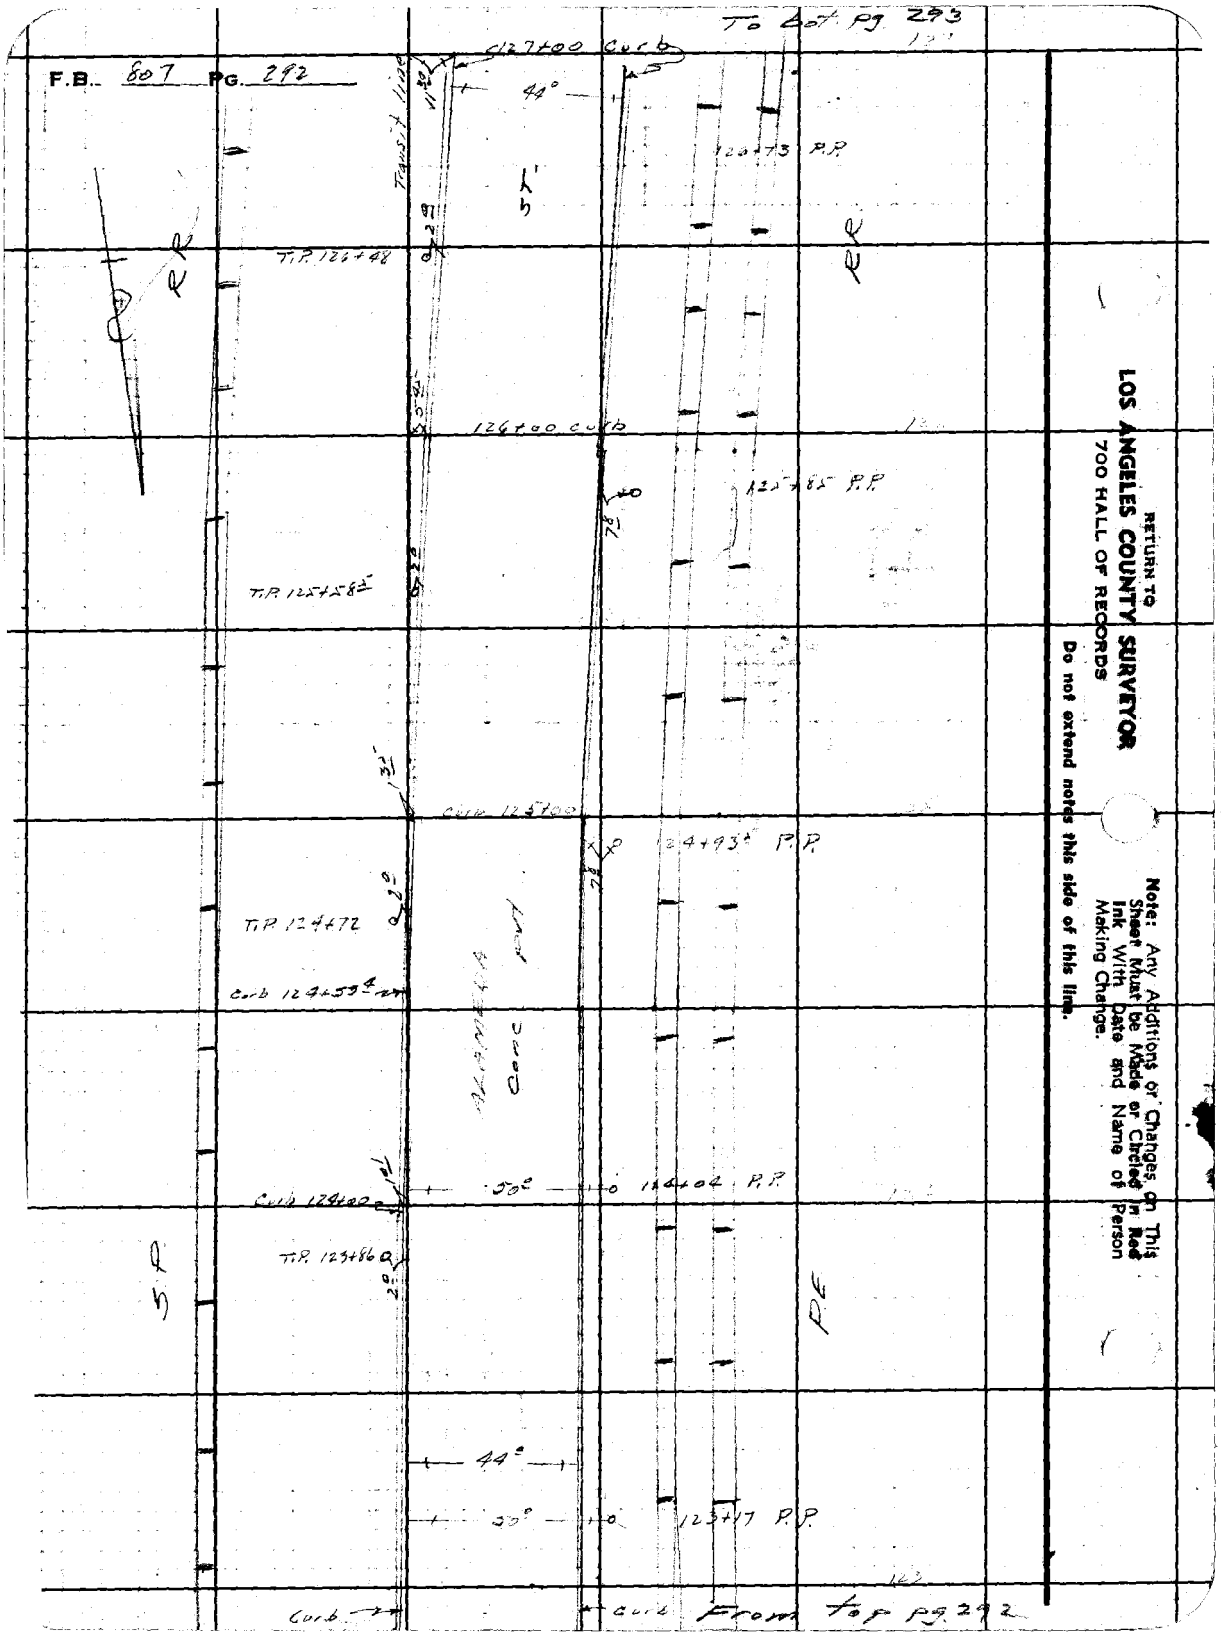

RETURN TO
LOS ANGELES COUNTY SURVEYOR
700 HALL OF RECORDS

Do not extend notes this side of this line.

Note: Any Additions or Changes on This Sheet Must be Made or Circled in Red Ink With Date and Name of Person Making Change.

Notes Ck'd by D. M. Finley	Survey of Alameda St
Map No. [illegible]	W. O. 8270 Tape No. St'd °F
Office Work	Surveyed by Moore
Checked	Notes Fenner Date 1-2-41
Date Mar. 1945	Indexed C. Johnson

F.B. [illegible] Pg. 293

To bot. 299

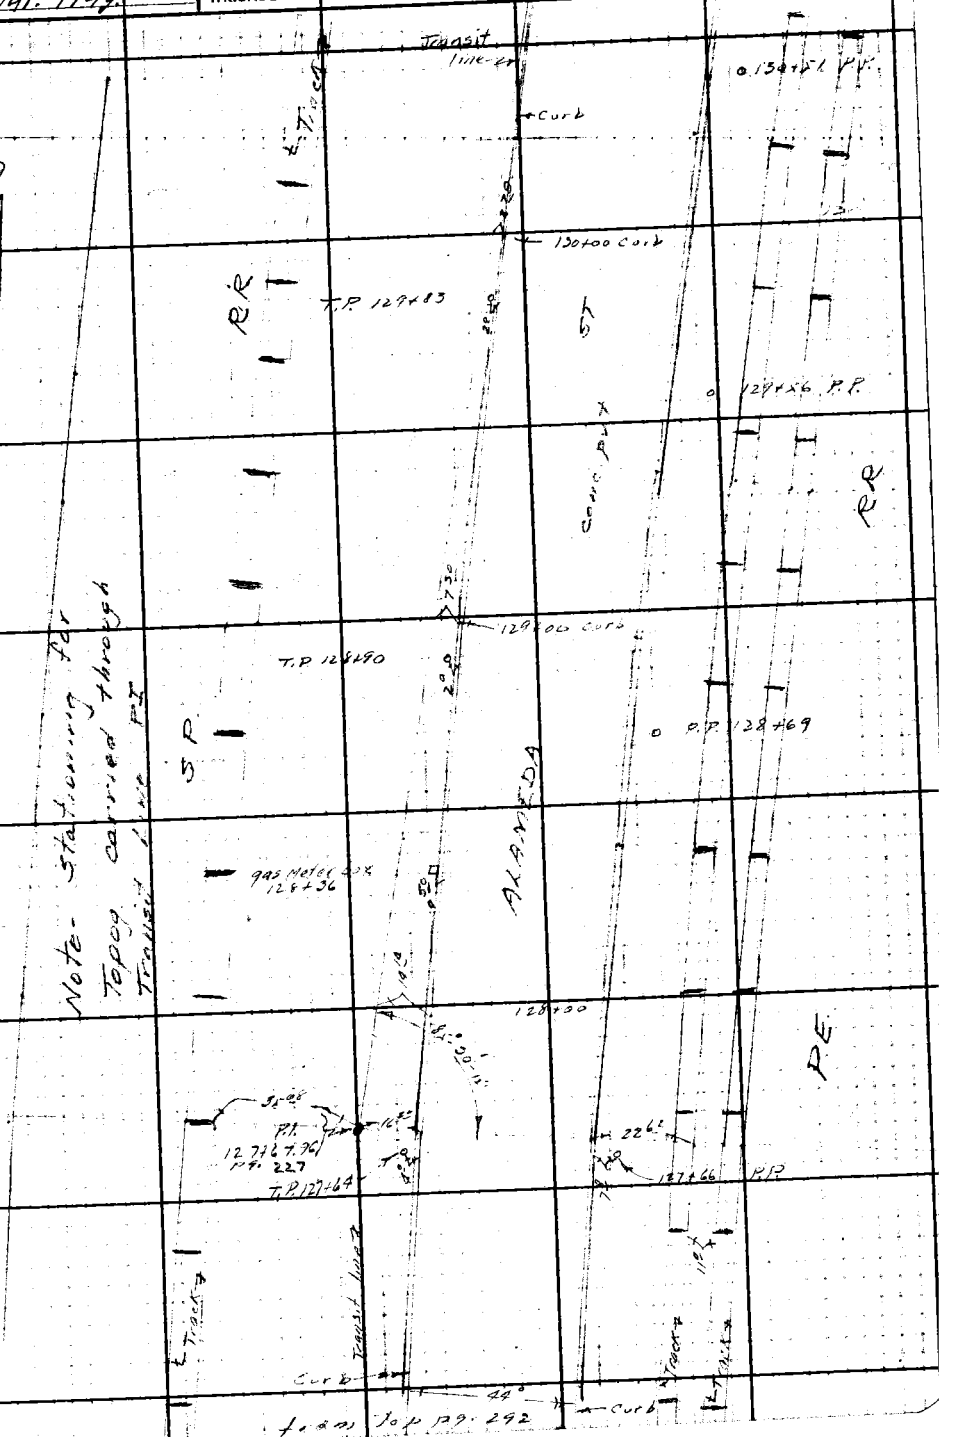

Note: Any Additions or Changes on This Sheet Must be Made or Circled in Red Ink With Date and Name of Person Making Change.

Do not extend notes this side of this line.

RETURN TO
LOS ANGELES COUNTY SURVEYOR
700 HALL OF RECORDS

FORM 247 5M 10-89

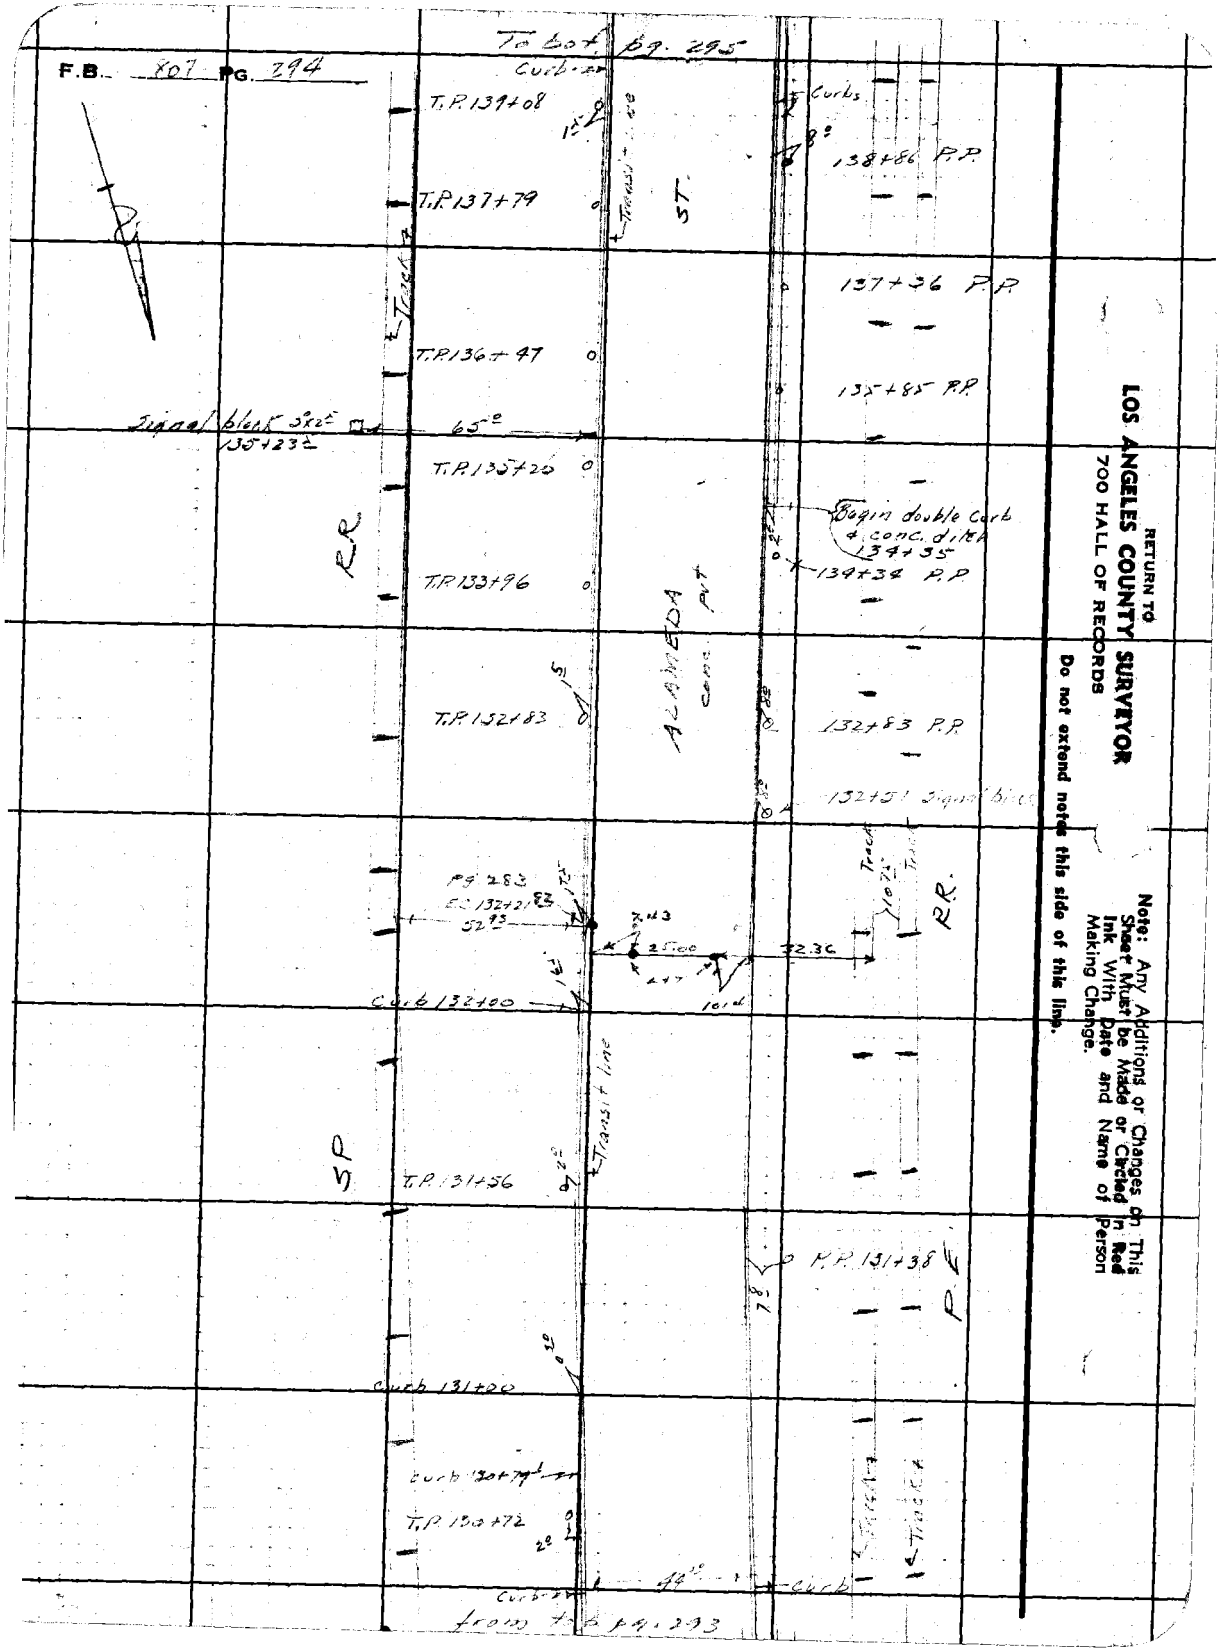

RETURN TO
LOS ANGELES COUNTY SURVEYOR
700 HALL OF RECORDS

Do not extend notes this side of this line.

Note: Any Additions or Changes on This Sheet Must be Made or Circled in Red Ink With Date and Name of Person Making Change.

Notes Ck'd by D. M. Pinter	Survey of Alameda ST.
Map No. [illegible]	W. O. 8270 Tape No. St'd °F
Office Work	Surveyed by Moore
Checked	Notes Farmer Date 1-3-41
Date Mar. 1945.	Indexed A. C. Johnson

F.B. 607 Pg. 2[illegible]

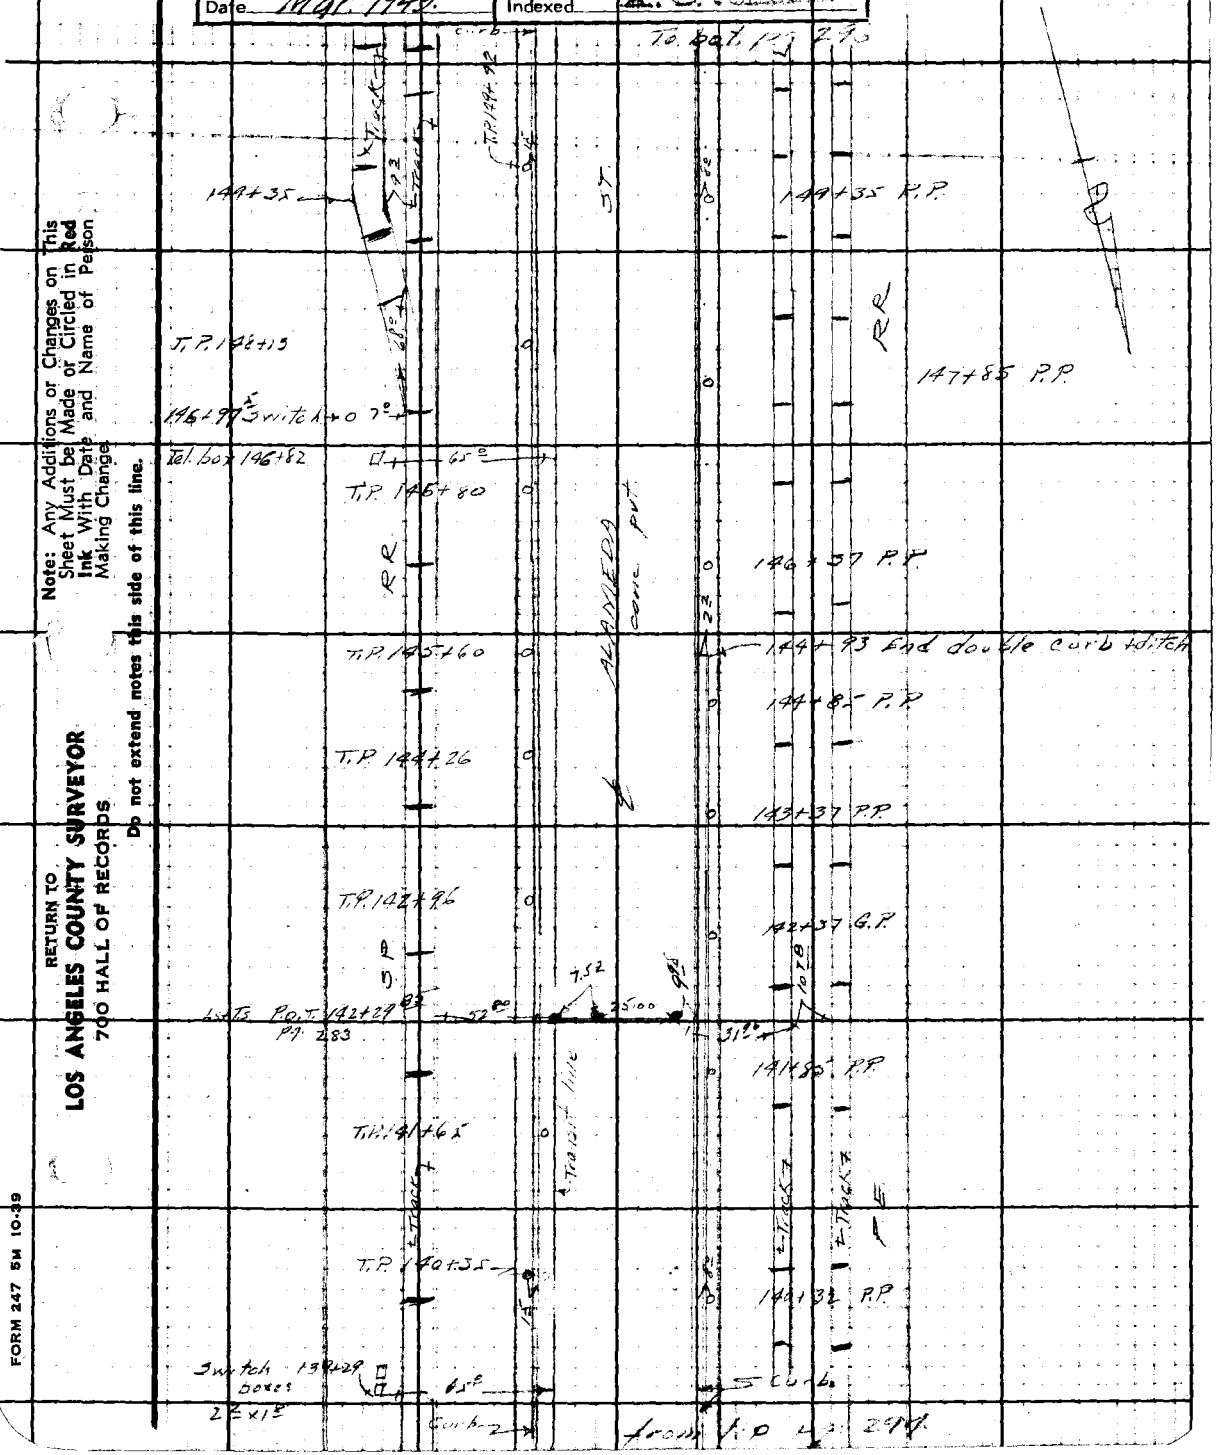

Note: Any Additions or Changes on This Sheet Must be Made or Circled in Red Ink With Date and Name of Person Making Change.

Do not extend notes this side of this line.

RETURN TO
LOS ANGELES COUNTY SURVEYOR
700 HALL OF RECORDS

FORM 247 5M 10-39

F.B. 807 PG. 296

To bot pg. 297

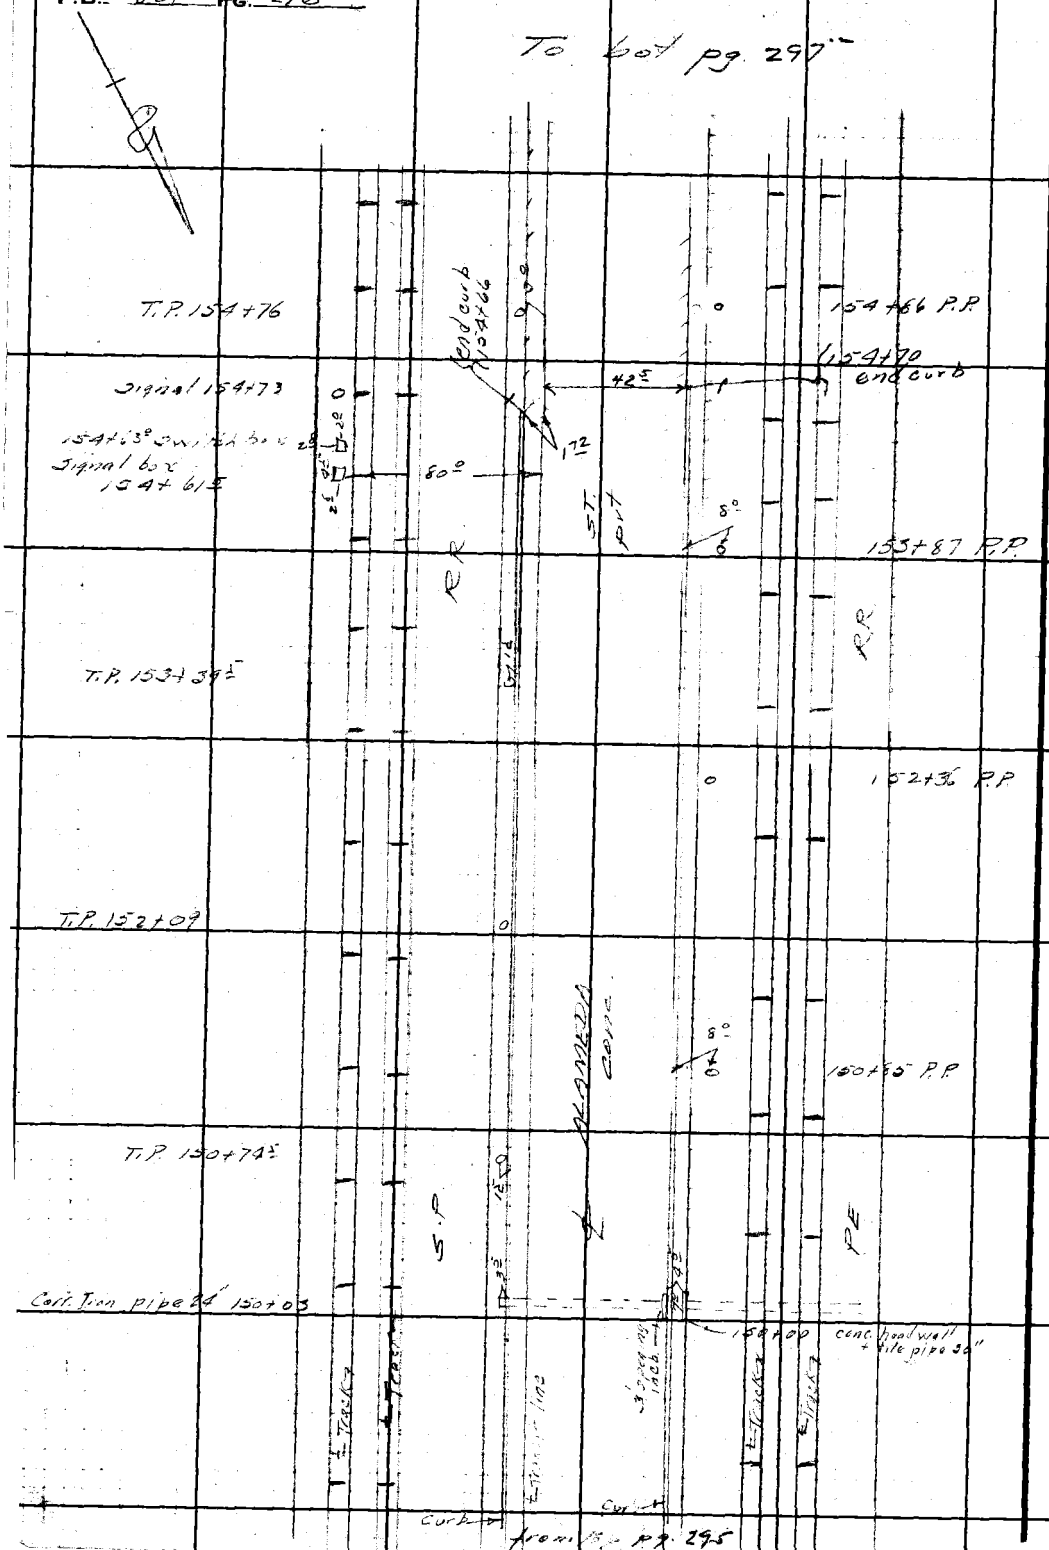

RETURN TO
LOS ANGELES COUNTY SURVEYOR
700 HALL OF RECORDS

Do not extend notes this side of this line.

Note: Any Additions or Changes on This Sheet Must be Made in Red Ink With Date and Name of Person Making Change.

Notes Ck'd by D. M. Finley	Survey of Alameda St	F.B. 807 Pg. 297
Map No. ~~[illegible]~~ B-1729-3	W. O. 8270 Tape No. St'd °F	
Office Work	Surveyed by Moore	
Checked	Notes Fenner Date 1-3-41	
Date Mar. 1945	Indexed [illegible]	

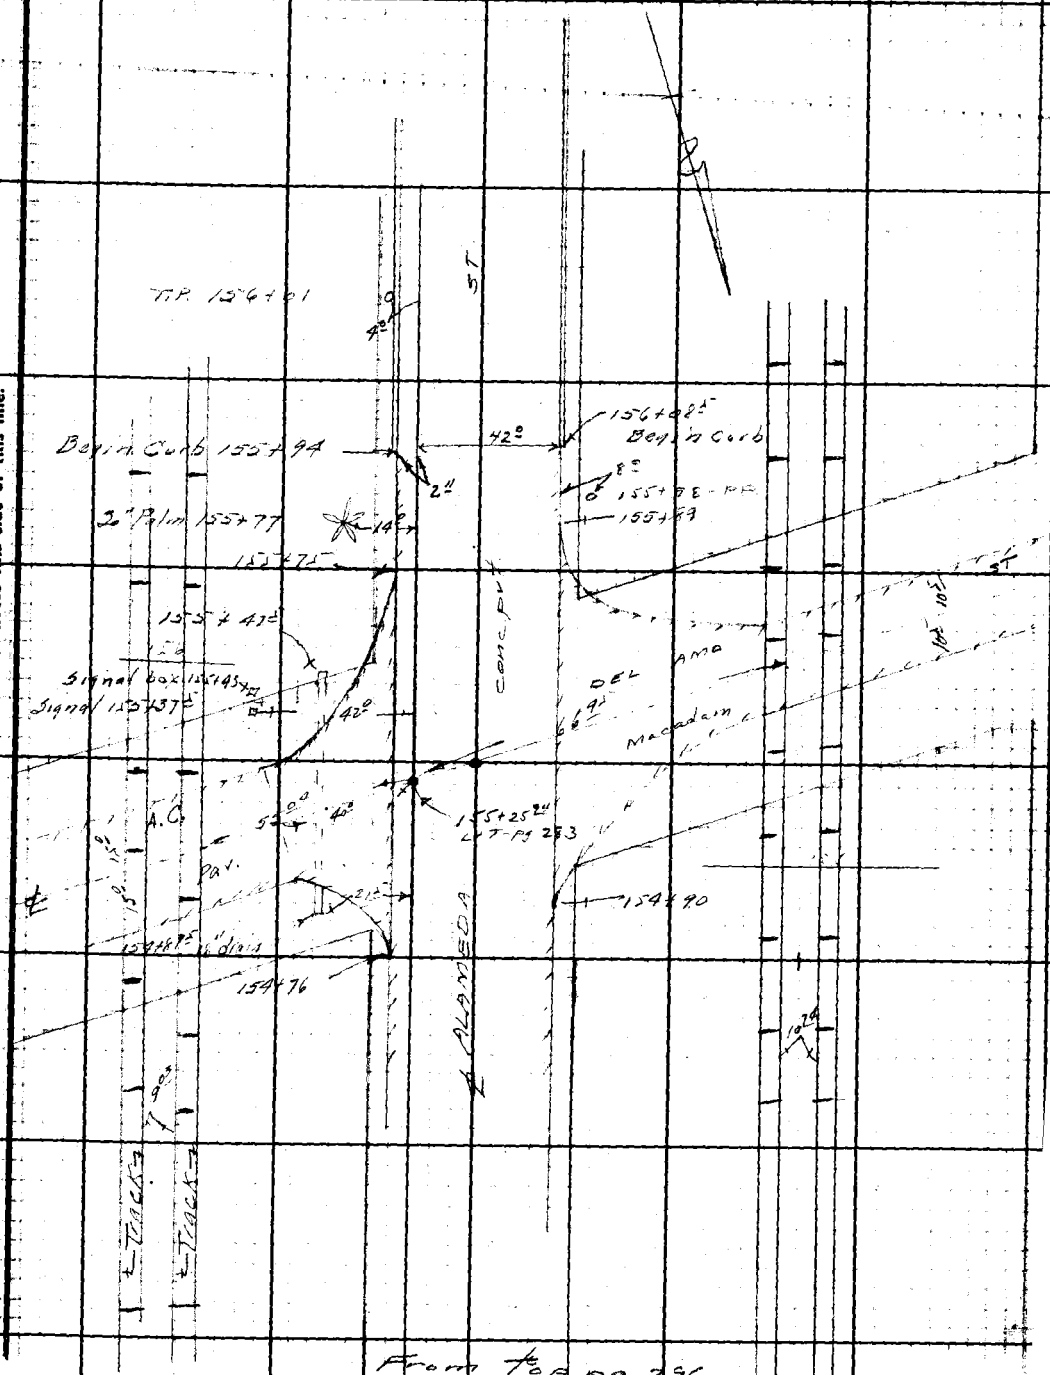

Note: Any Additions or Changes on This Sheet Must be Made or Circled in Red Ink With Date and Name of Person Making Change.

Do not extend notes this side of this line.

RETURN TO
LOS ANGELES COUNTY SURVEYOR
700 HALL OF RECORDS

FORM 247 5M 10-39

RETURN TO
LOS ANGELES COUNTY SURVEYOR
700 HALL OF RECORDS

Note: Any Additions or Changes on This Sheet Must be Made or Circled in Red Ink With Date and Name of Person Making Change.

Do not extend notes this side of this line.

F.B. 807 PG. 298

Notes Ck'd by D. M. Finley	Survey of Alameda St
Map No. [illegible] 1729-3	W. O. 8270 Tape No. St'd °F
Office Work	Surveyed by Moore
Checked	Notes R. Moore Date 1-3-41
Date Mar. 1945	Indexed

F.B. 200 PG. 299

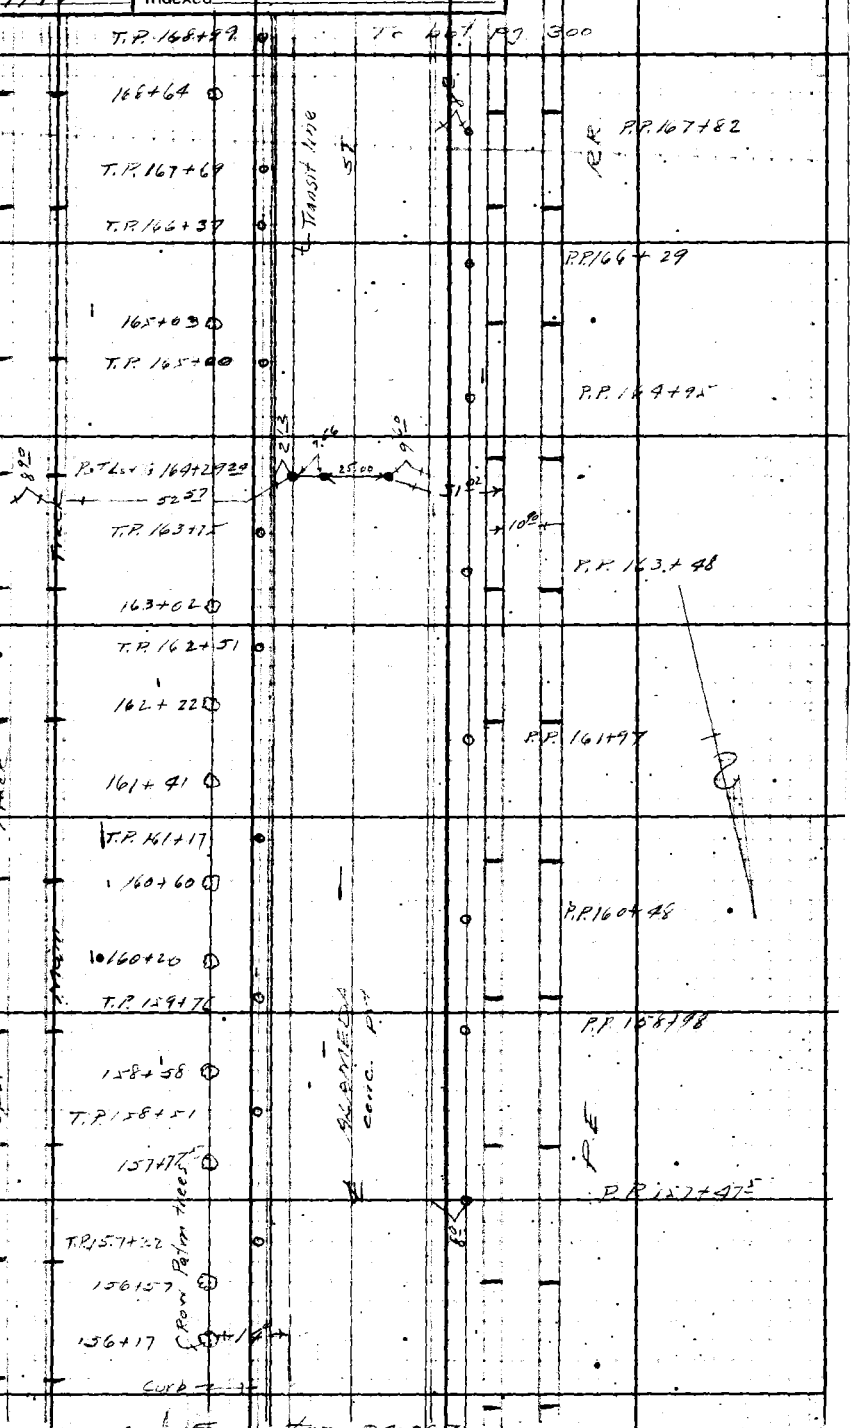

Note: Any Additions or Changes on This Sheet Must be Made or Circled in Red Ink With Date and Name of Person Making Change.

Do not extend notes this side of this line.

RETURN TO
LOS ANGELES COUNTY SURVEYOR
700 HALL OF RECORDS

FORM 247 5M 10-39

F.B. 807 PG. 300

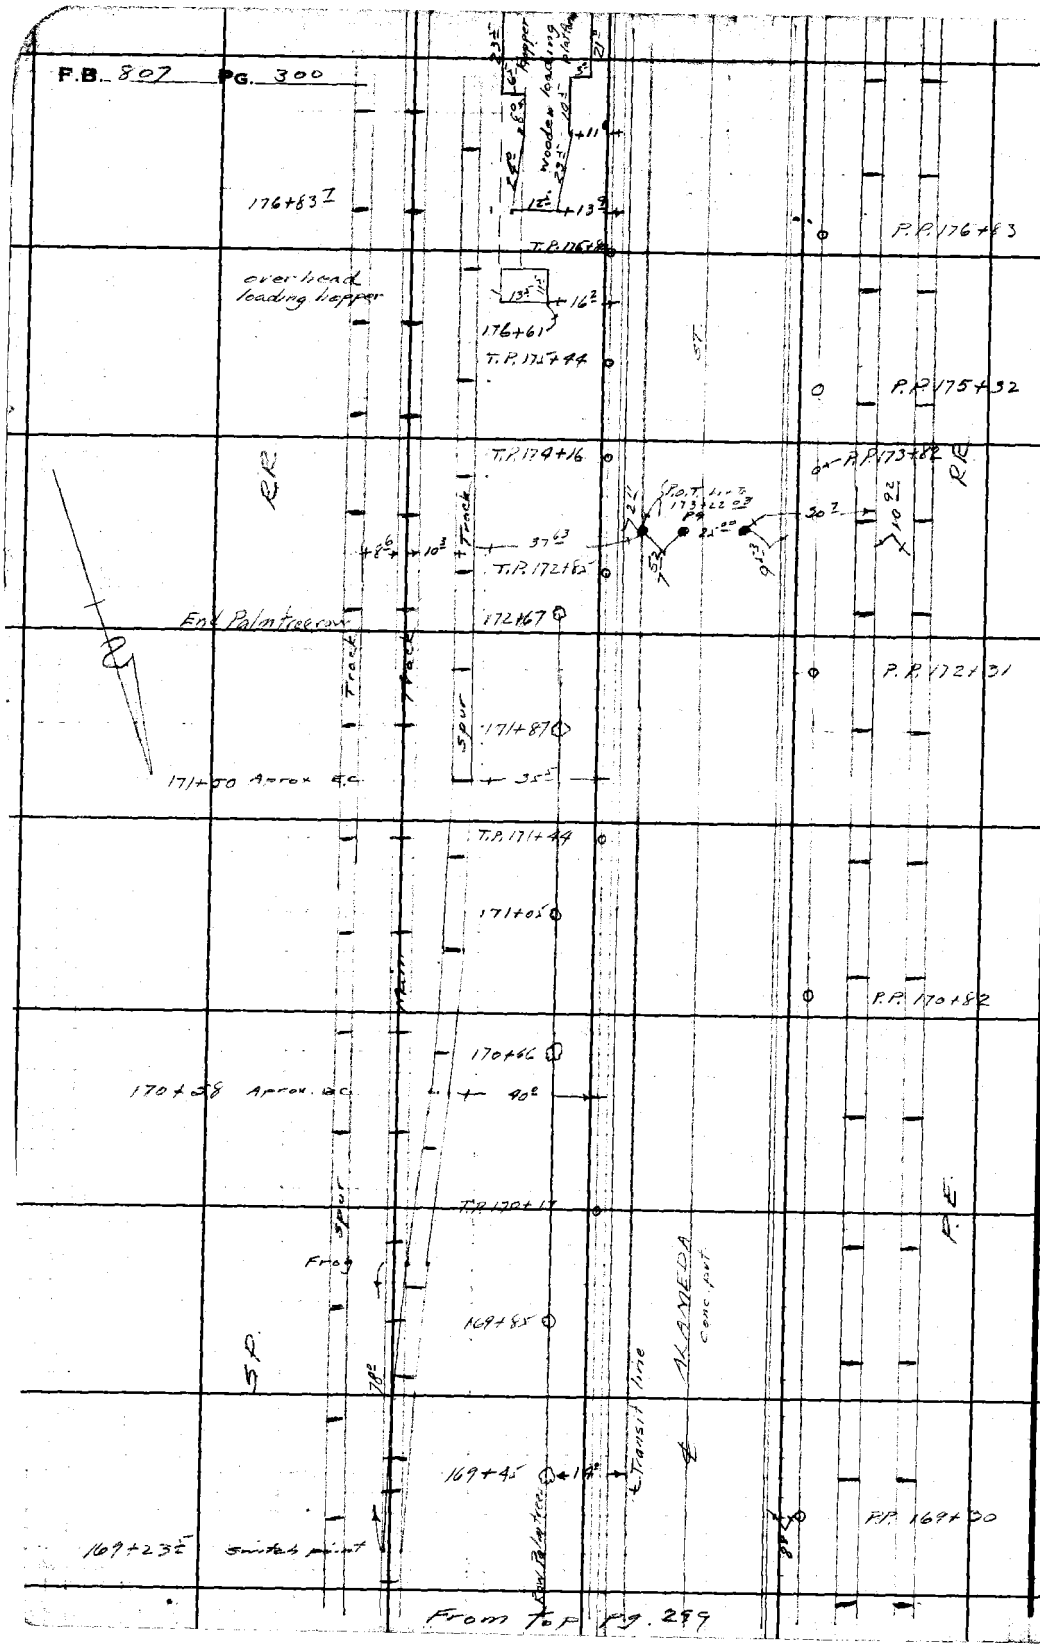

From Top Pg. 299

RETURN TO
LOS ANGELES COUNTY SURVEYOR
700 HALL OF RECORDS
Do not extend notes this side of this line.
Note: Any Additions or Changes on This Sheet Must be Made or Circled in Red Ink With Date and Name of Person Making Change.

Notes Ck'd by D. M. Finley	Survey of Alameda St.	F.B. 807 Pg. 301
Map No. ~~[illegible]~~ B-1729-3	W. O. 8270 Tape No. ____ St'd ____ °F	
Office Work	Surveyed by Moore	
Checked	Notes Moore Date 1-3-41	
Date Mar. 1945	Indexed A. C. Johnson	

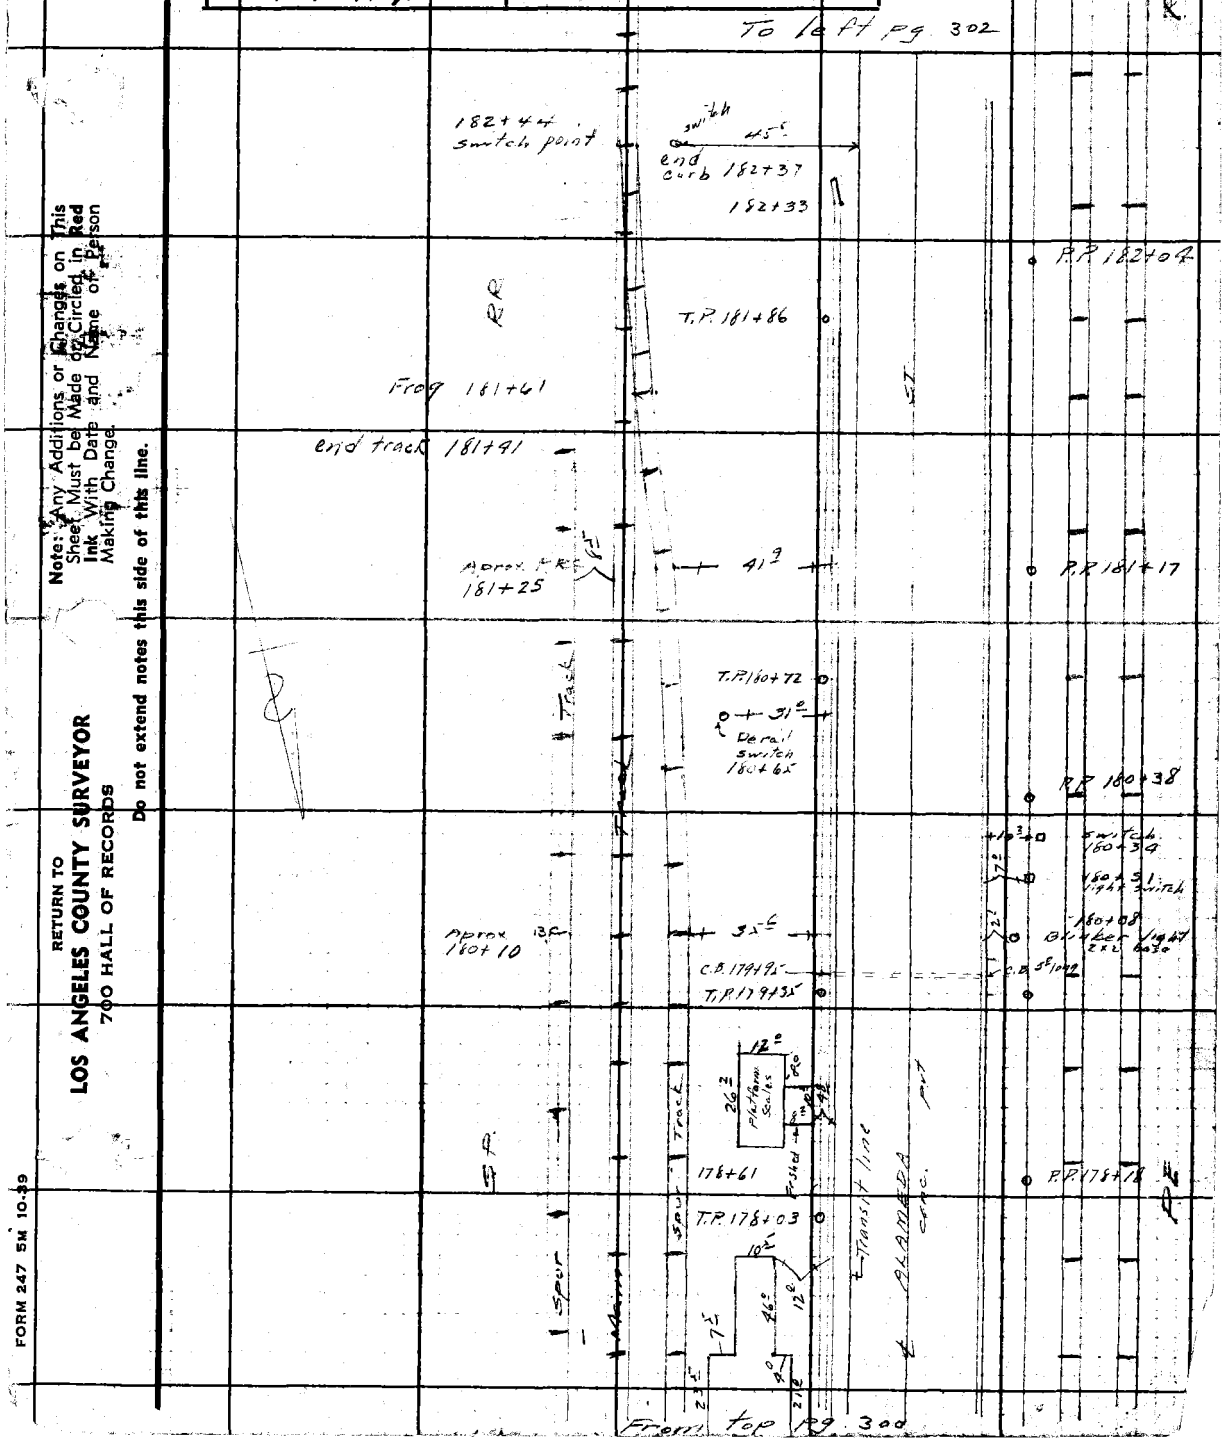

Note: Any Additions or Changes on This Sheet Must be Made or Circled in Red Ink With Date and Name of Person Making Change.

Do not extend notes this side of this line.

RETURN TO
LOS ANGELES COUNTY SURVEYOR
700 HALL OF RECORDS

FORM 247 5M 10-39

807

Do not extend notes this side of this

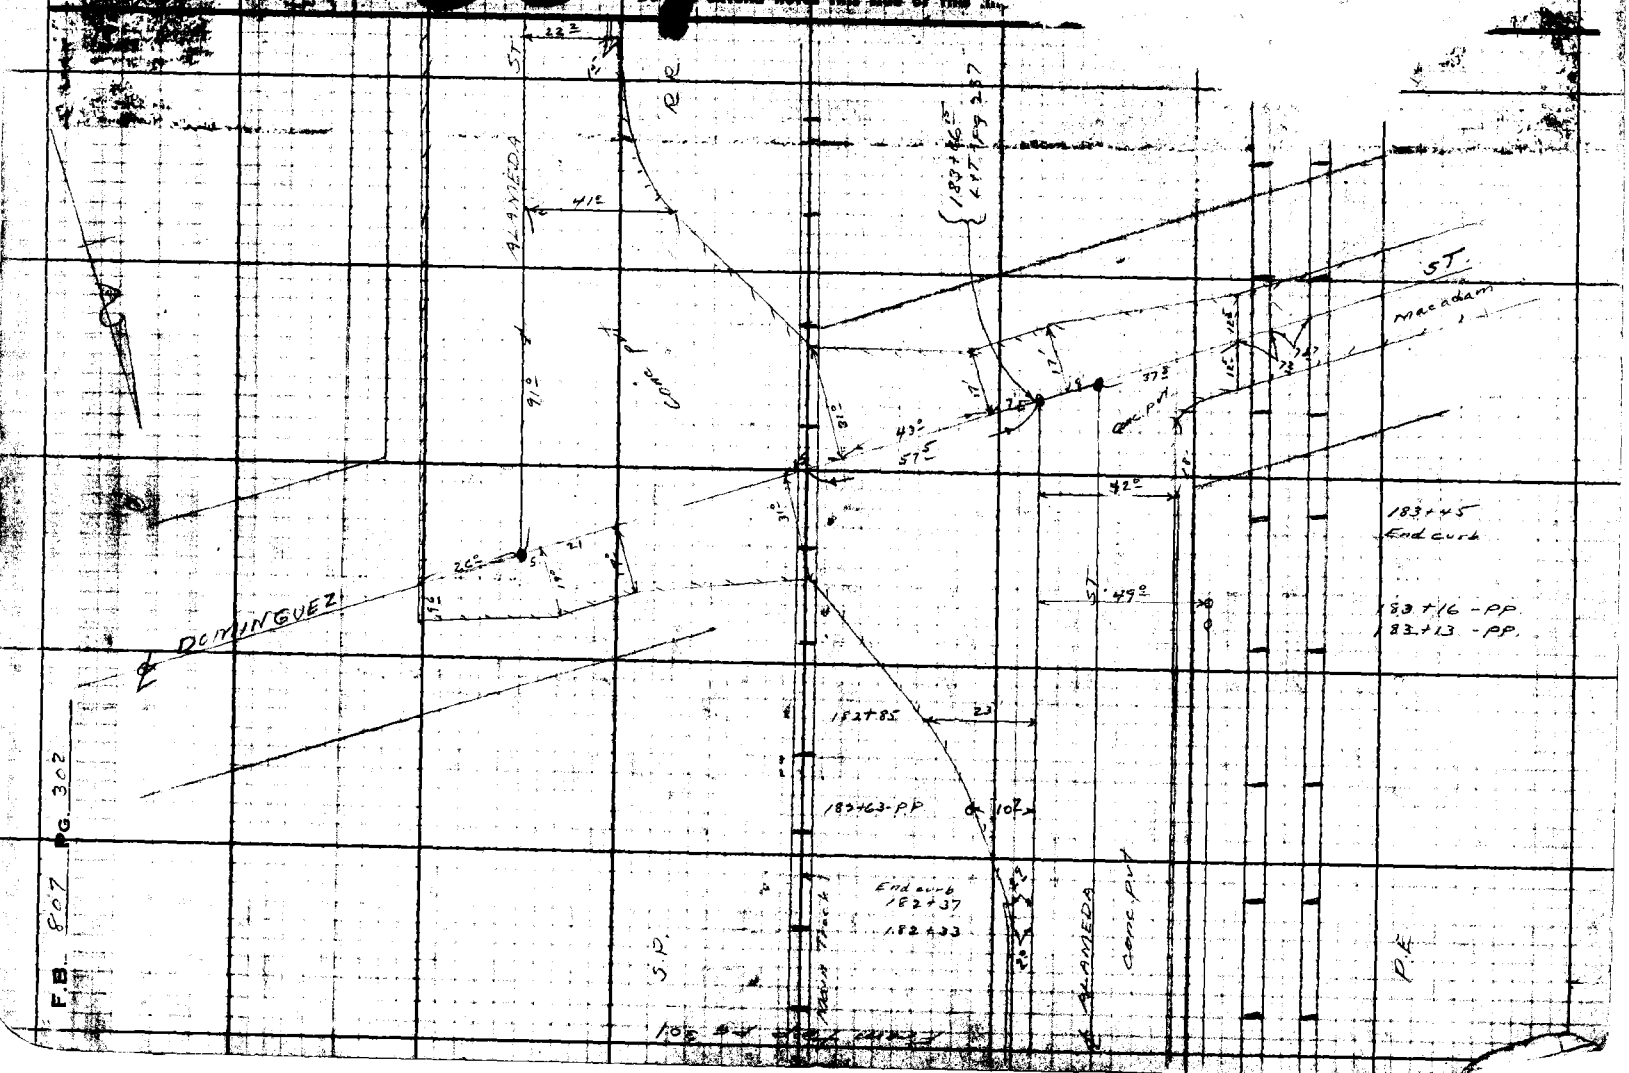

F.B. 807 PG. 302