Notes Ck'd by
No.
Other Work
Checked
Pg.

Survey of
W. O. Tape No. St'd °F
Surveyed by
Notes Date
Indexed

F. B. Pg.

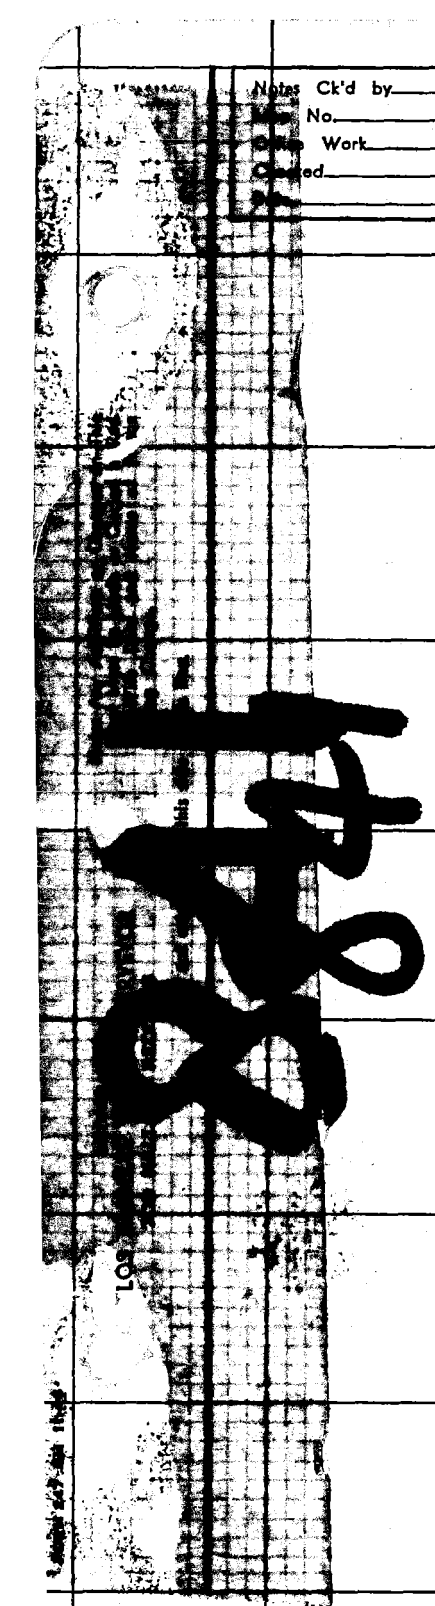

RETURN TO
LOS ANGELES COUNTY SURVEYOR
700 HALL OF RECORDS

Note: Any Additions or Changes on This Sheet Must be Made or Circled in Red Ink With Date and Name of Person Making Change.

Do not extend notes this side of this line.

F. B. _____ PG. _____

Notes Ck'd by	C. M. [illegible]	Survey of	ALLEN AVE
Map No.	B-949	W. O.	7125 Tape No. St'd °F
Office Work	Cox	Surveyed by	WA Miller
Checked	C. M. Finley	Notes	Miller Date 1940
Date	MAY 42	Indexed	[illegible] 10-31-40

F.B. 841 PG. 1

Note: Any Additions or Changes on This Sheet Must be Made in Red Ink With Date and Name of Person Making Change.

Do not extend notes this side of this line.

RETURN TO
LOS ANGELES COUNTY SURVEYOR
700 HALL OF RECORDS

ALLEN AVE. SURVEY
NEW YORK AVE TO FOOTHILL BLVD

TOPOGRAPHY
BLANCHE ST TO NEW YORK AVE.
Pages 8-57 Inc
NEW YORK AVE TO FOOTHILL BLVD
Pages 87-117 Inc

Miller
Living Ave
Gunnels
Harris

FORM 247 5M 10-39

RETURN TO
LOS ANGELES COUNTY SURVEYOR
700 HALL OF RECORDS

Note: Any Additions or Changes on This Sheet Must be Made or Circled in **Red Ink** With Date and Name of Person Making Change.

Do not extend notes this side of this line.

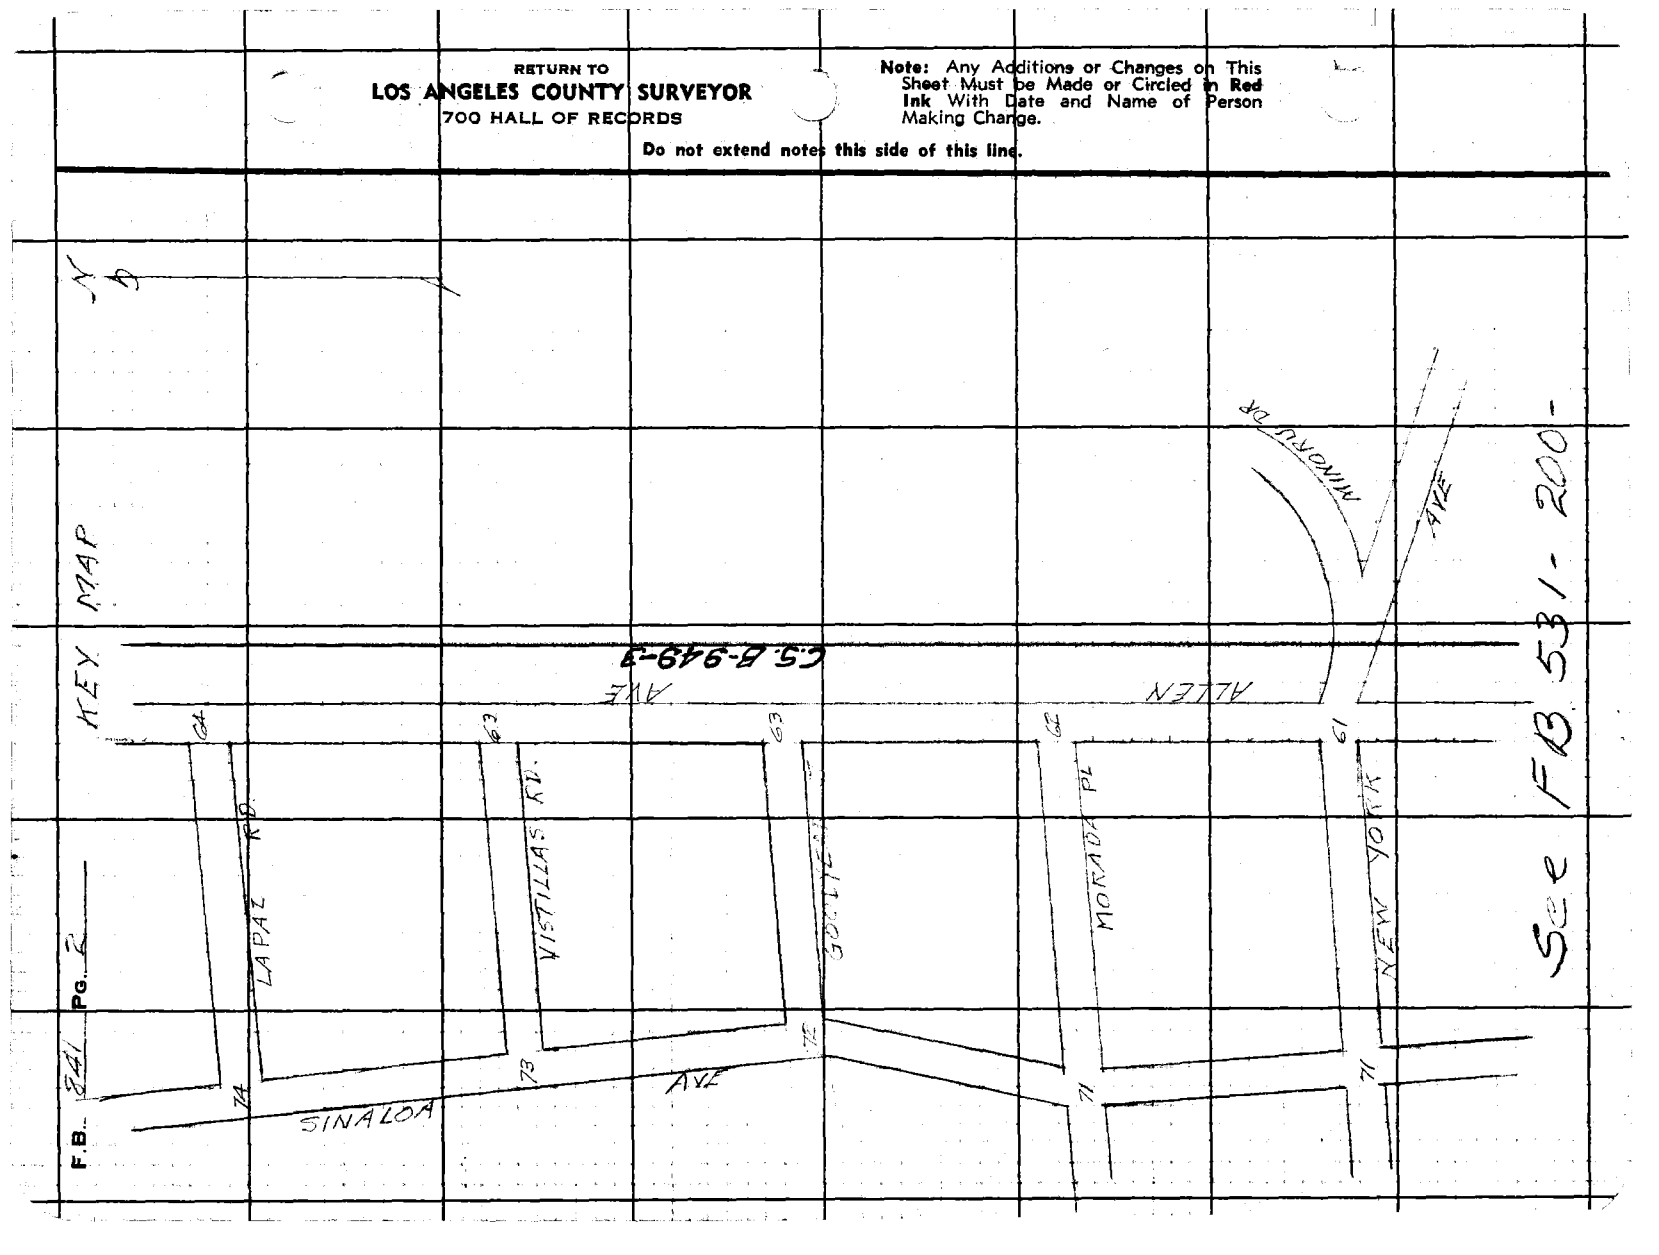

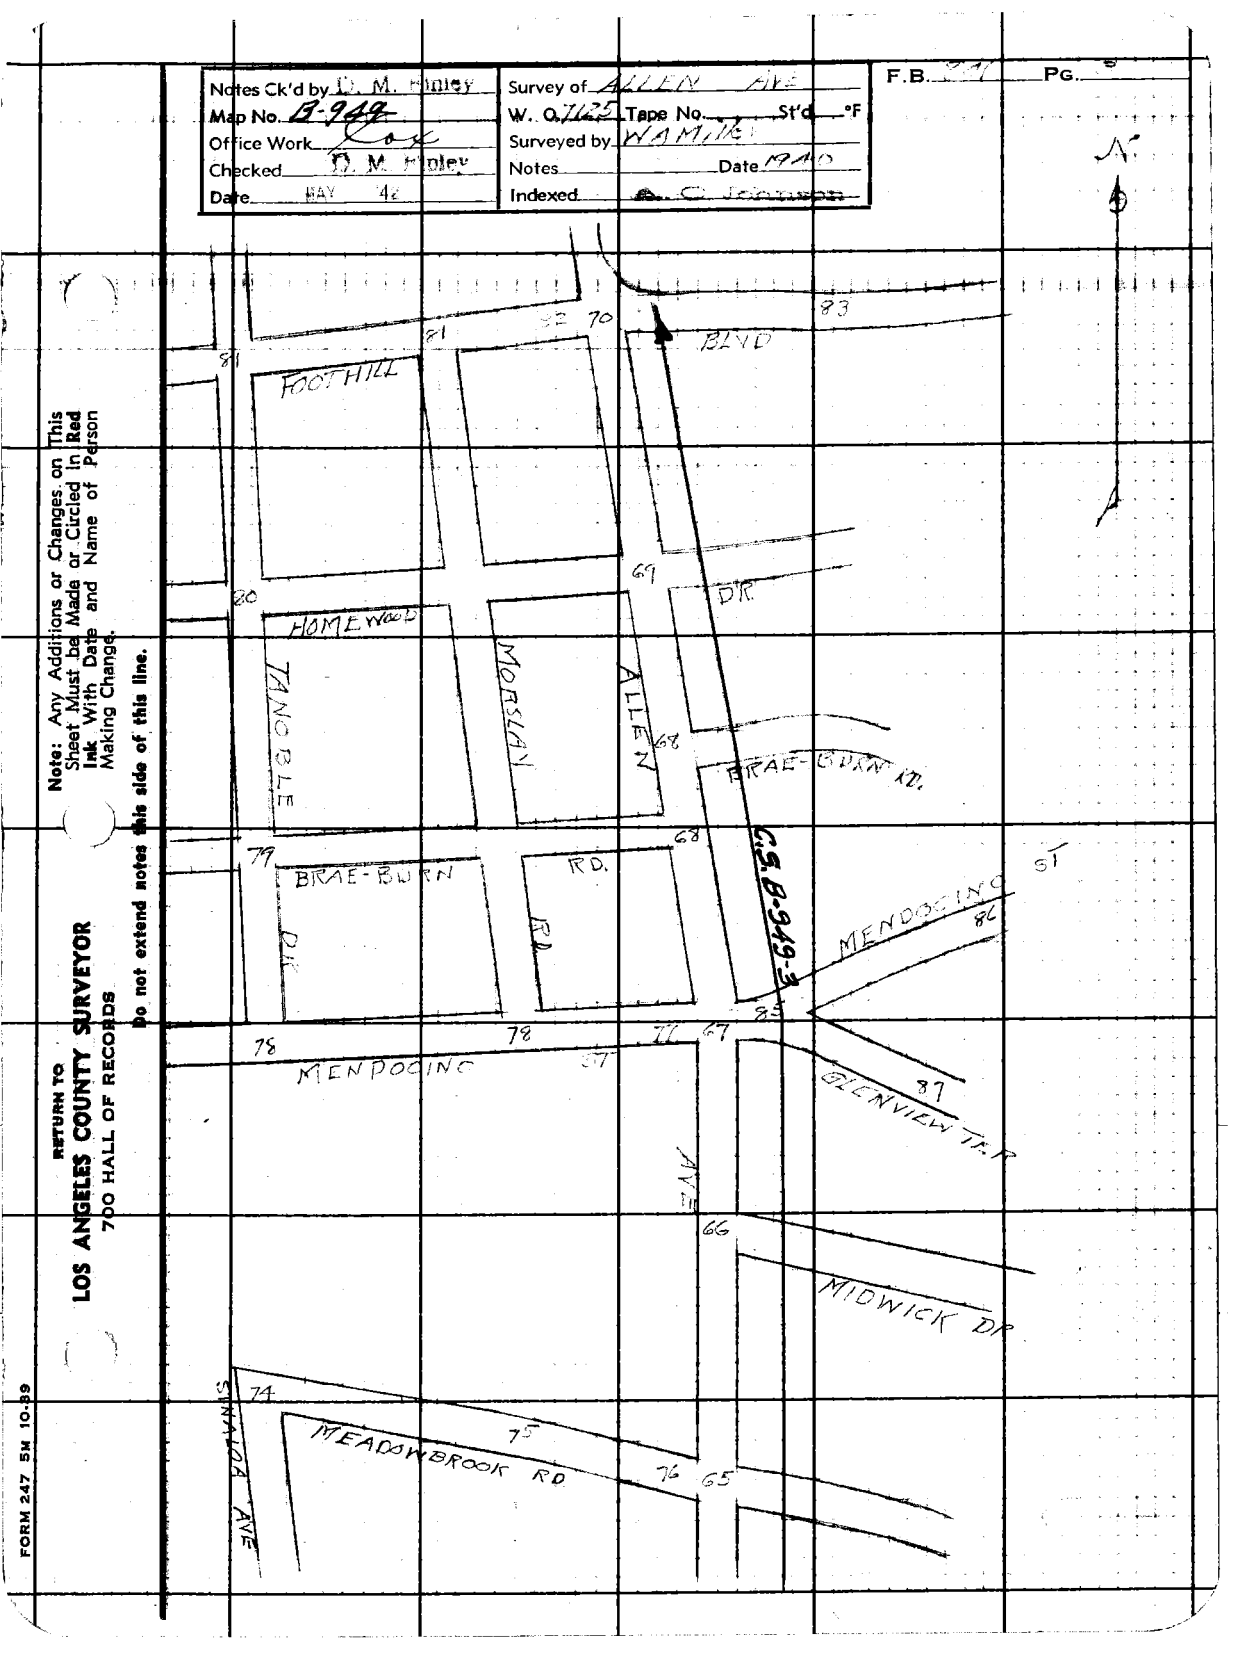
Notes Ck'd by D. M. Finley
Map No. B-949
Office Work Cox
Checked D. M. Finley
Date MAY 42
Survey of ALLEN AVE
W. O. 7125 Tape No. St'd °F
Surveyed by WAMINC
Notes Date MAY
Indexed C. Johnson
Note: Any Additions or Changes on This Sheet Must be Made or Circled in Red Ink With Date and Name of Person Making Change.
Do not extend notes this side of this line.
RETURN TO
LOS ANGELES COUNTY SURVEYOR
700 HALL OF RECORDS
FORM 247 5M 10-39
FOOTHILL BLVD
HOMEWOOD DR
TANOBLE
MORSLAN
ALLEN
BRAE-BURN RD.
BRAE-BURN DR.
C.S.B-949-3
MENDOCINO ST
GLENVIEW TR. P
MIDWICK DR
MEADOWBROOK RD
SINALOA AVE
81
70
83
91
80
69
68
79
78
67
87
66
74
75
76
65

RETURN TO
LOS ANGELES COUNTY SURVEYOR
700 HALL OF RECORDS

Note: Any Additions or Changes on This Sheet Must be Made or Circled in **Red Ink** With Date and Name of Person Making Change.

Do not extend notes this side of this line.

F.B. 841 PG. 4

FORM 247 5M 10-39

RETURN TO
LOS ANGELES COUNTY SURVEYOR
700 HALL OF RECORDS

Note: Any Additions or Changes on This Sheet Must be Made or Circled in **Red** Ink With Date and Name of Person Making Change.

Do not extend notes this side of this line.

Notes Ck'd by E. M. Finley
Map No.
Office Work
Checked
Date MAY 42

Survey of ALLEN AVE
W. O. 7123 Tape No. Std. °F
Surveyed by WALKER
Notes
Date 1942
Indexed

F.B. 677 Pg.

RETURN TO
LOS ANGELES COUNTY SURVEYOR
700 HALL OF RECORDS

Note: Any Additions or Changes on This Sheet Must be Made or Circled in **Red Ink** With Date and Name of Person Making Change.

Do not extend notes this side of this line.

F.B. 841 PG. 6

RETURN TO
LOS ANGELES COUNTY SURVEYOR
700 HALL OF RECORDS

Note: Any Additions or Changes on This Sheet Must be Made or Circled in Red Ink With Date and Name of Person Making Change.

Do not extend notes this side of this line.

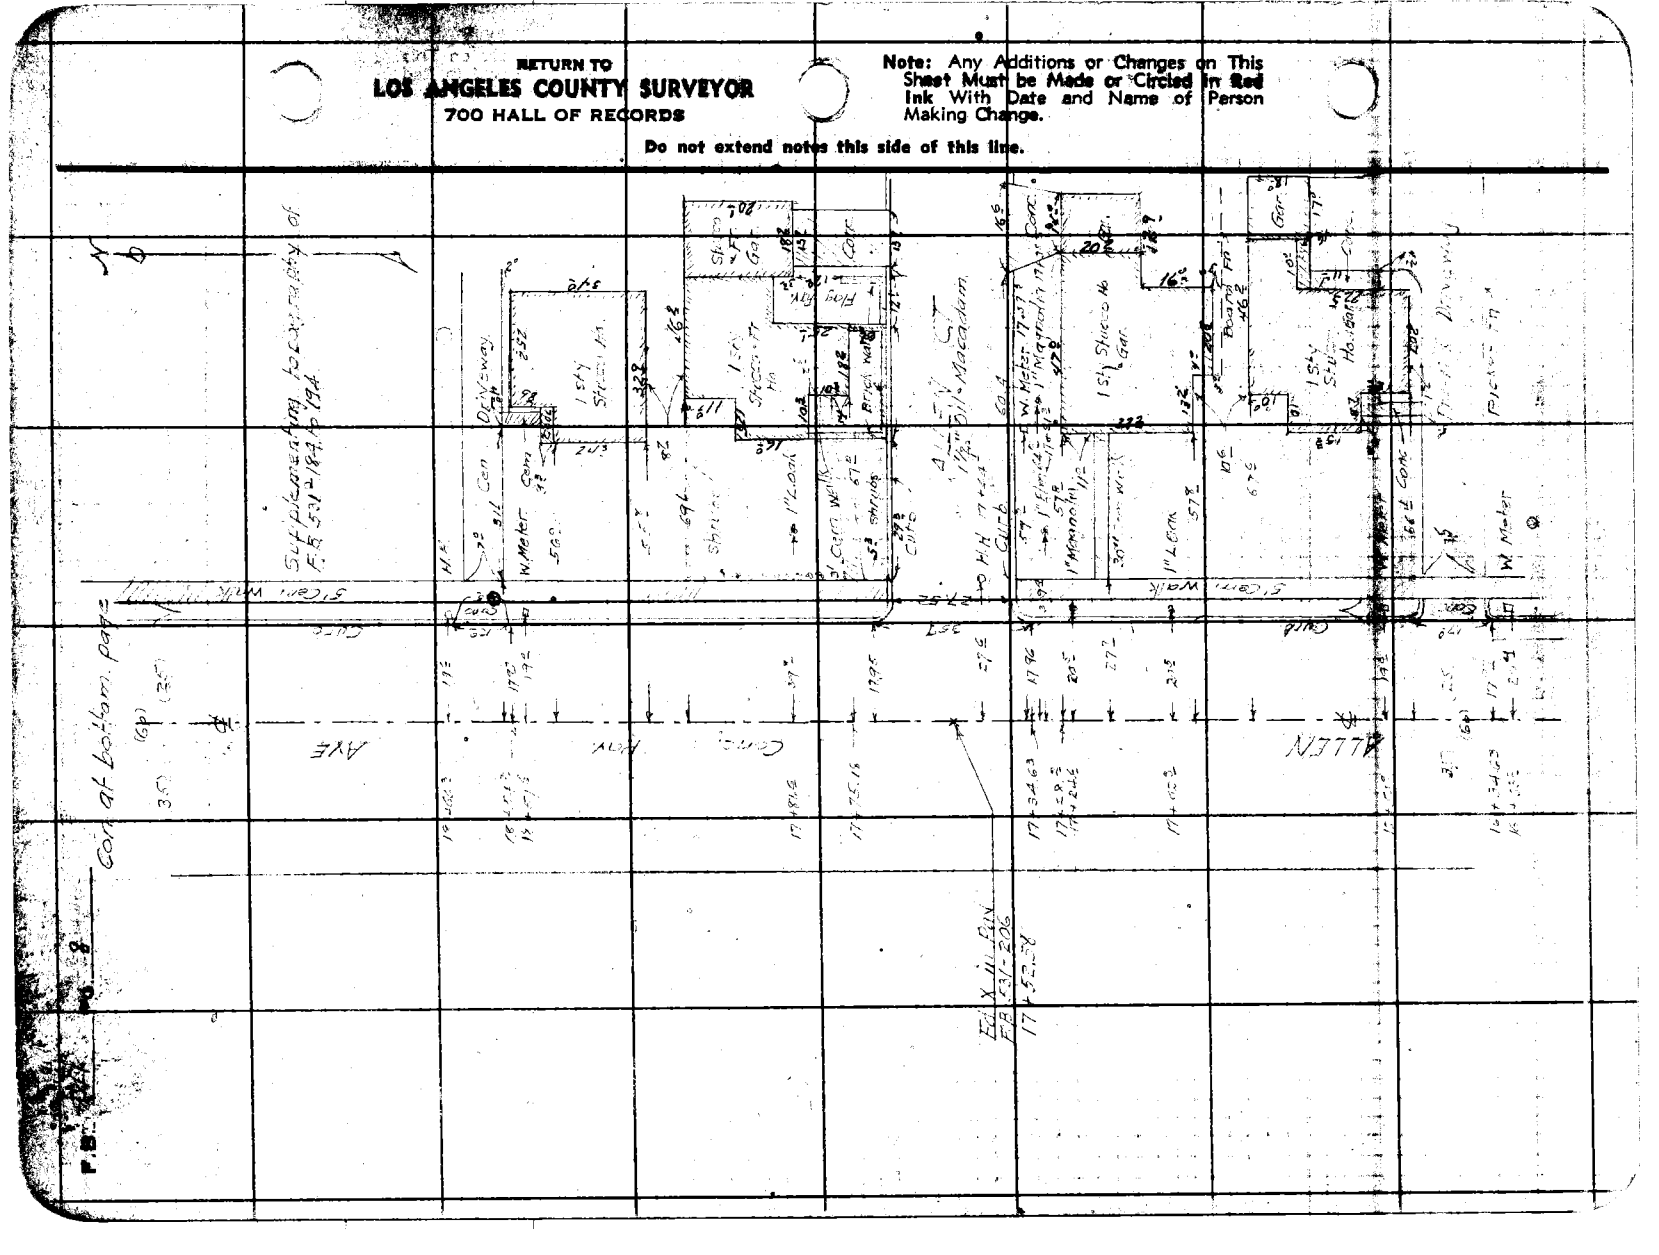

FORM 247 5M 10-59

RETURN TO
LOS ANGELES COUNTY SURVEYOR
700 HALL OF RECORDS

Note: Any Additions or Changes on This Sheet Must be Made or Circled in Red Ink With Date and Name of Person Making Change.

Do not extend notes this side of this line.

Notes Ck'd by D. M. Finley	Survey of ALLEY ETC
Map No. A-949-1	W. O. 7125 Tape No. St'd °F
Office Work [signature]	Surveyed by M. Miller
Checked D. M. Finley	Notes Date
Date MAY '42	Indexed 10-21-20

F. B. 841 Pg. 7

TOPOGRAPHY
BLANCHE ST TO NEW YORK AVE
Maps 2-59 Inc.

Miller
Livingston
Chandler
Hollis

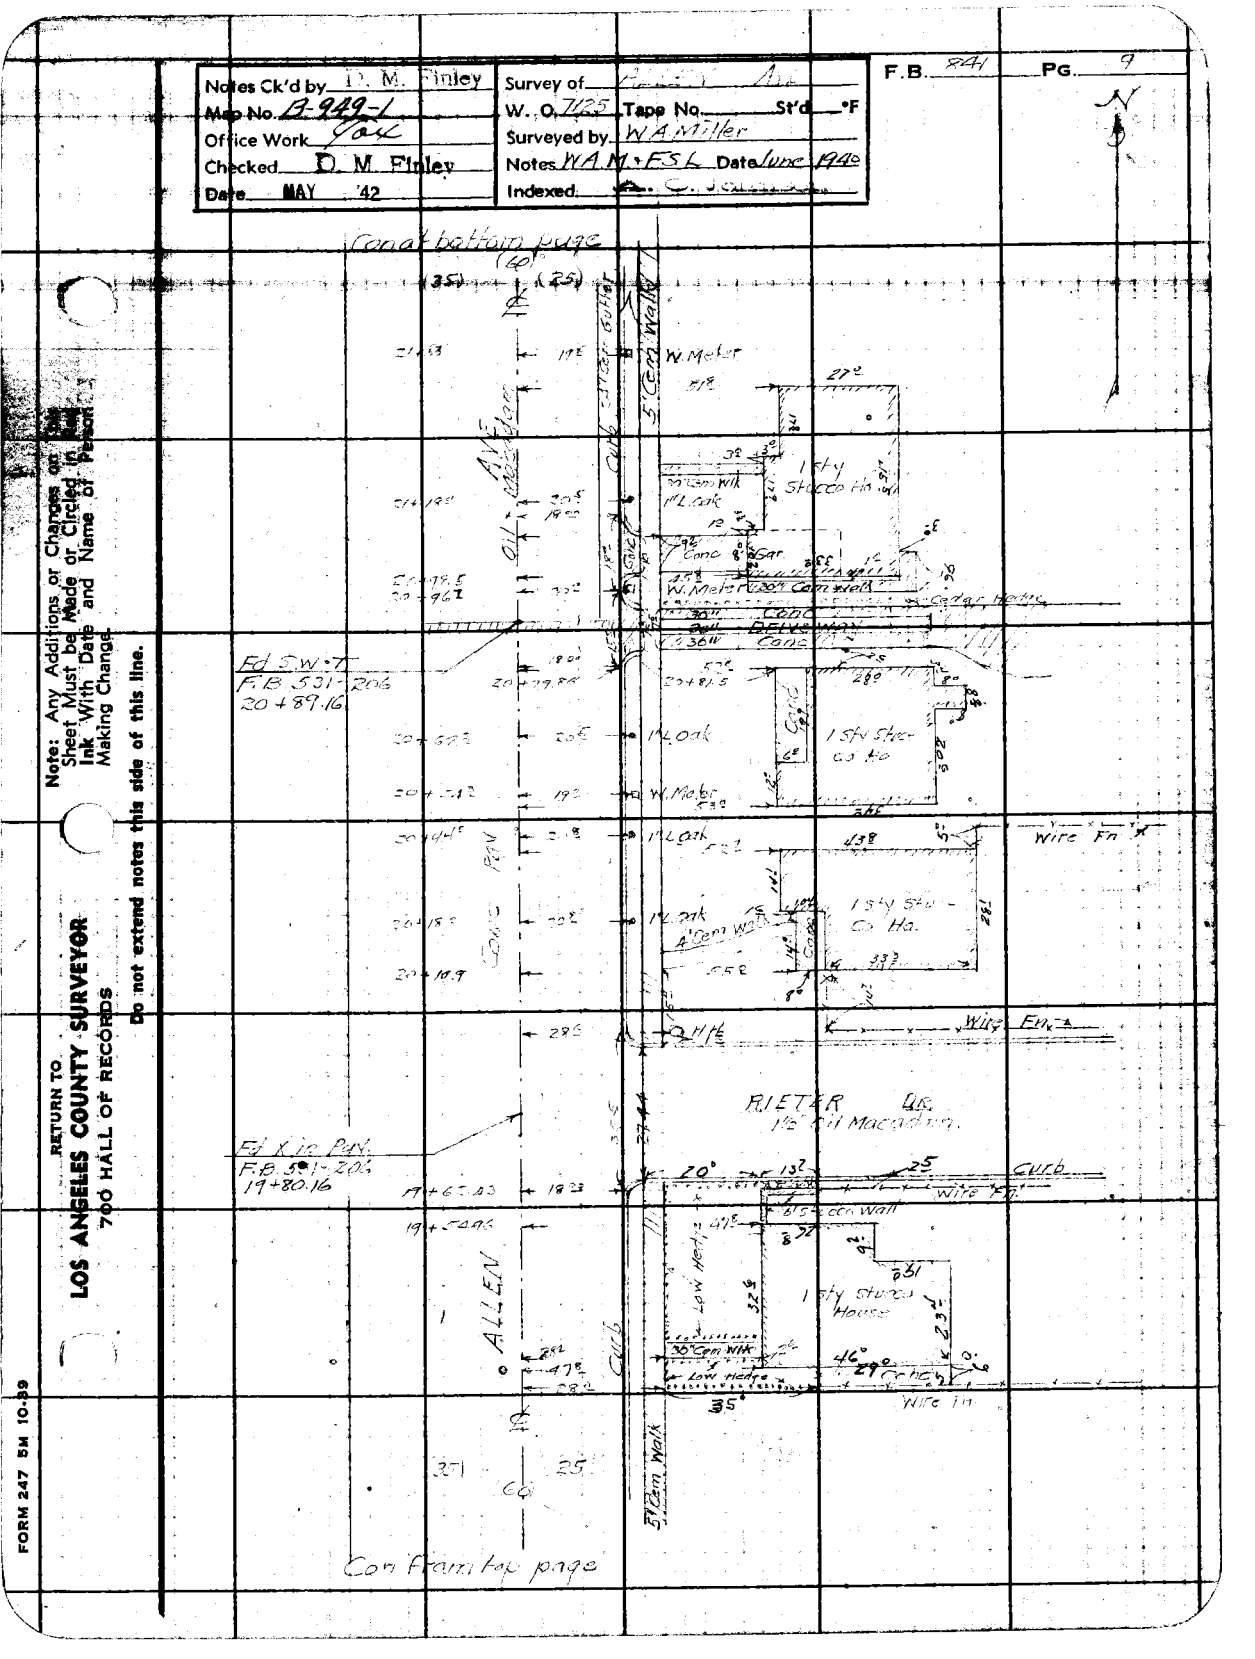
Notes Ck'd by D. M. Finley
Map No. B-949-1
Office Work Jak
Checked D. M. Finley
Date MAY '42
Survey of
W. O. 7425 Tape No. St'd °F
Surveyed by W.A.Miller
Notes W.A.M.-F.S.L. Date June 1940
Indexed
F.B. 841 PG. 9
Canal bottom page
ALLEN AVE
RIETER CR.
1½" Oil Macadam
Ed S.W.T.
F.B. 531-206
20+89.16
Ed X in Pav.
F.B. 531-205
19+80.16
1 sty Stucco Ho.
1 sty Stucco House
1 sty Shed
Co Ho.
Wire Fn.
Curb
Low Hedge
Con Walk
Con Frame top page
RETURN TO
LOS ANGELES COUNTY SURVEYOR
700 HALL OF RECORDS
Do not extend notes this side of this line.
Note: Any Additions or Changes on this Sheet Must be Made or Circled in Ink With Date and Name of Person Making Change
FORM 247 BM 10-39

F.B. 841 PG. 10

RETURN TO
LOS ANGELES COUNTY SURVEYOR
700 HALL OF RECORDS

Do not extend notes this side of this line.

Note: Any Additions or Changes on This Sheet Must be Made or Circled in Red Ink With Date and Name of Person Making Change.

See F.B. 531-194

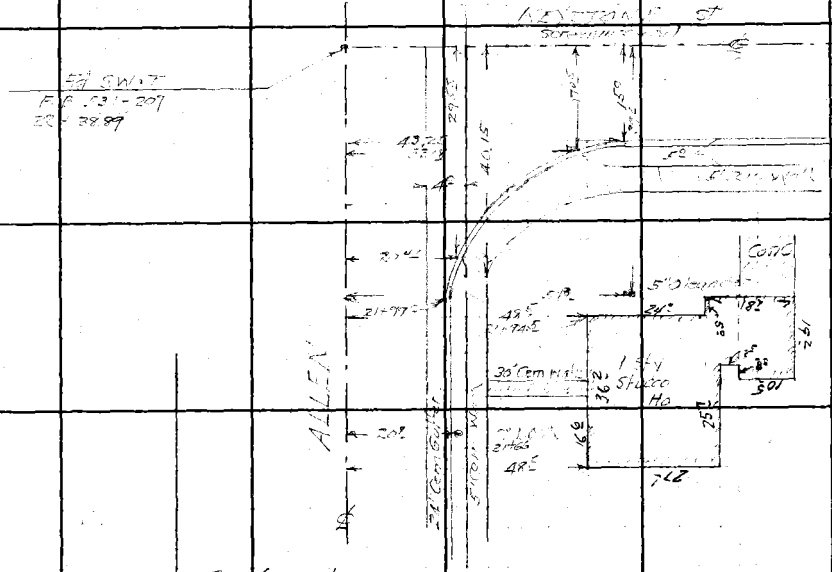

FORM 247 5M 10-39

RETURN TO
LOS ANGELES COUNTY SURVEYOR
700 HALL OF RECORDS

Note: Any Additions or Changes on This Sheet Must be Made or Circled in **Red Ink** With Date and Name of Person Making Change.

Do not extend notes this side of this line.

Notes Ck'd by E. M. Finley
Map No. B-1949-1
Office Work
Checked E. M. Finley
Date MAY '42

Survey of
W. O. 7125 Tape No. Std. °F
Surveyed by WALTHER
Notes
Indexed Date

F. B. 821 Pg. 11

F.B. 841 PG. 12

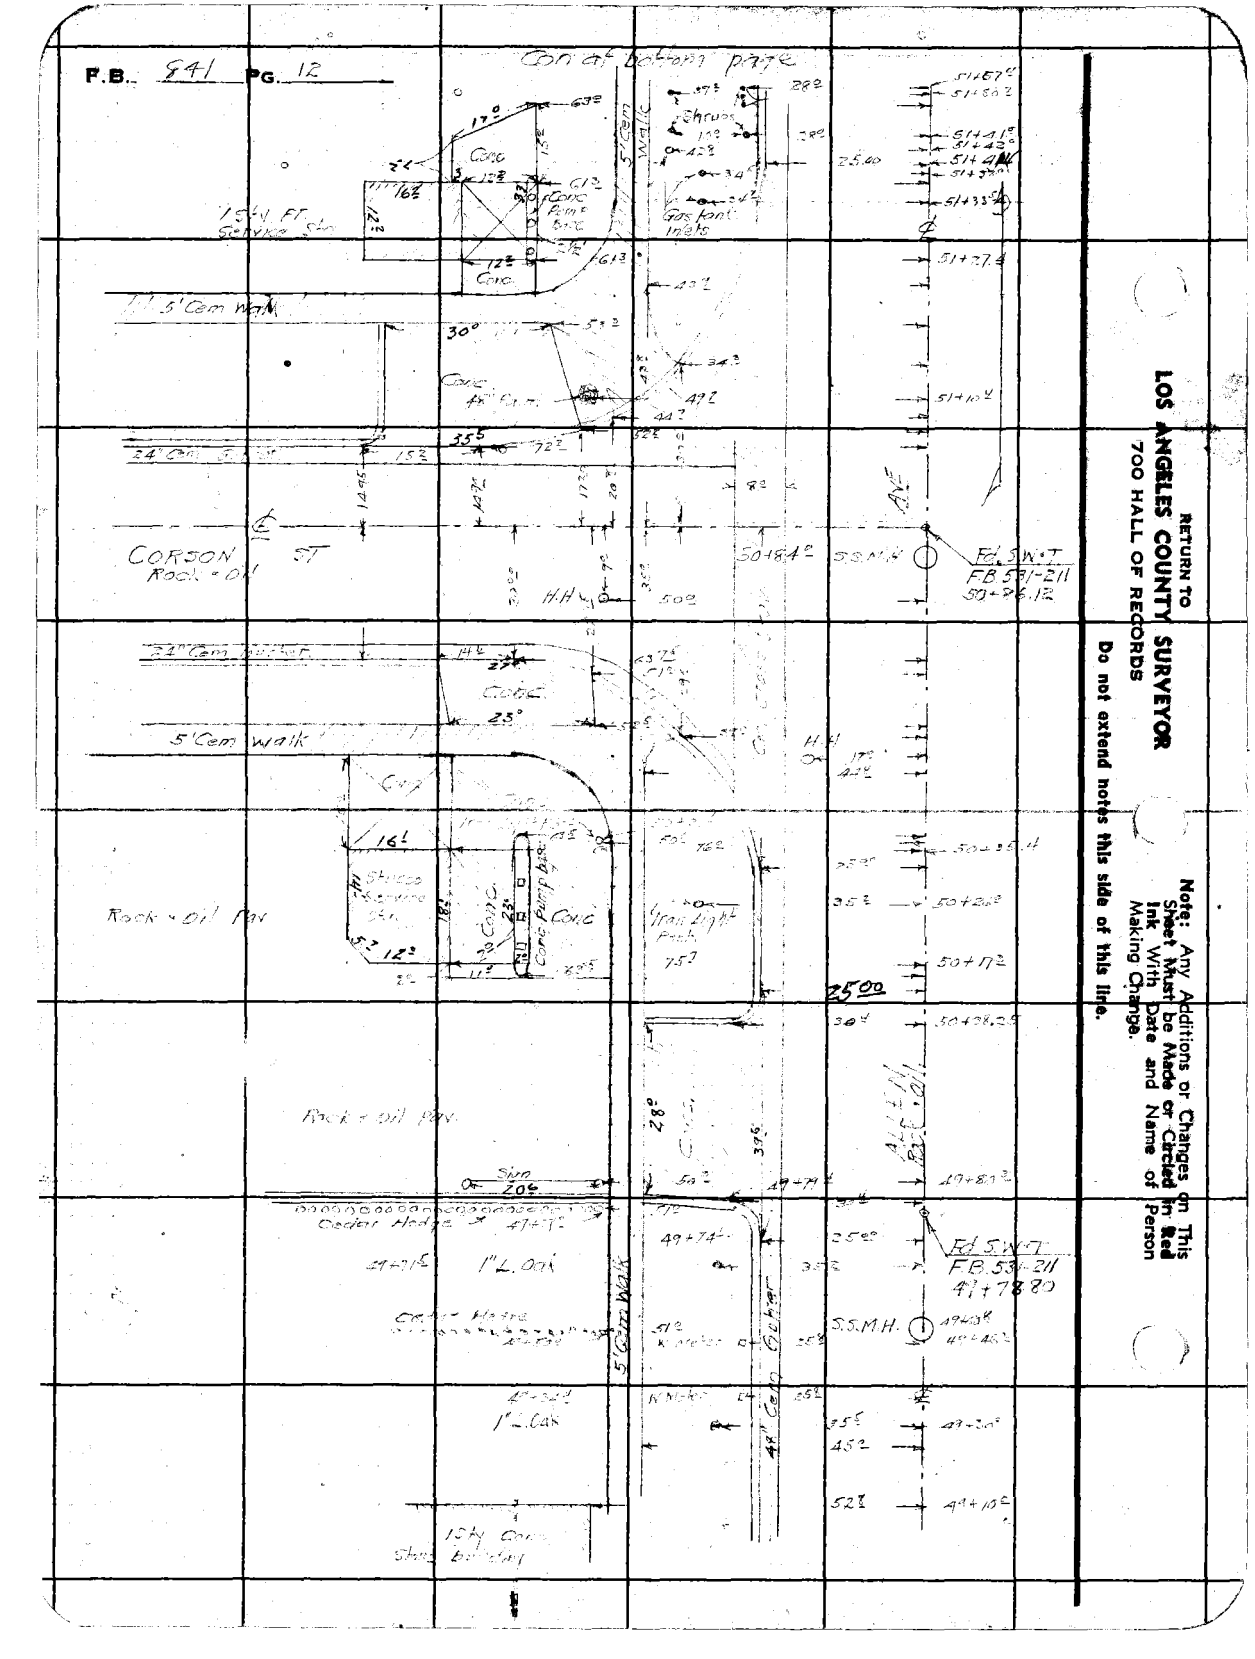

RETURN TO
LOS ANGELES COUNTY SURVEYOR
700 HALL OF RECORDS

Note: Any Additions or Changes on This Sheet Must be Made or Circled in Red Ink With Date and Name of Person Making Change.

Do not extend notes this side of this line.

Office Work [illegible]	Surveyed by W.A. Miller		
Checked D. M. Finley	Notes WAM °F-SL Date June 1940		
Date MAY 42	Indexed		

Note: Any Additions or Changes on This Sheet Must be Made or Circled in Red Ink With Date and Name of Person Making Change.

Do not extend notes this side of this line.

RETURN TO
LOS ANGELES COUNTY SURVEYOR
700 HALL OF RECORDS

FORM 247 SM 10-39

RETURN TO
LOS ANGELES COUNTY SURVEYOR
700 HALL OF RECORDS

Note: Any Additions or Changes on This Sheet Must be Made or Circled in Red Ink With Date and Name of Person Making Change.

Do not extend notes this side of this line.

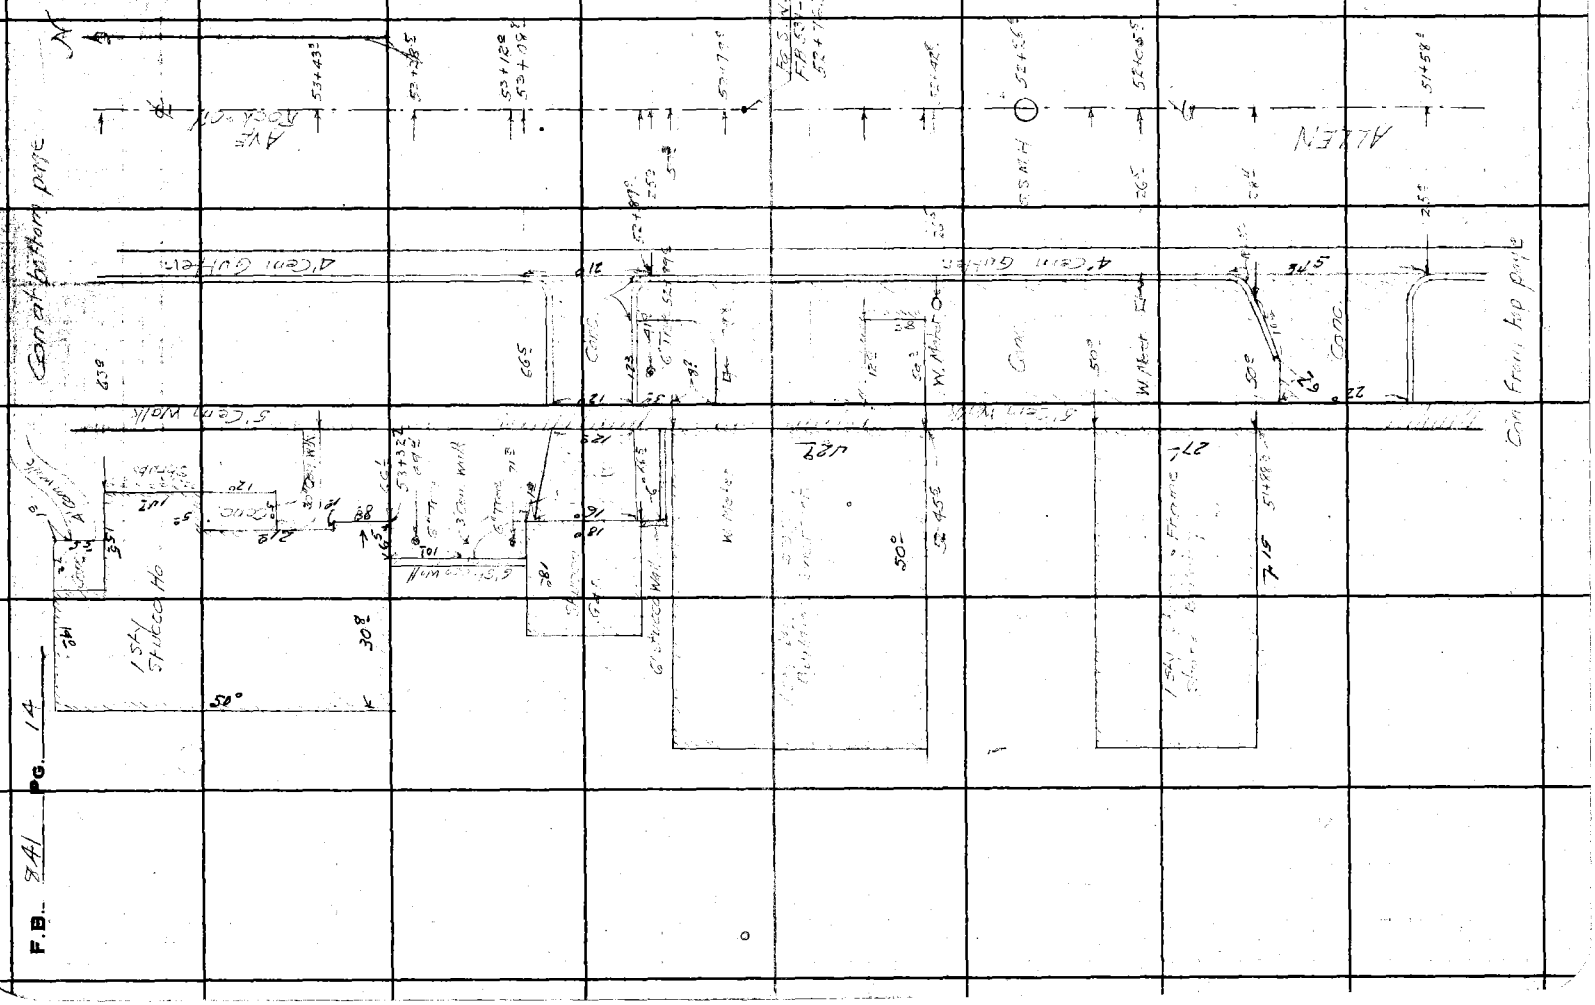


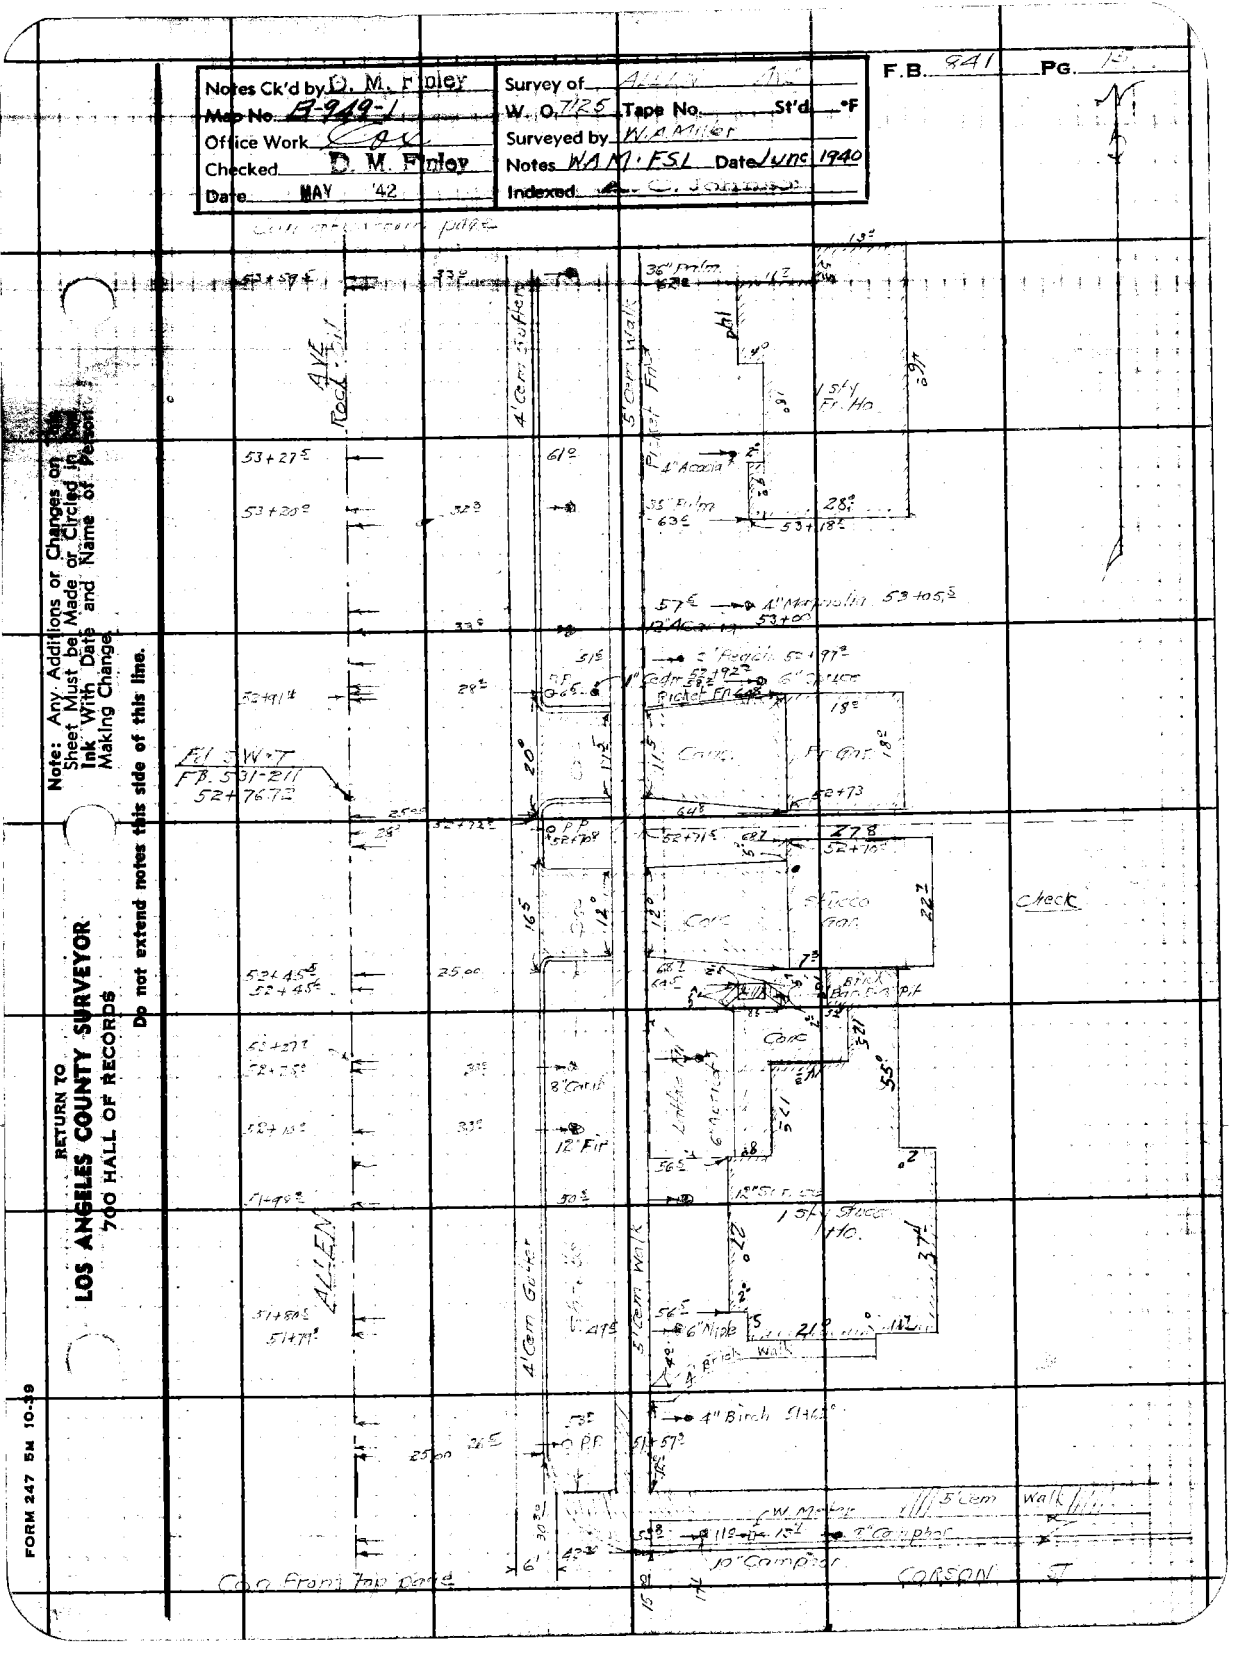
Notes Ck'd by D. M. Finley
Map No. B-949-1
Office Work Cpc
Checked D. M. Finley
Date MAY '42
Survey of Alley
W. O. 7125 Tape No. St'd °F
Surveyed by W. A. Miller
Notes WAM: FSL Date June 1940
Indexed
Note: Any Additions or Changes on This Sheet Must be Made in Ink With Date and Name of Person Making Change.
Do not extend notes this side of this line.
RETURN TO
LOS ANGELES COUNTY SURVEYOR
700 HALL OF RECORDS
FORM 247 5M 10-39
ALLEY
Rock Fill
4' Conc. Gutter
5' Conc. Walk
Pilot Fall
36" Palm
15 Sty Fr. Ho.
1" Acacia
55" Elm
28"
57" → 4" Magnolia
12" Acacia
2" Peach
1" Cedar
6" Privet
Picket Fence
Conc.
Fr. Gar.
Fr. Gar.
Stucco Gar.
Conc.
8" Conc.
12" Fir
Conc.
1 Sty Stucco Ho.
6" Nipa
Brick Walk
4" Birch
W. Meter
5' Conc. Walk
T" Cypress
10" Conifer
CORSON ST
Conc. From Face of Curb
Check

RETURN TO
LOS ANGELES COUNTY SURVEYOR
700 HALL OF RECORDS

Note: Any Additions or Changes on This Sheet Must be Made or Circled in Red Ink With Date and Name of Person Making Change.

Do not extend notes this side of this line.

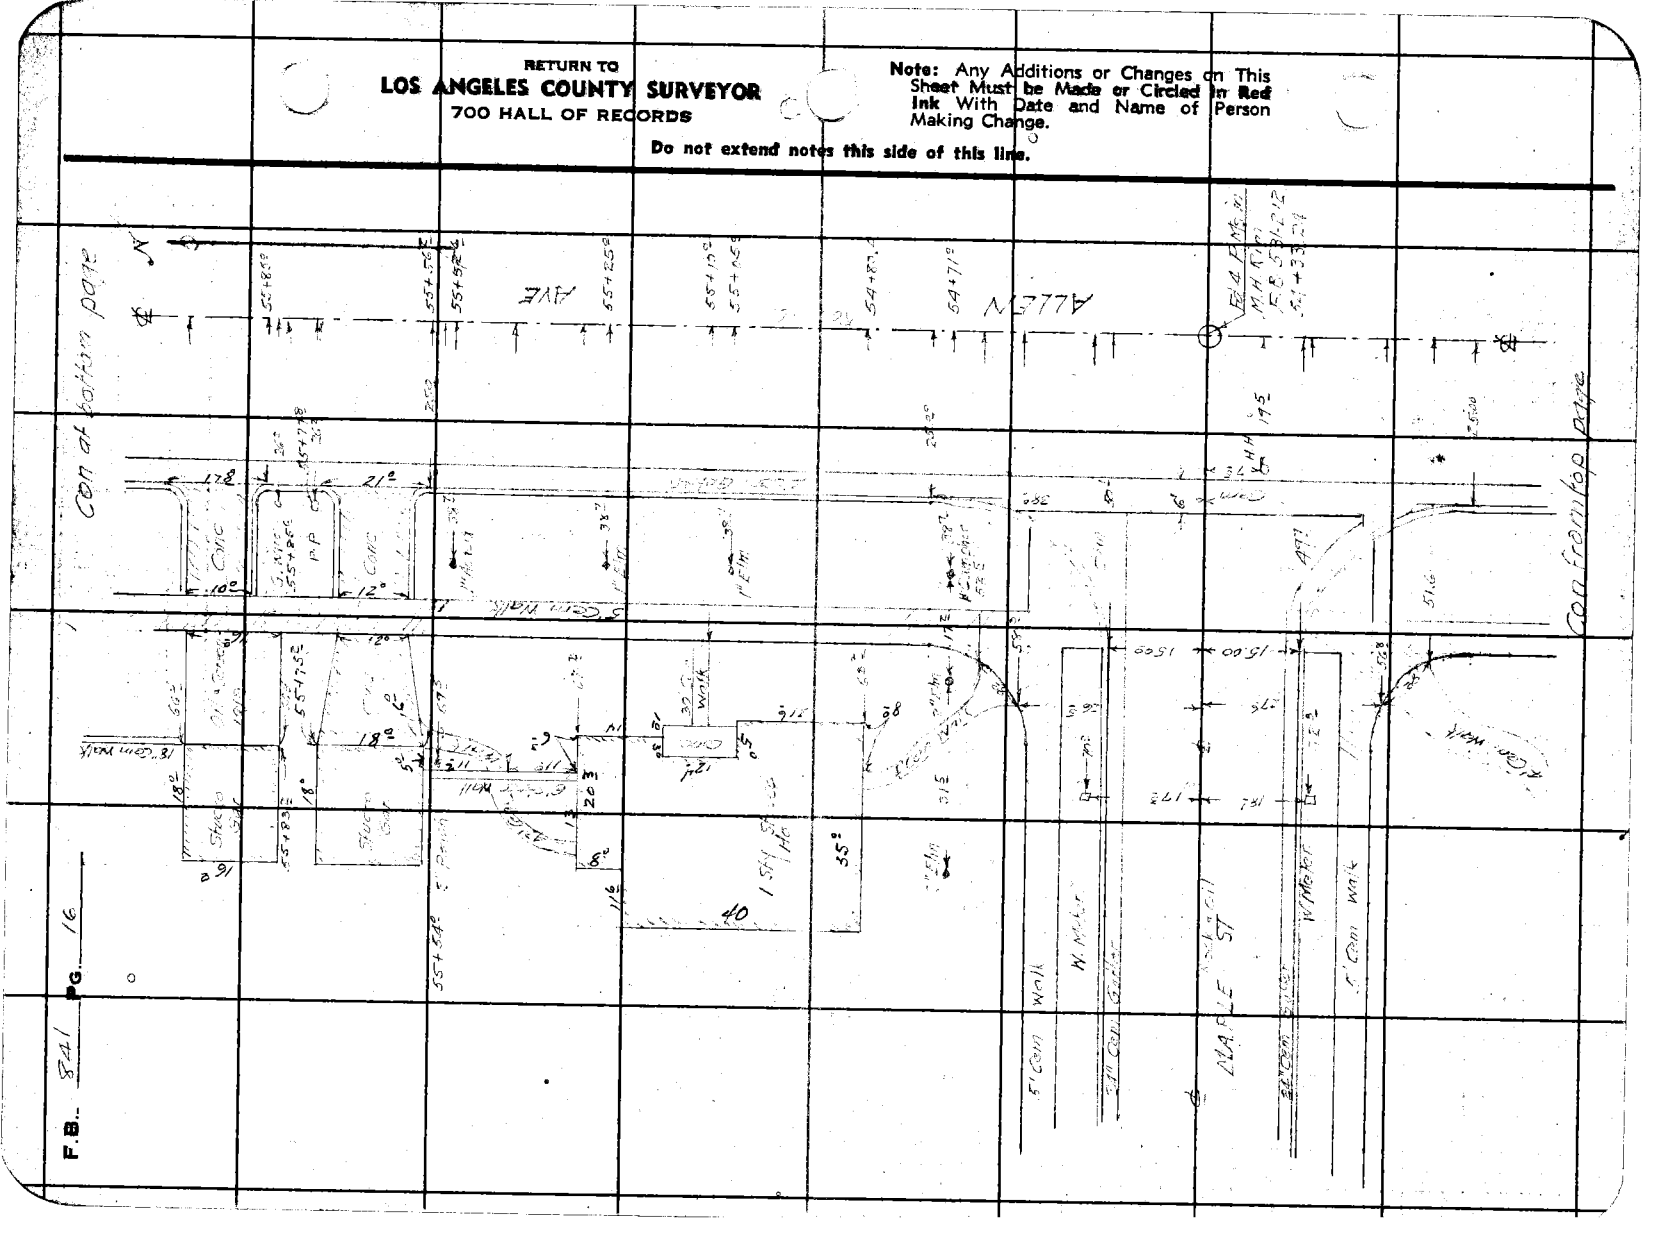
Con at bottom Dope
Con from top Dope
AVE
ALLEN
MAPLE ST
W. Main
5' Con Walk
Con Curb
Con Gutter
Con Walk
Stucco

Notes Ck'd by D. M. Finley	Survey of ALLEN Ave	F.B. 841	Pg. 12
Map No. B-949-1	W. O. 7125 Tape No. St'd °F		
Office Work Col	Surveyed by W.A. MILLER		
Checked D. M. Finley	Notes W.A.M. F.S.L. Date June 1940		
Date MAY 42	Indexed		

Note: Any Additions or Changes on This Sheet Must be Made or Circled in Red Ink With Date and Name of Person Making Change.

Do not extend notes this side of this line.

RETURN TO
LOS ANGELES COUNTY SURVEYOR
700 HALL OF RECORDS

Corr at bottom page

55+66 E
35.0
27.8
32.7
PP
1" A
Conc.
18"
20' Stucco Gar
20'
55+62 E
W.M. Fd
55+54.8
32.7
Conc.
18"
Conc.
18"
Stucco Gar
10'
59.1
55+33.4
55+32.8
25.8
32.7
6" Palm
55+33 E
55+32 E
55+32.5
53.8
8" Palm
60 L
20'
12'
55+05.8
35.7
1" Magnolia
54+92.4
52.8
1" Elm
38.8
Conc
12.8
15' Stucco Hse.
73.8
54+77.3
54+74.8
32.7
1" Magnolia
60'
Conc
25
21
54+49.5
54+42.8
25.8
24.90
51.3
O.P.P
1" Elm
14'
5' Conc. Walk
W. Meter
37.2
25.10
15.10
17.8
16'
Conc Curb
MAPLE
ST
Fd SMT
F.B. 531-512
54+16.79
46.8
OHH
16'
6" Palm
W. Meter
5' Conc Walk
24.90
Prop'd Fh
12" Agnolia 53+67.1
32.8
Corr from top page

FORM 247 5M 10-59

RETURN TO
LOS ANGELES COUNTY SURVEYOR
700 HALL OF RECORDS

Note: Any Additions or Changes on This Sheet Must be Made or Circled in Red Ink With Date and Name of Person Making Change.

Do not extend notes this side of this line.

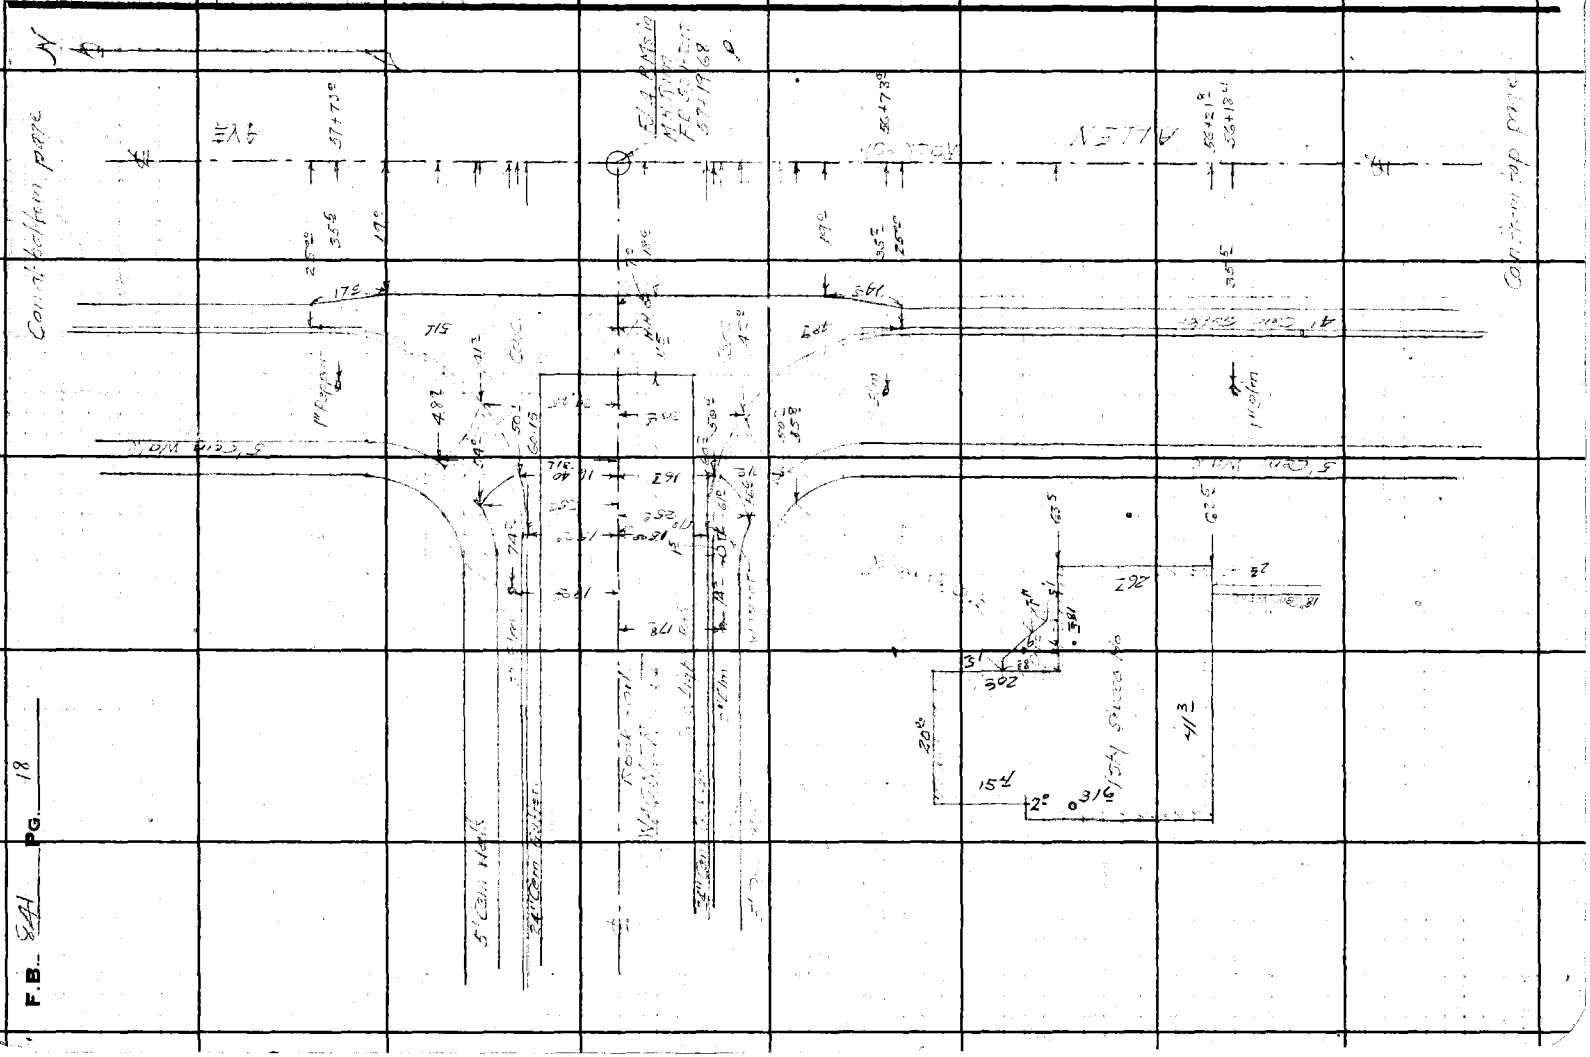
ALLEY
Concrete Pipe
Concrete Pipe
Concrete Pipe
Concrete Pipe
5' Cem. Walk
5' Cem. Walk
Rock Wall
Rock Wall
Rock Wall

Notes Ck'd by D. M. Finley
Map No. A-949-1
Office Work Cox
Checked D. M. Finley
Date MAY 42

Survey of
W., O. Tape No. St'd °F
Surveyed by W.A. Miller
Notes W.A.M.; F.S.L. Date June 1940
Indexed

F.B. 841 Pg. 19

Note: Any Additions or Changes on This Sheet Must be Made or Circled in Red Ink With Date and Name of Person Making Change.

Do not extend notes this side of this line.

RETURN TO
LOS ANGELES COUNTY SURVEYOR
700 HALL OF RECORDS

FORM 247 SM 10-39

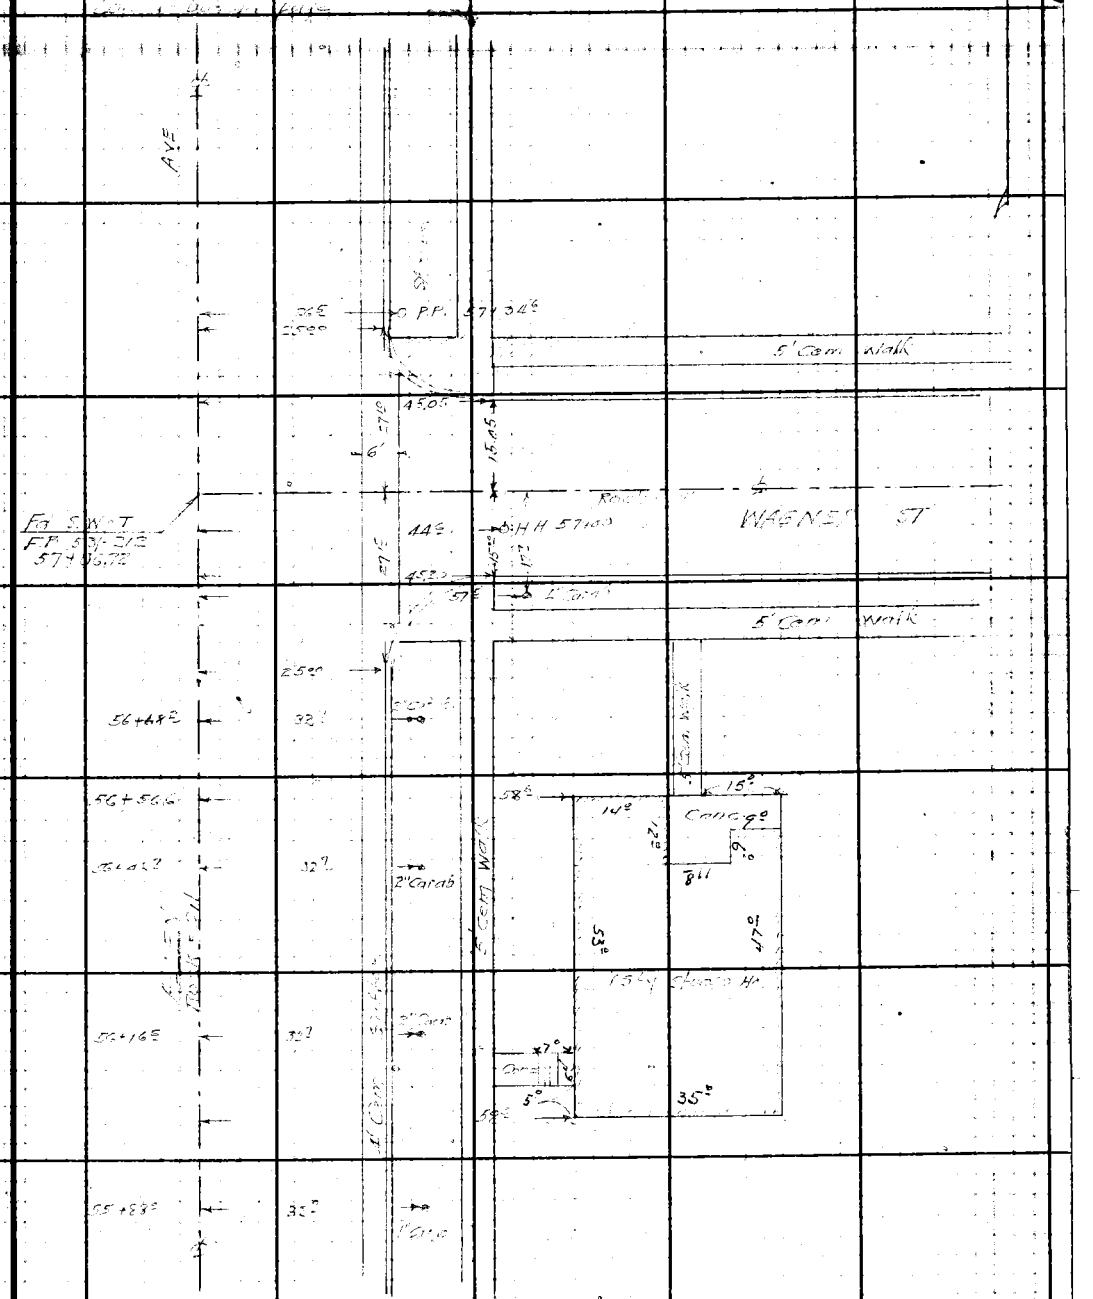
AVE
5' Conc. Walk
WAGNER ST
5' Conc. Walk
Fd. S.W.T.
FP. 5.0' S/E
57+05.72
56+44.2
56+56.6
56+16.5
55+88.8
12" Carob
Conc. Walk
Conc.
Bldg.
Bldg.
Conc. Walk
Conc. Walk
Conc. Walk

RETURN TO
LOS ANGELES COUNTY SURVEYOR
700 HALL OF RECORDS

Note: Any Additions or Changes on This Sheet Must be Made or Circled in Red Ink With Date and Name of Person Making Change.

Do not extend notes this side of this line.

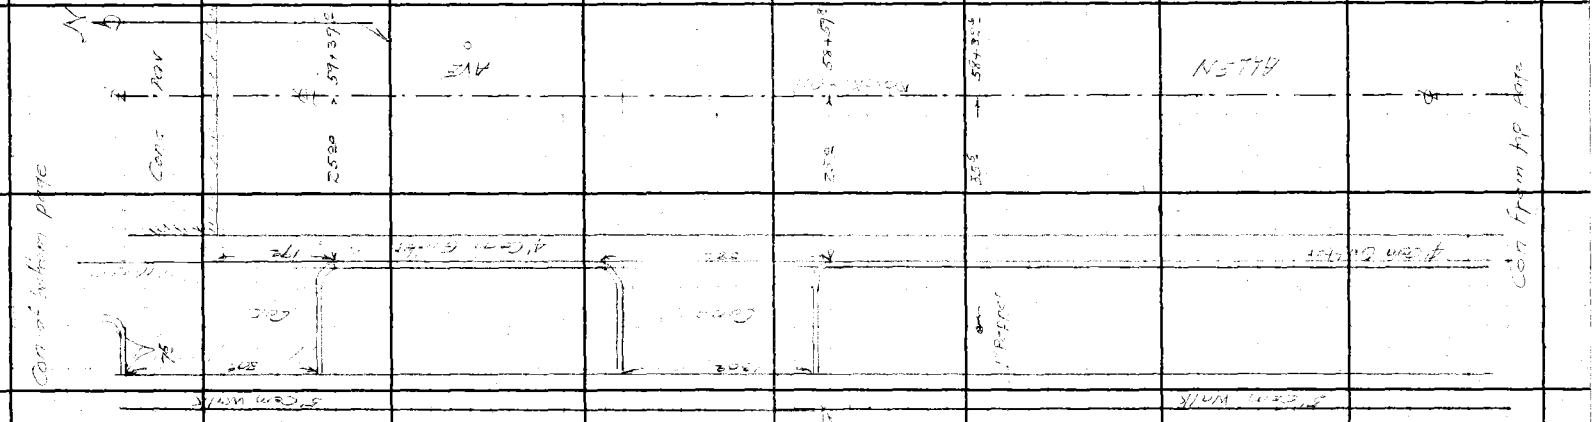
N 44°W
AVE
Conc. Mon.
2520
Con. from Hip Pipe
Con. from Hip Pipe
Con. from Hip Pipe

Notes Ck'd by E. M. Finley	Survey of Alley in Block	F.B. 847	Pg. 71
Map No. B-949-1	W.O. 7123 Tape No. St'd °F		
Office Work Cox	Surveyed by W. G. Miller		
Checked D. M. Finley	Notes W.A.M. - F.S.L. Date June 1940		
Date MAY '42	Indexed		

Note: Any Additions or Changes on This Sheet Must be Made or Circled in Red Ink With Date and Name of Person Making Change.

Do not extend notes this side of this line.

RETURN TO
LOS ANGELES COUNTY SURVEYOR
700 HALL OF RECORDS

FORM 247 5M 10-39

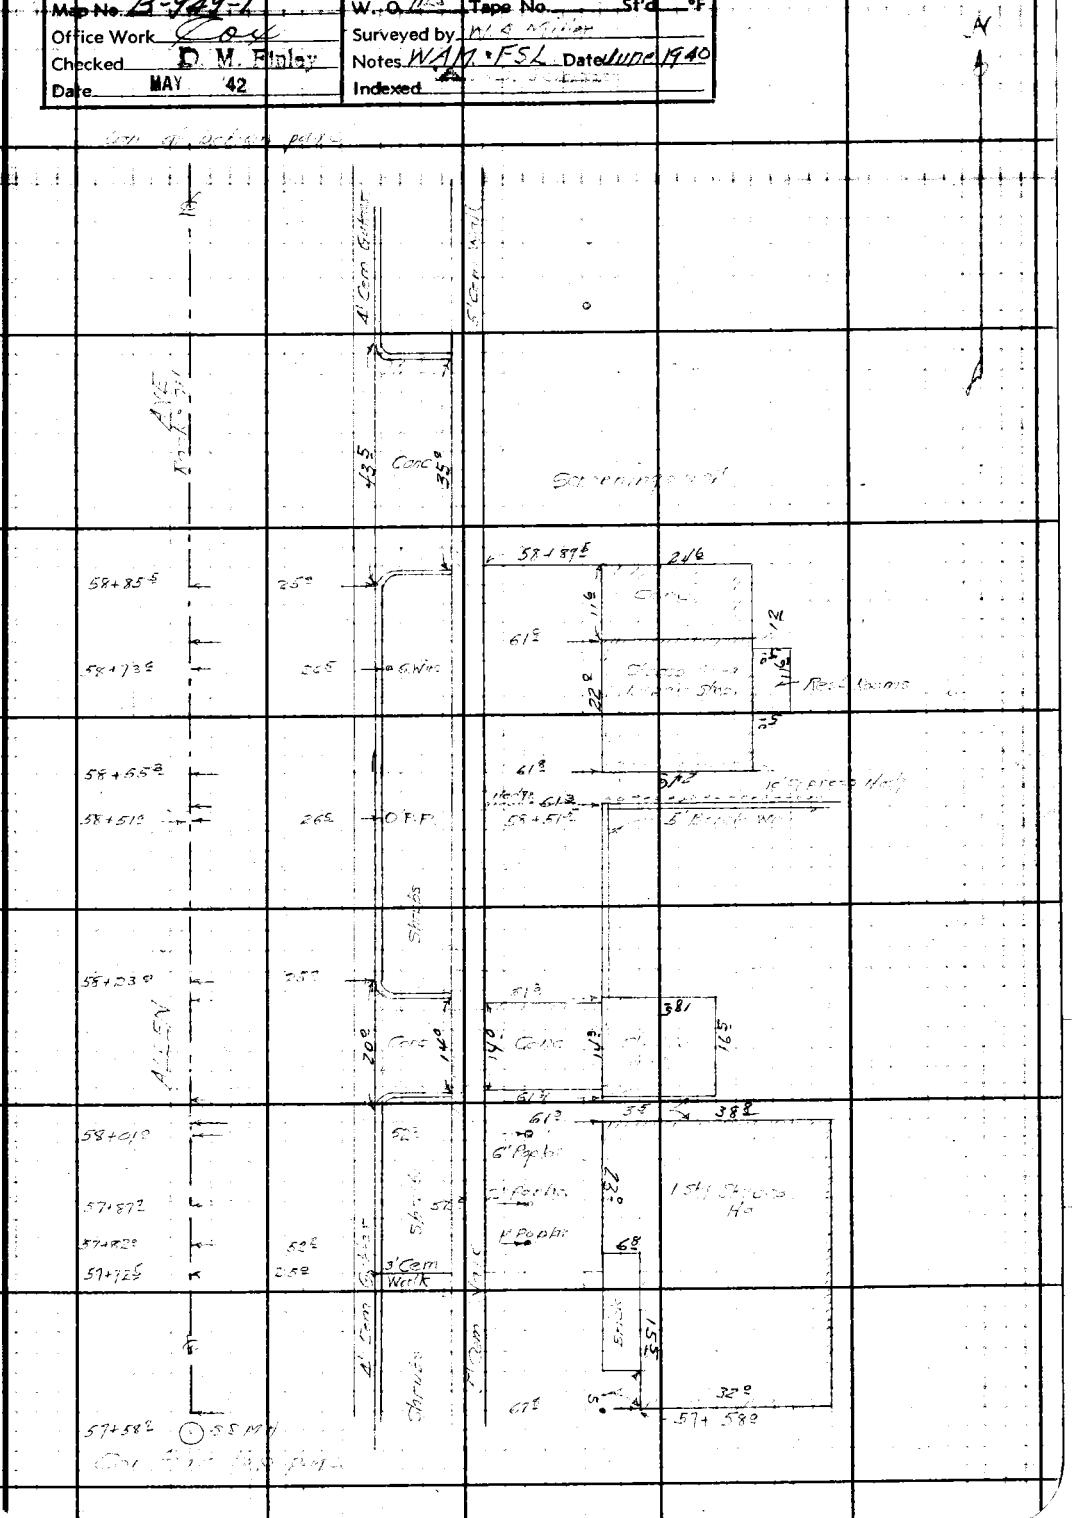

F.B. 941 PG. 22

RETURN TO
LOS ANGELES COUNTY SURVEYOR
700 HALL OF RECORDS

Do not extend notes this side of this line.

Note: Any Additions or Changes on This Sheet Must be Made or Circled in Red Ink With Date and Name of Person Making Change.

15'
Ornamental Iron Screen Fence
3' Conc Walk
Concrete
Grevillea Tree
Conc Pad
20'
19.3'
7.5'
10'
50'
15'y Metal Sign Post
Conc
4' Conc Gutter
12.6'
12.6'
61+93.2
7.5'
50'
Rd A-01
31.90
60+89.5
31.90
50'
60+79.2
60+92.3
Ornamental Iron Screen Fence
Conc
AVE
5' Conc Walk
8.2'
39.90
16'
8.2'
Conc
57'
Conc
Fd Reinforcing Rod
FB 531-213
60+17.13
VILLA
Rock Fill
7.6'
7'
9.99'
Fd 1/2" I.P.
No Tag
FB 531-213
60+17.14
Conc
28.7'
34.85'
39.80'
Conc
Conc
5' Conc Walk
4'
Pre-Mix Paving
50'
44.2'
H.H.
32.7'
59+78
Gas Tank Inlet
46.6'
46.2'
18.5'
20'
35'
Conc
20'
Conc
15'y Metal Sign Post
16.2'
Pre-Mix Paving
Conc
Conc
20'
5'
Pre-Mix Paving
Pre-Mix Paving
Gas Tank Inlets
4' Conc Gutter
ALLEN
Rock Fill
Conc from top of fill

Notes Ck'd by D. M. Finley	Survey of
Map No. B-949-1	W. O. 1125 Tape No. St'd °F
Office Work Cox	Surveyed by W.A.M.
Checked D. M. Finley	Notes W.A.M. F.S.L. Date June 1940
Date MAY '42	Indexed

F.B. 241 Pg. 23

Note: Any Additions or Changes on This Sheet Must be Made or Circled in Red Ink With Date and Name of Person Making Change.

Do not extend notes this side of this line.

RETURN TO
LOS ANGELES COUNTY SURVEYOR
700 HALL OF RECORDS

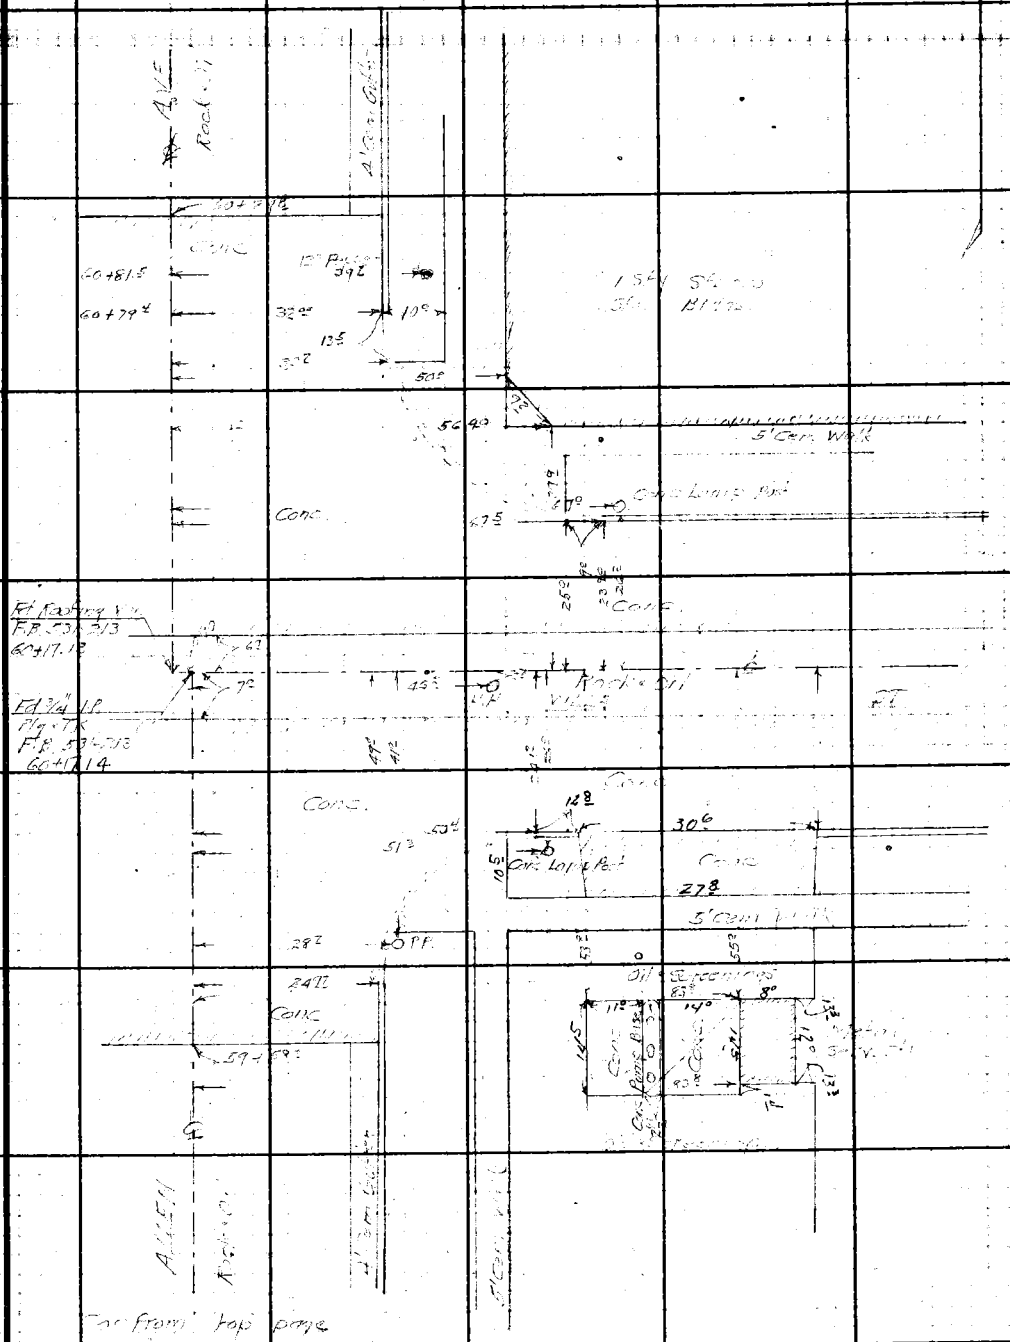
Conc
5' Conc. Walk
Conc Curb & Gutter
Conc Lamp Post
Conc Curb & Gutter
Conc
Conc
Conc

RETURN TO
LOS ANGELES COUNTY SURVEYOR
700 HALL OF RECORDS

Note: Any Additions or Changes on This Sheet Must be Made or Circled in Red Ink With Date and Name of Person Making Change.

Do not extend notes this side of this line.

F.B. 844 PG. 24

FORM 247 5M 10-39

RETURN TO
LOS ANGELES COUNTY SURVEYOR
700 HALL OF RECORDS

Note: Any Additions or Changes on This Sheet Must be Made or Circled in **Red Ink** With Date and Name of Person Making Change.

Do not extend notes this side of this line.

Notes Ck'd by [illegible]
Map No. B-247-2
Office Work [illegible]
Checked D. M. Fiden
Date MAY 42

Survey of
W. O. [illegible] Tape No. Std. °F
Surveyed by [illegible]
Notes Date
Indexed [illegible]


RETURN TO
LOS ANGELES COUNTY SURVEYOR
700 HALL OF RECORDS

Note: Any Additions or Changes on This Sheet Must be Made or Circled in Red Ink With Date and Name of Person Making Change.

Do not extend notes this side of this line.

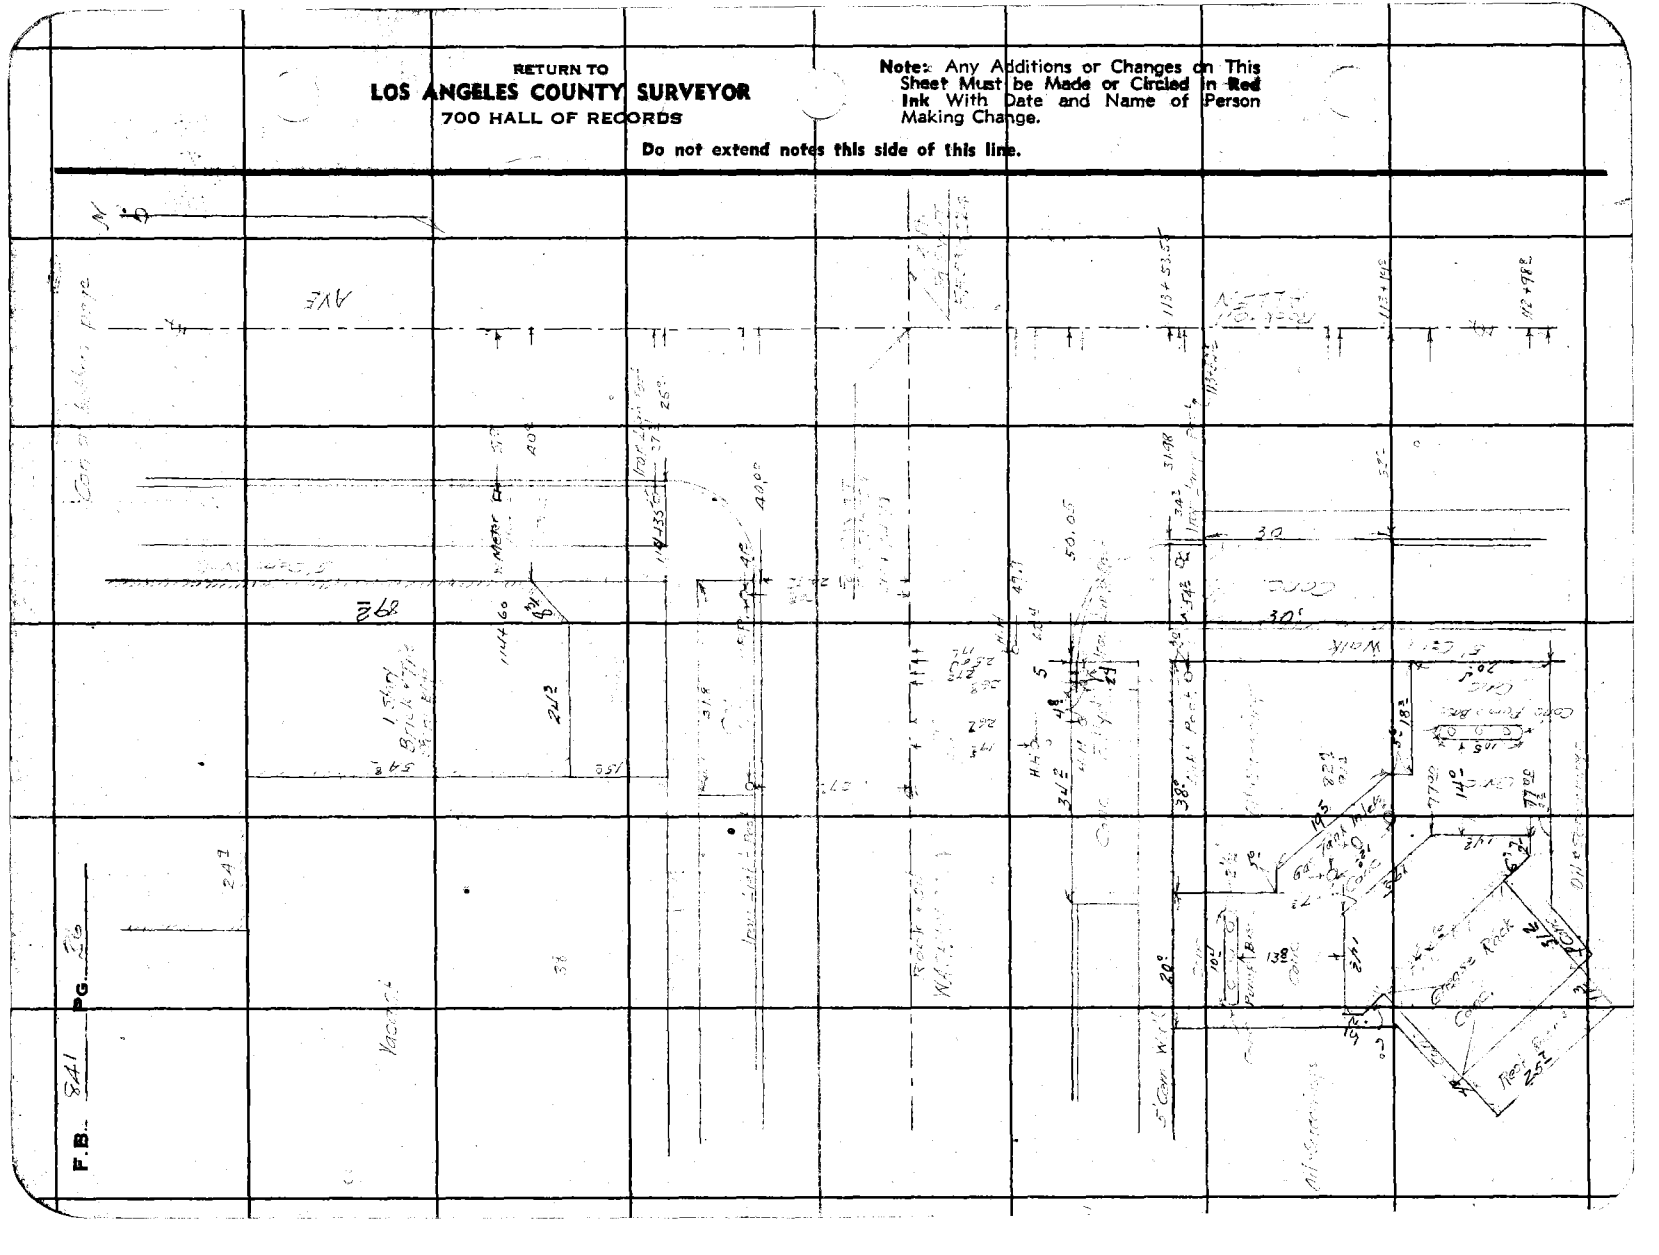

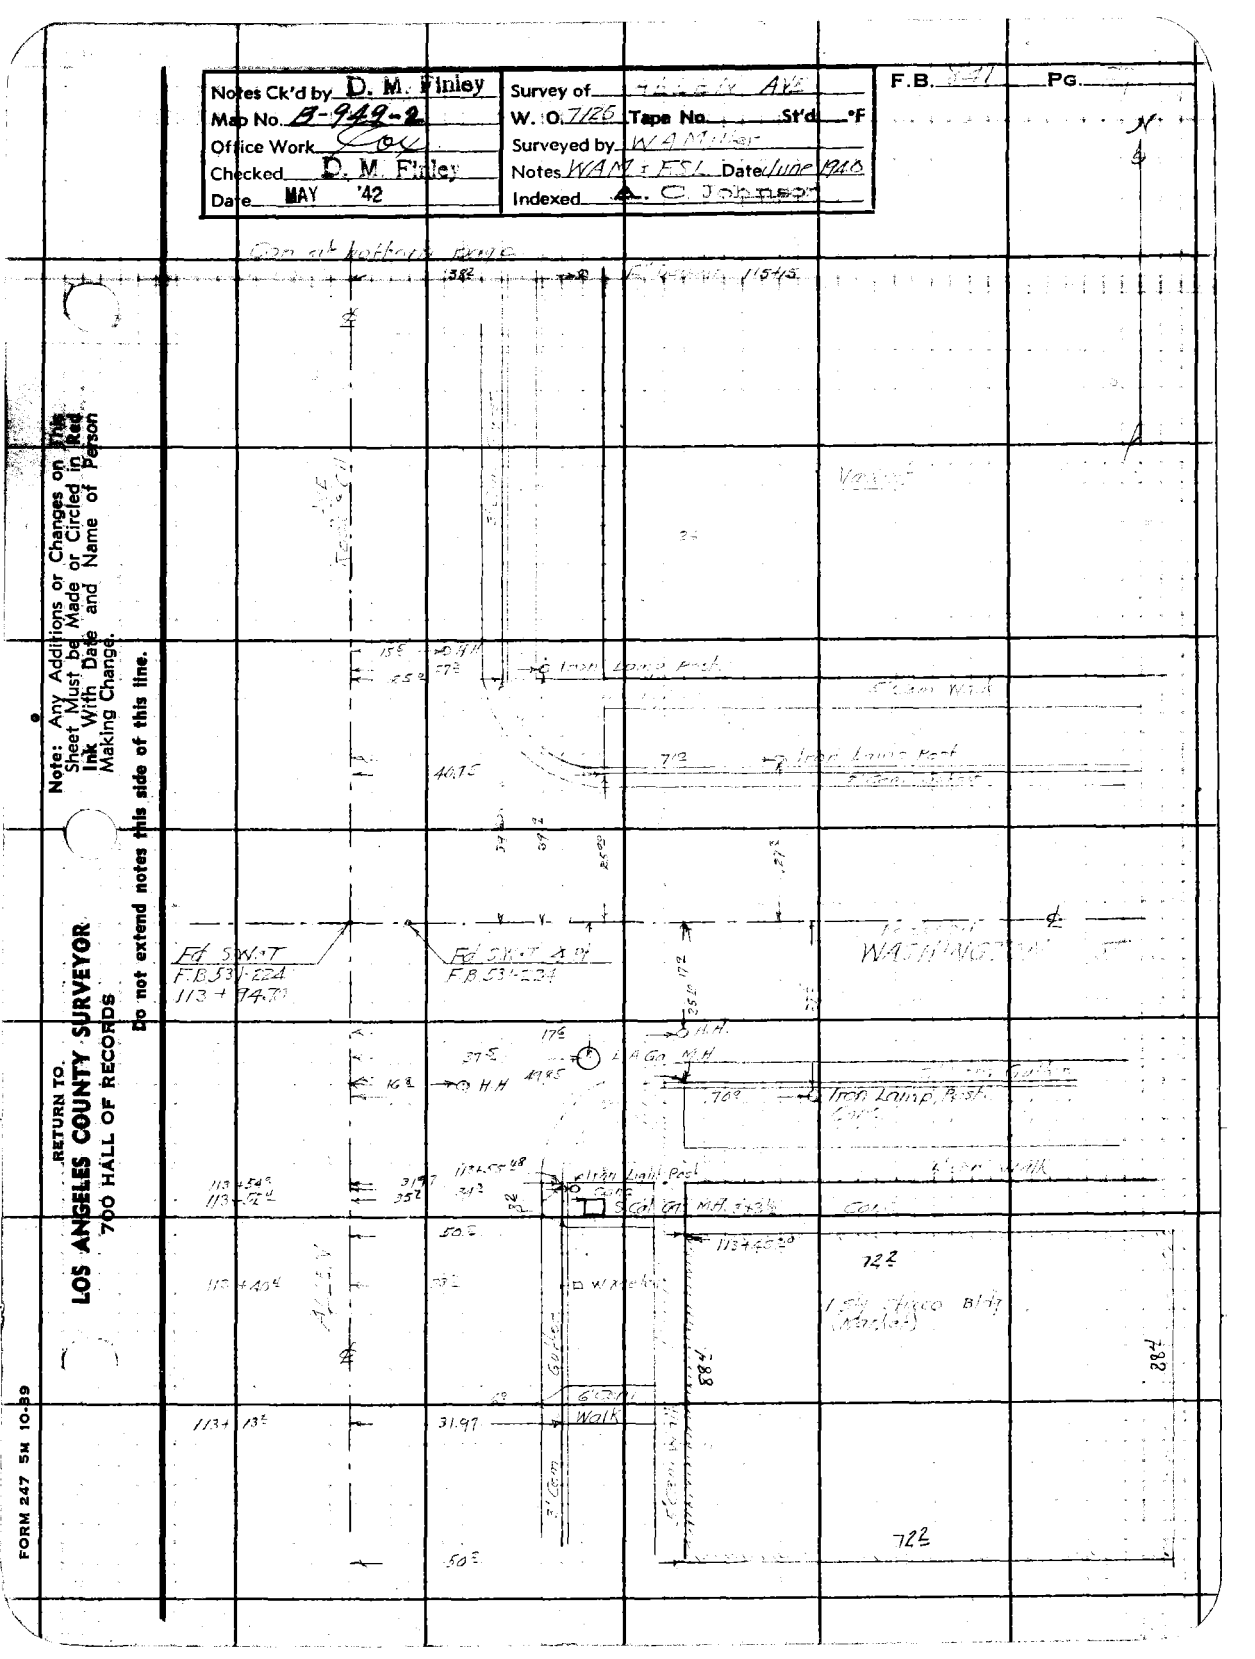
Notes Ck'd by D. M. Finley
Map No. B-949-2
Office Work
Checked D. M. Finley
Date MAY '42
Survey of
W. O. 7126
Tape No. St'd °F
Surveyed by W A Miller
Notes WAM & FSL Date June 1940
Indexed
F.B. PG.
Note: Any Additions or Changes on This Sheet Must be Made or Circled in Red Ink With Date and Name of Person Making Change.
Do not extend notes this side of this line.
RETURN TO.
LOS ANGELES COUNTY SURVEYOR
700 HALL OF RECORDS
FORM 247 5M 10-39
Fd S&T
F.B. 53-224
113 + 94.71
Fd S&T & P
F.B. 53-224
Iron Lamp Post
Walk
Curb
Gutter
Catch Basin
Walk
6" Conc.
Walk
722
722

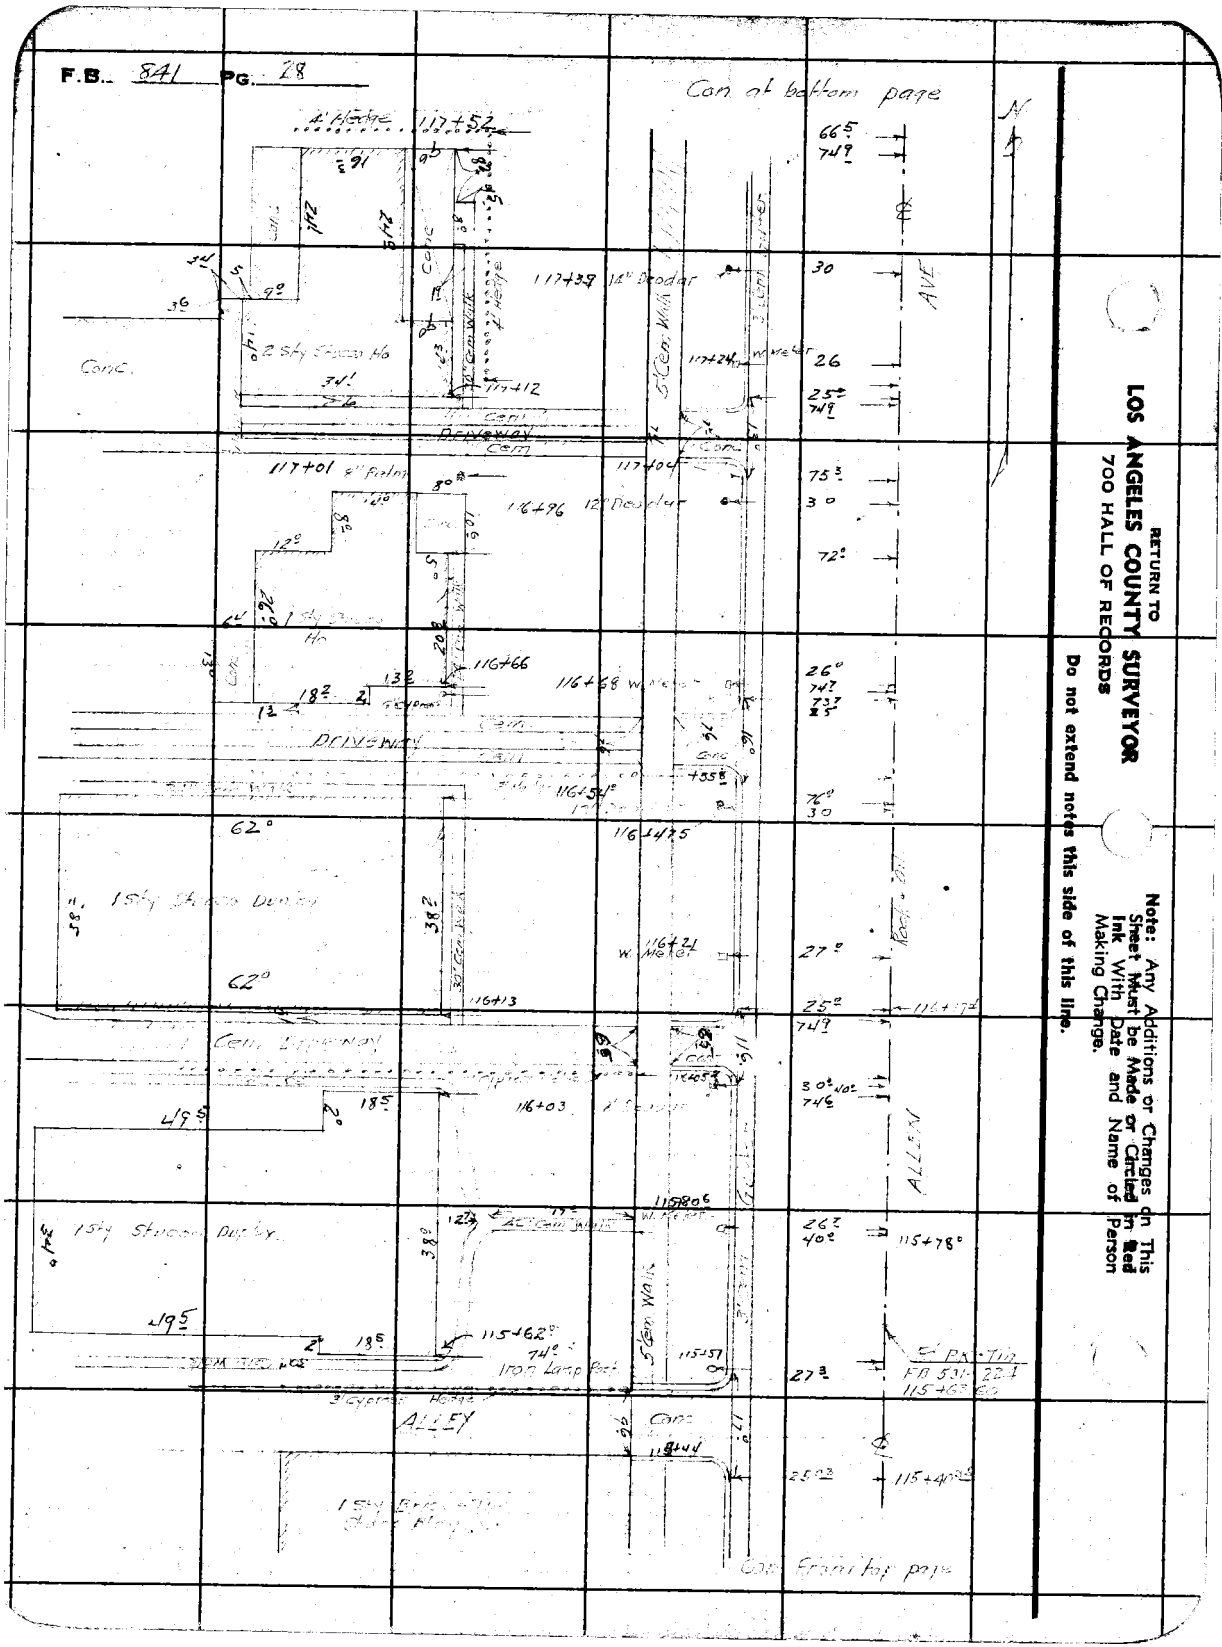
F.B. 841 PG. 28
Con at bottom page
1' Alley
117+52
117+39
Conc.
2 Sty Stucco Ho
Driveway
117+01
6" Main
116+96
116+66
116+68
Driveway
62°
1 Sty Stucco Duplex
116+13
116+75
W. Meter
Cem. Driveway
116+03
195
1 Sty Stucco Duplex
115+62
74°
Iron Lamp Post
5' Conc. Walk
115+57
115+80
W. Meter
ALLEY
115+44
115+78
E. P.K. Tin
FB 531-22
115+40
Con. from top page
AVE
ALLEN
RETURN TO
LOS ANGELES COUNTY SURVEYOR
700 HALL OF RECORDS
Note: Any Additions or Changes on This Sheet Must be Made or Circled in Red Ink With Date and Name of Person Making Change.
Do not extend notes this side of this line.


Note: Any Additions or Changes on This Sheet Must be Made or Circled in Red Ink With Date and Name of Person Making Change.

Do not extend notes this side of this line.

RETURN TO
LOS ANGELES COUNTY SURVEYOR
700 HALL OF RECORDS

FORM 247 5M 10-39

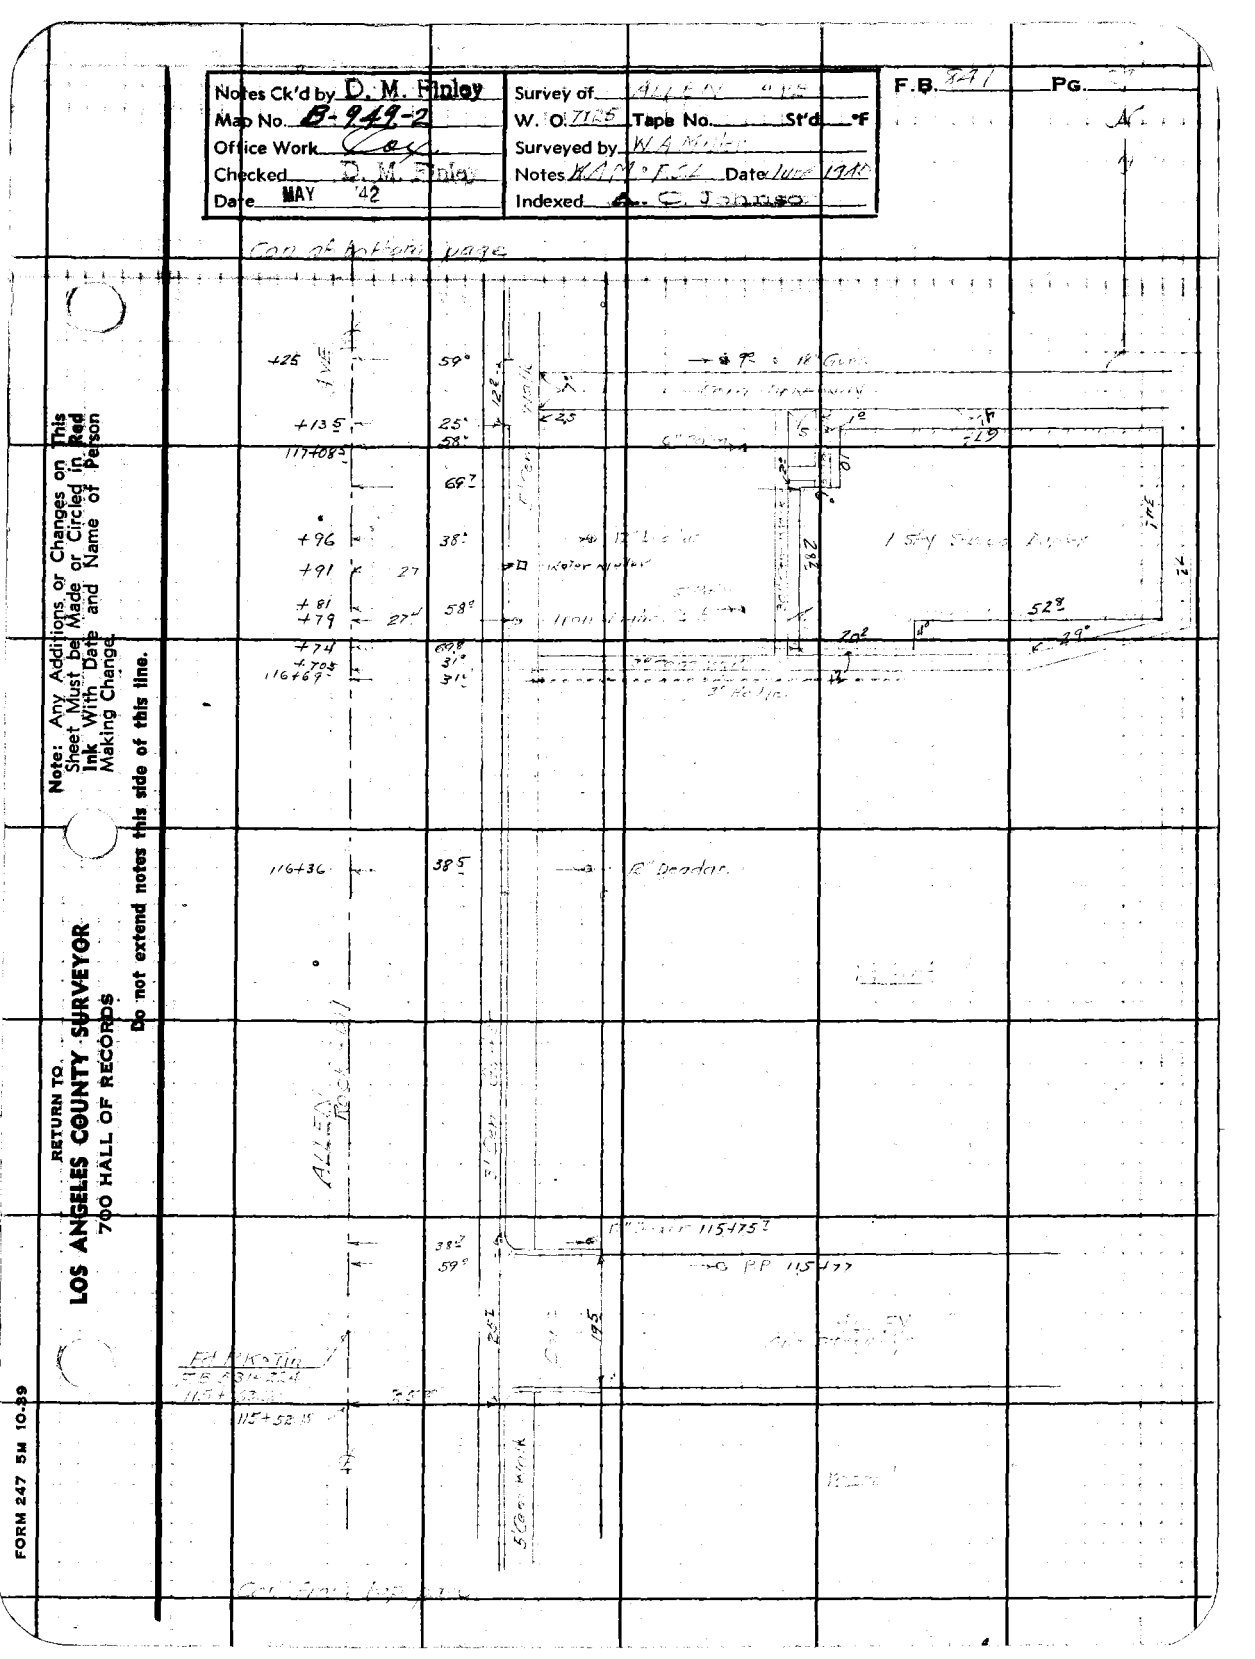

F.B. 841 PG. 30

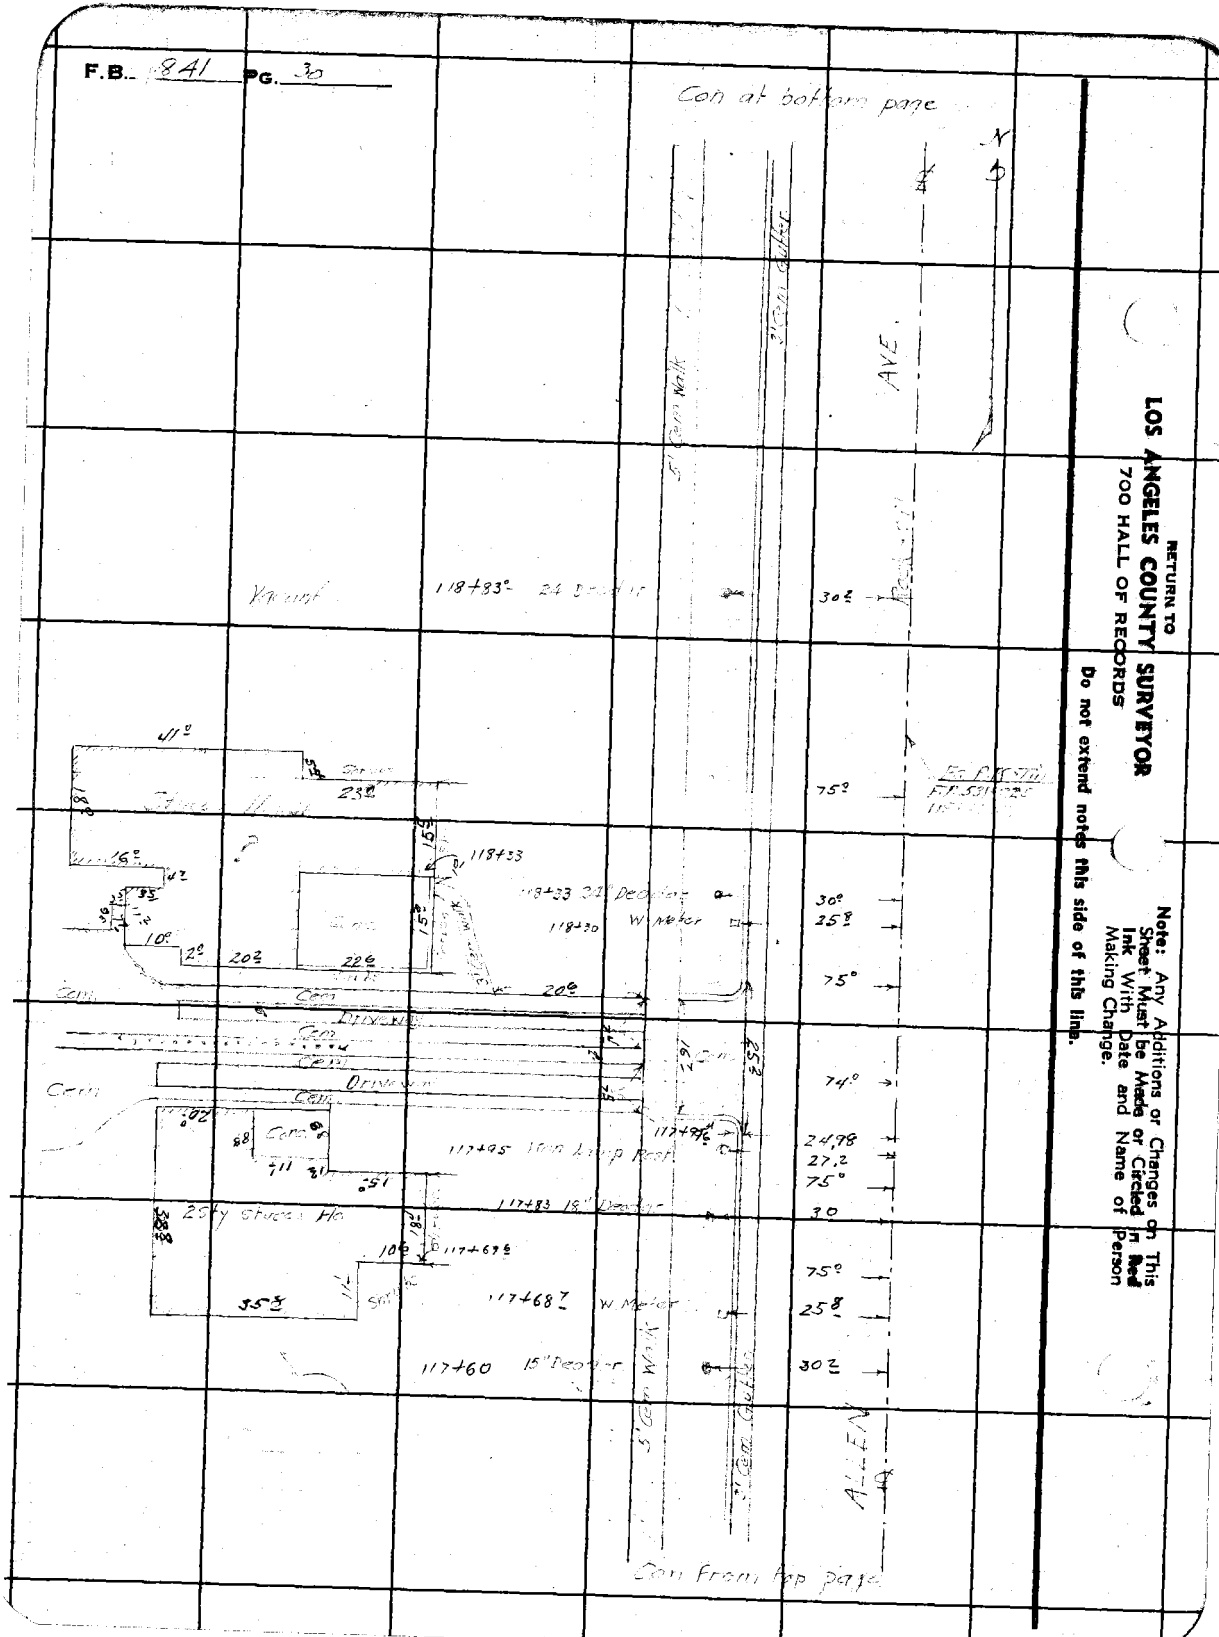

RETURN TO
LOS ANGELES COUNTY SURVEYOR
700 HALL OF RECORDS

Note: Any Additions or Changes on This Sheet Must be Made or Circled in Red Ink With Date and Name of Person Making Change.

Do not extend notes this side of this line.

Notes Ck'd by D. M. Finley	Survey of ALLEY	F.B. 2141	Pg. 51
Map No. B-949-2	W. O. 7125 Tape No.	St'd	°F
Office Work OK	Surveyed by W A M		
Checked D. M. Finley	Notes W.A.M. - F.S.L. Date June 1942		
Date MAY '42	Indexed C. Tennison		

Note: Any Additions or Changes on This Sheet Must be Made or Circled in Red Ink With Date and Name of Person Making Change

Do not extend notes this side of this line.

RETURN TO
LOS ANGELES COUNTY SURVEYOR
700 HALL OF RECORDS

FORM 247 5M 10-39

Corner Between Pages

119+23 — 27° — Iron Light Pole

25° — 58 — Conc

119+07.6 — 40° — Conc Driveway — 119+09

ROCKWELL AVE

Storm Gutter

+47.6 — 25 05 — 6° — 18° — 38' 11.9 — 15" — 10.3 — 15" — 10.5 — 18" — Gums

Sycamore

+30 — 25 2° — 12.6 — 6° — Conc — Screening — Driveway

+19 — 67° — 6" Palms — Stucco Wall — 36.0

+1.45 — 38.5 — 15" Decidu

118+ — 69.8

118+02.4 — 26° — Water Meter

+98.2 — 51.4 — 3 Conc Storm Drains — 18" — 15" — 7.3 — Conc Curb — 27.2

+90.0 — 70° — 51.4 — 18" — 7.2 — 15" — 17.2 — Conc — 10.5 — 35.3

+89.5

+82 — 31.4

+81 — 52° — 18" Conc — Storm Drain Easement

ALLEY

+69 — 25 5° — 11.2 — 2.5 — Conc — Drainage — Conc

+66 — 24.5 — 59 — Storm Drain — 25° — Conc — 38.7 — 0.9 — Conc — 23.2 — 7.8

+58 — 59

+56 — 38° — 6" Lead — 20.2 — 7.4

+49.3 — 51.2 — 4" Conc — 15-4 Storm Drain Outlet

41.4 — 58.7 — 12" Conc — 59.8

35.8 — 26° — W Meter — 10.0 — 27.0

117+32.6 — 59.4 — Wall

Conc from last page

F.B. 841 Pg. 32

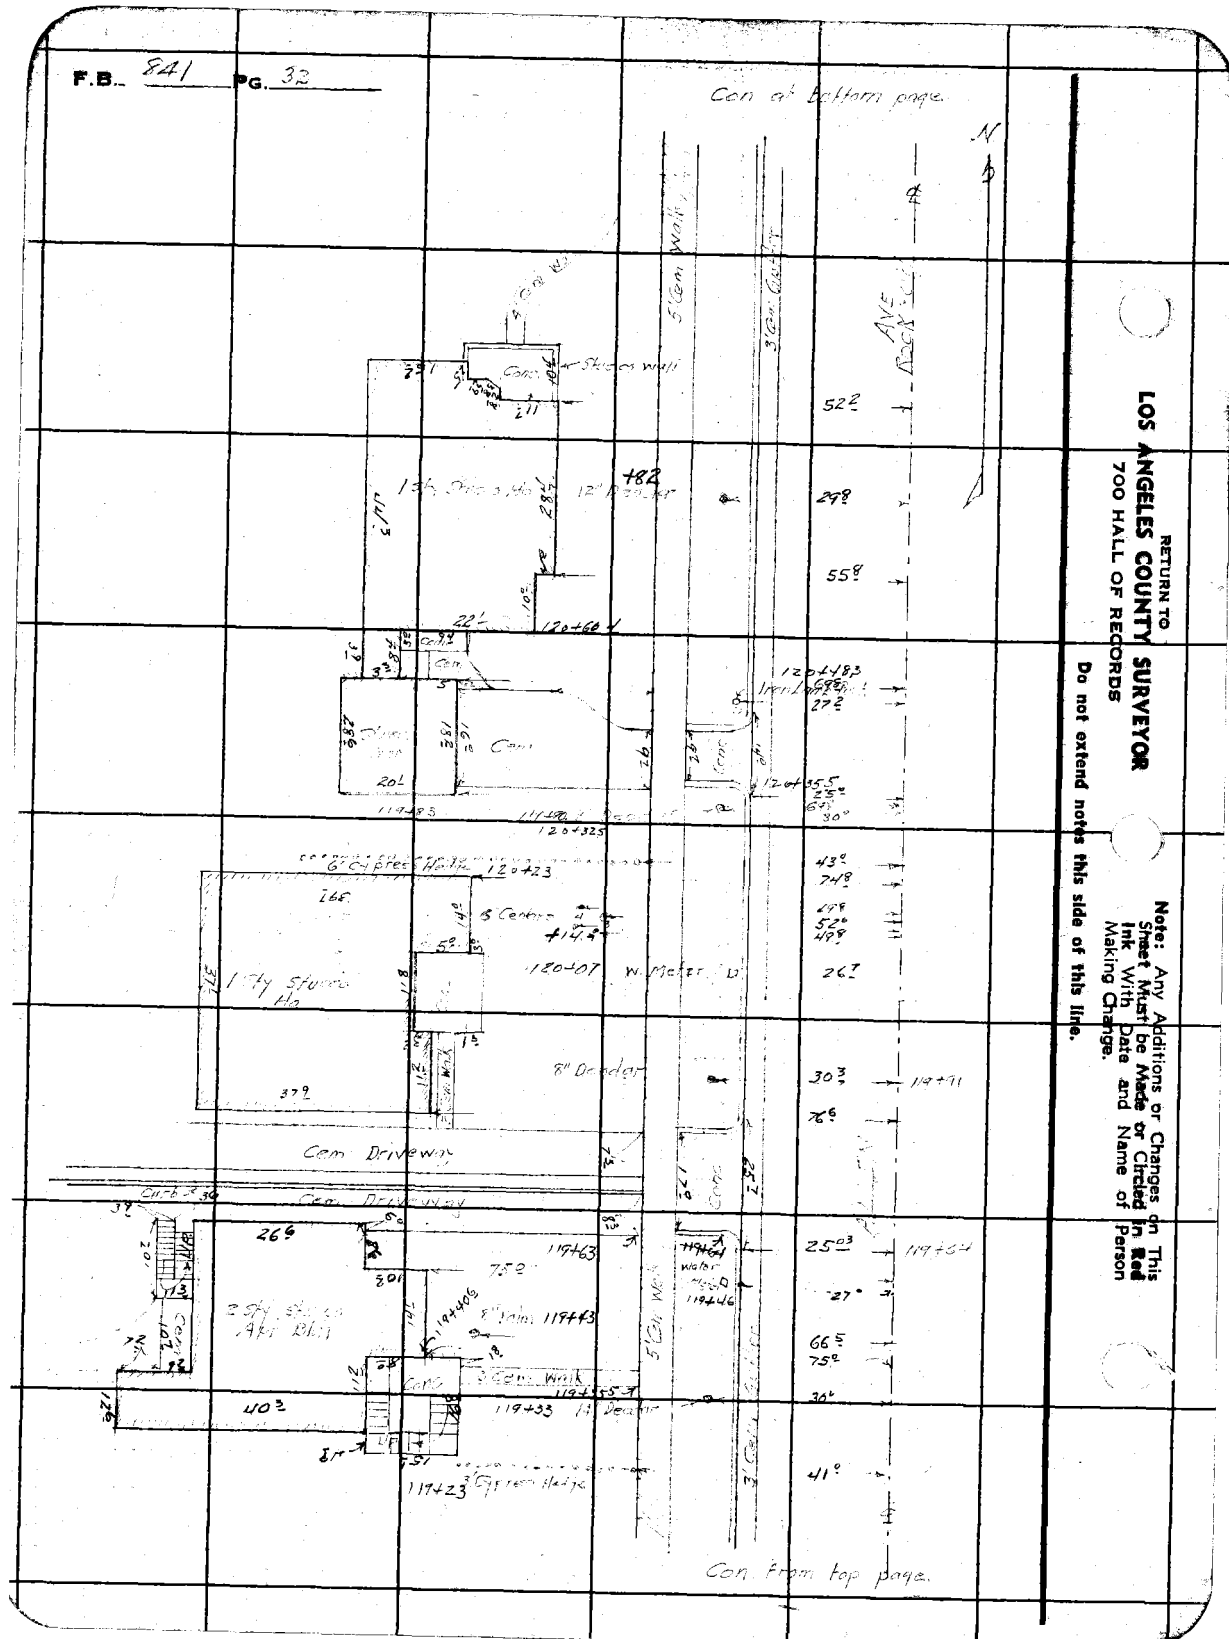

RETURN TO
LOS ANGELES COUNTY SURVEYOR
700 HALL OF RECORDS

Do not extend notes this side of this line.

Note: Any Additions or Changes on This Sheet Must be Made or Circled in **Red** Ink With Date and Name of Person Making Change.

Notes Ck'd by D. M. Finley	Survey of ALLEN AVE
Map No. B-949-2	W. O. 7125 Tape No. St'd °F
Office Work Cook	Surveyed by W.A.M. F.L.
Checked D. M. Finley	Notes W.A.M. F.L. Date June 1940
Date MAY '42	Indexed A. C. Johnson

F.B. 841 PG

Note: Any Additions or Changes on This Sheet Must be Made or Circled in Red Ink With Date and Name of Person Making Change.

Do not extend notes this side of this line.

RETURN TO
LOS ANGELES COUNTY SURVEYOR
700 HALL OF RECORDS

FORM 247 5M 10-39

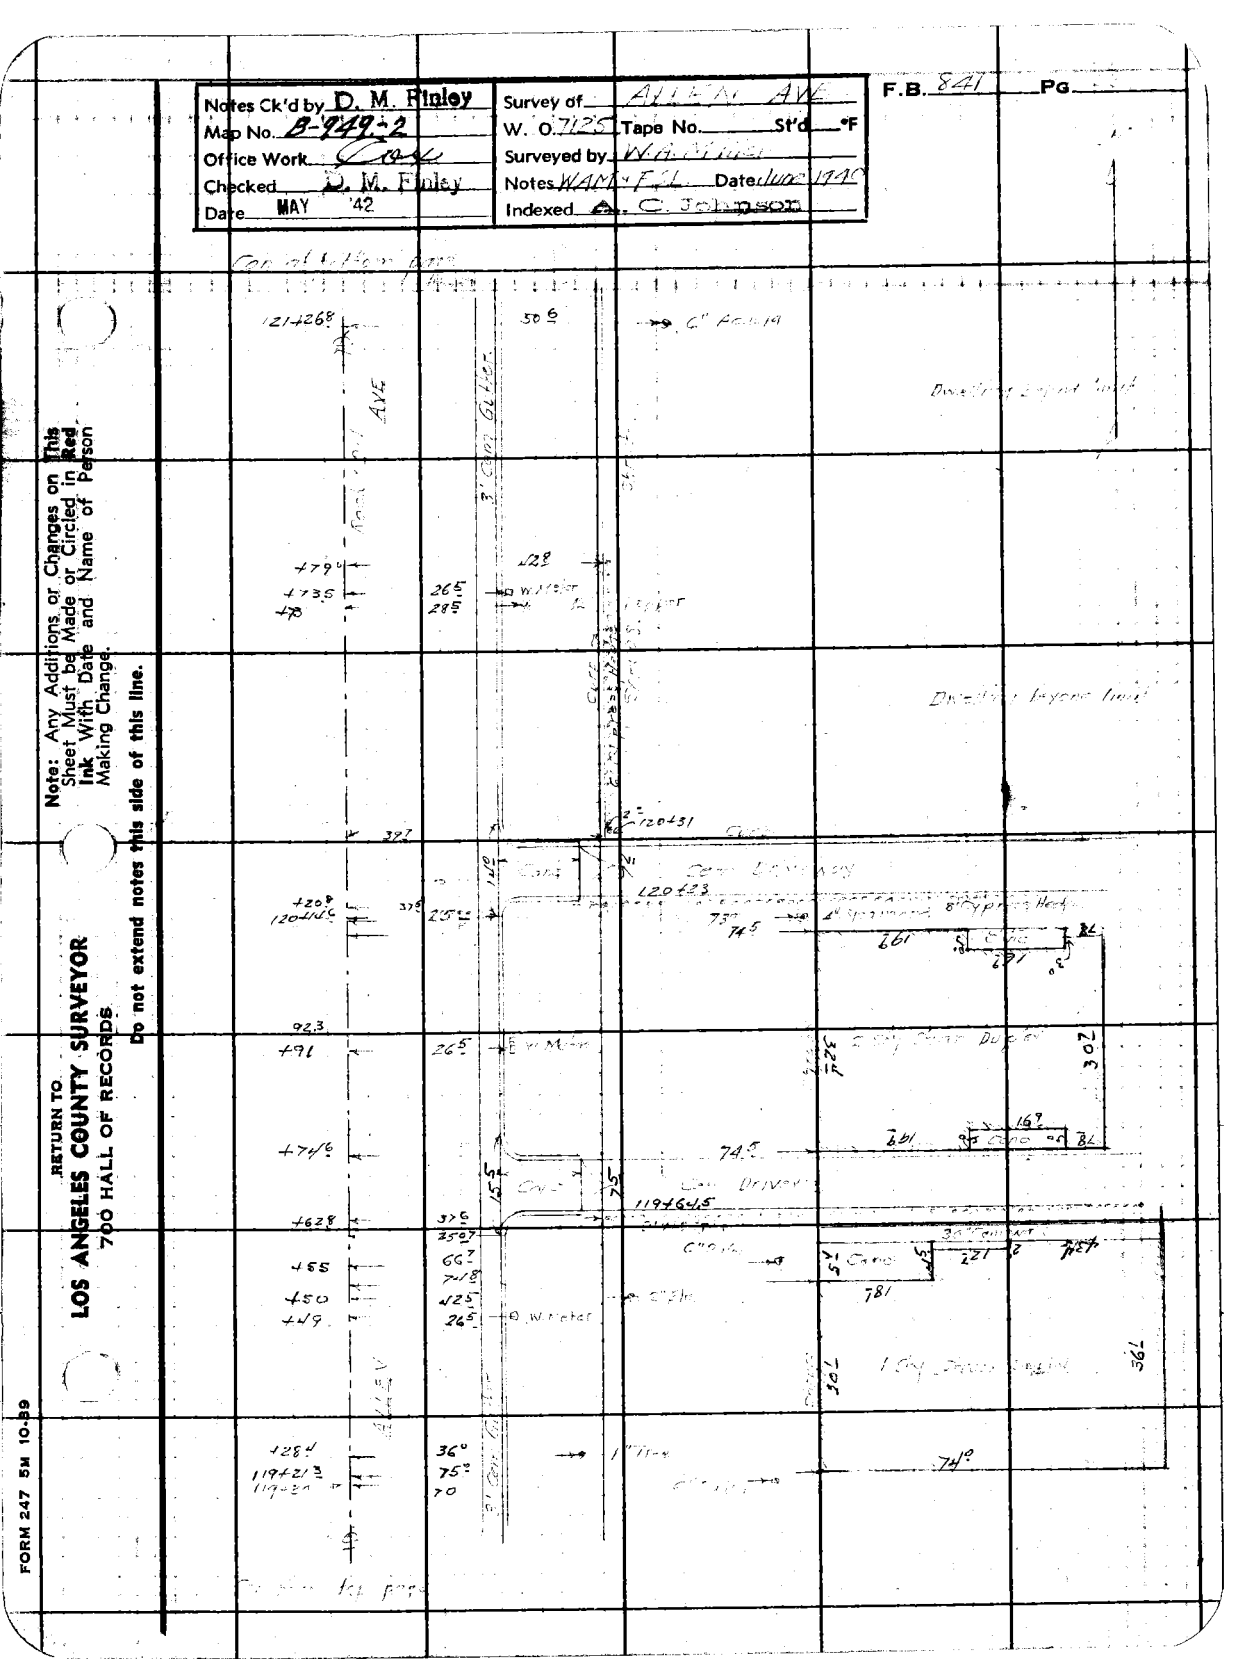
AVE
ALLEY
3' Conc Gutter

RETURN TO
LOS ANGELES COUNTY SURVEYOR
700 HALL OF RECORDS

Note: Any Additions or Changes on This Sheet Must be Made or Circled in Red Ink With Date and Name of Person Making Change.

Do not extend notes this side of this line.

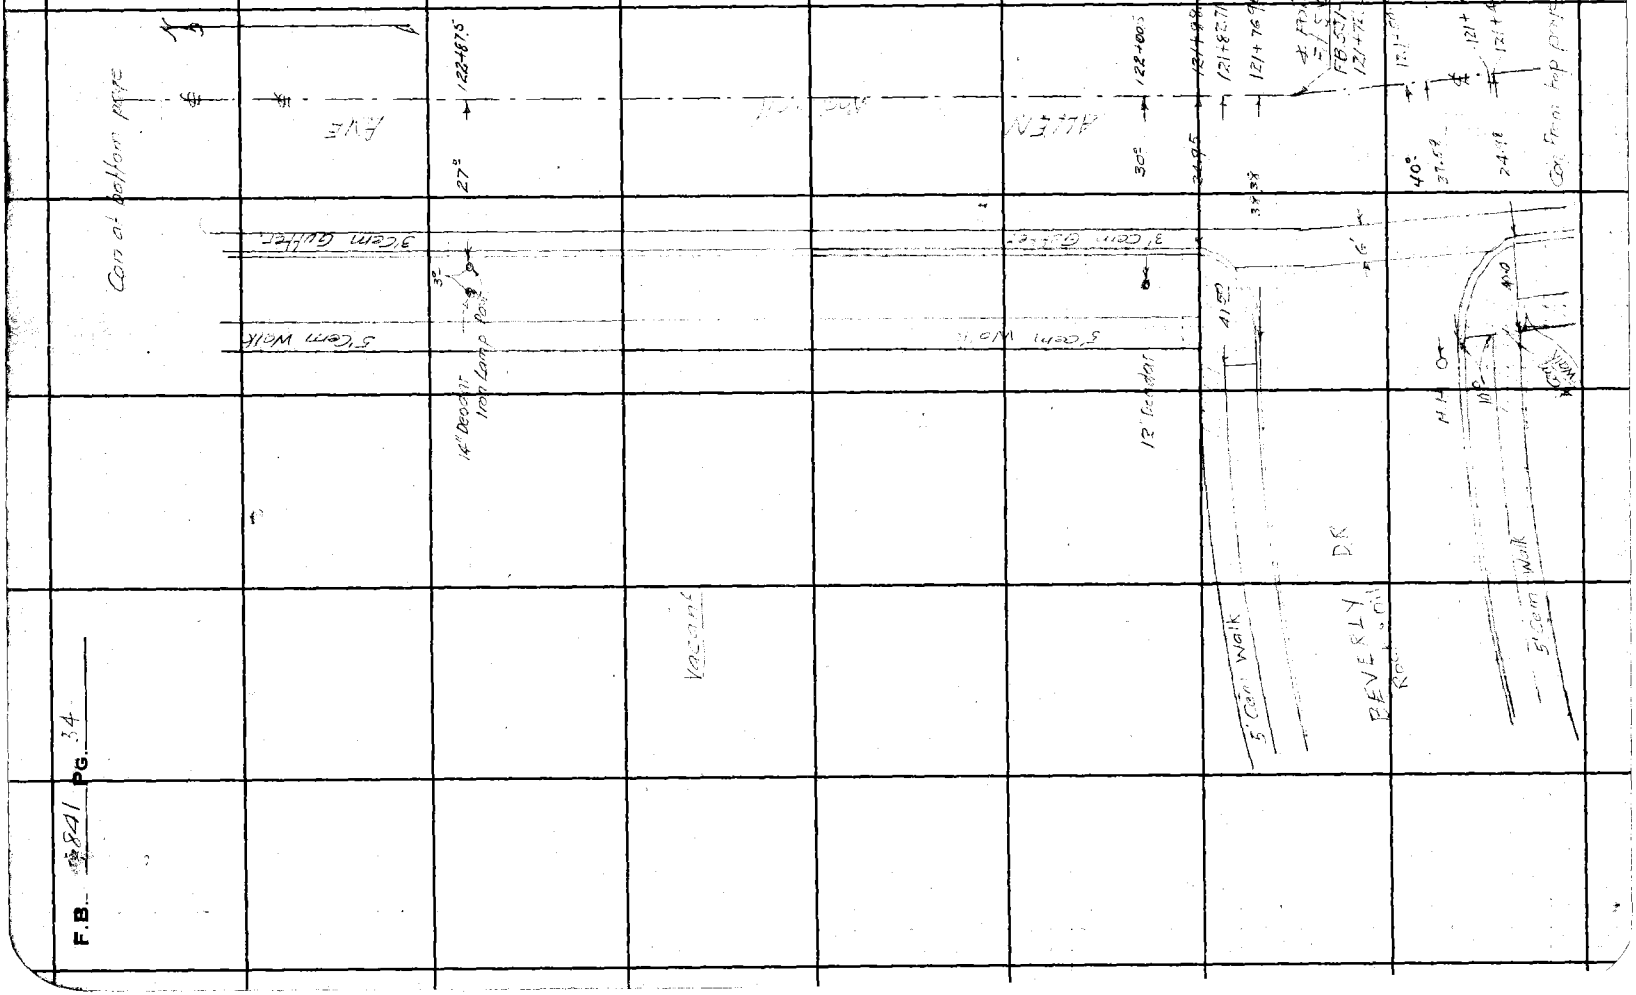
F.B. 8241 Pg. 34
AVE
ALLEN
122+00.5
121+99.55
121+82.71
121+76.96
121+74.8

Notes Ck'd by D. M. Finley	Survey of ALLEN AVE	F.B. 847	Pg. 36
Map No. B-949-2	W. O. 7125 Tape No. St'd °F		
Office Work Cox	Surveyed by W.A.M. & E.L.		
Checked D. M. Finley	Notes W.A.M. & E.L. Date JULY 1940		
Date MAY '42	Indexed C. Dammann		

RETURN TO
LOS ANGELES COUNTY SURVEYOR
700 HALL OF RECORDS

Note: Any Additions or Changes on This Sheet Must be Made or Circled in Red Ink With Date and Name of Person Making Change

Do not extend notes this side of this line.

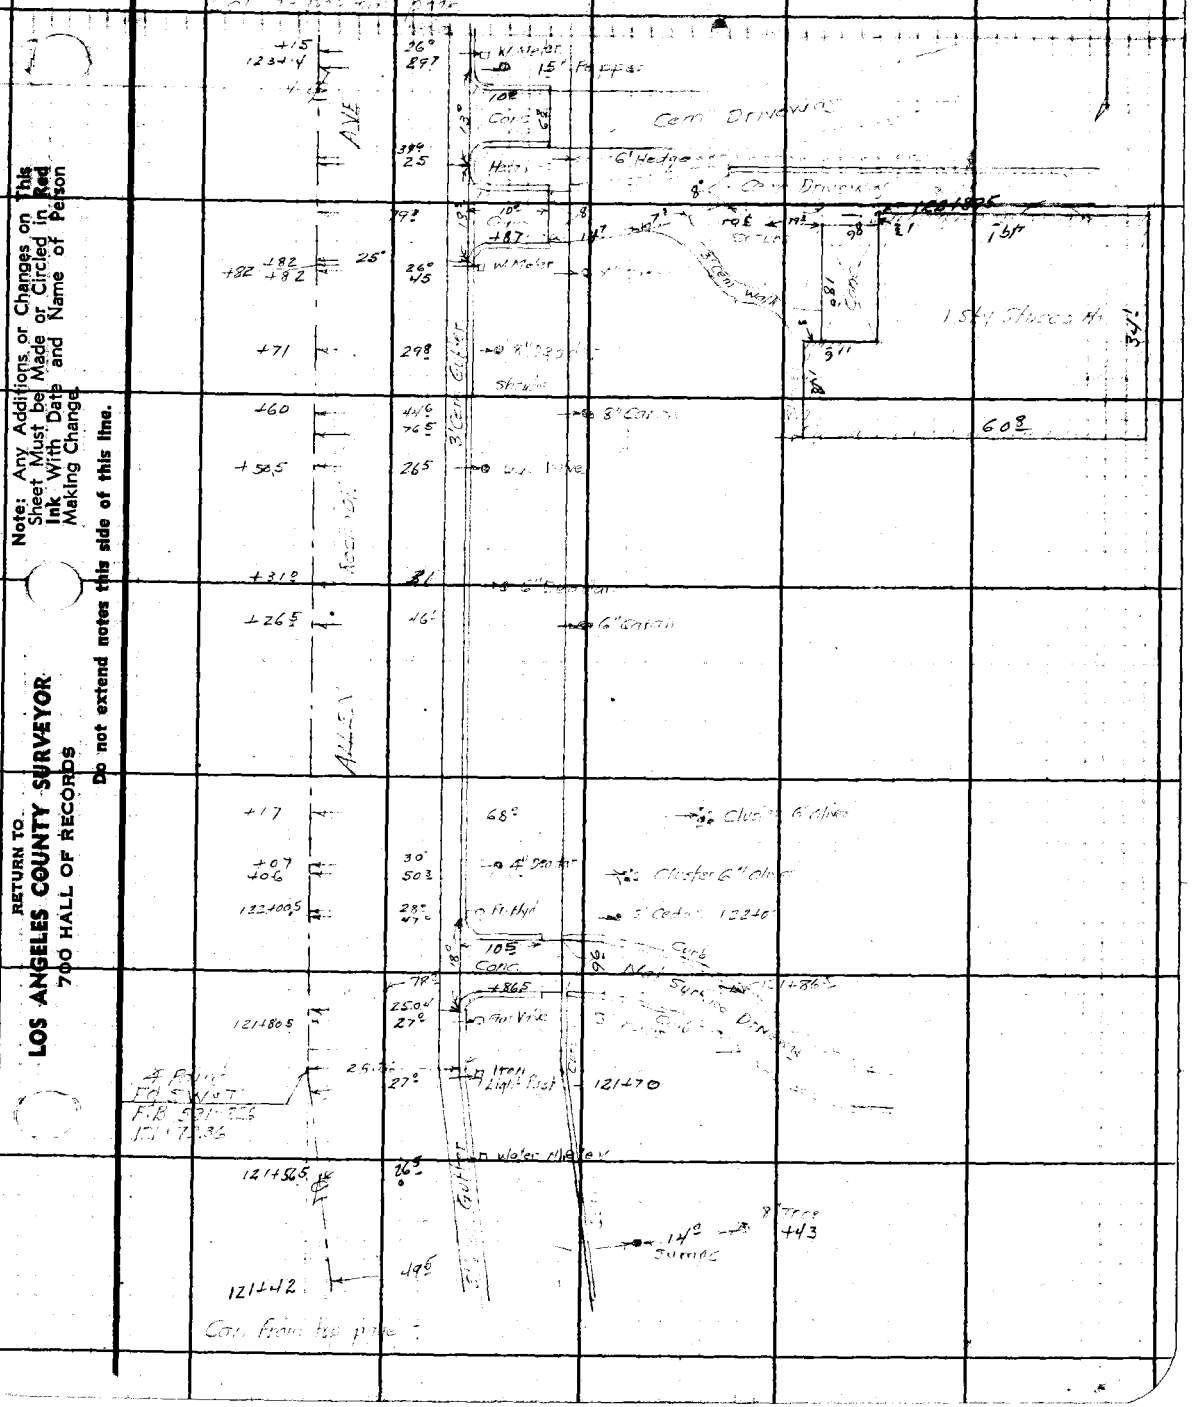

FORM 247 5M 10-39

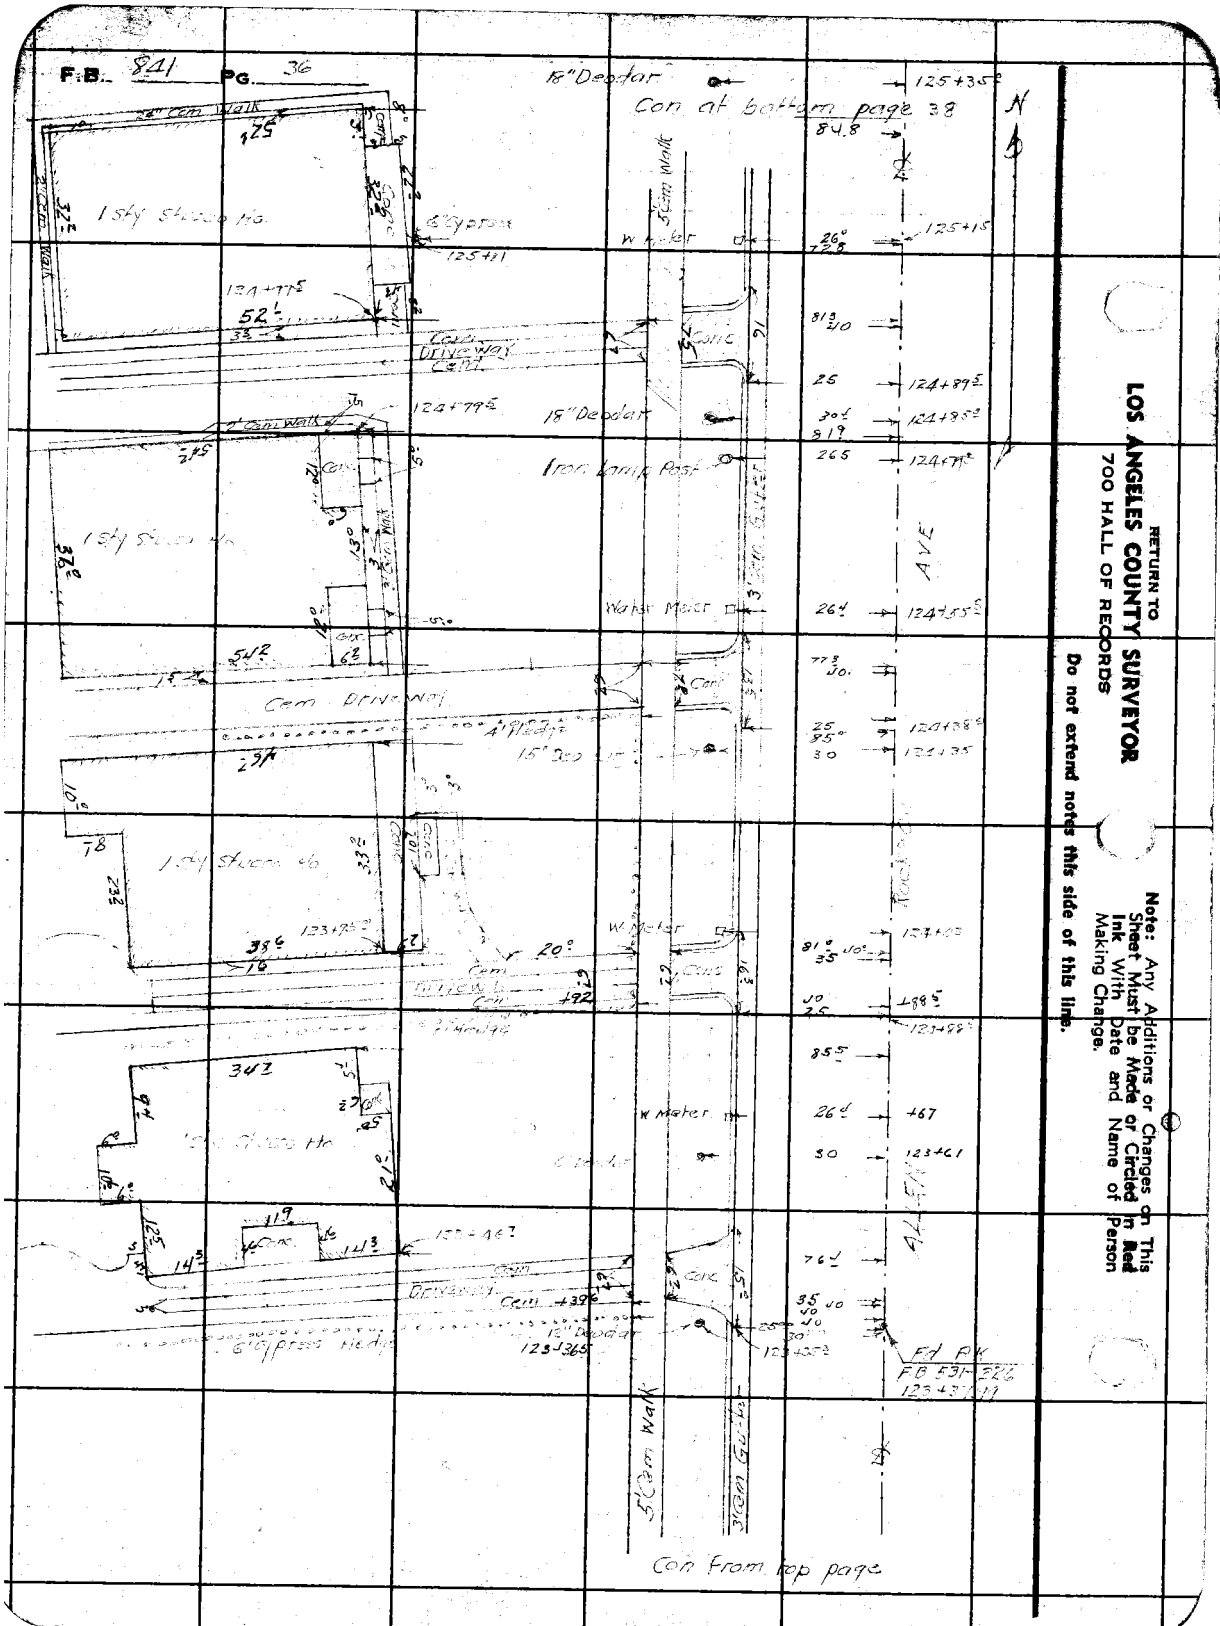

RETURN TO
LOS ANGELES COUNTY SURVEYOR
700 HALL OF RECORDS

Do not extend notes this side of this line.

Note: Any Additions or Changes on This Sheet Must be Made or Circled in Red Ink With Date and Name of Person Making Change.

Notes Ck'd by D. M. Finley	Survey of ALLEN AVE	F.B.	PG.
Map No. B-949-2	W. O. 7125 Tape No. St'd °F		
Office Work Cox	Surveyed by		
Checked D. M. Finley	Notes NAMES Date JULY 1942		
Date MAY '42	Indexed		

Cont'd bottom page 39

ALLEN AVE

Top of Hill

ALLEN

Cont'd top of page 35

Note: Any Additions or Changes on This Sheet Must be Made or Circled in Red Ink With Date and Name of Person Making Change.

Do not extend notes this side of this line.

RETURN TO
LOS ANGELES COUNTY SURVEYOR
700 HALL OF RECORDS

FORM 247 5M 10-39

F.B. 841 Pg. 38

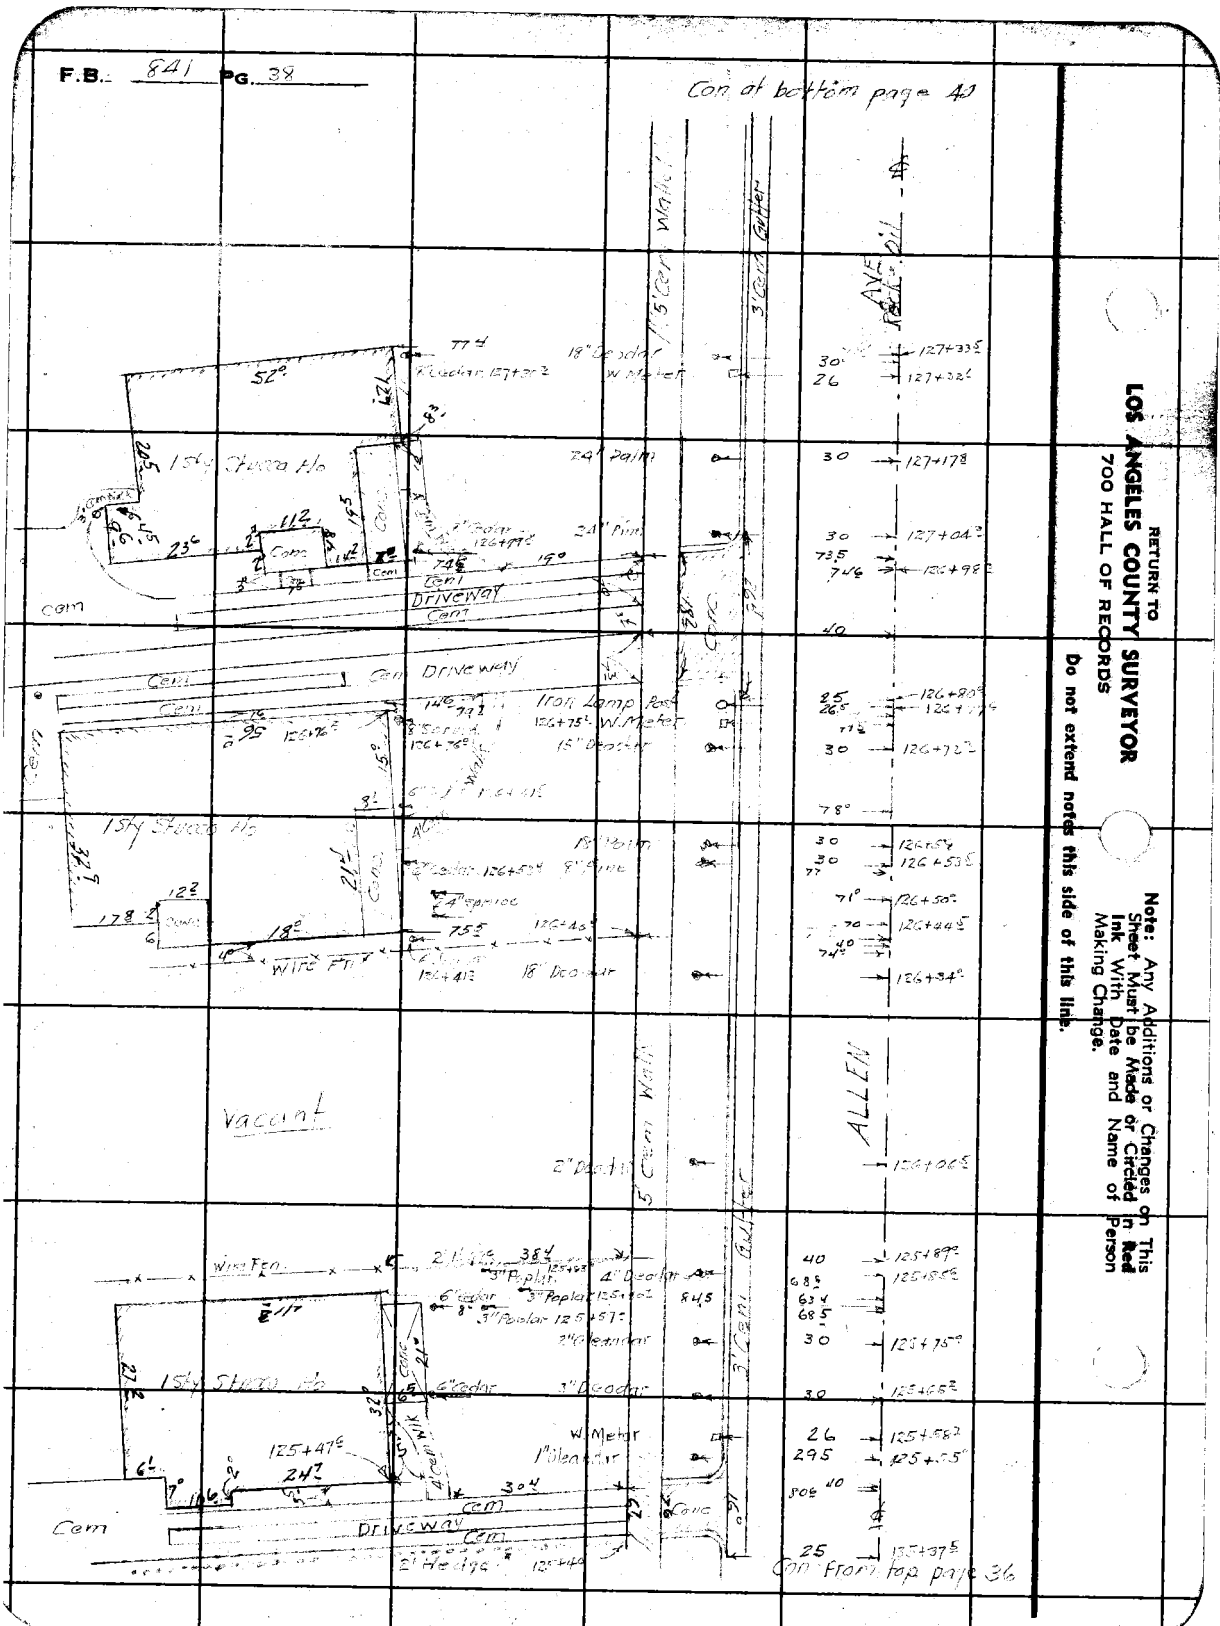
Con of bottom page 40
RETURN TO
LOS ANGELES COUNTY SURVEYOR
700 HALL OF RECORDS
Do not extend notes this side of this line.
Note: Any Additions or Changes on This Sheet Must be Made or Circled in Red Ink With Date and Name of Person Making Change.
Driveway
Com
Vacant
ALLEN
Wire Fen
Con From top page 36

Notes Ck'd by D. M. Finley	Survey of	F.B. 741	Pg. 39
Map No. B-949-2	W. O. 7125 Tape No. St'd °F		
Office Work Cox	Surveyed by W A Miller		
Checked D. M. Finley	Notes W A M - F S L Date 1940		
Date MAY '42	Indexed		

Cont'd from page 41

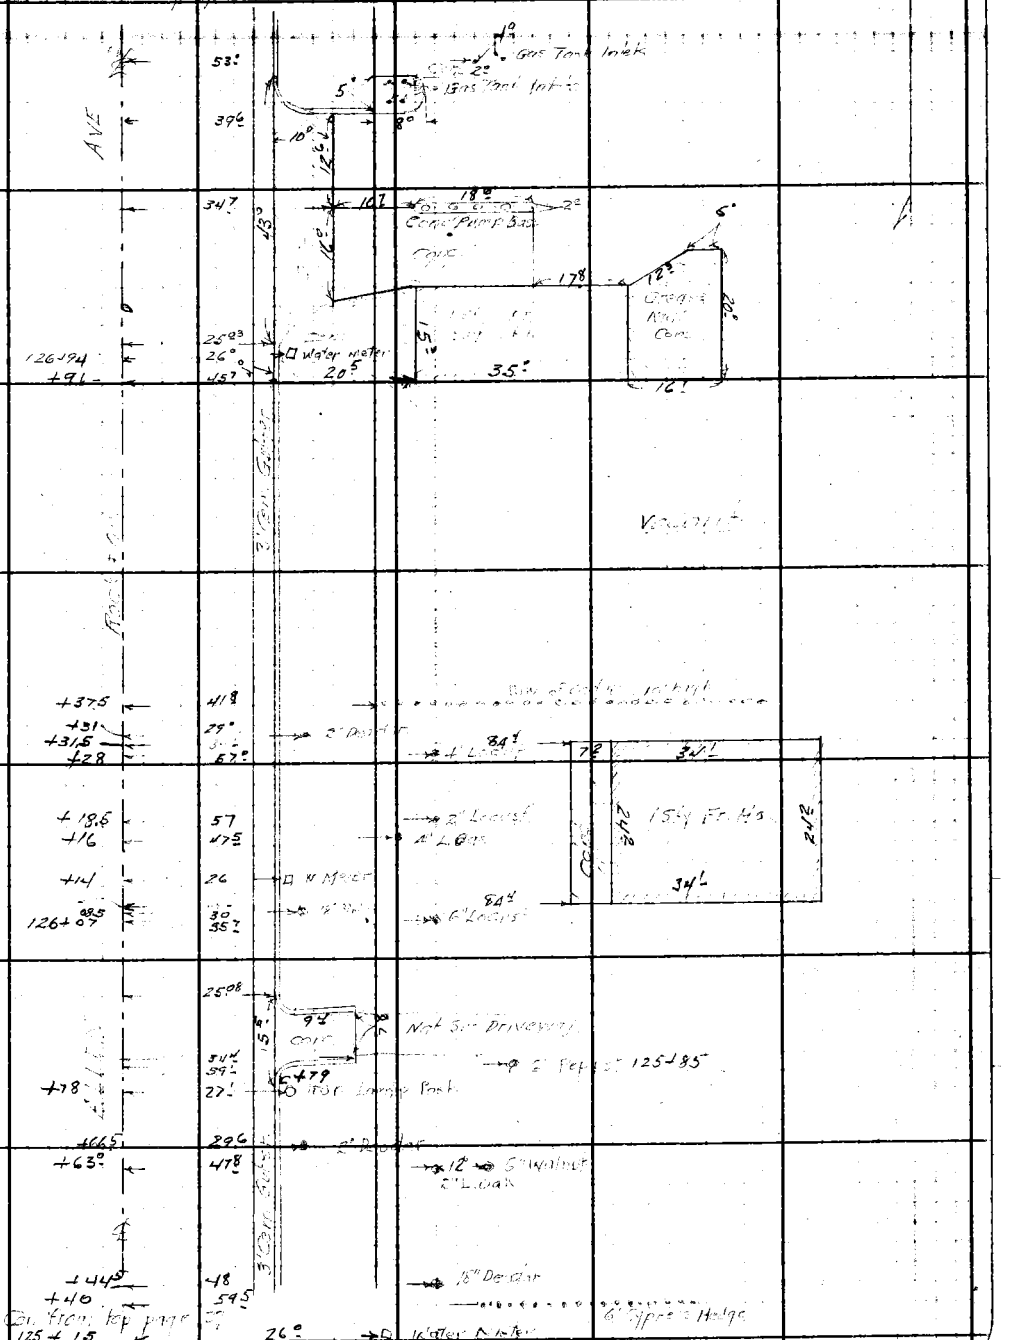

Note: Any Additions or Changes on This Sheet Must be Made or Circled in Red Ink With Date and Name of Person Making Change

Do not extend notes this side of this line.

RETURN TO
LOS ANGELES COUNTY SURVEYOR
700 HALL OF RECORDS

FORM 247 SM 10-39

F.B. 841 PG. 43

Con at bottom page 42

ELIZABETH ST.

Con from top page 39

RETURN TO
LOS ANGELES COUNTY SURVEYOR
700 HALL OF RECORDS

Note: Any Additions or Changes on This Sheet Must be Made or Circled in Red Ink With Date and Name of Person Making Change.

Do not extend notes this side of this line.

Notes Ck'd by D. M. Finley
Map No. A-949-2
Office Work OK
Checked D. M. Finley
Date MAY '42

Survey of Alley in Tract
W. O. 7125 Tape No. St'd °F
Surveyed by W. A. Miller
Notes W.A.M.-F.S.L. Date 1940
Indexed C. Johnson

F.B. 941 Pg. 41

Note: Any Additions or Changes on This Sheet Must be Made or Circled in Red Ink With Date and Name of Person Making Change

Do not extend notes this side of this line.

RETURN TO
LOS ANGELES COUNTY SURVEYOR
700 HALL OF RECORDS

FORM 247 5M 10-39

N

Con. of new curb & gutter

Fd. S.W.T.
F.B. 531-227
129+21.00

AVE

14

8 H.H

129+10

Vacant

Fd. S.W.T.

+84°

62°

6" Peach → 6" Plum
20

+68°
+63
+58?

25°
31
26

Conc. 5.9 Conc. Driveway

6" Deodar 4/13 → 8" Avocado

Hedge layer of knot

+6
+25?

31
31°

10" Deodar
12" Deodar
35 2" Tree 13 → 4" Pepper

128+06
+91
127+91

31°
28
28.05

8" Deodar

Vacant

Bell Sta. H.H
Iron Lamp Post

ALLEN

15.4

H.H

Conc. Gutter

15.00
5.7

LAYTON AVE

Fd. S.W.T.
F.B. 531-224
127+05.02

6°

15.00

35.6

2.5

Gas tank in lot's

Con. from for page 39

F.B. 841 Pg. 42

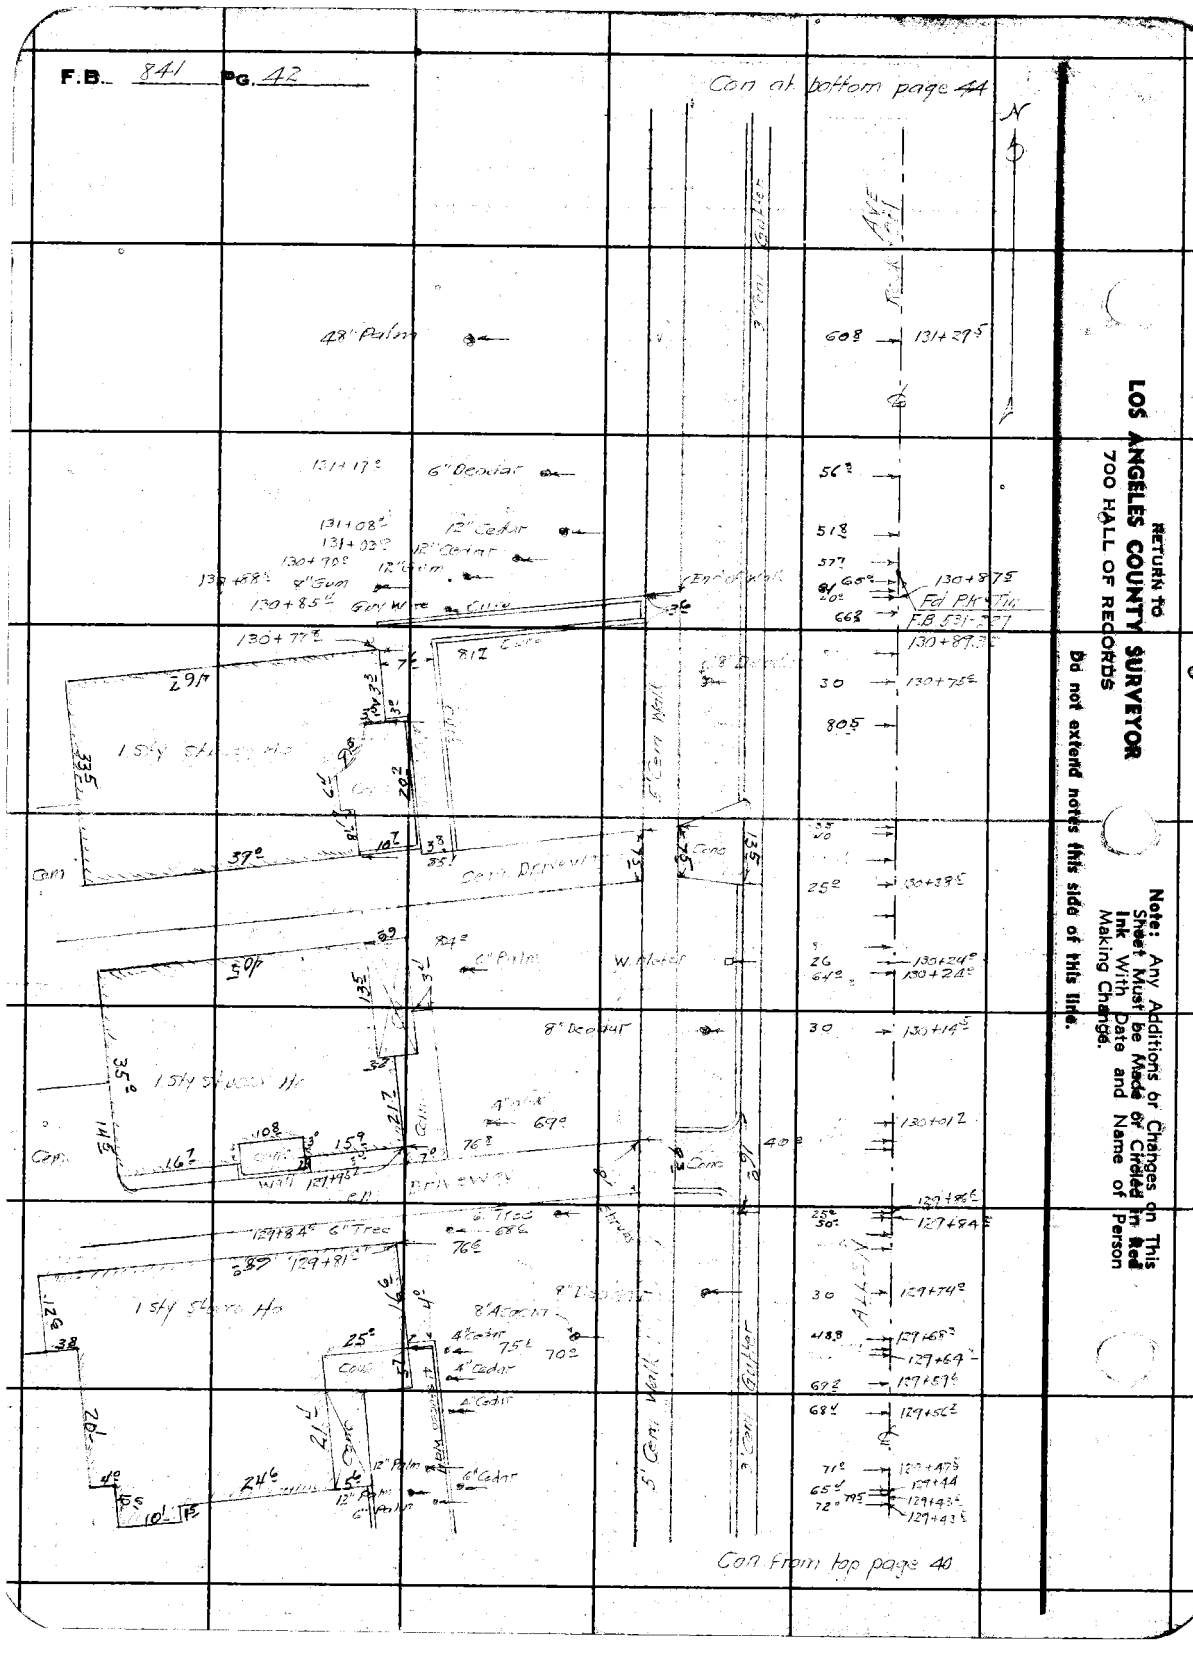

RETURN TO
LOS ANGELES COUNTY SURVEYOR
700 HALL OF RECORDS

Note: Any Additions or Changes on This Sheet Must be Made or Circled in Red Ink With Date and Name of Person Making Change.

Do not extend notes this side of this line.

Notes Ck'd by D. M. Finley	Survey of Allen Ave	F.B. 8	Pg. 1
Map No. B-949-2	W. O. 7165 Tape No. St'd °F		
Office Work Cox	Surveyed by W. A. Miller		
Checked D. M. Finley	Notes W. A. Miller Date 1940		
Date MAY '42	Indexed		

Con at bottom page 45

Note: Any Additions or Changes on This Sheet Must be Made or Circled in Red Ink With Date and Name of Person Making Change

Do not extend notes this side of this line.

RETURN TO
LOS ANGELES COUNTY SURVEYOR
700 HALL OF RECORDS

FORM 247 5M 10-39

Con from top page 41

F.B. 841 P.G. 44

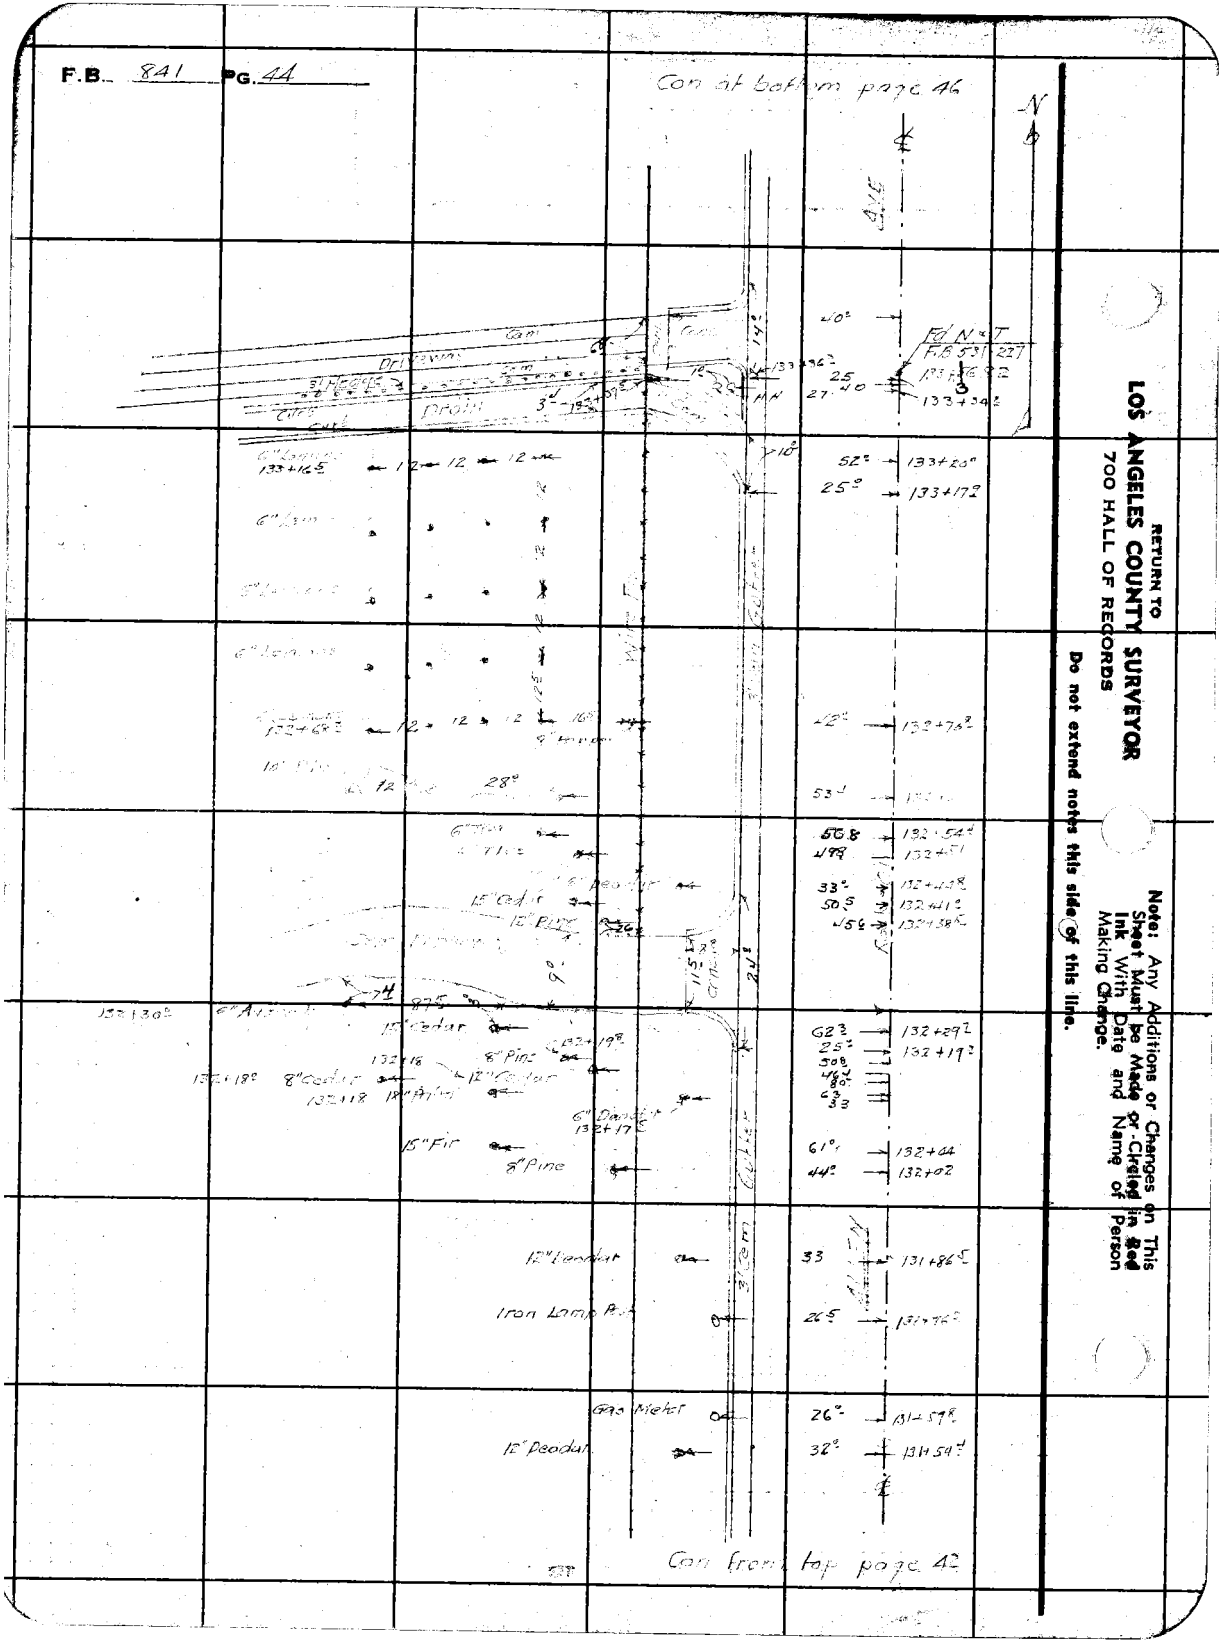

RETURN TO
LOS ANGELES COUNTY SURVEYOR
700 HALL OF RECORDS

Note: Any Additions or Changes on This Sheet Must be Made or Circled in Red Ink With Date and Name of Person Making Change.

Do not extend notes this side of this line.

Notes Ck'd by D. M. Finley
Map No. 5949-3
Office Work Cole
Checked D. M. Finley
Date MAY '42

Survey of ALLEY AVE
W. O. 7415 Tape No. St'd °F
Surveyed by W A Miller
Notes W.A.M. & F.S.L. Date 1940
Indexed

F.B. 97 PG. 15

Note: Any Additions or Changes on This Sheet Must be Made or Circled in Red Ink With Date and Name of Person Making Change.

Do not extend notes this side of this line.

RETURN TO
LOS ANGELES COUNTY SURVEYOR
700 HALL OF RECORDS

FORM 247 5M 10-39

Cont. from page 47

+36.5

+36.00

Fd N.T.
FIRST 227

133+36.82

133+36.82

+15.5

133+00

ALLEY

132+31

132+00

469

131+45

25°

26

30°

27°

68.8

39°

47.8

44.4

Driveway

Conc. Driveway

12"

8"

12" Sycamore

Pole

House Bryant Limit

Yucca

Cedar

New 1" Cypress

Cherry

Cont. from page 43

RETURN TO
LOS ANGELES COUNTY SURVEYOR
700 HALL OF RECORDS

Note: Any Additions or Changes on This Sheet Must be Made or Circled in Red Ink With Date and Name of Person Making Change.

Do not extend notes this side of this line.

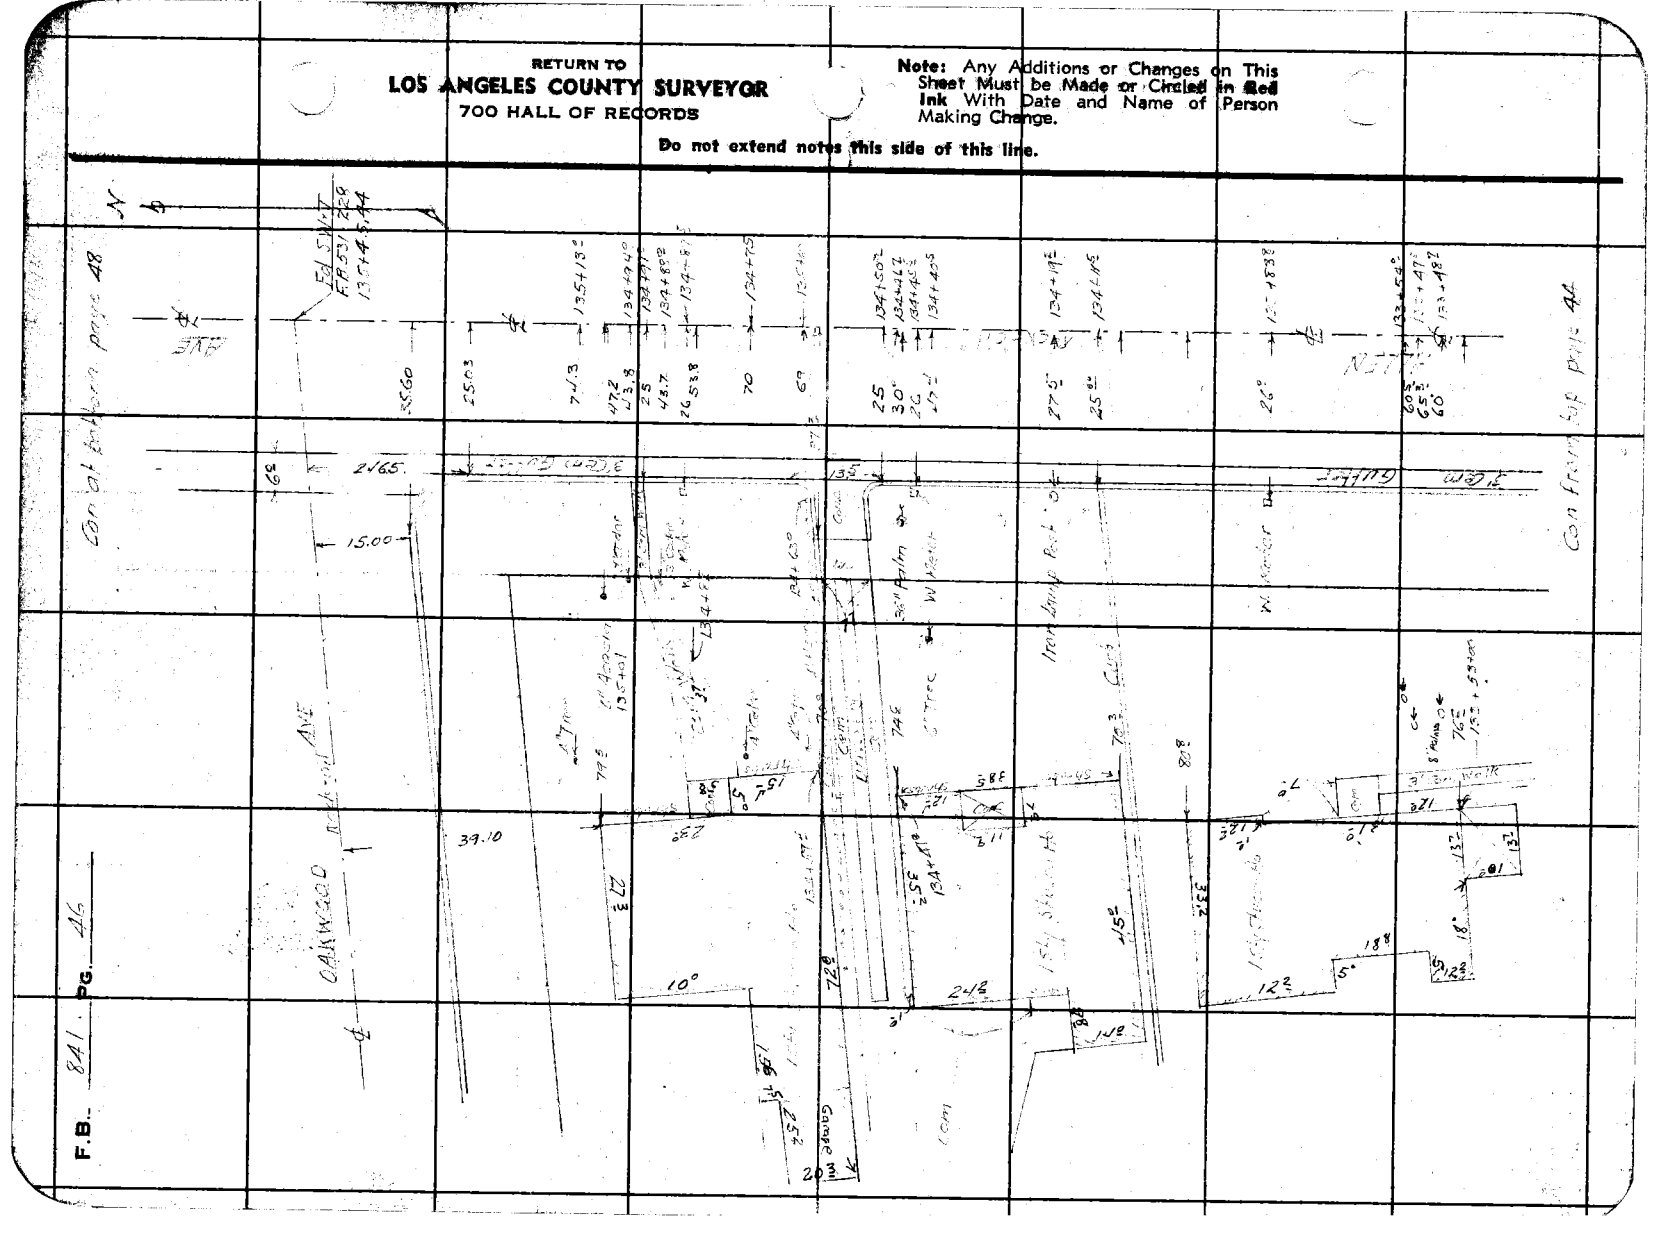

Notes Ck'd by D. M. Finley
Map No. B-949-3
Office Work Cox
Checked D. M. Finley
Date MAY '42

Survey of ALLEN AVE
W. O. 1126 Tape No. St'd °F
Surveyed by W. A. Mills
Notes W.A.M./T.V. Date 1940
Indexed A. C. Johnson

F. B. 241 Pg. 49

Con at bottom page 41

Note: Any Additions or Changes on This Sheet Must be Made or Circled in Red Ink With Date and Name of Person Making Change.

Do not extend notes this side of this line.

RETURN TO
LOS ANGELES COUNTY SURVEYOR
700 HALL OF RECORDS

FORM 247 5M 10-39

Con from top page 45

F.B. 841 Pg. 48

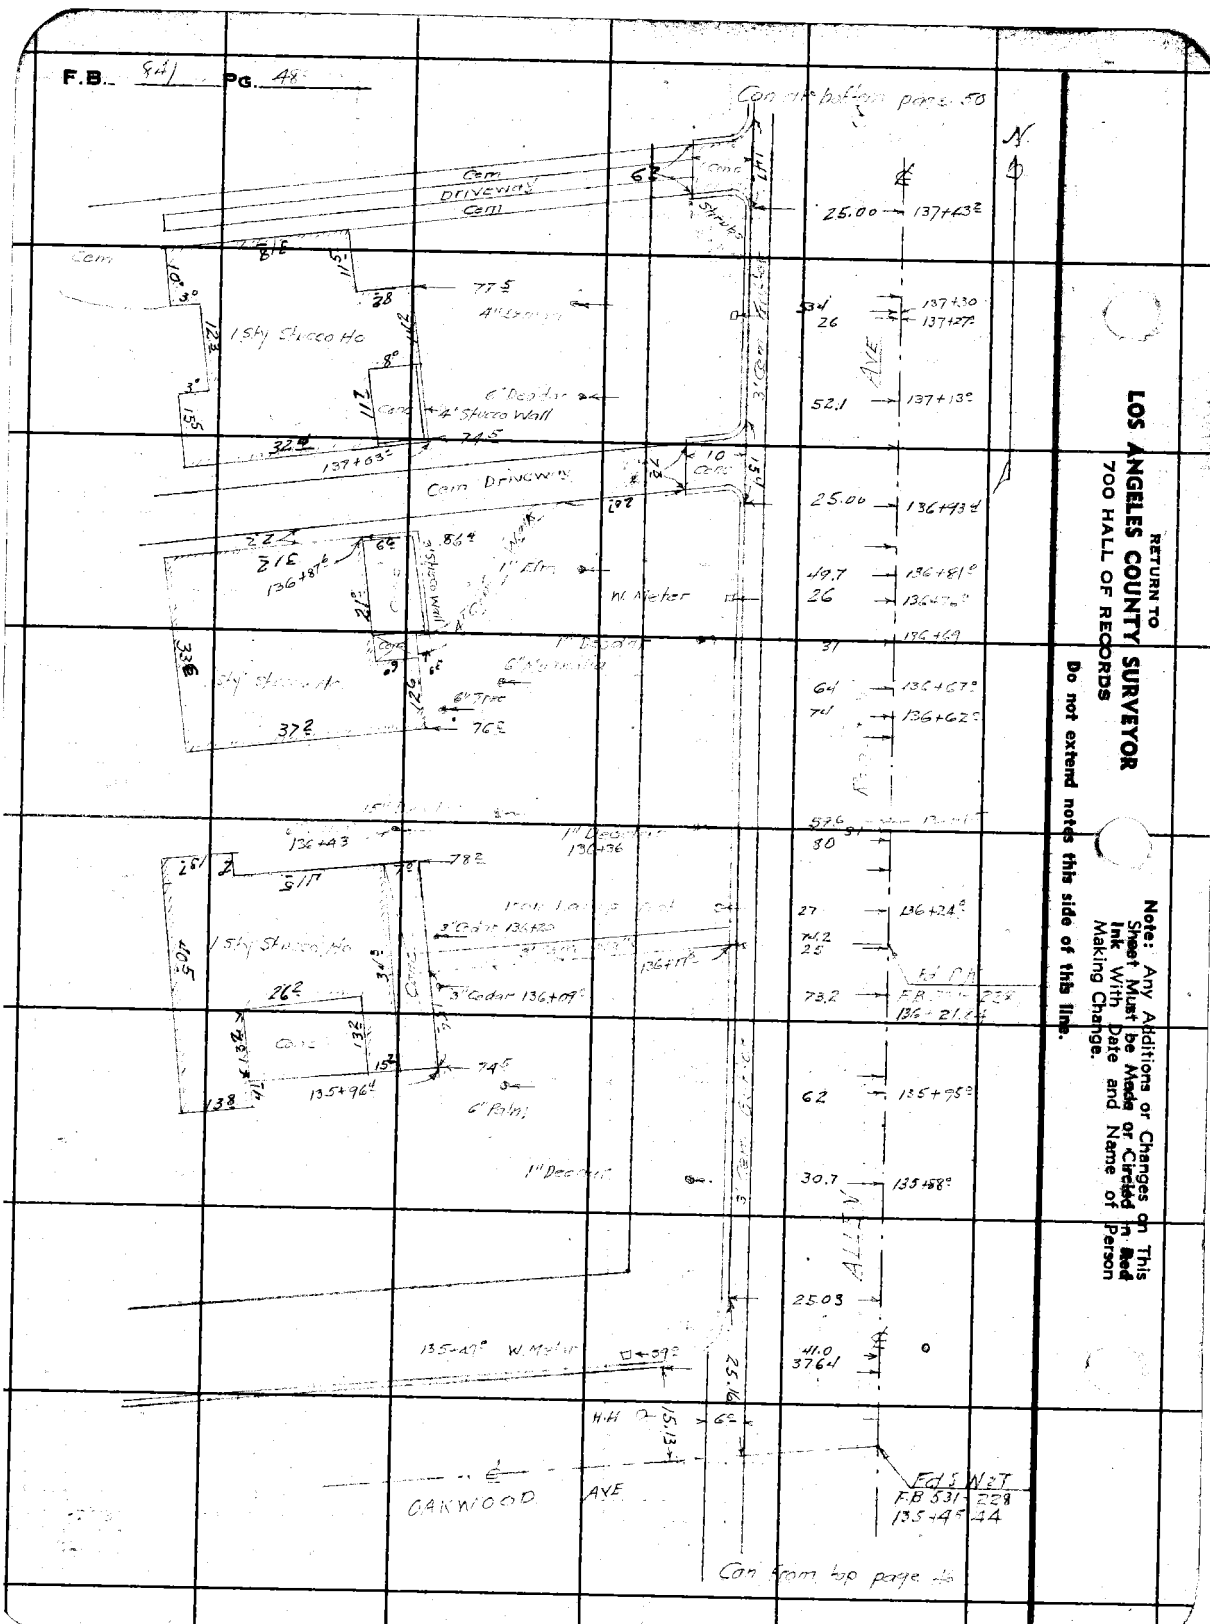
Con from bottom page 50
Conc
Driveway
Conc
Shrubs
25.00
137+43
N
Conc
10'
3°
1 Sty Stucco Ho
12.3
15.5
7.7
Conc
8°
6" Dead in
4' Stucco Wall
74.5
137+30
137+27
26
AVE
52.1
137+13
32.4
137+03
Conc Driveway
10
Conc
15.0
25.00
136+93
19.7
26
136+81
136+69
31
64
136+67
74
136+62
RETURN TO
LOS ANGELES COUNTY SURVEYOR
700 HALL OF RECORDS
Do not extend notes this side of this line.
Note: Any Additions or Changes on This Sheet Must be Made or Circled in Red Ink With Date and Name of Person Making Change.
31.2
136+87.6
1" Elm
86.4
Shrubs
Conc
Wall
12°
Conc
N. Meter
1" Dead in
6" Stump
6" Tree
33.6
1 Sty Stucco Ho
37.2
76.2
136+43
1" Dead in
136+36
78.2
5.1
7
1 Sty Stucco Ho
40.5
3" Cedar 136+20
3" Cedar 136+09
136+17
26.2
Conc
13.2
15.2
74.5
13.8
135+96
6" Palm
1" Dead in
80
27
136+24
7.2
2.5
73.2
62
135+75
30.7
135+58
ALLEY
25.03
135+47 W. Meter
41.0
37.64
25.16
H.H
15.13
Conc
OAKWOOD AVE
Fd 5 W&T
F.B. 531 - 228
135+49 - 44
Con from top page 46

Notes Ck'd by D. M. Finley	Survey of Alley N. of Ave	F.B. 541	Pg. 49
Map No. B-949-3	W. O. 7165 Tape No. St'd °F		
Office Work OK	Surveyed by W.A. Miller		
Checked D. M. Finley	Notes W.A. Miller Date 1940		
Date MAY '42	Indexed A. C. Johnson		

Note: Any Additions or Changes on This Sheet Must be Made or Circled in Red Ink With Date and Name of Person Making Change

Do not extend notes this side of this line.

RETURN TO
LOS ANGELES COUNTY SURVEYOR
700 HALL OF RECORDS

FORM 247 5M 10-39

137+43.9
137+23.9
137+12
137+11.2
137+10
136+94.8
136+70.5
136+48.3
136+38.9
136+27.9
136+15.5
136+5.0
136+1.6
135+73.9
135+49.8
135+39.8
135+29.7
135+17.4
135+6.3
135+5.7
135+0.0

29
64.3
76.2
26.0
74.0
29
12" Oak
65
70.0
29
69.4
45.5
37.6
29.2
55.2
43.2
39.2
35.8
25.0
25.60
35.9
25.0
59.7
43.8
71.8
55.4
30
26.7
0.0

24" Fir
18" Oak
W. Mistletoe
4" Tree
Com.
House beyond limit
76'
30" Fir
8.0
10" Oak
15" Palm
12" Oak
Zx
Zx
10" Oak
30
15" Oak
12.5
25.0
18.0
Scrub Oak
Ed PK
F.B. 53-228
136+21.84
1.5" Locust
15" Palm
15" Palm
18" Oak
17" Palm
12" Palm
El. Sw. pt.
F.B. 53-228
135+65.44

Continued top page 47

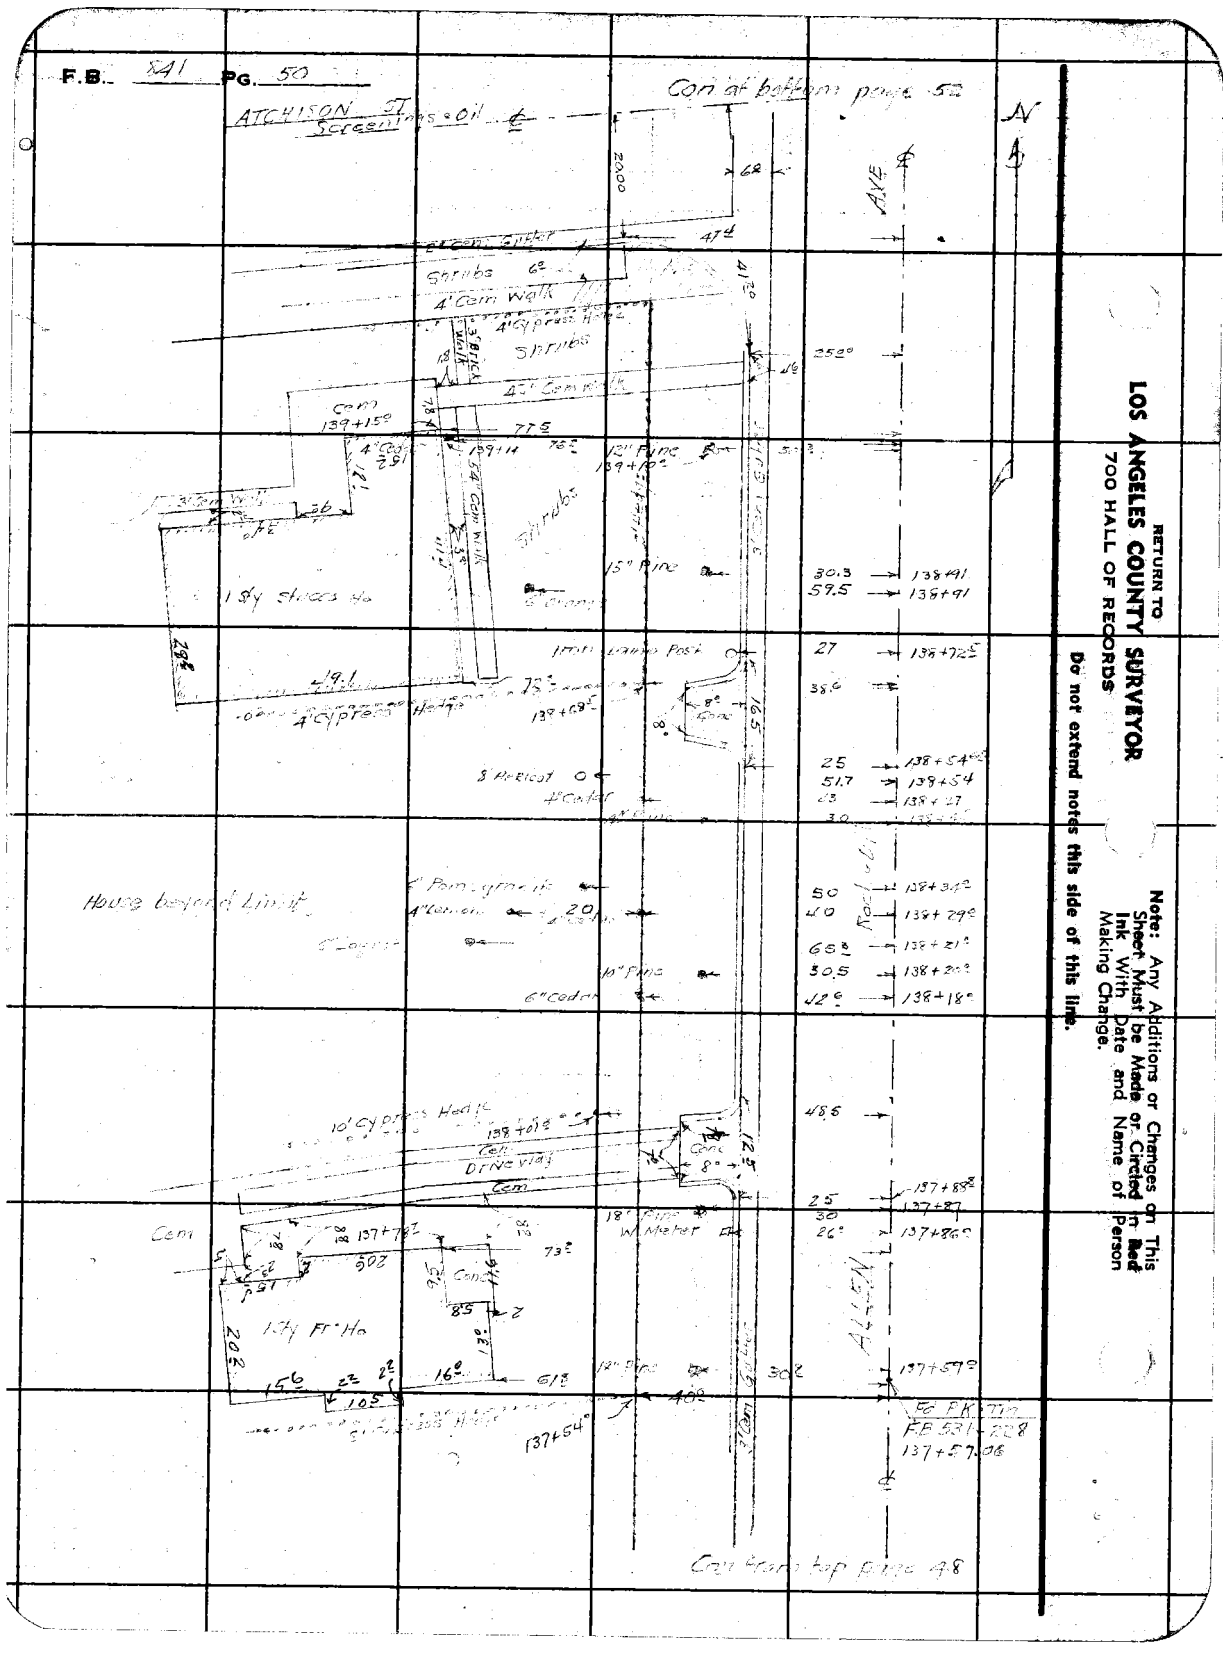
F.B. 241 PG. 50
ATCHISON ST
Screen
N
AVE
Shrubs
4' Conc Walk
4' Cypress Hedge
3' Brick Wall
Conc
Shrubs
4' Conc Walk
12" Pine
15" Pine
1 Sty Stucco Ho
Shrubs
Conc Walk
Iron Lead Pipe
4' Cypress Hedge
8" Apricot
4" Cedar
House beyond Limit
4" Pomegranate
4" Conc
6" Cedar
10' Cypress Hedge
Conc
Drive Way
Conc
Conc
1 Sty Fr Ho
18" Pine
W Meter
12" Pine
ALLEN
Conc
Conc at top page 48
RETURN TO
LOS ANGELES COUNTY SURVEYOR
700 HALL OF RECORDS
Note: Any Additions or Changes on This Sheet Must be Made or Circled in Red Ink With Date and Name of Person Making Change.
Do not extend notes this side of this line.

Notes Ck'd by D. M. Finley	Survey of ALLEN AVE	F.B.	Pg.
Map No. B-949-3	W. O. 7125 Tape No. St'd °F		
Office Work Co.	Surveyed by W.A.M. F.G.L.		
Checked D. M. Finley	Notes W.A.M. F.G.L. Date 1940		
Date MAY '42	Indexed A. C. Johnson		

Con't bottom page 53

139+34	← 37		Stake		
139+26	← 37		Stake	72° →	℄ L 139+27 House beyond limit
139+20					
139+16 E	← 26	26	Water Meter 139+17.7	72° →	4" Drain
		10° Conc. 13°			Conc Driveway
		13° 10 Conc	138+96 ℄ Hedge		Conc Driveway
139+81	← 25				
138+73		26	W. Meter		4' Conc Walk
138+70	← 40				House beyond limit
			6" Pine		4" Pine
138+59	← 47				
138+46		40			Lattice Fn.
138+46		29.3	8" L.oak		
138+37	← 71	52.2			18" → 4" Jenning 138+40
138+33		35.5	12" L.oak		
138+30		45	8" L.oak		
			12" L.oak		
138+22		29.3			
138+20		70.2			6" Locust
138+04		51			
138+00		29.2	8. 10" L.oak		Cluster of 4" Trees
137+85					24" Locust
137+78		29	14" L.oak		
		29	12" L.oak	137+56	
Ed Partin F.B. 537-228					
137+37.66		27.3	Iron Lamp Post	137+43	

Con From Imp yard: 49

Note: Any Additions or Changes on This Sheet Must be Made or Circled in Red Ink With Date and Name of Person Making Change.

Do not extend notes this side of this line.

RETURN TO
LOS ANGELES COUNTY SURVEYOR
700 HALL OF RECORDS

FORM 247 5M 10-39

F.B. 841 PG 52

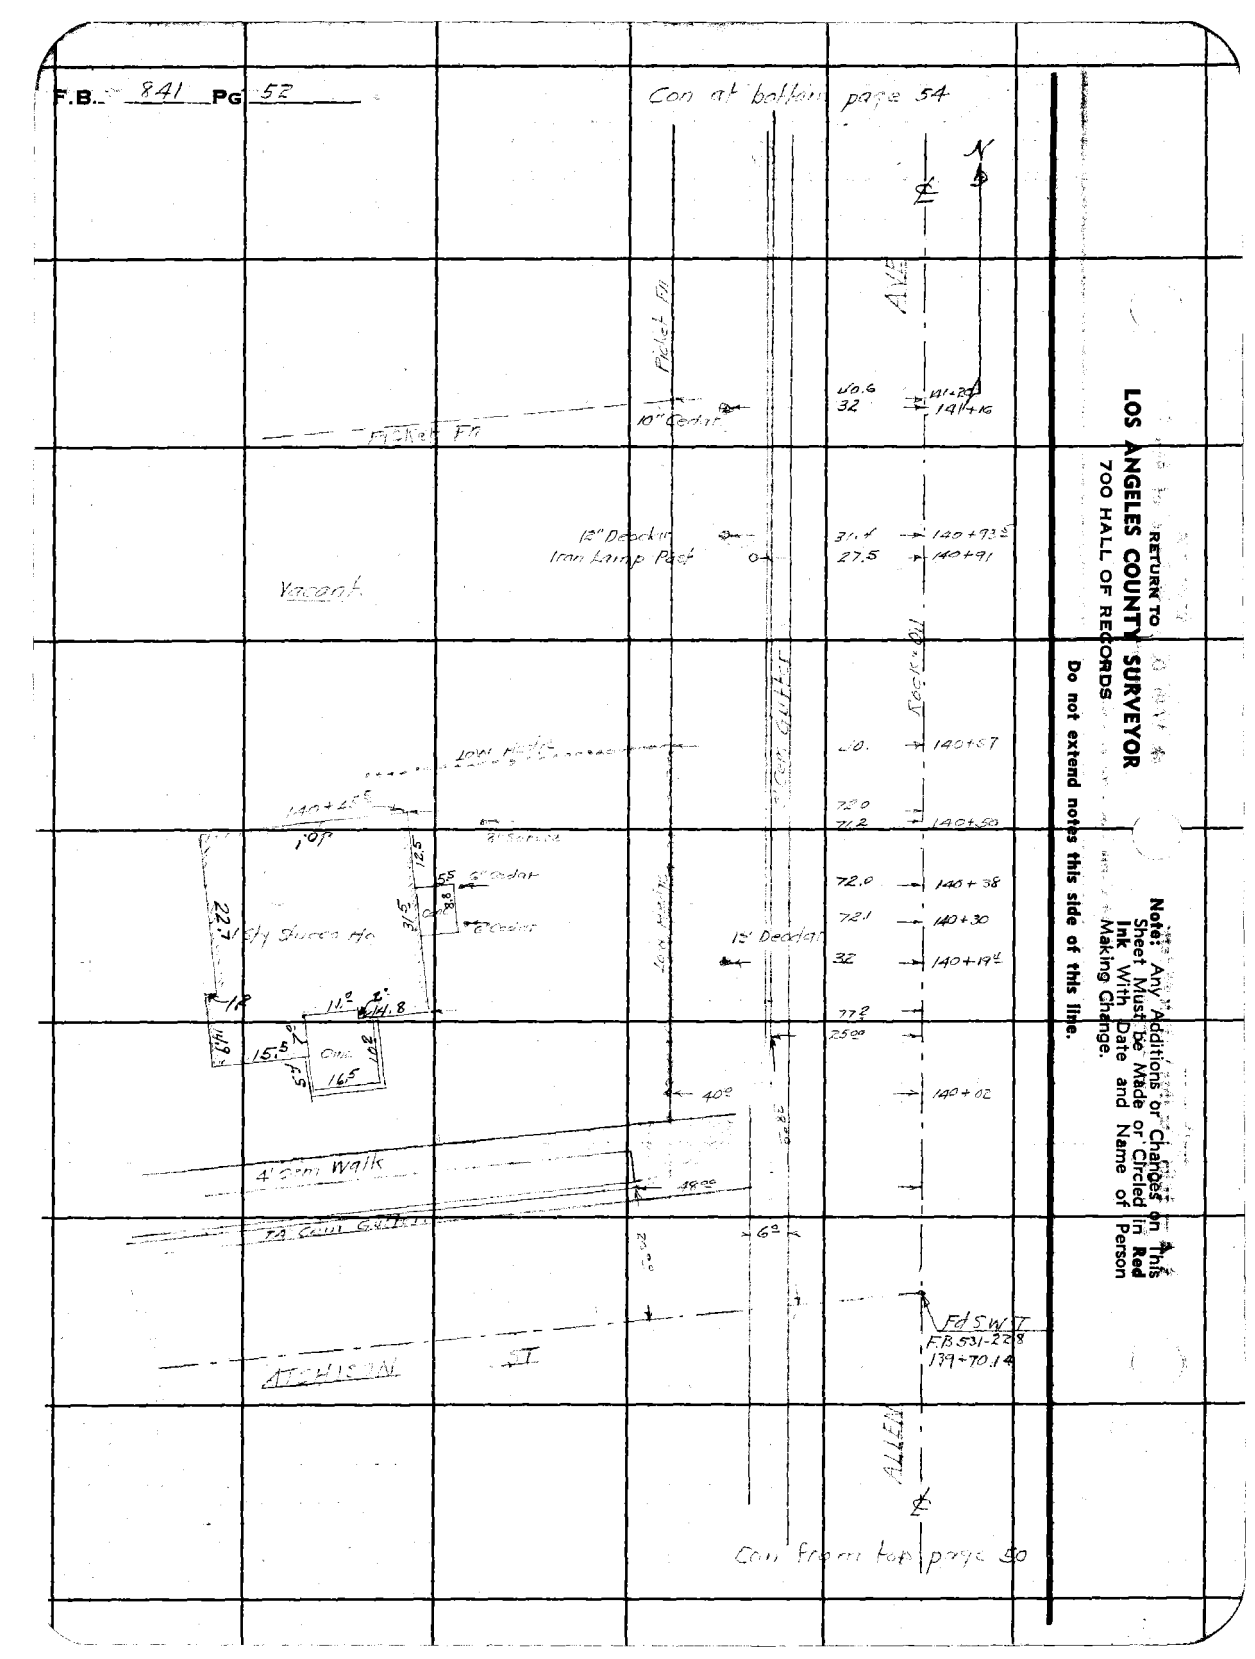

RETURN TO
LOS ANGELES COUNTY SURVEYOR
700 HALL OF RECORDS

Do not extend notes this side of this line.

Note: Any Additions or Changes on This Sheet Must be Made or Circled in Red Ink With Date and Name of Person Making Change.

Notes Ck'd by D. M. Finley	Survey of ALLEN AVE	F.B. 641	Pg.
Map No. B-949-3	W. O. 7125 Tape No. St'd °F		
Office Work Cox	Surveyed by W.A. Miller		
Checked D. M. Finley	Notes W.A.M. - E.C. Johnson Date 1940		
Date MAY '42	Indexed		

Con at bottom page 55

Note: Any Additions or Changes on This Sheet Must be Made or Circled in Red Ink With Date and Name of Person Making Change.

Do not extend notes this side of this line.

RETURN TO
LOS ANGELES COUNTY SURVEYOR
700 HALL OF RECORDS

AVE
3' Conc Gutter
Rock Wall
Varnish
N
140+45 S 10
140+40 S 55
140+31 29
140+30
140+21 S 55
8" Dead in 64
4" Cypress Hedge
6" Sycamore 22' 22'
20 4" Eucalyptus
20 4" Eucalyptus
140+12 29
140+07
40
139+77 26 40.2
26°
Nat Soil Driveway
Wire Fence
139+96.7
Conc
8
Pk & tack
139+97.4
W Mistr
139+71
Ef SW-T
FB 53-228
139+70.14
15.3
3" Iron Gate
76.0
27°
20 Iron Lamp Post 139+67
8" Mg 139+67
139+67
92+
Nat Soil Driveway
139+45 S
35
25°
15.3
NO HH
139+50
4' Cypress Hedge
ALLEN
Con from back page 51

FORM 247 5M 10-39

F.B. 841 PG. 54

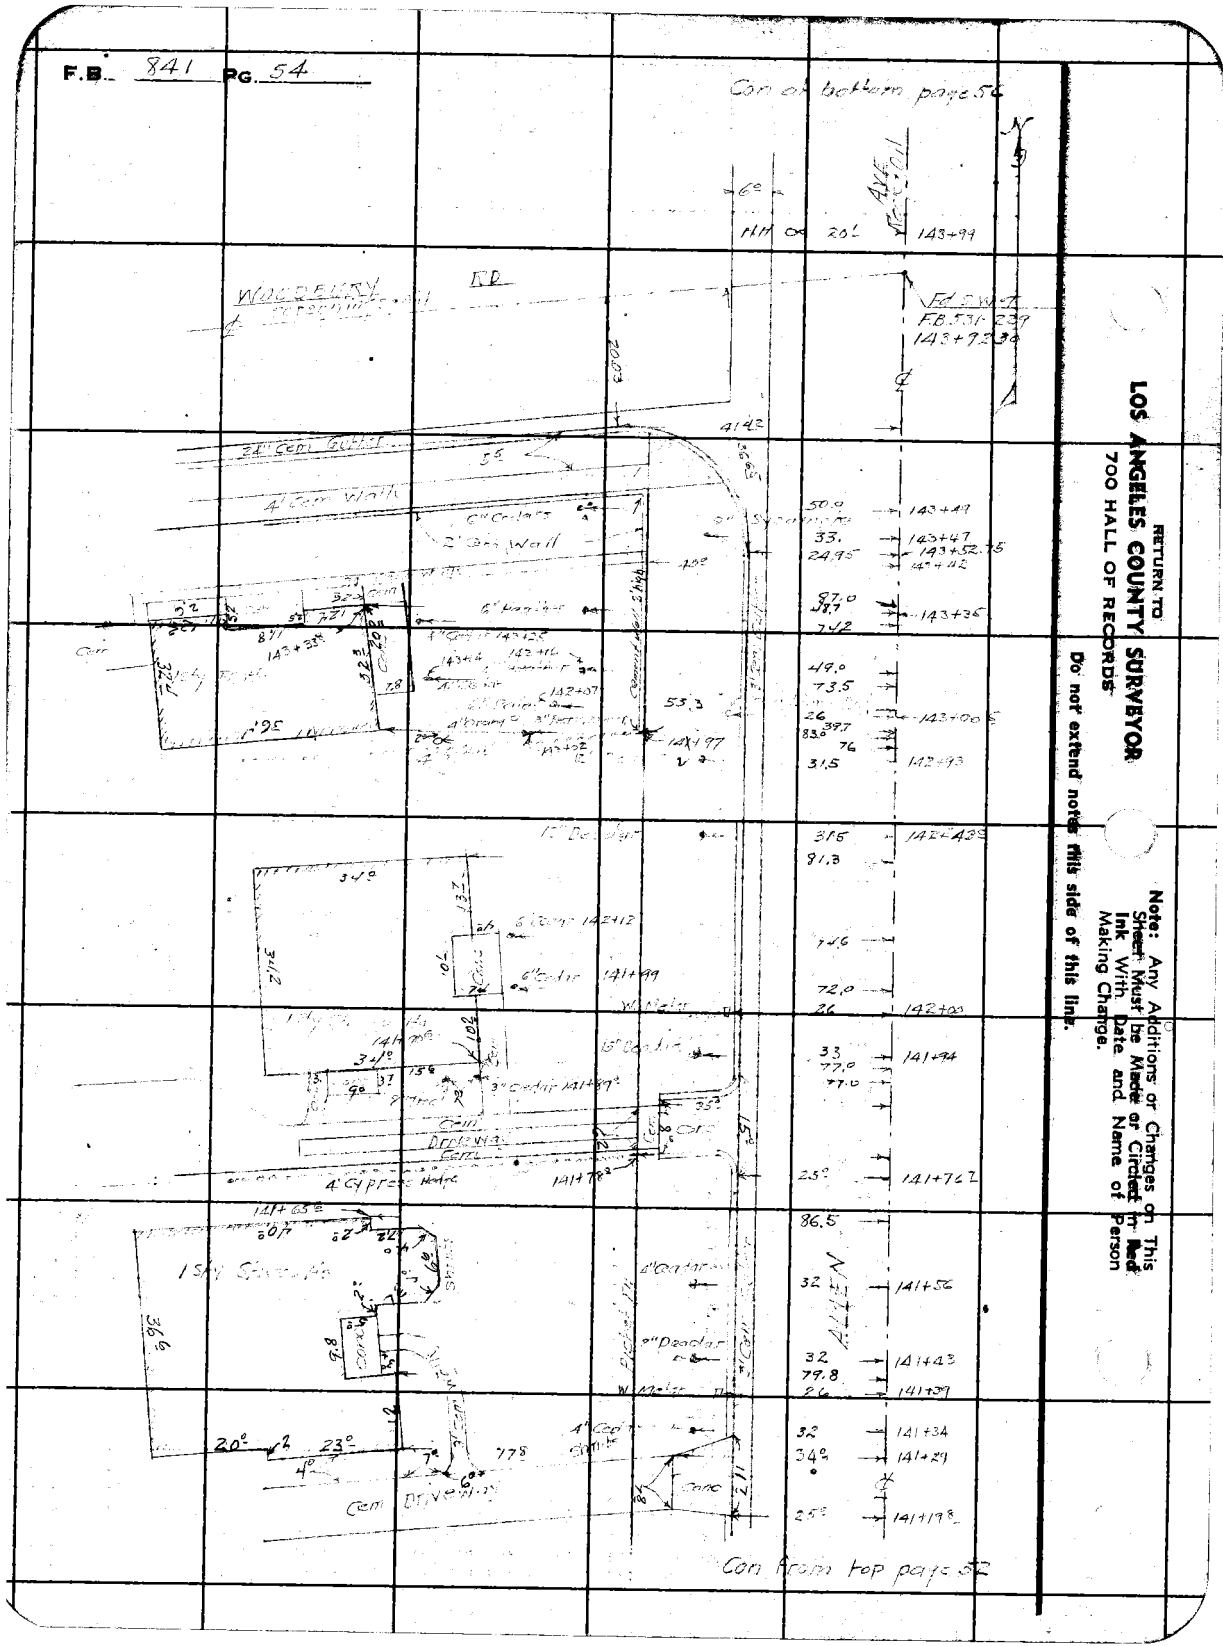
Con at bottom page 54
Woodbury Rd
24" Cem Gutter
4' Cem Walk
2' Brk Wall
6" Curb
6" Header
4" Cem Walk
4' Cypress Hedge
15" Cedar
3" Cedar
6" Cedar
4" Cedar
8" Pear
Iron Pipe
Return to
Los Angeles County Surveyor
700 Hall of Records
Do not extend notes this side of this line.
Note: Any Additions or Changes on This Sheet Must be Made or Circled in Red Ink With Date and Name of Person Making Change.

Notes Ck'd by D. M. Finley	Survey of ALLEN AVE	F.B.	Pg.
Map No. 9-949-8	W. O. 7145 Tape No.	St'd	°F
Office Work OK	Surveyed by W. A. Miller		
Checked D. M. Finley	Notes W.A.M.-T.S.L. Date 1940		
Date MAY '42	Indexed P. C. Johnson		

Con. on bk. of map p. 9, c. 57

Note: Any Additions or Changes on This Sheet Must be Made or Circled in Red Ink With Date and Name of Person Making Change.

Do not extend notes this side of this line.

RETURN TO
LOS ANGELES COUNTY SURVEYOR
700 HALL OF RECORDS

FORM 247 5M 10-39

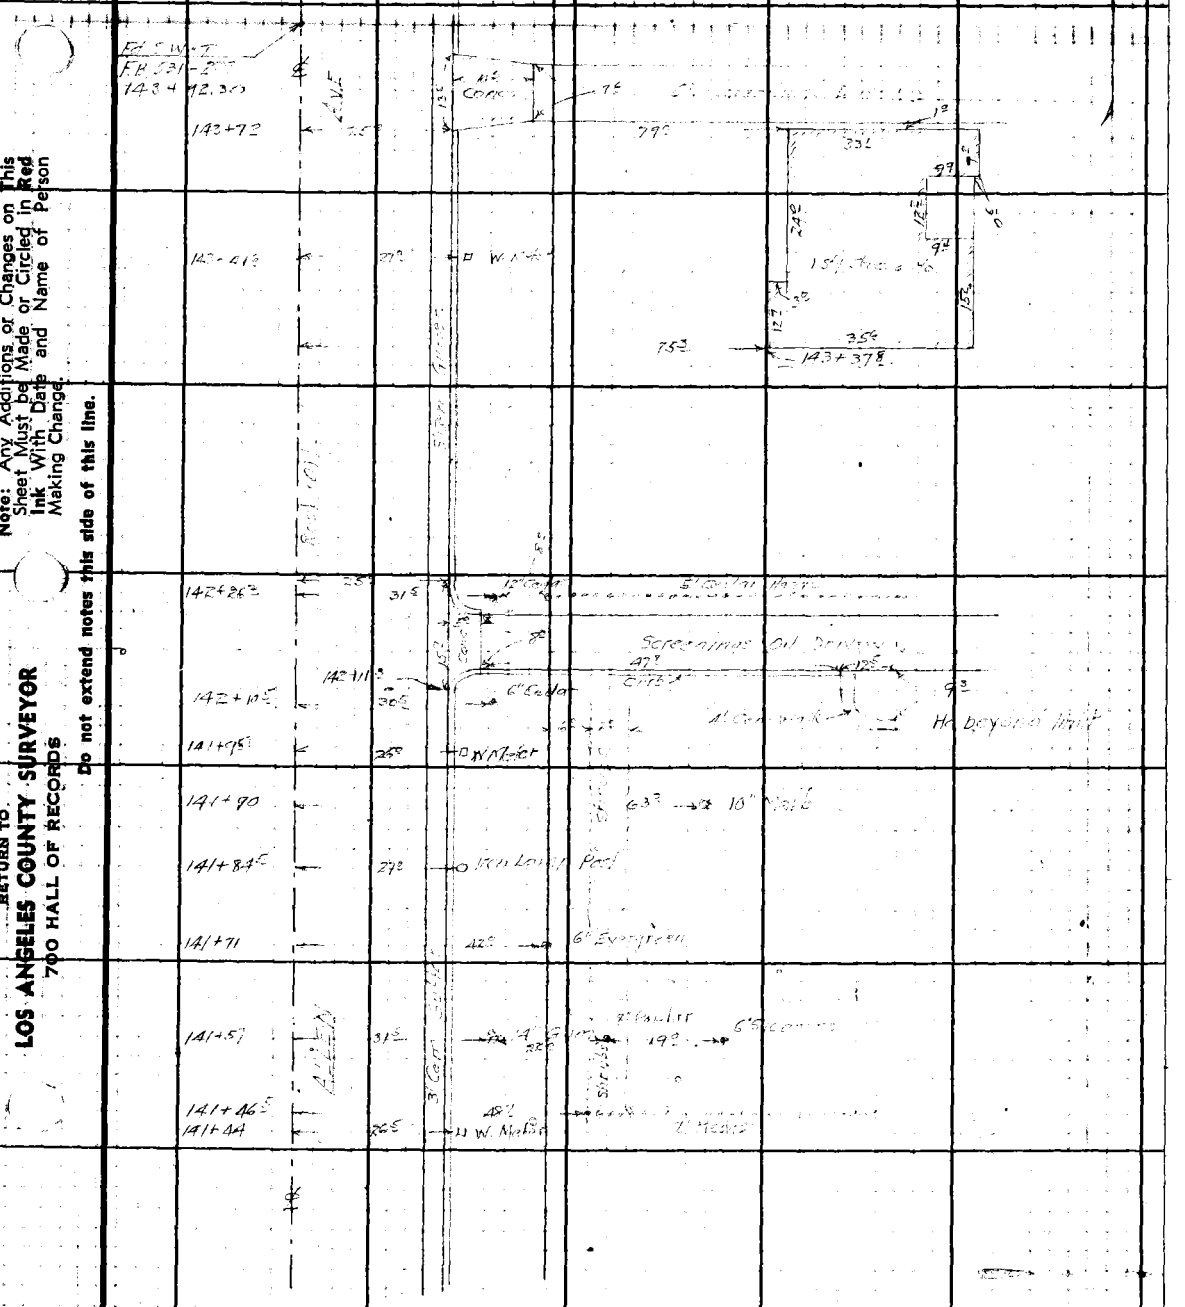

F.B. 841 PG. 56

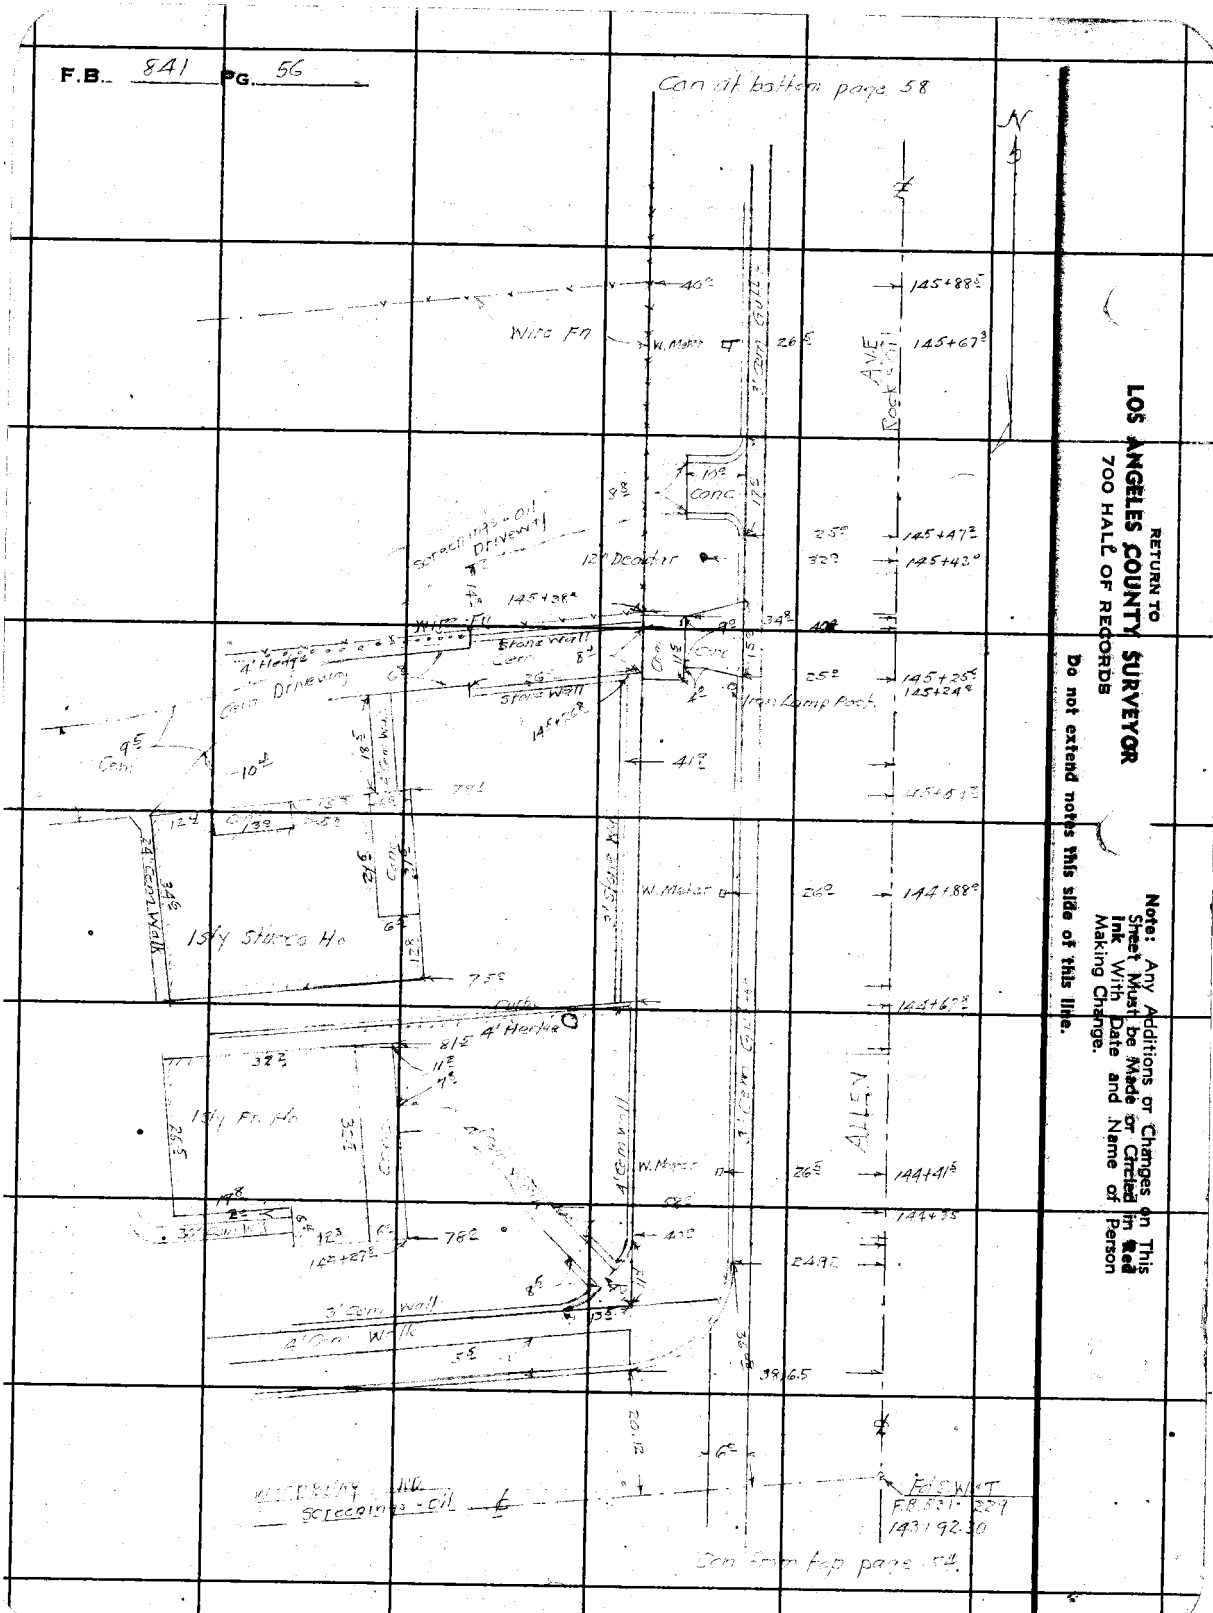

RETURN TO
LOS ANGELES COUNTY SURVEYOR
700 HALL OF RECORDS

Note: Any Additions or Changes on This Sheet Must be Made or Circled in Red Ink With Date and Name of Person Making Change.

Do not extend notes this side of this line.

Notes Ck'd by D. M. Finley	Survey of ALLEN AVE	F.B. 841	PG. 57
Map No. B-949-3	W. O. 7125 Tape No.	St'd	°F
Office Work Cox	Surveyed by WALTER		
Checked D. M. Finley	Notes WALTER Date 1942		
Date MAY '42	Indexed		

Note: Any Additions or Changes on This Sheet Must be Made or Circled in Red Ink With Date and Name of Person Making Change.

Do not extend notes this side of this line.

RETURN TO
LOS ANGELES COUNTY SURVEYOR
700 HALL OF RECORDS

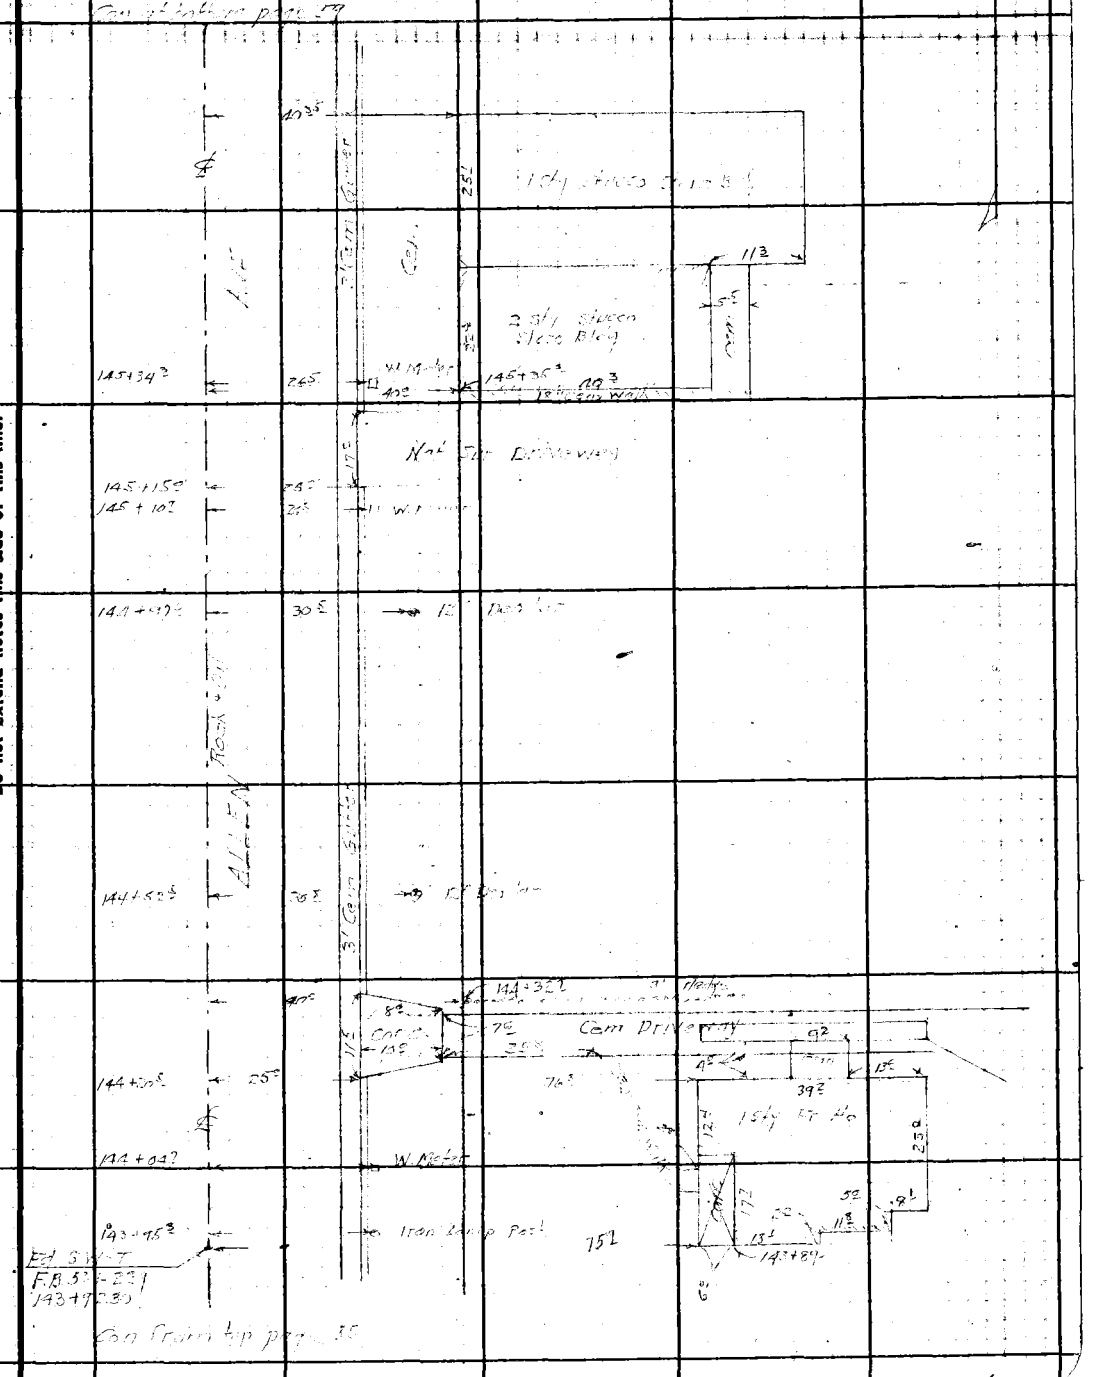

FORM 247 5M 10-39

RETURN TO
LOS ANGELES COUNTY SURVEYOR
700 HALL OF RECORDS

Note: Any Additions or Changes on This Sheet Must be Made or Circled in Red Ink With Date and Name of Person Making Change.

Do not extend notes this side of this line.

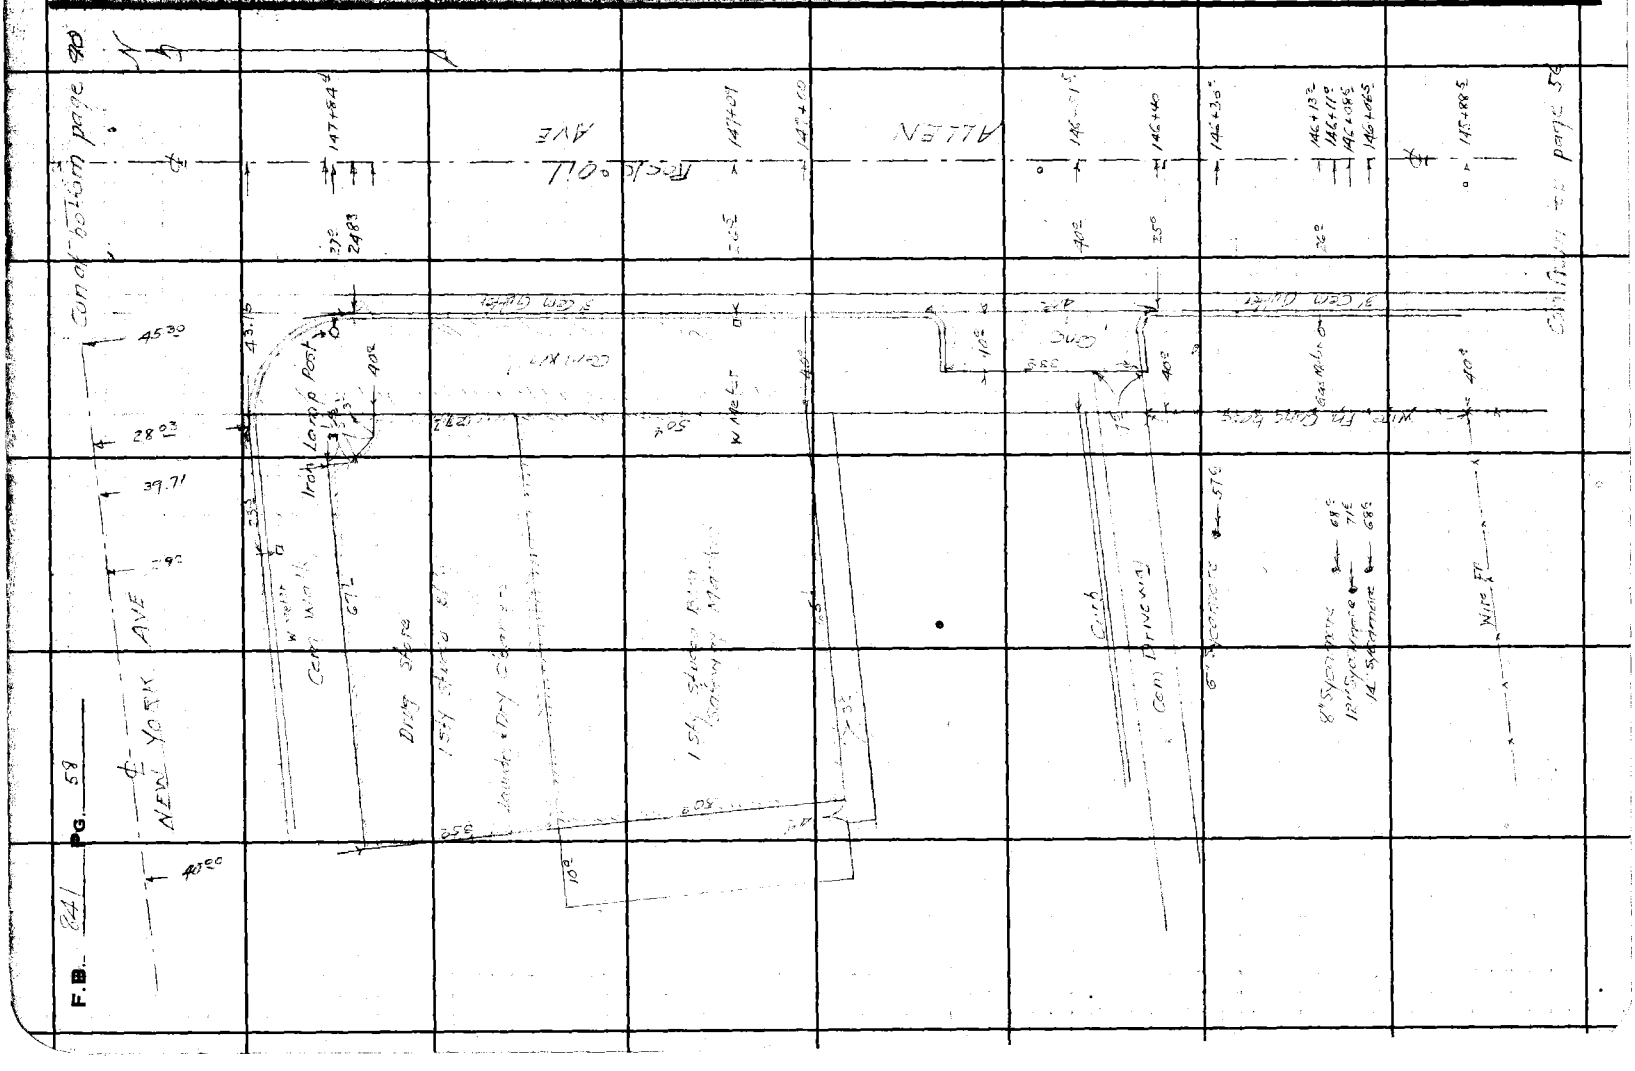

Notes Ck'd by D. M. Finley	Survey of ALLEN AVE	F.B. 44	Pg. 5
Map No. B-949-3	W. O. 725 Tape No.	St'd °F	
Office Work Cons	Surveyed by WAM		
Checked D. M. Finley	Notes WAM-FSL Date 1942		
Date MAY '42	Indexed		

Con at bottom page 91

Note: Any Additions or Changes on This Sheet Must be Made in Red Ink or Circled With Date and Name of Person Making Change

Do not extend notes this side of this line.

RETURN TO
LOS ANGELES COUNTY SURVEYOR
700 HALL OF RECORDS

FORM 247 5M 10-39

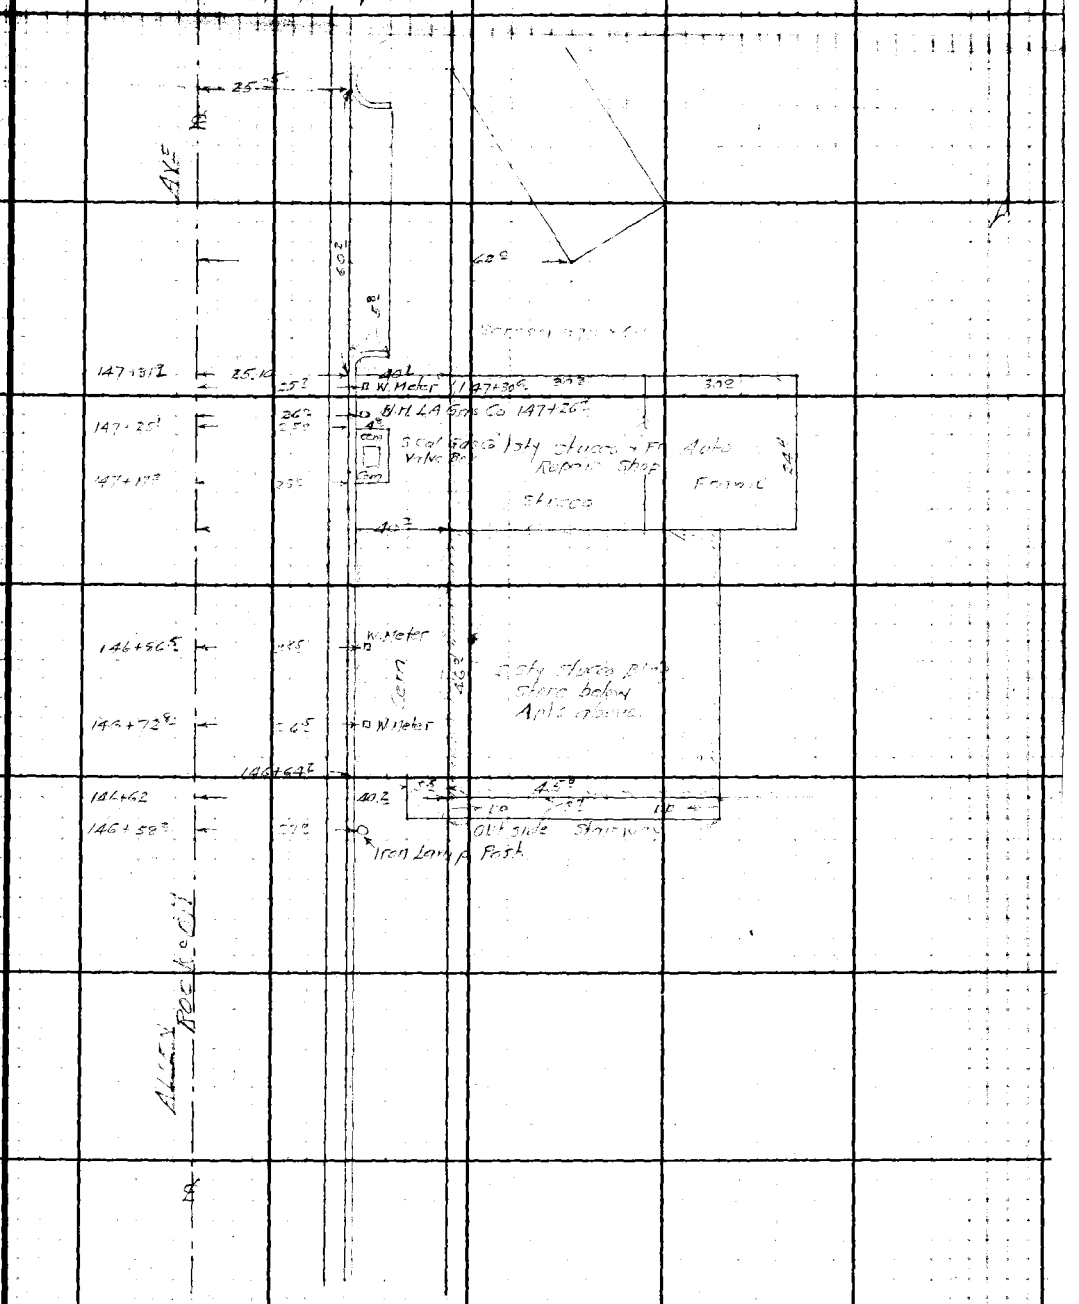

Con from last page 57

RETURN TO
LOS ANGELES COUNTY SURVEYOR
700 HALL OF RECORDS

Note: Any Additions or Changes on This Sheet Must be Made or Circled in Red Ink With Date and Name of Person Making Change.

Do not extend notes this side of this line.

F.B. 841 Pg. 615

Notes Ck'd by D. M. Finley	Survey of ALLEN AVE	F.B.	Pg.
Map No. A-929-3	W. O. 7125 Tape No. 047 St'd 84 °F		
Office Work Cac	Surveyed by W.A.Miller		
Checked D. M. Finley	Notes Miller Date 6-21-1942		
Date MAY '42	Indexed A. C. Johnson 10-31-50		

W.S. 50, D-2

Cont'd bottom page 62

0+41.05
1+71.29
2+13.34

N

164.81 @ 0-00 T 72 = 164.80 164.80'
164.81 @ 0-00 T 72 = 164.80

164.80' AVE

TRACT M.B 6533 57-24

52L PK
P.I. 34.
150+42.60

171.33 @ 0-00 T 72 = 171.29 171.29'
171.33 @ 0-00 T 72 = 171.29

171.29' ALLEY

TRACT M.B 2123 22-194, 195

195-19-10
24-38-20
315-37-30
96-09-360

52L SW
FB 104-104
P.I. 148+71.31

Pt. Cor. for none destroyed in building Curb

30°

Fd L.&T.

MANORU DR

Fd Nail at Sinaloa Ave
FB 531-270
1102.96 FB 531-14, 229

NEW YORK AVE

Fd C.S.Pk
FB 104-104
FB 531-14, 229

Fd S.W.T
FB 104-104
FB 531-14, 229
P.I. 148+30.26

Fd S.W.T
FB 104-104
FB 531-14, 229
Angle Point
149+79.66

ALLEN AVE

See F.B. 531-14, 229

RETURN TO
LOS ANGELES COUNTY SURVEYOR
700 HALL OF RECORDS

Note: Any Additions or Changes on This Sheet Must be Made or Circled in Red Ink With Date and Name of Person Making Change.

Do not extend notes this side of this line.

FORM 247 5M 10.59

F.B. 841 PG. 62

W.S. 50, D-2

RETURN TO
LOS ANGELES COUNTY SURVEYOR
700 HALL OF RECORDS

Note: Any Additions or Changes on This Sheet Must be Made or Circled in Red Ink With Date and Name of Person Making Change.

Do not extend notes this side of this line.

2+12.34
17.64.80
3+77.14
2+11.37
5+88.51

Con of bottom page 63

(80)
(40) (40)

140.69

140.70 @ 0-00 T 74 = 140.69
140.70 @ 0-00 T 74 = 140.69

TRACT
M.B.

6788
72-11

Fd 2" I.P. Plg - TK
N.E. Cor - L.F. 55 TK 653
5+77.78
154+09.24

9.58
40.12

Set Pk - Tin
5+88.54
154+18.77

TRACT
M.B.

5483
67-23

211.38 @ 0-00 T 74 = 211.37
211.38 @ 0-00 T 74 = 211.37

211.57

TRACT 2153

192-17-10
24-38-10
216-57-00
96-09-30

Fd 2" I.P. Plg - No Tk
5+47.00
152+28.23

Set Lead Tack

Set Lst.

40.11

Set 3/4" I.P. Plg - Tk 2" Dia
Fd Intersection
5+87.14
152+07.40

2755

31.28

2838

Set Lst.

MORADA

Pl. 65

30.17

Set Lst.

40.11

Fd 2" I.P. No Plg on TK
5+47.86
151+71.92

(40) (40)

Con from top pg 61

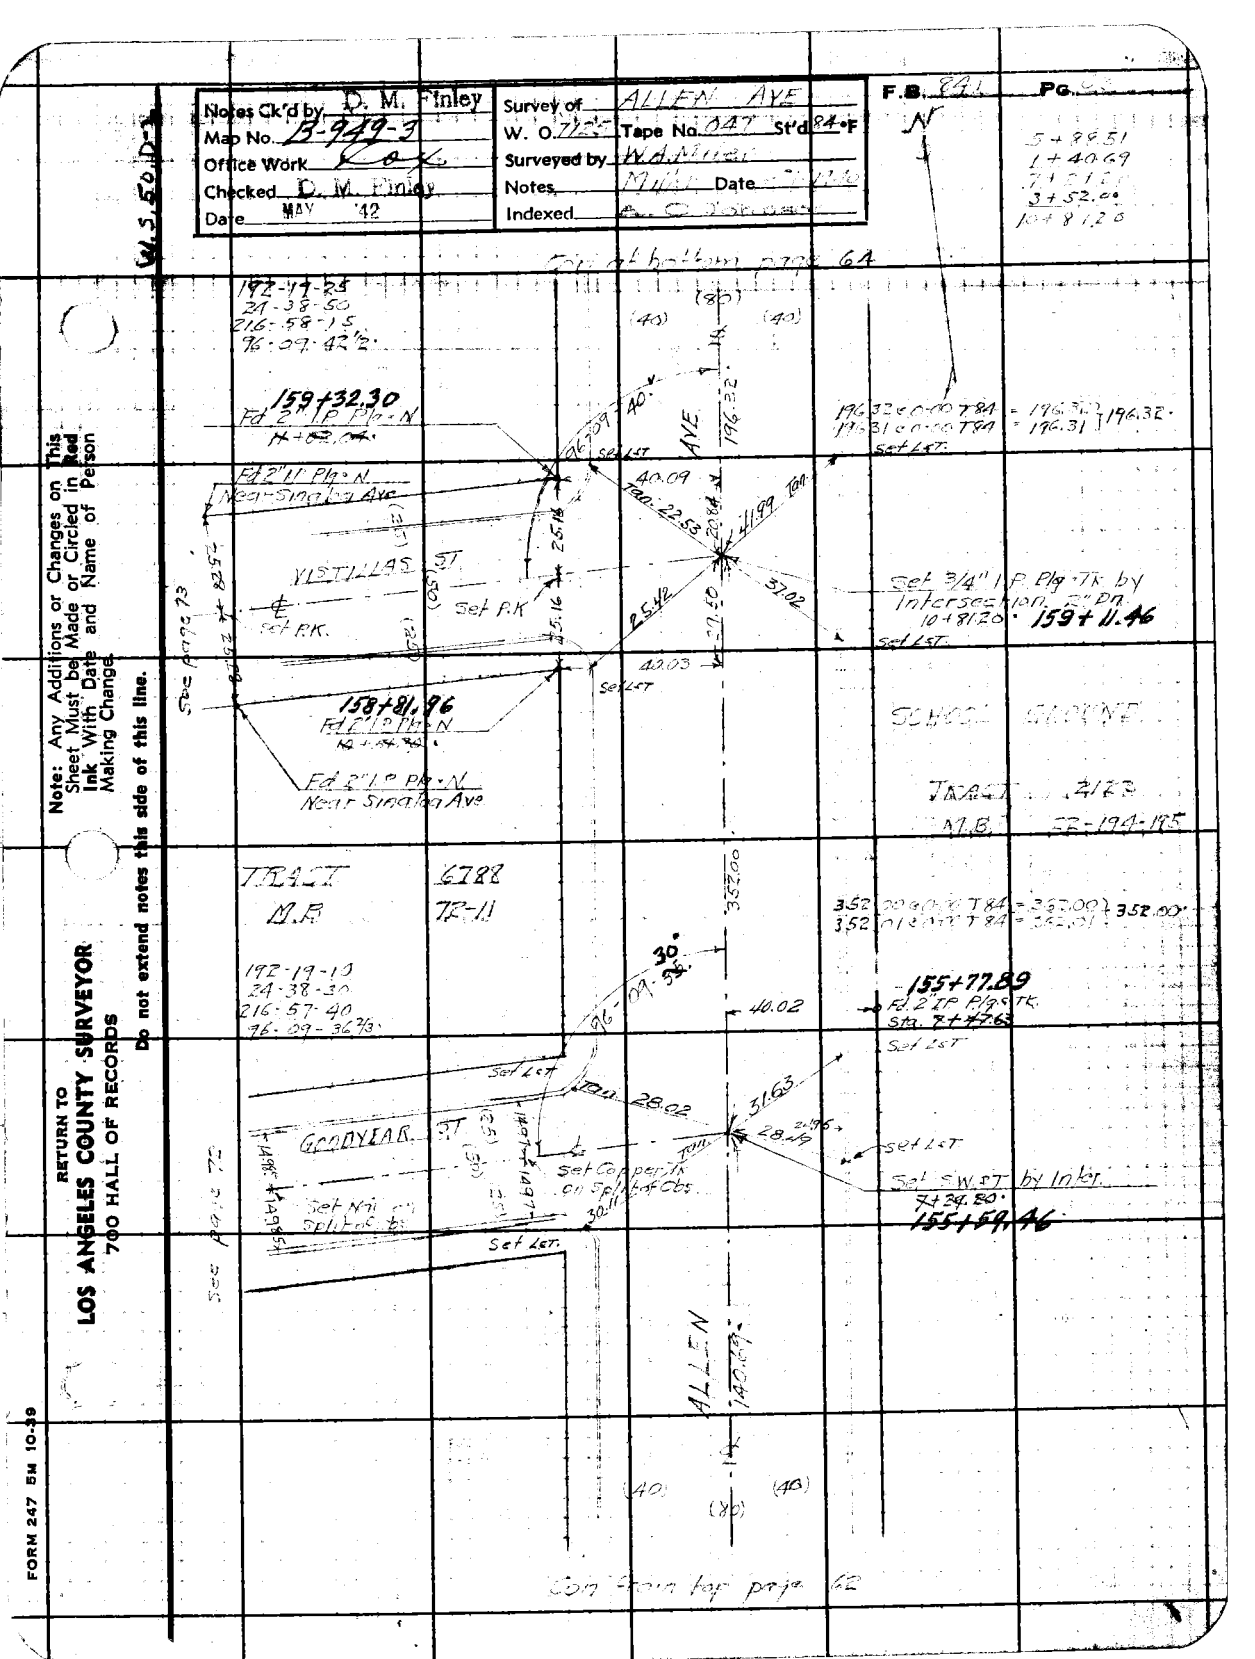

RETURN TO
LOS ANGELES COUNTY SURVEYOR
700 HALL OF RECORDS

Note: Any Additions or Changes on This Sheet Must be Made or Circled in Red Ink With Date and Name of Person Making Change

Do not extend notes this side of this line.

FORM 247 BM 10-39

F.B. 841 PG. 64

Con at bottom page 65

10+81.20
1+96.32
12+77.52
1+50.65
14+28.17

(80)
40' (40)

N

W.S. SG D-2

192-19-20
24-38-50
216-58-10
96-09-41 2/3

AVE
241.79'

241.80 @ 0-00 T 80 = 241.79
241.80 @ 0-00 T 80 = 241.79 } 241.79'

RETURN TO
LOS ANGELES COUNTY SURVEYOR
700 HALL OF RECORDS

Do not extend notes this side of this line.

Note: Any Additions or Changes on This Sheet Must be Made or Circled in Red Ink With Date and Name of Person Making Change.

162+79.24
Fd 2" I.P. Ph. TK
14+88.98
Fd 2" I.P. Ph. TK
Near Simaloa Ave

96.07 40'

40.05

Set L&T

(2.5') Tan 27.34 20.81 51.31

5.00

RD

LA PAZ

Set P.K.

Set P.K.

Set L&T

Set 3/4" I.P. Ph. TK by tie 2" Dn
14+58.43
162+58.43

Set L&T

40.00

40.04

Fd 2" I.P. Ph. TK.
Stg. 13+87.23
162+17.49

Fd 2" I.P. Ph. TK
Near Simaloa Ave

Fd 2" I.P. No Ph. or Tk
13+78.34
162+28.90

150.65'

TRACT
M.B

2128
22-194, 195

TRACT
M.B

7053
76-5

ALLEN

150.65 @ 0-00 T 80 = 150.65
150.65 @ 0-00 T 80 = 150.65 } 150.65'

Fd 2" I.P. Ph. No TK
N.E. Cor Lot 78 TR 6788
15+92.75
161+13.41

40.10
563

Set P.K. & Tin
12+79.52
161+07.78

TRACT
M.B

6788
72-11

142.35'

(40) (80) (40)

Con from top page 63

Notes Ck'd by D. M. Finley	Survey of ALLEN AVE	F.B. 841	PG. 65
Map No. B-949-3	W. O. 7125 Tape No. 047 Std. 84 °F		
Office Work Cox	Surveyed by W. A. Miller		
Checked D. M. Finley	Notes Miller Date 5-11-1942		
Date MAY 42	Indexed C. Jones		

W.S. 50 D-7

Note: Any Additions or Changes on This Sheet Must be Made or Circled in Red Ink With Date and Name of Person Making Change

Do not extend notes this side of this line.

RETURN TO
LOS ANGELES COUNTY SURVEYOR
700 HALL OF RECORDS

FORM 247 5M 10-39

14+29.17
2+41.79
16+69.96
20.49
18+90.45
29.44
19+17.89
28.04
19+45.93

Coin at bottom page 66

40' left 40'

TRACT M.B 7345 118-11,12

ALLEN AVE 70.17

TRACT M.B 7123. ER: 194, 195

167+74.83
Fd 2" I.P. Pkd. N 15°00'
19+42.57

167+20.03
Fd 2" I.P. Dim. Tk
19+39.87

Set P.K. Tk
19+46.82
167+77.24

85.55 40.04 3.41 7.21 4.38

39.97 10.02

Set P.K. Tk
19+19.84
167+49.15

Fd New 2"C Tag Tk
R.E. 4675
19+28.4 167+59.17

228.46 + 0.00 T&B = 228.41
228.46 + 0.00 T&B = 228.44 228.44

167-05.17
216-10-30
117-15-30
79-52-35

165+59.55
Fd 2" I.P. Pkd. N Tk
19+83.89

165+74.28
Fd New 2" C Tag Tk
R.E. 4675
19+54.02
44.02

40' 40.00 22.57

Set L&T

MEADOWBROOK RD

See page 76

196.52 ℄

Fd N.T. L.P. 781.38

Set L&T

Set 3/4" I.P. Pkd. Tk 2" Dia.
16+99.45 165+20.71

77.42 11.82 11.82 3.84 23.57 60.16

Fd New 2" C Tag Tk
R.E. 4675
16+99.45

20.89

Fd 2" I.P. Pkd. Tk
Disturbed N 90°E

MEADOWBROOK RD

Set P.K.
16+54.96
165+00.22

Set L&T

TRACT M.B 7053 76-5

ALLEN 79.31

46.98
7.21
39.77

(40) (40)

Coin from top page 64

F.B. 841 Pg. 66

Con at bottom page 67

19+46.98
Tan 17
20+17.15
1+77.69
21+94.84

(25) (65) 40

N

Fd 3" Casing Conc. Nail 12' LD
24+84.20 172+61.46

39.91

TRACT 2123
M.B 22-194,195

Fd 1½" IP Lead & Tag Nail
R.E. 1216
23+11.17 171+41.43

40.00

420.31 @ 0-00 TBE = 420.30
420.31 @ 0-00 TBE = 420.30 420.30

EAST WALL OF SD

420.30

109-58-20

3998

219-56-40
79-53-30
299-50-10
109-58-21 1/2

Fd 1/2" IP Pkg-TK (New)
R.E. 1216
22+39.74 170+60.00

Set L&T

Set L&T

21.42

55.15

56.42

Fd 2"P-TK New
R.E. 1216
22+06.57

Fd 1½" IP Pkg-TK

170+25.10
Set 3/4" IP Pkg-TK 2" Dn
by II Transection
24+84.34

Set L&T

19.12

66.03

Tan

Set L&T

95.20

Set PK

Set PK-Tin on Spherical Curbs

Set L&T

TRACT 2343
M.B 110-11,12

179.14 @ 0-00 TBE = 179.14
179.14 @ 0-00 TBE = 179.14 179.14

177.69

168+57.41
Fd 2" IP
28+29.15

(25) (68) (40)

25.01

40.03

10.13

177.79 @ 3-00 TBE = 177.69
177.70 @ 0-00 TBE = 177.69 177.69

TRACT 2123
M.B 22-194,195

168+57.44
Fd 2" IP Pkg-TK
N Cor Lot D TR 2788
28+27.78

Set PK-Tin
28+17.15
168+47.41

70.17

(40) (80) (40)

Con from top page 66

RETURN TO
LOS ANGELES COUNTY SURVEYOR
700 HALL OF RECORDS

Do not extend notes this side of this line.

Note: Any Additions or Changes on This Sheet Must be Made or Circled in Red Ink With Date and Name of Person Making Change.

W.S. 90, D-2

Notes Ck'd by		Survey of	ALLEN AVE
Map No.	B-929-3	W. O.	7125
Office Work	Cox	Tape No.	047
Checked	D. M. Finley	Surveyed by	W.A. Miller
Date	MAY 42	Notes	Miller Date 6-24-1940
		Indexed	

F.B. 841 Pg. 67

W.S.50, D-2

Note: Any Additions or Changes on This Sheet Must be Made or Circled in Red Ink With Date and Name of Person Making Change.

Do not extend notes this side of this line.

RETURN TO
LOS ANGELES COUNTY SURVEYOR
700 HALL OF RECORDS

Con. from bottom pg. 68

Set PK-Tin
30+00.23
178+26.01

177+73.06 E.C.

Fd 2x2 T.K.
29+20.26.

R.E. 5411 MR 60-68

Fd ⊥ Mon. Alloy K2

Fd ⊥ Mon. Alloy K2A

Fd L.S.T.

Fd 5/8" I.P. Flg. N 6" Dn

MENDOCINO ST

Fd 2" I.P. Flg. N 6" Dn

Set L.S.T.

Fd 2" I.P. Flg. N 2" Dn
26+67.50.

Fd X in bottom of shallow Cem. Drain
26+24.43.

Δ = 18° 20' 30"
R = 1500.00
L = 480.18

Fd X in bottom of shallow Cement Drain
26+34.11.

Fd 2" I.P. Flg. N 1" Dn
26+24.11.

Con. from bot. of pg 66

172+92.88 E.C.

Fd 2" I.P. Flg. N 2" Dn
26+15.14.

Fd 2x2 T.T. TK R.E. 1697
30+08.26.
178+33.84

T.A.C.T. 2123
M.B. 22: 194, 195.

Fd N.T.
29+14.15.

Set SW.T. by Inter
27+21.24.
P.I. Established by Intersection

Fd L.S.T. in Conc. Wall.

Fd L.S.T.

MENDOCINO LANE

Fd SW.T. 2" Dn
FB 104: 16
26+78.34

Fd L.S.T. in C.B.

Fd 4" I.P. Cor. N

Fd 4" I.P. Cor. N 10" Dn
29+36.39.

ALLEN AVE

Set PK-Tin
26+15.14.

FORM 247 5M 10-39

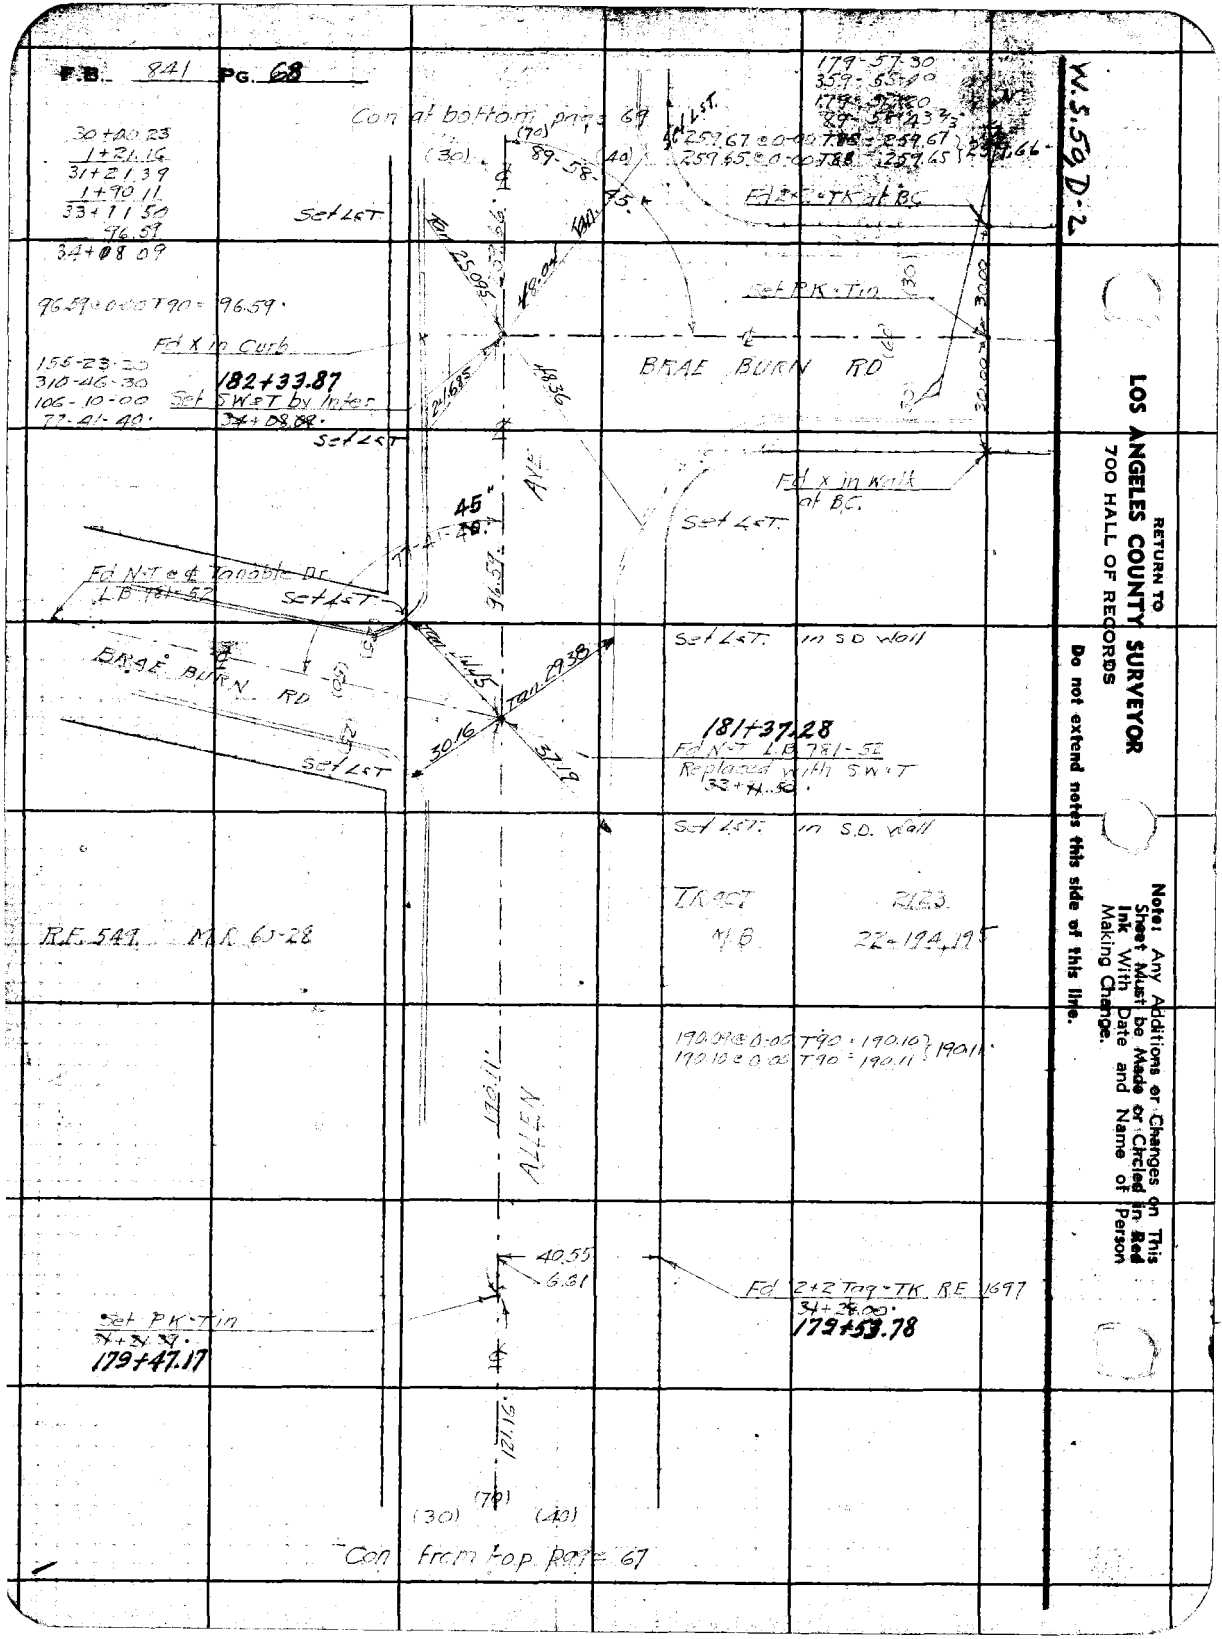

W.S.59 D-2

RETURN TO
LOS ANGELES COUNTY SURVEYOR
700 HALL OF RECORDS

Do not extend notes this side of this line.

Note! Any Additions or Changes on This Sheet Must be Made or Circled in Red Ink With Date and Name of Person Making Change.

Notes Ck'd by T. N. Tiner
Map No. B-949-3
Office Work Cor.
Checked D. M. Finley
Date MAY 42

Survey of ALLEN AVE
W. O. 7125 Tape No. 047 St'd 84°F
Surveyed by W. A. Miller
Notes Miller Date 6-25-1940
Indexed C. Graham

F.B. 841 PG. 69

W.S. 52 D2

Std 68° (2-13-1941) W.M.M

598.50 50 @ 0.00 T 48 = 598.50
598.50 50 @ 0.00 T 68 = 598.50

498.45 498.44 T 44 = 498.45
498.45 498.44 T 44 = 498.45

155-22-30
310-45-00
105-37-30
77-01-15

Ave 52.50

T.N. 4-ST
M.B.
2123
P.B. M 1/2 175

25.00

39+48.53

10'

Fd N-T at ℄ Tan. Bf
L.B. 781-83

Set L-T

HOMEWOOD

36.62

5/8" Iron

98.39

38+80.99

187+05.07
Fd N-T L.B. 781-83
Replacing W 1/4 S.W.-T
38+79.24

28.36

Set L-T

68.75

38+48.21

Set L-T

211.54 @ 0.00 T 86 = 211.54
211.54 @ 0.00 T 86 = 211.54

211.54

40.23

186+36.75
Fd Iron & Tag in Conc. Mon.
R.E. 2410

RETURN TO
LOS ANGELES COUNTY SURVEYOR
700 HALL OF RECORDS

Note: Any Additions or Changes on This Sheet Must be Made or Circled in Red Ink With Date and Name of Person Making Change

Do not extend notes this side of this line.

R/E 547 . M.R 60-28

185+24.03
36+98.55
Fd Nail & L.P. P.T. Tan
R.E. 2410

185+04.63
Fd 2x2 - T.K.
36+78.85

30.10
11.10

40.48

184+93.53
Set P.K. - T.K.
36+68.75

Fd 3/4" I.P. Tag - T.K. R.E. 2410
36+38.75 184+63.93

40.48

30'

Con from top page 68

FORM 247 5M 10-39

F.B. 841 Pg. 70

W.S.52,D-1

RETURN TO
LOS ANGELES COUNTY SURVEYOR
700 HALL OF RECORDS

Do not extend notes beyond edge of this line.

Any Additions or Changes on This Sheet Must be Made or Circled in Red Ink With Date and Name of Person Making Change.

Fd 2" I.P. Pla. TK
44+36.69
54+36.74

FOREST BDY

39+79.29
4+98.75
44+77.74
14.93
44+92.67
1+93.79
46+86.46
7+50.23
54+36.69

38+79.29
5+98.50
44+77.79
14.93
44+92.72
1+93.70
46+86.51
7+50.23
54+36.74

750.23

180.17 @ 8°-25' T86 = 178.23 } 178.23'
180.00 @ 8°-05' T86 = 178.01 }
299.25 @ 2°-17' T86 = 296.13 } 296.12'
299.15 @ 2°-11' T86 = 296.10 }
212.67 @ 5°-05' T86 = 211.72 } 211.82'
212.62 @ 4°-54' T86 = 211.82 }
64.23 @ 4°-24' T86 = 64.07 } 64.07'
64.29 @ 4°-16' T86 = 64.07 }

750.23

Fd Stone & Cap
Pnt 12' of Boundary Survey
of Irontown Tract
Per TR 2762E
~~46+86.46~~
46+86.51

TRACT
M.B.

2762
32-51

193.79'

Fd 2" I.P. Pla. TK
Per TR 2762E
46+29.93

359°57'-20"
179.58'-38"

179°-58'-38"

50' vAdj.

See Page 82

179.54

178.52

FOOTHILL

14.93

0.03

Set S.W.T. N.Y. Inter.
~~44+77.74~~
44+77.79
Set S.W.T. P.O.C.
~~44+92.67~~
44+92.72

Fd 2" I.P. Pla. N. Flush
~~44+92.67~~
44+92.72

102.19'

15°

110.14

See Page 82

192.85' G.L.P.O.C.

ALLEN AVE

580.50'

(30) (40) (30)

Con From for page 69

TRACT
M.B.

2123
22-113,115

DAF. 519

M.B. 36-38

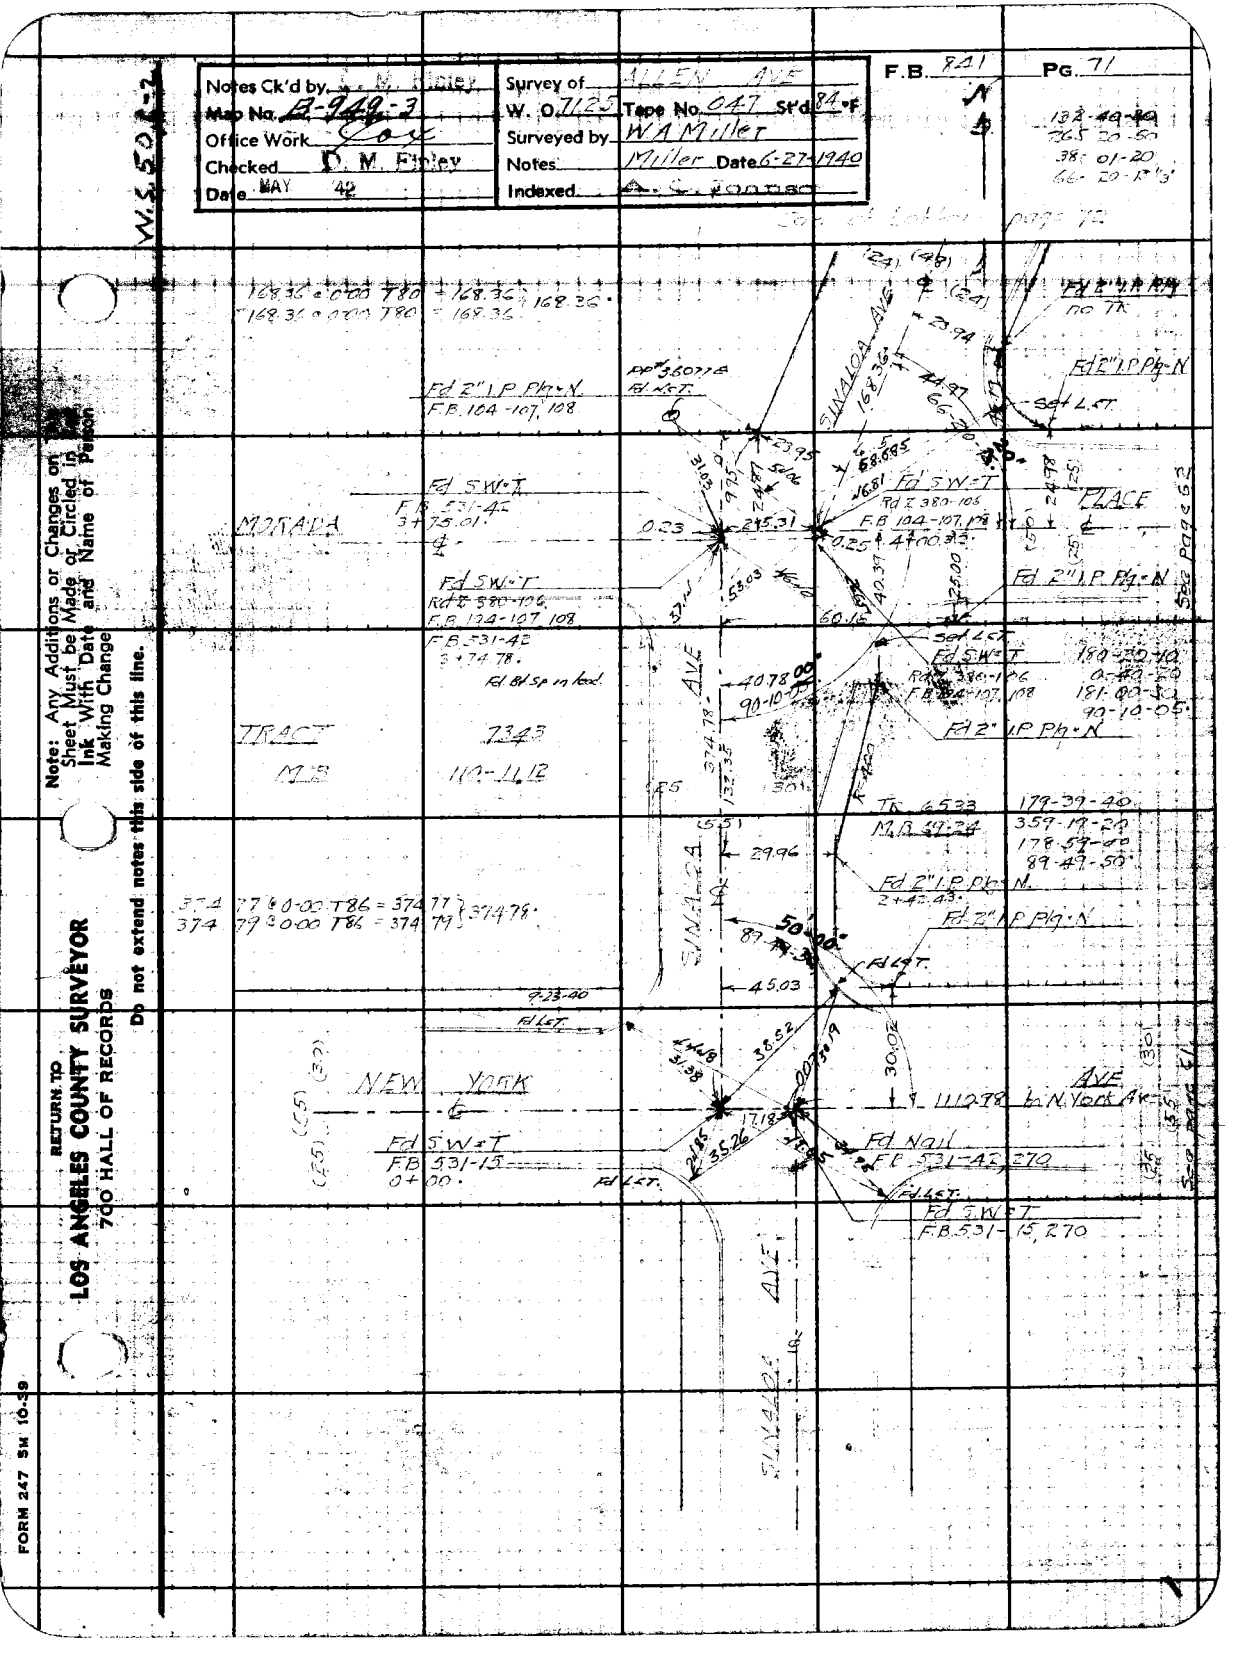
Notes Ck'd by D. M. Finley
Map No. B-949-3
Office Work Cox
Checked D. M. Finley
Date MAY 42
Survey of ALLEN AVE
W. O. 7125 Tape No. 047 Std. 84°F
Surveyed by W A Miller
Notes Miller Date 6-27-1940
Indexed
F.B. 841 Pg. 71
W.S.50, 1-2
Note: Any Additions or Changes on This Sheet Must be Made in Ink With Date and Name of Person Making Change
Do not extend notes this side of this line.
RETURN TO
LOS ANGELES COUNTY SURVEYOR
700 HALL OF RECORDS
FORM 247 SW 10-39
SINALOA AVE
NEW YORK AVE
MOHAVE PLACE
TRACT 7343
M.B. 110-11 12
Fd 2" I.P. Pkg-N
Fd SW-T
Fd Nail
Fd 1/2" I.P. Pkg-N
Fd 2" I.P. Pkg-N
Fd 1/2" I.P. No Tag
Fd 2" I.P. Pkg-N
Fd 2" I.P. Pkg-N
Fd SW-T
F.B. 531-15, 270
Fd SW-T
F.B. 531-15, 270
Fd SW-T
F.B. 531-42
3+74.78.
Fd Bl. Sp. in lead
Fd SW-T
F.B. 531-42
3+75.01.
Fd SW-T
Rd. Z 380-106
F.B. 104-107, 108
Fd SW-T
Rd. Z 380-106
F.B. 104-107, 108
Fd 2" I.P. Pkg-N
Fd 2" I.P. Pkg-N
Fd 2" I.P. Pkg-N

F.B. 541 PG. 72

W.S.S.C. D-2

RETURN TO
LOS ANGELES COUNTY SURVEYOR
700 HALL OF RECORDS.

Do not extend notes this side of this line.

Note: Any Additions or Changes on This Sheet Must be Made or Circled in Red Ink With Date and Name of Person Making Change.

Corr at bottom page 73.

4+00.38
1+68.36
5+68.68
6488
6+33.52
1+48.89
7+82.41

235.99 @ 0-00 T 92 = 236.00
236.01 @ 0-00 T 92 = 236.02 } 236.01

7+82.41
22.28
8+04.69

Fd 2"x2" Nail & WL 3" DH
No 2 380-107
8+04.69

297-29-50
234-59-40
17E-29-20
148-44-53½

Set SWET by InP
7+82.41

TRACT 7343
M.B. 110-11, 12

148.89 @ 0-00 T 86 = 148.89
148.89 @ 0-00 T 86 = 148.89 } 148.89

227-20-00
94-39-50
321-59-20
113-39-53½

Fd 2"x2" Nail & WL 3" DH
No 2 380-107
5+68.68.

Fd 2"x2" Nail & WL 3" DH
No 2 380-107
1+68.36.

Corr from A-2 page 71

TRACT
M.B.

TRACT No. 6788
M.B. 72-11

Fd 2" I.P.

GOODYEAR ST.

SYCAMORE AVE.

Fd 2" I.P. Plg in N

Set P.K. & Tin
6+33.52.

Fd 2" I.P. No Plg
Nor TR.

Fd SWET
No 2 380-107
5+68.68.

(24) (48) (24) (24)

W.S.S.D. D-2

Notes Ck'd by	A. M. Finley	Survey of	ALLEY
Map No.	B-949-3	W. O.	7125
Office Work	Coy	Surveyed by	W.A. Miller
Checked	D. M. Finley	Notes	Miller
Date	MAY 42	Indexed	

Tape No. 047 St'd 84°F Date

F.B. 941 Pg. 73

8+04.69
11+36.01
10+40.70
16.48
11+37.18
2103.50
13+40.68

Con at bottom page 74

(48) (24) (24)

144.58 @ 0-00 788 = 144.58
144.58 @ 0-00 788 = 144.58 } 144.58'

Fd 2" LP Plg = Nail

+0.07

Set PK x Tin
13+40.68'

203.49 @ 0-00 788 = 203.50
203.49 @ 0-00 788 = 203.50 } 203.50'

195-09-50
30-19-10
225-29-40
97-34-56 3/3

Fd 2" LP Plg = TK

Fd 2" LP Plg = N

Set PK x Tin
11+37.18'

Set L&T

VISTALLAS

Set L&T

Fd 2" LP Plg No TK

Fd 2" LP Plg No TK

96.48 @ 0-00 788 = 16.48'

TRACT
M.B.
7343
110-11 12

TRACT
M.B.
7053
26-5

Fd SW-T
10+40.70'

Fd 2" LP Plg TK

TRACT
M.B.
6728
72-11

Con From top page 72

RETURN TO
LOS ANGELES COUNTY SURVEYOR
700 HALL OF RECORDS

Note: Any Additions or Changes on This Sheet Must be Made or Circled in Red Ink With Date and Name of Person Making Change.

Do not extend notes this side of this line.

FORM 247 5M 10-39

1

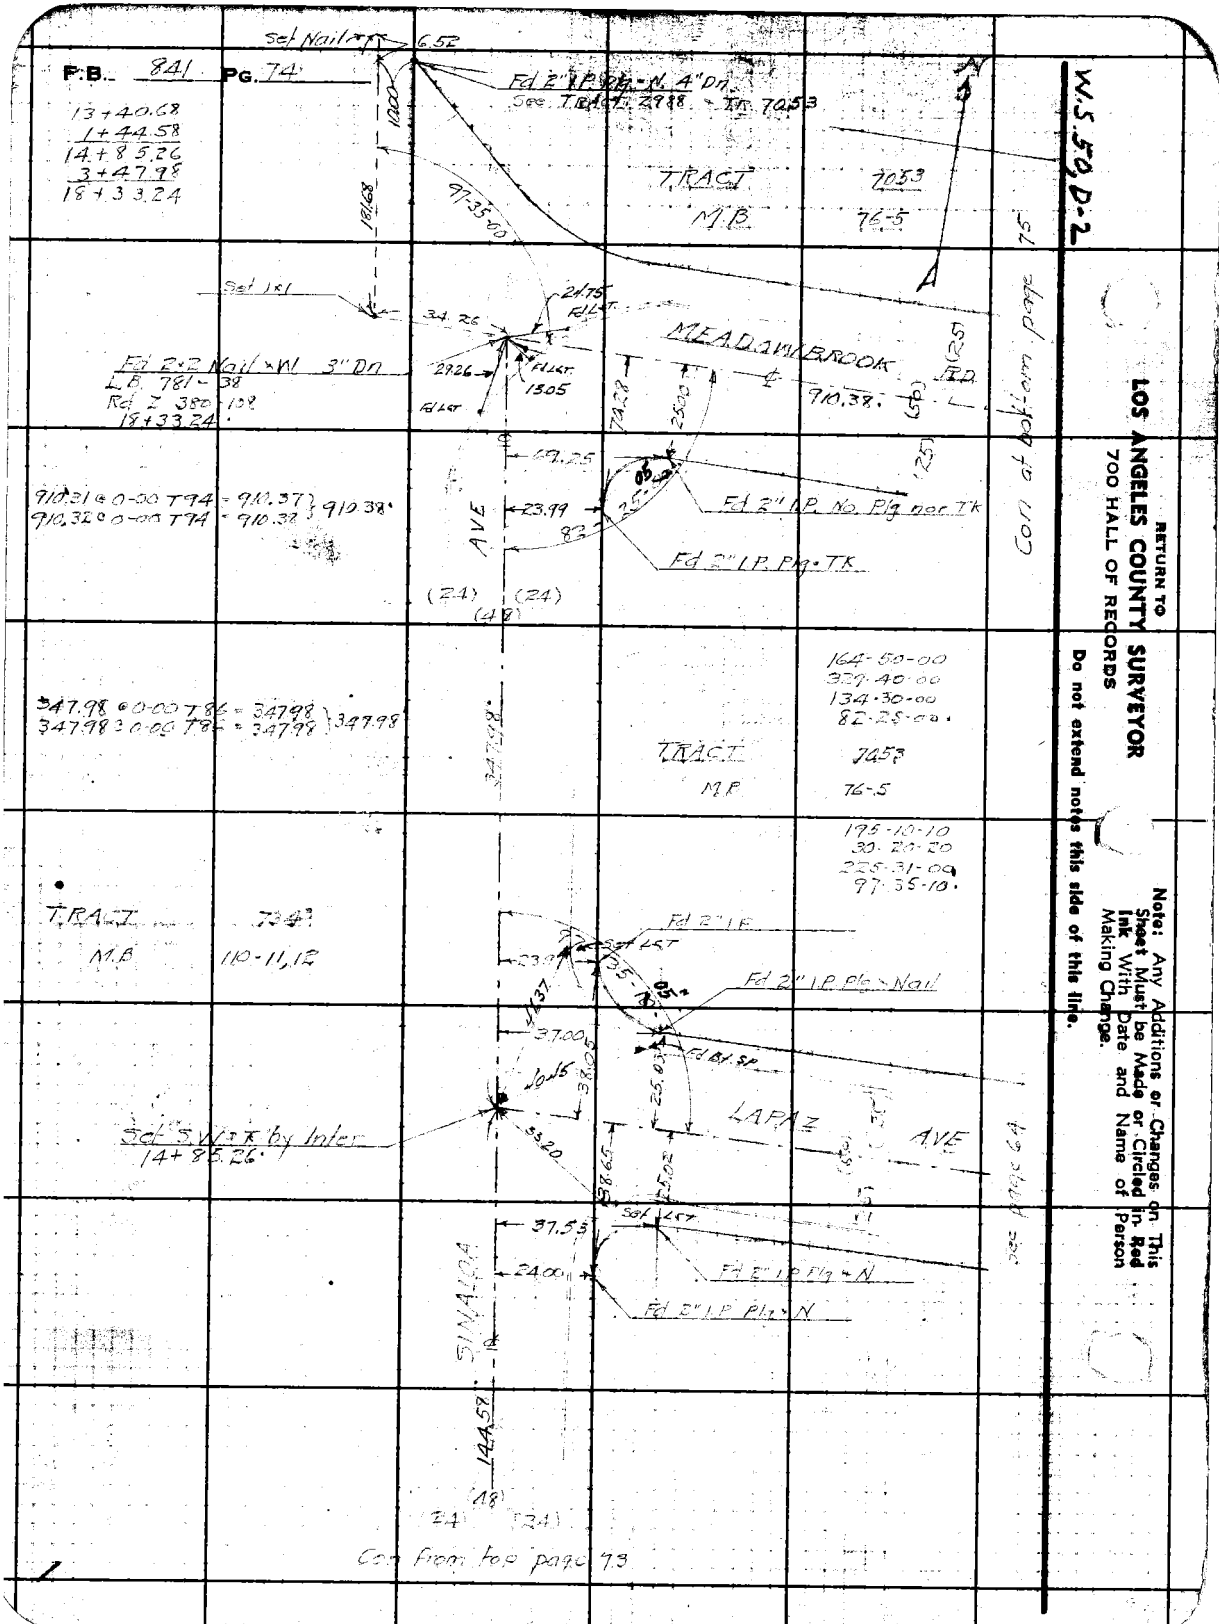
P.B. 84 Pg. 74
13+40.68
1+44.58
14+85.26
3+47.98
18+33.24
Set Nail & T 6.52
1200
1868
Fd 2" I.P. P.L. N. 4" Dn.
See T.R.A.T. 2988 - In 7053
TRACT
M.B
7053
76-5
97°35'00"
Set I.R.
34.26
24.75
R.I.LAT.
MEADOW BROOK
910.38.
(50)
R.D.
(25)
Fd 2" Nail & W 3" Dn
L.B. 781-38
Rd. Z 380-108
18+33.24
2926
1305
R.I.LAT.
7428
2500
910.21 @ 0-00 T94 = 910.37
910.32 @ 0-00 T94 = 910.38
910.38
69.25
23.99
82°
Fd 2" I.P. No. P/g nec. T.K.
Fd 2" I.P. Pkg. T.K.
AVE
(24)
(24)
(48)
347.98 @ 0-00 T84 = 347.98
347.98 @ 0-00 T84 = 347.98
347.98
347.98
TRACT
M.P
7453
76-5
164-50-00
329-40-00
134-30-00
82-25-00
195-10-10
30-20-20
225-31-00
97-35-10
TRACT
7341
M.B
110-11,12
Fd 2" I.P.
23.99
Set I.R.T.
Fd 2" I.P. Plug & Nail
37.00
Fd Bk. Sp.
LAPAZ
AVE
Set "S W" R by Inter
14+85.26
55.20
37.53
Set I.R.T.
Fd 2" I.P. Plug & N
24.00
Fd 2" I.P. Plug & N
SINALOA
144.58
(18)
(24)
(24)
Con from top page 93
W.S. 59, D-2
RETURN TO
LOS ANGELES COUNTY SURVEYOR
700 HALL OF RECORDS
Note: Any Additions or Changes on This Sheet Must be Made or Circled in Red Ink With Date and Name of Person Making Change.
Do not extend notes this side of this line.

Notes Ck'd by D. M. Finley	Survey of ALLEN AVE	F.B. 211-84	Pg. 71-87
Map No. B-949 sh 3	W. O. 7125 Type No. 047 St'd 84°F		
Office Work Cox	Surveyed by W.A.M./Iler		
Checked D M Finley	Notes M./Iler Date 7-23-42		
Date MAY 42	Indexed C. C. Johnson		

W.S.50, D.7

Note: Any Additions or Changes on This Sheet Must be Made or Circled in Red Ink With Date and Name of Person Making Change.

Do not extend notes this side of this line.

RETURN TO
LOS ANGELES COUNTY SURVEYOR
700 HALL OF RECORDS

FORM 247 5M 10-39

194.52 c 0-00 T 74 = 194.53) 194.53.
194.52 c 0-00 T 74 = 194.53)
196.52 c 0-00 T 74 = 196.52) 196.52.
196.52 c 0-00 T 74 = 196.53)

Con on bottom page 76

+04

Fd 2" I.P Pkg. TK

Set Lead

Reset S.W.ST.
Fd N.T.
L.S. 791 38
27+41.41.

Set Lead

Fd 2" I.P Pkg No TK

E.C.

343-21-30
326-43-00
310-04-40
171-40-46½

197.78 c 0-00 T 94 = 197.79) 197.79.
197.78 c 0-00 T 94 = 197.79)

Established P.I. by intersection.

Δ = 16°37'10"
R = 684.53
T = 99.98
L = 198.55

TRACT 7053
M.R. 76-5

Set Lead

Fd 2" I.P Pkg. N
Per Tr. 7053

Fd 2" I.P Pkg No TK
E.C. Per TR. 7053

Fd B.L. Spk
27+43.66.

Set Lead

MEADOW BROOK DR.

Con from top right page 74

18+38.24
9+10.38
27+43.62
1+77.79
27+41.41

+04

Set Lead

343-24-30
326-48-40
310-13-00
171-42-10

RETURN TO
LOS ANGELES COUNTY SURVEYOR
700 HALL OF RECORDS

Note: Any Additions or Changes on This Sheet Must be Made or Circled in **Red Ink** With Date and Name of Person Making Change.

Do not extend notes this side of this line.

W.S. 50, D-2

F.B. 841 Pg. 76

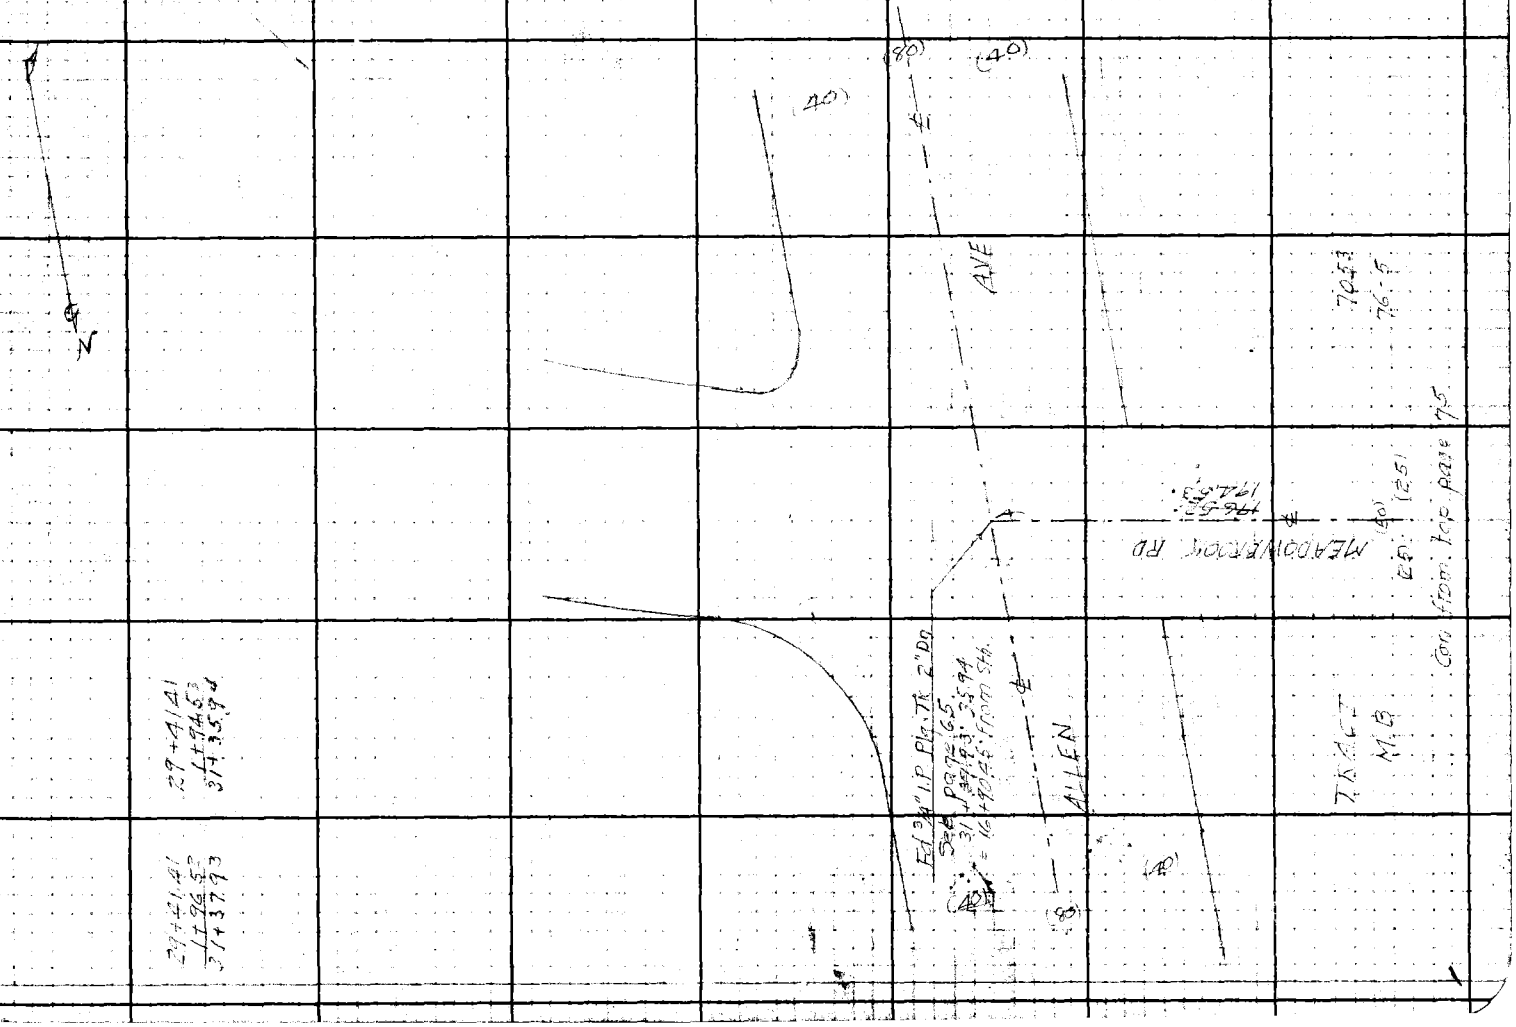

Notes Ck'd by L. M. Farley
Map No. B-949-3
Office Work Coy
Checked L. M. Farley
Date MAY '43

Survey of ALLEN AVE
W. O. 7125 Tape No. 947 St'd 34 °F
Surveyed by W. A. Miller
Notes Miller Date 7-27 1940
Indexed C. J. Johnson

F.B. Pg.

3 at bottom page 78

25 (35)

408.66 + 0.00 Tan = 408.68
408.66 + 0.00 Tan = 408.68
408.68'

ST.

RUBIO CANON PROTECTION DISTRICT
MR 60-27

TRACT 7343
MR 110-16 LR

MENDOCINO

Col P.K.T
1+45.71'

1456.36
Fd 2" TK

35.04
10.65

(60)

145.71'

(25) (35)

1457.1'

30'

ALLEN AVE

ALLEN AVE

2.14

Fd S.W.T
Page 67
0400

Fd S.W.T
Pg. 67

(55) (40)

(35) (35)

Note: Any Additions or Changes on This Sheet Must be Made or Circled in Red Ink With Date and Name of Person Making Change.

Do not extend notes this side of this line.

RETURN TO
LOS ANGELES COUNTY SURVEYOR
700 HALL OF RECORDS

FORM 247 5M 10-39

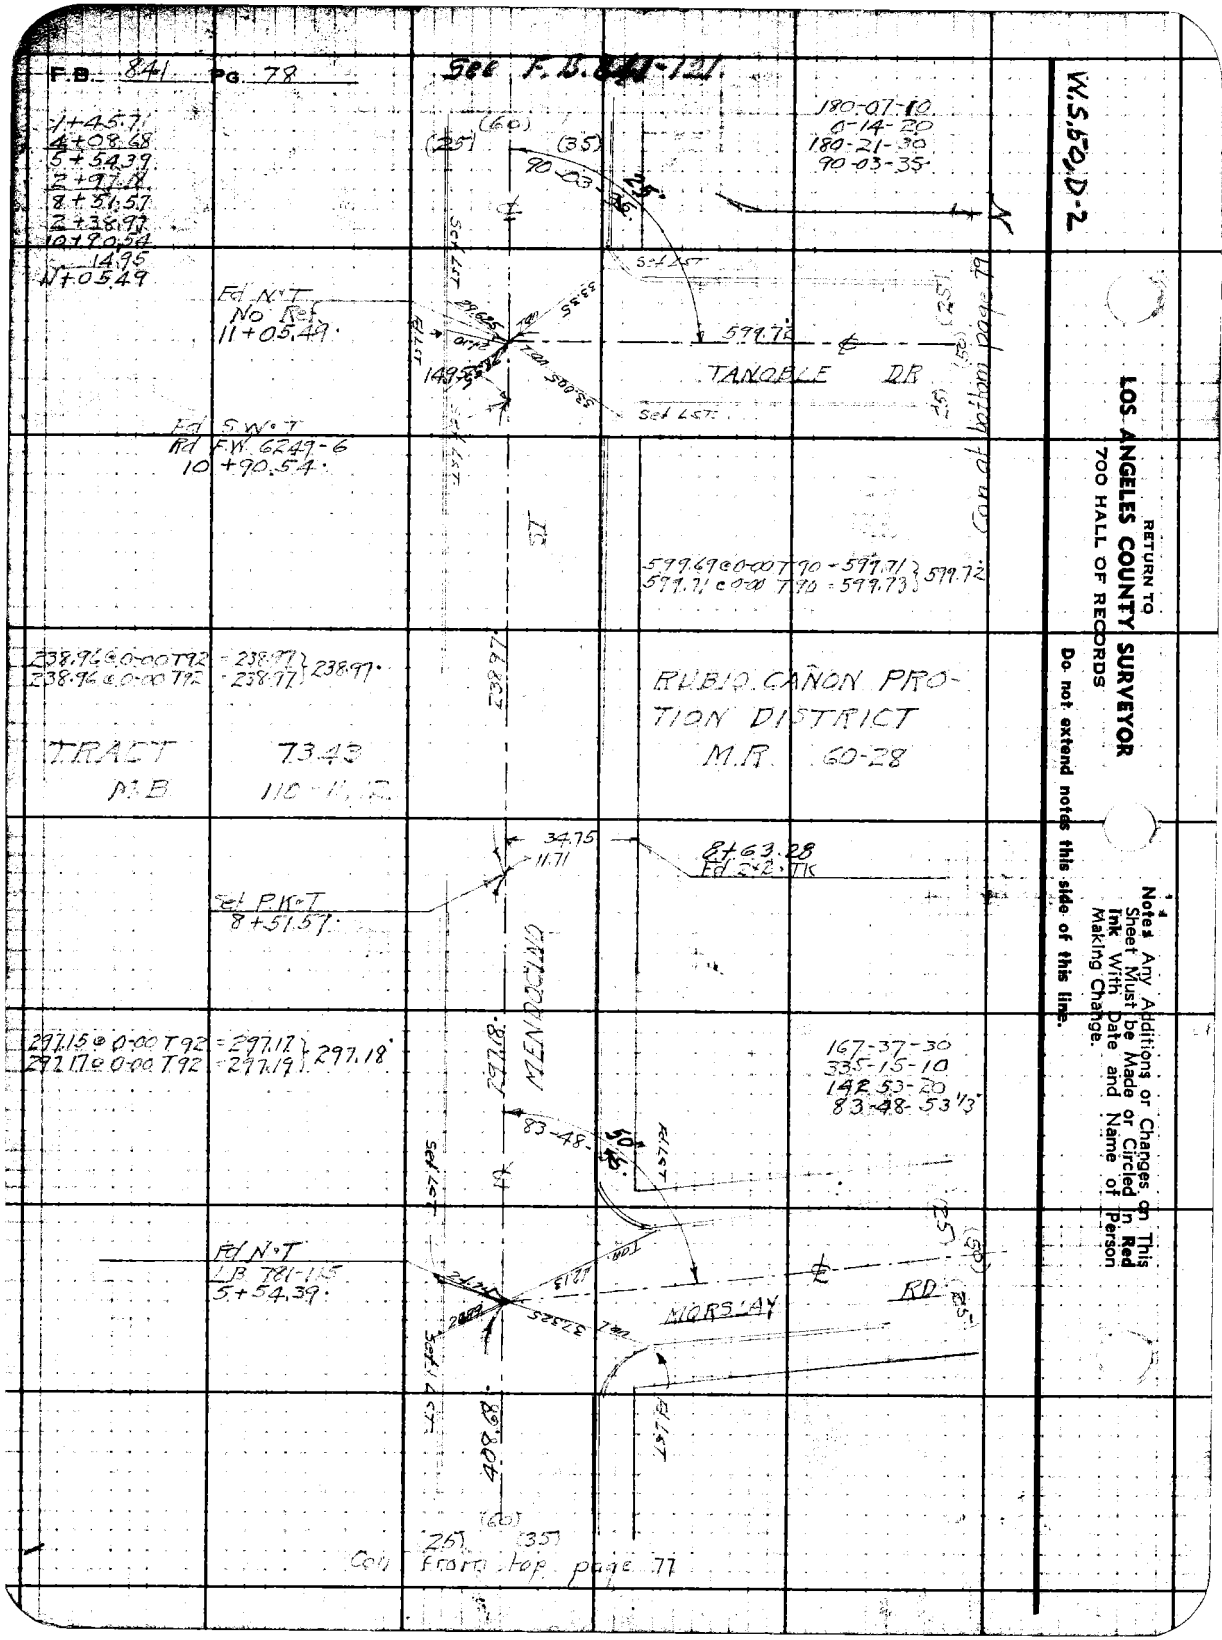
F.B. 841 Pg. 78
See F.B. 841-121
W.S.50, D-2
1+45.71
4+08.68
5+54.39
2+97.18
8+51.57
2+38.97
10+90.54
14.95
N+05.49
Fd N.T
No Rel
11+05.49
Fd S.W.T
Rel F.W. 6249-6
10+90.54
180-07-10
0-14-20
180-21-30
90-03-35
599.72
TANOBLE DR
Set L&T
599.69@0-00 T90 = 599.71
599.71@0-00 T90 = 599.73
599.72
238.96@0-00 T92 = 238.97
238.96@0-00 T92 = 238.97
238.97
TRACT
M.B
7343
110 M.R.
RUBIO CAÑON PROTION DISTRICT
M.R. 60-28
34.75
11.71
8+63.28
Fd 3/4" I.P.
Set PK N.T
8+51.57
297.15@0-00 T92 = 297.17
297.17@0-00 T92 = 297.19
297.18
167-37-30
33.5-15-10
142.53-20
83-48-53 1/3
83-48
Fd N.T
LB 791-LS
5+54.39
MORSLAY
RD
Con from top page 77
Con from top page 77
RETURN TO
LOS ANGELES COUNTY SURVEYOR
700 HALL OF RECORDS
Do not extend notes this side of this line.
Notes: Any Additions or Changes on This Sheet Must be Made or Circled in Red Ink With Date and Name of Person Making Change.

W.S. 50; D-7

Notes Ck'd by		Survey of	ALLEN AVE
Map No.	A-949-3	W. 0°12'S	Tape No. 047 St'd 84 °F
Office Work	Cox	Surveyed by	W A Miller
Checked		Notes	Miller Date 7-25-42
Date	MAY '42	Indexed	

F.B. 841 Pg. 79

11+05.49
5+71.73
16+77.22
1+93.09
18+49.30

Con at bottom page 80

Note: Any Additions or Changes on This Sheet Must be Made or Circled in Red Ink With Date and Name of Person Making Change.

Do not extend notes this side of this line.

RETURN TO
LOS ANGELES COUNTY SURVEYOR
700 HALL OF RECORDS

411.81 @ 0-00 T 88 - 411.82
411.83 @ 0-00 T 88 - 411.84 } 411.83'

(50) (25) (25)

TRACT M.B 241 21-192

DR 411.83'


Fd 3/4" I.P. Conc. Tag R.E. 24.10

25.05

16.40

Set P.K.T. 18+48.30

143.11 @ 0-00 T 88 - 143.10
143.08 @ 0-00 T 88 - 143.08 } 143.09'

180-04-30
0-09-00
180-14-00
90-02-20

Fd 3/4" I.P. Conc. Tag R.E. 24.10

90°02'20" 89°58'40"

125.00

Set L&T

R=25.00 Tan 25.03 Tan 25.35

Set L&T

179-57-14
357-55-00
177-52-30
89 58-45

BRAE BURN

RD

(50) (25) (25)

Fd N.T. at E Porter Ave LB 781-52

Fd N.T. L.B. 781-52 17+05.21. Set L&T.

25.38

89°58'

Set L&T

TRACT M.B 241 21-192

TANOE-E

FM 72.

(25) (50) (25)

Con from top right page 78

FORM 247 5M 10-59

F.B. 841 Pg. 80

18+48.30
4+11.83
22+60.13
3+60.90
26+21.03

Con at bottom right page 81.

(25) (50) (25)

193.88' ℄

DR

193.87 @ 0-00 774 = 193.88
193.87 @ 0-00 774 = 193.88 } 193.88

Fd 2"I.P. Pg. TK

25.00'

774

Set PK "T"
26+21.03.

RUBIO CANON PROTECTION DISTRICT M.R. 60-28

360.92 @ 0-00 774 = 360.90
360.92 @ 0-00 774 = 360.90 } 360.90

TRACT M.B. 2141 21-192

360.90' TANGENT

Set L.&T.

Fd N.T. L.B. 781-83.

Fd N.T. L.B. 781-83 22+60.13'

(50) (25)

HOMEWOOD

DR

25.516

25.598

25.565

Set L.&T.

Fd 2"I.P. Pg. TK

179-54-30
3-59-49-60
179-45-30
89-57-15

180-01-30
0-02-40
180-03-50
90-00-38½

411.83'

(25) (50) (25)

Con from top page 77

RETURN TO
LOS ANGELES COUNTY SURVEYOR
700 HALL OF RECORDS

Do not extend notes this side of this line.

Note: Any Additions or Changes on This Sheet Must be Made or Circled in Red Ink With Date and Name of Person Making Change.

W.S.Sq. D-2

Notes Ck'd by L. M. Finley
Map No. B-949-3
Office Work Cox
Checked
Date MAY '42

Survey of ALLEN AVE
W. O. 7125 Tape No. 947 Std. 84°F
Surveyed by W. A. Miller
Notes Miller Date
Indexed

F.B. 291 Pg. 81

W.S.So.Del.

Con at bottom pg. 82

26+21.03
1+93.58
28+14.71
28+44.91
3+60.90
32+05.81

167-31-40
335-03-30
142-35-30
83-45-55

(60)
30 (30)

193.38 @ 0-00 780 = 193.37 | 193.37'
193.38 @ 0-00 780 = 193.37 |

BLVD
173.37'
83-45-55
R/W
Set L&T in Conc Bk Sid in Lead B.M.'s

Set S.W.T. by Inter 32+05.81.

MORSLAY RD
(60)
25
25
2700
1200
32.81 (35.81)
50.46

360.92'
Set L&T in Conc Bk Sidewalk

PUBLIC CANON PROTECTION DISTRICT
M.R. 60-29

360.92 @ 0-00 T72 = 360.89 | 360.90'
360.92 @ 0-00 T72 = 360.90 |

180-01-00
360-02-00
180-02-00
90-01-30

EQUITABLE
70-00
40.00
Set L&T

Set S.W.T. by Inter 28+44.91.

25
(50)
TANOBLE
12" Mag
30.00
193.88'
Fd Nail L.B. 781.93 28+14.97'
2700
1200
30.00
Fd 2" I.P. Lead & Tk
Con from Ex. Joint

Fd Nail
Fd Nail
Set L&T
(30)
30.00
Fd 4" I.P. Conc. Nail at S.E. Cor. Porter Ave

RETURN TO
LOS ANGELES COUNTY SURVEYOR
700 HALL OF RECORDS

Note: Any Additions or Changes on This Sheet Must be Made in Red Ink With Date and Name of Person Making Change

Do not extend notes this side of this line.

FORM 247 5M 10-39

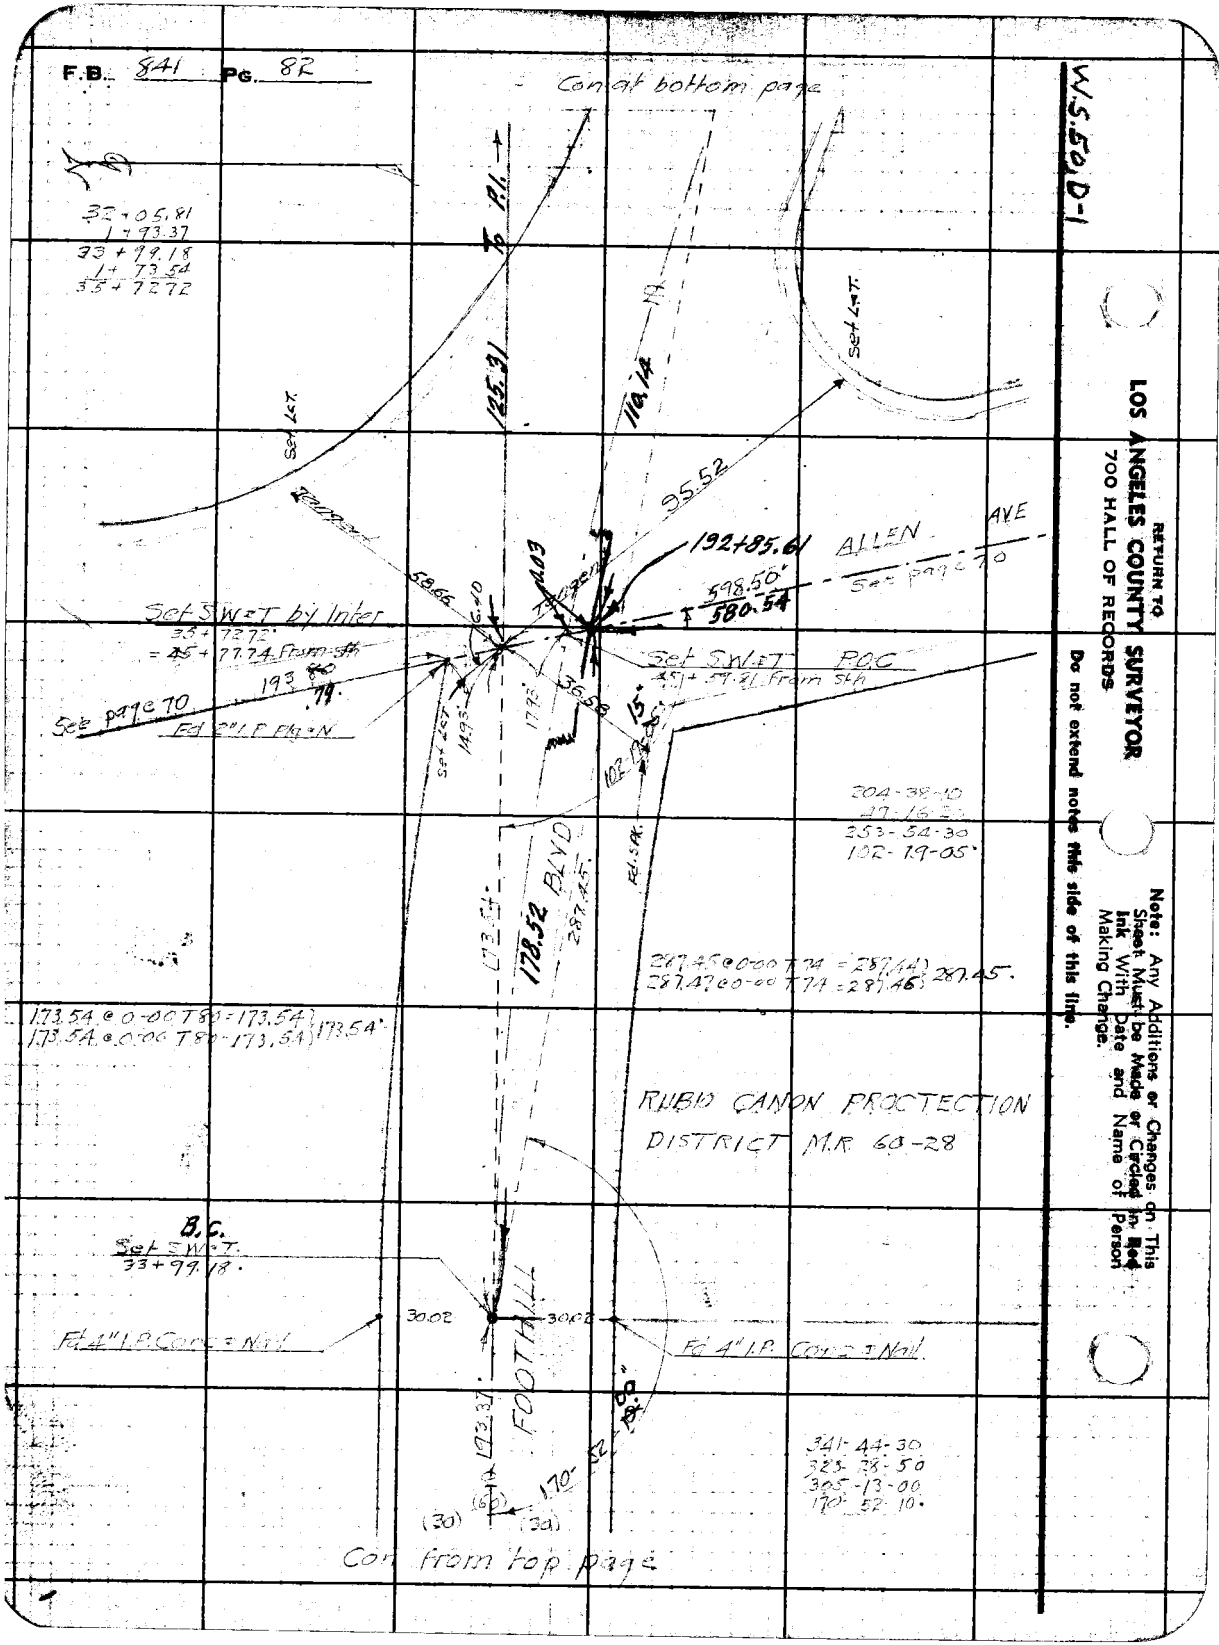
F.B. 841 Pg. 82
Con at bottom page
W.S.Co.D-1
RETURN TO
LOS ANGELES COUNTY SURVEYOR
700 HALL OF RECORDS
Do not extend notes this side of this line.
Note: Any Additions or Changes on This Sheet Must be Made or Circled in Red Ink With Date and Name of Person Making Change.
32+05.81
1+93.37
33+99.18
1+73.54
35+72.72
To P.I.
125.31
116.14
Set L+T.
95.52
192+85.61
ALLEN AVE
598.50'
580.54
See page 70
Set SW+T by Inter
33+72.72
= 45+77.74 from Sta
193.79
Fd 2" I.P. Plug N
Set SW+T P.O.C.
49+59.21 from Sta
59.66
178.52
BLVD
287.45'
173.54'
Fd. Sta.
204-38-10
17-16-20
253-54-30
102-19-05
287.45 @ 0.00 T 74 = 287.44
287.45 @ 0.00 T 74 = 287.46
287.45'
173.54 @ 0.00 T 80 = 173.54
173.54 @ 0.00 T 80 = 173.54
173.54'
RUBIO CANON PROTECTION
DISTRICT M.R. 60-28
B.C.
Set SW+T
33+99.18
Fd 4" I.P. Corn = N+W
30.02
30.02
Fd 4" I.P. Corn = N+W
FOOTHILL
193.37
170.52
(30)
(30)
341-44-30
325-33-50
305-13-00
170-52-10
Con from top page

Notes Ck'd by	U. M. Finley	Survey of	ALLEN AVE
Map No.	B-949-3	W. O.	7125 Tape No. 047 Std 84°F
Office Work	Cox	Surveyed by	W A Miller
Checked		Notes	Mt's of Date 5-27 1942
Date	MAY 42	Indexed	

F.B. 84 PG. 93

W.S.Eq. D-1

Note: Any Additions or Changes on This Sheet Must be Made or Circled in Red Ink With Date and Name of Person Making Change.

Do not extend notes this side of this line.

RETURN TO
LOS ANGELES COUNTY SURVEYOR
700 HALL OF RECORDS

FORM 247 5M 10-39

Fd 1" LP Cor. N hole

30.00

E.C.
Fd. W.T.

Fd. 1" IP Cor. N

ELVD

TRACT
M B
30-51

TRACT
M B
22 - 194, 195

2123

298.85

288.64

287.41

285.16 @ 0-00 T 76 = 285.14
285.17 @ 0-00 T 76 = 285.15
2.27 @ 0-00 T 76 =

285.14'
2.27
287.41'

FOOTHILL

Set L.C.T.

POC Set C.W.T.

Set L.C.T.

P.I.
Established
by Intersection

3960

Set L.C.T.

Set L.C.T.

125.31

287.45

323-27-00
286-54-20
250-21-30
161-43-35

Δ = 36-32-30
R = 905.18
T = 298.85
L = 577.30

Con from top page

RETURN TO
LOS ANGELES COUNTY SURVEYOR
700 HALL OF RECORDS

Note: Any Additions or Changes on This Sheet Must be Made or Circled in Red Ink With Date and Name of Person Making Change.

Do not extend notes this side of this line.

F.B. 841 PG. 84

W.S.S.D.D.2

Notes Ck'd by	Survey of ALLEN AVE
Map No. 9949-3	W. 07125 Tape No. 047 St'd 84°F
Office Work Cox	Surveyed by W.A. Miller
Checked D. M. Finley	Notes Miller Date 7-24-1940
Date MAY 42	Indexed E. S. Jameson

F.B. 911 Pg. 85

Con at bottom page 86

Con at bottom page 87

MENDOCINO ST

142.41'

142.41 @ 0-00 T84 = 142.41' 142.41'
142.41 @ 0-00 T84 = 142.41'

148.51'

148.51 @ 0-00 T84 = 148.51'
148.51 @ 0-00 T84 = 148.51' 148.51'

Set Lot in Cb

Tan

700'

S-H S.W.T

62.54

13.56

17.54

37.07

Set S.W.T

Set Lot in Cb

Set Lot in Cb

Tan

273-46-30
187-33-00
101-19-30
136-53-15

136-53-15

10

142.59

LANE

GLENVIEW

38.5-58-40
211-57-20
137-56-00
142-59-20

183.63'

183.63 @ 0-00 T84 = 183.63' 183.63'
183.63 @ 0-00 T84 = 183.63'

Fd S.W.T 2" on Page 67

ALLEN AVE

2.14

ALLEN AVE

Fd S.W.T Page 67

MENDOCINO STREET

Note: Any Additions or Changes on This Sheet Must be Made or Circled in Red Ink With Date and Name of Person Making Change.

Do not extend notes this side of this line.

RETURN TO
LOS ANGELES COUNTY SURVEYOR
700 HALL OF RECORDS

FORM 247 5M 10-39

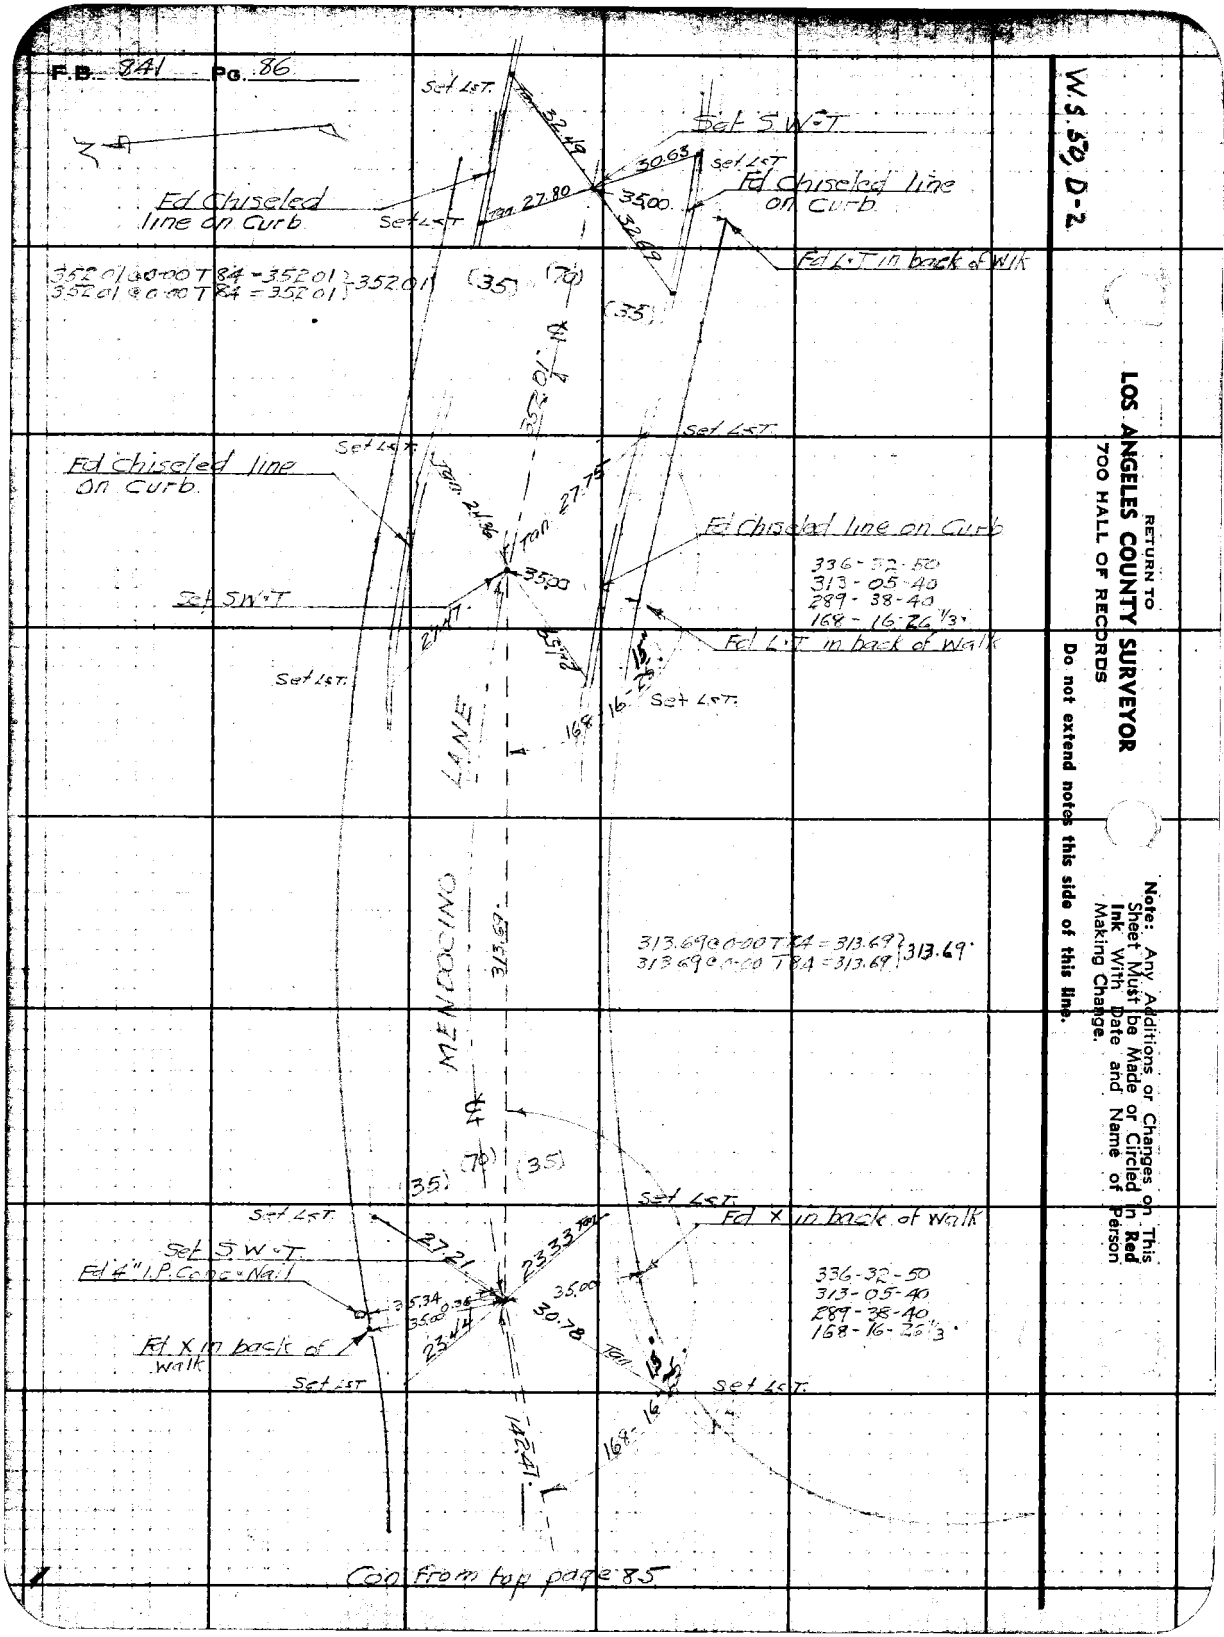
F.B. 841 Pg. 86
W.S. 59, D-2
RETURN TO
LOS ANGELES COUNTY SURVEYOR
700 HALL OF RECORDS
Do not extend notes this side of this line.
Note: Any Additions or Changes on This Sheet Must be Made or Circled in Red Ink With Date and Name of Person Making Change.
Set L&T.
Set S.W.T.
Fd Chiseled line on Curb
Fd L.T. in back of Walk
Fd X in back of Walk
Set S.W.T. Fd 4" I.P. Copper Nail
Set L&T.
32.49
30.63
27.80
35.00
32.89
35.07 N
27.75
21.96
35.00
35.42
16.26
168.16
LANE
35.69
313.69
313.69
27.21
23.33
35.34
35.00
0.76
23.44
30.78
168.16
142.41
(35)
(70)
(35)
336-32-50
313-05-40
289-38-40
168-16-26 1/3
336-32-50
313-05-40
289-38-40
168-16-26 1/3
Coin from top page 85

W. S. 50, D-2

Notes Ck'd by	D. M. Finley	Survey of	ALLEN AVE
Map No.	Br 949-3	W. O.	7125 Tape No. 0471 Std 84.°F
Office Work	Ck	Surveyed by	W. A. Miller
Checked	D. M. Finley	Notes	Miller Date 7-23-1940
Date	MAY '42	Indexed	A. C. Johnson

F.B. 2011 Pg. 87

Note: Any Additions or Changes on This Sheet Must be Made or Circled in Red Ink With Date and Name of Person Making Change

Do not extend notes this side of this line.

RETURN TO
LOS ANGELES COUNTY SURVEYOR
700 HALL OF RECORDS

FORM 247 SM 10-39

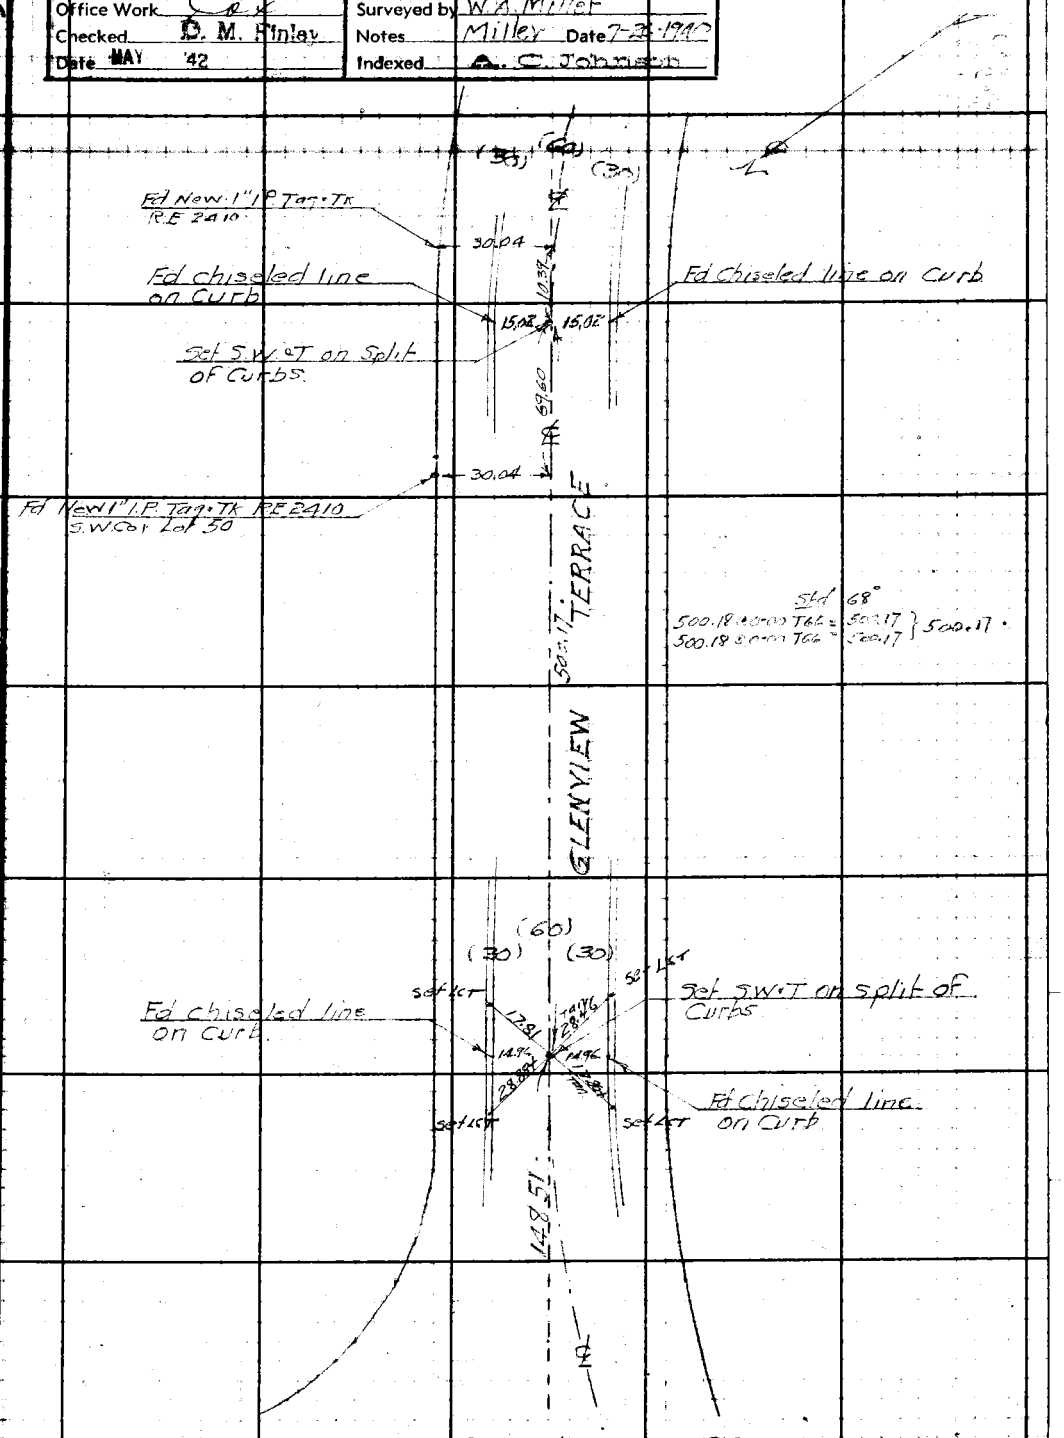

RETURN TO
LOS ANGELES COUNTY SURVEYOR
700 HALL OF RECORDS

Note: Any Additions or Changes on This Sheet Must be Made or Circled in **Red Ink** With Date and Name of Person Making Change.

Do not extend notes this side of this line.

F.B. 841 Pg. 58

Notes Ck'd by D. M. Finley	Survey of ALLEN AVE
Map No. B-949-3	W. O. 7425 Tape No. St'd P
Office Work OK	Surveyed by W A Miller
Checked D. M. Finley	Notes Date 5/1 MAR
Date MAY '42	Indexed A. C. Johnson 10-31-40

F.B. 3411 Pg. 87

Note: Any Additions or Changes on This Sheet Must be Made or Circled in Red Ink With Date and Name of Person Making Change.

Do not extend notes this side of this line.

RETURN TO
LOS ANGELES COUNTY SURVEYOR
700 HALL OF RECORDS

TOPOGRAPHY ALLEN AVE
NEW YORK AVE TO FOOTHILL BLVD
Pages 87-117 Inc.

Miller
Livingston
Gunderson
Harris

FORM 247 SM 10-39

RETURN TO
LOS ANGELES COUNTY SURVEYOR
700 HALL OF RECORDS

Note: Any Additions or Changes on This Sheet Must be Made or Circled in **Red Ink** With Date and Name of Person Making Change.

Do not extend notes this side of this line.

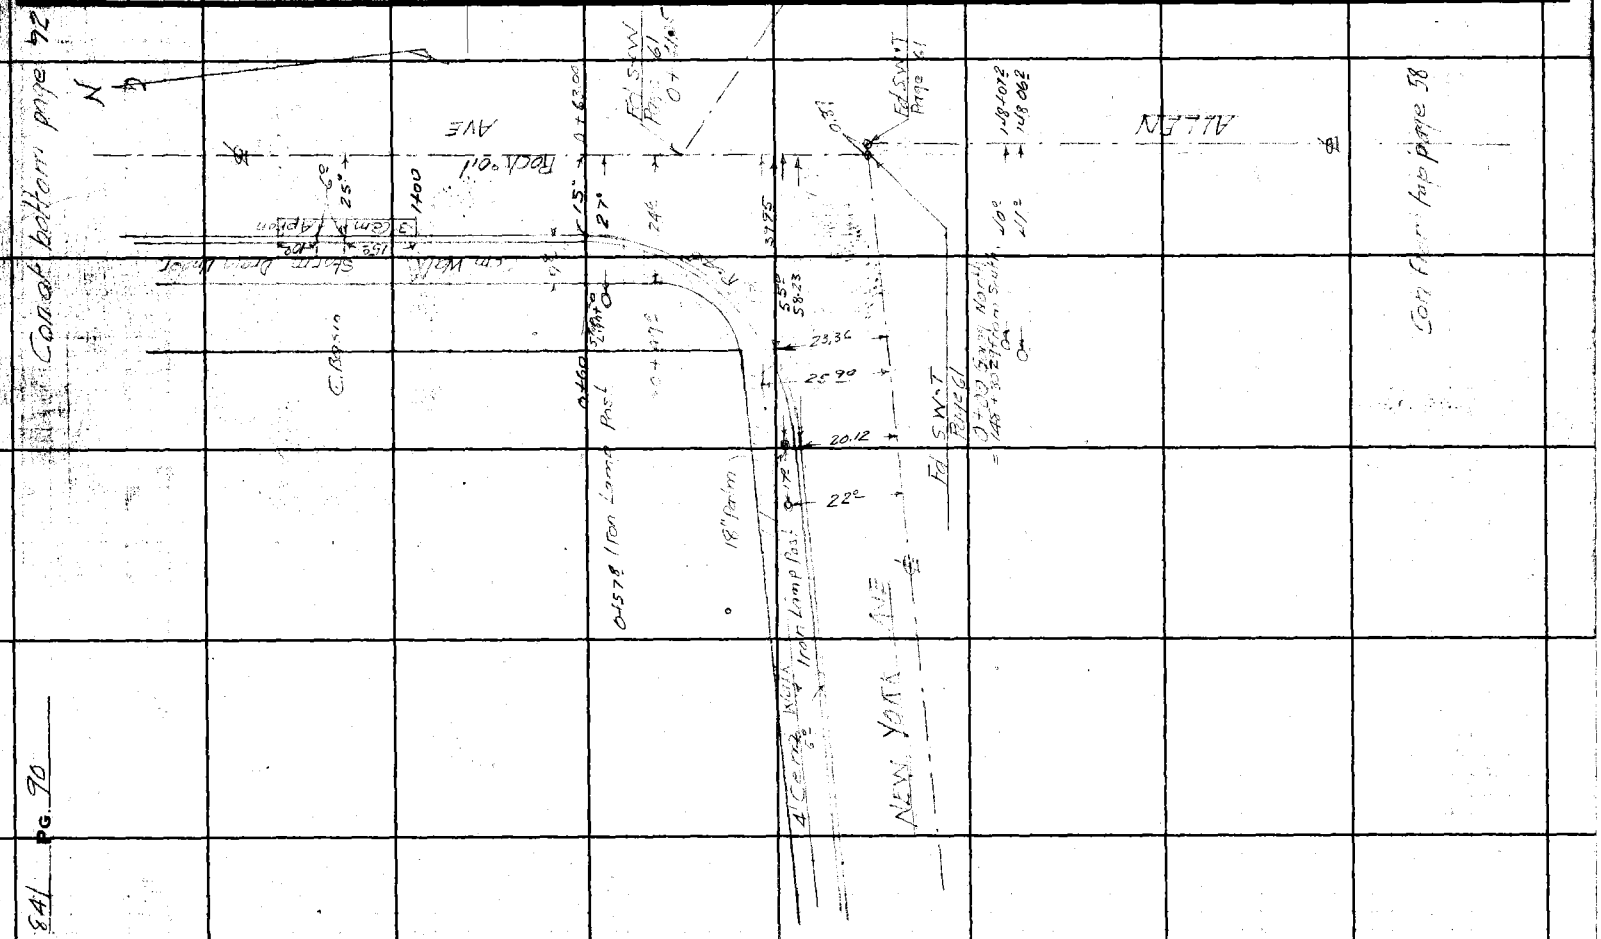
AVE
Block 61
ALLEN
1400
3725
1.48-102
148 062
Fd SSW
Fd SWT
Fd SWT
Pin & Tag
Pin & Tag
Pin & Tag

Notes Ck'd by D. M. Finley	Survey of ALLEN AVE	F.B. 641	Pg. 1
Map No. A-949-7	W. O.	Tape No.	Sht. of
Office Work COK	Surveyed by W.A.M. & F.		
Checked D. M. Finley	Notes W.A.M. & F. Date 9-24-40		
Date MAY '42	Indexed A. C. Johnson		

Con at bottom page 93

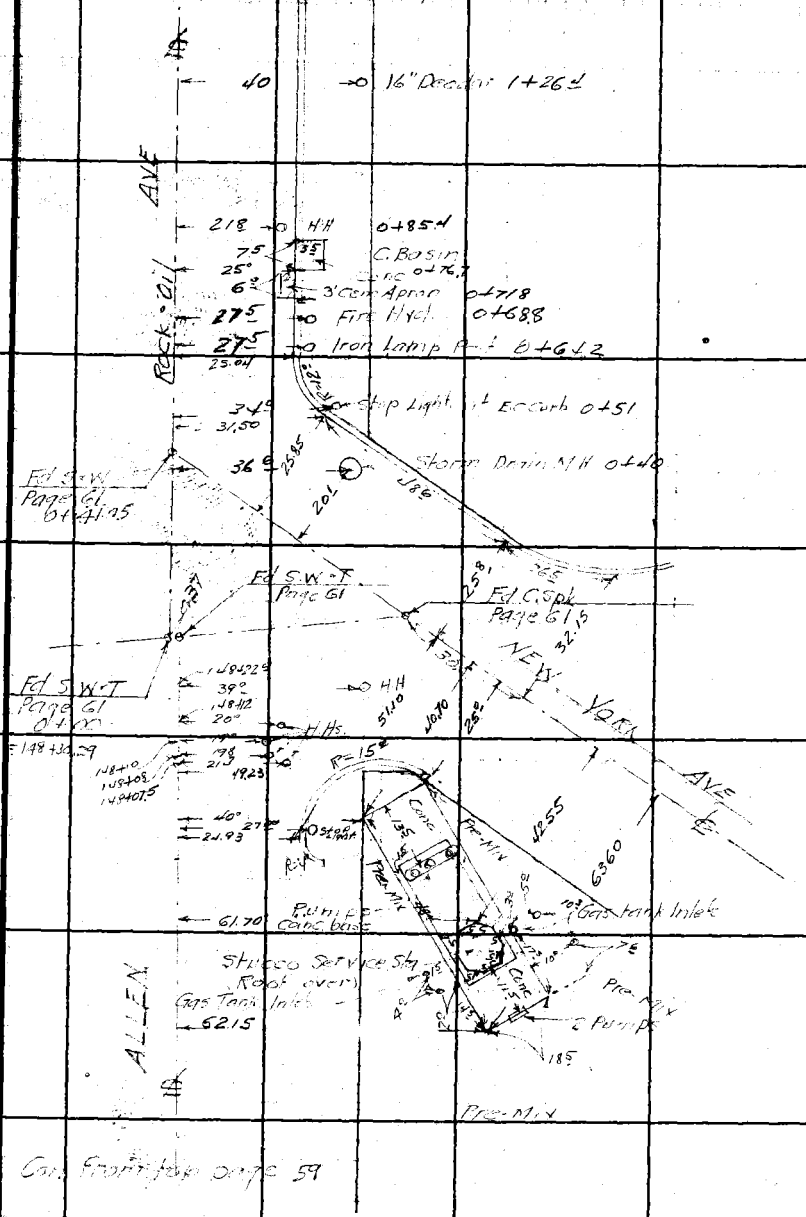

Con from top page 59

RETURN TO
LOS ANGELES COUNTY SURVEYOR
700 HALL OF RECORDS

Note: Any Additions or Changes on Sheet Must be Made or Circled in Ink With Date and Name of Person Making Change

Do not extend notes this side of this line.

FORM 247 5M 10-39

F.B. 841 Pg. 92

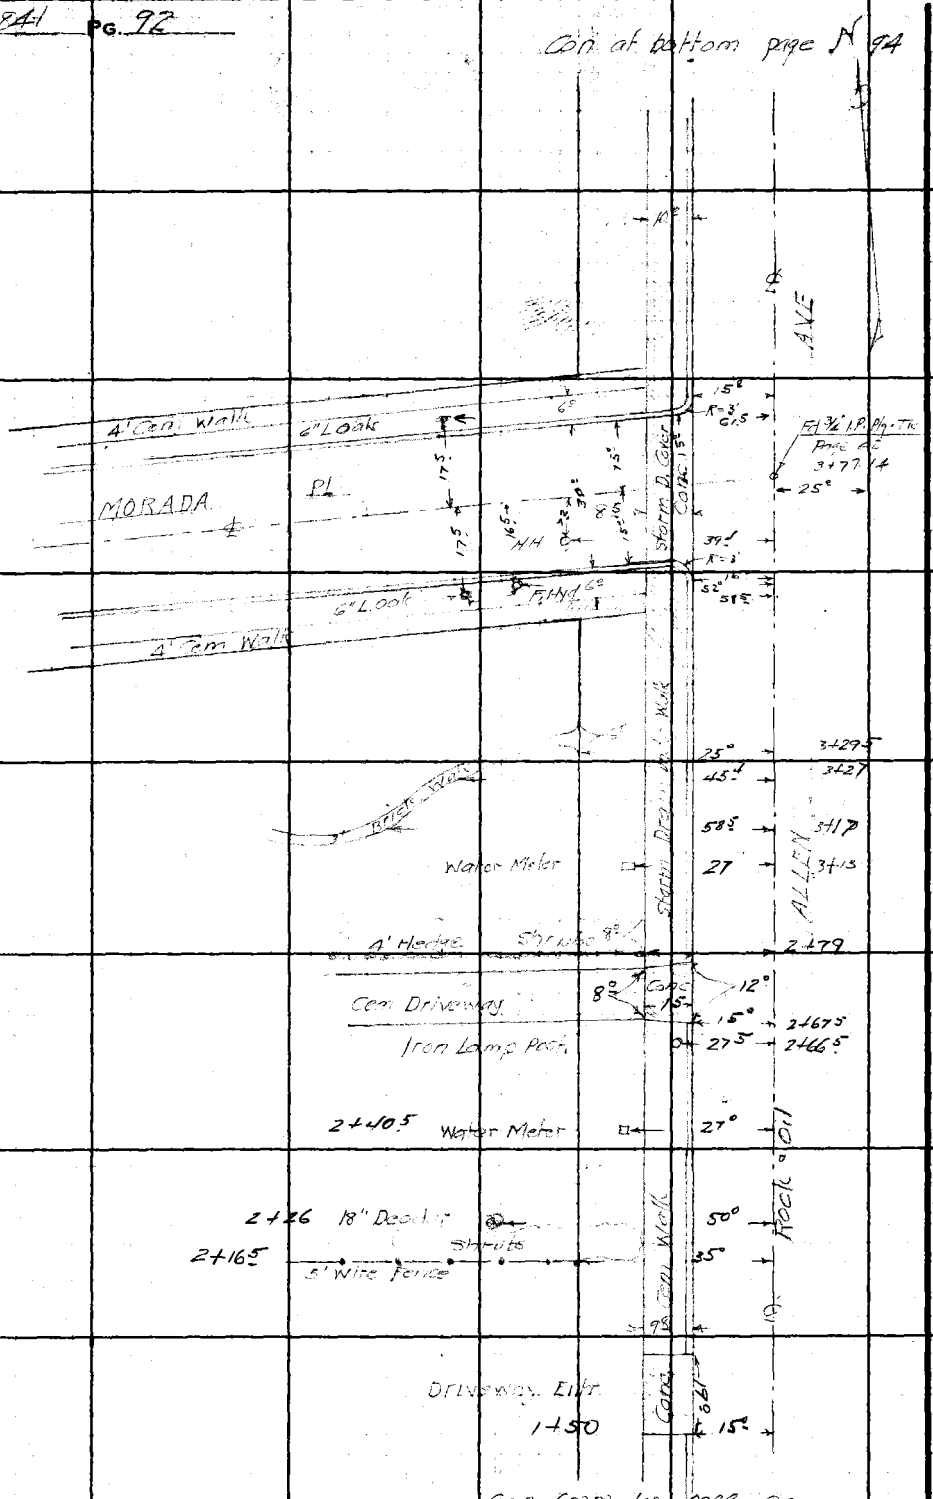

RETURN TO
LOS ANGELES COUNTY SURVEYOR
700 HALL OF RECORDS

Do not extend notes this side of this line.

Note: Any Additions or Changes on This Sheet Must be Made or Circled in Red Ink With Date and Name of Person Making Change.

Notes Ck'd by D. M. Finley	Survey of ALLEY A-F	F.B. 944	Pg. 93
Map No. A-949-3	W. O. 7125 Tape No. St'd °F		
Office Work Cot	Surveyed by W.A. Miller		
Checked D. M. Finley	Notes W.A.M.-F.S.L. Date 7-24-40		
Date MAY 42	Indexed		

Con't bottom Page 95

27 — 0 Iron Lamp Post 3+78.5

Rd 3/4" IP Pig'th
Page 65
3+71.4

ALLEY Back of Oil AVE

Yucca St

11.2 — Conc 7.3 Conc Driveway
25 — 24.63.5
27 — Water Meter 2+57.7
40 — 12 Deg Cur 2+50.1

42 — 4" Header 2+12

27° — 0 Iron Lamp Post 1+60.3

Con from top page 91

RETURN TO
LOS ANGELES COUNTY SURVEYOR
700 HALL OF RECORDS

Note: Any Additions or Changes on This Sheet Must be Made or Circled in Red Ink With Date and Name of Person Making Change

Do not extend notes this side of this line.

FORM 247 5M 10-39

F.B. 841 Pg. 94

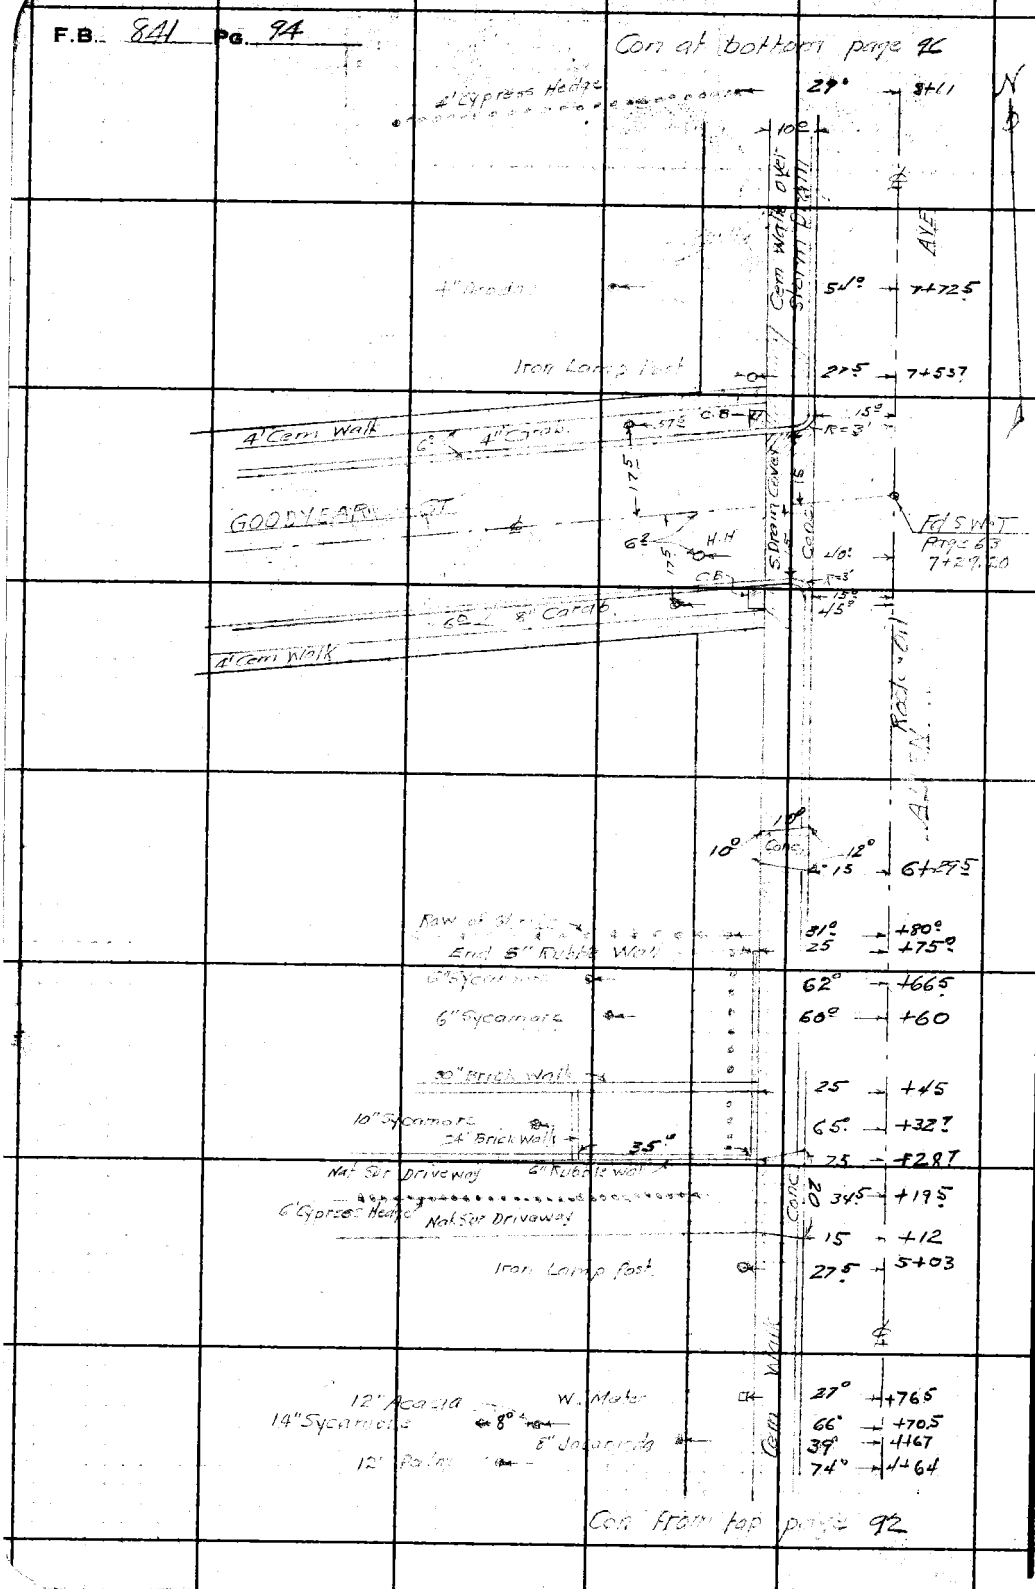

RETURN TO
LOS ANGELES COUNTY SURVEYOR
700 HALL OF RECORDS

Note: Any Additions or Changes on This Sheet Must be Made or Circled in Red Ink With Date and Name of Person Making Change.

Do not extend notes this side of this line.

Notes Ck'd by D. M. Finley	Survey of [illegible]	F.B. 841	Pg. 95
Map No. B-949-3	W. O 7125 Tape No. St'd °F		
Office Work Cox	Surveyed by W.A.M. Miller		
Checked D. M. Finley	Notes W.A.M. & C.S. Date Sept 1940		
Date MAY '42	Indexed		

Con. of bottom page 97

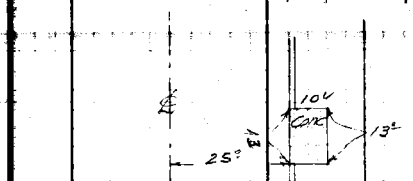

7+57.5

Sheet Iron

40

N Post 7+33?

Fd S W T
Tags 63
7+21.20

VINEYARD

41.7

6" Conc Post 6+91

AVE

27° 40

Iron Pipe 6+43

40°

15" Post 6+12.5

ALLEN

Rock Wall

40?

24" Post 4+93?

Con from left page 73

Note: Any Additions or Changes on This Sheet Must be Made or Circled in Red Ink With Date and Name of Person Making Change

Do not extend notes this side of this line.

RETURN TO
LOS ANGELES COUNTY SURVEYOR
700 HALL OF RECORDS

FORM 247 5M 10-39

F.B. 84 PG. 96

Con at bottom page 98

RETURN TO
LOS ANGELES COUNTY SURVEYOR
700 HALL OF RECORDS

Note: Any Additions or Changes on This Sheet Must be Made or Circled in Red Ink With Date and Name of Person Making Change.

Do not extend notes this side of this line.

4' Conc Walk

6" S "Carob

C.B

E/3/4 I.P. Rh-TR Page 63 16+81.20

VISTALLIS ST

F. Hyd

Oleander

Conc

4' Conc Walk

11" Palm

6" Palm

Conc Walk over Storm Drain

AVE

12" Palm

4' Hedge

Free-Mix Concrete

Iron Gate & Hedge

12" Sycamore

8" Sycamore

6" Palm

5' Hedge

Conc Walk

ROCK OIL ALLEY

Conc

Con from page 94

Notes Ck'd by D. M. Finley	Survey of ALLEN Alley
Map No. B-949-3	W. O. 7125 Tape No. St'd °F
Office Work Cox	Surveyed by W.A.M. Yeo
Checked D. M. Finley	Notes W.A.M. - E.S.L. Date Sept 1940
Date MAY '42	Indexed C. Johnson

F.B. 841 Pg. 97

Col. at bottom page 79

Note: Any Additions or Changes on This Sheet Must be Made or Circled in Red Ink With Date and Name of Person Making Change

Do not extend notes this side of this line.

RETURN TO
LOS ANGELES COUNTY SURVEYOR
700 HALL OF RECORDS

FORM 247 5M 10-39

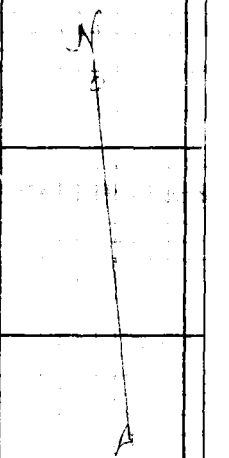

Col. at bottom page 75

F.B. 841 Pg. 98

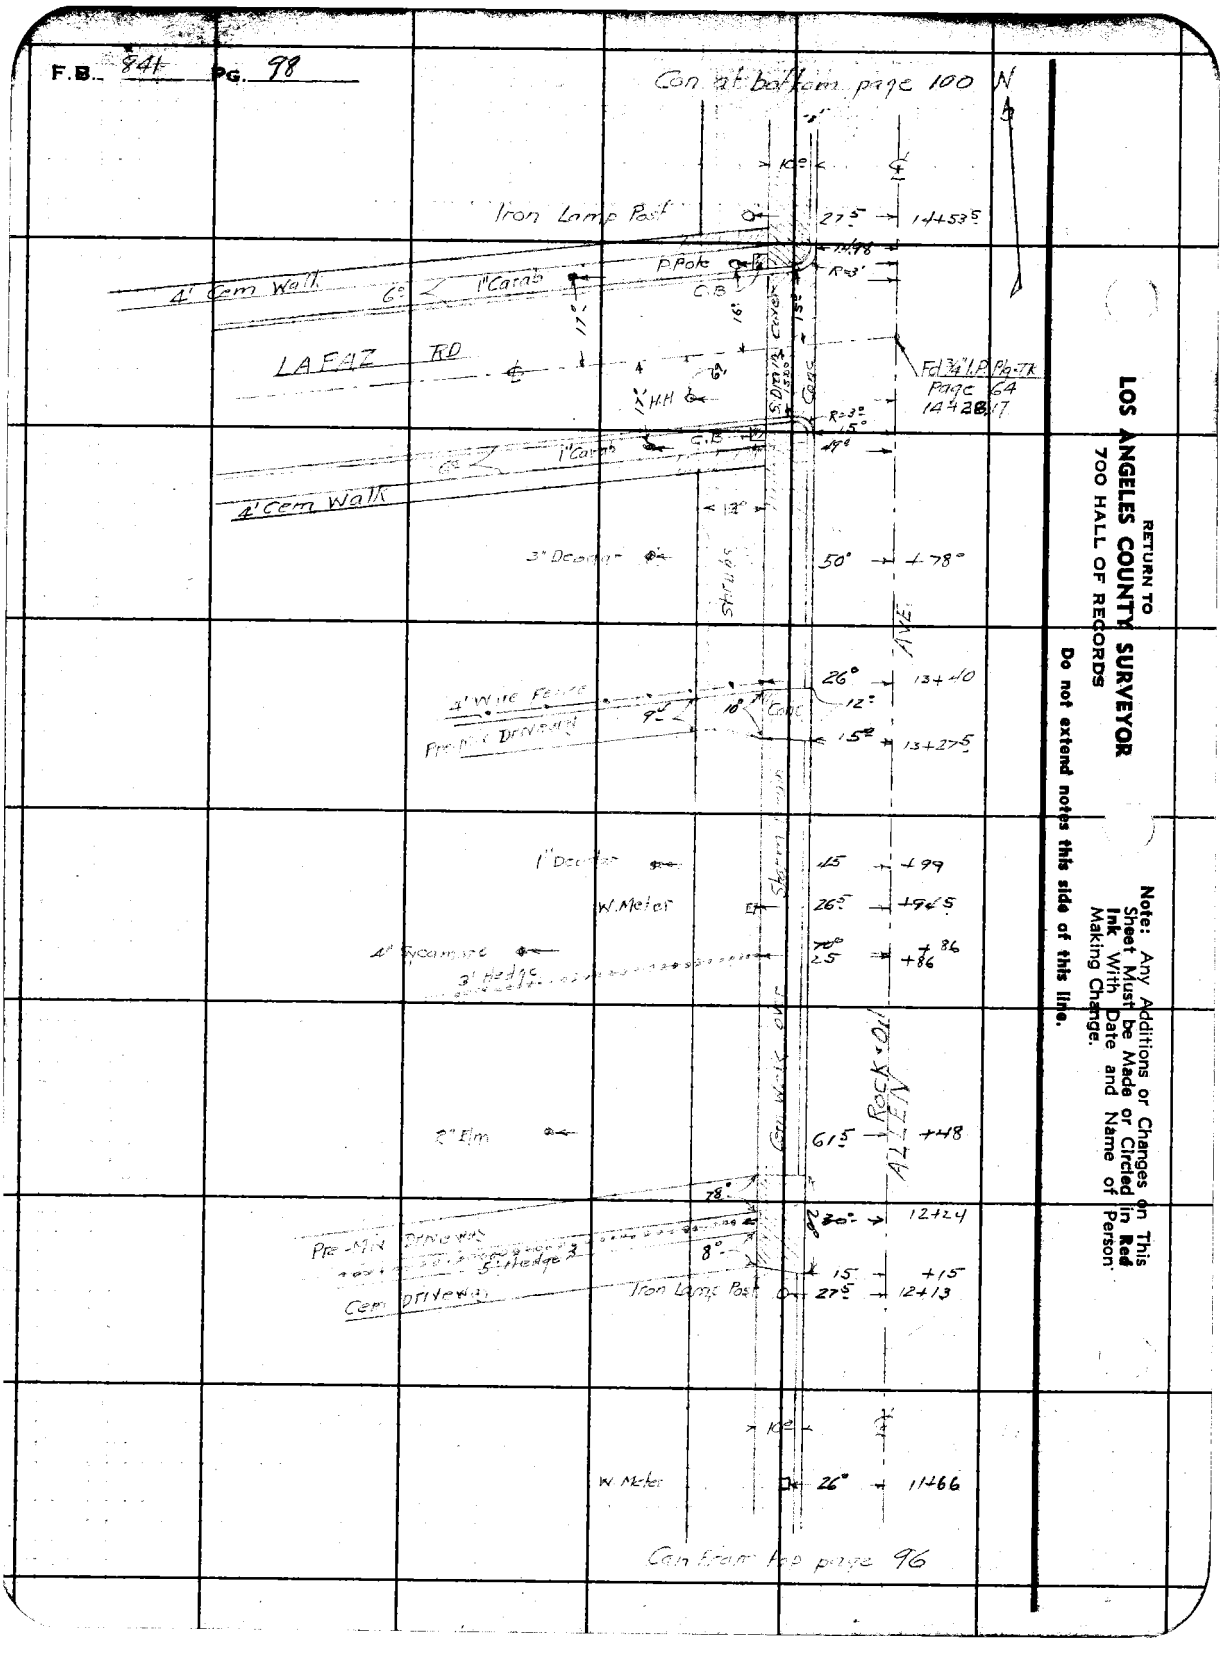

RETURN TO
LOS ANGELES COUNTY SURVEYOR
700 HALL OF RECORDS

Do not extend notes this side of this line.

Note: Any Additions or Changes on This Sheet Must be Made or Circled in **Red Ink** With Date and Name of Person Making Change.

Notes Ck'd by D. M. Finley	Survey of	F.B. 5411	Pg. 99
Map No. B-949-3	W. O. 7125 Tape No.	St'd °F	
Office Work Cox	Surveyed by W. A. Miller		
Checked D. M. Finley	Notes W.A.M. - F.S.L.	Date Sept 1940	
Date MAY '42	Indexed		

Con from page 101

14+55 18" Deodar

65° 2" Lemon 14+46

Page 44 14+28.17 13° Conc 8° Conc Drive-way

14+22 25°

14+03 27° W. Mole

+94 40 54" Palm

+85 41° 3' Hedge

+38 27½ Iron Lamp post

13+33 40 18" Deodar

School Grounds

+70 40° 48" Palm

12+17.5 40° 18" Deodar

Con from top page 97

Note: Any Additions or Changes on This Sheet Must be Made or Circled in Red Ink With Date and Name of Person Making Change

Do not extend notes this side of this line.

RETURN TO
LOS ANGELES COUNTY SURVEYOR
700 HALL OF RECORDS

FORM 247 5M 10-39

RETURN TO
LOS ANGELES COUNTY SURVEYOR
700 HALL OF RECORDS

Note: Any Additions or Changes on This Sheet Must be Made or Circled in **Red Ink** With Date and Name of Person Making Change.

Do not extend notes this side of this line.

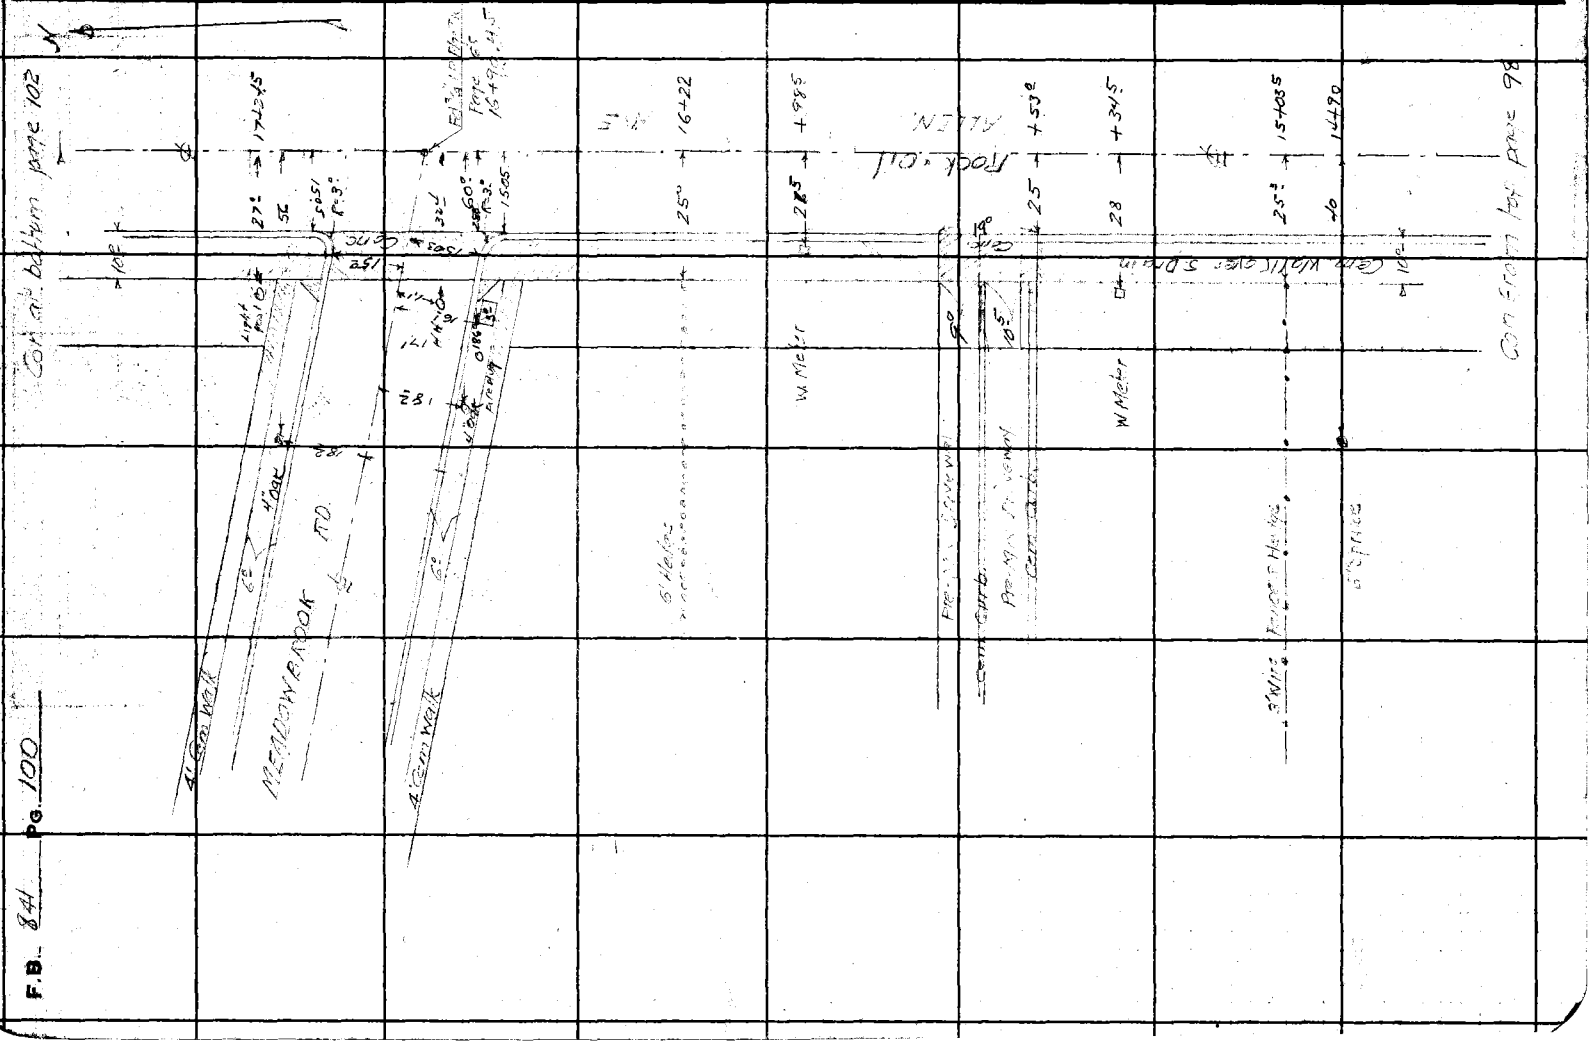
F.B. 841 PG. 100
MEADOWBROOK RD.
ALLEN
W Meyer
S Hope
Pcc. N. 1/4 Cor.
Cen. Sec.
Pcc. N. 1/4 Cor.
Cen. Sec.
Rock Oil
Cen. Wash. Sec. 5 Down 1'
Cen. Wash. Sec. 5 Down 1'
Cen. Wash. Sec. 5 Down 1'

Notes Ck'd by D. M. Finley
Map No. B-919-3
Office Work Col
Checked D. M. Finley
Date MAY 42

Survey of ALLEN Ave
W. O. 7425 Tape No. Std. °F
Surveyed by W. A. Miller
Notes W.A.M.-F.S.L. Date Sept 1940
Indexed A. C. Johnson

F.B. 841 Pg. 101

Note: Any Additions or Changes on Sheet Must be Made or Circled in Ink With Date and Name of Person Making Change

Do not extend notes this side of this line.

RETURN TO
LOS ANGELES COUNTY SURVEYOR
700 HALL OF RECORDS

FORM 247 5M 10-39

Cont. at bottom page 103

17+11.20

16+91.31

66.66

16+88.4

16+70.45

16+58

40.3

H.H

36.86

62.61

+475

+48°

12" Palm

42.23

16+47.64

Shrubs

+475

16+16°

27.5

25°

6 Iron Lamp Post

16+08

30

Shrub

16+01

25°

4' Cement Walk

+97

30

Shrub

11°

Conc

25.3

58.1

+75

58.8

40

16" Deodar

30

2 Sty Stucco Dwelling

20.8

6°

Conc

13.2

ALLEN

ROCKWELL

440

40

15" Deodar

L 35.3

+32

32°

26.5

D.W. Meter

15+14

41

36" Palm

58.6

38°

12.5

18°

16

15+ Sty Stucco Gar

Conc.

14+74.5

25

58.7

58

14+73.5

10'

3" Fig

3" Apricot

14+71

Co. from top page 99

F.B. 841 PG. 102

Section of Open Cem. Storm Drain

Con at bottom page 104

Ph Pole
25° 19+80
94° 19+76
12" Acacia
5" Acacia
G. Wire
14" Gum
19+57
+49 P. Pole
Iron Lamp post
rail shed
G. Wire
Open Storm Drain
AVE.
58.5
27.5
25.5
19+56
19+48.5
19+45
19+41
G. Oak
15" Pine
3" Cedar
19+14
15
6" Palm
8" Palm
12" Deodar
W. Maint
3' Hedge
Cem Driveway
Cem Walk
Cem Driveway
35
8°
50.5
8°
29°
72°
31°
31°
50
27.5
15.8
26°
19+33
19+31
Fd PK Tin
Pag c 65
19+18.59
19+02
18+96
18+93
+64.0
26°
25.5
Wall
6' Cross Hedge
ROCK GIL ALLEN
8" Rock
G. Poplar
3' Hedge
Cem Curb
12" Oak
Cem walk over storm drain
23
39°
37°
64°
+15
+06
18+03
17+91
3' Redwood Walk
60.5
+67.0
19.5
68°
25°
5.5
19+85
17+36.5
12" Sycamore
Con from top page 100

RETURN TO
LOS ANGELES COUNTY SURVEYOR
700 HALL OF RECORDS
Do not extend notes this side of this line.

Note: Any Additions or Changes on This Sheet Must be Made or Circled in Red Ink With Date and Name of Person Making Change.

Notes Ck'd by L. M. Finley
Map No. B-949-3
Office Work OK
Checked D. M. Finley
Date MAY '42

Survey of ALLEN AVE
W. O. 7125 Tape No. St'd °F
Surveyed by W A Miller
Notes WAM-FSL Date Feb 1940
Indexed A. C. Jones

F.B. 941 Pg. 103

Con at bottom page 105

+40 40 16" Dead

+31 19+29 27° ? P.Pole End of Curb

Ed P/L Tin Pags 65 19+18.89

ALLEN AVE

18+39.5 27.5 Iron Lamp Post

ALLEN ROCK ST

17+60 40 36" Palm

Con from top page 101

Note: Any Additions or Changes on This Sheet Must be Made or Circled in Red Ink With Date and Name of Person Making Change

Do not extend notes this side of this line.

RETURN TO
LOS ANGELES COUNTY SURVEYOR
700 HALL OF RECORDS

FORM 247 5M 10-39

F.B. 841 PG. 104

Con of bottom page 106

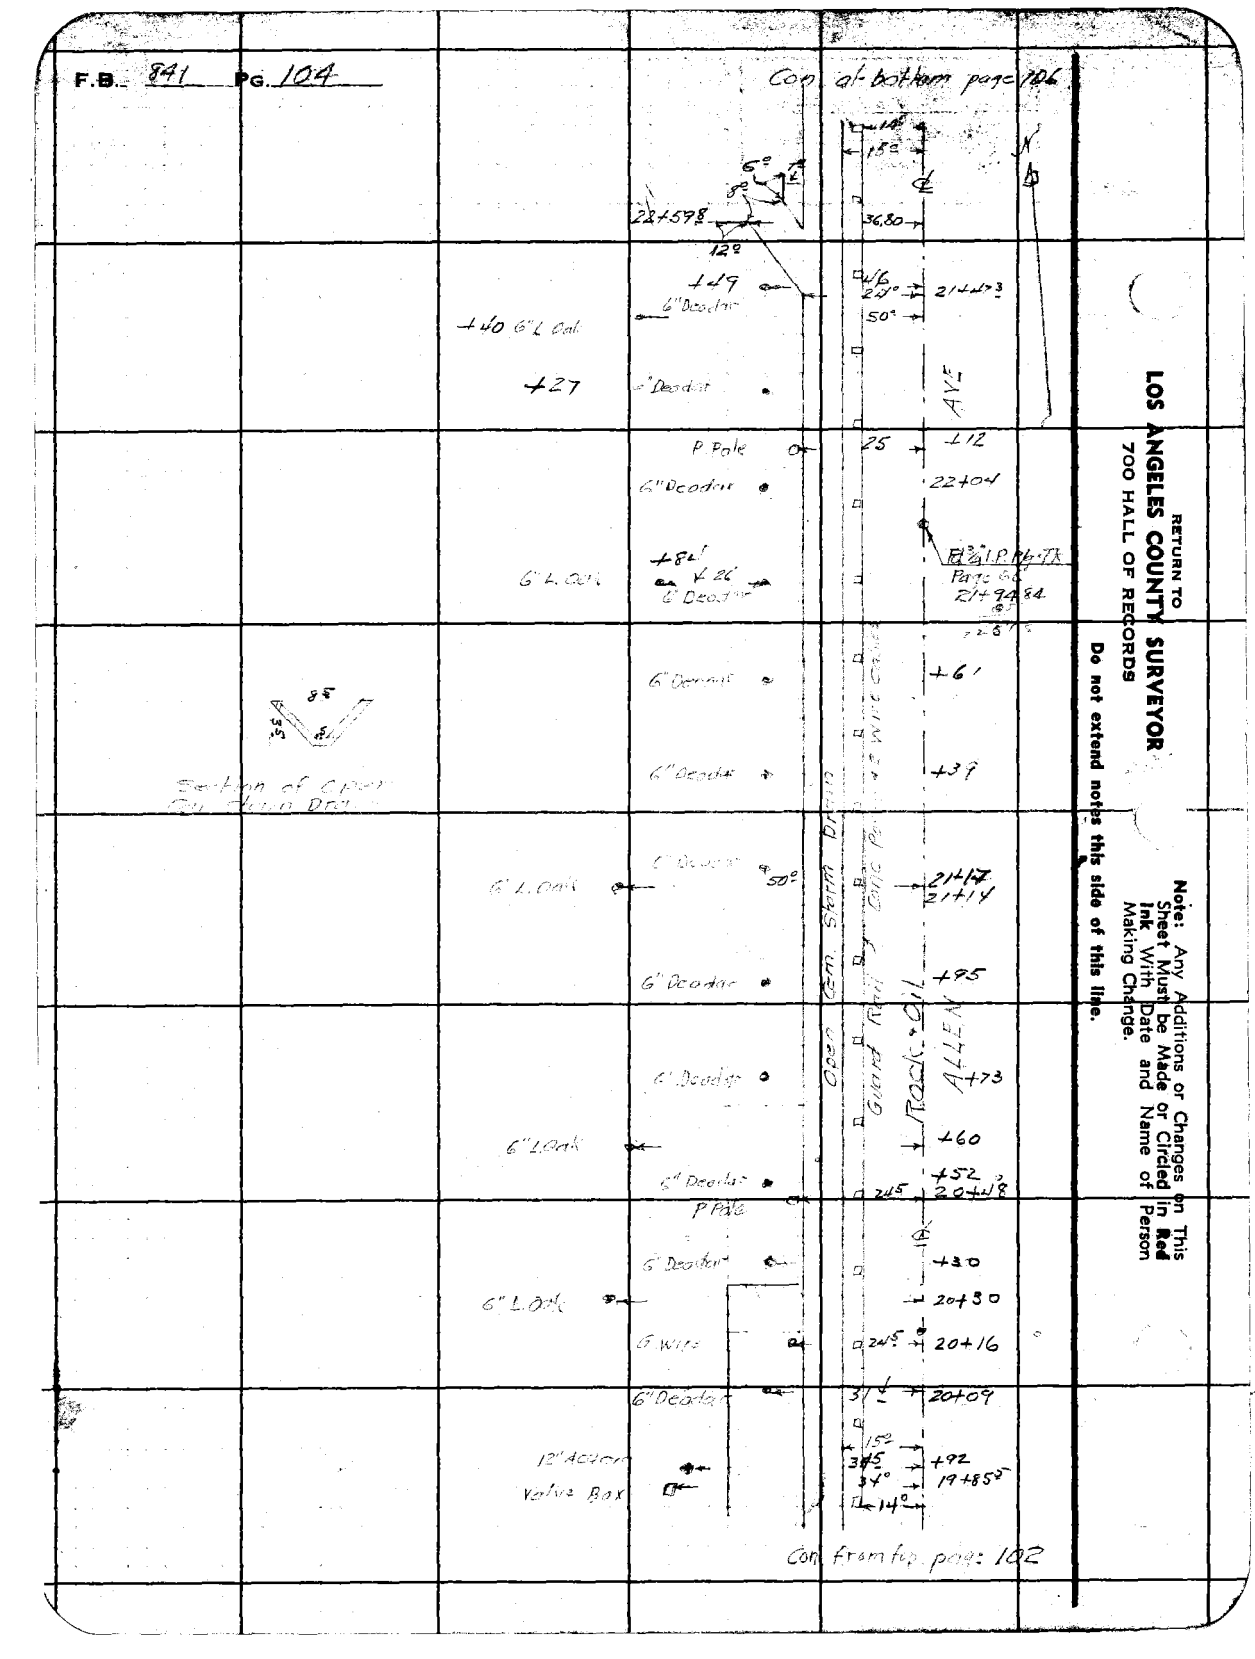

RETURN TO
LOS ANGELES COUNTY SURVEYOR
700 HALL OF RECORDS

Do not extend notes this side of this line.

Note: Any Additions or Changes on This Sheet Must be Made or Circled in **Red Ink** With Date and Name of Person Making Change.

Notes Ck'd by D. M. Finley	Survey of ALLEN AVE	F.B. 24	Pg. 105
Map No. A-949-3	W. O. 7125 Tape No. Std. P		
Office Work [illegible]	Surveyed by W.A. Miller		
Checked D. M. Finley	Notes W.A.M. + F.S.L. Date Sept 1940		
Date MAY '42	Indexed [illegible]		

Con at bottom page 107

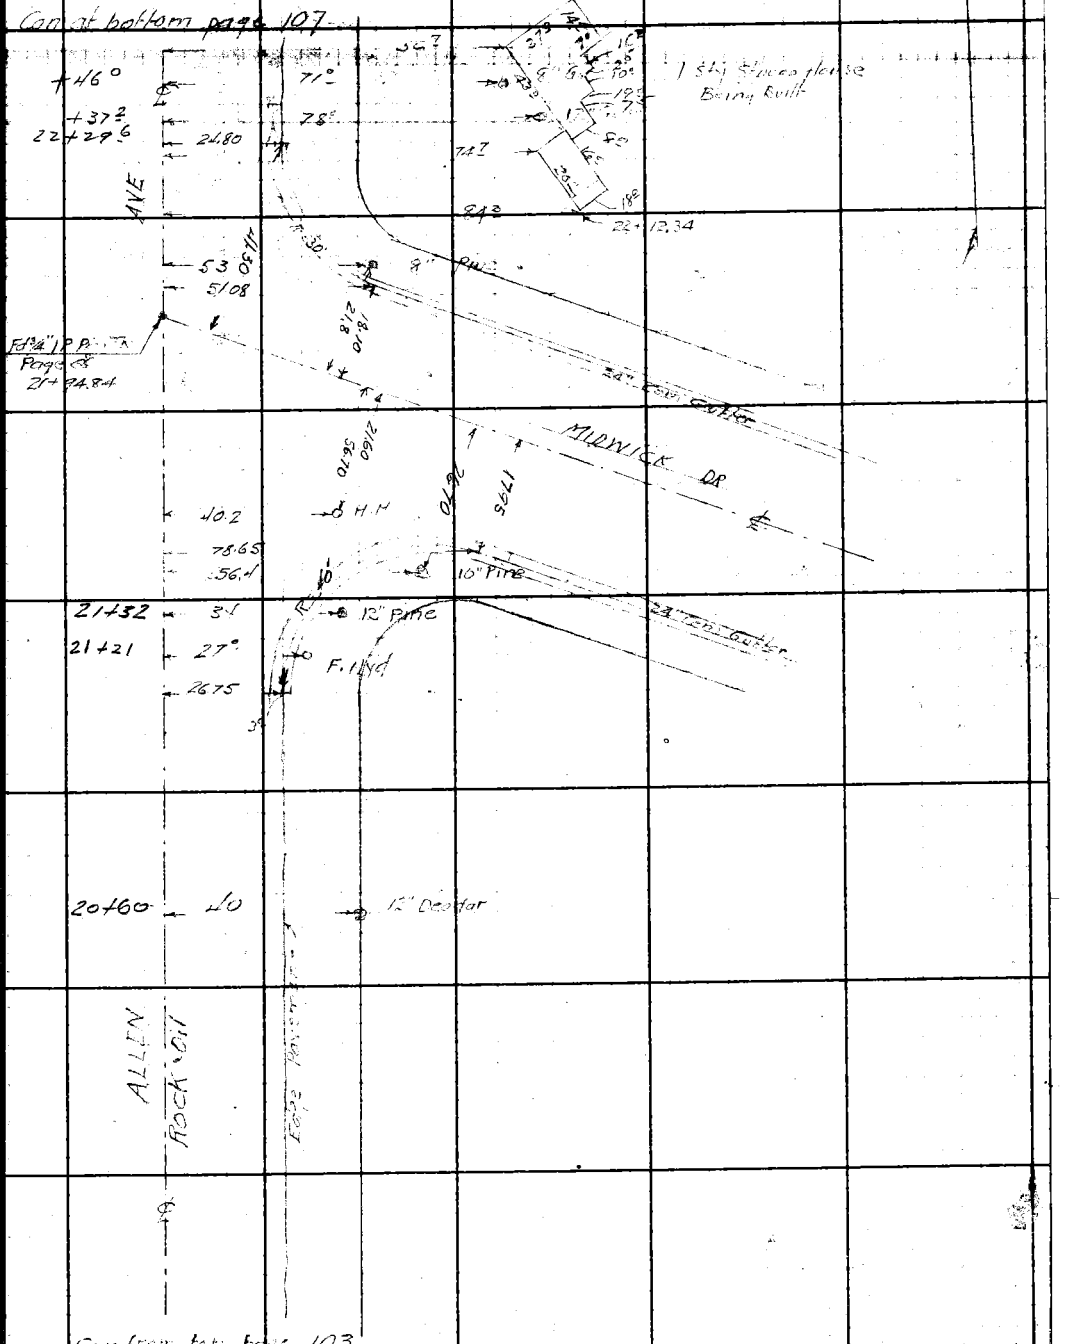

Note: Any Additions or Changes on This Sheet Must be Made or Circled in Red Ink With Date and Name of Person Making Change

Do not extend notes this side of this line.

RETURN TO
LOS ANGELES COUNTY SURVEYOR
700 HALL OF RECORDS

FORM 247 5M 10-39

F.B. 841 Pg. 106

Con at bottom page 108

12" Deodar

31½ 1.52 14° → +72

N

12" Deodar

+53

12" Deodar

P Pole

+33

+28

12" Deodar

25+09

AVE

12" Deodar

+83

8" Deodar

+62

6" Deodar

+39

+3'

8" Deodar

+18

6" pine

26 → 24+05

6" Deodar

+93

8.5 0.5 35

Section of Open Gutter Drain

Storm Drain

Open Cut Gutter Runs 201

do

+73

ALLEN

do

+46

P Pole

25° → +27

do

+20

do

23+07

6" Deodar

31° → 22+78

15°

14°

Con from top page 104

RETURN TO
LOS ANGELES COUNTY SURVEYOR
700 HALL OF RECORDS

Do not extend notes this side of this line.

Note: Any Additions or Changes on This Sheet Must be Made or Circled in Red Ink With Date and Name of Person Making Change.

Notes Ck'd by D. M. Finley	Survey of ALLEN AVE.	F.B. 841	PG. 127
Map No. B-949-3	W. Office Tape No. St'd °F		
Office Work Cor	Surveyed by WAM		
Checked D. M. Finley	Notes WAM Date Sept 1940		
Date MAY '42	Indexed A. C.		

Con at bottom page 109

40°

24°

12" Dead - 25+43

ALLEN AVE

40°

G Wire

12"

24+31.5

P Pole

40°

12" Dead - 24+22.5

ROCK DIT

40°

36" Palm 23+63

ALLEN

60°

23+04

24

Con at bottom page 105

Note: Any Additions or Changes on This Sheet Must be Made or Circled in Red Ink With Date and Name of Person Making Change.

Do not extend notes this side of this line.

RETURN TO
LOS ANGELES COUNTY SURVEYOR
700 HALL OF RECORDS

FORM 247 5M 10-39

F.B. 841 Pg. 108

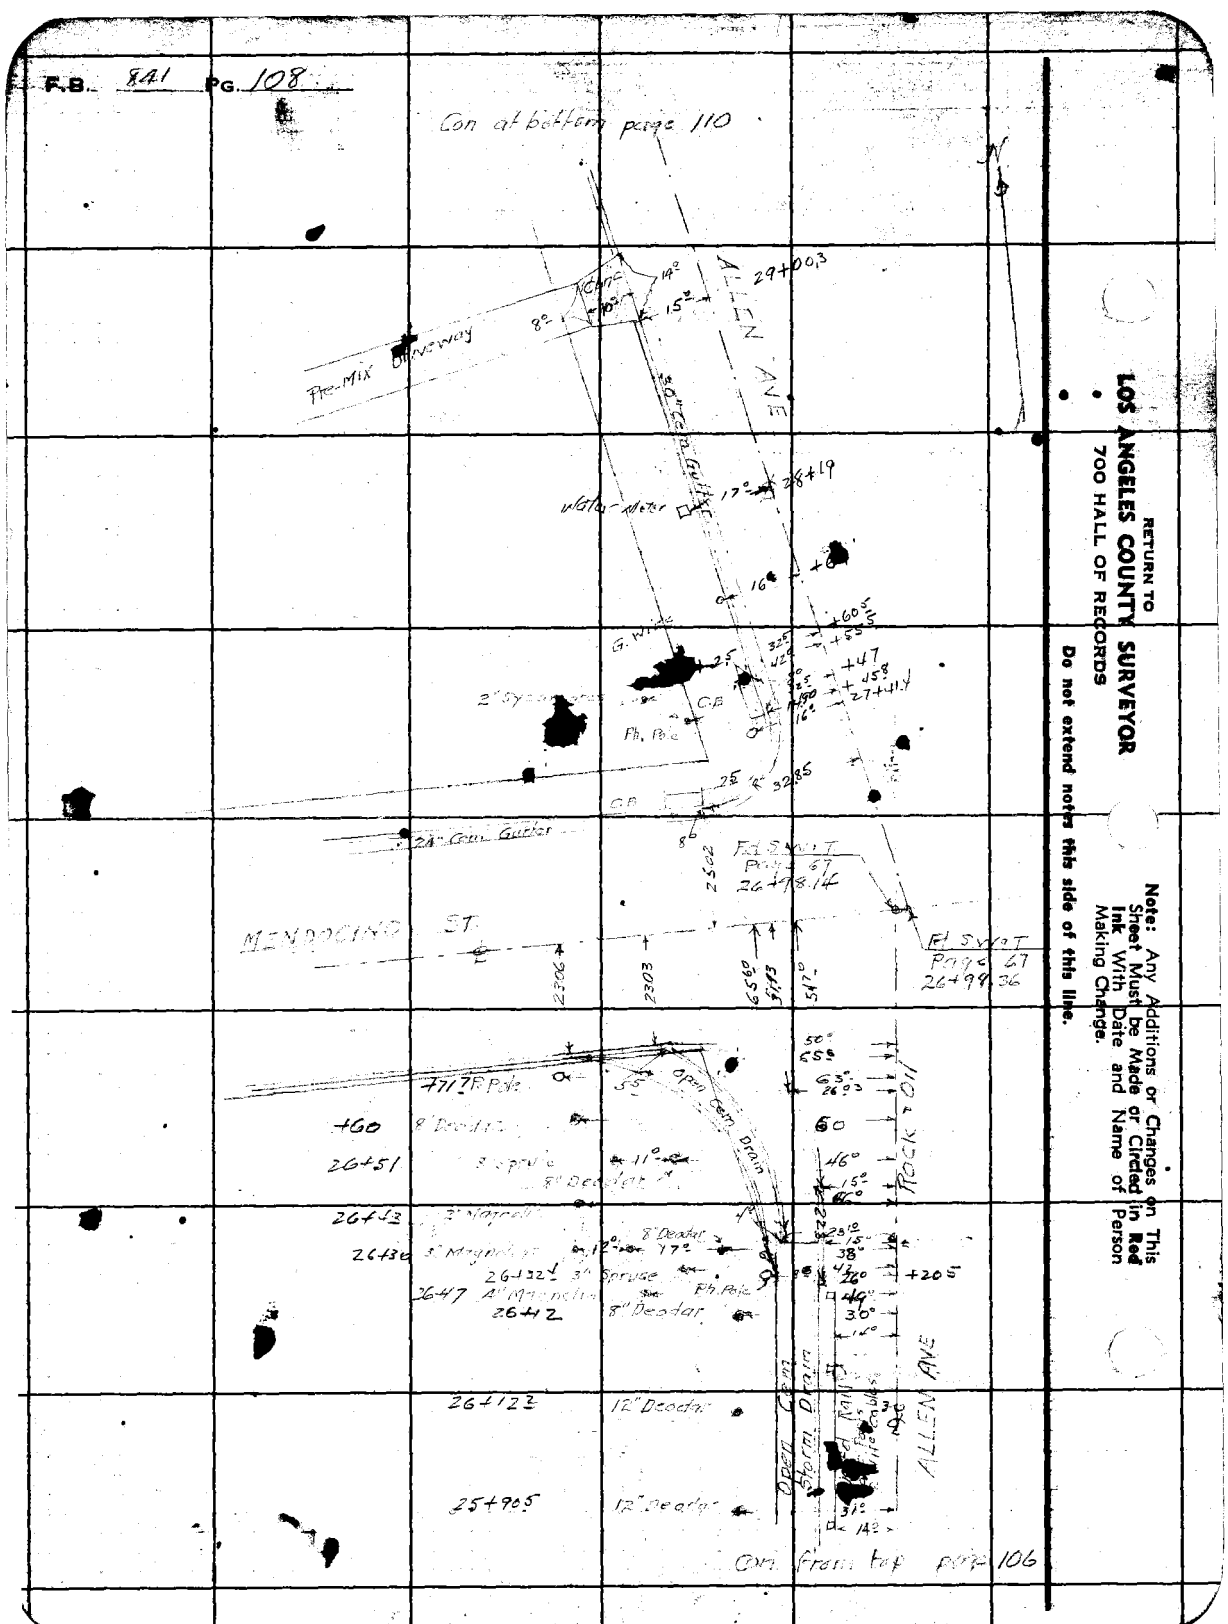

RETURN TO
LOS ANGELES COUNTY SURVEYOR
700 HALL OF RECORDS

Do not extend notes this side of this line.

Note: Any Additions or Changes on This Sheet Must be Made or Circled in Red Ink With Date and Name of Person Making Change.

Notes Ck'd by D. M. Finley	Survey of ALLEN AVE	F.B. 841	Pg. 107
Map No. B-29-3	W. O. 7125	Tape No.	St'd °F
Office Work	Surveyed by W.A.Miller		
Checked D. M. Finley	Notes W.A.M. & A. C. Johns	Date	
Date MAY '42	Indexed		

Note: Any Additions or Changes on This Sheet Must be Made or Circled in Ink With Date and Name of Person Making Change

Do not extend notes this side of this line.

RETURN TO
LOS ANGELES COUNTY SURVEYOR
700 HALL OF RECORDS

FORM 247 5M 10-39

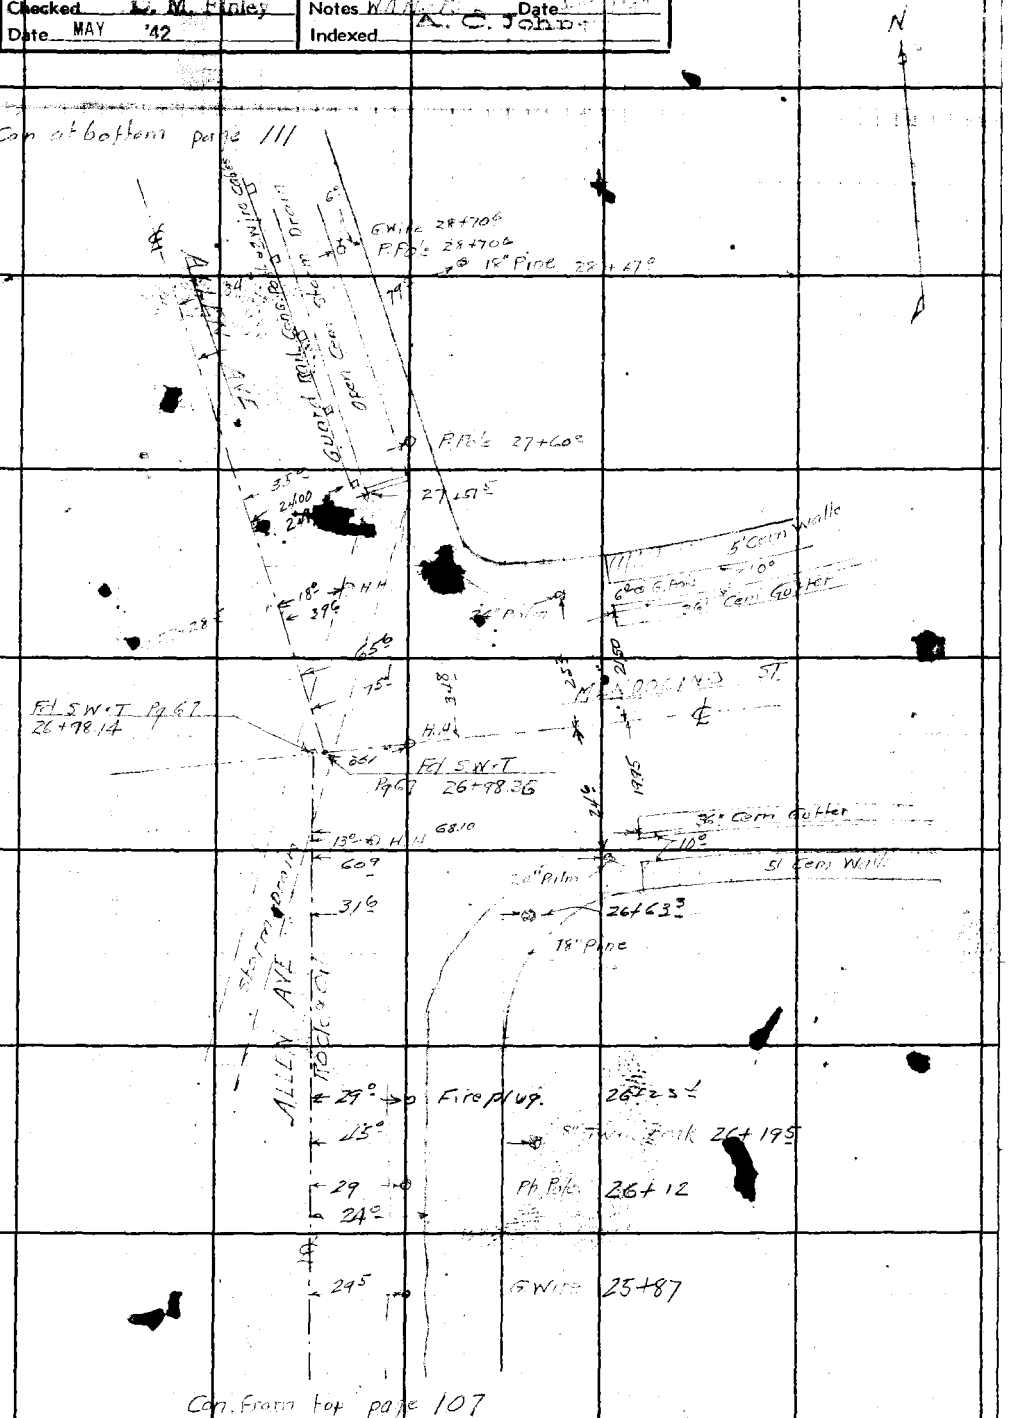

RETURN TO
LOS ANGELES COUNTY SURVEYOR
700 HALL OF RECORDS

Note: Any Additions or Changes on This Sheet Must be Made or Circled in **Red Ink** With Date and Name of Person Making Change.

Do not extend notes this side of this line.

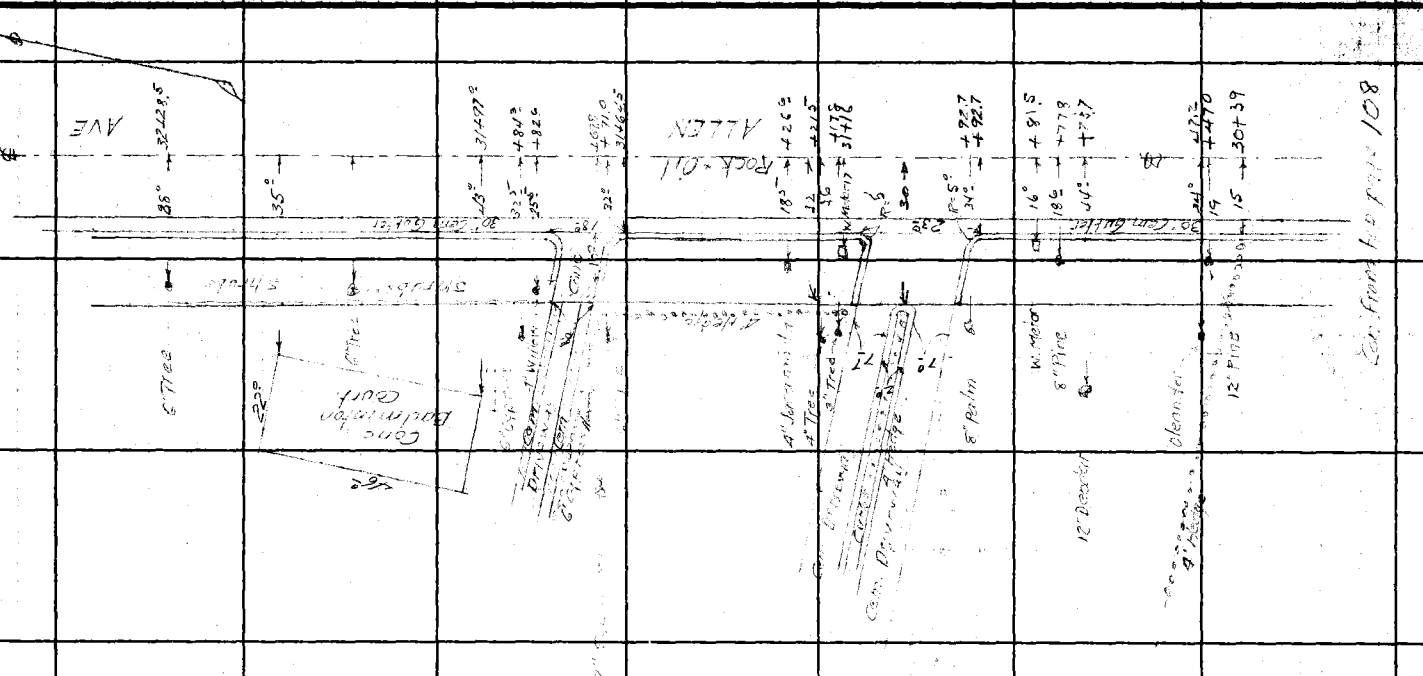
Con at bottom page 112
AVE
Rock Oil
ALLEN
Cont. Gutter
Cont. Gutter
Cont. Gutter

Notes Ck'd by D. M. Finley	Survey of ALLEN AVE	F.B. 841	PG. 111
Map No. B-949-3	W. O. 7125 Tape No. Std °F		
Office Work Cox	Surveyed by W.A. Niver		
Checked D. M. Finley	Notes W.A.N. & A.L. Date Sept 1942		
Date MAY '42	Indexed A. C. Johnson		

Con at bottom page 113

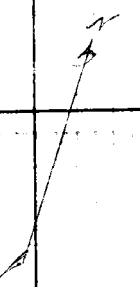

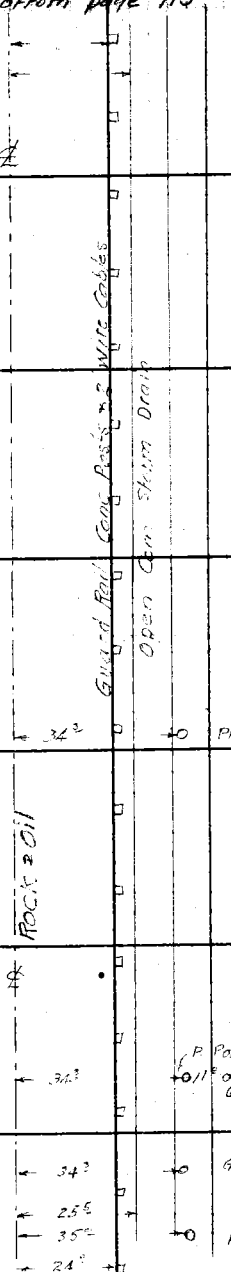

Con from top page 109

Note: Any Additions or Changes on This Sheet Must be Made or Circled in Red Ink With Date and Name of Person Making Change.

Do not extend notes this side of this line.

RETURN TO
LOS ANGELES COUNTY SURVEYOR
700 HALL OF RECORDS

FORM 247 SM 10-39

RETURN TO
LOS ANGELES COUNTY SURVEYOR
700 HALL OF RECORDS

Note: Any Additions or Changes on This Sheet Must be Made or Circled in **Red Ink** With Date and Name of Person Making Change.

Do not extend notes this side of this line.

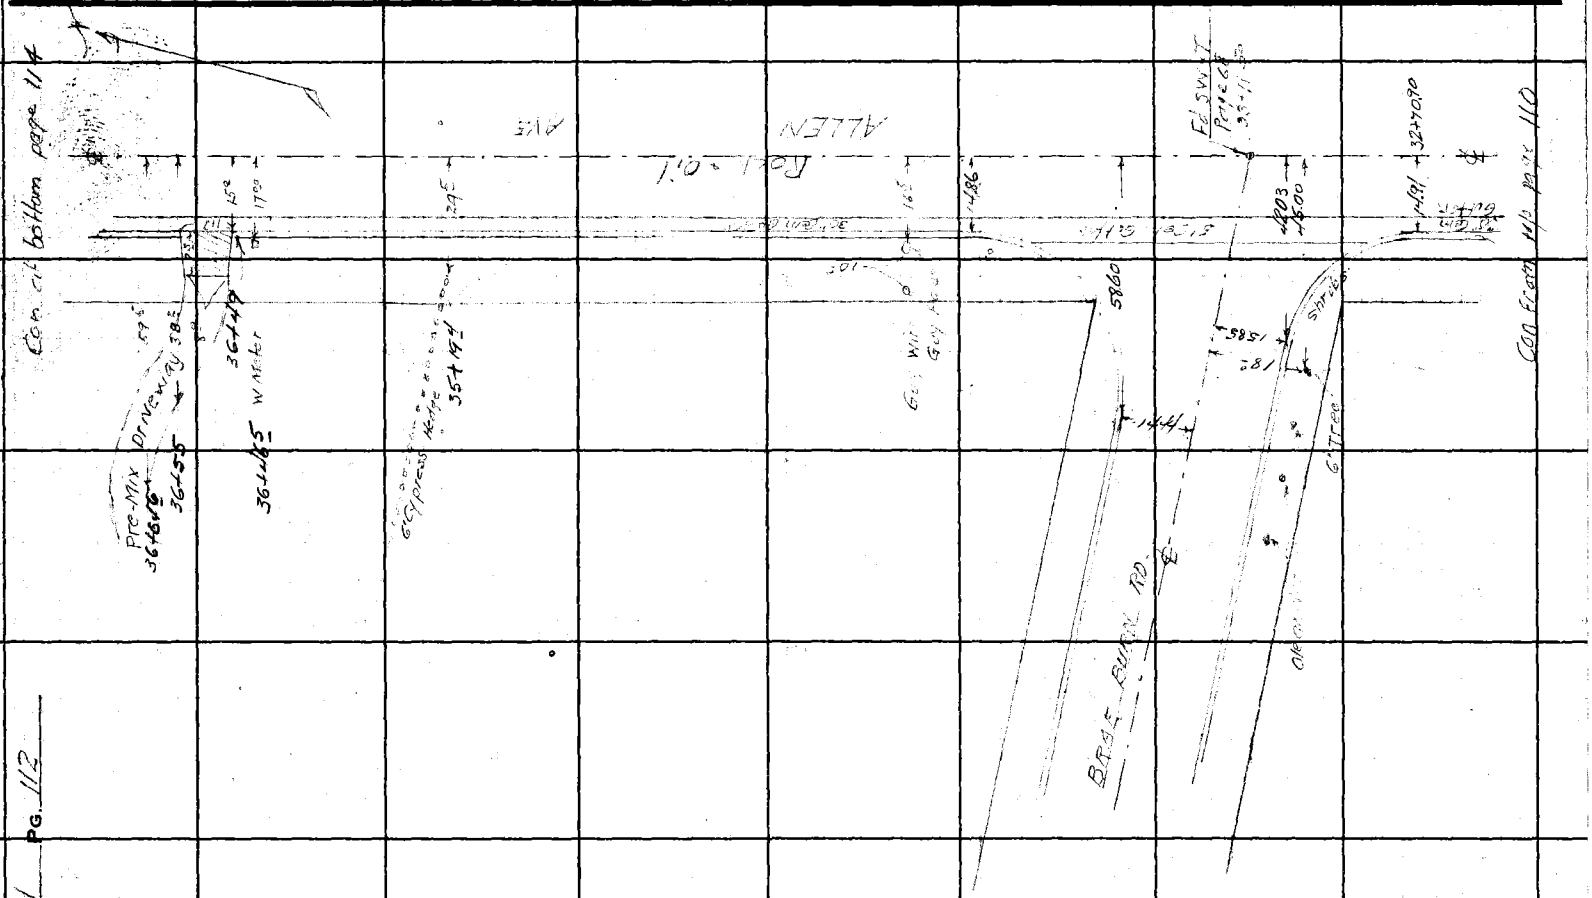

F.B. 641 Pg. 112

Notes Ck'd by D. M. Finley
Map No. B-949-3
Office Work Col
Checked D. M. Finley
Date MAY '42

Survey of ALLEN AVE
W. O. 7625 Tape No. Std. °F
Surveyed by W.A. Miller
Notes W.A.M. - F.S.L. Date 9-26-40
Indexed A. C. Johnson

F.B. 841 Pg. 112

Con. at bottom page 112

36+74 34.5 G Wire
36+52 34.5 R Pole
23.80
20° 25° R Pole
G Wire
2480
35+91 34.2 Ph Pole
AVE
3J+63.40 25.09
Open Ditch
+42.2 34.9 Ph Pole
3J+35 34.6 10° HH
62.30
Ed S.W.I. Page 91
34+08.09
Storm Drain
3002
1801
16.2 15.7 10.4 3.3 2700 14.5
12.3 10.0 19.5 16.3° HH 12.9
1.0 35.5 GB 75
63°
38°
HH
F Hyd
ALLEN
2502
24.00
331529
Ft. S.W.I. Page GR 33+11.50
34.3 P.Pole 331405
34.5 G Wire 321865
Con. Storm Drain
Con from top page 111

Note: Any Additions or Changes on This Sheet Must be Made or Circled in Ink With Date and Name of Person Making Change
Do not extend notes this side of this line.

RETURN TO
LOS ANGELES COUNTY SURVEYOR
700 HALL OF RECORDS

FORM 247 SW 10-39

RETURN TO
LOS ANGELES COUNTY SURVEYOR
700 HALL OF RECORDS

Note: Any Additions or Changes on This Sheet Must be Made or Circled in **Red Ink** With Date and Name of Person Making Change.

Do not extend notes this side of this line.

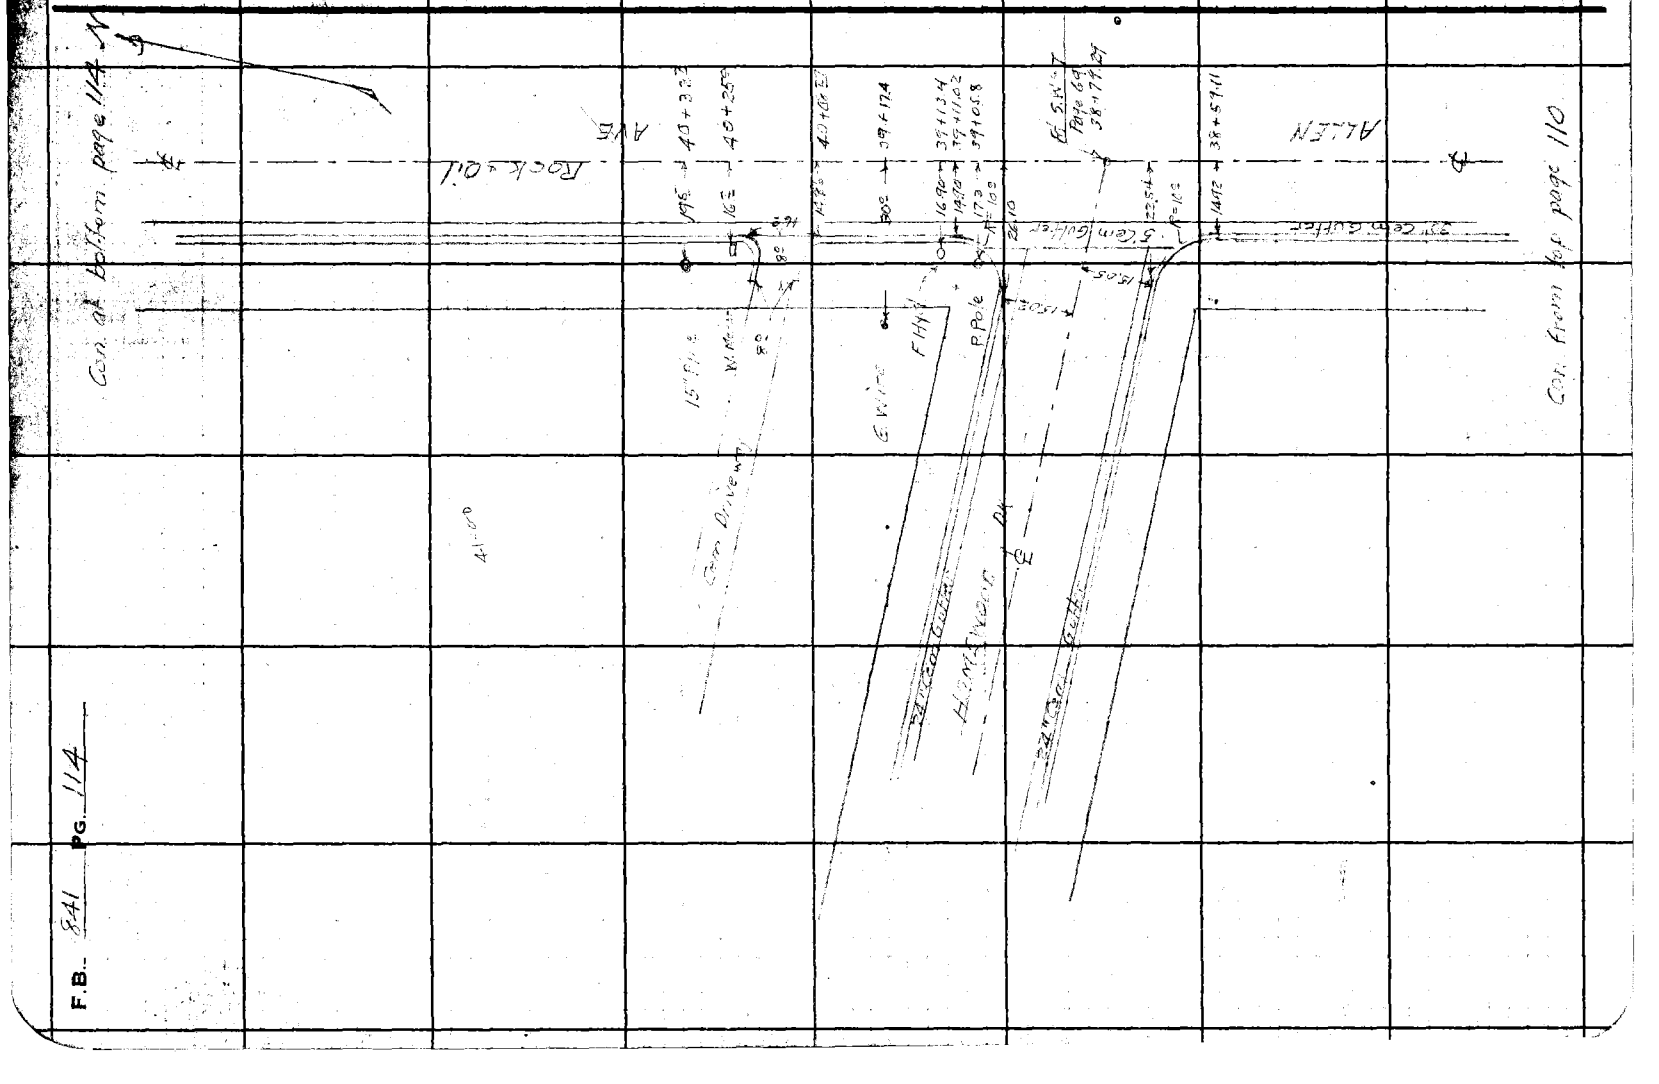
Con. at bottom page 114
AVE
Rock-Oil
ALLEN
Con. From top page 110

Notes Ck'd by L. M. Finley	Survey of		F.B. 941 Pg. 115
Map No. B-949-3	W. O. 7125	Tape No.	St'd °F
Office Work	Surveyed by W.A. Miller		
Checked D. M. Finley	Notes W.A.M. & F.S.L.	Date 9-26-1940	
Date MAY '42	Indexed		

Go at bottom page 117

RETURN TO
LOS ANGELES COUNTY SURVEYOR
700 HALL OF RECORDS

Note: Any Additions or Changes on This Sheet Must be Made or Circled in Red Ink With Date and Name of Person Making Change

Do not extend notes this side of this line.

ALLEY

ROCK & OIL

Edge Road, Curb & Pavement, Existing Gates

Open Cut, Storm Drain

40+36 — 33.1 — Ph. Pole

39+42.86 — 25.00

37+16.8 — 34.2

39+17.31 — 33.15 — Ph Pole

38+93.57 — 54.65

38+85 — 23.3 — H H

38+79.39

Ref S.N.T. Page 69 38+79.39

38+79.99 — 24" Conc Gutter

HOLLYWOOD DR

38+48.39 — 78.75 — 38+52.39 — 5.5 — 78.75 — 24" Conc Gutter

68.76

38+41.6 — 18.3 — H H — 58.19 — 38+43.9

38+26.39 — 28.42

Storm Drain

16" Conc Gutter

38+10.64 — 25.31

38+10.9 — 33.5 — G.W. Fire

37+76.3 — 33.5 — Ph Pole

Continue top page 113

FORM 247 5M 10-39

RETURN TO
LOS ANGELES COUNTY SURVEYOR
700 HALL OF RECORDS

Note: Any Additions or Changes on This Sheet Must be Made or Circled in **Red Ink** With Date and Name of Person Making Change.

Do not extend notes this side of this line.

F.B. 824 PG. 116

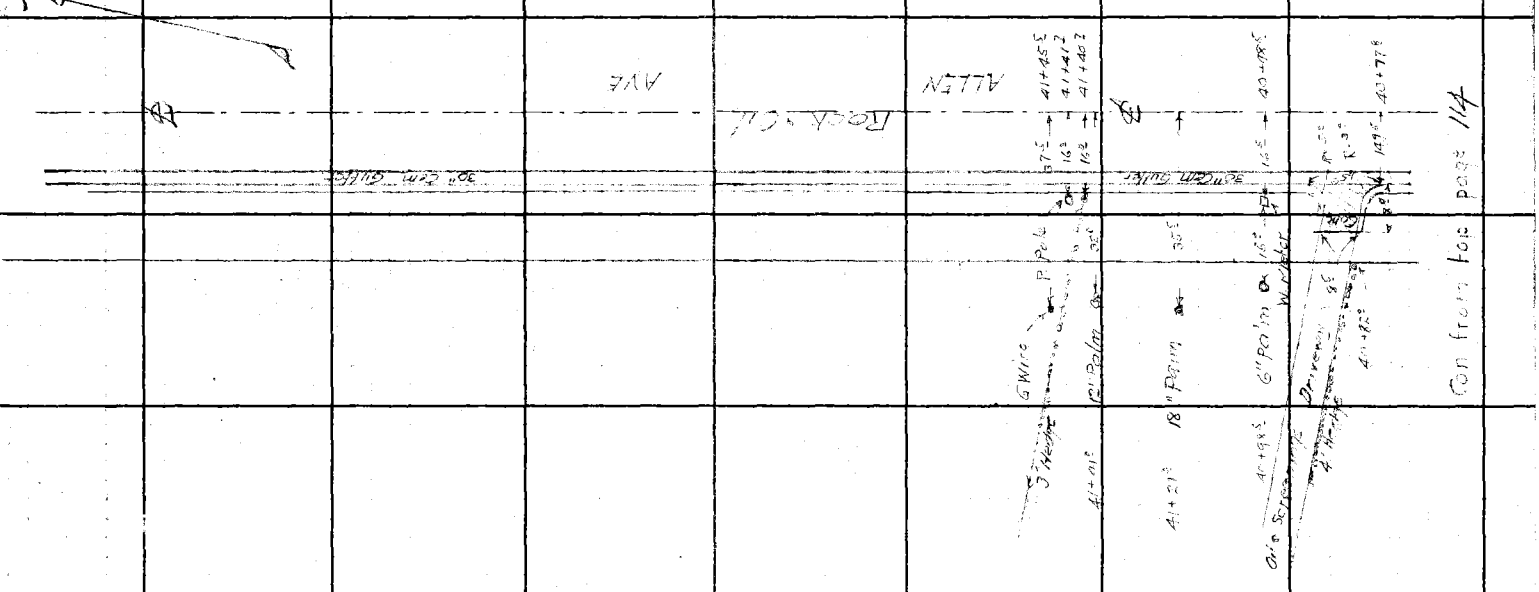

Notes Ck'd by D. M. Finley
Map No. 8-949-3
Office Work Col
Checked D. M. Finley
Date MAY '42

Survey of ALLEN Alley
W. O. 7125 Tape No. St'd °F
Surveyed by W.A. Miller
Notes W.A.M.-F.S.L. Date 9-30-1940
Indexed

F.B. 241 Pg. 117

Car at bottom page 119

Note: Any Additions or Changes on This Sheet Must be Made or Circled in Red Ink With Date and Name of Person Making Change

Do not extend notes this side of this line.

RETURN TO
LOS ANGELES COUNTY SURVEYOR
700 HALL OF RECORDS

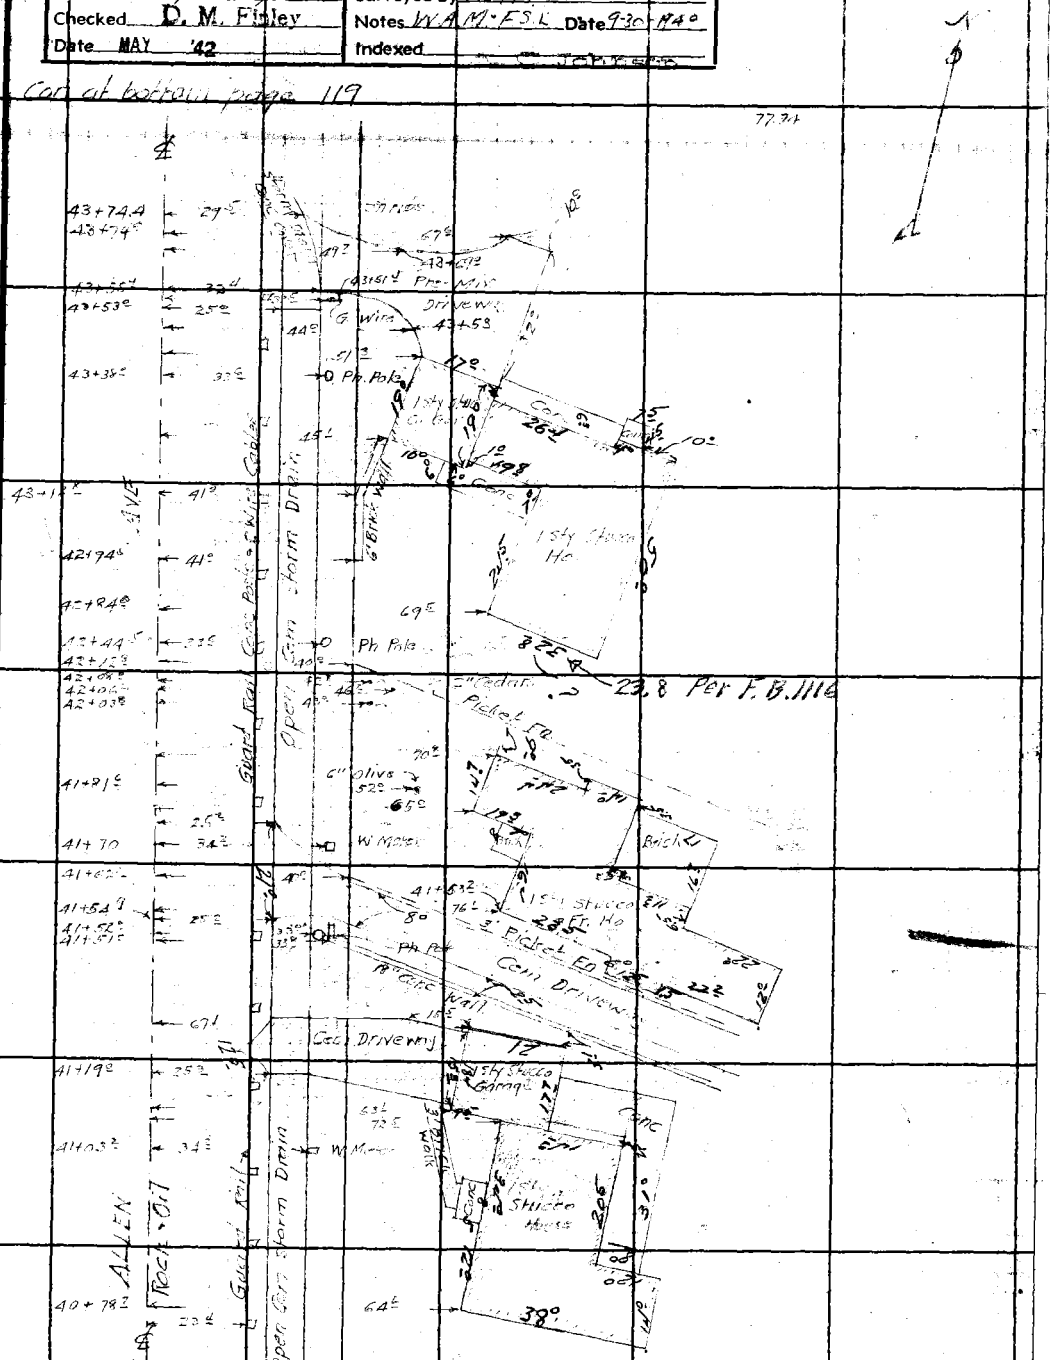

Con From top page 115

FORM 247 5M 10-39

RETURN TO
LOS ANGELES COUNTY SURVEYOR
700 HALL OF RECORDS

Note: Any Additions or Changes on This Sheet Must be Made or Circled in Red Ink With Date and Name of Person Making Change.

Do not extend notes this side of this line.

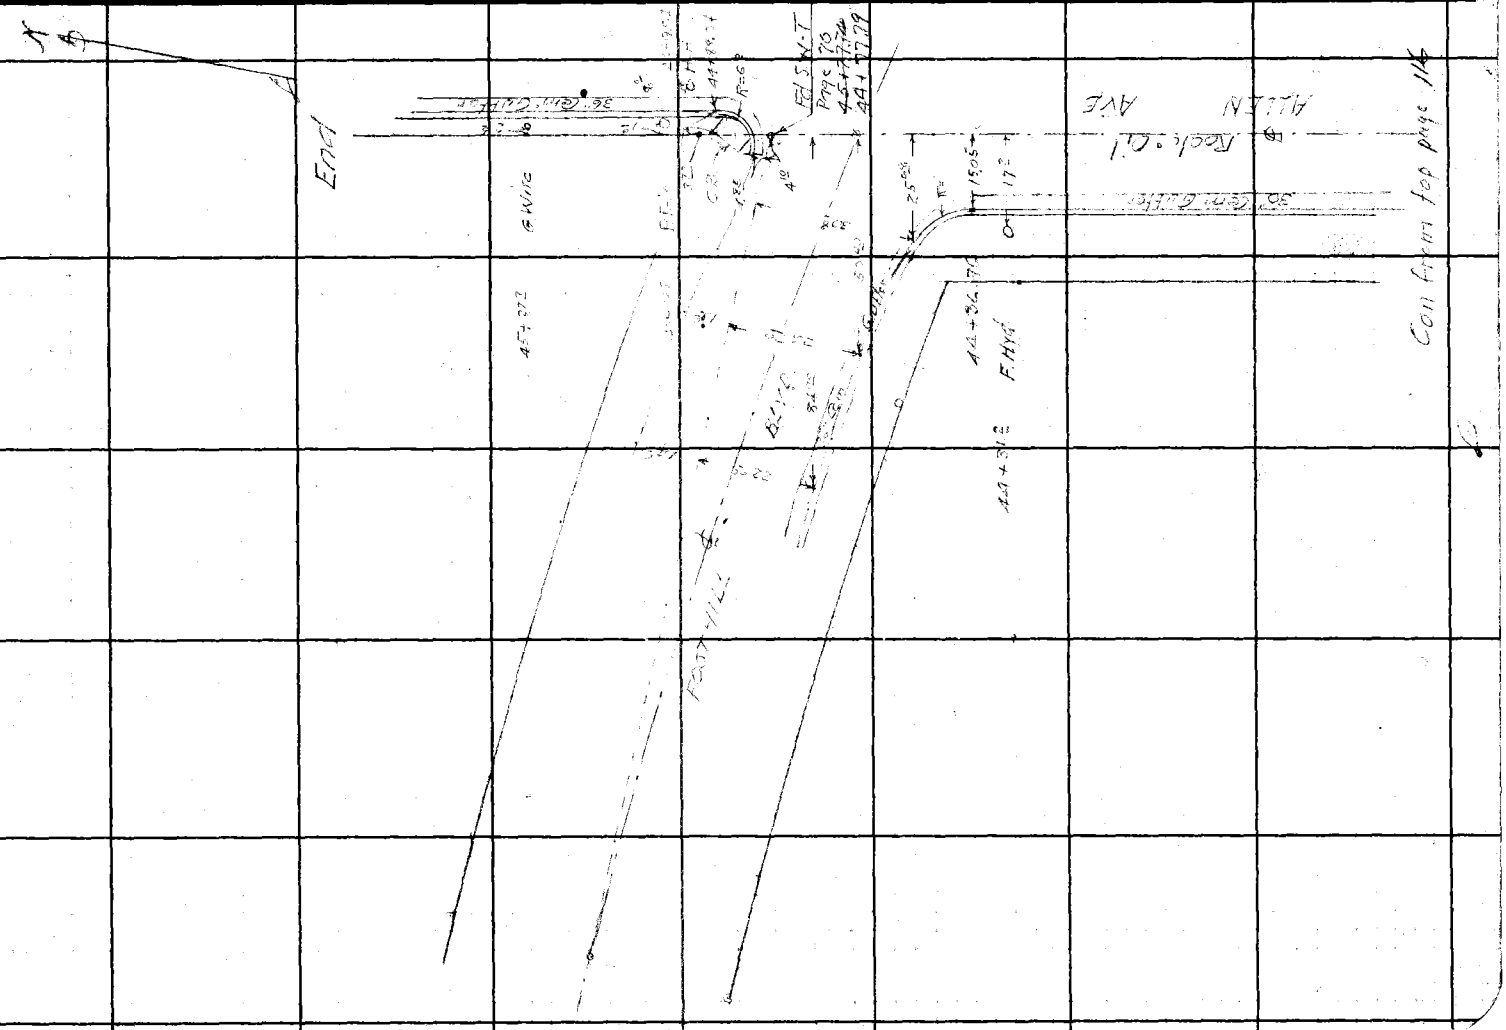

F.B. 841 PG. 118

Notes Ck'd by	Survey of ALLEN AVE
Map No. B-949-3	W. O. 7125 Tape No. St'd °F
Office Work Cox	Surveyed by W A Miller
Checked C. M. Finley	Notes W A M - F S L Date 7-30-1940
Date MAY '42	Indexed

F.B. 611 Pg. 119

Note: Any Additions or Changes on This Sheet Must be Made or Circled in Red Ink With Date and Name of Person Making Change!

Do not extend notes this side of this line.

RETURN TO
LOS ANGELES COUNTY SURVEYOR
700 HALL OF RECORDS

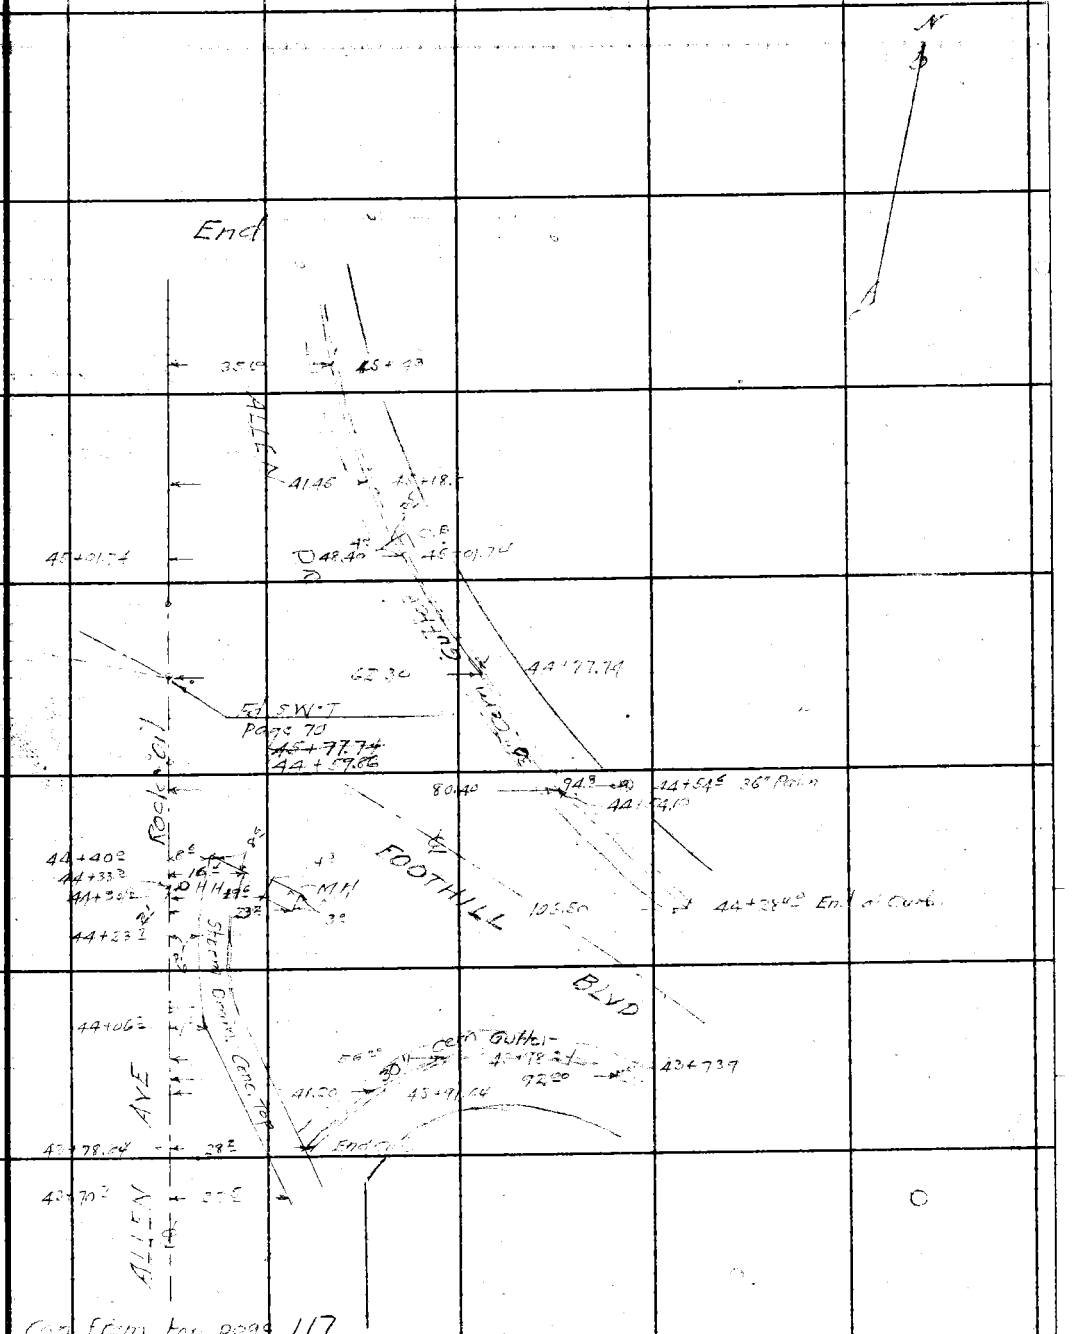

Cont from for page 117

FORM 247 5M 10-39

RETURN TO
LOS ANGELES COUNTY SURVEYOR
700 HALL OF RECORDS

Note: Any Additions or Changes on This Sheet Must be Made or Circled in **Red Ink** With Date and Name of Person Making Change.

Do not extend notes this side of this line.

F.B. 941 Pg. 120

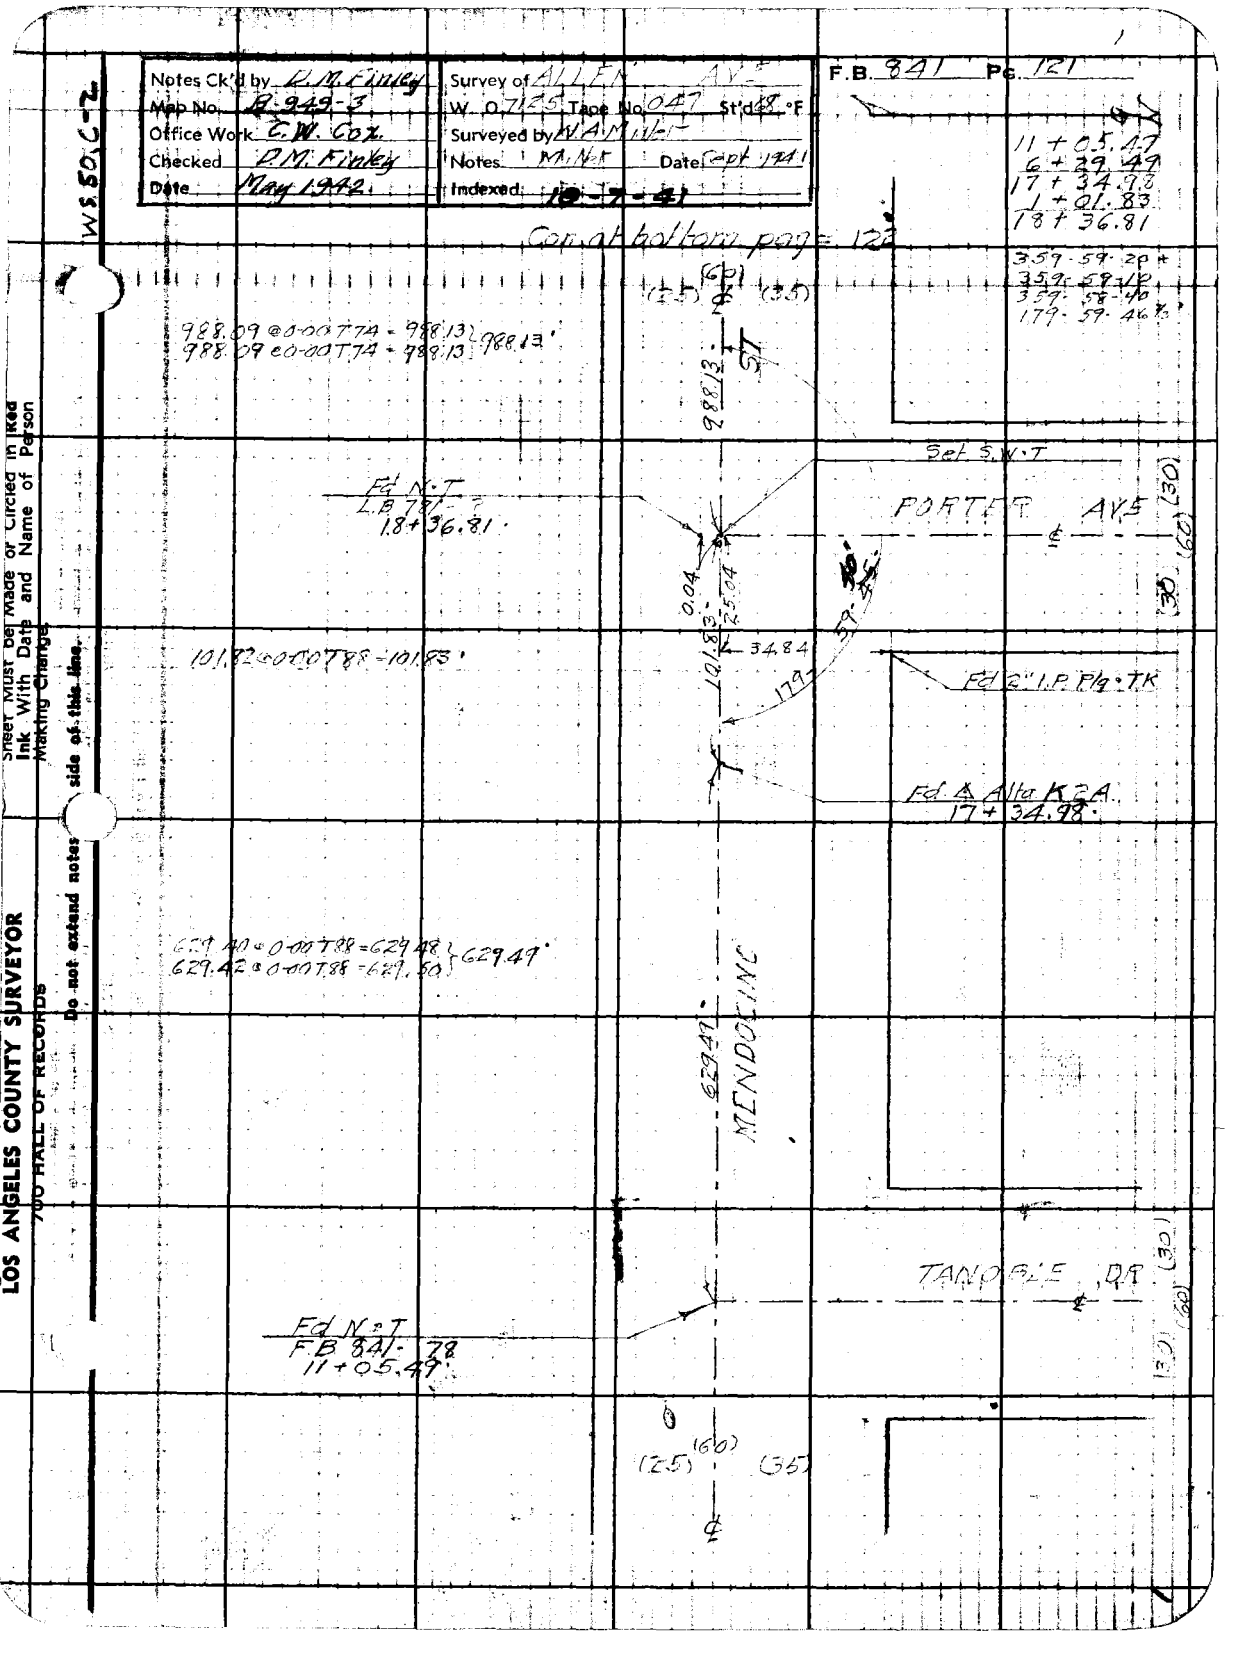
Notes Ck'd by R.M. Finley
Map No. R. 949-3
Office Work E.W. Cox.
Checked R.M. Finley
Date May 1942.
Survey of ALLEN AVE
W.O. 7135 Tape No. 047 St'd 68 °F
Surveyed by M.A.M.-F
Notes M.A.M.-F Date Sept 1941
Indexed 10-7-41
F.B. 841 Pg. 121
W.S. 50, C-2
Cor. at bottom pag = 123
11 + 05.47
6 + 29.49
17 + 34.98
1 + 01.83
18 + 36.81
359° 59' 20" ±
359° 59' 10"
359° 58' 40"
179° 59' 46" ±
988.09 @ 0.00 T.74 = 988.13
988.09 @ 0.00 T.74 = 988.13
988.13'
Fd N.T
L.B 791 - F
18 + 36.81
Set S.W.T
PORTER AVE
101.82 @ 0.00 T.88 = 101.83'
34.84
Fd 2" I.P. P/g + TK
Fd ⊥ Alla K 2A
17 + 34.98
629.40 @ 0.00 T.88 = 629.48
629.42 @ 0.00 T.88 = 629.50
629.49'
MENDOCINO
629.41'
TANOBLE DR
Fd N.T
F.B 841 - 78
11 + 05.49'
(25) (60) (35)
(30)
(30)
(30)
Sheet must be made or Circled in Red Ink With Date and Name of Person Making Change
Do not extend notes side of this line.
LOS ANGELES COUNTY SURVEYOR
700 HALL OF RECORDS

F.B. 841 PG. 122

Con at bottom page 123

W.S. 50, C-2

18+36.81
9+88.13
28+29.94

(25) (65) (40)

817.13 @ 0-00 7' 78 = 817.18
817.13 @ 0-00 7' 78 = 817.18

817.18'

817.18'

N 27° W

Nothing Found

Fd N.T.
LB 781-54
Replaced With S.W.T
28+24.94.

BIRCH-BURTON RD

(25) (50)

Nothing Found

787.13'

(25) (60) (35)

Con from top page 121

RETURN TO
LOS ANGELES COUNTY SURVEYOR
700 HALL OF RECORDS

Note: Any Additions or Changes on This Sheet Must be Made or Circled in Red Ink With Date and Name of Person Making Change.

Do not extend notes this side of this line.

Notes Ck'd by
Map No. A-949-3
Office Work
Checked D. M. Finley
Date MAY 42

Survey of ALLEN AVE
W. 07125 Tape No. 047 Std. 68 °F
Surveyed by W.A. Miller
Notes Miller Date Oct 1941
Indexed

F.B. 841 PG. 123

50, C-2

P8+24.94
8+17.19
36+42.12

Note: Any Additions or Changes on This Sheet Must be Made or Circled in Red Ink With Date and Name of Person Making Change.

Do not extend notes this side of this line.

RETURN TO
LOS ANGELES COUNTY SURVEYOR
700 HALL OF RECORDS

FORM 247 5M 10-38

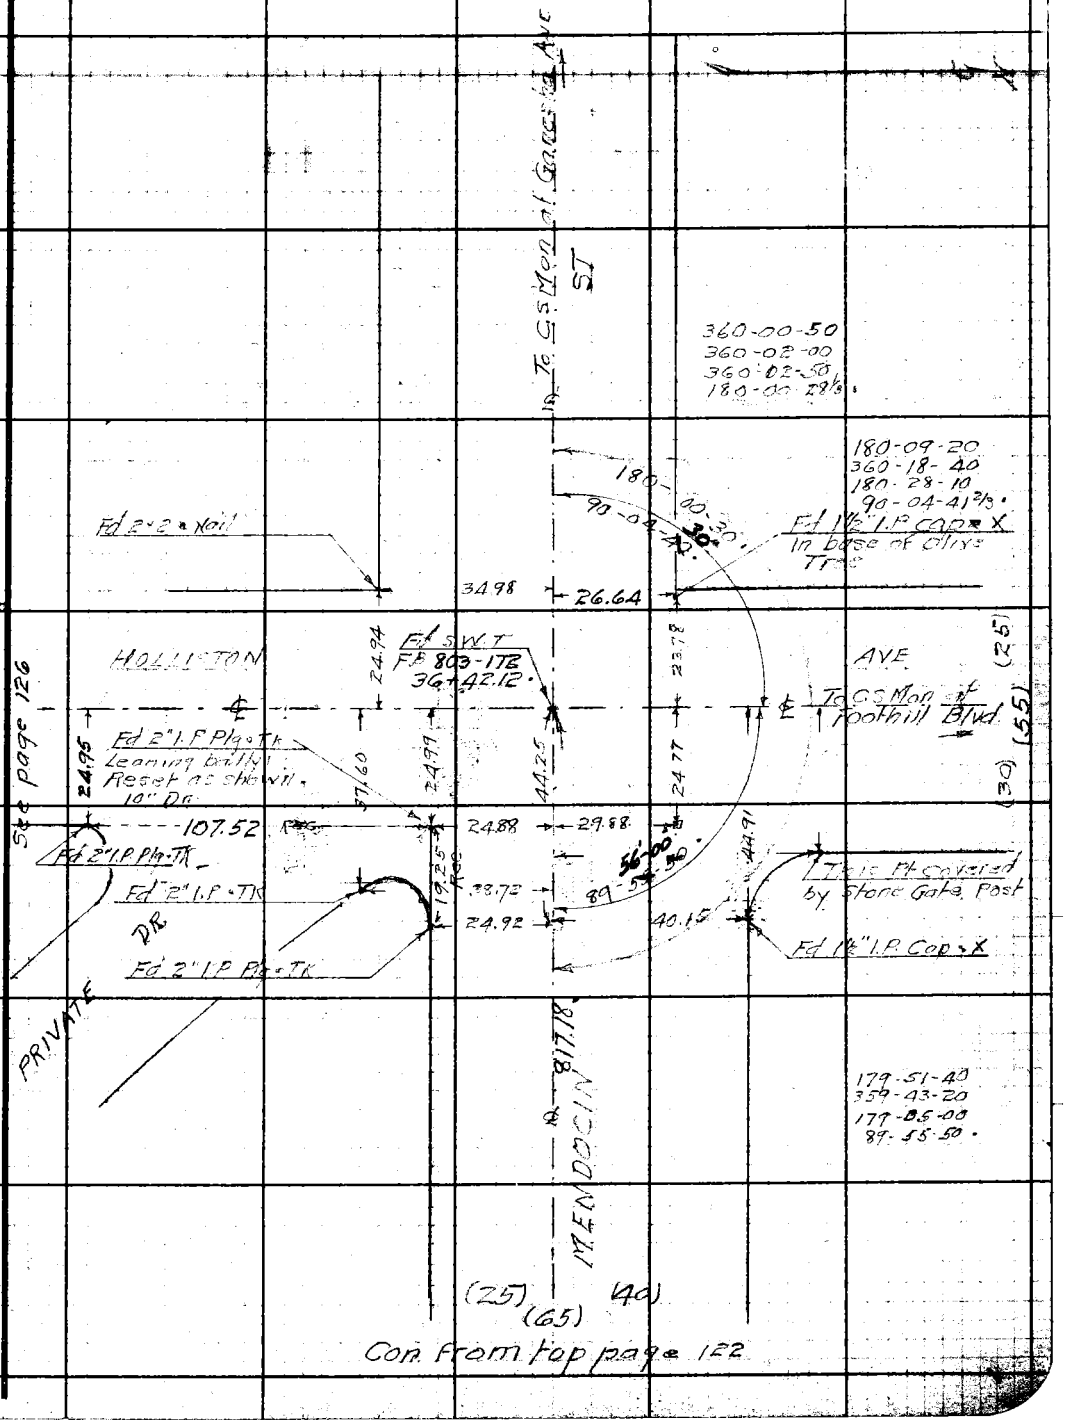

F.B. 841 PG. 124

W.S. 89 Cy D-1

RETURN TO
LOS ANGELES COUNTY SURVEYOR
700 HALL OF RECORDS

Do not extend notes this side of this line.

Note: Any Additions or Changes on This Sheet Must be Made or Circled in Red Ink With Date and Name of Person Making Change.

359-59-30
359-59-00
359-58-20
179-59-43½"

BLVD

(30) (60) (30)

Ed C.S Mon
F.B. 779-6'

PORTER

AVE

(30) (60) (30)

30.00

179-59-45"
180-00-00"

4" I.P. Conc. * Nail
F.B 841-81

731.99 @ 0-00 T 78' = 732.04
732.02 @ 0-00 T 78' = 732.07

732.05

359-58-20
359-56-30
359-54-50
179-59-08½"

732.05

FOOTHILL

Fd 2" I.P. lead-TK

30.00

Fd S.W. * T
F.B. 841-81

TANOBLE

DR

(30) (60) (30)

90-00-25"

179-59-35"

90-00-25"

20.00

180-01-10
360-01-50
180-02-30
90-00-25"

(30) (60) (30)

Notes Ck'd by D. M. [illegible]	Survey of ALLEN AVE
Map No. 19-949-3	W. 0.1125 Tape No. Std. °F
Office Work C & L	Surveyed by W.A. Miller
Checked D. M. [illegible]	Notes Miller Date Oct 1941
Date MAY 42	Indexed

F.B. 941 Pg. 125

W.S. 50, C-1

HOLLISTON

℄

(30)

Fd C.S. Mon.
F.B. 779-12

AVE

30

90

180-07-50
360-15-30
180-23-00
90-03-50

BLVD

(60)

(30) (30)

326-56-50
293-53-30
260-50-00
163-28-20

Pl. Fd S.W.T
F.B. 779-11

BOULDER RD

PAGE DR

CREST DR

Pl. Fd S.W.T
F.B. 779-9

326-52-30
293-45-20
260-38-10
163-26-21½

FOOTHILL

(30) (30)

Note: Any Additions or Changes on This Sheet Must be Made or Circled in Red Ink With Date and Name of Person Making Change.

Do not extend notes this side of this line.

RETURN TO
LOS ANGELES COUNTY SURVEYOR
700 HALL OF RECORDS

FORM 247 5M 10-39

F.B. 841 Pg. 126

WS 59 C-2

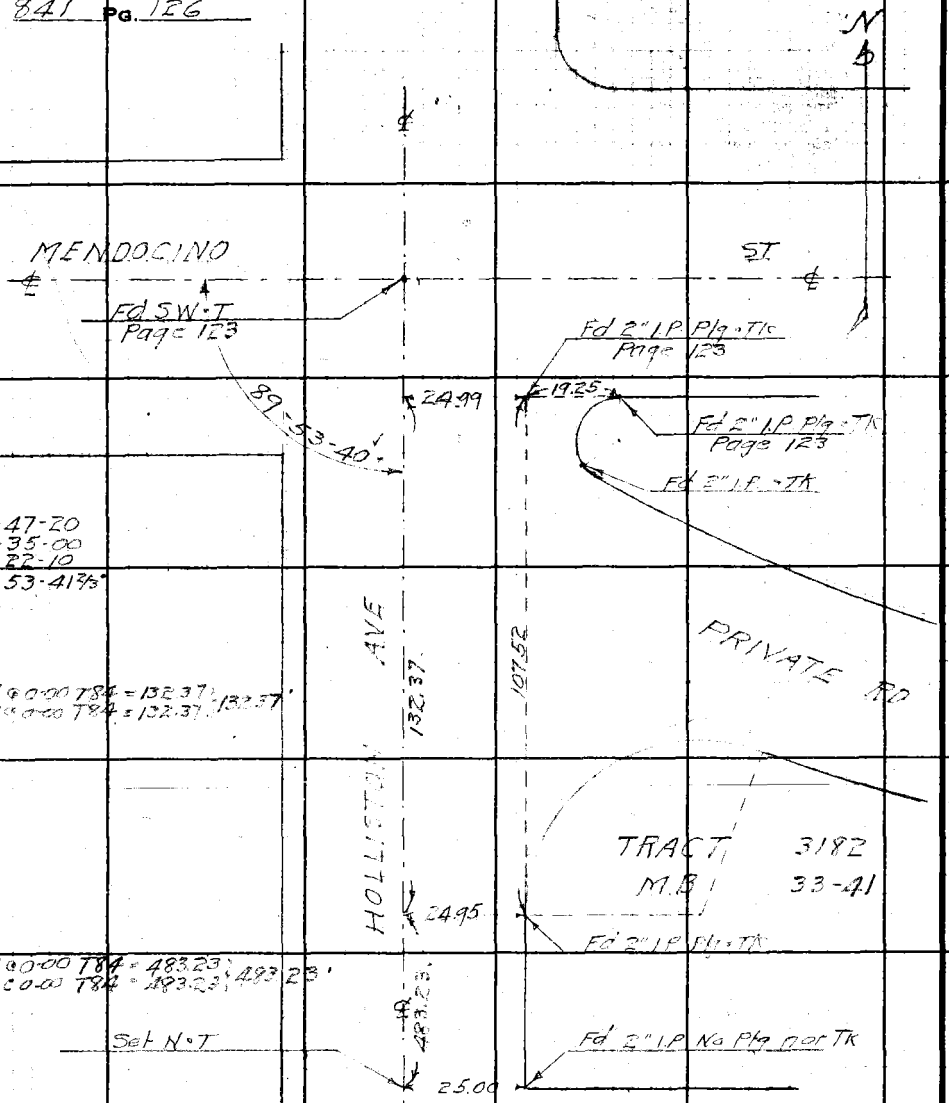

RETURN TO
LOS ANGELES COUNTY SURVEYOR
700 HALL OF RECORDS

Note: Any Additions or Changes on This Sheet Must be Made or Circled in Red Ink With Date and Name of Person Making Change.

Do not extend notes this side of this line.

Notes Ck'd by	Survey of SAN MARINO AVE
Map No.	W. O. 7144 Tape No 058 St'd 84 of.
Office Work	Surveyed by W.A.Miller
Checked	Notes Miller Date 9-17-34
Date	Indexed C. Johnson 10-22-34

F.B. 841 Pg. 211

Note: ANY ADDITIONS OR CHANGES ON THIS SHEET MUST BE MADE OR CIRCLED IN Red Ink WITH DATE AND NAME OF PERSON MAKING CHANGE.

Do not extend notes this side of this line

SURVEY
SAN MARINO AVE
CALIFORNIA ST TO BLANCHE ST
J.N.7144

RETURN TO
LOS ANGELES COUNTY SURVEYOR
700 HALL OF RECORDS

FORM 247 BM 2-34

F.B. 841 Pg. 212

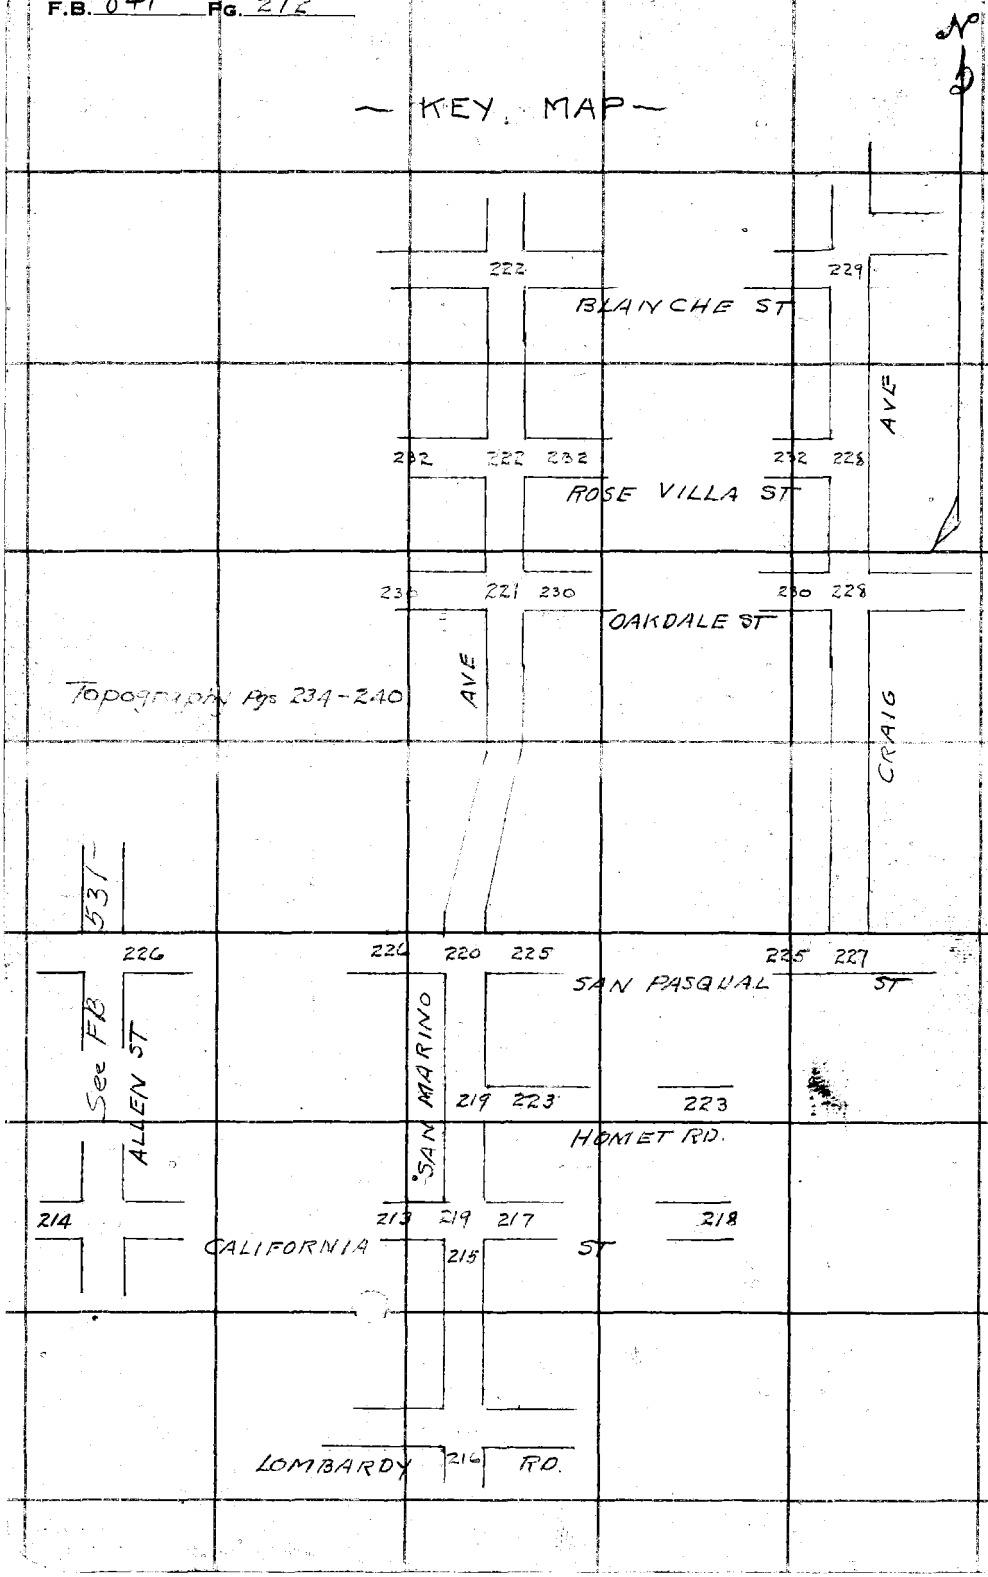

RETURN TO
LOS ANGELES COUNTY SURVEYOR
700 HALL OF RECORDS

Do not extend notes this side of this line

Note: ANY ADDITIONS OR CHANGES ON THIS SHEET MUST BE MADE OR CIRCLED IN Red Ink WITH DATE AND NAME OF PERSON MAKING CHANGE.

Notes Ck'd by MEB	Survey of SAN MARINO AVE
Map No.	W. O. 7144 Tape No 058 St'd 84 OF.
Office Work	Surveyed by W. A. Miller
Checked	Notes Miller Date 9-18-34
Date	Indexed C. Johnson 10-22-34

F.B. 841 Pg. 213

W.S. 44 A-3

Con at bottom page 214

410.15 c 0.00 T 100 - 410.19
410.15 c 0.00 T 100 - 410.19 } 410.19

(40) ST (80) (40)

This is a reproduction of Center Line shown on Map of Ardengrove - M.B. 80-26. They call it Cy. Engrs. Cy and picked up points to fix it that are now gone

BERKELEY AVE (60) (30) (30)

ARDENGROVE TR

CALIFORNIA

410.19

TR 6769

Fd 2" I.P Plug & Tk ARDENGROVE TR

40.00

39.97

0.05

Fd x in walk

Set Nail

39.85

49.75

(40)

SAN MARINO

See page 215

AVE (35)

See page 219

Set S.W.T. by Ink. See page 219

See page 217

Note: ANY ADDITIONS OR CHANGES ON THIS SHEET MUST BE MADE OR CIRCLED IN Red Ink WITH DATE AND NAME OF PERSON MAKING CHANGE.

Do not extend notes this side of this line

RETURN TO
LOS ANGELES COUNTY SURVEYOR
700 HALL OF RECORDS

FORM 247 BM 2-34

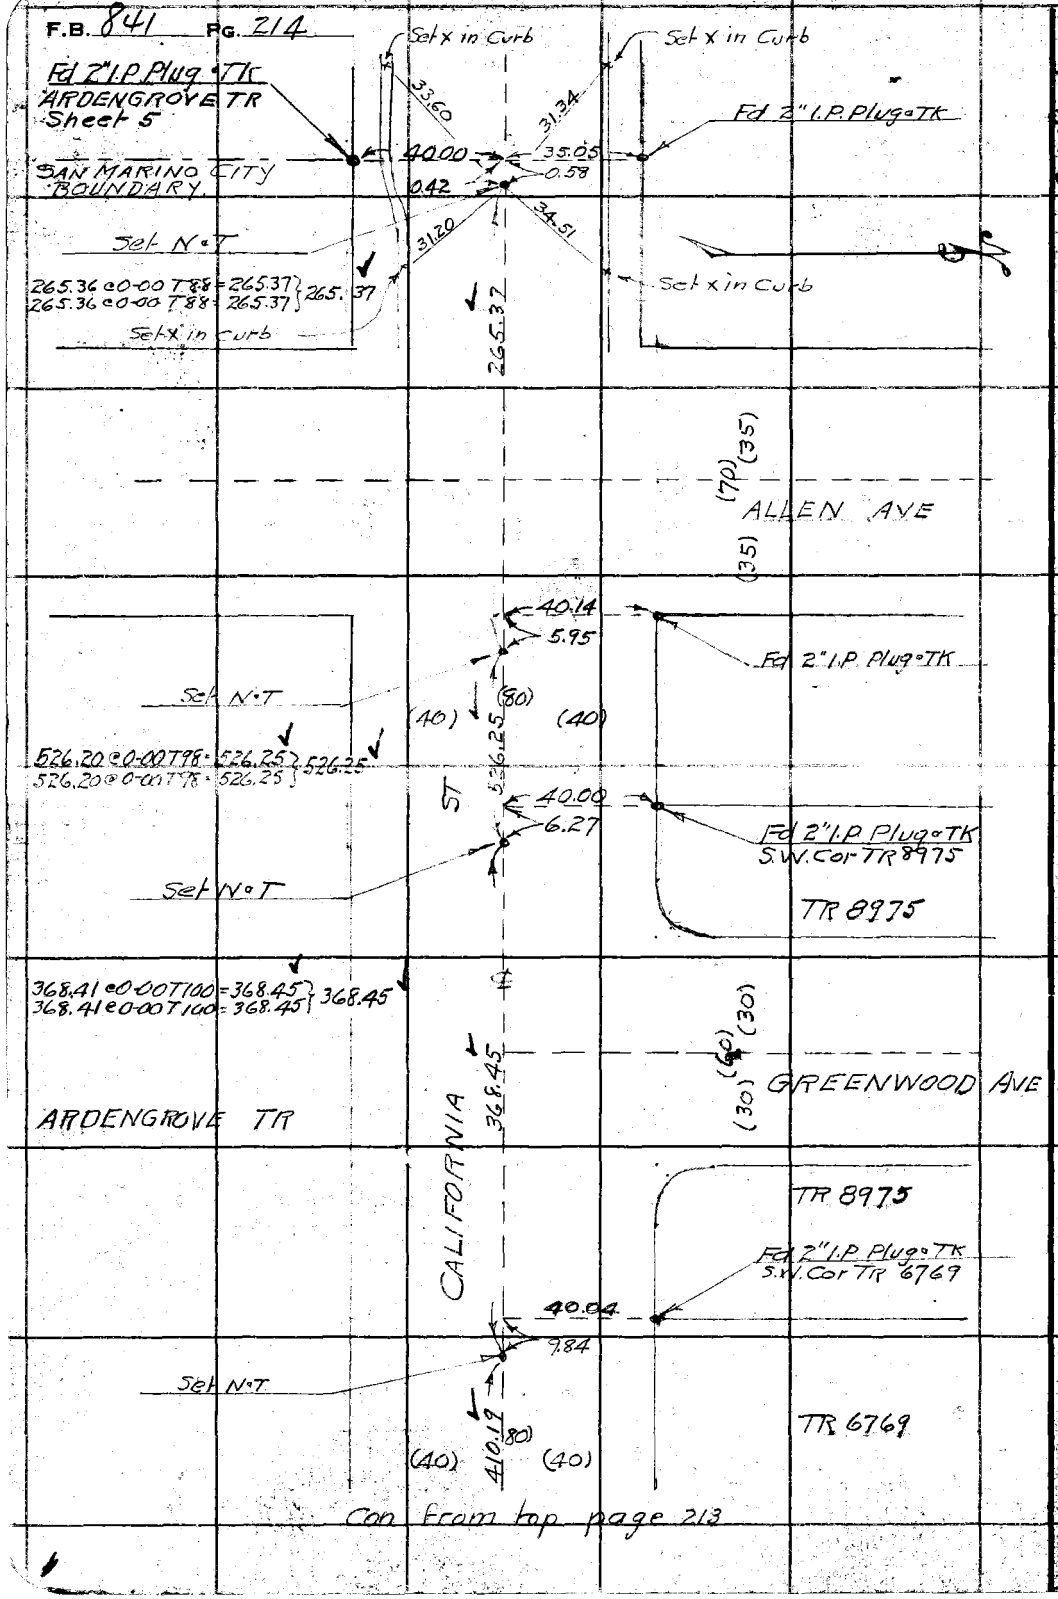
F.B. 841 Pg. 214
Fd 2" I.P. Plug & TK
ARDENGROVE TR
Sheet 5
SAN MARINO CITY BOUNDARY
Set N & T
265.36 @ 0-00 T 88 = 265.37
265.36 @ 0-00 T 88 = 265.37
265.37
Set x in Curb
Set x in Curb
Set x in Curb
Fd 2" I.P. Plug & TK
33.60
31.34
40.00
35.05
0.42
0.58
31.20
34.51
265.37
W.5,44A-3
(70) (35)
ALLEN AVE
(35)
40.14
5.95
Fd 2" I.P. Plug & TK
Set N & T
(40) (80) (40)
526.20 @ 0-00 T 98 = 526.25
526.20 @ 0-00 T 98 = 526.25
526.25
ST
40.00
6.27
Fd 2" I.P. Plug & TK
S.W. Cor TR 8975
Set N & T
TR 8975
368.41 @ 0-00 T 100 = 368.45
368.41 @ 0-00 T 100 = 368.45
368.45
ARDENGROVE TR
CALIFORNIA
368.45
(60) (30)
GREENWOOD AVE
TR 8975
Fd 2" I.P. Plug & TK
S.W. Cor TR 6769
40.04
9.84
Set N & T
410.12
(40) (80) (40)
TR 6769
Con from top page 213
RETURN TO
LOS ANGELES COUNTY SURVEYOR
700 HALL OF RECORDS
Do not extend notes this side of this line
Note: ANY ADDITIONS OR CHANGES ON THIS SHEET MUST BE MADE OR CIRCLED IN Red Ink WITH DATE AND NAME OF PERSON MAKING CHANGE.

Notes Ck'd by McPherson	Survey of SAN MARINO AVE
Map No.	W. O. 7144 Tape No 058 St'd 84 of.
Office Work	Surveyed by WA Miller
Checked	Notes Miller Date 9-18-34
Date	Indexed C. Johnson

F.B. 841 Pg. 215

W.S. 44, A-2

Con at bottom page 216

624.81 @ 0-00 T 102 = 624.38 } 624.39
624.33 @ 0-00 T 102 = 624.40 }

624.39

SAN MARINO AVE

ARDENGROVE JR

TR 9619

90-14-00
360-56-15
181-24-45
90-14-01½

(40) (80) (40)

89-59-30
359-57-00
179-55-30
89-59-15

Fd x in Walk

40.02

Fd 2" I.P Plug TR ARDENGROVE TR.

39.89

69.57

90-14-05

89-59-15

40.01

(40) (40)

See page 217

CALIFORNIA

See page 213

ST

Set SWT by Inf.
See page 219

See page 219

Note: ANY ADDITIONS OR CHANGES ON THIS SHEET MUST BE MADE OR CIRCLED IN Red Ink WITH DATE AND NAME OF PERSON MAKING CHANGE.

Do not extend notes this side of this line

RETURN TO
LOS ANGELES COUNTY SURVEYOR
700 HALL OF RECORDS

FORM 247 BM 2-34

F.B. 841 Pg. 216

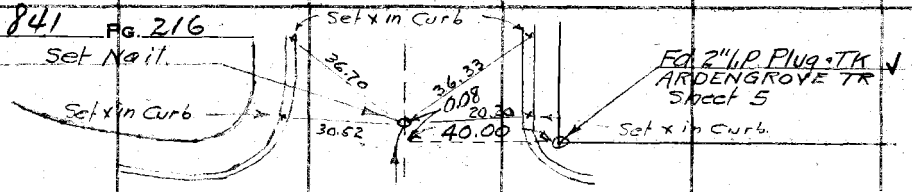

W.S. 44, A-2

LOMBARDY RD.

(40) (80) (40)

℄

TR 9619

ARDENGROVE TR

624.37

SAN MARINO AVE

Con from top page 215

RETURN TO
LOS ANGELES COUNTY SURVEYOR
700 HALL OF RECORDS

Do not extend notes this side of this line

Note: ANY ADDITIONS OR CHANGES ON THIS SHEET MUST BE MADE OR CIRCLED IN Red Ink WITH DATE AND NAME OF PERSON MAKING CHANGE.

W.S. 44 A-3

Notes Ck'd by McPherson	Survey of SAN MARINO AVE	F.B. 841	Pg. 217
Map No.	W. O. 7144 Tape No 058 Std 84 or.		
Office Work	Surveyed by W.A Miller		
Checked	Notes Miller Date 9-18-34		
Date	Indexed C. Johnson		

Con at bottom page 218

774.02 @ 0-00 T 102 = 774.11 } 774.11
774.02 @ 0-00 T 102 = 774.11 }

TR 9858

774.11

ST

Set N T

Fd 1½ I.P. Plug Tk in back edge of walk S.E. Cor TR 6186

4.80

39.94

TR 6186

313.29 @ 0-00 T 102 = 313.32 } 313.32
313.28 @ 0-00 T 102 = 313.31 }

313.32

CALIFORNIA

TR 9619

Fd L T in Walk

40.07

Fd k in Walk

69.76

SAN MARINO

see page 219

35.15
39.74

AVE

see page 215

Set S.W.T. by Ink.
See page 219

See page 213

RETURN TO
LOS ANGELES COUNTY SURVEYOR
700 HALL OF RECORDS

Do not extend notes this side of this line

Note: ANY ADDITIONS OR CHANGES ON THIS SHEET MUST BE MADE OR CIRCLED IN Red Ink WITH DATE AND NAME OF PERSON MAKING CHANGE.

FORM 247 BM 2-34

F.B. 841 PG. 218

44 B-3

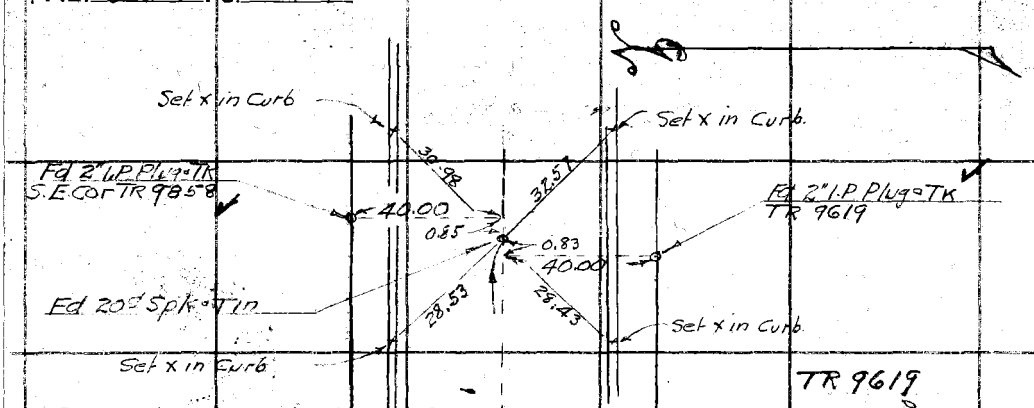

Reproduction of Center Line shown on Tracts 9858 (M.B. 137-100) & 9619 (M.B. 134-4 to 6). These Tracts call it Cy. Eng. & and used points, now gone, to fix it.

TR 9619

CALIFORNIA ST

(40)

CANTERBURY RD

(40) (80)

TR 9858

TR 9619

(40) (80) (40)

40

CHESTER AVE

40 (80)

Com from top page 217

RETURN TO
LOS ANGELES COUNTY SURVEYOR
700 HALL OF RECORDS

Do not extend notes this side of this line

Note: ANY ADDITIONS OR CHANGES ON THIS SHEET MUST BE MADE OR CIRCLED IN Red Ink WITH DATE AND NAME OF PERSON MAKING CHANGE.

W.S. 44-43

Notes Ck'd. by McPherson	Survey of SAN MARINO AVE
Map No.	W. O. 7144 Tape No 058 St'd 84 of.
Office Work	Surveyed by W.A. Miller
Checked	Notes Miller Date 9-18-34
Date	Indexed C. Johnson

F.B. 841 Pg. 219

Notes: ANY ADDITIONS OR CHANGES ON THIS SHEET MUST BE MADE OR CIRCLED IN Red Ink WITH DATE AND NAME OF PERSON MAKING CHANGE.

Do not extend notes this side of this line

RETURN TO
LOS ANGELES COUNTY SURVEYOR
700 HALL OF RECORDS

FORM 247 BM 8-34

N

89-44-45
359-00-00
178-30-15
89-45-02½

Con at bottom page 220

0+54.93
2+96.01
3+50.94
8.98
3+59.92

297.12 @ 0-00 T 94 = 297.14 } 297.12
297.09 @ 0-00 T 94 = 297.11 }

Set L.T in curb

Set S.W.T by Int
3+59.92

Set N.T
3+50.94

296.00 @ 0-00 T 90 = 296.01 } 296.01
296.01 @ 0-00 T 90 = 296.02 }

Set L.T in curb

90-01-30
360-06-30
180-10-00
90-01-40

TR 6769

Fd 2" I.P. Plug & Tk
TR 6769

Set L.T in curb return

297.12

AVE

89-34.98

30.23

25.28

37.62

8.98

39.71

44.63

35.00
0.02

34.97

296.01

SAN MARINO

(35) (70) (35)

TR 6186

Fd L.T in Walk

Set L.T in curb return

See page 223

HOMET RD

(35) (60)

TR 6186

89-45-00
358-59-45
178-29-45
89-44-57½

Set N.T
0+54.93

Fd L.T in Walk

Set L.T in Curb return

CALIFORNIA

(40) (80) (40)

See page 213

See page 217

(40) (80) (40)

90-01-40

54.93
40.23

18.36

41.90

89-44-45

34.67

44.87

89-59-15

90-14-05

Page

Page

Set S.W.T by Int of ℄ From North with ℄ From West
0+00

Set L.T in Curb return

Set L.T in Curb return

See page 215

(40) (80) (40)

F.B. 841 Pg. 220

Con at bottom page 221

W.S. 44-A3

3.17 @ 0-00 T 770 = 261.72
261.74 @ 0-00 T 770 = 261.72
261.73 @ 0-00 T 770 = 261.71

3.17
261.71
264.88

3+59.92
2+97.12
6+57.04
55.01
7+12.05
55.00
7+67.05
77.96
8+45.01

8+45.01
77.97
9+22.98

9-23-00
37-32-00
56-18-00
9-23-00

Set L.T in Curb

Set S.W.T - P.I.
8+45.01

Set N.T
9+22.98

Set L.T in Curb

Δ = 9° 23'00" = (Rec. per Tr. 7423)
R = 950
T = 77.965
L = 155.58

TR 7423

Set L.T in Curb

77.965 @ 0-00 T 86 = 77.965

TR 7423

Set L.T in Curb

77.965

AVE

90-00-00
360-00-00
180-00-00
90-00-00

Set N.T
7+67.05

Fd L.T in Walk

Set L.T in Curb return

Set L.T in Curb return

Set S.W.T by Inf.
7+12.05

See page 225

SAN PASQUAL

ST

180°

Set L.T in Curb return

Set L.T in Curb return

Fd 2" I.P. Plug - TK
TR 6769

Fd Nail
6+57.04

90-01-00
360-03-45
180-05-30
90-00-55

SAN MARINO

Con From top page 219

RETURN TO
LOS ANGELES COUNTY SURVEYOR
700 HALL OF RECORDS

Do not extend notes this side of this line

Note: ANY ADDITIONS OR CHANGES ON THIS SHEET MUST BE MADE OR CIRCLED IN Red Ink WITH DATE AND NAME OF PERSON MAKING CHANGE.

W.S. 44A-3

Notes Ck'd by McPherson	Survey of SAN MARINO AVE
Map No.	W. O. 7144 Tape No 058 St'd 84 of.
Office Work	Surveyed by W A Miller
Checked	Notes Miller Date 9-27-34
Date	Indexed A. C. Johnson

F.B. 841 Pg. 221

Con at bottom page 222

9+22.98
2+64.88
11+87.86
61.78
12+49.64
1+92.21
14+41.85

(60)
(30) ℄ (30)

58.50 @ 0-00 T 82 = 58.50 ✓
301.32 @ 0-00 T 82 = 301.32 ✓
301.33 @ 0-00 T 82 = 301.33 359.82 ✓

359.82 ✓

TR 7760

90-01-45
360-07-00
180-10-30
90-01-45 ✓

TR 7760

Fd x in Walk

Fd x in Walk

Set L.T in curb return

29.75 30.20

Set L.T in curb return

90-01-45 (Rad.)

37.02 29.97 29.97 38.56

(60) (30) OAKDALE ST (30) (60)

See page 230

36.77 29.99 30.02 38.08

Set S.W.T by Ink.
14+41.85 ✓

Set L.T in curb return

29.70 30.26

Set L.T in curb return

Fd x in walk

Fd x in walk

Set L.T in Curb

189.50 @ 0-00 T 70 = 189.48
189.51 @ 0-00 T 70 = 189.49 189.48
2.73 @ 0-00 T 70 = 2.73
192.21

192.21 ✓

Δ = 9°51'30" = Rec. per Tr 7760 ✓
R = 142.54 = Rec
T = 12.29
L = 24.53

25.92 30.00 25.90

Set L.T in Curb

170-08-30
320-34-30
300-51-45 ✓
170-08-37½

30.06 27.80

Set S.W.T. by intersection.
12+49.64 ✓

Set L.T in Curb

TR 7760

Set L.T in curb

TR 7760

AVE

61.78

SAN MARINO

Set N.T
11+87.86 ✓

264.88

TR 7423

TR 7423

(30) (60) (30)

Con from top 220

RETURN TO
LOS ANGELES COUNTY SURVEYOR
700 HALL OF RECORDS

Note: ANY ADDITIONS OR CHANGES ON THIS SHEET MUST BE MADE OR CIRCLED IN Red Ink WITH DATE AND NAME OF PERSON MAKING CHANGE.

Do not extend notes thisside of this line

FORM 247 BM 2-34

F.B. 841 Pg. 222

W.S. 44 A-2

RETURN TO
LOS ANGELES COUNTY SURVEYOR
700 HALL OF RECORDS

Do not extend notes this side of this line

Note: ANY ADDITIONS OR CHANGES ON THIS SHEET MUST BE MADE OR CIRCLED IN Red Ink WITH DATE AND NAME OF PERSON MAKING CHANGE.

14+41.85
3+59.82
18+01.67
1+53.17
19+54.84
8.04
19+62.88

19+62.89
80.02
20+42.91
1+55.11
21+98.02
29.52
22+27.54

Set L.T in Curb return

Set S.W.T by Ink.
22+27.54

Bearing Line on Blanche St. per C.S.B. 844 E
Hoyt B. Coffman
County Surveyor

Fd N.T
F.B. 511-8

176.36

BLANCHE ST

Not ℄

(60) (30)

Fd x at Allen St.
F.B. 511-6

Fd N.T at Craig St.
F.B. 511-9

90-02-30
360-10-15
180-15-15
90-02-32½

Set L.T in Curb return

Set N.T
21+98.02

Fd 2" I.P Plug & Nail
21+97.97

176.35 @ 0-00 T 94 = 176.36
176.36 @ 0-00 T 94 = 176.37
176.36

Fd chiseled line on curb

PASADENA

Fd Chiseled line on curb 22+30.94

CITY BOUNDARY
22+30.97

Fd 2" I.P Plug & Nail

155.10 @ 0-00 T 90 = 155.11
155.11 @ 0-00 T 90 = 155.12
155.11

Set Nail

168.86

AVE

Set N.T
20+42.90

SCHOOL GROUNDS

168.85 @ 0-00 T 88 = 168.85
168.87 @ 0-00 T 88 = 168.87
168.86

182.00 @ 0-00 T 86 = 182.00
182.00 @ 0-00 T 86 = 182.00
182.00

TR 8311

Set N.T
19+62.88

Fd 2 x 2 Tk

Set Nail

Fd 2" I.P Plug & Tk

Set N.T
19+54.84

153.17 @ 0-00 T 86 = 153.17
153.17 @ 0-00 T 86 = 153.17
153.17

Fd 1½ I.P Plug & Nail

TR 7760

MARINO

Fd x in walk

Fd 2" I.P Plug & Tk

Set L.T in Curb return

Set L.T in Curb return

Set S.W.T by Ink.
18+01.67

See page 232

ROSE VILLA

ST

Set L.T in Curb return

Set L.T in Curb return

Fd x in Walk

SAN

Fd x in Walk

Con from top page 221

Notes Ck'd by MPhinney
Map No.
Office Work
Checked
Date

Survey of SAN MARINO AVE
W. O. 7144 Tape No 058 St'd 84 OF.
Surveyed by W.A Miller
Notes Miller Date 9-19-34
Indexed A. C. Johnson

F.B. 841 PG. 283

44, B-3

Fd 1½" I.P. Plug-TK

1.26

60.00

Fd 1½" I.P. Plug-TK
N.E. Cor Lot 22
TR 9858

153.47 @ 0-00 T96 = 153.48 } 153.49
153.49 @ 0-00 T96 = 153.50 }

153.49

Set N.T

0.24
35.19

Fd 1½" I.P. Plug N.T.K
per TR 9858

531.91 @ 0-00 T96 = 531.95 } 531.95
531.92 @ 0-00 T96 = 531.96 }

TR 9858

HOMET RD.

531.95

? (631.95)

Fd 2" I.P. Plug-TK

25.00
0.02

35.00

Fd 2" I.P. Plug-TK
N.W. Cor TR 9858

Set N.T

TR 6186

308.20 @ 0-00 T94 = 308.22 }
308.20 @ 0-00 T94 = 308.22 } 308.22

(25) (35)
(60)

Fd L.T in Walk

308.22

TR 6186

25.12

35.10

SAN MARINO AVE

(70)
(35)
(35)

See page 219

See page 219

Set S.W.T. by Int
See page 219

Notes: ANY ADDITIONS OR CHANGES ON THIS SHEET MUST BE MADE OR CIRCLED IN Red Ink WITH DATE AND NAME OF PERSON MAKING CHANGE.

Do not extend notes this side of this line

RETURN TO
LOS ANGELES COUNTY SURVEYOR
700 HALL OF RECORDS

FORM 247 BM 2-34

F.B. 841 PG. 224

RETURN TO

LOS ANGELES COUNTY SURVEYOR

700 HALL OF RECORDS

Do not extend notes this side of this line

Notes: ANY ADDITIONS OR CHANGES ON THIS SHEET MUST BE MADE OR CIRCLED IN **Red Ink** WITH DATE AND NAME OF PERSON MAKING CHANGE.

W.S. 44, A+B 3

Notes Ck'd by McPherson	Survey of SAN MARINO AVE
Map No.	W. O. 7144 Tape No 058 St'd 84 of.
Office Work	Surveyed by W.A. Miller
Checked	Notes Miller Date 9-20-34
Date	Indexed A. C. Johnson

F.B. 841 Pg. 225

Fd 2" I.P. Plug. No Tk
L.S. 22-45
TR 7423
TR 6159
CRAIG AVE

39.95
Off Tan Proa

0.20

NOTE: Angle in SAN PASQUAL ST. at GRAIG AVE
Fd S.W.T
Z 172-142

(60) (30) (30)

54.93

30.50

40.00
on

Fd L.T in Walk
L.S. 22-45

381.47 @ 0-00 T84 = 381.47
381.46 @ 0-00 T84 = 381.46 } 381.46

381.46

L.S. 22-45
Set N.T.
used for line

(40) (variable)

SAN PASQUAL ST

TR 7423

Set N.T

Fd 2" I.P. Plug. Tk

39.95
0.09
0.08
35.68

Fd 2" I.P. Plug. Tk

308.40 @ 0-00 T84 = 308.40
308.40 @ 0-00 T84 = 308.40 } 308.40

(80)

(40) (40)

308.40

TR 6186

(35)

SAN MARINO AVE

See page 220

See page 220

(70)

Set S.W.T by Ink
See page 220

(35)

See page 226

Note: ANY ADDITIONS OR CHANGES ON THIS SHEET MUST BE MADE OR CIRCLED IN Red Ink WITH DATE AND NAME OF PERSON MAKING CHANGE.

Do not extend notes this side of this line

RETURN TO
LOS ANGELES COUNTY SURVEYOR
700 HALL OF RECORDS

FORM 247 BM 8-34

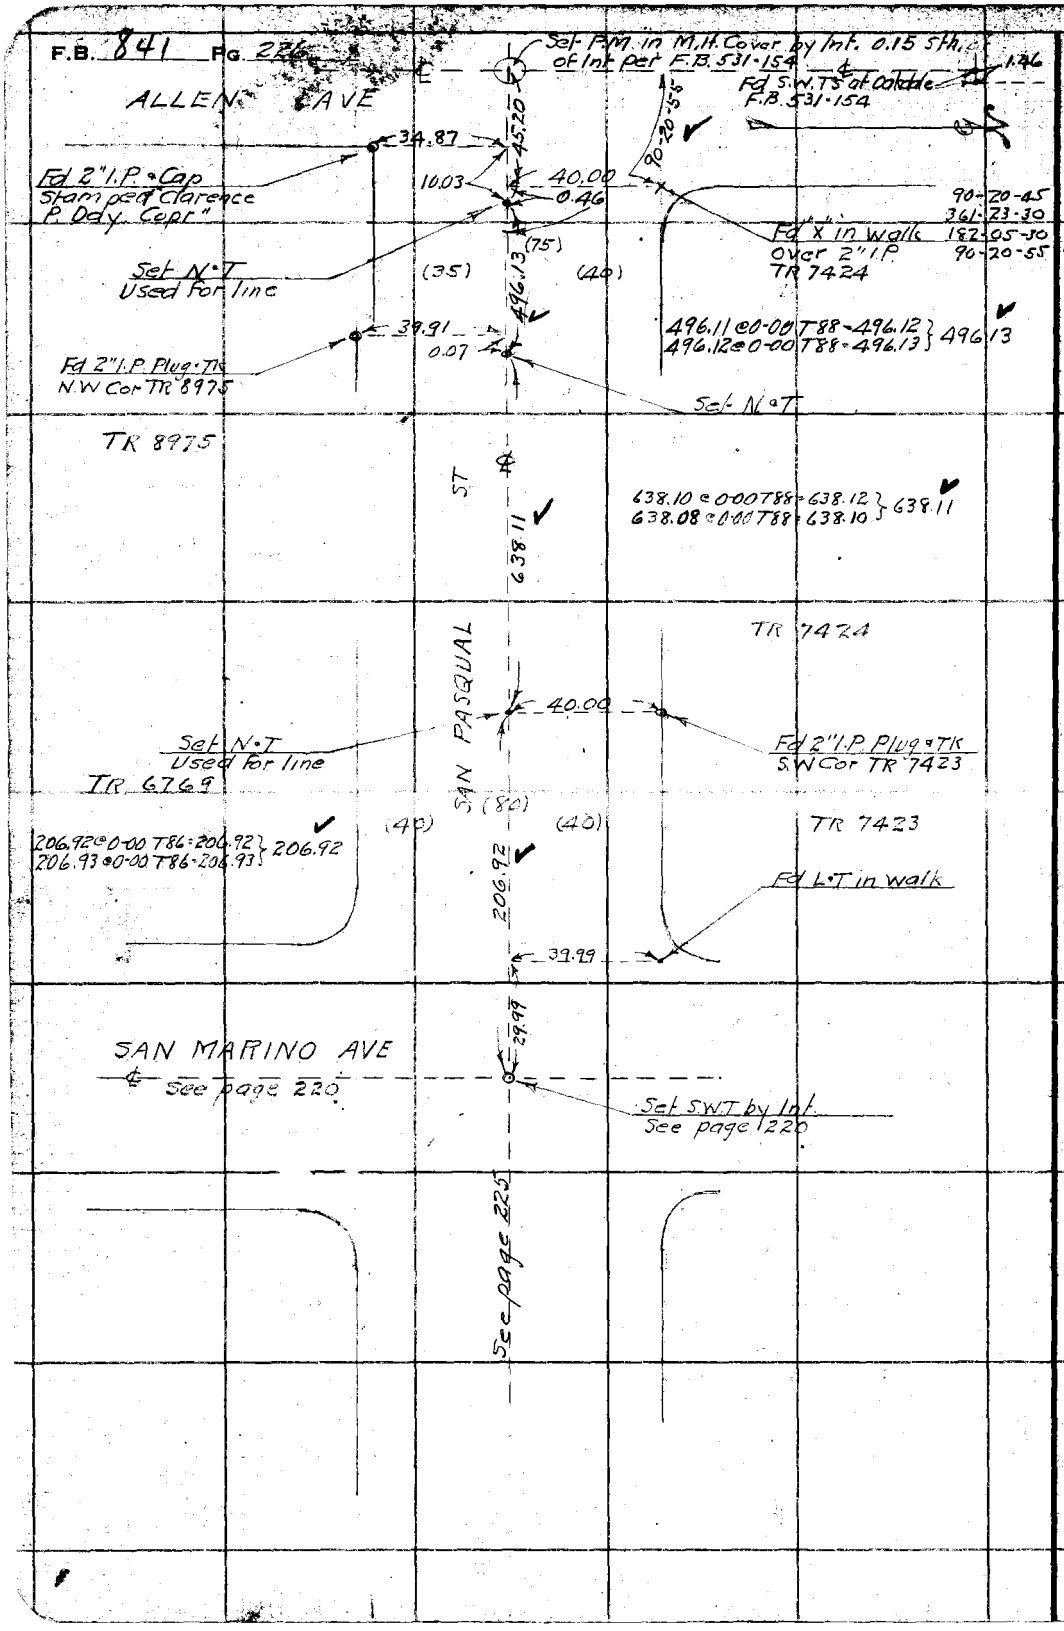
Set P.M. in M.H. Cover by Int. 0.15 S'ly of Int per F.B. 531-154
Fd S.W. TS at Cobble F.B. 531-154
1.76
ALLEN AVE
34.87
45.20
90-20-55
Fd 2" I.P. & Cap Stamped Clarence P. Daly Corp."
10.03
40.00
0.46
90-20-45
361-23-30
182-05-30
90-20-55
Fd "X" in walk over 2" I.P.
TR 7424
Set N.T Used for line
(35)
(75)
(40)
496.13
39.91
0.07
496.11 @ 0-00 T88 = 496.12
496.12 @ 0-00 T88 = 496.13
} 496.13
Fd 2" I.P. Plug & Tag NW Cor TR 8975
Set N. & T
TR 8975
ST
638.11
638.10 @ 0-00 T88 = 638.12
638.08 @ 0-00 T88 = 638.10
} 638.11
TR 7424
SAN PASQUAL
40.00
Set N.T Used for line
Fd 2" I.P. Plug & Tag SW Cor TR 7423
IR 6769
(40)
(80)
(40)
TR 7423
206.92 @ 0-00 T86 = 206.92
206.93 @ 0-00 T86 = 206.93
} 206.92
206.92
Fd L.T in walk
39.99
29.99
SAN MARINO AVE
See page 220
Set SWT by Int.
See page 1220
See page 225
W.S. 44 A-3
RETURN TO
LOS ANGELES COUNTY SURVEYOR
700 HALL OF RECORDS
Do not extend notes this side of this line
Note: ANY ADDITIONS OR CHANGES ON THIS SHEET MUST BE MADE OR CIRCLED IN Red Ink WITH DATE AND NAME OF PERSON MAKING CHANGE.

W, S, 47, B-3

Notes Ck'd by McPherson	Survey of SAN MARINO AVE
Map No.	W. O. 7144 Tape No 058 St'd 84 or.
Office Work	Surveyed by W.A Miller
Checked	Notes Miller Date 9-21-34
Date	Indexed A. C. Johnson

F.B. 841 Pg. 223

0+39.69
3+20.32
3+60.01
1+06.71
4+66.30

Con at bottom page 228

260.64 @ 0-00 T 74 = 260.62 } 260.61
260.62 @ 0-00 T 74 = 260.60 }

260.61 AVE

TR 7760

Fd 2" I.P Plug & Tk
4+71.46

+5.26

Fd 2" I.P Tk
4+71.56

24.95
5.16
5.05

Set N & T
4+66.30

106.30 @ 0-00 T 74 = 106.29 } 106.29
106.29 @ 0-00 T 74 = 106.29 }

106.29

TR 6159

Set N & T
3+60.01

30.05
4.55

Fd 2" I.P Plug & Tk
TR 6660
3+64.56

320.35 @ 0-00 T 74 = 320.33 } 320.32
320.34 @ 0-00 T 74 = 320.32 }

(30) (60) (30)

TR 6660
TR 6159

TR 7423

320.32 CRAIG

89-30-15
358-01-30
177-02-15
89-30-22½

+57

Fd L & T in Walk
0+40.26

29.92
25.00

Fd 2" I.P Plug & Tk
TR 6159
0+39.74

+05

30 Adj.
30.20

Set N & T
Used For line

(40)

Set N & T See page 225

89.30

50.16

39.69

46.96

(40)

SAN PASQUAL

AVE

30.44
0.70

See page 225

Set L & T by Ink In Conc. Gutter 6" down. Angle pt in San Pasqual ℄ 0+00

Fd S.W.T
Z 172.142

36.15

0.04

18.81

28.29

Fd L & T in Curb, near end.

Fd Spk in Curb. B.M.

Fd "X" in Curb.

RETURN TO
LOS ANGELES COUNTY SURVEYOR
700 HALL OF RECORDS

Note: ANY ADDITIONS OR CHANGES ON THIS SHEET MUST BE MADE OR CIRCLED IN Red Ink WITH DATE AND NAME OF PERSON MAKING CHANGE.

Do not extend notes this side of this line.

FORM 247 5M 2-34

F.B. 841 Pg. 228

Con at bottom page 229

4+66.30
2+60.61
7+26.91
3+59.65
10+86.56
2+74.40
13+60.96

Set L.T in Curb

154.07@0-00 T74 = 154.06 } 154.06
154.07@0-00 T74 = 154.06

154.06

Fd 2" I.P. Plug. TK 13+61.02
TR 6159

Fd 2" I.P. Plug. TK
13+61.01

PASADENA CITY
SCHOOL GROUNDS

BOUNDARY

Set N.T
13+60.96

Set L.T in Curb

274.42@0-00 T74 = 274.40 } 274.40
274.42@0-00 T74 = 274.40

274.40

AVE

TR 6159

Set L.T in Curb return

Set L.T in Curb

ROSE VILLA ST

See page 232

Set S.W.T by Int.
10+89.49

Set N.T
10+86.56

90-01-30
360-07-00
180-10-15
90-01-42½

TR 7760

50 Adj.

359.66@0-00 T74 = 359.64 } 359.65
359.68@0-00 T74 = 359.66

359.65

CRAIG

Set L.T in Curb return

Set N.T
7+29.50

OAKDALE ST

See page 230

90-02-30
Page 229

Set L.T in Curb return

Set N.T
7+26.91

40 Adj.

260.61

Con from top page 227

W.S. 99, B-2-23

RETURN TO
LOS ANGELES COUNTY SURVEYOR
700 HALL OF RECORDS

Do not extend notes this side of this line

Note: ANY ADDITIONS OR CHANGES ON THIS SHEET MUST BE MADE OR CIRCLED IN Red Ink WITH DATE AND NAME OF PERSON MAKING CHANGE.

Notes Ck'd by McPherson	Survey of SAN MARINO AVE
Map No.	W. O. 7144 Tape No 058 St'd 84 or.
Office Work	Surveyed by W.A. Miller
Checked	Notes Miller Date 9-27-34
Date	Indexed C. Johnson

F.B. 841 Pg. 229

13+60.96
1+54.06
15+15.02

Fd 2½ 12" On per ties F.B. 511-T

Fd N.T F.B. 511-9

Set N.T by Int 15+15.02

BLANCHE ST

Transit Line

29.86 30.03 0.11 12.44 12.41 30.02 27.50 29.53

90-03-40

29.89

Fd 2" I.P. Plug & Tk

Fd 2" I.P. Plug & Tk

(30) (60) (30)

90-03-45
360-14-45
180-22-00
90-03-40

CR 416 AVE

15+36

Con from top page 228

Note: ANY ADDITIONS OR CHANGES ON THIS SHEET MUST BE MADE OR CIRCLED IN Red Ink WITH DATE AND NAME OF PERSON MAKING CHANGE.

Do not extend notes this side of this line

RETURN TO
LOS ANGELES COUNTY SURVEYOR
700 HALL OF RECORDS

FORM 247 5M 8-34

F.B. 841 Pg. 230

W.S. 44, A + B-3

183.8/@0-00 T 70 = 183.79 } 183.78
183.80@0-00 T 70 = 183.78 }

(30) (60) (30)

183.78

Fd. x in walk

30.02 29.96

29.71
29.77

Set S.W.T by Int.
6+49.77

See page 221

SAN MARINO

1.67

AVE

30.28
30.22

Set N°T
6+48.10

30.02 29.98

Fd Cross in walk
See Pg. 221

TR 7760

648.10

OAKDALE ST

648.16@0-00 T 68 = 648.10 } 648.10
648.16@0-00 T 68 = 648.10 }

TR 7760

90-02-30
360-10-00
180-15-15
90-02-32½

(30) (60) (30)

40 Adj.
30

90-02-30

(30) (60) (30)

See page 228

CRAIG AVE

See page 228

Set N°T by Int. Page 229
0+00

RETURN TO
LOS ANGELES COUNTY SURVEYOR
700 HALL OF RECORDS

Do not extend notes this side of this line

Note: ANY ADDITIONS OR CHANGES ON THIS SHEET MUST BE MADE OR CIRCLED IN Red Ink WITH DATE AND NAME OF PERSON MAKING CHANGE.

W.S. 94 A-3

Notes Ck'd by McPherson	Survey of SAN MARINO AVE
Map No.	W. O. 7144 Tape No. 268 St'd 84 of.
Office Work	Surveyed by W.A. Miller
Checked	Notes Miller Date 9-27-34
Date	Indexed

F.B. 841 Pg. 291

Note: ANY ADDITIONS OR CHANGES ON THIS SHEET MUST BE MADE OR CHOSED IN Red Ink WITH DATE AND NAME OF PERSON MAKING CHANGE.

RETURN TO
LOS ANGELES COUNTY SURVEYOR
700 HALL OF RECORDS

Do not extend notes this side of this line

6+18.10
1+83.78
8+31.88
94.44
9+26.29

AVE

(45.68 = Rec. per Tr. 7760)
45.68
0.11

Fd 2" I.P. Cap Stamped "Clarence P. Day Corp." 9+26.40

Set N°T 9+26.29

94.42 C 0.00770 = 94.41

TR 7760

94.41

OAKDALE

TR 8389

(45.68 = Rec. per Tr. 7760)
45.68
4.88

Fd 2" I.P. Cap "X" S.E. Cor Torrens Title. 8+36.76 TR 8389

Set N°T 8+31.88

(60)
(30) (30)
183.78

TR 7760

Con from top page 230

FORM 247 5M 2-34

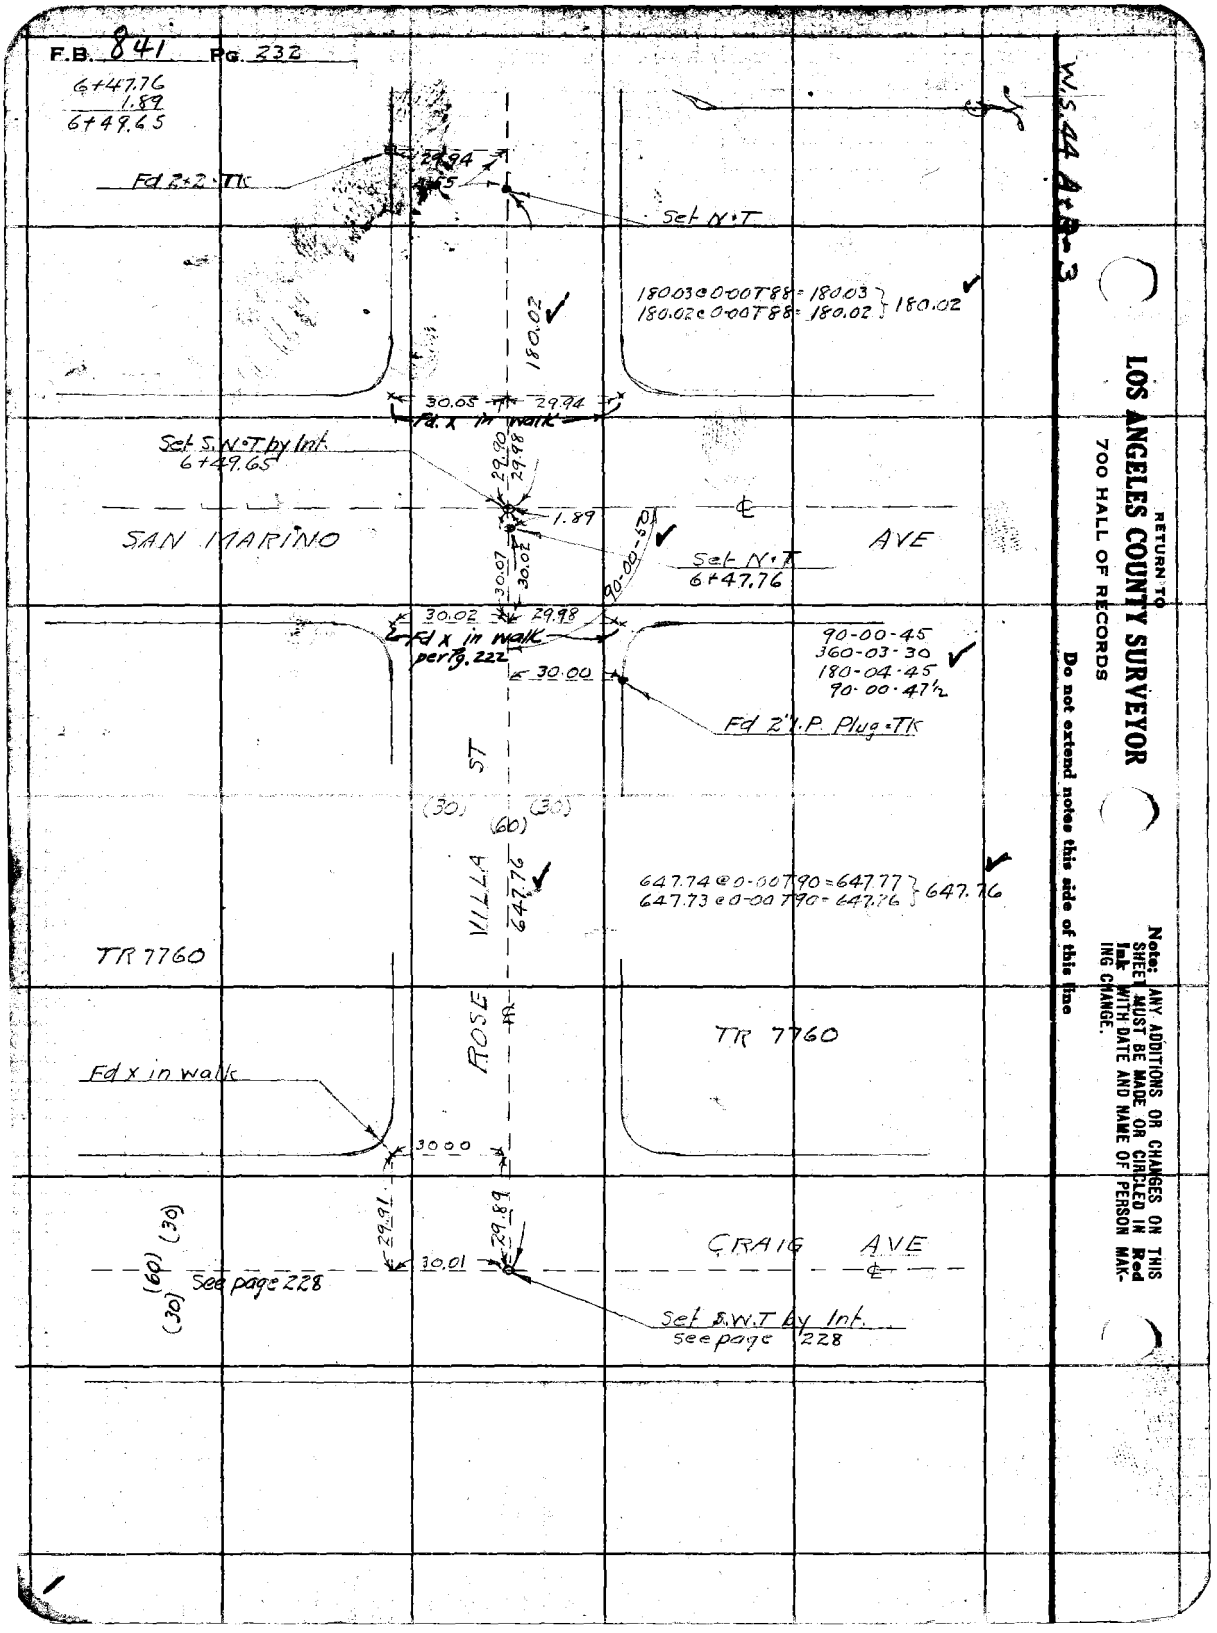
F.B. 841 Pg. 232
6+47.76
1.89
6+49.65
Fd 2"x2" Tk
29.94
Set N.T
180.02
180.03 @ 0-00T88" = 180.03
180.02 @ 0-00T88" = 180.02
180.02
30.03
29.94
Fd x in walk
Set S.N.T by Int.
6+49.65
29.90
29.98
1.89
SAN MARINO
AVE
30.07
30.02
90.00.50
Set N.T
6+47.76
30.02
29.98
Fd x in walk per fb. 222
30.00
90-00-45
360-03-30
180-04-45
90-00-47½
Fd 2" I.P. Plug-Tk
ST
(30)
(60)
(30)
VILLA
647.76
647.74 @ 0-00T90" = 647.77
647.73 @ 0-00T90" = 647.76
647.76
TR 7760
ROSE
TR 7760
Fd x in walk
30.00
29.91
29.89
(60)
(30)
See page 228
30.01
CRAIG AVE
Set S.W.T by Int.
see page 228
W.S. 44 Arch 3
RETURN TO
LOS ANGELES COUNTY SURVEYOR
700 HALL OF RECORDS
Do not extend notes this side of this line
Note: ANY ADDITIONS OR CHANGES ON THIS SHEET MUST BE MADE OR CIRCLED IN Red Ink WITH DATE AND NAME OF PERSON MAKING CHANGE.

Notes Ck'd by	Survey of SAN MARINO AVE
Map No.	W. O. 7144 Tape No St'd of.
Office Work	Surveyed by W.A. Miller
Checked	Notes Miller Date 10-9-34
Date	Indexed 10-22-34 C. Johnson

F.B. 841 Pg. 239

Notes: ANY ADDITIONS OR CHANGES ON THIS SHEET MUST BE MADE OR CIRCLED IN Red Ink WITH DATE AND NAME OF PERSON MAK. ING CHANGE.

Do not extend notes this side of this line

RETURN TO
LOS ANGELES COUNTY SURVEYOR
700 HALL OF RECORDS

TOPOGRAPHY
SAN MARINO AVE
J.N. 7144

FORM 247 BM 2-34

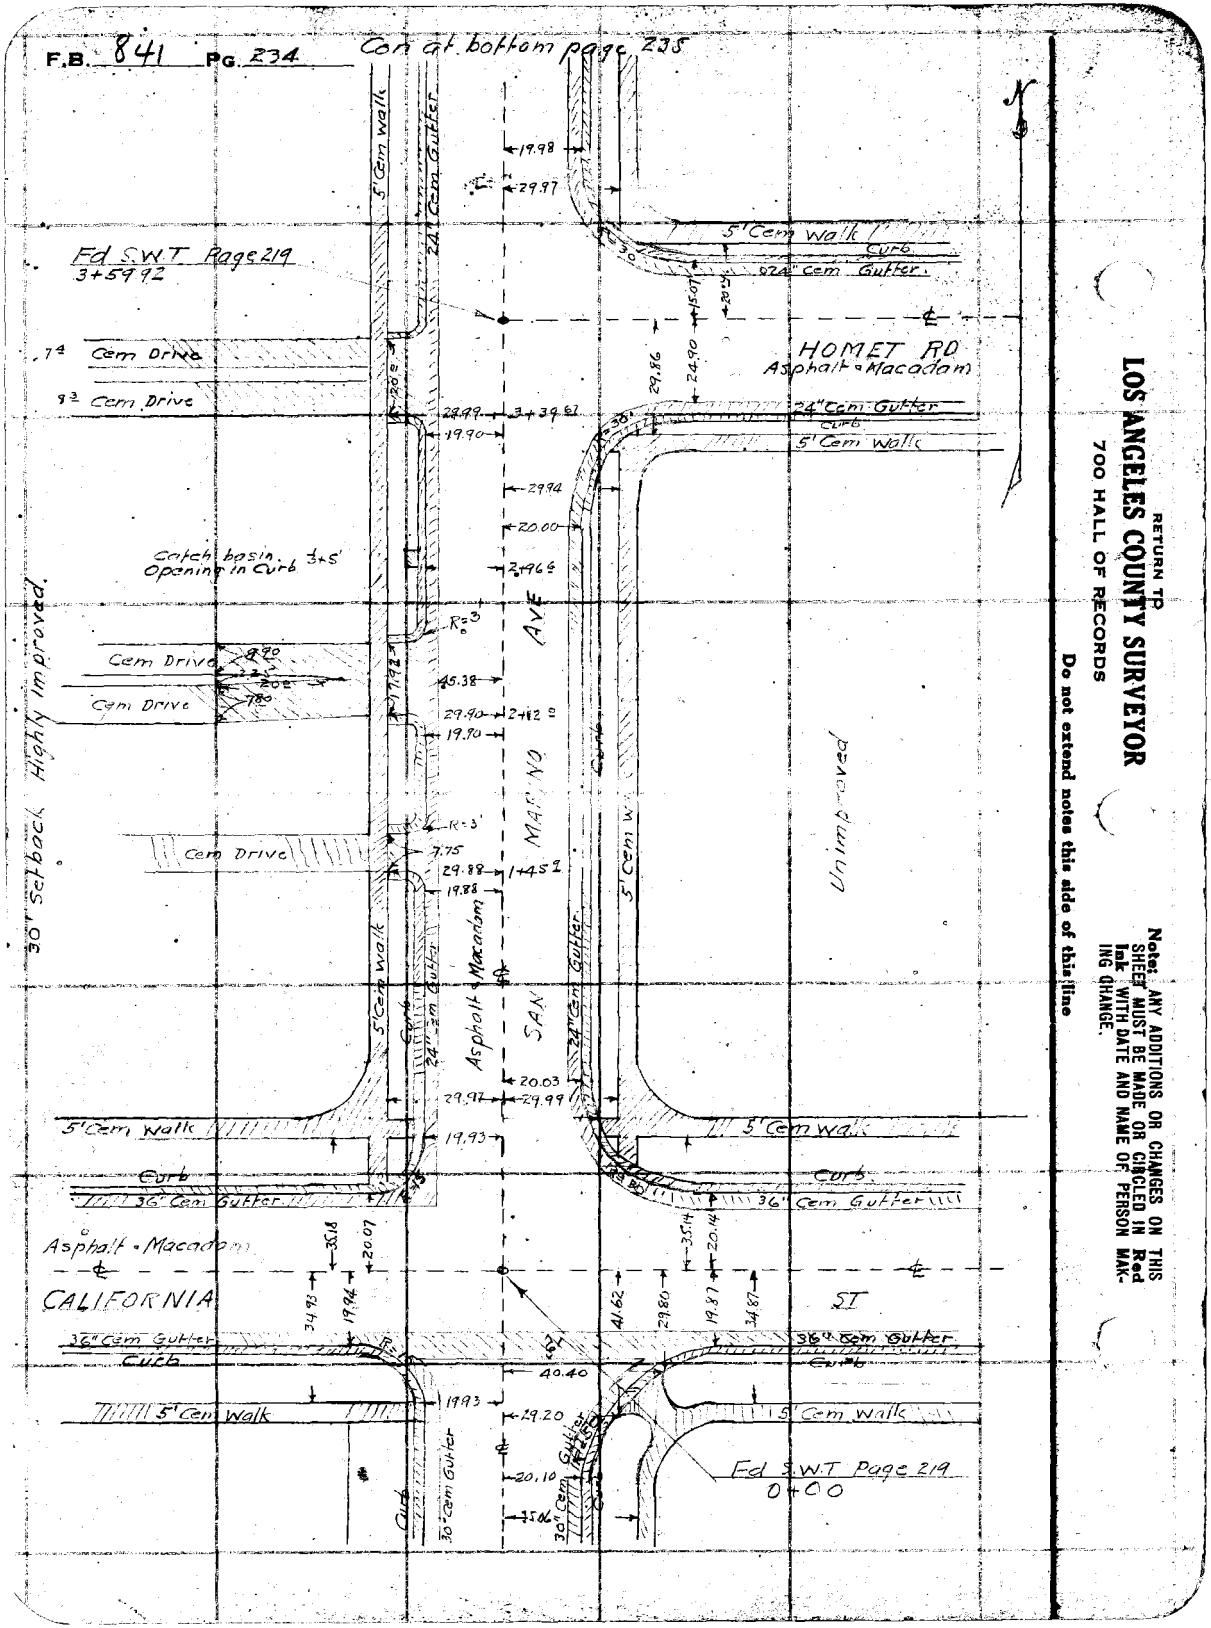
F.B. 841 Pg. 234
Con at bottom page 235
Fd S.W.T Page 219
3+59 92
5' Cem walk
24" Cem Gutter
5' Cem Walk
Curb
24" cem Gutter
HOMET RD
Asphalt - Macadam
7d Cem Drive
9d Cem Drive
24" Cem Gutter
Curb
5' Cem Walk
Catch basin
Opening in Curb
3+5'
AVE
Cem Drive
Cem Drive
MARINO
Unimproved
5' Cem walk
5' Cem walk
Curb
24" Cem Gutter
Asphalt - Macadam
SAN
24" Cem Gutter
5' Cem Walk
5' Cem walk
Curb
36" Cem Gutter
Curb
36" Cem Gutter
Asphalt - Macadam
CALIFORNIA
ST
36" Cem Gutter
Curb
36" Cem Gutter
Curb
5' Cem Walk
5' Cem walk
30" Cem Gutter
30" Cem Gutter
Fd S.W.T Page 219
0+00
RETURN TO
LOS ANGELES COUNTY SURVEYOR
700 HALL OF RECORDS
Do not extend notes this side of this line
Note: ANY ADDITIONS OR CHANGES ON THIS SHEET MUST BE MADE OR CIRCLED IN Red Ink WITH DATE AND NAME OF PERSON MAKING CHANGE.
105 Sheets
Highway Improved

Plotted Ch'd by
Map No.
Office Work
Checked
Date

Survey of SAN MARINO AVE
W. O. 7145 Topo No. St'd
Surveyed by W.A. Miller
Notes Miller Date 10-9-34
Indexed A. C. Johnson

F.B. 841 Pg. 235

Con at bottom page 236

Rd SWT Page 220
7+12.05

SAN PASQUAL ST

30" Cem Gutter
Curb
5' Cem Walk
5' Cem Walls
Asphalt Macadam
2 Story Stucco Ho.
Stucco Garage
Cem Drive
5' Stucco Wall
Stucco Posts 18'sq
Flower Garden
SAN MARINO AVE
Cem. Drive
Porch
Stucco Garage
2 Story Stucco Ho.

Con from top page 234

RETURN TO
LOS ANGELES COUNTY SURVEYOR
700 HALL OF RECORDS

Note: ANY ADDITIONS OR CHANGES ON THIS SHEET MUST BE MADE OR CIRCLED IN Red Ink WITH DATE AND NAME OF PERSON MAKING CHANGE.

Do not extend notes this side of this line

FORM 247 SM 2-34

F.B. 841 PG. 236

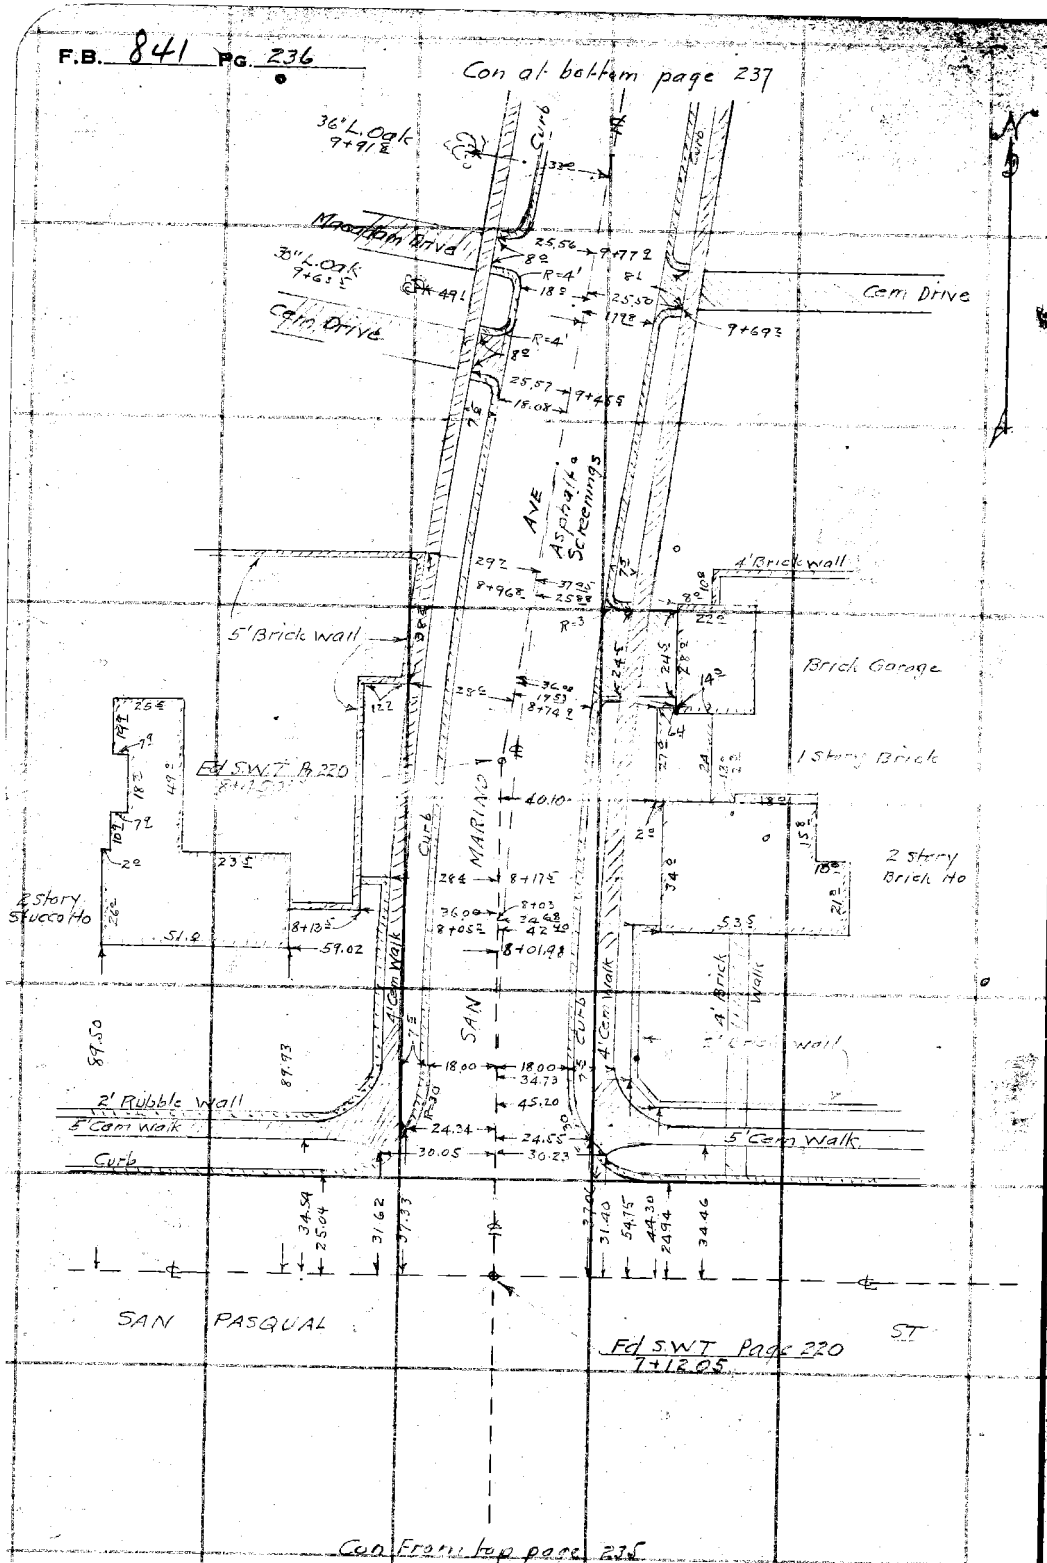

RETURN TO
LOS ANGELES COUNTY SURVEYOR
700 HALL OF RECORDS

Do not extend notes this side of this line

Note: ANY ADDITIONS OR CHANGES ON THIS SHEET MUST BE MADE OR CIRCLED IN Red Ink WITH DATE AND NAME OF PERSON MAKING CHANGE.

Drawn by G
Map No.
Office Work
Checked
Date

Survey of SAN MARINO AVE
W. O. 7144 Topo No. St'd of.
Surveyed by W.A.Miller
Notes Miller Date 10-10-34
Indexed A. C. Johnson

F.B. 841 Pg. 237

RETURN TO
LOS ANGELES COUNTY SURVEYOR
700 HALL OF RECORDS

Do not extend notes this side of this line

Note: ANY ADDITIONS OR CHANGES ON THIS SHEET MUST BE MADE OR CIRCLED IN Red Ink WITH DATE AND NAME OF PERSON MAKING CHANGE.

FORM 247 BM 8-34

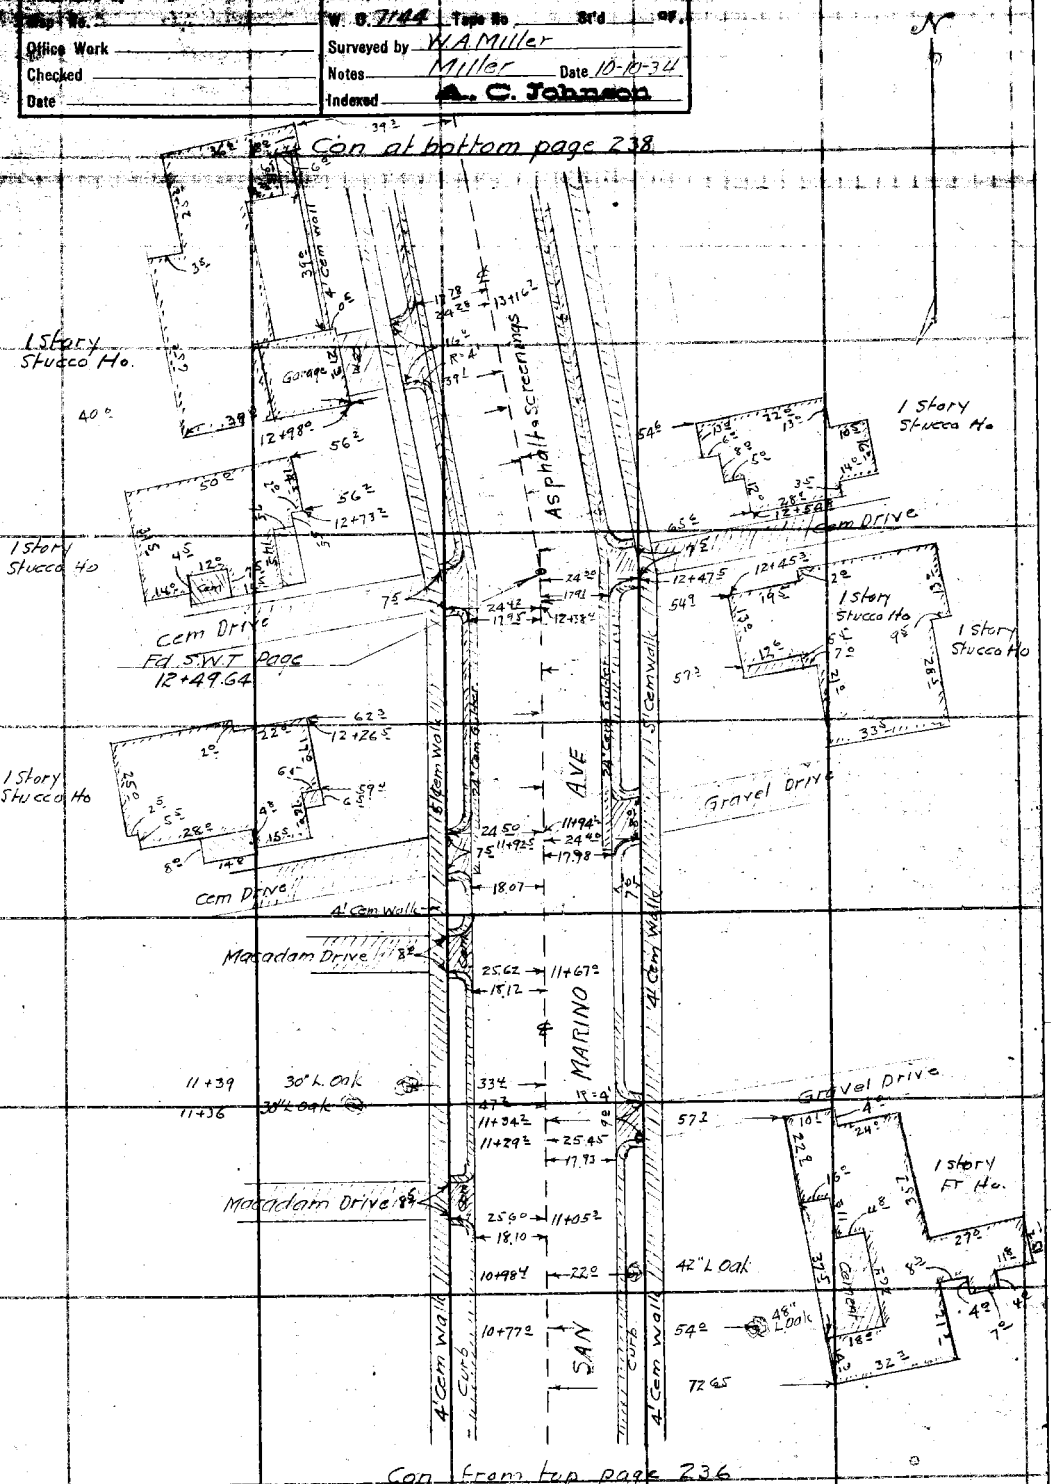

F.B. 841 Pg. 238

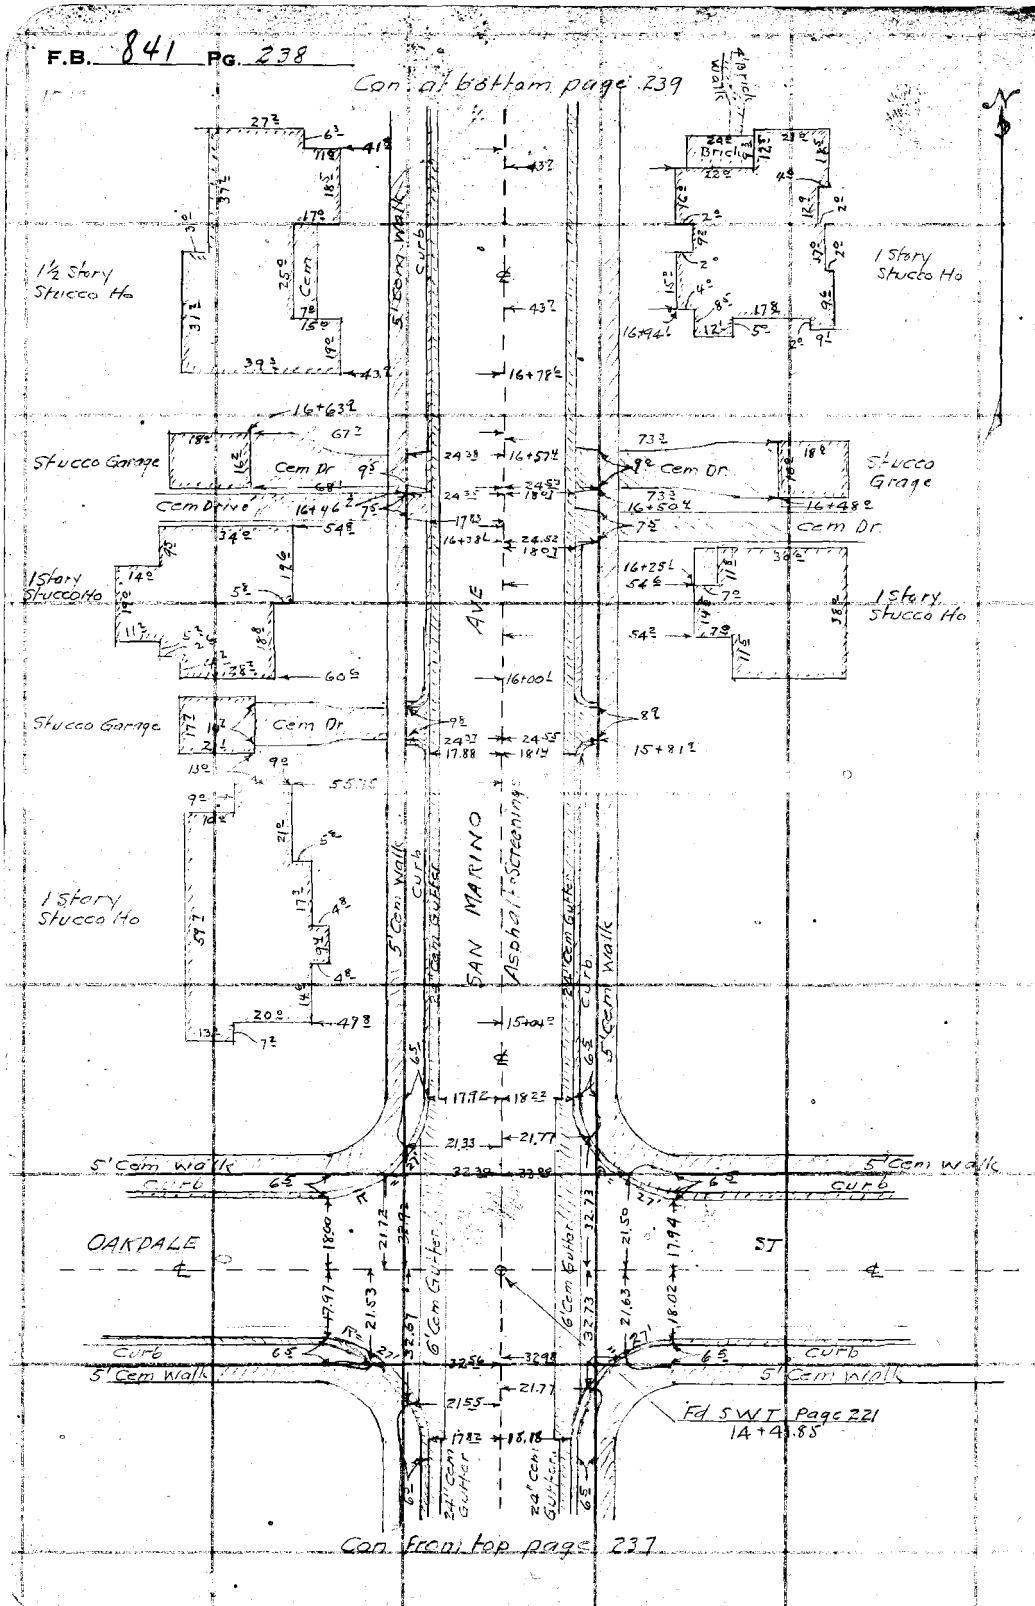

RETURN TO
LOS ANGELES COUNTY SURVEYOR
700 HALL OF RECORDS

Do not extend notes this side of this line

Note: ANY ADDITIONS OR CHANGES ON THIS SHEET MUST BE MADE OR CIRCLED IN **Red** Ink WITH DATE AND NAME OF PERSON MAKING CHANGE.

Notes Ck'd by	Survey of SAN MARINO AVE.
Map No.	W. O. 7444 Tape No. Sht. of
Office Work	Surveyed by W.A. Miller
Checked	Notes Miller Date 10-11-34
Date	Indexed A. C. Johnson

F.B. 841 Pg. 239

Con at bottom page 240

Pasadena City Limits

1 Story Stucco Ho.

Cem Dr

5' Cem Walk

Curb

24" Cem Gutter

Fd N.T Page 223
19+62.88

End walk 19+54.7

4' Cem wall

Stucco Garage

Stucco Wash Ho

1 Story Stucco Ho

SAN MARINO AVE

Asphalt Screenings

2' Cem Walk

4' Cem Walk

6' Cem Gutter

ROSE VILLA ST

Fd S.W.T Page 222
18+01.67

Con from top page 238

Note: ANY ADDITIONS OR CHANGES ON THIS SHEET MUST BE MADE OR CIRCLED IN Red Ink WITH DATE AND NAME OF PERSON MAKING CHANGE.

Do not extend notes this side of this line

RETURN TO
LOS ANGELES COUNTY SURVEYOR
700 HALL OF RECORDS

FORM 247 BM 2-34

F.B. 841 Pg. 240

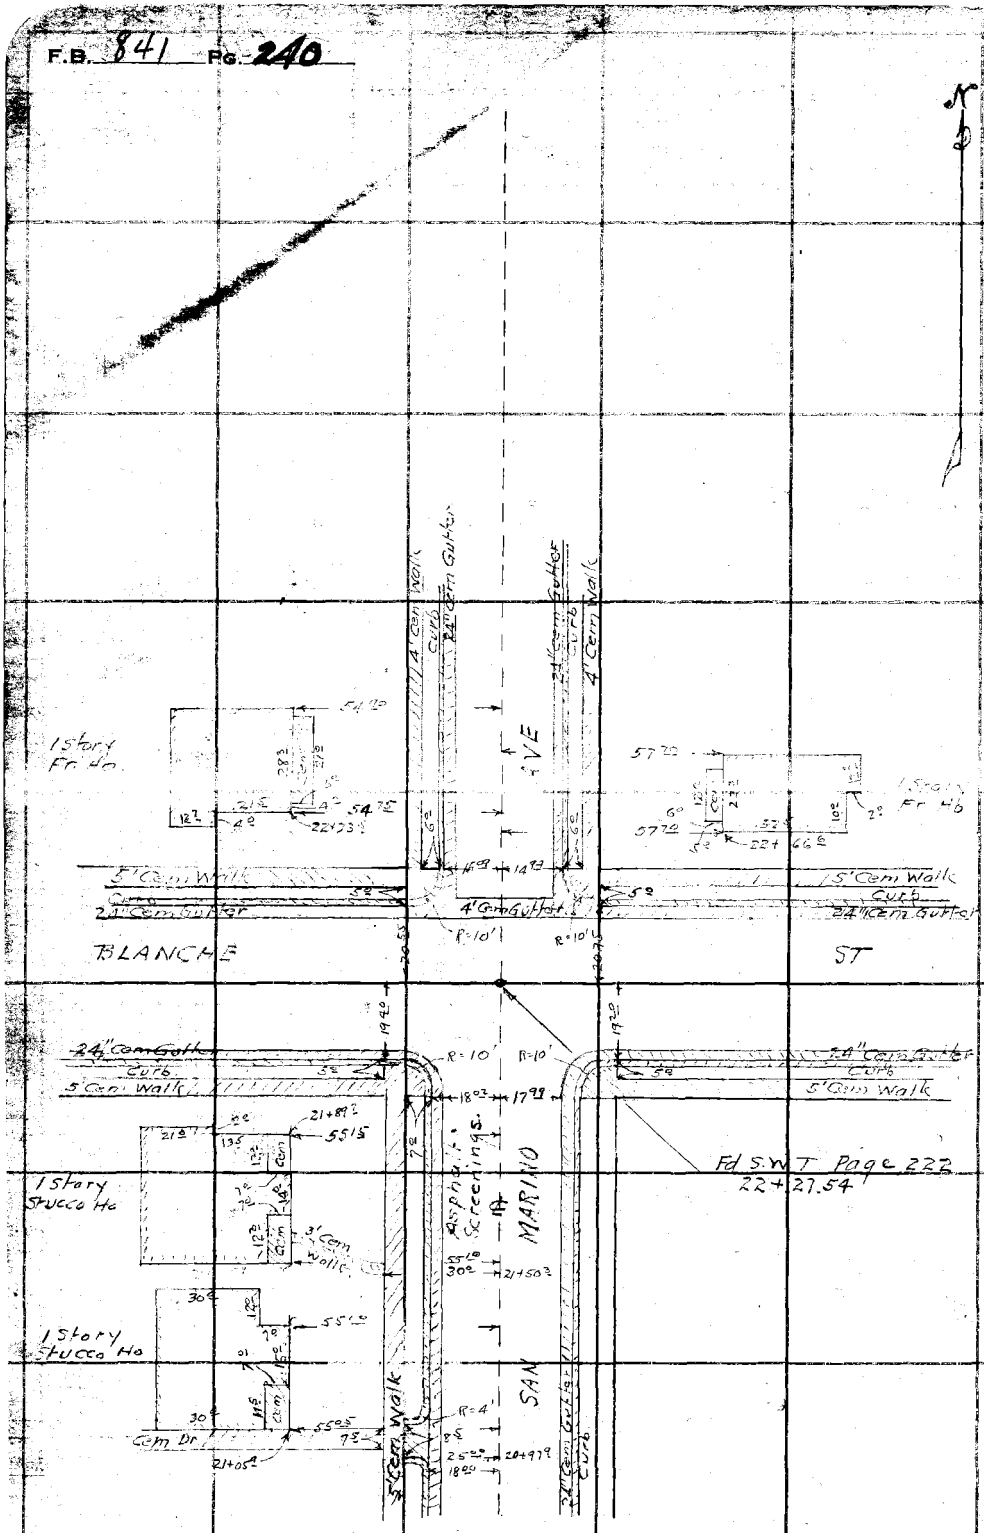

RETURN TO
LOS ANGELES COUNTY SURVEYOR
700 HALL OF RECORDS

Do not extend notes this side of this line

Note: ANY ADDITIONS OR CHANGES ON THIS SHEET MUST BE MADE OR CIRCLED IN Red Ink WITH DATE AND NAME OF PERSON MAKING CHANGE.