Notes Ck'd by K.B.M.	Survey of Spring St	F.B. 862	PG. 9
Map No. C.S.B-1759-182	W. O. 8311 Tape No.	Std. °F	
Office Work J.D.Price.	Surveyed by		
Checked	Notes	Date	
Date	Indexed 9-11-51 Johnson		

SPRING ST.

J.N. 8311

From Walnut Ave to Lakewood Ave.

F.J. McNeal
Geo. H. Nichols
A. Carrasco
J. L. Willey
L.C. Wilson
R.L. Willey
H.D. Heber
L.M. DeTilla

C.S. B-1759

Note: Any Additions or Changes on This Sheet Must be Made or Circled in Red Ink With Date and Name of Person Making Change.

Do not extend notes this side of this line.

RETURN TO
LOS ANGELES COUNTY SURVEYOR
700 HALL OF RECORDS

FORM 247 5M 10-38

F.B. 862 PG. 56A

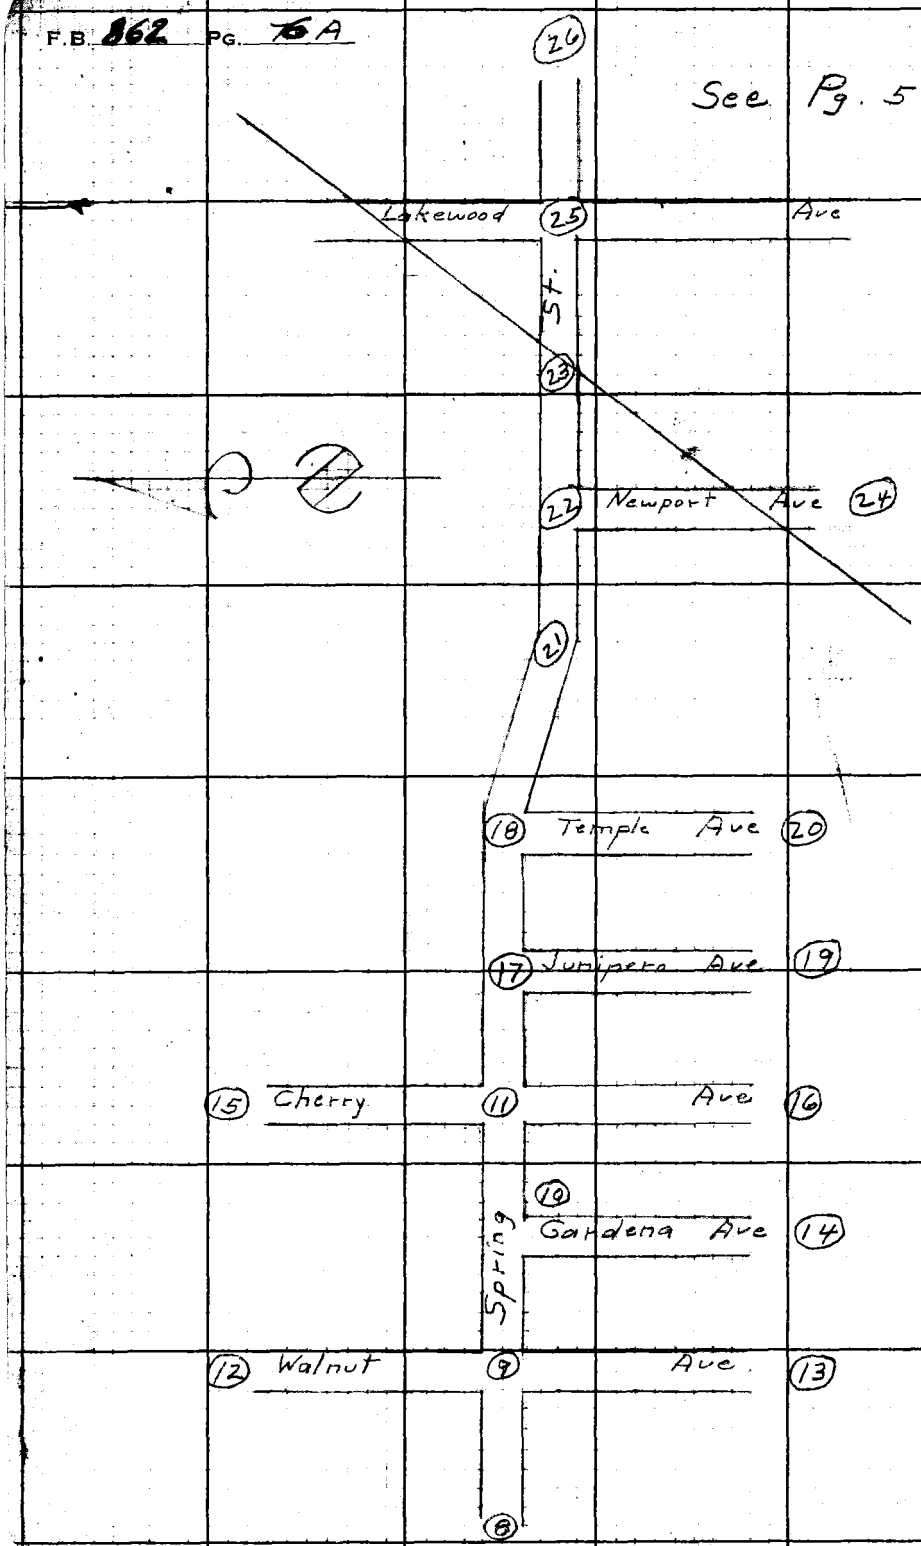

RETURN TO
LOS ANGELES COUNTY SURVEYOR
700 HALL OF RECORDS

Do not extend notes this side of this line.

Note: Any Additions or Changes on This Sheet Must be Made or Circled in **Red Ink** With Date and Name of Person Making Change.

Notes Ck'd by H.R.Mc.	Survey of Spring St.
Map No. B-175211	W. O. 8311 Tape No. St'd °F
Office Work J.D.Price	Surveyed by F.J. McNeal
Checked	Notes Mc Date 6-20-41
Date	Indexed Jamison

F.B. 862 PG. 7

SPRING ST.

CENTER LINE SURVEY

From Walnut Ave to Lakewood Ave.

F.J. McNeal
Geo. H. Nichols
A. Carrasco
J.L. Willey
L.C. Wilson
R.L. Willey

H.D. Heber
L.M. De Tilla

Note: Any Additions or Changes on This Sheet Must be Made or Circled in Red Ink With Date and Name of Person Making Change.

Do not extend notes this side of this line.

RETURN TO
LOS ANGELES COUNTY SURVEYOR
700 HALL OF RECORDS

FORM 247 5M 10-39

RETURN TO
LOS ANGELES COUNTY SURVEYOR
700 HALL OF RECORDS

Note: Any Additions or Changes on This Sheet Must be Made or Circled in Red Ink With Date and Name of Person Making Change.

Do not extend notes this side of this line.

W.S. 30-C-3

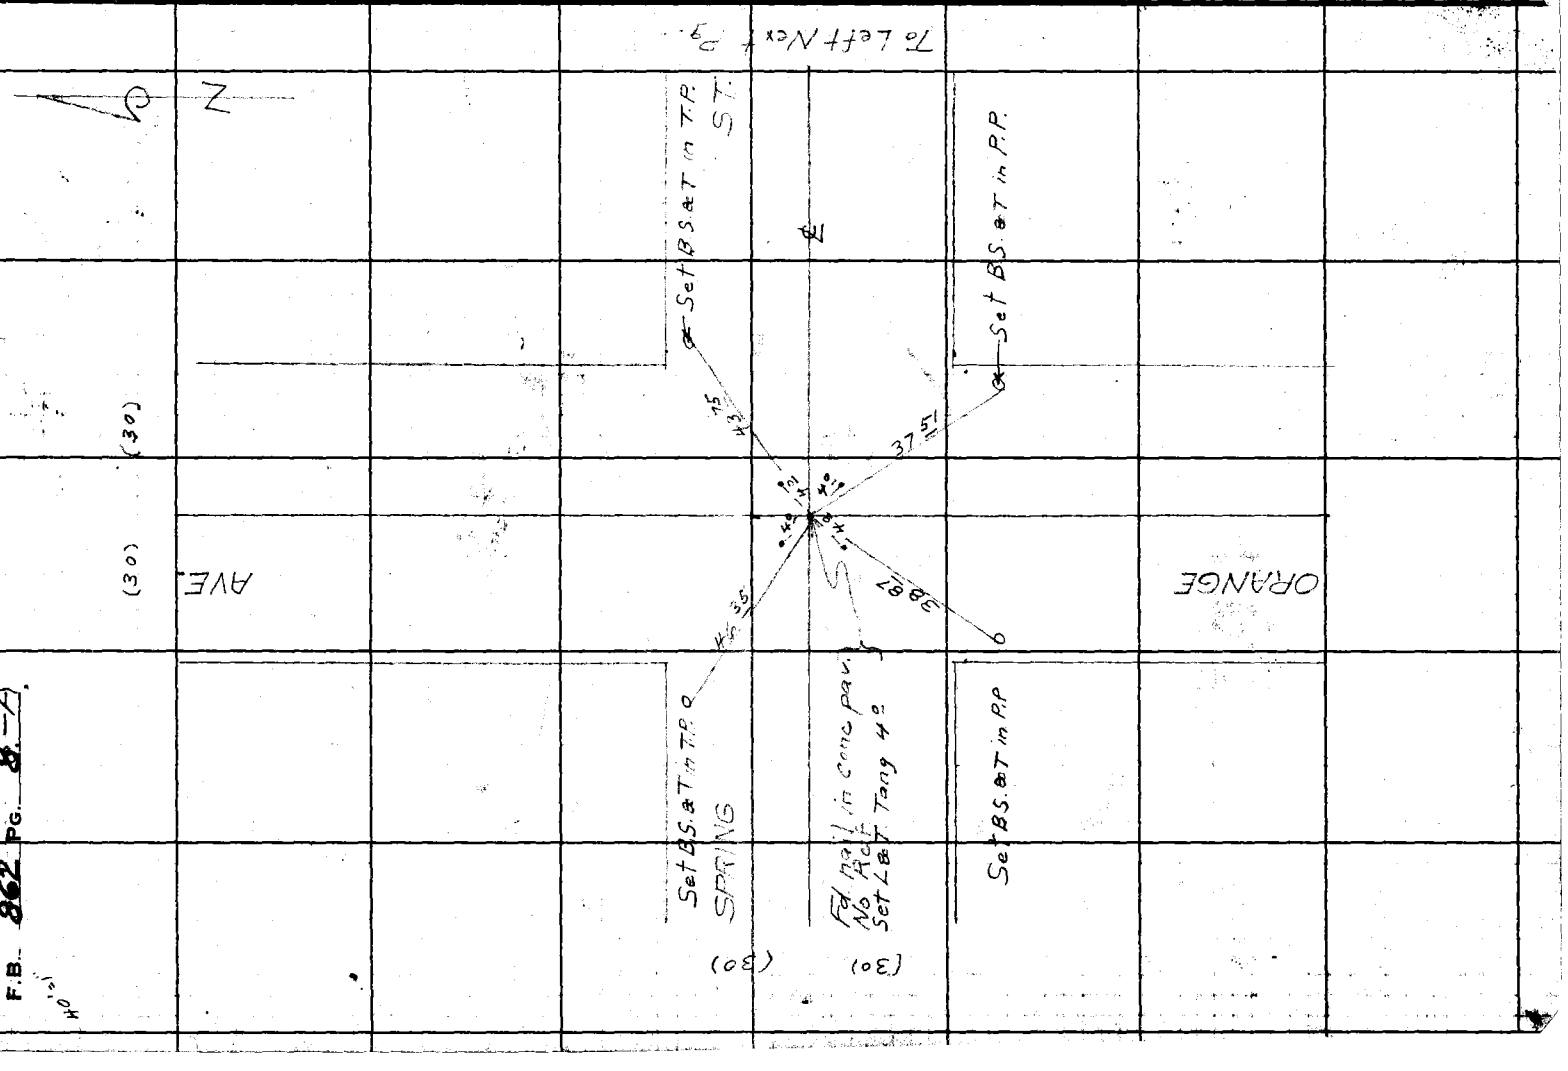

F.B. 862 Pg. 8-A

FORM 247 5M 10-39

RETURN TO
LOS ANGELES COUNTY SURVEYOR
700 HALL OF RECORDS

Note: Any Additions or Changes on This Sheet Must be Made or Circled in **Red** Ink With Date and Name of Person Making Change.

Do not extend notes this side of this line.

W.S. 30-C-3

From Right Last Pg.

1320.08 @ 78' 1320.08'

(30) (30)

Fd 2" I.P. Nail & W.S. 2037 leaning S.W. 4" up

SPRING

Set L & T.

For Improvements See F.B. 862-28 & 32

90-23-00 359-42-45

30.15

90°00'-05"

WALNUT

Set L & T. Inscb.

30.50

39.24

63.42

1320.08

(30)

AVE.

To Top Pg. - 13

To Balt. Pg. 1-12

45

30.00

90°

Set L & T. Inscb.

90°-07'

30.00

2.82.9

0+00 going East

Fd S. & W. per F.X. 218-16 Removed, Set 3/4" I.P. & t 10" Dn, set 1x2 & t flush

PETROLEUM

8-29-37 G.L.K.O.

Fd. Brass Cap in Mon. Flush

89-57-00 359-48-15

Fd. 2" I.P. & t - 4" up

29.95

994.11

251.11

ST.

29.95

90-07-30 360-29-30

To Left Next Pg.

Notes Ck'd by Map No. B-1259-1
Office Work J.D.P. Ltr.
Checked
Date

Survey of Spring St.
W.O. 823 Tape No. 0449 Std. Ft. °F.
Surveyed by E.V. Mc Nees
Notes Date 6-20-41
Indexed

F.B. 862 Pg. 9

F.B. 862 PG. 10

30TH D-3

RETURN TO
LOS ANGELES COUNTY SURVEYOR
700 HALL OF RECORDS

Do not extend notes this side of this line.

Note: Any Additions or Changes on This Sheet Must Be Made or Circled in Red Ink With Date and Name of Person Making Change.

From Rt Last Pg.

To Left Next Pg.

SPRING

(30)

(30)

994.11

329.96

Set L&T on Catch Basin

994.11
Set L&T on side of Sewer M.H. 3½" below Top M.H., MH 5" Dn by prop. pol LS 8274
Set 1x2 ± flush

Set N&T T.P. S.T.

Set N&T P.P.

Set X on F.P.

Set N&T P.P.

35.71

32.45

51.13

44.65

79.72

90°-00'-45"

90-00-45
360-03-00

1324.07 @ 72° = 1324.07
-329.96
994.11

AVE.

GARDENA

For Improvements
See F.B. 862-32

290.07 @ 72° = 290.07
246.97 @ 74° = 246.97
223.48 @ 74° = 223.48
233.65 @ 74° = 233.65
994.16

329.96 @ 74° = 329.96

(30) (30)

To Top Pg. 14

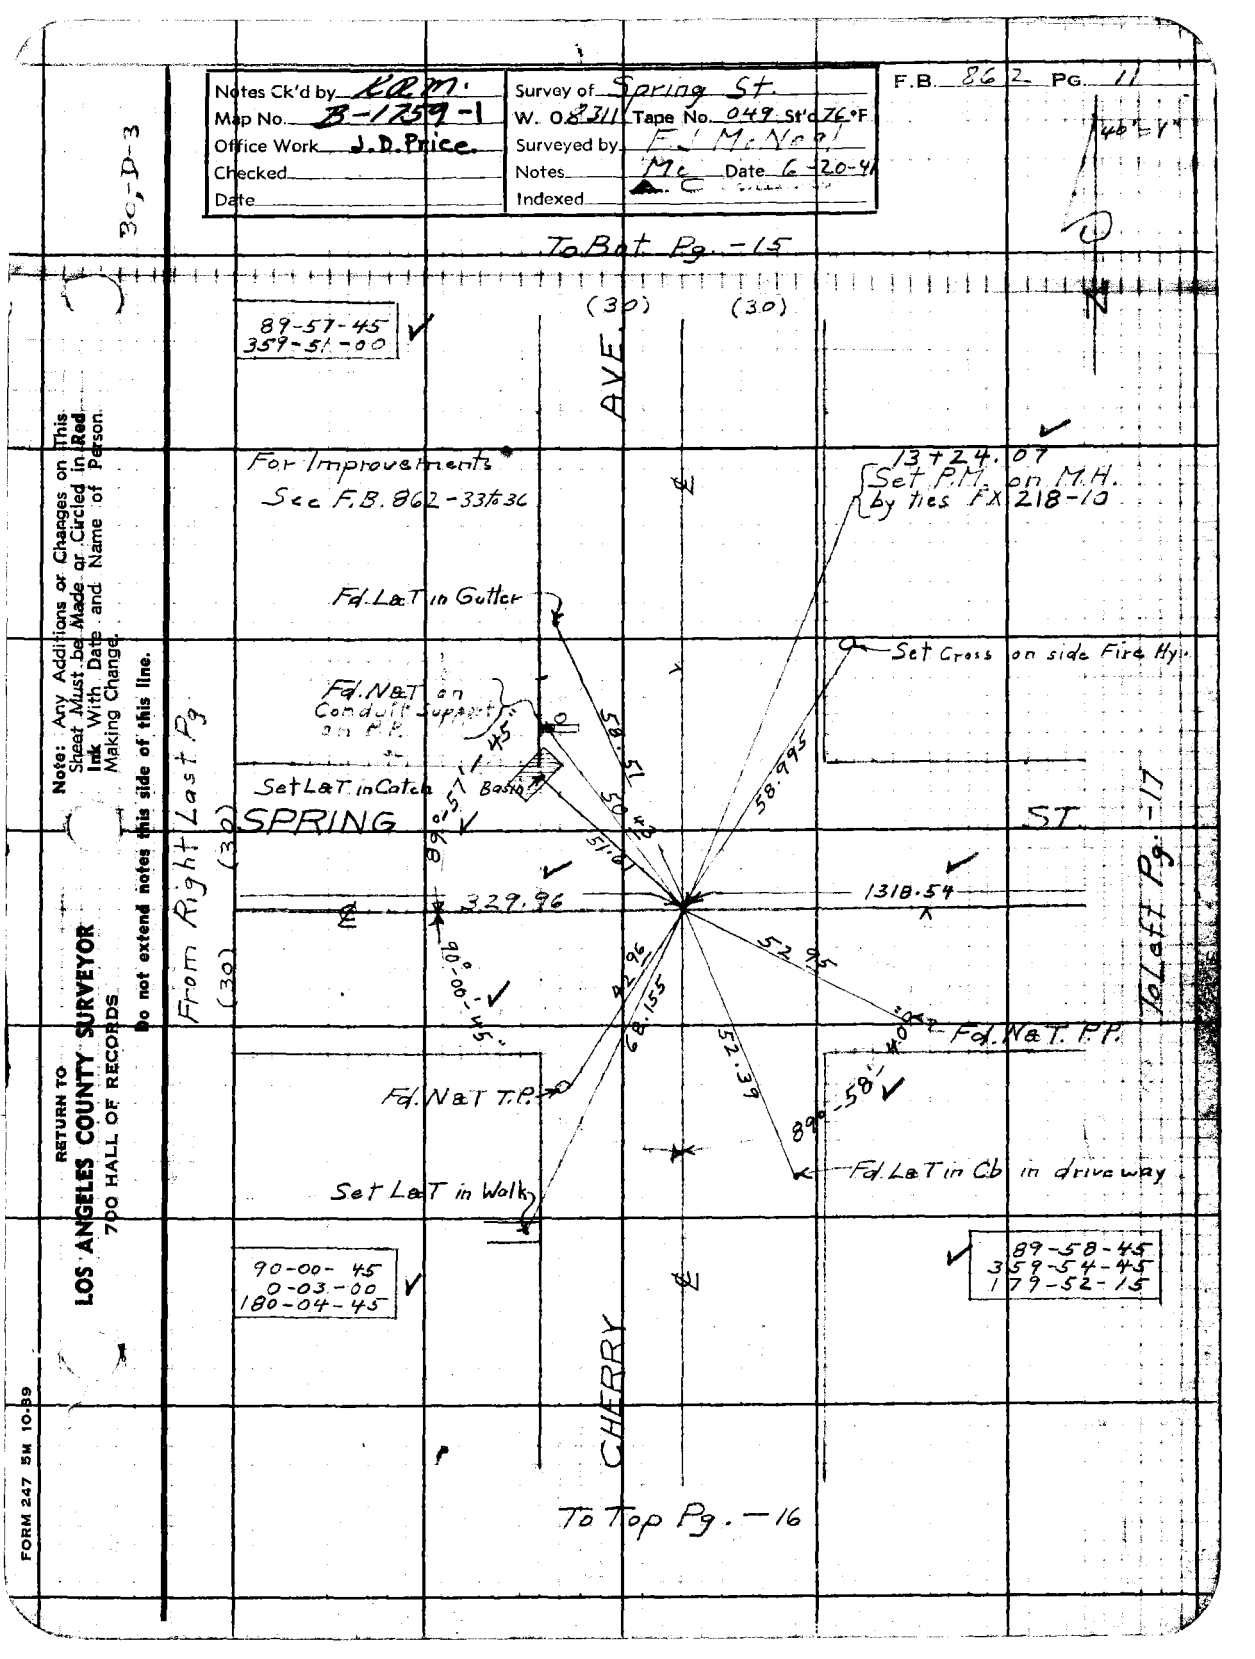
Notes Ck'd by KRM.
Map No. B-1259-1
Office Work J.D. Price.
Checked
Date
Survey of Spring St.
W. O. 8311 Tape No. 049 St'd. 76°F
Surveyed by F. I. McNeal
Notes Mc Date 6-20-41
Indexed
F.B. 862 Pg. 11
36-D-3
To Bot. Pg. -15
89-57-45
359-51-00
(30)
(30)
AVE.
For Improvements
See F.B. 862-33 to 36
13+24.07
Set P.K. on M.H.
by ties F.X. 218-10
Fd. L&T in Gutter
Set Cross on side Fire Hy.
Fd. N&T on Conduit Support on P.K.
Set L&T in Catch Basin
SPRING
ST.
To Left Pg. -17
From Right Last Pg.
(30)
329.96
1318.54
89°-57'-45"
90°-00'-45"
42.96
68.155
52.39
89°-58'-15"
Fd. N&T. P.P.
Fd. N&T. T.P.
Set L&T in Walk
Fd. L&T in Cb in driveway
90-00-45
0-03-00
180-04-45
89-58-45
359-54-45
179-52-15
CHERRY
To Top Pg. -16
Note: Any Additions or Changes on This Sheet Must be Made or Circled in Red Ink With Date and Name of Person Making Change.
Do not extend notes this side of this line.
RETURN TO
LOS ANGELES COUNTY SURVEYOR
700 HALL OF RECORDS
FORM 247 5M 10-59

F.B. 862 PG. 12

39 C-3

RETURN TO
LOS ANGELES COUNTY SURVEYOR
700 HALL OF RECORDS

Do not extend notes this side of this line.

Note: Any Additions or Changes on This Sheet Must be Made or Circled in Red Ink With Date and Name of Person Making Change.

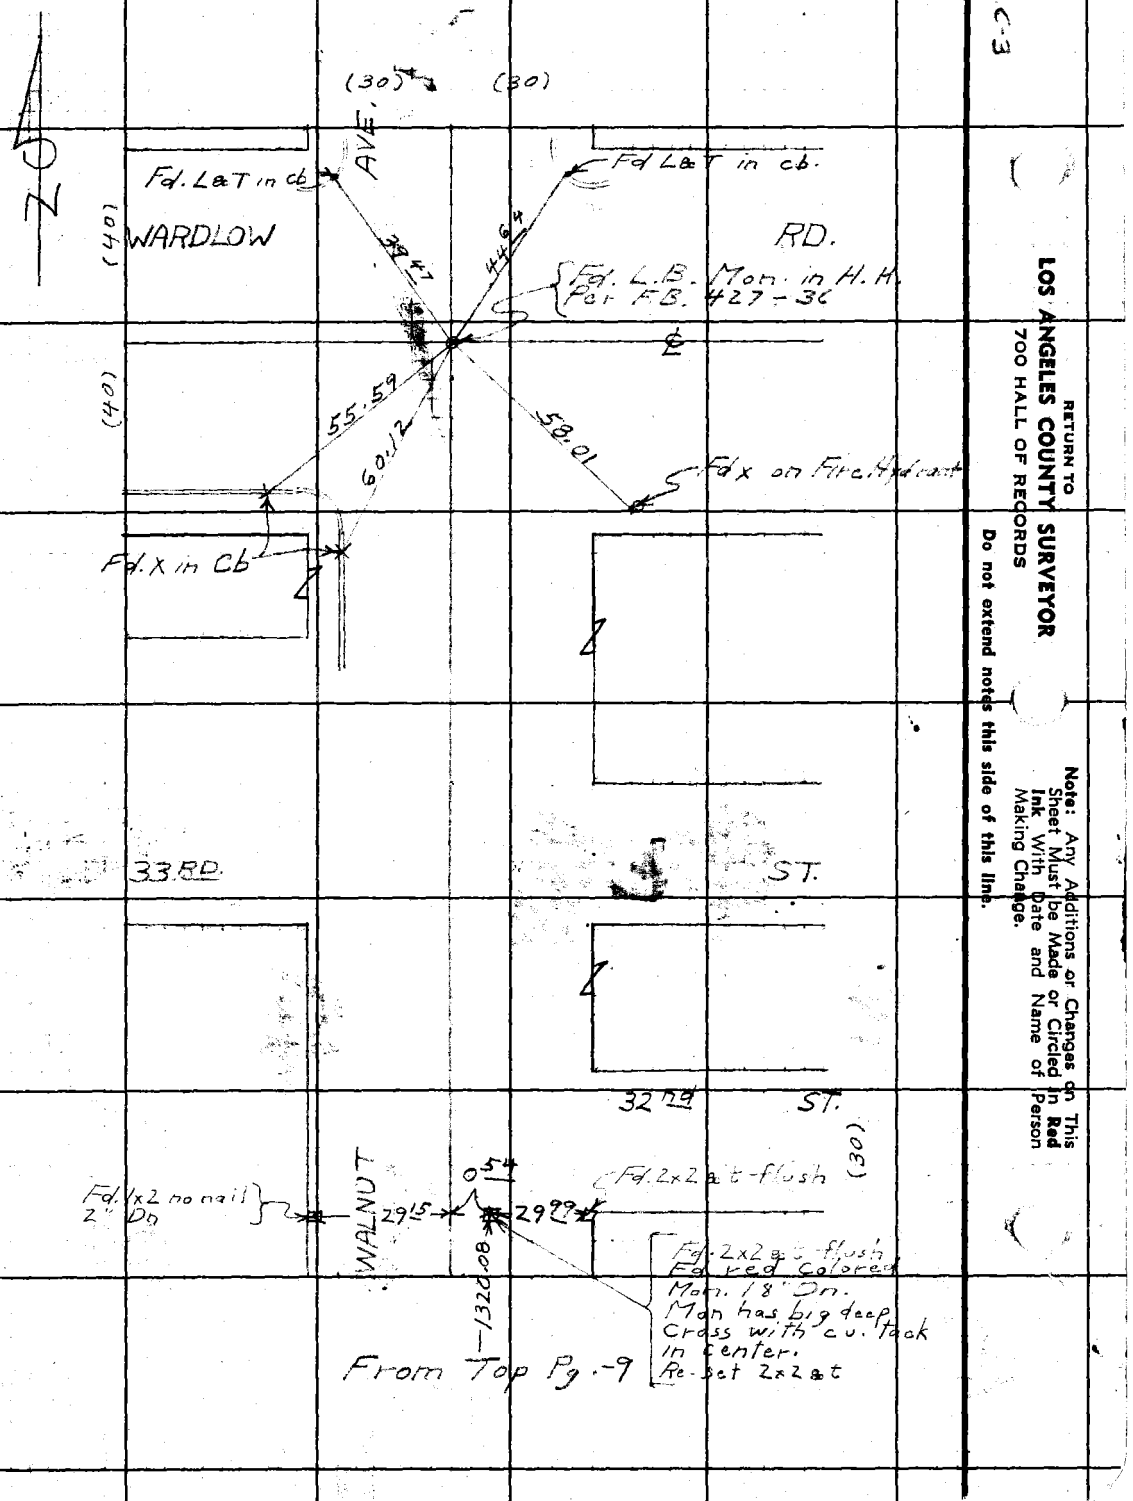

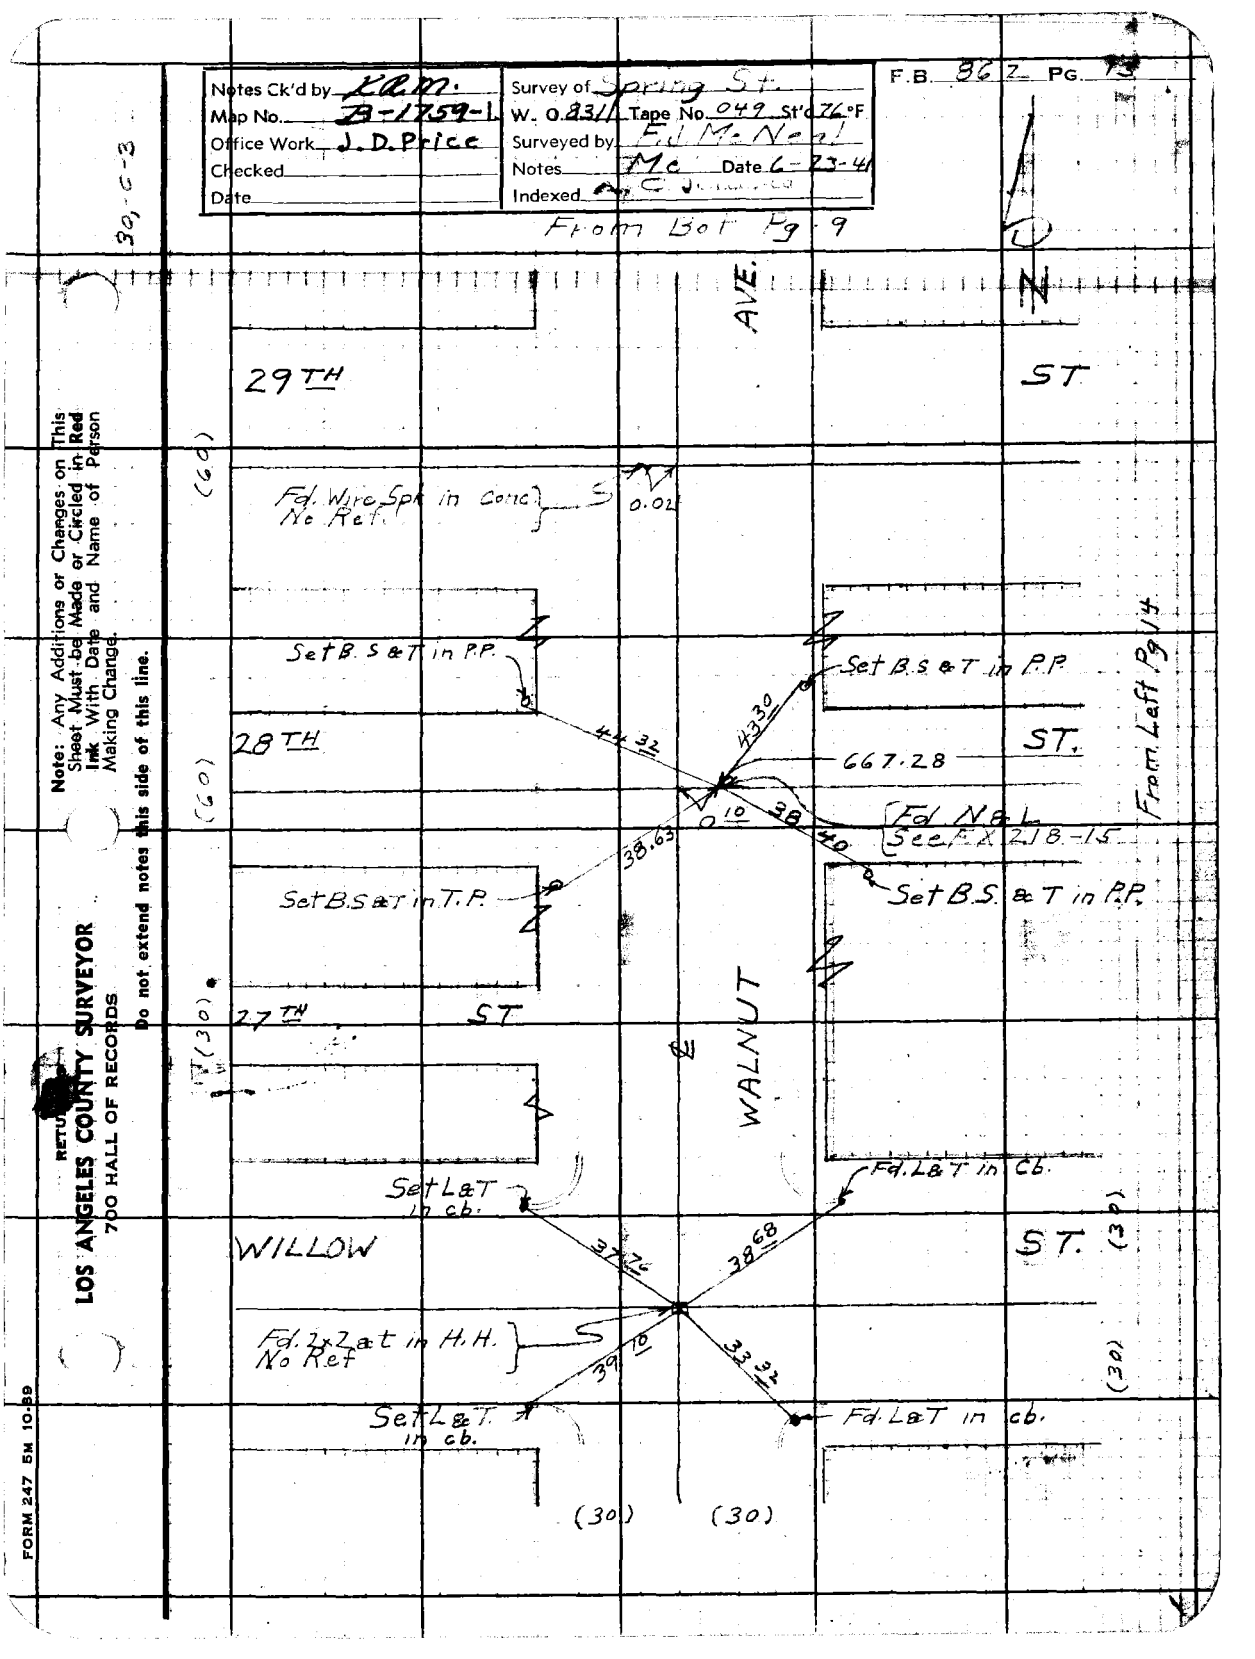
Notes Ck'd by K.R.M.
Map No. B-1759-1
Office Work J.D. Price
Checked
Date
Survey of Spring St.
W. O. 231 Tape No. 049 St'd 76°F
Surveyed by Ed McNeal
Notes Mc Date 6-23-41
Indexed
F.B. 86 Z Pg. 13
From Bot Pg. 9
30, G-3
29TH
AVE.
ST
(60)
Fd. Wire Spk in Conc. No Ref.
0.02
Set B.S & T in P.P.
28TH
(60)
667.28
ST.
From Left Pg 14
0.10
38
4.60
Fd. Nail See F.X 218-15
38.63
Set B.S & T in T.P.
Set B.S. & T in P.P.
27TH
ST
(30)
WALNUT
Set L & T in cb.
Fd. L & T in cb.
WILLOW
37.76
38.68
ST.
(30)
Fd. 2x2 at in H.H. No Ref
39.10
33.32
Set L & T in cb.
Fd. L & T in cb.
(30)
(30)
Note: Any Additions or Changes on This Sheet Must be Made or Circled in Red Ink With Date and Name of Person Making Change.
Do not extend notes this side of this line.
RETURN TO
LOS ANGELES COUNTY SURVEYOR
700 HALL OF RECORDS
FORM 247 5M 10-39

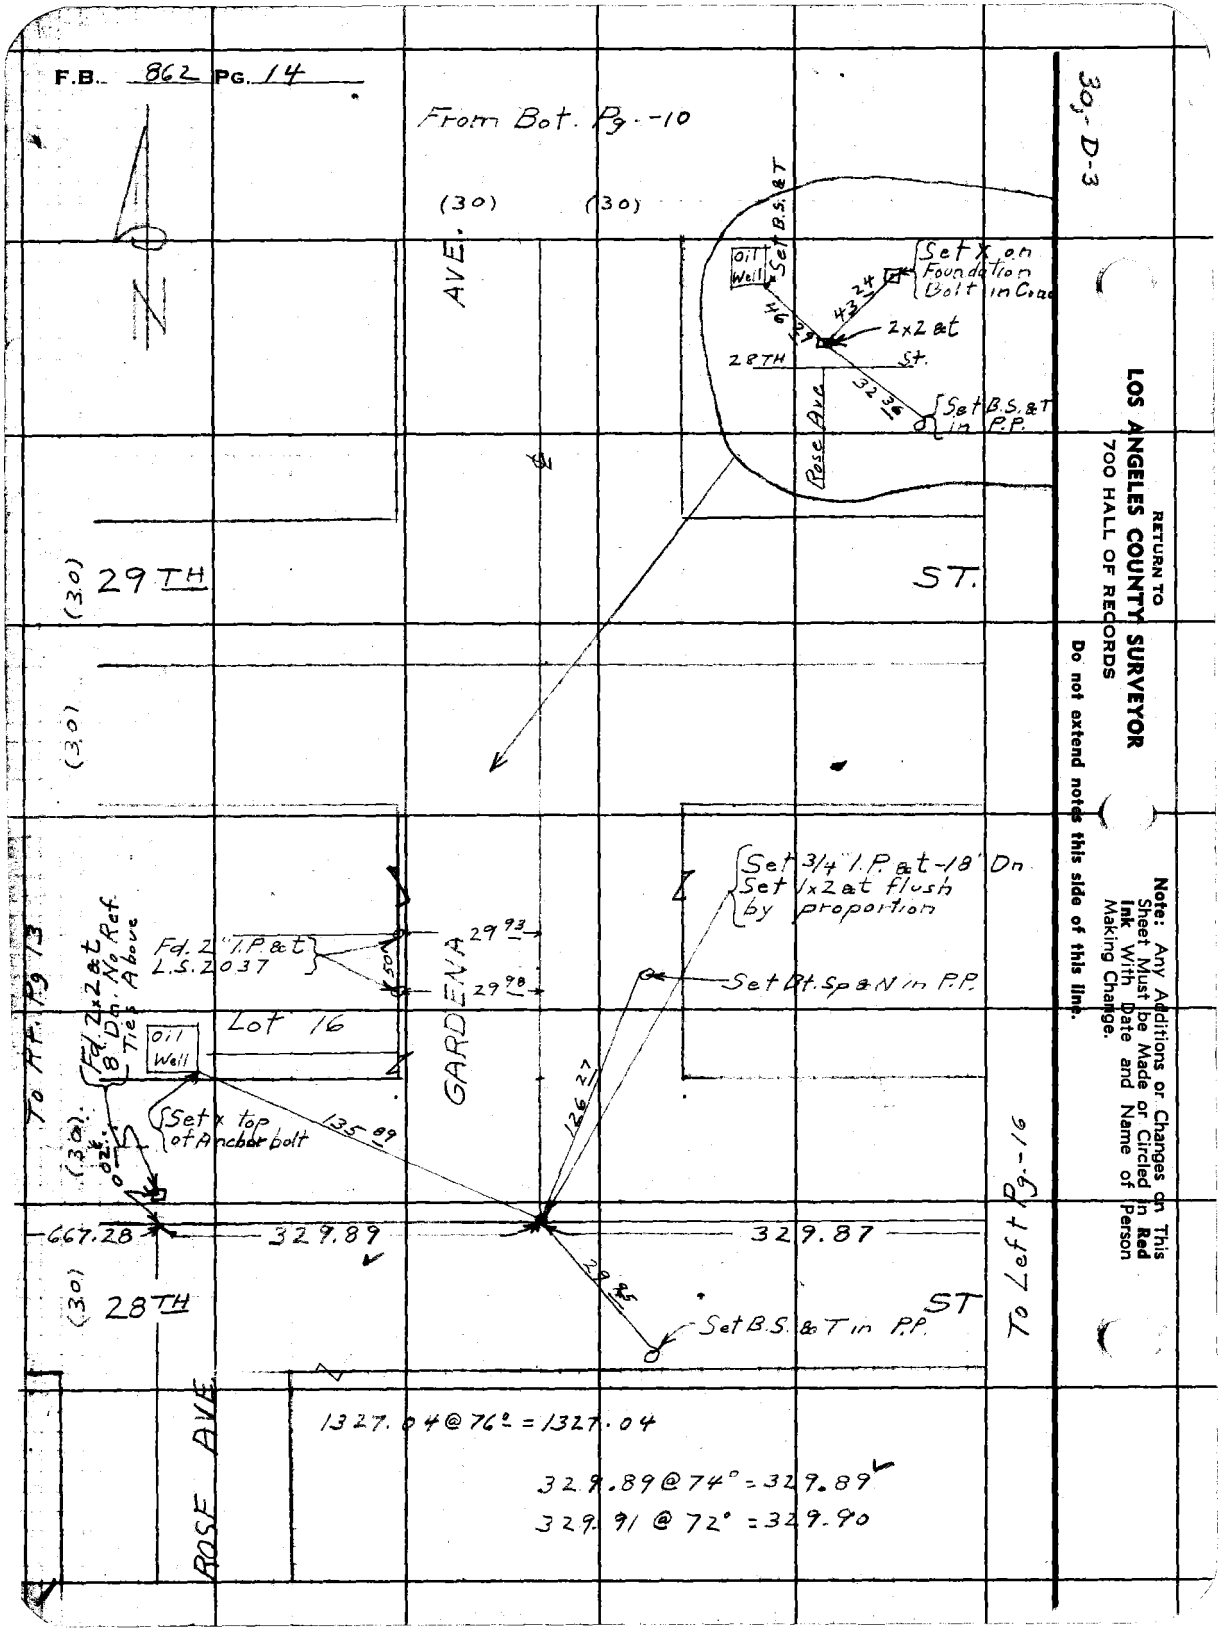
F.B. 862 PG. 14
From Bot. Pg. -10
30-D-3
(30)
(30)
AVE.
Set B.S. & T
Oil Well
Set X on Foundation Bolt in Curb
2x2 at
28TH ST.
Rose Ave
Set B.S. & T in P.P.
RETURN TO
LOS ANGELES COUNTY SURVEYOR
700 HALL OF RECORDS
Note: Any Additions or Changes on This Sheet Must be Made or Circled in Red Ink With Date and Name of Person Making Change.
Do not extend notes this side of this line.
(30) 29TH ST.
(30)
To Rt. Pg. 73
Set 3/4" I.P. at -18' Dn.
Set 1x2 at flush by proportion
Fd. 2" I.P. at
L.S. 2037
Dn. No Ref.
Ties Above
Fd. 2x2 at
8' Dn.
Lot 16
Oil Well
GARDENA
Set Dt. Sp. & N in P.P.
Set x top of Anchor bolt
135.89
126.27
(30)
667.28
329.89
329.87
28TH ST
Set B.S. & T in P.P.
To Left Pg. 91
ROSE AVE
1327.04 @ 76° = 1327.04
329.89 @ 74° = 329.89
329.91 @ 72° = 329.90

Notes Ck'd by K.L.M.	Survey of Spring St
Map No. B-1269-1	W. O. 8311 Tape No. 049 St. 76°F
Office Work J.D.Price.	Surveyed by Ed McNeal
Checked	Notes Mc Date 6-25-41
Date	Indexed E. O Johnson

F.B. 862 Pg. 15

39-D-3

Note: Any Additions or Changes on This Sheet Must be Made or Circled in Red Ink With Date and Name of Person Making Change

Do not extend notes this side of this line.

RETURN TO
LOS ANGELES COUNTY SURVEYOR
700 HALL OF RECORDS

FORM 247 5M 10-39

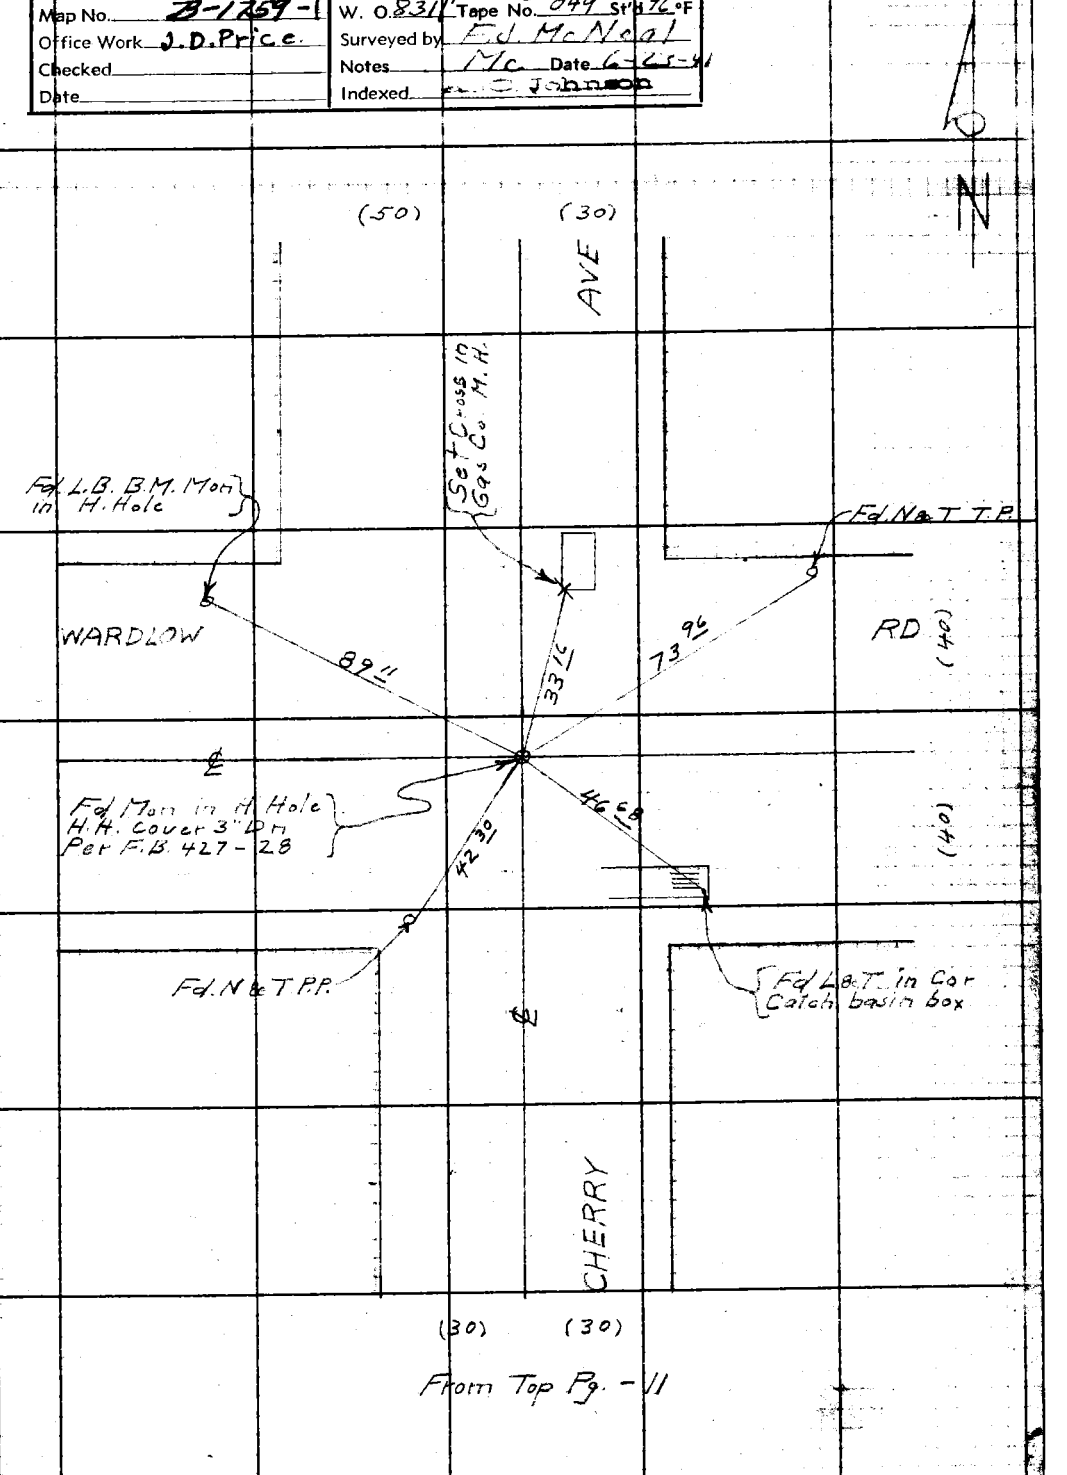

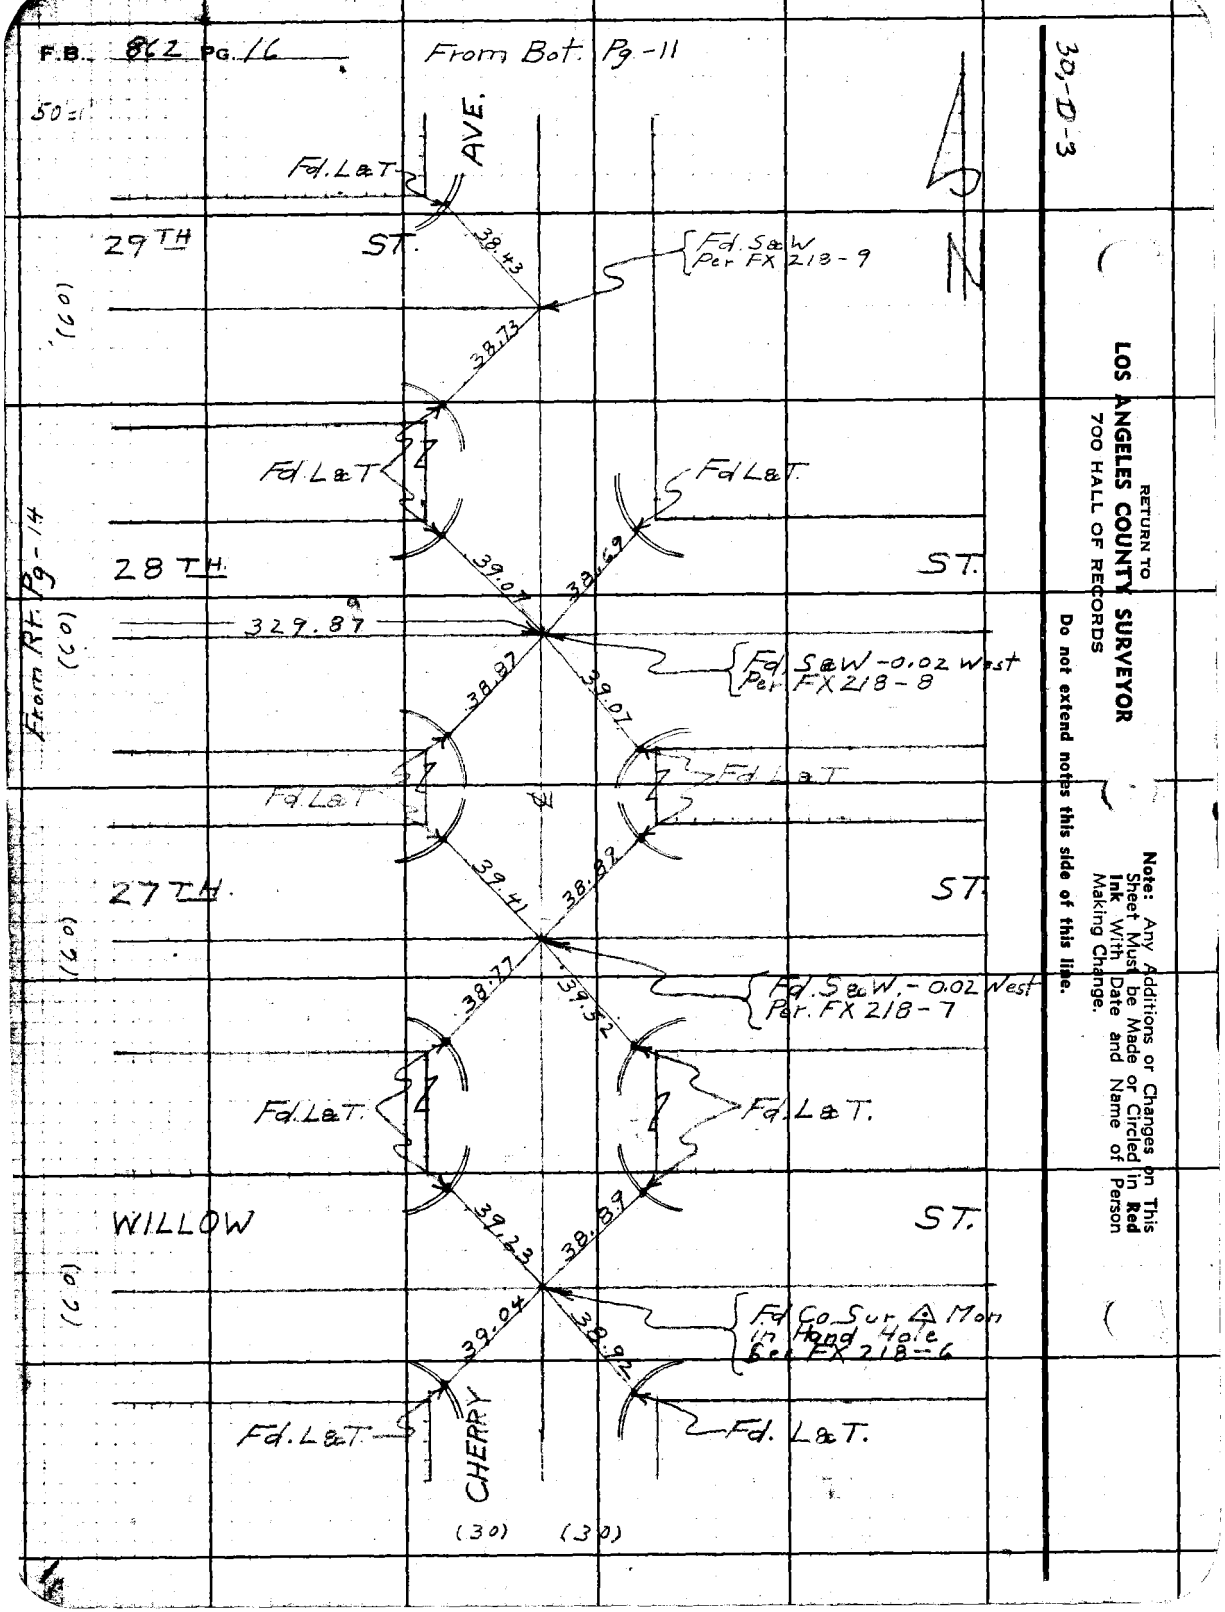
F.B. 862 PG. 16
From Bot. Pg. -11
50=1'
30-D-3
AVE.
Fd. L & T.
29TH ST.
38.43
Fd. S & W Per FX 218-9
38.73
(60')
Fd L & T.
Fd L & T.
28TH
ST.
From Rt. Pg. -14
39.07
38.69
329.87
Fd. S & W -0.02 West Per FX 218-8
38.87
39.07
Fd L & T.
Fd L & T.
27TH
ST.
39.41
38.82
38.77
39.52
Fd. S & W. - 0.02 West Per. FX 218-7
Fd. L & T.
Fd. L & T.
WILLOW
ST.
39.23
38.87
39.04
39.92
Fd Co. Sur. & Mon in Hand Hole Per FX 218-6
Fd. L & T.
Fd. L & T.
CHERRY
(30)
(30)
(60')
(60')
(60')
RETURN TO
LOS ANGELES COUNTY SURVEYOR
700 HALL OF RECORDS
Note: Any Additions or Changes on This Sheet Must be Made or Circled in Red Ink With Date and Name of Person Making Change.
Do not extend notes this side of this line.

FORM 247 5M 10-39

RETURN TO
LOS ANGELES COUNTY SURVEYOR
700 HALL OF RECORDS

Note: Any Additions or Changes on This Sheet Must be Made or Circled in **Red Ink** With Date and Name of Person Making Change.

Do not extend notes this side of this line.

30-D-3

From Rt. Pg. -11

Notes Ck'd by: Kemp
Map No. B-1257-1
Office Work J.D. Price
Checked
Date

Survey of Spring St
W. O. 8311 Tape No. 842 Std 76°F
Surveyed by E. McNeal Date 7-7-44
Notes
Indexed

1319.84@76° = 1319.84
1318.52@78° = 1318.54

378.21 @ 76° = 378.21
417.21 @ 76° = 417.21
523.12 @ 76° = 523.12
1318.54

90-05-00
0-20-30
180-30-45

50-50-06

SPRING ℄

Set L&T in Catch Basin

For Improvements See F.B. 862-37½39

Fd. Nail & Tin Tag "LS 4466" Flush with Curb Face 0.2' East of Tan Line, See F.B. 293-155

Fd. Nail & T.T.P.

1318.54

51.22

JUNIPERO AVE

(30)

To Top Pg. -19

1319.84 ℄

58.85

49.85

54.40

Fd. L&T in cb.

1318.64@ 78° = 1318.66

89°-54'-30"

1318.66

462.53 @ 78° = 462.54
479.75 @ 78° = 479.76
376.35 @ 78° = 376.35
1318.65

89-54-30
359-38-15
179-27-20

Set L&T in Catch Basin

Fd. L&T in Cb.

ST.

(30) 40 (30) 40

To Left Next Pg.

F.B. 862 Pg. 17

F.B. 862 PG. 18

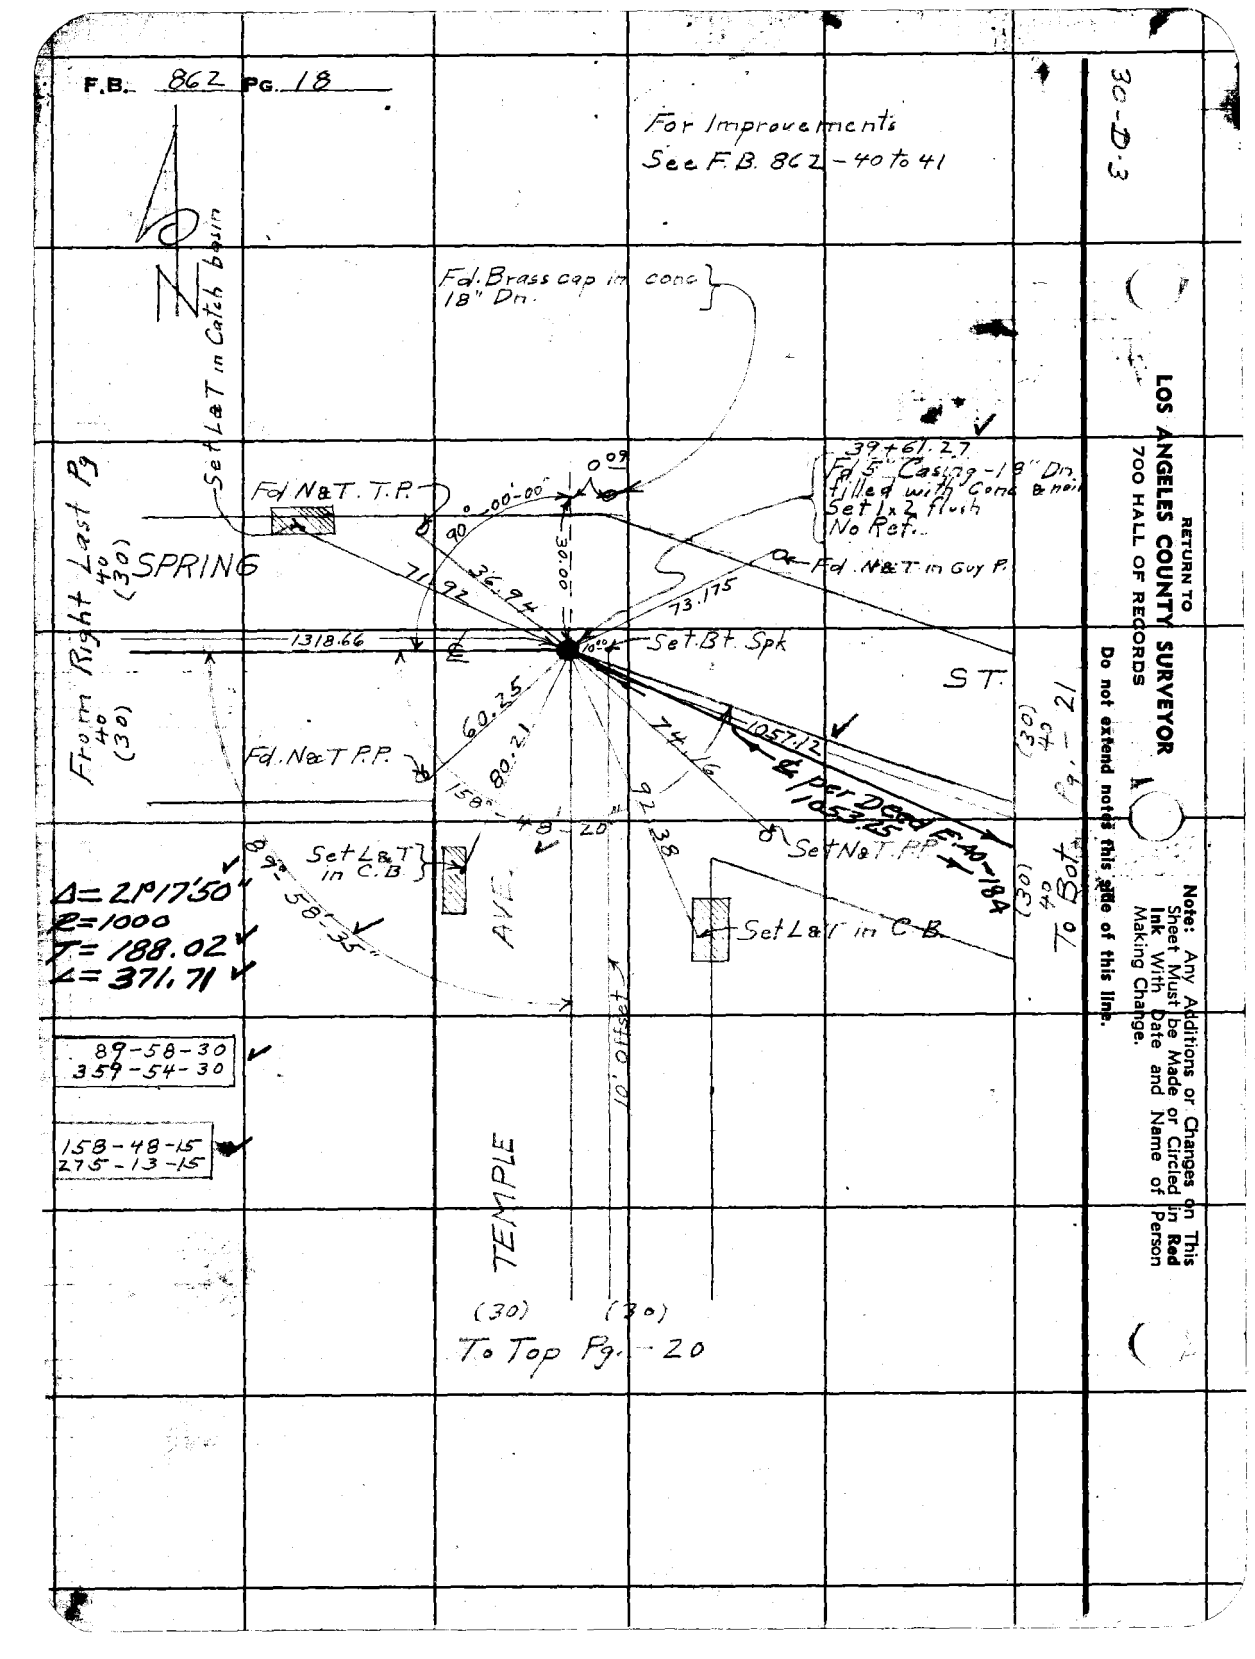

RETURN TO
LOS ANGELES COUNTY SURVEYOR
700 HALL OF RECORDS

Do not extend notes this side of this line.

Note: Any Additions or Changes on This Sheet Must be Made or Circled in Red Ink With Date and Name of Person Making Change.

Notes Ck'd by KRM
Map No. B-1259-1
Office Work J.D.Price
Checked
Date

Survey of Spring St
W. 0831 Tape No. 949 St'd 76°F
Surveyed by FJ McNeal
Notes Mc Date 7-3-41
Indexed A. O. Johnson

F.B. 962 Pg. 7

30-D-3

From 30 I. Pg. 11

(30) (30)

AVE

Set Cross in gate post

42.41

1319.84

28TH ST.

(30)

Fd 2" I.P. & brass cap Western Oil & Ref. Co

30.08

Fd 2x2 & t 1/4' Dn R.B. 293-155

Set 1x2 & t flush

67.63

Set Bt. Spk & T. in P.P.

27TH ST.

(30)

0.98

29.76

Fd 2" I.P. & brass cap Western Oil & Ref. Co. R.B. 293-155

Fd 2x2 only 2" Dn.

JUNIPERO

Fd. Nail T. Tel. P.

.93

53.

Fd. 4x4 6" Dn. no nail Set nail by Mes. F.B. 293-154 Set 1x2 & t. flush

WILLOW ST.

(30)

36.10

30.25

40.91

Fd. Nail T.P.

Fd. Nail P.P.

Fd Cross on post

Note: Any Additions or Changes on This Sheet Must be Made or Circled in Red Ink With Date and Name of Person Making Change.

Do not extend notes this side of this line.

RETURN TO
LOS ANGELES COUNTY SURVEYOR
700 HALL OF RECORDS

FORM 247 5M 10-39

F.B. 862 PG. 20

30-D-3

RETURN TO
LOS ANGELES COUNTY SURVEYOR
700 HALL OF RECORDS

Do not extend notes this side of this line.

Note: Any Additions or Changes on This Sheet Must Be Made or Circled in Red Ink With Date and Name of Person Making Change.

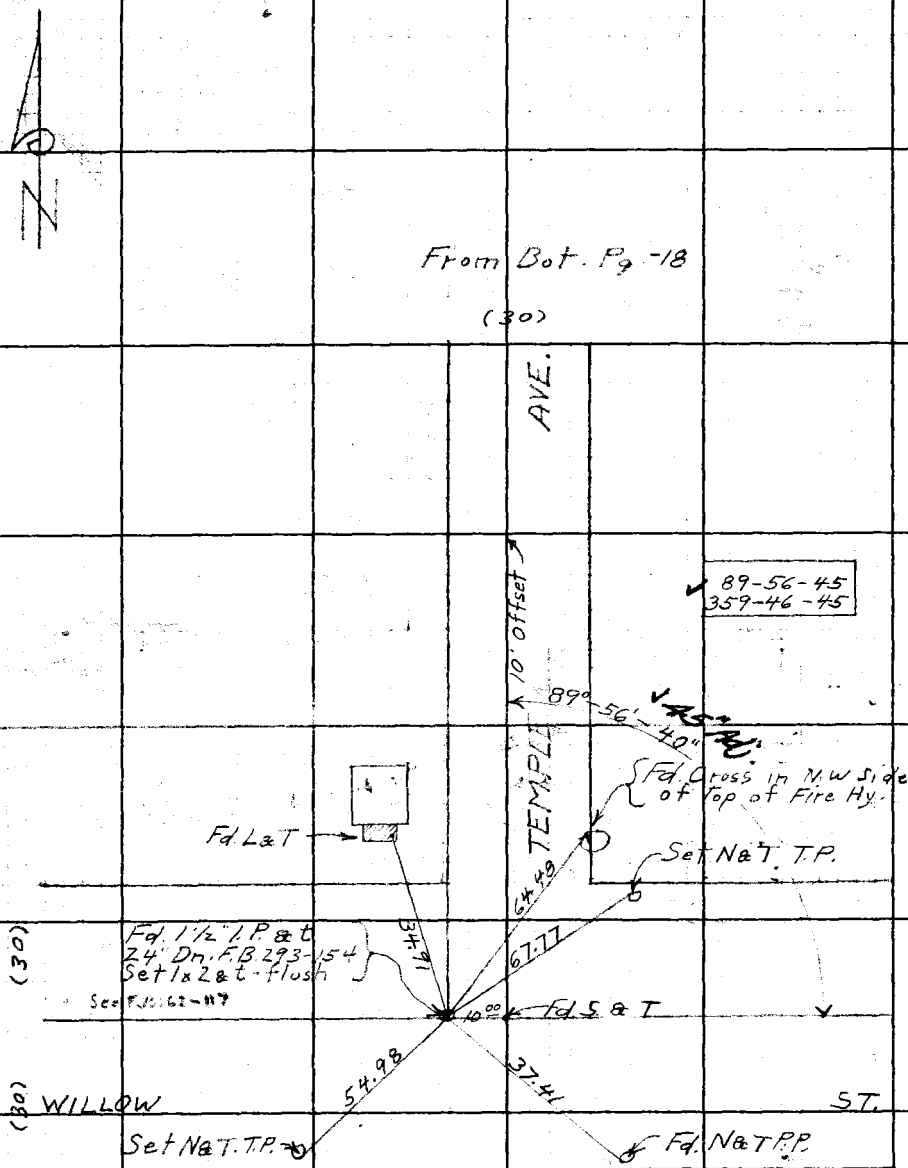

30-D-3

Notes Ck'd by KRM	Survey of Spring St
Map No. B-1759 sht 2	W. O. 8311 Tape No. 249 St. 76°F
Office Work J.D. Price.	Surveyed by F.J. McNeal
Checked	Notes Mc Date 7-30-41
Date	Indexed E. Jon

F.B. 862 Pg. 21

To Left Next Pg.

40 (30)

40 (30)

ST.

1324.74 @ 74° = 1324.72 − 4.29 = 1320.43

1324.75 @ 74° = 1324.73 − 4.29 = 1320.44

1320.43

E per E: 40-184 - 1324.72

159-03-45
276-15-00

Fd. Set T in Guy P.

Δ = 21°03'25"
R = 1000
T = 185.85
L = ~~372.99~~ 367.51

38.20

50+18.39
Fd 3x3 R.W. Stake no tack
7" Down, Stake resting on
2 pieces of brick
Set 3/4" I.P. at -20" Dn.
Set 1x2 at - flush

14.64

Fd N&T in P.P.

39.29

0°-03'-45"

Set N&T in Guy P.

Fd Wire Sph & T
Fd. Large 1x2 only - 3" Dn
under Spk.
Set 3/4" I.P. at - 20" Dn
Set 1x2 at flush

1057.11 @ 78° = 1057.12

1057.13 @ 78° = 1057.14

1057.12

1057.25

Set 3/4" I.P. at Tan. Prod.
12" dn

SPRING

For Improvements
See F.B. 862-pgs 43 to 44

From Rt. Pg-18

RETURN TO
LOS ANGELES COUNTY SURVEYOR
700 HALL OF RECORDS

Note: Any Additions or Changes on This Sheet Must be Made or Circled In Red Ink With Date and Name of Person Making Change.

Do not extend notes this side of this line.

FORM 247 SM 10-39

30-D-3

RETURN TO
LOS ANGELES COUNTY SURVEYOR
700 HALL OF RECORDS

Note: Any Additions or Changes on This Sheet Must be Made or Circled in **Red Ink** With Date and Name of Person Making Change.

Do not extend notes this side of this line.

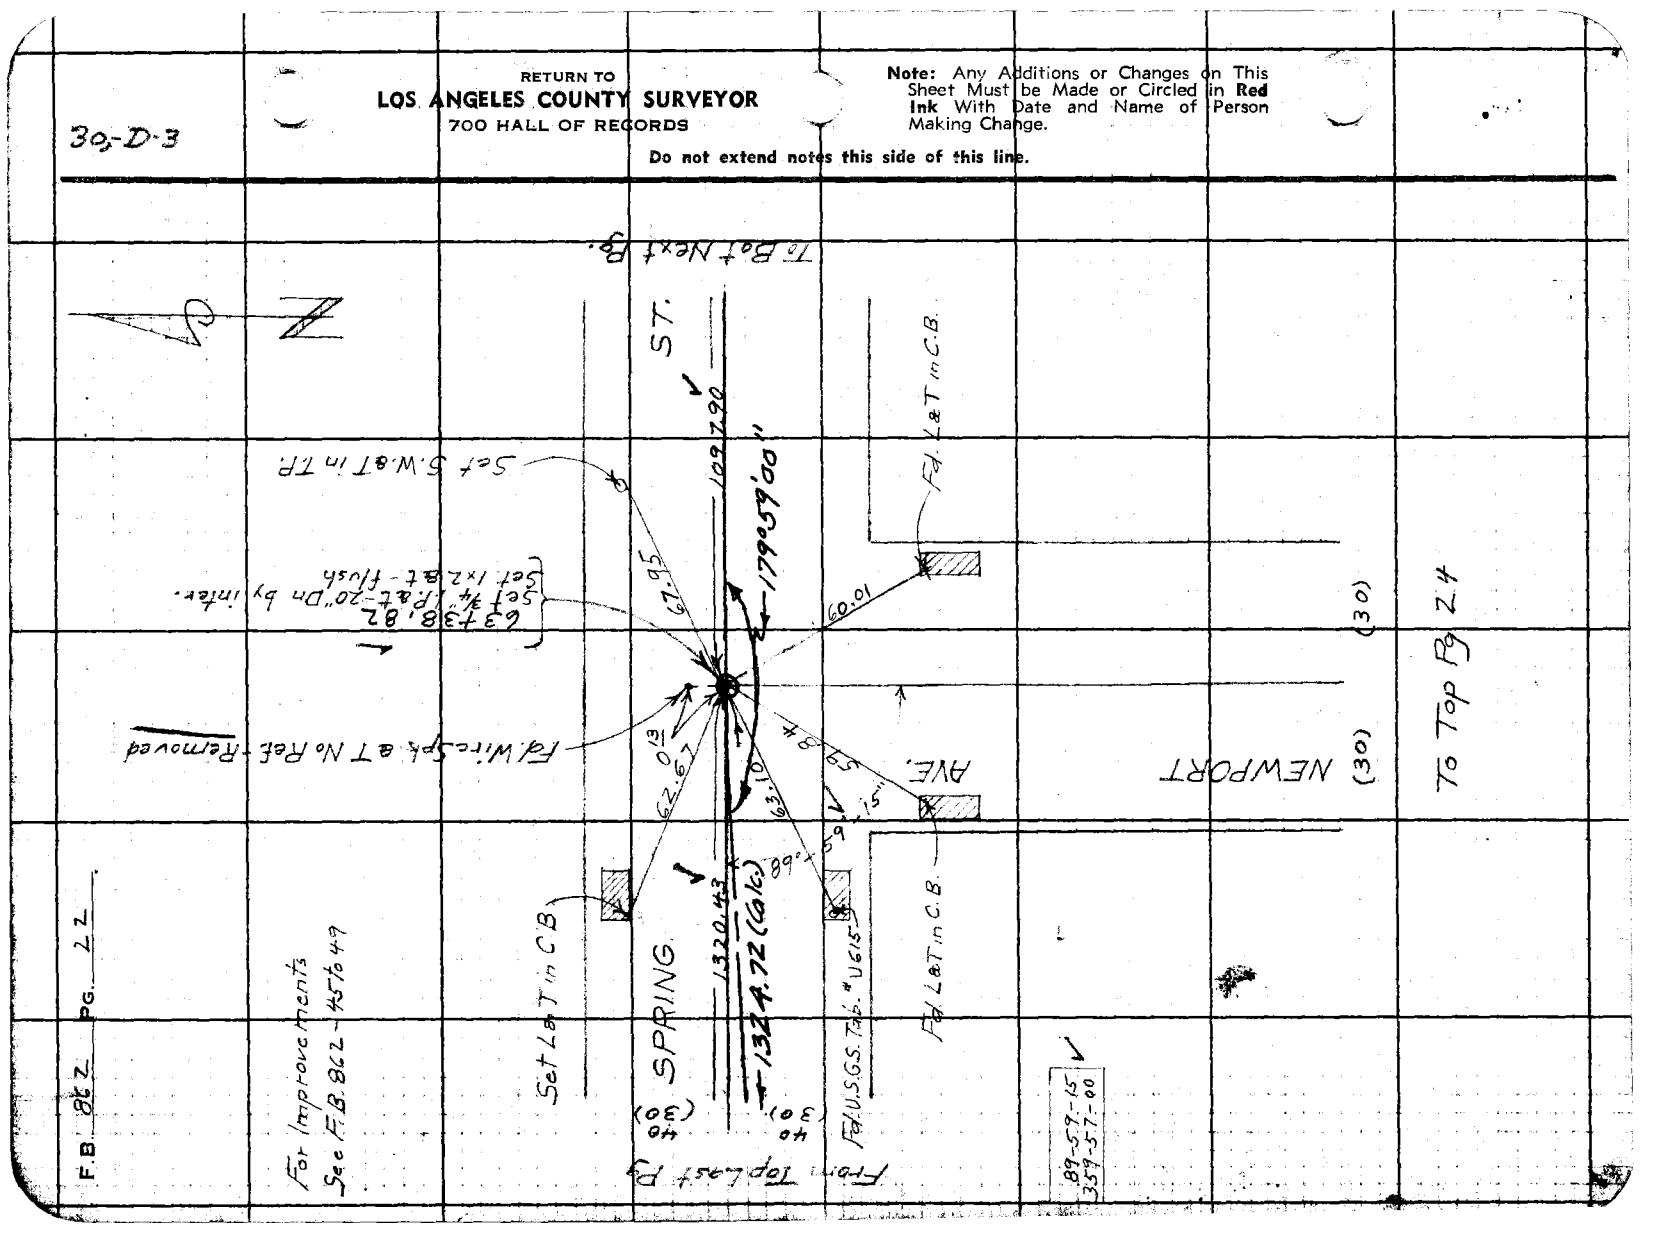

F.B. 862 Pg. 22

30-E-3

Notes Ck'd by K.R.M.	Survey of Spring St.
Map No. B-1259-1	W. O. 8311 Tape No. 949 Std 76°F
Office Work J.D.Price	Surveyed by F.L. McNeal
Checked	Notes Mc Date 7-30-41
Date	Indexed C. Johns

F.B. 862 Pg. 23

76 Left Pg 25

For Improvements
See F.B. 862-50 & 51

40 (30) 40 (30)

ST.

Fd. Nail T.P.

827+08.34

Fd 2" I.P. filled with conc. Large Copper tack & Punch mark, Down 20" Set 1x2 at 2" Dn.

10.96

0.09

771.35

34.41

26.78

29.59

13.44

771.62

1097.90

SPRING

771.34 T 78 = 771.35

771.365 T 78 = 771.38

Fd. Nail Fn. P.

Fd. Nail P.P.

Fd. Nail Guy P.

771.60 @ 80 = 771.62

771.61 @ 80 = 771.63

1097.87 @ 80 = 1097.90

1097.89 @ 80 = 1097.92

Fd Nail Fn. P.

744+36.72 Set Nail

From Right Last Pg

Note: Any Additions or Changes on This Sheet Must be Made or Circled in Red Ink With Date and Name of Person Making Change.

Do not extend notes this side of this line.

RETURN TO
LOS ANGELES COUNTY SURVEYOR
700 HALL OF RECORDS

FORM 247 5M 10-39

F.B. 862 Pg. 24

From Bot. Pg - 22

30-D-3

RETURN TO
LOS ANGELES COUNTY SURVEYOR
700 HALL OF RECORDS

Note: Any Additions or Changes on This Sheet Must be Made or Circled in Red Ink With Date and Name of Person Making Change.

Do not extend notes this side of this line.

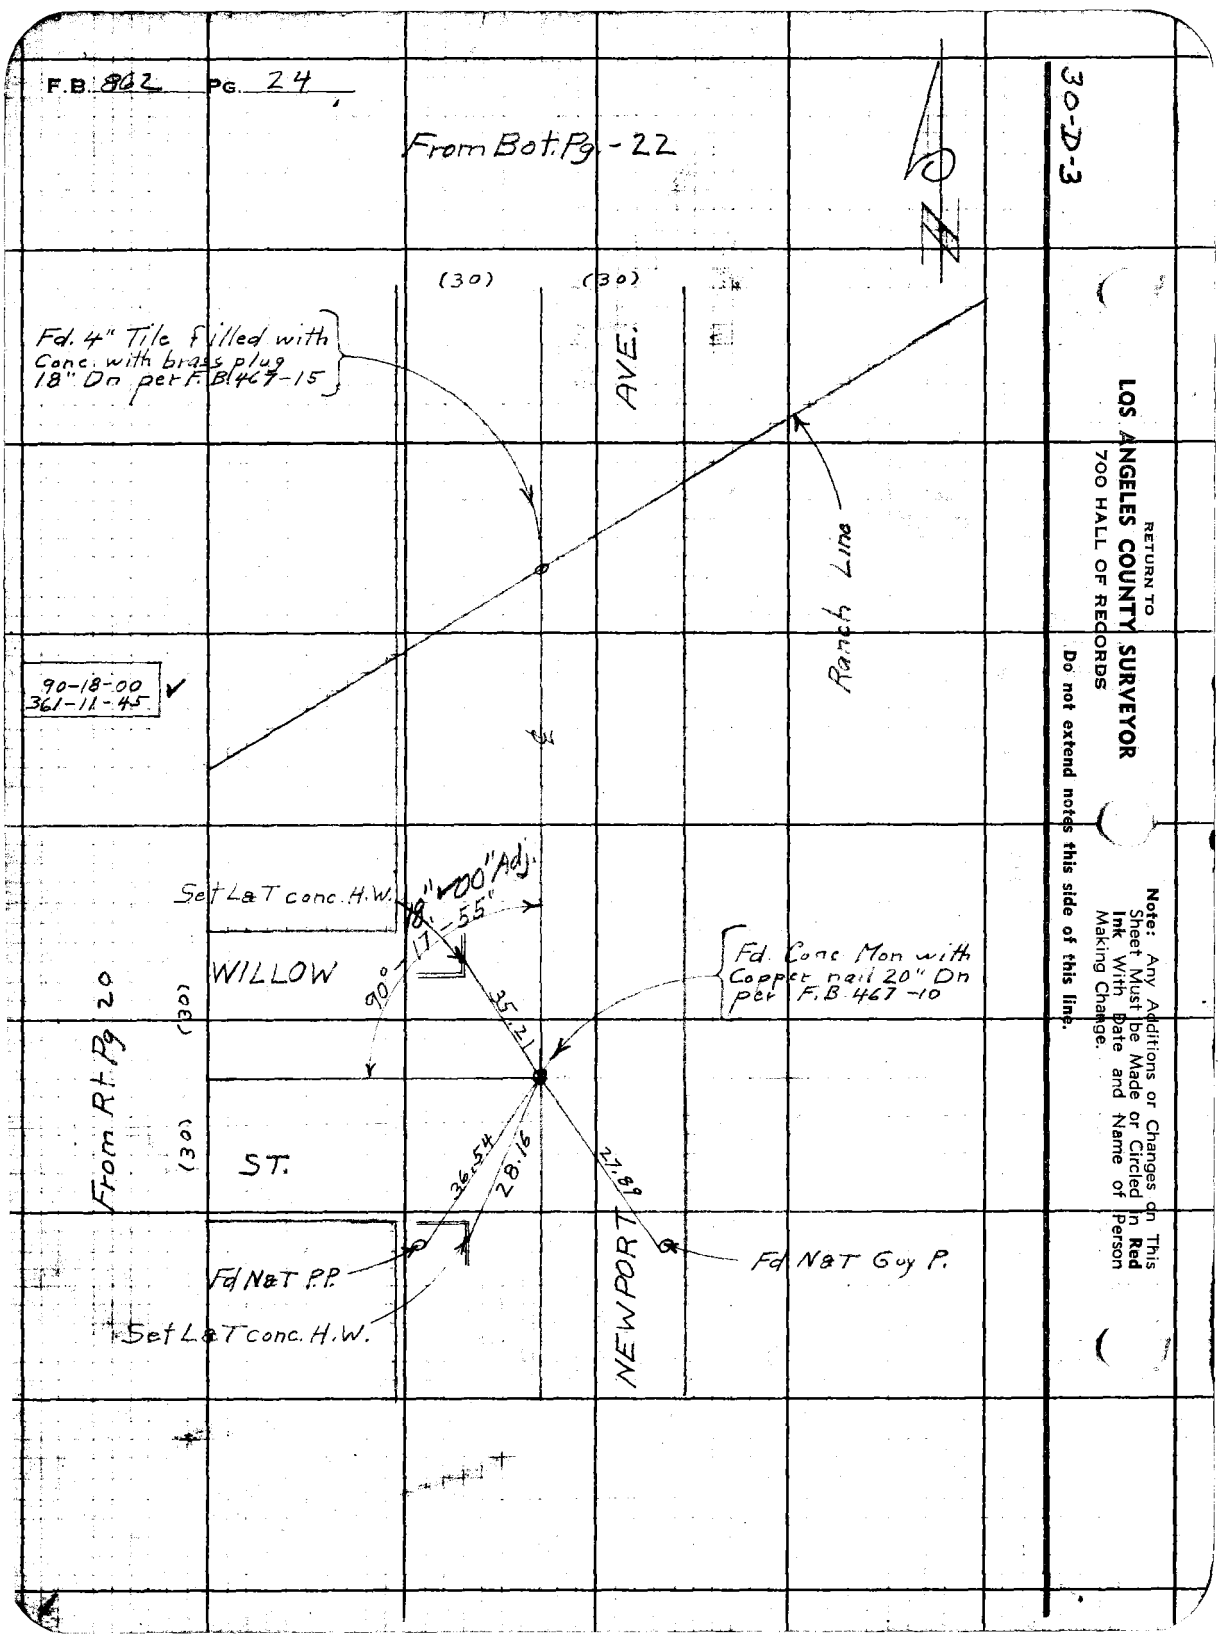

Notes Ck'd by KRM	Survey of Spring St
Map No. B-1259-1	W.O. 2314 Tape No. 049 St'd 76°F
Office Work J.D. Price	Surveyed by E.J. McNeal
Checked	Notes Mc Date 8-6-41
Date	Indexed C. Johnson

F.B. 862 PG. 25

3 Or E-3

Fd Conc Mon with bolt head - in hand hole 101+81.76 painted on pavement

90-00-00
360-00-15

40

BLVD.

40

For Improvements
See F.B. 862-52

Fd Conc Mon with bolt head - in hand hole 81+28.03 painted on pav.

0°01'

2640±

89+79.69
Fd Conc. Mon with brass nail in hand hole
Per F.B. 415-56

Fd. S.T. & Wire P.P.

Fd. N. & T. in T.P.

89°53'45"

90°00'-05"

90°39'40"

48.20

54.84

SPRING

ST.

From Top Pg 23

40 (30)

771.35

S 89° 59' 11" E

57.28

14.68

89°59'-40"

90-00-11

To Bot. Next Pg.

Fd. S.T. & Wire P.P.

Fd 2 N&T in P.P.

89-59-45
359-58-45

2640±

89-59-45
359-59-00

LAKEWOOD

Fd Conc. Mon with bolt head - in hand hole 49+01.47 painted on pavement

RETURN TO
LOS ANGELES COUNTY SURVEYOR
700 HALL OF RECORDS

Note: Any Additions or Changes on This Sheet Must be Made or Circled in Red Ink With Date and Name of Person Making Change.

Do not extend notes this side of this line.

FORM 247 5M 10-59

F.B. 862 PG. 26

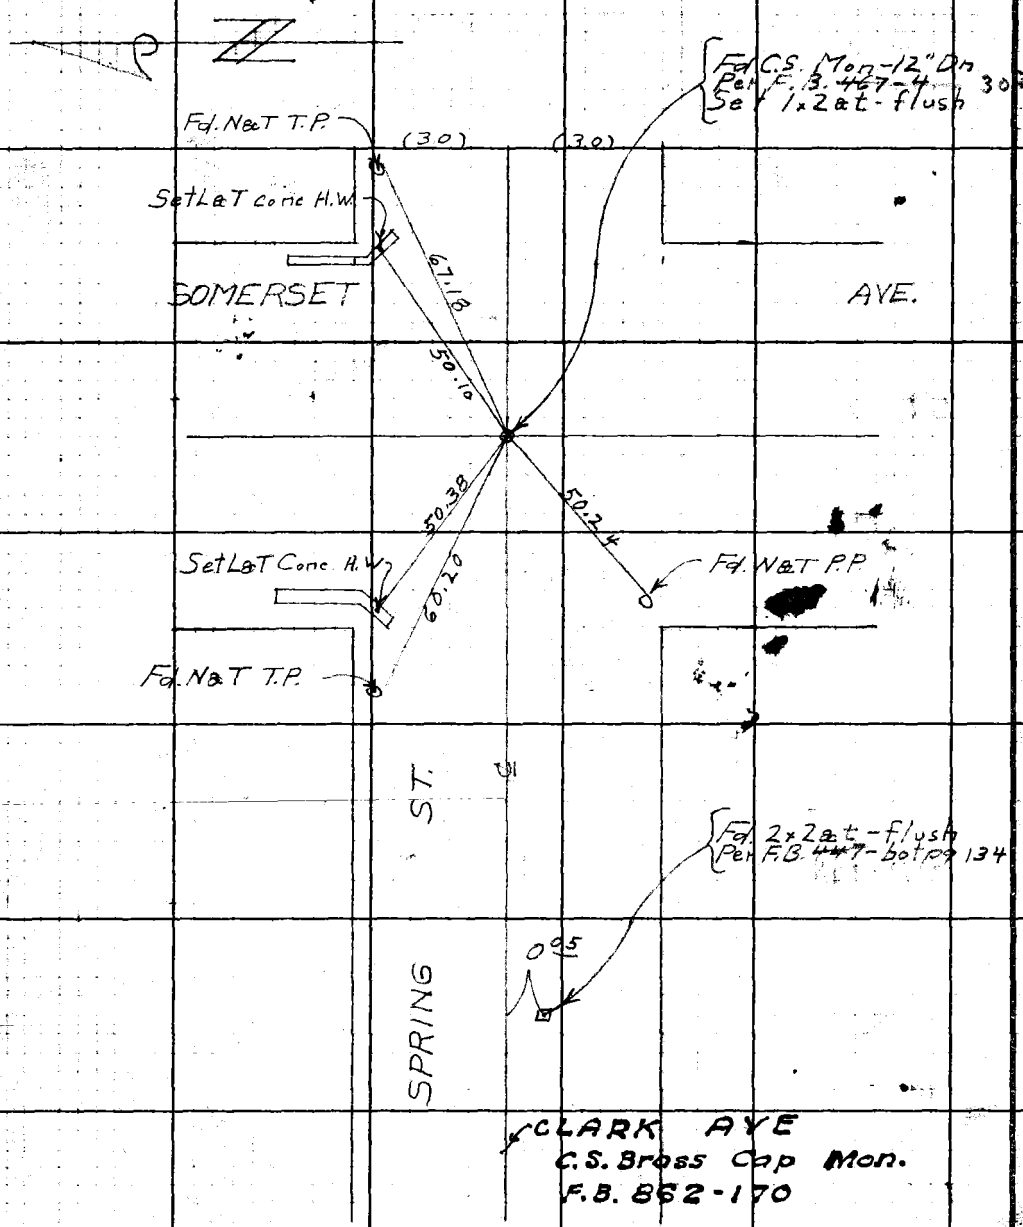

3-B-3

302-123

RETURN TO
LOS ANGELES COUNTY SURVEYOR
700 HALL OF RECORDS

Do not extend notes this side of this line.

Note: Any Additions or Changes on This Sheet Must be Made or Circled in **Red Ink** With Date and Name of Person Making Change.

Notes Ck'd by	Survey of Spring St
Map No. S.S.B-1759-1	W. O. 831 Tape No. St'd. °F
Office Work J.D.Price.	Surveyed by F.J. McNeal
Checked	Notes Mc Date 6-24-41
Date	Indexed E. Johnson 9-11-41

F.B. 862 Pg. 27

40+30=70

100' = 99.1

SPRING ST.

IMPROVEMENTS

From Walnut Ave to Lakewood Ave

F.J. McNeal
Geo. H. Nichols
A. Carrasco
J. L. Willey
R. L. Willey
H. P. Heber
L.C. Wilson
L. M. DeTina

Note: Any Additions or Changes on This Sheet Must be Made or Circled in Red Ink With Date and Name of Person Making Change.

Do not extend notes this side of this line.

RETURN TO
LOS ANGELES COUNTY SURVEYOR
700 HALL OF RECORDS

FORM 247 SM 10-39

F.B. 862 Pg. 28

30-C-3

To Bot Next Pg

40 (30) 40 (20)

ST.

SPRING

2+38.1 3° 3° 3° 2+32.5 T.P. Conc. Post

61.7 19.9 62.1 19.9 25.5

2+37.1 2+37.0 2.8 3.3 2.6 0.6 4.0 Valve Boxes

2+02.7 17.8 17.8 20.8 Valve Box P.P. 1+93.4

1+96.3 56.9 0.8 Brick Wall 1+81 P.P. 34.0

1+36.4 Fire Hydrant 32.5 1+25.1 57.8 16.0 27.0 16.0 27.0

1+30.5 6.0 4.0 Valve Boxes 1+23.6

14.3 Shed 24' Frame Office 3.0 4.1 5.0 4.1 0+97.3 T.P. 74.8 25.2 0+76.7 74.3

Oiled Dirt

Conc. Gas Island 3' wide R=11.4 4.5

39.3 12.9 21.7 1-Story Frame Office 4.6

0+43.6 48.9 0+31.2 Valve 30.6 19.8 R=10

2 6.6 23.3 0+36.3 Valve Boxes 25.7 17.7 28.4 32.5 0+26.6 P.P. 0+22.5 R=10

Oiled Dirt

WALNUT

0+00 Fd. 1 x 2 at E See Pg. -9

33.9 Union Oil Co M.H. 0+07.5 E

AVE. Oil & Rock

20.0 18" C.M.P. (10E)

R=10 20.0 19.5 R=10 18" C.M.P. (10E)

RETURN TO
LOS ANGELES COUNTY SURVEYOR
700 HALL OF RECORDS

Note: Any Additions or Changes on This Sheet Must be Made or Circled in Red Ink With Date and Name of Person Making Change.

Do not extend notes this side of this line.

Notes Ck'd by
Map No. C.S.B-1759-1.
Office Work J.D.Price.
Checked
Date

Survey of Spring St.
W. O. 831 Tape No. St'd °F
Surveyed by F.J. McNeal
Notes Mc Date 6-24-41
Indexed

F.B. 862 PG. 29

30-D-3

To Bot. Next Pg.

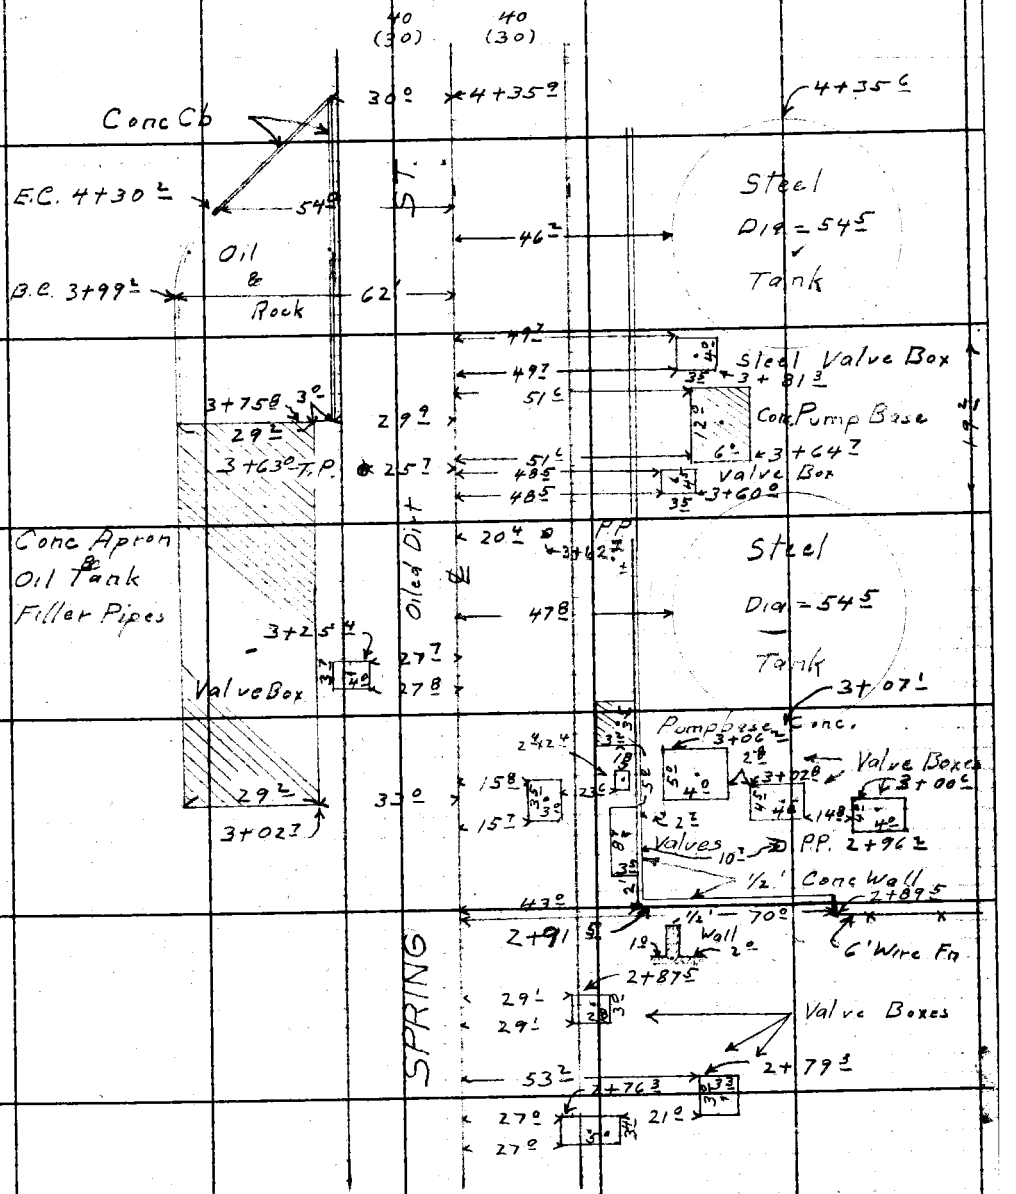

From Top Last Pg.

Note: Any Additions or Changes on This Sheet Must be Made or Circled in Red Ink With Date and Name of Person Making Change

Do not extend notes this side of this line.

RETURN TO
LOS ANGELES COUNTY SURVEYOR
7DO HALL OF RECORDS

FORM 247 5M 10-39

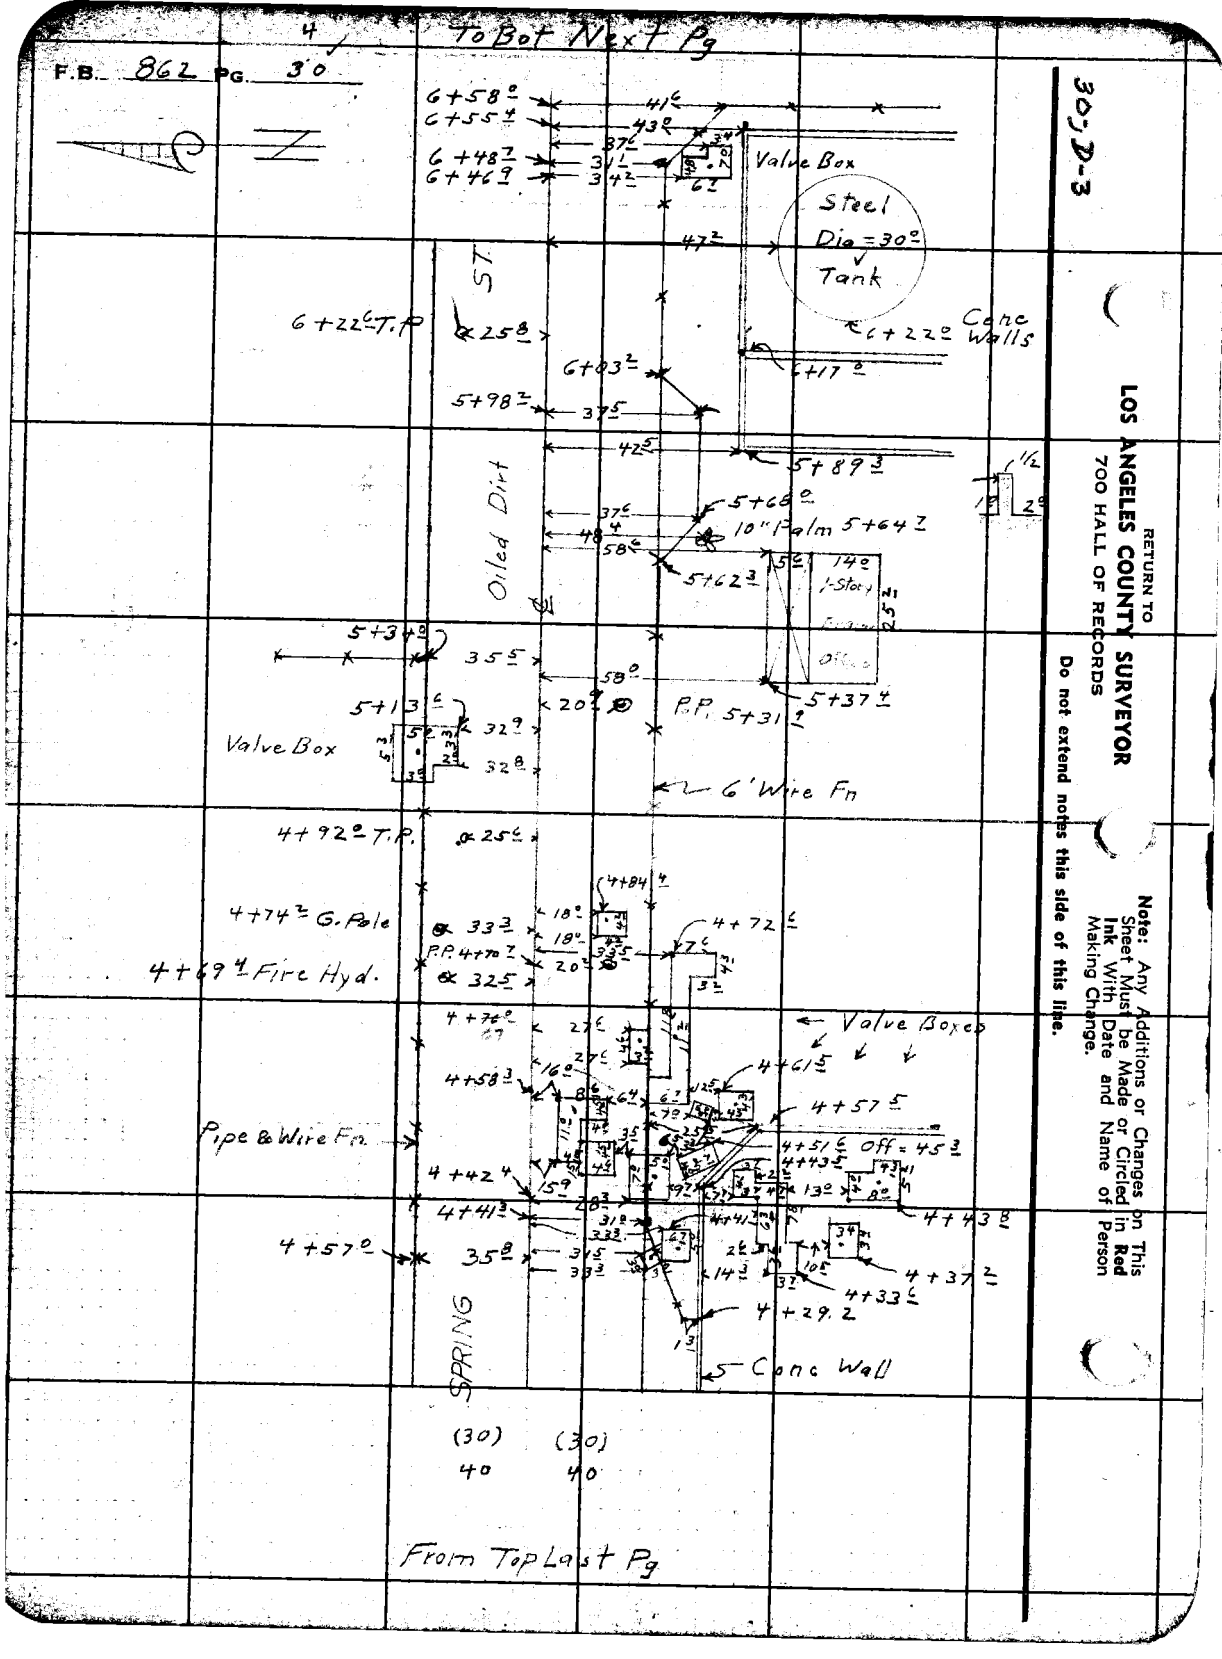
4
To Bot Next Pg
F.B. 862 Pg. 30
30, D-3
RETURN TO
LOS ANGELES COUNTY SURVEYOR
700 HALL OF RECORDS
Do not extend notes this side of this line.
Note: Any Additions or Changes on This Sheet Must be Made or Circled in Red Ink With Date and Name of Person Making Change.
6+58°
6+55 4
6+48 7
6+46 9
41 6
43°
37 6
31 1
34 2
Valve Box
Steel
Dia = 30°
Tank
47 2
ST
6+22 6 T.P
25 8
6+03 2
5+98 7
37 5
Conc Walls
6+22°
6+17 8
42 5
5+89 3
Oiled Dirt
37 6
48 4
58°
5+68°
10" Palm 5+64 7
5+62 3
5 2
14°
1-Story
25 2
OFFICE
5+34°
35 5
58°
5+13 6
5 2
3 9
32 9
32 8
20 2
P.P. 5+31 1
5+37 4
Valve Box
6' Wire Fn
4+92° T.P.
25 6
4+74 2 G. Pole
33 3
4+69 4 Fire Hyd.
P.P. 4+70 7
32 5
4+84 4
18°
18°
20 2
4+72 6
Valve Boxes
4+76°
27 6
4+61 5
4+58 3
16°
4+57 5
Pipe & Wire Fn
4+51 6 Off = 45 3
4+43 5
4+42 4
15°
13°
4+41 3
4+43 8
4+57°
35 8
4+37 21
4+33 6
4+29.2
SPRING
5 Conc Wall
(30)
40
(30)
40
From Top Last Pg

Notes Ck'd by	Survey of Spring St.
Map No. C.S. B-1758-1	W. O. 2311 Tape No. St'd °F
Office Work J. D. Price	Surveyed by F. J. McNeal
Checked	Notes Mc Date 6-25-41
Date	Indexed A. C. Johnson

F.B. 982 PG. 31

30 D3

To Bot Next Pg.

9+34 (40) (40) (36)

Valve Box

40 40

9+34 26.8 31.3 9+62.2

5' Conc Walk 9+00.7 28.9

8+79 ℄ 23.5 11.5

8+76.2 T.P. ∝ 26°

Hedge

8+57°

23° 11.5

22.9 P.P. 8+70.9

31° 8+65°

32.8 8+63.4

26.3

Conc. Wall 4.2

Steel

Conc Cbs & Oil filler Pipes

20° 42.9 7+45.5

7+52.4 T.P. ∝ 26°

Oiled Dirt

14.5

Dig = 115.9

5° 5°

20° 42.6 7+08.5

Valve Box

25.5 21.9 4.8 25.5

7+01.4 P.P.

6+98.4

32.6 6+88.2

Tank

46.6

SPRING

1½'

6+74.9

6+74.0

29 47

6+70

From Top Last Pg.

RETURN TO
LOS ANGELES COUNTY SURVEYOR
700 HALL OF RECORDS

Note: Any Additions or Changes on This Sheet Must be Made or Circled in Red Ink With Date and Name of Person Making Change.

Do not extend notes this side of this line.

FORM 247 5M 10-39

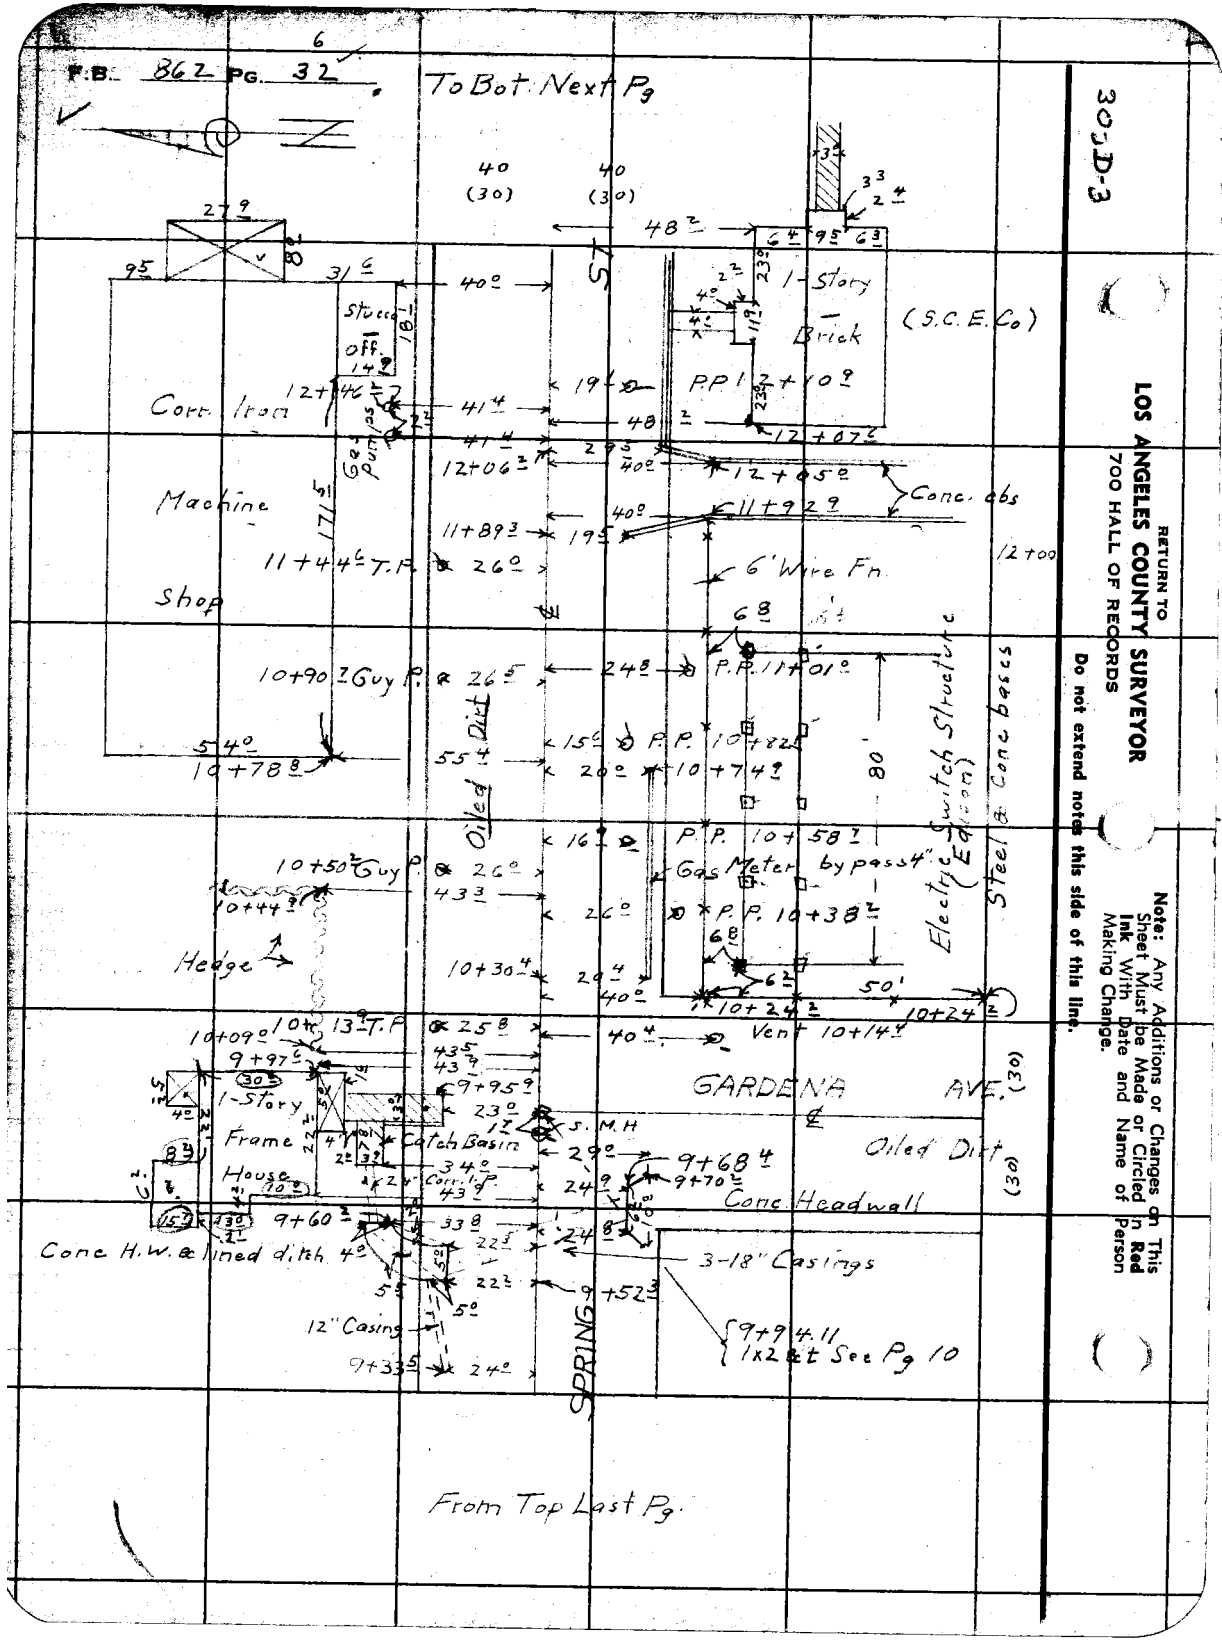
F.B. 862 PG. 32
6
To Bot. Next Pg
40
(30)
40
(30)
48 2
95
31 6
40°
ST
1-Story
Brick
(S.C.E. Co)
Stucco
Off
Corr. Iron
Gas Conn.
41 4
48 2
PP 12+10 9
12+07 6
12+06 3
12+05 9
Conc. cbs
Machine
Shop
171 5
11+89 3
11+92 9
11+44 6 T.P.
26°
6' Wire Fn.
12+00
10+90 7 Guy P.
26 5
24 8
P.P. 11+01°
Oiled Dirt
55 4
10+78 8
15 9
P.P. 10+82
20°
10+74 9
80'
Electric Switch Structure (Edison)
Steel & Conc bases
10+50 2 Guy P.
26°
43 3
16
P.P. 10+58 7
Gas Meter by pass 4"
10+44 7
Hedge
26°
P.P. 10+38 2
10+30 4
24 4
50'
10+24 2
10+24
10+09°
10+13 9 T.P.
25 8
40 4
Vent 10+14 4
9+97 6
43 5
43 9
9+95 9
GARDENA AVE.
(30)
1-Story
Frame
House
Catch Basin
23°
S.M.H
29°
9+68 4
9+70 2
Oiled Dirt
Conc Headwall
34°
Corr. I.P.
24 9
9+60 2
33 8
24 8
3-18" Casings
Conc H.W. & lined ditch 4°
22 2
9+52 3
12" Casing
9+94.11
1x2 & t See Pg 10
9+33 5
24°
SPRING
From Top Last Pg.
30-D-3
RETURN TO
LOS ANGELES COUNTY SURVEYOR
700 HALL OF RECORDS
Do not extend notes this side of this line.
Note: Any Additions or Changes on This Sheet Must be Made or Circled in Red Ink With Date and Name of Person Making Change.

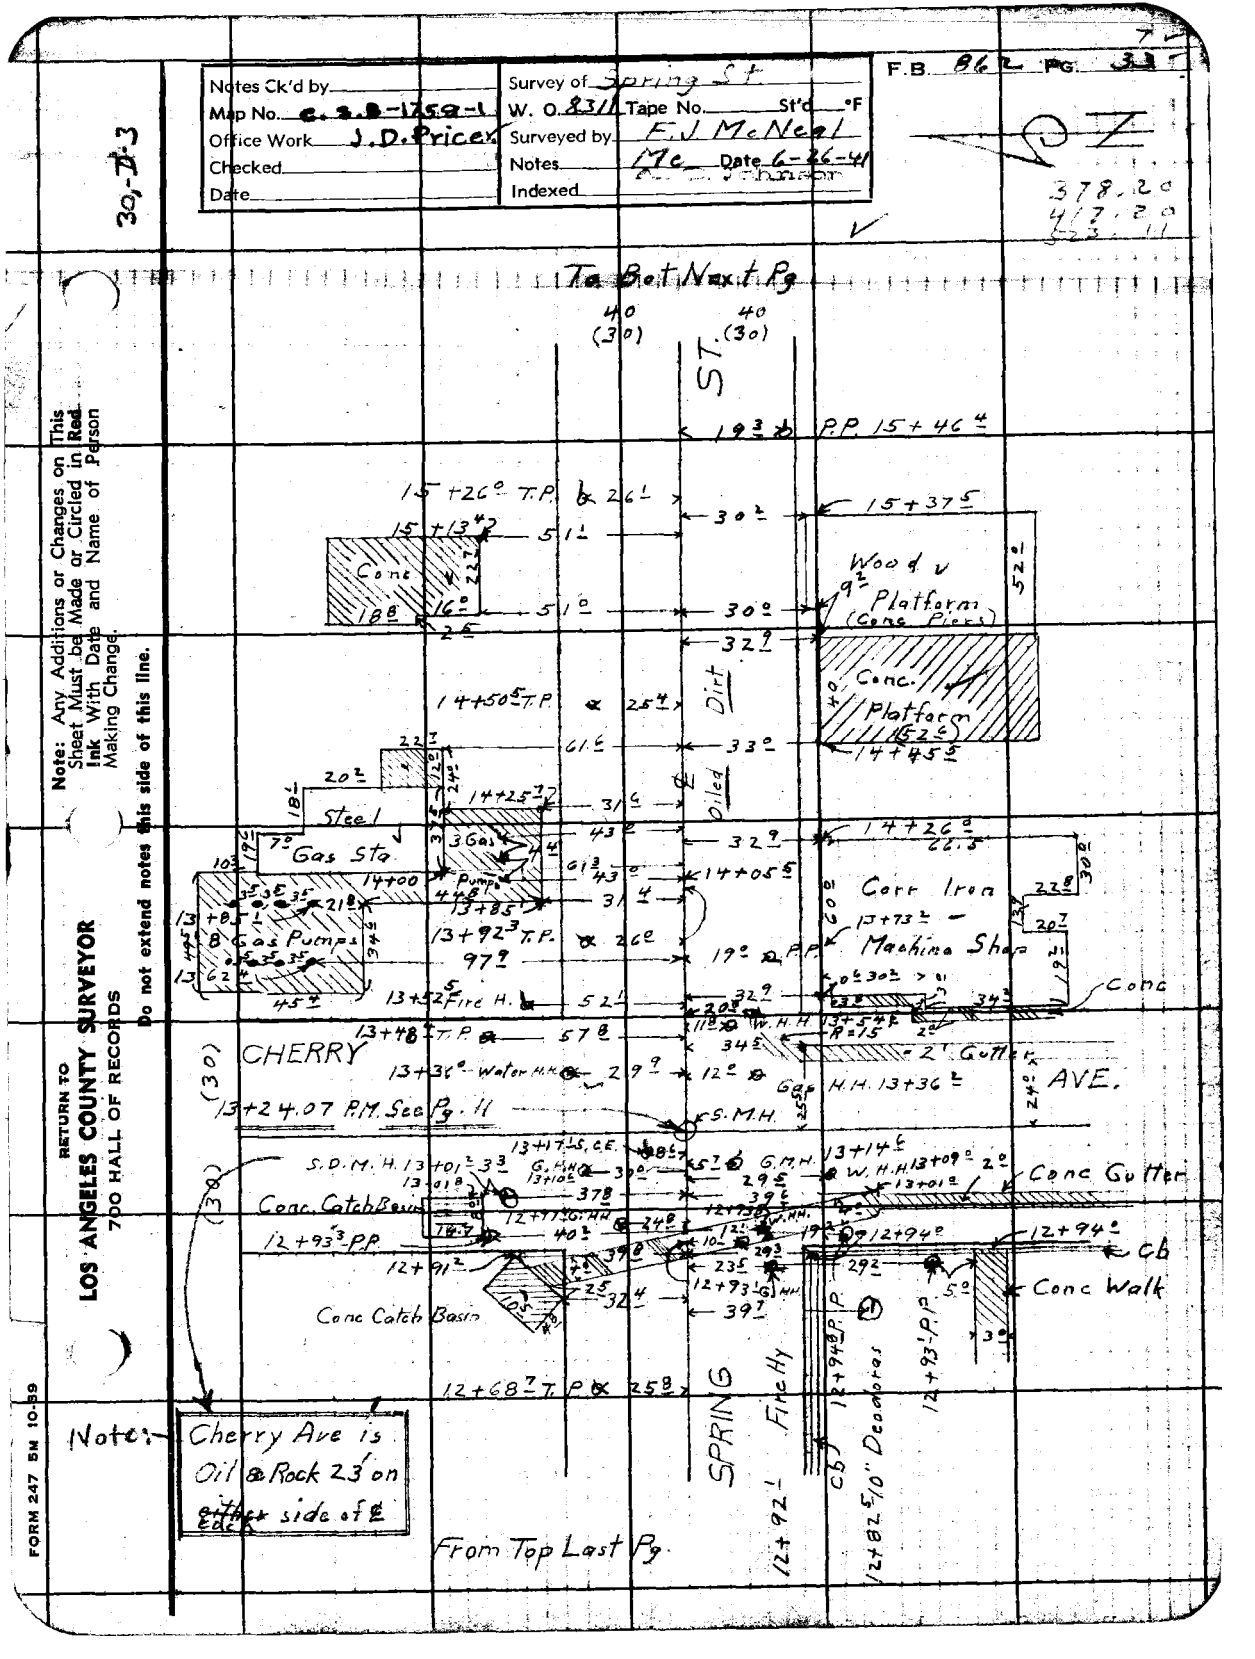
Notes Ck'd by
Map No. C.S.B-1759-1
Office Work J.D.Price
Checked
Date
Survey of Spring St
W. O. 831 Tape No. St'd °F
Surveyed by E.J McNeal
Notes Mc Date 6-26-41
Indexed
F.B. 862 PG. 31
30-B-3
To Bot Next Pg
ST.
P.P. 15+46.4
15+26.0 T.P. & 26.1
15+37.5
Wood v
Platform (Conc Piers)
Conc.
Platform
14+50.5 T.P.
Dirt
Oiled
14+45.5
Steel
Gas Sta
3 Gas
Pumps
14+00
13+85
13+92.3 T.P.
8 Gas Pumps
Fire H.
14+26.0
Corr Iron
Machine Shop
13+73 ±
Conc
CHERRY
AVE.
13+48 T.P.
13+36 Water M.H.
13+24.07 P.M. See Pg. 11
S.D.M.H. 13+01.2
Conc. Catch Basin
12+93.3 PP
12+91.2
Conc Catch Basin
12+68.7 T.P.
S.S.M.H.
13+17 S.S.E.
G.M.H. 13+14
W.M.H. 13+09.0
Conc Gutter
12+94.0
CB
Conc Walk
SPRING
Fire Hy
12+94.8 P.P.
12+93.1 P.P.
12+92.1
CB
12+82.5 10" Deodoras
Note:
Cherry Ave is Oil & Rock 23' on either side of ℄
From Top Last Pg
RETURN TO
LOS ANGELES COUNTY SURVEYOR
700 HALL OF RECORDS
Note: Any Additions or Changes on This Sheet Must be Made or Circled in Red Ink With Date and Name of Person Making Change.
Do not extend notes this side of this line.
FORM 247 5M 10-59

F.B. 862 PG. 34

30-2 D-3

RETURN TO
LOS ANGELES COUNTY SURVEYOR
700 HALL OF RECORDS
Do not extend notes this side of this line.

Note: Any Additions or Changes on This Sheet Must be Made or Circled in Red Ink With Date and Name of Person Making Change.

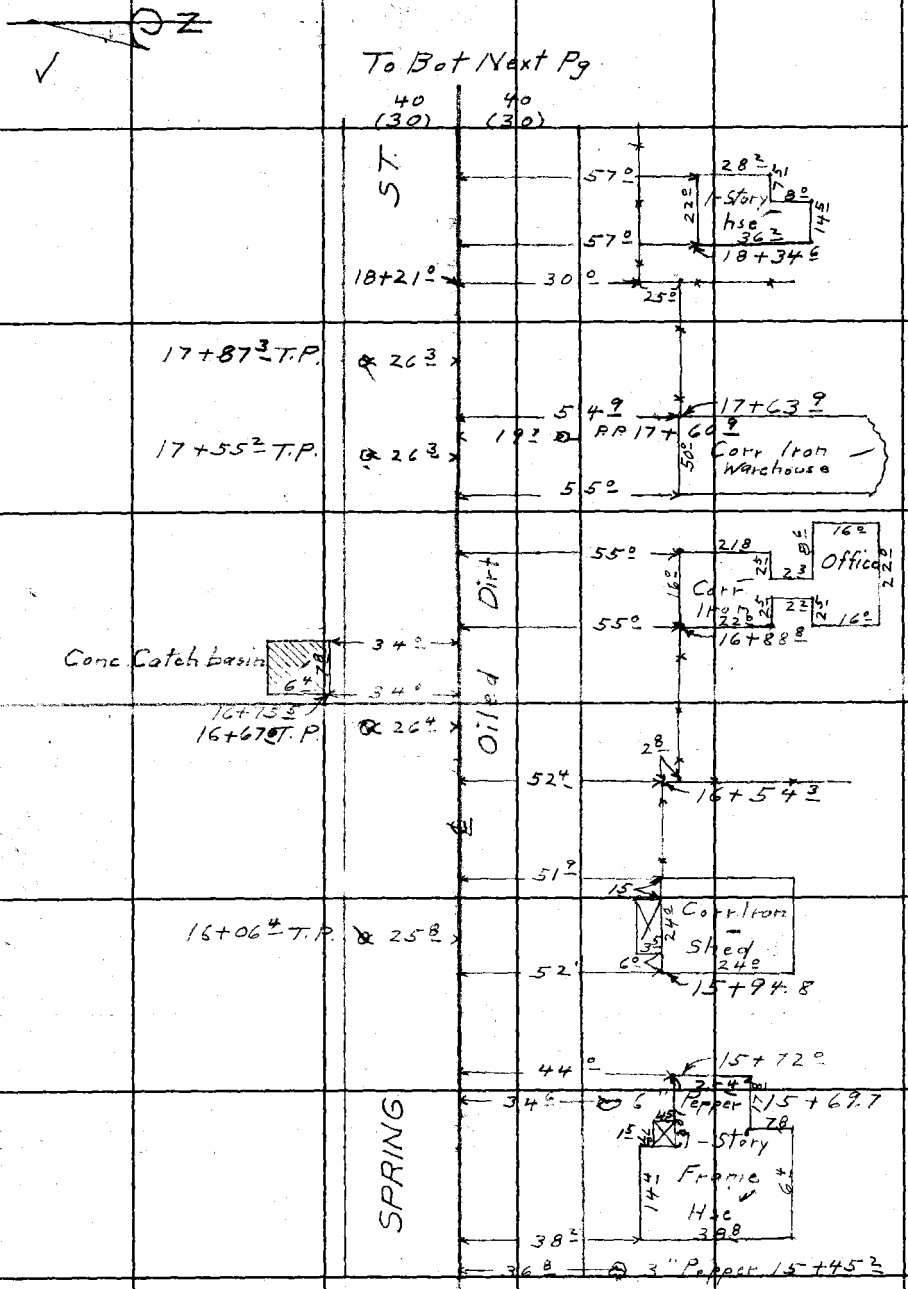

RETURN TO
LOS ANGELES COUNTY SURVEYOR
700 HALL OF RECORDS

Note: Any Additions or Changes on This Sheet Must be Made or Circled in Red Ink With Date and Name of Person Making Change

Do not extend notes this side of this line.

Notes Ck'd by
Map No. C.S. B-1759-1
Office Work J.D. Price
Checked
Date

Survey of Spring St
W. O. 8311 Tape No. St'd °F
Surveyed by E.J. McNeal
Notes Mc Date 7-8-41
C. Johnson

F.B. 862 Pg. 35

30, D-3

To Bot Next Pg

(30) 40 (30) 40

ST.

Corn from Office

39.1 — 18.2 — 6.0 — 8.3 — 2.8.3 — 18.9 — 9.9 — 24.7 — 21+97.9

24.7 — 38.9 — 4" Valve Box — 5.8.1 — 24.7 — 21+96.0

21+86.3 T.P. @ 26.8

21+73.6 T.P. @ 26.8

21.9 @ P.P. 21+54.4

30.0 — 21+42.6 — 10.0 — 10.0 — 22.7 — 21+36.7 — Sewer M.H. & Pump House — 30.0 — 30.0 — P.P. 21+31.6

Dirt

Oiled

43.4 — 5.9.5 — Corr from Bldg. not on permanent Found — 43.3 — 21+04.1

20+47.4 T.P. @ 26.7

20+37.5 T.P. @ 26.7

29.4 — 20+45.3 — C'Wire Fm.

SPRING

19+70.5

43.3 — 19+69.2 — 19+27.6 — C3.8 Corr from 15.2 Shed — 35.0 Wood Platform

19+22.6 T.P. @ 26.4 — 19.8 @ P.P.

19+11.3 T.P. @ 26.4 — 43.1

From Top Last Pg.

FORM 247 5M 10-39

F.B. 862 PG. 36

10

39-D-3

To Bot. Next Pg.

ST.

40 (30) 40 (80)

26+18 ±

26+11.7

Conc. Catch Basin

Valve Boxes

26+08 ±

T.P. 26+08 ±

25+72 ± T.P.

25+54 ± T.P.

Dead Dirt

24+98 ± PP

24+43 ± T.P.

24+28 ± T.P.

23+47 ± P.P.

P.P. 23+23 ±

23+12 ± T.P.

22+96 ± T.P.

Conc Catch Basin

22+84 ±

22+74 ±

22+70 ±

Valve Boxes

22+64 ±

SPRINGS

+39 ±

22+48 ±

Conc

22+46 ±

From Top Last Pg

RETURN TO
LOS ANGELES COUNTY SURVEYOR
700 HALL OF RECORDS

Do not extend notes this side of this line.

Note: Any Additions or Changes on This Sheet Must be Made or Circled in Red Ink With Date and Name of Person Making Change.

Notes Ck'd by
Map No. C.S. B-1759-1
Office Work J. D. Price
Checked
Date

Survey of Spring St
W. O. 8311 Tape No. St'd °F
Surveyed by F. J. McNeal
Notes Mc Date 7-8-41
Indexed A. C. Johnson

F.B. 362 PG. 37

30xD=3

To Bat Next Pg

40 (39) 40 (30)

28+90.7 End of Cb & Gutter — 25° — 26.5 — RP — 28+66 — 72 — 28+94.3 4" Cypress

28+35.2 4" Acacia — 70°

28+32.1 T.P. — 26.1

28+17.2 T.P. — 26.2

28+12.2

30.6 — 12.1

6' Wire Fn

6" Conc. Wall

2.9 — 2.9 — Conc. Muffler Pits — 17.3 — 17.3

55° — 19.3 — 12.9 — (L.B. Gas)

ST.

Oiled Dirt

27+30.4 — 49.8 — 42.2 — Cast Iron pump hse

27+08.5 — 55° — (Sump) Conc. Wall

18" Gutter

26+97.4 T.P. — 26.1 — 54.6 — 54.2 — 6.3 — 0.8 — Pipe Fn

26+89.0 — 34° — 26+86.4 — 27° — Fire Hy. 26+81.2 — 50.1 — 26+74.9 — P.P. 26+72.5 — R=10'

Conc. Catch Basin — 12.0 — 7° — T.P. — 2.1 — 34° — 26.4 — 25.1

26+65.2 M.H. — 42.8

Cb & 18" Gutter — 20.2 — 20.2 — (30)

26+42.6 See Pg. -17

Oiled Dirt

JUNIPERO AVE. (30)

SPRING

From Top Last Pg.

RETURN TO
LOS ANGELES COUNTY SURVEYOR
700 HALL OF RECORDS

Note: Any Additions or Changes on This Sheet Must be Made or Circled in Red Ink With Date and Name of Person Making Change

Do not extend notes this side of this line.

FORM 247 5M 10-39

F.B. 862 Pg. 38

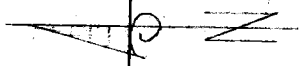

To Bot. Next Pg.

40 (30) 40 (30)

33 + 51 5 T.P. ℄ 26 7

33 + 36 6 T.P. ℄ 26 7

26 4 57.

P.P. 33 + 52 4

33 + 10 0 Fire Hy.

36 2

50 1

49 9

33 + 02 6

32 + 98.2

38 6 ℄ 1 5 3 2 Valves & Fire Hyd.

32 + 87.5

24 5

Cable Wire Fn

32 + 61 9

28 8

32 + 41 5

Conc. C.B.

34 8

34 8

34 0

34 0

32 + 41.3

Catch Basin

32 + 22 6 T.P. ℄ 26 3

32 + 88 8 T.P. ℄ 26 1

6" Wire Fn Conc Cb

26 1 ℄ P.P. 31 + 90 5

Oiled Dirt

℄

24 8

31 + 60 0

49 2 30 Valve 30 + 96.4

30 + 92 3 T.P. ℄ 26 5

30 + 77 6 T.P. ℄ 26 3

26 2 ℄ P.P. 30 + 21 9

29 + 37 6 End Wall Beg. Cb.

29 + 63 2 T.P. ℄ 26 2

29 + 46 5 T.P. ℄ 26 1

SPRING

From Top Last Pg

30-D-3

RETURN TO
LOS ANGELES COUNTY SURVEYOR
700 HALL OF RECORDS

Do not extend notes this side of this line.

Note: Any Additions or Changes on This Sheet Must be Made or Circled in **Red Ink** With Date and Name of Person Making Change.

30 - D-3

Notes Ck'd by		Survey of Spring St	
Map No. C.S.B-17594	W. O. 8311	Tape No.	St'd °F
Office Work J. D. Price		Surveyed by E. McNeal	
Checked		Notes	Date 7-9-41
Date		Indexed	A. C. John

F.B. 862 Pg. 13 39

To Bot Next Pg.

40 (30) 40 (30)

39+34.4 T.P. 25.1
39+08.9 Guy P. 25.2
Conc. C.B. 26.1
38+89.5 27.5
38+73.1 T.P. 25.9
38+56.9 T.P. 26.2
37+35.9 T.P. 26.2
37+23.6 T.P. 26.3
36+12.8 T.P. 26.2
35+98.1 T.P. 26.0
35+33.0 Fire Hy. 40.3
34+84.4 T.P. 26.5
34+69.2 T.P. 26.7
Cable Wire Fn. 34+11.1 28.7
33+71.3 2 Water H. H. 41.6

ST
Dirt
Oiled
SPRING

26.5 P.P. 38+26.8
26.7 P.P. 36+72.6
26.4 P.P. 35+12.3

39+31.1 56.8 41.7 2 T.P.
39+30.3
43.8 26.7 P.P. 39+07.2 Conc. C.B.
42.2 38+99.7

From Top Last Pg.

Note: Any Additions or Changes on This Sheet Must be Made or Circled in Red Ink With Date and Name of Person Making Change

Do not extend notes this side of this line.

RETURN TO
LOS ANGELES COUNTY SURVEYOR
700 HALL OF RECORDS

FORM 247 5M 10-39

F.B. 862 Pg. 40 ✓ 14

30-D-3

RETURN TO
LOS ANGELES COUNTY SURVEYOR
700 HALL OF RECORDS
Do not extend notes this side of this line.

Note: Any Additions or Changes on This Sheet Must be Made or Circled in Red Ink With Date and Name of Person Making Change.

To Bot Next Pg

40 (30) 40 (30)

ST.

20 ℄

P.P 43+22.4

43+19.0 T.P. ℄ 25.3

43+03.6 T.P. ℄ 25.1

41+88.8 T.P. ℄ 25.4

Oiled Dirt

41+75.3 T.P. ℄ 25.5

41+57.8 T.P. ℄ 26.1

SPRING

19.2 ℄

P.P. 41+54.0

40+59.5 T.P. ℄ 25.4

40+43.8 T.P. ℄ 25.8

40+29.3 T.P. ℄ 27.0

26.8 ℄

P.P. 40+30.0

39+63.3 Fire Hyd. ℄ 50.5

84 ℄

P.P. 49+27.3

39+50.8 S.S. M.H ℄ 44.5

Conc C.B.

39+61.27 -1x7
See F.B. 862-18

67.0

30.0 30.0

39+54.0 T.P. ℄ 23.8

TEMPLE ST.

30.0 30.0

Conc. C.B.

66.5

39+71.27
+50.8
10.3

M.H.

44.5

90°

90°

39+61.27
+54.0
7.3

From Top Last Pg

15 ✓

Notes Ck'd by		Survey of Spring St	
Map No. C.S.B-1759-1.		W. O. 2311 Tape No.	St'd. °F
Office Work J. D. Price		Surveyed by F.L. McNeal	
Checked		Notes MC Date 8-4-41	
Date		Indexed C. S. Jan	

F.B. 862 Pg. 41

30-D-3

Note: Any Additions or Changes on This Sheet Must be Made or Circled in Red Ink With Date and Name of Person Making Change

Do not extend notes this side of this line.

RETURN TO
LOS ANGELES COUNTY SURVEYOR
700 HALL OF RECORDS

To Bot. Next Pg

40 (30) 40 (30)

49+90 T.P. 25.7

49+11.8 T.P. 24.7

Oiled Dirt

B.C. 48+53.2 58.4

ST.

24.4 P.P. 48+45.5

48+37.5 T.P. 24.4

48+20.0 S.P.M.H. 0.2 No. 48+14.2

Conc. C.B. 32.4 35.5 Conc. C.B.

48+12.1 T.P. 24.6

32.4 35.4

47+09.0 T.P. 24.7 48+07.7

46+86.0 T.P. 24.9

4' Chicken Wire Fence 23.0 P.P. 46+54.2

45+78.4 T.P. 24.9

45+65.3 T.P. 25.0

58.8

45+28.5

SPRING

21.6 P.P. 44+82.6

44+49.2 T.P. 25.3

44+34.8 T.P. 25.3

From Top Last Pg.

FORM 247 5M 10-39

16

F.B. 862 PG. 42

30-D3

RETURN TO
LOS ANGELES COUNTY SURVEYOR
700 HALL OF RECORDS

Do not extend notes this side of this line.

Note: Any Additions or Changes on This Sheet Must be Made or Circled in **Red Ink** With Date and Name of Person Making Change.

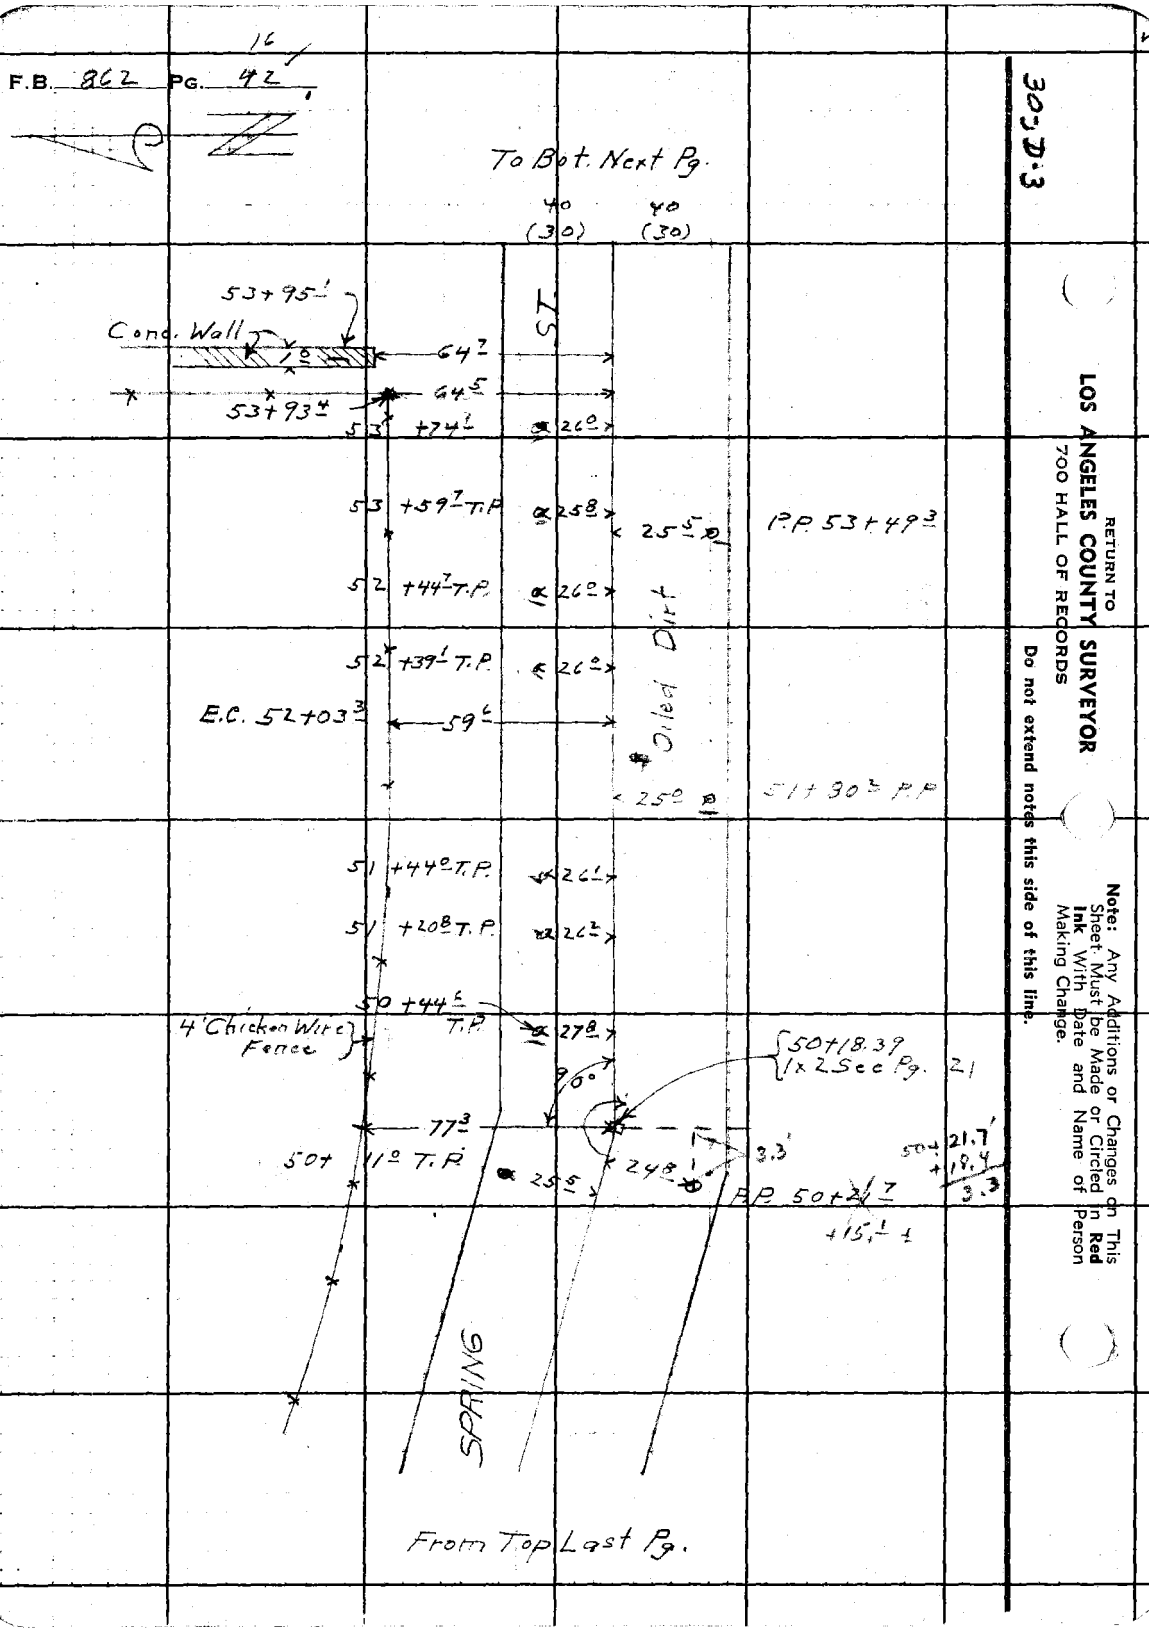

Notes Ck'd by	Survey of Spring St.
Map No. C.S.B-1759-1	W. O. 831 Tape No. Std. °F
Office Work J.D.Price	Surveyed by E.J. McNeal
Checked	Notes Mc Date 8-4-41
Date	Indexed C. Johnson

F.B. 2[illegible] Pg. 47

36-D-3

To Bot Next Pg

(40 30) (40 30)

58+79 T.P. ∝ 26°

58+76 T.P. ∝ 26°

14 Thick Conc Wall & 6' Wire Fn

ST.

68°

24° ∝

P.P. 58+63

Conc. Tennis Ct.

31

60

58+09°

41 3

68°

58+03

1'

55°

57+93

Oiled Dirt

57+51 Cable Fn

30

57+50 4 Sign ∝ 52°

57+48 5 T.P. ∝ 26°

57+32 1 T.P. ∝ 25 8

S.D.M.H. - 1 5 North 56+87°

56+94 3

33 8

25 1

P.P. 56+88 7

Conc. Catch Basin

Conc. C.B.

33 7

33 9

33 8

56+76 3

56+33° T.P. ∝ 25 8

56+22 8 T.P. ∝ 26 2

24 5

P.P. 55+20°

55+06 3

62°

62°

Catch Basin

SPRING

55+01 5 T.P. ∝ 26°

54+88 4 TP ∝ 25 7

From Top Last Pg

Note: Any Additions or Changes on This Sheet Must be Made or Circled in Red Ink With Date and Name of Person Making Change.

Do not extend notes this side of this line.

RETURN TO
LOS ANGELES COUNTY SURVEYOR
700 HALL OF RECORDS

FORM 247 5M 10-39

18

F.B. 862 PG. 44

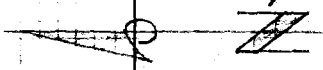

To Bot Next Pg

30-D-3

40 (30) 40 (30)

ST.

62+00 ±

41 ±

Oiled Dirt

Conc Wall & Wire Fn

61+53 ±

T. P. ∝ 26° ±

61+39 ±

T. P. ∝ 26° ±

41 ±

61+10 ±

R=14'

Gate

Hex. Sentry House

4.3

4 ±

4 ±

4 ±

R=14'

70 ±

60+71 ±

41 ±

60+61 ±

25 ± P.P 60+44 ±

60+22 ±

T. P. ∝ 26° ±

60+09 ±

T. P. ∝ 26° ±

1'

SPRING

From Top Last Pg

RETURN TO
LOS ANGELES COUNTY SURVEYOR
700 HALL OF RECORDS

Do not extend notes this side of this line.

Note: Any Additions or Changes on This Sheet Must be Made or Circled in Red Ink With Date and Name of Person Making Change.

Notes Ck'd by	Survey of Spring St.
Map No. C.S.B-1752-1.	W. O. 8311 Tape No. St'd °F
Office Work J. D. Price.	Surveyed by F.J. McNeal
Checked	Notes Mc Date 8-5-41
Date	Indexed Nilson

F.B. 862 Pg. 45

30-D-3

Note: Any Additions or Changes on This Sheet Must be Made or Circled in Red Ink With Date and Name of Person Making Change

Do not extend notes this side of this line.

RETURN TO
LOS ANGELES COUNTY SURVEYOR
700 HALL OF RECORDS

To Bot Next Pg

63+94.6 Fire Hy. ℄ 38.2 ST. ← Wire Fn

63+90.6 24" Palm 49.3 → ← 40.3 63+79.3

63+80.8 Fire Hy. ℄ 22.7 × ← 56.8 11.7 Conc. C.B.

63+38.82 1x2 See Pg - 22 NEWPORT (30)

TEL Co Box 5' 58.0 → Oiled Dirt

Edison Transformer Conc. Box 5.8 4.8 58.5 63+21.8 AVE. (30)

0 = Breathers 59.6 ← 56.7 11.8 Conc. C.B.

63+10.2 63+09.7 ℄ 58.5 ← 37.6 3.5 Valve Box

P.P. 63+05.4 63+16.8 Wire Fn

← 27.8 ← 40.3 62+98.9

Conc. C.B. 33.9 33.8 62+98.6

62+90.6 40" Palm 49.4 → 33.7 33.8 12 Conc. C.B.

62+86.3

62+84.2 T.P. ℄ 26.0

62+82.7 Guy Pole 10 ℄ 34.5 Dirt

62+71.6 T.P. ℄ 26.0

62+54.9 ← 37.4

62+26.0 ℄ M.H. 46'

62+19.4 36" Palm 49.7 →

Cable Fn

SPRING Oiled

25.6 ← ℄ P.P. 62+09.0

62+02.7 41.8 →

From Top Last Pg

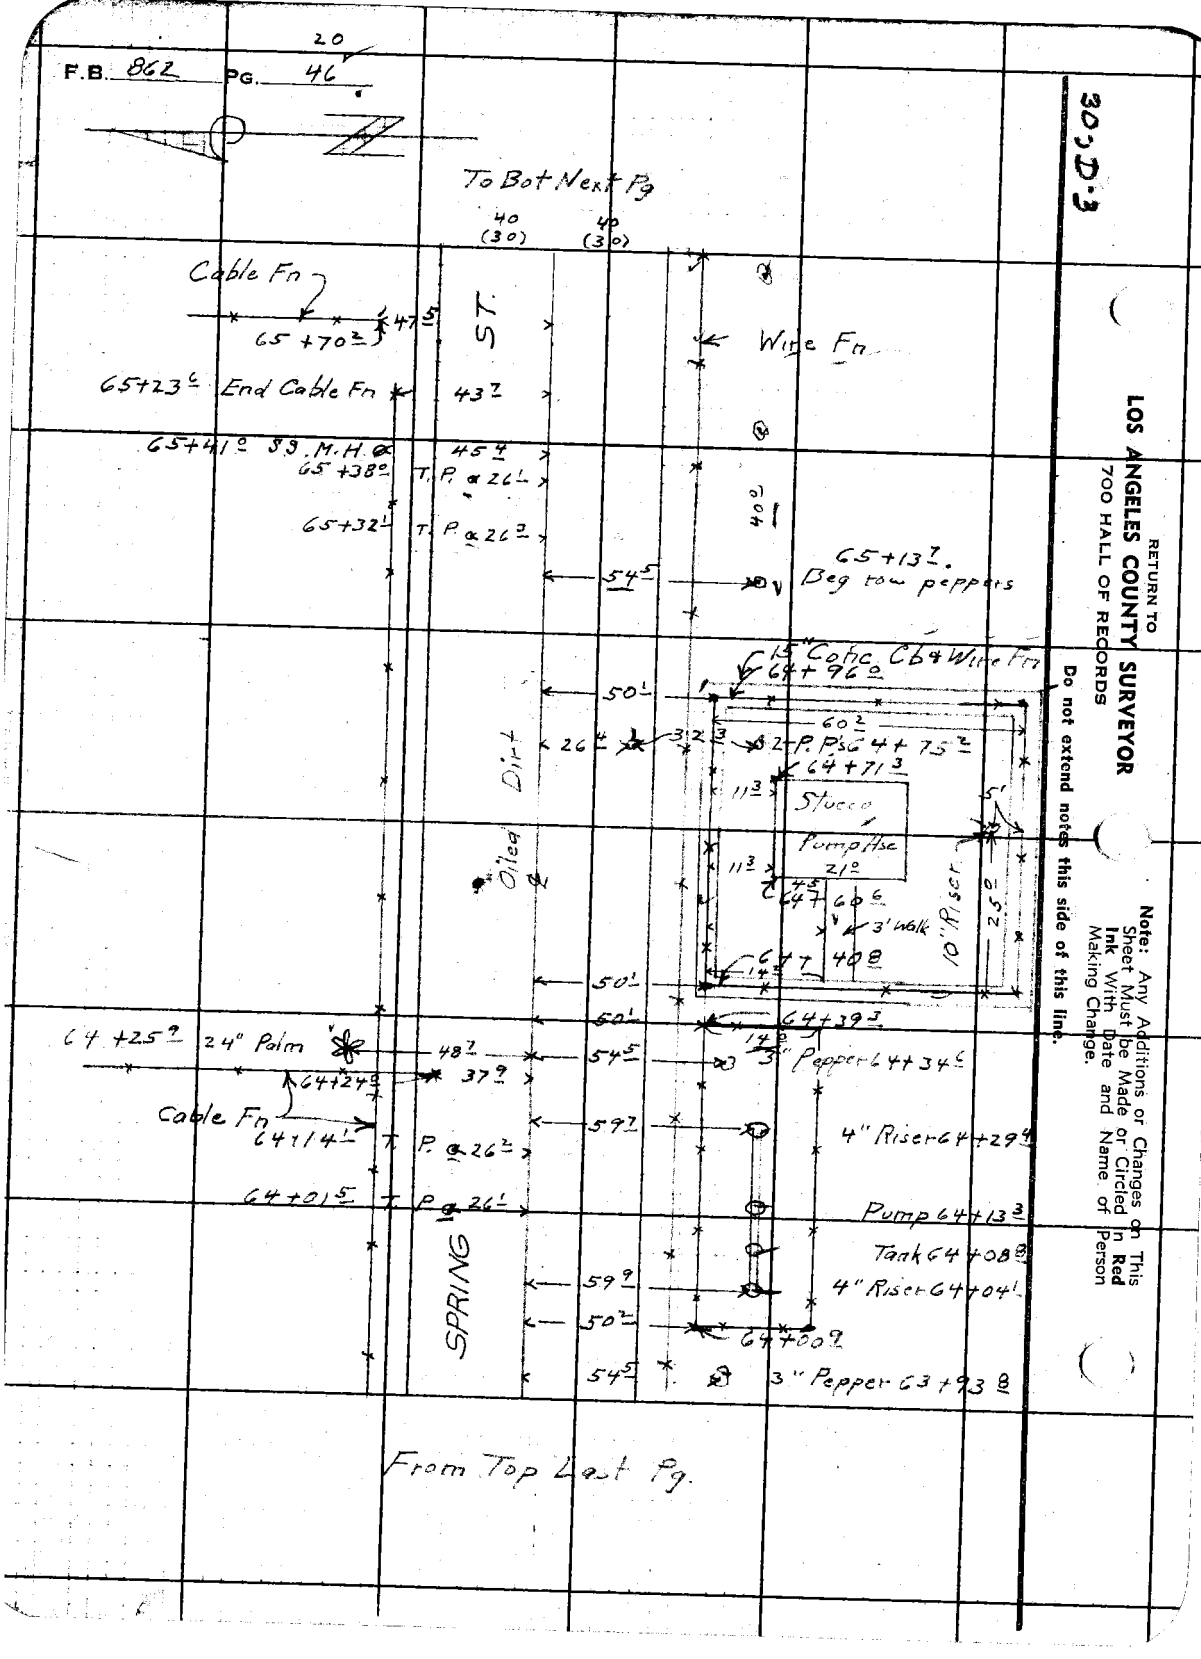

RETURN TO
LOS ANGELES COUNTY SURVEYOR
700 HALL OF RECORDS

Note: Any Additions or Changes on This Sheet Must be Made or Circled in Red Ink With Date and Name of Person Making Change.

Do not extend notes this side of this line.

Notes Ck'd by		Survey of Spring St	F.B. 862 Pg. 47
Map No. C.S.B-1759-1		W. O. 8311 Tape No. Std °F	
Office Work J.D. Price		Surveyed by F.J. McNeal	
Checked		Notes Mc Date 8 5 41	
Date		Indexed A. C. Johnson	

30-D-3

To Bot Next Pg

40 (30) 40 (30)

ST

68+03.6 T.P. 26.2

25° P.P. 68+02.7

TEL. Co Box

57.7

Edison Conc Box

67+86.9

59.3

67+86.6 T.P. 26.2

Wire Fn

Trees

67+51.3 Light Post 41.5

67+36.6 Poplars 38° 54°

67+25.4 51.4

67+21.3 55.2

Oiled Dirt

Row of pepper

40'

66+73.7 T.P. 26.1

High Wire Fn

66+59.5 T.P. 26.3

25° P.P. 66+43.6

12" Brick Wall

66+42.0

Gas Meter 14 sq.

27.4

27.4

65+88.6 55.5

65+84.3 51.6

58°

Edison Conc Box

58°

65+72.4

SPRING

From Top Last Pg

Note: Any Additions or Changes on This Sheet Must be Made or Circled in Red Ink With Date and Name of Person Making Change.

Do not extend notes this side of this line.

RETURN TO
LOS ANGELES COUNTY SURVEYOR
700 HALL OF RECORDS

FORM 247 SM 10-58

22

F.B. 862 PG. 48

To Bot Next Pg

40 (30) 40 (30)

73+24.0 T.P. @ 26.1

73+11.6 T.P. @ 26.3

ST

Wire Fn

25.7

P.P. 72+36.4

40'

71+93.0 T.P. @ 26.1

71+80.4 T.P. @ 26.0

34.2 33.5

Conc. C.B.

12

71+12.1 34.3 33.7 71+11.9

Conc. C.B.

70+51.5 T.P. @ 26.1

CL

70+65.2 T.P. @ 26.2

25.4

P.P. 70+30.3

Fire Hy. @ 37.8

70+15.8

Dirt

Trail

69+33.2 T.P. @ 26.3

69+21.1 T.P. @ 26.4

40'

Cable Fn

Oiled

Pgvmt

SPRING

68+54.4

54.9

40'

Top of

From Top Last Pg

RETURN TO
LOS ANGELES COUNTY SURVEYOR
700 HALL OF RECORDS

Do not extend notes this side of this line.

Note: Any Additions or Changes on This Sheet Must be Made or Circled in Red Ink With Date and Name of Person Making Change.

Bar D-3

Notes Ck'd by	Survey of Spring St
Map No. C.S.B-1759-1.	W. O. 8311 Tape No. Std. °F
Office Work J.D.Price.	Surveyed by F.J. McNeal
Checked	Notes Mc Date 8-5-41
Date	Indexed E. C. Johnson

F.B. 862 PG. 49

2-3

30-E-3

To Bat Next Pg

Cone Foundation

40 (30) 40 (30)

ST.

P.P. 80+29.4

79+92.0 3" Pepper

79+55.3 End Row

P.P. 78+52.4

79+79.7 79+79.4 61.6 24.9 2.5 12.5 12" 15.7 61.4

79+72.8 T.P. 26.7 25.8

79+65.5 T.P. 26.7 7.7 5.4 25.4

78+42.8 T.P. 26.6

78+27.1 T.P. 26.5

77+15.0 T.P. 26.5

Oil & Rock Cable Fn.

40' Row of Pepper Trees

77+00 T.P. 26.3

76+90 1.25 9.2

76+72.4 25.2 13.8

76+60.6 27.9

40' 8" Conc. Walls @ end of open Ditch

76+49.6 P.P.

76+46.6 27.9 10.3

75+84.5 T.P. 26.1 24.5 76+29.3

75+71.1 T.P. 26.4

Cable Fn

SPRING

Oiled Dirt

Wire Fn

74+57.2 T.P. 26.3

74+39.7 T.P. 26.1 25.7

P.P. 74+45.8

From Top Last Pg

Note: Any Additions or Changes on This Sheet Must be Made or Circled in Red Ink With Date and Name of Person Making Change.

Do not extend notes this side of this line.

RETURN TO
LOS ANGELES COUNTY SURVEYOR
700 HALL OF RECORDS

FORM 247 5M 10-39

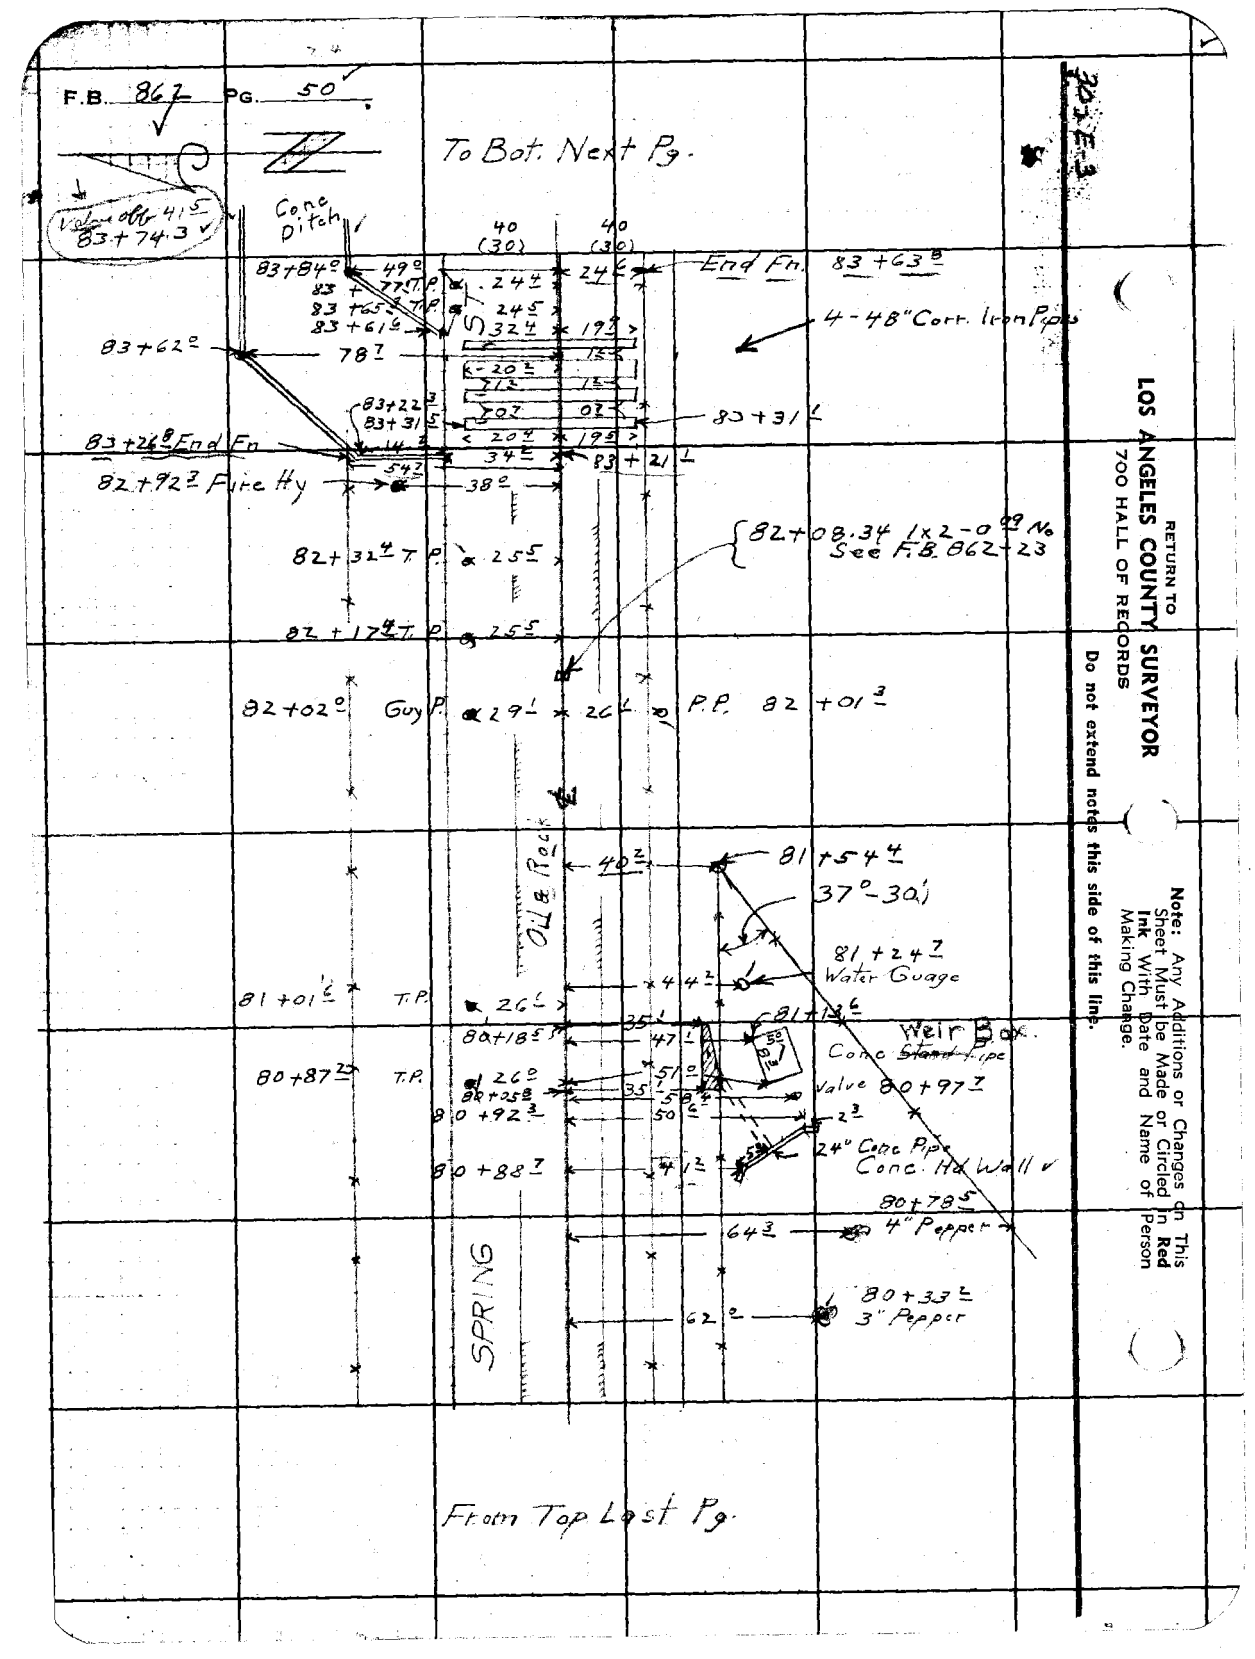
F.B. 867 PG. 50
To Bot. Next Pg.
Conc ditch
40 (30)
40 (30)
End Fn. 83+63.8
4-48" Corr. Iron Pipes
83+84.0
83+77.7 P
83+65.7 P
83+61.6
83+62.0
78.7
83+22.3
83+31.5
83+26.8 End Fn
82+92.3 Fire Hy
83+31.1
83+21.1
82+32.4 T.P.
82+17.4 T.P.
82+08.34 1x2-0.09 No
See F.B. 862-23
82+02.0 Guy P.
P.P. 82+01.3
81+54.4
37°-30'
81+24.7
Water Guage
81+01.1 T.P.
81+13.6
Weir Box
Conc Stand Pipe
80+18.5
80+87.2 T.P.
80+25.8
Valve 80+97.7
80+92.3
24" Conc Pipe
Conc. Hd Wall
80+88.7
80+78.5
64.3
4" Pepper
80+33.1
62.0
3" Pepper
OLIVE Rock
SPRING
From Top Last Pg.
30 E 3
RETURN TO
LOS ANGELES COUNTY SURVEYOR
700 HALL OF RECORDS
Do not extend notes this side of this line.
Note: Any Additions or Changes on This Sheet Must be Made or Circled in Red Ink With Date and Name of Person Making Change.

Notes Ck'd by	Survey of Spring St.
Map No. C.S.B-1752-1.	W. O. 2311 Tape No. St'd °F
Office Work J.D. Price. ✓	Surveyed by F.J. McNeal
Checked	Notes Mc Date 8-6-41
Date	Indexed A. C. Jon

F.B. 812 Pg. 51 ✓

30' E3

To Bot. Next Pg

40 (30) 40 (30)

ST.

Oil & Rock

R=110'

88+19.8 — 27.3 — 50.3 →

87+68.2 T.P. @ 24.3 → 25.6 @ P.P 88+02.8

87+54.8 T.P. @ 24.3 →

T.P. @ 24.1 → 86+36.9

T.P. @ 24.3 → 86+20.6

25.5 @ P.P 86+19.9

85+10.0 T.P. @ 24.5 →

84+95.5 T.P. @ 24.2 →

25.8 @ P.P 84+09.7

12.5 9

Conc.

Ditch (Conc.)

Conc

SPRING

From Top Last Pg

Note: Any Additions or Changes on This Sheet Must be Made or Circled in Red Ink With Date and Name of Person Making Change.

Do not extend notes this side of this line.

RETURN TO
LOS ANGELES COUNTY SURVEYOR
700 HALL OF RECORDS

FORM 247 5M 10-39

89+79.69

F.B. 862 PG. 52

30-E-3

RETURN TO
LOS ANGELES COUNTY SURVEYOR
700 HALL OF RECORDS

Do not extend notes this side of this line.

Note: Any Additions or Changes on This Sheet Must be Made or Circled in Red Ink With Date and Name of Person Making Change.

ST.

89+79.69 Mon
See F.B. 862-25

Asphaltic

20'

Conc.

LAKEWOOD

R=20'

R=20'

BLVD

89+45± O.I.Co M.H. 37± 40± Gas H.H. 89+39±

12.5 x 9

89+33± Guy P 52± 33± P.P 89+33±

89+27± Water H.H. 37±

89+19± Fire Hy 37±

Oil & Rock SPRING

88+98± T.P. 24±

88+86± T.P. 24±

(30) 40 (30) 40

From Top Last Pg

Notes Ck'd by	Survey of Spring St
Map No. C.S.B-189-2	W. O. 8311 Tape No. 013 St'd 66 °F
Office Work J.D.Price	Surveyed by L.S Hammond
Checked	Notes L.S.H. Date 5-1-41
Date	Indexed 9-11-41

F.B. BL2 Pg. 53

Note: Any Additions or Changes on This Sheet Must be Made or Circled in Red Ink With Date and Name of Person Making Change

Do not extend notes this side of this line.

RETURN TO
LOS ANGELES COUNTY SURVEYOR
700 HALL OF RECORDS

FORM 247 BM 10-39

SPRING ST

J.N. 8311

FROM
HOODRUFF AVE
TO
ORANGE CO. LINE

L.S. HAMMOND
F.H. BLANCHARD
H.B. FORNEY
C.W. WALLACE

F.B. 862 PG. 54

59

58

ORANGE / LOS ANGELES CO. / CO.

- INDEX -

58

PIONEER BLVD 60

ST

STUDEBAKER RD. 61

LA CO

SAN GABRIEL 57 RIVER

57 58

SPRUCE

56 CITY LONG BEACH WATER DEPT

C.S. B-659
Sta. 1331+06.09

55

WOODRUFF AVE

FR #15-13

RETURN TO
LOS ANGELES COUNTY SURVEYOR
700 HALL OF RECORDS

Note: Any Additions or Changes on This Sheet Must be Made or Circled in Red Ink With Date and Name of Person Making Change.

Do not extend notes this side of this line.

Notes Ck'd by
Map No. C.S.B-1759-2
Office Work J.D.Price.
Checked
Date

Survey of
W. O. 8511 Tape No. 812 St'd 68°F
Surveyed by E.S.Hammond
Notes E.S.H. Date 5-16-61
Indexed

F.B. 862 PG. 55

3J-C3

For 1956 19.56 For Improvements
See F.B. 864 64 to 68

638.34 Δ 0°00' T 80° = 638.39

Note: Any Additions or Changes on This Sheet Must be Made or Circled in Red Ink With Date and Name of Person Making Change
Do not extend notes this side of this line.

RETURN TO
LOS ANGELES COUNTY SURVEYOR
700 HALL OF RECORDS

FORM 247 SM 10-39

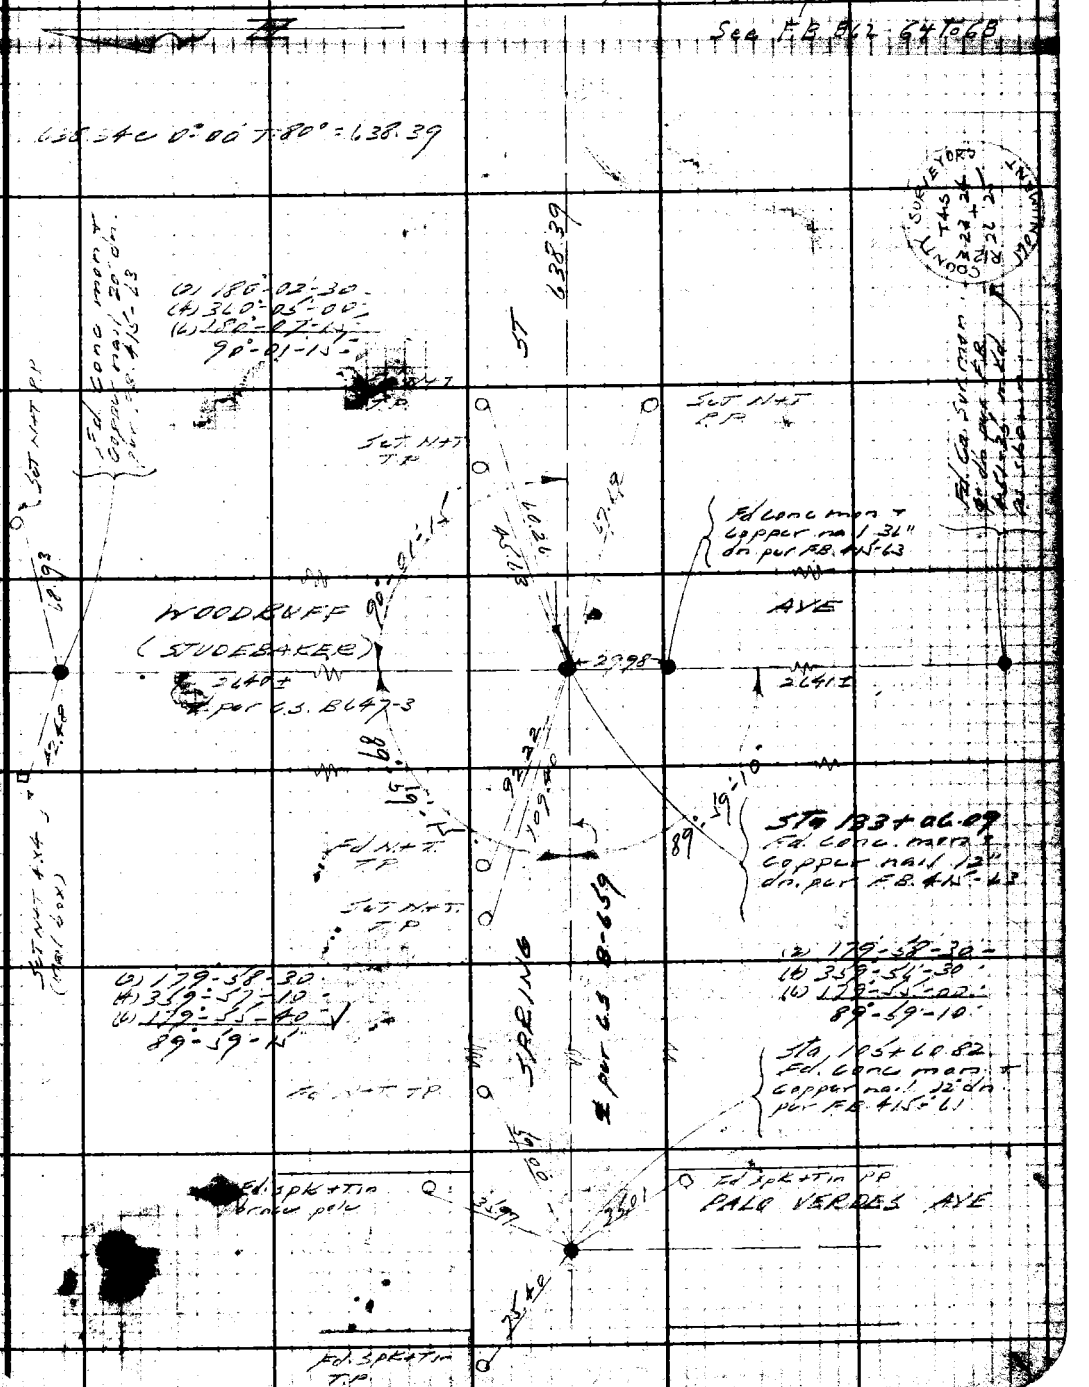

RETURN TO
LOS ANGELES COUNTY SURVEYOR
700 HALL OF RECORDS

Note: Any Additions or Changes on This Sheet Must be Made or Circled in Red Ink With Date and Name of Person Making Change.

Do not extend notes this side of this line.

31-C-3

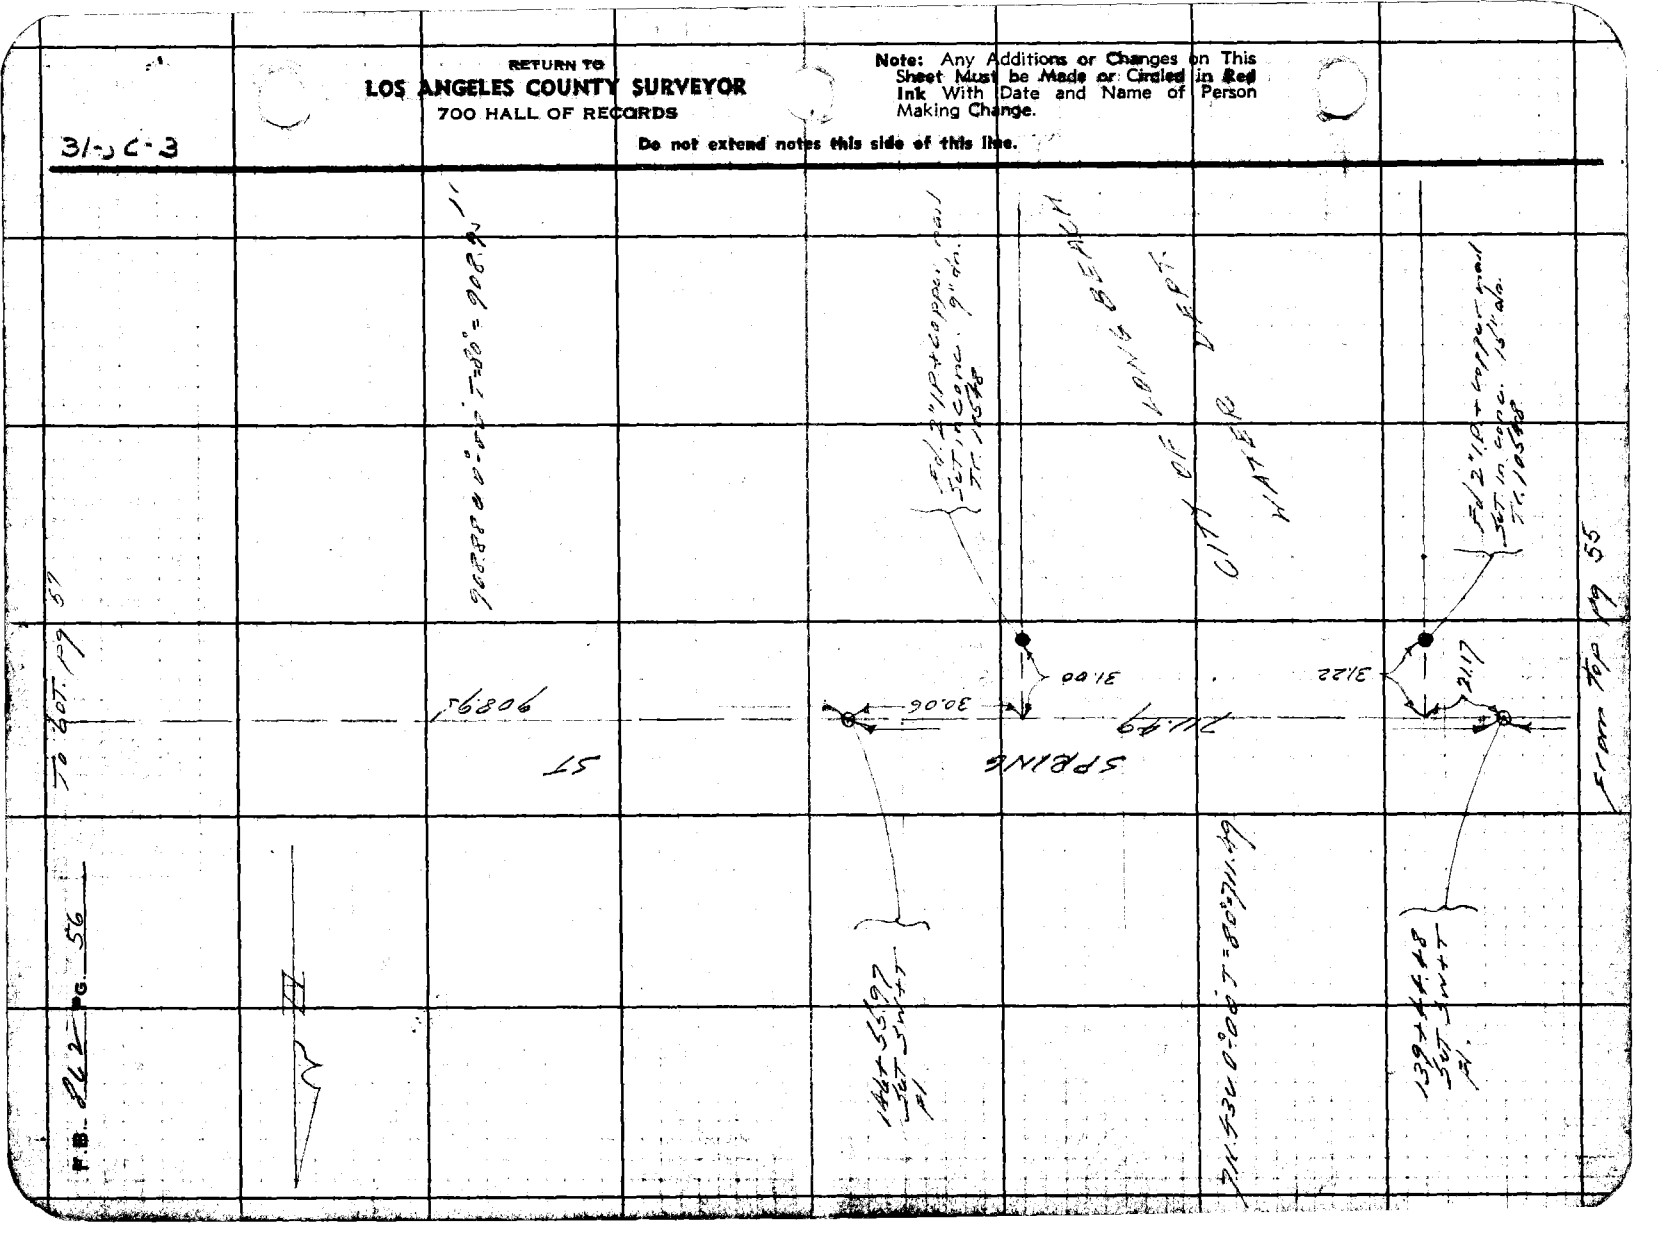

Notes Ck'd by	Survey of
Map No. C.S.B.-1781-1	W. O. 821 Tape No. 813 St'd 66°F
Office Work J. D. PRICE.	Surveyed by J. Hammond
Checked	Notes: Date 5-6-41
Date	Indexed

F.B. 862 Pg. 57

949 @ 76°

& F.J. McNeal

S 1/2 C-3

40 (30) 40 (30)

Set By Spike

1526.36 @ 76° = 1526.36
1526.39 @ 76° = 1526.39

For Improvements
See F.B. 862-69 to 72

See Pg. 61

ST

1526.36

~~STUDEBAKER~~

prop ℄

160+65.56
Ednail by ties F.B. 468-28
See Page 61

92-34-46
10-19-00

92°-34'-45"

RIVER ~~BLVD~~

500.65 @ 74° = 500.64
500.67 @ 74° = 500.66

SAN GABRIEL

SPRING

500.64

Set X Top RR. rail post.

Set X Top R.R. rail post

1455+64.92
Fd Cut X mon. & Copper rivet & 6" dia. pipe - Ft.
F18-28 415-68
TAYLOR

908.95

From Top. Pg. 56

Note: Any Additions or Changes on This Sheet Must be Made or Circled in Red Ink With Date and Name of Person Making Change

Do not extend notes this side of this line.

RETURN TO
LOS ANGELES COUNTY SURVEYOR
700 HALL OF RECORDS

FORM 247 5M 10-39

F.B. 862 PG. 58

To Bot pg. 59

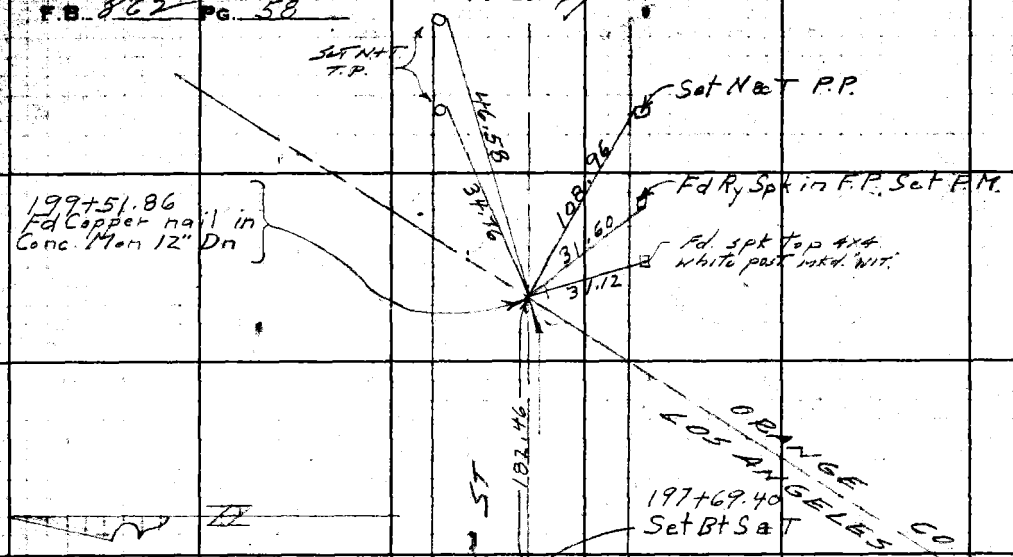

From Top pg 57

To Top pg 59

31, C-3, D-3

RETURN TO
LOS ANGELES COUNTY SURVEYOR
700 HALL OF RECORDS

Do not extend notes this side of this line.

Note: Any Additions or Changes on This Sheet Must be Made or Circled in Red Ink With Date and Name of Person Making Change.

Notes Ck'd by	Survey of
Map No. C.S.B. 17 [illegible]	W. O. 2324 Tape No. 913 St'd 68°F
Office Work J. D. Price.	Surveyed by L. S. Hammond
Checked	Notes Date
Date	Indexed

F.B. 862 Pg. 59

& F.J. McNeal
8-26-41

31-D-3

Note: Any Additions or Changes on This Sheet Must be Made or Circled in Red Ink With Date and Name of Person Making Change

Do not extend notes this side of this line.

RETURN TO
LOS ANGELES COUNTY SURVEYOR
700 HALL OF RECORDS

FORM 247 SM 10-39

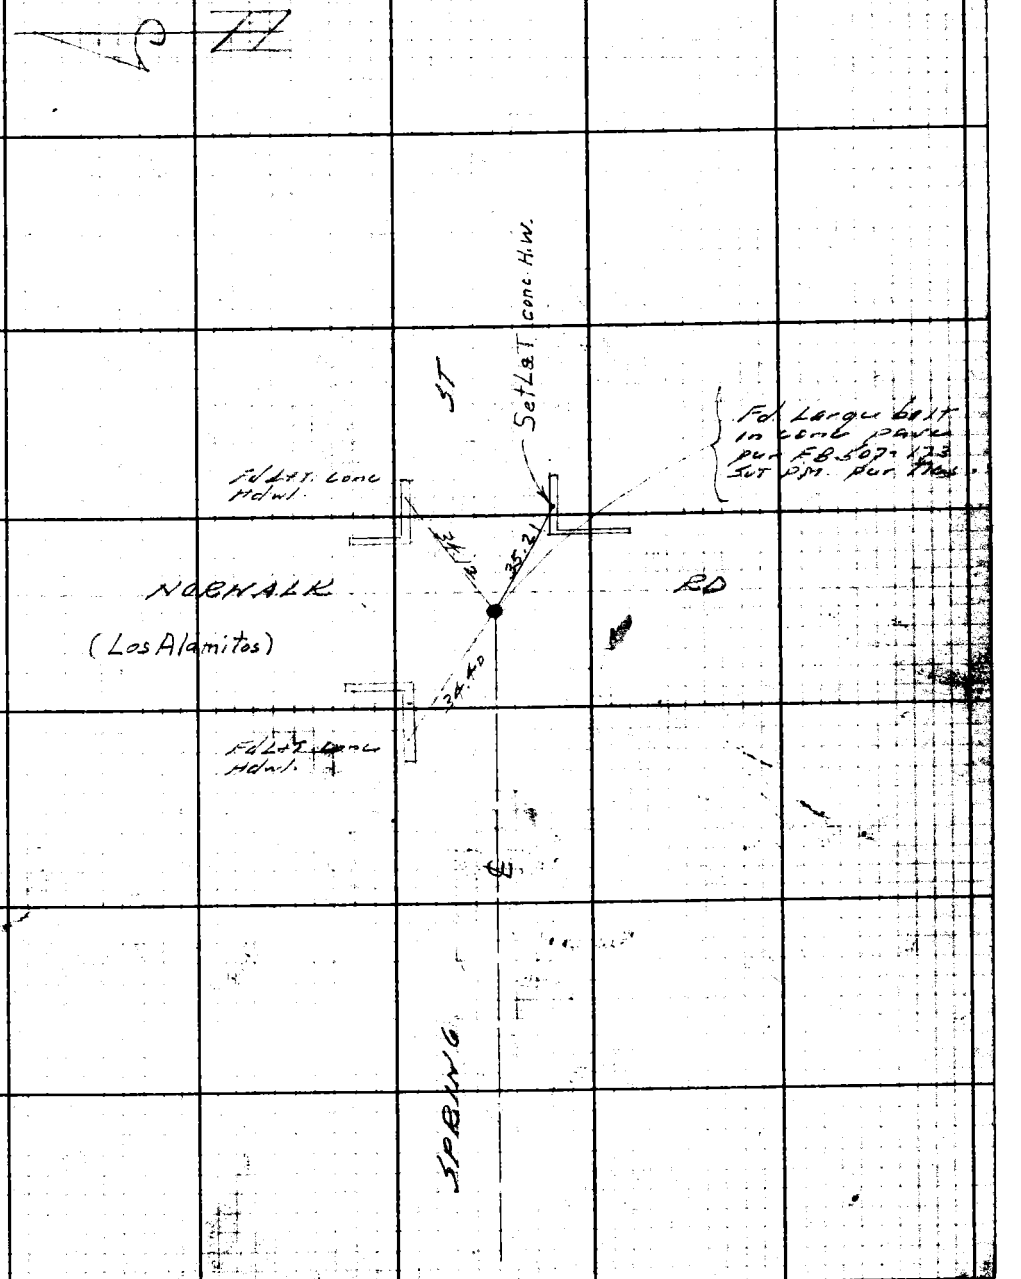

From Top Pg.

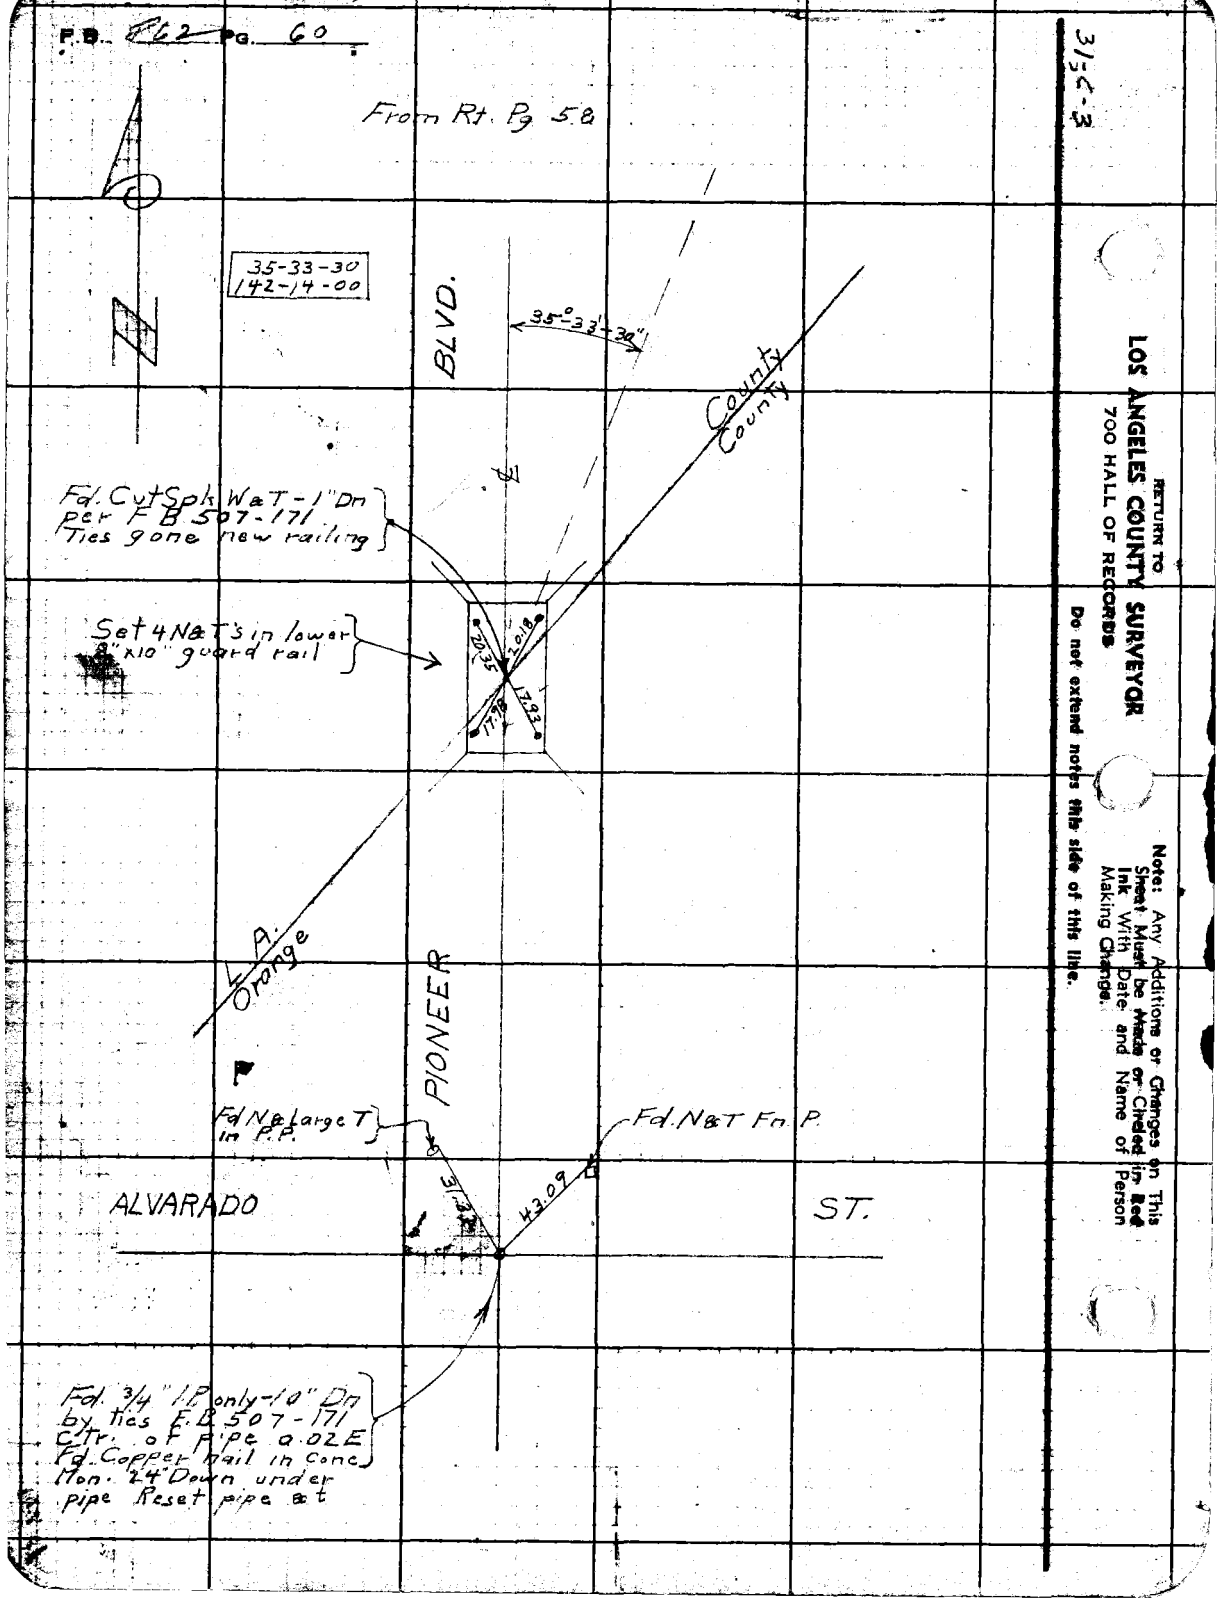
F.B. 562 Pg. 60
From Rt. Pg 58
35-33-30
142-14-00
BLVD.
35°33'30"
County
County
Fd. Cut Spk W&T - 1" Dn
per F.B 507-171
Ties gone new railing
Set 4 N&T's in lower
8" x 10" guard rail
20.35
20.18
17.93
L.A.
Orange
PIONEER
Fd. N&T large T
in P.P.
Fd. N&T Fn. P.
ALVARADO
ST.
31.32
43.09
Fd. 3/4" IP only - 1.0" Dn
by ties F.B 507-171
Ctr. of Pipe a.02E
Fd. Copper nail in Conc.
Mon. 24" Down under
pipe Reset pipe &t
RETURN TO
LOS ANGELES COUNTY SURVEYOR
700 HALL OF RECORDS
Note: Any Additions or Changes on This Sheet Must be Made or Checked in Red Ink With Date and Name of Person Making Change.
Do not extend notes this side of this line.
3135-3

Notes Ck'd by	Survey of Spring St
Map No. C.S.B-1759-2.	W. O. 8311 Tape No. 049 St'd 76°F
Office Work J.D. Price	Surveyed by F.J. McNeal
Checked	Notes Mc Date 8-25-41
Date	Indexed C. John

F.B. 962 Pg. 61

31-J C-3

Fd nail. North

Fd nail by Nes F.B 468-20
See Pg - 57

Set N&T Bride rail

Fd. N&T top wing wall

Set x Top Ry Iron Guard

40 (30)

40 (30)

SPRING

ST.

22.38
14.42
13.70
9.91
4.73
20.46

0.09
3.02
2.20
0.02

Fd. Copper N&T in conc.
Mon. 30" Dn. - F.B. 468-20

Fd. 2" I.P. only -18" Dn
Ref. F.B. 468-20
Set nail in ctr.

E. R/W. San Gabriel River

2611.11 Ref. F.B 468-20 & 21

Fd copper nail & T. in Conc.
Mon - 8" Dn F.B. 468-21

Note: Any Additions or Changes on This Sheet Must be Made or Circled in Red Ink With Date and Name of Person Making Change.

Do not extend notes this side of this line.

RETURN TO
LOS ANGELES COUNTY SURVEYOR
700 HALL OF RECORDS

FORM 247 5M 10-39

RETURN TO
LOS ANGELES COUNTY SURVEYOR
700 HALL OF RECORDS

Note: Any Additions or Changes on This Sheet Must be Made or Circled in **Red Ink** With Date and Name of Person Making Change.

Do not extend notes this side of this line.

F.B. 862 PG. 62

Notes Ck'd by	Survey of Spring St.
Map No. C.S.B-1759-2	W. O. 831 Tape No. St'd °F
Office Work J.D.PRICE.	Surveyed by F.J. McNeal
Checked	Notes Mc Date 8-26-41
Date	Indexed 9-11-41

F.B. 967 PG. 63

SPRING ST.

IMPROVEMENTS

WOODRUFF AVE TO CO. LINE

F.J. McNeal
Geo. H. Nichols
L.C. Wilson
H.D. Hebert

Note: Any Additions or Changes on This Sheet Must be Made or Circled in Red Ink With Date and Name of Person Making Change.

Do not extend notes this side of this line.

RETURN TO
LOS ANGELES COUNTY SURVEYOR
700 HALL OF RECORDS

FORM 247 5M 10-39

2

F.B. 862 Pg. 64

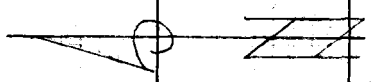

40 (30) 40 (30)

137+94.8

65.8

137+18.2 T.P.
Cypress Hedge

ST.

Pav.

26°

62.8

65.4

44°

54.3

56°

14" Cypress 137+65.6
Beg Wood Fn 137+44.8
10" Fig 137+17.8
6" Peach 137+07.3

137+03.3 T.P.

62.9

8" Apricot 136+89.2

136+65.7

33.5

24.3

136+66.0

See Note

135+87.3 T.P.

135+78.4

135+73.7 T.P.

60.6

134+54.6 T.P.

Premix

Note
Add 6.90 to all
plusses between
134+54.6 & 142+38.5
inclusive.
134+54.6 = 134+60.45
142+38.5 = 142+44.35

134+41.8 T.P.

SPRING

27.4

P.P. 133+67.3

133+60.5 T.P.

133+43.6 T.P.

WOODRUFF
(STUDEBAKER)

10.5 10.0

AVE

Dirt Rd.

Macadam

17.2

R=30

133+06.09
Set nail by ties
F.B. 862-55

RETURN TO
LOS ANGELES COUNTY SURVEYOR
700 HALL OF RECORDS

Do not extend notes this side of this line.

Note: Any Additions or Changes on This Sheet Must be Made or Circled in Red Ink With Date and Name of Person Making Change.

31-C-3

Notes Ck'd by		Survey of Spring St.	F.B. 862 Pg. 65
Map No. C.S.B-1759-2		W. O. 8311 Tape No. St'd °F	
Office Work J.D.Price.		Surveyed by F.J.McNeal	
Checked		Notes Mc Date 8-26-41	
Date		Indexed	

31-C-3

To Bot Next Pg

40 (30) 40 (39)

ST Macadam

142+29.5 Wire Fn

142+30.5 T.P. 25.8 31.0 28.0 P.P. 142+28.1

142+27.5 T.P. 25.8

141+97.0 end Premix Beg Macad.

141+72.0 T.P. 25.9

140+97.6 T.P. 25.8 27.5 P.P. 140+9.3

141+03 49.5 Water H.H. 140+12.0

Fav.

Wire Fn.

See Note (Pg. 64)

140+66 11.5 9.5

140+00 40.2 Water H.H. 140+02.2

139+72 T.P. 26.2 40.2 Water H.H. 140+00.0

139+69.6 G.P. 26.8

139+49.3 T.P. 26.2 27.4 P.P. 139+62.2

139+49.2 3.1.3 139+59.5

138+44.2 T.P. 26.1 27.5 P.P. 138+45.2

138+21.9 T.P. 26.3

SPRING (Premix)

37.4 10.3

37+69.5

30.3

30.3

35.2

37.4

137+58.3

Scale Platform & Corr. Iron Shed

From Top Last Pg.

RETURN TO
LOS ANGELES COUNTY SURVEYOR
700 HALL OF RECORDS

Do not extend notes this side of this line.

Note: Any Additions or Changes on This Sheet Must be Made or Circled in Red Ink With Date and Name of Person Making Change

FORM 247 5M 10-39

F.B. 867 PG. 66

To Bot. Next Pg.

RETURN TO
LOS ANGELES COUNTY SURVEYOR
700 HALL OF RECORDS

Do not extend notes this side of this line.

Note: Any Additions or Changes on This Sheet Must be Made or Circled in Red Ink With Date and Name of Person Making Change.

317-3

40 (30)

40 (30)

ST.

Pav. ℄

146+33 T.P. ∝ 21°

146+19 T.P. ∝ 21°

146+20

31°

23

46°

6" Drain

146+25

Wire Fn

146+17.9

12

146+05

145+73

145+61

145+58

14545

Row of 2" Palms

R=20

Conc Cbs

41

145+40

145+43

145+37

58° → 8" Pear 1454 30 L

12 × 10° ×

145+25

145+15

145+03 T.P. ∝ 25°

60

81

180

75

124

326

1-Story Frame House

144+88 T.P. ∝ 25°

144+87

69

26

70

16

46

11 ∝

144+75

31°

144+69

Wire Fn

27 ∝ P.P. 144+60

143+73 T.P. ∝ 25°

143+61 T.P. ∝ 25°

Macadam

SPRING

From Top Last Pg.

Notes Ck'd by		Survey of Spring St	F.B. 312 Pg. 27
Map No. C.S.B-1759-2		W. O. 3111 Tape No. Std. °F	
Office Work J.D.Price.		Surveyed by E.J McNeal	
Checked		Notes Mc Date 8-26-41	
Date		Indexed A. C. Johnson	

31,C-3

To Bot Next Pg.

40 (30) 40 (30)

ST

Rev

4'x4' Valve Box 153+79° 25.1 153+57.4

153+53.9 24.4 Valve Box 4.3 x 4.3

Conc Valve Box 8' 12' 15.7 14.9 Valve Box 3.3 x 3.3

153+48.1

153+45.5 Beg. Guard Rail 15.9 14.9 Beg Guard rail 153+45.2

153+39.8 Valve 14.9 13.8

23.7

27.8 P.P. 153+32.8

12.8 10.2 22.1

Valve Box 3'x3' 153+17°

152+74° T.P. 26.5

152+63° T.P. 26.5

151+53.1 T.P. 26.5

151+33.2 T.P. 26.5

27.8 P.P. 151+00

150+21.5 T.P. 25.9 43.3 Irr. Valve 150+98°

150+09.2 T.P. 26.2

148+93.2 T.P. 26.0

27.2 P.P 148+83°

148+78.5 T.P. 25.9

147+63° T.P. 25.9

SPRING

Macadam

147+49° T.P. 25.9

27.4 P.P. 146+66.6

From Top Last Pg.

Note: Any Additions or Changes on This Sheet Must be Made or Circled in Red Ink With Date and Name of Person Making Change

Do not extend notes this side of this line.

RETURN TO
LOS ANGELES COUNTY SURVEYOR
700 HALL OF RECORDS

FORM 247 5M 10-39

RETURN TO
LOS ANGELES COUNTY SURVEYOR
700 HALL OF RECORDS
Do not extend notes this side of this line.
Note: Any Additions or Changes on This Sheet Must be Made or Circled in Red Ink With Date and Name of Person Making Change.

F.B. 862 PG. 68

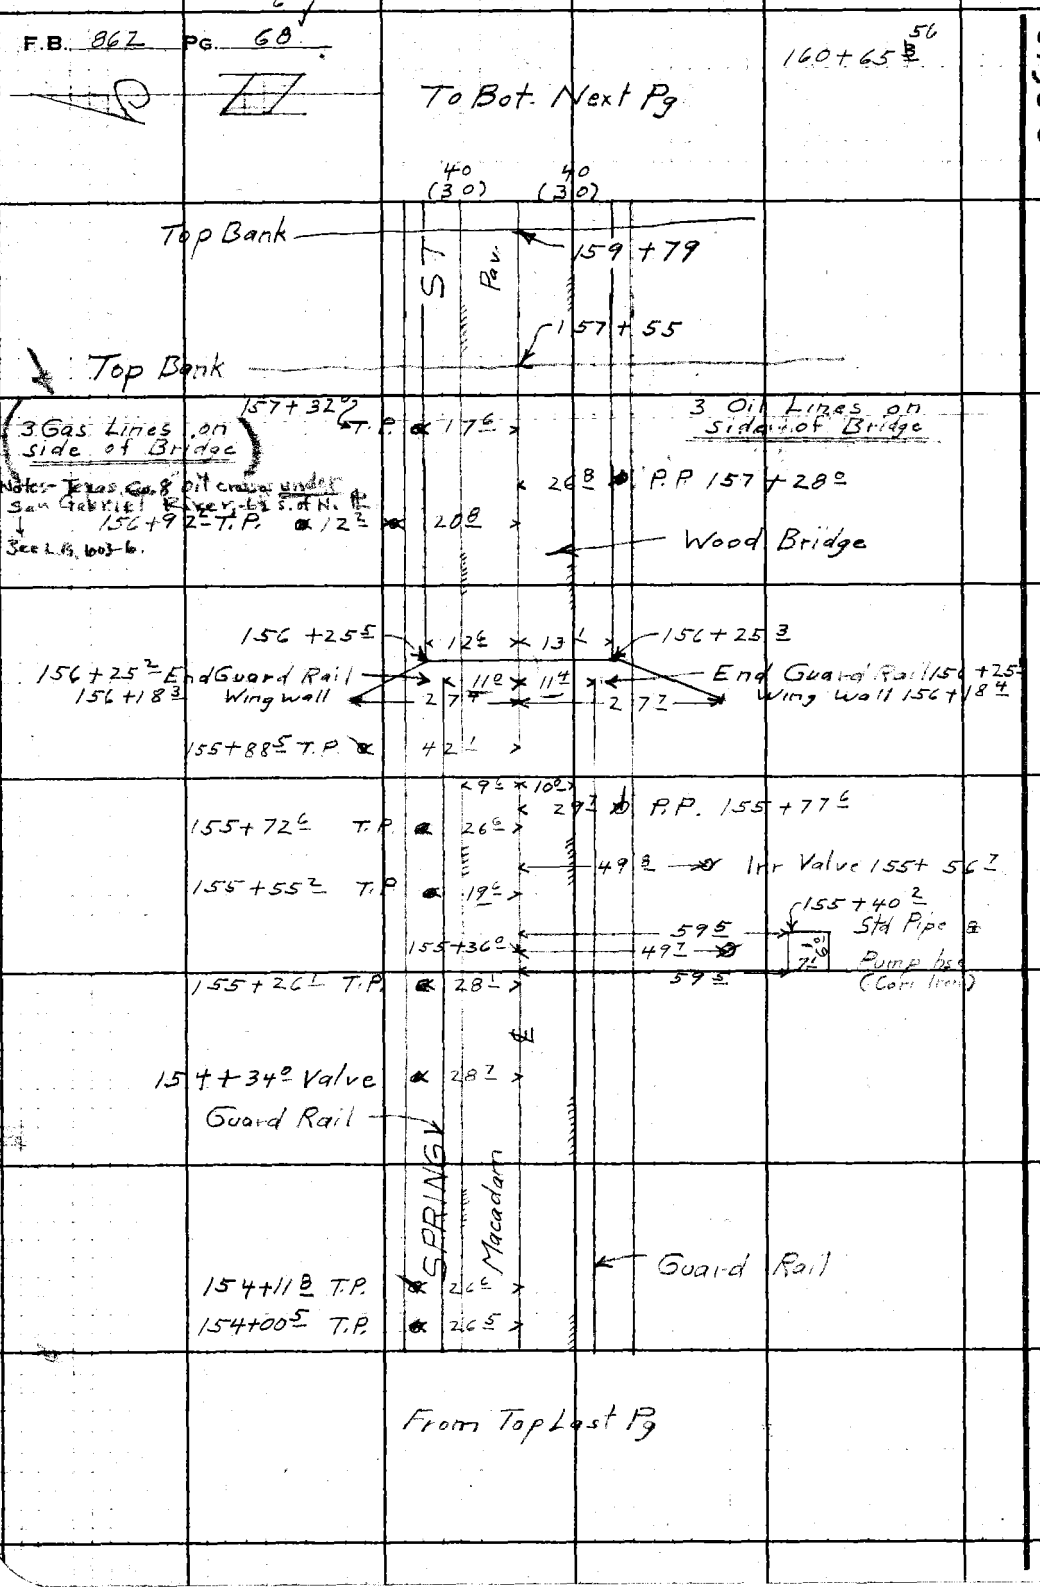

Notes Ck'd by	Survey of Spring St
Map No. C.S.B-1759-2	W. O. 8311 Tape No. St'd °F
Office Work J. D. Price	Surveyed by E. M. Neal
Checked	Notes Mc Date 8-26-41
Date	Indexed A. C. Johnson

F.B. 962 PG. 19

3/16-3

Note: Any Additions or Changes on This Sheet Must be Made or Circled in Red Ink With Date and Name of Person Making Change.

Do not extend notes this side of this line.

RETURN TO
LOS ANGELES COUNTY SURVEYOR
700 HALL OF RECORDS

FORM 247 5M 10-39

To Bot. Next Pg

40 (30) 40 (30)

SPRING ST

Pav.

163 + 68.7 — 27.1 — P.P 164 + 22.0

Valve Box — 22.3 — 22.3

163 + 60.9 — Valve Box — 19.8 — Premix — 163 + 59.7

163 + 59.8 T.P. — 26.5 — 22.0 — Valve Box

163 + 52.7 End Guard Rail — 17.4 — 15.3 — 21.2° — End Guard Rail 163 + 52.8

163 + 46.2 T.P. — 26.1 — 28.0 — Valve Box

163 + 49.3

Valve Box

162 + 22.0 T.P. — 27.5 — 14.5 — 163 + 43.5

Beg Premix 162 + 83

End Macadam

162 + 16.1 T.P. — 27.6

161 + 95.4 ?

Conc. Valve Box — 32.3 — 27.9 — P.P 161 + 94.2

161 + 79.6 T.P. — 32.7 — 19.8

Conc. Valve Box

161 + 67.2 — 27.3

160 + 79.5 Wing Wall — 26.9 — 26.3 — Wing Wall 160 + 79.4

160 + 73.6 Beg Guard rail — 10.9 — 11.2 — Beg Guard rail 160 + 73.7

160 + 73.3 T.P. — 12.2 — 20.5 — 160 + 73.4

160 + 73.3 — 12.5 — 13.2

9.2 — 9.7

SPRING ST

Macadam

Wood Bridge

160 + 03.5 T.P. — 18.5 — 28.5 — P.P 160 + 02.2

From Top Last Pg.

8

F.B. 862 PG. 70

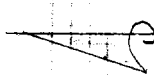

To Bot Next Pg

40 (30) 40 (30)

ST Pav

44± → 2" Water Valve 174+08±

44± → 24" Stand Pipe 174+06±

173+21± T.P. 26±

173+06± T.P. 26±

171+88± T.P. 26±

171+73± T.P. 26±

26± P.P 172+94±

27° P.P 170+81±

170+51° T.P. 26±

27° 2" Riser 170+77°

170+38± T.P. 26±

169+19± T.P. 26±

169+07° T.P. 26±

26± P.P 168+66±

167+61± T.P. 26±

167+53° T.P. 26±

167+00 113 9° 27±

166+37° T.P. 26±

P.P 166+48°

166+23° T.P. 26±

165+06± T.P. 26±

164+93± T.P. 26±

SPRING Premix

35± → Stand Pipe 164+72

From Top Last Pg

31;C-3

RETURN TO
LOS ANGELES COUNTY SURVEYOR
700 HALL OF RECORDS

Do not extend notes this side of this line.

Note: Any Additions or Changes on This Sheet Must be Made or Circled in Red Ink With Date and Name of Person Making Change.

Notes Ck'd by		Survey of Spring St.	F.B. Bk 5 Pg.
Map No. G.S.B-1759-2		W. O. 234 Tape No.	St'd °F
Office Work J. D. Price		Surveyed by E. McNeal	
Checked		Notes Mc Date 8-27-41	
Date		Indexed A. C. Johnson	

31-C-3

To Bot Next Pg.

40 (30) 40 (30)

ST.

179+74⁴ T.P. ℄ 27³

179+61 T.P. ℄ 27⁶

25⁴ ℄ P.P. 179+03

65⁶ → P.P. 178+72⁶

178+45¹ T.P. ℄ 26⁹

178+30⁶ T.P. ℄ 27⁶

178+28⁵

58³ 30" Stand Pipe

53⁸ 8¹ - 9² Wood Pump Hse

58² 178+23¹

177+13⁰ T.P. ℄ 26⁹

176+99⁰ T.P. ℄ 26⁸

12" 8" 26¹ ℄ P.P. 176+97⁰

175+94⁶ T.P. ℄ 27⁶

175+71¹ T.P. ℄ 27⁶

43⁷ ℄ Irr. Valve 15" 175+37⁴

174+97³ 30⁵ - 20⁰ 174+98⁰

2 Cast Iron Pipes 24"

174+94⁴ 30⁵ - 20⁰ 174+95³

26² ℄ P.P. 174+91⁴

174+51¹ T.P. ℄ 26⁴

SPRING

174+37¹ T.P. ℄ 26⁸

From Top Last Pg

Note: Any Additions or Changes on This Sheet Must be Made or Circled in Red Ink With Date and Name of Person Making Change.

Do not extend notes this side of this line.

RETURN TO
LOS ANGELES COUNTY SURVEYOR
700 HALL OF RECORDS

FORM 247 5M 10-39

F.B. 862 Pg. 72

To Bot Next Pg

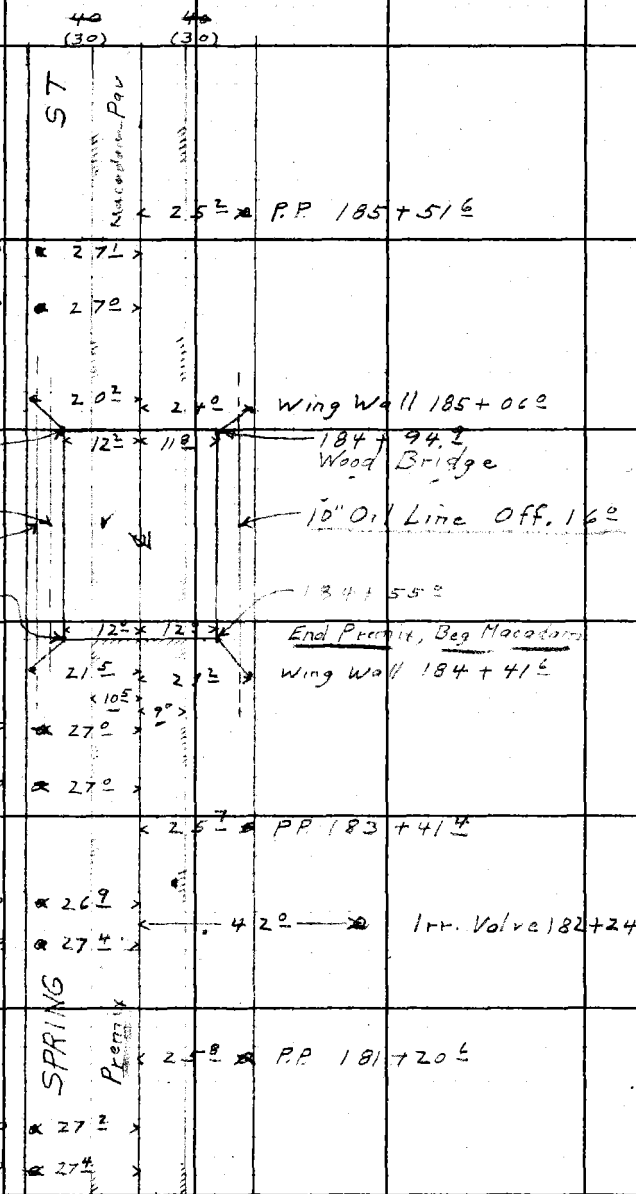

From Top Last Pg

31-C-3

RETURN TO
LOS ANGELES COUNTY SURVEYOR
700 HALL OF RECORDS

Do not extend notes this side of this line.

Note: Any Additions or Changes on This Sheet Must be Made or Circled in **Red Ink** With Date and Name of Person Making Change.

Notes Ck'd by	Survey of Spring St
Map No. C.S.B-1799-2	W. 0831 Tape No. St'd °F
Office Work J.D. Price	Surveyed by E.M. McNeal
Checked	Notes Mc Date 8-22-41
Date	Indexed

F.B. [illegible] Pg. 7-3

31-C-3

To Bot. Next Pg.

40 (39) 40 (30)

ST.

189+10° T.P. ∠ 2 8° →
189+06.5 2-8" Willows ← 40.3 →
189+00 8" Willow ← 26° →

188+63° 4"±6" Willow ← 25.5 →
188+57° 9" Willow ← 20.7 →
< 13° < 9° >
12" Willow & T.P. ← 12.5 ∠ 2 7.1 → 187+95°

187+83° 6" Willow ← 39.7 →
187+78° T.P. ∠ 2 7.4 → < 25.5 P.P. 187+70°
← 36.2 → 3 Willows 187+65° (6", 9" & 12")

186+98.5 -6" Willow ← 35.8 →
4-5"
186+85.5 Willows ← 28.4 →
186+61.5 T.P. ∠ 2 7.2 → L-Wire Fn
186+09.7
186+48° T.P. ∠ 2 7.1 → < 3.1.2

PIONEER BLVD.

SPRING

Macadam

Dirt Road

185+86.76-3/4" I.P.
See F.B. 862-58

From Top Last Pg

RETURN TO
LOS ANGELES COUNTY SURVEYOR
700 HALL OF RECORDS

Note: Any Additions or Changes on This Sheet Must be Made or Circled in Red Ink With Date and Name of Person Making Change.

Do not extend notes this side of this line.

FORM 247 SM 10-39

F.B. 862 Pg. 74

12

To Bot. Next Pg

(30) (30)

ST.

Pvt.

190+60 T.P. 27

14" Willow Be T.P. 14 28

190+46

190+34 8" Willow 44

190+26 12" Willow 43

190+15 12" Willow 41

190+08 14" Willow 39

190+00 12" Willow 42

189+97 10" Willow 40

189+92 9" Willow 42

12 8

P.P. 189+83

189+81 12" Willow 42

189+53 14" Willow 44

189+44 12" Willow 44

189+29 9" Willow 44

189+23 T.P. 27

SPRINGS

Macadam

189+21 14" Willow 42

189+15 18" Willow 44

From Top Last Pg

31-26-3

RETURN TO
LOS ANGELES COUNTY SURVEYOR
700 HALL OF RECORDS

Do not extend notes this side of this line.

Note: Any Additions or Changes on This Sheet Must be Made or Circled in **Red Ink** With Date and Name of Person Making Change.

13 M

Notes Ck'd by		Survey of Spring St	F.B. 26 Pg. 75
Map No. C.S.B-1759-2		W. O. 831 Tape No.	St'd °F
Office Work J.D.Price		Surveyed by E.V.McNeal	
Checked		Notes Mc Date 8-28-41	
Date		Indexed A. C. John	

31-D-2

To Bot Next Pg

40 (30) 40 (30)

ST

Pav.

196+28 ± 7

31 ± 4

25 ± 2 P.P. 196+27 ± 4

196+21 ± 5 10" Willow 35 ± 7

Wire Fe

195+98 ± T.P. 27 ± 0

195+83 ± T.P. 27 ± 5

195+56 ± 8" & 10" Willow 36 ± 3

195+36 ± 12" Willow 36 ± 8

194+61 ± T.P. 27 ± 0

194+48 ± T.P. 27 ± 2

26 ± P.P. 194+15 ±

194+02 ± 10" Willow 37 ± 4

193+26 ± T.P. 26 ± 9

193+12 ± T.P. 27 ± 4

192+16 ± -24" Willow 37 ± 0

26 ± 2 P.P. 191+98 ±

191+95 ± T.P. 27 ± 4

SPRING

Macadam

191+83 ± T.P. 27 ± 8

191+02 ± -24" Willow 44 ± 5

From Top Last Pg.

Note: Any Additions or Changes on This Sheet Must be Made or Circled in Red Ink With Date and Name of Person Making Change.

Do not extend notes this side of this line.

RETURN TO
LOS ANGELES COUNTY SURVEYOR
709 HALL OF RECORDS

FORM 247 5M 10-39

14 ✓

F.B. 862 PG. 76

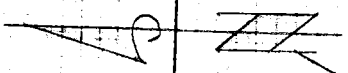

199+51.86 Mon
See F.B. 862-58

40 (30)

40 (30)

ST

Par

ORANGE Co.
L.A. COUNTY

198+74.8 — 6" Willow — 28.0 →

198+64.5 — 6" Willow — 36.8 →

198+61.3 — 6" Willow — 36.9 →

198+56.4 T.P. — 2.6.3

198+69.7

198+46.0 — 4" 6" Willow — 36.6 → — 60.7 → — 60.7 → — 10.5

Water Tank

198+42.0 T.P. — 2.7.0

198+40.0 — 5" Willow — 30.7 → — 25.7 — 37.3 — PP's 198+32.3

198+31.0

198+29.0 — 9" Willow — 38.5 →

198+24.0 — 8" Willow — 38.3 →

198+17.0 — 7" Willow — 2.8.9

<12.5> <10.5>

197+98.0 — 9" Willow — 35.2 →

35.0 — 5" Plum — 197+61.1

197+43.5 — 9" Willow — 36.5 →

47.3 — 7" Plum 197+40.5

197+40.5 — 7" Willow — 29.9 →

197+23.5 T.P. — 2.7.0

SPRING — Meadow

197+10.5 T.P. — 2.7.0

197+03.0 Willow 9" @ 11 — 35.3 →

From Top Last Pg

31-D-3

RETURN TO
LOS ANGELES COUNTY SURVEYOR
700 HALL OF RECORDS

Do not extend notes this side of this line.

Note: Any Additions or Changes on This Sheet Must be Made or Circled in Red Ink With Date and Name of Person Making Change.

Notes Ck'd by [illegible]
Map No. 1749-
Office Work
Checked
Date

Survey of MISC. SURVEYS
W. O. 7000 Tape No. SEE BELOW St'd. — °F
Surveyed by Mitchell & Smith
Notes R. J. MITCHELL Date 5/52
Indexed A. C. Johnson 8/12/58

F. B. 862 PG. 77

Note: Any Additions or Changes on This Sheet Must be Made or Circled in Red Ink With Date and Name of Person Making Change.

Do not extend notes this side of this line.

RETURN TO
LOS ANGELES COUNTY SURVEYOR
726 LOS ANGELES COUNTY
ENGINEERING BLDG.

JN 7000
MISCELANEOUS SURVEYS

SURVEY TO
RE-ESTABLISH
THE INTERSECTION OF
PROPOSED STATE STREET
AND THE
LA-O-Co. LINE
AND TO RE-ESTABLISH
Co. LINE STATION No. 7
ALL IN
T4S - R12W

RJ Mitchell & NR. Smith
J. Gregory
O.A. Wind
Jose Maldonado
Bonnie
G. R. Marino
G. C. Miller

June 1952

For More Recent Survey See
FB 862 - 791 and following
8/12/58 - R.J.M.

76F3095 247 2-51

F. B. 862 PG. 78

W.S. 31-B-4

RETURN TO
LOS ANGELES COUNTY SURVEYOR,
725 LOS ANGELES COUNTY
ENGINEERING BLDG.

Do not extend notes this side of this line.

Note: Any Additions or Changes on This Sheet Must be Made or Circled in Red Ink With Date and Name of Person Making Change.

cont'd on page 79 bot.

S 89° 58' 51" W 1,320.00'

Set n&t. on Palo Verde

Fd. Cut Spk. & W. in conc. Mon. chis. 30" W. 4x4 Cat. Post 3' S & W. mkd. L.A. Co. Fc. Mon. per F.B. 902-38

1.92

Set 1x1 Spk. on top of 2" Pipe

5.00

Fd. Std. C.S. Bk. Cob. Mon. dig. 15" on d. fitd. 1/4 Sect. Cor. S 26 S 35 T 4 S R 12 W" FB 862-110 FB 1685-9

See FB 862-260 Aug. 27, 1958 R.J.M.

PROP. STATE ST & ATHERTON

PROP. PRODUCTION ST.

LOS CERRITOS CHANNEL

OFFSET

LINE

PALO VERDE

76F309S 247 2-51

RETURN TO
LOS ANGELES COUNTY SURVEYOR
726 LOS ANGELES COUNTY
ENGINEERING BLDG.

Note: Any Additions or Changes on This Sheet Must be Made or Circled in Red Ink With Date and Name of Person Making Change.

Do not extend notes this side of this line.

W.S. 31-F-4

Cont. on pg. 87

26

25

T4S-R12W

DETAIL

STATE ST.

STUDEBAKER ROAD

FENCE LINE

Fd 2" IP wood ref. TS Sta.
0.6' E, 1.1' N of RE 2858
1/2 Ref. Mon. intended to be 2" IP Mon. on E. & sec. line

Set 1x24" on Rec. Mtg. Fr. Sec. Cor.

2382.90

1833.45

270.84

84.05

75.18 calc.

84.05 calc.

10.58° calc.

76.67 @ 10°59' = 75.27 m

13.54 calc.

8.87

1) 2° 42 00
2) 5° 24 00
Av 2° 42 00

1) 1773.97 @ Lev. T=70 (Tape No. 0119 Sta. 66 to Sta. 84) = 1773.99
2) 1774.00 @ Lev. " (" " " ") = 1774.02
Av = 1774.00

1) 16.17 @ 13° 35' T=68° (" " 79 " @84°) = 57.45
2) 41.00 @ 12° 53 " (" " " " ") = 59.45
Av. = 59.45
Total = 1833.45

1) 270.87 @ Lev (T=68°) (Tape No. 79 Sta 84) = 270.84
2) 270.87 @ " " Av. " " = 270.84
Av = 270.84

36

1)	89	56	00	1)	179	57	20
4)	359	48	20	4)	359	49	20
6)	179	38	40	6)	359	44	00
4)	89	56	26 2/3	4)	179	57	20
1)	89	56	40	1)	90	00	40
4)	359	56	20	4)	360	02	40
6)	179	40	00	6)	180	04	00
	89	56	40	Av	90	00	40

Notes Ck'd by: [illegible]
Map No.
Office Work
Checked
Date

Survey of MISC. SURVEYS
W. O. 7000 Tape No. Sec's Std. °F
Surveyed by [illegible] Date 5/52
Notes
Indexed Date
C. Johnson

F. B. Pg.

SEC 2 T4S R12W

RETURN TO
LOS ANGELES COUNTY SURVEYOR
725 LOS ANGELES COUNTY
ENGINEERING BLDG.

Note: Any Additions or Changes on This Sheet Must be Made or Circled in Red Ink With Date and Name of Person Making Change.

Do not extend notes this side of this line.

W.S. 31 - C - 4

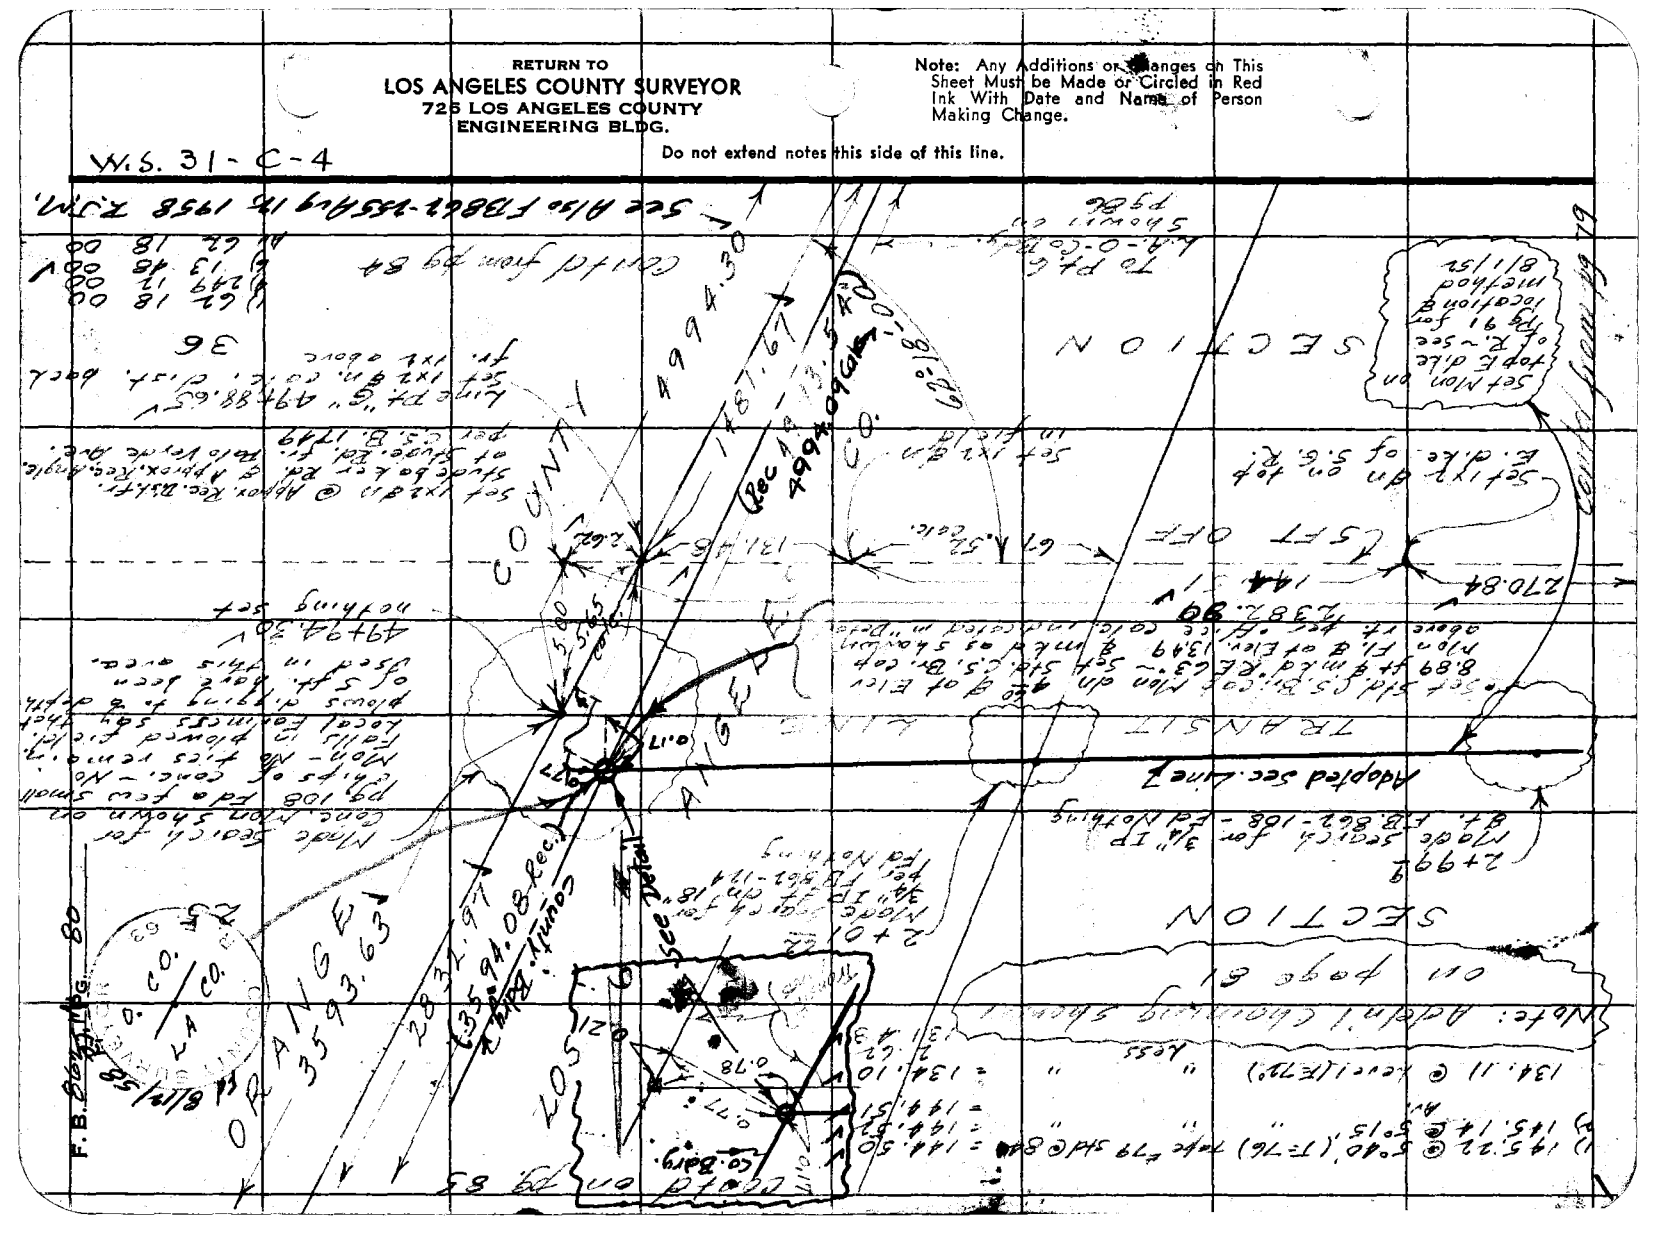

Notes Ck'd by KRM
Map No.
Office Work
Checked
Date

Survey of MISC. SURVEYS
W. O. 7000 Tape No. SEE BELOW Ck'd. °F
Surveyed by Mitchell & Sullivan
Notes R.J.M. Date 5/52
Indexed C. Johnson

F. B. 382 Pg. 81

Note: Any Additions or Changes on This Sheet Must be Made or Circled in Red Ink With Date and Name of Person Making Change.

Do not extend notes this side of this line.

RETURN TO
LOS ANGELES COUNTY SURVEYOR
726 LOS ANGELES COUNTY
ENGINEERING BLDG.

76F3095 247 2-51

See Bk 382 pg 82 thru 85 FEB 962

Explanation of Chaining Shown on Pages 80, 83-85

	Distance	Vert ∠	Temp.	Tape	Used
1)	1203.64	Level	64°	79 Std @ 84°	1203.48
2)	1203.63	"	"	"	1203.47
		Avg			1203.47
1)	1067.14	Level	64°	"	1067.00
2)	1067.12	"	"	"	1066.98
		Avg			1066.99
1)	281.52	"	"	"	281.48
2)	281.53	"	"	"	281.49
		Avg			281.48
1)	281.25	2°01'	"	"	281.04
2)	281.28	2°12'	"	"	281.03
		Avg			281.03
				Total	2832.97
	28.27	Level	66	"	28.27
1)	146.55	6°35	66	79 Std @ 84°	145.56
2)	146.37	6°00	"		145.55
		Avg			145.55
1)	336.53	Level	"	"	336.49
2)	336.55	"	"	"	336.51
		Avg			336.50
1)	162.62	5°36	"	"	161.82
2)	162.45	5°01	"	"	161.81
		Avg			161.81
				Total	643.86
1)	118.72	5°02	66	79 Std @ 84°	118.25
2)	118.62	4°27	"	"	118.25
		Avg			118.25
	24.07	Level	-	See detail	- 24.07
				Difference	94.18
				Grand Total	3599.28
1)	413.31	Level	60	79 Std @ 84°	413.25
2)	413.35	"	"	"	413.29
		Avg.			413.27
1)	300.69	2°26	"		300.37
2)	300.70	2°32	"		300.35
		Avg			300.36
				Total	713.63
	43.19	Level	64	79 Std @ 84°	43.18
1)	269.99	Level	64	"	
	260.19	3°30'	"	"	
2)	270.91	Level	"	"	529.63
	259.27	3°25	"	"	529.66
		Avg			529.64
1)	345.89	Level	"	"	345.85
2)	345.89	"	"	"	345.85
		Avg			345.85
1)	300.91	1°20	64	"	300.29
2)	300.42	1°31	"	"	300.27
		Avg			300.28
				Total	1175.77
		See pg 82			280.21
				Total	1455.98

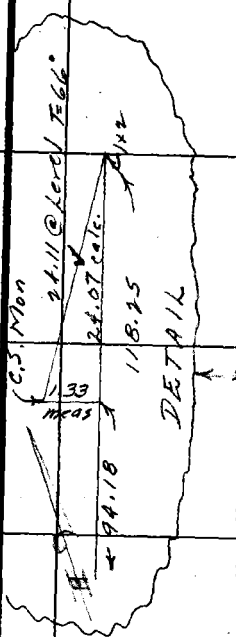

F. B. 862 PG. 82

Explanation of Chaining (Contd.)

	Distance	Vert.	Temp	Tape	Reduced	
1)	192.17	2°14	64	79 std @ 84°	191.99	✓
2)	192.14	1°55	"	"	192.00	✓
	88.73	Level	Avg. 64	"	191.99	✓
				Total	88.22	✓
					280.21	✓
by N.R.S.	186.22	Level	64	100 std @ 84°	186.20	✓
	259.83	Level	"	"	259.80	✓
	848.30	Level	"	"	848.19	✓
	1481.86	Level	"	"	1481.67	✓

Sec A/50 Avg 12 FB 867-241 RF 458

RETURN TO
LOS ANGELES COUNTY SURVEYOR
725 LOS ANGELES COUNTY
ENGINEERING BLDG.

Do not extend notes this side of this line.

Note: Any Additions or Changes on This Sheet Must be Made or Circled in Red Ink With Date and Name of Person Making Change.

Notes Ck'd by K Rotty
Map No.
Office Work
Checked
Date

Survey of Misc. Surveys
W. O. 7000 See Tape No. below Sit'd. °F
Surveyed by R. J. MITCHELL & N. R. SMITH
Notes R. J. MITCHELL Date 5/52
Indexed A. C. Johnson

F. B. 867 Pg. 83

Note: Any Additions or Changes on This Sheet Must be Made or Circled in Red Ink With Date and Name of Person Making Change.

Do not extend notes this side of this line.

RETURN TO
LOS ANGELES COUNTY SURVEYOR
726 LOS ANGELES COUNTY
ENGINEERING BLDG.

For Water Survey See Bk. 13, Pg. 87

F3886-491 M

LOS ANGELES COUNTY

ORANGE COUNTY

Contd on pg 84

848.19

26+58.79
Line Pt. "E"
Set 1x2 @ n

set n&t in 12" willow

4.38

30.22

set n&t in 12" willow

259.80

23+98.99
Line Pt. "D"
Set 1x2 @ n

Toe of Slope

186.20

94.30

TOP-E. LEVEED
SAN G. R. & SERV. RD.

22+12.79
Line Pt. "C"
Set 1x2 @ n

145.98

Toe of Slope

Contd fr. pg 86

76F3095 247 2-51

F. B. 862 PG. 84

RETURN TO
LOS ANGELES COUNTY SURVEYOR
725 LOS ANGELES COUNTY
ENGINEERING BLDG.

Note: Any Additions or Changes on This Sheet Must be Made or Circled in Red Ink With Date and Name of Person Making Change.

Do not extend notes this side of this line.

For Mapc Section & Survey see FB 862 - 201 ff
Aug. 12, 58 - R.J.M.

LOS ANGELES COUNTY

ORANGE COUNTY

Lg. Sel. 8-62

contd from pg. 83

contd on page 80

Set 8" in Fd. Post

848.19'

Set 8" in Fd. Post

1481.91'

N 49 34.30 W

Set nail in Fd. Post

Line Pt "F"

357.06.98'

Set 1x2 8" in

Gore 7-8-14-58

F.B. 862 PG. 05

Notes Ck'd by K.R.M.
Map No.
Office Work
Checked
Date

Survey of Misc. Surveys
W. O. 11000 Tape No. See Prior Std'd. °F
Surveyed by Wilcox & Smith
Notes R. J. MITCHELL Date 5/52
Indexed K. C. Johnson

W.S. 31 - C-4

Note: Any Additions or Changes on This Sheet Must be Made or Circled in Red Ink With Date and Name of Person Making Change.

Do not extend notes this side of this line.

RETURN TO
LOS ANGELES COUNTY SURVEYOR
726 LOS ANGELES COUNTY
ENGINEERING BLDG.

Fd. std. C.S. Bk. Cap Mon. on line as shown. - Assumed to be Mon shown on C.S.B. 1149 as Sta 7 ~ L.A. - O. - Co. Bdry. See also FB 862-107 See FB 52-167

COUNTY SURVEYOR WIT QDR RE 2177

Line Pt "K" Set 1x2 sh in at toe of d. ke

85487.93

1.33

This Survey Not contd to North

See Also FB 862-258

Aug 12, 1958 R.J.M.

94.18

118.25

CO.

Line Pt "J" 84+93.75 Set 1x2 sh in top of d. ke W side

Sta 7 L.A. - O. - Co. Line No Scale Sh See C.S. B 1685 See pg 88 See pg 94 for mon'l Set here = 83+77.27

NOTE
chaining shown on page 81

Top of d. ke

COYOTE CREEK R.J.M.

COUNTY SURVEYOR L.A. CO. LINE RE 63

Gone 8/14/58

3594.08 Rec.

3593.86

3593.63

1.12

L N.

ANGELES

SECT

NOTE
For addtnl. data in this Area see page 88

Set 1x2 sh by calc offset

Line Pt "I" Set 1x2 sh in top of d. ke

78+49.89

1.22

28.27

1.31

78+21.62

1/4

25

SECTION

6.39

LOS

ORANGE

Set 1" std. C.S. Bk. Cap Mon. on line betw. adj. 1x2's sh. 2.62 ft Mkd. same as shown at above Mon. - Top of Mon is at Elev. 24.33 Set 1x2 sh flush over Mon. - Top of 1x2 is at Elev. 26.95 See pg. 93 ff for Ties Set W.C. "F" 16d. 1.5 ft S. of Mon. on Co. Line

2832.97

Set 1x2 sh in top of d. ke

Line Pt "H"

Set 1x2 sh by calc. offset

Contd from pg. 80

76F3095 247 2-51

RETURN TO
LOS ANGELES COUNTY SURVEYOR
726 LOS ANGELES COUNTY
ENGINEERING BLDG.

Note: Any Additions or Changes on This Sheet Must be Made or Circled in Red Ink With Date and Name of Person Making Change.

Do not extend notes this side of this line.

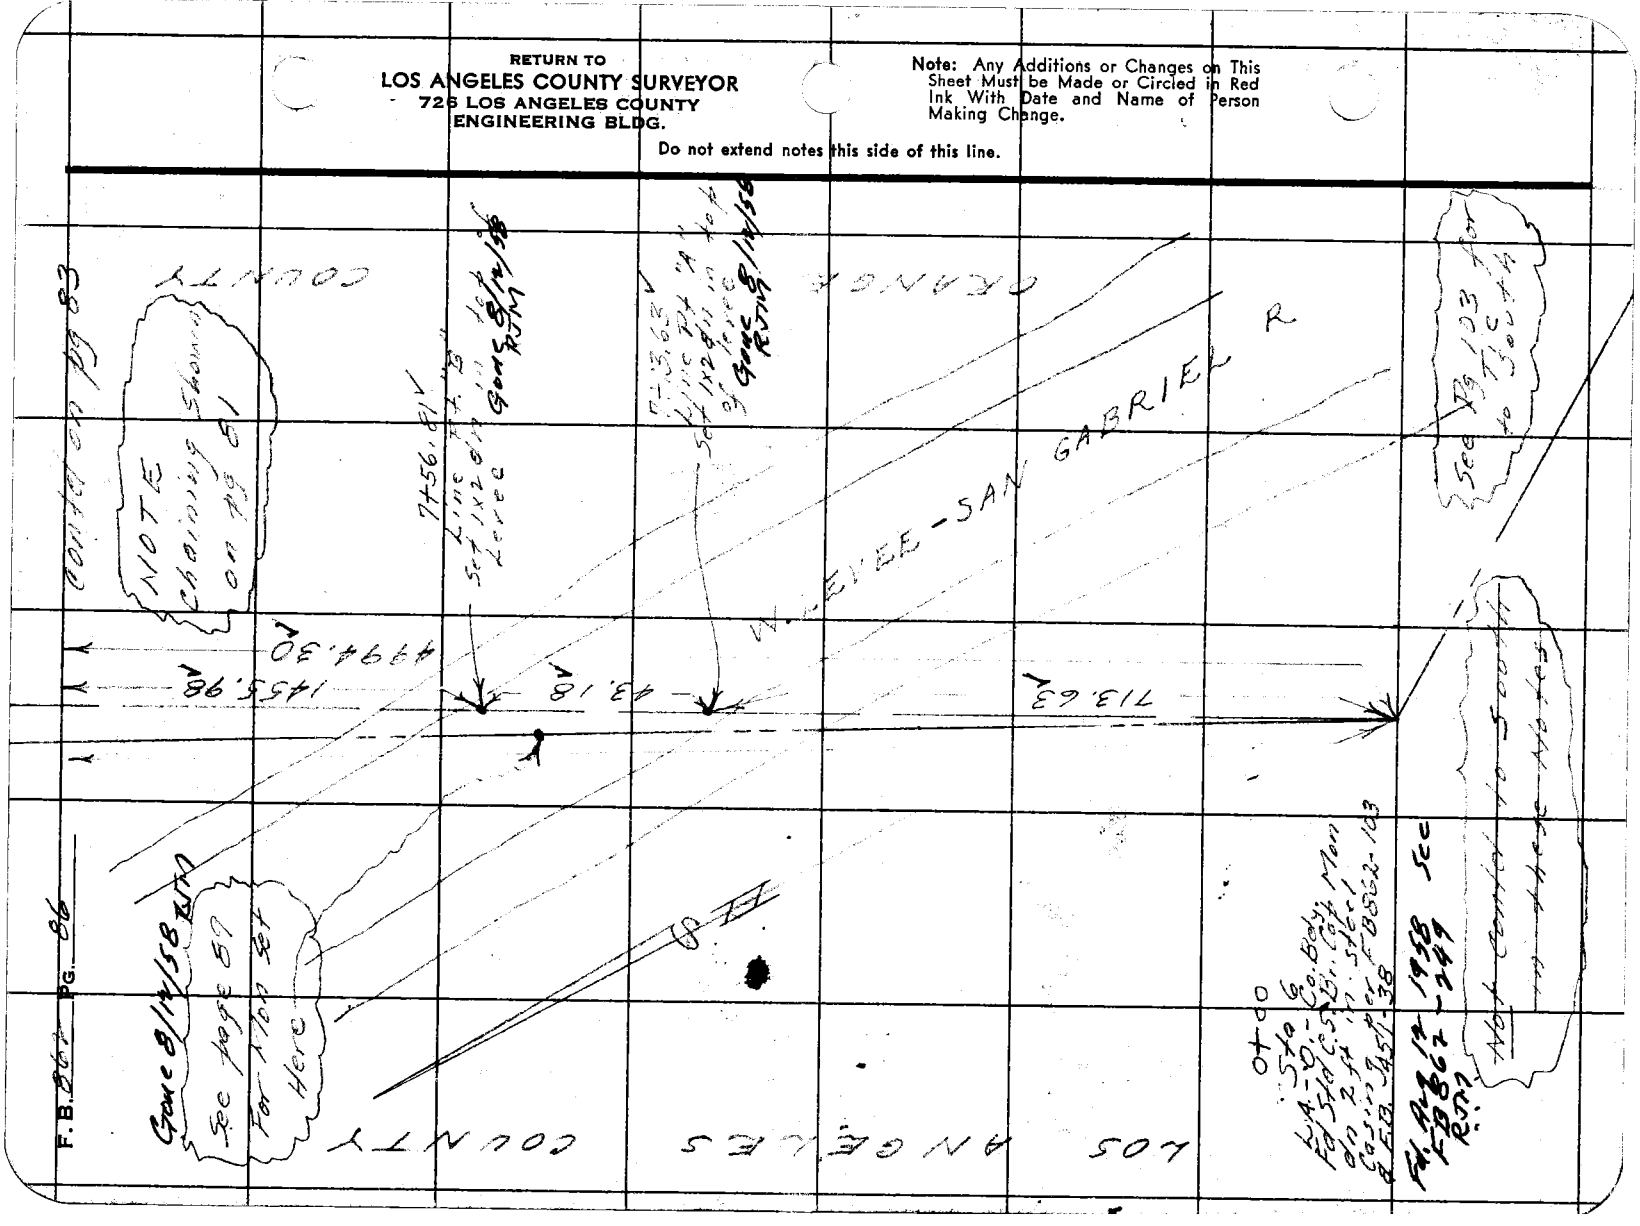

W.S. 31 - C-4

Notes Ck'd by	Survey of MISC. SURVEYS
Map No.	W. O. 7000 Tape No. SEE BELOW St'd. — °F
Office Work	Surveyed by MITCHELL & SMITH
Checked	Notes R. J. MITCHELL Date 5/52
Date	Indexed C. Johnson

F. B. 929 PG. 87

1) 89 59 20
1) 359 57 20 ✓
6) 179 56 00
Av) 89 59 20

Note: Any Additions or Changes on This Sheet Must be Made or Circled in Red Ink With Date and Name of Person Making Change.

Do not extend notes this side of this line.

RETURN TO
LOS ANGELES COUNTY SURVEYOR
726 LOS ANGELES COUNTY
ENGINEERING BLDG.

TR. 17176
25

WILLOW ST

SECT COR
Fd. Std. C.S. Br. Cap Mon
Mkd as cor. of Sect
23, 24, 25 & 26 T 4 S
R 12 W Bdn. 12" per
Tr. 17176 - M.R. C.S.
F.B. 929-65

RD

89° 59' 20" ✓

Cont'd in FB
1685-17

26

STUDEBAKER

25'

STEARNS ST.

SECTION

SECTION

0° 56' 35" ✓

1/4 C.S.R.
Fd. Std. C.S.
Br. Cap Mon
dn 8" per FB
862-117

40

1) 179 56 40
6) 359 46 20 ✓
6) 359 39 20
Av) 179 56 33 1/3

Contd from pg. 79

76F3095 247 2-51

RETURN TO
LOS ANGELES COUNTY SURVEYOR
726 LOS ANGELES COUNTY
ENGINEERING BLDG.

Note: Any Additions or Changes on This Sheet Must be Made or Circled in Red Ink With Date and Name of Person Making Change.

Do not extend notes this side of this line.

W. S. 31 - C-4

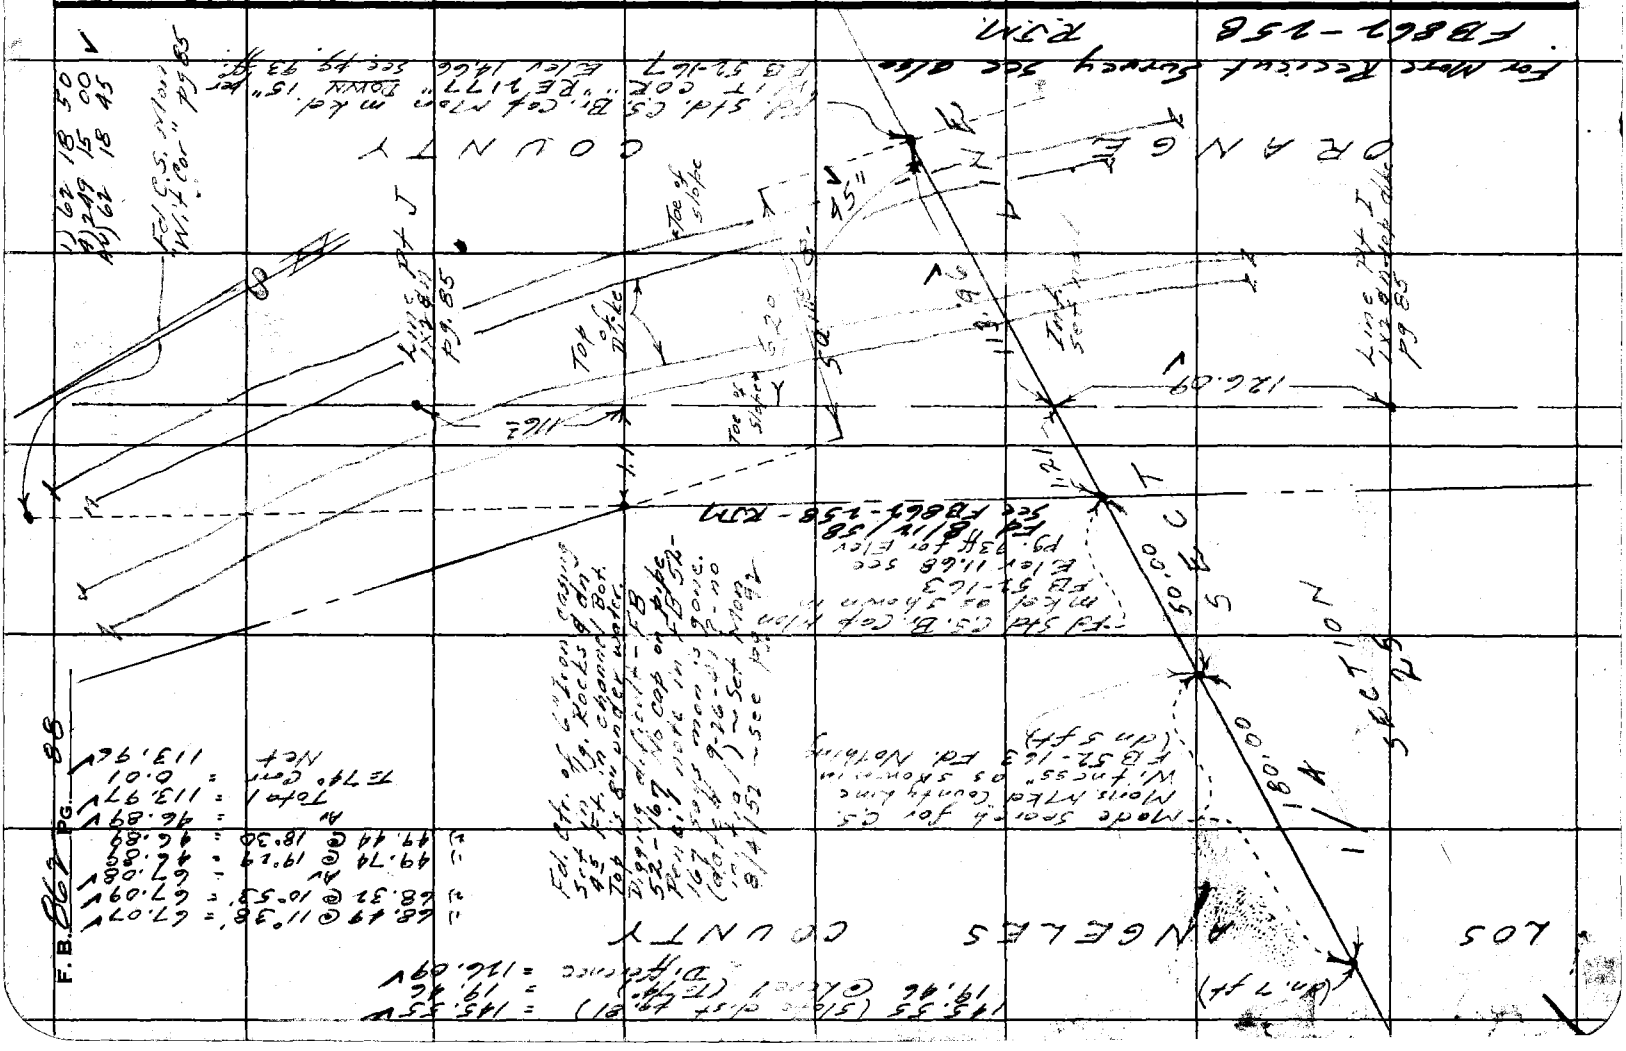
ORANGE COUNTY
LOS ANGELES COUNTY
N 50° 00' W
N 1° 00' W
Toe of slope
Top of slope
Fd. Std. C.S. Bk. Cap "RE 1177" Down 15" Mdst. 1.1' E. of cor. Elev. 146.6 See Pg. 93 F.B. 52-167
Fd. Std. C.S. Bk. Cap "RE 1177" Mdst. 15" Down

F. B. [illegible] Pg. 69

Notes Ck'd by	Survey of Misc. Surveys
Map No.	W. O. 7000 Tape No. 79 St'd. 64° °F
Office Work	Surveyed by R.J. Pinckert
Checked	Notes R.J. Pinckert Date 8/52
Date	Indexed C. Johnson 8-11-62

W.O. 31-C-5

Note: Any Additions or Changes on This Sheet Must be Made or Circled in Red Ink With Date and Name of Person Making Change.

Do not extend notes this side of this line.

RETURN TO
LOS ANGELES COUNTY SURVEYOR
726 LOS ANGELES COUNTY
ENGINEERING BLDG.

1) 300.06 @ 124° (N76) = 299.78
2) 300.14 @ 2°50' = 299.75
Ar = 299.76
48.39 @ Acr = 48.39
Total = 348.15

Cont'd on page 90

Set n of calc. offset dist fr. transit line ← 0.12 → Line Pt "B" Fd 1x2 Bn 90° pg 86

LOS ANGELES CO. FLOOD CONTROL DIST. LINE

18.63 meas

ORANGE CO.

See pg 86 for Ties to Pt. in Line & Pt. in Line (West) Fd. 1" Pipe, Rusty

TRANSIT

Fd PK in Std. L.A. Co. F.C.D. Disc set in Conc. Footing of NE leg of City of L.A. Bur. of Pwrs. tower #19 ~ Disc. is mkd. 2M173-2C 1946 ~ No Ref
Elev. of BM = see pg. for

1)	132	35	30
2)	134	41	20
3)	75	32	00
4)	132	35	20

1)	138	38	40
2)	194	34	30
3)	11	51	50
4)	138	38	38½

Set Std. C.S. Br. Cap Mon on line betw. n.s shown on this pg. & Mkd. as shown below. Set 1x2 Bn over Mon. & Flush. Top of Mon is 2.23 ft below top of 1x2 & in top of NW dike of R.R.

Elev. of Top of Mon = 13

Set n at calc. offset fr. Transit Line ← 0.11 → Line Pt "A" Fd 1x2 Bn 90° pg 86

24.55 meas

Elev of top of 1x2 13

See pg 93ff for Elev's

COUNTY SURVEYOR
L.A. Co. C.S.
LINE 63
RE

Cont'd on pg 86

76F309S 247 2-51

RETURN TO
LOS ANGELES COUNTY SURVEYOR
726 LOS ANGELES COUNTY
ENGINEERING BLDG.

Note: Any Additions or Changes on This Sheet Must be Made or Circled in Red Ink With Date and Name of Person Making Change.

Do not extend notes this side of this line.

W.S. 31-C-4

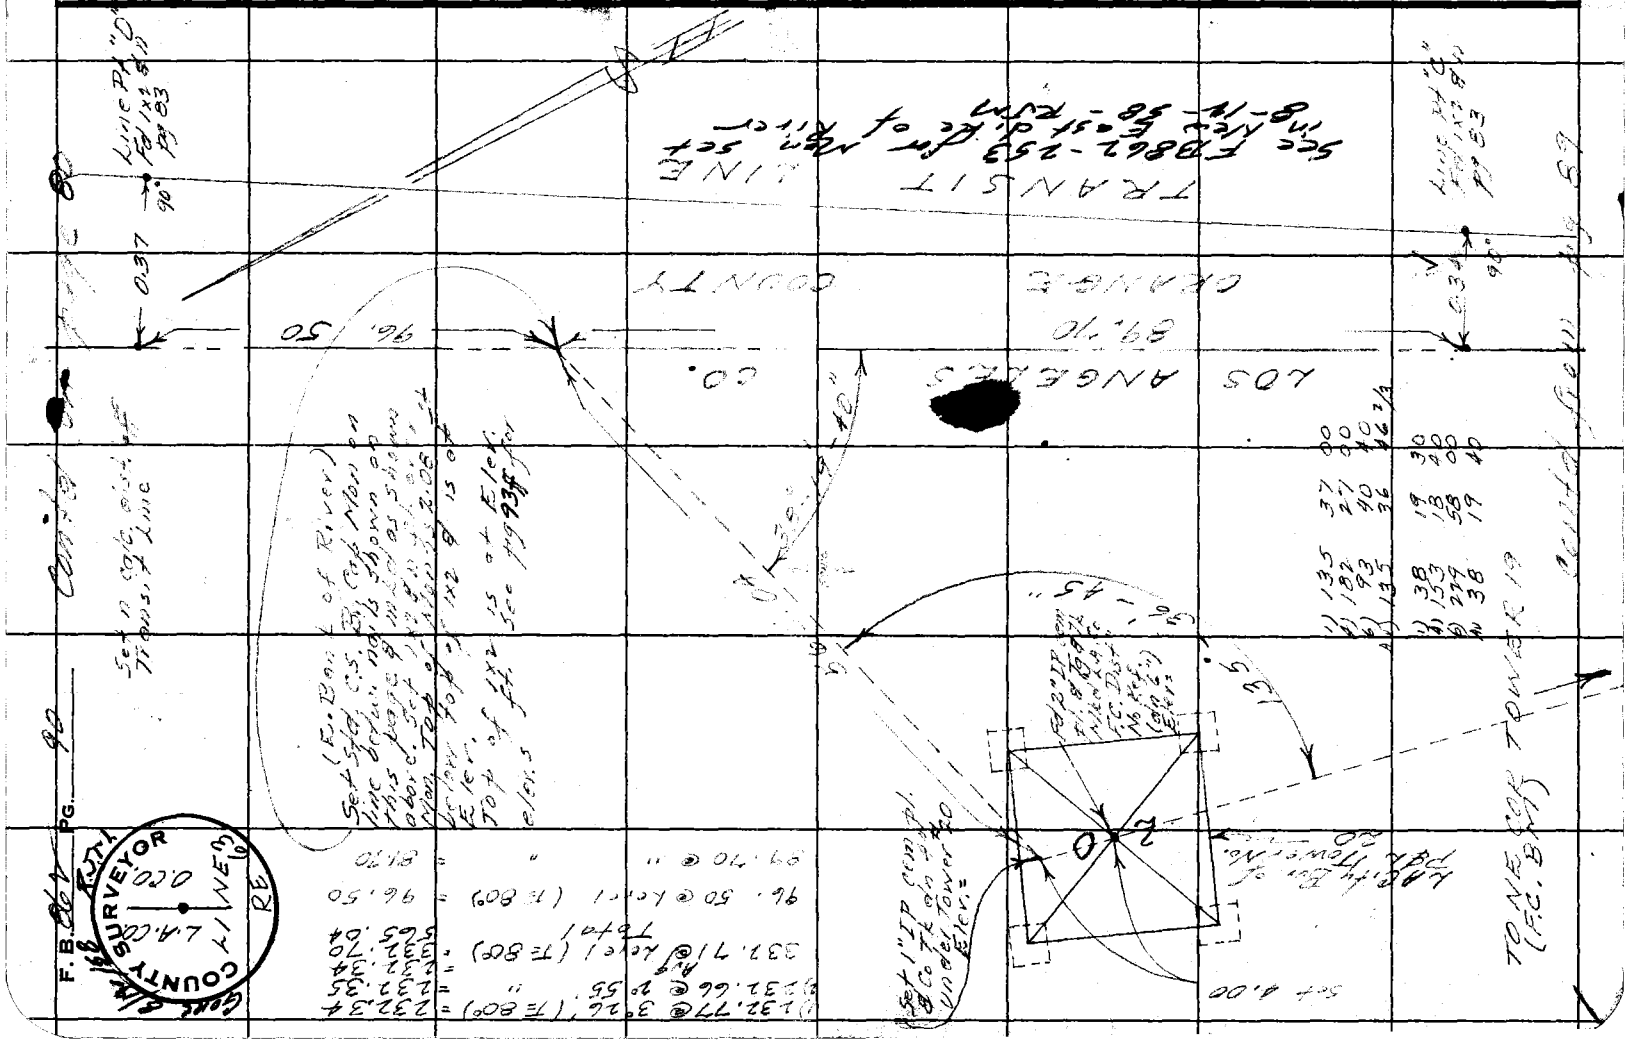

76F309S 247 10M 1-49

RETURN TO
LOS ANGELES COUNTY SURVEYOR
726 LOS ANGELES COUNTY
ENGINEERING BLDG.

Note: Any Additions or Changes on This Sheet Must be Made or Circled in Red Ink With Date and Name of Person Making Change.

Do not extend notes this side of this line.

W.S. 31 - C-4

Noted 8/12/68 RJM
COUNTY SURVEYOR
R 14 W T 4 S
25
36
R RE 63

Set Std. C.S. Mon on line shown & mkd as shown at left. Set 1x2 Sh in conc. mon & on C.L. Top of mon is 2.12 ft. below top of 1x2 & is at Elev. 21.73 ft. Top of 1x2 is at Elev. 21.15 ft. See Pg 93 for Elev.'s

C.S. Mon Pg 80

Set 1x2 Sh in ⌀ Calc. fr. 5.00 off Sec. Ln. to P.L. Line See Pg 80

7.68

S 15° W

275.99

C 5 FT OFF. LN.

Fd 1x2 Sh Top E dike S.G.R. Pg 80

Line Pt "G" Fd 1x2 Sh Pg 80

N 13° 30' W

Notes Ck'd by
Map No. B-17
Office Work R.W. WEA
Checked
Date

Survey of Sta. Surveys.
W. O. Jeepage No. 29 Sh'd 84° E
Surveyed by
Notes
Indexed C. Johnson Date 2-52

See FB 862-262, 263 for more detailed survey data 12, 1968 RJM.

F.B. 862 Pg. 91

RETURN TO
LOS ANGELES COUNTY SURVEYOR
726 LOS ANGELES COUNTY
ENGINEERING BLDG.

Note: Any Additions or Changes on This Sheet Must be Made or Circled in Red Ink With Date and Name of Person Making Change.

Do not extend notes this side of this line.

W.S.3/C-4

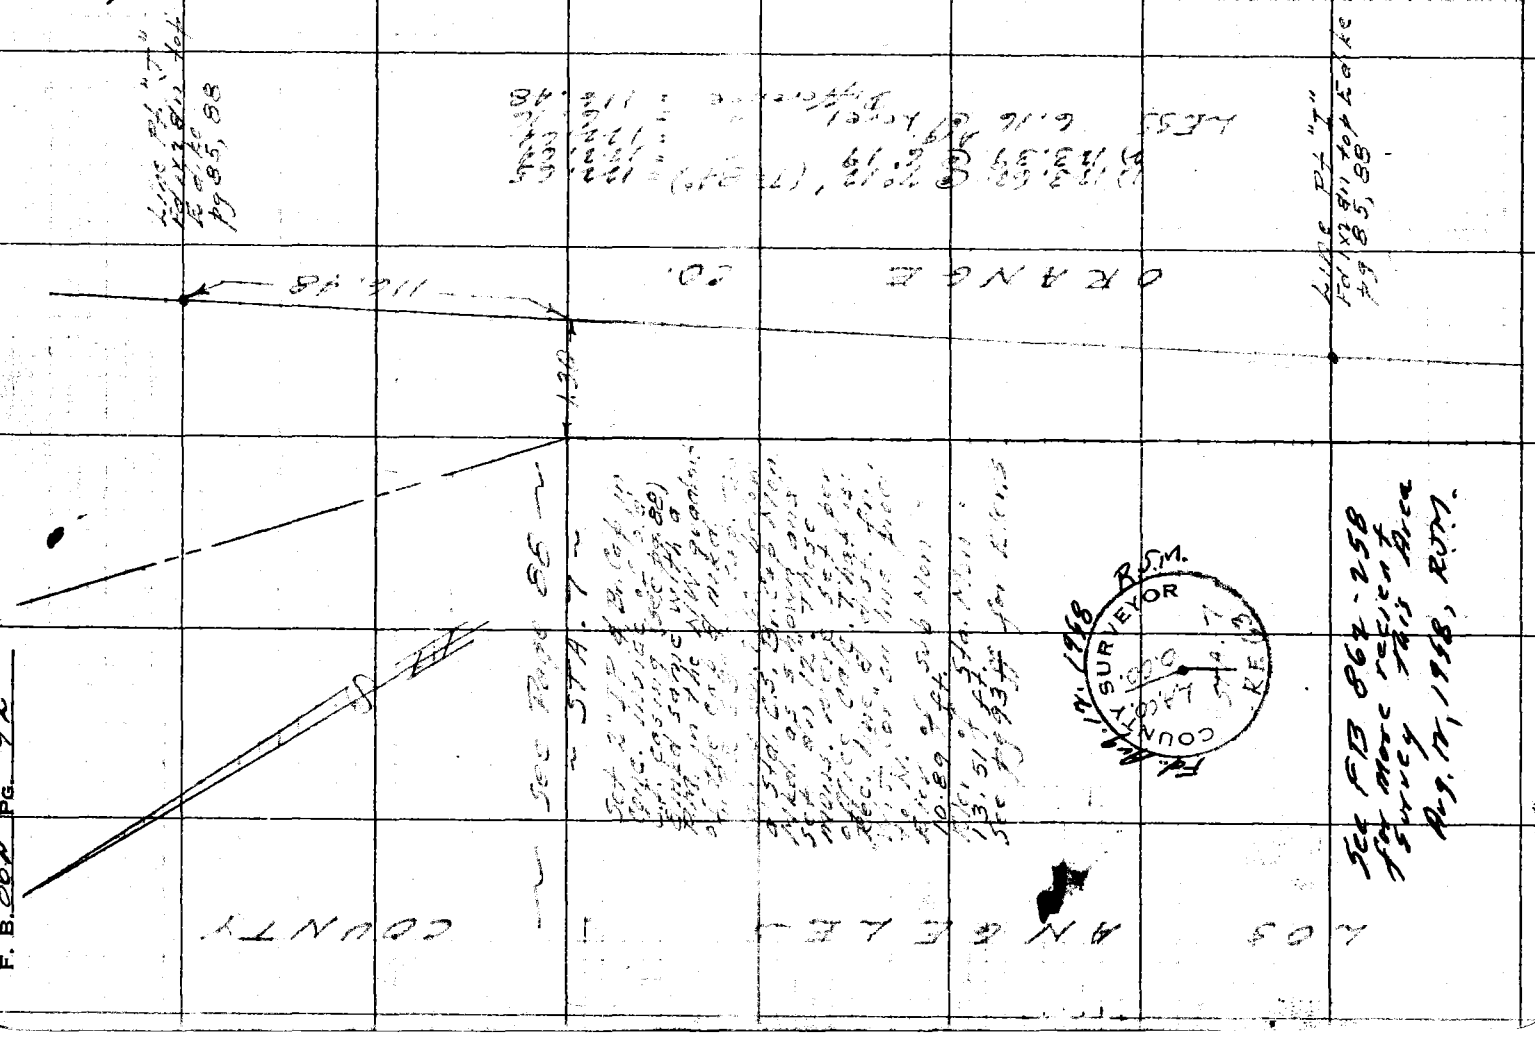

76F309S 247 2-51

RETURN TO
LOS ANGELES COUNTY SURVEYOR
726 LOS ANGELES COUNTY
ENGINEERING BLDG.

Note: Any Additions or Changes on This Sheet Must be Made or Circled in Red Ink With Date and Name of Person Making Change.

Do not extend notes this side of this line.

EXTRACT OF ELEVATIONS SHOWN IN FIELD BOOK NO. ~PGS TO

Notes Ck'd by
Map No.
Office Work
Checked
Date

Survey of [illegible] Sec. [illegible] T. [illegible] R. [illegible] S.B.B.M.
W. O. [illegible] Tape No. [illegible] Std. [illegible] °F
Surveyed by R. J. MITCHELL Date
Noted R. J. MITCHELL Date
Indexed C. Johnson

STATION	ELEVATION	DISCRIPTION {Not Complete}
BM 8-28	23.789	About 9 mi S of Artesia P.O. in the int. of Spring St. & Pioneer Blvd. [illegible]
BM 8-27	24.067	Spring St. & Pioneer Blvd - 2 ft. E. of [illegible]
BM XV-1	27.42	On Pioneer Blvd 0.25 mi S of Spring St. at the N end of a wooden Bridge over Los Cerritos Creek. A cross is in the top of a timber, 12.1 ft E of the E'ly line of the roadway
BM XV-2 (Co. Line Sta 7)	13.51	In Los Cerritos Creek 0.8 mi SWly along the creek from C.S. 7 in the intersection of Pioneer Blvd & Del Amo Blvd. [illegible]
BM XV-2, Alternate (Co. Line Sta 7)	10.89	In the same position as BM XV-2 but on a [illegible]
BM XV-3	11.68	In Los Cerritos Creek 0.9 mi SWly from [illegible] Pioneer Blvd. As shown on [illegible] Sheet - 38 [illegible] from the E'ly line [illegible]
BM XV-4	24.33 GONE 8/38 RSM	In the E side of Los Cerritos Creek [illegible] Pioneer Blvd. & 14.19 ft. SEly along [illegible]

For Refn'l Data See Bks 265-296

RETURN TO
LOS ANGELES COUNTY SURVEYOR
726 LOS ANGELES COUNTY
ENGINEERING BLDG.

Note: Any Additions or Changes on This Sheet Must be Made or Circled in Red Ink With Date and Name of Person Making Change.

Do not extend notes this side of this line.

STATION	ELEVATION	DESCRIPTION
BM XV-9		For Hyd. Hwy. Data see pages 265-296 Adopted August 1958
BM XV-8	11.73	Cone Mon. 85 Ahead 25M
BM XV-7	13.49	
BM XV-6	8.89	
BM XV-5	14.66	
Top of Well	16.70	

F.B. 6012 PG. 10

76F309S 247 2-51

RETURN TO
LOS ANGELES COUNTY SURVEYOR
726 LOS ANGELES COUNTY
ENGINEERING BLDG.

Note: Any Additions or Changes on This Sheet Must be Made or Circled in Red Ink With Date and Name of Person Making Change.

Do not extend notes this side of this line.

STATION	ELEVATION	DESCRIPTION
		Upper East nut holding the NE leg
BM XV 15	19.96	About 1.05 mi. S of Sierra Hwy along the W line of Sec. 2 T. 5 N. R. 13 W. S.B.B.M. 30 ft. S of a 2" pipe in fence, 2 ft. W of fence corner, 1 ft. N of a witness post, 0.2 ft. above RM. at 43 ft.
BM XV 14	15.44	About 1 mi. S of Sierra Hwy along the W line of Sec. 2 T. 5 N. R. 13 W. S.B.B.M. 1.5 ft. W of fence corner, 0.5 ft. N of fence, 3.5 ft. E of witness post, 0.2 ft. above RM. at 43 ft.
EM-8-30	24.092	Station on the W line of Sec. 2 T. 5 N. R. 13 W. S.B.B.M. 1950 ft. S of the W 1/4 cor. of said Sec. 2, 5 ft. W of the W line of a fence, 1.5 ft. S of a witness post, 0.2 ft. above RM. at 43 ft.

For Route 1 Dale 765 Sheet 2 of 2 Sheets

F.B. 765-296 REVD.

Notes Ck'd by
Map No.
Office Work
Checked
Date

Survey of Sec. 2 T. 5 N. R. 13 W. S.B.B.M. Tape No. 2 Std. 68 °F
Surveyed by R. J. MITCHELL
Noted R. J. MITCHELL Date
Indexed C. Johnson

F.B. PG.

RETURN TO
LOS ANGELES COUNTY SURVEYOR
726 LOS ANGELES COUNTY
ENGINEERING BLDG.

Note: Any Additions or Changes on This Sheet Must be Made or Circled in Red Ink With Date and Name of Person Making Change.

Do not extend notes this side of this line.

F. B. 5 P. 7 PG. 2

76F309S 247 2-51

RETURN TO
LOS ANGELES COUNTY SURVEYOR
726 LOS ANGELES COUNTY
ENGINEERING BLDG.

Note: Any Additions or Changes on This Sheet Must be Made or Circled in Red Ink With Date and Name of Person Making Change.

Do not extend notes this side of this line.

W.S. 316-4

Notes Ck'd by
Map No.
Office Work
Checked
Date

Survey of
W. O. Tape No. 76 Std. 64 °F
Surveyed by C. S. Date
Notes C. S.
Indexed C. Johnson

F. B. 862 Pg. 97

Tower #28 BP#4.

No Search By L.A. COUNTY SURVEYOR RE 63

No Search By L.A. COUNTY SURVEYOR RE 63

Gene By L.A. COUNTY SURVEYOR L.A. CO. LINE O. CO RE 63

Ed By L.A. COUNTY SURVEYOR L.A. CO. O. CO STA. 7 RE 63

200.00

82°

S 7.99

63.01

LOS COYOTES CREEK

Fd Pg

Fd Pg

LOS ANGELES COUNTY

ORANGE COUNTY

RETURN TO
LOS ANGELES COUNTY SURVEYOR
725 LOS ANGELES COUNTY
ENGINEERING BLDG.

Note: Any Additions or Changes on This Sheet Must be Made or Circled in Red Ink With Date and Name of Person Making Change.

Do not extend notes this side of this line.

F.B. 862 PG. 98

Notes Ck'd by KRM.	Survey of State St	F.B. 3c	Pg. 99
Map No. B-1749	W. O. 8310 Tape No.	Std.	°F
Office Work McCallister (White)	Surveyed by F.J. McNeal		
Checked	Notes Mc Date 9-12-41		
Date June 1946	Indexed 10-24-41		

STATE ST.

J.N. 8310

FROM COUNTY LINE TO LAKEWOOD BLVD.

F.J. McNeal
Geo. H. Nichols
L.C. Wilson
H.D. Hebert
A. Carrasco
J.L. Willey
T.I. O'Brien
J.F. Matyanow

H.C. 31-54
C.S.B. 1749

Note: Any Additions or Changes on This Sheet Must be Made or Circled in Red Ink With Date and Name of Person Making Change

Do not extend notes this side of this line.

RETURN TO
LOS ANGELES COUNTY SURVEYOR
700 HALL OF RECORDS

FORM 247 5M 10-39

RETURN TO
LOS ANGELES COUNTY SURVEYOR
700 HALL OF RECORDS

Note: Any Additions or Changes on This Sheet Must be Made or Circled in **Red Ink** With Date and Name of Person Making Change.

Do not extend notes this side of this line.

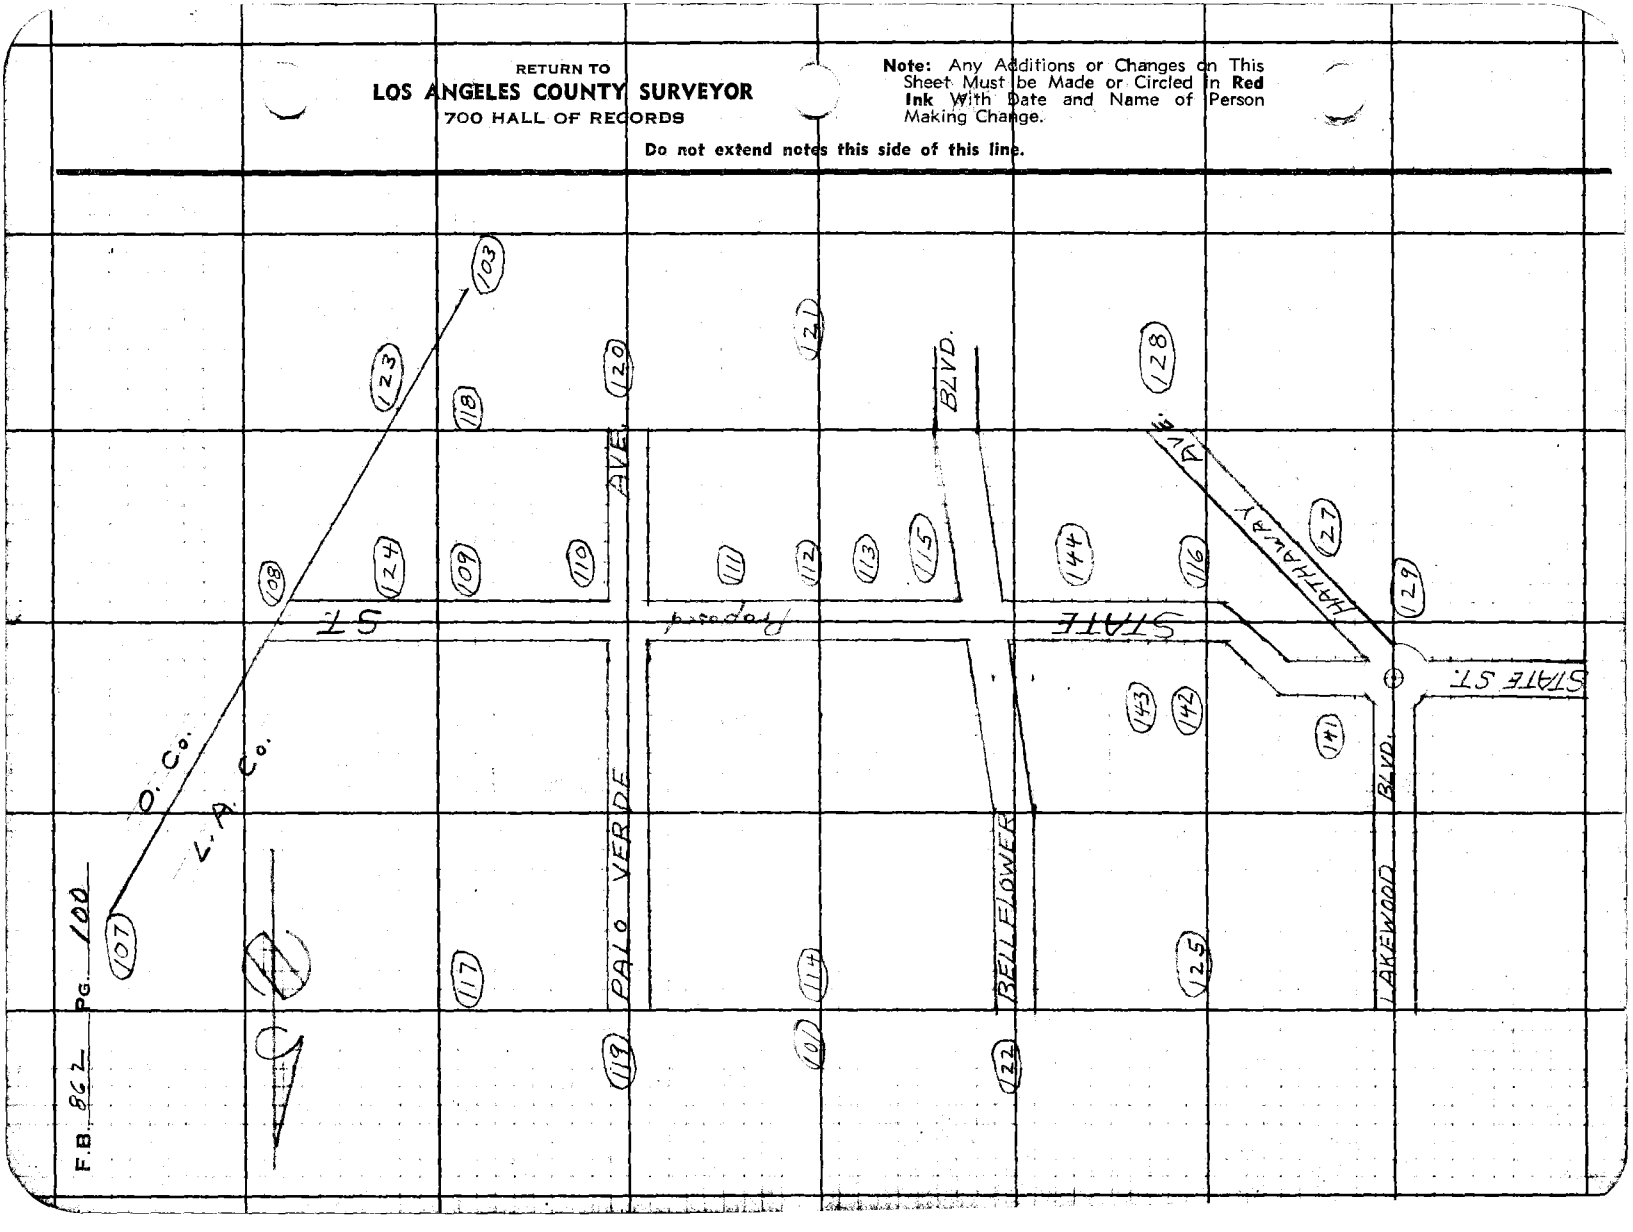

F.B. 862 PG. 100

Notes Ck'd by K.R.M.		Survey of State St	
Map No. B-1749		W. O. 7840 Tape No. #13 St'd 68 °F	
Office Work McAllister		Surveyed by L. L. Hammond	
Checked		Notes L S/H Date 2-18-41	
Date		Indexed	

F.B. 862 Pg. 101

31-B-4

Note: Any Additions or Changes on This Sheet Must be Made or Circled in Red Ink With Date and Name of Person Making Change

Do not extend notes this side of this line.

RETURN TO
LOS ANGELES COUNTY SURVEYOR
700 HALL OF RECORDS

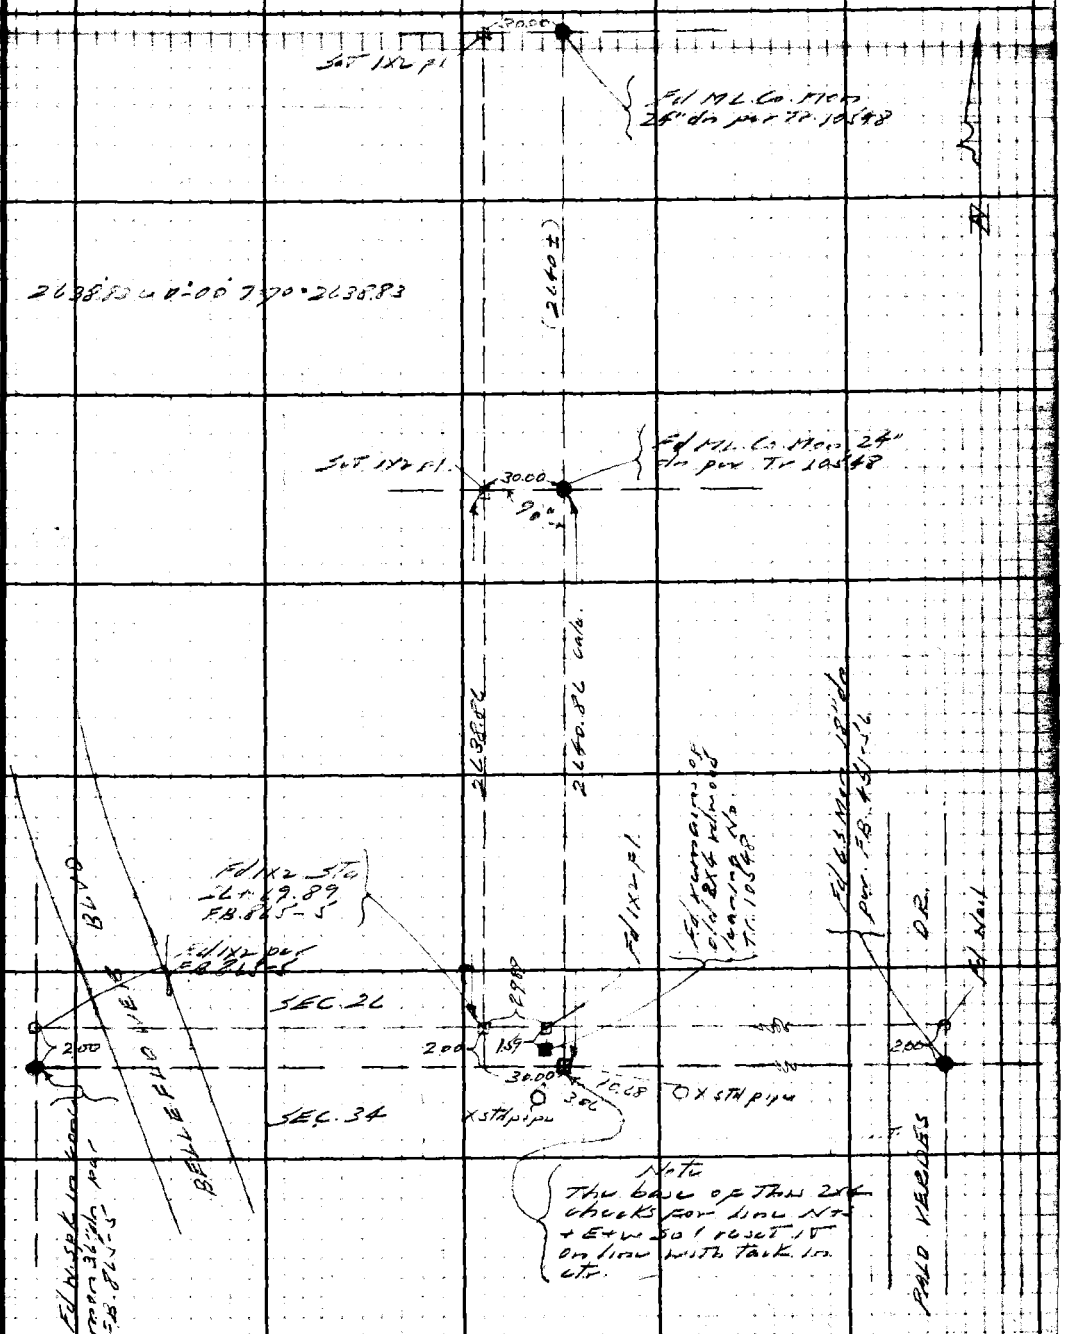

FORM 247 5M 10-39

RETURN TO
LOS ANGELES COUNTY SURVEYOR
700 HALL OF RECORDS

Note: Any Additions or Changes on This Sheet Must be Made or Circled in Red Ink With Date and Name of Person Making Change.

Do not extend notes this side of this line.

F.B. 862 PG. 102

Notes Ck'd by	Aak	Survey of	Sale St
Map No.	B-1749	W. O.	831 Tape No. 049 St'd 74 °F.
Office Work	MSMcMaster	Surveyed by	F.J. McNeal
Checked		Notes	Mc Date 9-10-41
Date		Indexed	

F.B. 962 PG. 103

31-C-5

Note: Any Additions or Changes on This Sheet Must be Made or Circled in Red Ink With Date and Name of Person Making Change.

Do not extend notes this side of this line.

RETURN TO
LOS ANGELES COUNTY SURVEYOR
700 HALL OF RECORDS

To Sh't. Next Pg.

To Rt Pg 109

℄ Prop. Woodworth Ave.
Per F.B. 451-38

Station for ℄
Per F.B. 451-38

NOTE: Sta's & Bearings of ℄ Woodworth Ave. as shown hereon are record data per F.B. 962-146 & F.B. 451-38 - RJM

28-16-45
113-07-00

120-40-30
122-42-00

118-15-00
113-00-00

388.15 @ 0-0 T 72° = 388.15
120.83 @ 80-0 T 72° = 120.83

28° 16' 45" Co.

L.A. Co.

77.11

00 01' 21" W

90°

196.44 Calc

57.19 Calc

120.83

Set 1x2

388.15

ANAHEIM ST

ABANDONED 7/28/52 RJM

118° 15' 00"

130° 55' 20" 7/31/52 RJM

120° 40' 30"

0+00
Fd Brass Cap Mon "Sta" C-12"Dn Per F.B. 451-38

906.84

Replaced 1x2 with 1½ x 1½ x 30" ± Wood Stake 7/29/52 RJM

Fd. x on No. Walk at Bridge

111° 25' 53" 7/31/52 RJM

169.27 ±

1) 111 26 00
2) 85 43 40
3) 208 35 40
4) 111 25 53⅓ 7/31/52 RJM

1) 130 55 20
2) 163 41 20
3) 65 31 50
4) 130 55 18⅓

7TH ST.

Set Lat in W'ly end of N'ly wall of Bridge 7/29/52 RJM

Fd 2x2 & t-12"Dn
Per F.B. 451-38

Fd. Brass cap & pipe 12" Dn "Sta" No. 6
Per F.B. 60-125
Fd 8/12/52 - RJM
See F.B. 962-146

708.01 @ Lev, (Y=78°) = 708.01
1) 199.57 @ 1°56' (Y=76°) = 198.82
2) 199.63 @ 5°05' = 198.84
= 198.83
Total = 906.84 7/31/52 RJM

FORM 247 BM 10-59

F.B. 862 Pg. 104

T#21 = 84°

To Bot. Next Pg

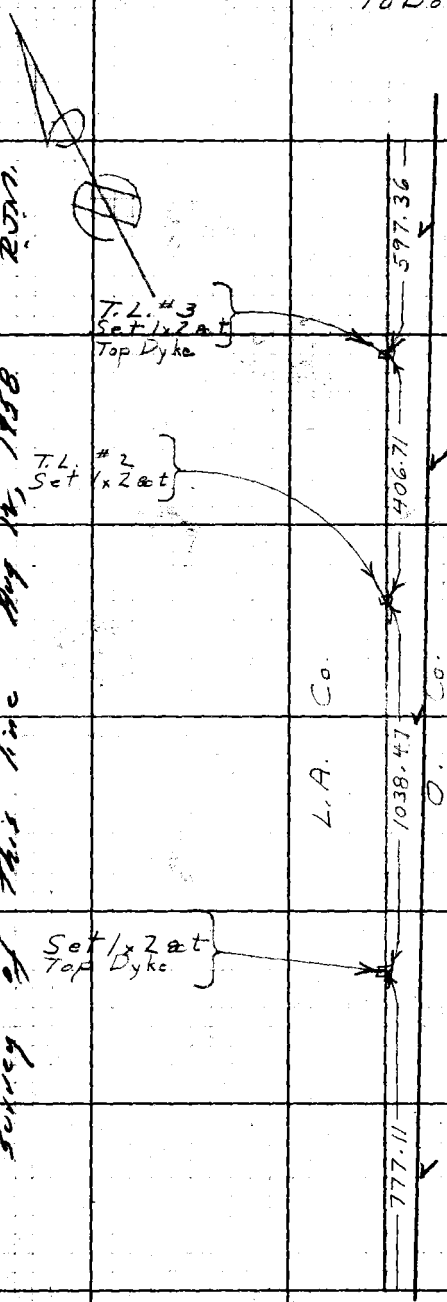

297.99 @ 0-0 T 78° = 297.98 ✓
299.55 @ 1-53 T 78° = 299.38 ✓
597.36 ✓

111.28 @ 0-0 T 76° = 111.27 ✓
295.57 @ 1-35 T 76° = 295.44 ✓
406.71 ✓

244.94 @ 1-11 T 76° = 244.88 ✓
298.55 @ 0-0 T 72° = 298.53 ✓
298.01 @ 0-0 T 72° = 297.99 ✓
197.34 @ 2-52 T 72° = 197.07 ✓
1038.47 ✓

232.44 @ 3-11 T 70° = 232.06 ✓

298.79 @ 0-0 T 74° = 298.77 ✓
246.30 @ 0-0 T 74° = 246.28 ✓
777.11 ✓

From Top Last Pg

RETURN TO
LOS ANGELES COUNTY SURVEYOR
700 HALL OF RECORDS

Note: Any Additions or Changes on This Sheet Must be Made or Circled in Red Ink With Date and Name of Person Making Change.

Do not extend notes this side of this line.

Notes Ck'd by: aap	Survey of: State St.	F.B. 862	Pg. 105
Map No. 23-1749	W. O. 8310 Tape No. 21 St'd 84°F		
Office Work: McAllister	Surveyed by: Ed. McNeil		
Checked:	Notes: Mc Date: 9-11-41		
Date:	Indexed: C. Jones		

To Bot Next Pg.

50+08.50
T.L. #8
Set 3/4" I.P. at
416.80

49+93.81
14.69
2.63
Fd. Copper nail in Conc
1/2" DH No Ref. - See Pg - 108
0.67

T.L. #7
Set 1x2 at
In Island
367.60

68.20 @ 0-0 T 74° = 68.20
299.42 @ 0-0 T 74° = 299.40
367.60

300.20 @ 0-0 T 74° = 300.18

T.L. #6
Set 1x2 at
533.15

232.99 @ 0-0 T 74° = 232.97
533.15

L.A. Co.

T.L. #5
Set 3/4 I.P. at
596.71

297.58 @ 0-0 T 80 = 297.57

299.15 @ 0-0 T 80 = 299.14
596.71

91.01 @ 0-0 T 30° = 91.01

28+19.65
T.L. #4
Set 1x2 at
Plowed Field
691.39

300.33 @ 0-0 T 80° = 300.37
300.32 @ 0-0 T 80° = 300.01
691.39

597.36

From Top Last Pg.

See FB 862 pg 104 for more recient survey of this line

R.S. 55-8

Note: Any Additions or Changes on This Sheet Must be Made or Circled in Red Ink With Date and Name of Person Making Change

Do not extend notes this side of this line.

RETURN TO
LOS ANGELES COUNTY SURVEYOR
700 HALL OF RECORDS

FORM 247 5M 10-39

F.B. 862 PG. 106

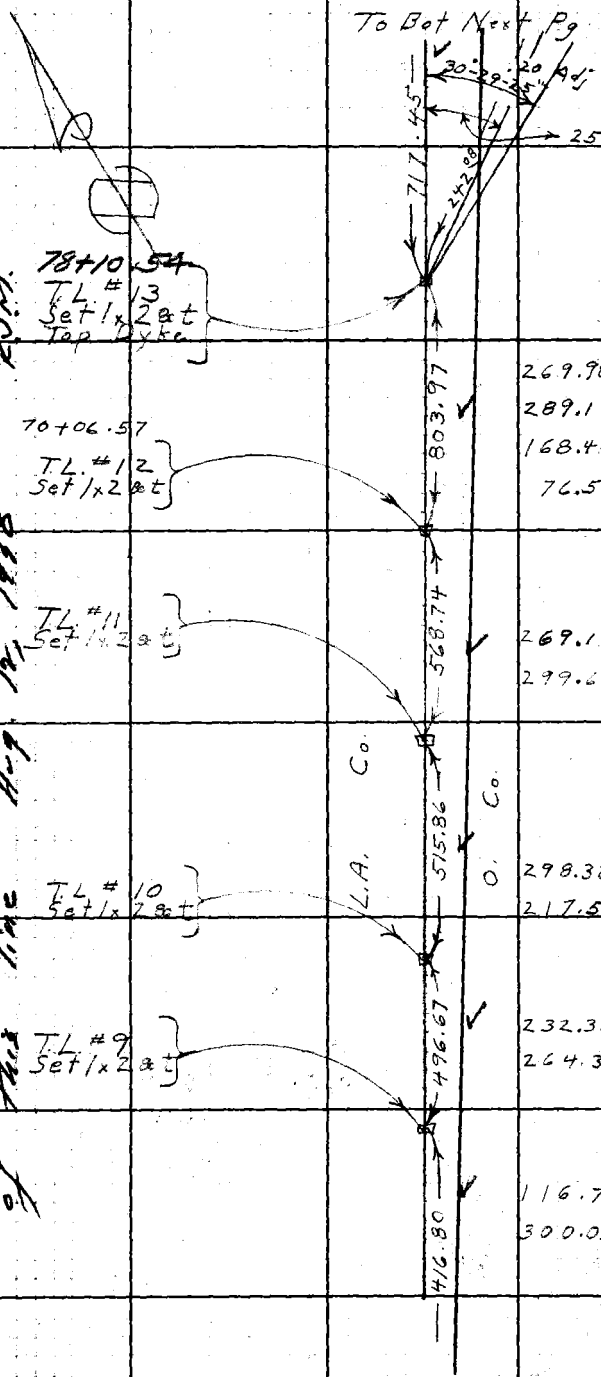

30-29-30
121-57-30

25-46-00
103-04-30

269.98@1°-55' T78° = 269.82
289.17@0-0 T78° = 289.16
168.44@0-0 T76° = 168.43
76.50@0-0 T76° = 76.56
803.97

269.12@0°-44' T78° = 269.09
299.62@0°-05' T78° = 299.65
568.74

298.38@0°-23' T78° = 298.36
217.52@0°-38' T76° = 217.50
515.86

232.38@0°-28' T80° = 232.36
264.34@0°-46' T80° = 264.31
496.67

116.77@0-0 T80° = 116.77
300.05@0°-32' T80° = 300.03
416.80

From Top Last Pg.

RETURN TO
LOS ANGELES COUNTY SURVEYOR
700 HALL OF RECORDS

Note: Any Additions or Changes on This Sheet Must be Made or Circled in Red Ink With Date and Name of Person Making Change.

Do not extend notes this side of this line.

Notes Ck'd by: Auer	Survey of: State St
Map No.: B-1749	W. O. 2310 Tape No.: 4L St'd: 84°F
Office Work: McAllister	Surveyed by: E. J. Mc Neil
Checked:	Notes: Mc Date: 9-13-41
Date:	Indexed: A. C. Jones

F.B. S17 Pg. 107

Note: Any Additions or Changes on This Sheet Must be Made or Circled in Red Ink With Date and Name of Person Making Change

Do not extend notes this side of this line.

RETURN TO
LOS ANGELES COUNTY SURVEYOR
700 HALL OF RECORDS

FORM 247 BM 10-39

85+27.99
T.L. #14
Set 1x2 at
Top Dyke

3-14-00
6-28-00

E3-56-15
335-44-45

24-19-15
97-17-15

3.14
3.37
59.93

145.46 @ 5°09' T72° = 144.86
399.79

85 + 87.62
WIT. COR.
Fd. C.S. Mon-12"Dm
Per F.B. 52-167

60.51 @ 9-12 T84° = 59.73

Δ Set 1x2 at

399.79

83°-56'-10" Adj' .05

24°-19'-20"

65°-34'-35" Adj' .40

65-34-45
262-18-30

To Left Pg 109

L.A. Co.
717.45
O. Co.

Fd. Brass Cap Mon
Flush - Per F.B. 52-167

102.24

2442.08

235.45 @ 3°-09' T78° = 235.08
7.00 @ 0-0-0 = 7.00
242.08

From Top Last Pg

RETURN TO
LOS ANGELES COUNTY SURVEYOR
700 HALL OF RECORDS

Note: Any Additions or Changes on This Sheet Must be Made or Circled in **Red Ink** With Date and Name of Person Making Change.

Do not extend notes this side of this line.

31, C-4

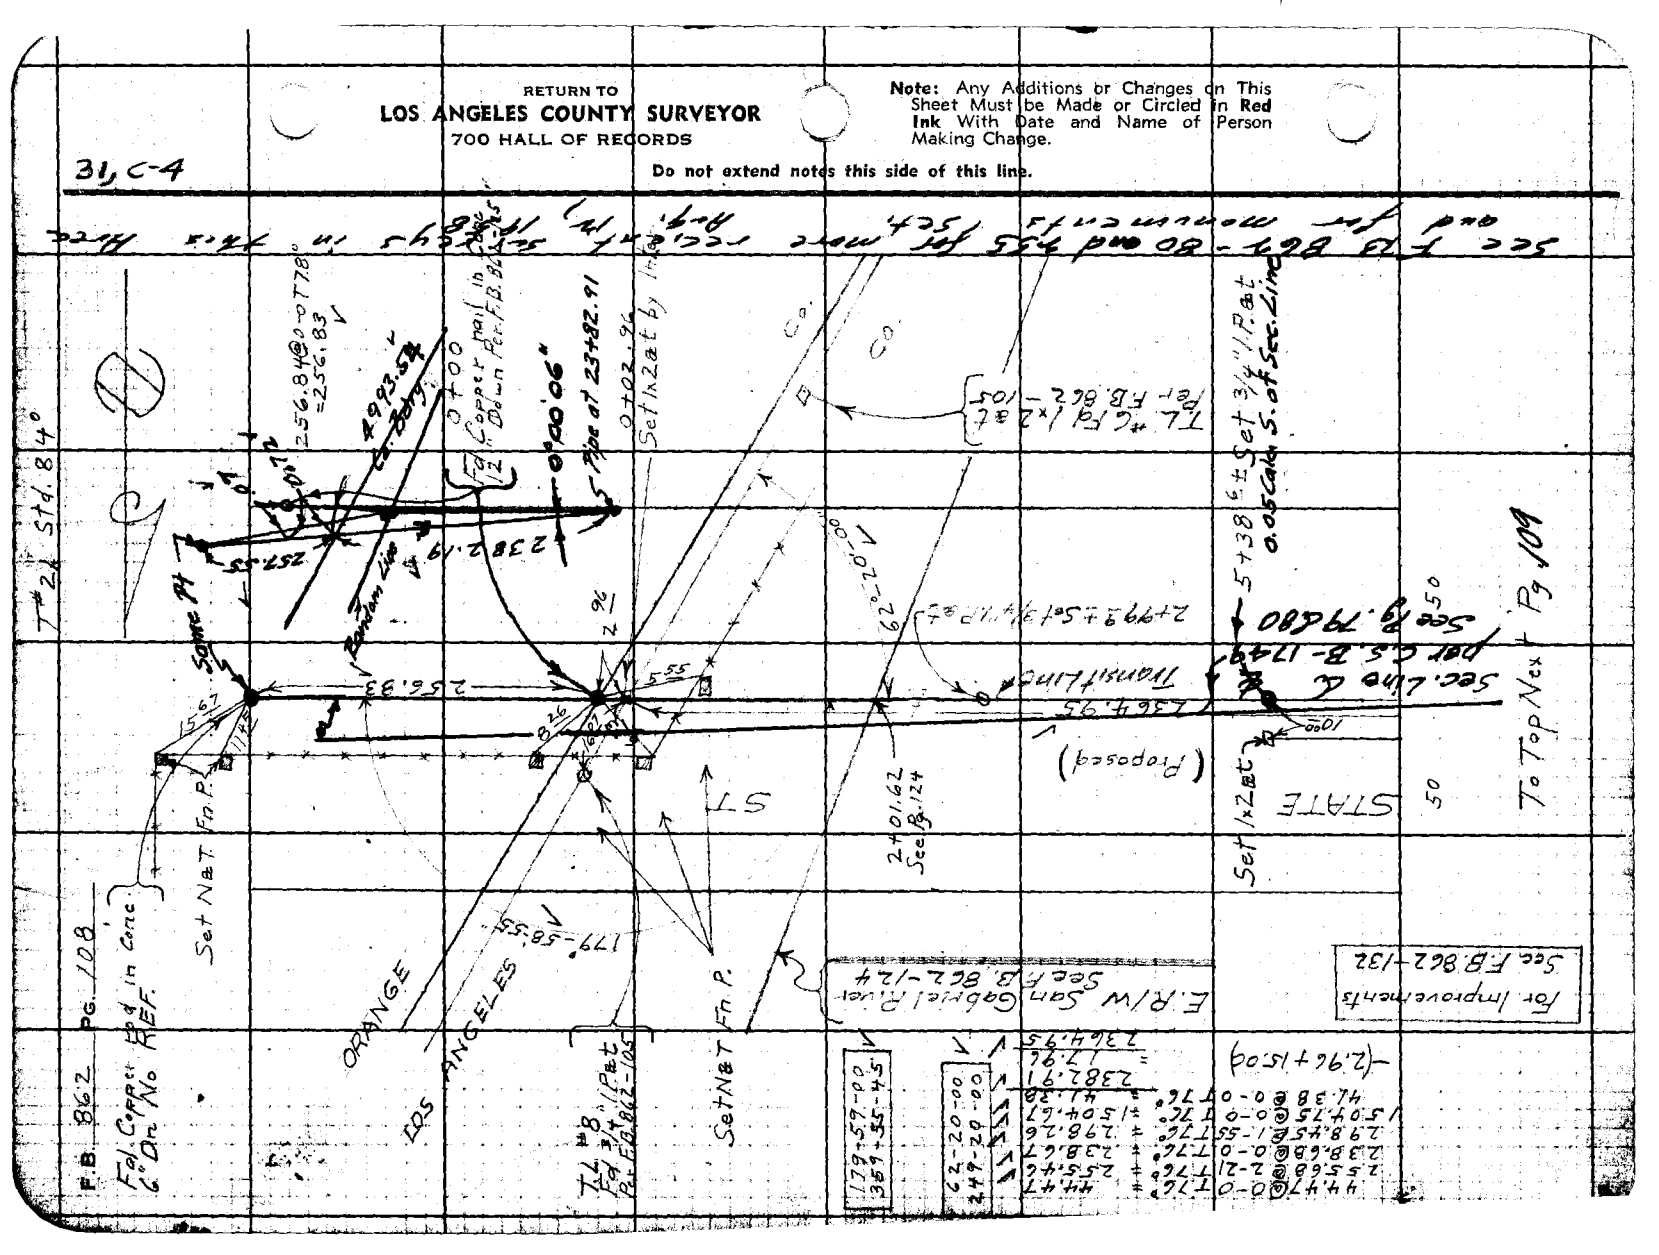
T 2S Std. 84°
Set Nail & T. Fn. P.
Set 1x2 at
Set 3/4" I.P. at
Tangent Line
Radial Line
Proposed
STATE
ORANGE
LOS ANGELES
Set N & T
Fn. P.
Tie #8
Fd. 3/4" I.P. at
P.L. F.B. 862-105
E.R/W San Gabriel Rver
See F.B. 862-124
For Improvements
See F.B. 862-132
To Top Next Pg 109
See Pg 79680
Per C.S. B-1749
Sec. Line
Fd. Copper Nail in
Copper Mon. Flush
Fd. Copper Nail in
Down Per F.B. 862-105
Set 3/4" I.P. at
0.05 Calc. S. of Sec. Line

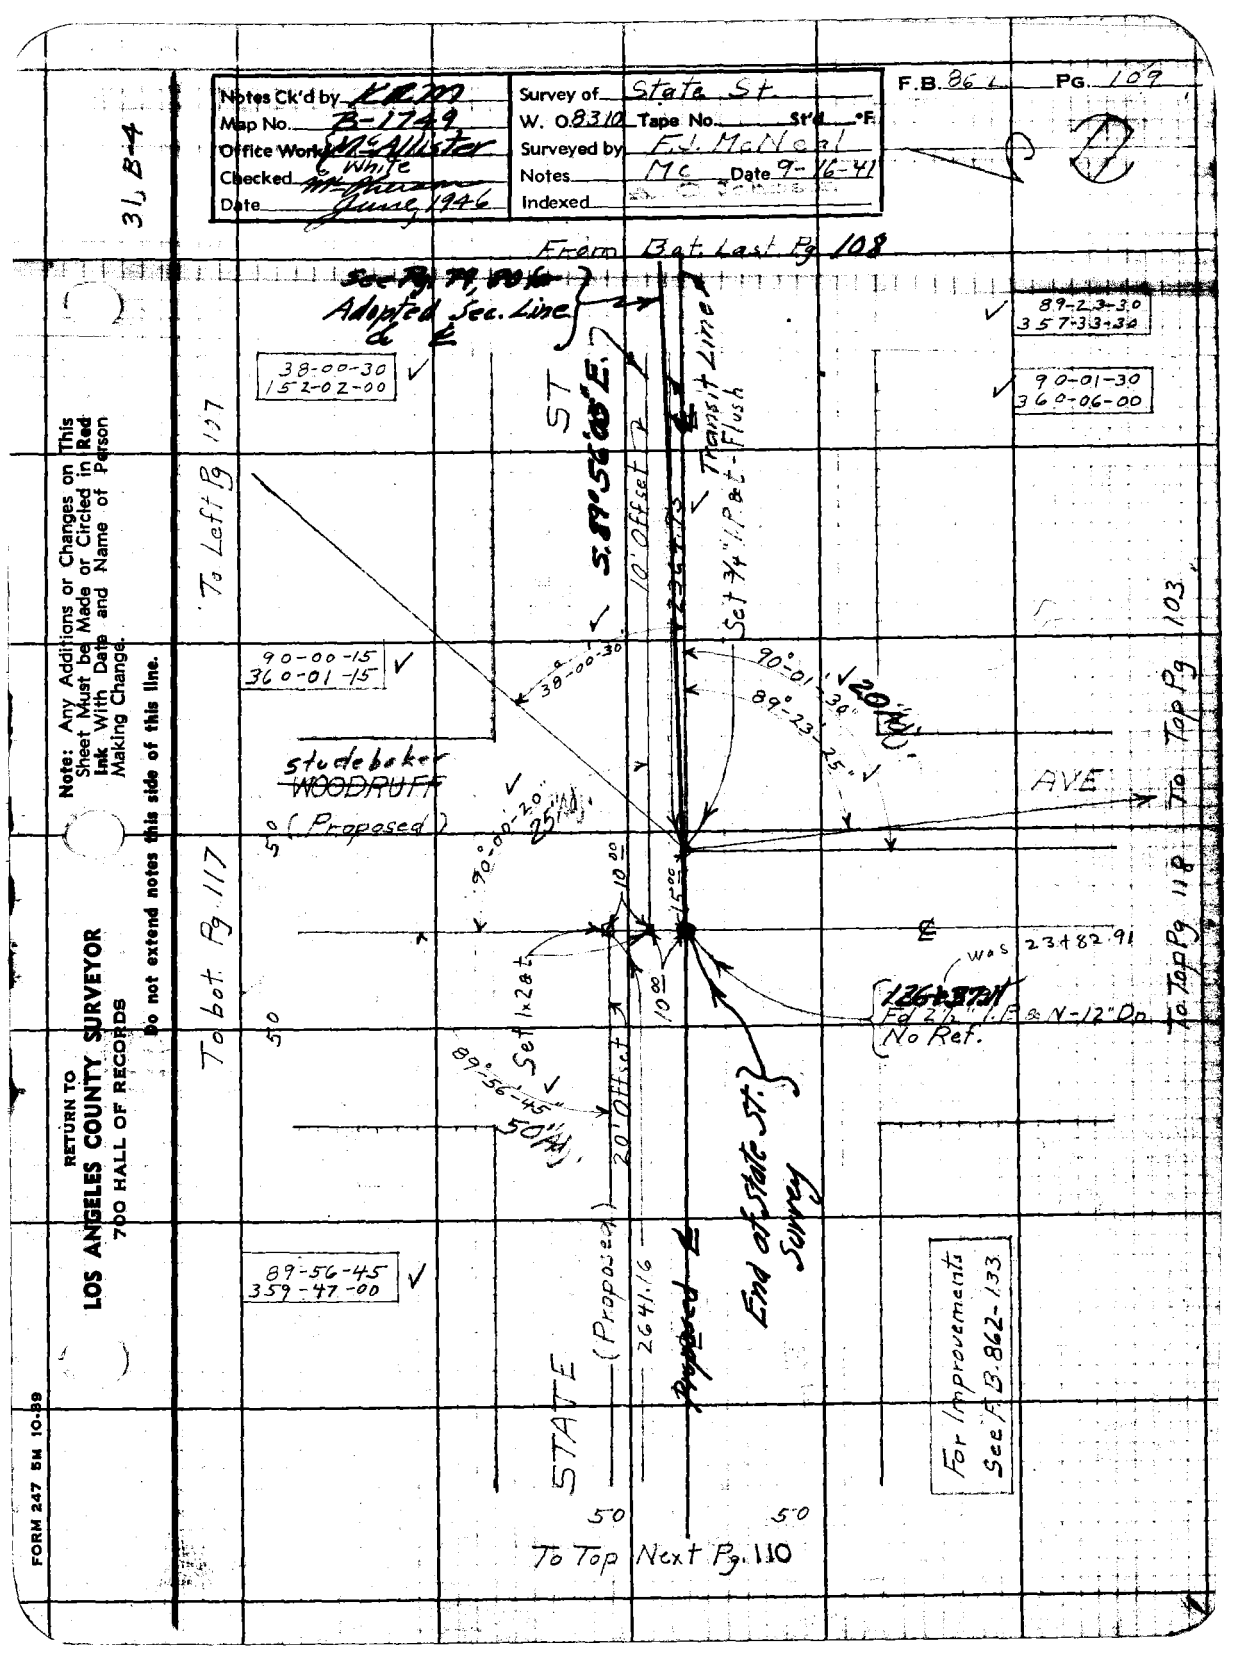
Notes Ck'd by KLM
Map No. B-1749
Office Work McAllister
Checked C. White
Date June, 1946
Survey of State St
W. O. 8310 Tape No. St'd °F.
Surveyed by F.L. McNeal
Notes Mc Date 9-16-41
Indexed
F.B. 861 PG. 109
31, B-4
From Bat Last Pg 108
Adopted Sec. Line
S. 89°56'45" E.
ST
10' Offset
Transit Line
Set ¾" I.P. & t. - Flush
38-00-30
152-02-00
89-23-30
357-33-30
90-01-30
360-06-00
To Left Pg 117
90-00-15
360-01-15
38-00-30
90°-01'-30"
89°-23'-25"
20' (M)
Studebaker
WOODRUFF
(Proposed)
50
25' (M)
90°-00'-20"
AVE
To Top Pg 103
To Bot. Pg 117
10.00
15.00
Set 1.28 ±
W.O.S.
2318.91
1264.37
Fd 2" I.P. & N-12° Dp.
No Ref.
To Top Pg 118
89°-56'-45"
50' (M)
20' Offset
End of State St. Survey
89-56-45
359-47-00
2641.16
STATE
(Proposed)
Proposed
For Improvements
See A.B. 862-133
50
50
To Top Next Pg. 110
Note: Any Additions or Changes on This Sheet Must be Made or Circled in Red Ink With Date and Name of Person Making Change.
Do not extend notes this side of this line.
RETURN TO
LOS ANGELES COUNTY SURVEYOR
700 HALL OF RECORDS
FORM 247 SM 10-89

RETURN TO
LOS ANGELES COUNTY SURVEYOR
700 HALL OF RECORDS

Note: Any Additions or Changes on This Sheet Must be Made or Circled in **Red Ink** With Date and Name of Person Making Change.

Do not extend notes this side of this line.

31, B-4

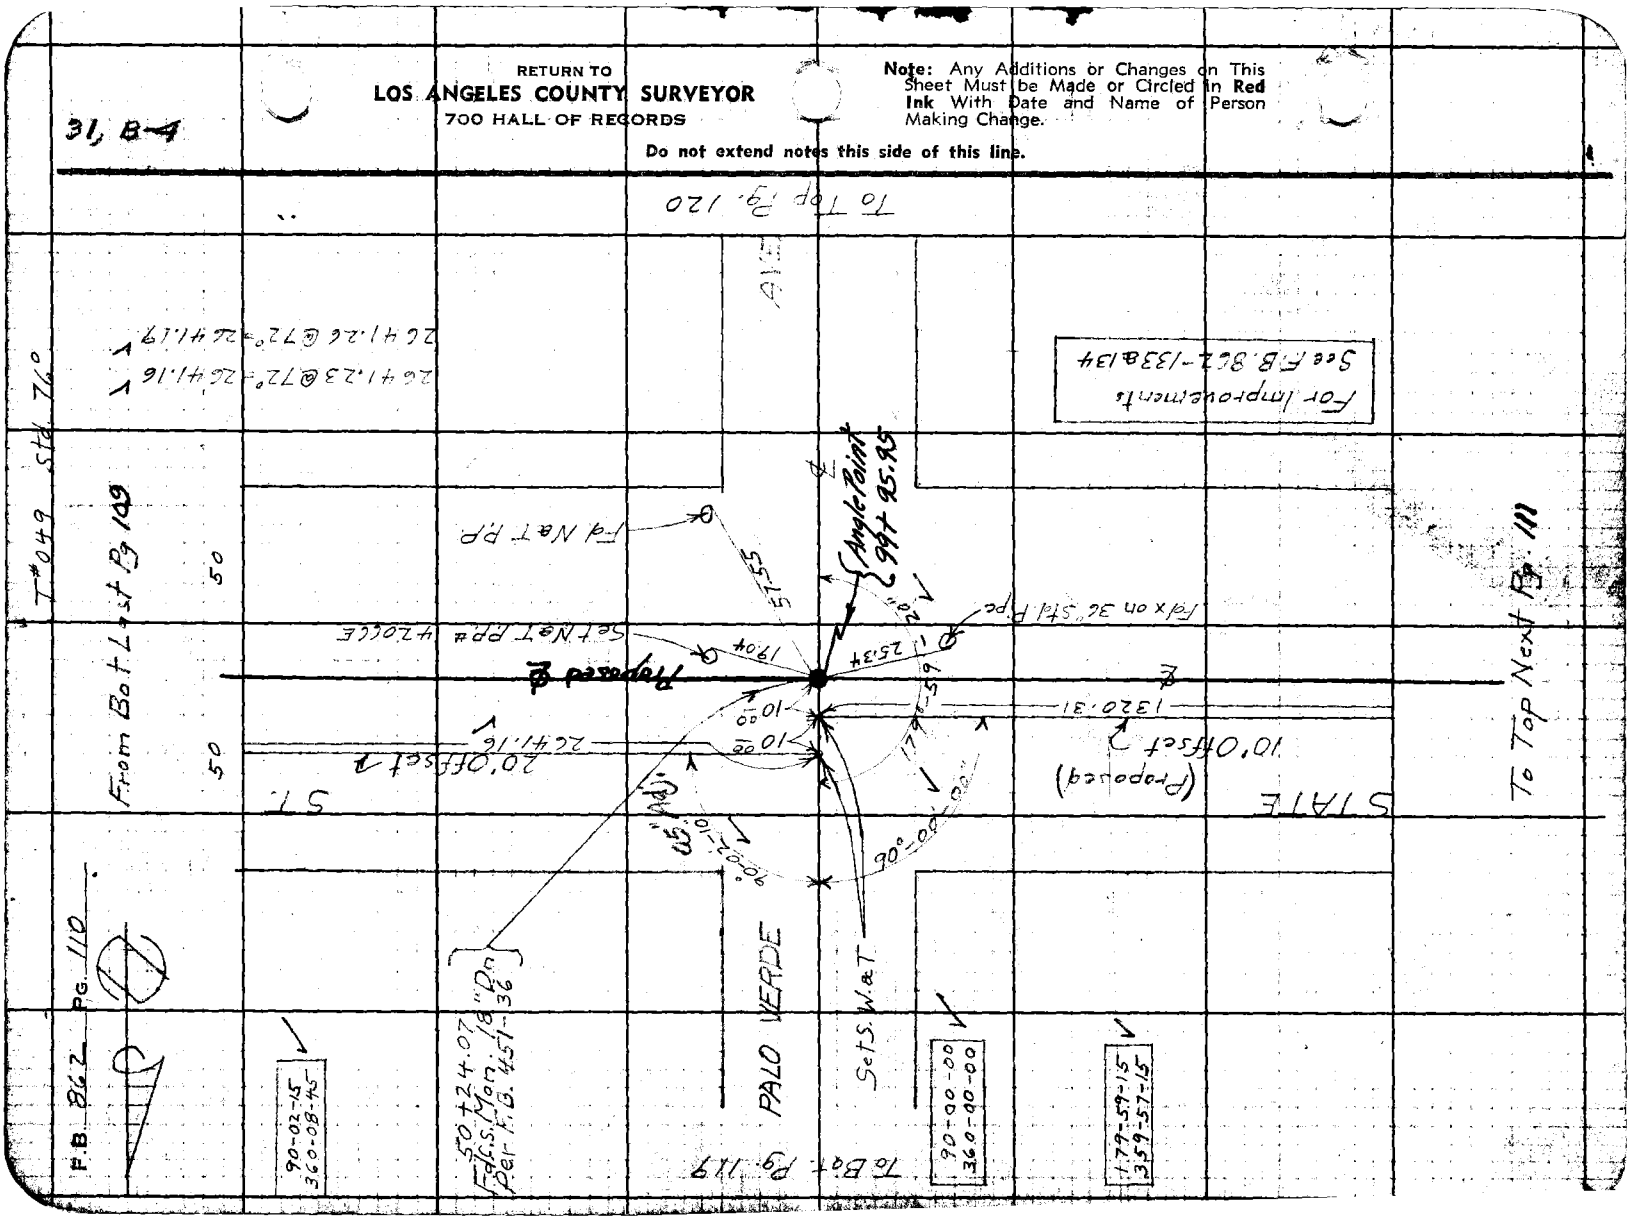

FORM 247 5M 10-39

RETURN TO
LOS ANGELES COUNTY SURVEYOR
700 HALL OF RECORDS

Note: Any Additions or Changes on This Sheet Must be Made or Circled in **Red Ink** With Date and Name of Person Making Change.

Do not extend notes this side of this line.

21 B-4

Notes Ck'd by [illegible]
Map No. B-1748
Office Work [illegible]
Checked [illegible]
Date [illegible]

Survey of State
W. O. 8230 Tape No. 049 Std 76°F
Surveyed by E. J. McNeal
Notes
Indexed Date 9-22-41

F.B. 27 Pg. 111

1297.05@0-0 T 82° = 1297.90
− 13.65
1283.45
+ 36.65
1320.10

For Improvements
See F.B. 862-135

Sec. 26

1306.61@0-0 T 82° = 1306.66
+ 13.65
1320.31

STATE

(Proposed)

1320.10

86+85.64 P.T.

Set 1x2a th by inter.

0.15

Set N&T in P.P.

ST.

10' Offset

1320.31

Set x on 40' Conc. Stand Pipe

Set x on 12" Steel Wall Casing

From Bell Last Rg. No.

To Top Next Rg. No. 112

63 T+44.38
Fd. 1½" I.P. & T-Flush
Per F.B. 865-4

2649 ±

N 00°-00'-30" E

90-00-30
360-02-00

1/4, 1/4 Cor
Fd. C.S. Mon 36" Dn
Per F.B. 397-41

Sec. 35

RETURN TO
LOS ANGELES COUNTY SURVEYOR
700 HALL OF RECORDS

Note: Any Additions or Changes on This Sheet Must be Made or Circled in **Red Ink** With Date and Name of Person Making Change.

Do not extend notes this side of this line.

31, B-4

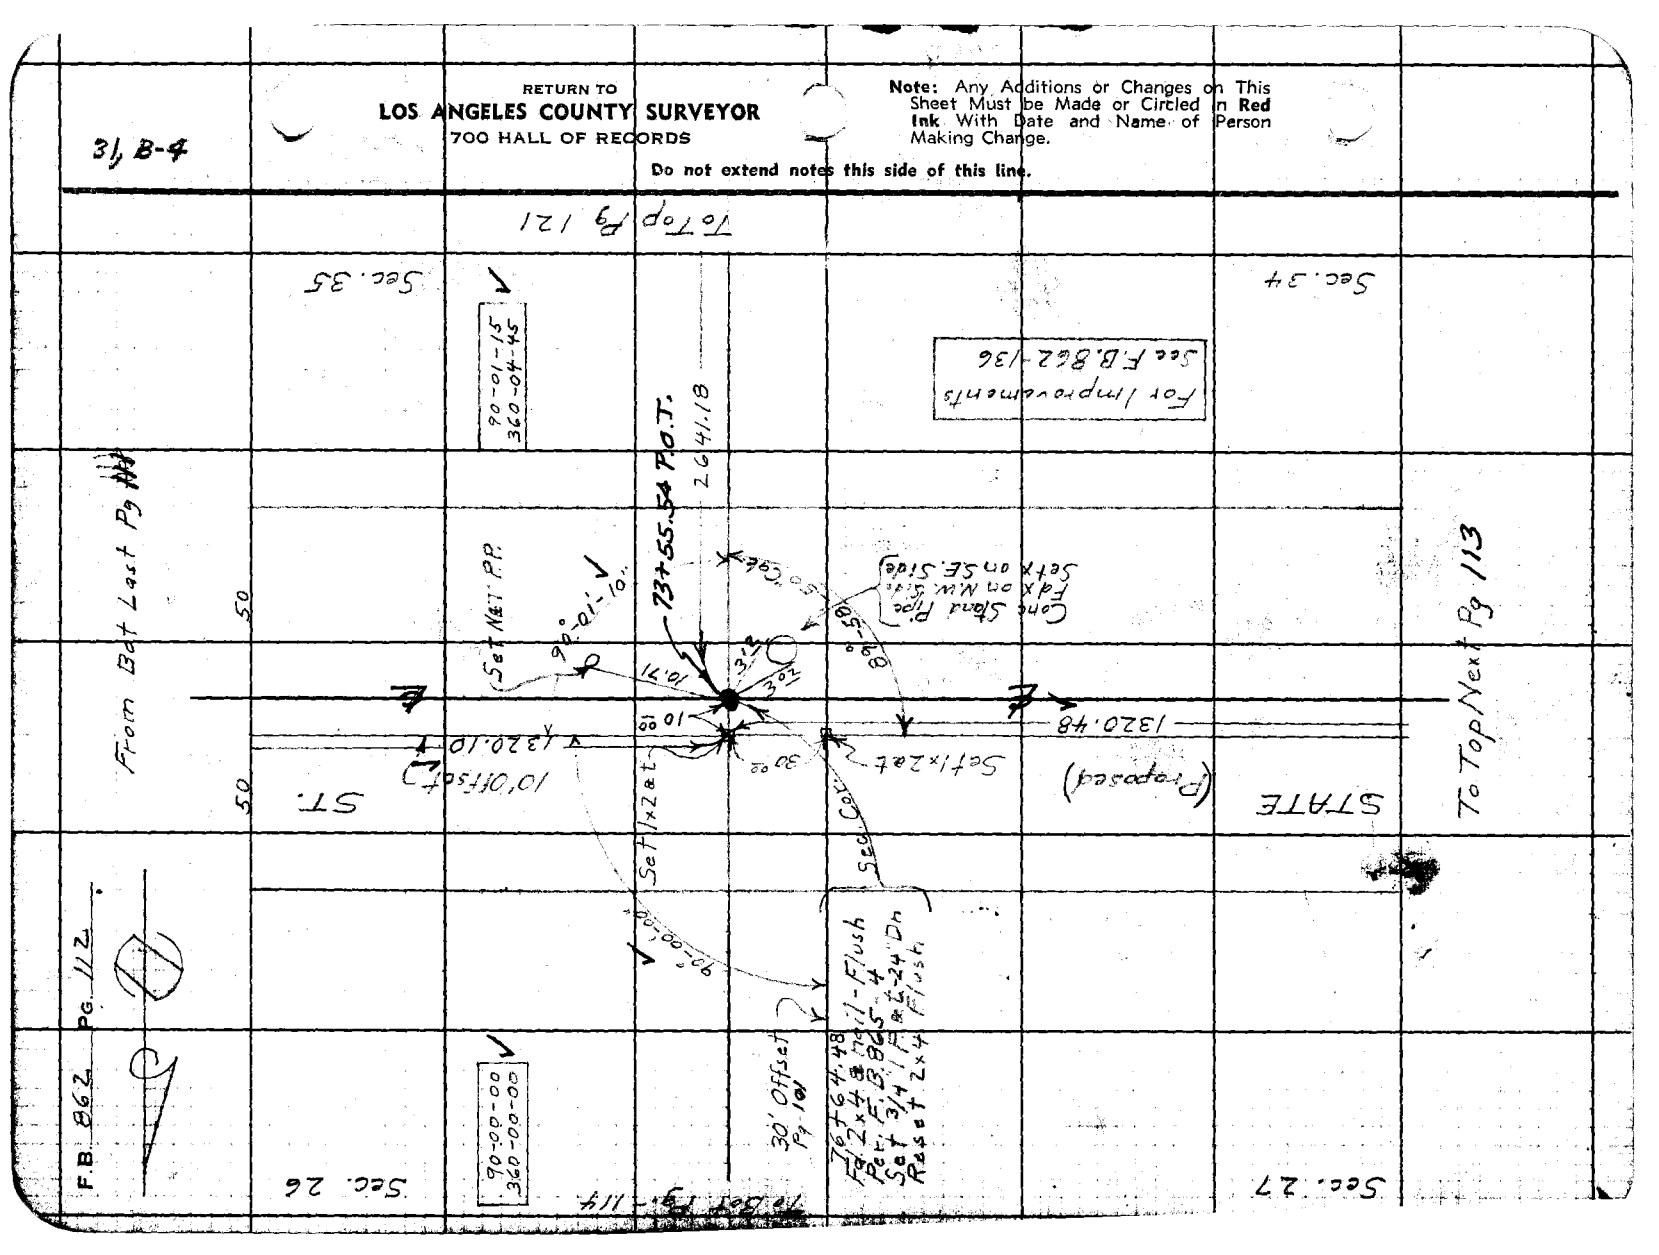

FORM 247 5M 10-39

RETURN TO
LOS ANGELES COUNTY SURVEYOR
700 HALL OF RECORDS

Note: Any Additions or Changes on This Sheet Must be Made or Circled in **Red Ink** With Date and Name of Person Making Change.

Do not extend notes this side of this line.

31, B-4

Notes Ck'd by [illegible] Map No. B-1369 Office Work [illegible] Checked [illegible] Date [illegible]

Survey of State St. W. O. 8312 Tape No. 042 Steel "F" Surveyed by E. J. Mc Neal Date 9-23-41 Notes Indexed

Sec. 27

1270.26@0-0 T 76° = 1270.26 + 50.44 = 1320.70

For Improvements See F.B. 862-136

1407.52@0-0 T 82° = 1437.57 − 36.65 + 70.44 = 107.07 = 1300.48 + 20.00 = 1320.48

STATE (Proposed)

89+84.96 Fd. 3/4" I.P. & t - Flush Per F.B. 865-5 1/4 - 1/4 Sec. Cor

Set 1x2 & t By Inter

ST.

From Bot. Last Ltr. Ht.

50

50

1320.70

10' Offset

20.00

1320.48

Set N & T. P.P.

Set N & T. Fn. P.

89.59

60+35.06 P.O.T.

89-59-15
359-56-30

2640 ±

Set N & T. P.P. #B200BY

1/4 - 1/4 Sec. Cor. Fd. C.S. Mon. - 8" Dm Per F.B. 397-42

74.07

Set 1x2 & t

Set N & T. 10" Pine

20.92

Sec 34

F.B. 862 PG. 113

RETURN TO
LOS ANGELES COUNTY SURVEYOR
700 HALL OF RECORDS

Note: Any Additions or Changes on This Sheet Must be Made or Circled in **Red Ink** With Date and Name of Person Making Change.

Do not extend notes this side of this line.

31 B-4

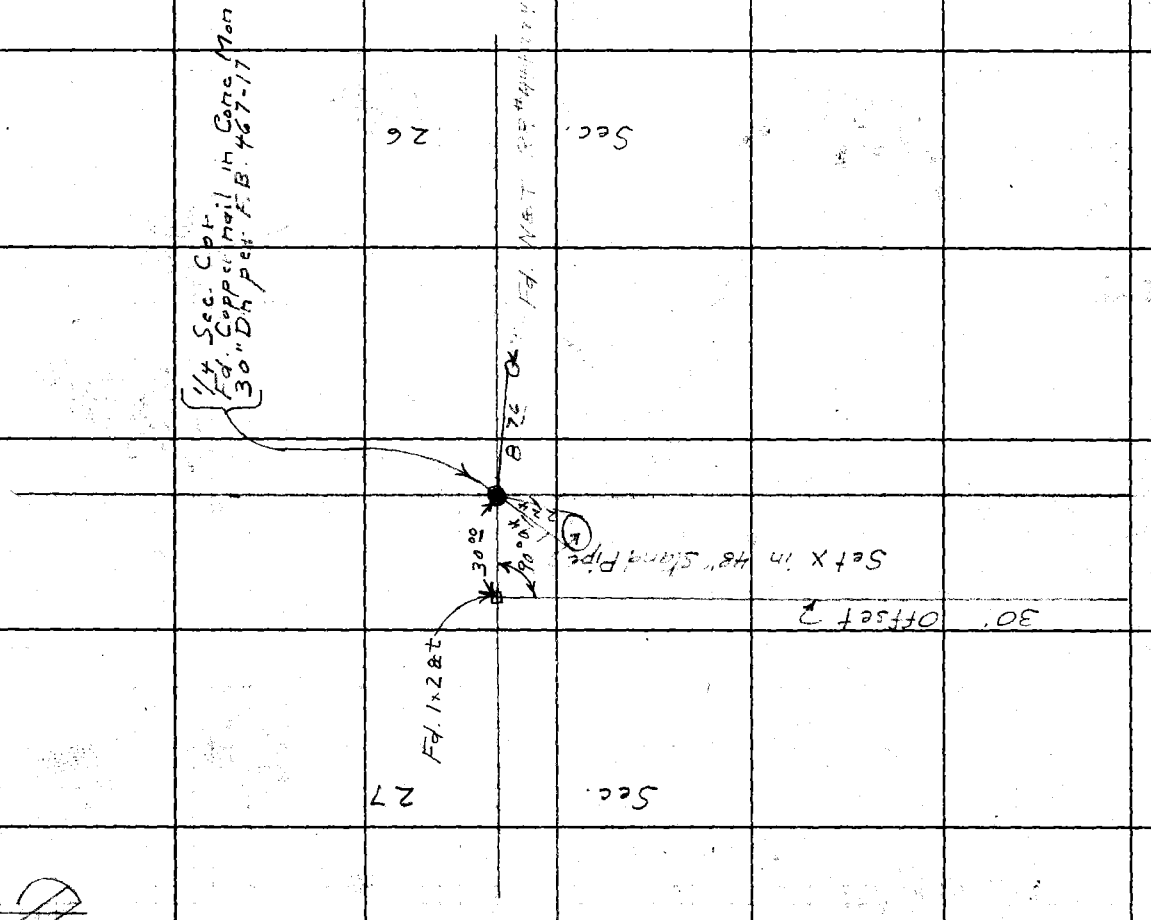

F.B. 862 Pg. 114

Notes Ck'd by KRM.	Survey of State St
Map No. B-1749.	W. O. 2316 Tape No. 21 St'd 24°F
Office Work McCallister & White	Surveyed by F. L. McNeal
Checked Mac Duncan	Notes Mc Date 9-22-41
Date June 1946	Indexed

F.B. 562 Pg. 115

31, B-4

From Bot. Pg. 115

P.I. Fd. R.D. Bronze Cap in Conc. 12" Dn Per F.A. 159-132

E.C. 56+76.54 Pg 148.

50 50

1363.62 @ 70° = 1363.50 ✓

119-59-15
119-57-00

89-57-30
359-57-30

162.18

Adopted P.I. - Set 3/4" I.P. See Pg. 148

ST. BLVD.

per F.B. 865-5

Set N&T T.P. # B-6587 Y

10' Offset

Set N&T F.P.

1320.70 - 800.00

60° 00' 00"

Fd. 3/4" I.P.

1363.50

119° 59' 15"

25' Hwy.

BELLFLOWER

11.56

33.29

60.04

Set Bt. Spk. by Int.

198.39

To Bot. Pg. 122

89-59-25"

10.00

Hdpc

1034 05.66 1/4 Sec. Cor Fd. 2x 2 a.t per F.B. 865-5

Set 1x2 a.t

39.97

Fd. Spk in Conc. Mon. 18" Dn Per F.B. 865-5

89° 59' 45"

55' Hwy.

(Proposed)

STATE

P.I. Fd. Rd. Dept Bronze Cap in Conc. Mon. 12" Dn Per F.B. 865-5

89-59-45
359-59-00

2640.27

For Improvements See F.B. 862-137

To Top Next Pg.

Note: Any Additions or Changes on This Sheet Must be Made or Circled in Red Ink With Date and Name of Person Making Change

Do not extend notes this side of this line.

RETURN TO
LOS ANGELES COUNTY SURVEYOR
700 HALL OF RECORDS

FORM 247 SM 10-39

RETURN TO
LOS ANGELES COUNTY SURVEYOR
700 HALL OF RECORDS

Note: Any Additions or Changes on This Sheet Must be Made or Circled in **Red Ink** With Date and Name of Person Making Change.

Do not extend notes this side of this line.

36 A 4

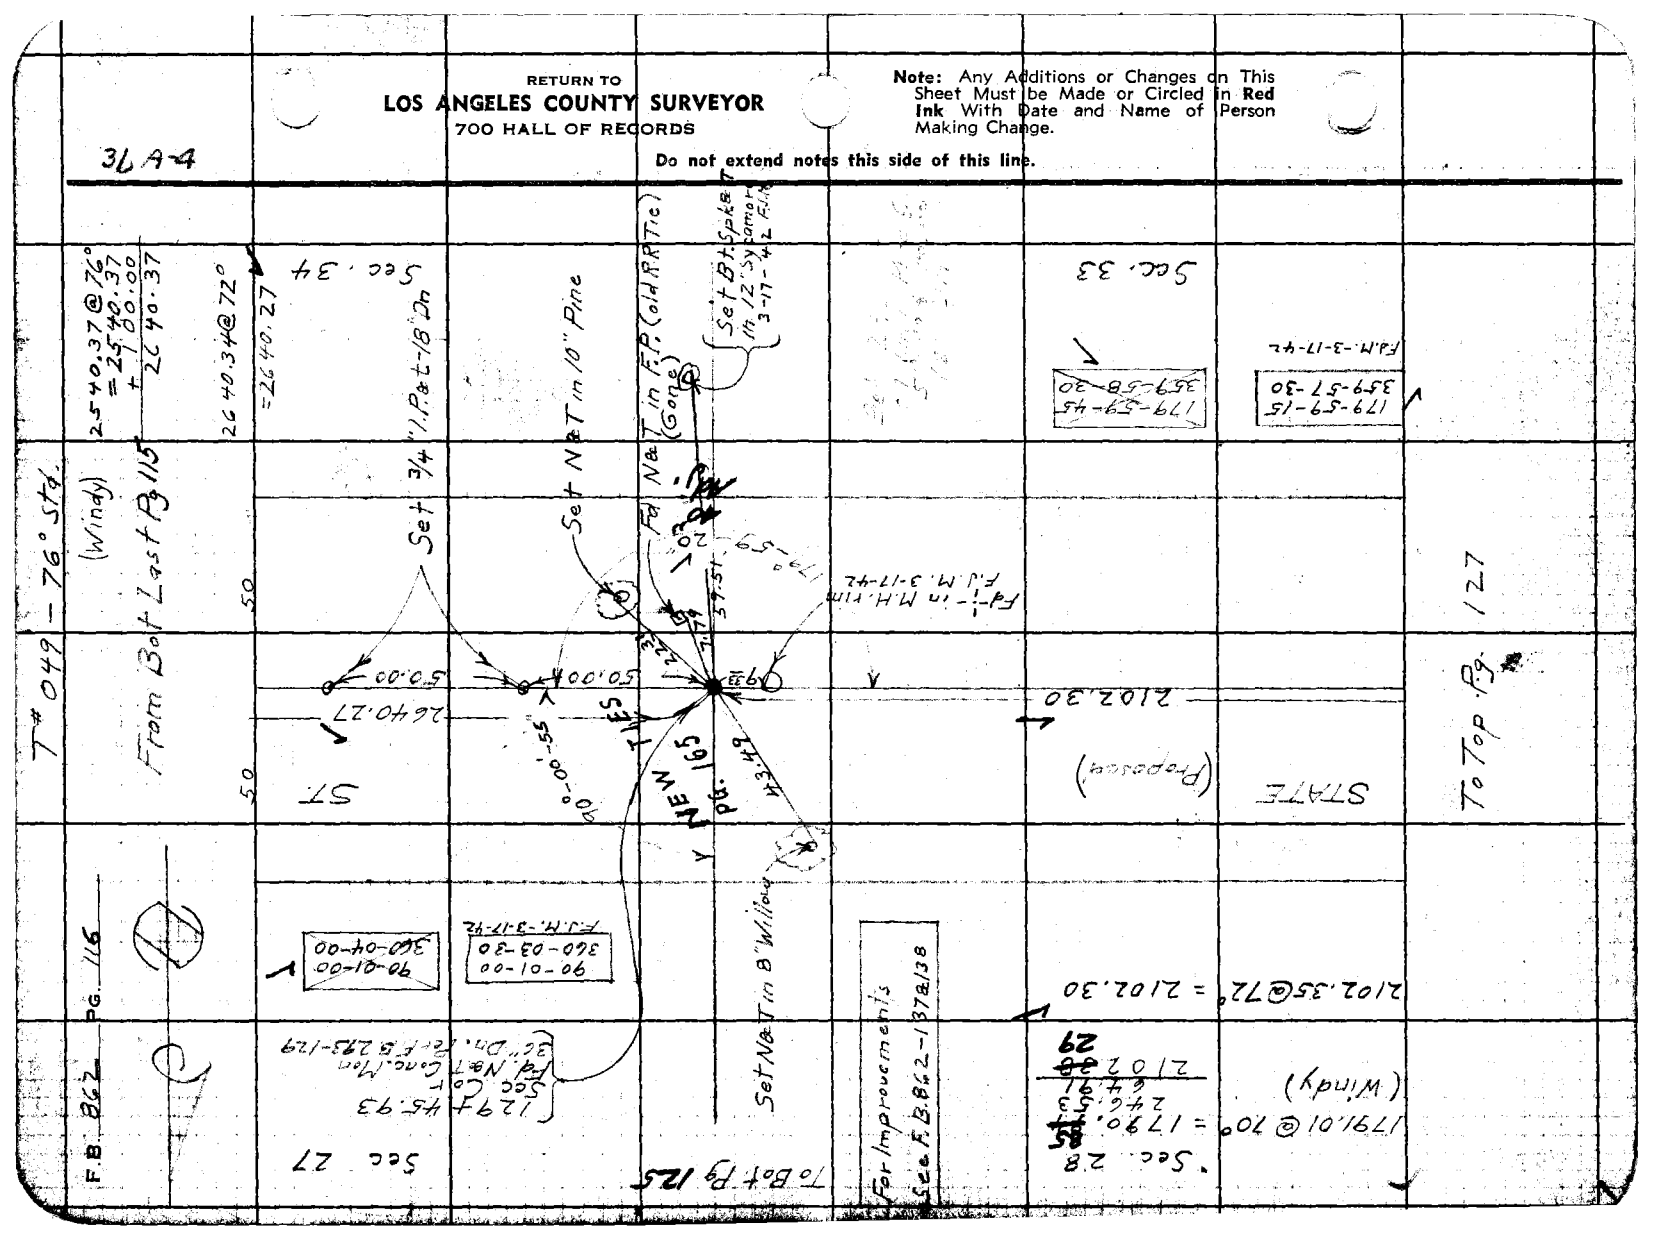

Notes Ck'd by KR.M.	Survey of Site Sr.	F.B. 867	Pg. 167
Map No. B-1249	W. O. 2310 Tape No. St'd °F		
Office Work [illegible] White	Surveyed by E.J. McNeal		
Checked [illegible]	Notes Mc Date 9-18-41		
Date June 1946	Indexed		

31, B-3

Note: Any Additions or Changes on This Sheet Must be Made or Circled in Red Ink With Date and Name of Person Making Change.

Do not extend notes this side of this line.

RETURN TO
LOS ANGELES COUNTY SURVEYOR
700 HALL OF RECORDS

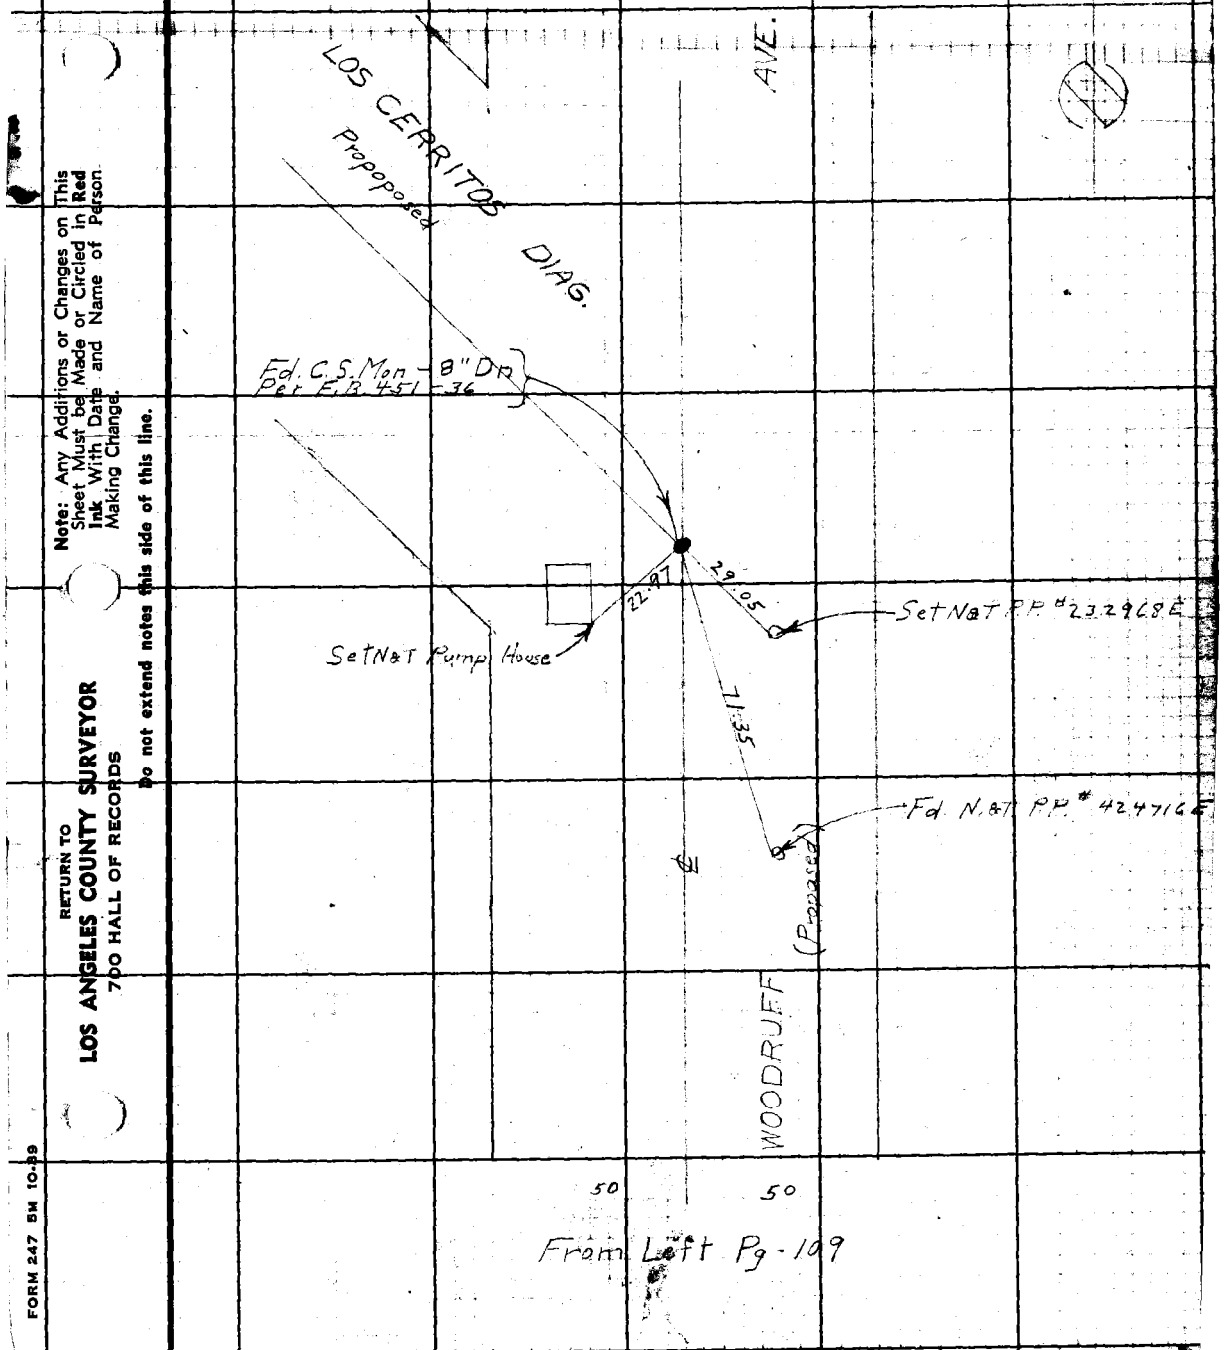

From Left Pg - 109

FORM 247 5M 10-39

RETURN TO
LOS ANGELES COUNTY SURVEYOR
700 HALL OF RECORDS

Note: Any Additions or Changes on This Sheet Must be Made or Circled in **Red Ink** With Date and Name of Person Making Change.

Do not extend notes this side of this line.

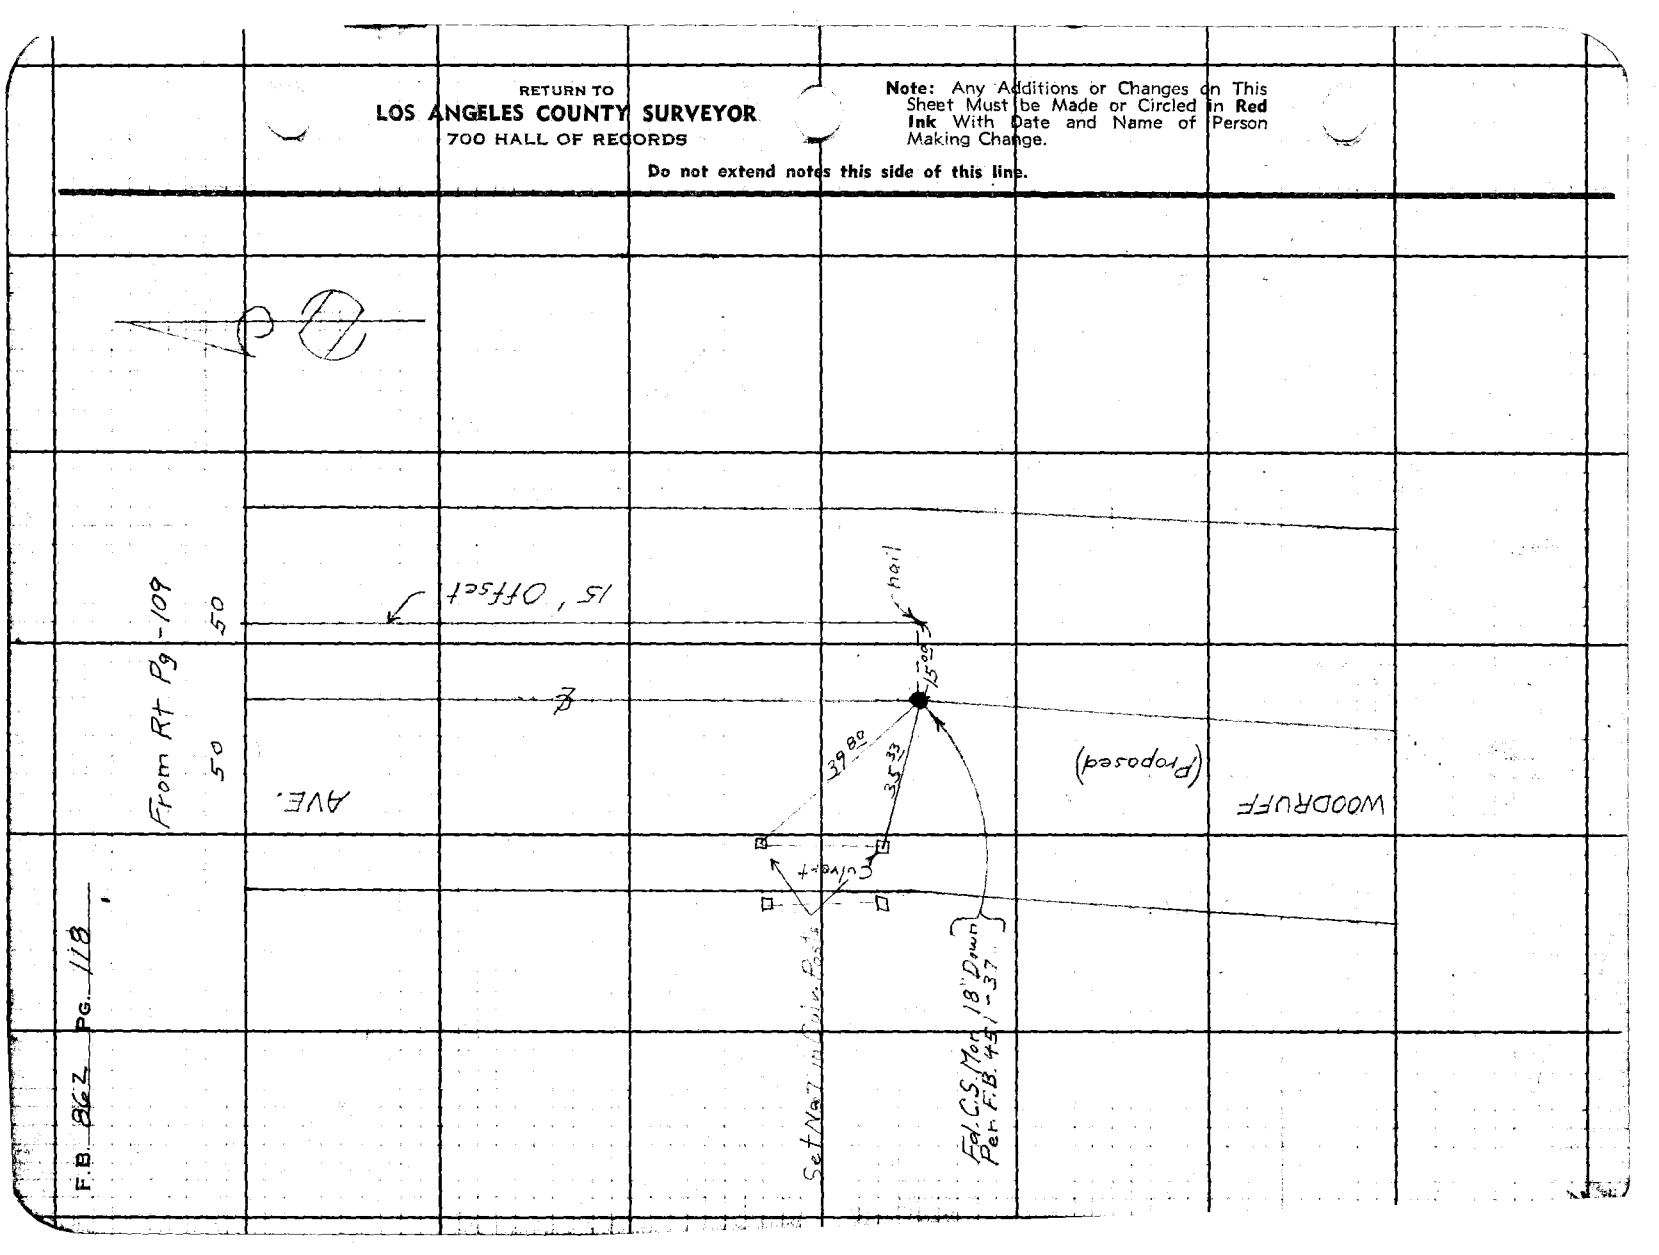

Notes Ck'd by KRM.	Survey of Slate St.
Map No. B-1749	W. O 8310 Tape No. Std. °F
Office Work McAllista White	Surveyed by F.V. McNeal
Checked McKinney	Notes Mc Date 9-18-41
Date June 1946	Indexed C.O. Johnson

F.B. 962 Pg. 119

31, B-4

Note: Any Additions or Changes on This Sheet Must be Made or Circled in Red Ink With Date and Name of Person Making Change

Do not extend notes this side of this line.

RETURN TO
LOS ANGELES COUNTY SURVEYOR
700 HALL OF RECORDS

FORM 247 5M 10-39

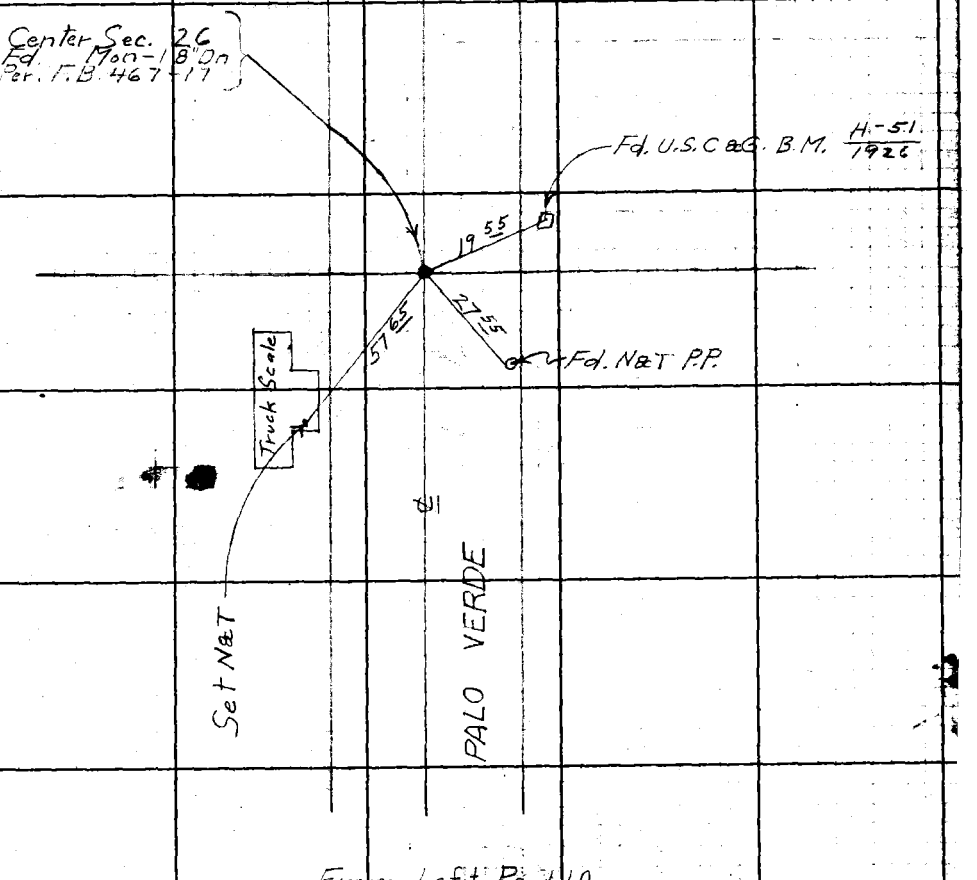

From Left Pg. 119

RETURN TO
LOS ANGELES COUNTY SURVEYOR
700 HALL OF RECORDS

Note: Any Additions or Changes on This Sheet Must be Made or Circled in **Red Ink** With Date and Name of Person Making Change.

Do not extend notes this side of this line.

31 B-4

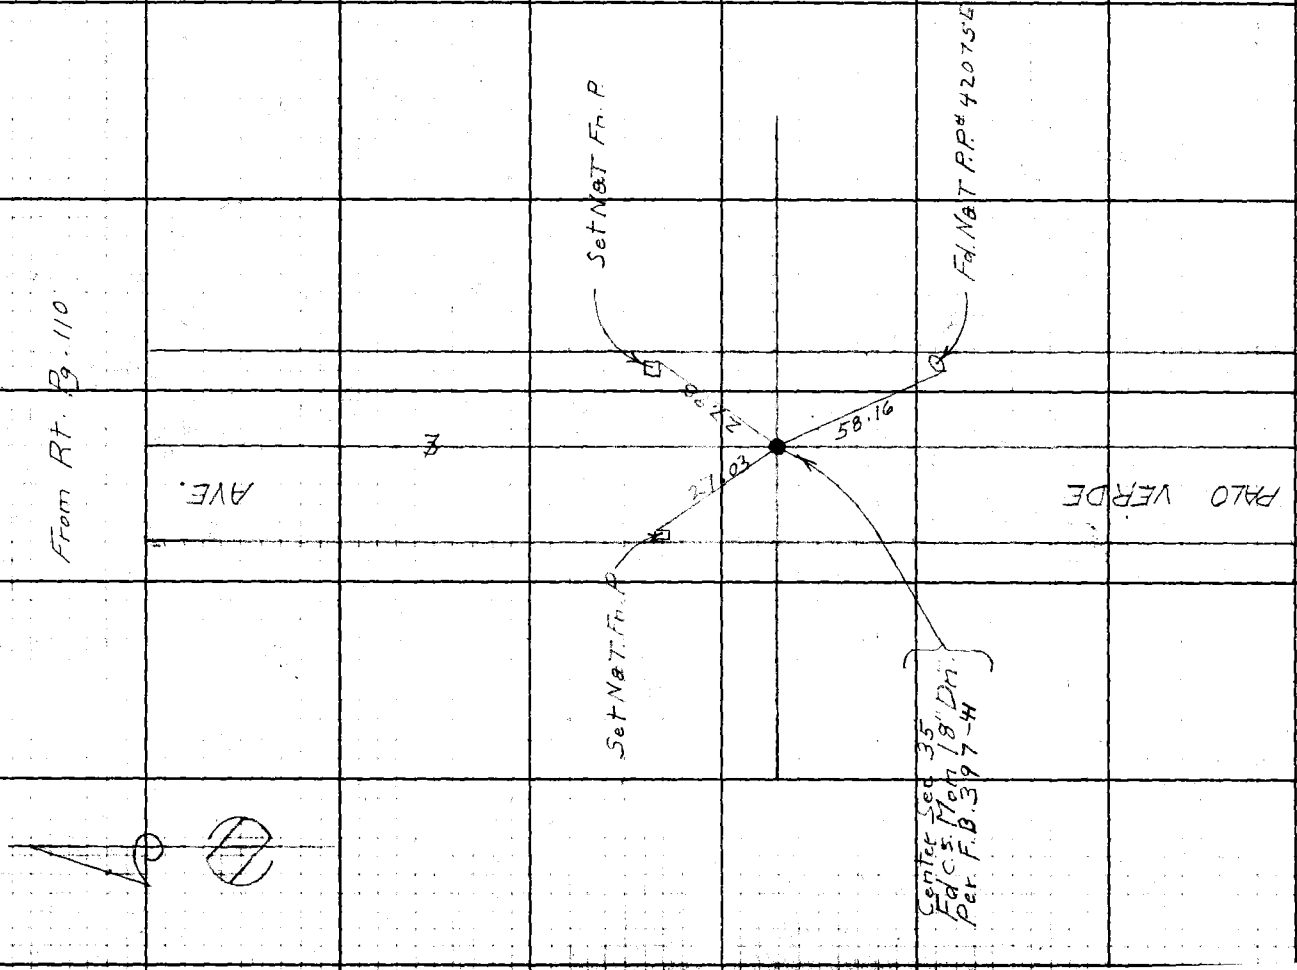

FORM 247 5M 10-39

RETURN TO
LOS ANGELES COUNTY SURVEYOR
700 HALL OF RECORDS

Note: Any Additions or Changes on This Sheet Must be Made or Circled in **Red Ink** With Date and Name of Person Making Change.

Do not extend notes this side of this line.

B1, B-4

Notes Ck'd by [illegible]
Map No. 23-1242
Office Work [illegible]
Checked [illegible]
Date [illegible]

Survey of State St.
W. O. B23 Tape No. 21 Std 84°F
Surveyed by [illegible] Date 9-23-41
Notes
Indexed

F.B. 862 Pg. 121

Sec 34

1/4 Sec Cor
Fd G.S. Mon - 12" Dm
Per R.S. 397-42

2641.18

From R.P. 13-112

Sec 35

1378.88 @ 0-0 T 78° = 1378.83
300.58 @ 0-0 T 78° = 300.57
61.09 @ 0-0 T 78° = 61.09
300.53 @ 2-23 T 78° = 300.26
300.68 @ 2-38 T 78° = 300.35
300.44 @ 2-45 T 78° = 300.28
2641.18

RETURN TO
LOS ANGELES COUNTY SURVEYOR
700 HALL OF RECORDS

Note: Any Additions or Changes on This Sheet Must be Made or Circled in **Red Ink** With Date and Name of Person Making Change.

31, B-4

Do not extend notes this side of this line.

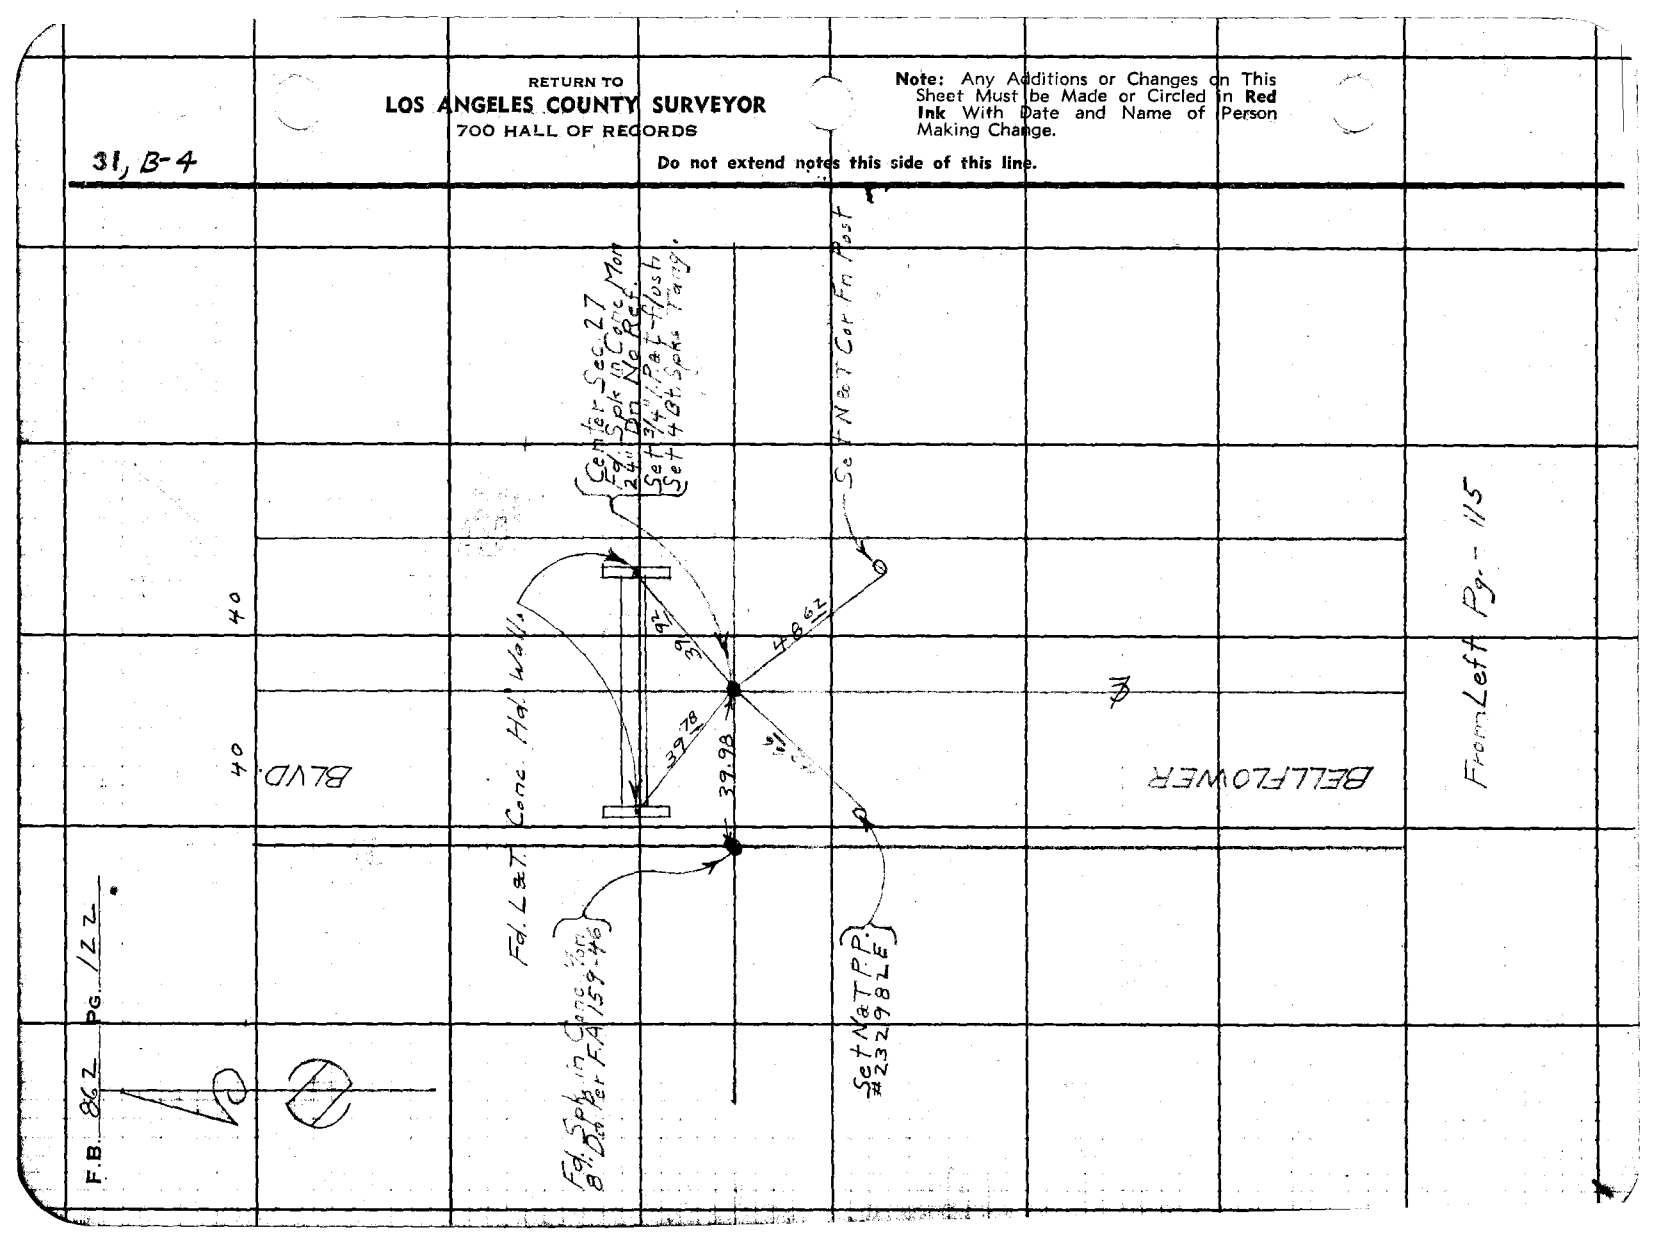

Notes Ck'd by KRM	Survey of State St.
Map No. B-1949	W. O. 8310 Tape No. 21 Std 84°F
Office Work McArthur White	Surveyed by F.J. McNeal
Checked [illegible]	Notes Mc Date 9-25-41
Date June 1946	Indexed [illegible]

F.B. 864 Pg. 123

Note: Any Additions or Changes on This Sheet Must be Made or Circled in Red Ink With Date and Name of Person Making Change.

Do not extend notes this side of this line.

RETURN TO
LOS ANGELES COUNTY SURVEYOR
700 HALL OF RECORDS

FORM 247 BM 10-39

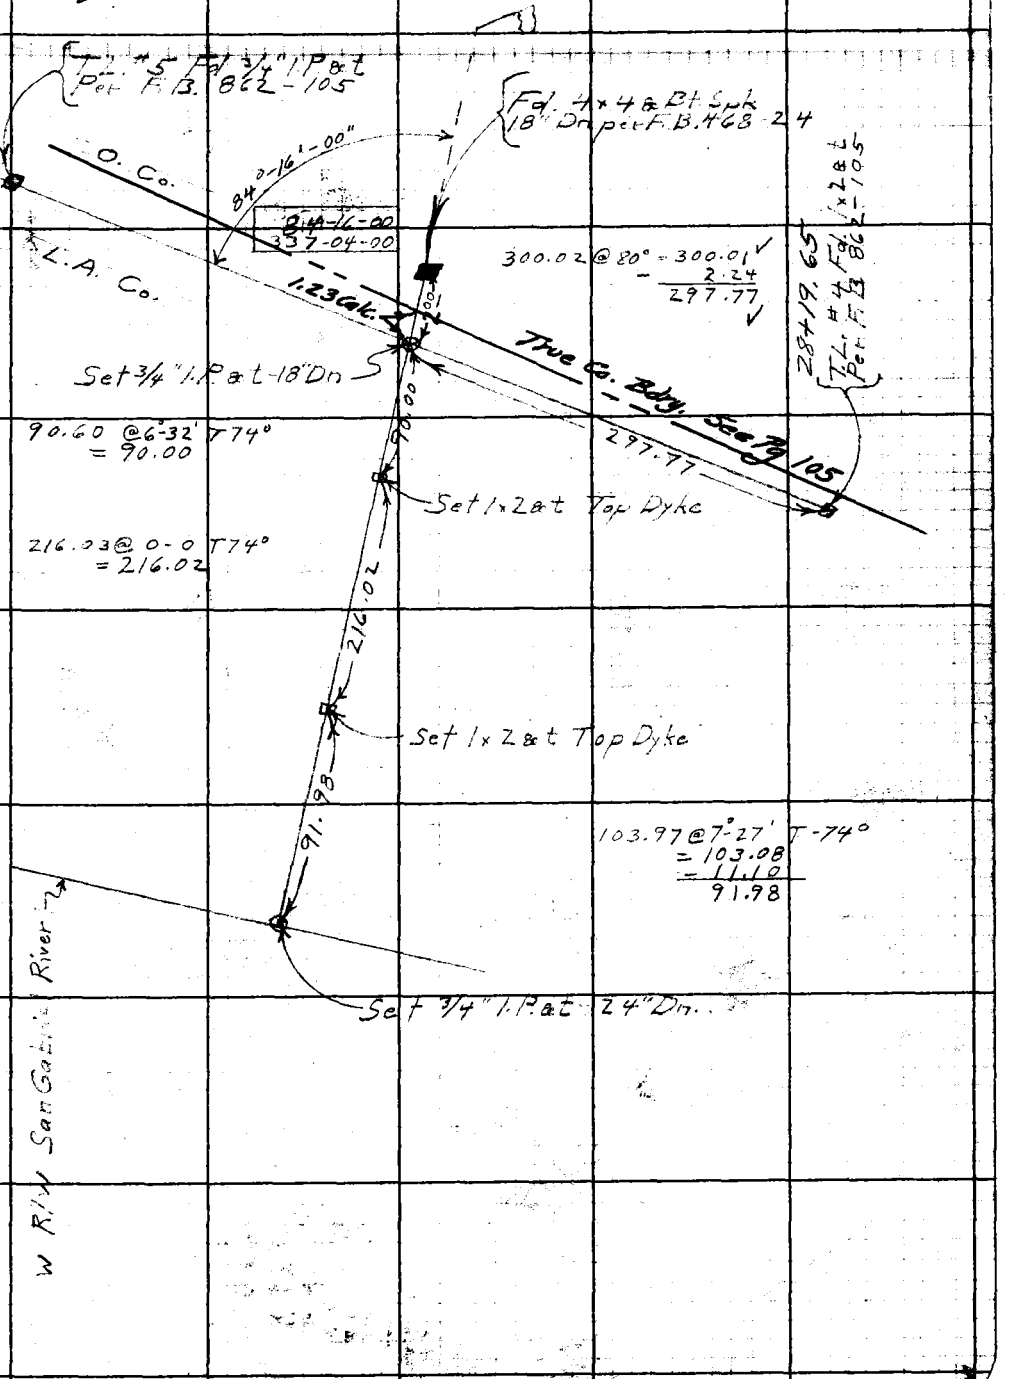

F.B. 862 PG. 124

T# 21 Std @ 84°

Fd Brass Cap Mon 3' Dn See F.B. 468-24

400

384.29@0-0 T82° = 384.28

0.03

For Improvements See F.B. 862-132

RIVER

68-01-45 272-07-30

East R/W

384.28

201.62@0-0 T82° = 201.62

2+01.62 Set 3/4" I.P. & T. 18" Dn. by Inter.

(Proposed)

50

201.62

2+99.9± Fd. 3/4" I.P. & T. See F.B. 862-108

STATE ST.

50

Fd. 2x2 & T-4" Dn Per F.B. 468-24

0.03

Fd 4x4 & Bt. Spk - 1/4" Dn Per F.B. 468-24

0.02

SAN GABRIEL

A.C.

O. Co.

Fd 2x2 & 2 tacks F lps b 1-t on line 1-t 0.04 W See F.B. 468-24

0+08 Fd Cu. nail in Conc. 12" On Per F.B. 862-105 & 108

Fd 4x4 & Bt. Spk - 18" Dn See F.B. 862-123

True Co. Bdry. See Pg. 105

3 C-4

RETURN TO LOS ANGELES COUNTY SURVEYOR 700 HALL OF RECORDS

Do not extend notes this side of this line.

Note: Any Additions or Changes on This Sheet Must be Made or Circled in Red Ink With Date and Name of Person Making Change.

Notes Ck'd by KRM.	Survey of State St	F.B. 862	PG. 125
Map No. B-1749	W. O. 8310 Tape No.	Std.	°F
Office Work CWhite	Surveyed by E.J. McNeal		
Checked [illegible]	Notes Mc Date 10-2-41		
Date June 1946	Indexed		

31, A-4

Note: Any Additions or Changes on This Sheet Must be Made or Circled in Red Ink With Date and Name of Person Making Change.

Do not extend notes this side of this line.

RETURN TO
LOS ANGELES COUNTY SURVEYOR
700 HALL OF RECORDS

FORM 247 5M 10-39

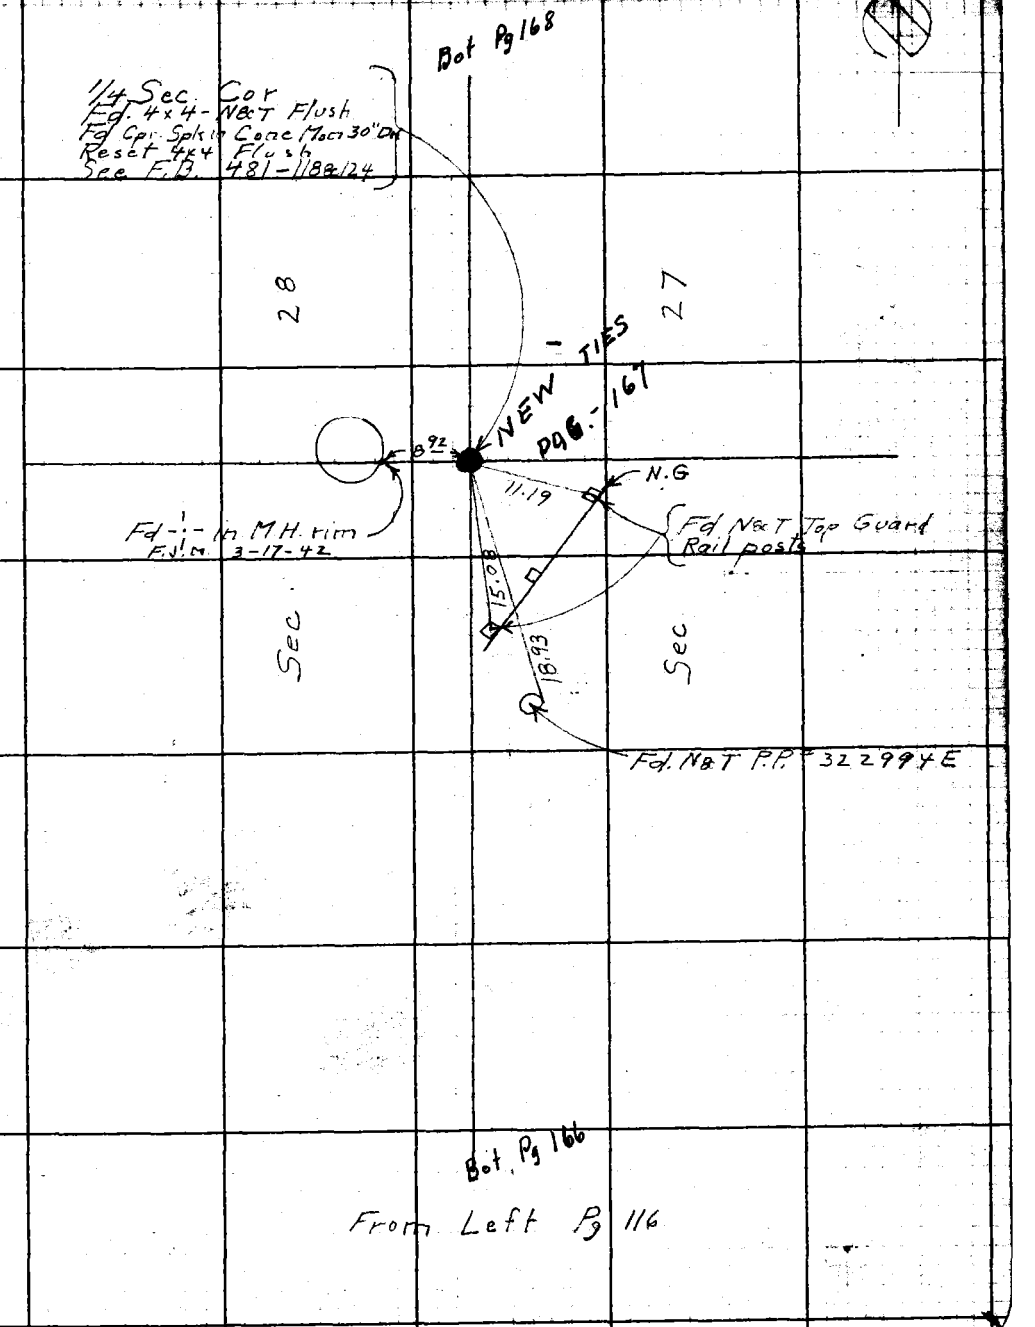

RETURN TO
LOS ANGELES COUNTY SURVEYOR
700 HALL OF RECORDS

Note: Any Additions or Changes on This Sheet Must be Made or Circled in **Red Ink** With Date and Name of Person Making Change.

Do not extend notes this side of this line.

Sec 34

F.B. 862 PG. 126

FORM 247 5M 10-39

RETURN TO
LOS ANGELES COUNTY SURVEYOR
700 HALL OF RECORDS

Note: Any Additions or Changes on This Sheet Must be Made or Circled in **Red Ink** With Date and Name of Person Making Change.

Do not extend notes this side of this line.

31/A-4

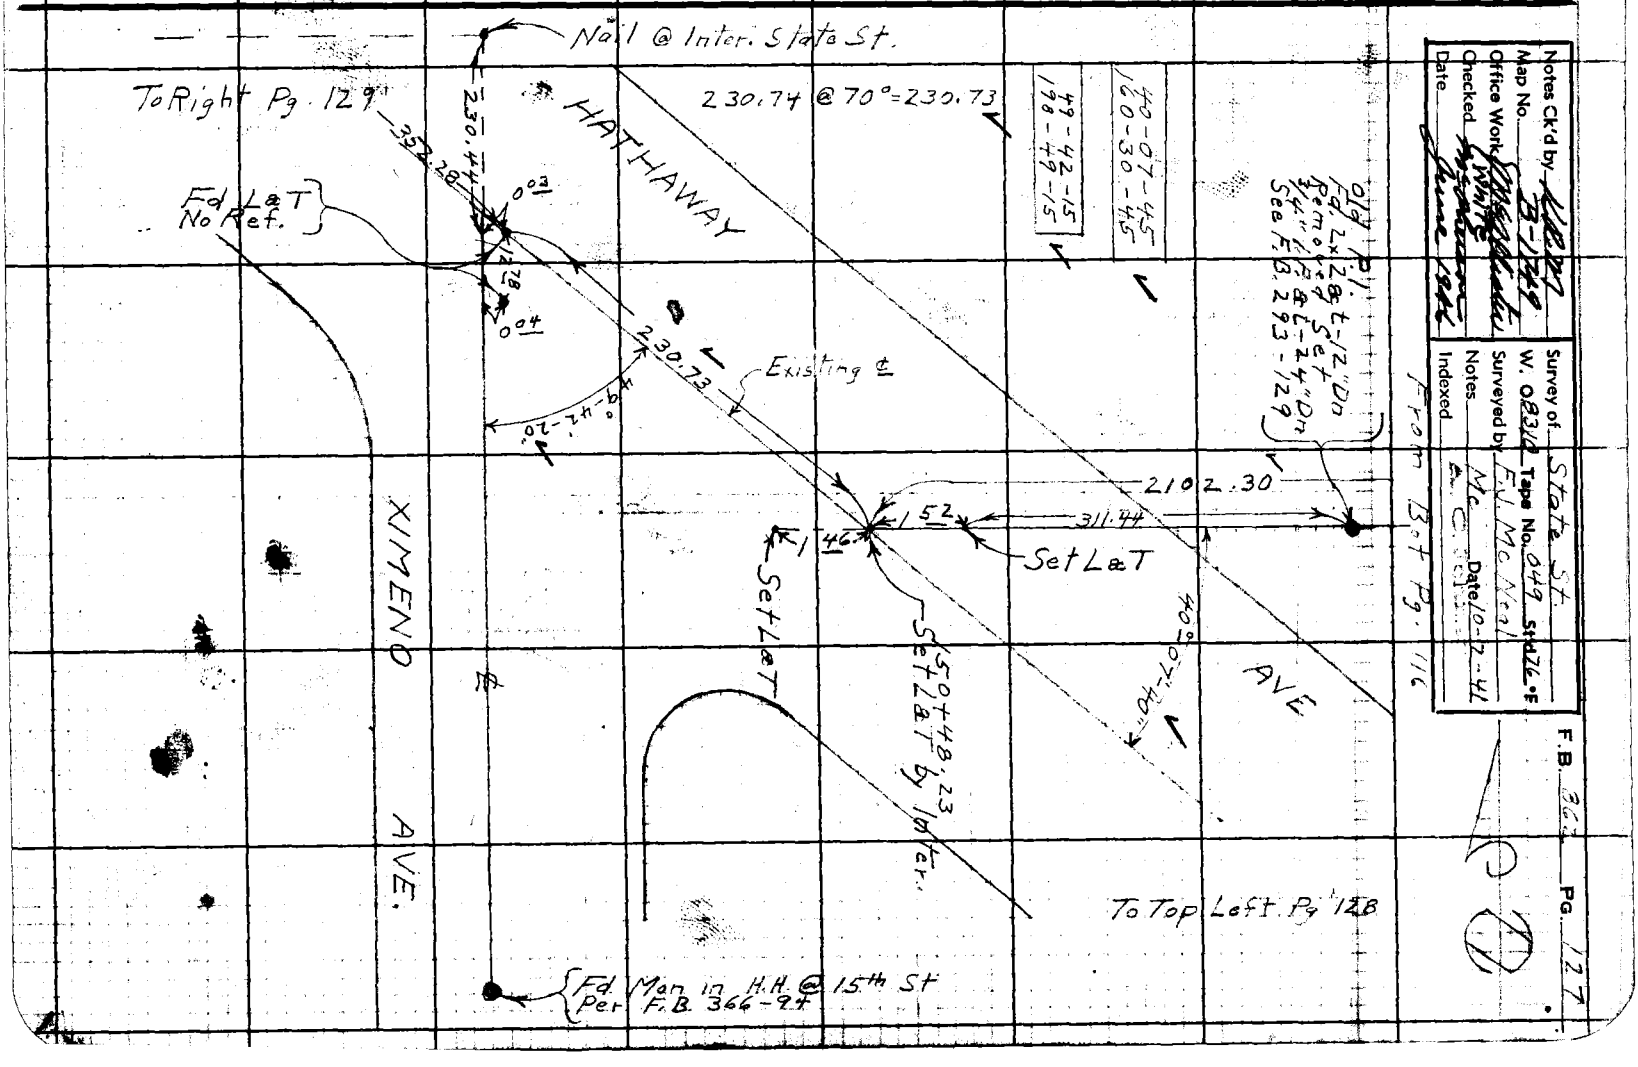

Notes Ck'd by [illegible] 3-1942
Map No. [illegible]
Office Work [illegible]
Checked [illegible]
Date [illegible] 1942

Survey of State St.
Surveyed by F.J. Mc Neal
Notes [illegible] Date 10-12-41
Indexed [illegible]


RETURN TO
LOS ANGELES COUNTY SURVEYOR
700 HALL OF RECORDS

Note: Any Additions or Changes on This Sheet Must be Made or Circled in **Red Ink** With Date and Name of Person Making Change.

Do not extend notes this side of this line.

31, A-4

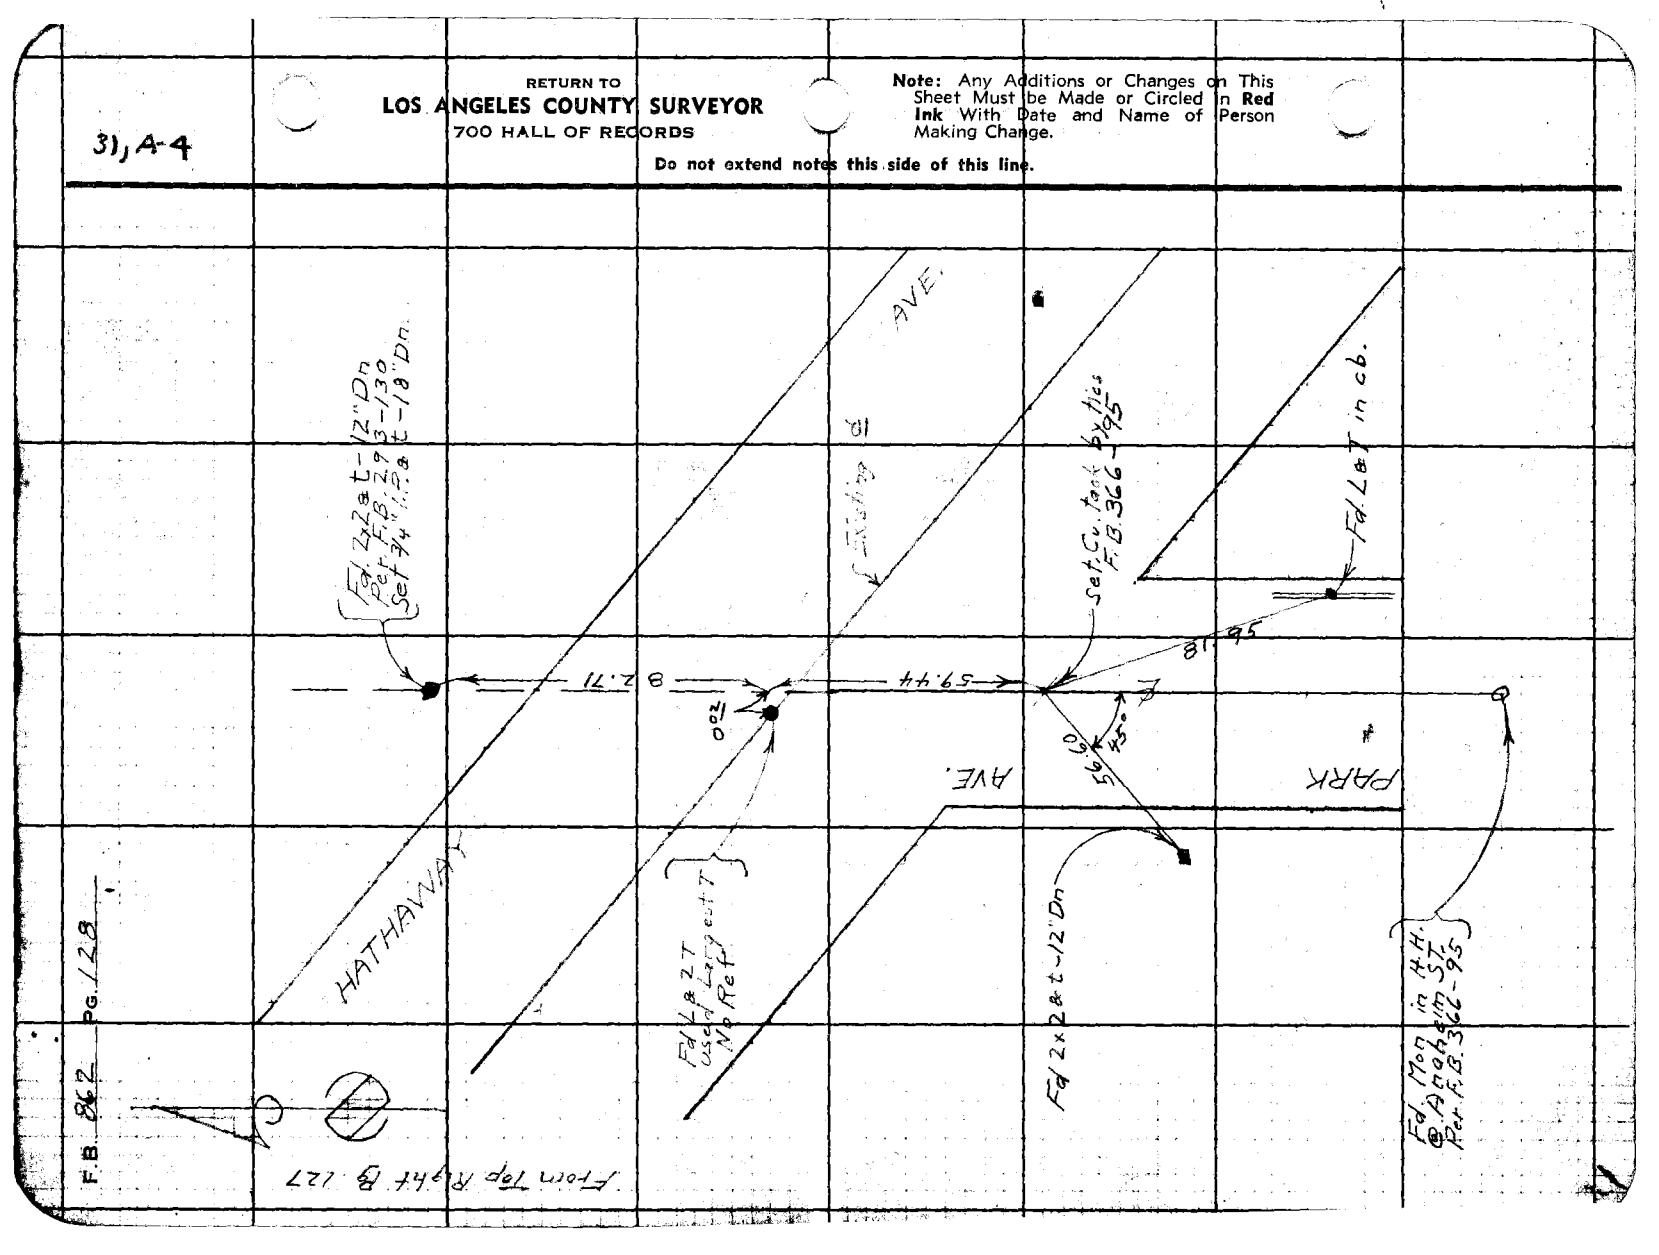

F.B. 862 PG. 128

FORM 247 5M 10-39

RETURN TO
LOS ANGELES COUNTY SURVEYOR
700 HALL OF RECORDS

Note: Any Additions or Changes on This Sheet Must be Made or Circled In **Red** Ink With Date and Name of Person Making Change.

Do not extend notes this side of this line.

31, A-4

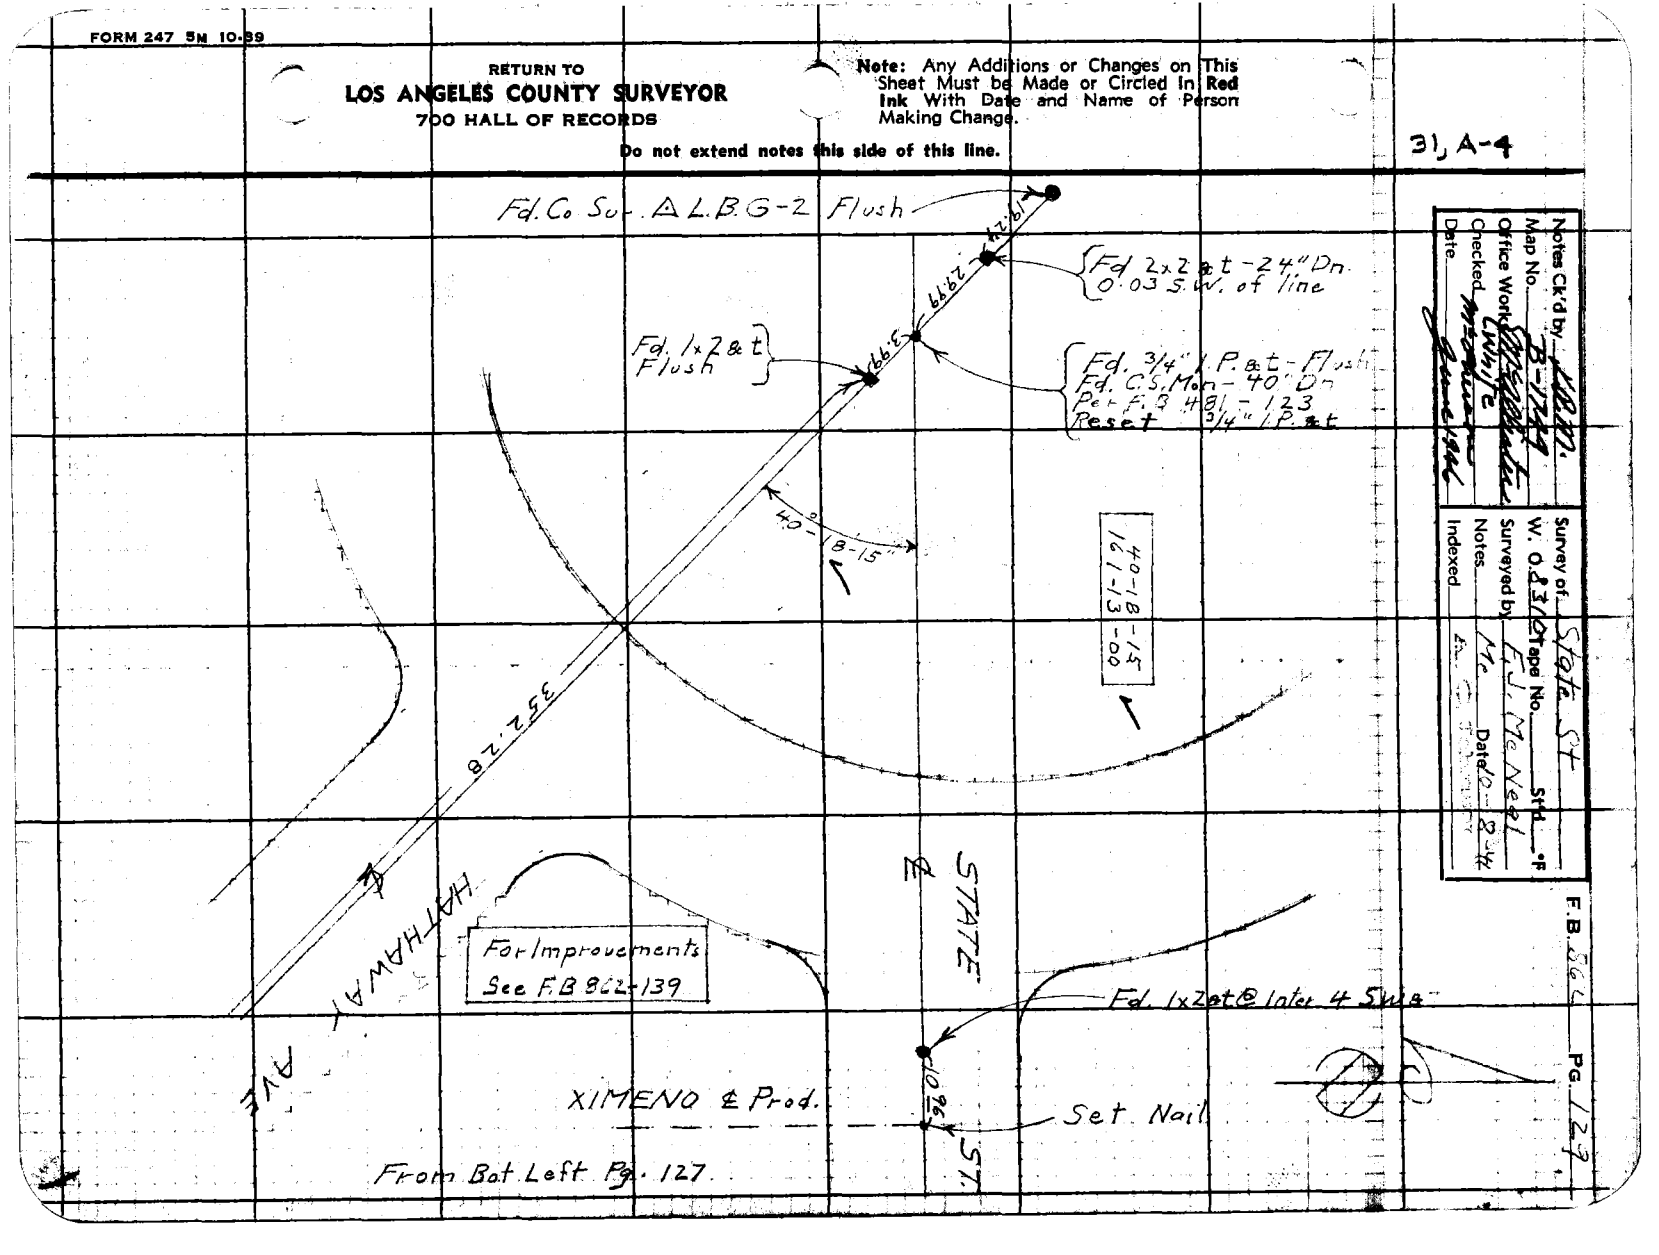

Notes Ck'd by
Map No.
Office Work
Checked
Date

Survey of State St
Surveyed by F.J. McNeal
Notes Date 12-8-44
Indexed


RETURN TO
LOS ANGELES COUNTY SURVEYOR
700 HALL OF RECORDS

Note: Any Additions or Changes on This Sheet Must be Made or Circled in **Red Ink** With Date and Name of Person Making Change.

Do not extend notes this side of this line.

F.B. 842 Pg. 130

Notes Ck'd by K.W.M.	Survey of State St.
Map No. 3-1249	W. O. 8310 Tape No. Std °F
Office Work Smc Wayne Lvm/jc	Surveyed by F.J. McNeal
Checked mcpherson	Notes Nichols Date 9-19-41
Date June 1946	Indexed A.C. Jonnes 10-22-41

F.B. 862 PG. 131

STATE ST.

J.N.- 8310

FROM COUNTY LINE

TO LAKEWOOD BLVD.

F.J. McNeal
Geo. H. Nichols
A. Carrasco
J.L. Willey
T.I. O'Brien

Note: Any Additions or Changes on This Sheet Must be Made or Circled in Red Ink With Date and Name of Person Making Change.

Do not extend notes this side of this line.

RETURN TO
LOS ANGELES COUNTY SURVEYOR
700 HALL OF RECORDS

FORM 247 5M 10-59

RETURN TO
LOS ANGELES COUNTY SURVEYOR
700 HALL OF RECORDS

Note: Any Additions or Changes on This Sheet Must be Made or Circled in **Red Ink** With Date and Name of Person Making Change.

Do not extend notes this side of this line.

31, C-4

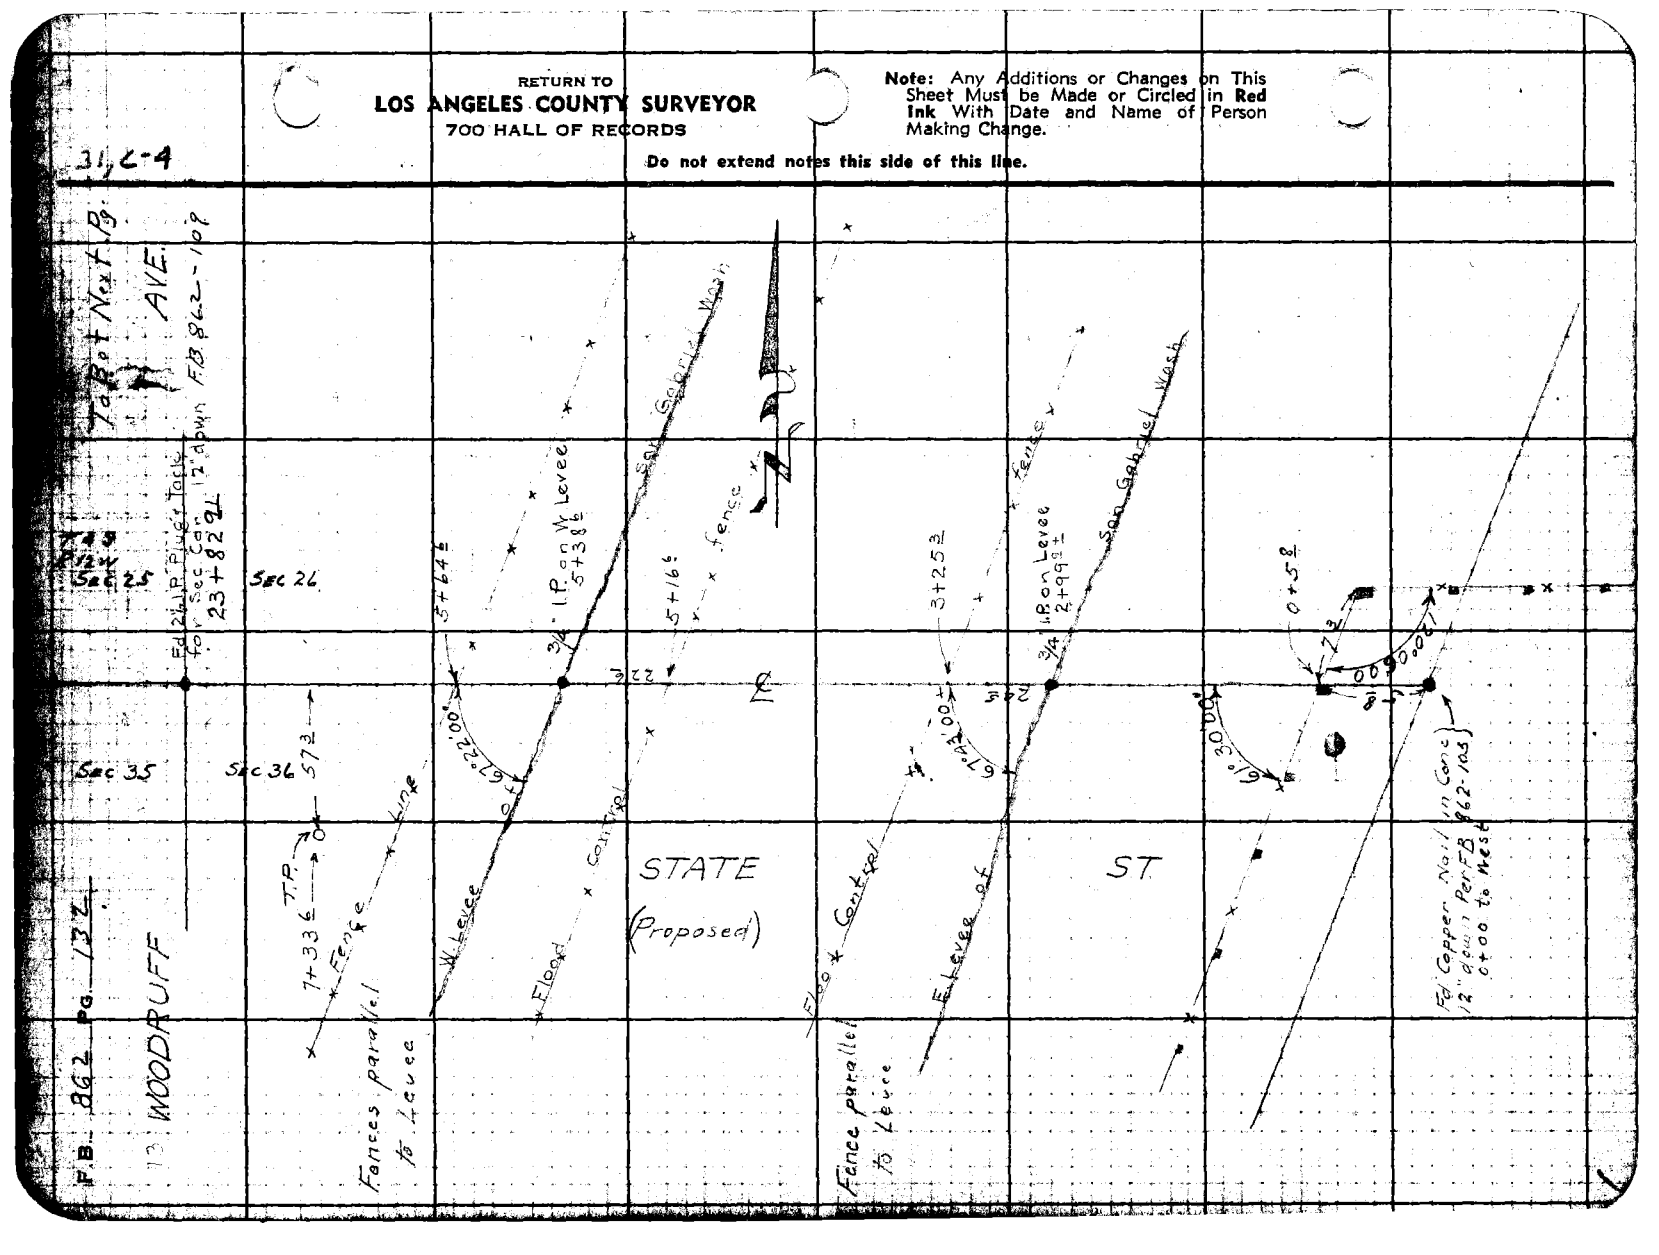

Notes Ck'd by	Survey of State St.
Map No. 13-1727	W. O. 5010 Tape No. St'd °F
Office Work	Surveyed by F.J. McKeag
Checked M.S.H.	Notes Nichols Date 9-19-41
Date June 1946	Indexed

F.B. 862 PG. 132

To bot Next Pg

Note: Any Additions or Changes on This Sheet Must be Made or Circled in Red Ink With Date and Name of Person Making Change

Do not extend notes this side of this line.

RETURN TO
LOS ANGELES COUNTY SURVEYOR
700 HALL OF RECORDS

FORM 247 5M 10-39

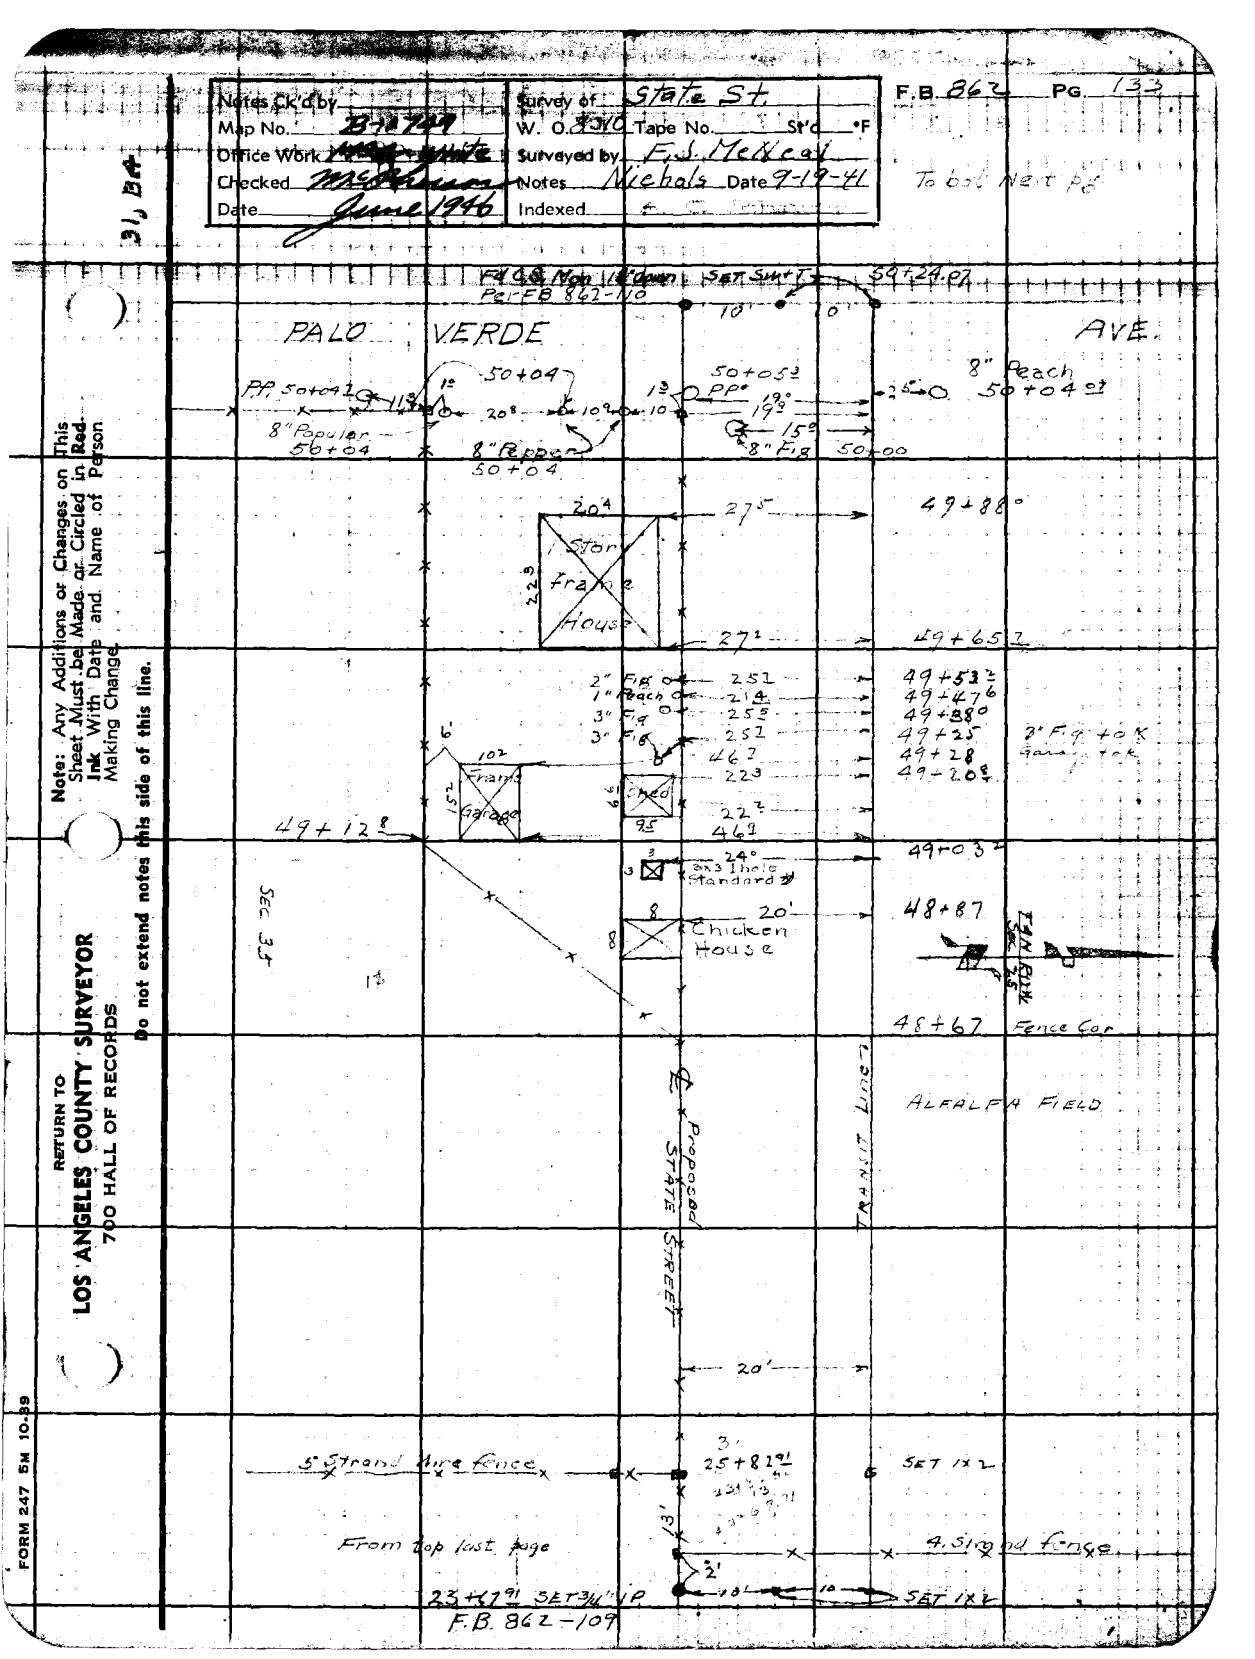

F.B. 862 Pg. 134

To Bot. Next Pg.

31 B-4

T 4 N R 12 W Sec 25

PP# 4208 2E

RETURN TO
LOS ANGELES COUNTY SURVEYOR
700 HALL OF RECORDS

Do not extend notes this side of this line.

Note: Any Additions or Changes on This Sheet Must be Made or Circled in Red Ink With Date and Name of Person Making Change.

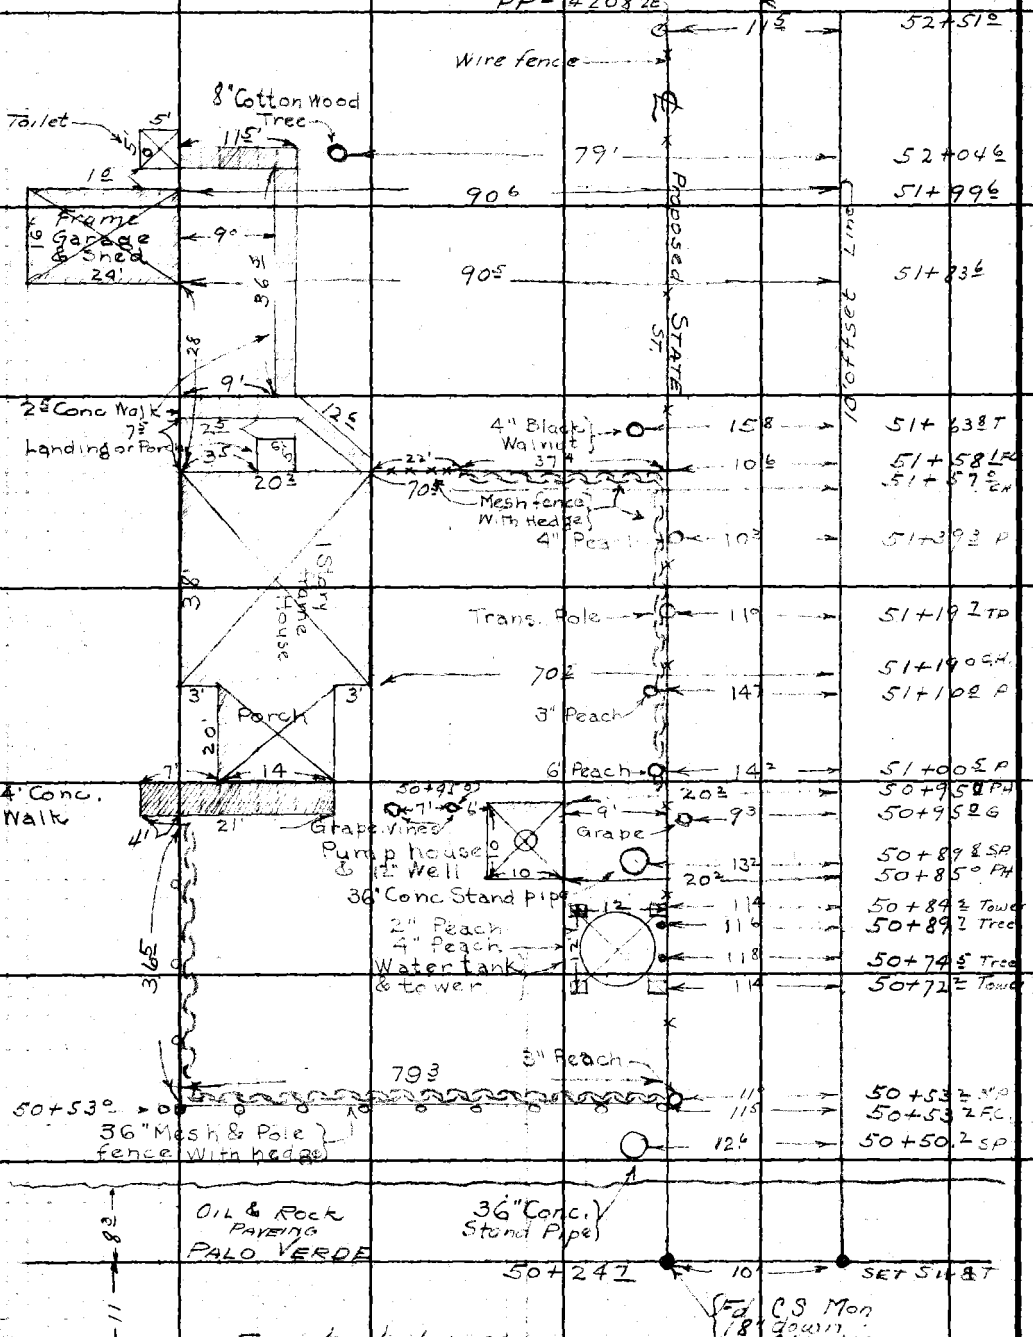

Notes Ck'd by		Survey of State St	F.B. 862 Pg. 135
Map No. B-1249		W. O. 2310 Tape No. St'd °F	
Office Work MEA-WHITE		Surveyed by E. M. Neal	
Checked McPherson		Notes Nichols Date 10-1-41	
Date June 1946		Indexed	

31 B-4

To B.t Next Pg.

1.0 PP# 90E 76+53 ℄

PP. New 73+57 ℄

PROPOSED

PP# 088E 70+52 ℄

36" Conc. Stand pipe 70+05 ±

STATE

PP# 087E 67+52 ±

PP# 086E 64+52 ±

Gate post 63+45 ±

1 1/2" IP 63+44.38 F.B. 862-111

12" Casing 63+39 ±

36" Conc. Stand pipe 63+27 ±

STREET

PP# 085E 61+52 ±

PP# 084E 58+52 ±

PP# 42083E 55+52

From Top Last Pg. 134

PP 42082E 52+51

SEC 26 T4N R13W

SEC 25

Note: Any Additions or Changes on This Sheet Must be Made or Circled in Red Ink With Date and Name of Person Making Change.

Do not extend notes this side of this line.

RETURN TO
LOS ANGELES COUNTY SURVEYOR
700 HALL OF RECORDS

FORM 247 5M 10-39

F.B. 862 PG. 136

31,B-4

RETURN TO
LOS ANGELES COUNTY SURVEYOR
700 HALL OF RECORDS

Do not extend notes this side of this line.

Note: Any Additions or Changes on This Sheet Must be Made or Circled in Red Ink With Date and Name of Person Making Change.

Fd 2x2 — 103+05.6 — F.B. 862-115

Power line turns S. Here — P.P. — 97+56

549.6

301

PP# 096E — 94+55

297.6

PROPOSED

PP# 420952E — 91+57.4

PP — 48L — 80 — 171.8

PP#324450E

Fence 11.7E — 14.2 — 3/4" I.P. End of fence 0.7W — 89+84.96 F.B. 862-113

STATE

PP# — 88+28

Fence — 86+62

SEC 27

T4N R12W SEC 34

STREET

107.8

PP # 093E — 85+54.3

36" Conc S.P. — 83+26.5

14" Valve — 83+22

678.2

PP. 420926E — 82+54.4

300.3

PP# 091E — 79+54

289.6

From Top Last Pg. 137

36" Conc Stand Pipe — 3/4" I.P. Sec Cor — 76+64.48 — F.B. 862-112

Notes Ck'd by		Survey of State St.	F.B. 862 PG. 137
Map No. B-1749		W. O. 8310 Tape No. St'd °F	
Office Work MSA-White		Surveyed by F.J. McNeal	
Checked McPherson		Notes MC Date 10-7-41	
Date June 1946		Indexed	

31, B-4

Note: Any Additions or Changes on This Sheet Must be Made or Circled in Red Ink With Date and Name of Person Making Change

Do not extend notes this side of this line.

RETURN TO
LOS ANGELES COUNTY SURVEYOR
700 HALL OF RECORDS

FORM 247 5M 10-39

76+64.48
2x4
Per F.B. 862-112

14 Strand Wire Fence

ST.

62°-35'

100+14

BLVD.

T.P.

1°
60'

63°-30'

100+43.3±

115°

15'±
Oil & Rock

BELLFLOWER

75'±

100+75.8±

100+67.27
SW
Per F.B. 862-115

117°-25'

65°-25'

103+05.66=
See Pg 115

2x2

77.8±

127+61.9±
9" Sycamore

64°

127+91.3±
12" Sycamore

Proposed ℄

66.2±

128+29.8±
7" Cypress

STATE

78°

128+45.6±
14" Pine

To Top Next Pg.

F.B. 862 Pg. 138

31, A-4

From Bot. Last Pg 137

129+11 2
51 5
12" Acacia

Sec Cor 129+45.93
Mon. See F.B. 862-116

129+26 2
56 9
12" Sycamore

129+27 7
12 2
10" Pine

ST

10°
S.S. M.H.

10°
15" Sewer - 12' Down

131 6 50'

18" Sewer - 12' Down

This Sewer laid while we were present

129+74 3
2-10" Willows
31 7

129+73 9

Drainage
24' Wide

Ditch
4' Deep

STATE

Proposed ℄

150+48.23
Left @ Inter of Hathaway
See F.B. 862-127

RETURN TO
LOS ANGELES COUNTY SURVEYOR
700 HALL OF RECORDS

Do not extend notes this side of this line.

Note: Any Additions or Changes on This Sheet Must be Made or Circled in Red Ink With Date and Name of Person Making Change.

Notes Ck'd by	Survey of State St
Map No. B-1742	W. O. 3310 Tape No. Std. °F
Office Work MSA-White	Surveyed by E J McNeal
Checked McPherson	Notes Mc Date 10-6-41
Date June 1944	Indexed A C Johnson

F.B. 562 PG. 139

31, A-4

Note: Any Additions or Changes on This Sheet Must be Made in Red Ink or Circled in Red With Date and Name of Person Making Change

Do not extend notes this side of this line.

RETURN TO
LOS ANGELES COUNTY SURVEYOR
700 HALL OF RECORDS

FORM 247 SM 10-39

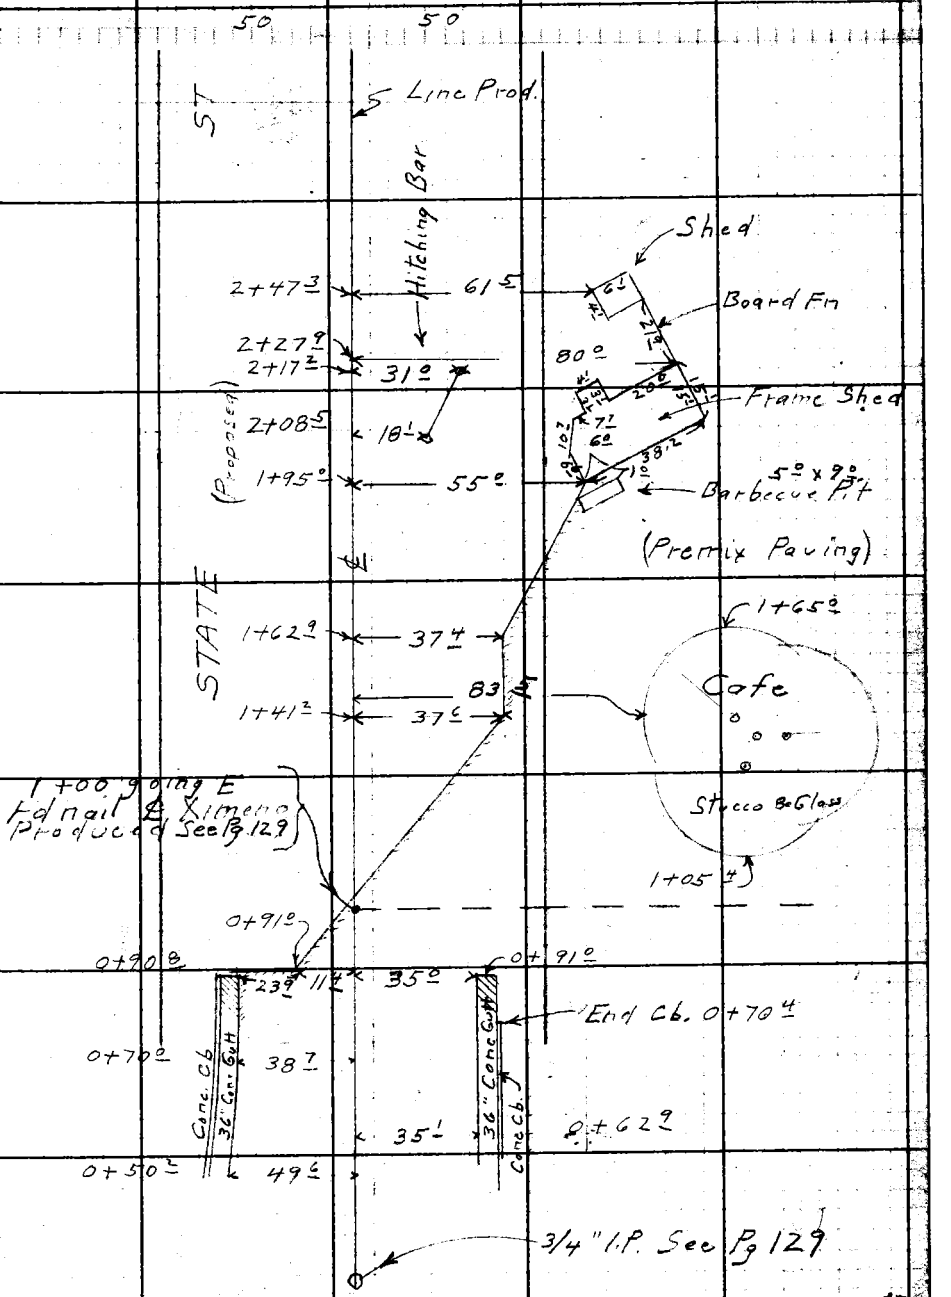

RETURN TO
LOS ANGELES COUNTY SURVEYOR
700 HALL OF RECORDS

Note: Any Additions or Changes on This Sheet Must be Made or Circled in **Red Ink** With Date and Name of Person Making Change.

Do not extend notes this side of this line.

F.B. 862 PG. 140

FORM 247 SN 11-41

RETURN TO
LOS ANGELES COUNTY SURVEYOR
700 HALL OF RECORDS

Note: Any Additions or Changes on This Sheet Must be Made or Circled in Red Ink With Date and Name of Person Making Change.

Do not extend notes this side of this line.

31, A-4

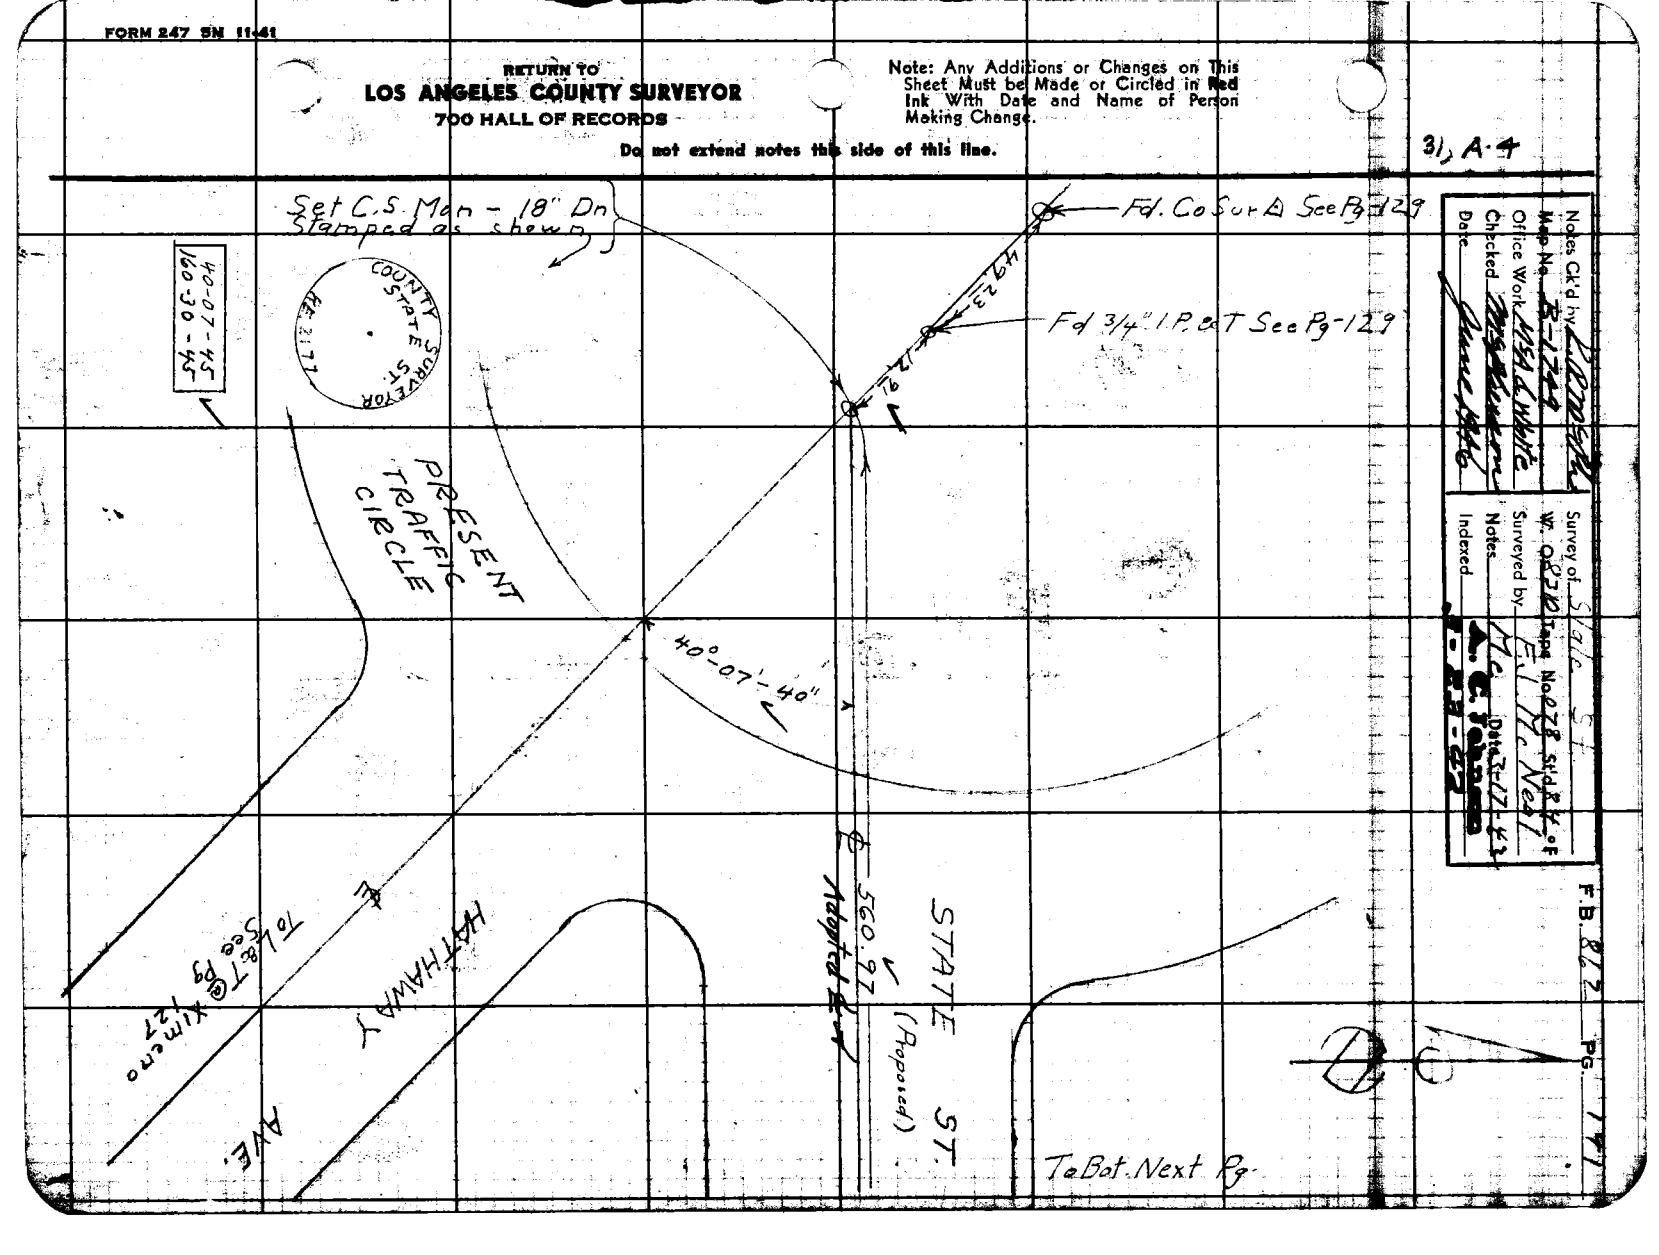

Notes Ck'd by [illegible]
Map No. B-1744
Office Work [illegible]
Checked [illegible]
Date [illegible]

Survey of State St
W. O. 2210 Tape No 28 Std. 24 F
Surveyed by E. M. & C. Nest
Notes
Indexed
Date 7-17-42
A. C. Johnson
R.E. 2177

F.B. 842 Pg. 171

RETURN TO
LOS ANGELES COUNTY SURVEYOR
700 HALL OF RECORDS

Note: Any Additions or Changes on This Sheet Must be Made or Circled in Red Ink With Date and Name of Person Making Change.

Do not extend notes this side of this line.

31 A-4

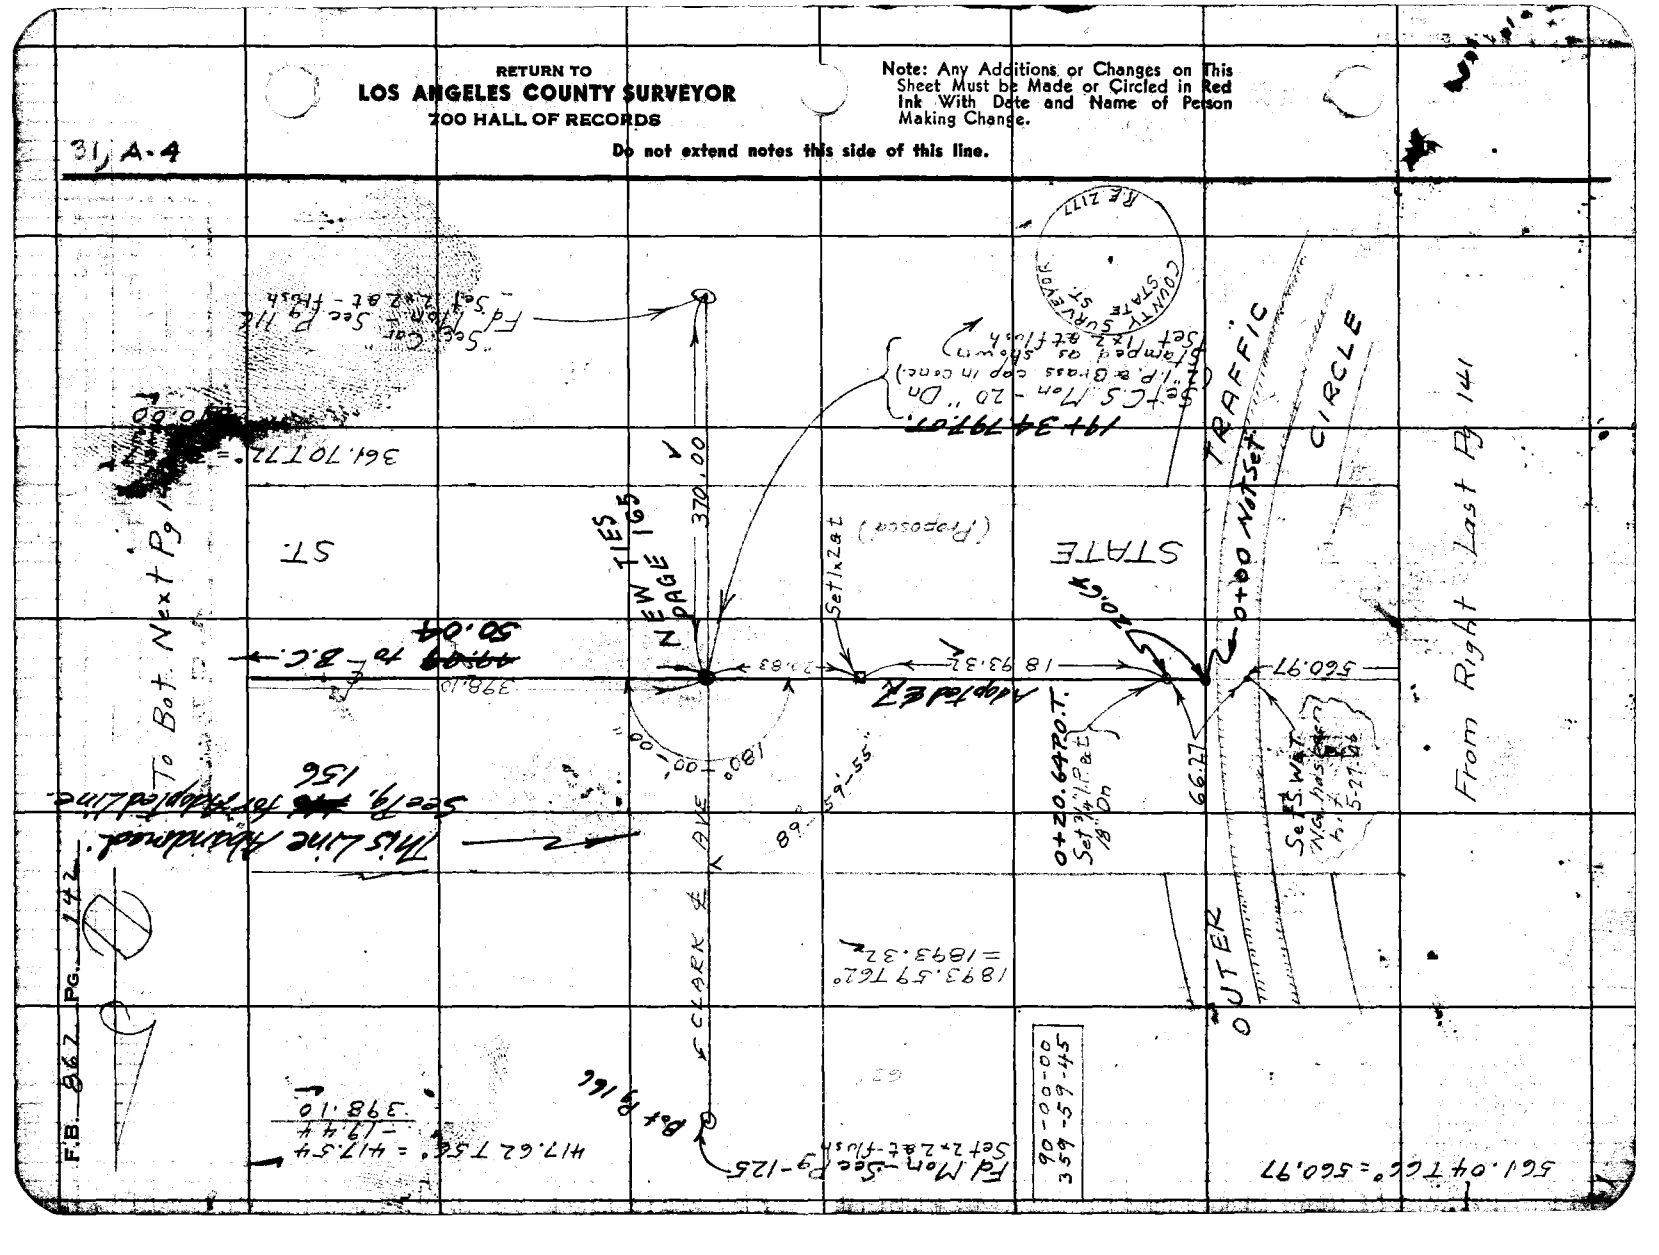

FORM 247 BM 11-41

RETURN TO
LOS ANGELES COUNTY SURVEYOR
700 HALL OF RECORDS

Note: Any Additions or Changes on This Sheet Must be Made or Circled in Red Ink With Date and Name of Person Making Change.

Do not extend notes this side of this line.

3b 4-4

Set C.S. Mon - 20" Dn
Stamped as shown

1096.18 T64° = 1096.04

COUNTY SURVEYOR
STATE ST.
P.I.
R.E. 2117

This Line Abandoned
See Pg. ~~156~~ 56 for Adopted Line.

STATE

ST.

1096.04

398.10

49.99 Calc.
50.04

(Proposed)

160° - 15' - ~~10~~ 20" Adj.

400.02

160-15-15
281-01-00

From Top Last Pg 142

To Top Next Pg

Noted Ck'd by K.E. 7-7-42
Map No.
Office Work
Checked
Date

Survey of State St.
W. O. 2331 Map No. 278 Sht. 4 of 4
Surveyed by E.J. Mc No. 4
Notes
Indexed C. Johnson Date 3-7-42

F.B. 862 Pg. 143

RETURN TO
LOS ANGELES COUNTY SURVEYOR
700 HALL OF RECORDS

Note: Any Additions or Changes on This Sheet Must be Made or Circled in Red Ink With Date and Name of Person Making Change.

31, A-4

Do not extend notes this side of this line.

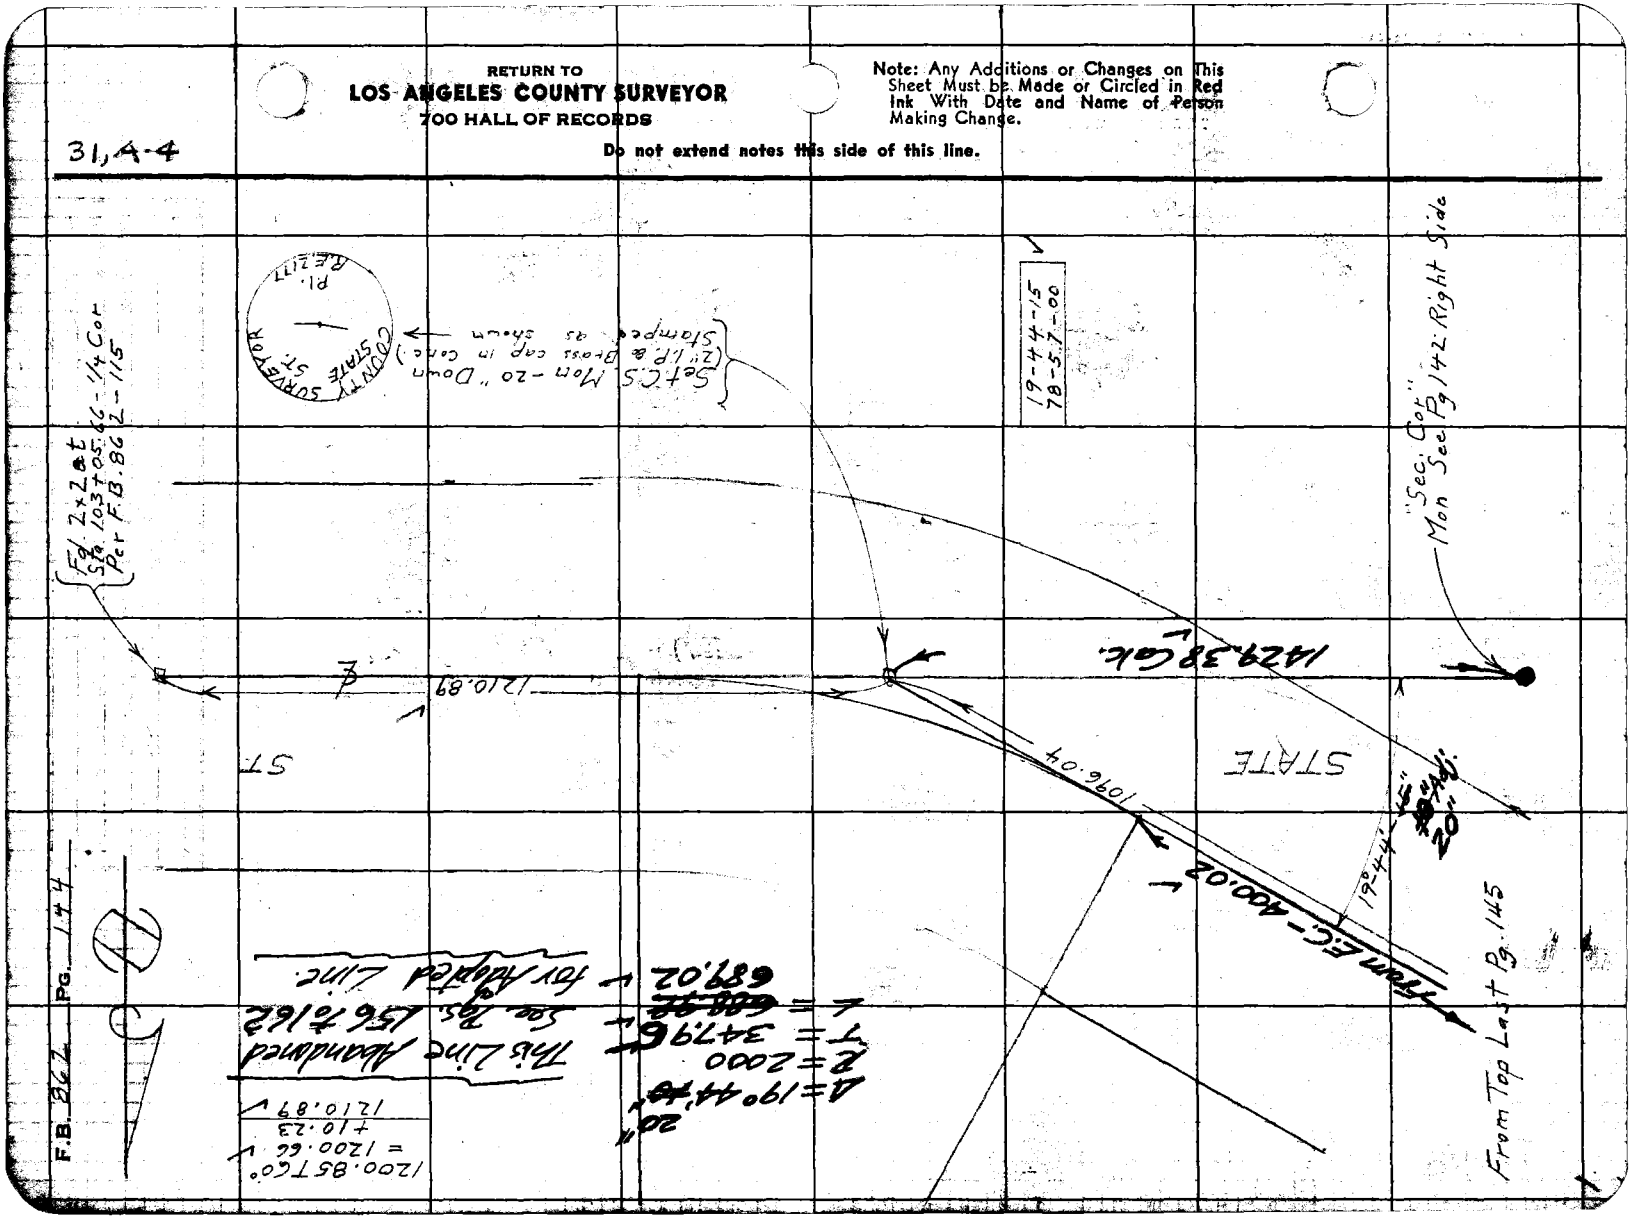

Notes Ck'd by K.R.M.	Survey of State St
Map No. B-1749	W. O. 8310 Tape No. 081 St'd 68 °F
Office Work White	Surveyed by Porter
Checked McPherson	Notes Porter Date 5-27-46
Date June 1946	Indexed A. C. Johnson 6-5-46

F.B. 862 PG. 195

LINE CHANGE

PROP. STATE ST.

Lakewood Blvd East to Bellflower Blvd

JN. 8310

5-27-46

Porter

Holmes

Hand

Ochsner

For Final Adopted L. See Pgs. 156 to 162.

H.C. 31-54

C.S. B-1749

Note: Any Additions or Changes on This Sheet Must be Made or Circled in Red Ink With Date and Name of Person Making Change.

Do not extend notes this side of this line.

RETURN TO
LOS ANGELES COUNTY SURVEYOR
700 HALL OF RECORDS

FORM 247 5M 11-41

F.B. 862 PG. 196

Cont B.t pg

1182.93 @ 0°T 76°
1182.99

To Post.

1182.99

New 5/8" I.P. Set 36" 16"

P.C. 27+80.20

Fd CS Mon dn 18" F.B. 862-143 old P.I. New Post.

150° 39' 45"

71.90

Δ = 29° 20' 15"
R = 1500
L = 768.05

Δ1 = 150° 39' 45"
Δ2 = 242° 39' 00"
150° 39' 45"

BC Dot 12.15 N of Sta

PROP. STATE

398.10

Fd CS Mon dn 1/2" F.B. 862-142 19+39.79

Sac. Cor Fd 2"x2" - F.B. 862-142 -116

370.0

Fd 3/4" I.P. dn 18" F.B. 862-142 used for line

outer Traffic Circle

Void: - See pg. 150 last for Finale
For Back Survey
See pg 149-152

RETURN TO
LOS ANGELES COUNTY SURVEYOR
700 HALL OF RECORDS

Do not extend notes this side of this line.

Note: Any Additions or Changes on This Sheet Must be Made or Circled in Red Ink With Date and Name of Person Making Change.

Notes Ck'd by KBM	Survey of State St
Map No. B-1334	W. O. 8310 Tape No. 081 St'd. 68°F
Office Work White	Surveyed by Porter
Checked McPherson	Notes Porter Date 5-27-46
Date June 1946	Indexed [illegible]

F.B. 962 PG. 147

RETURN TO
LOS ANGELES COUNTY SURVEYOR
700 HALL OF RECORDS
Do not extend notes this side of this line.

Note: Any Additions or Changes on This Sheet Must be Made or Circled in Red Ink With Date and Name of Person Making Change.

FORM 247 BM 11-41

Cent Bot Pg

750.67 @ 0° T. 72°
750.69

E.C. 42+25.92 Not Set.

Δ = 38° 36' 45"
R = 1500
T = 525.92
L = 1010.93

B.C. 32+14.99

Set 1/2 Pipe

150.69

24" Gum tr Set Nail

40 Adj. 47½

21.02

164° 38' 47½"

Set Nail in 14" Acacia tr Not Set

400.50

25 Adj. 27½

156° 44' 27½"

169.24 Calc

33.98

Set Nail in 12" Pine tr.

Post Set 3/4" I Pipe in 12"

18.85

Set Nail in 8" Bush.

STATE ST

1182.99

PROP

Sec Line

Cent Curve Top Pg

Void: See B. 157 for Final
Check Survey 157

(1) = 156° 44' 30"
(4) = 266 57 50"
(6) = 220 26 40"
156° 44 27½"

(1) = 164° 38 50"
(4) = 298° 35 10"
(6) = 267 52 40"
164° 38 47½"

400.46 @ 0° T. 82
400.50

F.B. 862 PG. 148

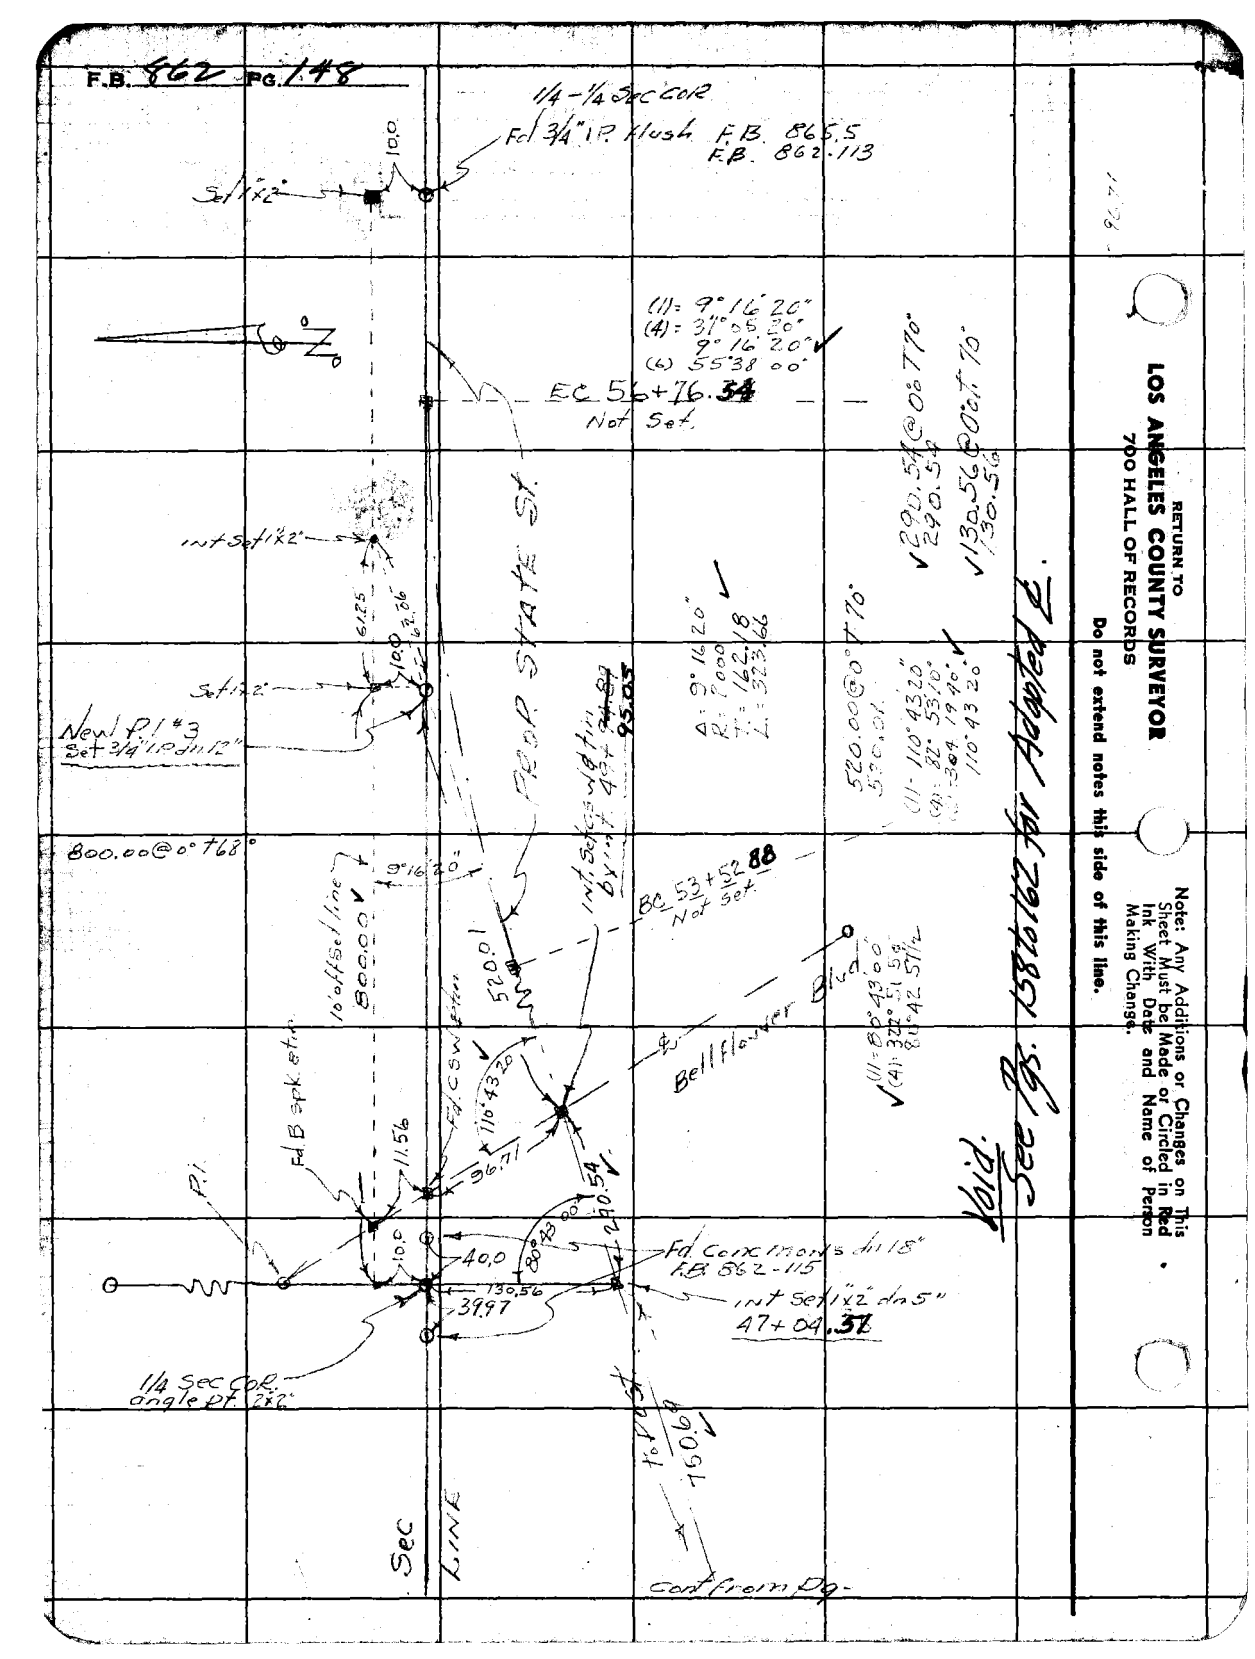
1/4 - 1/4 Sec COR
Fd 3/4" I.P. Flush F.B. 865.5 F.B. 862.113
Set 1"x2"
10.0
(11) = 9° 16' 20"
(4) = 31° 05' 30"
9° 16' 20"
(6) 55° 38' 00"
EC 56+76.34
Not Set
int Set 1"x2"
6.25
62.56
10.0
Set 1"x2"
New P.I. #3
Set 3/4" I.P. in 12"
ROAD STATE ST.
int Set Spk in
Brick
45+87.85
95.03
Δ = 9° 16' 20"
R = 1000
T = 162.18
L = 323.66
520.00@0° T 70°
520.00
(11) - 110° 43' 20"
(8) - 82° 53' 10"
(3) - 304 19' 40"
110° 43' 20"
290.54@0° T 70°
290.54
130.56@0° T 70°
130.56
800.00@0° T 68°
9° 16' 20"
10' off Set line
800.00
520.01
int Set Spk in Brick
80+53.52
Not Set
88
Bellflower Blvd.
(11) = 80° 43' 00"
(4) = 32° 51' 50"
81° 42' 51"
Fd C&W Etch
110° 43' 20"
Fd B Spk etch
11.56
36.71
190.54
P.I.
10.0
40.0
80° 43' 00"
Fd Concrete mon's dn 1.8"
F.B. 862-115
130.56
39.97
int Set 1"x2" dn 5"
47+04.37
1/4 Sec COR
angle pt. 22°
to P.I. #4
760.64
Sec
LINE
Cont from Dg-
Void.
RETURN TO
LOS ANGELES COUNTY SURVEYOR
700 HALL OF RECORDS
Do not extend notes this side of this line.
Note: Any Additions or Changes on This Sheet Must be Made or Circled in Red Ink With Date and Name of Person Making Change.

F. B. 862 Pg. 149

Notes Ck'd by	Survey of State St
Map No.	W. O. 8310 Tape No. 085 St'd 68 °F
Office Work	Surveyed by Geo. H. Nichols
Checked	Notes G.H.N. Date 6-16-47
Date	Indexed A. C. Johnson 6-17-47

Note: Any Additions or Changes on This Sheet Must be Made or Circled in Red Ink With Date and Name of Person Making Change.

Do not extend notes this side of this line.

RETURN TO
LOS ANGELES COUNTY SURVEYOR
700 HALL OF RECORDS

FORM 247 5M 5-46

W.O. 8310 Re Chain of 6-16-47

State St.

from

C.S. Mon 19+34.79

to

Bellflower Blvd

NOTE!
Data on Pgs 150 to 153 is Void. For Final Adopted & See Pgs. 156 to 162

Nichols
Dickie
Culp
Campbell
Gaffey

F. B. 862 Pg. 150

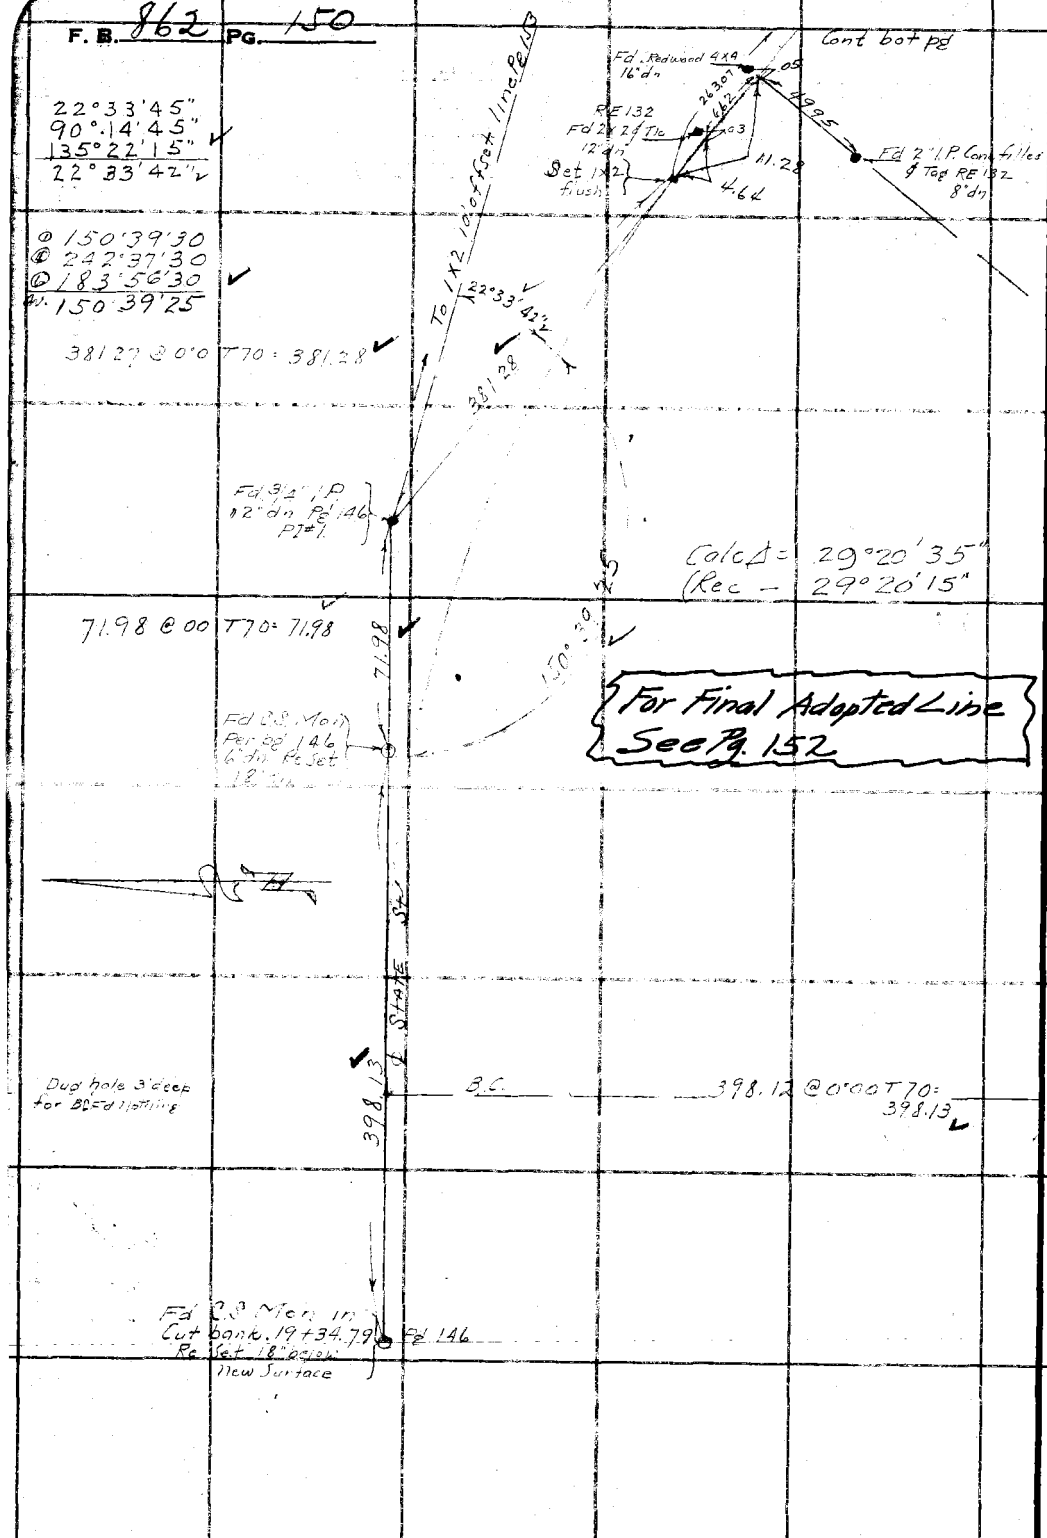

RETURN TO
LOS ANGELES COUNTY SURVEYOR
700 HALL OF RECORDS

Do not extend notes this side of this line.

Note: Any Additions or Changes on This Sheet Must be Made or Circled in Red Ink With Date and Name of Person Making Change.

F.B. 862 Pg. 151

Notes Ck'd by
Map No.
Office Work
Checked
Date

Survey of Sta. C.L.
W. O. 8310 Tape No. 085 St'd. 68 °F
Surveyed by Geo. H. Nichols
Notes G.H.N. Date 6-17-47
Indexed A. C. Jensen

Cont. bot pg

164°39'30"
298°37'15"
26°56'00" ✓
164°39'20"

15"Alg.

Set 1"x2" Reg. from 3/4" I.P. Post 4" Ground false pd 15 x 11 ties

253.85

Calc 4 = 38°36'55"
(Rec. 38°36'55")

For Final Adopted
& See Pg. 157

400.48 @ 0°00' T 76 = 400.50 ✓

Fd N&T. in 12" pine Per pd 147

169.85

33.98

18.85

Fd N&T. in 8" bush Per pd 147

POINT Fd 3/4" I.P. Knocked over; Reset 3/4" I.P. from ties. 1/2 dia. br

0156°44'00
2266°55'45
3220°23'30
4156°43'55 ✓

53.55

362.24 @ 0°00' T 74 = 362.25 ✓

362.25

Fd 2" I.P. Conc filled & tag 12" in. R.E. 132

Fd 2" x 2" E.T.C. 3.3' S. Con. Fence 50.26

L.P.C.

Fd 2" I.P. Conc. filled & tag 12' dn R.E. 132

Set 1"x2" pk flush

176.37 @ 0°00' T 70 = 176.37 ✓

12" dn
3 Ass. Break

263.07 @ 0°00' T 70 = 263.07 ✓

Cont from top pg

263.07

1x2

Note: Any Additions or Changes on this Sheet Must be Made or Circled in Red Ink With Date and Name of Person Making Change.

Do not extend notes this side of this line.

RETURN TO
LOS ANGELES COUNTY SURVEYOR
700 HALL OF RECORDS

FORM 247 5M 5-46

F. B. 862 PG. 152

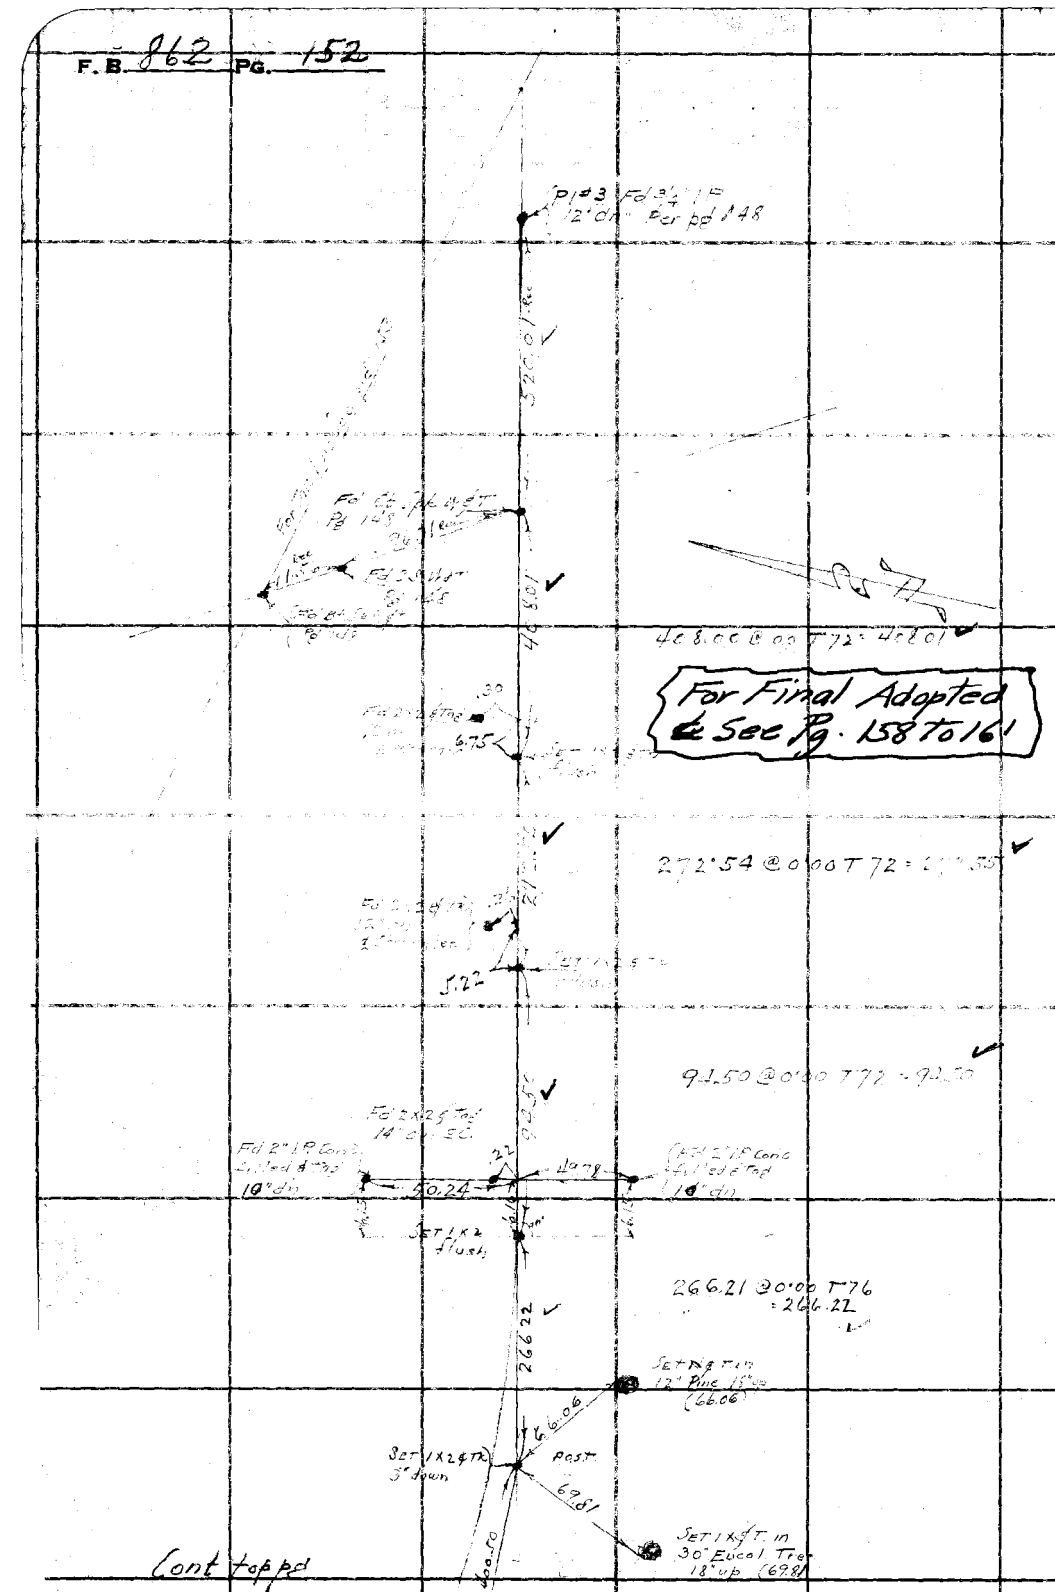
P/#3 Fd 3/4" I.P. 12" dn. Per pb 148
S 2°00' W Rec
S 2°00' W
Fd 3/4" I.P. Cond. Pb 148

LS 2210

Notes Ck'd by	Survey of
Map No.	W. O. 8210 Tape No. St'd 68 °F
Office Work	Surveyed by
Checked	Notes Date 6-26-47
Date	Indexed

F. B. 862 Pg. 153

For Final Adopted & See Pg. 158 to 161

Set 1x24" 7/8" dn. 10E

Fd 2x48" 5/8" dn. = 813.112
Checked with Ties. OK

16°03'15"
64°13'00"
96°19'30"
16°03'15"

Fd 2" I.P. (one ft) & Tag LS 2210 D.D.H. 10E

459.36 @ 0.00 T 72 = 459.37

Set 1x24" 3" dn

9°16'00"
37°04'30"
35°36'30"
9°16'05"

62.02 @ 0.00 T 74 = 62.02

Fd 3/4" I.P. 12 d
26.148

16°03'13"
0°16'05"

Set 2x24" 4" dn

628.55 @ 0.00 T 70 = 628.56

11.57 @ 0.00 T 70 = 11.57

96.73 @ 0.00 T 70 = 96.72

Fd 3/4" I.P. 12 d

Fd 3/4" I.P. 12 d

Bellflower Blvd

Sec Line

Fd 6" Cyl. Conc Mon. w/ Ch. Spk Ctr. 18" down

Set 1x24" 5/8"

Fd 2" I.P. old bottomless pipe 1/2" Sec Cor No nail 48" down Set N in old Wood Rec. From Dillon

Note: Any Additions or Changes on This Sheet Must be Made or Circled in Red Ink With Date and Name of Person Making Change.

Do not extend notes this side of this line.

RETURN TO
LOS ANGELES COUNTY SURVEYOR
700 HALL OF RECORDS

FORM 247 SM 5-46

RETURN TO
LOS ANGELES COUNTY SURVEYOR
700 HALL OF RECORDS

Note: Any Additions or Changes on This Sheet Must be Made or Circled in Red Ink With Date and Name of Person Making Change.

Do not extend notes this side of this line.

F. B. 963 Pg. 154

Notes Ck'd by KAMcK
Map No. B-1749
Office Work Rose
Checked McPherson
Date July 1947

Survey of STATE ST.
W. O. 8310 Tape No. 283 St'd 68 °F
Surveyed by HELLSTROM
Notes A.N.H. Date 7-1-47
Indexed A. C. Johnson 7-22-47

F. B. [illegible] Pg. [illegible]

J.M. 8310

STATE ST.

SURVEY TO ESTABLISH FINAL ℄
ON PROPOSED STATE ST. FROM
BELLFLOWER BLVD. TO CLARK AVE.

JULY - 1947

Hellstrom
Frank
Muslin
Rike
Gomez

Note: Any Additions or Changes on This Sheet Must be Made or Circled in Red Ink With Date and Name of Person Making Change.

Do not extend notes this side of this line.

RETURN TO
LOS ANGELES COUNTY SURVEYOR
700 HALL OF RECORDS

FORM 247 SM 11-46

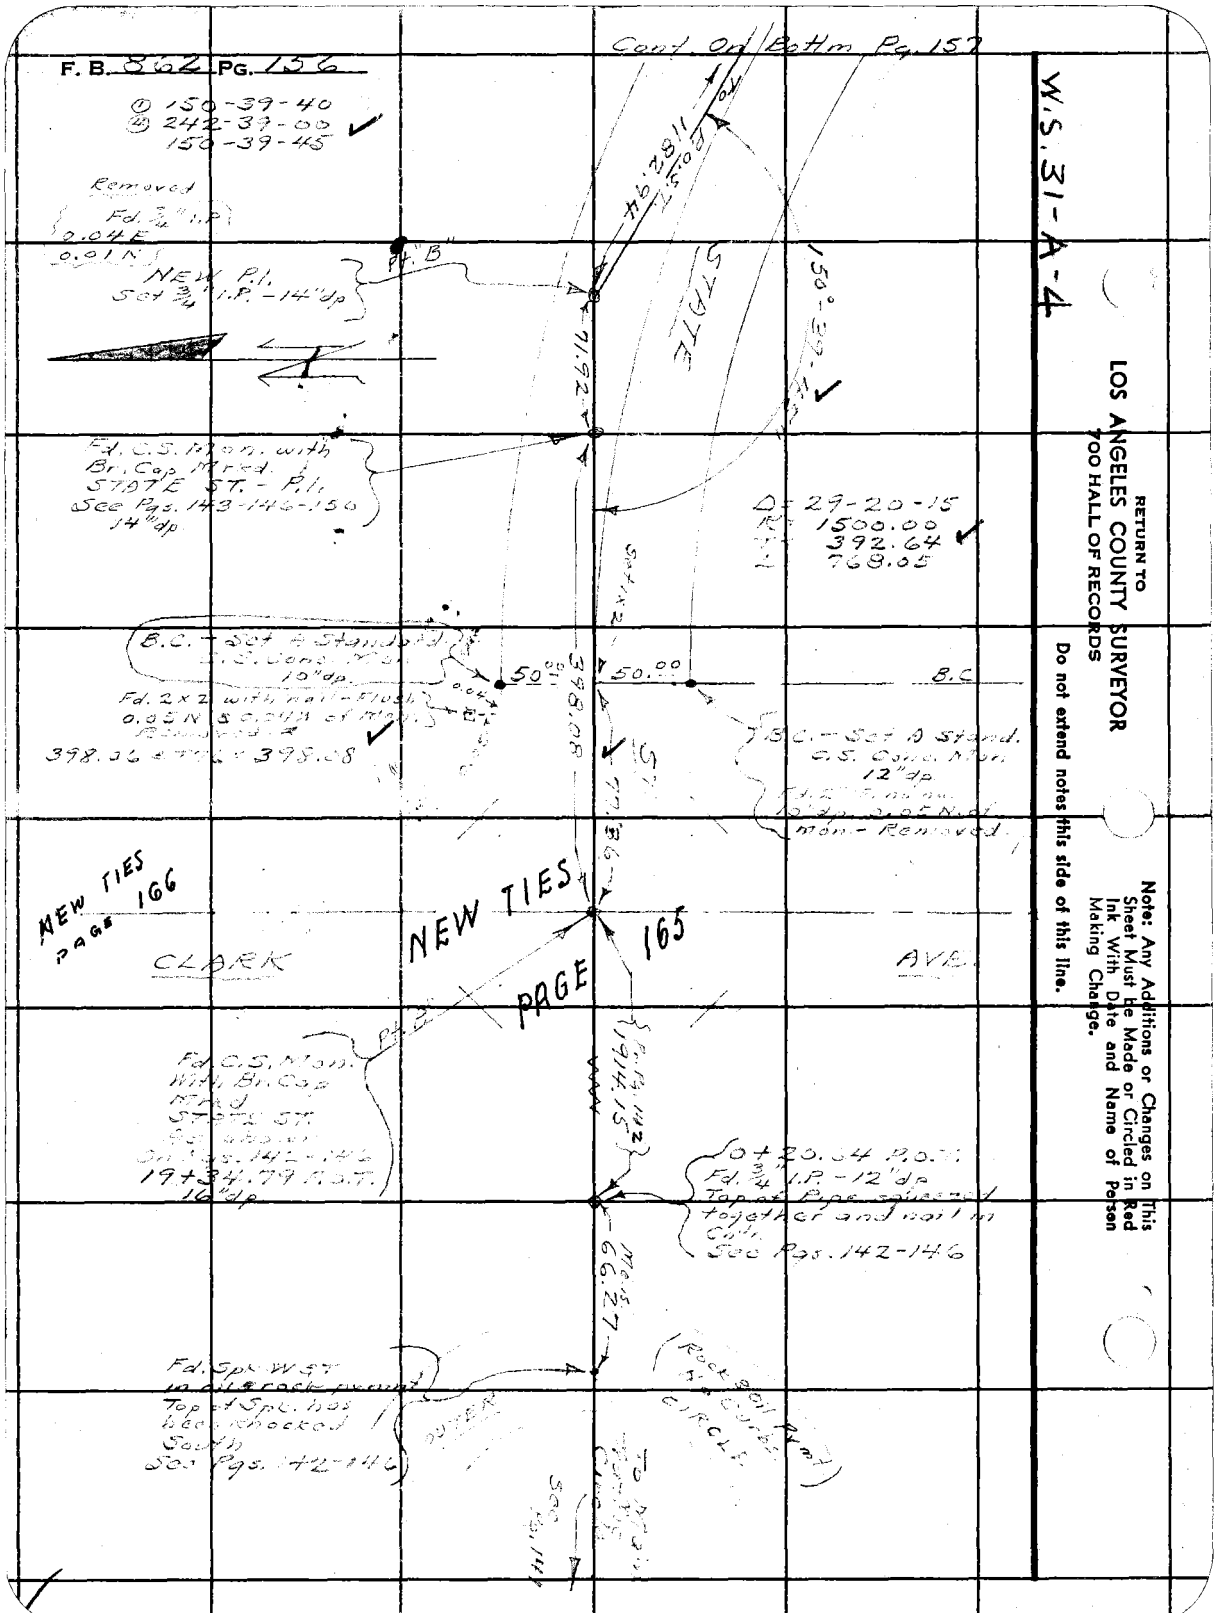
F. B. 862 PG. 156
① 150-39-40
④ 242-39-00
150-39-45
W.S. 31-A-4
RETURN TO
LOS ANGELES COUNTY SURVEYOR
700 HALL OF RECORDS
Do not extend notes this side of this line.
Note: Any Additions or Changes on This Sheet Must be Made or Circled in Red Ink With Date and Name of Person Making Change.
Removed
Fd. 3/4" I.P.
0.04 E
0.01 N
NEW Pt.
Set 3/4" I.P. - 14" up
Pt. B"
STATE
150.00
Fd. C.S. Mon. with
Br. Cap. Marked
STATE ST. - Pt.
See Pgs. 143-146-150
14" dp
D = 29-20-15
R = 1500.00
T = 392.64
L = 768.05
B.C. - Set 8 Stand. I.S. Conc. Mon. 10" dp
Fd. 2x2 with nail - Flush
0.02 N of Mon.
398.36 + TAN = 398.08
50.00
398.08
50.00
B.C.
B.C. - Set 8 Stand. C.S. Conc. Mon. 12" dp
Fd. Iron Pin 0.2' S. of N. of Mon. - Removed
NEW TIES
PAGE 166
CLARK
NEW TIES
PAGE 165
AVE.
Pt. 2
Fd. C.S. Mon. With Br. Cap Marked STATE ST. See Pgs. 142-146
19+34.79 P.O.T.
16" dp
S 43° 19' 11" W
1914.15
0+20.34 P.O.T.
Fd. 3/4" I.P. - 12" dp
Top of Pipe Stuffed
together and nail in
Cap.
See Pgs. 142-146
Meas. 66.27
Fd. Spk. W. ST.
in oil rock pavement
Top of Spk. has
been chocked
South
See Pgs. 142-146
ROCK
Rock Bolt
At Curve
CIRCLE
Set Nail
Set Nail

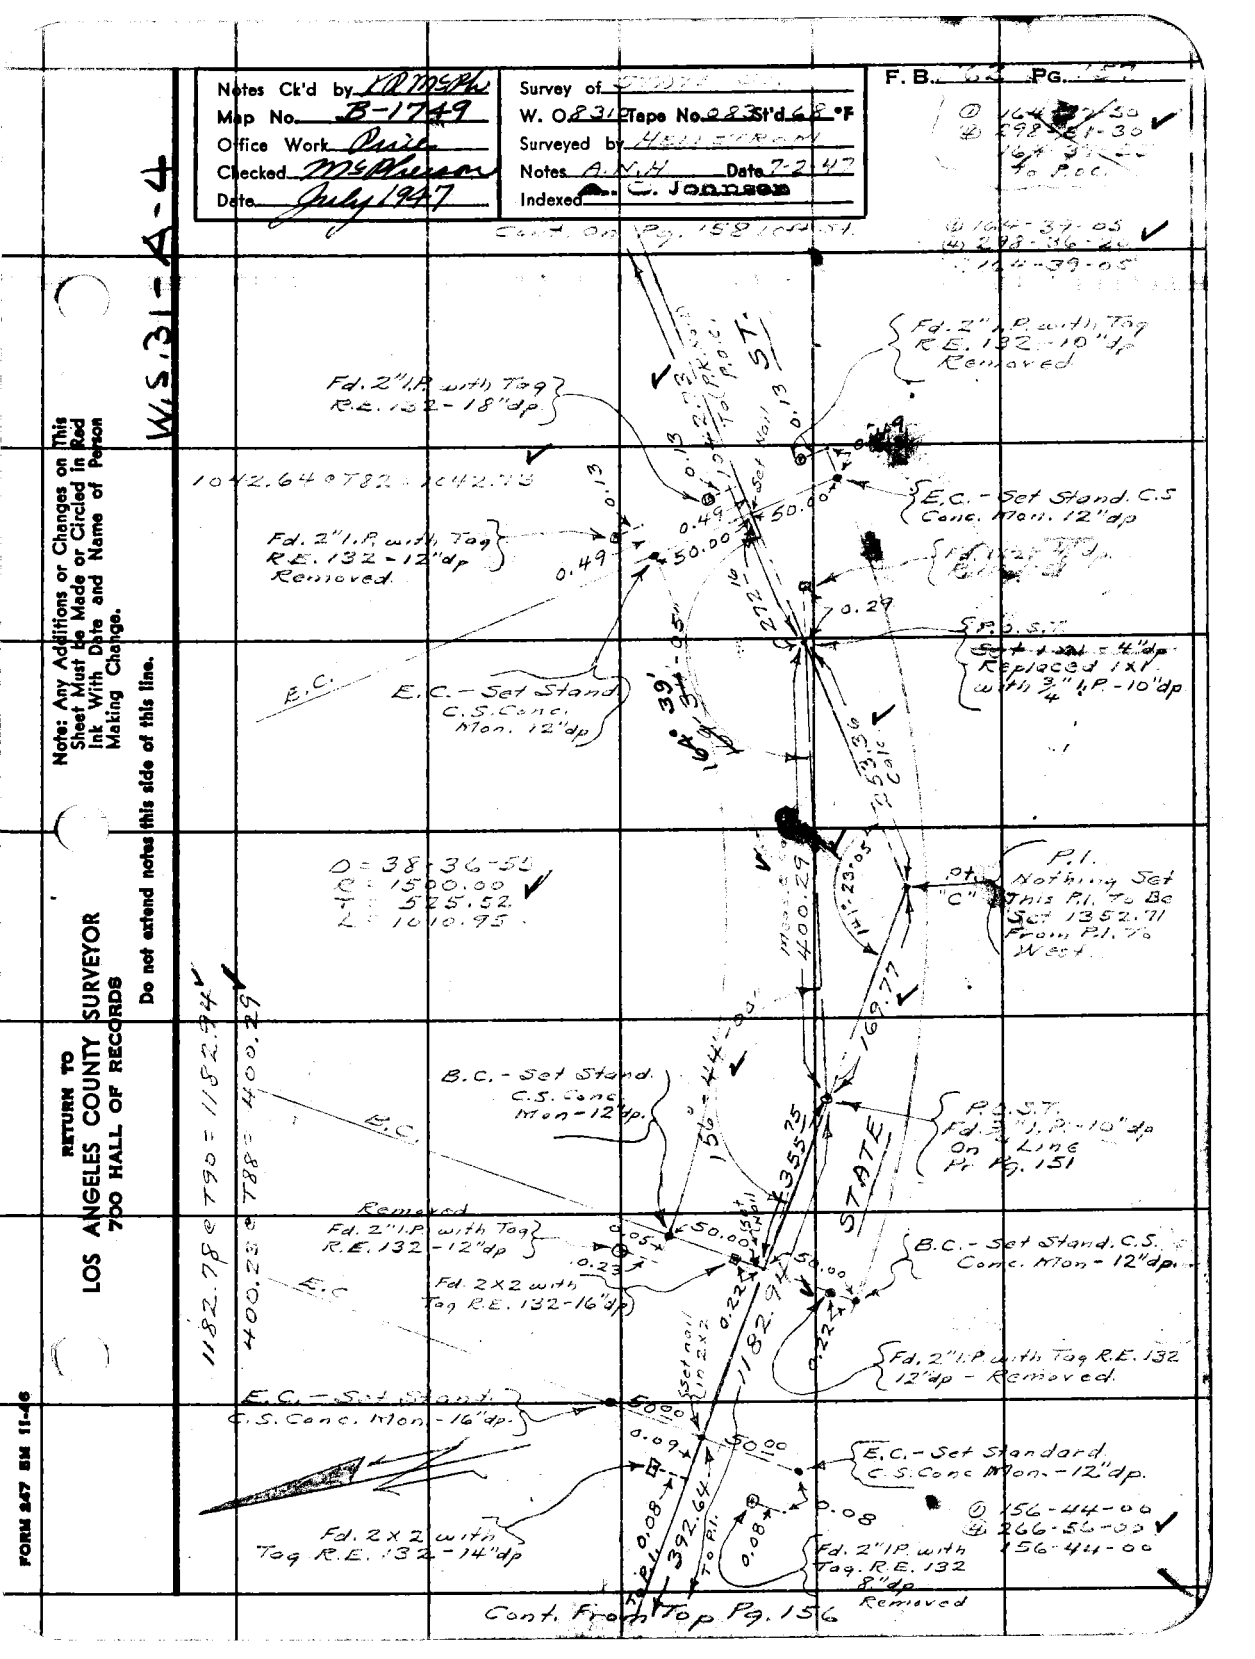
Notes Ck'd by KRMcPh
Map No. B-1749
Office Work Pasic
Checked McPherson
Date July 1947
Survey of
W. O. 8317 Tape No. 223 St'd 68 °F
Surveyed by
Notes A.N.H. Date 7-2 47
Indexed C. Jonnson
F. B. PG.
W.S.31-A-4
Note: Any Additions or Changes on This Sheet Must be Made or Circled in Red Ink With Date and Name of Person Making Change.
Do not extend notes this side of this line.
RETURN TO
LOS ANGELES COUNTY SURVEYOR
700 HALL OF RECORDS
FORM 247 EM 11-46
Cont. From Top Pg. 156
Fd. 2" I.P. with Tag R.E. 132 - 18" dp
Fd. 2" I.P. with Tag R.E. 132 - 10" dp Removed
E.C. - Set Stand. C.S. Conc. Mon. 12" dp
Fd. 2" I.P. with Tag R.E. 132 - 12" dp Removed
E.C. - Set Stand C.S. Conc. Mon. 12" dp
Replaced 1"x1" with 3/4" I.P. - 10" dp
D = 38-36-52
R = 1500.00
T = 525.52
L = 1010.95
P.I. Nothing Set This P.I. To Be Set 1352.71 From P.I. To West
B.C. - Set Stand. C.S. Conc. Mon - 12" dp.
P.C.S.T. Fd. 3/4" I.P. - 10" dp On Line Pg. 151
Removed Fd. 2" I.P. with Tag R.E. 132 - 12" dp
Fd. 2x2 with Tag R.E. 132 - 16" dp
B.C. - Set Stand. C.S. Conc. Mon - 12" dp.
Fd. 2" I.P. with Tag R.E. 132 12" dp - Removed.
E.C. - Set Stand. C.S. Conc. Mon. - 16" dp.
Fd. 2x2 with Tag R.E. 132 - 14" dp
E.C. - Set Standard C.S. Conc Mon. - 12" dp.
Fd. 2" I.P. with Tag R.E. 132 8" dp Removed
1182.78 e T90 = 1182.94
400.23 e T88 = 400.29
1142.64 e T82 = 1142.78
STATE ST.

RETURN TO
LOS ANGELES COUNTY SURVEYOR
700 HALL OF RECORDS

Note: Any Additions or Changes on This Sheet Must be Made or Circled in Red Ink With Date and Name of Person Making Change.

Do not extend notes this side of this line.

W.S. 31 - B-4

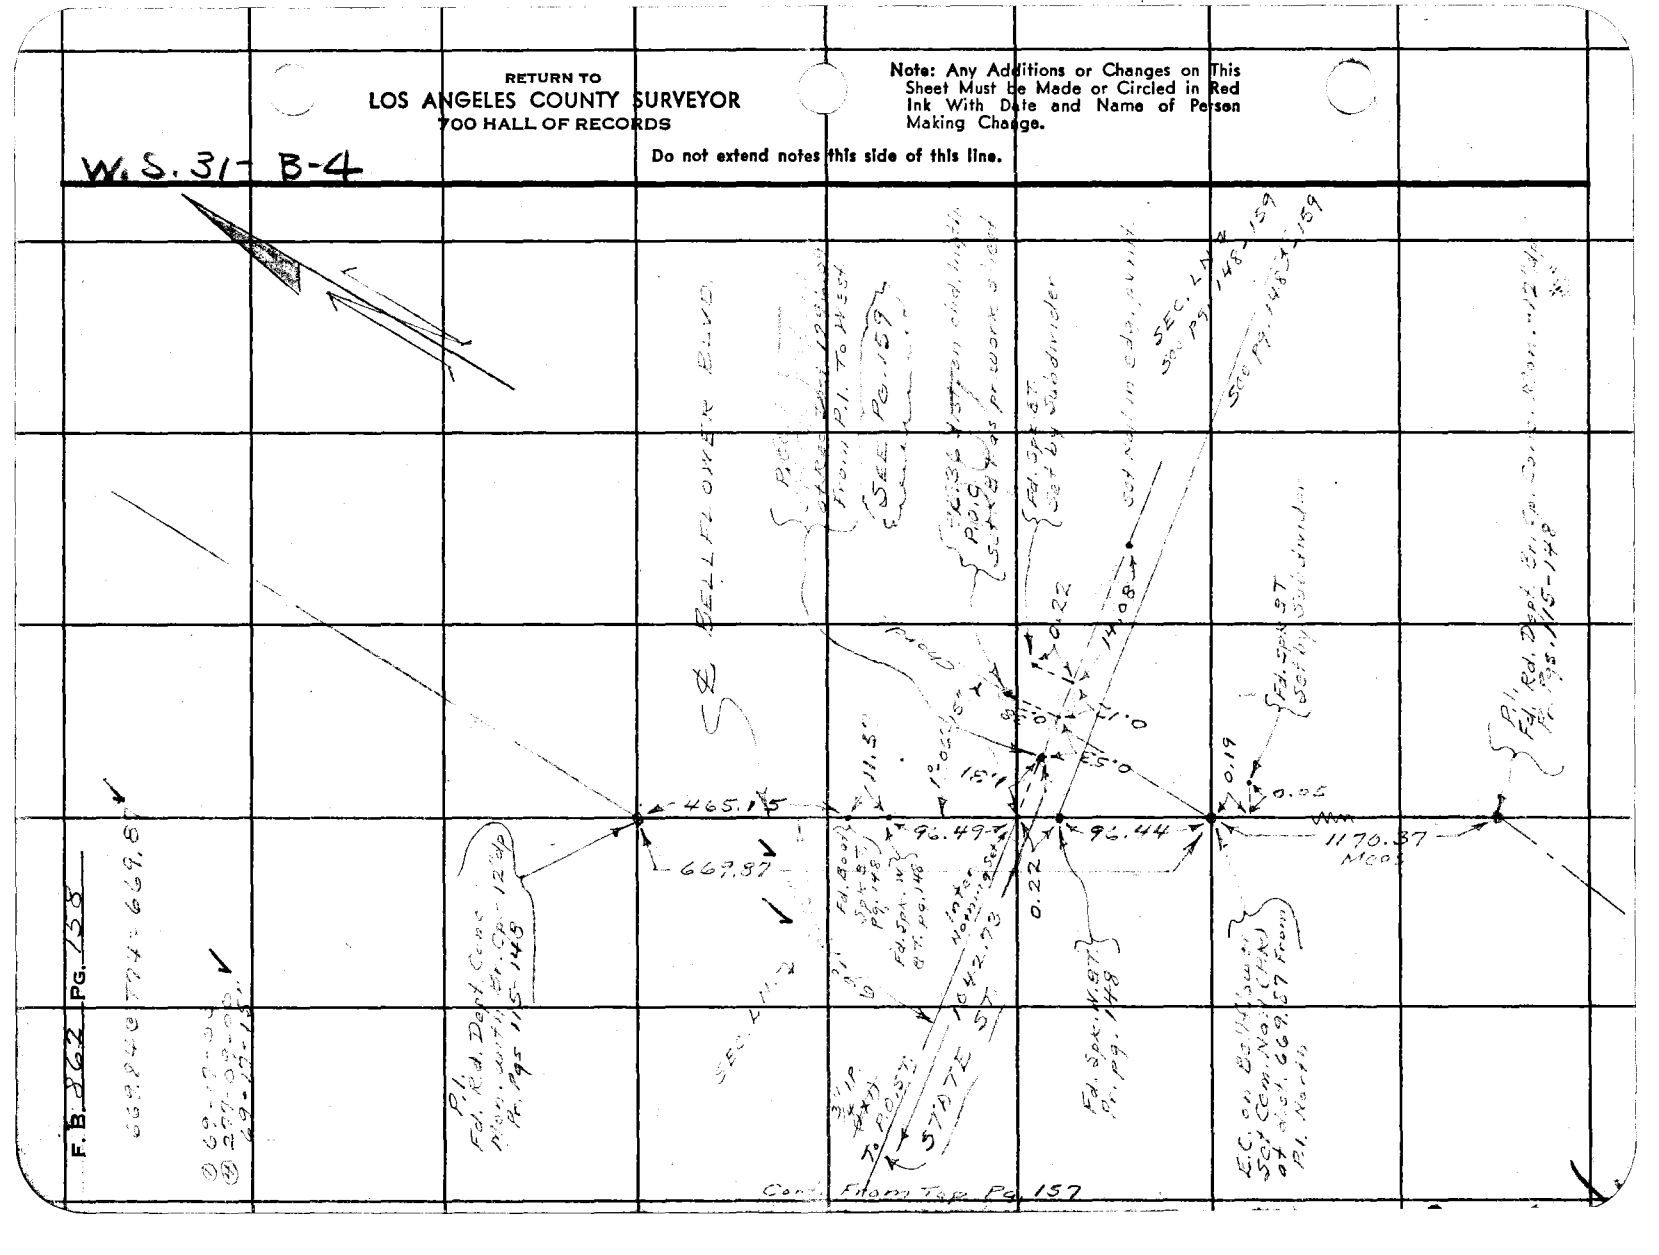
BELLFLOWER BLVD
SEC. LINE
See Pg. 148-159
Fd. Spk. & T. Cap't By Surveyor
Fd. Spk. & T.
Fd. Spk. & T. (See Pg. 148)
Fd. Spk. & T. (See Pg. 148)
Fd. Spk. & T. (See Pg. 148)

FORM 247 SM 11-46

RETURN TO
LOS ANGELES COUNTY SURVEYOR
700 HALL OF RECORDS

Note: Any Additions or Changes on This Sheet Must Be Made or Circled in Red Ink With Date and Name of Person Making Change.

Do not extend notes this side of this line.

W.S. 31 - B-4

Notes Ck'd by [illegible]
Map No. B-1749
Office Work Basis
Checked [illegible]
Date July 1947

Survey of [illegible]
W. O. 5837 Tape No. 2833 Std. 66 °F
Surveyed by [illegible]
Notes [illegible] Date 7-3-47
Indexed A. C. Johnson

F.B. [illegible] Pg. [illegible]

P.I. Rd. Bdy. Cons. Mon. with Sr. Cp. -12"dia. Fr. pg. 156

582.03 + T 79 = 582.11

E BELLFLOWER BLVD

628.50 + T 78 = 628.58

SEE Pg. 160

110-44-30
22-58-15
110-44-35

119-58-45
119-58-45
119-59-30

9°-15-00
9°-15-00

9°-17-15

Spk. W.C. Fr. pg. 158

100 OFFSET

110°-44'-35"

40" Adj.

S 0°-15'-25" E 1041.42 STATE

Spk. W.C. Fr. pg. 158

582.11

Not R For R. See Pg. 160, 161.

51.20

SEE Pg. 155

E.C. on Bellflower Blvd Cons. No. Pg. 155

SEE Pg. 157

RETURN TO
LOS ANGELES COUNTY SURVEYOR
700 HALL OF RECORDS

Note: Any Additions or Changes on This Sheet Must be Made or Circled in Red Ink With Date and Name of Person Making Change.

Do not extend notes this side of this line.

W.S. 31 - B-4

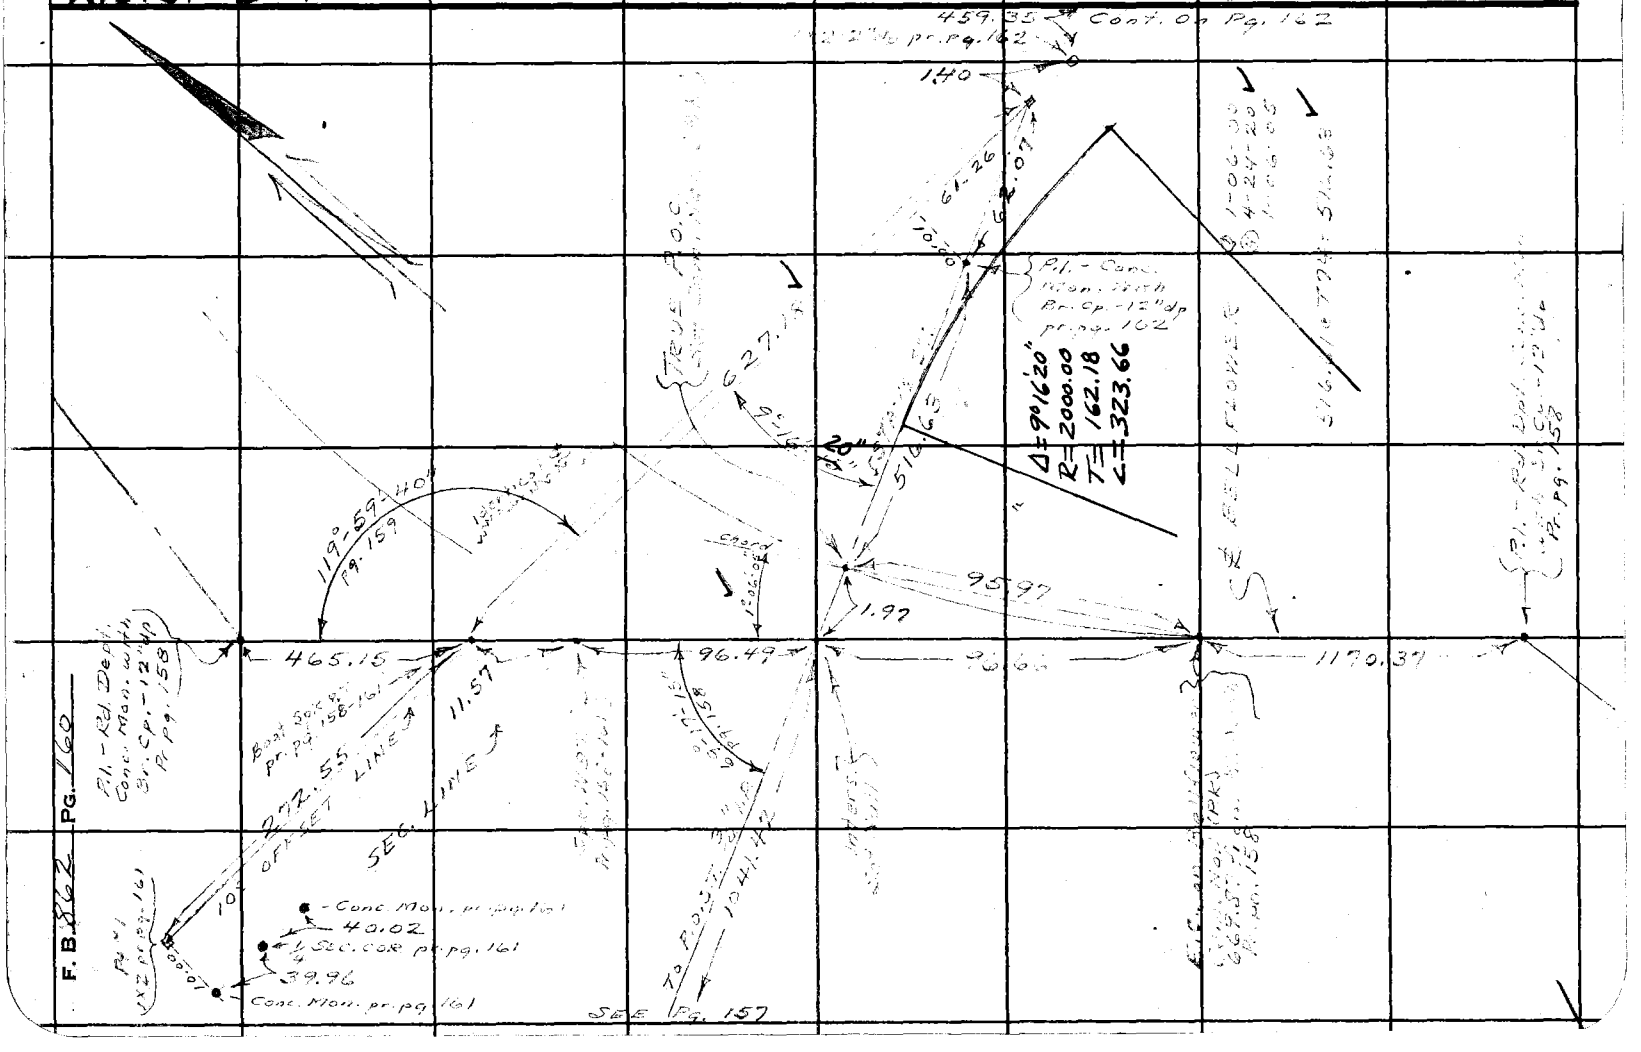

FORM 247 SM 11-46

RETURN TO
LOS ANGELES COUNTY SURVEYOR
700 HALL OF RECORDS

Note: Any Additions or Changes on This Sheet Must be Made or Circled in Red Ink With Date and Name of Person Making Change.

Do not extend notes this side of this line.

W.S. 31 - B-4

Notes Ck'd by Kennedy
Mpp No. B-1749
Office Work Davis
Checked McMillan
Date July 1947

Survey of Subdivision
W. O. 831 Tape No. 3 Std. 100' F
Surveyed by
Notes
Indexed A. C. Johnson
Date 7-11-47

F. B. PG.

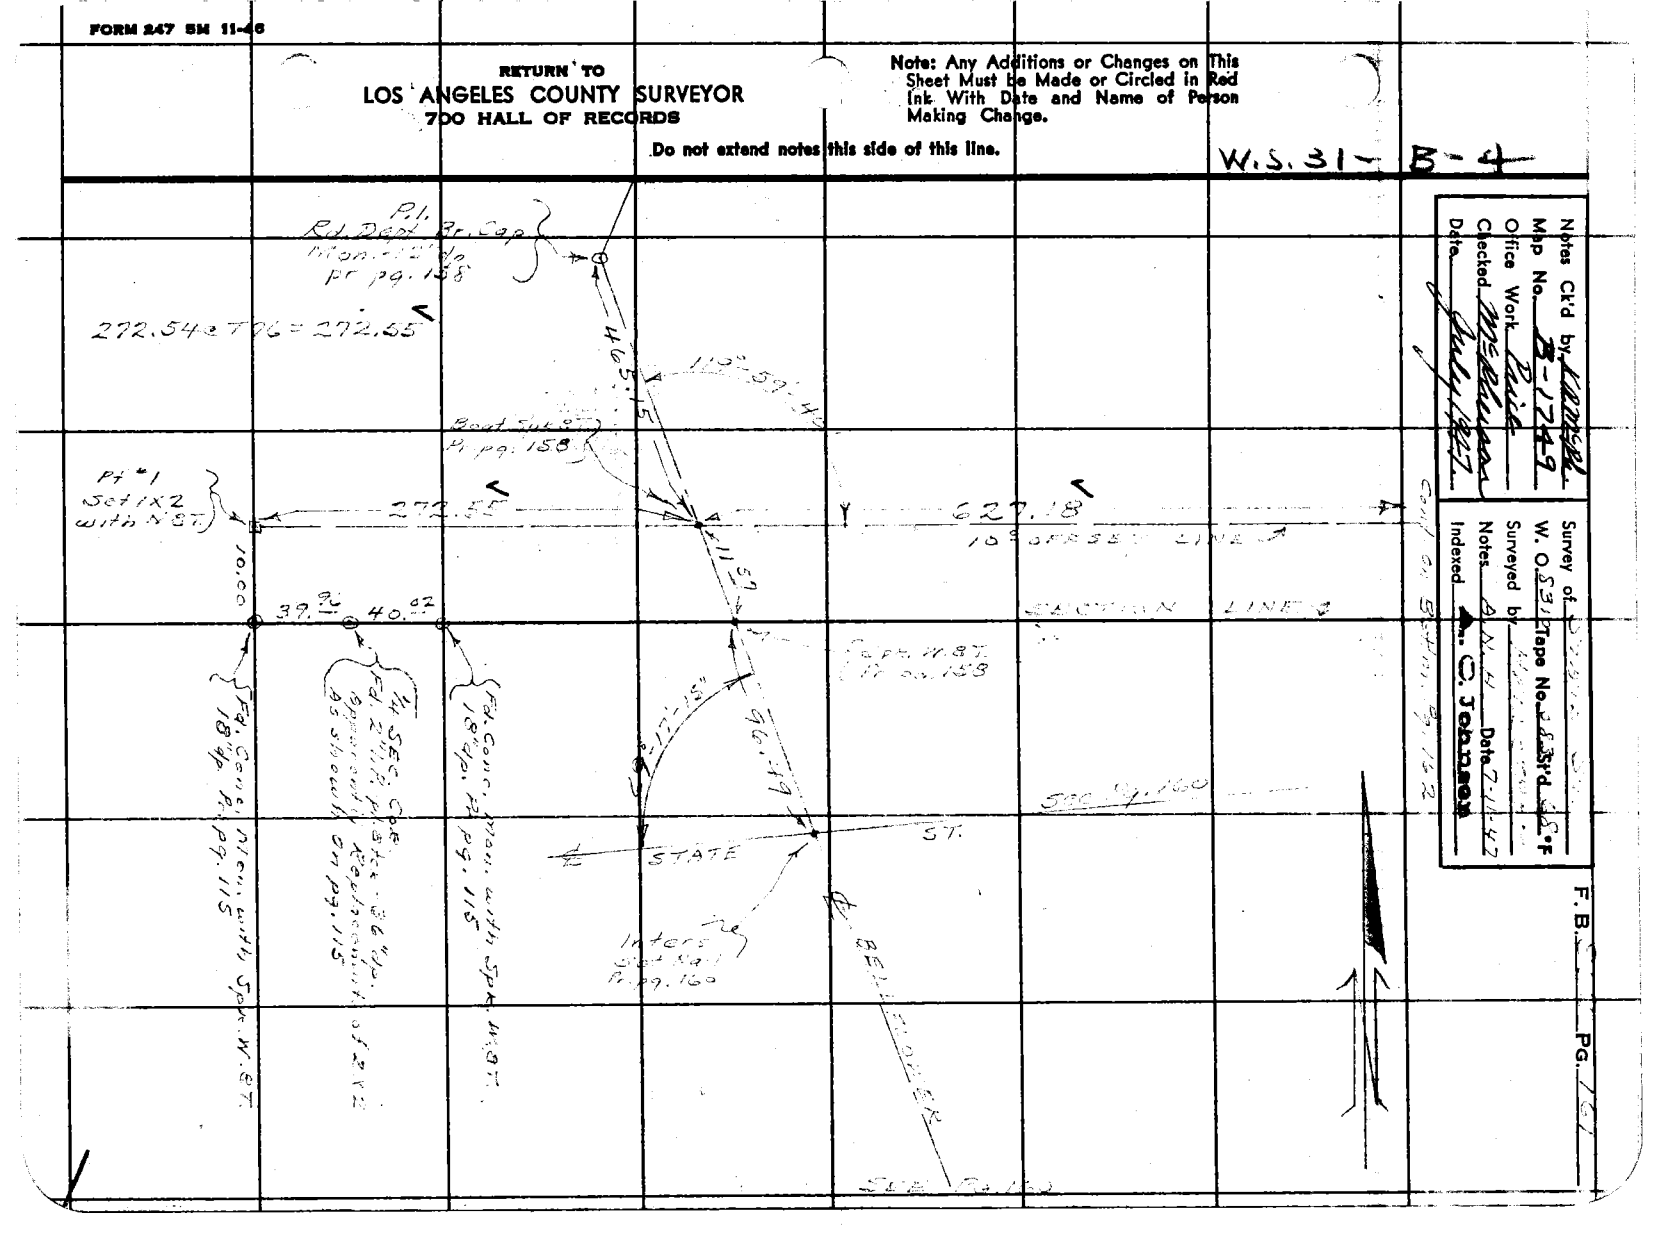

RETURN TO
LOS ANGELES COUNTY SURVEYOR
700 HALL OF RECORDS

Note: Any Additions or Changes on This Sheet Must be Made or Circled in Red Ink With Date and Name of Person Making Change.

Do not extend notes this side of this line.

W.S. 31-B-4

F.B. 562 PG. 162

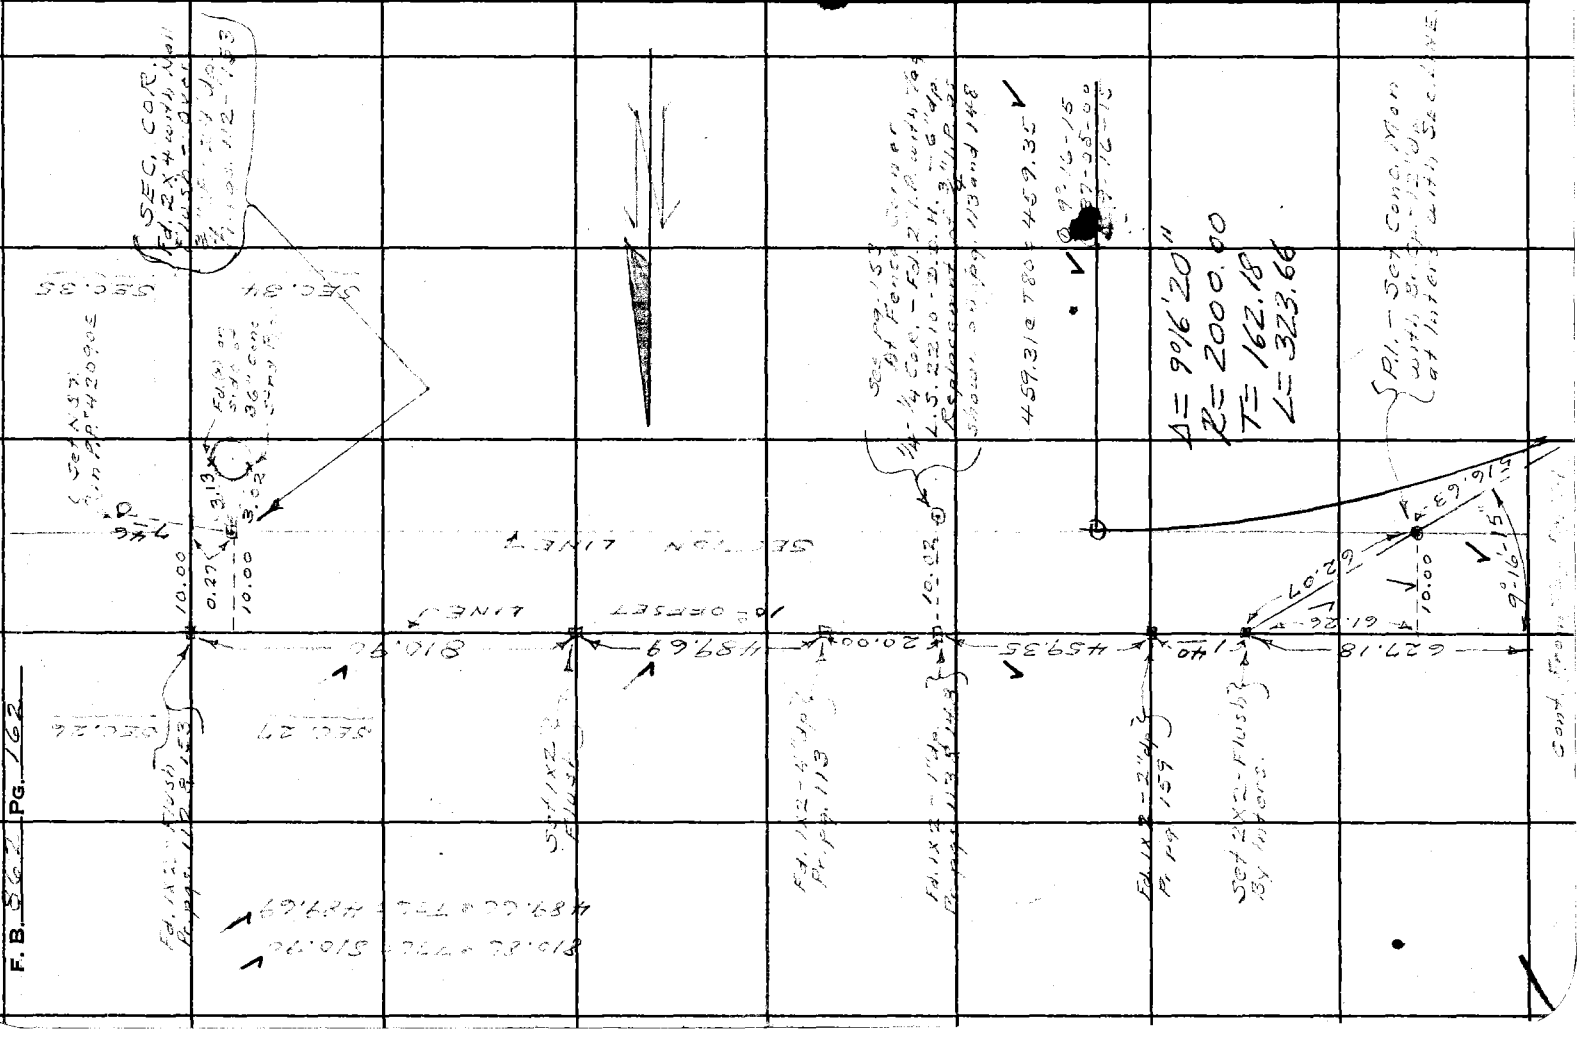
SEC. COR.
Fd. 2X4 witness

Notes Ck'd by	Survey of Clark Ave
Map No.	W. O. 7000 Tape No. 100' St'd. 68 °F
Office Work	Surveyed by M. A. Van Deren
Checked	Notes VDM Date 9-13-50
Date	Indexed A. C. Johnson 9-27-50

F. B. 862 Pg. 163

JN 7000 MISC SURVEYS

NEW & TIES ON CLARK AVE

FROM SEC COR 370.00 SOUTH OF STATE ST

TO SPRING ST

ALL & POINTS REPLACED AFTER CONS'T

9-13-50
M. A. Van Deren
B. Blankenship
J. H. Brown

Note: Any Additions or Changes on This Sheet Must be Made or Circled in Red Ink With Date and Name of Person Making Change.

Do not extend notes this side of this line.

RETURN TO
LOS ANGELES COUNTY SURVEYOR
726 LOS ANGELES COUNTY
ENGINEERING BLDG.

76F3098 247 10M 1-49

F. B. 862 PG. 164

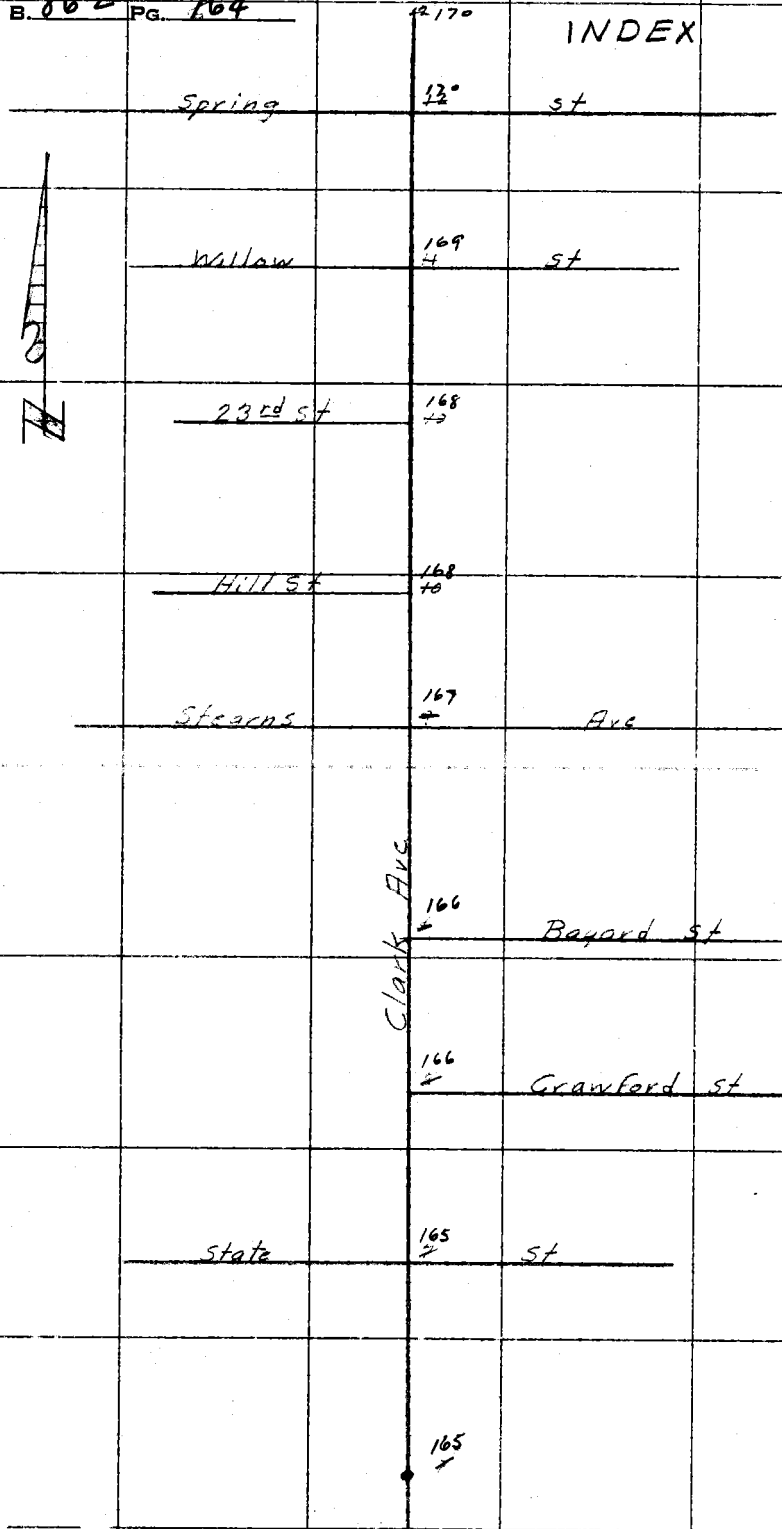

RETURN TO
LOS ANGELES COUNTY SURVEYOR
726 LOS ANGELES COUNTY
ENGINEERING BLDG.

Do not extend notes this side of this line.

Note: Any Additions or Changes on This Sheet Must be Made or Circled in Red Ink With Date and Name of Person Making Change.

F. B. 862 Pg. 165

Notes Ck'd by	Survey of Clark Ave
Map No. B-1745	W. O. Tape No. St'd. °F
Office Work R.W.M.F.A.	Surveyed by Van Deren
Checked	Notes Van Date 1-9-50
Date	Indexed E. C. Johnson

W.S.M.-A 4

To act pg & 166

CLARK ST ℄

STATE ST ℄

Set L&T

Conc walk

Set L&T

Conc culvert

Set L&T Conc walk

Set L&T

Set Kut in cinder Bell T&B M.H

1951 Tang

Set L&T

Fd L&T

8631 Tang

46.47

35.45 Tang

55.59

47.02 Tang

Fd Co Surv Br Cp Mon 14"dp marked state st. per FB 862-156 " " 142 Replaced with C.S. Br Cp Mon 12"dp in casing with C.I. Cover by Tan Ries after Const 9-13-50. V.D.

COUNTY SURVEYOR R.E. 329

49°32'

used for line for tang

37.00 per FB 862-142

28 | 27
33 | 34

Sec Cor of Sec 27-28-34-33 Fd conc Mon With large cop nail in ctr. no RP in hole used ctr of nail. Mon is 36"dp Set FB 862-116 FB 299-129 FB 349-3 OK after const 5-8-50 V.D.

Set 3/4 I.P. Plug Tk 12"dp

90°00'

Fd X cut in E. ring of S.M.H.

932

22.39

47.00

Set Bt Spk in 12" Pine tree

Set 3/4 I.P. Plug Tk 12"dp

60.47 Tang

126.09 T=56=126.08

130.39 Tang

126.08

Fd Bt Spk in 12" Stump

130.40 T=56=130.39

Set L&T in conc bridge on line prod

Set L&T

Conc bridge

Note: Any Additions or Changes on This Sheet Must be Made or Circled in Red Ink With Date and Name of Person Making Change.

Do not extend notes this side of this line.

RETURN TO LOS ANGELES COUNTY SURVEYOR 726 LOS ANGELES COUNTY ENGINEERING BLDG.

76F3095 247 10M 5-49

F. B. 862 Pg. 166 To bot pg 167

W.S. 31-A-4

Fd 2X2 + TK 12"dp
Set L&T in E. side of
conc at S.M.H. by ties
after Const
9-13-50. VD

Set L&T in conc walk
to ho # 2108

5.15

Fd L&T

Set L&T in conc walk

47.49

64.35
Tang

Fd L&T

73.08
Tang

BAYARD ST

73.04
Tang

Fd L&T

45.68

62.91

Set L&T in conc walk

Fd L&T

ALAMEDA

Fd L&T

63.19

Fd L&T

75.06

CRAWFORD

Fd 2X2 notk 12"dp
Set 2 x 2 TK by Ties
after Const 9-13-50 VD

a30

75.65

ST

Fd old 2X2 top broken off
9 notk 14"dp

0.10

65.20

Fd L&T

CLARK

From top Pg X 165

RETURN TO
LOS ANGELES COUNTY SURVEYOR
726 LOS ANGELES COUNTY
ENGINEERING BLDG.

Do not extend notes this side of this line.

Note: Any Additions or Changes on This Sheet Must be Made or Circled in Red Ink With Date and Name of Person Making Change.

F. B. 862 PG. 167

Notes Ck'd by	Survey of Clark Ave
Map No.	W. O. Tape No 9166 St'd. 68 °F
Office Work	Surveyed by Van Deren
Checked	Notes Van Date 1-9-50
Date	Indexed A. C. Johnson

W.S. 31-A-4

To Let pg #168

Set L+T in C6 use for line

Tan

1/4 Cor Fd conc mon with cop nail in ctr 20" dp. per FB 862-125 FB 981-124 EO 349-2 Fd Set w after const Chs Tan Ties. normal at this int. as per I.S.I. E of new S.M.H. 9-13-50 V D

Fd X cut in SMH. ring

8.94

62.18

120.81 Tan

Set 3/4 I.P. PH TK 14' dp

120.81 T=68=120.81

Set L+T

STEARNS AVE

34.19

Set s & w

51.80 Tan

85.52 Tan

Set L+T

33.62

Set L+T

Set L+T

SEC 28

SEC 27

23.49

CLARK AVE

Set L+T in conc walk ho #2152

From Tape pg #166

Note: Any Additions or Changes or This Sheet Must be Made or Circled in Red Ink With Date and Name of Person Making Change.

Do not extend notes this side of this line.

RETURN TO
LOS ANGELES COUNTY SURVEYOR
726 LOS ANGELES COUNTY
ENGINEERING BLDG.

76F3099 247 10M 1-49

F. B. 862 PG. 10 168

To bot pg # 169

W.S. 31-A-4

23RD ST

no evid new sewer line

Fd Brass cp Mon set
Win Conc 14" dp. per R 0349-2

40.00'

ST

Set St Win prt

20.66

HILL ST

Fd 2X2 TK Flush

Fd 2X2 Tag RE 2059 Flush
after const Calks Tags
9-13-50 V.D.

18.95

Set St Win prt

28.60

Set x cut in Ring of SMH

From top pg # 167

RETURN TO
LOS ANGELES COUNTY SURVEYOR
726 LOS ANGELES COUNTY
ENGINEERING BLDG.

Do not extend notes this side of this line.

Note: Any Additions or Changes on This Sheet Must be Made or Circled in Red Ink With Date and Name of Person Making Change.

F. B. 862 PG. 169

Notes Ck'd by
Map No.
Office Work
Checked
Date

Survey of Clark Ave
W. O. 7000 Tape No. 6106 St'd. 68 °F
Surveyed by Van Deren
Notes Van Date 1-1950
Indexed A. C. Johnson

W.S. 31-A-3

Set 3/4 I.P. Plug T. 19" d/p

48.27

Fd 4" Brass tablet in conc 14" dia. inscribed "L.A. County Survey Control System Traverse Station Clearwater I-12 - RE 2177. Set by County Surveyor." per FB 929-69-70
" 967-9-22
" 981-124

RM #1 Fd 4" Brass Cp Mon 12" d/p Marked L.A. Co. Surv Cont. Sys: Ref Mark, and Stamped Clearwater I-12, RE 2177 RM #1 See FB 929-69-70

Set 4 Tan X Cuts PM in Cir. on S.M.H. ring by Tan Ties after Const 9-13-50

Set X Cut in N. ring of S.M.H.

VD 9.875

41.12 Tan 9

40.00

Fd Conc Mon 5" d/p per FB 349-1 N.C. have been hit by plow

40.00

WILLOW ST

27.71

29.47

Set 5/8 x w in prt

44.885 Tan 9

87° 00'

RM #2 Fd Conc Mon 12" d/p with Cut Spk & Washer in Cir. Stamped RE 1277 - See FB 929-69-70

46° 30' 00"

45.33

Set 3/4 I.P. Plug T. 19" d/p

CLARK ST

From Top pg 168

Notes: Any Additions or Changes on This Sheet Must be Made or Circled in Red Ink With Date and Name of Person Making Change.

Do not extend notes this side of this line.

RETURN TO
LOS ANGELES COUNTY SURVEYOR
726 LOS ANGELES COUNTY ENGINEERING BLDG.

76F3095 247 10M 1-49

F. B. 867 Pg. 12170

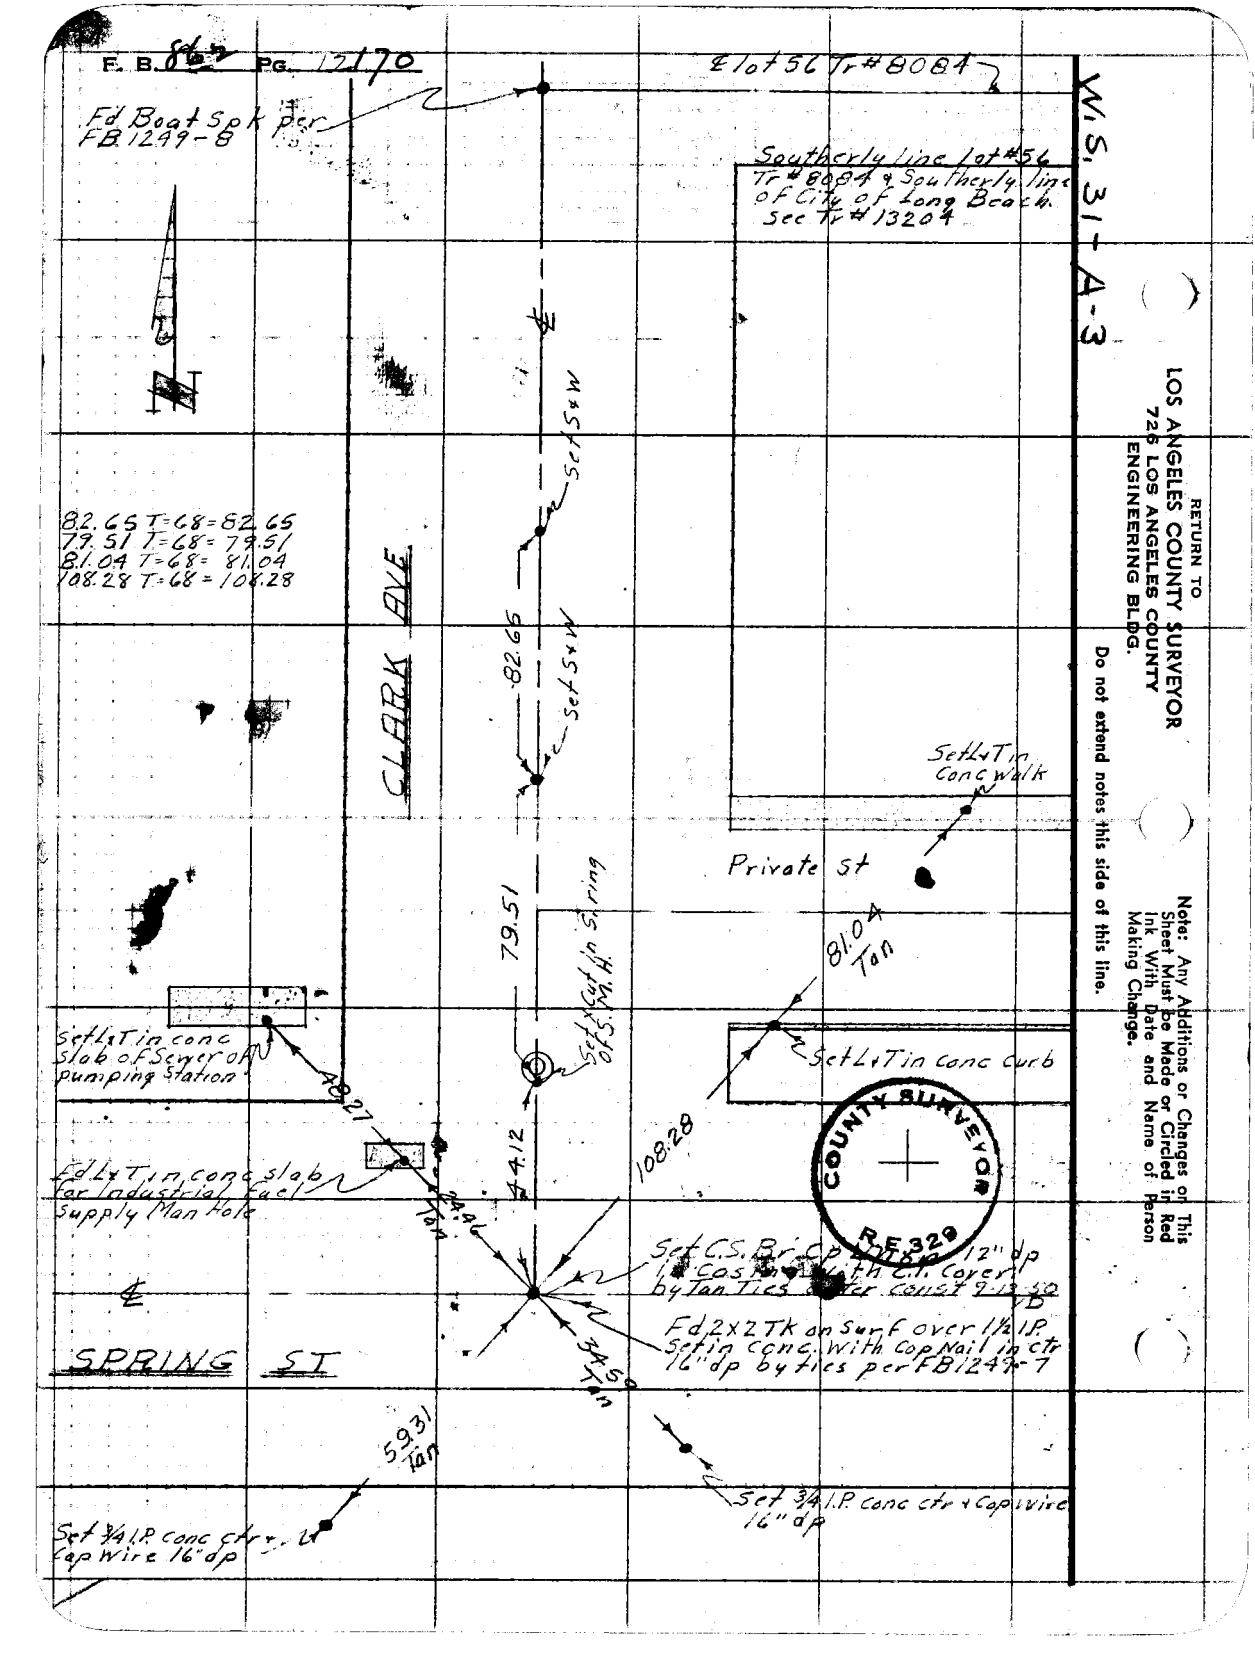

RETURN TO
LOS ANGELES COUNTY SURVEYOR
726 LOS ANGELES COUNTY
ENGINEERING BLDG.

Do not extend notes this side of this line.

Note: Any Additions or Changes on This Sheet Must be Made or Circled in Red Ink With Date and Name of Person Making Change.

FORM 247 SM 11-46

RETURN TO
LOS ANGELES COUNTY SURVEYOR
700 HALL OF RECORDS

Note: Any Additions or Changes on This Sheet Must be Made or Circled in Red Ink With Date and Name of Person Making Change.

Do not extend notes this side of this line.

Notes Ck'd by
Map No.
Office Work
Checked
Date

Survey of
W. O. Tape No. Std. °F
Surveyed by
Notes Date
Indexed

F. B. 962 PG. 171

8.0

171-174 plan

RETURN TO
LOS ANGELES COUNTY SURVEYOR
700 HALL OF RECORDS

Note: Any Additions or Changes on This Sheet Must be Made or Circled in Red Ink With Date and Name of Person Making Change.

Do not extend notes this side of this line.

F. B. 883 PG. 114

Notes Ck'd by D.M. Finley	Survey of Anaheim Rd
Map No. B-1929	W. O. 8407 Tape No. 2 1/2 Std. [illegible] R
Office Work C.W. Cox	Surveyed by Blanchard
Checked	Notes FNB Date 11-1-45
Date Jan 1946.	Indexed 12-20-45

F. B. 844 Pg. 175

ANAHEIM ROAD

JN 8407

From Studebaker Road West along Section line to Pacific Coast Highway.

Oct & Nov. 1945

References
FB-397
FB-302
FB-365
FB-[illegible]
FB-287
FB-431
FB-491
FB-465
FB-902

Party
Blanchard
Nicholl
Westenland
Liddle
Knowles

For Adopted & See F.B. 862-201-209

Note: Any Additions or Changes on This Sheet Must be Made or Circled in Red Ink With Date and Name of Person Making Change.

Do not extend notes this side of this line.

RETURN TO
LOS ANGELES COUNTY SURVEYOR
700 HALL OF RECORDS

FORM 247 3M 12-40

F.B. 862 PG. 176

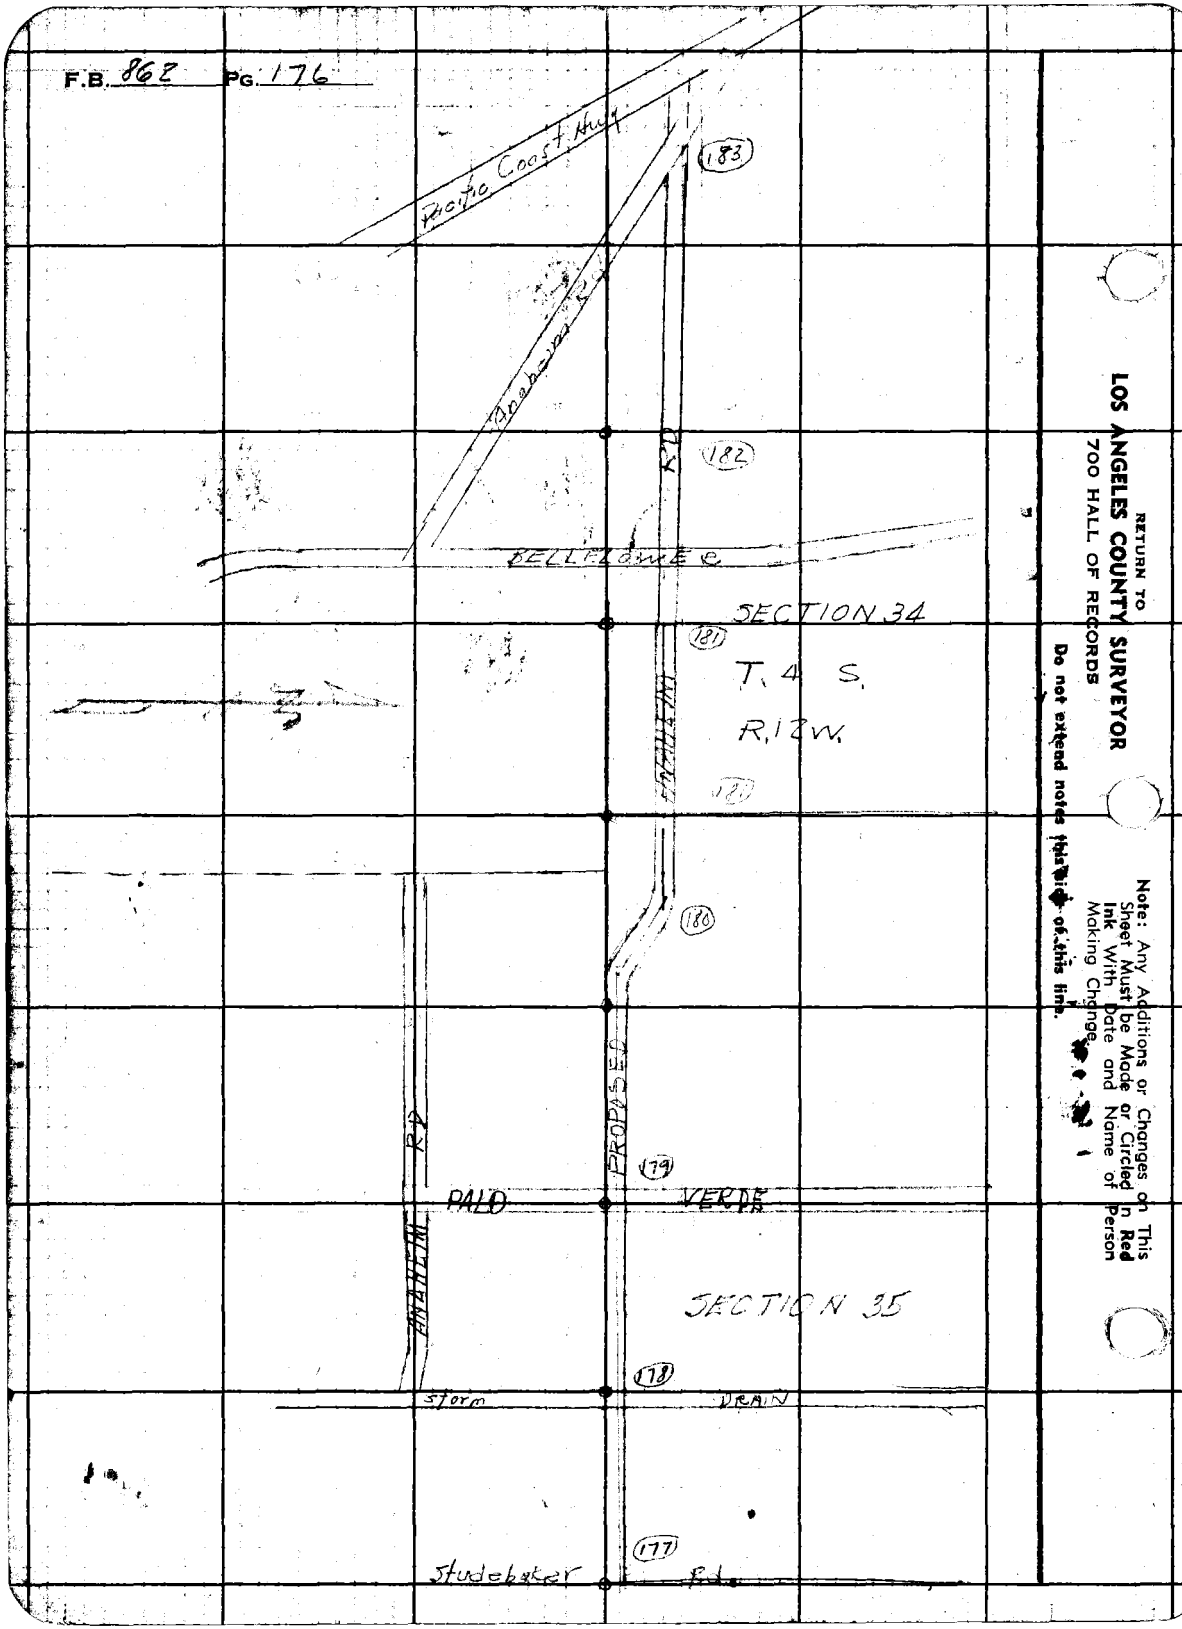

RETURN TO
LOS ANGELES COUNTY SURVEYOR
700 HALL OF RECORDS

Do not extend notes this side of this line.

Note: Any Additions or Changes on This Sheet Must be Made or Circled in Red Ink With Date and Name of Person Making Change.

Notes Ck'd by D.M. Finley	Survey of ANAHEIM RD.
Map No. B-1929	W. O. 8407 Tape No. 30 Std 84 °F.
Office Work C.M. Cox	Surveyed by F.H. Blanchard
Checked	Notes F.H.B. Date 10-24-45
Date Jan. 1946.	Indexed A. D. Johnson

F.B. 862 Pg. 177

31, C-4

Found 2½" I.P. & M. 12" dn. per F.B. 862-109. F.H.B. 12-27-45.

Proposed State St.

Note: Any Additions or Changes on This Sheet Must be Made or Circled in Red Ink With Date and Name of Person Making Change.

Do not extend notes this side of this line.

SECTION 35
T. 4 S.

SECTION 36
R. 12 W.

Proposed Slide Butler Rd

90° 00' 45"
360° 03' 15"
180° 04' 45"
90° 00' 50"

90° 00' 50"

Set 3/4" I.P. 1.0" dn. 0+00 going West.

Bot pg 178

Center line
Enc. 04

35+56

Set 1/2" 0+35.56 Section line

3000

Fd C.S. mon 18" dn. 1/4 cor. per 902-38

COUNTY SURVEYORS
T. 4 S.
R. 12 W.
35 - 36
1/4 Sec Cor
MONUMENT

RETURN TO
LOS ANGELES COUNTY SURVEYOR
700 HALL OF RECORDS

FORM 247 BM 12-40

F.B. 862 PG. 178

out pg 179

31, B-4

RETURN TO
LOS ANGELES COUNTY SURVEYOR
700 HALL OF RECORDS

Do not extend notes this side of this line.

Note: Any Additions or Changes on This Sheet Must be Made or Circled in Red Ink With Date and Name of Person Making Change.

SECTION 35

T.4S. R.12W.

T76°
1072.34 @ 0.00 = 1072.28'

89° 59' 45"
359° 59' 00"
179° 58' 30"
89° 59' 45"

1072.28'

89°

55'

6" round

13+54.10
Set 3/4" IP by
flt. 12" in.

Los Cerritos channel
C.S.E. 1627

T72°
118.12 @ 0.00 = 112.11'

112.11'

12+35.99
Set 1/x2

T72°
600.09 @ 0.00 = 600.39'

600.09'

6+35.60
Set 1/x2

T72°
600.09 @ 0.00 = 600.04'

600.04'

out Left sht 2, pg 177

Notes Ck'd by D.M. Finley	Survey of Anaheim Roads
Map No. B-1929	W. Co. Tape No. 36 Std. [illegible] °F
Office Work C.W. Cox	Surveyed by FHB Blanchard
Checked	Notes FHB Date 11-
Date Jan. 1946	Indexed A. C. Johnson

F.B. [illegible] Pg. [illegible]

31, B-4

Note: Any Additions or Changes on This Sheet Must be Made or Circled in Red Ink With Date and Name of Person Making Change.

Do not extend notes this side of this line.

RETURN TO
LOS ANGELES COUNTY SURVEYOR
720 HALL OF RECORDS

FORM 247 5M 12-40

not pg 180

SECTION 35

T.4S. R.12W.

ROAD

1320.38'

T76°
1320.45 @ 0°00' = 1320.38'

MONUMENT
COUNTY SURVEYOR
R12W. T4S.
CEN OF SEC 35

T74°
2611.67 @ 0°00' = 2611.50

26+41.34'
Set ¾" IP 12" dn
Lg in +

Fd CS Mon 18" dn
per FB 902-38
marked as shown

Set N&T Fence ⊥

Set N&T Fen ⊥

Palo Verde Ave.

2611.50'
CS Mon 18" dn per FB 902-38
FB 862-110T.

Fd SW 5" T
FB 397-11

Anaheim

3000

25.33

22.99

22.82

25'

30'

Set N&T Fence ⊥

Set N&T Fence ⊥

89°

59

89°59'30"
359°58'00
179 57 00
89°59'30"

T76°
214.97 @ 0°00' = 214.96'

214.96'

Redondo Street

ANAHEIM

24+26.38
Set 1x2

1077.22'

top pg 178

F.B. 862 PG. 120

US NAVY HOSPITAL GROUNDS

RETURN TO LOS ANGELES COUNTY SURVEYOR 700 HALL OF RECORDS

Do not extend notes this side of this line.

Note: Any Additions or Changes on This Sheet Must be Made or Circled in Red Ink With Date and Name of Person Making Change.

31, B-4

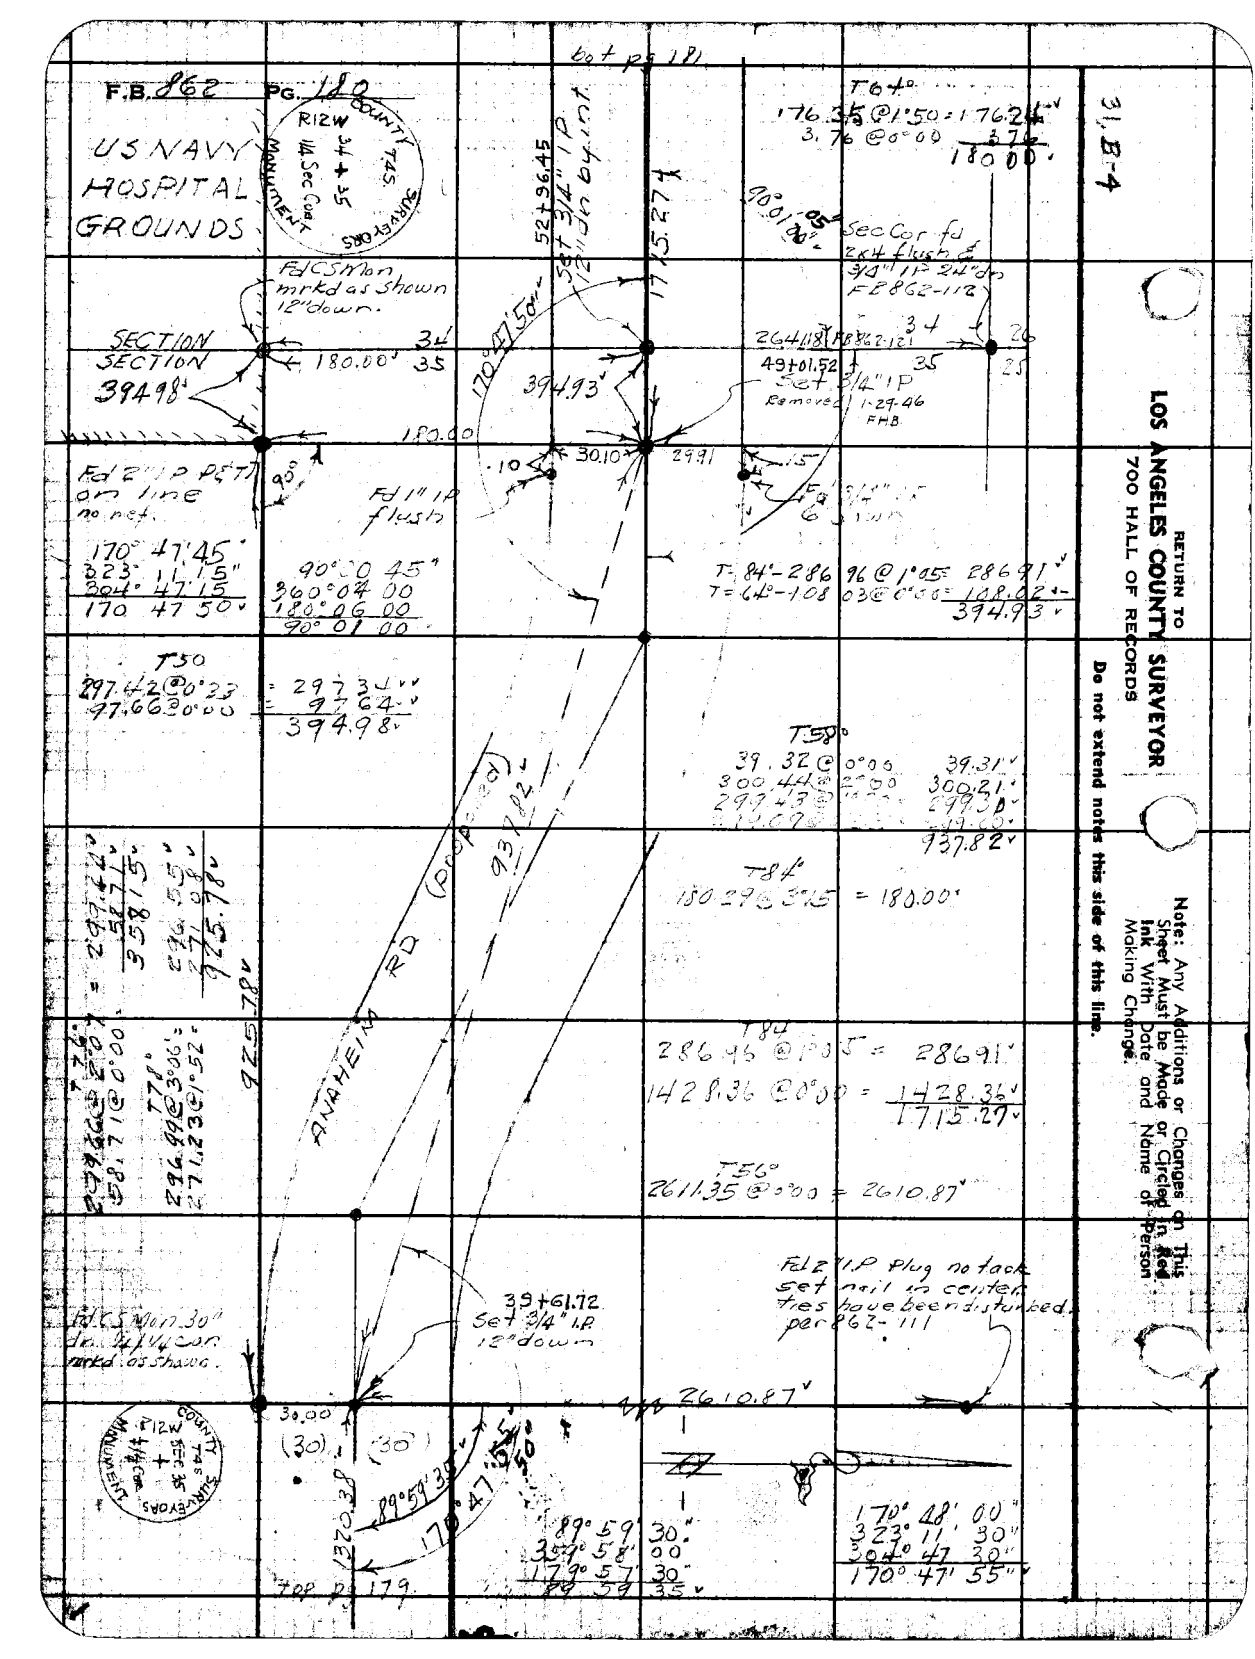

Notes Ck'd by D.M. Finley		Survey of Anaheim Road	F.B. 462 Pg. 181
Map No. B-1929.		W. O. 8407 Tape No. 36 Stdy 82 °F.	
Office Work C.W. Cox		Surveyed by F.H. Blanchard	
Checked Jan 1946		Notes FHB Date 12-14-45	
Date		Indexed A. C. Johnson	

31, B-4

bot pg 182

99.FL 2.0
B60°06'E
150.09
90°01'30"

90°01'30"

659.45'

70+16.83
Set 3/4" IP
by tie

1279.70'

Fd Conc mon 20" dn
Brass cap stamped
L.A. Co Rd Dept
FA 159-133

BELLFLOWER AVE

Fd Conc mon
18" dn Brass Cap
stamped LA Co
Rd Dept.
FA 159-132

762'
299.64@2°04 = 299.41'
980.43@0°00 = 980.29'
1279.70.

SECTION 34

T.1S. R.12W.

Note: Any Additions or Changes on This Sheet Must be Made or Circled in Red Ink With Date and Name of Person Making Change.

Do not extend notes this side of this line.

RETURN TO
LOS ANGELES COUNTY SURVEYOR
700 HALL OF RECORDS

179°58'15"
359°56'45"
359°55'00"
179°58'15"

Fd old GS mon 6"down
per FB
Was not on line, the fence built
by Naval Hospital, had concrete base
Last set against it so I replaced it on line
Setting rd mon marked as shown

(Proposed) Anaheim Rd

390.69'

212.65@21°34 = 212.55'
178.14 Tan = 178.14'
390.69'

66+26.14
Set 3/4" IP
flush

66+16.79
Set 3/4" IP
flush with
ground

180.00'

93'

66+01.82
Set 1"x2" by
tie

1/4" con
Fd 3/4" IP flush
1/4" con per
FB 862-113

15' offset

Set 1"x2"

1800.01@10°00 = 180.00'

1715.27'

89°59'15"

89°59'15"

89°59'15"
359°56'45"
179°55'30"
89°59'15"

GROUNDS

U.S. NAVY HOSPITAL

Top pg 180

FORM 247 3M 12-40

F.B. 862 PG. 182

dot pg 183

dot pg 183

619.82

91+87.99
Set 1x2

100.00

set 1x2

90°

SECTION 34

T.4S. R.12W.

31 B-4

RETURN TO
LOS ANGELES COUNTY SURVEYOR
700 HALL OF RECORDS

Do not extend notes this side of this line.

Note: Any Additions or Changes on This Sheet Must be Made in Red Ink With Date and Name of Person Making Change.

T=56

110 58 @ 2°39' = 110.46
297 90 @ 2°46' = 297.53
300.30 @ 2°45' = 300.02
242.99 @ 0°00' = 242.95
300.06 @ 0°00' = 300.01
1250.97

ANAHEIM 1250.97 R&I

T=0
180.00 @ 0°00' = 180.00

Cntr Sec 34 per FA 159-49 FB 289-20 Fd 2x48 nail 0.45' Terra cotta 1/2 8" deep.

79+37.06
INT Set 3/4" IP 1 sign by 1.17

Fd old Sec corn replaced with 3/4" IP 0.10 on

Fd 6" conc mon with cut "+" in cut 18" deep FA 159-48

180.00

set 1x2

100.00

400.00

90°

1/4 Section

90°01'15"

760.24

Fd 6" conc mon with cut spk in mon per FA 159-49 12" deep

T=0
760.24 @ 0°00' = 760.24

90° 01' 15"
360° 00' 00"
180° 01' 30"
90° 01' 15"

1/4 SECTION LINE

76+76.78
Set 3/4" IP flush

Driveway to

Mrs Bryant's House

Set 1/2" I.P. 0.51 Set 1/2" I.P. 0.19

Set Nail in Pepper tr. 5.40

Set Nail in Pepper tr. 7.58

(PRODUCED)

639.95

91°20'00" = 91.20
299°59'30" = 299.81
268°01'30" = 268.94
639.95

top pg 181

Notes Ck'd by R.A. Finley
Map No. B-1929
Office Work C.W. Cox
Checked Jan. 1946
Date

Survey of Anaheim Rd
W. O. 8407 Tape No. 36 Std. 84 °F
Surveyed by F.H.P. Inc.
Notes F.H.P. Date 12-18-45
Indexed A. C. Johnson

F.B. Pg.

31, A-4

Note: Any Additions or Changes on This Sheet Must be Made or Circled in Red Ink With Date and Name of Person Making Change.
Do not extend notes this side of this line.

RETURN TO
LOS ANGELES COUNTY SURVEYOR
720 HALL OF RECORDS

FB 393-52

FD SWET FB 293-97

SANTIAGO AVE

(PROPOSED) ANAHEIM RD.

PACIFIC HWY

Old Centerline per DSB 350-1 Calc.

Set L&T by int.

Set L&T Calc dist.

Set SWET by int.

Set SWET Calc dist.

Set SWET (Easterly Somerset Ave)

T60° 160 83 00 00

41° 16' 00"
165° 04' 00"
247° 36' 00"
41° 16' 00"

160.80

295.84'

191.17'

278.50

30'

21° 02' 35"

619.89'

100' Street

Fd L&T set N.W. FB 302-134

Fd L.A. County Geod. Mon. 14" dn in cast iron well no ref.

Fdx per FB 366-133

SECTION 34
T. 4 S., R 12 W

T60° 295.89 @ 0°00 = 295.84

T60° 191.20 @ 0°00 = 191.17

T60° 278.50 @ 0°00 = 278.50

T = 58
51.21 @ 0°00
269.49 @ 0°00
299.29 @ 0°00
619.99 @ 0°00 = 619.89

81° 02' 30
84° 10 30
126 15 30
21° 02' 35"

FORM 247 3M 12-45

RETURN TO
LOS ANGELES COUNTY SURVEYOR
700 HALL OF RECORDS

Note: Any Additions or Changes on This Sheet Must be Made or Circled in Red Ink With Date and Name of Person Making Change.

Do not extend notes this side of this line.

31, A-4

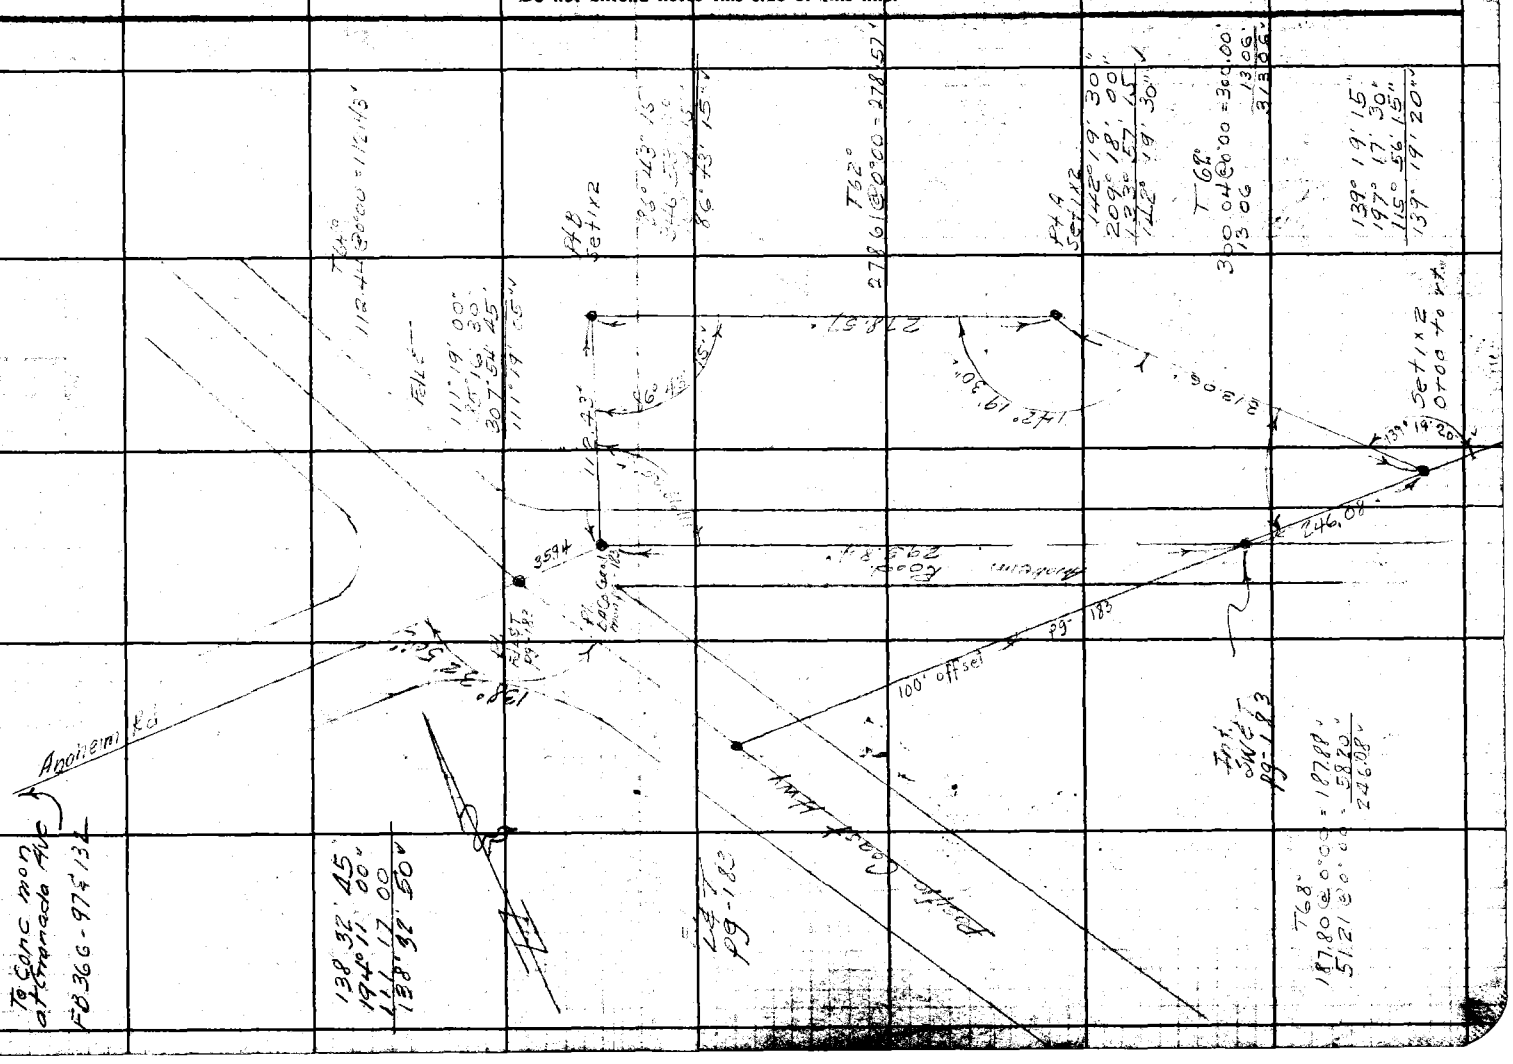

FORM 247 5M 12-40

RETURN TO
LOS ANGELES COUNTY SURVEYOR
700 HALL OF RECORDS

Note: Any Additions or Changes on This Sheet Must be Made or Circled in **Red Ink** With Date and Name of Person Making Change.

Do not extend notes this side of this line.

31, A-4

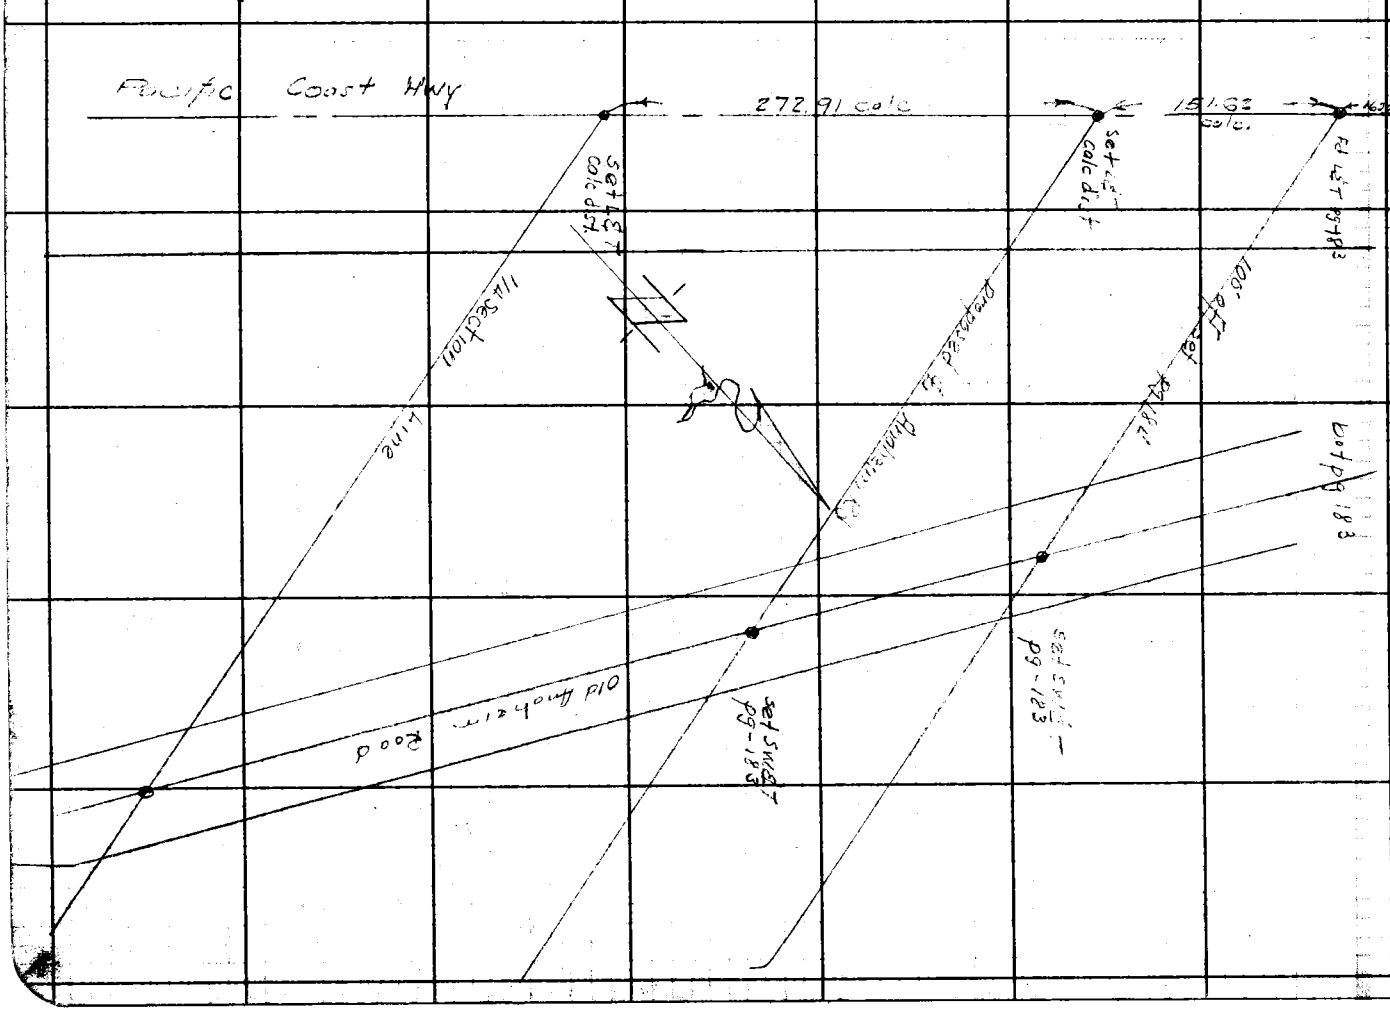

Notes Ck'd by
Map No. 2-1829
Office Work C.W. Cox
Checked Jan 1946
Date

Survey of Angeles Tract
W. O. 84827 Tape No. 30 Std. °F
Surveyed by FHB
Notes
Indexed Date 1-9-46

F.B. 847 Pg. 125

RETURN TO
LOS ANGELES COUNTY SURVEYOR
700 HALL OF RECORDS

Note: Any Additions or Changes on This Sheet Must be Made or Circled in **Red Ink** With Date and Name of Person Making Change.

Do not extend notes this side of this line.

F.B. 962 PG. 186

Notes Ck'd by	Survey of Anaheim Road
Map No. B-1929	W. O. 8407 Tape No. 36 Std 64 °F
Office Work C.W. Cox.	Surveyed by F.H. Blanchard
Checked [illegible]	Notes F.H.B. Date 1-9-46
Date Jan. 1946	Indexed 1-10-46

F.B. 91-5 Pg. 189

TOPOGRAPHY

of

ANAHEIM ROAD

From Studebaker W. West along 1/4 Sec line to Navy Hospital then parallel to 1/4 Sec line. 150' No. to Pacific Coast Highway on old Anaheim Rd.

JN 8407

-Party-
Blanchard
Nichols
Riddle
Brown

Note: Any Additions or Changes on This Sheet Must be Made or Circled in Red Ink With Date and Name of Person Making Change.

Do not extend notes this side of this line.

RETURN TO
LOS ANGELES COUNTY SURVEYOR
700 HALL OF RECORDS

FORM 247 5M 12-40

RETURN TO
LOS ANGELES COUNTY SURVEYOR
700 HALL OF RECORDS

Note: Any Additions or Changes on This Sheet Must be Made or Circled in **Red Ink** With Date and Name of Person Making Change.

Do not extend notes this side of this line.

F.B. 862 PG. 188

F.B. R&S 109 Pg.

Notes Ck'd by
Map No. B-1929
Office Work C.W. Cox
Checked
Date Jan. 1946.

Survey of ANAHEIM ROAD
W. O. 8427 Tape No. 36 Std 84 °F.
Surveyed by FHE to [illegible]
Notes FHE. Date 1-7-46
Indexed E. C. Johnson

Note: Any Additions or Changes on This Sheet Must be Made or Circled in Red Ink With Date and Name of Person Making Change.

Do not extend notes this side of this line.

RETURN TO
LOS ANGELES COUNTY SURVEYOR
700 HALL OF RECORDS

FORM 247 5M 12-40

Fence FP No Wire 30.00 Fence 3 Strands 26+60.6

W edge of Macadam Rd 26+50.1

℄ PALO VERDE RD Fd 3/4" IP 12' down 26+44.34 PJ-177

E edge of Macadam Rd 26+30.00

Fence FP No Wire Fence 4 Strands of wire 26+20.8

30.1 Fd 1x2 24+26.38

RD

13+54.6 Start of Fence No Wire 30.5 Fd 3/4" IP 12' down 13+54.10 PJ-178

3/4" IP 13+54.10 Elev on Grade

W edge Top bank 13+20.5

W edge bot. ditch 13+07.5

Los Carritos Channel

E edge bot ditch 12+48.9

E edge Top bank 12+40.5

1x2 Edge 12+35.99 Elev 8.5

Elev 0.00 Fd 1x2 12+35.99 PG-178

℄ Prop ANAHEIM

Fd 3/4" IP 0+00 PG-177

F.B. 862 PG. 190

bot pg- 191

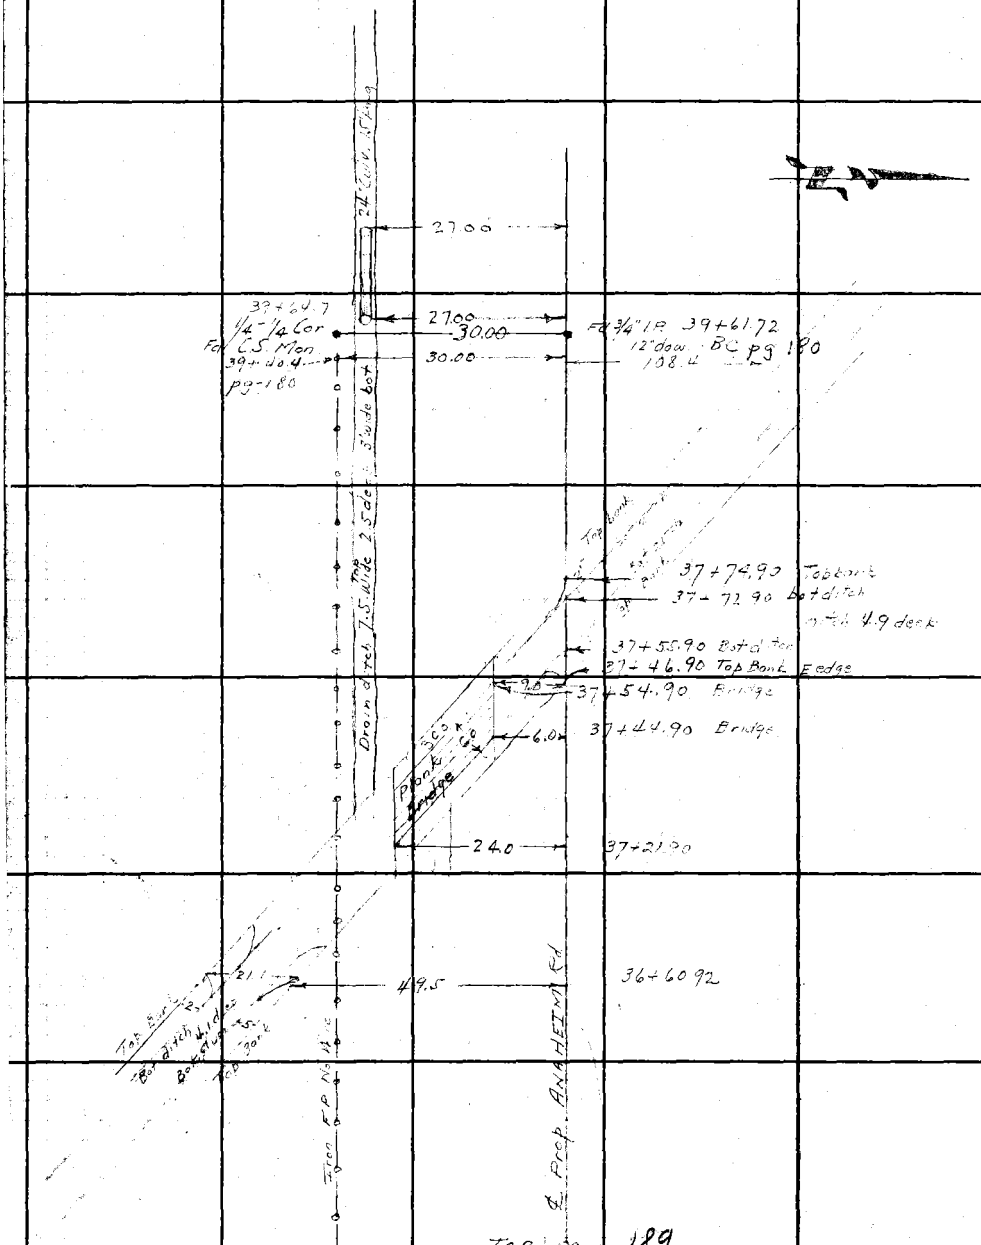

Top pg- 189

RETURN TO
LOS ANGELES COUNTY SURVEYOR
700 HALL OF RECORDS

Do not extend notes this side of this line.

Note: Any Additions or Changes on This Sheet Must be Made or Circled in Red Ink With Date and Name of Person Making Change.

F.B. 847 PG. 198

Notes Ck'd by
Map No. B-1929
Office Work C.W. Cox
Checked
Date Jan. 1946.

Survey of Anaheim Road
W. O. 847 Tape No. 36 Std. 84 °F.
Surveyed by FH Blanchard
Notes FH BLANCHARD Date 1-9-46
Indexed S. C. Johnson

194

Note: Any Additions or Changes on This Sheet Must be Made or Circled in Red Ink With Date and Name of Person Making Change.

Do not extend notes this side of this line.

RETURN TO
LOS ANGELES COUNTY SURVEYOR
700 HALL OF RECORDS

FORM 247 5M 12-60

1+55.8 — 70.3 — 8" Pine
1° 11°

1+35.9 — 26.5 — 26" Pepper — 60.8 — Oleander
278.50
1+20.9 — 63.3 — 10" Pepper

1+12.5 — 41.1 — Shrub — 42.0 — Mock Orange
DOT 5.7 CS W S T
Calc dist from int of 100' offset 6.8 of old Anaheim Rd

0+91.6 — 75.1 — 10" Eucal.
0+86.6 — 49.1 — 10" Pine
0+81.1 — 25.3 — TP #6132 US
0+75.0 — 25.3 — 14" Pepper — 55.9 — Ole. — 13.6 — Mock Orange
0+73.3

0+59.4 — 17.3 — Ole.
0+50.1 — 73.1 — Shrub
0+53.5 — 54.7 — Shrub — 10.5 — Olive
Cent. of old Anaheim Rd

0+42.2 — 43.5 — 8" Pepper — 45.6 — 12" Pine
0+26.7 — 39.8 — 8" Acacia — 19.0 — Shrub
100.00
0+15.7 — 25.3 — 14" Pepper
80-182

0+11.2 — 52.6 — 11.0 — Mock Orange — 10" Pine — 29.7 — Mock Orange
29.0 — 0+00.8 — 10" Pine — 15.0 — Oleander Bush
Prof. Cent. Anaheim Rd. Bear S 45° E
0+00 (102) & (125)
Set PK spike going West.

F.B. 862 PG. 194

Bot. pg. 195

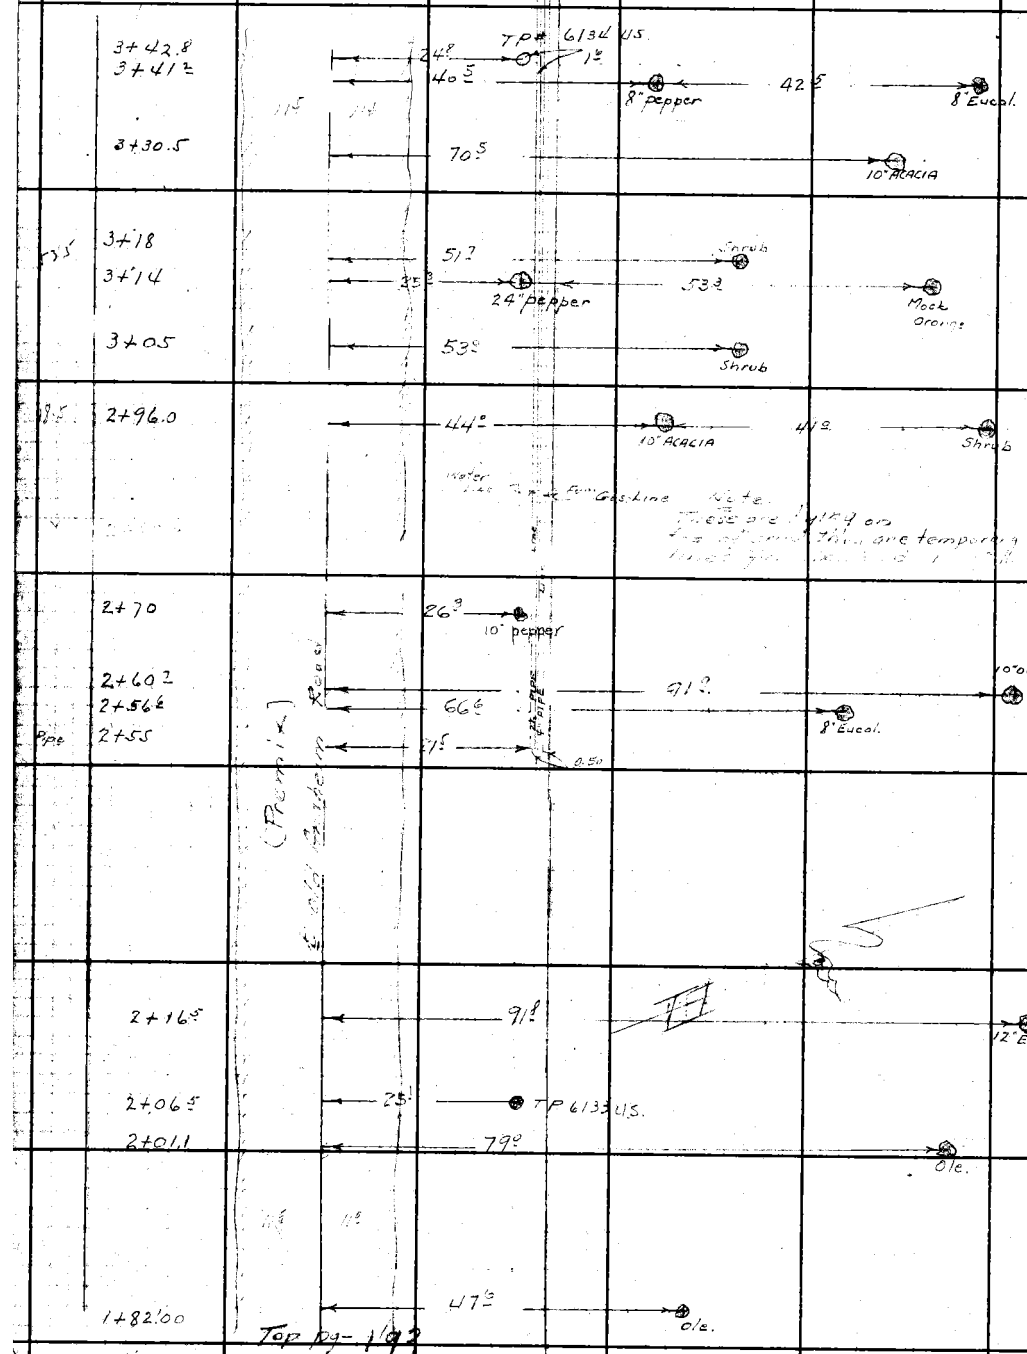

RETURN TO
LOS ANGELES COUNTY SURVEYOR
700 HALL OF RECORDS

Do not extend notes this side of this line.

Note: Any Additions or Changes on This Sheet Must be Made or Circled in Red Ink With Date and Name of Person Making Change.

Notes Ck'd by	Survey of ANAHEIM K
Map No. B-1929	W. O. 8447 Tape No. 36 Std 84 °F
Office Work C.W.Cox	Surveyed by FHB
Checked	Notes EHP Date 1-7-46
Date Jan. 1946	Indexed A. C. Johnson

F.B. 842 PG. 101

6 + pg 192

Note: Any Additions or Changes on This Sheet Must be Made or Circled in Red Ink With Date and Name of Person Making Change.

Do not extend notes this side of this line.

RETURN TO
LOS ANGELES COUNTY SURVEYOR
700 HALL OF RECORDS

70+59.9 8" Sycamore

70+66 Proj. 49 12 36.5 70+60 = B 79311 N 23 70+60 18" pine

70+39.8

OER Shoulder ½" thick.

70+32.3

Paveing OER. Proj N

℄ BELLFLOWER AVE

Fd SURVEY 70+16.83 PG-181

70+00.83

OER Shoulder ½" thick

69+92.1

48 17 31 49 6" Sycamore

69+71.6 4" sycamore

Proposed Alignment

66+56 N 3¼" IP PG-181

Fd 3¼" IP PG-181 66+16.79

0+00 going S

0+00 going N

Top pg-190

FORM 247 BM 12-0

F.B. 862 PG. 192

RETURN TO
LOS ANGELES COUNTY SURVEYOR
700 HALL OF RECORDS

Do not extend notes this side of this line.

Note: Any Additions or Changes on This Sheet Must be Made or Circled in Red Ink With Date and Name of Person Making Change.

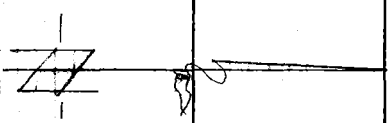








top pg - 191

F.B. A-2 — 195 — PG.

Notes Ck'd by
Map No. B-1929
Office Work C.W. Cox
Checked
Date Jan. 1946.

Survey of Anaheim #280
W. O. 8402 Tape No. 36 Std. 81° F
Surveyed by F.H.B. & S.H.W. Date 1-9-46
Notes F.H.B. & S.H.W.
Indexed C. D. Johnson

Note: Any Additions or Changes on This Sheet Must be Made in Red Ink or Circled in Red With Date and Name of Person Making Change.

Do not extend notes this side of this line.

RETURN TO
LOS ANGELES COUNTY SURVEYOR
700 HALL OF RECORDS

FORM 247 SM 12-40

5+47 — 57.5 — 11.5 — 11.5 — Shrub 16° Holly
5+01 — 17.8 — Shrub 30° Holly
4+97 — 55°
4+95.7 — 25.7 — 14" Pepper — 8" Eucal. 27° 8" Tree
2½" water — 4" fuel gas
4+76 — 38.4 — 8" Pine
4+72° — 24.3 — 2.5 — 0.50 — TP #6135 US
4+68.3 — 25.3 — 6" Pepper — 2 Shrubs 32° Calif Holly
4+65 — 60°
4+58.5 — 36.8 — Mock Orange
4+53 — 9.5 — 6" Pine
4+48.5 — 70° — 10" Eucal
4+35.4 — 26.3 — 16" Pepper — 34.5 — Holly
4+30.6 — 49° — Shrub
4+10 — 61.2 — Holly
4+05 — 44.3 — 12" Pine
3+98 — 72.5 — Holly
3+90.2 — 41.5 — 6" Pepper — 8" Pepper
3+85 — 61.3
3+80.5 — 47° — Shrub
3+78.50 SET SPIKE
3+75.0 — 24.2 — 14" Pepper
3+68.2 — 58.9 — Shrub
3+60.0 — 37.7 — 68.5 — Mock Orange — 37.5 — Mock Orange — 5" Pine
3+53.3
3+50 — 278.50 — top

100' Old Anaheim Road (Premix)

pg - 194

F.B. 862 PG. 196

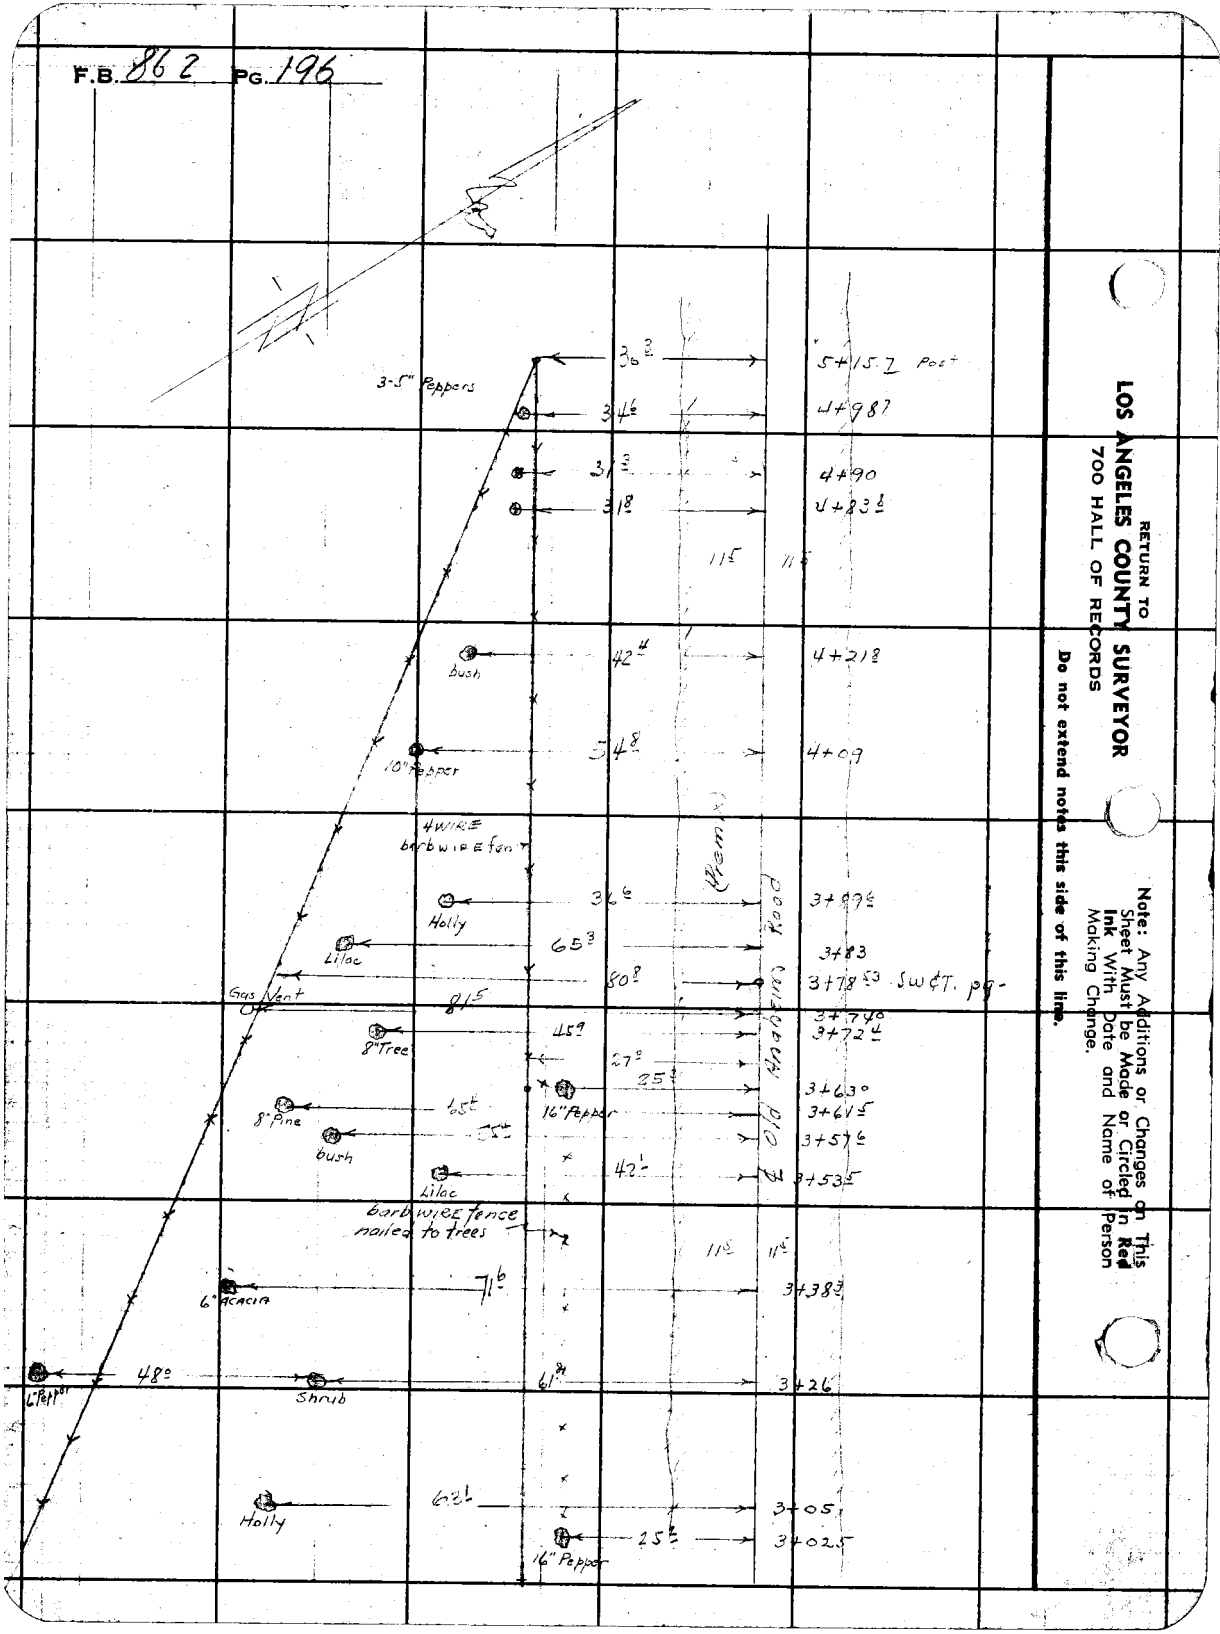

RETURN TO
LOS ANGELES COUNTY SURVEYOR
700 HALL OF RECORDS

Do not extend notes this side of this line.

Note: Any Additions or Changes on This Sheet Must be Made or Circled in Red Ink With Date and Name of Person Making Change.

Notes Ck'd by	Survey of Anaheim Bay 8
Map No. B-1939	W. O. 8407 Tape No. 36 Std. 74 °F
Office Work C.W. Coz	Surveyed by FHB Chambers
Checked	Notes FHB Date 1-9-46
Date Jan 1946	Indexed C. Johnson

F.B. 82 Pg. 197

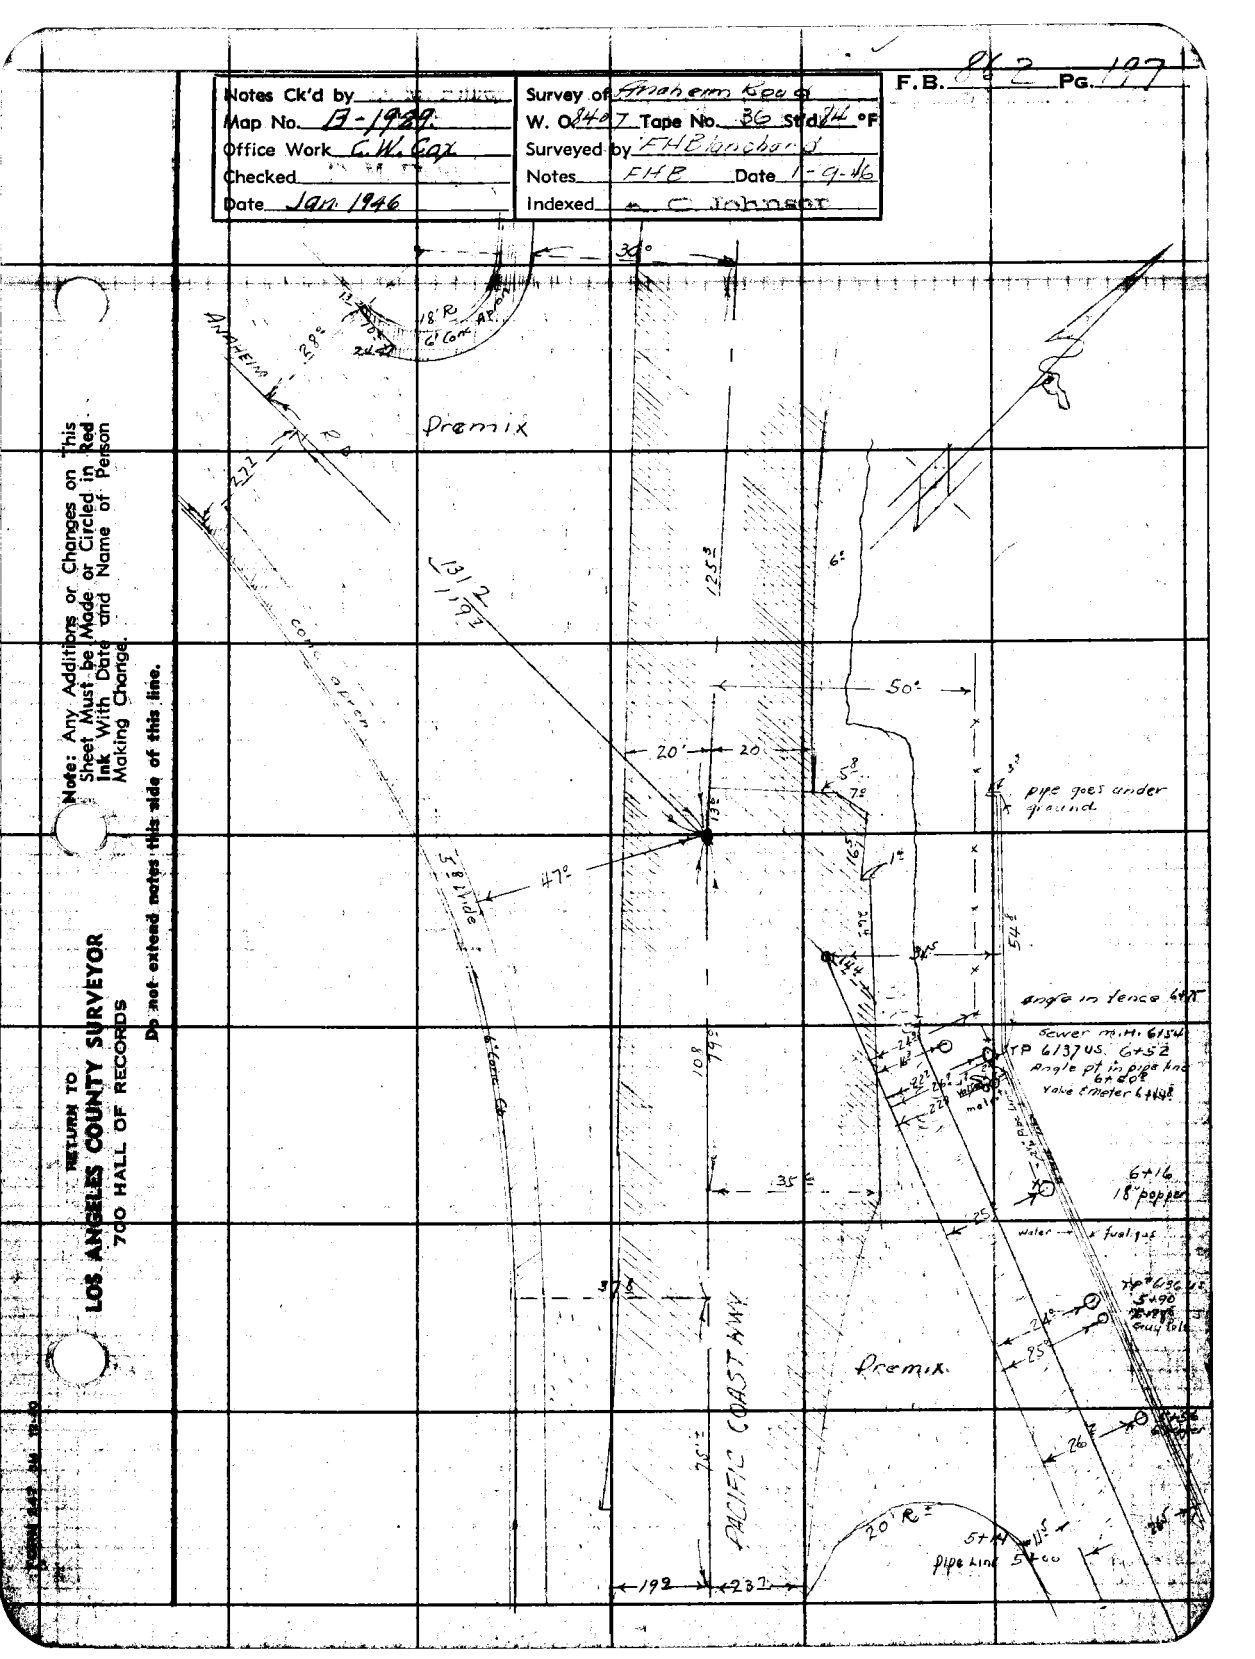

RETURN TO
LOS ANGELES COUNTY SURVEYOR
700 HALL OF RECORDS

Note: Any Additions or Changes on This Sheet Must be Made or Circled in Red Ink With Date and Name of Person Making Change.

Do not extend notes this side of this line.

FORM 242 RM 11-0

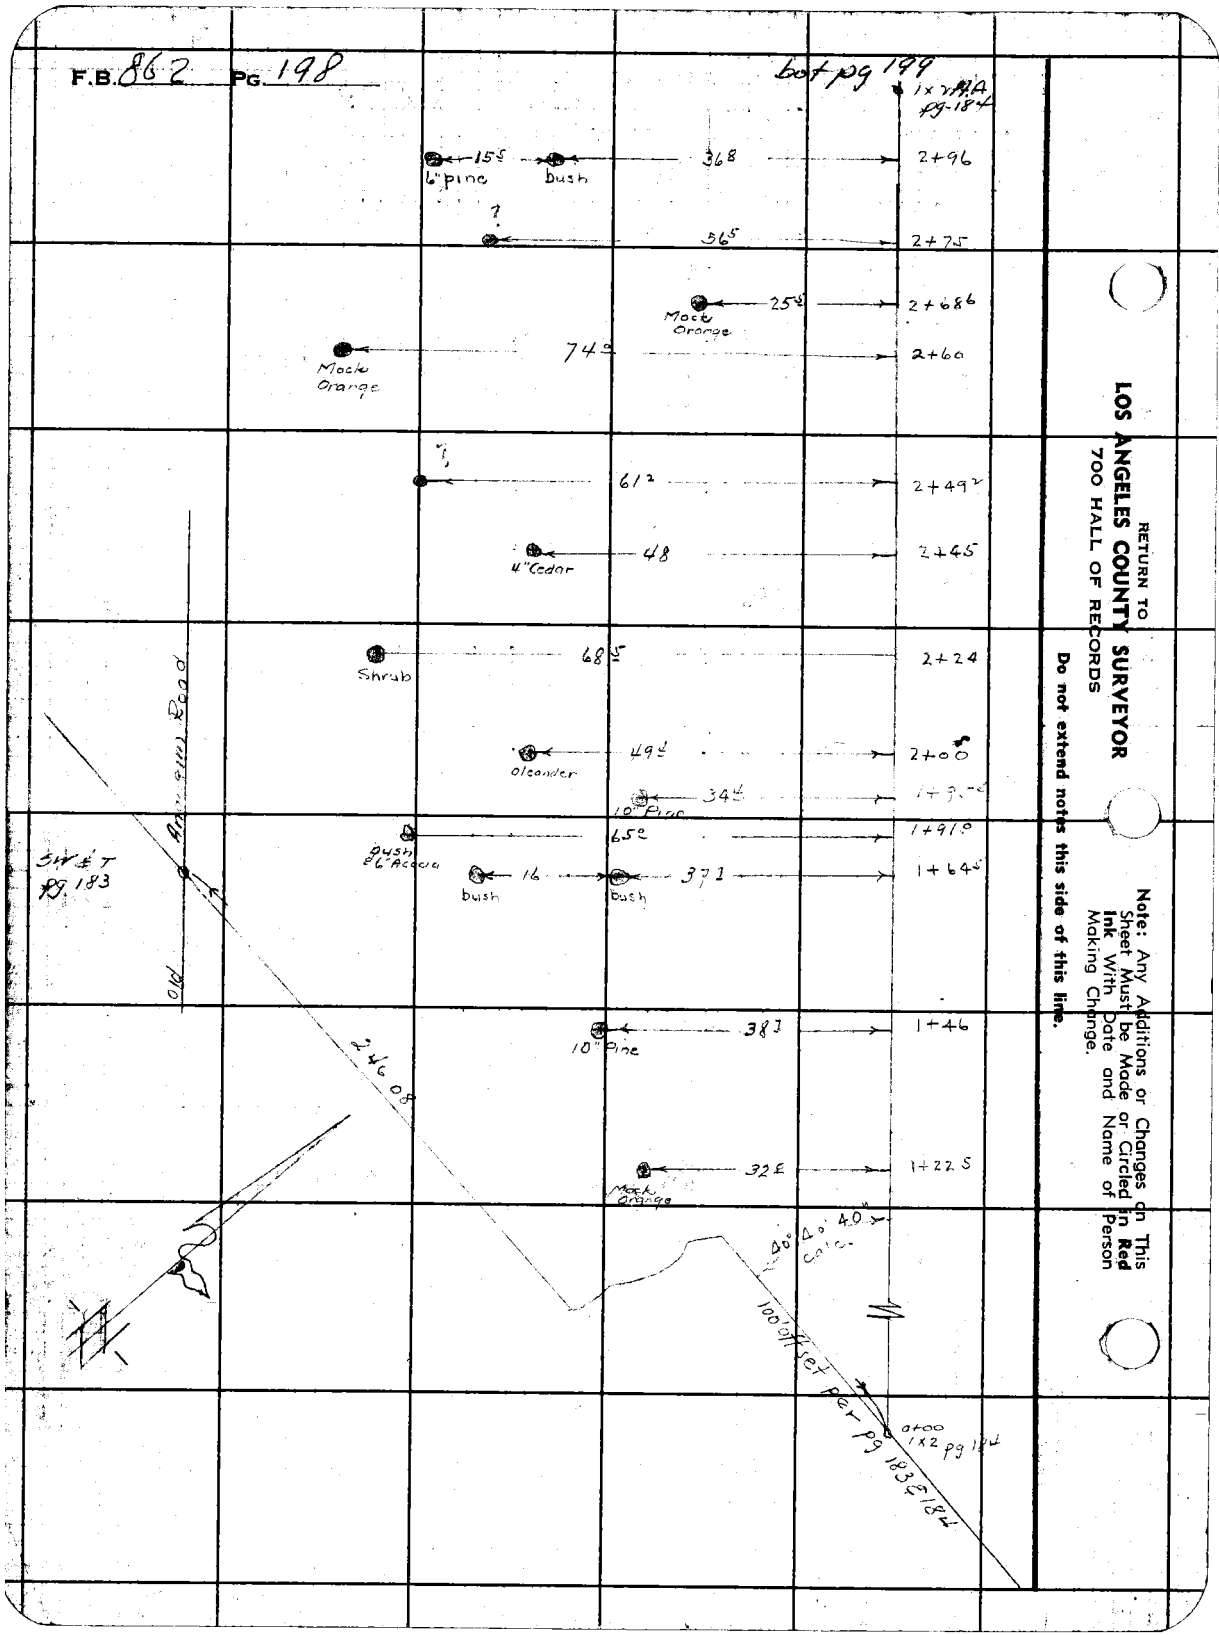
F.B. 862 PG. 198
Last pg 199
1 x MA pg 184
15'
6" pine
bush
368
2+96
?
365
2+75
Mock Orange
25'
2+686
Mock Orange
749
2+60
?
612
2+49
4" Cedar
48
2+45
Shrub
68'
2+24
Oleander
49'
2+00
10" Pine
34'
1+91.6
65'
1+91.6
Bush 6" Acacia
16
bush
bush
371
1+64
10" Pine
381
1+46
Mock Orange
32'E
1+22.5
Old Road
SHEET pg 183
24.08
40° 0' 40"
Calc.
100' off set Per pg 183 & 184
0+00
1x2 pg 184
RETURN TO
LOS ANGELES COUNTY SURVEYOR
700 HALL OF RECORDS
Do not extend notes this side of this line.
Note: Any Additions or Changes on This Sheet Must be Made or Circled in Red Ink With Date and Name of Person Making Change.

F.B. 84-2 Pg. 199

Notes Ck'd by	Survey of Anaheim Road
Map No. B-1929	W. O. 84-07 Tape No. 30 Std 84 °F
Office Work C.W.Co.	Surveyed by F.H. Blanchard
Checked	Notes FHB Date 1-9-46
Date Jan. 1946	Indexed A. C. Jones

Bot pg 200

5+41

10" Pine — 55° — 5+41

Mock Orange — 22.2 — 5+28

Holly — 21.5 — bush — 55° — 5+11

10" Pine — 27° — 10" Pine — 66° — 5+00

14" Pine — 14° — 4+93

bush — 51° — 4" Cedar — 28° — 4+84

Mock Orange — 45° — bush — 43.4 — 4+77

8" Tree? — 13.5 — 4+72

4" Cedar — 46.5 — 10" Pine — 60° — 4+67

14" Pine — 38.3 — 4+65

bush — 41° — bush — 24.5 — 4+55

12" Pine — 32 — 14" Pine — 19.4 — Holly — 12.3 — 4+25

8" Pepper — 28 — 8" Pine — 93°30' — 4+18

12" Eucal — 11.3 — 4+11

8" Pine — 14° — 20 — 3+92

Shrub — 5.8 — 3+83.5

8" Pine — 60.3 — 3+82

8" Eucal. — 8.5 — 3+64

bush — 21.6 — 3+48

bush — 6.2 — 3+23

Top pg 198 — 1 1/2" P.A. & 9t. — 3+13.2

Note: Any Additions or Changes on This Sheet Must be Made or Circled in Red Ink With Date and Name of Person Making Change.

Do not extend notes this side of this line.

RETURN TO
LOS ANGELES COUNTY SURVEYOR
700 HALL OF RECORDS

FORM 247 5M 12-50

45

F.B. 862 Pg. 200

RETURN TO
LOS ANGELES COUNTY SURVEYOR
700 HALL OF RECORDS

Note: Any Additions or Changes on This Sheet Must be Made or Circled in Red Ink With Date and Name of Person Making Change.

Do not extend notes this side of this line.

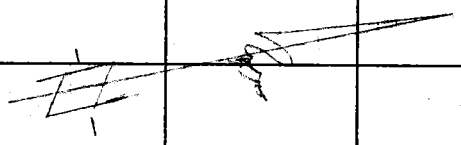

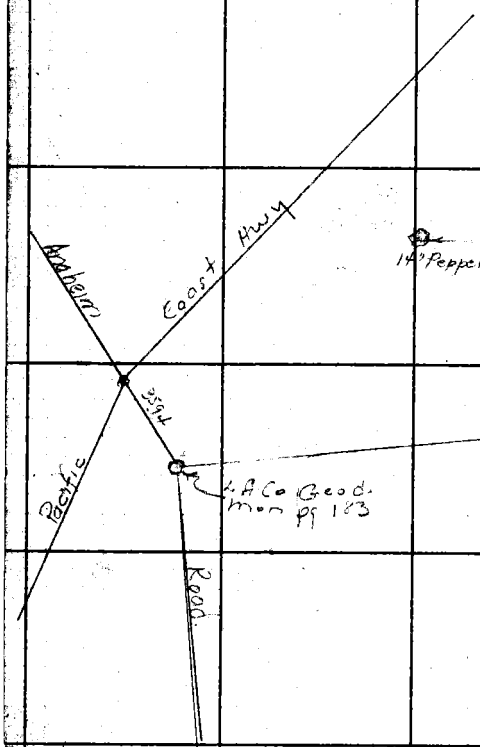

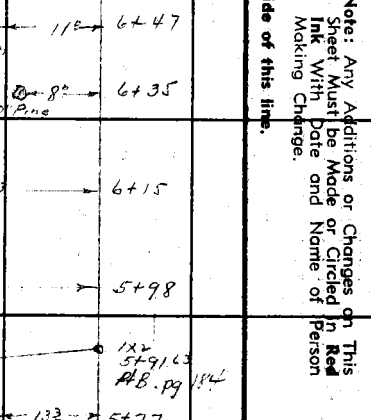

Top pg 179

Notes Ck'd by	Survey of
Map No. B-1929	W. O. 5407 Tape No. 56 St'd 64 °F
Office Work C.W. Cox	Surveyed by F.H. Blanchard
Checked	Notes F.H.B. Date 1-28-46
Date Jan. 1946	Indexed 1-31-46

F.B. 862 Pg. 201

FINAL CENTER LINE
OF
ANAHEIM ROAD

From Studebaker Road west to Pacific Coast Highway.

JN 5407

Jan 23 1946

SEE pg's 175 to 200 incl for Preliminary Survey

Reference

FB 597
FB 302
FB 306
FB 411
FB 287
FB 251
FB 481
FB 466
FB 502

Party

Flewelling
Nicholas
Liddle
Brown

Note: Any Additions or Changes on This Sheet Must be Made or Circled in Red Ink With Date and Name of Person Making Change

Do not extend notes this side of this line.

RETURN TO
LOS ANGELES COUNTY SURVEYOR
700 HALL OF RECORDS

FORM 247 5M 12-45

F.B. 862 Pg. 202

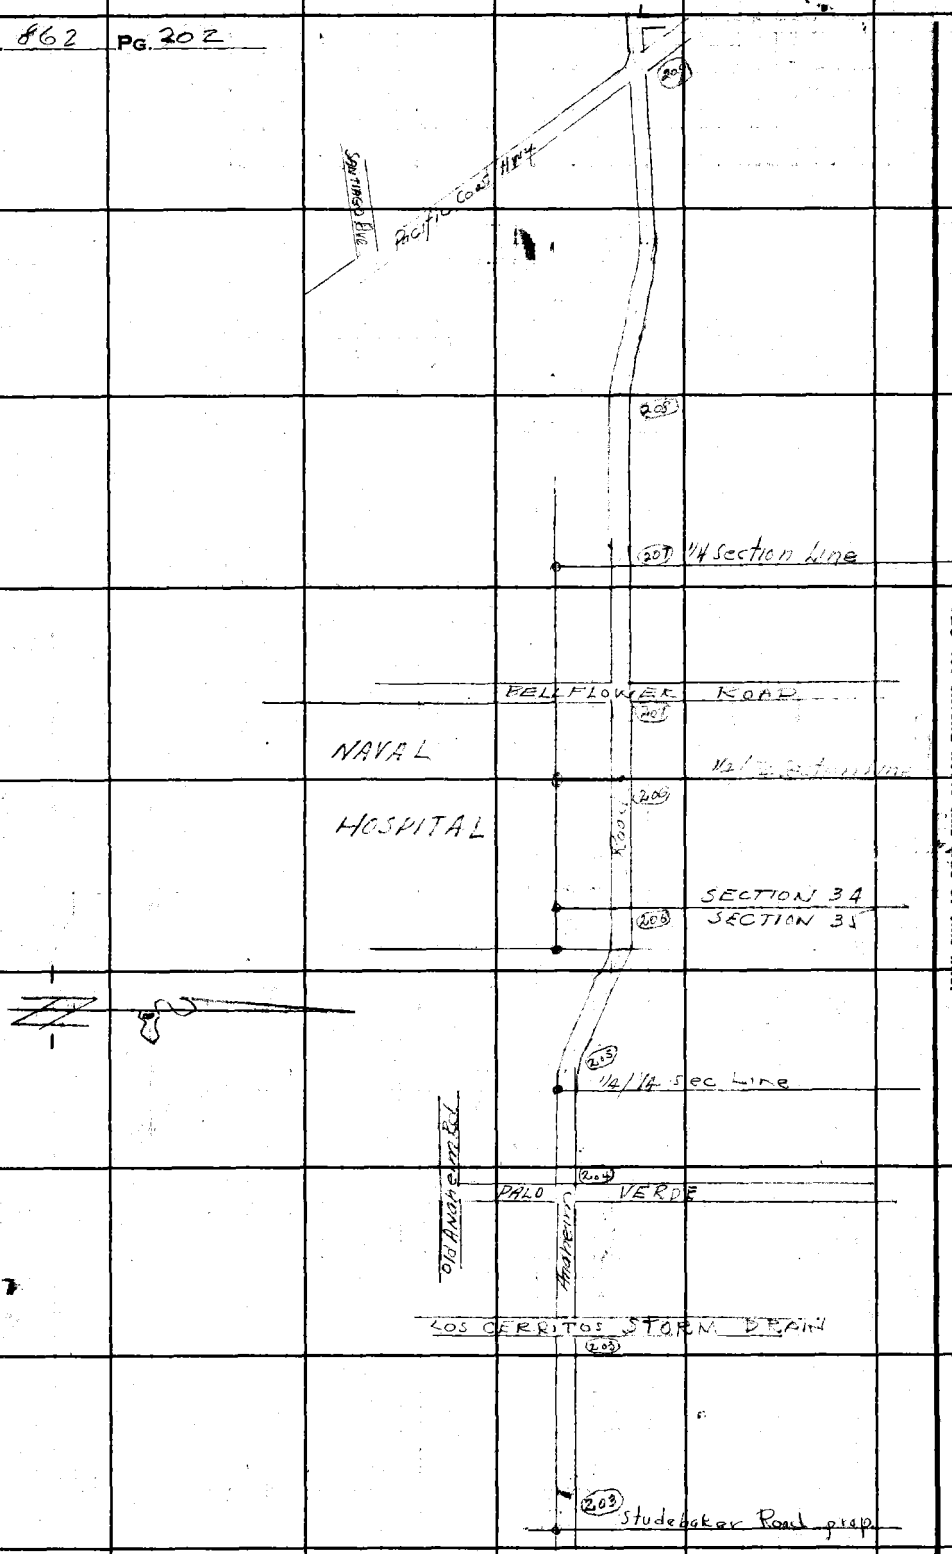

RETURN TO
LOS ANGELES COUNTY SURVEYOR
700 HALL OF RECORDS

Do not extend notes this side of this line.

Note: Any Additions or Changes on This Sheet Must be Made or Circled in **Red Ink** With Date and Name of Person Making Change.

Notes Ck'd by
Map No. B-1929
Office Work C.W.Cox.
Checked
Date Jan. 1946

Survey of
W. O. 8462 Tape No. 36 St'd 84 °F
Surveyed by F.H.Blanchard
Notes F.H.B. Date 1-1946
Indexed

F.B. 167 PG. 103

21, C-4

SECTION 35
T4S R12W

R12W. T4S. COUNTY SURVEYORS MONUMENT

Fd CS mon 24"d in per F.B. 902-38 mk'd as shown

Las Cerritos Channel

1072.28'

S1°59'45"E

55'

30.00'

INT 13+34.10' Set 3/4" IP 12" on L.T. line

Fd 6" round stone mon w/o spun cntr. as set per F.B. 902-38

T 76°
1072.34 @ 0°00 = 1072.28'

S1°59'45"E
35°57'30"
179°58'30"
91°59'45"

118.11'

T 72°
118.12 @ 0°00 = 118.11'

POT 12+35.99'
Set 1"x2"

600.39'

T 72°
600.44 @ 0°00 = 600.39'

POT 6+35.60'
Set 1"x2"

T 72°
600.44 @ 0°00 = 600.39'

Anaheim

600.04'

90°00'45"
360°03'15"
180°04'45"
90°00'50"

R12W. T4S. COUNTY SURVEYORS MONUMENT 35+36

30 30

Set 1"x2"

40°00'50"

Fd CS mon 18"d in 1/4 Cor mk'd as shown per F.B. 902-38

3000' 3000'

Set 3/4" IP 18" on

Prop. L. Studebaker Rd.

Fd 2½" I.P. & nail 12" on per F.B. 862-139

0+00
Set 3/4" IP 10" on
See 99-177

RETURN TO
LOS ANGELES COUNTY SURVEYOR
700 HALL OF RECORDS

Note: Any Additions or Changes on This Sheet Must be Made or Circled in Red Ink With Date and Name of Person Making Change

Do not extend notes this side of this line.

FORM 247 3M 12-49

F.B. 852 Pg. 202

SECTION 35

T. 4 S. R. 12 W.

bot pg. 205

31 B-4

RETURN TO
LOS ANGELES COUNTY SURVEYOR
700 HALL OF RECORDS

Do not extend notes this side of this line.

Note: Any Additions or Changes on This Sheet Must be Made or Circled in Red Ink With Date and Name of Person Making Change.

T 76'
1320.45 @ 0°00 = 1320.38'

1322.38'

ROAD

89° 59' 30"
0° 59' 00"
179° 57' 60"
89° 57' 30"

R12W. CEN OF SEC 35
COUNTY SURVEYORS
MONUMENT

Set 1" I.P.

Set 1" I.P.

Rd. Sta. 18+00
per FE 902-38
Rd. Sta. 18+00
E. F. 8862-157

22.28

25.53

26°41'34"
Set 3/4" I.P. 12" in
by iron

PALO VERDE RD

26.11.30'

Rd Sta 4+
FE 307-11

89°59'

T 74°
26.11.30 = 26.11.30'

T 76°
214.97 @ 0°00 = 214.96'





RO 24+26.38'
Set 1 x 2

Top pg 203

Notes Ck'd by	Survey of
Map No. B-1929	W. O. 8460 Tape No. 36 St'd 84 °F
Office Work C.W.Cox	Surveyed by FH Blanchard
Checked	Notes FHB Date 1-28-46
Date Jan. 1946.	Indexed

F.B. 864 PG. 205

31, B-4

Note: Any Additions or Changes on This Sheet Must be Made or Circled in Red Ink With Date and Name of Person Making Change

Do not extend notes this side of this line.

LOS ANGELES COUNTY SURVEYOR
700 HALL OF RECORDS

RETURN TO

FORM 247 SM 12-45

T=84° 286.96 @ 1°00 = 286.71
T=64 106.68 @ 4°00 = 106.66
393.64

NAVY HOSPITAL
Fd 1" P.P. 1.00 N
pg 180

180.00

Δ = 11°46 37"
R = 1000
T = 103.14
L = 205.55

EC 41+01.47
Set 3/4" I.P.

P.I. #2
Set 3/4" I.P.
1" down

RPP1 #2
Set 3/4" I.P. 16" dn

106.08

T62°
106.51 @ 5°05 = 106.39
106.08

EC 46+95.92
Set 2X2 14" dn

SECTION 35
T1S R12W

T62°
2998.4 @ 1°53 = 299.64
2290.76 @ 0°52 = 229.01
528.65

168° 13' 30"
312 53 45
289 0 15
168° 13' 22½"

P.I. #1
Set 3/4" I.P.
14" down

EC 41+67.27
Set 3/4" I.P. 16" dn

53.72
44.10

RPP1 #1
Set 3/4" I.P. 12" dn

Δ = 11° 46' 37"
R = 1000
T = 103.14
L = 205.55

89° 59' 30"
359° 58' 00"
179° 57' 30"
89° 59' 35"

Fd C&S Mon 30" dn
14/1/4 Cor pg 180

3000

BC 39+61.72
Set 3/4" I.P.
12" down

2610.87

T56
2611.35 @ 0°03 = 2610.87

Fd C&S P&T
pg 114 180

1370.38

tap pg 204

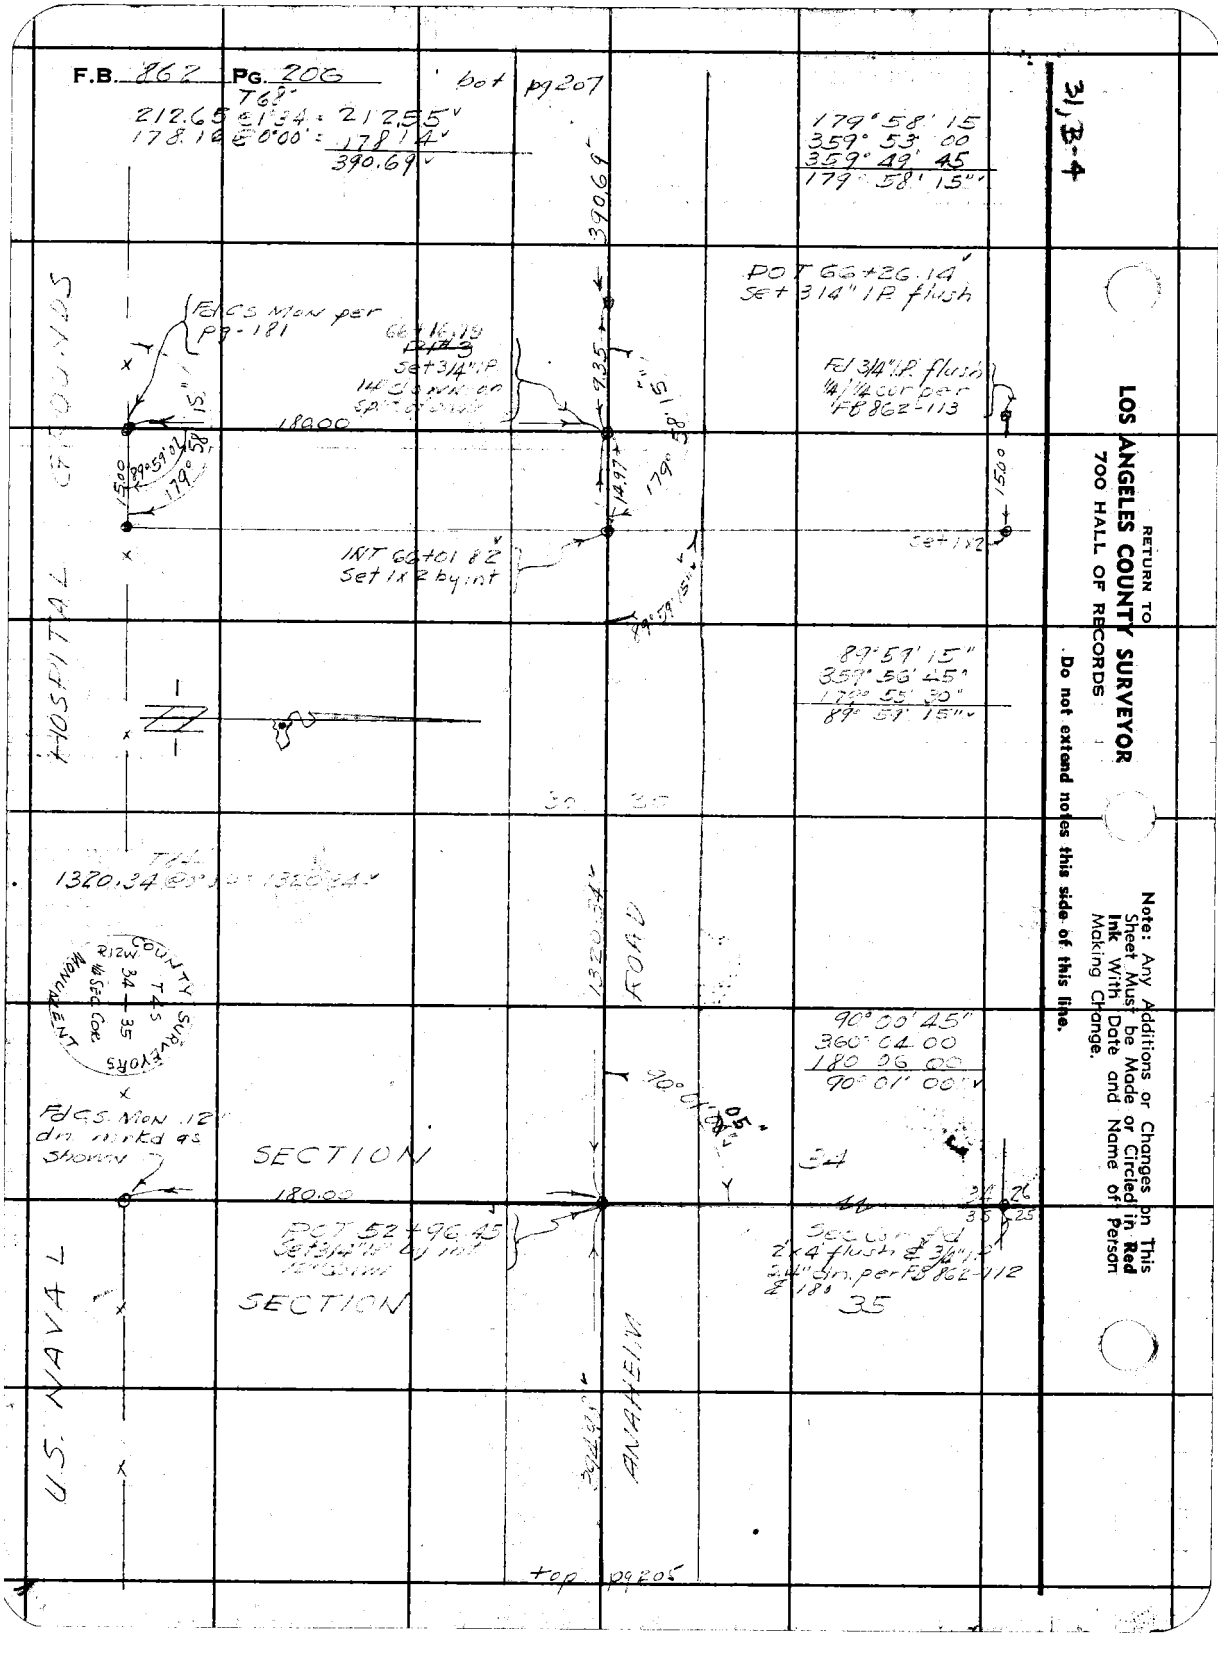
F.B. 862 Pg. 206
bot pg 207
212.65 @ 1°34' = 212.55'
178.12 @ 0°00' = 178.14'
390.69'
390.69'
179° 58' 15"
359° 53' 00
359° 49' 45
179° 58' 15"
POT 66+26.14'
Set 3/4" IP flush
FCS Mon per PB-181
66+16.19
Set 3/4" IP
FD 3/4" IP flush
1/4 cor per FB 862-113
1800.00
179° 58' 15"
14.97'
179° 58' 15"
1505.1
INT 66+01.82
Set 1x2 by int
Set 1x2
89° 57' 15"
359° 56' 45"
179° 55' 30"
89° 57' 15"
HOSPITAL
1320.34 @ 90° 00' 00" = 1320.34'
1320.34'
COUNTY SURVEYORS MONUMENT
T 4 S
R 12 W
34 — 35
FD CS Mon 12" dia marked as shown
SECTION
180.00
90° 00' 45"
360° 04' 00"
180° 00' 00"
90° 01' 00"
90° 01' 00"
34
POT 52+96.45
Set 3/4" IP & tack
SECTION
Accepted 2x4 flush @ 36" 3/4" Sm. per FB 862-112 & 180°
35
U.S. NAVAL
ANAHEIM
top pg 205
31, B-4
RETURN TO
LOS ANGELES COUNTY SURVEYOR
700 HALL OF RECORDS
Do not extend notes this side of this line.
Note: Any Additions or Changes on This Sheet Must be Made or Circled in Red Ink With Date and Name of Person Making Change.

31, B-4

Notes Ck'd by	Survey of
Map No. B-1929	W. O. 8462 Tape No. 36 St'd 84 °F
Office Work C.W. Cox	Surveyed by FH Flanagan & Ord
Checked	Notes FHF Date 1-29-46
Date JAN. 1946	Indexed

F.B. 862 Pg. 207

Note: Any Additions or Changes on This Sheet Must be Made or Circled in Red Ink With Date and Name of Person Making Change

Do not extend notes this side of this line.

RETURN TO
LOS ANGELES COUNTY SURVEYOR
700 HALL OF RECORDS

Cntr. Sec. 34
FA 159 8FF289-20
Fd CK'd Expan rd
15" Ter. in Calc't/e
180.00

INT. 79+37.02
Set 3/4" I.P. 12"dn
by int.

Lot 1

Fd Copper Rivet
in Mon. in Well
12"dn FA 159-48

Fd Copper Rivet
reference with 3/4"
I.P. 12"dn

Mt. Section Line →

Fd 6" conc Mon
with C.S. set in
cntr. 12"dn FA 159-48

SECTION 34

T4S. R12W.

90°01'
260.24

90°01'15"
360°05'15"
180°07'30"
90°01'15"

260.24 @ 1.000 = 260.24

DOT 76+76.78
Set 3/4" I.P. flush

Mrs Bryant's Orchard

Set NAIL in
30" pepper tr

Set NAIL in
30" pepper tr

71.22 @ 0°00 = 71.20
299.87 @ 0°04 = 299.81
264.32 @ 1°50 = 46.94
659.45

Set NAIL in
30" pepper tr.

30

30

657.45

ANAHEIM ROAD

90°01'30"
360°06'30"
180°09'00"
90°01'30"

TG 2°
299.64 @ 2°04 = 299.41
980.43 @ 0°06 = 980.29
1279.70

Fd
Fd Concrete
Brass Cap Tag
Stamped LACo
Surv Dept FA 159-133

BELLFLOWER

90°01'30"

1279.70

ROAD

Fd
Fd C.S. with
Brass Cap 12"dn
Stamped L.A. Co Rd Dept
F.A. 159-132

INT. 70+16.83
Set SWET by int.

390.69

top pg 206

FORM 247 5M 12-45

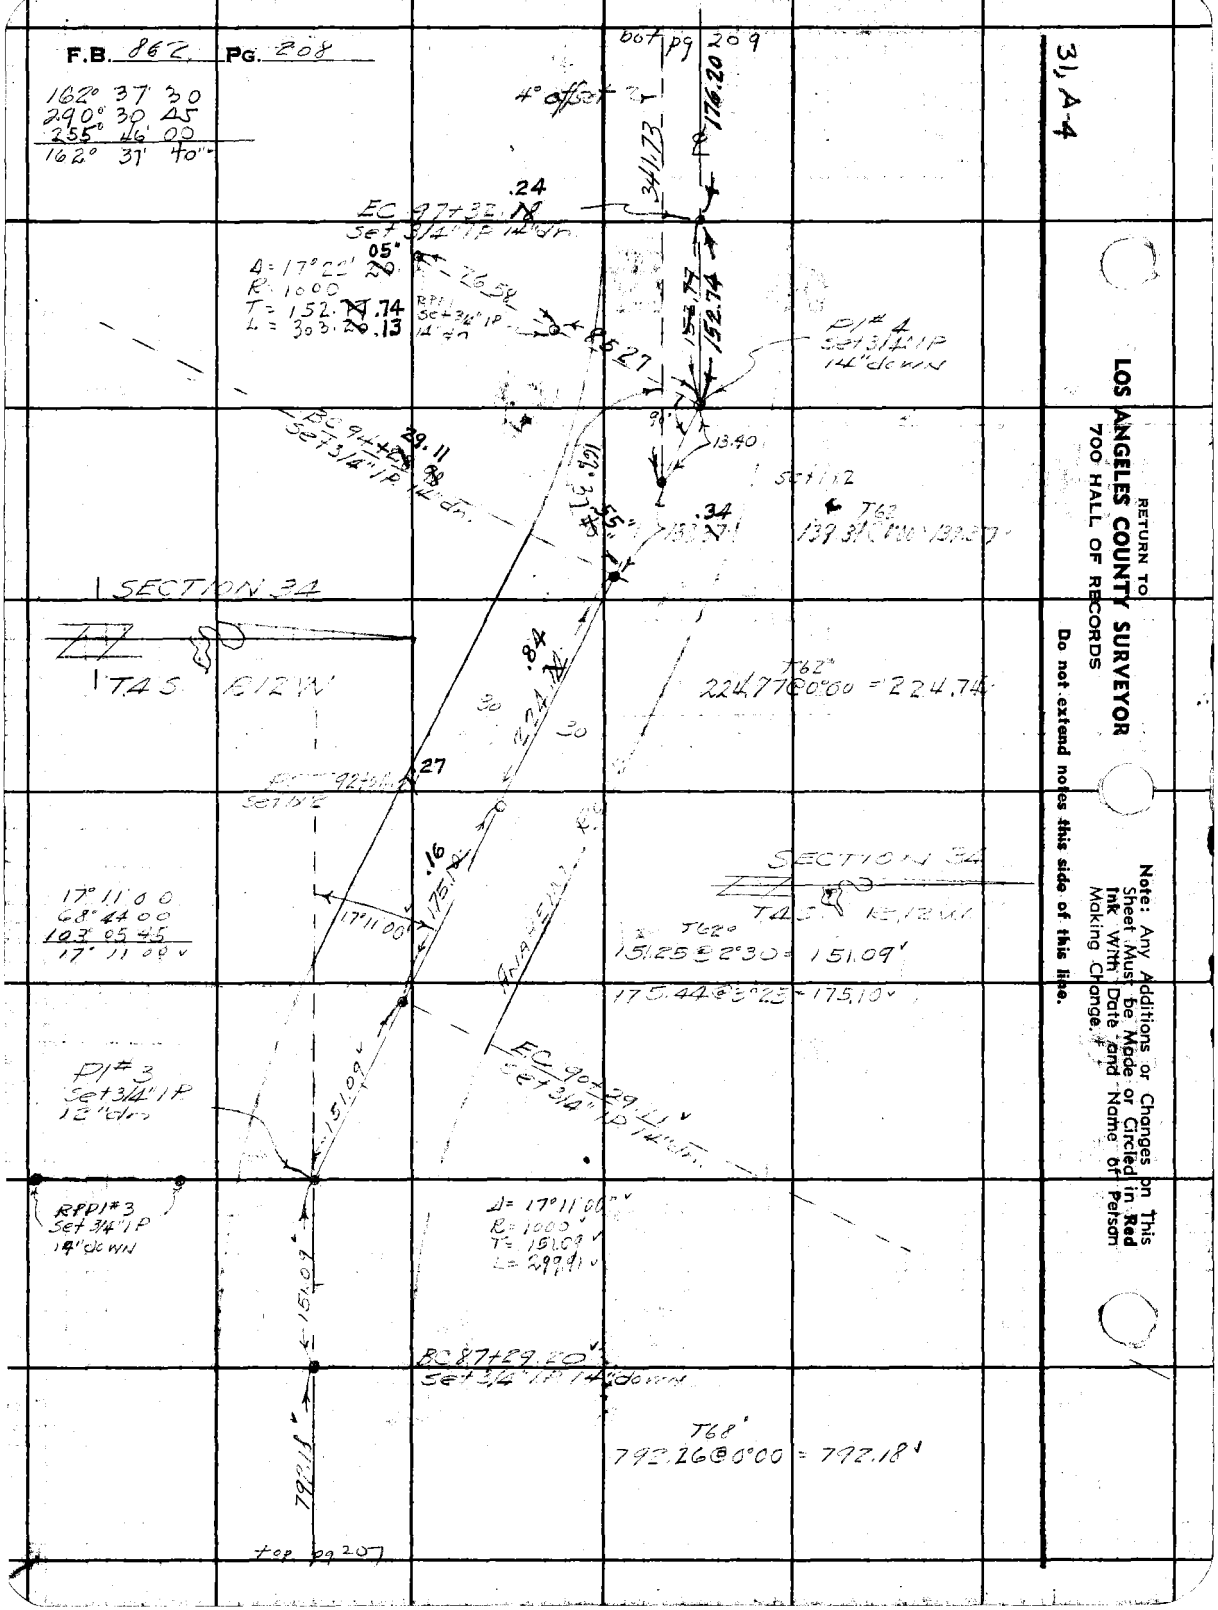

31, A-4

RETURN TO
LOS ANGELES COUNTY SURVEYOR
700 HALL OF RECORDS

Do not extend notes this side of this line.

Note: Any Additions or Changes on This Sheet Must be Made or Circled in Red Ink With Date and Name of Person Making Change.

Notes Ck'd by		Survey of Henderson Co	
Map No. B-1929		W. O. 8407 Tape No. 36 St'd 84 °F	
Office Work C.W.Cox		Surveyed by F.H.Blanchard	
Checked		Notes FHB Date 1-29-46	
Date JAN. 1946		Indexed G. C. Johnson	

F.B. 86 Pg. 209

Note: Any Additions or Changes on This Sheet Must be Made or Circled in Red Ink With Date and Name of Person Making Change

Do not extend notes this side of this line.

RETURN TO
LOS ANGELES COUNTY SURVEYOR
700 HALL OF RECORDS

FORM 247 5M 12-40

31, A-4

Fd Mon in well City Long Beach Grandon Ave

138° 34' 45"
194° 11' 30"
111° 17' 00"
138° 32' 50"

138°32'50"

SECTION 34

T.4S. R.12W.

S1°14'00"E
84 56 15
127 24 30
21° 14' 05"

T&C
295.84'
202.35'

set x 4"

Fd L.A.Co Geod Mon 1.4dn in cast iron well pg 193

101+10.79

C.S.B.814 (2.1°19'35") N.0°1'

202.35

Hwy

Present Alignment

295.84'

398.55

set 1x2

99+08.35
.44

set 1x2

Fd Mon FB 293-97

Fd Mon pg 129

Proposed

176.20

341.73'

122+80.00 12+78'
55+66.00 5575'
163+24.00 16320'
341.73'

top pg 208

RETURN TO
LOS ANGELES COUNTY SURVEYOR
700 HALL OF RECORDS

Note: Any Additions or Changes on This Sheet Must be Made or Circled in **Red Ink** With Date and Name of Person Making Change.

Do not extend notes this side of this line.

F.B. 862 PG. 110

U. S. C. 141

F. B. ____ Pg. ____

Notes Ck'd by	Survey of
Map No.	W. O. 0303.00 Tape No. ____ St'd. 68 °F
Office Work Outside	Surveyed by Engineer
Checked	Notes EA Date 12-55
Date	Indexed A. C. Johnson 12-12-55

BALL RD.

J.N. 0075.11

FROM: L.A. & ORANGE CO. BDRY.

TO: PIONEER BLVD.

CENTERLINE

Dec. 1955
English
Sunday
Santucci & Peterson
Foulger

Note: Any Additions or Changes on This Sheet Must be Made or Circled in Red Ink With Date and Name of Person Making Change.

Do not extend notes this side of this line.

RETURN TO
LOS ANGELES COUNTY SURVEYOR
726 LOS ANGELES COUNTY
ENGINEERING BLDG.

76F9088 247 4-55

RETURN TO
LOS ANGELES COUNTY SURVEYOR
726 LOS ANGELES COUNTY
ENGINEERING BLDG.

Note: Any Additions or Changes on This Sheet Must be Made or Circled in Red Ink With Date and Name of Person Making Change.

Do not extend notes this side of this line.

INDEX MAP

L. A. Co.

E'ly. Bdry.

Blvd.

Norwalk

Pulleryon Rd.

217 218 220 221 222

R.11 W.
R.12 W.

F. B. 232 Pg. 5 & 6

M.S. 31/D-3

Notes Ck'd by	Survey of
Map No.	W. O. 0075.4 Tape No. 0148 St'd. 68 °F
Office Work Dutch	Surveyed by
Checked	Notes Date
Date	Indexed C. Johnson

F. B. Pg.

RETURN TO
LOS ANGELES COUNTY SURVEYOR
726 LOS ANGELES COUNTY
ENGINEERING BLDG.

Note: Any Additions or Changes on This Sheet Must be Made or Circled in Red Ink With Date and Name of Person Making Change.

Do not extend notes this side of this line.

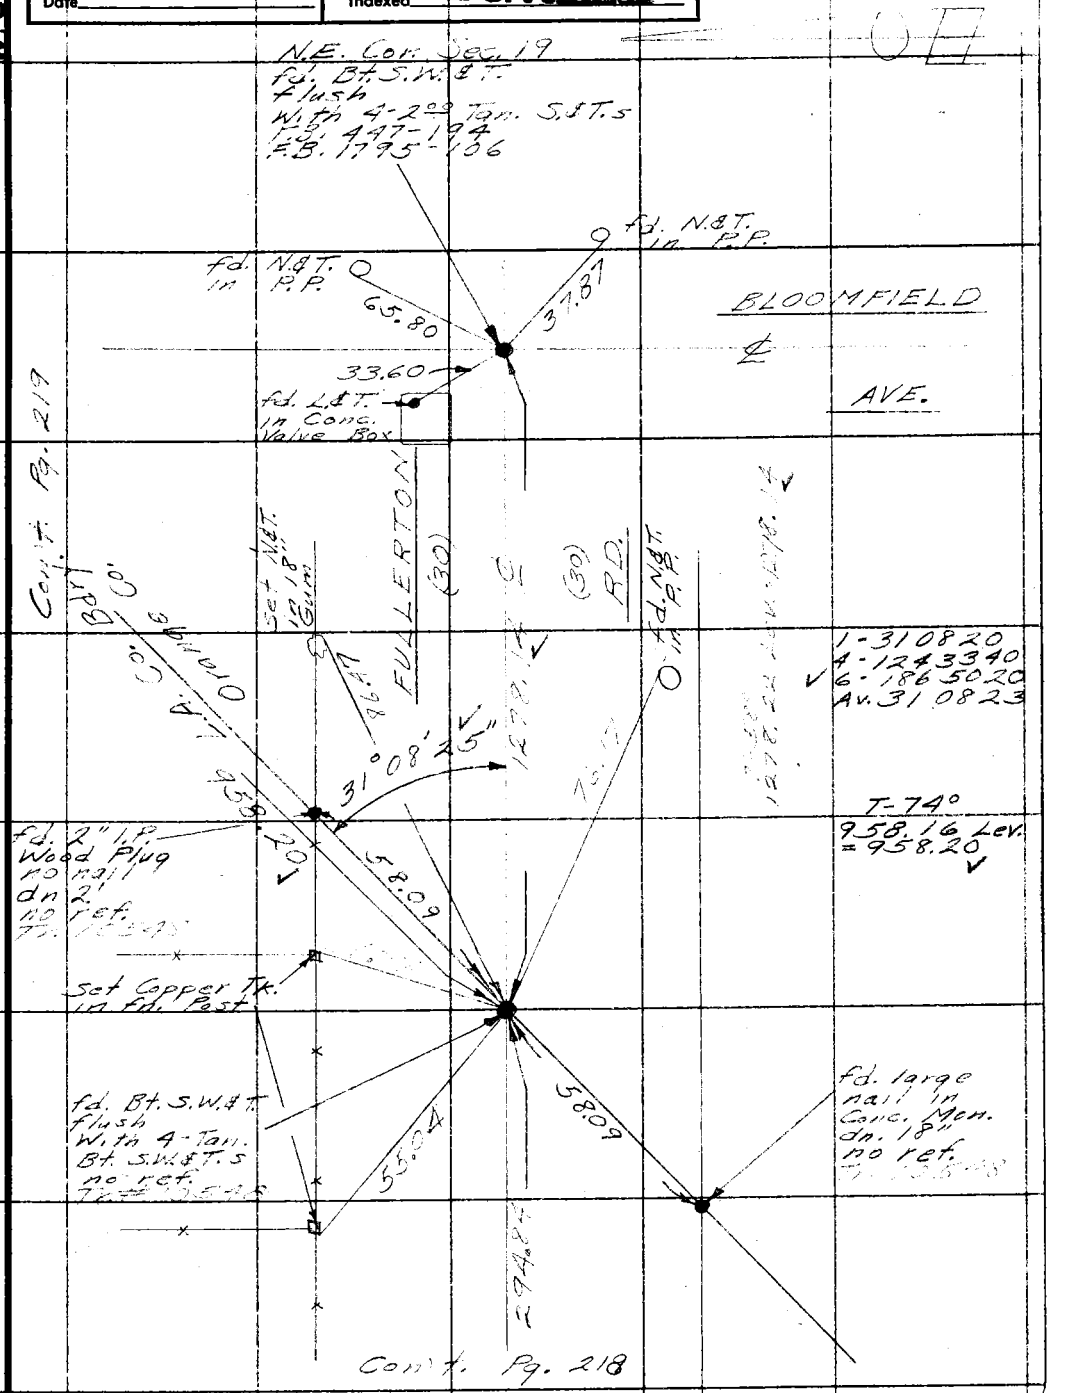

76FS008 247 4-85

RETURN TO
LOS ANGELES COUNTY SURVEYOR
726 LOS ANGELES COUNTY
ENGINEERING BLDG.

Note: Any Additions or Changes on This Sheet Must be Made or Circled in Red Ink With Date and Name of Person Making Change.

Do not extend notes this side of this line.

W.S.31/D-3

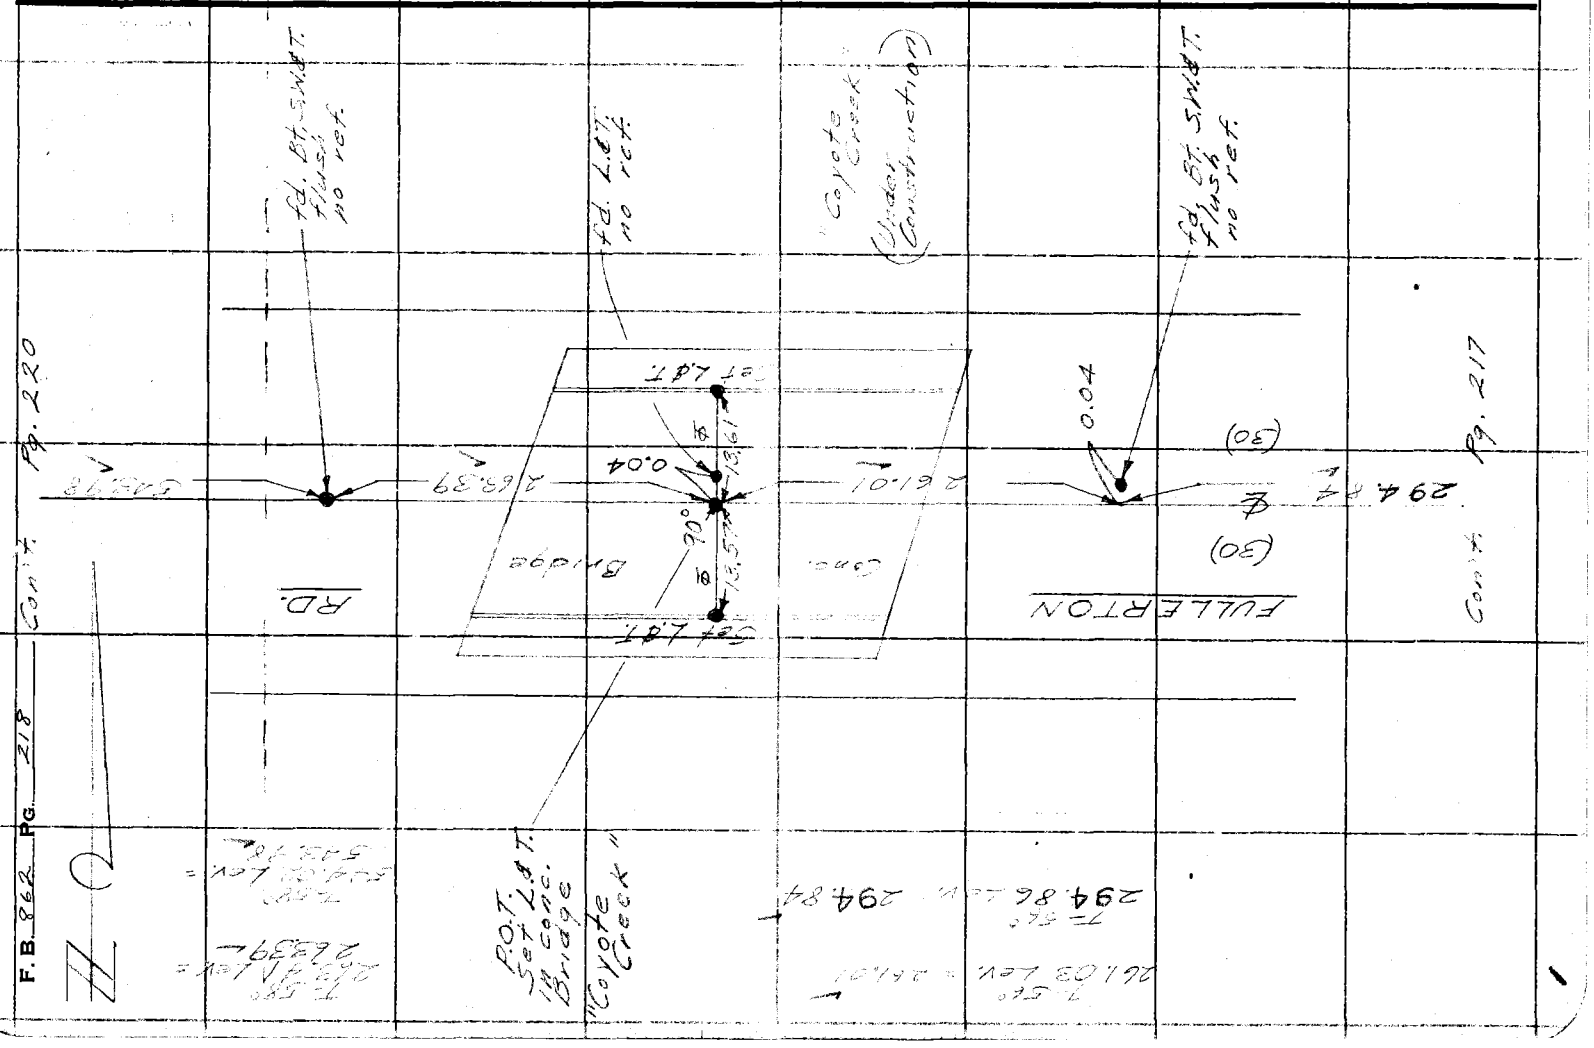

M.S. 31/D-2.3

Notes Ck'd by	Survey of
Map No.	W. O. 75.11 Tape No. Sta'd. °F
Office Work Dutch	Surveyed by
Checked	Notes Date
Date	Indexed A. C. Johnson

F.B. 862 Pg. 219

Note: Any Additions or Changes on This Sheet Must be Made or Circled in Red Ink With Date and Name of Person Making Change.

Do not extend notes this side of this line.

RETURN TO
LOS ANGELES COUNTY SURVEYOR
726 LOS ANGELES COUNTY
ENGINEERING BLDG.

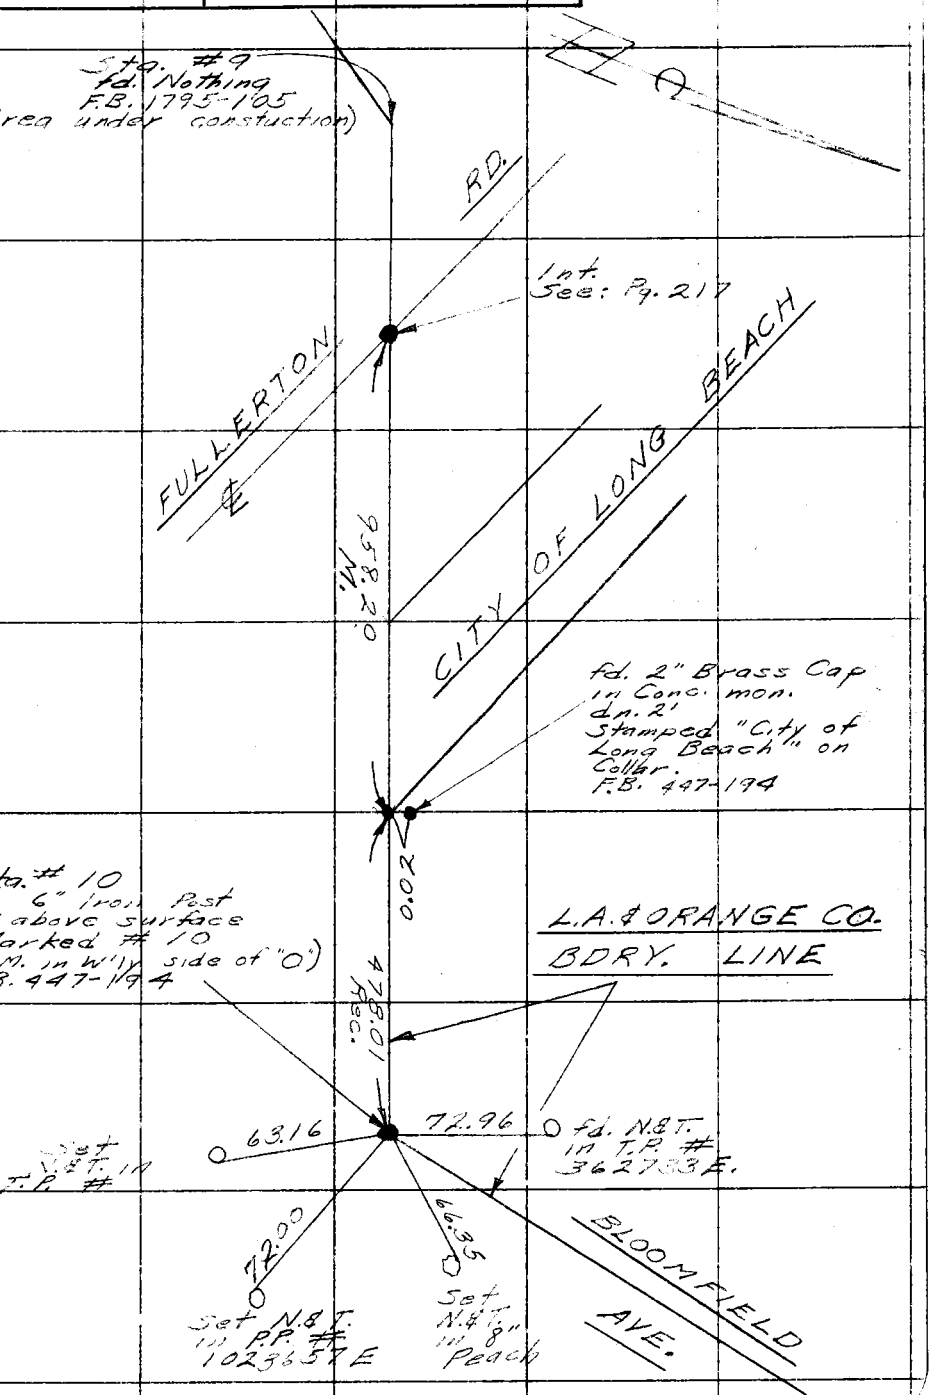

76FSOS 247 4-55

RETURN TO
LOS ANGELES COUNTY SURVEYOR
726 LOS ANGELES COUNTY
ENGINEERING BLDG.

Note: Any Additions or Changes on This Sheet Must be Made or Circled in Red Ink With Date and Name of Person Making Change.

Do not extend notes this side of this line.

W.S. 310-3

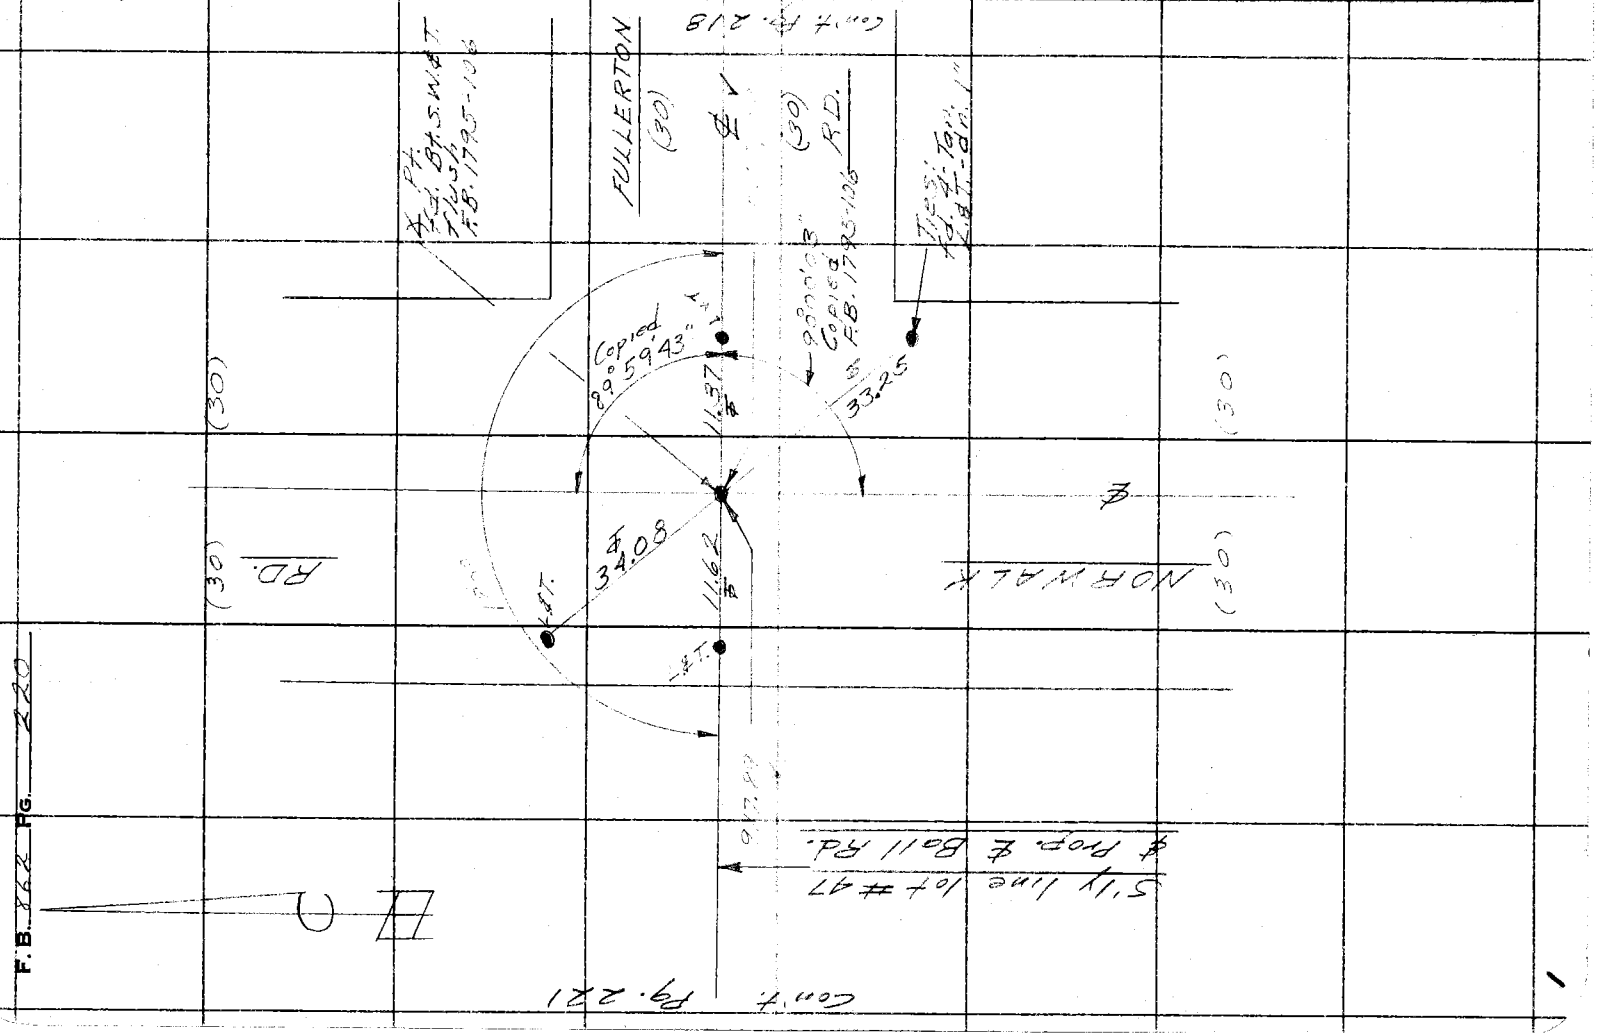

W.S. 31-D-3

Notes Ck'd by K.M.W.	Survey of Dutch Rd.
Map No.	W. O. 0303.00 Tape No. 0148 St'd. 68 °F
Office Work Dutch	Surveyed by Engineer
Checked	Notes Ed. Date 12-55
Date	Indexed A. C. Johnson

F. B. ____ PG. ____

223rd

℄

fd. Nothing
F.B. 1795-109
Under Construction

15'±

ST.

fd. Blue & Yellow
Stain on Surface
of Conc. Bridge
H-Wall

Note: Any Additions or Changes on This Sheet Must be Made or Circled in Red Ink With Date and Name of Person Making Change.

Do not extend notes this side of this line.

RETURN TO
LOS ANGELES COUNTY SURVEYOR
726 LOS ANGELES COUNTY
ENGINEERING BLDG.

Con't

Fd. 1.22

Prop. ℄ Sur. 104 #47

Fd. Bolt, 1.2 E.N.
Brl. & T.
F.B. 1795-122

L.A. Co. F.C. CHANNEL

T-720
917.87 Lev. =
917.89

917.89

Fd. 2.30

Con't

R.O.T.
Set L.B.T.

2077.94

6.45

67.49

Conc. Bridge

62.58

4.80

R.O.T.
Set L.B.T.

L.A. Co. F.C. R/W
fd. 2" I.P. P.B.T.
dn. 3'
no ref.

T-74°
2077.86 Lev. =
2077.94

1 - 90 43 50
4 - 362 59 50
6 - 180 22 30
Av. 90 43 45

S. 12.

(New Construction)
fd. Nothing
F.B. 1795-105

SPRING

℄

ST.

76F3095 247 2-51

1

F.B. 862 PG. 222

W.S.3/C-3

RETURN TO
LOS ANGELES COUNTY SURVEYOR
726 LOS ANGELES COUNTY
ENGINEERING BLDG.

Do not extend notes this side of this line.

Note: Any Additions or Changes on This Sheet Must be Made or Circled in Red Ink With Date and Name of Person Making Change.

Cont. Pg. 223

1 - 90 18 30
4 - 360 13 30
6 - 181 51 10 ✓
Av. 90 18 32

Prop. ℄ Pioneer Blvd.

25' Offset

Tract # 10546

T.4S. R.12W. T.4S. R.11W.

Sec. Cor. fd. Nothing dn. 5' FB. 507-174 C.S.B-1025-1 Set 3/4" I.P. P&T. dn. 5'

Note: Sec. Cor. R.P.S. Set 4-Tan. 3/4" I.P. P&T's dn. 18"

R.P. 70.00 ℄ 70.00 ℄ 70.00 ℄ 70.00 ℄ 25.00 45° 90° 18' 30" ✓ 2077.94 3020.83 M. 3020.94 Tk. Rec'd ✓ To E. Norwalk Blvd" Pg 290 45° 90 00 55" 24 19 B 53

fd. 1" I.P. no tag dn. 3' no ref.

1 - 90 00 50
4 - 360 03 30
6 - 180 05 30 ✓
Av. 90 00 55

Cont. Pg. 223

W.S.3W,C-23,D-3

Notes Ck'd by	Survey of
Map No.	W. O. 0303.00 Tape No. 0148 St'd. 68 °F
Office Work Dutch	Surveyed by
Checked	Notes
Date	Date 12-50
	Indexed A. C. Johnson

F. B. [illegible] Pg. [illegible]

Note: Any Additions or Changes on This Sheet Must be Made or Circled in Red Ink With Date and Name of Person Making Change.

RETURN TO
LOS ANGELES COUNTY SURVEYOR
726 LOS ANGELES COUNTY
ENGINEERING BLDG.

Do not extend notes this side of this line.

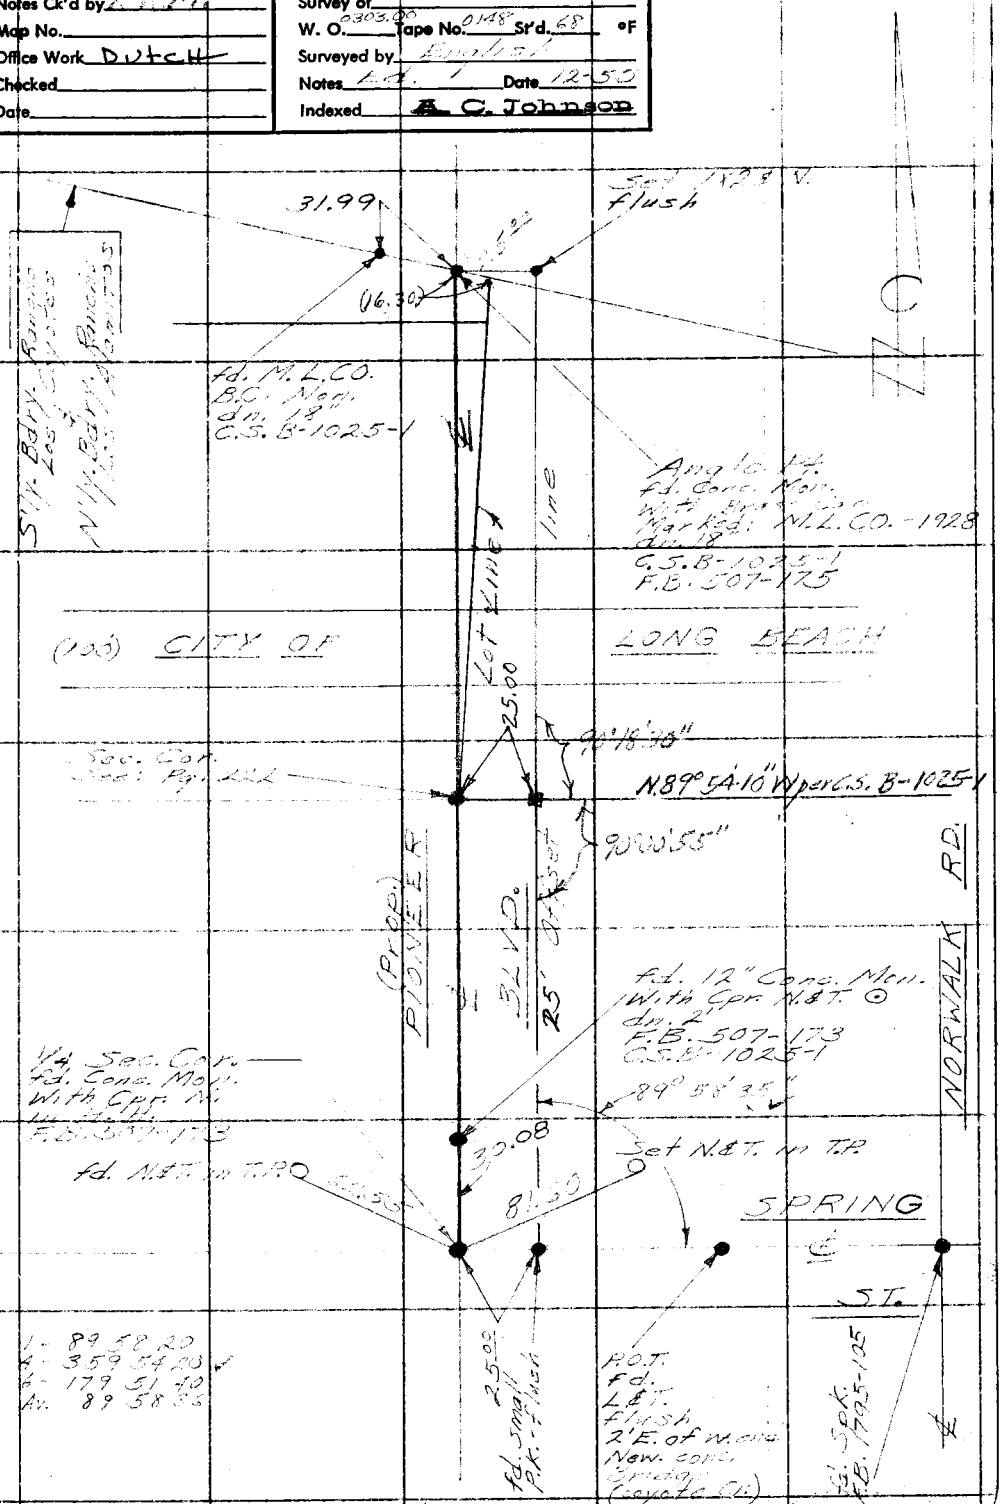

76F3008 247 4-58

RETURN TO
LOS ANGELES COUNTY SURVEYOR
726 LOS ANGELES COUNTY
ENGINEERING BLDG.

Note: Any Additions or Changes on This Sheet Must be Made or Circled in Red Ink With Date and Name of Person Making Change.

Do not extend notes this side of this line.

F. B. 883 PG. 224

Notes Ck'd by	Survey of
Map No.	W. O. Tape No. Std. 68 °F
Office Work Dutch	Surveyed by
Checked	Notes Date
Date	Indexed A. S. Johnson 12-16-55

F. B. Pg.

BALL RD.

J.N. 00?5.11

TOPOG.

FROM: L.A. & ORANGE CO. BDRY.

TO: PIONEER BLVD.

Dan [illegible]
English
Smiley
Robinson & Sandmeier
Foulger

Note: Any Additions or Changes on This Sheet Must be Made or Circled In Red Ink With Date and Name of Person Making Change.

Do not extend notes this side of this line.

RETURN TO
LOS ANGELES COUNTY SURVEYOR
726 LOS ANGELES COUNTY
ENGINEERING BLDG.

76F3095 S&E #247. 8-54

RETURN TO
LOS ANGELES COUNTY SURVEYOR
726 LOS ANGELES COUNTY
ENGINEERING BLDG.

Note: Any Additions or Changes on This Sheet Must be Made or Circled In Red Ink With Date and Name of Person Making Change.

Do not extend notes this side of this line.

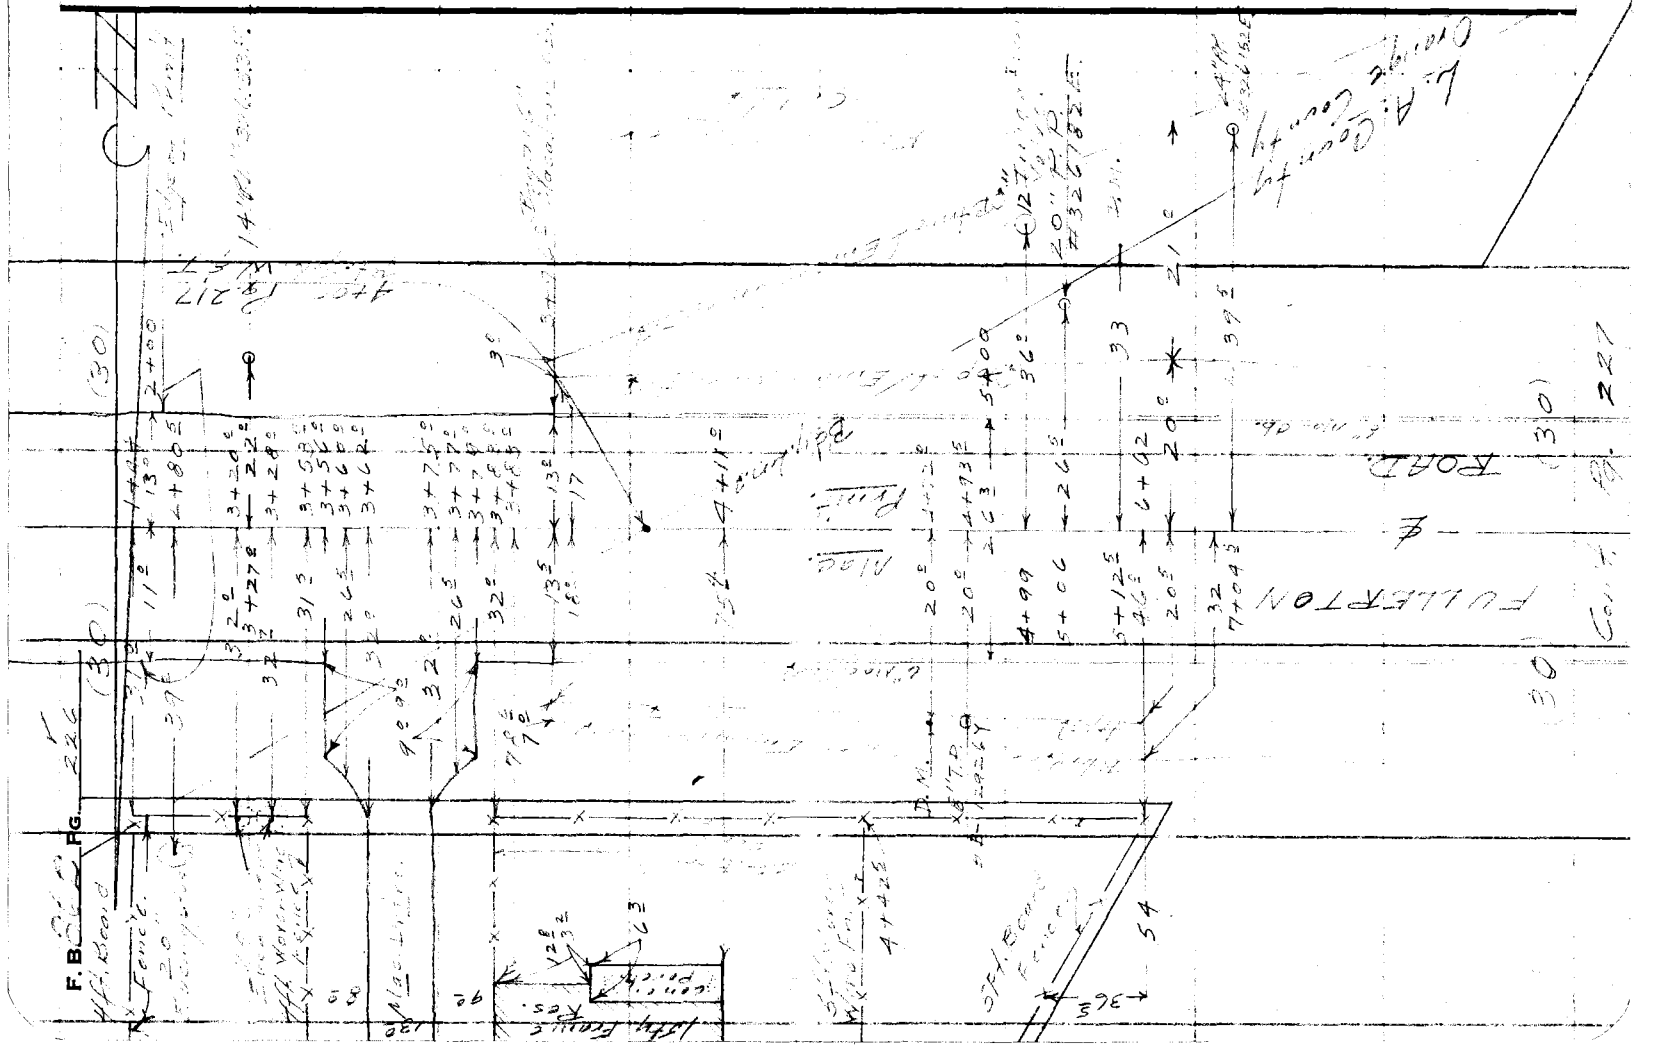
FULLERTON
ROAD
F. B.
Fence
Fence
Fence

Notes Ck'd by	Survey of
Map No.	W.O. Tape No. Std. 68 °F
Office Work Dutch	Surveyed by
Checked	Notes Date 2-1-54
Date	Indexed A. C. Johnson

F.B. 247 Pg. 227

Note: Any Additions or Changes on This Sheet Must be Made or Circled in Red Ink With Date and Name of Person Making Change.

Do not extend notes this side of this line.

RETURN TO
LOS ANGELES COUNTY SURVEYOR
726 LOS ANGELES COUNTY
ENGINEERING BLDG.

76F3095 S&E #247. 8-54

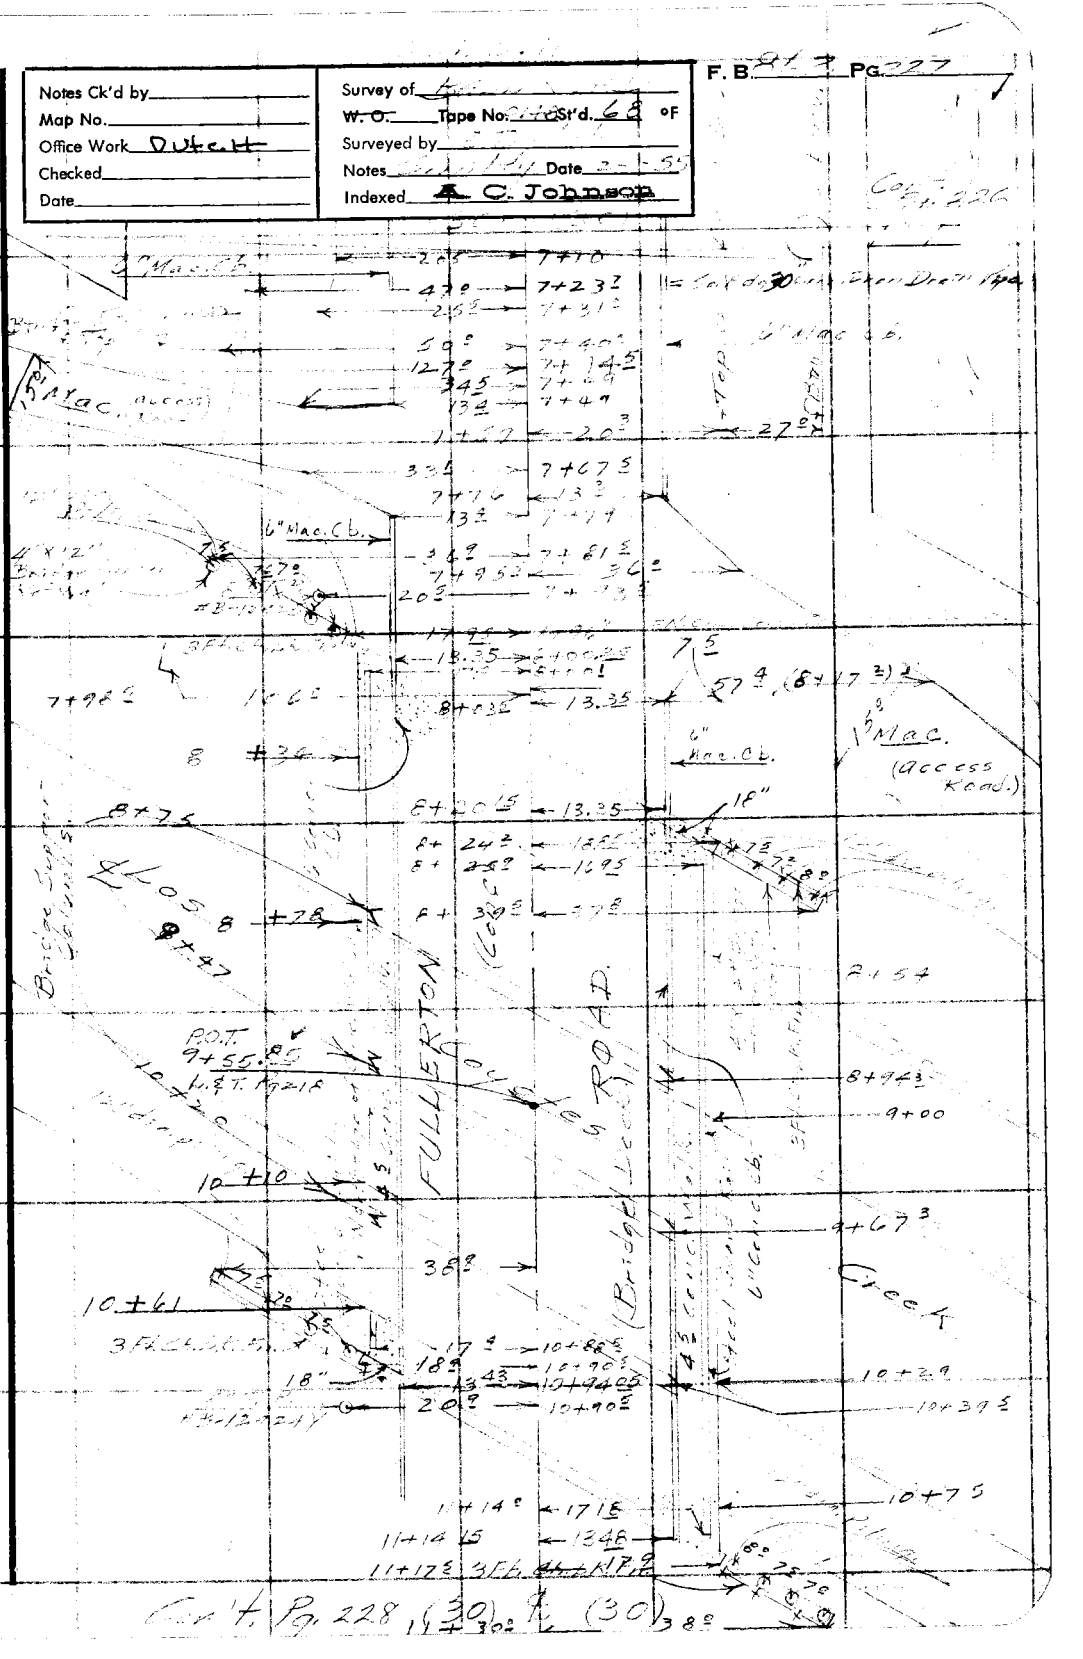

F.B. 862 PG. 228

Cont. Pg. 227

(30) (30)

RETURN TO
LOS ANGELES COUNTY SURVEYOR
726 LOS ANGELES COUNTY
ENGINEERING BLDG.

Do not extend notes this side of this line.

Notes: Any Additions or Changes on This Sheet Must be Made or Circled in Red Ink With Date and Name of Person Making Change.

Mac.

6" Mac. Ch.

6" Conc. Ch.

Conc.

6" Mac. Ch.

FULLERTON

24" J.D. Iron Stand

Mac

Mac

(30) (30) Cont. Pg. 229

Notes Ck'd by	Survey of
Map No.	W.O. Tape No. St'd. °F
Office Work Outcult	Surveyed by
Checked	Notes Date 12-1-54
Date	Indexed C. Johnson

F. B. Pg.

Note: Any Additions or Changes on This Sheet Must be Made in Red Ink or Circled With Date and Name of Person Making Change.

Do not extend notes this side of this line.

RETURN TO
LOS ANGELES COUNTY SURVEYOR
726 LOS ANGELES COUNTY
ENGINEERING BLDG.

78F308 S&E #247. 8-54

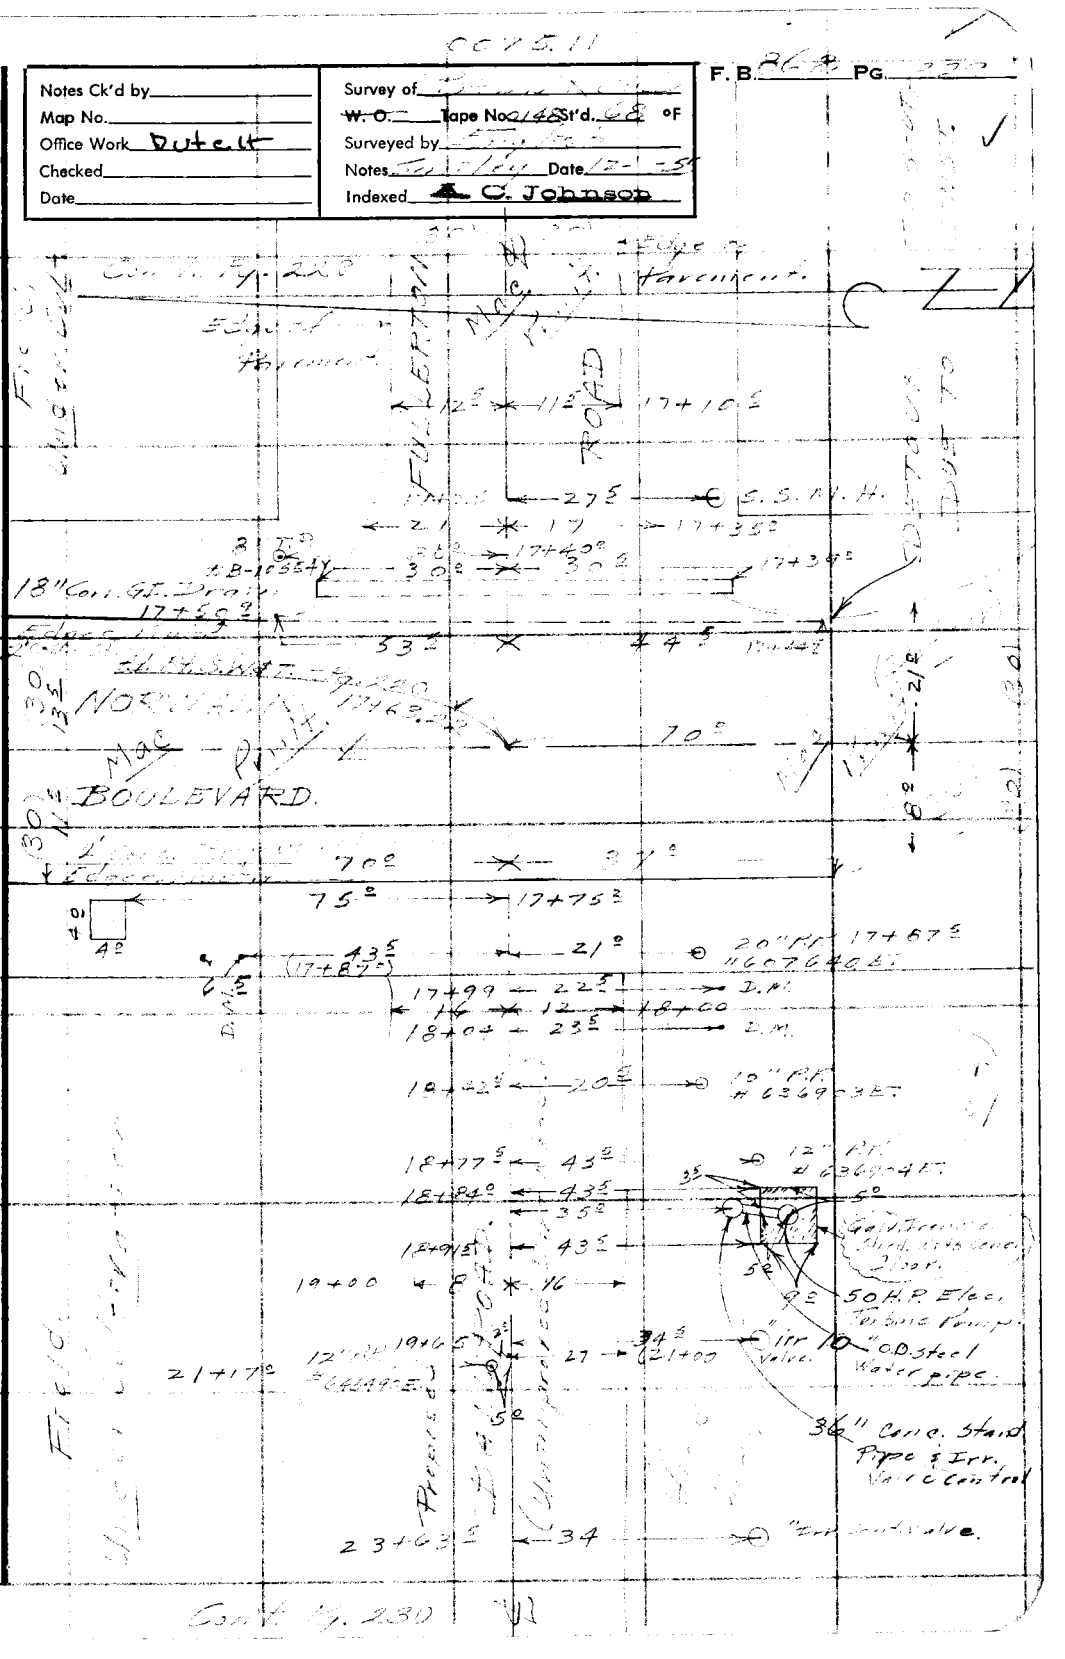

F.B. 862 Pg. 230

Field Under Cont. Cont. Pg. 229

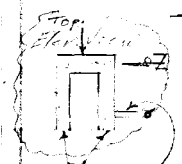

36" C.M.P. Storm Drain
10 7 SH. P.S.C. Tarbo Culvert

Wood Wall Ft. Ea. Side of Road

Edge of Road

Ft. Chain Fence

Top

Conc.

L.A. COUNTY STORM DRAIN EASEMENT

Edge of Road

Top

Conc.

Field Under Cont.

Cont. Pg. 231

RETURN TO
LOS ANGELES COUNTY SURVEYOR
726 LOS ANGELES COUNTY
ENGINEERING BLDG.
Do not extend notes this side of this line.

Note: Any Additions or Changes on This Sheet Must be Made or Circled in Red Ink With Date and Name of Person Making Change.

Notes Ck'd by	Survey of
Map No.	W. O. Tape No. St'd. °F
Office Work Dutch	Surveyed by
Checked	Notes Date
Date	Indexed A. C. Johnson

F. B. Pg.

Note: Any Additions or Changes on This Sheet Must be Made or Circled in Red Ink With Date and Name of Person Making Change.

Do not extend notes this side of this line.

RETURN TO
LOS ANGELES COUNTY SURVEYOR
726 LOS ANGELES COUNTY
ENGINEERING BLDG.

76F3085 S&E #247. 8-54

RETURN TO
LOS ANGELES COUNTY SURVEYOR
726 LOS ANGELES COUNTY
ENGINEERING BLDG.

Note: Any Additions or Changes on This Sheet Must be Made or Circled In Red Ink With Date and Name of Person Making Change.

Do not extend notes this side of this line.

F.B.____ PG.____

Notes Ck'd by	Survey of L.A.-O. Co. Bdy
Map No.	JN 0038.27 Tape Std °F
Office Work	Surveyed by R.J. Mitchell
Checked	Notes Mitchell Date Aug 56
Date	Indexed C. Johnson

F. B. 862 Pg. 241

Note: Any Additions or Changes on This Sheet Must be Made or Circled In Red Ink With Date and Name of Person Making Change.

Do not extend notes this side of this line.

RETURN TO
LOS ANGELES COUNTY ENGINEER
700 Los Angeles County Engineering Bldg.

SURVEY SHOWING
MONUMENTS FOUND AND SET
ALONG THE
LOS ANGELES-ORANGE
COUNTY BOUNDARY
FROM
STA. 2 TO STA. 7

J.N. 0038.27

Mitchell
Survey
Bushnell
Merino

August - 1956

76F3095 CE #247—3-57

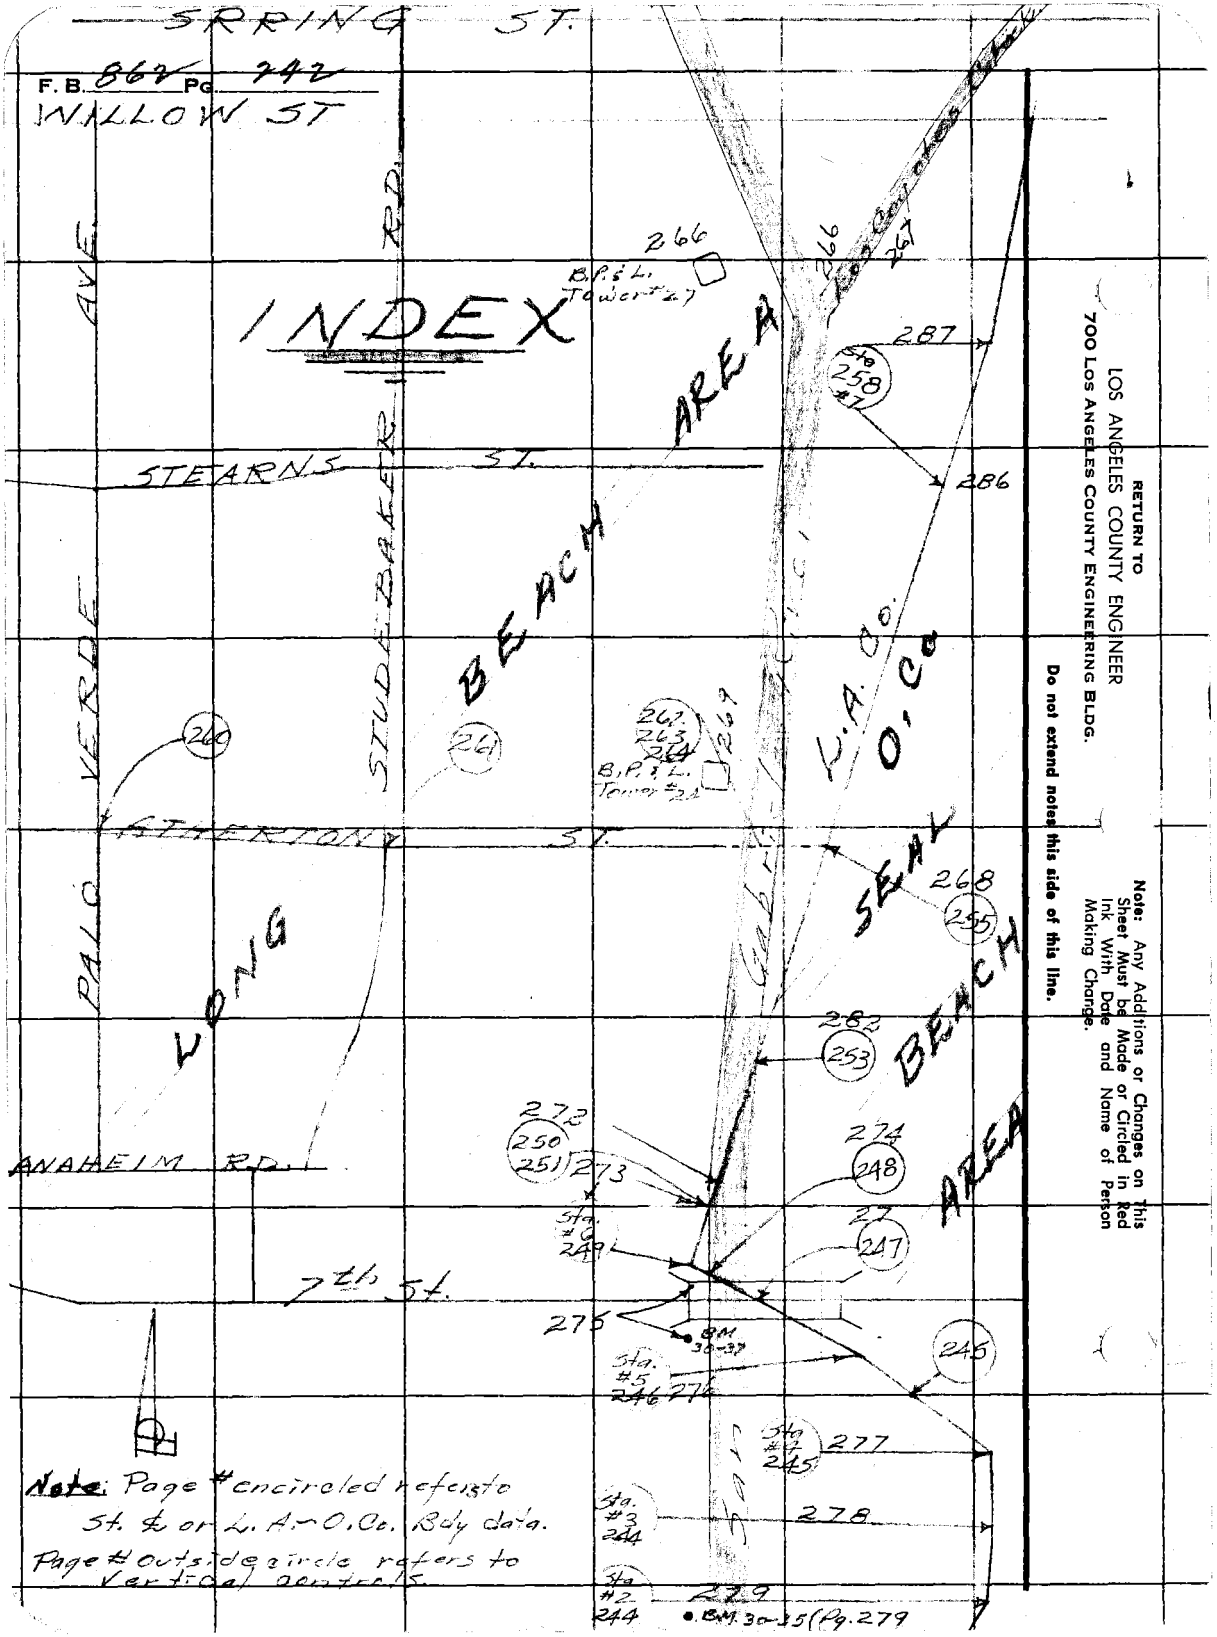

RETURN TO
LOS ANGELES COUNTY ENGINEER
700 LOS ANGELES COUNTY ENGINEERING BLDG.

Do not extend notes this side of this line.

Note: Any Additions or Changes on This Sheet Must be Made or Circled in Red Ink With Date and Name of Person Making Change.

Note: Page # encircled refers to St. & or L.A.-O.Co. Rdy data.
Page # outside circle refers to Vertical controls.

Notes Ck'd by	Survey of LH-O-Co. Eng	F. B. 867 Pg. 243
Map No.	JN 00382 Tape Std °F	
Office Work	Surveyed by R.J. Mitchell	
Checked	Notes M. Mitchell Date 9/58	
Date	Indexed C. Johnson	

NOTES

1. This survey made at request of Kemmerer Engr. Co. who report Co. Line Monuments shown on M's 89 & 90 to be gone and Co. Line Sta # 7 to be inaccessable
2. Since the two "Line" monuments were set in 1952 the Co. F.C. Dist has made major improvements in the channels of the San Gabriel River and Coyote Creek. These monuments - Then in the toes of the River Levees - are now gone.
3. The field party has available unfiled & unindexed maps as follows:
   a. By: Kemmerer Engr. Co. Inc.
      Date: June 1956
      Title: Street Centerline and Boundary Map Tract # 1550
   b. By: Nat H. Neff - 13016 Euclid Ave, Garden Grove
      Date: "Revised May 20, 1954"
      Title: Map of Portion of Los Coyotes - Orange County Boundary with reference to the Right of Way of the San Gabriel River in Sec. 36 T 4 S R 11 W S B B & M
4. Elevations of Precise Bench Marks - Line # 30 - taken from Mimeograph List 3 sheet "Long Beach - Los Angeles Harbor Area Subsidence Study"
5. L.A.C.Fy BP&L Field Book No. 1120 was made available to our party by BP&L Engr. (Mr. Gordon) directing work of party now in field.

RETURN TO
LOS ANGELES COUNTY ENGINEER
700 LOS ANGELES COUNTY ENGINEERING BLDG.

Note: Any Additions or Changes on This Sheet Must be Made or Circled in Red Ink With Date and Name of Person Making Change.

Do not extend notes this side of this line.

76F3095 CE #247—3-57

RETURN TO
LOS ANGELES COUNTY ENGINEER
700 LOS ANGELES COUNTY ENGINEERING BLDG.

Note: Any Additions or Changes on This Sheet Must be Made or Circled in Red Ink With Date and Name of Person Making Change.

Do not extend notes this side of this line.

W.S.3, C-5.6

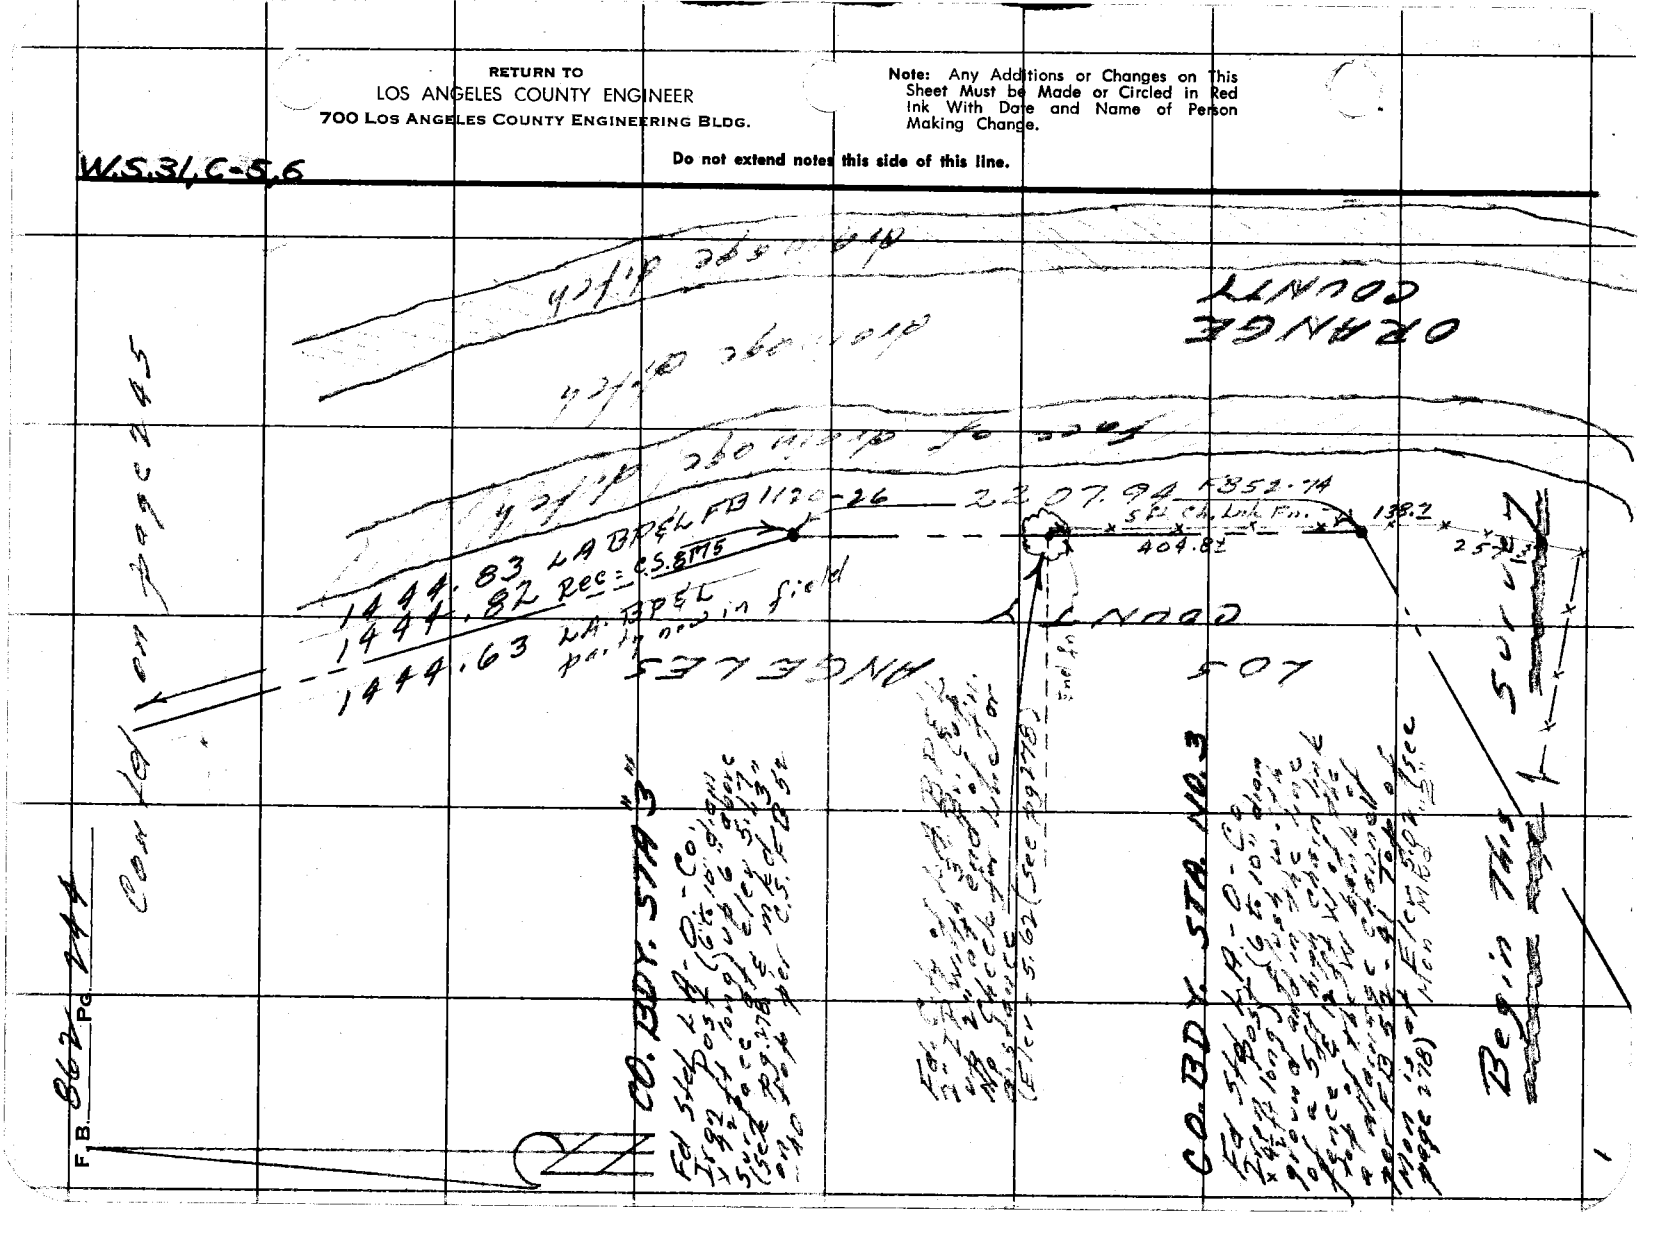

76F309S CE #247—3-57

RETURN TO
LOS ANGELES COUNTY ENGINEER
700 LOS ANGELES COUNTY ENGINEERING BLDG.

Note: Any Additions or Changes on This Sheet Must be Made or Circled In Red Ink With Date and Name of Person Making Change.

Do not extend notes this side of this line.

W.S.3LC-5

Notes Ck'd by
Map No.
Office Work
Checked
Date

Survey of
Surveyed by
Notes
Indexed

F. B. Bk. Pg. 245

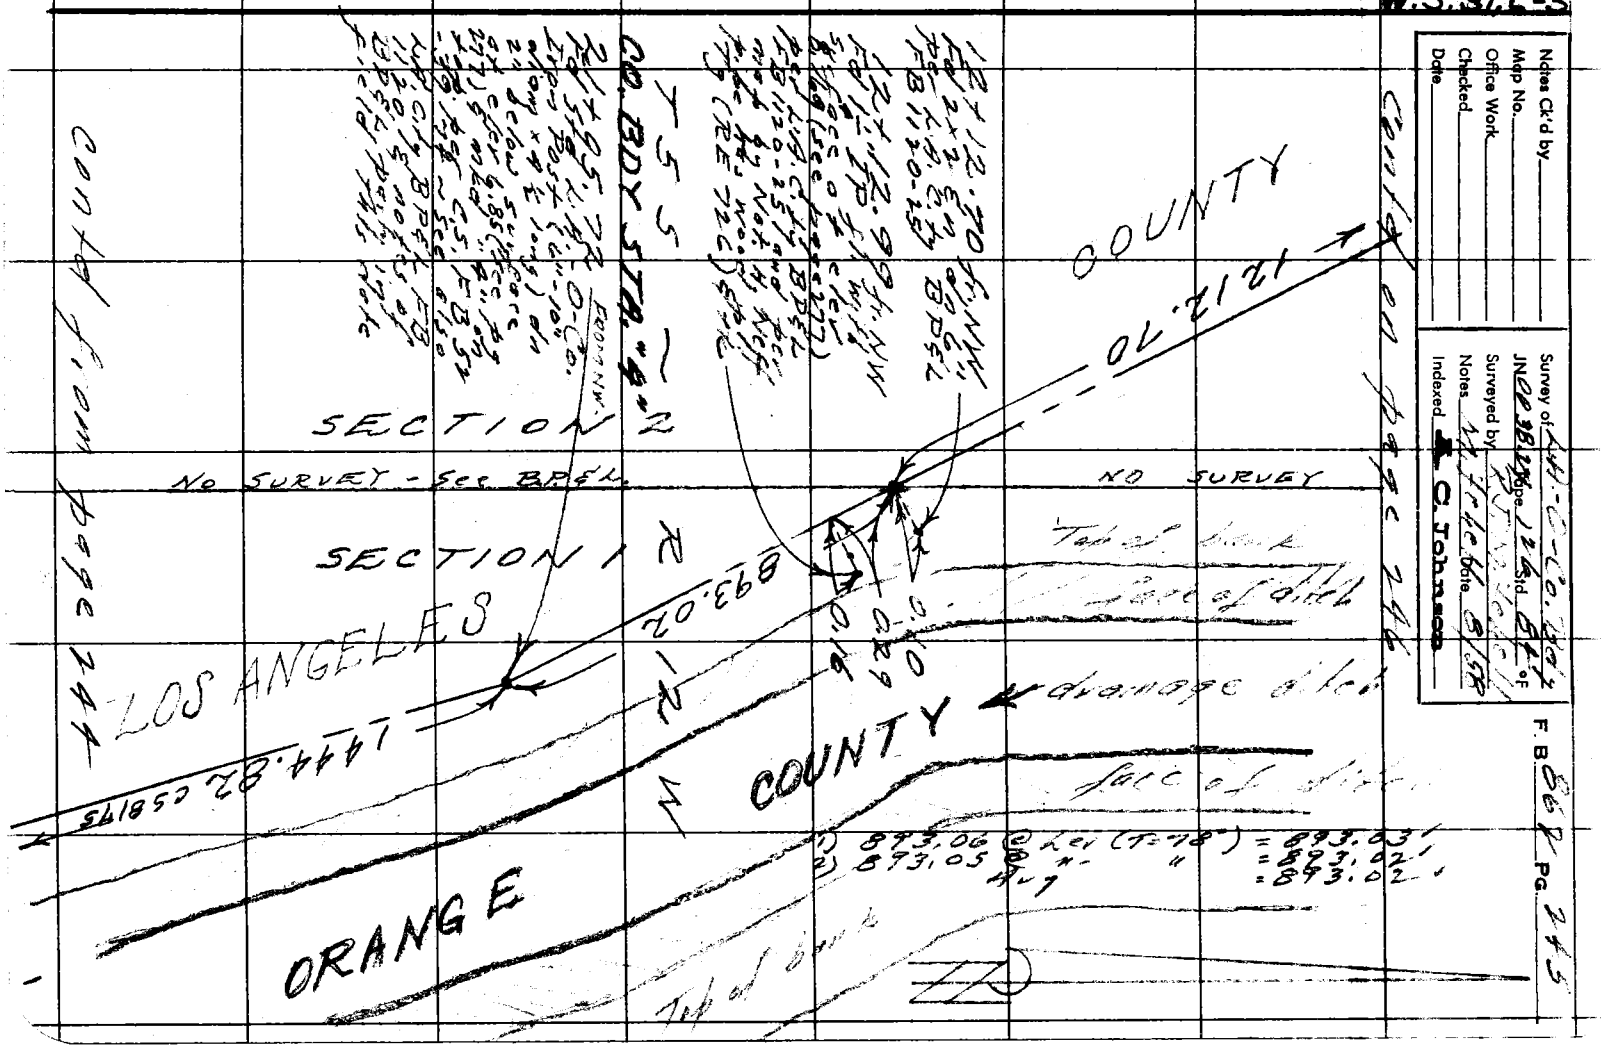

RETURN TO
LOS ANGELES COUNTY ENGINEER
700 LOS ANGELES COUNTY ENGINEERING BLDG.

Note: Any Additions or Changes on This Sheet Must be Made or Circled in Red Ink With Date and Name of Person Making Change.

Do not extend notes this side of this line.

W.S.346-5

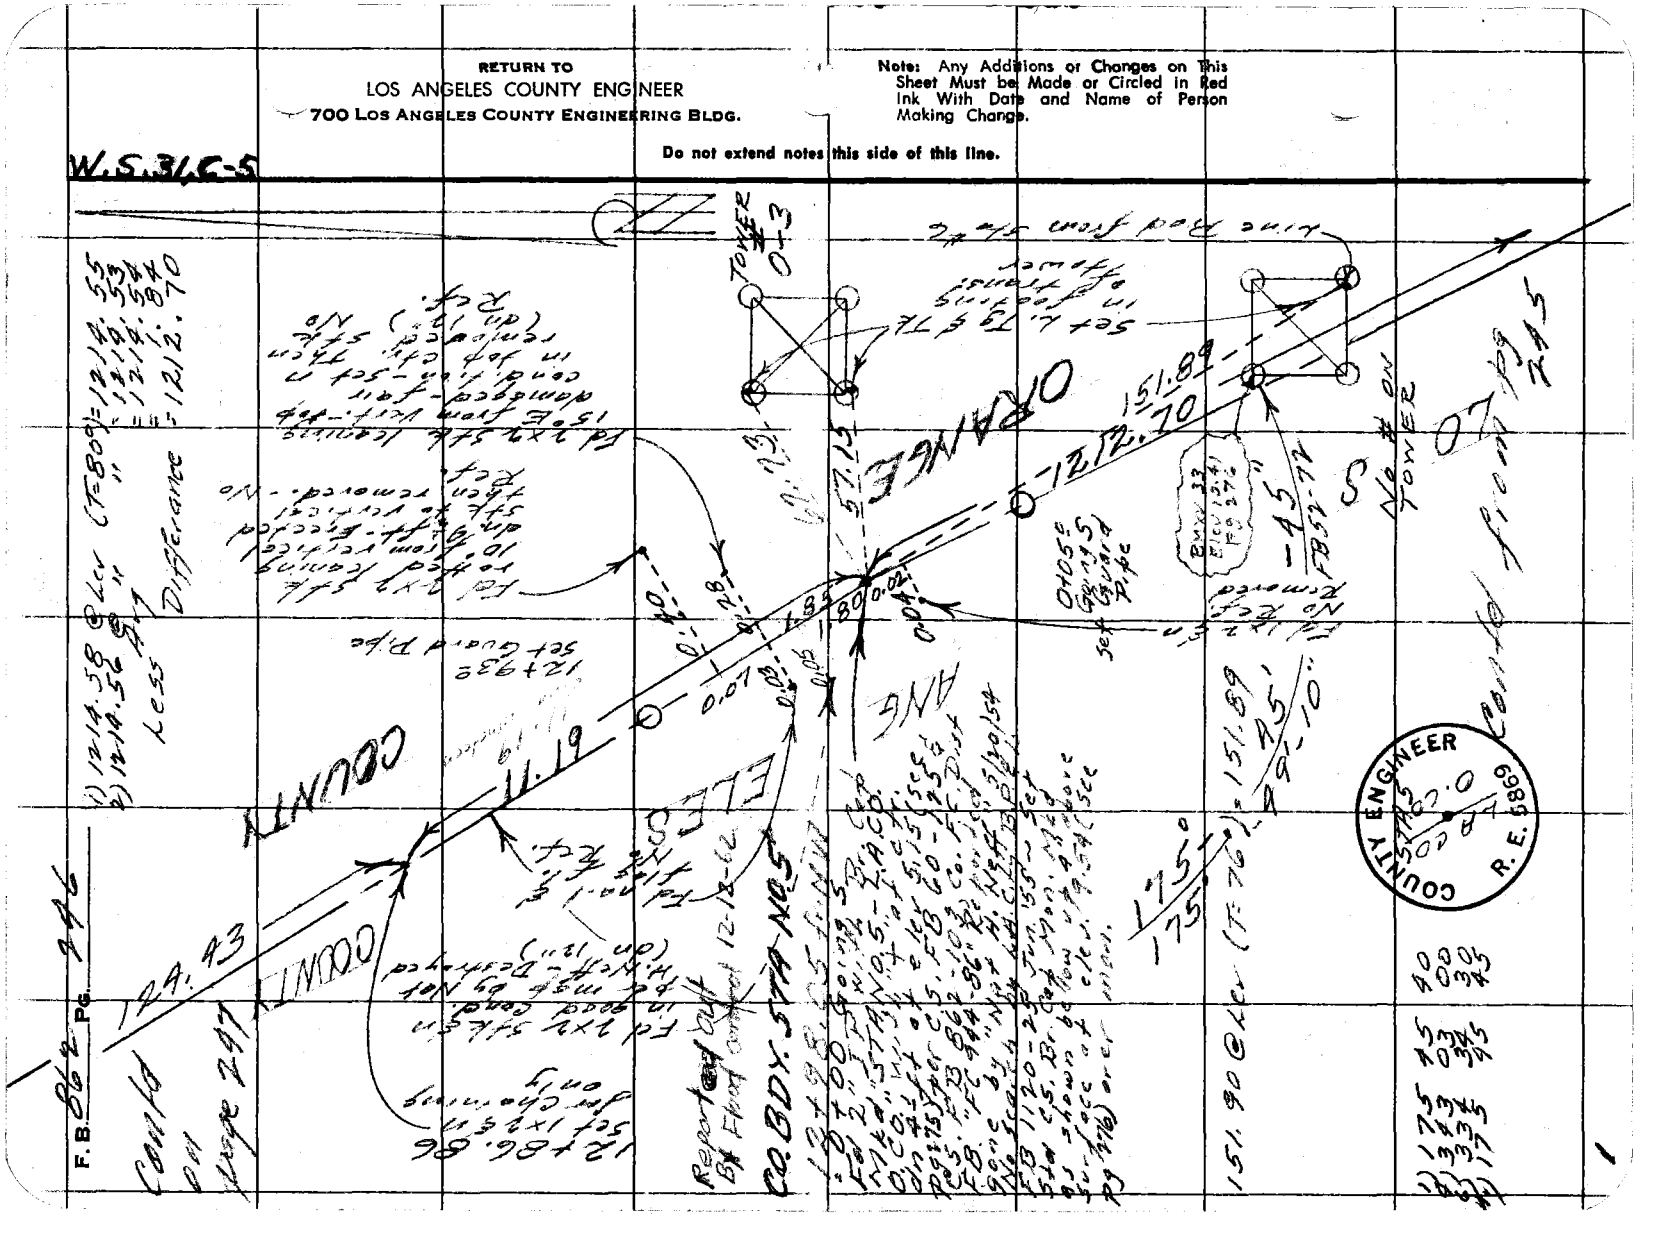

76F309S CE #247—3-57

RETURN TO
LOS ANGELES COUNTY ENGINEER
700 LOS ANGELES COUNTY ENGINEERING BLDG.

Note: Any Additions or Changes on This Sheet Must be Made or Circled in Red Ink With Date and Name of Person Making Change.

Do not extend notes this side of this line.

W.S. 31, C-5

Notes Ck'd by
Map No.
Office Work
Checked
Date

Survey of 4-A-0.0 to 5-A-0.0 JN02382 Tape 426 Std 84 OF
Surveyed by R.T.M. Date 9-58
Notes R.T.M. Date 9-58
Indexed C. Johnson

F.B. 8628 PG. 42

Cont. of Pg 248

Sta 82.02 Back = Sta 96.58 Ahead

8+10.90 Ch. Pt. D set 1"x2" in R.W. bo Hom (typ.)

0.06

Rail
Walk

BM XV 31 Elev 23.75 Pg 275

0.56

Cb.

0.04

0.04

17.61

0+00 Going N Fd Ch. Stk W.C. punched by N.C.E. per mkg by Kennerer Eng. Co.

Fd Ch. "t" in N. Wall of Bridge

No Ref.

T4S SEC 36 T5S SEC 2

10+26.80 Ch. Pt. F set 1"x2" stk in S. Wall of Bridge on l.n.c.

Rec. 99.90

SEVENTH ST.

Cb.

Walk

Rail

BM 30-37 8.836 Pg 275

ORANGE COUNTY

105.13

124.43

1) 29.90 @ Ler (T=72°)	=	29.90		
2) 29.91 @ "	=	29.91		
Avg	=	29.90	10+32.53 Ch. Pt. "G" set 1"x2" stk for ch. only	
1) 125.39 @ 7°03 (T=72°)	=	124.43		
2) 125.18 @ 6°13 "	=	124.43		
Avg	=	124.43		
17.61 @ Ler (T=72°)	=	17.61		
17.17 @ Ler "	=	17.17		
			10+48.63 P.C. of 2°30' Curve to Rt. R=2292.96 Rad. Brg. to C. N 87°-56'-06" E FC 99+86.96 Not Marked	29.90
1) 267.93 @ 3°06' (T=78°)	=	267.55		
2) 267.97 @ 3°09' "	=	267.55		
Avg	=	267.55	11+62.43 Ch. Pt. "H" set 1"x2" stn for ch. only	
20.93 @ Ler "	=	20.93		
		288.48		

Cont'd. from Pg. 246

RETURN TO
LOS ANGELES COUNTY ENGINEER
700 LOS ANGELES COUNTY ENGINEERING BLDG.

Note: Any Additions or Changes on This Sheet Must be Made or Circled in Red Ink With Date and Name of Person Making Change.

Do not extend notes this side of this line.

W.S.3, C-5

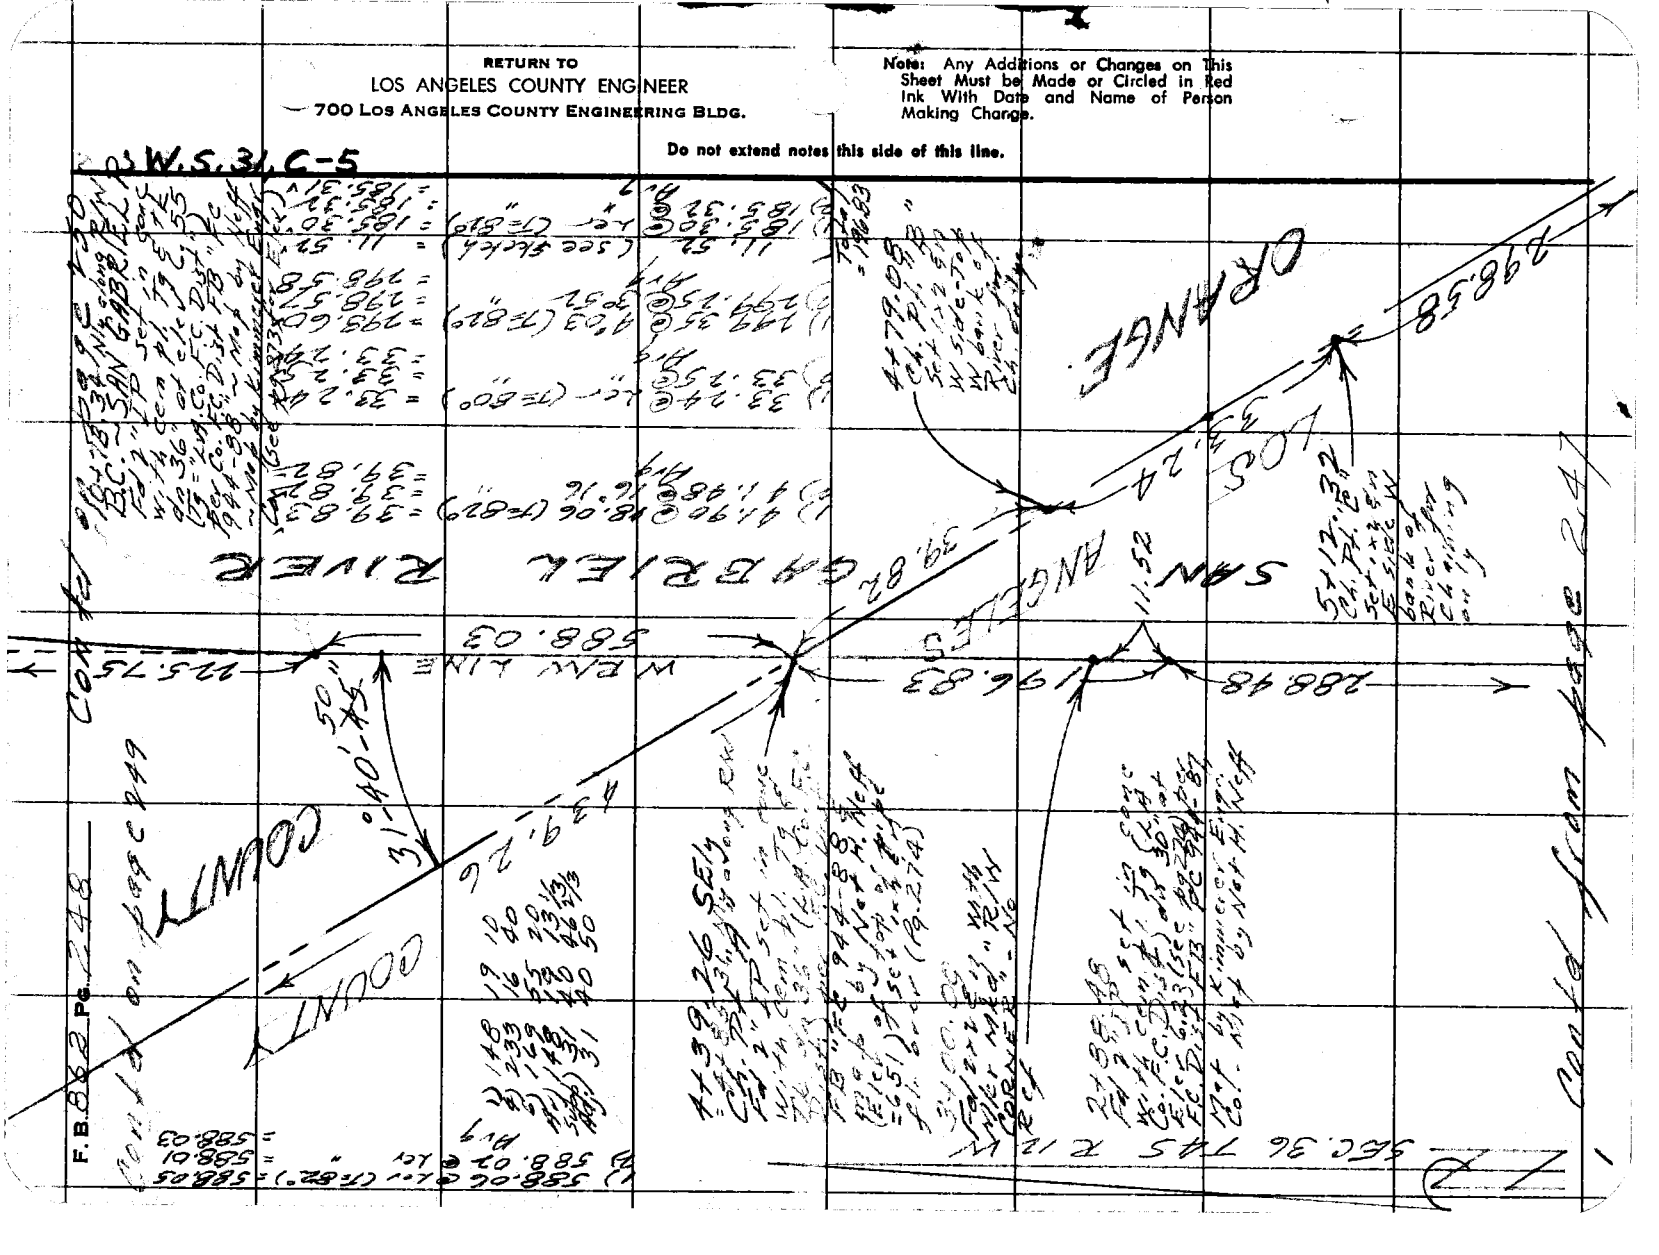

F.B. 882 Pg. 248

76F3095 CE #247—3-37

RETURN TO
LOS ANGELES COUNTY ENGINEER
700 LOS ANGELES COUNTY ENGINEERING BLDG.

Note: Any Additions or Changes on This Sheet Must be Made or Circled in Red Ink With Date and Name of Person Making Change.

Do not extend notes this side of this line.

W.S. 3½ C-5

Fd Std C.S. Br. Cap Mon Mkd as shown in F.B. 451-38 & 39
36" per F.B. 863-103 & 86 ~ Set Std. C.S. Br. Cap Mon Mkd as shown on this tape & flush over Fd. Mon & set 10 ft. high 5/8" rebar over same.
0+00 Going NE & 0+00 Going SE
Note: Upper Mon. is @ El: 9.13
See: Pg. 273.

COUNTY ENGINEER
R.E. 5869
L.A. Co. STA.
O.Co.

Sec 36 T4S R10W

LOS ANGELES COUNTY LINE STA 6

ORANGE COUNTY

496.14 ~~on 55.40~~ set in 2 sets on line in field w/ Std. Ec. of San Gabriel River

Survey of JN 2238 Tape 12 Std. Ec. of
Surveyed by
Notes
Indexed H. C. Johnson Date

Notes Ck'd by
Map No.
Office Work
Checked
Date

F.B. 246 PG. 249

See F.B. 3536-11 for latter ties 12-30-48

439.28 @ Ler (T=90°) = 439.26
439.28 @ A-9 " = 439.26

496.18 @ Ler (T=90°) = 496.16
496.18 @ A-9 " = 496.16

93.50 @ 6°29' (T=72°) = 93.47
93.30 @ 6°34 A-9 = 93.27

RETURN TO
LOS ANGELES COUNTY ENGINEER
700 LOS ANGELES COUNTY ENGINEERING BLDG.

Note: Any Additions or Changes on This Sheet Must be Made or Circled in Red Ink With Date and Name of Person Making Change.

Do not extend notes this side of this line.

W.S.3.C-5

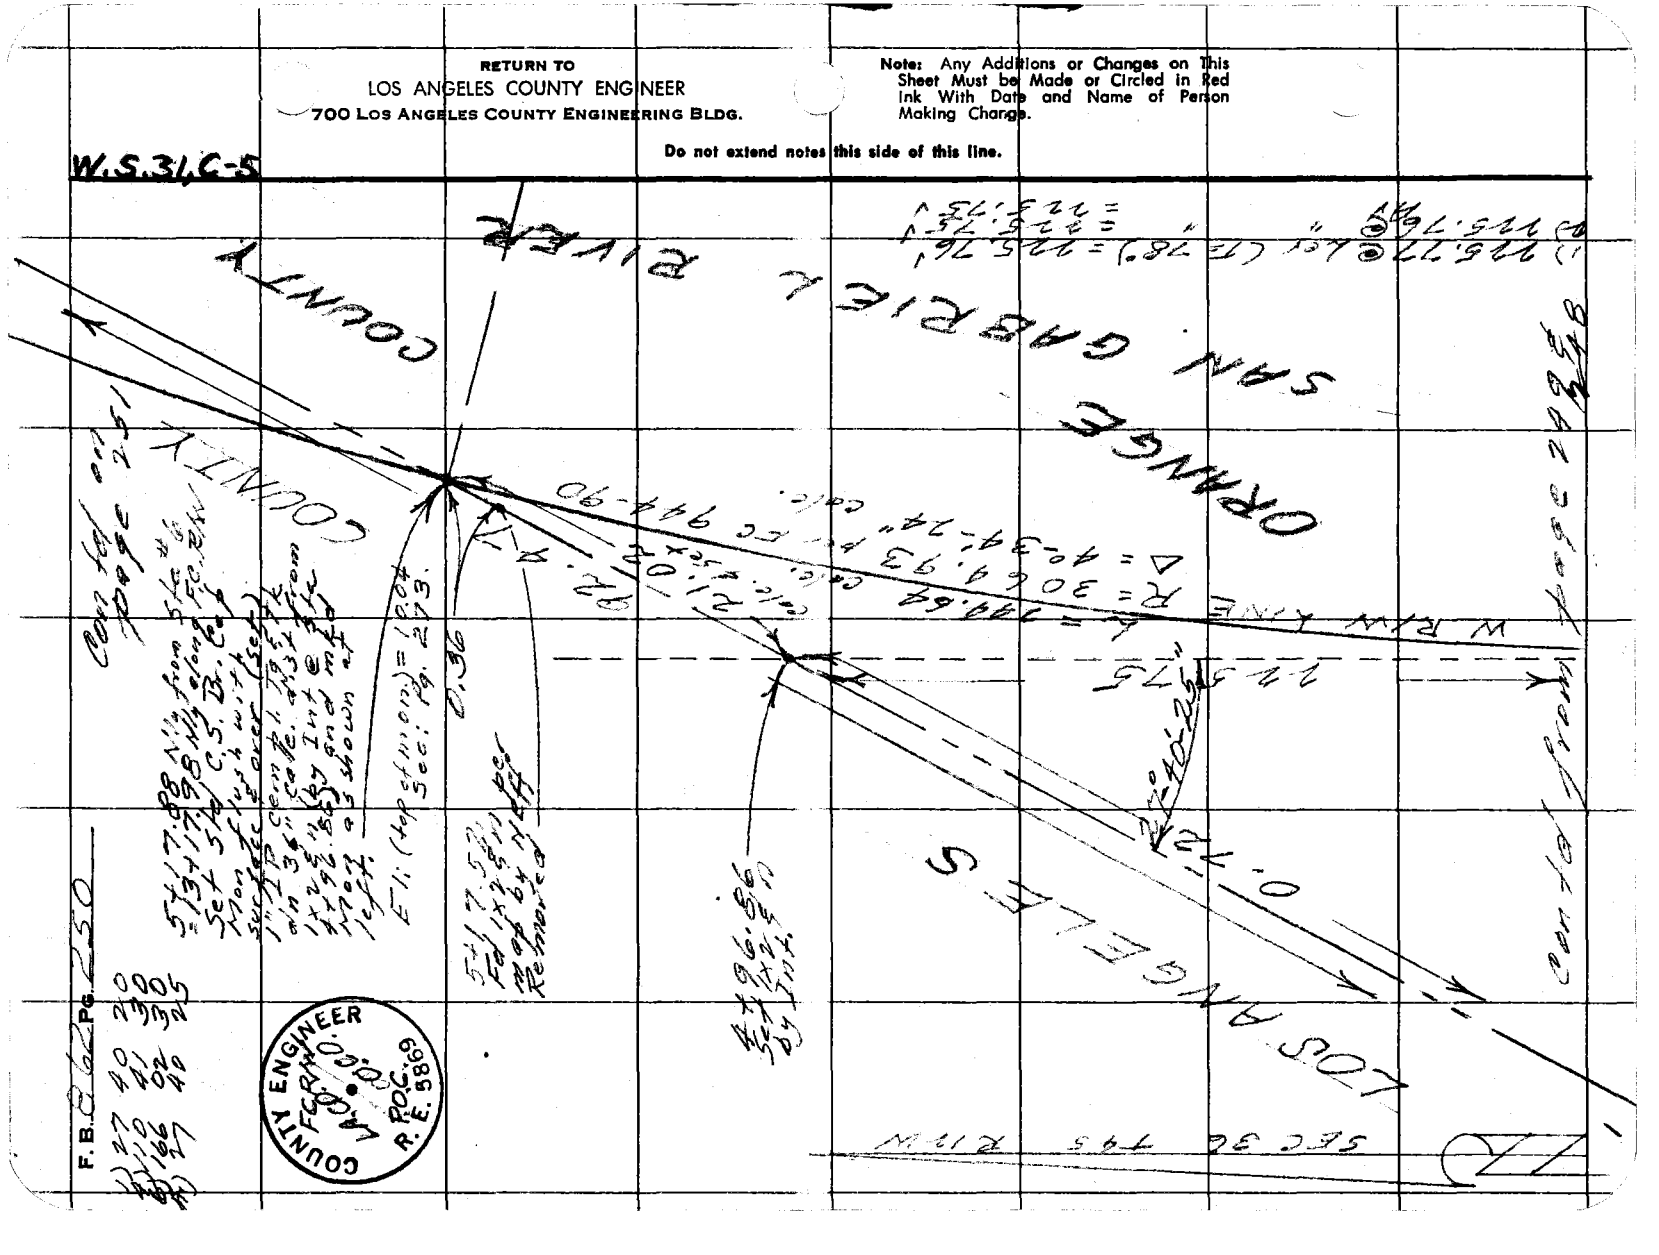

Contd. on Pg. 249

W.S.3.G-5

Notes Ck'd by	Survey of L.A.-O.Co. Bdy.
Map No.	JN00382 Tape 126 Std 84 °F
Office Work	Surveyed by R.J. Mihaell
Checked	Notes R.J.M. Date 8-58
Date	Indexed E. C. Johnson

F.B. 882 Pg. 251

Note: Any Additions or Changes on This Sheet Must be Made or Circled in Red Ink With Date and Name of Person Making Change.

Do not extend notes this side of this line.

RETURN TO
LOS ANGELES COUNTY ENGINEER
700 LOS ANGELES COUNTY ENGINEERING BLDG.

76F3095 CE #247 3-57

SEC 36 T1S R11W

LOS ANGELES COUNTY

ORANGE COUNTY

SAN GABRIEL RIVER

298.19

Ch. Pt. "C"
67+09.00
Set 1"x36" in Co. Line at E. edge of W. dike

COUNTY ENGINEER
L.A. CO. / O. CO.
R.E. 5869

20.39

12.73

17.66

5+96.27
Set Std. C.S. Br. Co. Mon. mkd with R.M. of C+S "RE 5869" dn 36" be low top of W. dike of S.G. River at edge of dike East of Ch. of 19.49. (See pg 272)
Set Std. C.S. Br. Cap mon. up 1" above ctr. of dike & mk'd same as shown. Elev. of upper mon. is 22.05. Set 2" Iron Pipe in Co. Line at E. edge of W. dike of River. (See Pg. 272)

5+88.61
Set na.1

20.20

5+88.61
Pt. 1"x36" in No Ref - Assume same to have been set by Kammerer Eng. Co. = Ch. Pt. "B"

Top of W. Dike

92.47

20.39 @ Ler (T=77°) = 20.39'
1) 298.88 @ 3' 50 (T=76°) = 298.19'
2) 298.78 @ 3 33 " = 298.19'
Avg

Contd. from Pg. 250

Cont'd. on Pg. 253

F.B. 862 Pg. 252

1) 1012.12 @ Ler (T= 76°) = 1012.07 ✓
2) 1012.11 @ " = 1012.06 ✓
Avg = 1012.06

1) 90 00 00
2) 180 00 00
3) 360 00 00
4) 90 00 00

1) 85.30 @ 11°01 (T= 76°) = 83.73
2) 85.57 @ 11°55 = 83.73
Avg. = 83.73

1) 270.72 @ Ler (T= 76°) = 270.71 ✓
2) 270.74 @ " = 270.73 ✓
Avg = 270.72

Ch. Pk. "E"
19+19.25
Set 1x2 in at edge of water in bottom of S.G. R.V.

Ch. Pk. "D"
9+07.19
Set 1x2 in in bottom of S.G. River

W.S.3/4-S

839.78 calc.

COUNTY

COUNTY

ORANGE RIVER

LOS ANGELES

SAN GABRIEL

Set 90

1012.06

270.72

Face of E Dike

Face of W Dike

Top W Dike

R&O

169.01 Set

River 160± Bottom

0.24

298.19

Set 30 T.S. R.W.

R&O

T= 38.18
To spike set per map by Kennicker Engr. Co. in T.S. Mon. Prior to 89. Def. Ent. Sta. to be 2.60 ft. W. of Sta. to be below elev. of top of Mon. This point is W. of Sta. prior to 1915 when it is gone.

(See Pg. 290 for EL.)

Cont'd. from Pg. 251

RETURN TO
LOS ANGELES COUNTY ENGINEER
700 LOS ANGELES COUNTY ENGINEERING BLDG.

Note: Any Additions or Changes on This Sheet Must be Made or Circled in Red Ink With Date and Name of Person Making Change.

Do not extend notes this side of this line.

Contd on page 254

M.S. 31-C-4

Notes Clrd by
Map No.
Office Work
Checked
Date

Survey of Ltd. C. Co. Line
JN 00382 Tape 176 Std. 84 °F
Surveyed by R.T. Mitchell
Notes Mitchell Date 8/58
Indexed C. Johnson

F. B. 862 Pg. 253

1) 564.28 @ Lev (T=76°) = 564.26 ✓
2) 564.32 @ " " = 564.29 ✓
Avg = 564.27 ✓

1) 44.60 @ 23°57 (T=76) = 40.76 ✓
2) 44.97 @ 24°55 " = 40.78 ✓
= 40.77 ✓
4.13 @ Lev = 4.11 ✓
44.88

1) 145.52 @ Lev = 1 (T=76°) = 145.51 ✓
2) 145.51 @ " = 145.50 ✓
Avg = 145.50

1) 5° 45 20
2) 23 01 20
3) 34 31 30
4) 5 45 15

COUNTY ENGINEER
L.A. CO. / O. CO.
R.E. 5869

SANGABRIEL RIVER

ANGELES

COUNTY

CO.

145.50

19.94

28+15.59
Set Std. C.S. Tri. Cut Mon mkd with P.M. at ext. "RE 5869" also 2.9 ft (@ Elev see pg 282) in top Ctr. E. side of San Gabriel R. E. Set Std C.S. Tri. Cut Mon mkd as shown up 2' over (@ Elev 1948 see page 282)

27+50.09
Ch. Pt. G
Set 1x2 Stk on Co. Line

Set Guard Pipe

same

23+02.49
Ld 1x2 Stk per Kemmerer Engrg Co. 9.56 low water level (at elev 0.37 per pg 291) Ref position of C.S. Mon shown on pg 90. Elev of mon as shown to be ft. Conclude the mon. is same (pt. falls at base of E. side of Riv (shown in ref to be top of Bank)

44.88
Calc. Set

Ch. Pt. F-2
Set 1x2 Stk on line betw Ch. Pt. "F" & Ch. Pt. "G"

830.78

Face of Bank

118.39

Ch. Pt. F-1
Set nail

LOS

ORANGE

Se 45-15"

270.12

T 4 S R 12 W

SEC 36

Contd. to Pg. 252

Note: Any Additions or Changes on This Sheet Must be Made or Circled in Red Ink With Date and Name of Person Making Change.

Do not extend notes this side of this line.

RETURN TO
LOS ANGELES COUNTY ENGINEER
700 Los Angeles County Engineering Bldg.

78F3095 CE #247—3-57

Cont'd on Pg. 255

F. B. 862 Pg. 254

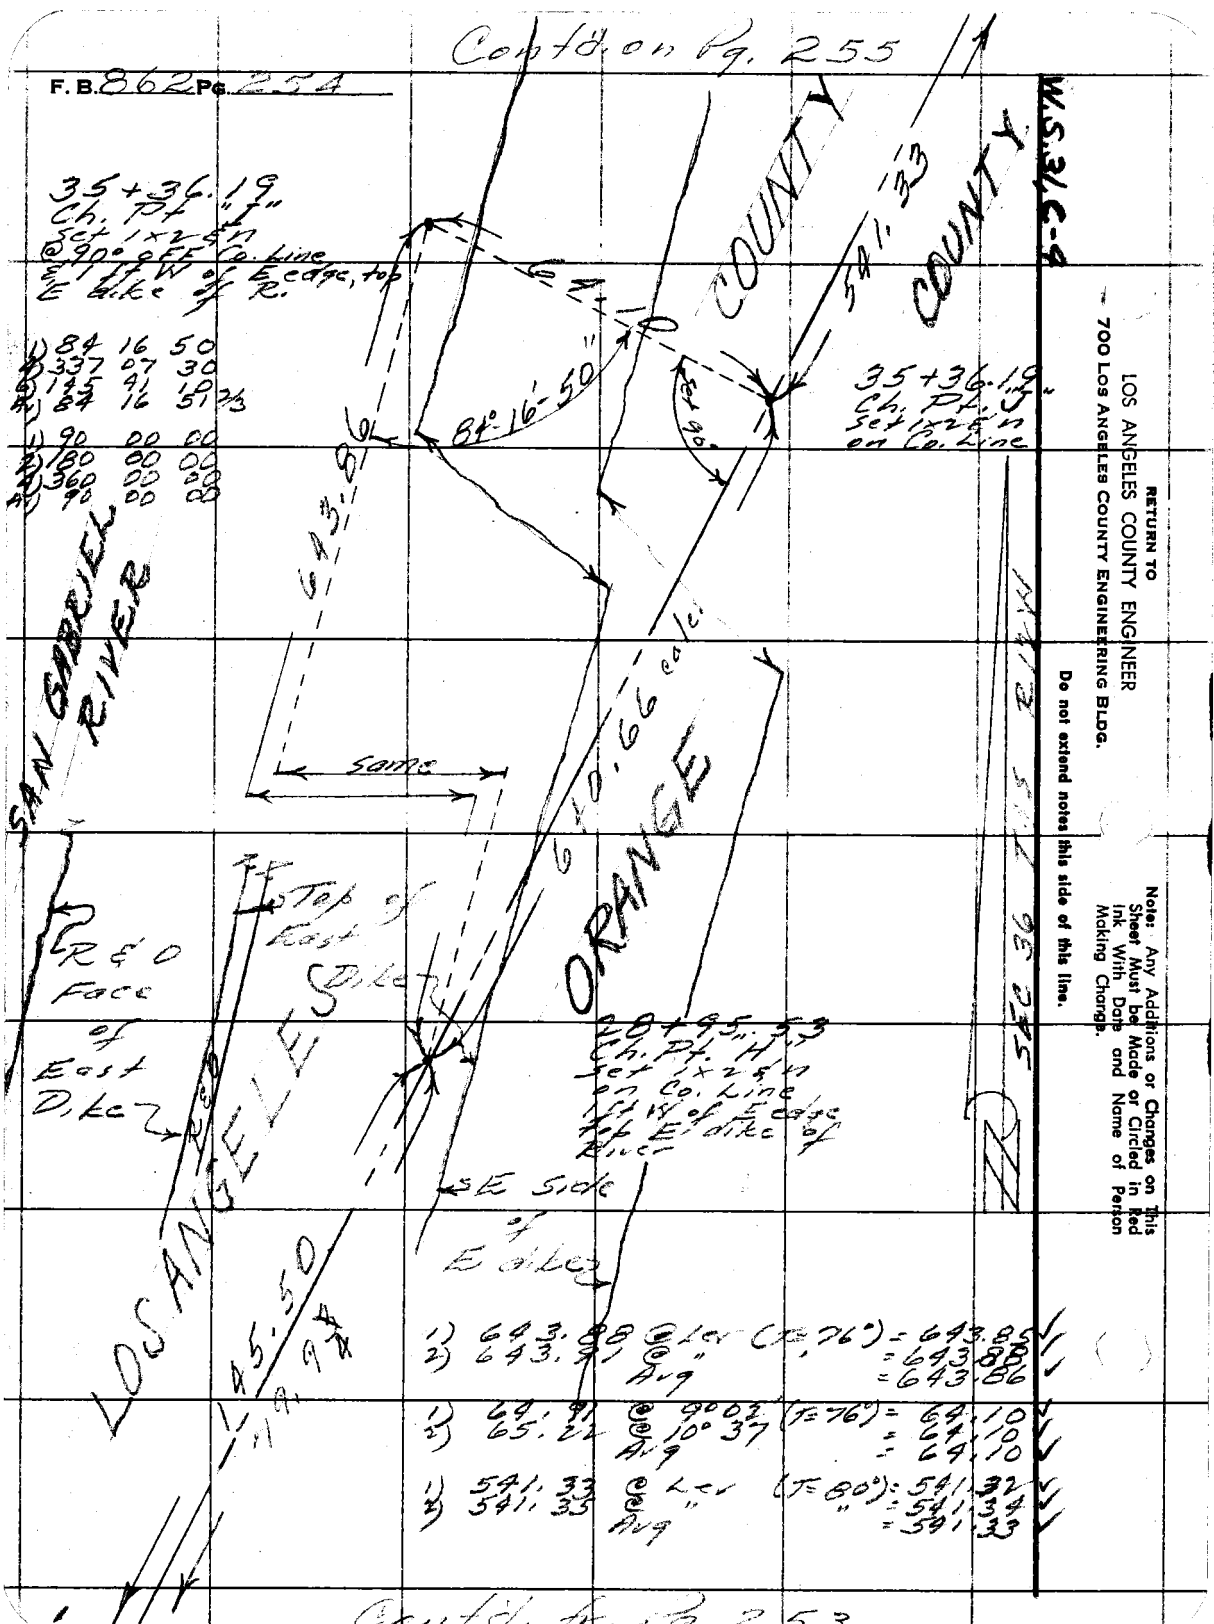

Cont'd fr. Pg. 253

Cont'd on pg. R56

W.S.3,C-9

Notes Ck'd by	Survey of LH.-O-Co. Bdy
Map No.	JN 00387 Tape 1216 Std. 84 °F
Office Work	Surveyed by RJM, MKell
Checked	Notes M. K. Kell Date 8/58
Date	Indexed C. Johnson

F. B. 661 Pg. 255

Note: Any Additions or Changes on This Sheet Must be Made or Circled in Red Ink With Date and Name of Person Making Change.

Do not extend notes this side of this line.

RETURN TO
LOS ANGELES COUNTY ENGINEER
700 LOS ANGELES COUNTY ENGINEERING BLDG.

76F3095 CE #247—3-57

1) 127.21 @ Lcr (T=82°) = 127.23
2) 127.23 @ " = 127.24
Avg = 127.23
(Topc @ 0138 std @ 68°)

(Topc @ 126 std @ 84° - 300 ft.)
1) 601.75 @ Lcr (T=76°) = 601.75
2) 601.77 @ " = 601.77
Avg = 601.74

1) 506.13 @ Lcr (T=80°) = 506.14
2) 506.13 @ " = 506.12
Avg = 506.13

1) 410.11 @ Lcr (T=80°) = 410.10
2) 410.14 @ " = 410.13
Avg = 410.11

SECTION LINE

COUNTY

233.27

SECTION LINE

197.68

127.20 Calc.

127.23 m.

49+98 ± Ed. Guard Post

36 49+93.76 Ch. Pt. M Bearing North = 23+82.2 ft. W. Co. Pt. "F" on West - Ed Std. C.S. Br. Cob Mon fd. with Orange Envelope as shown in FB 862-80 per same - Elev = 13.24 (see pg 268)

2.53

45+83.65 Ch. Pt. L set 1x2 sn on Co. Line

49+98 ± Ed. Guard Post

410.11

506.13

541.33

40+77.52 Ch. Pt. K set nail

1+55.03 Ch. Pt. "I" set 1x2 sn on Transit Line

Con tel

T 4 S

R 12 W

LOS ANGELES

ORANGE

Ed. Co. Tower

Ed. Co. Tower

Cont'd on pg. 254

Cont'd. on Pg. 257

F.B. 862 Pg. 256

1) 312.24 @ Lcr (T=70°) = 312.21 ✓
2) 312.23 @ " " = 312.20 ✓
Avg = 312.20 ✓

312.20 crossing drain ditch

70+40.11
Ch. Pt. 8
Set 1x2 E.T.
for chaining
on W. edge drain ditch

1) 290.50 @ Lcr (T=70°) = 290.47 ✓
2) 290.51 @ " " = 290.48 ✓
Avg = 290.48 ✓

290.47

67+49.65
Ch. Pt. 7
Set 1x2 E.T.
for chaining
only

COUNTY

752.56

COUNTY

1) 752.65 @ Lcr (T=70°) = 752.58 ✓
2) 752.66 @ " " = 752.57 ✓
Avg = 752.58 ✓

59+97.06
Ch. Pt. 0
Set 1x2 E.T.
for chaining
only

LOS ANGELES

401.56

ORANGE

1) 401.58 @ Lcr (T=76°) = 401.56 ✓
2) 401.58 @ Lcr (T=76°) = 401.56 ✓
Avg = 401.56 ✓

55+75.30
Ch. Pt. N
Set 1x2 E.T.
for chaining
only

601.14

SECTION 25
T 4 S R 12 W

Cont'd. fr. Pg. 255

RETURN TO
LOS ANGELES COUNTY ENGINEER
700 LOS ANGELES COUNTY ENGINEERING BLDG.

Do not extend notes this side of this line.

Note: Any Additions or Changes on This Sheet Must be Made or Circled in Red Ink With Date and Name of Person Making Change.

Contd. fr. Pg. 256

Notes Ck'd by	Survey of A.H.-O-Co. Party
Map No.	JN 003827 Type 126 Std. 84 °F
Office Work	Surveyed by R.T. Mitchell
Checked	Notes Mitchell Date 8/58
Date	Indexed C. Johnson

F. B. 864 Pg. 257

1) 198.98 @ Lcr (Δ=72°) = 198.96 ✓
2) 199.08 @ " " = 198.98 ✓
Avg

77+76.20
Ch. Pt. "F"
Set 1x2 E.T.
for chaining
on S. side
of drain ditch

198.81

78+28.01
Set 1x2 E.T.
on apex of
1.0 ft. rad.
elev to be
17.69. No
scratch for C.S.
Mon. (shown
to be at elev
24.33) which
is considered to
be gone - F.B.
862-85

1) 108.01 @ Lcr (Δ=70°) = 108.00 ✓
2) 108.01 @ " " = 108.00 ✓
Avg = 108.00 ✓

108.00

crossing conc. lined ditch

Note: Any Additions or Changes on This Sheet Must be Made or Circled in Red Ink With Date and Name of Person Making Change.

Do not extend notes this side of this line.

SECTION 25

T 4 S

LOS ANGELES COUNTY

ORANGE COUNTY

315.89

crossing drain

76+68.80
Ch. Pt. "S"
Set 1x2 E.T. for
chaining only
on S. side drain
ditch

315.88 @ Lcr (Δ=70°) = 315.88
315.94 @ Lcr " = 315.91
Avg = 315.89

73+32.31
Ch. Pt. "R"
Set 1x2 E.T. for
chaining only
on E. edge of
drain ditch.

R 12 W.

312.21
crossing dia ditch

RETURN TO
LOS ANGELES COUNTY ENGINEER
700 LOS ANGELES COUNTY ENGINEERING BLDG.

76F9095 CE #247—3-57

Contd. fr. Pg. 256

X

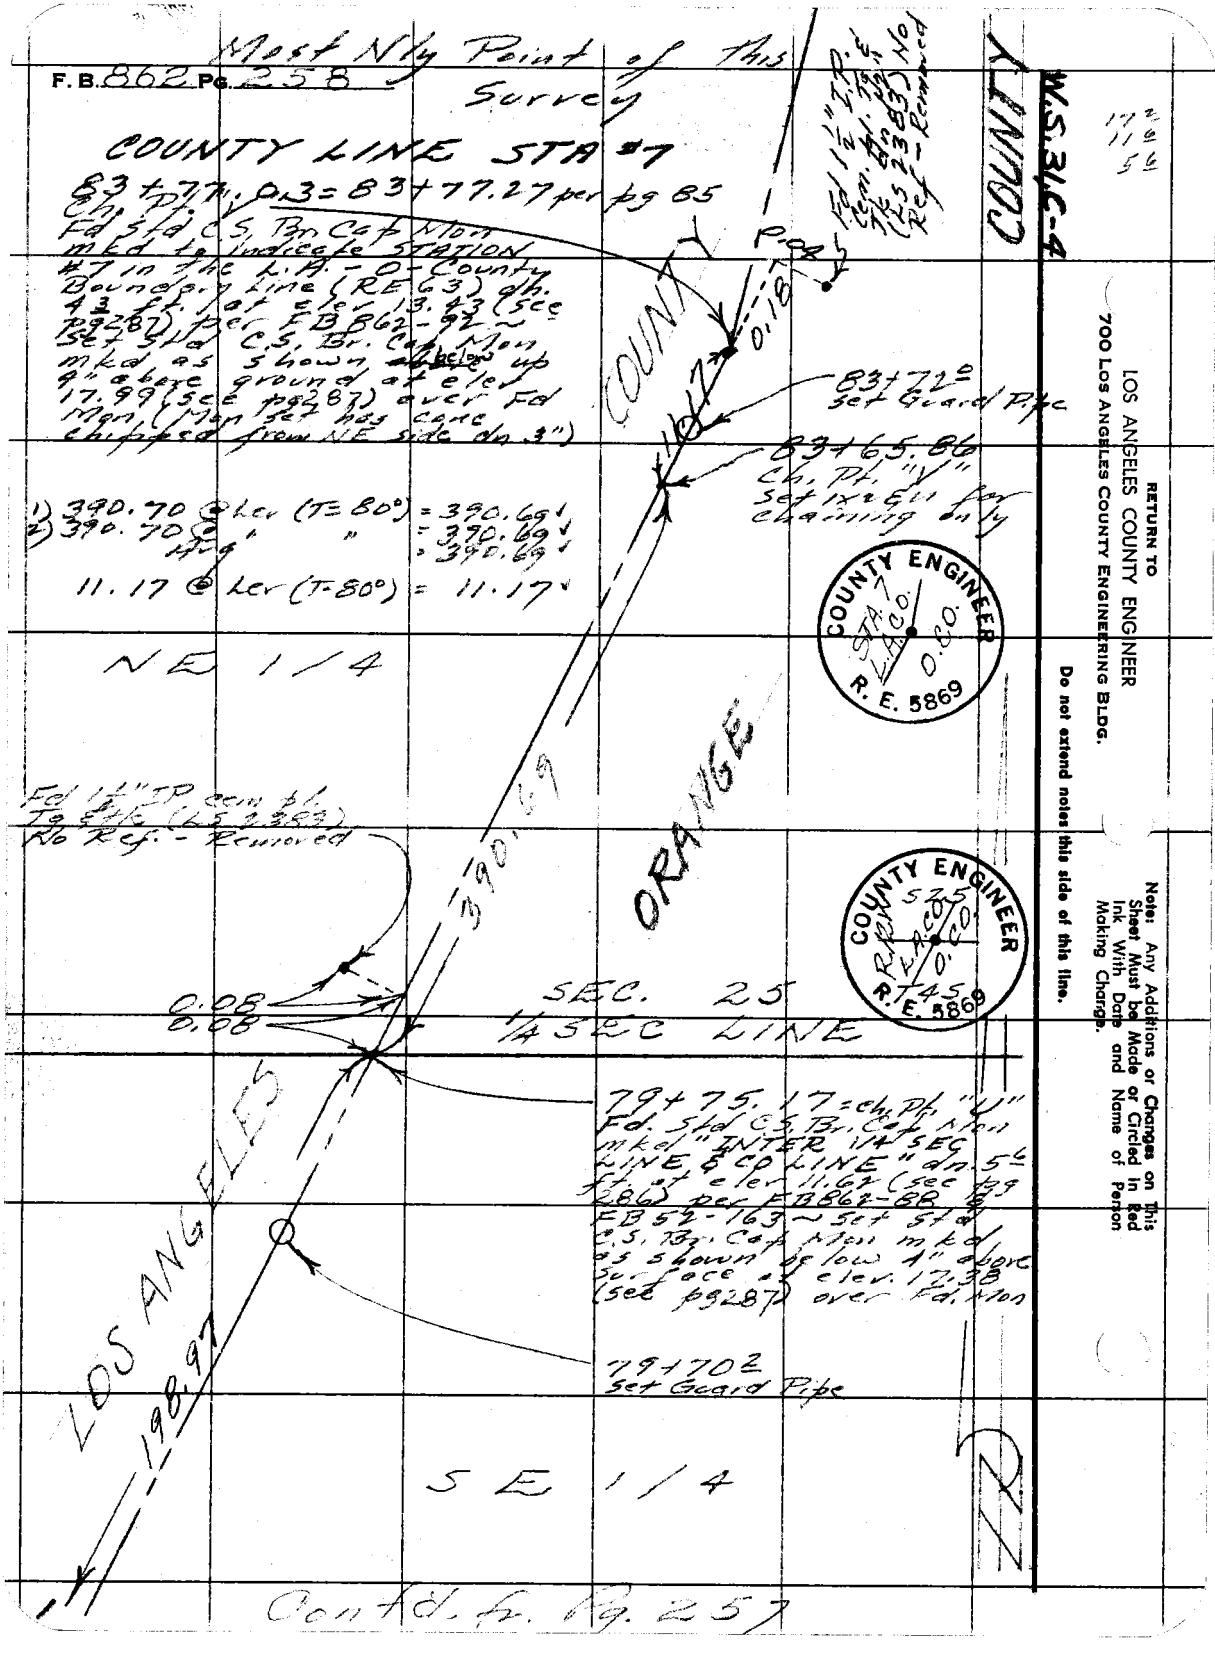
F. B. 862 Pg. 258
Most Nly Point of This Survey
83+77.27 P.O.B. = 83+77.27 per pg 85
Ch. Pt. "V" Fd. Std. C.S. Br. Cap Mon. mkd. to indicate STATION 97 in the L.H.-O-County Boundary Line (RE 63) Gh. 4 3/4 ft. at Elev. 13.43 (See pg 287) per FB 862-92 ~ Set Std. C.S. Br. Cap Mon. mkd. as shown, also up 9" above ground at elev. 17.99 (See pg 287) over Fd. Mon. (Mon. set has core chipped from NE side dn. 3")
Fd. 1" I.P. 0.18 Ctr. Bdy. Mon. (RS 23-83) No Ref. - Removed
COUNTY
ORANGE
LOS ANGELES
1) 390.70 @ Lcr (T=80°) = 390.69
2) 390.70 @ " " = 390.69
11.17 @ Lcr (T=80°) = 11.17
83+72.0 Set Guard Pipe
83+65.86 Ch. Pt. "V" Set 1"x5" pg. chaining only
COUNTY ENGINEER STA 97 L.H.O. 0.80' R.E. 5869
COUNTY ENGINEER R.E. 5869
NE 1/4
Fd 1/2" IP Gen Pt. Tg Ends (RS 2-56) No Ref. - Removed
0.08
0.08
SEC. 25
1/4 SEC LINE
390.69
198.97
79+75.17 = Ch. Pt. "V" Fd. Std. C.S. Br. Cap Mon. mkd. "INTER. 1/4 SEC LINE & CO. LINE" dn. 5/8 ft. at elev. 11.62 (See pg 286) per FB 862-88 ~ FB 52-163 ~ Set Std. C.S. Br. Cap Mon. mkd. as shown, 1" low above surface at elev. 12.38 (See pg 287) over Fd. Mon.
79+70Z Set Guard Pipe
SE 1/4
Cont'd. fr. Pg. 257
RETURN TO LOS ANGELES COUNTY ENGINEER 700 LOS ANGELES COUNTY ENGINEERING BLDG.
Do not extend notes this side of this line.
Note: Any Additions or Changes on This Sheet Must be Made or Circled in Red Ink With Date and Name of Person Making Change.
W.S. 31C-4
17 11 5

W.S.3,C-4

Notes Ck'd by	Survey of L.A. City, Dept.
Map No.	JN C362 Tape 0138 Std 68 °F
Office Work	Surveyed by
Checked	Notes Date
Date	Indexed C. Johnson

F. B. Book PG. 259

TIES

Ed. Co. Tower

Ed. Co. Tower

C.O.

C.O.

SECTION 25

SECTION 30

C.S. No. 11
M.J. 2-55

LOS ANGELES

ORANGE

T4S ~ R12W

Note: Any Additions or Changes on This Sheet Must be Made or Circled in Red Ink With Date and Name of Person Making Change.

Do not extend this side of this line.

PLEASE RETURN TO
LOS ANGELES COUNTY ENGINEER
700 LOS ANGELES COUNTY ENGINEERING BLDG.

76F3095 S&E #247 1-56

PLEASE RETURN TO
LOS ANGELES COUNTY ENGINEER
700 LOS ANGELES COUNTY ENGINEERING BLDG.

Note: Any Additions or Changes on This Sheet Must be Made or Circled in Red Ink With Date and Name of Person Making Change.

Do not extend this side of this line.

W.S.3/B-4

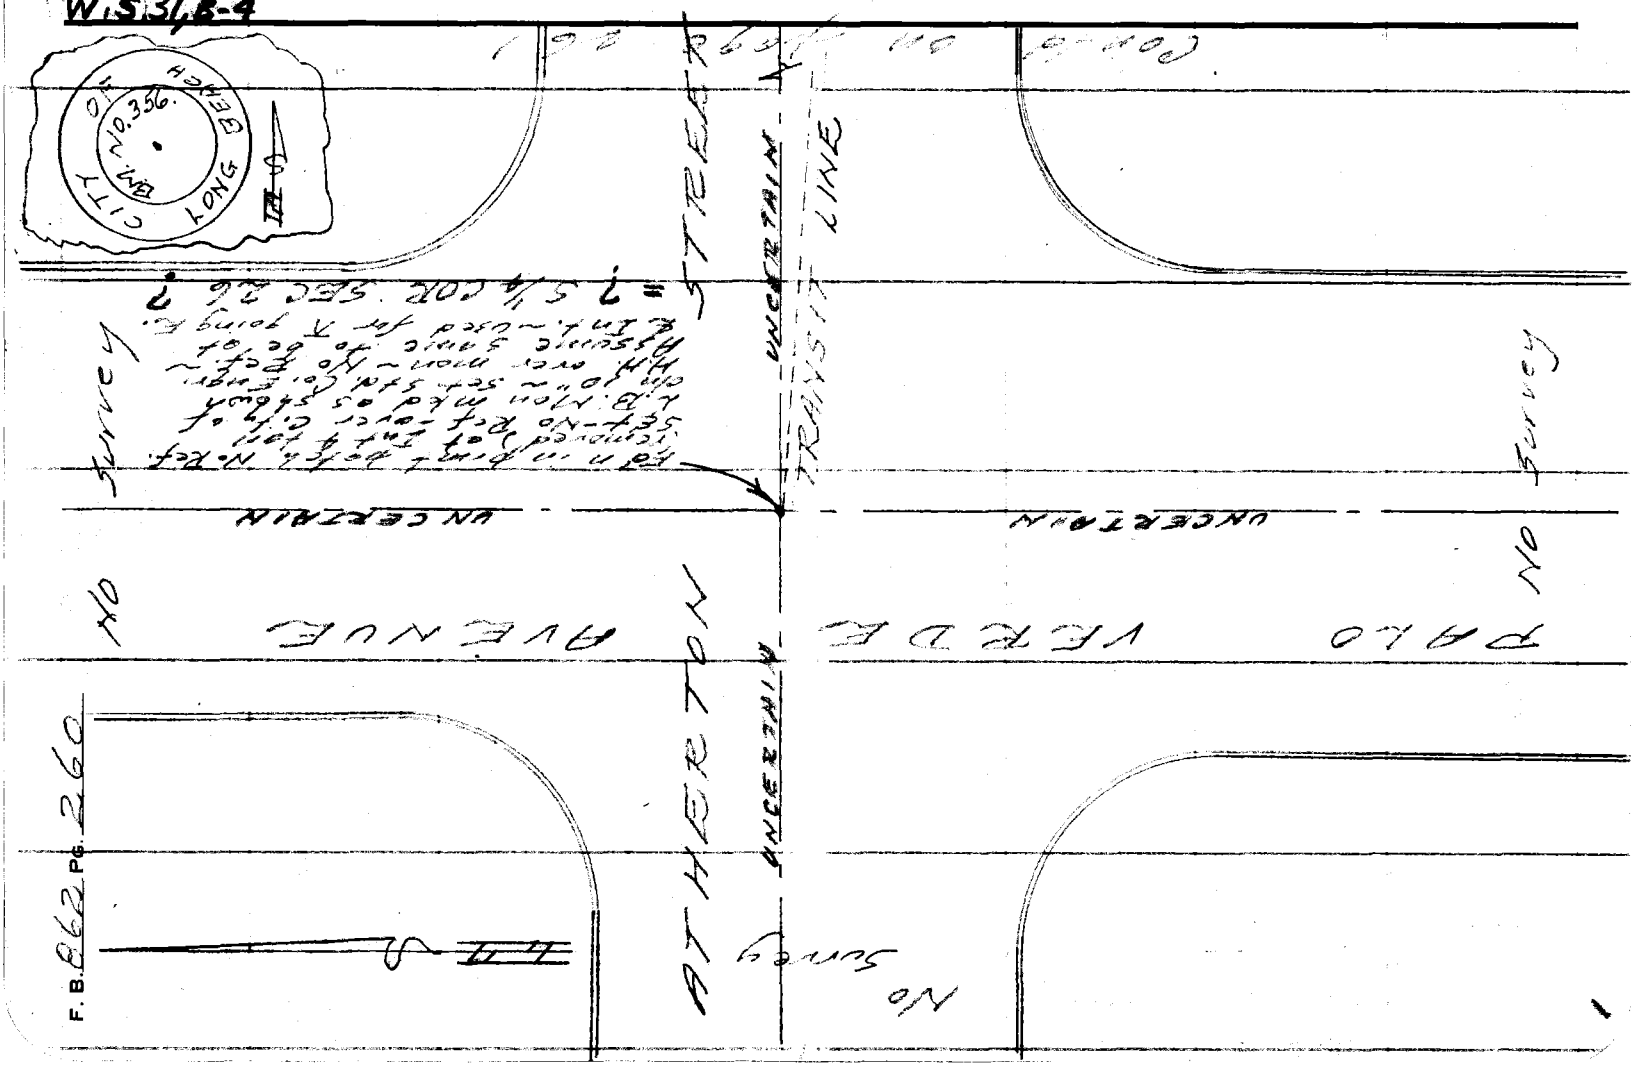

76F309S CE #247—3-57

RETURN TO
LOS ANGELES COUNTY ENGINEER
700 LOS ANGELES COUNTY ENGINEERING BLDG.

Note: Any Additions or Changes on This Sheet Must be Made or Circled in Red Ink With Date and Name of Person Making Change.

Do not extend notes this side of this line.

W.S.3/E-4

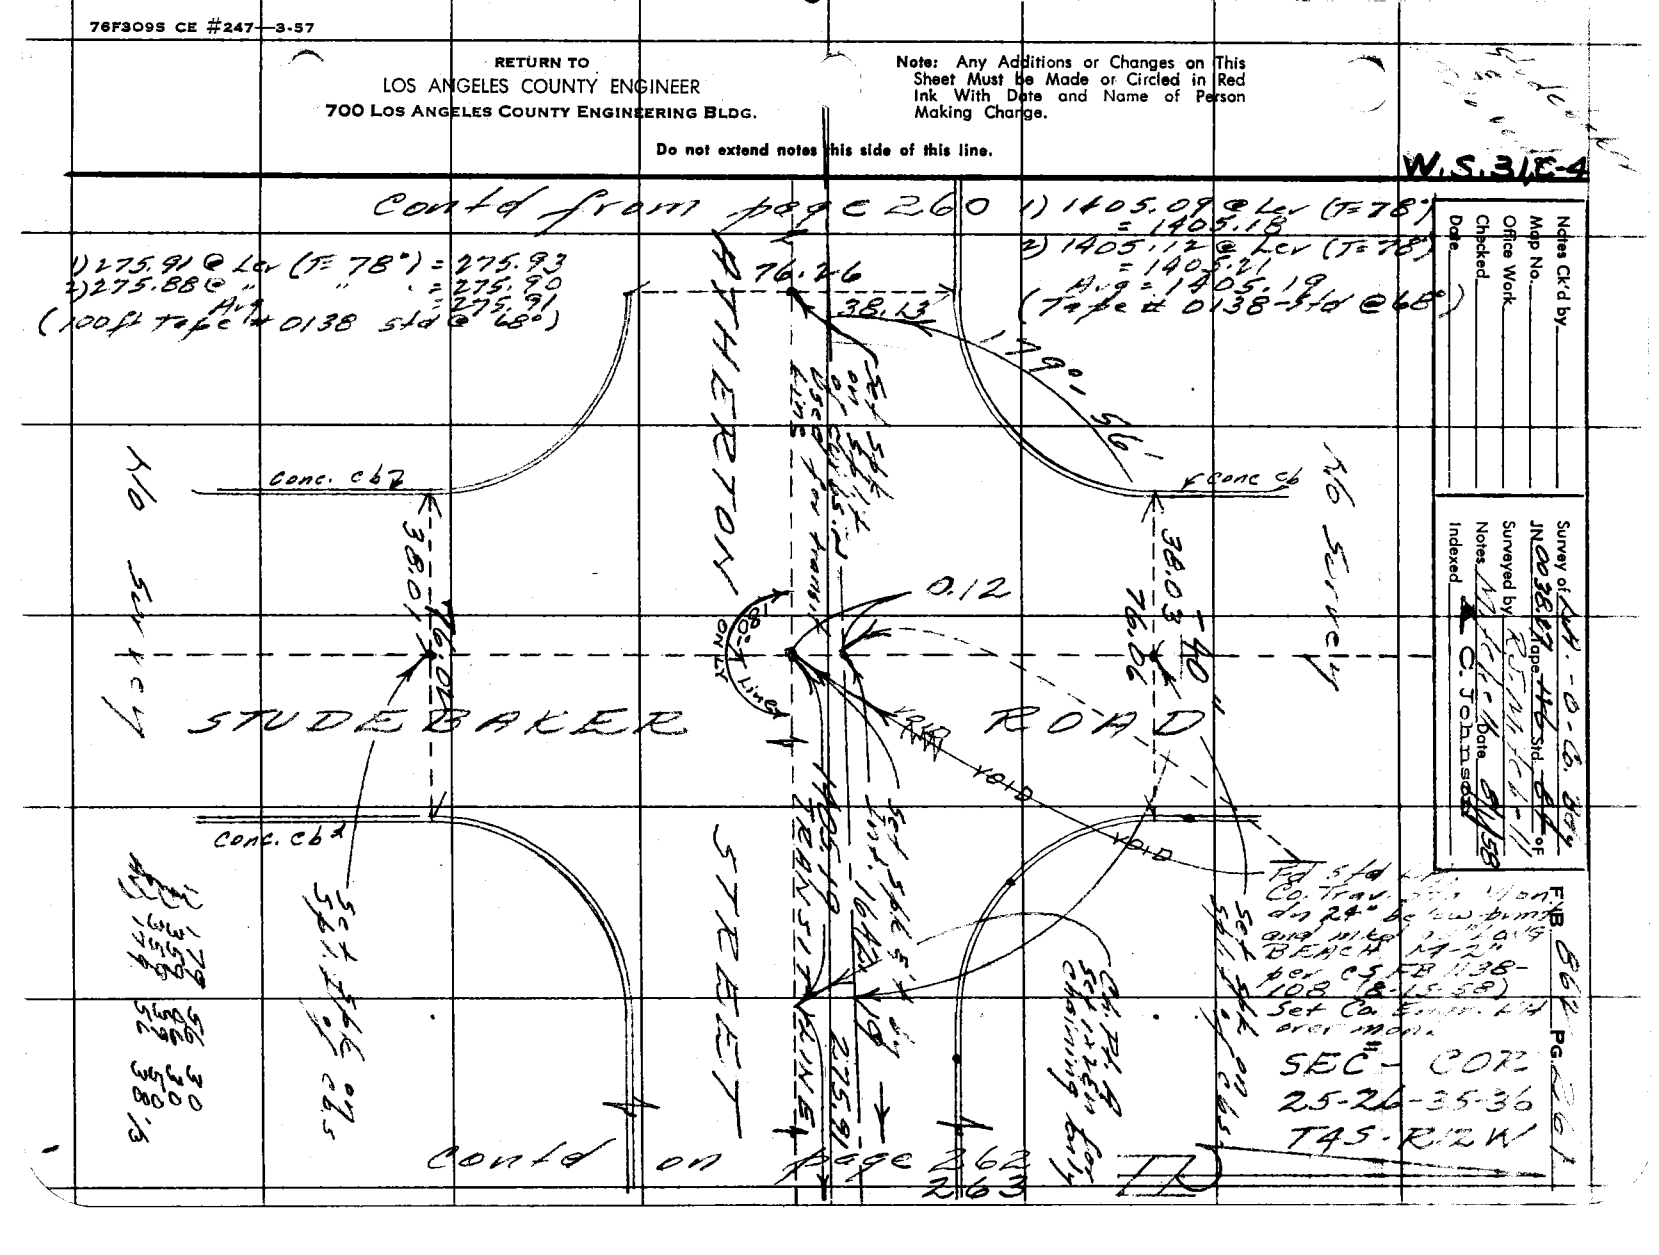

F. B. 862 PG. 262

T4S - R12W

NOTE:

@ "B", "E", "F" - Set 1"x2" Sq. ch. Pk. only
@ "C", "G", & "H" - Set 1"x2" Sq. on Transit Line
@ "D" - Set Spk & Wash. " " "

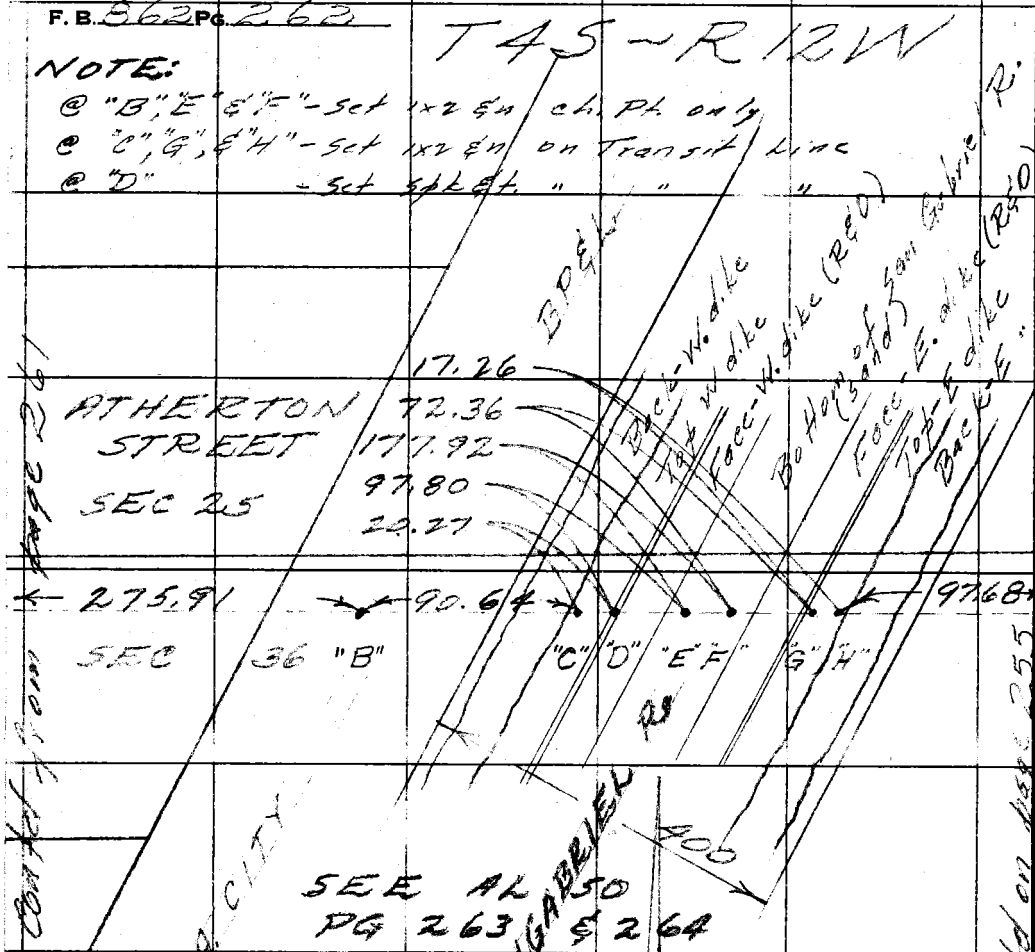

(100 Ft tape #0138 Std @ 68°)

1) 91.69 @ 8°43' (T=78°) = 90.64
2) 91.51 @ 7°54 " = 90.63
Avg. = 90.64

20.27 @ Lev (T=79°) = 20.27

1) 99.94 @ 11°53 (T=74°) = 97.80
2) 99.65 @ 11°03 " = 97.80
Avg. = 97.80

1) 177.93 @ Lev (T=79°) = 177.93
2) 177.90 @ " = 177.91
Avg. = 177.92

1) 73.95 @ 11°53 (T=74°) = 72.37
2) 74.17 @ 10°41 " = 72.36
Avg. = 72.36

17.26 @ Level (T=79°) = 17.26

1) 98.97 @ 9°15 (T=74°) = 97.68
2) 98.21 @ 8°37 " = 97.68
Avg. = 97.68

POINT	STATION
B	16+81.10
C	17+71.74
D	17+92.01
E	18+89.81
F	20+67.73
G	21+90.09
H	21+57.35

RETURN TO
LOS ANGELES COUNTY ENGINEER
700 LOS ANGELES COUNTY ENGINEERING BLDG.

Note: Any Additions or Changes on This Sheet Must be Made or Circled in Red Ink With Date and Name of Person Making Change.

Do not extend notes this side of this line.

W.S.3,C-4

Notes Ck'd by	Survey of
Map No.	JNCCE W Tape 176 Std 84 °F
Office Work	Surveyed by
Checked	Notes Date 6-55
Date	Indexed C. Johnson

F. B. Pg.

COUNTY ENGINEER
R.R. 5-25
36
T 4S.
R. E. 5869

Note: Any Additions or Changes on This Sheet Must be Made or Circled in Red Ink With Date and Name of Person Making Change.

PLEASE RETURN TO
LOS ANGELES COUNTY ENGINEER
700 LOS ANGELES COUNTY ENGINEERING BLDG.
Do not extend this side of this line.

SECTION 25

SECTION 36

T 4 S

R 12 W

B.P.E.L. R/W

Top-W Dike

SANGABRIEL RIVER

1642.19

138.96

367.81

0.40 m.

38.91 calc.

9.41 calc.

9.61 m

10.86 calc.

11.03 m

20.27

pg 262

Ch. Rt. 1 1"=2640' pg 262

Ch. Rt. 72 1"=2640' pg 262

Ch. Rt. 1 1"=2640' pg 262

Ch. Rt. 1 1"=2640' pg 262

Contact

1.93
1.40
2.33

76F309S S&E #247 1-56

PLEASE RETURN TO
LOS ANGELES COUNTY ENGINEER
700 LOS ANGELES COUNTY ENGINEERING BLDG.

Note: Any Additions or Changes on This Sheet Must be Made or Circled in Red Ink With Date and Name of Person Making Change.

Do not extend this side of this line.

W.S.31,C-4

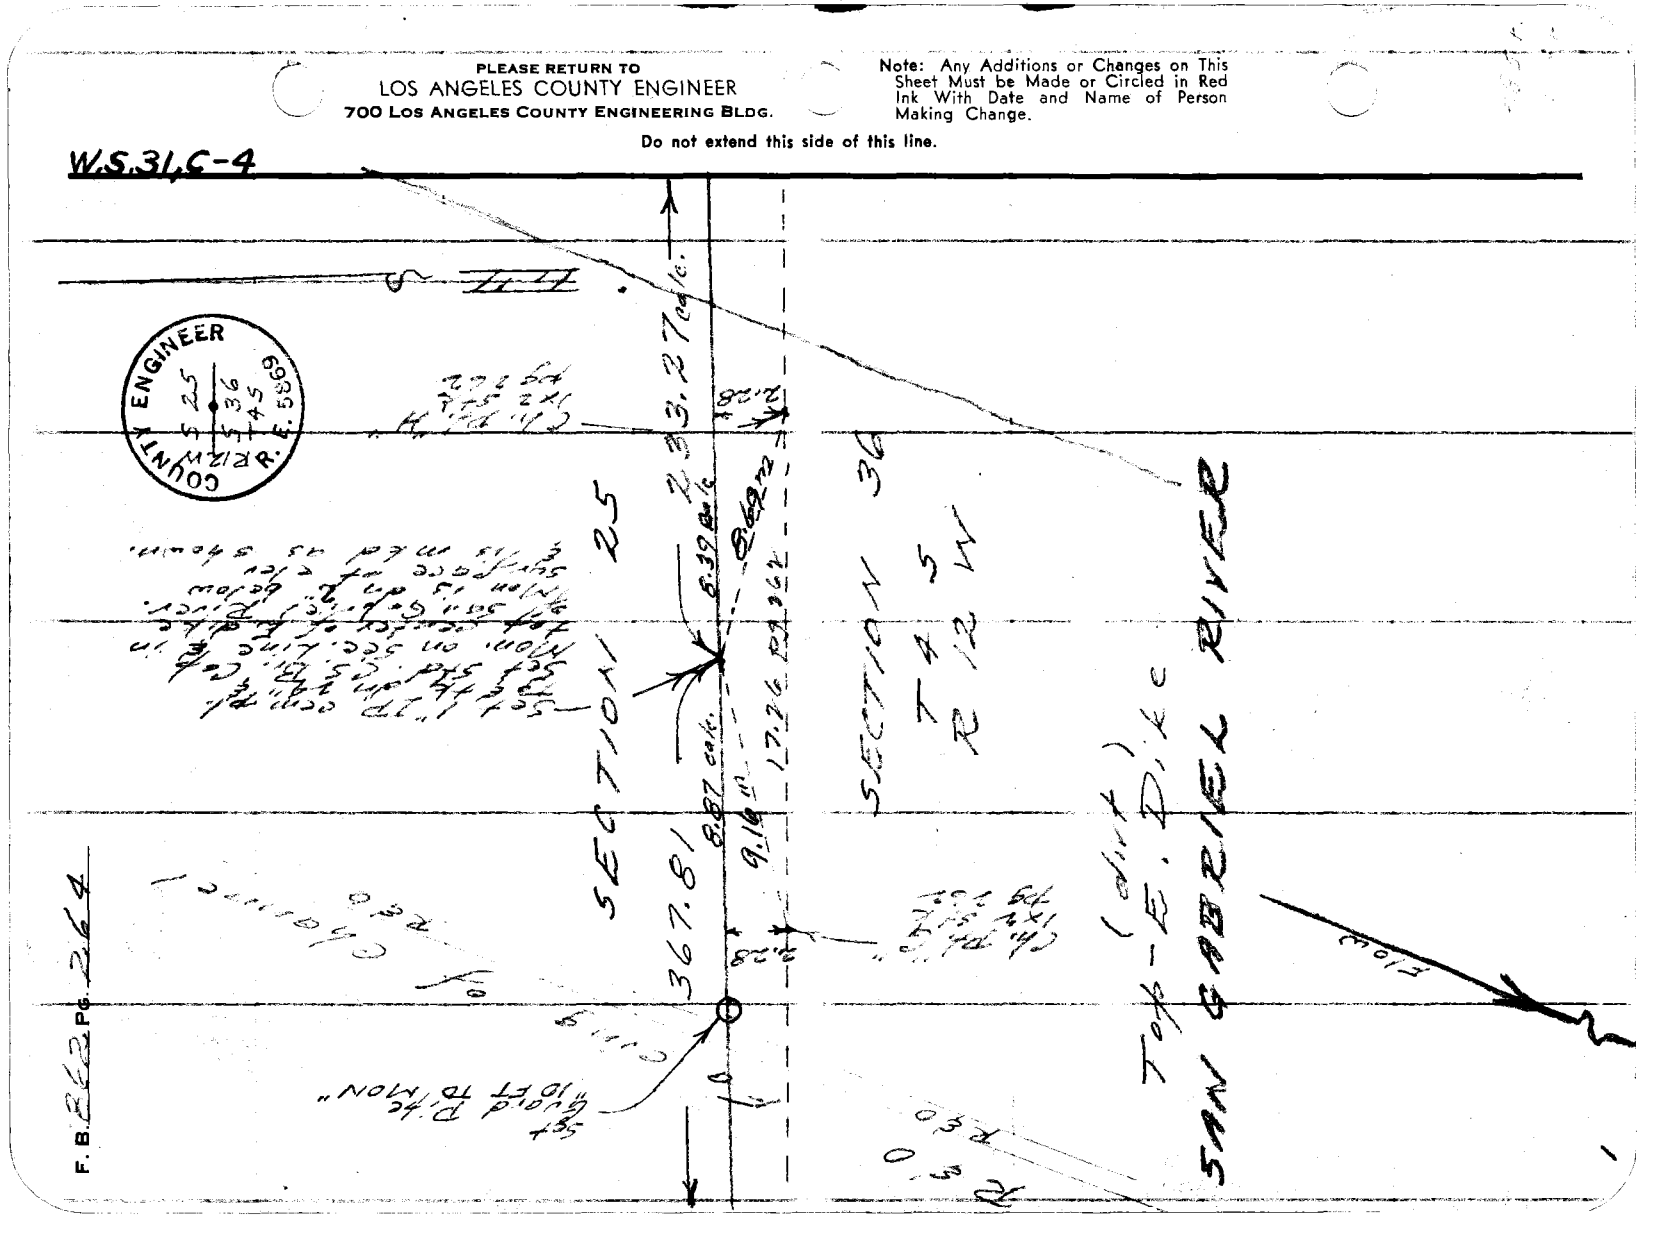

Profile No. | Notes Red. | Plotted | Date | Job No. 298 | Division No. 10 | F. B. | Pg.
X-Sec. No. | Notes Chkd. | Checked | Date | Survey of | Survey by [illegible] | Notes [illegible] | Date 8-58
Map No. | Indexed | Date 8-21-58

NOTE: ANY ADDITIONS OR CHANGES ON THIS SHEET MUST BE MADE OR CIRCLED IN RED INK, WITH DATE AND NAME OF PERSON MAKING CHANGE.

PLEASE RETURN TO
LOS ANGELES COUNTY SURVEYOR
726 Los Angeles County Engineering Bldg.

Do not extend notes this side of this line.

4TH ORDER
BENCH MARK LEVELS
TO DETERMINE ELEVATIONS OF THE
LOS ANGELES - ORANGE COUNTY BDY. MONS
AND AUXILLIARY POINTS
BETWEEN BOUNDARY STATIONS 2 AND 7

J.N. 0038.27

R.J. Mitchell
L.C. Smiley
M.L. Bushnell
G.R. Merrill

August 1958

STATION	B. S.	H. I.	F. S.	ELEV.

76L298 S & E #307 9-54

76L298 S & E #307 9-54

PLEASE RETURN TO
LOS ANGELES COUNTY SURVEYOR
726 LOS ANGELES COUNTY ENGINEERING BLDG.

NOTE: ANY ADDITIONS OR CHANGES ON THIS SHEET MUST BE MADE OR CIRCLED IN RED INK, WITH DATE AND NAME OF PERSON MAKING CHANGE.

Do not extend notes this side of this line.

F. B. 862 Pg. 26 Job No. 0038.27 Division No. 10 Notes Red. Plotted
Survey of L.A.-O. Co. Bdy. Date 2-58 Date
Survey by Mitchell Notes Chkd. Checked
Indexed C. Johnson Date Date
Profile No. X-Sec. No.

STATION	B. S.	H. I.	F. S.	ELEV.		
BM XV-13	5.97			19.96	BM XV 13 Elev 19.96	FB 862-93 (Extract)
		25.93			About 1.05 mi. S of Sierra Highway Street along the W bank of the San Gabriel River & about 115 ft W of the W bank. 1½ Std L.A.Co.Fl.Co. Dist. B.C. set in conc under the edge of a 30"Cdy BPed. Power #27 & N&S arm with a PM & tag.
					(See also desc. of BM 30-18 L.A. Co. Precise Level Net) (NOT SAME) & See page 292
TP #1	10.99		3.04	27.89	
		33.35			
TBM #1	5.07		5.77	28.17	TBM #1 Elev. FB
		33.18			Top of Dyke (E. Dyke) at its junct. with ~~Coyotes~~ Creek. 5 ft 234+ 30 ft ~ 6 Lg. Bl. Stk W of the top of the W side of the Dyke.
TBM #2	11.81		12.08	27.90	TBM #2 Elev.
		32.91			In the conc wing forming the junction of the San Gabriel River & ~~Coyotes~~ Creek

76L298 S & E #307 9-54

PLEASE RETURN TO
LOS ANGELES COUNTY SURVEYOR
726 LOS ANGELES COUNTY ENGINEERING BLDG.

NOTE: ANY ADDITIONS OR CHANGES ON THIS SHEET MUST BE MADE OR CIRCLED IN RED INK, WITH DATE AND NAME OF PERSON MAKING CHANGE.

Do not extend notes this side of this line.

0+00 = 213.86 65

STATION	B. S.	H. I.	F. S.	ELEV.		
TBM #3 (cont'd)		32.91			in So. Cal. Ed. Co. tower # 1-5 S in the SW leg of the tower. The top of the highest nut on the south face of the leg where the leg joins the footing	
TBM #2	[illegible]		3.53	29.38		
		33.19				
TBM #3	[illegible]		5.21	27.98	TBM #3 Elev.	
		32.99			Los Coyotes Creek W side of levee dyke and on line of towers in So. Cal. Ed. I-5 and 3 S of tower #18-A 1.2 ± S.L. & nail	
[illegible]	[illegible]		5.50	27.49	So. Cal. Ed. Co. Tower #18-A, S 4.05, E 10.00, [illegible]	
		33.23				
[illegible]	5.26		5.44	[illegible]	" " "	Sta 1+00, [illegible]
		31.65				
[illegible]	[illegible]		5.71	25.94	" " "	Sta 2+00, [illegible]
		[illegible]				
TBM #6	[illegible]		5.23	26.46	" " "	Sta 3+00, [illegible]
		31.63				
[illegible]	2.31		5.39	25.94	" " "	Sta 210+00, [illegible]

Profile Notes Red. Plotted Job No. 0232 Division No.
No. Date Date Survey of
X-Sec. Notes Chkd. Checked Survey by Notes Checked
No. Date Date Map No. Indexed R. C. Johnson Date
F. B. Pg.

76L298 S & E #307 9-54

PLEASE RETURN TO
LOS ANGELES COUNTY SURVEYOR
726 LOS ANGELES COUNTY ENGINEERING BLDG.

NOTE: ANY ADDITIONS OR CHANGES ON THIS SHEET MUST BE MADE OR CIRCLED IN RED INK, WITH DATE AND NAME OF PERSON MAKING CHANGE.

Do not extend notes this side of this line.

F. B. Pg. Job No. Division No. Notes Red. Plotted
Survey of Date Date
Survey by Notes Notes Chkd. Checked
Indexed C. Johnson Date Date

Profile No. X-Sec. No.

STATION	B. S.	H. I.	F. S.	ELEV.		
		26 25				
BM #5	9 57		8 47	1883	BM #5 Elev	
		29 40			San Gabriel R E S side of Sta 108+93	
					in Ed. Co. tower # 1 - 2nd S face of	
					the SE leg, # nail on the bolt	
					holding the lower end of the	
					northeast brace & 62 above	
					the ground.	
TP #6	0 97		3 15	2625	Ed. Co. Sta. Tower	
		27 17				
TP #7	3 00		11 57	1560	1 x 2 s/k	
		15 60				
BM #7 Alternate	9 97		5 36	1324	BM #7 Alt. Elev 1349 F.B. 861 - 94	
		18 21			State Street Proposed i.e. the prolonged	
					continuation of Whittier Street to the E)	
					0.95 mile ± of Intersection on the E side	
					of the San Gabriel River 175 ft ± E of the	
					line of Slope of the E side of H Sta. C.S.	
					B. Cap Mon set at a Second Mon. & 51	
					with the surface of the ground with a	
					PK nail & tag stamped "RE CE 2 H.C.O. 200."	

76L298 S & E #307 9-54

PLEASE RETURN TO
LOS ANGELES COUNTY SURVEYOR
726 LOS ANGELES COUNTY ENGINEERING BLDG.

NOTE: ANY ADDITIONS OR CHANGES ON THIS SHEET MUST BE MADE OR CIRCLED IN RED INK, WITH DATE AND NAME OF PERSON MAKING CHANGE.

Do not extend notes this side of this line.

Profile No. ____ Notes Red ____ Plotted ____ Job No. 6332 Division No. 11
X-Sec. No. ____ Date ____ Date ____ Survey of ____
Notes Chkd. ____ Checked ____ Survey by ____ Notes C. Johnson
Date ____ Date ____ Map No. ____ Indexed ____ Date ____ Date ____
F. B. ____ Pg. ____

STATION	B. S.	H. I.	F. S.	ELEV.		
		18.1			Mo' [illegible]	
					[illegible] on page	
TP #10	11.66		2.0	25.1	1X2 STK.	
		37.76				
TBM #6	4.53		0.69	25.57	TBM #6 Elev =	
		37.10			[illegible] on the [illegible]	
					of Atherton Street [illegible]	
					[illegible] on page 262)	
TBM #7	0.95		4.62	26.45	TBM #7 Elev =	
		27.93			[illegible] on the [illegible]	
					of Atherton Street [illegible]	
					on page 262)	
TP #11	5.16		11.71	15.72	1X2 in toe W side W.C. Inc	
BM XV 9		20.88				
	7.49		7.09	13.79	BM "XV 9" Elev.	F.B.
		21.28			0.85 Mi. East of Palo Verde Ave.	

76L298 S & E #307 9-54

PLEASE RETURN TO
LOS ANGELES COUNTY SURVEYOR
726 Los Angeles County Engineering Bldg.

NOTE: ANY ADDITIONS OR CHANGES ON THIS SHEET MUST BE MADE OR CIRCLED IN RED INK, WITH DATE AND NAME OF PERSON MAKING CHANGE.

Do not extend notes this side of this line.

F. B. 262 Pg. 27 Job No. 6382.27 Division No. 16 Notes Red. Plotted Profile No.
Survey of Atherton St. Date 2-38 X-Sec.
Survey by C. Johnson Notes Chkd. Checked
Indexed Date Date No.

STATION	B. S.	H. I.	F. S.	ELEV.	BM XV-9 (cont'd)
		21 28			350± North of the South line of Sec. 25 T. 4 S. R. 12 W. (alias "State St" or "Atherton St.") & on the North side of the N.E. leg of L.A. City R.R. & L. tower #24. The top of the upper East nut holding the N.E. leg to its footing. (See also page 295)
TP No. 1059		31 27		60 2068	
TBM #7	4 52			4 60 2647	TBM #7 (see above)
		30 99			
TP 12	5 20			5 31 2548	Bk. spk. in misc. c. Mirage E. dike
		30 68			
TP 13	5 27			5 03 2505	" " " " " " "
		30 32			
TP 14	5 19			5 52 2419	" " " " " " "
		29 99			
TP 15	5 36			5 07 2432	" " " " " " "
		29 68			
TBM #8	4 66			5 06 2460	TBM #8 El. San Gabriel River (E. dike - top E. s. dc) On L.A.-Orange line. 1" N. of Bdy Mon. #6
		29 26			

@ about 186+05 (F.C. Stationing) =

76298 S & E #307—7-55

PLEASE RETURN TO
L ANGELES COUNTY ENGINEER
700 L ANGELES COUNTY ENGINEERING BLDG.

NOTE: ANY ADDITIONS OR CHANGES ON THIS SHEET MUST BE MADE OR CIRCLED IN RED INK, WITH DATE NAME OF PERSON MAKING CHA

Do not extend notes this side of this line.

STATION	B. S.	H. I.	F. S.	ELEV.		
		29.26				
T.B.M #9	5.03		505	24.21	T.B.M. #9 El:	
		29.24			San Gabriel River (E. dike - top of side on) L.A.-O.C. Line 27450.03 ± [illegible] bdy Sta. #6 ± @ about 184+60 [illegible] station o.) a 1"x2" e.m. Shown as Ch. pt. "G". F.B. 862	
T.B.M #10	4.22		4.99	24.35	T.B.M. #10 El:	F.B.
		23.87			San Gabriel River (E. dike - top of [illegible] Sta. — approx 27' E. of [illegible] bdy Line Approx 2310 ± N. of [illegible] @ abt 182+05 [illegible] 1"x2" e.m.	
T.P. #14	5.08		5.22	23.13	[illegible] top [illegible]	
		28.34				
T.P. #17	1.91		5.15	23.01	BM. " " top E. side of W. of [illegible]	
		28.30				
T.P. #16	4.74		5.20	23.56	" " " "	
		27.29				
T.P. #19	0.37		5.37	22.12	" " " " " " " "	
		27.29				

Profile Notes Red. Plotted Job No. Division No. F. B. Pg.
No. Date Date Survey of
X-Sec. Notes Chkd. Checked Survey by Notes Date
No. Date Date Map No. Indexed C. Date

76298 S & E #307—7-55

PLEASE RETURN TO
LOS ANGELES COUNTY ENGINEER
700 LOS ANGELES COUNTY ENGINEERING BLDG.

NOTE: ANY ADDITIONS OR CHANGES ON THIS SHEET MUST BE MADE CIRCLED IN RED INK, WITH DATE NAME OF PERSON MAKING CHANGE

1634-01
1,82

Do not extend notes this side of this line.

F. B. 8642 Pg. 272 Job No. 2338 Division No. 10 Notes Red. Date Plotted
Survey of Profile No. X-Sec. No.
Survey by C. Johnson Notes Date Date
Indexed Notes Chkd. Checked
Date Date Date

STATION	B. S.	H. I.	F. S.	ELEV.		
T.B.M. #11	5.17	27.49	5.46	22.03	T.B.M. #11 El:	
		27.20			San Gabriel River (W. dike - top near N. side, on L.A.-O.Co. line 609.99 +- N'ly of Bdy. Sta. #6 & Co. line 163+66 (F.O. Stationing) as shown on Sheet No. 2 in Set "C" in F.B.	
BM XV25	7.48	26.97	7.71	19.26	BM XV25 El:	F.B.
				+9.8	San Gabriel River (W. dike 0.26 mi N'ly from Bdy. Sta. #6 on L.A.-O.Co. Line 596.27 +- N.E'ly from Bdy. Sta. #6 4 3-4", 6.5, Br. Cap, Mon. in Conc. R.E. 58.69' 30" below top of dike. (10 +- W'ly of E. edge of C 163+38 (F.O. Stationing)	
BM XV25A	0.03	27.08	4.92	22.05	BM XV25A El:	F.B.
					Same location as B.M. XV25 (Same County) this B.M. is 1" above top of dike & is N/L of L.A. Co.-O.Co.	N.E. 58.69'

Sec. 4 T1N R11W

76L298 S & E #307 9-54

PLEASE RETURN TO
LOS ANGELES COUNTY SURVEYOR
726 LOS ANGELES COUNTY ENGINEERING BLDG.

NOTE: ANY ADDITIONS OR CHANGES ON THIS SHEET MUST BE MADE OR CIRCLED IN RED INK, WITH DATE AND NAME OF PERSON MAKING CHANGE.

Do not extend notes this side of this line.

Profile Notes Red. Plotted Job No. Division No. F. B. 5[illegible] Pg 273
No. Date Date Survey of [illegible]
X-Sec. Notes Chkd. Checked Survey by R. J. MITCHELL Note R. J. MITCHELL Date
No. Date Date Map No. Indexed Chkd. Job Date

STATION	B. S.	H. I.	F. S.	ELEV.		
		22 08				
BM XV 26	5 02	15 06	12 04	10 04	BM XV 26 Elev	FB
					On the W R/W Line of the	
					San Gabriel River and on the	
					L.A. Co. - O. Co. Bdy Line 5[illegible] ft	
					NE'ly from Co Bdy Sta #6	
					and 1320 ft NE'ly from 72 St.	
					A Std C.S. Bn. Cap Mon [illegible] in	
					the surface.	
BM XV 27	7 14	14 29	8 51	6 55	BM XV 27 Elev.	FB
					On the W R/W line of the	
					San Gabriel River at the beg[illegible]	
					of a curve to the E and	
					1073 ft N of the E 72 St.	
					a 2" I.P. set in conc. 48" below Gr[illegible]	
BM XV 28	5 22	14 35	5 16	9 13	BM XV 28 Elev.	FB
					860 ft W of 72 St. & 730 ft	
					W of the W R/W line of the	
					San Gabriel River at a Point	
					Point in the L.A.-O-Co. line	
					A Std C.S. Bn. Cap Mon flush	

76L298 S & E #307 9-54

PLEASE RETURN TO
LOS ANGELES COUNTY SURVEYOR
726 Los Angeles County Engineering Bldg.

NOTE: ANY ADDITIONS OR CHANGES ON THIS SHEET MUST BE MADE OR CIRCLED IN RED INK, WITH DATE AND NAME OF PERSON MAKING CHANGE.

Do not extend notes this side of this line.

F. B. 862 Pg. 274 Job No. 00387 Division No. Notes Red. Plotted
Survey of LA-2-Equip by Bay Date Date
Survey by R. J. MITCHELL Notes Chkd. Checked
Indexed R. C. Johnson Date Date
Profile No. X-Sec. No.

STATION	B. S.	H. I.	F. S.	ELEV.		
		14 35			With the surface of Mkd "STA. 6" & "RE 5869"	See Page 249
BMXV-29	765	14 16	784	651	BMXV-29 Elev FB 485 ft N'ly from 72nd St in the W'ly R/W Line of the San Gabriel River and on the CA.-Co. Co. Brdy — 12 2" TP set in conc. dn 36"	See Pg 248
T.P. #30	4 38	14 35	463	9 53	1x2 Stk over BMXV-29	
BMXV-30	5 51	14 74	8 15	6 23	BMXV 30 Elev FB In the W'ly R/W Line of the San Gabriel River & 28± ft N. from 72nd St. — 11 2" TP in conc. dn 30" below the surface	See Pg 248
TP #21	11 42	22 41	3 75	10 99	top punch hole S.P.U.S. of BMXV-30	
TP #22	4 94	26 18	1 17	21 24	1x2 Stk top of dike	
BMXV-31	0 45	24 22	41	2 317	BMXV-31 (=S.L. Co. BM #12-179A-55 -CBM #12) Elev FB — In the 72nd St Bridge over the San Gabriel R.	

76L298 S & E #307 9-54

PLEASE RETURN TO
LOS ANGELES COUNTY SURVEYOR
726 LOS ANGELES COUNTY ENGINEERING BLDG.

NOTE: ANY ADDITIONS OR CHANGES ON THIS SHEET MUST BE MADE OR CIRCLED IN RED INK, WITH DATE AND NAME OF PERSON MAKING CHANGE.

Do not extend notes this side of this line.

Profile Notes Red_____ Plotted_____ Job No._____ Division No._____
No._____ Date_____ Date_____ Survey of 4WD-C.O. Mtce. Date Aug. '58
X-Sec. Notes Chkd._____ Checked_____ Survey by M.H.&C.W. Notes by C. Tebbetts
No._____ Date_____ Date_____ Map No._____ Indexed_____ Date_____

F. B. 822 Pg. 2

STATION	B. S.	H. I.	F. S.	ELEV.	
BMXV-31		24 22			- W end - N work ~ A Std. Lvg.
(Co. Mon.)					Co. F.C. Br. Disc with no number
T.P. #23	2 44	16 66	10 00	14 22	Top Guard Post SW 5 ft BM 30-37
BM-30-37	~~14 04~~		7 81	8 85	BM 30-37 Elev 5 836 (1953 adj.)
					FB ~ San Gabriel River, W Side, 70 ft S of center line 7 ft E ~ A Std. F.C. Disc set in conc 2 below surface stamped "BM 30"
~~BM 30-37~~	~~14 04~~	~~20 90~~			
	~~1 36~~	~~16 20~~		8 84	corrected Elev.
TP #24	8 18	27 72	1 36	19 54	valve, SW cor LB Gas Station
BMXV-31	6 30	30 02	3 95	23 77	BMXV-31 Elev LB (see above) Sec. 19, 2S, 12W
TP #24	0 05	23 84	6 33	23 77	7½ St. B. of C Found S nail & "TP" on wall
~~TP #25~~					
TP #25	0 01	13 22	9 51	13 78	B/H in Guard Rail Post
TP # 26	4 36	13 86	5 09	8 90	1x2 stk - ob. at 1' pg
BMXV-31	6 71	13 14	8 39	5 67	BMXV 31 Elev. FB 243 ft S of P.O. St. ccl E 65 ft E of the base of the E Bank of the San Gabriel River ~ A Br. Cap on a 3" IP mkd to indicate Std. No.

76L298 S & E #307 9-54

PLEASE RETURN TO
LOS ANGELES COUNTY SURVEYOR
726 LOS ANGELES COUNTY ENGINEERING BLDG.

NOTE: ANY ADDITIONS OR CHANGES ON THIS SHEET MUST BE MADE OR CIRCLED IN RED INK, WITH DATE AND NAME OF PERSON MAKING CHANGE.

F. B. 862 Pg. 276 | Job No. 0038.27 | Division No. Apr. '58 | Notes Red. | Plotted | No. | Profile
Survey of L.A.-O.-Co. Bdy. | Date | Date | No. | X-Sec.
Survey by Mitchell | Notes Wilke 4 & 11 | Notes Chkd. | Checked
Indexed K. C. Johnson | Date | Date | Date | No.

Do not extend notes this side of this line.

STATION	B. S.	H. I.	F. S.	ELEV.	
BM XV-32 (Cont'd)		13 14			(No 5) on the L.A.-O. Co. Bdy. line & 4° ft below the surface and under BM XV-32 A (See: Pg. 246)
BM XV-33	3 00	13 41	3 01	10 13	BM XV 33 Elev. FB 330 ft S. of 7th St & 100 ft E of base of the E side of the San Gabriel River in the NW leg of a So. Cal Ed. Co. Tower - Top of the W Gusset plate holding the leg to its footing (See: Pg. 246)
BM XV 32-A	3 42	12 96	3 87	9 54	BM XV 32 A Elev. FB 293 ft S. of 7th St and 95 ft E of the base of the E side of the San Gabriel River - a Std. C.S.B.C. Alum. Mkd to indicate (the #5) on the L.A.-O.-Co. Line & Set over 9' BM XV 32 (see page 246 for loc.)
T.P. 27	5 76	14 67	4 05	8 63	1x2 Stk off on Co. Line
T.P. 28	4 37	13 97	5 07	9 32	" " " "

76L298 S & E #307 9-54

PLEASE RETURN TO
LOS ANGELES COUNTY SURVEYOR
726 LOS ANGELES COUNTY ENGINEERING BLDG.

NOTE: ANY ADDITIONS OR CHANGES ON THIS SHEET MUST BE MADE OR CIRCLED IN RED INK, WITH DATE AND NAME OF PERSON MAKING CHANGE.

Do not extend notes this side of this line.

Profile Notes Red. Plotted Job No. C336 Division No. 10 F. B. 862 Pg. 177
No. Date. Date. Survey of 1938
X-Sec. Notes Chkd. Checked Survey by Mitchell Notes Mitchell Date July 1938
No. Date. Date Map No. Indexed K. C. Johnson Date

STATION	B. S.	H. I.	F. S.	ELEV.		
		13 69				
BM XV-34	598	14 59	528	8 41	BM XV-34 Elev	FB
					1321 ft. S of 7th St. along the Line between Sections 1 & 2 (T5S R12W) and 610 ft E of the base of the E side of the San Gabriel River at the int of the Sec. line & the L.A. Co. Bdy — a 1¼" IP flush w/ the surface of ground Reference
		42		46		
T.P. #29	696	14 14	721	7 18		1x2 stk in Rd W of above
T.P. #30	481	14 12	483	9 31		
BM XV-35	618	13 75	755	6 57	BM XV-35 Elev	FB
		1303			0.38 mi. S of 7th St (from a point	
					0.12 mi. E of the E end of a bridge over the San Gabriel River along the W bank of a drainage channel & 14 ft W of the top of the bank — a std L.A. Co. Iron Post numbered "4" flush with	
		81		31		
TP # 31	350	11 53	972	6 09		1x2 stk in Rd W of above

76L298 S & E #307 9-54

PLEASE RETURN TO
LOS ANGELES COUNTY SURVEYOR
726 LOS ANGELES COUNTY ENGINEERING BLDG.

NOTE: ANY ADDITIONS OR CHANGES ON THIS SHEET MUST BE MADE OR CIRCLED IN RED INK, WITH DATE AND NAME OF PERSON MAKING CHANGE.

Do not extend notes this side of this line.

F. B. 862 Pg. 178 | 6038.17
Survey of L.A. - O. - Co. Bdy.
Survey by Mitchell Notes Chkd. Checked
Indexed C. Johnson Date Date
Profile Plotted
Job No. Division No. Notes Red. Date No.
X-Sec. Date No.

STATION	B. S.	H. I.	F. S.	ELEV.	
		11 53			
TP# 32	471	10 98	526	6 55	1x2 stk in Rd W of ditch
TP# 33	483	10 44	537	5 99	" " " " " "
BM XV 36	437	9 54	555	5 17	BM XV-36 Elev FB
					0.67 mi. S of 7th St (from a point
					0.12 mi. E of the E end of the
					bridge over the San Gabriel River)
					along the W boundary drainage
					ditch & 14 ft W of the bank ~
					A Std L.A. - O - Co. Bridge Brass
					88 Post numbered "3" (See: Pg. 244)
TP# 34	504	10 64 92	366	5 52	1x2 stk in rd W of ditch
TP# 35	458	10 43 75	509	5 57 85	" " " " "
TP # 36	465	10 07 9 79	501	5 14 42	" " E side Rd W "
TP# 37	520	10 26 54	473	5 06	" " W " " " " "
HH of Sta #2			492	5 34 5 62	L.A. C. Co BPEL Br. Cap Mon at N'ly end of ch. Lnk Fn. shown on page 244
		10 19			
TP# 38	527	9 91	562	4 84 92	
BM XV 37	508	9 84 10 10	517	4 74 02	BM XV-37 Elev FB
					1.67 mi. S of 7th St. (from a point

76L298 307 8-53

PLEASE RETURN TO
LOS ANGELES COUNTY SURVEYOR
726 LOS ANGELES COUNTY ENGINEERING BLDG.

NOTE: ANY ADDITIONS OR CHANGES ON THIS SHEET MUST BE MADE OR CIRCLED IN RED INK, WITH DATE AND NAME OF PERSON MAKING CHANGE.

Do not extend notes this side of this line.

Profile Notes Red. Plotted Job No. Division No.
No. Date Date Survey of
X-Sec. Notes Chkd. Checked Survey by
No. Date Date Map No. Indexed

F. B. 862 Pg. 177

STATION	B. S.	H. I.	F. S.	ELEV.		
BM XV-37 (cont'd.)		10 10 ~~9 82~~			0.12 m. E of the E end of the Bridge over the San Gabriel River along the W bank of a drainage channel & 14 ft W of the back ~ A Std L.A. - D - Co. Iron Post numbered "2" (See: Pg. 2-4)	
TP # 39	534	10 ~~40~~ 36	446	~~5 64~~ 5 36	1 x 2 stk in field	
TP # 40	476	10 ~~21~~ 49	525	~~5 42~~ 5.73	" " " "	
TP # 41	5 66	11 ~~13~~ 41	474	~~5 47~~ 5.75	" " " "	
NW Cor Deck	—	—	4 15	6 38	o. Co. F.C. Dist Dec. of Pumping Plant m. S of 7th St. and 100 ft. E of L.A. Co. BP&L Tower Line @ Tower No 9	
TP # 42	4 85	~~11 88~~ 12 16	4 10	~~7 03~~ 7 31	1 x 2 stk in field	
TP # 43	5 90	14 ~~67~~ 97	3 11	~~8 77~~ 8 25	" " E edge Rd - E side	
TP # 44	9 ~~69~~ 70	20 ~~13~~ 78	1 59	10 ~~08~~ 38	" " W " " "	
TP # 45	0 61	17 ~~33~~ 72	2 44	17 ~~96~~ 7 13	" " W " W edge of	
TP # 46	4 56	11 ~~47~~ 25	10 46	6 ~~84~~ 39		
BM 30-35			7 88	~~3 59~~ 3 20	BM 30-35 Elev = 3.793 FB San Gabriel River on W R/W Line 310.5' N of a private wooden bridge 53.40 up stream from	

76L298 307 8-53

PLEASE RETURN TO
LOS ANGELES COUNTY SURVEYOR
726 LOS ANGELES COUNTY ENGINEERING BLDG.

NOTE: ANY ADDITIONS OR CHANGES ON THIS SHEET MUST BE MADE OR CIRCLED IN RED INK, WITH DATE AND NAME OF PERSON MAKING CHANGE.

F. B. 862 Pg. 180 Job No. 0038.27
Survey of L.A.-O-Co. Eng.
Survey by Mile 4 Crl Notes Mitchell
Indexed L. C. Johnson Date
Profile No.
Plotted Notes Red. Division No.
Date Date
X-Sec. No.
Checked Notes Chkd.
Date Date

Do not extend notes this side of this line.

STATION	B. S.	H. I.	F. S.	ELEV.		
BM 130-35 (Cont'd.)					comparative section Station 81+74.74 B.C. ~ 4 std F.C. mon stamped "BM 72-3)"	
					~ End of Line ~	

F. B. 867 Pg. 78

Profile No. ____ Notes Red. ____ Date ____ Plotted ____ Date ____ Job No. ____ Division No. ____

X-Sec. No. ____ Notes Chkd. ____ Date ____ Checked ____ Date ____ Survey of L.A. Co. Flood Dist.

Survey by Mitchell Notes Mitchell Date Aug 20

Map No. ____ Indexed J. C. Johnson Date ____

AUXILLIARY LINE
#1

(SEE TITLE ON PAGE 265)

STATION	B. S.	H. I.	F. S.	ELEV.

Do not extend notes this side of this line.

NOTE: ANY ADDITIONS OR CHANGES ON THIS SHEET MUST BE MADE OR CIRCLED IN RED INK, WITH DATE AND NAME OF PERSON MAKING CHANGE.

PLEASE RETURN TO
LOS ANGELES COUNTY SURVEYOR
726 Los Angeles County Engineering Bldg.

76L298 S & E #307 9-54

76L298 S & E #307 9-54

PLEASE RETURN TO
LOS ANGELES COUNTY SURVEYOR
726 Los Angeles County Engineering Bldg.

NOTE: ANY ADDITIONS OR CHANGES ON THIS SHEET MUST BE MADE OR CIRCLED IN RED INK, WITH DATE AND NAME OF PERSON MAKING CHANGE.

Do not extend notes this side of this line.

F. B. 862 Pg. 282 | Job No. 00 38.27 | Division No. 22 | Profile No. | X-Sec. No.

Survey of L.A. - O. - County Line | Plotted | Notes Red. | Date | Checked | Date

Survey by Mitchell | Date | Notes Chkd. | Date

Indexed E. C. Johnson | Date

STATION	B. S.	H. I.	F. S.	ELEV.		
TBM #9	4.99	29.20		24.21	TBM #9 Elev 24.21 FB 862 – San Gabriel River E. bk. – top – W. side on the L.A. - O. - Co. line 2695.53 ft. N. of Reg. Sta. #6 and of about Station 189+60 (F.C. Stationing) – A 1x2 Fir (shown as Ch. Pt. "G" FB 862 – 253)	
BM #V38	7.93	29.98	7.65	21.55	BM #V38 Elev FB 862 On the Los Angeles – Orange County line and in the top center of the E. bk. of the San Gabriel River 11.1 Ft. W. from 7" Sycamore Post 2.1 Ft. Sly from a 2" Iron Guard Post and 0.4 Ft. Wly of Sta. 185+25 F.C. Stationing along the San Gabriel River) Elev 28.15.59 ft. Wly from Co. Line Sta. #6 on N. Sta. C.S. Br. C.L. also 2½ ft. below the surface mkd with a Pk. & "RE 5869"	
—		Continued on next page.				—

See page 2

76L298 S & E #307 9-54

PLEASE RETURN TO
LOS ANGELES COUNTY SURVEYOR
726 Los Angeles County Engineering Bldg.

NOTE: ANY ADDITIONS OR CHANGES ON THIS SHEET MUST BE MADE OR CIRCLED IN RED INK, WITH DATE AND NAME OF PERSON MAKING CHANGE.

Do not extend notes this side of this line.

STATION	B. S.	H. I.	F. S.	ELEV.		
		2993				
BM XV38A	4 36	18 57	5 00	24 93	BM XV38A Elev	53
					On the Los Angeles-Orange Co line and in the bed of the East side of the San Gabriel River 0.7 mi. S'ly from Stewart St. 75 ft W'ly from a 2" Iron Pipe at Post and Sign at the S.E. Cor. of a Concrete Bridge along the San Gabriel River and 25 ft E'ly from Co. Line Station 46 + 75 of the L.A. Co. Flood Control Dist. Line 2 inches above the Set Chiseled X V38 in the Concrete Wall and 2.20' W of Set Nail & Tag RE 5596 (see page 253)	
TBM #10			4 53	24 25	TBM #10 Elev. 24.25 FB 262 - San Gabriel River (E side) Highway Co. Set E of the L.A.-O.-Co. Boy Line -	

Profile Notes Red. Plotted Job No. Division No.
No. Date Date Survey of
X-Sec. Notes Chkd. Checked Survey by Notes
No. Date Date Map No. Indexed Date

F. B. RG 2 Pg. 283

76L298 S & E #307 9-54

PLEASE RETURN TO

LOS ANGELES COUNTY SURVEYOR

726 Los Angeles County Engineering Bldg.

NOTE: ANY ADDITIONS OR CHANGES ON THIS SHEET MUST BE MADE OR CIRCLED IN RED INK, WITH DATE AND NAME OF PERSON MAKING CHANGE.

Do not extend notes this side of this line.

F. B. 862 Pg. 184 | Job No. 0038.17 Division No. Notes Red. Plotted

Survey of Lug - Co. - County Engr. Date Date No.

Survey by McEachin Notes Chkd. Checked X-Sec.

Indexed C. Johnson Date Date Date No.

Profile

STATION	B. S.	H. I.	F. S.	ELEV.		
TB#1-10 (cont'd)					2310 S.L. 4 1/ at about Sta 188+05 (EC. Stationing) @ 1+2 Eq.	Co. Bdy. Sta +6

F. B. 863 Pg. 285

Profile No. ____ Notes Red. ____ Date ____ Plotted ____ Date ____ Job No. ____ Division No. ____

X-Sec. No. ____ Notes Chkd. ____ Date ____ Checked ____ Date ____ Survey of ____ Survey by ____ Notes ____ Date ____ Map No. ____ Indexed ____ Date ____

C. Johnson

AUXILIARY LINE
2

(SEE TITLE ON PAGE 265)

STATION	B. S.	H. I.	F. S.	ELEV.

NOTE: ANY ADDITIONS OR CHANGES ON THIS SHEET MUST BE MADE OR CIRCLED IN RED INK, WITH DATE AND NAME OF PERSON MAKING CHANGE.

PLEASE RETURN TO
LOS ANGELES COUNTY SURVEYOR
726 Los Angeles County Engineering Bldg.

Do not extend notes this side of this line.

76L298 S & E #307 9-54

76L298 S & E #307 9-54

PLEASE RETURN TO
LOS ANGELES COUNTY SURVEYOR
726 Los Angeles County Engineering Bldg.

NOTE: ANY ADDITIONS OR CHANGES ON THIS SHEET MUST BE MADE OR CIRCLED IN RED INK, WITH DATE AND NAME OF PERSON MAKING CHANGE.

Do not extend notes this side of this line.

F. B. 862 Pg. 28 | Job No. 0238.17 | Division No. | Notes Red. | Plotted
Survey of L.H. - Q - County Eqty. | Date | Date
Survey by W.H. Hadell | Notes | Notes Chkd. | Checked
Indexed C. Johnson | Date | Date | Date
Profile | No. | X-Sec. | No.

STATION	B. S.	H. I.	F. S.	ELEV.	
TBM #3	4 22	32 20		27 98	TBM #3 Elev 27.98 FB 862 - Los Coyotes Creek W side of E bike and on line with towers No 1-5, So. Cal. Ed. Co. & No 28 W.A.S. 3 ft E of A in 4 in sq. C.S. mon.
T.P. #	0 25	23 17	9 18	27 92	Top of Sign Post
T.P. #	4 65	22 77	5 05	18 12	1x2 Elev ~ Ch. Pk. T pg.
78+28.01			5 08	17 69	1x2 std f/l with ground impression of BM 1x V-4, 2 C.S. down which is considered to be grade (Elev of BM 1x V-4 = 23.33)
TP	4 82	22 06	5 53	17 24	1x2 std
BM 1x V-3	10 88	22 50	10 44	11 62	BM 1x V-3 Elev 11.68 FB 862-93 In Los Coyotes Creek 0.9 Mi. Sly from the intersection W/L of Bowcer Blvd. & Stu C.S.B. Cap Elev Miles Survey in FB 52-163 & located as shown in FB 862-93 (Elev is 0.15 ft Wly from the Int of the Cen line & the ½ sec line running E & W thru Sec 25 T 4 S R 12 W.)

See Page 858

76298 S & E #307—7-55

PLEASE RETURN TO
LOS ANGELES COUNTY ENGINEER
700 LOS ANGELES COUNTY ENGINEERING BLDG.

NOTE: ANY ADDITIONS OR CHANGES ON THIS SHEET MUST BE MADE OR CIRCLED IN RED INK, WITH DATE AND NAME OF PERSON MAKING CHANGE.

22.50 Do not extend notes this side of this line.

STATION	B. S.	H. I.	F. S.	ELEV.		
BMXV-3A	519	22 57	5 12	1738	BMXV-3A Elev = In Los Coyotes Creek 0.9 Mi. S'ly from its intersection with Pioneer Blvd. A Std C.S. Br. Cap Mon Mkd as shown in FB 57-163 & located as shown in FB 862-88 & (Mon is 0.15 ft. W'ly from the Int of the Co. Line & the 1/4 Sec line running E & W thru Sec 33 T 4 S R 12 W) This Mon is above BM XV-3.	F.B. 857
794 75.98			5 4	17 2	grnd. at BMXV-3A	
BMXV-2 (Co Line Sta 7)	926	22 71	914	13 43	BMXV-2 Elev 13.51 FB 862-93 In Los ~~Coyotes~~ Coyotes Creek 0.8 Mi. S'ly along the creek from its intersection with Pioneer Blvd., a Std C.S. Br. Cap Mon mkd to indicate Station on the Lgt.-D.E. Bdy and is located & descr. both as shown & on file	852
BM XV-2A	488	22 87	472	17 99	BM XV-2A Elev In the e'ly extension of the Sec	FB 852

Profile Notes Red. Plotted Job No. Division No. F. B.
No. Date Date Survey of
X-Sec. Notes Chkd. Checked Survey by
No. Date Date Map No. Indexed Notes

76298 S & E #307—7-55

PLEASE RETURN TO
LOS ANGELES COUNTY ENGINEER
700 LOS ANGELES COUNTY ENGINEERING BLDG.

NOTE: ANY ADDITIONS OR CHANGES ON THIS SHEET MUST BE MADE OR CIRCLED IN RED INK, WITH DATE AND NAME OF PERSON MAKING CHANGE.

Do not extend notes this side of this line.

F. B. 562 Pg. 28 Job No. 00.38.27 Division No. Notes Red. Plotted
Survey of Lit. C. Creek Ty. Date Date
Survey by Mitchell Notes Chkd. Checked
Indexed Date Date
Profile No. X-Sec. No.

STATION	B. S.	H. I.	F. S.	ELEV.		
BMXV-2A (cont'd.)		2787			Creek 0.8 mi SWly along the creek from its intersection with Pioneer Blvd (1,C. 1350 ft W/ of Pioneer Blvd extended) and 3290 ft S of Spring St.) at a point from which T.P. & L. Tower #28 Bears N69°55'W and from which Tower #16 Bears S52°20'W—2 Sta. S. Co. Mon. mkd. as indicated Sta #7 on the L.A.-O. Co. Bdry. Mon. Elev. Elev. Mon. located and described on Dig 158. This Mon. is set over BMXV-2	See page 258
Co. Bdry. Sta 7			53	176	Ground at Mon.	
BMXV-3A			550	1737	BMXV 3-A Elev	FB
					For description	See Above
	+	End	of	Roll	+	

76L298 S & E #307 9-54

PLEASE RETURN TO
LOS ANGELES COUNTY SURVEYOR
726 LOS ANGELES COUNTY ENGINEERING BLDG.

NOTE: ANY ADDITIONS OR CHANGES ON THIS SHEET MUST BE MADE OR CIRCLED IN RED INK, WITH DATE AND NAME OF PERSON MAKING CHANGE.

Do not extend notes this side of this line.

Profile No. ____ Notes Red. ____ Plotted ____ Job No. ____ Division No. ____
X-Sec. No. ____ Date ____ Date ____ Survey of ____
Notes Chkd. ____ Date ____ Checked ____ Survey By J. MITCHELL Notes Red. MITCHELL Date Dec 56
Date ____ Map No. ____ Indexed K. C. Johnson Date Dec 56

F. B. 362 Pg. 20

STATION	B. S.	H. I.	F. S.	ELEV.		
TO	Distance & Position of		Ground on U.S. Mon in FB 362 pg. 91		Elevation shown	
TBM #6	4.52	31.09		26.57	TBM #6 Elev 26.57 FB 362-26 (See Also pg 262) San Gabriel River E bank (N side) on the easterly prod. of the centerline of Valley Way known as L (Ch. Pt. "A" shown on pg 262-29)	
285.51 W of Co. Line			24.03	7.06	S 85° E 285.51 W along Valley Way from its int. with the E.L. O. Co. Line	
					Vert. Angle	Dist. fr. Rod to Rod	Vert. Dist.	Sight on Rod	F.S.
					1) 23°43'	43.37	19.05	5.00	24.05
					2) 24°47'	"	20.02	4.00	24.04
					3) 22°35'	"	18.04	6.00	24.04
					4) 25°52'	"	21.03	3.00	24.03
							Avg.		24.04
					T @ Ch. Pt. "G" FB 362-262				

76L298 S & E #307 9-54

PLEASE RETURN TO
LOS ANGELES COUNTY SURVEYOR
726 Los Angeles County Engineering Bldg.

NOTE: ANY ADDITIONS OR CHANGES ON THIS SHEET MUST BE MADE OR CIRCLED IN RED INK, WITH DATE AND NAME OF PERSON MAKING CHANGE.

Do not extend notes this side of this line.

F. B. 862 Pg. 240 | Job No. 0038.27 Division No. Plotted
Survey of L.A.-O. Co. Line by Party Notes Red. Date No.
Survey by R. J. MITCHELL Notes R. J. MITCHELL Date X-Sec.
Indexed C. Johnson Date Notes Chkd. Checked
Date Date No.

STATION	B. S.	H. I.	F. S.	ELEV.		
To Determine Present Ground Elevation at Position of C.S. Mon shown in FB 862-89						(See also #9252
TBM #11	522	7.125		22.03	TBM #11 Elev 22.03 FB 862-272 San Gabriel River (W. dike – top near E. side, on L.A.–O. Co. Line) 609.29 ft. N. of Bdge. Sta. #6 + about 12+68 (F.C. Stationing) # 1972 "Q" in shown as line Pt. "C." in F.B. 862-251	
738.18 N of Co. Line Sta #6			2465	20.56	56 ft in R&D Face of dike nr. bottom & 738.18 N along the L.A.-O. Co. Line from Sta #6	

	Vert ∠	Dist Fr. π to Rod	Vert Dist.	Sight on Rod	FS
1D)	9°05	129.18	20.65	4.00	24.65
1R)	8°38	"	19.61	5.00	24.61
2D)	9°31	"	21.66	3.00	24.66
2R)	8°13	"	18.65	6.00	24.65
			Avg =		24.64

π @ ch. pt. "C" – FB 862-251

76L298 S & E #307 9-54

PLEASE RETURN TO
LOS ANGELES COUNTY SURVEYOR
726 LOS ANGELES COUNTY ENGINEERING BLDG.

NOTE: ANY ADDITIONS OR CHANGES ON THIS SHEET MUST BE MADE OR CIRCLED IN RED INK, WITH DATE AND NAME OF PERSON MAKING CHANGE.

Do not extend notes this side of this line.

Profile No. ____ Notes Red. ____ Plotted ____ Job No. ____ Division No. ____
X-Sec. No. ____ Date ____ Date ____ Survey of ____ Date ____ F. B. ____ Pg. ____
Notes Chkd. ____ Checked ____ Survey by MERCH Notes W.H.C. Date ____
Date ____ Date ____ Map No. ____ Indexed ____ C. Job Book ____ Date ____

STATION	B. S.	H. I.	F. S.	ELEV.		
To	Determine		Present	Ground	Elevation	shown
	of Position		of	CS Mon.		
			in	FB 862 - Pg. 90		
						(Sec 1/30 Pg 253)
TBM #10	507	2932		2425	TBM #10 Elev 2925 FB 862-253	
					San Gabriel River (Eaike-Top E. side) ~~on the L.A. - O Co. Bdy~~	
					~~17+50 ± ft N of Bdy Sta #6 Mpsic~~	
					67 ft E of L.A. - O Co. Bdy Line	
					2310 ft N of Bdy Sta #4 of above	
					188+05 (Rec. Station) - a 1x2 st	
2302.49 N of Co. Line Sta #6			2895	037	1x2 st in hole 2½ down mark	
					℄ 2302.49 N along the L.A. - O. - Co. Line	
					Sta. #6	
					Vert ∠ / Dist Fr. ℄ to Rod / Vert Dist. / Sight on Rod / FS -	
					1D) 23°58 / 44.88 / 19.95 / 9.00 / 28.95	
					1R) 21 53 / " / 18.94 / 10.00 / 28.94	
					2D) 25 03 / " / 20.98 / 8.00 / 28.98	
					2R) 21 48 / " / 17.95 / 11.00 / 28.95	
					Avg / / / / 28.95	
					℄ @ sta. bk. "F-1" ~ FB 862 - 253	

76L298 S & E #307 9-54

PLEASE RETURN TO
LOS ANGELES COUNTY SURVEYOR
726 Los Angeles County Engineering Bldg.

NOTE: ANY ADDITIONS OR CHANGES ON THIS SHEET MUST BE MADE OR CIRCLED IN RED INK, WITH DATE AND NAME OF PERSON MAKING CHANGE.

Do not extend notes this side of this line.

F. B. 812 Pg. 27 Job No. 0038.27 Division No. Notes Red. Plotted
Survey of L.A.-L.B.-Co. Bdy. Line Date Date No.
Survey by Mitchell Notes Mitchell Chkd. Checked X-Sec.
Indexed C. Johnson Date Date Date No.
Profile

STATION	B. S.	H. I.	F. S.	ELEV.

To Compare Elevation of
BM XV-13 ~ FB 862-93
and
Co. Precise BM 30-18 ~ LB-LA-Harbor Subsidence Net

BM XV-13 480 2476 19.96 BM XV-13 Elev 19.96 FB
Abt 1.05 m. S of Spring St. along the W bank of the San Gabriel River & abt 11.5 ft W of the W bank. A Std L.A. Co. F.C. Dist. Bk. Cap set in conc under the center of L.A.C.Ly B.P.&L. Tower #27 & 1 ft. easterly with a P.K. nail in its Ctr.

BM 30-18 422 20.54 BM 30-18 Elev 20.491 FB.
San Gabriel River W.K. Side under S.W. Cor. B.P.&L. Tower #27, 7.1 from SW leg 23.4 from NE leg, 18.4 from NW leg. A Std F.C. Mon stamped "FC BM 73-6C 1946"

Profile No. ____ Notes Red. ____ Plotted ____ Job No. 0038.27 Division No. ____ F. B. 862 PG. 293

X-Sec. No. ____ Date ____ Date ____ Survey of L.A. - O. - County 1294

Notes Chkd. ____ Checked ____ Survey by Mitchell Notes Mitchell Date Aug 58

Date ____ Date ____ Map No. ____ Indexed ____ C. Johnson Date ____

AUXILLIARY LINE
3

(SEE TITLE ON PG. 265)

STATION	B. S.	H. I.	F. S.	ELEV.

NOTE: ANY ADDITIONS OR CHANGES ON THIS SHEET MUST BE MADE OR CIRCLED IN RED INK, WITH DATE AND NAME OF PERSON MAKING CHANGE.

Do not extend notes this side of this line.

PLEASE RETURN TO
LOS ANGELES COUNTY SURVEYOR
726 Los Angeles County Engineering Bldg.

761.298 307 8-53

76L298 307 8-53

PLEASE RETURN TO
LOS ANGELES COUNTY SURVEYOR
726 LOS ANGELES COUNTY ENGINEERING BLDG.

NOTE: ANY ADDITIONS OR CHANGES ON THIS SHEET MUST BE MADE OR CIRCLED IN RED INK, WITH DATE AND NAME OF PERSON MAKING CHANGE.

31.30
4.83
26.47

Do not extend notes this side of this line.

F. B. Pg. 294 Job No. Division No. Notes Red. Plotted No.
Profile
Survey of Date X-Sec.
Survey by Notes Chkd. Checked
Indexed C. Johnson Notes Date Date No.

STATION	B. S.	H. I.	F. S.	ELEV.		
TBM #6	4 24	30 81		26 57	TBM #6 Elev 26.57 FB 862-269	
					San Gabriel River E Bank - E side	
					on the approx ℄ of Atherton St.	
					Produced - A 1x2 $\frac{1}{2}$ in (Ch Pk "H" - pg 262)	
BM XV 38	5 52	31 30	5 03	25 78	BM XV-38 Elev	FB
					On the N Line of Sec 36 T4S	
					R12W (which is Atherton St.	
					Prod) and in the top ctr.	
					of the E dike of the	
					San Gabriel River - A Std. C.S.	
					Br. C - 2 Nom. (See page 264 for	
					location)	
BM XV 39	4 85	30 97	5 18	26 12	BM XV-39 Elev	FB
					On the N line of Sec 36 T4S	
					R12W (which is Atherton St.	
					Prod) and in the top ctr of	
					the W dike of the San Gabriel	
					River - A Std C.S. Br. C-2 Nom.	
					(See page 263 for location)	
TBM #7			4 50	26 47	TBM #7 Elev 26.48 FB 862-269	
					San Gabriel River W bank	

STATION	B. S.	H. I.	F. S.	ELEV.	
	0 19	26 66		26.47	BM #7 (cont'd) (W side) on the ... center line of Atherton ... Produced N 1x2 Ft (ch) ... as shown on page 262.)
TP	5 34	21 00	5 10 95	15 51	
BM XV-9	7 09	20 70	7 24	13 61	BM XV-9 Elev FB ... 0.85 Mi E of Palo Verde ... 350 Ft N of the South line of Sec ... 45 R12W (which is Atherton St) and on the N side of the NE leg of L.A. City BP&L tower ... at the top of the upper E. nut ... the leg to its footing.
BM "TBM" Precise Level Net Line #30			7 11	13 59	BM "TBM" (FC BM 73-7) ... 13.649 (1954) FD San Gabriel River W Side E side NE leg BP&L Tower # 24. Top of N Bolt, B ... Square on end of bolt

Plotted _____ Job No. _____ Division No. _____
Date _____ Survey of _____
Notes Ckd. _____ Checked _____ Survey by _____ Notes _____ Date _____
Date _____ Date _____ Map No. _____ Indexed _____ Date _____

F. B. 562 Pg. 295