Notes Ck'd by D. Finley
Map No. B-1811-1812
Office Work R.W. Mc A
Checked D. M. Finley
Date Aug. 1949.

Survey of Central Ave
W. 0.8326 Tape No. Std °F
Surveyed by F.J. McNeal
Notes Date
Indexed C. Johnson 2-6-49

F.B. 907 Pg. 39

# CENTRAL AVE

J.N. 8326

FROM ROSECRANS AVE.
TO MANCHESTER AVE.

F.J. McNeal
Geo. H. Nichols R.E.
A. Carrasco H.C.
J.J. Lanigan R.C.
H.R. Foster R.C.
C.W. Wallace R.C.
H.D. Heber H.C.

Note: Any Additions or Changes on This Sheet Must be Made or Circled in Red Ink With Date and Name of Person Making Change.

Do not extend notes this side of this line.

RETURN TO
LOS ANGELES COUNTY SURVEYOR
700 HALL OF RECORDS

FORM 247 5M 10-49

F.B. 901 Pg. 2

To Bot Next Pg

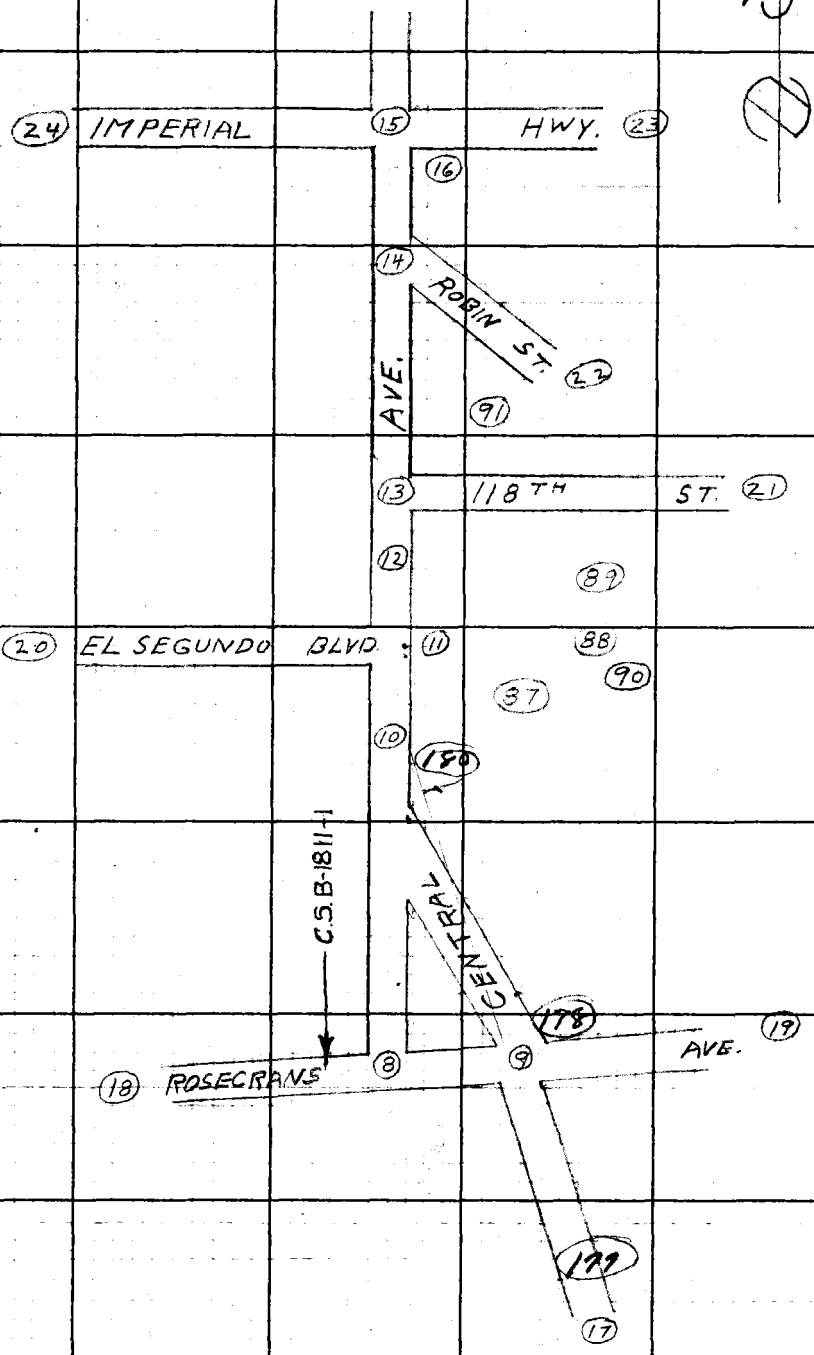


RETURN TO
LOS ANGELES COUNTY SURVEYOR
700 HALL OF RECORDS

Do not extend notes this side of this line.

Note: Any Additions or Changes on This Sheet Must be Made or Circled In Red Ink With Date and Name of Person Making Change.

| | |
|---|---|
| Notes Ck'd by | Survey of Central Ave |
| Map No. B-1811-1&2 | W. O. 8326 Tape No. Std °F |
| Office Work R.W.McA | Surveyed by F.J. McNeal |
| Checked D. M. Finley | Notes Date |
| Date Aug. 1949 | Indexed 2-64 |

F.B. 901 PG. 3

To Bot. Next Pg.

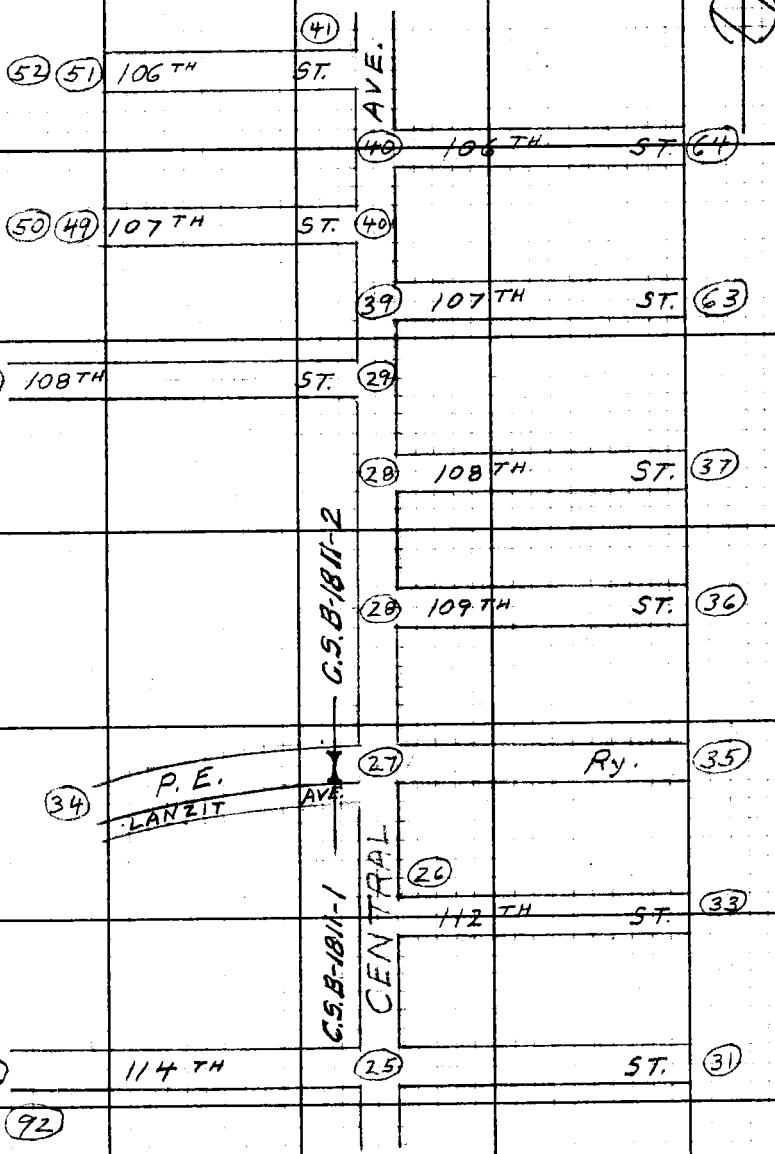


From Top Last Pg.

RETURN TO
LOS ANGELES COUNTY SURVEYOR
700 HALL OF RECORDS

Note: Any Additions or Changes on This Sheet Must be Made or Circled in Red Ink With Date and Name of Person Making Change.

Do not extend notes this side of this line.

FORM 247 SM 10-59

F.B. 901 PG. 4

To Bot. Next Pg.

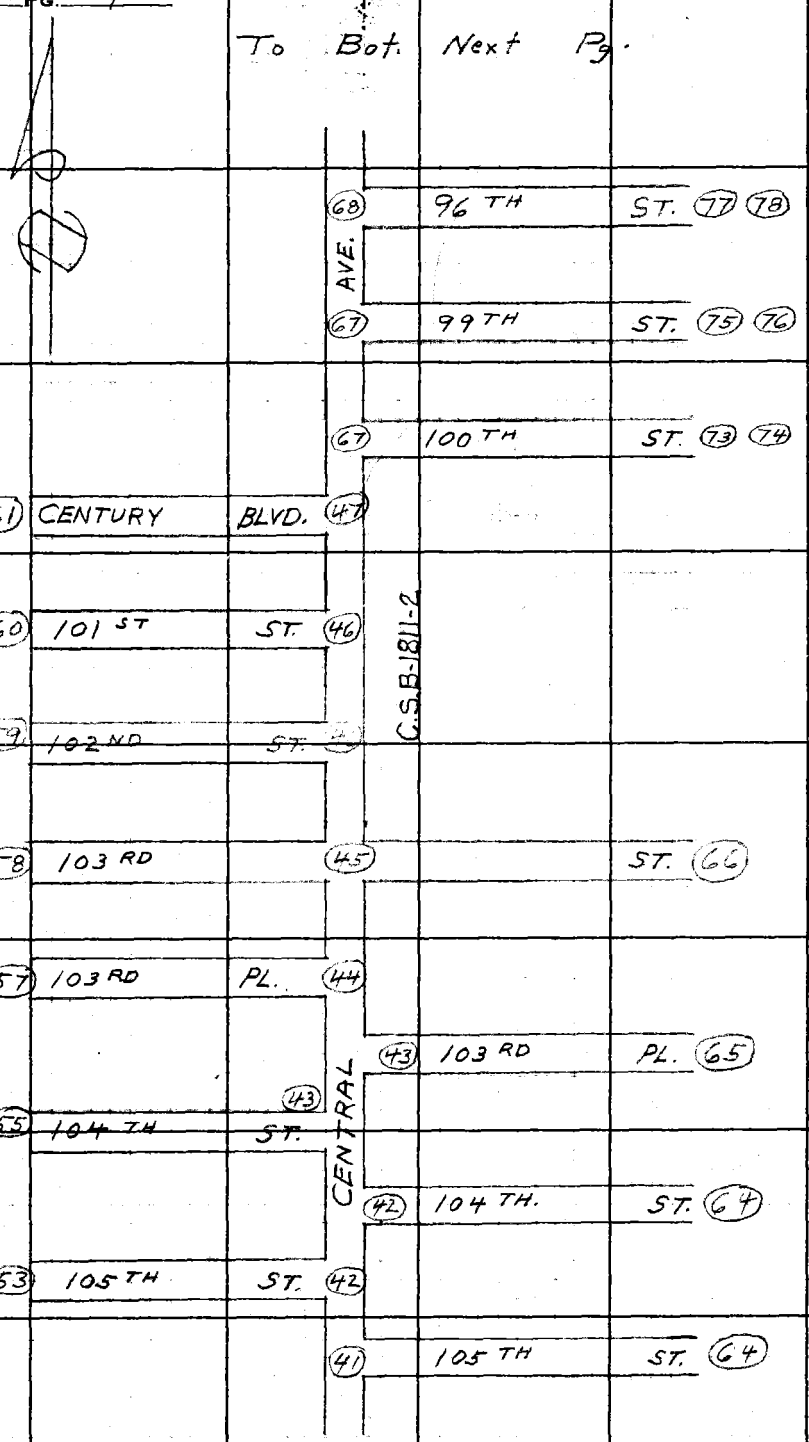


From Top Last Pg.

RETURN TO
LOS ANGELES COUNTY SURVEYOR
700 HALL OF RECORDS

Note: Any Additions or Changes on This Sheet Must be Made or Circled in Red Ink With Date and Name of Person Making Change.

Do not extend notes this side of this line.

| | |
|---|---|
| Notes Ck'd by D. M. Finley | Survey of Central Ave |
| Map No. B-1811-1&2 | W. O. 8326 Tape No. Std °F |
| Office Work R.W. Mc A. | Surveyed by E.J. McNeal |
| Checked D. M. Finley | Notes Date |
| Date Aug 1949 | Indexed 2-642 |

F.B. 901 Pg. 5

To Get Next Pg.

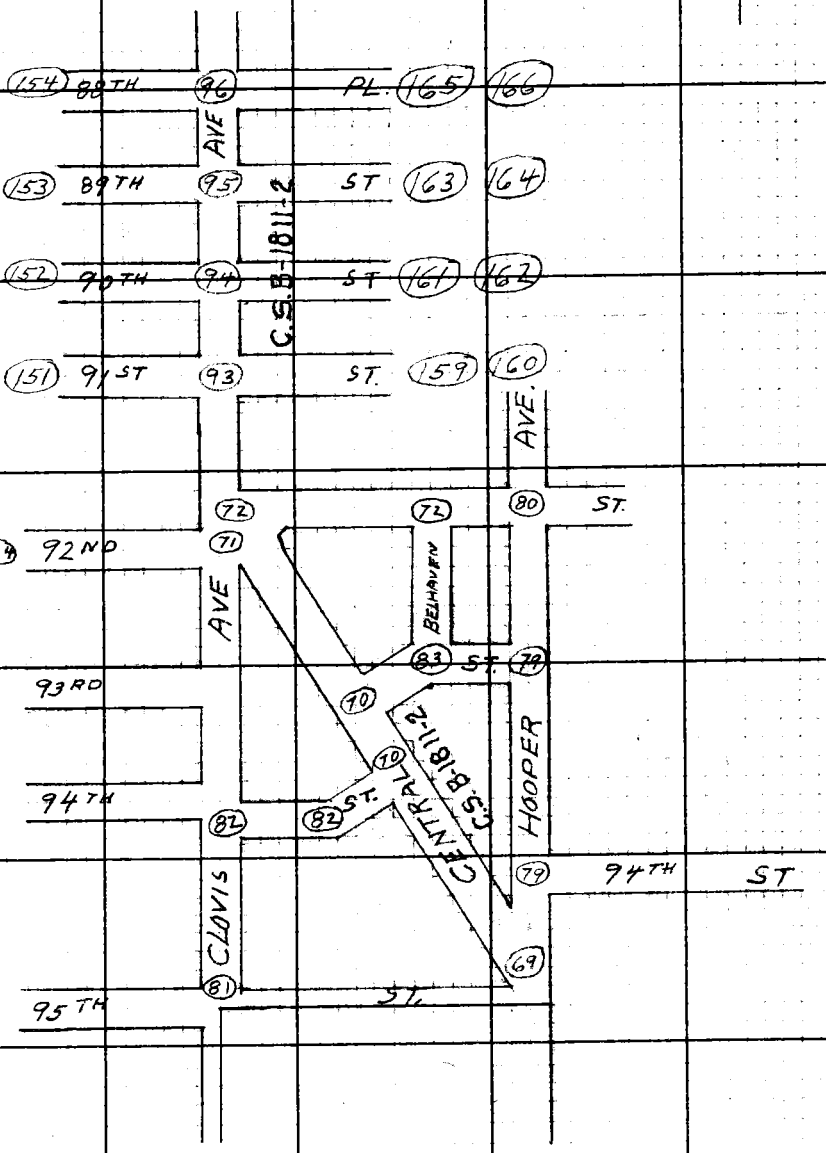


From Top Last Pg.

Note: Any Additions or Changes on This Sheet Must be Made or Circled in Red Ink With Date and Name of Person Making Change.

Do not extend notes this side of this line.

RETURN TO
LOS ANGELES COUNTY SURVEYOR
700 HALL OF RECORDS

FORM 247 5M 10-49

F.B. 901 Pg. 6

Stop
~~End~~

Pages 101 to 150
Improvements

174

AVE.

158 MANCHESTER AVE (100) FIRESTONE BLVD (173)

(157) 87TH (99) ST. (171) (172)

(156) 87TH (98) PL (169) (170)

CENTRAL

C.S.B. 811-2

(155) 88TH (97) ST. (167) (168)

From Top Last Pg

RETURN TO
LOS ANGELES COUNTY SURVEYOR
700 HALL OF RECORDS

Do not extend notes this side of this line.

Note: Any Additions or Changes on This Sheet Must be Made or Circled In Red Ink With Date and Name of Person Making Change.

FORM 247 5M 10-39

RETURN TO
LOS ANGELES COUNTY SURVEYOR
700 HALL OF RECORDS

**Note:** Any Additions or Changes on This Sheet Must be Made or Circled in Red Ink With Date and Name of Person Making Change.

**Do not extend notes this side of this line.**

BLANK

Survey of Central Ave.
W. O. 8326 Tape No. Std. °F
Surveyed by E.J. McNeal
Notes MC Date 10-28-41
Indexed

Notes Ck'd by
Map No.
Office Work
Checked
Date

F.B. 82 PG. 7

RETURN TO
LOS ANGELES COUNTY SURVEYOR
700 HALL OF RECORDS

**Note:** Any Additions or Changes on This Sheet Must be Made or Circled in **Red Ink** With Date and Name of Person Making Change.

**Do not extend notes this side of this line.**

WS. 26 C-3

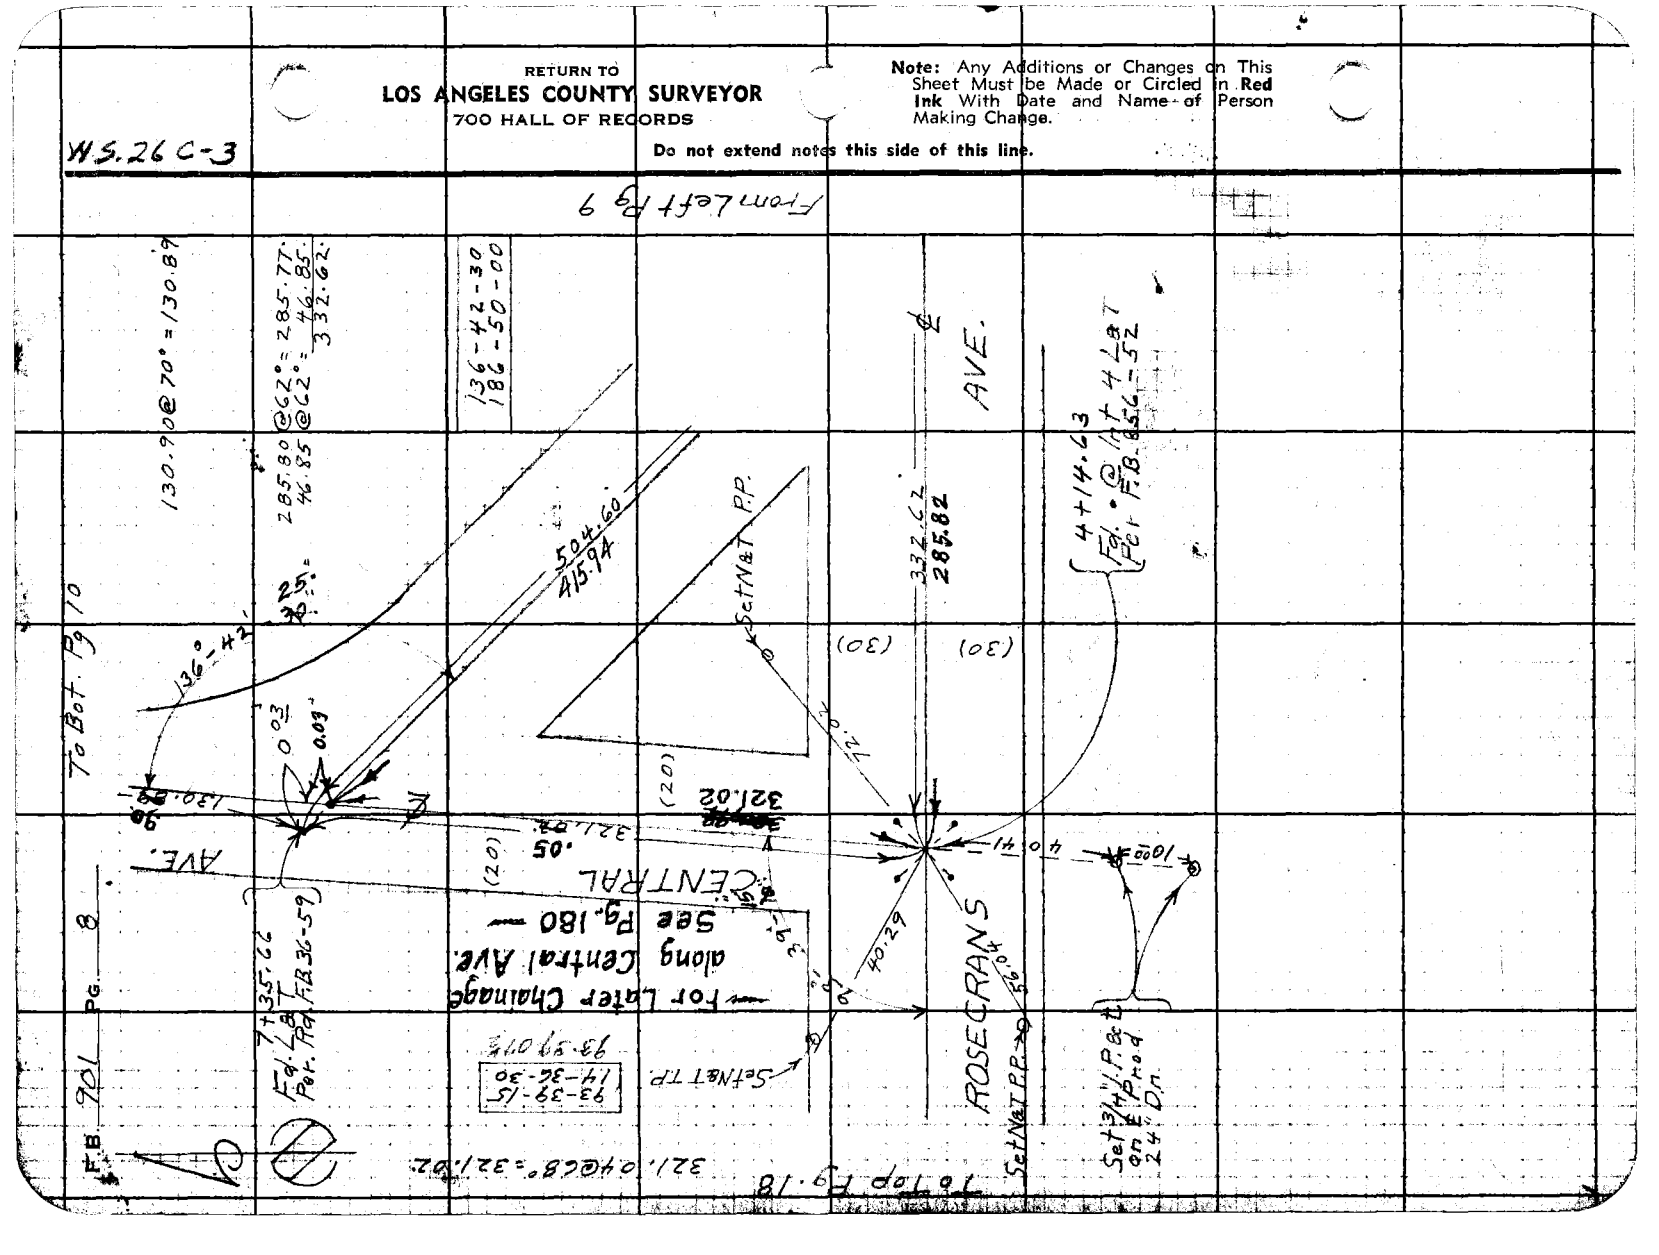

W.S. 26C-3

| | |
|---|---|
| Notes Ck'd by Finley | Survey of Central |
| Map No. B-1811-1 | W. O. 8326 Tape No. 049 Std 76 °F |
| Office Work R.W. McA. | Surveyed by E.J. McNeal |
| Checked D. M. Finley | Notes Mc Date 02-28-41 |
| Date Aug. 1949 | Indexed [illegible] 2-1-44 |

F.B. 901 Pg. 9

Note: Any Additions or Changes on This Sheet Must be Made or Circled In Red Ink With Date and Name of Person Making Change.

Do not extend notes this side of this line.

RETURN TO
LOS ANGELES COUNTY SURVEYOR
700 HALL OF RECORDS

FORM 247 5M 10-39

201.00 @ 78° = 201.06
303.54 @ 78° = 303.54
504.60

CENTRAL

To Rt. 8.

(30)

A 15.94
504.60

Set N&T T.P.

3+00.07
Fd. • @ Inf 4 L&T
Per F.B. 856-51.

Set X in S.W. Cor.
Gas Co. M.H.

23.47

64.50
0.07

332.62

285.82

46.81

ROSECRANS

N.1.

AVE

To Bot. Pg 17

71.13

98°

68.95

68.93

Set N&T T.P.

69.01 @ 64° = 69.001
0.07
68.93

Fd. Wire nail in lead
in Gas island

2+31.06
Fd. S.W. & T

0.10

0.05

148-25-15
232-41-30

98-04-00
32-16-00

AVE.

To Top Pg. 17

RETURN TO
LOS ANGELES COUNTY SURVEYOR
700 HALL OF RECORDS

**Note:** Any Additions or Changes on This Sheet Must be Made or Circled in **Red Ink** With Date and Name of Person Making Change.

**Do not extend notes this side of this line.**

W526-C-2#3

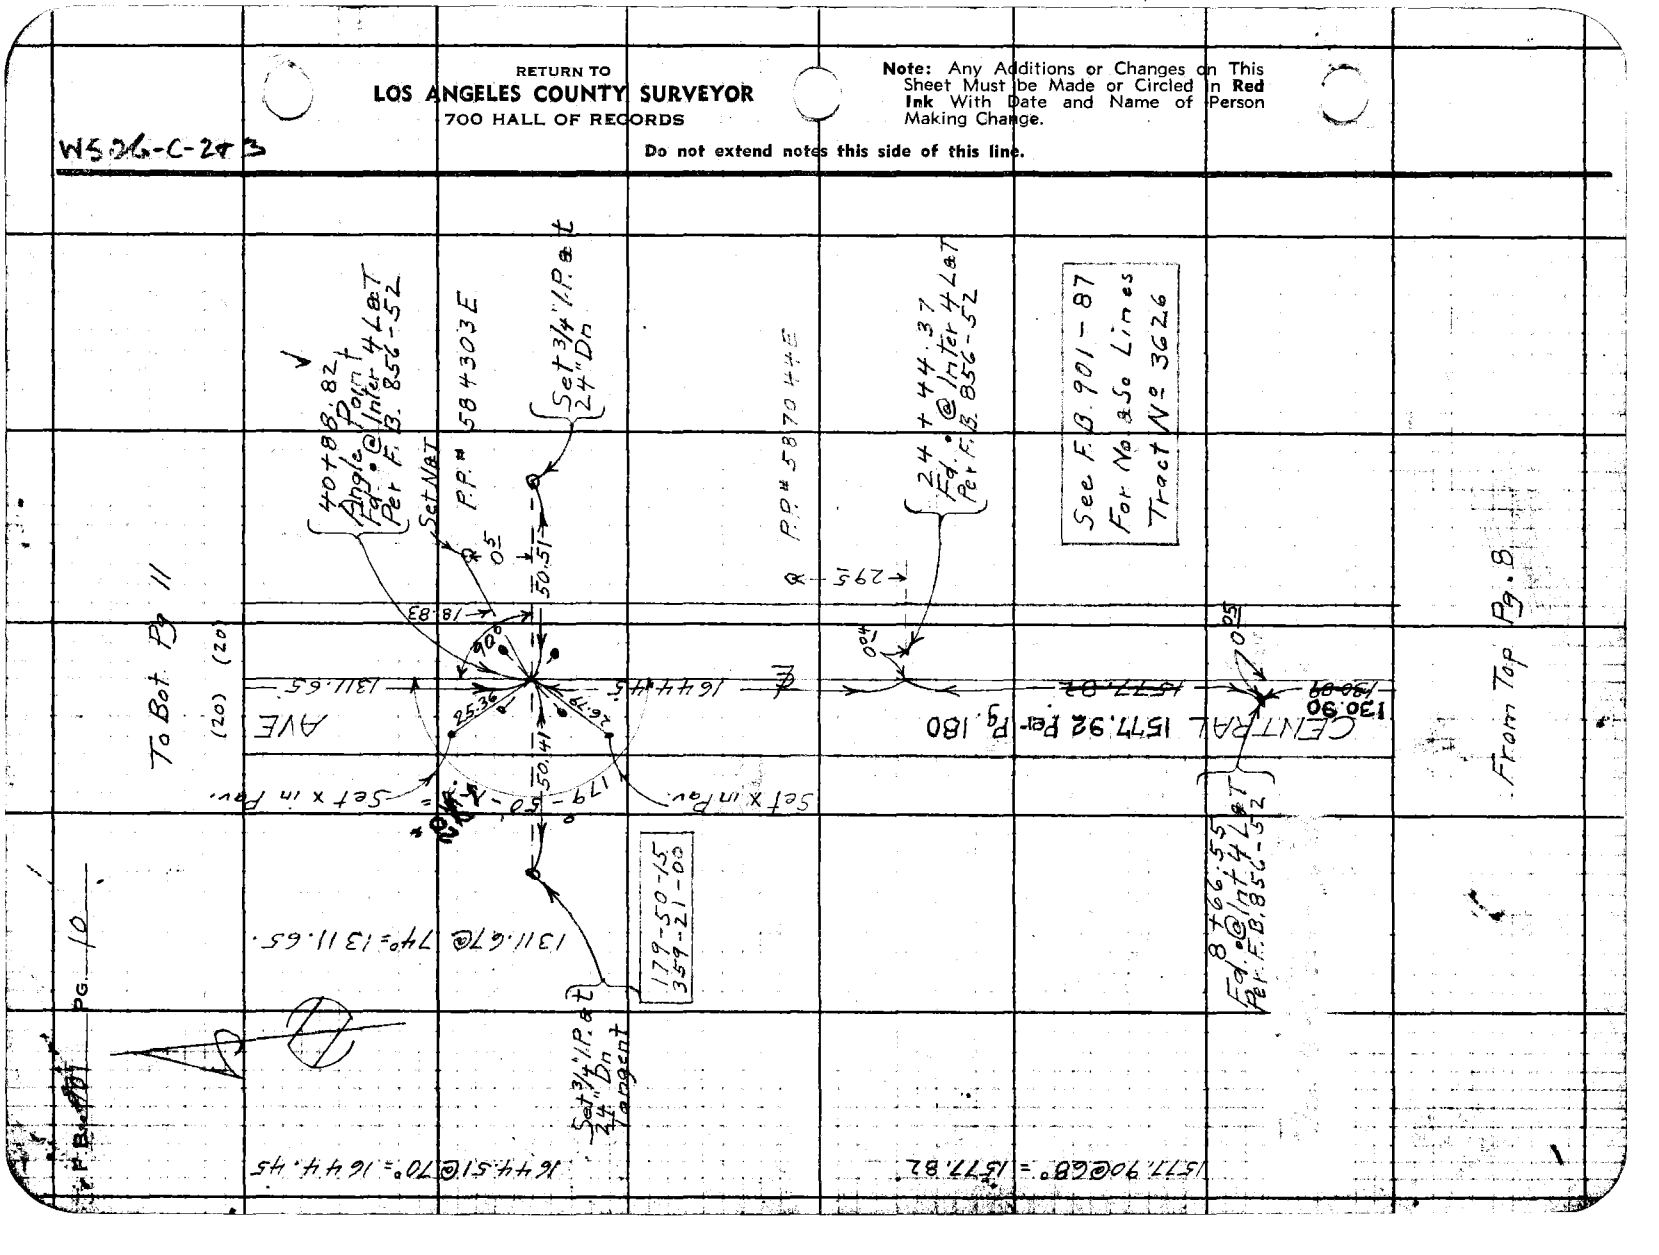

W.S. 26C-2

| | | | |
|---|---|---|---|
| Notes Ck'd by D. M. Finley | Survey of Central Ave. | F.B. 901 | Pg. 11 |
| Map No. B-1811-1 | W. O. 8326 Tape No. 049 Std 76°F | | |
| Office Work R.W.McA. | Surveyed by F.J. McNeal | | |
| Checked D. M. Finley | Notes Mc Date 10-29-41 | | |
| Date Aug. 1949. | Indexed | | |

1/0 Cor 54-12

AVE.

644.82

1422.47 @ 74° = 1422.45

644.87 @ 64° = 644.82

90-51-15
363-24-45

For Tract Lines
See Pg 88

Note: Any Additions or Changes on This Sheet Must be Made or Circled in Red Ink With Date and Name of Person Making Change.

Do not extend notes this side of this line.

To Top Pg - 20

Set N&T P.P.

90°-51'-30" 28.90

1422.45' ℄

54+00.47
Fd. • @ Intr 4 L&T
Per F.B. 299-64.

EL SEGUNDO BLVD.
(128')

(20) (20)

60.19

28.90

Fd S.W.T. in P.P.

℄ 644.82

(20)

179°-53'-45"

For Proposed
Delphi Ave
See Pg 90

179-53-45
359-34-45

1311.65'

178.13

Fd. S.W.&T P.P.

RETURN TO
LOS ANGELES COUNTY SURVEYOR
700 HALL OF RECORDS

Ave.

71.44

72.44

El Segundo

72.53

71.18

44°

45°

Central

CENTRAL

(20) (20)

Set 4-3/4" I.P. & t-24" Dn. Tang.

From Top Pg - 10

FORM 247 5M 10-39

RETURN TO
**LOS ANGELES COUNTY SURVEYOR**
700 HALL OF RECORDS

**Note:** Any Additions or Changes on This Sheet Must be Made or Circled in **Red Ink** With Date and Name of Person Making Change.

**Do not extend notes this side of this line.**

WS 76-C-2

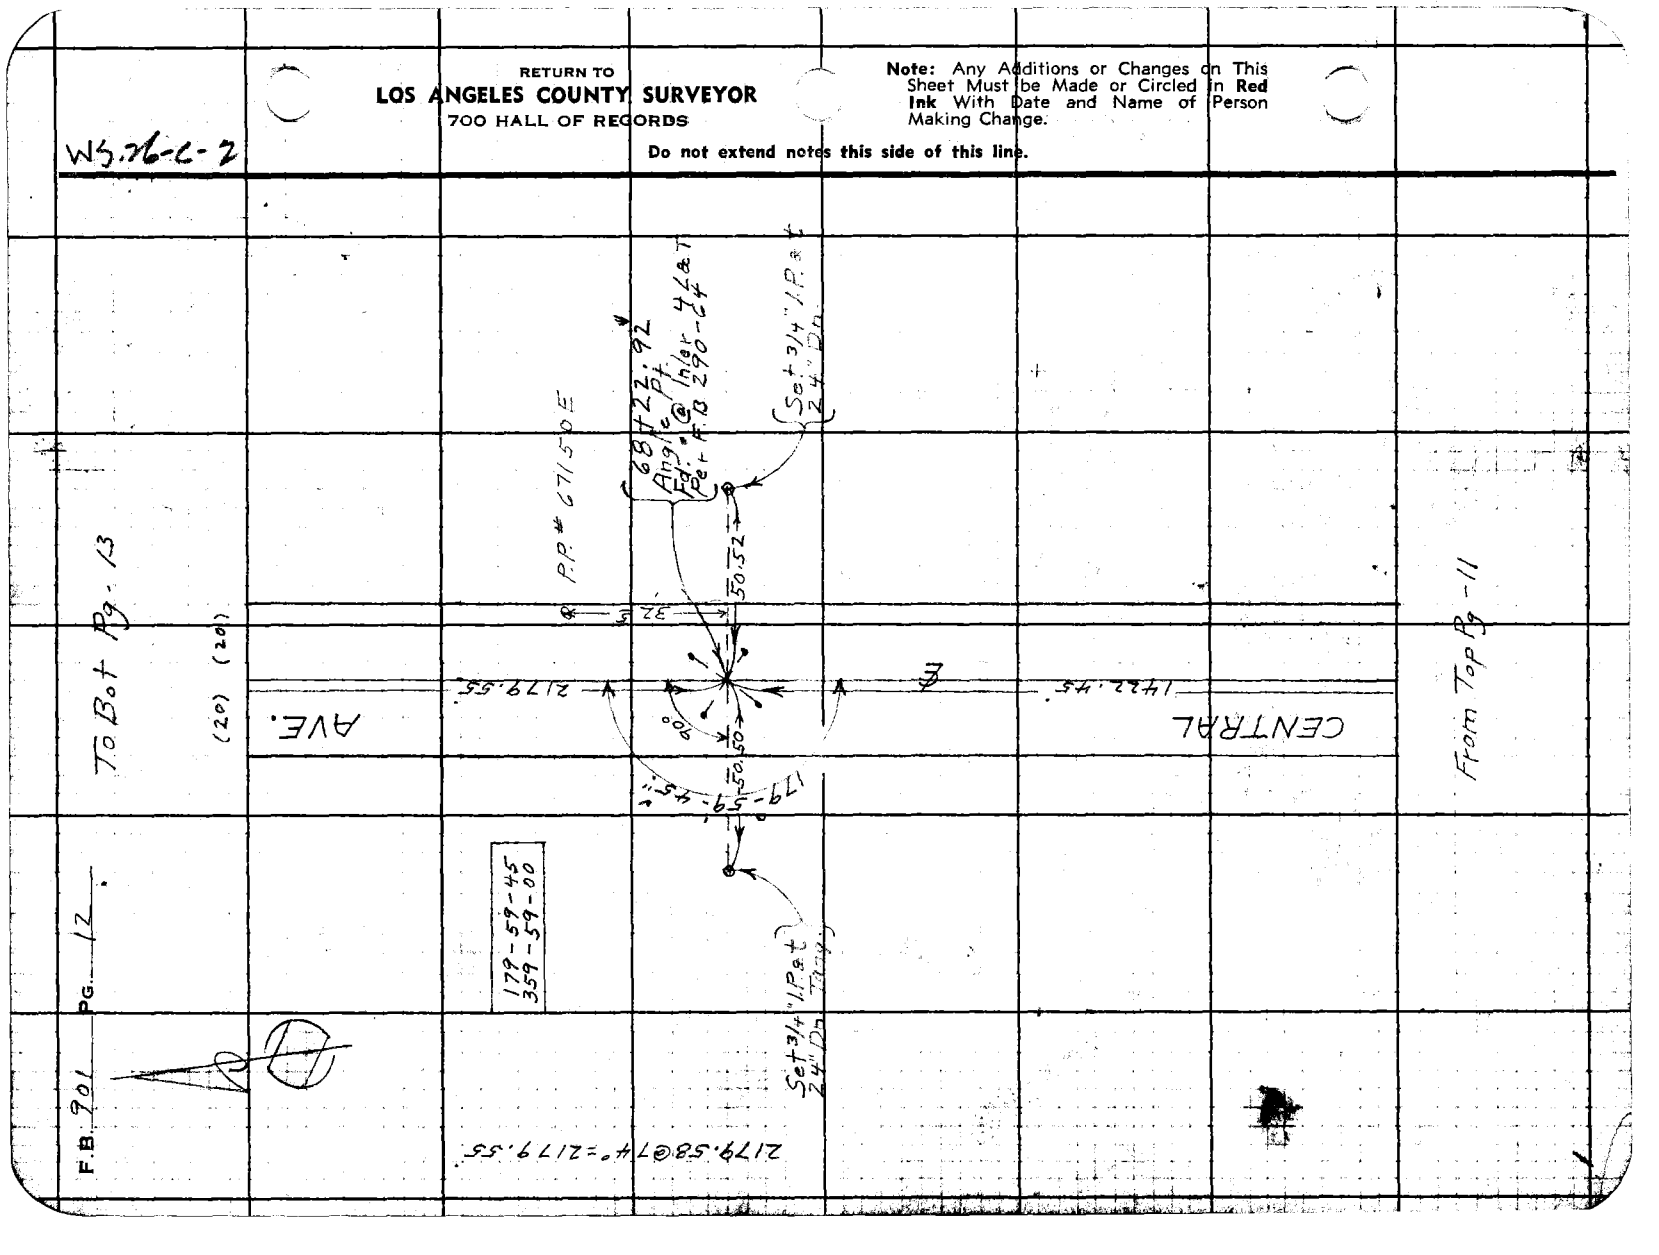

WS 26 C-2

| | |
|---|---|
| Notes Ck'd by D. M. Finley | Survey of Central Ave |
| Map No. B-1811-1 | W. O. 8324 Tape No. 049 Std 74°F |
| Office Work R.W. Mc A. | Surveyed by F.J. McNeal |
| Checked D. M. Finley | Notes Mc Date 10-29-41 |
| Date Aug. 1949. | Indexed C. J. [illegible] |

F.B. 901 Pg. 13

To Bot Next Pg.

(20) (50)

AVE.

855.97 @ 74° = 855.96 − 0.11 = 855.85

℄ 855.85

89-29-30
357-58-00

90+02.58
Fd. • @ Inter 4 Lot
No. Ref.

Fd Wire Spks in Lead

89°

29-36

47.35 Tan

90+02.47
Fd 1x2 set @ Inter of
Lots Shown on Page
119 of F.B. 275

Fd L&T in Pav.

22.29

0.11

118TH ST

399.93

(Stoner)

(25) (25)

To Bot Pg. 21

23.29

2179.55

CENTRAL

47.01 Tan

Fd L&T

From Top Last Pg

For Tract Lines
See Pg. 89

Note: Any Additions or Changes on This Sheet Must be Made or Circled in Red Ink With Date and Name of Person Making Change.

Do not extend notes this side of this line.

RETURN TO
LOS ANGELES COUNTY SURVEYOR
700 HALL OF RECORDS

FORM 247 5M 10-49

F.B. 901 PG. 14

To Bot Next Pg.

W.S. 26 C-2

RETURN TO
LOS ANGELES COUNTY SURVEYOR
700 HALL OF RECORDS

Do not extend notes this side of this line.

Note: Any Additions or Changes on This Sheet Must be Made or Circled in Red Ink With Date and Name of Person Making Change.

274.91 @ 74°=274.91'

(20)

(45)

AVE.

274.91

Fd. White Spk in Lead

Fd. L&T Pav.

25°00'

44.80

21.96

24.58

0°05'

Fd. L&T in pav.

ROBIN

ST.

98+58.43
Fd. RR Spk
Per F.B. 275-126
0.03 West
Angle turned @
Inter. but not set

38.17

19.18

98+20.26
Fd. C.S. & Mon Wells G.S.
Aux #1

15

43-55-05"

(25)

(25)

To Pg. 92

855.85'

For Proposed
Pacific Blvd
See Pgs 91 & 92

43-55-00
175-40-15

CENTRAL

From Top Last Pg.

W.S. 26C-2

| | |
|---|---|
| Notes Ck'd by M. Dio | Survey of Central Ave |
| Map No. B-1811-1 | W. O. 8316 Tape No. 049 Std 76°F |
| Office Work R.W.McA | Surveyed by F.J. McNeal |
| Checked D. M. Finley | Notes Mc Date 10-30-41 |
| Date Aug. 1949. | Indexed C. Jackson |

F.B. 92' Pg. 15

Note: Any Additions or Changes on This Sheet Must be Made or Circled In Red Ink With Date and Name of Person Making Change.

Do not extend notes this side of this line.

RETURN TO
LOS ANGELES COUNTY SURVEYOR
700 HALL OF RECORDS

FORM 247 5M 10-39

To Bot Pg. 25

(20) (25) AVE

89-23-15
357-33-30
176-20-30

(25) COMPTON

547.37'

101+33.34
Fd L&T with F.C. Tag
Per F.C.3C-110

99°-23'-10" Set 3/4" I.P. & t. 24" Dn

IMPERIAL

Fd L&T in Culv. H.W.

To Top Pg 24

50

Fd L&T

63.55

42.50

HWY.

2083.58
314.10

(25)

To Bot. Pg. 23

0°39'

Fd. RR Spk

0°09'

Fd Spk & P.M. in Lead in H.W.

43.90

(30)

50

Set 3/4" I.P. & t. 24" Dn. Tang.

90°-04'-00"
90°-05'-50"

90°-36'-55"

CREEK

90-03-45
360-15-15

274.91'

CENTRAL

See Pg 14

(50)

(20) (45)

(50)

90-37-00
362-27-30

From Top Last Pg.

F.B. 901 PG. 16

WS 26 C-2

Check chaining Central Ave
From Rosecrans Ave to Imperial Hwy

Tape # 047 Std 68°F

From Imperial Hwy
To Robin St.
274.92 @ 70° = 274.92

From Robin St.
To 118th St
856.04 @ 70° = 856.05

From 118th St
To El Segundo
2179.63 @ 72° = 2179.69
1422.50 @ 72° = 1422.54
3602.23

From El Segundo
To Rosecrans Ave
1311.68 @ 74° = 1311.73
1644.45 @ 74° = 1644.51
1577.84 @ 76° = 1577.92
130.89 @ 76° = 130.90
320.98 @ 76° = 328.00
4986.06

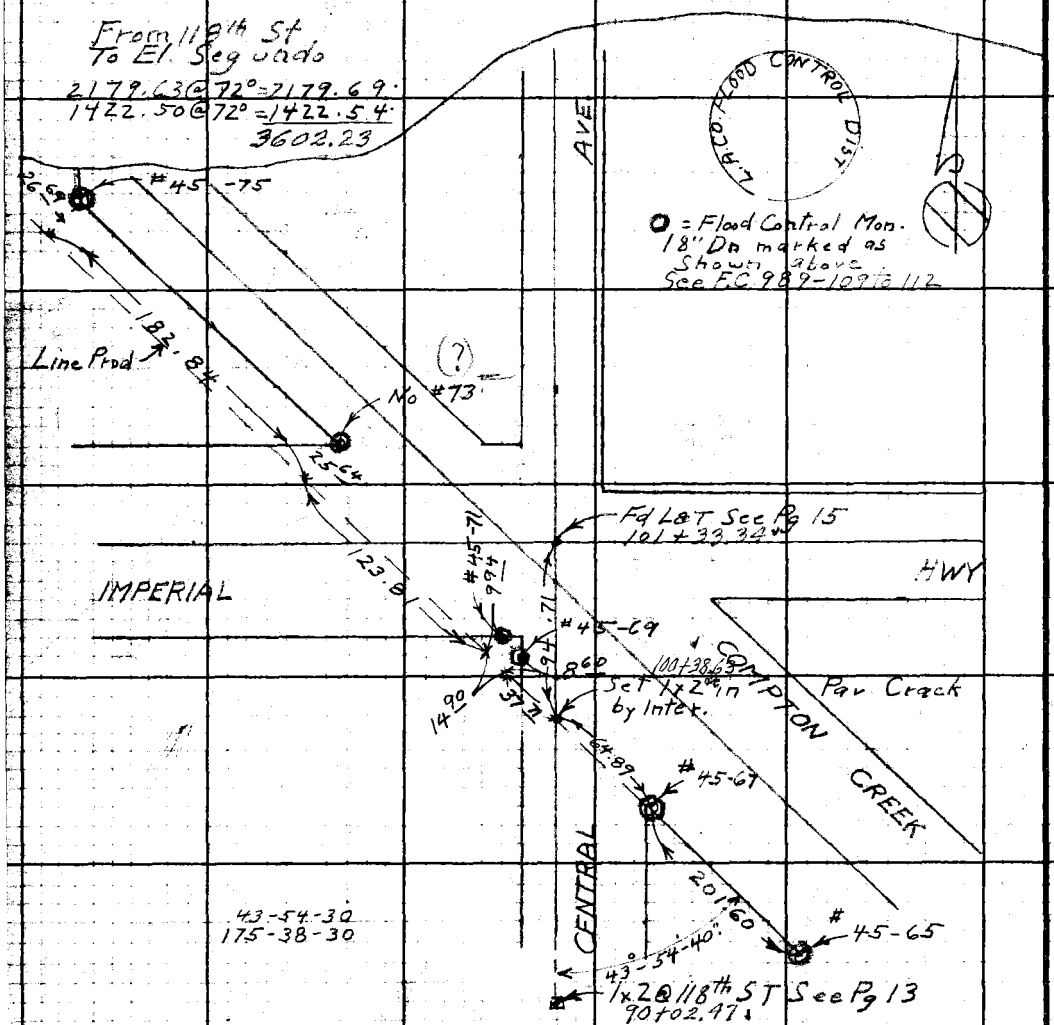


RETURN TO
LOS ANGELES COUNTY SURVEYOR
700 HALL OF RECORDS

Do not extend notes this side of this line.

Note: Any Additions or Changes on This Sheet Must be Made or Circled in Red Ink With Date and Name of Person Making Change.

W.S. 26C-7

| | |
|---|---|
| Notes Ck'd by D. M. Finley | Survey of |
| Map No. B-1811-1 | W. O. 8324 Tape No. Std °F |
| Office Work R. W. M. | Surveyed by F.J. McNeal |
| Checked D. M. Finley | Notes Mc Date 10-28-41 |
| Date AUG '41 | Indexed E. J. |

F.B. 901 PG. 17

From Sht. Fg 7

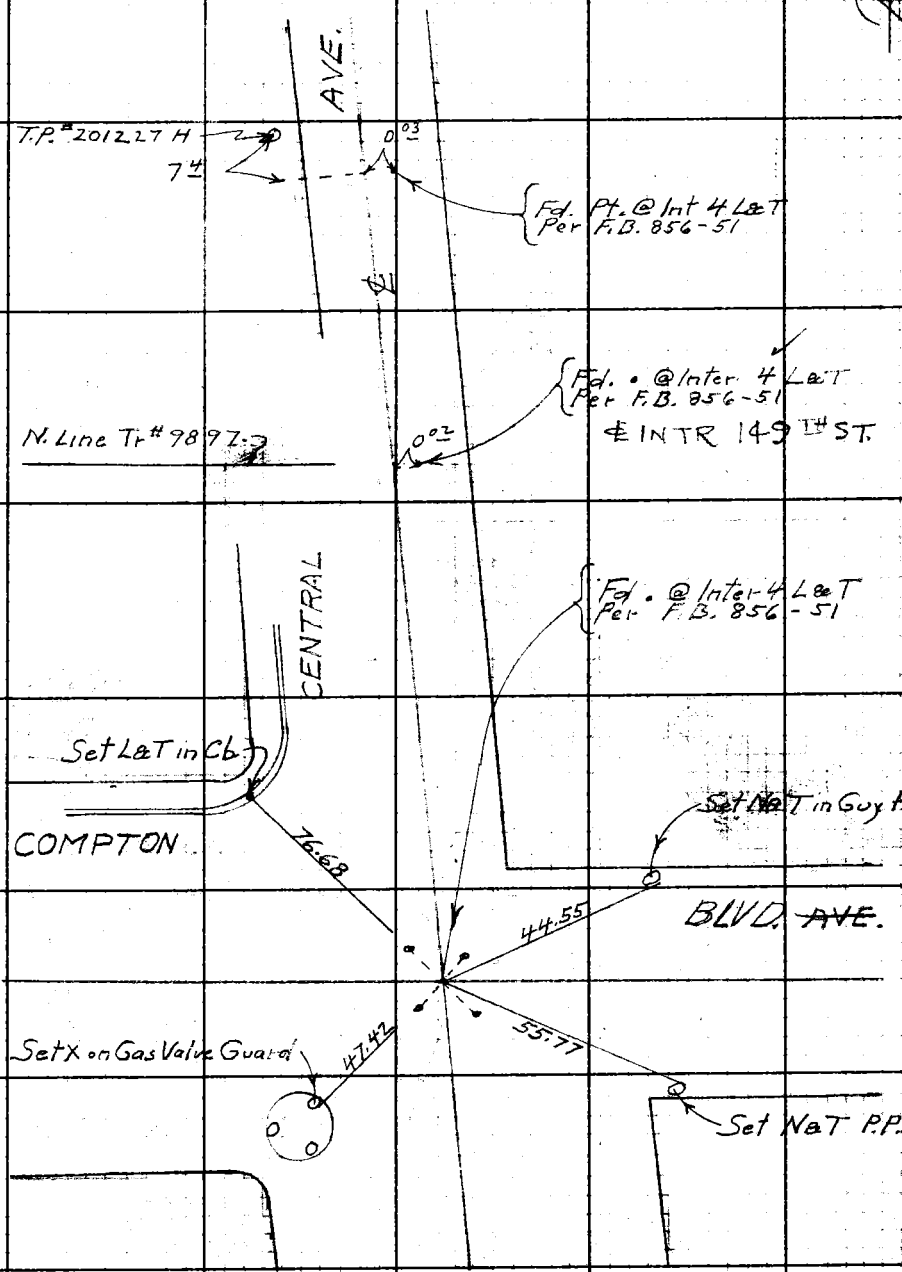


Note: Any Additions or Changes on This Sheet Must be Made or Circled in Red Ink With Date and Name of Person Making Change.

Do not extend notes this side of this line.

RETURN TO
LOS ANGELES COUNTY SURVEYOR
700 HALL OF RECORDS

FORM 247 5M 10-39

F.B. 901 PG. 18

From Left Pg. 8

W.S. 26C-3

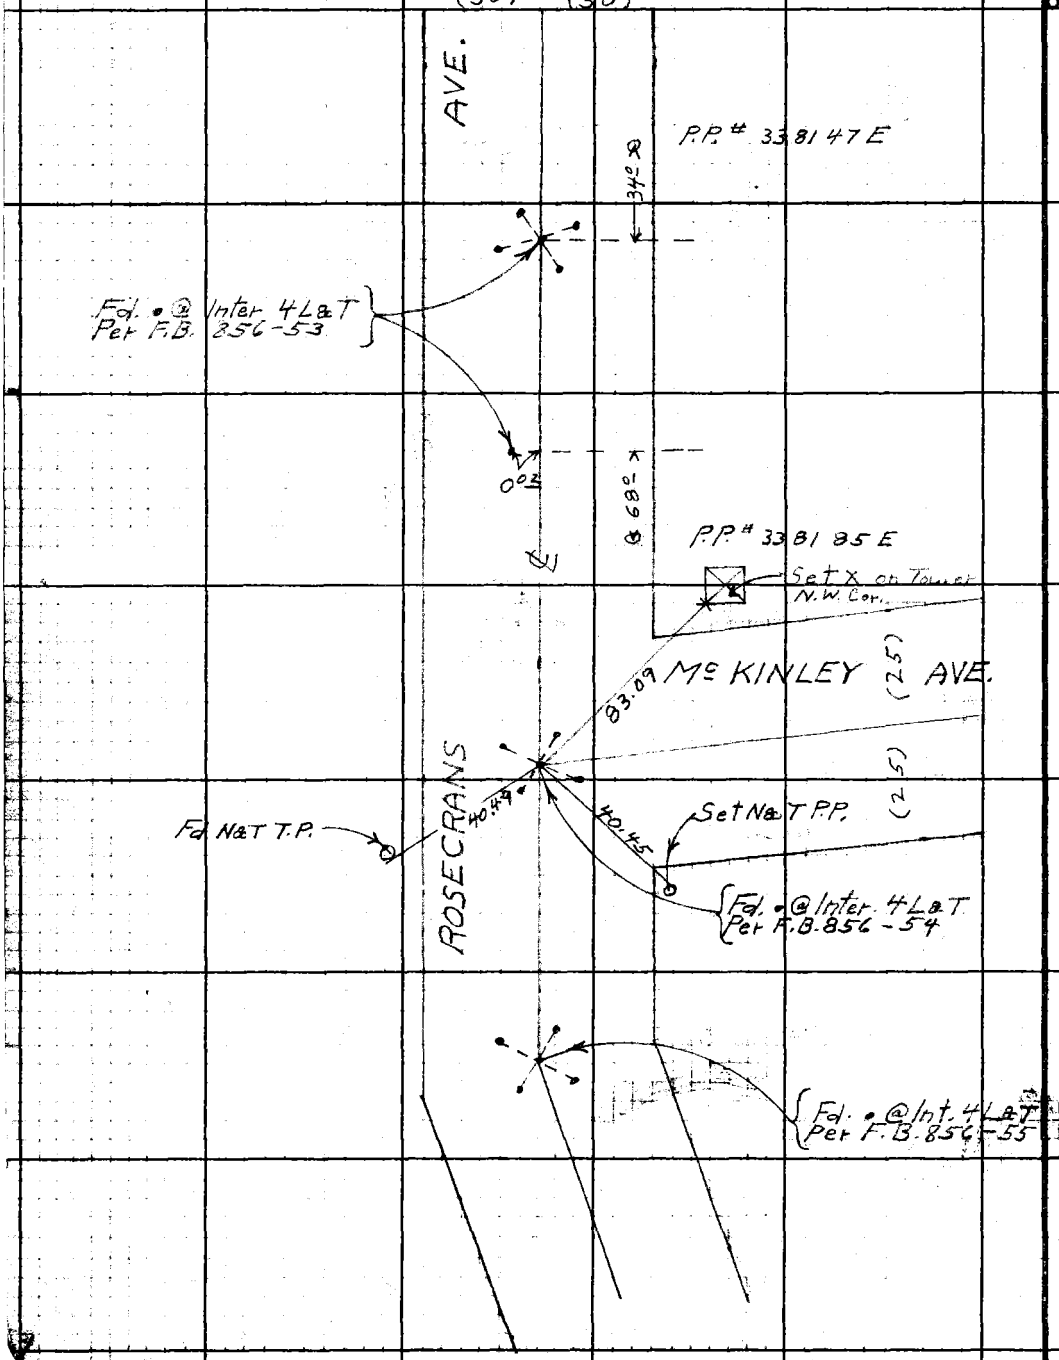


RETURN TO
LOS ANGELES COUNTY SURVEYOR
700 HALL OF RECORDS

Do not extend notes this side of this line.

Note: Any Additions or Changes on This Sheet Must be Made or Circled in Red Ink With Date and Name of Person Making Change.

W.S. 26 C-3

| | |
|---|---|
| Notes Ck'd by | Survey of Cerritos Ave. |
| Map No. B-1811-1 | W. O. 8324 Tape No. Std °F |
| Office Work R. W. M. | Surveyed by F. J. McNeal |
| Checked D. M. Finley | Notes Mc Date 10-28-41 |
| Date Aug. 1943 | Indexed |

F.B. 901 Pg. 19

Note: Any Additions or Changes on This Sheet Must be Made or Circled in Red Ink With Date and Name of Person Making Change.

Do not extend notes this side of this line.

RETURN TO
LOS ANGELES COUNTY SURVEYOR
700 HALL OF RECORDS

FORM 247 5M 10-38

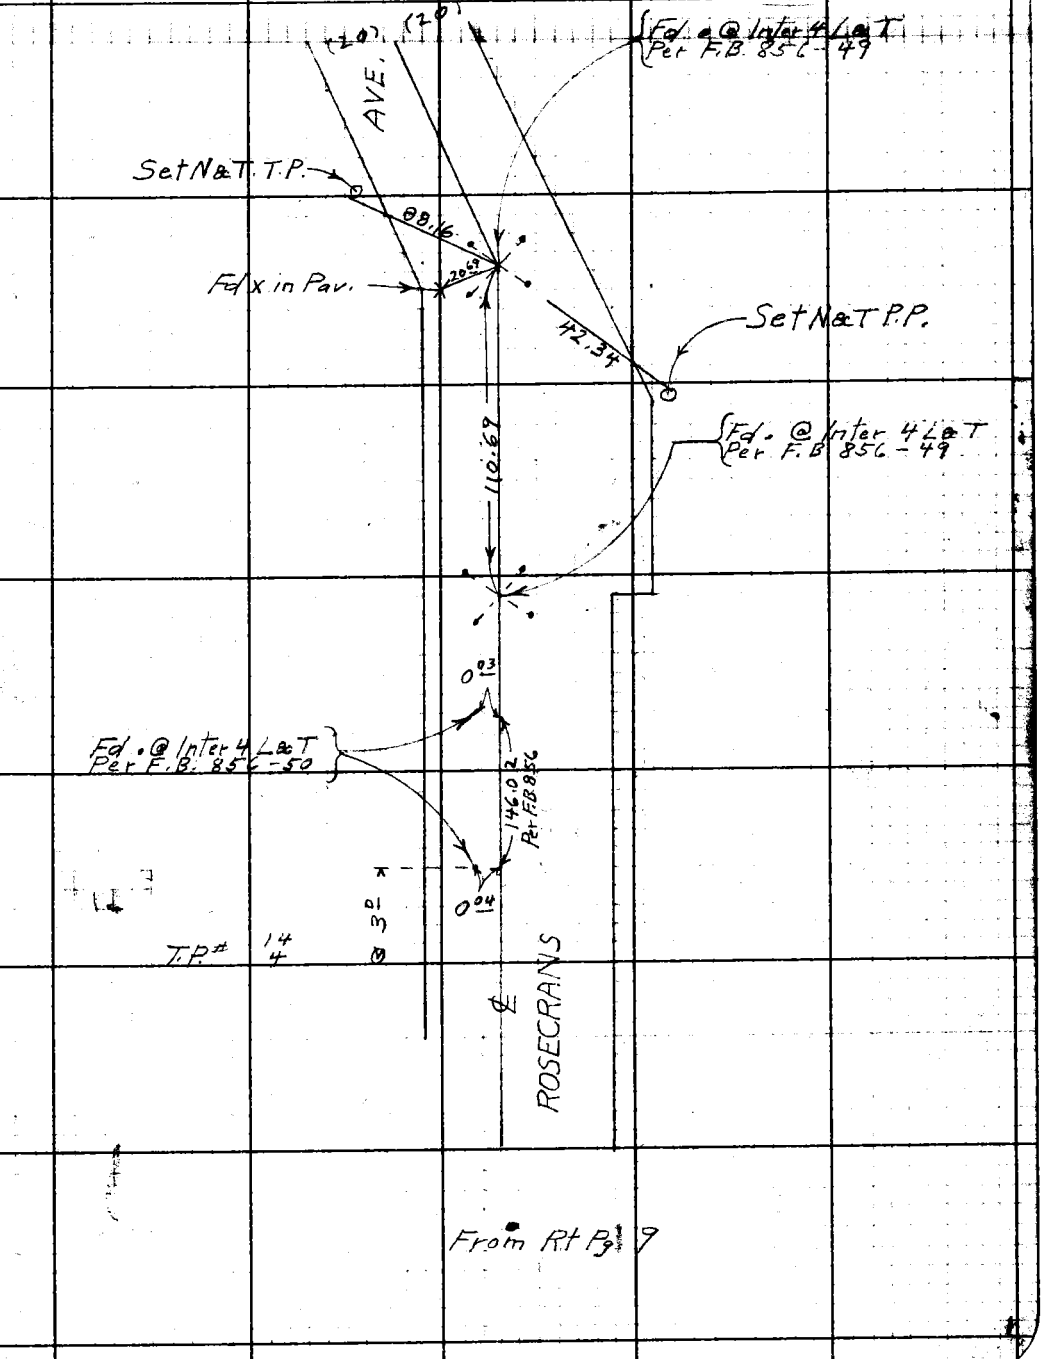

F.B. 90 PG. 20

W.S. 26 C-2

From Left Pg. - 11

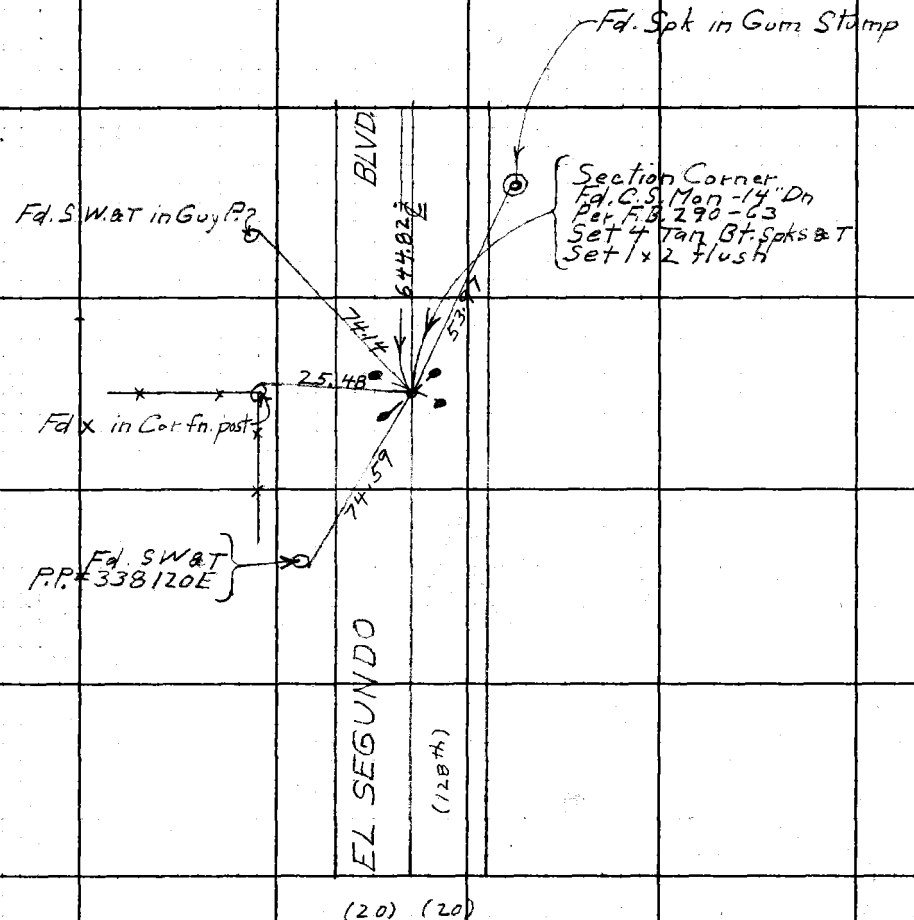


RETURN TO
LOS ANGELES COUNTY SURVEYOR
700 HALL OF RECORDS

Do not extend notes this side of this line.

Note: Any Additions or Changes on This Sheet Must be Made or Circled in Red Ink With Date and Name of Person Making Change.

W 5.26-(-)

| | |
|---|---|
| Notes Ck'd by D. M. Finley | Survey of Central Ave |
| Map No. B-1811-1 | W. O. 8326 Tape No. Std °F |
| Office Work R. W. M. | Surveyed by F.J. McNeal |
| Checked D. M. Finley | Notes Me Date 10-29-41 |
| Date AUG '49 | Indexed C. Johnson |

F.B. 901 Pg. 21

Note: Any Additions or Changes on This Sheet Must be Made or Circled in Red Ink With Date and Name of Person Making Change

Do not extend notes this side of this line.

RETURN TO
LOS ANGELES COUNTY SURVEYOR
700 HALL OF RECORDS

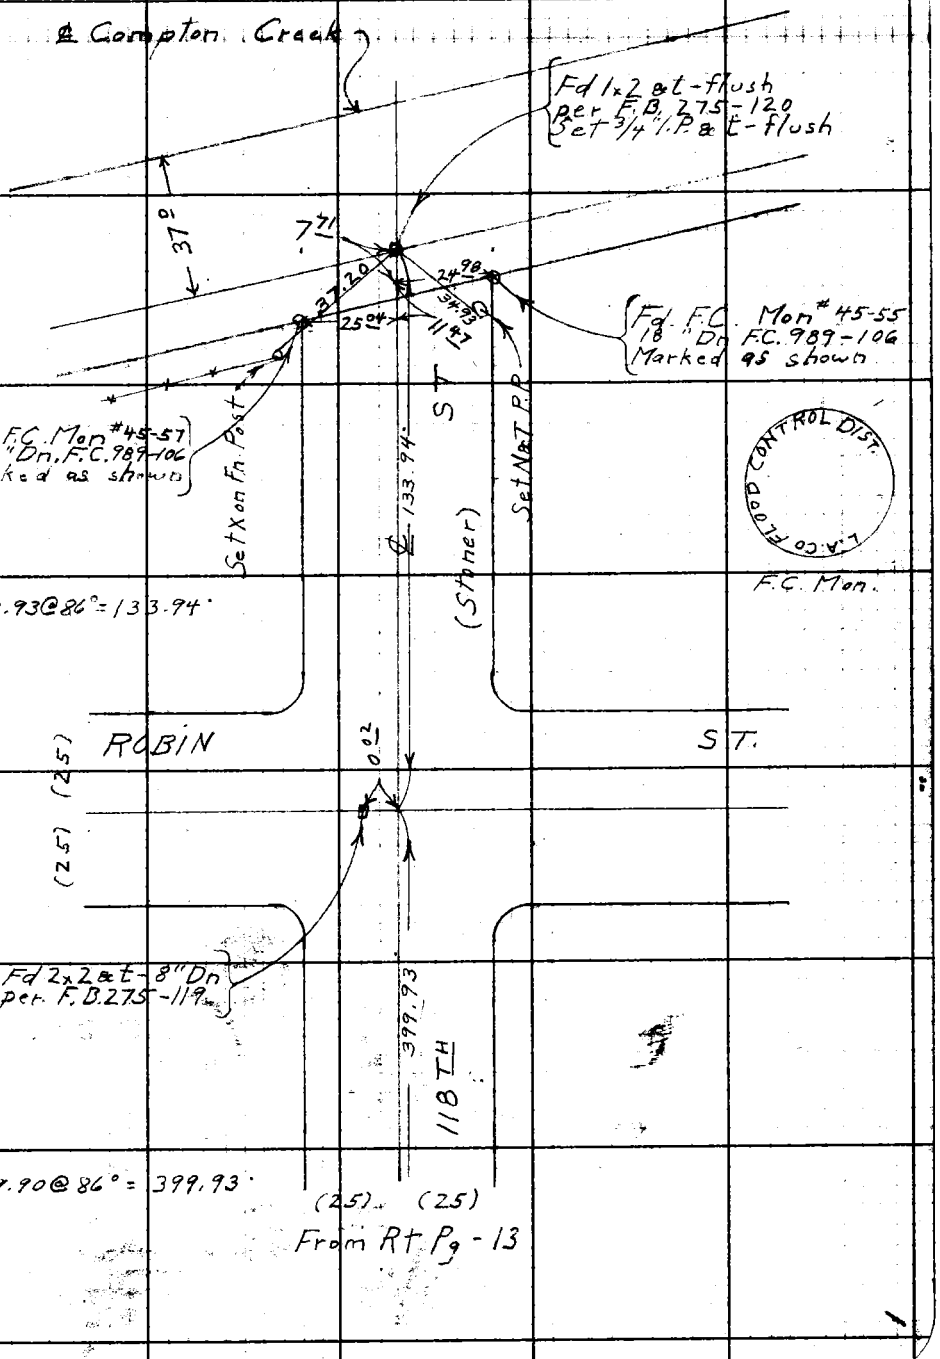


FORM 247 5M 10-59

RETURN TO
**LOS ANGELES COUNTY SURVEYOR**
700 HALL OF RECORDS

**Note:** Any Additions or Changes on This Sheet Must be Made or Circled in **Red Ink** With Date and Name of Person Making Change.

**Do not extend notes this side of this line.**

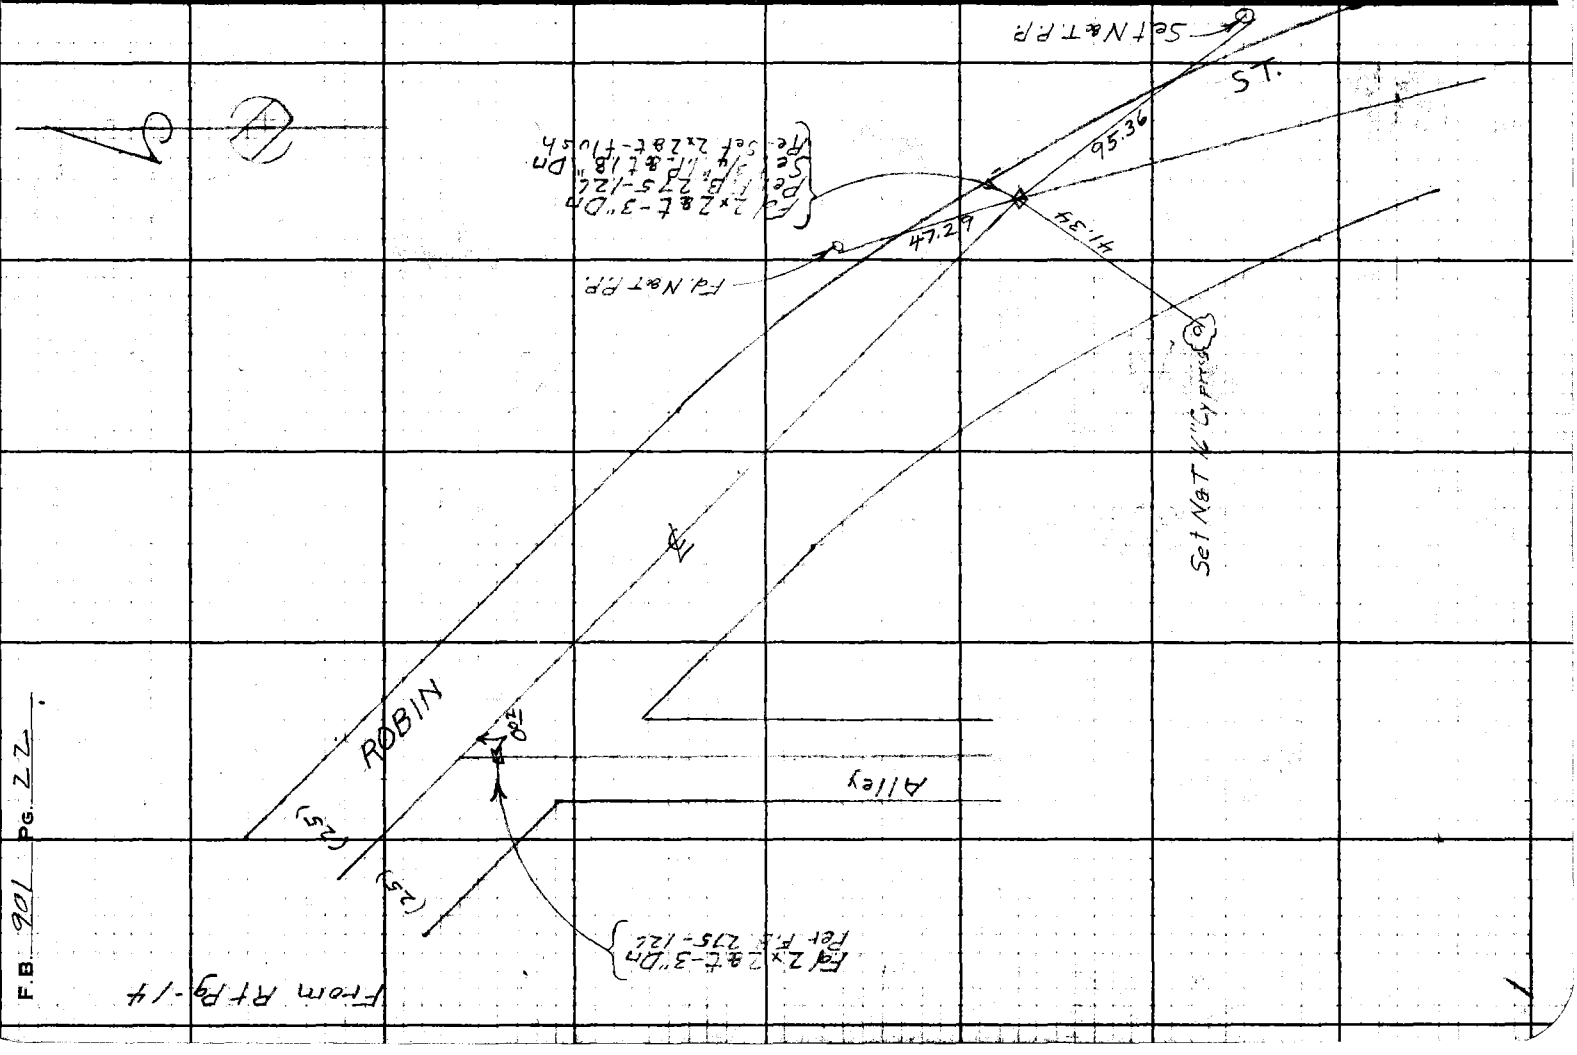


F.B. 901 PG. 22

From RT Pg-14

W.S. 26 D-1

| | |
|---|---|
| Notes Ck'd by | Survey of Central Ave |
| Map No. B-1811-1 | W. O. 8326 Tape No. 049 Std. 74°F |
| Office Work R. W. M. | Surveyed by F.J. McNeal |
| Checked D.M. Finley | Notes Mc Date 10-10-41 |
| Date AUG '41 | Indexed |

F.B. 901 PG. 27

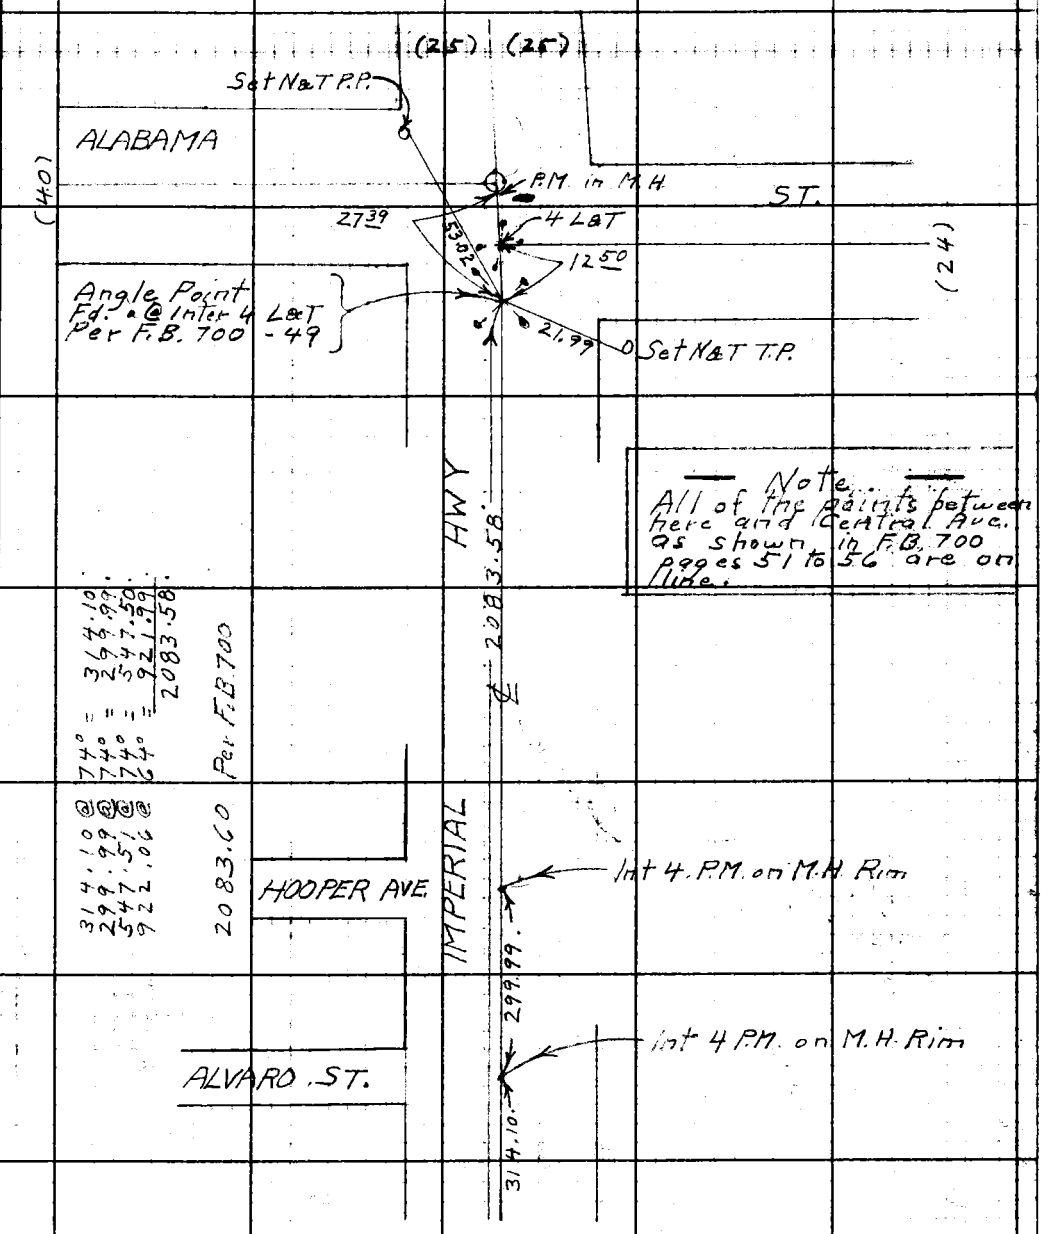


Note: Any Additions or Changes on This Sheet Must be Made or Circled in Red Ink With Date and Name of Person Making Change.

Do not extend notes this side of this line.

RETURN TO
LOS ANGELES COUNTY SURVEYOR
700 HALL OF RECORDS

FORM 247 5M 10-39

RETURN TO
**LOS ANGELES COUNTY SURVEYOR**
700 HALL OF RECORDS

**Note:** Any Additions or Changes on This Sheet Must be Made or Circled in **Red Ink** With Date and Name of Person Making Change.

**Do not extend notes this side of this line.**

WS. 21-C-2

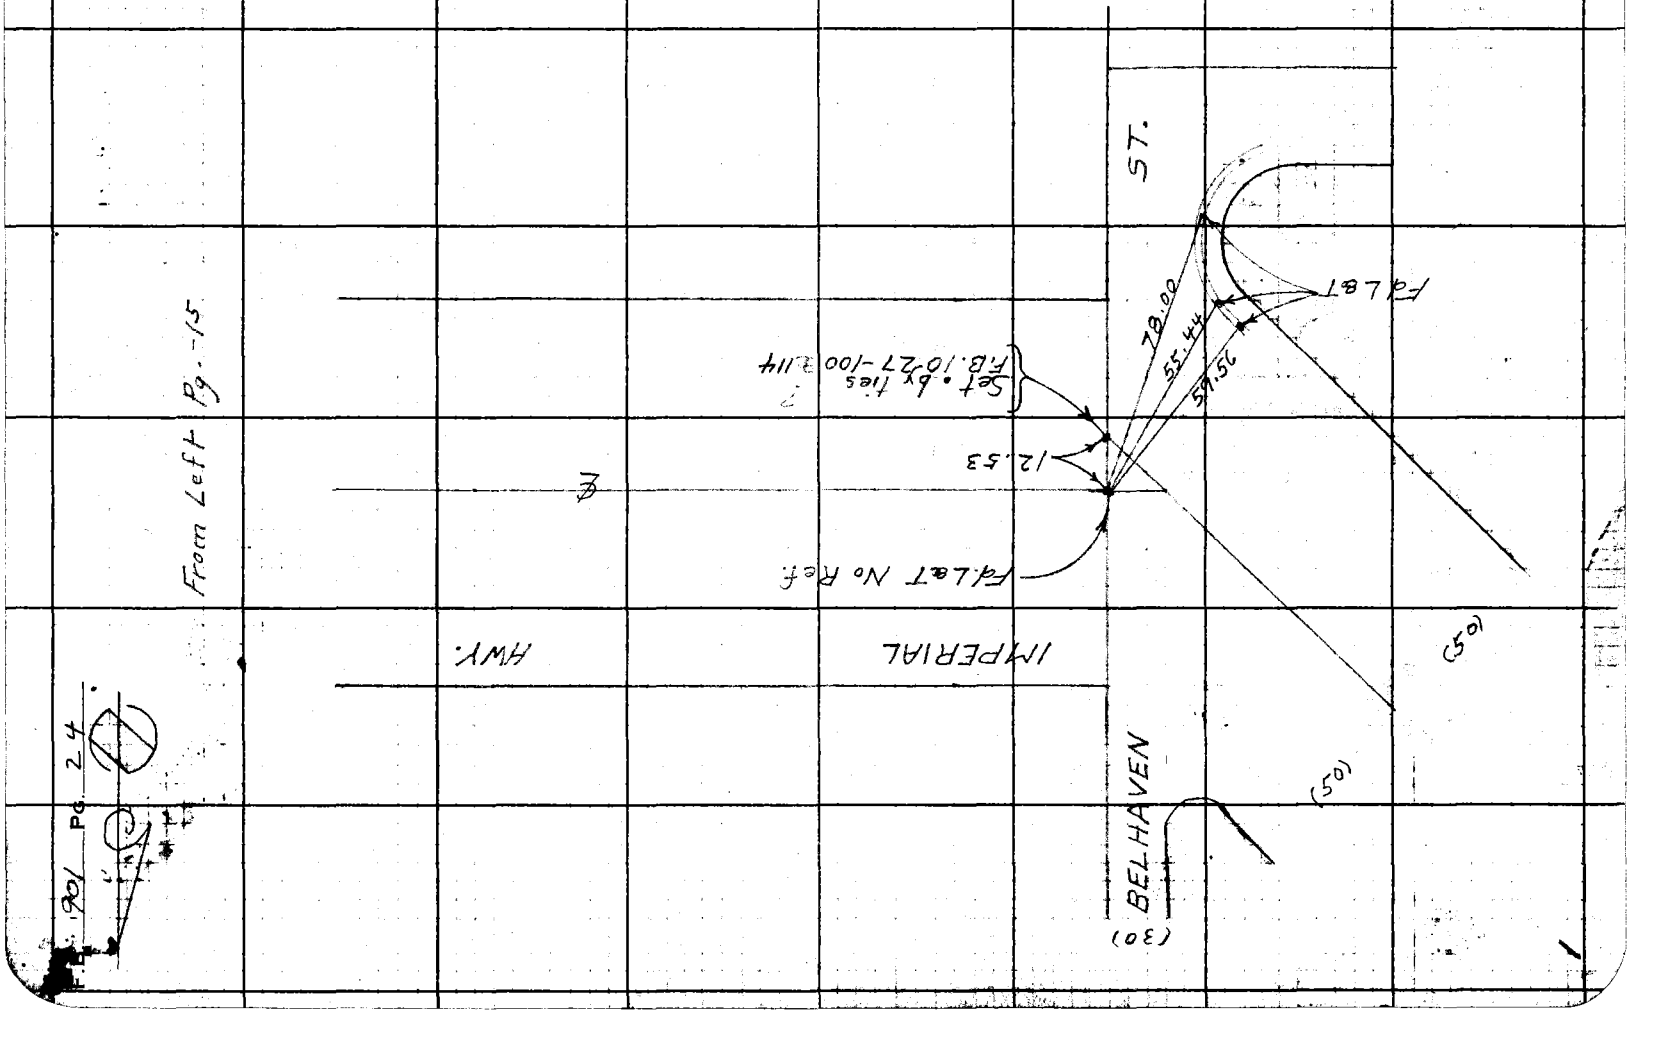

FORM 247 5M 10-39

RETURN TO
**LOS ANGELES COUNTY SURVEYOR**
700 HALL OF RECORDS

**Note:** Any Additions or Changes on This Sheet Must be Made or Circled in **Red Ink** With Date and Name of Person Making Change.

**Do not extend notes this side of this line.**

W.S. 26 C-1

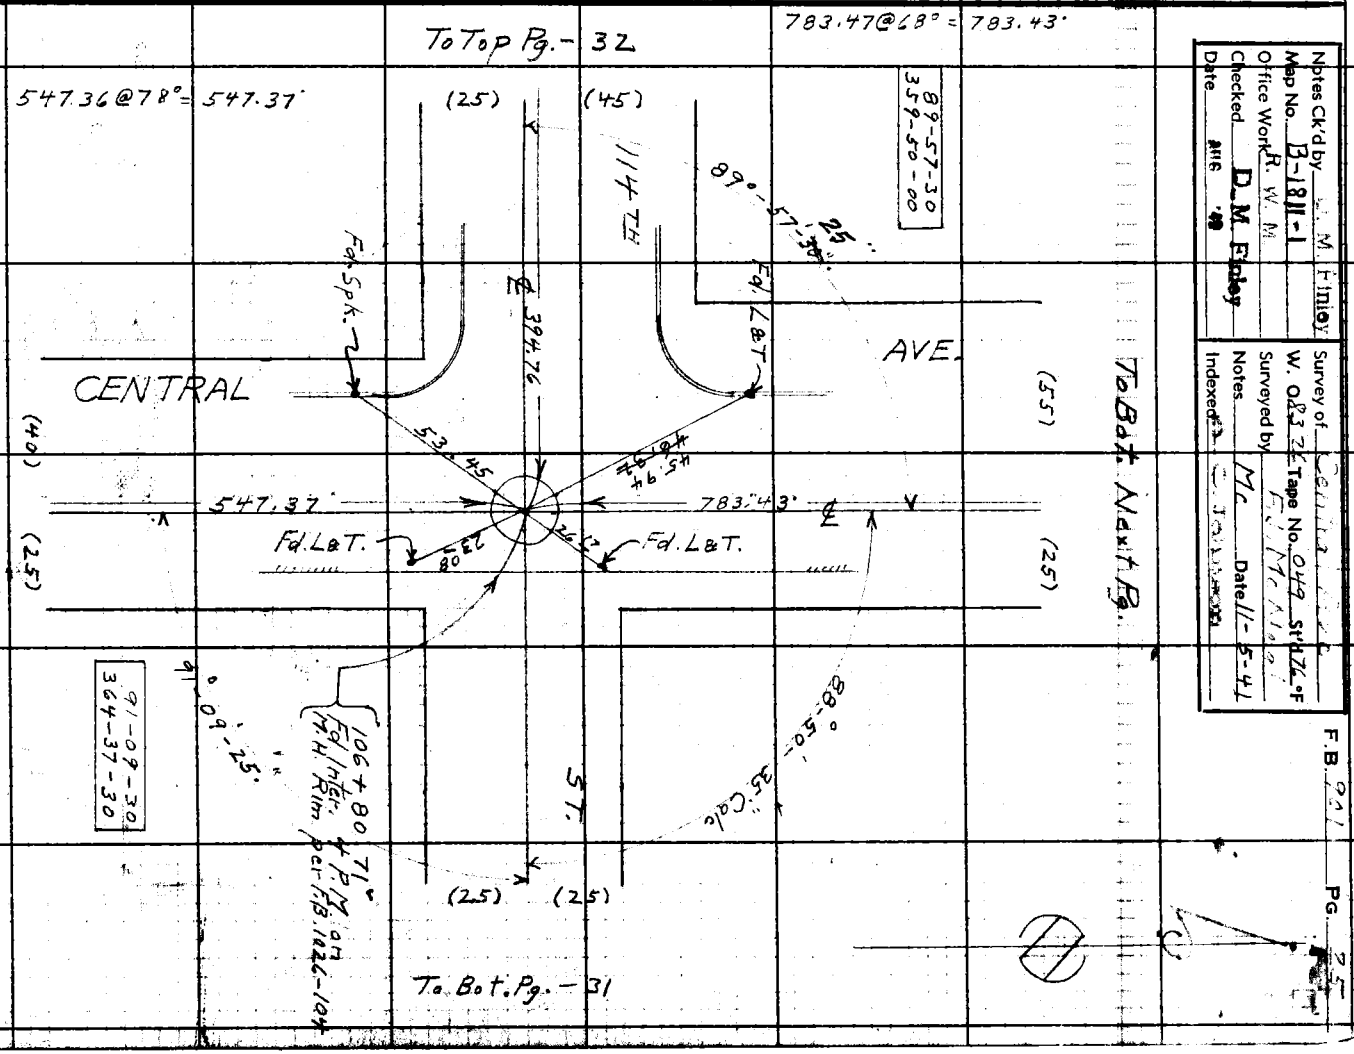


Notes Ck'd by [illegible]
Map No. B-1811-1
Office Work R. W. M.
Checked D. M. Finley



RETURN TO
**LOS ANGELES COUNTY SURVEYOR**
700 HALL OF RECORDS

**Note:** Any Additions or Changes on This Sheet Must be Made or Circled in **Red Ink** With Date and Name of Person Making Change.

**Do not extend notes this side of this line.**

W.S. 26C-1

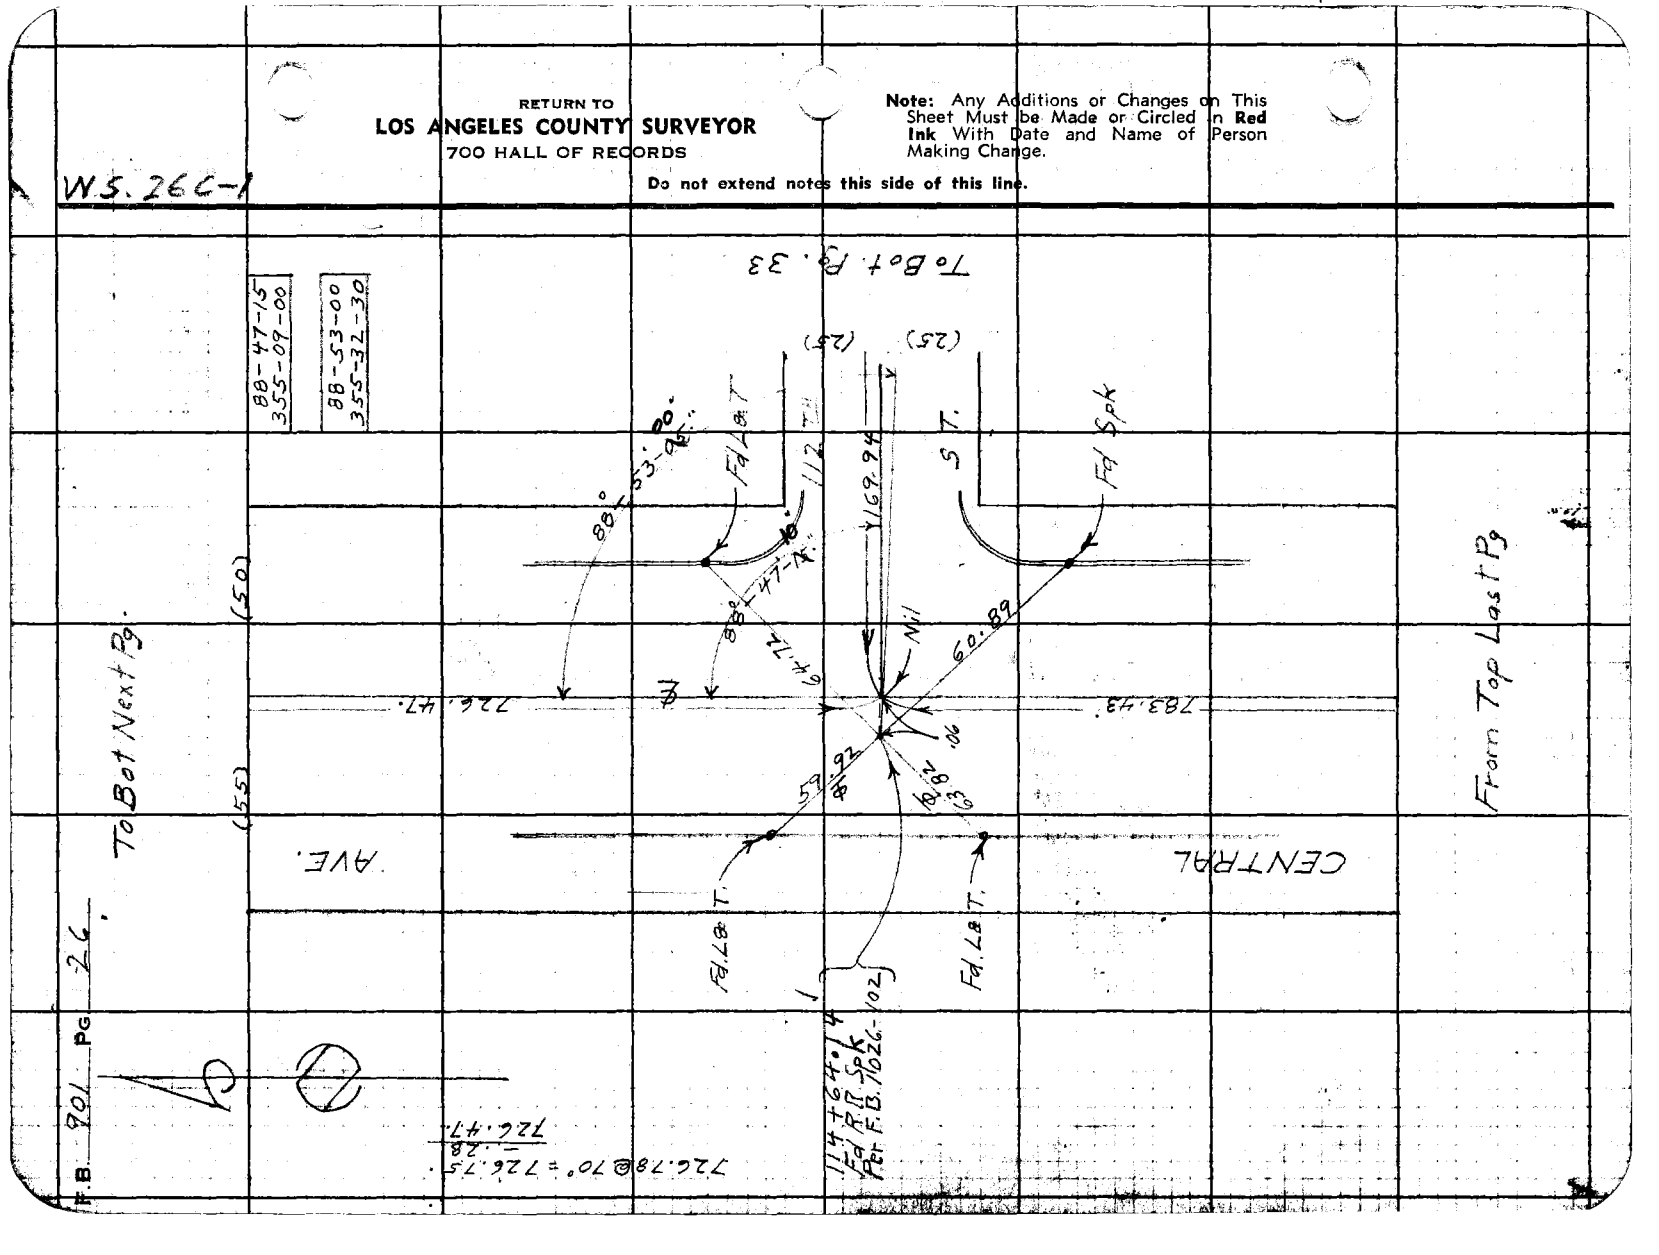

W.S. 16 C-1

| | | | |
|---|---|---|---|
| Notes Ck'd by | D. M. Finley | Survey of | Cal. Co. |
| Map No. | B-1811-2 | W. O. | 2326 Tape No. 049 St'd 76°F |
| Office Work | R. W. M. | Surveyed by | F. J. McNeal |
| Checked | D. M. Finley | Notes | Mc Date 11-5-41 |
| Date | Attg | Indexed | |

F.B. 901 Pg. 27

90-49-45
363-19-00

To Bot. Next Pg.

(50) (20)

89-09-15
356-36-30

AVE.

551.33

551.43 @ 70°
= 551.41
-.08
551.33

Fd L&T Pav.

Fd L&T in Pav.

89°
09'
4° Offset

P.E. 90° 49' 45"

60.54

30.50

4°

4°

19.78

RY.

To Bot Pg. 35

To Top Pg. 34

(80)

155.09

122+50.61
Fd. RR Spk Per F.B 1026-98
122+27.79
Fd C.S. Mon. Watts So. Aux #2

Fd 3" I.P. & nail
Per F.B. 1026-98
1" Down

Fd L&T Pav.

30.54

60.00

58.41

18.98

23.10

Fd L&T Pav.

121+90.61

LANZIT

395.01

35.24

Fd L&T in Cb. & Prod.

Set Cu. tack

(40)

AVE.

395.03 @ 70°
= 395.01

726.47

CENTRAL

Note
All pavement points are shifting except RR Spk on ℄ L.E. Ry.
Points No of Ry move So.
Points So of Ry move No.

(40) (50)

From Top Last Pg

Note: Any Additions or Changes on this Sheet Must be Made or Circled in Red Ink With Date and Name of Person Making Change.

Do not extend notes this side of this line.

RETURN TO
LOS ANGELES COUNTY SURVEYOR
700 HALL OF RECORDS

FORM 247 5M 10-39

F.B. 901 PG. 28

To Bot Next Pg.

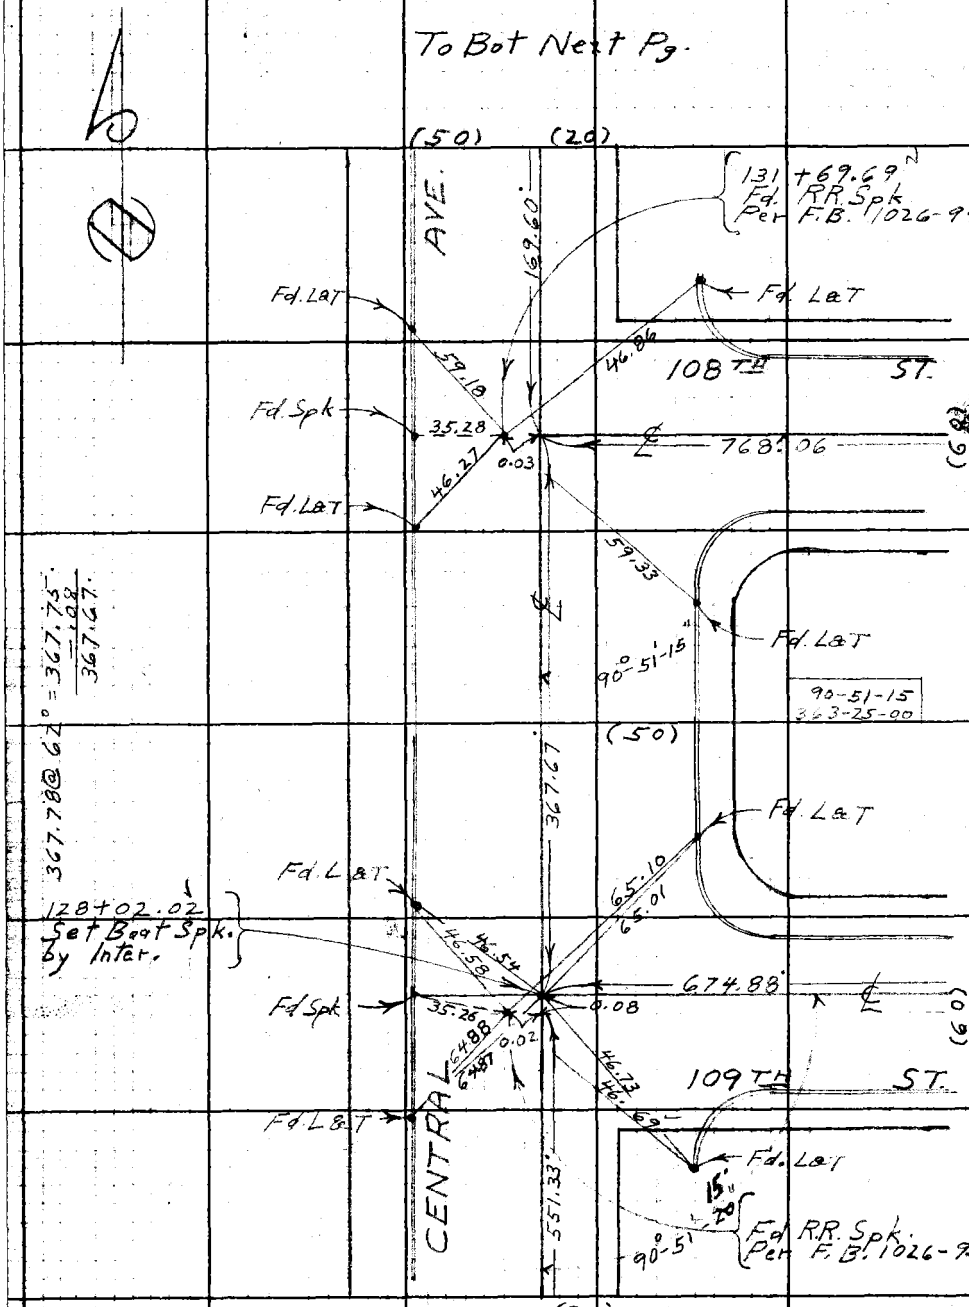


RETURN TO
LOS ANGELES COUNTY SURVEYOR
700 HALL OF RECORDS

Do not extend notes this side of this line.

**Note:** Any Additions or Changes on This Sheet Must be Made or Circled in **Red Ink** With Date and Name of Person Making Change.

FORM 247 5M 10-39

RETURN TO
**LOS ANGELES COUNTY SURVEYOR**
700 HALL OF RECORDS

**Note:** Any Additions or Changes on This Sheet Must be Made or Circled in **Red Ink** With Date and Name of Person Making Change.

**Do not extend notes this side of this line.**

W. S. 26C-1

169.62 @ 62° = 169.60'

To Top Pg-38

197.97 @ 72°
= 197.96'

Notes Ck'd by D. M. Finley
Map No. B-811-2
Office Work R. W. M.
Checked D. M. Finley
Date 10/6 19

Survey of Central Ave
W. O. 8376 Tape No. 249 ST HZ °F
Surveyed by F. S. M. & Assoc.
Notes
Indexed Date 11-5-41

F.B. 200 PG. 29

89-44-15
358-56-45

(40) (40)

Set 3/4" I.P. & t 24" Dn.

ST.

174.26'

108TH

Set 3/4" I.P. & t 22" Dn.

Fd L & T

CENTRAL

AVE.

(50)

(20)

57.29 70.68 65.19 57.30

45°

169.60

197.96

95.22 27.78

45°

Fd L & T

70.68

70.70

Set 3/4" I.P. & t 24" Dn.

133+39.29 P.O.T. Angle Eq/Sol't & R.M. Per F.B. 102-87

179°-59'-30"

Set 3/4" I.P. & t 24" Dn.

179-59-30
359-58-00

From Top Last Pg

To Bot. Pg. 39

RETURN TO
**LOS ANGELES COUNTY SURVEYOR**
700 HALL OF RECORDS

**Note:** Any Additions or Changes on This Sheet Must be Made or Circled in **Red Ink** With Date and Name of Person Making Change.

**Do not extend notes this side of this line.**

F.B. 901 Pg. 30

W 5.26 - C-1 D-1

| | |
|---|---|
| Notes Ck'd by D. M. Finley | Survey of Central Ave |
| Map No. B-1811-2 | W. O. 8324 Tape No. 049 Sta 76 °F |
| Office Work R. W. M. | Surveyed by F. J. McNeal |
| Checked D. M. Finley | Notes Mc Date 11-12-41 |
| Date AUG '42 | Indexed |

F.B. 901 PG. 31

Note: Any Additions or Changes on This Sheet Must be Made or Circled in Red Ink With Date and Name of Person Making Change.

Do not extend notes this side of this line.

RETURN TO
LOS ANGELES COUNTY SURVEYOR
700 HALL OF RECORDS

M. = Lamp Hole

Set P.K. Spk & T. in P.P.

(9.11) (25)

Fd. 2x2 & t -4" Dn

Fd. Remains of 2x2, 8" Dn.

47.54

43°30'

18.23

28.00

31.42

Fd 2x2 & t 6" Dn

34.94

37

L.H.

89°38'

Fd N & T Top Fn. P.

Fd 2x2 & t -10° Dn.
Pct F.G. 700-37
Set 3/4" I.P. & t -18" Dn.
Reset 2x2 & t -4" Dn.

ST.

Int 4 P.M. on M.H. Rim

PARMALEE AVE

.03

.02

ZAMORE AVE

.02

.01

HOOPER AVE.

.04

ALVARO ST

.02

Fd P.M. on M.H. Rims

114TH

(25) (25)

From Rt. Pg. 25

FORM 247 5M 1949

RETURN TO
LOS ANGELES COUNTY SURVEYOR
700 HALL OF RECORDS

**Note:** Any Additions or Changes on This Sheet Must be Made or Circled in **Red Ink** With Date and Name of Person Making Change.

**Do not extend notes this side of this line.**

W.S. 26C-1

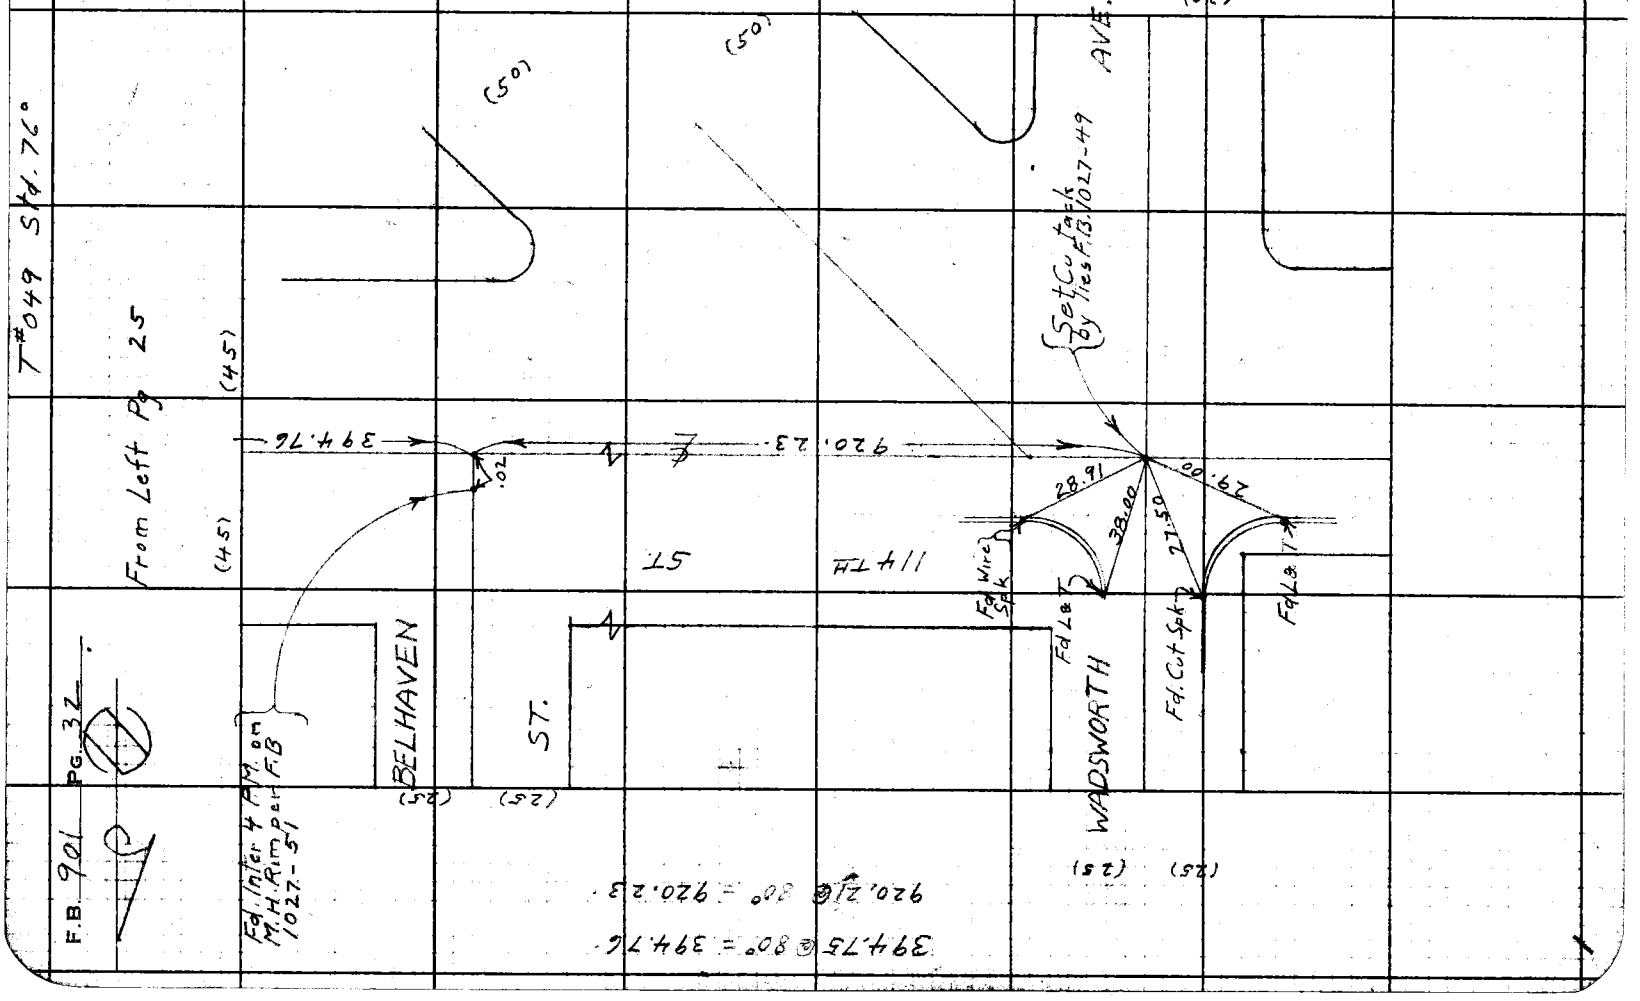

| | |
|---|---|
| Notes Ck'd by C. M. Finley | Survey of Central Ave |
| Map No. B-1811-1 | W. O. 8326 Tape No. 049 Std 76°F |
| Office Work L. W. M. | Surveyed by Ed McNeal |
| Checked D. M. Finley | Notes Mc Date 11-12-41 |
| Date AUG '43 | Indexed C. Johnson |

F.B. 901 PG. 33

Note: Any Additions or Changes on This Sheet Must be Made in Red Ink With Date and Name of Person Making Change

Do not extend notes this side of this line.

RETURN TO
LOS ANGELES COUNTY SURVEYOR
700 HALL OF RECORDS

FORM 247 5M 10-39

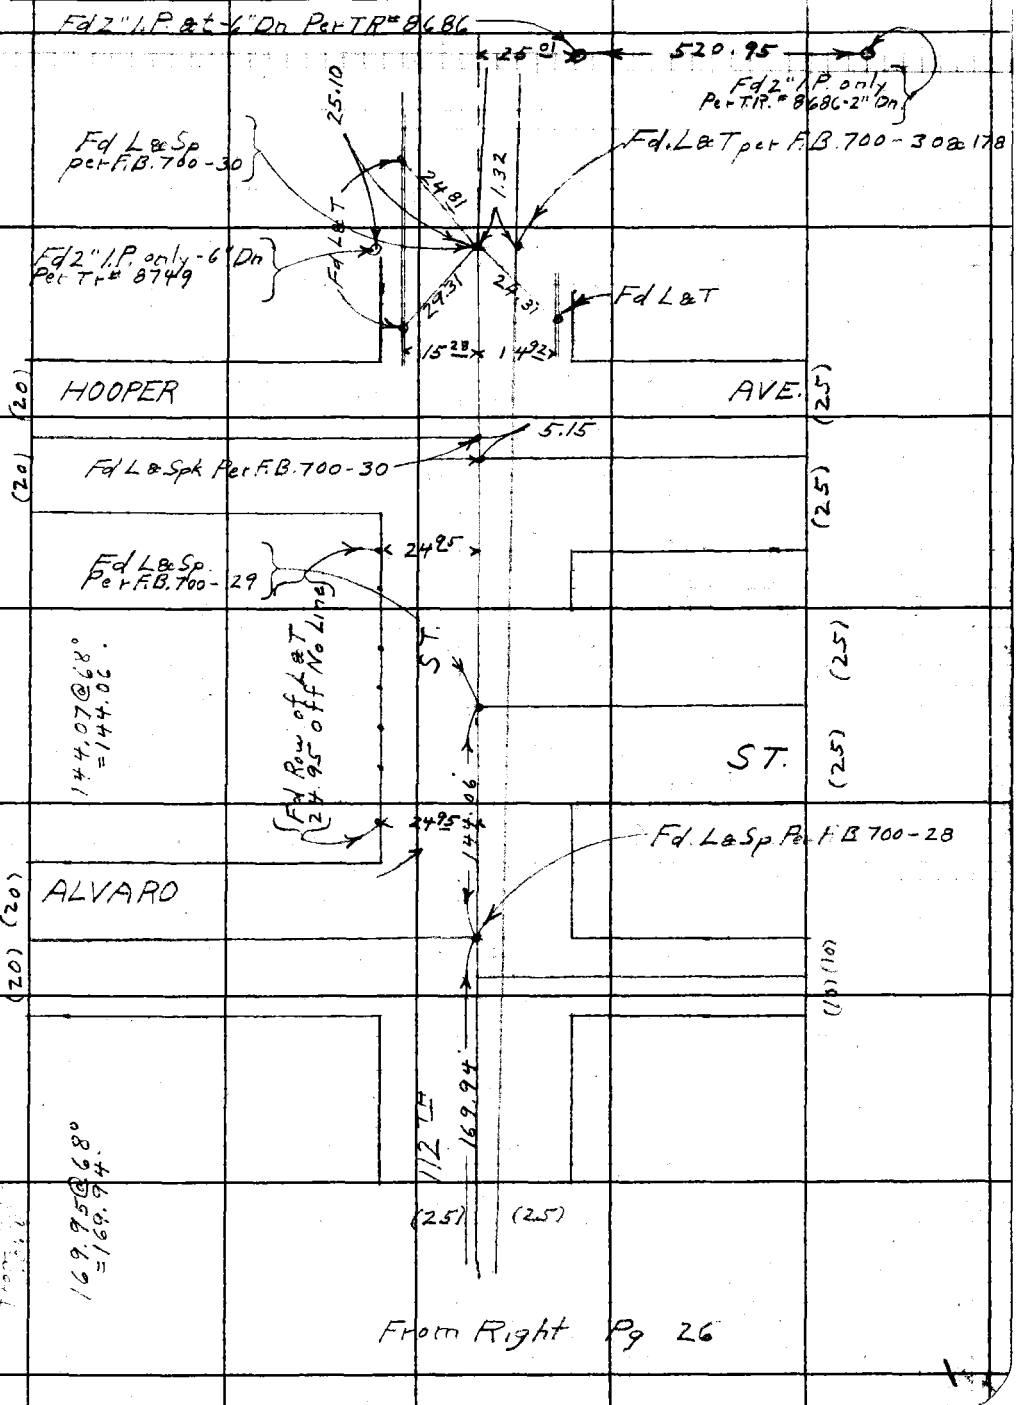

RETURN TO
LOS ANGELES COUNTY SURVEYOR
700 HALL OF RECORDS

**Note:** Any Additions or Changes on This Sheet Must be Made or Circled in **Red Ink** With Date and Name of Person Making Change.

**Do not extend notes this side of this line.**

W.S. 26C-1

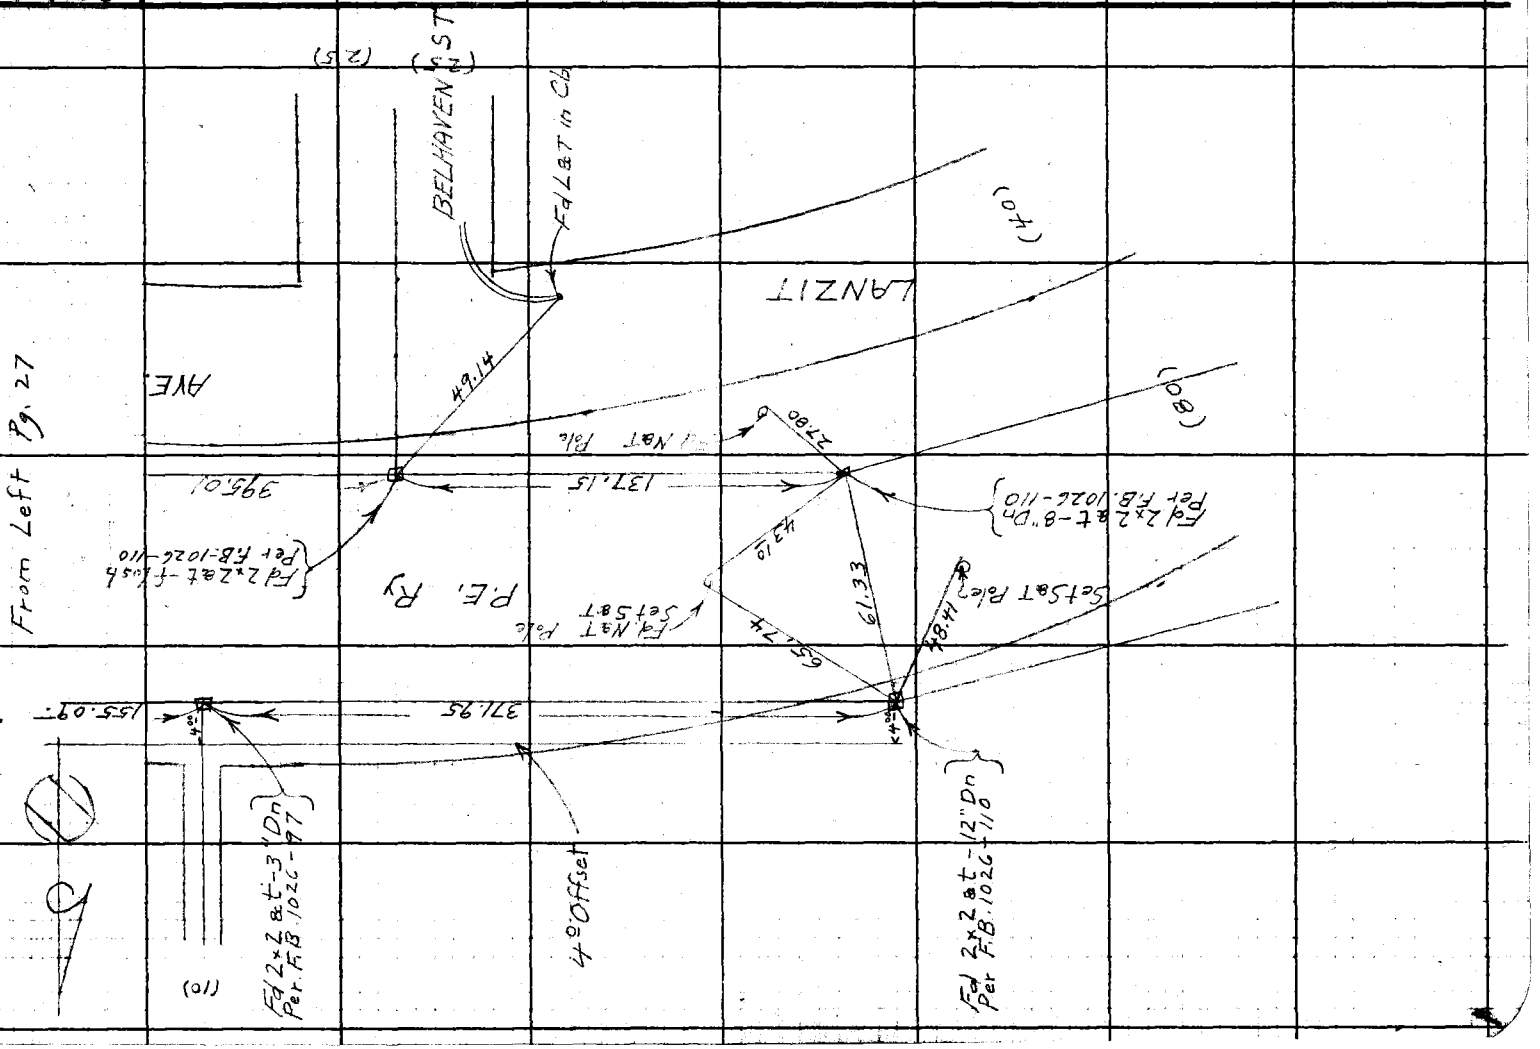


F.B. 901 Pg. 34

| | |
|---|---|
| Notes Ck'd by E. M. Finley | Survey of Central Ave |
| Map No. B-184-1 & 2 | W. O. 8326 Tape No. 049 Std 76 °F |
| Office Work B. W. M. | Surveyed by F. V. McNeal |
| Checked D. M. Finley | Notes Mc Date 11-14-41 |
| Date AUG '42 | Indexed [illegible] |

F.B. 701 PG. 35

W.S. 26 C-1

Set B.S.&T. in Trolley P.

77.34 79.11

34.85 36.40

Set B.S.&T. in Trolley P.

B.C. of Ry.
Ed. 3" Casing
filled with Conc
and nail 6" up
Per L.B. 5514-188.

Ry.

Fd. Wire Spk by
Tie. L.B. 5514-218.7

SLATER ST.

(2.5) (2.5)

46.85 40.01 2.70 2.53 47.50 39.99

Fd. 2" I.P. Fd. 2" I.P.

(50) HOOPER AVE.

P.E.

(40) (40)

From Rt. Pg 27

Note: Any Additions or Changes on This Sheet Must be Made or Circled in Red Ink With Date and Name of Person Making Change

Do not extend notes this side of this line.

RETURN TO
LOS ANGELES COUNTY SURVEYOR
700 HALL OF RECORDS

FORM 247 5M 10-39

RETURN TO
**LOS ANGELES COUNTY SURVEYOR**
700 HALL OF RECORDS

**Note:** Any Additions or Changes on This Sheet Must be Made or Circled in **Red Ink** With Date and Name of Person Making Change.

**Do not extend notes this side of this line.**

W.S. 260-1

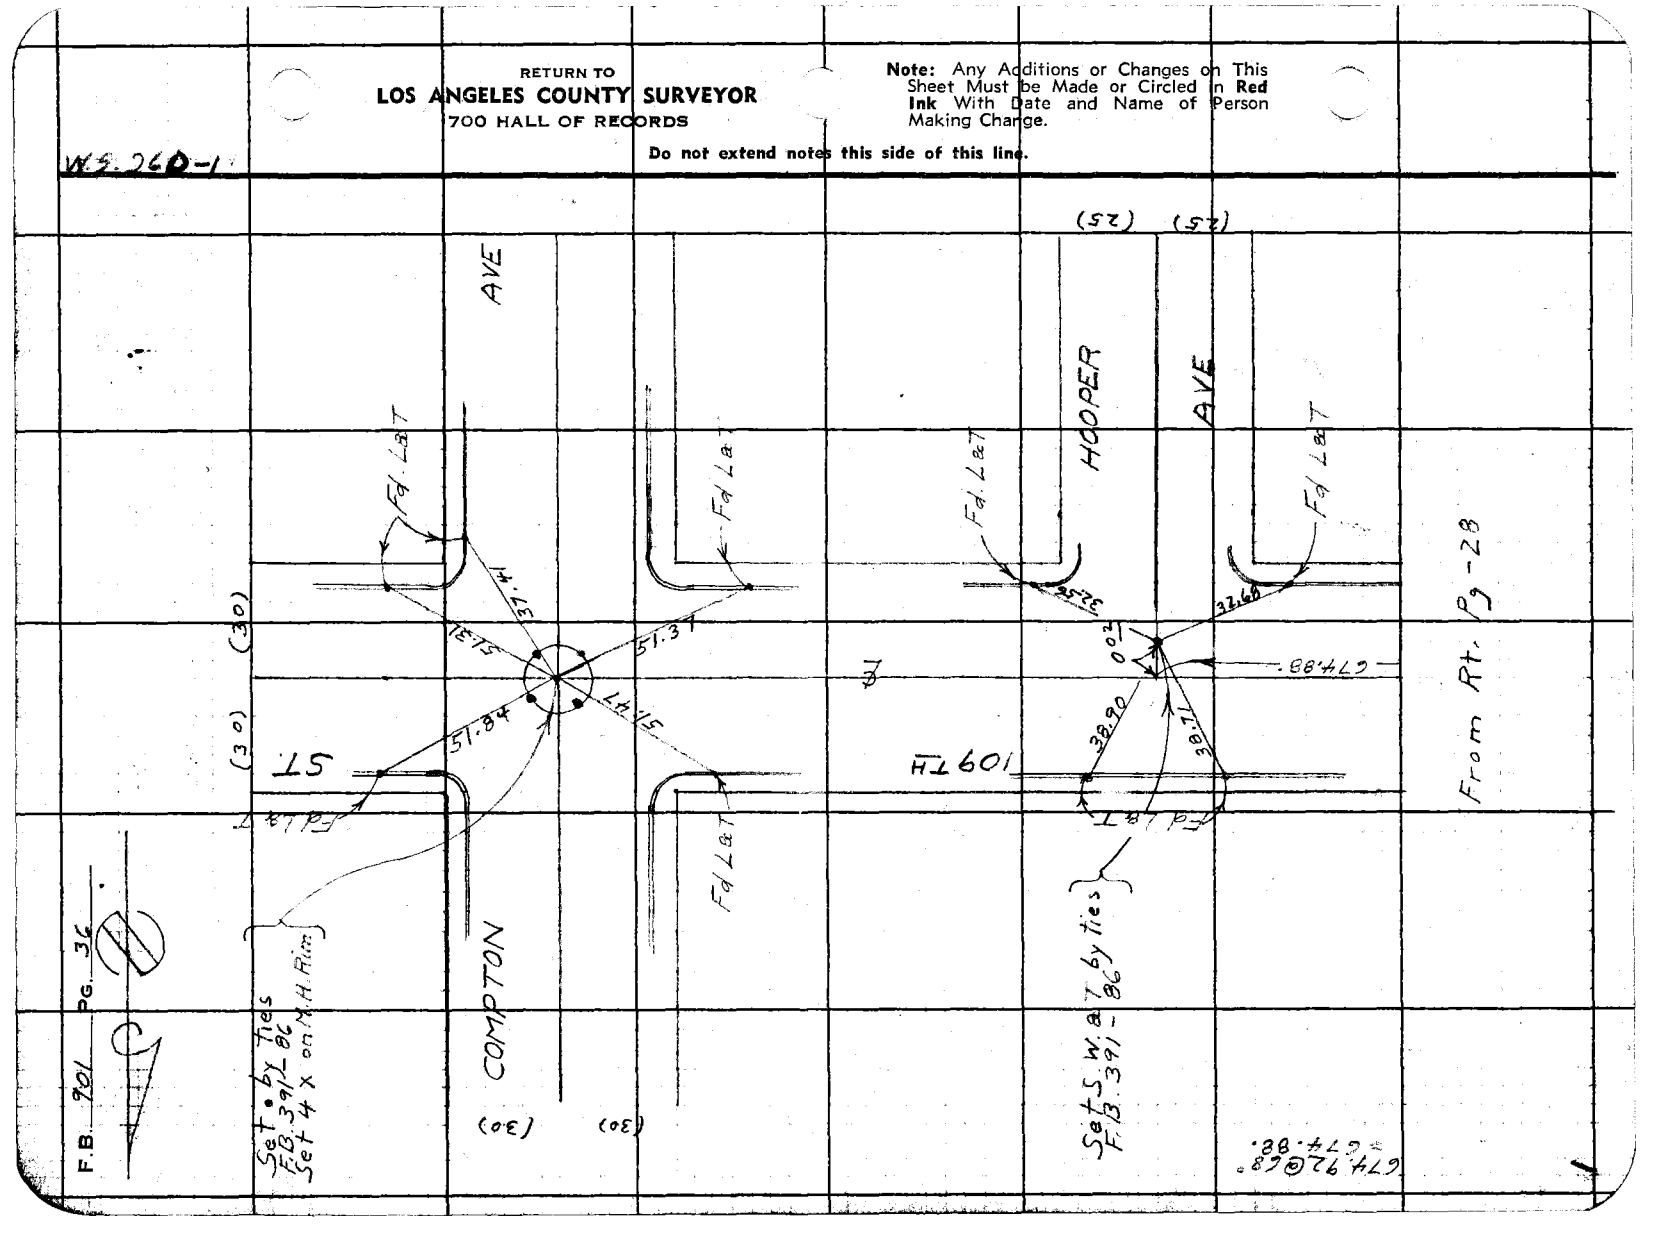

WS-26 D-1

| | |
|---|---|
| Notes Ck'd by L. M. Finley | Survey of Central Ave |
| Map No. B-1811-2 | W. O. 8326 Tape No. 049 Std 76 °F |
| Office Work R. W. M. | Surveyed by F. J. McNeal |
| Checked D. M. Finley | Notes Mc E. Johnson Date 11-17-41 |
| Date AUG. '49 | Indexed |

F.B. 901 Pg. 31

Note: Any Additions or Changes on This Sheet Must be Made or Circled in Red Ink With Date and Name of Person Making Change

Do not extend notes this side of this line.

RETURN TO
LOS ANGELES COUNTY SURVEYOR
700 HALL OF RECORDS

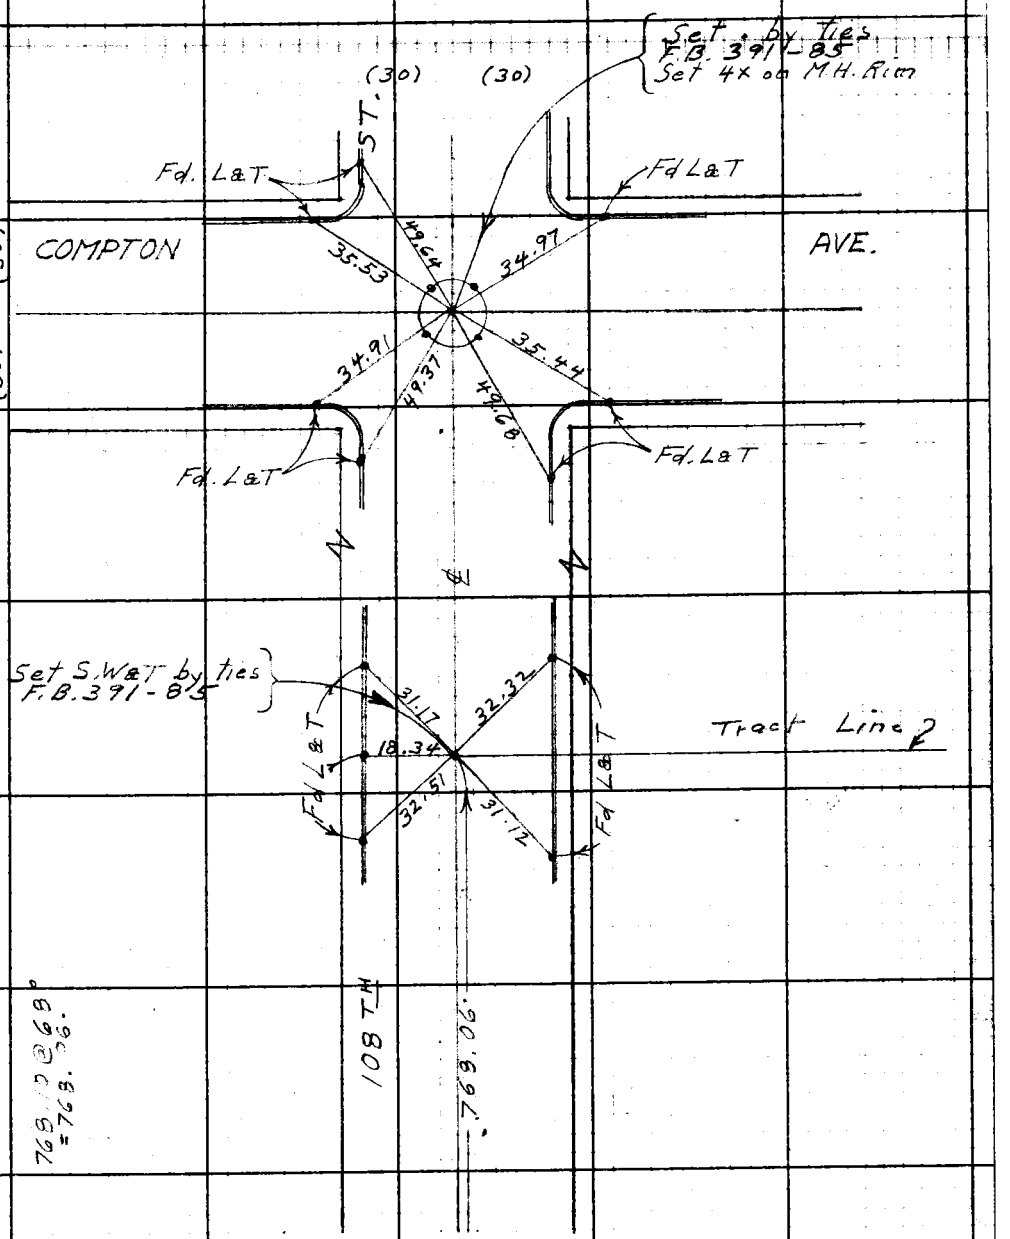


From Right Pg 28

FORM 247 5M 10-48

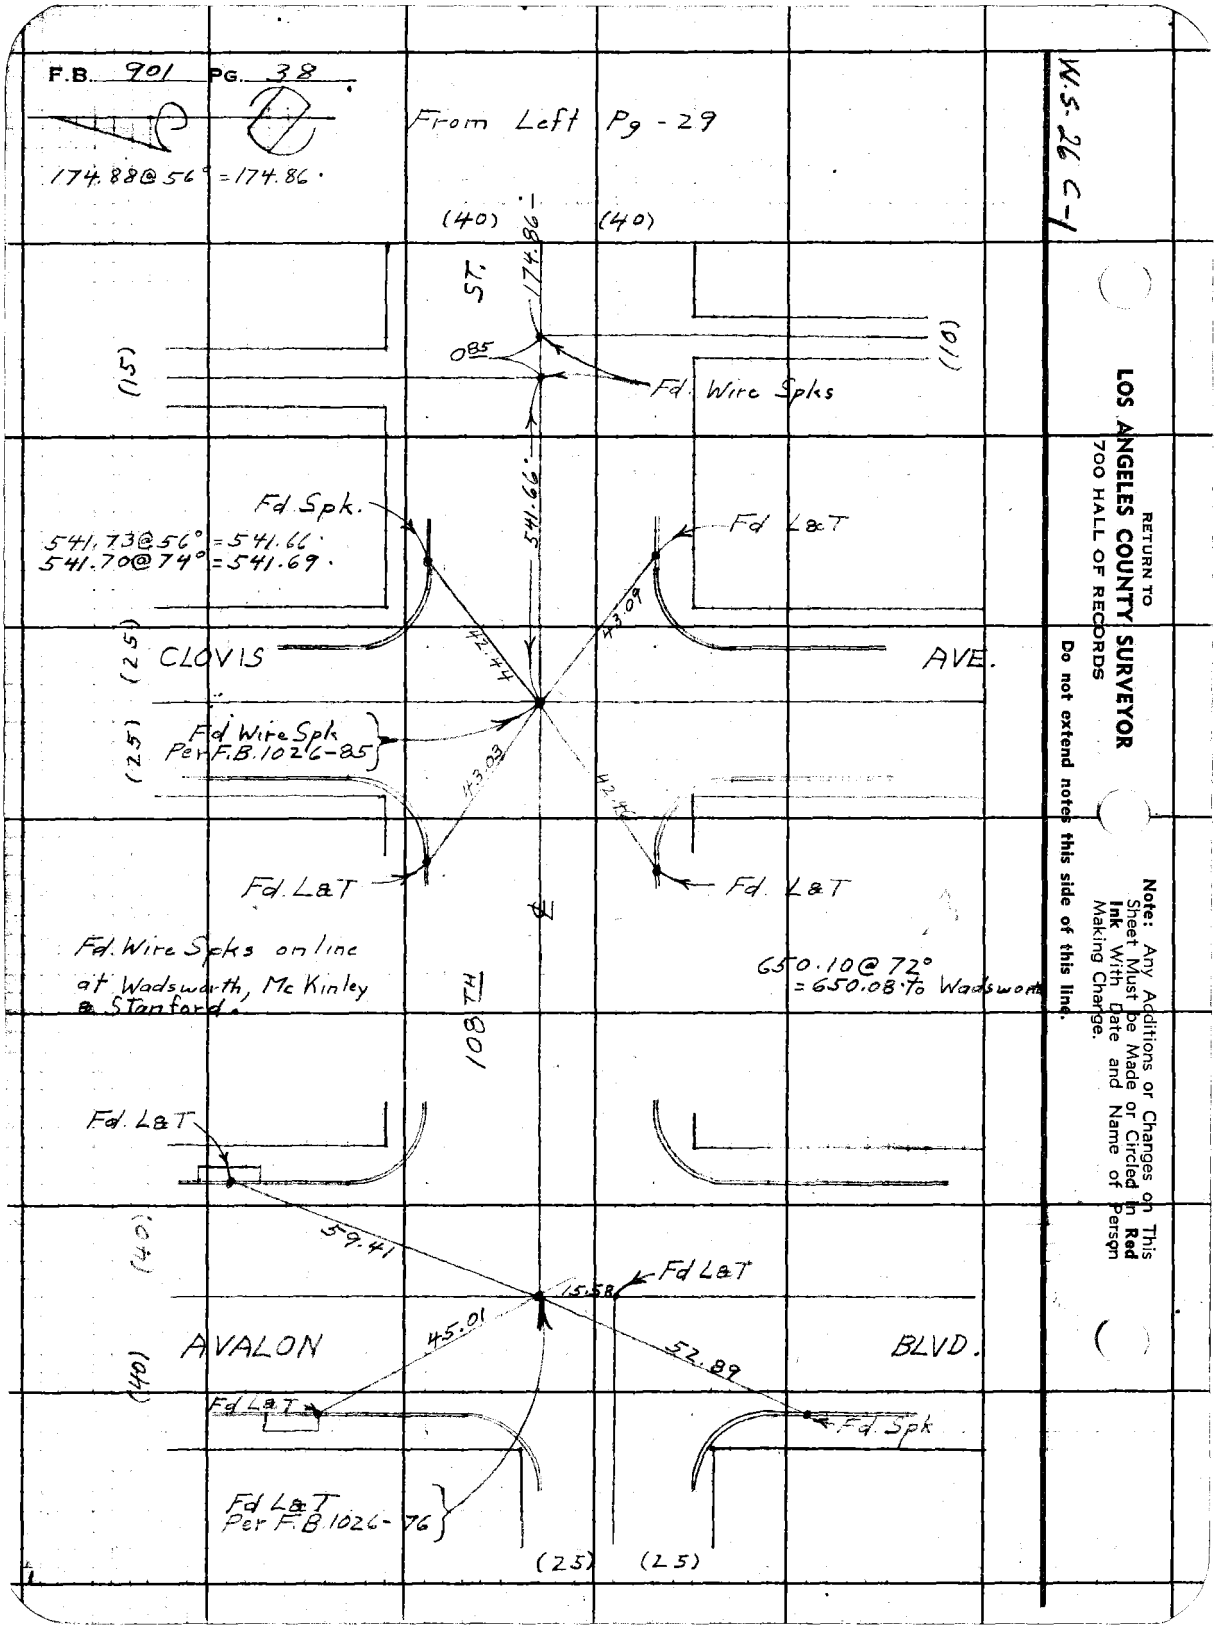
F.B. 901 PG. 38
174.88@56° = 174.86.
From Left Pg - 29
(40)
(40)
W.S. 26 C-1
RETURN TO
LOS ANGELES COUNTY SURVEYOR
700 HALL OF RECORDS
Do not extend notes this side of this line.
Note: Any Additions or Changes on This Sheet Must be Made or Circled in Red Ink With Date and Name of Person Making Change.
174.86
085
Fd. Wire Spks
(15)
(10)
Fd Spk.
541.73@56° = 541.66.
541.70@74° = 541.69.
541.69
Fd L&T
43.09
42.44
CLOVIS
AVE.
(25)
(25)
Fd Wire Spk
Per F.B. 1026-85
43.03
42.42
Fd. L&T
Fd. L&T
Fd. Wire Spks on line
at Wadsworth, Mc Kinley
& Stanford.
650.10@72°
= 650.08 To Wadsworth
HL 801
Fd. L&T
59.41
(10)
Fd L&T
15.58
45.01
52.89
AVALON
BLVD.
(40)
Fd L&T
Fd Spk
Fd L&T
Per F.B. 1026-76
(25)
(25)

FORM 247 5M 10-39

RETURN TO
**LOS ANGELES COUNTY SURVEYOR**
700 HALL OF RECORDS

**Note:** Any Additions or Changes on This Sheet Must be Made or Circled in **Red** Ink With Date and Name of Person Making Change.

**Do not extend notes this side of this line.**

WS-36 C-1

157.19 @ @ 70° = 157.17'

Notes Ck'd by
Map No. B-181-2
Office Work R. W. M.
Checked D. M. Finley



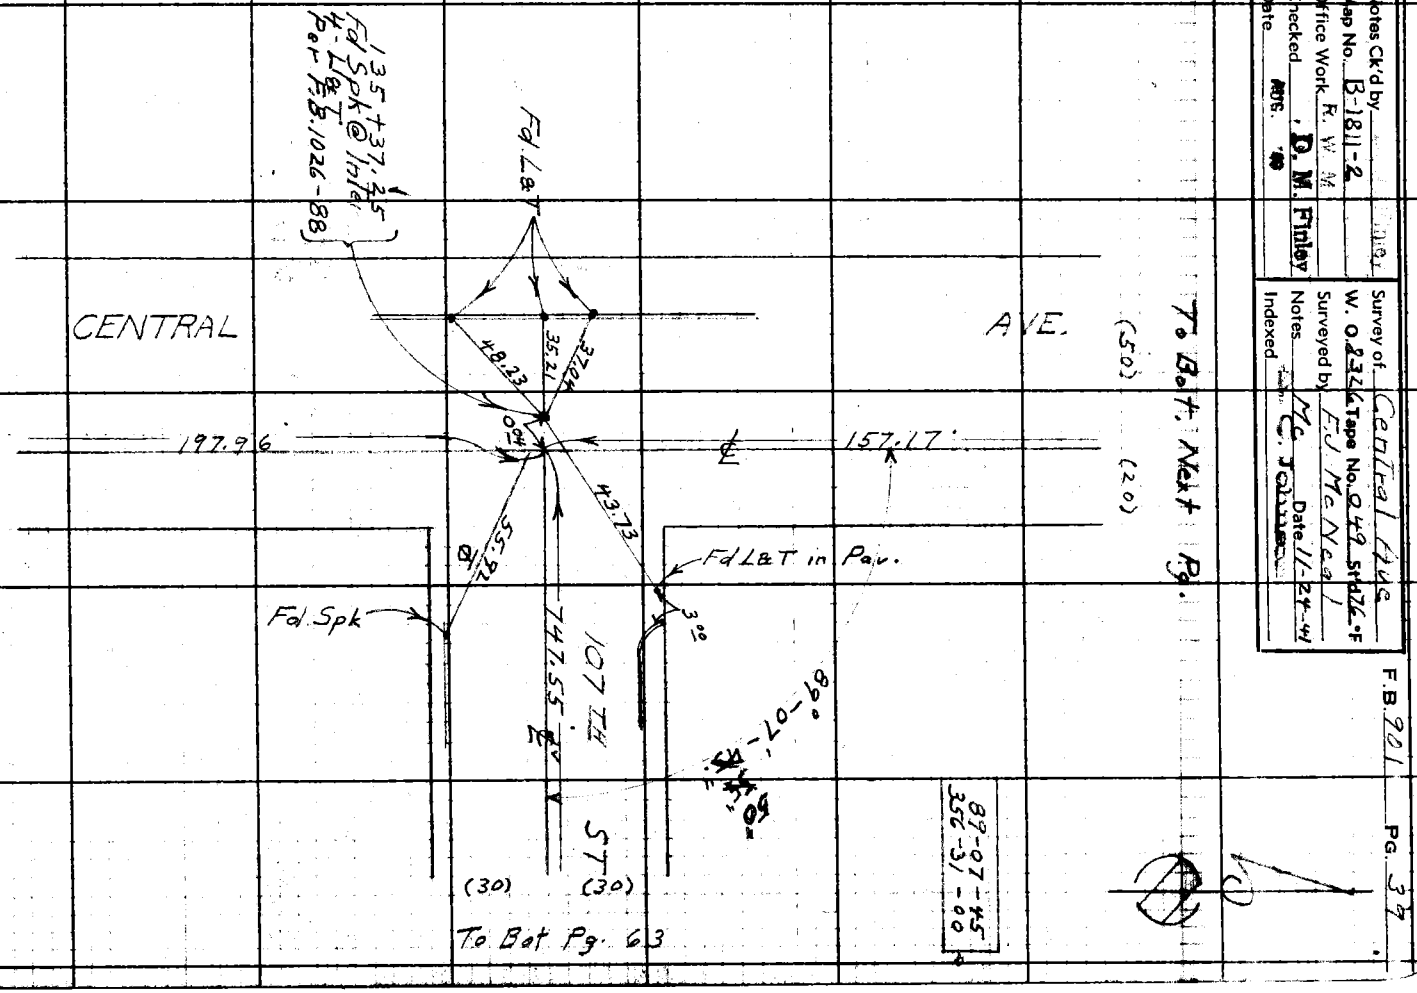

F.B. 901 PG. 40

To Bot. Next Pg

89-30-30
358-01-30
177-02-30

138+54.06
Fd L&T
Per F.B. 1026-74

W.S. 26C-1

49 6 left 7

RETURN TO
LOS ANGELES COUNTY SURVEYOR
700 HALL OF RECORDS

Do not extend notes this side of this line.

Note: Any Additions or Changes on This Sheet Must be Made or Circled in Red Ink With Date and Name of Person Making Change.

(50) (20)

150.26

Fd L&T

49.77

89°30'00"

30'

(25)

747.52

Transit Line

106TH ST.

(25)

49.90

.01

Fd L&T

150.26 T 72°
= 150.26

90-17-00
361-07-30

CENTRAL AVE.

159.64

Fd L&T

Walk

49 159.64 T 72
= 159.64

45"

52'

90-16

71.57

138+94.42
Fd L&T
Per F.B. 1026-73

To Top Pg

(25)

107TH ST.

179.31

1426

Fd. L&T & Prod.

72.45

(25)

157.17

Fd. L&T

Walk

From Top Last Pg

W.S. 26 B-1

| | | | |
|---|---|---|---|
| Notes Ck'd by | | Survey of Central Ave | F.B. 901 Pg. 41 |
| Map No. B-1811-2 | | W. 08326 Tape No. 049 St'd 76°F | |
| Office Work | | Surveyed by F.I. McNeal | 89-30-30 |
| Checked D. M. Finley | | Notes Mc Date 11-24-48 | 358-02-00 |
| Date AUG '49 | | Indexed C J [illegible] | 177-02-45 |

To Bot. Next Pg.

89-30-00
358-00-00

Fd L&T (50 (20)

145.36

89°-30'-00"

49.91

49.87

.02

747.54

(25)

(25)

Transit Line
105TH ST

To Left Pg. 64

Fd L&T

141+79.04
Fd L&T
Per F.B. 1026-66

145.36 T 78°
= 145.36'

90-16-30
361-25-45

2@78°
= 174.72'

90°-16'-30"

CENTRAL AVE.

174.72

140+04.32
Fd L&T
Per F.B. 1026-65

Fd. L&T

50.65

59.41

To Top Pg 51

(25)

106TH ST.

177.46

14°31'

Fd L&T in Pav. on ℄ Prod.

(25)

49.89

Fd. Spk.

150.26

From Top Last Pg.

Note: Any Additions or Changes on This Sheet Must be Made or Circled in Red Ink With Date and Name of Person Making Change.

Do not extend notes this side of this line.

RETURN TO
LOS ANGELES COUNTY SURVEYOR
700 HALL OF RECORDS

FORM 247 5M 10-39

F.B. 901 PG. 42

To Bot. Next Pg.

89-30-15
358-01-00

WS-26 C-1

(50) | (20)

145.00 T 90°
=145.00'

Fd. L&T

49.89

145.00

145+04.03
Fd L&T
Per F.B 1026-58

89°-30-15 = 30'

Transit Line
747.58

(25) (25)

104TH ST.

49.89

Fd L&T

To Left Pg 64

AVE.

℄

179.63 T 80°
=179.63'

90-16-15
361-05-15

90°-16'-30" = 30'

CENTRAL

179.63

Fd. L&T

143+24.40
Fd. L&T
Per F.B 1026-57

50.70

To Top Pg 53

105TH ST.

(25)

180.61

℄

14.09

Fd L&T & Prog.

(25)

51.11

76.28

145.32

Fd. L&T

16.65

Fd. C.S. △ Mon in H.H.
(Watts G & Aux No 3)

From Top Last Pg.

RETURN TO
LOS ANGELES COUNTY SURVEYOR
700 HALL OF RECORDS

Do not extend notes this side of this line.

Note: Any Additions or Changes on This Sheet Must be Made or Circled in Red Ink With Date and Name of Person Making Change.

| | | | |
|---|---|---|---|
| Notes Ck'd by | | Survey of Central Ave | F.B. 901 PG. 43 |
| Map No. B-1811-2 | | W. O. 8320 Tape No. 049 Std. 76°F | |
| Office Work R. W. M. | | Surveyed by F. J. McNee | |
| Checked D. M. Finley | | Notes Mc Date 11-25-41 | |
| Date AUG '49 | | Indexed E. Johnson 2-6-42 | |

W.S. 26C-1

To Bat Next Pg

Fd. L&T (50) (20)

115.11 T 76°
= 115.11

42.84

103RD PL

747.55

Transit Line

(25) (25)

To Bat Pg 65

42.86

Fd. L&T

AVE.

148+29.02
Fd L&T
Per F.B. 1026-50

90-16-30
361-06-30

162.50 T 76°
= 162.50
+17.49
179.99

90°-16'-30"

90-29-30
361-57-30

CENTRAL

179.99

Fd. L&T

104TH

(30)

51.14

58.05

146+49.03
Fd. L&T
Per F.B. 1026-49

177.50

51.96

.02

Fd L&T in Par.

(30)

ST.

Fd. L&T

53.79

Fd Spk

145.00

From Top Last Pg.

To Top Pg 55

Note: Any Additions or Changes on This Sheet Must be Made or Circled in Red Ink With Date and Name of Person Making Change.

Do not extend notes this side of this line.

RETURN TO
LOS ANGELES COUNTY SURVEYOR
700 HALL OF RECORDS

FORM 247 5M 10-39

RETURN TO
LOS ANGELES COUNTY SURVEYOR
700 HALL OF RECORDS

Note: Any Additions or Changes on This Sheet Must be Made or Circled in Red Ink With Date and Name of Person Making Change.

Do not extend notes this side of this line.

W.S. 26C-1

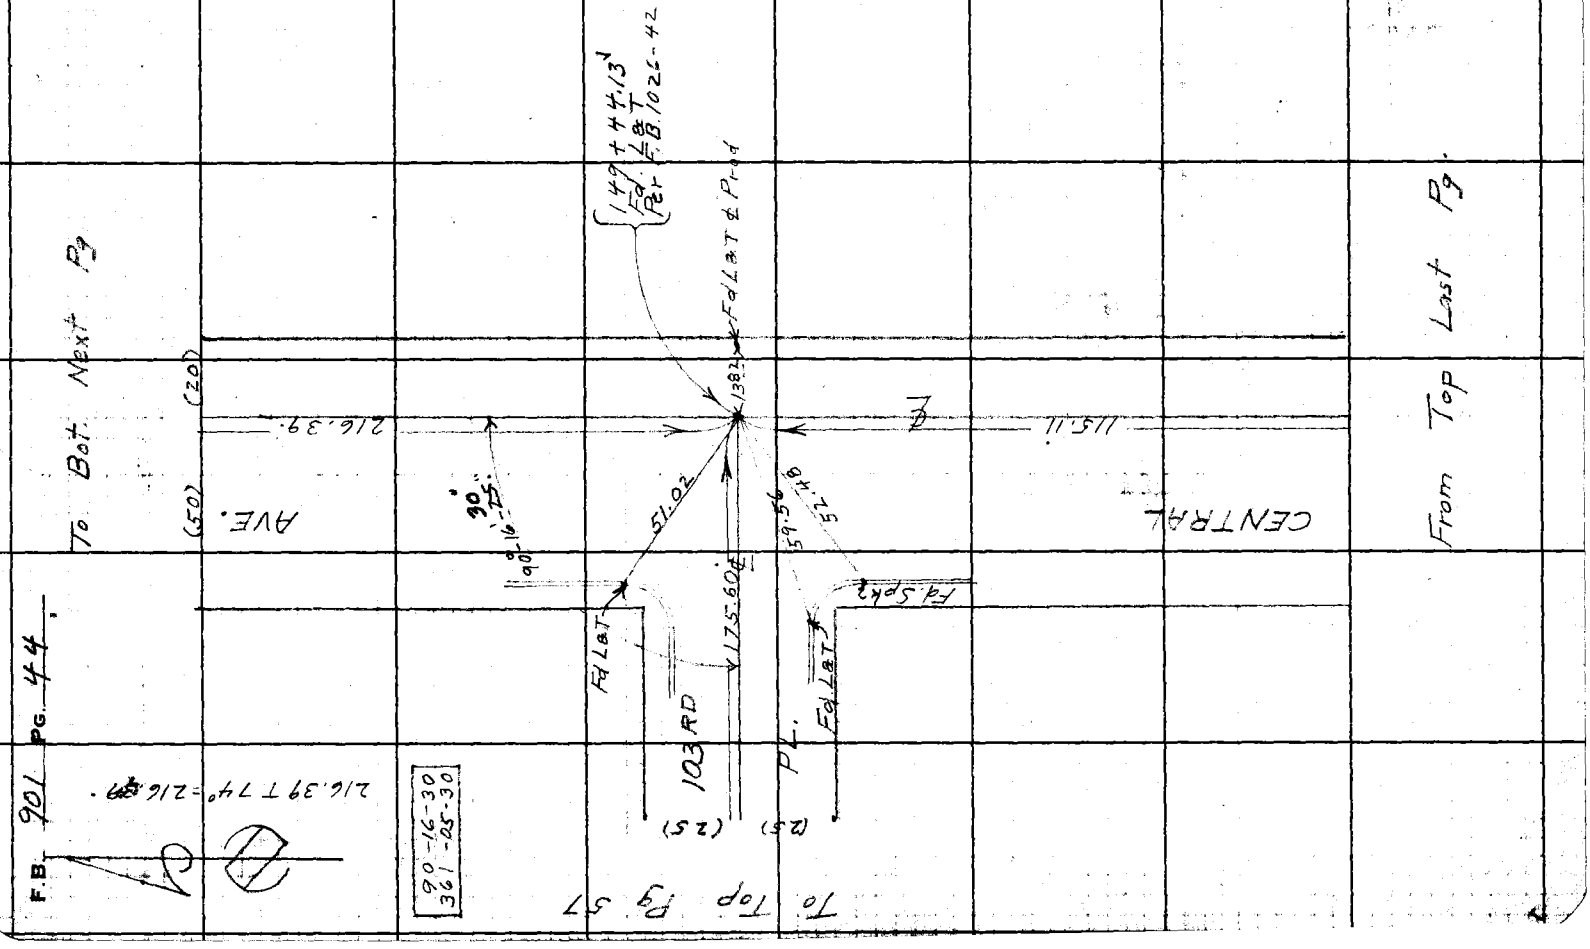

FORM 247 5M 10-39

RETURN TO
**LOS ANGELES COUNTY SURVEYOR**
700 HALL OF RECORDS

**Note:** Any Additions or Changes on This Sheet Must be Made or Circled in **Red Ink** With Date and Name of Person Making Change.

**Do not extend notes this side of this line.**

W.S. 26L-1

Notes Ck'd by D. M. Finley
Map No. B-1811-2
Office Work R. W. M.
Checked D. M. Finley
Date AUG '68

Survey of Central Ave.
W. O. 9726 Tape No. 049 Std. 76°F
Surveyed by F. J. Mc Nea
Notes
Indexed by Mc Date 1-21-44
E. Johnson

F.B. 721 Pg. 42

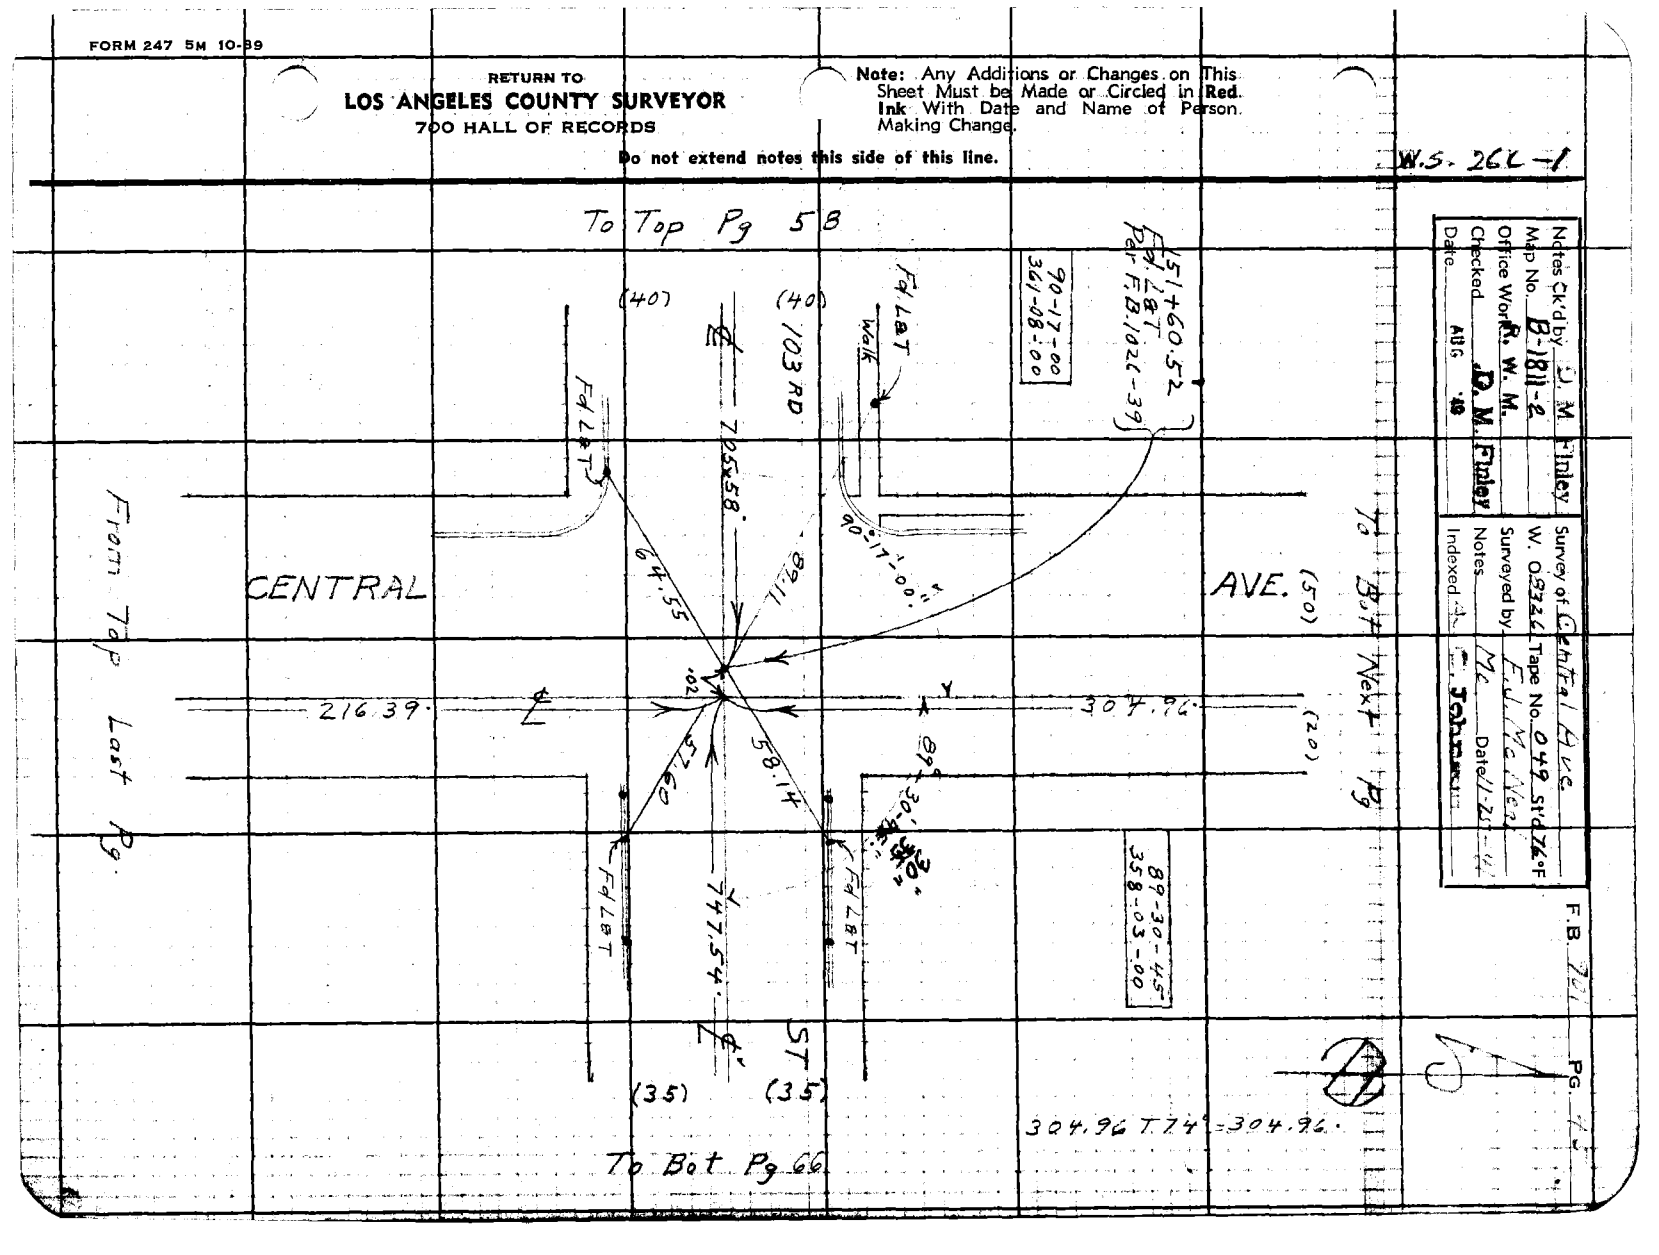

RETURN TO
**LOS ANGELES COUNTY SURVEYOR**
700 HALL OF RECORDS

**Note:** Any Additions or Changes on This Sheet Must be Made or Circled in **Red Ink** With Date and Name of Person Making Change.

**Do not extend notes this side of this line.**

W.S. 26C-1

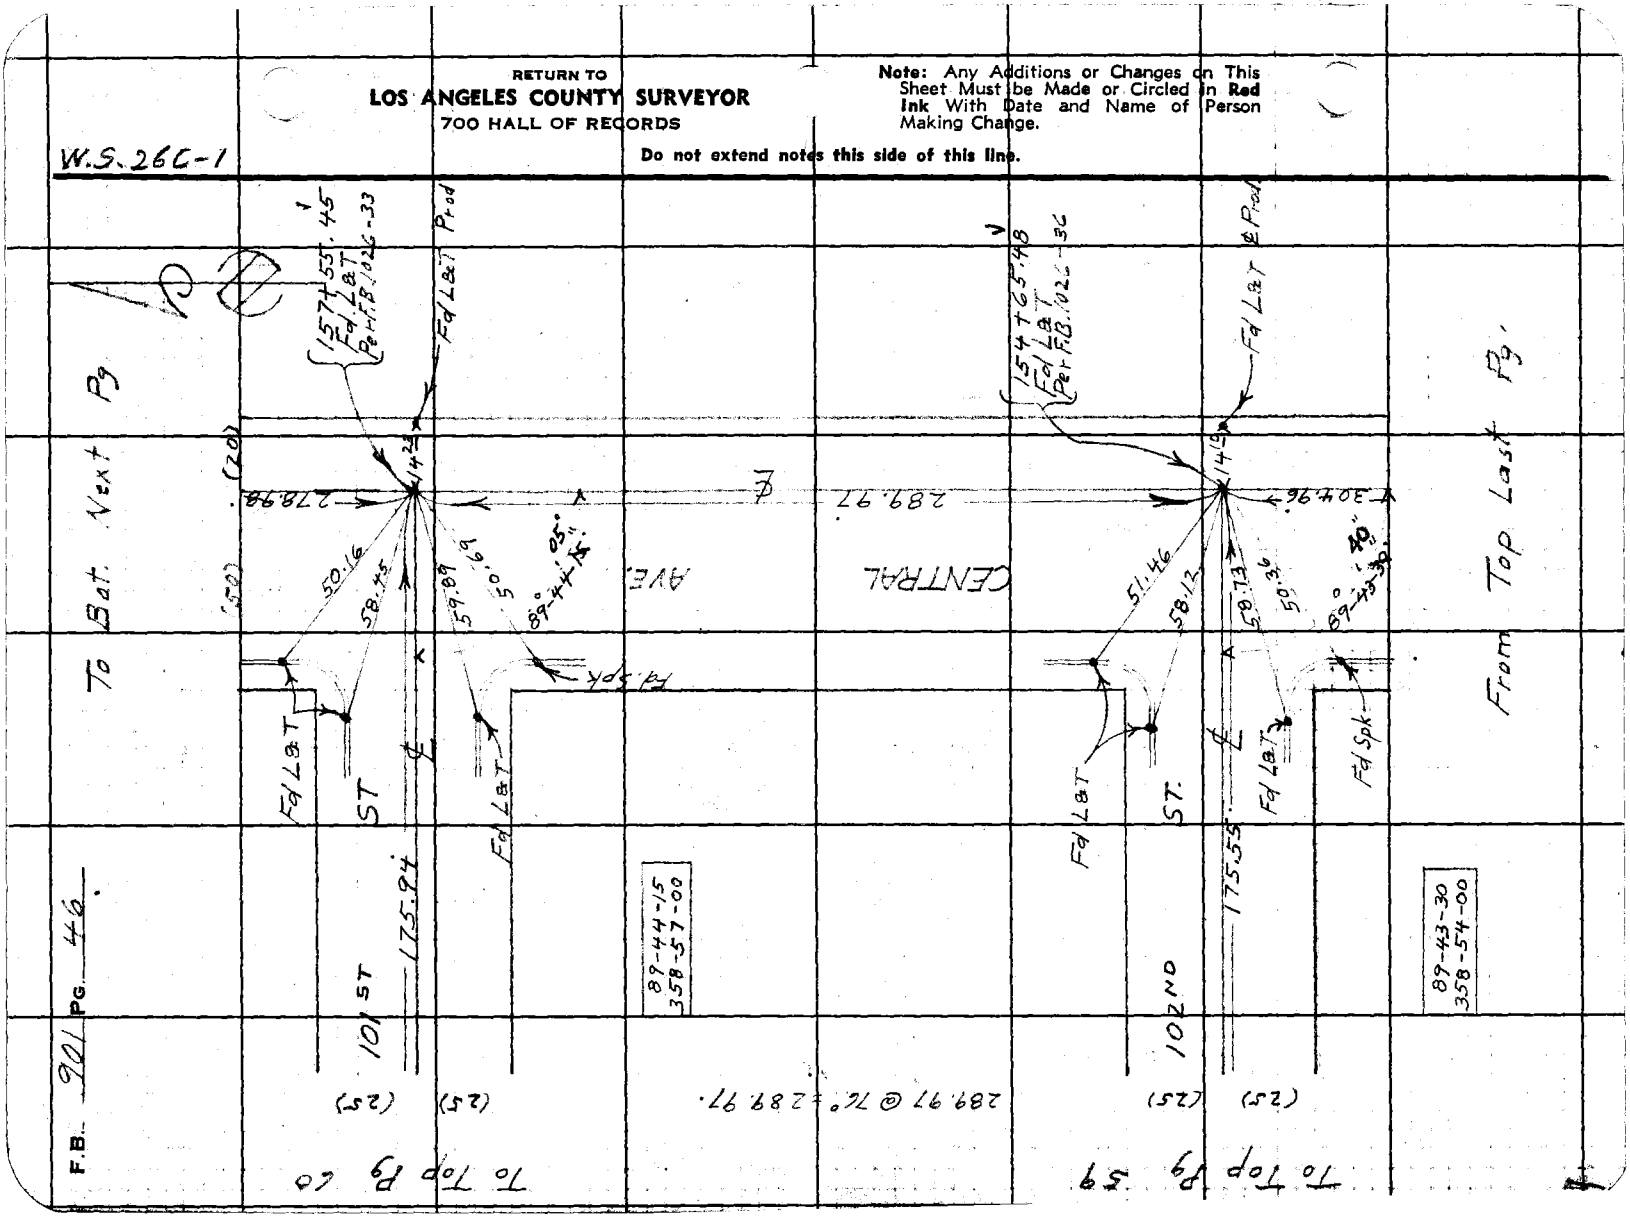

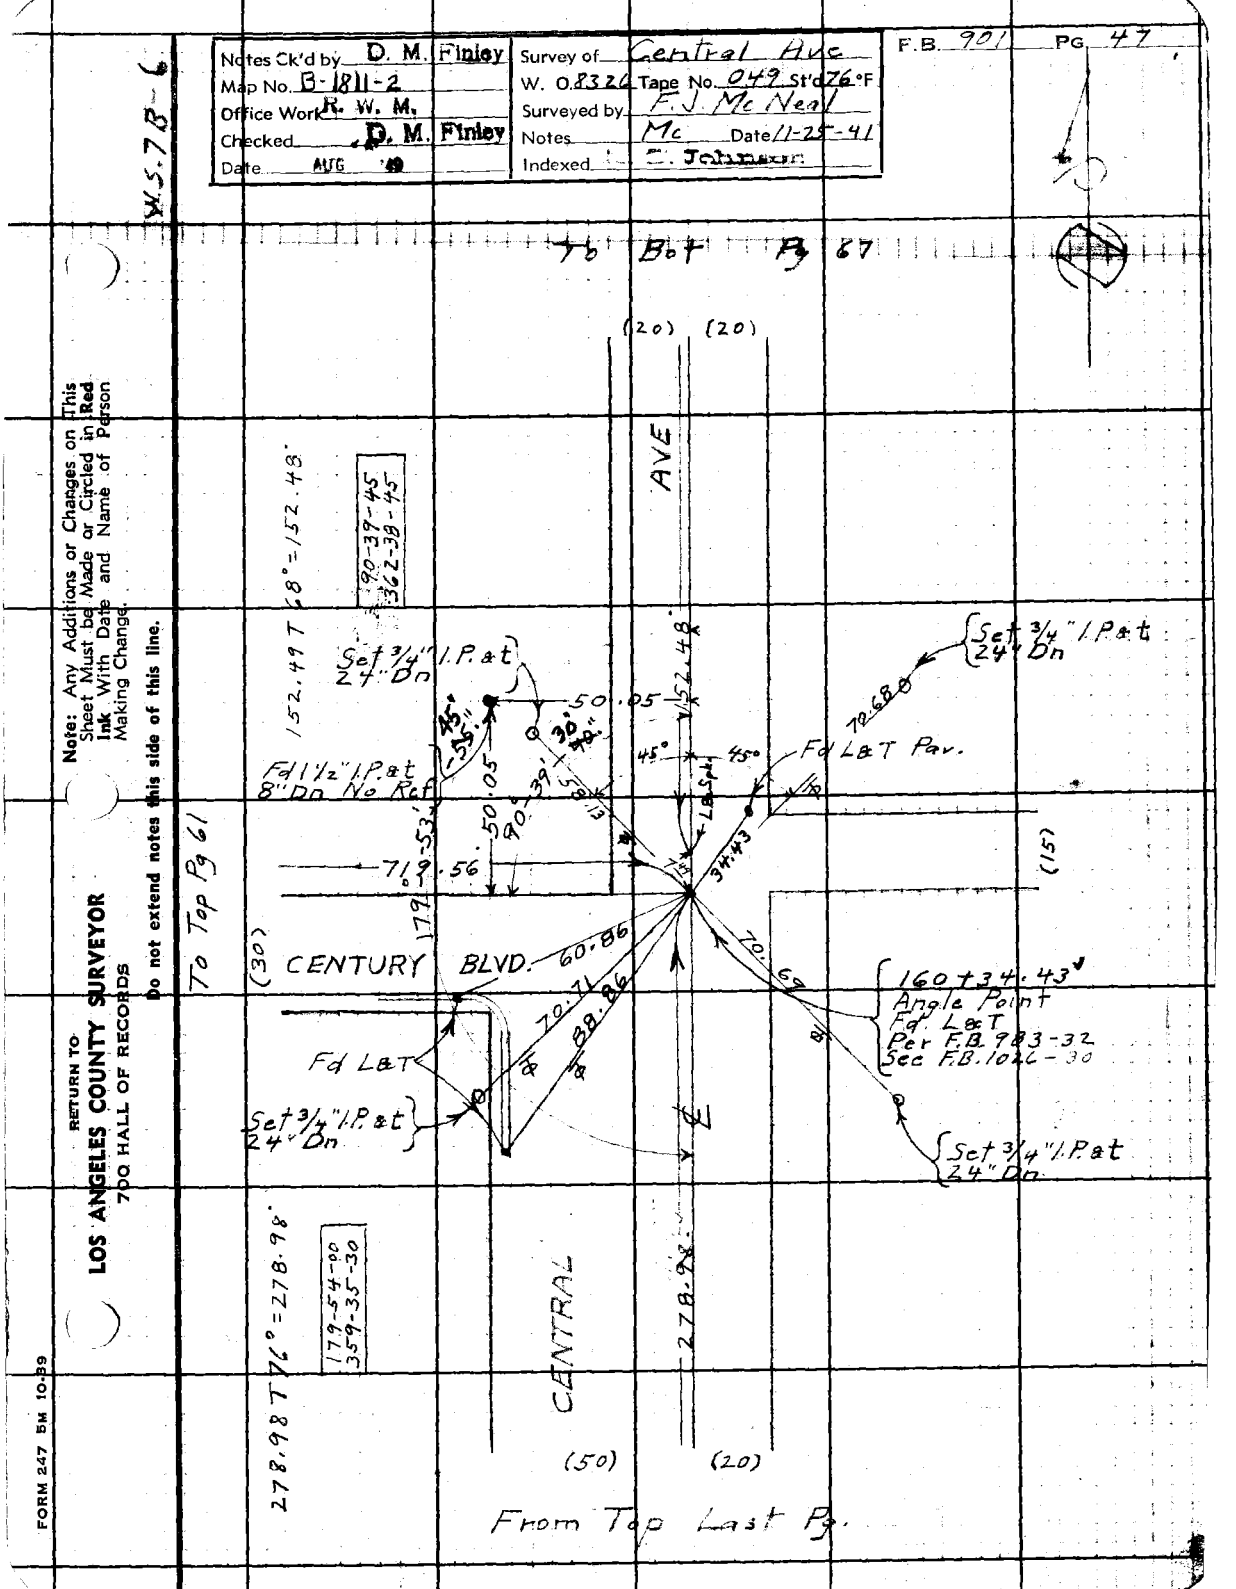
Notes Ck'd by D. M. Finley
Map No. B-1811-2
Office Work R. W. M.
Checked D. M. Finley
Date AUG
Survey of Central Ave
W. O. 8326 Tape No. 049 St'd 76°F
Surveyed by F. J. Mc Neal
Notes Mc Date 11-25-41
Indexed E. Johnson
F.B. 901 PG 47
W.S. 78-6
To Bk Pg 67
Note: Any Additions or Changes on This Sheet Must be Made or Circled in Red Ink With Date and Name of Person Making Change.
Do not extend notes this side of this line.
RETURN TO
LOS ANGELES COUNTY SURVEYOR
700 HALL OF RECORDS
FORM 247 5M 10-39
To Top Pg 61
(30)
CENTURY BLVD.
(20) (20)
AVE
CENTRAL
(50) (20)
(15)
152.49 T 68°=152.43'
90-39-45
362-38-45
278.98 T 76°=278.98'
179-54-00
359-35-30
Set 3/4" I.P. & t 24" Dn
Fd 1 1/2" I.P. & t 8" Dn No Ref
Fd L & T Pav.
Fd L & T
Set 3/4" I.P. & t 24" Dn
160 + 34.43 Angle Point Fd L & T Per F.B. 983-32 Sec F.B. 1026-30
Set 3/4" I.P. & t 24" Dn
50.05
50.05
71.56
60.86
70.71
88.86
34.43
70.68
152.48
278.98
From Top Last Pg.

RETURN TO
**LOS ANGELES COUNTY SURVEYOR**
700 HALL OF RECORDS

**Note:** Any Additions or Changes on This Sheet Must be Made or Circled in **Red Ink** With Date and Name of Person Making Change.

**Do not extend notes this side of this line.**

F.B. 201 PG. 48

W.S. 26 C-1

Notes Ck'd by D. M. Finley
Map No. B-1811-2
Office Work R. W. M.
Checked D. M. Finley
Date AUG '40

Survey of Central Ave
W. O. 8326 Tape No. 049 St'd 76 °F
Surveyed by F. J. McNeal
Notes Mc Date 11-29-41
Indexed C. Johnson

F.B. 901 PG. 49

From Left Pg. 40

179.32 @ 70° = 179.31'

541.93 @ 70° = 541.91'

Note: Any Additions or Changes on This Sheet Must be Made or Circled in Red Ink With Date and Name of Person Making Change

Do not extend notes this side of this line.

RETURN TO
LOS ANGELES COUNTY SURVEYOR
700 HALL OF RECORDS

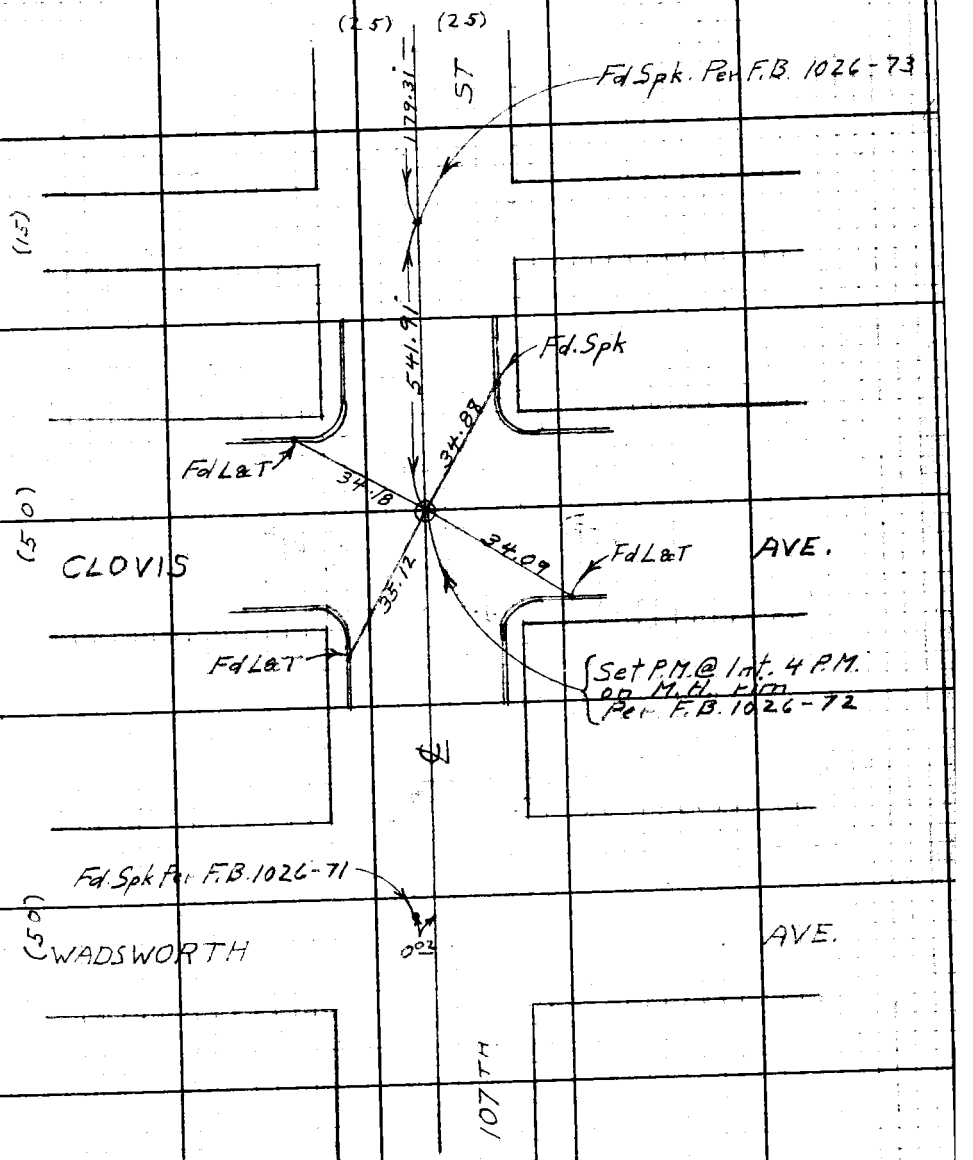


To Top Next Pg.

FORM 247 5M 10-39

F.B. 901 PG. 50

From Bot. Last Pg.

WS 266-1

RETURN TO
LOS ANGELES COUNTY SURVEYOR
700 HALL OF RECORDS

Note: Any Additions or Changes on This Sheet Must be Made or Circled in Red Ink With Date and Name of Person Making Change.

Do not extend notes this side of this line.

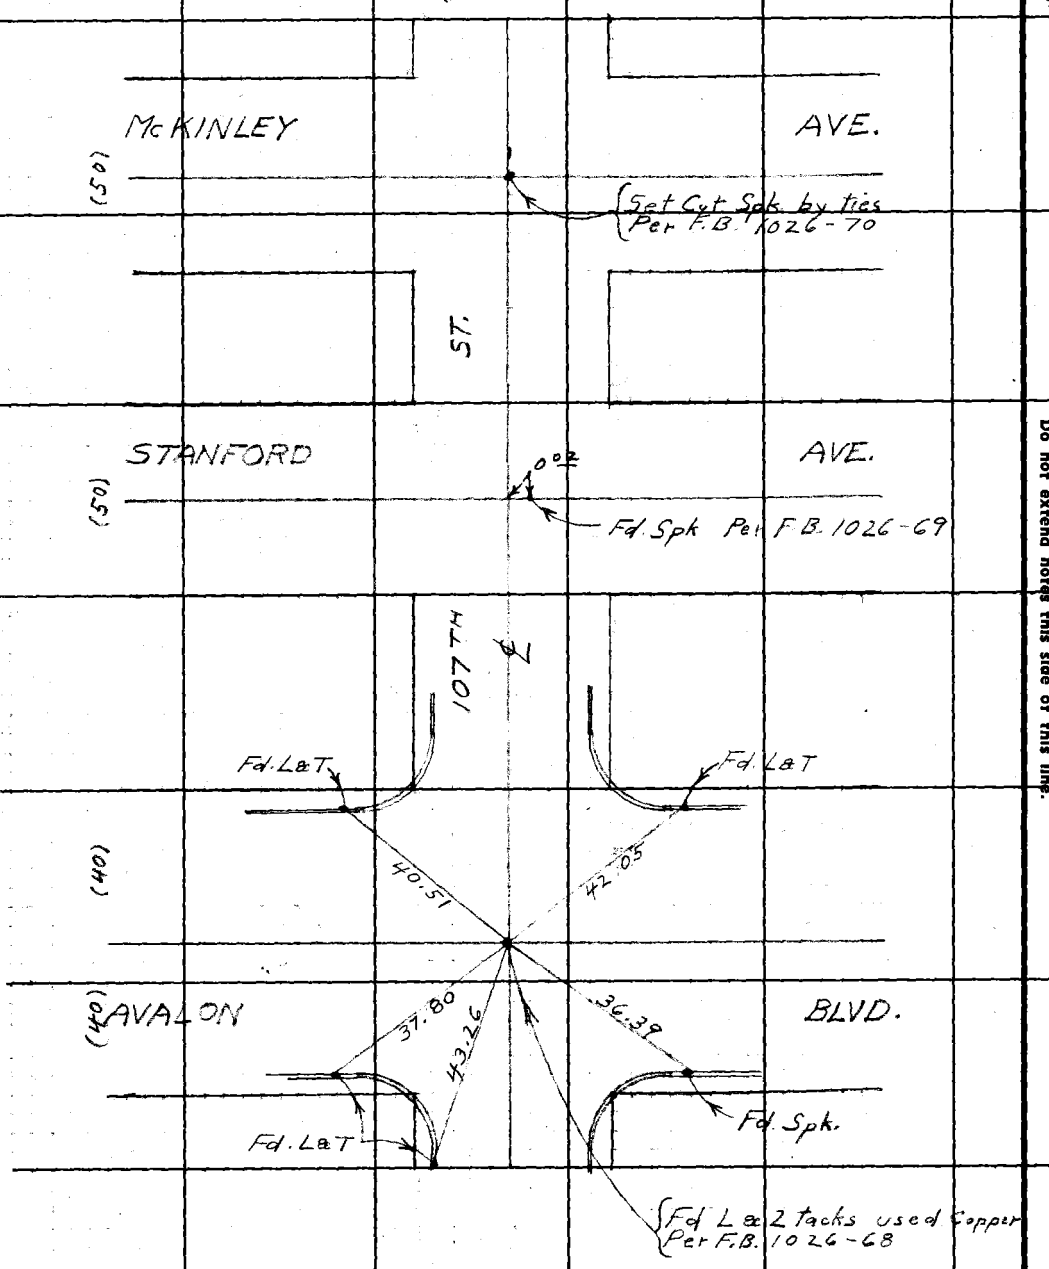

| | | | |
|---|---|---|---|
| Notes Ck'd by D. M. Finley | Survey of Central Ave. | F.B. 901 | Pg. 51 |
| Map No. B-1811-2 | W. O. 8320 Tape No. 049 St'd 76°F | | |
| Office Work R. W. M. | Surveyed by F. J. Mc Neal | | |
| Checked D. M. Finley | Notes Mc Date 11-26-41 | | |
| Date AUG '49 | Indexed C. Johnson | | |

W5.26 C-1

177.46 @ 72°
= 177.46'

542.12 @ 72°
= 542.11'

Note: Any Additions or Changes on This Sheet Must be Made or Circled in Red Ink With Date and Name of Person Making Change.

Do not extend notes this side of this line.

RETURN TO
LOS ANGELES COUNTY SURVEYOR
700 HALL OF RECORDS

FORM 247 5M 10-39

From Left Pg - 41

Fd. Wire Spk Per F.B. 1026-65

(25)

177.46'

(25)

ST.

4.91

(15)

(15)

Fd. L & T

542.11'

Fd Spk

33.01

.99

32.

Fd Inter. 4 P.M. on M.H. rim Per F.B. 1026-64

(50)

CLOVIS

AVE

32.99

32.63

Fd. L & T

Fd. L & T

℄

WADSWORTH

AVE.

(50)

Fd. Inter 4 P.M. on M.H. rim Per F.B. 1026-63

106 FT

To Top Next Pg-

RETURN TO
**LOS ANGELES COUNTY SURVEYOR**
700 HALL OF RECORDS

**Note:** Any Additions or Changes on This Sheet Must be Made or Circled in **Red Ink** With Date and Name of Person Making Change.

**Do not extend notes this side of this line.**

W.S. 26C-1

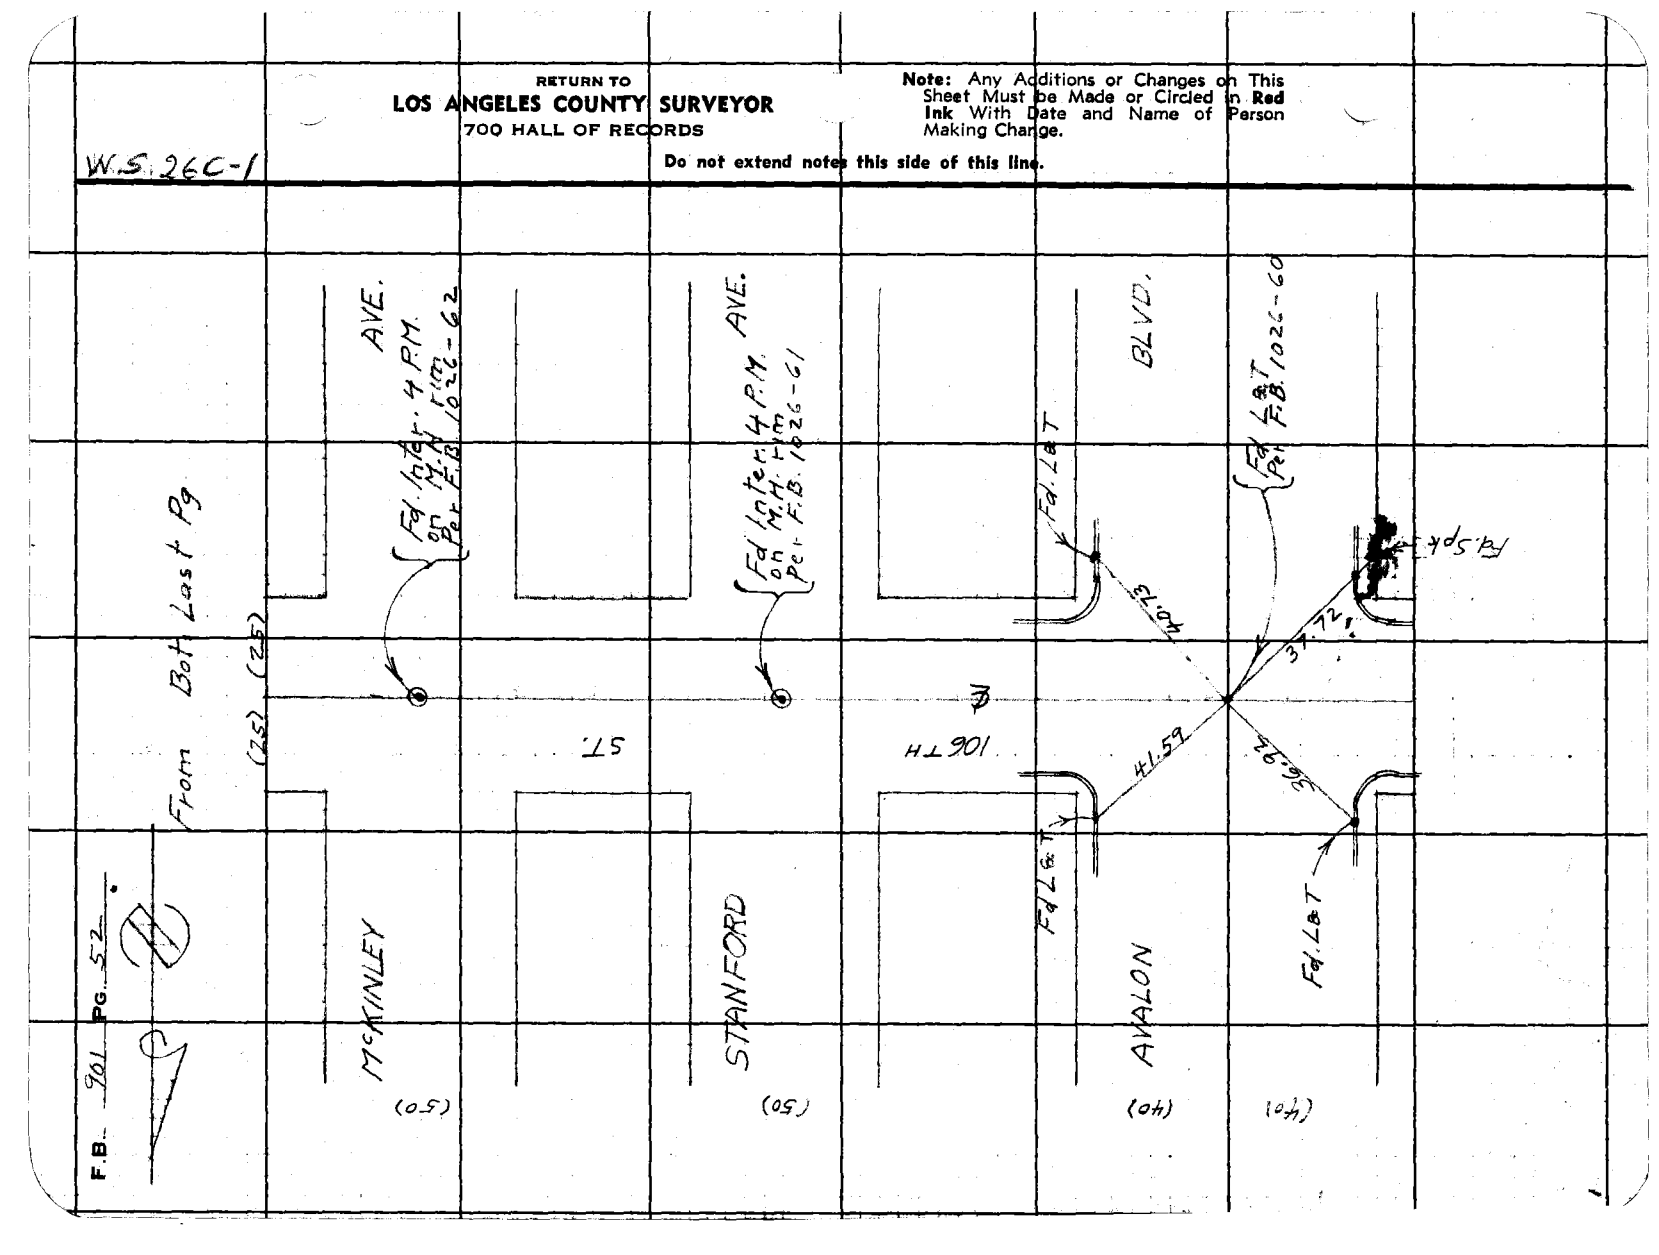


F.B. 901 PG. 52

Notes Ck'd by D. M. Finley
Map No. B-18.1-2
Office Work R. W. M.
Checked D. M. Finley
Date AUG '49

Survey of Central Ave
W. O. 1326 Tape No. 049 St'd 76°F
Surveyed by F. J. McKeel
Notes Mc Date 11-26-41
Indexed C. Johnson

F.B. 901 Pg. 53

W.S. 26C-1

180.60 N 84°
= 180.61

547.27 T 84°
= 547.30

Anam. Left Pg. 42

(25) (25)

180.61

ST.

Fd Spk Per F.B. 1026-57

(15)

547.30

Fd. L & T

Fd. L & T

32.75

0°03

31.97

CLOVIS

AVE.

(50)

Fd. Inter 4 P.M. on M. H. rim Per F.B. 1026-56

31.93

32.74

Fd. Spk

Fd. L & T

℄

(50) WADSWORTH

AVE.

Fd. Inter 4 P.M. on M. H. rim Per F.B. 1026-55

105 TH

To Top Next Pg.

Note: Any Additions or Changes on This Sheet Must be Made or Circled in Red Ink With Date and Name of Person Making Change.

Do not extend notes this side of this line.

RETURN TO
LOS ANGELES COUNTY SURVEYOR
700 HALL OF RECORDS

FORM 247 SM 10-89

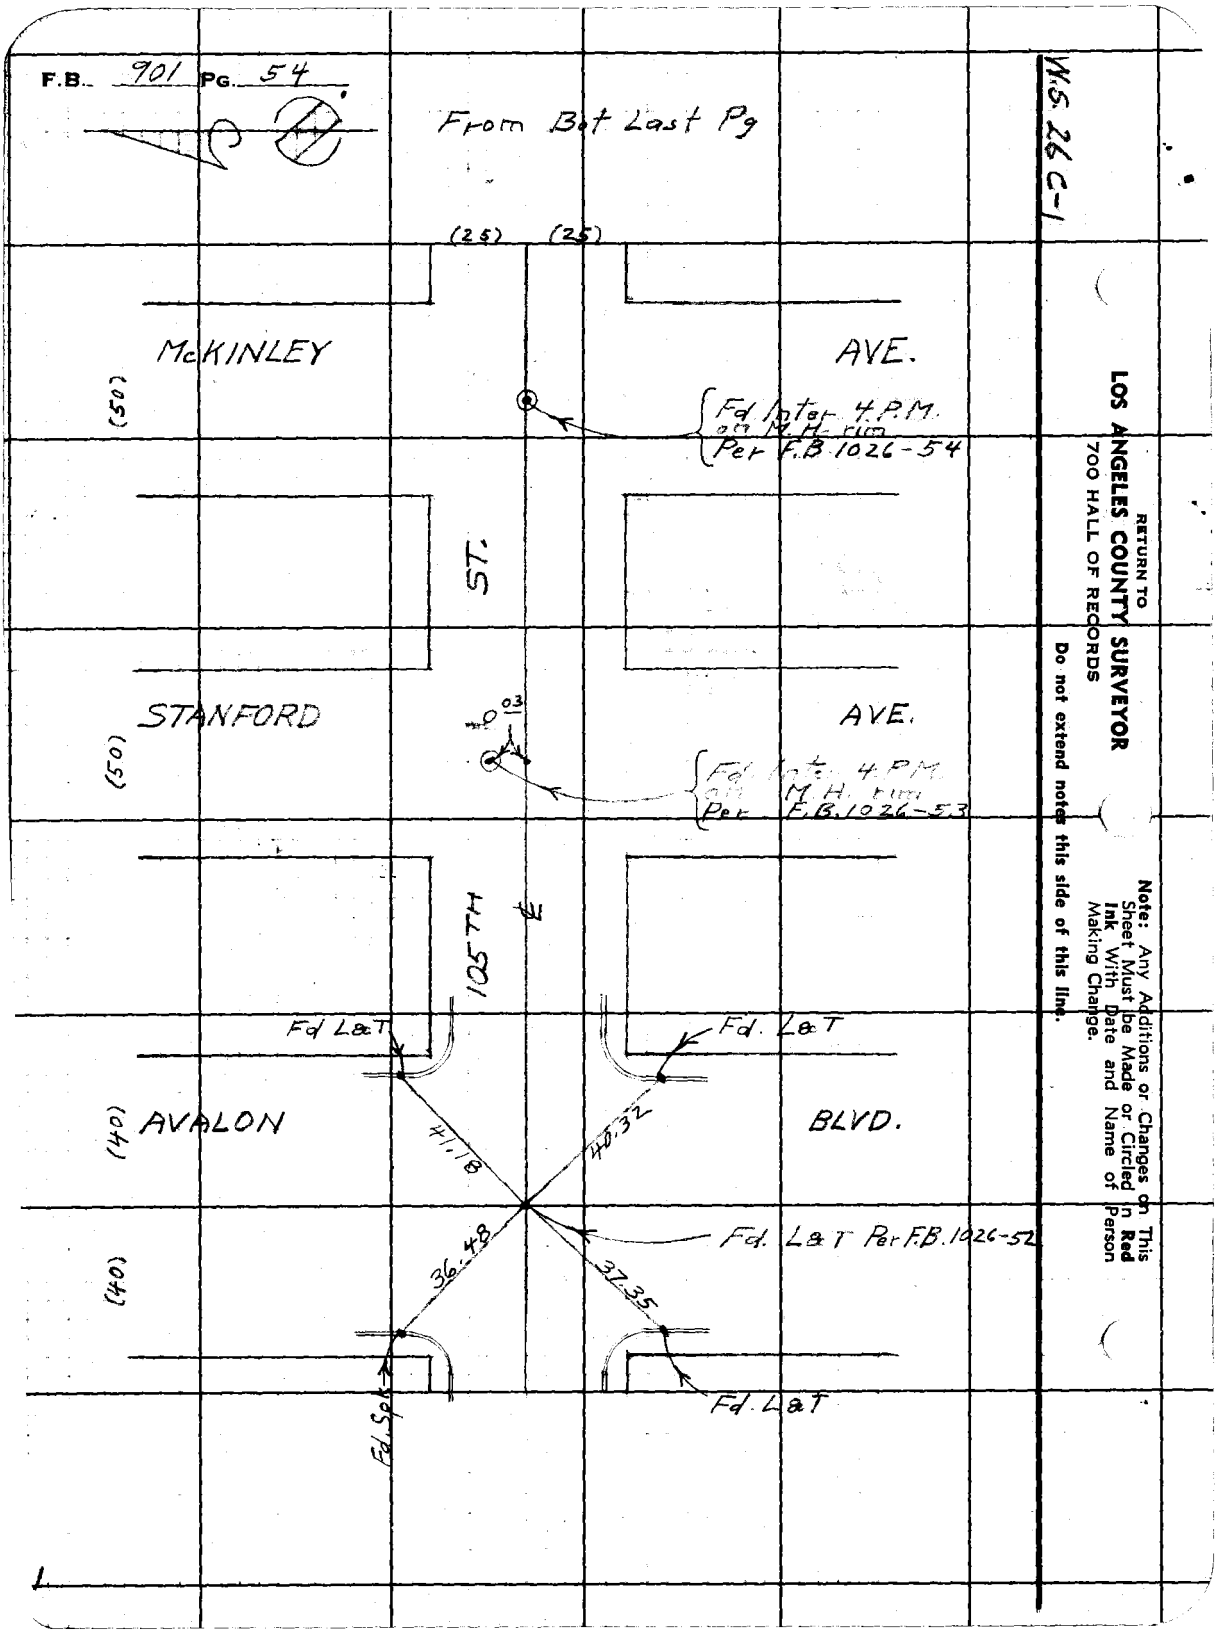
F.B. 901 PG. 54
From Bot Last Pg
W.S. 26 C-1
(25) (25)
McKINLEY
AVE.
(50)
Per F.B. 1026-54
ST.
STANFORD
AVE.
(50)
4.0 03
Per F.B. 1026-53
105TH
Fd L&T
Fd. L&T
AVALON
BLVD.
(40)
41.18
40.32
36.48
37.35
Fd. L&T Per F.B. 1026-52
(40)
Fd. L&T
Fd. L&T
RETURN TO
LOS ANGELES COUNTY SURVEYOR
700 HALL OF RECORDS
Do not extend notes this side of this line.
Note: Any Additions or Changes on This Sheet Must be Made or Circled in Red Ink With Date and Name of Person Making Change.

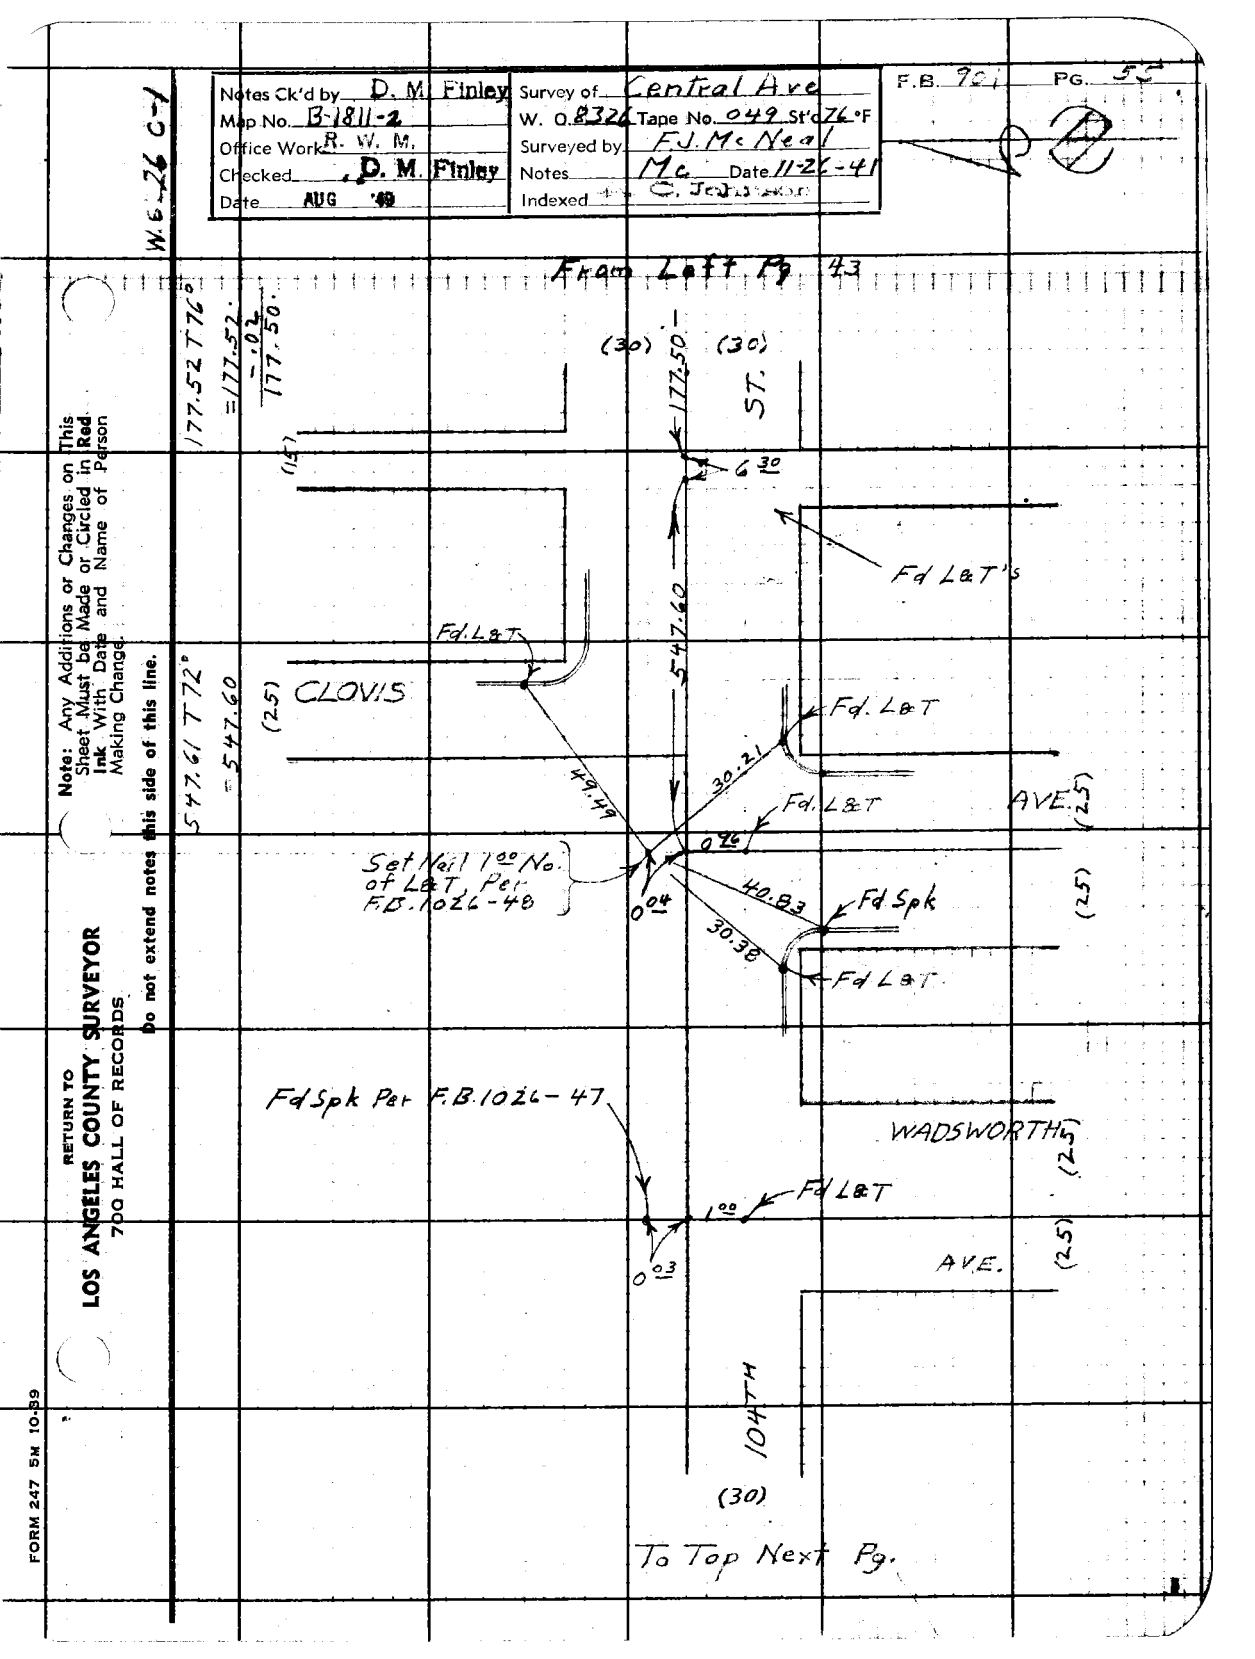
Notes Ck'd by D. M. Finley
Map No. B-1811-2
Office Work R. W. M.
Checked D. M. Finley
Date AUG '49
Survey of Central Ave
W. O. 8326 Tape No. 049 St'd 76°F
Surveyed by F. J. McNeal
Notes Mc Date 11-26-41
Indexed
W. 6-26 C-1
From Left Pg. 43
177.52 T 76°
=177.52
-.02
177.50
(30)
(30)
ST.
177.50
(14)
6 30
Fd L&T's
Fd. L&T
547.60
CLOVIS
(25)
547.61 T 72°
=547.60
Fd. L&T
49.49
30.21
Fd. L&T
AVE.
(25)
0 26
Set Nail 1.00 No. of L&T Per F.B. 1026-48
0 04
40.83
Fd Spk
30.38
Fd L&T
(25)
Fd Spk Per F.B. 1026-47
WADSWORTH
(25)
1.00
Fd L&T
0 03
AVE.
(25)
104TH
(30)
To Top Next Pg.
Note: Any Additions or Changes on This Sheet Must be Made or Circled in Red Ink With Date and Name of Person Making Change.
Do not extend notes this side of this line.
RETURN TO
LOS ANGELES COUNTY SURVEYOR
700 HALL OF RECORDS
FORM 247 5M 10-39

RETURN TO
LOS ANGELES COUNTY SURVEYOR
700 HALL OF RECORDS

**Note:** Any Additions or Changes on This Sheet Must be Made or Circled in **Red Ink** With Date and Name of Person Making Change.

**Do not extend notes this side of this line.**

W.S. 26 C-1

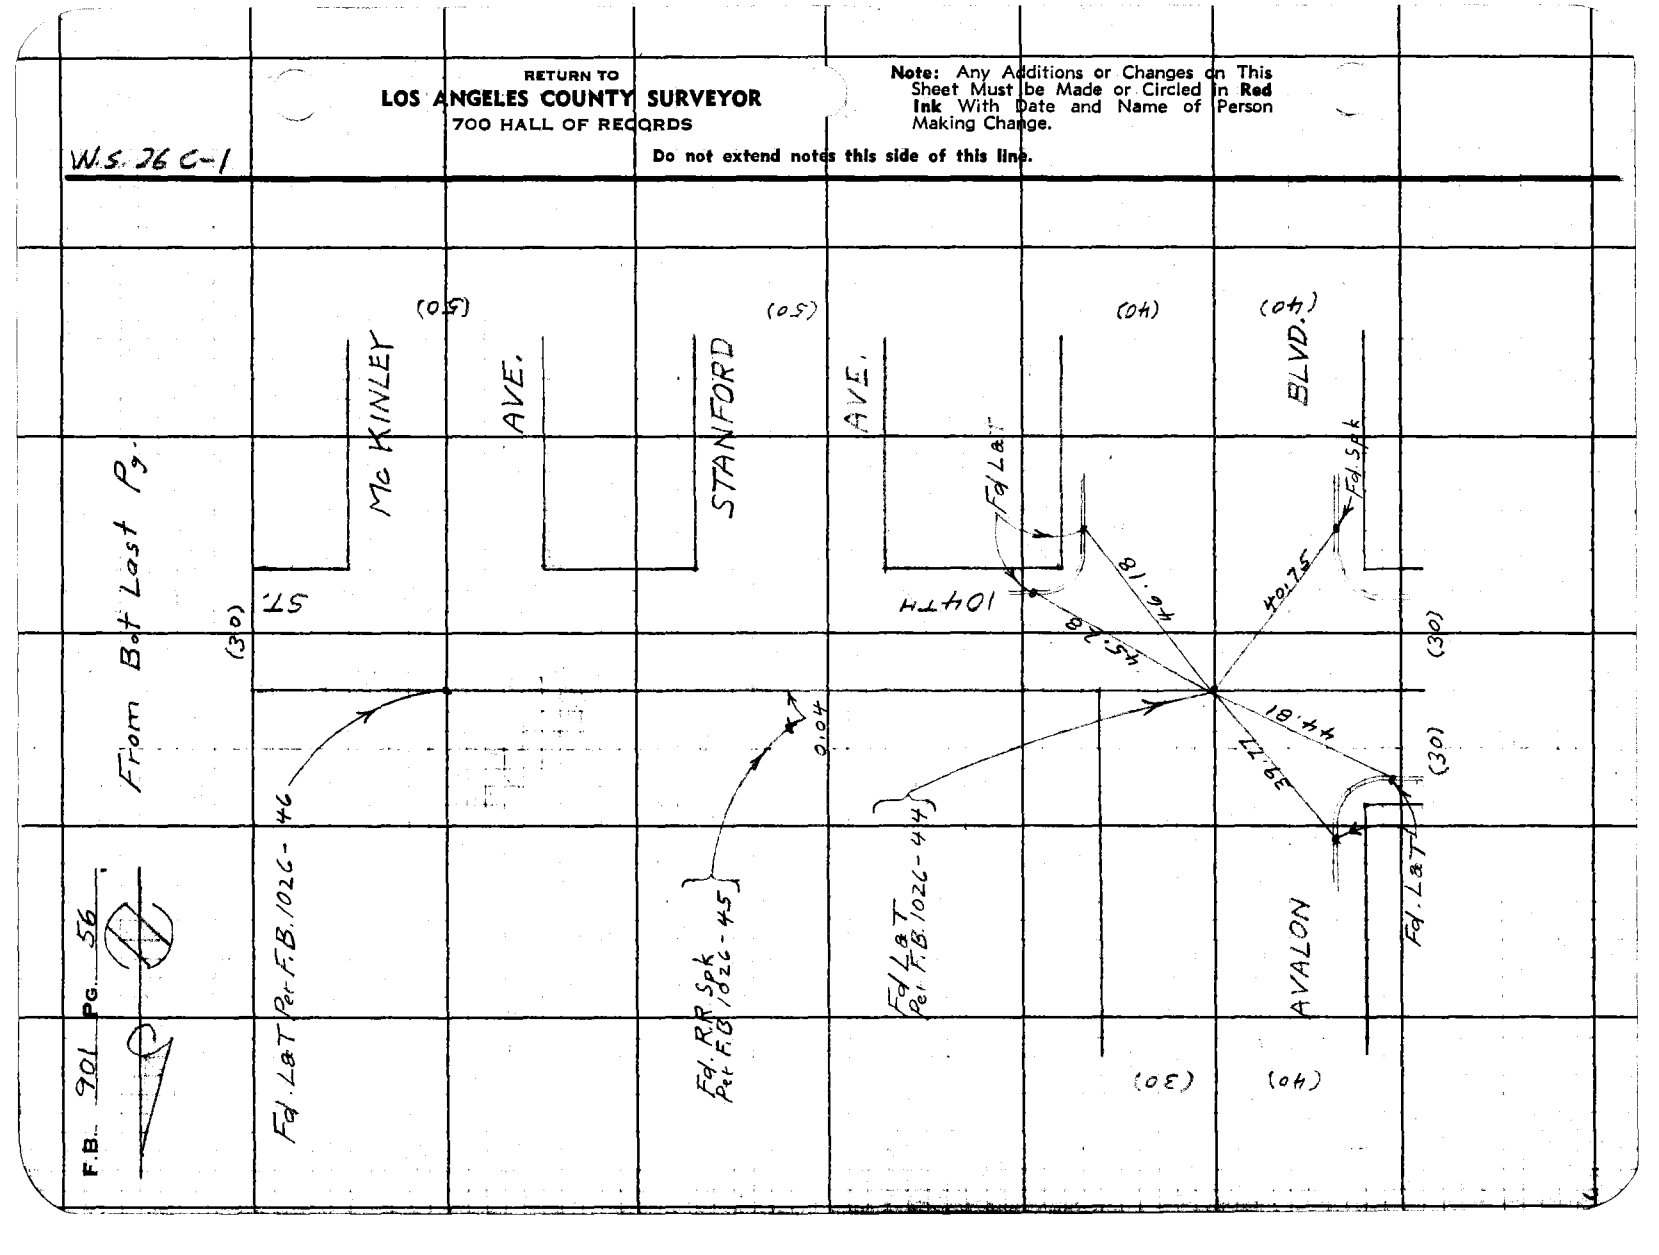

W.S. 26 C-1

Notes Ck'd by
Map No. B-1811-2
Office Work R. W. M.
Checked D. M. Finley
Date AUG '41

Survey of Central Ave.
W. O. 8326 Tape No. 049 Std. 76°F
Surveyed by Fd. McNeal
Notes Mc Date 11-27-41
Indexed

F.B. 93 Pg. 57

From Left Pg 44

175.61 T 68° = 175.60

(25) (25)

175.60

P.I.

Fd. PM in M.H. rim .03 So. Per F.B. 1026-42

1.91 Rec.

(15)

528.41

528.44 T 68° = 528.41

528.41

103RD

Fd L&T

Fd L&T

No Tack

27.39

31.86

29.69

93.74

Fd Spk.

7°49'

(25) CLOVIS AVE

Fd 2" I.P. only 16" Dp

Fd Inter 4 P.M. on rim M.H. Per F.B. 1026-41

Note: Any Additions or Changes on This Sheet Must be Made or Circled in Red Ink With Date and Name of Person Making Change.

Do not extend notes this side of this line.

RETURN TO
LOS ANGELES COUNTY SURVEYOR
700 HALL OF RECORDS

FORM 247 5M 10-39

RETURN TO
LOS ANGELES COUNTY SURVEYOR
700 HALL OF RECORDS

**Note:** Any Additions or Changes on This Sheet Must be Made or Circled in **Red Ink** With Date and Name of Person Making Change.

**Do not extend notes this side of this line.**

WS. 26C-1

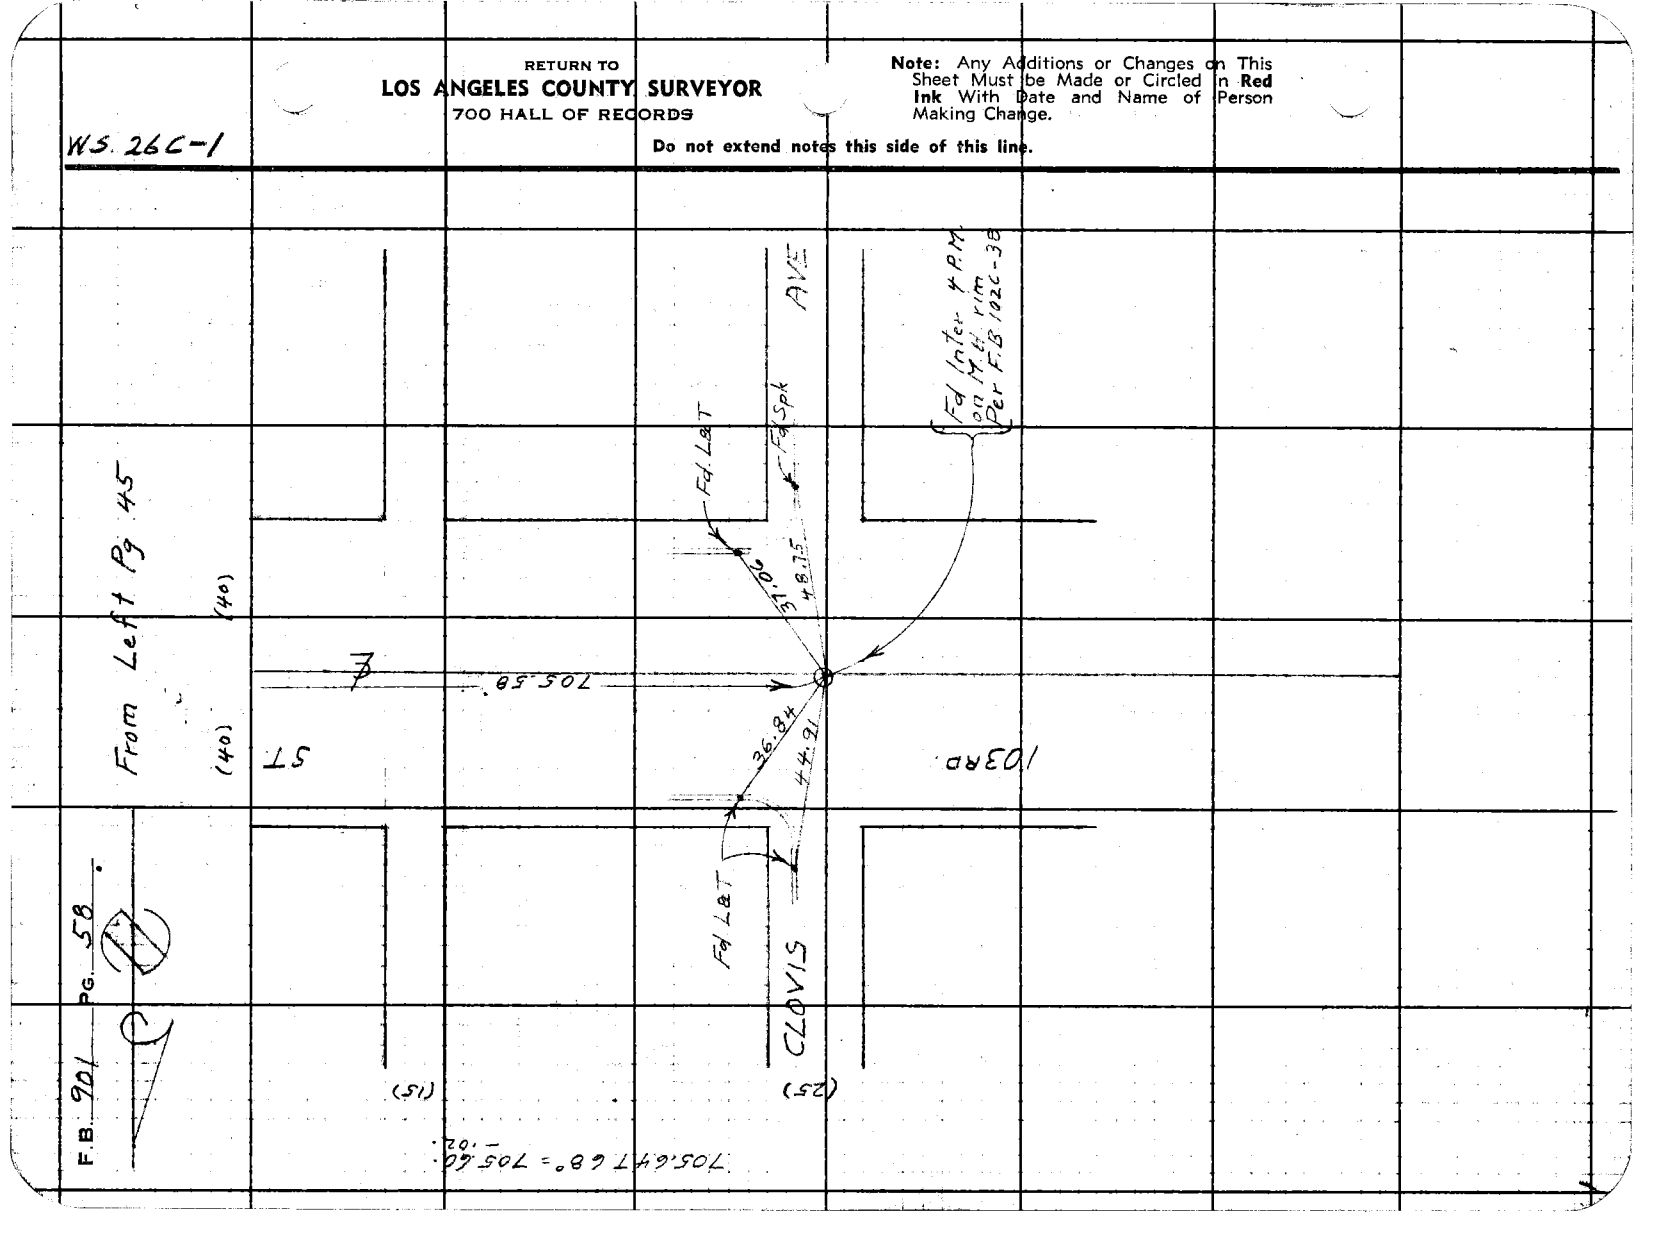

W.S. 26 C-1

| | |
|---|---|
| Notes Ck'd by | Survey of Central Ave. |
| Map No. B-1811-2 | W. O. 8326 Tape No. 049 St'd 76°F |
| Office Work R. W. M. | Surveyed by F.J. McNeal |
| Checked D. M. Finley | Notes Mc Date 11-27-41 |
| Date AUG '41 | Indexed C. Jenson |

F.B. 701 PG. 57

175.56 T66° = 175.55

532.44 T66° = 532.41

Note: Any Additions or Changes on This Sheet Must be Made or Circled in Red Ink With Date and Name of Person Making Change

Do not extend notes this side of this line.

RETURN TO
LOS ANGELES COUNTY SURVEYOR
700 HALL OF RECORDS

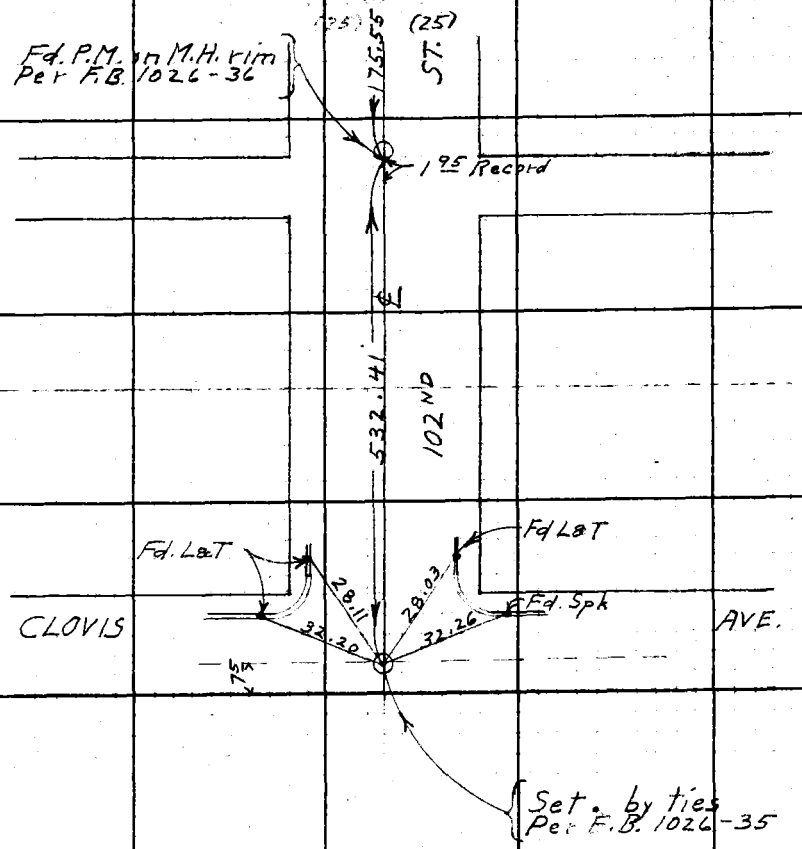


FORM 247 5M 10-39

F.B. 901 PG. 60

From Left Pg 46

W.S. 26 C-1

175.25 T 66°
=175.94'

534.14 T 64°
=534.10'

Fd. P.M. on rim of M.H. Per F.B. 1026-33

(25) (25)

175.94'

ST.

(15)

1/55 Rec.

534.10'

101ST

Fd L&T

Fd L&T

28.41

28.11

Fd Spk.

(25) CLOVIS AVE.

31.79

32.23

7 46

Fd 2" I.P. & t 24" Dn Per F.B. 1026-32

Set by ties F.B. 1026-32

RETURN TO
LOS ANGELES COUNTY SURVEYOR
700 HALL OF RECORDS

Do not extend notes this side of this line.

Note: Any Additions or Changes on This Sheet Must be Made or Circled in Red Ink With Date and Name of Person Making Change.

| | |
|---|---|
| Notes Ck'd by | Survey of Central Ave. |
| Map No. B-1811-2 | W. O. 8332 Tape No. 049 St'd 76°F |
| Office Work R. W. M. | Surveyed by F.J. McNeal |
| Checked D. M. Finley | Notes Mc Date 11-28-41 |
| Date AUG '69 | Indexed C. Sec. 2.6.42 |

F.B. 901 Pg. 61

2

47-B-6

From Left Pg 47

(30)

(15)

719.54 T 80° = 719.56'

719.56

BLVD.

Set L&T

52.76

Fd L&T

32.87

AVE

(25)

CLOVIS

(50)

71.41

Angle Point
Fd. Wire Spk
Per F.B. 739-208
See also F.B. 1026-29

Fd L&Spk

CENTURY

(50)

Note: Any Additions or Changes on This Sheet Must be Made or Circled in Red Ink With Date and Name of Person Making Change

Do not extend notes this side of this line.

RETURN TO
LOS ANGELES COUNTY SURVEYOR
700 HALL OF RECORDS

FORM 247 SM 10-39

F.B. 901 PG. 62

From Bot. Last Pg

(50)

WADSWORTH

(60)

AVE

VOID

BLVD.

CENTURY

(30) McKINLEY AVE.

RETURN TO
**LOS ANGELES COUNTY SURVEYOR**
700 HALL OF RECORDS

**Note:** Any Additions or Changes on This Sheet Must be Made or Circled in **Red Ink** With Date and Name of Person Making Change.

**Do not extend notes this side of this line.**

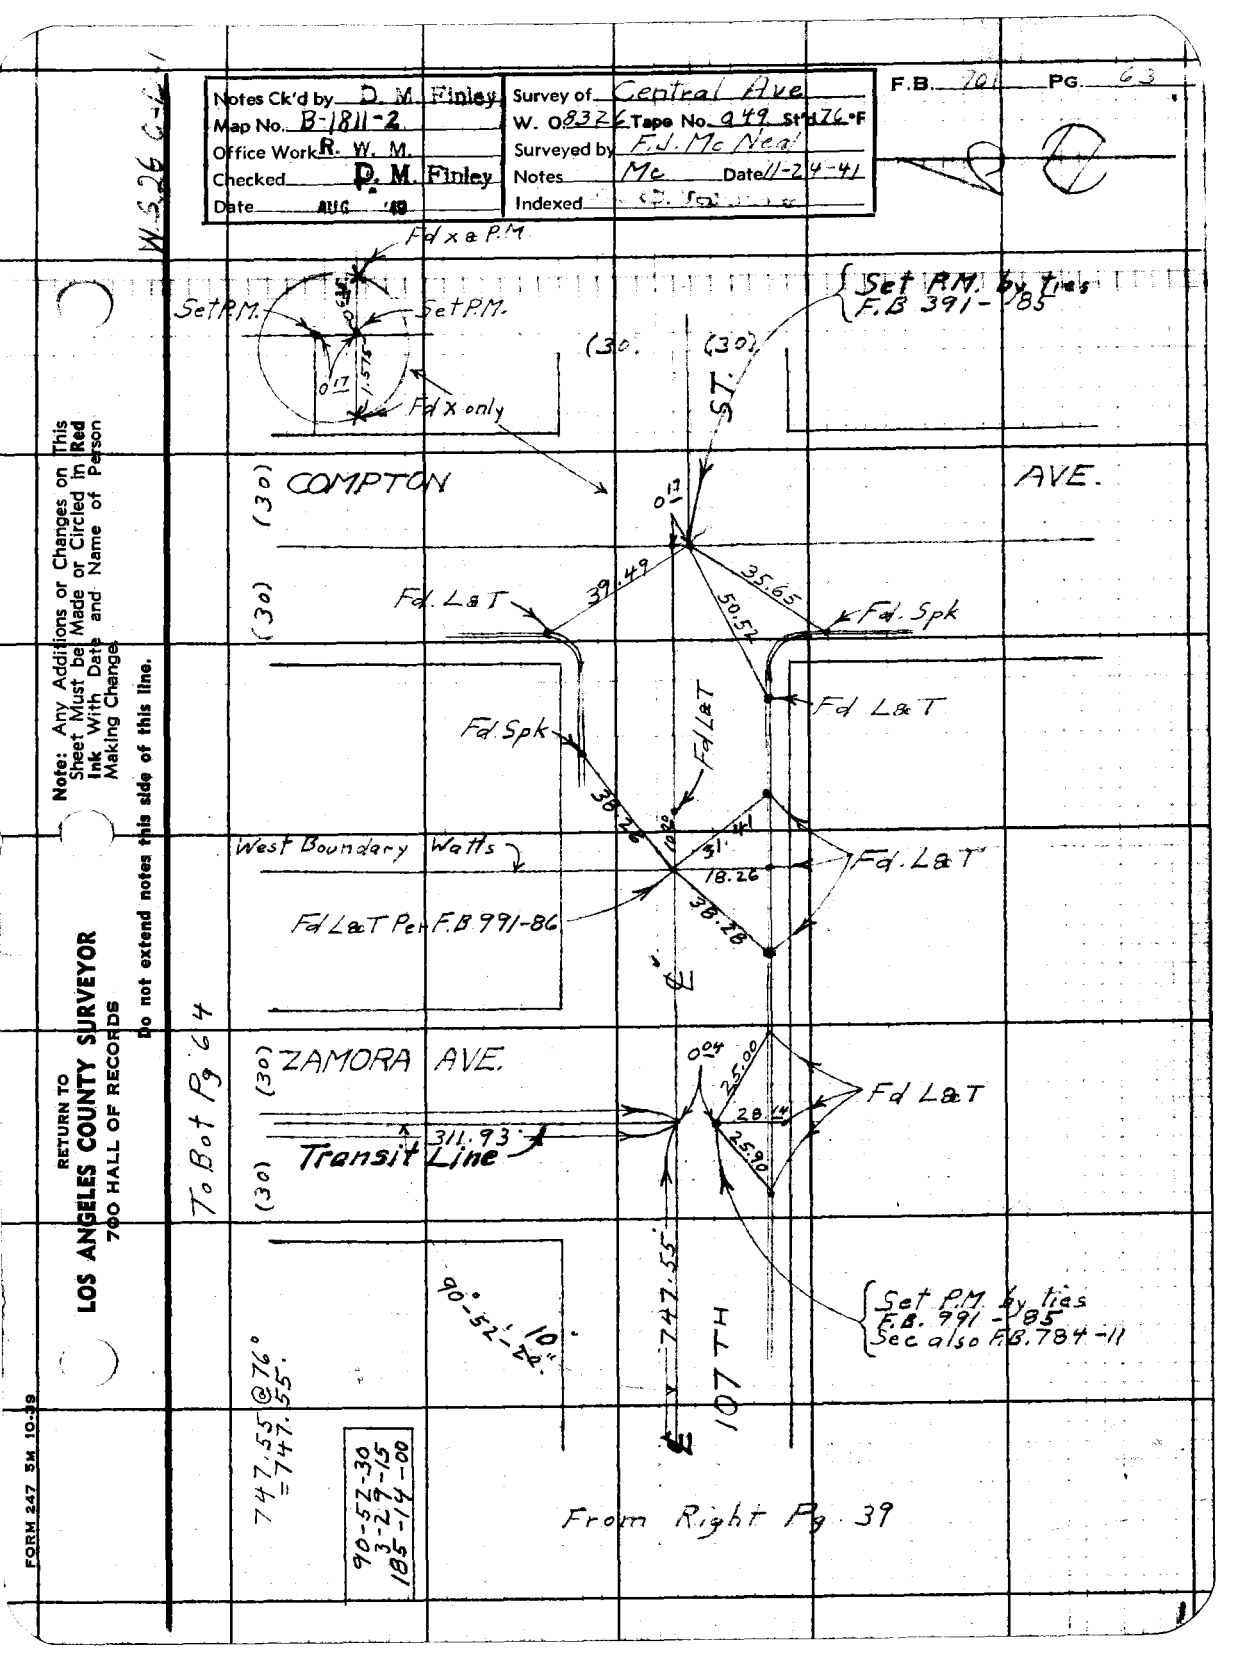
Notes Ck'd by D. M. Finley
Map No. B-1811-2
Office Work R. W. M.
Checked D. M. Finley
Date AUG '41
Survey of Central Ave
W. 0832' Tape No. 949 St. 376 °F
Surveyed by F. J. McNeal
Notes Mc Date 11-24-41
Indexed
F.B. 701 PG. 63
W. 326 C-1
Fd x & P.M.
Set P.M.
Set P.M.
Fd X only
Set P.M. by ties F.B 391-185
(30)
(30)
ST.
COMPTON
AVE.
(30)
(30)
0.17
39.49
35.65
50.54
Fd. L & T
Fd. Spk
Fd. Spk
Fd L & T
Fd L & T
38.26
West Boundary Watts
18.26
Fd. L & T
38.28
Fd L & T Per F.B 991-86
ZAMORA AVE.
(30)
0.04
25.00
Fd L & T
28.14
25.90
311.93'
Transit Line
747.55'
107TH
Set P.M. by ties F.B. 991-185 See also F.B. 784-11
90°-52'-22"
10'
747.55 @ 76°
= 747.55'
90-52-30
3-27-15
185-14-00
From Right Pg. 39
To Bot Pg 64
RETURN TO
LOS ANGELES COUNTY SURVEYOR
700 HALL OF RECORDS
Note: Any Additions or Changes on This Sheet Must be Made or Circled in Red Ink With Date and Name of Person Making Change
Do not extend notes this side of this line.
FORM 247 5M 10-39

F.B. 901 Pg. 64

To Rt Pg. 65

30 30

AVE

324.99

324.96 T 72° = 324.95
+.04
324.99

747.58 T 76° = 747.58

(25)

747.58

(25) 104TH ST.

Transit Line

From Rt Pg 42

Set 3/4" I.P. & t-18" Dn by Prop. Set 103rd PL & 107th St.

324.97 T 70° = 324.96
+.08
-.04
325.00

747.55 T 78° = 747.56 - 0.02

(25)

747.54

(25) 105TH ST.

Transit Line

(Field)

℄ 325.00

From Rt Pg 41

Set 3/4" I.P. & t-18" Dn by Prop.

324.95 T 70° = 324.94
+.13
-.08
324.99

324.99

1286.93

Transit Line

1287.05 T 66°
-1286.97
-.04
1286.93

(25) 106TH ST.

747.52

(26)

Transit Line

From Rt Pg 40

747.50 T 82° = 747.53 - 0.01

Set 3/4" I.P. & t-18" Dn by Prop. Set 103rd PL & 107th ST.

312.11 T 70° = 312.10
-0.04
312.06
-.13
311.93

311.93

ZAMORA

From Left Pg 63

WS 76 C 1

RETURN TO
LOS ANGELES COUNTY SURVEYOR
700 HALL OF RECORDS

Do not extend notes this side of this line.

Note: Any Additions or Changes on This Sheet Must be Made or Circled in Red Ink With Date and Name of Person Making Change.

| | |
|---|---|
| Notes Ck'd by W. M. Finley | Survey of Central Ave |
| Map No. B-1811-2 | W. O. 8226 Tape No. 049 St'd 76°F |
| Office Work R. W. M. | Surveyed by E.J. McNeal |
| Checked D. M. Finley | Notes Mc Date 11-28-41 |
| Date AUG '42 | Indexed C. Johnson |

F.B. 901 Pg. 65

W 5326 6-1

Note: Any Additions or Changes on This Sheet Must be Made or Circled in Red Ink With Date and Name of Person Making Change

Do not extend notes this side of this line.

RETURN TO
LOS ANGELES COUNTY SURVEYOR
700 HALL OF RECORDS

(25) (25)

PL.

(30)

(30) COMPTON AVE

Fd L&T

DILLER

Fd. Spk

Tract Line

+5.70

16.94

+5.54

16.44

Fd L&T TR.

Angle Point
Fd. Wire Spk. Per F.B. 391-80

SUCCESS AVE.

(60)

0°03'

℄

Fd 3/4" I.P. at -12" Dn
Per F.B. 474-16

103RD

Set 3/4" I.P. at -18" Dn
by Intersection

To Rt. Pg 66

(30) (30)

Transit Line

331.47'

324.99'

(30) ZAMORA AVE.

From Top Pg 64

89°-30'-15"

30.15

Transit Line

247.55'

89°-30'-15"

747.57 T 72°
= 747.55'

89-30-15
358-01-30
177-02-30

331.50 T 70° = 331.49'
-.02

From Right Pg 43

FORM 247 5M 10-39

F.B. 901 PG. 66

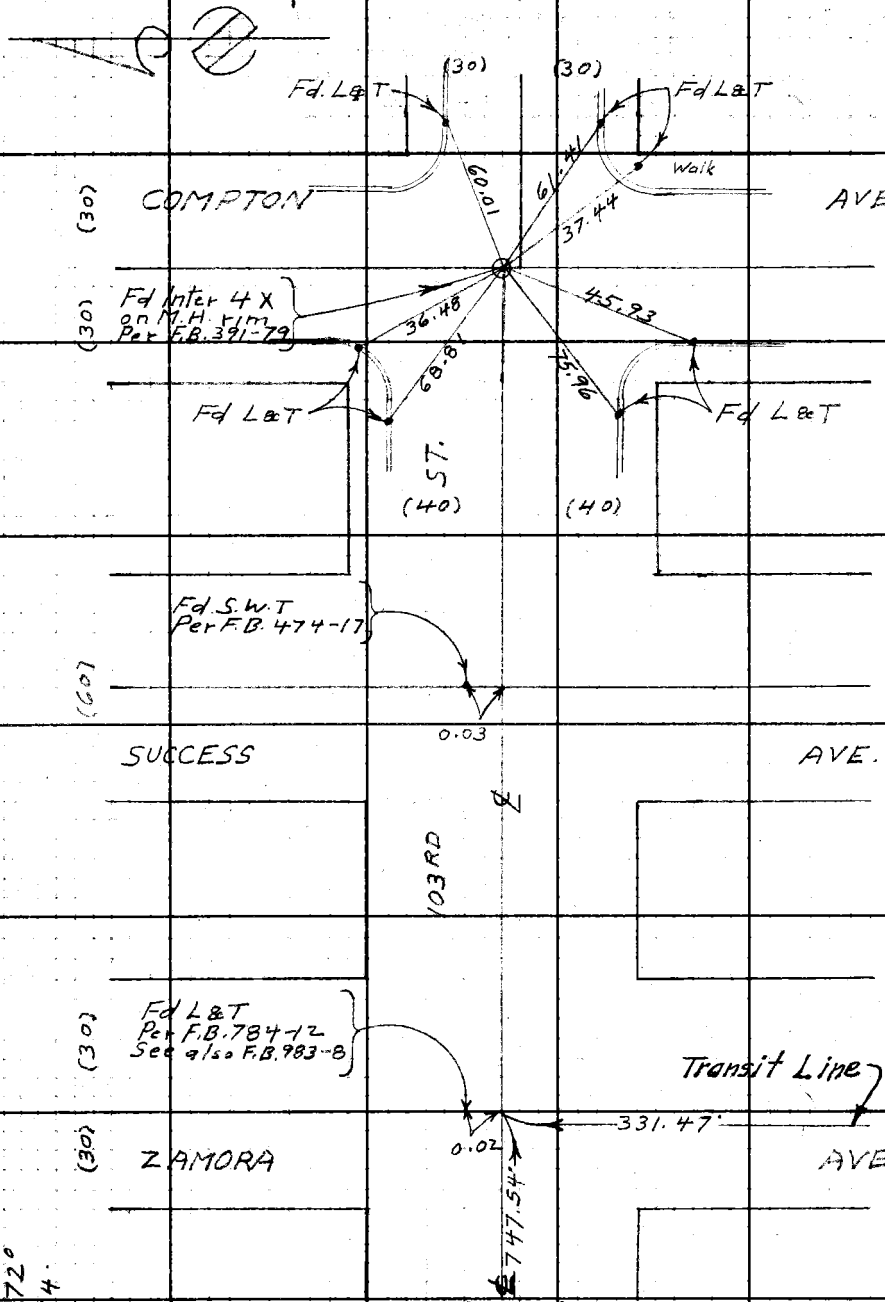


747.56 T 72°
= 747.54

W.S.T. B-6

RETURN TO
LOS ANGELES COUNTY SURVEYOR
700 HALL OF RECORDS

Do not extend notes this side of this line.

Note: Any Additions or Changes on This Sheet Must be Made or Circled in Red Ink With Date and Name of Person Making Change.

| | | | |
|---|---|---|---|
| Notes Ck'd by D. M. Finley | | Survey of Central Ave | F.B. 901 Pg. 47 |
| Map No. B-1811-2 | | W. O. 8326 Tape No. 049 St'd 76°F | |
| Office Work R. W. M. | | Surveyed by F.J. McNeal | |
| Checked D. M. Finley | | Notes Mc Date 12-2-41 | |
| Date AUG '42 | | Indexed C. Johnson 12-42 | |

W 37 B

To Bot Next Pg

89-36-15
358-25-00

(20) (20)

AVE.

89° 36' 15"

Fd L&T

839.26'

1647 + 99.26
Fd. Wire Spk in L
Per F.B. 983-29

99TH ST.

53.52

149.44'

54.56

Fd. Spk

(20) (20)

To Bot Pg 75

304.87 770° = 304.86'

304.86'

89-36-30
358-24-00

89° 36' 30"

Fd. L&T

1611 + 94.40
Fd. Wire Spk in L
Per F.B. 983-31

100TH ST.

55.56

150.80'

57.30

Fd. Spk

(20) (20)

To Bot Pg. 73

CENTRAL

152.48'

From Top Pg 47

Note: Any Additions or Changes on This Sheet Must be Made or Circled in Red Ink With Date and Name of Person Making Change

Do not extend notes this side of this line.

RETURN TO
LOS ANGELES COUNTY SURVEYOR
700 HALL OF RECORDS

FORM 247 5M 10-39

RETURN TO
**LOS ANGELES COUNTY SURVEYOR**
700 HALL OF RECORDS

**Note:** Any Additions or Changes on This Sheet Must be Made or Circled in **Red Ink** With Date and Name of Person Making Change.

**Do not extend notes this side of this line.**

W.S. 78-4

To Bot. Pg 77

88-51-00
355-24-00

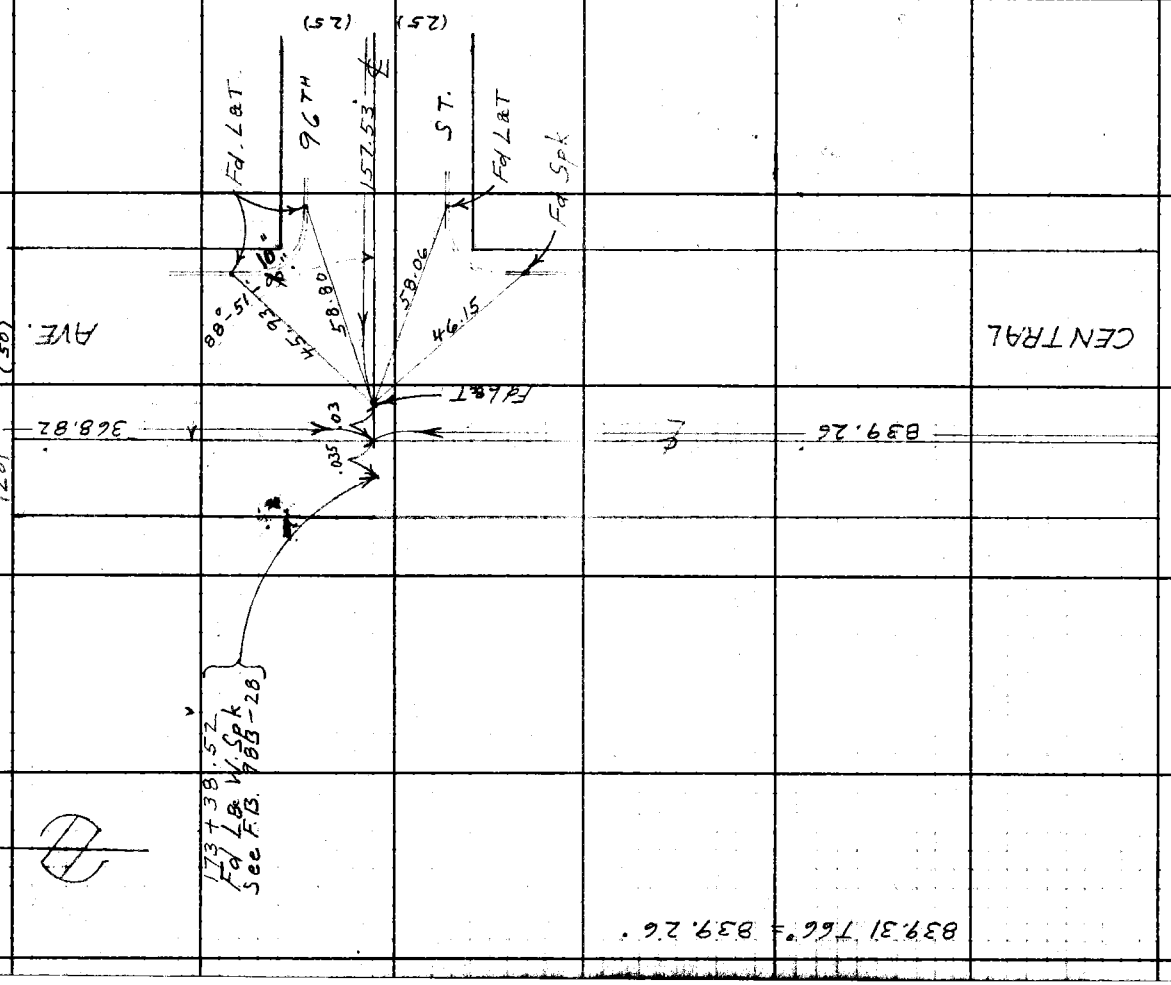


To Bot. Next Pg.

From Top Last Pg

F.B. 921 PG. 68

| | | | |
|---|---|---|---|
| Notes Ck'd by D. M. Finley | Survey of Central Ave | F.B. 901 | Pg. 19 |
| Map No. B-1811-2 | W. O. 8326 Tape No. 049 St'd 76°F | | |
| Office Work R. W. M. | Surveyed by F.J. Mc Neal | | |
| Checked D. M. Finley | Notes Me Date 12-3-41 | | |
| Date AUG '69 | Indexed C. Jones | | |

W.S. 7B-4

To Bot Pg. 79

(20) (50)

HOOPER AVE.

507.03 T 62° = 506.98'

To Bot Next Pg.

(50)

(50)

AVE

37-22-45
149-31-00

355.02'

177+07.34
Fd. Cu. Tack
See F.B. 1025-113

Note: Any Additions or Changes on This Sheet Must be Made or Circled in Red Ink With Date and Name of Person Making Change

Do not extend notes this side of this line.

RETURN TO
LOS ANGELES COUNTY SURVEYOR
700 HALL OF RECORDS

To Top Pg. 81

(25)

95TH ST.

198.45'

50'

35'

37°-22'-45"

53°-45'-45"

605.28'

3.79

4.39

45.34

49.07

walk

℄ Prod

Fd L&T

42.37

58.11

Fd L&T in Pav.

℄ Prod
24.69

Set 3/4" I. Pat
24" On ℄ Prod.

368.84 T 64° = 368.82'

53-45-45
215-03-00

368.82'

CENTRAL

From Top Last Pg.

FORM 247 5M 10-59

F.B. 901 PG. 70

To Right Bot. Next Pg

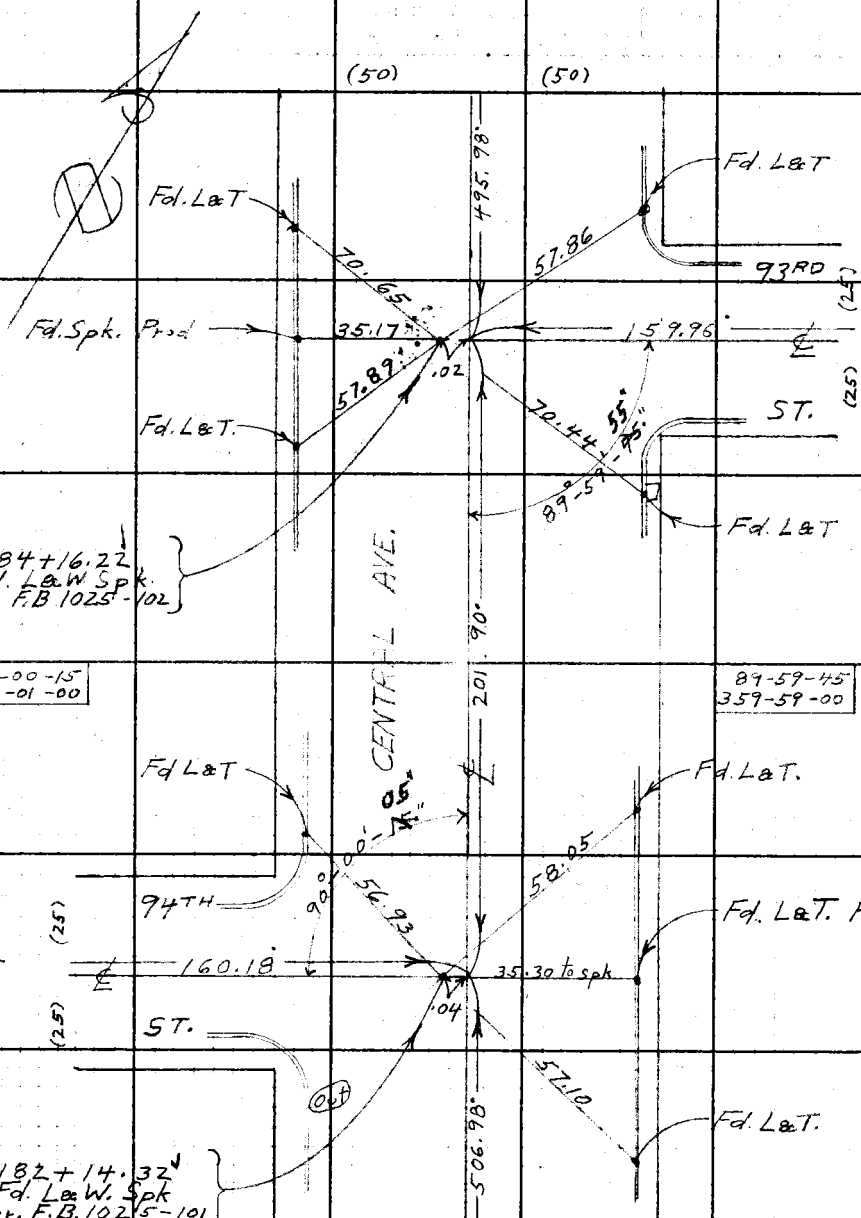


To Top Pg 82

To Left Pg - 83

From Top Left Last Pg.

W.S. 73-6

RETURN TO
LOS ANGELES COUNTY SURVEYOR
700 HALL OF RECORDS

Do not extend notes this side of this line.

Note: Any Additions or Changes on This Sheet Must be Made or Circled in Red Ink With Date and Name of Person Making Change.

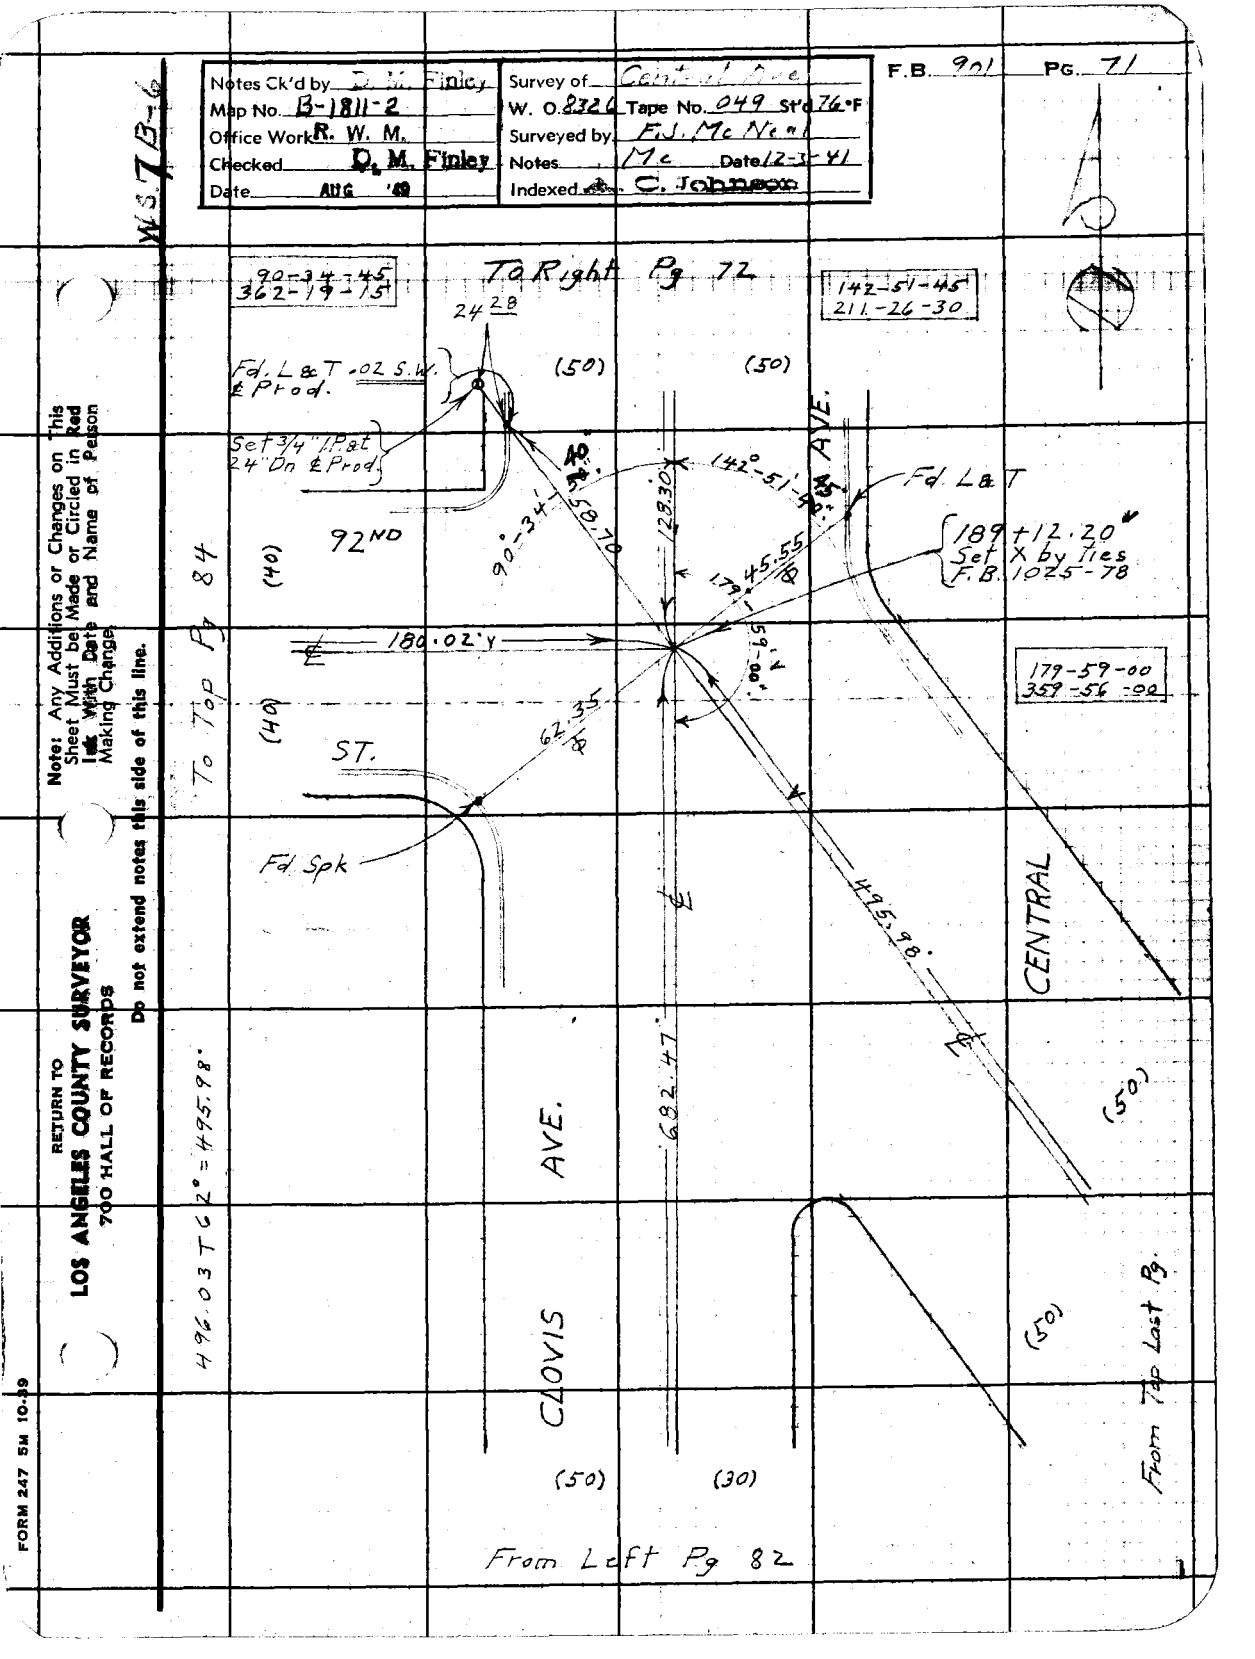
Notes Ck'd by D. M. Finley
Map No. B-1811-2
Office Work R. W. M.
Checked D. M. Finley
Date AUG '49
Survey of Central Ave
W. O. 8320 Tape No. 049 Std 76°F
Surveyed by F.J. Mc Neal
Notes Mc Date 12-3-41
Indexed C. Johnson
F.B. 901 PG. 71
W.S. 7 B-6
90-34-45
362-19-15
To Right Pg 72
142-51-45
211-26-30
24 2.8
Fd. L & T .02 S.W. & Prod.
Set 3/4" I.Pat 24" On & Prod.
(50)
(50)
AVE.
Fd L & T
189+12.20
Set X by ties
F.B. 1025-78
92ND
(40)
90°-34'
185.70
128.30'
142°-51'-45"
179-45.55
180.02' Y
179-59-00
359-56-00
To Top Pg 84
(40)
ST.
62.35
Fd Spk
495.98'
CENTRAL
(50)
496.03 T 62° = 495.98'
682.47'
CLOVIS
AVE.
(50)
(30)
From Last Pg.
From Left Pg 82
Note: Any Additions or Changes on This Sheet Must be Made or Circled in Red Ink With Date and Name of Person Making Change
Do not extend notes this side of this line.
RETURN TO
LOS ANGELES COUNTY SURVEYOR
700 HALL OF RECORDS
FORM 247 5M 10-39

RETURN TO
**LOS ANGELES COUNTY SURVEYOR**
700 HALL OF RECORDS

**Note:** Any Additions or Changes on This Sheet Must be Made or Circled in **Red Ink** With Date and Name of Person Making Change.

**Do not extend notes this side of this line.**

WS 7 B-6

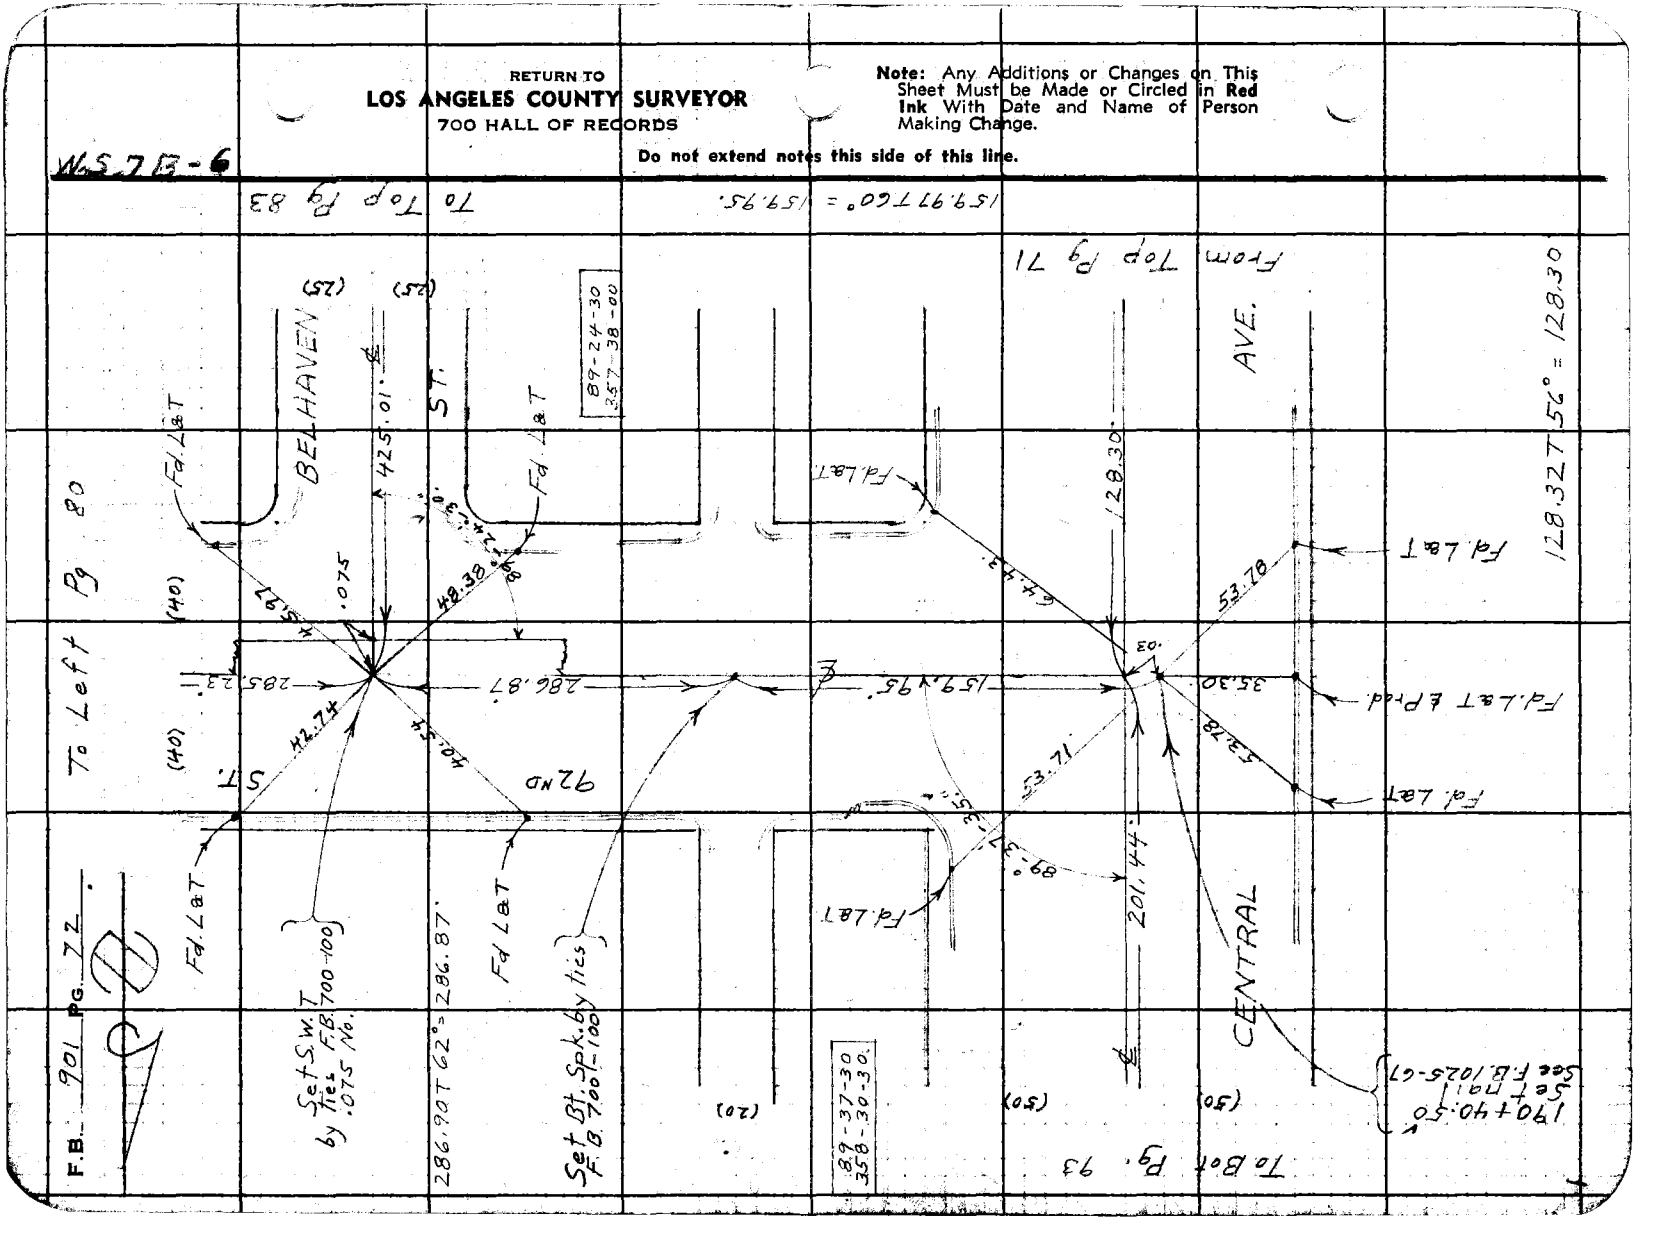

W.S. 78-6

| | |
|---|---|
| Notes Ck'd by D. M. Finley | Survey of Central Ave |
| Map No. B-1811-2 | W. O. 8326 Tape No. 049 Std 76 °F |
| Office Work R. W. M. | Surveyed by F. J. McNeal |
| Checked D. M. Finley | Notes Mc Date 12-4-41 |
| Date AUG '48 | Indexed C. Johnson |

F.B. 99 Pg. 23

2

To Bot Next Pg

(20) (20)

ST.

Fd. S.W&T Per F.B. 739-207

Fd. Spk.

Fd. L&T.

2533

2596

2527

2525

ZAMORA

AVE

(20)

(20)

Fd L

Fd L&T.

601.18 @ T 74 = 601.17'

601.17'

Fd Nail Per F.B. 739-207

(12)

150.80'

100TH

150.80 @ T 74° = 150.80'

From Right Pg 67

Note: Any Additions or Changes on This Sheet Must be Made or Circled in Red Ink With Date and Name of Person Making Change.

Do not extend notes this side of this line.

RETURN TO
LOS ANGELES COUNTY SURVEYOR
700 HALL OF RECORDS

FORM 247 5M 10-39

F.B. 901 Pg. 74

W.S. 28-6

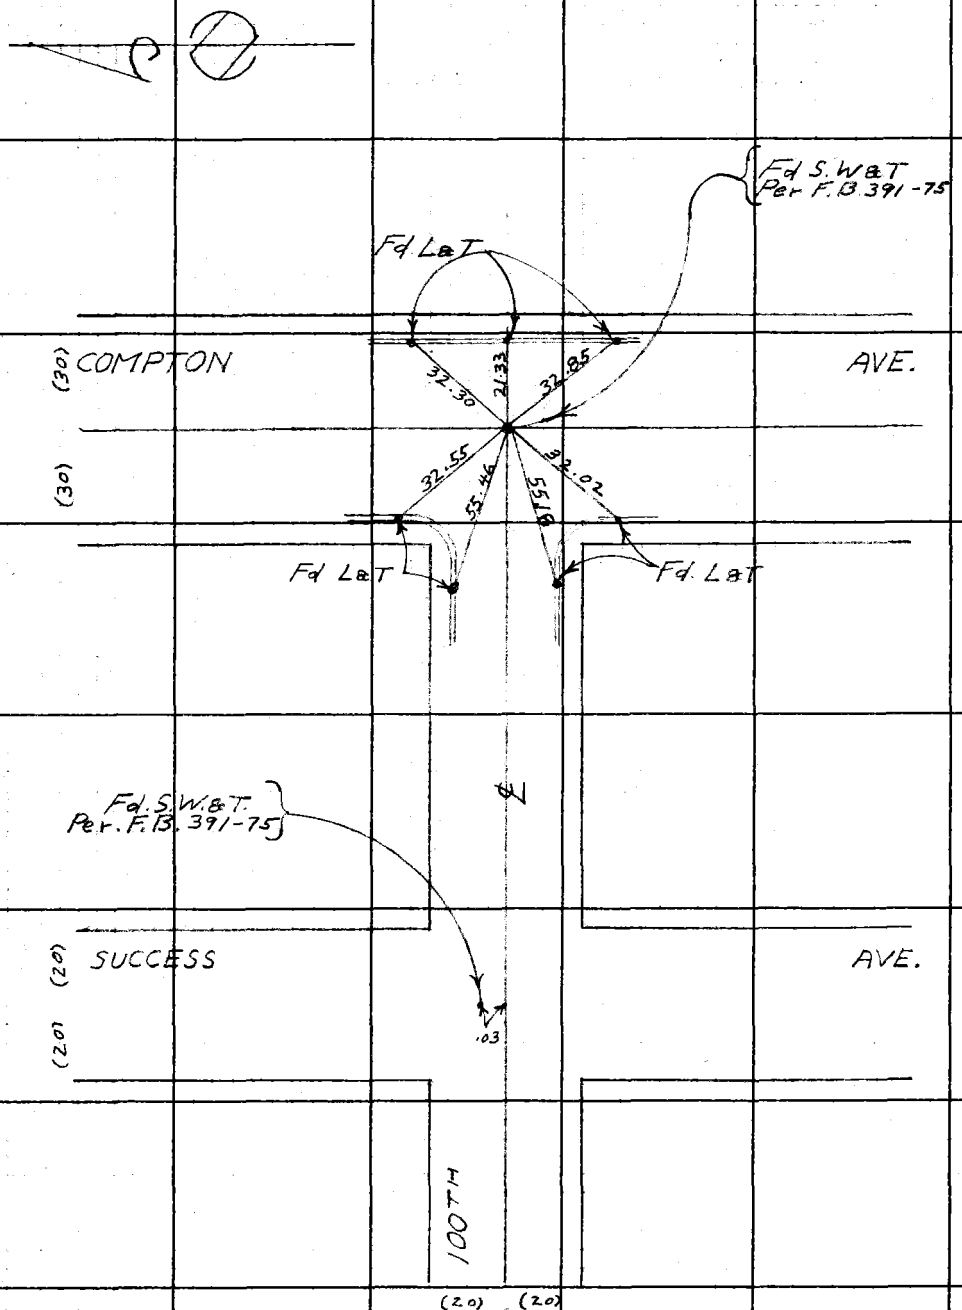


From Top Last Pg.

RETURN TO
**LOS ANGELES COUNTY SURVEYOR**
700 HALL OF RECORDS

**Do not extend notes this side of this line.**

**Note:** Any Additions or Changes on This Sheet Must be Made or Circled in **Red Ink** With Date and Name of Person Making Change.

Notes Ck'd by
Map No. B-181-2
Office Work R W M
Checked D. M. Finley
Date AUG '42

Survey of Central Ave.
W. O. 8326 Tape No. 049 Std. 76°F
Surveyed by F. J. Mc Neal
Notes Mc Date 12-4-41
Indexed E. Johnson

F.B. 701 Pg. 25

W.S. 7/3-6

To Bot Next Pg

Fd L&T (20) (20) Fd L&T

{Set S.M. at by ties Per F.B. 739-207

25.67 25.19

ZAMORA AVE.

(20) (20)

25.43 25.32

Fd L. Set T. ST. Fd L&T

600.97 T 42° = 600.93

600.93

{Fd Wire Spk & T Per F.B. 739-207

(12)

149.45 T 66° = 149.44

149.44

99 TH

From Right Pg 67

Note: Any Additions or Changes on This Sheet Must be Made or Circled in Red Ink With Date and Name of Person Making Change.

Do not extend notes this side of this line.

RETURN TO
LOS ANGELES COUNTY SURVEYOR
700 HALL OF RECORDS

FORM 247 5M 10-39

F.B. 901 PG. 76

W.S. 73-6

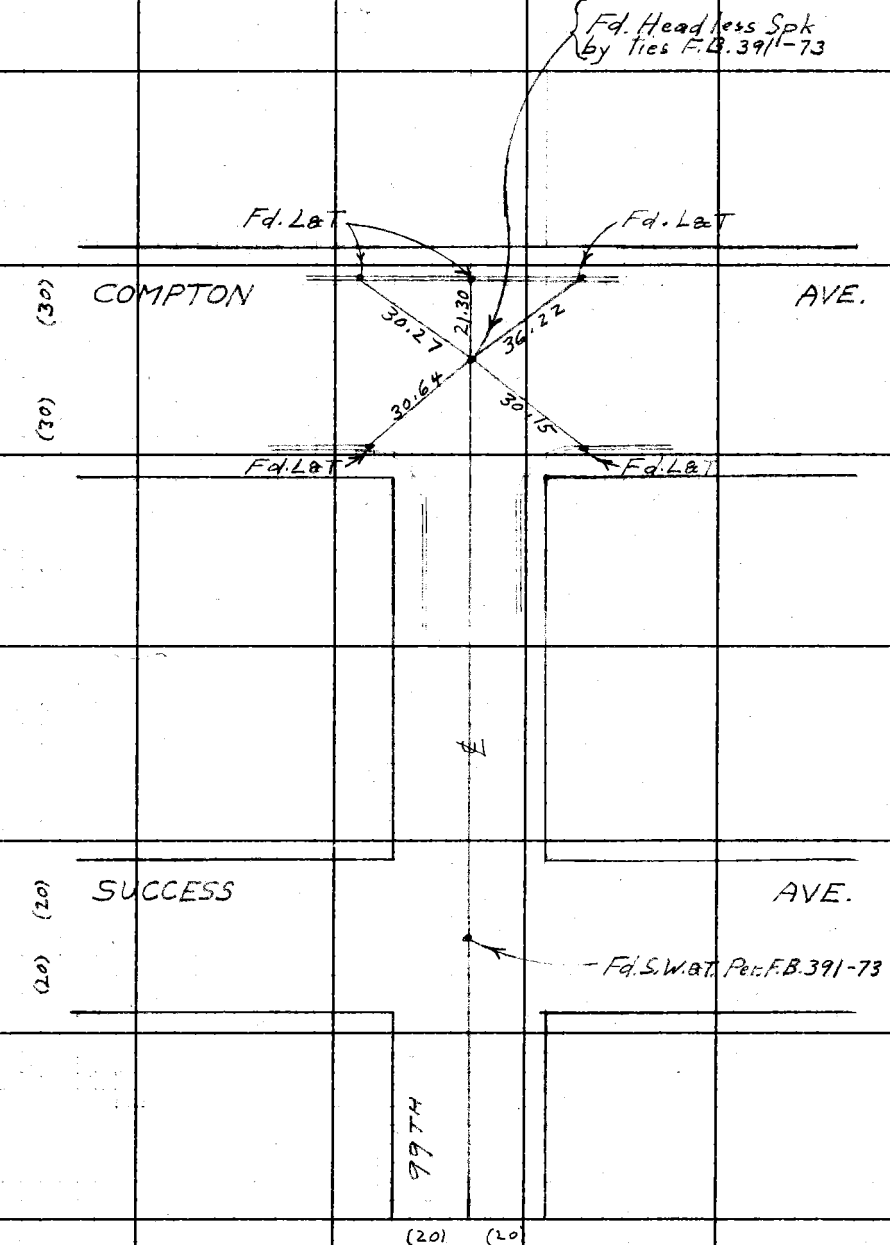


From Top Last Pg.

RETURN TO
**LOS ANGELES COUNTY SURVEYOR**
700 HALL OF RECORDS

**Do not extend notes this side of this line.**

**Note:** Any Additions or Changes on This Sheet Must be Made or Circled in **Red Ink** With Date and Name of Person Making Change.

FORM 247 5M 10-39

RETURN TO
**LOS ANGELES COUNTY SURVEYOR**
700 HALL OF RECORDS

**Note:** Any Additions or Changes on This Sheet Must be Made or Circled in **Red Ink** With Date and Name of Person Making Change.

**Do not extend notes this side of this line.**

W S. 78-6

157.55 T 56° = 157.53'

152.38 T 56° = 152.36'

Notes Ck'd by
Map No. B-181-2
Office Work R. W. M.
Checked D. M. Finley
Date AUG '

Survey of Central Ave
W. O. 8326 Tape No. 244 ST 76°F
Surveyed by Ed McNeal
Notes
Indexed Date 12-9-41
C. Johnson

F.B. 231 PG. 77

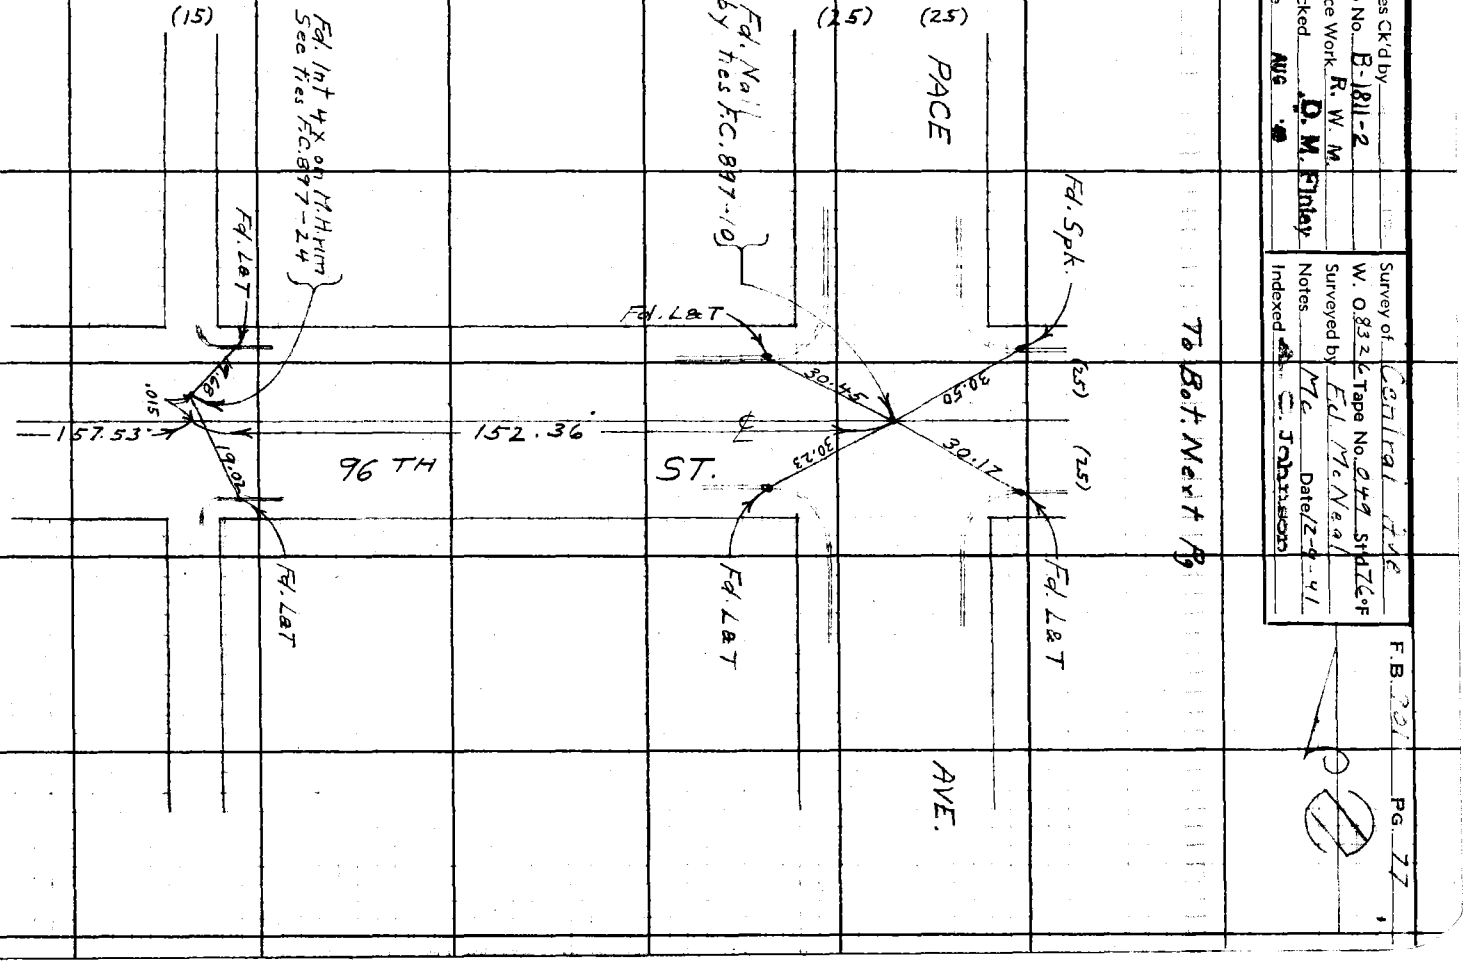

F.B. 901 Pg. 78

WS 72-6

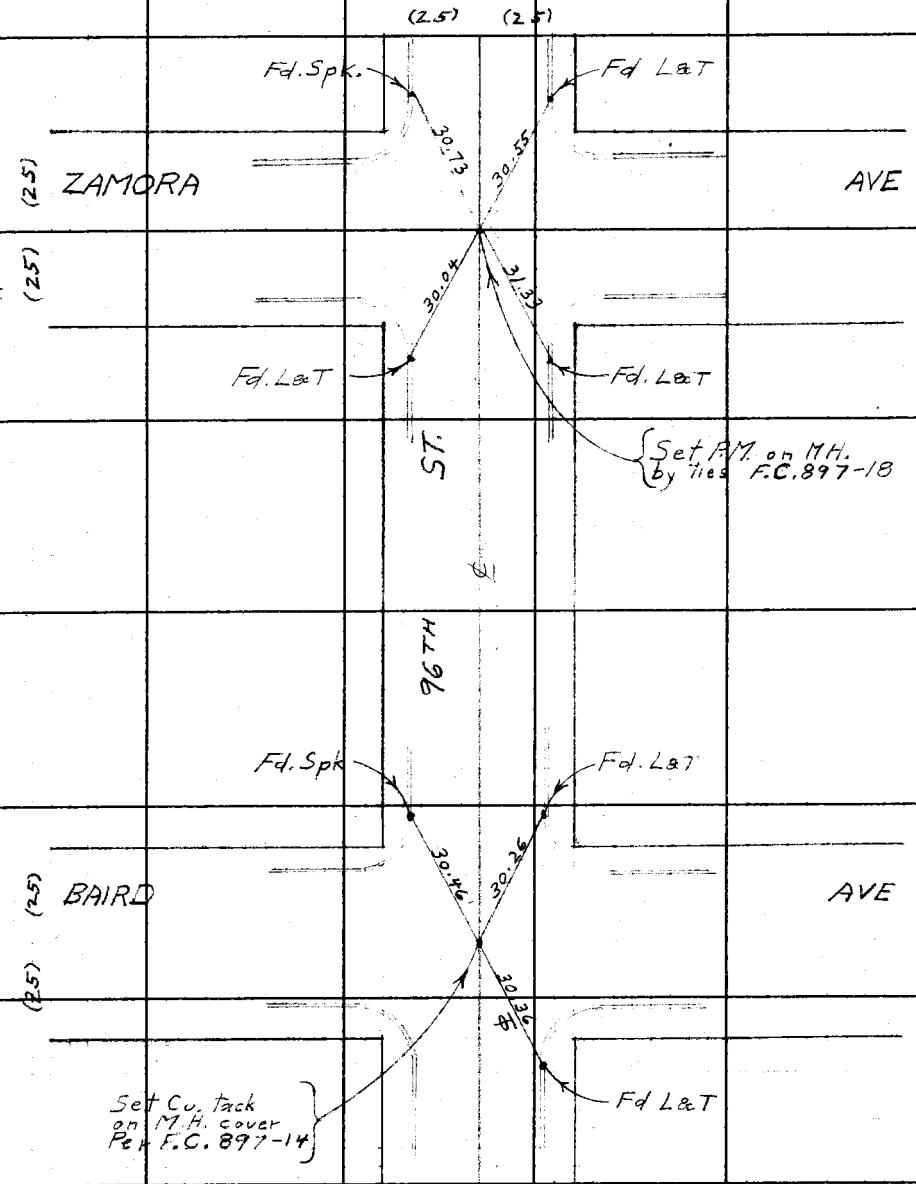


From Top Last Pg.

RETURN TO
LOS ANGELES COUNTY SURVEYOR
700 HALL OF RECORDS

Do not extend notes this side of this line.

Note: Any Additions or Changes on This Sheet Must Be Made or Circled in Red Ink With Date and Name of Person Making Change.

W.S. 7 B-6

Notes Ck'd by
Map No. B-1811-2
Office Work R. W. M.
Checked D. M. Finley
Date AUG '88

Survey of Central Ave
W. O. 8326 Tape No. 049 Std. 76°F
Surveyed by F.J. McNeal
Notes Mc Date 12-8-41
Indexed E. Johnson

F.B. 901 Pg. 79

90-36-15
362-24-30

To Bot. Next Pg.

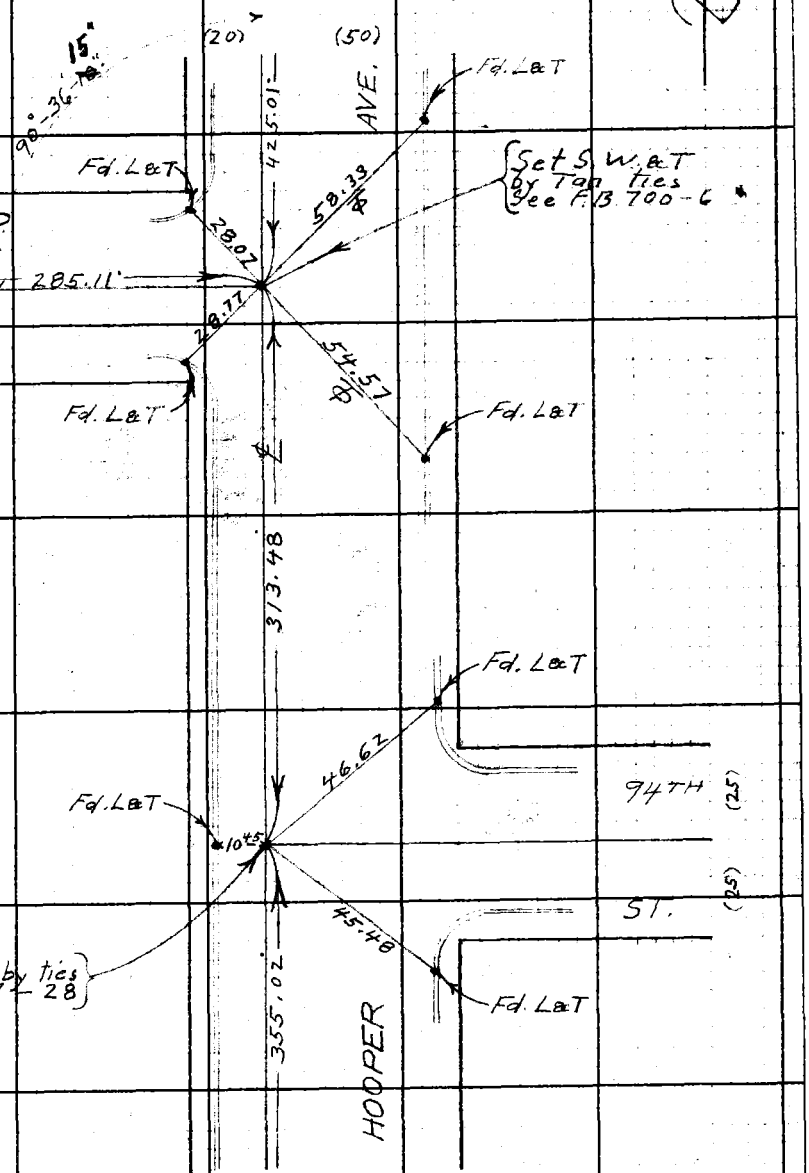


To Right Pg. 83

313.50 T = 313.48'

355.04 T = 355.02'

From Top Pg. 69

Note: Any Additions or Changes on This Sheet Must be Made or Circled in Red Ink With Date and Name of Person Making Change.

Do not extend notes this side of this line.

RETURN TO
LOS ANGELES COUNTY SURVEYOR
700 HALL OF RECORDS

FORM 247 5M 10-89

RETURN TO
**LOS ANGELES COUNTY SURVEYOR**
700 HALL OF RECORDS

**Note:** Any Additions or Changes on This Sheet Must be Made or Circled in **Red Ink** With Date and Name of Person Making Change.

**Do not extend notes this side of this line.**

W.S. 73-6

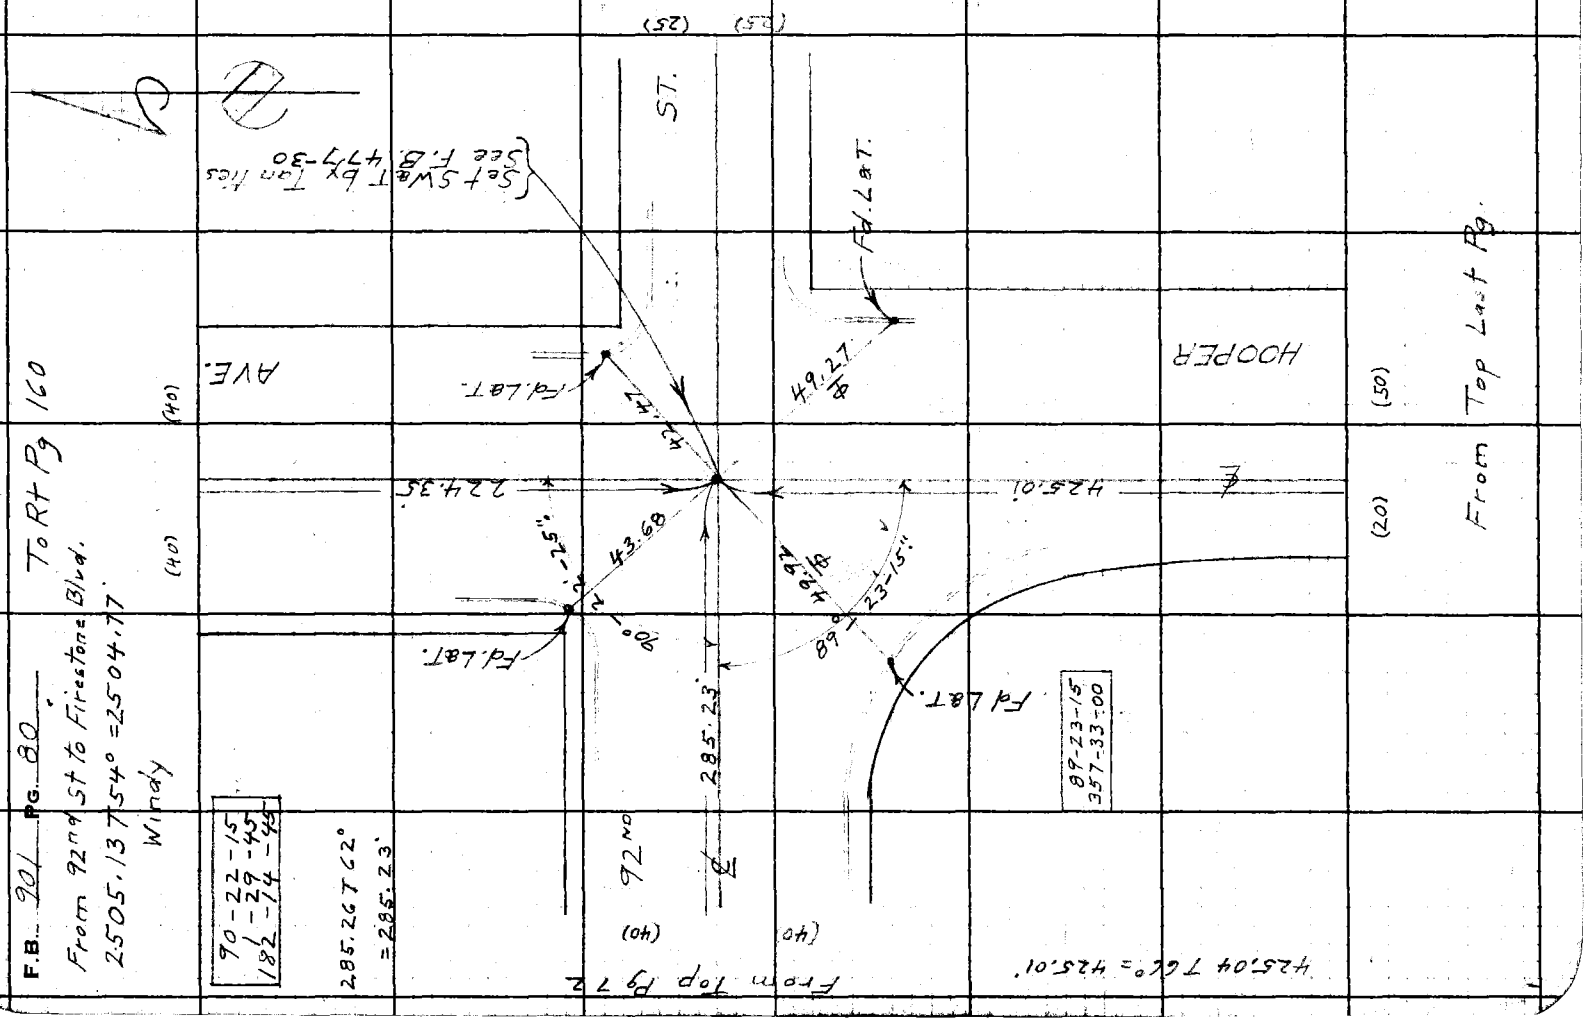

FORM 247 5M 10-59

RETURN TO
**LOS ANGELES COUNTY SURVEYOR**
700 HALL OF RECORDS

**Note:** Any Additions or Changes on This Sheet Must be Made or Circled in **Red Ink** With Date and Name of Person Making Change.

**Do not extend notes this side of this line.**

WS 78-6

To Rt. Pg 82

From Left Pg. 67

(50) CLOVIS (30)

(30)

(30)

(50) AVE

(25) ST.

(20)

95TH

Fd L&T

Fd L&T

Fd L&T

Fd Spk.

Set S w&T By Ties F.B. 1025-113

Set Cr. Tack By Ties F.B. 1025-113

Set Spk

Set Spk

289.47'

602'

104'

179°-59'

528.80'

198.45'

80.00'

80.00'

80.00'

179-59-45
359-58-30

90-53-15
363-32-30

To W Spk @ Centerline

528.86 T 58° = 528.80

198.47 T 58° = 198.45

Notes Ck'd by [illegible]
Map No. B-1811-2
Office Work R. W. M.
Checked D. M. Pinkey
Date AUG '69

Survey of [illegible]
W. O. 8126 Tape No. 044 Stdzed
Surveyed by F. J. M. L. Neal
Notes [illegible] Date 12-9-41
Indexed [illegible]

F.B. 941 PG. 81

F.B. 901 PG. 82

From Left Pg 70

160.19 T 64° = 160.18'

W.S. 7 B-6

RETURN TO
LOS ANGELES COUNTY SURVEYOR
700 HALL OF RECORDS

Do not extend notes this side of this line.

Note: Any Additions or Changes on This Sheet Must be Made or Circled in Red Ink With Date and Name of Person Making Change.

(25) (25) ST. (20)

160.19'

Fd. Nail

Fd. L&T & Prod

411.17

24.20

Fd. L&T

10.10

20.12

24.84

Fd. L&T 143°

Fd. L&T & Prod.

143-51-45
215-27-00

Set Cutack
by Tie's F.B. 1025-99

94TH

260.71'

269.72 T 68° = 260.71'

89-00-45
356-03-00

Fd L&T

Fd. L&T

89.00'

48.26

682.47'

289.47'

(30)

CLOVIS

AVE

37.15

From Left Pg 81

To Bot. Pg 71

(50)

Fd 1X2 B&Spk
Per F.B. 1025-98

(30) (30)

Fd. L&T

℄ Prod.

682.55 T 58° = 682.47'

289.50 T 58° = 289.47'

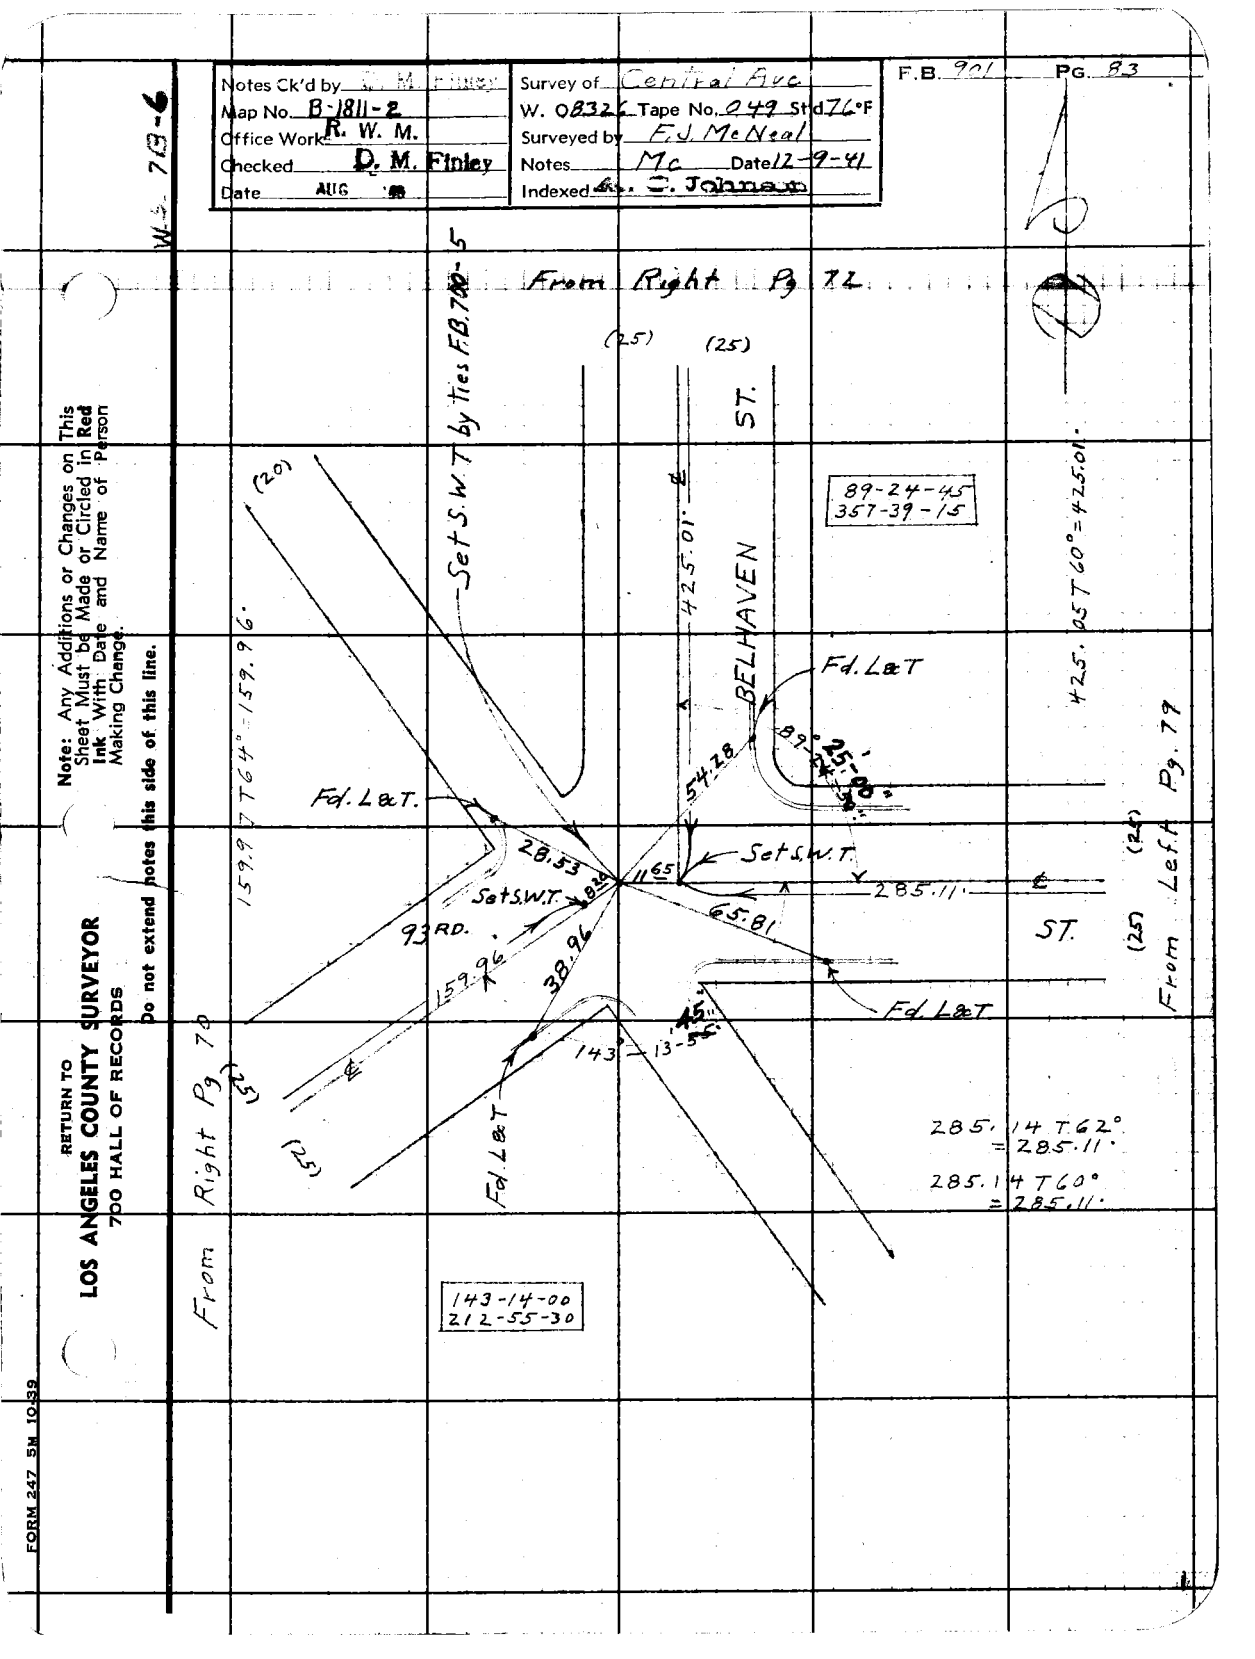
Notes Ck'd by D. M. Finley
Map No. B-1811-2
Office Work R. W. M.
Checked D. M. Finley
Date AUG
Survey of Central Ave.
W. 0832 Tape No. 249 Std 76°F
Surveyed by F.J. McNeal
Notes Mc Date 12-9-41
Indexed by C. Johnson
F.B. 901 Pg. 83
W.S. 79-6
From Right Pg 72
Set S.W.T by ties F.B. 720-5
(25)
(25)
ST.
(20)
425.01'
BELHAVEN
89-24-45
357-39-15
Fd. L&T
425.25 T 60° = 425.01'
From Left Pg. 79
159.97 T 64° = 159.96'
Fd. L&T.
54.28
89° 24' 45"
28.53
Set S.W.T.
11.65
285.11'
Set S.W.T.
93RD.
159.96'
38.96
65.81
ST.
Fd. L&T
143° 13' 55"
(50')
(50')
Fd. L&T
From Right Pg 70
285.14 T 62° = 285.11'
285.14 T 60° = 285.11'
143-14-00
212-55-30
Note: Any Additions or Changes on This Sheet Must be Made or Circled in Red Ink With Date and Name of Person Making Change.
Do not extend notes this side of this line.
RETURN TO
LOS ANGELES COUNTY SURVEYOR
700 HALL OF RECORDS
FORM 247 SM 10-39

F.B. 901 Pg. 84

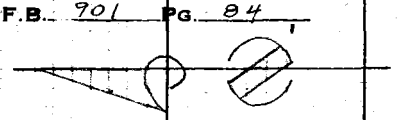

From Left Pg 71

(40) (40)

180.02'

Fd. Spk 1" Dp. Per F.B. 1025-78

180.04 T 62° = 180.02'

(20)

Set Cu. tack on M.H. Per F.B. 1025-76

481.15'

ST.

481.19 T 62° = 481.15'

W. 57 Bg.

Fd. L&T

Fd. L&T

WADSWORTH

AVE.

(60)

60.28

49.32

44.61

59.74

Fd. L&T

Fd. Spk

92ND

McKINLEY

AVE.

(60)

Set Cu tack on M.H. by ties F.B. 1025-74

.01

To Top Next Pg

RETURN TO
LOS ANGELES COUNTY SURVEYOR
700 HALL OF RECORDS

Do not extend notes this side of this line.

Note: Any Additions or Changes on This Sheet Must Be Made or Circled in Red Ink With Date and Name of Person Making Change.

Notes Ck'd by D. M. Finley
Map No. B-1811-2
Office Work R. W. M.
Checked D. M. Finley
Date AUG '41

Survey of Central Ave.
W. O. 8326 Tape No. 049 Sta 176 °F
Surveyed by F. J. McNeal
Notes Mc Date 12-11-41
Indexed E. Johnson

F.B. 901 Pg. 37

From Bot. Last Pg.

(40) (40)

ST.

STANFORD AVE.

(60)

Set Sat Co. tack by ties F.B. 1025-72

Fd. L & W. Spk Pct. F.B. 1025-70

E

92 WD

Fd. L & T

Fd. L & T

AVALON BLVD.

(40)

45.22

61.44

56.01

(40)

Out

Fd. L & T

Note: Any Additions or Changes on This Sheet Must be Made or Circled in Red Ink With Date and Name of Person Making Change.

Do not extend notes this side of this line.

RETURN TO
LOS ANGELES COUNTY SURVEYOR
700 HALL OF RECORDS

FORM 247 5M 10-39

RETURN TO
**LOS ANGELES COUNTY SURVEYOR**
700 HALL OF RECORDS

**Note:** Any Additions or Changes on This Sheet Must be Made or Circled in **Red Ink** With Date and Name of Person Making Change.

**Do not extend notes this side of this line.**

BLANK

F.B. 201 PG. 86

| | | | |
|---|---|---|---|
| Notes Ck'd by D. M. Finley | | Survey of Central Ave | |
| Map No. B-1811-1 | | W. O. 8326 Tape No. 049 Std 72°F | |
| Office Work R. W. M. | | Surveyed by E. L. McNeal | |
| Checked D. M. Finley | | Notes Mc Date 12-15-47 | |
| Date AUG '49 | | Indexed | |

F.B. 901 Pg. 87

W 5 Z 6 C. S.
W 3 Z 17

PROPERTY LINES

Note: Any Additions or Changes on This Sheet Must be Made or Circled in Red Ink With Date and Name of Person Making Change

Do not extend notes this side of this line.

RETURN TO
LOS ANGELES COUNTY SURVEYOR
700 HALL OF RECORDS

793.82 T 68° = 793.78'

793.78'

24+44.37
Fd 1" I.P. & T
See Pg 10
& 181.

℄ Per F.B. 901-10 AVE.

Fd 2" I.P. and 8" Pg
Set nail ⊙ See TR #3626

89-04-15
356-17-00

1180.51 T 68°
= 1180.45
-20.13
1160.32

Fd 2" I.P. only Flush
See TR #3626

89°

15.38
20.00
4.62

1160.32'

6' off

5.92

Road to Central Airport

CENTRAL

Fd 2" I.P. with
Pinched Top
Bent, used Cente
Per TR #3626

TR NO
3626

Fd 2" I.P. & t
R.E. 2093 Tag
See TR #3626

19.86

1170.77'

10+50.59
Set P.M. By Inter

90° 38'

1170.85 T 64° = 1170.77

90-38-45
362-35-00

FORM 247 5M 10-39

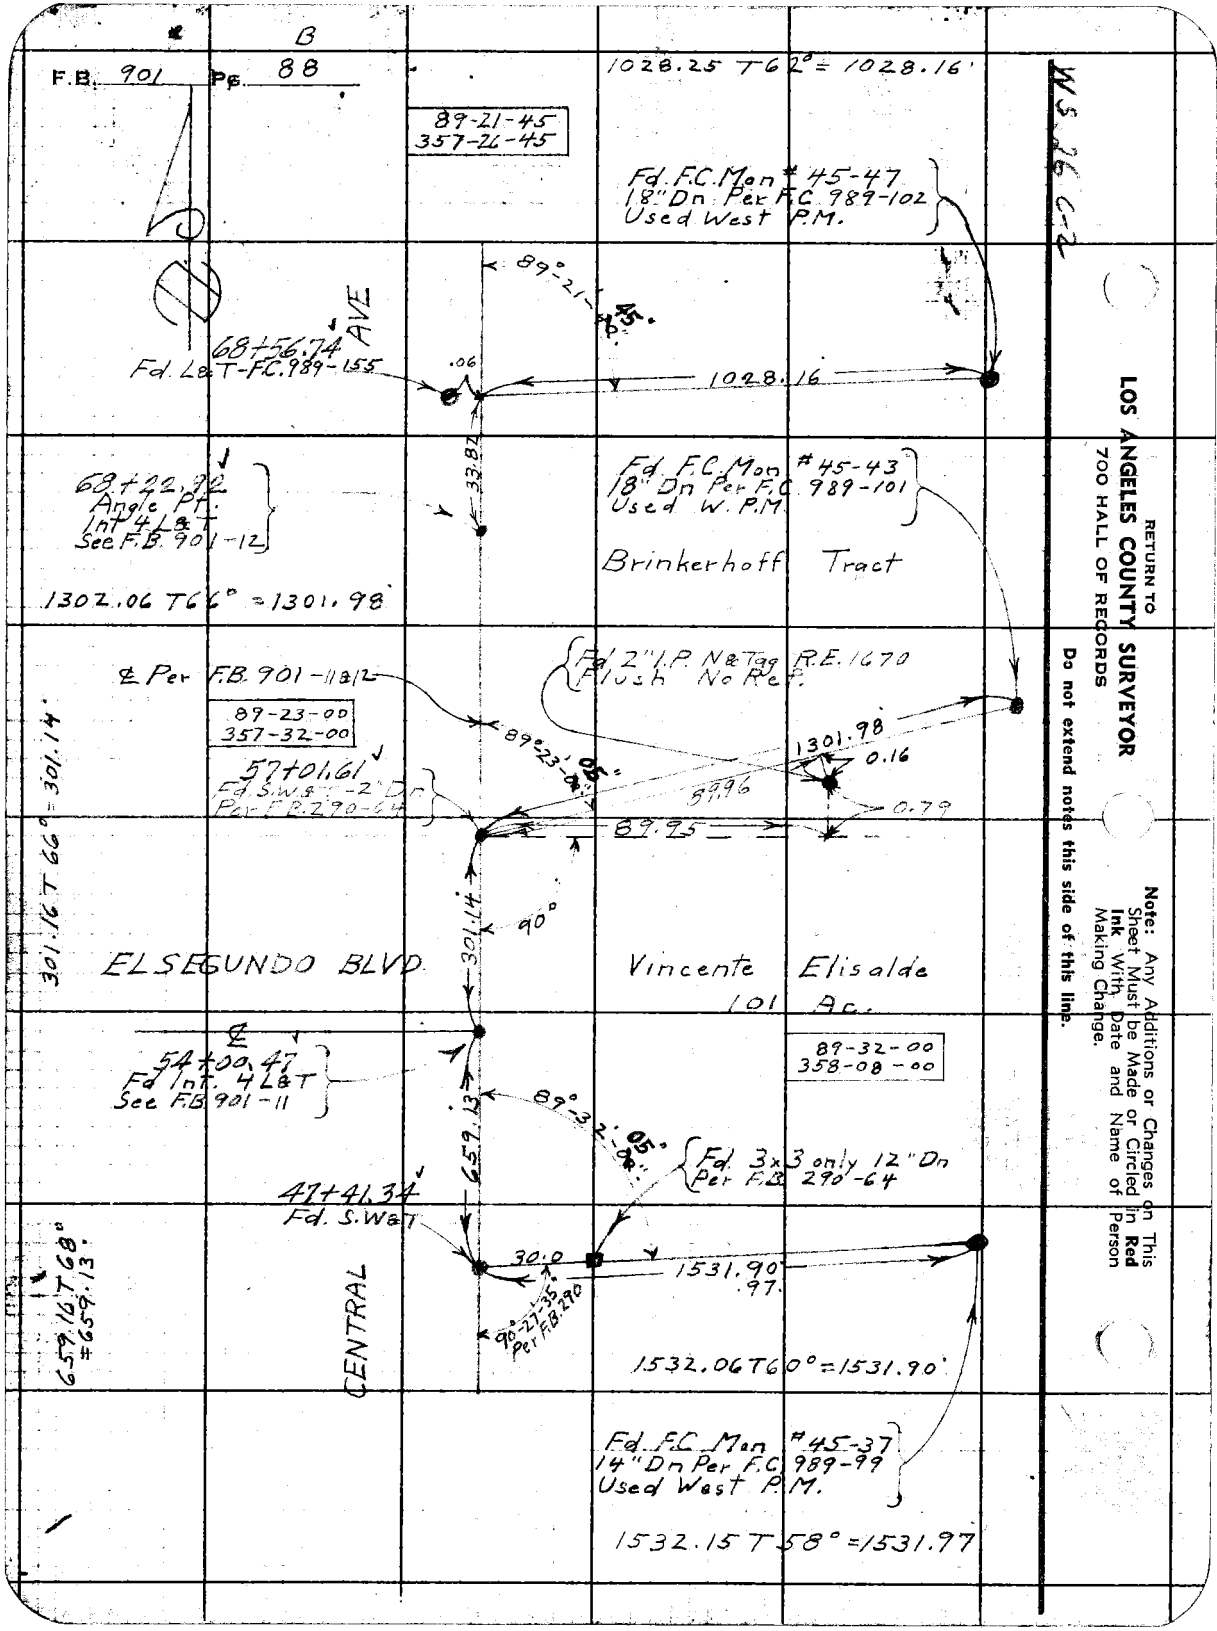
B
F.B. 901 Pg. 88
89-21-45
357-26-45
1028.25 T 62° = 1028.16'
Fd. F.C. Mon # 45-47
18" Dn Per F.C. 989-102
Used West P.M.
W.S. 26 C-2
89°-21'-45"
68+56.74
Fd. L&T-F.C. 989-155
AVE
.06
1028.16
68+42.22
Angle Pt.
Int. 4 L&T
See F.B. 901-12
33.82
Fd. F.C. Mon # 45-43
18" Dn Per F.C. 989-101
Used W. P.M.
Brinkerhoff Tract
1302.06 T 6° = 1301.98
℄ Per F.B. 901-118/12
Fd 2" I.P. No Tag R.E. 1670
Flush No Ref.
89-23-00
357-32-00
89°23'-05"
1301.98
0.16
57+01.61
Fd. S.W.S. - 2" Dn
Per F.B. 290-64
89.96
0.79
89.95
301.14'
301.16 T 6° = 301.14'
90°
ELSEGUNDO BLVD.
Vincente Elisalde
101 Ac.
℄
54+00.47
Fd Int. 4 L&T
See F.B. 901-11
89-32-00
358-08-00
89°-32'-05"
659.13'
Fd. 3x3 only 12" Dn
Per F.B. 290-64
47+41.34
Fd. S.W.S.
30.0
1531.90'
.97
90°-27'-35"
Per F.B. 290
CENTRAL
659.10 T 6° = 659.13'
1532.06 T 6° = 1531.90'
Fd. F.C. Mon # 45-37
14" Dn Per F.C. 989-99
Used West P.M.
1532.15 T 5° = 1531.97
RETURN TO
LOS ANGELES COUNTY SURVEYOR
700 HALL OF RECORDS
Do not extend notes this side of this line.
Note: Any Additions or Changes on This Sheet Must be Made or Circled in Red Ink With Date and Name of Person Making Change.

FORM 247 5M 10-39

RETURN TO
**LOS ANGELES COUNTY SURVEYOR**
700 HALL OF RECORDS

**Note:** Any Additions or Changes on This Sheet Must be Made or Circled in **Red Ink** With Date and Name of Person Making Change.

**Do not extend notes this side of this line.**

W. 26C-2

618.78 T 52° = 618.68'

336.27 T 64° = 336.24

Fd Nail & T Per F.B. 275-159

Fd 1"x2" & N Per F.B. 901-13

Fd 1"x2" & N Per F.B. 989-155

Fd L & T Per F.C. 989-155

CENTRAL AVE.

℄ Per F.B. 901-13

.07 .05

.06

618.68'

336.24'

90° 37'

90° 30'

Jose M. Abila 538.28 Ac.

19.91'

3.51

49.92'

Fd 2" I.P. & t-Flush Per F.B. 275-158

TR. No 6518

118 TH

57

Fd 2" I.P. & t-5" Dn Per F.B. 275-159

747.82'

Fd F.C. Mon. 14" Dp. Used West P.M.

747.90 T 60° = 747.82'

550.74 T 62° = 550.69'

550.69'

Fd F.C. Mon. - 14" Dp. #45-53 See F.C. 989-105

90-37-15
362-29-30

90-30-30
362-02-00

Notes Ck'd by
Map No. B-1811-1
Office Work R. W. M.
Checked P. M. Finley
Date

Survey of
W. 0.83 z
Surveyed by
Tape No. 0 to 95 ft. 76°F
Notes
Indexed
Date 2-17-42

F.B. 921 Pg. 87

RETURN TO
**LOS ANGELES COUNTY SURVEYOR**
700 HALL OF RECORDS

**Note:** Any Additions or Changes on This Sheet Must be Made or Circled in **Red Ink** With Date and Name of Person Making Change.

**Do not extend notes this side of this line.**

W.S 266-2

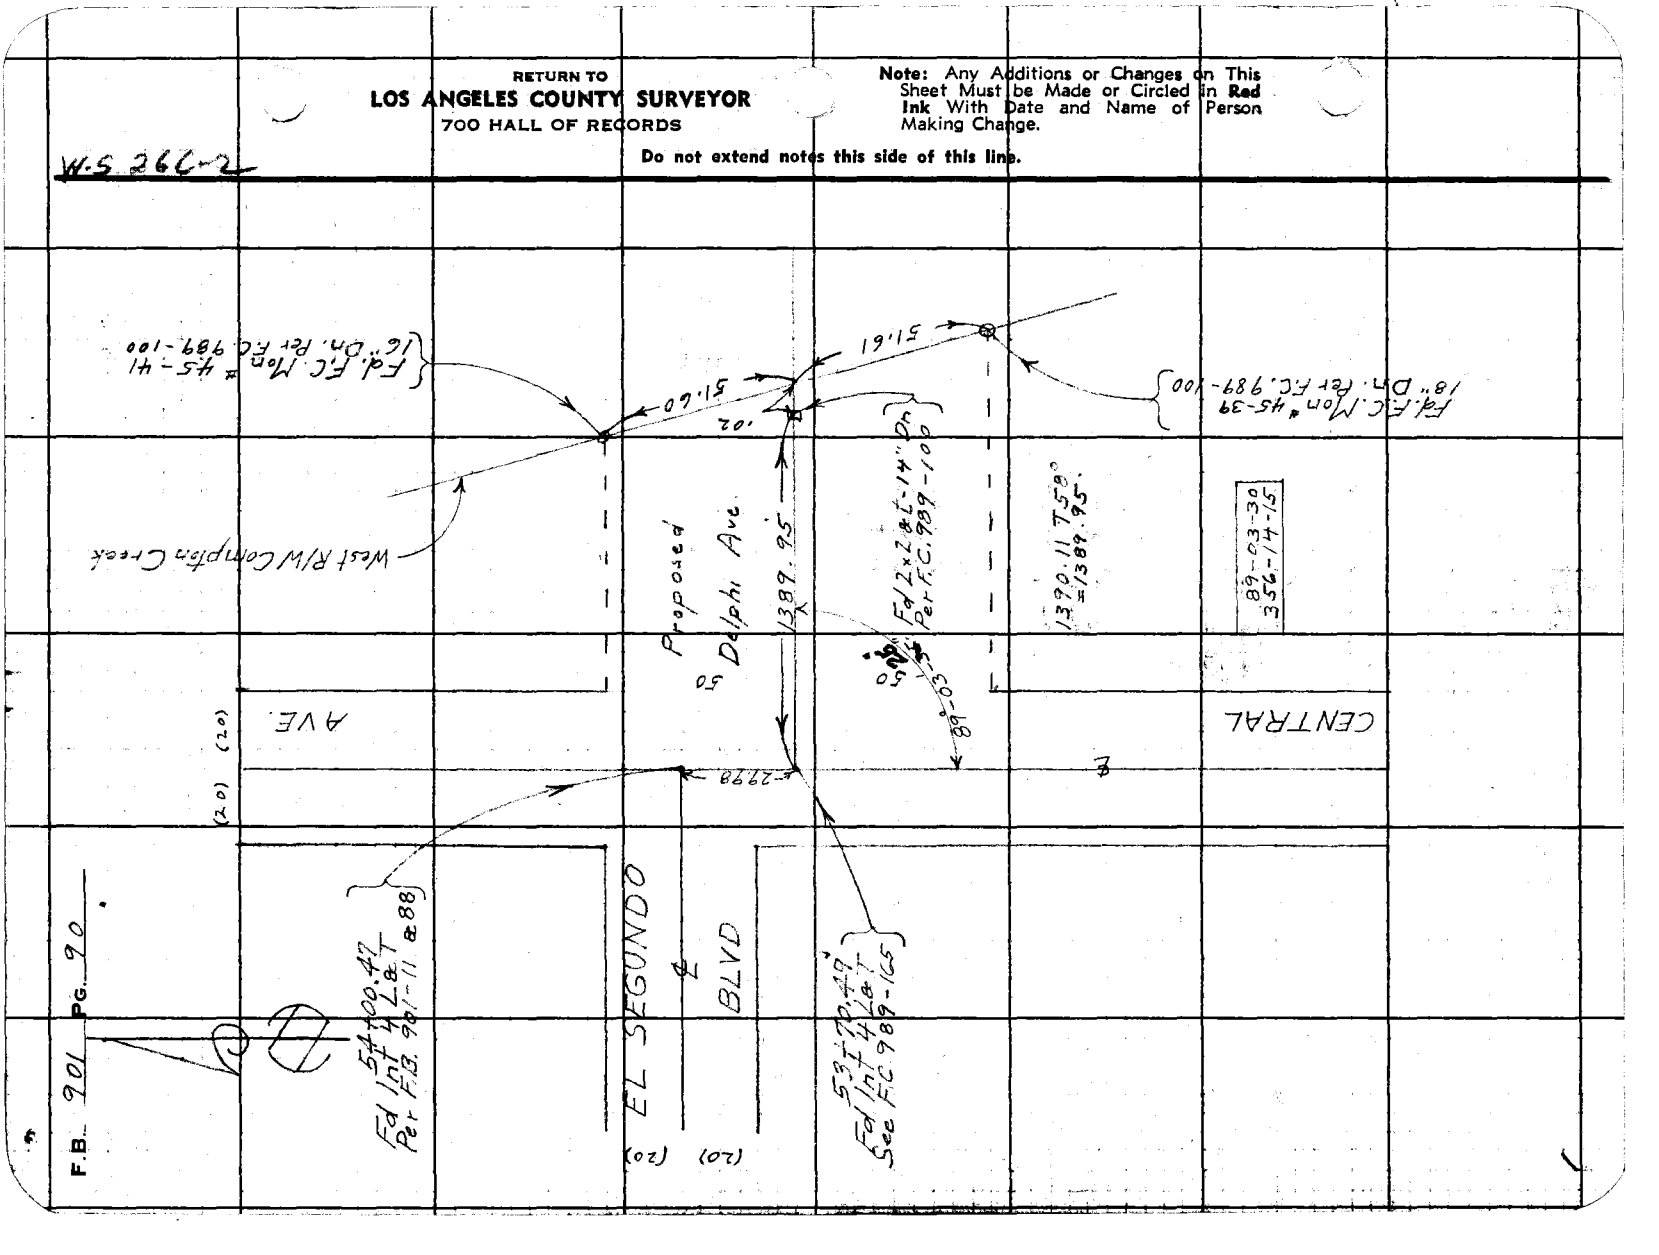

FORM 247 5M 10-39

RETURN TO
**LOS ANGELES COUNTY SURVEYOR**
700 HALL OF RECORDS

**Note:** Any Additions or Changes on This Sheet Must be Made or Circled in **Red Ink** With Date and Name of Person Making Change.

**Do not extend notes this side of this line.**

W 5-26 C-2

Notes Ck'd by
Map No. B-1811-1
Office Work R. W. M.
Checked D. M. Finley
Date Aug '39

Survey of Central Ave.
W. O. 2320 Tape No. 949 Std. 76°F
Surveyed by F. L. McNeal
Notes
Indexed C. [illegible] Date 2-3 V-41

F.B. 701 PG. 91

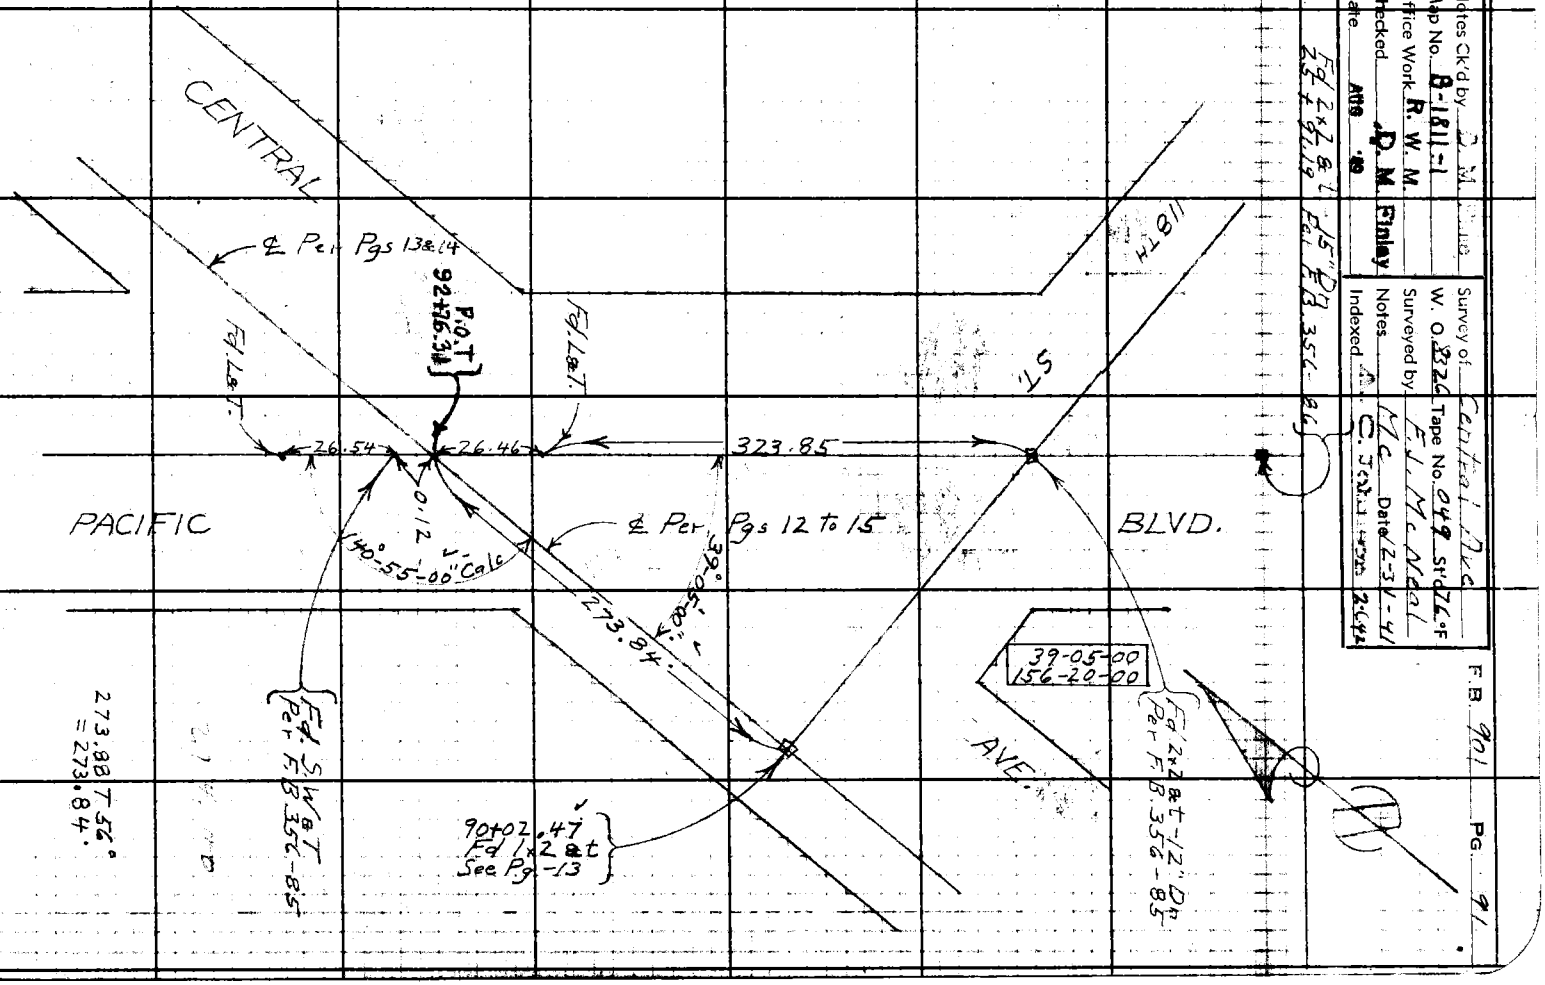

RETURN TO
**LOS ANGELES COUNTY SURVEYOR**
700 HALL OF RECORDS

**Note:** Any Additions or Changes on This Sheet Must be Made or Circled in **Red Ink** With Date and Name of Person Making Change.

**Do not extend notes this side of this line.**

W.S. 26C-1

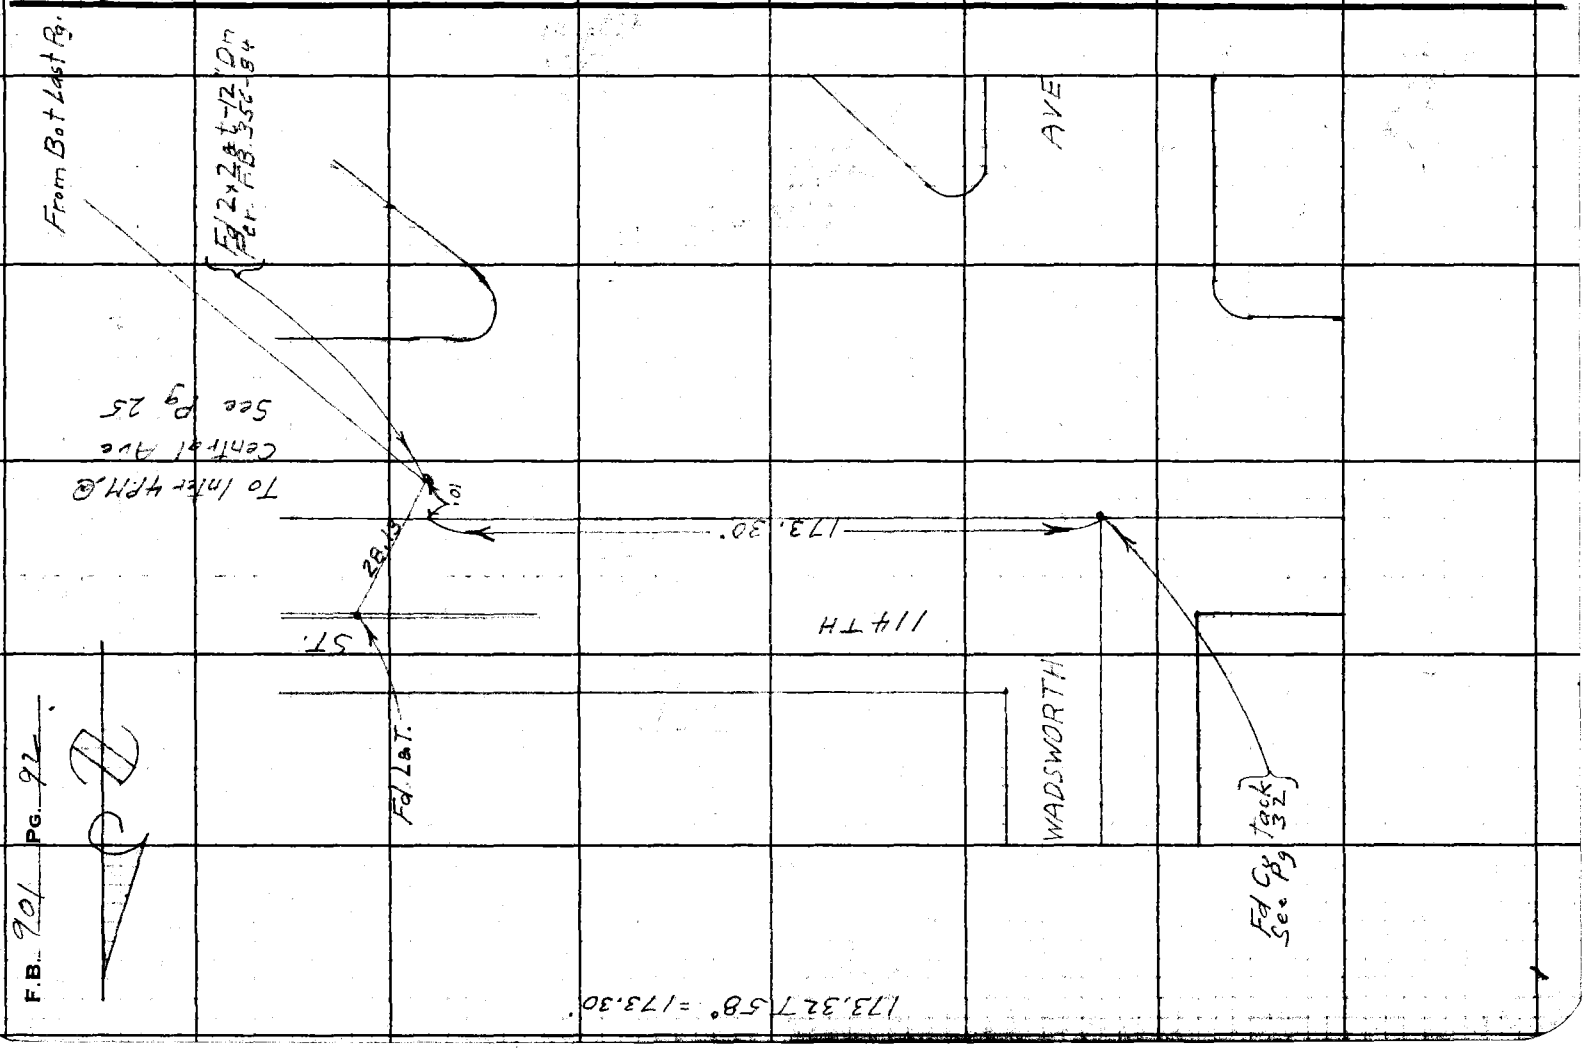

FORM 247 5M 10-39

RETURN TO
**LOS ANGELES COUNTY SURVEYOR**
700 HALL OF RECORDS

**Note:** Any Additions or Changes on This Sheet Must be Made or Circled In **Red Ink** With Date and Name of Person Making Change.

**Do not extend notes this side of this line.**

W.S.7 B-6

Notes Ck'd by [illegible]
Map No. B-181-2
Office Work R. W. [illegible]
Checked D. M. Finley
Date AUG '40

Survey of Central Ave
W. O. 8326 Tape No. 049 Std. 26°F
Surveyed by F. W. McNeal
Notes
Date 12-26-41
Indexed by C. Jones

F.B. [illegible] PG. 93

201.47 T56 = 201.44'

300.09 T56° = 300.05'

To Top Pg. 151

(40) (40)

90-32-30
362-09-45

Fd Spk

Fd L & T

66.12' ℄

1927 + 41.94
Fd L & W Spk
Pol. F.B. 1025-68

91 ST.

90°-32'

20"

55.92

40.45

37.38

℄ 201.44'

.02

27.08

300.05

To Bot Next Pg

(50)

(50)

From Left Pg. 72

CENTRAL

AVE.

36.57

50.05

27.54

17.75

45.80

49.93

S 89°-57'-15" E

30.00

30.10

Fd 2x2 & T flush

Fd L & T ℄ Prod

Fd L & T

732.04' ℄

1927 + 69.02
Fd L & W Spk
Pol. F.B. 1025-68

Fd 2x2 & T - flush

Fd L & T

ST.

(30) (30)

89-57-15
359-49-00

To Bot Pg 159

1

RETURN TO
**LOS ANGELES COUNTY SURVEYOR**
700 HALL OF RECORDS

**Note:** Any Additions or Changes on This Sheet Must be Made or Circled in **Red Ink** With Date and Name of Person Making Change.

**Do not extend notes this side of this line.**

WS. 70-6

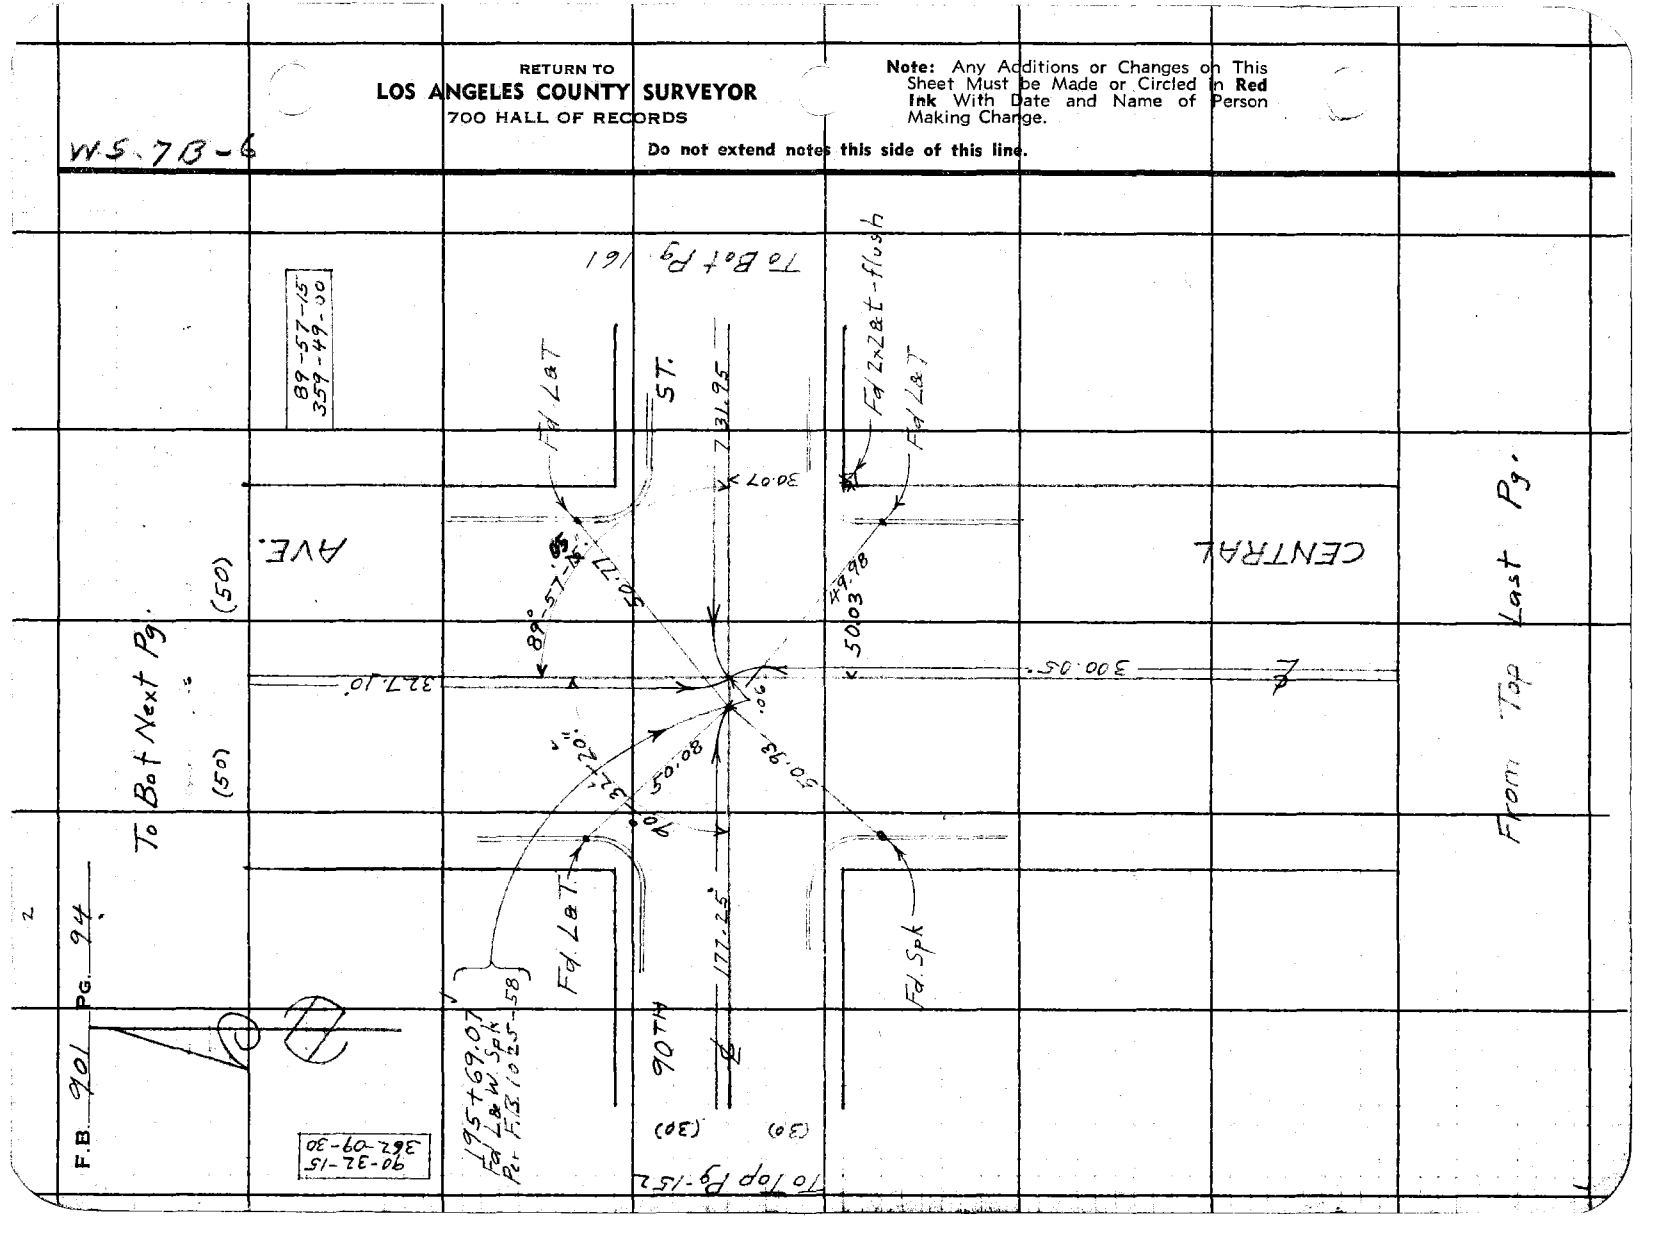

| | |
|---|---|
| Notes Ck'd by D. M. Finley | Survey of Central Ave |
| Map No. B-1811-2 | W. O. 2326 Tape No. 049 Std 76°F |
| Office Work R. W. M. | Surveyed by F. J. McNeal |
| Checked D. M. Finley | Notes Mc Date 12-16-41 |
| Date AUG '49 | Indexed C. Johnson |

F.B. 201 Pg. 95

W 5-7 B-6

Note: Any Additions or Changes on This Sheet Must be Made or Circled in Red Ink With Date and Name of Person Making Change
Do not extend notes this side of this line.

RETURN TO
LOS ANGELES COUNTY SURVEYOR
700 HALL OF RECORDS

FORM 247 5M 10-39

To Bot. Next Pg

327.28 T 56°
=327.24'

(50) (50)

198+96.17
Fd. Law. Spk
Per F.B 1025-48

327.24'

AVE.

Fd. L&T

49.70

50.10

49.21

Fd. L&T

Fd. 2x2&t-flush

30.18

731.97

153

(30)

To Top Pg

℄ 661.10

89 TH

(30)

106

89°27'40"

49.63

03-00

29.90

ST.

To Bot. Pg 163

50.06

90°0'

Fd 2x2 only - 3" Dn

Fd. L&T

(Out)

89-27-45
357-50-30

327.10'

90-03-00
360-12-00

327.14 T 56°

327.10'

℄ CENTRAL

From Top Last Pg.

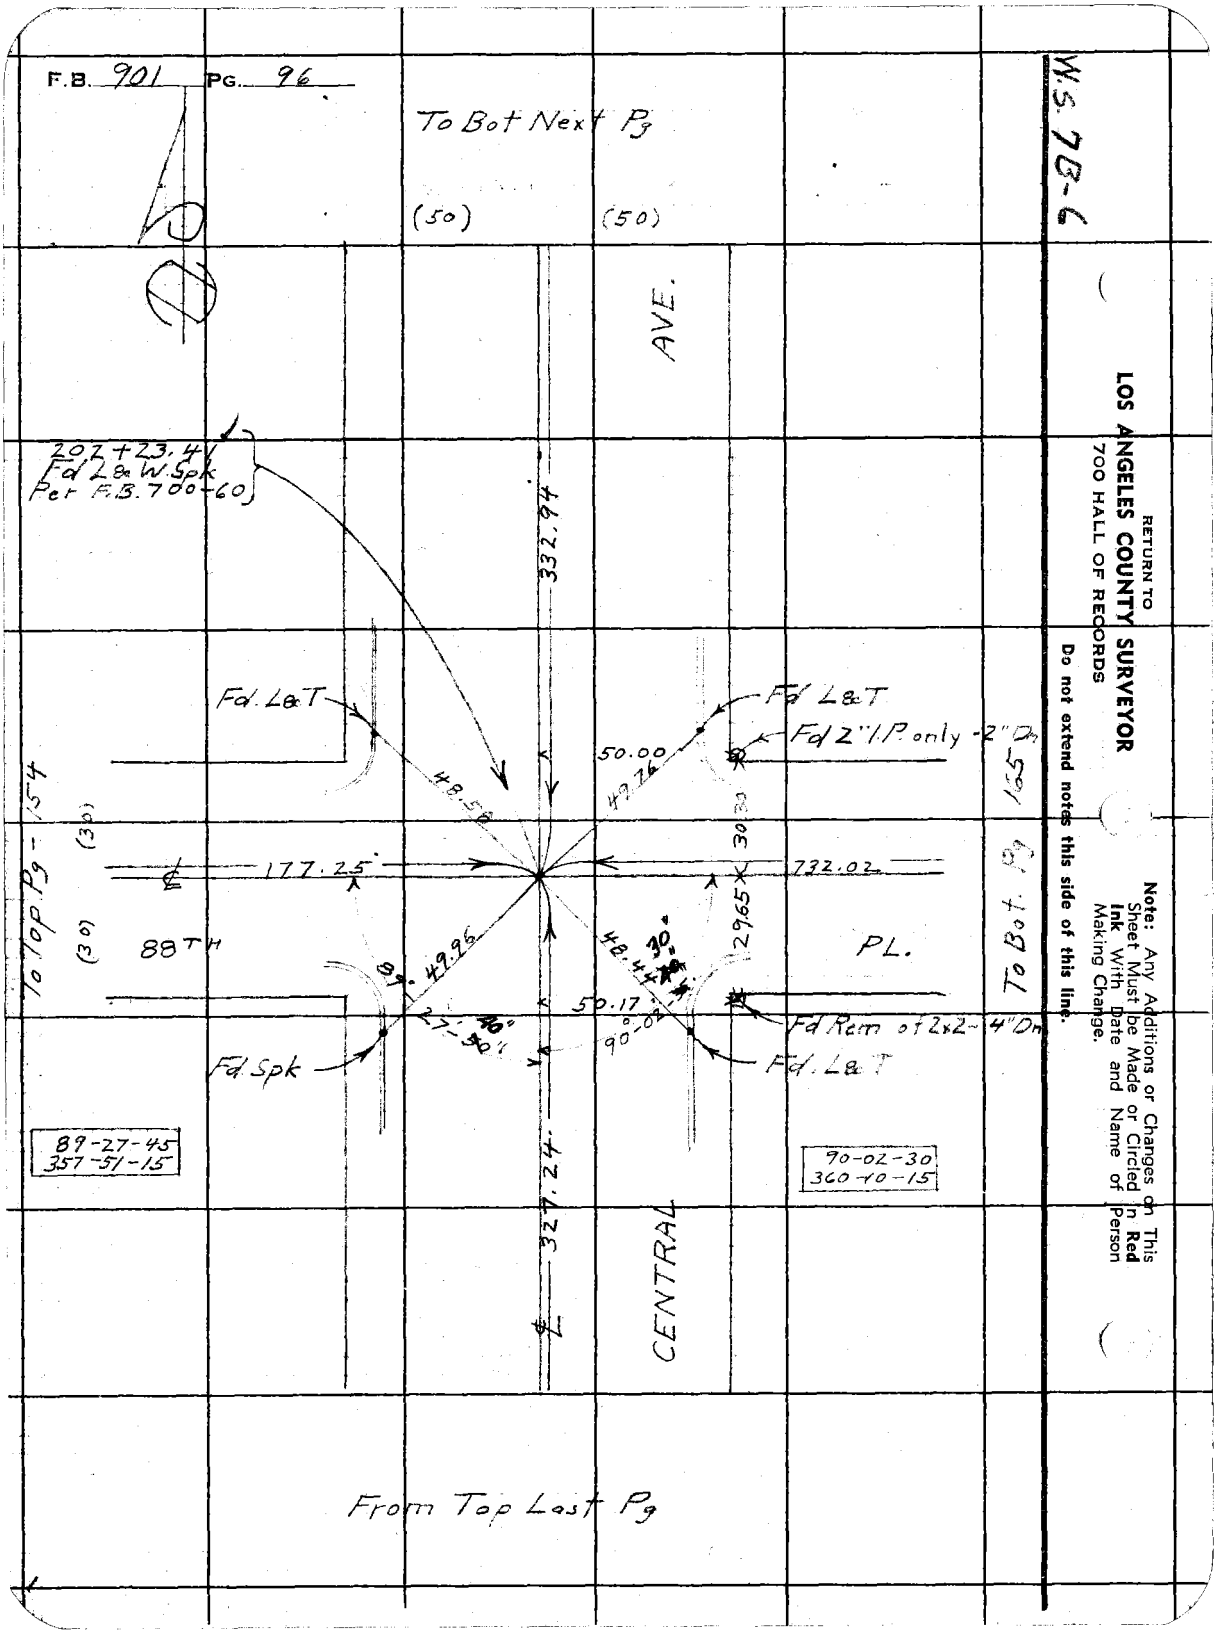
F.B. 901 PG. 96
To Bot Next Pg
(50)
(50)
AVE.
W.S. 78-6
RETURN TO
LOS ANGELES COUNTY SURVEYOR
700 HALL OF RECORDS
Note: Any Additions or Changes on This Sheet Must be Made or Circled in Red Ink With Date and Name of Person Making Change.
Do not extend notes this side of this line.
207+23.41
Fd 2" W. Spk
Per F.B. 700-60
332.94
Fd. L&T
Fd 2" I.P. only -2" Dp
50.00
49.76
48.58
177.25
(30)
(30)
88TH
49.96
30°
30°
27.50'
90-02
50.17
132.02
30.00
29.65
PL.
Fd Rem of 2x2 - 4" Dp
Fd. L&T
Fd Spk
89-27-45
357-51-15
90-02-30
360-40-15
327.24
CENTRAL
To Bot Pg 155
To Top Pg 154
From Top Last Pg

W.S. 76-4

| | | | |
|---|---|---|---|
| Notes Ck'd by | D. M. Finley | Survey of | Central Ave |
| Map No. | B-1811-2 | W. O. | 8326 Tape No. 049 St'd 76 °F |
| Office Work | R. W. | Surveyed by | Ed McNeal |
| Checked | D. M. Finley | Notes | Mc Date 12-19-41 |
| Date | AUG '49 | Indexed | C. Johnson |

F.B. 901 PG. 27

To Bot. Next Pg.

(50) (50)

205+56.35
Fd. W Spk + L.
Per F.B. 1025-32

AVE.

332.91

332.96 T 54"

= 332.91'

Fd. L & T.

48.80

50.02

49.48

Fd. L & T.

Fd. 2 x 2 & t - flush

(30)

661.13'

30.21

731.95'

(30)

88TH

49.53

48.82

29.98

ST.

49.98

89°27'45"

90°02'00"

Fd. Spk.

Fd. 2 x 2 & t - flush

Fd. L & T.

To Top Pg 155

To Bot. Pg. 167

89-27-45
357-50-45

90-02-00
360-08-00

332.94

332.997 - 54" = 332.94'

CENTRAL

From Top Last Pg.

RETURN TO
LOS ANGELES COUNTY SURVEYOR
700 HALL OF RECORDS

Note: Any Additions or Changes on This Sheet Must be Made or Circled in Red Ink With Date and Name of Person Making Change

Do not extend notes this side of this line.

FORM 247 BM 10-39

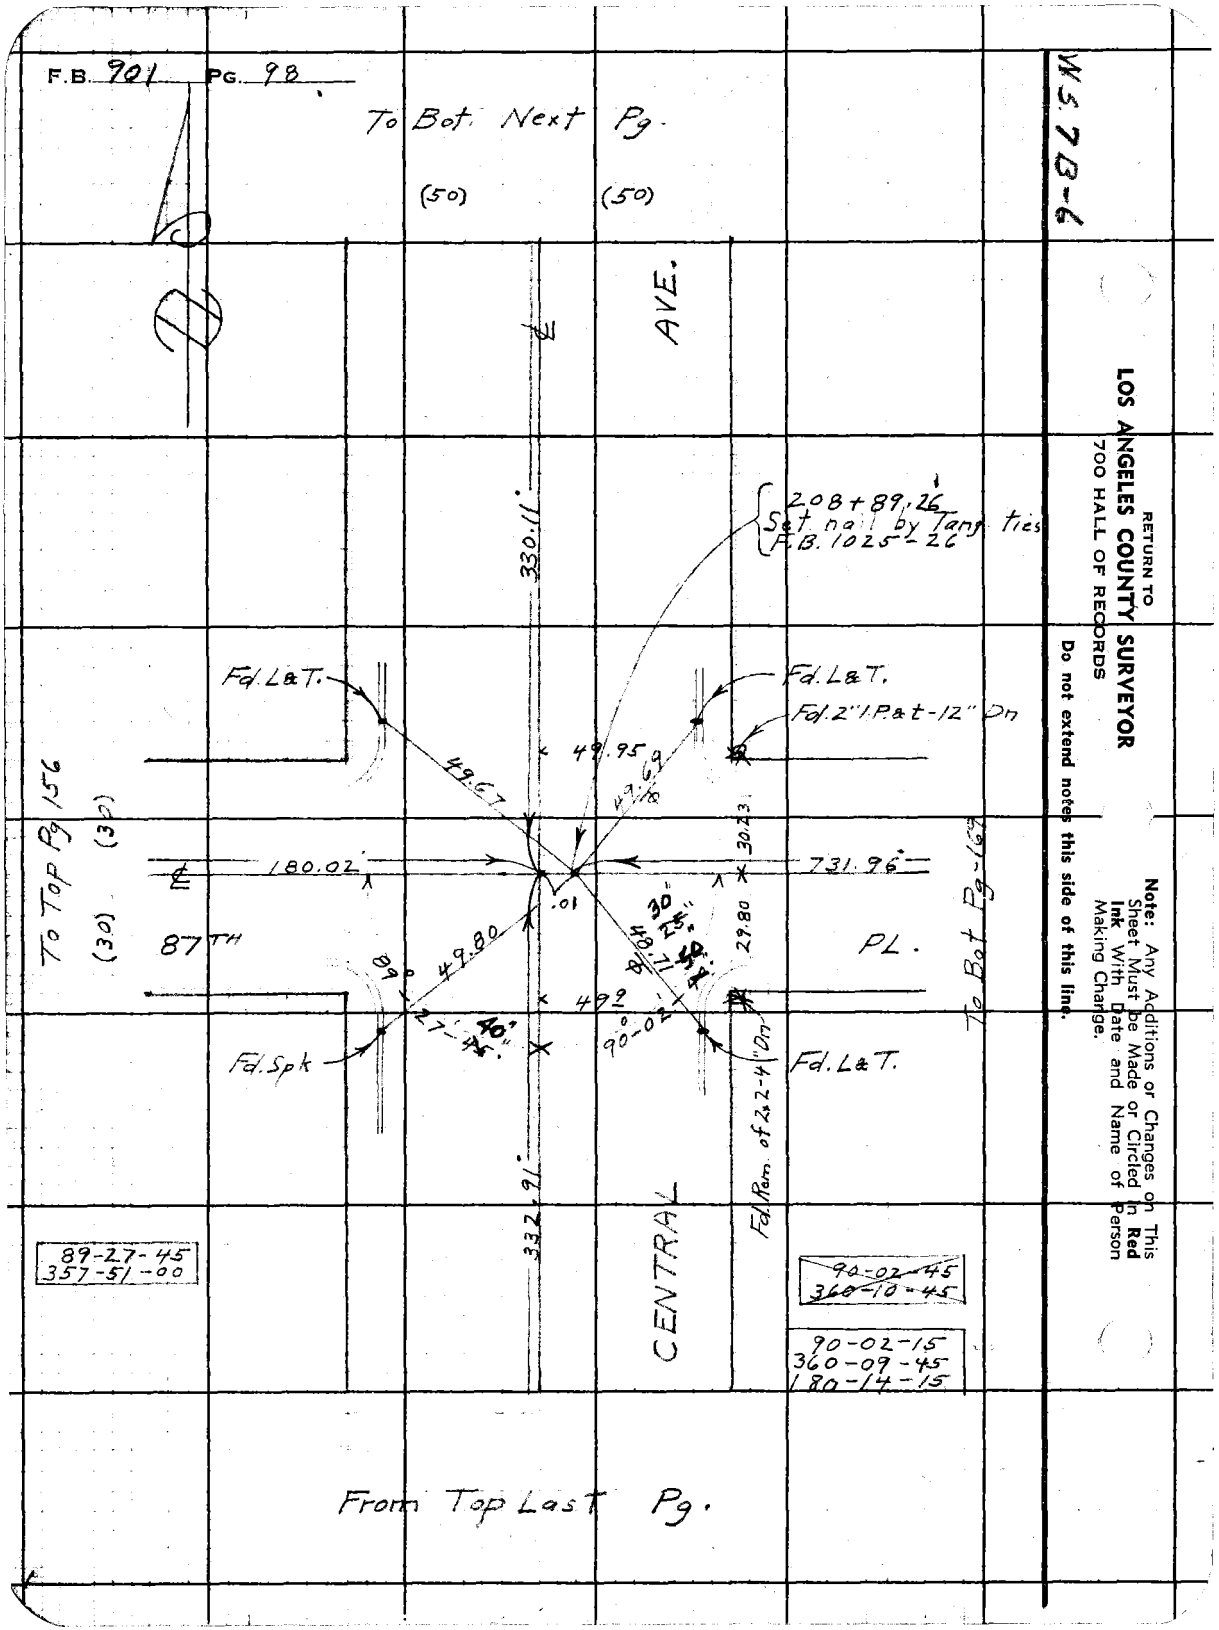
F.B. 901 PG. 98
To Bot. Next Pg.
(50)
(50)
AVE.
W.S. 73-6
RETURN TO
LOS ANGELES COUNTY SURVEYOR
700 HALL OF RECORDS
Note: Any Additions or Changes on This Sheet Must be Made or Circled in Red Ink With Date and Name of Person Making Change.
Do not extend notes this side of this line.
208+89.26
Set nail by Tang. ties
F.B. 1025-26
330.11'
Fd. L&T.
Fd. L&T.
Fd. 2" I.P. & t-12" Dn
49.67
49.95
49.67
180.02'
731.96'
30.23'
To Top Pg 156
(30) (30)
87TH
PL.
To Bot Pg 156
49.80
89°-27'-45"
49.80
90°-02'-15"
29.80
30-25"
30-14"
Fd. Spk
Fd. L&T.
332.91'
CENTRAL
Fd. Rem. of 2 2-4" Dn
89-27-45
357-51-00
90-02-45
360-10-45
90-02-15
360-09-45
180-14-15
From Top Last Pg.

| | | | |
|---|---|---|---|
| Notes Ck'd by D. M. Finley | Survey of Central Ave. | F.B. 901 | Pg. 97 |
| Map No. B-1811-2 | W. 0232.6 Tape No. 049 Std 76 °F | | |
| Office Work R. W. M. | Surveyed by F.J. McNeal | | |
| Checked D. M. Finley | Notes Mc Date 12-19-41 | | |
| Date AUG '42 | Indexed [illegible] 2-6-42 | | |

WS 7 B-6

Note: Any Additions or Changes on This Sheet Must be Made or Circled in Red Ink With Date and Name of Person Making Change

Do not extend notes this side of this line.

RETURN TO
LOS ANGELES COUNTY SURVEYOR
700 HALL OF RECORDS

To Bot Next Pg.

(50) (50)

330.03 T 64° = 330.00
330.06 T 64° = 330.03

AVE.

330.00

212+19.37
Fd L & T Spk
Per. F.B. 1025-18

Fd. L & T.

Fd. L & T

Fd. Rem. of 2x2 - 3" Dp

49.95
49.91

48.63

To Top Pg 157

(30) (30)

661.12'

731.935'

30.14

87TH

ST

.045

49.27

89°

27-30"

48.73

90°-02'

2.82

out

Fd. Spk

Fd L & T.

To Bot. Pg 171

90-02-45
360-10-30

89-27-30
357-50-00

330.11'

℄ 330.11'

CENTRAL

Fd Rem of 2x2 - flush

330.16 T 54° = 330.11'

From Top Last Pg.

FORM 247 SM 10-39

F.B. 901 PG. 100

To Bot Pg 174

W.S. 7 B-6

(50) (50)

AVE.

215+49.37
Fd Hex. rod + P.M.
In Hand Hole
@ Inter. of 4 Le Sabs
Per F.B. 1027-31

90-18-45
361-15-15

90-10-00
360-40-00

Fd. L & T.

Fd. L & Spk

90°-10'-00"

69.01

MANCHESTER

90°-18'-45"

72.99 FIRESTONE

(50)

To Top Pg. 158

661.09'

731.97'

74.26

72.56

AVE.

BLVD.

To Left Pg. 173

(50)

(50)

89°-27'-40"

90°-03'-20"

Fd. L & T.

Fd L & T

89-27-45
357-50-30

330.00'

CENTRAL

90-03-15
360-13-30

(50) (50)

From Top Last Pg.

RETURN TO
LOS ANGELES COUNTY SURVEYOR
700 HALL OF RECORDS

Do not extend notes this side of this line.

**Note:** Any Additions or Changes on This Sheet Must be Made or Circled in **Red** Ink With Date and Name of Person Making Change.

| | | | |
|---|---|---|---|
| Notes Ck'd by D. M. Finley | Survey of Central Ave. | F.B. 72 | Pg. 101 |
| Map No. B-1811 | W. O. 8326 Tape No. | St'd °F | |
| Office Work R. W. M. | Surveyed by F.J. McNeal | | |
| Checked D. M. Finley | Notes Me Date 11-3-41 | | |
| Date AUG '49 | Indexed [illegible] 2-6-42 | | |

# CENTRAL AVE.

## J.N.-8326

## LOCATION OF IMPROVEMENTS

FROM - ROSECRANS AVE.

TO - SLAUSON AVE.

F.J. McNeal
Geo. H. Nichols T
A. Carrasco H.C.
J.J. Lanigan R.C.
H.R. Foster R.C.
C.W. Wallace R.C.
H.D. Heber H.C.

Note: Any Additions or Changes on This Sheet Must be Made or Circled in Red Ink With Date and Name of Person Making Change.

Do not extend notes this side of this line.

RETURN TO
LOS ANGELES COUNTY SURVEYOR
700 HALL OF RECORDS

FORM 247 5M 10-39

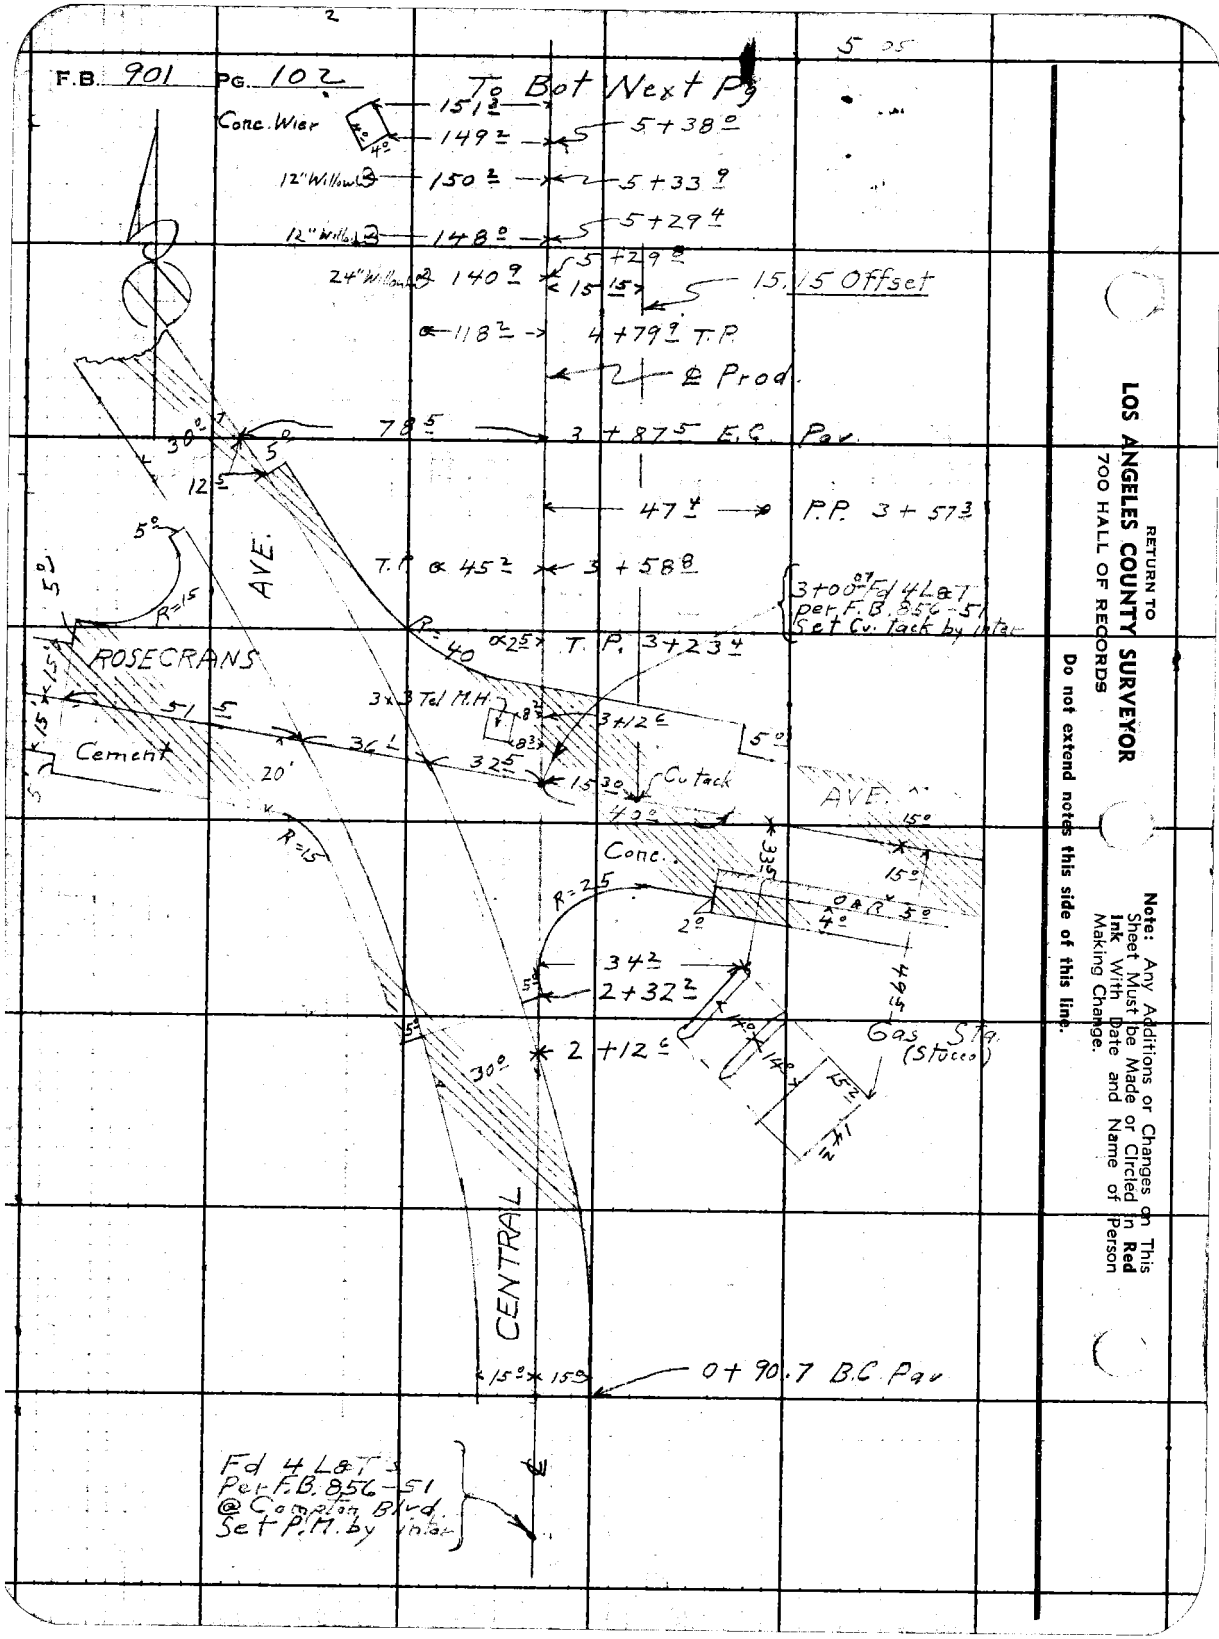


RETURN TO
LOS ANGELES COUNTY SURVEYOR
700 HALL OF RECORDS

Do not extend notes this side of this line.

**Note:** Any Additions or Changes on This Sheet Must be Made or Circled in **Red Ink** With Date and Name of Person Making Change.

Notes Ck'd by D. M. Finley
Map No. B-1811-1
Office Work A. W. W.
Checked D. M. Finley
Date AUG '49

Survey of Central Ave
W. O. 8326 Tape No. Std °F
Surveyed by E. J. McNeal
Notes Mc Date 10-31-41
Indexed

F.B. 901 Pg. 103

300.0
117.15

End of this Line

7+70.5 Set 1x2 at

Outhse

25.4

Frame

Shed

32.4

15.0

Barn

34.5

7+15

7+26.5

7+25.2

7+41.2

7+35.4

42.7

23.1

7+21.7

30.7

7+08.7

Bath Hse

32.3

15.15 Offset to ℄ Central Ave Prod.

46.0

6+73.9 P.P. @ 115

Frame House

Laundry

6+54.1

6+49.0

6+48.2

24.0

39.0

37.6

1-10" 2-6" Gum

6+40.5

2-8" 1-4" Gum

6+36.5

6+20

43.5

Frame House

24.51

24.5

Outhouse

6+08.7

Frame

Barn

5+81.7

5+85.3

45.0

24.0

Garage

Shed

5+79.7

5+86.2

5+83.9

45.0 P.P. 5+62.2

5+65.80 Set 1x2 at P.O.T.

15.15 Set 1x1

From Top Last Pg

Note: Any Additions or Changes on This Sheet Must be Made or Circled in Red Ink With Date and Name of Person Making Change.

Do not extend notes this side of this line.

RETURN TO
LOS ANGELES COUNTY SURVEYOR
700 HALL OF RECORDS

FORM 247 5M 10-39

F.B. 901 PG. 104

To Bot Rig At Pg 106

30' ⊗ T.P. 6+54.0

AVE

6+07.7 B.C. of Pav.

Conc.

5+34.60 R

Conc. Wier 4.4'

29.8

29.8

5+70.0

Cement

CENTRAL

3+88.5 T.P. ∝ 33' →

2+31.0 S W&T
See F.B. 901 Pg - 9

RETURN TO
LOS ANGELES COUNTY SURVEYOR
700 HALL OF RECORDS

Do not extend notes this side of this line.

Note: Any Additions or Changes on This Sheet Must be Made or Circled in **Red Ink** With Date and Name of Person Making Change.

| | | | |
|---|---|---|---|
| Notes Ck'd by D. M. Finley | Survey of Central Ave | F.B. 901 | Pg. 102 |
| Map No. B-1811-1 | W. O. 8326 Tape No. St'd °F | | |
| Office Work R. W. M. | Surveyed by E.J. McNeal | | |
| Checked D. M. Finley | Notes Mc Date 10-31-41 | | |
| Date AUG '49 | Indexed | | |

Note: Any Additions or Changes on This Sheet Must be Made or Circled In Red Ink With Date and Name of Person Making Change.

Do not extend notes this side of this line.

RETURN TO
LOS ANGELES COUNTY SURVEYOR
700 HALL OF RECORDS

To Bot Next Pg

(20) (20)

AVE.

CENTRAL

15 x 15

36.5

8°

8°

Tank & Platform

36.8

5+105±

44.9

4+96.4
Well & Pump

40.3

4+88.4
Shed

16.3

10°

40.3

4+65.3

10.5

5°

Wood Valve Box

22.5

48.8 → P.P. 4+67.1

22°

64° → T.P. 4+51.0±

4+46.2

134.9 → T.P.

AVE.

4+35.8

T.P. ∝ 34°45'

R'

R=25

ROSECRANS

Cement

Conc.

15 x 15

15 x 15

(30)

(30)

4+14.63
Int. 7+58.7
See F.B. 901 Pg 8

F.B. 901 Pg. 106

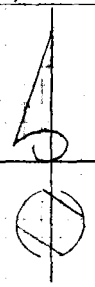

To Bot Next Pg

(20) (20)

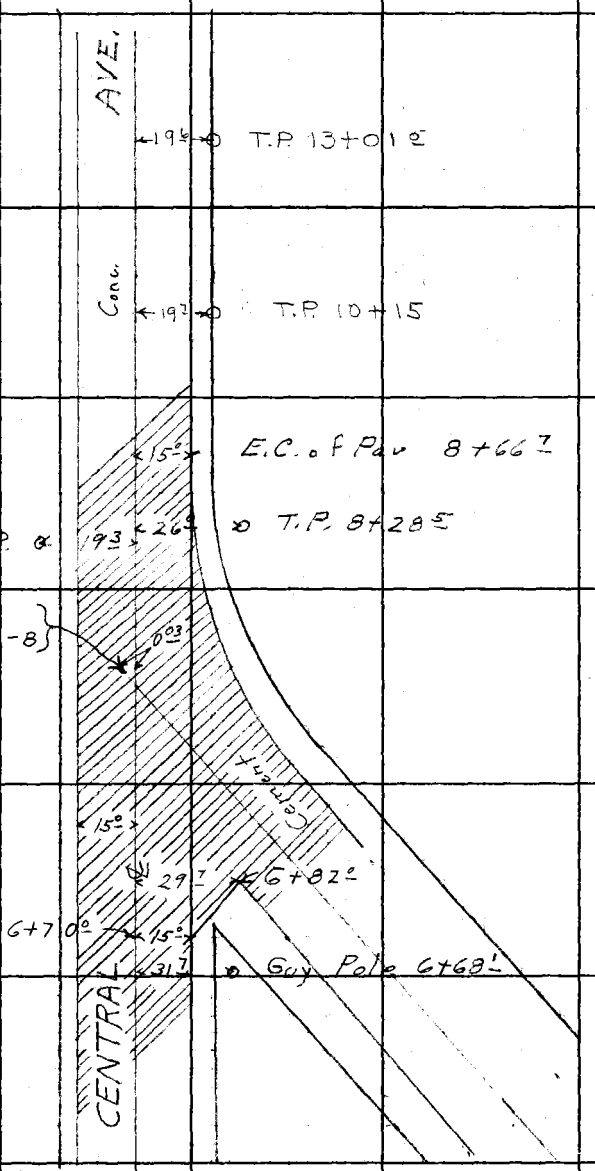


From Top Last Pg.

From Top Pg 104

RETURN TO
LOS ANGELES COUNTY SURVEYOR
700 HALL OF RECORDS

Note: Any Additions or Changes on This Sheet Must be Made or Circled in Red Ink With Date and Name of Person Making Change.

Do not extend notes this side of this line.

Notes Ck'd by L. M. Finley
Map No. B-1811-1
Office Work R. W. M.
Checked D. M. Finley
Date AUG '49

Survey of Central Ave
W. O. 8324 Tape No. Std °F
Surveyed by F. J. McNeal
Notes Nichols Date 10-31-41
Indexed

F.B. 901 PG. 101

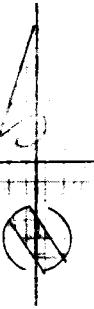

To Bet Next Pg.

Ottinson Brickyard 22+08

22+44.37
See F.B. 901-10

(20) (20)

R=20'

Gate Post 21+91.5 38.2

AVE.

19.2

TP 21+69.5

Gate Post 21+66.0
TP 21+60.5

64.2

5" Picket fence
16" Brick Posts 16' apart

21+50.2

22.1

15'

19+52
40" Palm

81.1

Cement Conc.

Stone 19+28.5 66.7
8" Cedar 19+28 62.8
12" Cedar 19+27 52.8
10" Cedar 19+26 49.2
12" Cedar 19+25 45.9
5" Cedar 19+22 42.1

CENTRAL NURSERY

Edge Lagoon 19+06.5 21.9

24" Pine 19+00 29.2

16" Cedar 18+99 22.3

18+86.5 21.5
16" Cedar

19.5 T.P. 18+80

18+67.5 31.3
36" Pine

18+40 31.1

40.2 36.2
18+29.5

4" Woven Wire

CENTRAL

20.2 T.P. 15+88

From Top Last Pg.

Note: Any Additions or Changes on This Sheet Must be Made or Circled in Red Ink With Date and Name of Person Making Change.

Do not extend notes this side of this line.

RETURN TO
LOS ANGELES COUNTY SURVEYOR
700 HALL OF RECORDS

FORM 247 SM 10-39

F.B. 901 PG. 108

To Bot. Next Pg.

(20) (20)

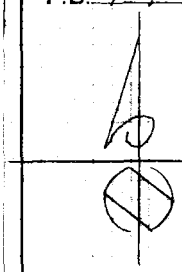

Cement Conc.

19½ T+PP 33+69⁸

19° T+PP 31+91⁵

19½ T+PP 30+13

15 × 15

AVE

19½ T+PP 28+33⁴

CENTRAL

Row of Eucalyptus Trees

27+64 — 71⁵

End of Mill 27+56⁵

16" Brick Posts 18 apart

22½

19½ T+PP 26+55

73⁵

26+35⁵

FRAME HOUSE

40'

44'

Porch

25+95⁴

ATKINSON BRICK YARD

5' Picket Fence

22⁵

73⁵

24+78⁵

25⁵

Gas Reg & (3" line) METERS

19° T+PP 24+74

25⁵

24+56

27⁵

66²

6×6 Pump House

24+63⁵

From Top Last Pg.

RETURN TO
LOS ANGELES COUNTY SURVEYOR
700 HALL OF RECORDS

Do not extend notes this side of this line.

Note: Any Additions or Changes on This Sheet Must be Made or Circled in Red Ink With Date and Name of Person Making Change.

| | |
|---|---|
| Notes Ck'd by | Survey of Central Ave |
| Map No. B-1811-1 | W. O. 822 Tape No. St'd °F |
| Office Work R. W. M. | Surveyed by F. J. McNeal |
| Checked D. M. Finley | Notes Nichols Date 11-4-41 |
| Date AUG '49 | Indexed C. Johnson |

F.B. [illegible] Pg. 102

Note: Any Additions or Changes on This Sheet Must be Made or Circled in Red Ink With Date and Name of Person Making Change.

Do not extend notes this side of this line.

RETURN TO
LOS ANGELES COUNTY SURVEYOR
700 HALL OF RECORDS

FORM 247 SM 10-39

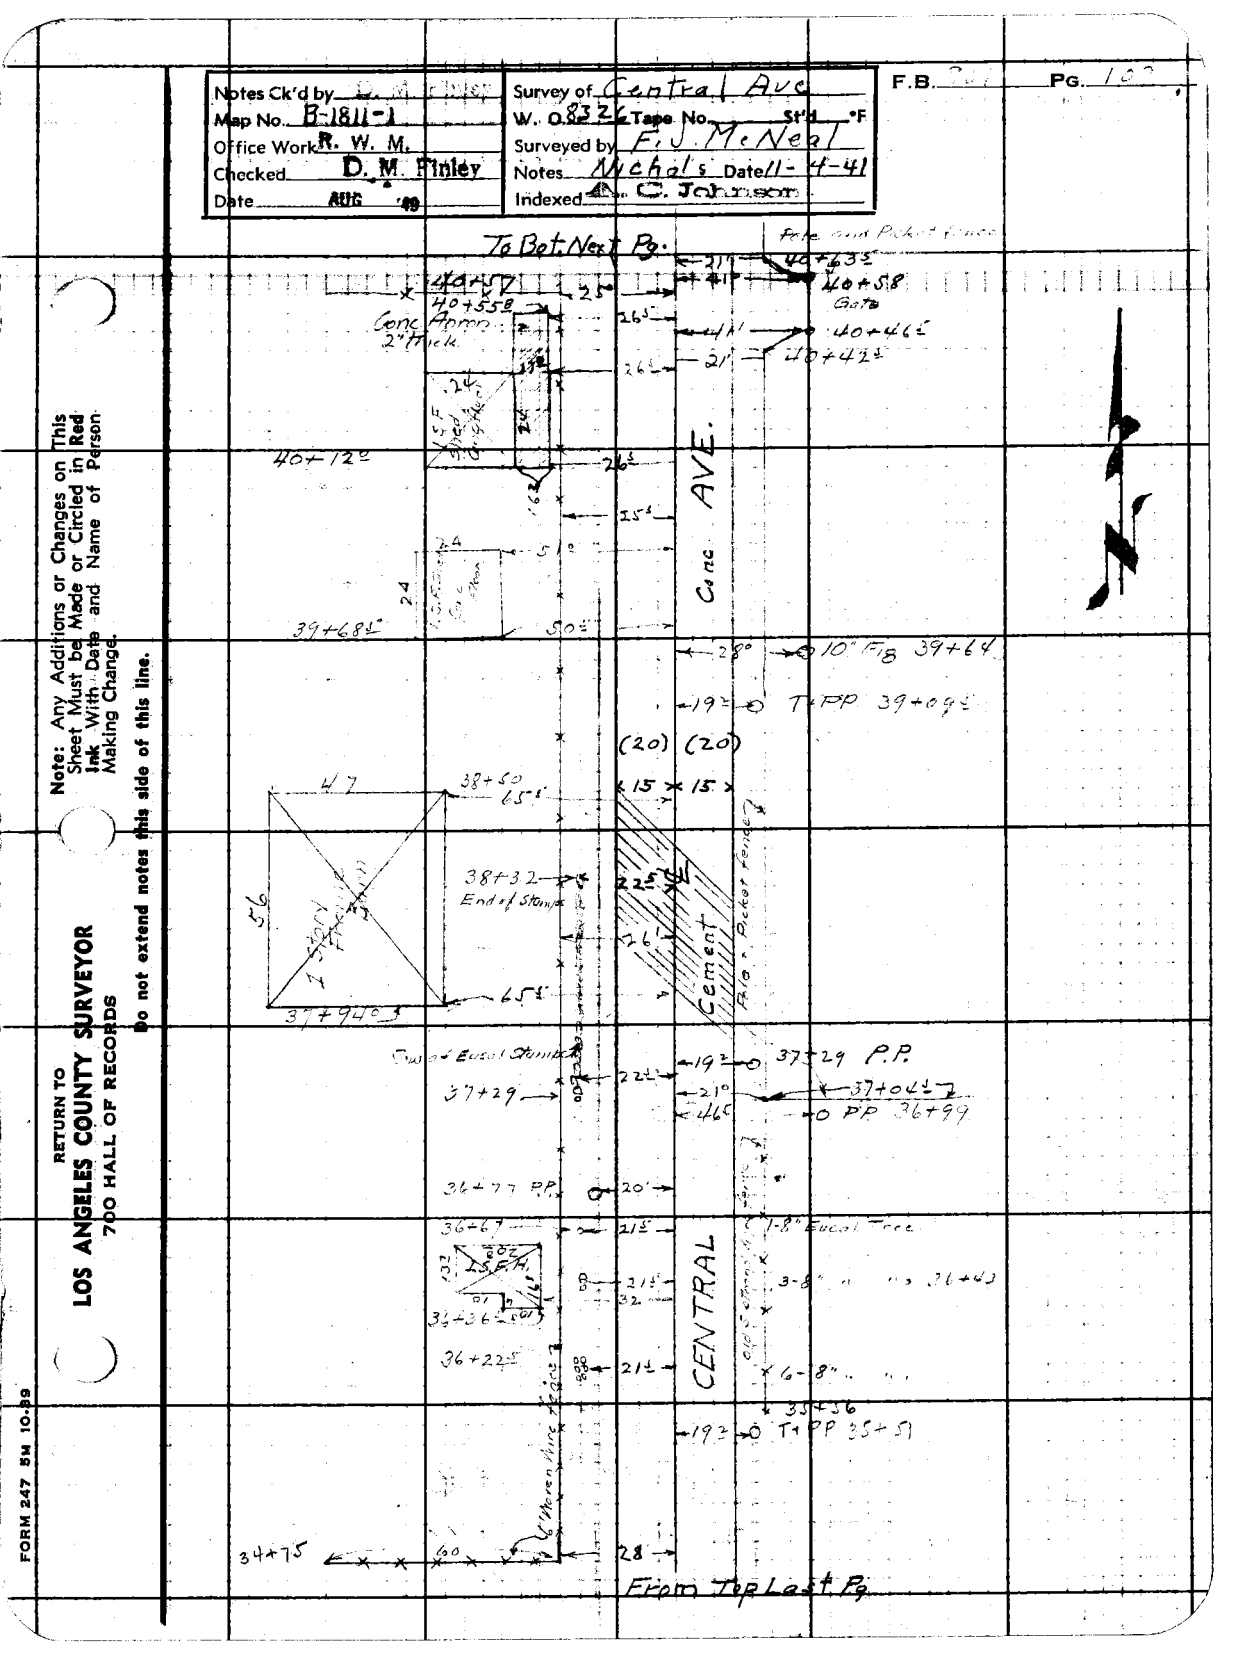

F.B. 901 Pg. 110

To Bot. Next Pg.

(20) (20)

Guy Pole 49+67

20

29

10T+PP 49+65

Conc. Drive

12°

49+61

36

34" Palm 49+27

Pav.

21

36

36" Palm 48+79

36

36" Palm 48+31

T.P. 48+25

19

19

T+PP 47+98

22

47+28 FC

Conc.

19

T+PP 46+14

30

5

15

Eucalyptus Grove

3 Plank Board Wire fence

CENTRAL AVE.

19

T+PP 44+40

2 Strand Wire fence

19

T+PP 42+64

40+88.82
Int 4 L & T
See F.B. 901-10

PP 40+89

40+89

19

22

Pole & Picket fence

40+86

20

40+80

48

48

PP 40+84

24

40+74

50 Eucal Trees

60

40" Palm 40+70

From Top last Pg.

30

12" Pine 40+63

RETURN TO
LOS ANGELES COUNTY SURVEYOR
700 HALL OF RECORDS

Do not extend notes this side of this line.

Note: Any Additions or Changes on This Sheet Must be Made or Circled in Red Ink With Date and Name of Person Making Change.

| | |
|---|---|
| Notes Ck'd by D. M. Finley | Survey of Central Ave |
| Map No. B-1811-1 | W. O. 8326 Tape No. Std °F |
| Office Work R. W. M. | Surveyed by F. J. McNeil |
| Checked D. M. Finley | Notes Nichols Date 11-5-41 |
| Date AUG '42 | Indexed |

F.B. 901 PG. 111

To Bot. Next Pg.

Note: Any Additions or Changes on This Sheet Must be Made or Circled in Red Ink With Date and Name of Person Making Change.

Do not extend notes this side of this line.

RETURN TO
LOS ANGELES COUNTY SURVEYOR
700 HALL OF RECORDS

FORM 247 5M 10-39

20' PP 55+77

(20) (20)

TP 54+75 21

45° and Wire Fence 52+40

54+38

PP 54+19.0 68°-24' R=24

20' PP 54+20

(20) ℄ EL SEGUNDO BLVD.

(20) MAC. Pave

53+90 R=20 36'

53+23 24

53+69

54+00.47 Int ℄ ℄ See F.B. 901-11

Conc

30

15 15 24 PP 53+26

TP 52+94 19

℄ CENTRAL AVE

Cement

TP 51+63 19

24 PP 51+37

Eucalyptus Grove

Stump 14" Fence

51+06 2-20" Gum

36 62 8 51+05 2-12" Gum

6' 14" Gum 50+98

TP 50+43 20

21

From Top Last Pg

F.B. 901 PG. 11

To Bot. Next Pg.

68+22.92
Int. 4 L&T
See F.B. 901-12

(20) (20)

PP 68+55
48±
20.0 21.5
fence
PP 68+55
P.L. Cont East
= 68+54
Fence is 3° / Pin
Conc 2-3/4" Cables
Gate
68+42

T.P. 66+94 20° 21 PP 66+96

Conc

T.P. 64+95 21 21 PP 65+36

67° 34" Palm 64+44

68° 36" Palm 64+19

22.8 21 PP 63+78

15 15

T.P. 62+17

20 PP 62+15

Asphalt Alley

Cement

T.P. 60+96 21° 20 PP 60+55±

Central Ave

T.P. 58+96 20± 20 PP 58+80

20 PP 57+36

T.P. 56+86 20±

From Top Last Pg.

RETURN TO
LOS ANGELES COUNTY SURVEYOR
700 HALL OF RECORDS

Do not extend notes this side of this line.

Note: Any Additions or Changes on This Sheet Must be Made or Circled in Red Ink With Date and Name of Person Making Change.

Notes Ck'd by D. M. Finley
Map No. B-184-1
Office Work R. W. M.
Checked D. M. Finley
Date AUG '42

Survey of Central Ave
W. O. 8326 Tape No. St'd °F
Surveyed by F.J. McNeal
Notes Nichols Date 11-5-41
Indexed [illegible] 2.6.42

F.B. 901 PG. 113

To Bot. Next Pg.

T.P. 82+93 ℄ 23°

(20) (50)

37° ⊗ P.P. 82+10

50'

TP 80+94 ℄ 28°

Water Valve 80+46 ℄ 17'

F.H. 80+40 ℄ 19°
Water Valve

37°
20 ⊗ 28 Sum 80+31½ Guy Pole 80+340

T.P. 78+12 ℄ 20°

Cone

20° ⊗ 38" Gum 78+12

AVE 7

20 ⊗ 40" Gum 77+86½

T.P. 76+94 ℄ 20°

15 N

CENTRAL

20 ⊗ 30" Gum 75+18.

TP 74+94½ ℄ 20½°

21° ⊗ 40" Gum 74+50

Cement

T.P. 72+94 ℄ 20'

21° ⊗ 40' Gum 72+71

TP = 70+93 ℄ 21'
Ø Strand Fence 70+93 22'

TP 68+94 ℄ 21°

(20) (20)

From Top Last Pg.

Note: Any Additions or Changes on This Sheet Must be Made or Circled in Red Ink With Date and Name of Person Making Change.

Do not extend notes this side of this line.

RETURN TO
LOS ANGELES COUNTY SURVEYOR
700 HALL OF RECORDS

FORM 247 5M 10-39

F.B. 901 Pg. 114

To Bot. Next Pg.

T.P. 92+91 ℄ 24° (20) (50)

36' PP 92+61.5

36' PP 91+13

T.P. 90+92.5 ℄ 24°

35' 90+39 15' R

50'

90+02.47 1 x 2 at ℄ See F.B. 901-13

17.5' 17.5' ℄ 118th St (54') (54')

(Dirt Rd)

50'

15' R

FH. 89+64 ℄ 3° ℄ 19° N Walk 36' 35' PP 89+74.5 BC 89+73

T.P. 88+92.5 ℄ 23.5°

Conc.

36.5' PP 88+24.5

T.P. 86+93 ℄ 23.5°

35'

37' 17.5' PP 86+68.5

86+66.5

86+06.3

17.5'

Cement

15' 15'

37.5' PP 85+20

50'

TP 84+94 ℄ 24°

3°

F.H. 84+53 ℄ 19° Water Valve

37.5' PP 83+70

From Top Last Pg.

RETURN TO
LOS ANGELES COUNTY SURVEYOR
700 HALL OF RECORDS

Do not extend notes this side of this line.

Note: Any Additions or Changes on This Sheet Must be Made or Circled in Red Ink With Date and Name of Person Making Change.

Notes Ck'd by D. M. Finley
Map No. B-1811-1
Office Work R. W. M.
Checked D. M. Finley
Date AUG '00

Survey of Central Ave
W.O. 2326 Tape No. St'd °F
Surveyed by E.J. McNeal
Notes Nichols Date 11-5-41
Indexed

F.B. 901 PG. 15

To Bat. Next Pg.

(20) (45)

35

99+02 End of Cb

TP 98+92 ℄ 24±

98+78

15

35'

98+52 BC + PP

Gas Valve

21±

98+46 R = 20'

Mac = 80'R approx

44±

EC

98+58.43 P.R. Sp. See F.B. 901-14

98+27

62.5'

PP 98+20

Conc

16'

10

8

30'

1'

60±

15'

175

35'

R=

97+64 BC

E Rabin St (25')

Cement

175

36±

PP 97+05

(25')

TP 96+91 ℄ 24'

76±

76±

CENTRAL AVE

28'

90°

63'

15' F.H.

35°

76+65

FH 95+97 ℄ 24'

19±

Water Valve

36±

PP 95+59

TP 94+92 ℄ 23?

36±

PP 94+10

From Top Last Pg.

Note: Any Additions or Changes on This Sheet Must be Made or Circled in Red Ink With Date and Name of Person Making Change.

Do not extend notes this side of this line.

RETURN TO
LOS ANGELES COUNTY SURVEYOR
700 HALL OF RECORDS

FORM 247 5M 10-59

F.B. 901 PG. 116

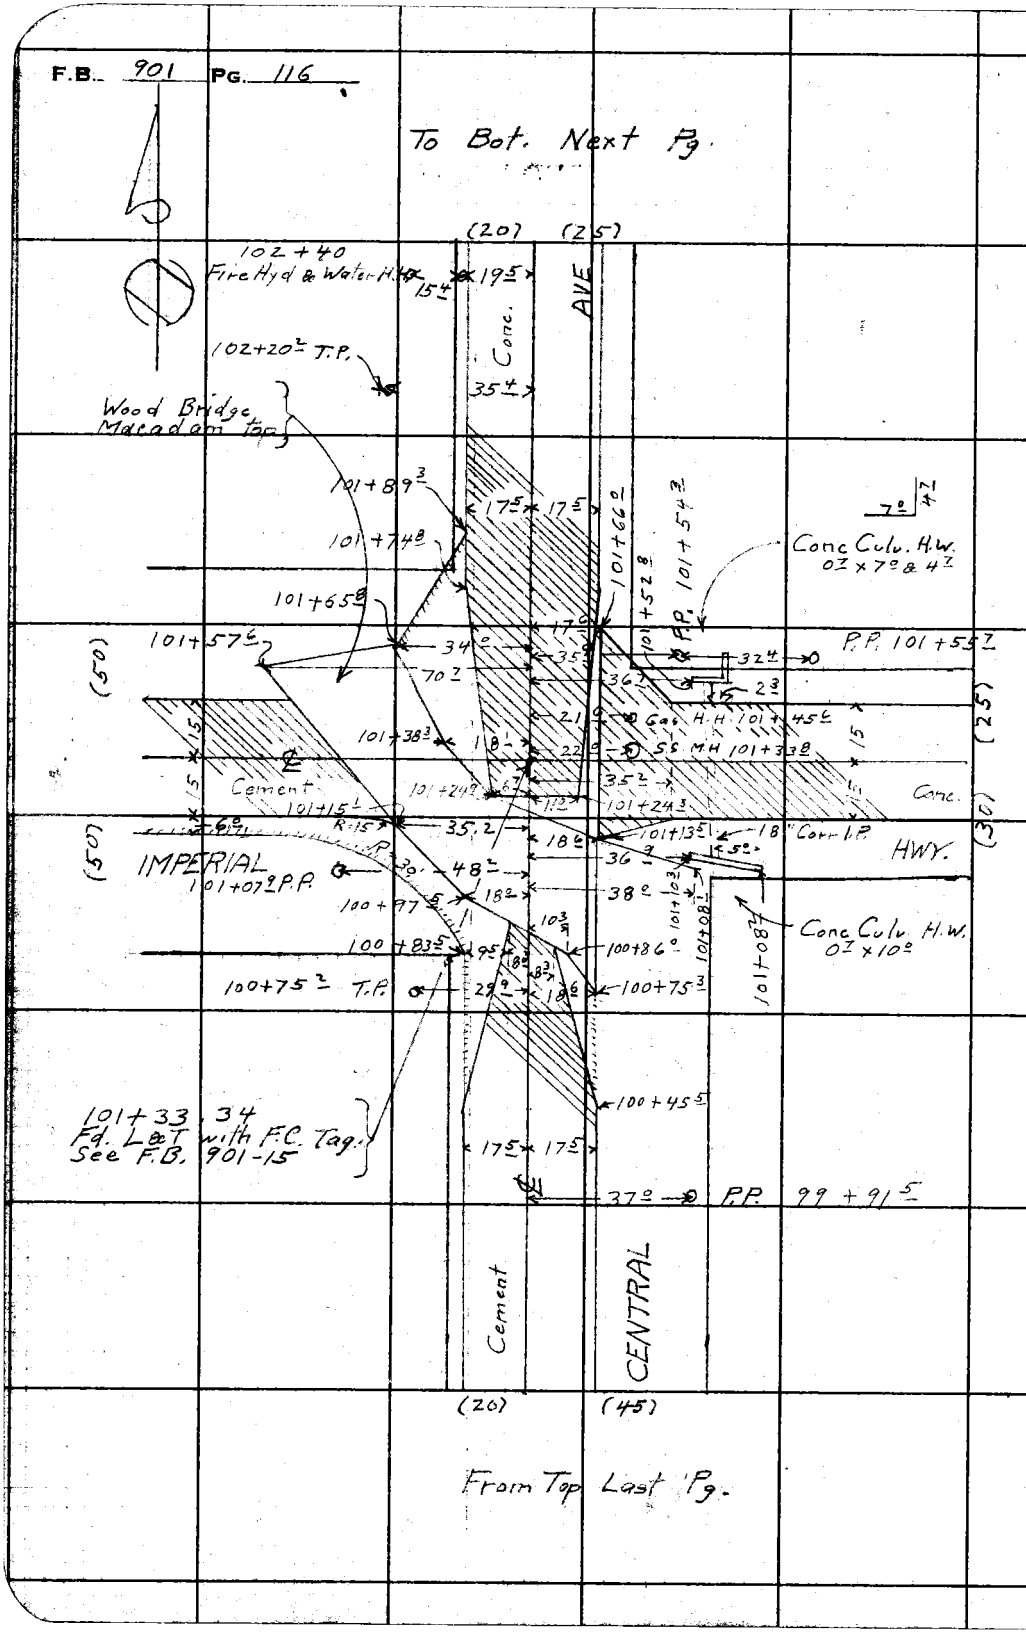


RETURN TO
LOS ANGELES COUNTY SURVEYOR
700 HALL OF RECORDS

Do not extend notes this side of this line.

Note: Any Additions or Changes on This Sheet Must be Made or Circled in Red Ink With Date and Name of Person Making Change.

| | | | |
|---|---|---|---|
| Notes Ck'd by D. M. Finley | Survey of Central Ave | F.B. 901 | Pg. 117 |
| Map No. B-1811-1 | W. O. 832 Tape No. St'd °F | | |
| Office Work R. W. M. | Surveyed by E.J. McNeil | | |
| Checked D. M. Finley | Notes Mc Date 11-3-41 | | |
| Date AUG '42 | Indexed J. C. Johnson 2.6.42 | | |

Note: Any Additions or Changes on This Sheet Must be Made or Circled in Red Ink With Date and Name of Person Making Change.

Do not extend notes this side of this line.

RETURN TO
LOS ANGELES COUNTY SURVEYOR
700 HALL OF RECORDS

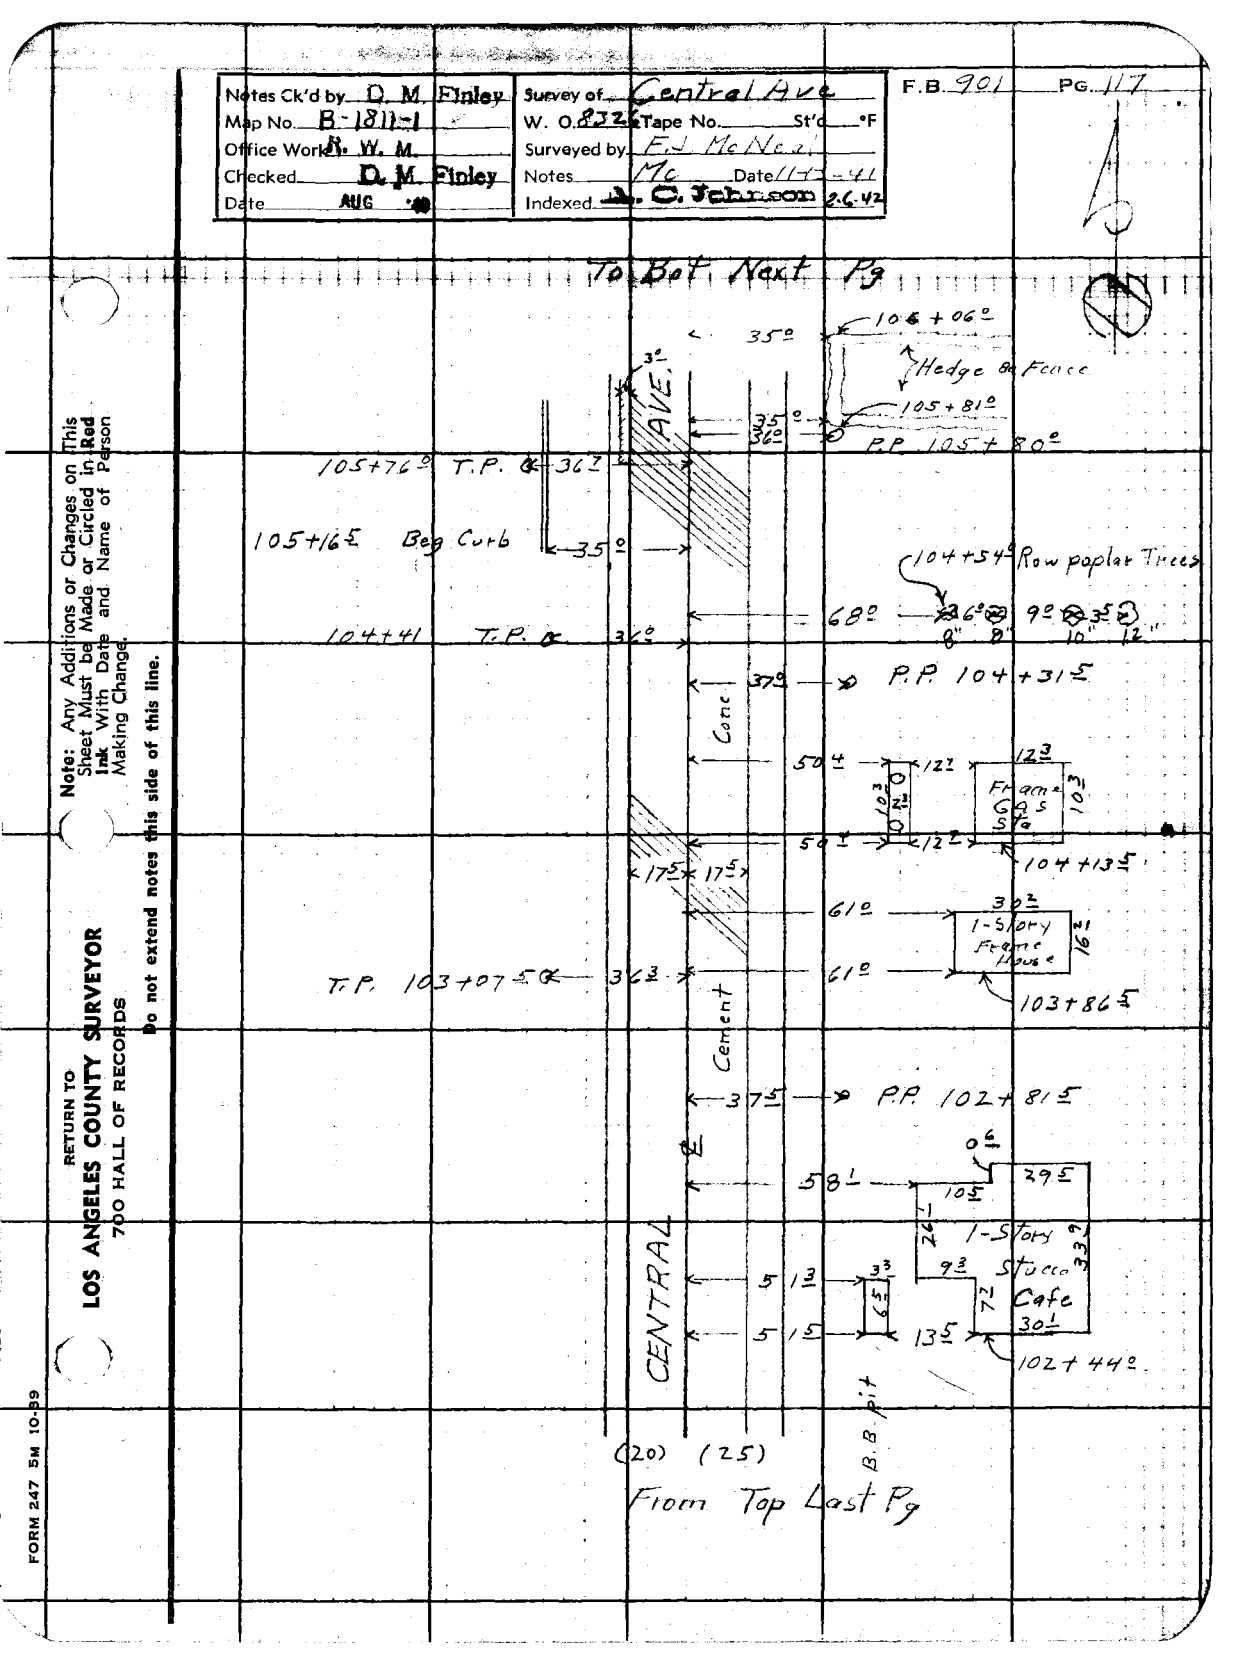


FORM 247 5M 10-39

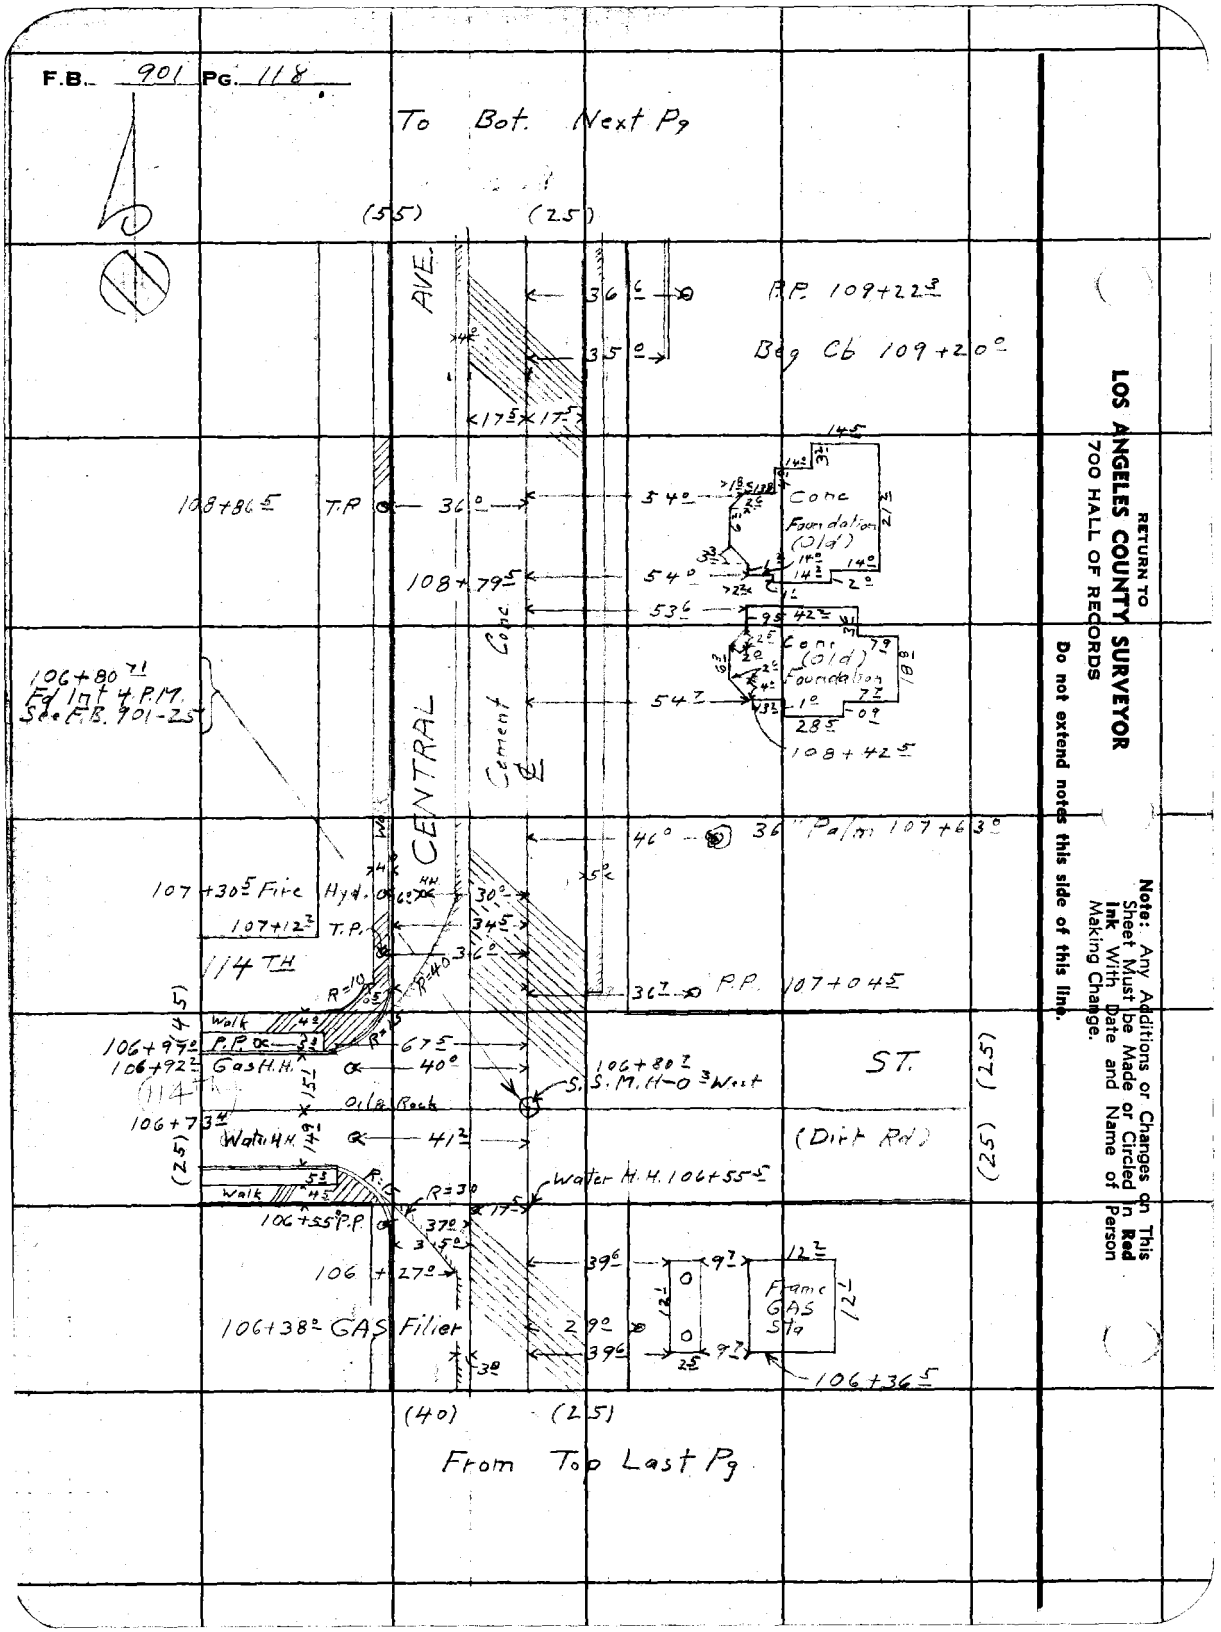
F.B. 901 Pg. 118
To Bot. Next Pg
(55)
(25)
AVE.
36 ℄
35
B.P. 109+22.5
Beg CB 109+20
17.5
17.5
145
108+86.5
T.P.
36°
54
Conc Foundation (Old)
108+79.5
54°
53.6
42.5
Conc (Old) Foundation
106+80.7
Fd Int 4 P.M.
See F.B. 901-25
CENTRAL
Cement ℄
108+42.5
46°
36" Palm 107+63
107+30.5 Fire Hyd.
107+12.7 T.P.
30°
114 TH
36.7 P.P. 107+04.5
R=10
R=40
Walk
P.P.
106+99.2
106+92.2 Gas H.H.
67.5
40°
S.S.M.H-0.3 West
106+80.7
ST.
(114 TH)
106+73.4
Water H.H.
41.2
(Dirt Rd)
Walk
R=30
Water H.H. 106+55.5
106+55 P.P.
37°
106+27
39.6
9.7
12.7
Frame GAS Sta
106+38.2 GAS Filler
2.9
106+36.5
(40)
(25)
From Top Last Pg
RETURN TO
LOS ANGELES COUNTY SURVEYOR
700 HALL OF RECORDS
Do not extend notes this side of this line.
Note: Any Additions or Changes on This Sheet Must be Made or Circled in Red Ink With Date and Name of Person Making Change.

| | | | |
|---|---|---|---|
| Notes Ck'd by D. M. Finley | Survey of Central Ave | F.B. 901 | PG. 117 |
| Map No. B-1811-1 | W. O. 8324 Tape No. | St'd | °F |
| Office Work W. W. M. | Surveyed by E. J. McNeal | | |
| Checked D. M. Finley | Notes MC Date 11-13-41 | | |
| Date AUG '42 | Indexed J. C. Johnson 2642 | | |

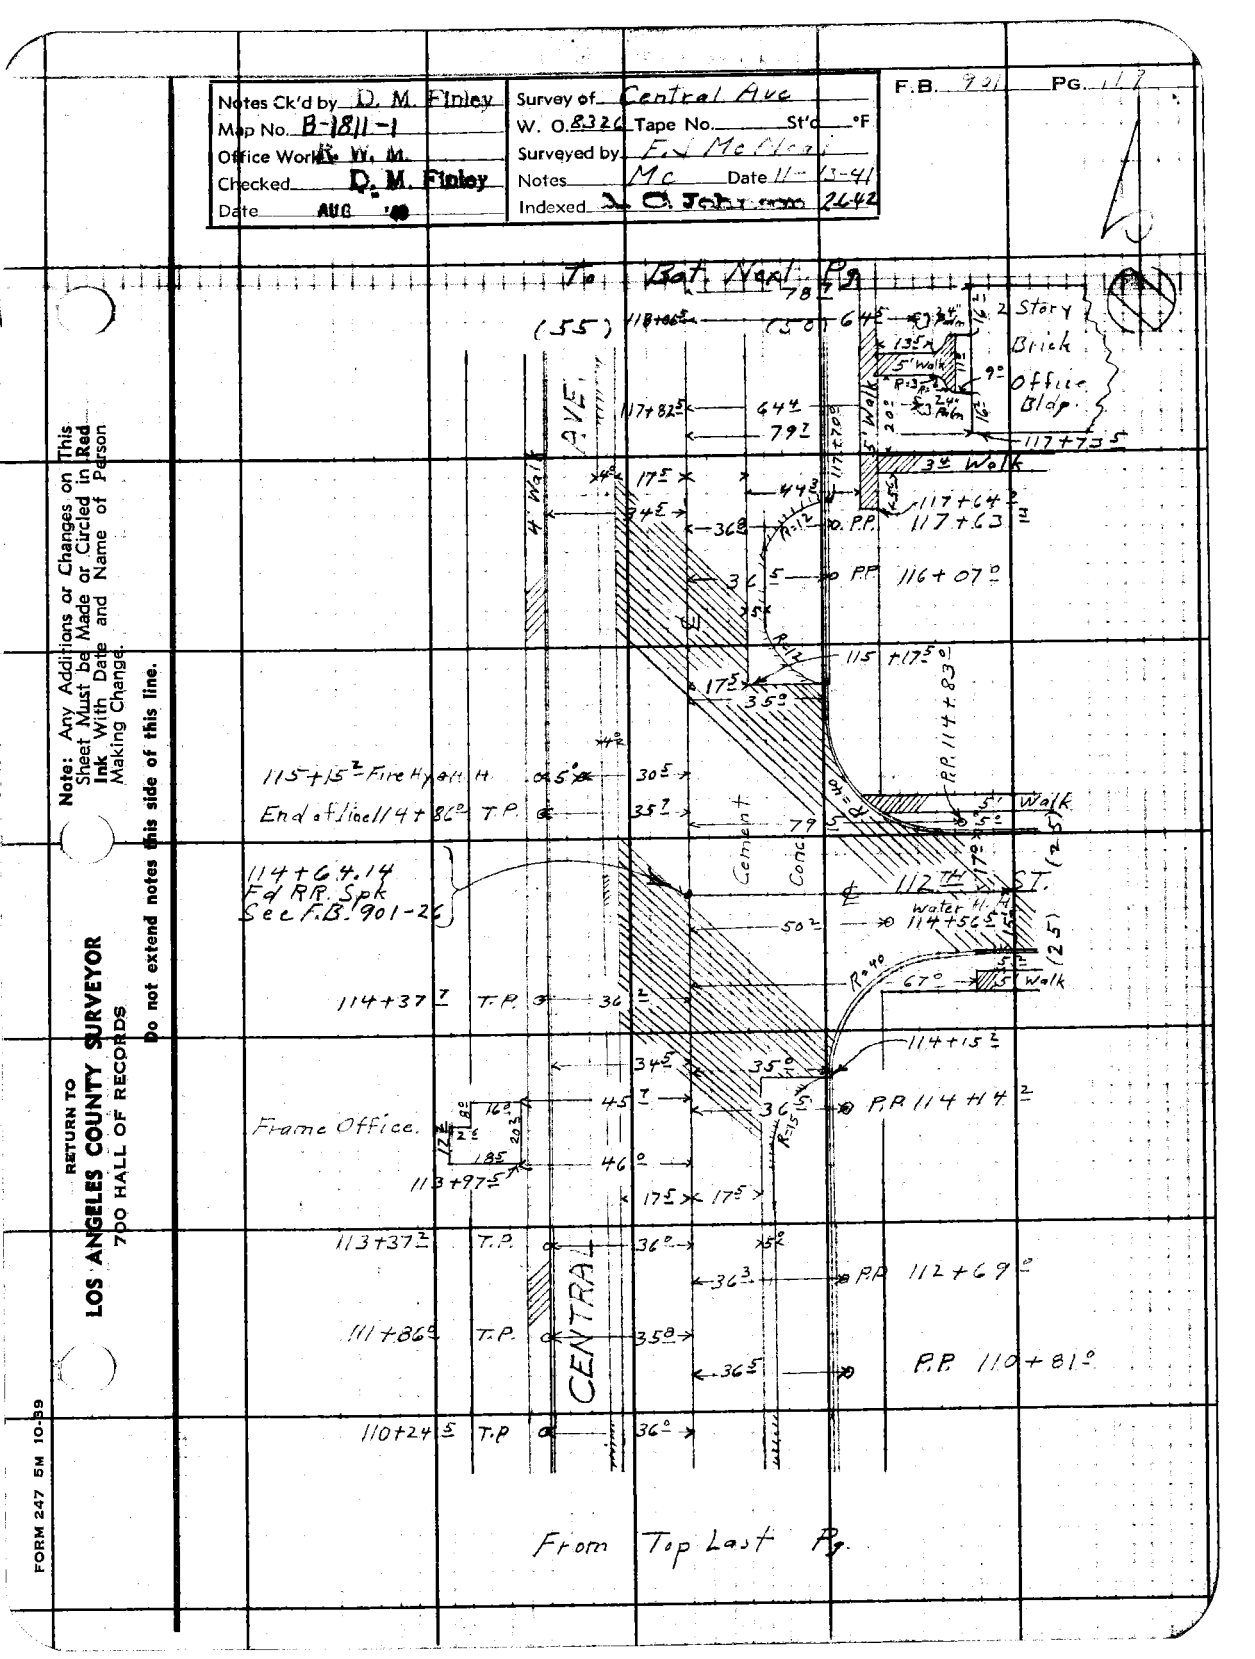


Note: Any Additions or Changes on This Sheet Must be Made or Circled in Red Ink With Date and Name of Person Making Change.

Do not extend notes this side of this line.

RETURN TO
LOS ANGELES COUNTY SURVEYOR
700 HALL OF RECORDS

FORM 247 5M 10-39

F.B. 901 Pg. 120

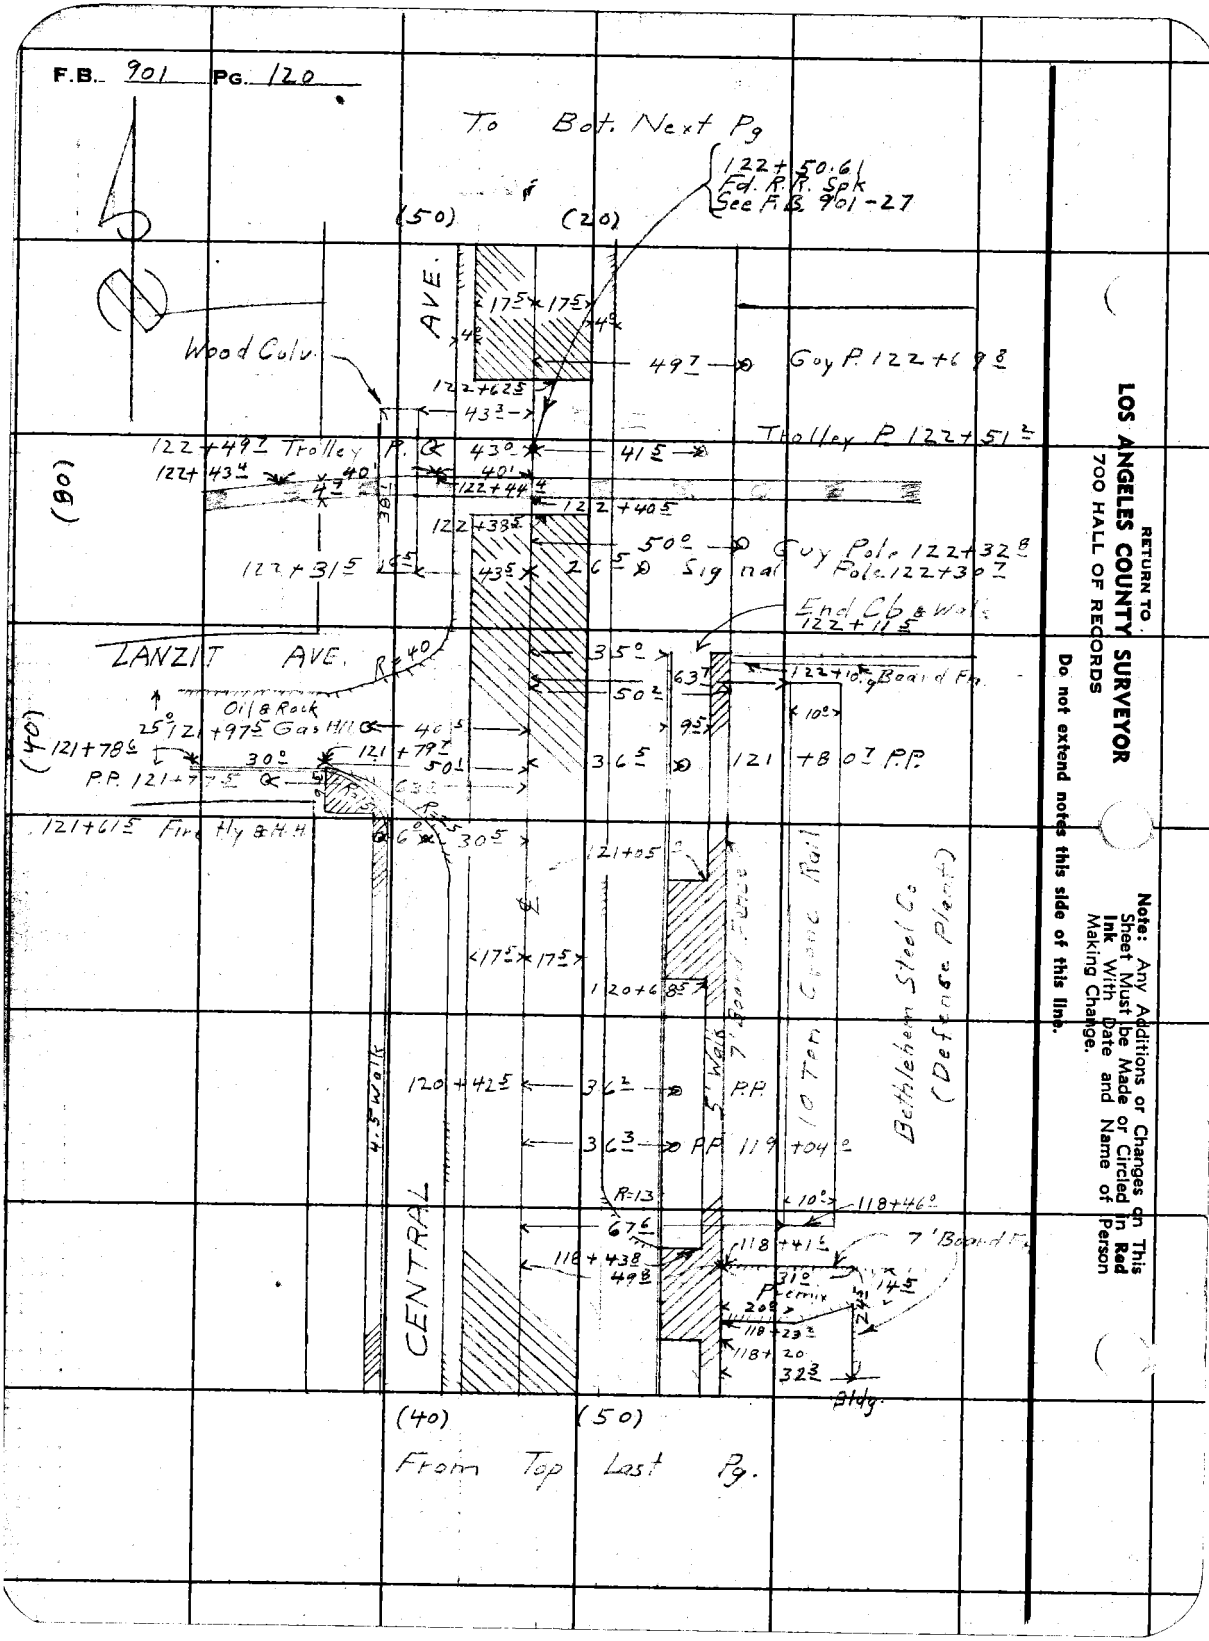


RETURN TO
LOS ANGELES COUNTY SURVEYOR
700 HALL OF RECORDS

Note: Any Additions or Changes on This Sheet Must be Made or Circled in Red Ink With Date and Name of Person Making Change.

Do not extend notes this side of this line.

| | |
|---|---|
| Notes Ck'd by D. M. Finley | Survey of Central Ave. |
| Map No. B-1811-2 | W. O. 8529 Tape No. St'd °F |
| Office Work R. W. M. | Surveyed by F J McNeal |
| Checked D. M. Finley | Notes Nichols Date 11-18-41 |
| Date AUG '43 | Indexed |

F.B. 701 Pg. 2

128+02.02 Fd Bt. Sol. Per. F.B. 701-28

To Bot Next Page

128+55 E

128+51 E G.P.

36°

Conc

Cob Conc Gutter

Cb 7

4' Back of Sidewalk

36 E Gas Valve 128+18

68 Spk

65 E

℄ 109th St

19 E W Valve 127+91 E

Cob Conc Gutter

178

76

35°

MH 127+81 E

Beg of Cb. 127+70

37° PP 127+70

127+49 Fire Hydrant

127+49 Valve

7°

80 E

AVE

Cement

35'

37° PP 126+23 E

17°

17°

Sidewalk

℄ CENTRAL

Cb 7

4' Back of Sidewalk

37° PP 124+71

37° PP 124+51

124+05 Beg. of Curb

35°

123+13 E G.P.

35 E

37° PP 123+14

From top Last Pg

Note: Any Additions or Changes on This Sheet Must be Made or Circled in Red Ink With Date and Name of Person Making Change.

Do not extend notes this side of this line.

RETURN TO
LOS ANGELES COUNTY SURVEYOR
700 HALL OF RECORDS.

FORM 247 5M 10-39

F.B. 901 PG. 122

To Bot | Next Pg.

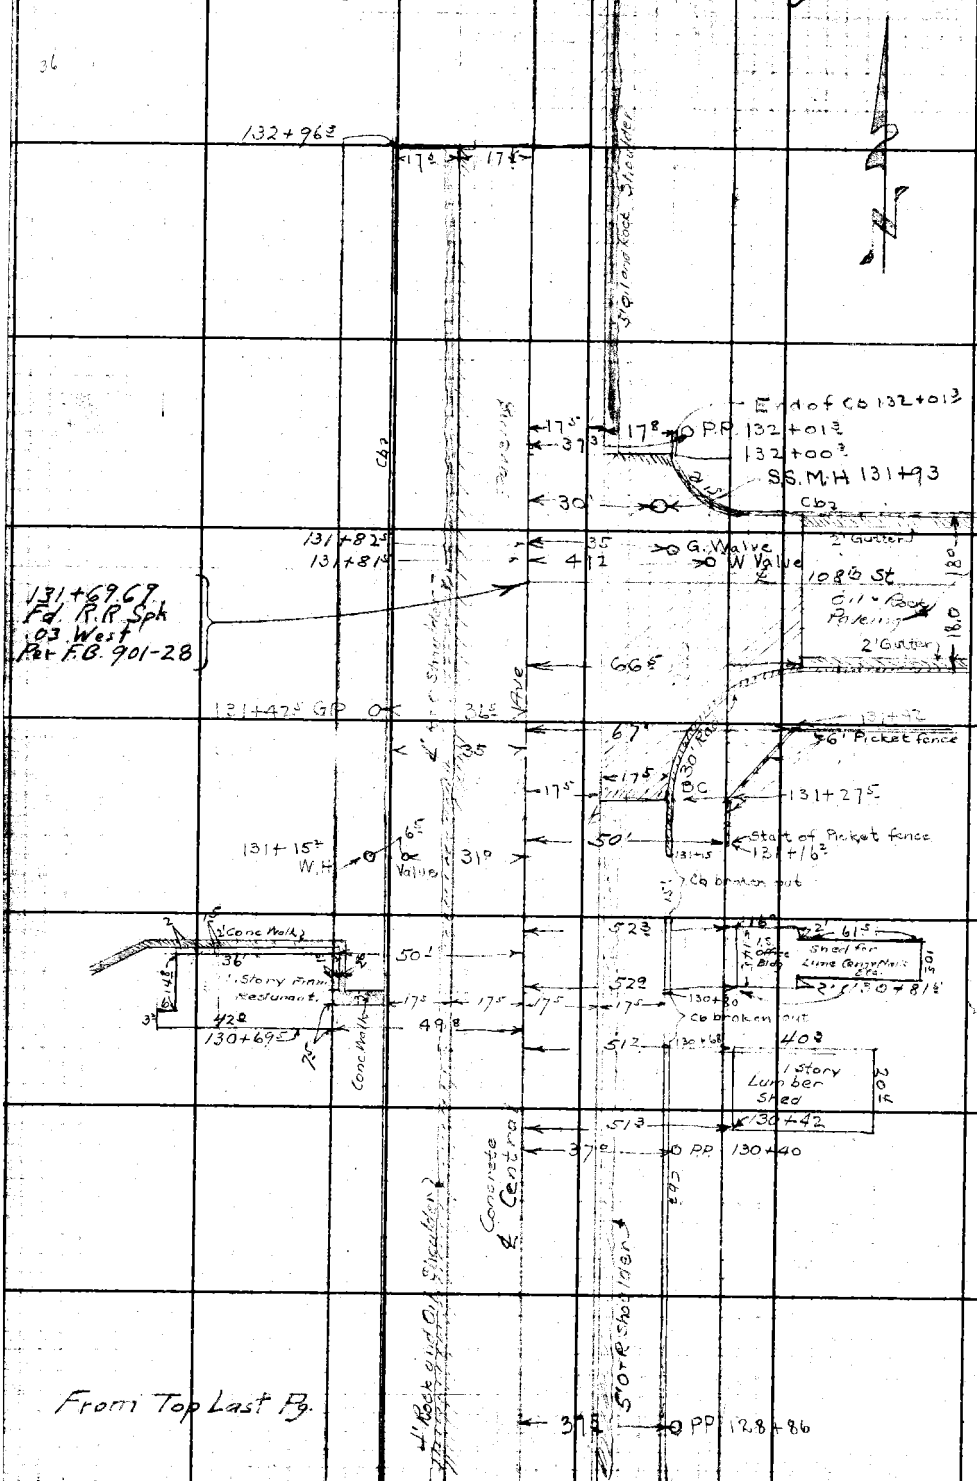


RETURN TO
LOS ANGELES COUNTY SURVEYOR
700 HALL OF RECORDS

Note: Any Additions or Changes on This Sheet Must be Made or Circled in Red Ink With Date and Name of Person Making Change.

Do not extend notes this side of this line.

| | |
|---|---|
| Notes Ck'd by D. M. Finley | Survey of Central Ave |
| Map No. B-1811-2 | W. O. 8326 Tape No. Std °F |
| Office Work R. W. M. | Surveyed by F. L. McNeal |
| Checked D. M. Finley | Notes Nichols Date 11-27-41 |
| Date AUG '42 | Indexed C. C. Jan. 1942 |

F.B. 201 PG. 123

To Bot. Next Pg.

135+37.25 SP & F.B. 901-39

1' Conc Gutter

℄ E 107th St

Cold Paving

8' Parkway

3' Conc Walk

135+05 E Co

Note: Any Additions or Changes on This Sheet Must be Made or Circled in Red Ink With Date and Name of Person Making Change

Do not extend notes this side of this line.

2½' Picket fence

Rock + oil Paving

Gas pump Islands

Conc Drive

Conc Apron

Conc Walk

Rock + oil

Conc Drive

Conc Walk

℄ 108th St

Oil & Rock Pave

Water Valve

1' Conc Gutter

Conc Walk

133+39.29 Bolt Per F.B. 901-29

Pavement

3' R + O Shoulder

℄ Conc

4' R + O Shoulder

2 Story Frame Building (Old Jazz Island Dance Hall)

From Top Last Pg.

RETURN TO
LOS ANGELES COUNTY SURVEYOR
700 HALL OF RECORDS

FORM 247 5M 10-39

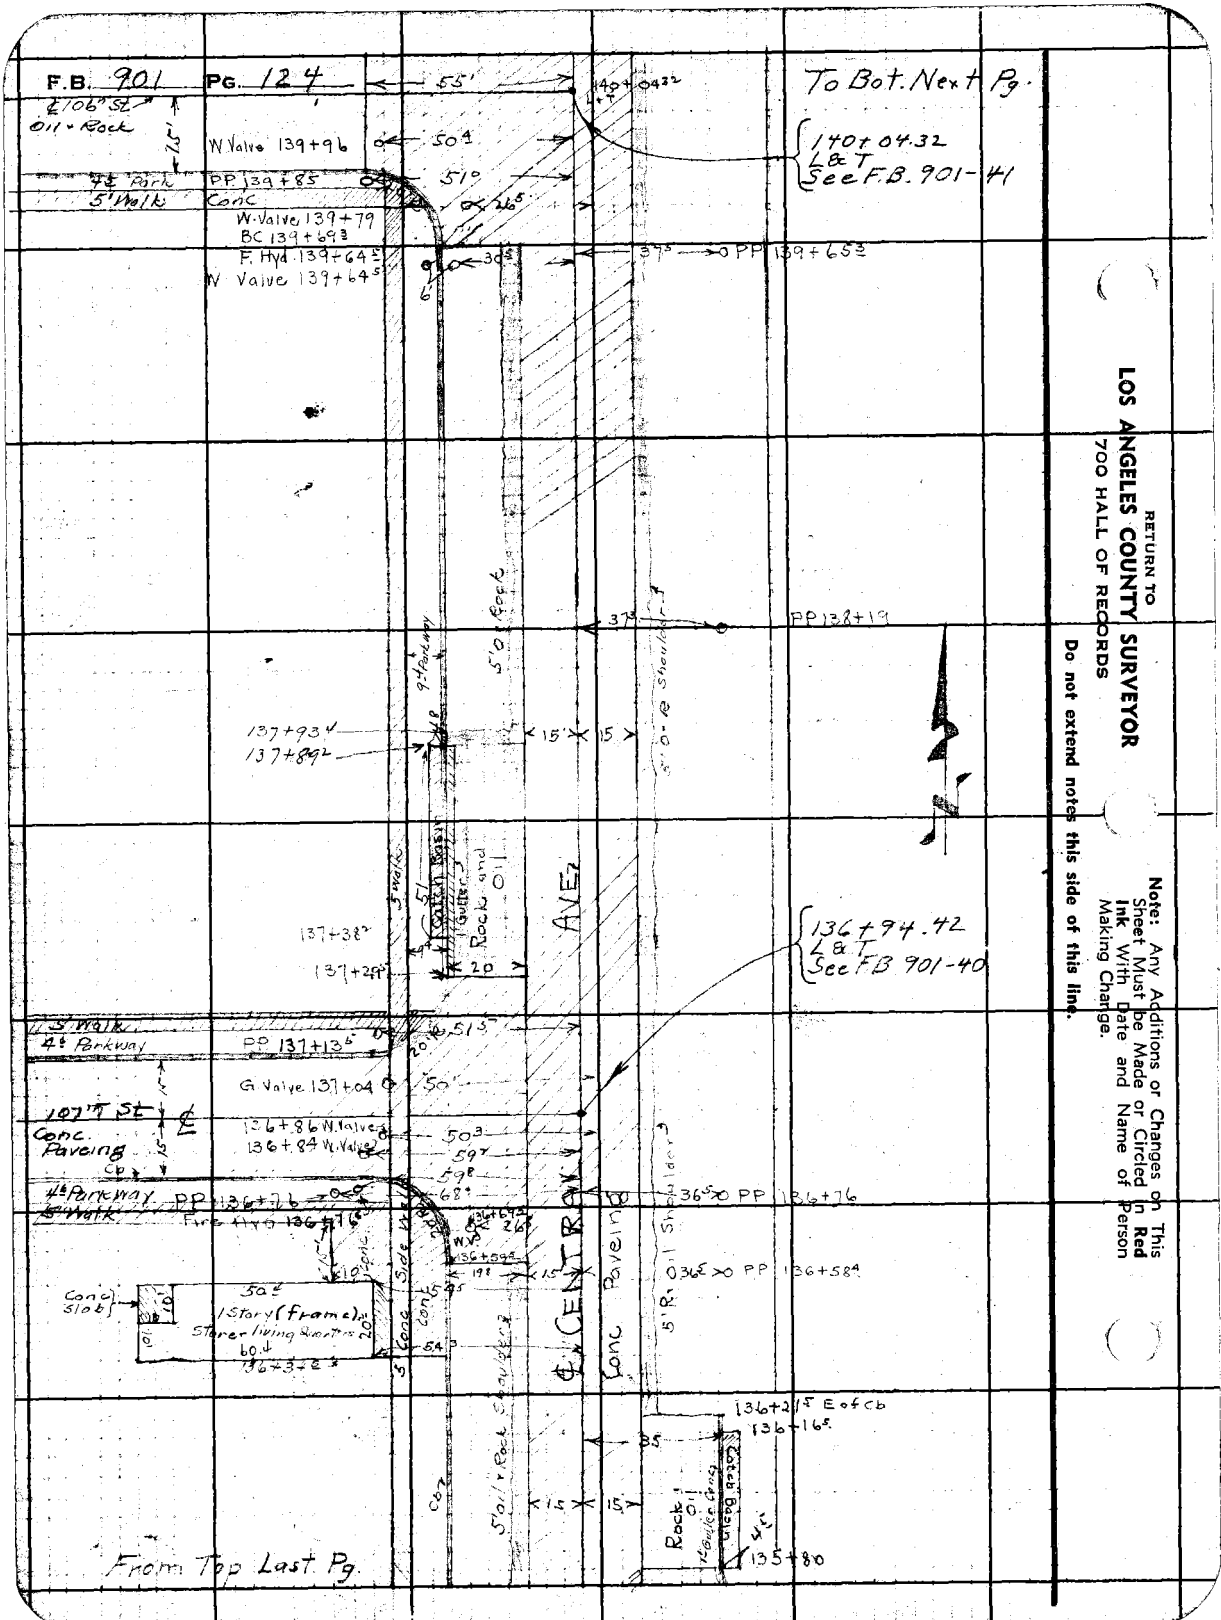
F.B. 901 Pg. 124
To Bot. Next Pg.
140+04.32 L&T See F.B. 901-41
W. Valve 139+96
PP 139+85
Conc
W. Valve 139+79
BC 139+69
F. Hyd 139+64
W. Valve 139+64
PP 139+65
PP 138+19
137+93
137+89
Rock and Oil
137+38
137+28
136+94.42 L&T See FB 901-40
PP 137+13
G. Valve 137+04
136+86 W. Valve
136+84 W. Valve
PP 136+76
136+58
136+29
136+21 E of Cb
136+16
135+80
Conc Slab
1 Story (Frame) Store & living Quarters
From Top Last Pg.
RETURN TO
LOS ANGELES COUNTY SURVEYOR
700 HALL OF RECORDS
Do not extend notes this side of this line.
Note: Any Additions or Changes on This Sheet Must be Made or Circled in Red Ink With Date and Name of Person Making Change.

| | |
|---|---|
| Notes Ck'd by D. M. Finley | Survey of Central Ave |
| Map No. B-1811-2 | W. O. 2324 Tape No. Std °F |
| Office Work R. W. M. | Surveyed by F.J. McNeal |
| Checked D. M. Finley | Notes G.H. Nichols Date 12-2-41 |
| Date AUG '49 | Indexed C. J. |

F.B. Pg.

To Bot. Next Pg

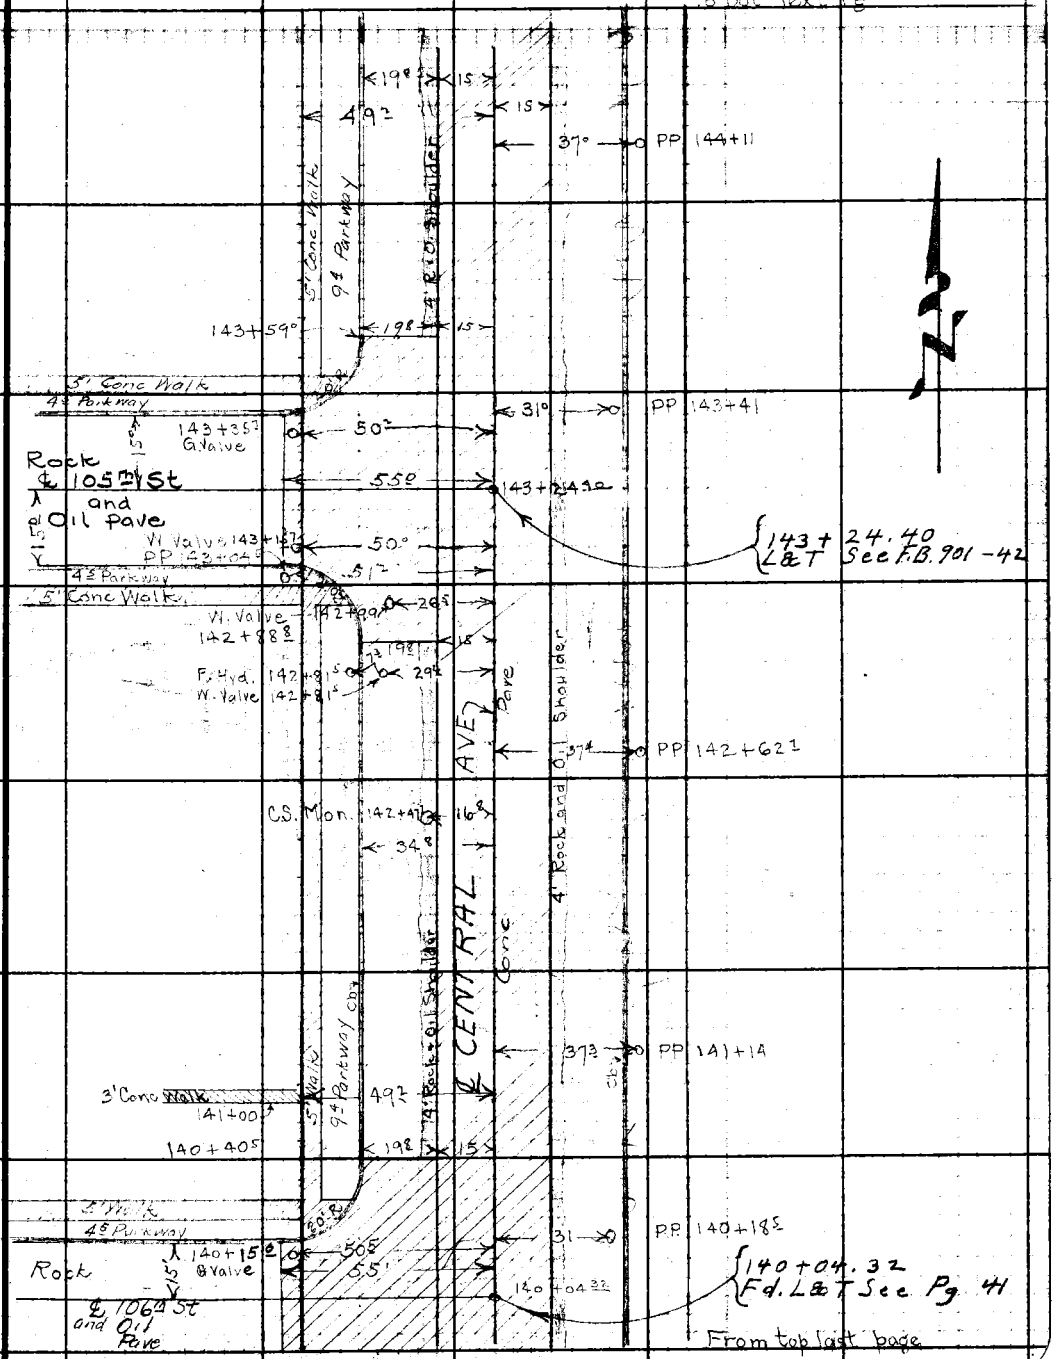


Note: Any Additions or Changes on This Sheet Must be Made or Circled in Red Ink With Date and Name of Person Making Change

Do not extend notes this side of this line.

RETURN TO
LOS ANGELES COUNTY SURVEYOR
700 HALL OF RECORDS

FORM 247 5M 10-39

F.B. 901 Pg. 126

To bot next Pg

RETURN TO
LOS ANGELES COUNTY SURVEYOR
700 HALL OF RECORDS

Do not extend notes this side of this line.

Note: Any Additions or Changes on This Sheet Must be Made or Circled in Red Ink With Date and Name of Person Making Change.




Cont from top last Page.

Notes Ck'd by D. M. Finley
Map No. B-181-2
Office Work R. W. M.
Checked D. M. Finley
Date AUG '41

Survey of Central Ave
W. O. 2227 & Tape No. 5th "F"
Surveyed by F. V. McNeal
Notes Nichols Date 12-5-41
Indexed

F.B. 901 Pg. 127

To Bot. Next Pg.

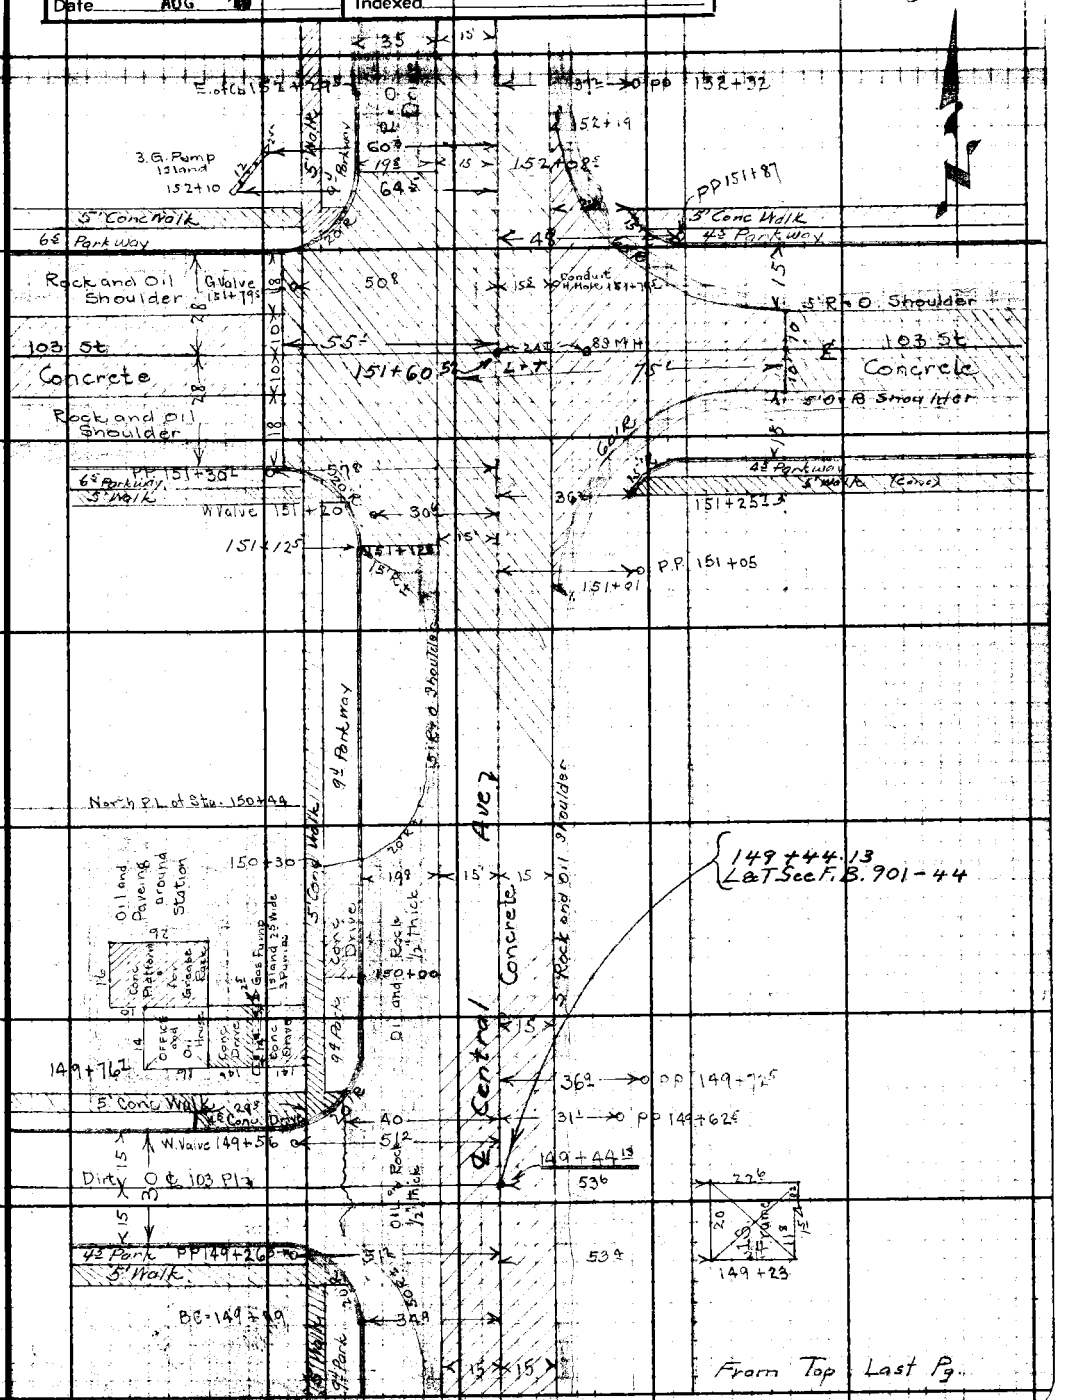


From Top Last Pg.

Note: Any Additions or Changes on This Sheet Must be Made or Circled in Red Ink With Date and Name of Person Making Change

Do not extend notes this side of this line.

RETURN TO
LOS ANGELES COUNTY SURVEYOR
700 HALL OF RECORDS

FORM 247 5M 10-39

F.B. 901 PG. 128

156+23 ↗
4' Picket Fence

To Bot. Next Pg.

5' Walk
9± Parkway

19° 15 37½ → PP 155+00

5' Walk
9± Parkway
G Valve 154+76±0
102nd St
Dirt
℄
30
15
15
Cb 2
45° Mark
PP 154+69
5' Walk

51½
31½ → P.P. 154+78
154+65.48
15
154+30±
34½
15
154+65.43
L & T See F.B. 901-46

AVE
Concrete
CENTRAL
℄

19° 15 37½ → PP 153+61

5' Conc Walk
9± Parkway
Y 5 Rock + Oil Shoulder
3' Sand & Shoulder

152+80
19°
B. of Cb 152+58
0+ Rock
Dr
34½

From Top Last Pg

RETURN TO
LOS ANGELES COUNTY SURVEYOR
700 HALL OF RECORDS

Do not extend notes this side of this line.

**Note:** Any Additions or Changes on This Sheet Must be Made or Circled in **Red Ink** With Date and Name of Person Making Change.

| | | | |
|---|---|---|---|
| Notes Ck'd by D. M. Finley | Survey of CENTRAL AVE | F.B. 901 | Pg. 129 |
| Map No. B-1811-2 | W. O. 8326 Tape No. St'd °F | | |
| Office Work B. W. M. | Surveyed by Ed McNeal | | |
| Checked D. M. Finley | Notes Nichols Date 12-8-41 | | |
| Date AUG '42 | Indexed | | |

Cont. bot next pg

Note: Any Additions or Changes on This Sheet Must be Made or Circled in Red Ink With Date and Name of Person Making Change

Do not extend notes this side of this line.

RETURN TO
LOS ANGELES COUNTY SURVEYOR
700 HALL OF RECORDS

FORM 247 5M 10-39

50 | 20 | 15 | 15 | 50

2' Conc Walk
159+28

50'

36.2 → PP 159+25

Guy P. 158+79.2 ← 39.5

15' | 15'

5' R/D Shoulder

5' R/D Shoulder

← 35

5' Conc Walk

9' Parkway

158+05

157+98

℄ CENTRAL AVE

Paving

37.2 → PP 157+825

31 → PP 157+74

5' Conc Walk

4.5' Park

G Valve 157+67.0

50

℄ 101 St.

O & R Paving

157+55.45

4.5' Park

3' Conc Walk

PP 157+37

20' R

51.2

157+55.45
L&T See F.B. 901-46

157+17

19.2

15'

Concrete

156+90.5

61

Redwood Fence

69.5

24'

4'

15'

Brick

Wall

20'

Real Estate Office

1 S.F. Dwelling

10'

12'

36'

105'

70.2

15.8

2

156+57.5

5' Conc Walk

9.4' Park

6" Apricot
156+20

69.5'

7.1'

5' R/D Shoulder

37 → PP 156+42

Cont from top last pg

RETURN TO
**LOS ANGELES COUNTY SURVEYOR**
700 HALL OF RECORDS

**Note:** Any Additions or Changes on This Sheet Must be Made or Circled in **Red Ink** With Date and Name of Person Making Change.

**Do not extend notes this side of this line.**

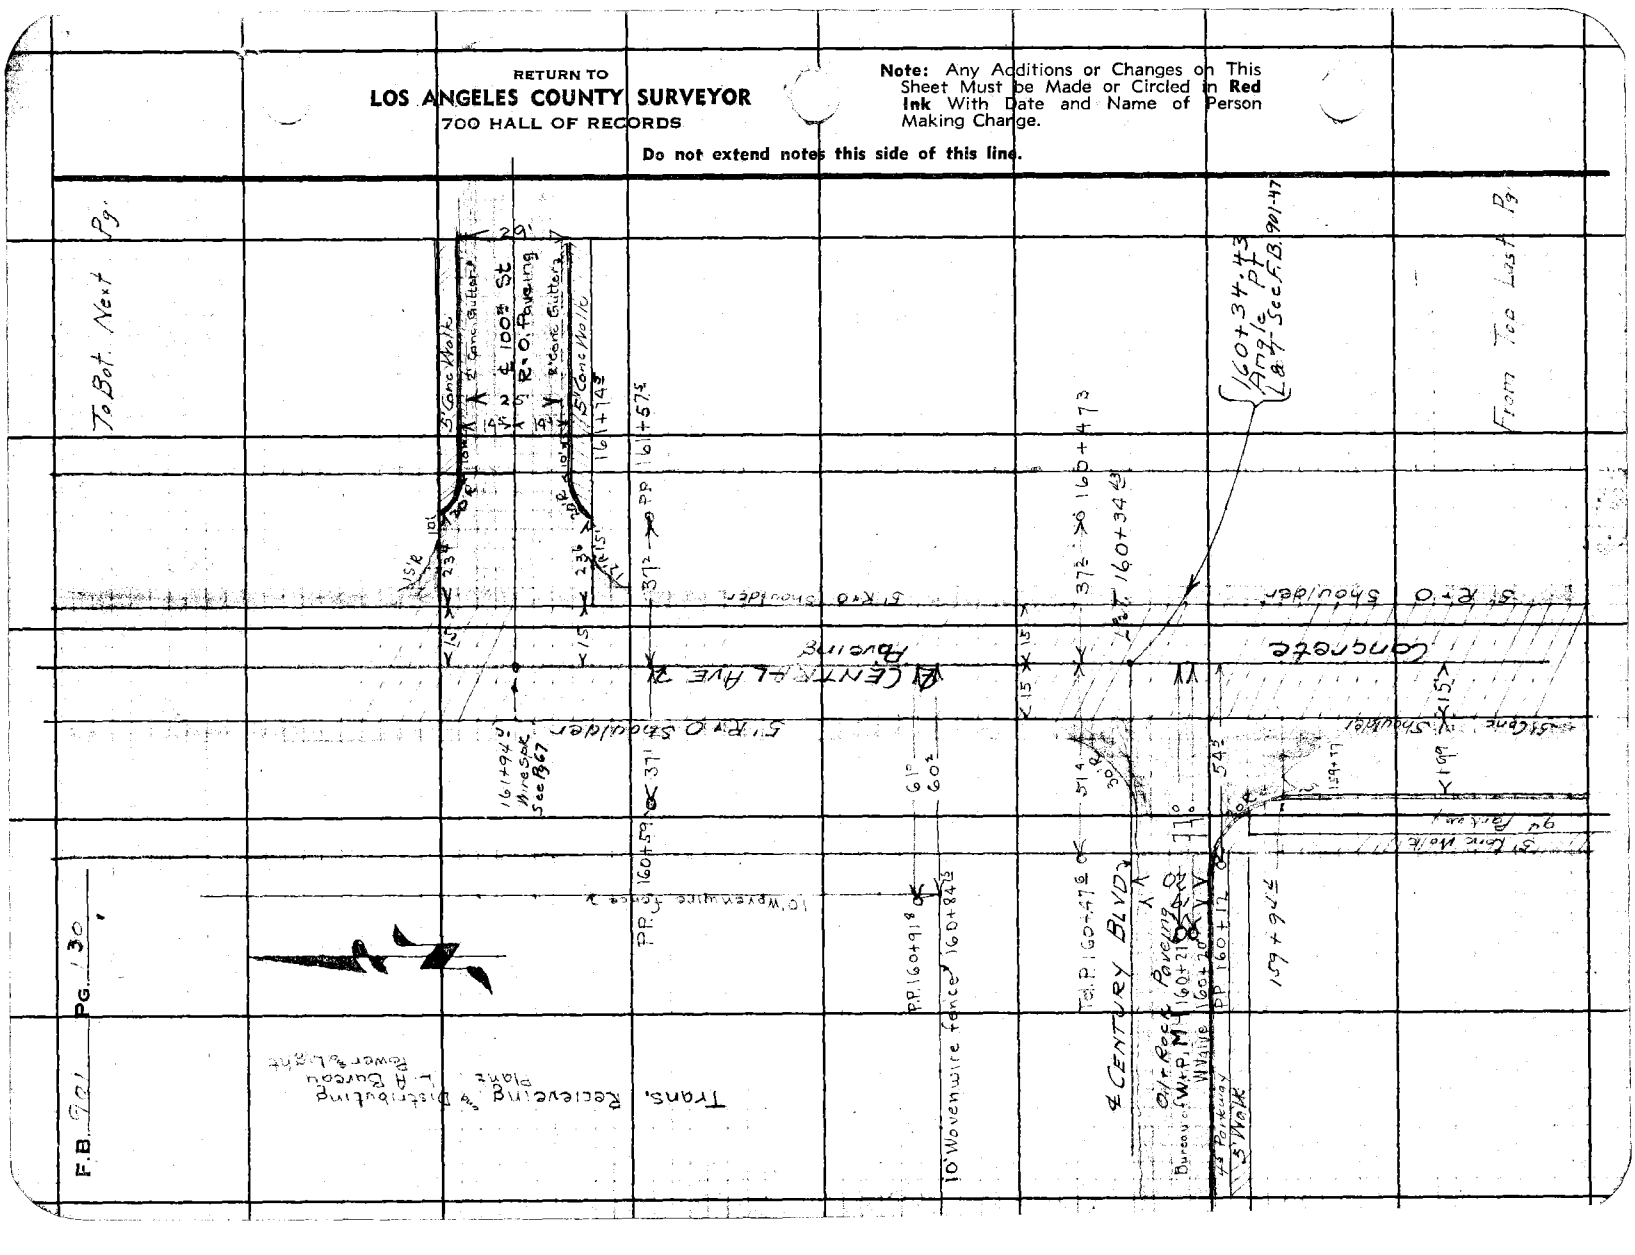
To Bot. Next Pg.
From Top Last Pg.
100' St
R.O.Fbuilding
5' Conc Walk
2' Conc Gutter
5' Conc Walk
2' Conc Gutter
5' Conc Walk
5' Conc Walk
161+57.5
161+94.5
Wire SOK See B67
PP 161+94.5
PP 160+84.8
PP 160+91.8
10' Wovenwire fence
10' Wovenwire fence
160+34.43
Sta/c of F.B. 901-47
160+47.3
160+34.43
37½'
37½'
37½'

| | | | |
|---|---|---|---|
| Notes Ck'd by D. M. Finley | Survey of CENTRAL AVE | F.B. | Pg. |
| Map No. B-1811-2 | W. O. 8328 Tape No. | Std. | °F |
| Office Work R. W. M. | Surveyed by F.J. McNeer | | |
| Checked D. M. Finley | Notes G. Nichols Date 12-17-41 | | |
| Date AUG '42 | Indexed C. John 2-6-42 | | |

To Bot. Next Pg.

From Top Last Pg

Note: Any Additions or Changes on This Sheet Must be Made or Circled in Red Ink With Date and Name of Person Making Change.

Do not extend notes this side of this line.

RETURN TO
LOS ANGELES COUNTY SURVEYOR
700 HALL OF RECORDS

FORM 247 5M 10-39

RETURN TO
**LOS ANGELES COUNTY SURVEYOR**
700 HALL OF RECORDS

**Note:** Any Additions or Changes on This Sheet Must be Made or Circled in **Red Ink** With Date and Name of Person Making Change.

**Do not extend notes this side of this line.**

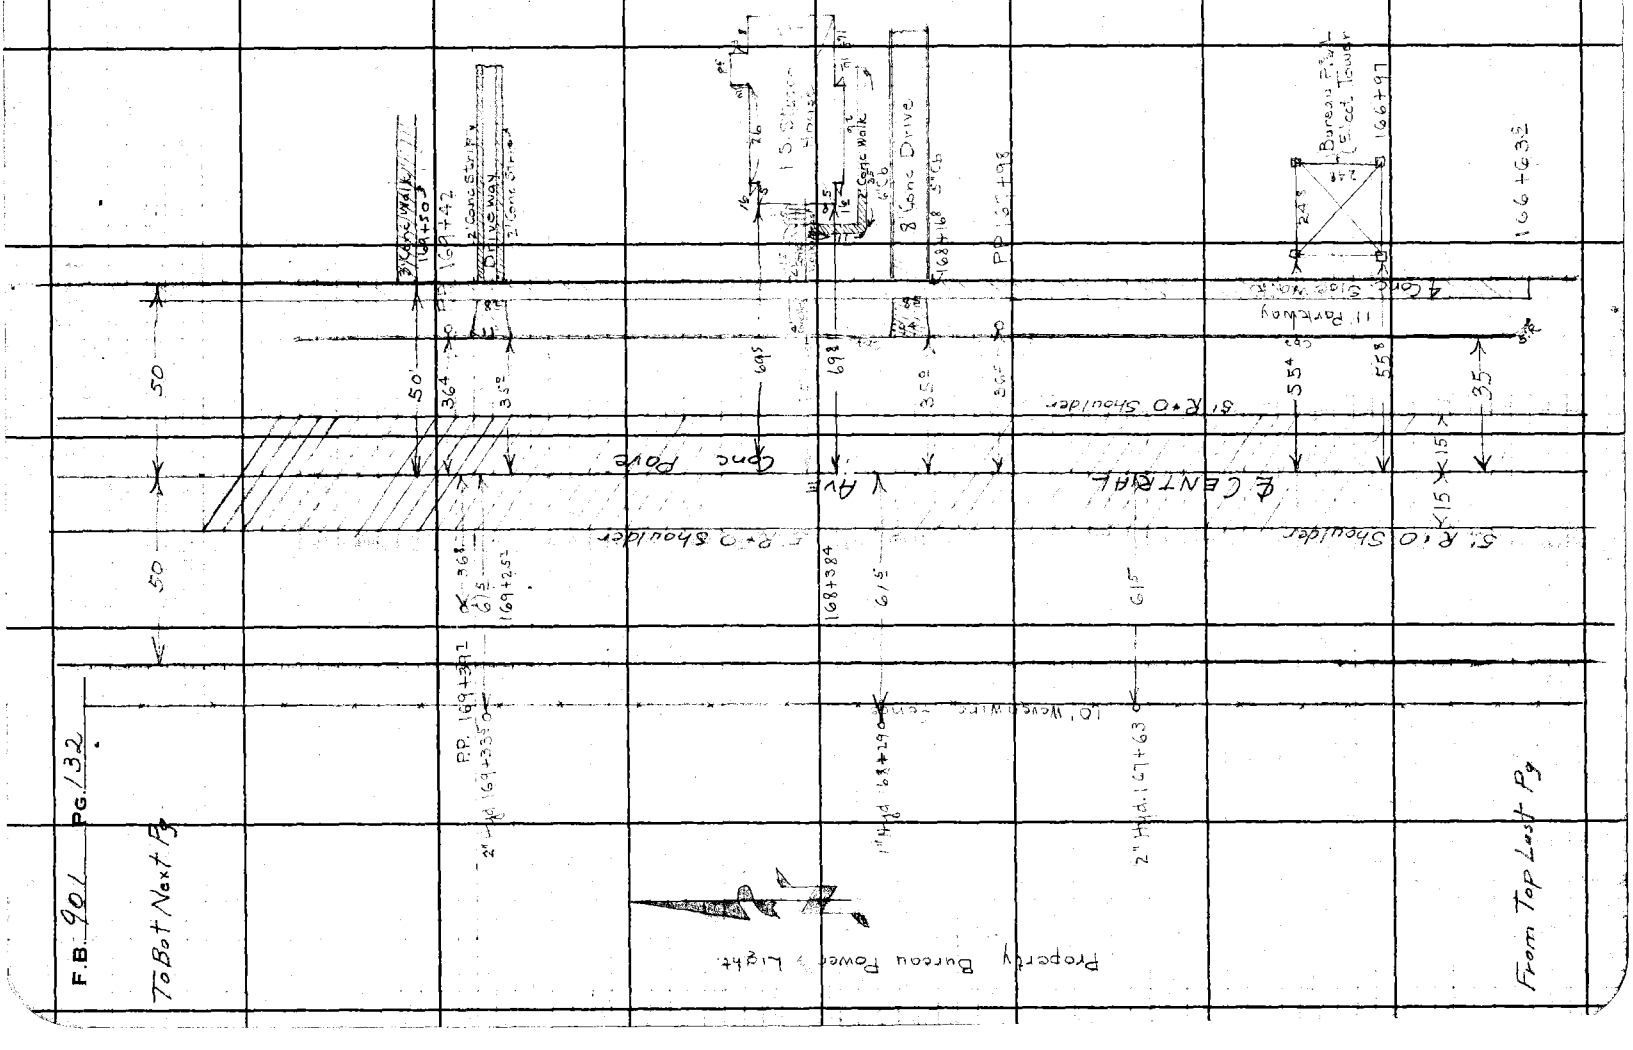

FORM 247 5M 10-39

RETURN TO
**LOS ANGELES COUNTY SURVEYOR**
700 HALL OF RECORDS

**Note:** Any Additions or Changes on This Sheet Must be Made or Circled in **Red Ink** With Date and Name of Person Making Change.

**Do not extend notes this side of this line.**

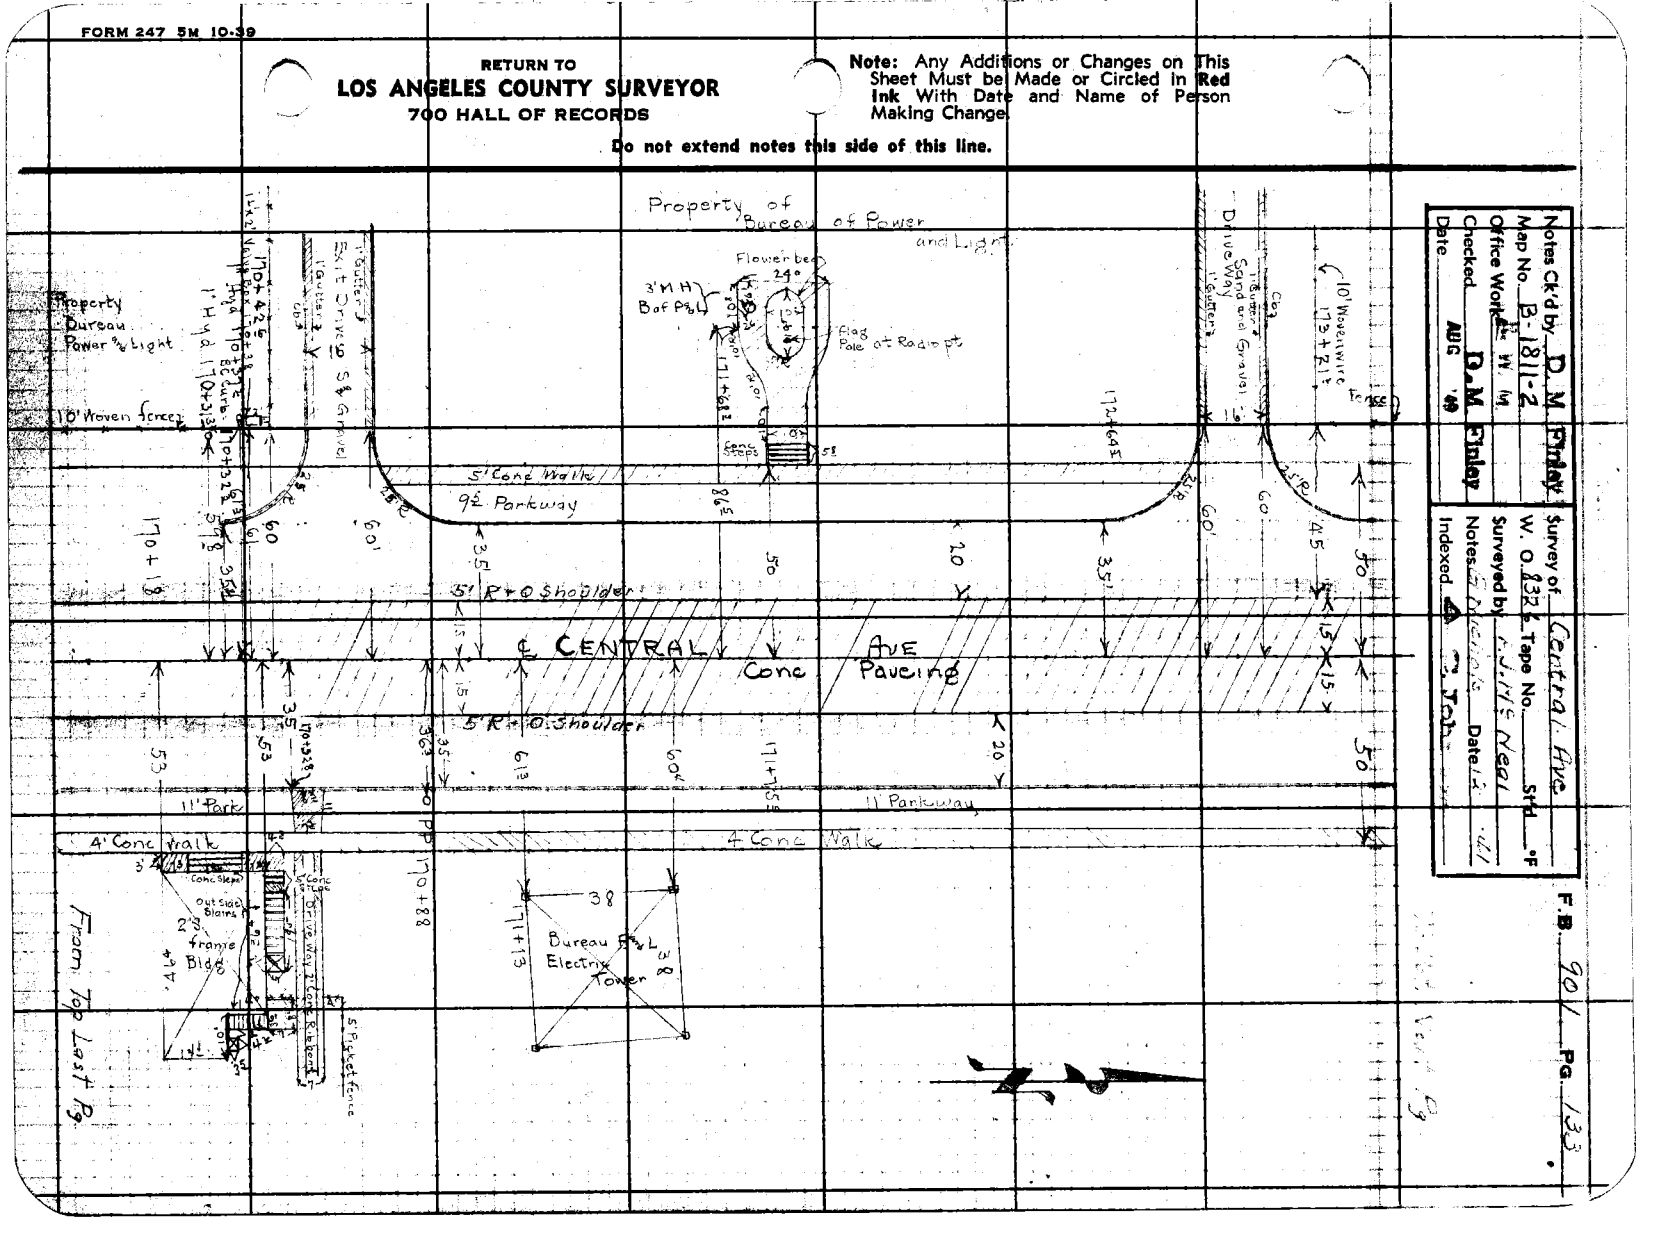
Property of Bureau of Power and Light
Flower bed
3' M H Bof Pgal
Flag Pole at Radio pt
Property Bureau Power & Light
10' Woven fence
Exist Drive S & G gravel
1' Gutter & Cb
5' Conc Walk
9½ Parkway
5' R+O Shoulder
℄ CENTRAL AVE
Conc Paving
11' Park
11' Parkway
4' Conc walk
4' Conc Walk
Conc Steps


To Bot Next Pg.

RETURN TO
LOS ANGELES COUNTY SURVEYOR
700 HALL OF RECORDS

Do not extend notes this side of this line.

Note: Any Additions or Changes on This Sheet Must be Made or Circled in Red Ink With Date and Name of Person Making Change.

2" Hyd 176+32?

61'

36'

65.3'

PP 176+32?

Road Pave

1 Story frame House

4' Walk

176+04

175+88?

68'

20.5'

Steps Landing

Drive 2' Conc Ribbon

175+77?

50'

1" Hyd 175+29?

61'

Property Bureau Power and Light

10' Power Wire

15' 15' 20'

36'

PP 174+14?

5' R+O Shoulder

Conc Pave

CENTRAL AVE

2" Hyd 174+26?

61'

5' R+O Shoulder

11' Parkway

4' Walk

PP 173+62?

36'

R25'

10'

4' Walk Conc

6' Park

Road O Paving

COLDEN AVE

15'

15'

173+38.52

173+38.52 L&T See F.B. 901-68

96TH ST.

6' Parkway

4' Concwalk

173+19?

PP 173+13

R25'

11' Parkway

4' Walk

From Top Last Pg

Notes Ck'd by D. M. Finley
Map No. B-1811-2
Office Work R. W. M.
Checked D. M. Finley
Date AUG '40

Survey of Central Ave
W. O. 8326 Tape No. St'd °F
Surveyed by F. J. McNeal
Notes Mc & Nichols Date 12-19-41
Indexed

F.B. 901 PG. 135

Note: Any Additions or Changes on This Sheet Must be Made or Circled in Red Ink With Date and Name of Person Making Change.

Do not extend notes this side of this line.

RETURN TO
LOS ANGELES COUNTY SURVEYOR
700 HALL OF RECORDS

FORM 247 5M 10-39

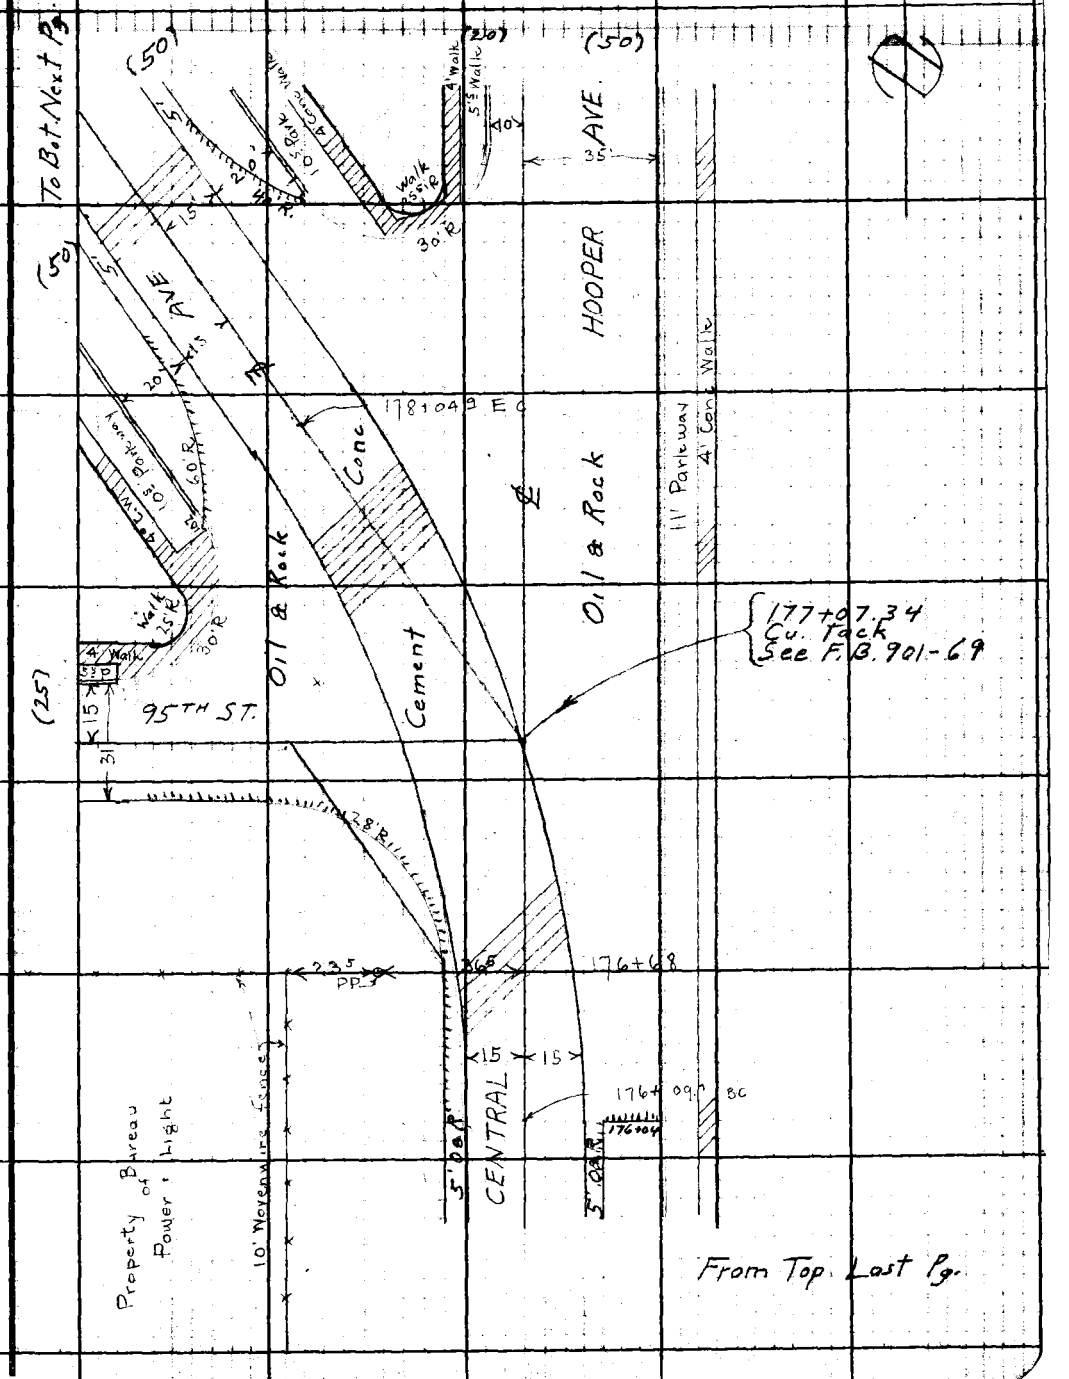

RETURN TO
**LOS ANGELES COUNTY SURVEYOR**
700 HALL OF RECORDS

**Note:** Any Additions or Changes on This Sheet Must be Made or Circled in **Red Ink** With Date and Name of Person Making Change.

**Do not extend notes this side of this line.**

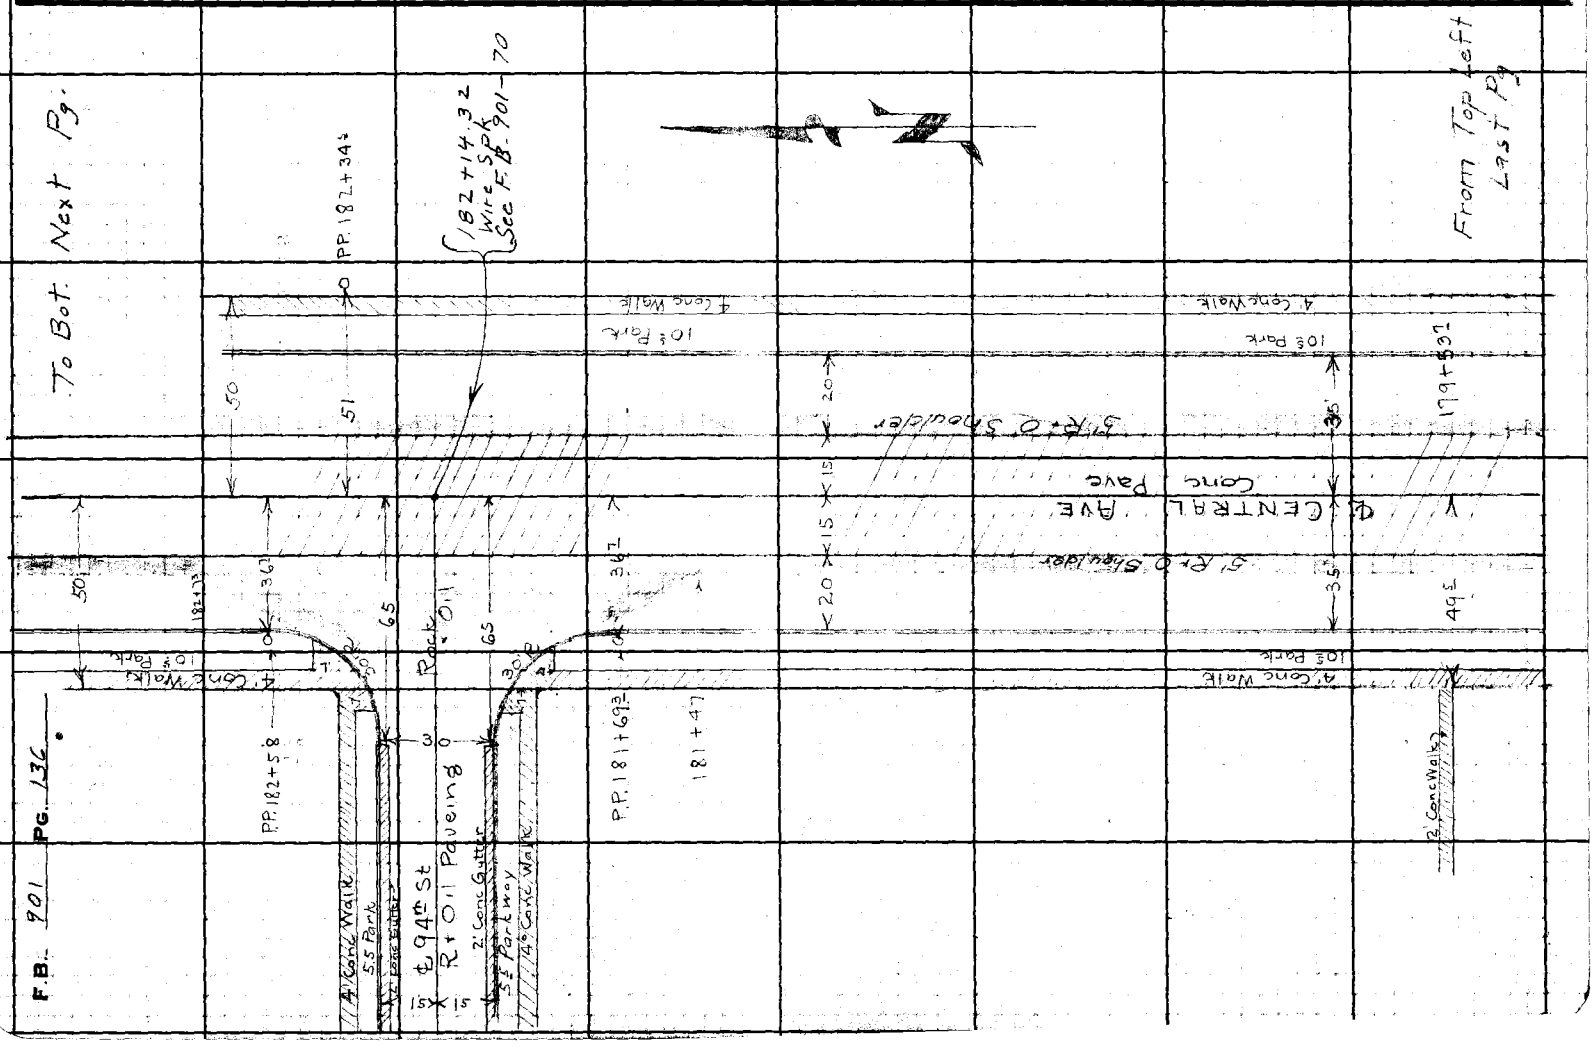

| | | | |
|---|---|---|---|
| Notes Ck'd by D. M. Finley | Survey of CENTRAL AVE | F.B. 721 | Pg. 137 |
| Map No. B-1811-2 | W. O. 82.3C Tape No. | Std °F | |
| Office Work R. W. M | Surveyed by F.J. McNeal | | |
| Checked D. M. Finley | Notes G. Nichols Date 12-19-41 | | |
| Date AUG '69 | Indexed C. Johns | | |

To Last Pg

Note: Any Additions or Changes on This Sheet Must be Made or Circled in Red Ink With Date and Name of Person Making Change.

Do not extend notes this side of this line.

RETURN TO
LOS ANGELES COUNTY SURVEYOR
700 HALL OF RECORDS

PP 184+34 — 36' — 18" CMP Bonded Pipe — 20' — 64' — 36' — PP 185+94.3

185+89.4 — 18" — 1 Story Stucco Restaurant Dwelling — 24' — 64'

184+16.22
Wire Spk
Set F.B. 901-70

4' Walk — 10' Park — 5' R+O Shoulder — 20' — 15' — 15' — 20' — 184+91

Conc. Pave — AVE — CENTRAL — 5' R+O Pave

PP 184+49 — 50 — 38' — 65' — 50' — 11' Park — 4' Walk

2 S. Stucco Business Apts. — 31 — 25 — 184+41 — 4' Walk — 5' Park

1 Story Stucco Business and Residence — .09 — 50 — 9L — 183+89.4

184+16.2 — Conc. — 50' — 5' R+O Pave

R+O Pave — 149' — 15' — 93rd St — Pave — 38' — 30' — 5' Park — 4' Walk

73 — 65 — 35 — 183+66 — 183+53

Gasoline Island — Conc Drive

R+O Pave — 67 — 35 — 183+23 — 183+16

281 — 243 — 1 S. Stucco Office Store Room

4' Walk — 10' Park — 11' Park — 4' Walk

From Top Last Pg


RETURN TO
**LOS ANGELES COUNTY SURVEYOR**
700 HALL OF RECORDS

**Note:** Any Additions or Changes on This Sheet Must be Made or Circled in **Red Ink** With Date and Name of Person Making Change.

**Do not extend notes this side of this line.**

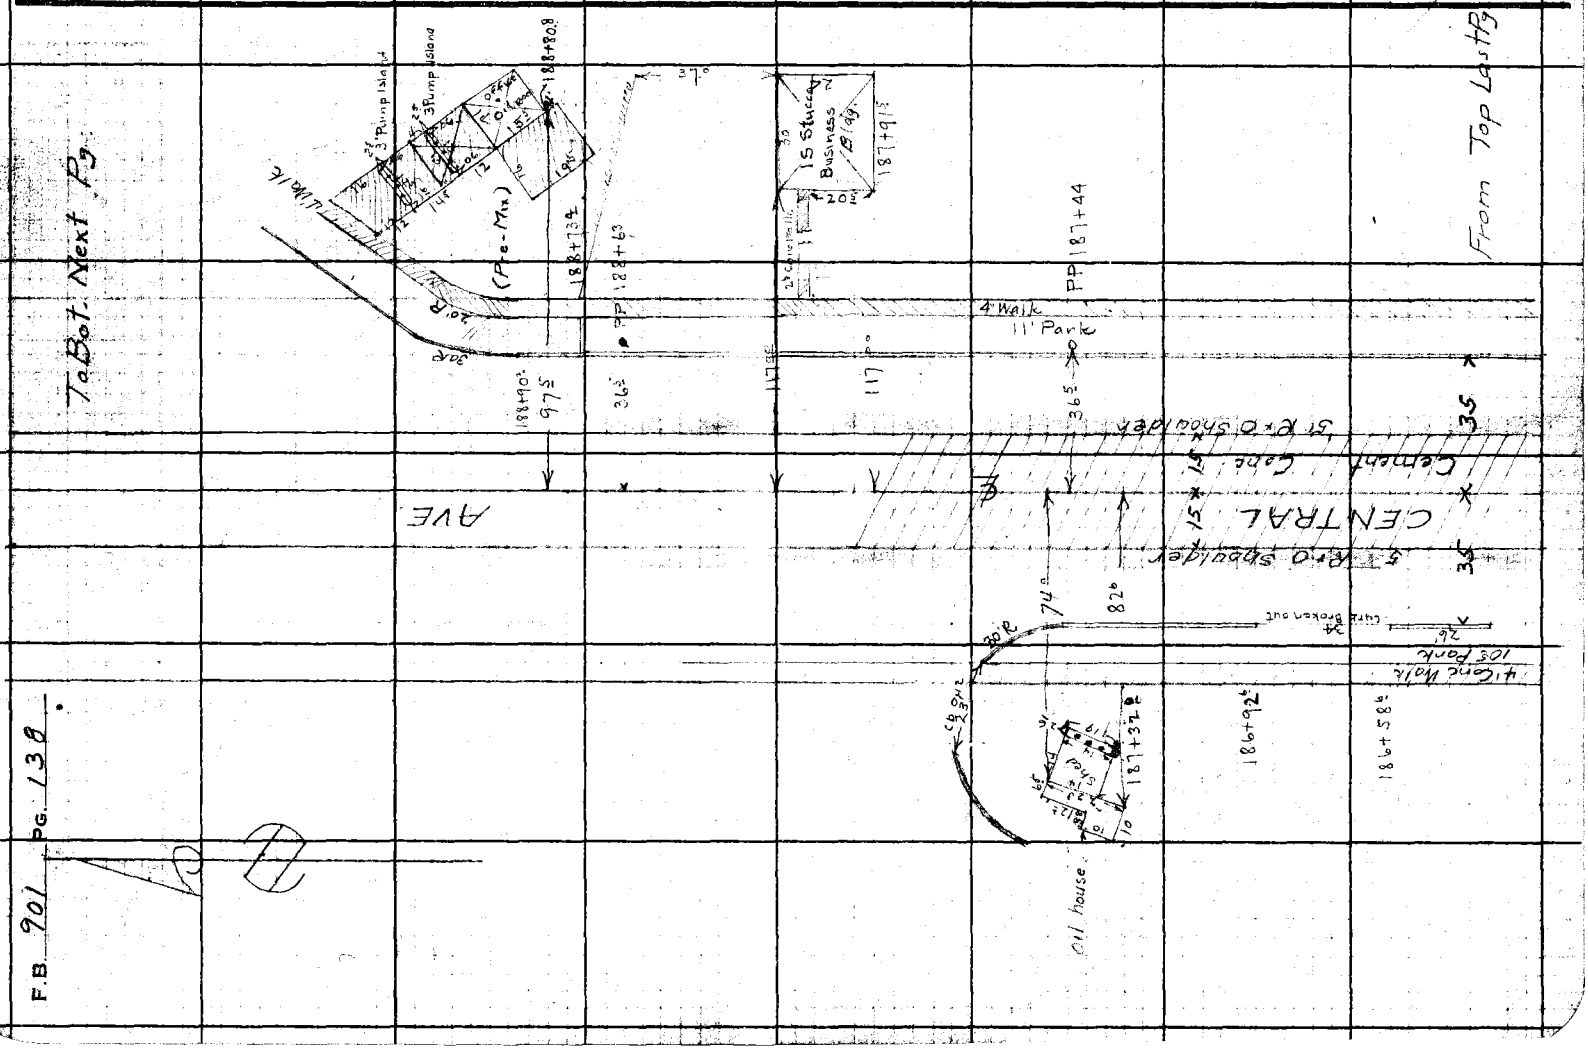

| | | | |
|---|---|---|---|
| Notes Ck'd by D. M. Finley | Survey of Central Ave. | F.B. 901 | Pg. 137 |
| Map No. B-181-2 | W. 0.832 Tape No. | St'd | °F |
| Office Work R. W. M. | Surveyed by F. J. McNeal | | |
| Checked D. M. Finley | Notes McC & Nichols Date 2-19-41 | | |
| Date AUG '41 | Indexed | | |

To Bot Next Pg.

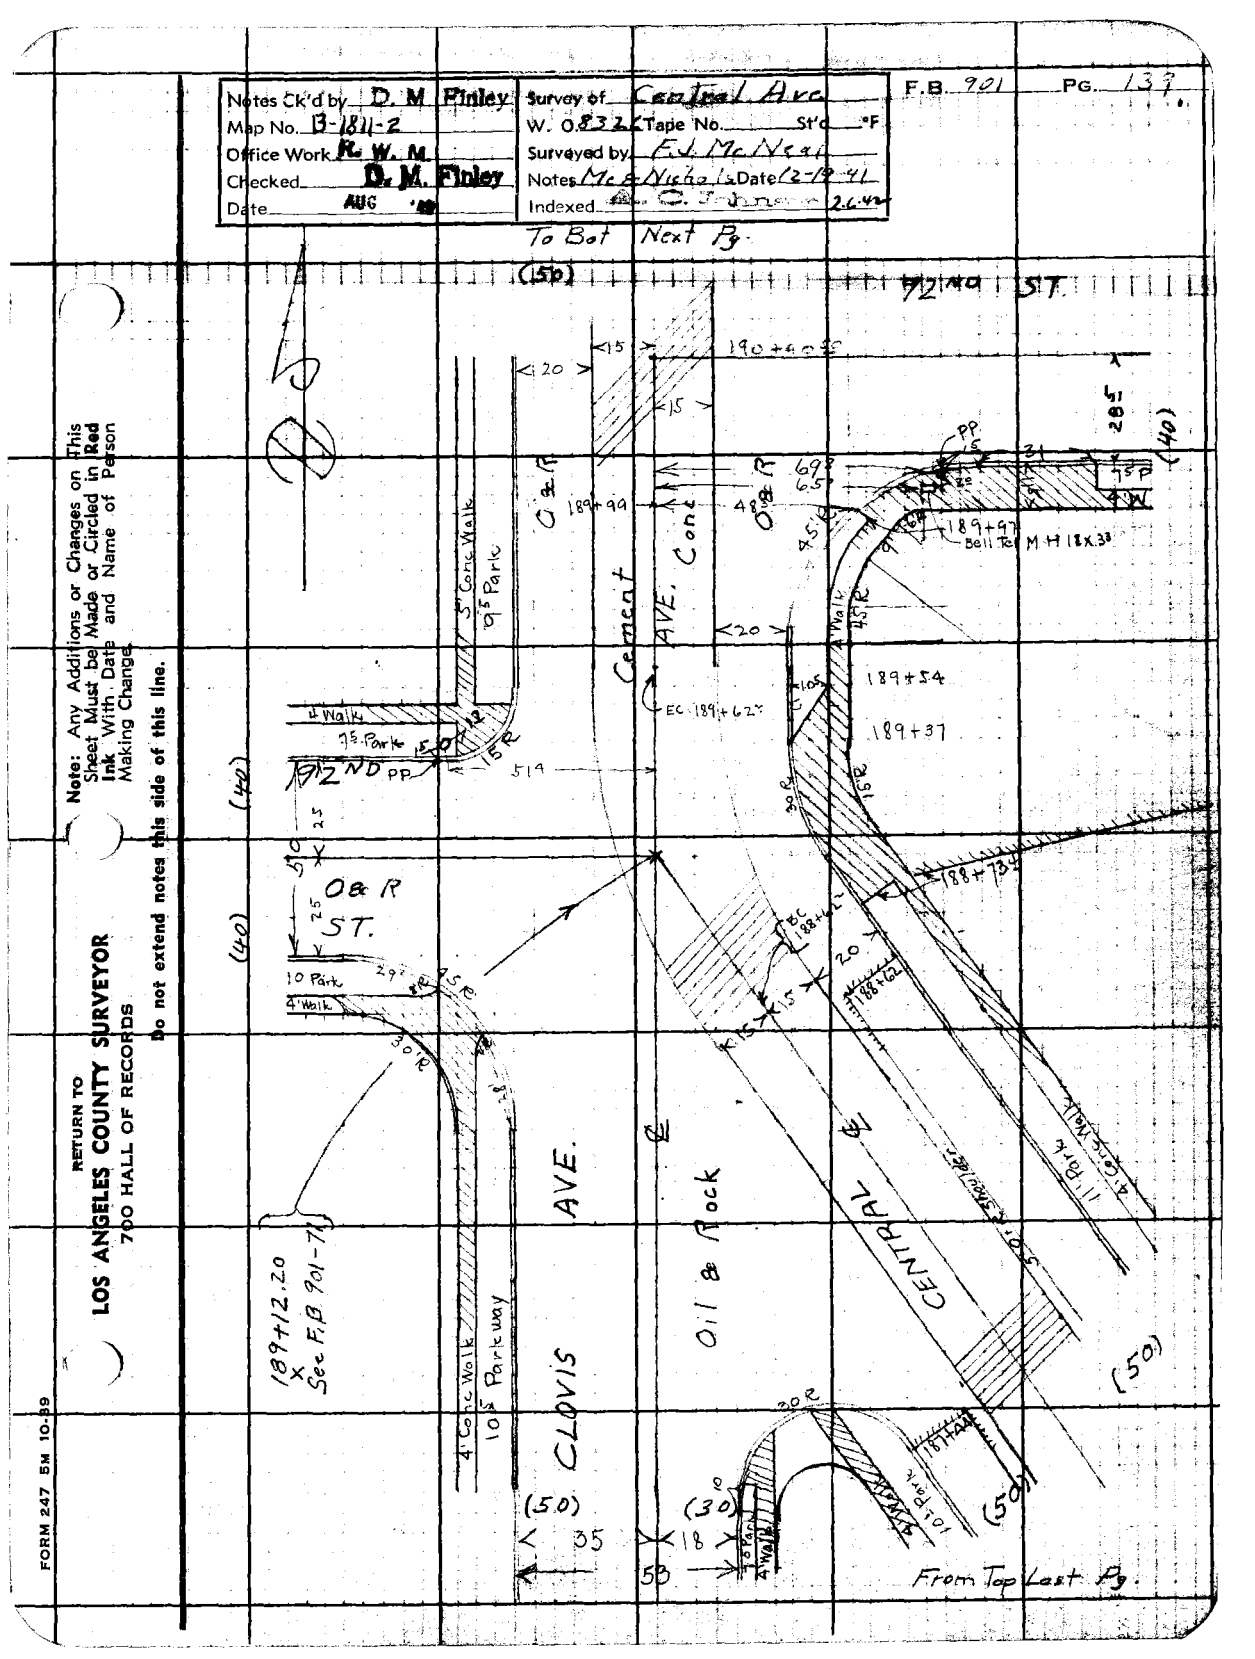


RETURN TO
LOS ANGELES COUNTY SURVEYOR
700 HALL OF RECORDS

Note: Any Additions or Changes on This Sheet Must be Made or Circled in Red Ink With Date and Name of Person Making Change

Do not extend notes this side of this line.

FORM 247 5M 10-39

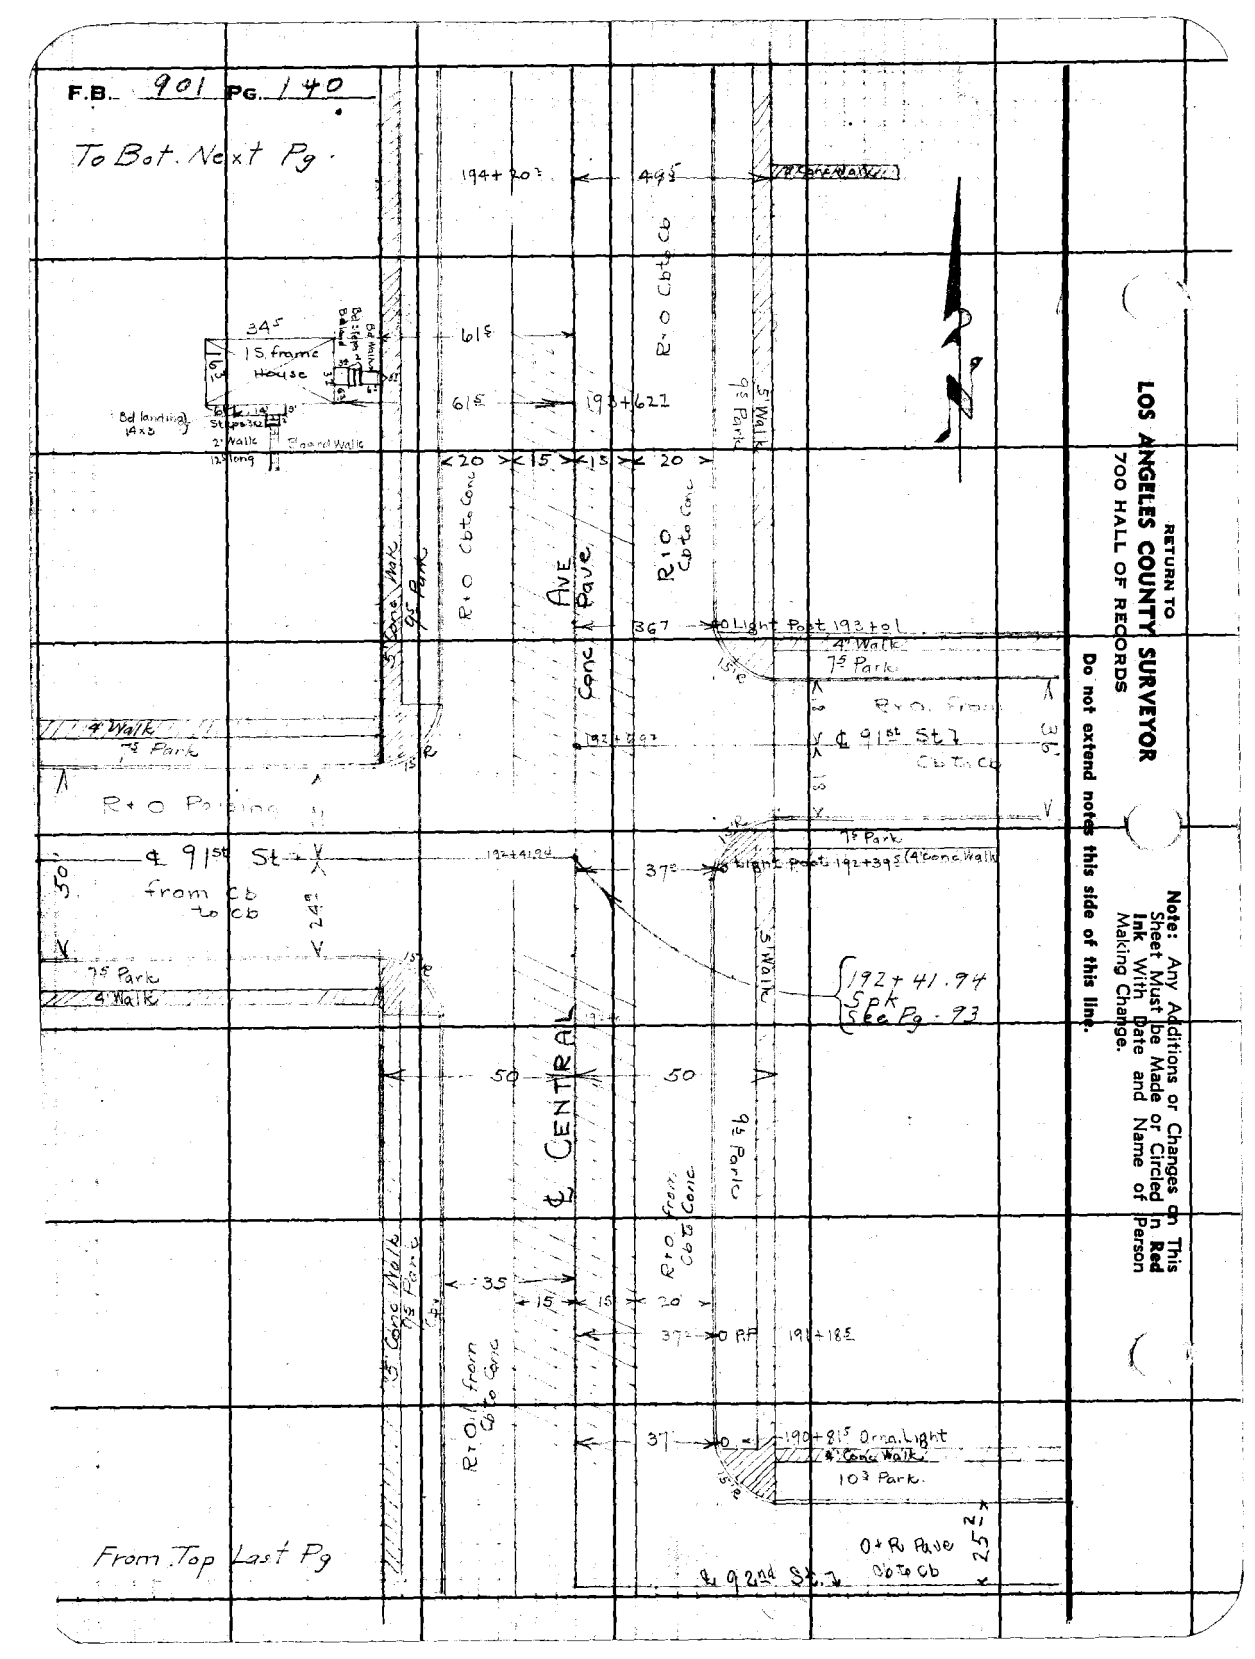
F.B. 901 PG. 140
To Bot. Next Pg.
194+20?
49?
R+O Cb to Cb
34?
15 frame House
61?
61?
193+62?
5' Walk
9½ Park
Bd landing 4'x3'
Bd steps
2' Walk
Stepped Walk
12½ long
20
15
15
20
R+O Cb to Conc
Conc Walk
9½ Park
Ave
Conc Pave
36?
Light Post 193+01
4' Walk
7½ Park
15' R
R+O from Cb to Cb
℄ 91st St
4' Walk
7½ Park
R+O Parking
℄ 91st St
from cb to cb
24?
50
192+41.94
37?
Light Post 192+39? (4' Conc Walk)
7½ Park
5' Walk
192+41.94
SPK
See Pg. 93
℄ CENTRAL
50
50
9½ Park
35
15
15
20
37?
0 P.P.
191+18?
R+O from Cb to Conc
9½ Conc Walk
9½ Park
37?
0
190+81? Ornl. Light
4' Conc Walk
10½ Park.
From Top Last Pg
℄ 92nd St.
0+R Pave
Cb to Cb
25?
RETURN TO
LOS ANGELES COUNTY SURVEYOR
700 HALL OF RECORDS
Do not extend notes this side of this line.
Note: Any Additions or Changes on This Sheet Must be Made or Circled in Red Ink With Date and Name of Person Making Change.

| | | | |
|---|---|---|---|
| Notes Ck'd by D. M. Finley | Survey of Central Ave | F.B. 10 | Pg. 171 |
| Map No. B-1811-2 | W. O. 8324 Tape No. | Std. °F | |
| Office Work L. W. M. | Surveyed by F. J. McNeal | | |
| Checked D. M. Finley | Notes Nichols Date 1-2-42 | | |
| Date AUG '49 | Indexed | | |

To B of M Next Pg

20 | 15 | 15 | 20
49'

50'

1" Picket fence

2' Conc Walk

Pave

195+91

50'

1" Picket fence

5' Conc Walk

195+69.07
Spk
See Pg 94

Conc

50.2

5' Telephone Pull Box Conc Slope

To Stucco

25. Stucco

5' Walk

9' Park

Ave

195+99.2

367

4' Walk

7½ Park

4' Conc Walk

90th St

Pave

1' Gutter

195+60.2

Light Post

195+98

Light Post 195+38

CENTRAL

Conc

29'

12'

Stucco

50.2

50.2

194+72

From Top Last Pg

Note: Any Additions or Changes on This Sheet Must be Made or Circled in Red Ink With Date and Name of Person Making Change

Do not extend notes this side of this line.

RETURN TO
LOS ANGELES COUNTY SURVEYOR
700 HALL OF RECORDS

FORM 247 SM 10-39

F.B. 901 Pg. 142

To Bot. Next Pg.

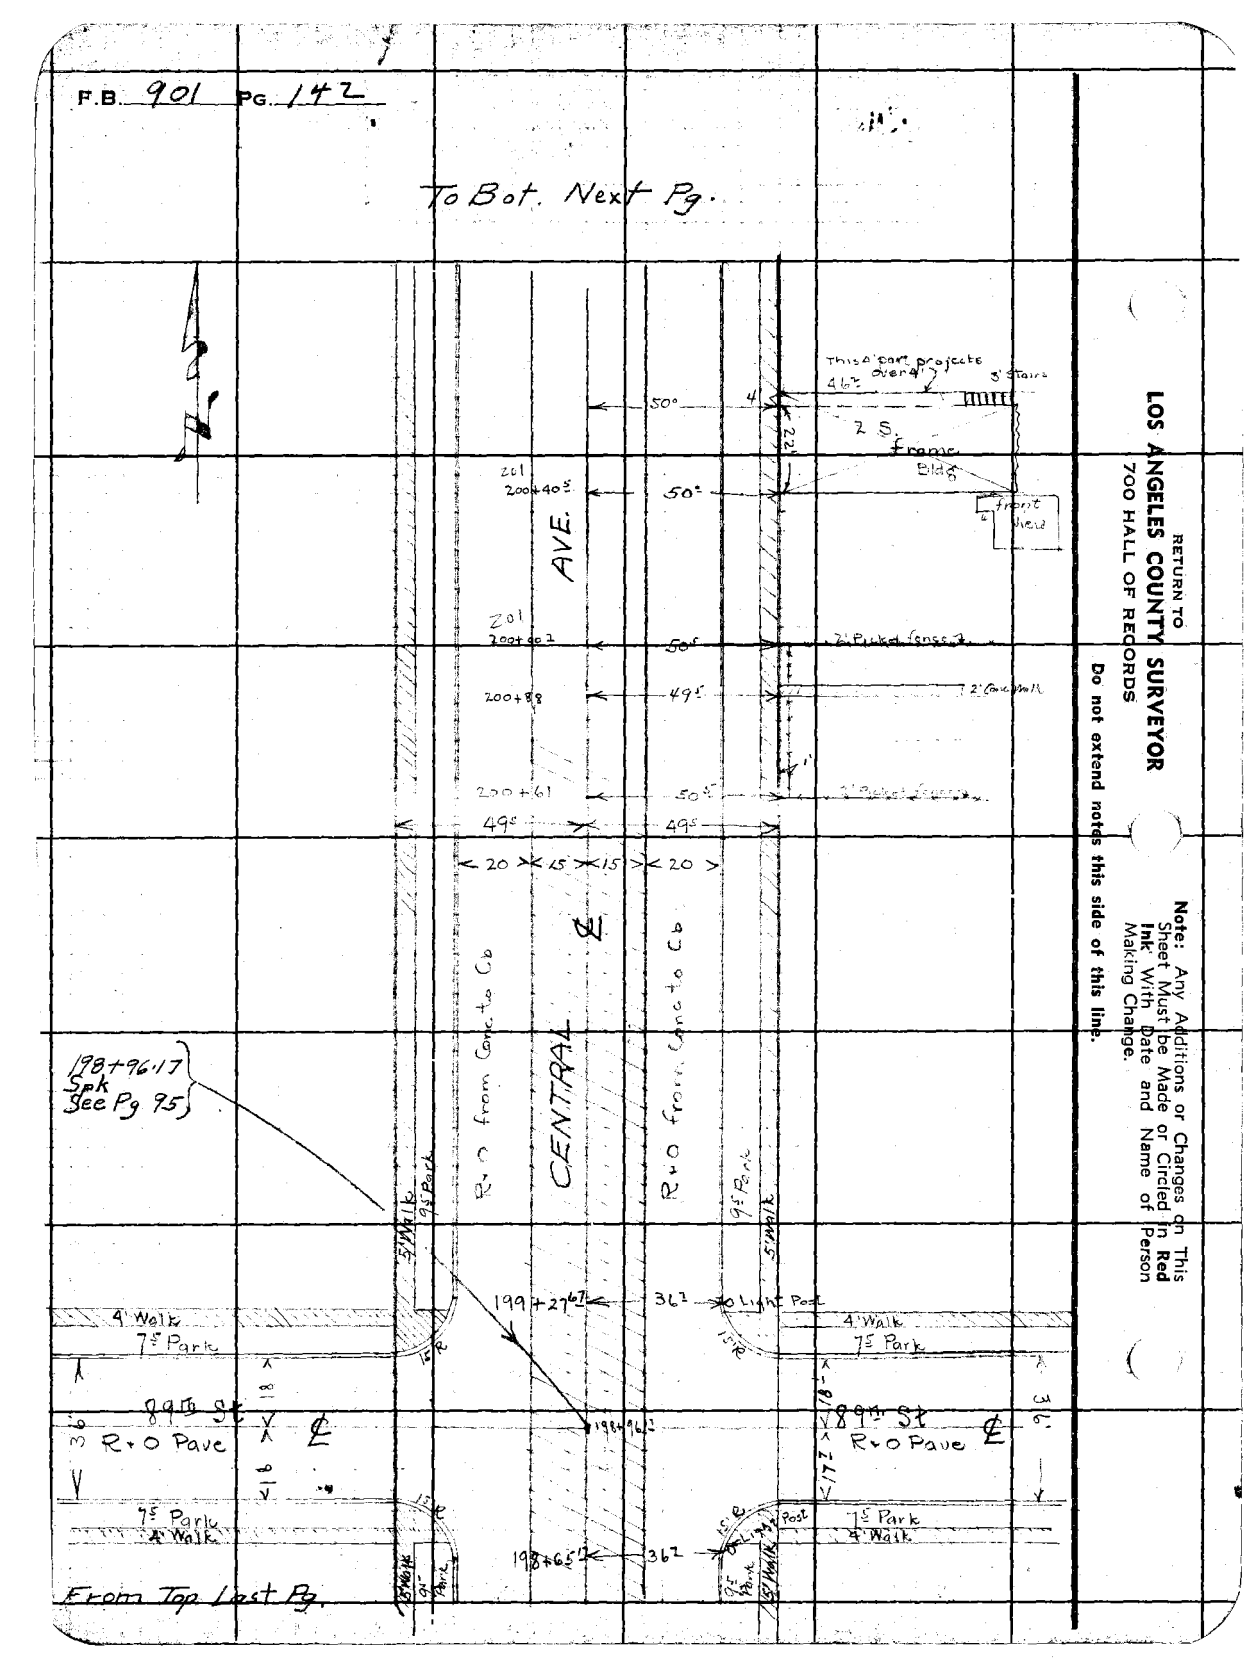


From Top Last Pg.

RETURN TO
LOS ANGELES COUNTY SURVEYOR
700 HALL OF RECORDS

Note: Any Additions or Changes on This Sheet Must be Made or Circled in Red Ink With Date and Name of Person Making Change.

Do not extend notes this side of this line.

Notes Ck'd by D. M. Finley
Map No. B-1811-2
Office Work R. W. M.
Checked D. M. Finley
Date AUG '49

Survey of Central Ave
W. O. 8327 Tape No. St'd °F
Surveyed by F.J. McNeal
Notes Nichols Date 1-5-42
Indexed C. Johnson 2642

F.B. 901 PG. 143

To Bot. Next Pg

Note: Any Additions or Changes on This Sheet Must be Made or Circled in Red Ink With Date and Name of Person Making Change.

Do not extend notes this side of this line.

RETURN TO
LOS ANGELES COUNTY SURVEYOR
700 HALL OF RECORDS

FORM 247 5M 10-89

495 — 495

20 — 15 — 15 — 20

1½ S Frame th Covered

Conc Border Drive

3' Conc Walk

CENTRAL AVE Conc Pave

O + R Conc to Cb

9½ Park

5' Walk

203+96.5

203+83.2

203+11.2

202+99.2

202+80.2

202+58.5

202+53.9

202+34.1

204+08.5

204+07.4

512

74.8

74.5

63.3

63.8

36.7

Ornamental Fence

Grass Park

Island 5 Pumps

Conc Drive Hump Resy

Conc Walk

7½ Park

4 Walk

4 Conc Walk

36' Drive

℄ 88th Pl

R + O 1 Pave

18½

177

202+23.41 SPK See Pg 96

From Top Last Pg.

F.B. 901 Pg. 144

To Bot Next Pg.

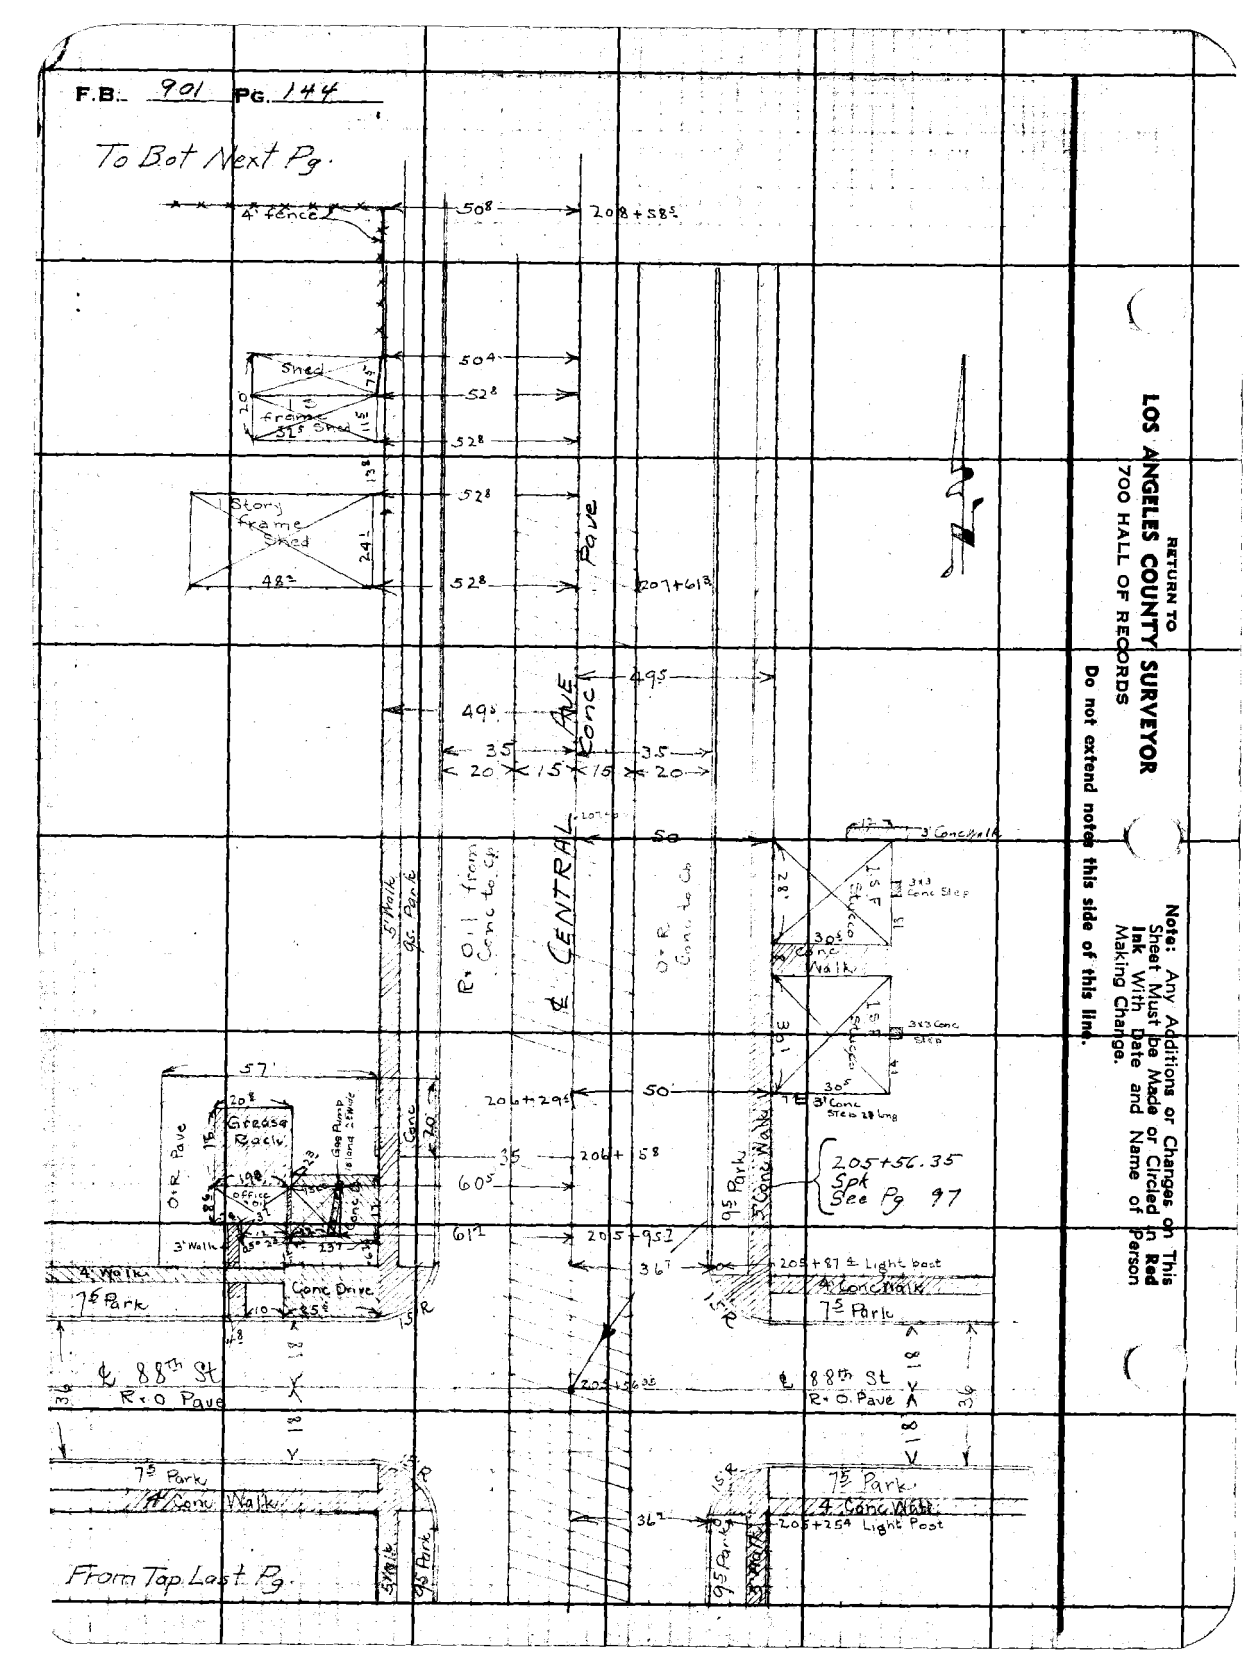


From Tap. Last Pg.

RETURN TO
LOS ANGELES COUNTY SURVEYOR
700 HALL OF RECORDS

Note: Any Additions or Changes on This Sheet Must be Made or Circled in Red Ink With Date and Name of Person Making Change.

Do not extend notes this side of this line.

| | |
|---|---|
| Notes Ck'd by D. M. Finley | Survey of Central Ave. |
| Map No. B-1811-2 | W. O. 8326 Tape No. St'd °F |
| Office Work R. W. M. | Surveyed by F. J. McNeal |
| Checked D. M. Finley | Notes Nichols Date 1-5-42 |
| Date AUG '42 | Indexed A. C. Jones |

F.B. 901 PG. 145

To Bot. Next Pg

Note: Any Additions or Changes on This Sheet Must be Made or Circled in Red Ink With Date and Name of Person Making Change

Do not extend notes this side of this line.

RETURN TO
LOS ANGELES COUNTY SURVEYOR
700 HALL OF RECORDS

FORM 247 5M 10-39

From Top Last Pg.

212+19.37 Spk See Pg 99

212+99.7 4' Woven fence

PP 212+00

PP 211+99.2

211+88.7 Light Post

211+83 Tel pole

208+89.26 nail See Pg 98

208+20.2 Light Post

208+57.2 Light Post

℄ 87th St
R+O Pave

℄ 87th Pl.
R+O Pave

℄ CENTRAL AVE
Conc Pave

7.5 Park

4' Walk

5' Conc Walk

9.5 Park

3x3 Conc Steps

4' Brick Walk

1.5 Stucco

F.B. 901 PG. 146

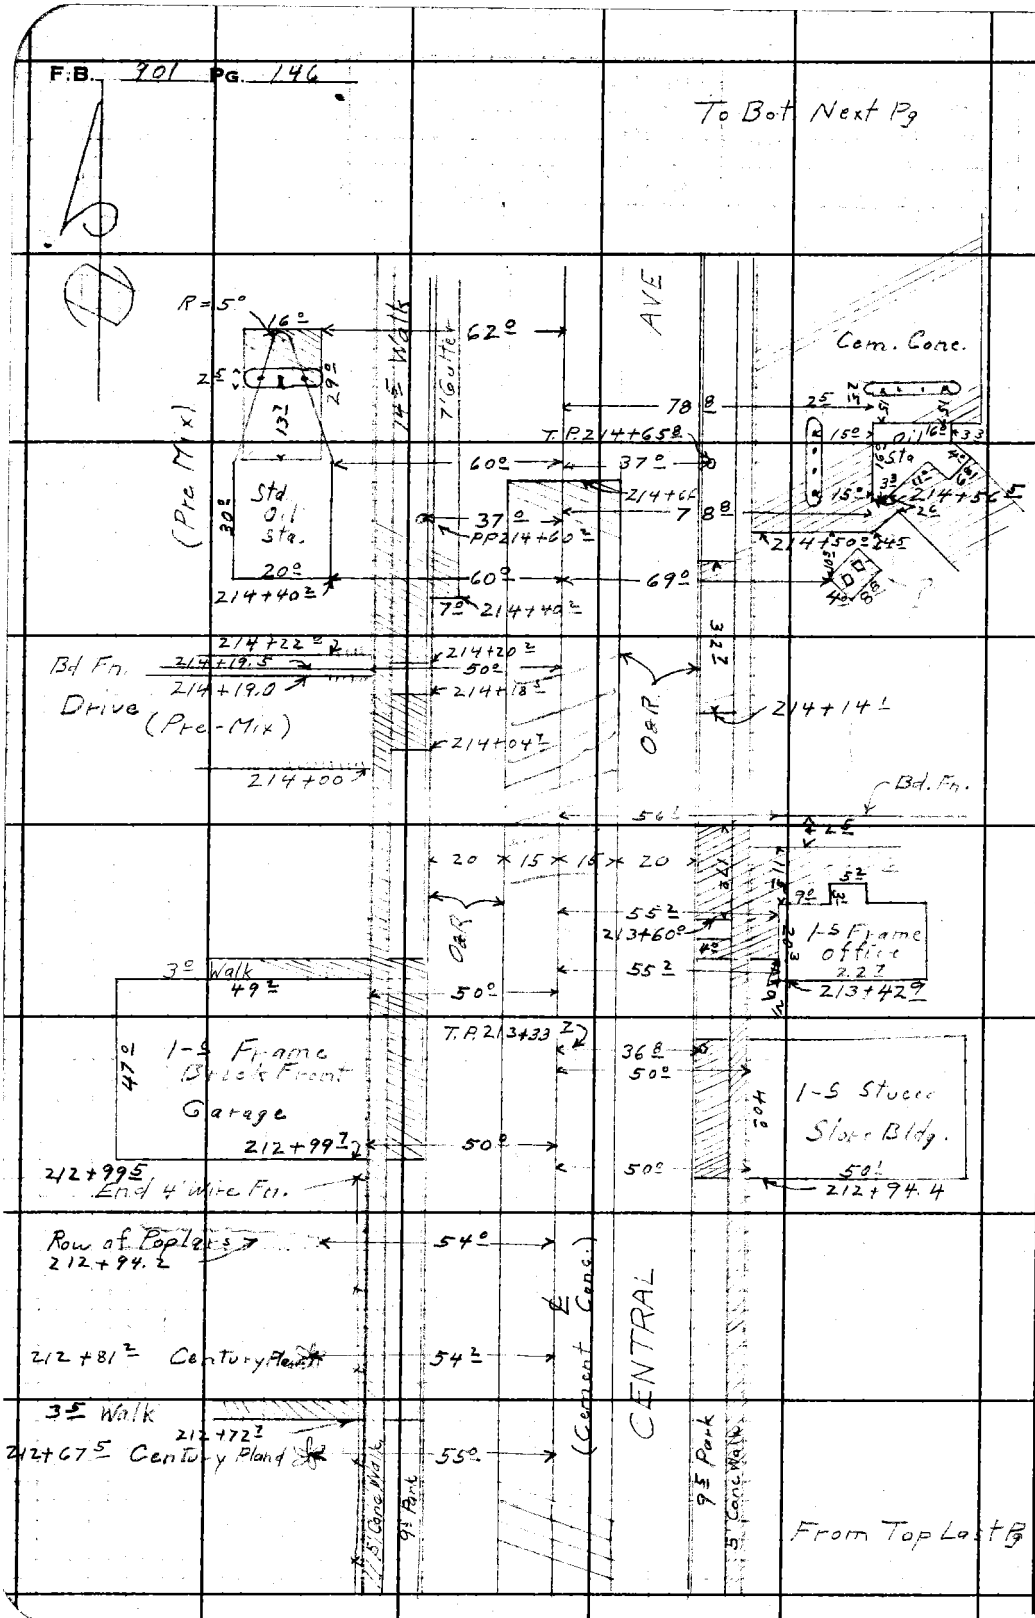


RETURN TO
LOS ANGELES COUNTY SURVEYOR
700 HALL OF RECORDS

Do not extend notes this side of this line.

Note: Any Additions or Changes on This Sheet Must be Made or Circled in Red Ink With Date and Name of Person Making Change.

| | | | |
|---|---|---|---|
| Notes Ck'd by | D. M. Finley | Survey of | Central Ave |
| Map No. | B-1811-2 | W. O. | 8320 Tape No. St'd °F |
| Office Work | R. W. M | Surveyed by | E.J. Mc Neal |
| Checked | D. M. Finley | Notes | Mc Date 1-5-42 |
| Date | ADC '40 | Indexed | A. C. Jahn |

F.B. 901 Pg. 147

Note: Any Additions or Changes on This Sheet Must be Made or Circled in Red Ink With Date and Name of Person Making Change.

Do not extend notes this side of this line.

RETURN TO
LOS ANGELES COUNTY SURVEYOR
700 HALL OF RECORDS

End

AVE.

Cem Conc

5' Walk

11' Park

12' Park

4' Walk

33°

35±

23±

35°

34±

35±

Light P 216+29±

P.P. 216+23±

216+24± Light P.

216+16± P.P.

216+06± Signal

216+03± Fire Hyd.

215+98±

5° Signal Light Post

14' Walk

16°

2' Curb

54°

60°

7' Gutter

15' Walk

50°

SS M H

5±

FIRESTONE

℄

BLVD.

35° O&R

Light 215+86

P.P. 215+77° R

W.M.H. 215+20 R

215±

28°

28°

22°

7' Gutter

15' Walk

48±

59±

37°

214+97± G.P.

28°

214+88±

214+84° Signal

36±

O&R

35°

℄

CENTRAL

215+49.37

More

See F.B. 901-100

Light P. 215+

Signal 215+

14' Walk

7' Gutter

35°

95' Park

5' Walk

From Top Last Pg.

FORM 247 SM 10-39

RETURN TO
**LOS ANGELES COUNTY SURVEYOR**
700 HALL OF RECORDS

**Note:** Any Additions or Changes on This Sheet Must be Made or Circled in **Red Ink** With Date and Name of Person Making Change.

**Do not extend notes this side of this line.**

F.B. 901 Pg. 148

| | |
|---|---|
| Notes Ck'd by | Survey of |
| Map No. | W. O. Tape No. St'd °F |
| Office Work | Surveyed by |
| Checked | Notes Date |
| Date | Indexed |

F. B. 9, 1 Pg. 20

# CENTRAL AVE

## J.N 8326

## ALIGNMENT

## FROM 91ST ST TO FIRESTONE BLVD

Note: Any Additions or Changes on This Sheet Must be Made or Circled in Red Ink With Date and Name of Person Making Change.

Do not extend notes this side of this line.

RETURN TO
LOS ANGELES COUNTY SURVEYOR
726 LOS ANGELES COUNTY
ENGINEERING BLDG.

76F3098 247 10M 1-49

RETURN TO
LOS ANGELES COUNTY SURVEYOR
726 LOS ANGELES COUNTY
ENGINEERING BLDG.

Note: Any Additions or Changes on This Sheet Must be Made or Circled in Red Ink With Date and Name of Person Making Change.

Do not extend notes this side of this line.

F. B. 101 PG. 137

W.S. 7B-6

| | |
|---|---|
| Notes Ck'd by D. M. Finley | Survey of Central Ave |
| Map No. B-181-2 | W. O. 8546 Tape No. 049 Std 76°F |
| Office Work R. W. M. | Surveyed by F.J. McNeal |
| Checked D. M. Finley | Notes Mc Date 12-23-41 |
| Date AUG '49 | Indexed C. Johnson |

F.B. 901 Pg. 151

From Left Pg 93

Note: Any Additions or Changes on This Sheet Must be Made or Circled in Red Ink With Date and Name of Person Making Change.

Do not extend notes this side of this line.

RETURN TO
LOS ANGELES COUNTY SURVEYOR
700 HALL OF RECORDS

(40) (40) ST

(20)

661.12'

661.12' T 55° = 661.12'

Set nail by ties
F.B. 1025-66

Fd. L&T.

Fd. L&T

44.49'

44.52'

(30) WADSWORTH

44.44'

44.61'

AVE.

Fd Spk

Fd L&T.

Fd. L&T.

91 ST

℄

42.39'

(30)

47.10'

(1.02)

Ties are to this point

(30) McKINLEY

46.46'

AVE.

45.31'

Fd. Spk.

Fd L&T.

Fd. Int 4 P.M. on M.H. rim
Rel. F.B. 1025-64.

FORM 247 5M 10-39

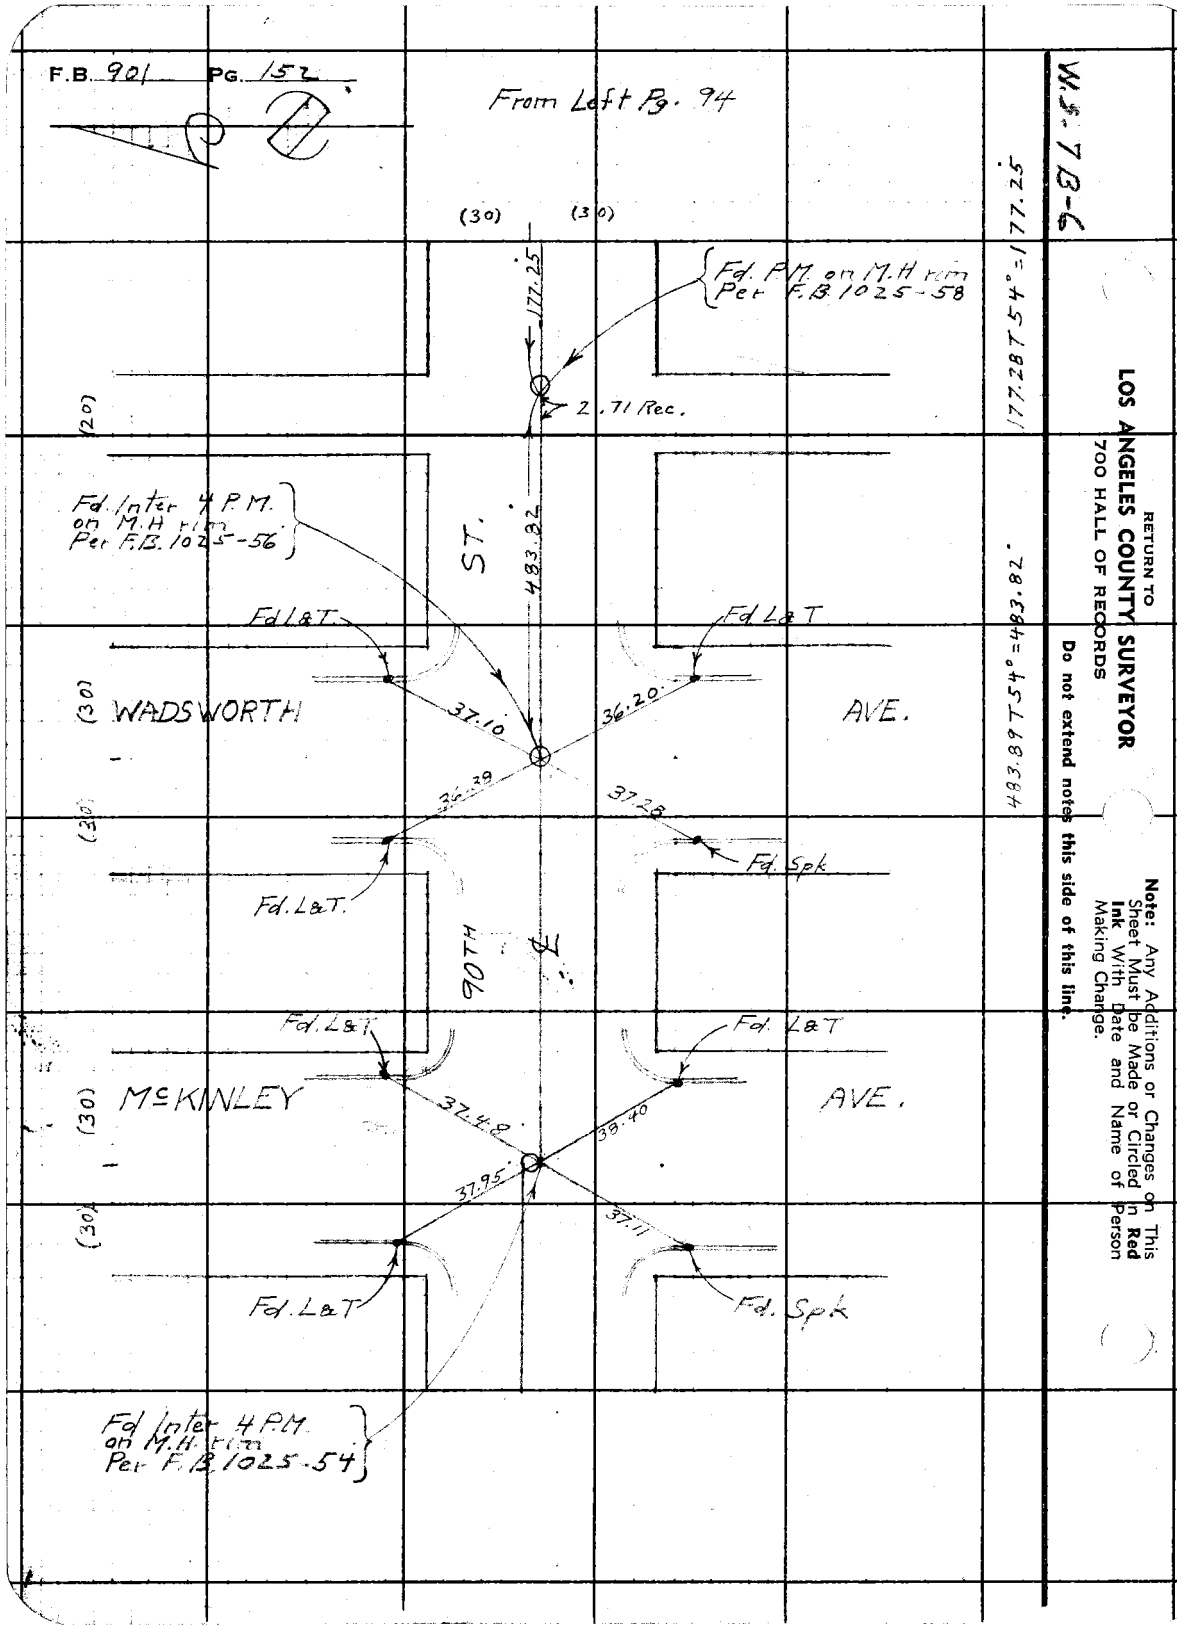


RETURN TO
LOS ANGELES COUNTY SURVEYOR
700 HALL OF RECORDS

Do not extend notes this side of this line.

**Note:** Any Additions or Changes on This Sheet Must be Made or Circled in **Red Ink** With Date and Name of Person Making Change.

| | |
|---|---|
| Notes Ck'd by D. M. Finley | Survey of Central Ave |
| Map No. B-1811-2 | W. O. 2226 Tape No. 049 Std 76°F |
| Office Work R. W. M. | Surveyed by E. H. Neal |
| Checked D. M. Finley | Notes Yc Date 12-23-41 |
| Date AUG '49 | Indexed |

F.B. 701 Pg. 102

W.S. 78-6

From Left Fig. 95

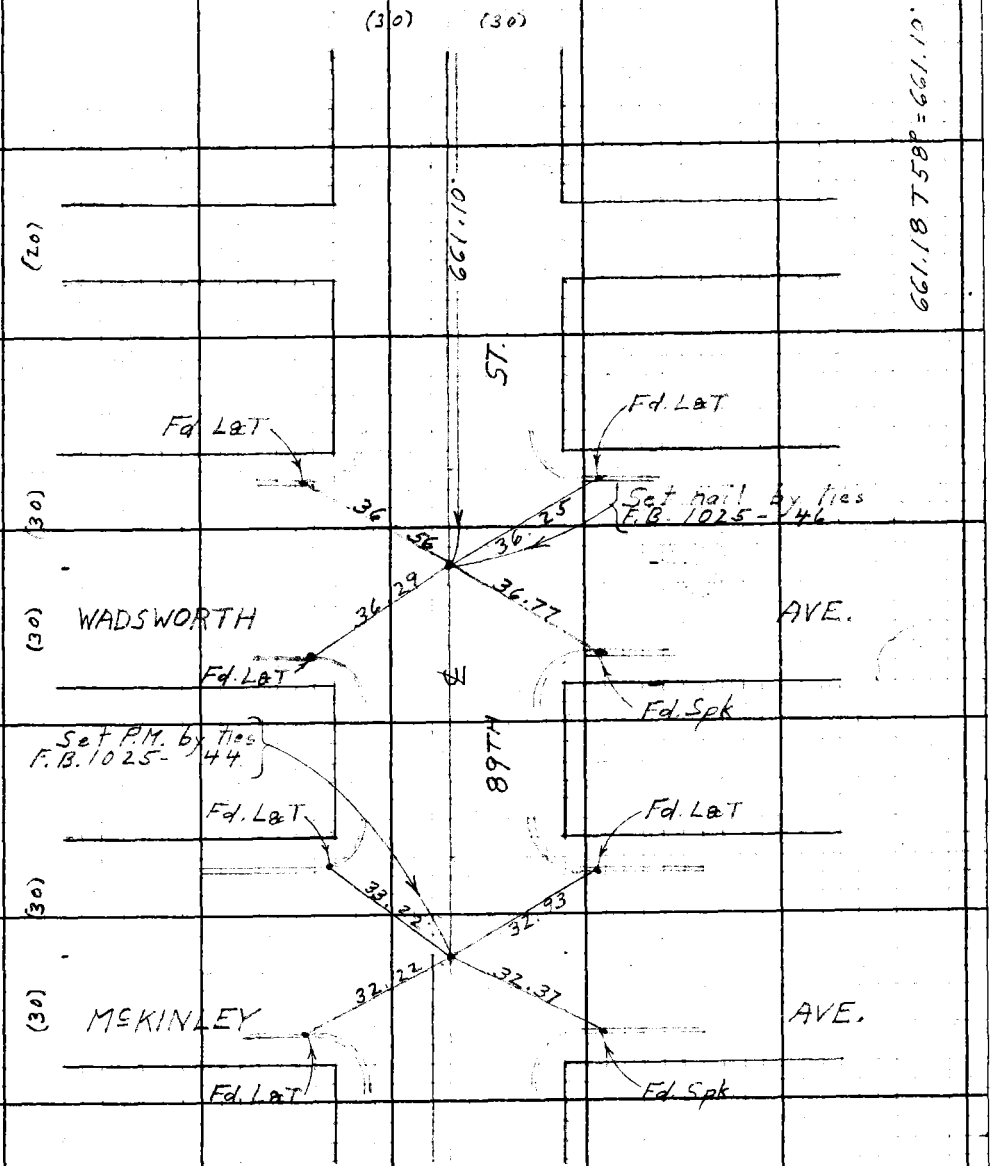


Note: Any Additions or Changes on This Sheet Must be Made or Circled in Red Ink With Date and Name of Person Making Change.

Do not extend notes this side of this line.

RETURN TO
LOS ANGELES COUNTY SURVEYOR
700 HALL OF RECORDS

FORM 247 5M 10-39

RETURN TO
LOS ANGELES COUNTY SURVEYOR
700 HALL OF RECORDS

**Note:** Any Additions or Changes on This Sheet Must be Made or Circled in **Red Ink** With Date and Name of Person Making Change.

**Do not extend notes this side of this line.**

W-5 78-6

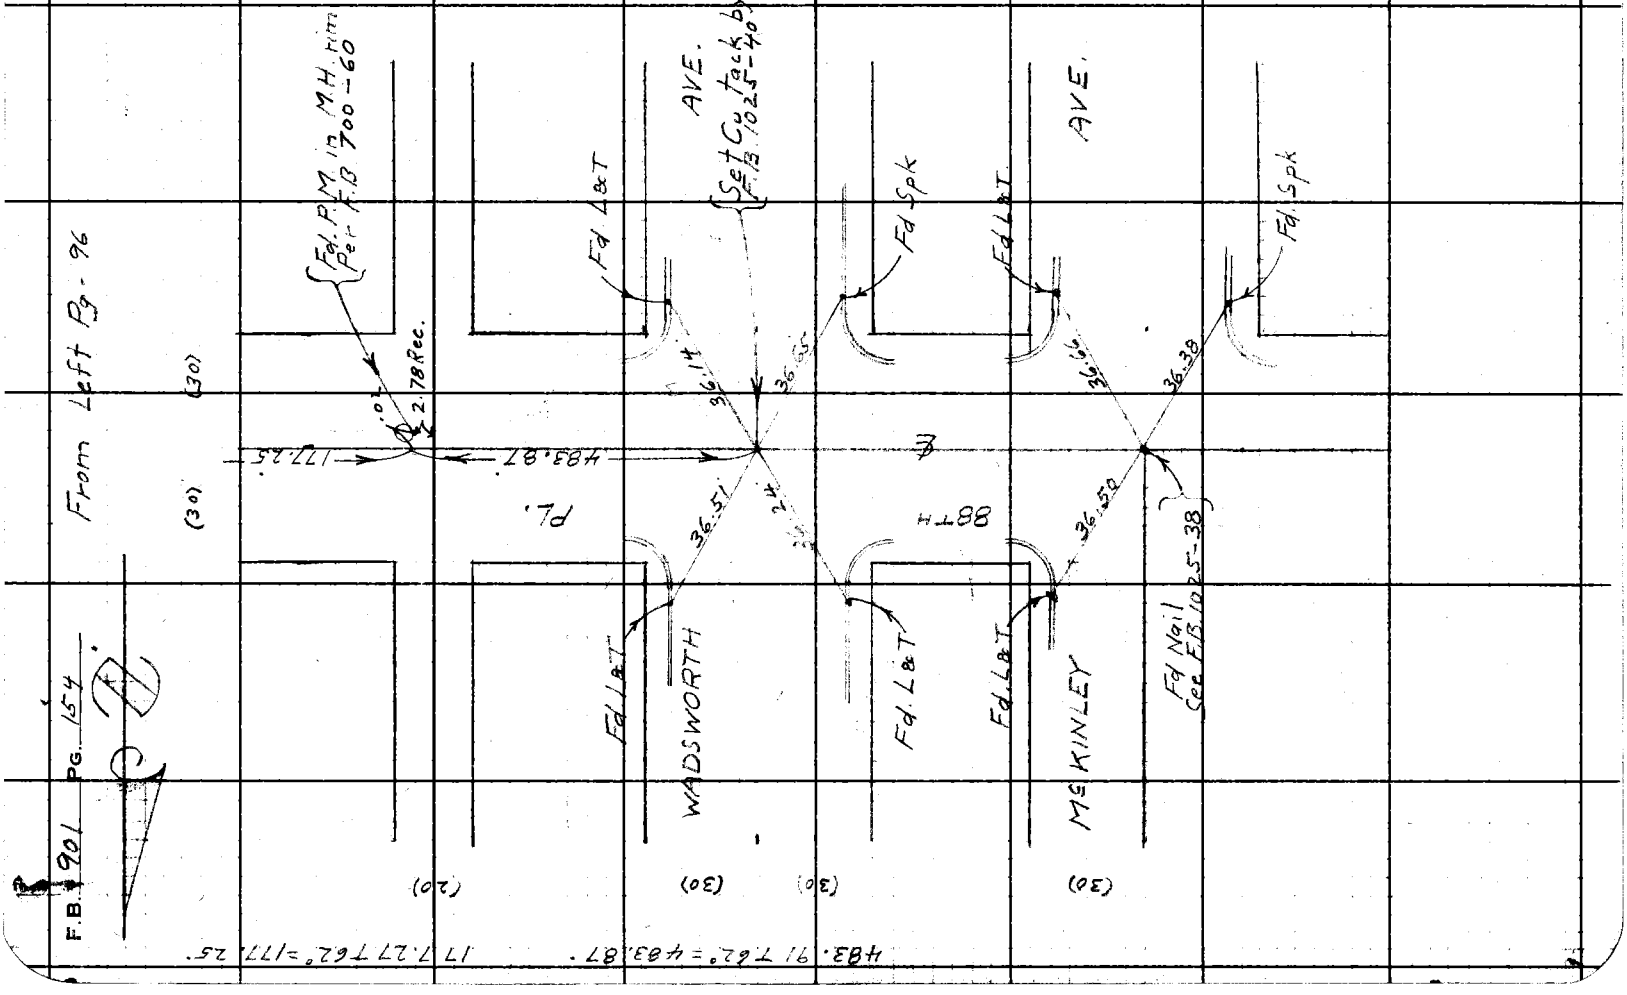

W.S. 76-6

| | | | |
|---|---|---|---|
| Notes Ck'd by D. M. Finley | Survey of Central Ave | F.B. 23 | Pg. 135 |
| Map No. B-181-2 | W. O. 8326 Tape No. 049 St'd 76°F | | |
| Office Work R. W. N | Surveyed by Fd. Mc Nee | | |
| Checked D. M. Finley | Notes Mc Date 12-23-41 | | |
| Date AUG '49 | Indexed | | |

From Left Pg. 97

661.20 T 60° = 661.13'

661.13'

(30) (30)

(20)

(30)

(30)

Set nail by ties F.B. 1025-30

Fd. L & T.

Fd. L & T.

WADSWORTH

ST.

AVE.

36.62

36.03

.02

36.02

36.65

Fd. Spk.

Fd. L & T.

88TH

Fd L & T.

Fd. L & T

Fd. Spk

32.12

32.14

McKINLEY

AVE.

34.98

34.08

Fd Inter 4 P.M. on M.H. Him
Per F.B. 1025-28

Note: Any Additions or Changes on This Sheet Must be Made or Circled in Red Ink With Date and Name of Person Making Change

Do not extend notes this side of this line.

RETURN TO
LOS ANGELES COUNTY SURVEYOR
700 HALL OF RECORDS

FORM 247 5M 10-39

F.B. 901 PG. 156

From Left Pg. 98

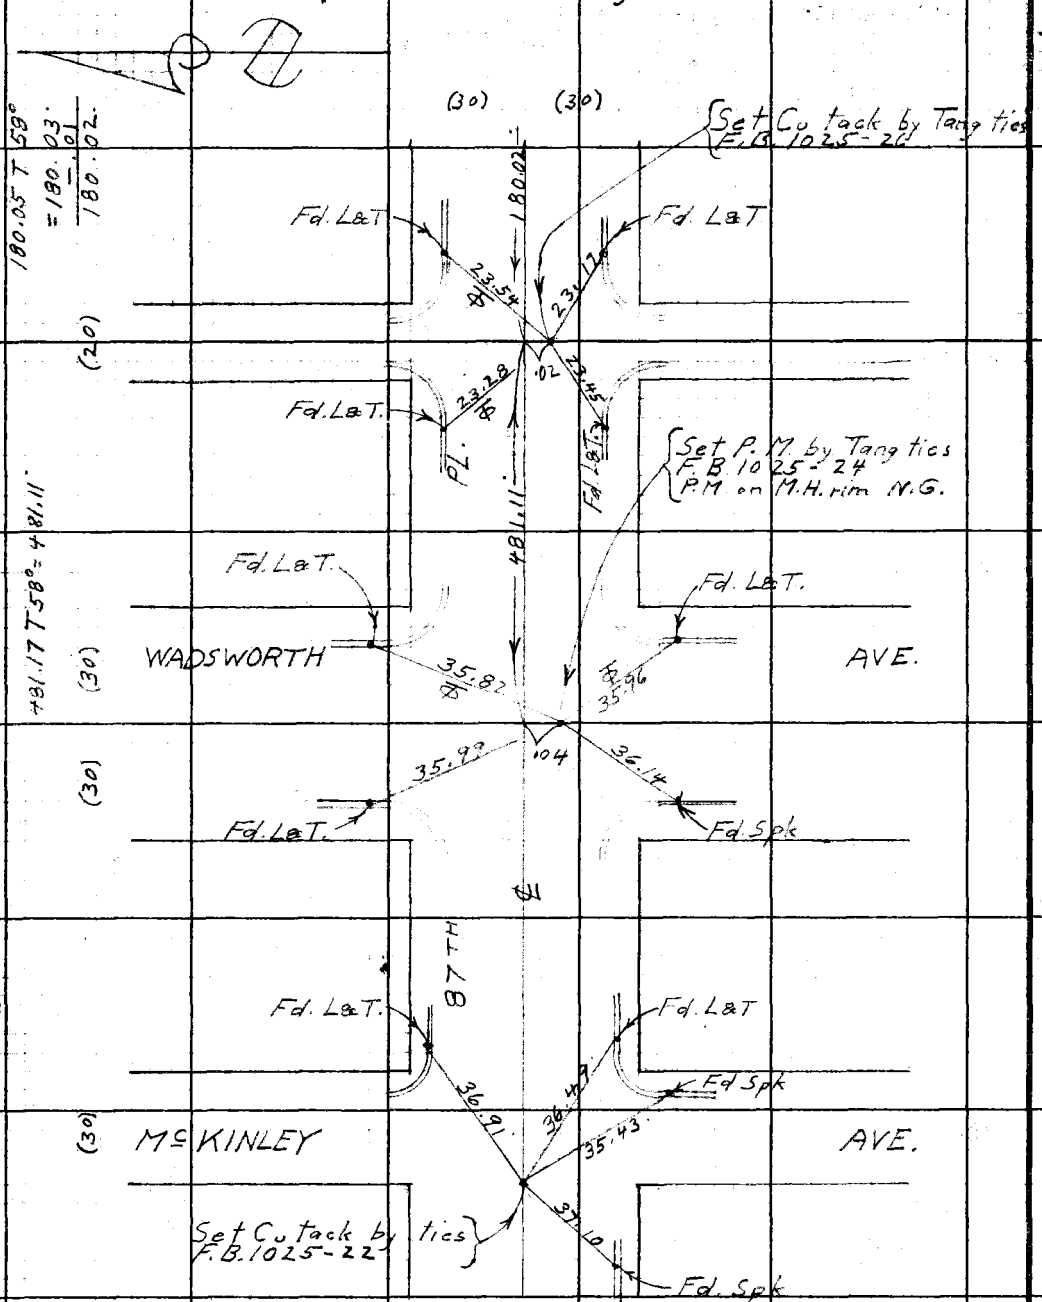


W5.78-6

RETURN TO
LOS ANGELES COUNTY SURVEYOR
700 HALL OF RECORDS

Do not extend notes this side of this line.

**Note:** Any Additions or Changes on This Sheet Must Be Made or Circled in **Red Ink** With Date and Name of Person Making Change.

Notes Ck'd by D. M. Finley
Map No. B-1811-2
Office Work
Checked D. M. Finley
Date AUG '48

Survey of Central Ave.
W. O. 8326 Tape No. 049 St'd 76°F
Surveyed by F. J. McNeal
Notes
Indexed

F.B. 70 PG. 157

W.S. 73-6

From Left P3 79

(30) (30)

661.12'

661.20 T 58° = 661.12'

(20)

Set Cu tack by ties P.B. 1025-16

ST.

Fd L&T

Fd L&T

WADSWORTH

(30)

36.62

38.18

AVE.

38.58

36.76

(30)

Fd L&T

Fd Spk

87TH

Fd L&T

Fd L&T

Fd Spk

(30) McKINLEY

36.19

37.43

AVE.

Set Cu. tack by ties P.B. 1025-14

Note: Any Additions or Changes on This Sheet Must be Made or Circled in Red Ink With Date and Name of Person Making Change.

Do not extend notes this side of this line.

RETURN TO
LOS ANGELES COUNTY SURVEYOR
700 HALL OF RECORDS

FORM 247 SM 10-59

RETURN TO
**LOS ANGELES COUNTY SURVEYOR**
700 HALL OF RECORDS

**Note:** Any Additions or Changes on This Sheet Must be Made or Circled in **Red Ink** With Date and Name of Person Making Change.

**Do not extend notes this side of this line.**

W.S. 78-6

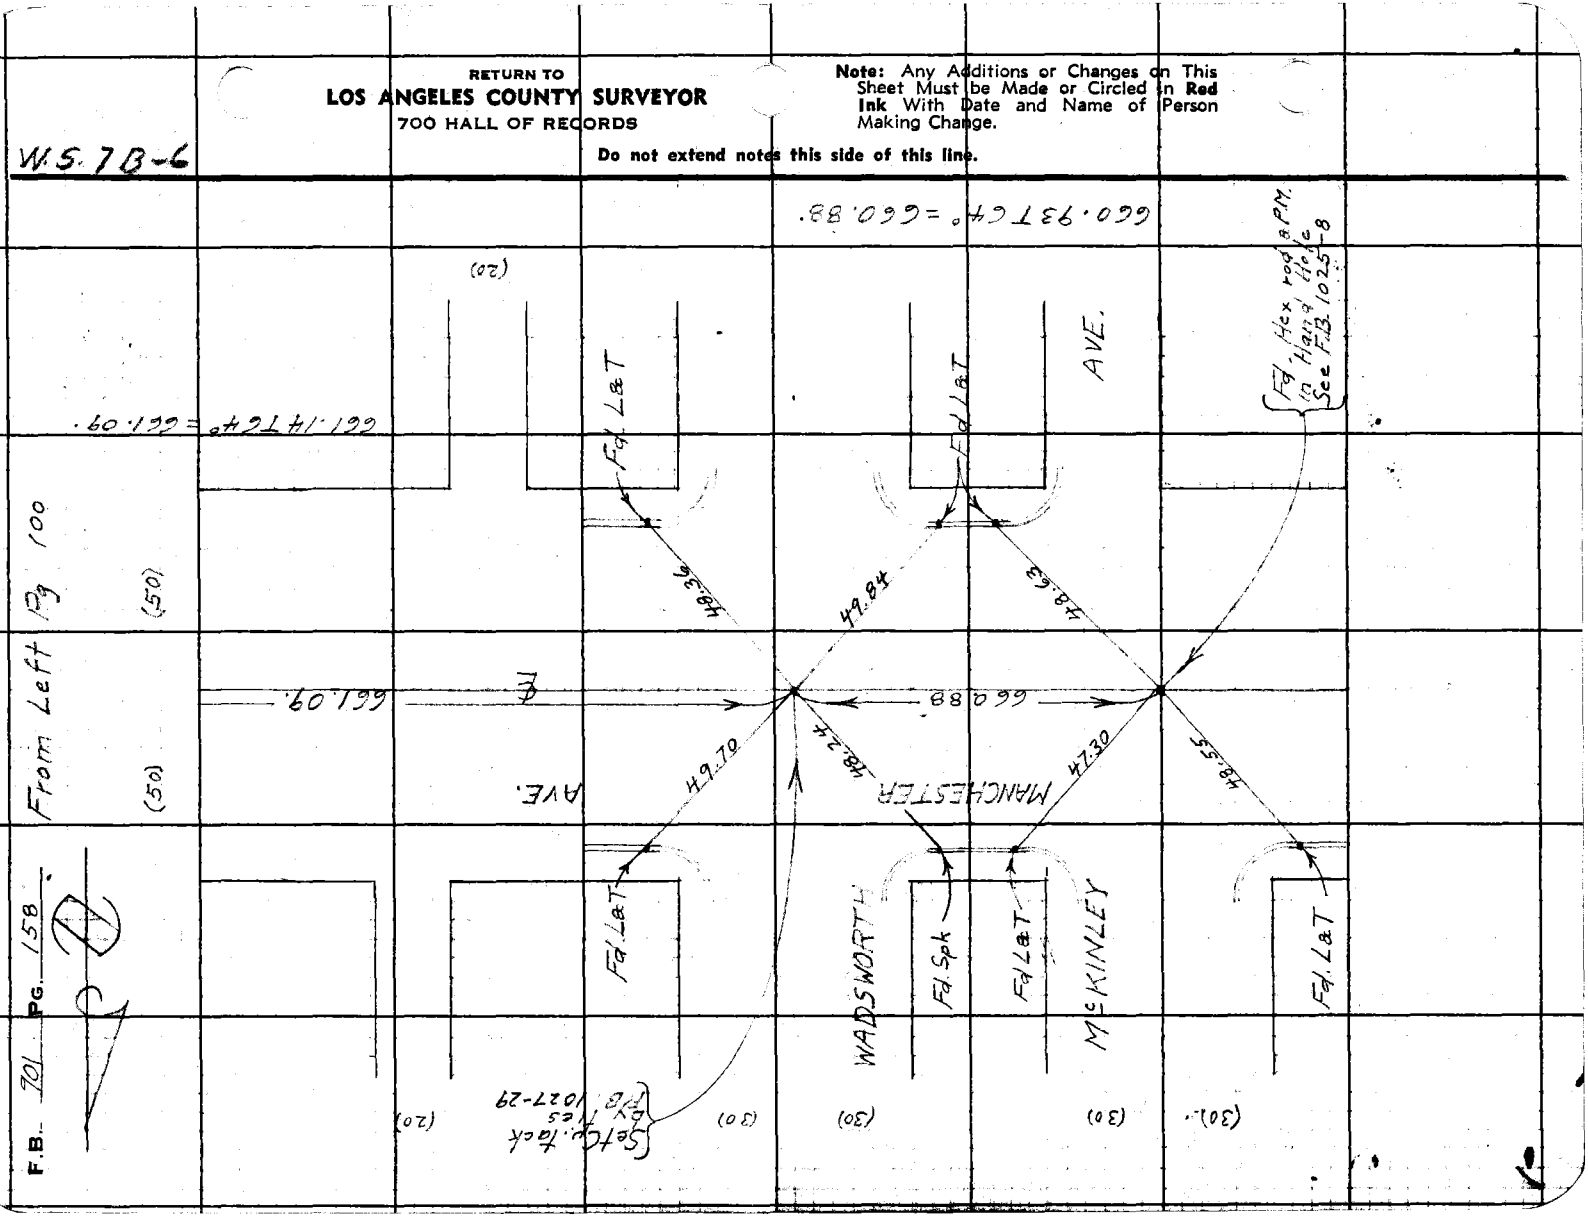

| | | | |
|---|---|---|---|
| Notes Ck'd by D. M. Finley | Survey of Central Ave | F.B. 901 | Pg. 159 |
| Map No. B-1811-2 | W. O. 8326 Tape No. 049 St'd 76°F | | |
| Office Work R. W. M. | Surveyed by F.J. McHeal | | |
| Checked D. M. Finley | Notes Mc Date 12-24-41 | | |
| Date AUG '49 | Indexed | | |

To Bot. Next Pg.

(30) (30)

ST

Lot 445

Fd. Remains of 2x2 4" Down

29.92

732.04

Lot 444

9/ST

Fd 2x2 only - 2" Dn.

30.02

(20)

From Right 43.93

Note: Any Additions or Changes on This Sheet Must be Made in Red Ink or Circled in Red With Date and Name of Person Making Change

Do not extend notes this side of this line.

RETURN TO
LOS ANGELES COUNTY SURVEYOR
700 HALL OF RECORDS

FORM 247 5M 10-39

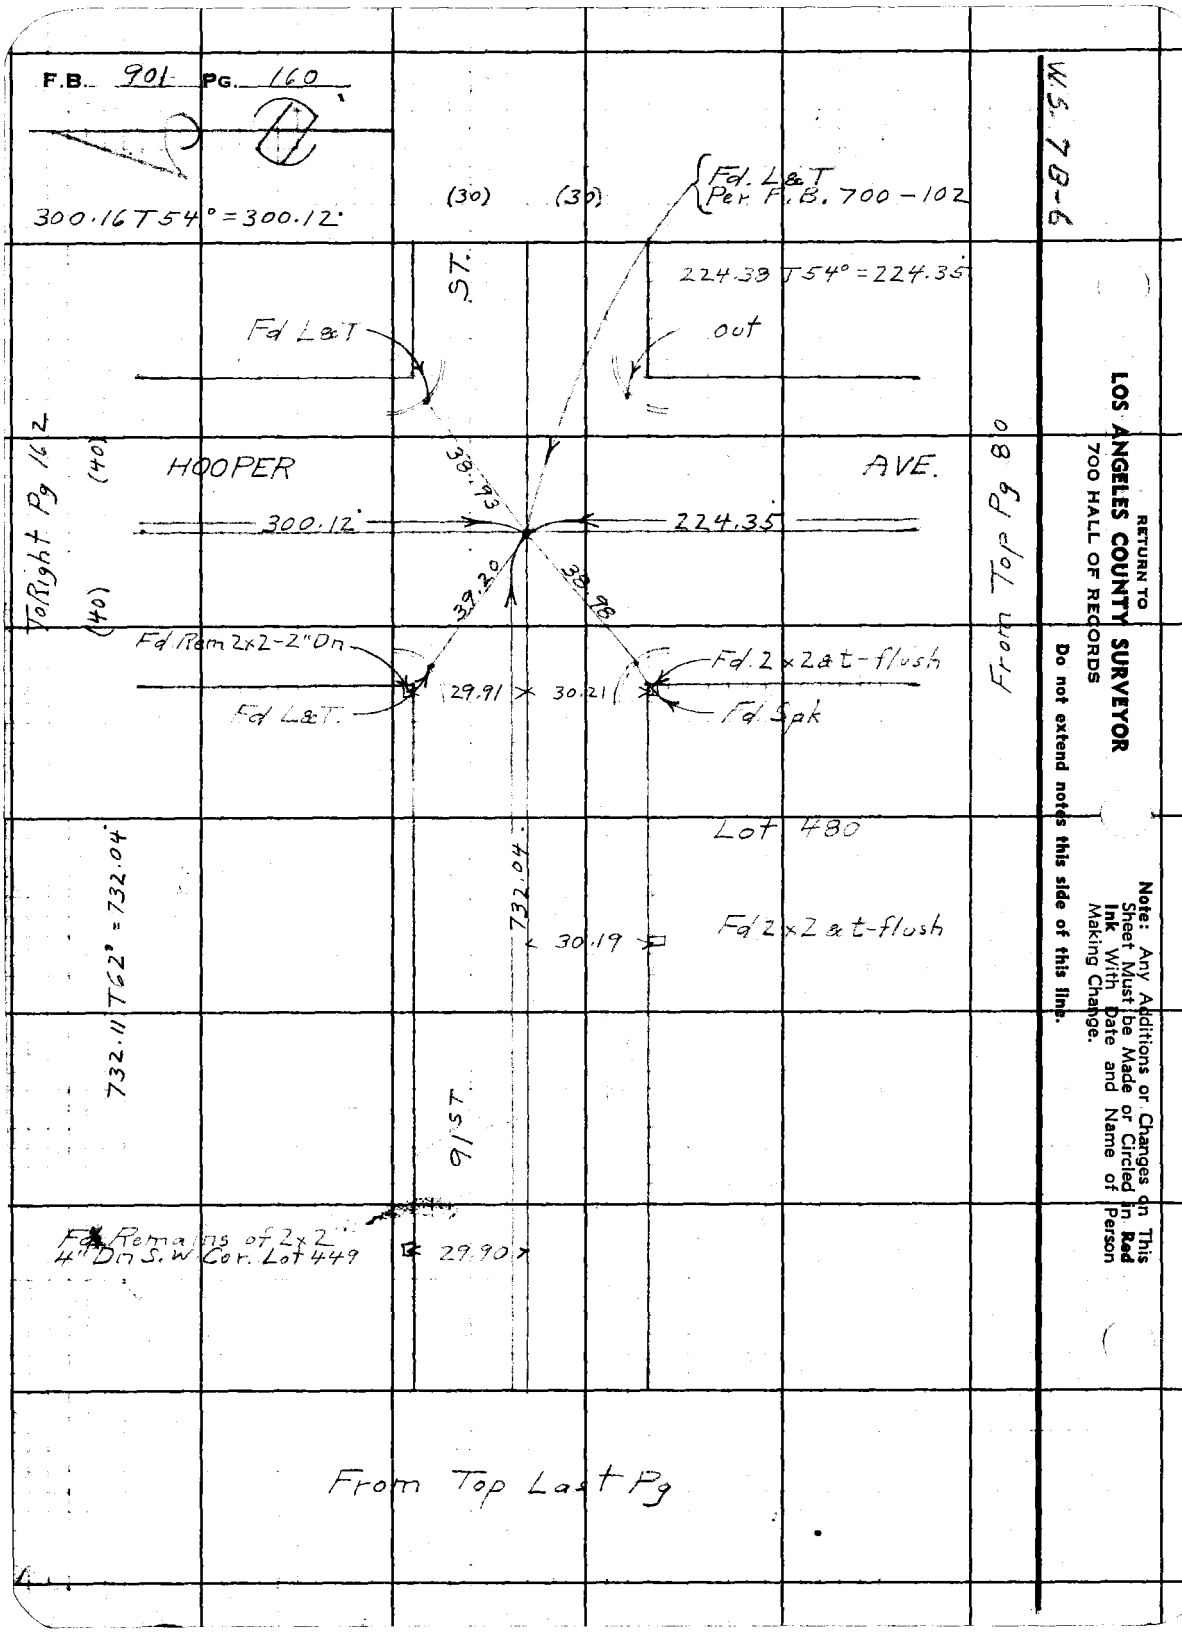
F.B. 901 PG. 160
300.16 T 54° = 300.12'
(30) (30)
Fd. L & T Per F.B. 700 - 102
224.38 T 54° = 224.35'
out
ST.
Fd L & T
HOOPER
AVE.
(40)
(40)
To Right Pg 162
From Top Pg 80
300.12'
224.35
38.93
39.30
Fd Rem 2x2-2" Dn
Fd L & T.
29.91
30.21
Fd. 2 x 2 & t-flush
Fd Spk
Lot 480
732.04'
30.19
Fd 2 x 2 & t-flush
732.11 T 62° = 732.04'
91ST
Fd Remains of 2x2 4" Dn S.W. Cor. Lot 449
29.90
From Top Last Pg
W.S. 78-6
RETURN TO
LOS ANGELES COUNTY SURVEYOR
700 HALL OF RECORDS
Do not extend notes this side of this line.
Note: Any Additions or Changes on This Sheet Must be Made or Circled in Red Ink With Date and Name of Person Making Change.

| | | | |
|---|---|---|---|
| Notes Ck'd by D. M. Finley | Survey of Central Ave | F.B. | PG. 16 |
| Map No. B-1811-2 | W. O. 8320 Tape No. 349 St'd 77° F | | |
| Office Work F. W. to | Surveyed by F.W. to | | |
| Checked D. M. Finley | Notes Mc Date 12-26-41 | | |
| Date AUG '42 | Indexed | | |

To Bot. Next Pg

(30) (30)

Fd Rem 2x2- 3"Dn

Lot 377

Fd 2x2 at flush
L.S. 1608

Lot 376

Fd 2x2 at flush
L.S. 1608
(Disturbed)

29.97 × 731.95 ST.

30.00 ×

29.71 × 30.15 ×

90TH

30.10 ×

Fd Rem. 2x2-2" Dn
P.O. set Angle Iron

Lot 433

Fd Remains 2x2-2" Dn

(20)

From Rt. Pg. 94

Note: Any Additions or Changes on This Sheet Must be Made in Red Ink or Circled With Date and Name of Person Making Change.

Do not extend notes this side of this line.

RETURN TO
LOS ANGELES COUNTY SURVEYOR
700 HALL OF RECORDS

FORM 247 5M 10-39

RETURN TO
LOS ANGELES COUNTY SURVEYOR
700 HALL OF RECORDS

**Note:** Any Additions or Changes on This Sheet Must be Made or Circled in **Red Ink** With Date and Name of Person Making Change.

**Do not extend notes this side of this line.**

W.S. 78-6

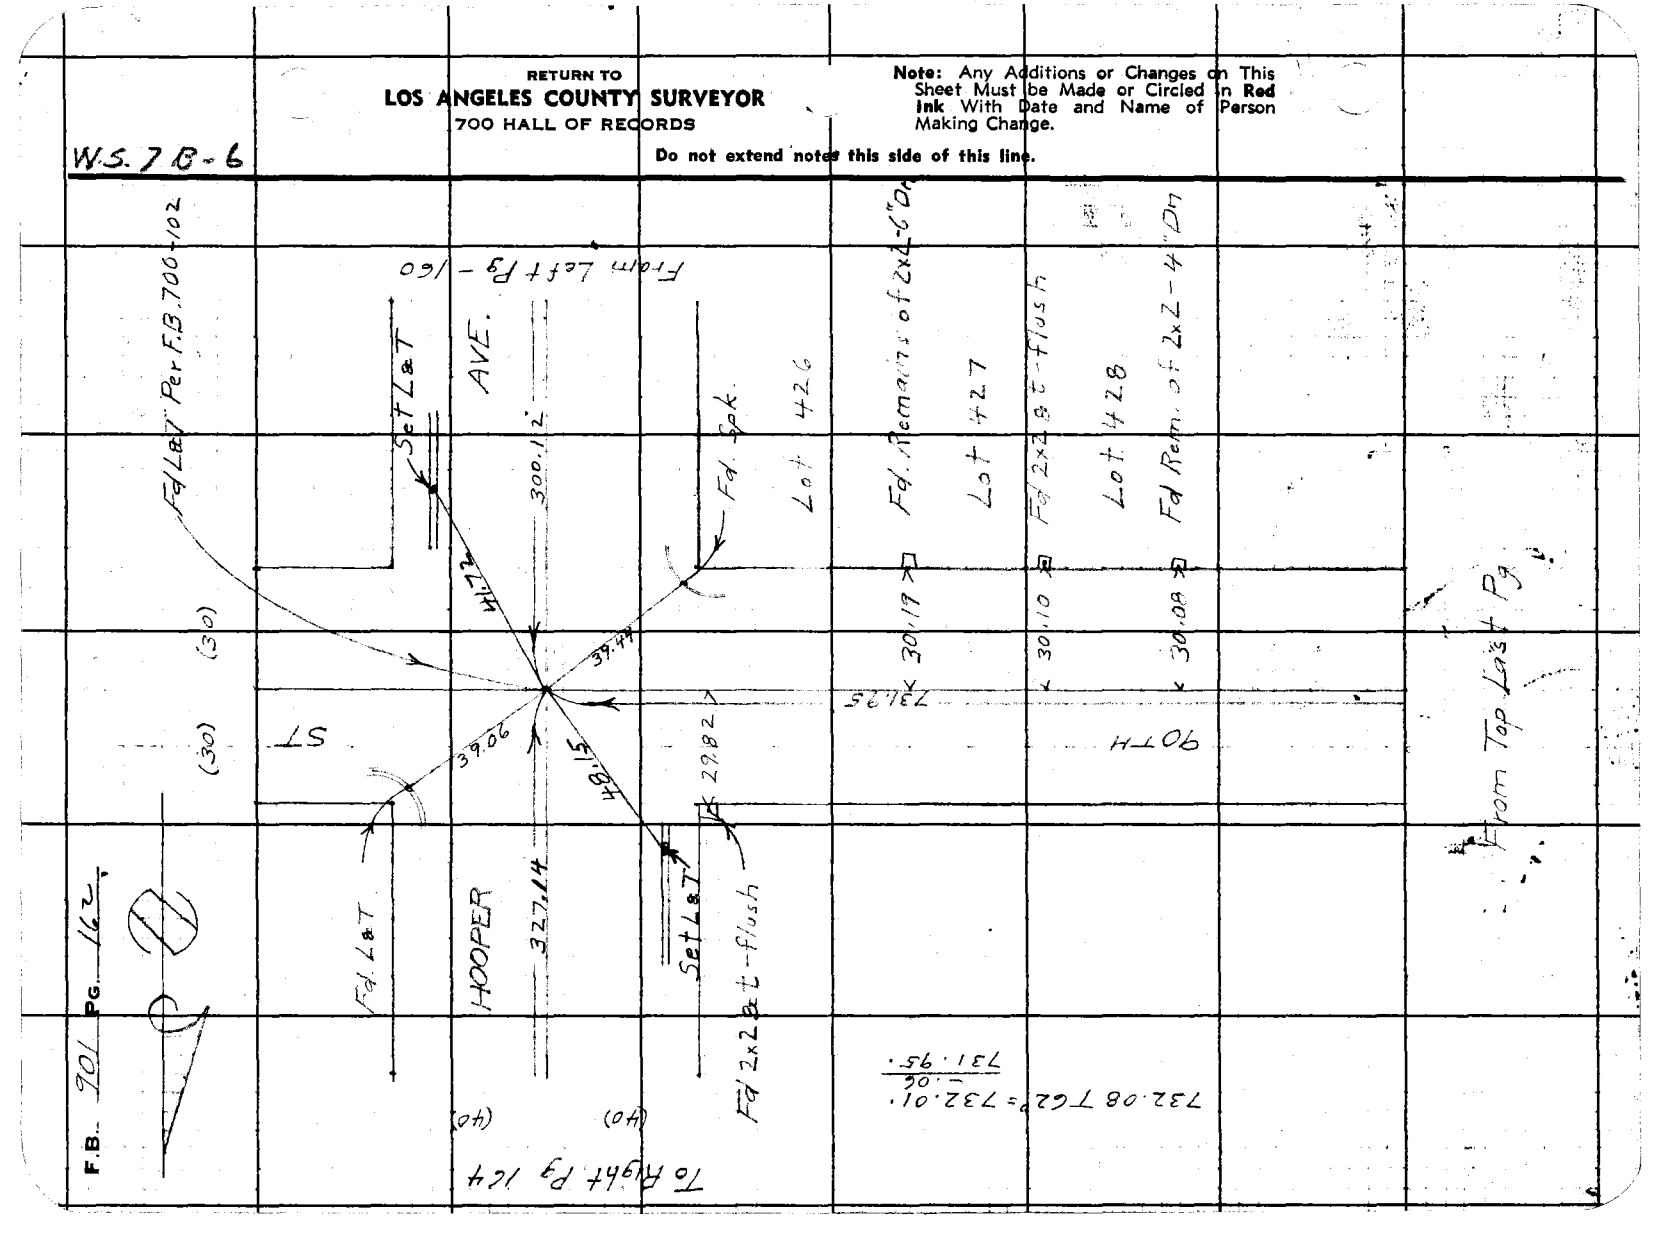

Notes Ck'd by D. M. Finley
Map No. B-1811-2
Office Work R. W. M.
Checked D. M. Finley
Date AUG '40

Survey of Central Ave
W. O. 8320 Tape No. 049 St'd 76 °F
Surveyed by F. J. McNeal
Notes Mc Date 12-24-41
Indexed A. C. Johnson

F.B. 721 Pg. 163

To Bdt West Fg.

(30) (30)

Fd 2x2 only - flush

30.13

ST.

Lot 311

Fd 2x2 at -2" Dn

30.14 30.15

Fd Rem of 2x2 - 4" Dn

Lot 310

Fd 2x2 at - 2" Dn

30.13

731.97

Lot 309

Fd 3/4" I.P. - flush (leaning)

30.13

Lot 308

Fd. 3/4" I.P. - flush

30.20

89 TH

30.00

Fd Rem of 2x2 - 4" Dn

Lot 365

Fd Rem. of 2x2-2" Dn

30.25 29.90

Fd 2x2 at - 4" Dn

(20)

From Rt. Fg. 9.5

Note: Any Additions or Changes on This Sheet Must be Made or Circled in Red Ink With Date and Name of Person Making Change.

Do not extend notes this side of this line.

RETURN TO
LOS ANGELES COUNTY SURVEYOR
700 HALL OF RECORDS

FORM 247 5M 10-39

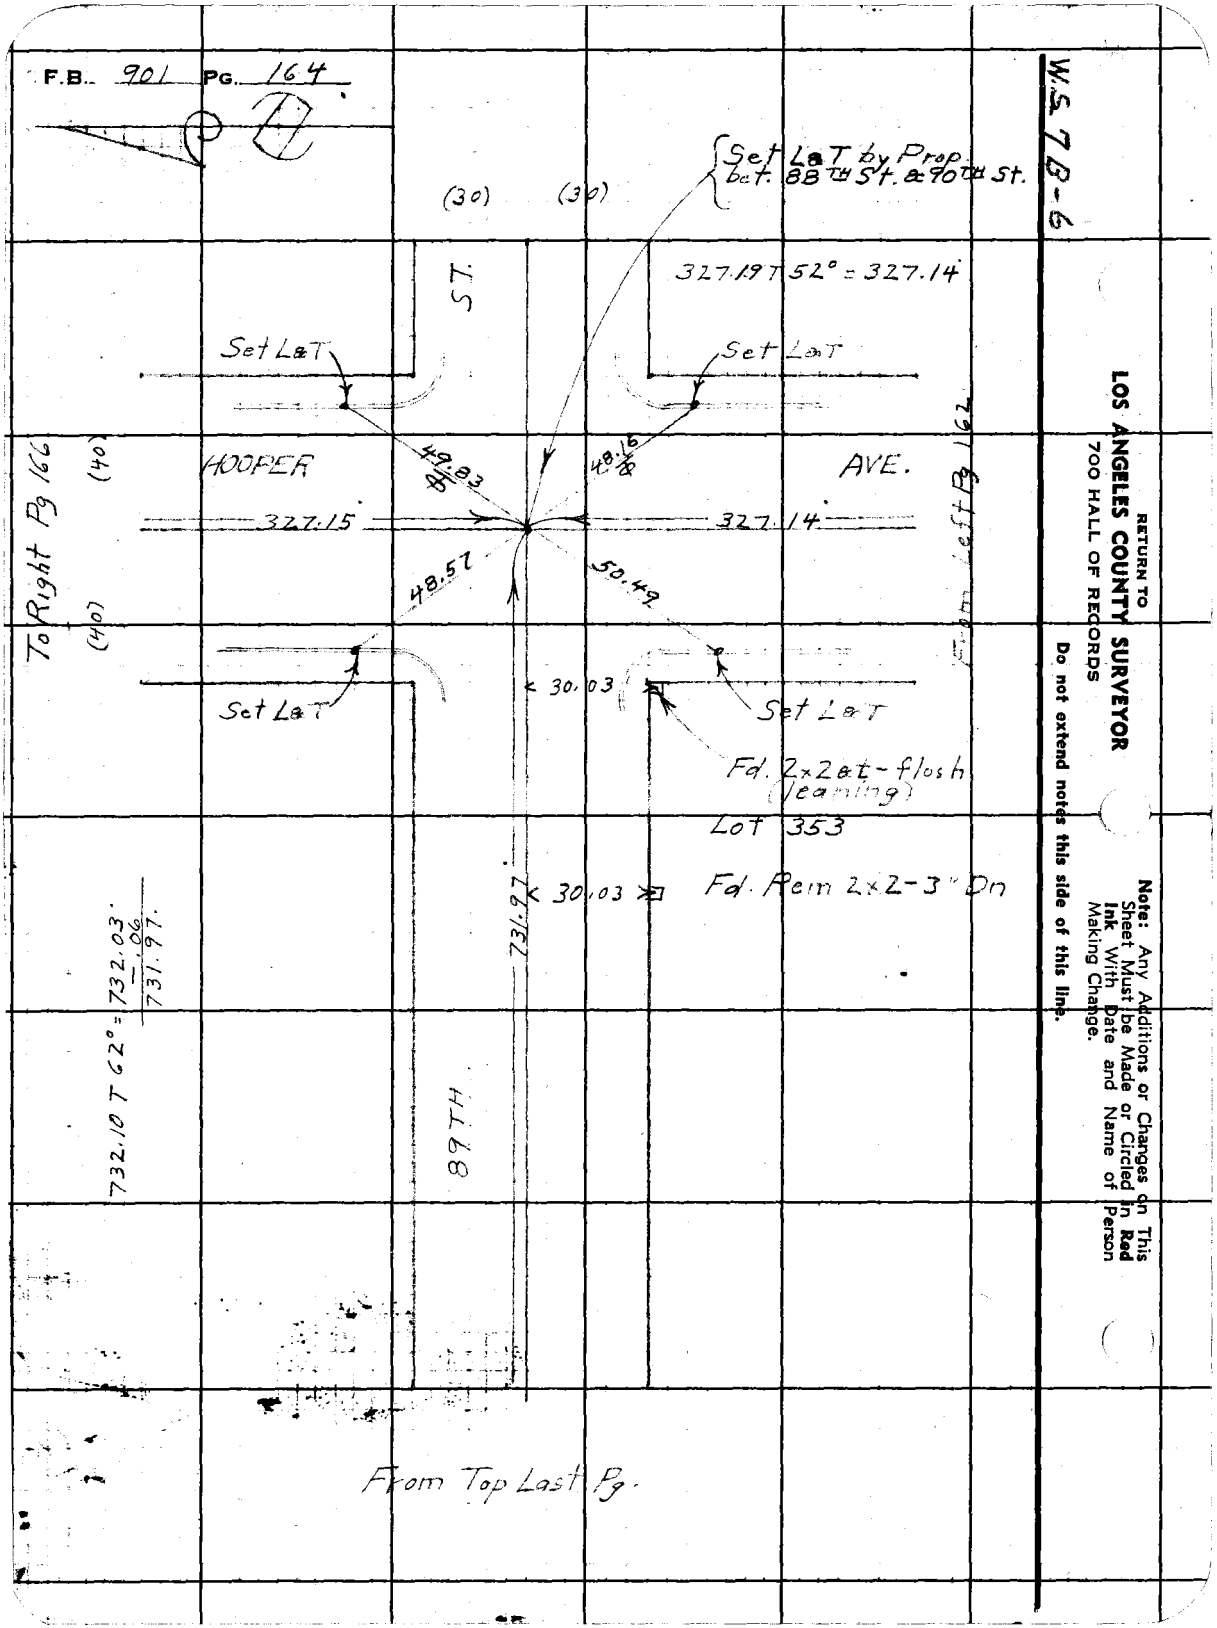
F.B. 901 PG. 164
W.S. 78-6
(30) (30)
Set L&T by Prop bet. 88TH St. & 90TH St.
ST.
327.19 T 52° = 327.14
Set L&T
Set L&T
HOOPER
AVE.
48.16
327.15
327.14
To Right Pg 166
(40)
(40)
48.57
50.49
Set L&T
30.03
Set L&T
Fd. 2x2 at - flush (leaning)
Lot 353
30.03
Fd. Rem 2x2-3" Dn
731.97
732.10 T 62° = 732.03 / .06 / 731.97
89TH
From Top Last Pg.
RETURN TO
LOS ANGELES COUNTY SURVEYOR
700 HALL OF RECORDS
Do not extend notes this side of this line.
Note: Any Additions or Changes on This Sheet Must be Made or Circled in Red Ink With Date and Name of Person Making Change.

| | | | |
|---|---|---|---|
| Notes Ck'd by D. M. Finley | Survey of Central Ave. | F.B. 901 | Pg. 165 |
| Map No. B-1811-2 | W. O. 8326 Tape No. 049 St'd 76 °F | | |
| Office Work R. W. M. | Surveyed by E.U. McNair | | |
| Checked D. M. Finley | Notes Mc Date 12-20-41 | | |
| Date AUG '40 | Indexed [illegible] | | |

To Bdy. Next Pg.

(30) (30)

Fd 2x2 at - flush

30.25

29.61

Fd Axle - flush

PL

Lot 294

29.58

Fd Axle - flush

732.02'

29.85

Fd 2x2 at - 1" Dn

Lot 297

Fd Rem. of 2x2-3" Dn

30.28

29.76

Fd Rem of 2x2-1" Dn

Lot 298

Lot 241

Fd 2x2 at - 1" On

30.35

29.85

Fd Rem. of 2x2 - 3" On

(20)

From Rt. Pg. 96

Note: Any Additions or Changes on This Sheet Must be Made or Circled in Red Ink With Date and Name of Person Making Change.

Do not extend notes this side of this line.

RETURN TO
LOS ANGELES COUNTY SURVEYOR
700 HALL OF RECORDS

FORM 247 5M 10-39

F.B. 901 PG. 166

W.S. 78-6

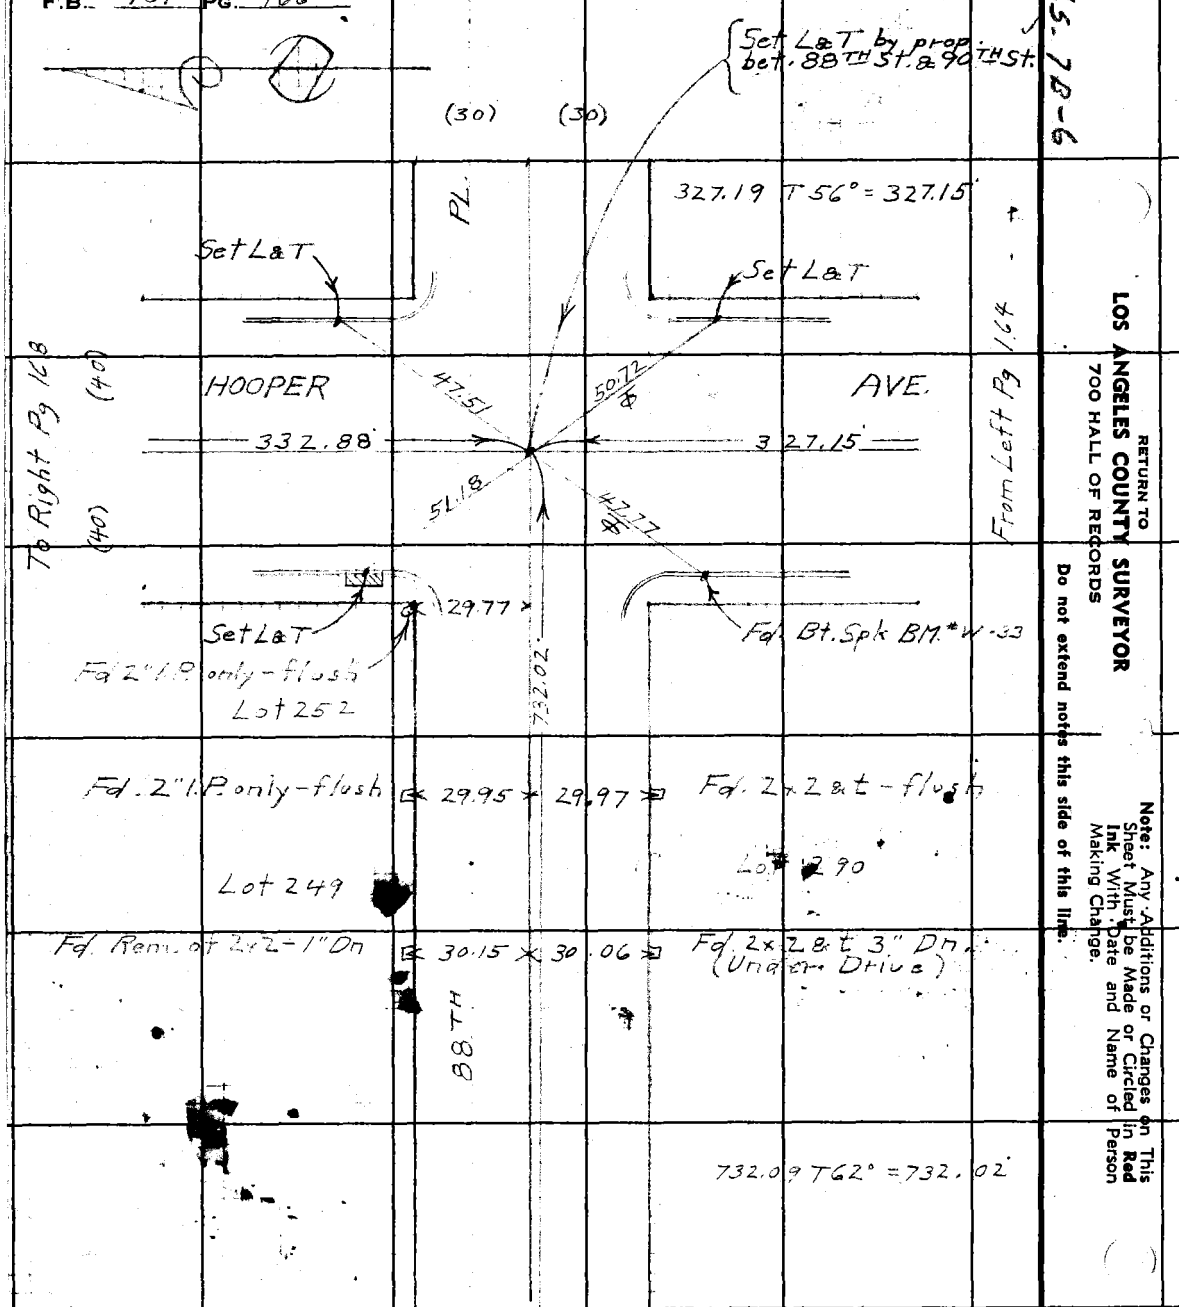


To Right Pg 168

From Left Pg 164

From Top Last Pg

RETURN TO
LOS ANGELES COUNTY SURVEYOR
700 HALL OF RECORDS

Do not extend notes this side of this line.

Note: Any Additions or Changes on This Sheet Must be Made or Circled in Red Ink With Date and Name of Person Making Change.

Notes Ck'd by D. M. Finley
Map No. B-181-2
Office Work R. W. M
Checked D. M. Finley
Date AUG '49

Survey of Central Ave
W. O. 8324 Tape No. 049 St'd 76°F
Surveyed by F. V. Fiorini
Notes MC Date 12-29-41
Indexed

F.B. 901 Pg. 161

To Bot. Next Pg.

(30) (30)

ST.

731.95'

30.15 Fd. Rem. of 2x2-2" Dn. N.E. Cor Lot 227

30.17 Fd 1½" I Pat - flush Lot 229

Fd. 2x2 at -2" Dn. 30.15 30.12 Fd 2x2 & N. - flush

88TH

Fd. 2x2 at -2" Dn Lot 173 30.15

(20)

30.13 Fd. 2x2 at -2" Dn.

From Right Pg. 97

Note: Any Additions or Changes on This Sheet Must be Made or Circled in Red Ink With Date and Name of Person Making Change.

Do not extend notes this side of this line.

RETURN TO:
LOS ANGELES COUNTY SURVEYOR
700 HALL OF RECORDS

FORM 247 5M 10-59

F.B. 901 PG. 168

W.S. 7 B-5

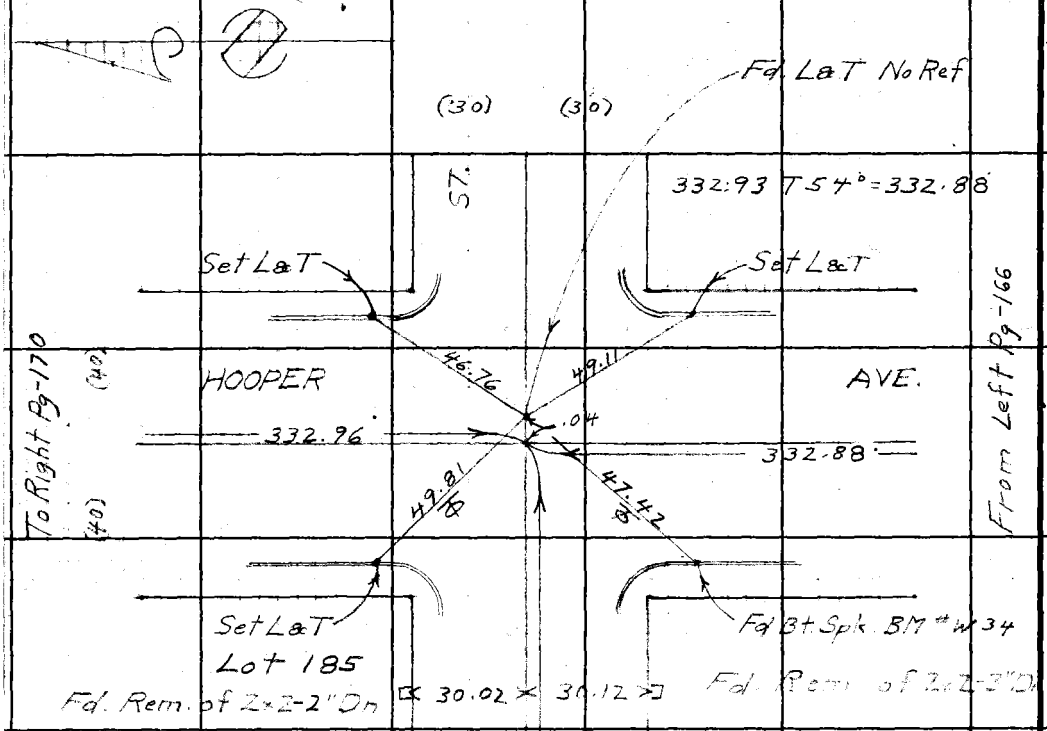


To Right Pg-170


Lot 185

Fd. Rem. of 2×2-2"Dn

30.02 × 30.12

Fd. Rem. of 2×2-3"Dn

Lot 182

Fd. Rem. of 2×2-1"Dn

30.06 × 30.23

Fd. 2×2 at-flush

Lot 181

Fd. 2×2 at-flush

30.20

731.95'

732.07 T 60° = 731.99'
−.04
731.95'

Lot 180

Fd. 2×2 only-3"Dn

30.16 × 30.21

Fd. Rem. of 2×2-6"Dn

8874

From Top Last Pg.

RETURN TO
LOS ANGELES COUNTY SURVEYOR
700 HALL OF RECORDS

Do not extend notes this side of this line.

Note: Any Additions or Changes on This Sheet Must be Made or Circled in Red Ink With Date and Name of Person Making Change.

| | | | |
|---|---|---|---|
| Notes Ck'd by D. M. Finley | Survey of Central Ave. | F.B. 921 | Pg. 169 |
| Map No. B-1811-2 | W. O. 8324 Tape No. 049 St'd 76 °F | | |
| Office Work R. W. M. | Surveyed by F. J. McNeil | | |
| Checked D. M. Finley | Notes Mc Date 1-2-42 | | |
| Date AUG '49 | Indexed A. C. Johnson | | |

76 Bot Next Pg.

(30) (30)

Fd Rem of 2x2 - 3" Dn S.E.Cor lot 111 < 30.15 > PL.

731.96

Fd 2x2&t - 2" Dn. S.E.Cor lot 108 < 30.20 >

< 30.05 > Fd Rem. of 2x2 - 5" Dn

Lot 163

Fd. 2x2&t - 5" Dn < 30.13 > 30.00 > Fd Rem. of 2x2 - 8" Dn

87TH

Lot 107

Fd 2x2&t - flush < 30.10 > 29.96 > Fd 2x2 only - Flush

Lot 164

20

From Right Pg 98

Note: Any Additions or Changes on This Sheet Must be Made or Circled in Red Ink With Date and Name of Person Making Change.

Do not extend notes this side of this line.

RETURN TO
LOS ANGELES COUNTY SURVEYOR
700 HALL OF RECORDS

FORM 247 5M 10-39

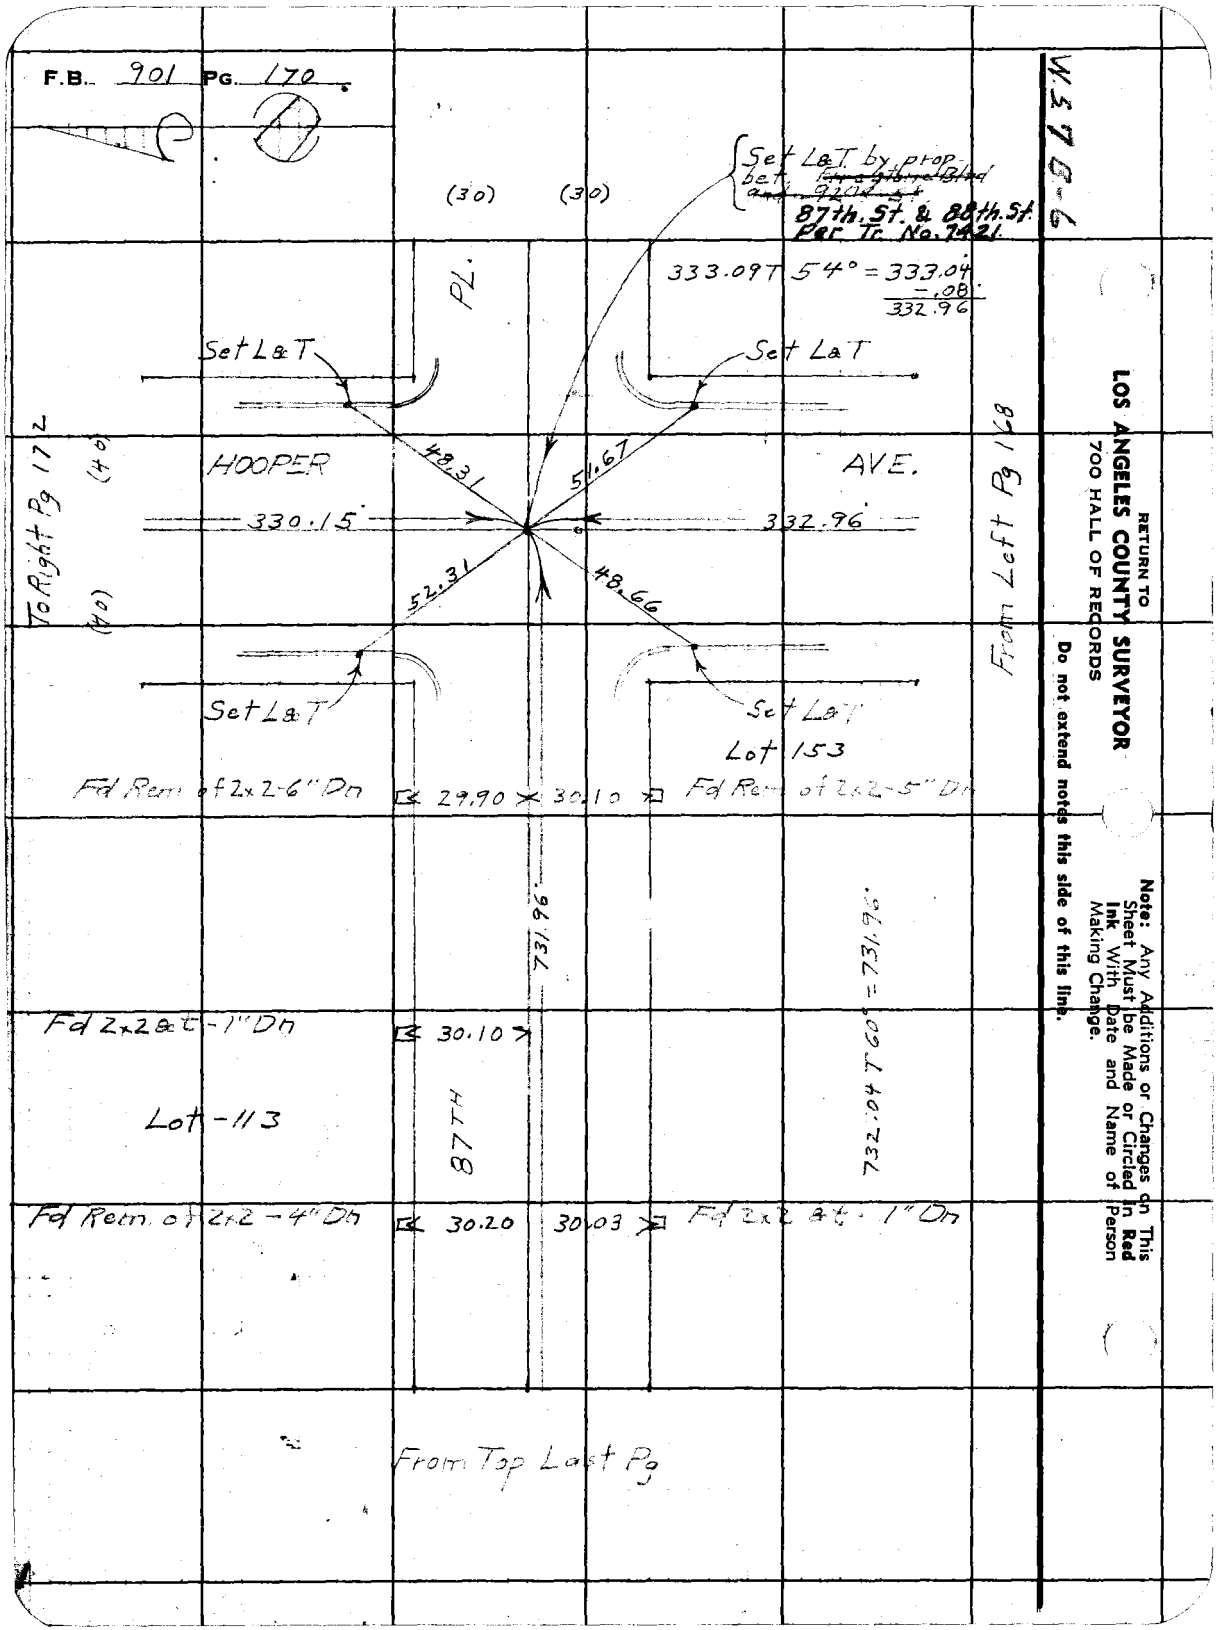
F.B. 901 PG. 170
W 37 0-6
(30)
(30)
Set L&T by prop. bet. Foothill Blvd and 92nd St.
87th St. & 88th St. PSC Tr. No. 7421
333.09 T 54° = 333.04
-.08
332.96
PL.
Set L&T
Set L&T
HOOPER
AVE.
(40)
(40)
To Right Pg 172
From Left Pg 168
48.31
51.67
52.31
48.66
330.15
332.96
Set L&T
Set L&T
Lot 153
Fd Rem of 2x2-6" Dn
29.90
30.10
Fd Rem of 2x2-5" Dn
731.96
732.04 T 60° = 731.96
Fd 2x2 at -1" Dn
Lot-113
30.10
87TH
Fd Rem of 2x2-4" Dn
30.20
30.03
Fd 2x2 at -1" On
From Top Last Pg
RETURN TO
LOS ANGELES COUNTY SURVEYOR
700 HALL OF RECORDS
Do not extend notes this side of this line.
Note: Any Additions or Changes on This Sheet Must be Made or Circled in Red Ink With Date and Name of Person Making Change.

Notes Ck'd by D. M. Finley
Map No. B-1811-2
Office Work R. W. M.
Checked D. M. Finley
Date AUG '42

Survey of Central Ave
W. O. 8324 Tape No. 049 St'd 76°F
Surveyed by F. J. McNeil
Notes MC Date 1-2-42
Indexed C. Johnson

F.B. 901 PG. 171

To Bot. Next Pg.

(30) (30)

ST.

731.93'

< 30.01 > Fd 2x2 only - 2" Dp
N.E. Cor Lot 94

Fd. 2x2 at flush < 29.97 >

Lot 40

Fd. 2x2 at - 3" up
L.S. 1855

< 29.96 > < 29.60 > Fd 3/4" I.P. only - flush

87TH

Lot 98

< 29.80 > Fd. 3/4" I.P. only - flush

Lot 99

(20)

From Right Pg. 99

Note: Any Additions or Changes on This Sheet Must be Made in Red Ink or Circled With Date and Name of Person Making Change

Do not extend notes this side of this line.

RETURN TO
LOS ANGELES COUNTY SURVEYOR
700 HALL OF RECORDS

FORM 247 5M 10-39

RETURN TO
LOS ANGELES COUNTY SURVEYOR
700 HALL OF RECORDS

Note: Any Additions or Changes on This Sheet Must be Made or Circled in Red Ink With Date and Name of Person Making Change.

Do not extend notes this side of this line.

W.S. 7B-6

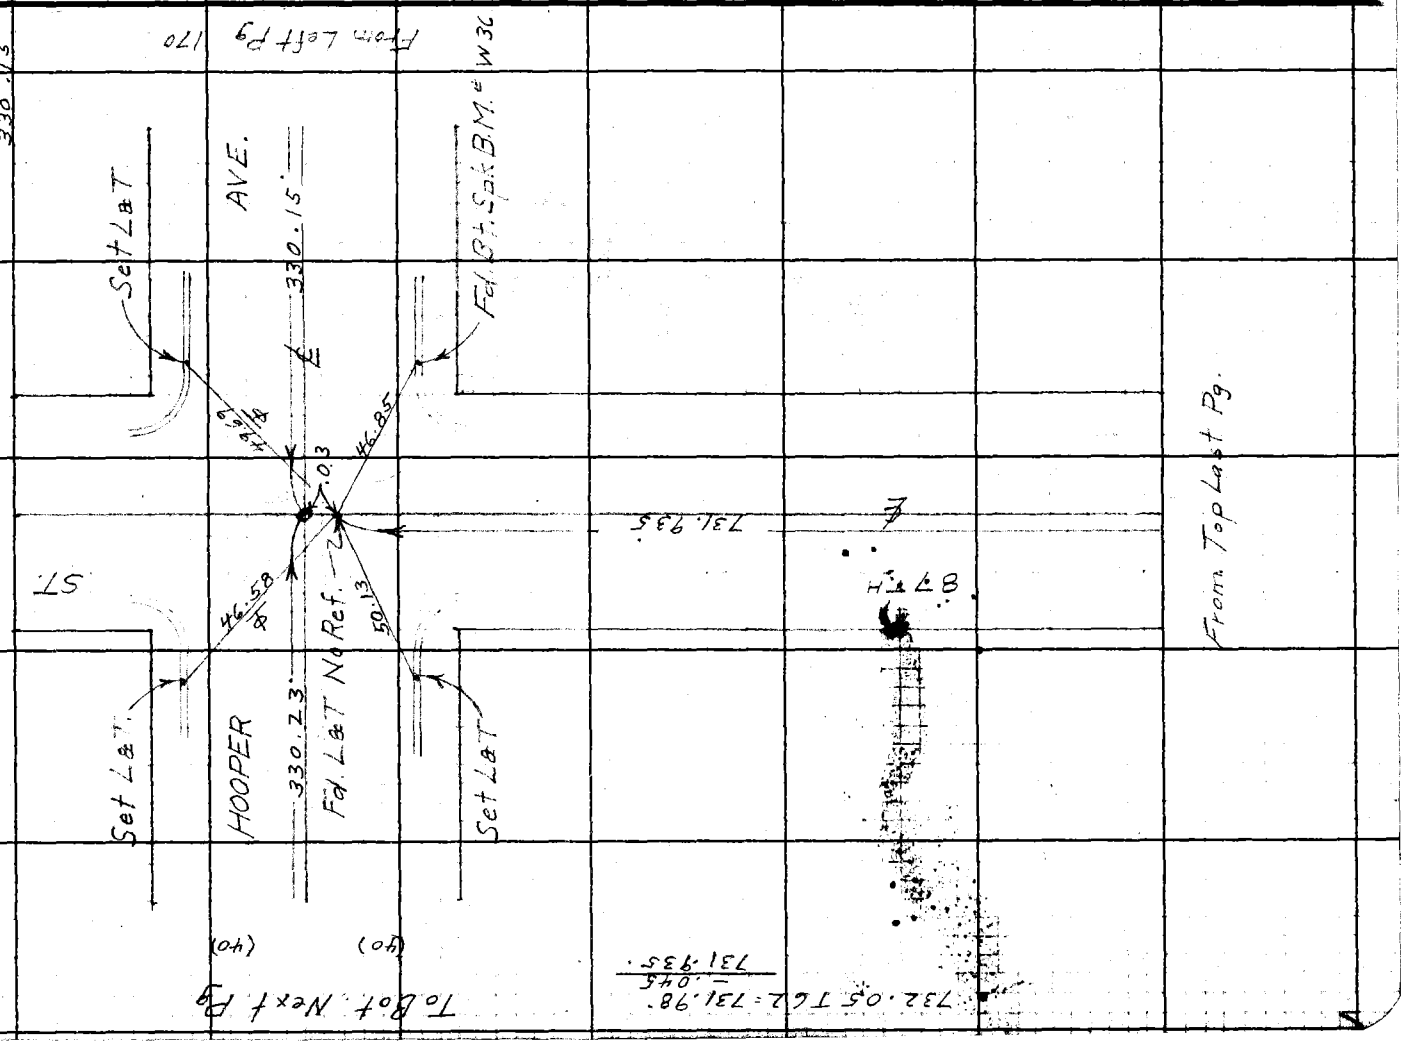

FORM 247 5M 10-39

RETURN TO
**LOS ANGELES COUNTY SURVEYOR**
700 HALL OF RECORDS

**Note:** Any Additions or Changes on This Sheet Must be Made or Circled in **Red Ink** With Date and Name of Person Making Change.

**Do not extend notes this side of this line.**

W.S. 7 B-6

From Right Pg 100

89-56-30
359-45-45
179-38-15

FIRESTONE

731.97

Fd. S.W. & T
Per F.A. 13-301

732.03 T64°=731.97'

(40)

Fd. L&T

57.95-68

Fd. L&T

51.925

58.60

14.19

48.89

330.23

HOOPER

10.35

AVE

(40)

52.22

58.15

65.79

S78 L5

Fd. L&T

Fd. L&T

Angle Point
Fd. S.W. & T
Per F.A. 13-301

From Left Pg.

BLVD.

(50)

(50)

Notes Ck'd by D. M. Finley
Map No. B-1811-2
Office Work R. W. M.
Checked AUG '39 D. M. Finley
Date

Survey of Central Ave
W. O. 832 Tape No. 049 St. 76°F
Surveyed by F. J. Mc Date 1-23-42
Notes
Indexed

F.B. 701 Pg. 172

RETURN TO
**LOS ANGELES COUNTY SURVEYOR**
700 HALL OF RECORDS

**Note:** Any Additions or Changes on This Sheet Must be Made or Circled in **Red** Ink With Date and Name of Person Making Change.

**Do not extend notes this side of this line.**

W 5.7-B-5

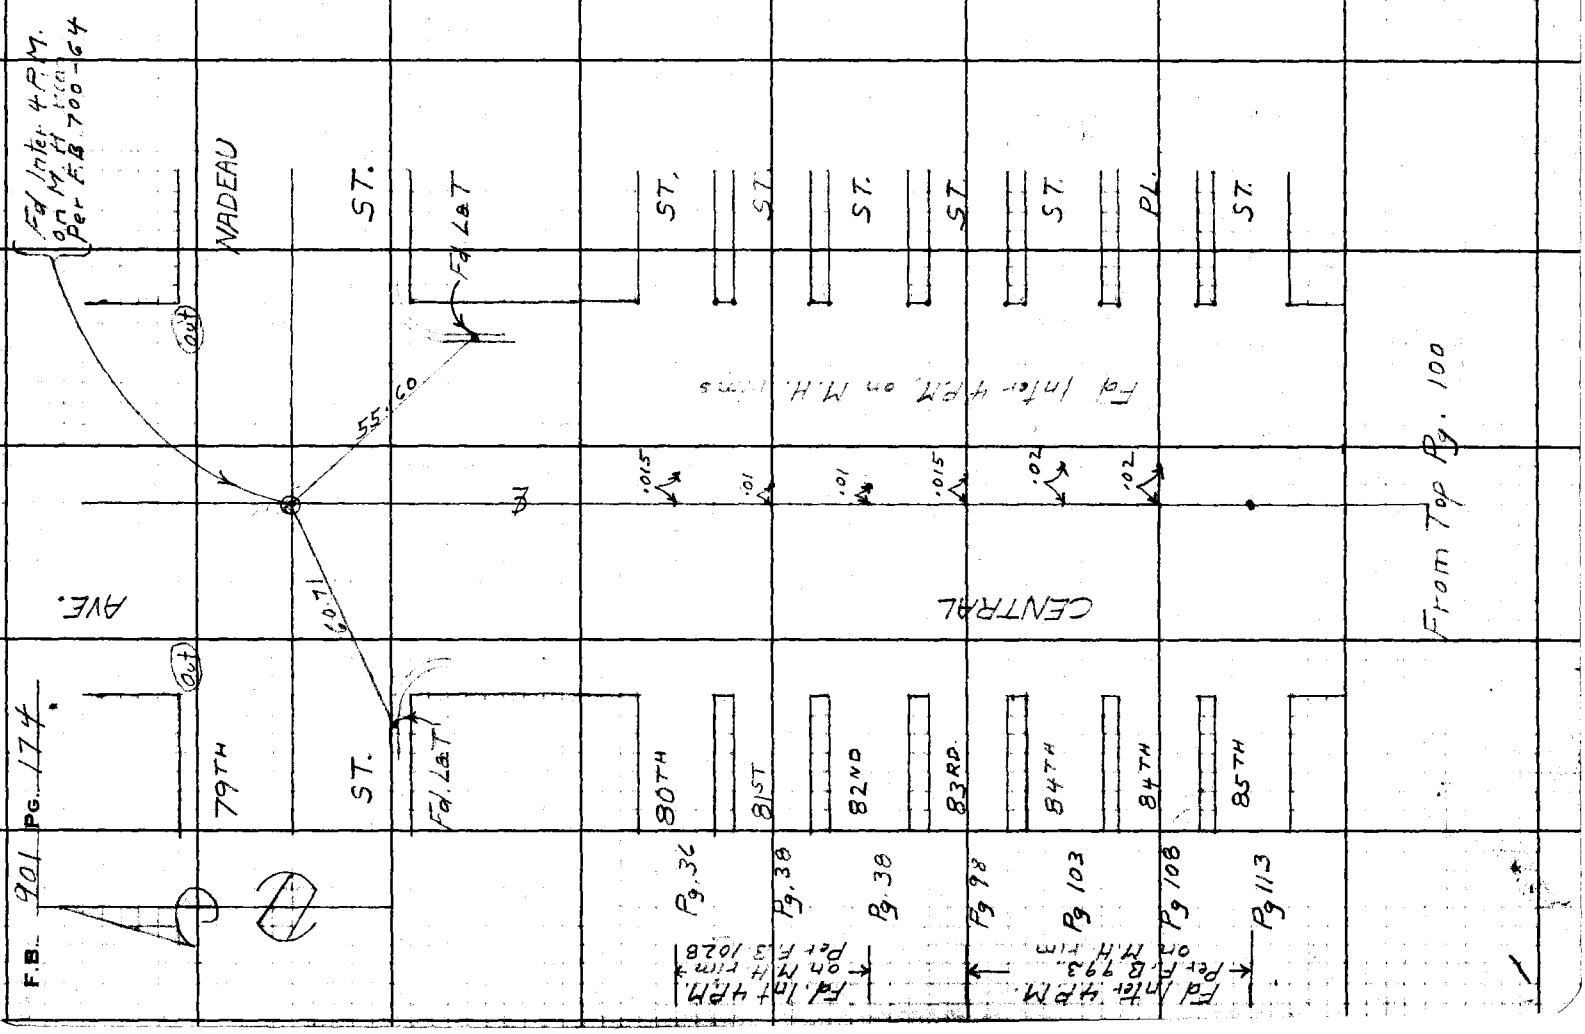

FORM 247 SM 10-59

RETURN TO
**LOS ANGELES COUNTY SURVEYOR**
700 HALL OF RECORDS

**Note:** Any Additions or Changes on This Sheet Must be Made or Circled in **Red** Ink With Date and Name of Person Making Change

**Do not extend notes this side of this line.**

Notes Ck'd by
Map No.
Office Work
Checked
Date

Survey of
W. O. Tape No. 2118 Sht. 4 F
Surveyed by INALLARE
Notes ACW Date 11-2-50
Indexed C. Johnson 11-3-50

F.B. 23 Pg. 175

170.35@92°=170.38'
168.10@92°=168.13'

323.62'@90°=323.67'

CENTRAL AVE.

170.38'

168.13

323.67'

Fd. Nail & Tag

Fd. 1" I.P. Tag

Fd. Small Nail

Fd. 4" L.T. Tag

2.56'

20.00'

20.00'

Fd. 2" I.P.

Fd. 2" I.P. Tag

Fd. 2" I.P. Nail

Fd. 2" I.P. 6" Stamp

3.89'

99.66@88°=99.67'

TR. 16766

585.17@88°=585.27'

TR. 16766

132.10@90°=132.12'

Fd. 2" I.P.

132.12'

Fd. 2" I.P.

Fd. 2" I.P. 3" Stamp

99.67'

PALMER AVE.

BRAZIL ST.

585.27'

EAST LINE TR.

Fd. 2" I.P.

RETURN TO
**LOS ANGELES COUNTY SURVEYOR**
700 HALL OF RECORDS

**Note:** Any Additions or Changes on This Sheet Must be Made or Circled in **Red Ink** With Date and Name of Person Making Change.

**Do not extend notes this side of this line.**

F.B. 901 PG. 176

W.S. 26-C-3

Notes Ck'd by KRM&PL
Map No. B-1811-1
Office Work R. W. M
Checked D. M. Finley
Date AUG '48

Survey of CENTRAL AVE
W. O. 8326 Tape No. 083 St'd 68 °F
Surveyed by HELLSTROM
Notes A.N.H. Date 1-7-47
Indexed ALBERT E. TIMMONS 1-16-47

F.B. 901 Pg. 177

Cont. on Pg. 178

TRACT #12933

E. 148TH ST.

INTERS
Fd. Nail Midway
Between (2) L&T
No Ref.

PROPOSED NEW ℄
FOR
CENTRAL AVE
AT
INTERS
ROSECRANS AVE

AVE

E. 149TH ST.

INTERS.
Fd. Nail at Int.
of (4) L&T. Tang. Ties
Pr. TRACT #12933

CENTRAL

E. 150TH ST.

INTERS
Fd. Spk. W.&T.
No Ref.

E. COMPTON BLVD.

INTER
Fd. Chiseled Int
of (4) L&T
Tang. Ties
See F.B. 901-17

Note: Any Additions or Changes on This Sheet Must be Made or Circled in Red Ink With Date and Name of Person Making Change.

Do not extend notes this side of this line.

RETURN TO
LOS ANGELES COUNTY SURVEYOR
700 HALL OF RECORDS

FORM 247 5M 1-41

F.B. 901 Pg. 178

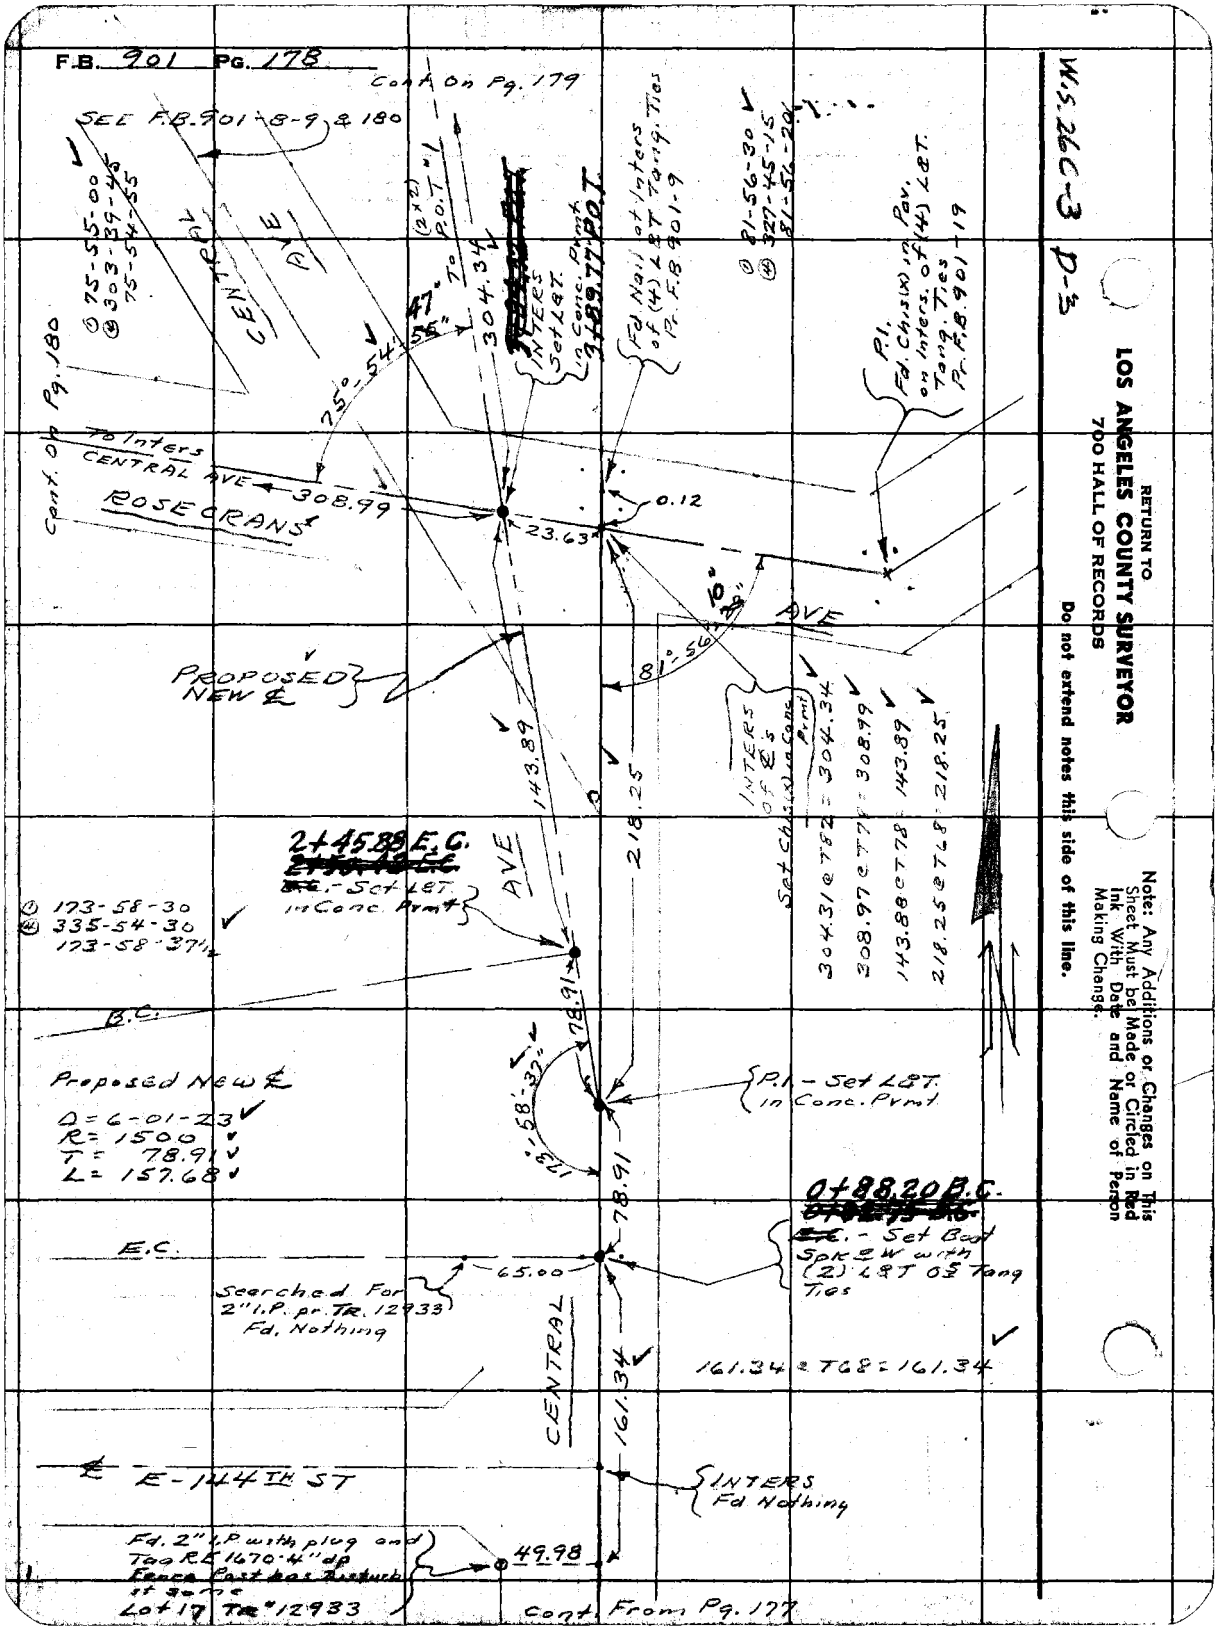


W.S. 26C-3 D-3

RETURN TO
LOS ANGELES COUNTY SURVEYOR
700 HALL OF RECORDS

Do not extend notes this side of this line.

Note: Any Additions or Changes on This Sheet Must be Made or Circled in Red Ink With Date and Name of Person Making Change.

Notes Ck'd by K.R.McP.
Map No. B-1811-1
Office Work R. W. M.
Checked D. M. Finley
Date AUG '48

Survey of CENTRAL AVE
W. O. 8326 Tape No. 683 St'd. 66 °F
Surveyed by HELLSTROM
Notes A.K.H Date 1-8-47
Indexed ALBERT E. TIMMONS

F.B. 701 PG. 179

W.S. 16-C3

Note: Any Additions or Changes on This Sheet Must be Made or Circled in Red Ink With Date and Name of Person Making Change.

Do not extend notes this side of this line.

RETURN TO
LOS ANGELES COUNTY SURVEYOR
700 HALL OF RECORDS

FORM 247 5M 1-48

Cont. on Pg. 180

E.E. See Pg. 180

523.53 e T62 = 523.51

168-52-30
315-28-45
168-52-11¼

Proposed R/W Line based on Preliminary Plat No. 14435

P.O.S.T. Set 1x2 - Flush 10'± E. of Edg. of Pvmt.

Set ± of Ang. 27.27

Set LET. 12 in from edg. pv.

P.O.S.T. - Set 2" I.P. with Plug & Tck N.B.T. - 12" up. with 1x2 on Surf.

Set 1x2 with B/W marker

Set 1x2 with B/W marker

Set 1x2 - Flush

Frame House Pr. F.B. 901-103

7+26.5 pg. 103

24.5' x 24.5' Frame House Pr. F.B. 901-103

6+08.5 pg. 103

FOR TOPOG SEE F.B. 901-102-103

627.41 e T78 = 627.45

117.70 e T78 = 117.71

6+94.11 P.O.T.
6+88.66
P.O.T. - 1
Set 2X2 - Flush

To Inter Rosecrans Ave

Cont. From Pg. 178

F.B. 901 Pg. 180

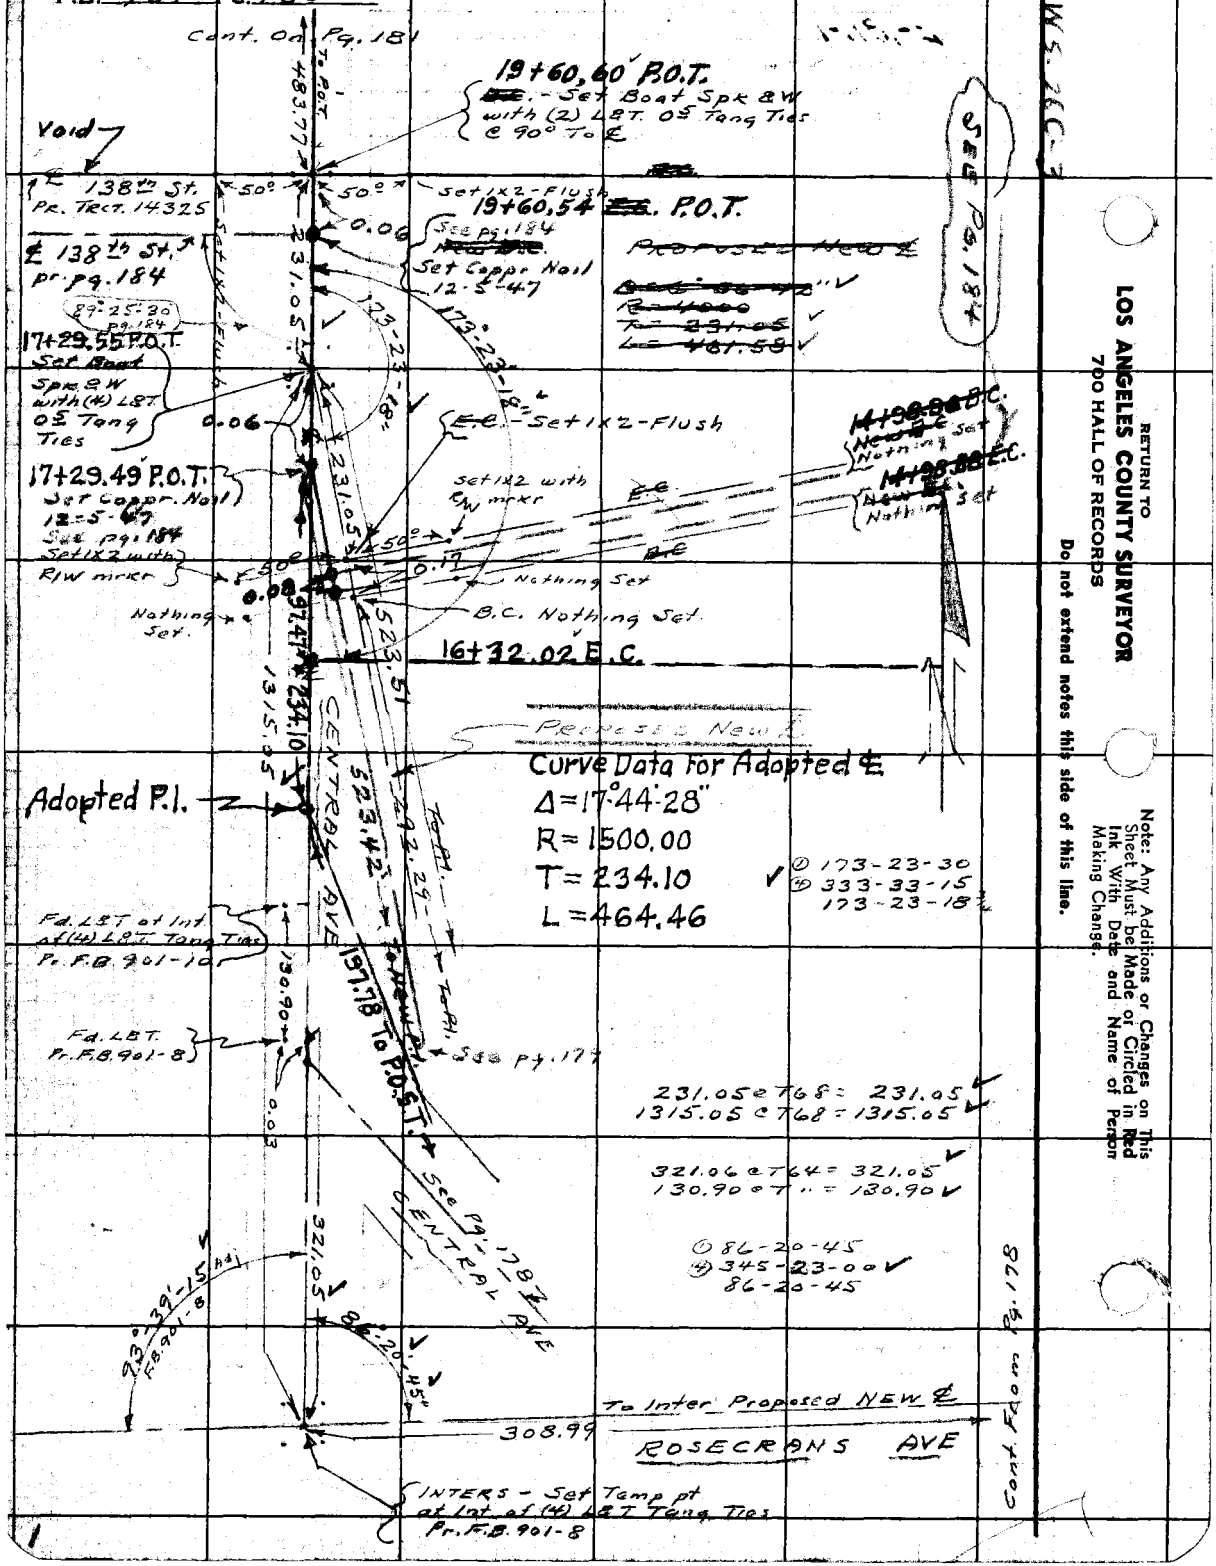


RETURN TO
LOS ANGELES COUNTY SURVEYOR
700 HALL OF RECORDS

Do not extend notes this side of this line.

Note: Any Additions or Changes on This Sheet Must be Made or Circled in Red Ink With Date and Name of Person Making Change.

W.S.26C-3

Notes Ck'd by K.R.McP.
Map No. B-1811-1
Office Work L. W. M.
Checked D. M. Finley
Date AUG '49

Survey of CENTRAL AVE
W. O. 8326 Tape No. 983 St'd 68 °F
Surveyed by HELLSTROM
Notes A.N.M. Date 1-9-47
Indexed ALBERT B. TIMMONS

F.B. 901 PG. 181

Note: Any Additions or Changes on This Sheet Must Be Made or Circled in Red Ink With Date and Name of Person Making Change.

Do not extend notes this side of this line.

RETURN TO
LOS ANGELES COUNTY SURVEYOR
700 HALL OF RECORDS

(Ma+88.82)
ANGLE POINT
Fd Spk at Inter
of (4) L&T Tang Ties
Pr F.B. 901-10

20'
Δ 14°-05'-10"
R 81.69'
L 19.93'

150'±

E. 132ND ST.

AVE.

1644.45
F.B. 901-10

CENTRAL

Set N&T in
P.P. 589.04 44E

(244.44.37)
P.O.T.
Set Temp. Pt.
at Inters of
(4) L&T Tang.
Ties
Pr F.B. 901-10 & 87
This Point is on
Line Between
Ang. Pt and
Int. of Rosecrans Ave.

35.40

Line of Power Poles
>4'

16°

16' Oil & Rock Road
To CENTRAL AIRPORT

483.77
T.B.C.

483.74 + T 76 = 483.77

cont. From Pg. 180

FORM 247 5M 11-41

RETURN TO
**LOS ANGELES COUNTY SURVEYOR**
700 HALL OF RECORDS

Note: Any Additions or Changes on This Sheet Must be Made or Circled in Red Ink With Date and Name of Person Making Change.

**Do not extend notes this side of this line.**

F.B. 701 PG. 182

Notes Ck'd by D. M. Finley
Map No. B-1811-1
R. W. M.
Office Work
Checked D. M. Finley
Date AUG '40

Survey of CENTRAL AVE
W. O. 8236 Tape No. 283 St'd. 68 °F
Surveyed by Hellstrom
Notes A.N.H. Date 12-3-40
Indexed A. C. Johnson 12-16-40

F. B. 161 Pg. 183

# CENTRAL AVE

## J.N. 8236

SURVEY OF

138TH ST

FROM

CENTRAL AVE TO WADSWORTH AVE

Note: Any Additions or Changes on This Sheet Must be Made or Circled in Red Ink With Date and Name of Person Making Change.

Do not extend notes this side of this line.

RETURN TO
LOS ANGELES COUNTY SURVEYOR
700 HALL OF RECORDS

FORM 247 SM 11-40

RETURN TO
LOS ANGELES COUNTY SURVEYOR
700 HALL OF RECORDS

Note: Any Additions or Changes on This Sheet Must be Made or Circled in Red Ink With Date and Name of Person Making Change.

Do not extend notes this side of this line.
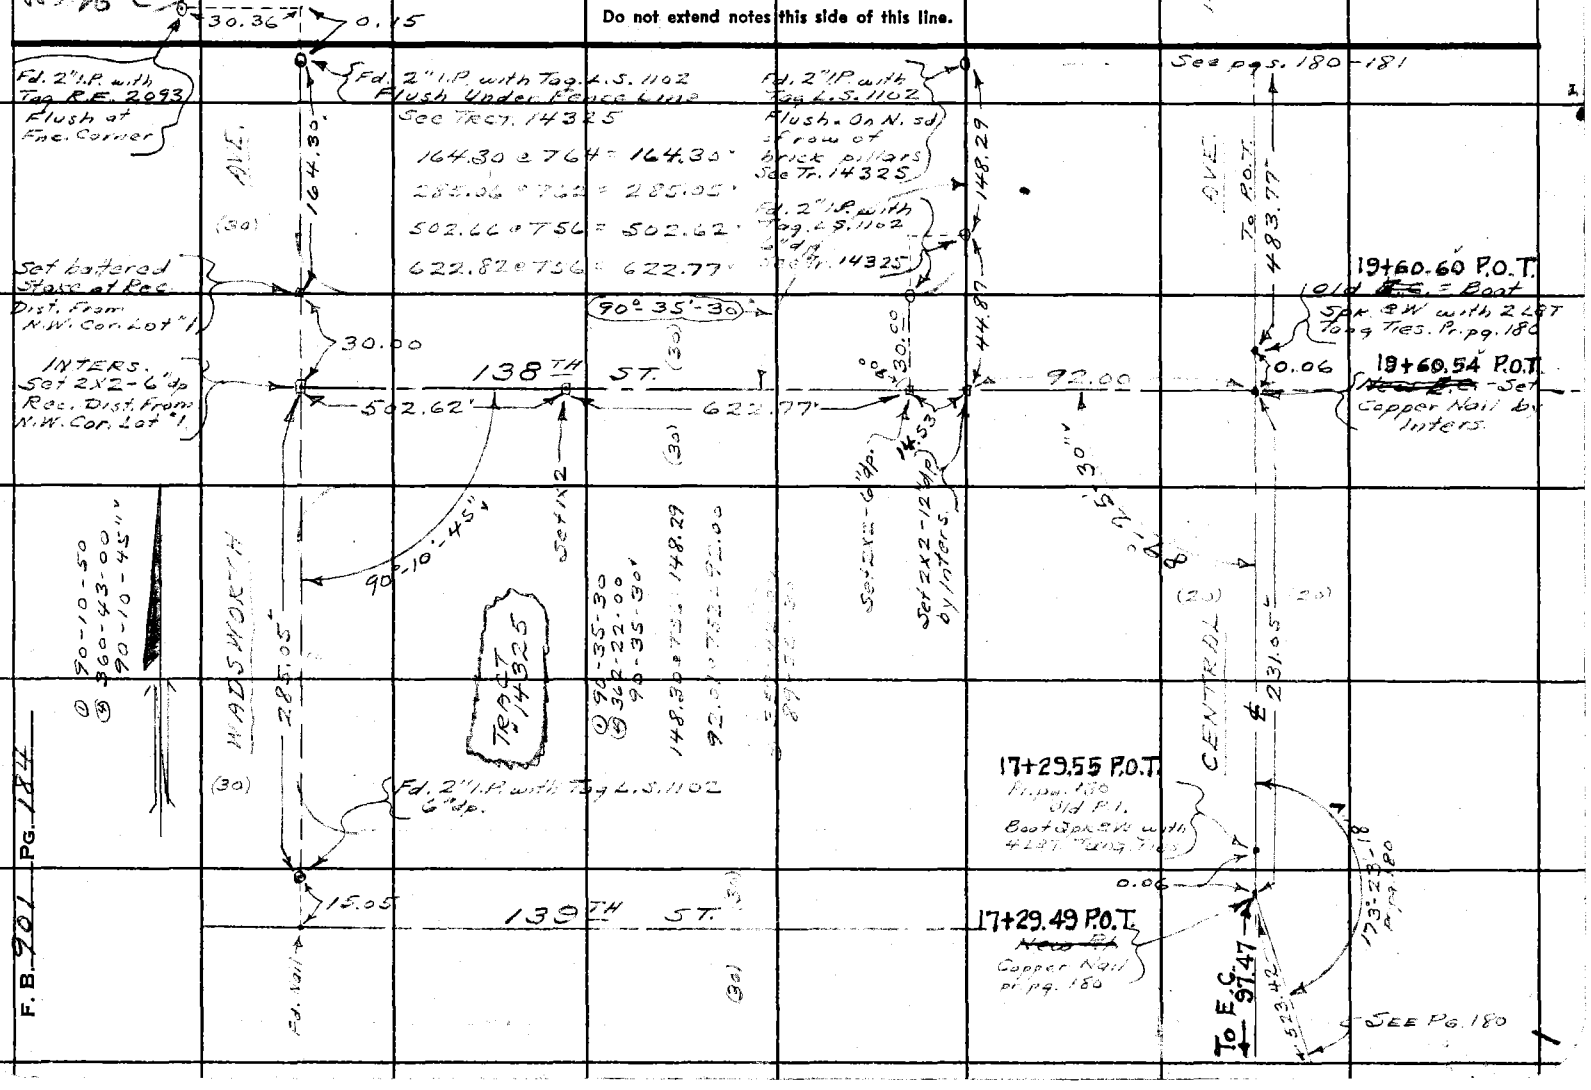
W 576-C-3