Notes Ck'd by
Map No. M-1842.
Office Work C.W.Cox
Checked D.M. Finley.
Date

Survey of Compton Blvd
W. O. 834 Tape No. Sht'd
Surveyed by L.S. Hammond
Notes L.S.H. Date
Indexed 1-5-42

P.B. 9 p. 6

COMPTON BLVD.

J.N. 8345

L.S. HAMMOND
F.H. BLANCHARD
H.R. FORNEY
R. LINGENFELDER

Note: Any Additions or Changes on This Sheet Must be Made or Circled in Red Ink With Date and Name of Person Making Change

RETURN TO
LOS ANGELES COUNTY SURVEYOR
706 HALL OF RECORDS

Do not extend notes this side of this line.

FORM 247 SM 11-41

RETURN TO
LOS ANGELES COUNTY SURVEYOR
7200 HALL OF RECORDS

Note: Any Additions or Changes on This Sheet Must be Made or Circled in Red Ink With Date and Name of Person Making Change.

Do not extend notes this side of this line.

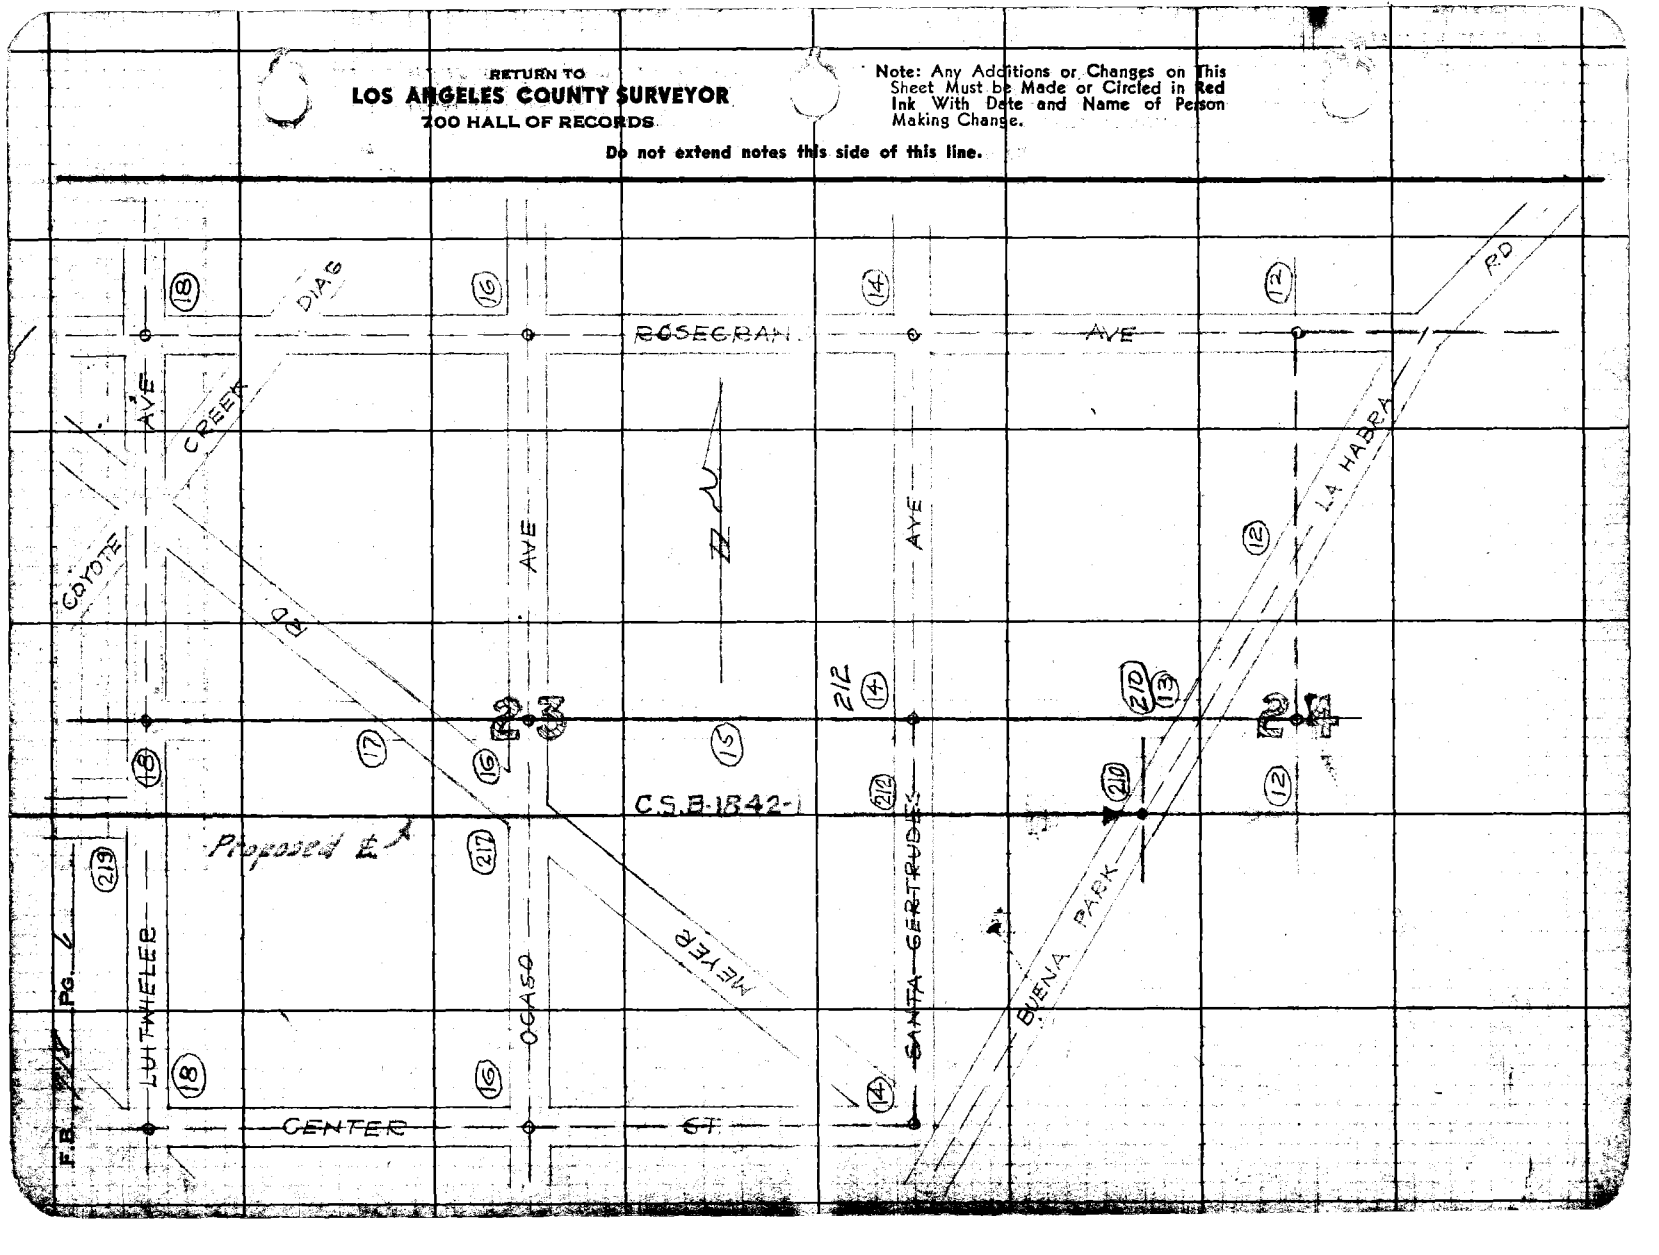

Notes Ck'd by
Map No. B-1842
Office Work Cox
Checked D. M. Finley
Date

Survey of Co. T. P.
W. O. 2346 Tape No. St'd. °F
Surveyed by L. S. Hammock
Notes Date
Indexed J. Hinson

F.B. 218 Pg. 26

Note: Any Additions or Changes on This Sheet Must be Made or Circled in Red Ink With Date and Name of Person Making Change.

Do not extend notes this side of this line.

RETURN TO
LOS ANGELES COUNTY SURVEYOR
700 HALL OF RECORDS

FORM 847 BM 12

C.S.E.-1842-2

Proposed E

C.S.E.-1842-1

Proposed E

BLVD

MARQUARDT

AVE

FIRESTONE

CENTER

ST

VALLEY V. FWY

ROSECRANS

AVE

COYOTE CREEK

HOLDER AVE

SANTA FE

LA MIRADA

RIGELSTOR

DIG

27 229 227 226 225 224 23 22 221 20 21 19 26 25

RETURN TO
LOS ANGELES COUNTY SURVEYOR
700 HALL OF RECORDS

Note: Additions or Changes on This Sheet Must be Made or Circled in Red Ink with Date and Name of Person Making Change.

Do not extend notes this side of this line

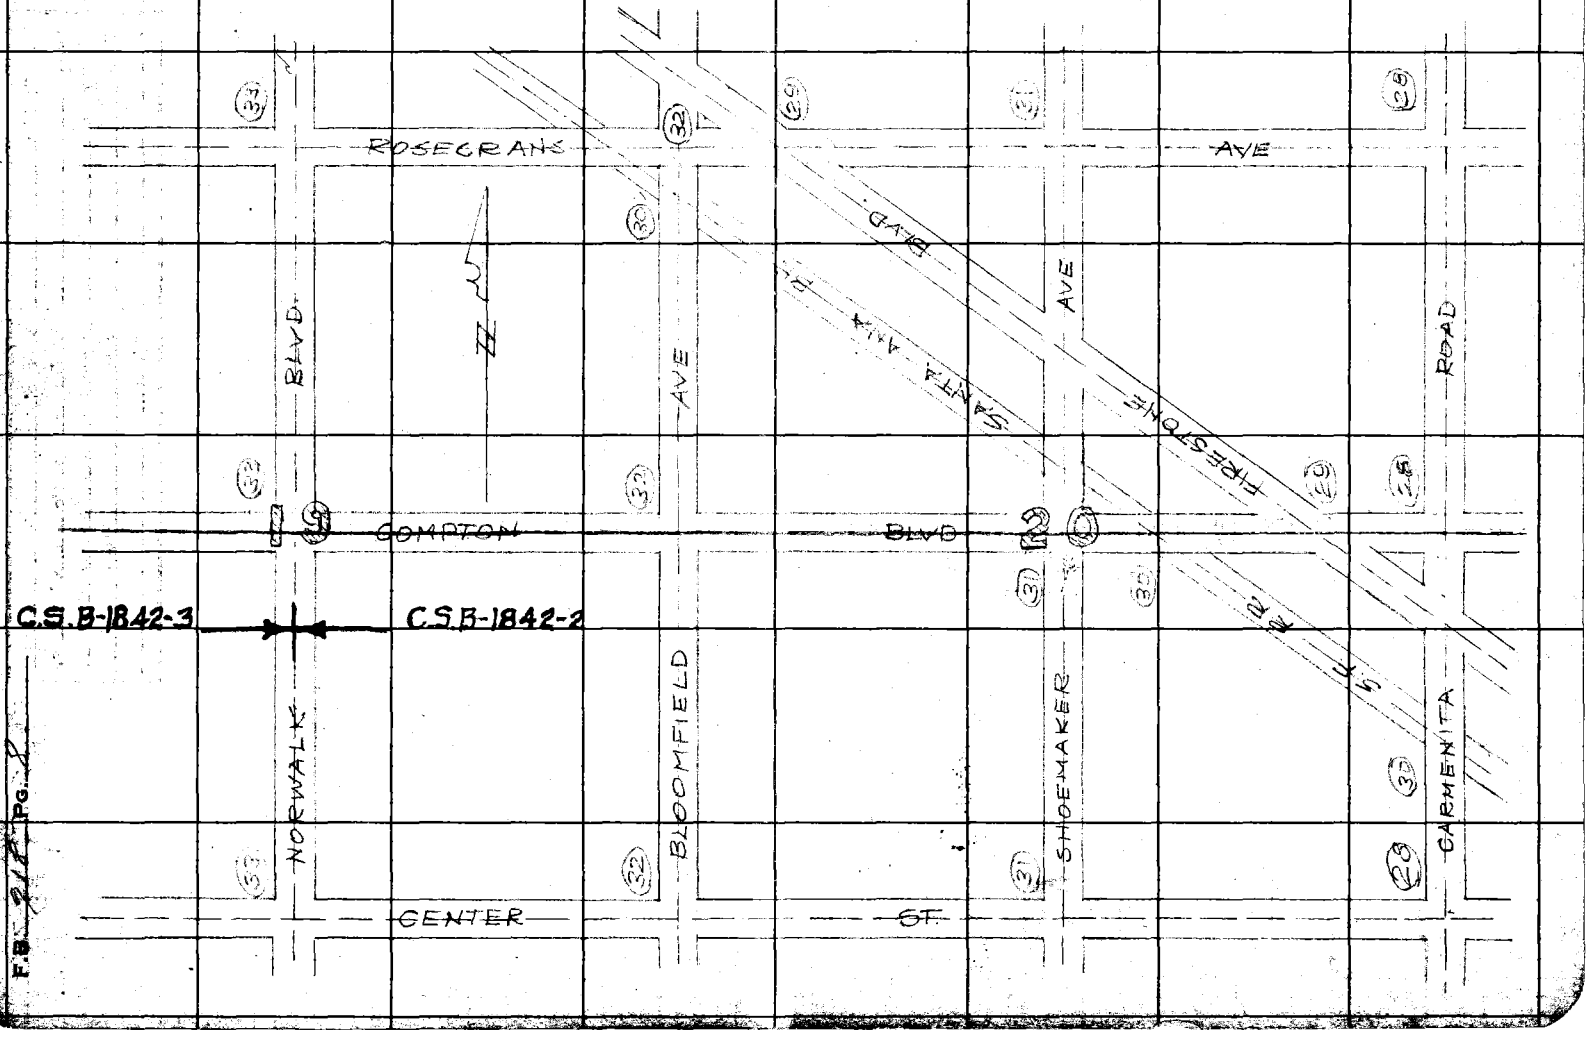

F.B. 214 Pg. 2

Notes Ck'd by	Survey of Compton Blvd
Map No. B-1842	W. O. 1345 Tape No. 1 St'd. P.A.
Office Work Cox	Surveyed by L. S. Hammond
Checked D. M. Finley	Notes L.S.H. Date
Date	Indexed C. Johnson

F.B. 918 Pg. 2

Note: Any Additions or Changes on This Sheet Must be Made or Circled in Red Ink With Date and Name of Person Making Change.

Do not extend notes this side of this line.

RETURN TO
LOS ANGELES COUNTY SURVEYOR
700 HALL OF RECORDS

FORM 247 SM 11-41

C.S.B.-1842-3

SAN GABRIEL RIVER R/W.

CENTER ST

COMPTON BLVD

ROSECRANS AVE

STUDEBAKER RD

SAN ANTONIO DRIVE (PROP.)

PIONEER BLVD

TR 6699

Pg 38 To 44

RETURN TO
LOS ANGELES COUNTY SURVEYOR
700 HALL OF RECORDS

Note: Any Additions or Changes on This Sheet Must be Made or Circled in Red Ink With Date and Name of Person Making Change.

Do not extend notes this side of this line.

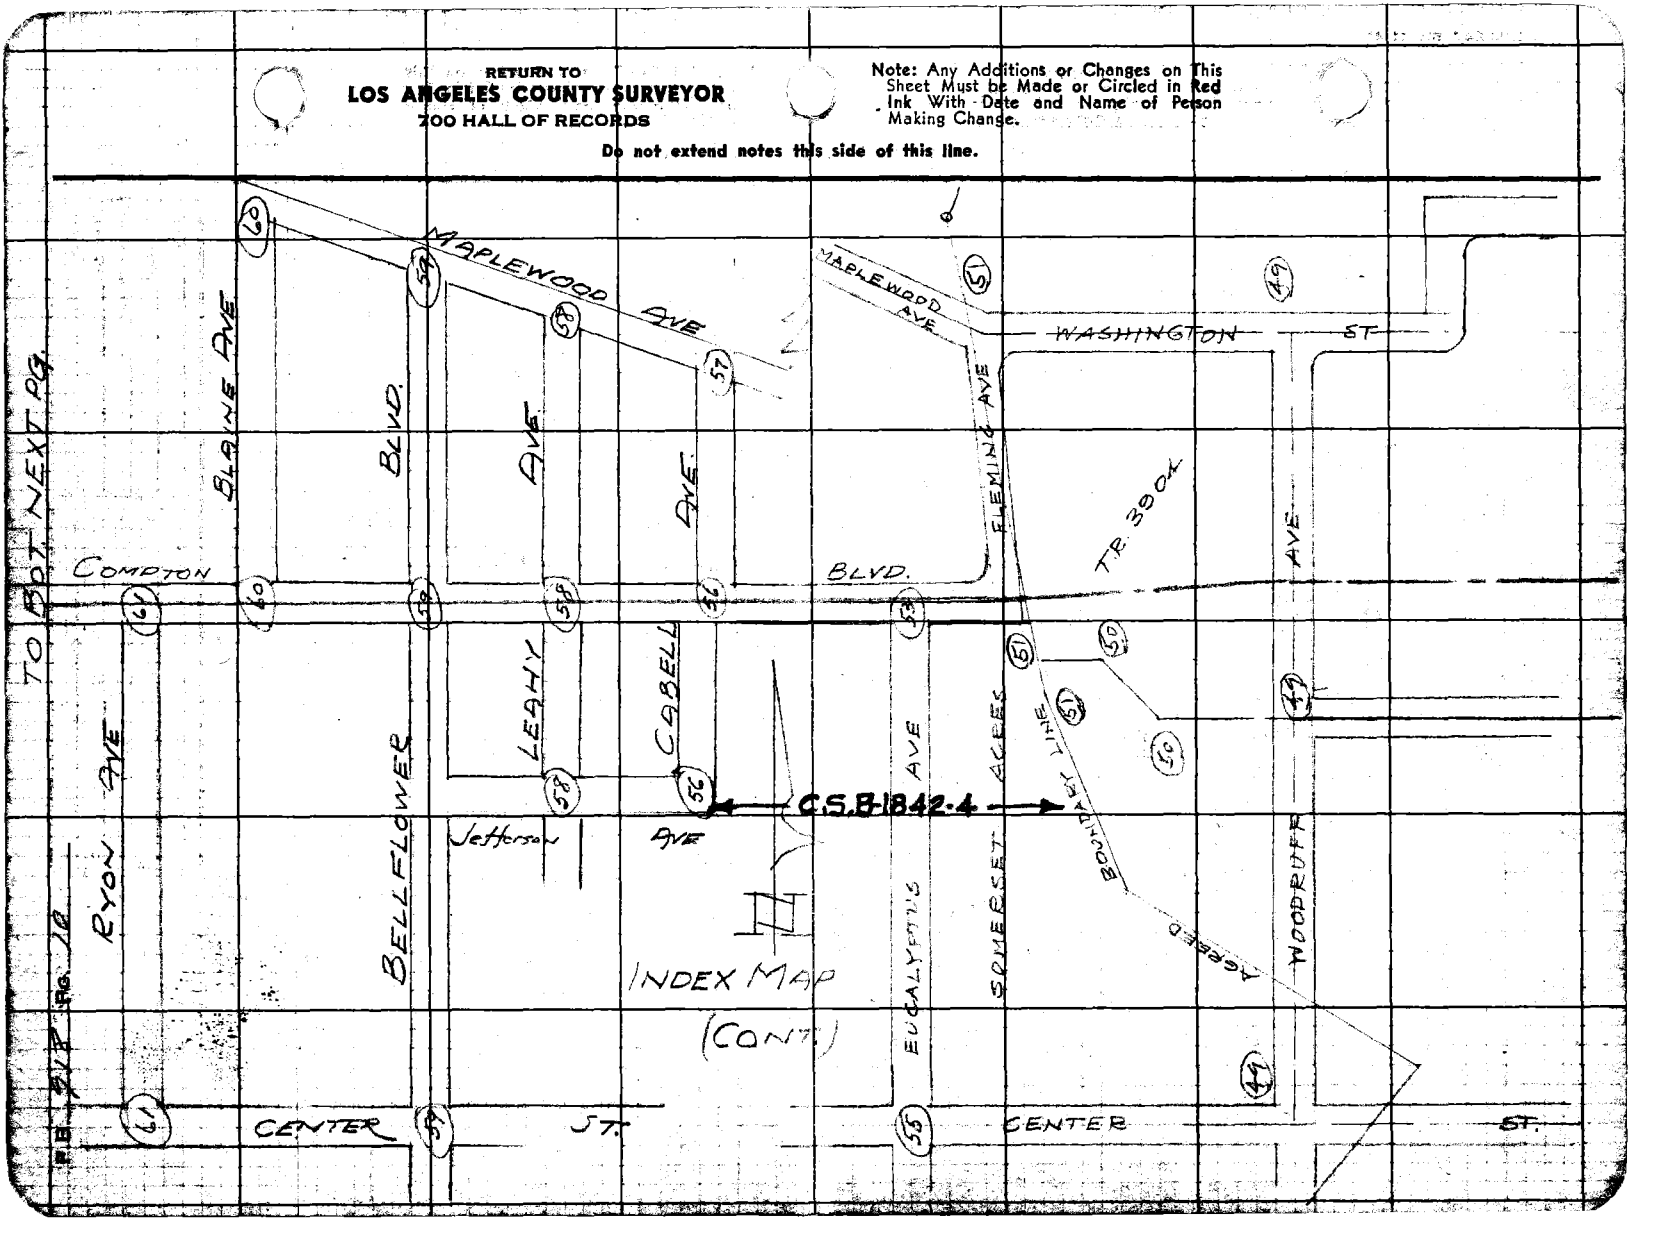

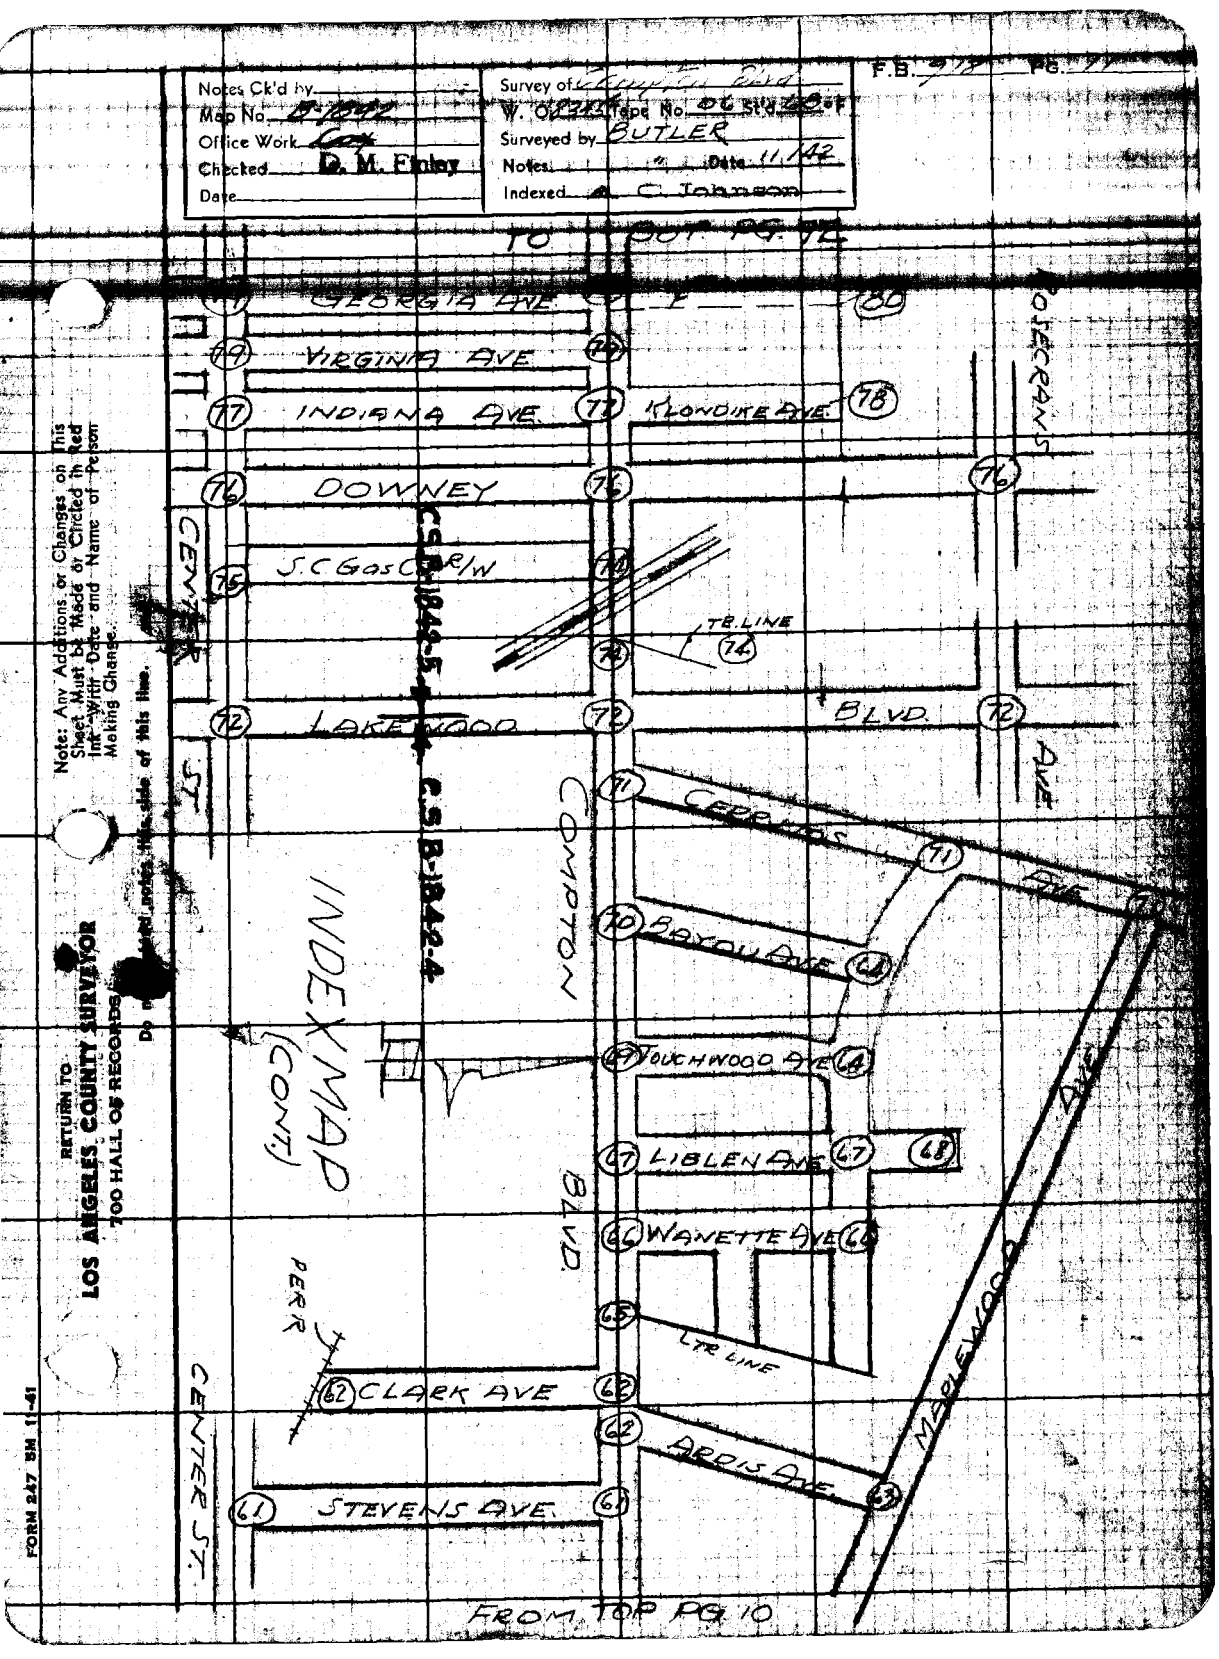
Notes Ck'd by
Map No. 8-1002
Office Work
Checked D. M. Finley
Date
Survey of
W. O.
Map No.
Surveyed by BUTLER
Notes
Date 11/42
Indexed C. Johnson
F.B.
Pg.
TO
GEORGIA AVE
VIRGINIA AVE
INDIANA AVE
KLONDIKE AVE
DOWNEY
S.C. Gas C. R/W
TR. LINE
LAKEWOOD
BLVD.
CENTER ST.
C.S. B-1842-4
INDEX MAP (CONT.)
COMPTON BLVD.
CREEKS
BAYOU AVE
TOUCHWOOD AVE
LIBLEN AVE
WANETTE AVE
PERR
CLARK AVE
ARDIS AVE
STEVENS AVE
CENTER ST.
MADELWOOD
LTR LINE
FROM TOP PG 10
Note: Any Additions or Changes on This Sheet Must be Made or Circled in Red Ink With Date and Name of Person Making Change.
RETURN TO
LOS ANGELES COUNTY SURVEYOR
700 HALL OF RECORDS
FORM 247 SM 11-61

RETURN TO
LOS ANGELES COUNTY SURVEYOR
7DO HALL OF RECORDS

Do not extend notes this side of this line.

Note: Any Additions or Changes on This Sheet Must be Made or Circled in Red Ink With Date and Name of Person Making Change.

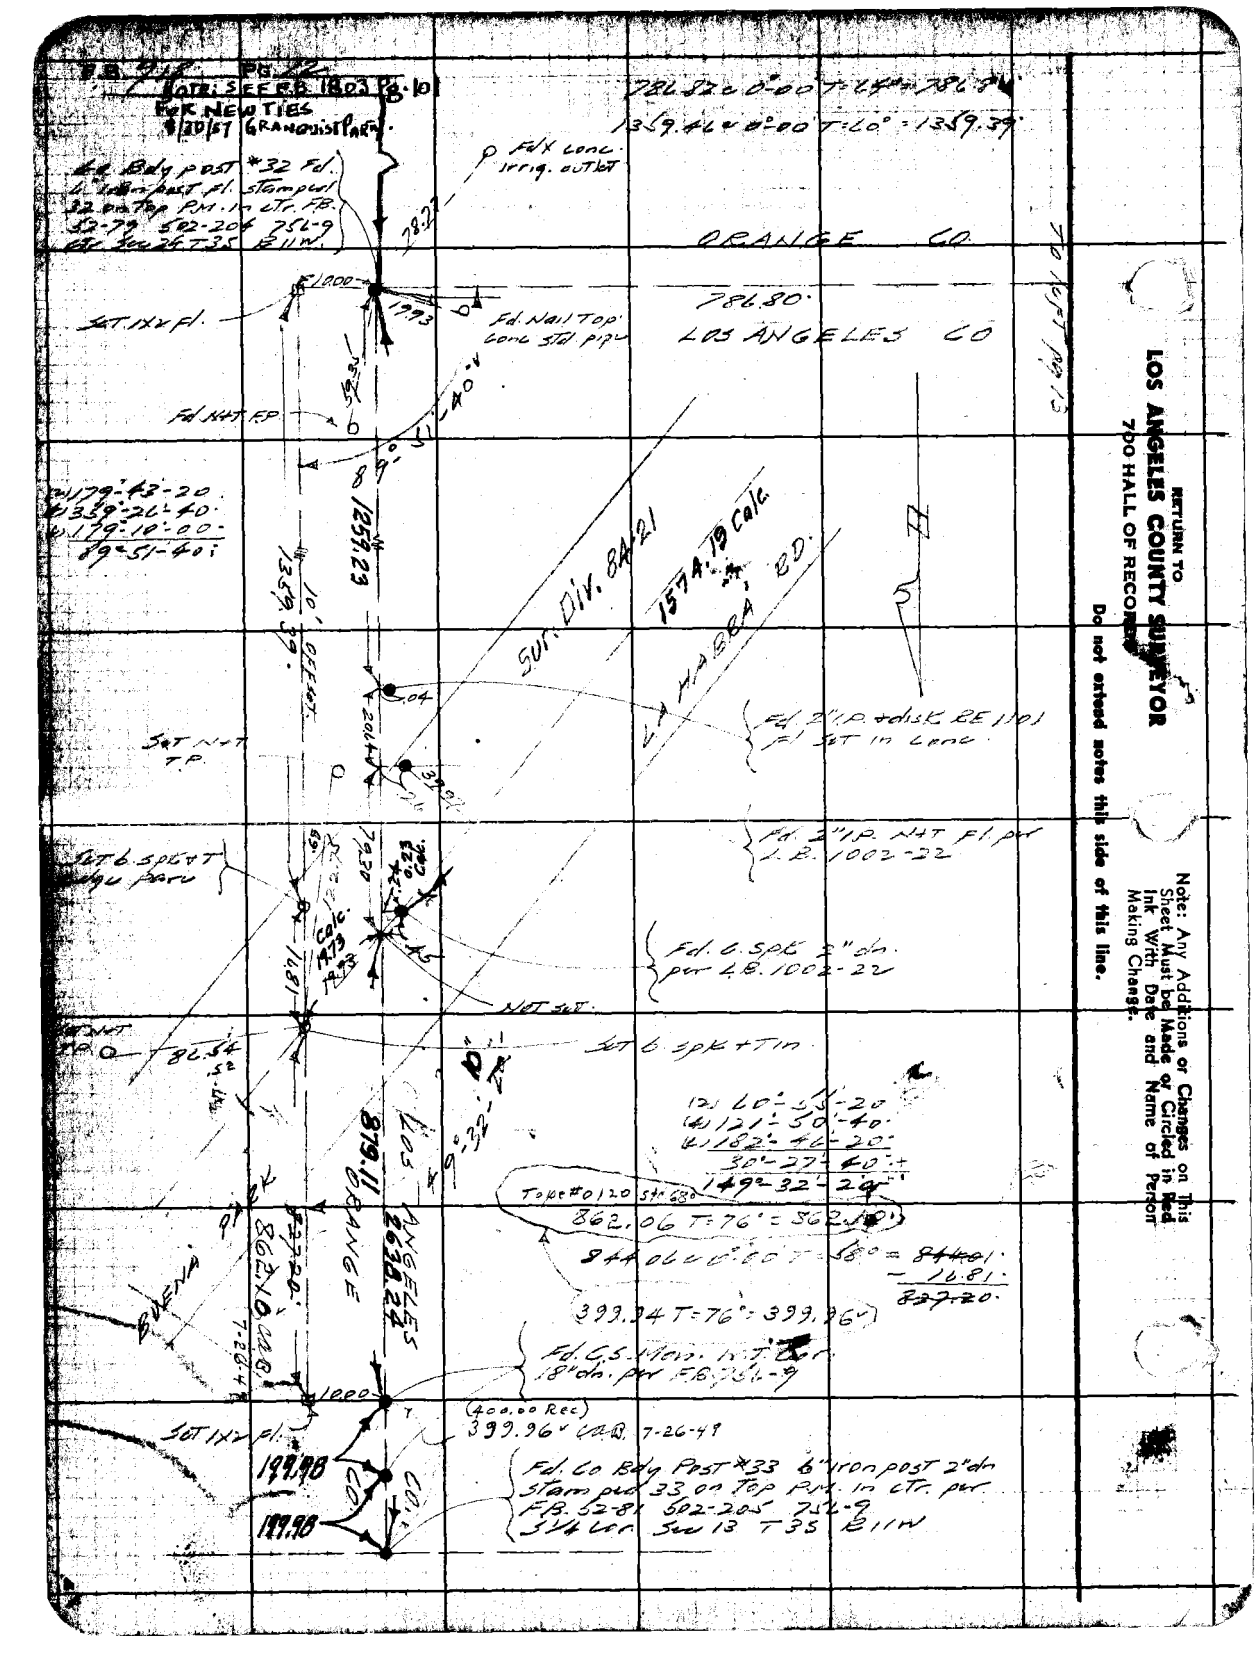

Notes Ck'd by
Map No. 12-1242-1
Office Work E.W. Cox
Checked
Date

Survey of
W. O. [illegible] Tape Notes stacked on
Surveyed by L.S. Hammond
Notes [illegible] Date 5-4-42
Indexed [illegible] 7-5-43

F.B. 918

Note: Any Additions or Changes on This Sheet Must be Made or Circled in Red Ink With Date and Name of Person Making Change.

Do not extend notes this side of this line.

RETURN TO
LOS ANGELES COUNTY SURVEYOR
700 HALL OF RECORDS

FORM 827 RM 11-41

Fd. C.spk. 2" dn. per L.R. 1502-22

Fd. 2" I.P. PAT in 8" conc. filled casing N.

SET Nail

.07 34.71 11.55 8.66 .06

SET SMAT edge para.

LA HABRA RD

ORANGE CO.

LOS ANGELES CO.

30

SET SMAT edge para.

120° - 19' - 35"

1574.19 Calc. A

BUENA PARK

(a) 240° - 39' - 15"
(f) 120° - 19' - 20"
(w) 341° - 59' - 40"
120° - 19' - 35"

F.B. 2268 Pg. 14

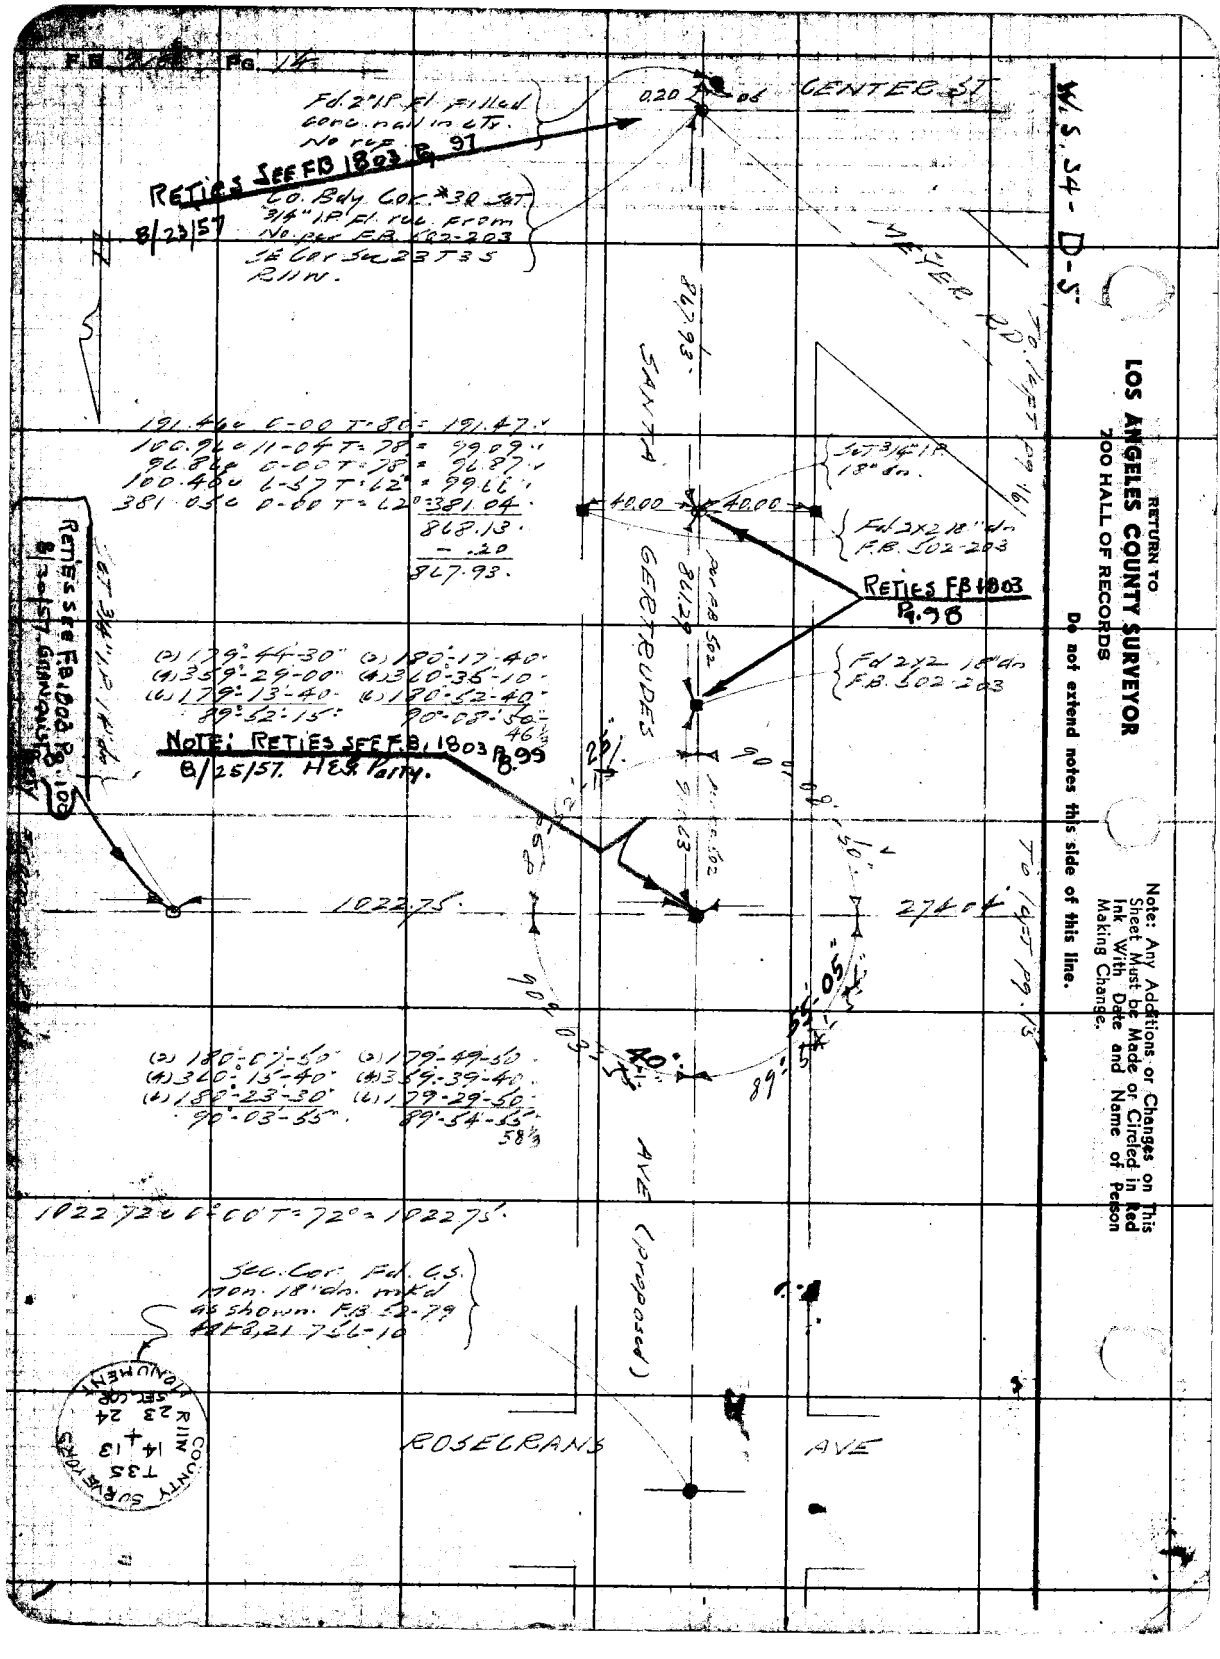

RETURN TO
LOS ANGELES COUNTY SURVEYOR
7100 HALL OF RECORDS

Do not extend notes this side of this line.

Note: Any Additions or Changes on This Sheet Must be Made or Circled in Red Ink With Date and Name of Person Making Change.

W.S. 54 - D-5

Notes Ck'd by
Map No. 19-1842 Sht
Office Work Cal
Checked
Date

Survey of Compton Blvd
W. of 244 Tape No 244 St'd 66' °F
Surveyed by L. S. Hammond
Notes 4-44 Date 3-17-42
Indexed A. C. Johnson

F.B. 918

87.35 = 4-10 T = 62° = 87.12'
274.04.
196.35 = 00-00 T = 62° = 196.34'
1016.70 = 00.00 T = 62° = 1016.70'

Set 3/4" I.P. Flg.

196.34'

Set 3/4" I.P. Flg.

Set 3/4" I.P. Flg.

1016.70'

Second set this line

274.04
196.34
1016.70
1181.51
668.59

Note: Any Additions or Changes on This Sheet Must be Made or Circled in Red Ink With Date and Name of Person Making Change.

Do not extend notes this side of this line.

RETURN TO
LOS ANGELES COUNTY SURVEYOR
700 HALL OF RECORDS

FORM 247 SM 11-41

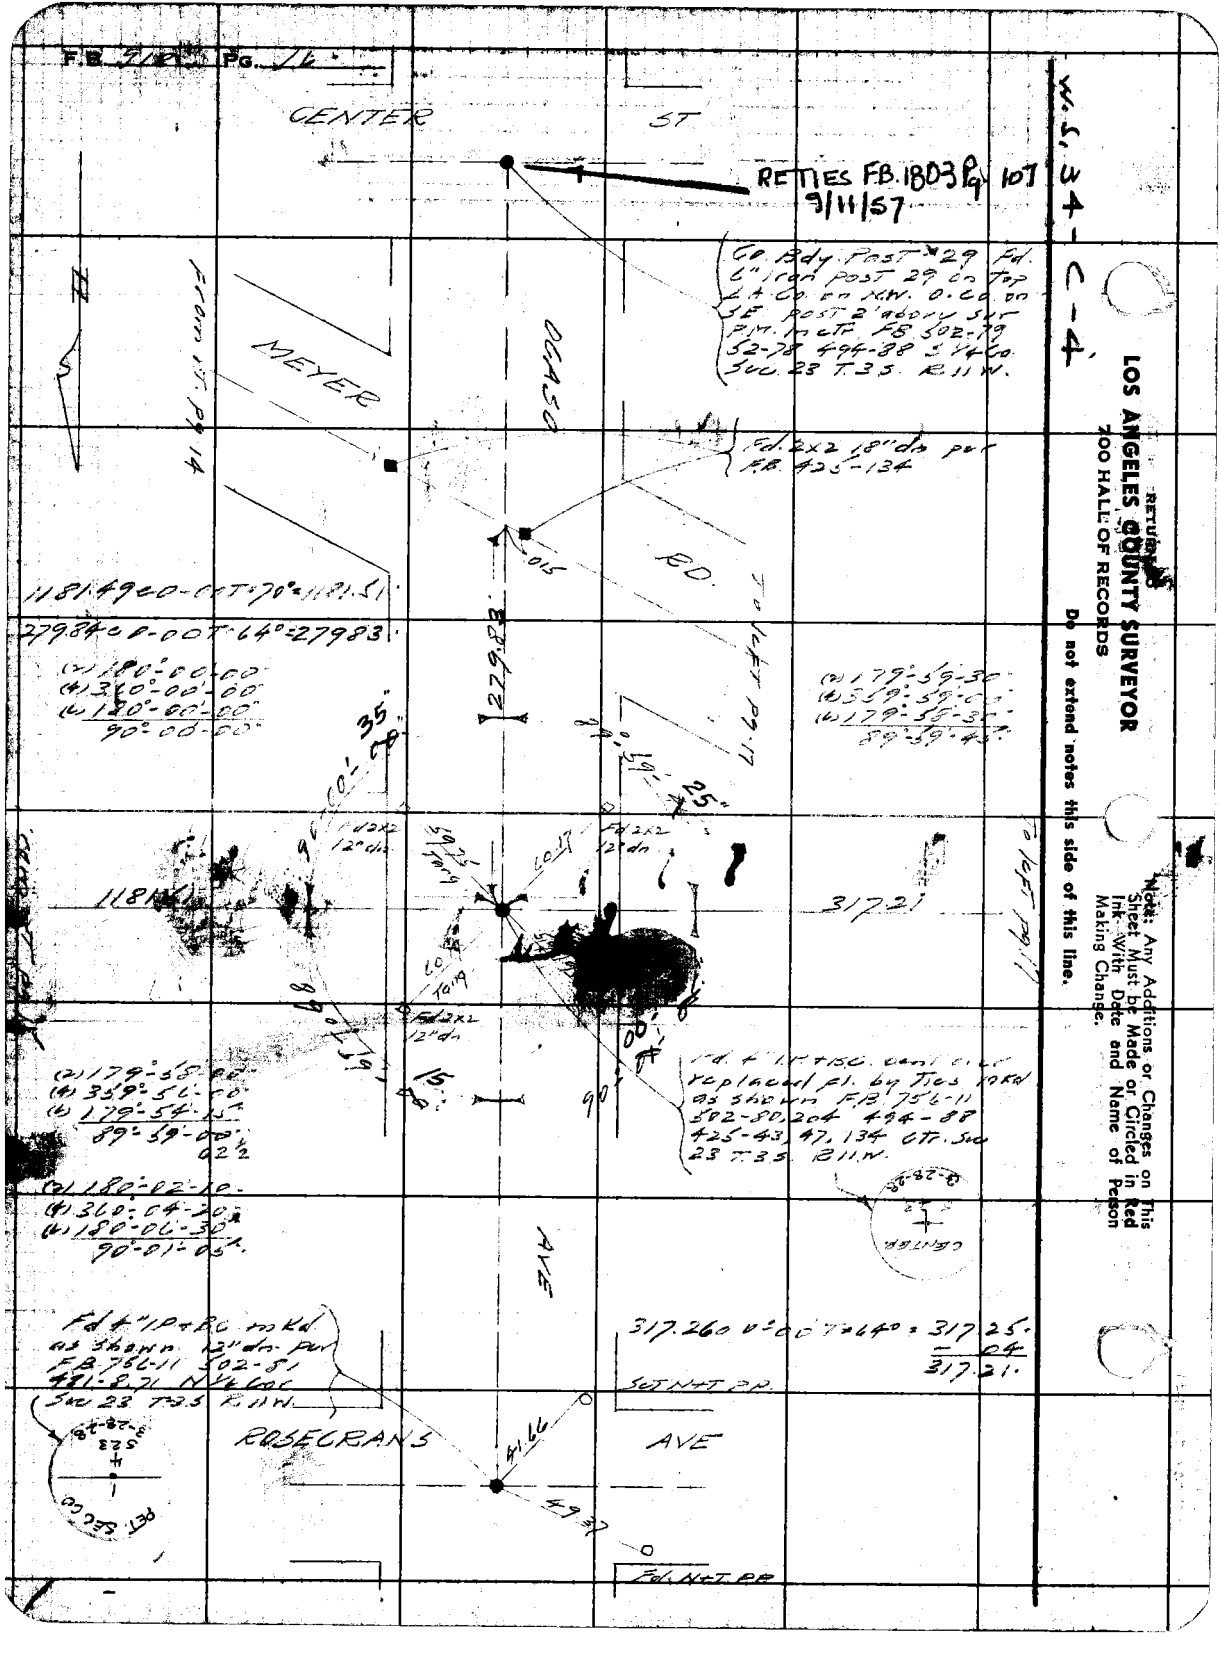
CENTER
ST
RETIES FB. 1803 Pg. 107
9/11/57
W.S. W4 - C-4,
LOS ANGELES COUNTY SURVEYOR
RETURN TO
700 HALL OF RECORDS
Do not extend notes this side of this line.
Note: Any Additions or Changes on This Sheet Must be Made or Circled in Red Ink With Date and Name of Person Making Change.
Co. Bdy. Post N29 Fd. 6" Iron Post 29 Co. Top 4 Co. on N.W. 0.6 Co. on SE Post 2' above Surf P.M. in CTR FB 502-79 52-78 494-88 314 Co. Sec 23 T.3S. R.11W.
Fd. 2x2 18" dia per FB #25-134
MEYER
FROM ST. PG 14
OCASO
RD.
TO VET PG 17
1181.49 e-cut 70' = 1181.51
279.84 e-out 64' = 279.83
(2) 180°-00-00
(4) 360°-00-00
(6) 180°-00-00
90°-00-00
35' CO
279.83
84°-59-25"
(2) 179°-59-35
(4) 359°-59-00
(6) 179°-59-35
89°-59-40
Fd 2x2 12" dia
10.19
10.17
1181.49
317.21
TO VET PG 17
(2) 179°-35-22
(4) 359°-54-10
(6) 179°-54-15
89°-59-02½
90°
Fd 4" I.P. + TBC. Cond. C.L.C. replaced Fl. by Ties 10 KN 83 360 KN FB 756-11 502-80, 204 494-88 425-43 47, 134 CTR. Sec 23 T.3S R.11W.
CENTER
(2) 180°-02-10
(4) 360°-04-20
(6) 180°-02-30
90°-01-05
Fd 4" I.P. + BC no Rd. as shown 12" dia. per FB 756-11 502-81 441-8.21 N¼ Cor. Sec 23 T.3S R.11W.
317.260 e-out 64' = 317.25
-.04
317.21
SET NAIL & P.P.
ROSECRANS
AVE
41.66
41.37
Fd. NAIL & P.P.
GET. SEC. CO
3-23-28

FORM 847 SM 11-41

RETURN TO
LOS ANGELES COUNTY SURVEYOR
700 HALL OF RECORDS

Note: Any Additions or Changes on This Sheet Must be Made or Circled in Red Ink With Date and Name of Person Making Change.

Do not extend notes this side of this line.

Notes Ck'd by
Map No.
Office Work
Checked
Date

Survey of
Surveyed by
Noted
Indexed

F.B.

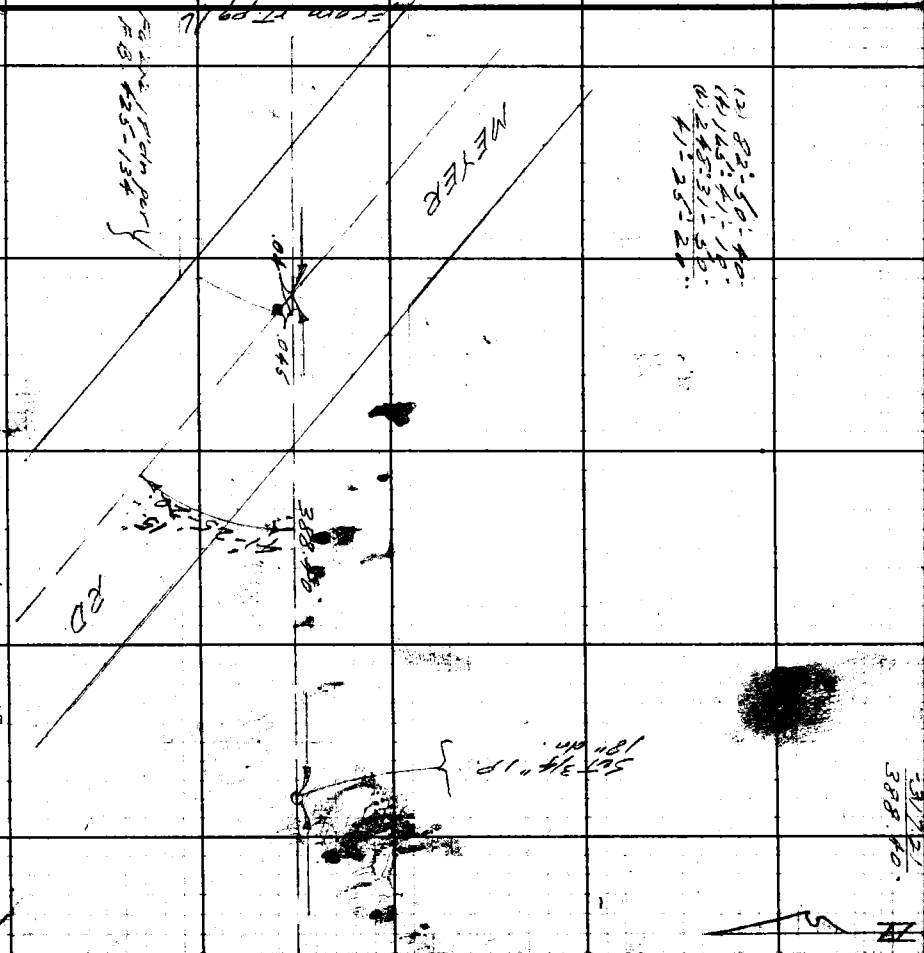

RETURN TO
LOS ANGELES COUNTY SURVEYOR
700 HALL OF RECORDS

Note: Any Additions or Changes on This Sheet Must be Made or Circled in Red Ink With Date and Name of Person Making Change.

Do not extend notes this side of this line.

W.S. 34-C-4, C-5 To Ref Pg 19

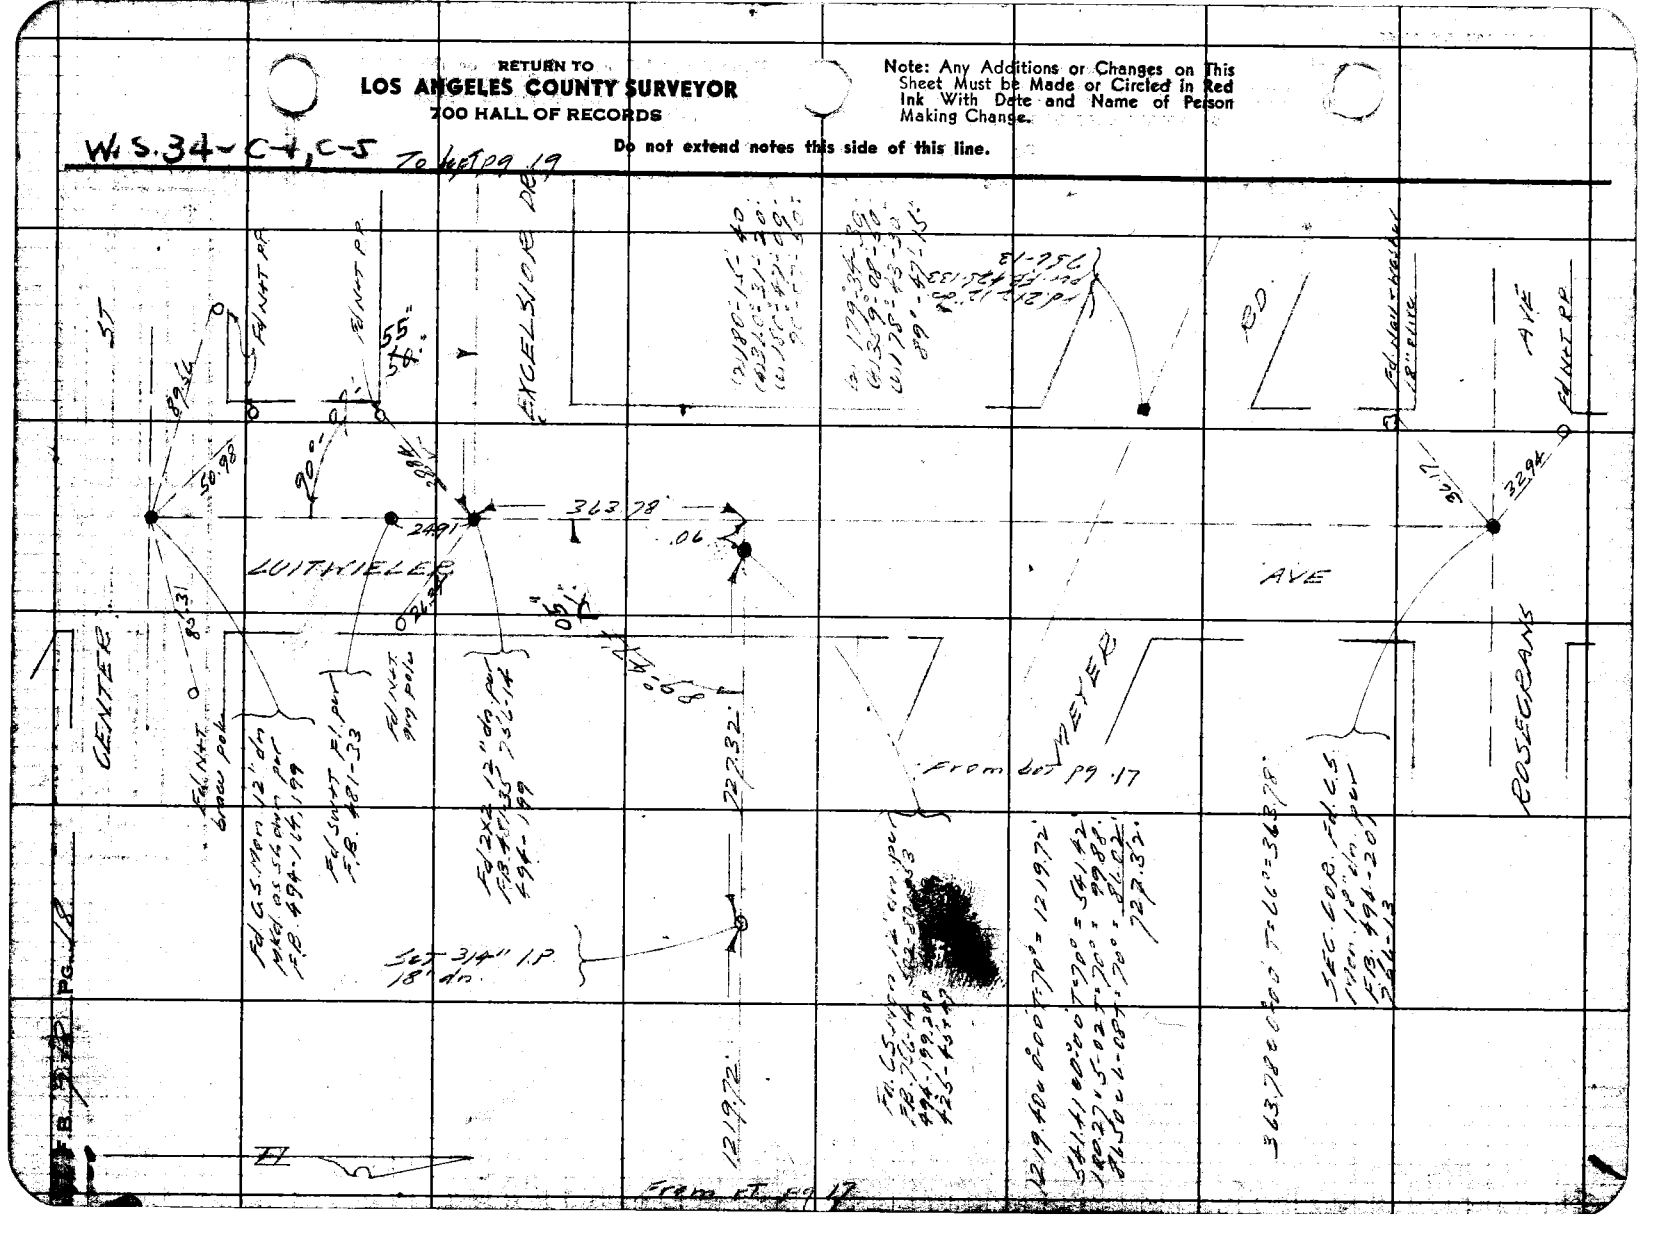

FORM 247 SM 11-41

RETURN TO
LOS ANGELES COUNTY SURVEYOR
700 HALL OF RECORDS

Note: Any Additions or Changes on This Sheet Must be Made or Circled in Red Ink With Date and Name of Person Making Change.

Do not extend notes this side of this line.

W 15, 34 C-4

Notes Ck'd by
Map No.
Office Work
Checked
Date

Survey of
W.O.
Surveyed by
Notes
Indexed

F.B.
PG.

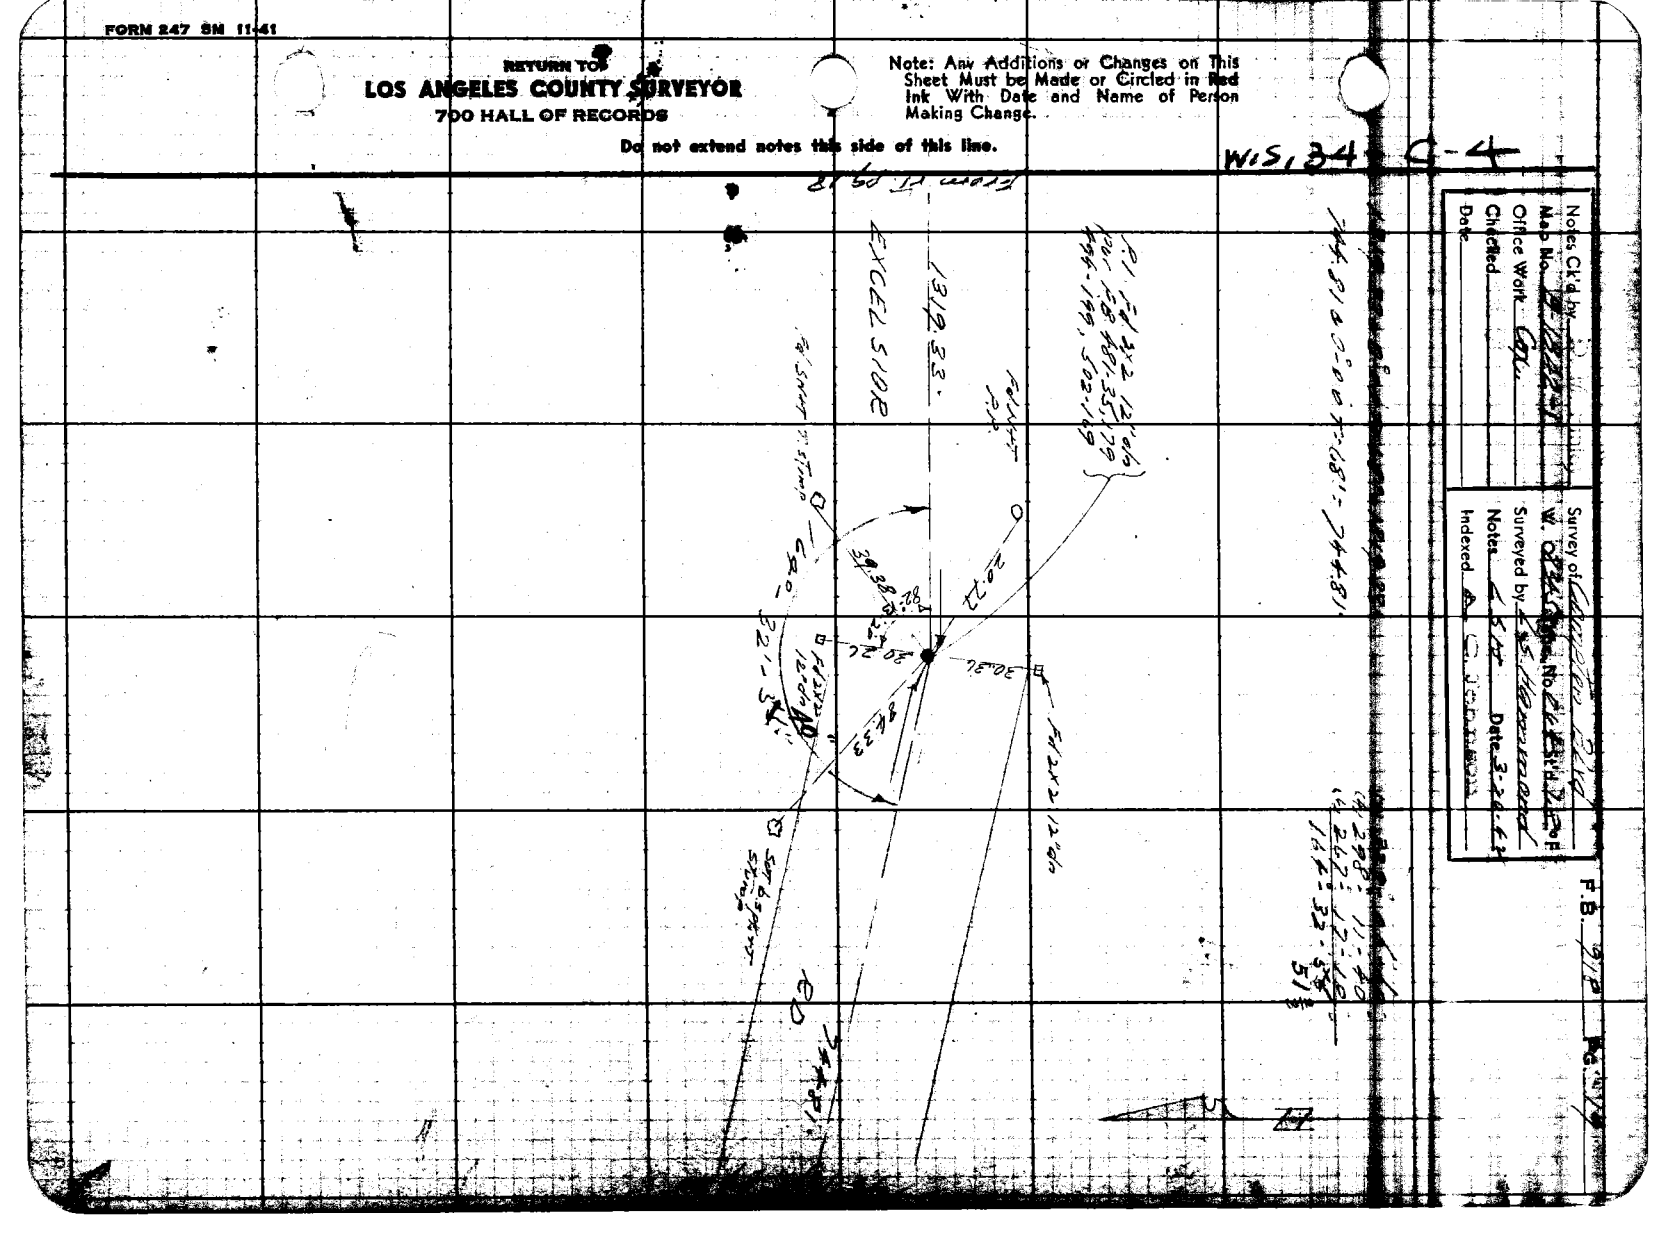

F.B. 712 Pg. 20

628.30 Δ 40°-00' T = 168° = 628.30'
258.01 Δ 6°-00' T = 72° = 258.07'

W.S. 34-B-4

RETURN TO
LOS ANGELES COUNTY SURVEYOR
700 HALL OF RECORDS
Do not extend notes this side of this line.

Note: Any Additions or Changes on This Sheet Must be Made or Circled in Red Ink With Date and Name of Person Making Change.

Set 1½" P.I.

160.00

To Set 1½" P.I.

(1) 337°-49'-00"
(2) 315°-37'-50"
(3) 293°-22'-10"
168°-54'-34"
31 2/3

Fd. Fd 3/4" I.P. 18" dn. per F.B. 481-178

Set 1x2 Fd.

25.95

15'

130'

(1) 233°-42'-00"
(2) 107°-24'-05"
(3) 246°-03'-30"
116°-57'-00"
50-58 1/3

168°-54'

For Later Survey See Pg. 221 258.07

Fd. Nail 20" q/m

5' offset

280.95

Set Nail

5.65'

48.12'

628.30'

RD.

To West 1921

EXCELSIOR

5.35'

Fd Sq'x't 20" q/m

50.40'

116°-54'

Fd 3/4" I.P. 12" dn. per F.B. 481-179

COYOTE CREEK DIV.

P.O.T. 22+69.18
Fd 2x2 3" dn.
per F.B. 481-180

Notes Ck'd by
Map No. D-1642-1
Office Work Cox
Checked
Date

Survey of Crenshaw Blvd
W. O. 8345 Tape No. 214 Std'd 6-[illegible]
Surveyed by L. S. Hammond
Notes L.S.H. Date 6-22-44
Indexed C. Johnson

F.B. 718 Pg. 27

WS 34 B 4

Set 1x2 Ft.

HOLLEE

(2) 180-49-20+
(4) 297-35-50
(6) 86-28-20
74-24-46+

(2) 211-10-10+
(4) 62-20-20+
(6) 273-30-50
105-35-10

(2) 180-21-30
(4) 360-48-10
(6) 181-05-00
90-10-50

(2) 179-38-20
(4) 359-16-30
(6) 178-55-00
89-49-10

(2) 179-27-00
(4) 358-23-50
(6) 178-21-00
89-43-30

Note: Any Additions or Changes on This Sheet Must be Made or Circled in Red Ink With Date and Name of Person Making Change.

Do not extend notes this side of this line.

RETURN TO
LOS ANGELES COUNTY SURVEYOR
700 HALL OF RECORDS

Fd. 0.3 iron 10" dn. per F.B. 502-157

¼ COR. Fd. C.S. iron. 12" dn. per F.B. 756-16 502-158, 160, 161

ROSECRANS AVE

FORM 247 SM 11-41

RETURN TO
LOS ANGELES COUNTY SURVEYOR
700 HALL OF RECORDS

Note: Any Additions or Changes on This Sheet Must be Made or Circled in Red Ink With Date and Name of Person Making Change.

Do not extend notes this side of this line.

W. S. 34 - B - 4

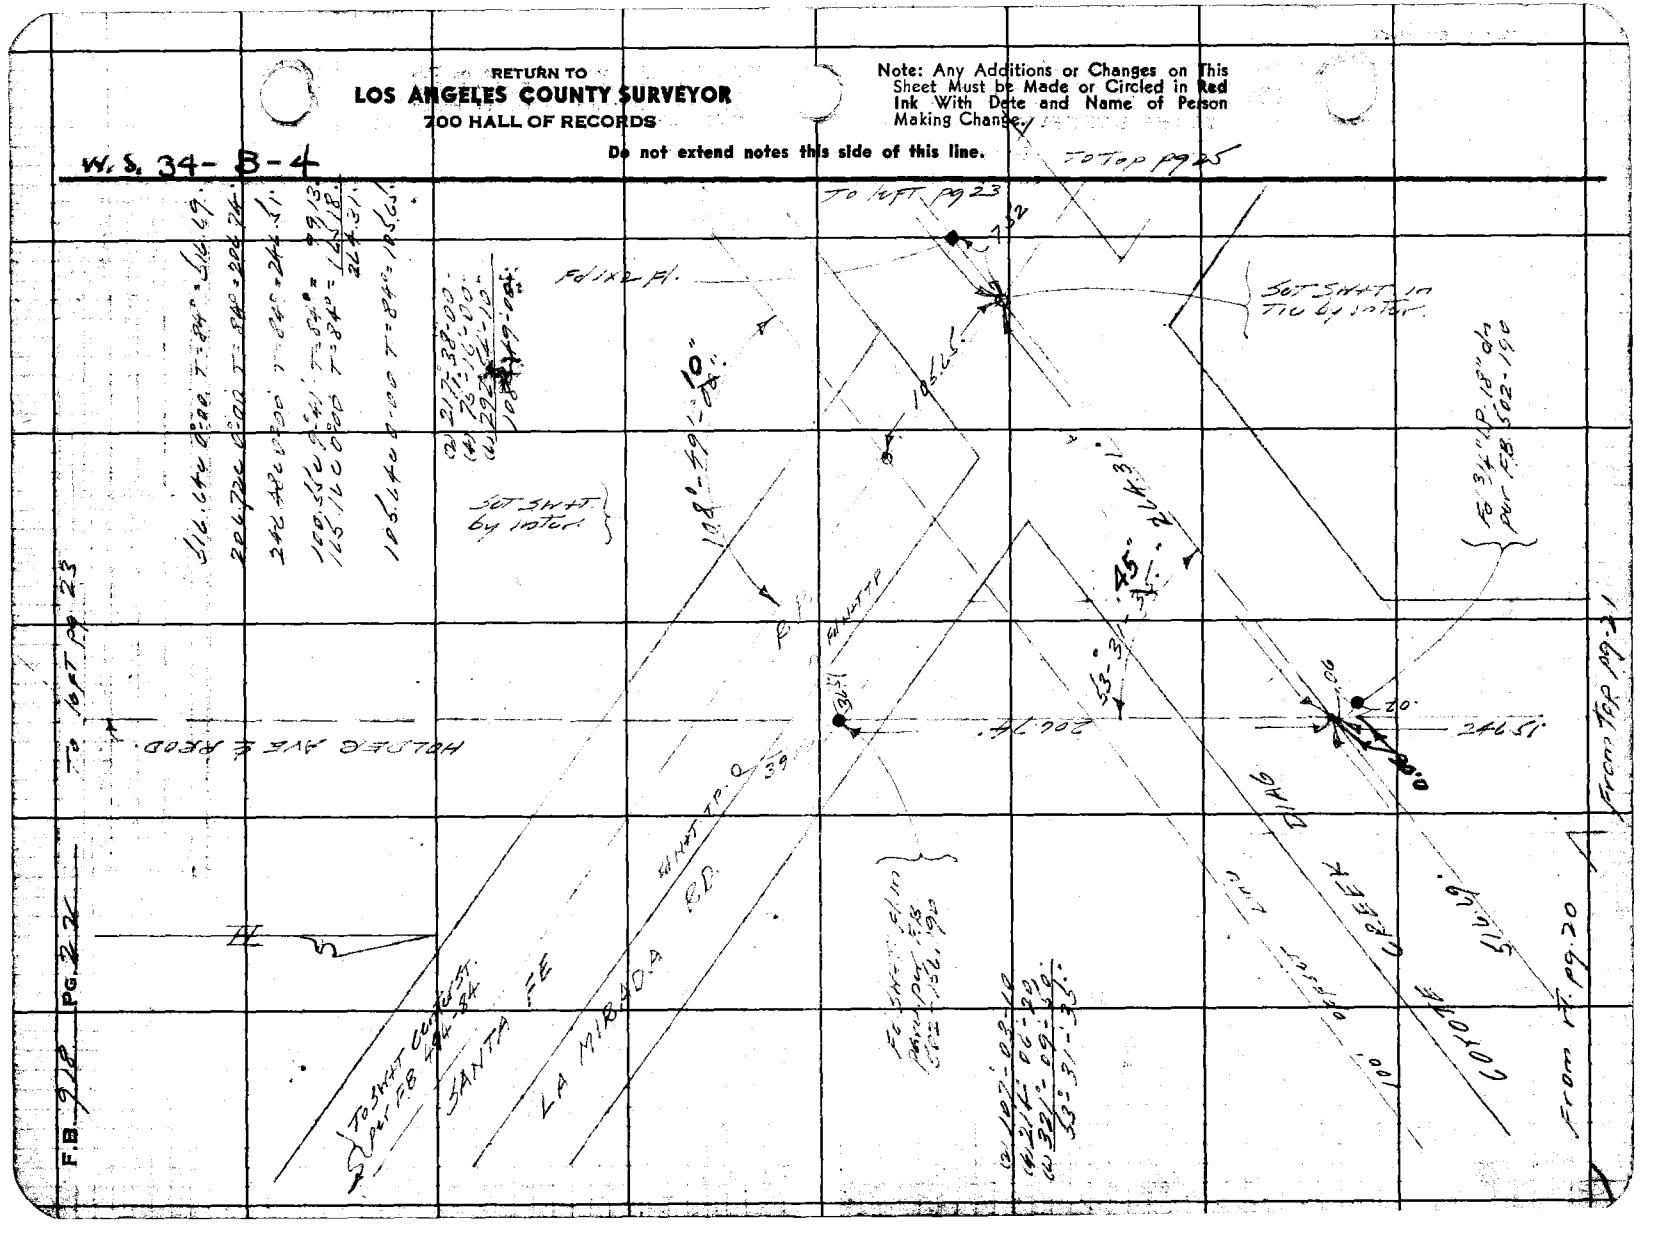

Notes Ck'd by
Map No. B-1842-1
Office Work Cox
Checked
Date

Survey of Aqueduct Bldg
W. O. 8245 Tape No. 644 St'd 62 °F
Surveyed by L. S. Hammond
Notes 644 Date 6-23-62
Indexed C. Johnson

F.B. 918 Pg. 28

Note: Any Additions or Changes on This Sheet Must be Made or Circled in Red Ink With Date and Name of Person Making Change.

Do not extend notes this side of this line.

RETURN TO
LOS ANGELES COUNTY SURVEYOR
720 HALL OF RECORDS

FORM 247 5M 11-61

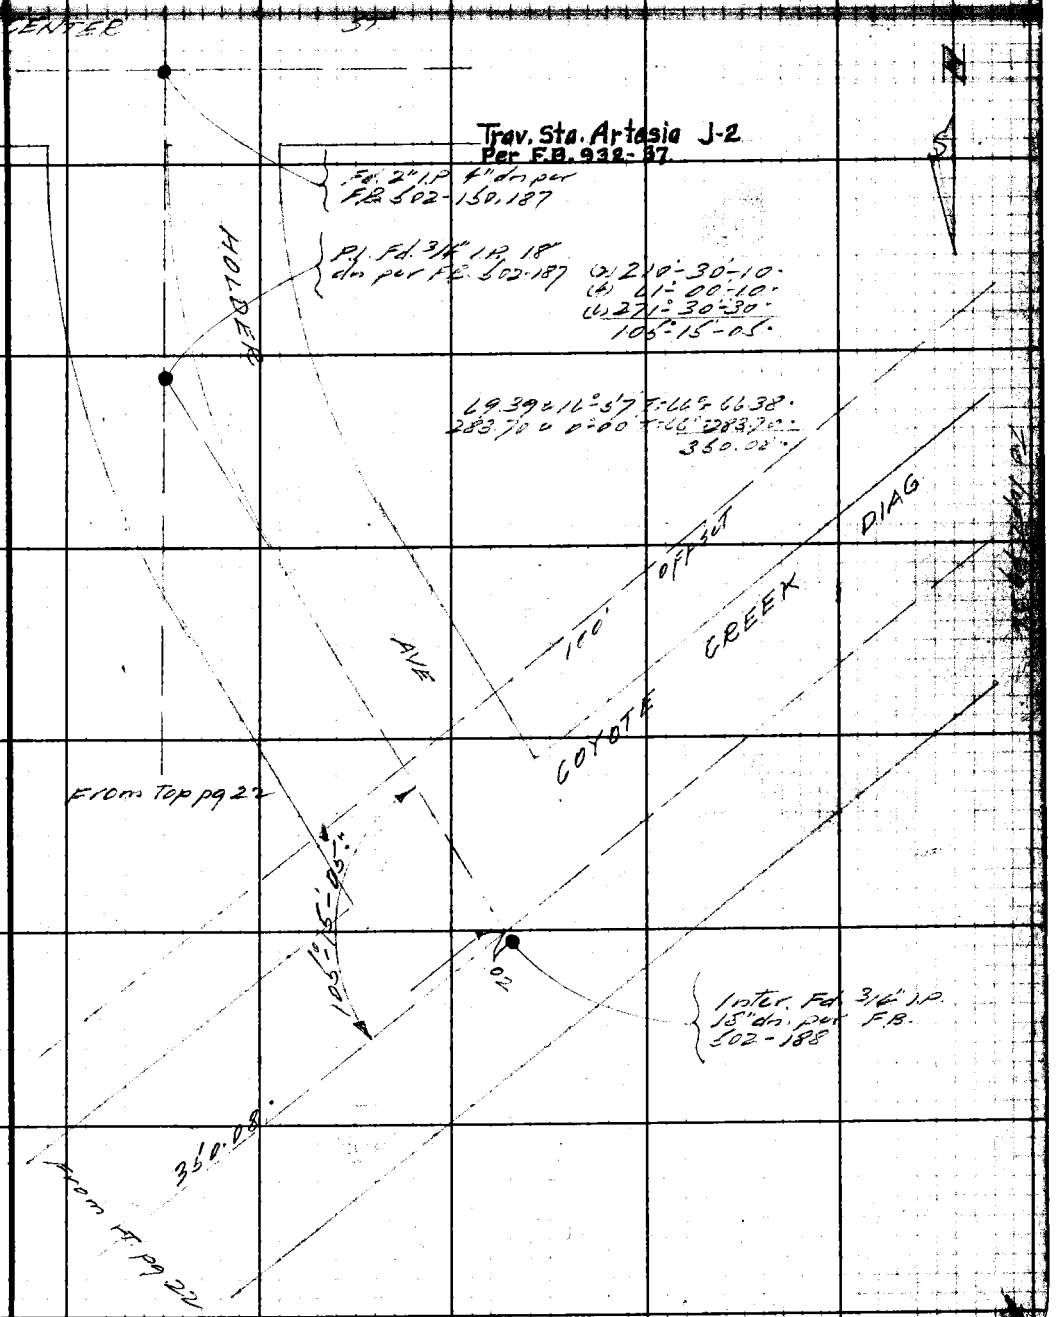

F.B. 918 PG. 24

W.S. 34 - B-4

RETURN TO
LOS ANGELES COUNTY SURVEYOR
700 HALL OF RECORDS

Do not extend notes this side of this line.

Note: Any Additions or Changes on This Sheet Must be Made or Circled in Red Ink With Date and Name of Person Making Change.

398.74 C Δ 0°00'T=720°=398.7'.

Fd. L+T Walk.

Set 6.5pk+T. Fl. on random line

Fd. N+T

22.2

15.3

398.7'.

759.35

To left 10 2

548

317

393.06' Calc.

765.08' Calc.

24.39

Fd. N+T 14" Acacia

Fd. 3/4" I.P. 2" dn. per F.B. 502-157

Notes Ck'd by
Map No. B-1842-1
Office Work COX
Checked
Date

Survey of Compton Blvd
W. O. 8234 Tape No. C.C. St'd. 1.0 F
Surveyed by L. S. Hammond
Notes Cl'd Date 3-27-42
Indexed A. C. Johnson

F.B. 918 Pg. 25

W.S. 34-13

From Lt. Pg 22

248.04 40-00 T 78 = 258.06

1483.98
+ 258.06
1225.92

SANTA FE

LA MIRADA

Set N&T on random line

Set N&T in Tie by Inter

258.06

1225.92

9.21

1483.99 calc

Set 6.spk+tin on N Sec. Line

P.E.

P.D.

E/M

Set 6.spk+ T.P.

Set N&T T.P.

28.23
36.44
43.98
35.66
13.04
19.63

Set 6.spk+ T 18' Alg. Line

To Lft Pg 26

RETURN TO
LOS ANGELES COUNTY SURVEYOR
700 HALL OF RECORDS

Note: Any Additions or Changes on This Sheet Must be Made or Circled in Red Ink With Date and Name of Person Making Change.

Do not extend notes this side of this line.

FORM 247 SM 11-41

F.B. 918 Pg. 26

W.S. 34 - B-4

RETURN TO
LOS ANGELES COUNTY SURVEYOR
700 HALL OF RECORDS
Do not extend notes this side of this line.

Note: Any Additions or Changes on This Sheet Must be Made or Circled in Red Ink With Date and Name of Person Making Change.

SET 1X2

CENTER

Fd. L+T

Fd. L+T

2.08'

2.07'

2.28'

2.27'

Fd. L+T

100' OFF SEC.

21.28

Fd. L+T.

Fd. L+T

Fd. L+T per F.B. 494-79 -237, 602-151 448-185

COYOTTE 6K. DIAG.

PAVED

T.P. 23

AVE

900.42 0.42 0.82 = 900.50

(2) 180° 34' 00"
(4) 361° 08' 00"
(6) 181° 42' 00"
90° 17' 00"

(2) 180° 32' 00"
(4) 361° 04' 00"
(6) 181° 32' 00"
90° 16' 00"

16.55

90° 17' 00"

35"

66.4

20'

SET N+T

E.C.

Fd N+T P.P.

2100.04

24.40

8138

900.50

Fd N+T 8" Olive

32.88

Fd N+T T.P.

Fd. G.S. Mon 16" dp. per F.B. 494-237 Mkd. as shown.

MONUMENT
COUNTY SURVEYORS
T.3.S
R.11.W
21+22

SET S.W.T. Rod per F.B. 481-70

VALLEY

SANTA FE

LA MIRADA

R=1910.08'

Fd. S.W.T. per F.B. 494-239+79 481-34,70 502-152

R.R.

RD.

Notes Ck'd by
Map No. [illegible]
Office Work Cox
Checked W. M. Finley
Date AUG '51

Survey of Complex Sht
W. Of [illegible] Tract No. [illegible] Sht. [illegible]
Surveyed by L. S. Hammond
Notes L.S.H. Date 7-1-51
Indexed A. C. Johnson

F.B. [illegible] P.G. [illegible]

W. Sta. 24 + 0-5

Note: Any Additions or Changes on this Sheet Must be Made or Circled in Red Ink With Date and Name of Person Making Change.

Do not extend notes this side of this line.

RETURN TO
LOS ANGELES COUNTY SURVEYOR
700 HALL OF RECORDS

FORM 247 RM 11-41

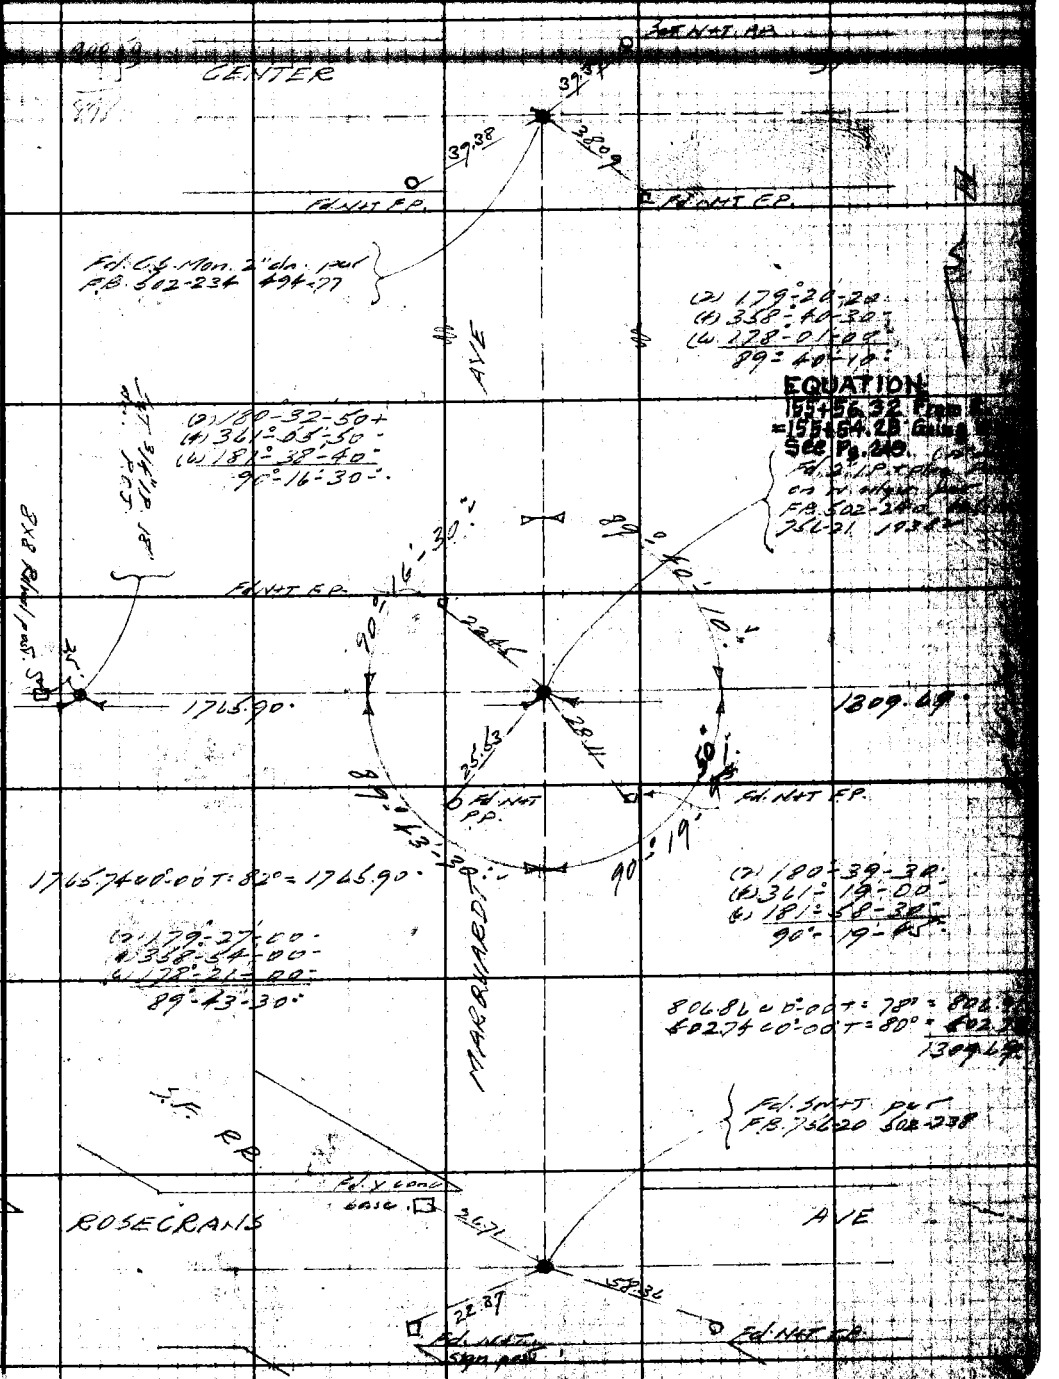

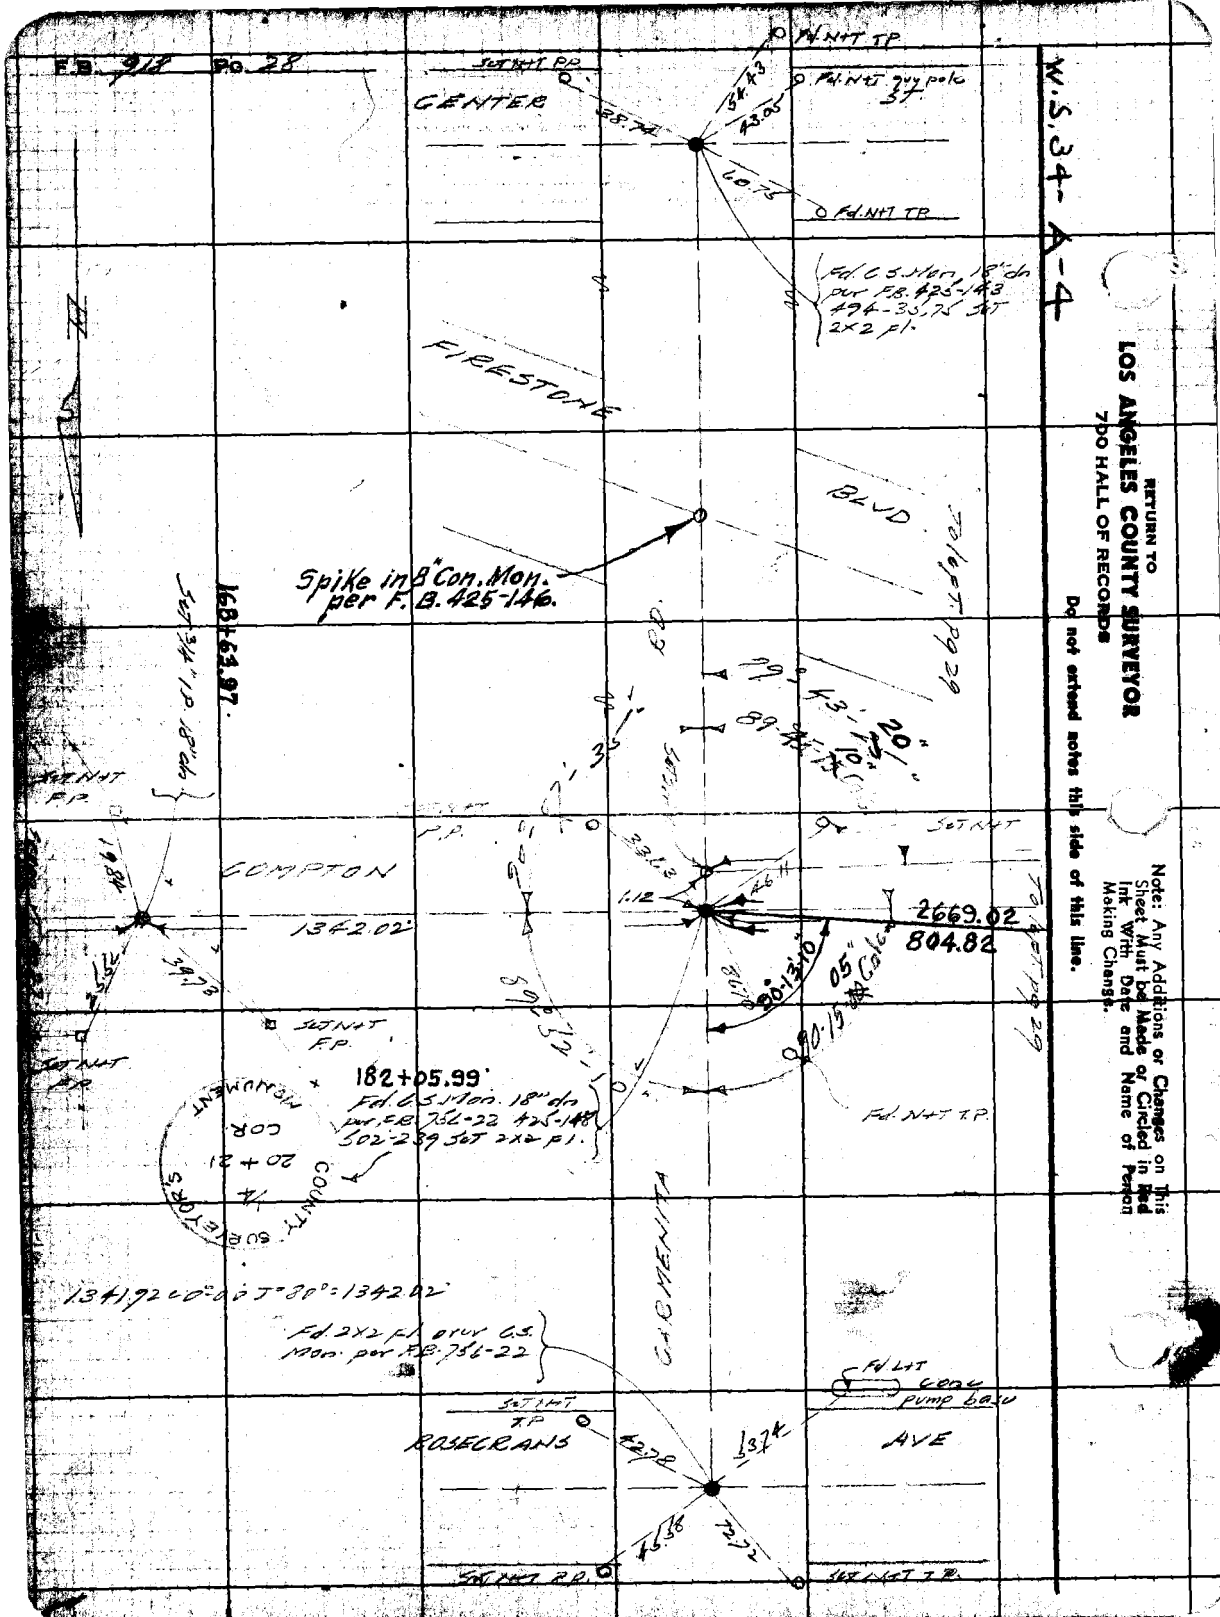
F.B. 918 PG. 28
W.S. 34-A-4
RETURN TO
LOS ANGELES COUNTY SURVEYOR
7DO HALL OF RECORDS
Do not extend notes this side of this line.
Note: Any Additions or Changes on This Sheet Must be Made or Circled in Red Ink With Date and Name of Person Making Change.
Fd. NAIL TP
SET NAIL PP
CENTER
Fd. NAIL guy pole
Fd. NAIL TP
Fd. C.S. Mon. 18" dn per F.B. 425-143 494-35, 75 SET 2x2 PI.
FIRESTONE
BLVD.
Spike in 8" Con. Mon. per F.B. 425-146.
168+63.97
SET 3/4" I.P. 18" dn
SET NAIL P.P.
COMPTON
1342.02'
SET NAIL P.P.
SET NAIL P.P.
182+05.99'
Fd. C.S. Mon. 18" dn per F.B. 756-22 425-148 502-239 SET 2x2 PI.
COR
20 + 21
COUNTY SURVEYOR'S
1341.92 CO: 0.08 T: 80°: 1342.02'
Fd 2x2 PI. over C.S. Mon. per F.B. 756-22
SET NAIL P.P.
ROSECRANS
CARMENITA
Fd. NAIL
Conc. pump base
AVE
SET NAIL P.P.
SET NAIL P.P.
2669.02
804.82
Fd. NAIL TP

Notes Ck'd by
Map No. B-1[illegible]
Office Work Car
Checked D. M. Finley
Date AUG '51

Survey of [illegible]
W. O. [illegible] Tape No. [illegible] Std. [illegible]
Surveyed by L. E. Hammond
Notes [illegible] Date 7-6-42
Indexed [illegible]

F.B. [illegible] Pg. [illegible]

Note: Any Additions or Changes on This Sheet Must be Made or Circled in Red Ink With Date and Name of Person Making Change.

Do not extend notes this side of this line.

RETURN TO
LOS ANGELES COUNTY SURVEYOR
700 HALL OF RECORDS

FORM 267 SM 11-41

257.74=03°00'T=86°=258.05'

961.67'

(D) 292:33:30
(E) 225:57:20
(F) 158:52:50
761:29:20
33:30:40

FROM FT. 79.28

FIRESTONE

Tie to Rd dept.
(2) mg mon.

SET NAT.

Set 6.5PK+T
Fl. by inter.

764.11'

37.74

961.67'

39.33

2669.02

804.82

0.74

925.21

33:30:40

39:26:40

SET 3/4"PT by inter.

190+10.81

764-03°00'-00T=84°=764.11'

ROSECRANS AVE

S.W. & T. per
F.B. 756-25

RETURN TO
LOS ANGELES COUNTY SURVEYOR
700 HALL OF RECORDS

Note: Any Additions or Changes on This Sheet Must be Made or Circled in Red Ink With Date and Name of Person Making Change.

Do not extend notes this side of this line.

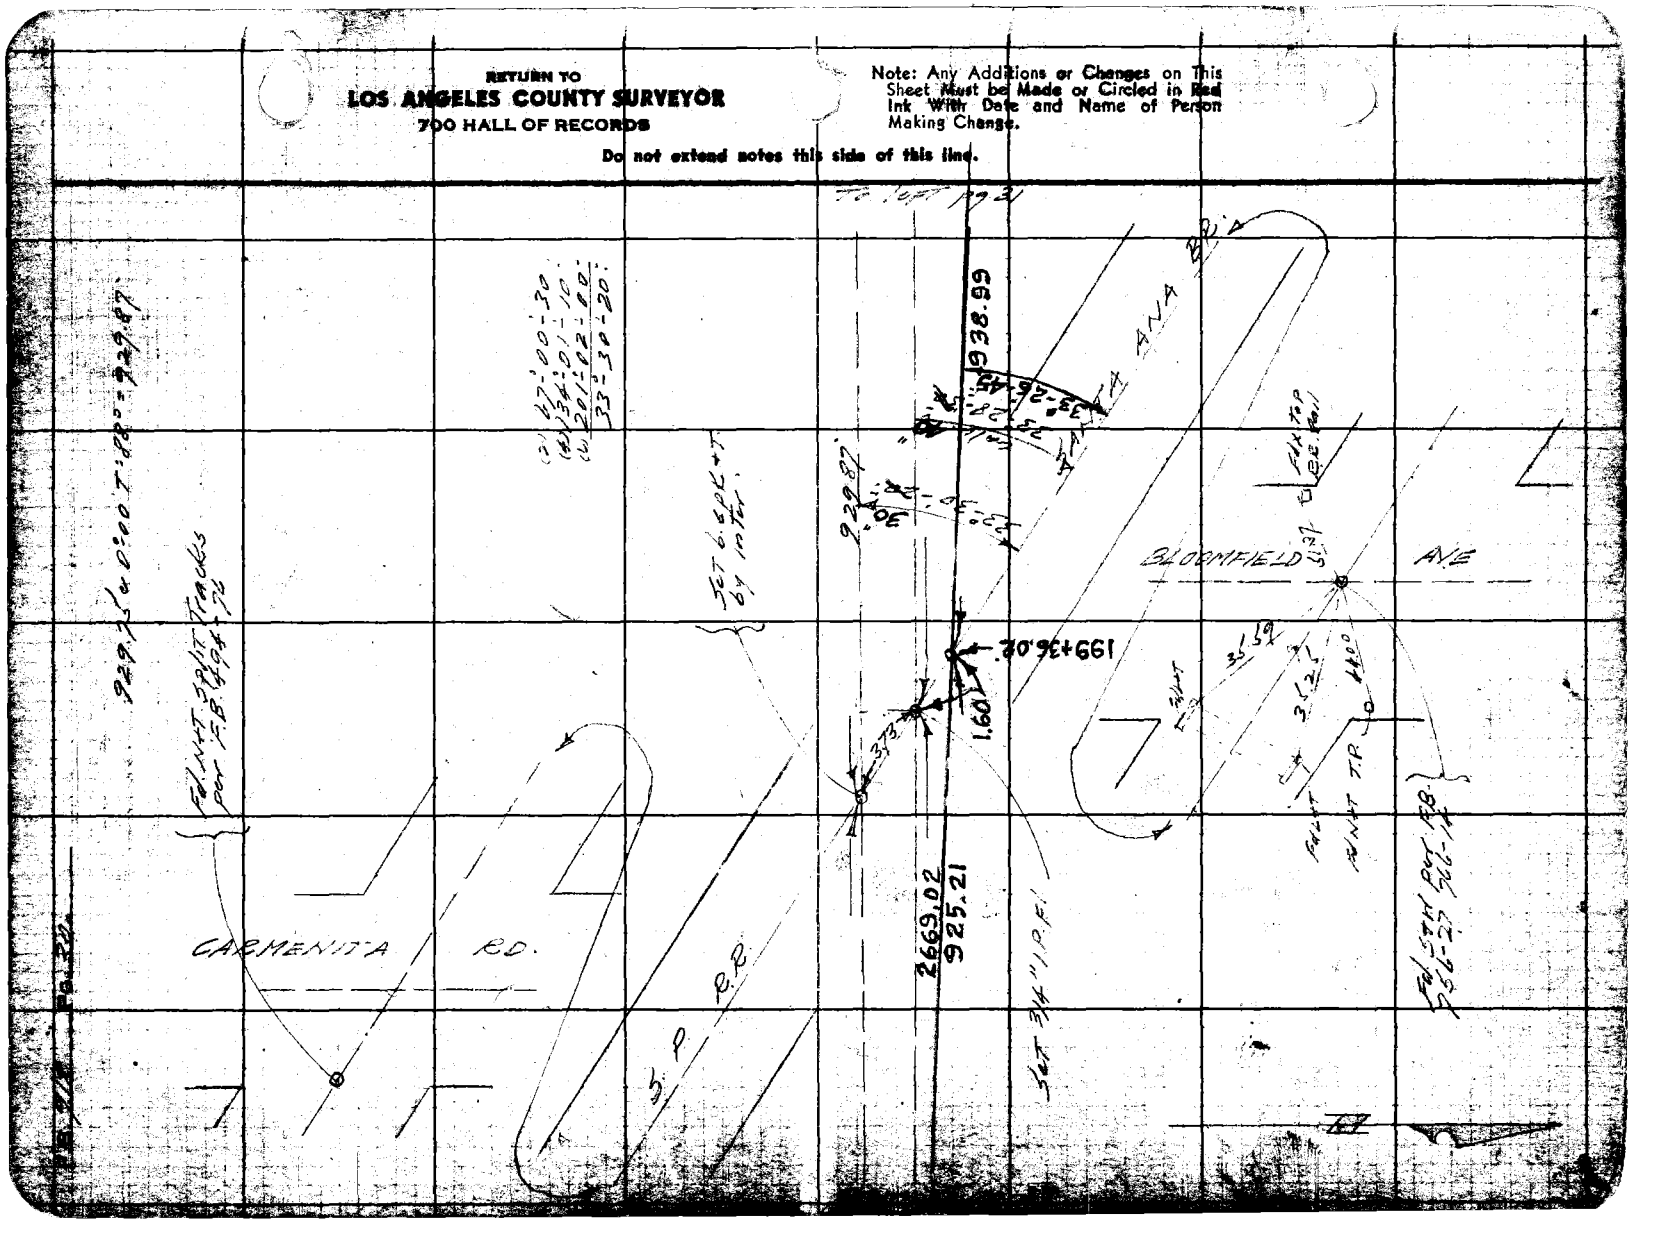

Notes Ck'd by
Office Work Complete
Checked D. M. Finley
Date AUG '51

Survey of
Surveyed by
Notes Date
Indexed

Note: Any Additions or Changes on this Sheet Must be Made or Circled in Ink With Date and Name of Person Making Change.

Do not extend notes this side of this line.

RETURN TO
LOS ANGELES COUNTY SURVEYOR
700 HALL OF RECORDS

CENTER

W.S. 44

Fd. 2" I.P. No tag. Ht. 2½ Ft. pan F.D. 2-2p7 ±± 33-203

Trav. Sta. Artesia F-2 Per F.B. 932-31.

SET NAT B.P.

SET NAT F.P.

1331.72 N 0°-00' W 84°-12' W

(32.26)

Set 6" spk + T. by inter.

Set NAT edge pave.

89°-22'-00"

S 90°-34' E

SOUTHERN PACIFIC

R. 565

1.35

2634

2633.02

S 89°-58'-30" E 2636.99

SET NAT I.P.

On 9-29-52 Fd. R.R. Spk & Tack Mrk

Set NAT calc dist. from random line

208+75.01 Center of Sec. 20 T. 3 S. R. 11 W. Located at rec. dist. (20.00) from 1½" iron pipe per R.S. 35-29.

(2) 181°-32'-30"
(4) 363°-05'-00"
(6) 184°-37'-20"
90°-66'-15"

On 9-29-52 Set A Std. C.S. Mon. Mrkd. As Shown 12" dp. in A well with a Cast Iron Cover On Surf. Marked - County Surveyor Monument

4 Boat Spk & T. 2 Tan. Ties On Surf

COUNTY SURVEYOR R 11 E 63 T 3 S SEC. 20 CTR.

Transit Line

FIRESTONE BLVD.

Calc. int.

Adopted & Sept. 25, 1952. C.S. 8018 (1129.73)

1127.03

1220.06

ROSECRANS

Fd NAT I.P.

Fd NAT T.P.

Fd 2" I.P. pan F.D. 756-24 F.B. 735-148 Set drive C.S. Mon F.B. 711-14

Calc. Sec. Corner

S 89°-58'-30" E 2636.99

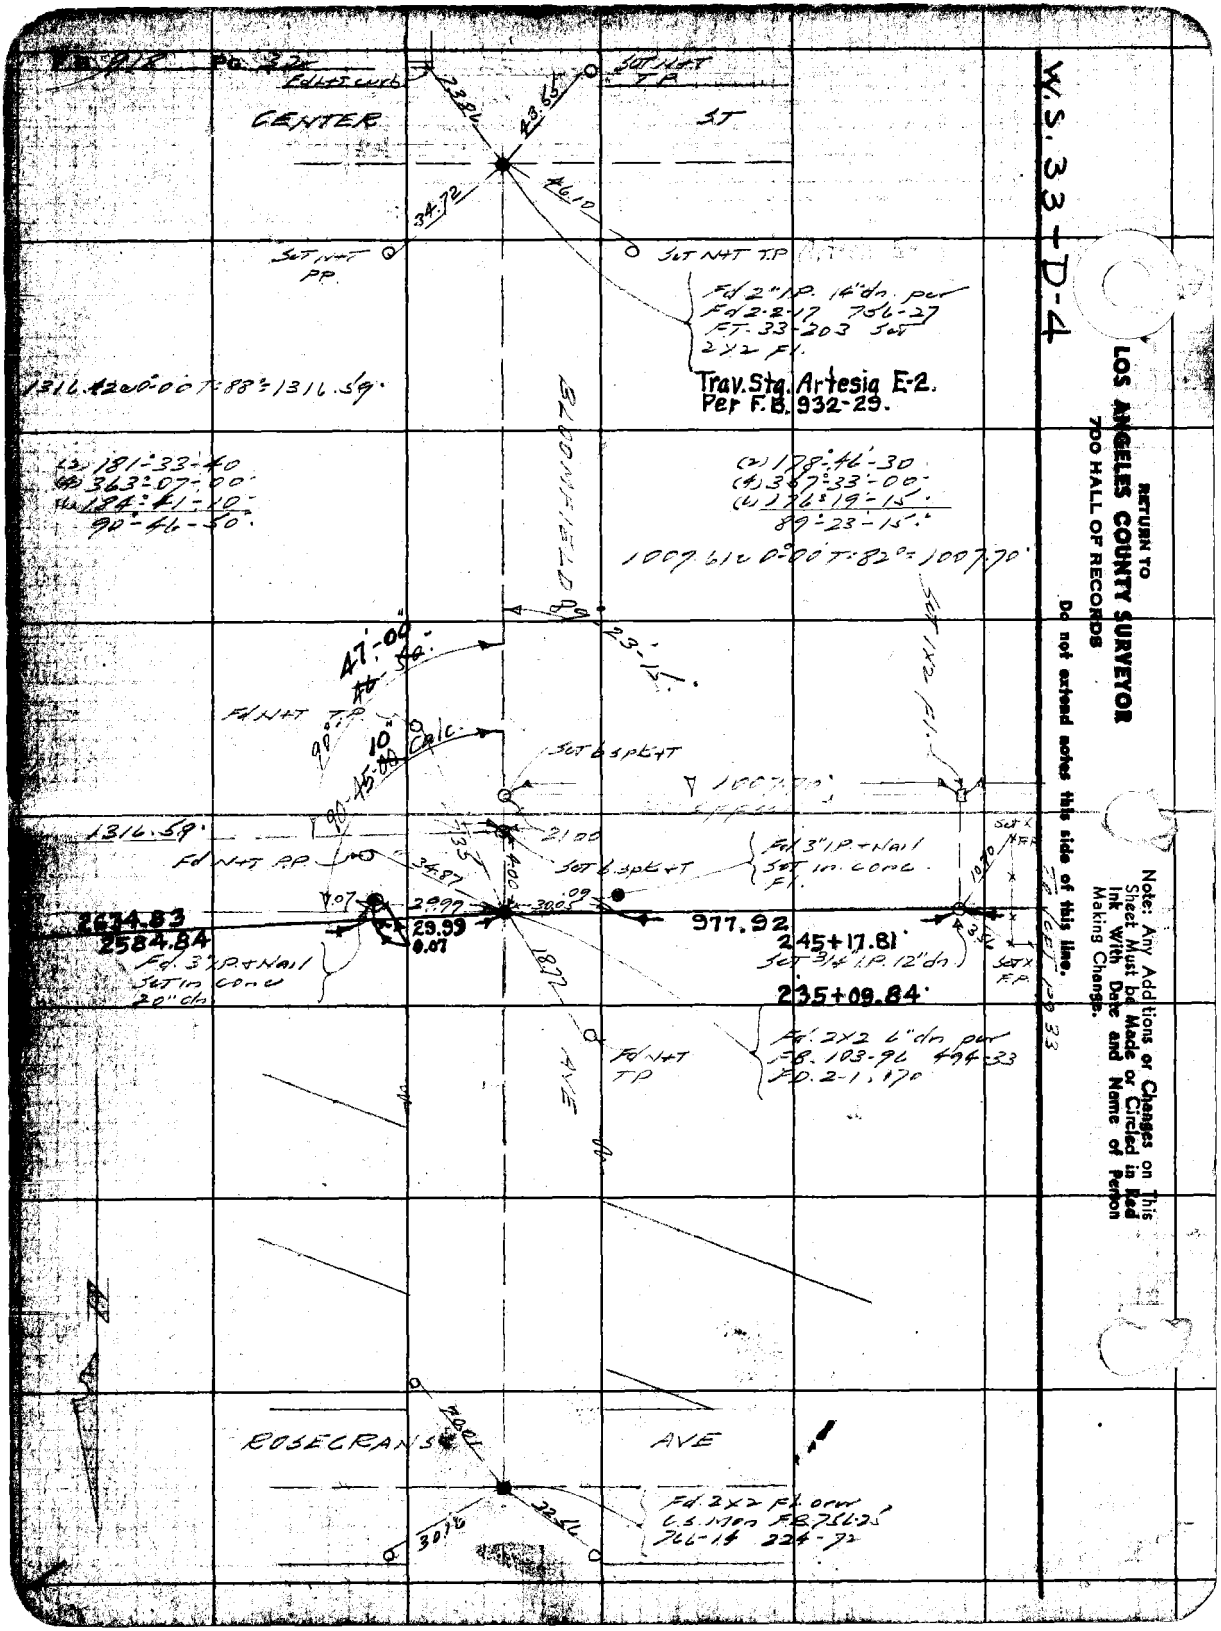
W.S. 33+D-4
RETURN TO
LOS ANGELES COUNTY SURVEYOR
700 HALL OF RECORDS
Do not extend notes this side of this line.
Note: Any Additions or Changes on This Sheet Must be Made or Circled in Red Ink With Date and Name of Person Making Change.
CENTER
ST
SET NAT TP
SET NAT PP
Fd 2" IP. 14' dn. per Fd 2-17 756-27 ET. 33-303 set 2x2 ft.
Trav. Stg. Artesia E-2. Per F.B. 932-29.
1316.42 0°00'T 88°=1316.59'
(2) 181°-33'-40"
(4) 363°-07'-00"
(6) 184°-41'-10"
90°-46'-50"
(2) 178°-46'-30"
(4) 357°-33'-00"
(6) 176°-19'-15"
89°-23'-15"
1007.61 0°00'T 82°=1007.70'
SET NAT FT.
47'-00"
Fd NAT TP
Calc.
Set 6 spk+t
1316.59'
Fd NAT PP
Fd 3" IP+Nail Set in conc F.
1674.83
2584.84
Fd 3" IP+Nail Set in conc 20" dn
977.92
245+17.81
Set 3/4" I.P. 12" dn
235+09.84
Fd 2x2 6" dn per 38-103-96 494-33 FD. 2-1-170
Fd NAT TP
ROSECRANS
AVE
Fd 2x2 FL. orw C.S. Mon FB 756-23 756-14 224-72

Notes Ck'd by
Map No. [illegible]
Office Work Cox
Checked D. M. Finley
Date AUG '51

Survey of Compton Blvd
W. O. [illegible] Tape No. [illegible] Ord. [illegible]
Surveyed by C.S. Haywood
Notes [illegible] Date 2-8-51
Indexed [illegible]

F.B. [illegible] Pg. [illegible]

Y.S. 35 10-4

CENTER

Fd X. Sign post

Fd Nail PP
Trav. Sta. Artesia Dr.
Per F.B. 932-27.
Fd C.S. Mon 20" ok
F.B. 502-26 Set 2x2
H.

179-05-15
359-60-45
179-48-15
89-57-40

NORMALO

1585.1700-00 T-78°=158

(a) 180-04-45
(b) 360-09-45
(c) 180-14-00
90-02-30

SOTX F.P.

1683.66
20' OFF SEC

FD NAIL PP

1683.66

1683.4800-00 T-84°=1683.66

262+01.49
Fd 2" I.P. in mon. well
cont. 12" dia. Asph.
F.D. 2, 170
T-58=1587.11

Fd 4"T into C
4"Ts. pvt. F.B. 7422
31 S82-29

ROSECRANS

AVE

BLVD.

Note: Any Additions or Changes on Sheet Must be Made or Circled in Ink With Date and Name of Person Making Change.

Do not extend notes this side of this line.

RETURN TO
LOS ANGELES COUNTY SURVEYOR
700 HALL OF RECORDS

FORM 847 3M 11-41

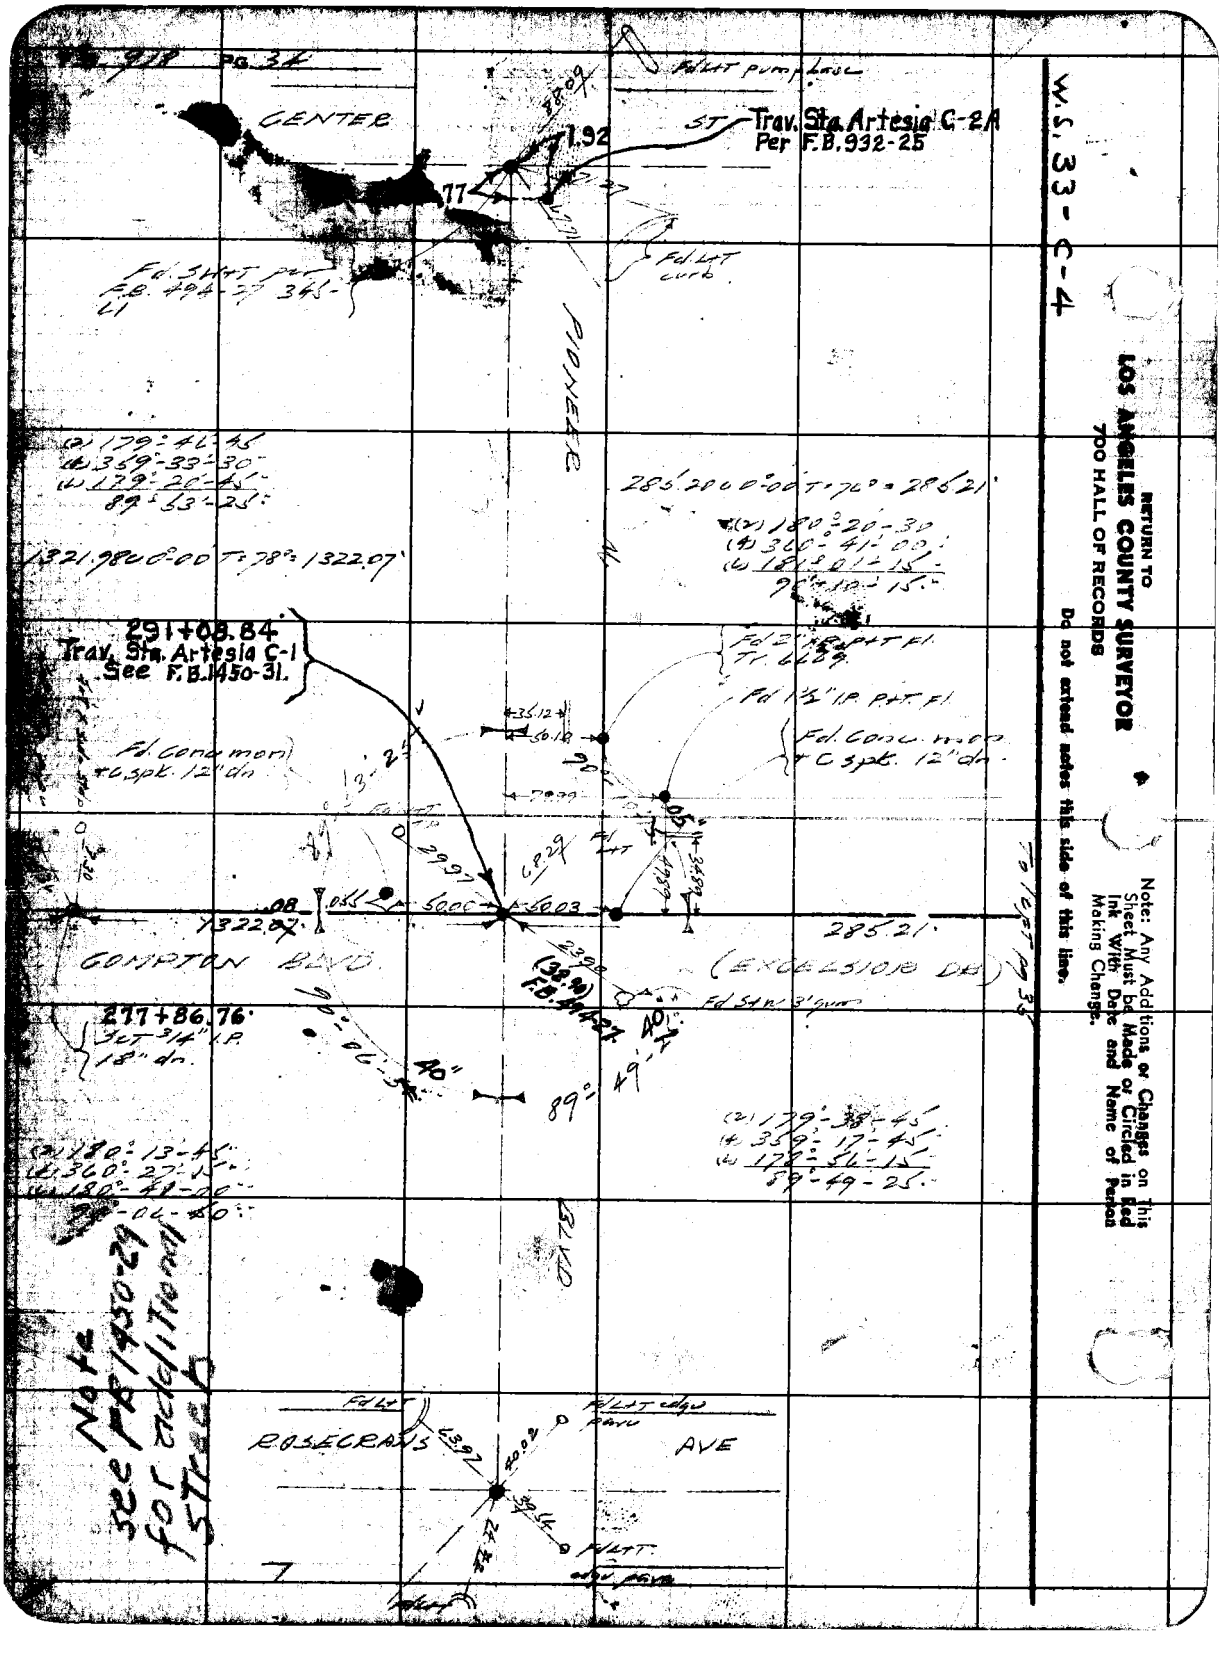
W.S. 33 - C-4
RETURN TO
LOS ANGELES COUNTY SURVEYOR
700 HALL OF RECORDS
Do not extend notes this side of this line.
Note: Any Additions or Changes on This Sheet Must be Made or Circled in Red Ink With Date and Name of Person Making Change.
CENTER
Trav. Sta. Artesia C-2A
Per F.B. 932-25
PIONEER
COMPTON BLVD
ROSECRANS AVE
291+08.84
Trav. Sta. Artesia C-1
See F.B. 1450-31.
217+86.76
Note
See PB 1450-29
for detail
station

Notes Ck'd by
Map No. A-1842 m.s.
Office Work Cox
Checked D. M. Finley
Date AUG 1ST

Survey of Compton Blvd
W. O. 3244 Tape No. 42 Ist'd. 40 °F
Surveyed by L. S. Hammond
Notes [illegible] Date 7-[illegible]-42
Indexed [illegible]

F.B. 918 Pg. 36

W.S. 33 34

Note: Any Additions or Changes on This Sheet Must be Made or Circled in Red Ink With Date and Name of Person Making Change.

Do not extend notes this side of this line.

RETURN TO
LOS ANGELES COUNTY SURVEYOR
700 HALL OF RECORDS









FORM 247 BM 11-41

F.B. 918 PG. 36

W. S. 33 - C - 4.

RETURN TO
LOS ANGELES COUNTY SURVEYOR
700 HALL OF RECORDS

Do not extend notes this side of this line.

Note: Any Additions or Changes on This Sheet Must be Made or Circled in Red Ink With Date and Name of Person Making Change.

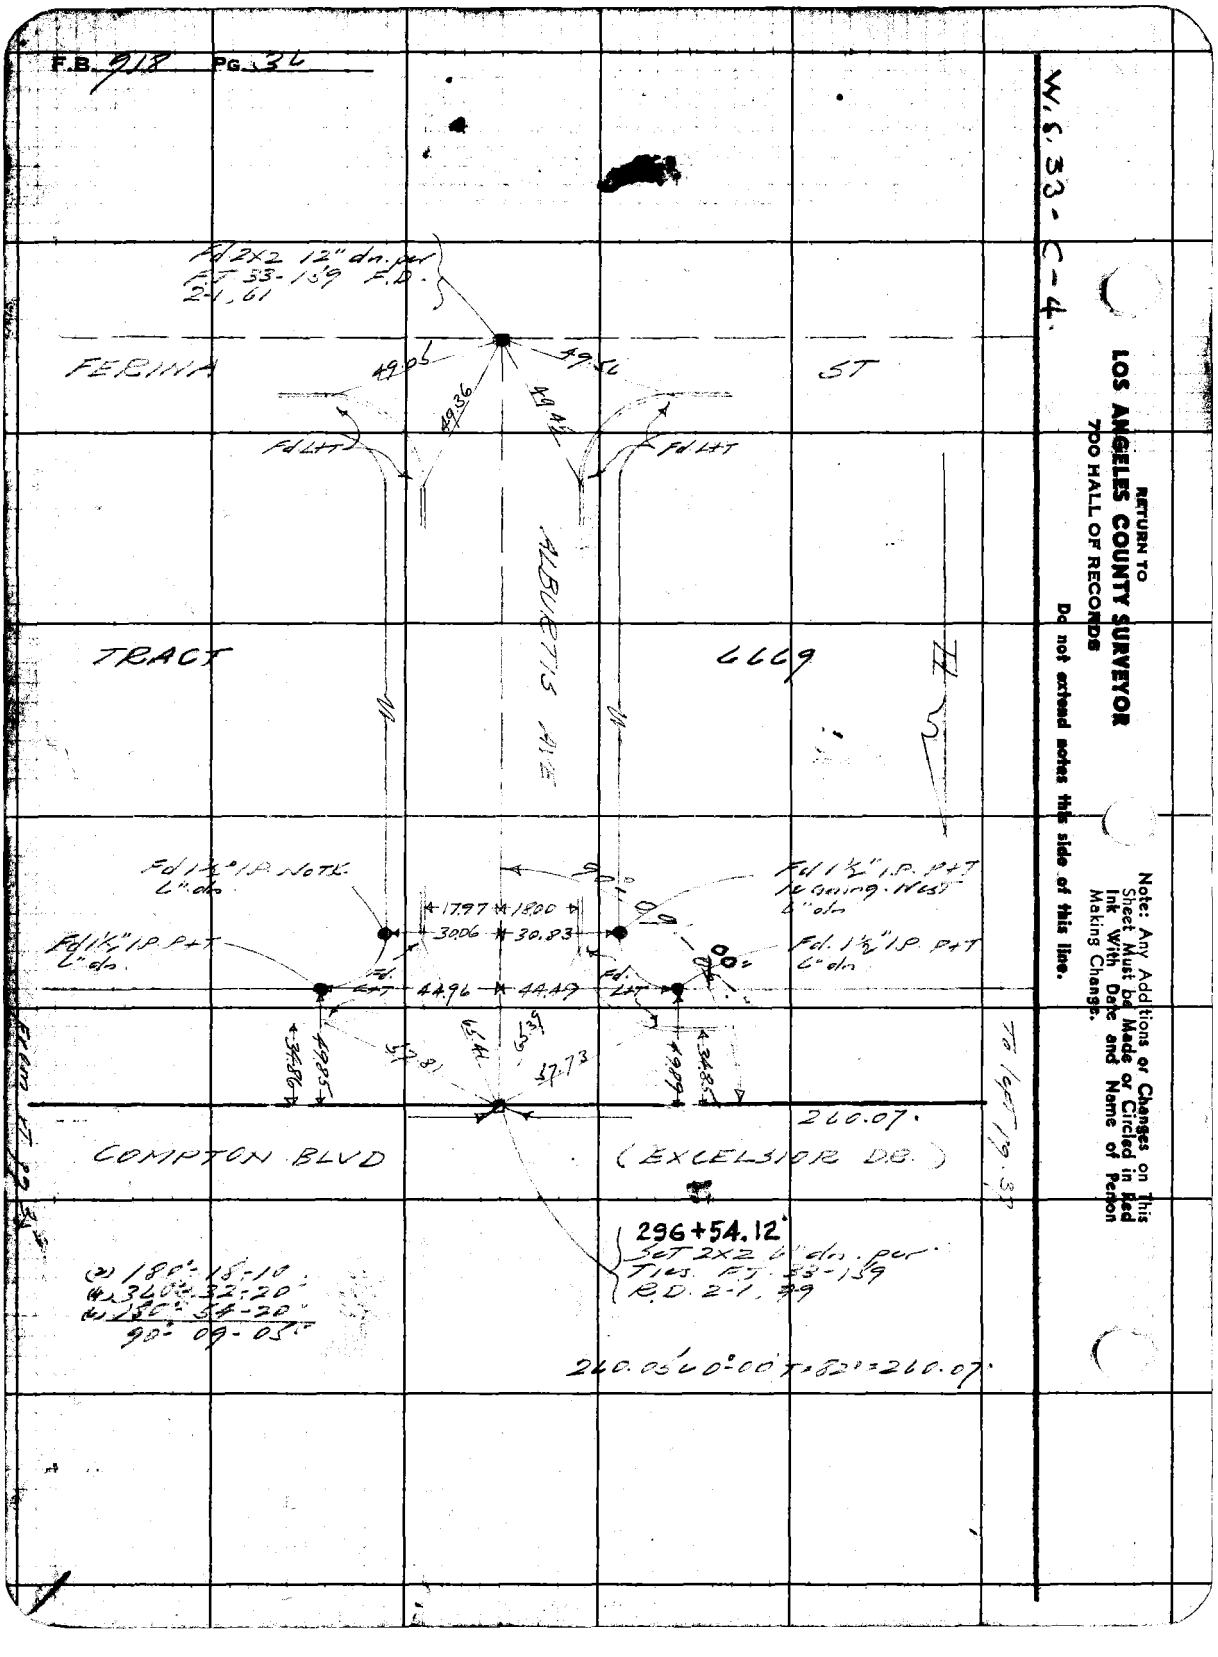

Notes Ck'd by
Map No. 5-1842-3
Office Work Cox
Checked D. M. Finley
Date AUG '51

Survey of
W. O. 834 Tape No. 273 St'd 68 °F
Surveyed by L.S. Hammond
Notes Date 7-21-51
Indexed A. G. Johnson

F.B. 918 Pg. 97

W.S. 33-4

Note: Any Additions or Changes on This Sheet Must be Made or Circled in Red Ink With Date and Name of Person Making Change.

Do not extend notes this side of this line.

RETURN TO
LOS ANGELES COUNTY SURVEYOR
700 HALL OF RECORDS

FORM 247 BM 11-41




























F.B. 918 Pg. 38

W.S. 33-C-4

RETURN TO
LOS ANGELES COUNTY SURVEYOR
700 HALL OF RECORDS
Do not extend notes this side of this line.

Note: Any Additions or Changes on This Sheet Must be Made or Circled in Red Ink With Date and Name of Person Making Change.

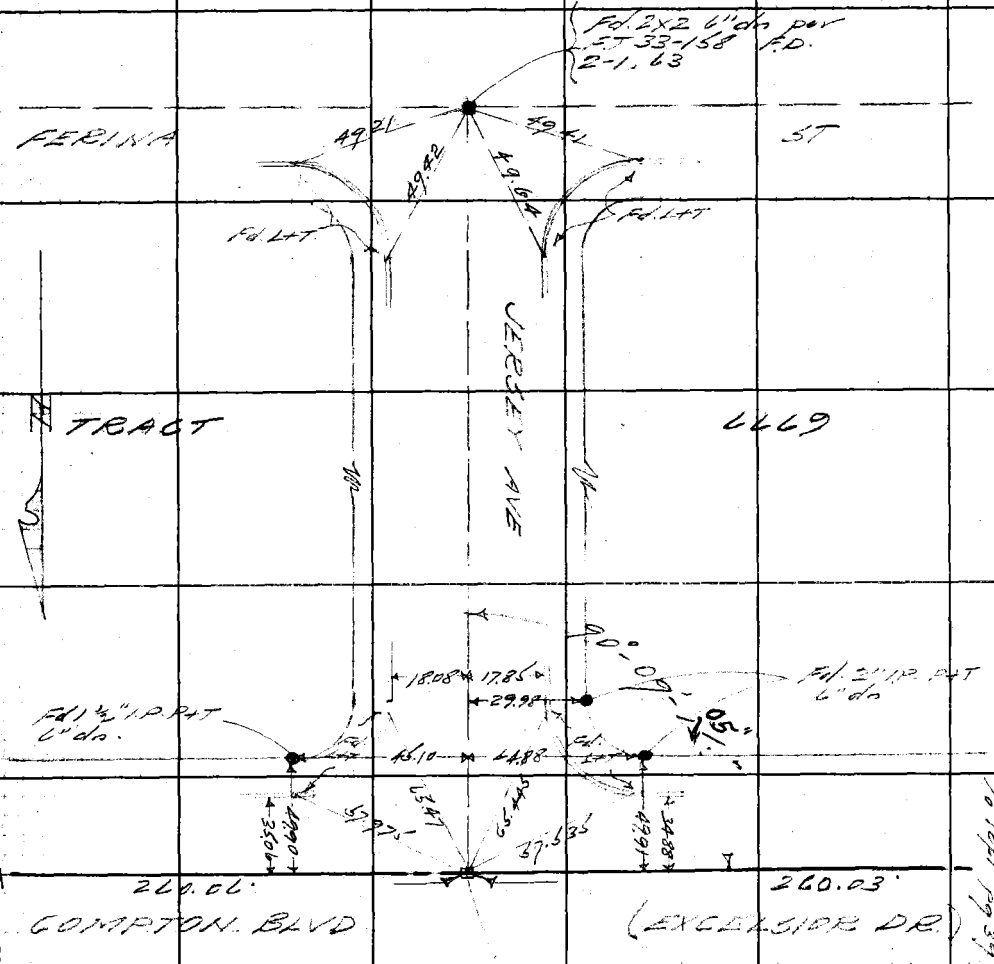

Notes Ck'd by
Map No. B-1842-3
Office Work Cox
Checked D. M. Finley
Date AUG '51

Survey of County Blvd
W. O. 234 Tape No. 973 St'd 6-5 °F
Surveyed by L. S. Hammond
Notes 6-21-51 Date 7-22-42
Indexed A. C. Johnson

F.B. 918 PG. 59

W.S. 33 C-4

Note: Any Additions or Changes on This Sheet Must be Made or Circled in Red Ink With Date and Name of Person Making Change.

Do not extend notes this side of this line.

RETURN TO
LOS ANGELES COUNTY SURVEYOR
700 HALL OF RECORDS

FORM 247 SM 11-41

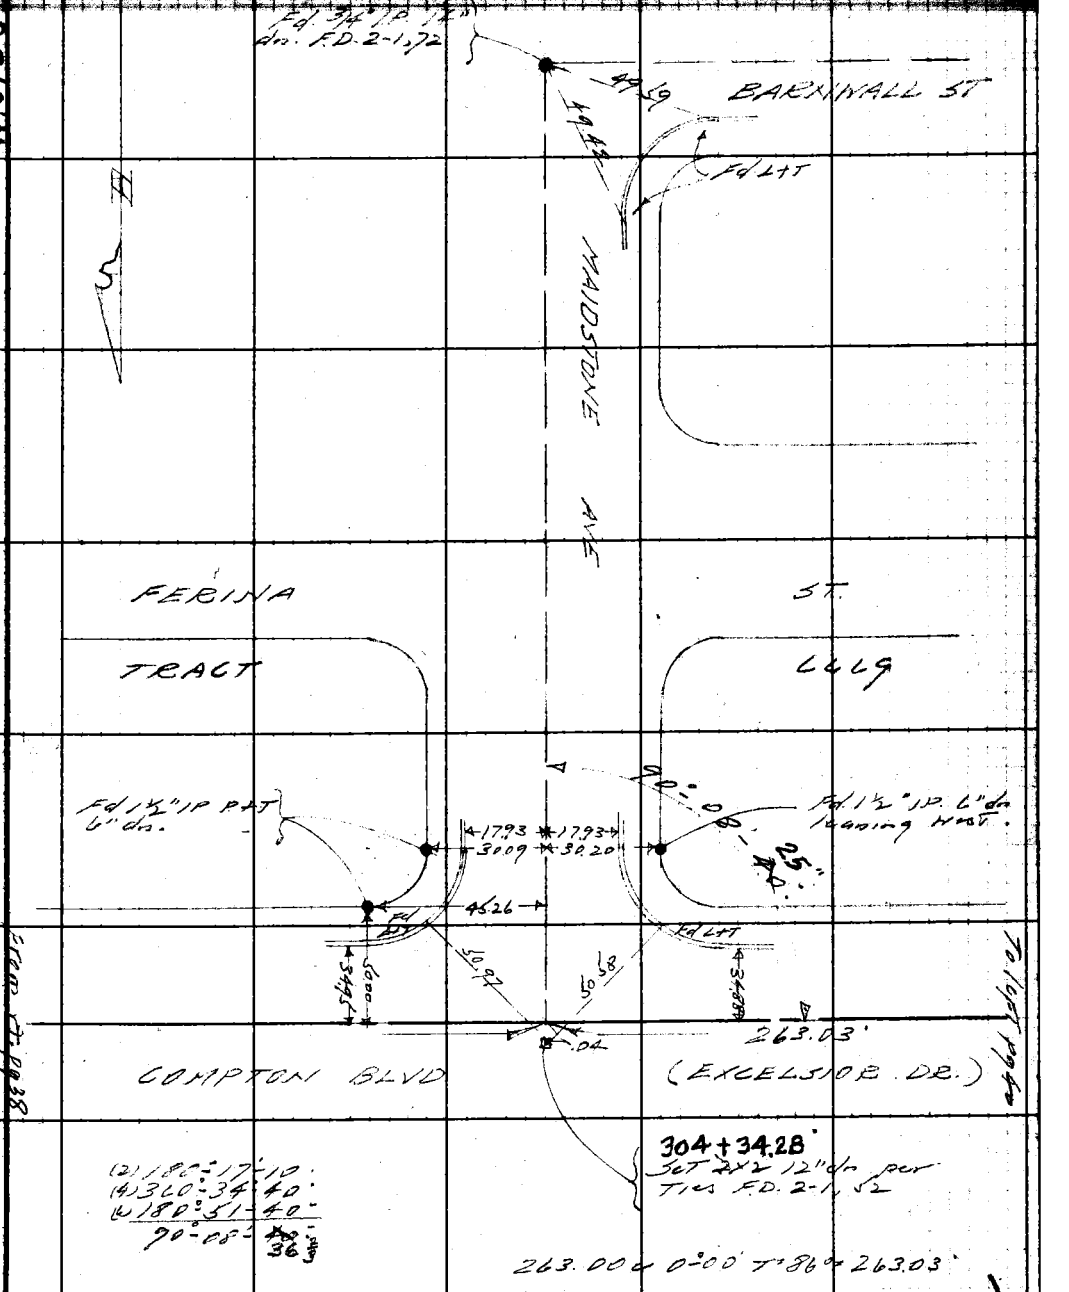

F.B. 918 PG. 40

W.S. 33-C-4

RETURN TO
LOS ANGELES COUNTY SURVEYOR
700 HALL OF RECORDS
Do not extend notes this side of this line.

Note: Any Additions or Changes on This Sheet Must be Made or Circled in Red Ink With Date and Name of Person Making Change.

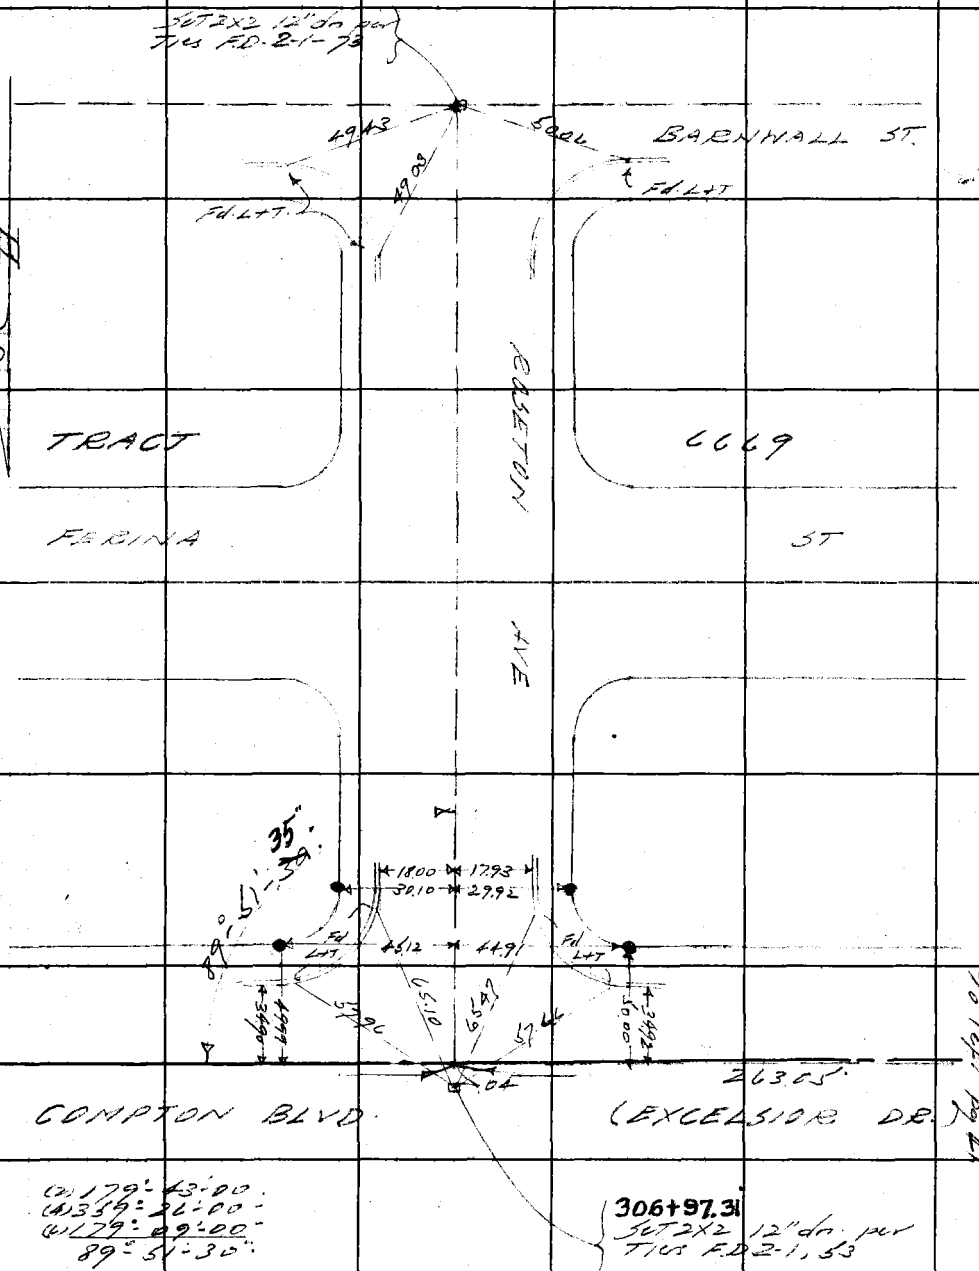

Notes Ck'd by
Map No. 19-1842-3
Office Work COX
Checked D. M. Finley
Date AUG '51

Survey of Compton 21
W. O. 834 Tape No. 873 St'd 48 °F
Surveyed by L. S. Hammond
Notes L.S.H. Date 7-24-51
Indexed E. C. Jones

F.B. 518 Pg. 41

W. S. 33 C-4

Note: Any Additions or Changes on This Sheet Must be Made or Circled in Red Ink With Date and Name of Person Making Change.

Do not extend notes this side of this line.

RETURN TO
LOS ANGELES COUNTY SURVEYOR
700 HALL OF RECORDS

FORM 247 BM 7-51

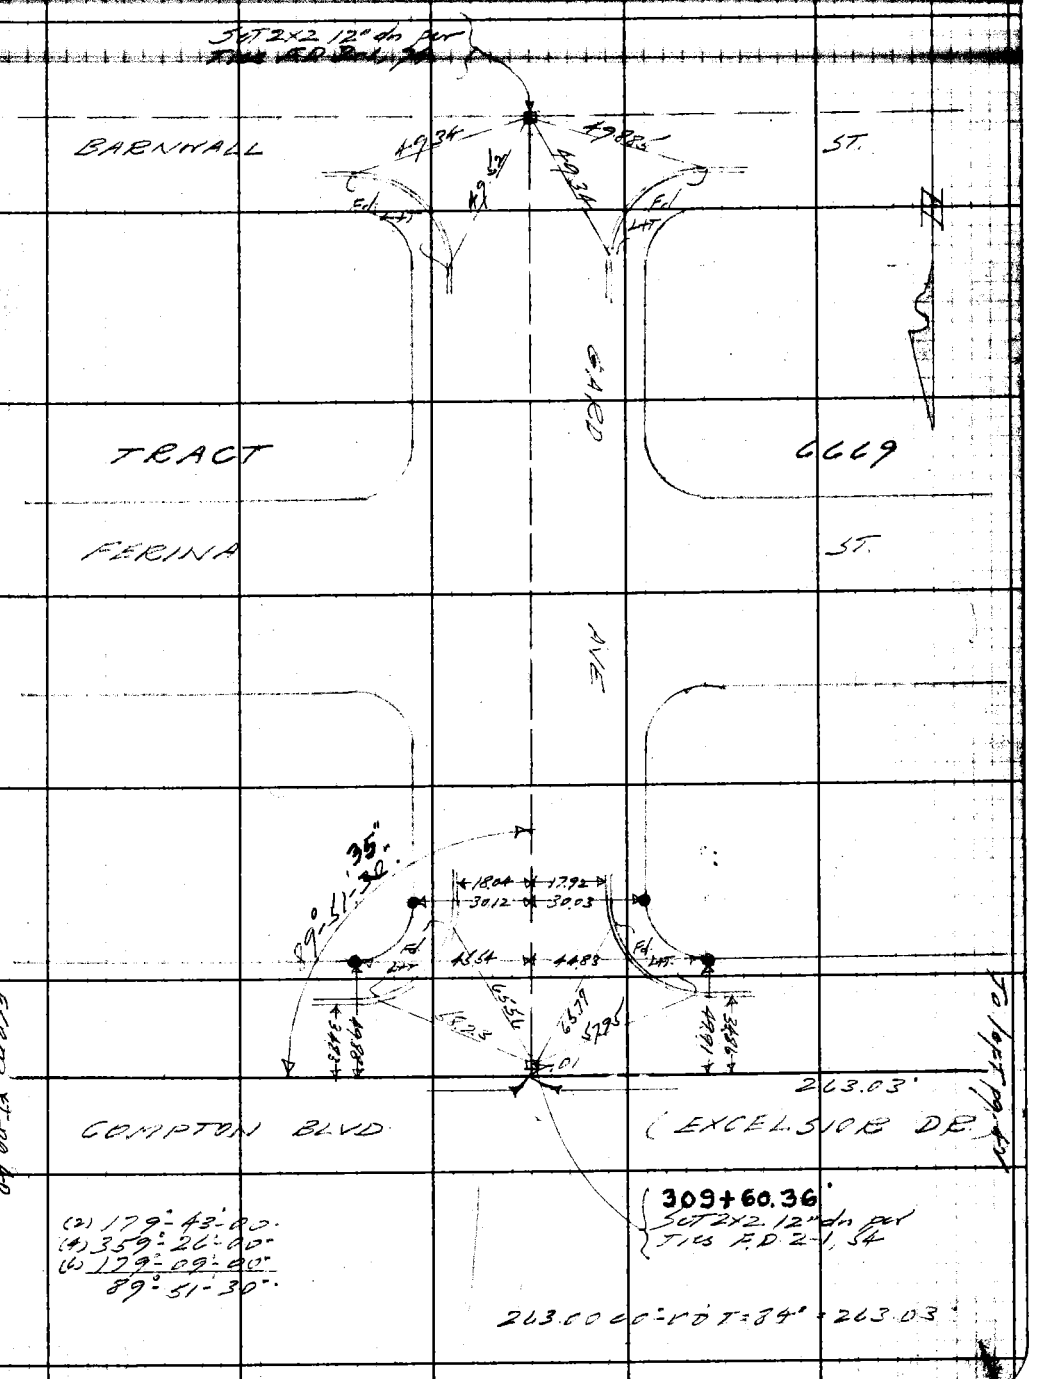

F.B. 918 Pg. 42

W.S. 33-C-4

RETURN TO
LOS ANGELES COUNTY SURVEYOR
700 HALL OF RECORDS
Do not extend notes this side of this line.

Note: Any Additions or Changes on This Sheet Must be Made or Circled in Red Ink With Date and Name of Person Making Change.

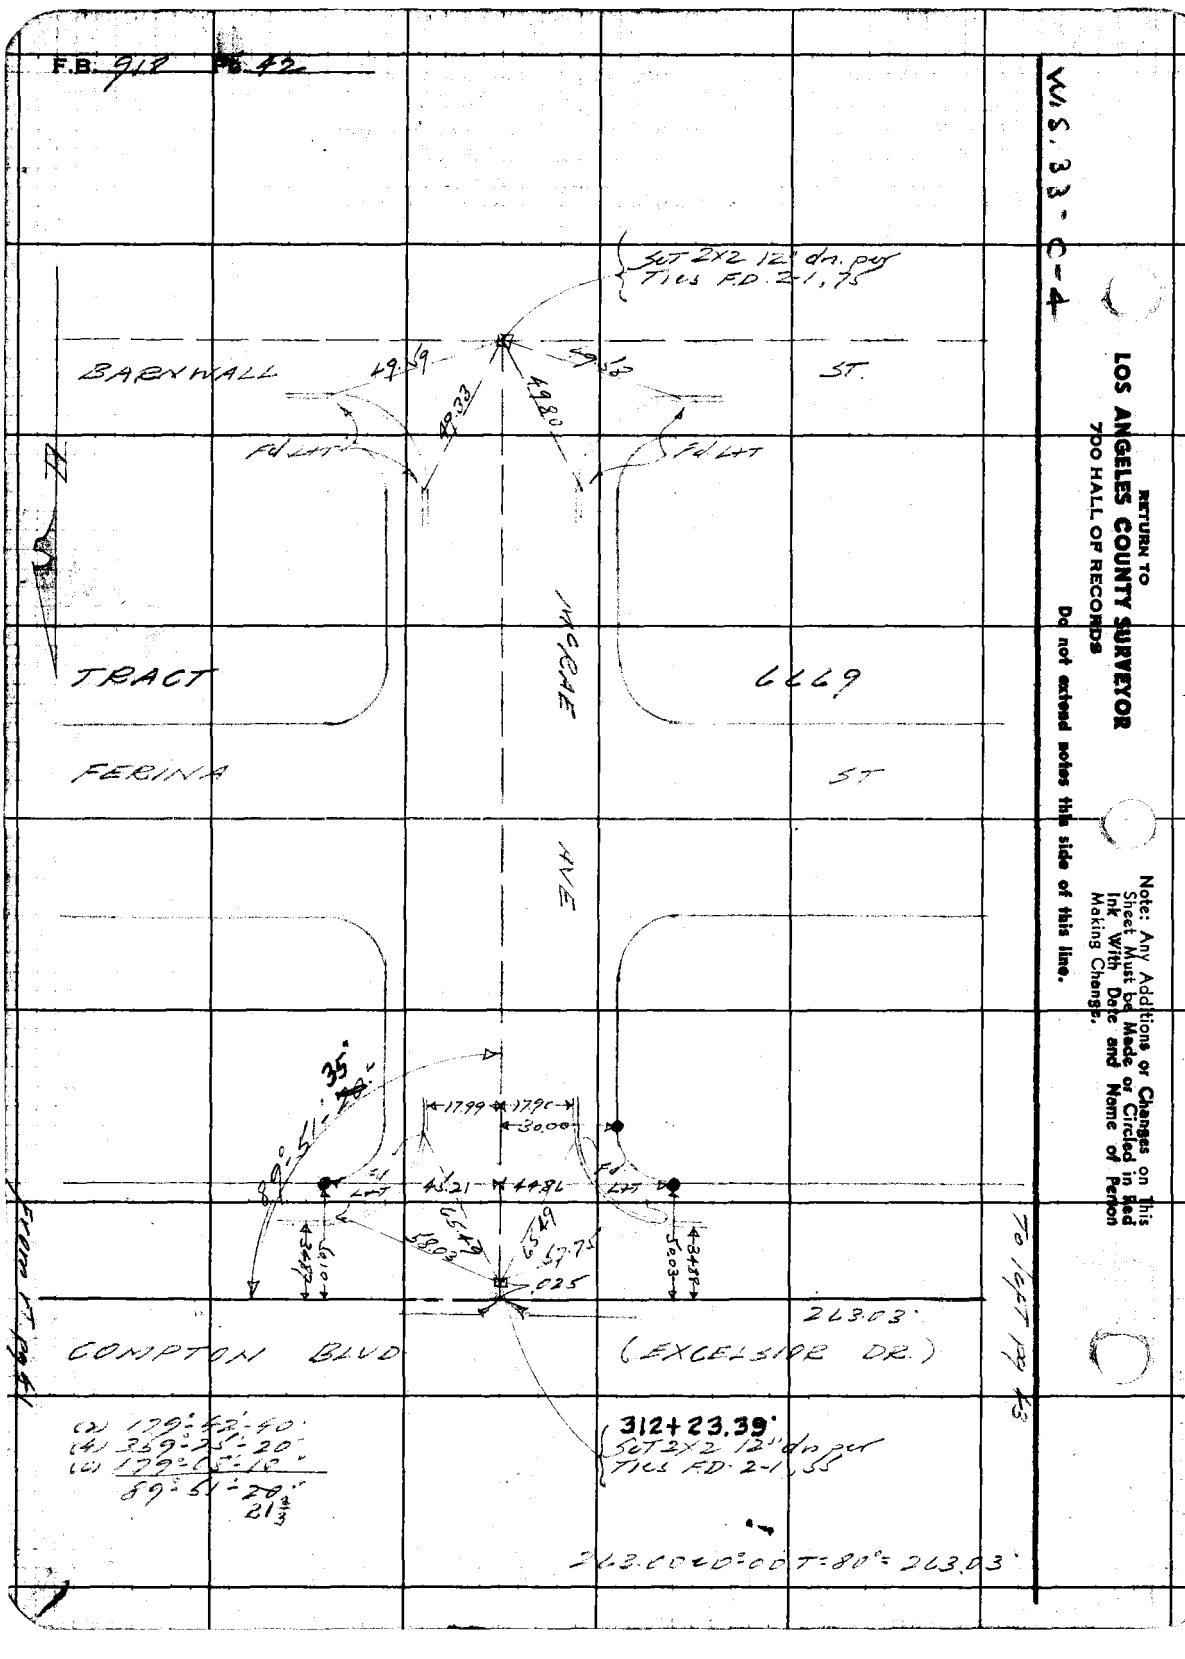

Notes Ck'd by
Map No. 9-1242-3
Office Work Cox
Checked D. M. Finley
Date AUG 51

Survey of Compton Blvd
W. O. 8351 Tape No. 273 St'd 62 °F
Surveyed by L. S. Hammond
Notes 4 S 14 Date 7-22-42
Indexed A. C. Johnson

F.B. 993 Pg. 49

W. S. 33 G-4

Note: Any Additions or Changes on This Sheet Must be Made or Circled in Red Ink With Date and Name of Person Making Change.

Do not extend notes this side of this line.

RETURN TO
LOS ANGELES COUNTY SURVEYOR
700 HALL OF RECORDS

FORM 247 BM 15-41

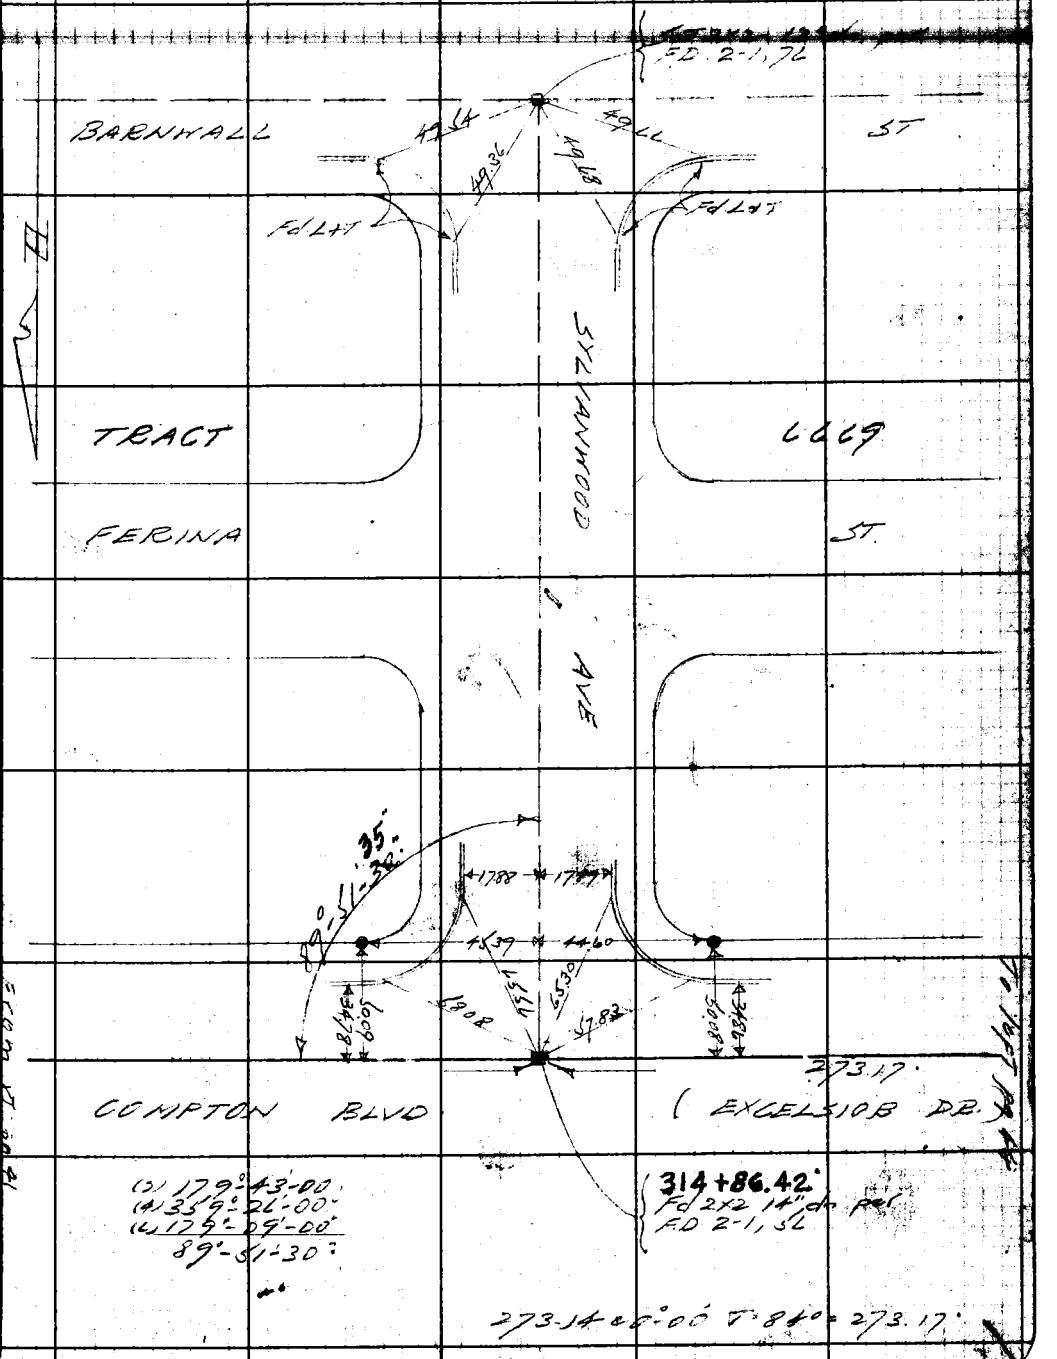

RETURN TO
LOS ANGELES COUNTY SURVEYOR
700 HALL OF RECORDS

Note: Any Additions or Changes on This Sheet Must be Made or Circled in Red Ink With Date and Name of Person Making Change.

Do not extend notes this side of this line.

W.S. 33-C-4

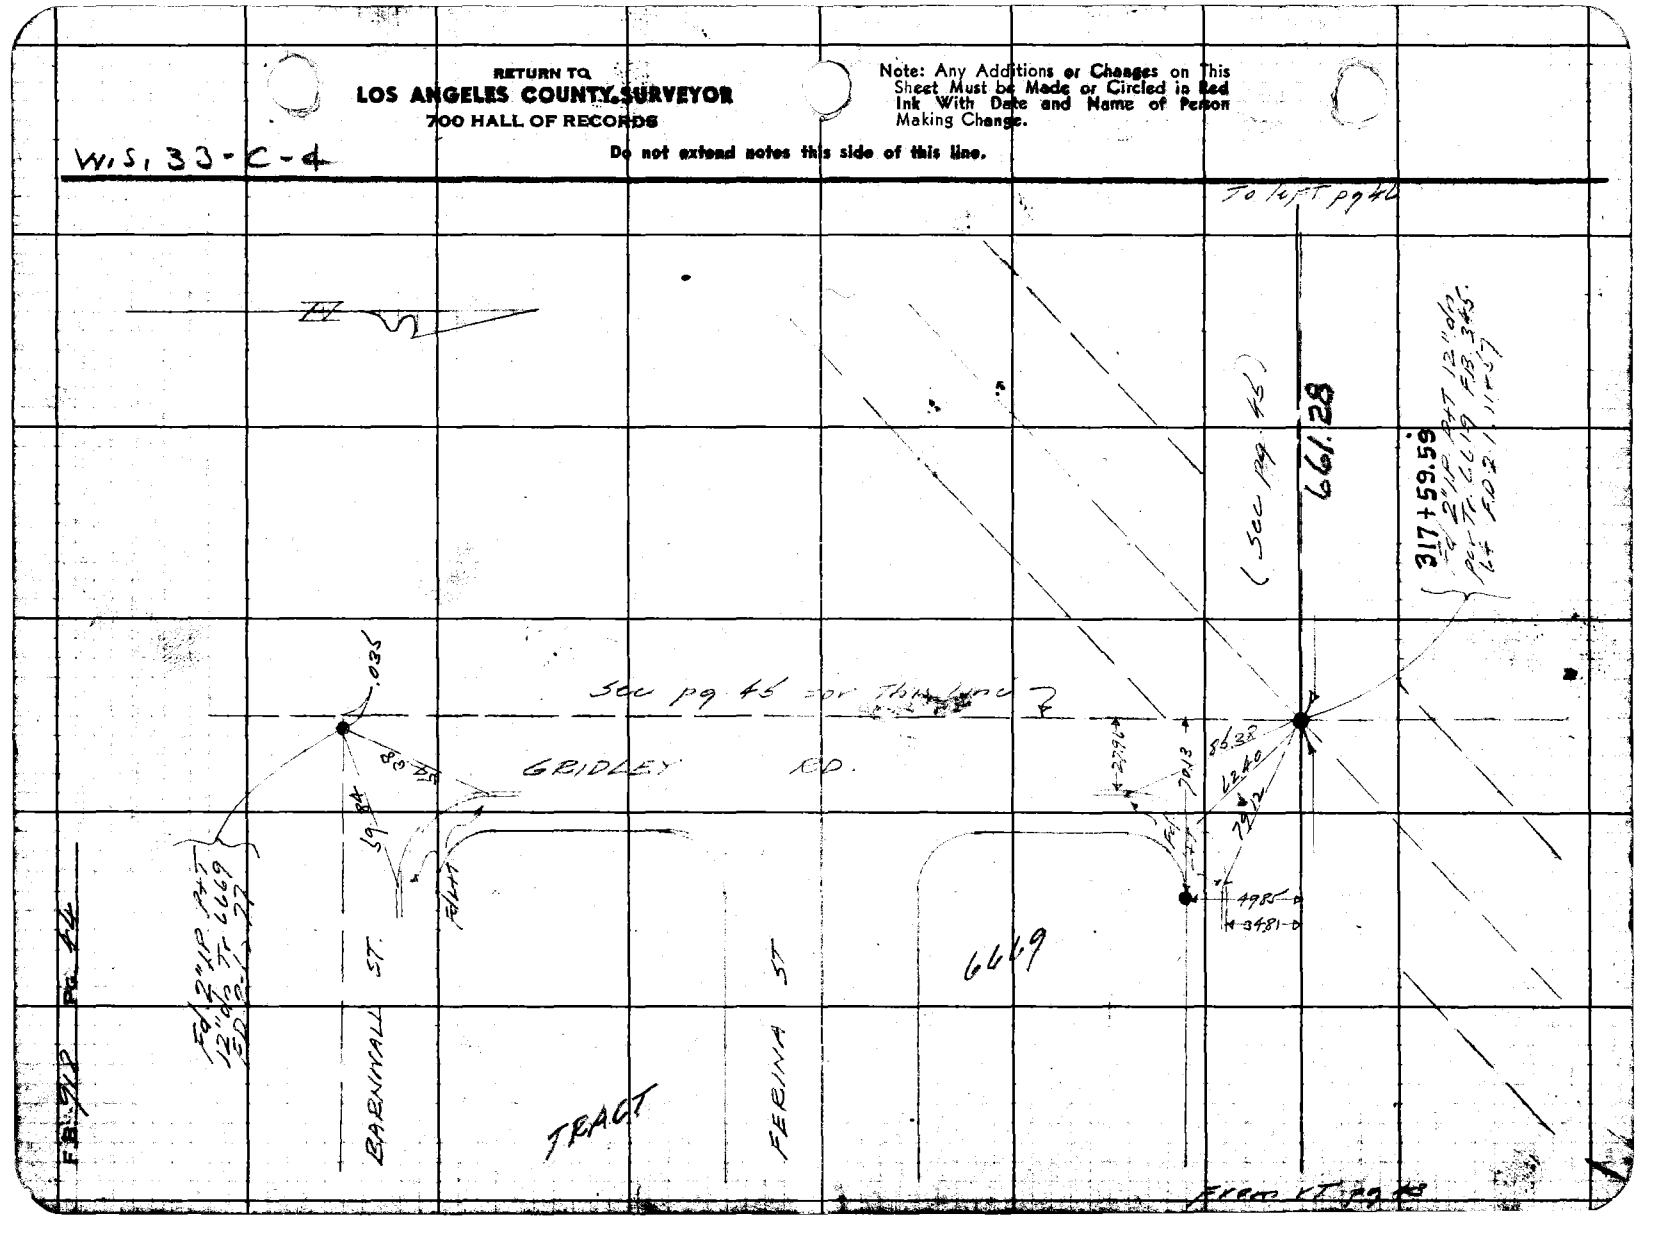

Notes Ck'd by
Map No. B-1942-3
Office Work Cor
Checked D. M. Finley
Date AUG 31

Survey of Gen. Eng. Dept.
W. O. 2314 Tape No. 073 Std. 08 °F
Surveyed by E. S. Hammond
Notes E.S.H. Date 8-29-22
Indexed

F.B. 918 PG. 39

W.S. 3-C-4

(a) 180-13-00
(b) 340-24-15
90-06-30

CENTER

(a) 179-47-00
(b) 359-33-45
(c) 179-20-45
89-53-30

Trav Sta Artesia B-2
Per F.B. 932-23
Fd. 3/4" I.P. per FD 2-1, RS
FD 393 RS

Fd. 0.5 pk + cone mon. 15" dn.

(PROPOSED)

317+59.59
Fd. 2" I.P. P&T 12" dp. per Tr. 6669 FB. 34
LA FD 2-1, 317

GUNDLEY RD.

DR.

90-04-35

BLVD

COMPTON

EXCELSIOR DR.

Fd. 2x2 24" obl. per FB. 345/12

45-03-35

50"

15"

ANTONIO

SAN

(a) 180-12-45
(b) 340-25-45
(c) 180-38-00
90-04-20

(a) 179-47-45
(b) 359-34-45
(c) 179-21-45
89-53-35

Fd. L&T. per FD 2-1, 9
FB. 756-106

Fd. L&T. Fd. L&T. Fd. L&T.

2127

(a) 90-07-00
(b) 180-14-15
(c) 270-21-30
45-03-35

ROSECRANS AVE

Note: Any Additions or Changes on This Sheet Must be Made or Circled in Red Ink With Date and Name of Person Making Change.

Do not extend notes this side of this line.

RETURN TO
LOS ANGELES COUNTY SURVEYOR
700 HALL OF RECORDS

FORM 247 BM 10-41

F.B. 918 Pg. 46

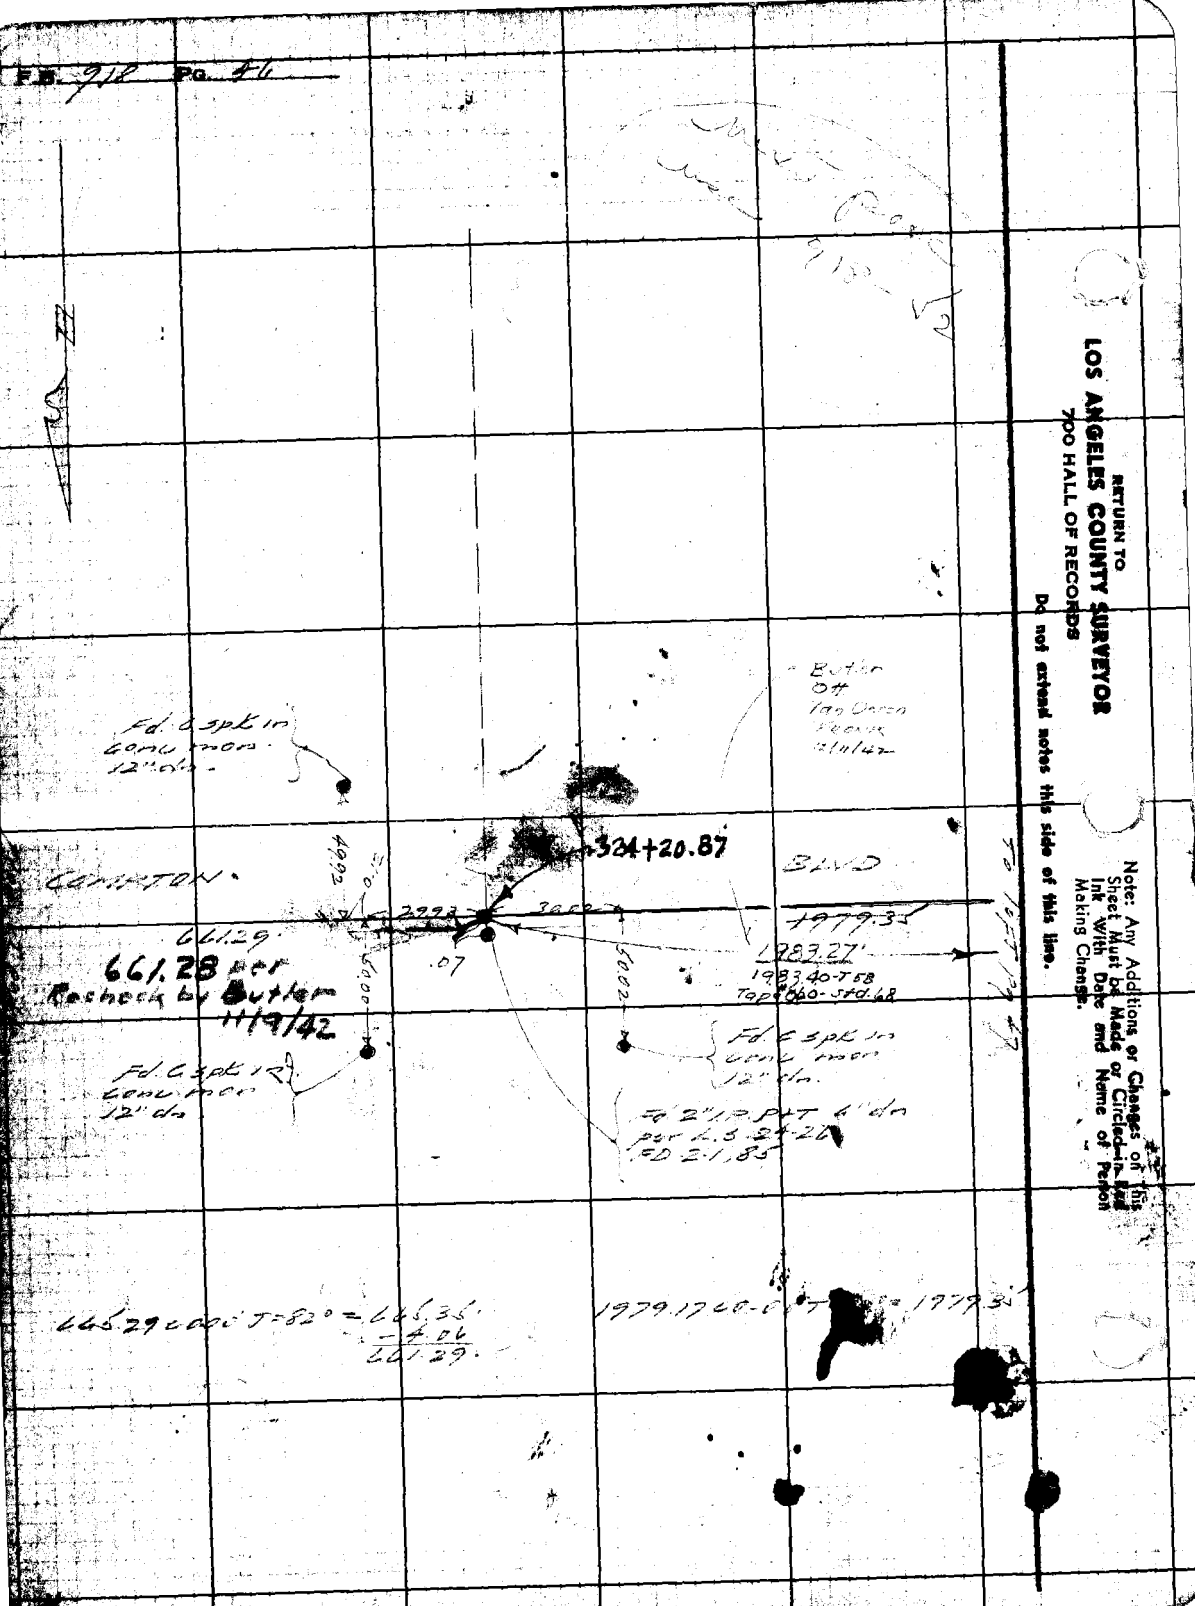
RETURN TO
LOS ANGELES COUNTY SURVEYOR
700 HALL OF RECORDS
Do not extend notes this side of this line.
Note: Any Additions or Changes on this Sheet Must be Made or Circled in Red Ink With Date and Name of Person Making Change.
Fd. C 3pk in conc mon 12" o/s
Butler 04 100 Varas Reset 11/11/42
324+20.87
BLVD
661.29
661.28 per Recheck by Butler 11/19/42
1979.32
1983.27'
1983.40-T58
Tape 060-SF0.68
Fd. C 3pk in conc mon 12" o/s
Fd. C 3pk in conc mon 12" o/s
Fd 2" IP PT 4' o/s per L.S. 2-20 ED 2-1-85
1979.32

Notes Ck'd by _____ Survey of _____ F.B. _____ No. _____
Map No. _____ Tape No. _____ Std. _____ of _____
Office Work Cox Surveyed by L.S. Hammond
Checked D. M. Finley Notes _____ Dated 8-27-51
Date AUG '51 Indexed _____

Note: Any Additions or Changes on Sheet Must be Made or Circled in Ink With Date and Name of Person Making Change.

Do not extend notes this side of this line.

RETURN TO LOS ANGELES COUNTY SURVEYOR 700 HALL OF RECORDS

CENTER

Trav. Sta. Artesia A-2
Per F.B. 932-21.

STUDEBAKER

Butler & Gregory Front Mon. 11/9/42

COMPTON

1983.27'
See prec. pg.

Found Tie

Set ¾ spkt.

281.10 To B.C.

2662.22

For Continuation of Proposed ℄ See F.B. 145-32

90°01'

N.E. Cor. Sec. 25 T. 3S. R. 11W.

ROSECRANS AVE.

9.67

9.70

RETURN TO
LOS ANGELES COUNTY SURVEYOR
700 HALL OF RECORDS
Do not extend notes this side of this line.
Note: Any Additions or Changes on This Sheet Must be Made or Circled in Red Ink With Date and Name of Person Making Change.

W.S. 33 - P-4

CENTER

SAN GABRIEL RIVER

Center of Sec. 23 T.3S., R.12W. Established by Intersection. Nothing set

¼ SECTION LINE

¼ Sec. Cor. Fd Sw+T per F.B. 494-22 756-109

Fd Nail+T pcw F.B. 494-23 756-109

(2) 179°-46'-00"
(4) 359°-32'-00"
(1) 179°-15'-00"
89°-53'-00"

(3) 179°-45'-30"
(4) 359°-31'-15"
(1) 179°-16'-30"
89°-52'-45"

Fd. 2" I.P. Cem. P.L. 2'N. & 1' on W. Lance. C.N.& E. 2'E. & 1' N. on W. Lance 3-16-50 [illegible]

ROSECRANS AVE

2602.22'
2455.35'
20
51.60
95.37
1.76
2558.53
2560.39
146.92
51.60
51.49
93.58
.57
145.17 Meas. F.B. 1450-35

Set 1x2 F1 top Lance Fd. 1x2 F1 N.04 W. of L.L. 3-16-50 [illegible]

Set 1x2 F1 on int.

Set 1x2 F1 top Lance Fd. 1x2 F1 N.04 W. of L.L. 3-16-50 [illegible]


¼ Sec. Cor. Fd L&T pcw F.B. 756-109

Fd 2x2 cor. F.B. 756-109 RM. 2' E. 4.60-2 RE. 4.07 Tie FD 21 29.

14.83
26.92
28.78
14.80
51.52
20.98
2.83
15.24
1.59°
5T.
14.83
23.83
23.50
21.43
51.68
39.15
24.09
23.14

Notes Ck'd by
Office Work Cox
Checked D. M. Finley
Date AUG '51

Survey of
Surveyed by
Notes
Indexed

F.B. P.G.

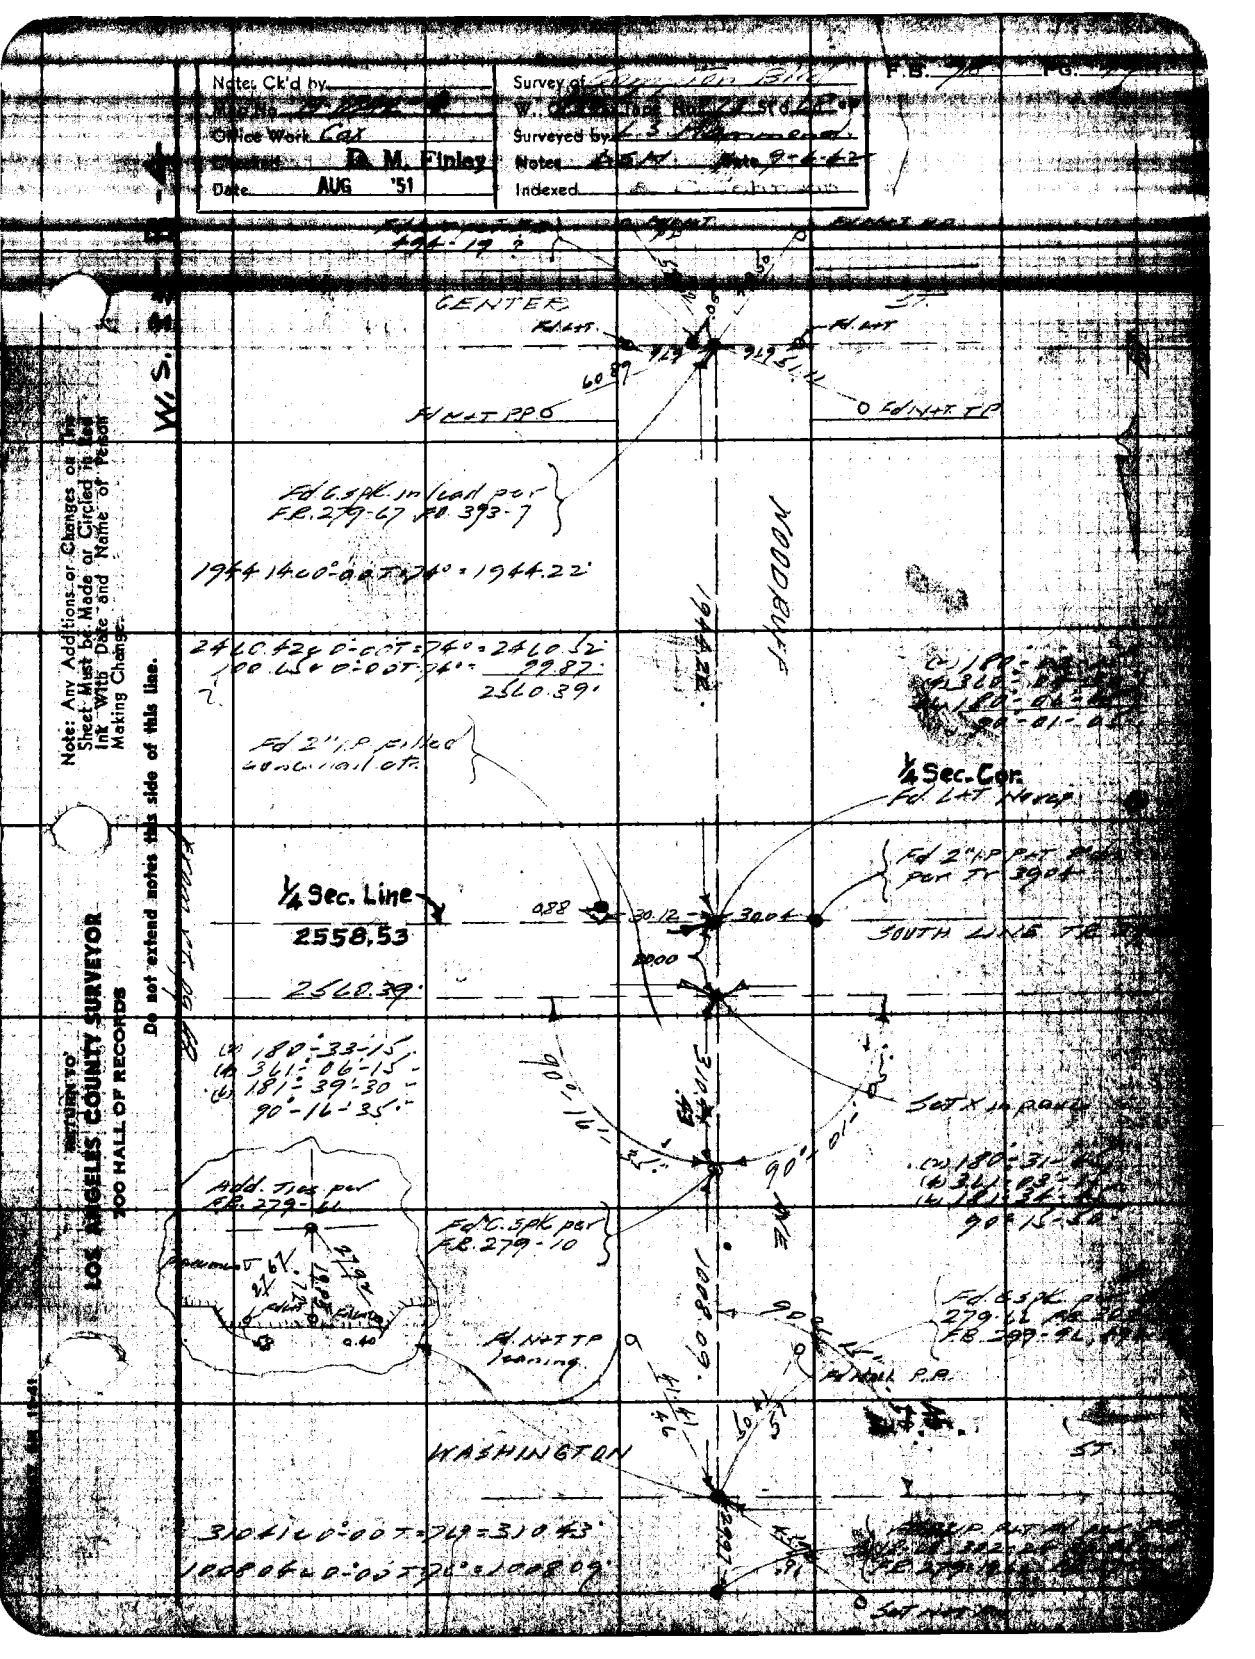

RETURN TO
LOS ANGELES COUNTY SURVEYOR
700 HALL OF RECORDS

Note: Any Additions or Changes on This Sheet Must be Made or Circled in Red Ink With Date and Name of Person Making Change.

Do not extend notes this side of this line.

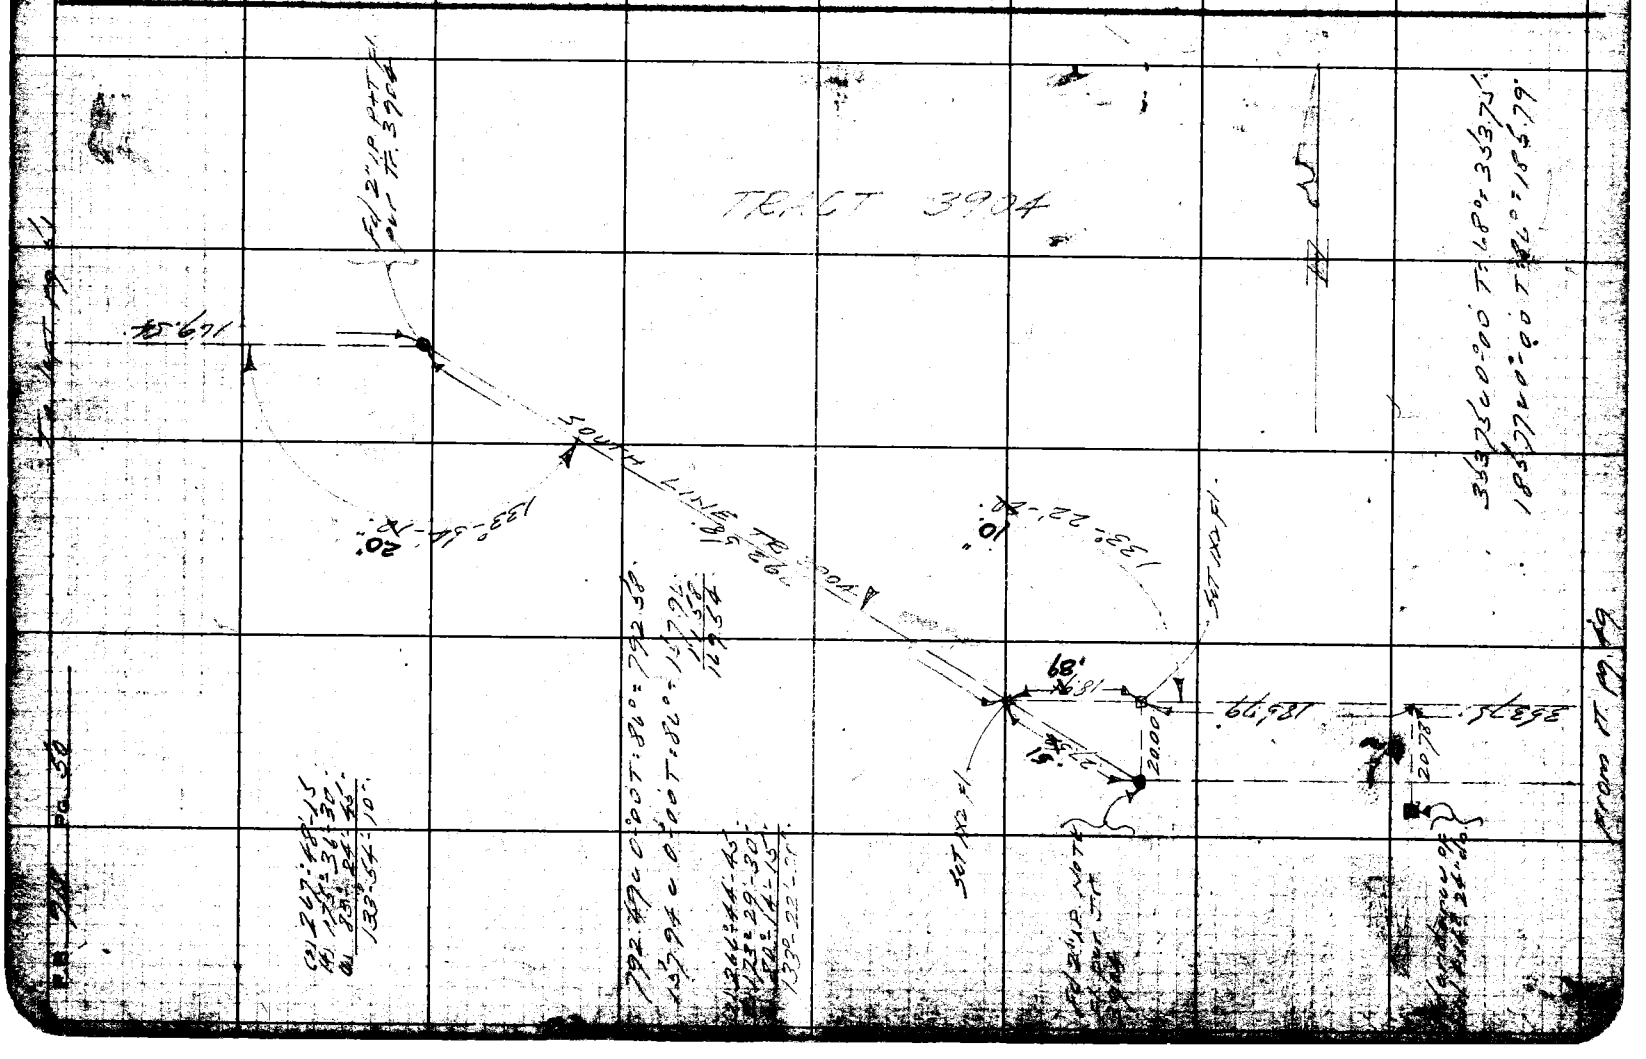

Notes Ck'd by [illegible]
Map No. A-1842-4
Office Work Cox
Checked D. M. Finley
Date AUG '59

Survey of Compton Blvd
W. O. [illegible] Tape No. 172 Std'd. 62 °F
Surveyed by L. Hammond
Notes L.S.A. Date 9-8-58
Indexed C. Johnson

F.B. 948 PG. 37

(a) 290°-15'-00"
(b) 220°-30'-00"
(c) 150°-45'00"
45°-07'-30"

Note: Any Additions or Changes on This Sheet Must be Made or Circled in Red Ink With Date and Name of Person Making Change.

Do not extend notes this side of this line.

RETURN TO LOS ANGELES COUNTY SURVEYOR ... RECORDS

W.S. 23-B4

1452.15 Cal. 1452.16 Rec.

Fd 3/4" I.P. Ft.

Set 1x2 Fl. Mk. 113.29 Pkt Somerset Acres Tract

Fd 4x4 N. 18" dn. pur FB. 279-17

Set 1x2 Fl

Fd 2x2 12" dn.

Re-Set pur FB 299-9 FB 302-25,26 FB 279-17 Set 3/4" I.P. 12" dn. by Inter.

Fd 2" I.P. Ft. N.T.L. Vis. Ctr. pur Tr. 3904 FB 279-17

Fd 2" I.P. Ft. Pur Tr. 3904 FB 279-17 FB 299-17 FB 302-25,26

Set 3/4" I.P. 12" dn. by Inter.

(See pg. 32 for Ties)

COMPTON BLVD

105.22 ± to Ctr Eucalyptus Ave Pur 62

℄ Per F.B. 1450-38,39

L=54.38 R=60.00 T=28.17 = L=54.38'
L=68.80 R=80.00 T=36.17 = L=66.95'
1142.00 R=860.00 T=28.13 = 1142.22'

Angle Point. Δ = 0°-14'-45"
EQUATION
411+53.16 From East =
412+00.42 Going W'ly.
Set 3/4" I.P. F.B. 1450-38,39.

Fd 2x2 12" dn. replaced with 3/4" I.P. 12" dn. F.B. 302-24,25 299-9.5

(a) 203°-28'-00"
(b) 46°-51'-00"
(c) 250°-24'-00"
101°-44'-00"

(a) 197°-59'-45"
(b) 36°-59'-30"
(c) 223°-59'-15"
98°-59'-30"

(a) 224°-14'-45"
(b) 8°-29'-45"
(c) 312°-44'-30"
112°-07'-25"

FLEMING AVE

See F.B. 1450-39,40

WASHINGTON ST

1142.22'

Set 1/2 Spk. Mk. by Inter.

MAPLEWOOD AVE

673.99 Along Cal. Mon. Line

Tr 2x2 pur F.B. 754-113-312-22

(a) 203°-48'-40"
(b) 47°-37'-20"
(c) 251°-26'-00"
101°-54'-20"

Fd 2" I.P. Pkt & P.T. Compromise Rd. Line Tr. 5484 FB 302-22,25 FB 279-17

FORM 247 SM 11-41

F.B. 918 PG. 52

TIES TO INTER.
COMPTON BLVD & FLEMING AVE

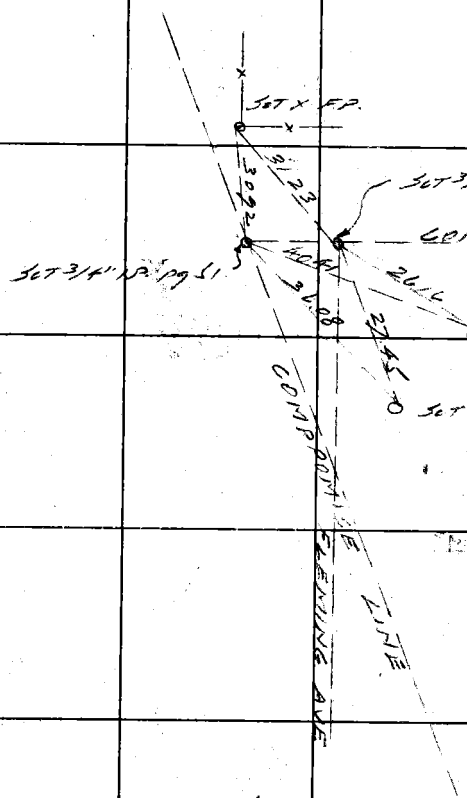

RETURN TO
LOS ANGELES COUNTY SURVEYOR
700 HALL OF RECORDS

Do not extend notes this side of this line.

Note: Sheet Ink Making Changes

[redacted] on This Sheet and/or Circled is Red Name of Person

RM 247 5M 10-59

RETURN TO
LOS ANGELES COUNTY [illegible]R
700 HALL OF RECORDS

Note: Any Additions or Changes on This Sheet Must be Made or Circled in Red Ink With Date and Name of Person Making Change.

Do not extend notes this side of this line.

W.S. 3 C T 9-4

TR # 12587

Notes Ck'd by
Map No. B-1842-4
Office Work Completed
Checked D. M. Finley
Date AUG

Survey of COMPTON BLVD.
W. O. 3544 Tape No. 06 Stricken
Surveyed by BUTLER
" Date 9/15/42
Notes
Indexed

F.B. 718 PG. 53

48 47 46 45

413.40 R 690.

10

COMPTON 30 BLVD. 1.26 FROM R SIDE PG 51

TO PG. 56

248.94-T74
248.93
24.45
56.17
105.22-T72
105.22'
TO 3/4" I.P.
P.I.

.003 .045 .015 .015

FD. C SPK per FR 279/64
FD. C SPK per FR 279/64
FD. L+T FB 494/17 FB 299/95 FR 279/19 FD 333/5 Z 185/29
FD. L+T per TR 12206 & TR 12587

(30)

45

89°57'45" 105.20

46

① 89-57-45
② 359-51-00
③ 179-46-15

47

EUCALYPTUS AVE.

44 ACRES

SOMERSET 48

(60)

43

TO PG. 54

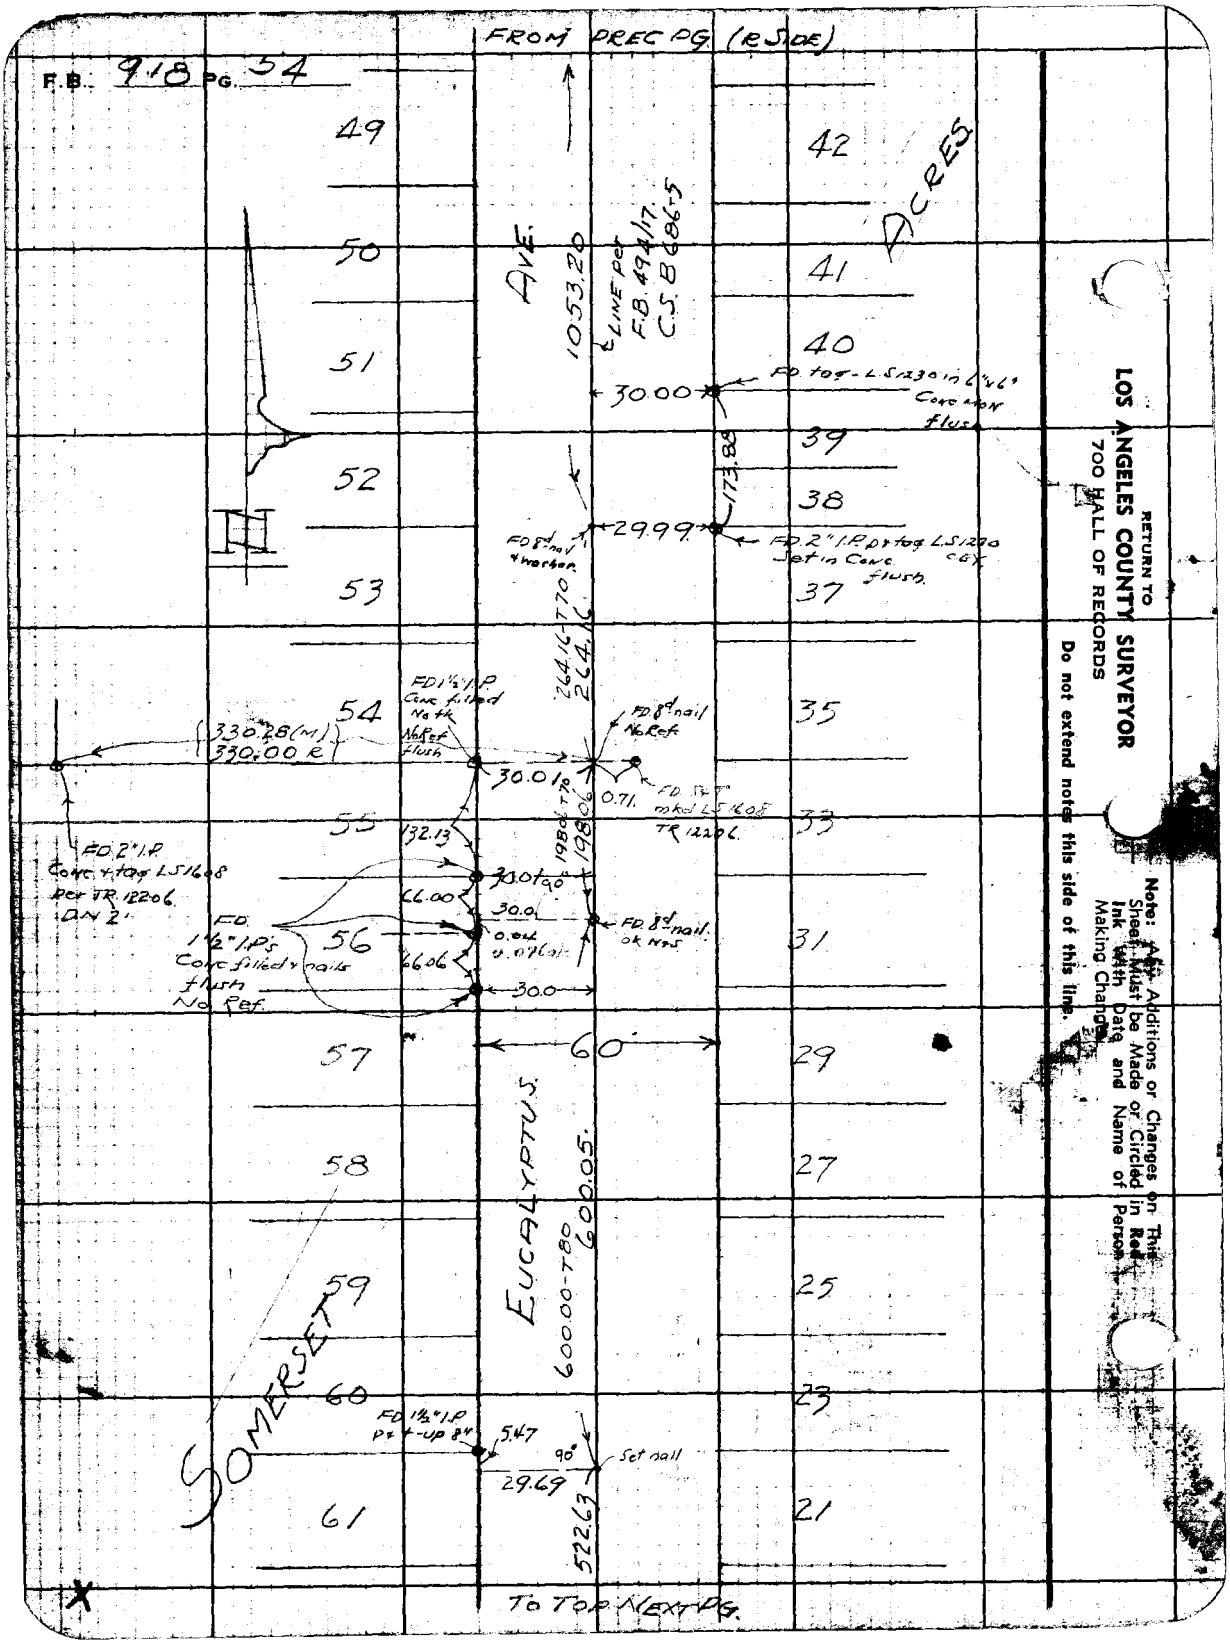
FROM PREC PG (R.S.06)
49
50
51
52
53
54
55
56
57
58
59
60
61
42
41
40
39
38
37
35
33
31
29
27
25
23
21
AVE.
1053.20
℄ LINE PER F.B. 494/17, C.S. 806-5
ACRES
FD tag - L.S. 1230 in 6"x6" Conc. mon. flush
3000
173.88
2999
FD 8d nail & washer
FD 2" I.P. & tag L.S. 1200 Set in Conc. C&T flush
264.16-770
264.16
FD 1½" I.P. Conc. filled No tk. No Ref. Flush
330.28(M)
330.00 R
30.01
FD 8d nail No Ref.
0.71
FD I.P. mkd L.S. 1608 TR 12206.
1980 TR
1980.06
132.13
33.01
66.00
30.0
0.04
0.07(M)
66.06
FD 8d nail. OK N&S
FD 2" I.P. Conc. & tag L.S. 1608 per TR 12206 ON 2'
FD 1½" I.P.s Conc. filled & nails flush No Ref.
60
EUCALYPTUS
600.00-T80
600.00 S.
SOMERSET
FD 1½" I.P. Pt. up 8"
5.47
90°
Set nail
29.69
522.63
To Top Next Pg.
RETURN TO
LOS ANGELES COUNTY SURVEYOR
700 HALL OF RECORDS
Do not extend notes this side of this line.
Note: All Additions or Changes on This Sheet Must Be Made or Circled in Red Ink With Date and Name of Person Making Change.

Notes Ck'd by D. M. Finley
Map No. B-1842-4
Office Work Cox
Checked D. M. Finley
Date AUG 1942

Survey of COMPTON BLVD.
W. O. 8945 Tape No. 06 St'd 68°F
Surveyed by Butler
Notes Date 9/5/42
Indexed

F.B. 918 PG. 55

FROM BOT. REC. PG.

W. S. 33 R 4

EUCALYPTUS AVE

S22.60-T78
S22.63.
℄ LINE per F.B. 4944/17
CSB 686-5

60'

ACRES

SOMERSET

FD 1½" I.P. P&T per F.B. 4944/17

300'

FD NAT T.P. per F.B. 4944/17

S2.38
S2.88
S3.02

.038

FD. CSPKS WHT flush per F.B. 4944/17

(30)

℄

Center

(30) ST.

S7.10

S7.29

S7.44

FD LPTS PD 4944/17

Note: Any Additions or Changes on This Sheet Must be Made or Circled in Red Ink With Date and Name of Person Making Change.

Do not extend notes this side of this line.

RETURN TO
LOS ANGELES COUNTY SURVEYOR
700 HALL OF RECORDS

FORM 247 5M 10-39

RETURN TO
LOS ANGELES COUNTY SURVEYOR
700 HALL OF RECORDS

Note: Any Additions or Changes on This Sheet Must be Made or Circled in Red Ink With Date and Name of Person Making Change.

Do not extend notes this side of this line.

W.S. 33 - B - 4

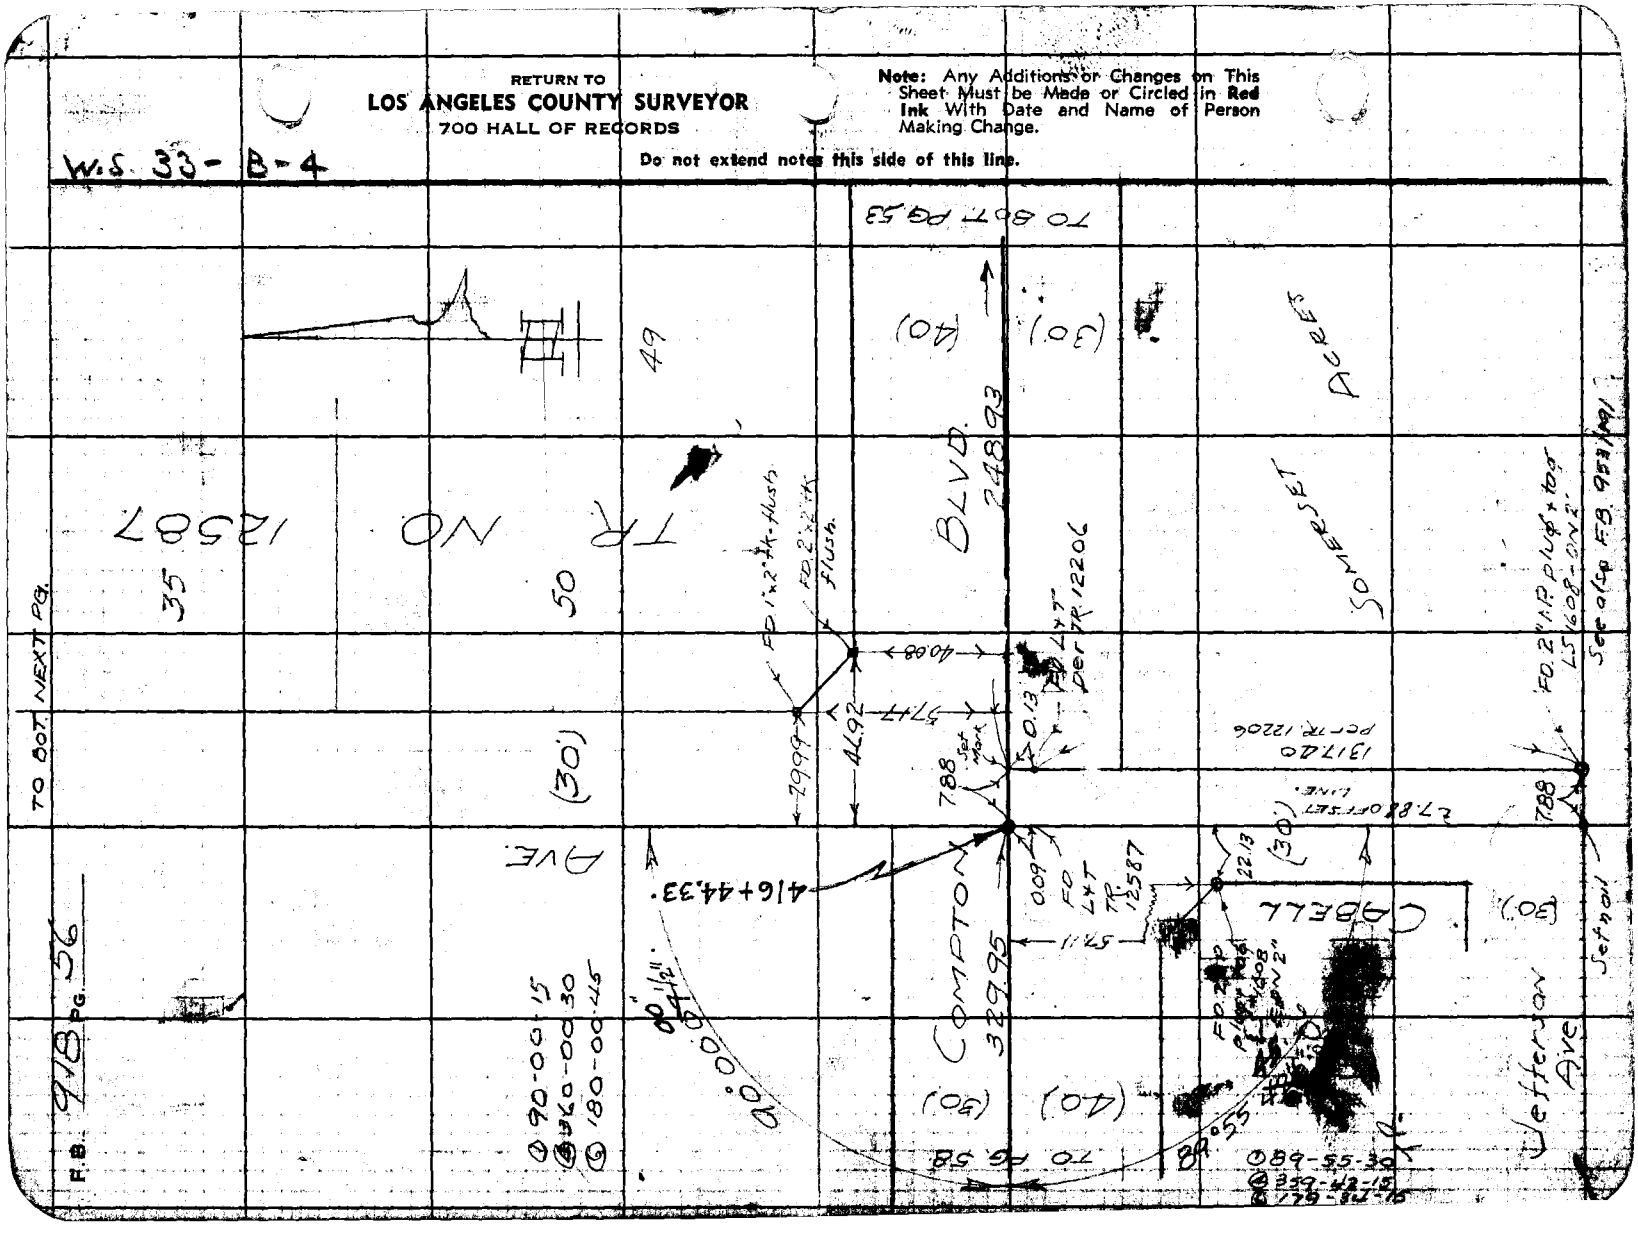

Notes Ck'd by E. W. Finley
Map No. B-1842-4
Office Work Cox
Checked D. M. Finley
Date

Survey of Compton Blvd
W. O. 834 Tape No. 06 St'd 68°F
Surveyed by Butler
Notes " Date 9/42
Indexed

F.B. 918 Pg. 57

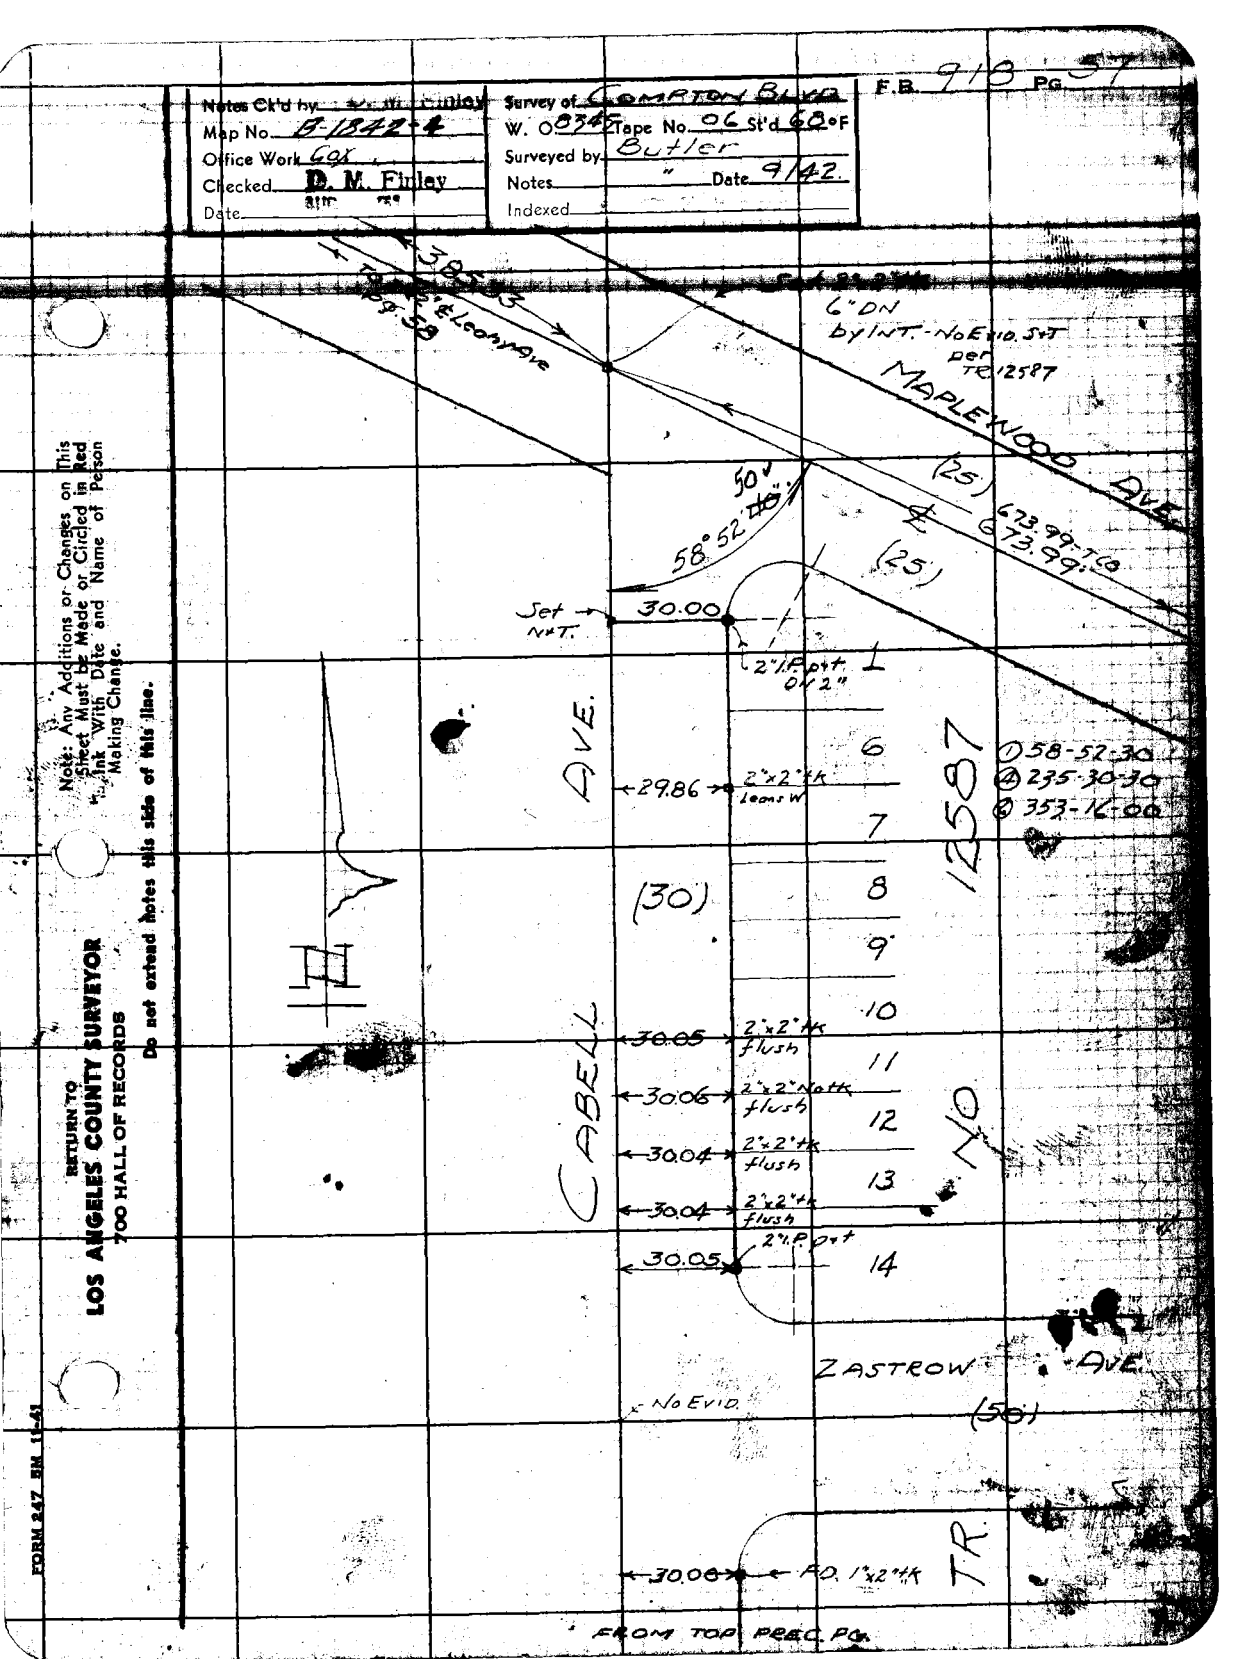

Note: Any Additions or Changes on This Sheet Must Be Made or Circled in Red Ink With Date and Name of Person Making Change.

Do not extend notes this side of this line.

RETURN TO
LOS ANGELES COUNTY SURVEYOR
700 HALL OF RECORDS

FORM 247 RM. 11-41

F.B. 918 PG. 58

W.S. 33-B-4

RETURN TO
LOS ANGELES COUNTY SURVEYOR
700 HALL OF RECORDS
Do not extend notes this side of this line.

Note: Any Additions or Changes on This Sheet Must be Made or Circled in Red Ink With Date and Name of Person Making Change.

377.43 (50')

MAPLEWOOD

FD. 1½" I.P. plug + tk ON 6"-No Ref.

FD 2"x2" tk ON 8" per F.B. 302/26

0.12

385.33-T&B (25')

385.33 ℄

(25') (25')

(25')

58°53'00"

AVE.

AVE.

① 58-52-45
④ 235-32-00
Ⓒ 353-18-00

90°00'15"

Ⓐ 90-00-15
Ⓓ 360-00-45
Ⓑ 180-01-30

419+74.28

Not Tied

329.92 T&B

(30')

COMPTON

32385

Set Mark

BLVD.

32995

(40')

0.08

FD L+T per F.B. 302/26

See also F.B. 953/194 + TR. 12206

90°16'45"

Ⓒ 90-16-45
Ⓓ 01-06-45
Ⓑ 181-40-30

(60')

TR NO. 12206

LEAHY

℄ LINE per F.B. 953/191

Jefferson

AVE.

(30')

FD. N+T per F.B. 953/191

Notes Ck'd by D. M. Finley
Map No. 9-1842-4
Office Work Cox
Checked D. M. Finley
Date

Survey of COMPTON BLVD. F.B. 918 Pg. 59
W. O. 8345 Tape No. 06 St'd 60 °F
Surveyed by Butler
Notes Date 9/42
Indexed

B 4

W.S. 11

(369.70) C.S. B-1649-6

MAPLEWOOD

0.19

FD SW x T per FB 756/112 & FB 299/194

0.42 ft DN 2° per FB 756/112 FB 299/194 FA 159/18 FB 302-27 FT 33198

377.43 377.43 T&B

(25') (50') (25')

Blvd.

(40') (40')

A
① 89-57-45
② 359-51-15
③ 179-47-15
B
① 90-02-15
② 360-08-45
③ 180-13-30
"C"
① 89-57-30
② 359-50-00
③ 179-45-00
"D"
① 90-02-15
② 360-09-00
③ 180-13-45

422+98.13 Trav. Sta. Clearwater, J-1. Per F.B. 932-105, 106.

COMPTON BLVD.

15" 17½" 90°02'15" 89°57'30" 89°57'45" 90°02'00"

FD L+T

9.82 9.82

FD C Spk. per FR 279/49

FD L+T

(30') 323.82 +80 323.85

(30') 336.28

Ag. 60

(30')

(40') Not to Scale

See also FA 159/19 FB 299/94 FB 302/29 FB 494/15

(40') (50') Not to Scale

Bellflower

Traverse Sta. Clearwater, J-1-A Per F.B. 932-13, 14

FB 494/15 FB 302/34 FB 309/23 FR 279/49 FB 273/85 FA 159/12

FD L+T

(30')

FD L+T

9.89

CENTER ST.

FD L+T

9.89

Note: Any Additions or Changes on This Sheet Must be Made or Circled in Red Ink With Date and Name of Person Making Change.

Do not extend notes this side of this line.

RETURN TO LOS ANGELES COUNTY SURVEYOR 700 HALL OF RECORDS

FORM 247 BM 11-41

W.S. 33-A-4

RETURN TO
LOS ANGELES COUNTY SURVEYOR
700 HALL OF RECORDS
Do not extend notes this side of this line.

Note: Any Additions or Changes on This Sheet Must be Made or Circled in Red Ink With Date and Name of Person Making Change.

F.B. 710 PG. 60

(3048.06) To Territas Ave.

2 to 2"x2" & Ardis Ave PG. 63

MAPLEWOOD

24.25

2" 299/93

FD 2"x2"Tk flush & 4 tang. B.Spks per F.B. 756/113 F.B. 299/93

(3637.70) C.S. B-V.45-6.

379.52-T&A

2 to C.S.& & the Inglewood PG. 59

AVE.

(25') (25')

BLAINE AVE.

(50')

℄

Ⓒ 89-59-15
Ⓐ 359-57-15
Ⓑ 179-55-45

15" 11½"

89°59'11½"

426+34.41

FD L×T per FB 302/26, FB 299/93 FR 279/14

651.36-T86
651.44

336.24-T86
336.28

13.36 13.05

FD. L×TS FB. 302/26

PG. 45 FROM

COMPTON BLVD.

Notes Ck'd by D. M. Finley | Survey of Compton Blvd | F.B. 718 Pg. 67
Map No. F-1842-4 | W. O. 5745 Tape No. 06 St'd 66°F | Note See FB 1450-39 for New Ryon HVC
Office Work Cox | Surveyed by Butler
Checked D. M. Finley | Notes " Date 9/42
Date | Indexed

W.S. 33-A 14

COMPTON per Fx 346/2 753/184 See also FB 918/61 BLVD.

TO NEXT PG

595.98 (30) 528.30-T86 528.36

FD NAIL & TAG 91.42 S1 80.64 FD NAIL & TAG

FD NAIL & TAG 32.79 FD NAIL & TAG

90°00'15" 90°00'15"

10'

(30)

STEVENS AVE. RYON AVE.

(50') (25') (25') (50')

90-00-15 L 160-01-00 R 180-01-30

(30)

CENTER ST.

12.81' 12.83' 13.14' 13.26' FD. L+T + 4 TAN. L+TS per F.B. 4944/111 See also F.B. 309/22

11.97' 12.37' 12.30' 12.41' FD. L+T per F.B. 4944/111 + 4 tang. L+TS Ties Copied + checked See also F.B. 279/112, F.B. 309/134

Note: Any Additions or Changes on This Sheet Must be Made or Circled in Red Ink With Date and Name of Person Making Change.

Do not extend notes this side of this line.

RETURN TO
LOS ANGELES COUNTY SURVEYOR
700 HALL OF RECORDS

FORM 247 BM 11-61

F.B. 918 PG. 62

"A"
Δ A
① 90-01-15
④ 00-05-30
⑥ 180-09-15
Adj. 90-01-32½

Δ B
① 89-59-00
④ 359-54-45
⑥ 179-52-30
Adj. 89-58-45

"C"
① 90-00-30
④ 360-01-15
⑥ 180-01-45
Adj. 90-00-17½

D
① 89-59-15
④ 359-57-00
⑥ 179-55-45
Adj. 89-59-17½

FD 2"x2"Ht "DNC" & prod. Greenwell ST. - per FQ 302/4 (Sta. 33+97.28)

FD L&T per FQ 302/5 (Sta 936+52.95)
Ties copied & checked
See also FB 3-7/12.

FOR LATER TIES SEE 1695-122

SEE FB 450-78

ARDIS AVE.

TO BOT NEXT PG.

per FW 6896-2

① 60-26-45
④ 247-41-45
⑥ 362-41-00

RETURN TO
LOS ANGELES COUNTY SURVEYOR
700 HALL OF RECORDS

Do not extend notes this side of this line.

Note: Any Additions or Changes on This Sheet Must be Made or Circled in Red Ink With Date and Name of Person Making Change.

W.S. 33-A-4

40' 58½"
90°0'
FD 3/4" Sq PP
FD L&T per FQ 302/5
449+33.61
55.36
40
66.44
66.03
FD L&T FQ 302/5
89°58'45"
347.92
167.42
957.98
957.87-786
(30)
(40)
FROM
89°59'17½"
30' 17½"
FD "X" in PP
FD Nail & TAG
FD Nail & TAG
37.19
77.82
.19
.05
COMPTON BLVD.
447+72.19
FD 'X' in pave. per FW 6896-2
(30)
(40)
Clark AVE.
per FQ 302/4
FD. C.S.P.K. Nail & T & Railroad Arc per FQ 302/8 - See also FB 494/9

Notes Ck'd by D. M. Finley
Map No. F-1842-4
Office Work Cat
Checked D. M. Finley
Date Aug. 51

Survey of Compton Blvd. F.B. 918 Pg. 63
W. O. 8345 Tape No. 06 St'd 66 ft
Surveyed by Butler
Notes Date 9/42
Indexed

Note: Any Additions or Changes on This Sheet Must be Made or Circled in Red Ink With Date and Name of Person Making Change.

Do not extend notes this side of this line.

RETURN TO
LOS ANGELES COUNTY SURVEYOR
700 HALL OF RECORDS

FORM 247 SM 11-61

Wis. 33 + 41 +

See Pg. 71

MAPLEWOOD AVE.

TP C/Sek W+T
LeCerritos

FD. Nail T.P. FW6896/3

FD. 1/2" I.P. No Plug No Ref. ON C

(25')

(30.48.06)

(25')

Set 2"x2"+k DN 6" BY INT. No Evid. Nail per FW6896/3

Set 2"x2"+k DN 6" Set by over approximate point of 2"x2" per FW6896/3 with nail & dent removed by FW party

Set 1/2" I.P. Marsh Surv. Post

2.40

2500

33.93

32.22

113.56 53

26.68

FD Nail TP FW6896/3

TP R/W Bdy Secs

(50')

FD Nail PC FW6896/3 & T 1832.32 checks

Set 3/4" I.P. DN 1' PP #80 LOE up 2'

FD. old 2"x2" DN 8" per FW6896/3 used Ctr. Reset 3/4" I.P. DN 1'

2.19.35 (M) 2.19.65 FW6896/3

90° 01' HR 1/2"

40"

Ⓐ 90-01-45
Ⓒ 180-10-45
Ⓑ 90-07-00

AVE.

(50') C/L per FW6896/3

25'

25'

FD 2"x2"+k in 2" I.P. - worn per FW6896/3

2.19.78 (M) 2.19.78 FW6896/3

0.22

FD. Remains of 2 (2"x2") ON 8" FW6896/3

X Set Nail

ARDIS

FROM TOP PREC.

RETURN TO
LOS ANGELES COUNTY SURVEYOR
700 HALL OF RECORDS

Note: Any Additions or Changes on This Sheet Must be Made or Circled in Red Ink With Date and Name of Person Making Change.

Do not extend notes this side of this line.

W.S. 33 - A-4

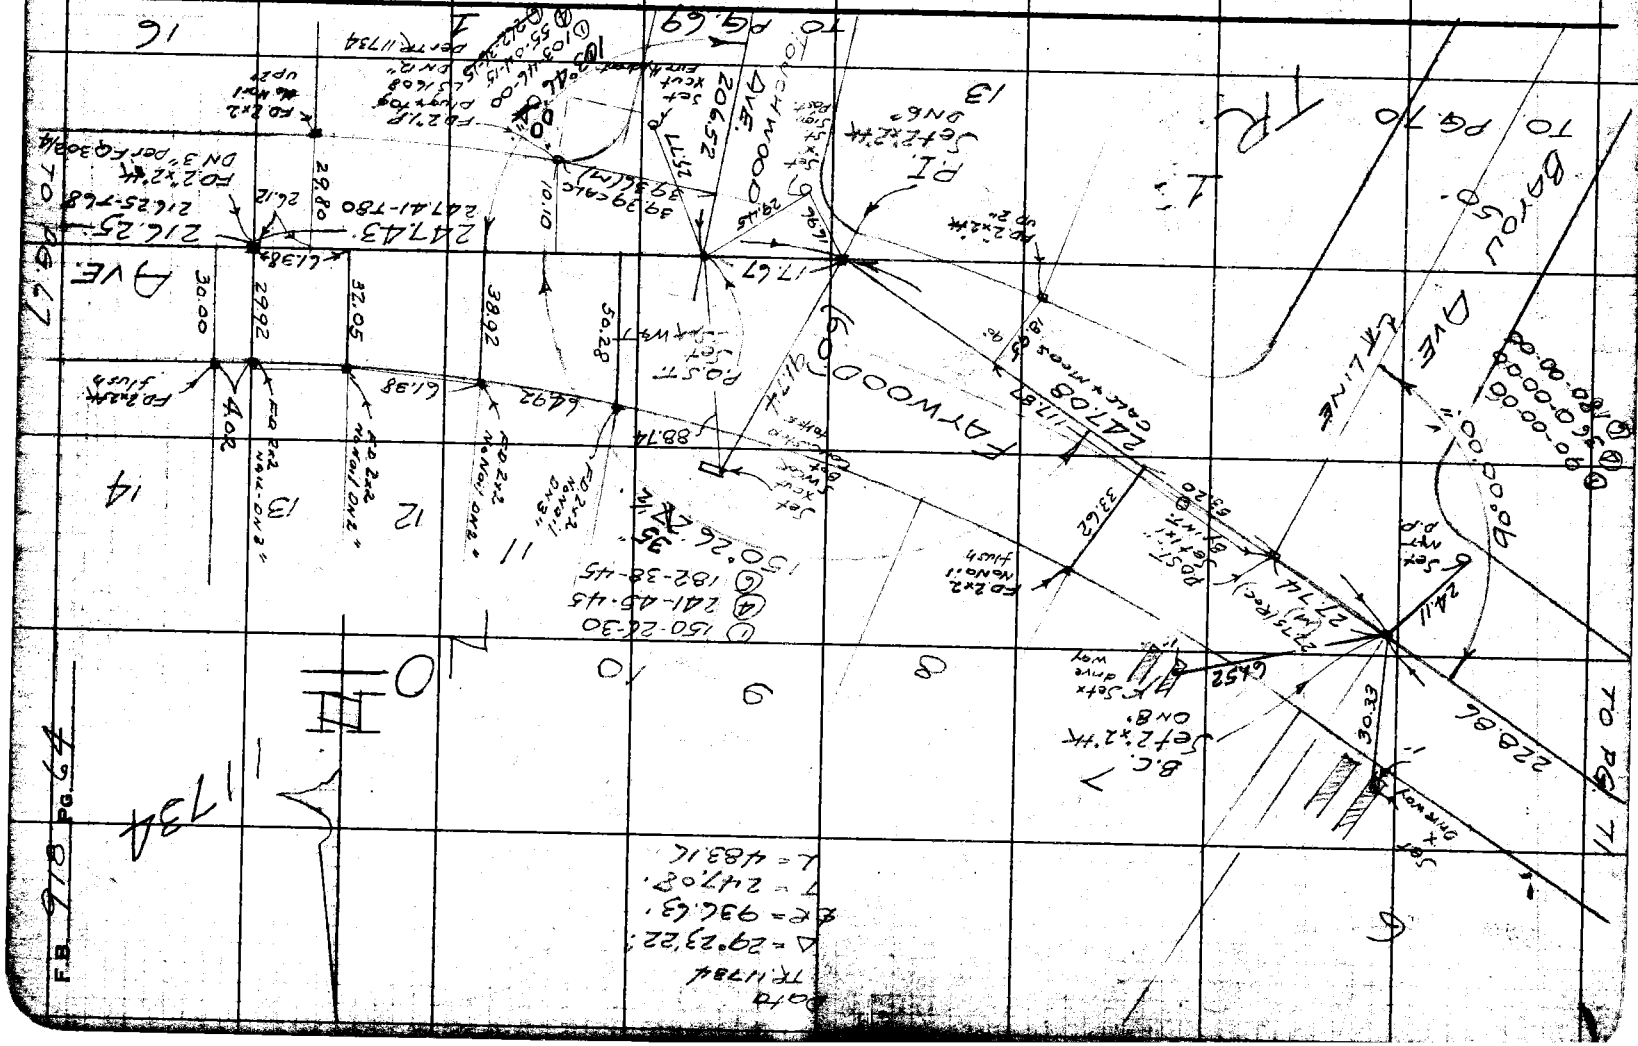
AVE.
247.43
247.41-780
216.25-768
FD 2"x2" DN 3" Def
FD 2"x2" Mkd
FD 2"x2" UP 2"

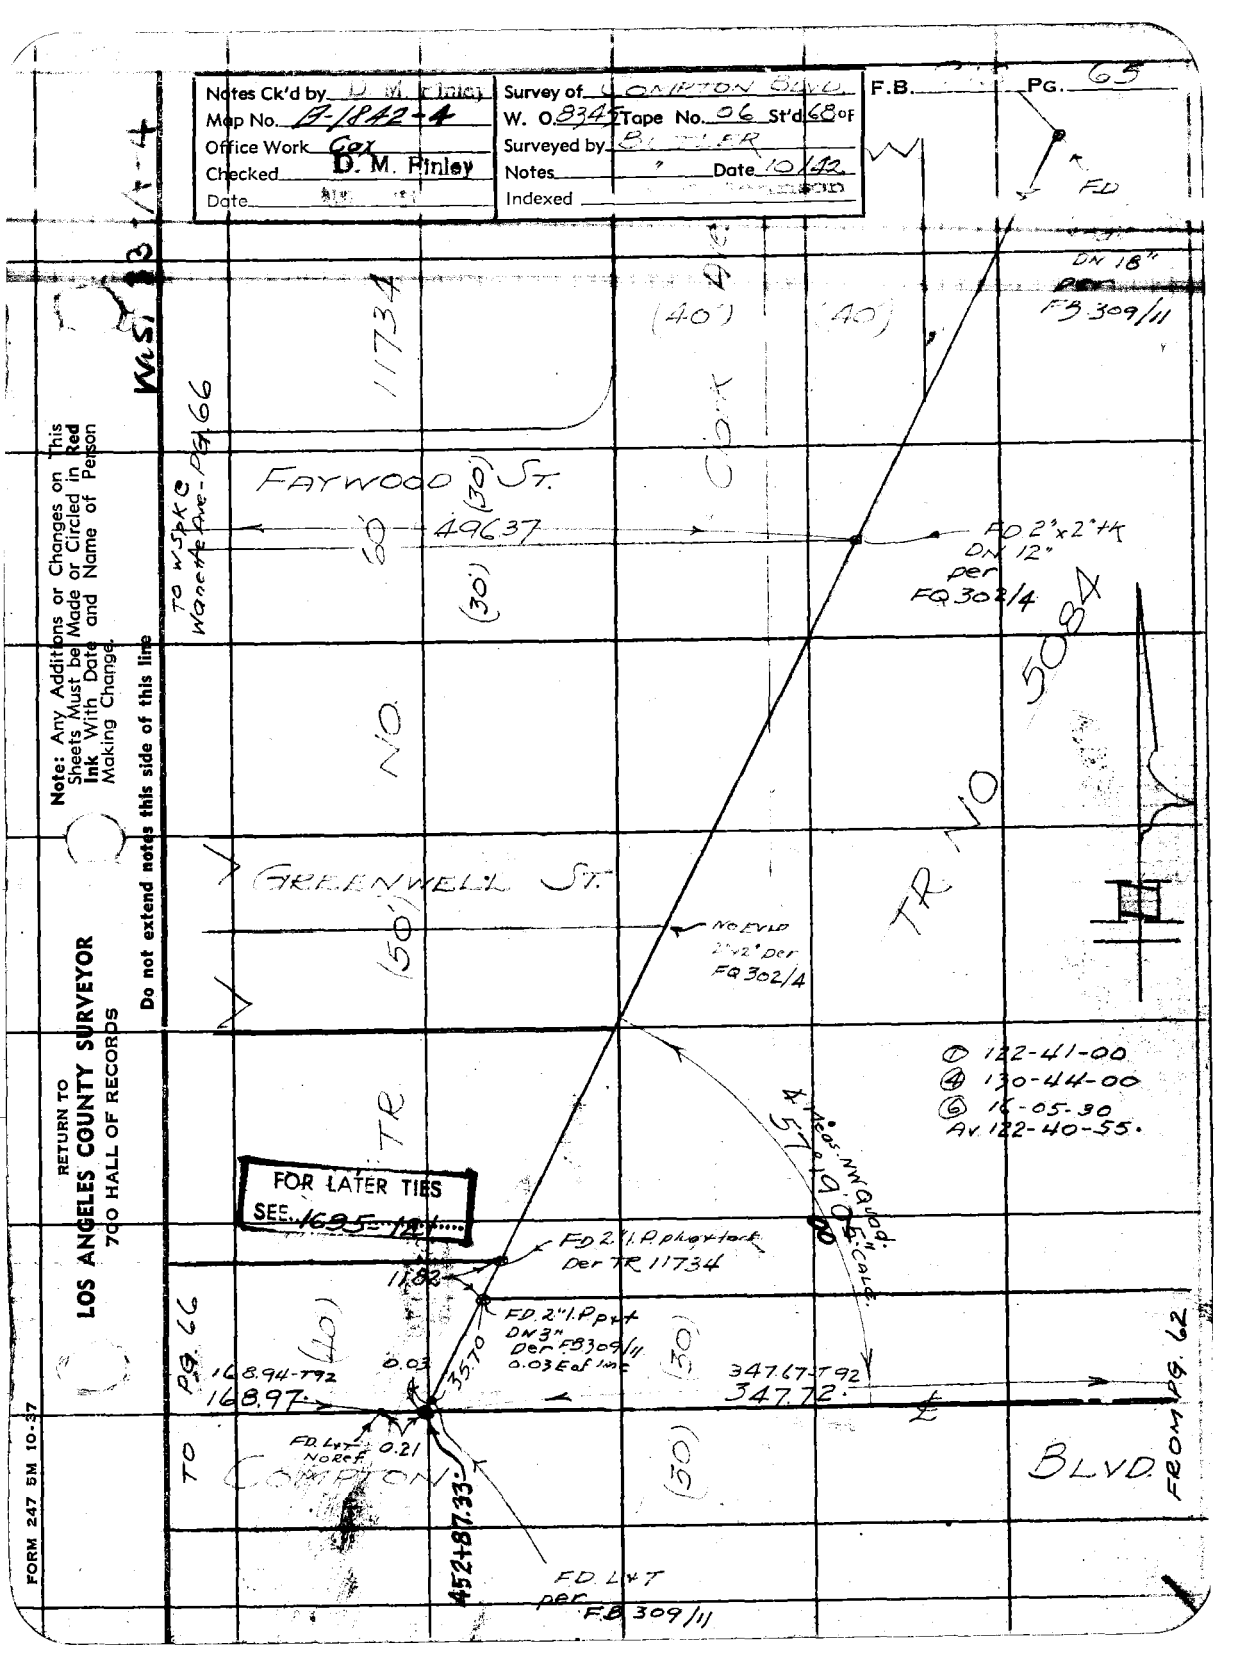
Notes Ck'd by D. M. Finley
Map No. A-1842-4
Office Work Cor
Checked D. M. Finley
Date
Survey of COMPTON BLVD.
W. O. 8345 Tape No. 96 St'd 68 OF
Surveyed by BUTLER
Notes Date 10/42
Indexed
F.B. PG. 65
FD
Ws 13 1-4
DN 18"
FB 309/11
(40')
40
11734
FAYWOOD ST.
50
49637
(30)
TO WSPRC Wanette Ave - PG 66
FD 2"x2" HK
DN 12"
per
FQ 302/4
50 84
NO
TR
GREENWELL ST.
(50')
NO EVID
2"x2" Der
FQ 302/4
122-41-00
130-44-00
16-05-30
Av. 122-40-55.
FOR LATER TIES
SEE 1695-121
FD 2" I.P plug+tack
Der TR 11734
11.82
FD 2" I.P plug+
DN 3"
Der FB 309/11
0.03 E of line
3570
168.94-T92
168.97
0.03
FD L+T
0.21 N of E
347.67-T92
347.72
BLVD.
FROM
PG. 62
TO COMPTON
(30)
452+87.33
FD L+T
per
F.B. 309/11
RETURN TO
LOS ANGELES COUNTY SURVEYOR
700 HALL OF RECORDS
Note: Any Additions or Changes on This Sheets Must be Made or Circled in Red Ink With Date and Name of Person Making Change
Do not extend notes this side of this line
FORM 247 SM 10-37

F.B. 918 PG. 66

W½ S. 33-A-4

RETURN TO
LOS ANGELES COUNTY SURVEYOR
700 HALL OF RECORDS

Note: Any Additions or Changes on This Sheets Must be Made or Circled in Red Ink With Date and Name of Person Making Change.

Do not extend notes this side of this line

FAYWOOD
255.02-T68
255.02-O
255'-TR 11734

49637-T68
496.37
496.35-TR 11734

59 ST.

TO PG 67

FD W SPK+T NO REF

FD 2"x2"+K

25.01

NO 11734

AVE.

(50')

GREENWELL ST.

WANETTE LN LINE

TR

25.02

FD 2"x2" USED ON

① 90-00-00
④ 359-59-45
⑥ 179-59-15

90°00'00" 52½"

FOR LATER TIES SEE..1695-120..

(30)

255.04

168.97

59 ST.

TO PG 67

(30)

COMPTON

0.03

BLVD.

FRONT

454+56.51

FD L+T NO REF

Notes Ck'd by W. H.
Map No. B-1842-4
Office Work Cox
Checked D. M. Finley
Date 3/16 '42

Survey of COMPTON OLIVE
W. O. 8345 Tape No. 06 St'd 68 OF
Surveyed by B. Hall
Notes Date 10/42
Indexed

F.B. 518 PG. 67

W.S. 33 A-4

14 15 16 TO LOT NEXT 13 14

FD 2"x2" ON 3¢ — FD. Spike ON 12" — Set N+T T.D PG.

64 — 30.03 — 30.04 — 30.04 — 216.25 — 60

Set 2"x2" TK ON 10" By INT. — 255.02 — PG 66

TO PG

FAIRWOOD

47.18

Set N+T PP

ST.

AVE. TO

16 15 14 13 12

(60') — 29.96 — 29.34 — FD 2"x2" No TK — FD 2"x2" No TK

FD 2"x2" nail flush

2 1 4

30.00 — 30.00 — FD. 2"x2" No TK - flush.

S 10° 09' E — S 10° 10' E

(20') (30')

30.03 — FD. 2"x2" No TK flush

30.14 — FD. 2"x2" No TK - flush

5

LIBLEY

89° 59' 30"

(30')

255.00-T92
255.04

PG. 66

495.10

241.11 — FD L+T FB 261/82 241.07-T94

457+11.55 FD L+T No Ref.

(30') COMPTON (30') BLVD.

TO PG 69

FROM

Proposed
E Century Blvd.
per FB 261/82

① 90-00-45
④ 360-02-30
⑤ 180-03-30

① 89-59-45
④ 359-58-45
⑥ 179-58-00

Note: Any Additions or Changes on This Sheets Must be Made or Circled in Red Ink With Date and Name of Person Making Change.

Do not extend notes this side of this line

RETURN TO
LOS ANGELES COUNTY SURVEYOR
700 HALL OF RECORDS

FORM 247 5M 10-37

RETURN TO
LOS ANGELES COUNTY SURVEYOR
700 HALL OF RECORDS

Note: Any Additions or Changes on This Sheets Must be Made or Circled in **Red Ink** With Date and Name of Person Making Change.

Do not extend notes this side of this line

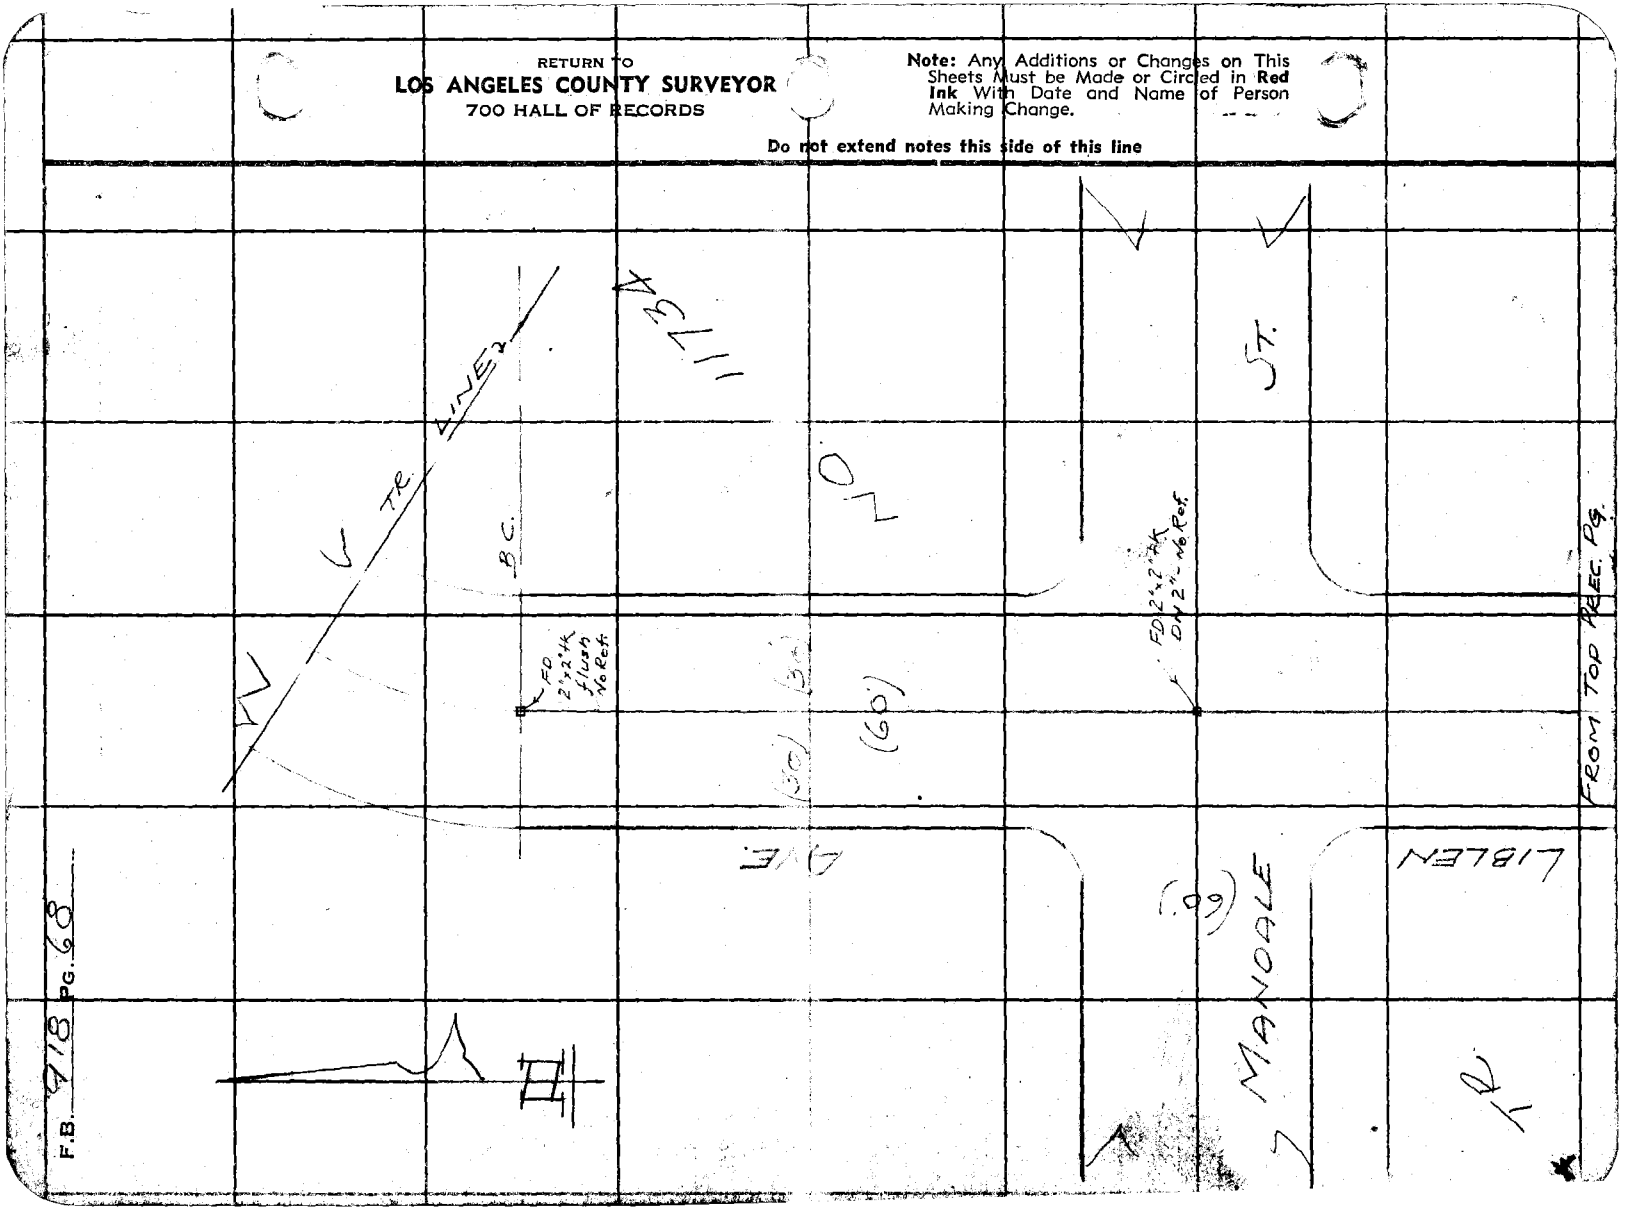

F.B. 918 PG. 68

Notes Ck'd by E.J. W. Finley
Map No. B-1842-4
Office Work Cpt
Checked D. M. Finley
Date 9/25/59

Survey of COMPTON BLVD.
W. O. 8345 Tape No. 06 St'd 68°F
Surveyed by BUTLER
Notes Date 10/42
Indexed

F.B. 918 PG. 67

Note: Any Additions or Changes on This Sheet Must be Made or Circled in Red Ink With Date and Name of Person Making Change.

Do not extend notes this side of this line.

RETURN TO
LOS ANGELES COUNTY SURVEYOR
700 HALL OF RECORDS

FORM 257

TO | PG. 64

W 61 33 A 4

Δ 13°46'00
Δ 55°04'00
Δ 13°46'

13°46' REC. MEAS
206.52'
206.52-T68

2

7134

9 AVE.

P.I. Set 2"x2" tk DN 6" Rec D.J. No. of ℄ COMPTON BLVD.

3

TR. REC.
Δ = 13°46'
R = 500'
T = 60.36
L =

4

79.52

25.16 FD 2x2 NO NAIL

① 166°14'
④ 304-56
⑥ 277 24

5

49.90

25.02 FD 2x2 NAIL FLUSH

309.49-TR. REC.
309.49 (M)

TOUCHWOOD

NO IR

6

① 90°
④ 360°
⑥ 180°

90.00 (M) TR REC.

(50)

70 509.81-T92

PG. (30) 509.89

FOR LATER TIES
SEE... 169.5-118.....

462+06.65
FD. L+T
NO REF

℄ 495.10 (40) (30)

FROM PG. 67

TO (30)

COMPTON BLVD.

F.B. 918 PG. 70

TO PG. 64.

W.S. 33-A-4

RETURN TO
LOS ANGELES COUNTY SURVEYOR
700 HALL OF RECORDS
Do not extend notes this side of this line.

Note: Any Additions or Changes on This Sheet Must be Made or Circled in Red Ink With Date and Name of Person Making Change.

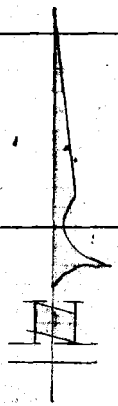

13 12 11 10 9 1 2 3 4 5 6 7

Set Nail

25.00

FD 2"x2" Nail flush.

FD 2"x2" +K flush

14.95

FD 2"x2" +K flush

24.86

AVE.

(50')

BAYOU

25.00

FD 2"x2" nail flush.

① 60-26-45
④ 241-46-30
⑥ 362-39-30
Ar. 60-26-35

60°26'35"
30°02'38" TO REC.

40'

(30')

295.50

467+16.54
FD. L+T - No Ref.

509.89

(30')

℄

COMPTON BLVD.

FROM PG. 69

FOR LATER TIES
SEE F.B. 1695-117

Notes C'd by: D. M. Finley
Map No. B-1842-4
Office Work Cox
Checked D. M. Finley
Date

Survey of COMPTON BLVD.
W. O. 8345 Tape No. 06 St'd 68°F
Surveyed by Butler
Notes " Date 10/42
Indexed

F.B. 948 PG. 71

W.S. 33 A-4

Note: Any Additions or Changes on This Sheet Must be Made or Circled in Red Ink With Date and Name of Person Making Change.

Do not extend notes this side of this line.

RETURN TO
LOS ANGELES COUNTY SURVEYOR
700 HALL OF RECORDS

per F.B. 299/72,91
See also FB 309, 8,10 FA 165/3 FT 33/42

408.19
408.18-T72

FD. NAIL No Ref.

FD. 1" I.P. No plug BENT

Set x in sidewalk

FD. NAIL & TAG No Ref.

Set NAIL & TAG

FD. 2" I.P. No plug

Set x in sidewalk

Fire Hydrant

FD. 2" I.P. flush

FD. 2" I.P. flush

FD. 2" I.P. put per TR 11734

Set NAIL & TAG

Set NAIL & TAG

Set NAIL & TAG

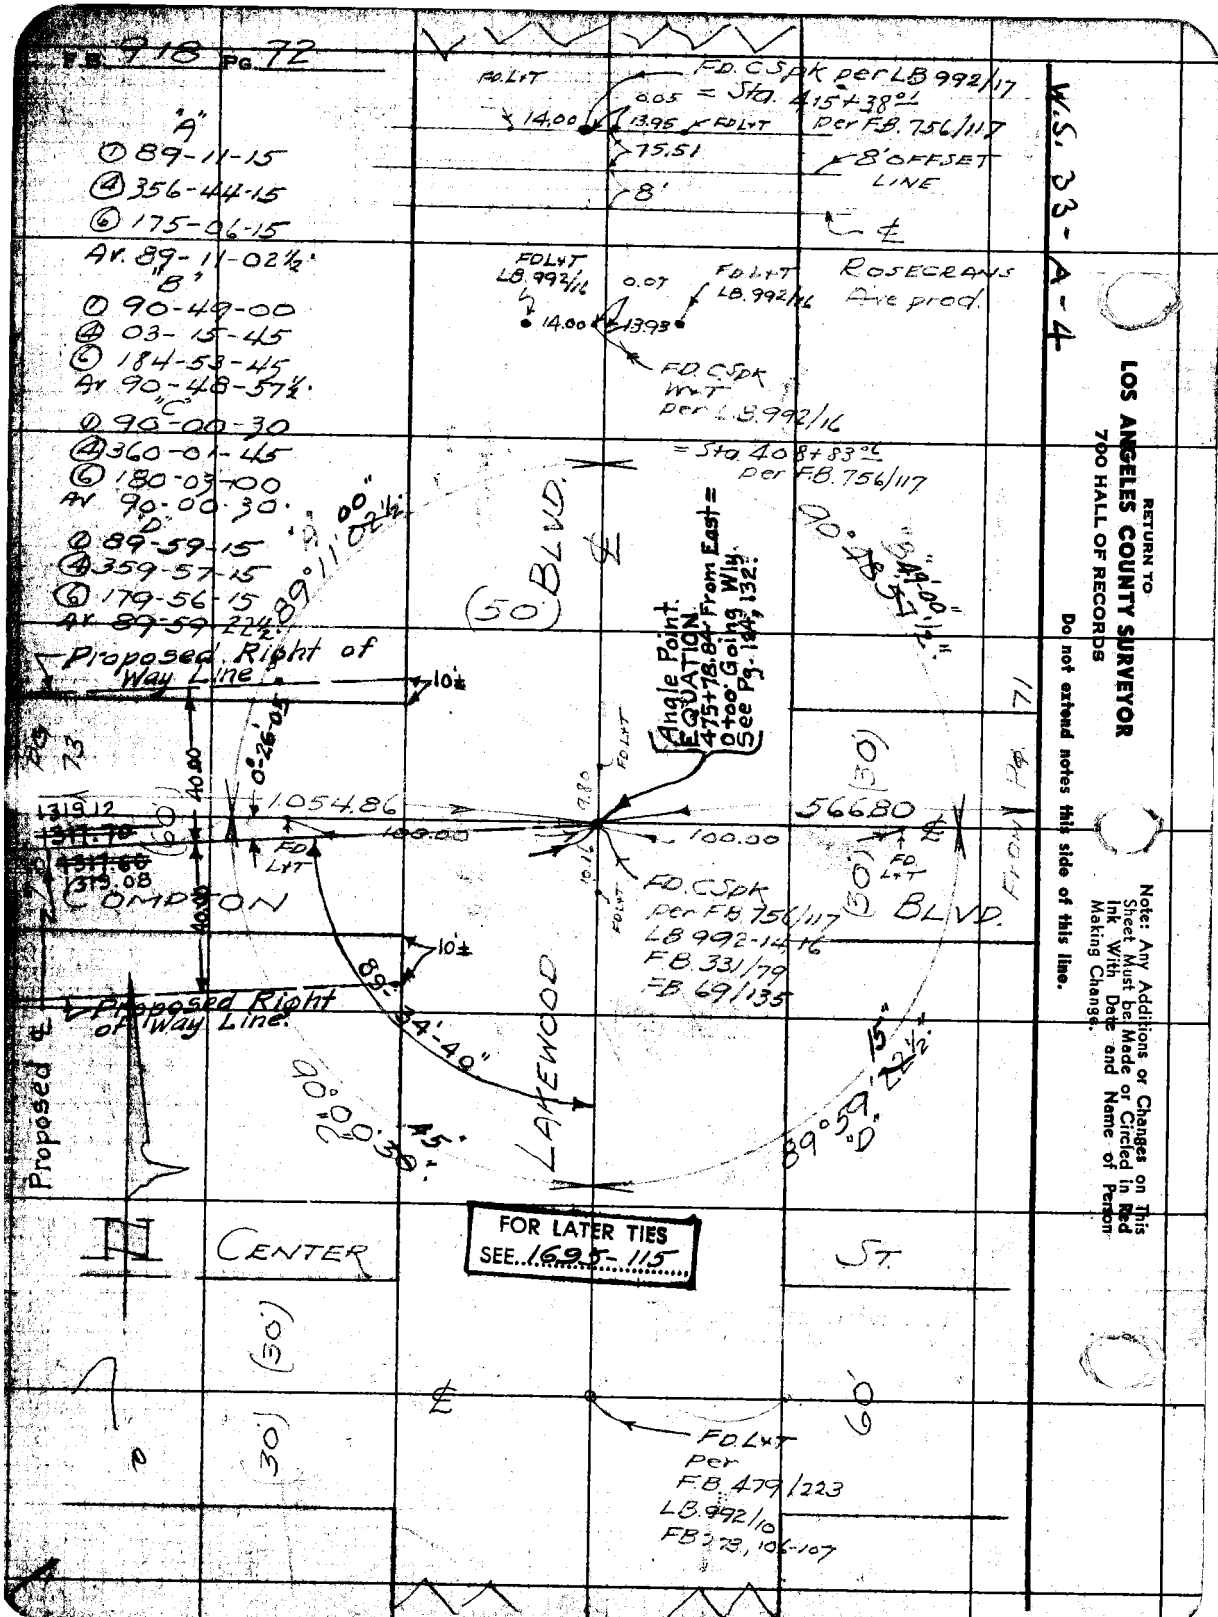
T.B. 718 Pg. 72
"A"
① 89-11-15
④ 356-44-15
⑥ 175-06-15
Av. 89-11-02½
"B"
① 90-49-00
④ 03-15-45
⑥ 184-53-45
Av 90-48-57½
"C"
① 90-00-30
④ 360-01-45
⑥ 180-03-00
Av 90-00-30
"D"
① 89-59-15
④ 359-57-45
⑥ 179-56-15
Av 89-59-22½
89°11'02½"
Proposed Right of Way Line
10±
40.00
0°26'05"
1319.12
1311.66
1319.08
COMPTON
1054.86
100.00
FD L+T
FD. C.S.pk per LB 992/17
0.05 = Sta. 415+38.02
per F.B. 756/117
14.00
13.95
75.51
8' OFFSET LINE
℄
ROSECRANS Ave prod.
FD L+T LB 992/16
0.07
13.93
FD. C.S.pk W/T per L.B. 992/16
= Sta. 408+83.02
per F.B. 756/117
(50) BLVD.
Angle Point EQUATION 475+78.84 From East = 0+00 Going W'ly See Pg. 144, 132
20°48'57½"
(30)
566.80
FD. C.S.pk per F.B. 756/117 LB 992-14-16 F.B. 331/79 F.B. 69/135
BLVD.
Proposed ℄
89°54'40"
20°00'30"
45'
LAKEWOOD
15'
12½'
89°59'
FOR LATER TIES SEE.. 1695-115
CENTER
ST.
(30)
FD L+T Per F.B. 479/223 LB. 992/10 FB 73, 106-107
RETURN TO
LOS ANGELES COUNTY SURVEYOR
700 HALL OF RECORDS
Do not extend notes this side of this line.
Note: Any Additions or Changes on This Sheet Must be Made or Circled in Red Ink With Date and Name of Person Making Change.
W.S. 33-A-4

FORM 247 5M 11-41

RETURN TO
LOS ANGELES COUNTY SURVEYOR
700 HALL OF RECORDS

Note: Any Additions or Changes on this Sheet Must be Made or Circled in Red Ink With Date and Name of Person Making Change.

Do not extend notes this side of this line.

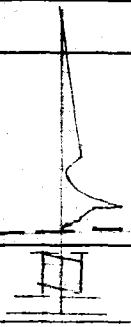

Proposed Right of Way Line

40.00 (30')

105486

1319.12

~~1317.16~~

~~1317.66~~

1319.08

℄

(30') ℄ Proposed ℄

40.08

TO

PG 74

COMPTON

BLVD.

Proposed Right of Way Line

Notes Gkd by [illegible]
Map No. B-1822 #3
Office Work Cox
Checked D. M. Finley
Date 8/17 '42

Surveyed by Compton Blvd
W. O. 8378 Type No. OCS'd 42 of
Surveyed by Butler Date 10/42
Notes
Indexed

F.B. 9 PG. 70

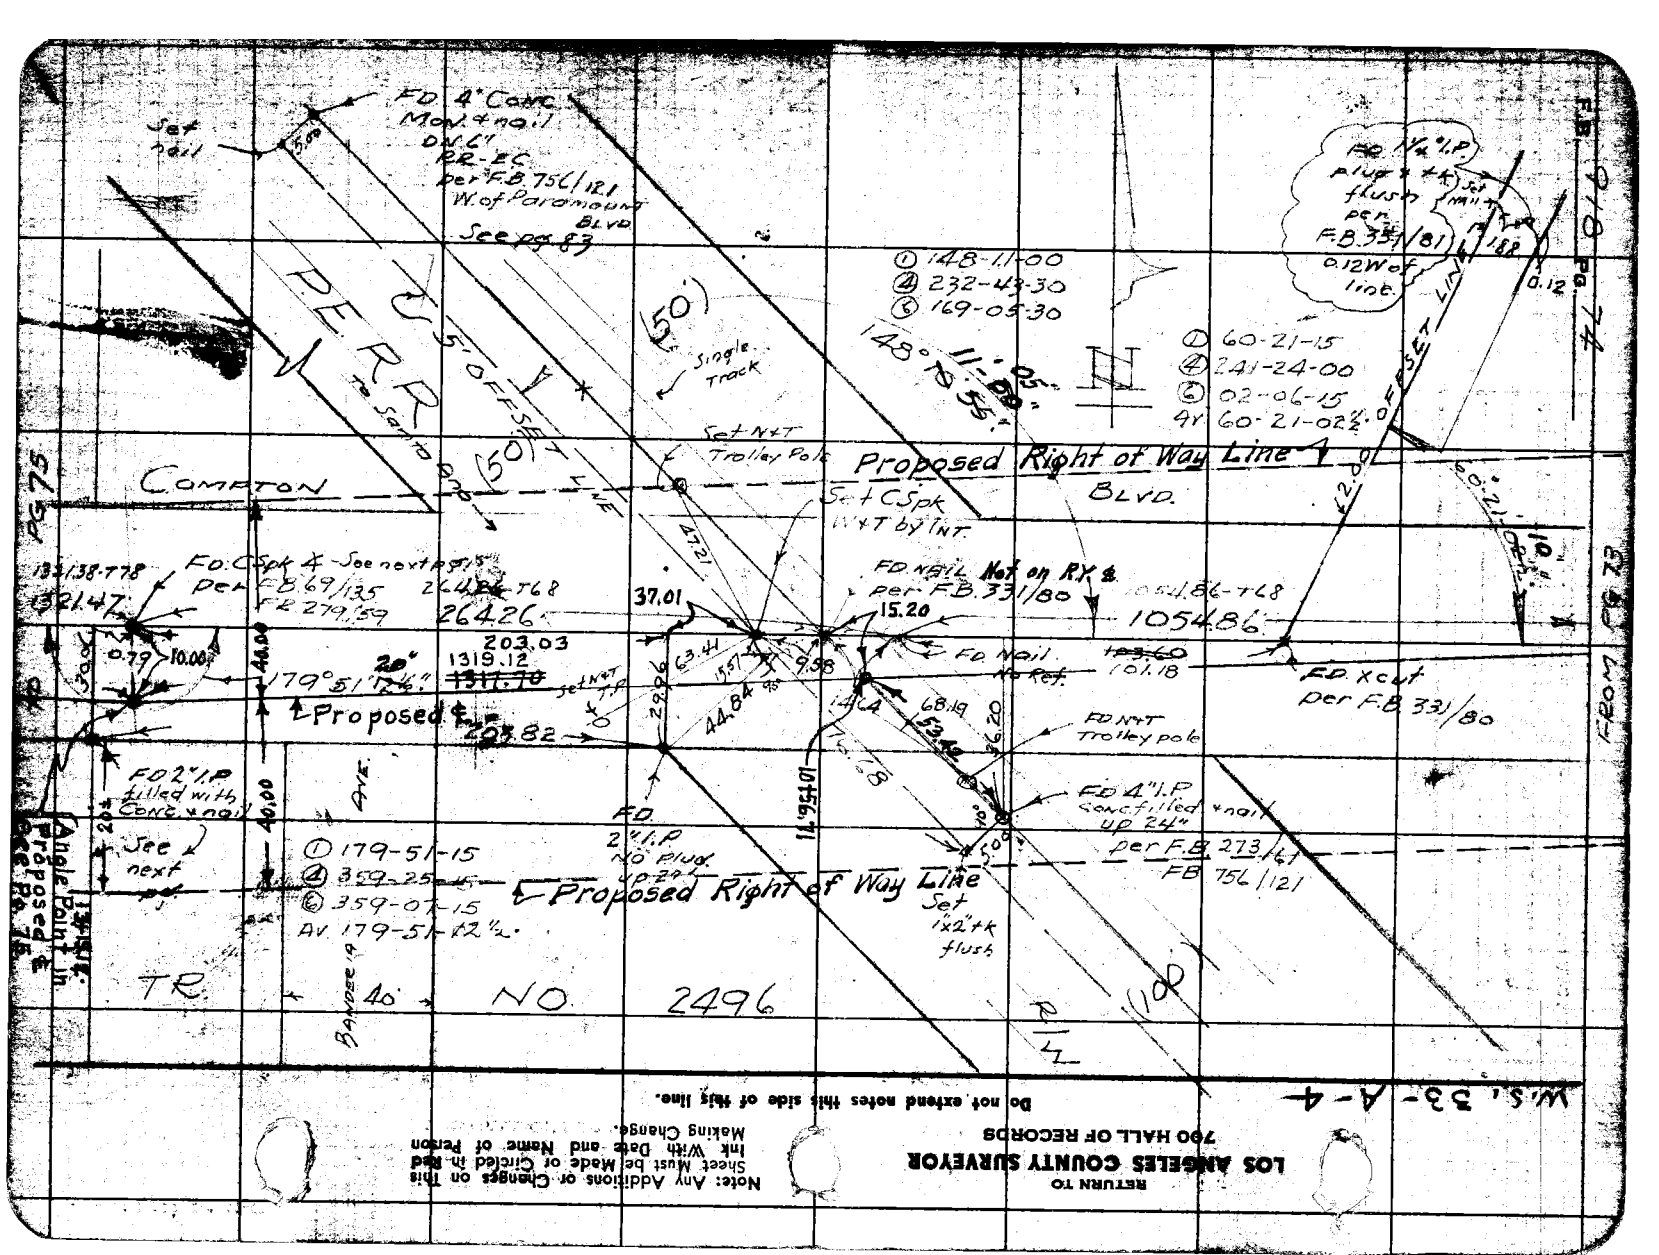

RETURN TO
LOS ANGELES COUNTY SURVEYOR
700 HALL OF RECORDS

Note: Any Additions or Changes on This Sheet Must be Made or Circled in Red Ink With Date and Name of Person Making Change.

Do not extend notes this side of this line.

Map Drawn by L. A. M. Finley
Map No. P-1242-5
Office Work Cox
Checked D. M. Finley
Date 10/42

Survey of Compton Blvd.
W. O. 0544 Tape No. 06 Std 66 F
Surveyed by Butler
Notes
Date 10/42
Indexed

F.B. 978 PG. 70

W.S. B3

Fd. 4" L.P.S. L.A.Co. Mon. filled with conc.

Proposed Right of Way Line

Set x cut

C Spk & per prec. pg.

Compton Blvd.

99.97

1321.38 - T
1321.47

1321.50

1321.46

99.86 (M)
99.98 F.B. 479/221

Set nail

Fd 4" L.P. in Conc. & conc. filled knocked No. per F.B. 479/221 & L.S. 2441

Set Nail

13+19.12 Angle Point in Proposed ℄

Fd 2" I.P. Conc. filled & nail per F.B. 479/221 & L.S. 2441

Proposed Right of Way Line

① B9-51-15
④ 359-25-00
⑤ 179-07-45
Az. 89-51-17½

Paseo

Bandeira St.

90.34 R

Chester St.

Fd. 4" I.P. in Conc. & Conc. filled & nail per F.B. 479/221 & L.S. 2441 - Sh. 11

No Evid.

Hoyt Ter. Ave.

94.94

Fd L & T No Ref

100.05 ℄

Fd. L & T & 4 Tang L & T's per F.B. 479/221 & R.D. 7520

Set Mark

Center St.

Note: Any Additions or Changes on this Sheet Must be Made or Ordered by the Init. With Date and Name of Person Making Change.

Do not extend notes to this side of this item.

RETURN TO
LOS ANGELES COUNTY SURVEYOR
700 HALL OF RECORDS

FORM 247 SUR 11-41

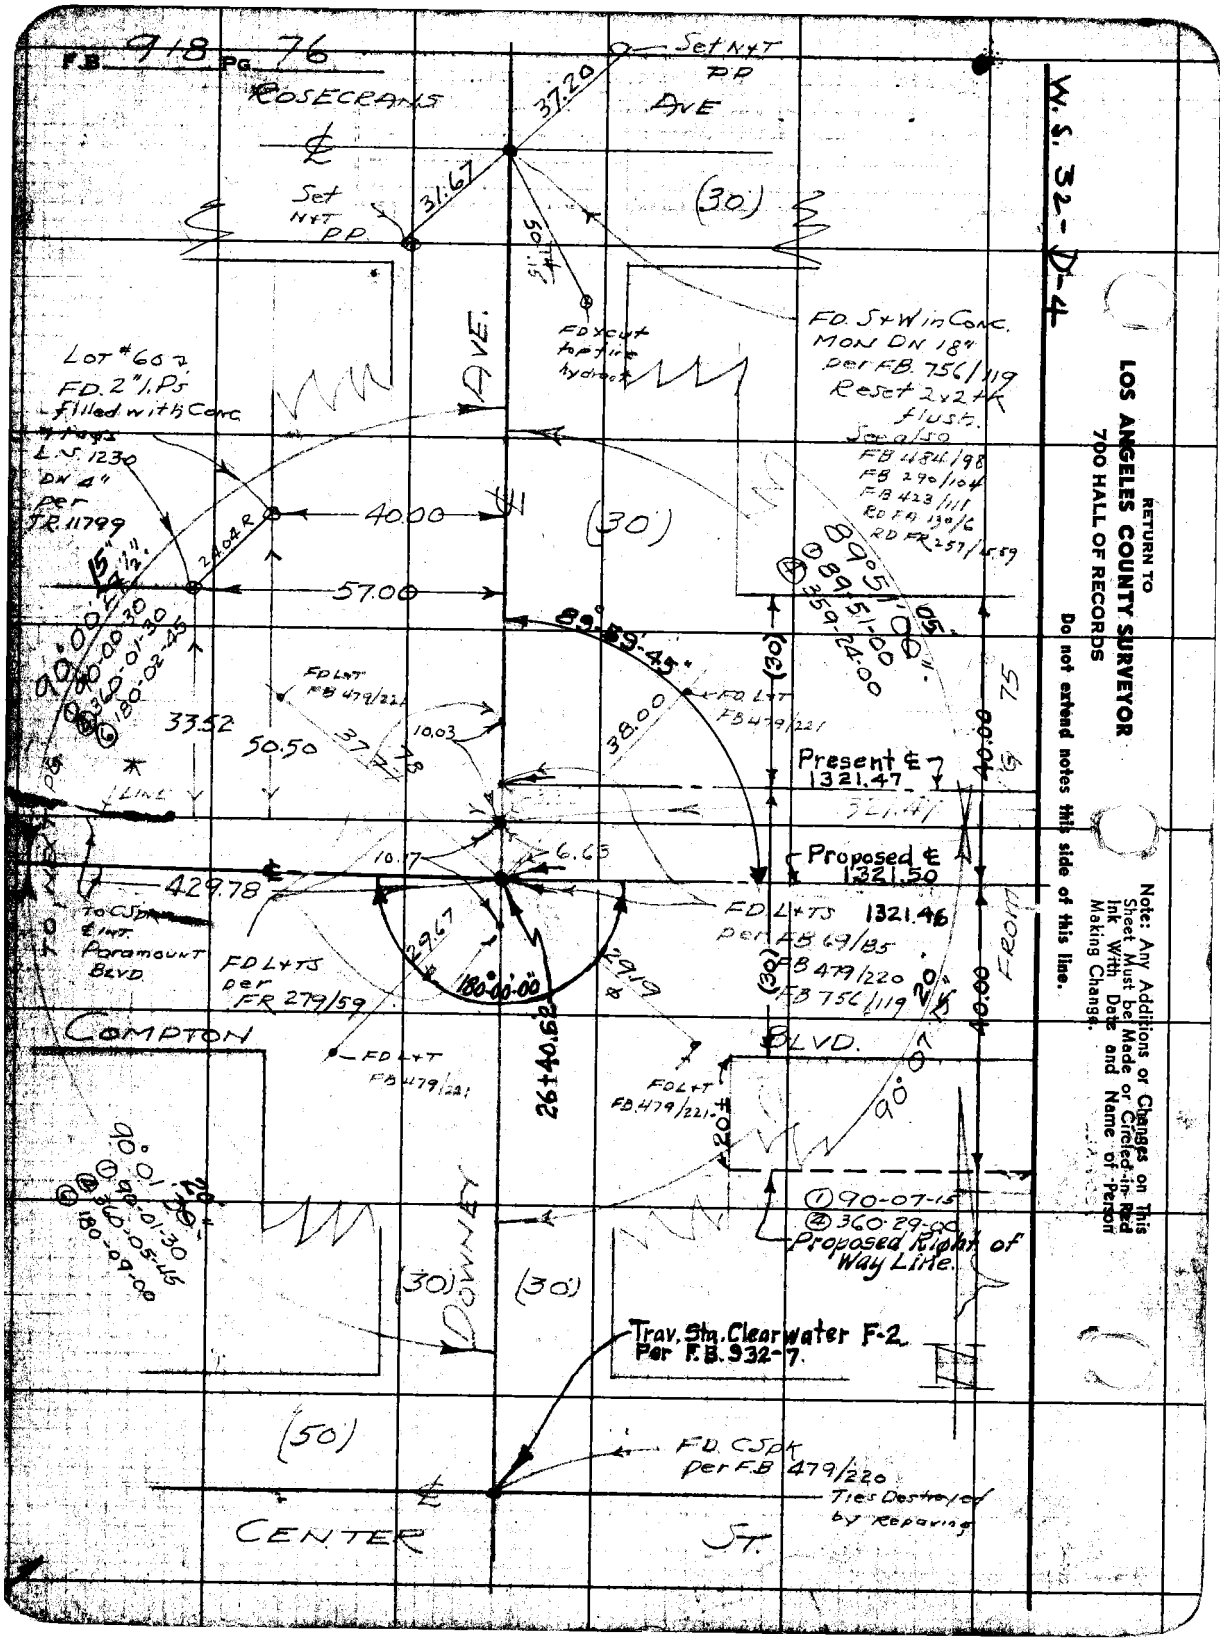
F.B. 918 Pg. 76
ROSECRANS
AVE
Set NYT PP
37.20
31.67
50.11
(30')
FD. S+W in Conc. MON ON 184 per F.B. 756/119 Reset 2x2 PK flush.
See also F.B. 484/98, F.B. 290/104, F.B. 423/111, R.O.S. 130/6, R.O. FR 257/56-59
FD X cut top fire hydrant
LOT #60
FD. 2" I.P.S. filled with ½ Conc. 7 Pkgs L.S. 1230 "DN 4" per T.R. 11799
24.04 R
40.00
57.00
89°59'45"
80°51'00"
89°51'00"
359-24-00
(30')
FD L+T F.B. 479/221
38.00
Present ℄ 1321.47
1321.47
Proposed ℄ 1321.50
33.52
50.50
37.72
10.03
10.17
6.65
429.78
℄
To CSJ ℄ Int. Paramount Blvd.
FD L+TS per F.R. 279/59
FD L+TS 1321.46 per R.O.S. 69/185 F.B. 479/220 F.B. 756/119
29.67
180-00-00
29.19
26+40.62
COMPTON
BLVD.
FD L+T F.B. 479/221
FD L+T F.B. 479/221
90°07'15"
120.00
90°07'15"
(1) 90-07-15
(2) 360-29-00
Proposed Right of Way Line.
90°01'30"
90-01-30
360-05-45
180-09-00
(30')
COMPTON BLVD.
(30')
Trav. Sta. Clearwater F-2 Per F.B. 932-7.
(50')
FD. CSJ pk per F.B. 479/220 Ties Destroyed by Repaving
CENTER ST.
W.S. 32-D-4
RETURN TO LOS ANGELES COUNTY SURVEYOR 700 HALL OF RECORDS
Do not extend notes this side of this line.
Note: Any Additions or Changes on This Sheet Must be Made or Circled in Red Ink With Date and Name of Person Making Change.

FORM 247 SM 11-41

RETURN TO
LOS ANGELES COUNTY SURVEYOR
700 HALL OF RECORDS

Note: Any Additions or Changes on This Sheet Must be Made or Circled in Red Ink With Date and Name of Person Making Change.

Do not extend notes this side of this line.

VAS. 32 - D - 4

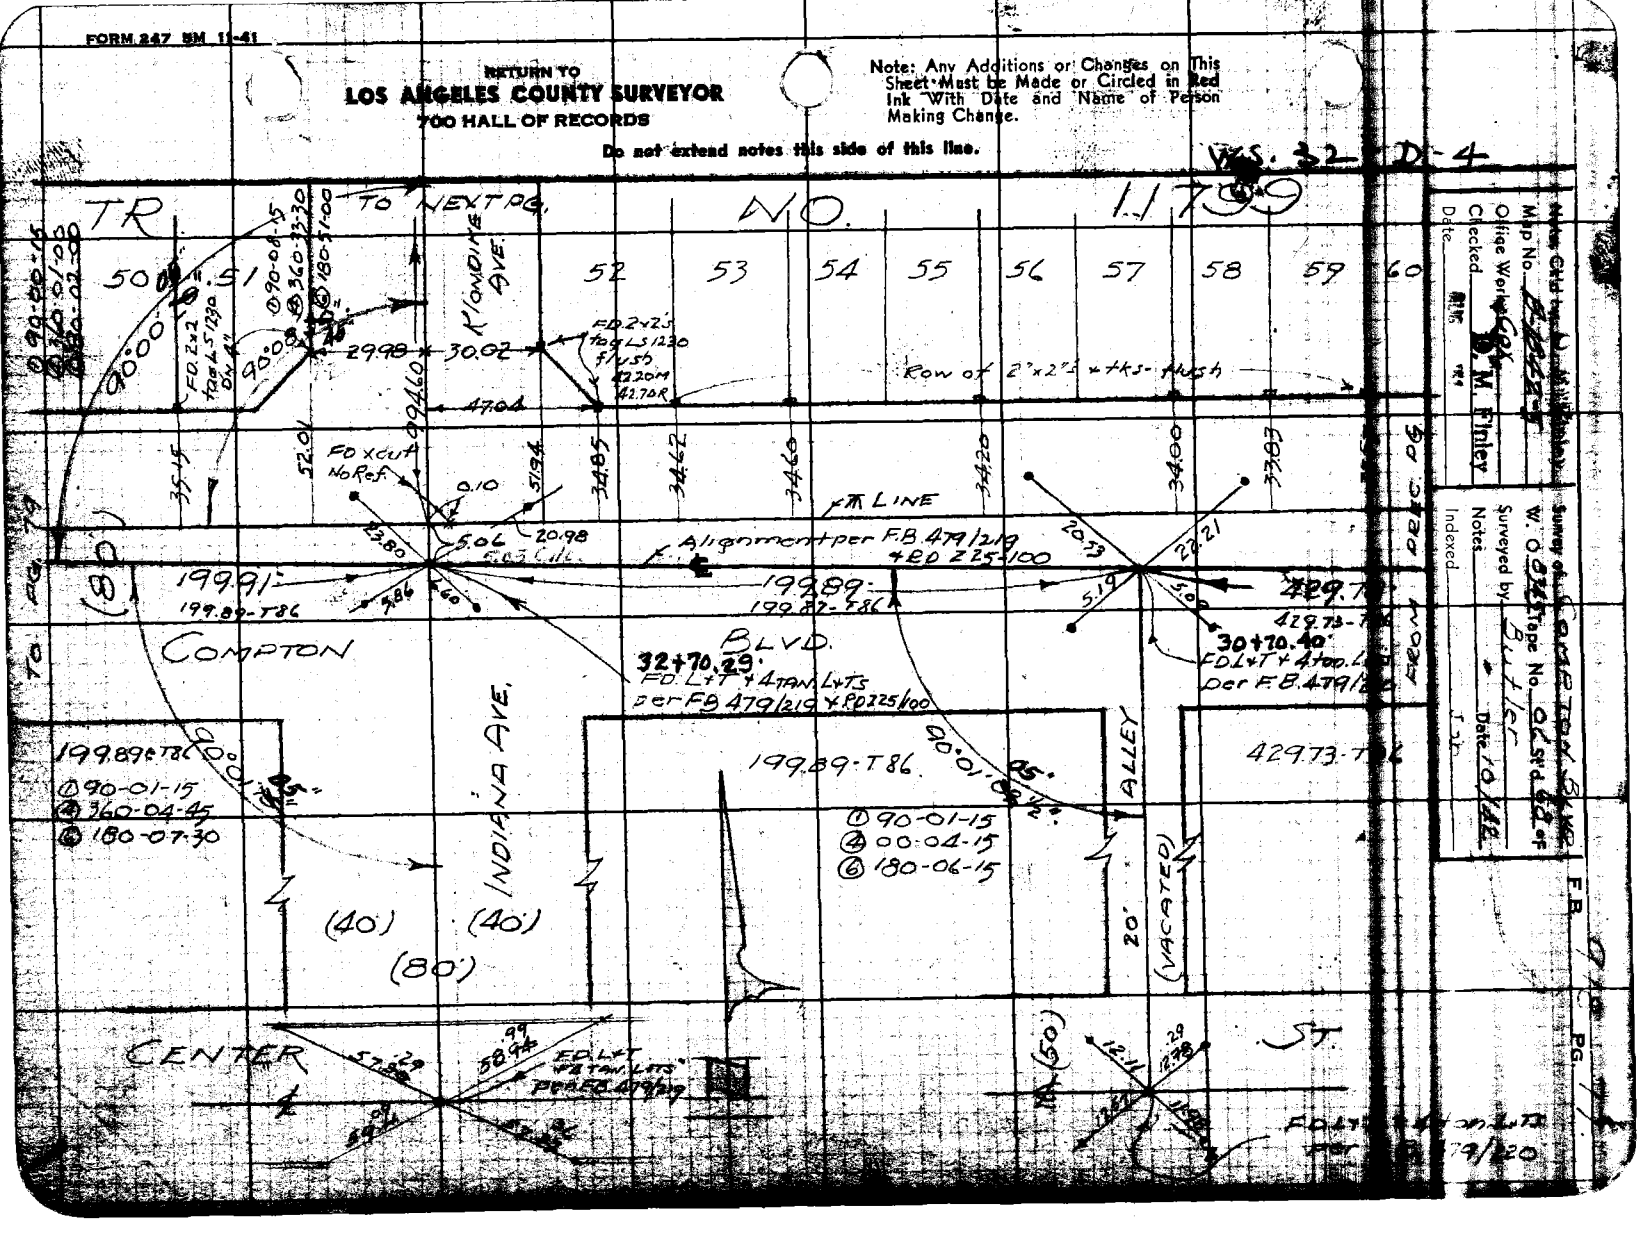

Office Work Checked [illegible] Date [illegible]
Map No. [illegible]
Surveyed by [illegible] Date 10/44
Notes
Indexed [illegible]
Survey of [illegible] Tract No. [illegible] W. O. [illegible] Tape No. [illegible] Std. [illegible] F.B. [illegible] PG. [illegible]

F.B. 918 Pg. 78

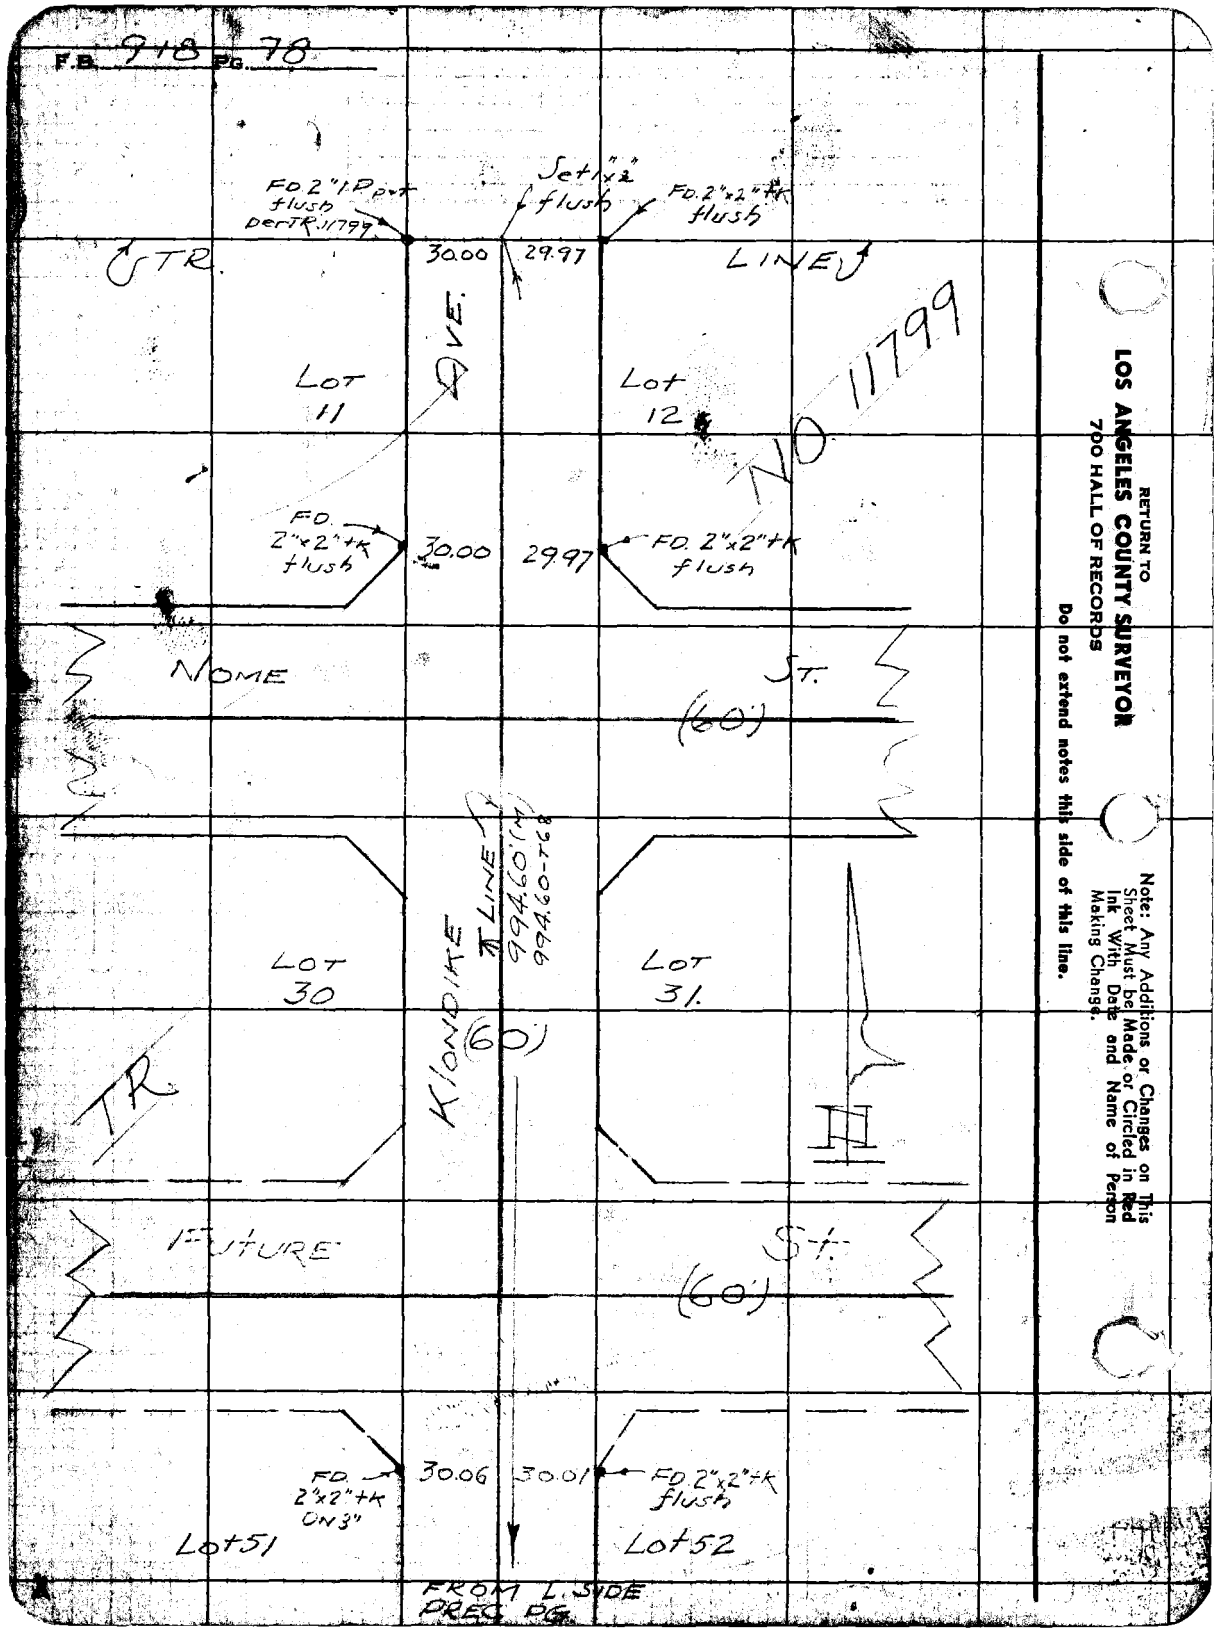

RETURN TO
LOS ANGELES COUNTY SURVEYOR
700 HALL OF RECORDS

Do not extend notes this side of this line.

Note: Any Additions or Changes on This Sheet Must be Made or Circled in Red Ink With Date and Name of Person Making Change.

FORM 247 SM 11-41

RETURN TO
LOS ANGELES COUNTY SURVEYOR
700 HALL OF RECORDS

Note: Any Additions or Changes on This Sheet Must be Made or Circled in Red Ink With Date and Name of Person Making Change.

Do not extend notes this side of this line.

W.I.S. 32-D-4

Prints Ckd. by [illegible]
Map No. 2-18222-3
Office Work by D. M. Finley
Checked by [illegible]
Date [illegible]

Survey of Compton Blvd. F.B. 219 Pg. 39
W. O. 5790
Surveyed by [illegible] Tape No. 82 Std. 42'
Notes [illegible] Date 10/42
Indexed [illegible]

TO NEXT PG.

TR #5790

① 90-05-45
④ 360-23-00
⑥ 180-34-00

TR. NO. 11799

41 42 43 44 45 46 47 48 49

55' OFFSET LINE

55'

LOT #126

FD. 2" I.P. Conc. filled + tags

L.S. 1230 flush

Set 1x2

FD ROW of 2"x2" tks - flush

3.21

5.80

130 129

36.63 36.45 36.39 36.21 36.04 35.89 35.78 35.43

COMPTON BLVD.

42+63.90

530.02

Set x cut in ∩ 17.32

℄ LINE

Alignment ℄ per F.B. 479/219

199.88' 199.86-T&C

199.92' 199.90-T&C

199.93' 199.91-T&C

199.87

FD. L+T + 4 TON LNTS per F.B. 479/217 + R.O. 225/100

FD. L+T + 4 TON LNTS per F.B. 479/218

FD. L+T + 4 TON LNTS per F.B. 479/218

FD. L+T + 4 TON LNTS per F.B. 479/218

30' ℄

20' ALLEY NOT OPEN

GEORGINA AVE.

① 90-00-30
④ 360-02-30
⑥ 180-03-45

(80')

(40')

20' NOT OPEN

① 90-0-00
④ 360-03-45
⑥ 180-05-30

VIRGINIA AVE. (VACATED)

① 90-0-00
④ 360-04-00
⑥ 180-05-45

20' ALLEY

FD. L+T + 4 TON LNTS per F.B. 479/218

FD. L+T + 4 TON LNTS per F.B. 479/218

FD. L+T + 4 TON LNTS per F.B. 479/218 R.O. 225-112 R.O. 224-98

FD. L+T + 4 TON LNTS per F.B. 479/218

CENTER

RETURN TO
LOS ANGELES COUNTY SURVEYOR
700 HALL OF RECORDS

Note: Any Additions or Changes on This Sheet Must be Made or Circled in Red Ink With Date and Name of Person Making Change.

Do not extend notes this side of this line.

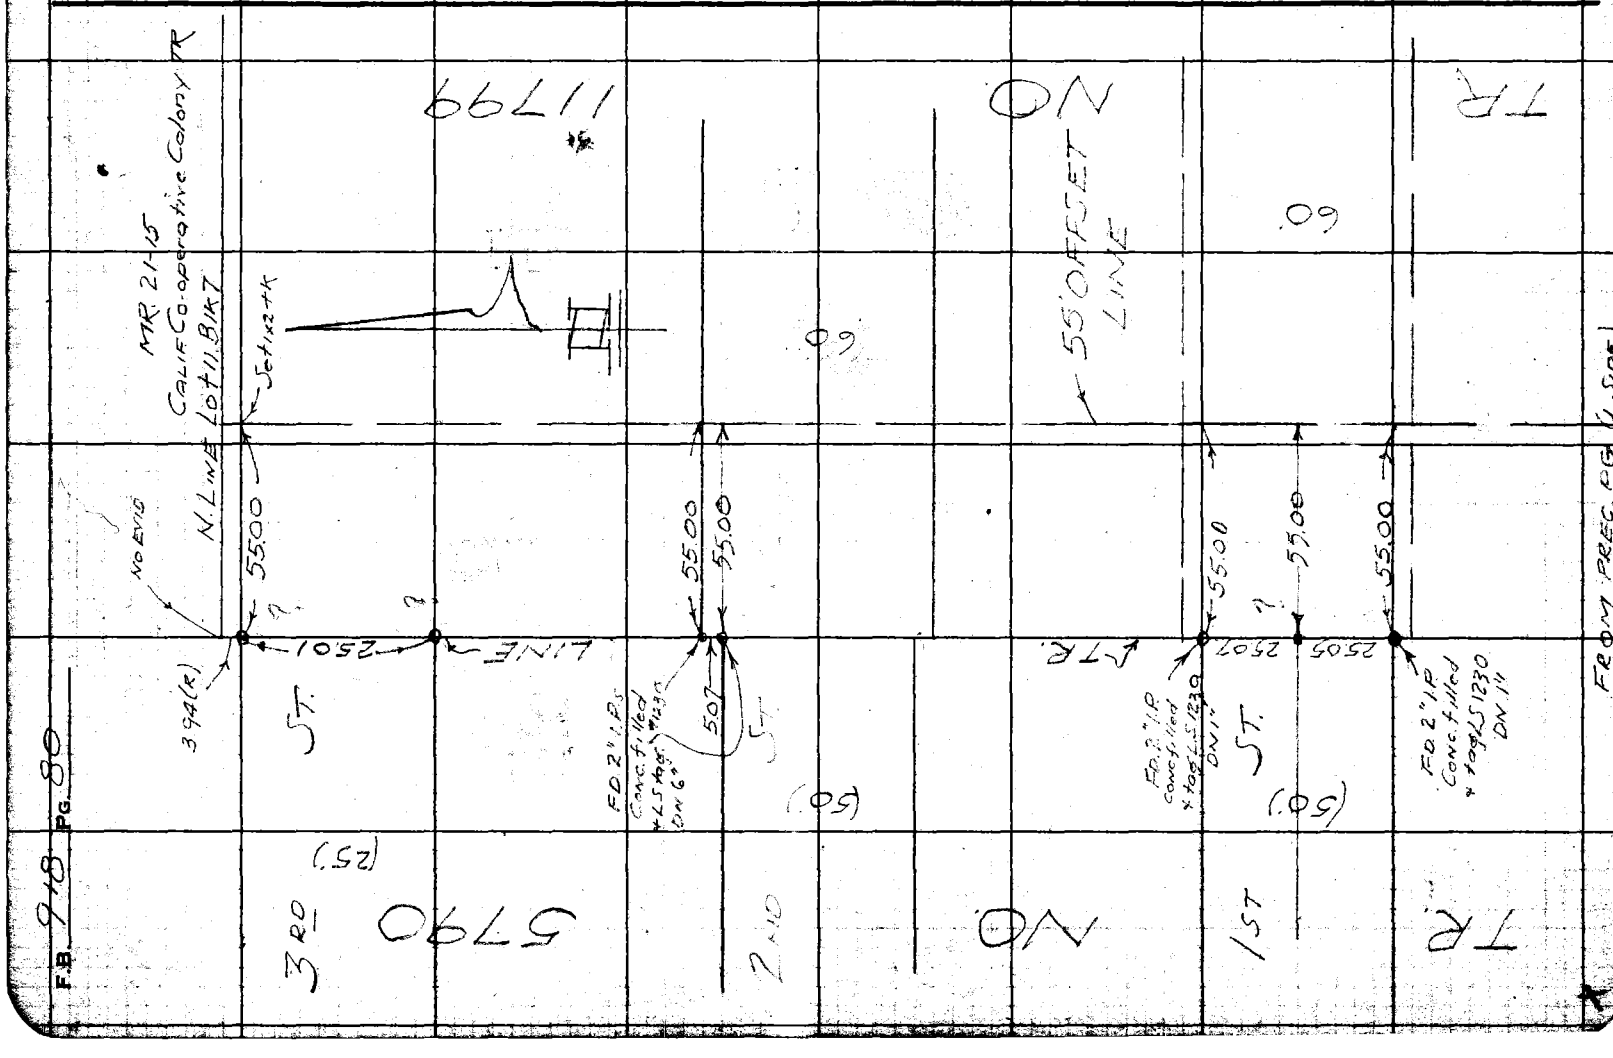
MR 21-15
Calif Co-operative Colony Tr
Lot 11, Blk 7
66111
Set 1x2 T K
N. Line
No Evid
55.00
55.00
55.00

FORM 247 RM 11-61

RETURN TO
LOS ANGELES COUNTY SURVEYOR
700 HALL OF RECORDS

Note: Any Additions or Changes on This Sheet Must be Made or Circled in Red Ink With Date and Name of Person Making Change.

Do not extend notes this side of this line.

W.S. 32-B4

TO NEXT BOT PG

TR. NO. 5790

142 141 140 139 138 137 136 135 134 133 132 131

50' " " " " " " 50'

FLORENCE AVE. (50')

COMPTON BLVD.

PG. 83

48+69.55

FD L+T per F.B 479/215 R.D 225-99

℄ LINE

ALIGNMENT per F.B 479/ + R.D 225-99

B8-44 TIED BY C.V.G.

35.27

25.27

35.27

FD C.SPK No Ref marked C-28

×2.16

×0.02

FD X-CUT No Ref.

992.29

N 89°53'30" E

89-53-30
399.34-00

530.01-T72
530.02.

199.87.
199.84-T88

399.84
399.79-T88

199.91.
199.89-T86

90°00'00" 30.0 (80')

44+62.71

FD L+T per F.B 479/216

90°

80'

(40') (40')

CALIFORNIA AVE.

ALLEY VACATED

90-00-15
360-01-00
89-58-02-00

Pennsylvania AVE

(50')

10.00 10.00 10.00 10.00

CENTER ℄ ST.

FD L+T
"CANCH"
PER F.B 479/2
R.D 225-111

FD L+T
"ATAN L+R"
PER F.B 479/216

Notes Grid Intersection W. 0.9344

Map No. 2-B 42 25

Office Work Cpk D. M. Fibley

Checked BUG

Date

Survey of COMPTON BLVD.

Surveyed by BUTLER

Notes

Indexed

Tape No. 06 St'd. Co. of

Date 10/42

F.B. 9/10 PG. 39

PG. 79

F.B. 918 Pg. 82

FD 2"x2" ON L.
NO REF.

3RD (25')

ST.

5790

16

17

AVE.

35

(50)

34

2ND

(50)

992.29'
992.276-770

66

67

85

NO

84

1ST

(50')

ST.

FLORENCE

TR

116

117

FROM DREC. PG(L)

RETURN TO
LOS ANGELES COUNTY SURVEYOR
700 HALL OF RECORDS

Do not extend notes this side of this line.

Note: Any Additions or Changes on This Sheet Must be Made or Circled in Red Ink With Date and Name of Person Making Change.

Notes Ck'd by: [illegible]
Map No. 6-1842-5
Office Work: Cox
Checked: D. M. Finley
Date: [illegible]

Survey of: Compton Blvd.
W. O. 8345 Tape No. 06 St'd 68°F
Surveyed by: Butler
Notes: [illegible] Date: 11/42
Indexed: [illegible]

F.B. 419 Pg. 83

W.S. 34 - 6 -

Note: Any Additions or Changes on This Sheet Must be Made or Circled in Red Ink With Date and Name of Person Making Change.

Do not write notes this side of this line.

RETURN TO
LOS ANGELES COUNTY SURVEYOR
700 HALL OF RECORDS

FORM 247 SM 11-41

5.00
FD L+T
FD L+T
FB 756/127
FD 4" Conc Mon 4 NAIL & PE IN DH C" per F.B. 756/121 = B.C. to W.
ROSECRANS
3 1/4 I.P. FB. 756/121
9.15
copied 66.58
44.18
FD L+T
30'
AVE.
FD L+T
TO 4" CASING & RIM - So. of COMPTON BLVD. See PP 74
L5' OFFSET LINE
L15' OFFSET LINE FB 756/121
① 89-58-30
④ 359-53-20
⑥ 179-51-00
89°58'30"
COMPTON
52+79.39
FD C SPK
per F.B. 479/214
" 756/121
" 273/46
" 427/80
FD L+T
FD. RDFD 247-72
Traverse Sta. Clearwater E-1. per F.B. 796-201, 202.
BLVD.
90°01'30"
① 90-01-30
④ 360-02-00
⑥ 180-00-30
FD. L+T
20
51.32
51.09
LINE AS per R.O. 225.
FD. L+T per F.B. 479/214 Flat about
0.52
29.99
209.76 T=72
209.76
0.60
179.99'
179.99-T68
51.27
51.55
51.82
(40)
(50)
(100)
PARK MOUNT
20' P.U.E.
90°00'00"
① 90-00-00
④ 360-00-20
⑥ 180-00-30
① 90
④ 360
⑥ 180
FD C SPK W+T per F.B. 279/14, F.B. 427/82. R.O.F.D. 247/73, R.O.F.R. 283/155
CENTER
ST.
559.91
FD L+T

RETURN TO
LOS ANGELES COUNTY SURVEYOR
700 HALL OF RECORDS

Note: Any Additions or Changes on This Sheet Must be Made of Circled in Red Ink With Date and Name of Person Making Change.

Do not extend notes this side of this line.

F.B. 918 PG. 84

Notes Ck'd by: D. M. Finley
Map No. B-1842-5
Office Work: Col
Checked: D. M. Finley
Date: Dec '51

Survey of: COMPTON BLVD.
W. O. 8347 Tape No. 06 St'd 66 °F
Surveyed by: Butler
Notes: H.E. 044 Date: 12-1-42
Indexed: A. C.

F.B. 918 PG. 85

W.S. 24 C 4

Fd. "X" & 4 Tang. L+Ts.
Rec. F.B. 479-213

COMPTON BLVD

TO PG. 86

(80) (40) ℄

199.94 T=72
199.94

19995'
199.94 T=72

56+89.09
Fd. L+T. & 4 Tang. L+Ts.
F.B. 479-213
R.D.Z-118-~~103~~
R.D.F.O. 210-19

90°-00'-00"

(1) 90°-00'-00"
(4) 360°-00'-00"
(6) 180°-00'-00"

(80)

(10) (10)

(40) (40)

COLORADO AVE.

ALLEY

Not used

FROM PG. 84

Fd. L+T. & 4 tang. L+Ts.
F.B. 479-213
R.D.Z-118-101
R.D.F.R. 283-39

(50) (50)
(100) ℄

CENTER STREET

Note: Any Additions or Changes on This Sheet Must be Made or Circled in Red Ink With Date and Name of Person Making Change.

Do not extend notes this side of this line.

RETURN TO
LOS ANGELES COUNTY SURVEYOR
700 HALL OF RECORDS

FORM 247 SM 11-41

RETURN TO
LOS ANGELES COUNTY SURVEYOR
700 HALL OF RECORDS

Note: Any Additions or Changes on This Sheet Must be Made or Circled in Red Ink With Date and Name of Person Making Change.

Do not extend notes this side of this line.

W.O.S. 32 - C - 4

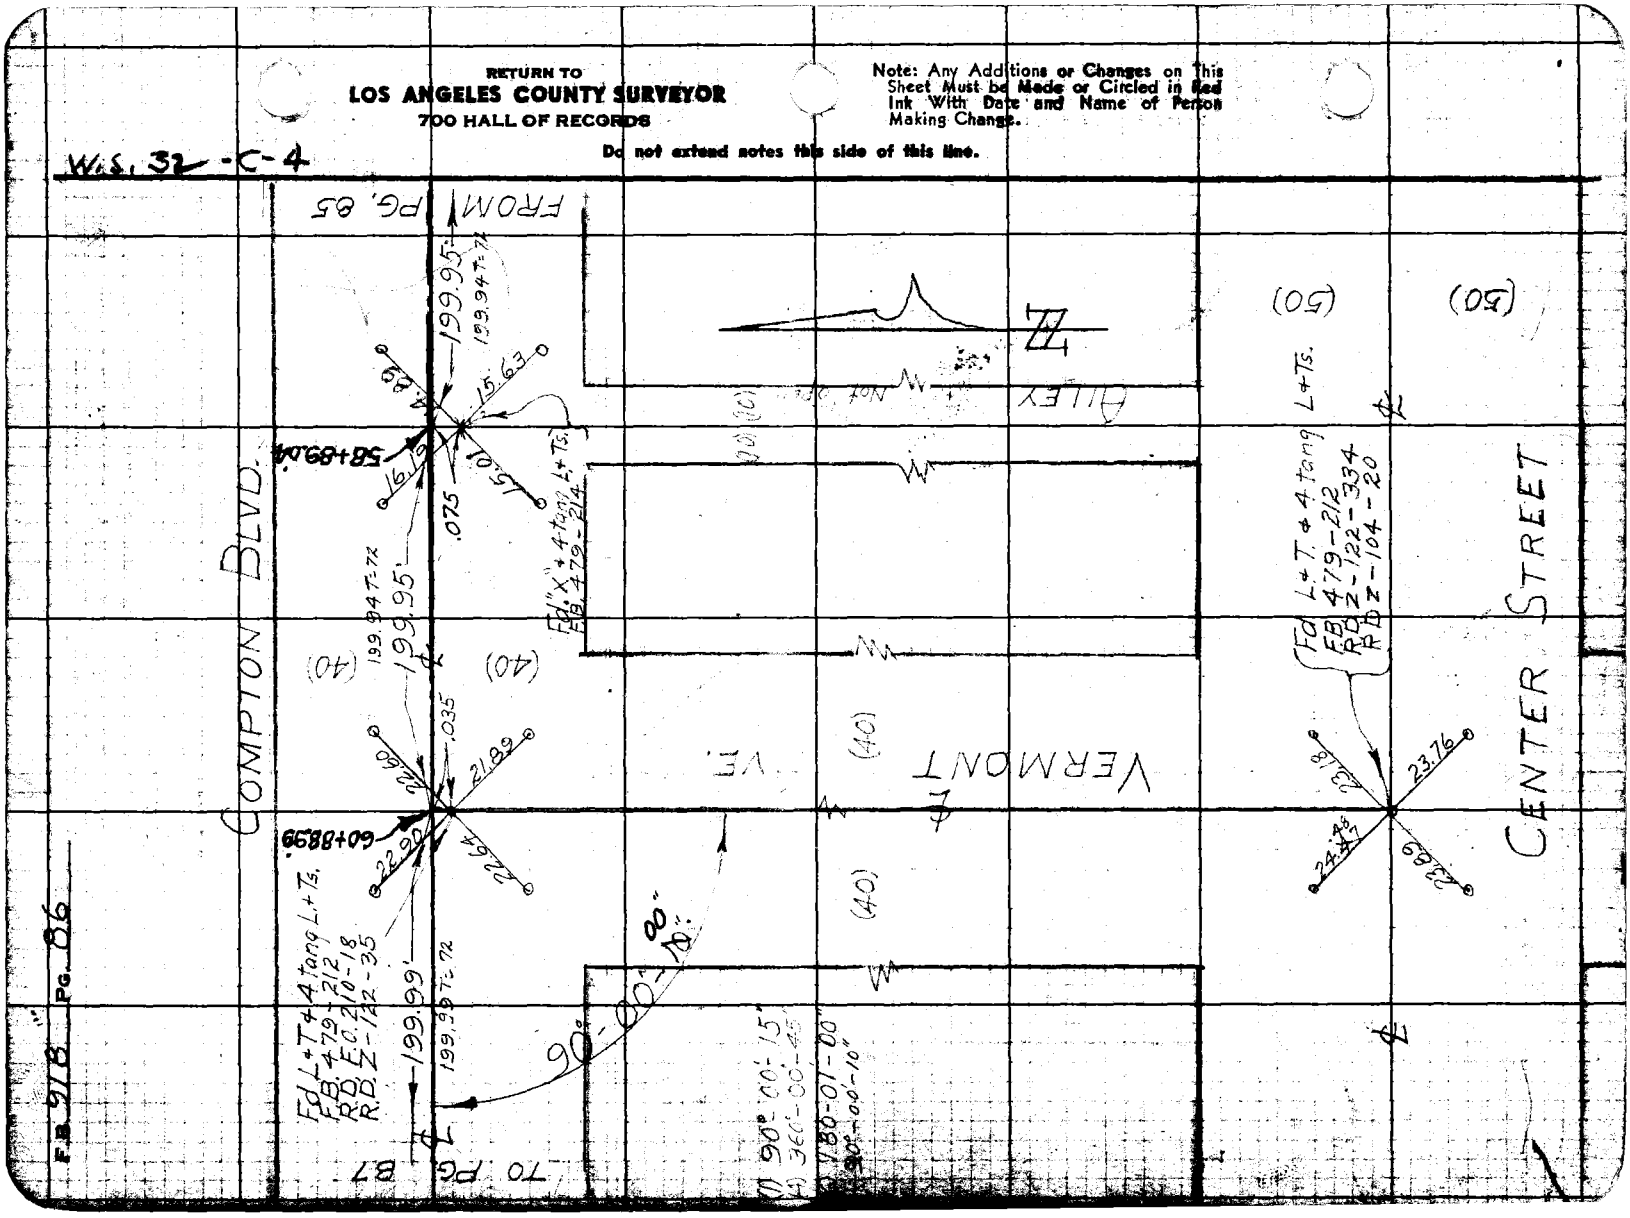

Notes Ck'd by: E. M. Finley
Map No. A-1842-5
Office Work: Col
Checked: E. M. Finley
Date: 9 Jan 43

Survey of COMPTON BLVD.
W. O. 8345 Tape No. 06 St'd 68 °F
Surveyed by: Butler
Notes: H.E. O++ Date 12-11-42
Indexed: C. J.

F.B. 918 PG. 87

W.S. 31 - 5-4

COMPTON BLVD.

TO PG 88

FROM PG 86

(40)

111.16 T=70
111.16'

200.05 T=72
200.05'

19999

64.03 D

62.08 D

15.47
15.32
15.47
14.51
14.69
14.81
14.61

.03

Fd. "X" + 4 tang L + Ts.
F.B. 479-211

Fd. "X" + 4 tang L + Ts.
Per F.B. 479-212

90° 00' 00"

(1) 90° 00' 00"
(4) 360° 00' 00"
(6) 180° 00' 00"
90° 00' 00"

(40)

(40)

OHIO AVE.

ALLEY Not Open

(50)

(50)

CENTER STREET

Fd. L + T. + 4 tang L + Ts.
F.B. 479-211

22.96
23.17
23.40
22.95

Note: Any Additions or Changes on This Sheet Must be Made or Circled in Red Ink With Date and Name of Person Making Change.

Do not extend notes this side of this line.

RETURN TO
LOS ANGELES COUNTY SURVEYOR
700 HALL OF RECORDS

FORM 247 SM 10-41

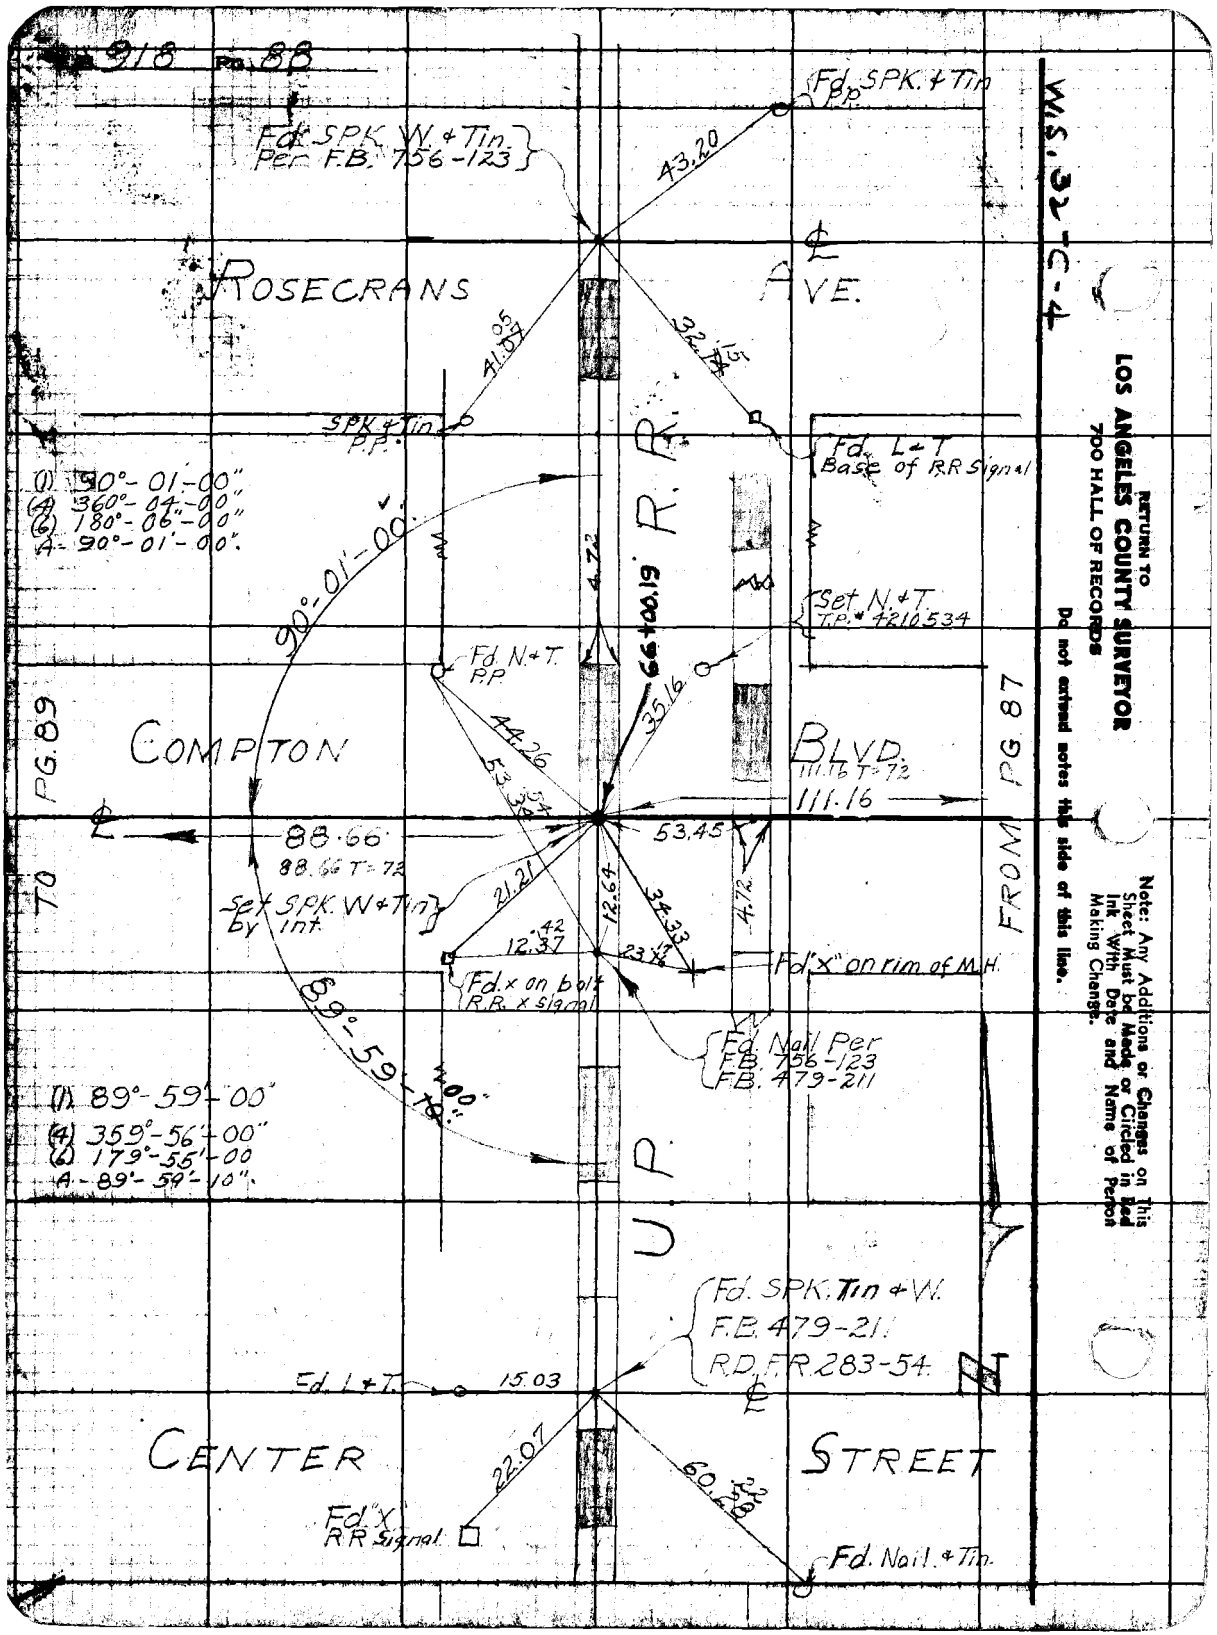
R 918 Pg. 88
Fd. SPK. W. & Tin. Per F.B. 756-123
Fd. SPK. & Tin P.P.
43.20
ROSECRANS
AVE.
41.05
32.15
SPK & Tin P.P.
Fd. L & T Base of R.R. Signal
(1) 90°-01'-00"
(A) 360°-04'-00"
(C) 180°-06'-00"
A - 90°-01'-00".
90°-01'-00"
U.P. R.R.
Set N. & T. P.P. 4210.534
Fd. N. & T. P.P.
44.26
53.39
35.16
COMPTON
BLVD.
111.16 T=72
111.16
PG. 89
PG. 87
88.60
88.66 T=72
53.45
Set SPK. W & Tin by Int.
21.21
12.64
34.33
47.24
12.42
12.37
23.14
Fd. x on bolt R.R. x signal
Fd. "x" on rim of M.H.
FROM
TO
Fd. Nail Per F.B. 756-123 F.B. 479-211
(1) 89°-59'-00"
(A) 359°-56'-00"
(C) 179°-55'-00
A - 89°-59'-10".
89°-59'-10"
Fd. SPK. Tin & V.I. F.B. 479-21. R.D.F.R. 283-54.
Fd. L & T.
15.03
CENTER
STREET
22.07
60.28
Fd. "X" R.R. Signal
Fd. Nail & Tin.
RETURN TO
LOS ANGELES COUNTY SURVEYOR
700 HALL OF RECORDS
Do not extend notes this side of this line.
Note: Any Additions or Changes on This Sheet Must be Made or Circled in Red Ink With Date and Name of Person Making Change.
W.S. 32-C-4

Notes Ck'd by: D. M. Finley
Map No. B-1842-5
Office Work Cor
Checked D. M. Finley
Date

Survey of COMPTON BLVD.
W. O. 8345 Tape No. 06 St'd 68° °F
Surveyed by Butler
Notes H.E. Ott Date 12-11-42
Indexed

F.B. 918 PG. 89

COMPTON BLVD.

W.S. 82 C-4

Fd. L+T. Headwall
Fd. L+T
Fd. L+T Per. FB 479-210 R.D.Z-118-26
27.88
19.86
.08
66+84.45
12.74
13.03
88.66
199.96'
199.95 T= 78
200.06'
200.05 T= 78
27.99
Fd. L+T.
Fd. L+T. Headwall
Fd. "X" & 4 tang L+Ts. Per. F.B. 479-211
68+88.91
90°-00'-00"
(9) 90°-00'-00"
(4) 360°-00'-00"
(6) 180°-00'-00"
(40)
(40)
(40)
(40)
(10)
(10)
ILLINOIS AVE.
ALLEY Not Open
Fd L+T & 4 tang L+Ts. Per. F.B. 479-210 RDZ-26-146 RDZ-118-24
23.64
23.11
23.19
23.59
(50)
(50)
CENTER STREET

TO. PG. 90

FROM PG. 88

Note: Any Additions or Changes on This Sheet Must be Made or Circled in Red Ink With Date and Name of Person Making Change.

Do not extend notes this side of this line.

RETURN TO
LOS ANGELES COUNTY SURVEYOR
700 HALL OF RECORDS

FORM 247 5M 11-41

F.B. 918 Pg. 90

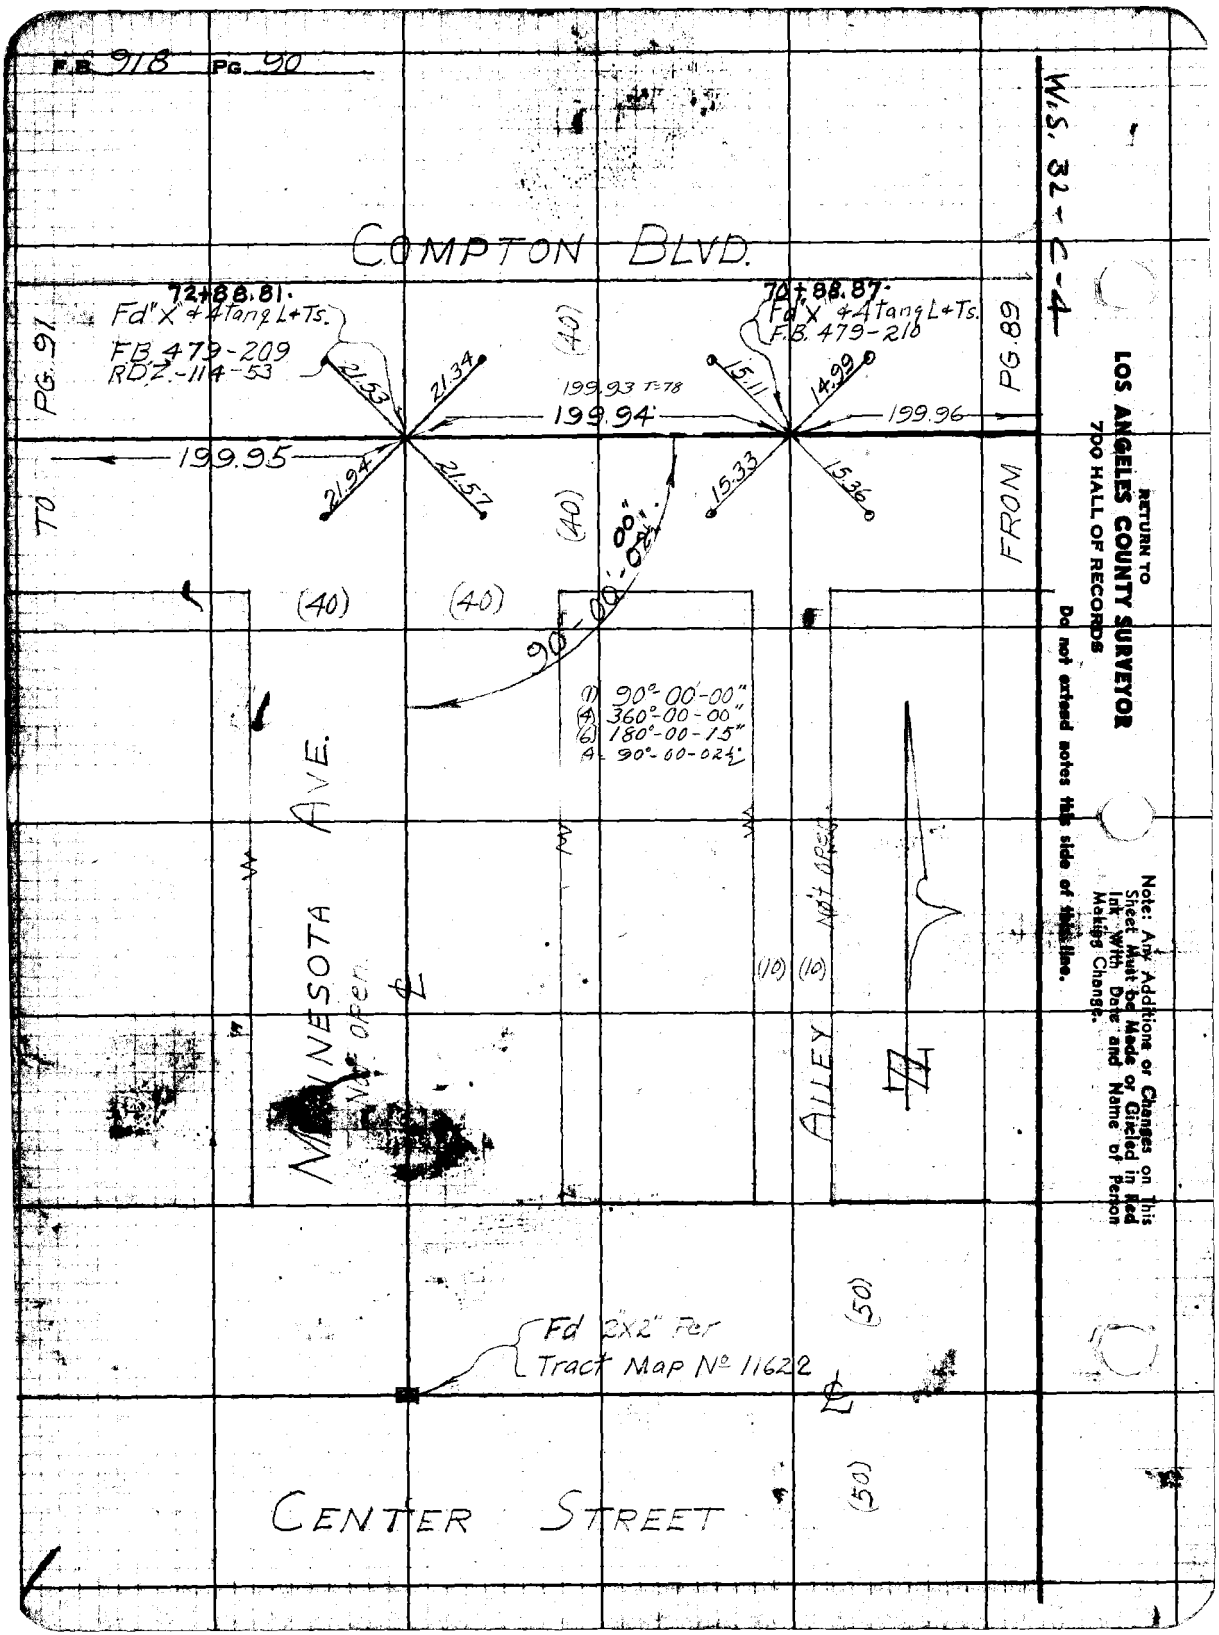

RETURN TO
LOS ANGELES COUNTY SURVEYOR
700 HALL OF RECORDS

Do not extend notes this side of this line.

Note: Any Additions or Changes on This Sheet Must be Made or Circled in Red Ink With Date and Name of Person Making Change.

Notes Ck'd by L. M. Finley
Map No. B-1842-Sht.
Office Work Cox
Checked D. M. Finley
Date AUG '51

Survey of Compton
W. O. 8744 Tape No. St'd °F
Surveyed by Butler
Notes H.E. Date 12-15-48
Indexed

F.B. 712 Pg. 91

W.S. 52 I-C-4

Traverse Sta. Ball D-12
Fd. L+T. +4 Tangs L+Ts.
F.B. 290-134
F.B. 423-115
R.D. F.A. 130-6

7.08
6.97
#11345

ROSECRANS AVE

(1) 90°-00'-45"
(4) 360°-03'-15"
(6) 180°-05'-00"
A = 90°-00'-50".

(1) 89°-59'-45"
(4) 359°-58'-45"
(6) 179°-58'-15"
A = 89°-59'-42".

TR. 12 11

40'

BLVD

89°-59'-30"

79+18.65
Fd. L+T 44
Tangs. L+Ts
F.B. 756-124
F.B. 423-115
F.B. 427-70

74+88.76
Fd X per
F.B. 479-209

Fd. L+T.
150.41
149.91 Tan. to
199.95

429.86 To 78
429.89'

670.09

COMPTON BLVD

Fd. L+T.

89°-59'-30"

90°-00'-15"

(1) 89°-59'-15"
(4) 359°-57'-00"
(6) 179°-55'-30"
A = 89°-59'-15".

(1) 90°-00'-15"
(4) 360°-01'-15"
(6) 180°-01'-30"
A = 90°-00'-15".

GARFIELD

Fd L+T
37.64
37.97
38.09
L+T.
Fd. C. S. Pk. & W.
F.B. 479-208
F.B. 427-70
R.D.F.R. 283-53
50

38.59
37.43
Fd L+T
L+T
50

OLIVE STREET
CENTER STREET

Note: Any Additions or Changes on This Sheet Must be Made or Circled in Ink With Date and Name of Person Making Change.

Do not extend notes this side of this line.

RETURN TO
LOS ANGELES COUNTY SURVEYOR
700 HALL OF RECORDS

FORM 247 5M 10-59

RETURN TO
LOS ANGELES COUNTY SURVEYOR
700 HALL OF RECORDS

Note: Any Additions or Changes on This Sheet Must be Made or Circled in Red Ink With Date and Name of Person Making Change.

Do not extend notes this side of this line.

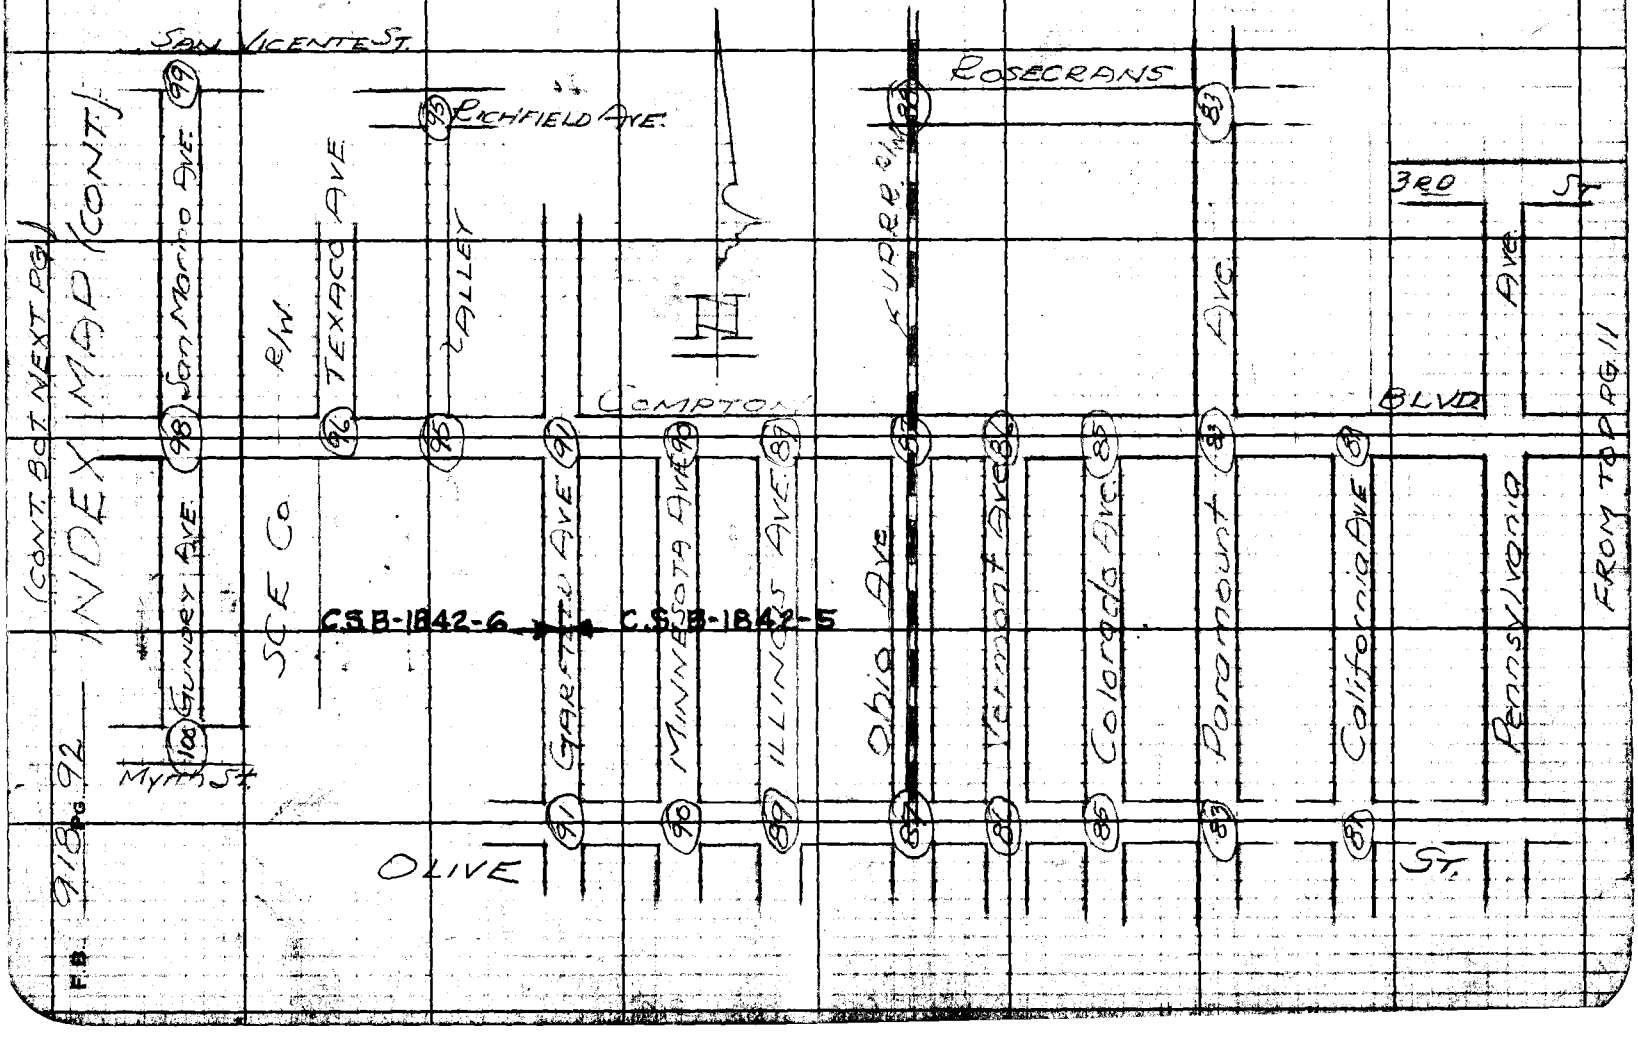

Notes Ck'd by	Survey of Compton Blvd
Map No. B-1842-1	W. O. 8345 Tape No. 06 St'd 66 F
Office Work Cox	Surveyed by BUTLER
Checked D. M. Finley	Notes " Date 12/42
Date AUG '51	Indexed A. C. Johnson 4-20-43

F.B. 940 PG. 93

INDEX MAP (CONT'd)

TO BOT. PG. 94

FROM TOP PG. 92

OLIVE ST.

COMPTON BLVD.

GIBSON AVE.

L. A. COUNTY F.C. RIVER CHANNEL

ROSECRANS AVE.

C.S.B-1842-K

SAN ANTONIO AVE

SAN VICENTE AVE

SAN JOSE AVE.

SAN CARLOS AVE.

MYRRH ST.

ROSE AVE

FAULKNER AVE.

EL CAMINO AVE.

ORANGE AVE.

OLIVE ST.

COMPTON BLVD.

110 109 108 107 106 105 104 103 102 101

Note: Any Additions or Changes on This Sheet Must be Made or Circled in Red Ink With Date and Name of Person Making Change.

Do not extend notes this side of this line.

RETURN TO
LOS ANGELES COUNTY SURVEYOR
700 HALL OF RECORDS

FORM 247 BM 10-51

F.B. 918 PG. 94

INDEX MAP (CONT.)

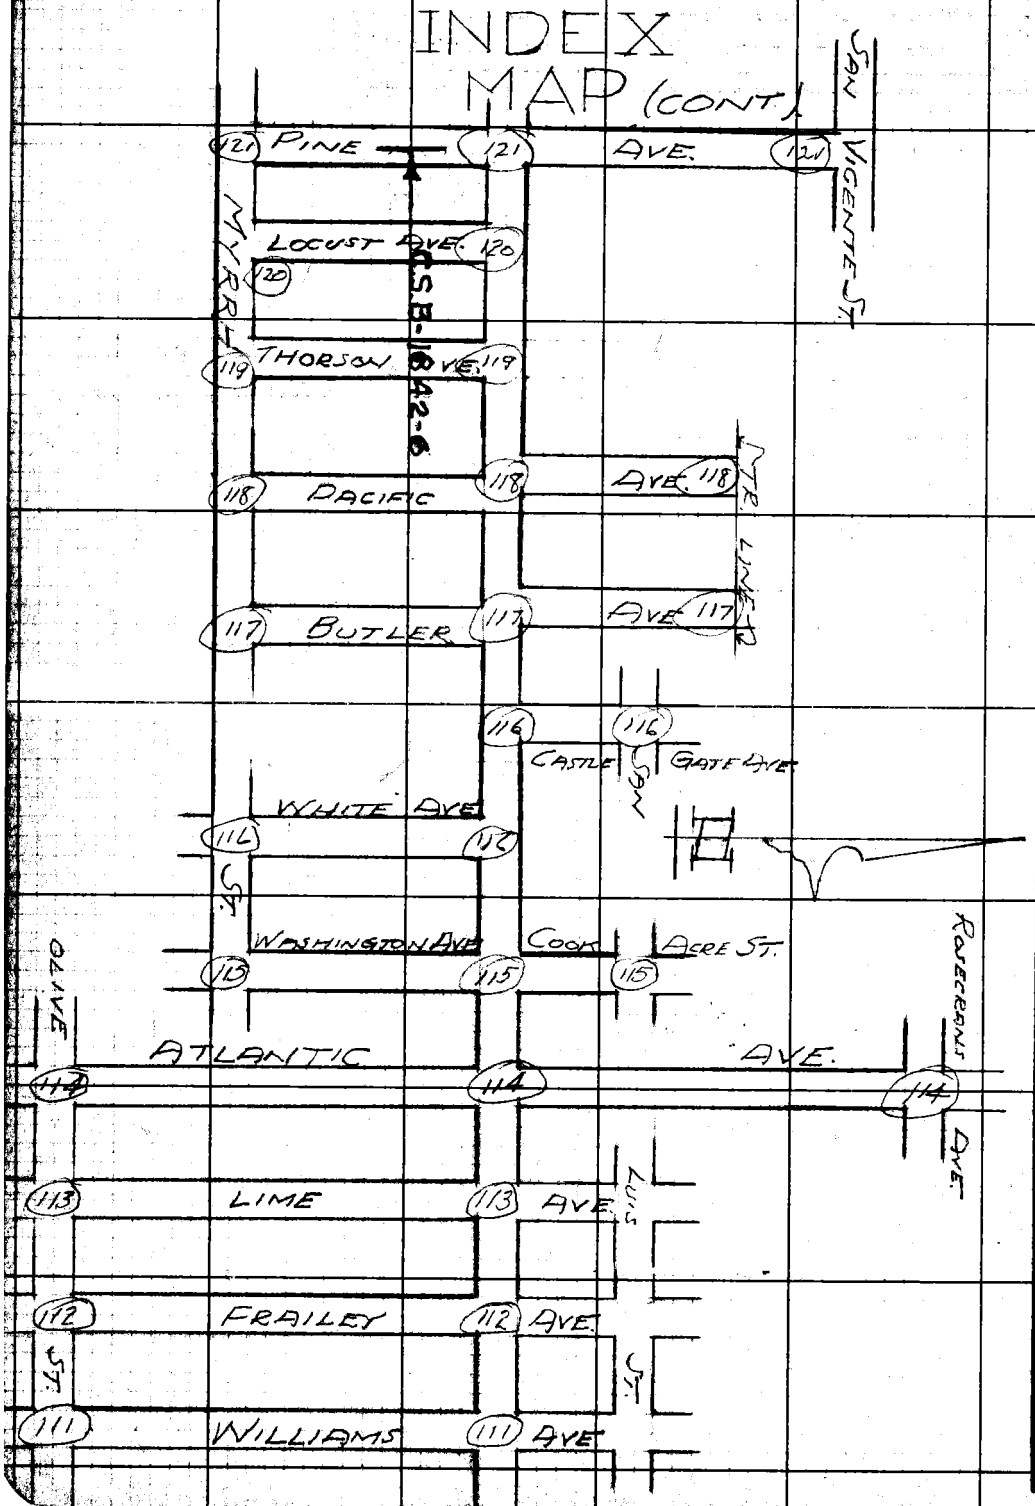

RETURN TO
LOS ANGELES COUNTY SURVEYOR
7DO HALL OF RECORDS

Do not extend notes this side of this line.

Note: Any Additions or Changes on This Sheet Must be Made or Circled in Red Ink With Date and Name of Person Making Change.

Notes Ck'd by D. M. Finley
Map No. B-1842-6
Office Work Cor
Checked D. M. Finley
Date 8/11/59

Survey of COMPTON BLVD.
W. 0834 Tape No. 06 St'd 68.0°F
Surveyed by Outfit
Notes
Indexed A. C. John 4-20-43

F.B. 910 PG. 95

W.S. 82 C 4

TR. LINE

A 5

6

ALAMEDA

RICHFIELD (60')

ST.

N 0° 13' 45" W

5

6

B

Set N47

10.00

FD. 1" IRON pipe DN 2.0

17

16

EXETER (60')

ST.

5

6

C

FD. OLD 2x2 TK ON 6"

10.07

18

17

DETROL (60')

FD. OLD 2x2 TK flush

ST.

TR.

00"

10 1/2"

5

6

D

FD. old 2"x2" TK DN 2"

10.01

20'

90-01-00

360-04-30

180-00-45

18

17

16

15

14

13

3'x3' CONC. WALK

Set x cut

Set N47 D.P.

46.16

35.99

PG 96

(80')

(40')

℄

649.59'

649.54-T80

670.09'

670.04-T80

TO

COMPTON

BLVD.

28.88

Set N47 8"x8" CONC. Post

B5+88.74

Set L x T by proportion bet. ℄ Garfield Ave. & WPL Texaco Ave.

FEB 20 '43

RETURN TO
LOS ANGELES COUNTY SURVEYOR
700 HALL OF RECORDS

Note: Any Additions or Changes on This Sheet Must be Made or Circled in Red Ink With Date and Name of Person Making Change.

Do not extend notes this side of this line.

FORM 247 BM 11-41

RETURN TO
LOS ANGELES COUNTY SURVEYOR
700 HALL OF RECORDS

Note: Any Additions or Changes on This Sheet Must be Made or Circled in Red Ink With Date and Name of Person Making Change.

Do not extend notes this side of this line.

W.S. 32 - C-4

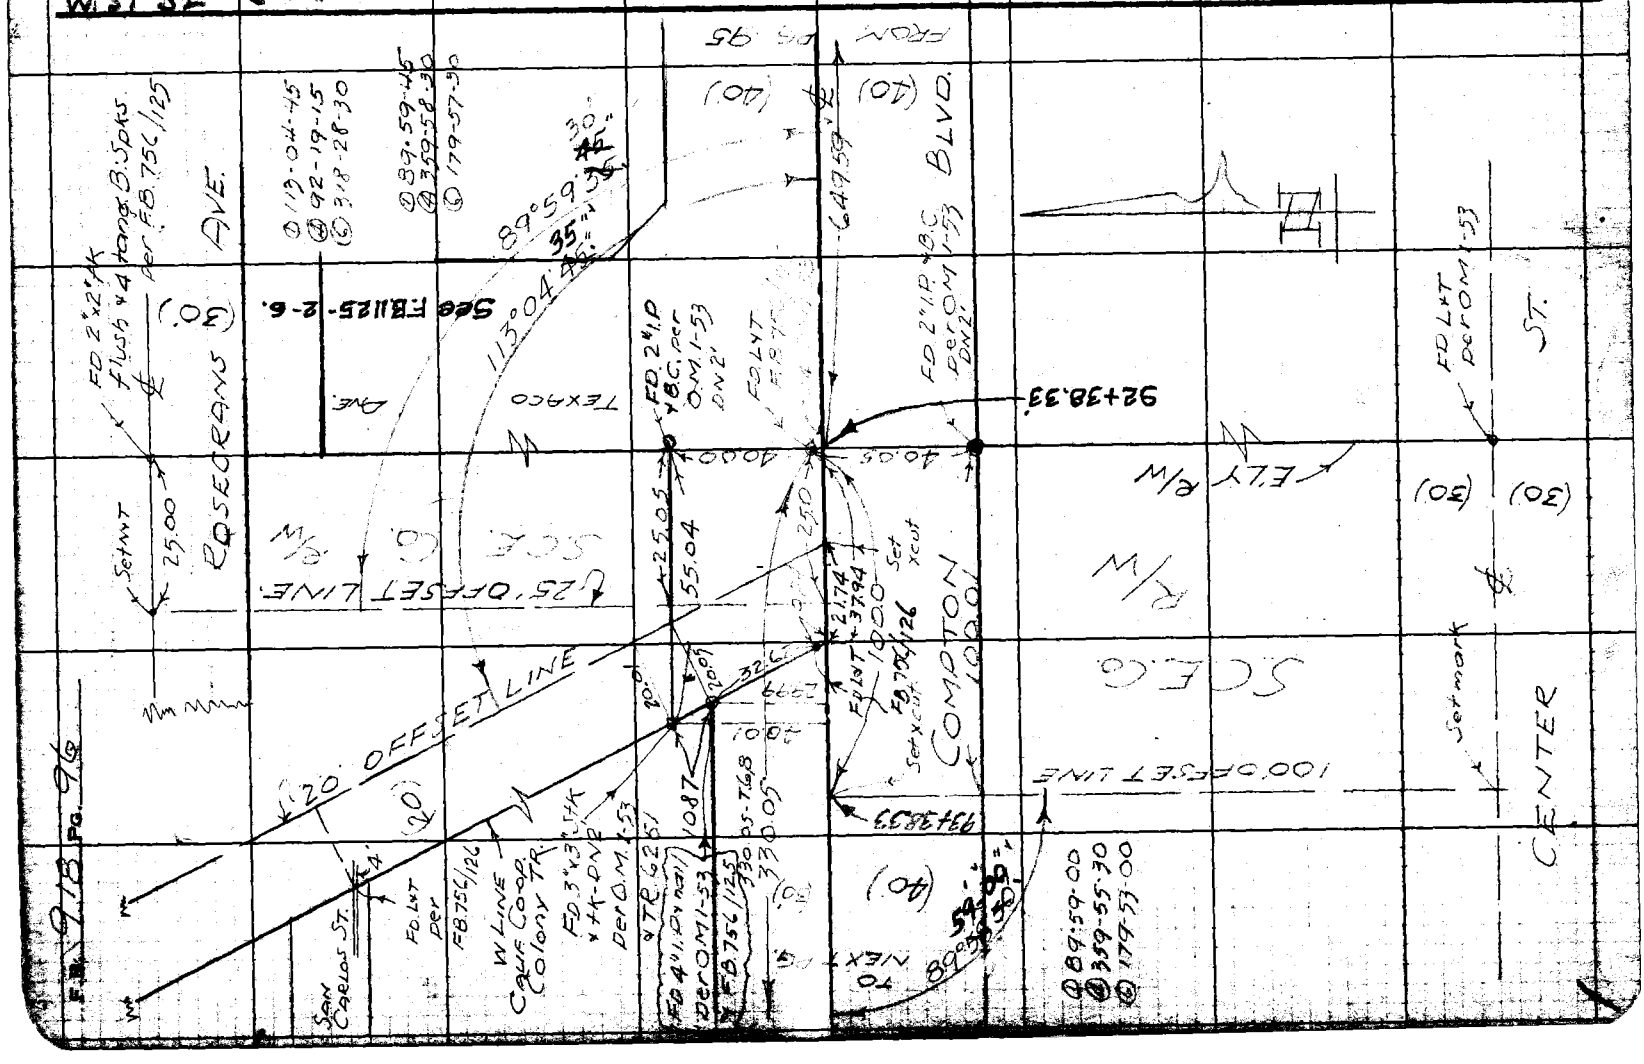
ROSECRANS AVE.
COMPTON BLVD.
CENTER ST.
25' OFFSET LINE
100' OFFSET LINE
20' OFFSET LINE
SCE CO. R/W
SCE CO.
R/W
ELY R/W
92+38.33
See FB 125-2-6.
FD 2"x2" PK flush w/ 4 tangs B. SONS. per FB 756/125
FD 2" I.P. B.C. per O.M. 1-53
FD L&T per O.M. 1-53
Set Nail
Set X cut
Set mark
W. LINE Gulf Coop Colony TR.
FD L&T per FB 756/126
FD 3"x3" PK + TACK DNE per O.M. 1-53
FD 4" I.P. (Dy Nail) per O.M. 1-53 per FB 756/125
NEXT TO
NEXT TO
TEXACO
FD L&T
FD L&T 1000
FD L&T 1000
Set X cut
Set X cut
N 89°59'30" E
N 89°59'30" E
S 89°59'00" E
S 89°59'00" E
S 89°59'00

F.B. 918 PG. 97

Notes Ck'd by E. M. Finley
Map No. B-1842-6
Office Work Cox
Checked D. M. Finley
Date 8/11/53

Survey of COMPTON BLVD.
W. O. 8345 Tape No. 06 St'd 68 °F
Surveyed by BUTLER
Notes " Date 12/1/52
Indexed C Johnson

W.S. 82 C-4

Note: Any Additions or Changes on This Sheet Must be Made or Circled in Red Ink With Date and Name of Person Making Change.

Do not extend notes this side of this line.

RETURN TO
LOS ANGELES COUNTY SURVEYOR
700 HALL OF RECORDS

FORM 247 BM 12-41

SAN MARCUS ST. (50')

SAN LUIS ST. (50')

625'

NO 15 Alley

TR

TO NEXT PG.

COMPTON BLVD. (40')

OLIVE ST. (30')

9.39 Set NKT

9.36

9.36

9.36

9.40

9.39

9.39' OFFSET LINE

FD 2"IP + BC mkd S.C.E.Co. 0N2' per M 1-53 723 DLR 1502 150' 12.39 Rec. 12.30

246.03 Rec. 246.08

500'

334.515-T 58
334.495

FD L+T OM 1-53

30.06

0.05

40.00

65.00

FD 2"IP + B.C. mkd S.C.E.Co. 0N2' per OM 1-53

95+68.38

95+13.38

33005

65.00 Set mark

65.00 OFFSET LINE

Set mark

0.12

FD L+T OM 1-53

See F.B. 1356 pg 204 & 69, F-2220.

D 89-59-10
④ 359-57-30
⑤ 179-56-30

90°00'

① 90-00-30
④ 360-02-40
⑤ 180-04-00

SCE CO. R/W

SCE CO 330' R/W

FROM PREC. PT.

F.B. 918 Pg. 98

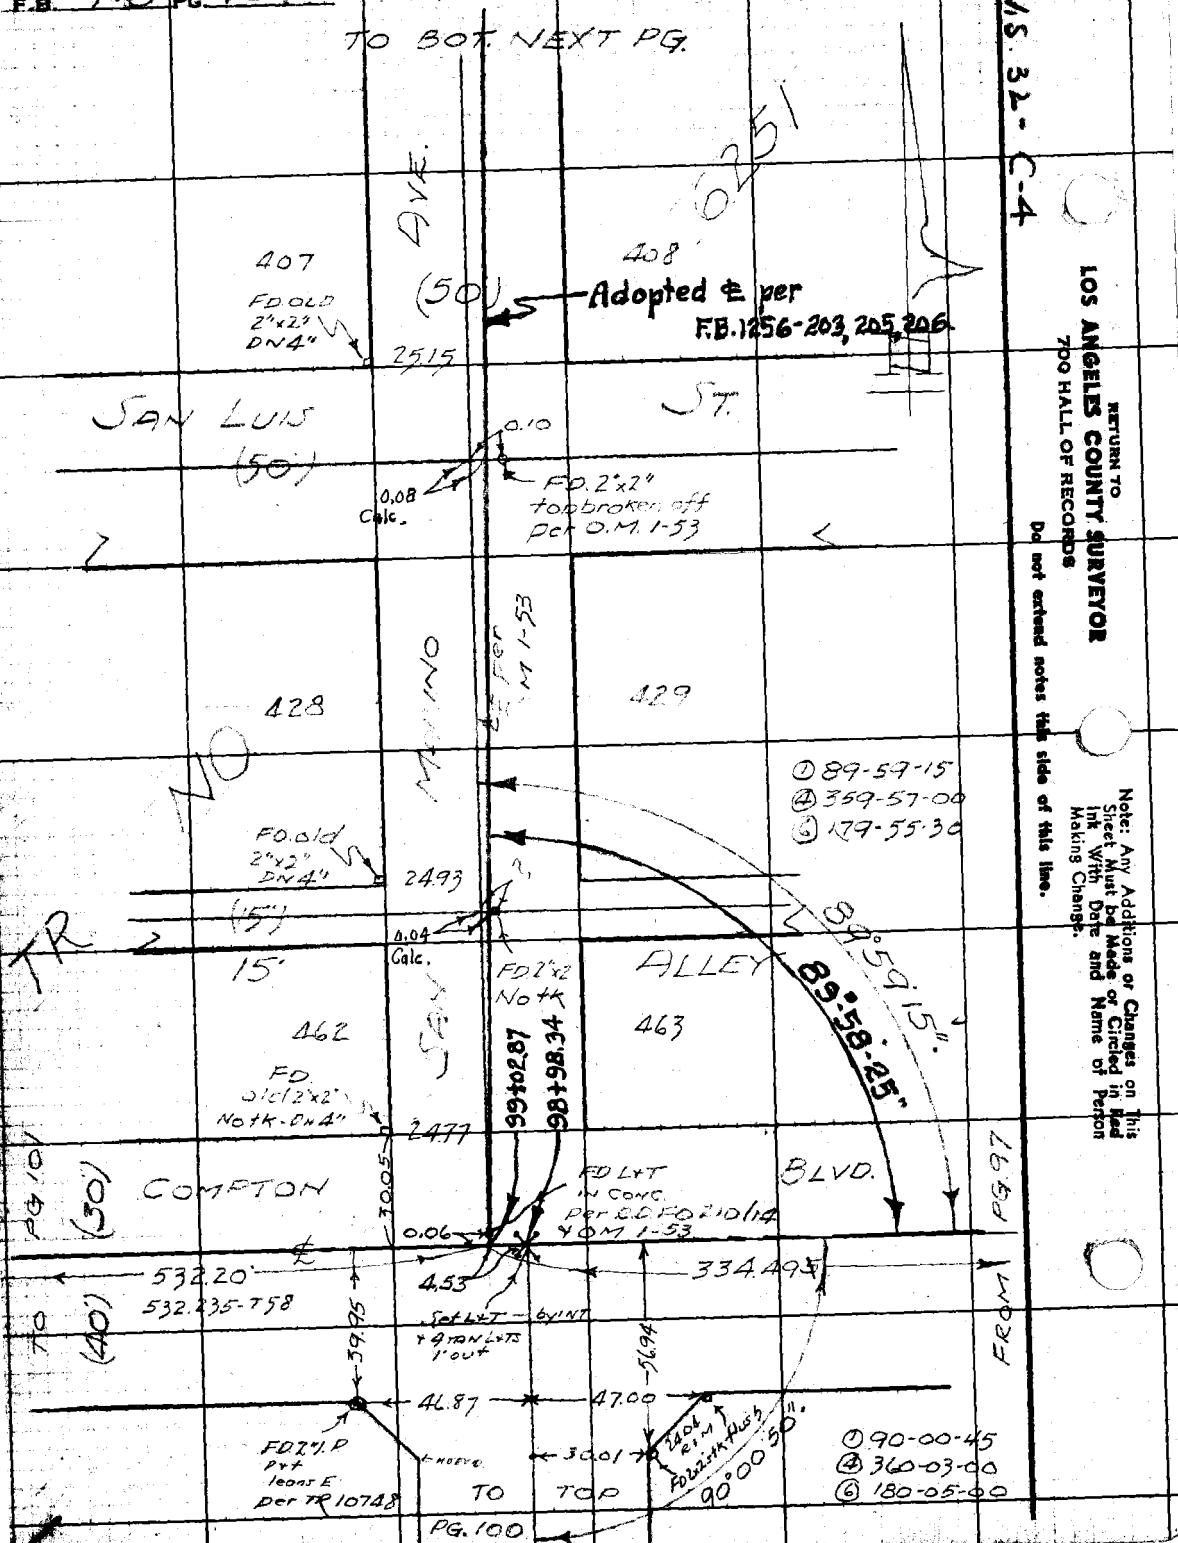
TO BOT. NEXT PG.
W.S. 32-C-4
RETURN TO LOS ANGELES COUNTY SURVEYOR 700 HALL OF RECORDS
Do not extend notes this side of this line.
Note: Any Additions or Changes on This Sheet Must be Made or Circled in Red Ink With Date and Name of Person Making Change.
251
(50)
Adopted & per F.B. 1256-203, 205, 206
407
408
FD OLD 2"x2" DN 4"
2515
SAN LUIS
(50)
ST.
0.10
0.08 Calc.
FD. 2"x2" top broken off per O.M. 1-53
428
429
N 0°01'30" E
1-53
① 89-59-15
④ 359-57-00
⑥ 179-55-30
FD old 2"x2" DN 4"
2493
0.04 Calc.
15'
ALLEY
N 89°59'15" E
89°58'25"
462
463
FD 3/4" I.P. (2"x2") No tk - DN 4"
2477
FD 1"x2" No tk
99+02.87
98+98.34
COMPTON
(30)
BLVD.
FD L&T IN CONC. per C.C. FD 210/14 & OM 1-53
0.06
532.20
532.235-T58
4.53
334.49
Set L&T - 6x INT & 4 RAD PTS 1' OUT
39.95
51.94
46.87
47.00
FD 3/4" I.P. P.T. leans E per TR 10748
3.01
90°00'50"
① 90-00-45
④ 360-03-00
⑥ 180-05-00
TO TOP
PG. 100

Notes Ck'd by: D. M. Finley
Map No. B-1842-6
Office Work: Cox
Checked: D. M. Finley
Date: [illegible]

Survey of: COMPTON, 54 4W
W. O. 8345 Tape No. 06 St'd 68°F
Surveyed by: CUTLER
Notes: " Date: 12/42
Indexed: C. Johr

F.B. [illegible] PG. [illegible]

W.S. 32 C-4

Note: Any Additions or Changes on This Sheet Must be Made or Circled in Red Ink With Date and Name of Person Making Change.

Do not extend notes this side of this line.

RETURN TO
LOS ANGELES COUNTY SURVEYOR
700 HALL OF RECORDS

FORM 247 5M 11-41

SAN VICENTE ST. (50)

Calc. 0.29

326 | 327

337 | 338

AVE. (50)

SAN MATEO ST. (50)

25.28

FD old 2"x2" ON 3" 357

356 | 371

370

SAN MARINO AVE. (50)

Set Lead & Tack

38.92

38.92

0.15 Calc.

FD 2"x2" TK flush per OM 1-53

38.32

38.32

Set 1/2" I.P. & Tack

391 | 392

FROM TOP PREC. PG.

RETURN TO
LOS ANGELES COUNTY SURVEYOR
700 HALL OF RECORDS

Note: Any Additions or Changes on This Sheet Must be Made or Circled in Red Ink With Date and Name of Person Making Change.

Do not extend notes this side of this line.

WS, 32-C-4

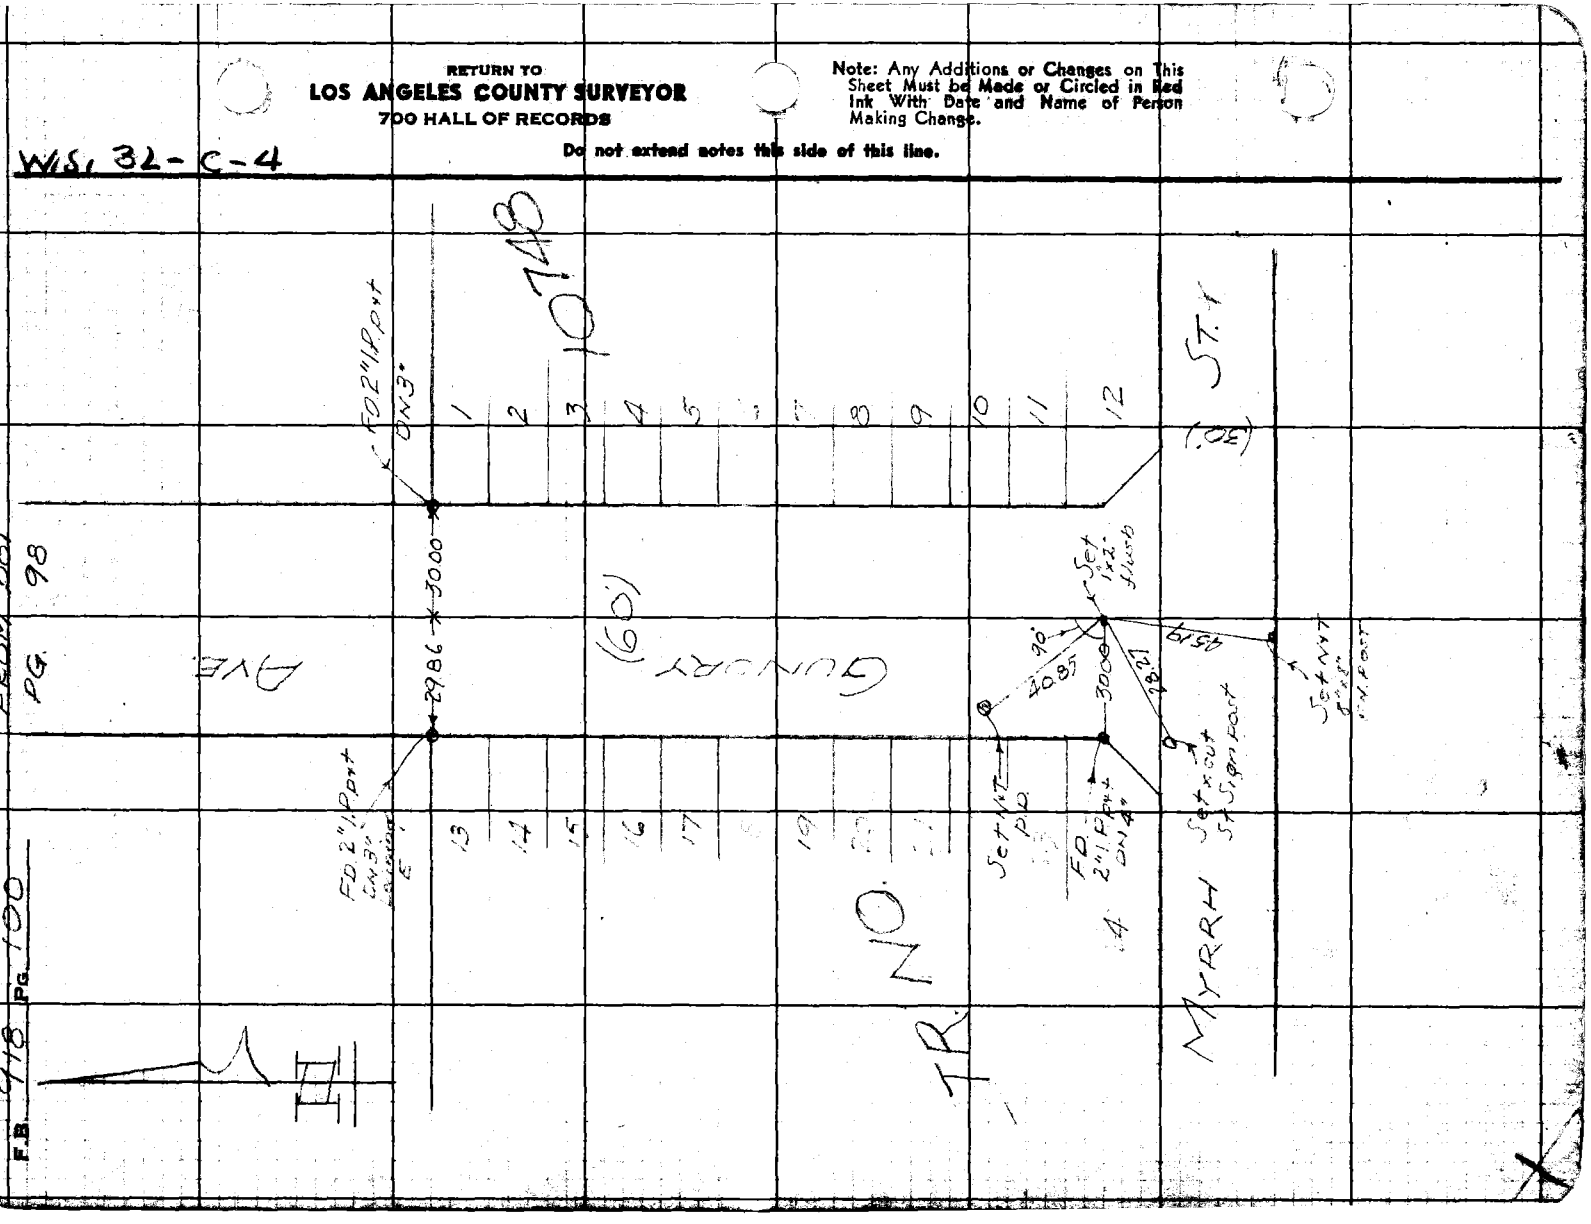

Notes Ck'd by D. M. Finley
Map No. 8-1842-6
Office Work Cal
Checked D. M. Finley
Date

Survey of COMPTON BLVD
W. O. 8345 Tape No. 06 St'd 68 °F
Surveyed by BUTLER
Notes Date 12/42
Indexed C. Joh

F.B. 710 Pg. 101

W.S. 32-

ROSECRANS AVE.

FD. L+T

FD. L+T

FD. NAIL & TAG

FD. L+T PP

FD 4" I.P filled w/ Tar, Conc. + nail 8' UP & 50 LINE

FD L+T Cap PAVE per FB. 756/127 " 484/154 " 479/207

105+57.88

FD L+T Cap PAVE per FB. 756/127 " 484/154

FD L+T Cap PAVE per R.D. FB 484-25/154, 161

Lot 442, BLK 63 per TR 6251-8 see FB 484/154

104+35.07

FD X IN CB

FD X IN CB

655.19-T&H

655.17'

122.81-T&H

122.81'

90°55'30"

90°

30.91

31.41

30.00

0.34

30.00

COMPTON BLVD.

ORANGE AVE. C.S. B769-2

48°18'35" CALC. C.S.B. 769/2

179°05'30"

SEE C.S. 769/2 WLY BDRY LINE CAL. COOP. COLONY TR.

① 179-05-30
② 356-21-45
③ 354-32-45

P.I. FD. C SPK, W+T ON 1" per FB. 484/180

ORANGE

① 179-59-45
② 359-58-45
③ 359-58-00

FD. L+T + 4 TAN. L+TS per FB. 479/207 " 484/155 R.D. FR 283/52

OLIVE ST.

26.99 27.25 27.15 27.20

(30) (30) (30) (30) (40)

102 PG 78

RETURN TO
LOS ANGELES COUNTY SURVEYOR
700 HALL OF RECORDS

Do not extend notes this side of this line.

Note: Any Additions or Changes on This Sheet Must be Made or Circled in Red Ink With Date and Name of Person Making Change.

FORM 247 SM 11-41

F.B. 918 Pg. 102

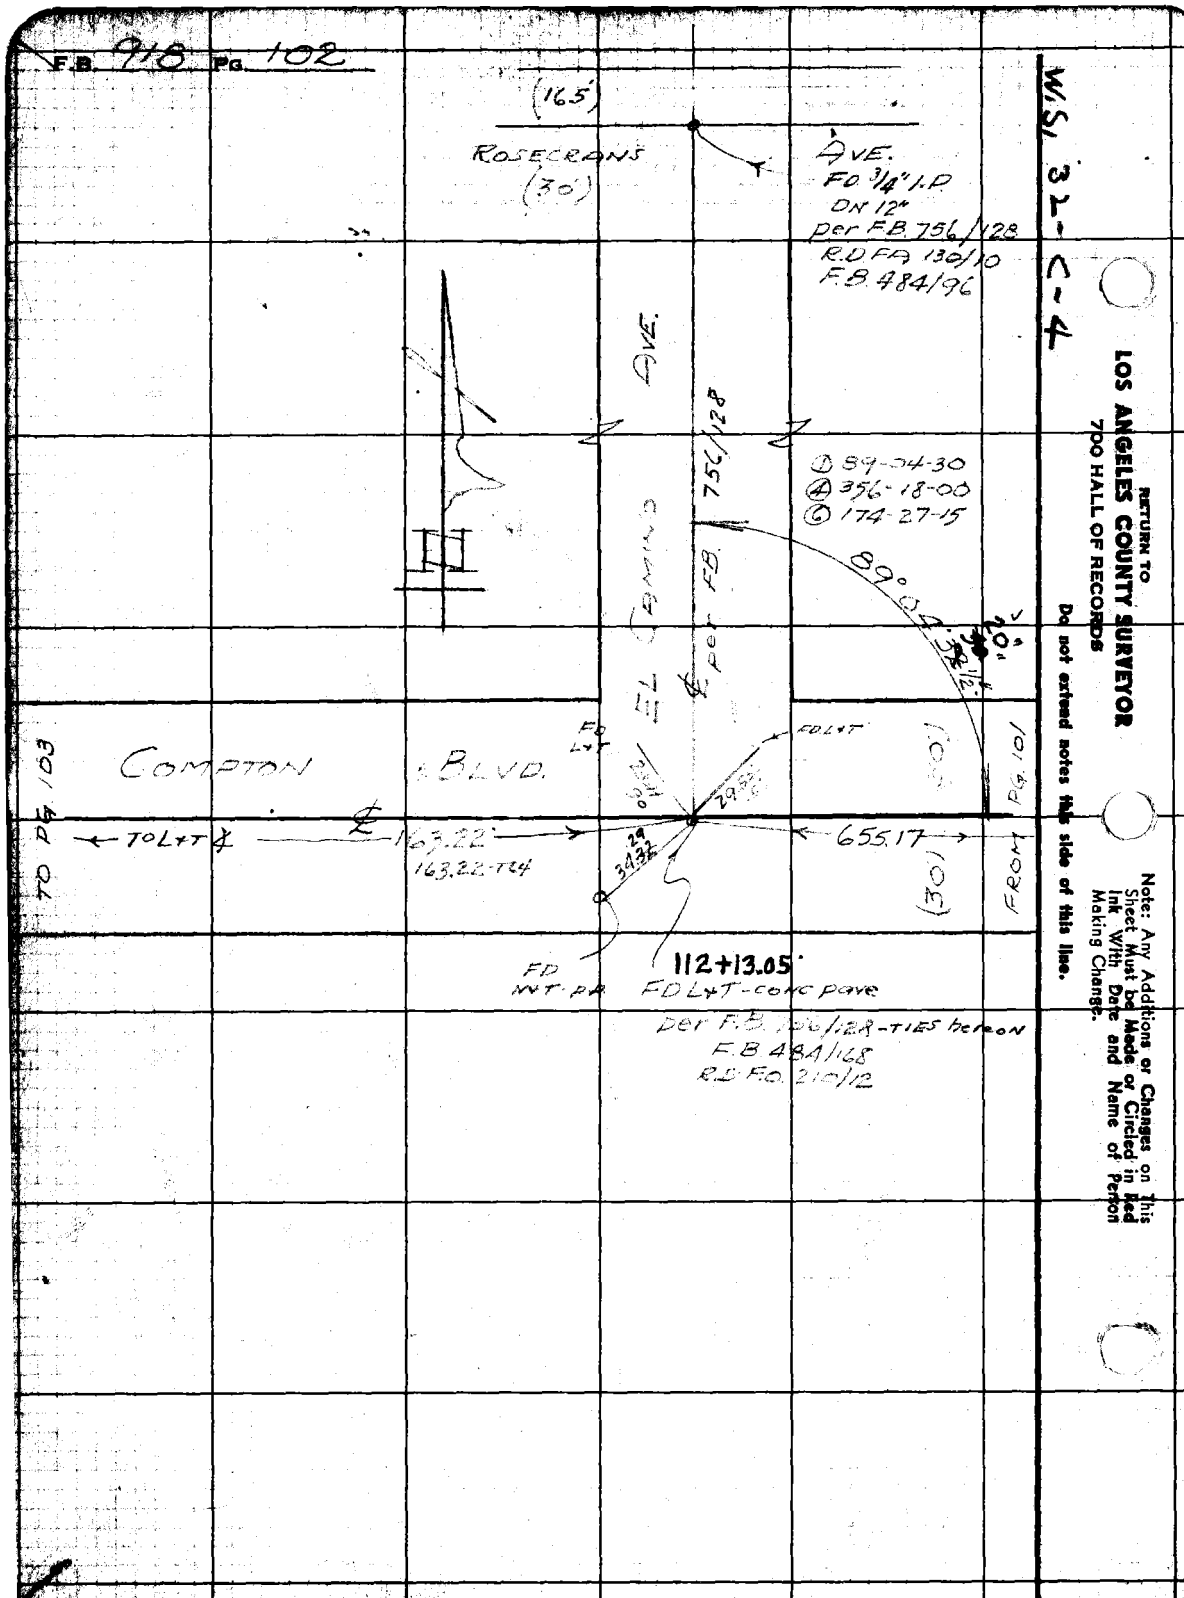

W.S. 32-C-4

RETURN TO
LOS ANGELES COUNTY SURVEYOR
700 HALL OF RECORDS
Do not extend notes this side of this line.

Note: Any Additions or Changes on This Sheet Must be Made or Circled in Red Ink With Date and Name of Person Making Change.

Notes Ck'd by [illegible]
Map No. B-1842-6
Office Work Cox
Checked D. M. Finley
Date AUG 51

Survey of COMPTON BLVD
W. O. 8345 Tape No. 06 St'd 68°F
Surveyed by HEOH
Notes " Date 1/43
Indexed [illegible]

F.B. 910 Pg. 103

W.S. 32-C-4

Note: Any Additions or Changes on This Sheet Must be Made or Circled in Red Ink With Date and Name of Person Making Change.

Do not extend notes this side of this line.

RETURN TO
LOS ANGELES COUNTY SURVEYOR
700 HALL OF RECORDS

FORM 247 SM 10-39

179°21'20"

(1) 176-21-15
(2) 357-25-30"
(3) 356-08-00
(4) 179-21-20.

COMPTON BLVD.

Fd. I.P. Plug & Tack filled with conc. 8" high per FB 484/154

(30')

(30')

(40')

(30')

TO PG. 104

FROM PG. 102

486.82

90°

30.05

163.22

16.56 (M)

39.65

30.03

15"

A

113+76.23

FD L&T in Conc. pave per FD 210/2 FB 484/154

112.32 (M)
112.00 (R)

30.18 (M)

0.17

Fd 4" I.P. filled with conc. y nail DN 3" NO REF

(1) 87°-49'-00"
(2) 35°-17'-00"
(3) 166°-55'-00"
A 87°-49'-10".

TR NO 7890

1106.40 Rec. Tract Map

N 1°11'E

Fd. 2" I.P. Per Tract Map No. 7890

RETURN TO
LOS ANGELES COUNTY SURVEYOR
700 HALL OF RECORDS

Note: Any Additions or Changes on This Sheet Must be Made or Circled in Red Ink With Date and Name of Person Making Change.

Do not extend notes this side of this line.

W.S. 32-C-4

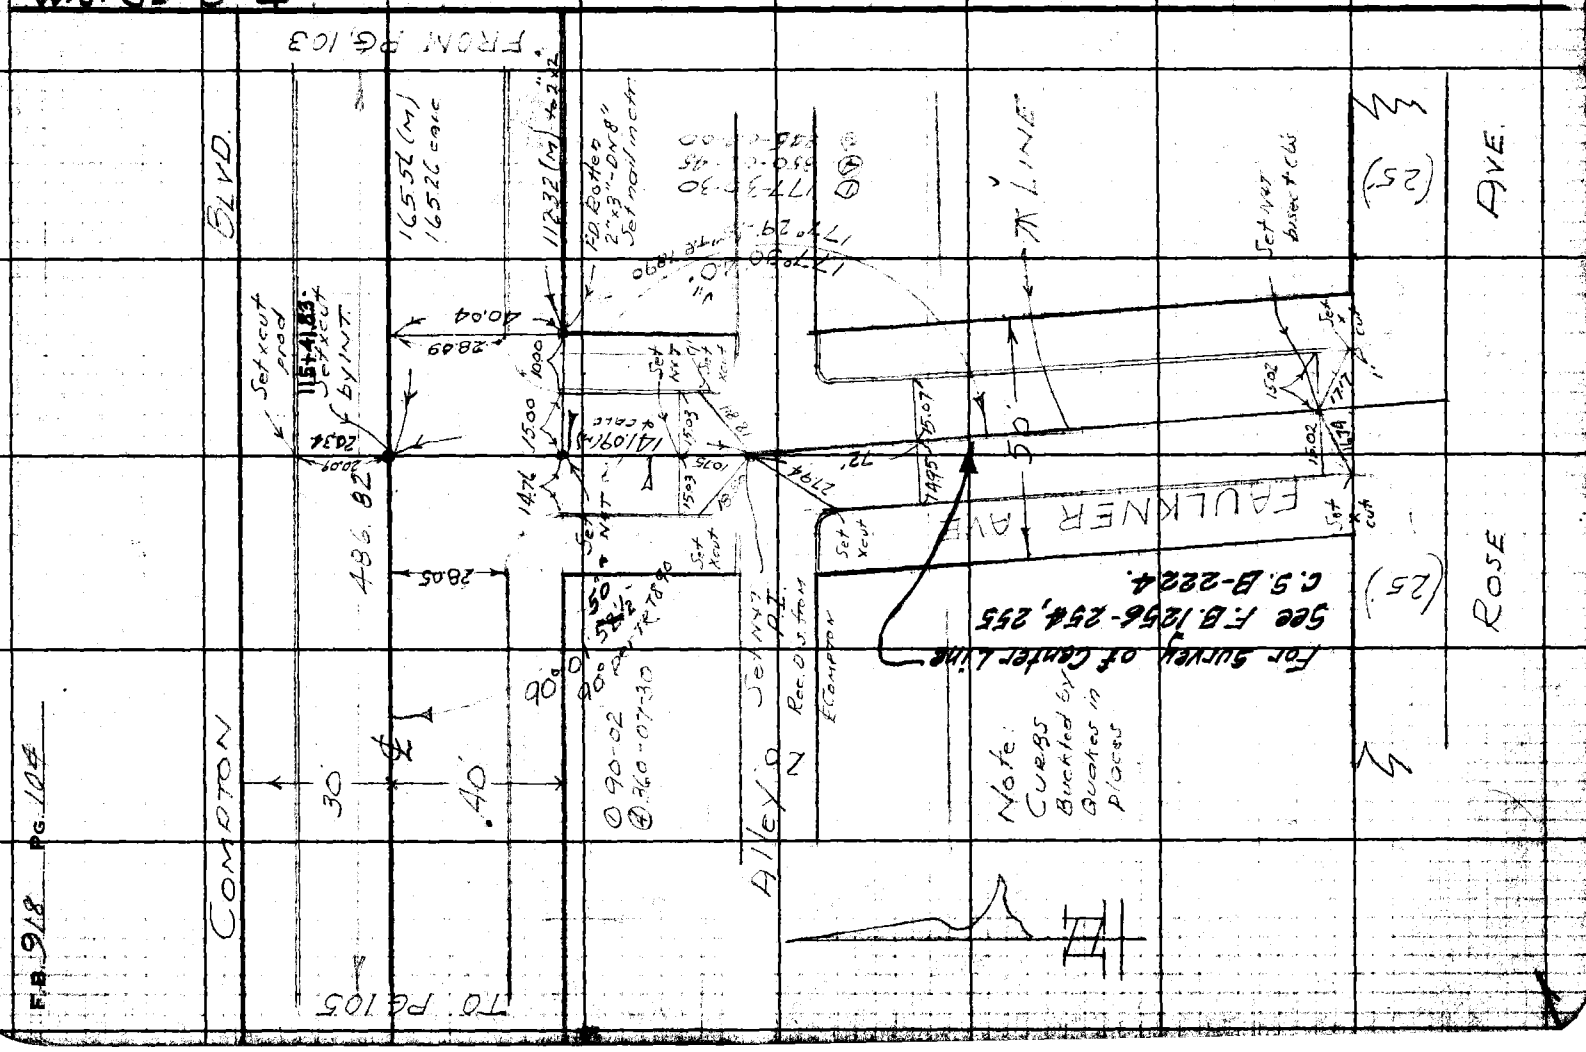
FROM PG. 103
TO PG. 105
COMPTON BLVD.
ROSE AVE.
FAULKNER AVE.
ALEXIS
Set nail & tag
Set x cut
Set nail & shiner
Set nail & brass tag
Set x cut in wall
Set nail & tag
Set nail & brass tag
Set x cut
Set x cut
Set x cut

Notes Ck'd by
Map No. 9-1844-6
Office Work Cox
Checked D. M. Finley
Date AUG '51

Survey of Compton Blvd
W. O. 8345 Tape No. 26 Std. 66 ft.
Surveyed by Butler
Notes Vol. 111 Date 3-14-51
Indexed A. C. Johnson

F.B. 918 Pg. 105

Note: Any Additions or Changes on This Sheet Must be Made or Circled in Red Ink With Date and Name of Person Making Change.

Do not extend notes this side of this line.

RETURN TO
LOS ANGELES COUNTY SURVEYOR
700 HALL OF RECORDS

FORM 247 BM 12-41


W.S. 3-1-C-4

(1) 90°-17'-00"
(2) 89°-54'-30"
(3) 181°-9'-45"
A-90°-16'-57½"

Fd 1" I.P. Plug + Tack Per F.C. 210-12

Fd L+T

COMPTON. BLVD.

486.82
486.87 T. 62

650.17 T. 649.87 301

188.65

40

Fd Pg. 107

Set X by 10th 118+81.78

118+63.09

(1) 89°-30'-15"
(2) 358°-00'-45"
(3) 17°-00'-45"
A-89°-30'-07½"

Set Nail

Fd L+T Per F.C. 210-12

15.08 15.08

12.70

Set N+T. P.I. Rec. Dis. from & Compton

15.06 15.15

ALLEY

(1) 176°-59'-30"
(2) 3°-57'-20"
(3) 3°-56'-00"
A=176°-59'-20"

Fd. 2"x2"

15.07 15.13

25.0

LINE

ROSE AVE

50

14.96 15.16

Fd. 2" I.P. Plug + Tack Per F.C. 224-12

SAN

14.03 15.11

S'LY LINE TRACT NO. 7890

RETURN TO
LOS ANGELES COUNTY SURVEYOR
700 HALL OF RECORDS

Note: Any Additions or Changes on This Sheet Must be Made or Circled in Red Ink With Date and Name of Person Making Change.

Do not extend notes this side of this line.

W. S. 32-C-3

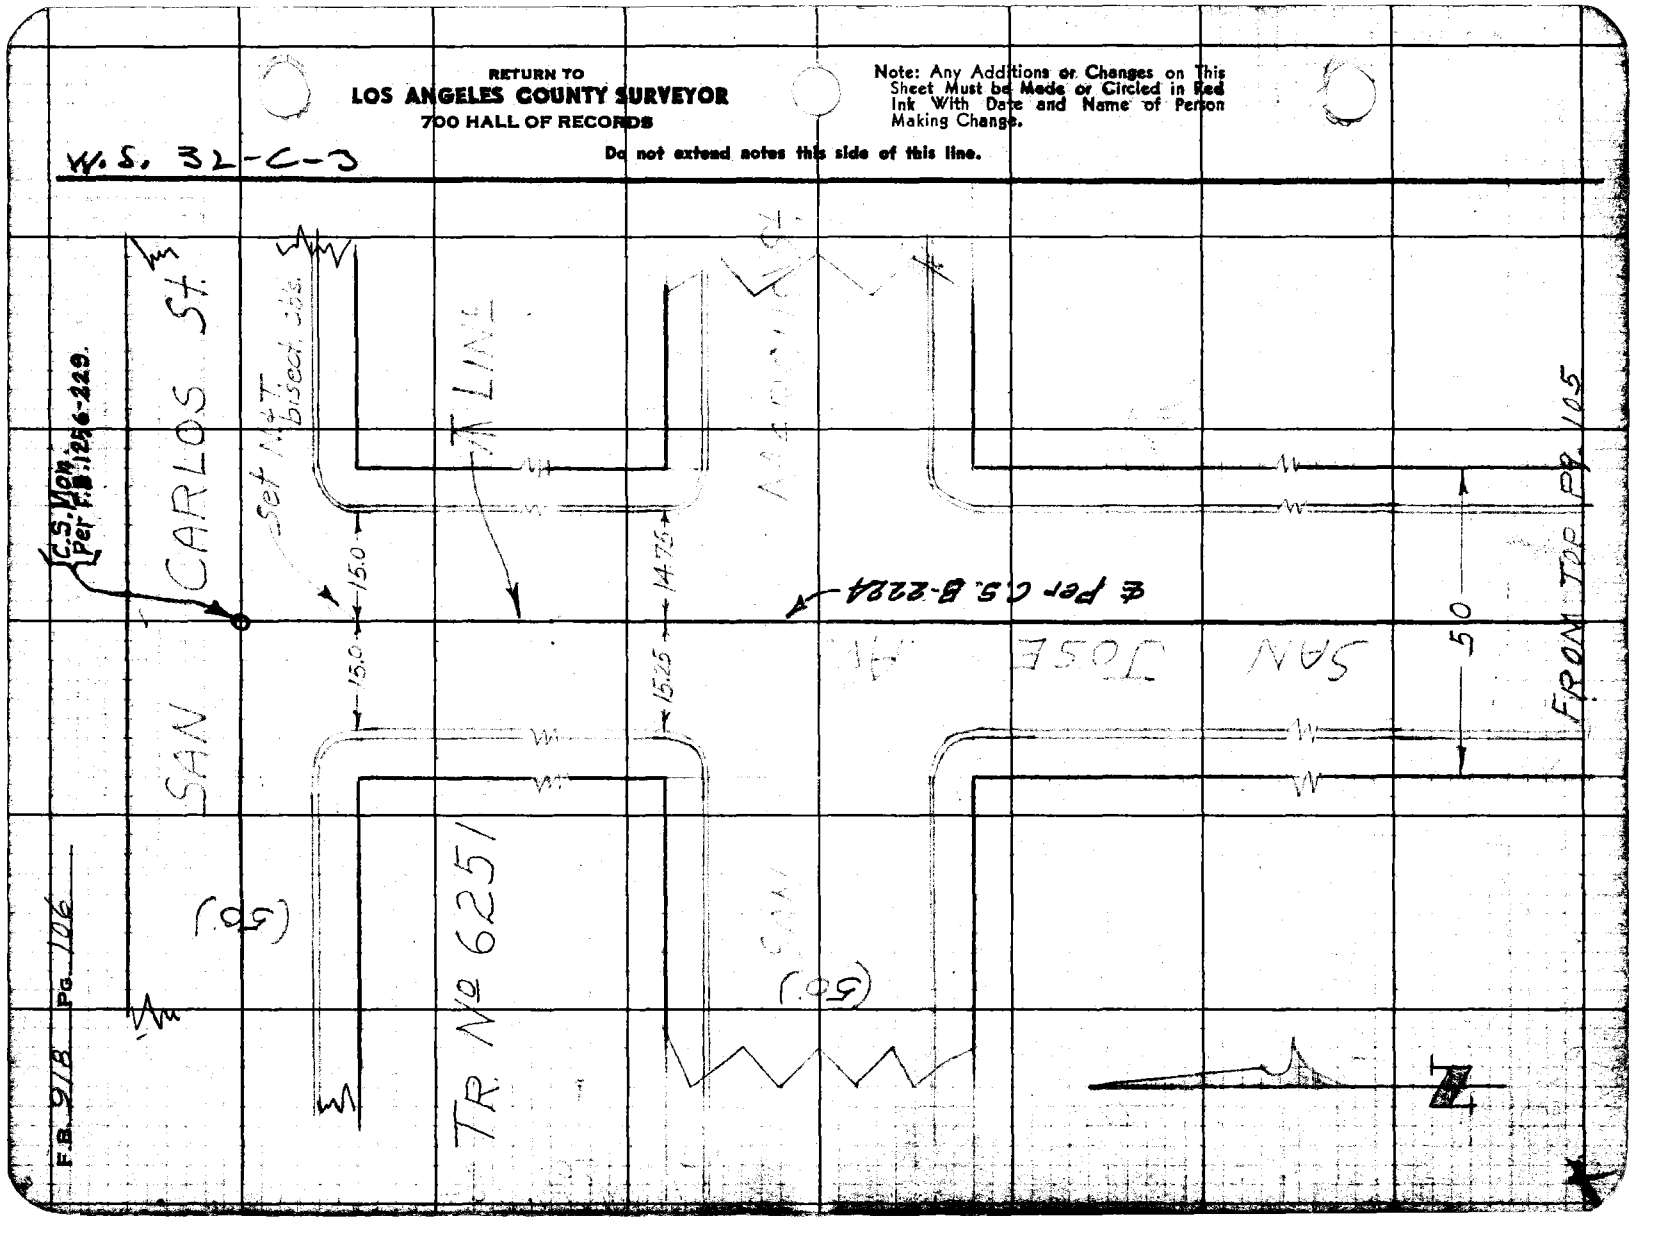

FORM 247 5M 11-48

RETURN TO
LOS ANGELES COUNTY SURVEYOR
700 HALL OF RECORDS

Note: Any Additions or Changes on This Sheet Must be Made or Circled in Red Ink With Date and Name of Person Making Change.

Do not extend notes this side of this line.

W.S. 32 C-4

Notes Ck'd by
Map No. B-1[illegible]
Office Work Cox
Checked D. M. Fidler
Date AUG '51

Survey of W. O. 8344 Map No. 66 Sht 2 of 2 Sht
Surveyed by Butler Date 3-12-51
Notes K. Utt
Indexed A. C. Johnson

F.B. 972 Pg. 107

TO P.B. 108

(1) 92°-31'-30"
(4) 10°-05'-30"
(6) 195°-08'-30"

(30') (30')

92°-31'-25"

Set Nail & Tag

1201.74

15' C.L.F. Set

15' C.L.F. Set

40.08

650.17

1325.93 Per Tract No 7890

N'LY BDRY LINE TRACT NO 7890

Fd. 2" I.P. Plug & tack

188.65

(40') (30')

TR. NO. 7890

Fd. 3" I.P.S.E. Cor. of Lot 4 Tract No 7890

FROM P.B. 105

F.B. 918 Pg. 108

C.S. Mon. Per F.B. 1256-239.











2.6 East of Ø

N

LINE

(1) 89°-43'-15"
(4) 358°-53'-30"
(6) 178°-20'-30"
Ak 89°-43'-25"

89°-42'-55"

89°-43'-25"

Fd 1" I.P. Dn. 2"

14.97 15.04

25.0 25.02

Fd 1" I.P.

Fd L+T.

Fd L+T.

32.46 32.81

650.17

(30')

60'

405.29 M+Rec. per F.C. 436/19

COMPTON BLVD.

FROM Pg 107

TO Pg 109

125+13.26'
Fd. L+T.
Per F.O 210-11

W.S. 32-B-4

RETURN TO
LOS ANGELES COUNTY SURVEYOR
700 HALL OF RECORDS

Do not extend notes this side of this line.

Note: Any Additions or Changes on This Sheet Must be Made or Circled in Red Ink With Date and Name of Person Making Changs.

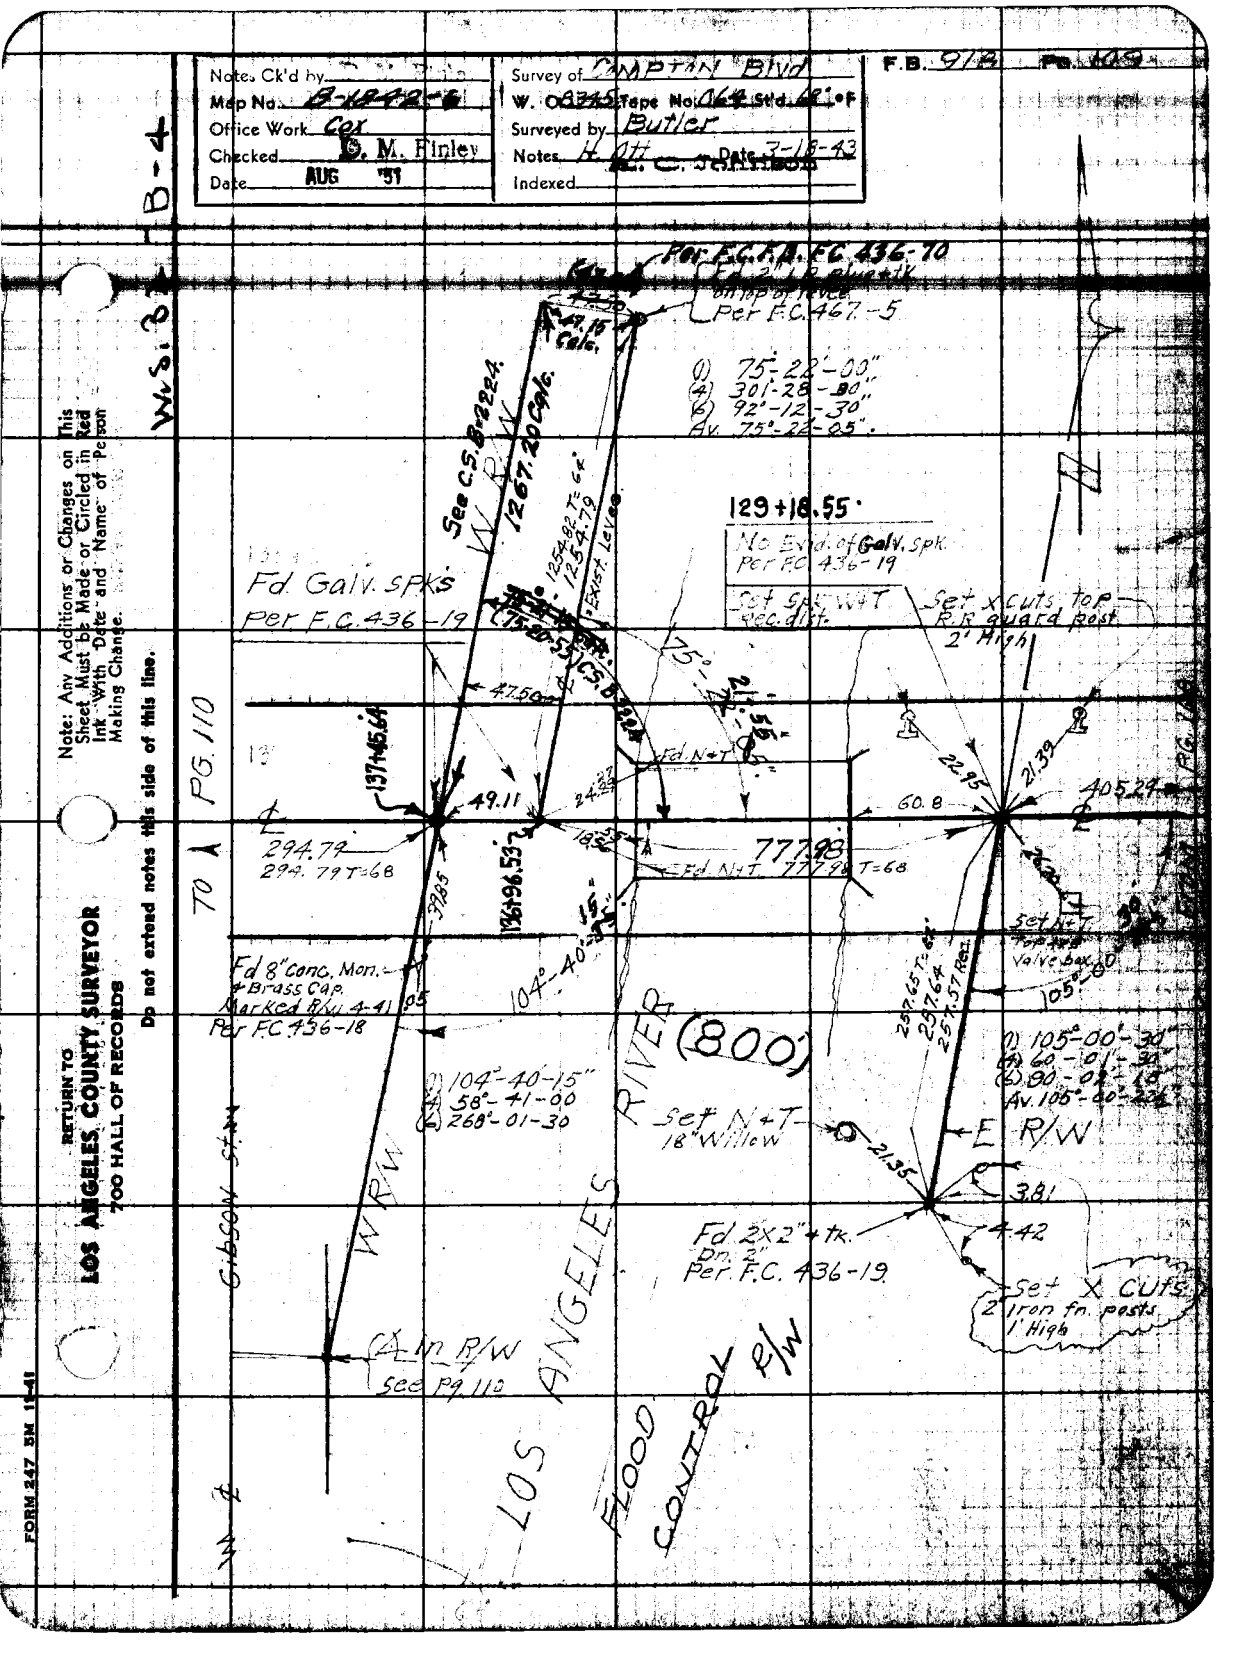
Notes Ck'd by
Map No. B-1842-6
Office Work Cox
Checked G. M. Finley
Date AUG '51
Survey of COMPTON Blvd
W. O. 0345 Tape No. 064 Std. 68°F
Surveyed by Butler
Notes H. Witt
Date 3-18-43
Indexed
F.B. 918 Pg. 109
B-4
W.S. 3
Note: Any Additions or Changes on This Sheet Must be Made or Circled in Red Ink With Date and Name of Person Making Change.
Do not extend notes this side of this line.
RETURN TO
LOS ANGELES COUNTY SURVEYOR
700 HALL OF RECORDS
FORM 247 SM 11-41
Per F.C.A.A. FC 436-70
Per F.C. 467-5
1) 75°-22'-00"
(4) 301°-28'-30"
(6) 92°-12'-30"
Av. 75°-22'-05".
See C.S.B. 2224
1267.20 Calc.
129+18.55
No End of Galv. Spk.
Per FC 436-19
Set Spk. W+T
Sec. dist.
Set X cuts top R.R. guard rest. 2' High
Fd Galv. Spks
Per F.C. 436-19
TO A PG. 110
294.79
294.79 T=68
Fd N+T
77798
77798 T=68
Fd 8" Conc. Mon. + Brass Cap. Marked R/W 4-41 Per F.C. 436-18
104°-40'-15"
(4) 58°-41'-00
(6) 268°-01'-30
(800')
Set N+T 18" Willow
Fd 2X2" Tk. Dn. 2" Per F.C. 436-19
Set X Cuts 2" Iron Fn. posts 1' High
1) 105°-00'-30"
(4) 60°-01'-31"
(6) 90°-01'-18"
Av. 105°-00'-26"
GIBSON ST.
W R/W
E R/W
CAL. R/W
See Pg. 110
LOS ANGELES FLOOD CONTROL R/W

F.B. 918 Pg. 110

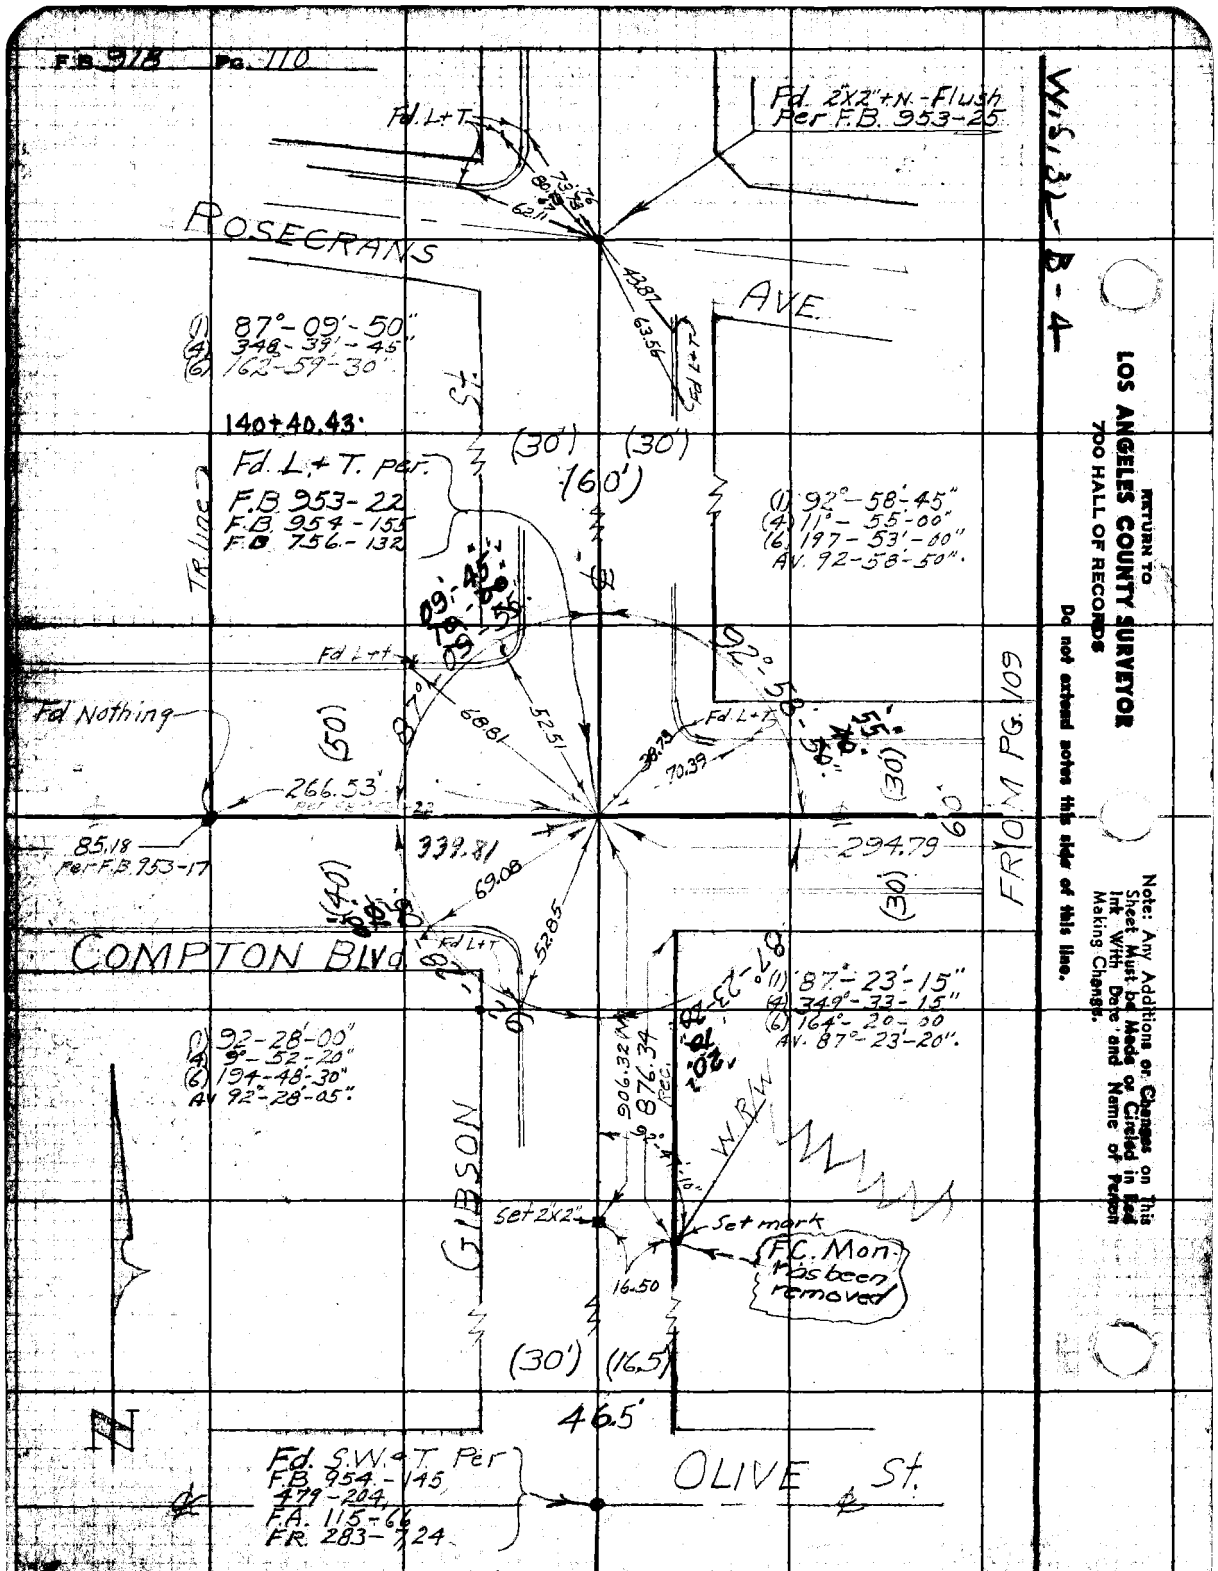

RETURN TO
LOS ANGELES COUNTY SURVEYOR
700 HALL OF RECORDS
Do not extend notes this side of this line.

Note: Any Additions or Changes on This Sheet Must be Made or Circled in Red Ink With Date and Name of Person Making Changes.

Notes Ck'd by
Map No. 8-1942-6
Office Work Cox
Checked D. M. Finley
Date AUG '51

Survey of COMPTON BLVD.
W. O. 8344 Tape No. 064 St'd. 66'+
Surveyed by Butler
Notes H. Att Date 7-12-43
Indexed A. C. Johnson

F.B. 918 Pg. 11

Yr. Sh. 32 B-4

Note: Any Additions or Changes on This Sheet Must be Made or Circled in Red Ink With Date and Name of Person Making Change.

Do not extend notes this side of this line.

RETURN TO
LOS ANGELES COUNTY SURVEYOR
700 HALL OF RECORDS

FORM 247 SM 12-41

SAN
LUIS ST.
66.71
58.75
57.14
Fd Bt Spk.
Fd S.W.+T.
F.B. 953-21
(30)
(30)
50'
45°
Fd L+T
8°7'-16"
Per F.B. 953-17
143+92.14
Ed L+T
Per F.B. 953-17
COMPTON
BLVD.
Fd. L+T.
Fd. L+T.
77.75
52.42
.49
650.15'
F.B. 953-17
85.18
F.B. 953-17
339.84'
F.B. 954-156
339.81
TO PG 1112
50
90'
(40)
45°14'
954-156
43.74
11.90
F.B. 954-156
Fd L+T
Per
F.B. 954-156
143+80.24
Fd L+T.
Fd L+T.
WILLIAMS
(30)
(30)
Fd L+T.
67.75
62.94
58.24
54.68
Fd L+T.
OLIVE
St.
Fd S+W. Per
F.B. 954-167

F.B. 918 Pg. 112

W.S. 02-B-4

RETURN TO
LOS ANGELES COUNTY SURVEYOR
700 HALL OF RECORDS
Do not extend notes this side of this line.

Note: Any Additions or Changes on This Sheet Must be Made or Circled in Red Ink With Date and Name of Person Making Change.

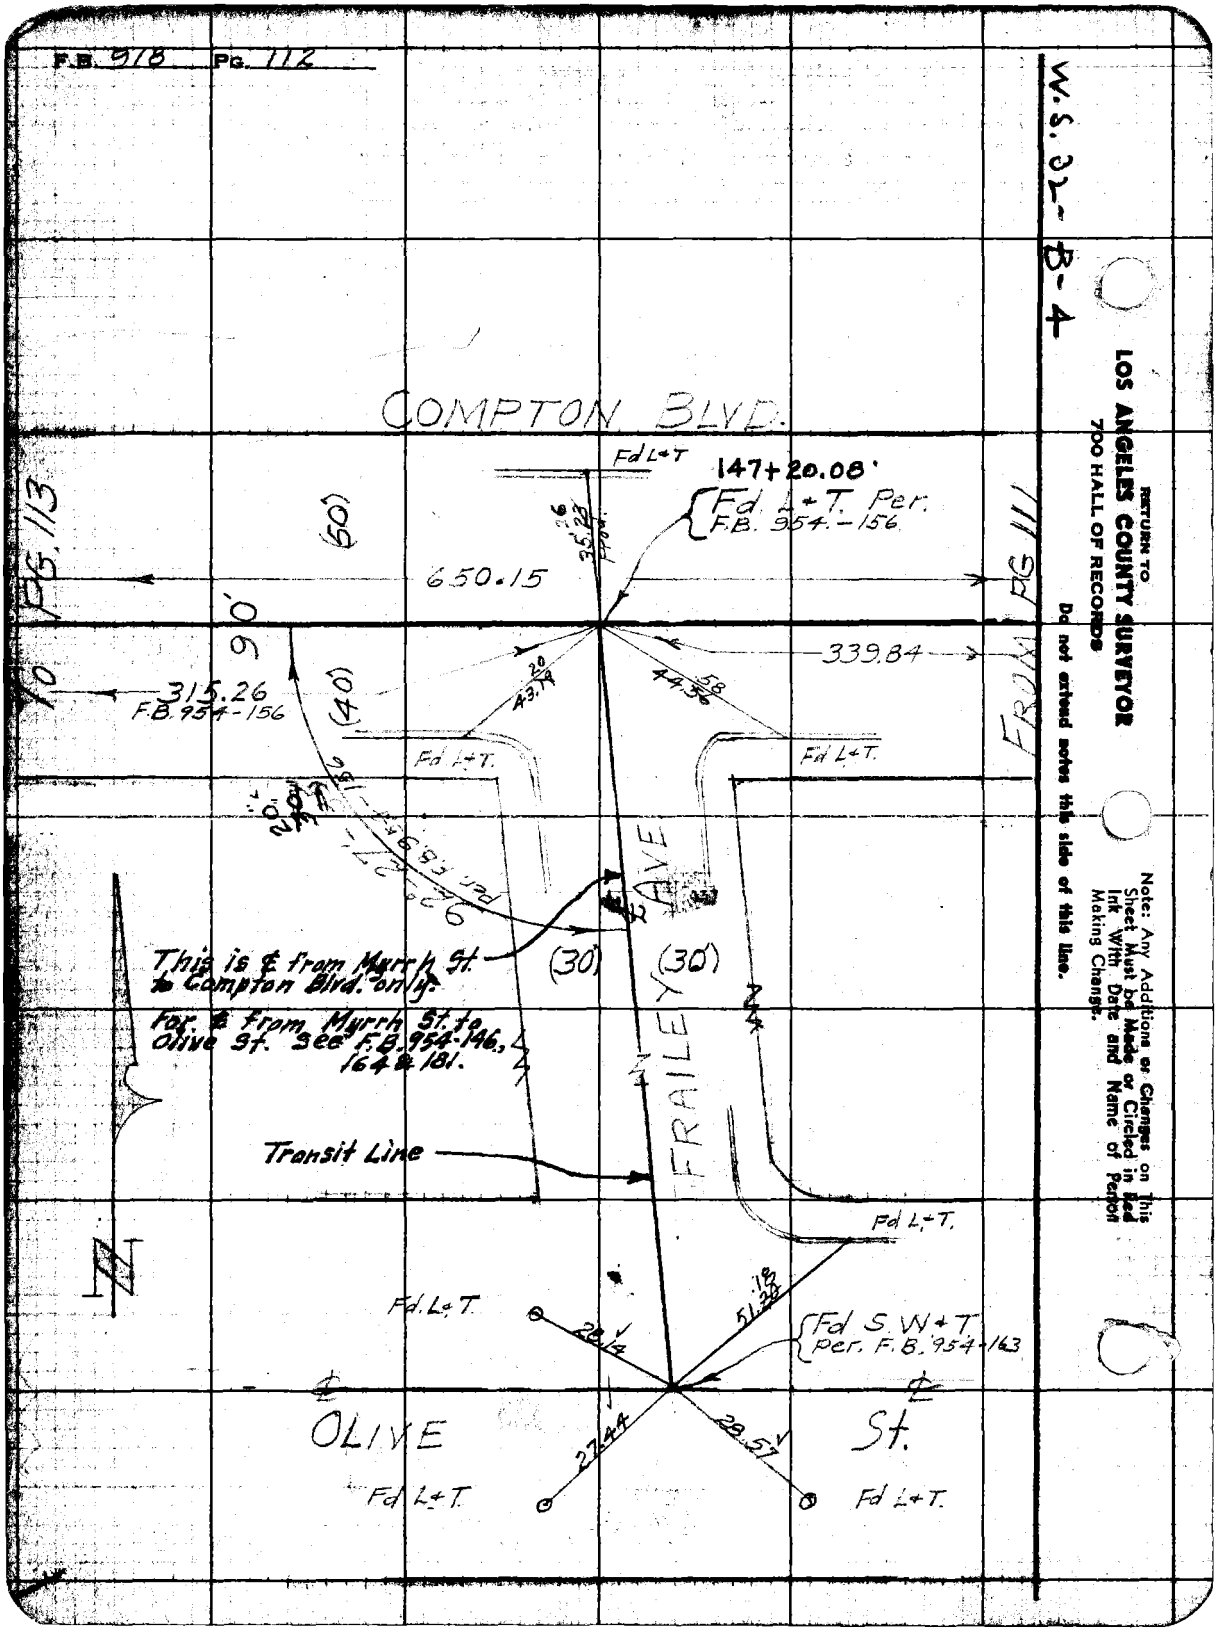

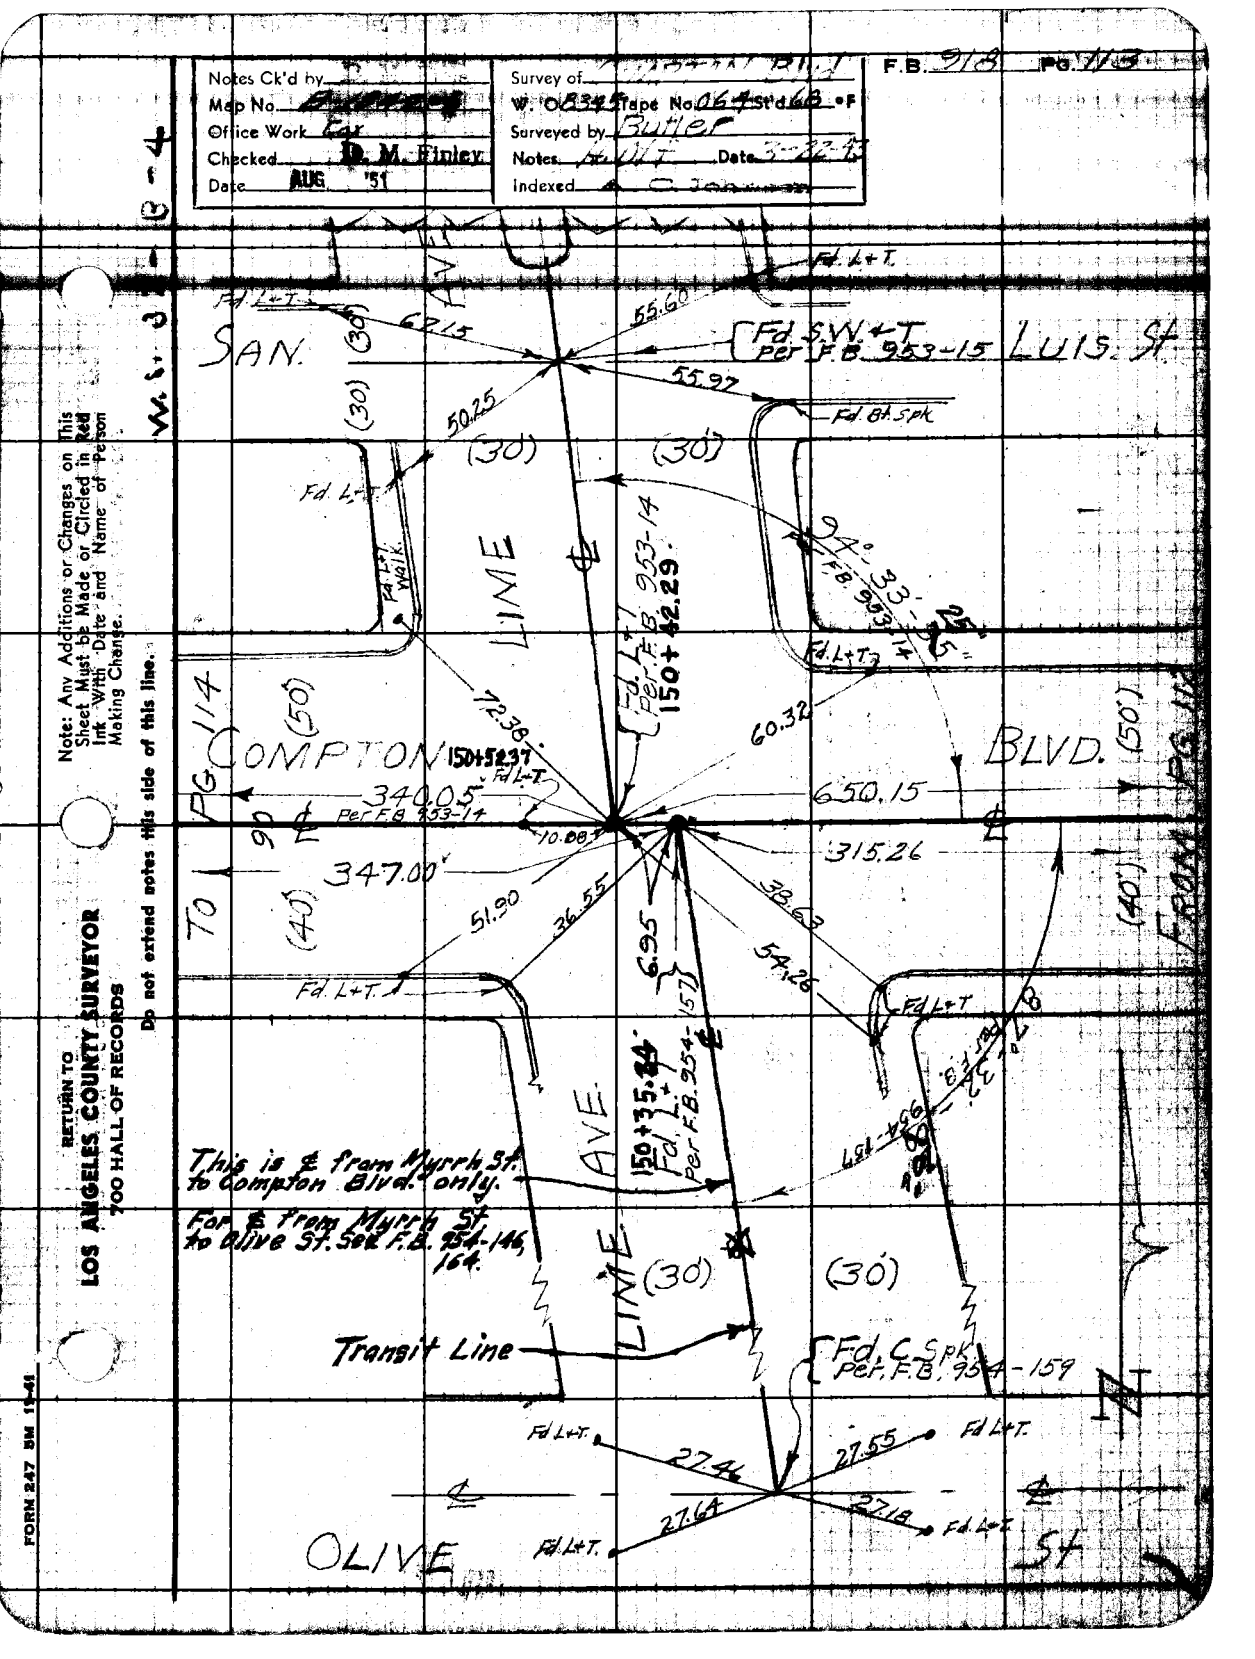
Notes Ck'd by
Map No.
Office Work
Checked D. M. Finley
Date AUG '51
Survey of
W. O.
Tape No.
Std
Surveyed by Butler
Notes
Date
Indexed
Fd L+T.
SAN
LUIS ST.
Fd SW L+T Per F.B. 953-15
Fd Bt Spk
(30)
(50)
(40)
COMPTON
BLVD.
AVE.
OLIVE
ST.
Fd L+T
Fd Bt Walk
Fd L+T Per F.B. 953-14
150+42.29
150+52.37
150+35.84
Fd L+T Per F.B. 954-157
Fd L+T Per F.B. 953-14
Fd L+T Per F.B. 954-157
Fd C.S.Pk Per F.B. 954-159
Pg 114
Pg 115
55.60
55.97
50.25
62.15
12.38
60.32
340.05
Per F.B. 953-14
10.00
650.15
315.26
347.00
51.90
36.55
6.95
38.63
54.26
This is ℄ from Myrrh St. to Compton Blvd. only.
For ℄ from Myrrh St. to Olive St. See F.B. 954-146, 164.
Transit Line
27.46
27.55
27.64
27.18
Note: Any Additions or Changes on This Sheet Must be Made or Circled in Red Ink With Date and Name of Person Making Change.
Do not extend notes this side of this line.
RETURN TO
LOS ANGELES COUNTY SURVEYOR
700 HALL OF RECORDS
FORM 247 BM 11-61

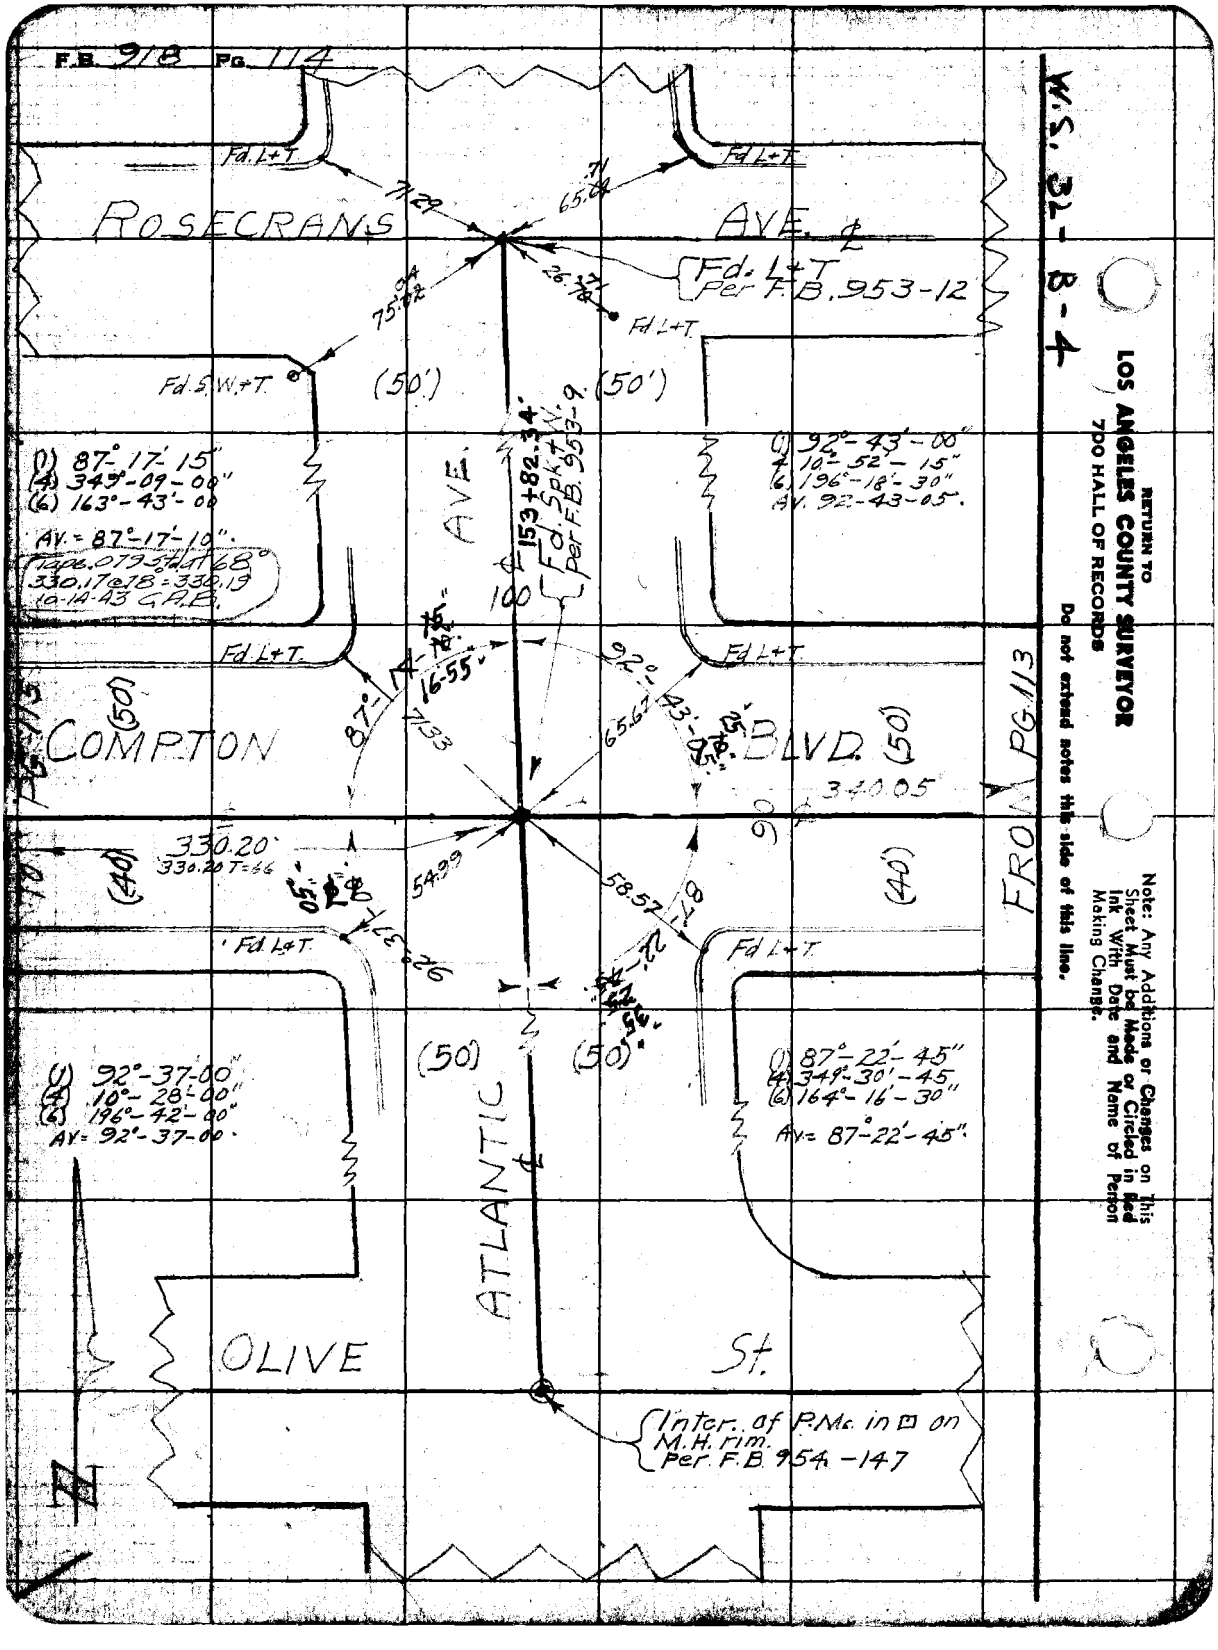
F.B. 918 Pg. 114
W.S. 32-B-4
RETURN TO
LOS ANGELES COUNTY SURVEYOR
7DO HALL OF RECORDS
Do not extend notes this side of this line.
Note: Any Additions or Changes on This Sheet Must be Made or Circled in Red Ink With Date and Name of Person Making Change.
ROSECRANS AVE. ℄
Fd. L+T
Fd. L+T Per F.B. 953-12
Fd. L+T
Fd. L+T
Fd. S.W. ℄ T
(50')
(50')
AVE.
153+82.34
Fd. Spk. ℄ W. Per F.B. 953-9.
100
1) 87°-17'-15"
4) 349°-09'-00"
6) 163°-43'-00"
Av. = 87°-17'-10".
Tape .079 ft at 68°
330.17 to 18 = 330.19
10-14-43 C.P.E.
1) 92°-43'-00"
4) 10°-52'-15"
6) 196°-18'-30"
Av. 92-43-05.
Fd. L+T
Fd. L+T
COMPTON
(60)
BLVD.
(50)
340.05
330.20
330.20 T=66
(40)
(40)
Fd. L+T
Fd. L+T
(50)
(50)
ATLANTIC ℄
1) 92°-37-00"
4) 10°-28-00"
6) 196°-42-00"
Av. 92°-37-00.
1) 87°-22-45"
4) 349°-30'-45
6) 164°-16'-30"
Av. = 87°-22'-45".
OLIVE
St.
Inter. of P.Mc. in ⊡ on M.H. rim. Per F.B. 954-147
N
FROM PG. 113

Notes Ck'd by
Map No. B-1842-6
Office Work Cor.
Checked E. M. Finley
Date AUG '59

Survey of Compton Blvd
W. O. [illegible] Tape No. 164 Std. [illegible] °F
Surveyed by: Butler
Notes Hall Date 2-20-43
Indexed E. C. Johnson

F.B. 918 PG. 115

B-4

W. S. 31

SAN LUIS St.

(30') (30')

Per R.B. 958-16

49.98

Fd. L+T.

(1) 87°-17'-15"
(2) 349°-08'-30"
(3) 163°-43'-00"
Av. 87°-17'-10".

Tape .079 Std. at 68°
316.12 @ 76°: 316.14
10-14-43 CAB

20'

87°-17'-10"

COOKACRE

Fd. L+T.

73.89

71.67

62.65

69.25

157+12.54
Fd. L+T.
Per R.B. 958-15

316.15 T=66
316.15'

116

(50')

(50')

To PG.

Fd. L+T. Per R.B. 958-15
157+28.52

15.98

O.K.
10-14-43 CAB

330.20

COMPTON BLVD.

(40')

(40')

WASHINGTON AVE.

Tape #079 Std. @ 68°

70°

30'-40"

(1) 92°-30'-30"
(2) 18°-02'-15"
(3) 159°-04'-15"
Av. 92°-30'-42".

#32

Fd. X in House Step

Fd. 2"x2"

(25') (25')

50.20

18.55 Tan.

Fd. Spk., T. + W. on surface
Per F.B. 64-51.

MYRRH St.

50.02

31.36

Fd. 2"x2"
4" deep.

N+T
P.P.

Note: Any Additions or Changes on This Sheet Must be Made or Circled in Red Ink With Date and Name of Person Making Change.

Do not extend notes this side of this line.

RETURN TO
LOS ANGELES COUNTY SURVEYOR
700 HALL OF RECORDS

FORM 247 BM 15-41

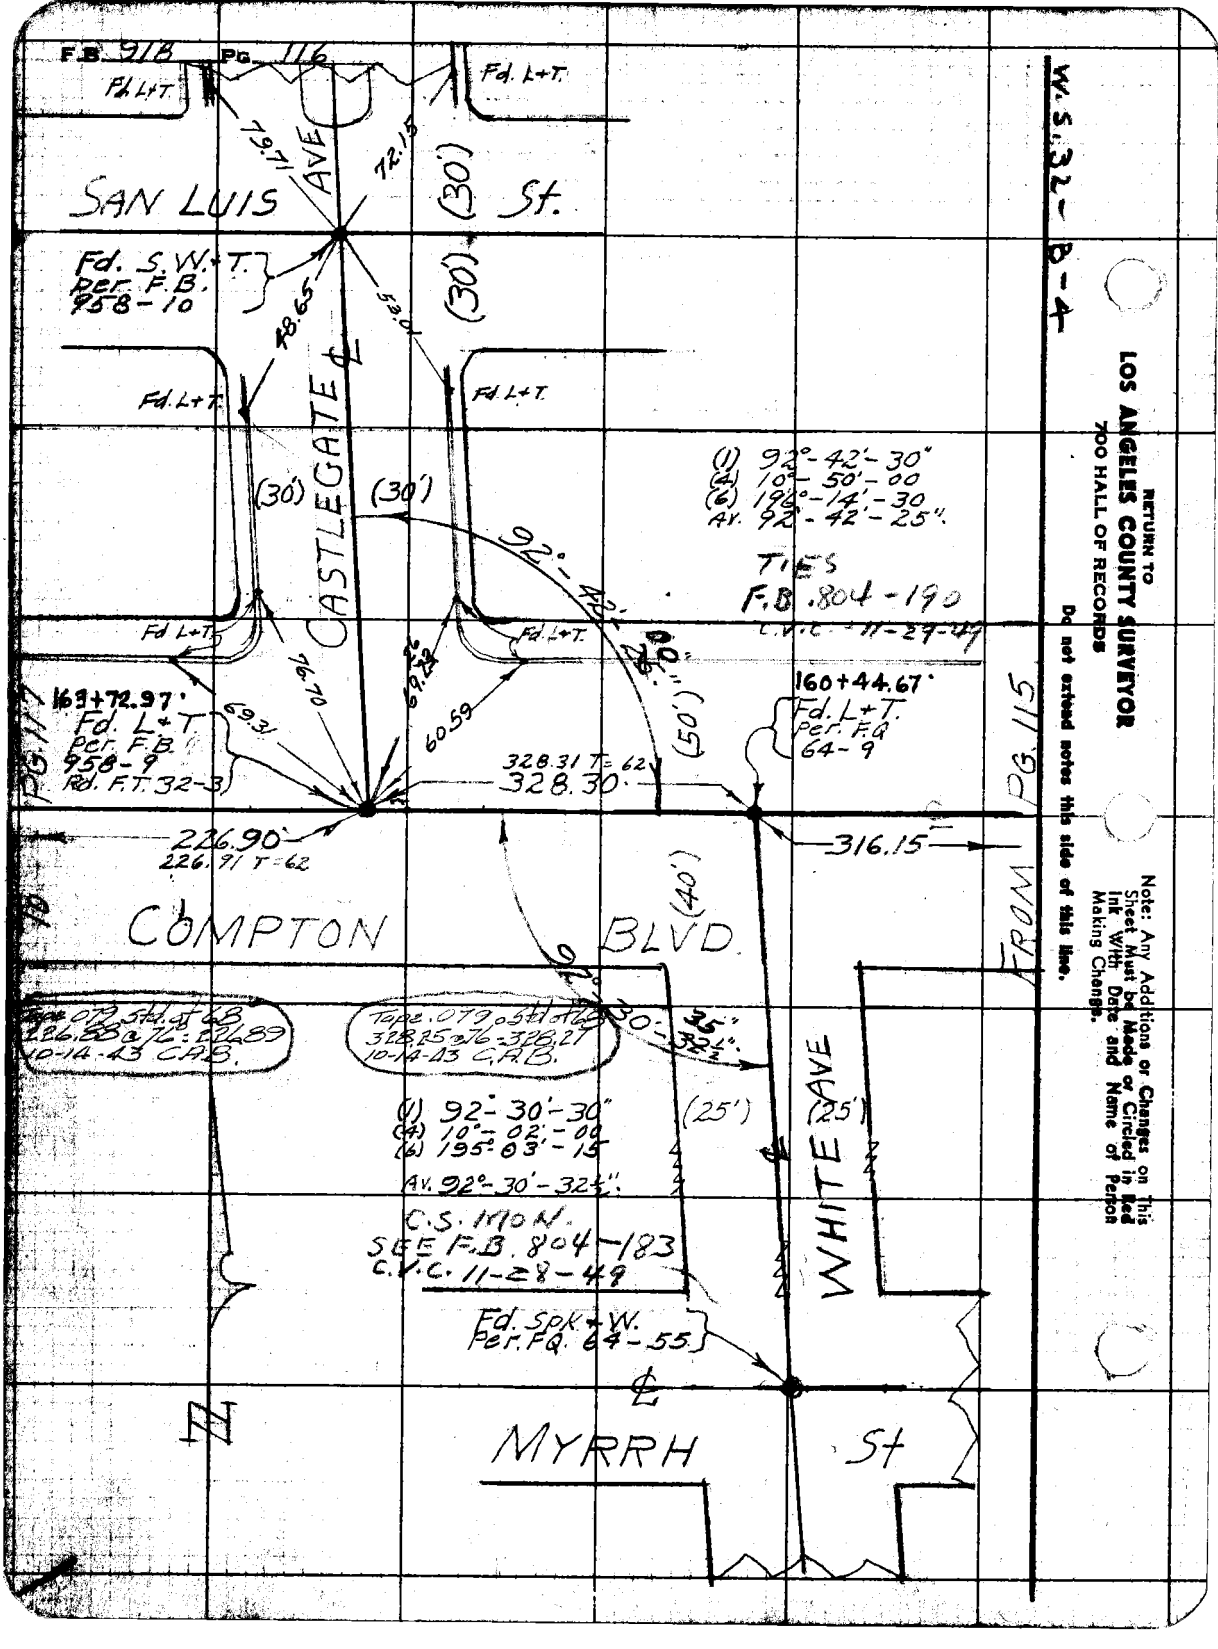

RETURN TO
LOS ANGELES COUNTY SURVEYOR
700 HALL OF RECORDS

Do not extend notes this side of this line.

Note: Any Additions or Changes on This Sheet Must be Made or Circled in Red Ink With Date and Name of Person Making Change.

Notes Ck'd by
Map No. B-1942-6
Office Work Cox
Checked D. M. Finley
Date AUG '51

Survey of Compton Blvd
W. O. 2345 Tape No. 064 Std. 66 ft
Surveyed by Butler
Notes H. Ott Date 3-30-43
Indexed A. C. Johnson

F.B. 918 Pg. 11

W.S. 3 - 4

Fd. 2" I.P. Flr. - 1K 12" Dn.

(30) (30) Tract line

TR. NO. 4186

TR. NO 10377

BUTLER AVE

(25') (30')

1) 92°-31'-00"
4) 10°-27'-45"
6) 195°-41'-45"
Av. = 92°-36'-57½"

92°-36'-57½"

TIES - F.B. 804-191
C.V.C. 11-29-49

Fd L+N.

B.M.T 3.93
Fd L+T

Fd. L+T.

52.10

68.11

35°-38'

℄ Prod.

(50')

296.71'
296.73 T=62

167+11.13
Fd L+T per F.B. 952-21

111.26'
111.26 T=62

.035

Fd. L+T
Per F.B. 64-8
165+99.07

226.90

PG 118

(30')

TO

(40')

COMPTON BLVD.

(40')

FROM

PG 116

10'

29°-00'

87°

Tape 079.5ft. 4768
296.78 @ 74 = 296.75
10-14-43 CAB

Tape 079.5ft. 1568
111.25 @ 74 = 111.24
10-14-43 CAB

BUTLER AVE

1) 87°-29'-00"
4) 349°-56'-00"
6) 164°-57'-00"
Av. 87°-27'-00"

(25') (25')

Fd. Spk. & W.
per F.B. 64-8

(25') (25')

MYRRH ST

Note: Any Additions or Changes on This Sheet Must be Made or Circled in Red Ink With Date and Name of Person Making Change.

Do not extend notes this side of this line.

RETURN TO
LOS ANGELES COUNTY SURVEYOR
700 HALL OF RECORDS

FORM 847 5M 11-41

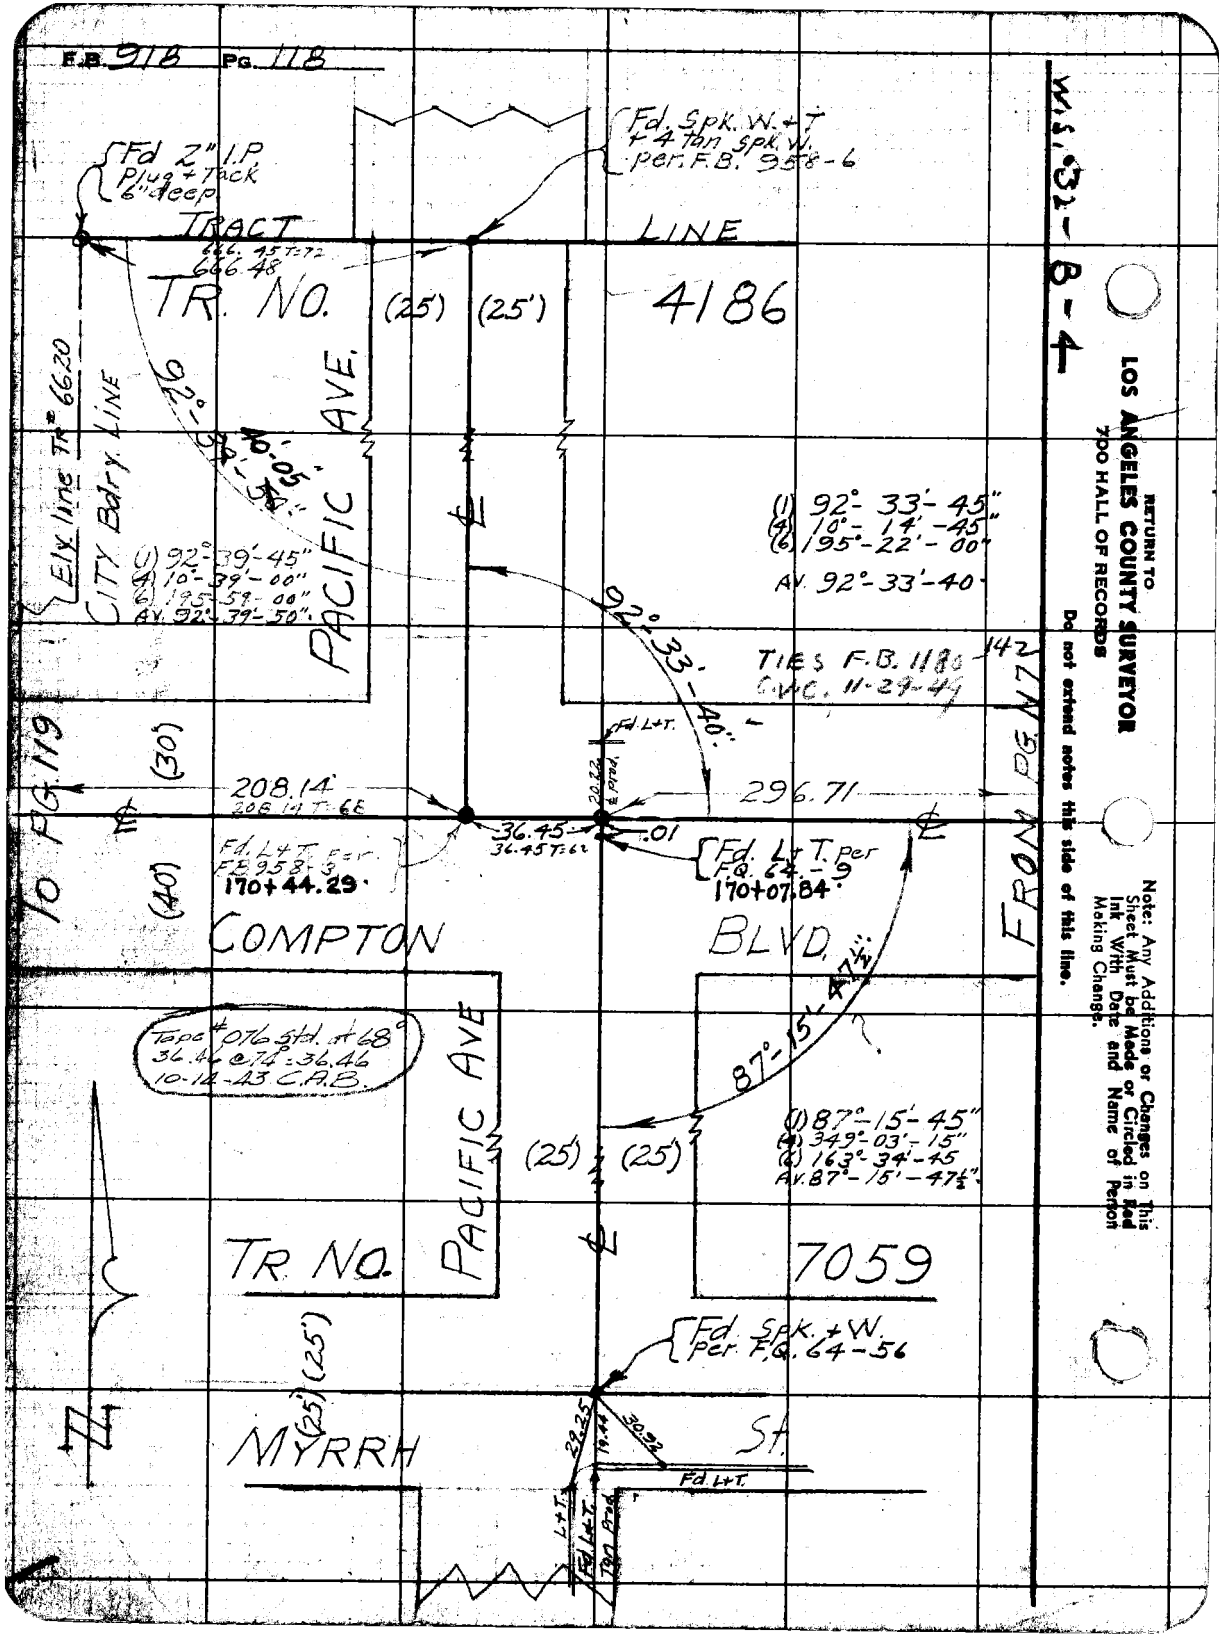
F.B. 918 Pg. 118
Fd 2" I.P Plug + Tack 6" deep
Fd. Spk. W. + T + 4 Tan Spk. W. per F.B. 958-6
TRACT LINE
666.45 T=72
666.48
TR. NO. 4186
(25) (25')
PACIFIC AVE.
E'ly line TR = 6620
CITY Bdry. LINE
(1) 92°-39'-45"
(4) 10°-39'-00"
(6) 195°-59'-00"
Av. 92°-39'-50"
(1) 92°-33'-45"
(4) 10°-14'-45"
(6) 195°-22'-00"
Av. 92°-33'-40"
92°-33'-40"
TIES F.B. 1181-142 C.W.C. 11-29-44
TO PG 119
(30)
208.14'
208.14 T=66
Fd L+T.
20.22 & prod.
296.71
FROM PG 117
36.45
36.45 T=62
.01
Fd L+T. Per F.B. 953-3
170+44.29
Fd L+T. Per F.Q. 64-9
170+07.84
(40)
COMPTON BLVD.
Topo #076 Std. #68°
36.46 @ 74°-36.46
10-14-43 C.A.B.
87°-15'
(1) 87°-15'-45"
(4) 349°-03'-15"
(6) 163°-34'-45"
Av. 87°-15'-47½"
PACIFIC AVE
(25) (25)
TR NO. 7059
Fd Spk. + W. Per F.Q. 64-56
MYRRH (25') ST.
22.35
19.44
30.23
Fd L+T.
Fd L+T.
Iron Post
RETURN TO LOS ANGELES COUNTY SURVEYOR 7100 HALL OF RECORDS
Do not extend notes this side of this line.
Note: Any Additions or Changes on This Sheet Must be Made or Circled in Red Ink With Date and Name of Person Making Change.
W.S. 32-B-4

Notes Ck'd by
Map No. B-1242-6
Office Work Cox
Checked D. M. Finley
Date AUG '51

Survey of COMPTON BLVD.
W. O. 8345 Tape No. 064 St'd 68° F
Surveyed by Butler
Notes H.A.M. Date 3-30-43
Indexed A. C. Johnson

F.B. 918 Pg. 119

804

W 5 3

Note: Any Additions or Changes on This Sheet Must be Made or Circled in Red Ink With Date and Name of Person Making Change.

Do not extend notes this side of this line.

RETURN TO
LOS ANGELES COUNTY SURVEYOR
700 HALL OF RECORDS

FORM 247 SM 17-41

173+77.48
Fd. L+T per
F.Q. 64-16

COMPTON BLVD.

Fd. L+T & M'od.

TO PS 120

164.87 T 68
164.87
(30')

125.05 T 68
125.05
(30')

208.14
(30')

Fd. L+T per
F.T. 32-4
F.Q. 64-16
172+52.43

(40')

FROM 46/16

(40')

(30')

(25')

(25')

(1) 92°-43'-45"
(4) 18°-55'-90"
(6) 196°-22'-15"
Av. 92°-43'-42½"

ELY. LINE TR. No 5729

TR. No. 7059

AVE.

THORSON

Fd. L+T in Walk

33.88

MYRRH St.

Fd 2"X2" 12" deep
per F.Q. 64-57

34.97
35.02

37.89

Fd. N+T. P.P.

Fd X in Walk.

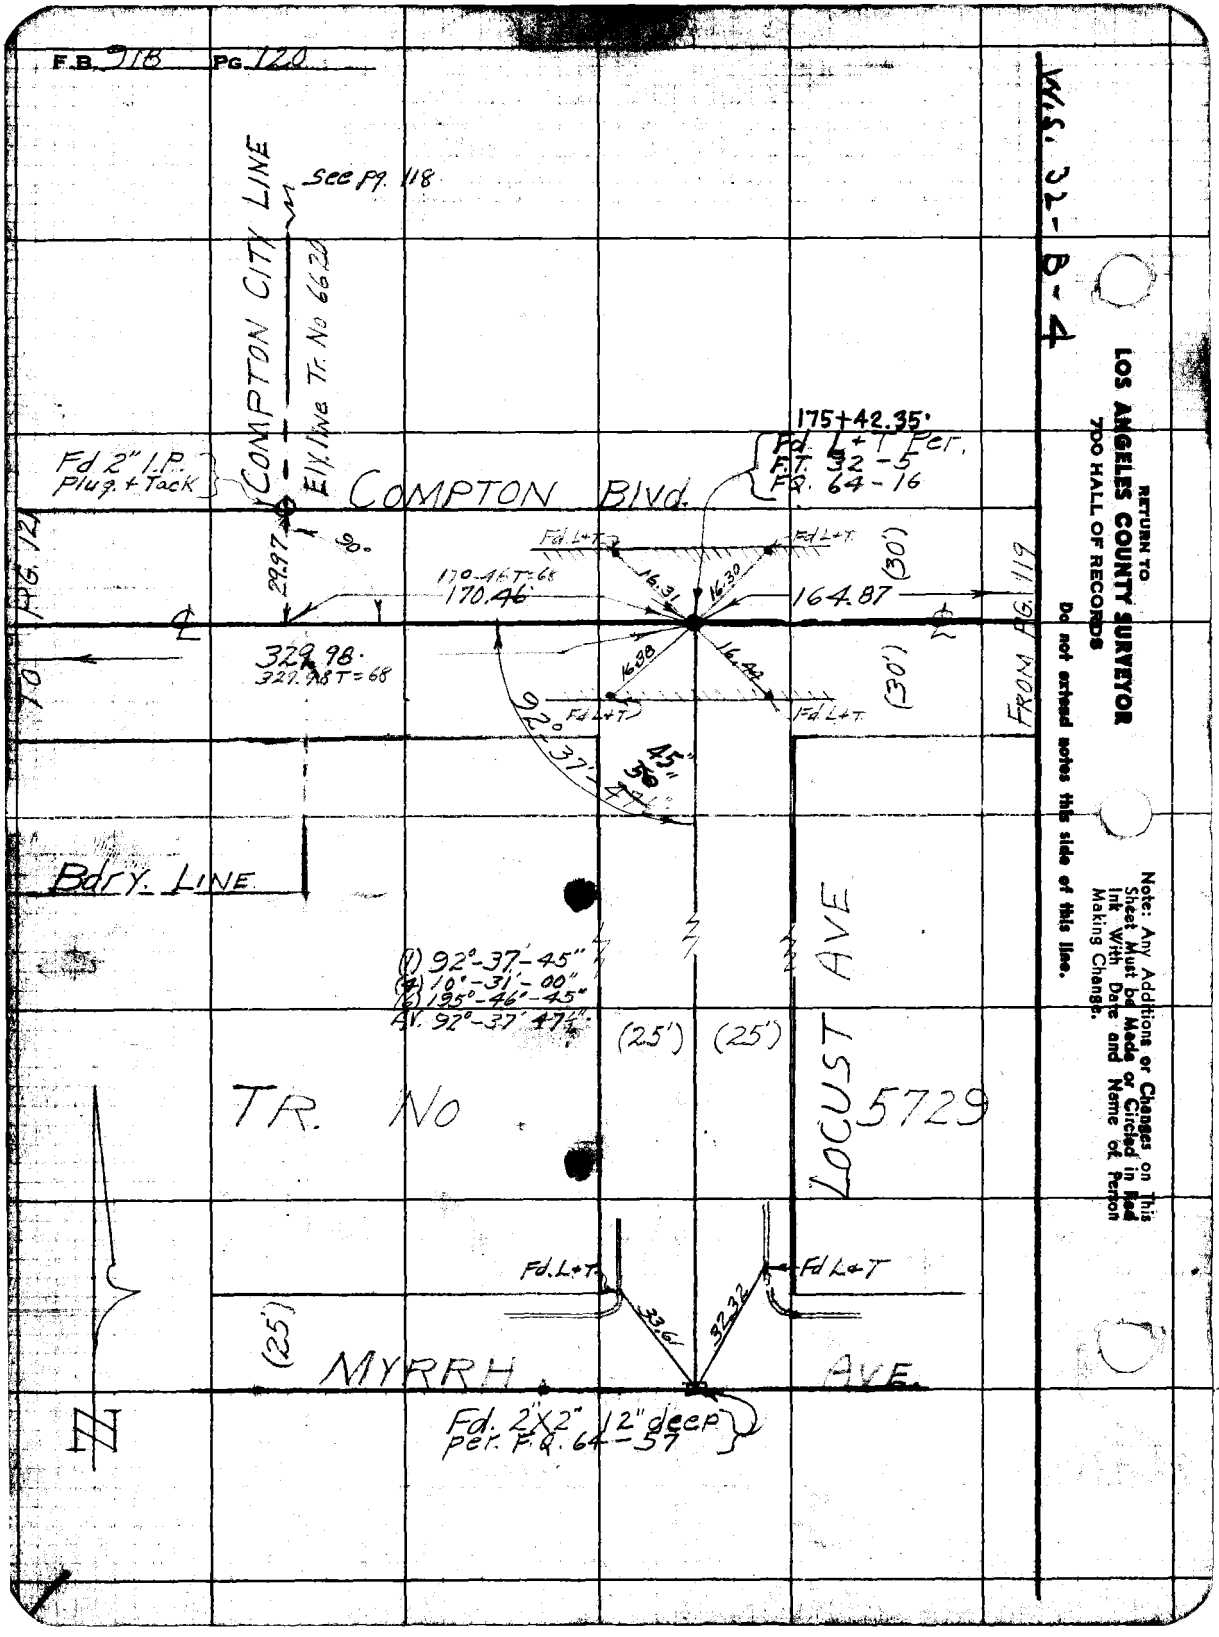
F.B. 918 Pg. 120
W.S. 32-B-4
RETURN TO
LOS ANGELES COUNTY SURVEYOR
700 HALL OF RECORDS
Do not extend notes this side of this line.
Note: Any Additions or Changes on This Sheet Must be Made or Circled in Red Ink With Date and Name of Person Making Change.
See Pg. 118
COMPTON CITY LINE
E'ly Line Tr. No 6622
Fd 2" I.P. Plug + Tack
COMPTON Blvd.
175+42.35'
Fd L+T Per.
F.T. 32-5
F.Q. 64-16
Fd L+T
Fd L+T
29.97
170.46+T=68
170.46
16.31
16.30
164.87
(30')
329.98'
329.98T=68
16.88
16.44
92°37'
Fd L+T
Fd L+T
(30')
45"
50
47½'
PG. 121
TO
FROM PG. 119
Bdry. LINE
(1) 92°-37'-45"
(2) 10°-31'-00"
(3) 195°-46'-45"
Av. 92°-37'-47½"
(25')
(25')
TR. No 5729
LOCUST AVE
Fd. L+T
Fd L+T
33.61
32.32
(25')
MYRRH AVE
Fd. 2"X2" 12" deep
Per. F.Q. 64-37
N

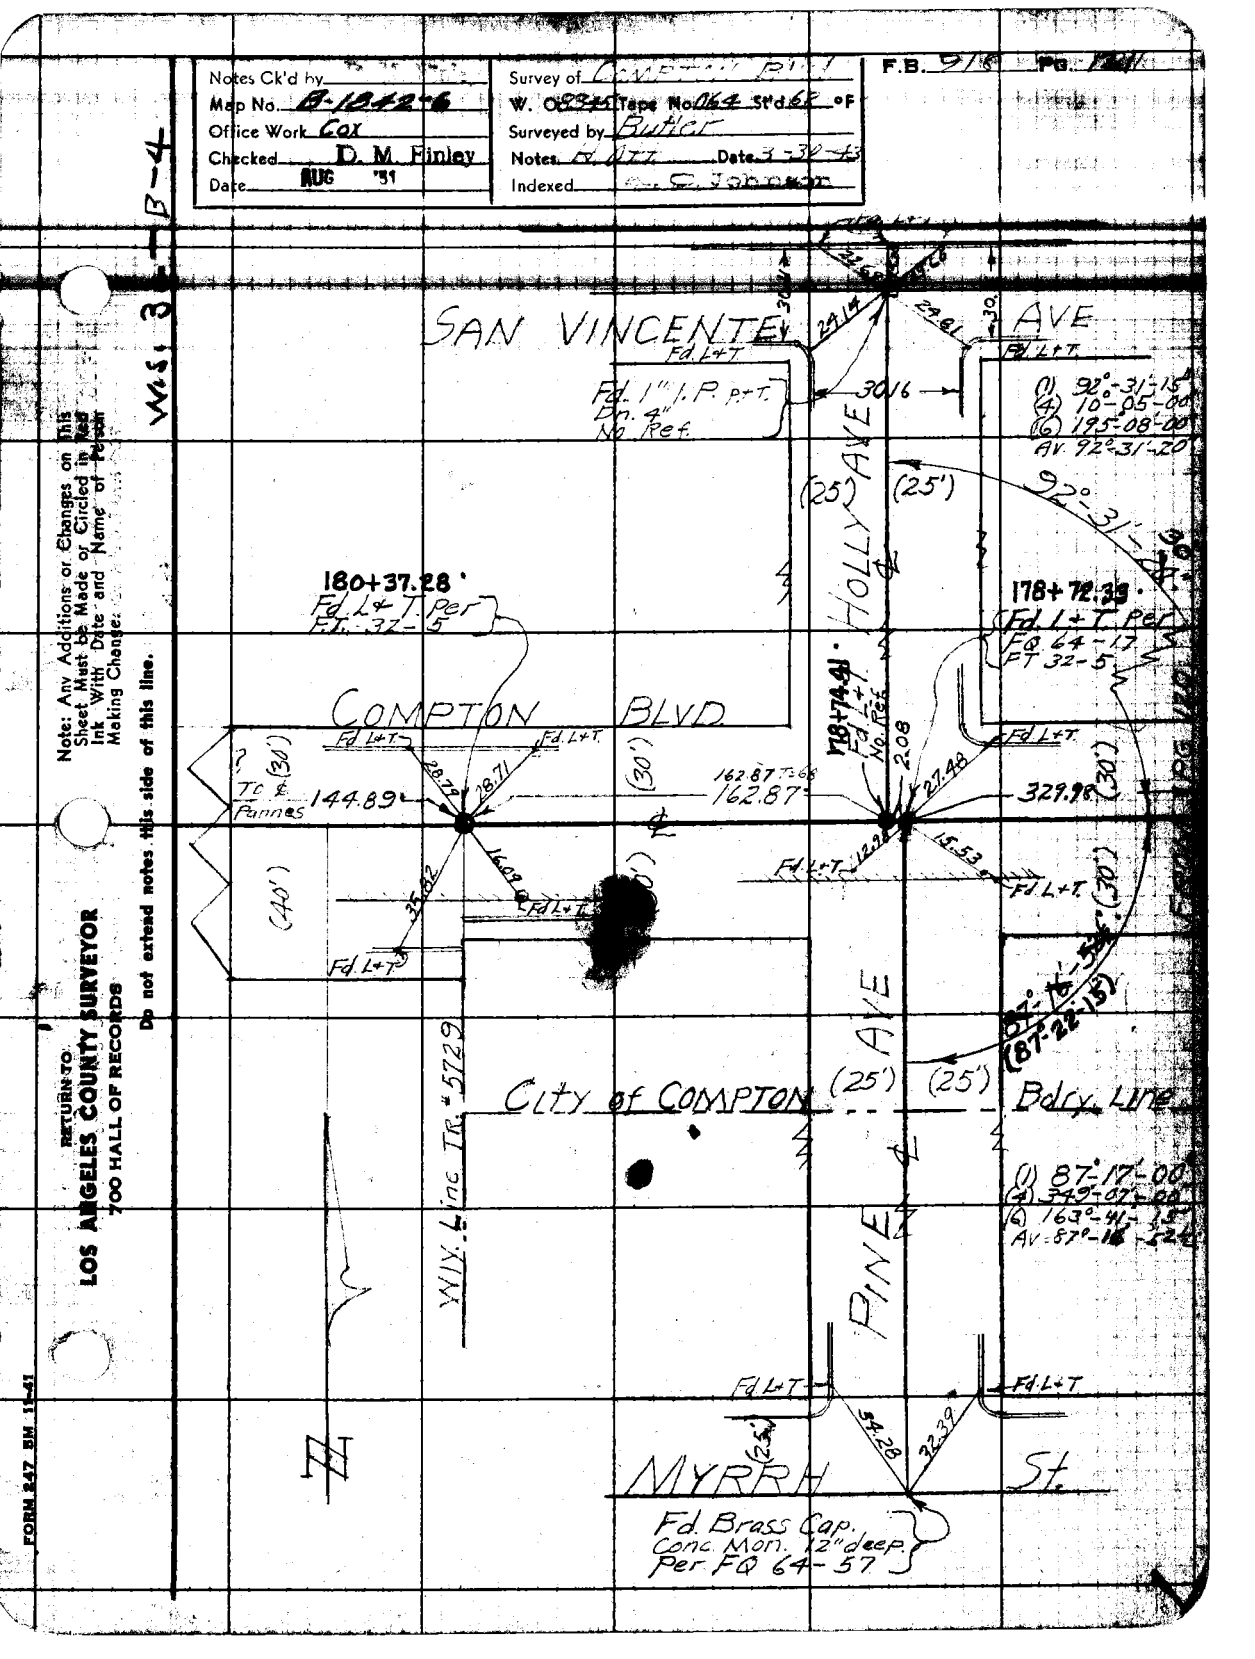
Notes Ck'd by
Map No. B-1242-6
Office Work Cox
Checked D. M. Finley
Date AUG '51
Survey of
W. O.
Tape No. 064 Std. 62 °F
Surveyed by Butler
Notes
Date 3-30-43
Indexed
F.B. 916 Pg.
W 51 3-4 B-4
SAN VINCENTE AVE
Fd. L+T.
Fd. 1" I. P. P+T. Bn. 4" No. Ref.
30.16
(1) 92°-31'-15"
(4) 10°-05'-00"
(6) 195°-08'-00"
Av. 92°-31'-20"
HOLLY AVE
(25')
180+37.28
Fd. L+T. Per F.T. 32-5
178+72.39
Fd. L+T. Per FQ 64-17 FT 32-5
178+74.41
Fd. L+T. No. Ref.
COMPTON BLVD
(30')
TC & Pannes
144.89
162.87
329.98
208
27.48
28.79
28.71
35.82
16.03
15.53
(40')
Fd. L+T.
City of COMPTON
(25')
Bdry. Line
(1) 87°-17'-00"
(4) 349°-07'-00"
(6) 163°-41'-35"
Av. 87°-18'-25"
(87°-22'-15")
PINE AVE
MYRRH St.
Fd. Brass Cap. Conc. Mon. 12" deep. Per FQ 64-57
54.28
32.32
(25')
N
Note: Any Additions or Changes on this Sheet Must be Made or Circled in Red Ink With Date and Name of Person Making Change.
Do not extend notes this side of this line.
RETURN TO
LOS ANGELES COUNTY SURVEYOR
700 HALL OF RECORDS
FORM 847 5M 11-41

RETURN TO
LOS ANGELES COUNTY SURVEYOR
700 HALL OF RECORDS

Note: Any Additions or Changes on This Sheet Must be Made or Circled in Red Ink With Date and Name of Person Making Change.

Do not extend notes this side of this line.

R.S. 718 Pg. 122

Notes Ck'd by D. M. Finley	Survey of COMPTON BLVD	F.B. 918 Pg. 123
Map No. B-1842-S	W. O. 8345 Tape No. Std °F	
Office Work Cox	Surveyed by C.V. Crumley	
Checked D. M. Finley	Notes C.V.C. Date 8-8-44	
Date AUG '51	Indexed ALBERT E. TIMMONS	

T.W. 8345

COMPTON BLVD

LOCATION OF IMPROVEMENT
FROM
LAKEWOOD BLVD
TO
DOWNEY AVE.

℄ Per F.B. 918-72 TO 76

AUG. 8, 1944

C.V. Crumley
G.G. Porter
M. Sommerschein
T.C. Peterson
A. Zambrano

Note: Any Additions or Changes on This Sheet Must be Made or Circled in Red Ink With Date and Name of Person Making Change.

Do not extend notes this side of this line.

RETURN TO
LOS ANGELES COUNTY SURVEYOR
700 HALL OF RECORDS

FORM 247 3M 12-49

F.B. 918 Pg. 124

Cont'd on Bottom Page 126

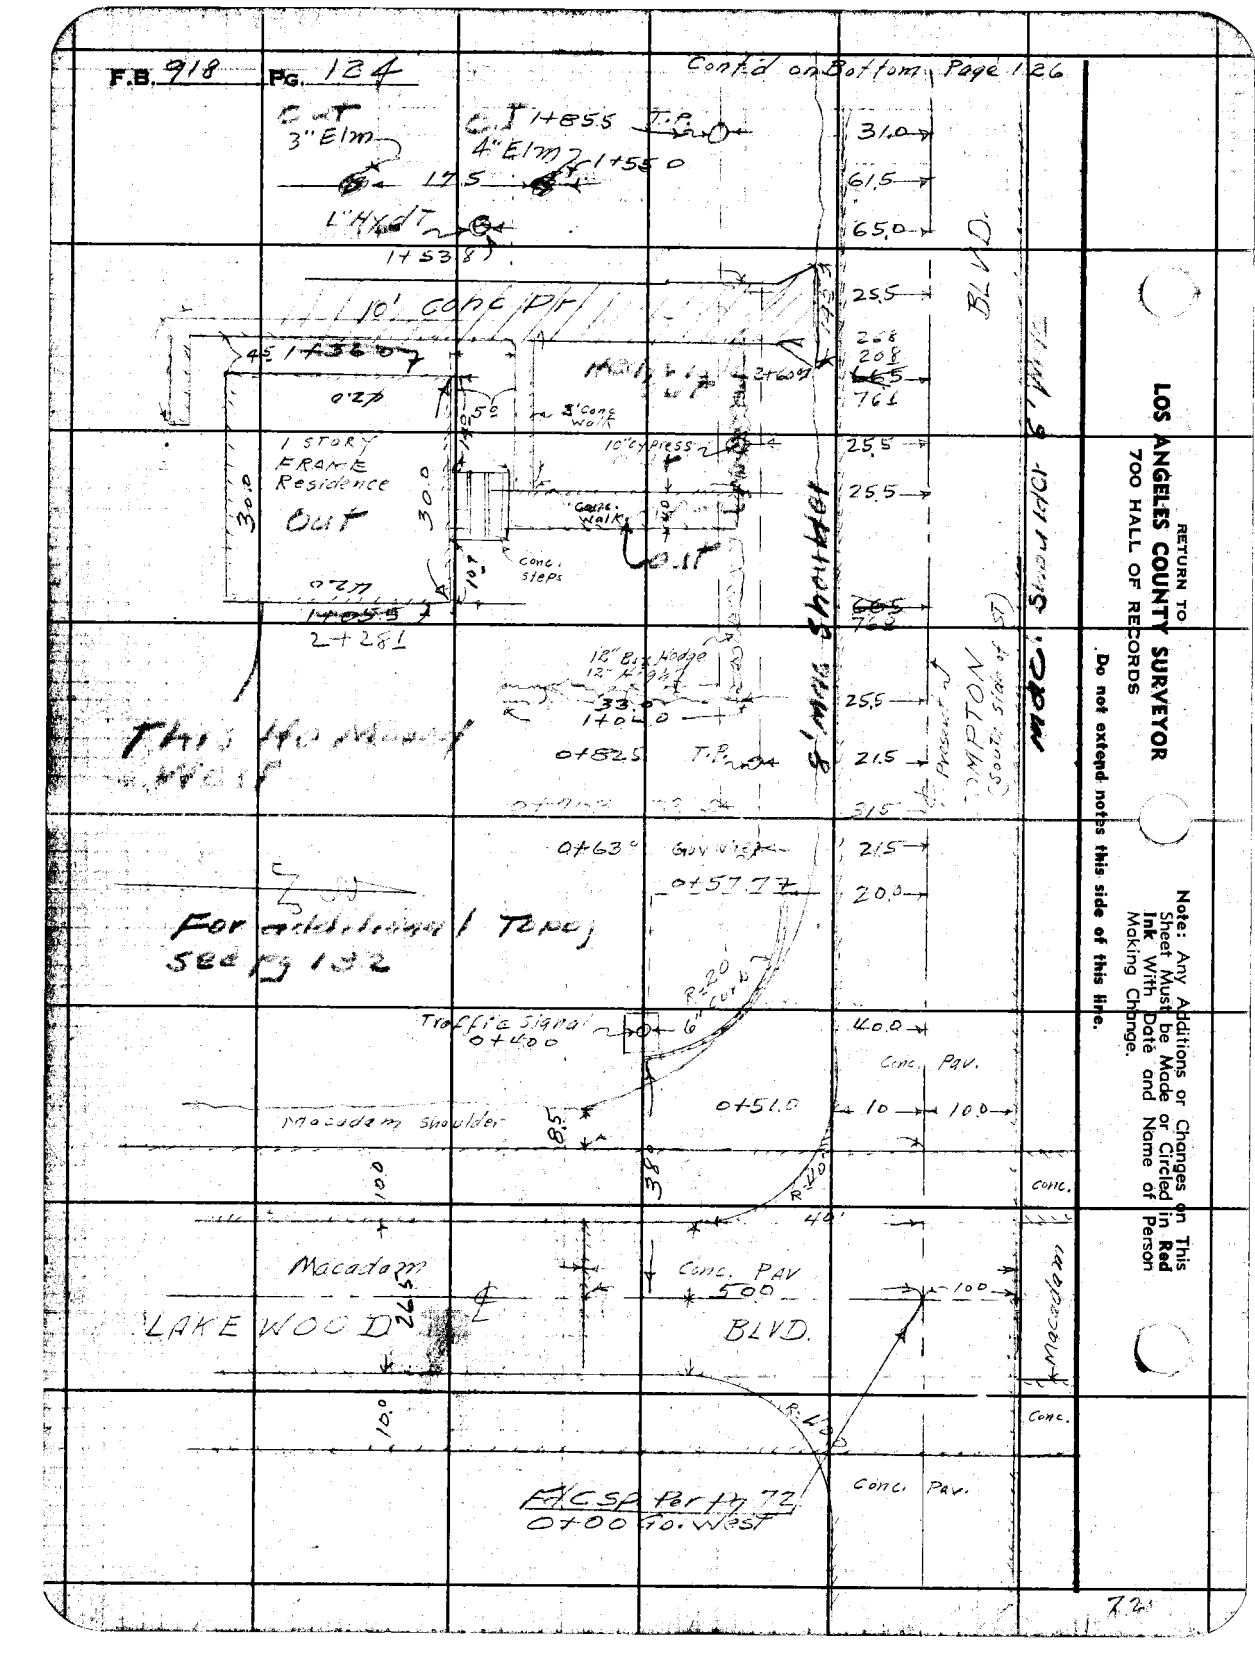

This Ho Monu... West

RETURN TO
LOS ANGELES COUNTY SURVEYOR
700 HALL OF RECORDS

Do not extend notes this side of this line.

Note: Any Additions or Changes on This Sheet Must be Made or Circled in Red Ink With Date and Name of Person Making Change.

Notes Ck'd by D. M. Finley	Survey of COMPTON BLVD	F.B. 918	Pg. 125
Map No. B-1842-5	W. O. 8345 Tape No. Std. °F		
Office Work Corr	Surveyed by C. V. Crumley		
Checked D. M. Finley	Notes W. C. & G. & P. Date 8-3-44		
Date AUG '51	Indexed ALBERT E. TIMMONS		

Note: Any Additions or Changes on This Sheet Must be Made or Circled in Red Ink With Date and Name of Person Making Change.

Do not extend notes this side of this line.

RETURN TO
LOS ANGELES COUNTY SURVEYOR
700 HALL OF RECORDS

FORM 247 3M 12-50

orchard out

Peach, Pear, Plum trees

ORCHARD TREES - 2" TO 6" Dia.

1+72.0 P.P.

1+39.0

1+29.0 6" Palm

1+25 Oleander

1+24.3

1+05.0 5" Tree

1+16.0

1 STORY FRAME RESIDENCE

Has been Moved West + offset 9.2

Cone. walk.

Stoop

0+86.3

0+90 24" Privet Hedge

0+64.2 12" Pepper

0+58.0 Traffic Signal 0+56.2

P.R. 0+55.4

Traffic Control Switch Box 0+52.5

20" Gum

24" Gum

14" Gum

For additional Topo see PS 132

Macadam shoulder

100 conc. Pav.

Macadam

LAKEWOOD BLVD

Conc. Pav.

Fd. Sp. for Hy 72

0+00 Co. West

COMPTON BLVD

(North Side) 8 Mile Southwest

10' Conc.

10' P.C.C.

Pav.

34.2

25.0

50.5

35.8

27.0

63.0

62.5

69.0

27.0

35.0

20.0

22.2

27.5

26.1

132

110

38.0

24.2

16.0

65

6.0

12.0

6.0

6.0

F.B. 918 Pg. 126

Cont'd on Bottom Pg 128

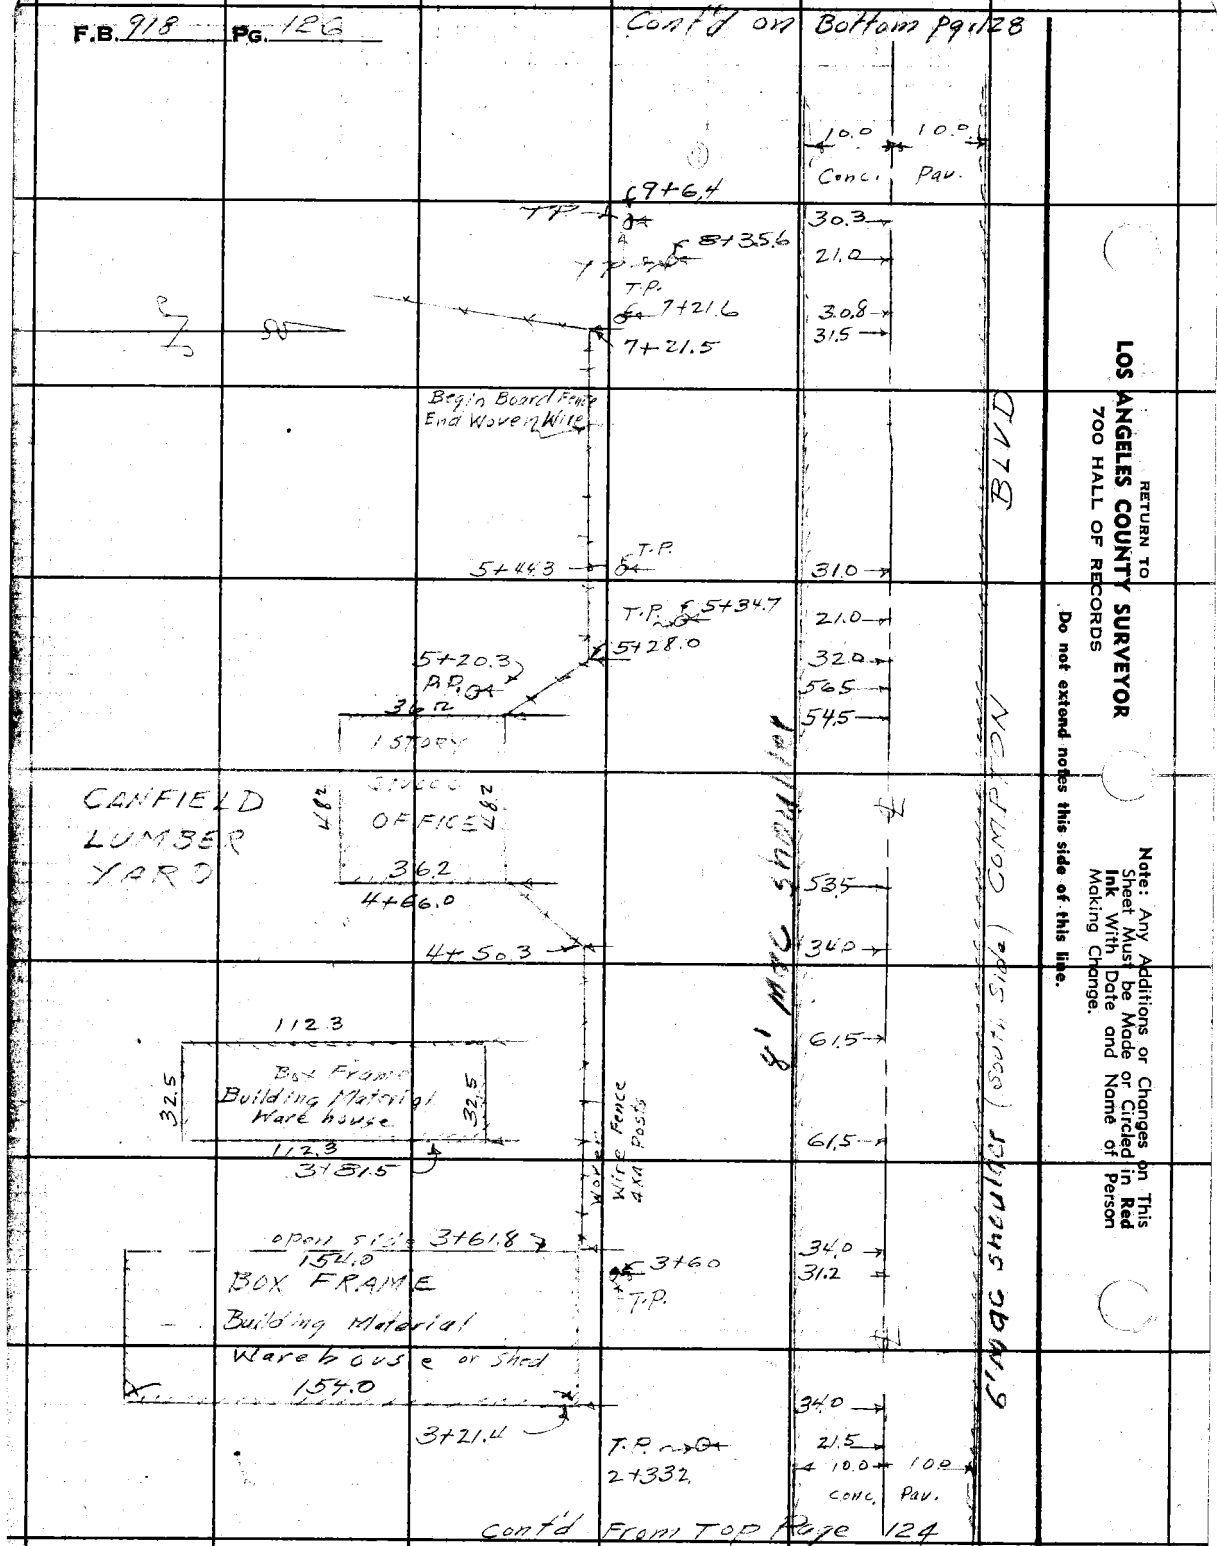

RETURN TO
LOS ANGELES COUNTY SURVEYOR
700 HALL OF RECORDS

Do not extend notes this side of this line.

Note: Any Additions or Changes on This Sheet Must be Made or Circled in Red Ink With Date and Name of Person Making Change.

Notes Ck'd by D. M. Finley
Map No. B-1642-5
Office Work Cox
Checked D. M. Finley
Date AUG '51

Survey of COMPTON BLVD.
W. O. 8345 Tape No. Std °F
Surveyed by C.V. Crumley
Notes C.V.C. Date 8-3-47
Indexed ALBERT E. TIMMONS

F.B. 916 Pg. 127

Note: Any Additions or Changes on This Sheet Must be Made or Circled in Red Ink With Date and Name of Person Making Change.
Do not extend notes this side of this line.

RETURN TO
LOS ANGELES COUNTY SURVEYOR
700 HALL OF RECORDS

FORM 247 BM 12-50

Comp 10.0 Pav't 10.0

683
30.7
60.7
33.0
70.8
30.1
19.2
25.0
30.3
24.8
30.6
25.2
30.5
30.3
25.1
10.0 Comp 10.0 Pav't

North Side Compton Blvd

R=18.0
8+31.0
8+30.0 10" Palm
8+22.7 6" Palm
8+17.0
8" Palm
8+20.6
R=10.0
8+16.2
8+18.2
60°
Gravel Dr.
Curb & Gutter
7+70.5
P.P.
Woven Wire Fence
6+31.4
Board Fence
Lattice Fence
60°
P.P.
6+22.7
6+13.0
Cow Stanchions & Feed Trough
40.0
60°
Barb Wire Fence
P.P. 4+66.6
4+62.2
6 Strand Barb Wire Fence
3+26.8
P.P. 3+22.7

Cont'd From Top Page 125

F.B. 918 PG. 128

(Cont'd on Bottom Page 129)

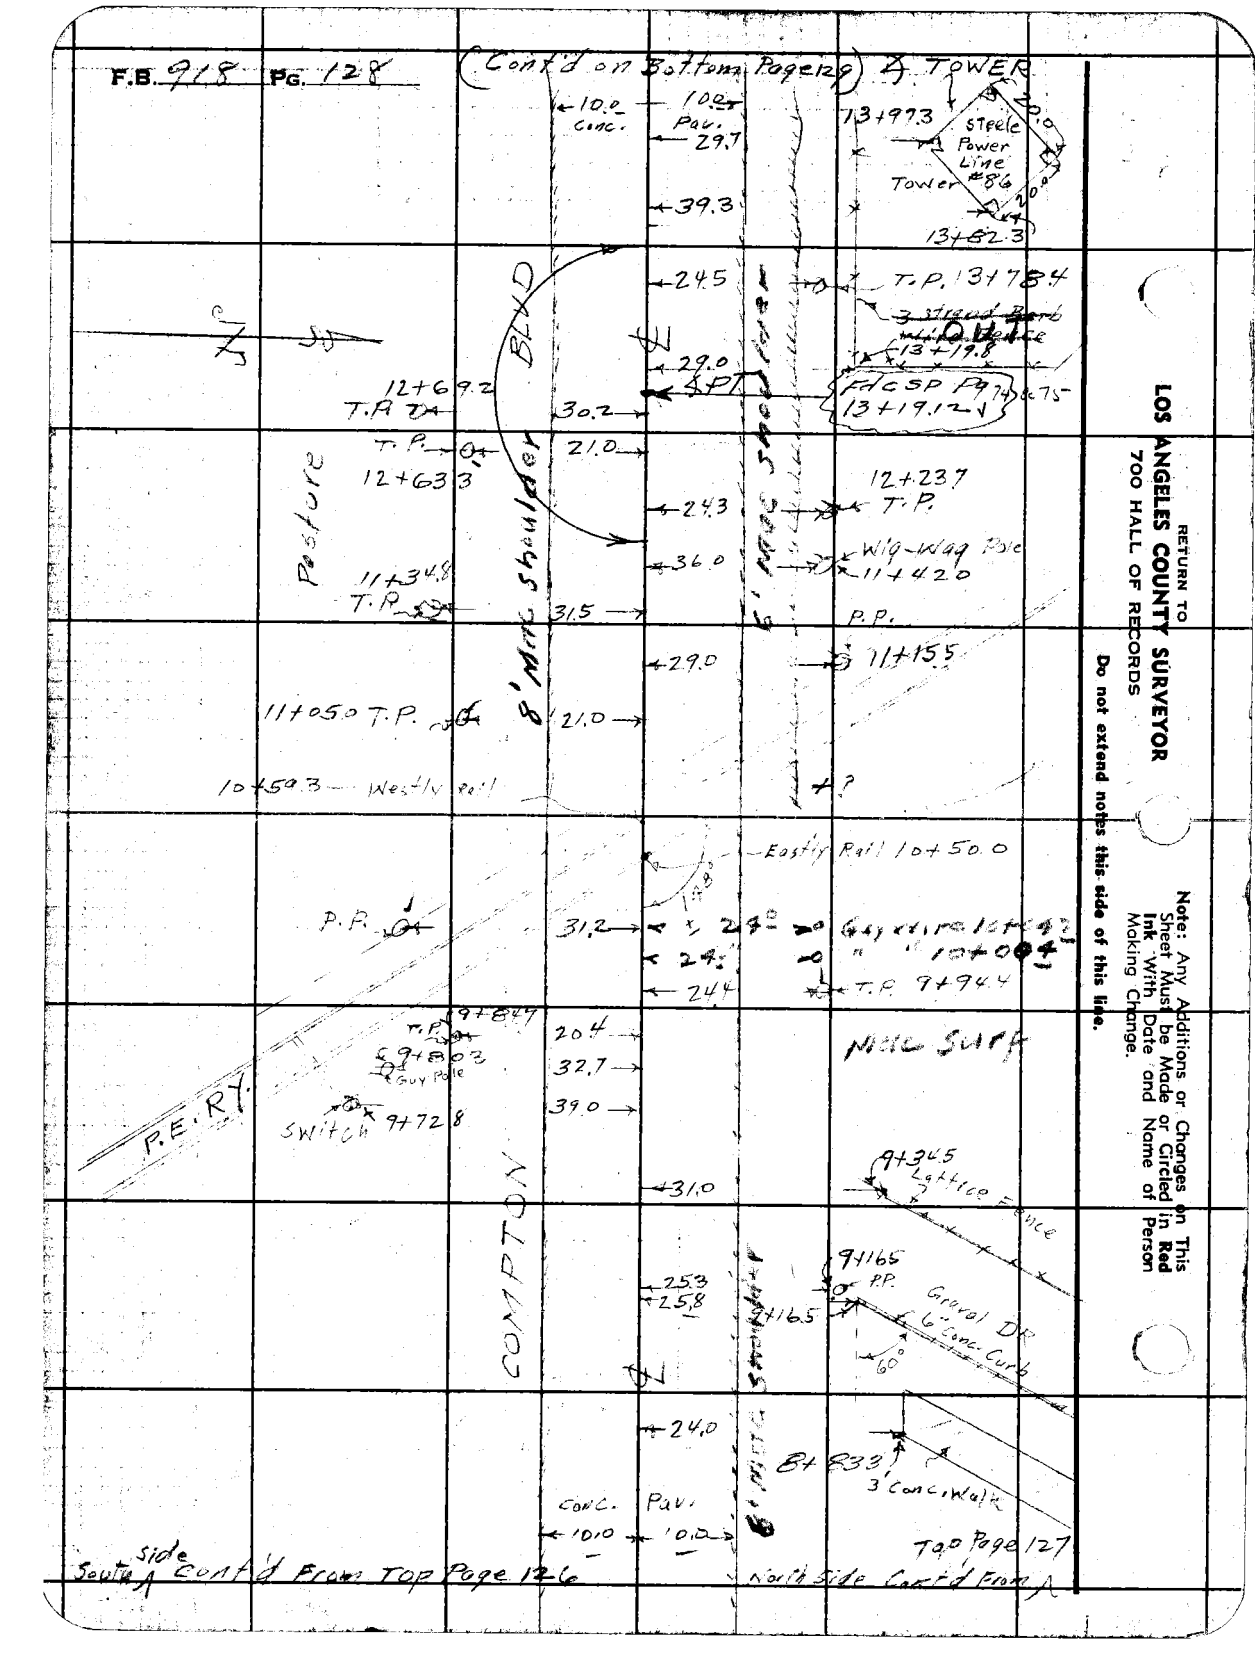

RETURN TO
LOS ANGELES COUNTY SURVEYOR
700 HALL OF RECORDS

Do not extend notes this side of this line.

Note: Any Additions or Changes on This Sheet Must be Made or Circled in Red Ink With Date and Name of Person Making Change.

Notes Ck'd by D. M. Finley	Survey of Comp. Blvd.	F.B. 918	Pg. 129
Map No. B-1942-5	W. 0834 S Tape No. Std °F		
Office Work OK	Surveyed by C.V.C. Crumley		
Checked D. M. Finley	Notes C.V.C. & A.G.M. Date 8-8-44		
Date AUG '31	Indexed ALBERT E. TIMMONS		

Note: Any Additions or Changes on This Sheet Must be Made in Ink With Date and Name of Person Making Change.
Do not extend notes this side of this line.

RETURN TO
LOS ANGELES COUNTY SURVEYOR
700 HALL OF RECORDS

FORM 247 BM 12-39

Contd. on Datum Page 1244

19+86.9 T.P.

19+78.0 Barb wire fence

OUT

19+77.5

P.P.

19+73.6 T.P.

19+54.0 T.P.

26.0
20.8
50.0
30.7

244

16+32.9 P.P.

18+35.0 T.P.

18+13.8 T.P.

Field

16+83.0 P.P.

21.5
30.7
21.4

243

16+82.3 T.P.

16+72.7 T.P.

Barb Wire Fence

OUT

16+35.0

30.7
24.8

BLVD

15+49.8 P.P.

T.P.

15+32.0

21.6
30.7
46.5

240

10' High Pomegranite Hedge

15+30.3

15+30.2 T.P.

Field

Fish Pond
Dia. = 65
15+07.7

71.0

3' Conc. Walk

For Addl Topog. See Page 133, 134

14+95.5

To unbroken part

39.6
71.7

8° dia

14+89.5

Fish Pond

8.0

14+79.2

62.6

14" Acacia

3" Lemon

38.4

45.2

COMPTON

15 story Stucco Store

36.2

36.2

3' Conc. Walk

38.4

14+19.6

T.P. 14+18.0

T.P.

14+17.5

46.1
30.8
22.8 Conc.

Cont'd From Top Page 129

F.B. 918 PG. 130

Cont'd on Bottom Page 131

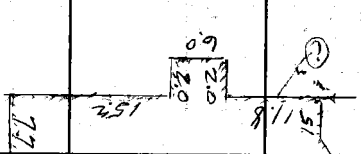

1 STORY FRAME House

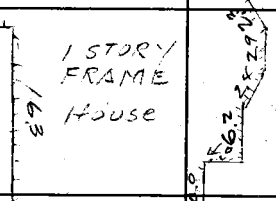

BLVD

Conc. Pav.
10.0 10.0
59.8

63.7
21.2 25.0
52.2

P.P. 24+41.0

T.P. 24+43.7

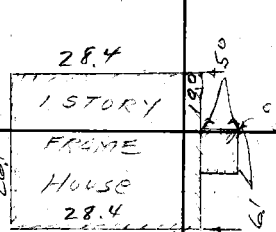

52.1
21.8

22+97.8 P.P.

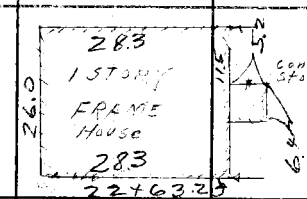

52.0 24.5
52.0

22+91.6 T.P.

Pioneer Blvd

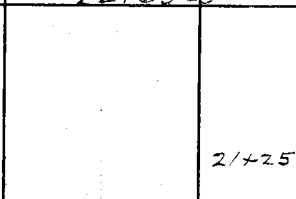

21+35.0
24.5
21.5

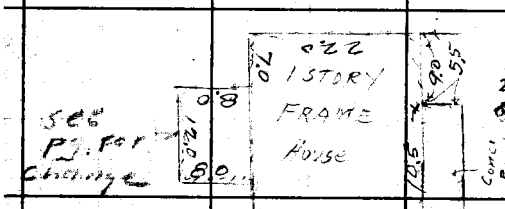

COMPTON

58.0
51.0

51.0
58.0
Conc. Pav.
10.0 10.0

Cont'd From Top Page 129

RETURN TO
LOS ANGELES COUNTY SURVEYOR
700 HALL OF RECORDS

Do not extend notes this side of this line.

Note: Any Additions or Changes on This Sheet Must be Made or Circled in Red Ink With Date and Name of Person Making Change.

Notes Ck'd by D. M. Finley	Survey of		F.B. 918 Pg. 131
Map No. B-4142-5	W. O.	Tape No. Std °F	
Office Work	Surveyed by		
Checked D. M. Finley	Notes	Date	
Date AUG '51	Indexed ALBERT E. TIMMONS		

Cont'd Pg. 137

Note: Any Additions or Changes on This Sheet Must be Made or Circled in Red Ink With Date and Name of Person Making Change.

Do not extend notes this side of this line.

RETURN TO
LOS ANGELES COUNTY SURVEYOR
700 HALL OF RECORDS

COMPTON BLVD

Conc. Pav.

26+85.2 E.H.
T.P. 26+71.0
P.P. 26+60.0
R=40
10.0 29.0 10.0
48.9
51.8
26+96.0
Fd L.Y. & I. Pg. 76
26+40.59
R=40

8 Macadam
Conc.
Pav.
8 Macadam
49.9
50.0
DOWNEY
AVE
3.8

R=40
61.5
39.3
32.0
25.2
25.0
25+82.5
10' 10'
T.P. 26+18.9
G.P. 26+16.4
25+95.6 (1)
25+92.6
T.P.
3 Str. of Barb Wire Fence
Conc. Pav.
P.P. 25+71.2
21.4
Ploughed Field
Cont'd From TOP Page 130

37.6

FORM 247 3M 12-50

F.B. 918: PG. 132

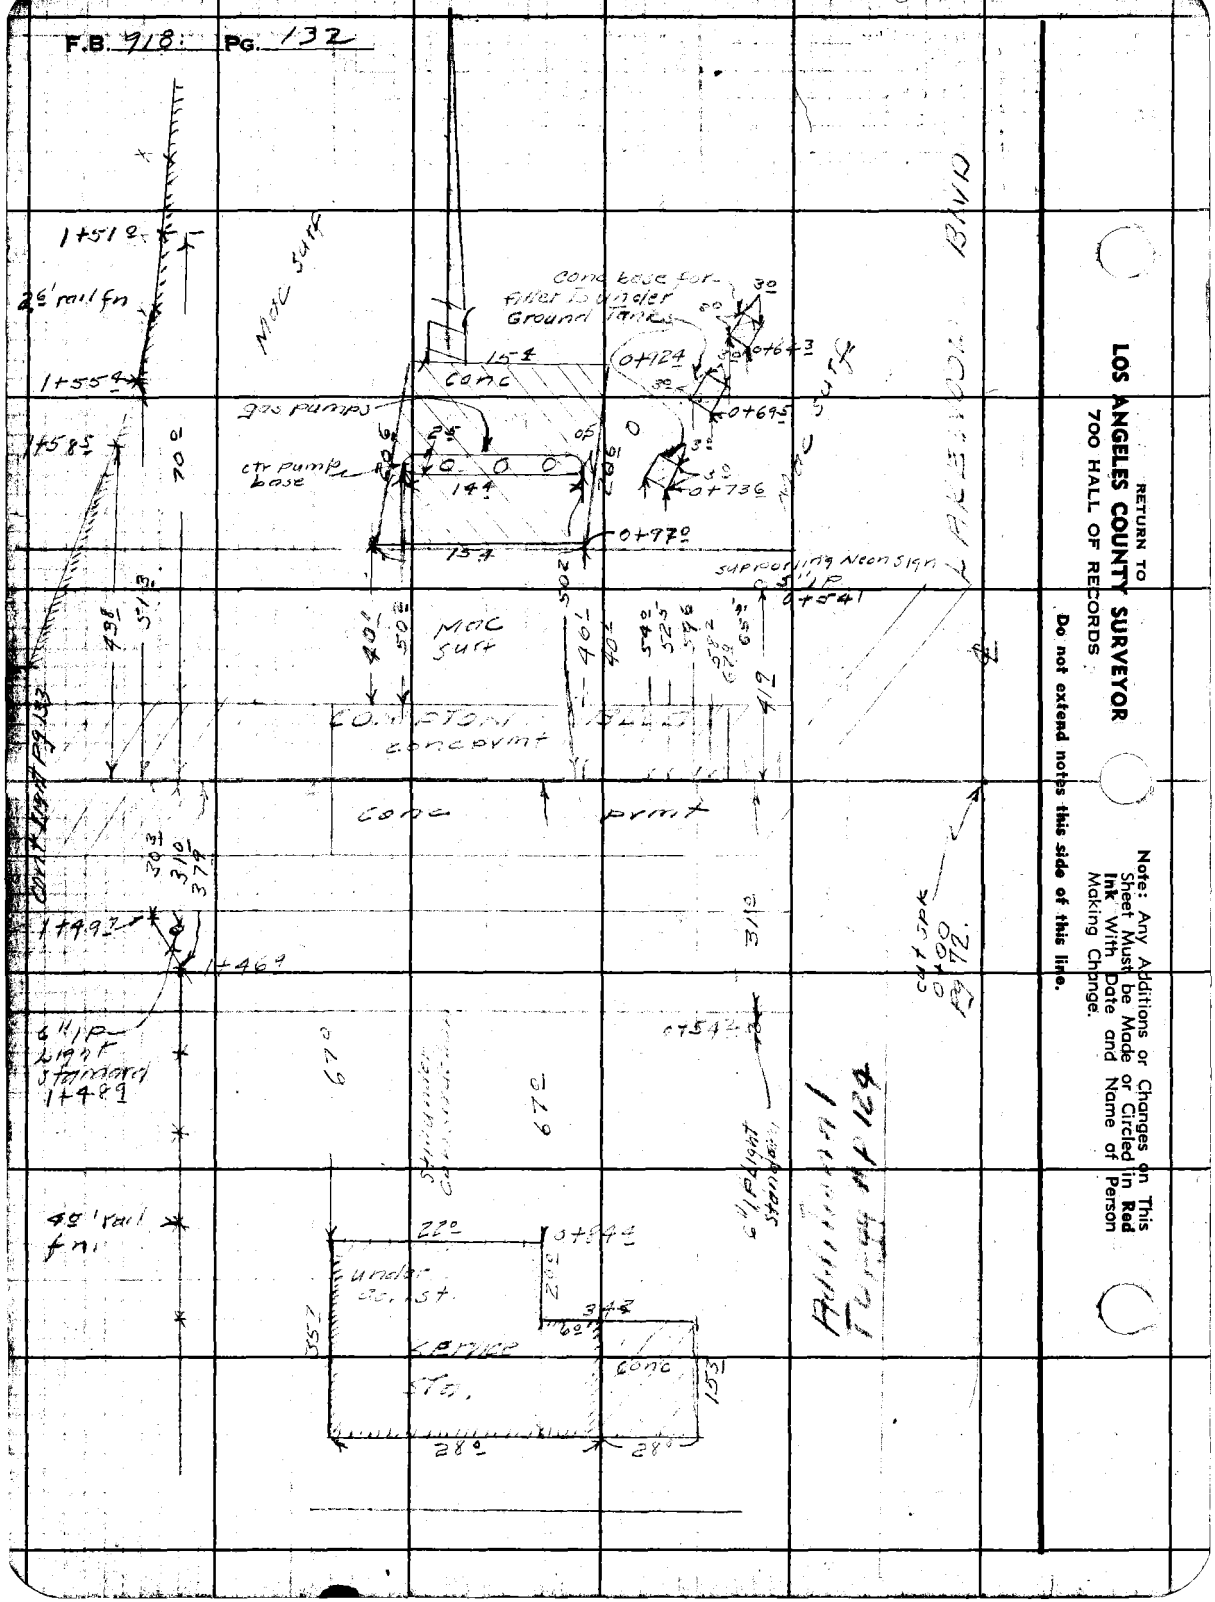

RETURN TO
LOS ANGELES COUNTY SURVEYOR
700 HALL OF RECORDS

Do not extend notes this side of this line.

Note: Any Additions or Changes on This Sheet Must be Made or Circled in Red Ink With Date and Name of Person Making Change.

FORM 247 5M 5-46

RETURN TO
LOS ANGELES COUNTY SURVEYOR
700 HALL OF RECORDS

Note: Any Additions or Changes on This Sheet Must be Made or Circled in Red Ink With Date and Name of Person Making Change.

Do not extend notes this side of this line.

Notes Ck'd by D. M. Finley
Map No. 13—1442-1
Office Work
Checked D. M. Finley
Date AUG '51

Survey of W. O. 8334 Tape No. Sh'd
Surveyed by R. L. Wiley Date '2-48
Notes
Indexed C. C. Johnson 5-24-48

F. B. 2171 PG. 133

Gravel Dr

15+55 ℄

0 21 ℄ 0 13 ℄ 21 ℄

ctr 12" PP 15+53 ℄ Guy wire 15+52 ℄ ctr 15" PP 15+51 ℄

Guy wire 15+09 ℄ 23 ℄

Conc Fence

30 ℄

31

Conc Fence

36 ℄

37 ℄

32 ℄

Conc Fence

Conc Fence

Conc Fence

RETURN TO
LOS ANGELES COUNTY SURVEYOR
700 HALL OF RECORDS

Note: Any Additions or Changes on This Sheet Must be Made or Circled in Red Ink With Date and Name of Person Making Change.

Do not extend notes this side of this line.

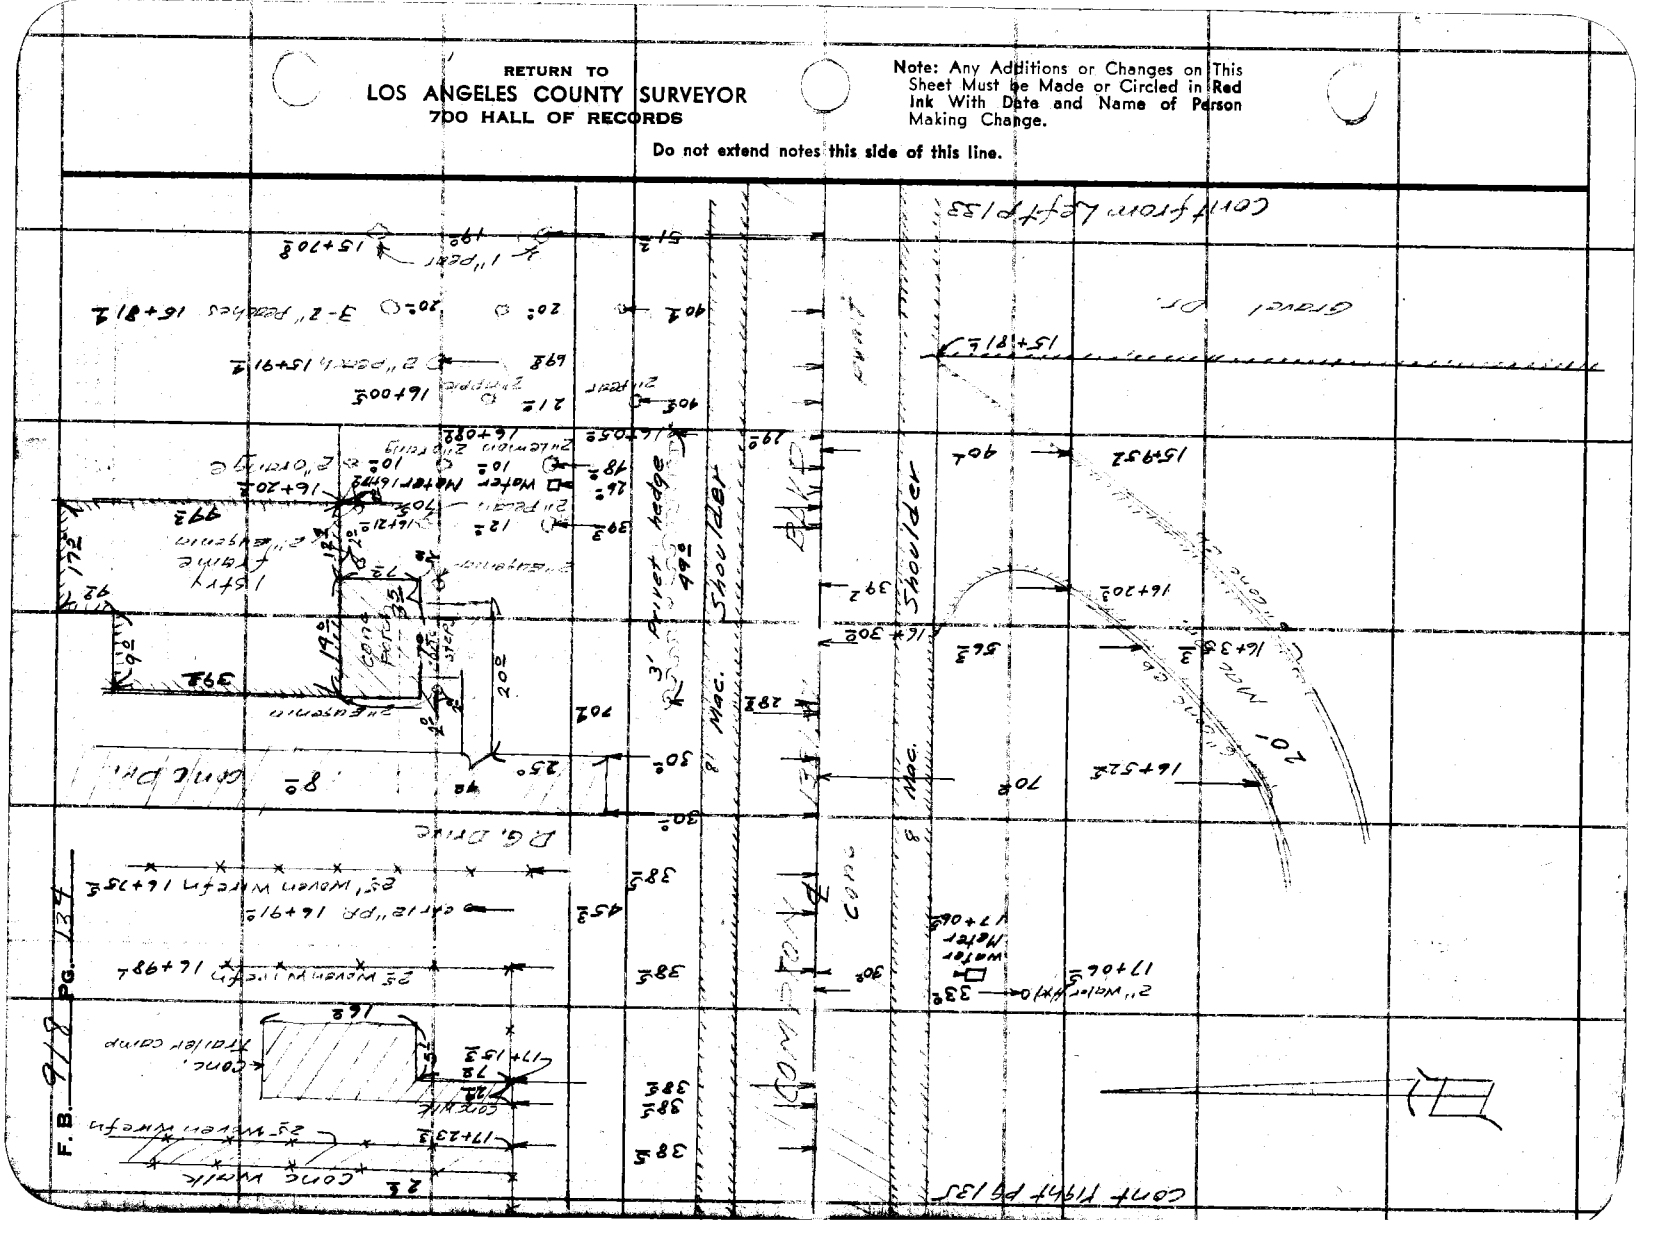
F.B. 918 PG. 134
Cont. Right PG 135
Cont. from Left PG 133
Gravel Dr.
Shoulder
Mac.
Mac.
Mac.

FORM 247 5M 5-46

RETURN TO
LOS ANGELES COUNTY SURVEYOR
700 HALL OF RECORDS

Note: Any Additions or Changes on This Sheet Must be Made or Circled in Red Ink With Date and Name of Person Making Change.

Do not extend notes this side of this line.

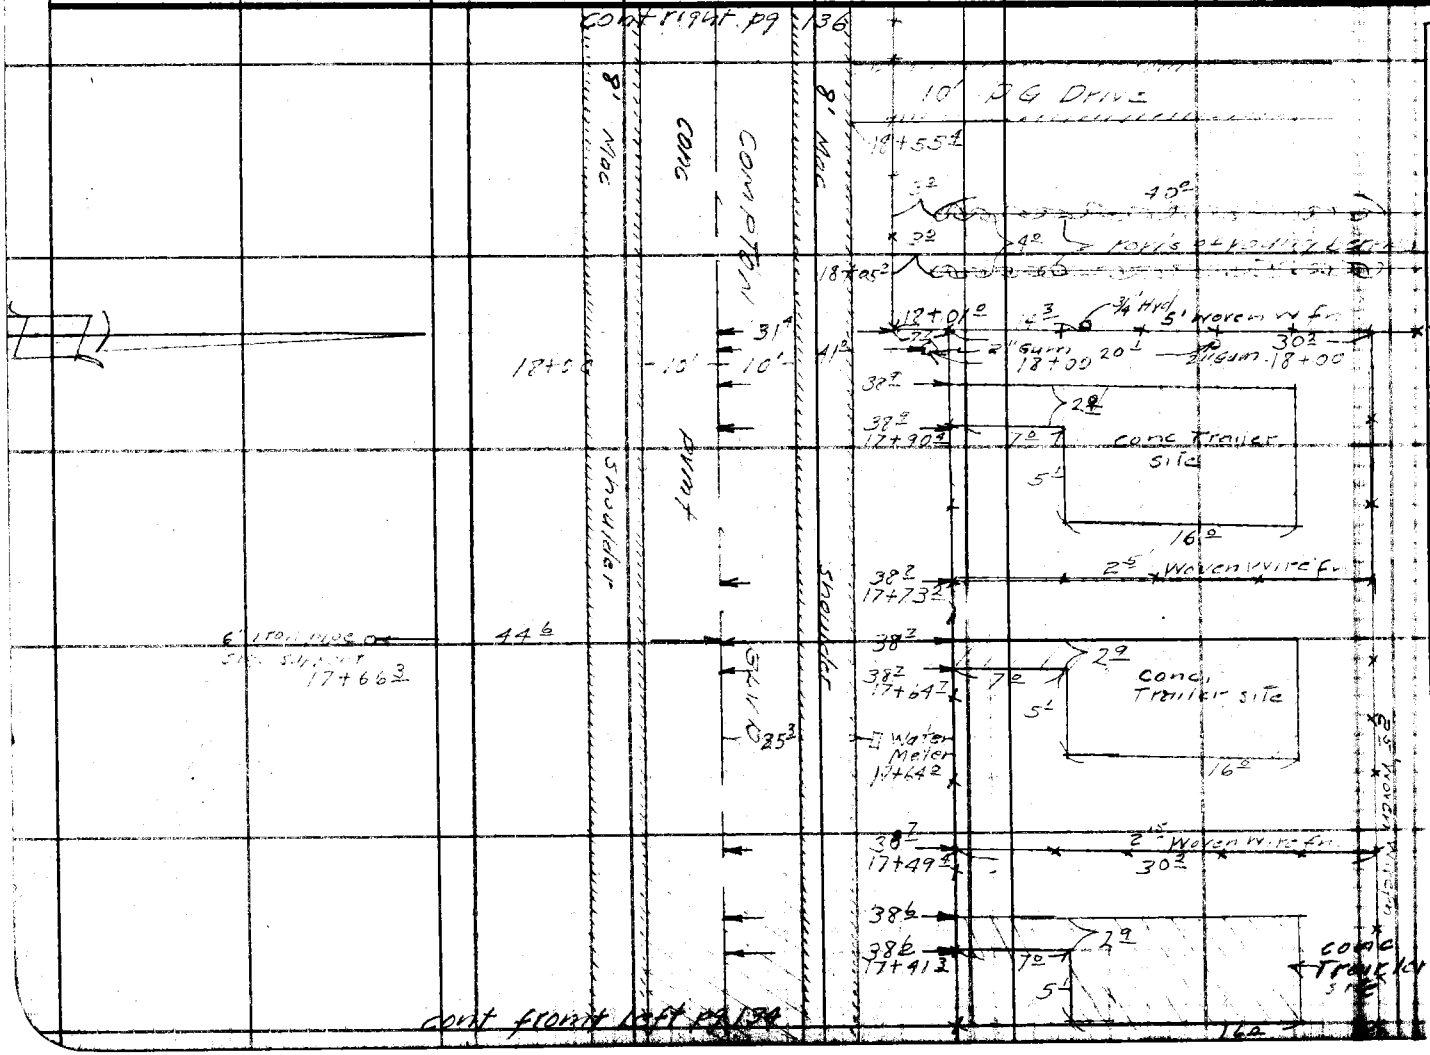

Notes Ck'd by D. M. Finley
Map No. B-1944-2
Office Work
Checked D. M. Finley
Date 4/16 '51

Survey of
W. O. 8345 Tape No. Std. °F
Surveyed by R. E. Miller
Notes Kelly Pete Date 2-42
Indexed C. Johnson

F. B. 1919 PG. 125

RETURN TO
LOS ANGELES COUNTY SURVEYOR
7DO HALL OF RECORDS

Note: Any Additions or Changes on This Sheet Must be Made or Circled in Red Ink With Date and Name of Person Making Change.

Do not extend notes this side of this line.

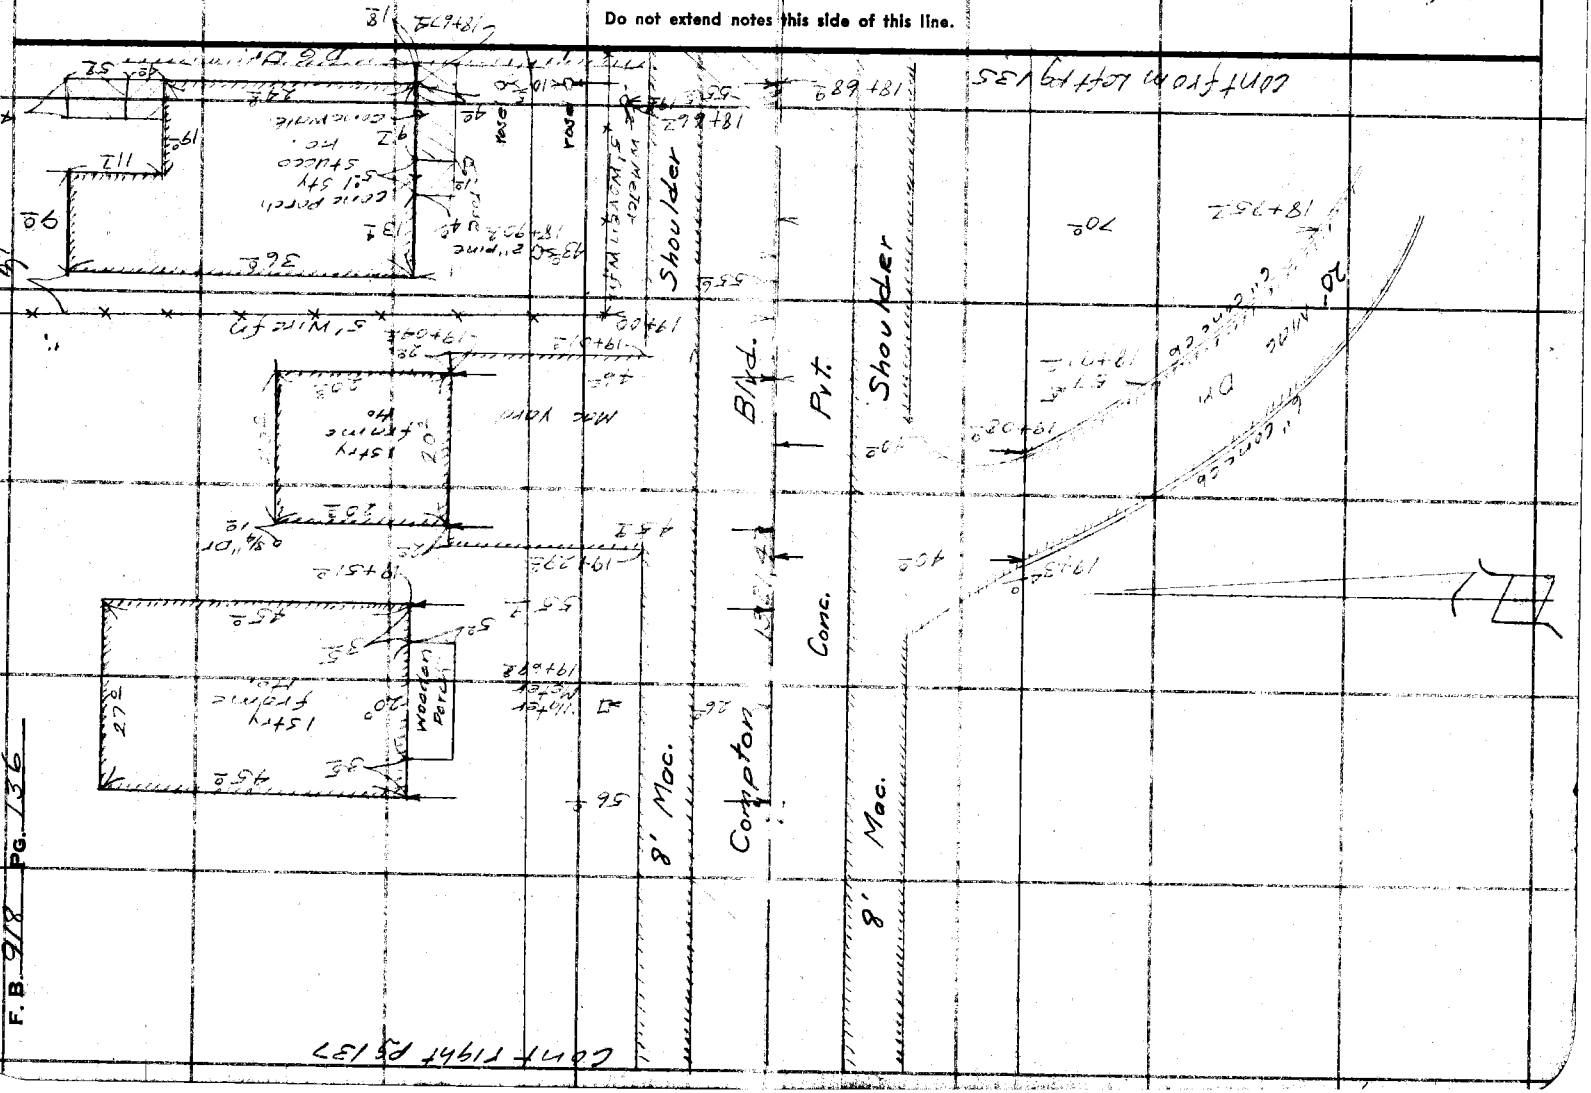

F.B. 918 Pg. 136

FORM 247 5M 5-46

RETURN TO
LOS ANGELES COUNTY SURVEYOR
700 HALL OF RECORDS

Note: Any Additions or Changes on This Sheet Must Be Made or Circled in Red Ink With Date and Name of Person Making Change.

Do not extend notes this side of this line.

Notes Ck'd by D. M. Finley
Map No. 3-1942-2
Office Work Clerk
Checked D. M. Finley
Date 5-51

Survey of W. O. 3345 Tape No. Std. F
Surveyed by
Notes
Date 2-42
Indexed C. Johnson


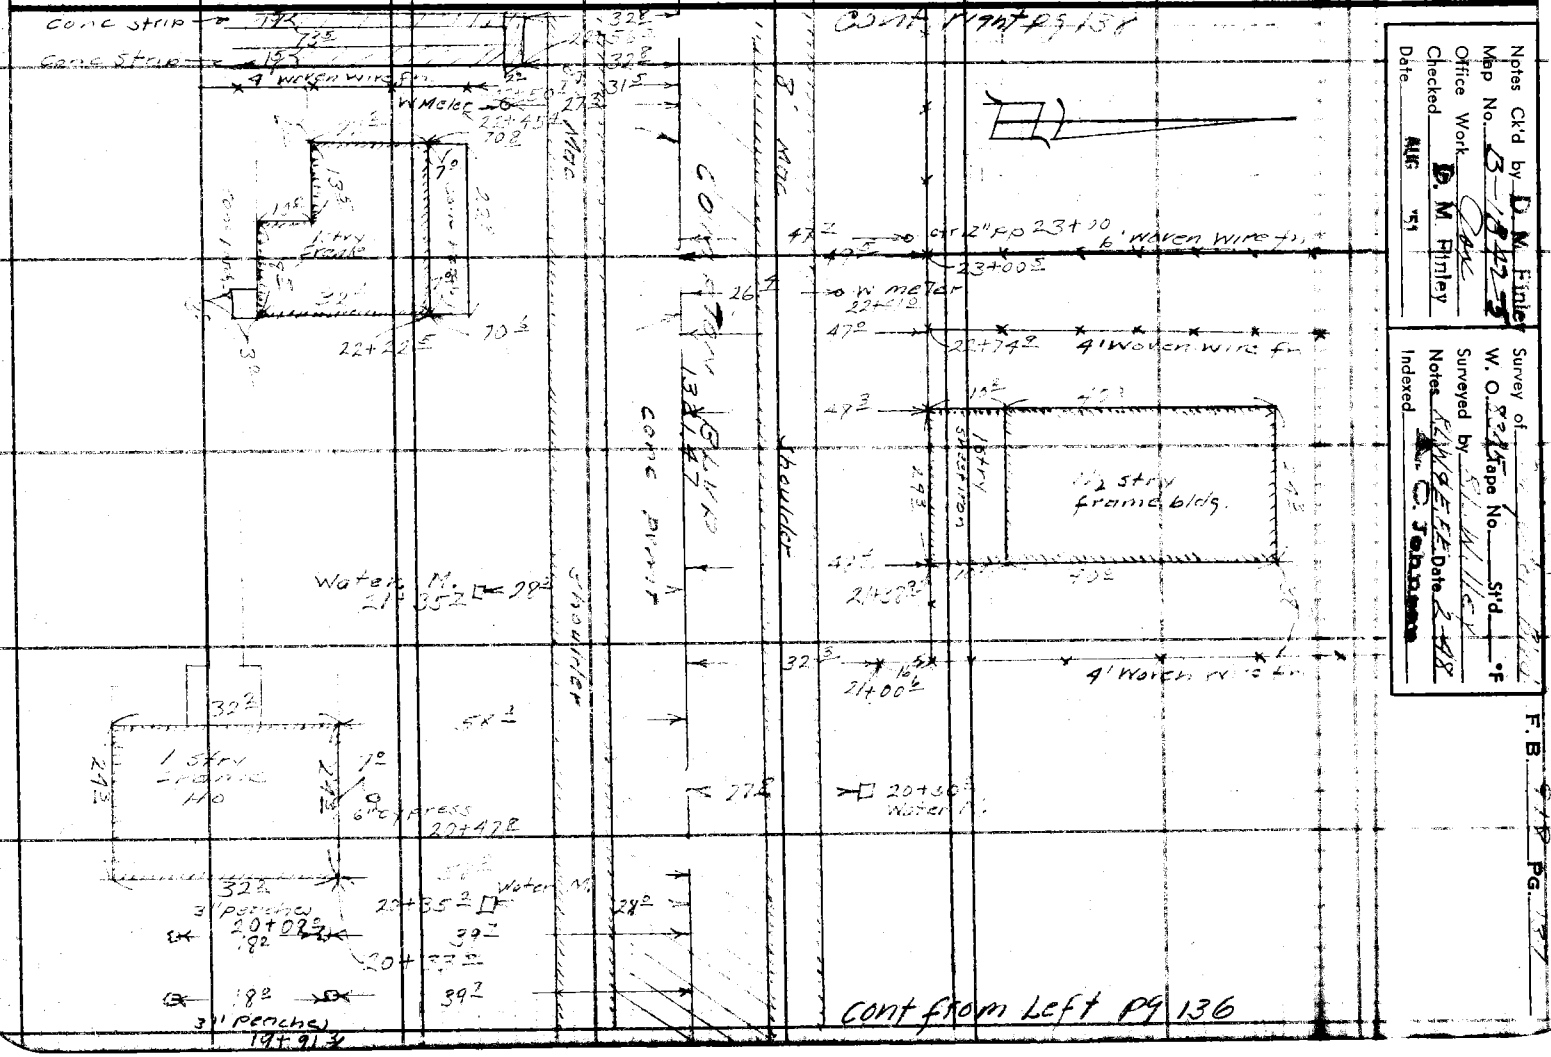

RETURN TO
LOS ANGELES COUNTY SURVEYOR
700 HALL OF RECORDS

Note: Any Additions or Changes on This Sheet Must be Made or Circled in Red Ink With Date and Name of Person Making Change.

Do not extend notes this side of this line.

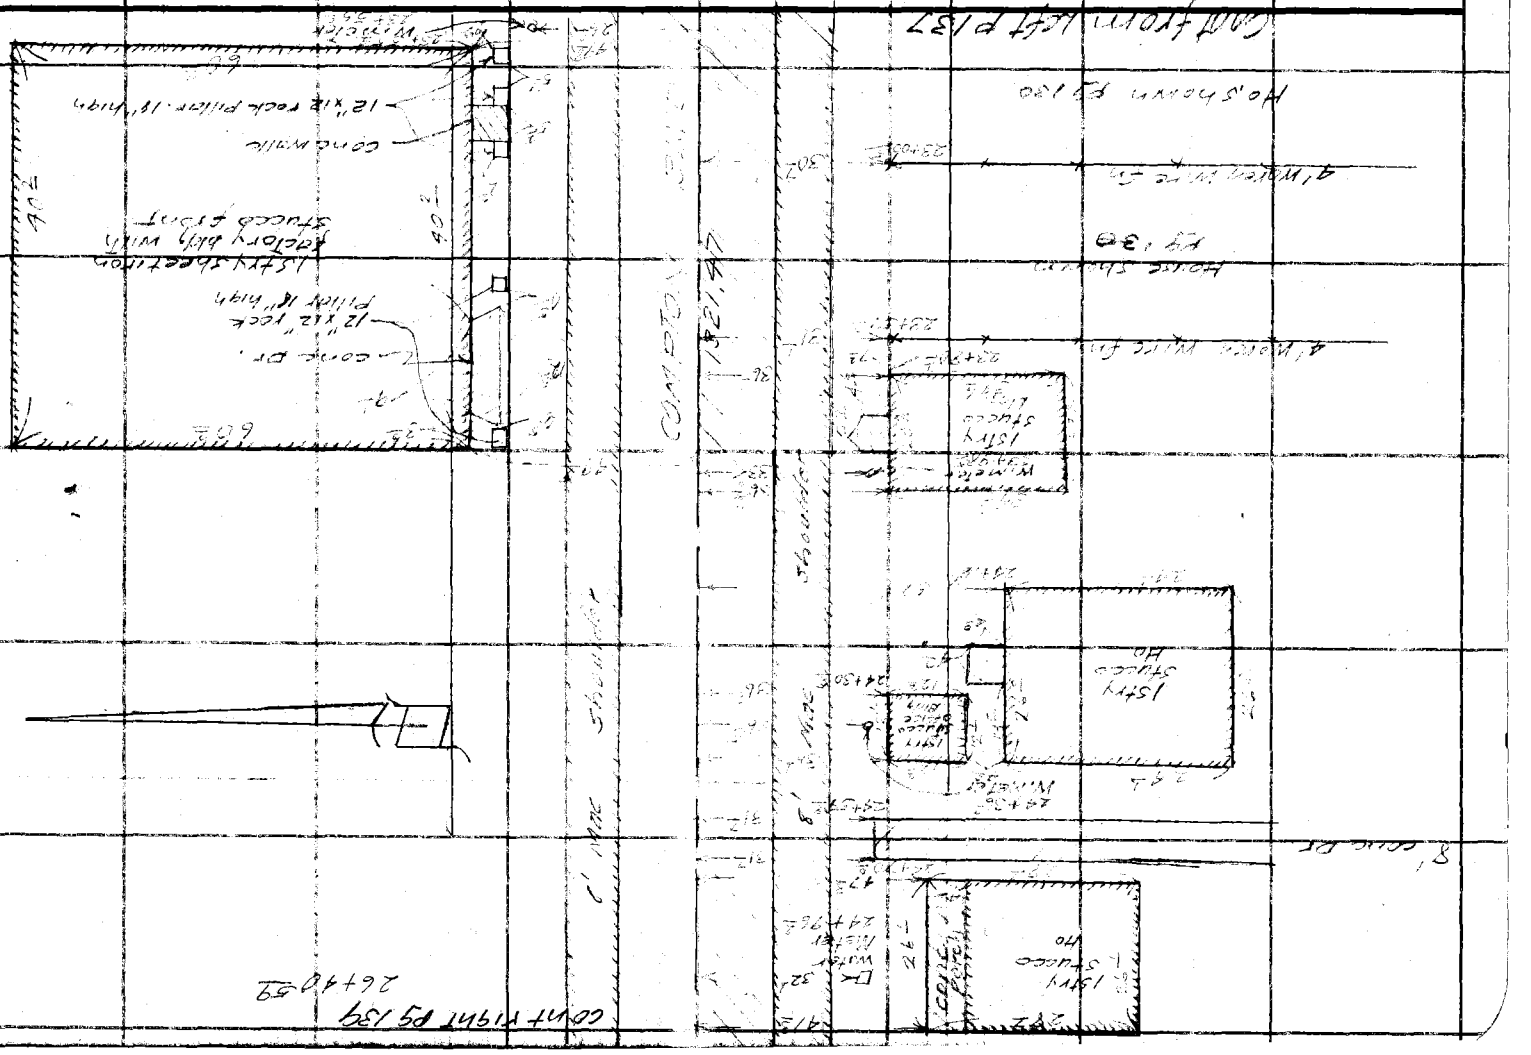

F. B. 918 PG. 38

FORM 247 5M 5-46

RETURN TO
LOS ANGELES COUNTY SURVEYOR
700 HALL OF RECORDS

Note: Any Additions or Changes on This Sheet Must be Made or Circled in Red Ink With Date and Name of Person Making Change.

Do not extend notes this side of this line.

cont right P 140

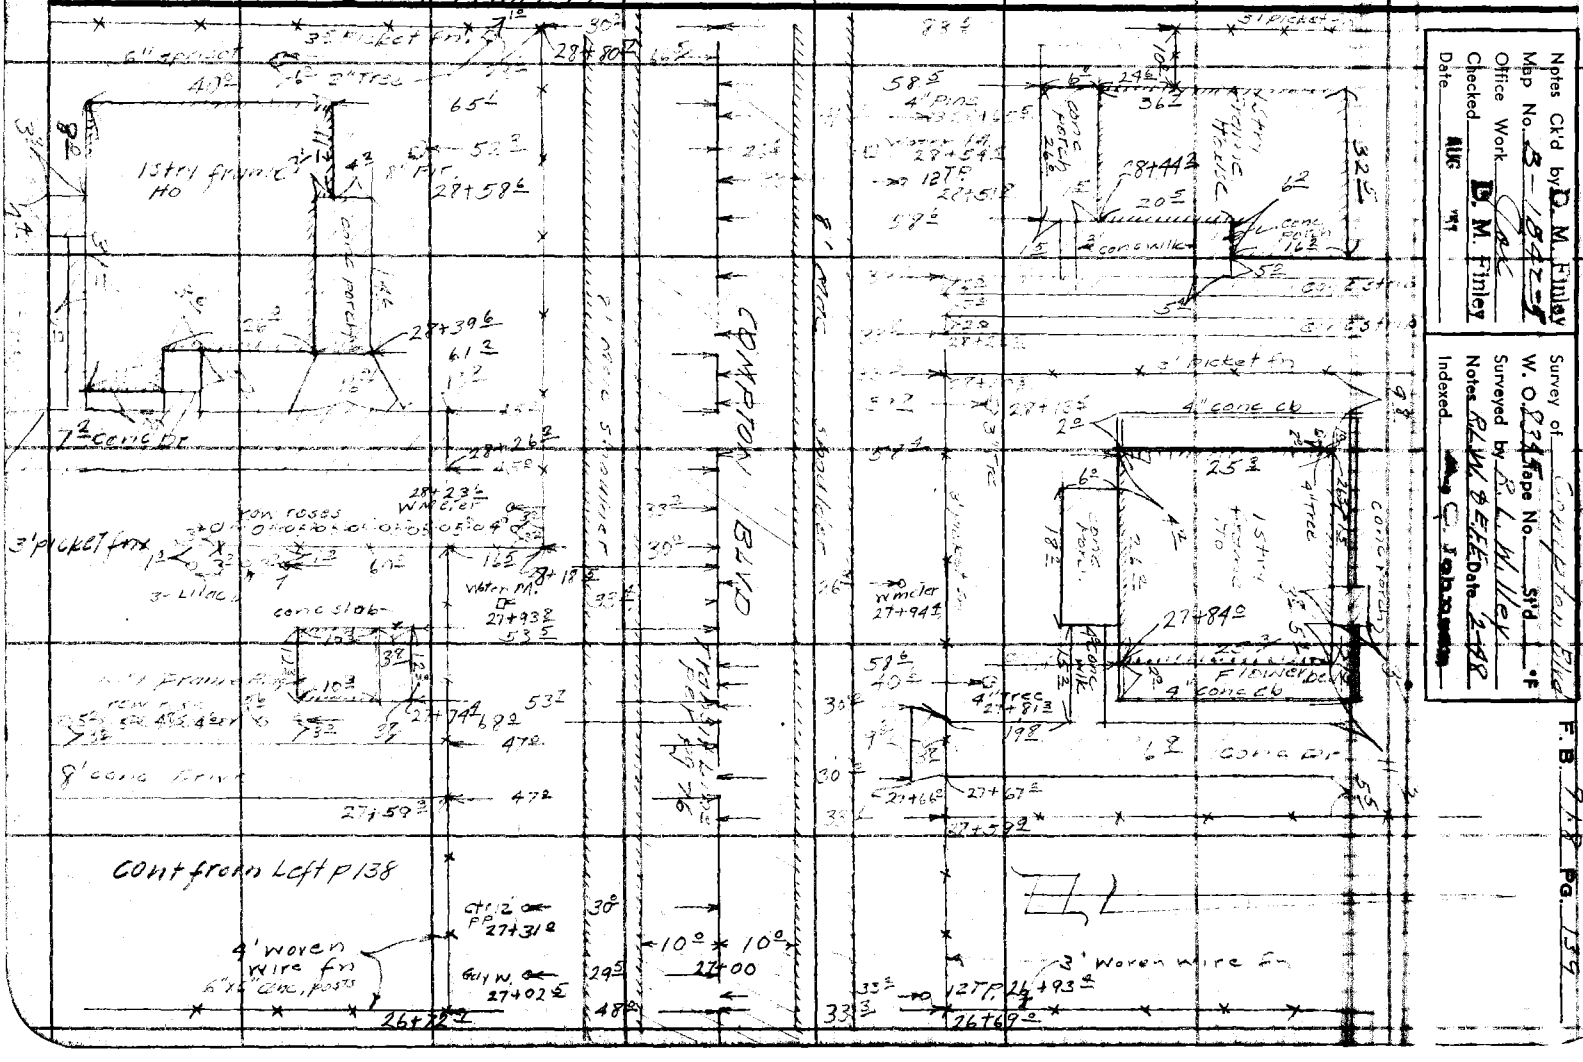

Notes Ck'd by D. M. Finley
Map No. 3-1542-F
Office Work
Checked D. M. Finley
Date

Survey of Compton Blvd
Surveyed by R. L. Wiley
Notes R.L.W. & E.E.E. Date 2-48
Indexed C. Johnson


RETURN TO
LOS ANGELES COUNTY SURVEYOR
700 HALL OF RECORDS

Note: Any Additions or Changes on This Sheet Must be Made or Circled in Red Ink With Date and Name of Person Making Change.

Do not extend notes this side of this line.

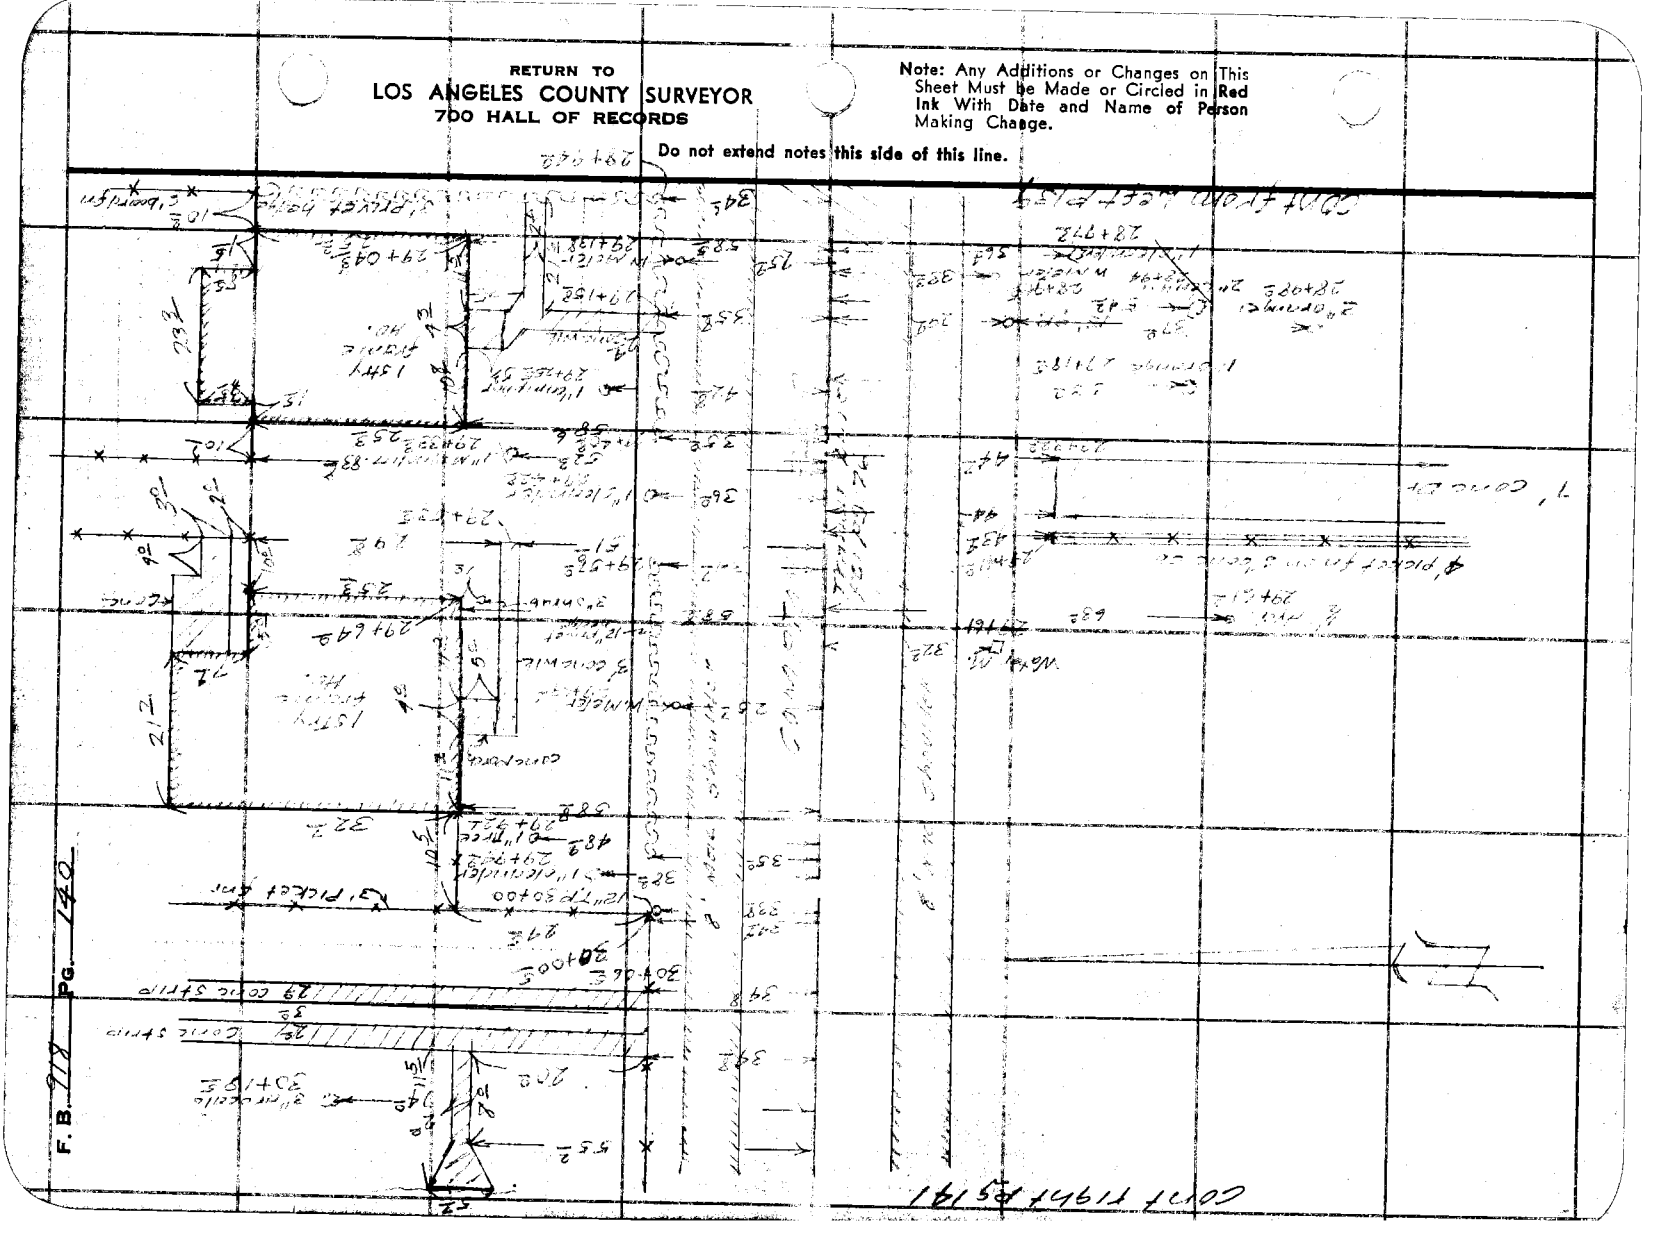


FORM 247 5M 5-46

RETURN TO
LOS ANGELES COUNTY SURVEYOR
700 HALL OF RECORDS

Note: Any Additions or Changes on This Sheet Must be Made or Circled in Red Ink With Date and Name of Person Making Change.

Do not extend notes this side of this line.

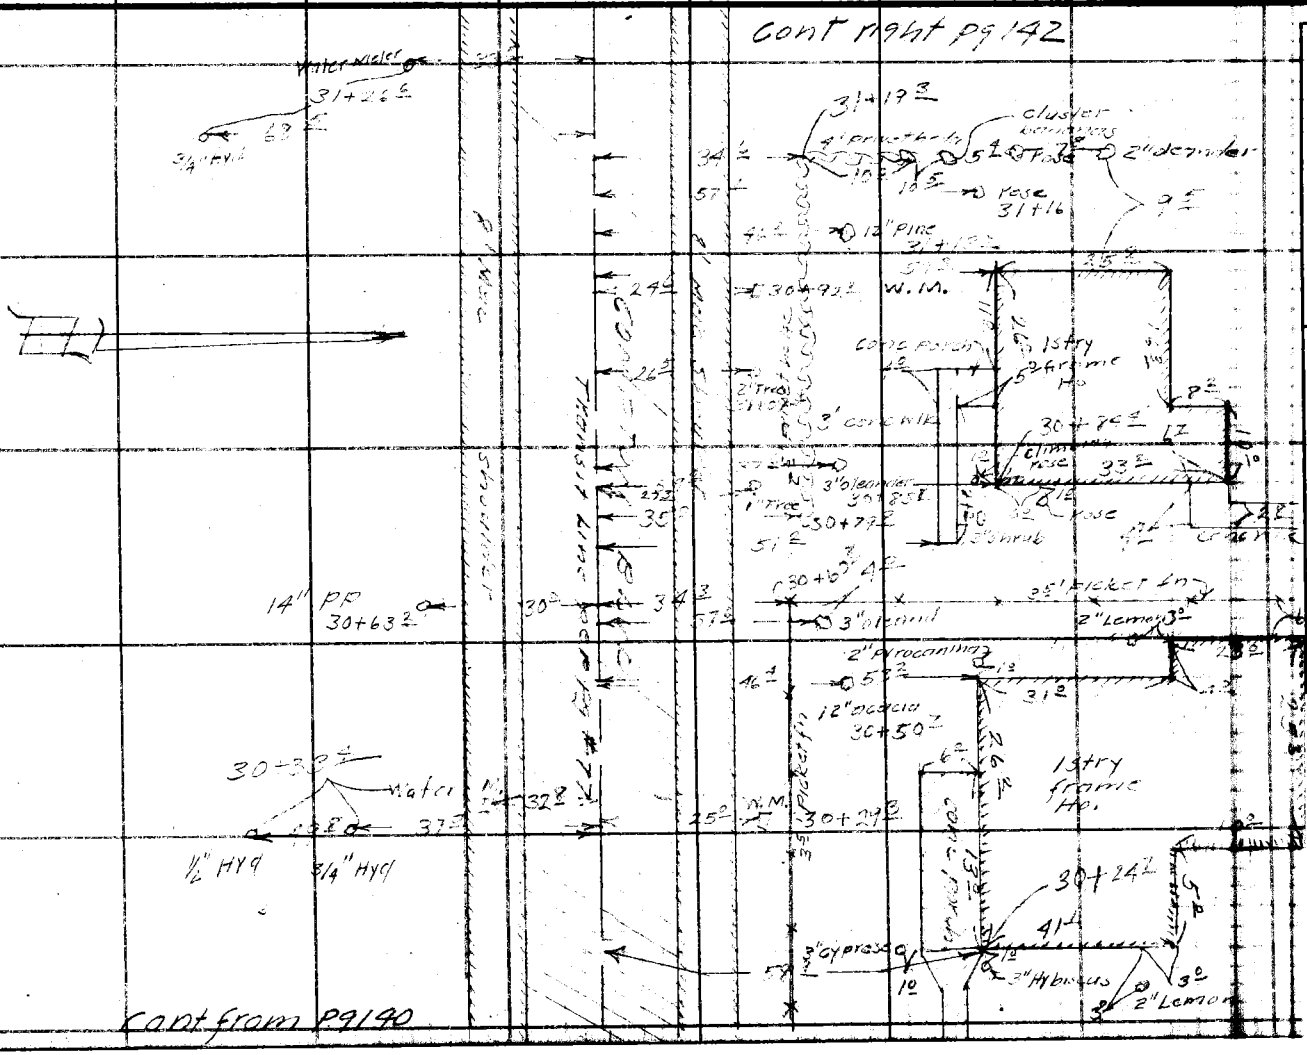

Notes Ck'd by D. M. Finley
Map No. 3-8427
Office Work Ck'd
Checked D. M. Finley
Date AUG '51

Survey of Compton Area
W. O. 8234 Tape No. Std °F
Surveyed by F. L. Wiley Date 12-48
Notes
Indexed C. Johnson

F.B. 214 PG. 137

RETURN TO
LOS ANGELES COUNTY SURVEYOR
700 HALL OF RECORDS

Note: Any Additions or Changes on This Sheet Must be Made or Circled in Red Ink With Date and Name of Person Making Change.

Do not extend notes this side of this line.

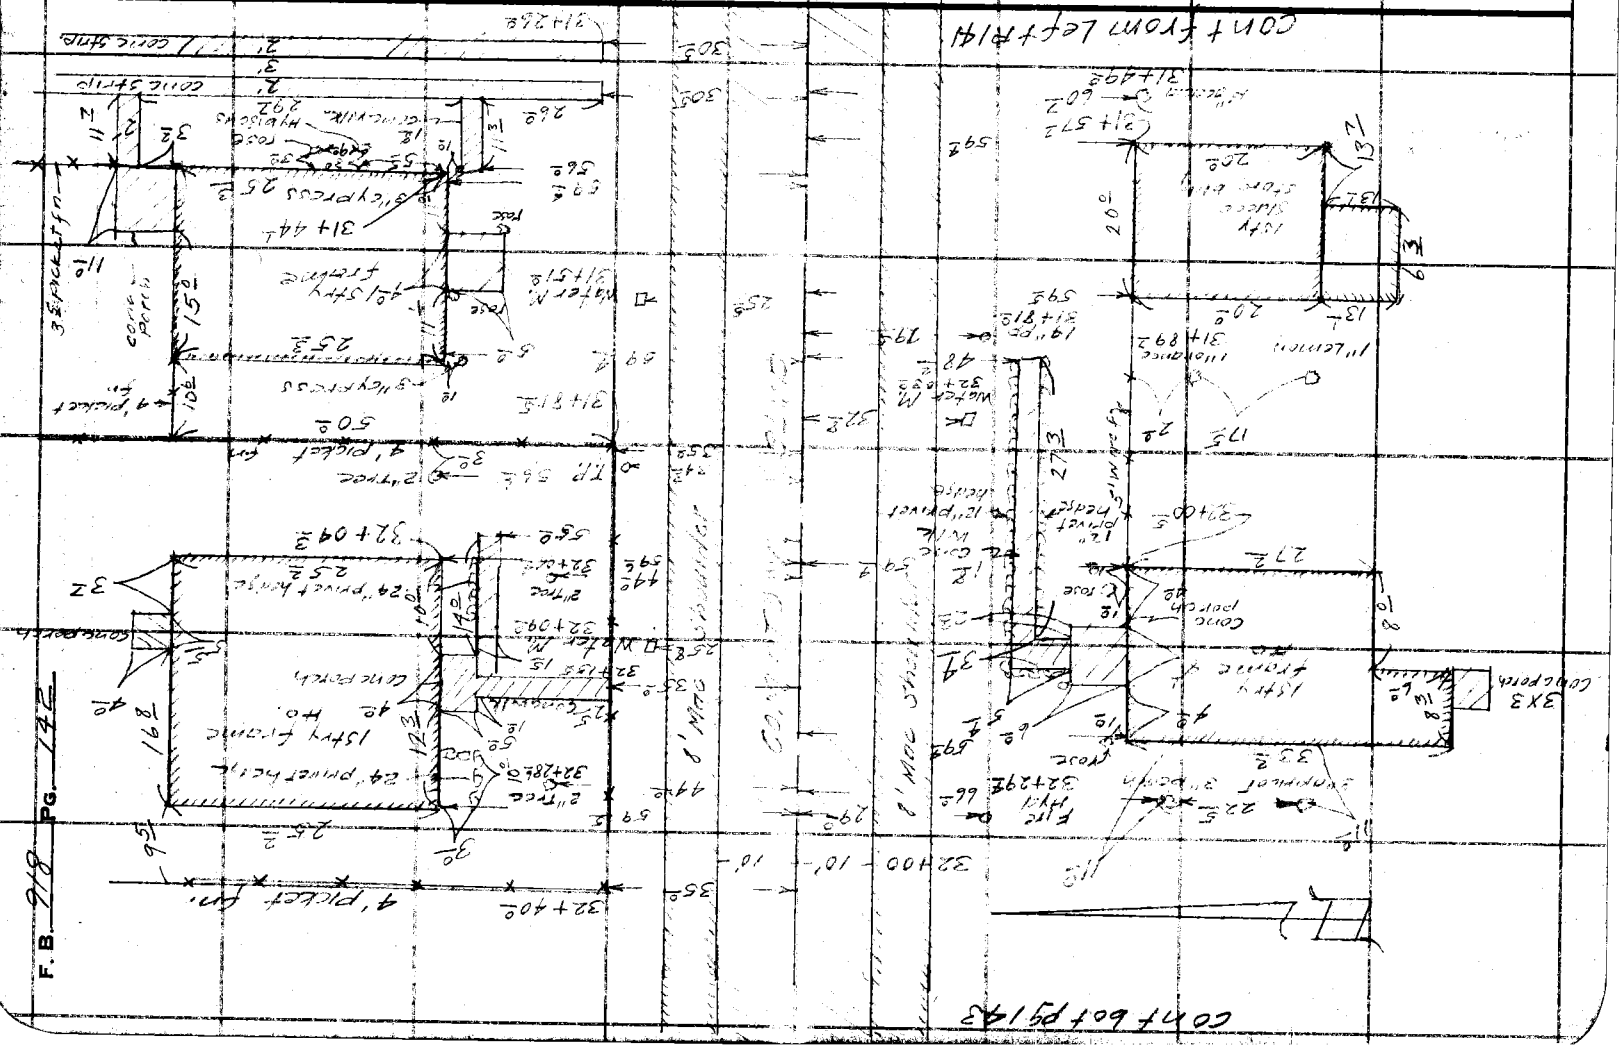

Notes Ck'd by D. M. Finley
Map No. 5-1842-5
Office Work Clear
Checked D. M. Finley
Date AUG '51

Survey of Compton Blvd.
W. O. 2395 Tape No. St'd °F
Surveyed by R.L. Willey
Notes R.L. W. & E.F.E Date 2-48
Indexed C. Johnson

F. B. 918 Pg. 142

Compton Pg 144

Note: Any Additions or Changes on This Sheet Must be Made or Circled in Red Ink With Date and Name of Person Making Change.

Do not extend notes this side of this line.

RETURN TO
LOS ANGELES COUNTY SURVEYOR
700 HALL OF RECORDS

FORM 247 SM 11-46

COMPTON BLVD

OPEN FIELD

2 strand barb wire fnc

Mac shoulder

Mac curb

Mac curb & gutter

Mac sidewalk

34+00

10'

10'

26°

35.1

35.4

34+08.1 3' woven wire fn

11.8

9.8

9.2

59.8

25°

10'

Water M

33+72.0

15 sty frame Res.

conc porch

conc slab

33+81.7

59.8

35°

33+69.8

33+60.0

4' picket fn.

94

rose

1" bridge

25

75

10.1

95

14.5

conc obs. Dia = 3'

59.2

35.1

33.3

99

15 sty frame Res.

4x4

16.9

4'

conc porch

33+21.2

water

33+26.7

25

15 sty frame 8'

34.2

26°

12" PP

33+17.4

2.9

5.0

1.0

59.1

conc curb

25.3

33+10.3

13.4

6.2

25

15" PP

33+33.2

1.9.2

39.2

33+19.2

35.5

24" Elm

100

rose

20.3

brick ob.

33+18.1

33+01.7

18.2

R=35.0

40.0

11.5

23.5

12" PP

Conv wire

31+90.3

32+26.31

32+80.0

58.1

INDIANA AVE

KLONDIKE AVE

Mac surf

506

58.3

32+59.3

R=35.0

32+32.8

18.9

Cont from Left Pg 142

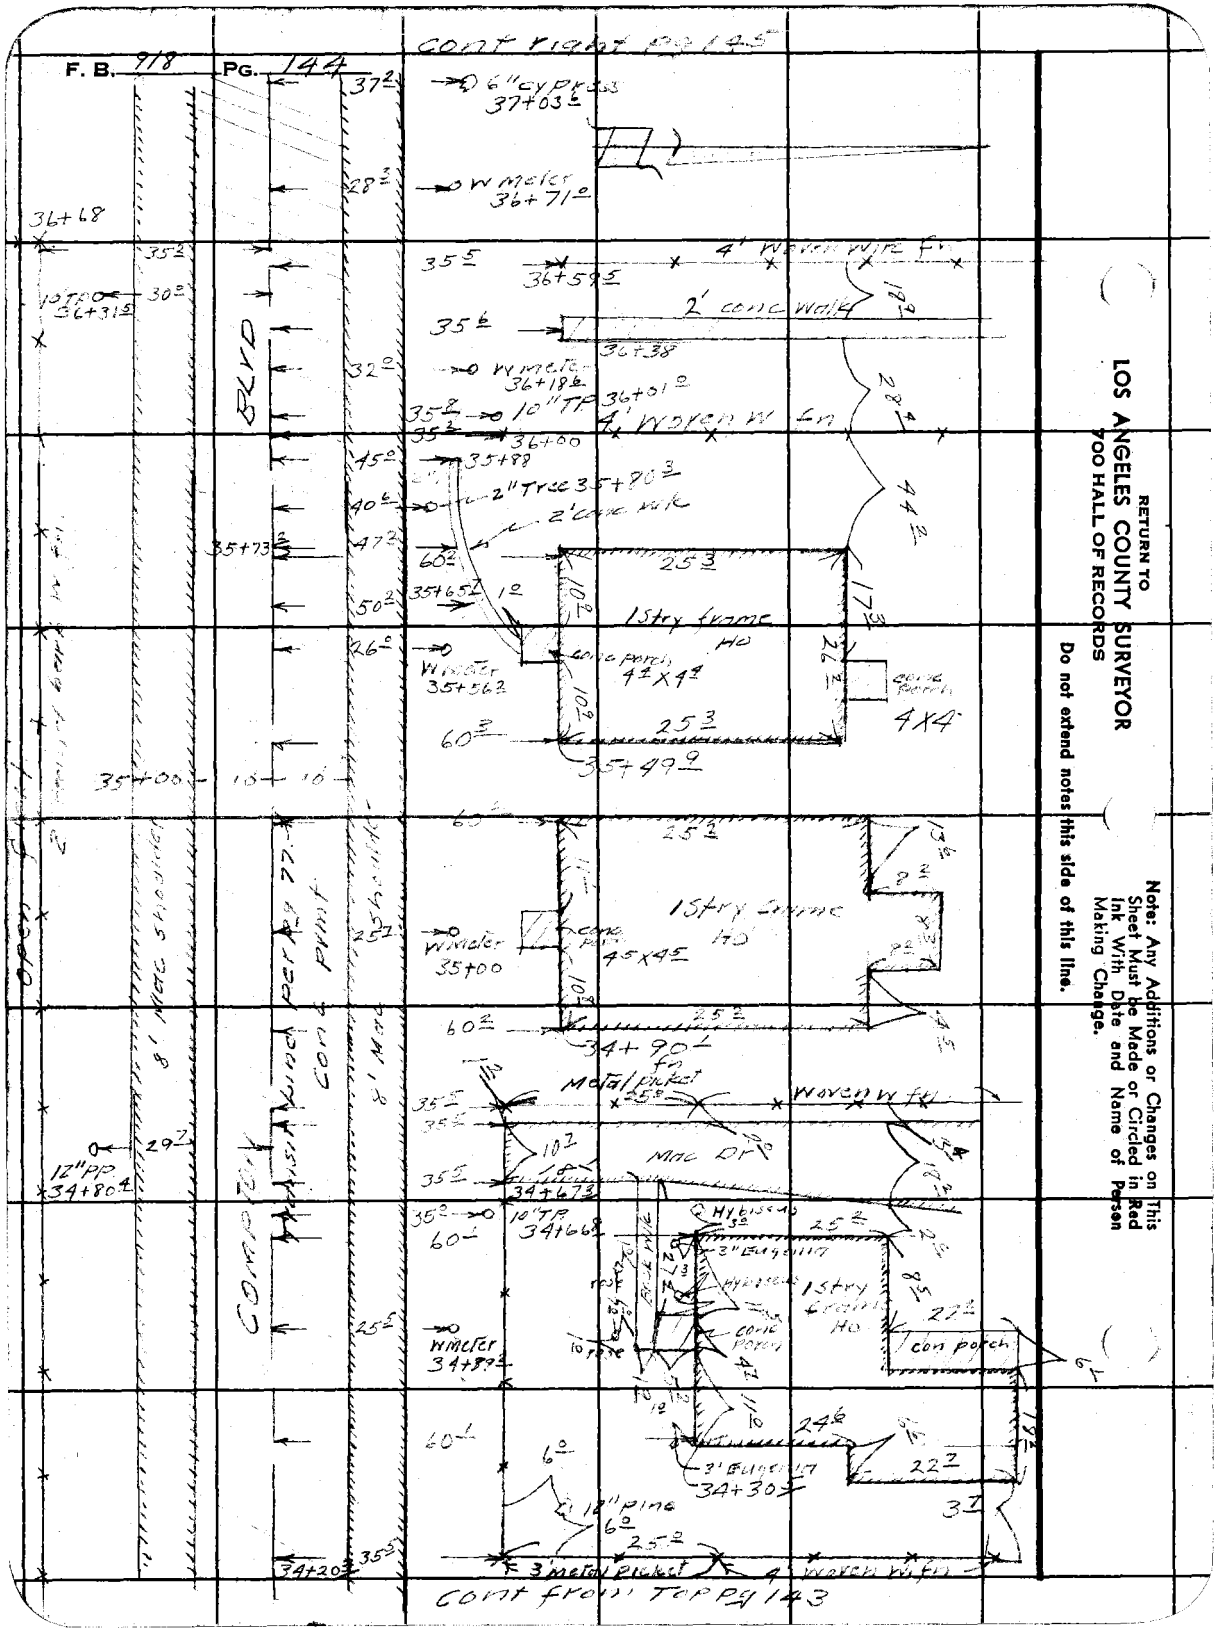
F. B. 918 PG. 144
cont from pg 145
6" cypress
37+03
W meter
36+71
36+68
4' Woven Wire Fn
35+59
2' conc walk
36+38
W meter
36+18
10" TP
36+01
4' Woven Wire Fn
36+00
35+88
2" Tree 35+80
2' Conc Walk
25
1 Story frame
Ho
Conc porch
4X4
W meter
35+56
35+49
25
1 Story frame
Ho
45X45
W meter
35+00
34+90
Metal picket Fn
Woven W Fn
Mac Dr
34+67
10" TP
34+66
1 Story frame
Ho
Conc porch
W meter
34+89
Conc porch
12" PP
34+80
3' Burglar Fn
34+30
12" pine
3 metal picket
4' woven wire fn
cont from top pg 143
BLVD

FORM 247 SM 11-46

RETURN TO
LOS ANGELES COUNTY SURVEYOR
700 HALL OF RECORDS

Note: Any Additions or Changes on This Sheet Must Be Made or Circled in Red Ink With Date and Name of Person Making Change.

Do not extend notes this side of this line.

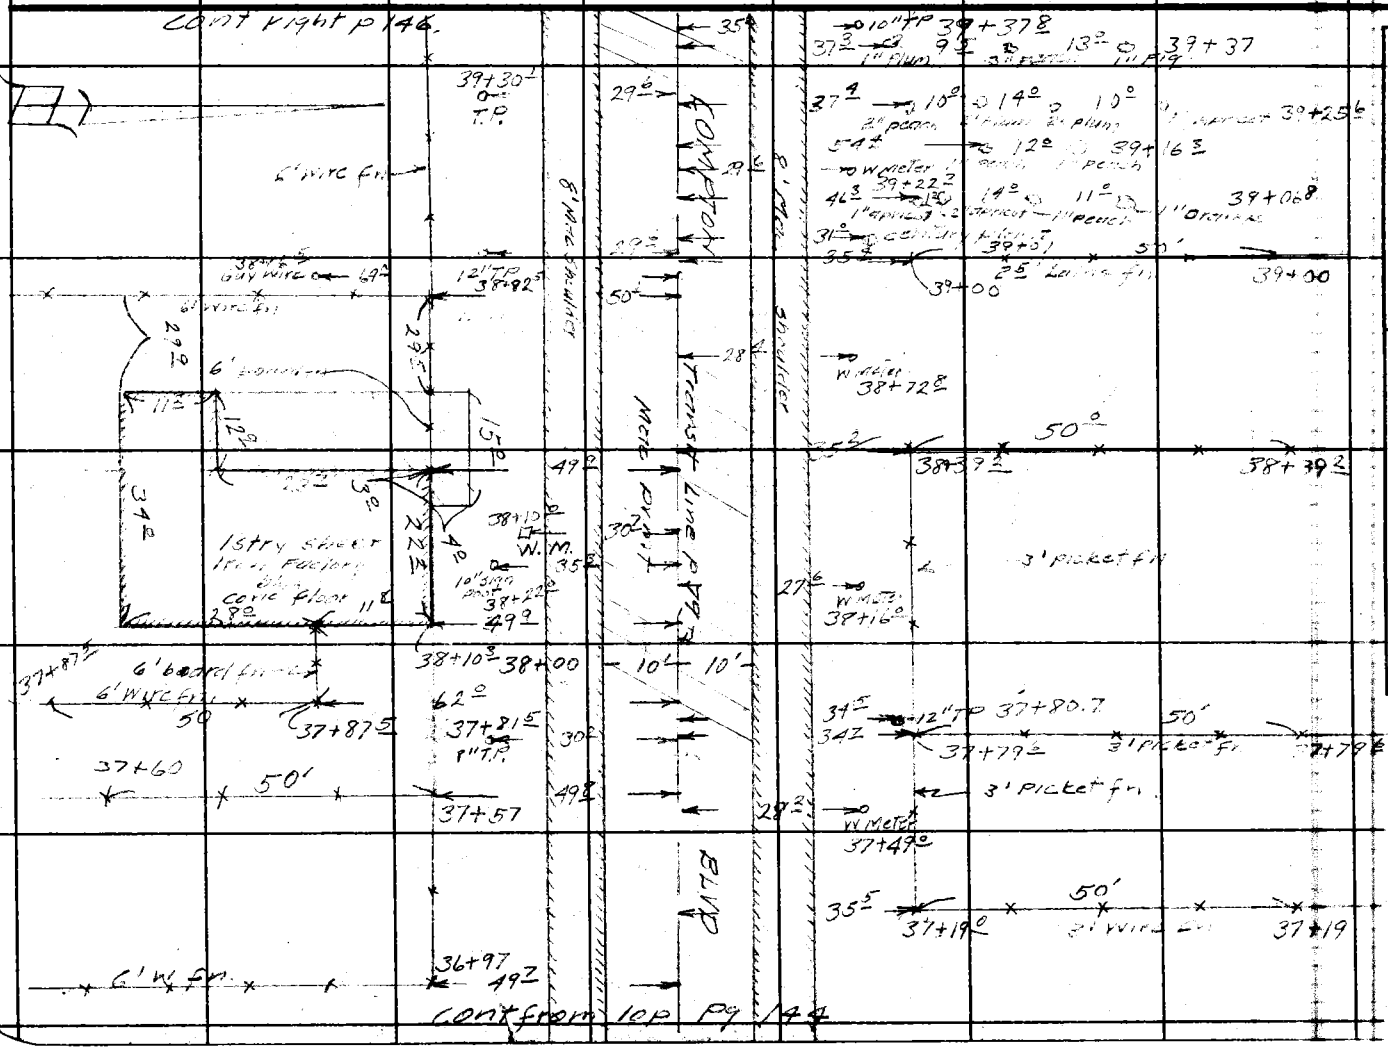

Notes Ck'd by D. M. Finley
Map No. 3-18-22-5
Office Work
Checked D. M. Finley
Date AUG '51

Survey of
W. O. 3234 Tape No. S'd °F
Surveyed by R.L. Wiley
Notes R.L. Wiley Date 2-52
Indexed C. Johnson

F. B. 2YP PG. 12

RETURN TO
LOS ANGELES COUNTY SURVEYOR
700 HALL OF RECORDS

Note: Any Additions or Changes on This Sheet Must Be Made or Circled in Red Ink With Date and Name of Person Making Change.

Do not extend notes this side of this line.

F. B. 918 Pg. 146

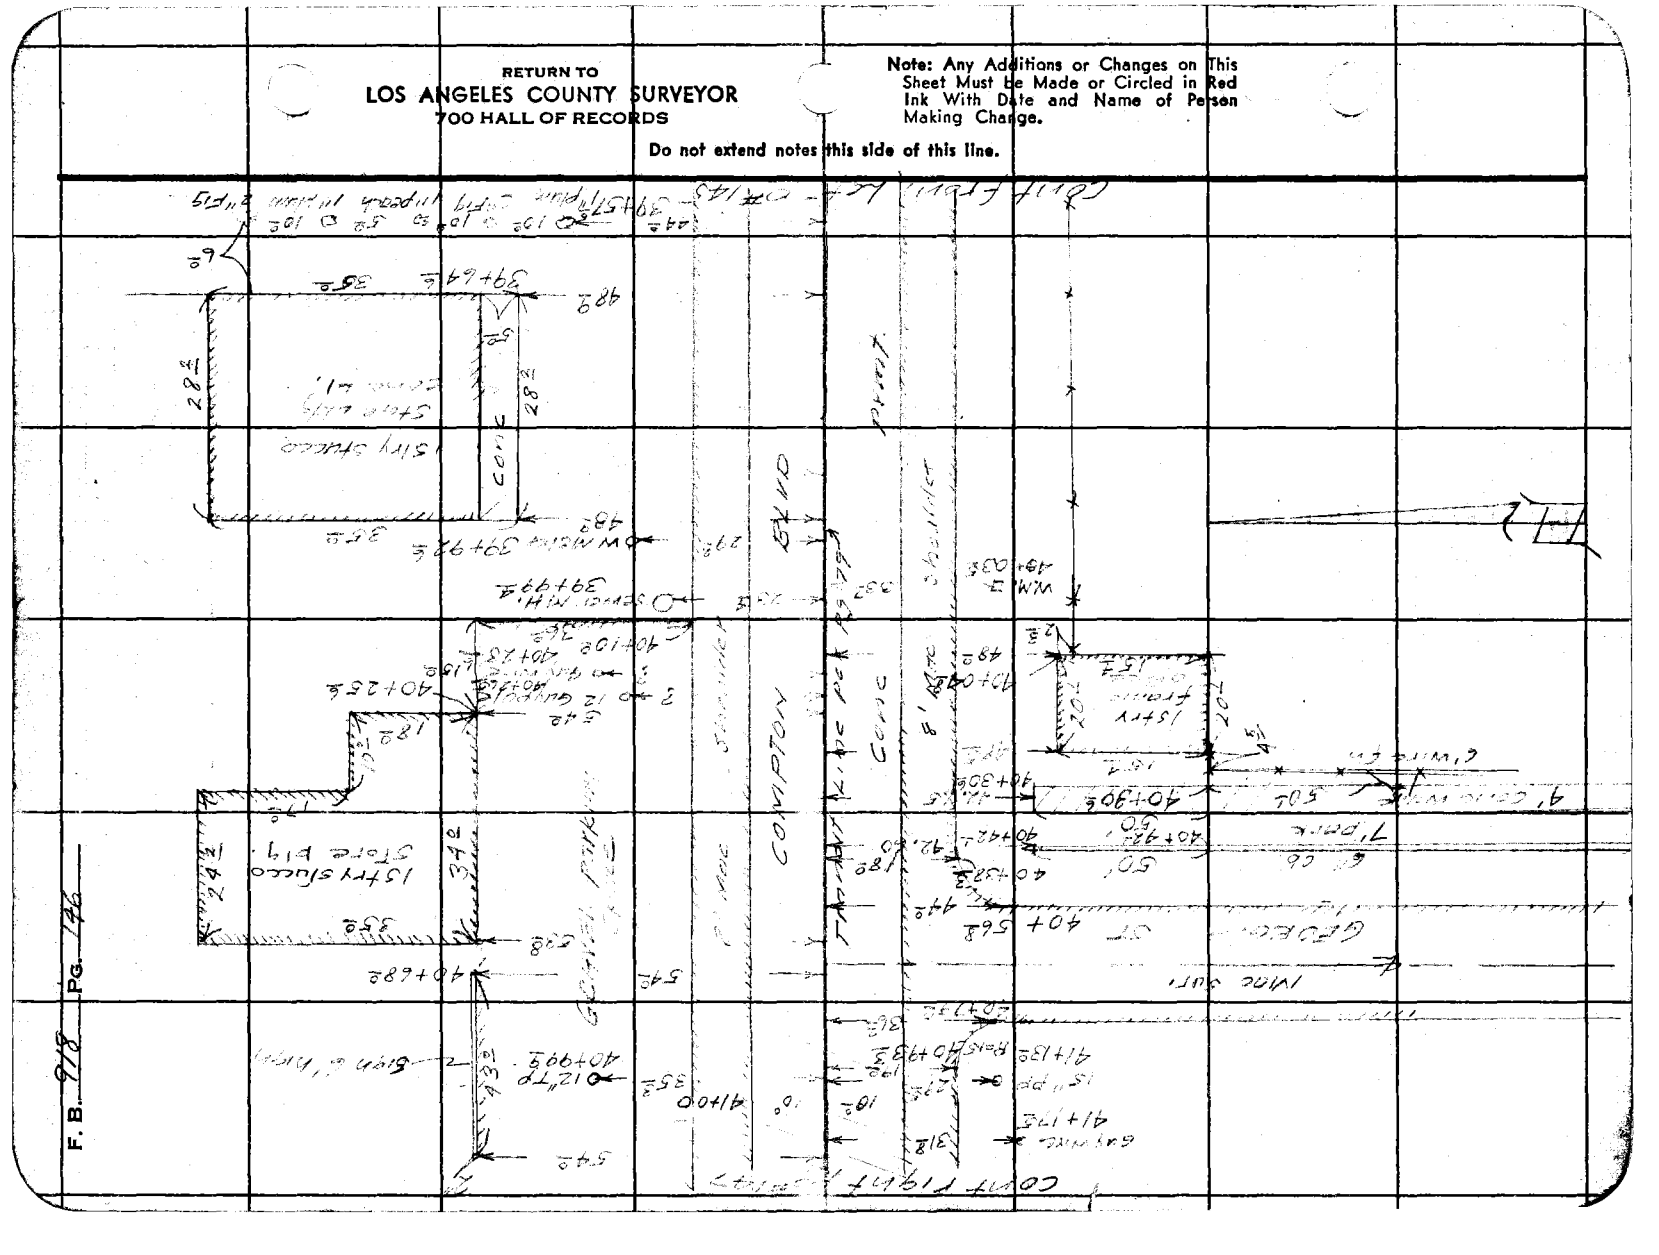
COMPTON
Stucco
Store Bldg.
Gravel Parking

FORM 247 5M 5-46

RETURN TO
LOS ANGELES COUNTY SURVEYOR
700 HALL OF RECORDS

Note: Any Additions or Changes on This Sheet Must be Made or Circled in Red Ink With Date and Name of Person Making Change.

Do not extend notes this side of this line.

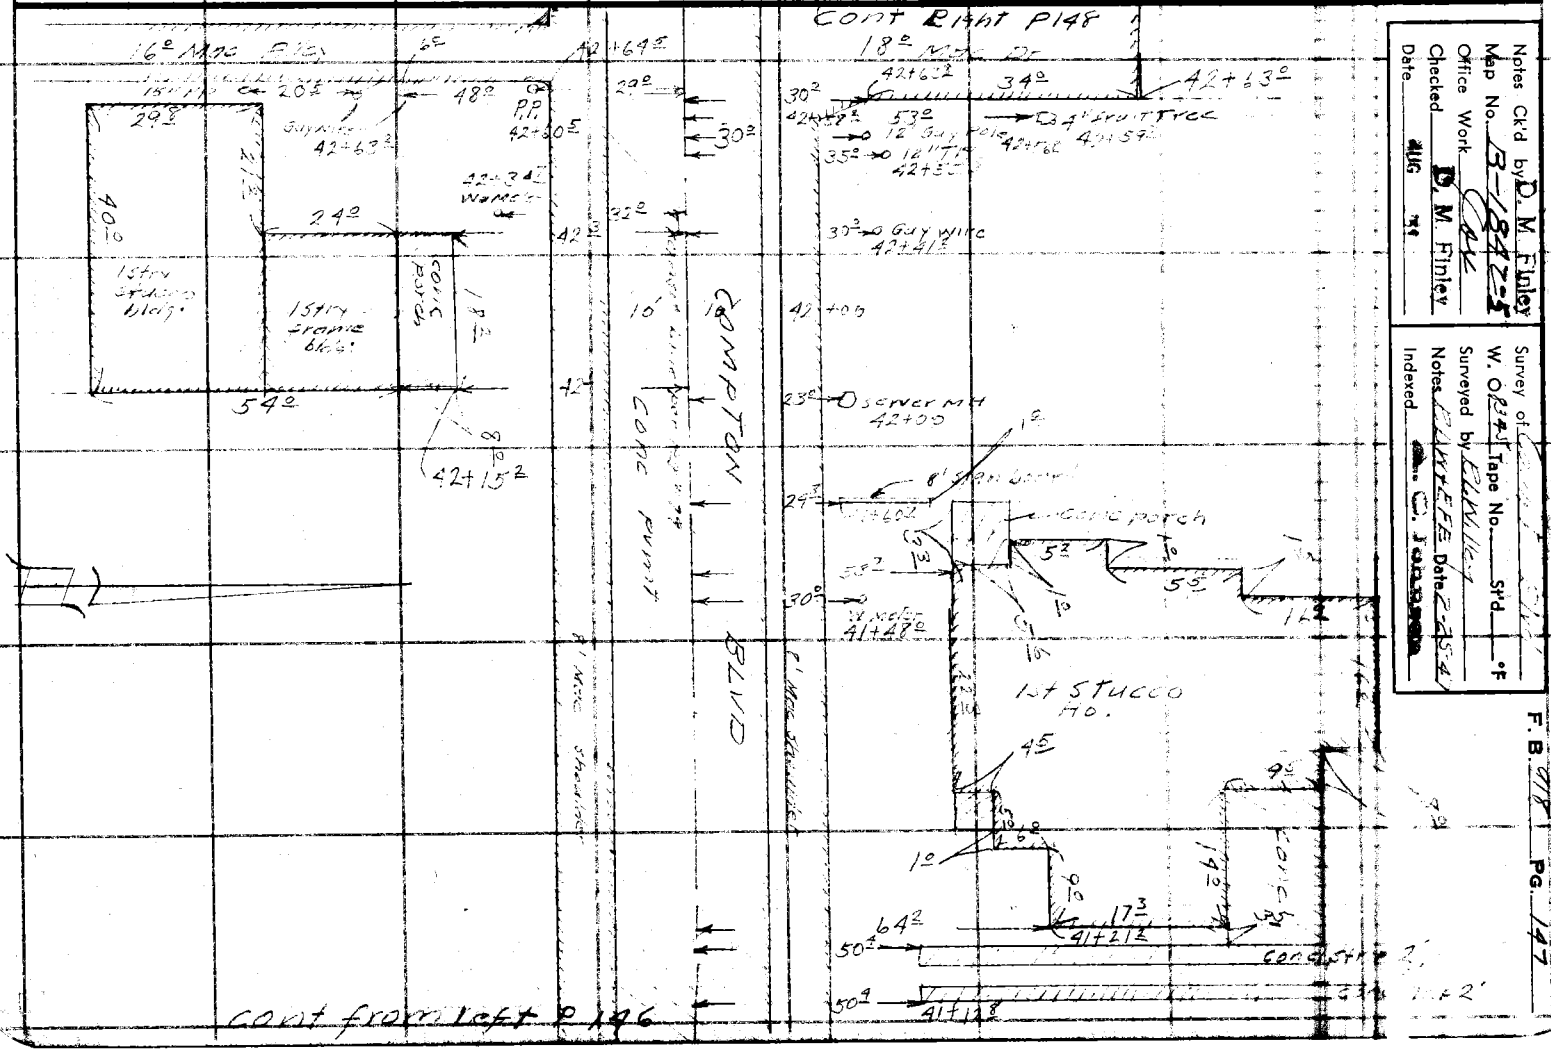

Notes Ck'd by D. M. Finley
Map No. B-1242-5
Office Work
Checked D. M. Finley
Date AUG 71

Survey of
W. O. 8341 Tape No. Std. °F
Surveyed by
Notes
Indexed


RETURN TO
LOS ANGELES COUNTY SURVEYOR
700 HALL OF RECORDS

Note: Any Additions or Changes on This Sheet Must be Made or Circled in Red Ink With Date and Name of Person Making Change.

Do not extend notes this side of this line.

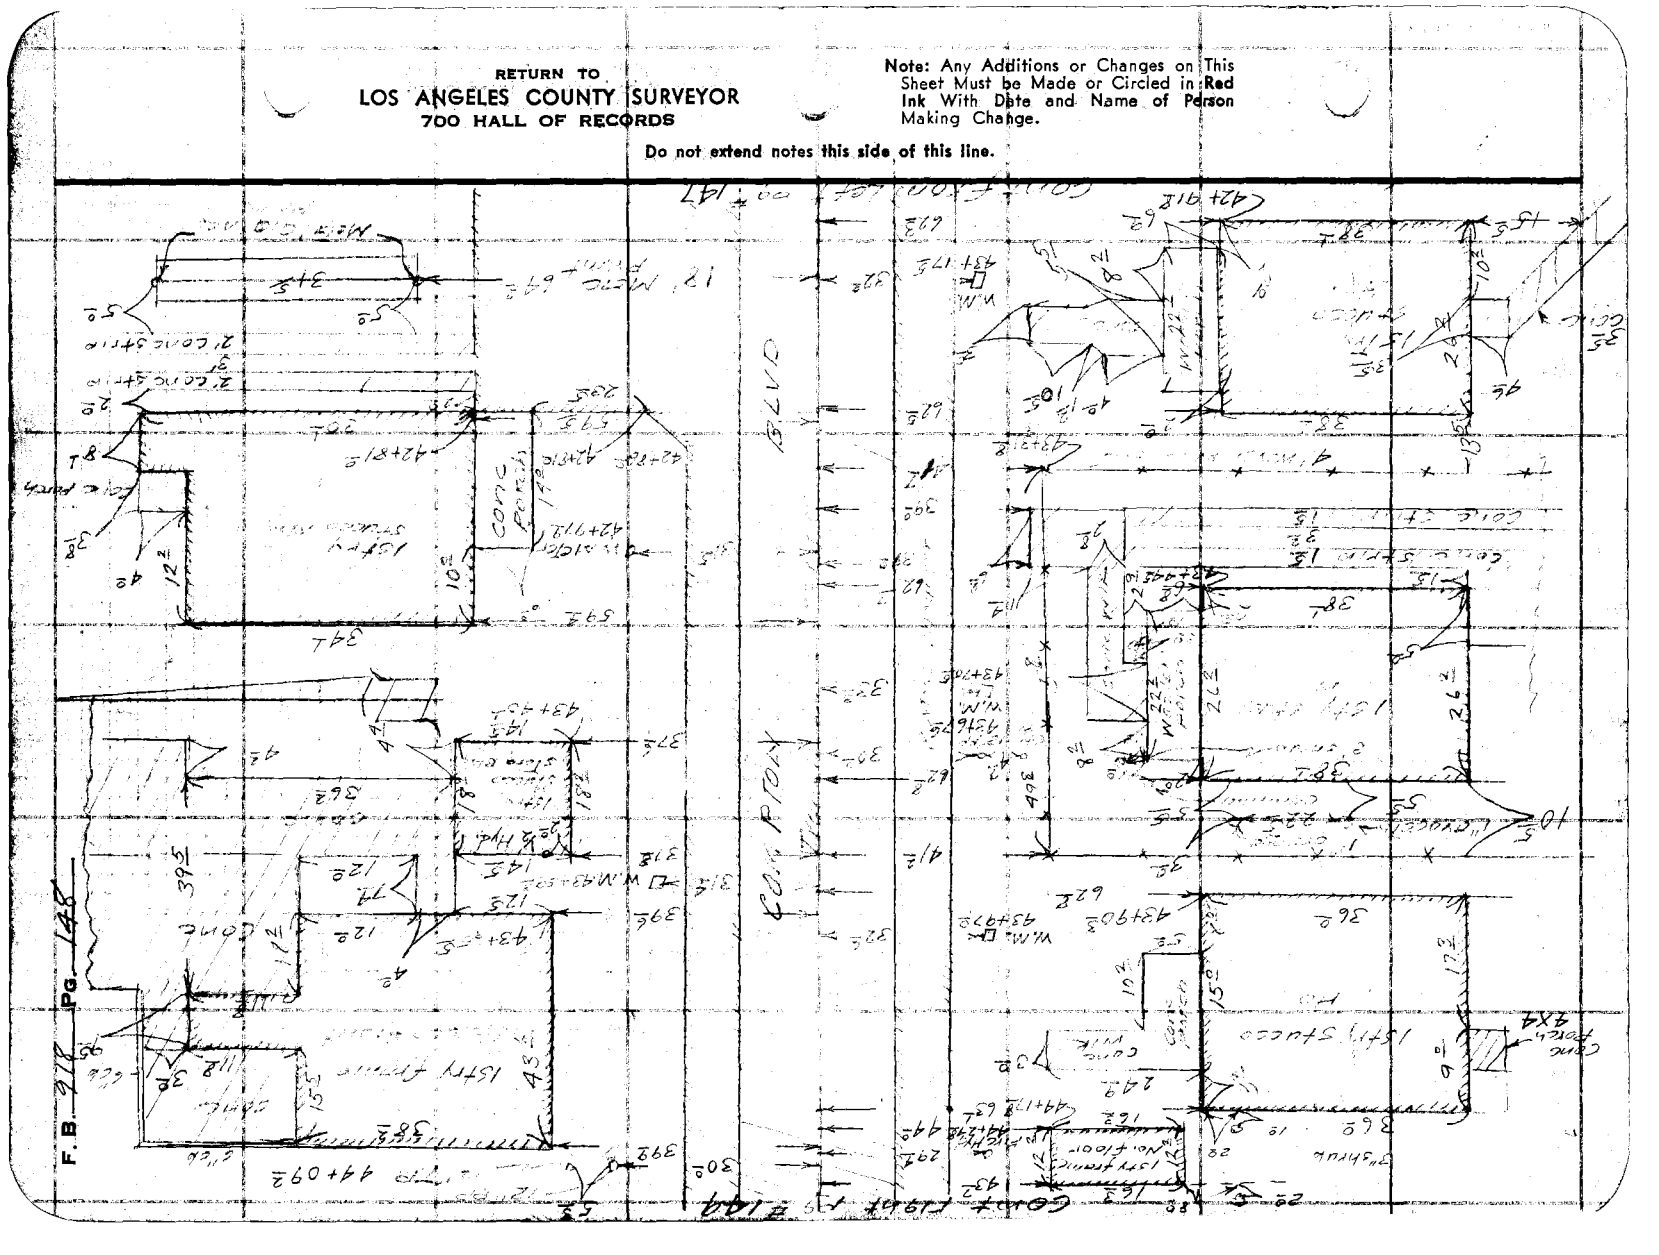

FORM 247 5M 5-46

RETURN TO
LOS ANGELES COUNTY SURVEYOR
700 HALL OF RECORDS

Note: Any Additions or Changes on This Sheet Must be Made or Circled in Red Ink With Date and Name of Person Making Change.

Do not extend notes this side of this line.

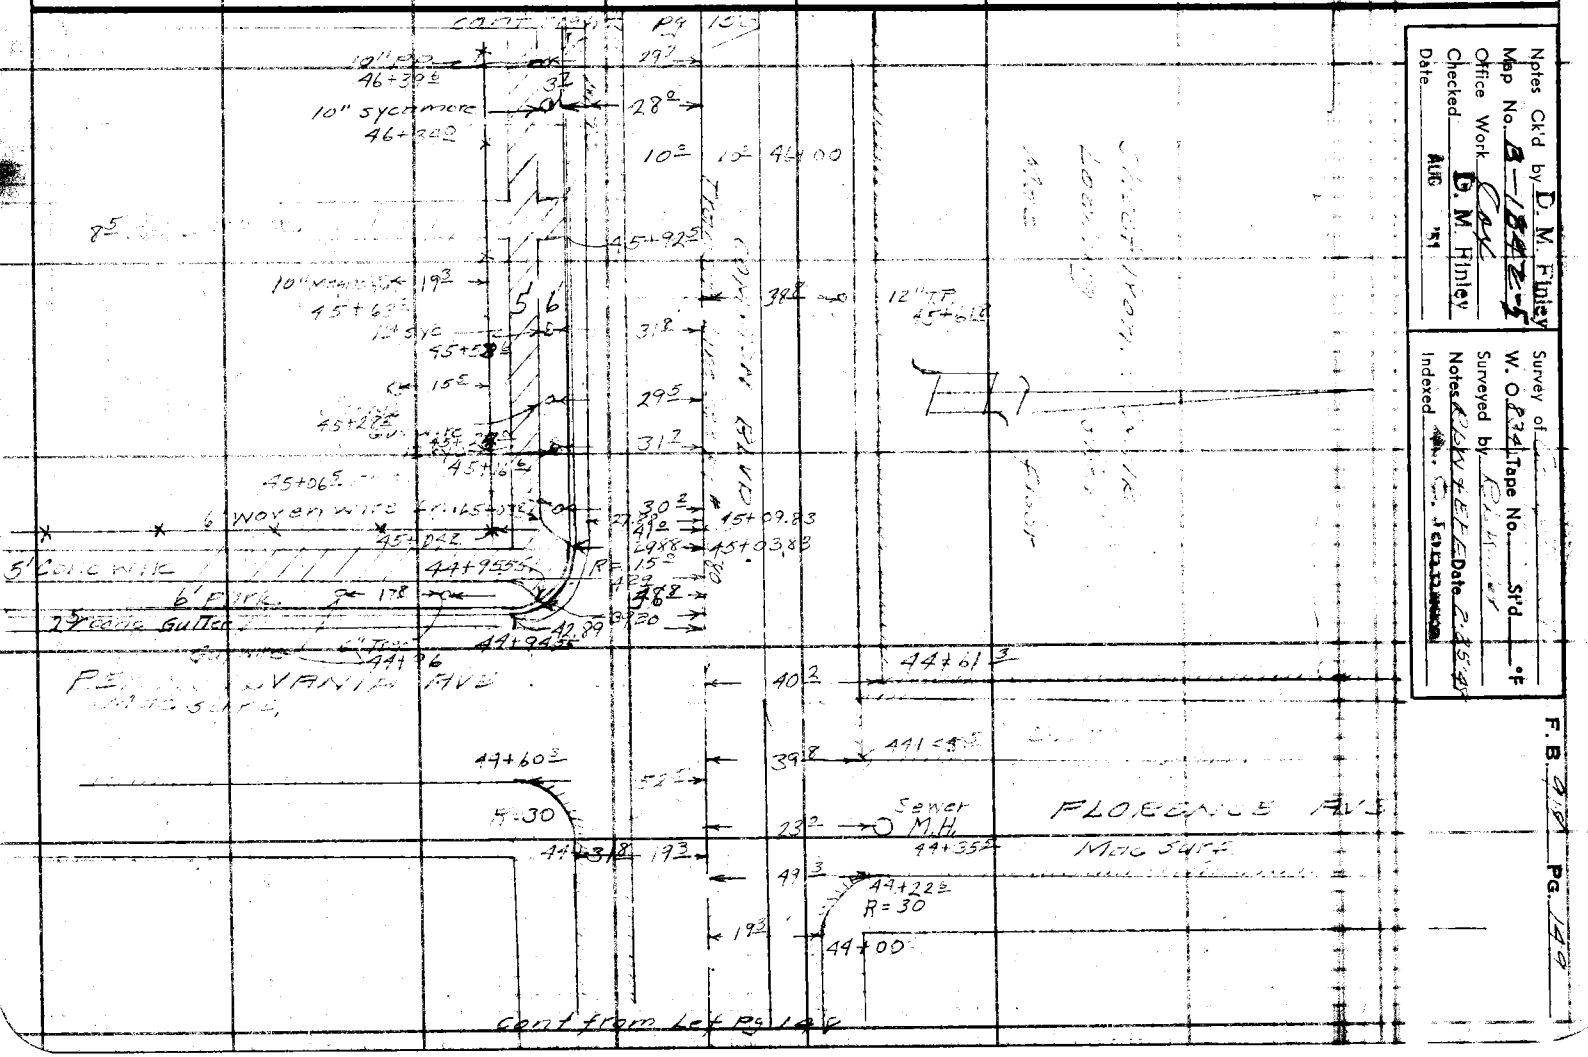

Notes Ck'd by D. M. Finley
Map No. B-1242-5
Office Work D. M. Finley
Checked
Date AUG '51

Survey of
W. O. 8374-Tape No. St'd °F
Surveyed by
Notes Ck'd by Date
Indexed


RETURN TO
LOS ANGELES COUNTY SURVEYOR
700 HALL OF RECORDS

Note: Any Additions or Changes on This Sheet Must be Made or Circled in Red Ink With Date and Name of Person Making Change.

Do not extend notes this side of this line.

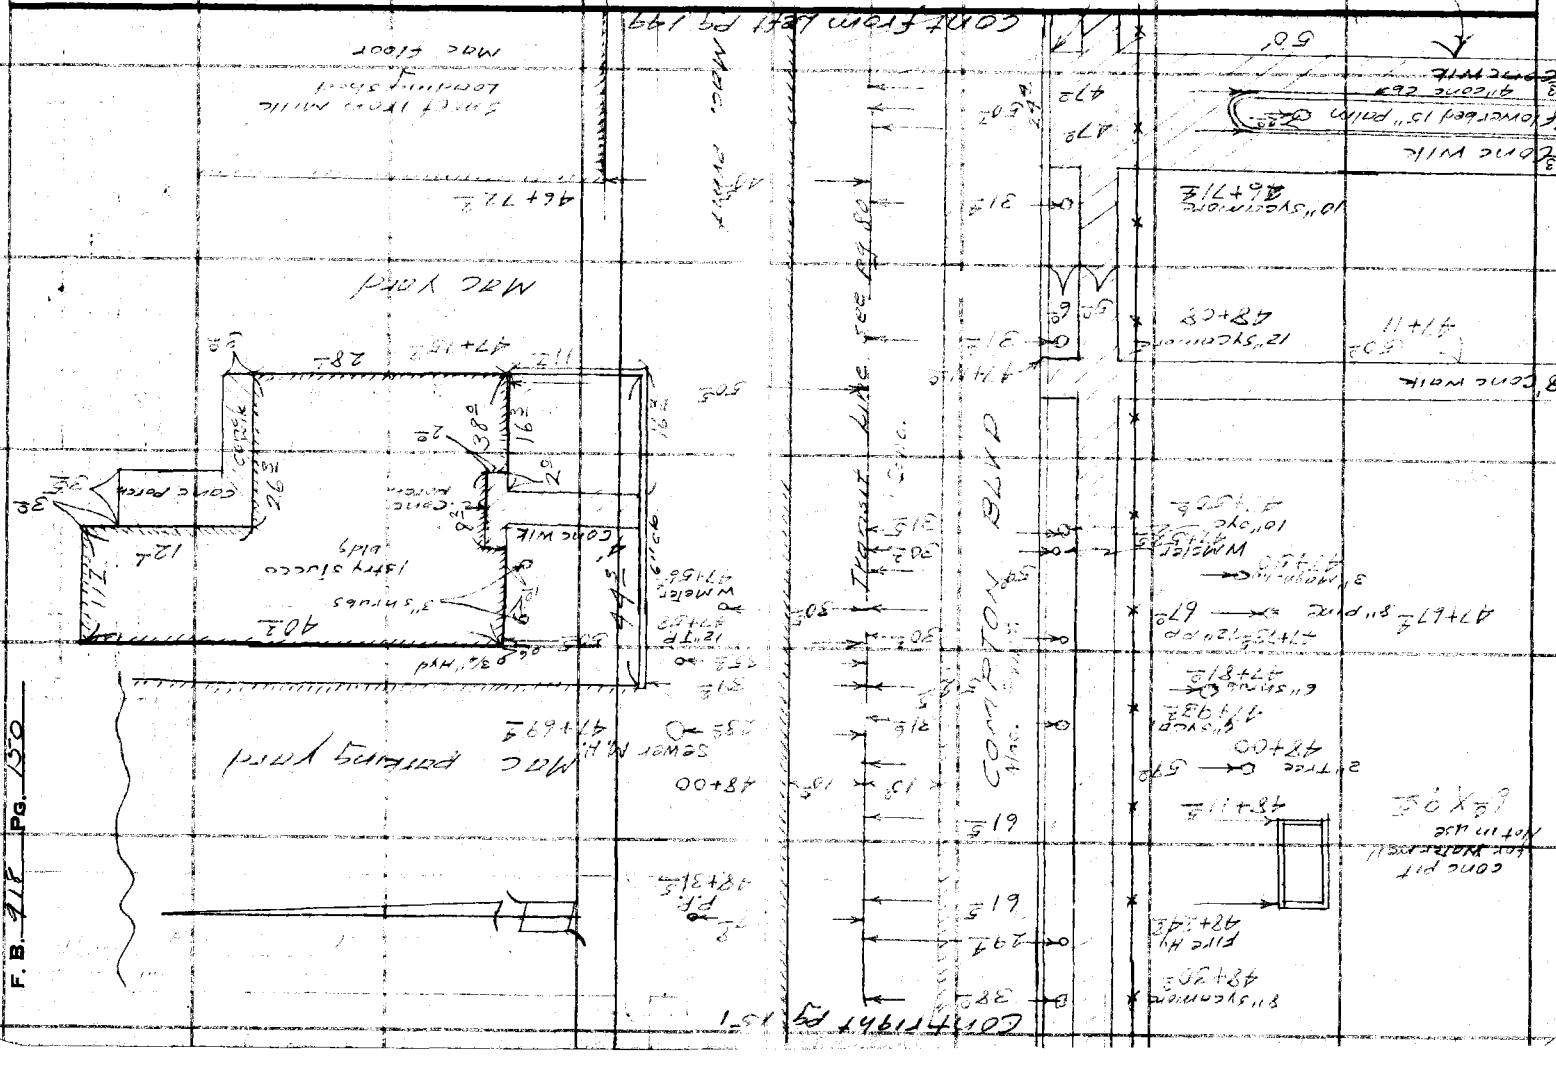
F.B. 316 Pg. 150
Conc. Porch
Conc. Walk
Brick Bldg.
Concrete Pavement

FORM 247 5M 5-46

RETURN TO
LOS ANGELES COUNTY SURVEYOR
700 HALL OF RECORDS

Note: Any Additions or Changes on This Sheet Must be Made or Circled in Red Ink With Date and Name of Person Making Change.

Do not extend notes this side of this line.

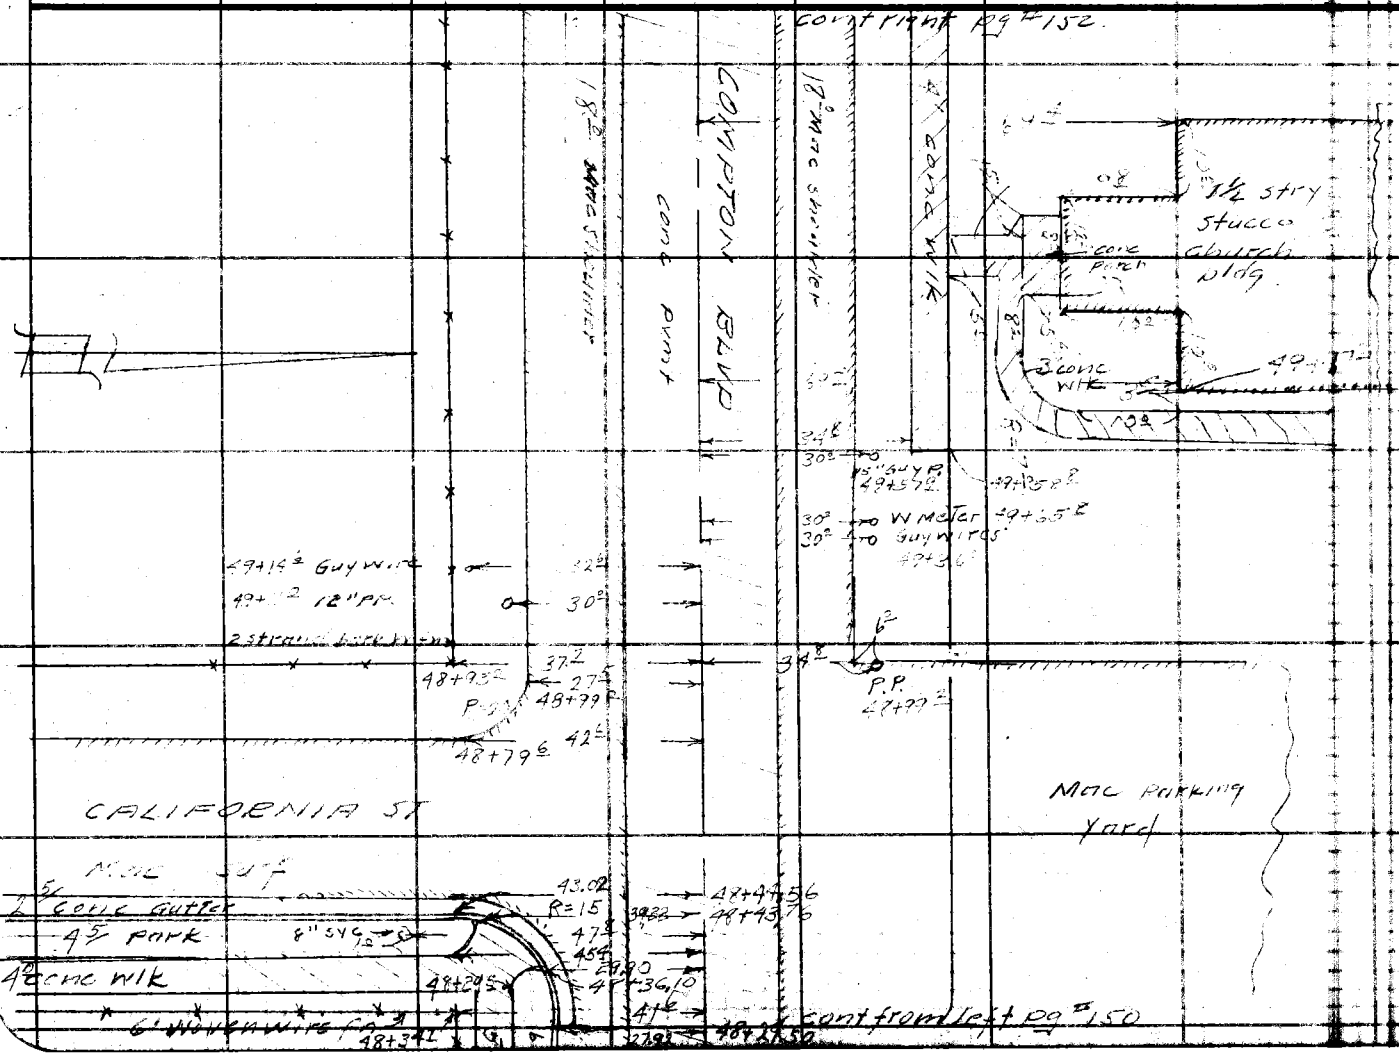

Notes Ck'd by D. M. Finley
Map No. B-15427
Office Work Clerk
Checked D. M. Finley
Date Aug. 51

Survey of Compton Blvd
W. O. 8334 Tape No. Std. °F
Surveyed by Kennedy
Notes Kennedy Date 7-26-51
Indexed A. C. Jacobsen

F. B. 318 PG. 157

RETURN TO
LOS ANGELES COUNTY SURVEYOR
700 HALL OF RECORDS

Note: Any Additions or Changes on This Sheet Must be Made or Circled in Red Ink With Date and Name of Person Making Change.

Do not extend notes this side of this line.

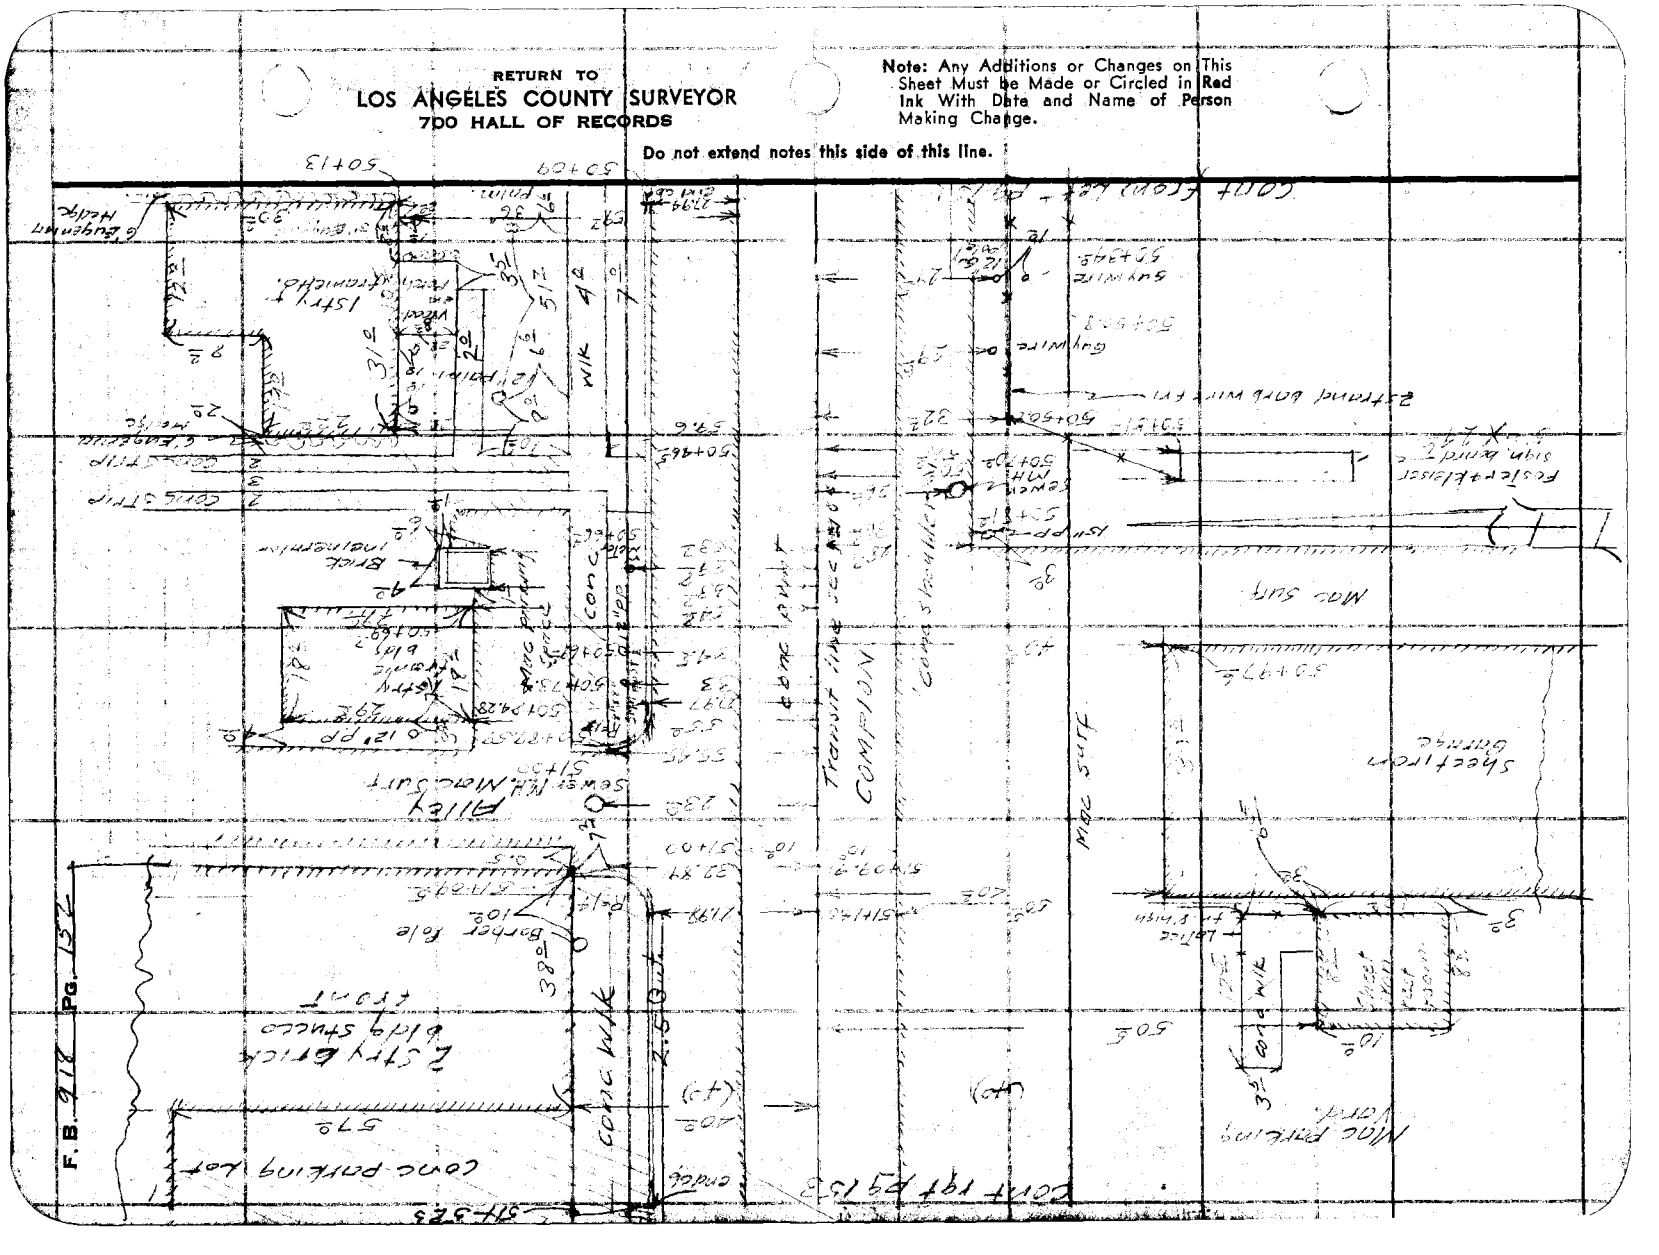

FORM 247 5M 5-46

4455
225
4725

RETURN TO
LOS ANGELES COUNTY SURVEYOR
700 HALL OF RECORDS

Note: Any Additions or Changes on This Sheet Must be Made or Circled in Red Ink With Date and Name of Person Making Change.

Do not extend notes this side of this line.

Notes Ck'd by D. M. Finley
Map No. B-1524-1
Office Work Ck'd D. M. Finley
Checked AUG '51
Date

Survey of
W. O.
Surveyed by
Notes
Indexed

Tape No. St'd. 'F
F. B. PG.

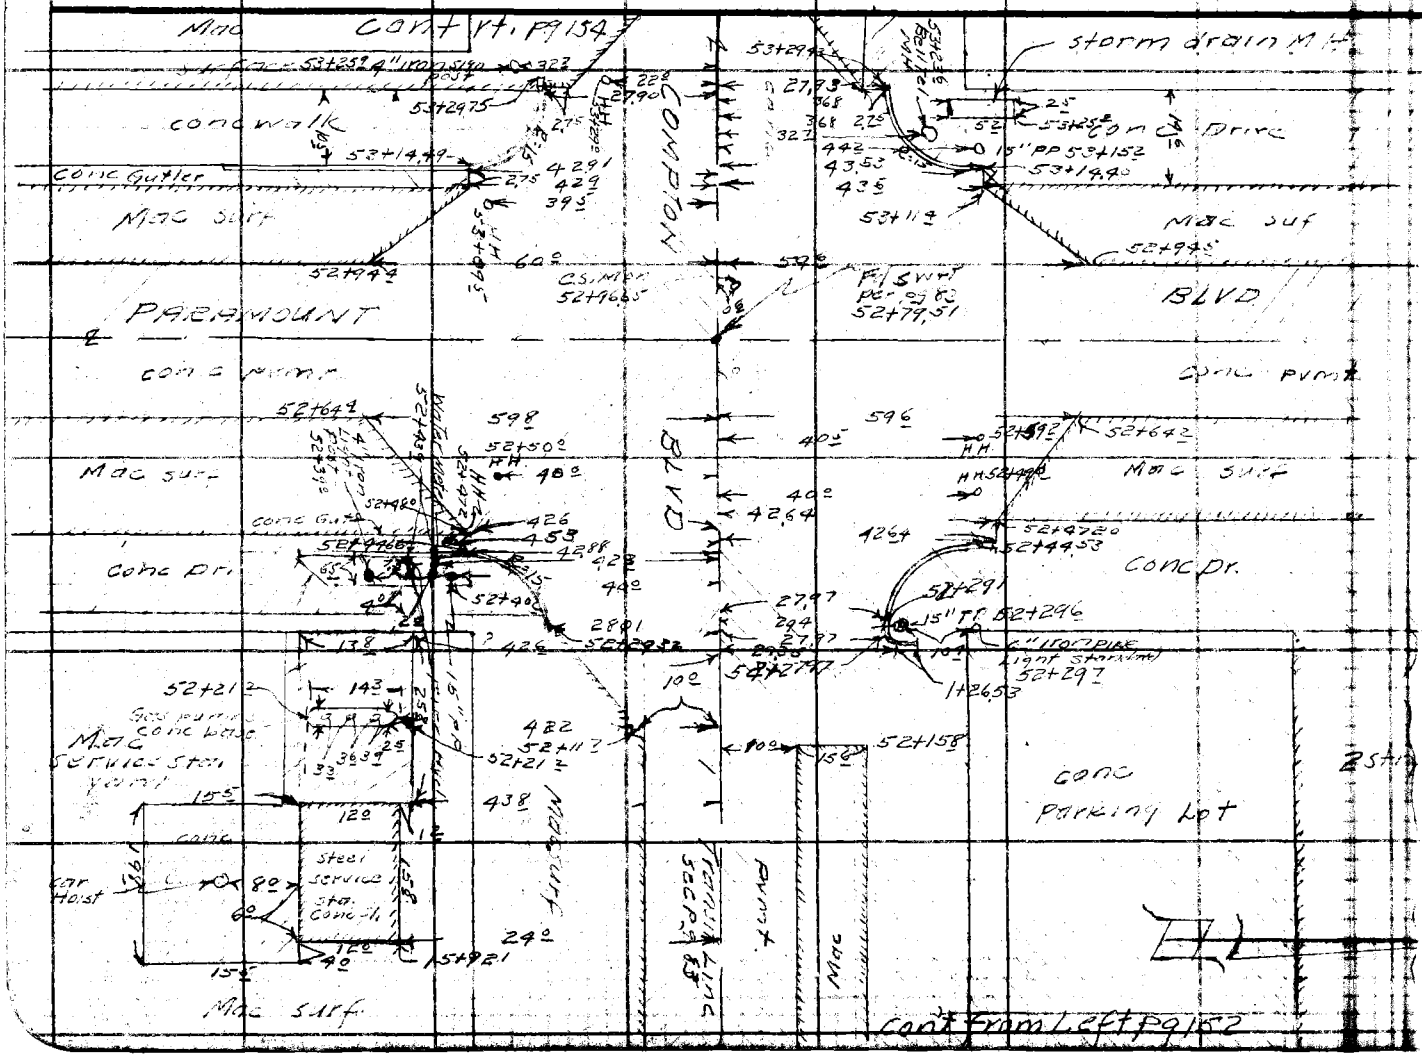

RETURN TO
LOS ANGELES COUNTY SURVEYOR
700 HALL OF RECORDS

Note: Any Additions or Changes on This Sheet Must be Made or Circled in Red Ink With Date and Name of Person Making Change.

Do not extend notes this side of this line.

F.B. 978 Pg. 134

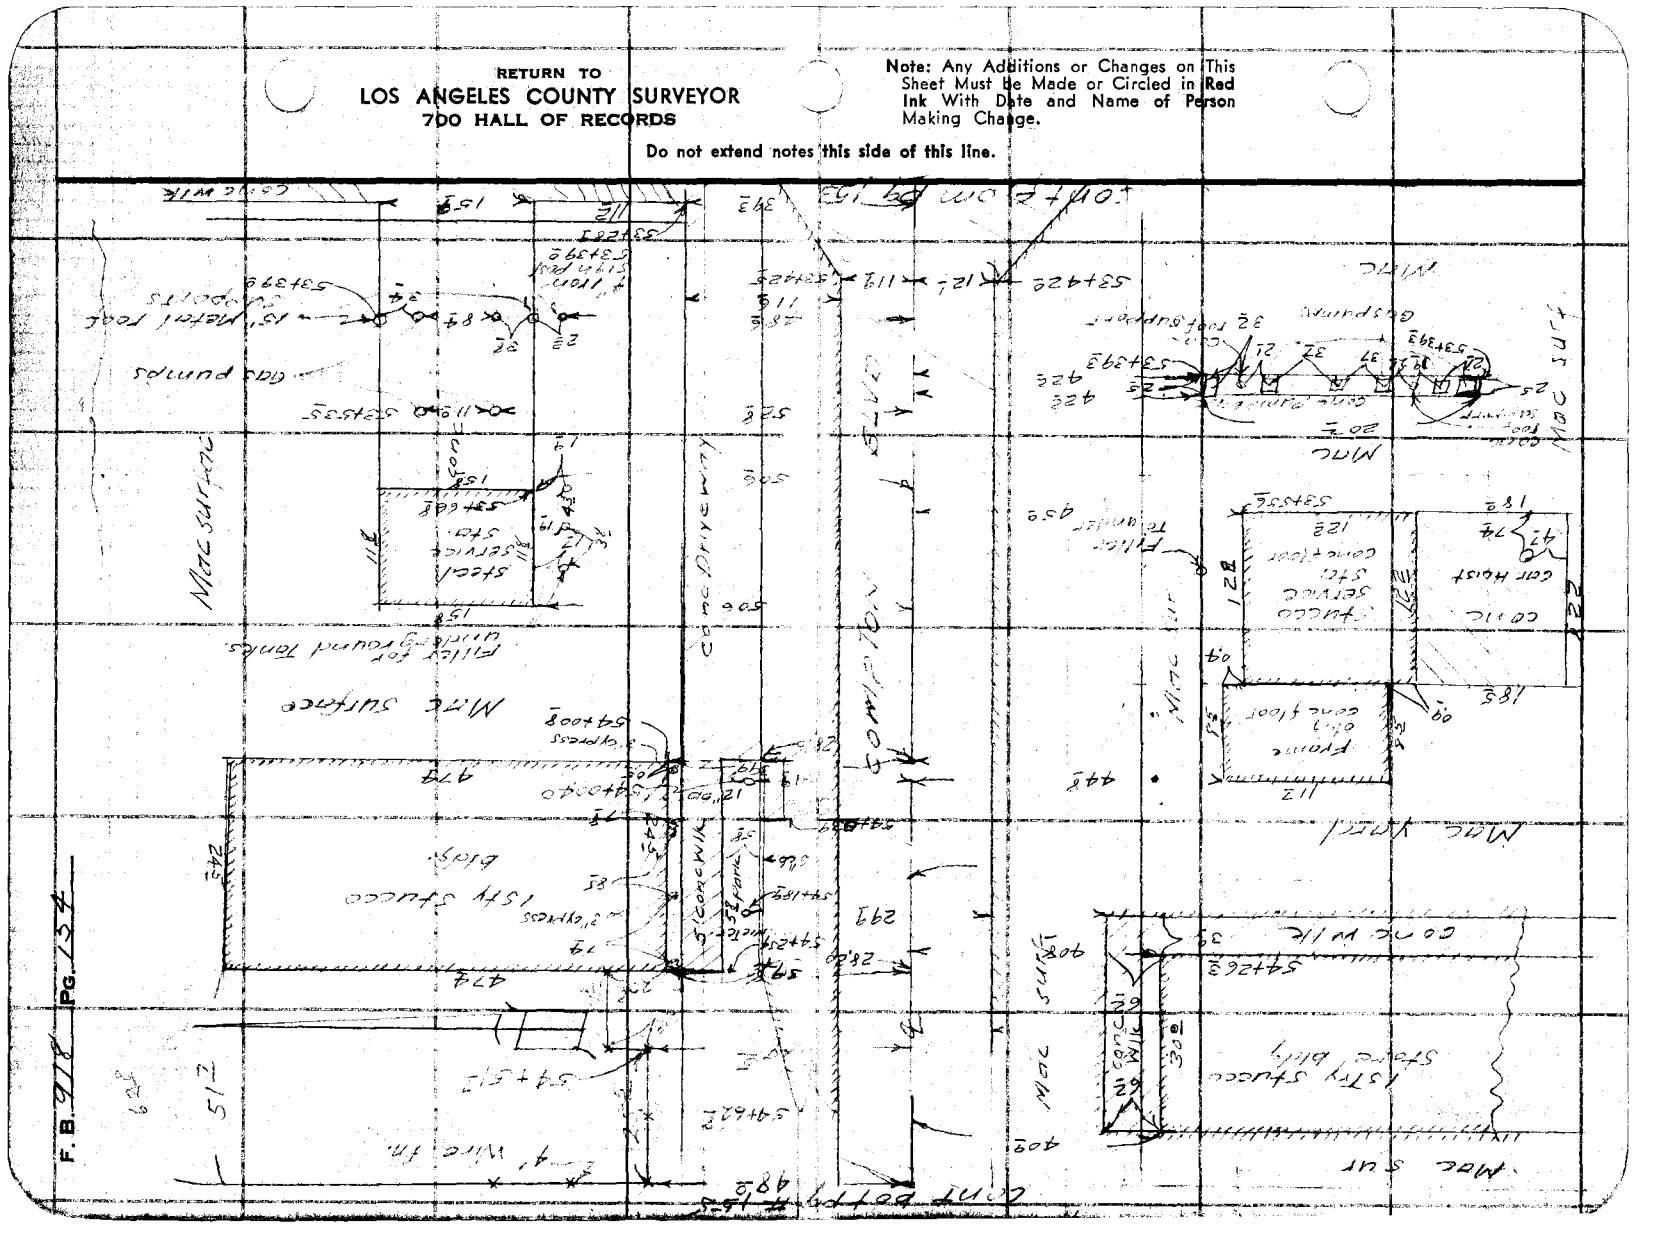

FORM 247 5M 5-46

RETURN TO
LOS ANGELES COUNTY SURVEYOR
700 HALL OF RECORDS

Note: Any Additions or Changes on This Sheet Must be Made or Circled in Red Ink With Date and Name of Person Making Change.

Do not extend notes this side of this line.

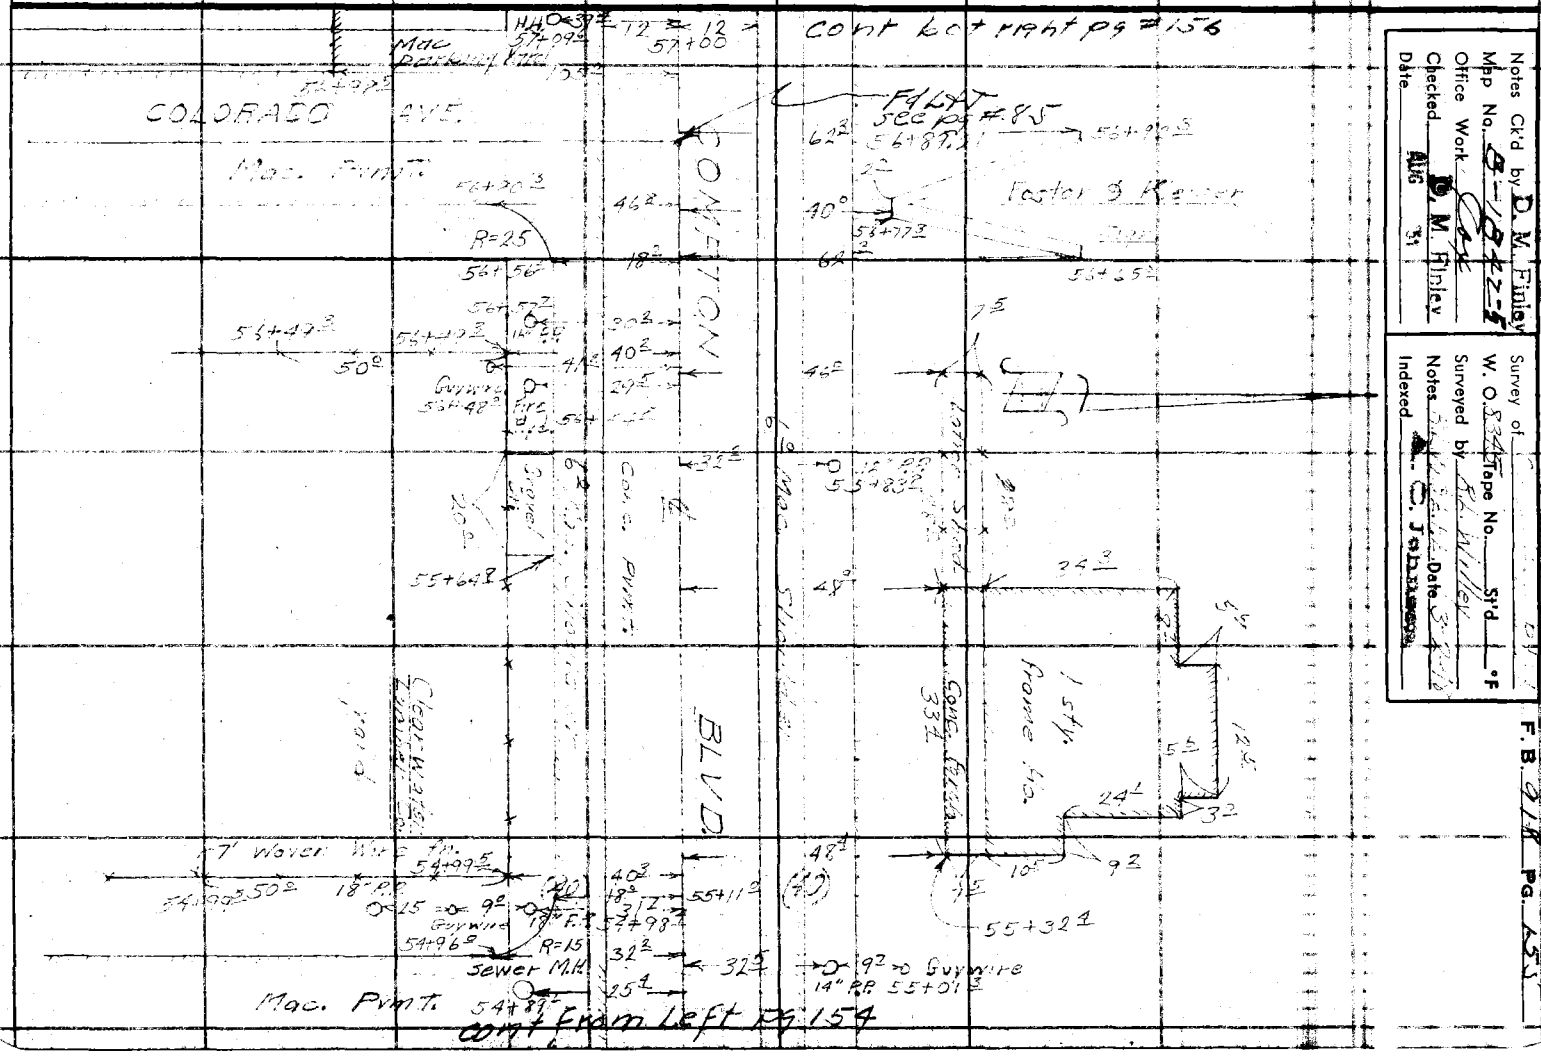

Notes Ck'd by D. M. Finley
Map No. 8-1422-F
Office Work D. M. Finley
Checked D. M. Finley
Date Aug 31

Survey of
W. O. 8422-F Tape No. St'd °F
Surveyed by F. B. Whitley Date 3-
Notes
Indexed C. C. Johnson


RETURN TO
LOS ANGELES COUNTY SURVEYOR
700 HALL OF RECORDS

Note: Any Additions or Changes on This Sheet Must Be Made or Circled in Red Ink With Date and Name of Person Making Change.

Do not extend notes this side of this line.

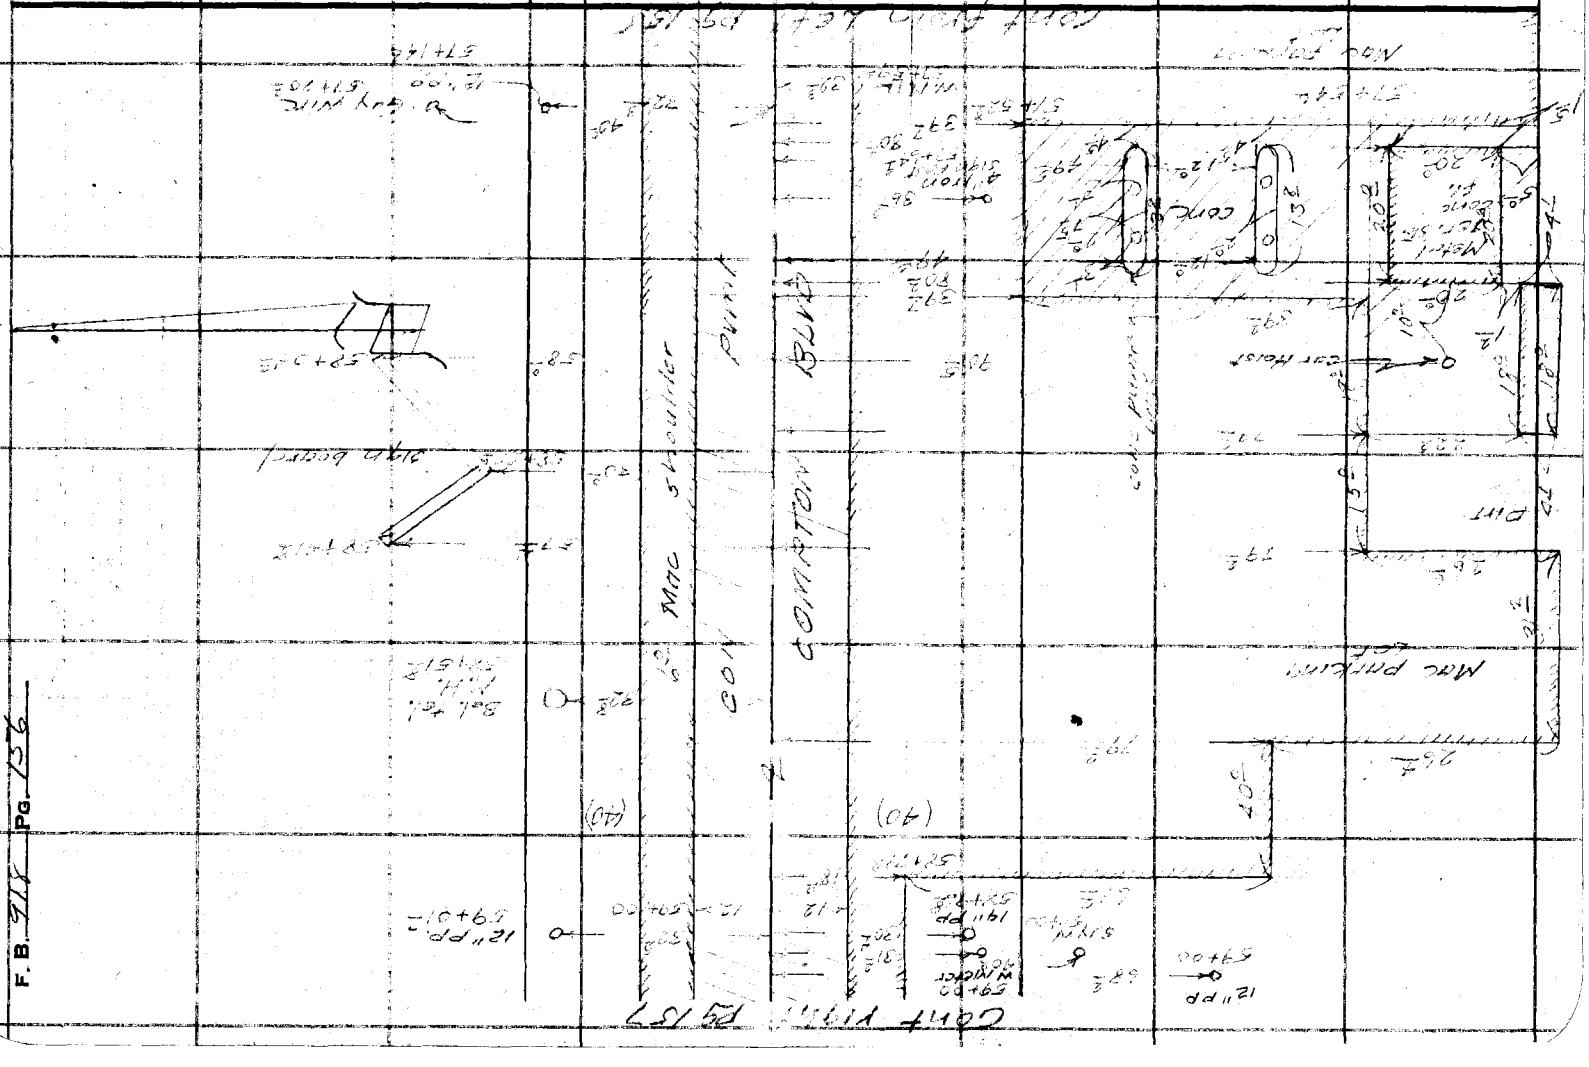

FORM 247 5M 5-46

RETURN TO
LOS ANGELES COUNTY SURVEYOR
700 HALL OF RECORDS

Note: Any Additions or Changes on This Sheet Must be Made or Circled in Red Ink With Date and Name of Person Making Change.

Do not extend notes this side of this line.

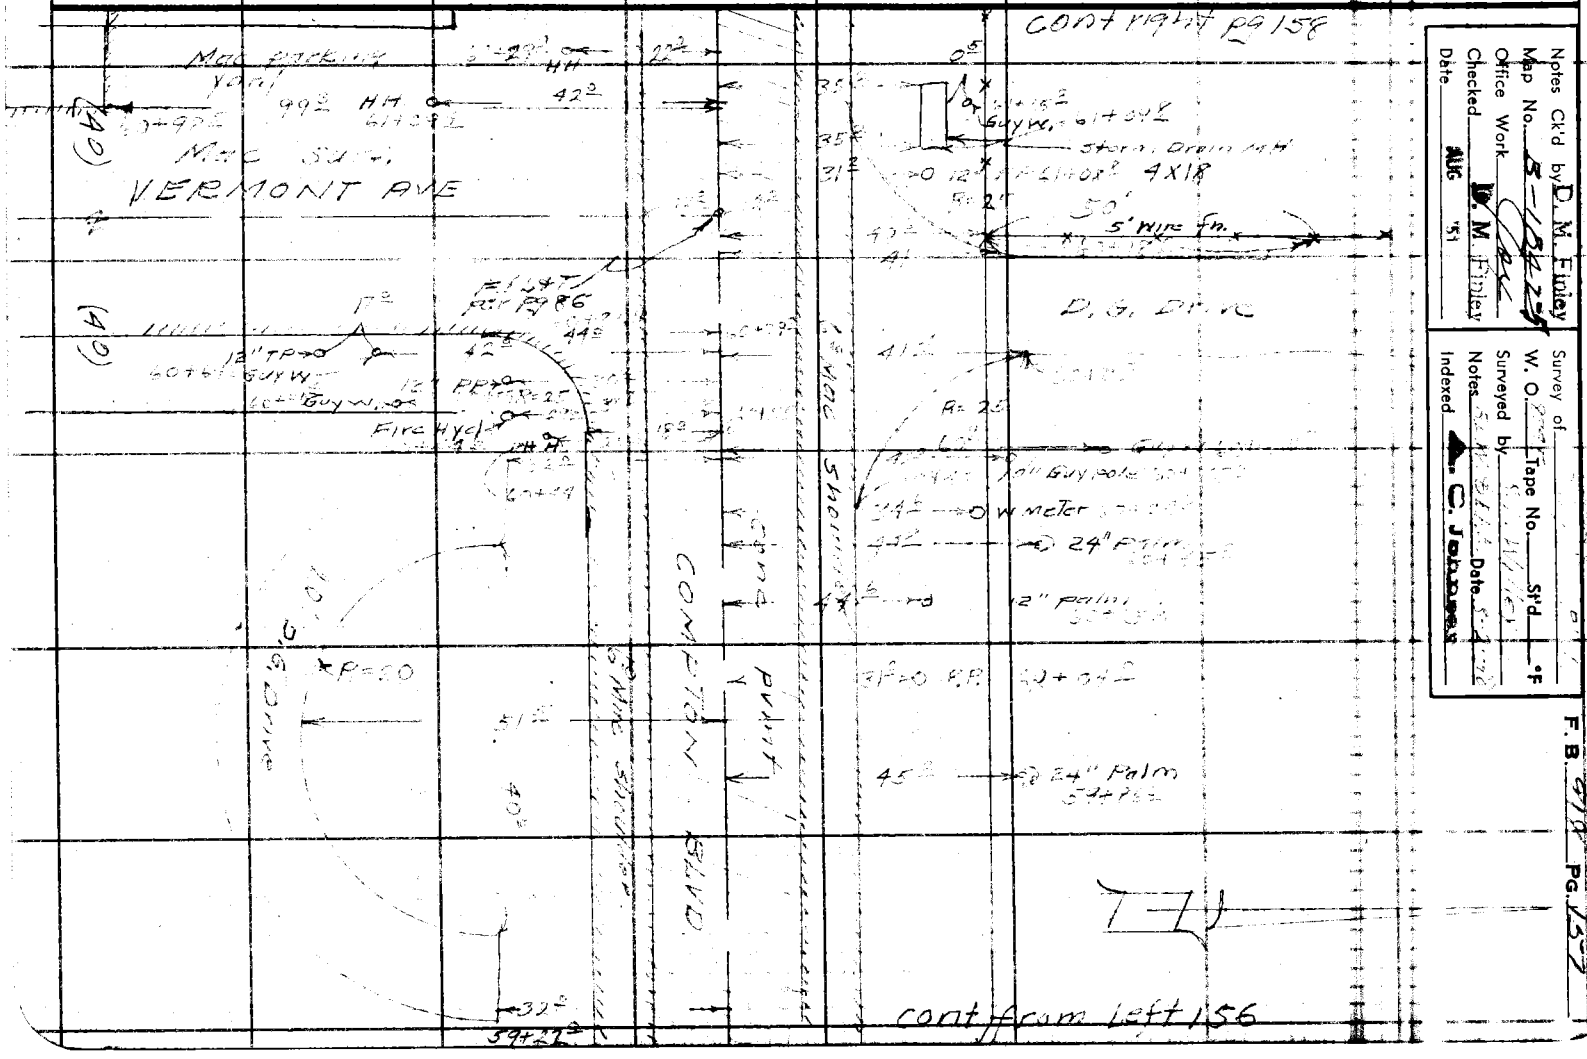

Notes Ck'd by D. M. Finley
Map No. B-1525
Office Work
Checked D. M. Finley
Date AUG '51

Survey of
W. O. Tape No. St'd °F
Surveyed by
Notes Date
Indexed C. Johnson


RETURN TO
LOS ANGELES COUNTY SURVEYOR
7DO HALL OF RECORDS

Note: Any Additions or Changes on This Sheet Must be Made or Circled in Red Ink With Date and Name of Person Making Change.

Do not extend notes this side of this line.

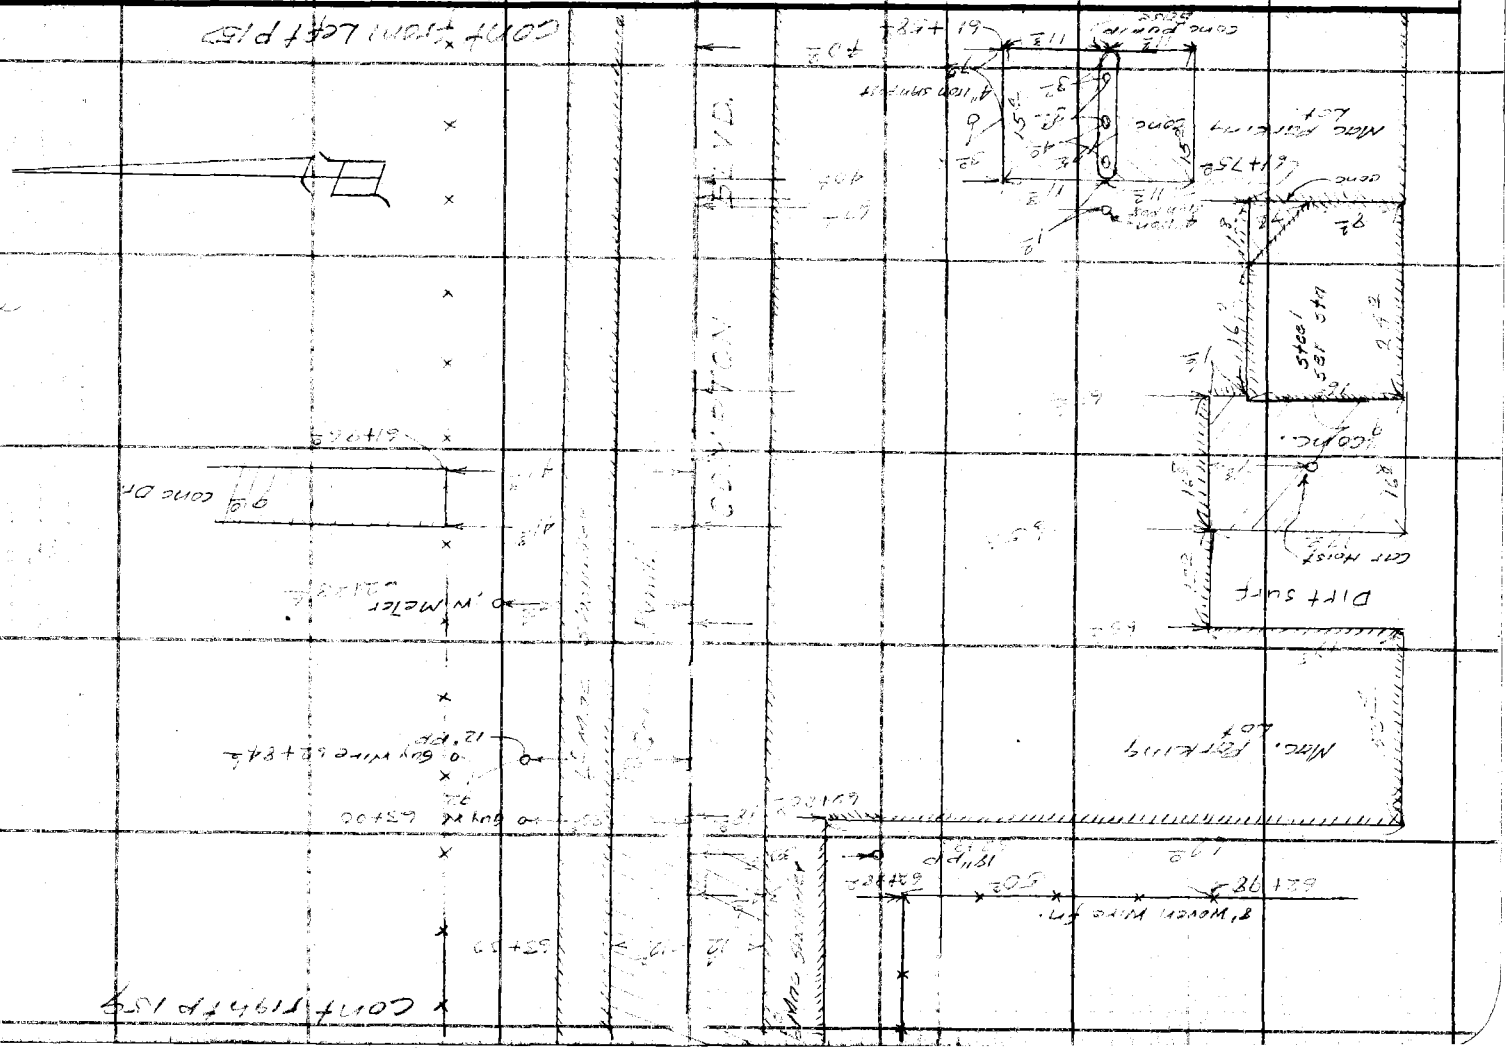
F.B. 918 PG. 1258
DIRT SURF
Steel Cat
Cone
Cone Post
Cone Fence
Cone Post
Cone Fence
Cone
Cone
Cone

FORM 247 5M 5-46

RETURN TO
LOS ANGELES COUNTY SURVEYOR
700 HALL OF RECORDS

Note: Any Additions or Changes on This Sheet Must be Made or Circled in Red Ink With Date and Name of Person Making Change.

Do not extend notes this side of this line.

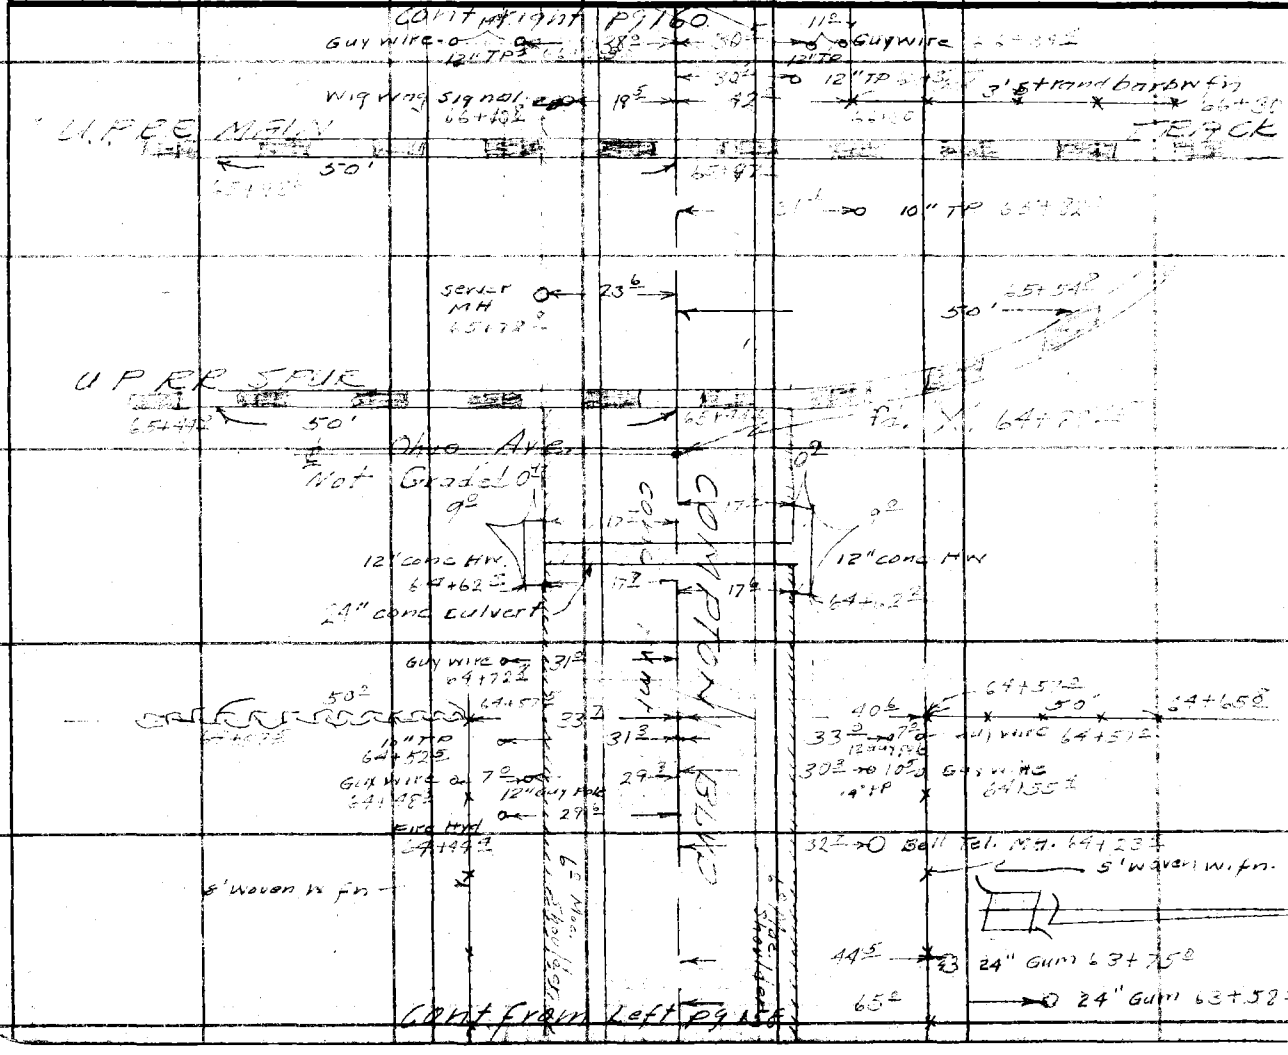

Notes Ck'd by D. M. Finley
Map No. B-1842-25
Office Work Complete
Checked D. M. Finley
Date 5-1-51

Survey of
W. O. 2211 Tape No. St'd. °F
Surveyed by
Notes Date
Indexed A. C. Jackson

F. B. 917 Pg. 137

RETURN TO
LOS ANGELES COUNTY SURVEYOR
7DO HALL OF RECORDS

Note: Any Additions or Changes on This Sheet Must be Made or Circled in Red Ink With Date and Name of Person Making Change.

Do not extend notes this side of this line.

F. B. 916 Pg. 162

FORM 247 5M 5-46

RETURN TO
LOS ANGELES COUNTY SURVEYOR
700 HALL OF RECORDS

Note: Any Additions or Changes on This Sheet Must be Made or Circled in Red Ink With Date and Name of Person Making Change.

Do not extend notes this side of this line.

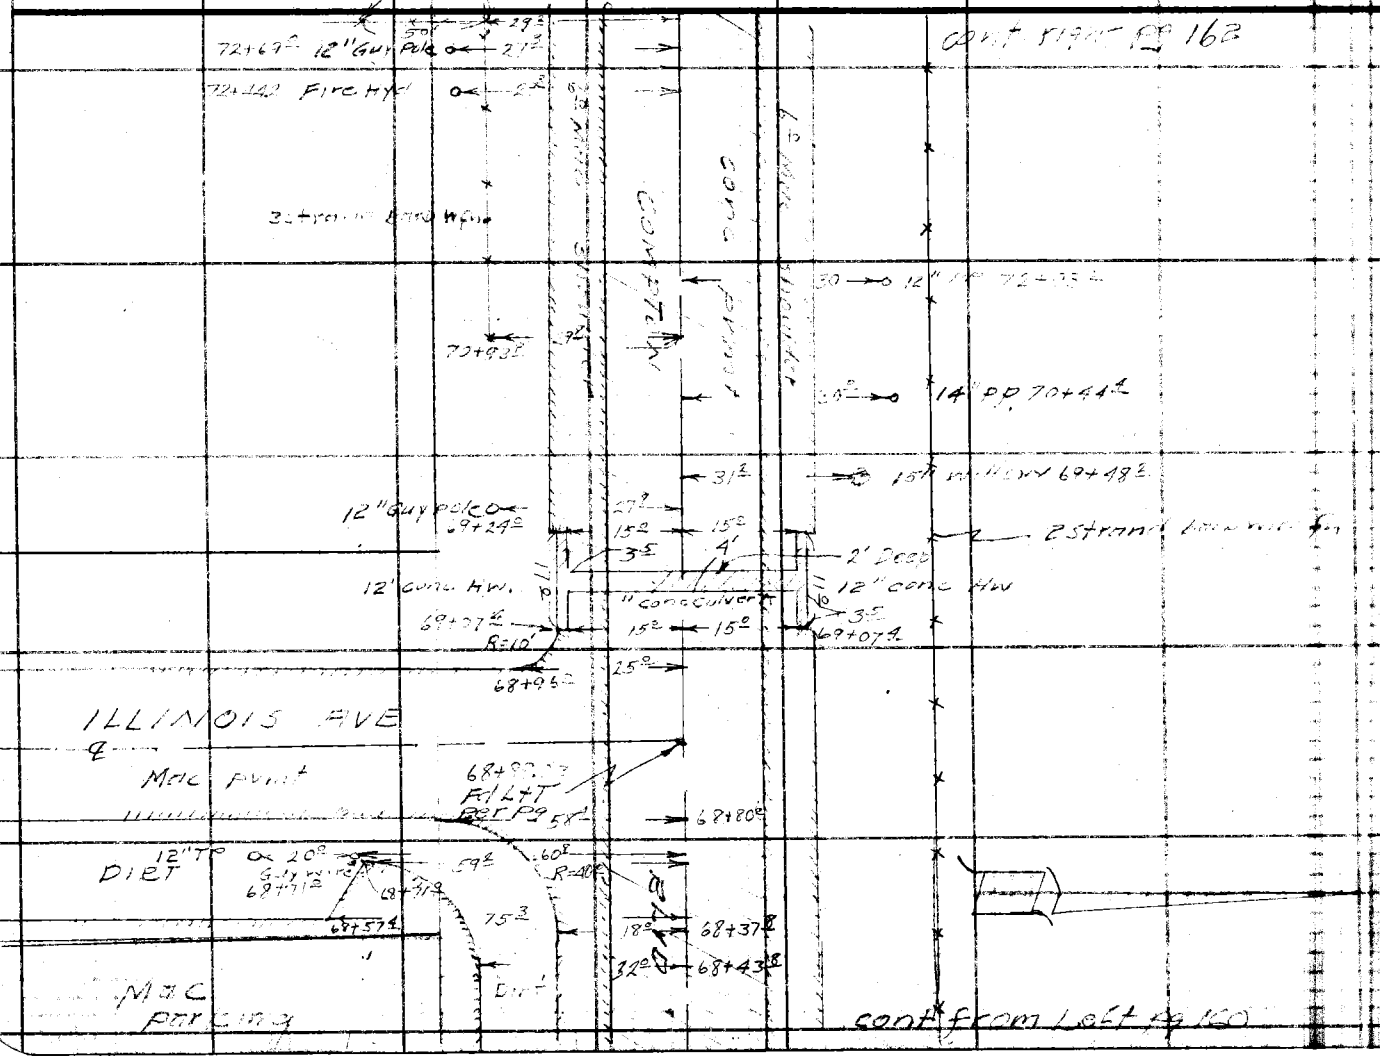

Notes Ck'd by D. M. Finley
Map No. B-1842-5
Office Work Cox
Checked D. M. Finley
Date Aug '51

Survey of
W. O. 4[illegible] Tape No. Std. °F
Surveyed by [illegible] Date 3-[illegible]
Notes
Indexed C. Johnson

F. B. 2[illegible] Pg. 76

RETURN TO
LOS ANGELES COUNTY SURVEYOR
700 HALL OF RECORDS

Note: Any Additions or Changes on This Sheet Must be Made or Circled in Red Ink With Date and Name of Person Making Change.

Do not extend notes this side of this line.

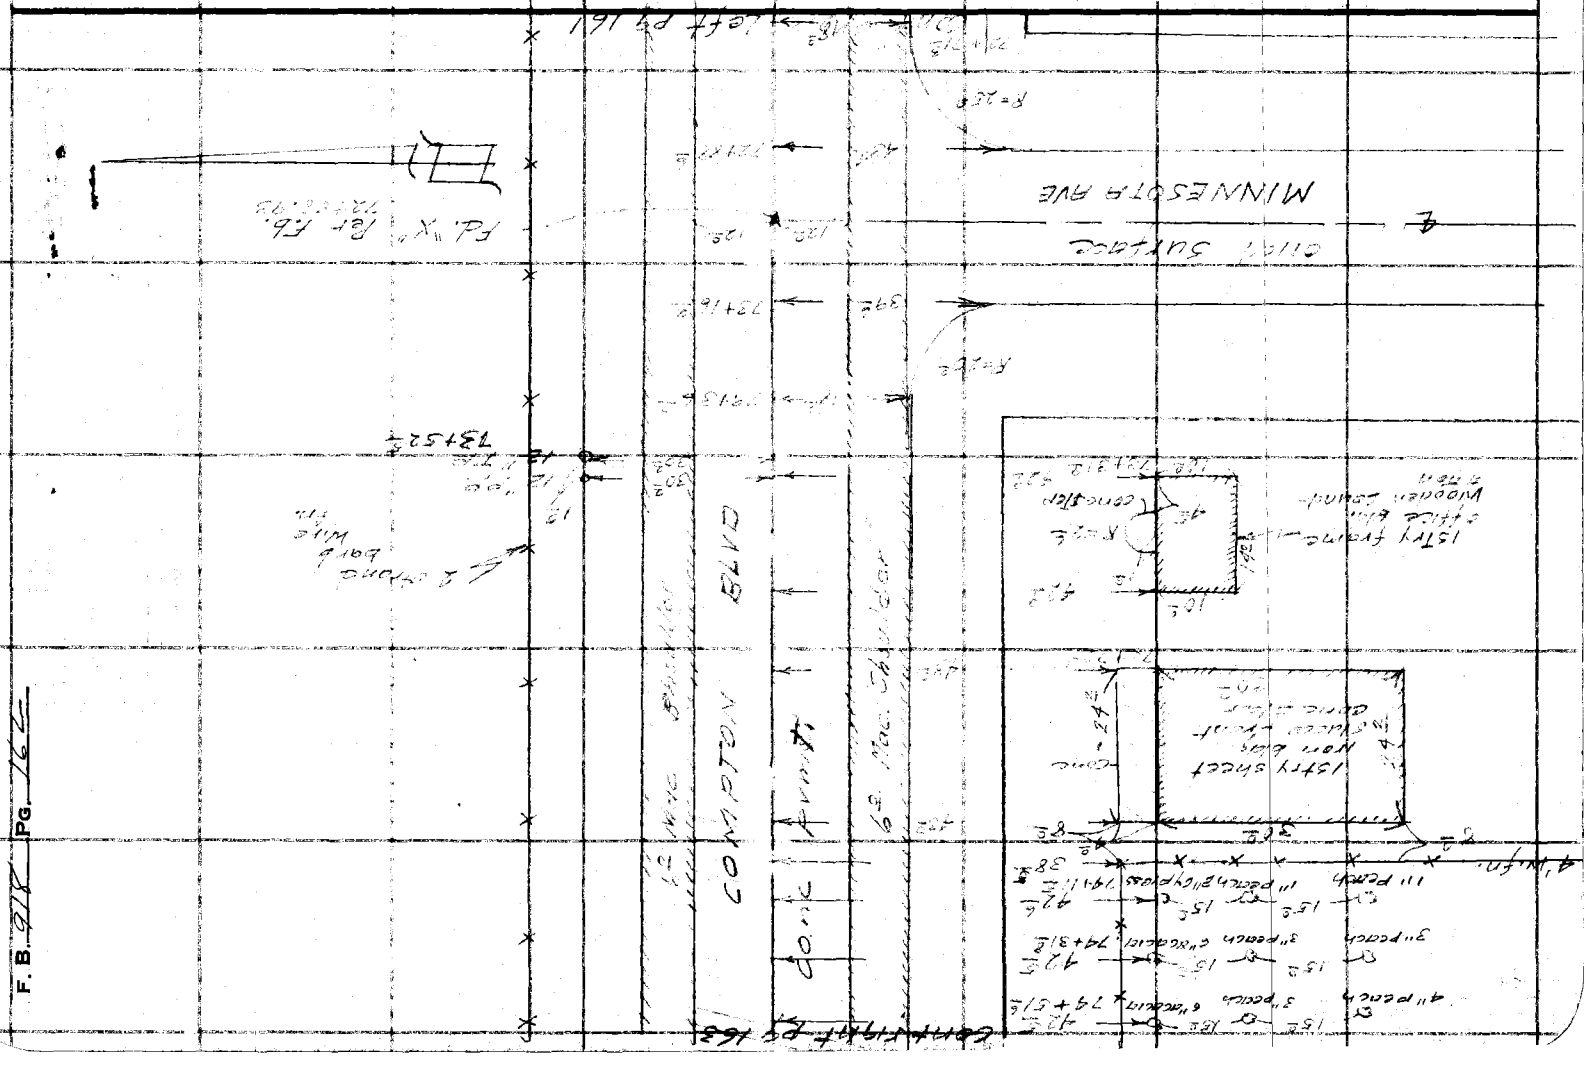


FORM 247 5M 5-46

RETURN TO
LOS ANGELES COUNTY SURVEYOR
700 HALL OF RECORDS

Note: Any Additions or Changes on This Sheet Must be Made or Circled in Red Ink With Date and Name of Person Making Change.

Do not extend notes this side of this line.

Notes Ck'd by D. M. Finley
Map No. B-1844-5
Office Work Cor
Checked D. M. Finley
Date AUG '51

Survey of
W. O.
Tape No. St'd °F
Surveyed by
Notes
Indexed C. Johnson Date

F. B. 378 PG. 165

cont rpt pg 164

4" Water Fr.

1" Water Fr.

To House Out Over 10'

3" Conc. Dr.

4" Main 76+39Z

76+79Z

9' Conc. Dr.

Cor' Wire Fn.

2" Alley 76+10Z

Water M.

2" Service

Bell Tel. M.H. 76+21S

3' barb wire fn.

To House Out Over 70'

9' Conc. Dr.

Water M. 75+59

2" Peach 75+46Z

Trailer Camp

Dirt Dr.

5'X14' Conc.

2" Peach 75+16E

10" P.P. 75+11± Guywire

Dirt Dr.

10" P.P.

4' wire fn.

Dirt Dr.

74+80

74+79Z

74+72Z

2" Peach

3" Cypress 74+71S

Water M.

74+63Z

cont from Left p 162

RETURN TO
LOS ANGELES COUNTY SURVEYOR
7DO HALL OF RECORDS

Note: Any Additions or Changes on This Sheet Must be Made or Circled in Red Ink With Date and Name of Person Making Change.

Do not extend notes this side of this line.

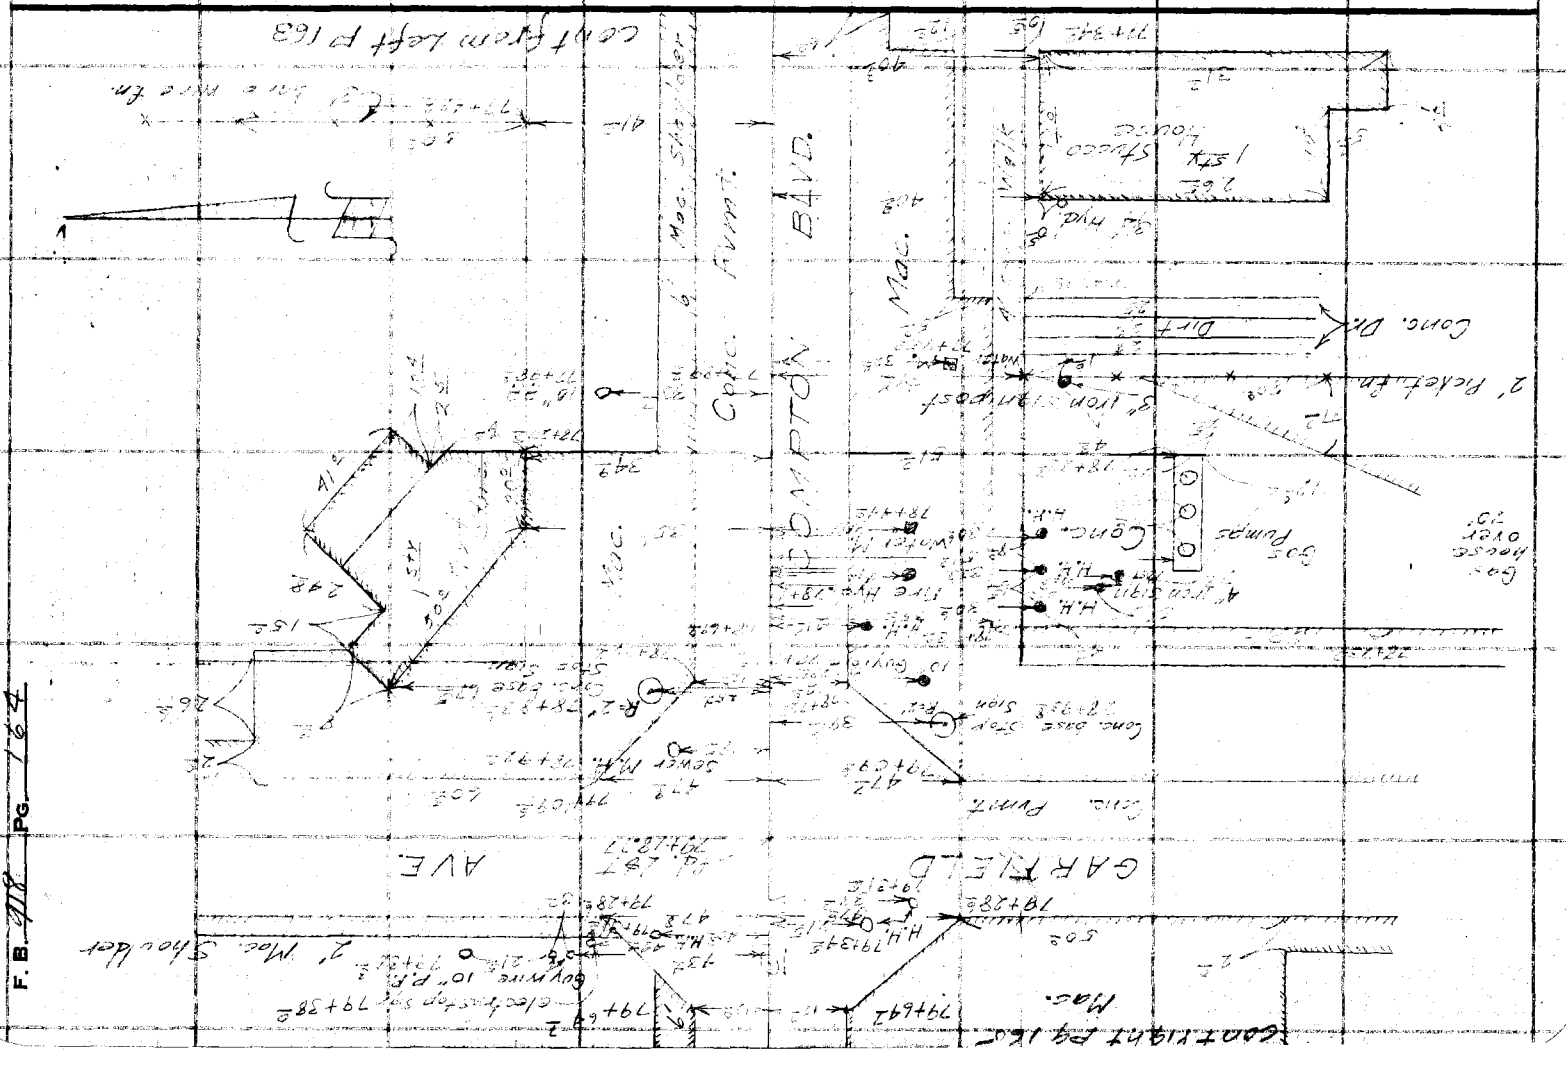
Mac.
Conc. Pvmt.
AVE
GARFIELD
Conc. Drive
Conc. Base
Sewer MH.
Conc. Pvmt.
Conc. Base Sign
Conc. Drive
Conc. Pvmt.
Conc. Base Sign

FORM 247 SM 5-46

RETURN TO
LOS ANGELES COUNTY SURVEYOR
700 HALL OF RECORDS

Note: Any Additions or Changes on This Sheet Must be Made or Circled in Red Ink With Date and Name of Person Making Change.

Do not extend notes this side of this line.

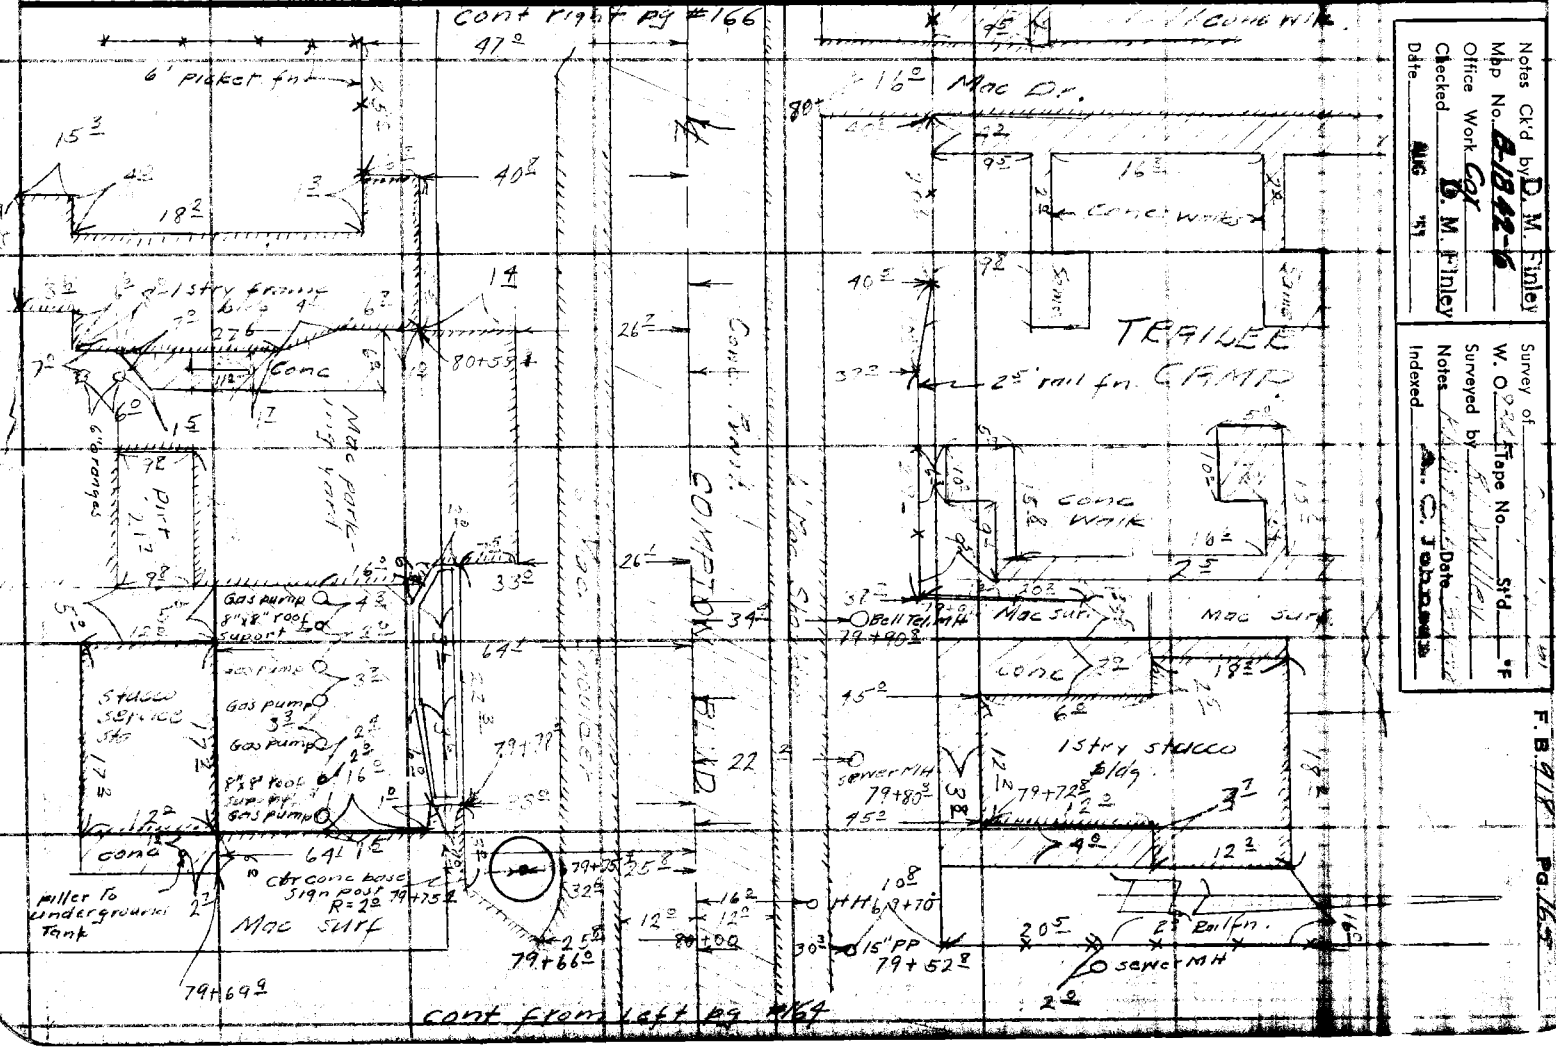

Notes Ck'd by D. M. Finley
Mbp No. B-1842-6
Office Work Cpr D. M. Finley
Checked
Date

Survey of
W. O. 9234 Tape No. Std °F
Surveyed by
Notes
Indexed Date

F. B. 911 Pg. 165

RETURN TO
LOS ANGELES COUNTY SURVEYOR
700 HALL OF RECORDS

Note: Any Additions or Changes on This Sheet Must Be Made or Circled in Red Ink With Date and Name of Person Making Change.

Do not extend notes this side of this line.

F. B. 778 PG. 766

Notes Ck'd by D. M. Finley
Map No. B-1842-6.
Office Work Cox
Checked D. M. Finley
Date AUG '51

Survey of Con. Imp. Bld.
W. O. 834 Tape No. St'd °F
Surveyed by R. L. Willey
Notes R.L.W. & E.F.F. Date 3-14-42
Indexed C. Johnson

F.B. 918 PG. 167

Note: Any Additions or Changes on This Sheet Must be Made or Circled in Red Ink With Date and Name of Person Making Change.

Do not extend notes this side of this line.

RETURN TO
LOS ANGELES COUNTY SURVEYOR
700 HALL OF RECORDS

FORM 247 5M 5-46

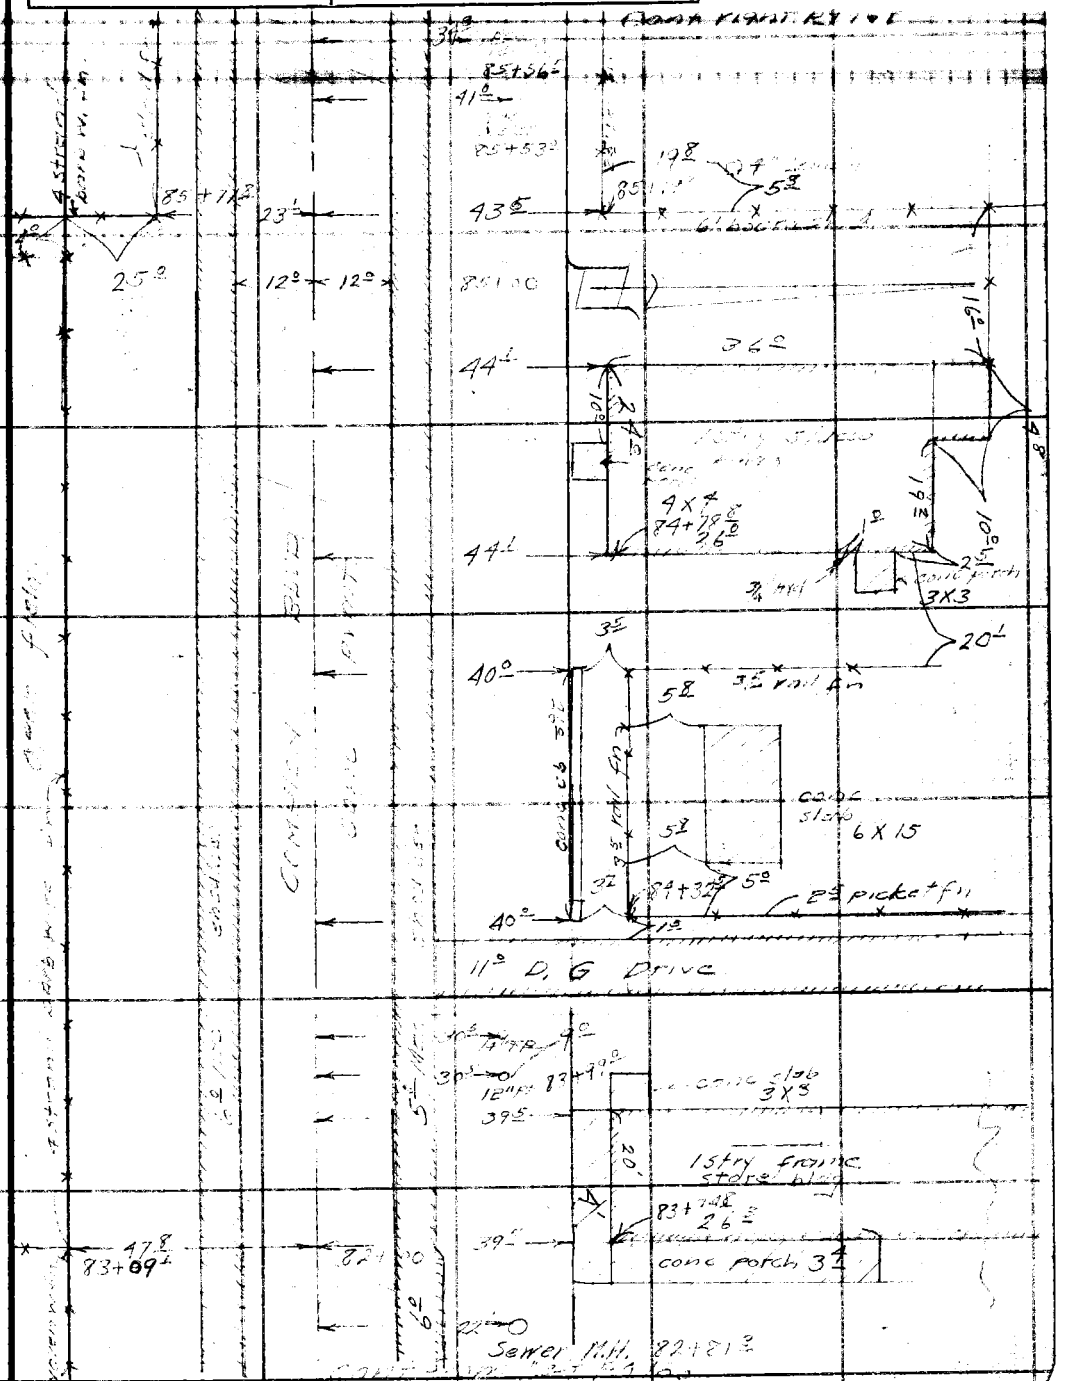

RETURN TO
LOS ANGELES COUNTY SURVEYOR
7DO HALL OF RECORDS

Note: Any Additions or Changes on This Sheet Must be Made or Circled in Red Ink With Date and Name of Person Making Change.

Do not extend notes this side of this line.

F. B. 918 PG. 177

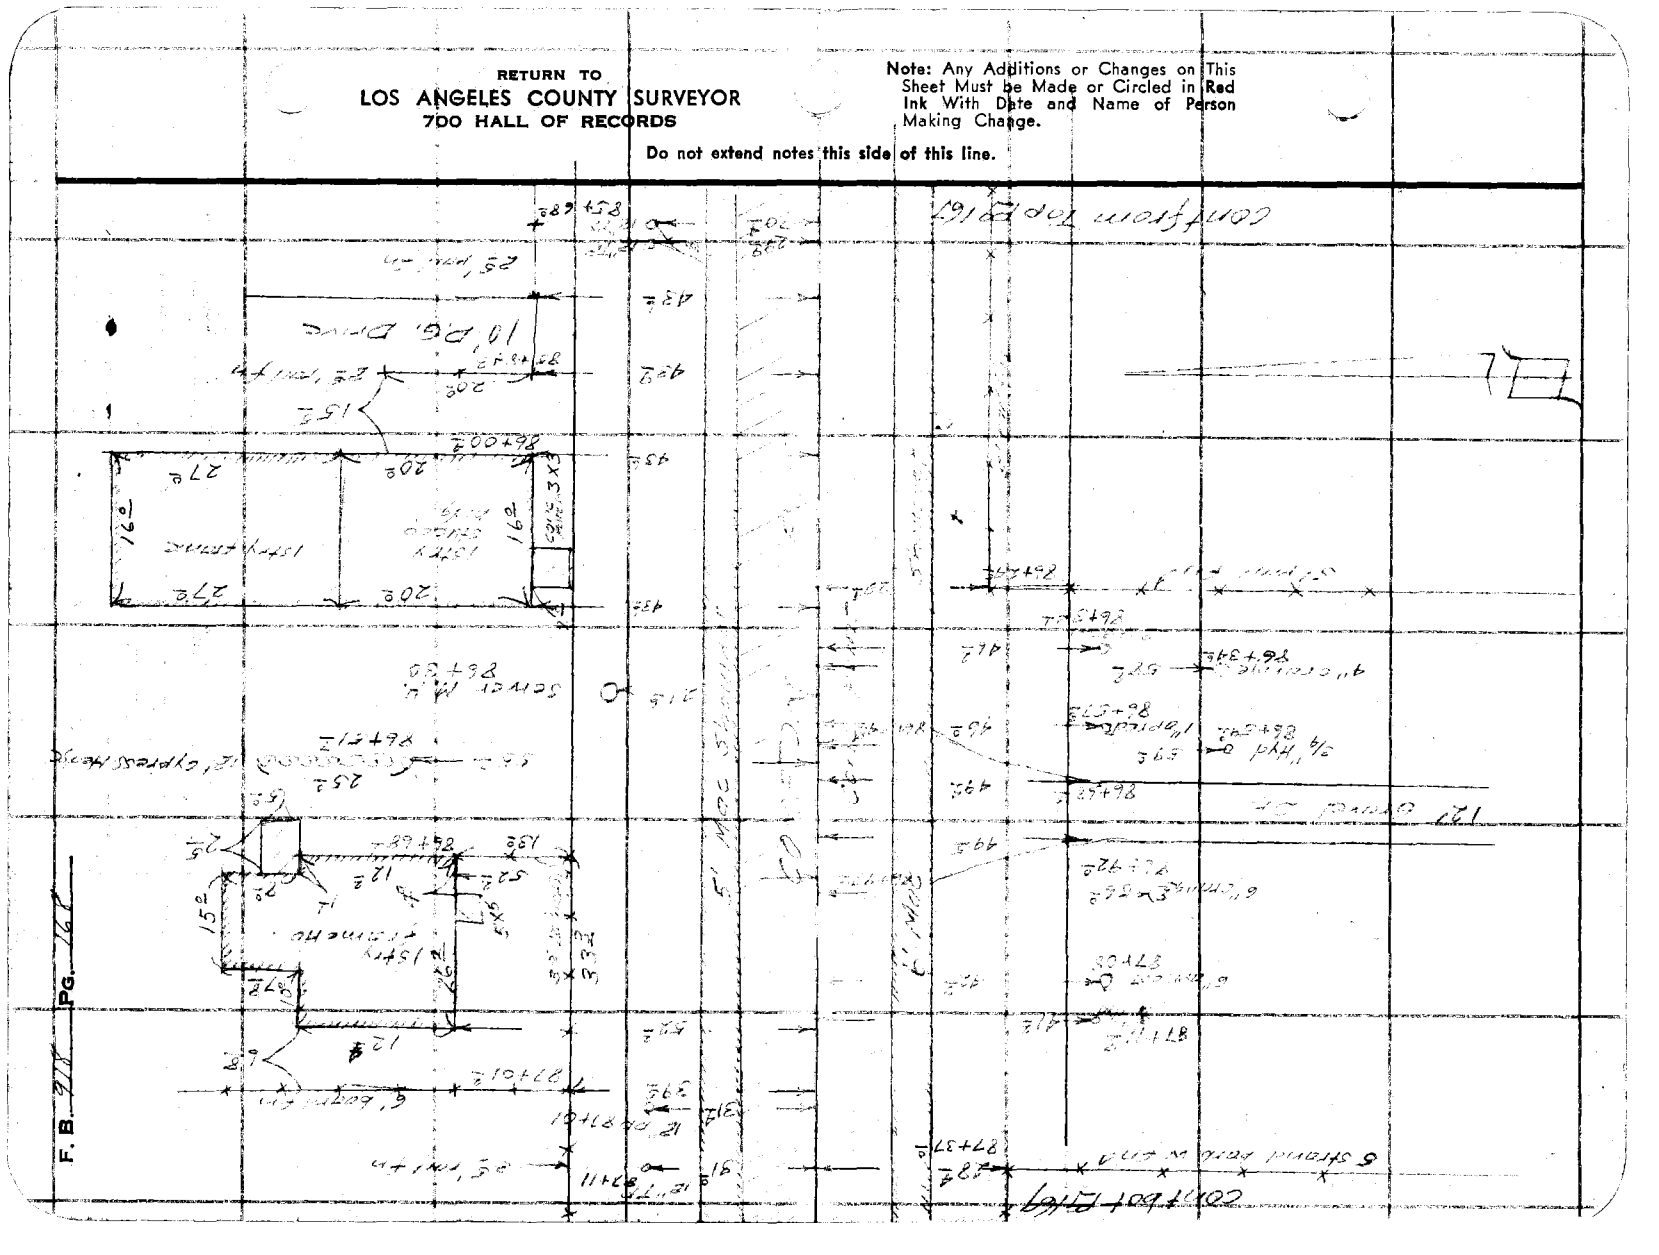

Notes Ck'd by D. M. Finley	Survey of
Map No. B-1842-6	W. O. 8[illegible] Tape No. St'd °F
Office Work Cox	Surveyed by R. L. Miller
Checked D. M. Finley	Notes R. L. M. & L. L. E. Date 3-X-48
Date AUG '51	Indexed A. C. Johnson


Note: Any Additions or Changes on This Sheet Must be Made or Circled in Red Ink With Date and Name of Person Making Change.

Do not extend notes this side of this line.

RETURN TO
LOS ANGELES COUNTY SURVEYOR
700 HALL OF RECORDS

FORM 247 SM 5-46

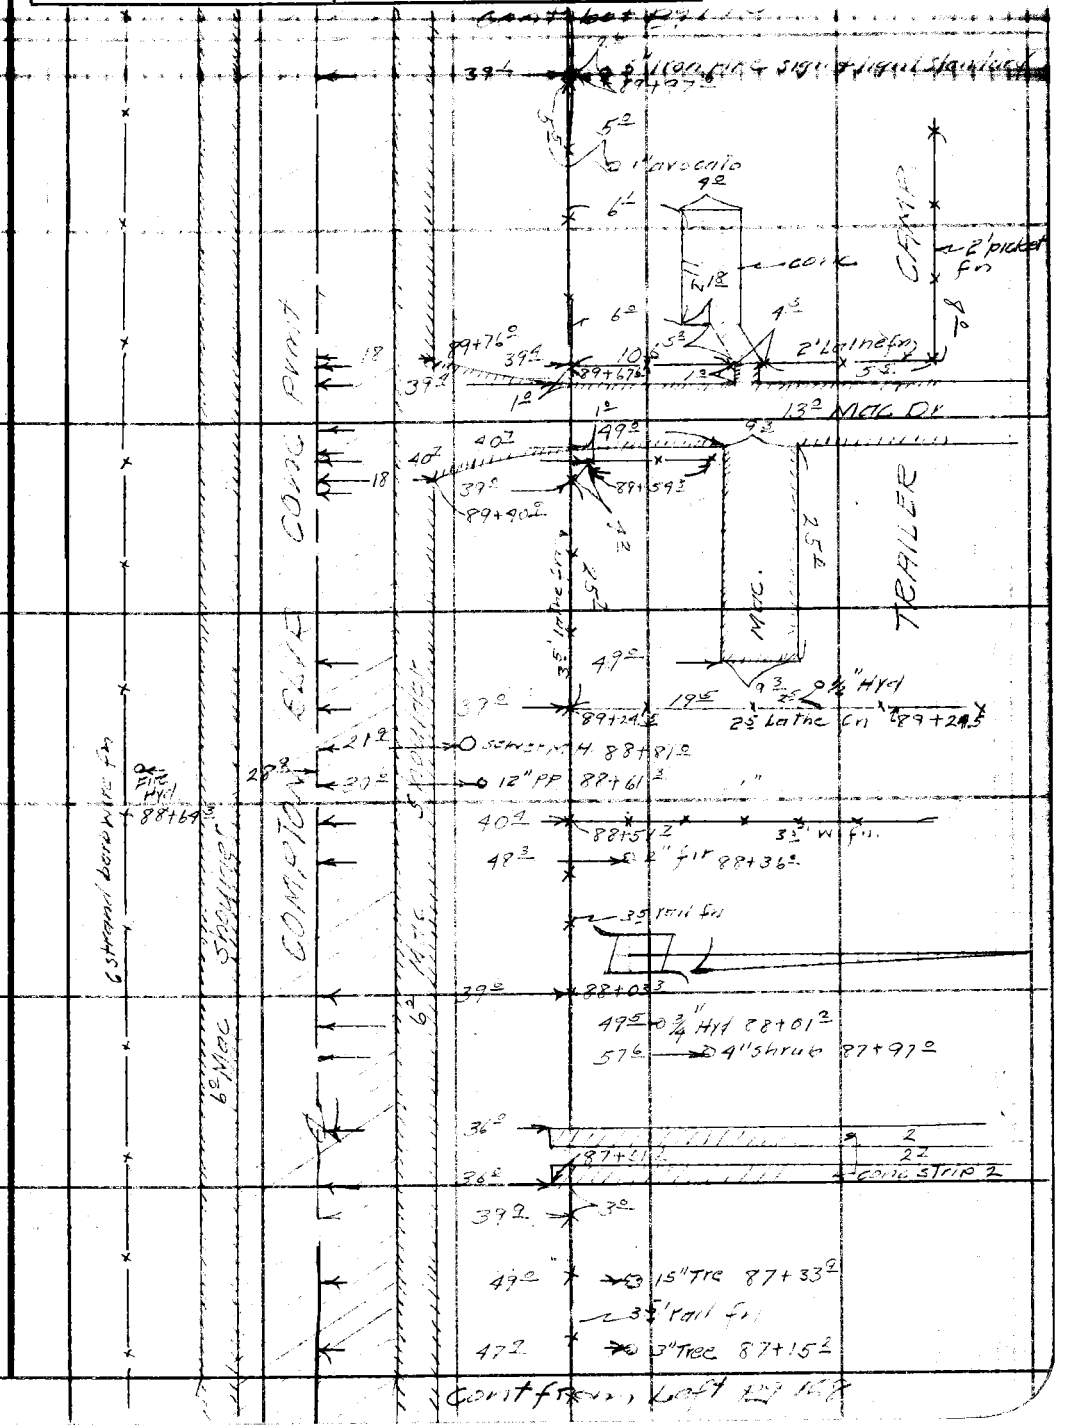
Compton Blvd
Mac Dr
Trailer
Mac.
Compton Blvd
Spruce
Mac
Mac
Mac

F. B. 18 Pg. 170

cont right Pg 171

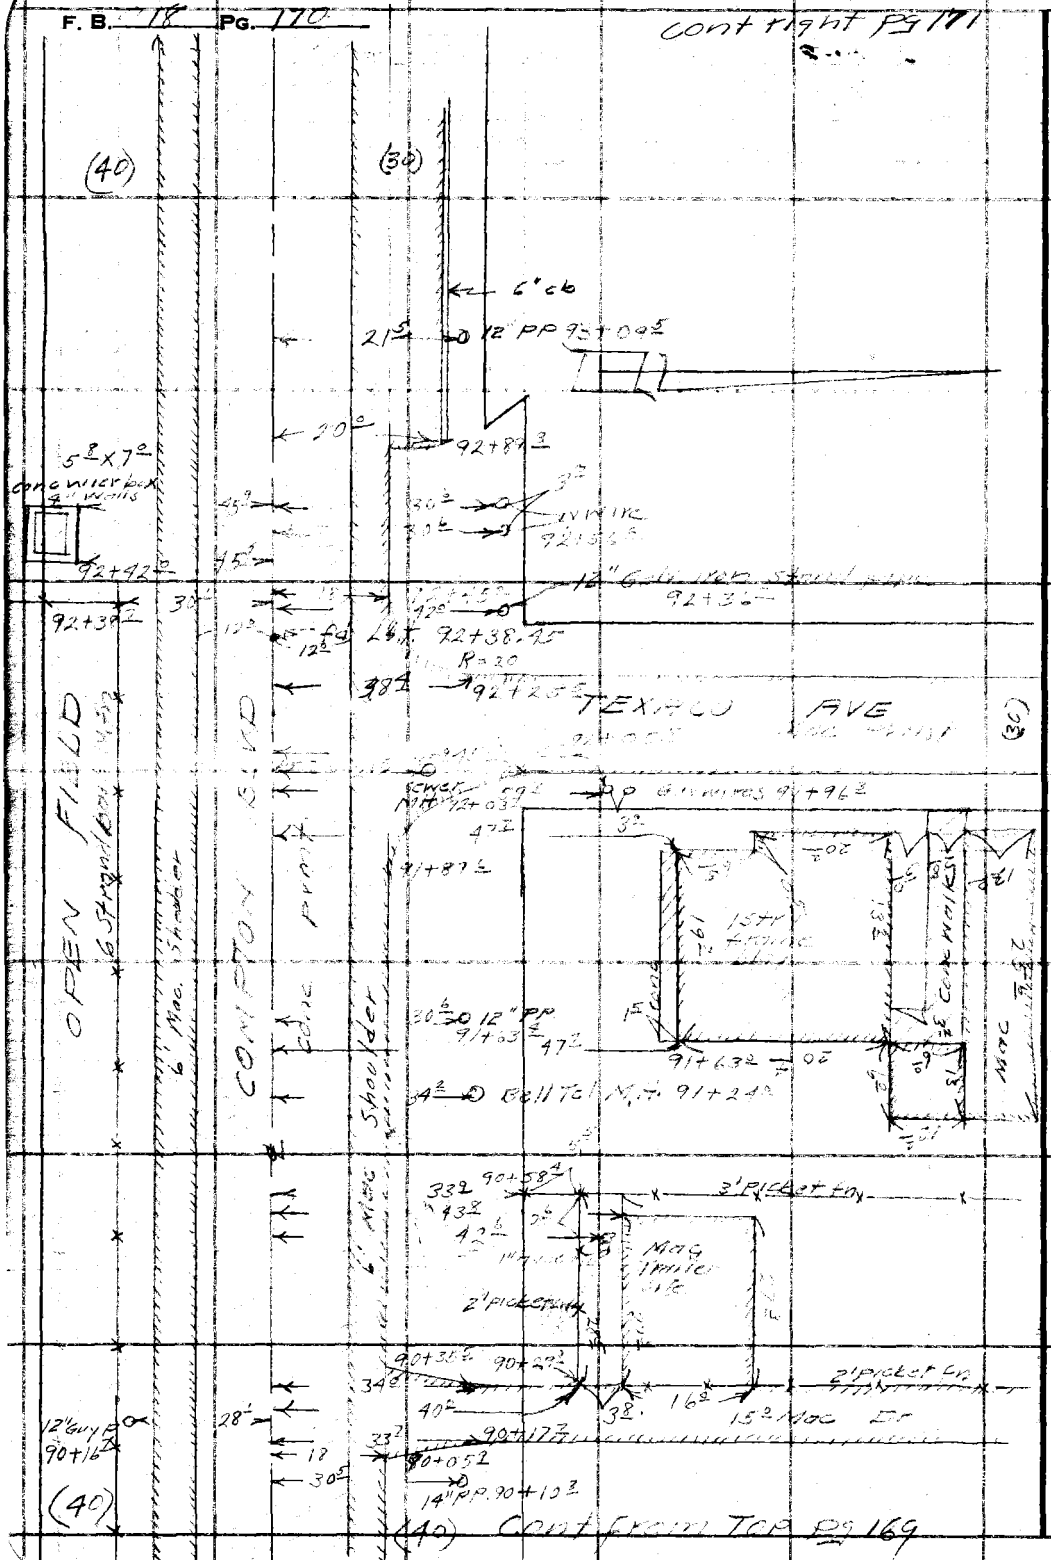

RETURN TO
LOS ANGELES COUNTY SURVEYOR
700 HALL OF RECORDS

Note: Any Additions or Changes on This Sheet Must Be Made or Circled in Red Ink With Date and Name of Person Making Change.

Do not extend notes this side of this line.

FORM 247 5M 5-46

RETURN TO
LOS ANGELES COUNTY SURVEYOR
700 HALL OF RECORDS

Note: Any Additions or Changes on This Sheet Must be Made or Circled in Red Ink With Date and Name of Person Making Change.

Do not extend notes this side of this line.

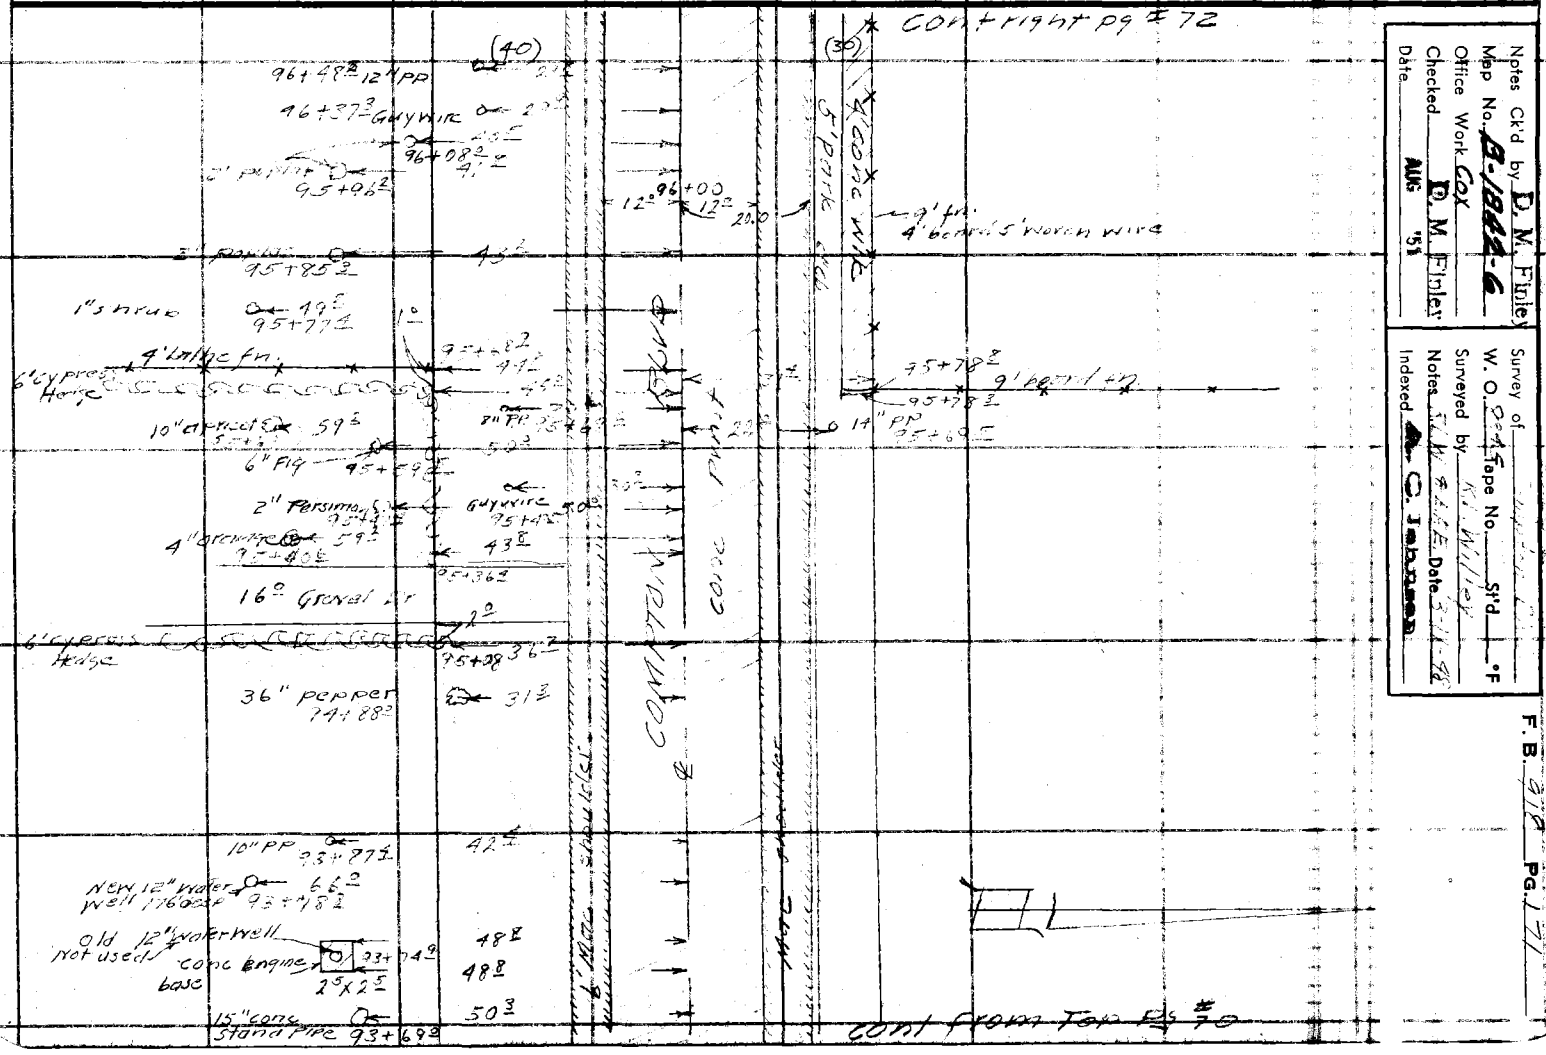

Notes Ck'd by D. M. Finley
Map No. B-1844-6
Office Work Cox
Checked D. M. Finley
Date Aug '51

Survey of
W. O. 2241 Tape No. S'd °F
Surveyed by
Notes
Indexed C. Johnson


RETURN TO
LOS ANGELES COUNTY SURVEYOR
700 HALL OF RECORDS

Note: Any Additions or Changes on This Sheet Must be Made or Circled in Red Ink With Date and Name of Person Making Change.

Do not extend notes this side of this line.


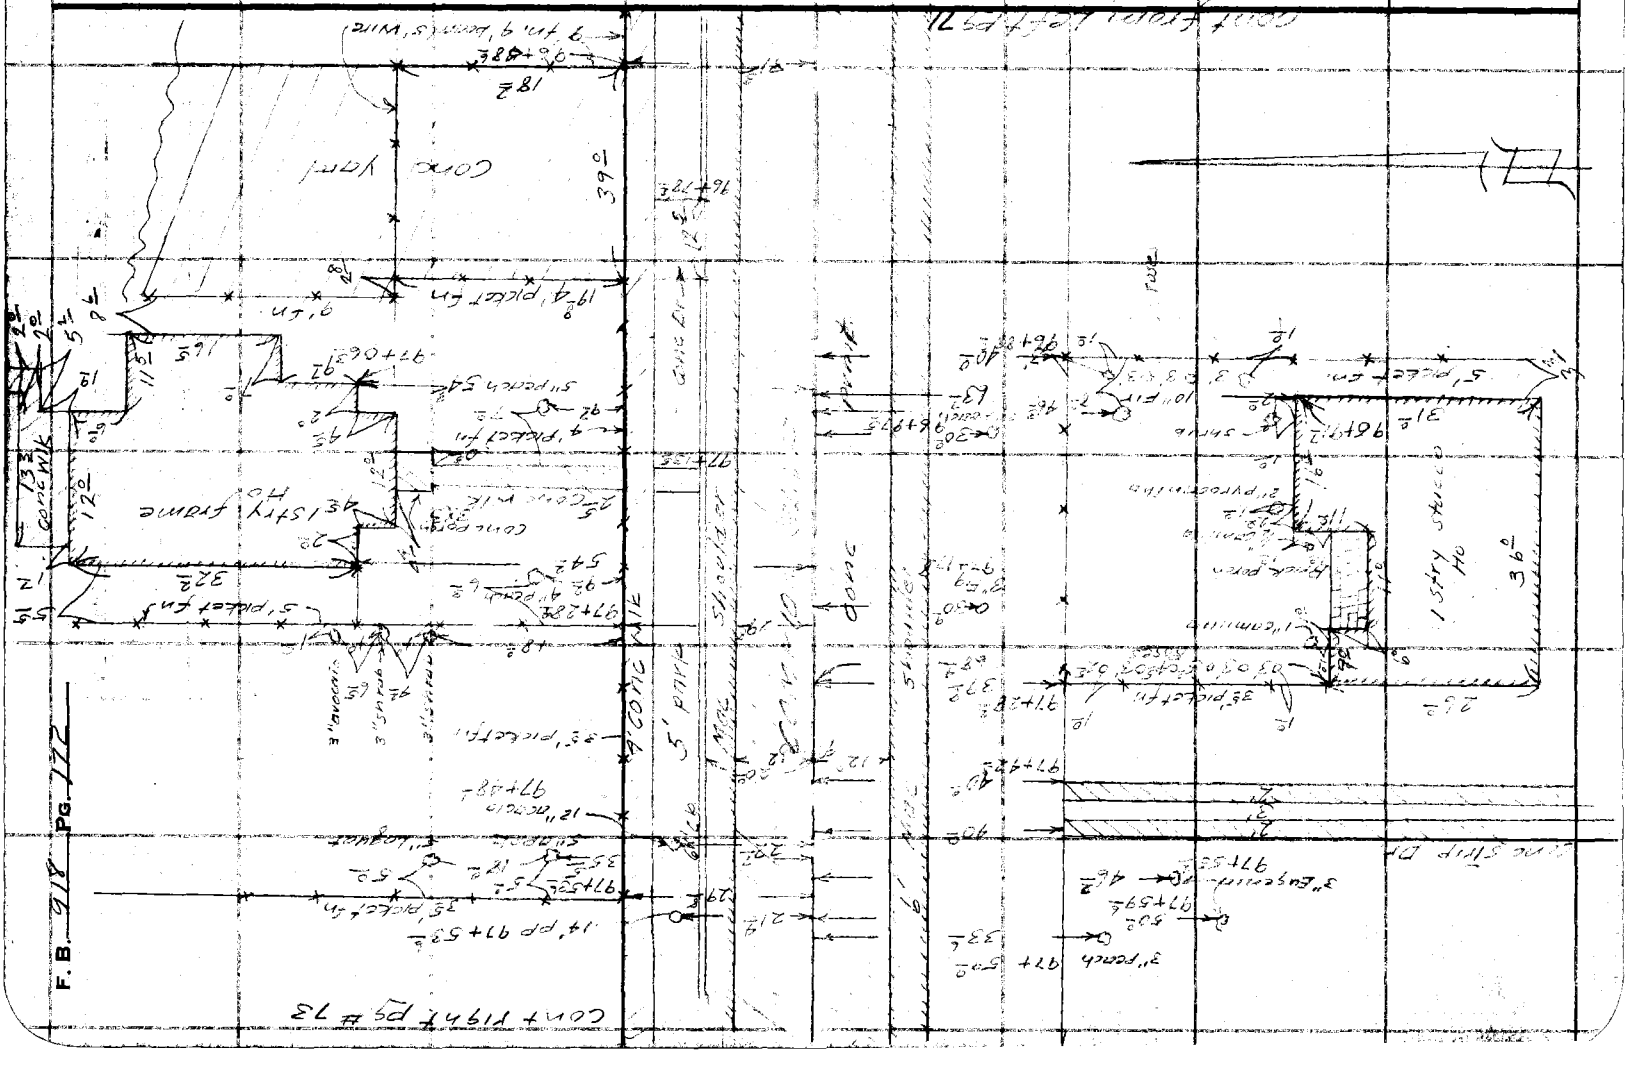
CONC WALK
CONC DR
CONC PORCH
1 STORY FRAME HO

FORM 247 5M 5-46

RETURN TO
LOS ANGELES COUNTY SURVEYOR
700 HALL OF RECORDS

Note: Any Additions or Changes on This Sheet Must be Made or Circled in Red Ink With Date and Name of Person Making Change.

Do not extend notes this side of this line.

Notes Ck'd by D. M. Finley
Map No. C-1844-6
Office Work Cox
Checked D. M. Finley
Date AUG '51

Survey of
W. O. 8315 Tape No. Std. °F
Surveyed by R.L.W. & E.L.C.
Notes R.L.W. & E.L.C. Date 7-12-49
Indexed [illegible] Johnson

F. B. 27 PG. 173

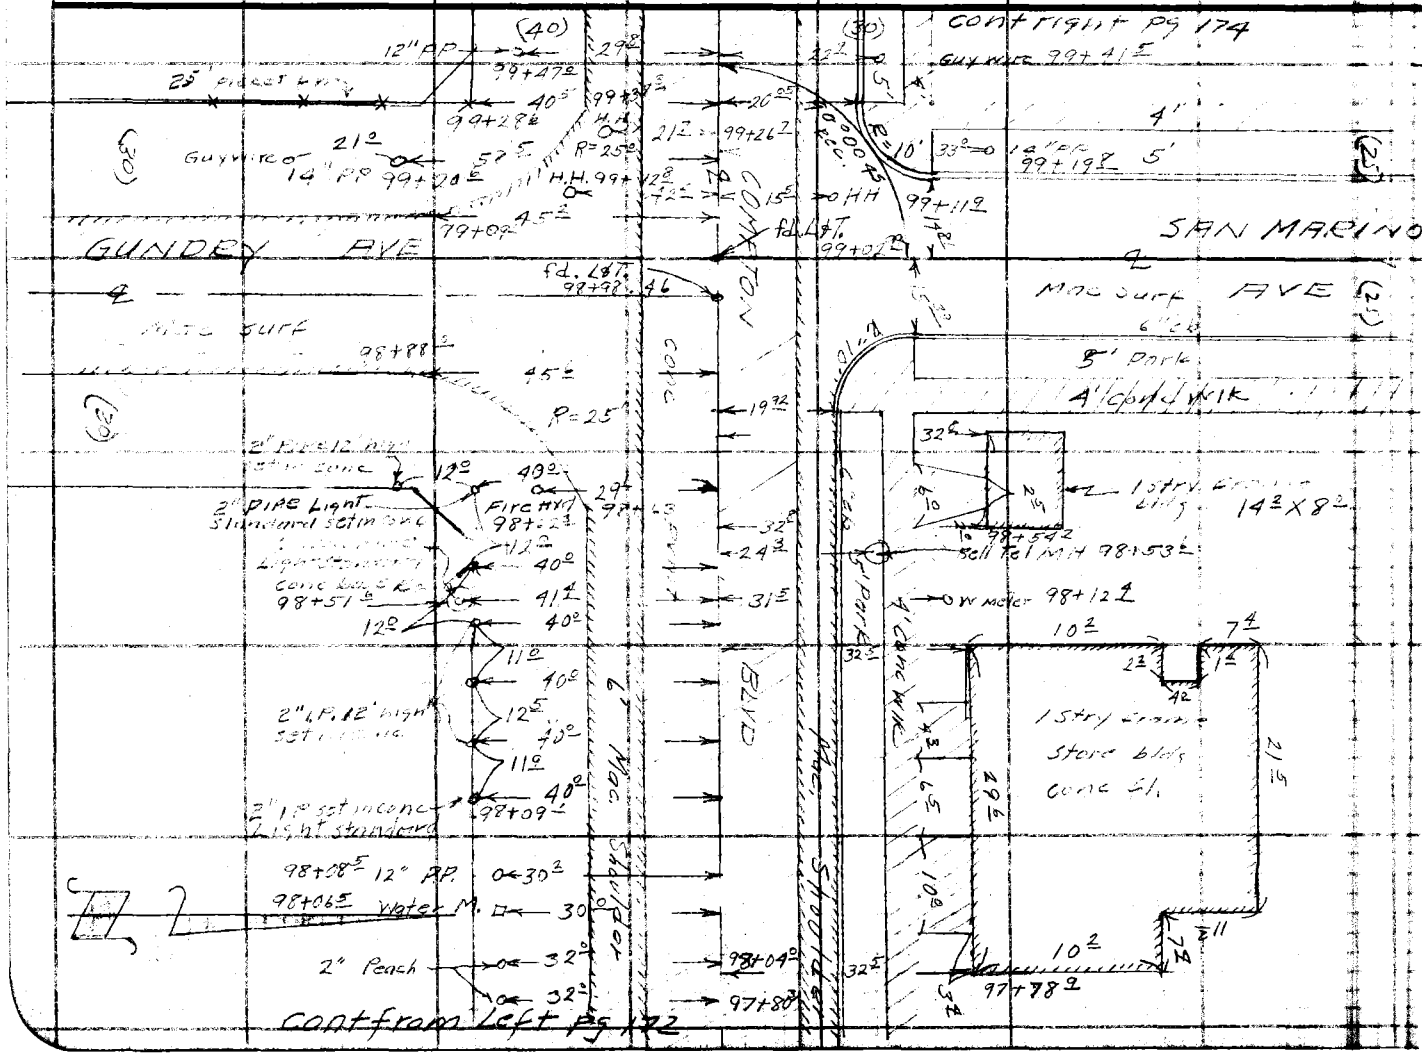
GUNDRY AVE
MacDuff AVE
SAN MARINO
BLVD
cont right Pg 174
cont from Left Pg 172
Guy wire 99+41 E
12" AP 99+47 E
99+28 E
99+26 E
99+19 E
99+11 E
99+09 E
98+98 E
98+88 E
98+65 E
98+54 E
98+53 E
98+12 E
98+09 E
98+04 E
97+88 E
97+78 E
Fd. L&T. 98+98. 46
Fd. L&T. 99+09
Fd. L&T. 99+11
Curb Return
Curb
Conc
5' Park
4' Conc Walk
6" Conc
Fire Hyd
Water M.
Sell Tel M.H.
W. Meter
1 Sty Frame Store Bldg Conc Fl.
14' X 8'
2" Peach
2" Pipe Light Standard set in Conc
2" L.P. 12' high set in conc
2" L.P. set in conc Light Standard
Conc Curb & Gutter
Conc Curb & Gutter
Conc Curb & Gutter

RETURN TO
LOS ANGELES COUNTY SURVEYOR
700 HALL OF RECORDS

Note: Any Additions or Changes on This Sheet Must be Made or Circled in Red Ink With Date and Name of Person Making Change.

Do not extend notes this side of this line.

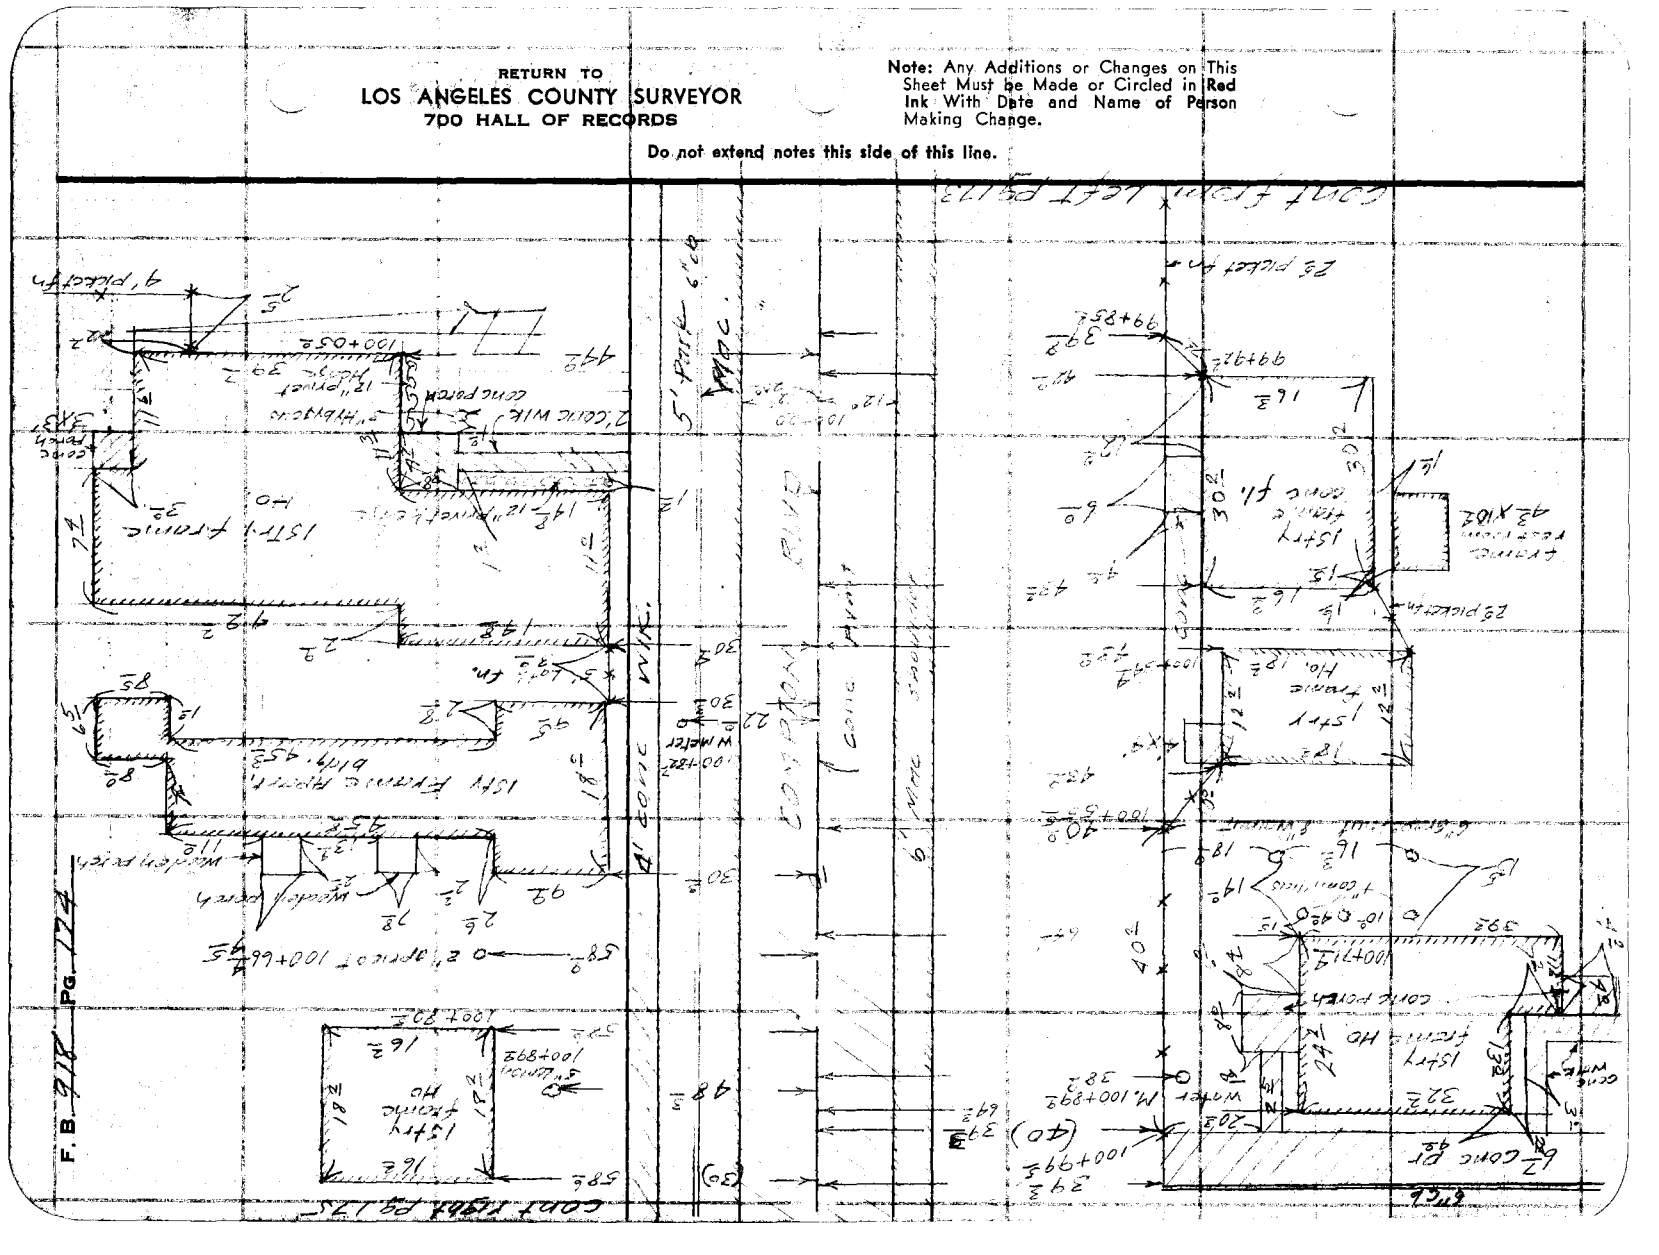
CONT. FROM LEFT PG 173
CONT. FROM PG 173
15TH FRAME
15TH FRAME HO
15TH FRAME PORCH
CONC PORCH
CONC WLK
CONC PL

FORM 247 5M 5-46

RETURN TO
LOS ANGELES COUNTY SURVEYOR
700 HALL OF RECORDS

Note: Any Additions or Changes on This Sheet Must be Made or Circled in Red Ink With Date and Name of Person Making Change.

Do not extend notes this side of this line.

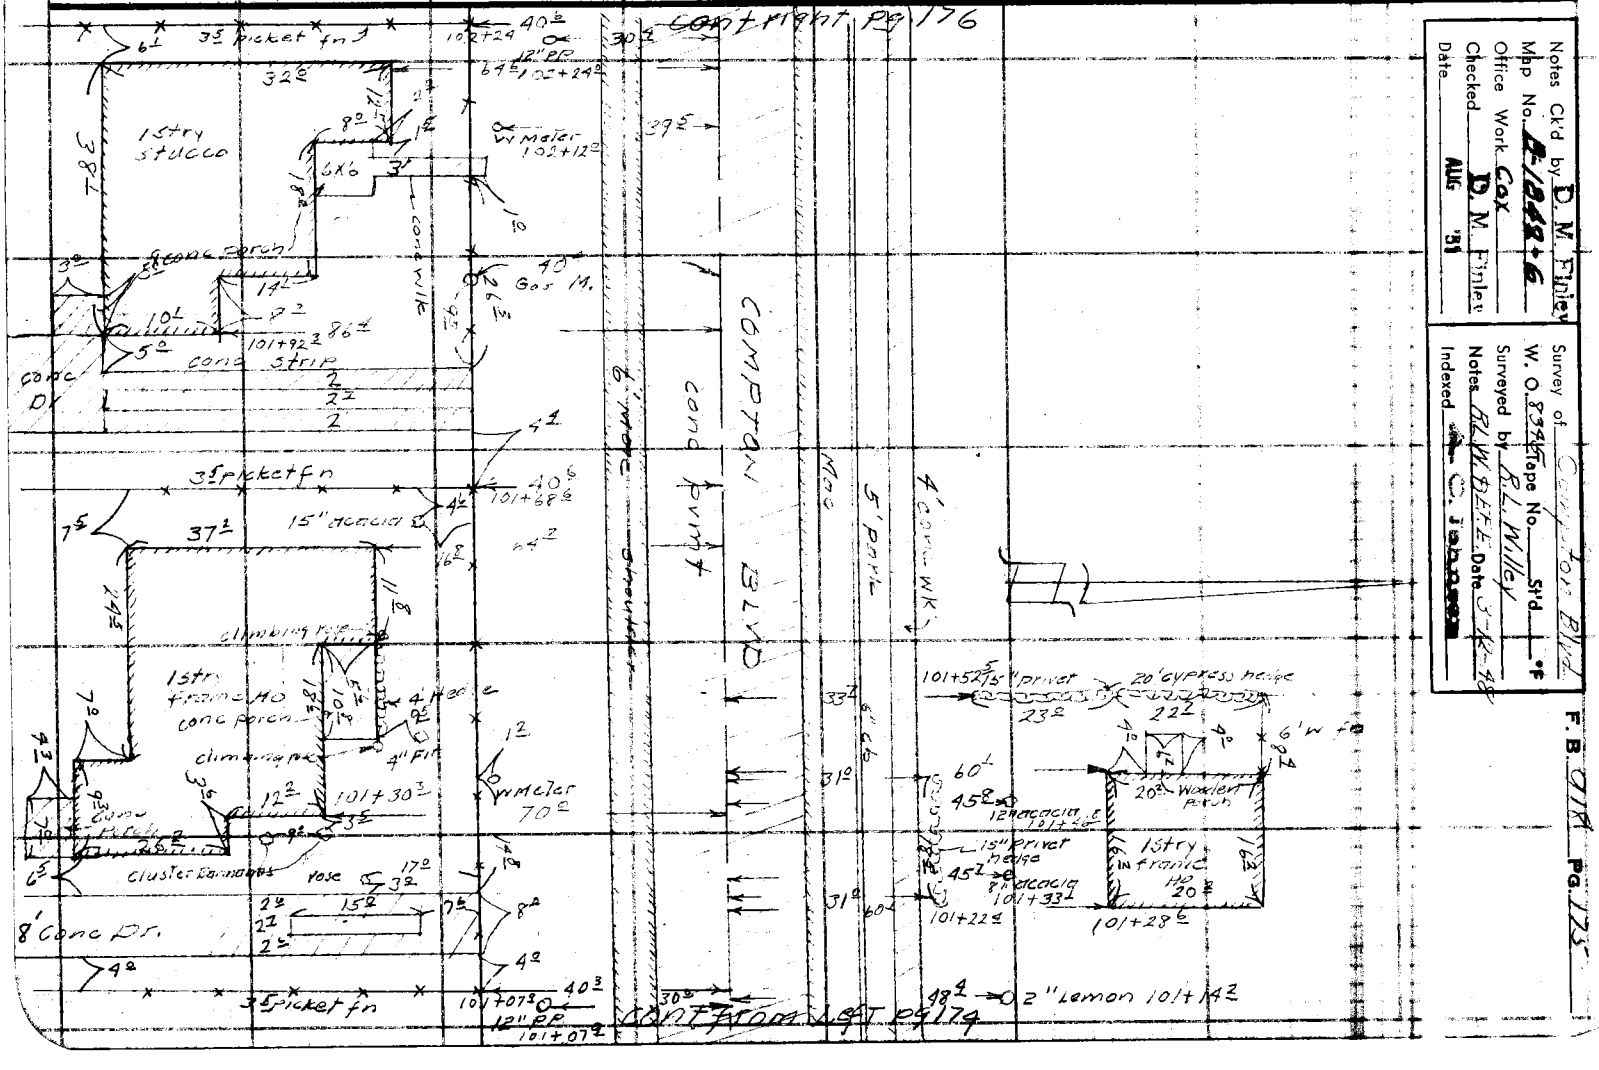

Notes Ck'd by D. M. Finley
Map No. B-1048-16
Office Work Cox
Checked D. M. Finley
Date AUG '31

Survey of Compton Blvd
W. O. 8334 Tape No. 5th'd °F
Surveyed by R.L.W. DEE Date 7-K-31
Notes
Indexed C. J. [illegible]


RETURN TO
LOS ANGELES COUNTY SURVEYOR
700 HALL OF RECORDS

Note: Any Additions or Changes on This Sheet Must be Made or Circled in Red Ink With Date and Name of Person Making Change.

Do not extend notes this side of this line.


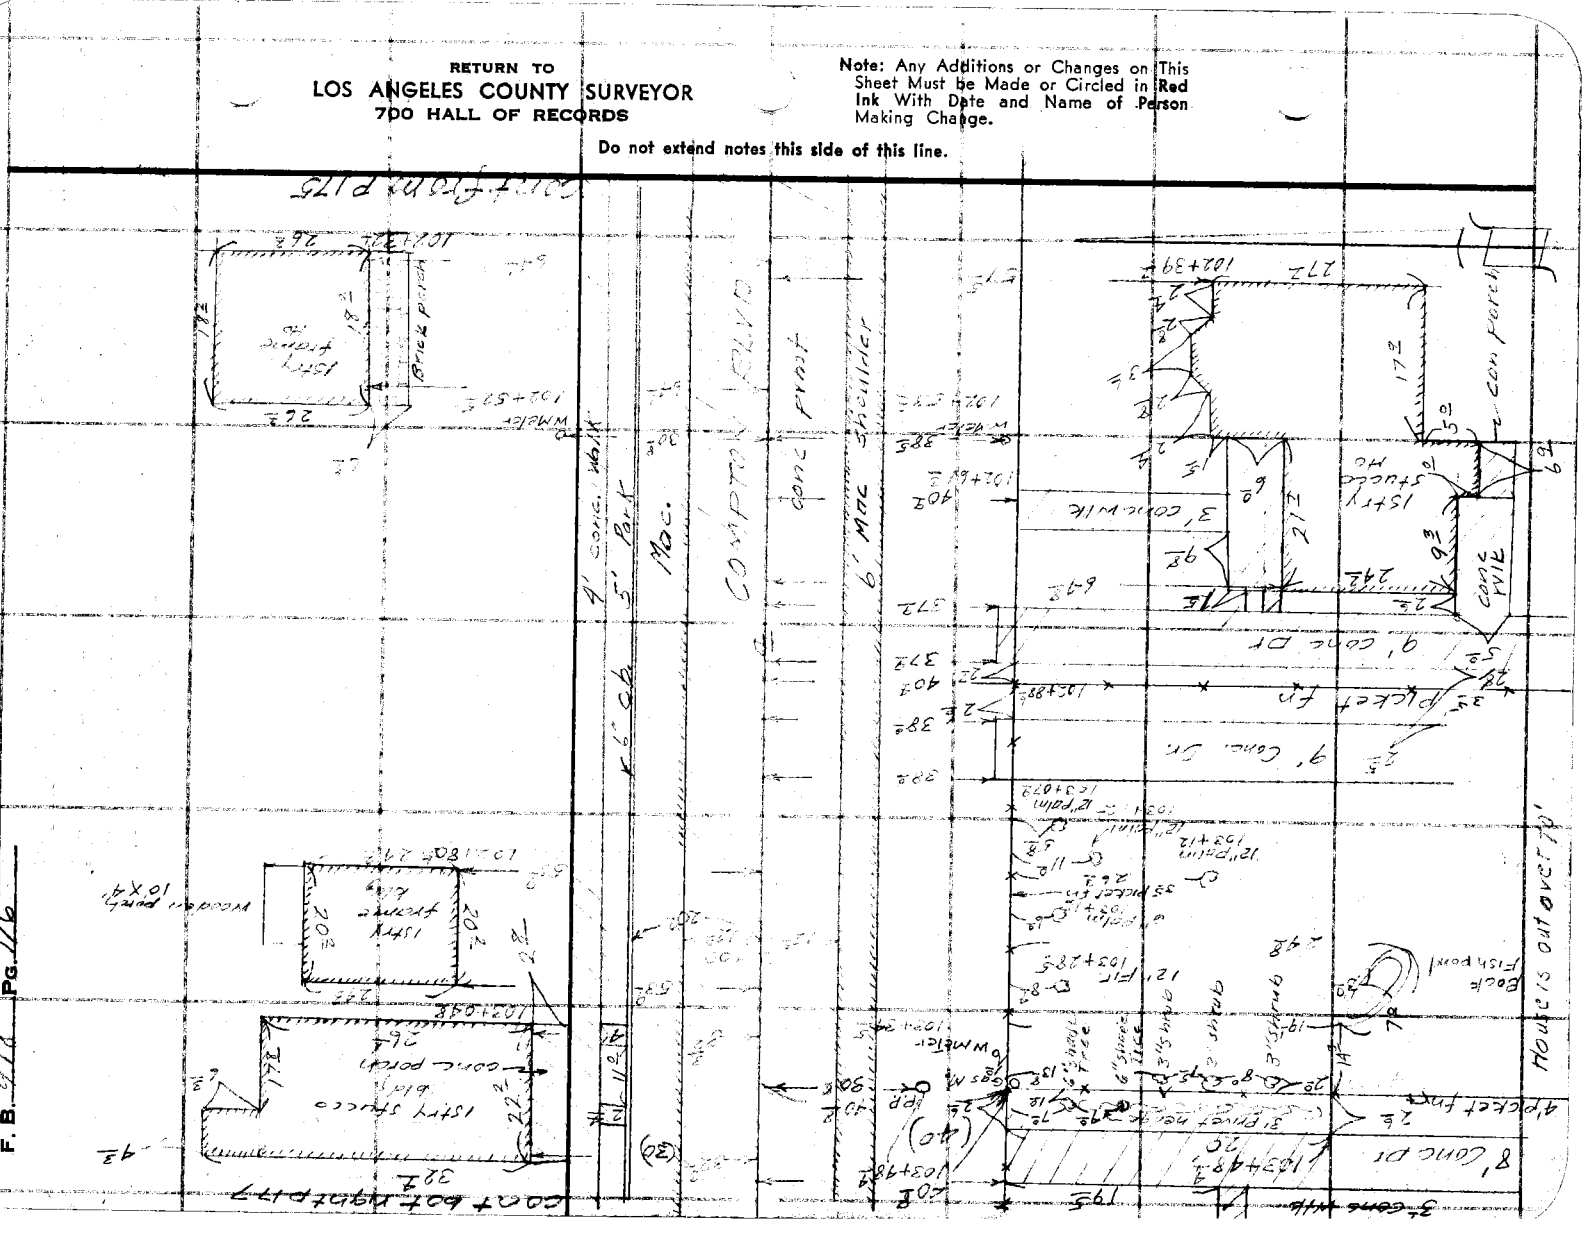
Mac.
4' conc. walk
5' park
9' conc. shoulder
conc. pvmt
15'+y stucco
bldg
3' conc. walk
9' conc. dr
9' conc. sh
8' conc. dr
conc. porch
15'+y frame
bldg
Brick porch
Wood'n. porch
10'x4'
conc. walk
conc. pvmt
conc. porch
15'+y stucco
bldg

FORM 247 5M 5-46

RETURN TO
LOS ANGELES COUNTY SURVEYOR
700 HALL OF RECORDS

Note: Any Additions or Changes on This Sheet Must be Made or Circled in Red Ink With Date and Name of Person Making Change.

Do not extend notes this side of this line.

Notes Ck'd by D. M. Finley
Map No. 7-1852-6
Office Work Cox
Checked D. M. Finley
Date Aug '51

Survey of
W. O. # Tape No. St'd °F
Surveyed by
Notes
Indexed

F. B. 2111 Pg. 177

cont right Pg 178

26±
39±
1 Sty Stucco Store Bldg
26±
104+25±
12±
24±
1 Sty Frame Bldg
104+35±
4' picket fence
40±
row of poplars
12" palm 103+27±
4" Pine
103+19±
38±
5' Curb
4' conc walk
6" curb
R=8±
58±
3' Conc Walk To ho.
103+59±
58±
40±
cont from Left Pg 176

RETURN TO
LOS ANGELES COUNTY SURVEYOR
7DO HALL OF RECORDS

Note: Any Additions or Changes on This Sheet Must be Made or Circled in Red Ink With Date and Name of Person Making Change.

Do not extend notes this side of this line.

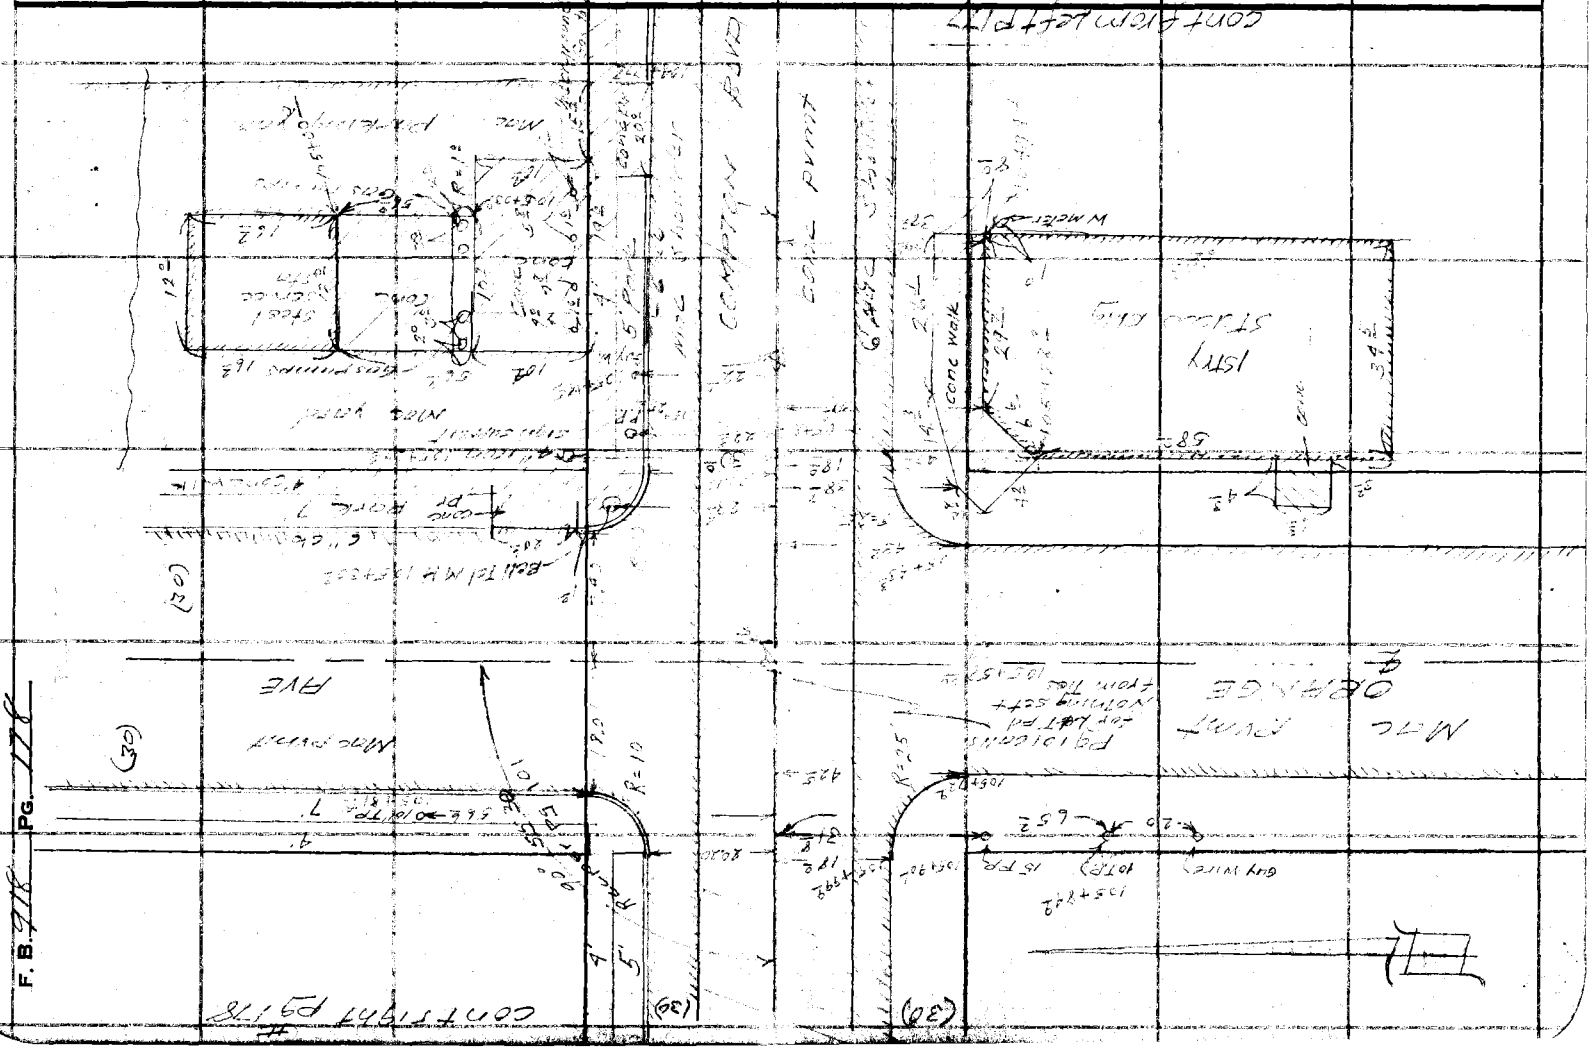
(30)
(30)
(30)

Notes Ck'd by D. M. Finley
Map No. B-1842-6
Office Work Cox
Checked D. M. Finley
Date AUG '51

Survey of
W. O. 234 Tape No. St'd °F
Surveyed by R. L. Finley
Notes Date
Indexed A. C. Johnson

F. B. 911 PG. 177

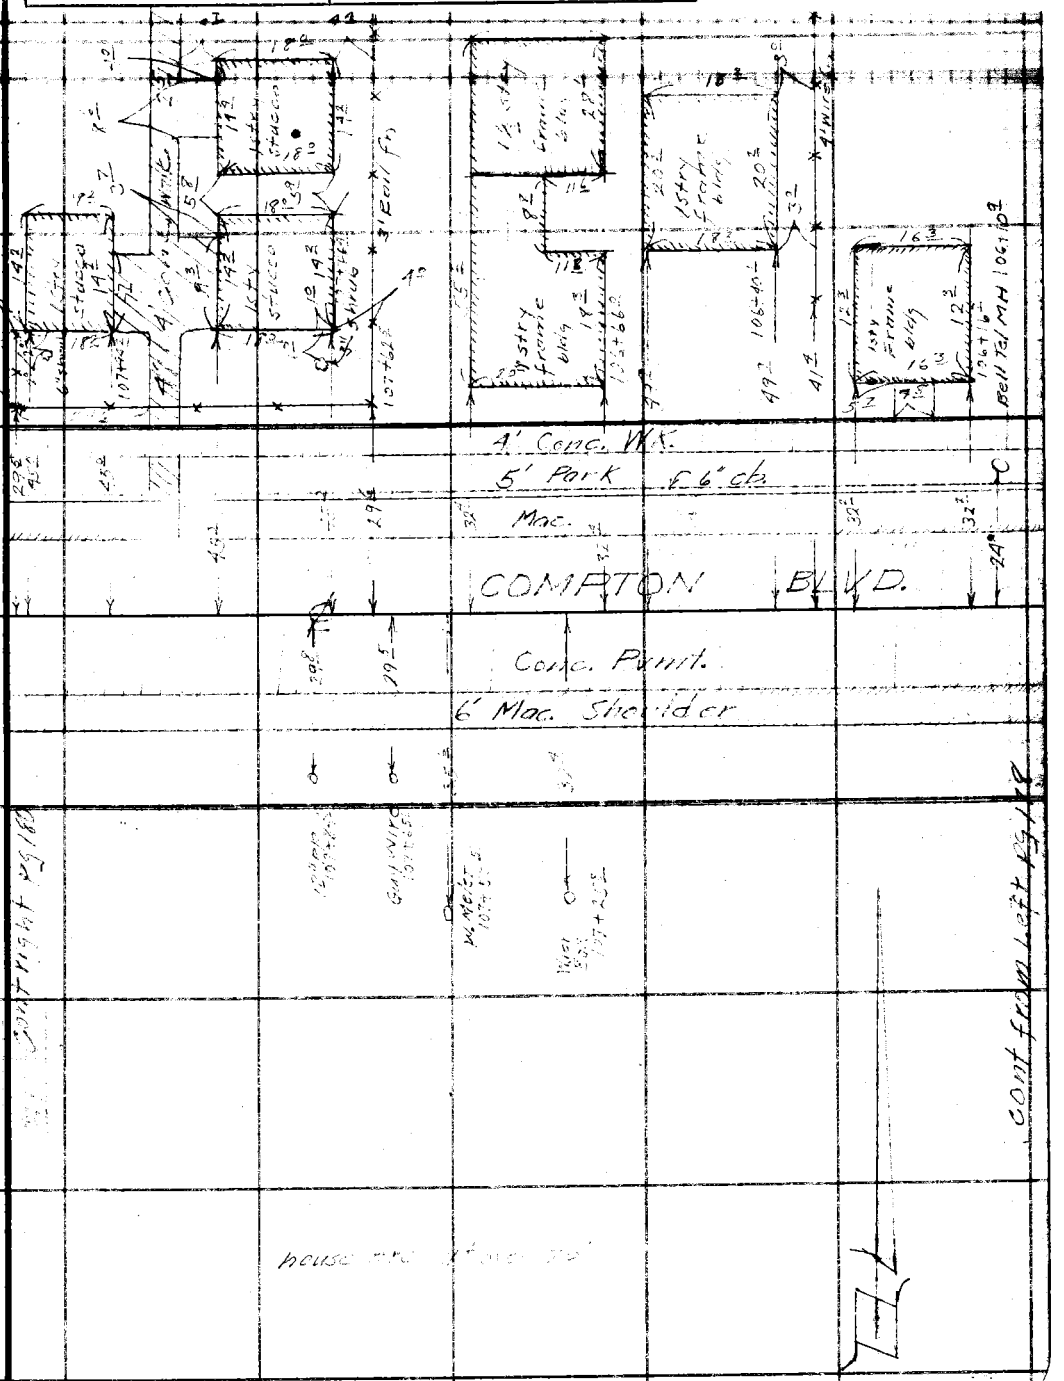

Note: Any Additions or Changes on this Sheet Must be Made or Circled in Red Ink With Date and Name of Person Making Change.

Do not extend notes this side of this line.

RETURN TO
LOS ANGELES COUNTY SURVEYOR
700 HALL OF RECORDS

FORM 247 SM 5-46

RETURN TO
LOS ANGELES COUNTY SURVEYOR
7DO HALL OF RECORDS

Note: Any Additions or Changes on This Sheet Must be Made or Circled in Red Ink With Date and Name of Person Making Change.

Do not extend notes this side of this line.

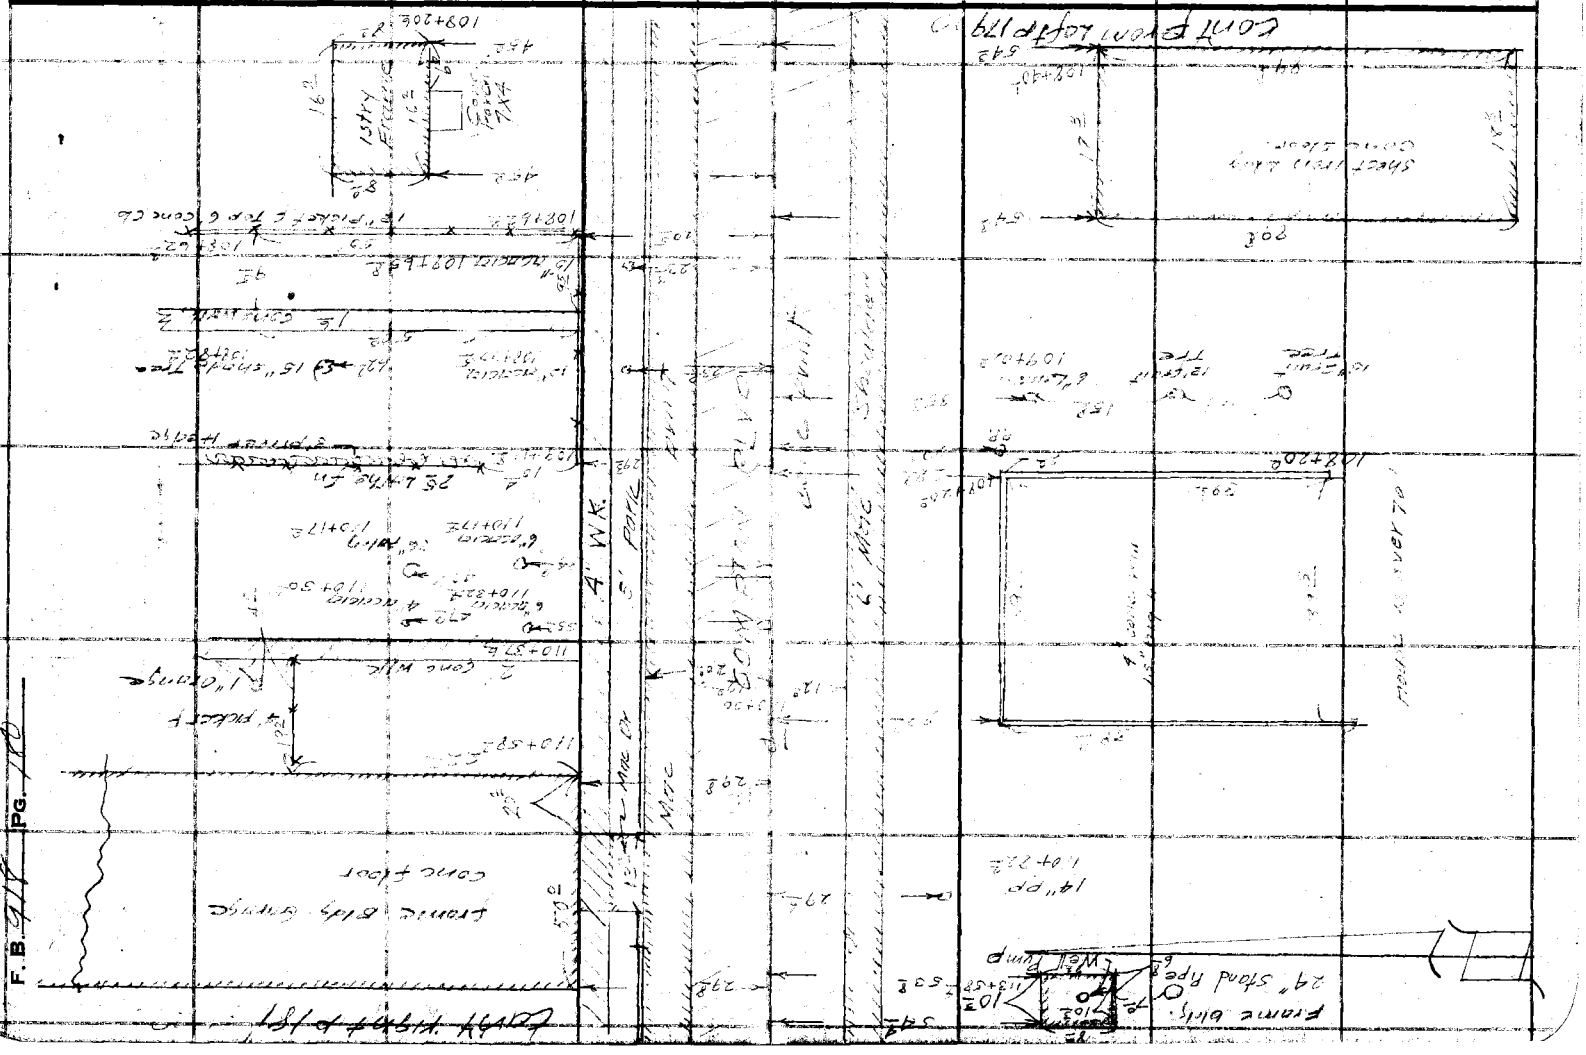

FORM 247 5M 5-46

RETURN TO
LOS ANGELES COUNTY SURVEYOR
700 HALL OF RECORDS

Note: Any Additions or Changes on This Sheet Must be Made or Circled in Red Ink With Date and Name of Person Making Change.

Do not extend notes this side of this line.

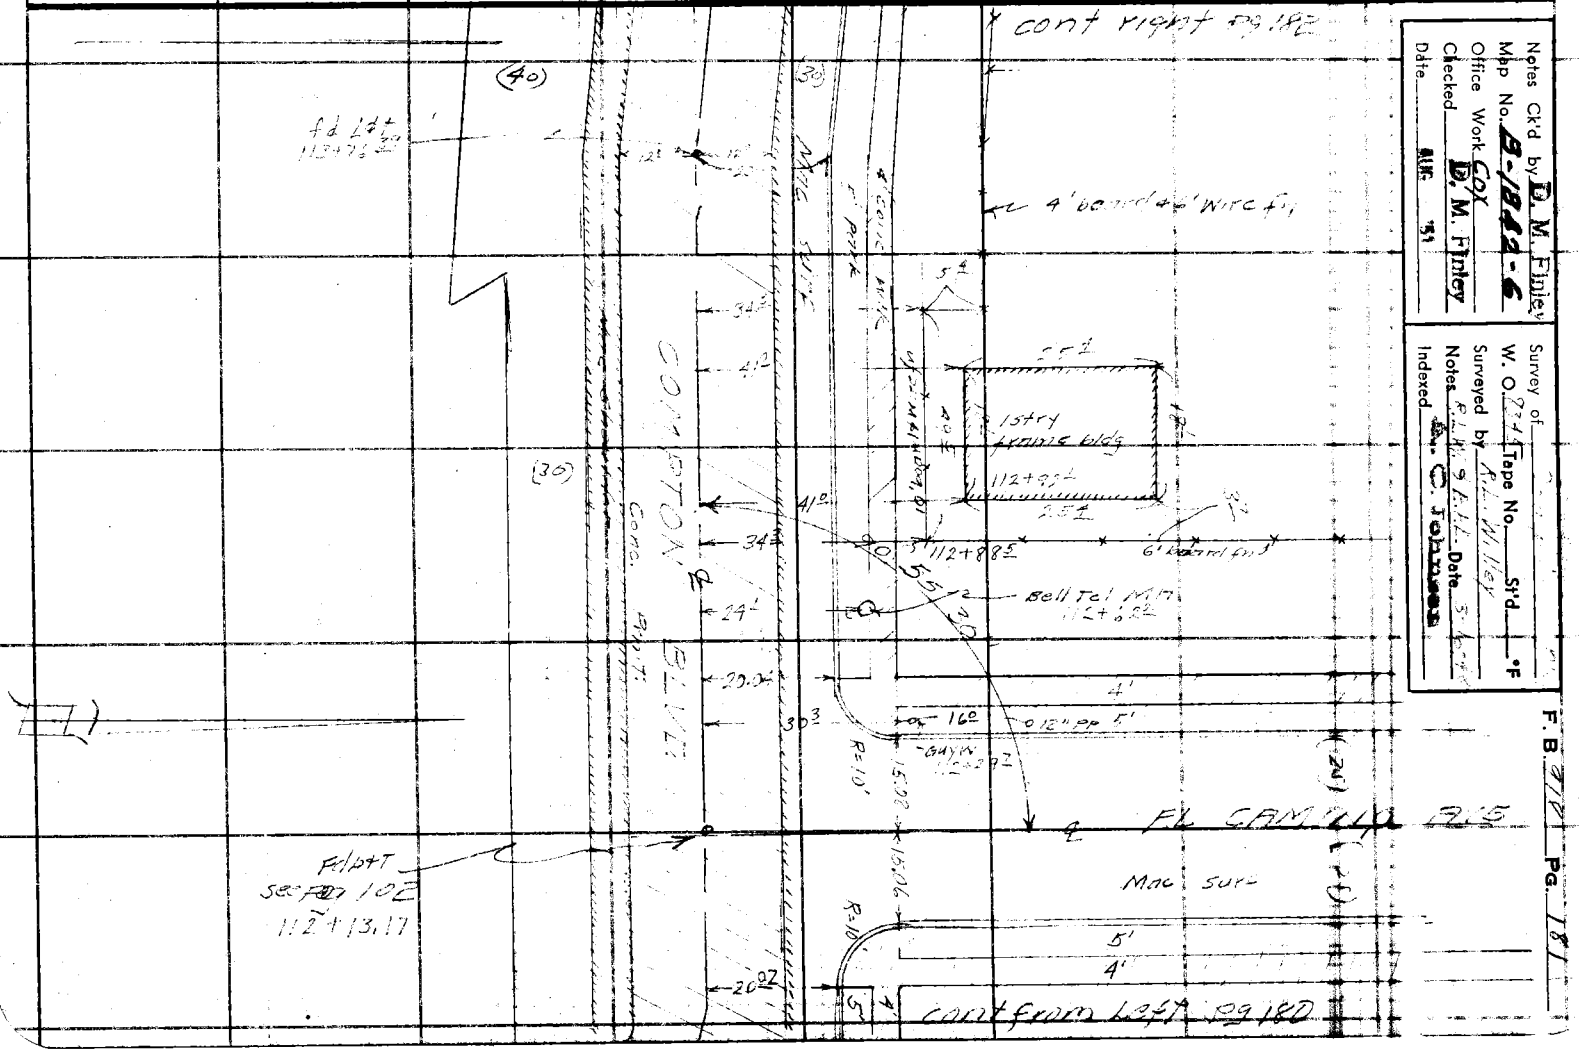

Notes Ck'd by D. M. Finley
Map No. B-1242-6
Office Work COX
Checked D. M. Finley
Date 8/6 51

Survey of
W. O. 7241 Tape No. Std °F
Surveyed by A.L. Wiley
Notes A.L.W. 8.1.51 Date 8.6.51
Indexed Wm. C. Johnson

F. B. 377 PG. 181

RETURN TO
LOS ANGELES COUNTY SURVEYOR
700 HALL OF RECORDS

Note: Any Additions or Changes on This Sheet Must be Made or Circled in Red Ink With Date and Name of Person Making Change.

Do not extend notes this side of this line.

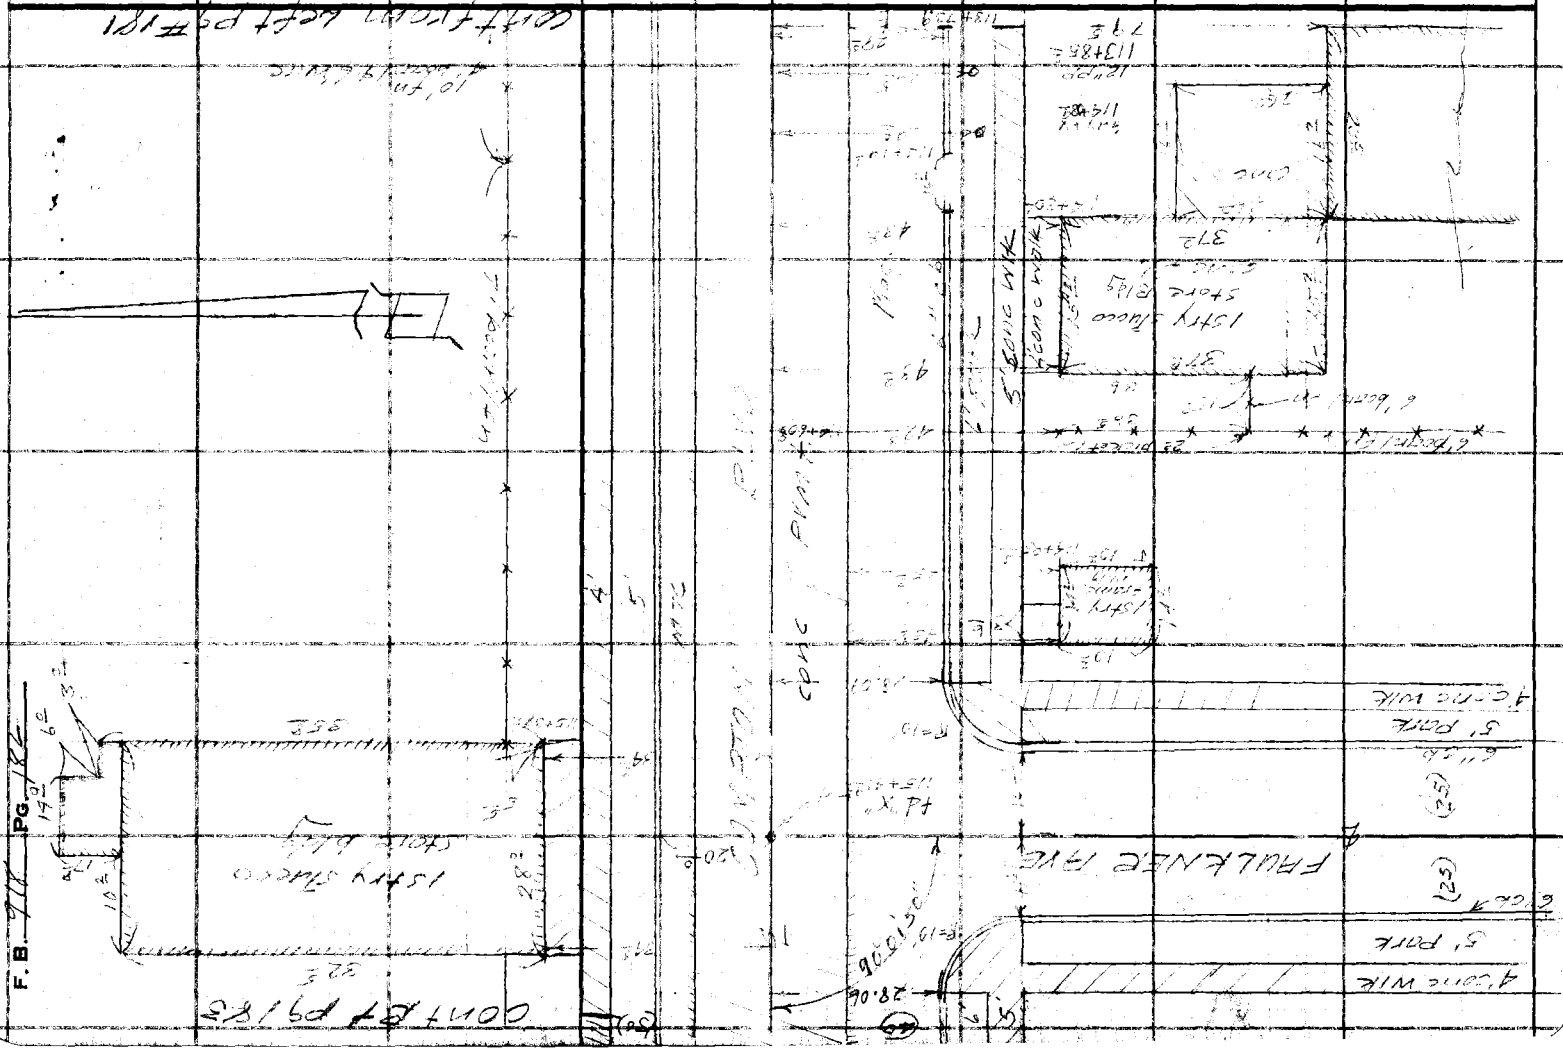

Notes Ck'd by D. M. Finley
Map No. 8-1842-6
Office Work Cox
Checked D. M. Finley
Date AUG '51

Survey of
W. O. 9345 Tape No. St'd °F
Surveyed by E. L. Willey
Notes R.L.W. D.L.F. Date 2-6-51
Indexed A. C. Johnson

F. B. 918 Pg. 183

Note: Any Additions or Changes on This Sheet Must be Made or Circled in Red Ink With Date and Name of Person Making Change.

Do not extend notes this side of this line.

RETURN TO
LOS ANGELES COUNTY SURVEYOR
700 HALL OF RECORDS

FORM 247 5M 5-46

COMPTON BLVD


4' conc wlk

5' Park

5' conc wlk

6 Park

conc wlk

conc Pr

Park

conc wlk
































RETURN TO
LOS ANGELES COUNTY SURVEYOR
700 HALL OF RECORDS

Note: Any Additions or Changes on This Sheet Must be Made or Circled in Red Ink With Date and Name of Person Making Change.

Do not extend notes this side of this line.

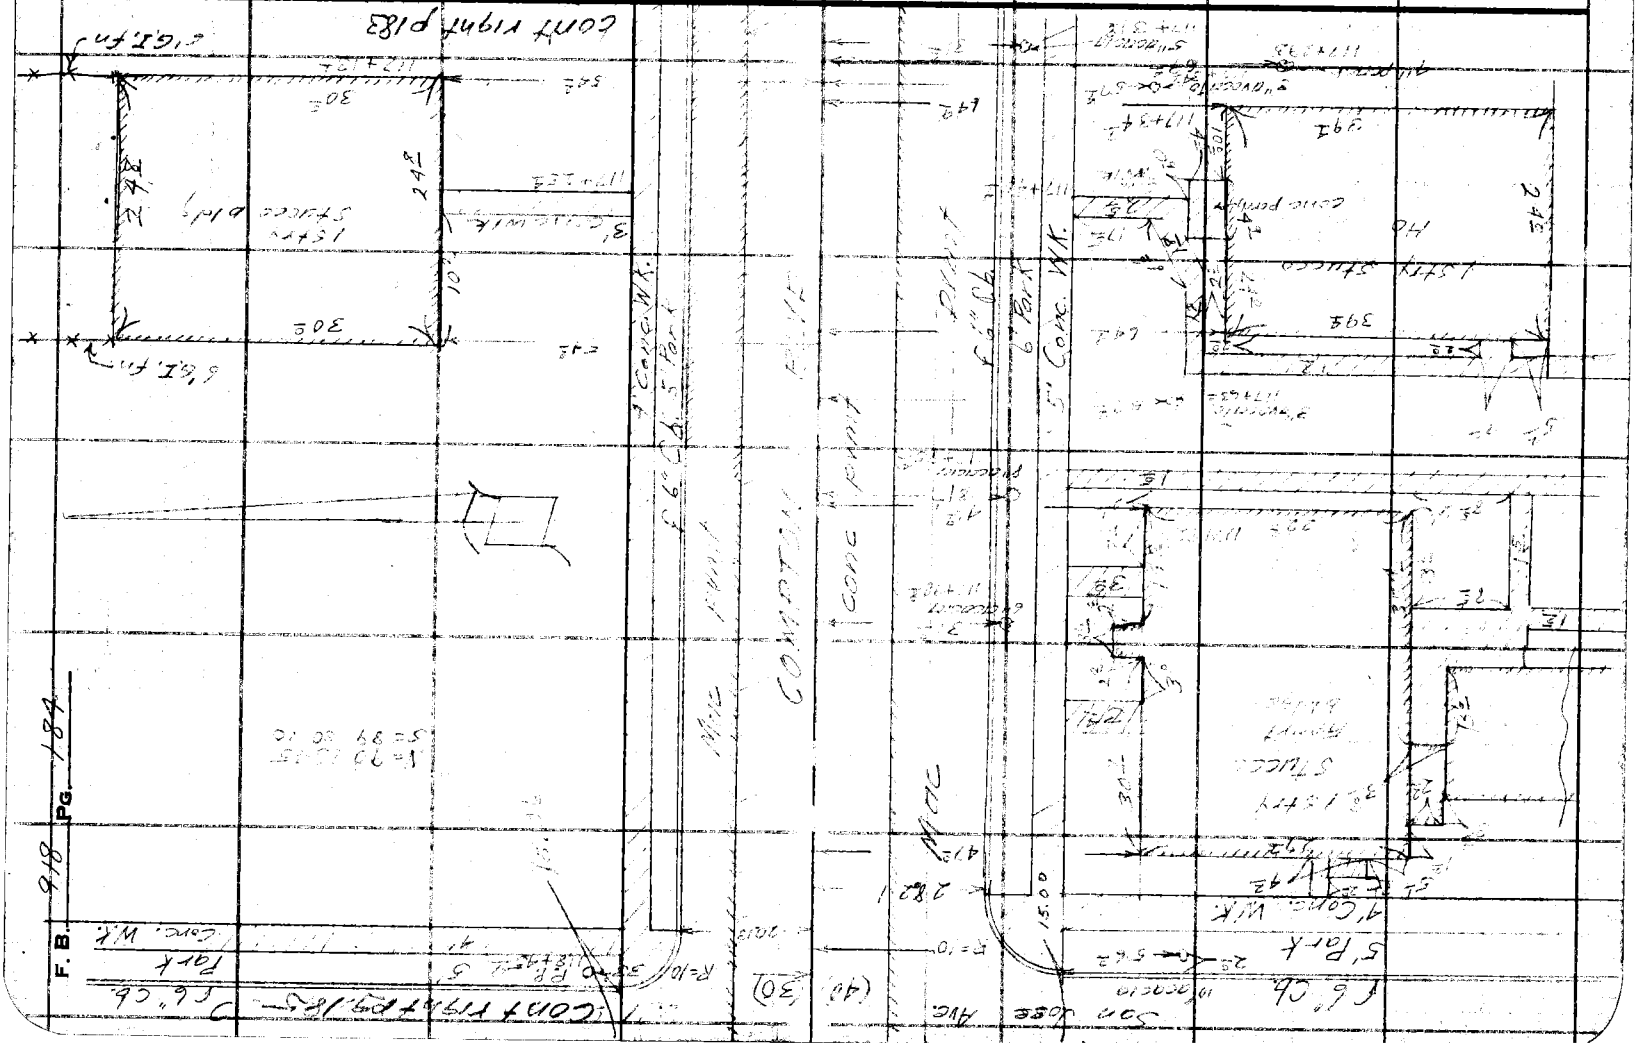
F. B. 918 PG. 184
5' Conc. Walk
6" Conc. Curb
Conc. Walk
Stucco
Comp. Roof
Conc. Pavement

FORM 247 5M 5-46

RETURN TO
LOS ANGELES COUNTY SURVEYOR
700 HALL OF RECORDS

Note: Any Additions or Changes on This Sheet Must be Made or Circled in Red Ink With Date and Name of Person Making Change.

Do not extend notes this side of this line.

Notes Ck'd by D. M. Finley
Map No. 0-1844-6
Office Work Cox
Checked D. M. Finley
Date AUG 51

Survey of
W. O. Tape No. St'd °F
Surveyed by
Notes
Date
Indexed C. C. Johnson

F. B. 777 Pg. 181

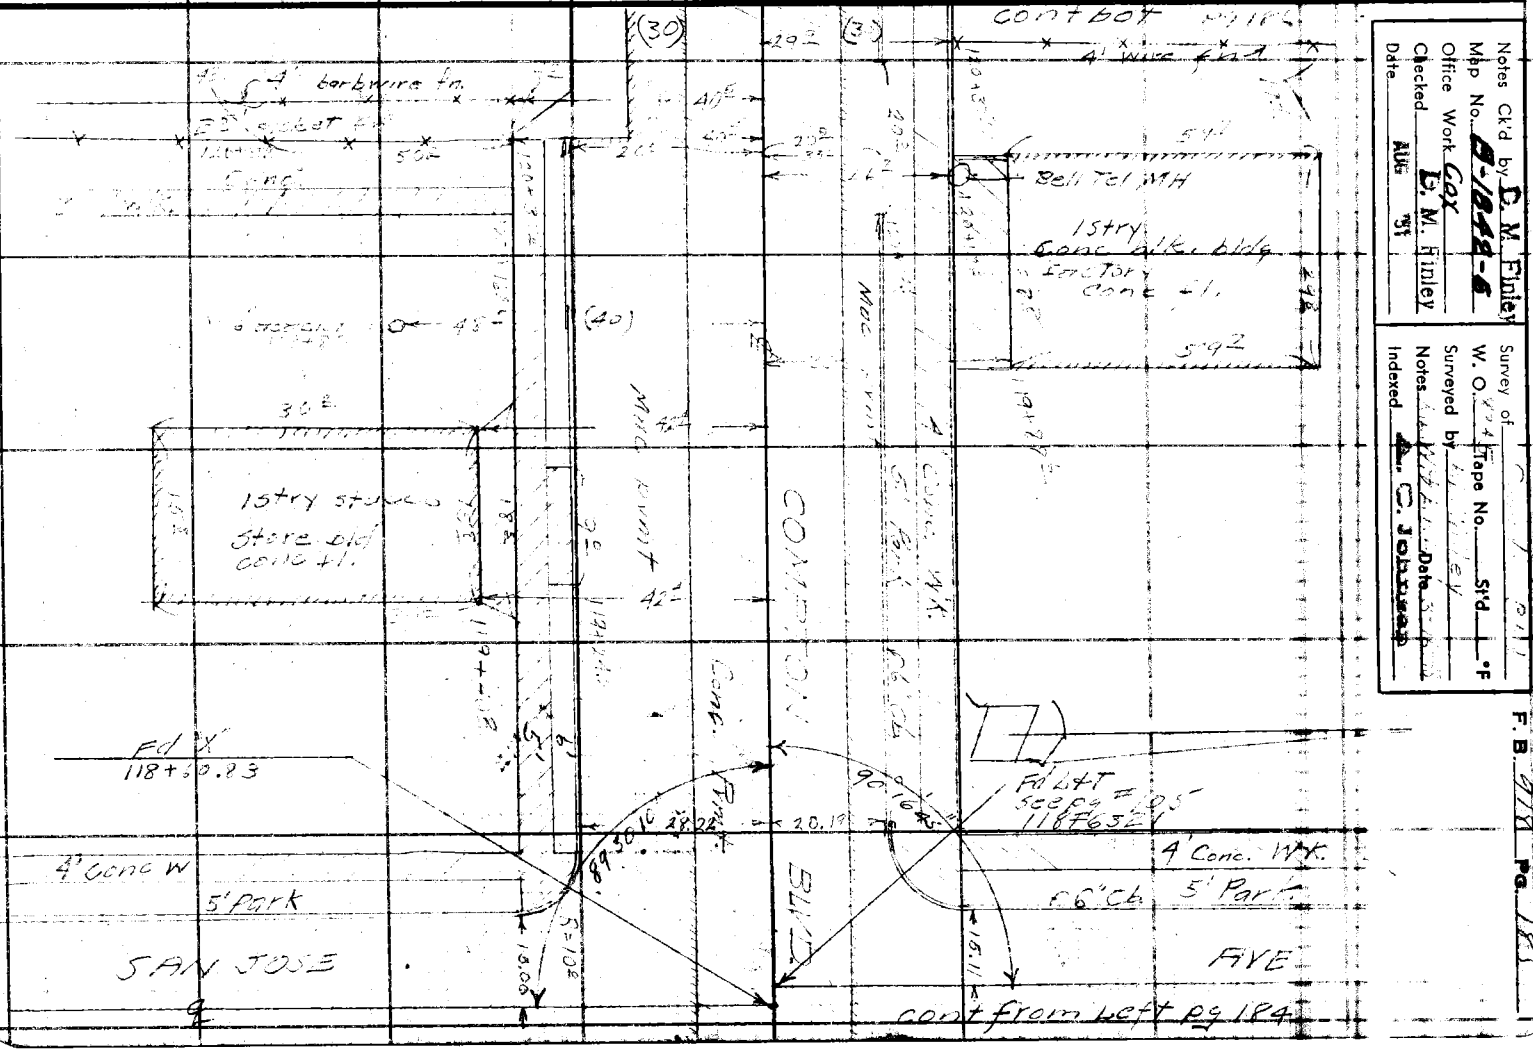

RETURN TO
LOS ANGELES COUNTY SURVEYOR
7DO HALL OF RECORDS

Note: Any Additions or Changes on This Sheet Must be Made or Circled in Red Ink With Date and Name of Person Making Change.

Do not extend notes this side of this line.

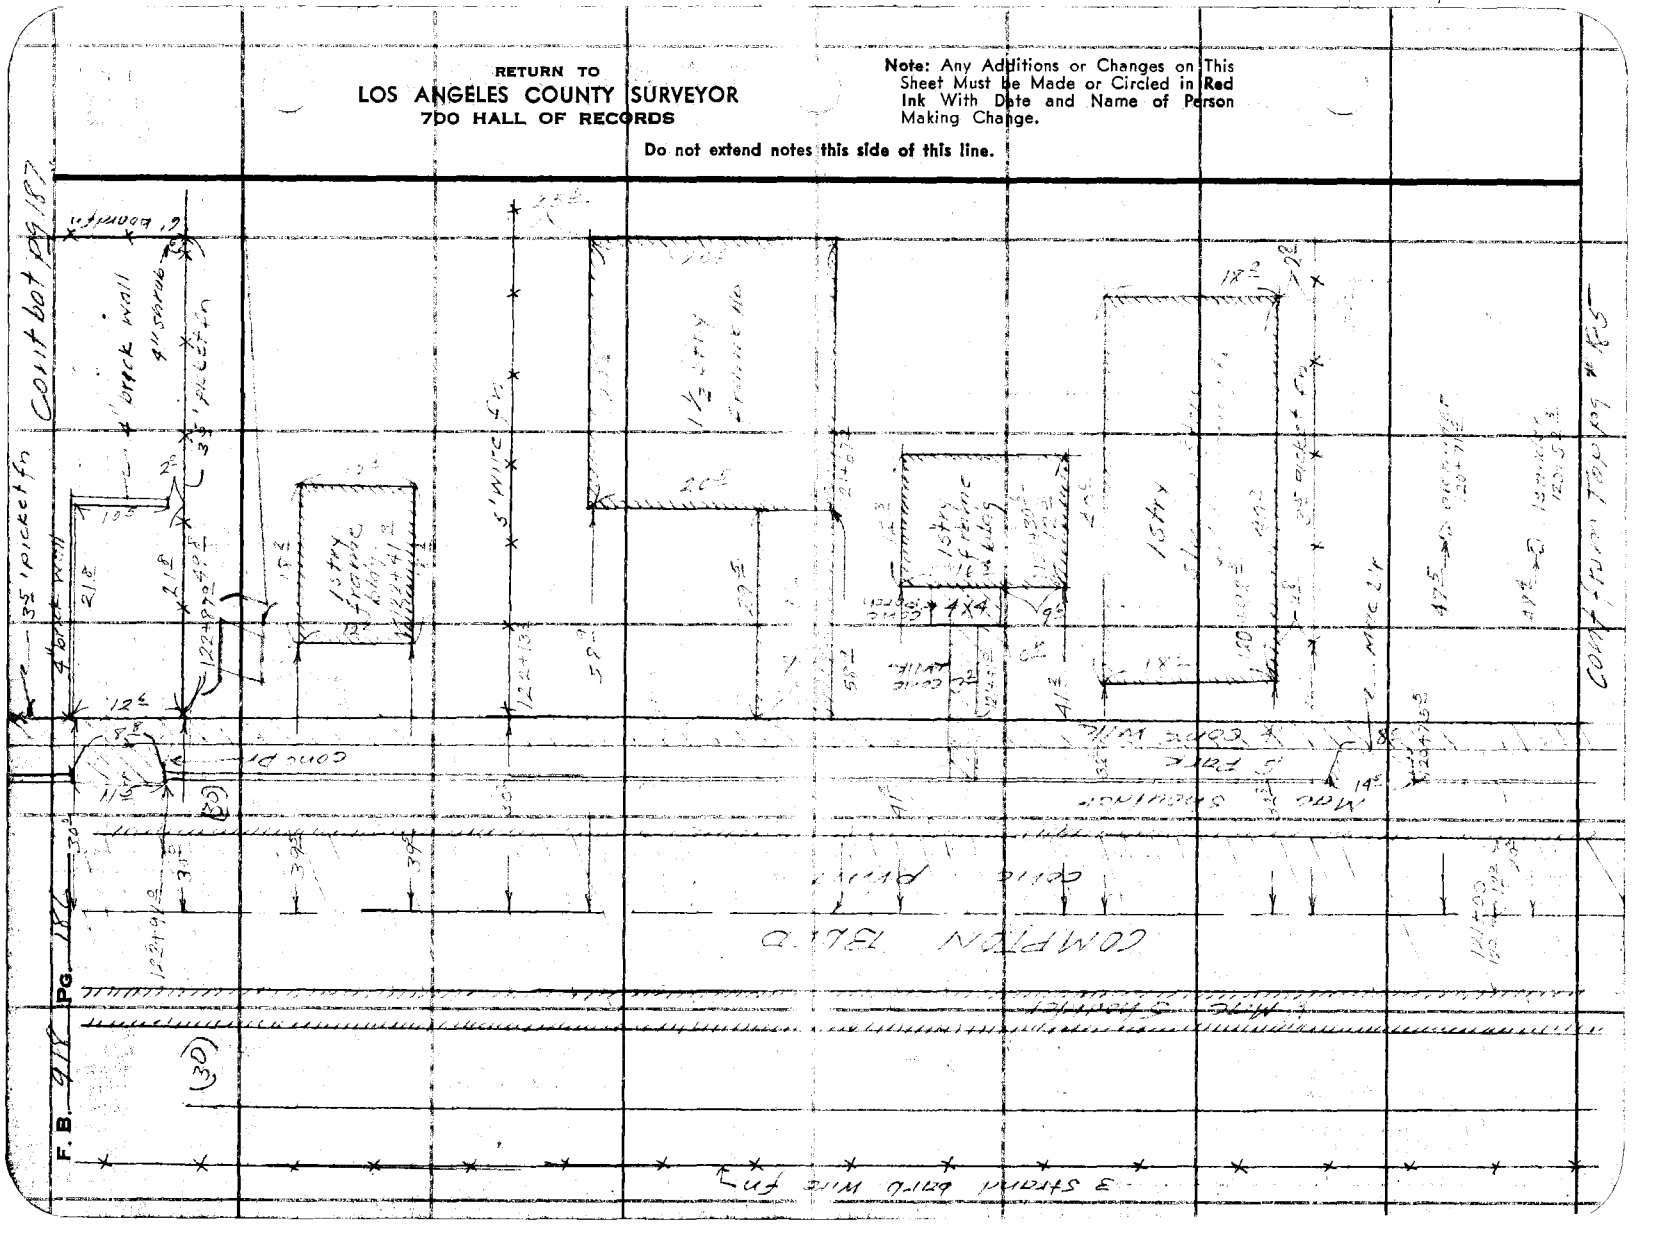

Notes Ck'd by D. M. Finley
Map No. B-1842-6
Office Work Cox
Checked D. M. Finley
Date AUG '51

Survey of
W. O. 8299 Tape No. St'd °F
Surveyed by R. L. Wiley
Notes K.L.W. 9 A.M.E. Date 3-1-42
Indexed A. C. Jenkins

F. B. 91A Pg. 187

Note: Any Additions or Changes on This Sheet Must be Made or Circled in Red Ink With Date and Name of Person Making Change.

Do not extend notes this side of this line.

RETURN TO
LOS ANGELES COUNTY SURVEYOR
700 HALL OF RECORDS

FORM 247 5M 5-46

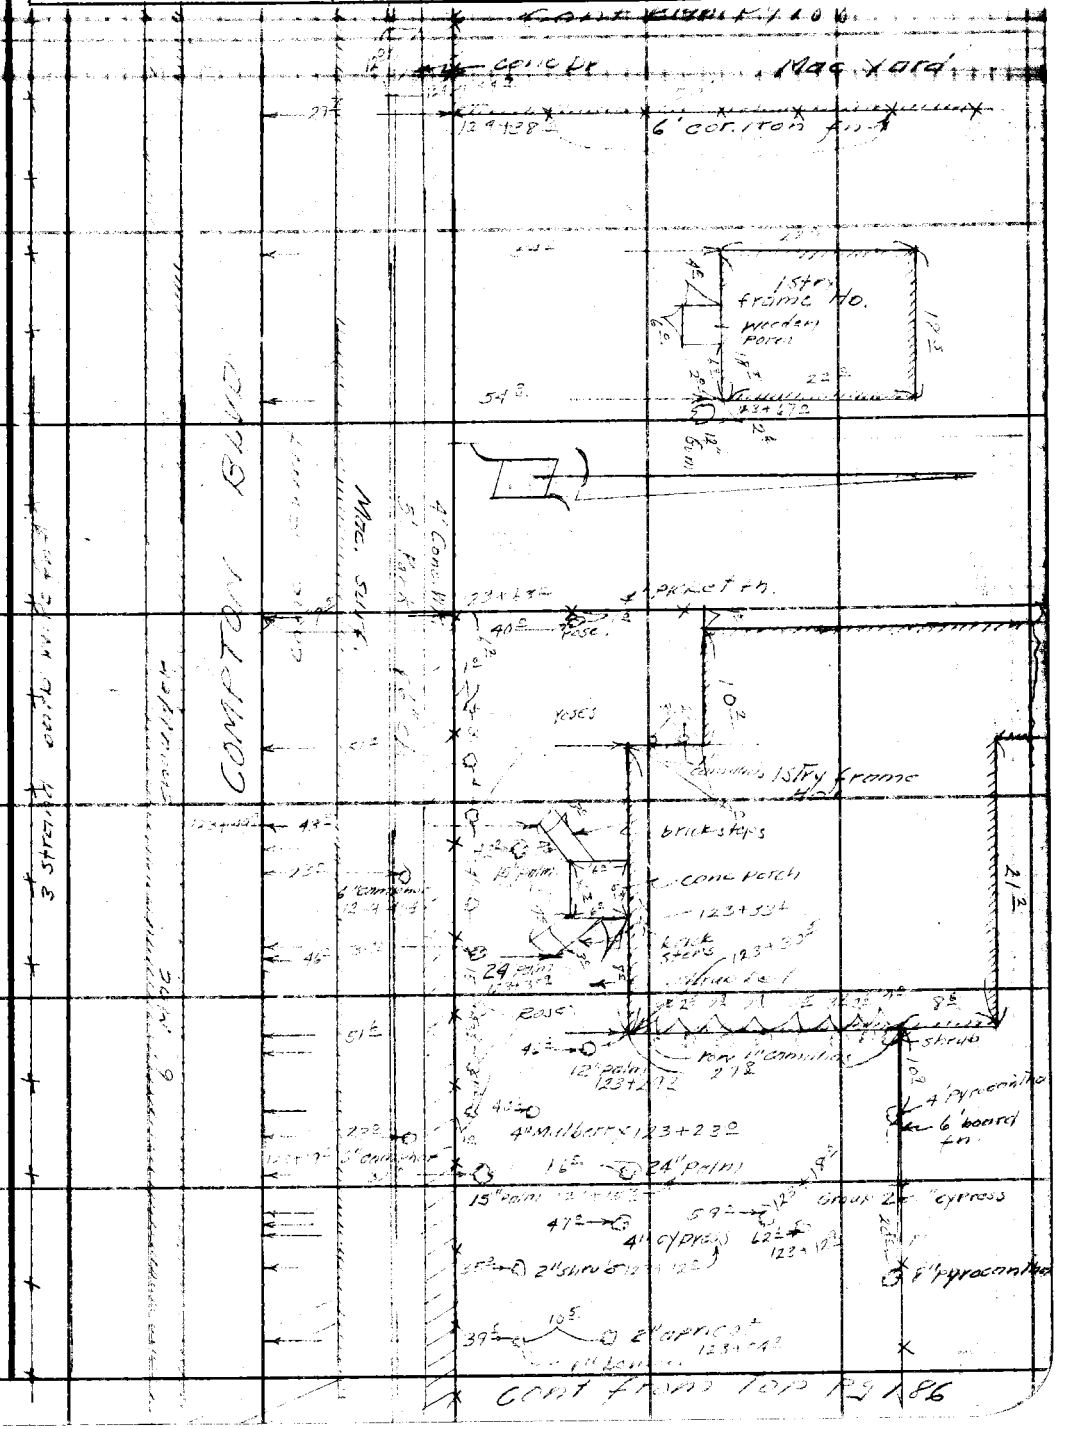

RETURN TO
LOS ANGELES COUNTY SURVEYOR
7DO HALL OF RECORDS

Note: Any Additions or Changes on This Sheet Must be Made or Circled in Red Ink With Date and Name of Person Making Change.

Do not extend notes this side of this line.

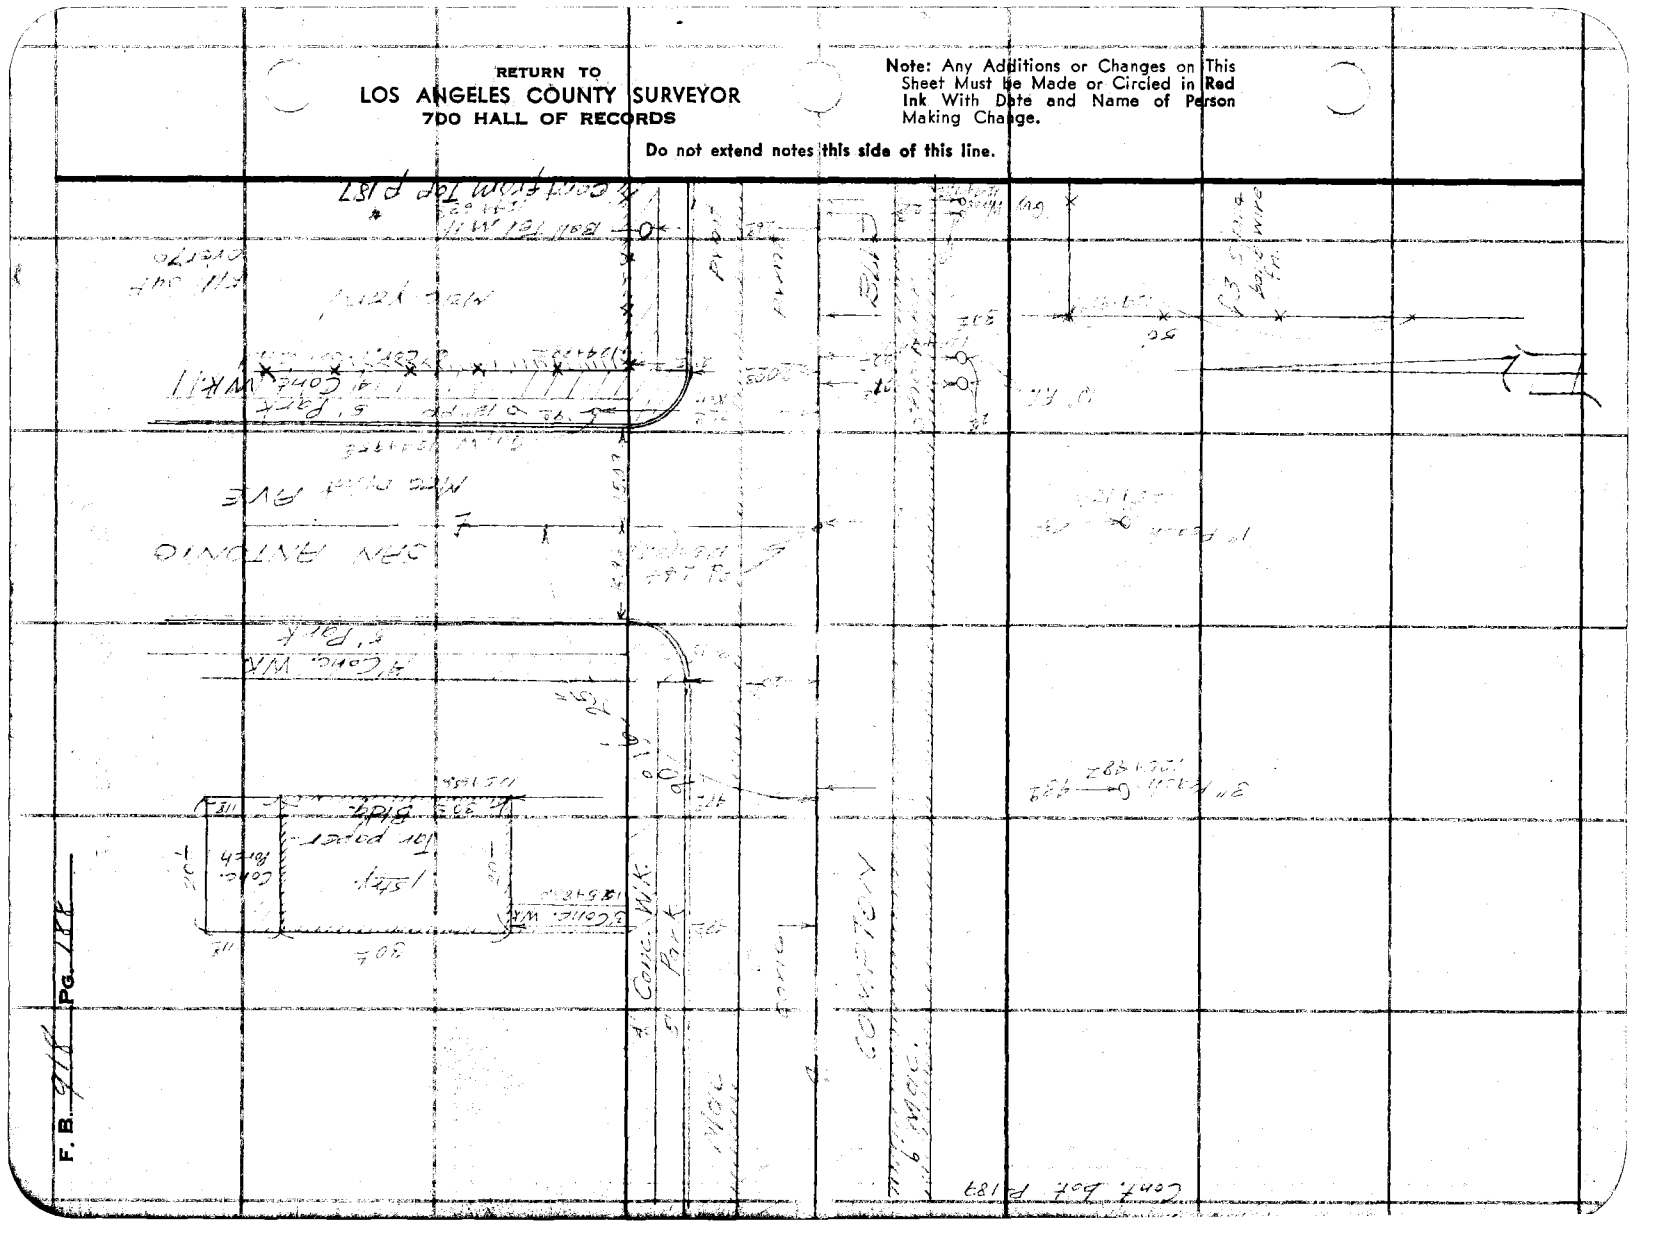
F. B. 911 Pg. 188
SAN ANTONIO AVE
Conc. Walk
Conc. Walk
Conc. Walk

Notes Ck'd by D. M. Finley
Map No. B-1842-6
Office Work Cox
Checked D. M. Finley
Date AUG 51

Survey of
W. O. 2345 Tape No. St'd °F
Surveyed by
Notes Date
Indexed A. C. Johnson

F. B. 418 Pg. 189

Note: Any Additions or Changes on this Sheet Must be Made or Circled in Red Ink With Date and Name of Person Making Change.

Do not extend notes this side of this line.

RETURN TO
LOS ANGELES COUNTY SURVEYOR

FORM 247 5M 5-46

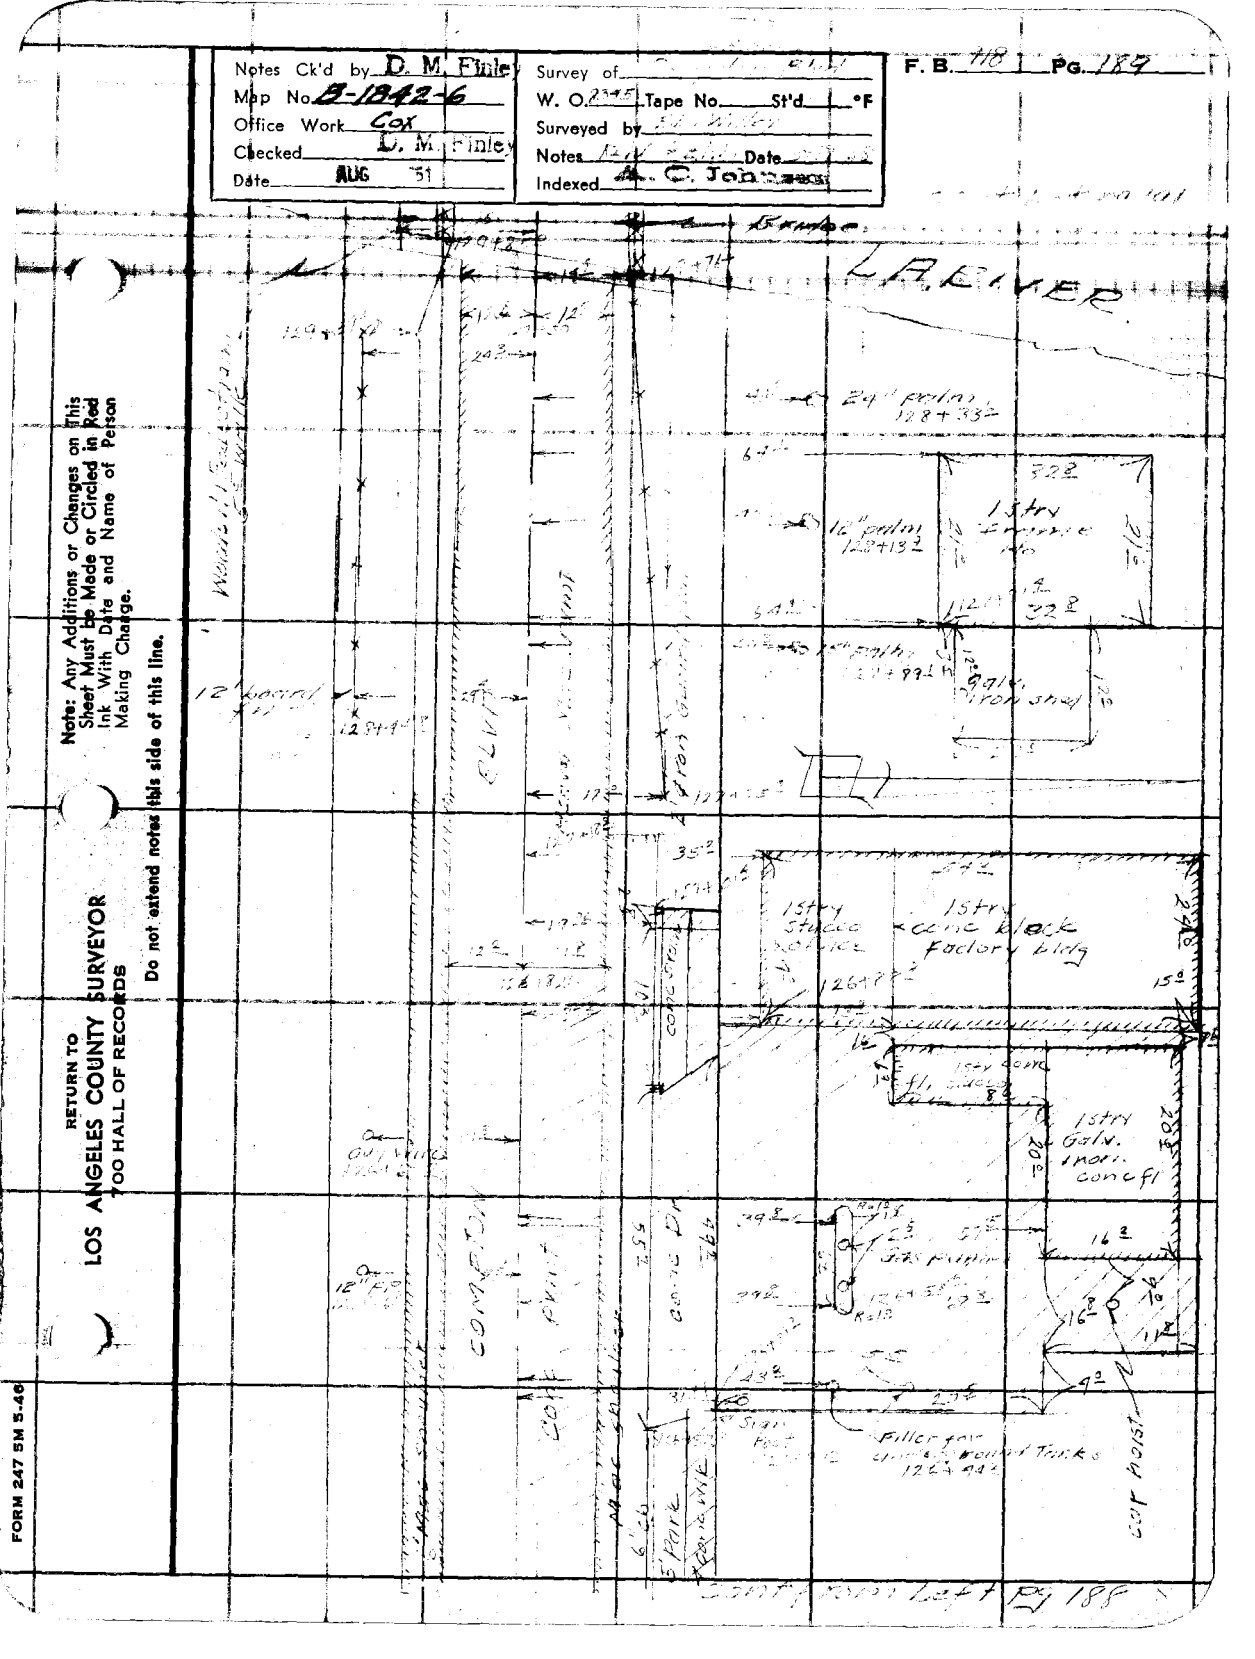

RETURN TO
LOS ANGELES COUNTY SURVEYOR
700 HALL OF RECORDS

Note: Any Additions or Changes on This Sheet Must be Made or Circled in Red Ink With Date and Name of Person Making Change.

Do not extend notes this side of this line.

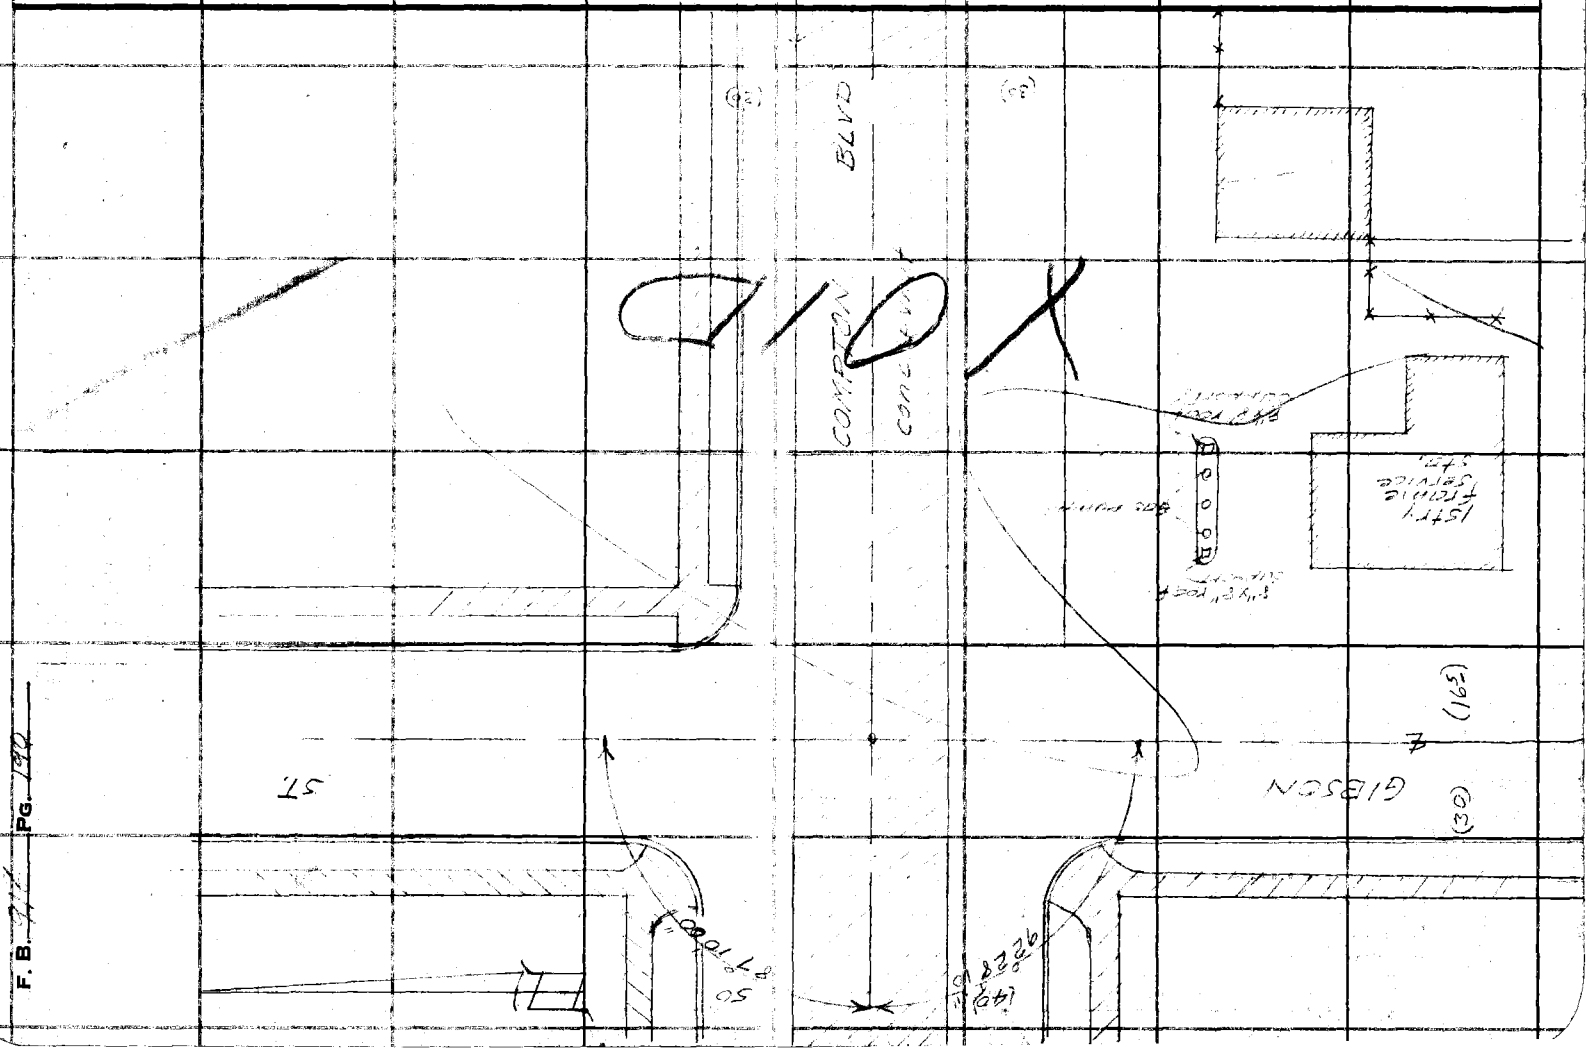


FORM 247 5M 5-46

RETURN TO
LOS ANGELES COUNTY SURVEYOR
700 HALL OF RECORDS

Note: Any Additions or Changes on This Sheet Must be Made or Circled in Red Ink With Date and Name of Person Making Change.

Do not extend notes this side of this line.

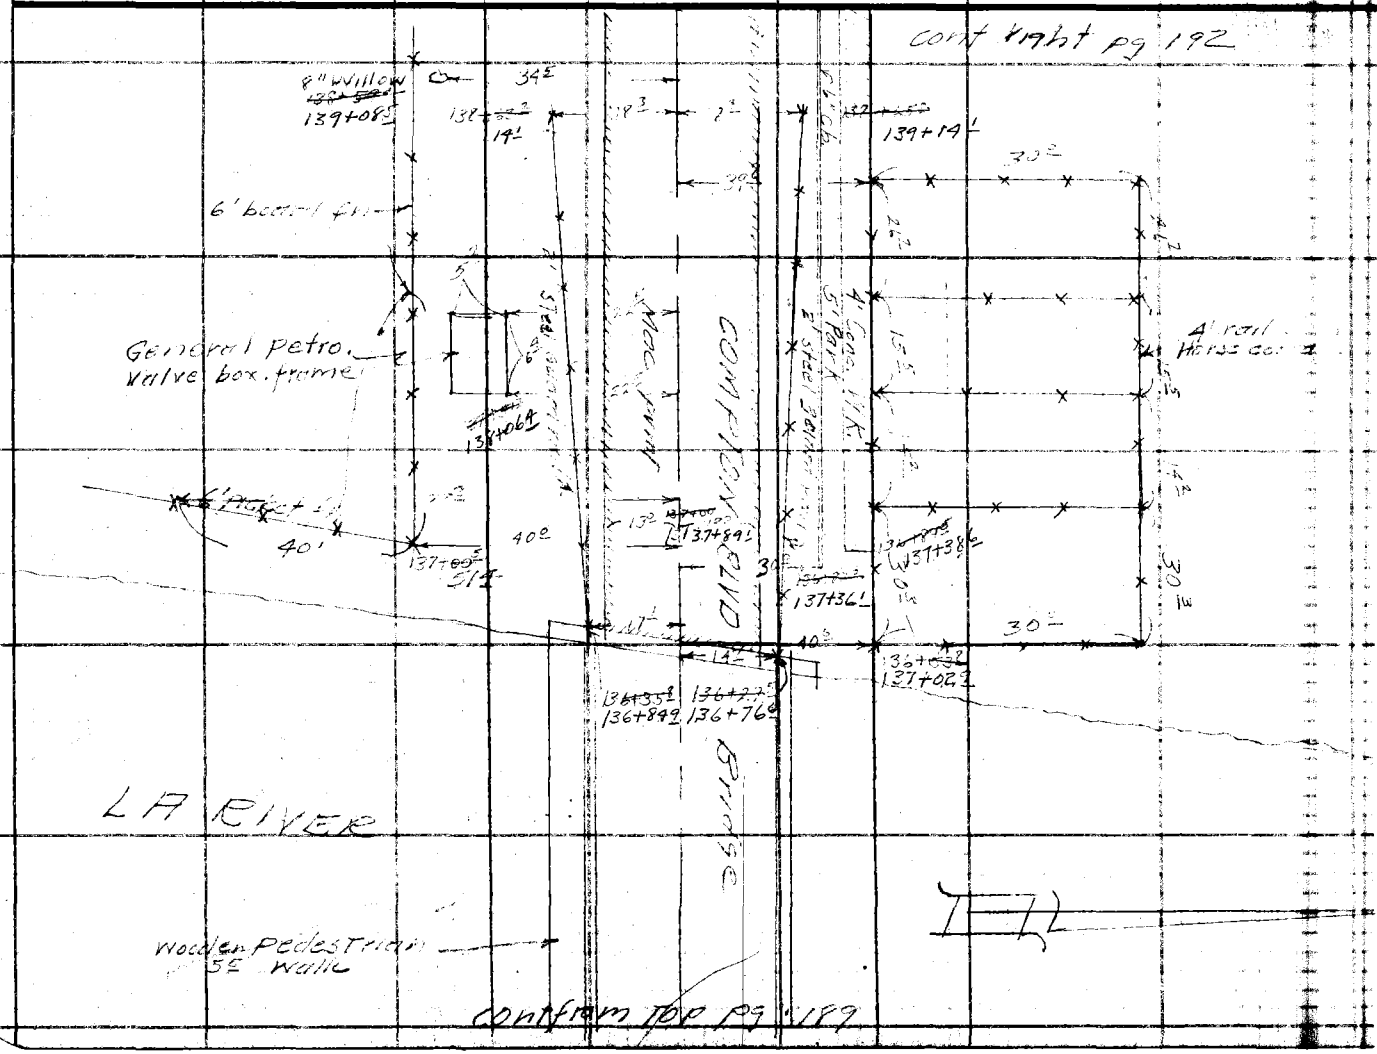

Notes Ck'd by D. M. Finley
Map No. B-18426
Office Work Cox
Checked D. M. Finley
Date AUG 51

Survey of Compton Blvd
W. O. & Tape No. Std. °F
Surveyed by E. Fuller
Notes Date 3-14-52
Indexed C. Jones

F. B. 211 Pg. 191

RETURN TO
LOS ANGELES COUNTY SURVEYOR
700 HALL OF RECORDS

Note: Any Additions or Changes on This Sheet Must be Made or Circled in Red Ink With Date and Name of Person Making Change.

Do not extend notes this side of this line.

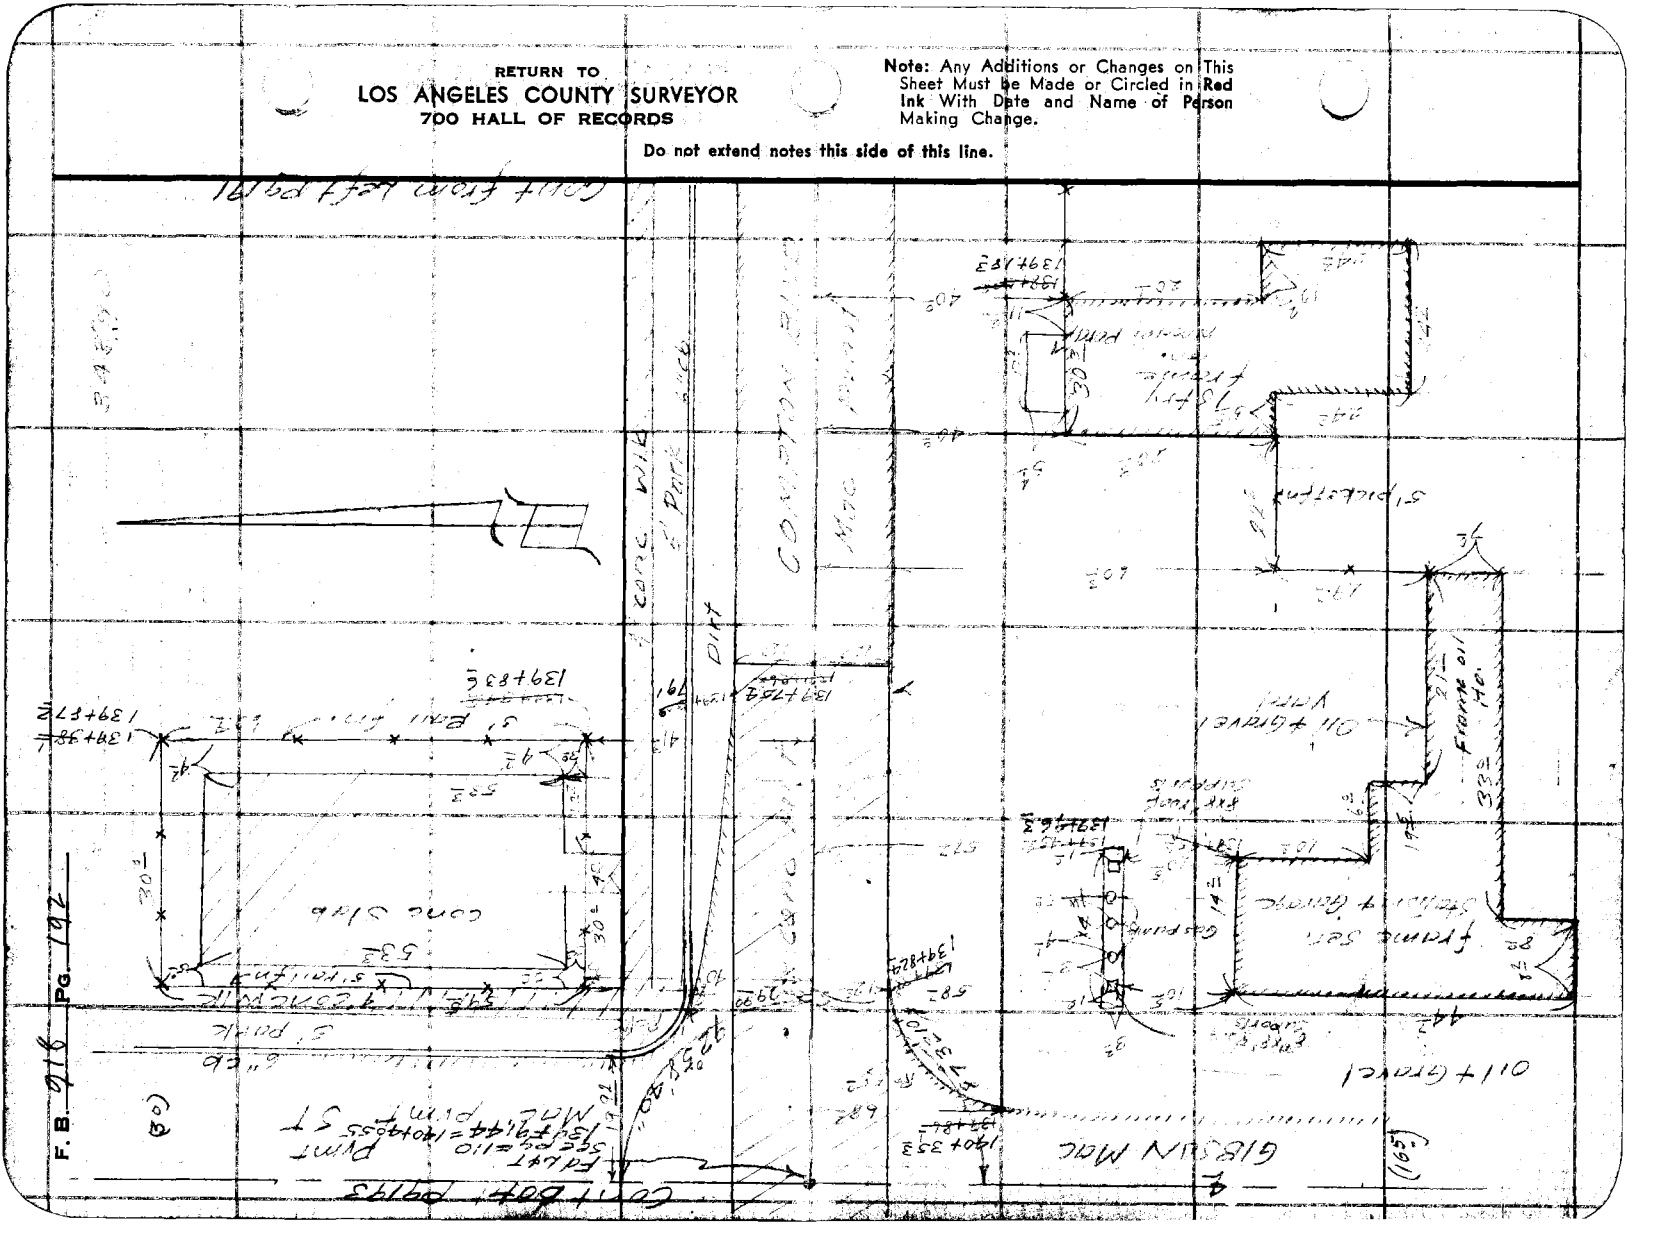
F.B. 916 Pg. 192
Oil + Grade
Gibson Mac
Point Mac Point ST
Frame Shed
Frame Garage
Frame Shed
Concrete Slab

Notes Ck'd by D. M. Finley
Map No. 9-1842-6
Office Work Cox
Checked D. M. Finley
Date AUG 51

Survey of
W. O. 8315 Tape No. St'd. °F
Surveyed by R. L. Willey
Notes
Date
Indexed

F.B. 915 Pg. 193

Note: Any Additions or Changes on This Sheet Must be Made or Circled in Red Ink With Date and Name of Person Making Change.

Do not extend notes this side of this line.

RETURN TO
LOS ANGELES COUNTY SURVEYOR
700 HALL OF RECORDS

1 story stucco apart bldg

Conc porches

1 story stucco apart. bldg

1 story frame bldg

4' conc walk

5' conc walk

5' conc walk

Conc Pvmt

Mac Pvmt

9' Park

COMPTON BLVD

EQUATION IN TOPOG. STATIONING.
140+40.55 From East.
=139+91.44 Going Wly.

Conc walk 4'

5' conc walk

Mac Pvmt

GIBSON

E/L 4T
PCT PG 110
139+91.44

cont from Left 192

10" SYC 141+95

10" SYC 141+68

10" SYC 141+42

10" SYC 141+18

10" SYC 140+65

FORM 247 SM 5-46

F. B. 918 PG. 194

COINT R19T P 195

RETURN TO
LOS ANGELES COUNTY SURVEYOR
700 HALL OF RECORDS

Do not extend notes this side of this line.

Note: Any Additions or Changes on This Sheet Must be Made or Circled in Red Ink With Date and Name of Person Making Change.

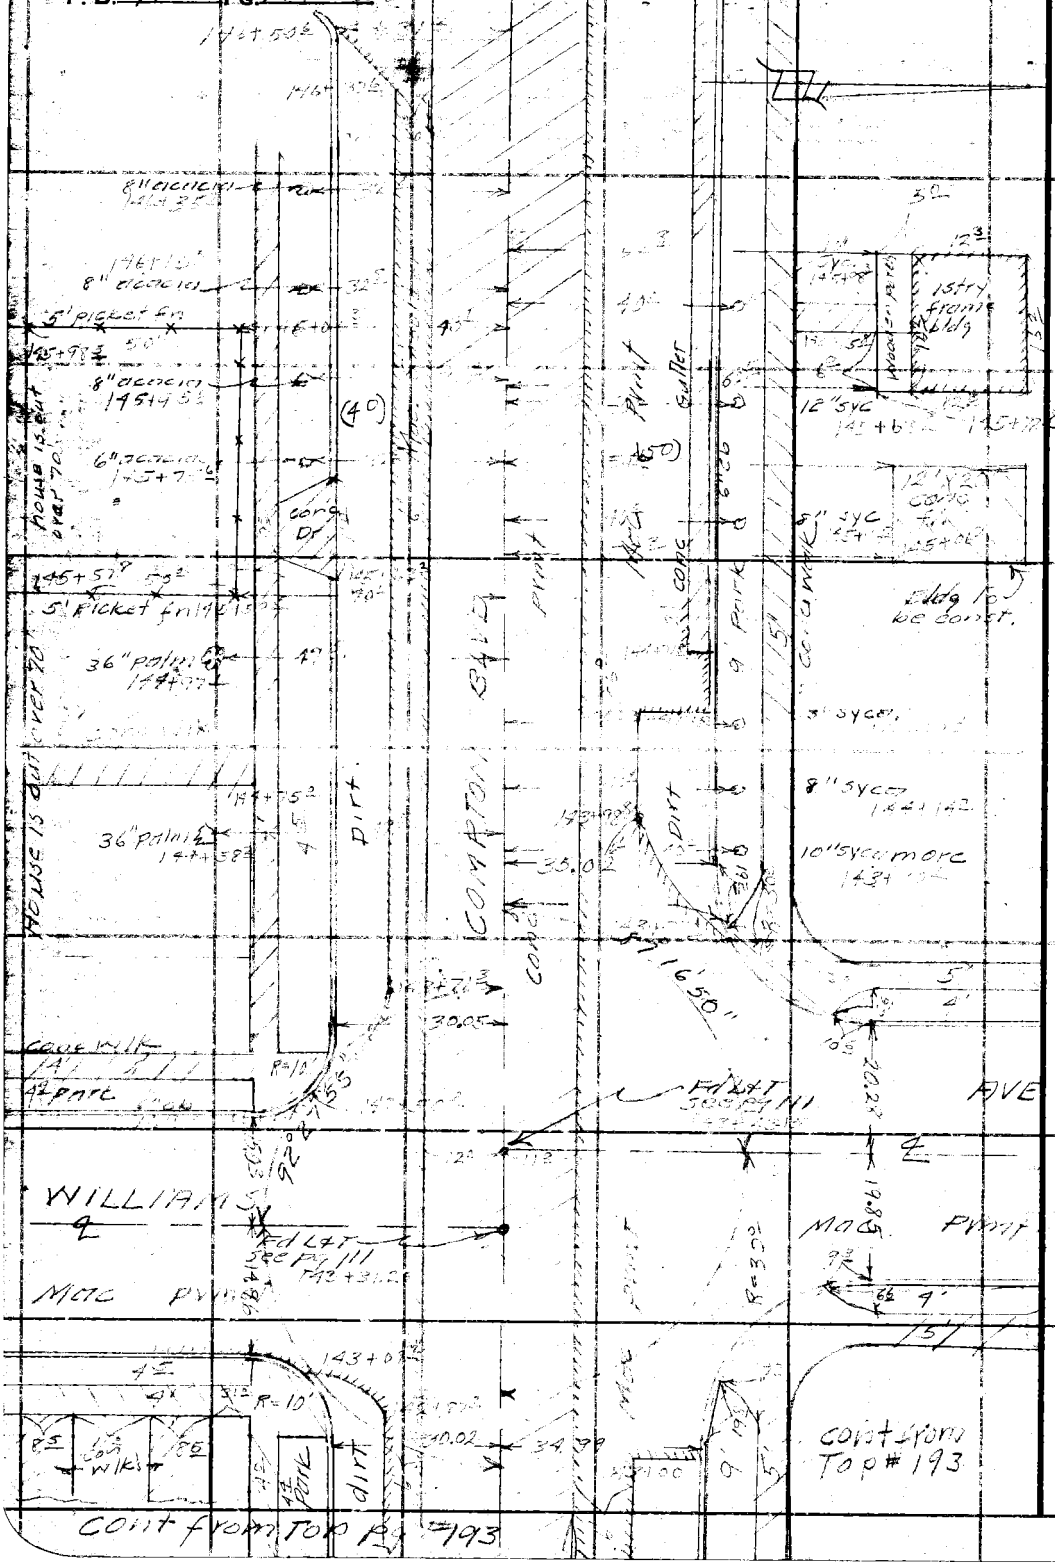

Notes Ck'd by D. M. Finley
Map No. 8-1842-6
Office Work Cox
Checked D. M. Finley
Date AUG '51

Survey of
W. O. 8345 Tape No. St'd °F
Surveyed by R. L. Willey
Notes Date
Indexed C. Jensen

F. B. 91F Pg. 195

Note: Any Additions or Changes on this Sheet Must be Made or Circled in Red Ink With Date and Name of Person Making Change.

Do not extend notes this side of this line.

RETURN TO
LOS ANGELES COUNTY SURVEYOR
700 HALL OF RECORDS

FORM 247 5M 5.46

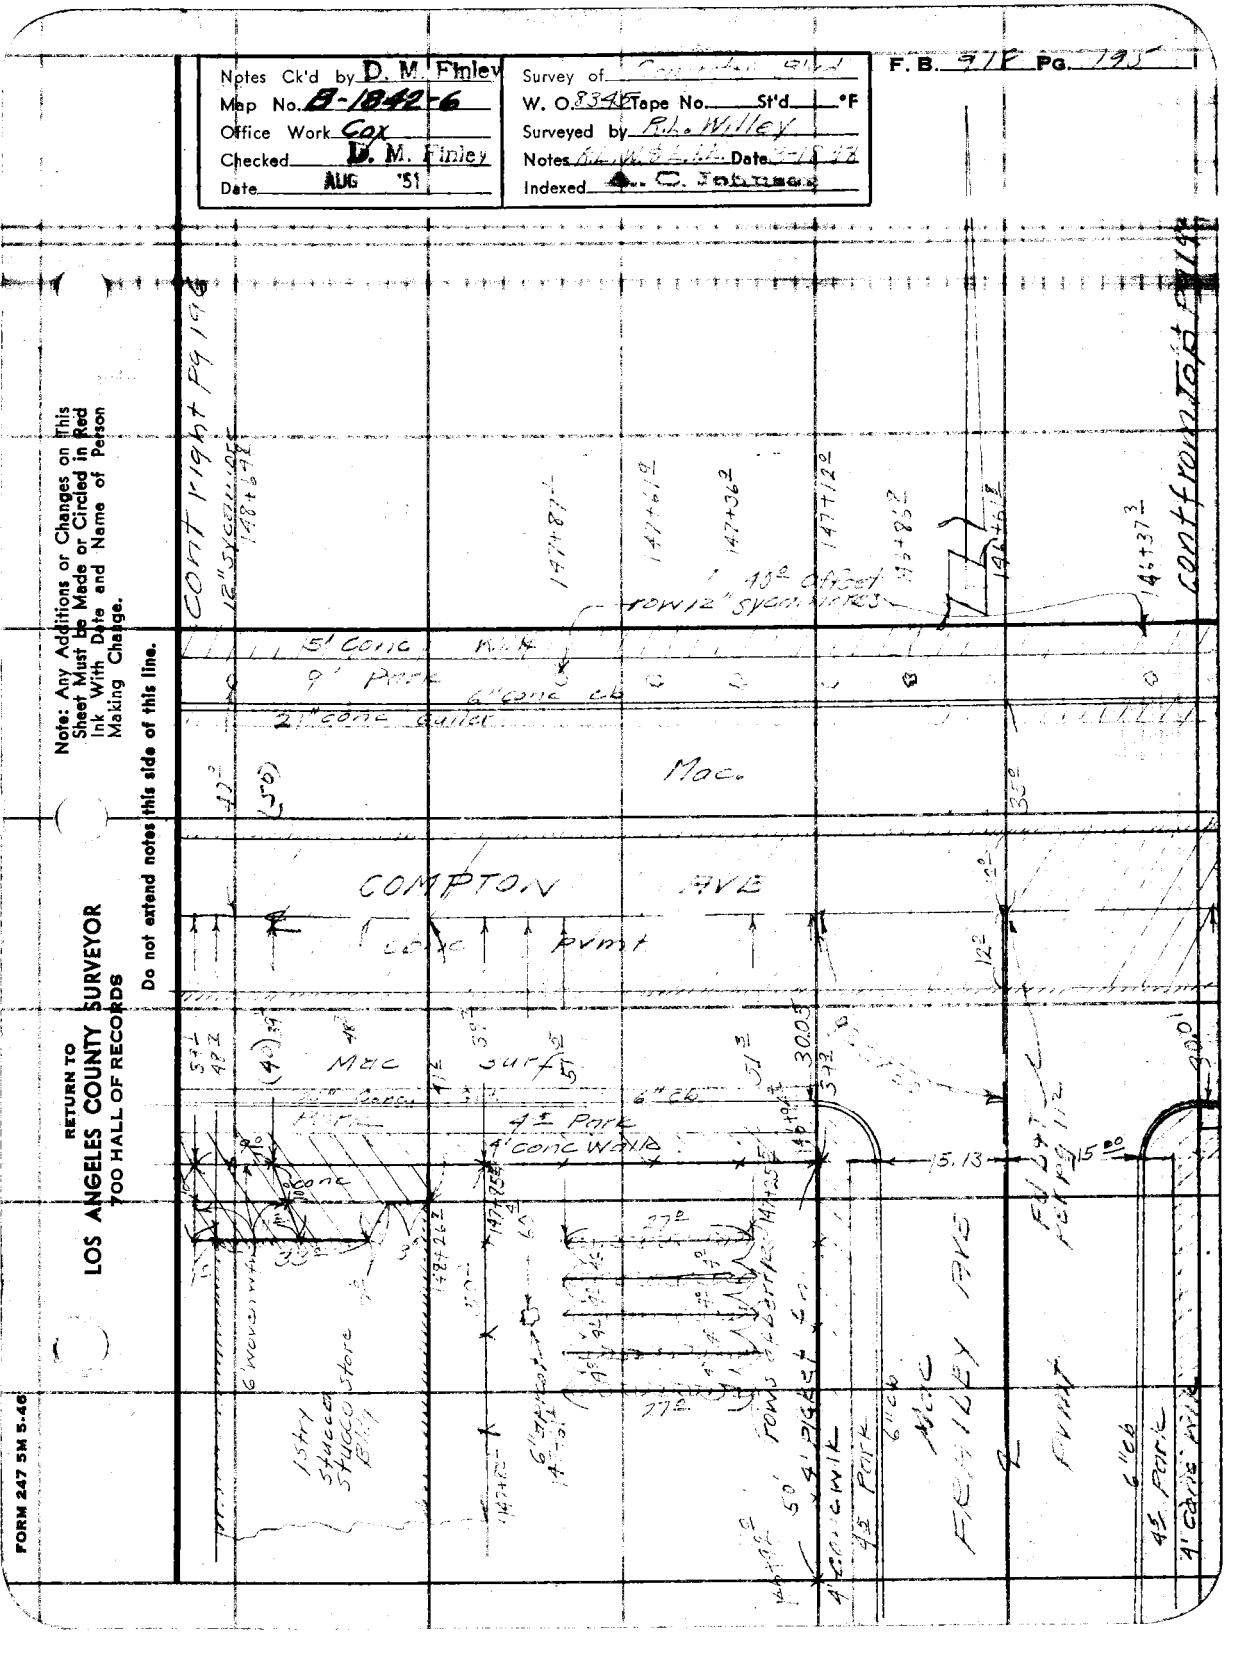

RETURN TO
LOS ANGELES COUNTY SURVEYOR
7DO HALL OF RECORDS

Note: Any Additions or Changes on This Sheet Must be Made or Circled in Red Ink With Date and Name of Person Making Change.

Do not extend notes this side of this line.

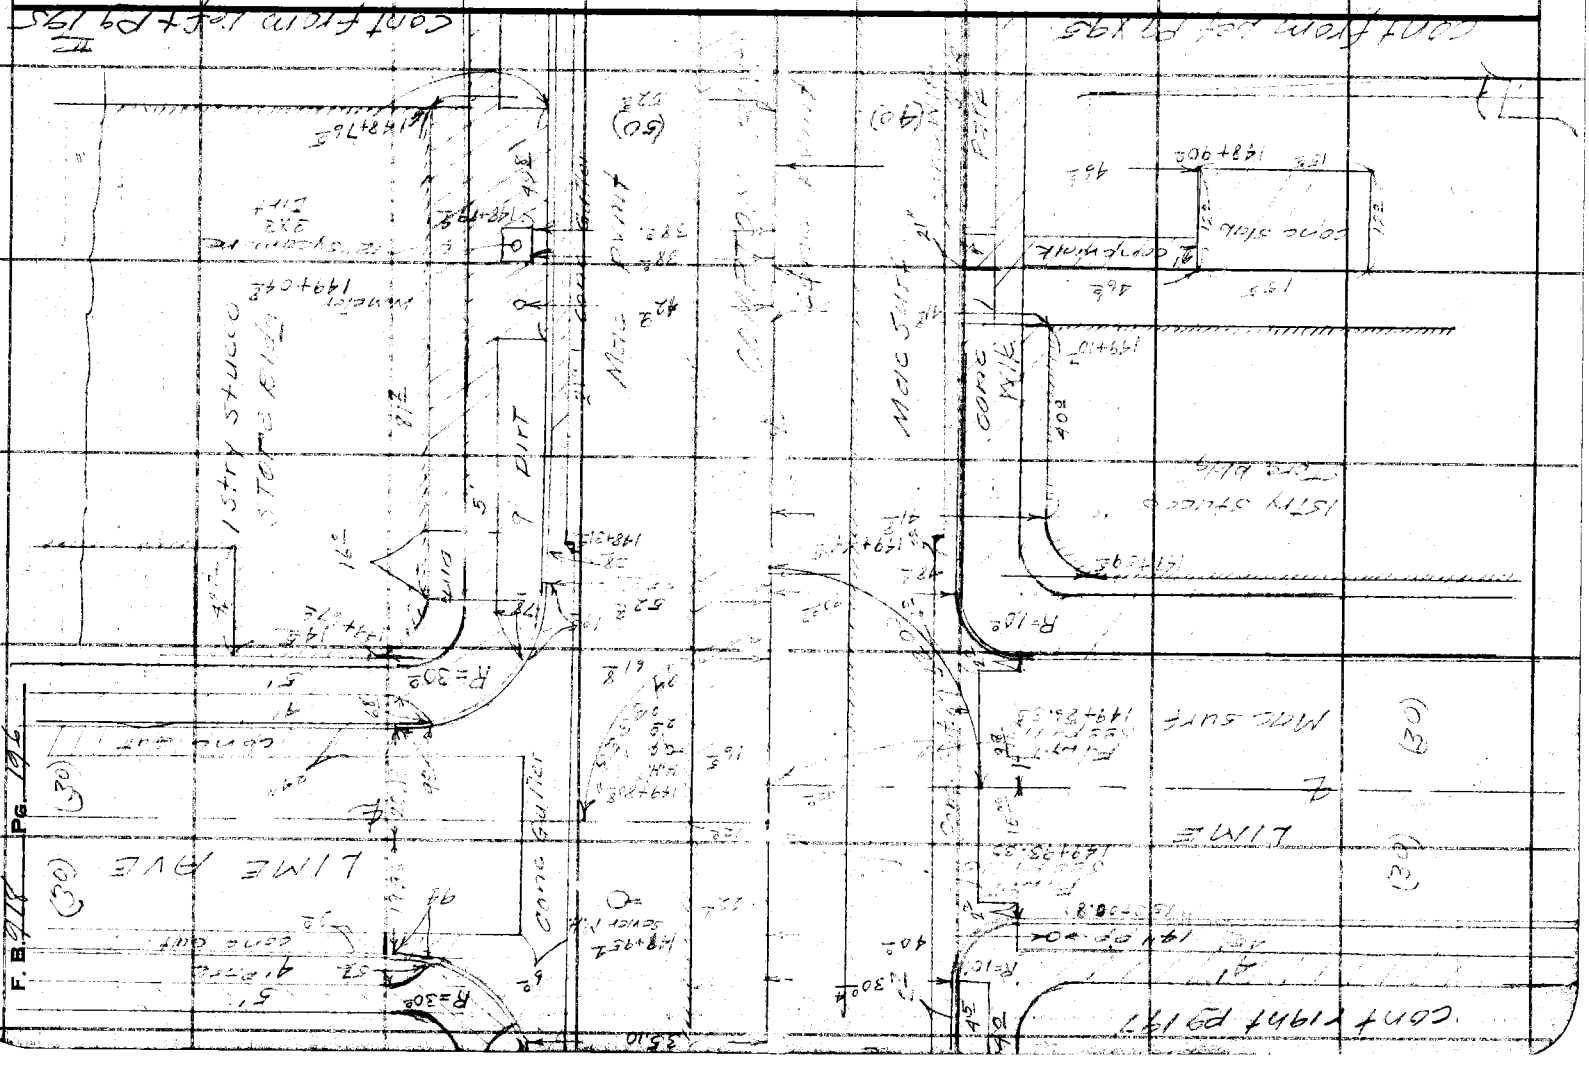

F. B. 2118 Pg. 196

FORM 247 5M 5-46

RETURN TO
LOS ANGELES COUNTY SURVEYOR
700 HALL OF RECORDS

1694

Note: Any Additions or Changes on This Sheet Must be Made or Circled in Red Ink With Date and Name of Person Making Change.

Do not extend notes this side of this line.

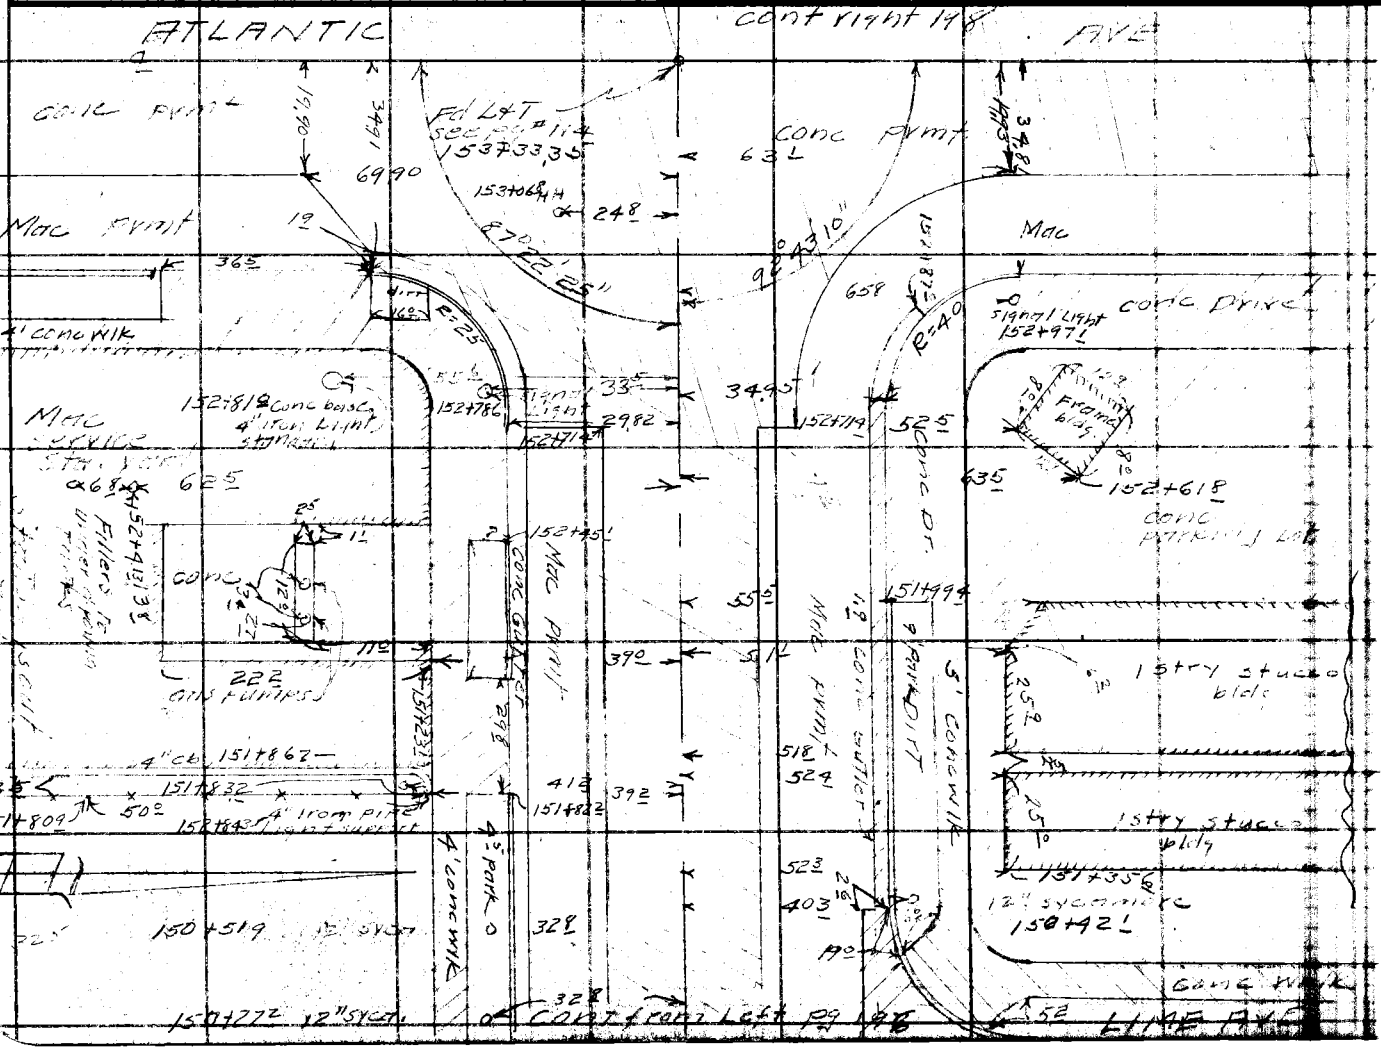

Notes Ck'd by D. M. Fraley
Map No. 2-1842-6
Office Work Cox
Checked W. N. Finley
Date AUG '51

Survey of
W. O. 2345 Tape No. St'd °F
Surveyed by
Notes
Indexed C. C. Johnson

F.B. 218 Pg. 177

RETURN TO
LOS ANGELES COUNTY SURVEYOR
7DO HALL OF RECORDS

Note: Any Additions or Changes on This Sheet Must be Made or Circled in Red Ink With Date and Name of Person Making Change.

Do not extend notes this side of this line.

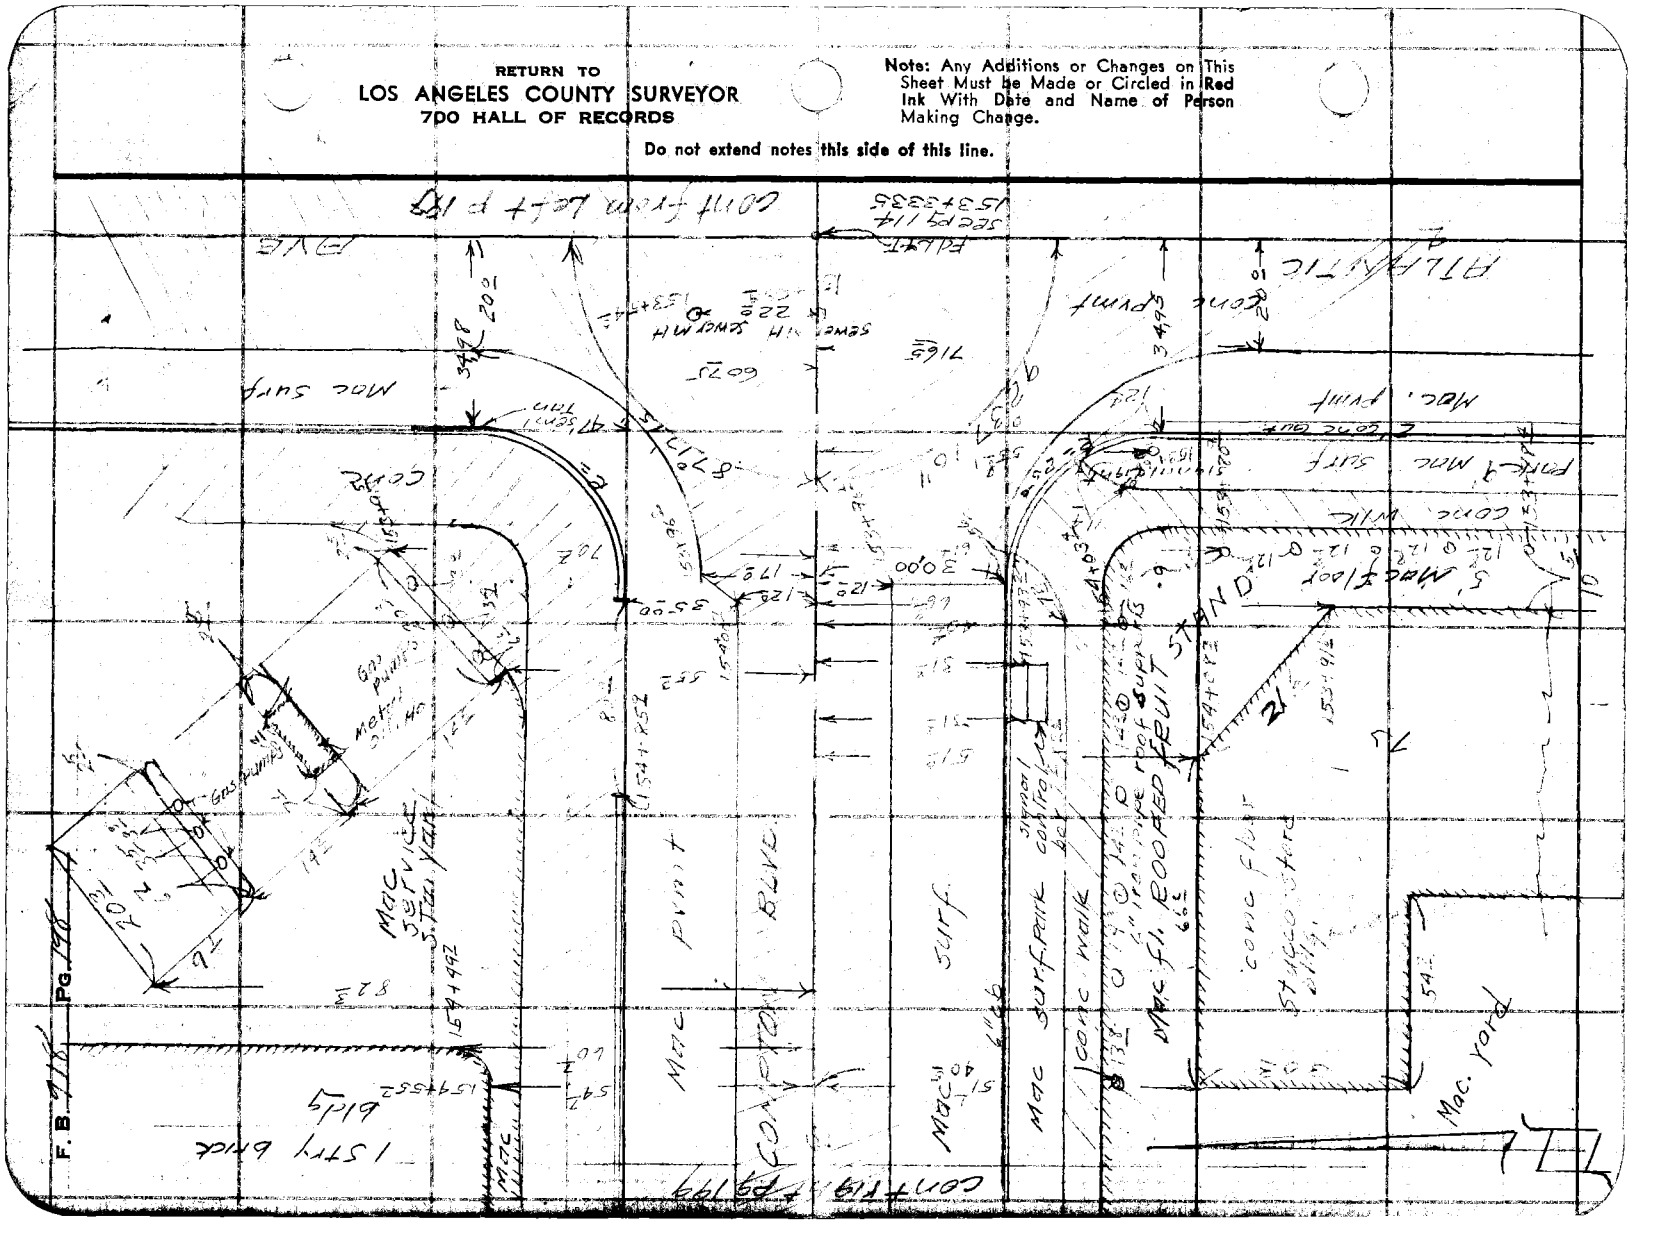

Notes Ck'd by D. M. Finley
Map No. 9-1842-6
Office Work Cox
Checked D. M. Finley
Date AUG '51

Survey of [illegible]
W. O. 8345 Tape No. St'd °F
Surveyed by R. L. Willey
Notes R.L.W. B.E.F. Date 5-23-46
Indexed [illegible]

F. B. 418 PG. 199

Note: Any Additions or Changes on This Sheet Must be Made or Circled in Red Ink With Date and Name of Person Making Change.

Do not extend notes this side of this line.

RETURN TO
LOS ANGELES COUNTY SURVEYOR
700 HALL OF RECORDS

FORM 247 5M 5-46

COUNTY RIGHT OF WAY

1 STORY STUCCO

BRICK BLDG

CONC WK

PARK

9' CONC WK

MAC SURF

COMPTON BLVD

DIRT

MAC PARK

COURT DR

2 STORY STUCCO

MAC. PARKING LOT

RETURN TO
LOS ANGELES COUNTY SURVEYOR
7DO HALL OF RECORDS

Note: Any Additions or Changes on This Sheet Must be Made or Circled in Red Ink With Date and Name of Person Making Change.

Do not extend notes this side of this line.

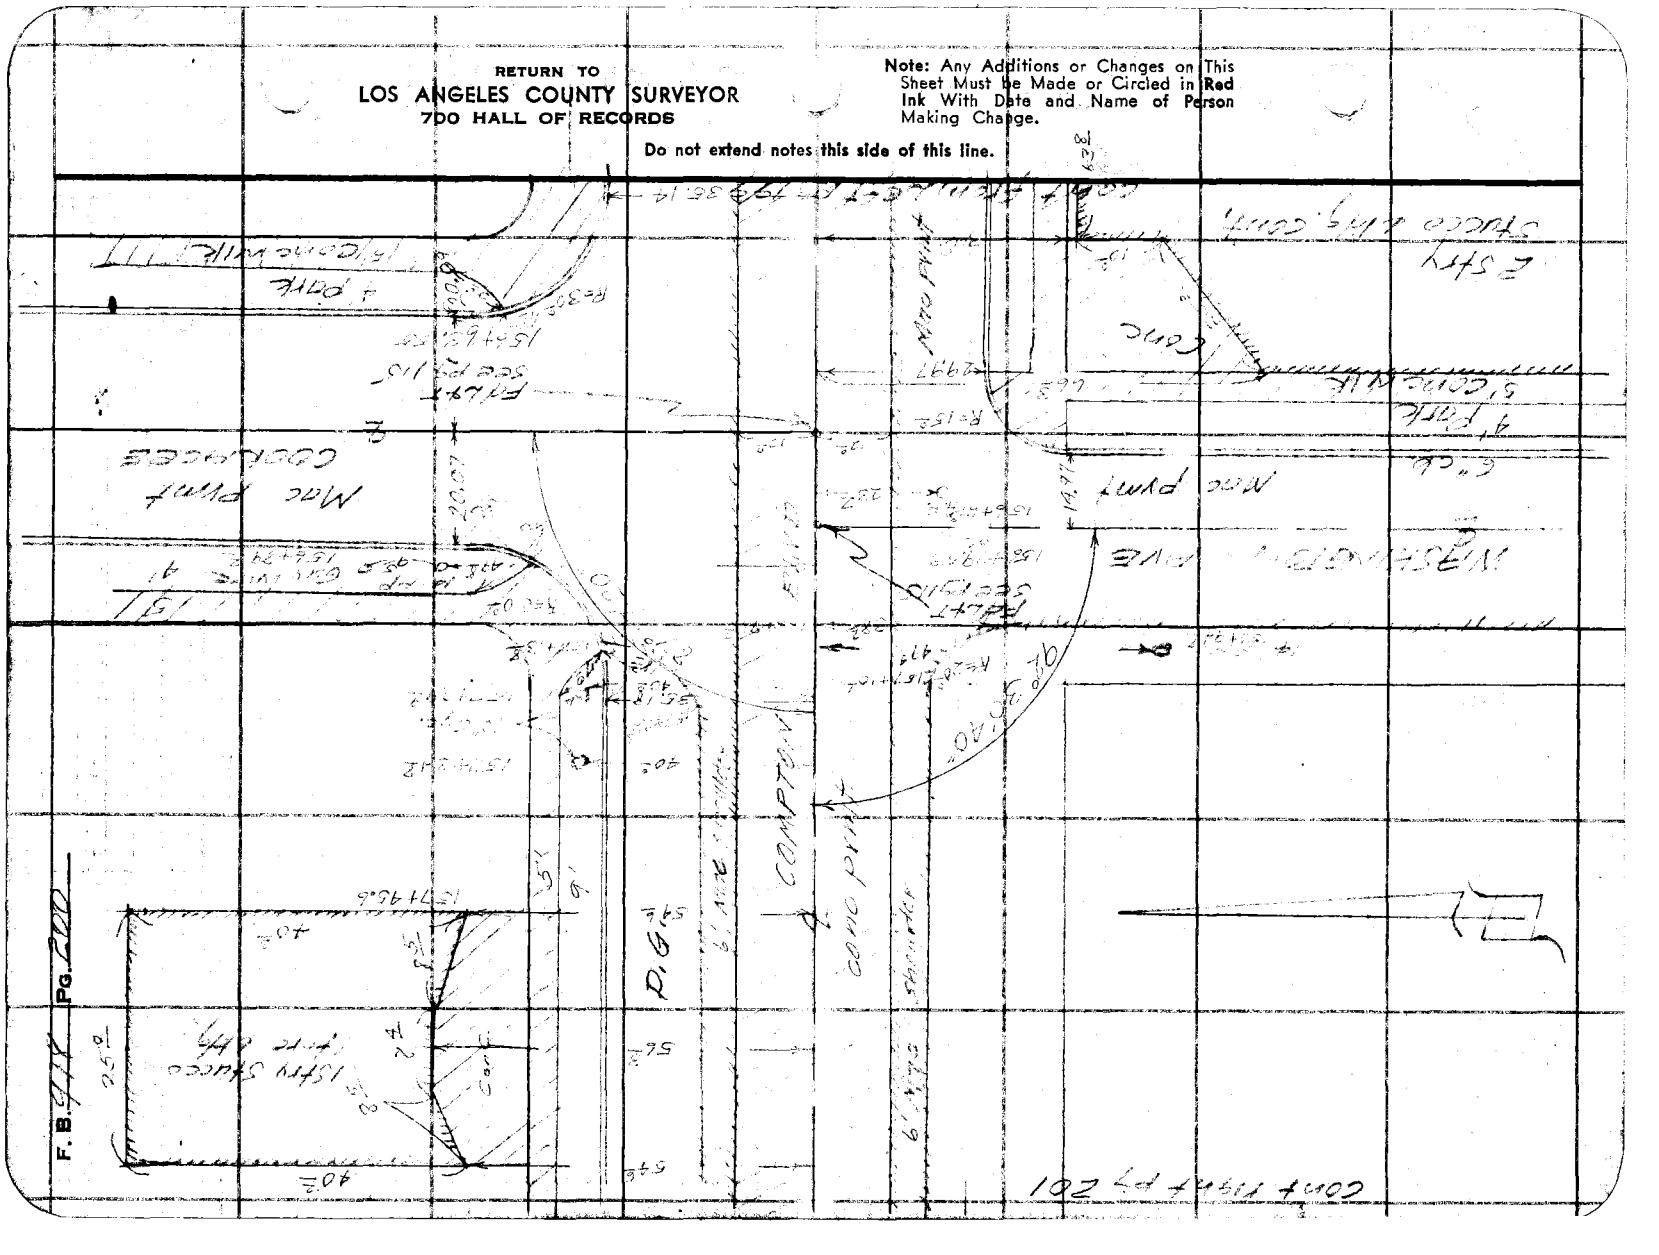

FORM 247 5M 5-46

RETURN TO
LOS ANGELES COUNTY SURVEYOR
700 HALL OF RECORDS

Note: Any Additions or Changes on This Sheet Must be Made or Circled in Red Ink With Date and Name of Person Making Change.

Do not extend notes this side of this line.

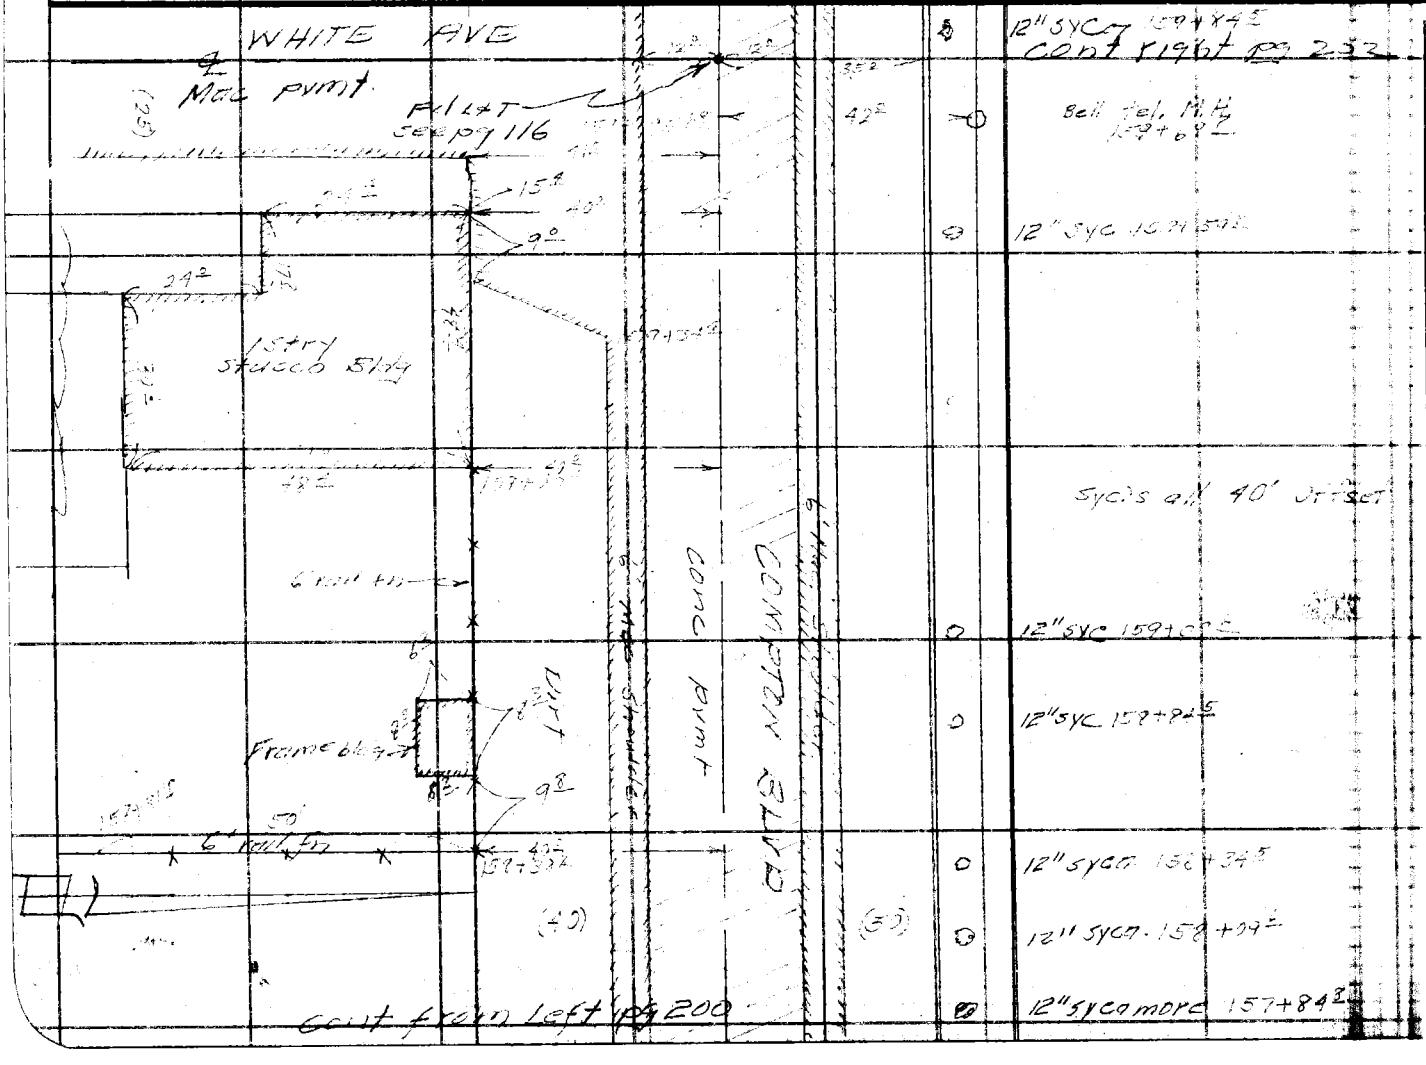

Notes Ck'd by D. M. Finley
Mbp No. 2-1002-6
Office Work Cox
Checked: D. M. Finley
Date AUG '51

Survey of
W. O. 5341 Tape No. Sr'd F
Surveyed by F. L. Miller
Notes Date 3-14-51
Indexed A. C. Jenkins

F. B. 211 PG. 201

RETURN TO
LOS ANGELES COUNTY SURVEYOR
700 HALL OF RECORDS

Note: Any Additions or Changes on This Sheet Must be Made or Circled in Red Ink With Date and Name of Person Making Change.

Do not extend notes this side of this line.

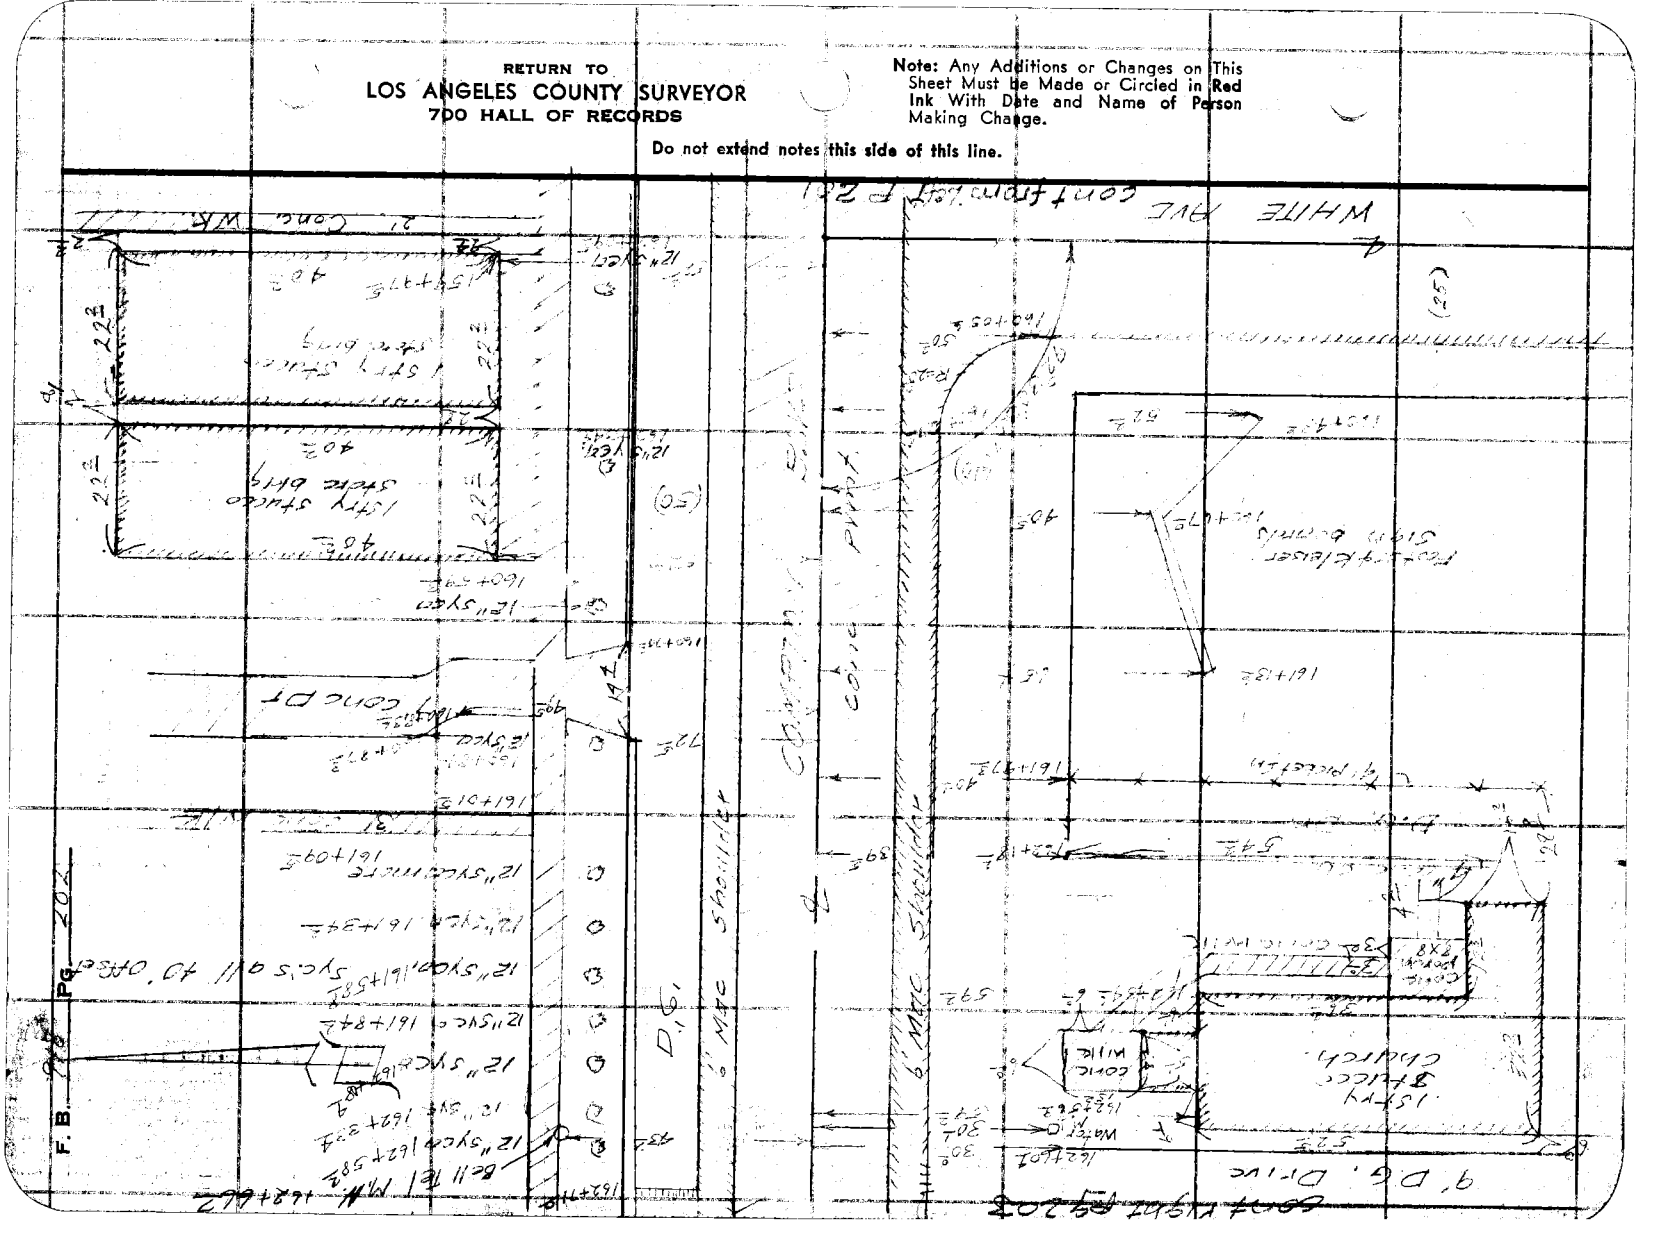

FORM 247 5M 5-46

RETURN TO
LOS ANGELES COUNTY SURVEYOR
700 HALL OF RECORDS

Note: Any Additions or Changes on This Sheet Must be Made or Circled in Red Ink With Date and Name of Person Making Change.

Do not extend notes this side of this line.

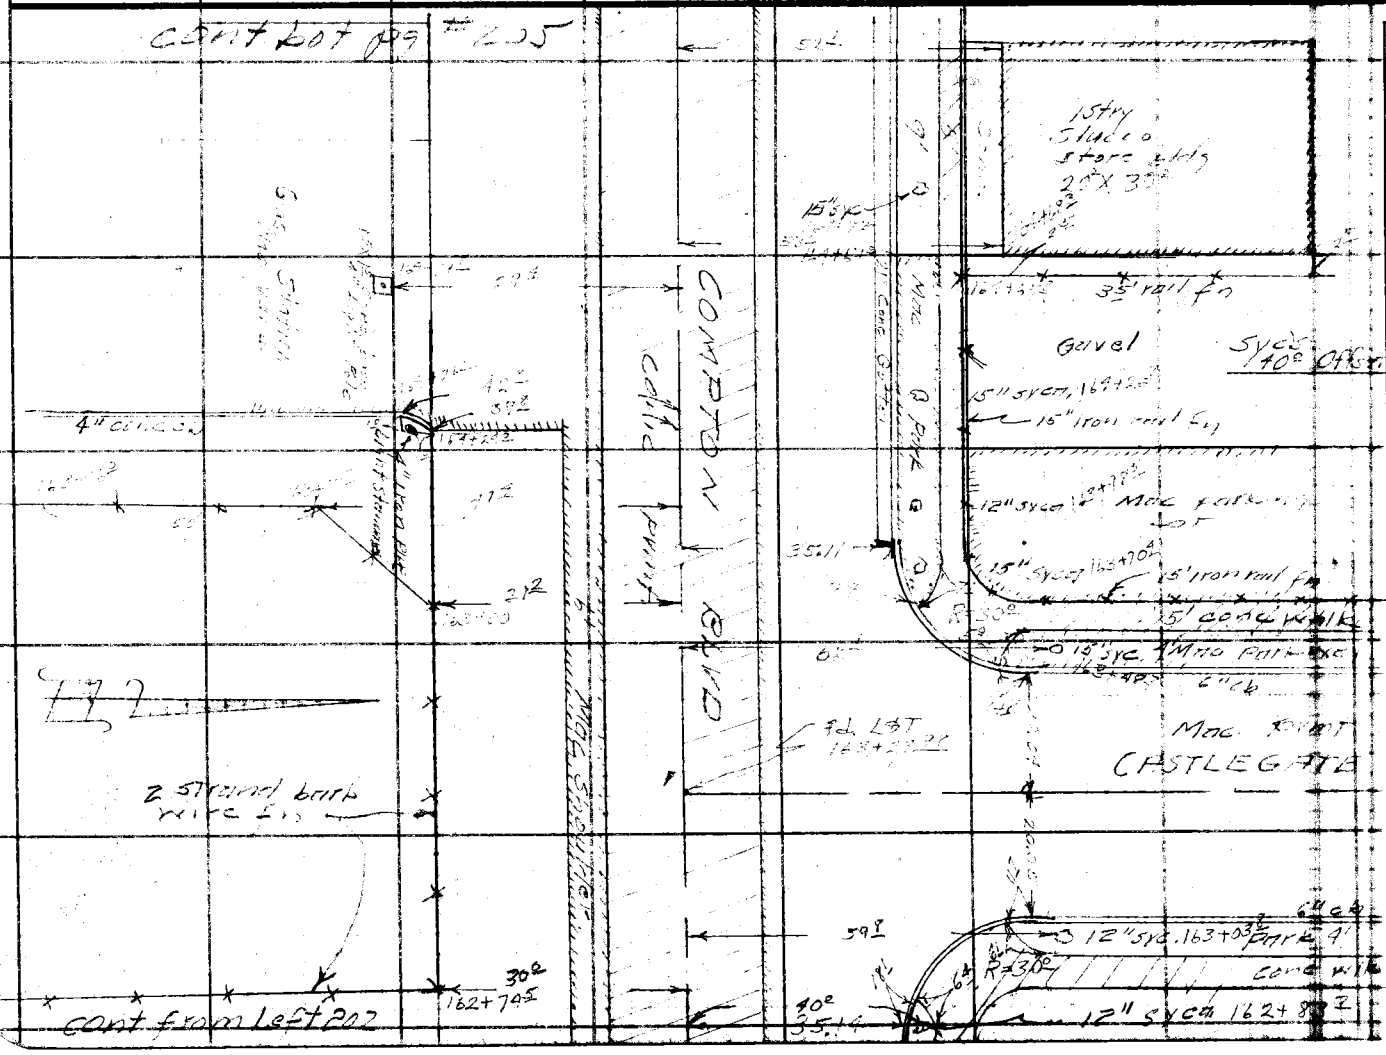
Cont Lot 99 M 205
15 Fry Stucco store bldg 24' X 35'
35' rail fn
Gravel
5yc 40° Oak
15" SYCM, 164+40
16" iron rail fn
12" SYCM 164+78
Mac Fence
15" SYCM 163+70
15' iron rail fn
5' conc walk
15" SYC M&O Pipe
6" Ck
Mac Fence
CASTLEGATE
9d Lat 163+22
2 Strand barb wire fn
12" SYC. 163+03
Pipe 4'
conc wlk
12" SYCM 162+80
162+74
Cont from Left 202
COMPTON BLVD
Mac Sidewalk
Mac Curb & Gutter
4" Conc Curb
Point
Point
Point

RETURN TO
LOS ANGELES COUNTY SURVEYOR
700 HALL OF RECORDS

Note: Any Additions or Changes on This Sheet Must be Made or Circled in Red Ink With Date and Name of Person Making Change.

Do not extend notes this side of this line.

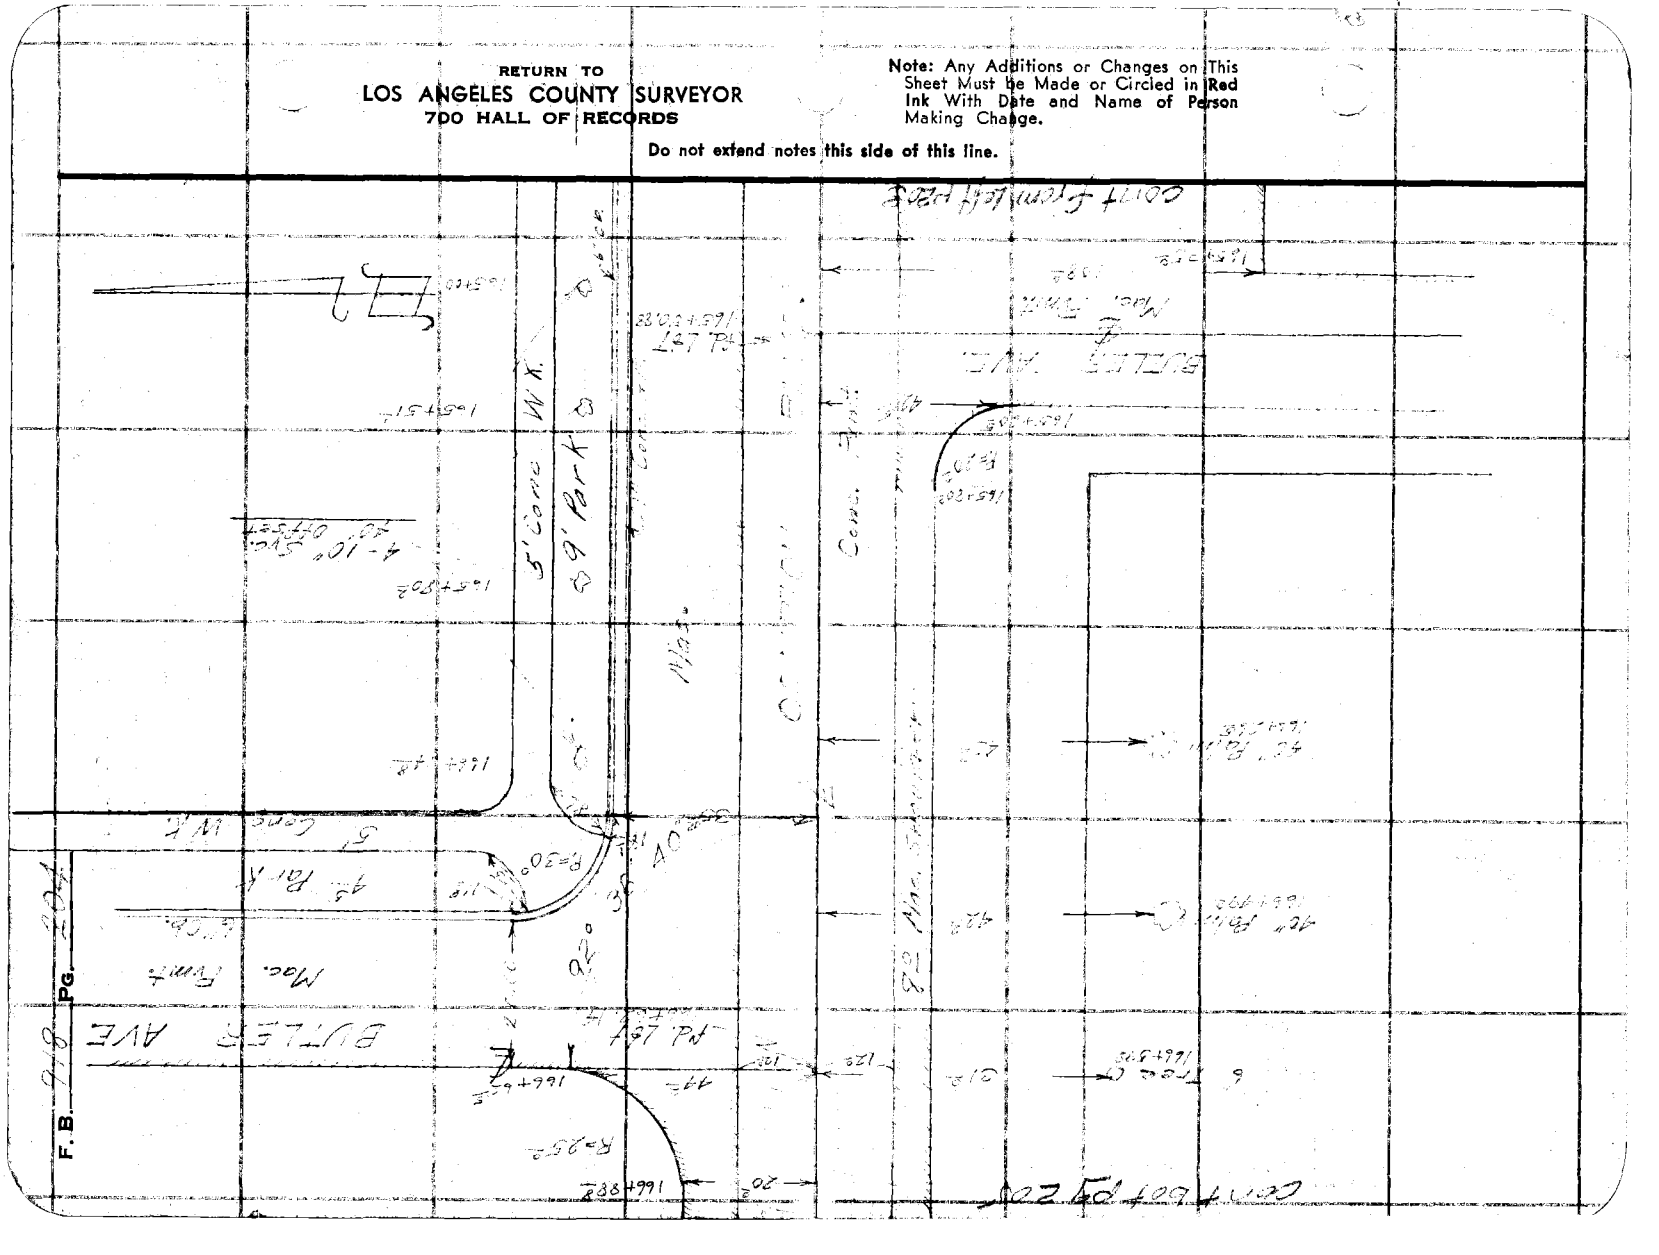

Notes Ck'd by D. M. Finley
Map No. D-1842-6
Office Work COX
Checked D. M. Finley
Date AUG '51

Survey of
W. O. 8345 Tape No. St'd °F
Surveyed by R. L. Willey
Notes RLW, D.E.L.E. Date 3-24-48
Indexed C. Jones

F. B. 4118 Pg. 205

Note: Any Additions or Changes on This Sheet Must be Made or Circled in Red Ink With Date and Name of Person Making Change.

Do not extend notes this side of this line.

RETURN TO
LOS ANGELES COUNTY SURVEYOR
700 HALL OF RECORDS

FORM 247 5M 8-46

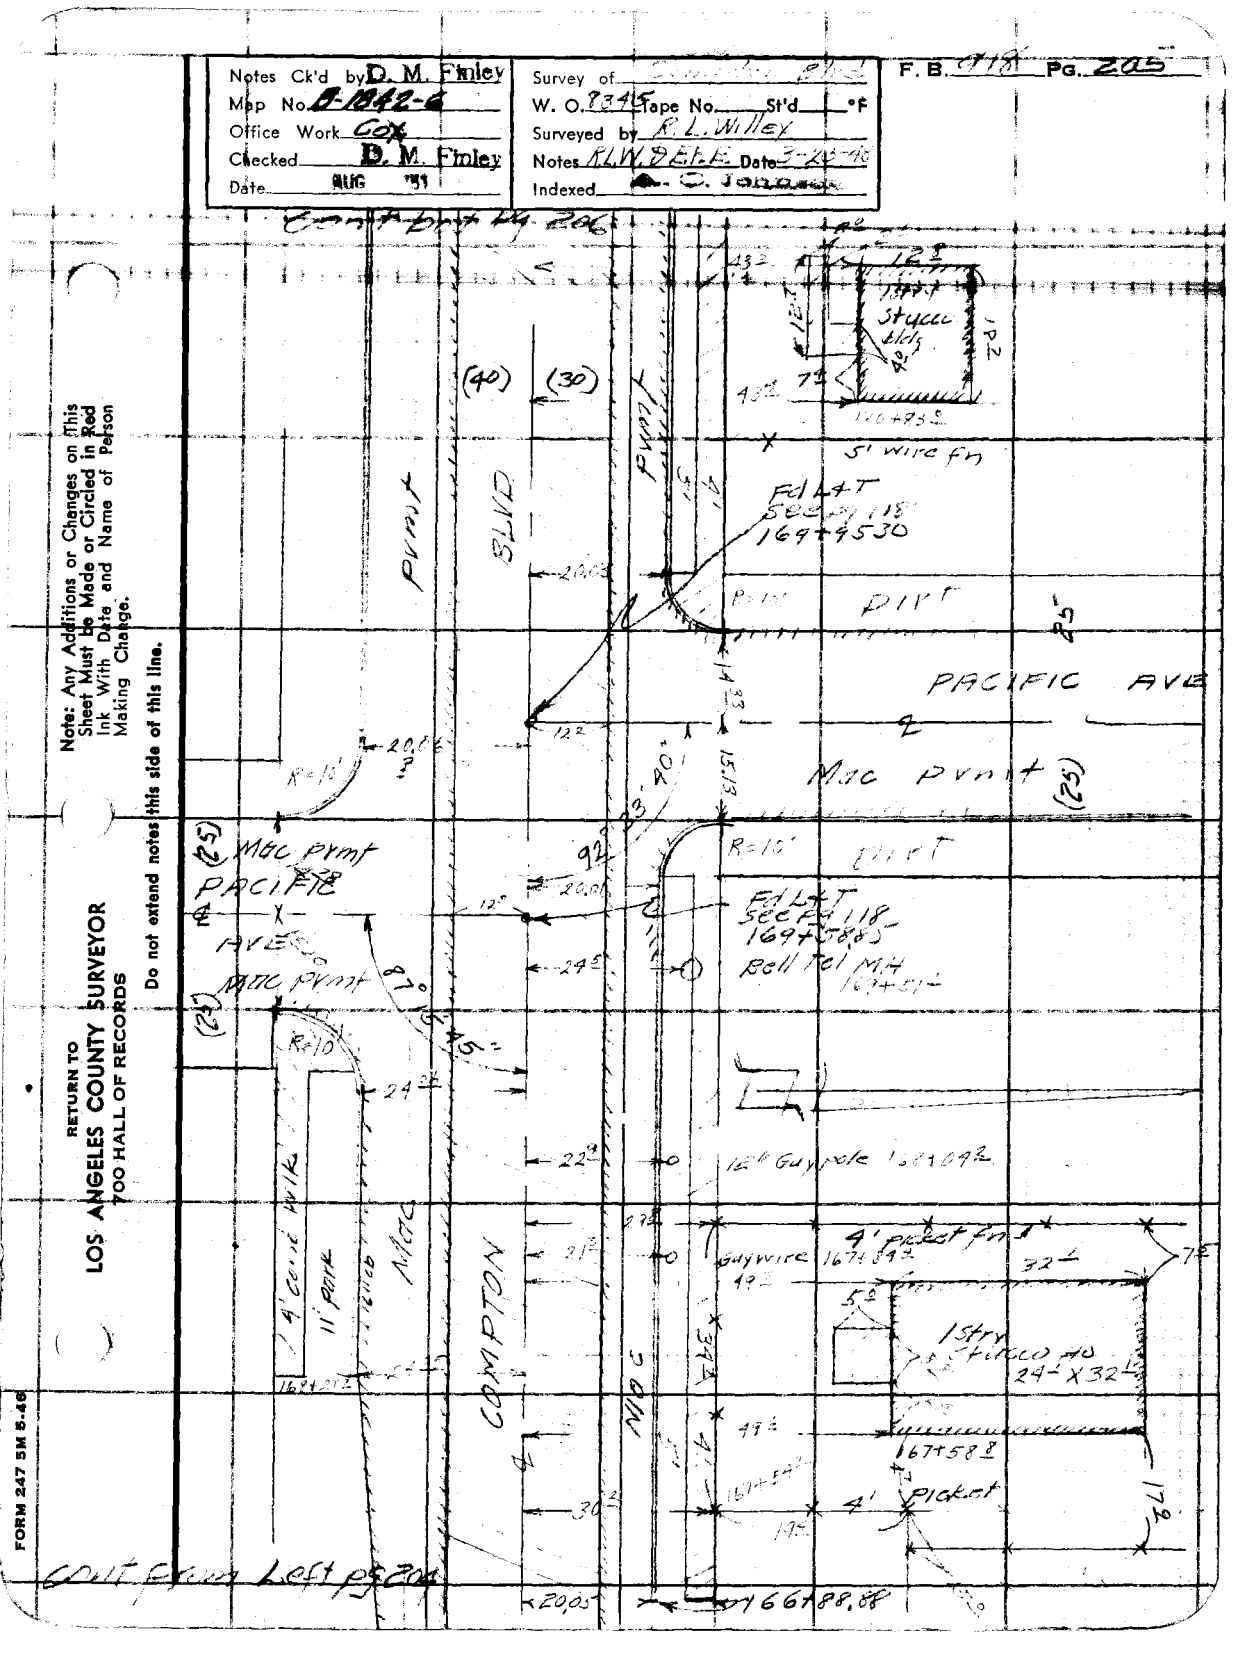

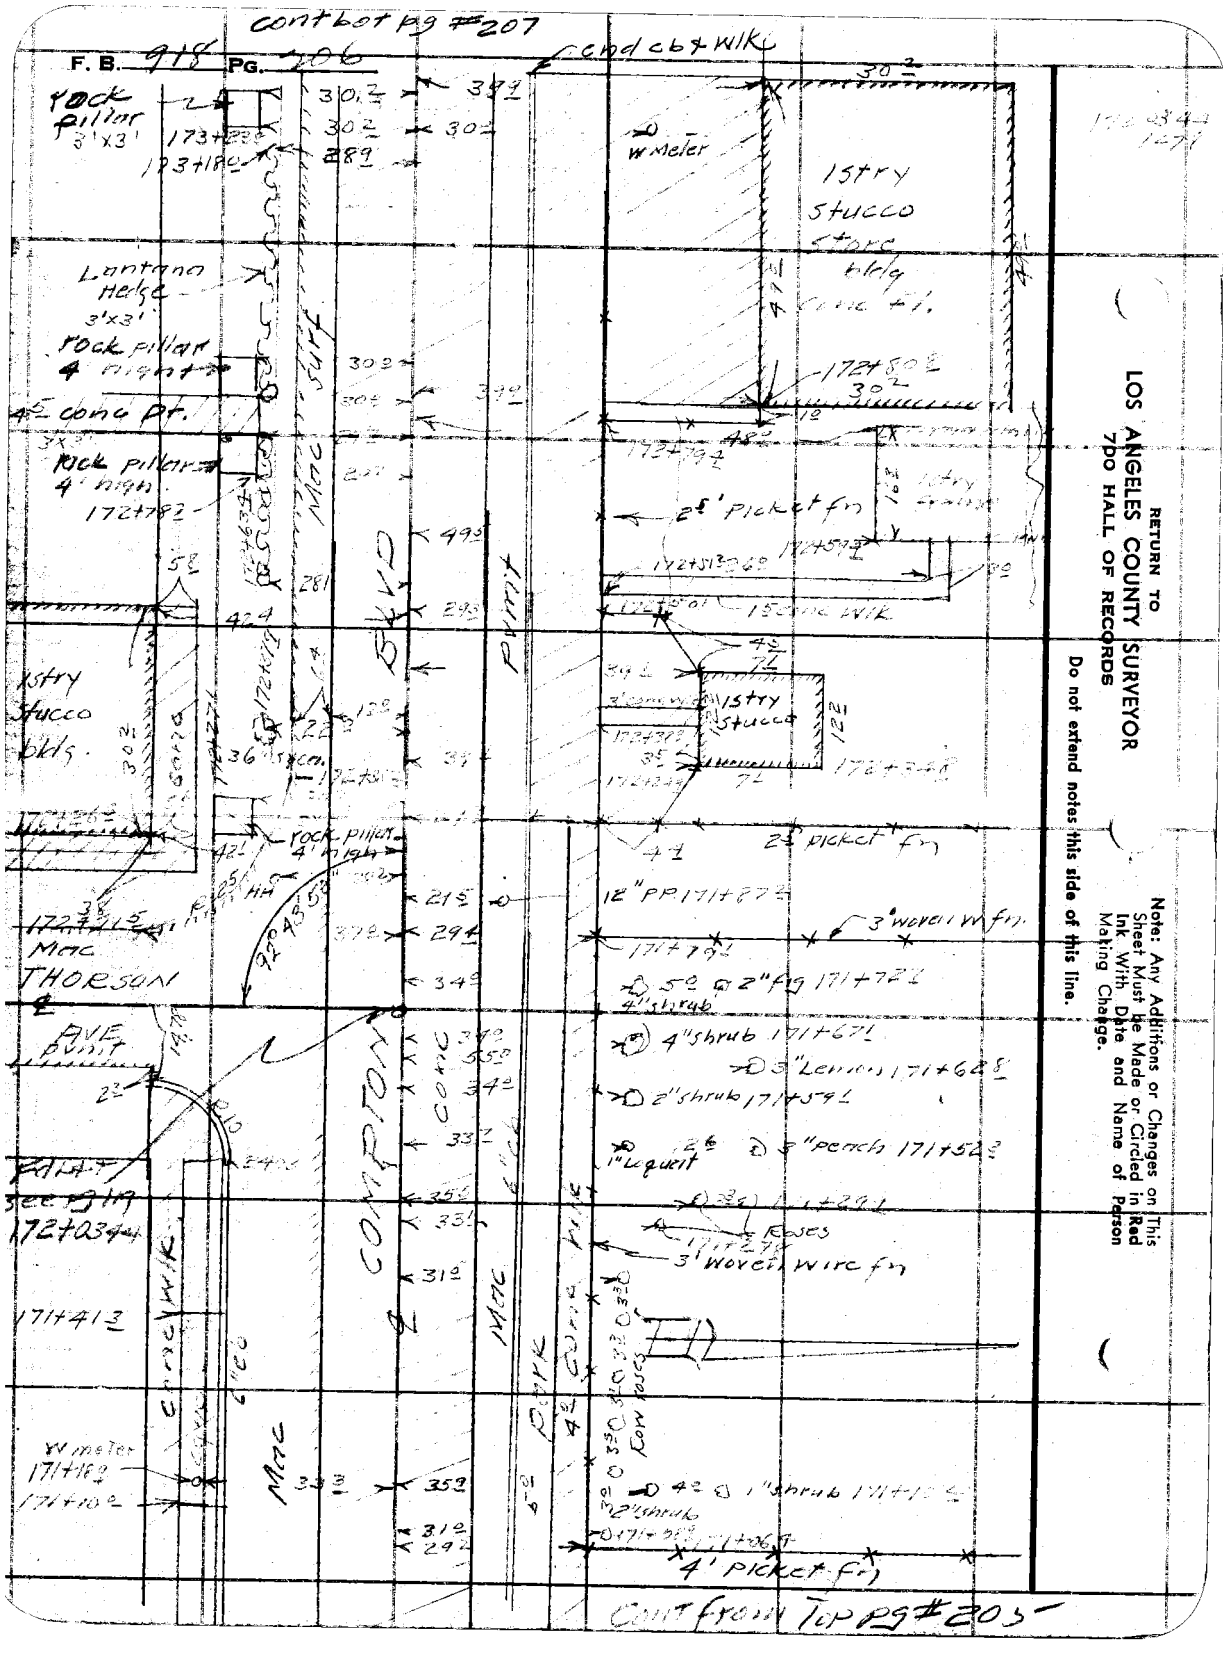
cont bot pg #207
F. B. 918 PG. 206
cond c&t wlk
rock pillar 3'x3'
W meter
1 story stucco bldg
Lantana Hedge
rock pillar 4' high
conc pt.
rock pillar 4' high
2" picket fn
1 story stucco bldgs.
rock pillar 4' high
2" picket fn
12" PP 171+27
3' wovel wire fn
5" @ 2" fg 171+72
4" shrub
4" shrub 171+67
3" Lemon 171+64
2" shrub 171+59
1" Laurel
5" peach 171+52
roses
3' wovel wire fn
4' picket fn
Cont from Top pg #203
Mac Thorson
Pave Bunit
See pg 119
Mac
Mac Curb Line
Mac Curb Line
Mac
Mac
Mac





Note: Any Additions or Changes on This Sheet Must be Made or Circled in Red Ink With Date and Name of Person Making Change.

Do not extend notes this side of this line.

RETURN TO
LOS ANGELES COUNTY SURVEYOR
700 HALL OF RECORDS

FORM 247 SM 5-46

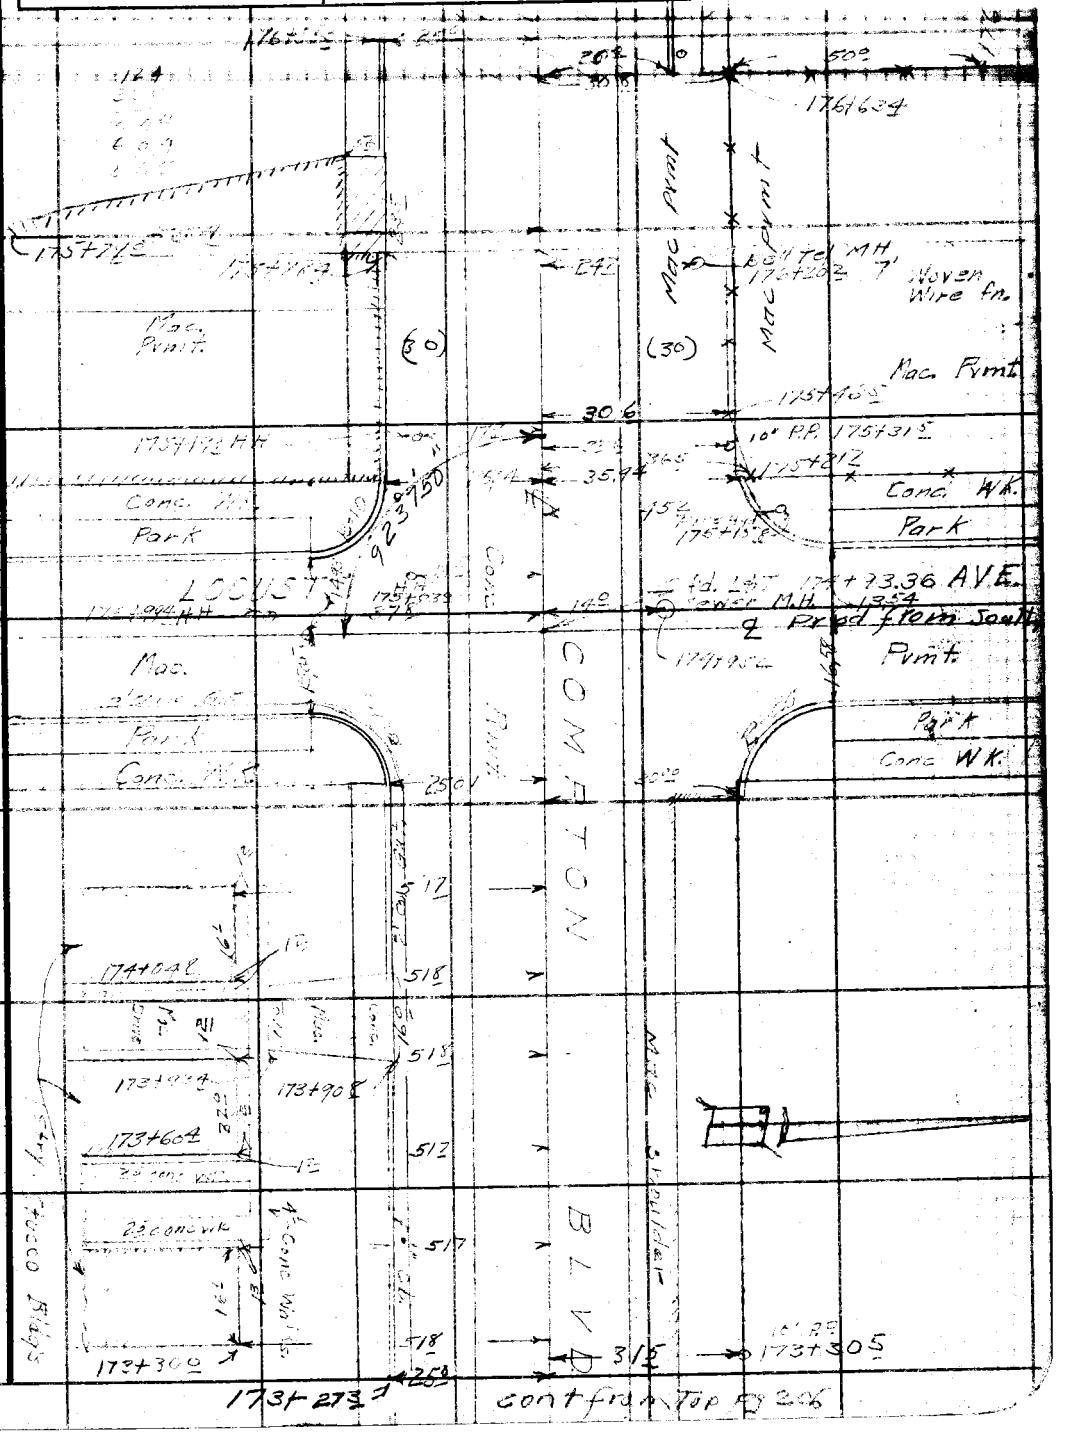

RETURN TO
LOS ANGELES COUNTY SURVEYOR
700 HALL OF RECORDS

Note: Any Additions or Changes on This Sheet Must be Made or Circled in Red Ink With Date and Name of Person Making Change.

Do not extend notes this side of this line.

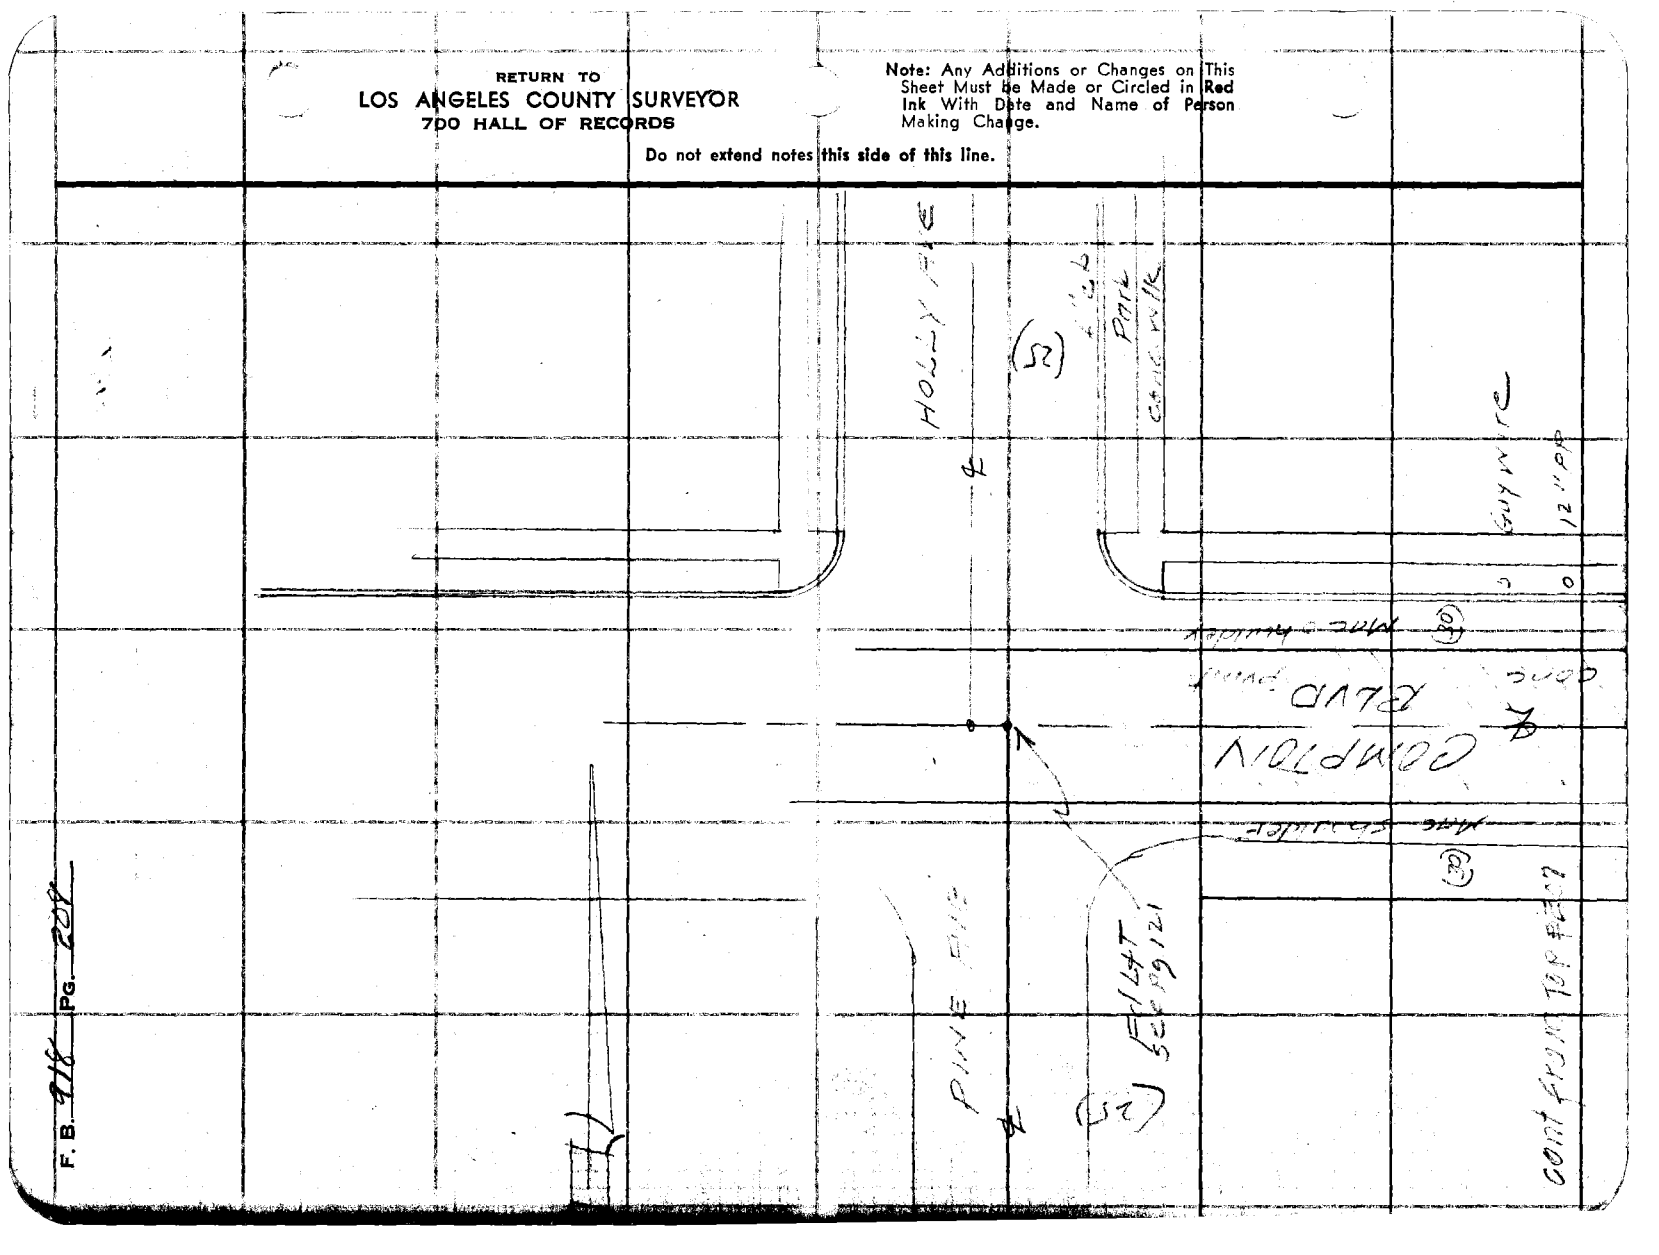

W.O. 34-D-V

Notes Ck'd by D. M. Finley
Map No. B-1842-1
Office Work Cox
Checked D. M. Finley
Date AUG '31

Survey of
W. O. 34 Tape No. 122 St'd °F
Surveyed by R.L.Willey
Notes Date 3-98
Indexed A. C. Johnson 6-24-98

F. B. 218 Pg. 209

NOTE

USED 100' TAPE
STAGG EXCEPT AS
NOTED

Fd SW+T
BY TIES PER
FB 918-12

8.54

Fd N+T
IN PP

BUENA PARK

A HABERFELD

122.35

Fd N+T IN PP

LOS ANGELES CO. TO COL ST.
ORANGE CO 10' offset Line

cont / To to pg 210

Note: Any Additions or Changes on This Sheet Must be Made or Circled in Red Ink With Date and Name of Person Making Change.

Do not extend notes this side of this line.

RETURN TO
LOS ANGELES COUNTY SURVEYOR
720 HALL OF RECORDS

FORM 247 SM 11-46

91

F. B. 918 PG. 210

cont from bot pg 209

WS 34 D4

120° 19' 20"
121 17 20
361 56 20

Pk Nail & T
Tag "3"
per FB 918-13

30"

120° 19' 23"

HARBOR BLVD

Set bt SPK
per pg 13

LOS ANGELES CO

1155

3472

.07

RETURN TO
LOS ANGELES COUNTY SURVEYOR
900 HALL OF RECORDS

Do not extend notes this side of this line.

Note: Any Additions or Changes on This Sheet Must Be Made or Circled in Red Ink With Date and Name of Person Making Change.

ORANGE CO.

120 19 20
121 17 20
361 56 10

T = 60 = 156.78'
156.79 @ LCV

1127.47' TO CL

.44 Adj

30"

120° 19' 22"

Y 421.

Y 156.78'

T = 60 = 421.42'
421.44 @ LCV

Set bt SPK & T
0+00

PROP. COMPTON

℄

BLVD

(19)







FORM 247 SM 11-46

RETURN TO
LOS ANGELES COUNTY SURVEYOR
700 HALL OF RECORDS

Note: Any Additions or Changes on This Sheet Must be Made or Circled in Red Ink With Date and Name of Person Making Change.

Do not extend notes this side of this line.

WS 34-D-4

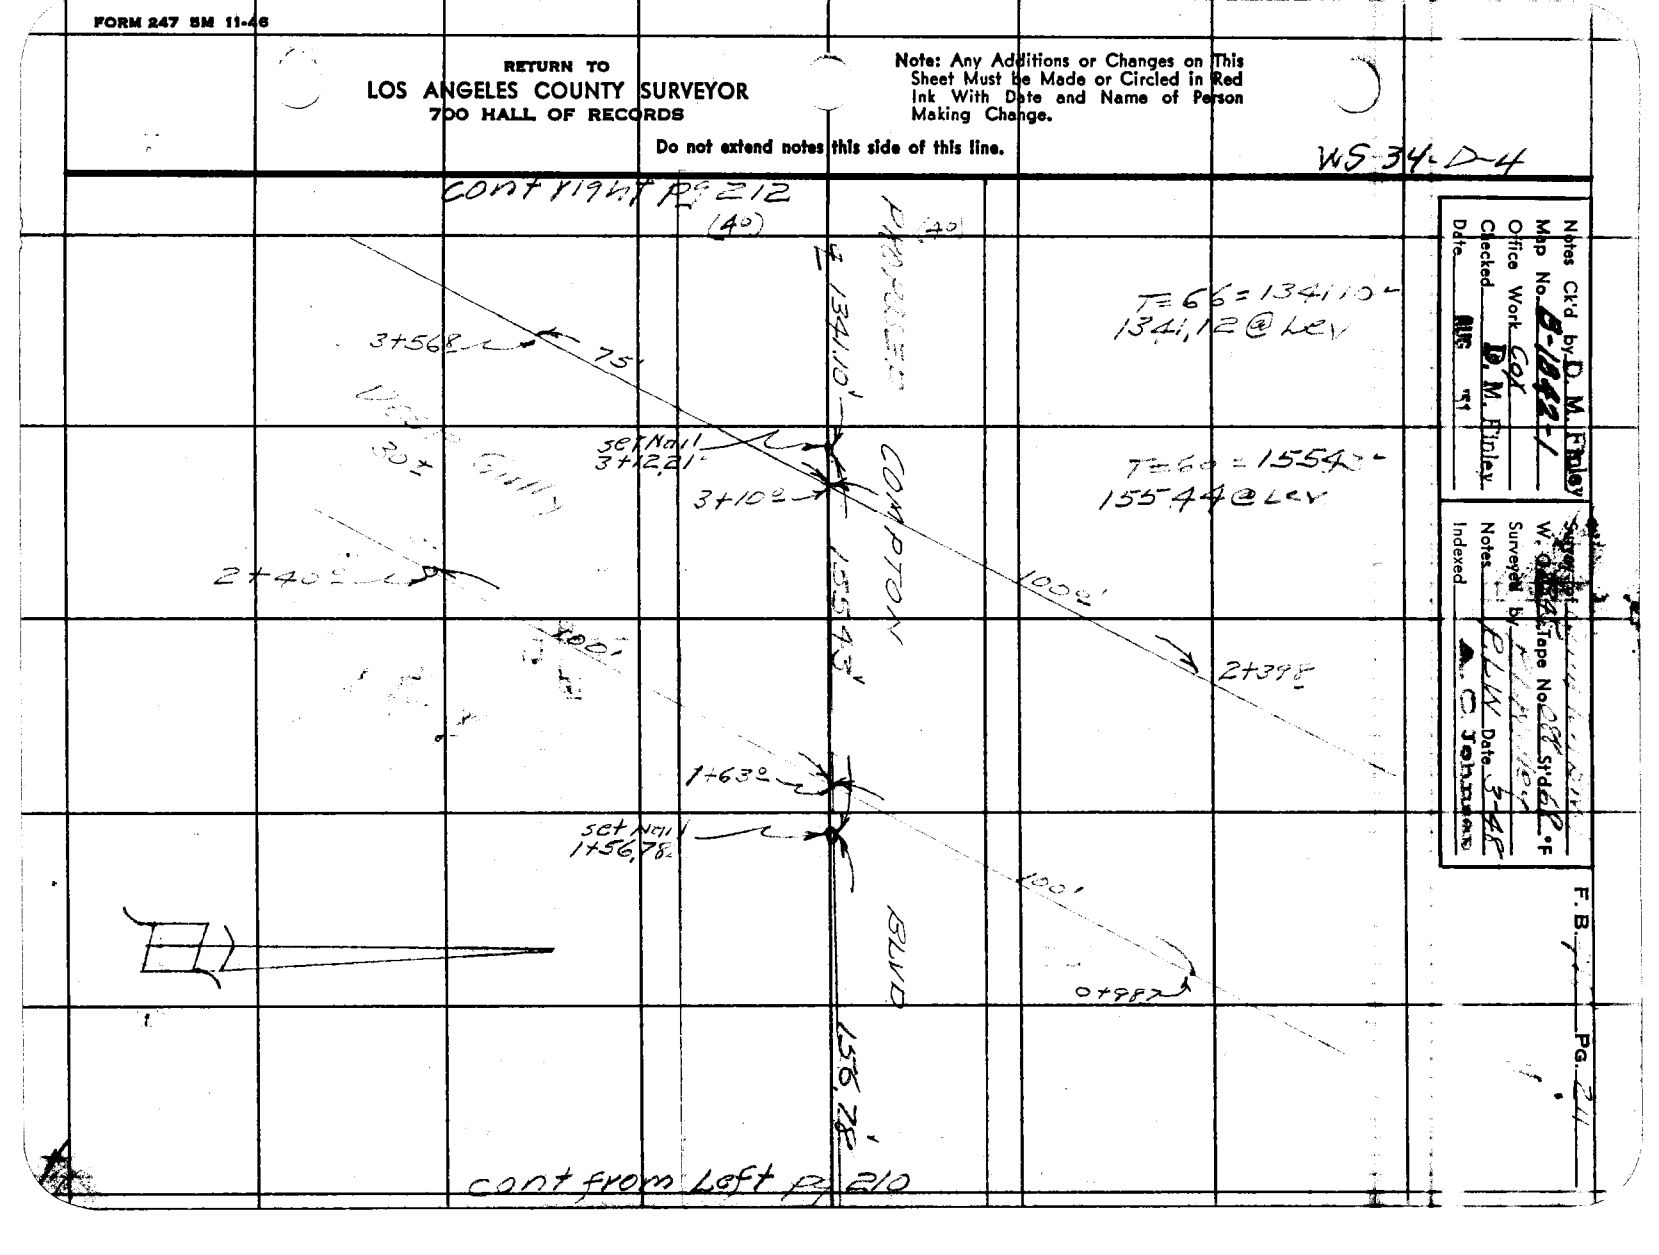

Notes Ck'd by D. M. Finley
Office Work Cpl
Checked D. M. Finley
Date 11

Surveyed by P.L.W.
W. O. No. Tape No. Std. °F
Surveyed by P.L.W. Date 3-52
Notes
Indexed A. C. Johnson

F. B. ____ Pg. 24

RETURN TO
LOS ANGELES COUNTY SURVEYOR
700 HALL OF RECORDS

Note: Any Additions or Changes on This Sheet Must be Made or Circled in Red Ink With Date and Name of Person Making Change.

Do not extend notes this side of this line.

WS 34 D4

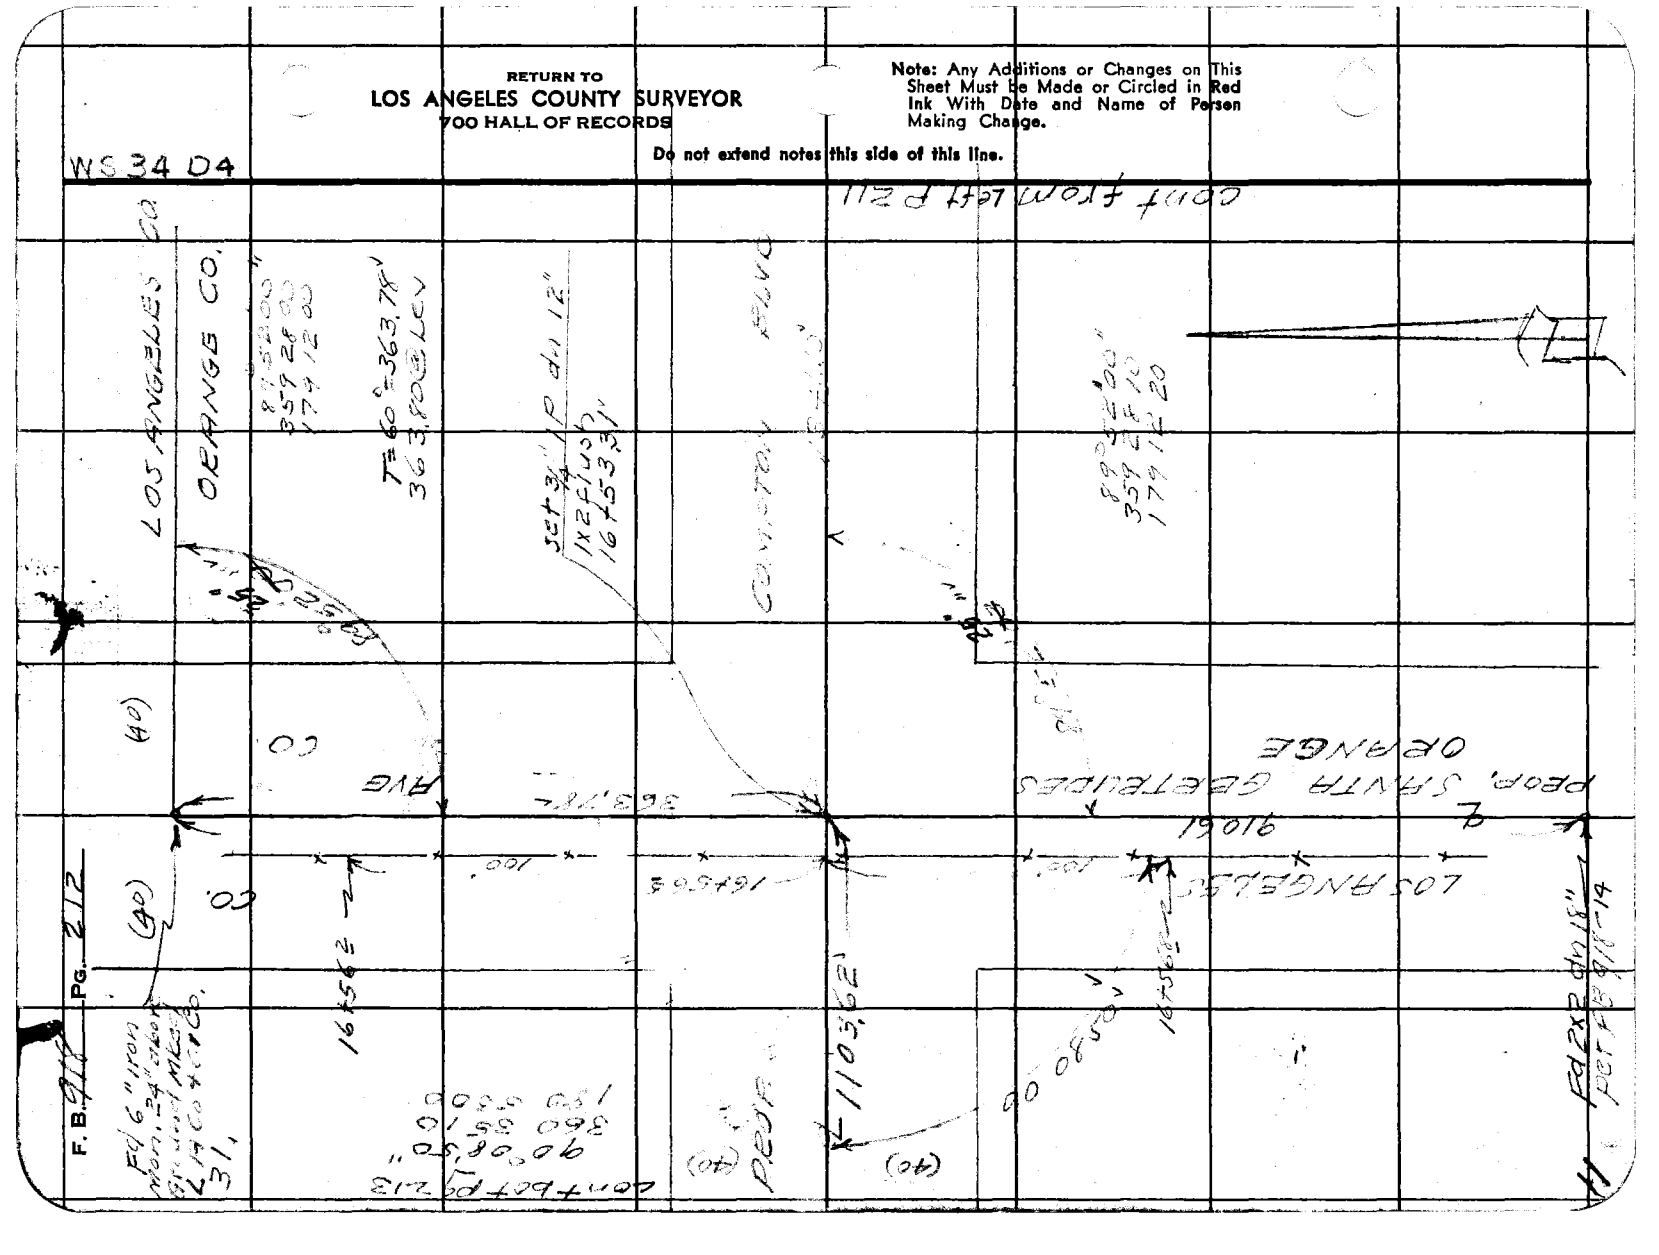

Notes Ck'd by D. M. Finley
Map No. B-1842-1
Office Work Cox
Checked D. M. Finley
Date AUG '51

Survey of Compton, City
W. O. 224 Tape No. 2 St'd 68°F
Surveyed by R. L. Miller
Notes " Date 3-48
Indexed A. C. Johnson

F. B. 214 Pg. 215

W 34-D5

cont Lot 5 pg 214

(30) (40)

1178

227+87

BLVD

300' Tan = #72 5+, @ 84°
T = 60° = 110362'
300.50 @ LCV = 300.50'
239.72 @ 12V = 239.65'
300.76 @ LCV = 300.76'
196.70 @ 530' = 195.77'
67.14 @ LCV = 67.14'
1103.82'

20+75 ± 37 ± 1103.82'

4 stations back with f

PROJ. COMPTON

19+83 ±

37 ± 18+ ±

cont from Left Pg 212

Note: Any Additions or Changes on This Sheet Must be Made or Circled in Red Ink With Date and Name of Person Making Change.

Do not extend notes this side of this line.

RETURN TO
LOS ANGELES COUNTY SURVEYOR
700 HALL OF RECORDS

FORM 247 SM 11-46

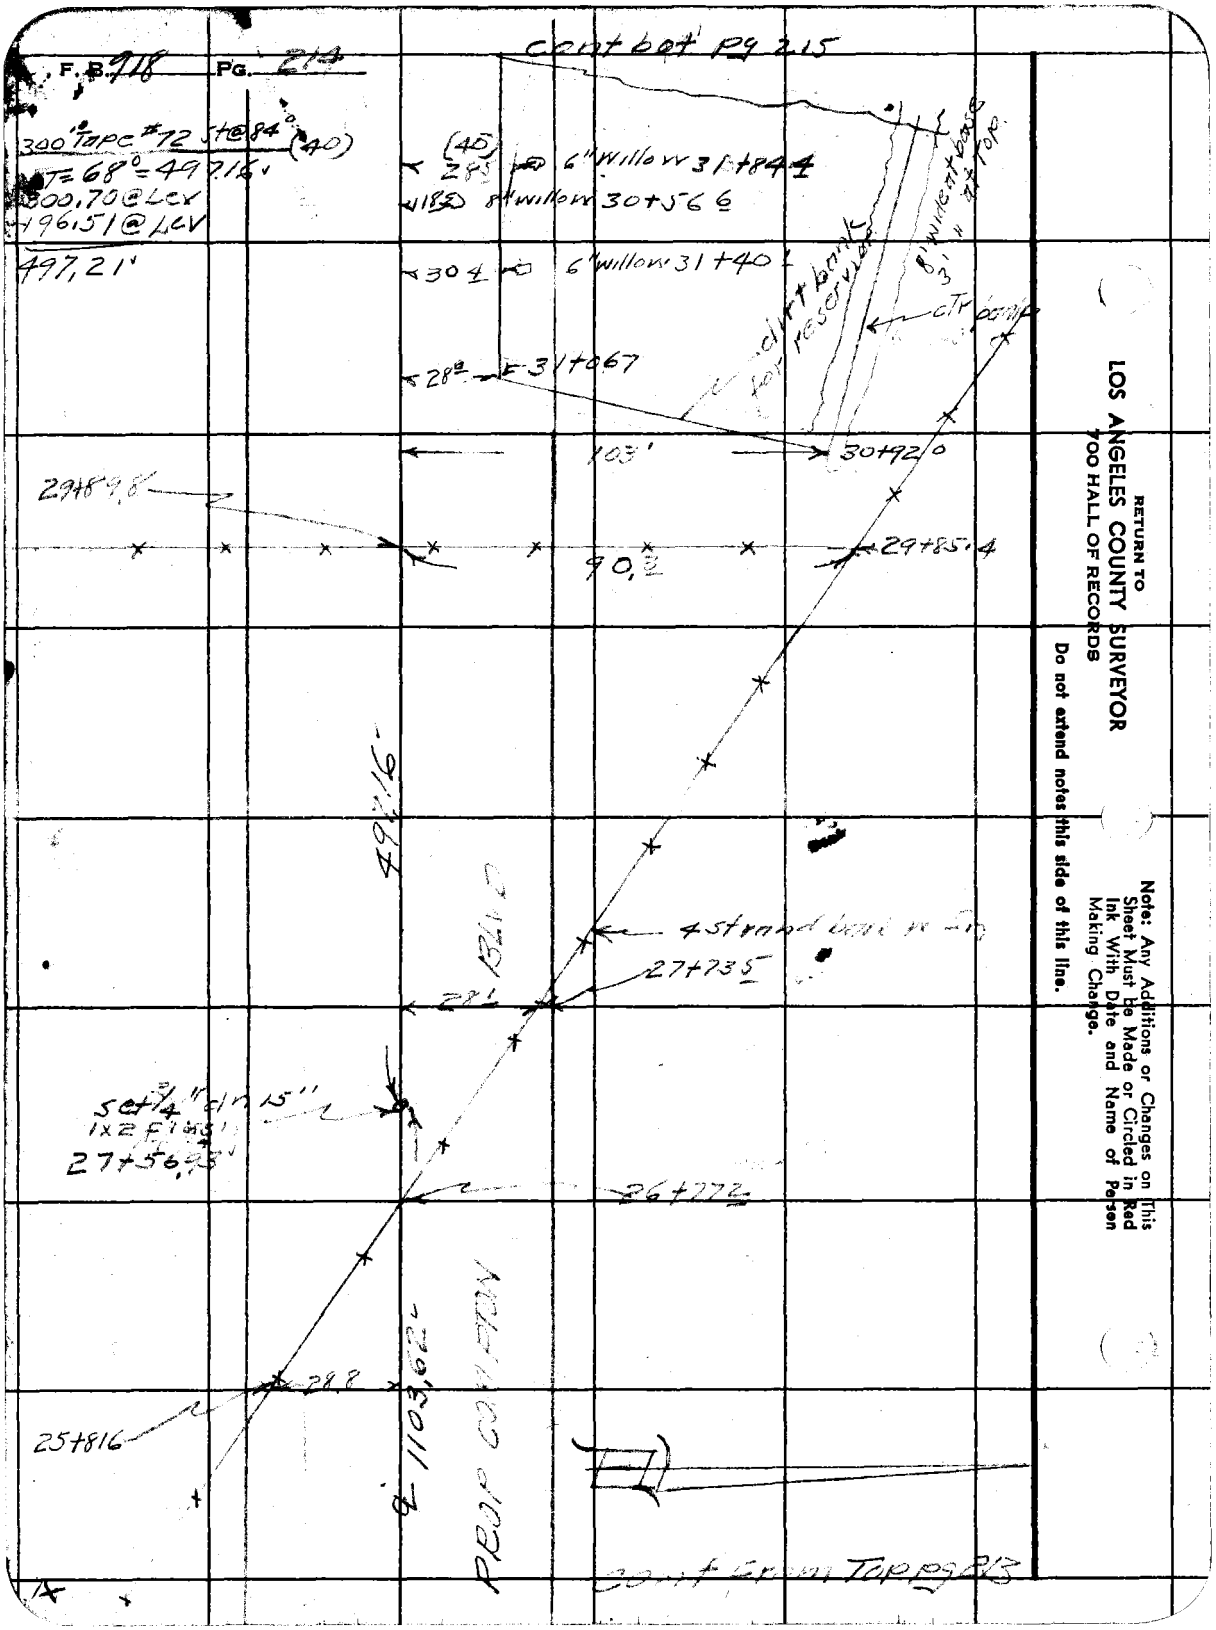
F.B. 918 PG. 214
cont bot pg 215
300' Tape #72 St@84°
T=68°=49.16'
300.70@Lcv
+196.51@LCV
497.21'
(40)
(45)
6" Willow 31+84±
8" willow 30+56
6" willow 31+40±
31+067
30+92.0
103'
90.3
29+85.4
29+89.8
497.16'
45 strand wire fence
27+73.5
27+56.8
26+77.2
25+816
1103.62'
RETURN TO
LOS ANGELES COUNTY SURVEYOR
700 HALL OF RECORDS
Do not extend notes this side of this line.
Note: Any Additions or Changes on This Sheet Must be Made or Circled in Red Ink With Date and Name of Person Making Change.

Notes Ck'd by D. M. Finley
Map No. B-1842-7
Office Work Cox
Checked D. M. Finley
Date AUG '51

Survey of Compton Creek
W. O. 8345 Tape No. 202 St'd 62 °F
Surveyed by R. Johnson
Notes " Date 3-47
Indexed A. C. Johnson

F. B. 214 Pg. 215

Note: Any Additions or Changes on This Sheet Must be Made or Circled in Red Ink With Date and Name of Person Making Change.

Do not extend notes this side of this line.

RETURN TO
LOS ANGELES COUNTY SURVEYOR
700 HALL OF RECORDS

FORM 247 SM 11-46

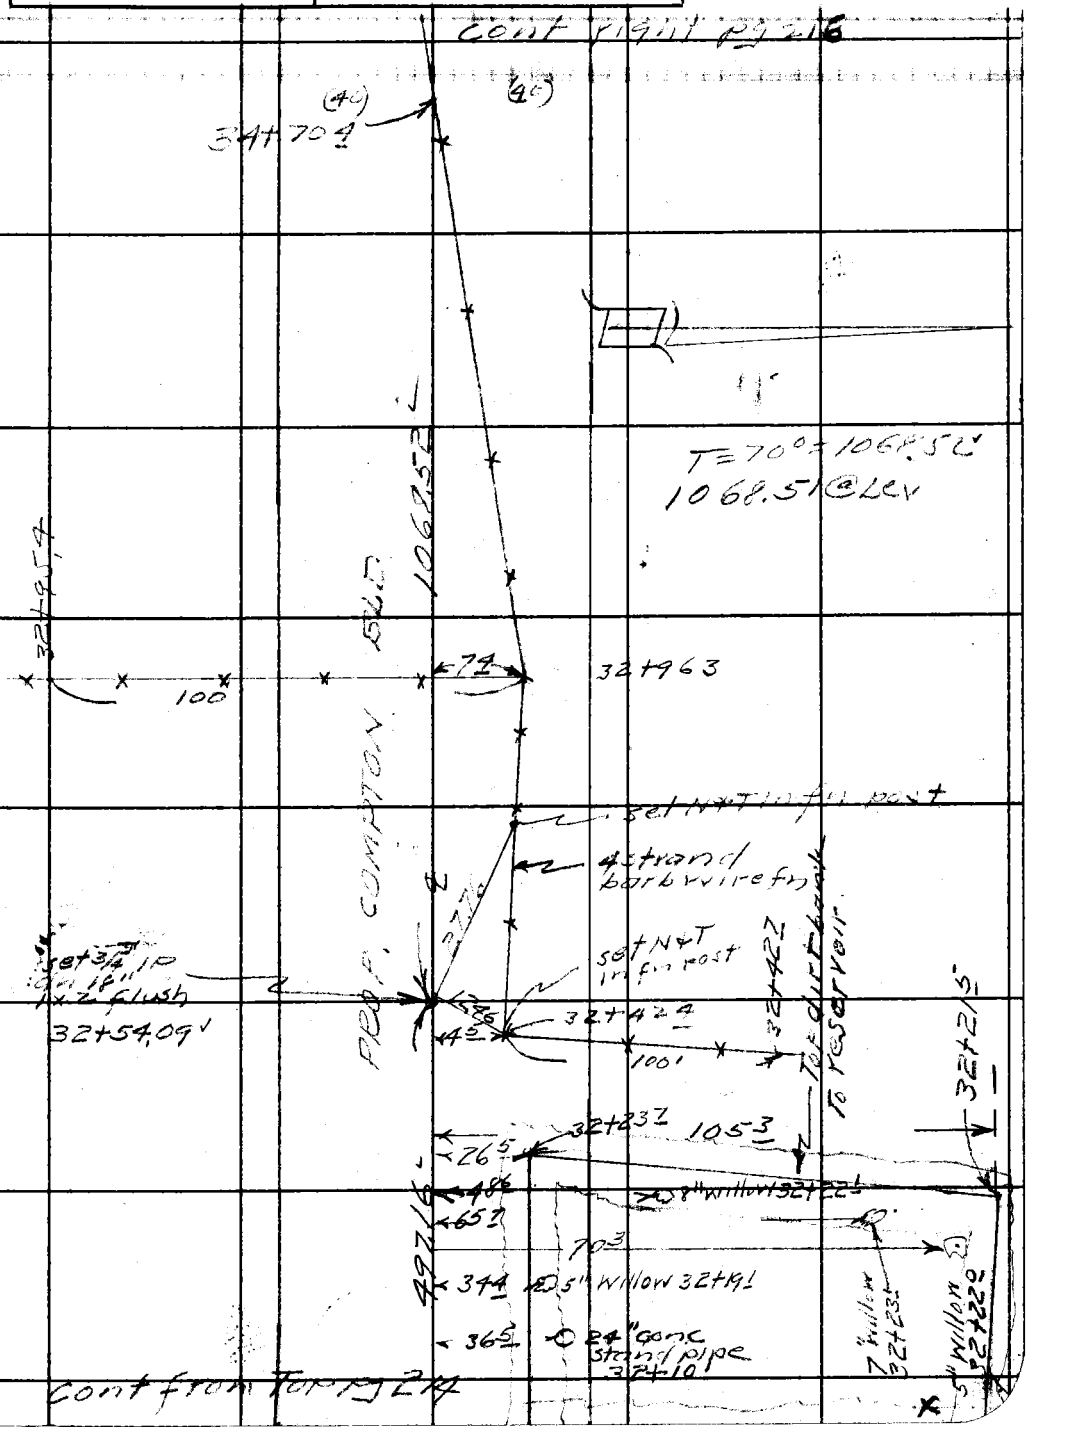

RETURN TO
LOS ANGELES COUNTY SURVEYOR
700 HALL OF RECORDS

Note: Any Additions or Changes on This Sheet Must Be Made or Circled in Red Ink With Date and Name of Person Making Change.

Do not extend notes this side of this line.

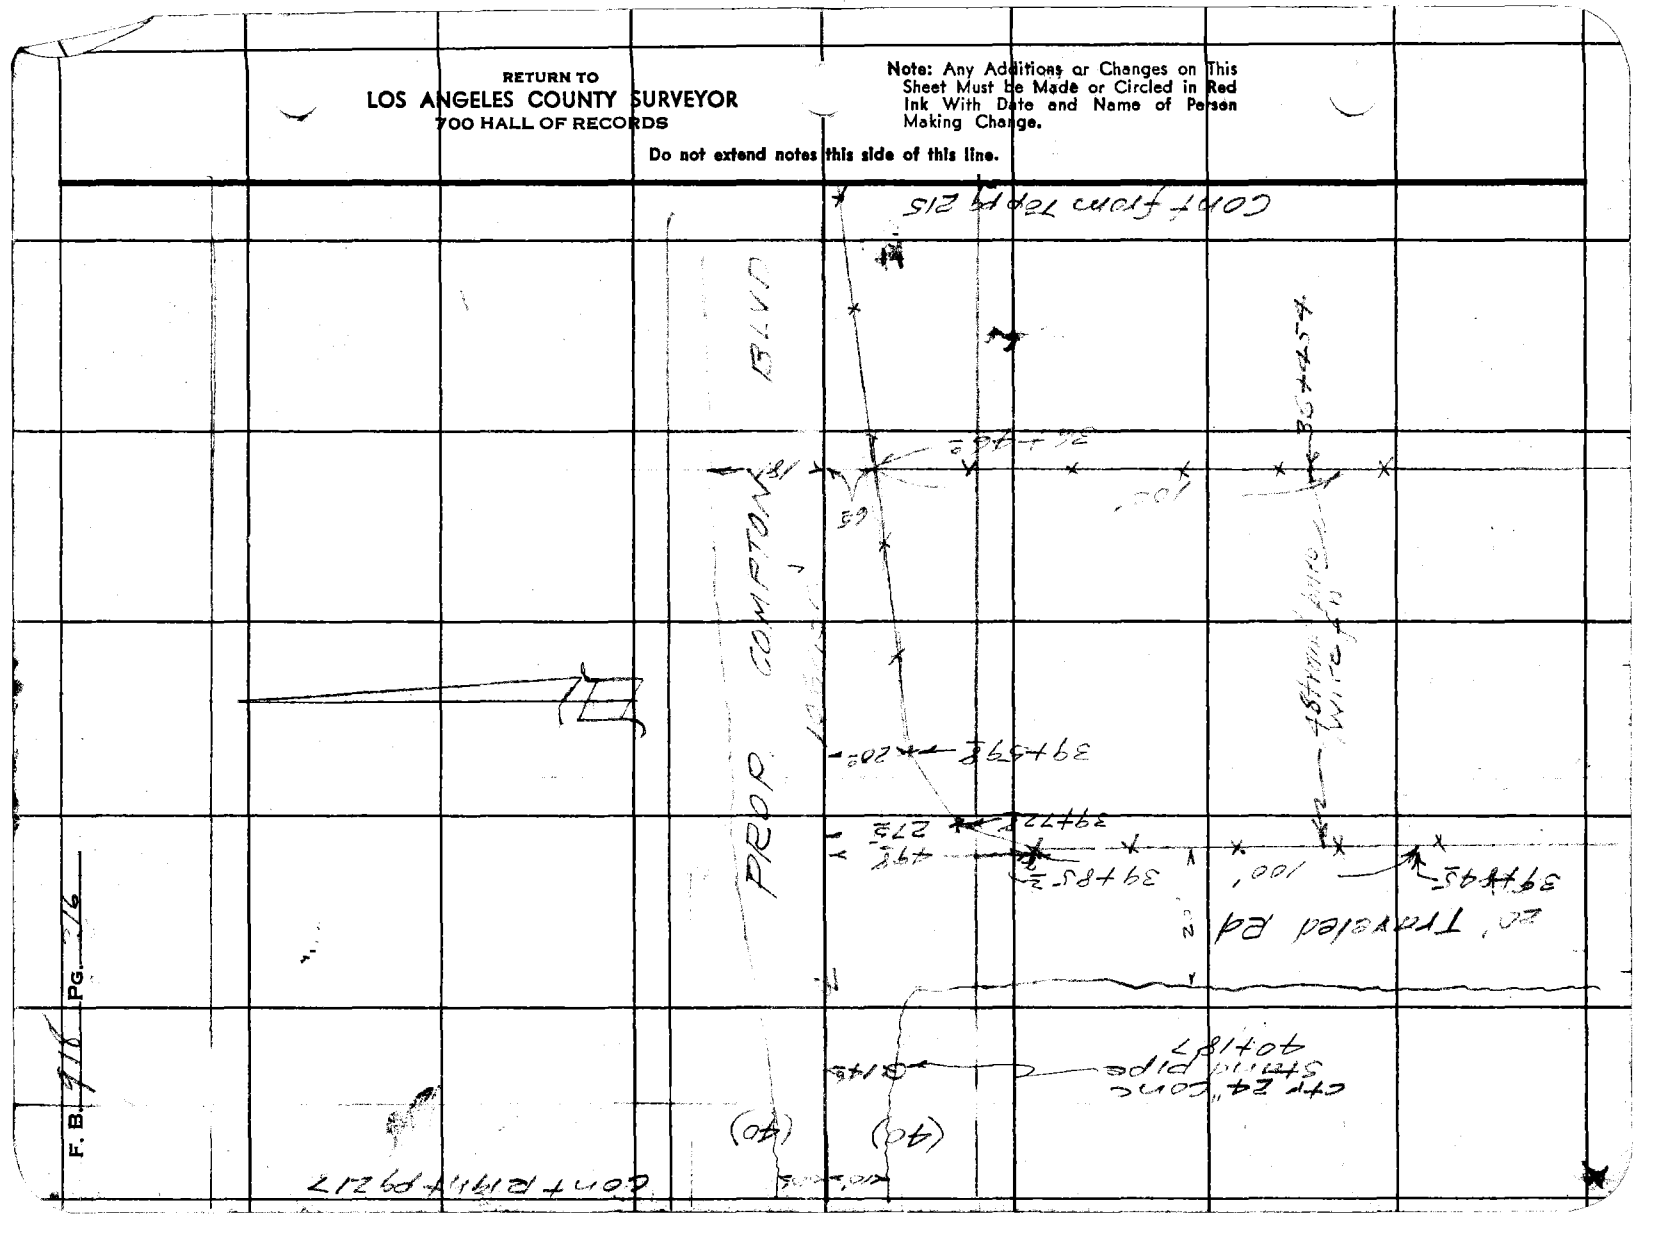

FORM 247 SM 11-46

RETURN TO
LOS ANGELES COUNTY SURVEYOR
700 HALL OF RECORDS

Note: Any Additions or Changes on This Sheet Must be Made or Circled in Red Ink With Date and Name of Person Making Change.

Do not extend notes this side of this line.

W 34 C4

Notes Ck'd by D. M. Finley
Map No. B-1882+1
Office Work COR
Checked D. M. Finley
Date AUG 51

Survey of W. Ore. Tape No. Std. °F
Surveyed by
Notes
Date 3-48
Indexed C. J. Parker

F. B. PG.

cont from right pg 218

T=60
95.18 SLev

COMPTON

95.18 SLev

T=58=126.93
126.93 SLev

N
E
126.92'

136° 34' 50"
1941.40
1111.29 40

136°

3 x 58

42+27.43

1 x 4 x 1/4 Stl

10 Timber Bd

cont from left pg 216

RETURN TO
LOS ANGELES COUNTY SURVEYOR
700 HALL OF RECORDS

Note: Any Additions or Changes on This Sheet Must be Made or Circled in Red Ink With Date and Name of Person Making Change.

Do not extend notes this side of this line.

WS 34 C4 ✦ 5

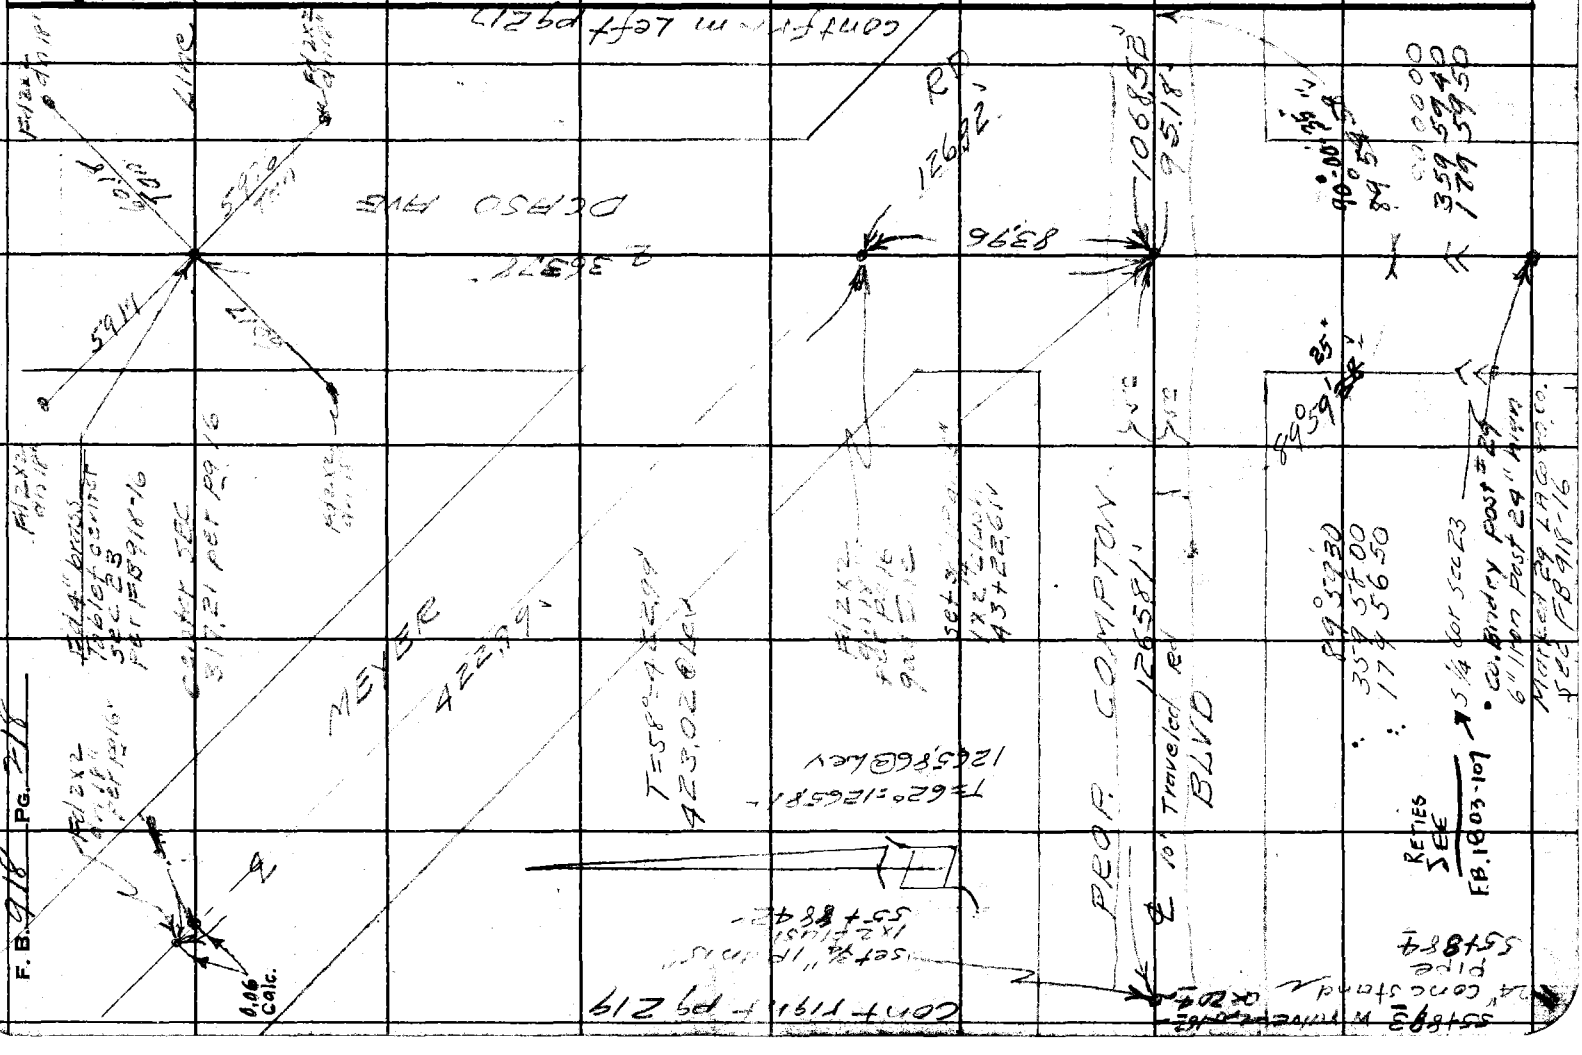

Notes Ck'd by D. M. Finley
Map No. 242-1
Office Work Cox
Checked D. M. Finley
Date AUG '51

Survey of
W. O. 3221 Tape No. 099 St'd 68 °F
Surveyed by E. B. Miller
Notes " Date 7-4-51
Indexed A. C. Johnson


N 34-W

Note: Any Additions or Changes on This Sheet Must be Made or Circled in Red Ink With Date and Name of Person Making Change.

Do not extend notes this side of this line.

RETURN TO
LOS ANGELES COUNTY SURVEYOR
700 HALL OF RECORDS

FORM 247 SM 11-46

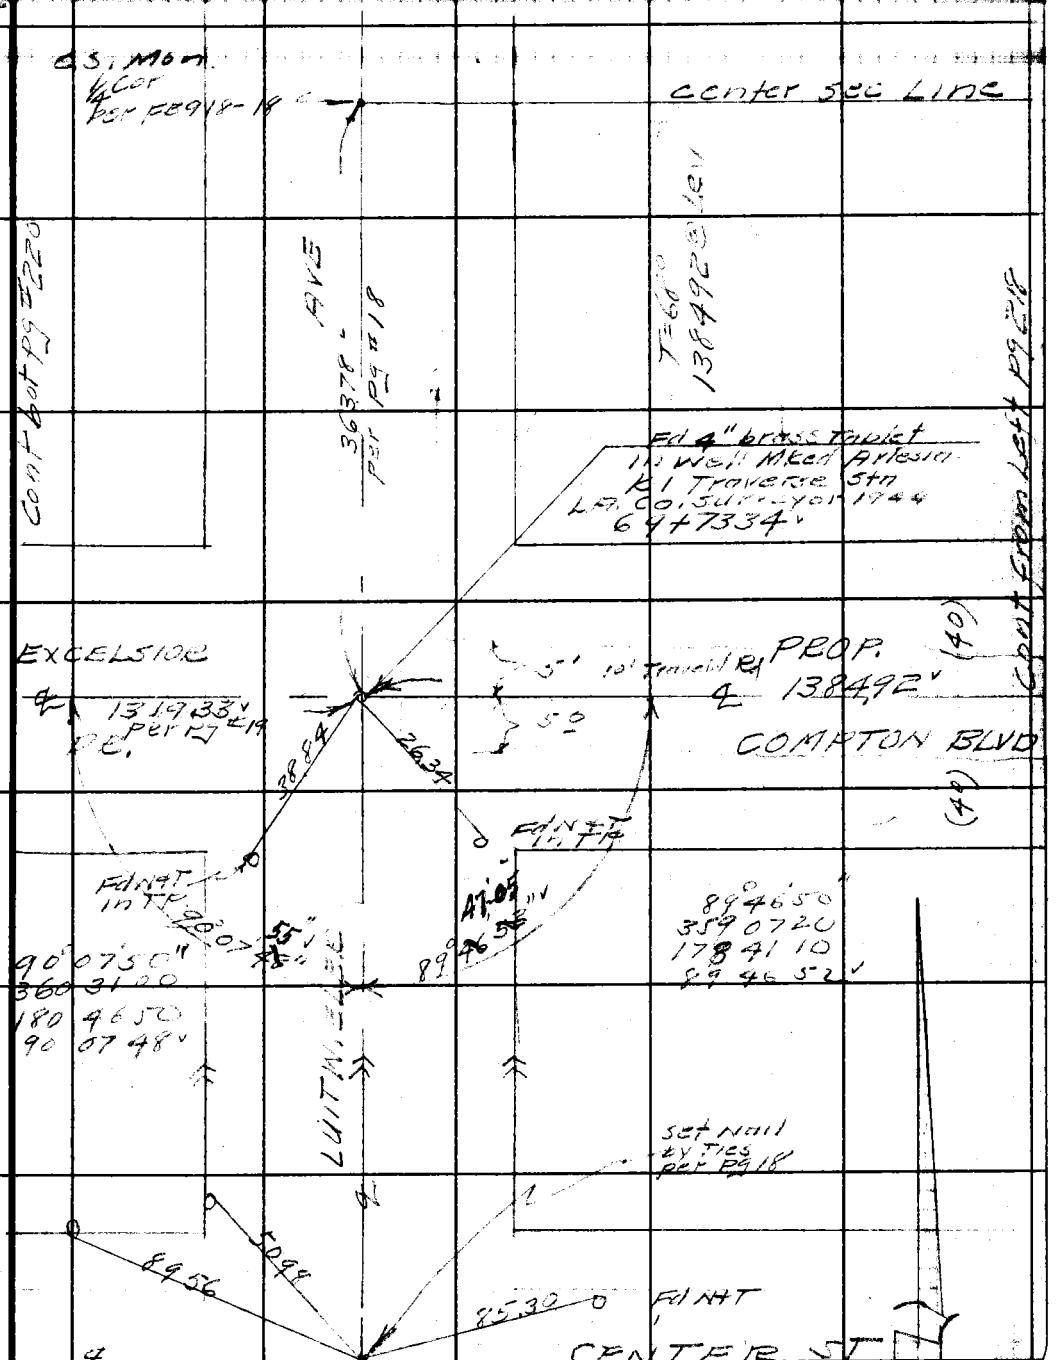

RETURN TO
LOS ANGELES COUNTY SURVEYOR
700 HALL OF RECORDS

Note: Any Additions or Changes on This Sheet Must be Made or Circled in Red Ink With Date and Name of Person Making Change.

Do not extend notes this side of this line.

WS 34 C4

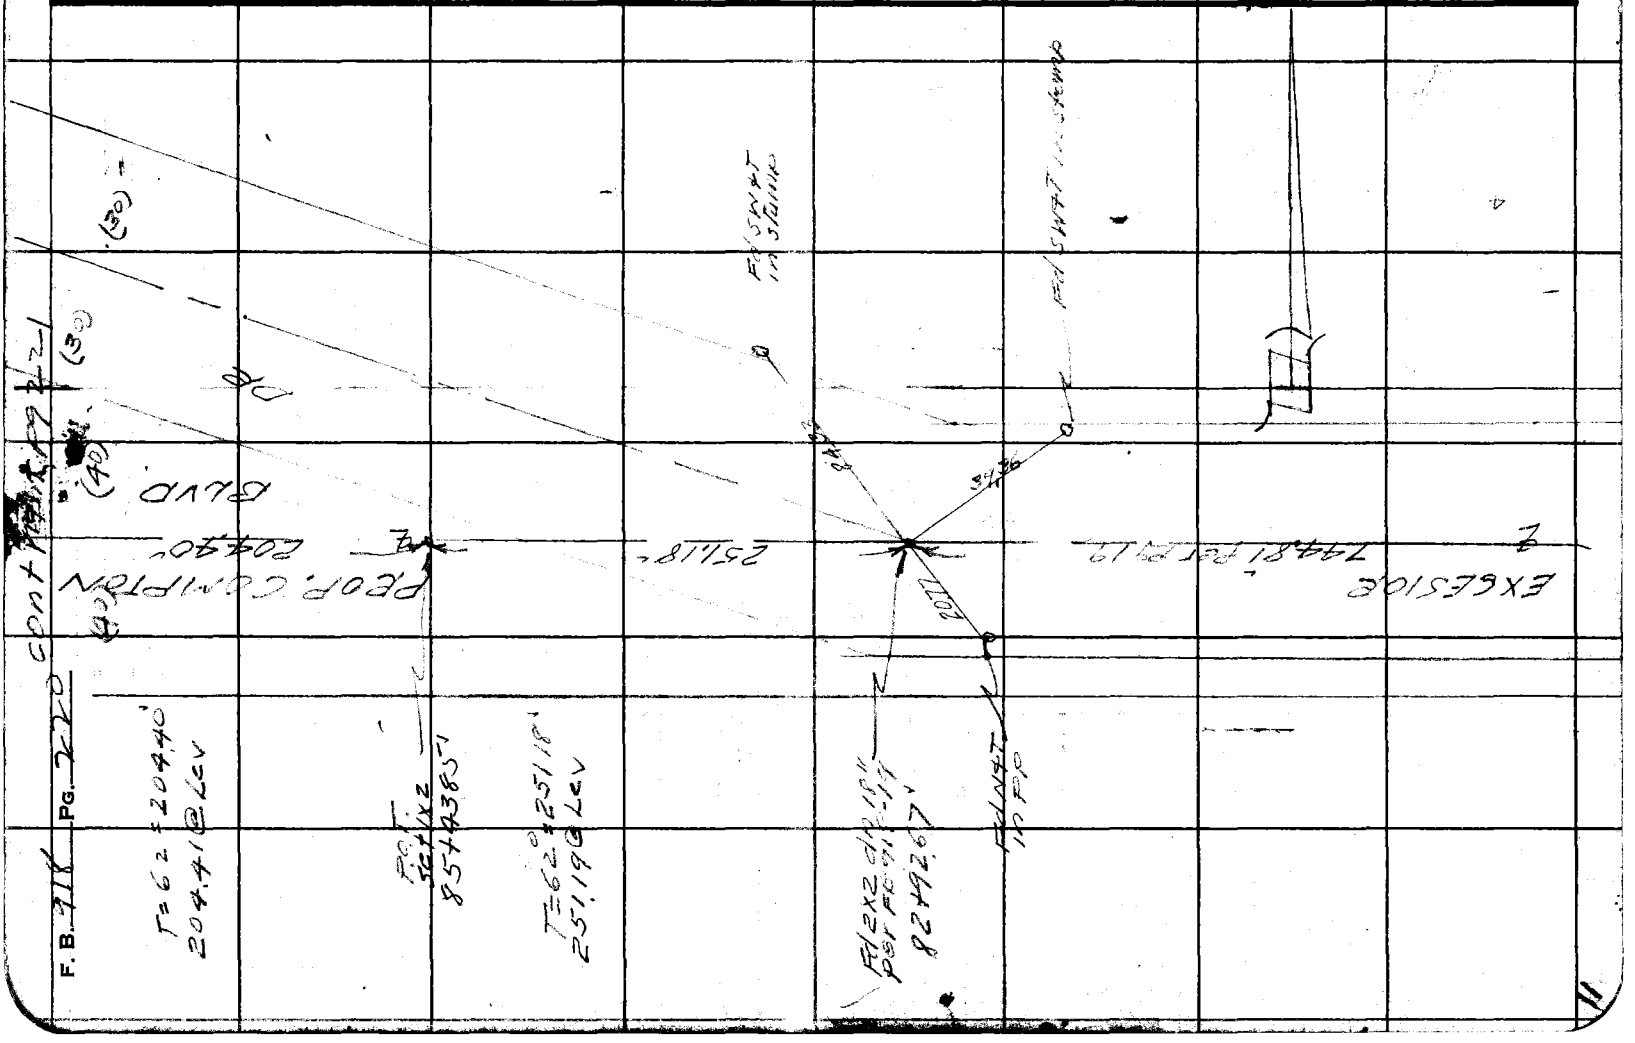

Notes Ck'd by D. M. Finley
Map No. B-1842-1
Office Work Cox
Checked D. M. Finley
Date AUG '51

Survey of
W. O. 824 Tape No. 28 St'd 67 °F
Surveyed by
Notes Date 4-48
Indexed C. Johnson

F. B. Pg. 221

Note: Any Additions or Changes on This Sheet Must be Made or Circled in Red Ink With Date and Name of Person Making Change.

Do not extend notes this side of this line.

RETURN TO
LOS ANGELES COUNTY SURVEYOR
700 HALL OF RECORDS

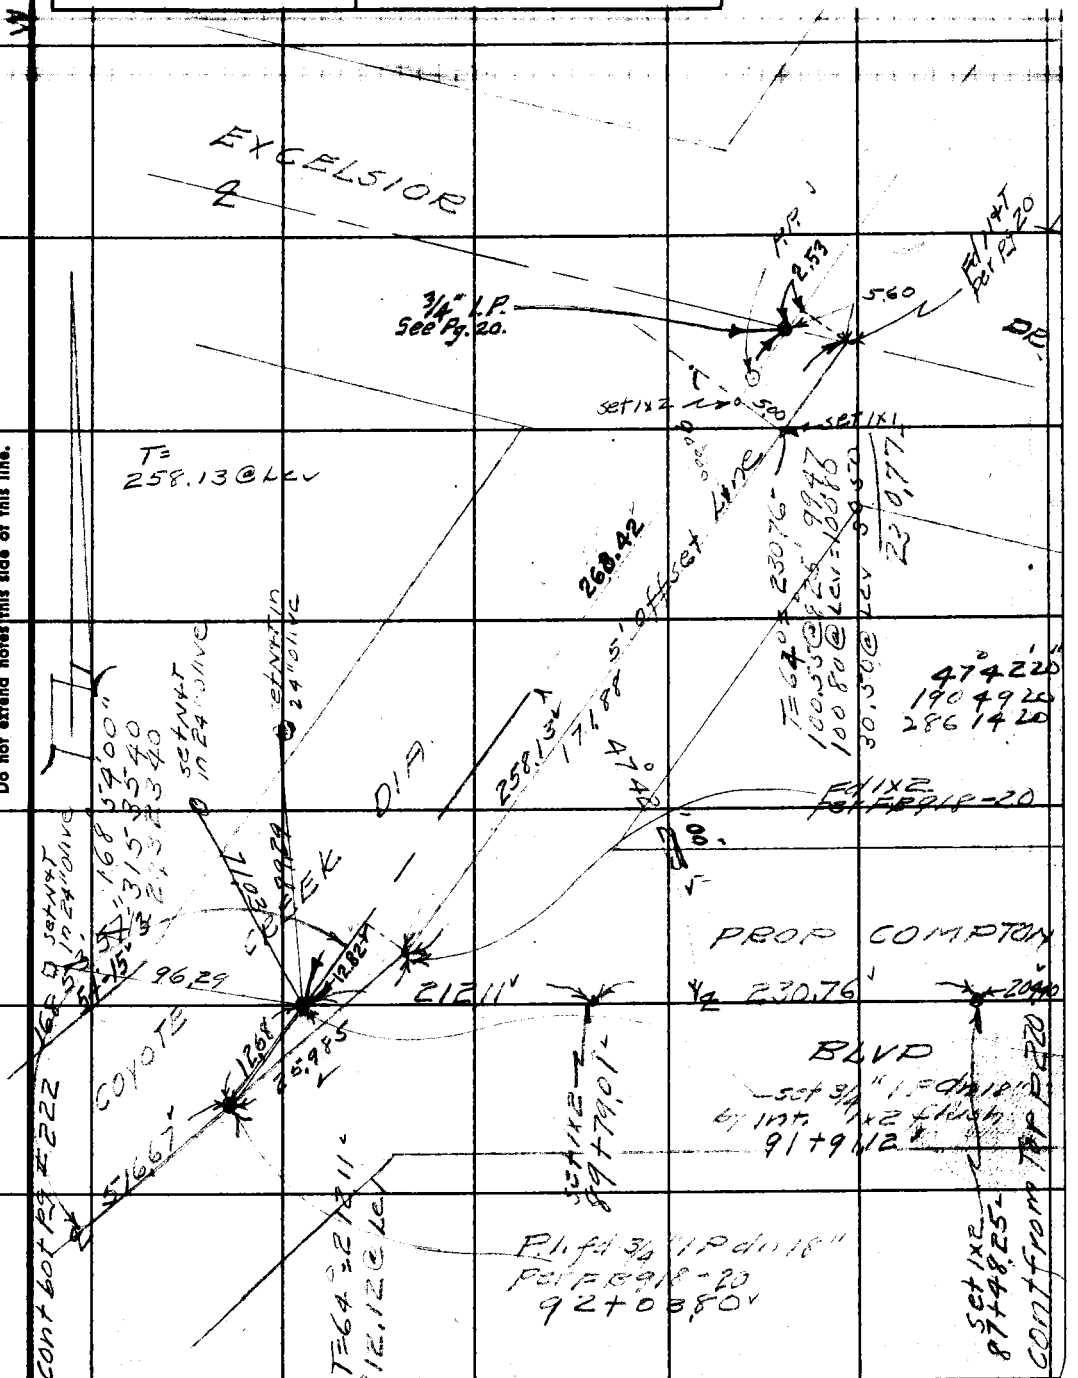
EXCELSIOR
3/4" I.P. See Pg. 20.
T= 258.13 @ Lv
268.42
Offset Line
258.13
17.88
47°
COYOTE CREEK
D.I.
PROP COMPTON BLVD
Sta 91+91.2
Sta 92+08.80
Sta 87+48.25
T=64.12 @ Lv
212.11
T=64.12 @ Lv
230.76
100.00 @ Lv
100.80 @ Lv
30.30 @ Lv
47°42'20"
190 49 20
286 14 20
Set 1x2 P.P. -20
Set 1x2 P.P. -20
Set 1x2 P.P. -

F. B. 918 Pg. 222

cont out pg 223

W 34-84

RETURN TO
LOS ANGELES COUNTY SURVEYOR
700 HALL OF RECORDS

Do not extend notes this side of this line.

Note: Any Additions or Changes on This Sheet Must be Made or Circled in Red Ink With Date and Name of Person Making Change.

T=66
100,94 @ Lev 100,94'
90,82 @ Lev, 90,82'
81,72 @ 1122 = 80,12'
271,88'

CREEK DIKE

27+88.72

Fd 2x2 dnail
good for line
97+20.47'

HOLDER
&
PVB

T=66' = 516.68'
516,68 @ Lev

27+91.57'

COYOTE

cont from out Left pg 221

Notes Ck'd by C. M. Finley
Map No. A-1842-1
Office Work Cox
Checked D. M. Finley
Date AUG '51

Survey of
W. O. 824 Tape No. 088 St'd. °F
Surveyed by
Notes Date 4-48
Indexed C. Johnson

F. B. 918 Pg. 22

W. 34 - B.4

cont out of 224

Fd 3/4" I Pdl
Perf FB 711-63
103+34.80'

Y = 1 SEC.

517.33
735.5

T = 66°
100.97 @ 11 28' = 989.5'
100.93 @ 1Cv = 100.93'
100.73 @ Lev = 100.73'
41.84 @ " = 41.84'
342.45'

COYOTE CREEK

342.45'

Set 1X2
Perf FB 918-22
99+92.35'

R.R.

To gage S. rail
99+97.33

99+82.47 Gage N. rail

SANTA FE

221.85'

STAGG RD

cont from Top Pg 222

Note: Any Additions or Changes on This Sheet Must be Made or Circled in Red Ink With Date and Name of Person Making Change.

Do not extend notes this side of this line.

RETURN TO
LOS ANGELES COUNTY SURVEYOR
700 HALL OF RECORDS

FORM 247 5M 11-46

RETURN TO
LOS ANGELES COUNTY SURVEYOR
700 HALL OF RECORDS

Note: Any Additions or Changes on This Sheet Must be Made or Circled in Red Ink With Date and Name of Person Making Change.

Do not extend notes this side of this line.

WS 34-B4

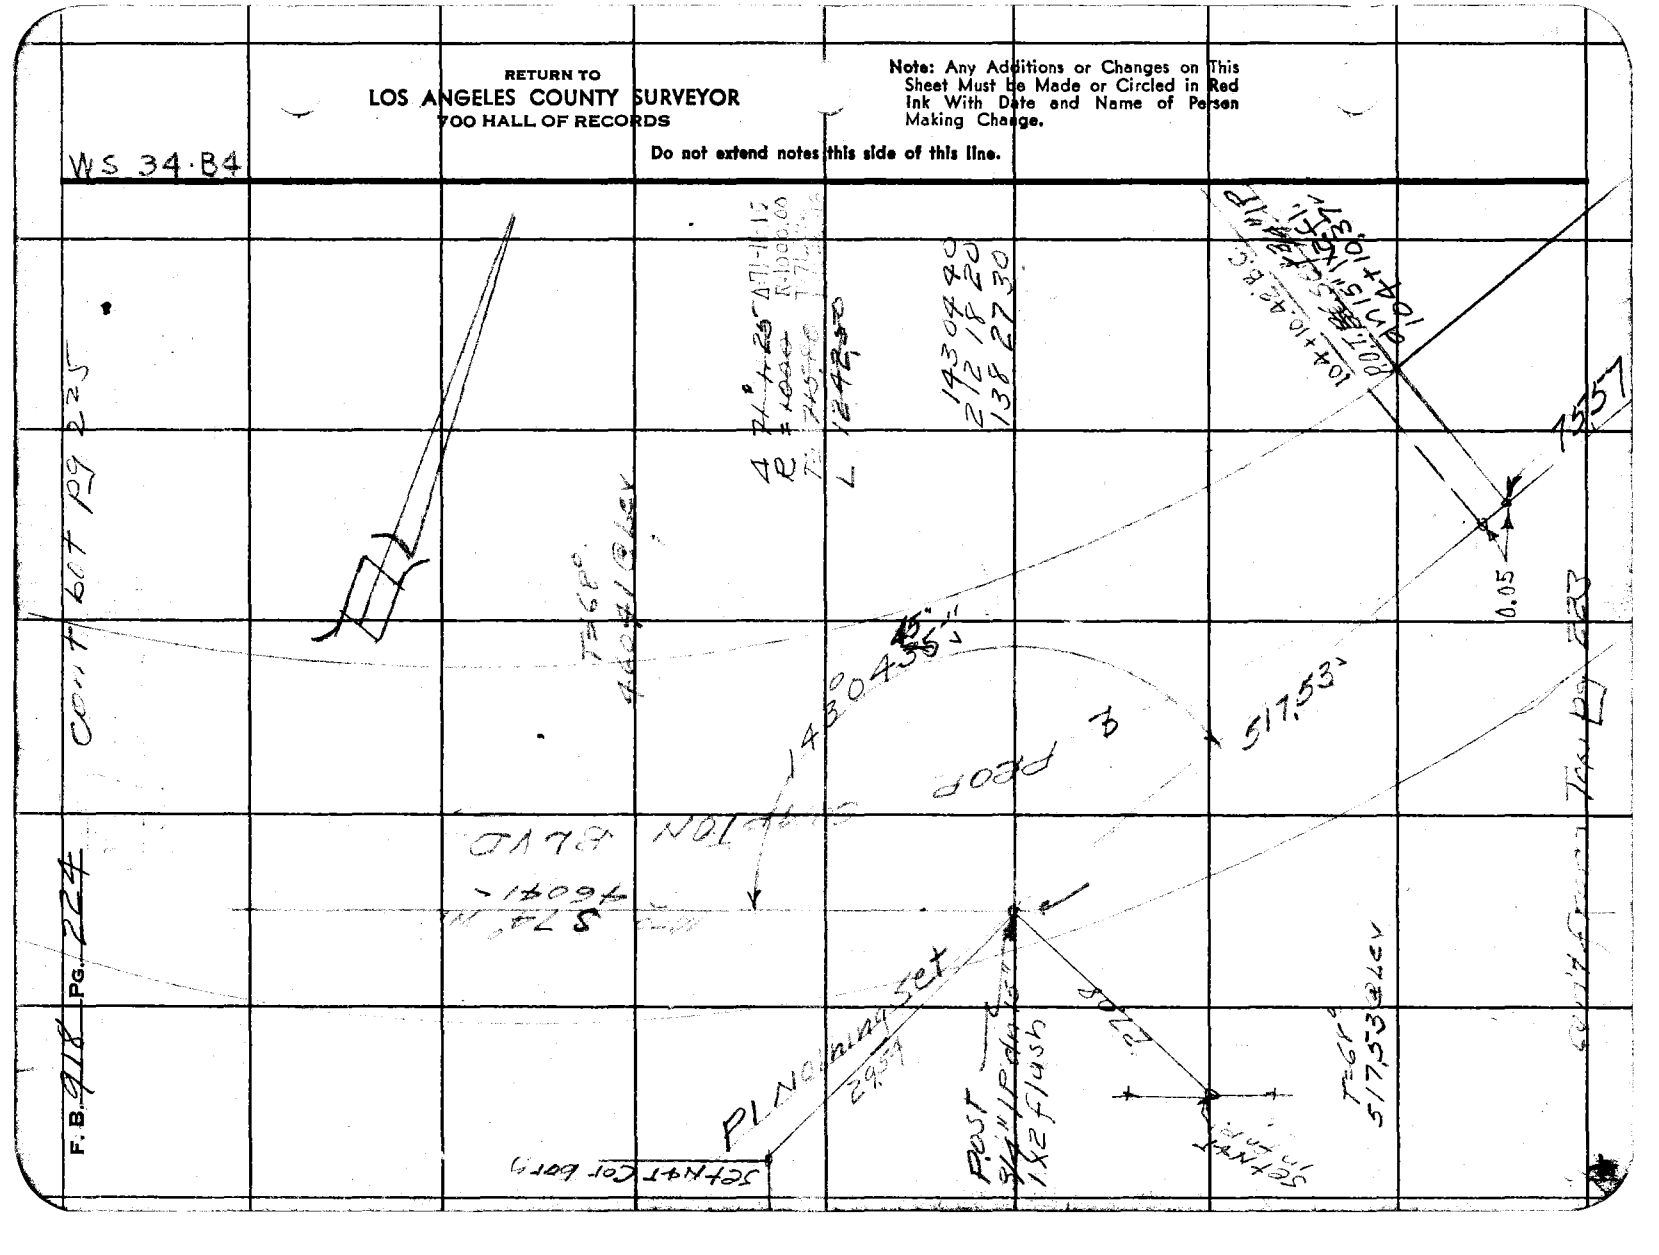

W S 24 B

Notes Ck'd by D. M. Finley	Survey of Compton Blvd
Map No 2-1842-1	W. O. 0345 Tape No. 035 St'd C °F
Office Work Cox	Surveyed by E. L. Miller
Checked D. M. Finley	Notes Date 4-48
Date AUG '51	Indexed C. Johnson

F. B. Pg.

Note: Any Additions or Changes on This Sheet Must be Made or Circled in Red Ink With Date and Name of Person Making Change.

Do not extend notes this side of this line.

RETURN TO
LOS ANGELES COUNTY SURVEYOR
700 HALL OF RECORDS

FORM 247 SM 11-46

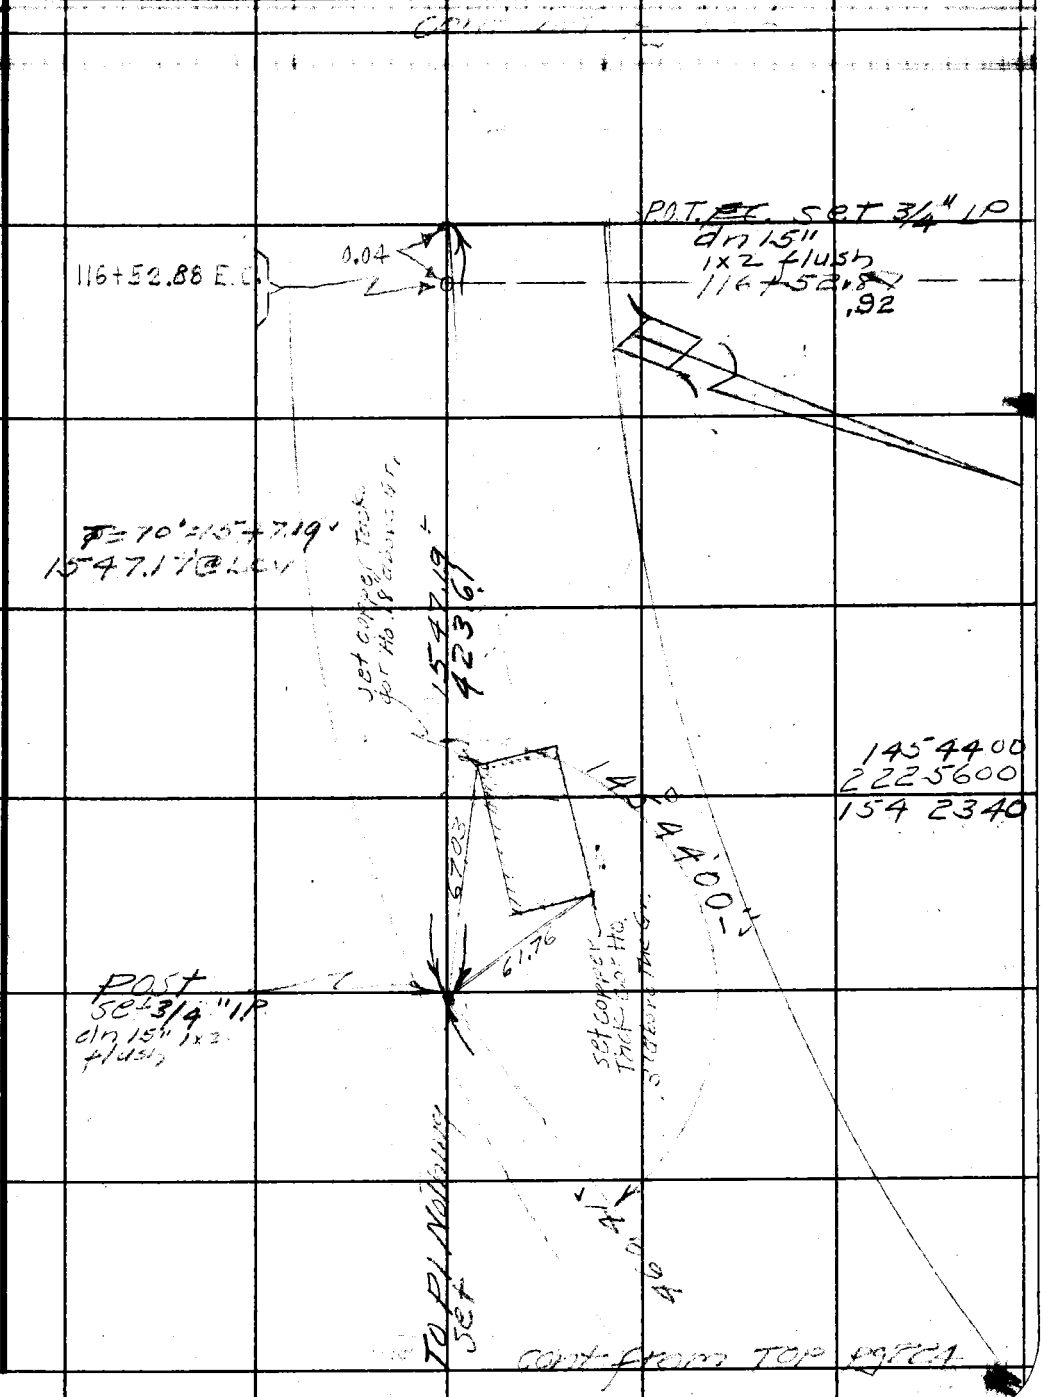

RETURN TO
LOS ANGELES COUNTY SURVEYOR
700 HALL OF RECORDS

Note: Any Additions or Changes on This Sheet Must be Made or Circled in Red Ink With Date and Name of Person Making Change.

Do not extend notes this side of this line.

WS 34 B4

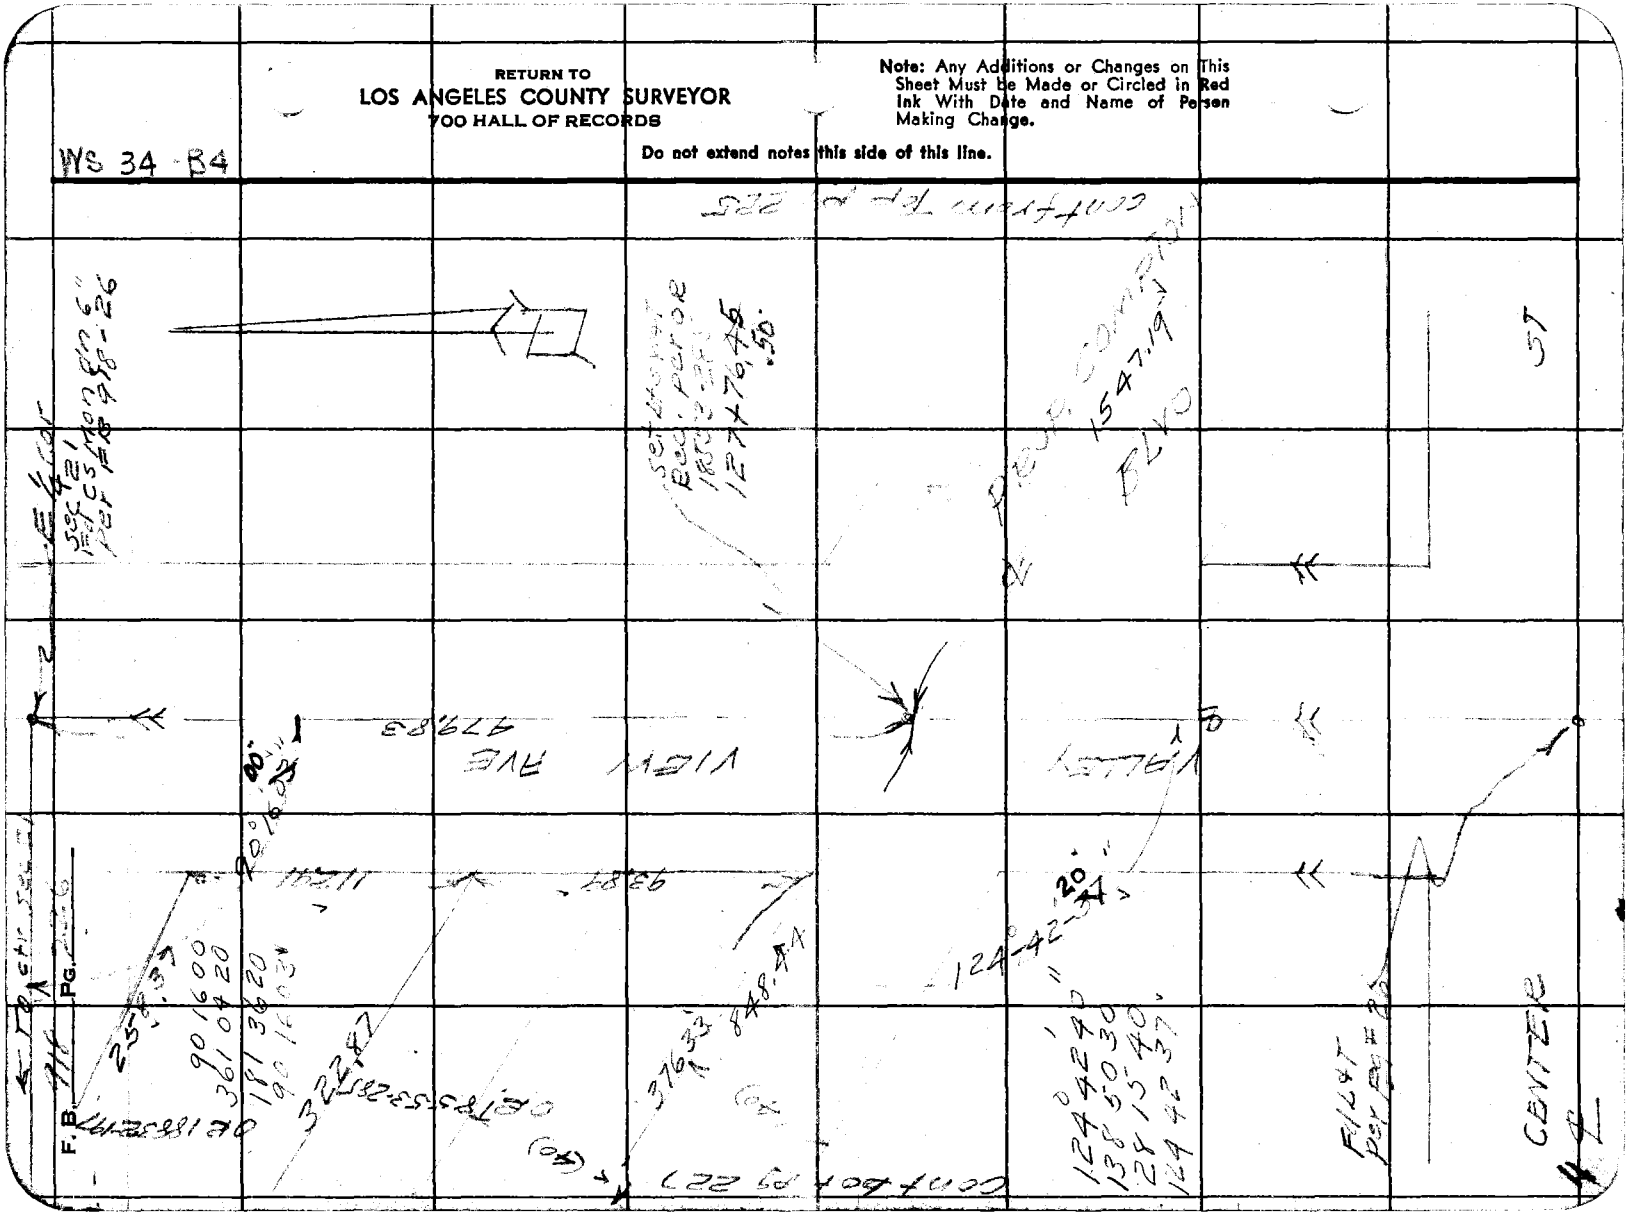

Notes Ck'd by D. M. Finley
Map No. A-1842-1
Office Work COX
Checked D. M. Finley
Date AUG '51

Survey of Compton Blvd
W. O. R34 Tape No. 208 St'd 68 °F
Surveyed by R.L.Willett
Notes Date 2-48
Indexed C. Johnson

F. B. 918 Pg. 7-25

34 B

Note: Any Additions or Changes on This Sheet Must be Made or Circled in Red Ink With Date and Name of Person Making Change.
Do not extend notes this side of this line.

RETURN TO
LOS ANGELES COUNTY SURVEYOR
700 HALL OF RECORDS

FORM 247 SM 11-46

cont from left pg 226

T=62°=203.06'
203.07@Lev

203.06'

Set 3/4" I P
on 15" by line

Δ 34°26'40"
R = 2000
T = 619.80
L = 1202.05
2.00 Error

Δ = 34°26'20"
R = 2000.00
T = 619.85
L = 1202.14

63.44'

20' To

34 26 To

To E'ly Co. Sec. 21

34°26'00"
137+44.20
226+32.00
34 26.0'

848.44'

T=62°=848.44'
848.47@Lev

P.O.T. Set 3/4" IP
on 15" line
1x2 Plug 130+35.09

0.05

130+05.09 B.C.

P.O.C. 130+77.73 ± P.T.

77.18'

92.82'

376.33'

OR 18532-285

OR 18832-97

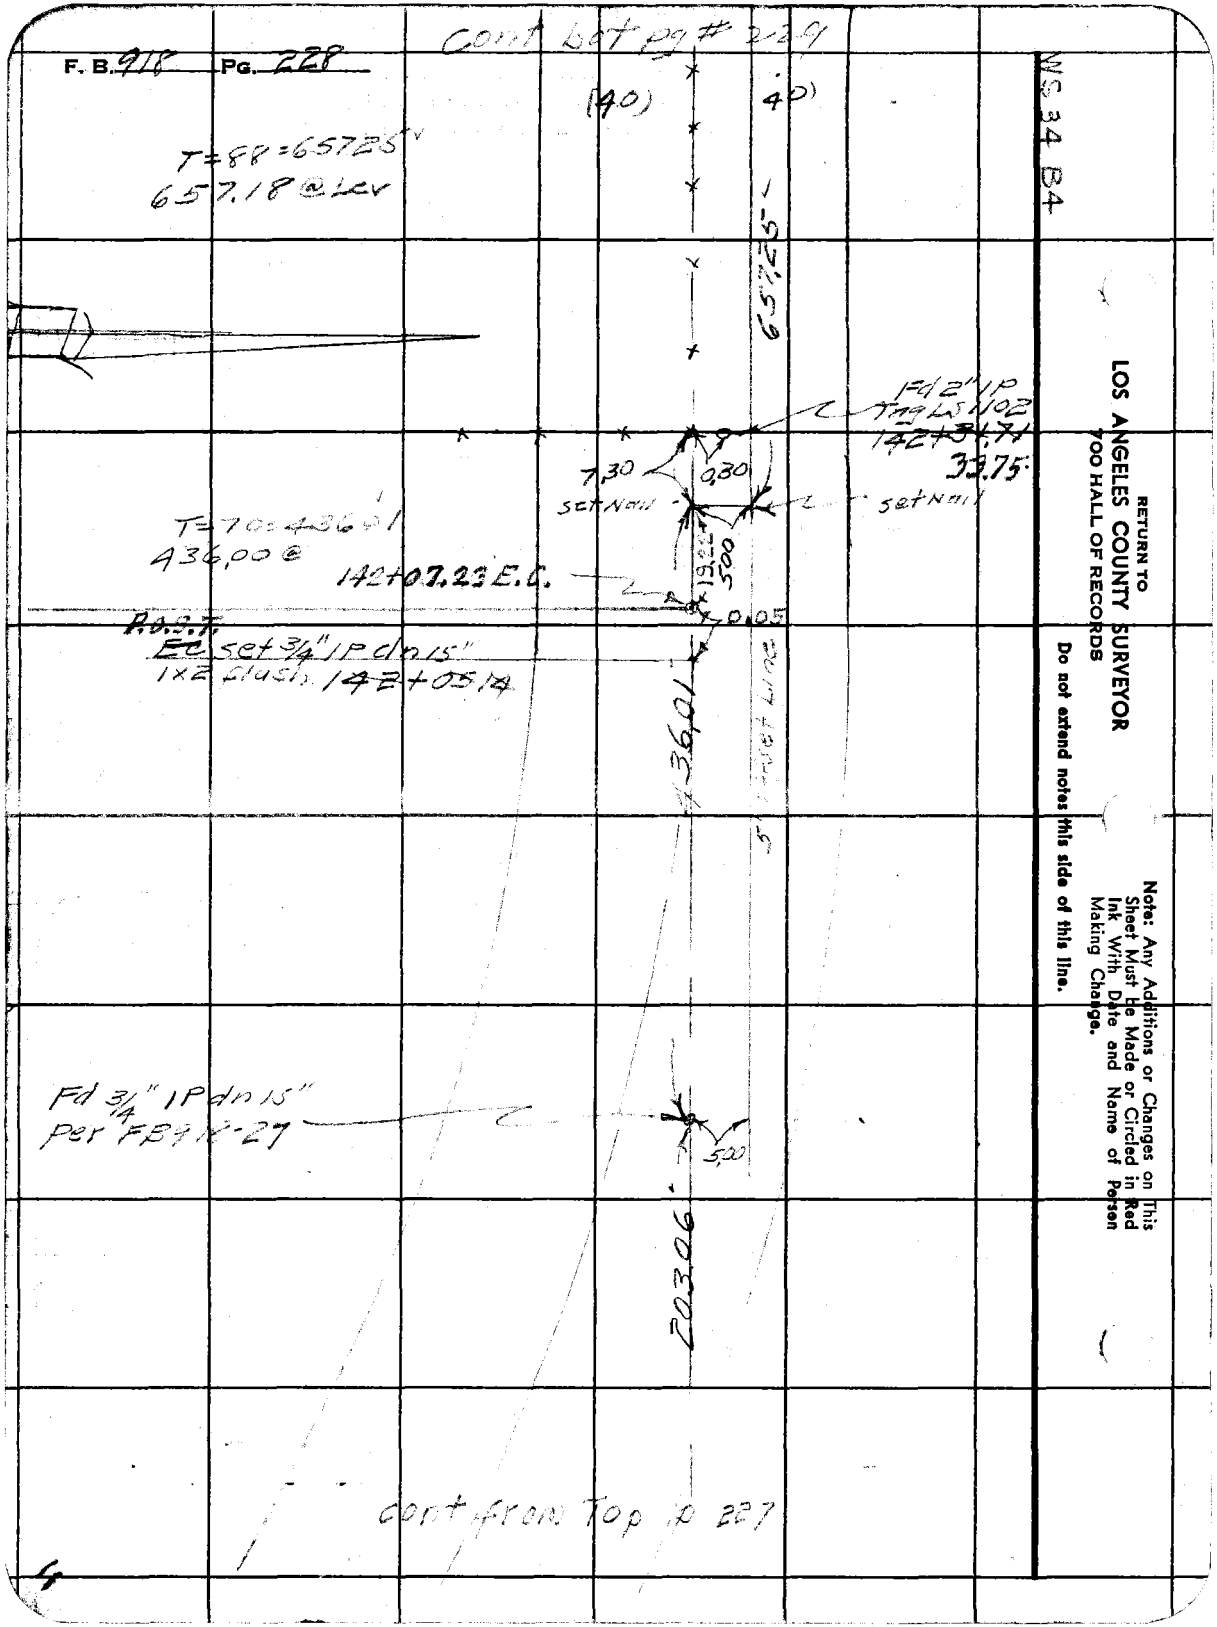

RETURN TO
LOS ANGELES COUNTY SURVEYOR
700 HALL OF RECORDS

Do not extend notes this side of this line.

Note: Any Additions or Changes on This Sheet Must Be Made or Circled in Red Ink With Date and Name of Person Making Change.

Notes Ck'd by D. M. Finley
Map No. A-1842-1
Office Work Cox
Checked D. M. Finley
Date AUG '51

Survey of Compton-Long Beach
W. O. 8334 Tape No. 088 St'd 68 °F
Surveyed by R. L. Willey
Notes Date 8-48
Indexed C. Johnson

F. B. 6 Pg. 22

W 34 B4

Continued in F.B. 918-27

EQUATION:
155+56.32 From E.
= 177+99.20 Sup. Mty.

Fd 2" IP under Wooden Bridge set wire spk LT in plank above 2" I.P See F.B. 918-27

SET NAT in fn post at cor bridge

1309.65

MARQUARDT AVE.

& Per F.B. 918-27

SET NAIL in PP

SET NAIL

SET NAT fm. P

SET NAT in Top of Curb

T=88=65309'
65302@Lev

65309'

0.83

Fd 2" IP Plug & N. No Tag 148+87.63 89.67

SET NAIL

5.00

65723'

Cont. to Horizon Pg 7238

Note: Any Additions or Changes on This Sheet Must be Made or Circled in Red Ink With Date and Name of Person Making Change.

Do not extend notes this side of this line.

RETURN TO
LOS ANGELES COUNTY SURVEYOR
720 HALL OF RECORDS

FORM 247 SM 11-48

RETURN TO
LOS ANGELES COUNTY SURVEYOR
700 HALL OF RECORDS

Note: Any Additions or Changes on This Sheet Must Be Made or Circled in Red Ink With Date and Name of Person Making Change.

Do not extend notes this side of this line.

F. B. 918 PG. 230

Notes Ck'd by D. M. Finley
Map No. B-1842-1
Office Work Cox
Checked D. M. Finley
Date AUG '51

Survey of Compton Blvd.
W. O. 5245 Tape No. St'd °F
Surveyed by R.L. Willey
Notes R.L.W. Date 4-8-48
Indexed C. Johnson

F. B. 713 PG. 231

Cont'd from Pg 230

71+60 ℄ Sta 19 Ahead of -20

COMPTON BLVD

EXCELSIOR DR

(REVISED)

Row of 12" Olives 20' apart

50'

51'

70+23.6

70+49 ℄

70+19 ℄

70+05.3 ℄

R=25°

70+15 ℄

Fd 4" Brass Cap in well See Pg 219

69+73.34

69+84 ℄

LUITWIELER

AVE

MAG SURF

69+57.8 ℄

Note

FOR TOPOG

FROM 0+00 TO 69+73.34 SEE FB 918-210 TO 219.

Note: Any Additions or Changes on This Sheet Must be Made or Circled in Red Ink With Date and Name of Person Making Change.

Do not extend notes this side of this line.

RETURN TO
LOS ANGELES COUNTY SURVEYOR
700 HALL OF RECORDS

FORM 247 SM 11-46

F. B. 118 Pg. 232

cont' to pg 233

51'

CTR 14" DV

76+38±

50'

BLVD

40'

40'

16" OLIVE

75+23±

50'

40'

74+78±

20'

40'

RAMONA

40'

Row of
12" Olives
20' apart

12" OLIVE

73+63±

50'

PROP. COMPTON

&

EXCELSIOR

CTR 14" DV

73+19±

20'

40'

51'

from Top pg 231

RETURN TO
LOS ANGELES COUNTY SURVEYOR
700 HALL OF RECORDS

Do not extend notes this side of this line.

Notes: Any Additions or Changes on This Sheet Must be Made or Circled in Red Ink With Date and Name of Person Making Change.

Notes Ck'd by D. M. Finley	Survey of
Map No. A-1242-1	W. O. 224 Tape No. St'd °F
Office Work Cox	Surveyed by
Checked D. M. Finley	Notes R.L.W. Date 4-8-48
Date AUG '51	Indexed A. C. Johnson

F. B. Pg. 232

Note: Any Additions or Changes on This Sheet Must be Made or Circled in Red Ink With Date and Name of Person Making Change.

Do not extend notes this side of this line.

RETURN TO
LOS ANGELES COUNTY SURVEYOR
700 HALL OF RECORDS

Row of 12" Olive's 20' apart except where noted

FORM 247 SM 11-46

F. B. 918 PG. 234

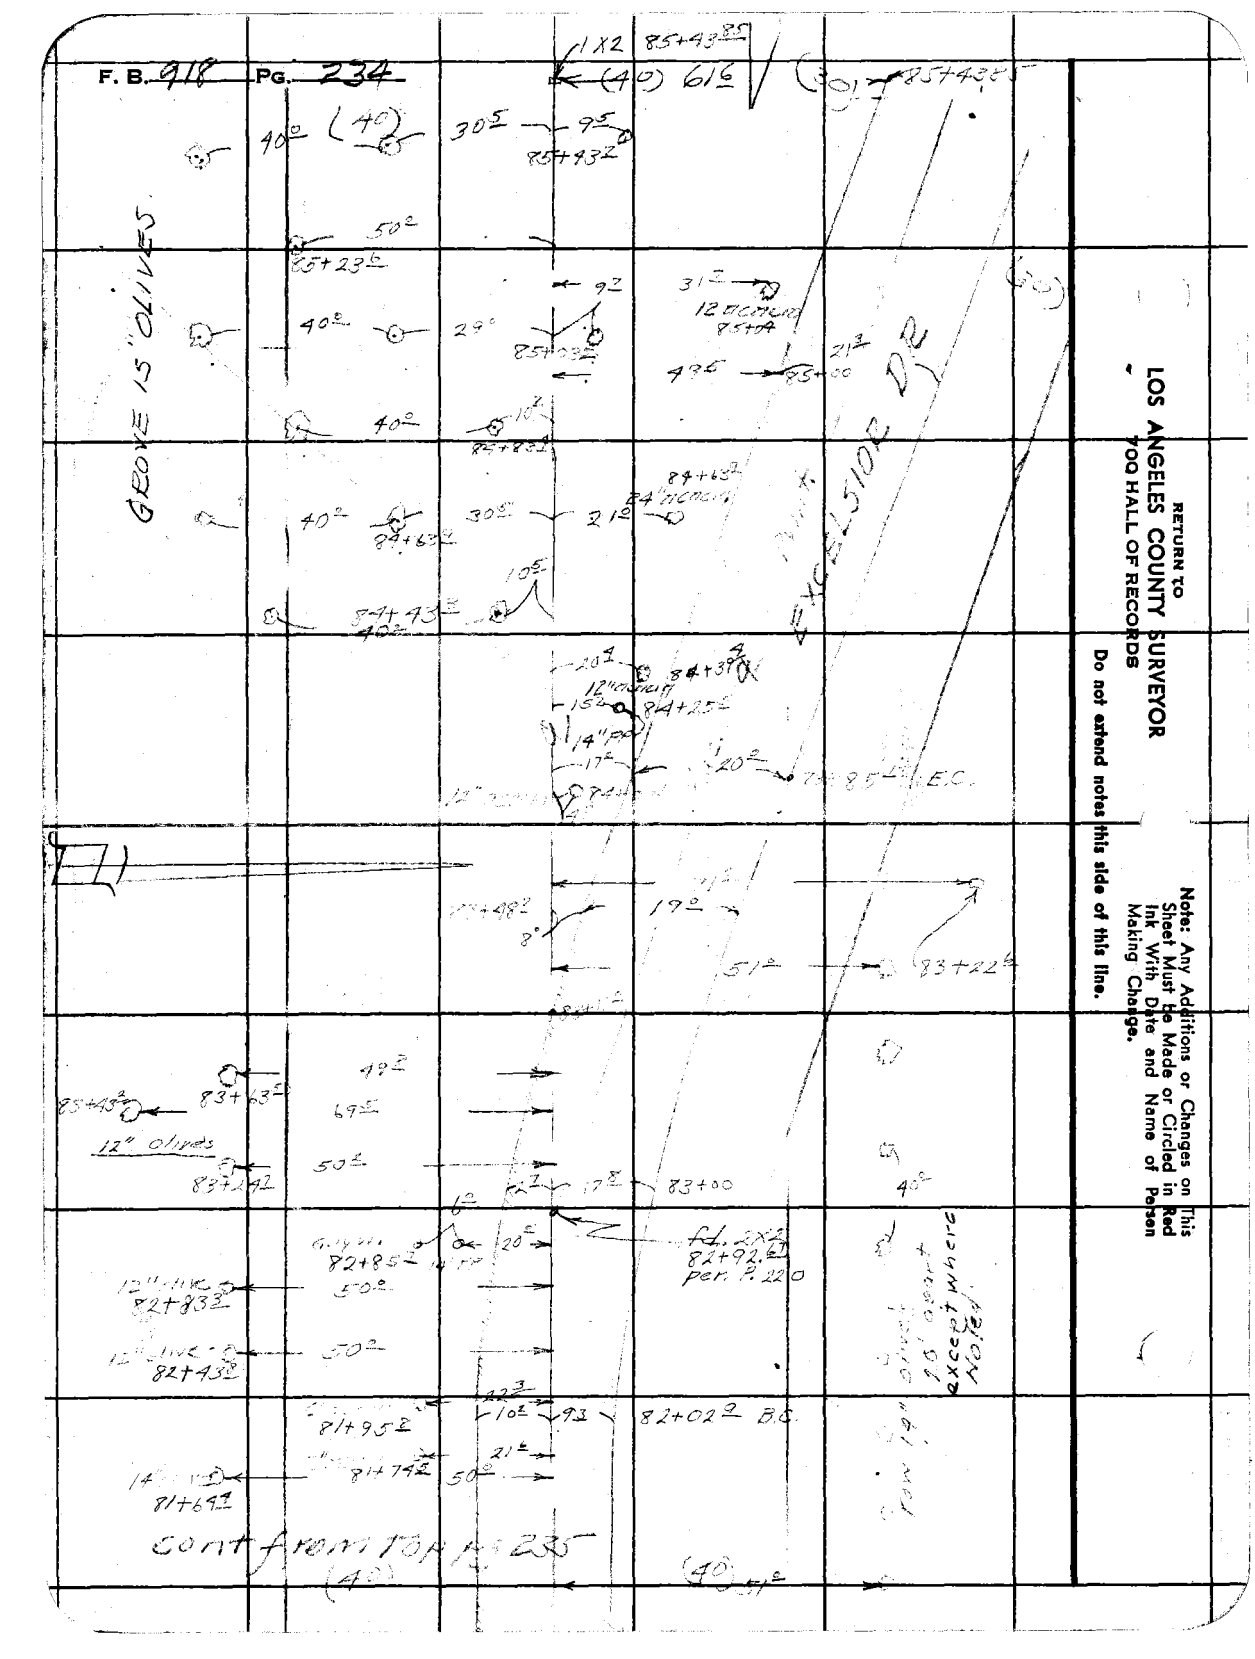

RETURN TO
LOS ANGELES COUNTY SURVEYOR
700 HALL OF RECORDS

Note: Any Additions or Changes on This Sheet Must Be Made or Circled in Red Ink With Date and Name of Person Making Change.

Do not extend notes this side of this line.

Notes Ck'd by D. M. Finley
Map No. B-1842-1
Office Work Cox
Checked D. M. Finley
Date AUG '31

Survey of
W. O. 734 Tape No. St'd °F
Surveyed by R. L. Wiley
Notes R.L.W. Date 4-8-31
Indexed A. O. Johnson

F. B. 918 Pg. 23

Note: Any Additions or Changes on This Sheet Must be Made or Circled in Red Ink With Date and Name of Person Making Change.

Do not extend notes this side of this line.

RETURN TO
LOS ANGELES COUNTY SURVEYOR
700 HALL OF RECORDS

FORM 247 SM 11-46

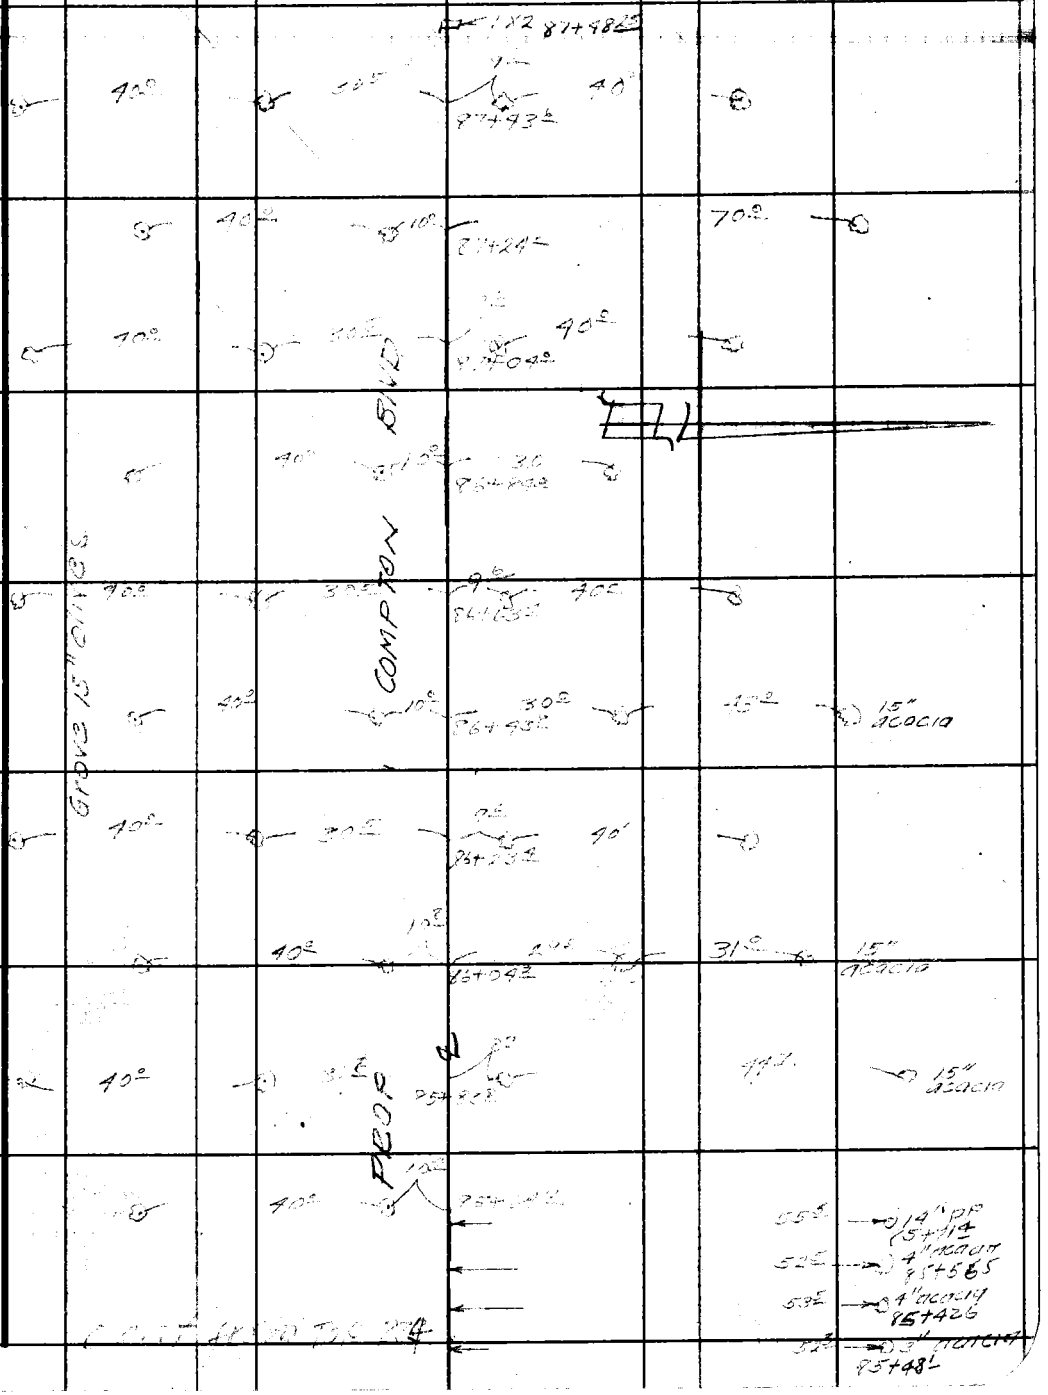

RETURN TO
LOS ANGELES COUNTY SURVEYOR
700 HALL OF RECORDS

Note: Any Additions or Changes on This Sheet Must be Made or Circled in Red Ink With Date and Name of Person Making Change.

Do not extend notes this side of this line.

F. B. [illegible] PG. [illegible]

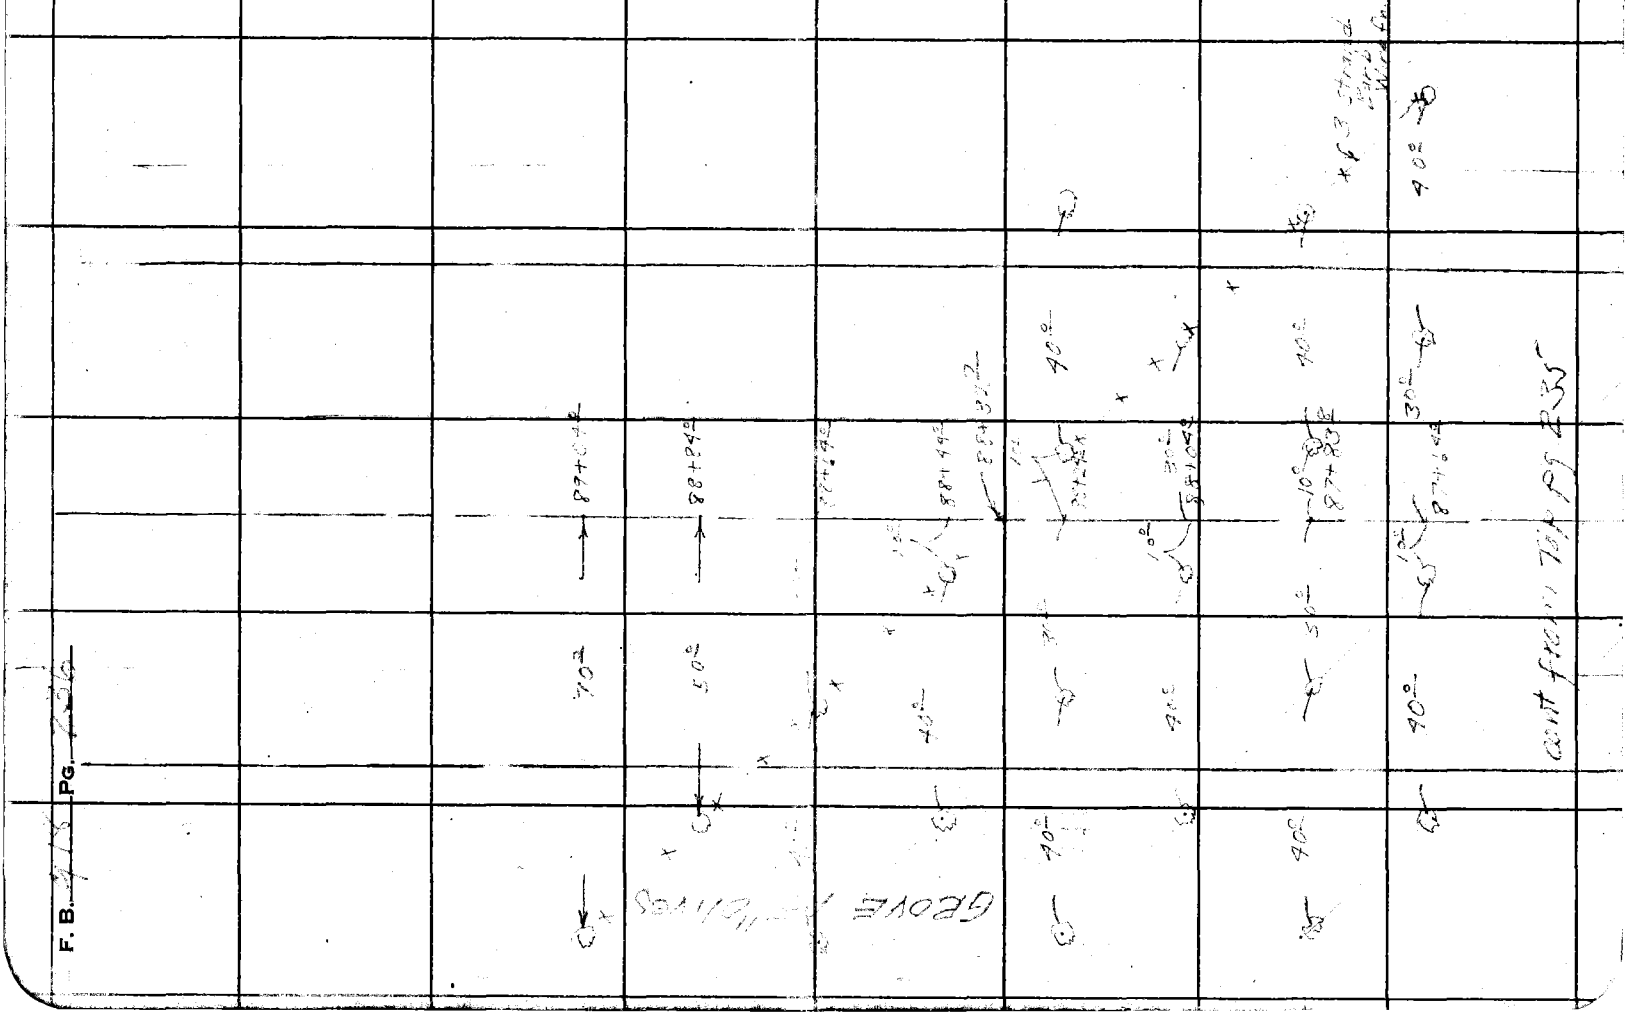

ORM 247 SM 11-46

RETURN TO
LOS ANGELES COUNTY SURVEYOR
700 HALL OF RECORDS

Note: Any Additions or Changes on This Sheet Must be Made or Circled in Red Ink With Date and Name of Person Making Change.

Do not extend notes this side of this line.

W.S. 34-B4

Notes Ck'd by D. M. Finley
Map No. 6-1842-1
Office Work Cox
Checked D. M. Finley
Date AUG 31

Survey of
W. O. 2224 Tape No. Std. °F
Surveyed by
Notes R.L.V. Date 4-25-49
Indexed C. Johnson

F.B. PG.

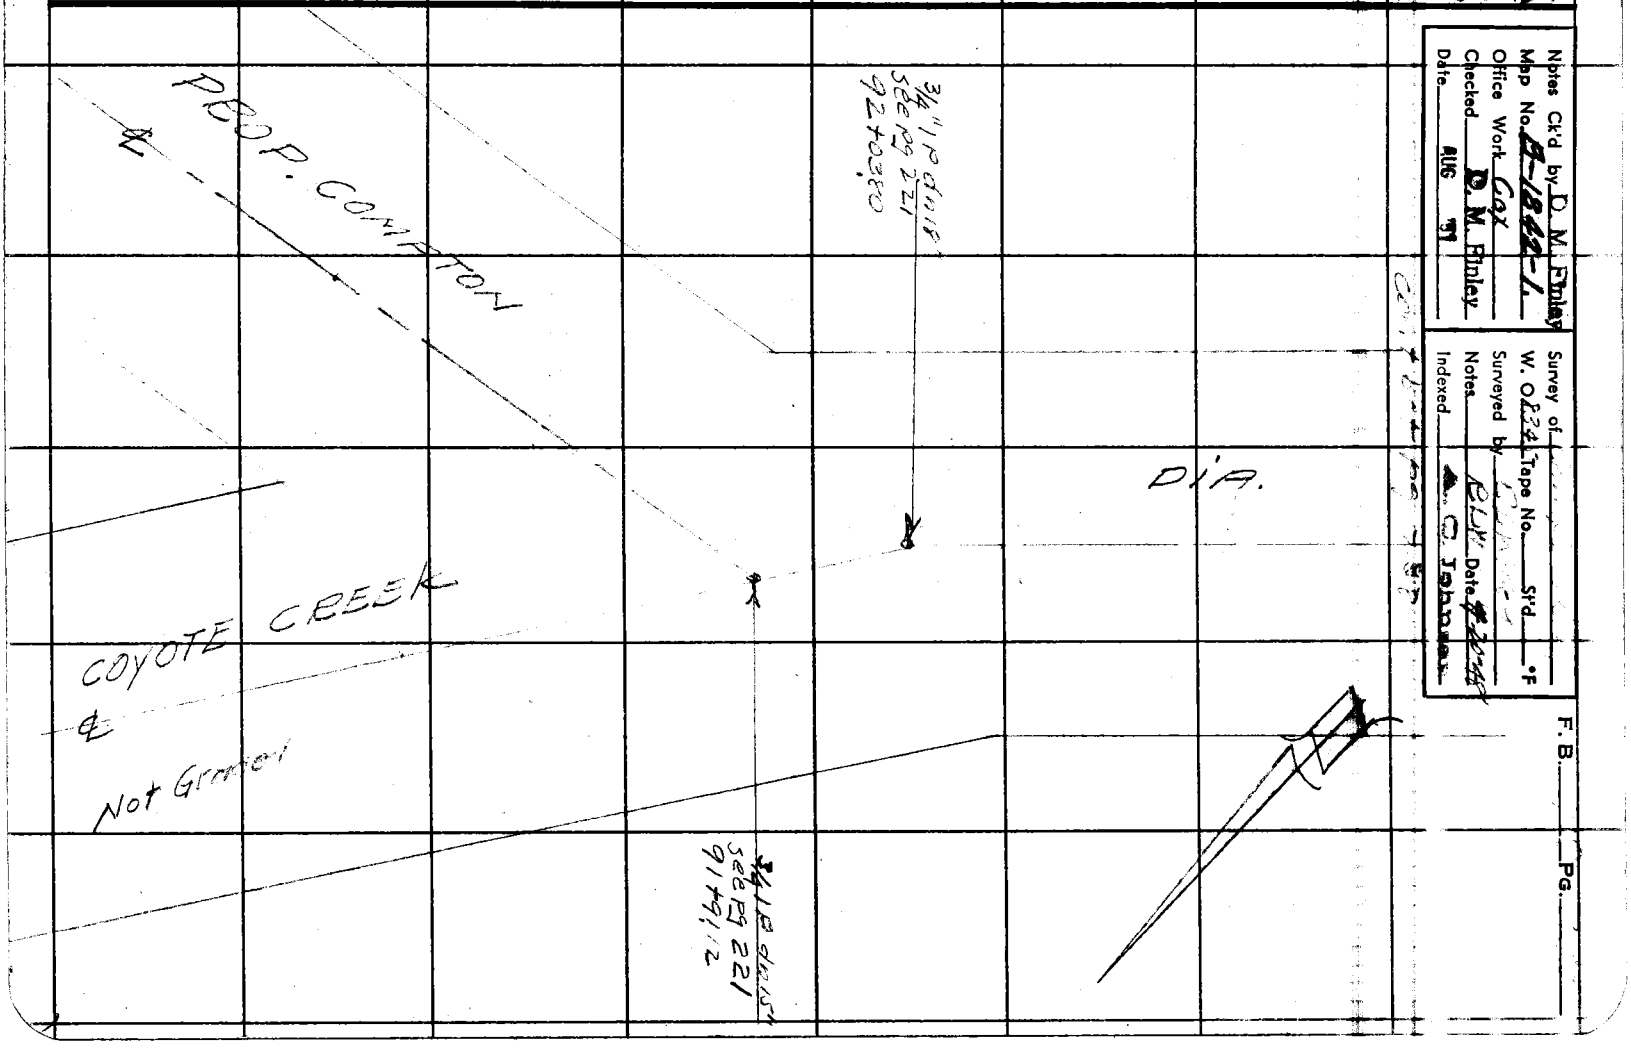

RETURN TO
LOS ANGELES COUNTY SURVEYOR
700 HALL OF RECORDS

Note: Any Additions or Changes on This Sheet Must be Made or Circled in Red Ink With Date and Name of Person Making Change.

Do not extend notes this side of this line.

W534 B4

Notes Ck'd by D. M. Finley
Map No. B-1842-1
Office Work Cox
Checked D. M. Finley
Date AUG '51

Survey of Compton Blvd
W. O. 8345 Tape No. St'd °F
Surveyed by E.D.W., Ley
Notes R.L.W. Date 4-20-49
Indexed A. C. Johnson

F. B. Pg. 239

34 B4

Note: Any Additions or Changes on This Sheet Must be Made or Circled in Red Ink With Date and Name of Person Making Change.

Do not extend notes this side of this line.

RETURN TO
LOS ANGELES COUNTY SURVEYOR
700 HALL OF RECORDS

HOLDER AVE

Not Graded

3/4" I Pdn 18"
103+34.80

102+02.4

101+14.

964

100+77.4

34.5 → 12" PP 100+43.9

99+78.26

99+78.47
Gage N Tail

1X2 Sec PP 223
99+92.35

70'

99+59.84

Contact on Top PP 228

FORM 247 SM 11-46

F. B. 918 PG. 240

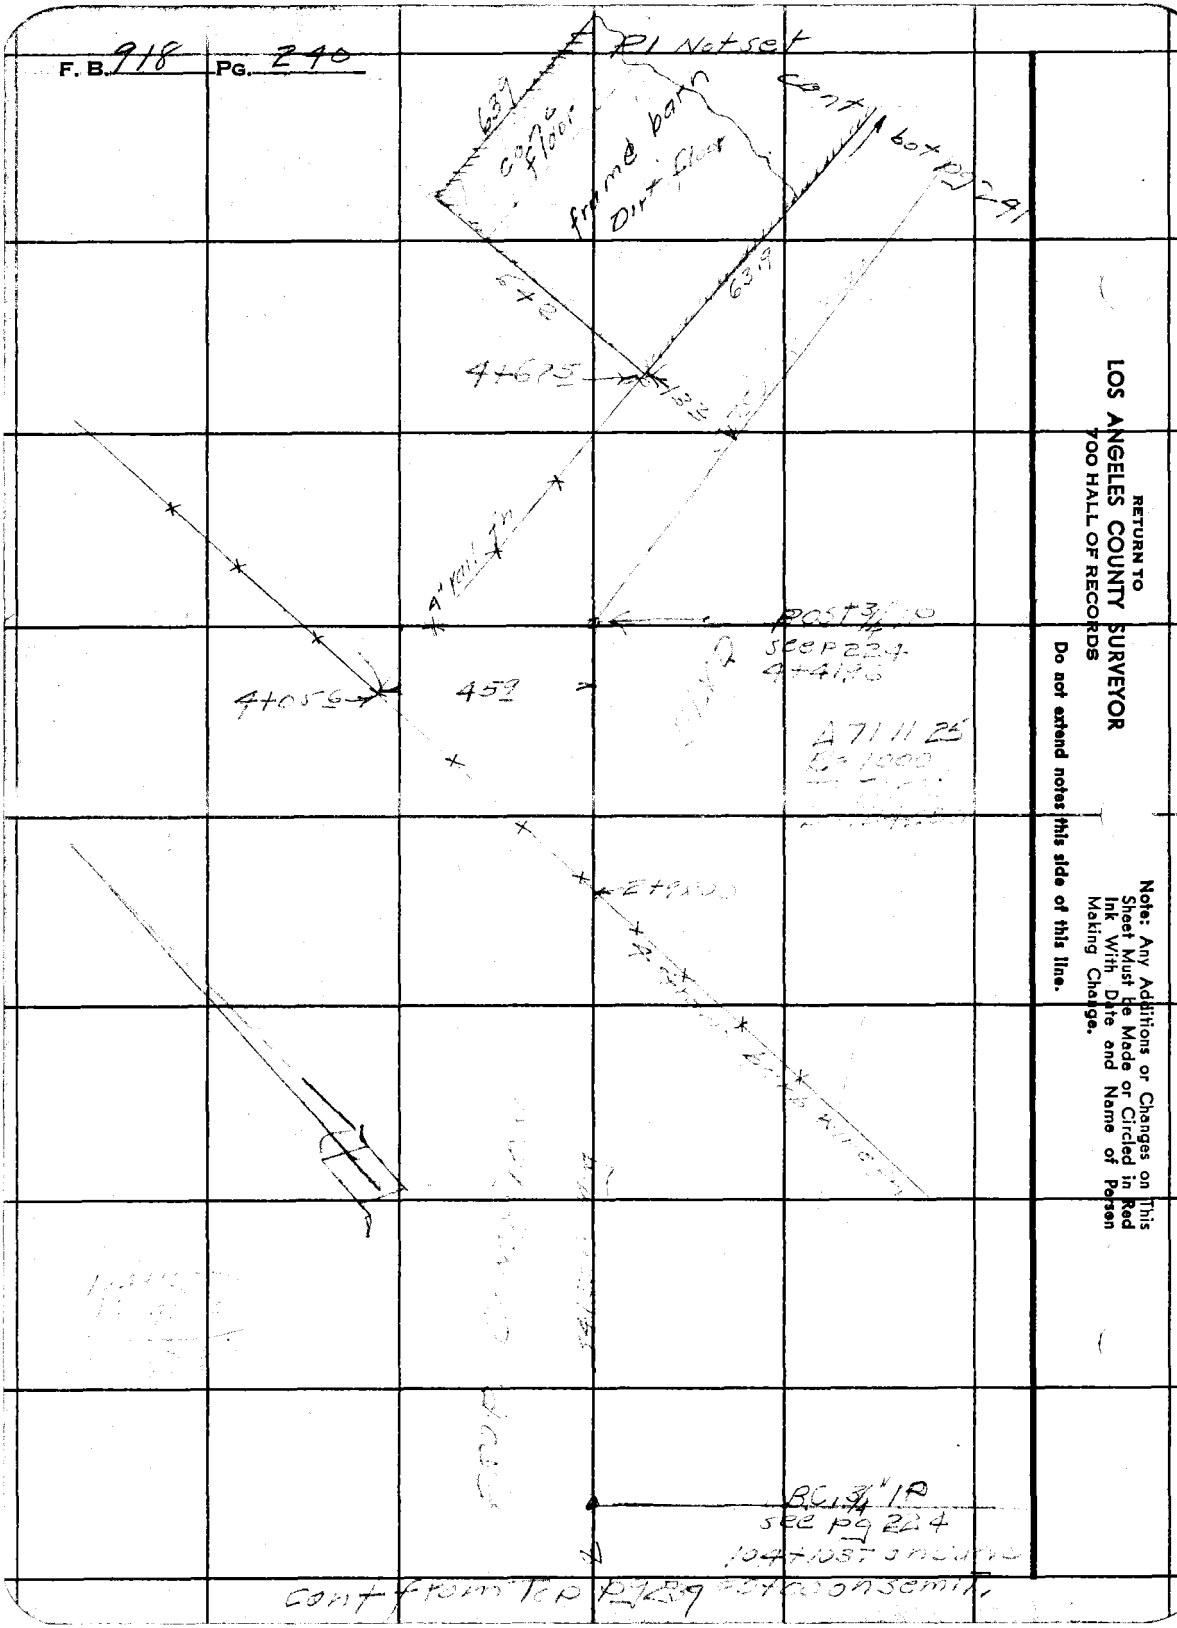

RETURN TO
LOS ANGELES COUNTY SURVEYOR
700 HALL OF RECORDS

Do not extend notes this side of this line.

Note: Any Additions or Changes on This Sheet Must be Made or Circled in Red Ink With Date and Name of Person Making Change.

Notes Ck'd by D. M. Finley
Map No B-1842-L
Office Work Cox
Checked D. M. Finley
Date AUG '77

Survey of Compton Blvd
W. O. 834 Tape No. St'd °F
Surveyed by R. L. Willey
Notes EFE Date 4-20-76
Indexed C. Johnson

F. B. 914 PG. 241

Note: Any Additions or Changes on This Sheet Must be Made or Circled in Red Ink With Date and Name of Person Making Change.

Do not extend notes this side of this line.

RETURN TO
LOS ANGELES COUNTY SURVEYOR
700 HALL OF RECORDS

FORM 247 SM 11-46

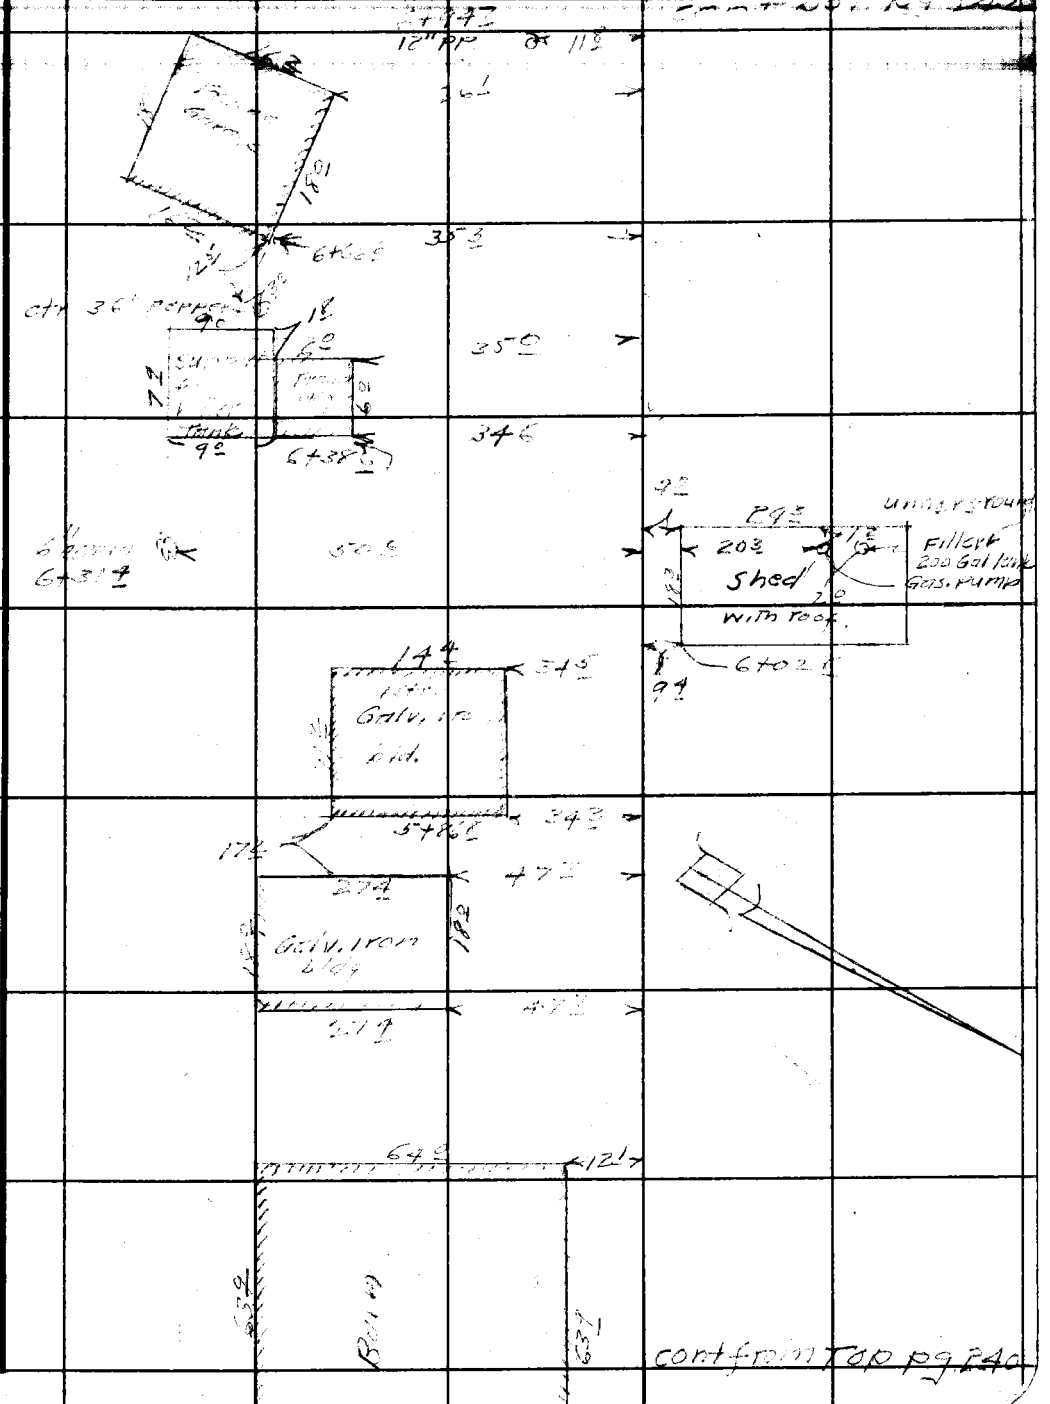

F. B. 918 PG. 242

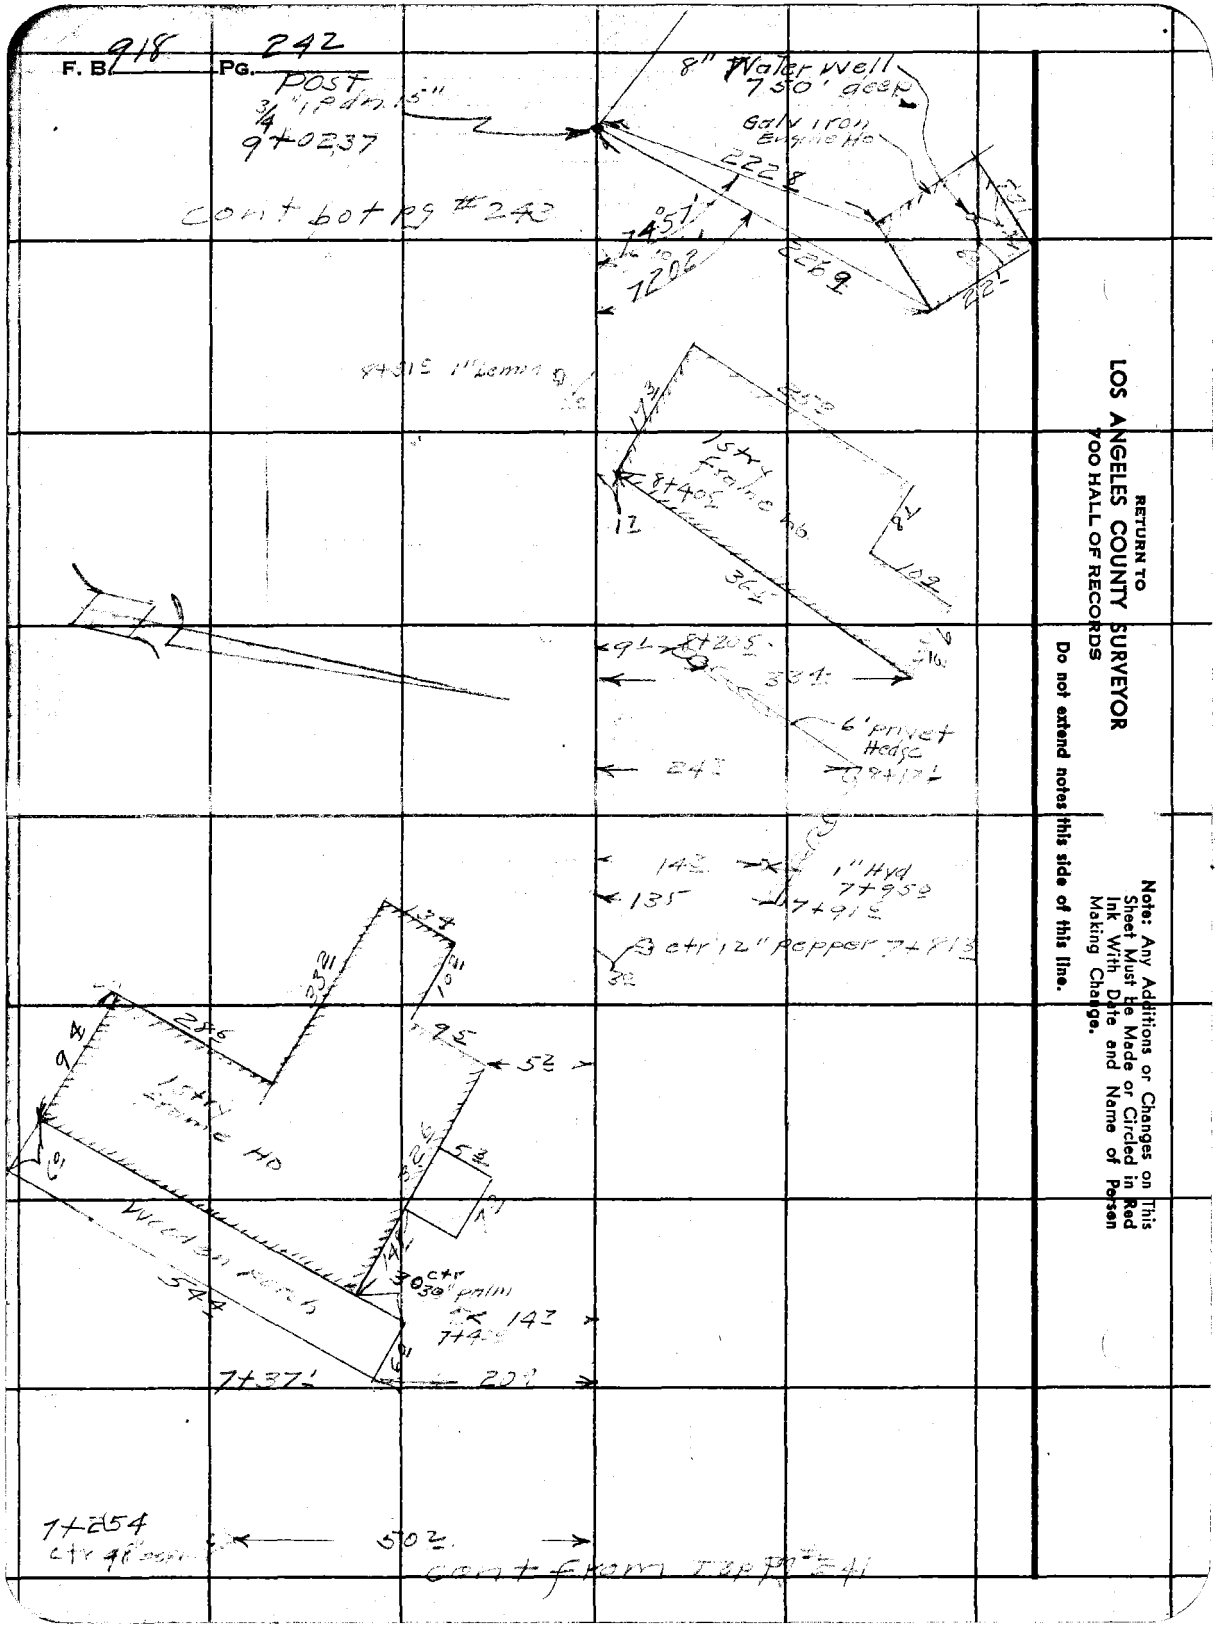

RETURN TO
LOS ANGELES COUNTY SURVEYOR
700 HALL OF RECORDS

Do not extend notes this side of this line.

Note: Any Additions or Changes on This Sheet Must Be Made or Circled in Red Ink With Date and Name of Person Making Change.

F. B. 2,6 243 Pg.

Notes Ck'd by D. M. Finley
Map No. B-1842-1.
Office Work Cox
Checked D. M. Finley
Date AUG '51

Survey of Commencing
W. O. 8345 Tape No. St'd °F
Surveyed by R. L. Willett
Notes RLW Date 4-49
Indexed O. Johnson

(39) (40)

Note: Any Additions or Changes on This Sheet Must be Made or Circled in Red Ink With Date and Name of Person Making Change.

Do not extend notes this side of this line.

RETURN TO
LOS ANGELES COUNTY SURVEYOR
700 HALL OF RECORDS

FORM 247 SM 11-46

F. B. 918 PG. 244

cont'd pg 245

(40)

(40) 0 12" valve.

122+51 12" Fire Line

122+70

RETURN TO
LOS ANGELES COUNTY SURVEYOR
700 HALL OF RECORDS

Note: Any Additions or Changes on This Sheet Must Be Made or Circled in Red Ink With Date and Name of Person Making Change.

Do not extend notes this side of this line.

cont from 244

FORM 247 SM 11-46

RETURN TO
LOS ANGELES COUNTY SURVEYOR
700 HALL OF RECORDS

Note: Any Additions or Changes on This Sheet Must be Made or Circled in Red Ink With Date and Name of Person Making Change.

Do not extend notes this side of this line.

Notes Ck'd by D. M. Finley
Map No. B-1842-1
Office Work Cat
Checked D. M. Finley
Date AUG 51

Survey of
W. O. Tape No. St'd °F
Surveyed by
Notes Date
Indexed A. O. Johnson

F. B. 210 PG. 245

RETURN TO
LOS ANGELES COUNTY SURVEYOR
700 HALL OF RECORDS

Note: Any Additions or Changes on This Sheet Must Be Made or Circled in Red Ink With Date and Name of Person Making Change.

Do not extend notes this side of this line.

WS 34 84

F. B. 912 PG. 246

F. B. 918 PG. 247

Notes Ck'd by D. M. Finley
Map No. B-1842-1
Office Work Cox
Checked D. M. Finley
Date AUG '51

Survey of Compton, Etc.
W. O. 8345 Tape No. St'd. °F
Surveyed by R.L.W. Ile y
Notes R.L.W. Date 4-48
Indexed A. C. Johnson

(40) (40) cont Pg 248

EC 30°
S 60°00' E
1411.59'

15"

BLVD

Δ = 34°26'10"
R = 2000
T = 619.10
L = 1200.01'

see Pg 227

cont from Top 246

RETURN TO
LOS ANGELES COUNTY SURVEYOR
700 HALL OF RECORDS

Note: Any Additions or Changes on This Sheet Must be Made or Circled in Red Ink With Date and Name of Person Making Change.

Do not extend notes this side of this line.

FORM 247 SM 11-46

F. B. 918 Pg. 248

cont bot pg 249 (40) (40)

RETURN TO
LOS ANGELES COUNTY SURVEYOR
700 HALL OF RECORDS

Do not extend notes this side of this line.

Notes: Any Additions or Changes on This Sheet Must be Made or Circled in Red Ink With Date and Name of Person Making Change.

cont from ten pg 247

F.B. 918 PG. 249

Notes Ck'd by D. M. Finley
Map No. F-1842-1
Office Work Cox
Checked D. M. Finley
Date

Survey of
W. O. Tape No. St'd °F
Surveyed by
Notes Date
Indexed A. C. Johnson 6-29-48

Cont bot Pg 250

155+56.32 From E. =
155+54.28 Going W.

MARQUARDT AVE.

℄ Per F.B. 918-27

(40) (40)

Note: Any Additions or Changes on This Sheet Must be Made or Circled in Red Ink With Date and Name of Person Making Change.

Do not extend notes this side of this line.

RETURN TO
LOS ANGELES COUNTY SURVEYOR
700 HALL OF RECORDS

FORM 247 BM 11-46

Cont from Top Pg 248

F. B. 918 PG. 250

cont bot pg 251

(40) (40)

RETURN TO
LOS ANGELES COUNTY SURVEYOR
700 HALL OF RECORDS

Do not extend notes this side of this line.

Note: Any Additions or Changes on This Sheet Must be Made or Circled in Red Ink With Date and Name of Person Making Change.

Strand wire

Sta

Wooden Water

Barbed wire fence

Guy Wire

4 strand bob wire fence

cont from TOP pg 249

Notes Ck'd by D. M. Finley
Map No. 2-1842-2
Office Work Cox
Checked D. M. Finley
Date AUG '51

Survey of
W. O. 234 Tape No. St'd °F
Surveyed by S.L. Willey
Notes S.L.W. & E.F.F. Date 4-24-48
Indexed A. C. Johnson

F. B. Pg. 251

continued on p.

Note: Any Additions or Changes on This Sheet Must be Made or Circled in Red Ink With Date and Name of Person Making Change.

Do not extend notes this side of this line.

RETURN TO
LOS ANGELES COUNTY SURVEYOR
700 HALL OF RECORDS

Roses 171+19.2

18" Locust

1st-y stucco mfg conc fl

1st-y sheet iron Milking barn conc fl

conc

conc

5' rail fm

5' rail fm

5' rail fm

5' rail fm

12" pp

12" pp

BLVD

PROP. COMPTON

barb wire fm

Cont from page 250

FORM 247 SM 11-48

RETURN TO
LOS ANGELES COUNTY SURVEYOR
700 HALL OF RECORDS

Note: Any Additions or Changes on This Sheet Must be Made or Circled in Red Ink With Date and Name of Person Making Change.

Do not extend notes this side of this line.

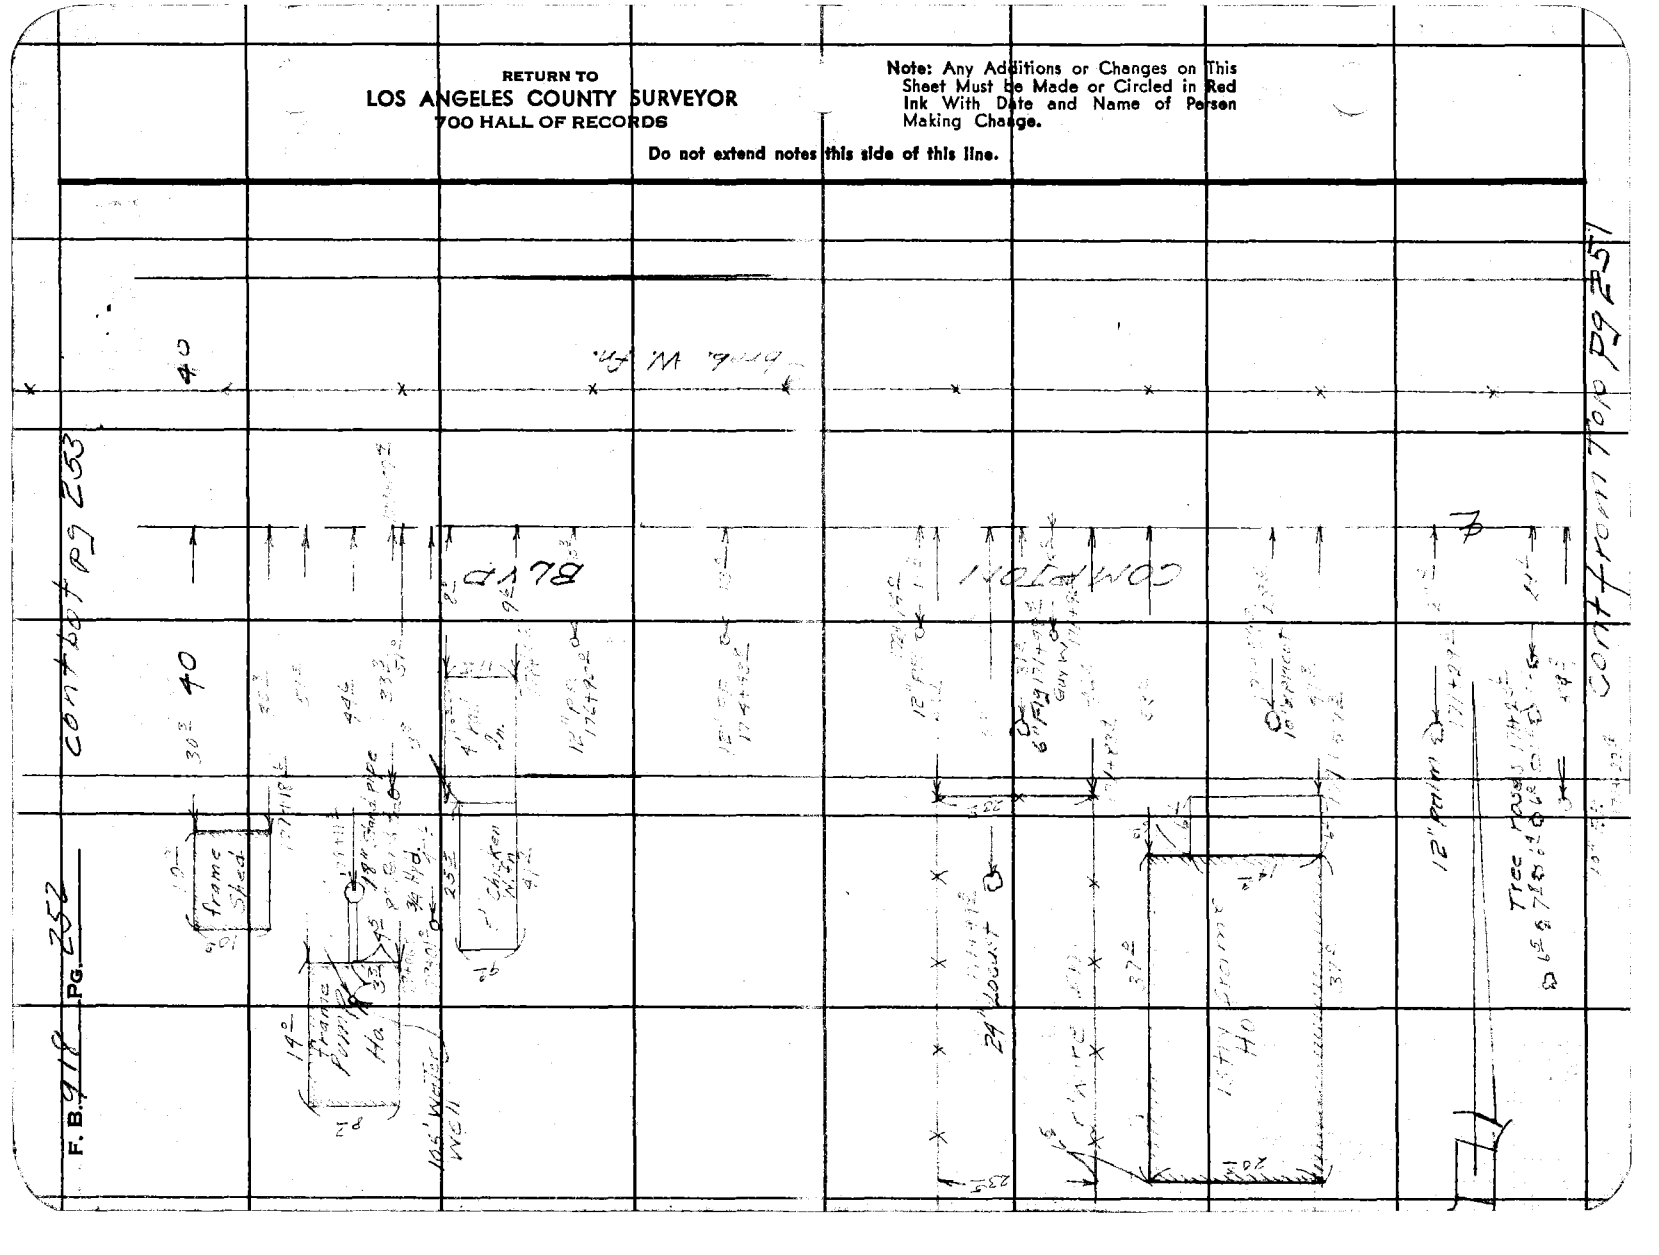

Notes Ck'd by D. M. Finley
Map No. B-1842-2
Office Work Cox
Checked D. M. Finley
Date AUG '51

Survey of
W. O. 934 Tape No. St'd °F
Surveyed by
Notes Date 4-21-48
Indexed A. C. Johnson

F. B. 416 Pg. 253

34 A4

Note: Any Additions or Changes on This Sheet Must be Made or Circled in Red Ink With Date and Name of Person Making Change.

Do not extend notes this side of this line.

RETURN TO
LOS ANGELES COUNTY SURVEYOR
700 HALL OF RECORDS

FORM 247 BM 11-46

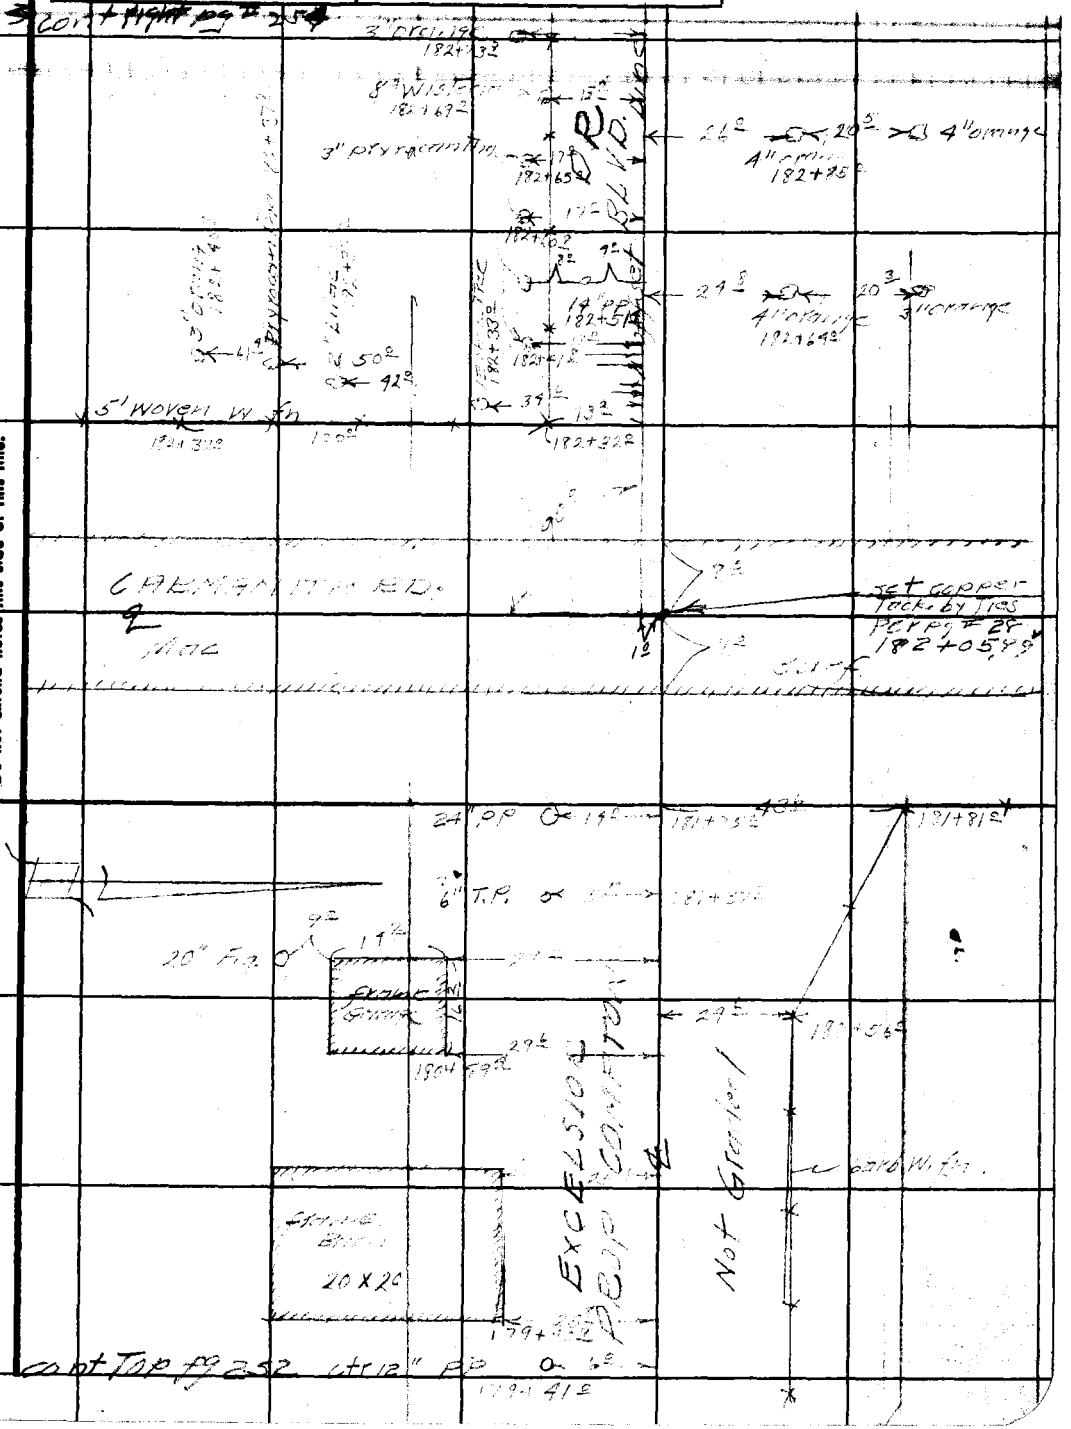

RETURN TO
LOS ANGELES COUNTY SURVEYOR
700 HALL OF RECORDS

Note: Any Additions or Changes on This Sheet Must Be Made or Circled in Red Ink With Date and Name of Person Making Change.

Do not extend notes this side of this line.

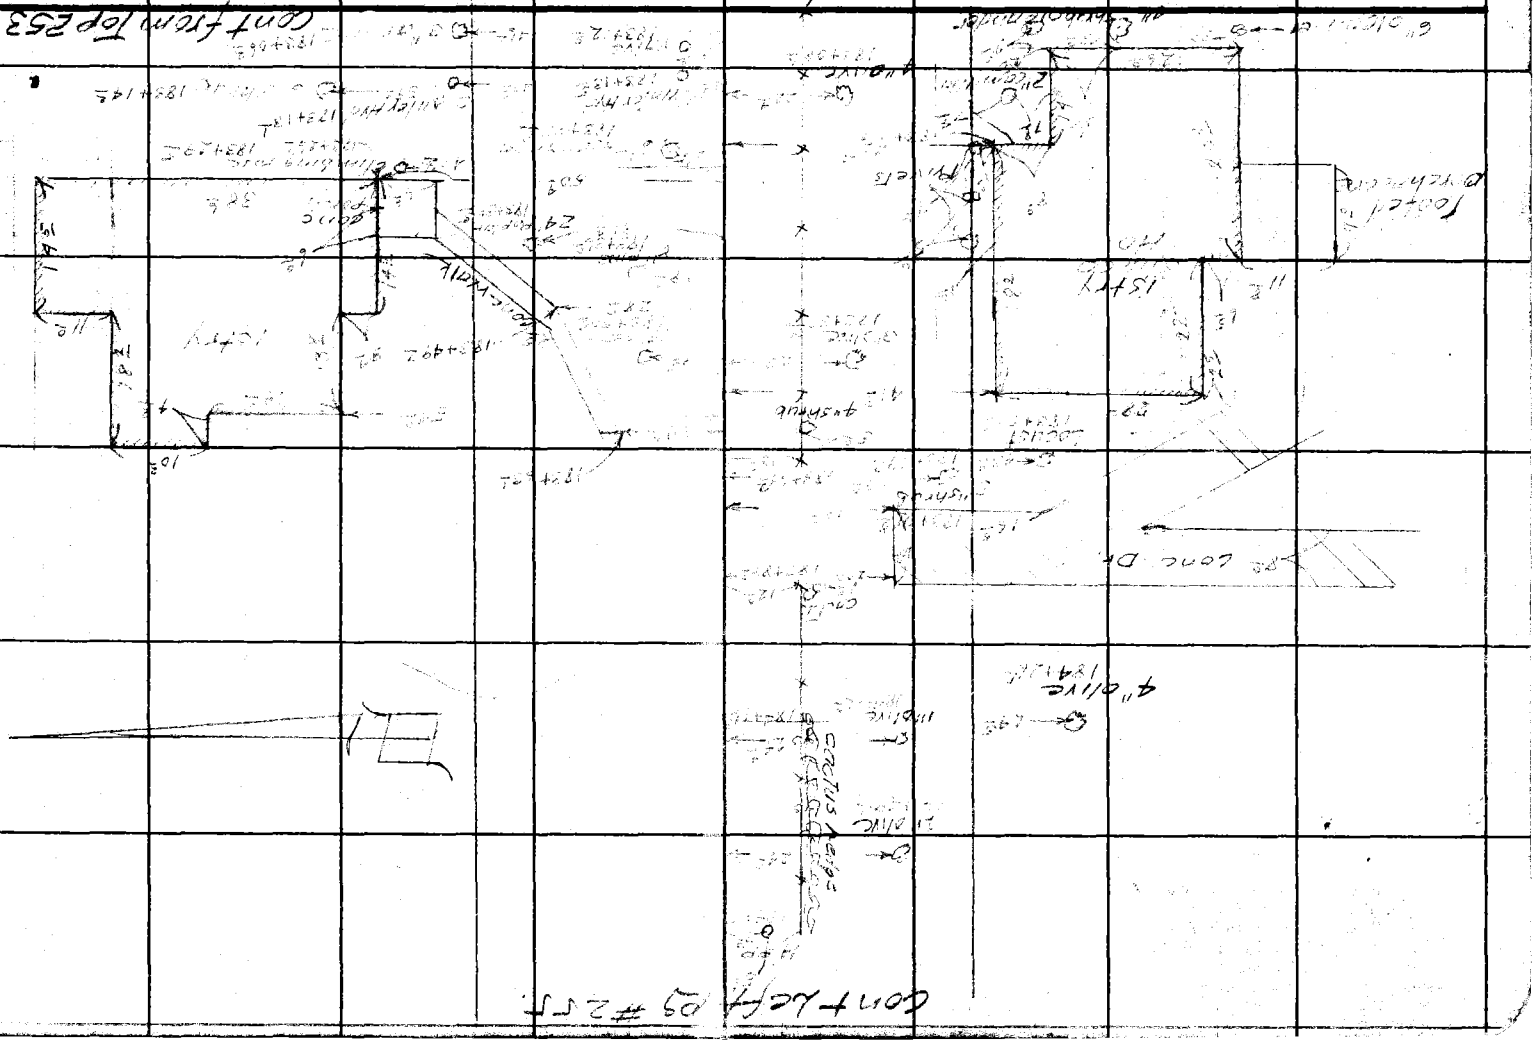

F.B. 818 PG. 254

FORM 247 SM 11-46

RETURN TO
LOS ANGELES COUNTY SURVEYOR
700 HALL OF RECORDS

Note: Any Additions or Changes on This Sheet Must be Made or Circled in Red Ink With Date and Name of Person Making Change.

Do not extend notes this side of this line.

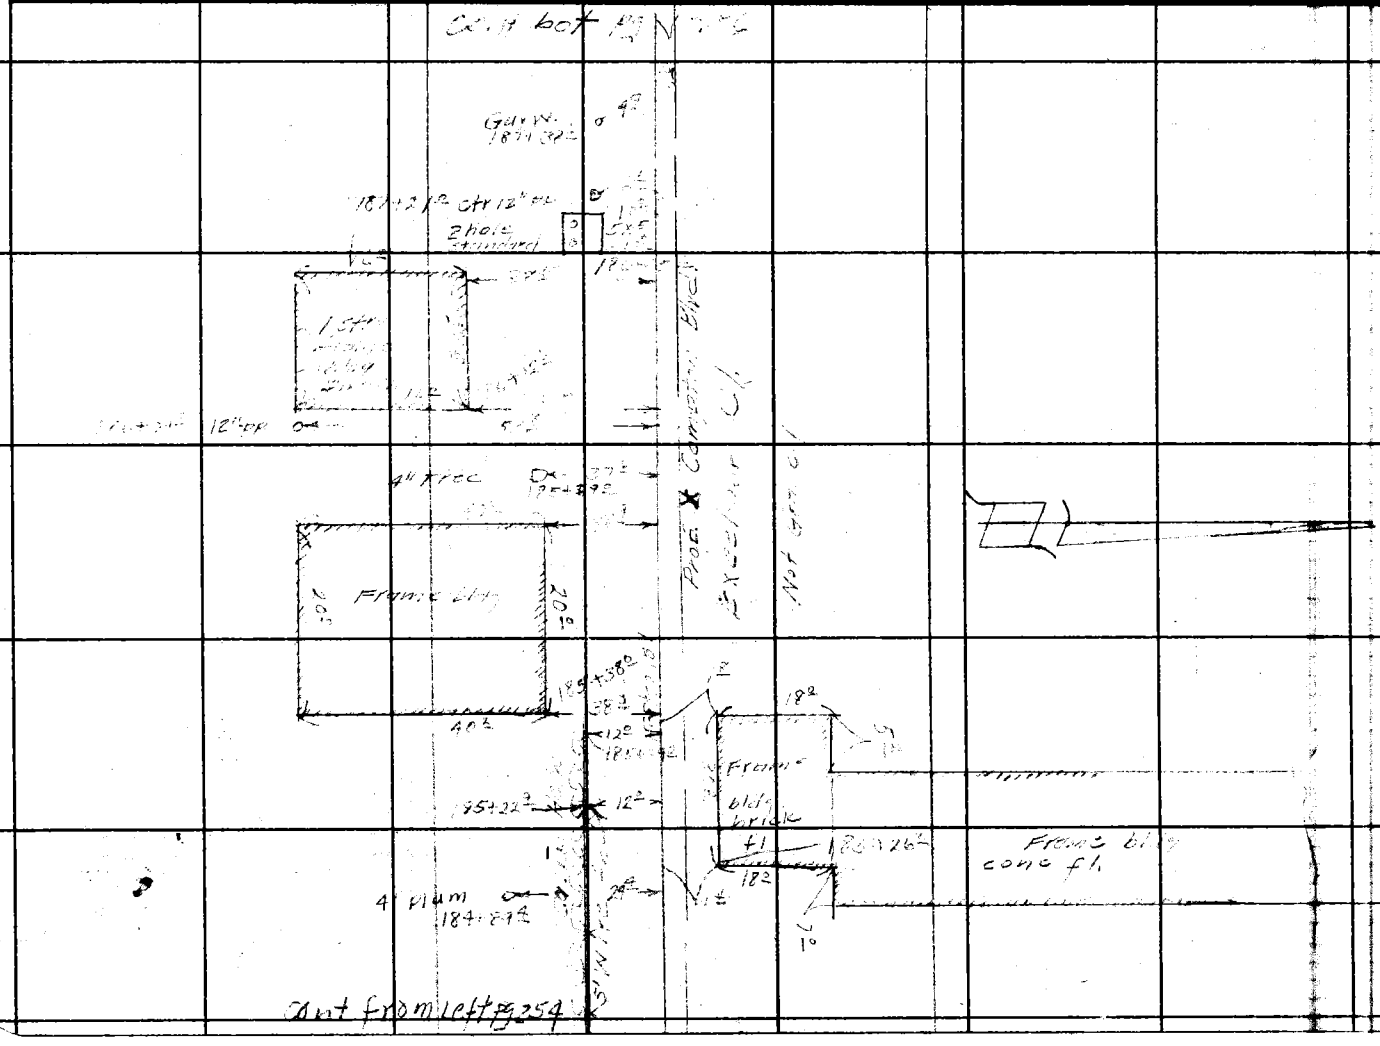

Notes Ck'd by D. M. Finley
Map No. 2-1242-2
Office Work Cox
Checked D. M. Finley
Date 5/51

Survey of
W. O. 2241 Tape No. Std °F
Surveyed by R. E. E. E. Date 4-42
Notes
Indexed C. Johnston

F. B. 911 PG. 255

F. B. 918 Pg. 256

cont 607 257

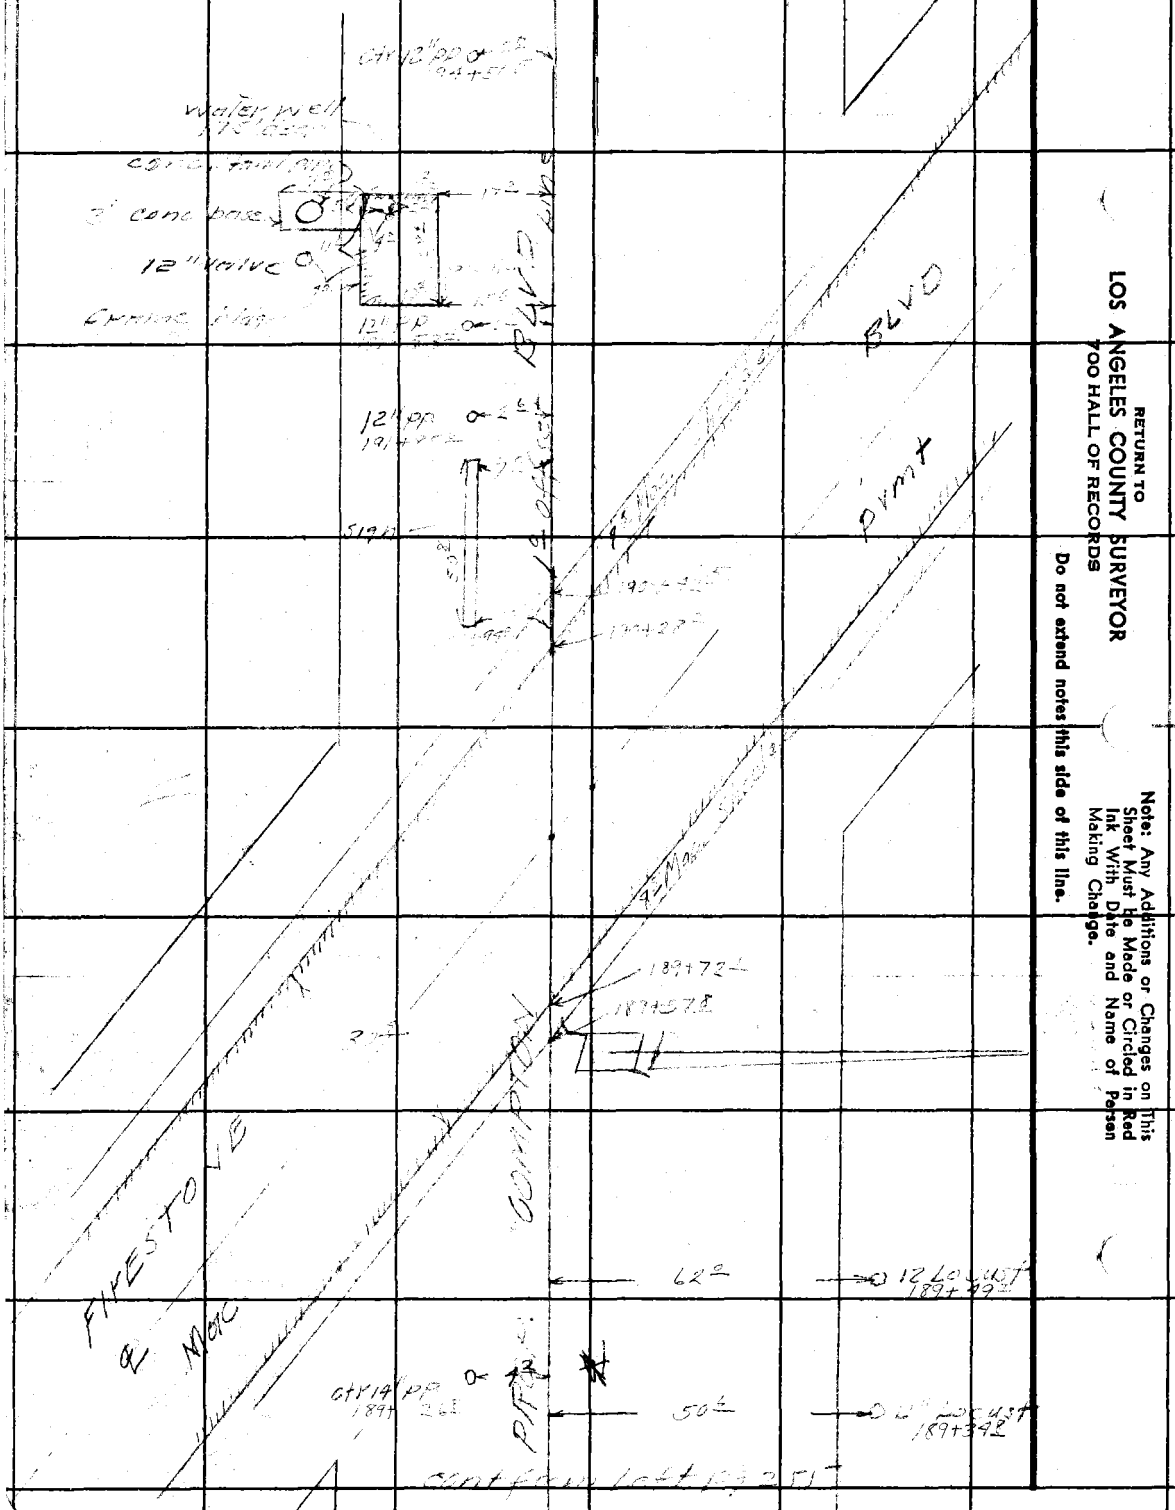

RETURN TO
LOS ANGELES COUNTY SURVEYOR
700 HALL OF RECORDS

Do not extend notes this side of this line.

Note: Any Additions or Changes on This Sheet Must Be Made or Circled in Red Ink With Date and Name of Person Making Change.

Notes Ck'd by D. M. Finley
Map No. B-1242-2
Office Work Cox
Checked D. M. Finley
Date AUG '51

Survey of
W. O. 234 Tape No. St'd °F
Surveyed by R.L.W. Notes R.L.W. & L. Date 9-47
Indexed A. C. Johnson

F. B. 317 Pg.

Note: Any Additions or Changes on This Sheet Must be Made or Circled in Red Ink With Date and Name of Person Making Change.

Do not extend notes this side of this line.

RETURN TO
LOS ANGELES COUNTY SURVEYOR
720 HALL OF RECORDS

FORM 247 BM 11-46

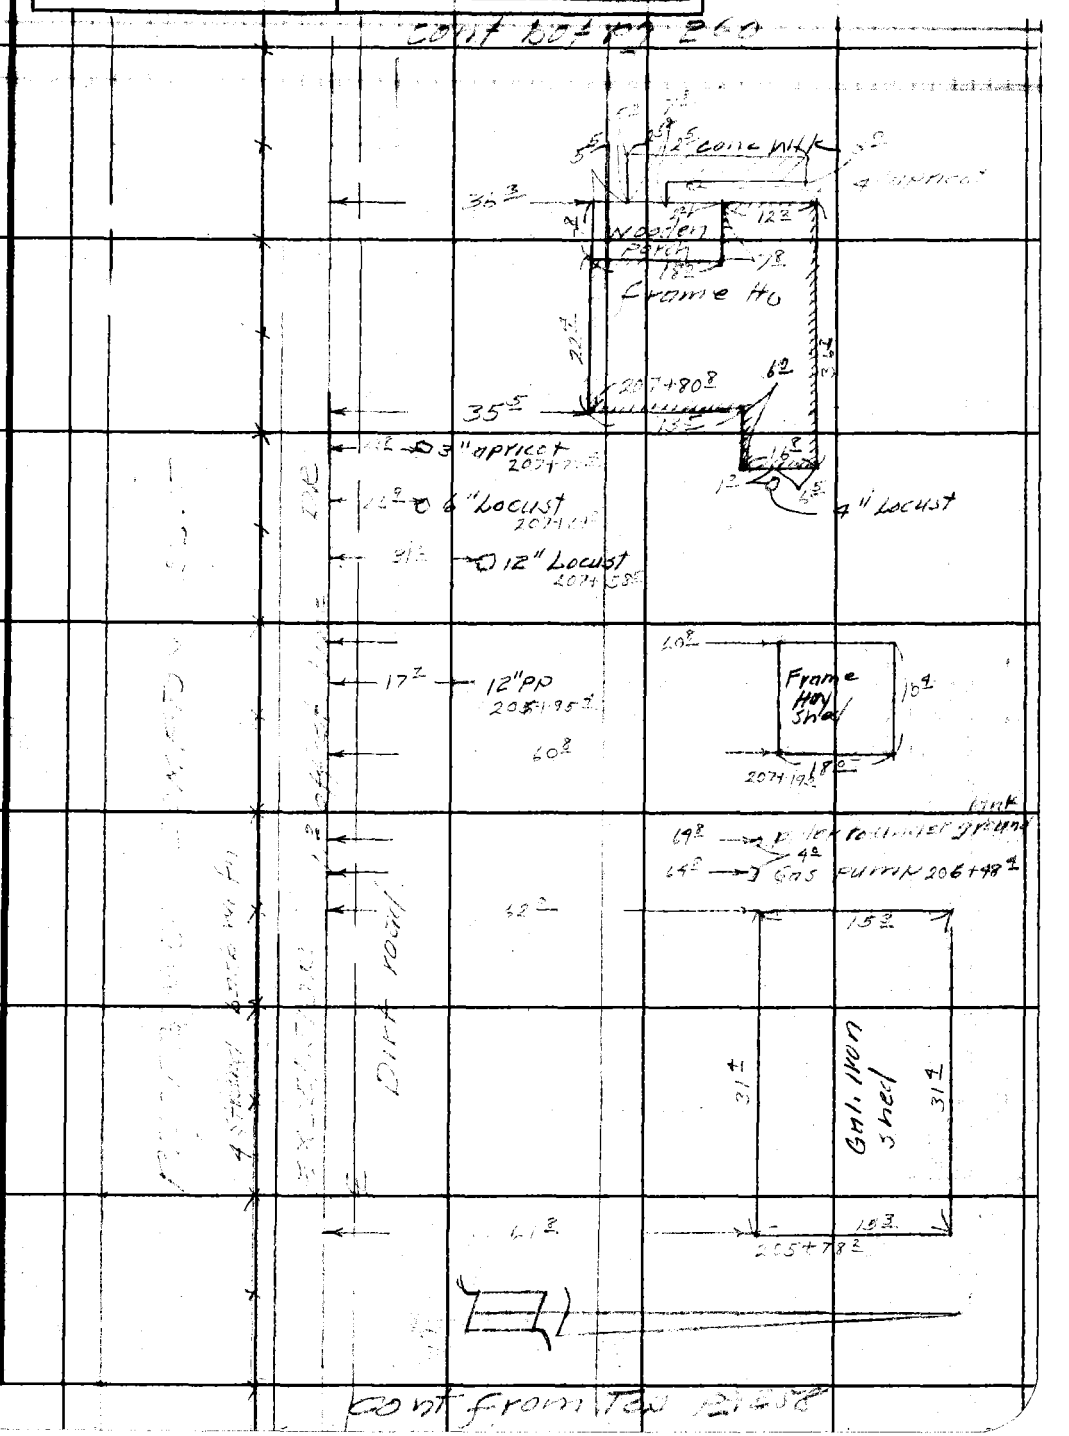

F. B. 918 Pg. 260

cont' last Pg 261

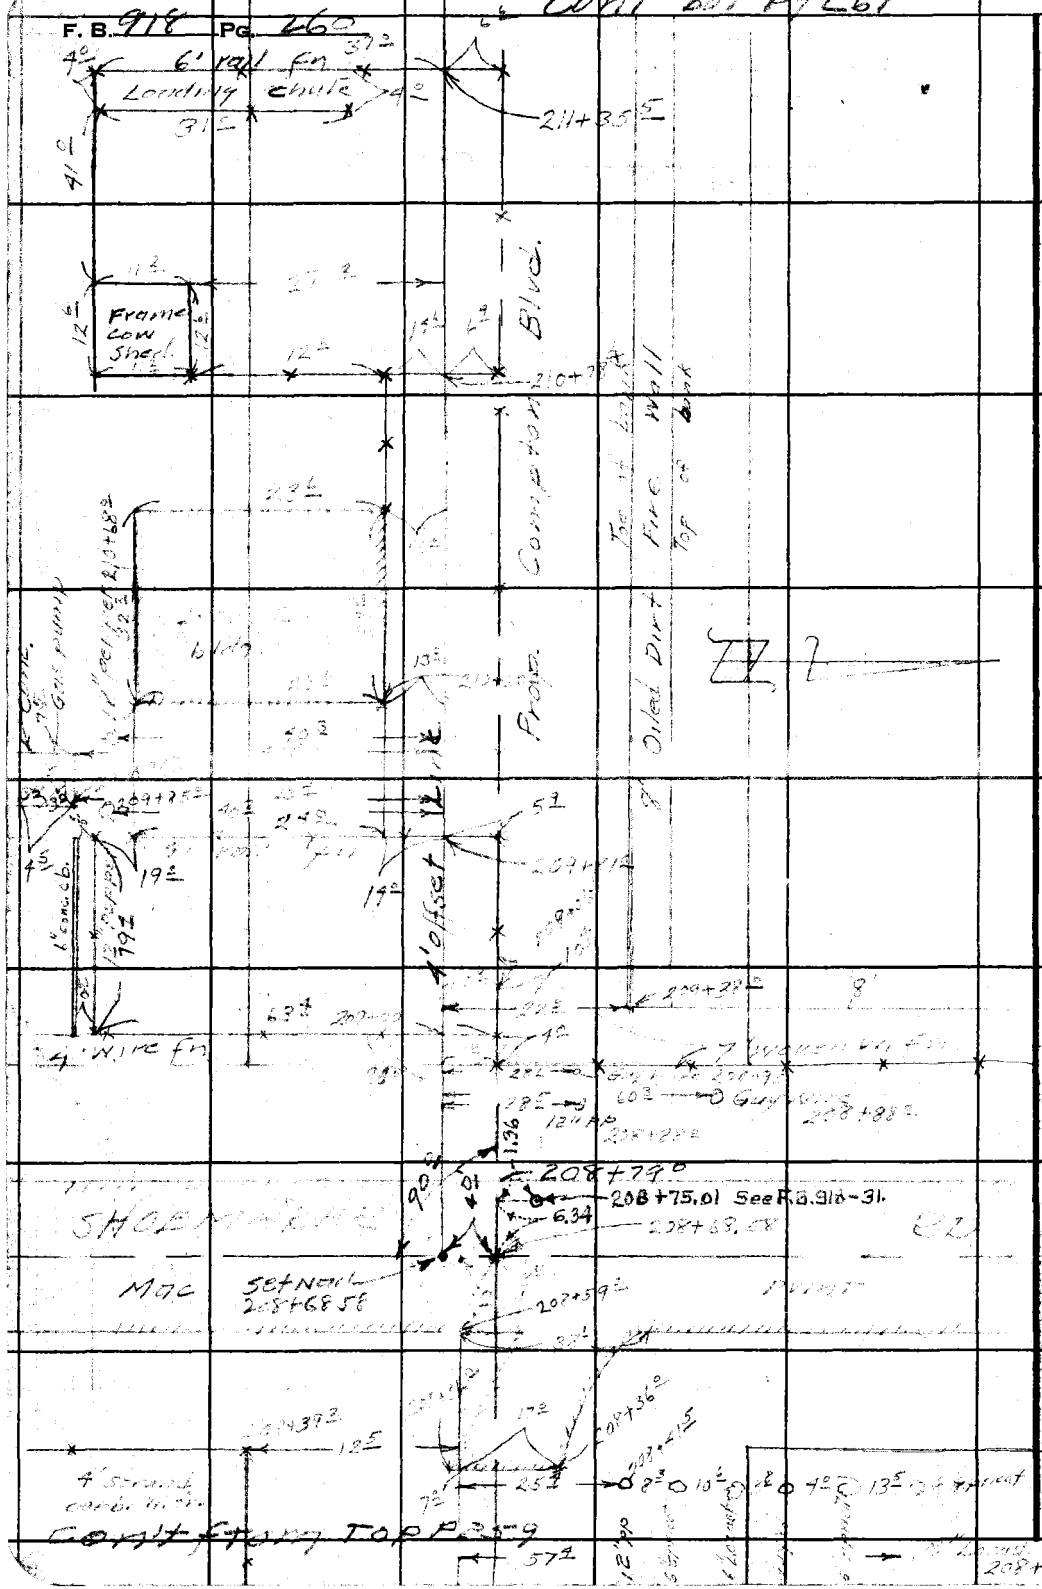

RETURN TO
LOS ANGELES COUNTY SURVEYOR
700 HALL OF RECORDS

Do not extend notes this side of this line.

Note: Any Additions or Changes on This Sheet Must be Made or Circled in Red Ink With Date and Name of Person Making Change.

Notes Ck'd by D. M. Finley
Map No. D-1542-2
Office Work Cox
Checked D. M. Finley
Date AUG '51

Survey of
W. O. 9345 Tape No. St'd °F
Surveyed by
Notes Date 4-22-48
Indexed A. C. Johnson

F. B. Pg.

W S 34 - A 4

Note: Any Additions or Changes on this Sheet Must be Made or Circled in Red Ink With Date and Name of Person Making Change.

Do not extend notes this side of this line.

RETURN TO
LOS ANGELES COUNTY SURVEYOR
720 HALL OF RECORDS

FORM 247 SM 11-46

conc sump tank

4 strand barb W. fn

R. R.

Mud Hole

S. P.

Fd 3/4" IP per pg # 30
199+34.68

12" PP 199+40

PROP COMPTON DR

EXCELSIOR

197+00 4 strand barb W fn

10' dirt bank

6" Gum

4" Gum

dry reservoir dirt bank

36" Gums

50'

CONT FROM TOP OF PG 256

RETURN TO
LOS ANGELES COUNTY SURVEYOR
700 HALL OF RECORDS

Note: Any Additions or Changes on This Sheet Must be Made or Circled in Red Ink With Date and Name of Person Making Change.

Do not extend notes this side of this line.

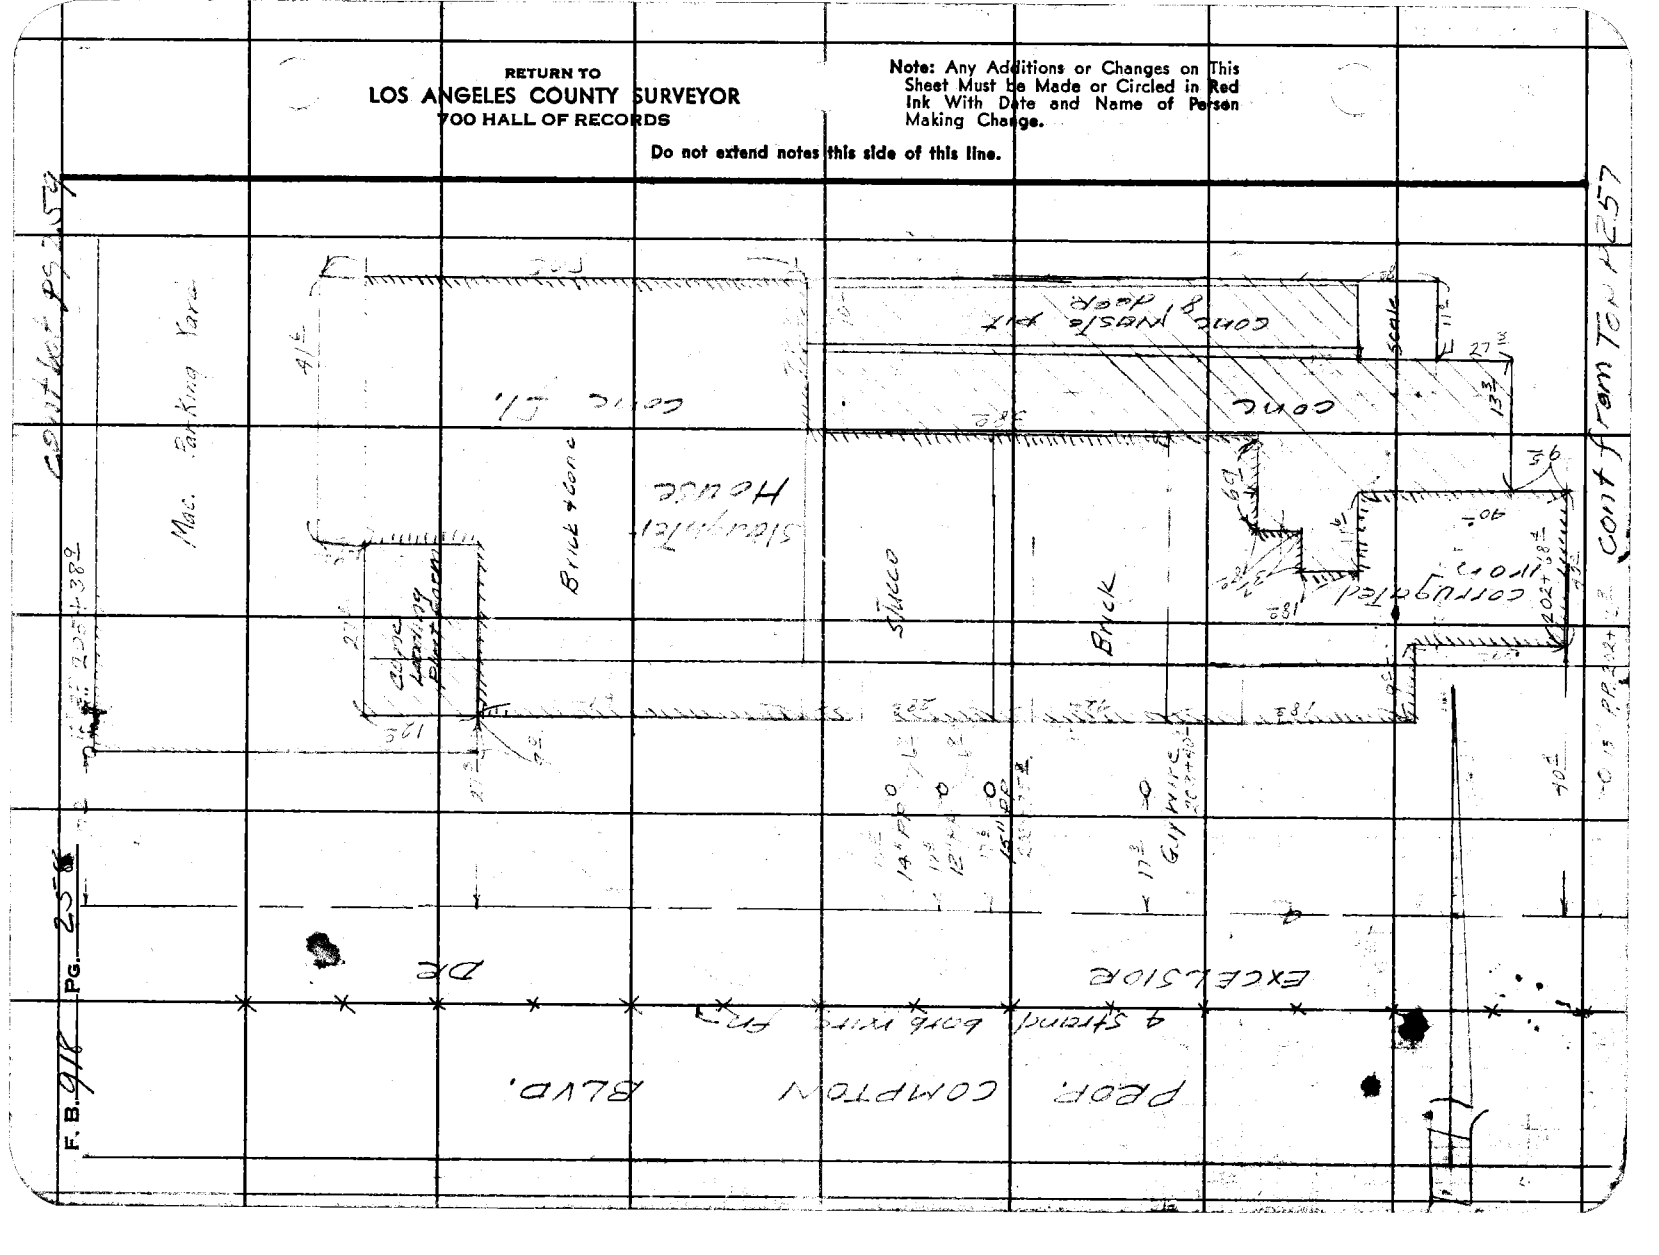
Mac. Parking Lot
Brick & Conc
Stucco
Brick
Conc Fl.

Notes Ck'd by D. M. Finley
Map No. B-1042-2.
Office Work Cox.
Checked D. M. Finley
Date AUG '51

Survey of
W. O. 8395 Tape No. St'd °F
Surveyed by R.L. Willey
Notes A.M. 9 E.F.A. Date 4-48
Indexed A. C. Johnson

F. B. 218 Pg. 261

Note: Any Additions or Changes on This Sheet Must be Made or Circled in Red Ink With Date and Name of Person Making Change.

Do not extend notes this side of this line.

RETURN TO
LOS ANGELES COUNTY SURVEYOR
700 HALL OF RECORDS

FORM 247 SM 11-48

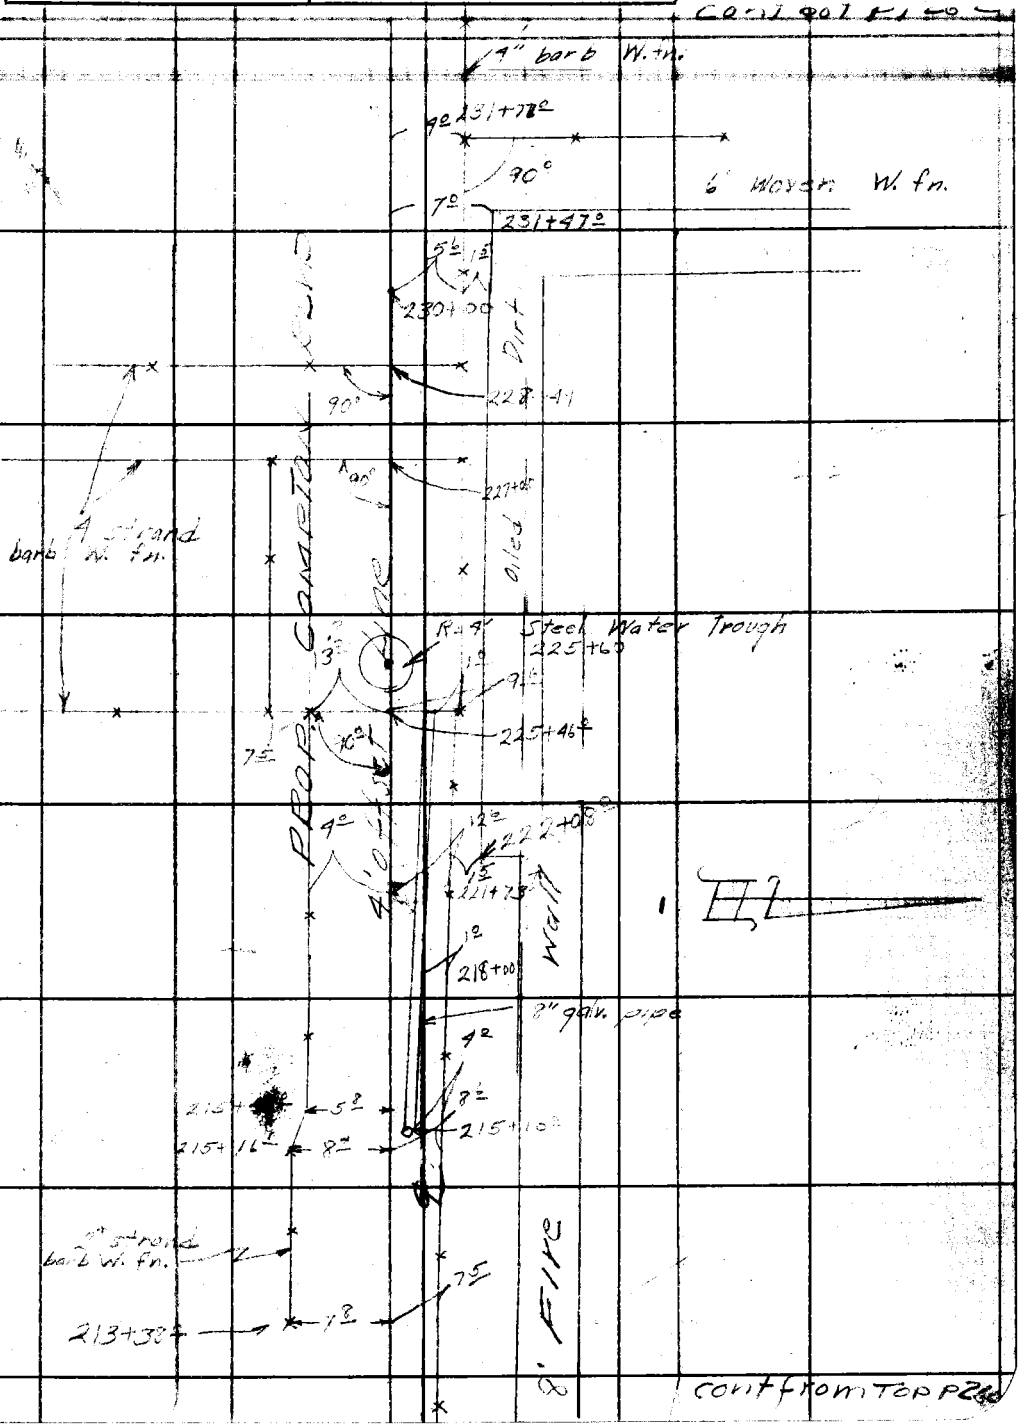

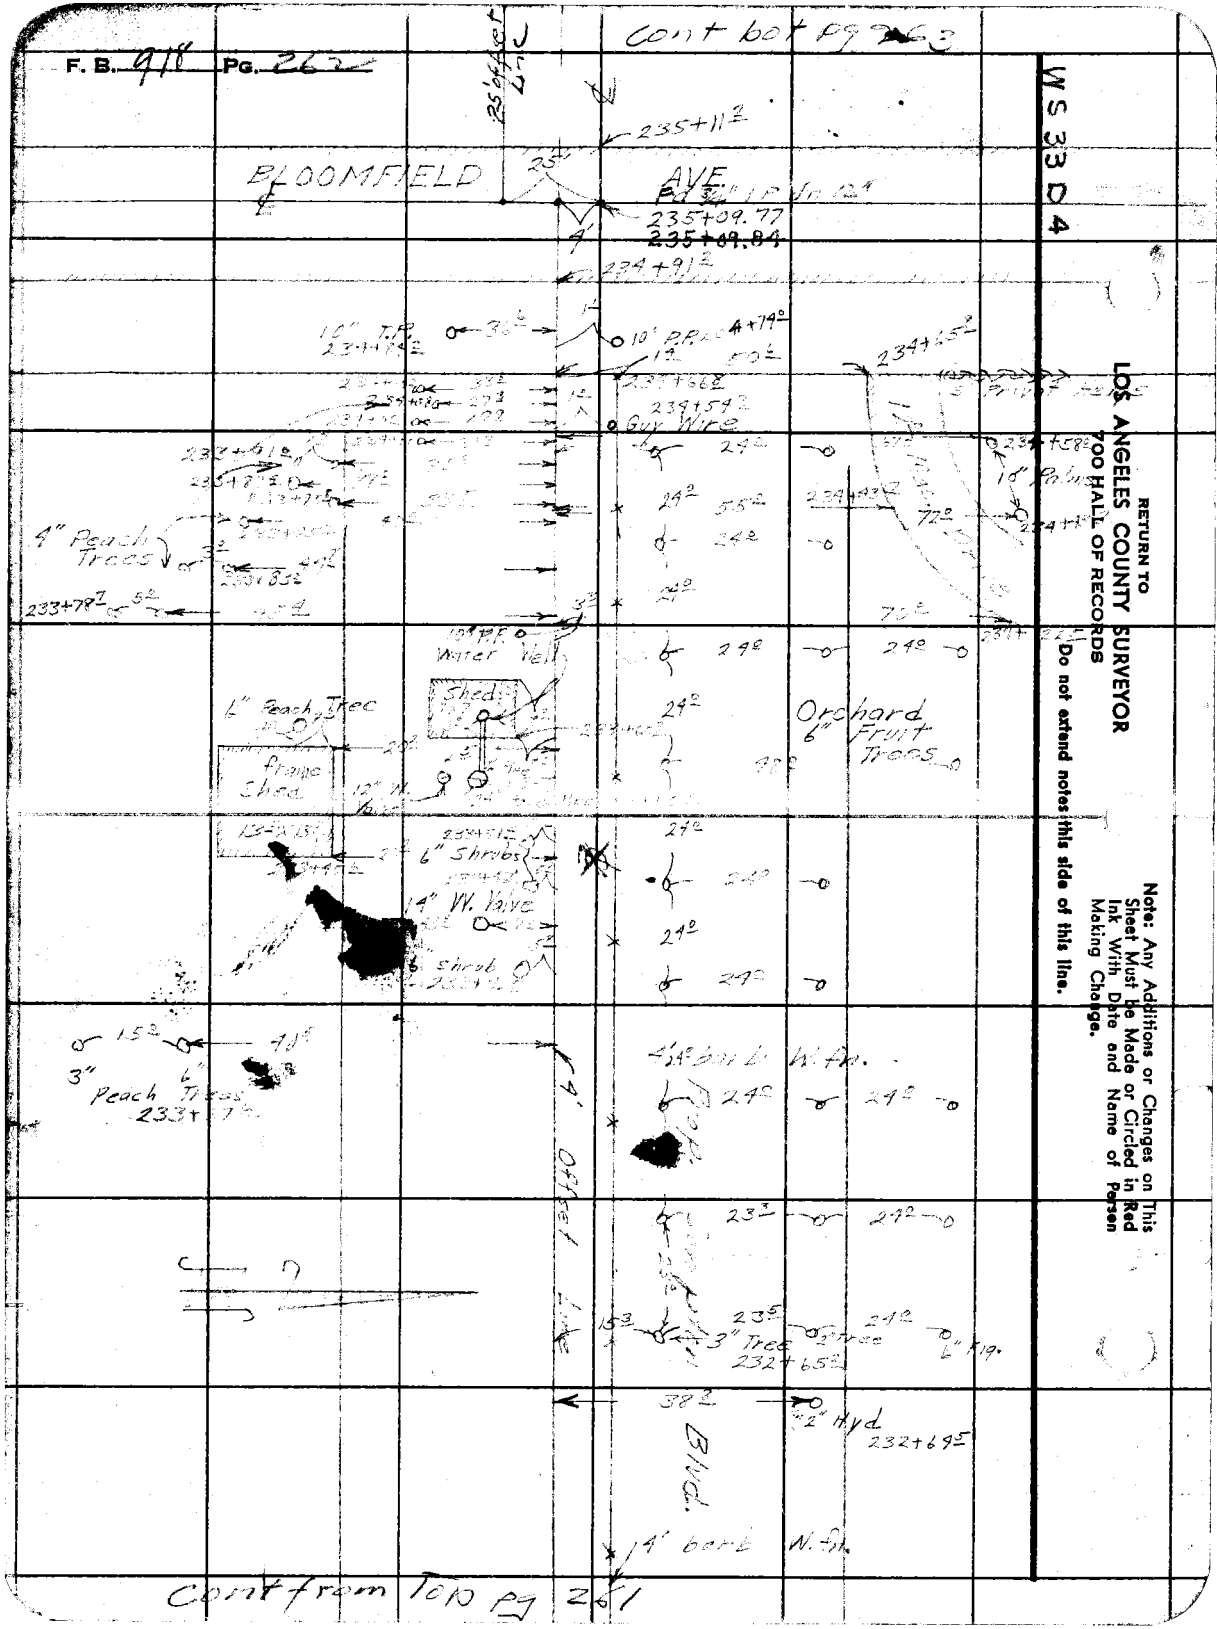
F. B. 918 Pg. 262
Cont to bk pg 263
WS 33 D 4
BLOOMFIELD AVE.
235+11.2
235+09.77
235+09.84
234+91.2
16" T.P.
10' P.P.
Guy Wire
4" Peach Trees
233+78.7
Water well
Shed
Frame Shed
6" Peach Tree
Orchard
6" Fruit Trees
6" Shrubs
14" W. Valve
3" Peach Trees
4' Ditch
Bind.
3" Tree
232+65.2
2" Hyd.
232+69.5
14' bank W. Fk.
Cont from to bk pg 261
RETURN TO
LOS ANGELES COUNTY SURVEYOR
700 HALL OF RECORDS
Do not extend notes this side of this line.
Note: Any Additions or Changes on This Sheet Must be Made or Circled in Red Ink With Date and Name of Person Making Change.

Notes Ck'd by D. M. Finley	Survey of		F.B. 918 Pg. 262
Map No. A-1942-2	W.O. 2345 Tape No.	St'd °F	
Office Work Cox	Surveyed by		
Checked D. M. Finley	Notes	Date	
Date AUG '51	Indexed A. C. Johnson		

RETURN TO
LOS ANGELES COUNTY SURVEYOR
700 HALL OF RECORDS

Note: Any Additions or Changes on This Sheet Must Be Made or Circled in Red Ink With Date and Name of Person Making Change.

Do not extend notes this side of this line.

FORM 247 BM 11-46

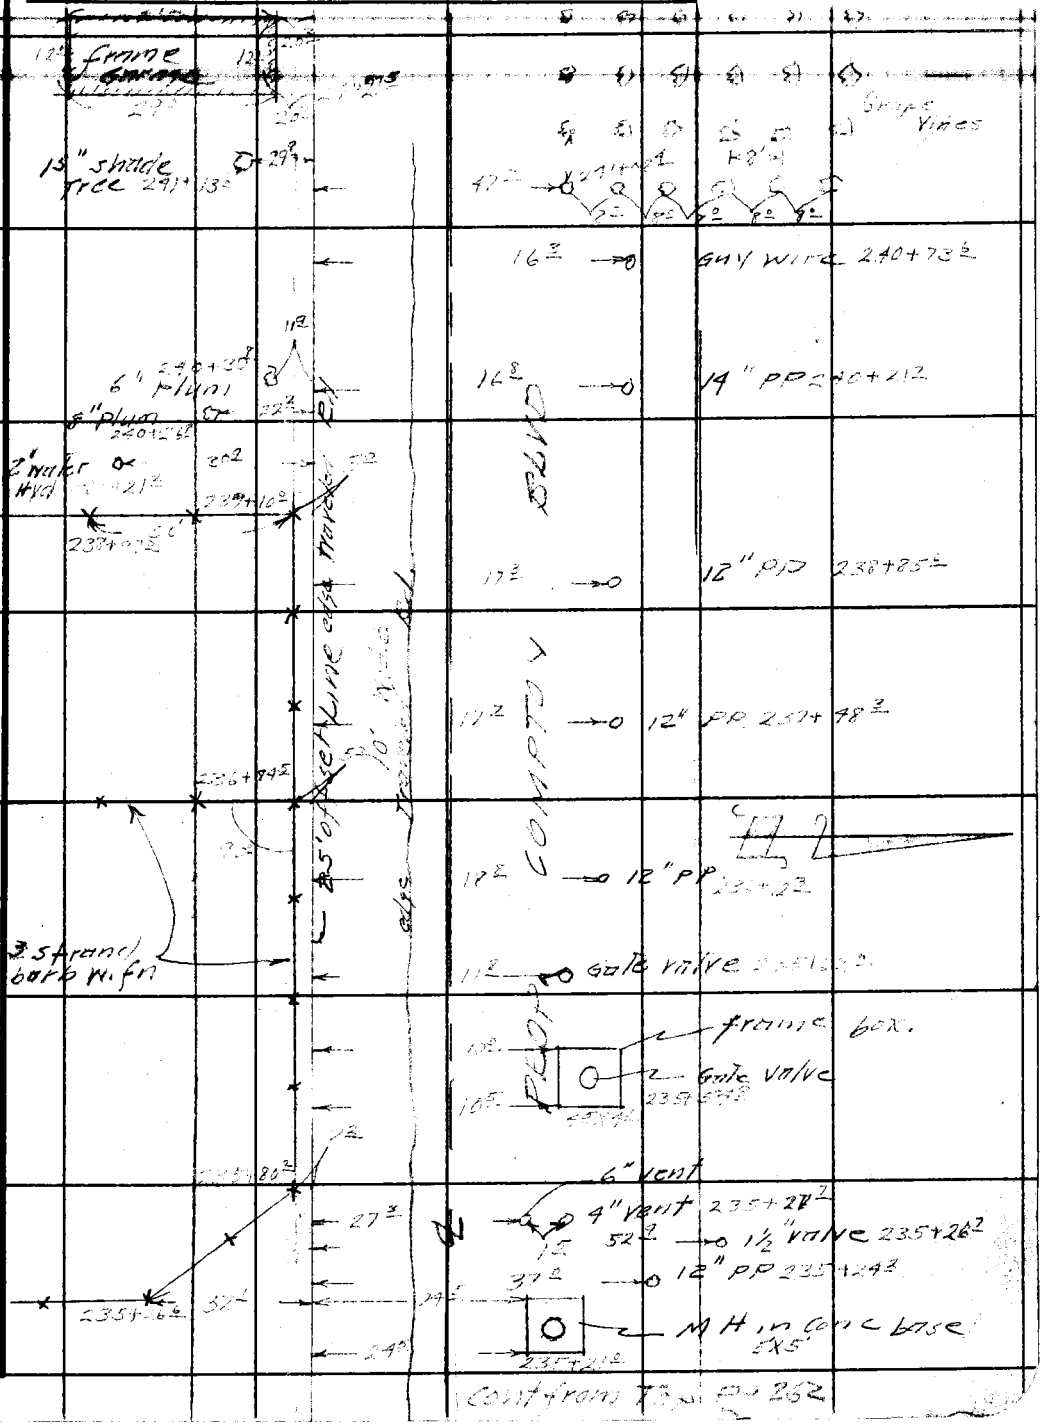

RETURN TO
LOS ANGELES COUNTY SURVEYOR
700 HALL OF RECORDS

Note: Any Additions or Changes on This Sheet Must be Made or Circled in Red Ink With Date and Name of Person Making Change.

Do not extend notes this side of this line.

F. B. 418 Pg. 264

Notes Ck'd by D. M. Finley
Map No. D-18A-2
Office Work Cox
Checked D. M. Finley
Date AUG '59

Survey of
W. O. 2949 Tape No. St'd °F
Surveyed by
Notes M. WATER Date 4-42
Indexed A. C. Johnson

F. B. 218 Pg. 27

cont'd to Pg 266

(40) (40)

Note: Any Additions or Changes on This Sheet Must be Made or Circled in Red Ink With Date and Name of Person Making Change.

Do not extend notes this side of this line.

RETURN TO
LOS ANGELES COUNTY SURVEYOR
700 HALL OF RECORDS

FORM 247 SM 11-46

cont'd from Pg 264

RETURN TO
LOS ANGELES COUNTY SURVEYOR
700 HALL OF RECORDS

Note: Any Additions or Changes on This Sheet Must be Made or Circled in Red Ink With Date and Name of Person Making Change.

Do not extend notes this side of this line.

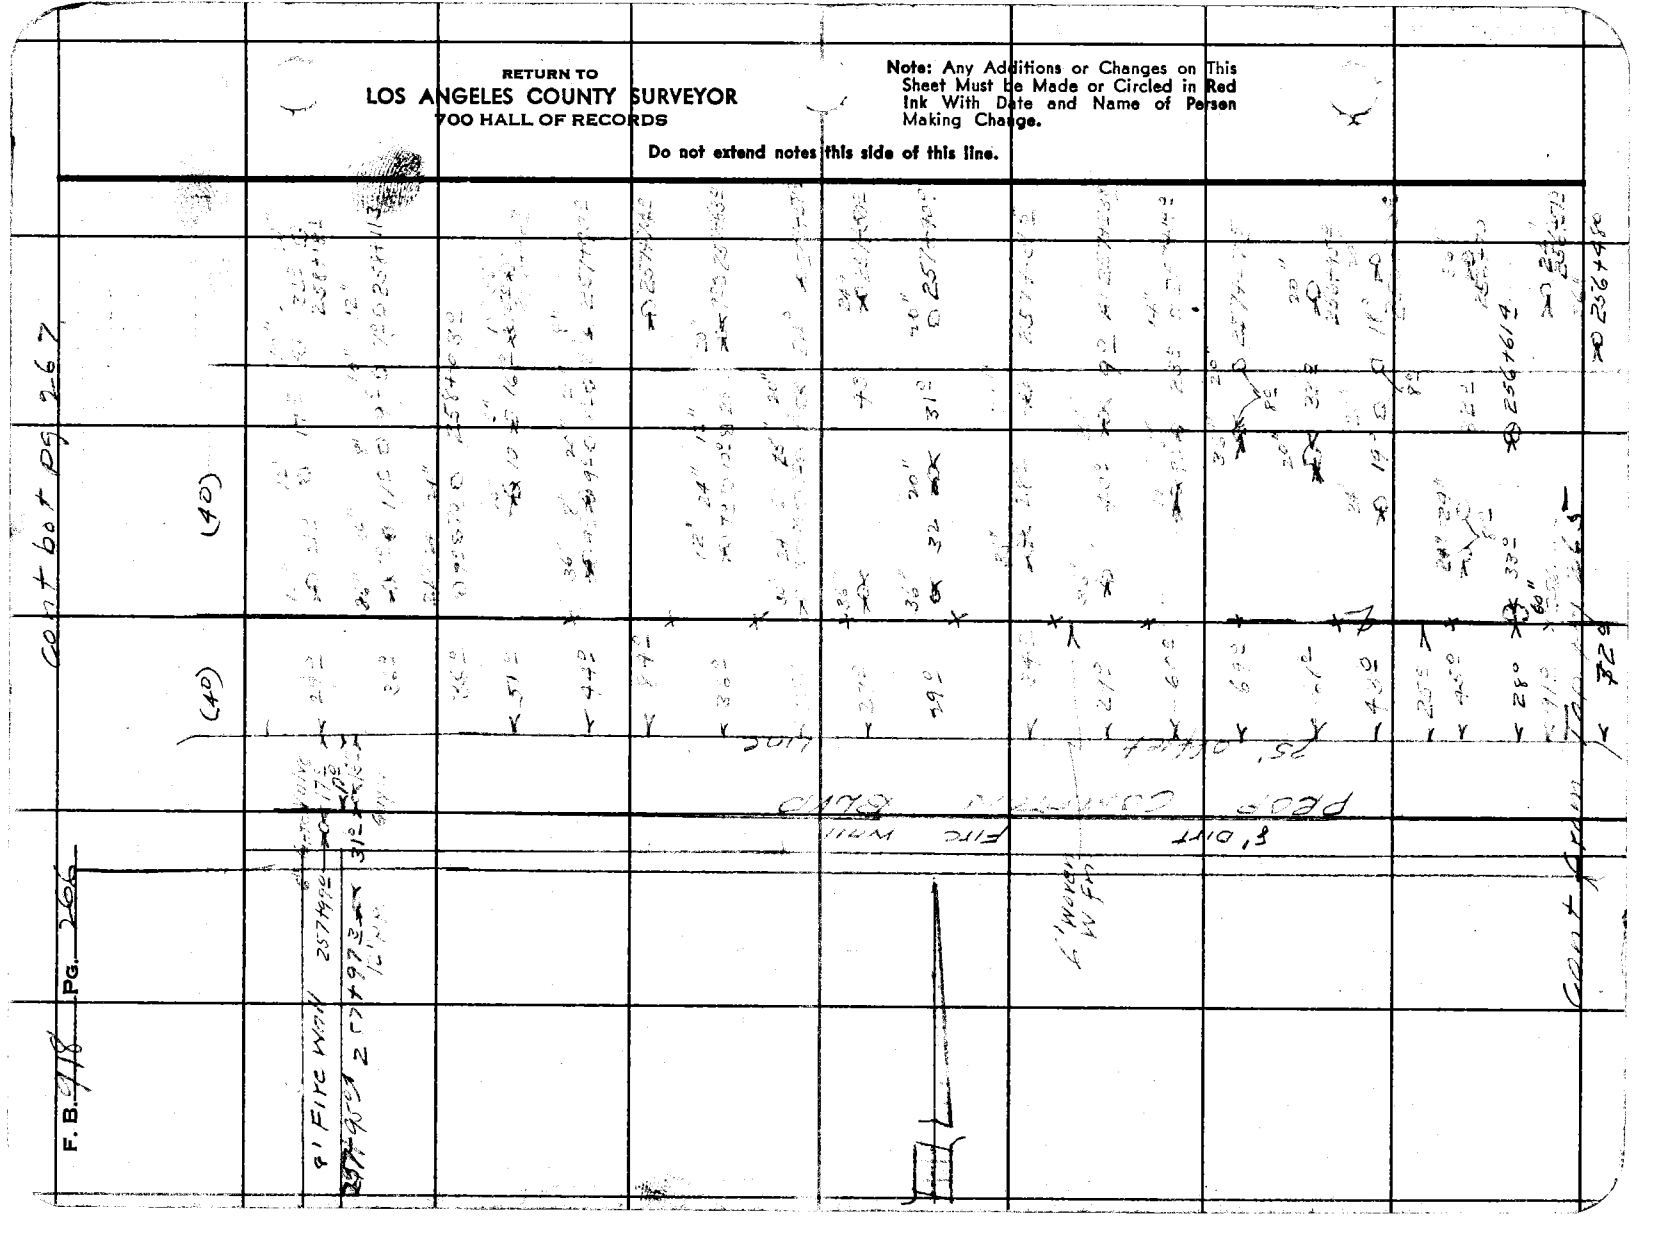

Notes Ck'd by D.M. Finley
Map No. B-1842-21
Office Work Cox
Checked D. M. Finley
Date AUG 1 '51

Survey of Compton Blvd
W. O. 8345 Tape No. St'd °F
Surveyed by R.L.W. Illey
Notes E of B.W. Date 9-49
Indexed A. O. Johnson

F. B. 918 Pg. 267

Cont'd from Pg 267

Cont'd from Pg 266

Note: Any Additions or Changes on This Sheet Must Be Made or Circled in Red Ink With Date and Name of Person Making Change.

Do not extend notes this side of this line.

RETURN TO
LOS ANGELES COUNTY SURVEYOR
700 HALL OF RECORDS

FORM 247 SM 11-46

F. B. ____ PG. ____

 
4°
CONT FROM 260-57
BLVD
SCF NAIL
266+01.51
262+01.49
MAC PVMT
261+76
261+57
261+28
261+72
261+42
261+25
260+88
260+74
260+58
260+53
260+42
8' DIRT FIRE WALL
PROP. COMPTON BLVD
35' R/W
