F.B. 985-1

B.P.L. F.B.#527

REC. STA "B" – CENTRAL AVE. AT 98th ST. TO WEST BOUNDARY OF CITY OF SOUTHGATE AT SANTA FE & SOUTHERN

PROPERTY. SURVEYS

B.T.L. & LOOP TRANSMISSION LINE R/W

STREET & TIES

BUREAU OF POWER & LIGHT OF CITY OF L.A.
DESIGN & CONSTRUCTION DIV.
H.C. GARDETT, ENGR. IN CHARGE
R.E. BALLINGER R/W ENGR.

The Street & Surveys & Property Monumenting as shown in this Field Book, Pages 1-17 and 60-76, made between May 20 and Sept 10, 1936 by Survey Parties noted Below. W.C. Watson Sup.

Central to 91st	G.B. Knight	April 20 to May 13 – May 21 to June 12, 1936
91st to Graham	R.L. Massey	Aug 5 to 10 – Sept 2 to 10, 1936
Graham to Elm	R.L. Massey	July 8 to 18, 1936.
Elm to Alameda	F.M. Nafley & R.W. Mathew	May 11 to June 11, 1936
	R.L. Massey	June 30 to Aug 4, 1936

INDEX

Central to Graham	Prop. T&Es	1-9	Elm to Alameda	& Survey & Ties	60-67
Graham to Elm	Prop. Survey	9-12	Graham to Elm	" " " "	68-72
Elm to Santa Fe	" "	12-17	Compton to Main	" " " "	73-75
S.P.R.R. R/W		18	Graham to Elm 87th to 85th	& Distances	76
So. R/W Line - E. Side Boundary		19			

INDEXED

INDEXED

5/26/38 To L.A. County Surveyor: Pages 1 to 18 incl.
60 to 76 incl.

B.P.L. F.B.#527

REC STA

5-20-36. For Traverse of Streets Rewind

TION "B"

ing Rec. Sta. "B" see F.B. 288-65.

Central Ave.

Lots No. 241 & 242

TRACT NO

6381

Lots No. 239 & 240

M.B. 69-88

Lots No. 229 & 230

39

Alley

E TIES

City Engineer

F.B. 1560B-77

F.B. 9543-98

To B-2

F.B. 985-4

F.B. 985-5

B.P.L. F.B.#527

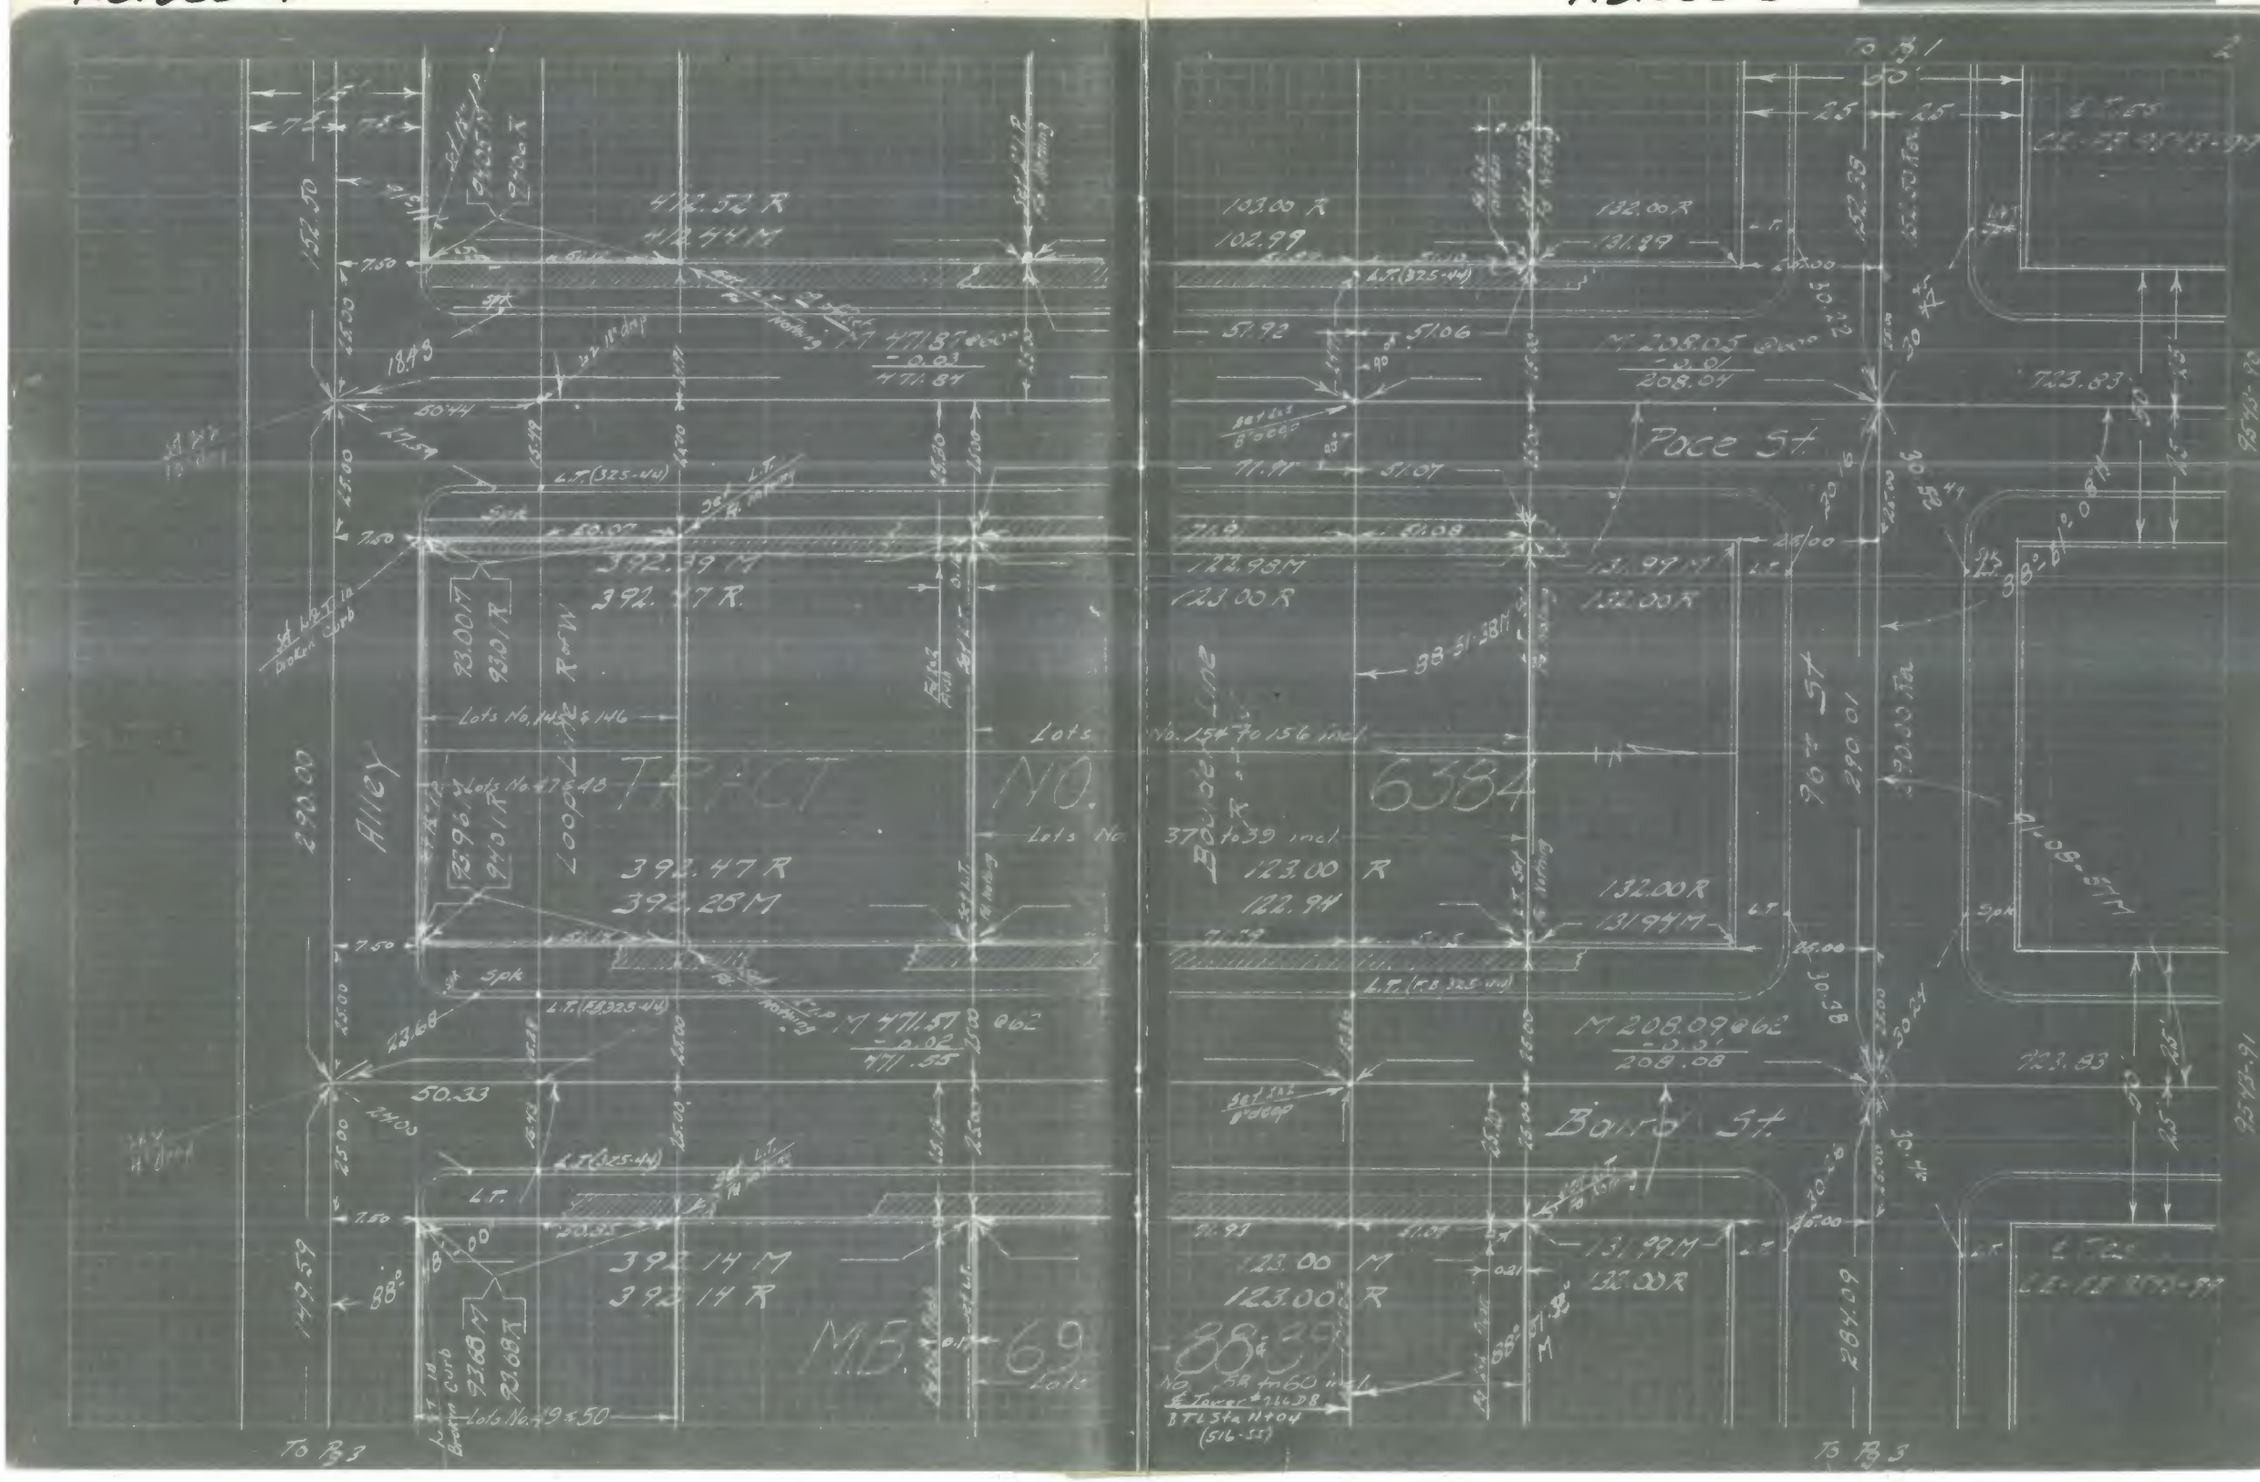

F. B. 985-C

F.B. 985-7

B.P.L. F.B.#527

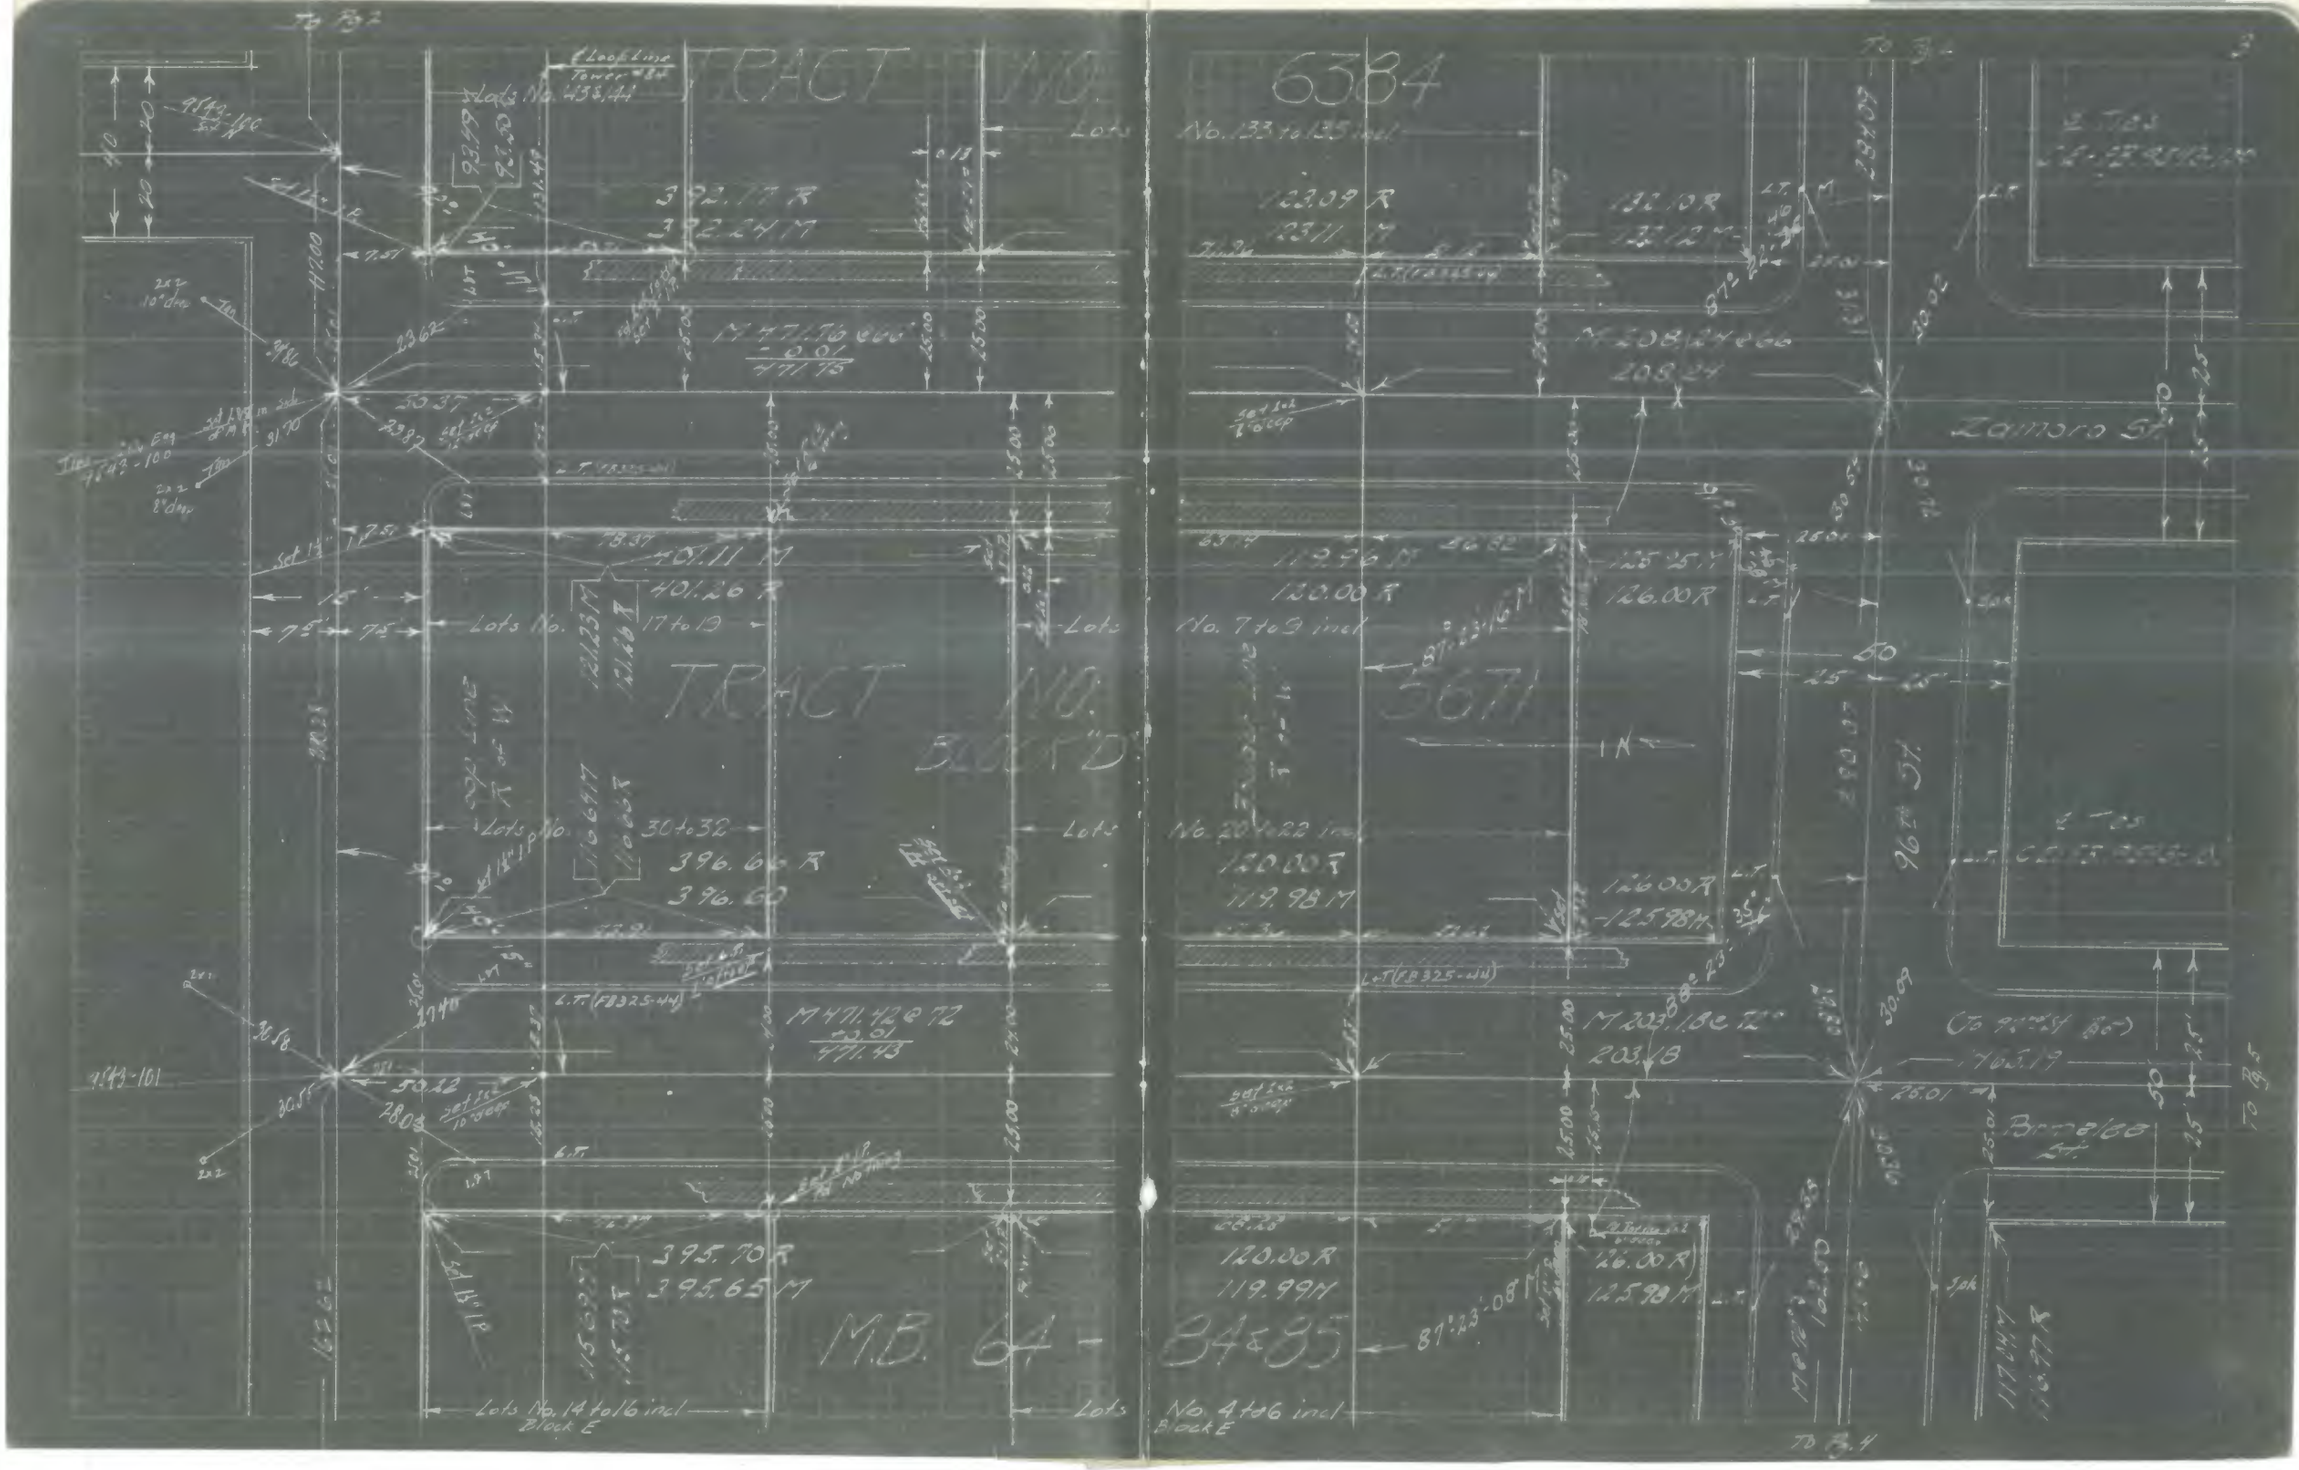

F. B. 985-8

F.B. 985-9

B.P.L. F.B.#527

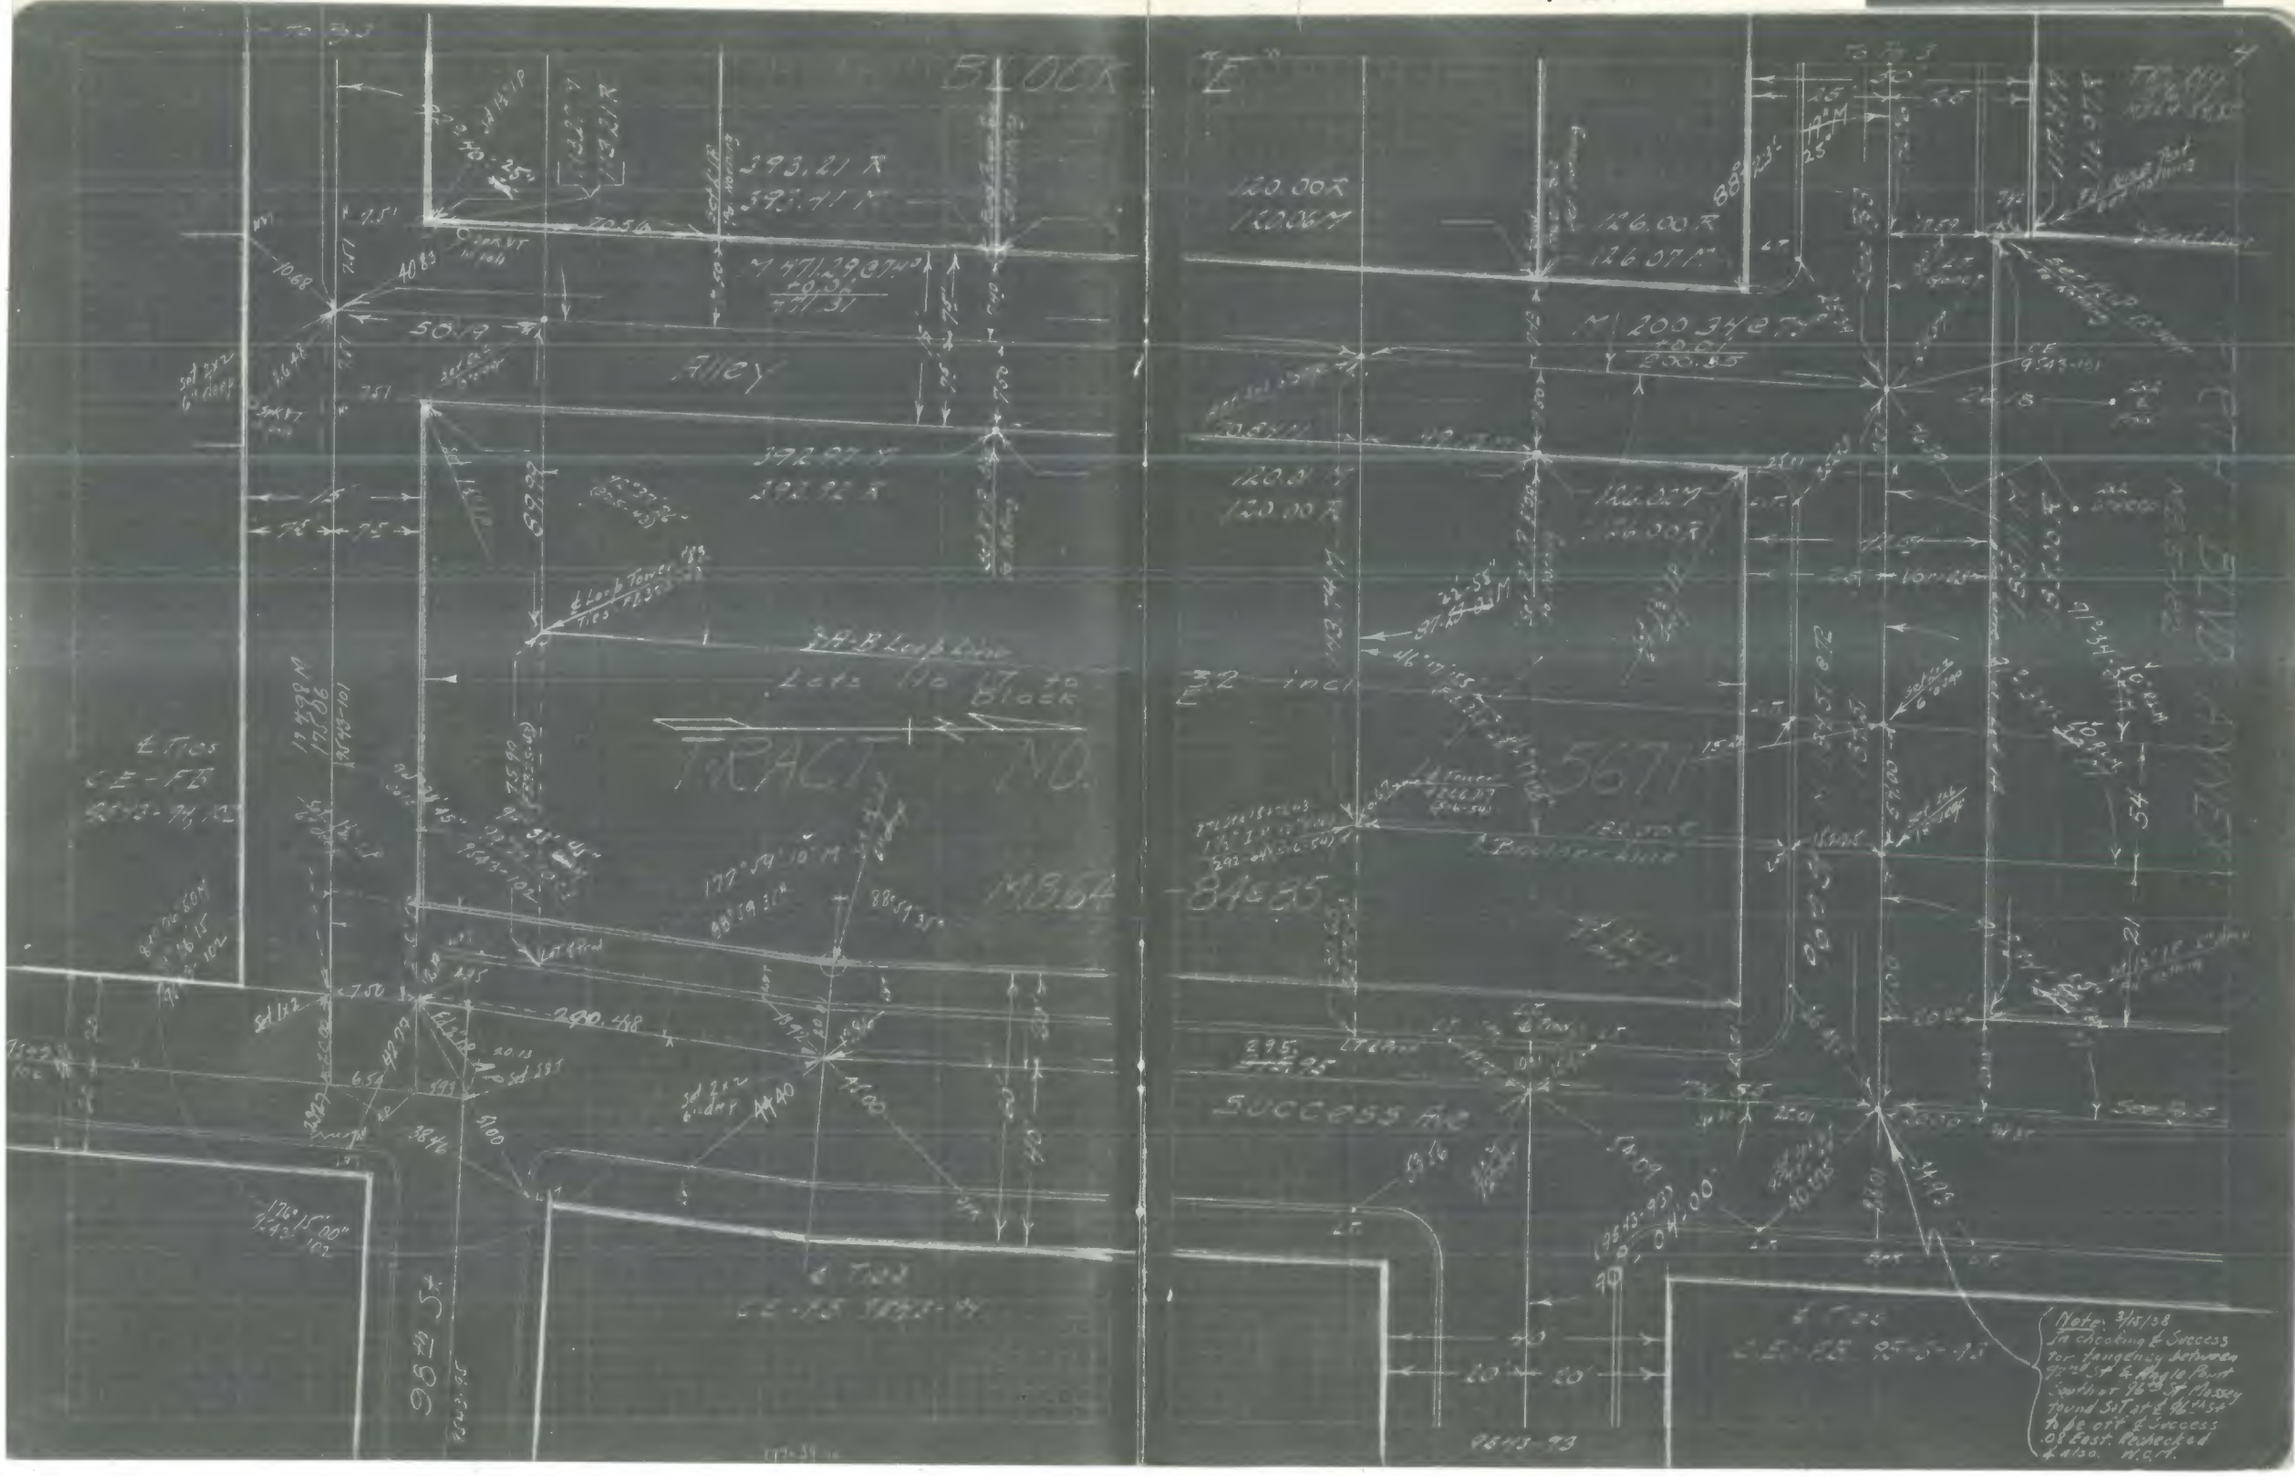

F.B. 985-10

F.B. 985-11

B.P.L. F.B.#527

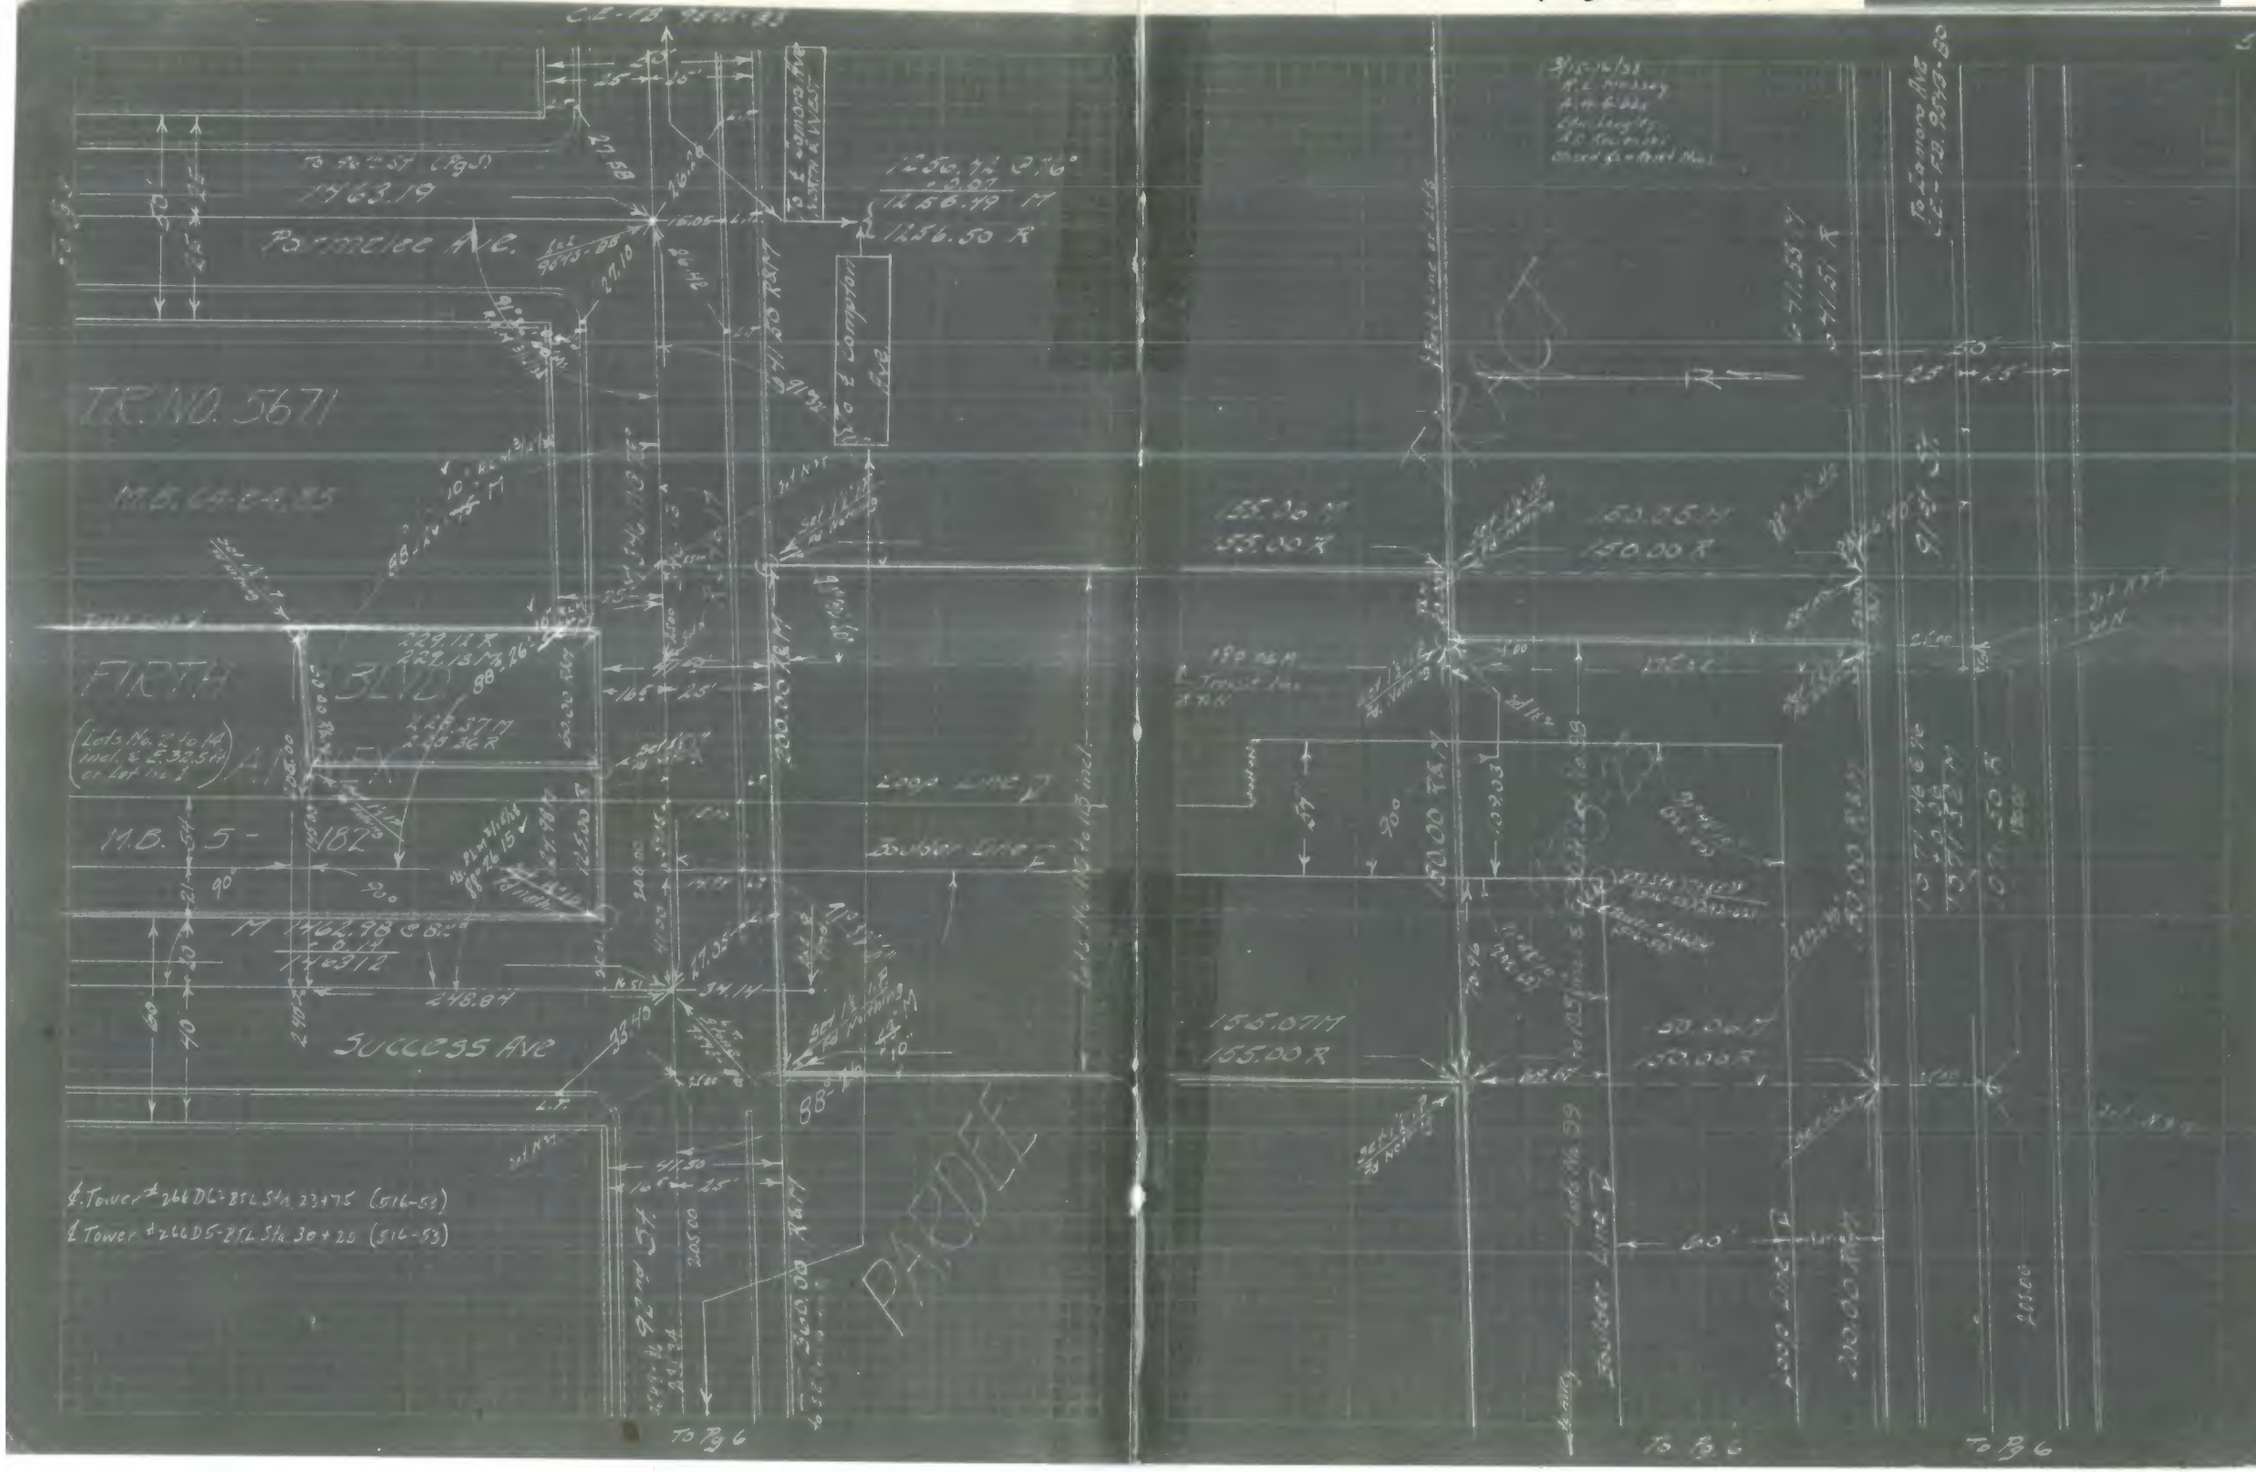

F.B. 985-12

F. B. 985-13

B.P.L. F.B.#527

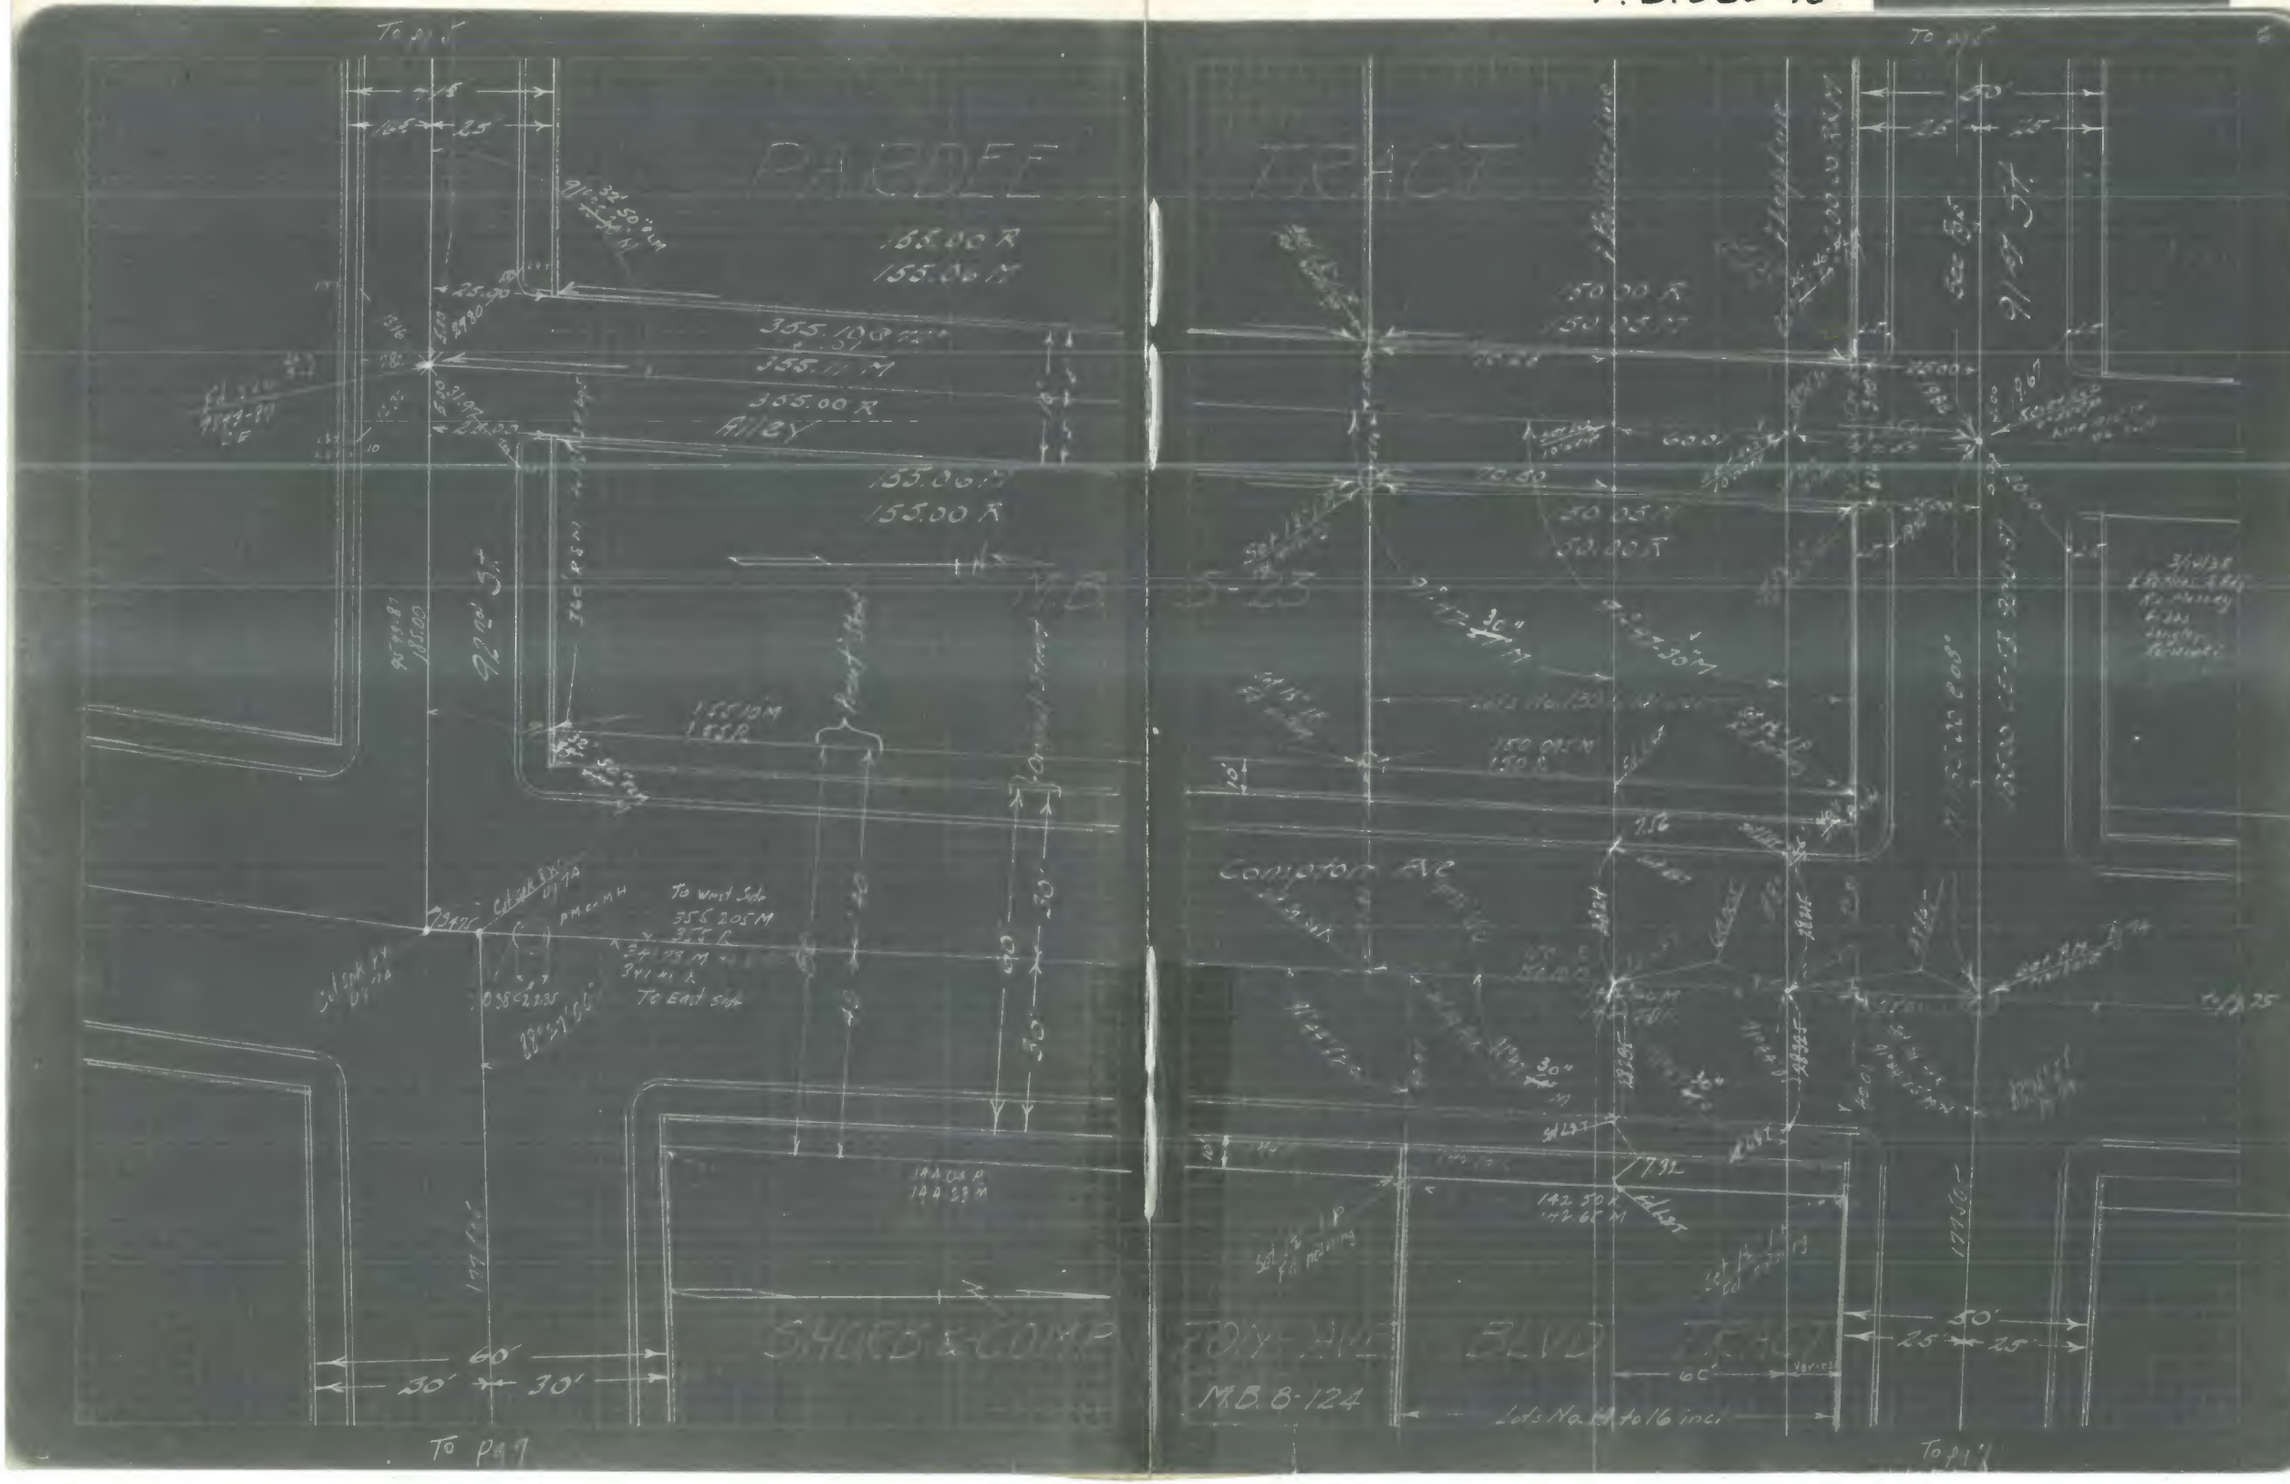

F. B. 985-14

F. B. 985-15

B.P.L. F.B.#527

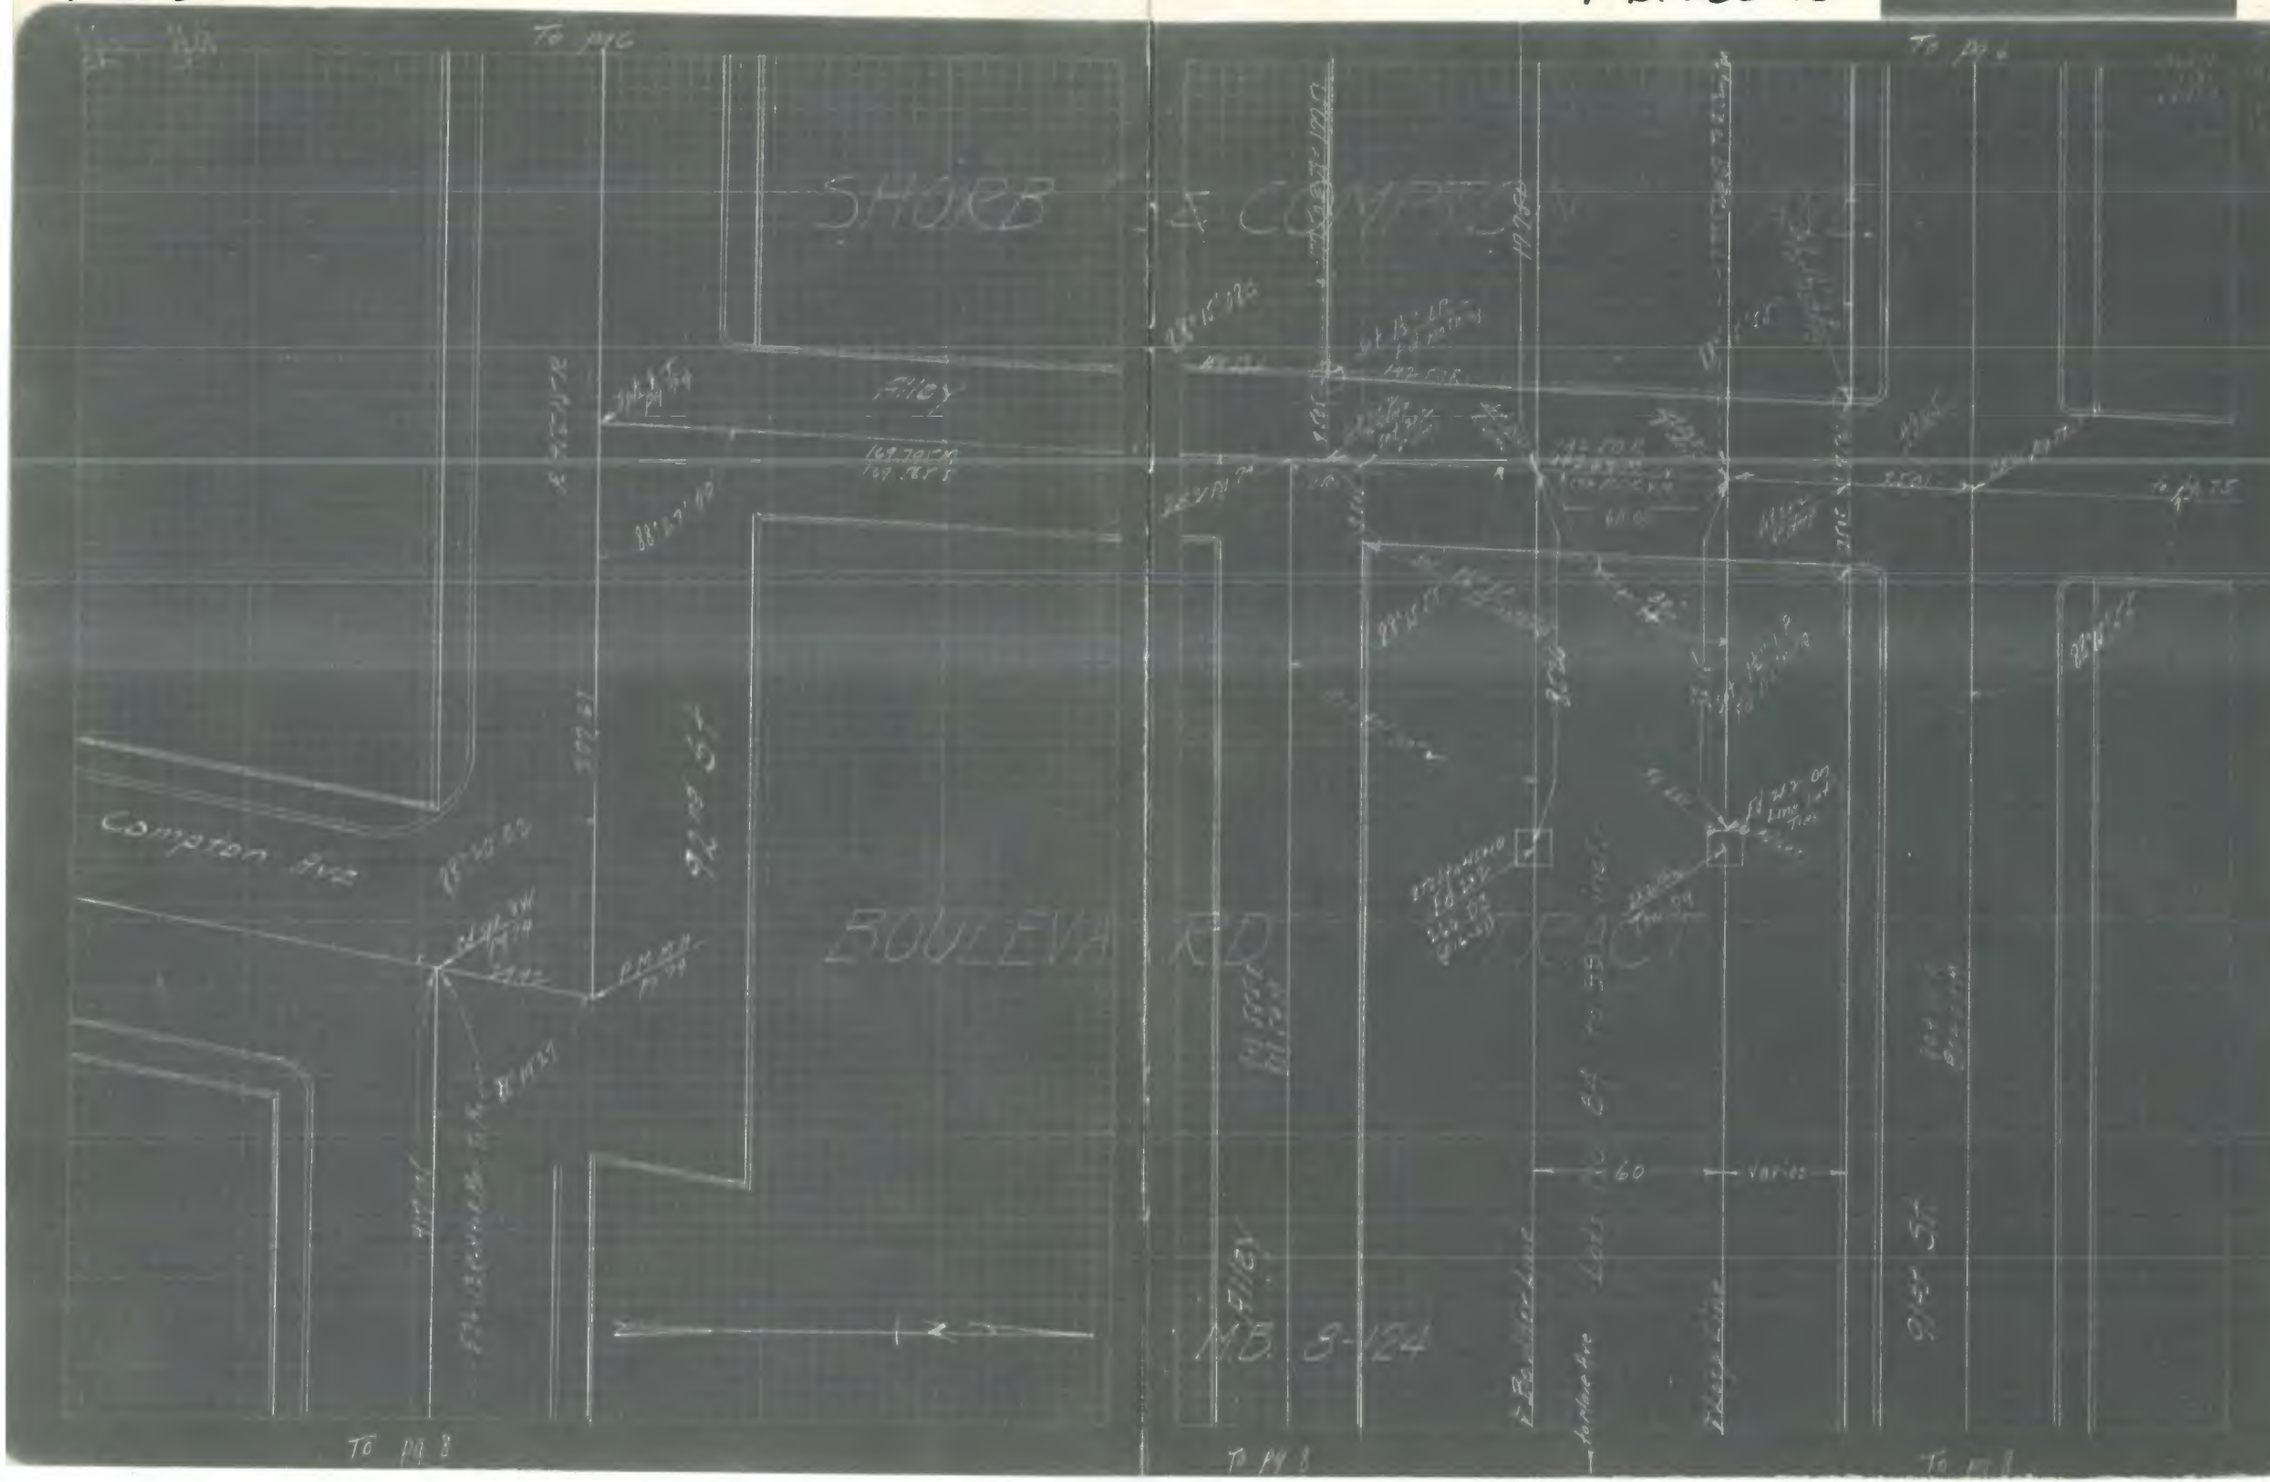

F. B. 985-16

F. B. 985-17

B. P. L. F. B. #527

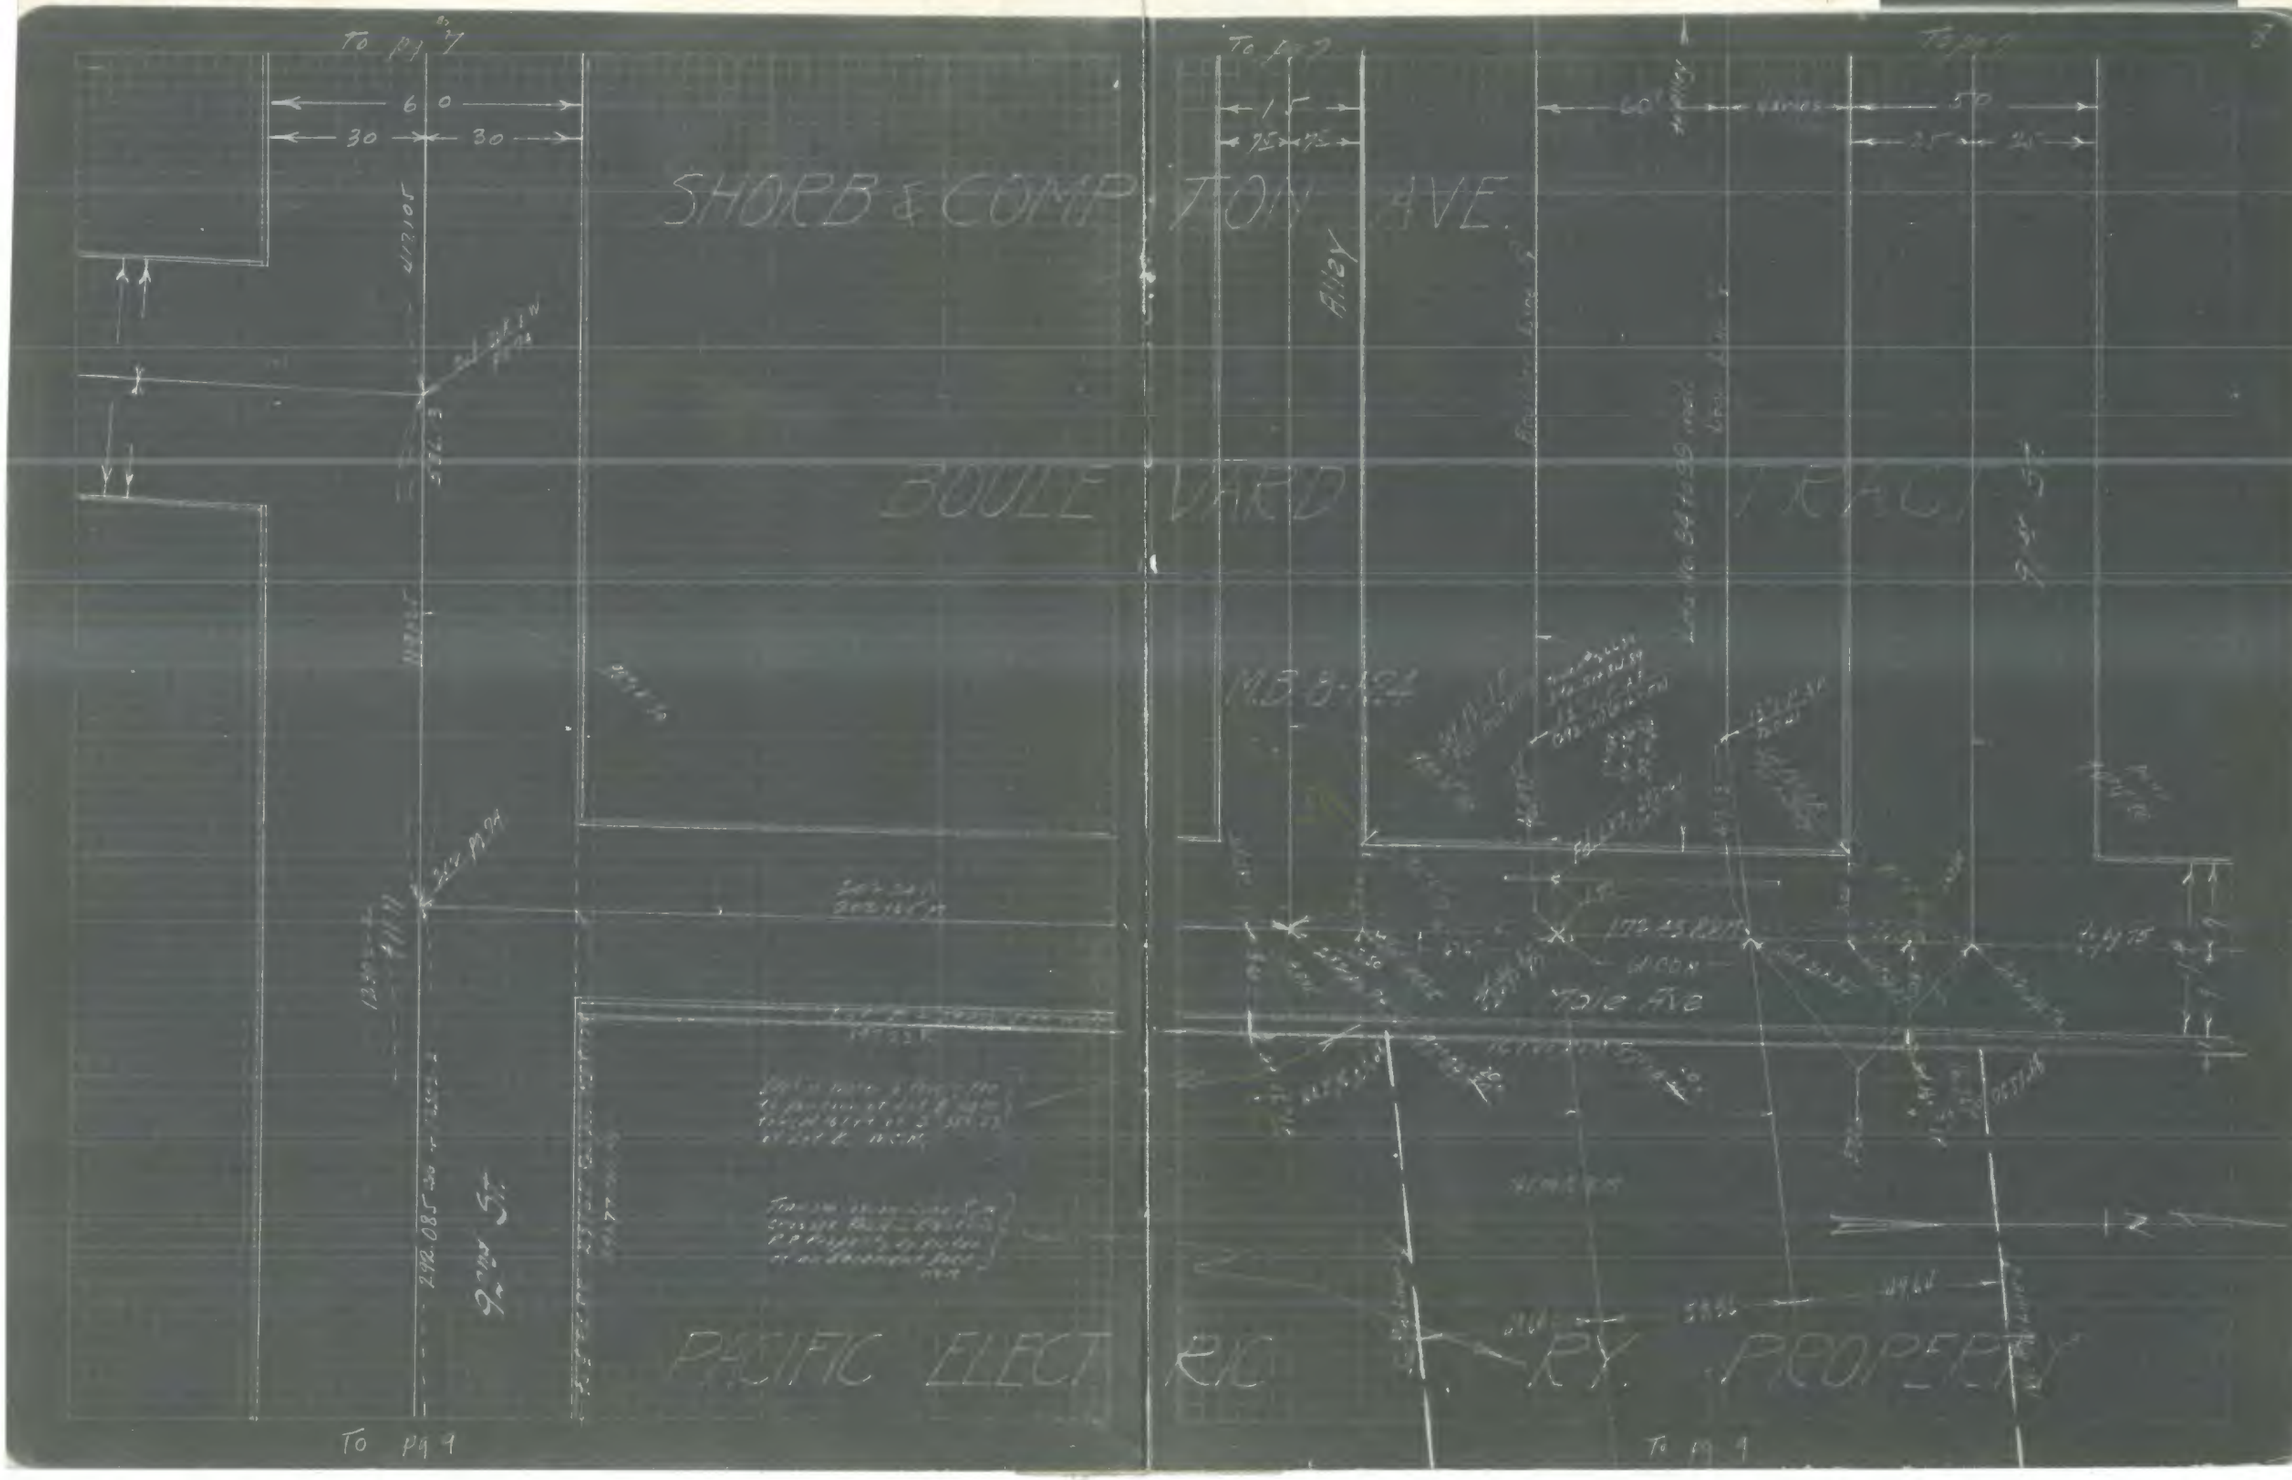

F.B. 985-18

F.B. 985-19

B.P.L. F.B.#527

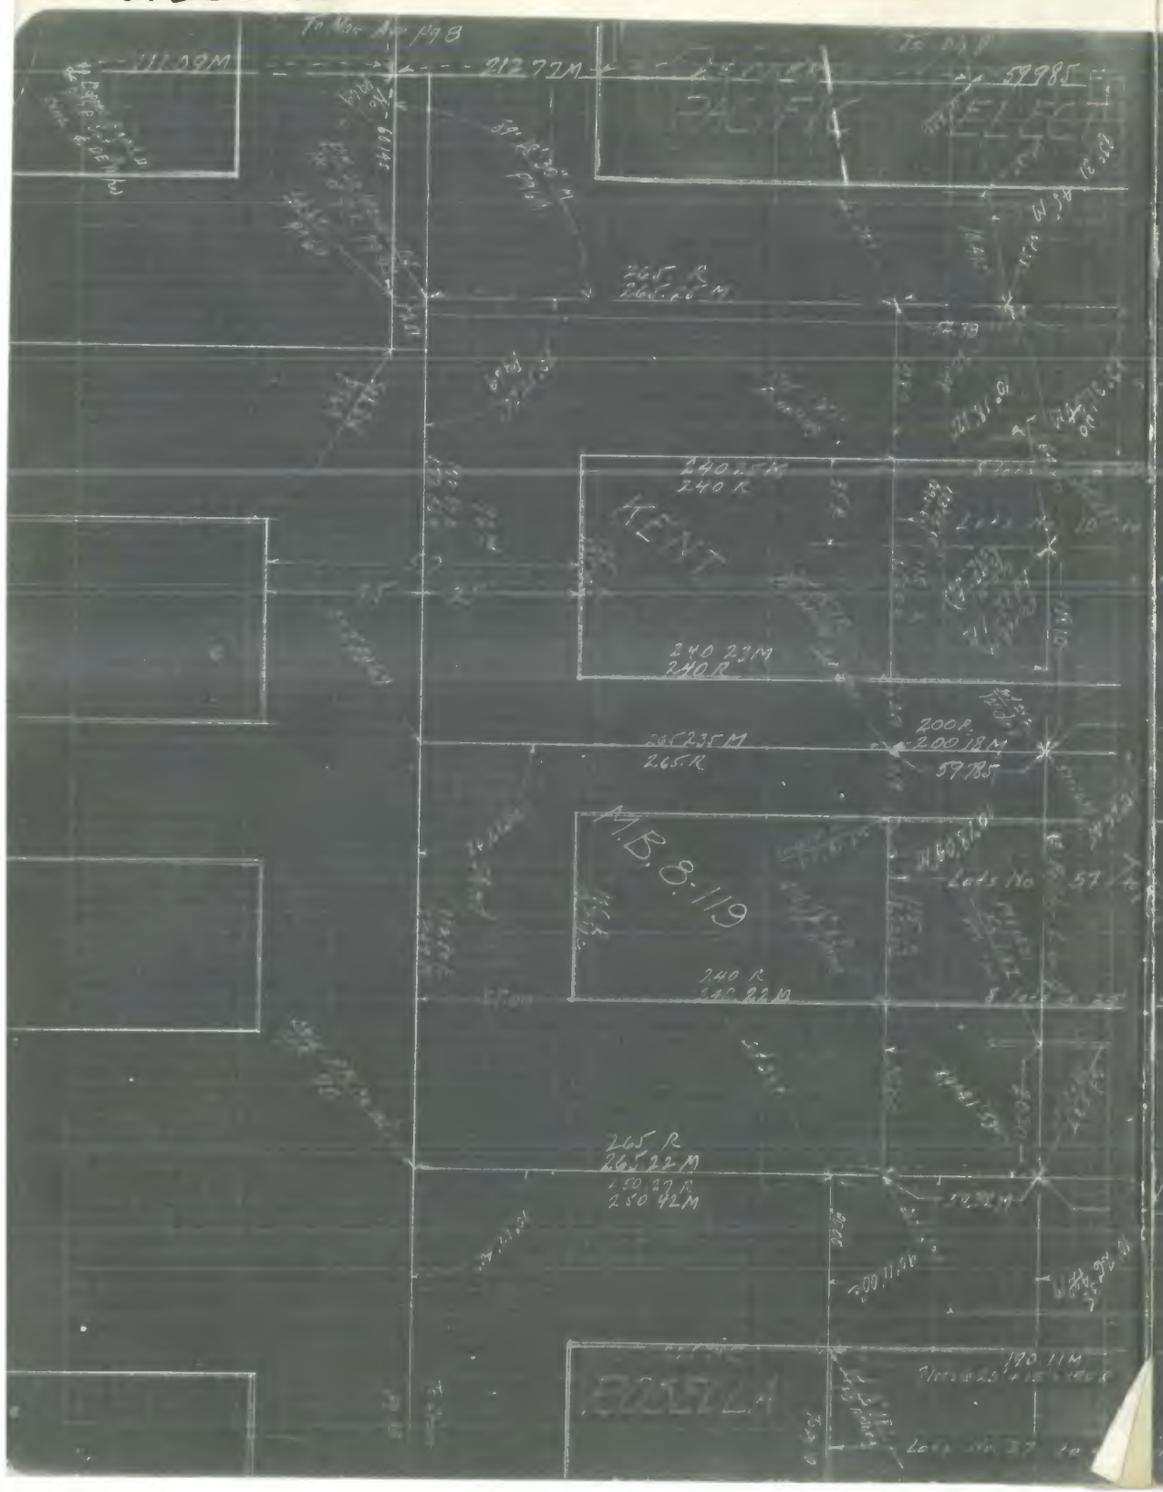

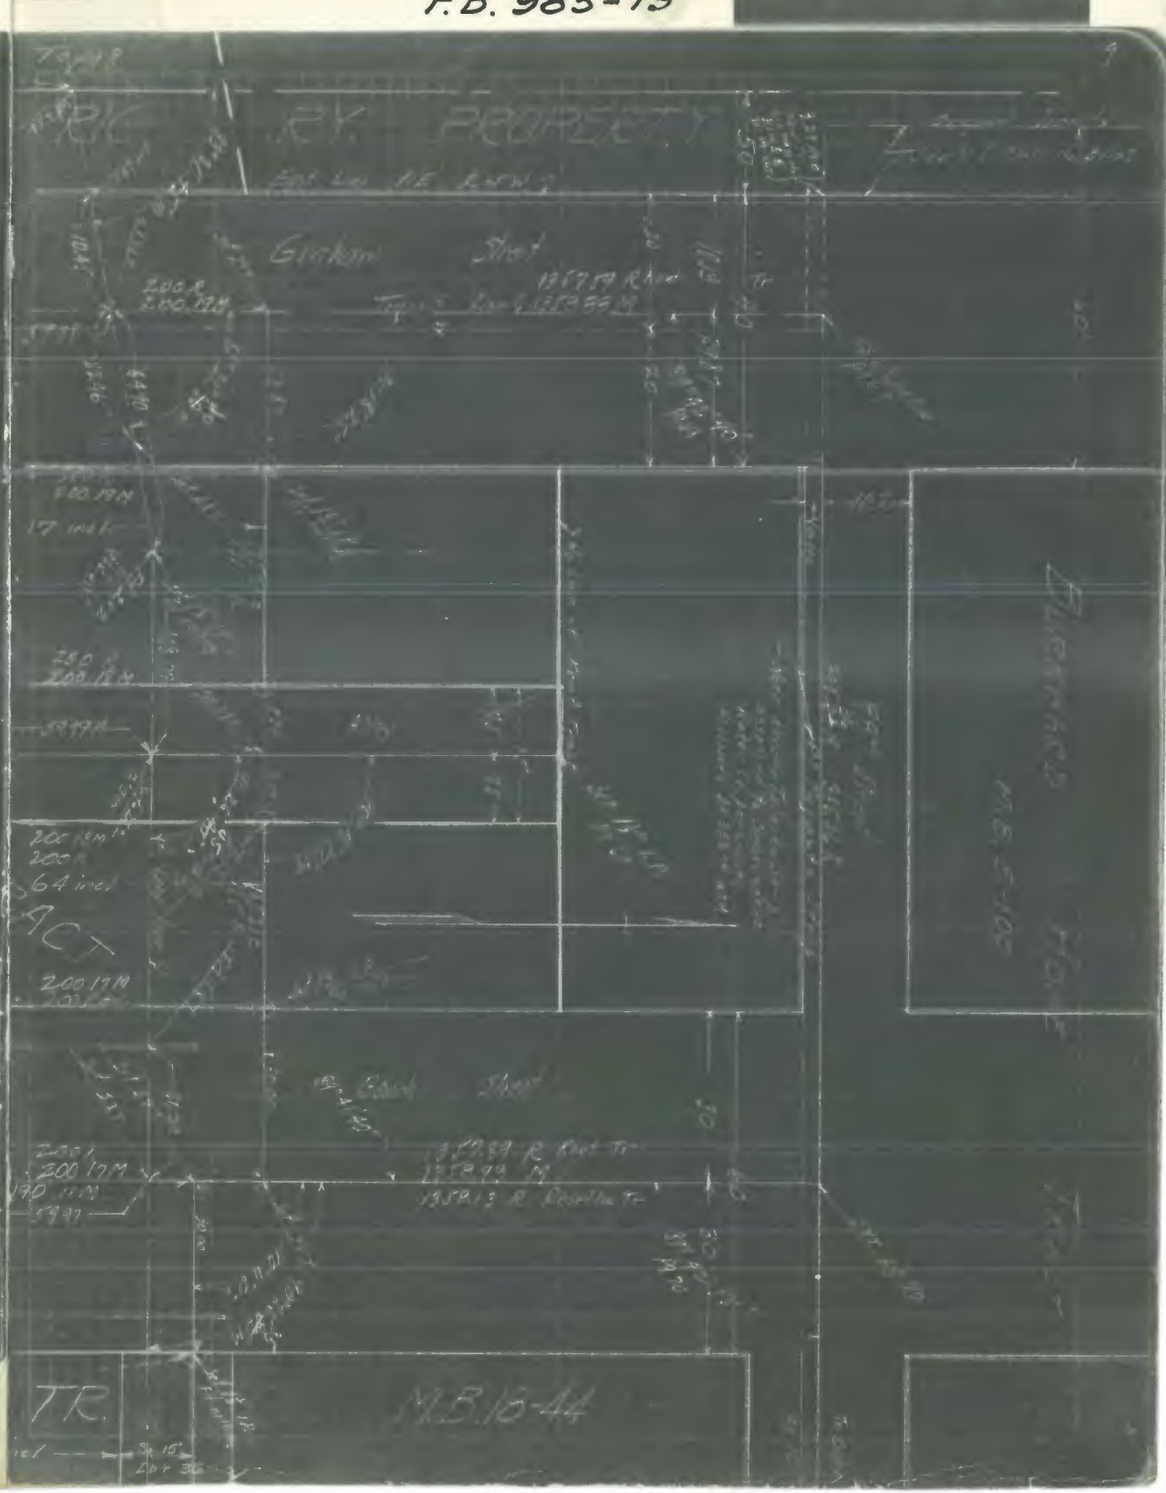

F.B. 985- 20

F.B. 985-21

B.P.L. F.B.#527

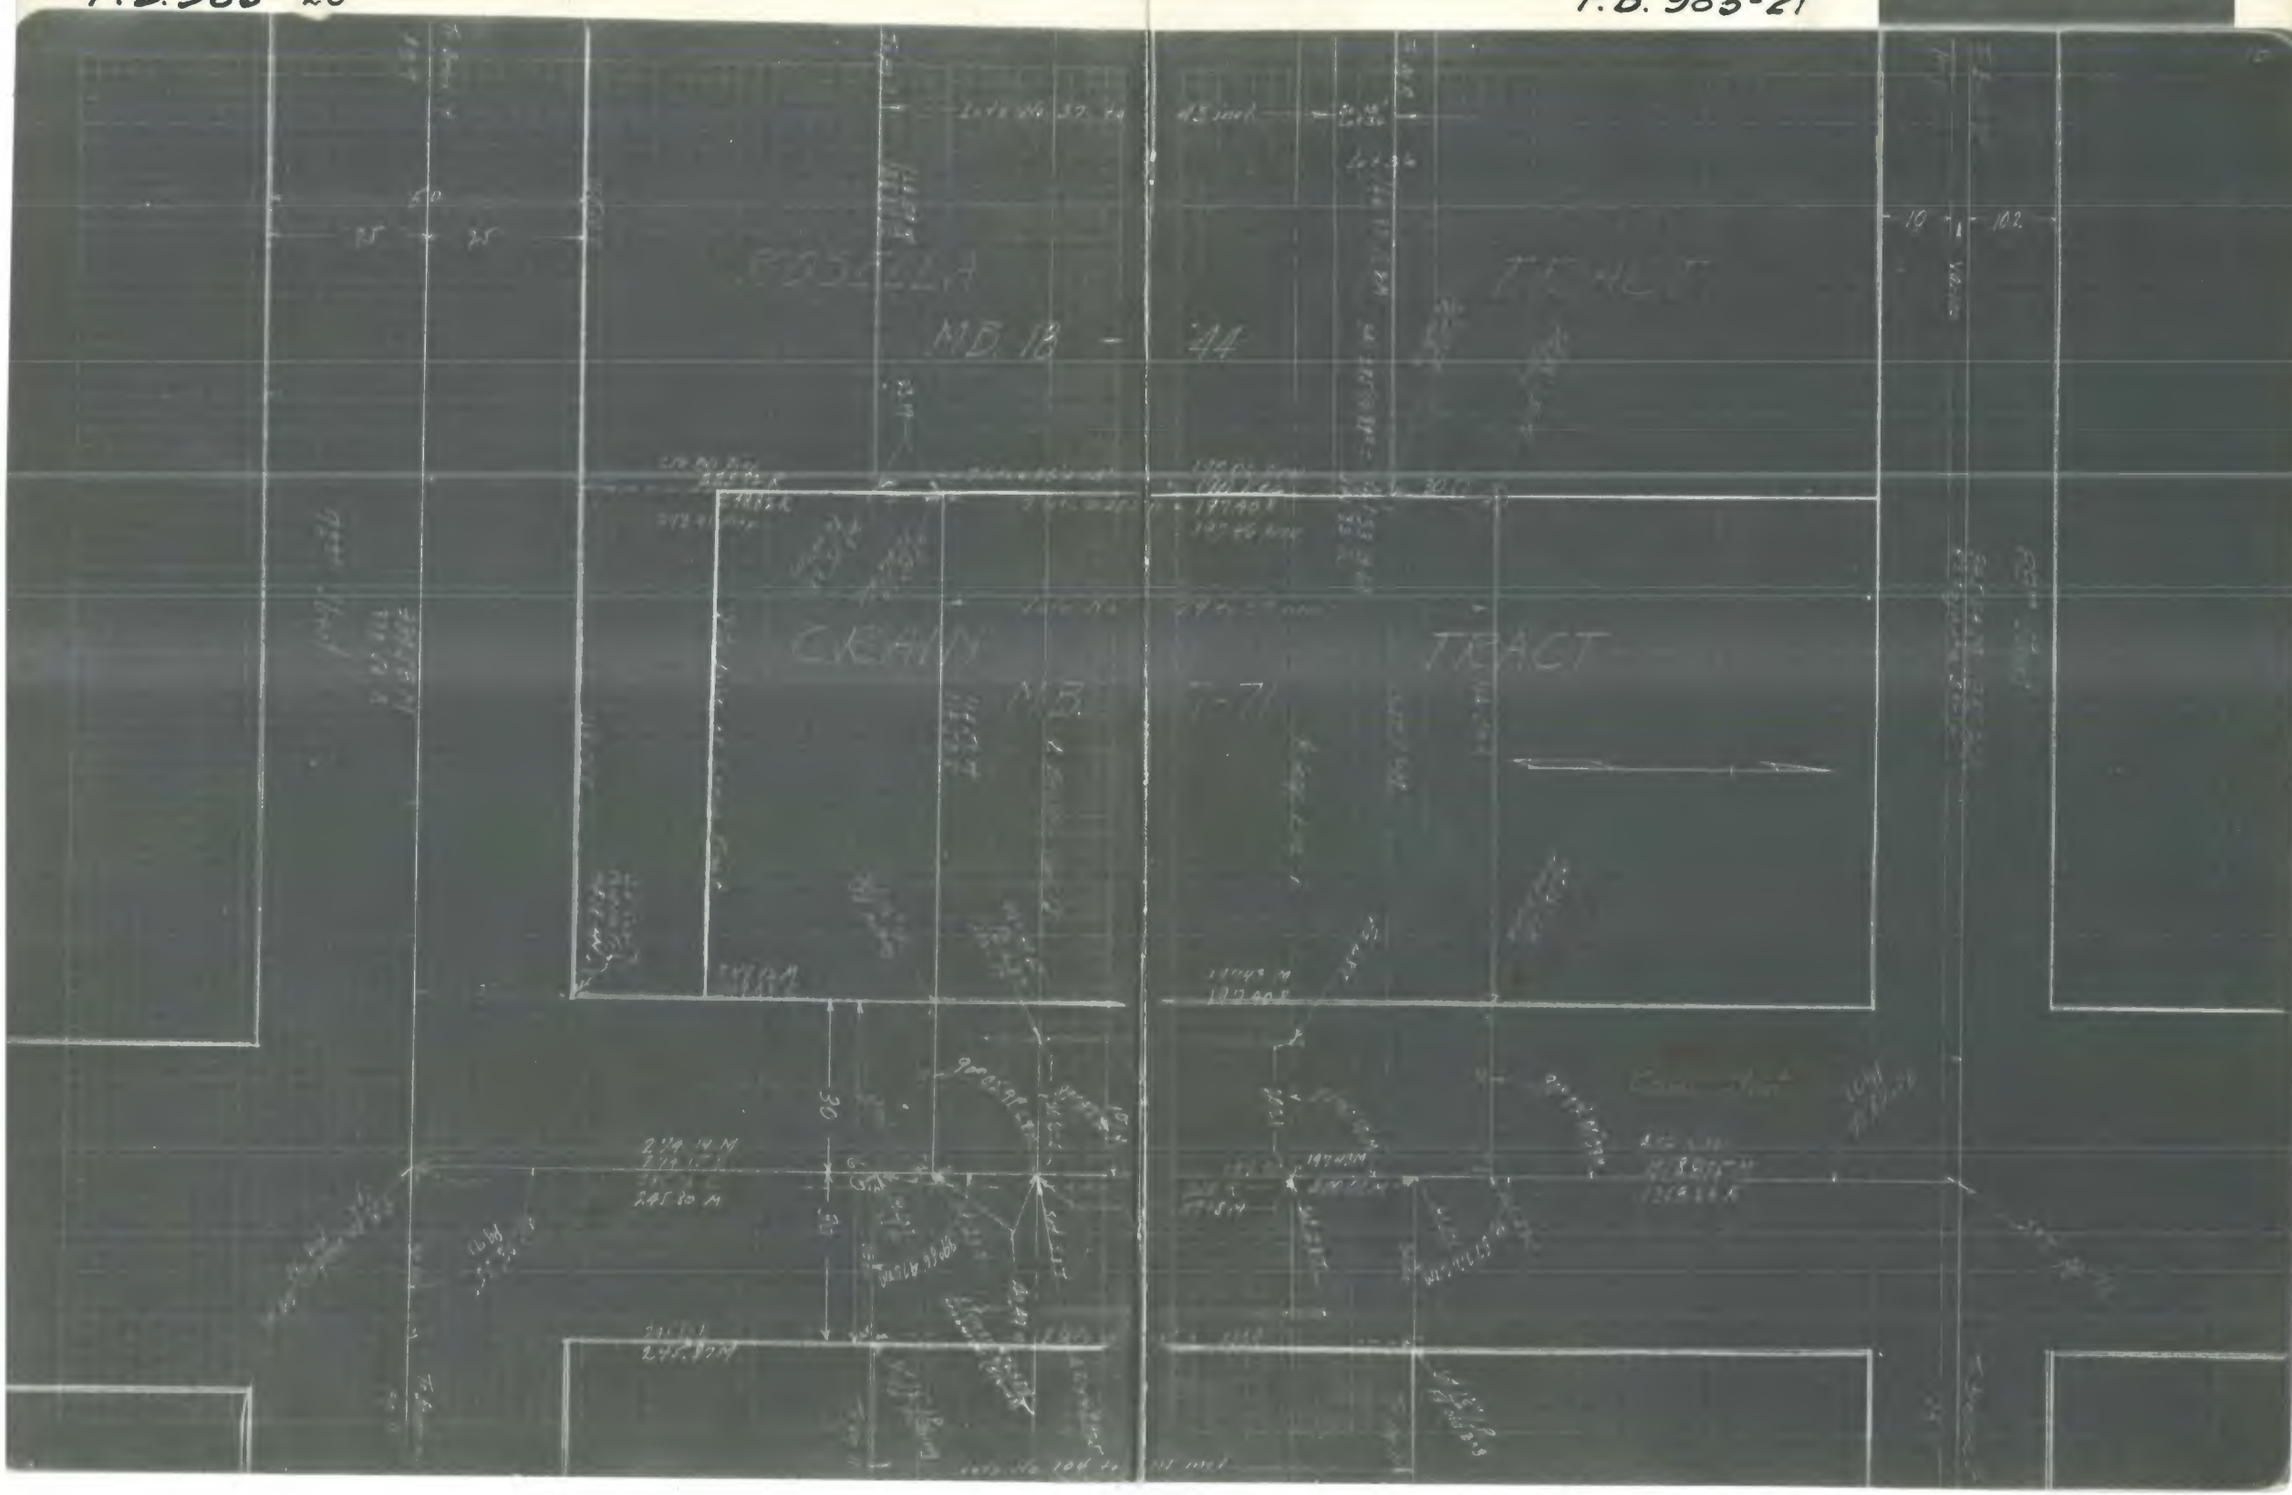

F.B. 985-22

F.B. 985-23

B.P.L. F.B.#527

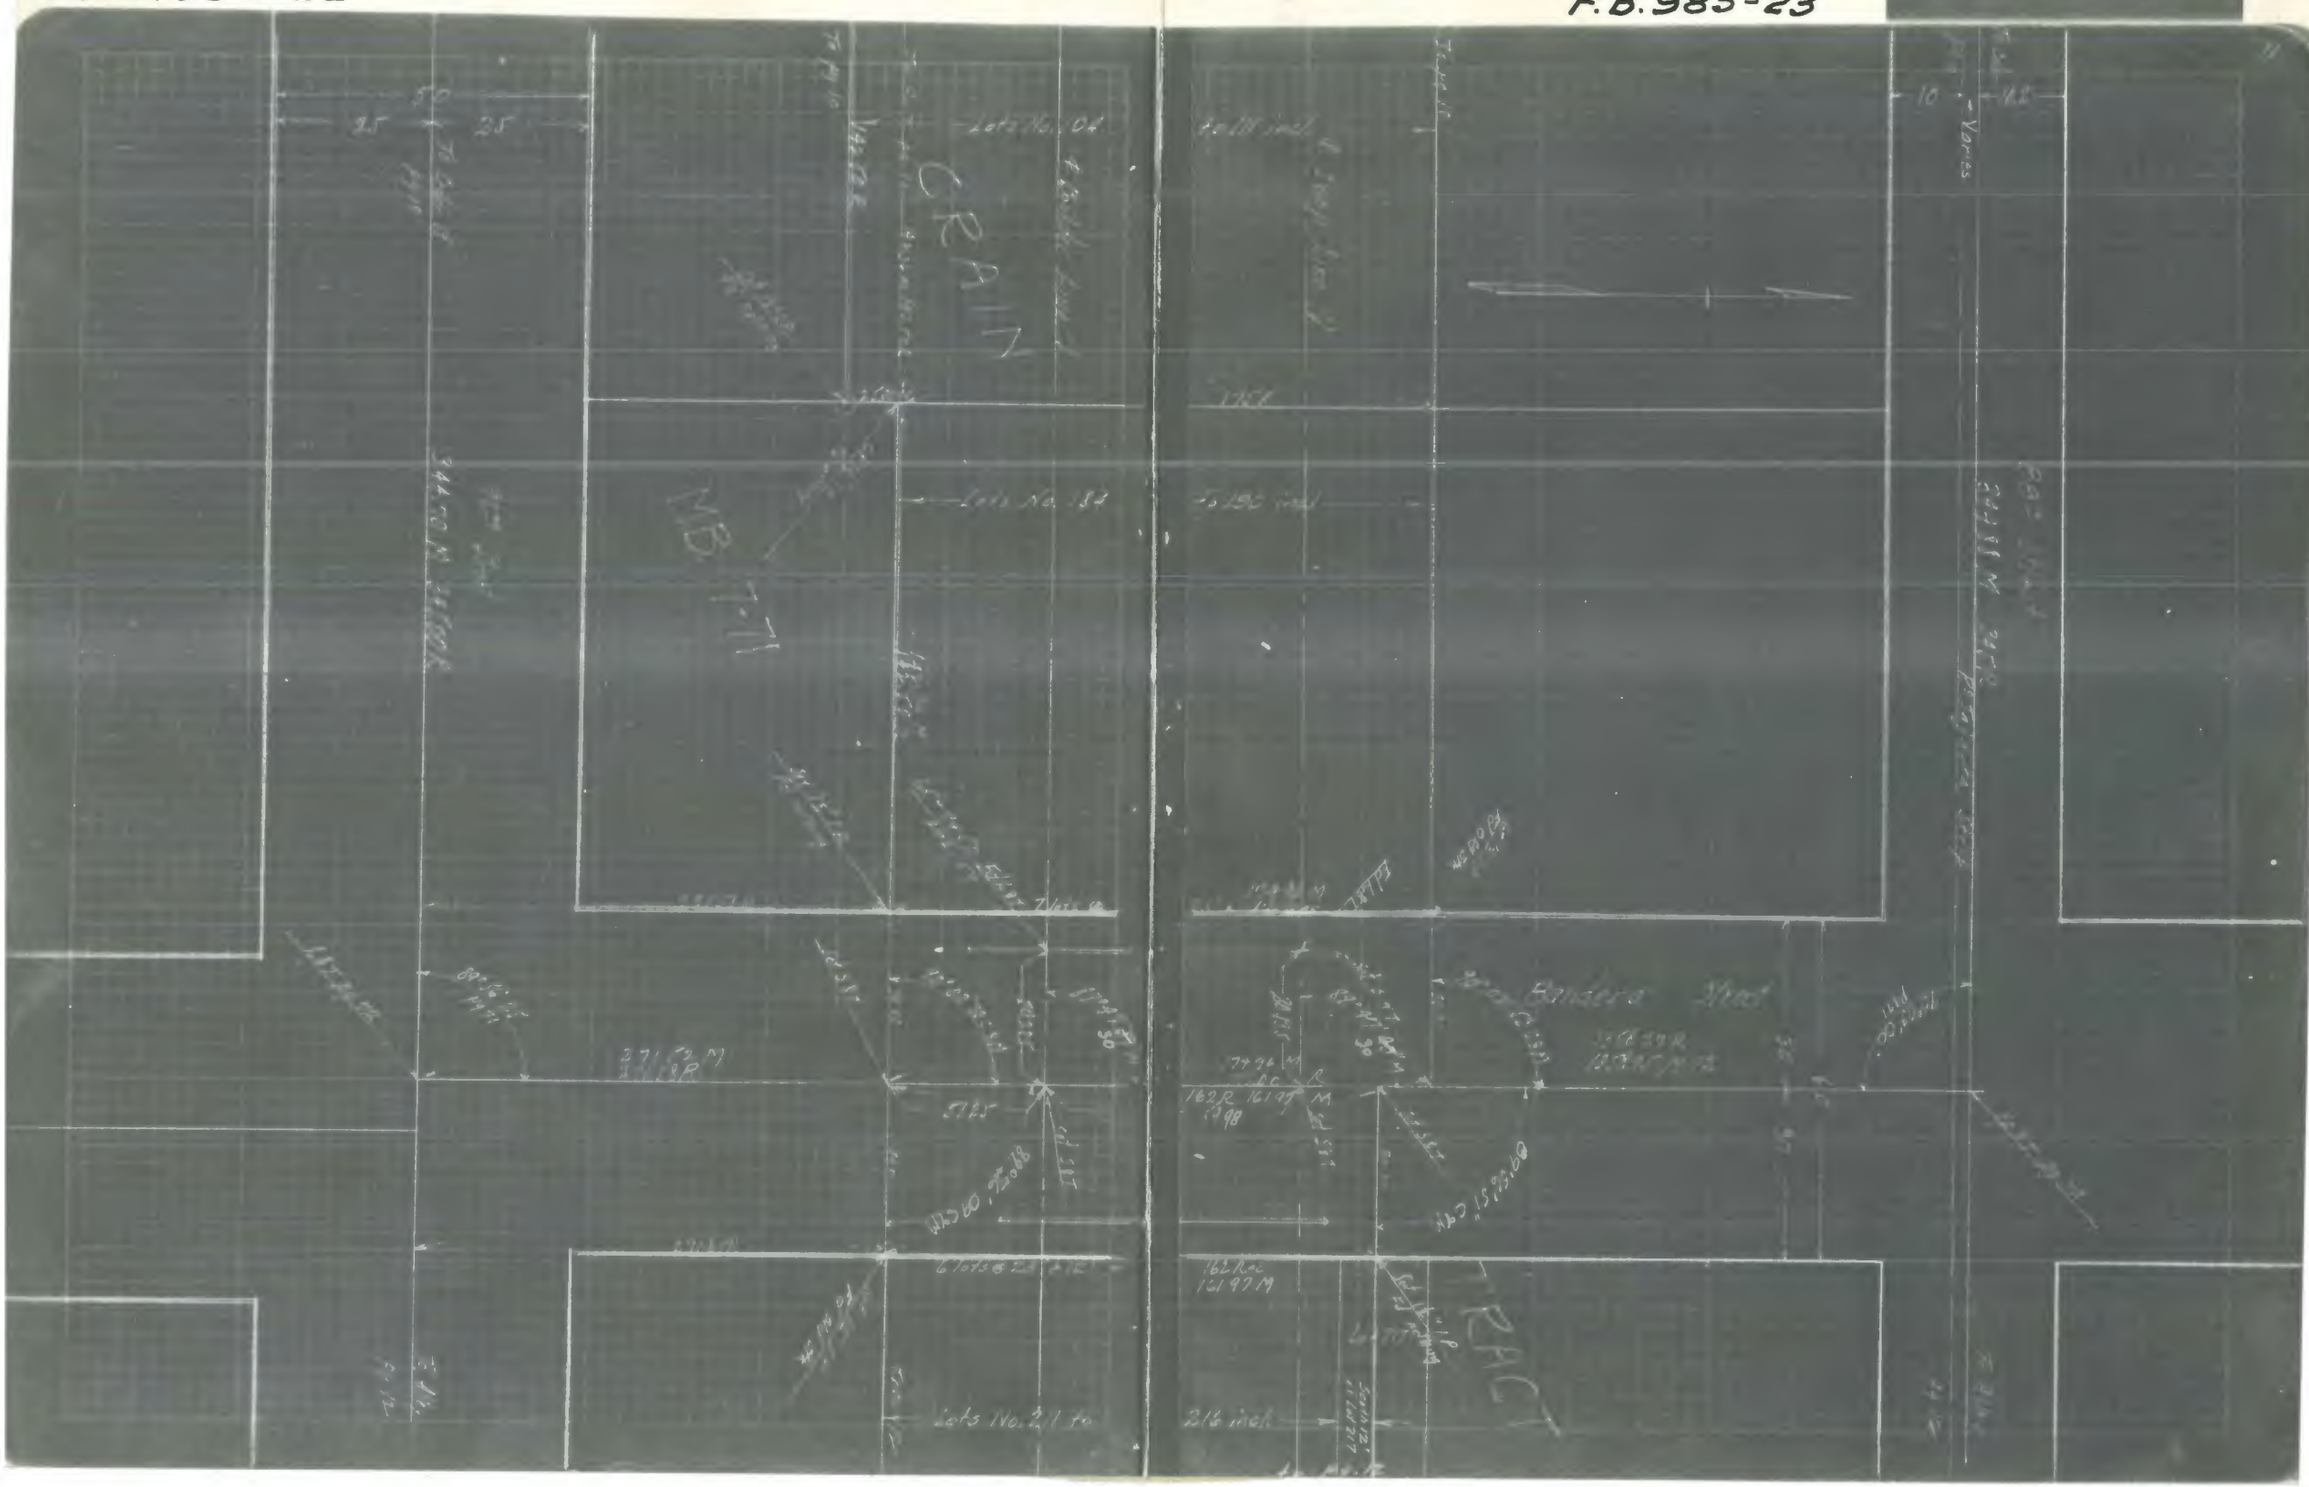
Lots No. 184
Lots No. 211 to
Lots No. 184
Lots No. 211 to
Varies
Varies
Varies

F.B. 985-24

F.B. 985-25

B.P.L. F.B.#527

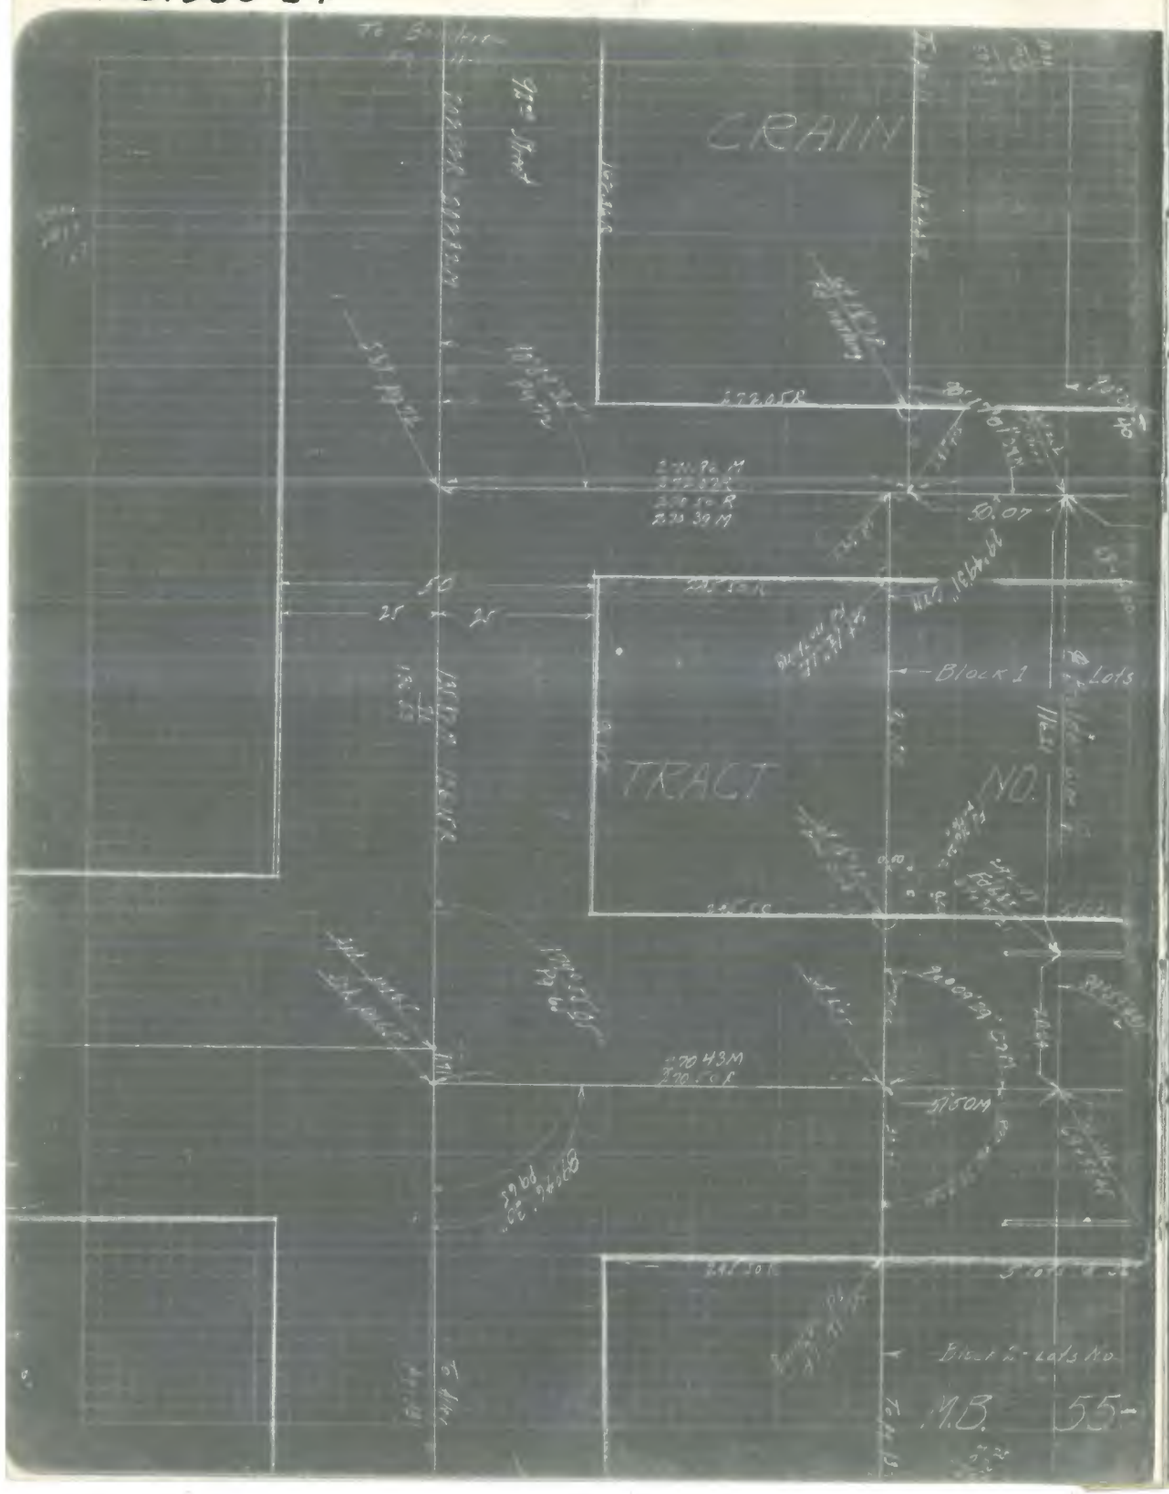

F. B. 985-26

F. B. 985-27

B.P.L. F.B.#527

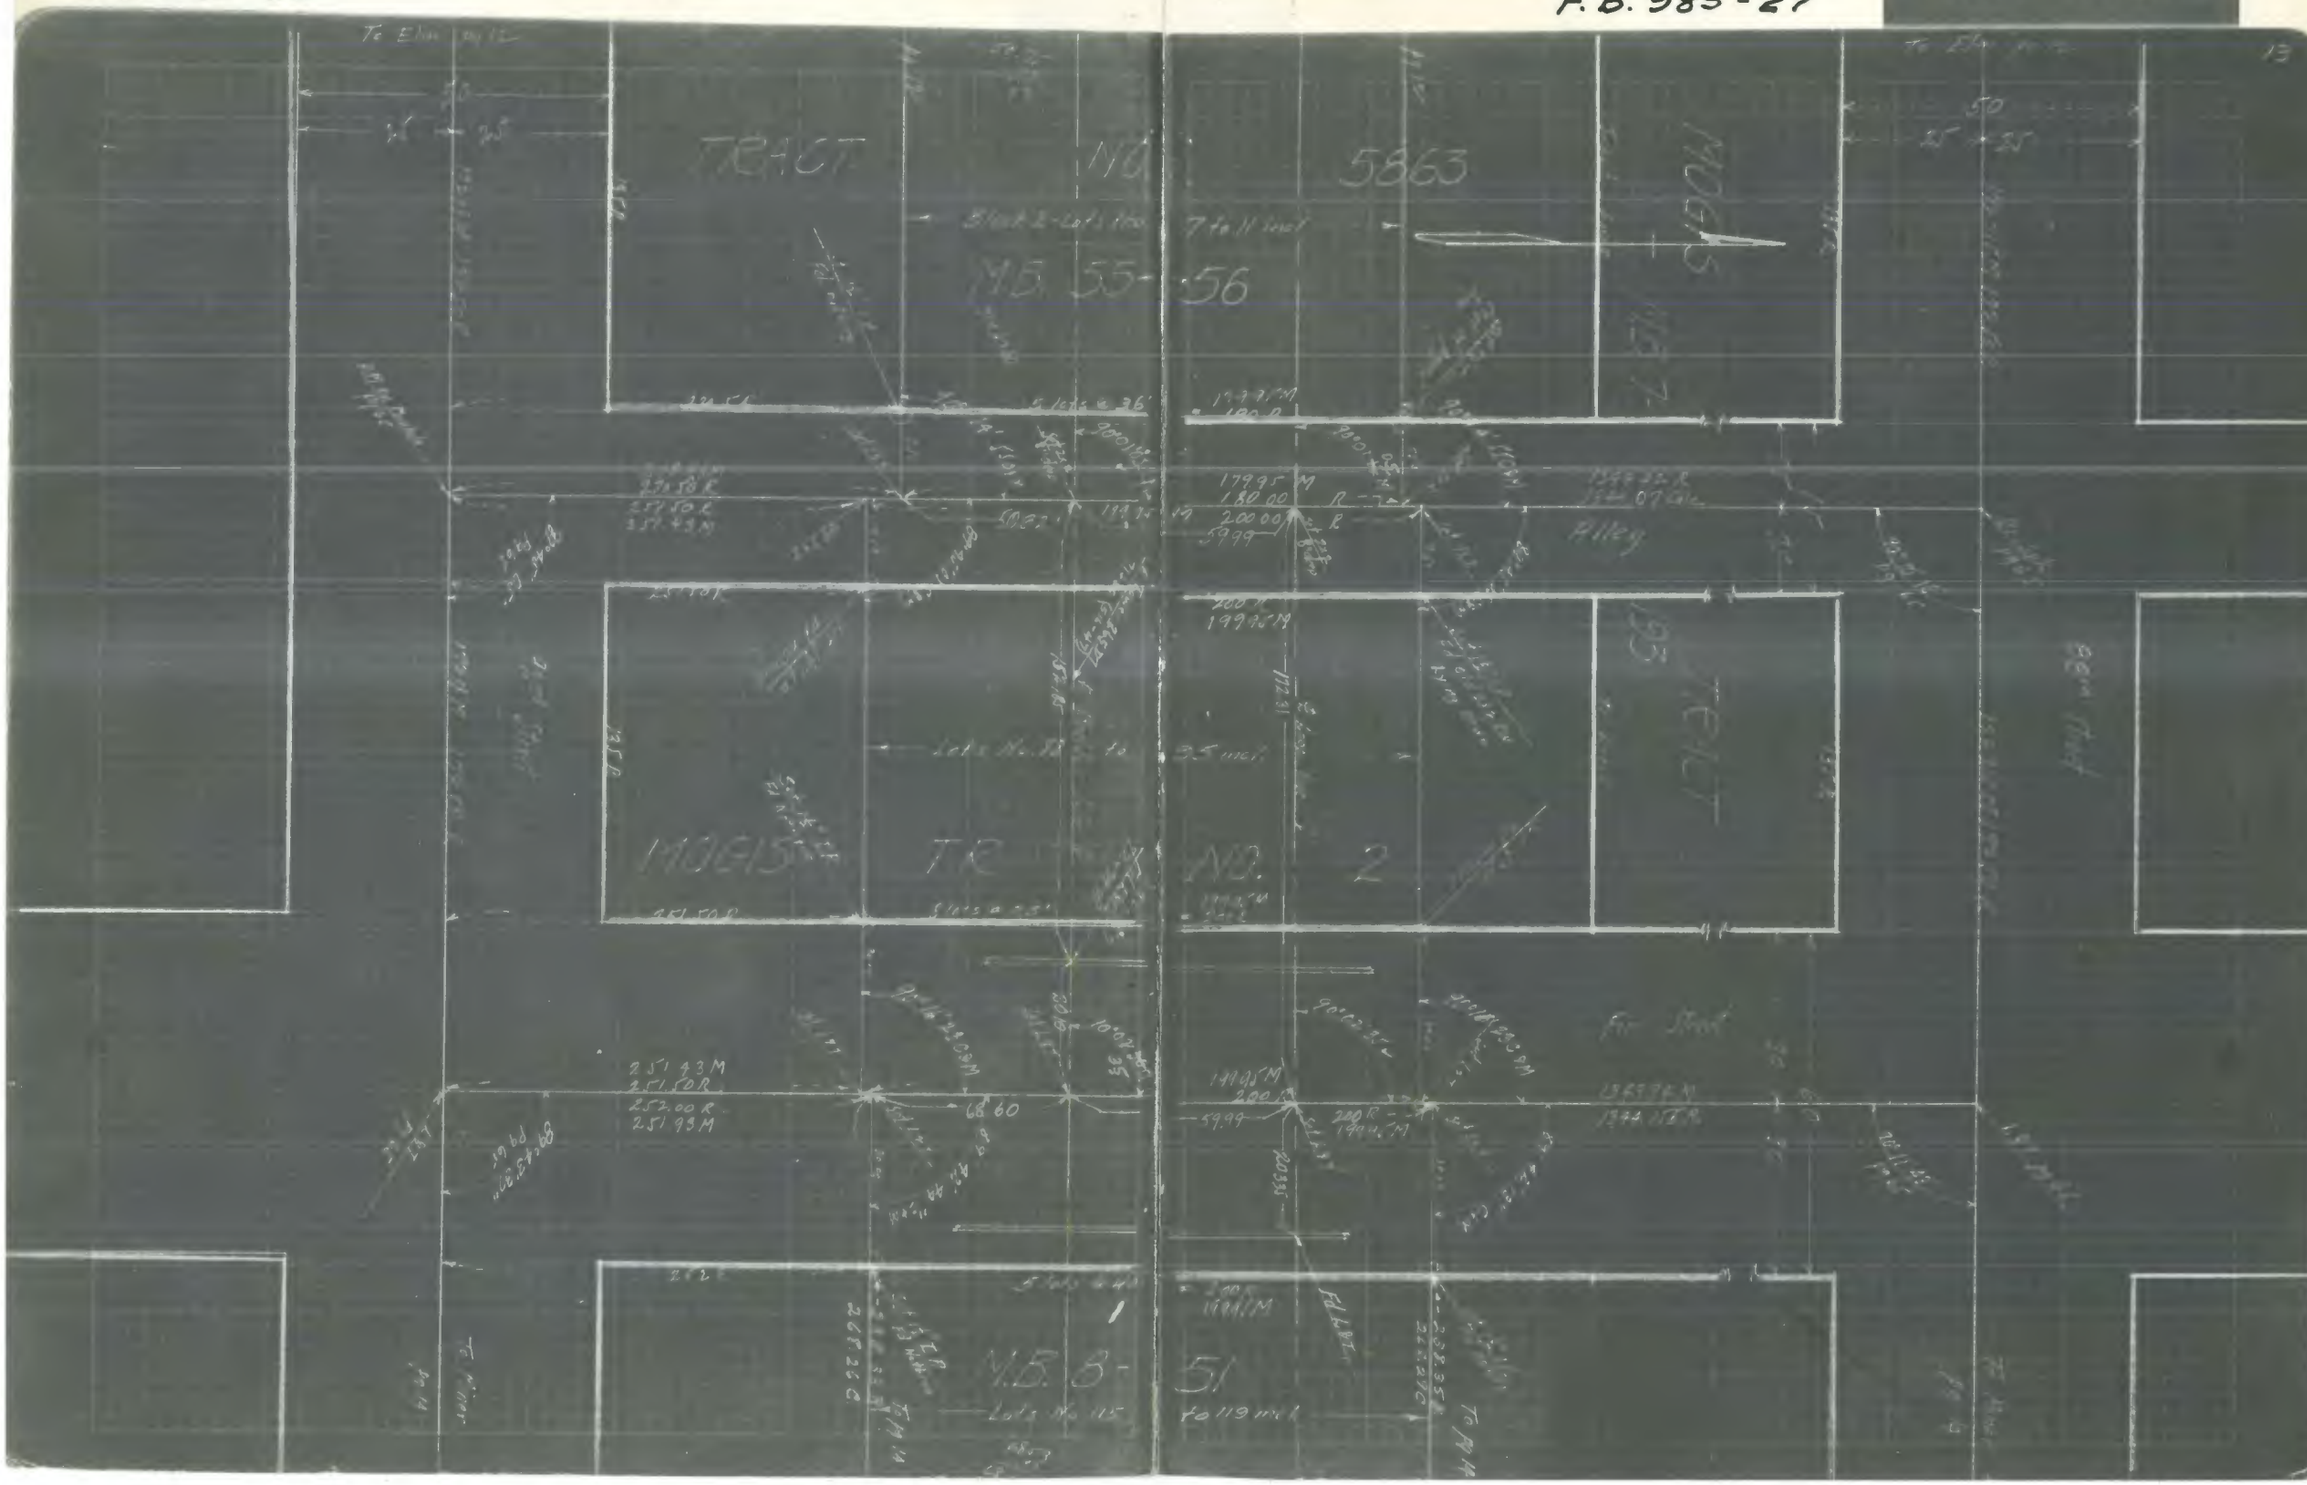
TRACT
M.S. 55-56
5863
Alley
M.B. 8-
Lots No. 115
51
To 119 m'l
To Elm

F.B. 985-28

F.B. 985-29

B.P.L. F.B.#527

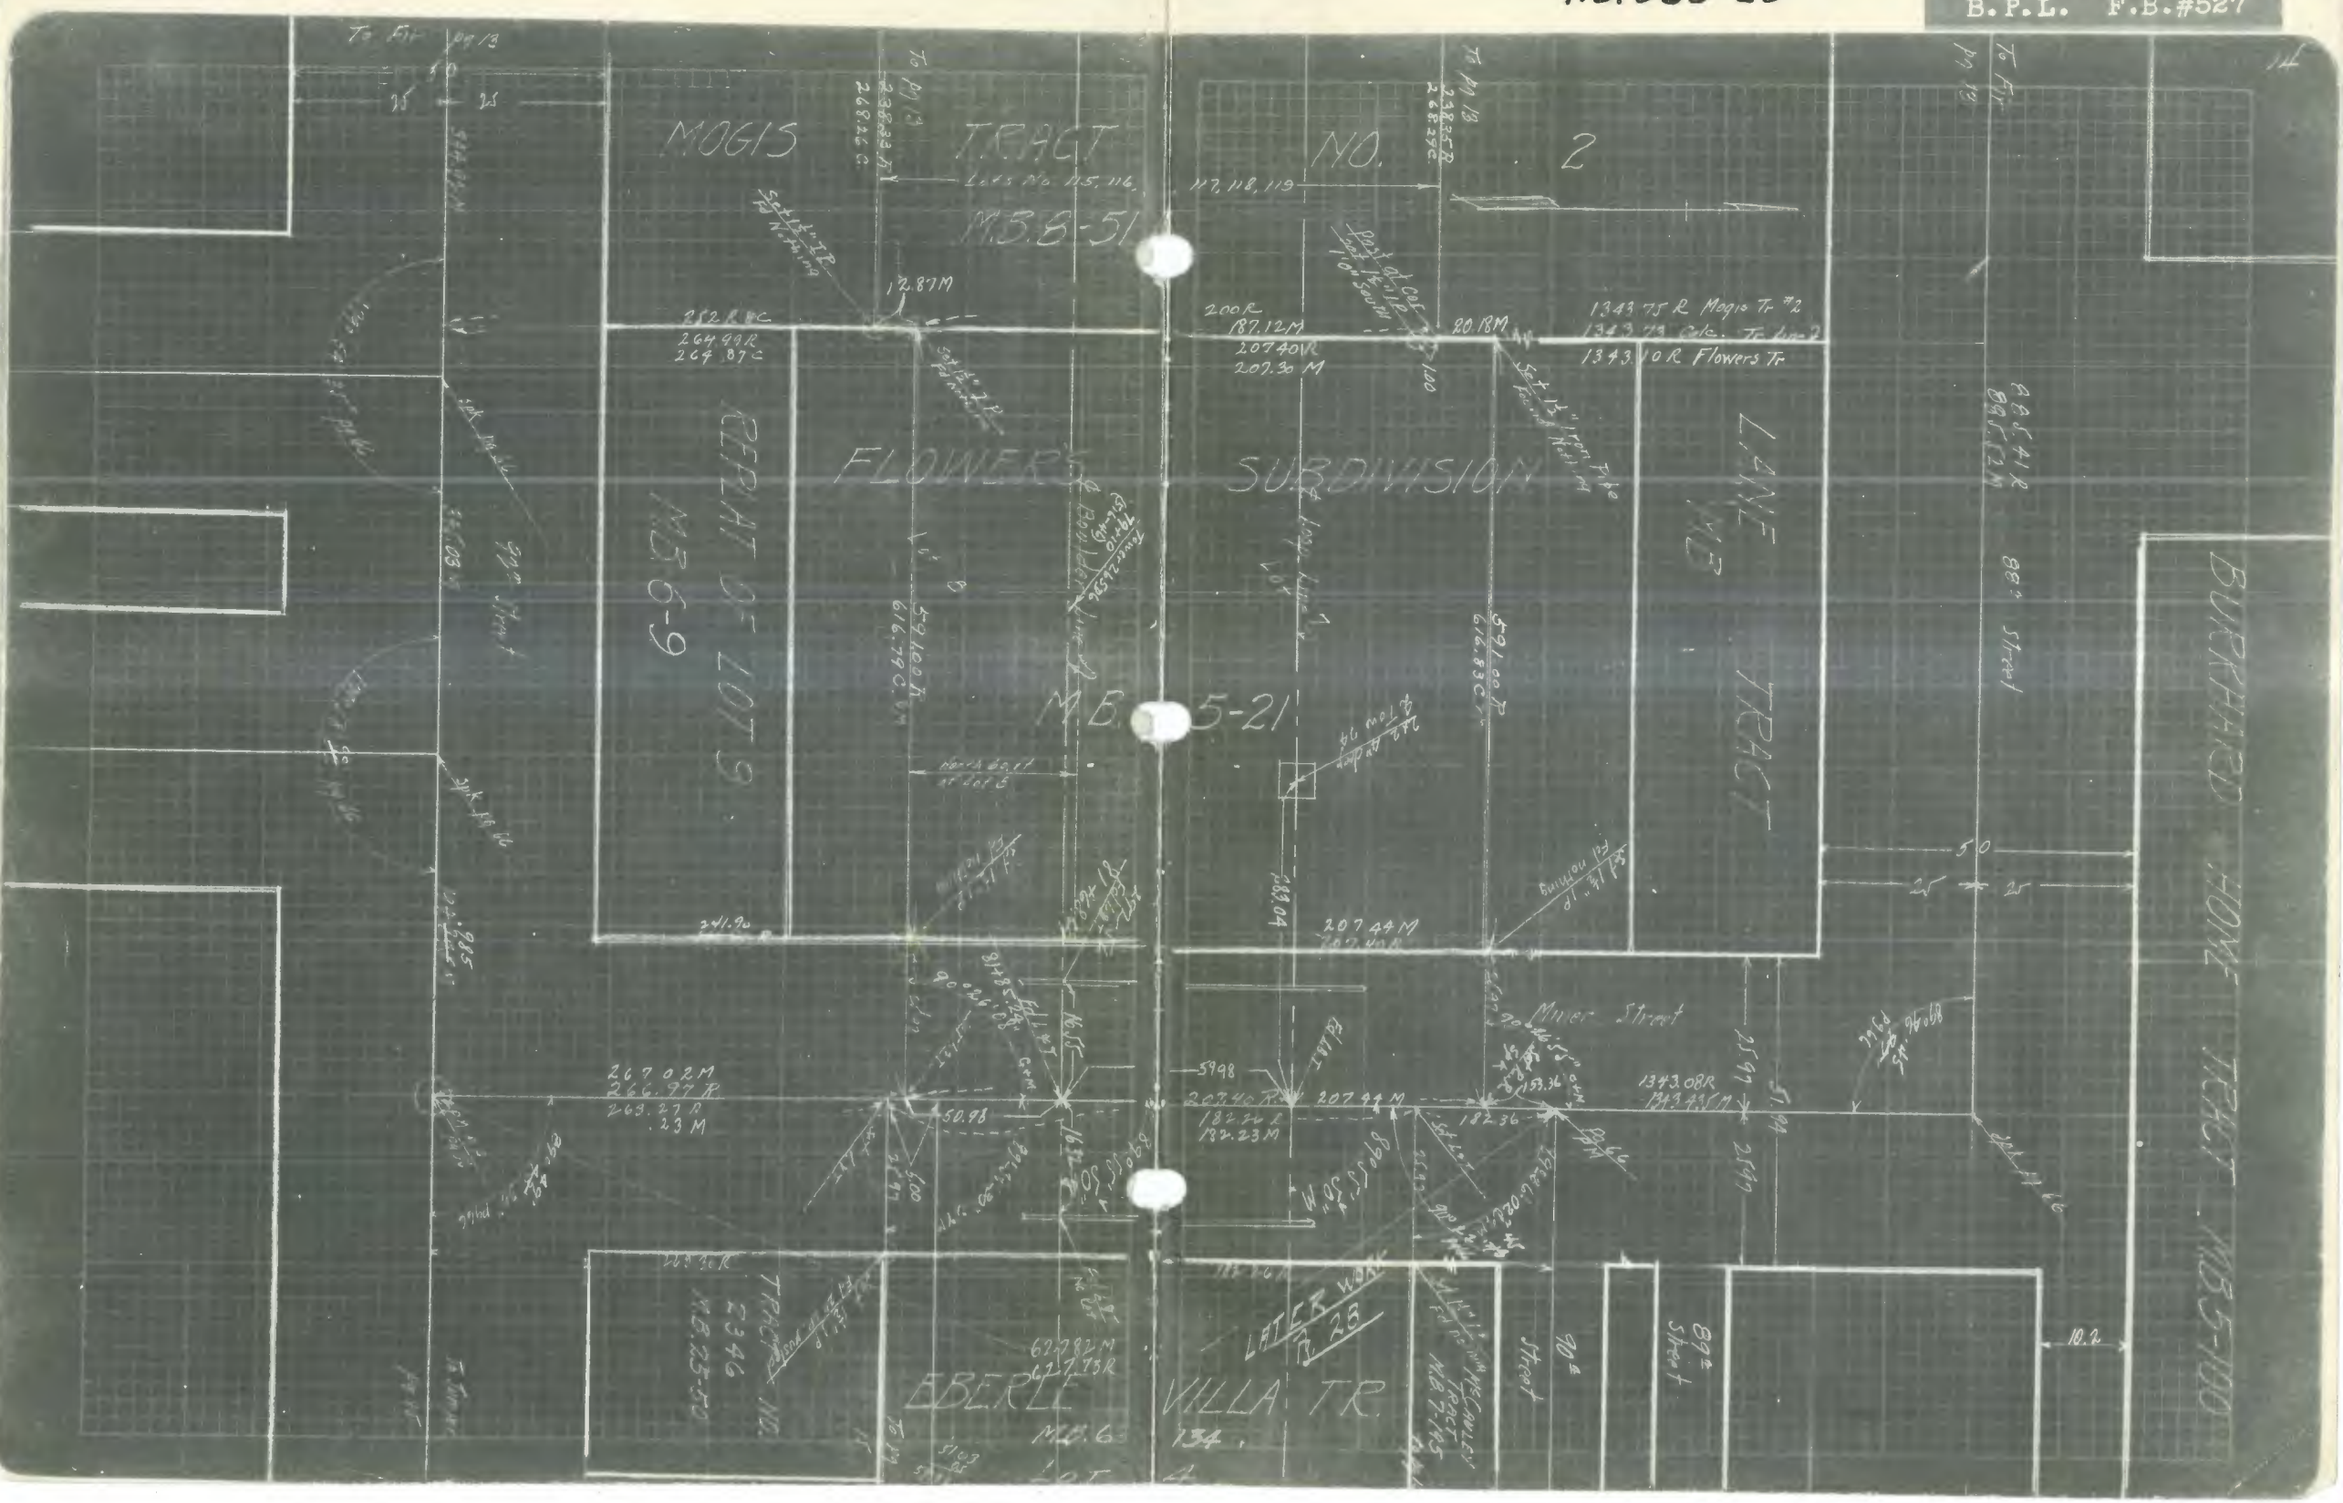

F.B. 985-30

F.B. 985-31

B.P.L. F.B.#527

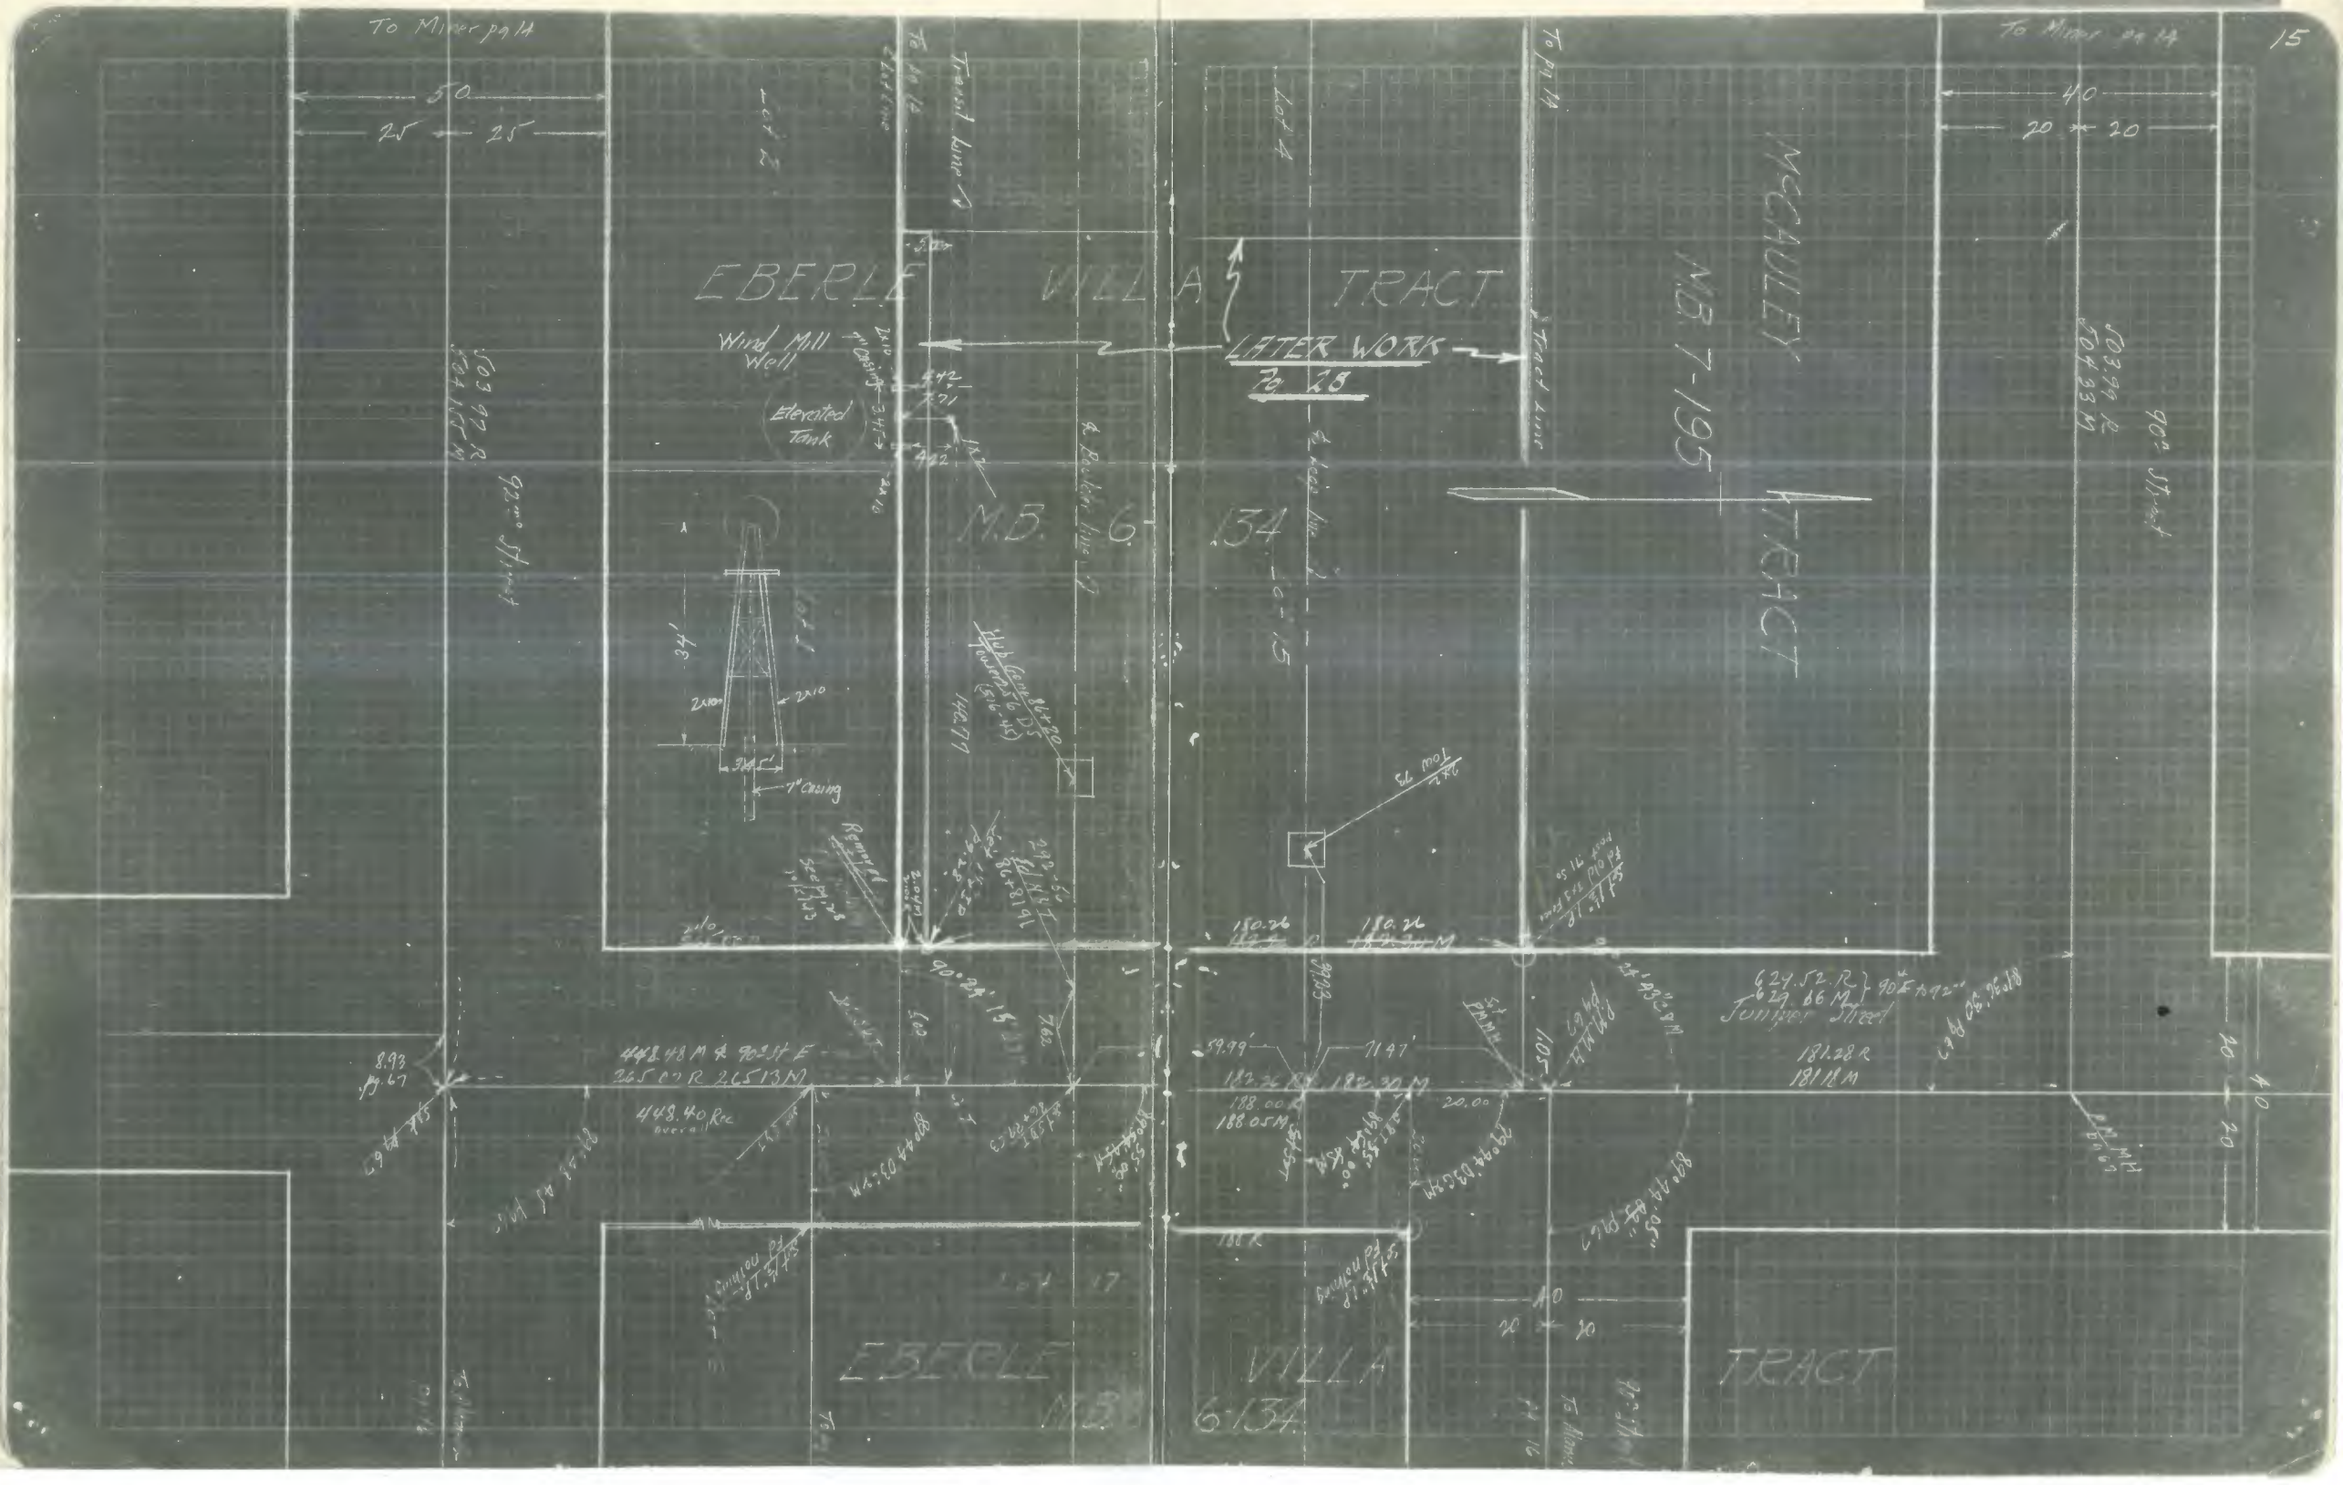
To Miner pg 14
50
25
25
EBERLE
VILLA
TRACT
Wind Mill Well
Elevated Tank
LATER WORK
To 28
M.D. 6
134
McCAULEY
M.D. 7-195
TRACT
Lot 4
Lot 17
EBERLE
VILLA
6-134
TRACT
Juniper Street
90° St.
40
20
20
448.48 M & 90° St E
265.07 R 265.13 M
448.40 Rec
624.52 R
629.66 M
181.28 R
181.18 M
188.00
188.05 M
59.99'
71.97'
182.24 R
182.30 M
150.26
180.22
56 mod
7" Casing

F.B. 985-32

F.B. 985-33

B.P.L. F.B.#527

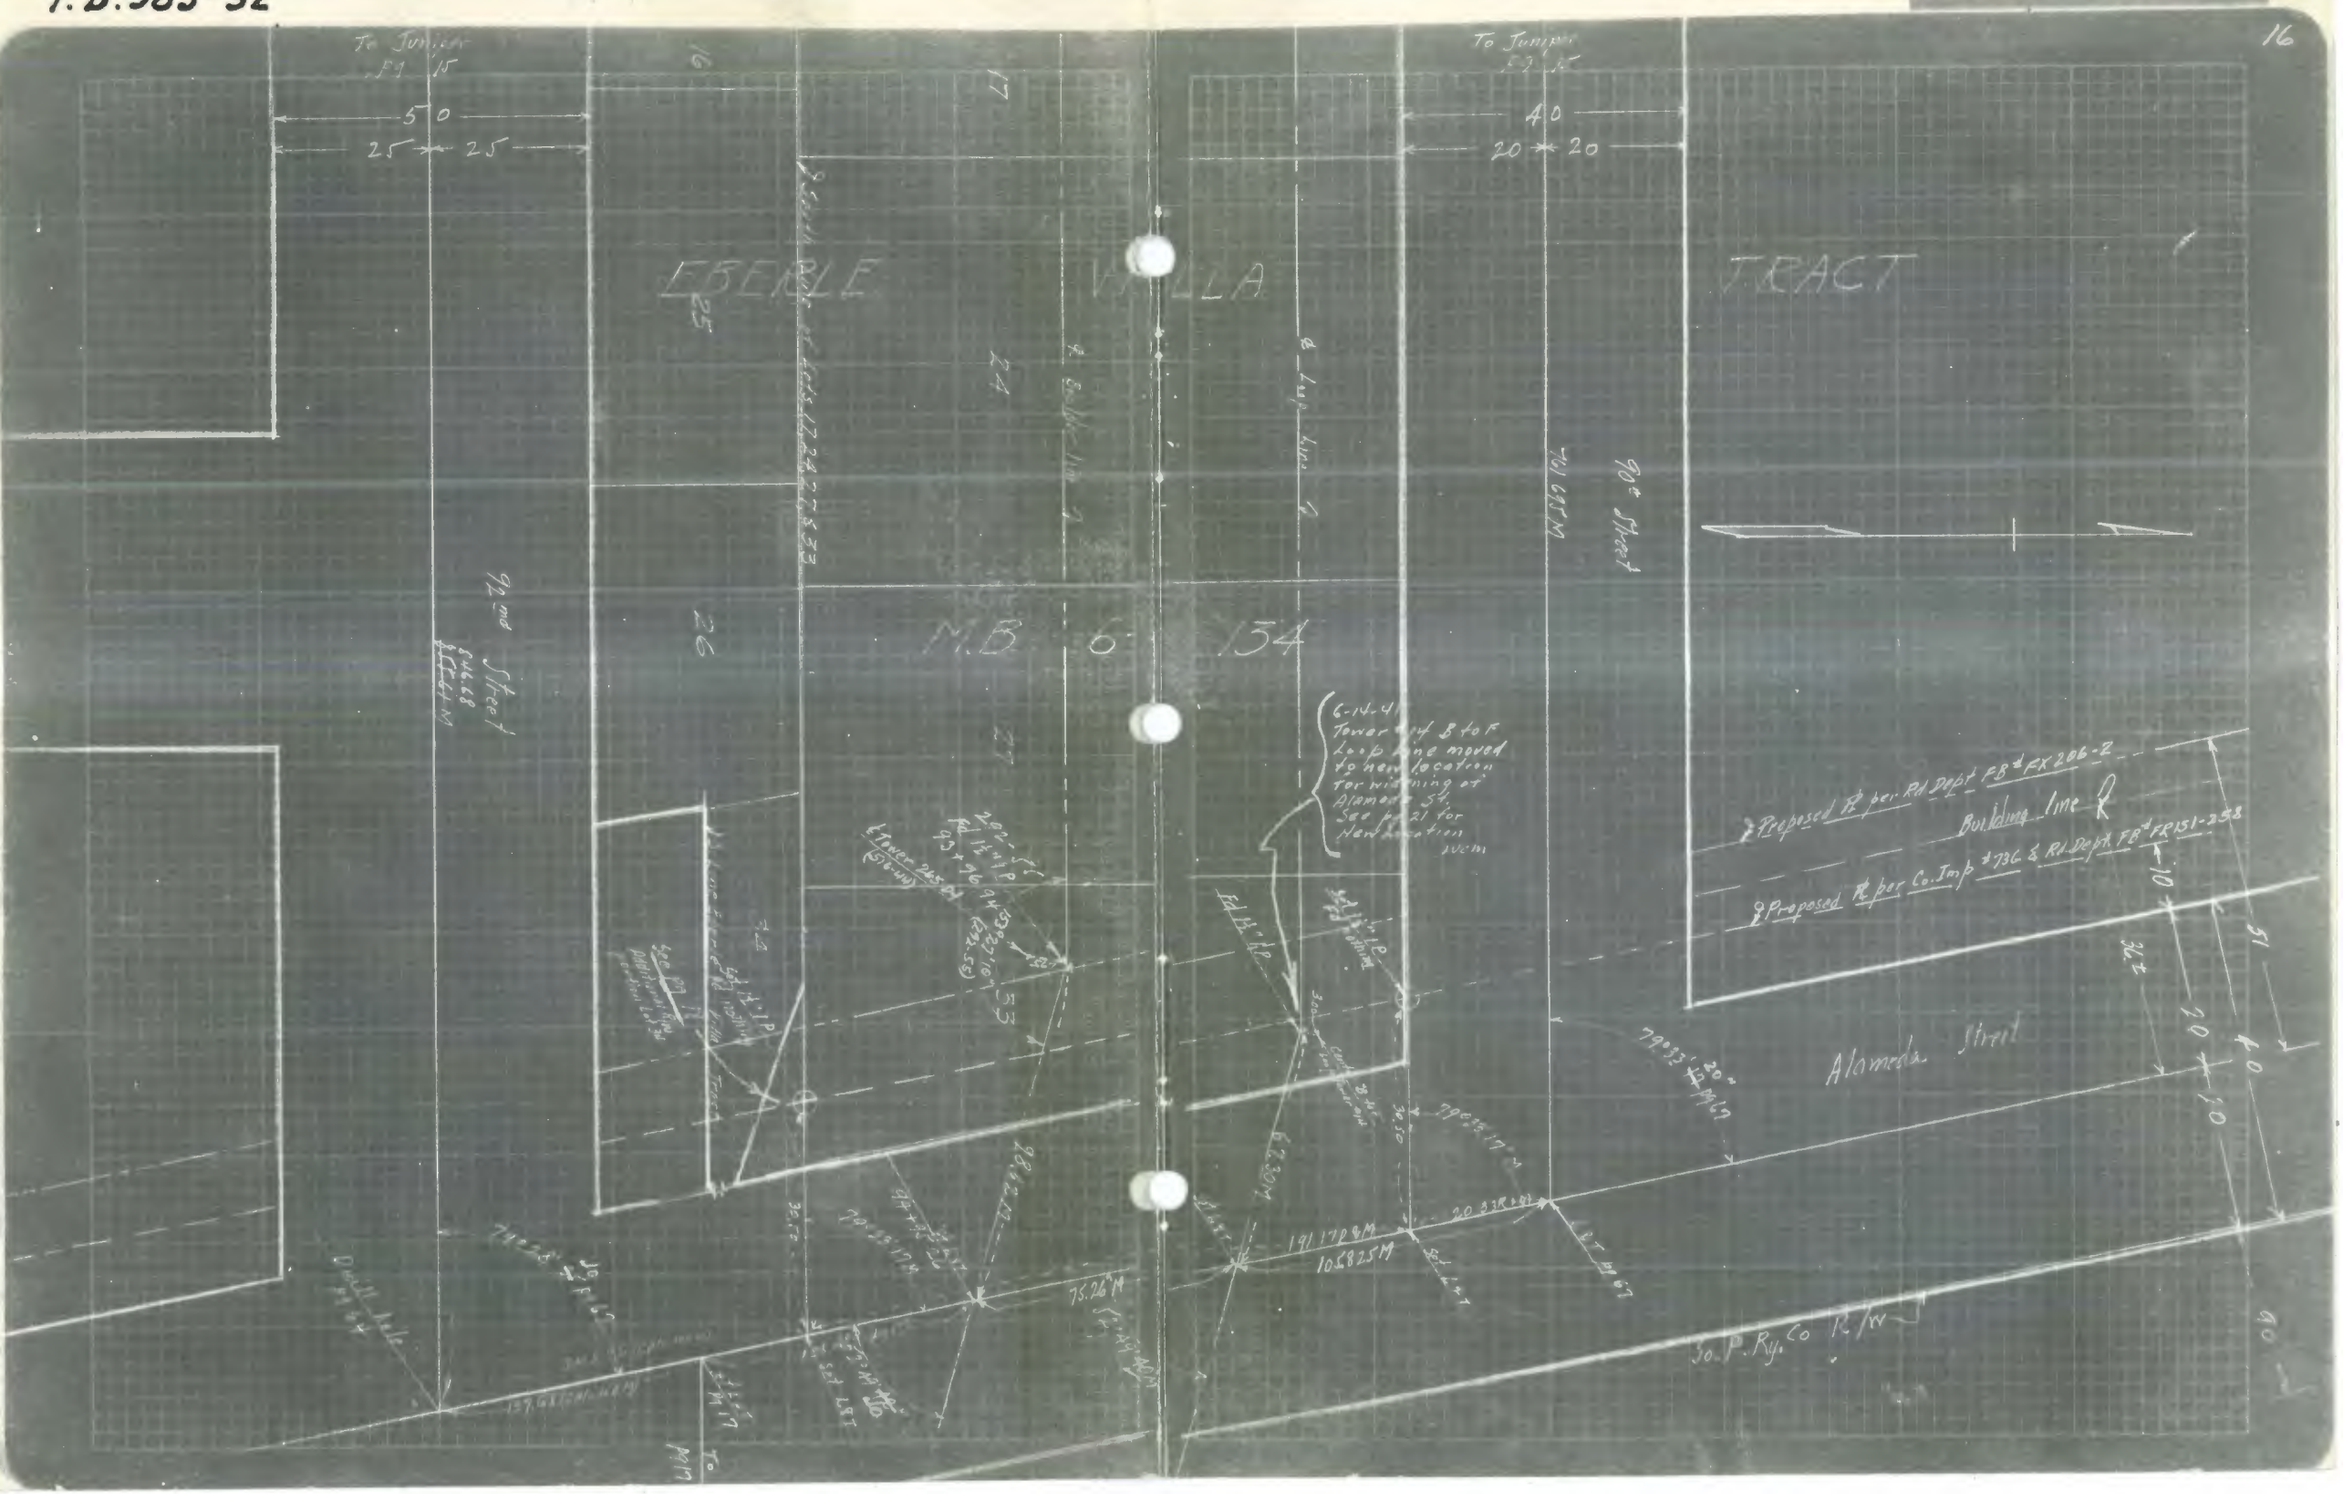

F. B. 985-34

F. B. 985-35

B.P.L. F.B.#527

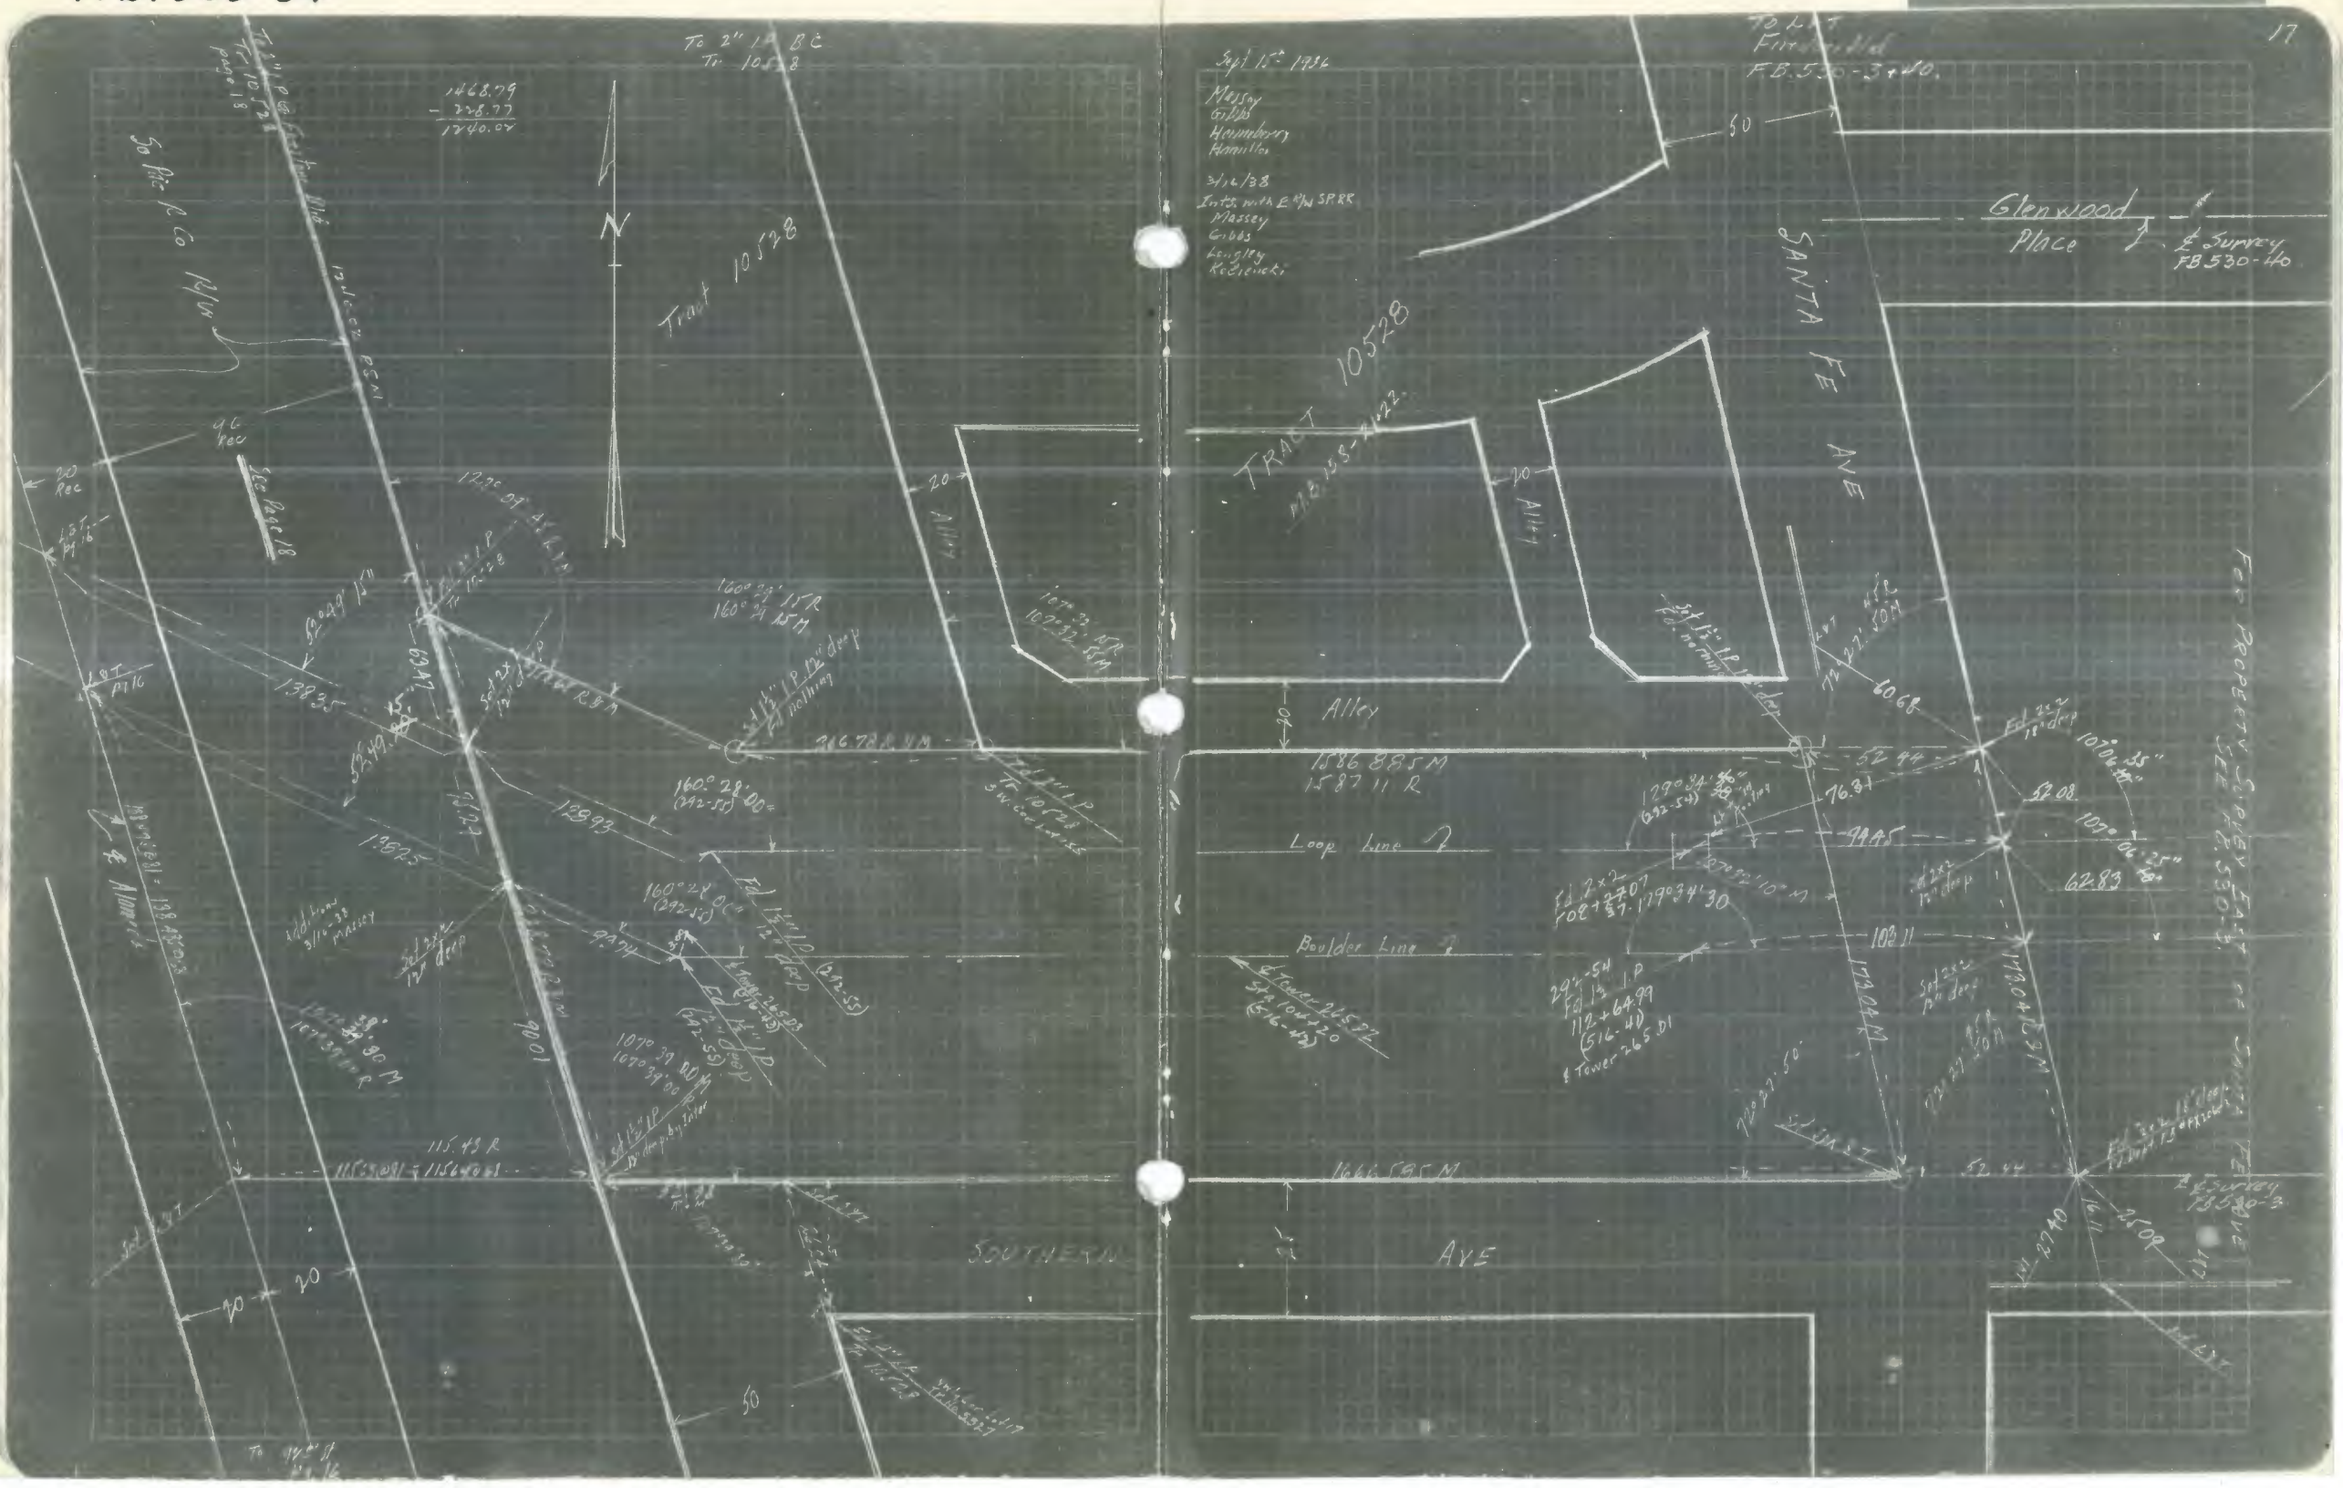

F.B. 985-36

F.B. 985-37

B.P.L. F.B.#527

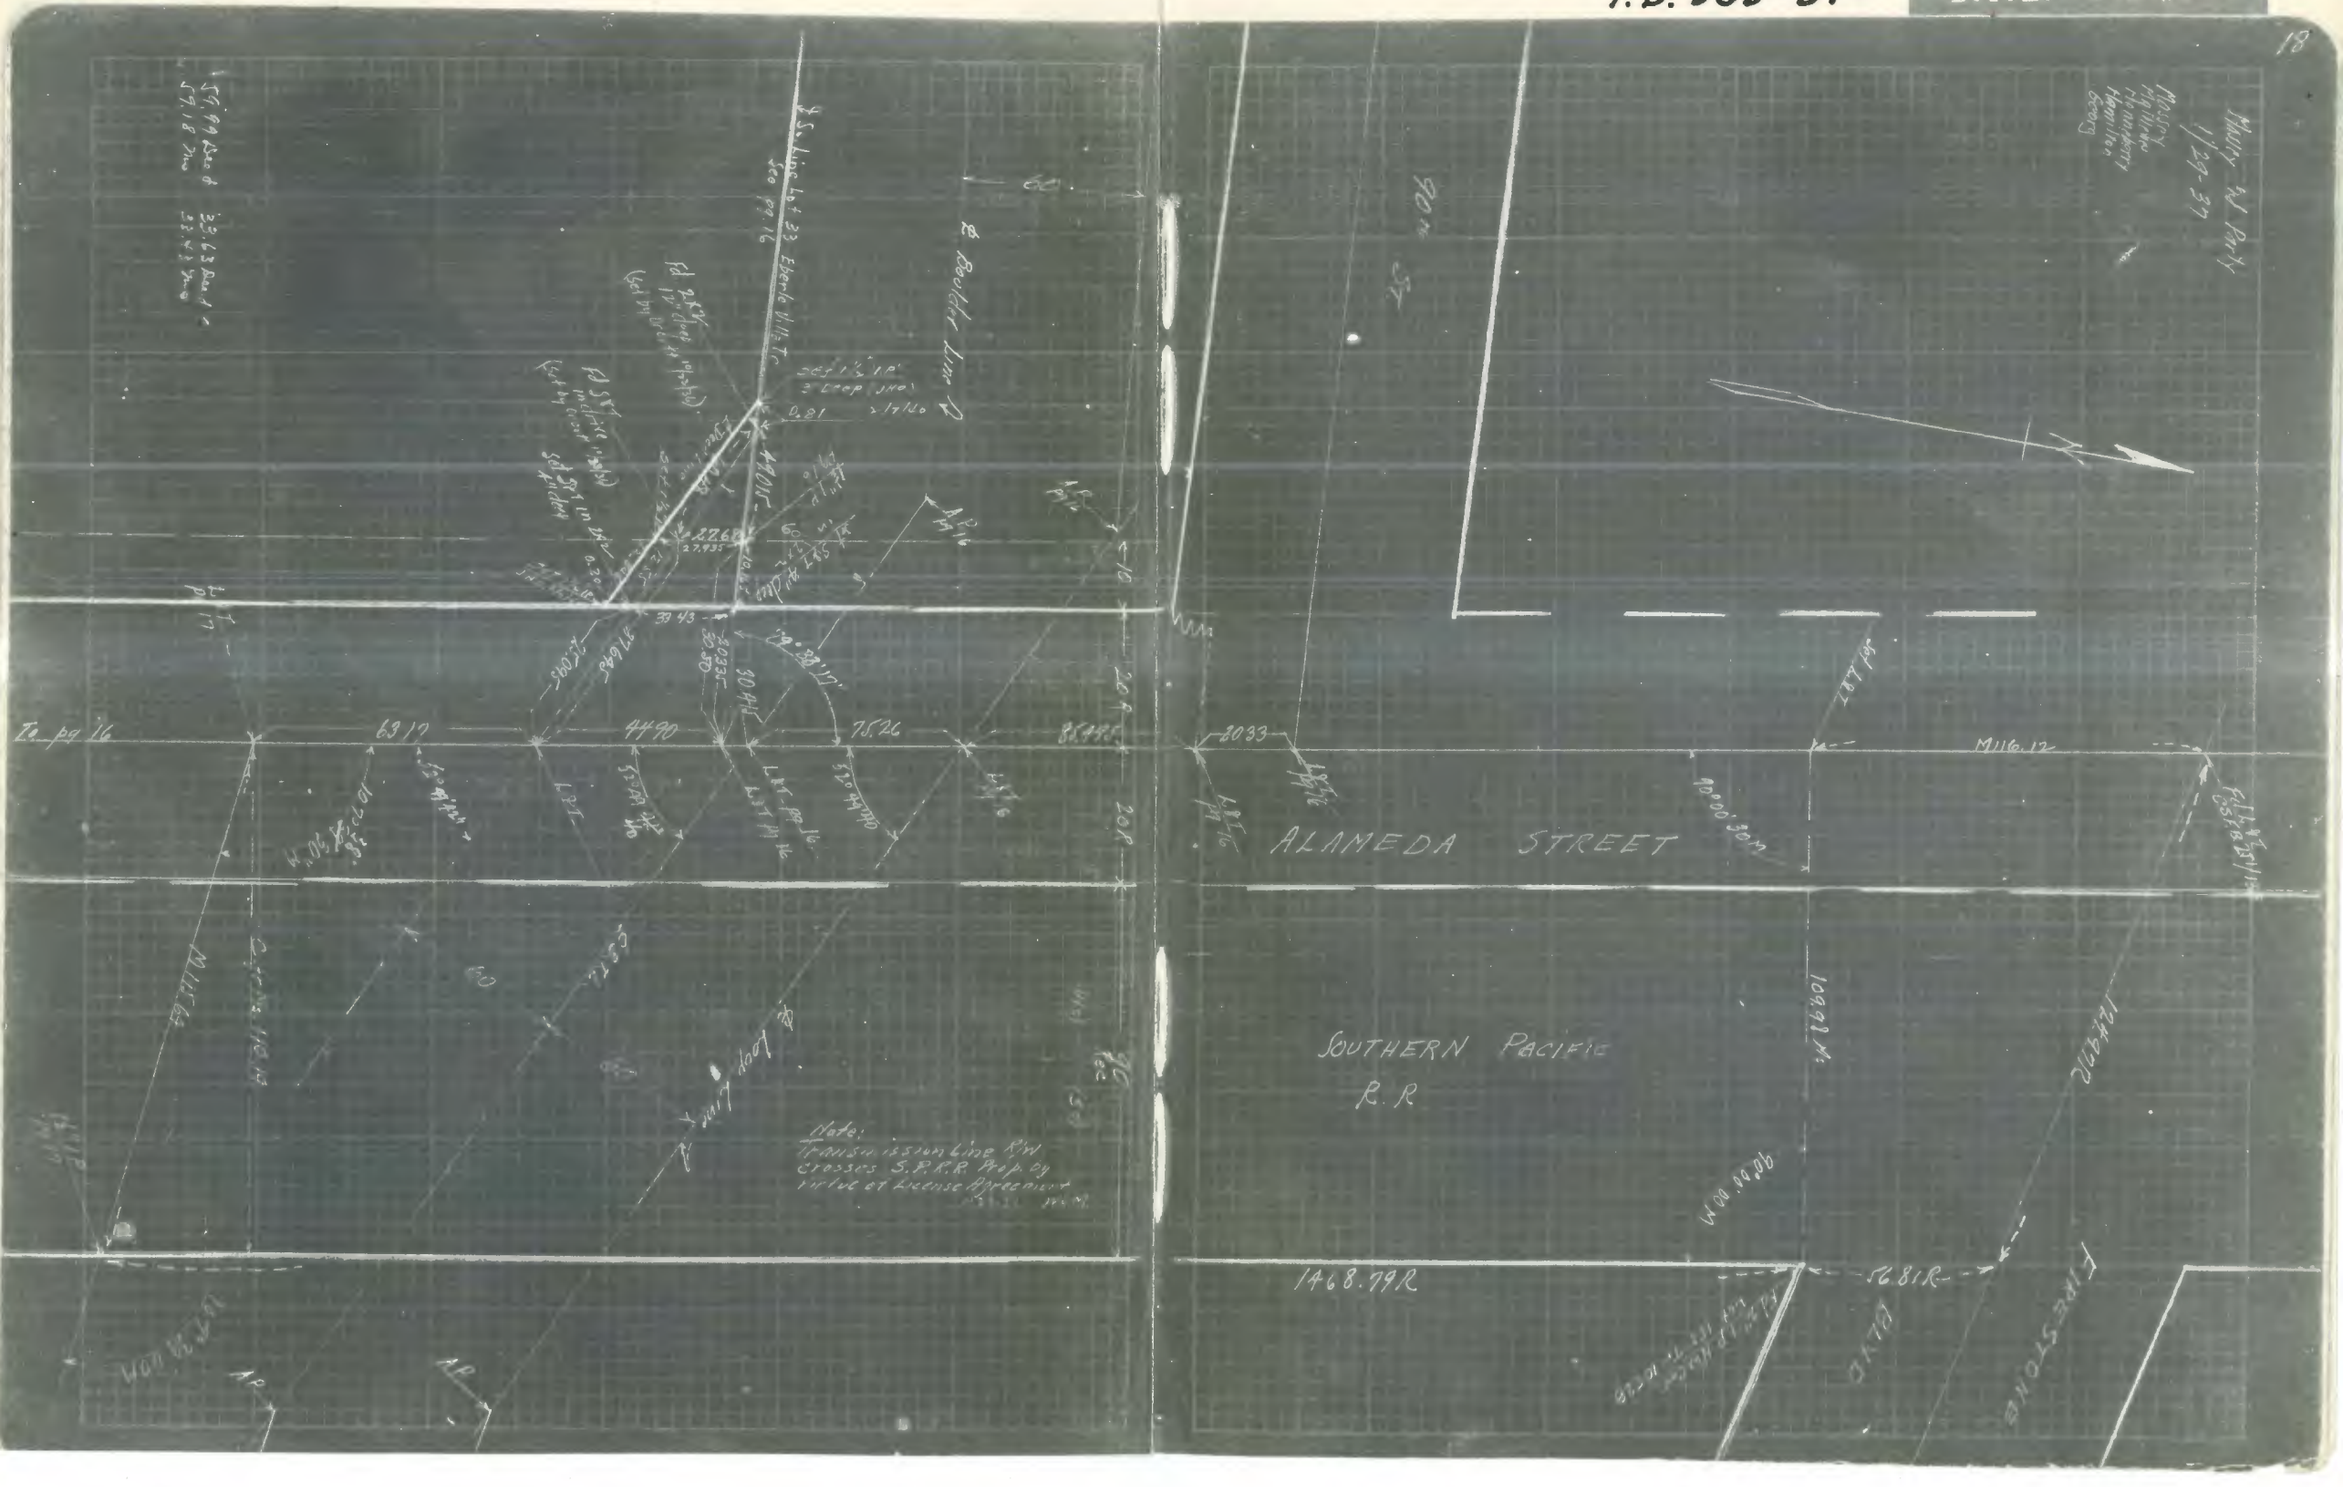

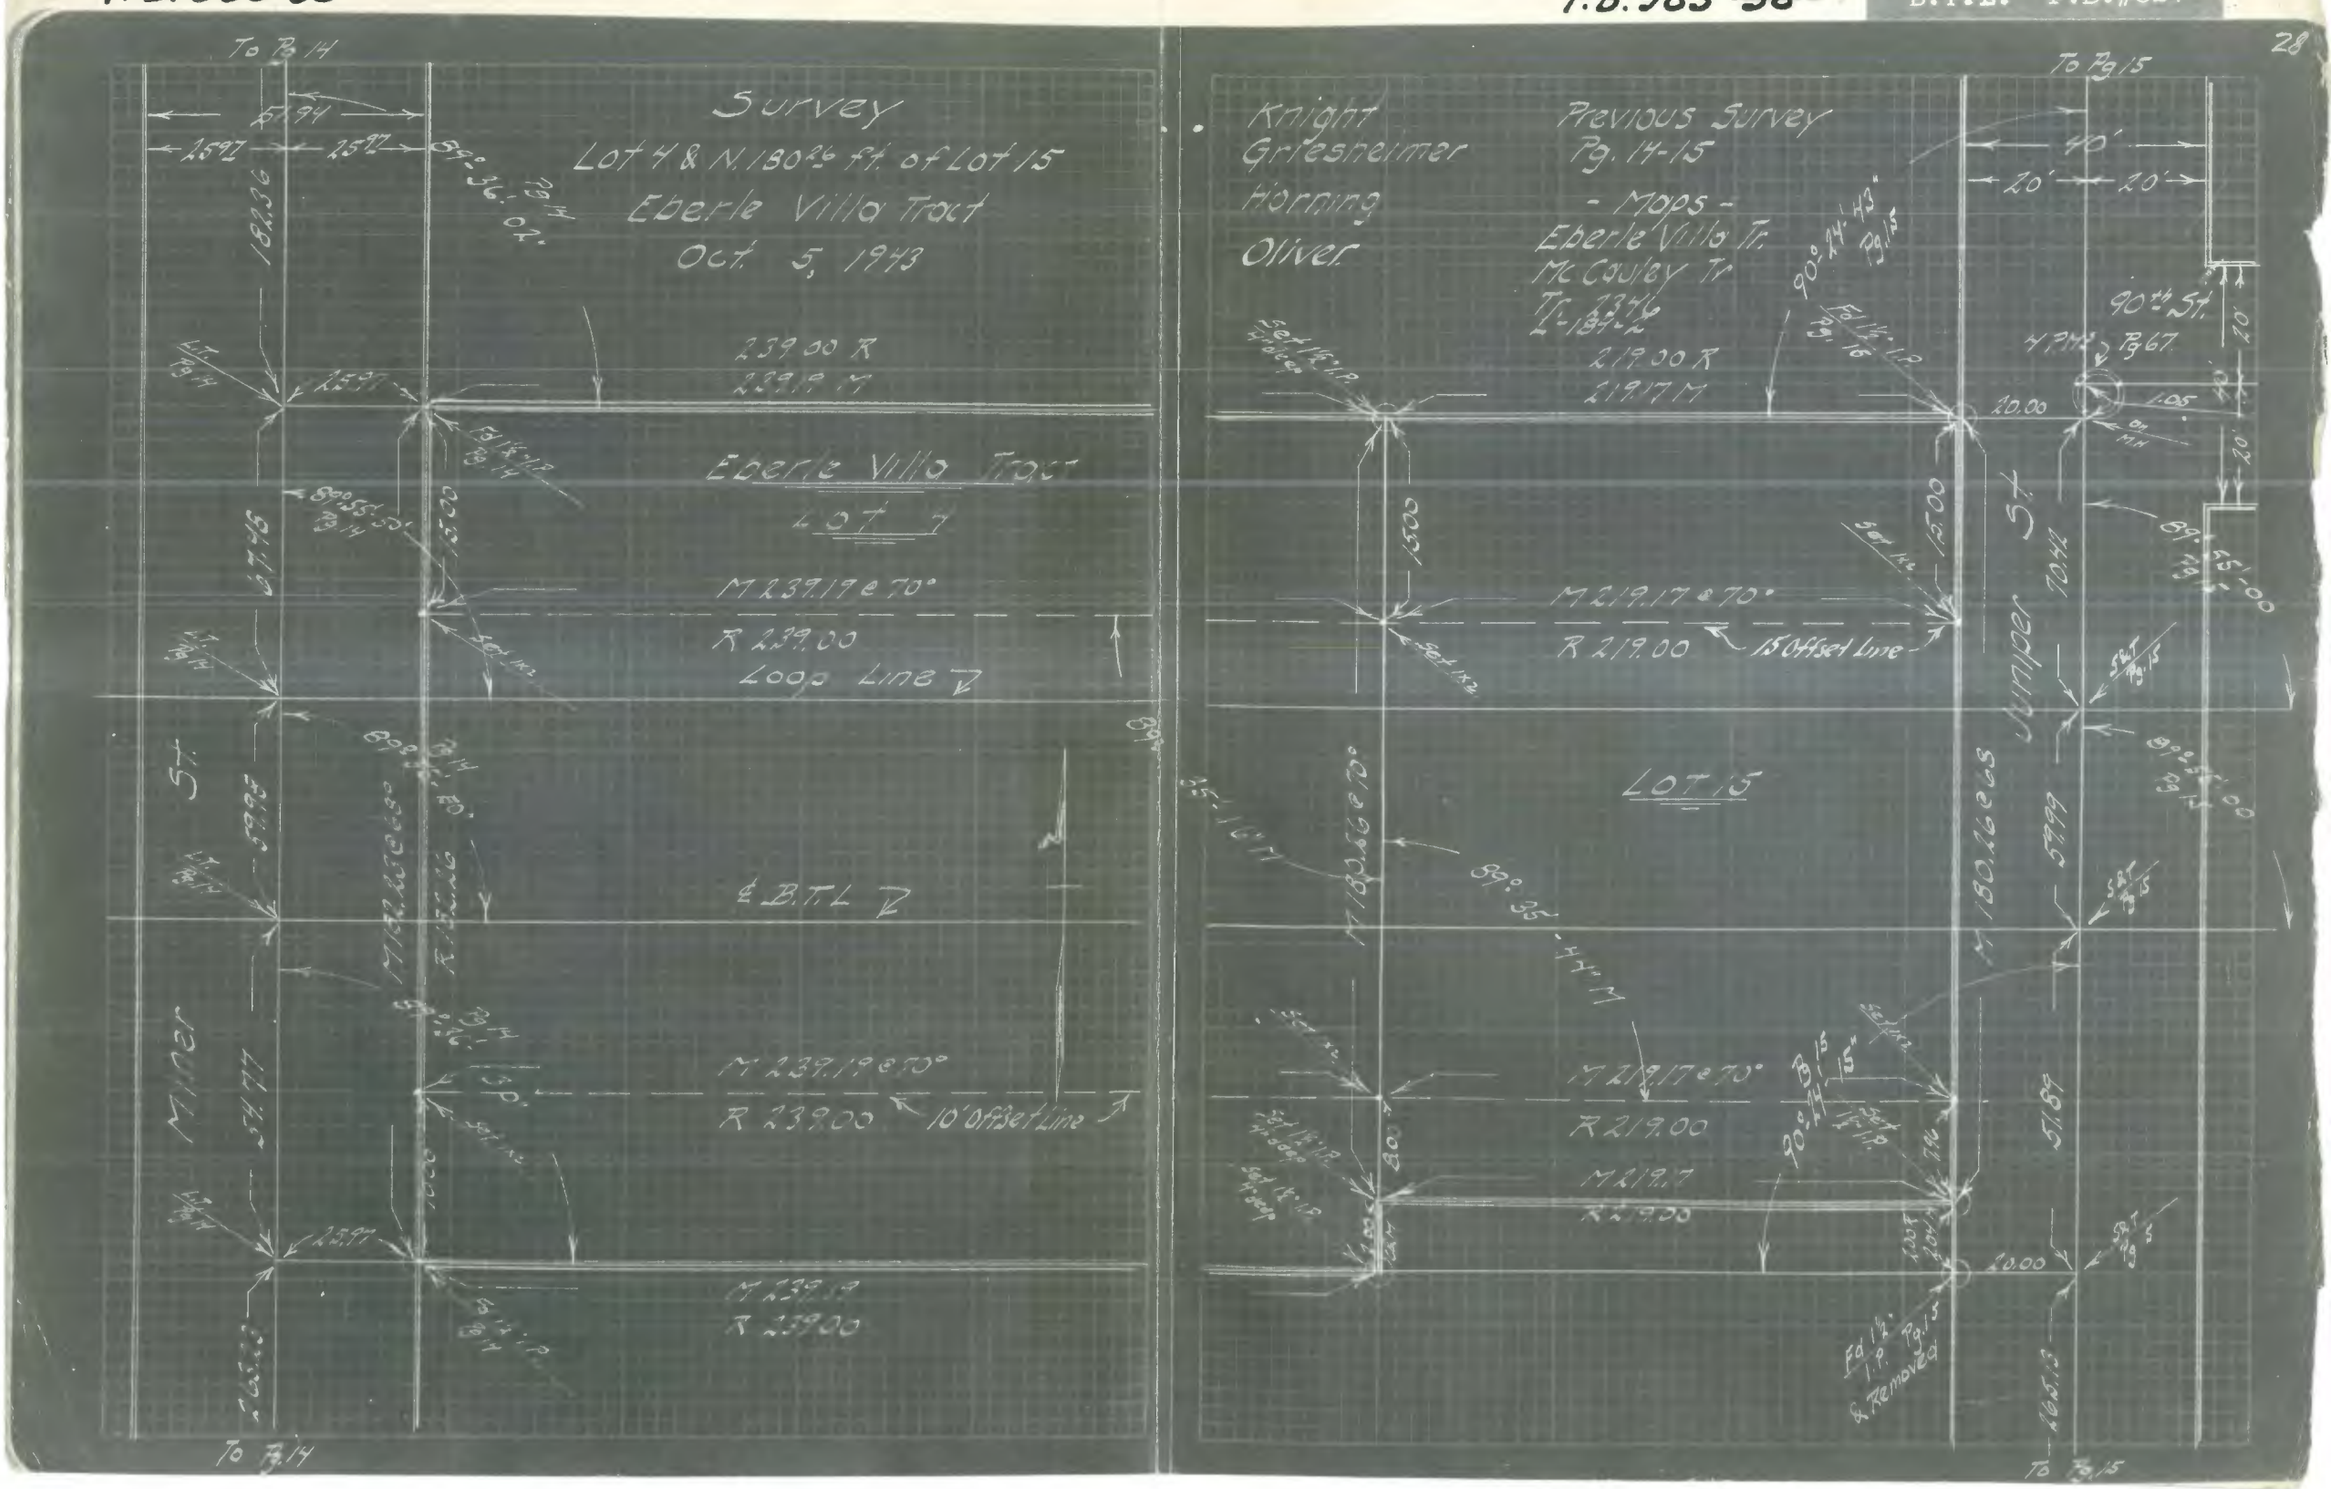
To B 14
Survey
Lot 4 & N. 180.26 ft. of Lot 15
Eberle Villa Tract
Oct. 5, 1943
61.94
25.97
25.97
89°-36'-02"
182.36
239.00 R
239.19 M
Eberle Villa Tract
Lot 7
M 239.19 @ 70°
R 239.00
Loop Line
89°-55'-30"
100.00
89°-36'-02"
239.00 R
239.19 M
Miller St.
Rising 80.
@ B.T.L.
M 239.19 @ 70°
R 239.00
10' Offset Line
54.77
25.97
M 239.19
R 239.00
To B 14
To Pg 15
Knight
Griesheimer
Horning
Oliver
Previous Survey
Pg. 14-15
- Maps -
Eberle Villa Tr.
Mc Cauley Tr.
90°-24'-43"
Eq. 1½" I.P. Pg. 15
Eq. 1½" I.P. Pg. 16
219.00 R
219.17 M
Set 1½" I.P.
40'
20'
20'
90th St.
4 P.M.
Pg 67
1.05
20.00
Set 1½" I.P.
150.00
M 219.17 @ 70°
R 219.00
15 Offset Line
89°-49'-55"
55.00
Jumper St.
Set Pg. 15
M 180.16 @ 70°
35.16
89°-35'-44" M
Set 1½" I.P.
80.
Set 1½" I.P.
90°-24'
Set 1½" I.P.
Eq. 1½" I.P. Pg. 15 & Removed
20.00
To Pg 15

F.B. 985-39

F.B. 985-39

B.P.L. F.B.#527

R. Survey, Ties to Buildings

ELM STREET

to

ALAMEDA STREET

58° Street To 92nd Street

Reference

City Eng	F.B	12316 - 5.9
		12312 - 6.5
County Sur	F.B	183 4
		183 3
		201 - 31
Real Est		151 - 94

Tract Maps

Re plat of Lot 9	M.B	6 - 9
Flowers Subdivision	M.B	5 - 21
McCarley Tract	M.B	9 - 147
Tract 2346	M.B	27 - 50
Elliott Villa Tract	M.B	8 - 13
Magee Tract # 2	M.B	8 - 61

Final Notes: Ray Mathews, R.L. Mooney, Surveyors
C.S. Smith, Ray Mathews, Transit
Ed Mooney, Harry Hamilton, Chainmen
Chuck Bryan, Geo Hathaway

May 11 to June 1, 1936. & June 30 to July 1 1936

B.P.L. F.B.#527

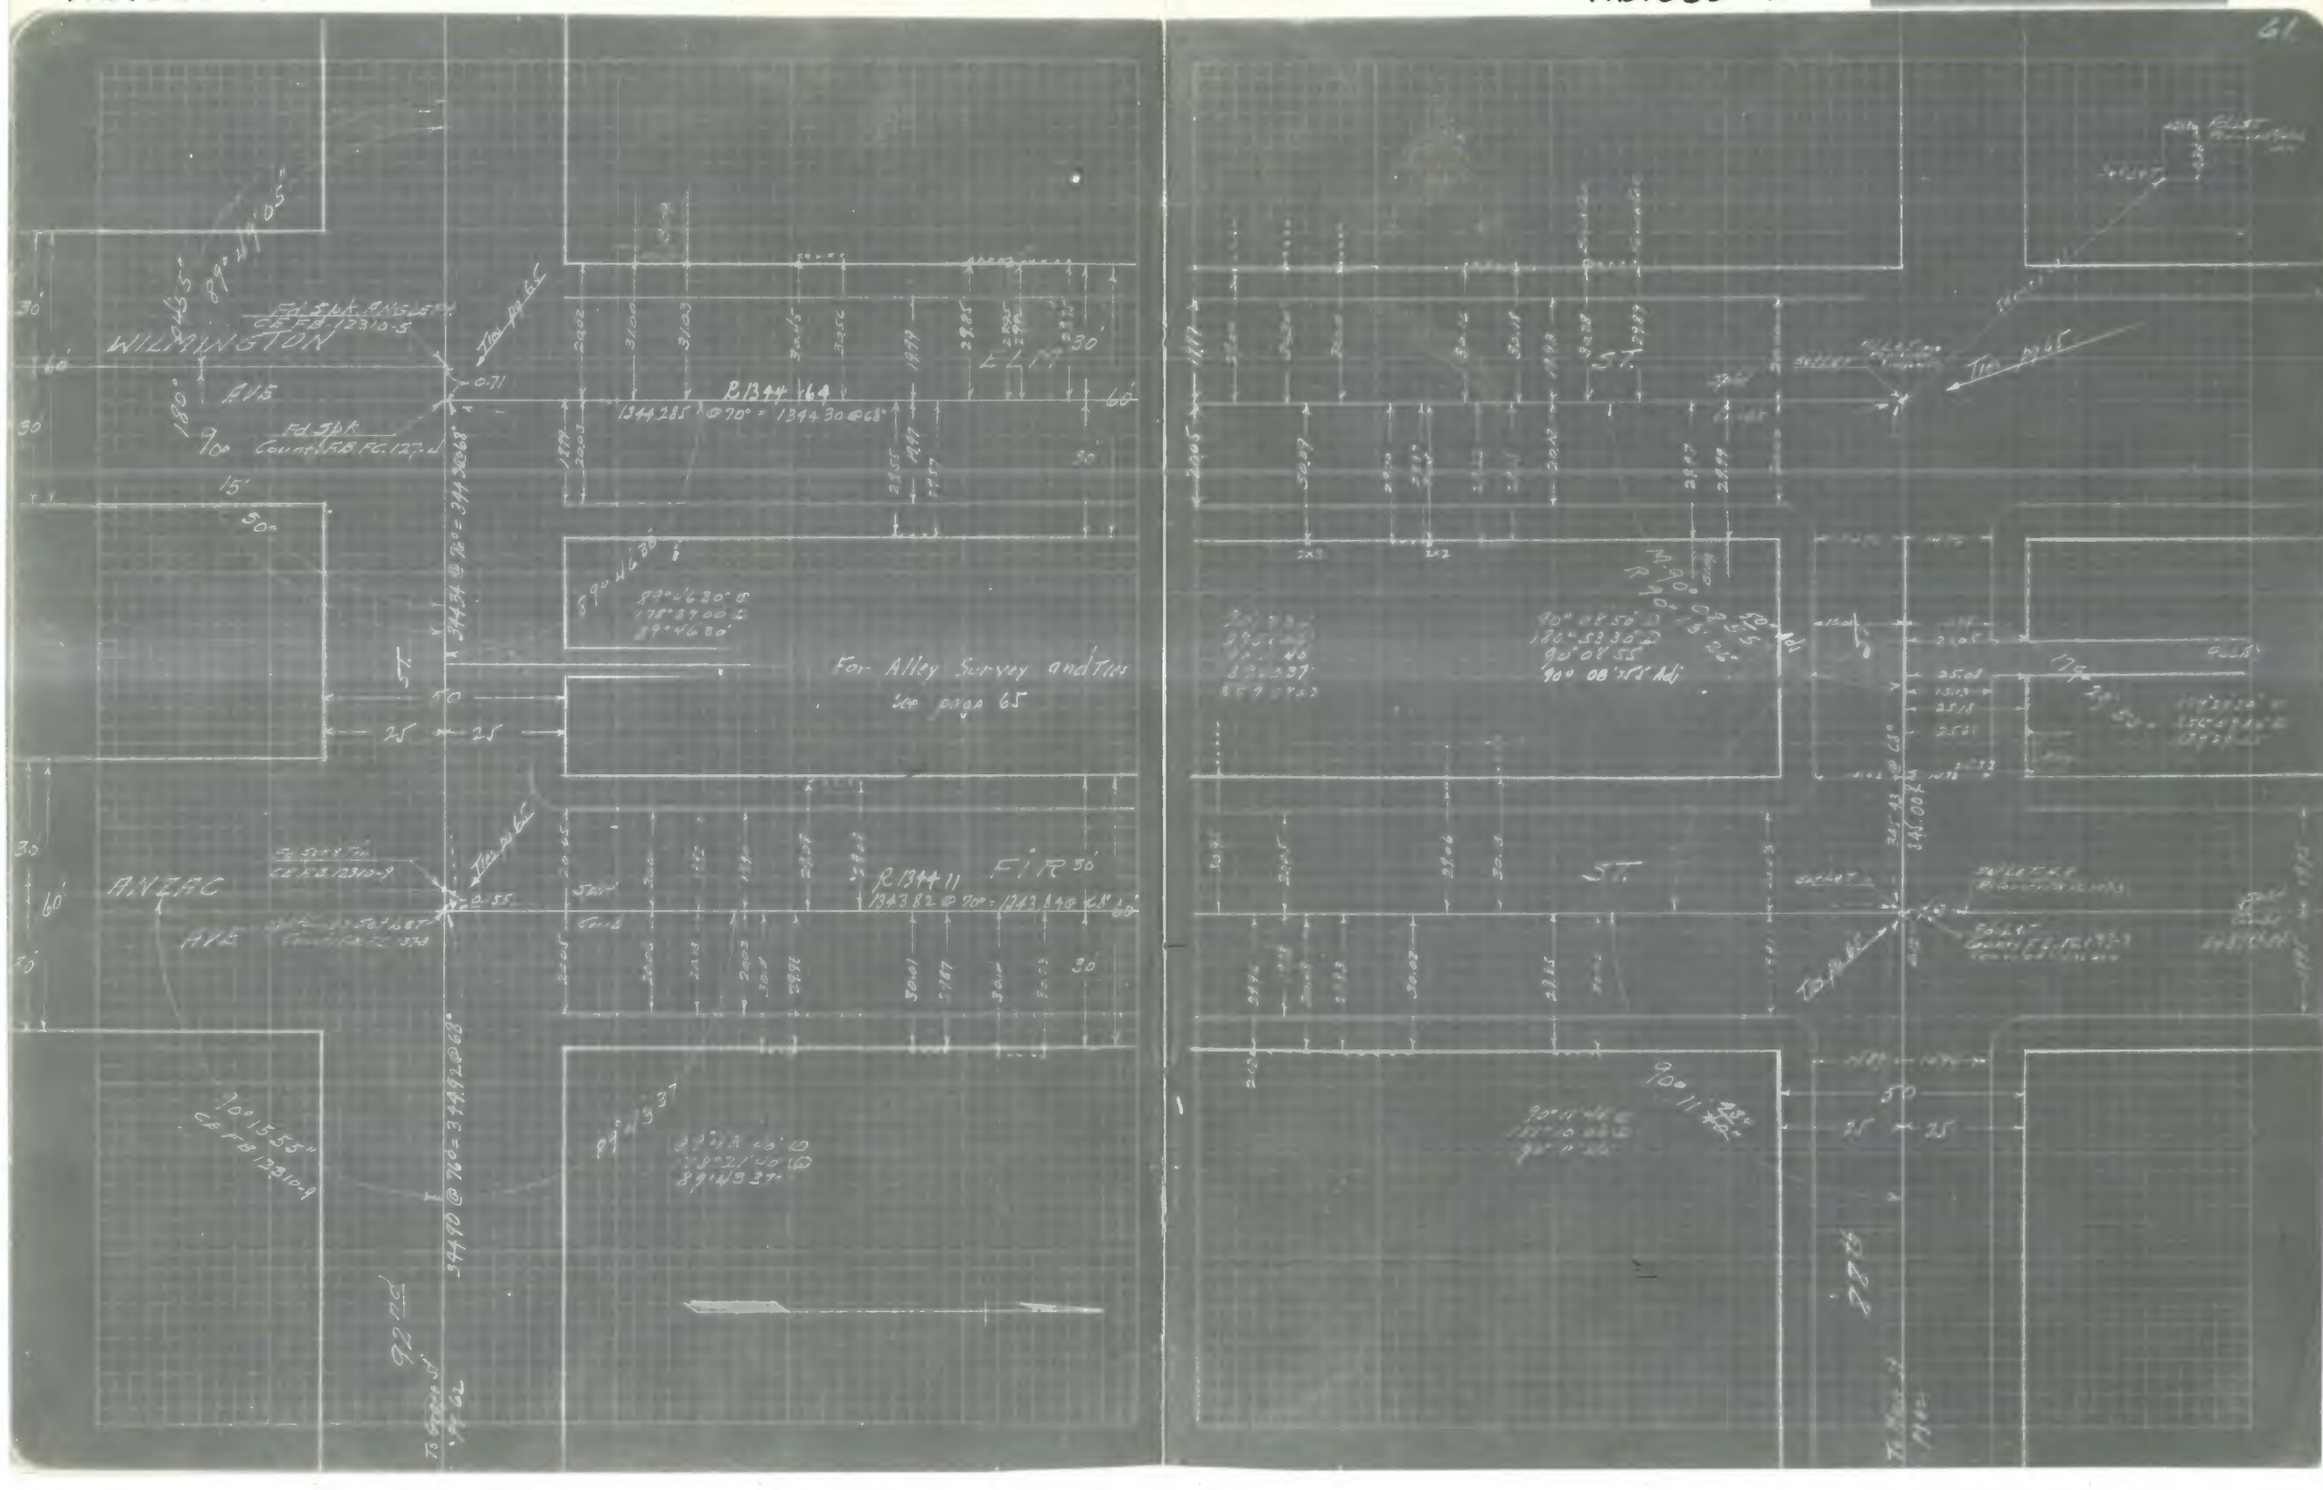
WILMINGTON
AVE
ANEFC
AVE
ST
ST
For Alley Survey and Tie
see page 65
R1344 64
R1344 11
F.I.R. 30'
Tie page
To page
89° 46' 30"
90° 13' 55"
89° 14' 37"
90° 11' 46"
90° 08' 55"
90° 08' 55" Adj
180° 00' 05"
89° 11' 05"
90°
30'
60'
50'
25
15'

F.B. 985-42

F.B. 985-43

B.P.L. F.B.#527

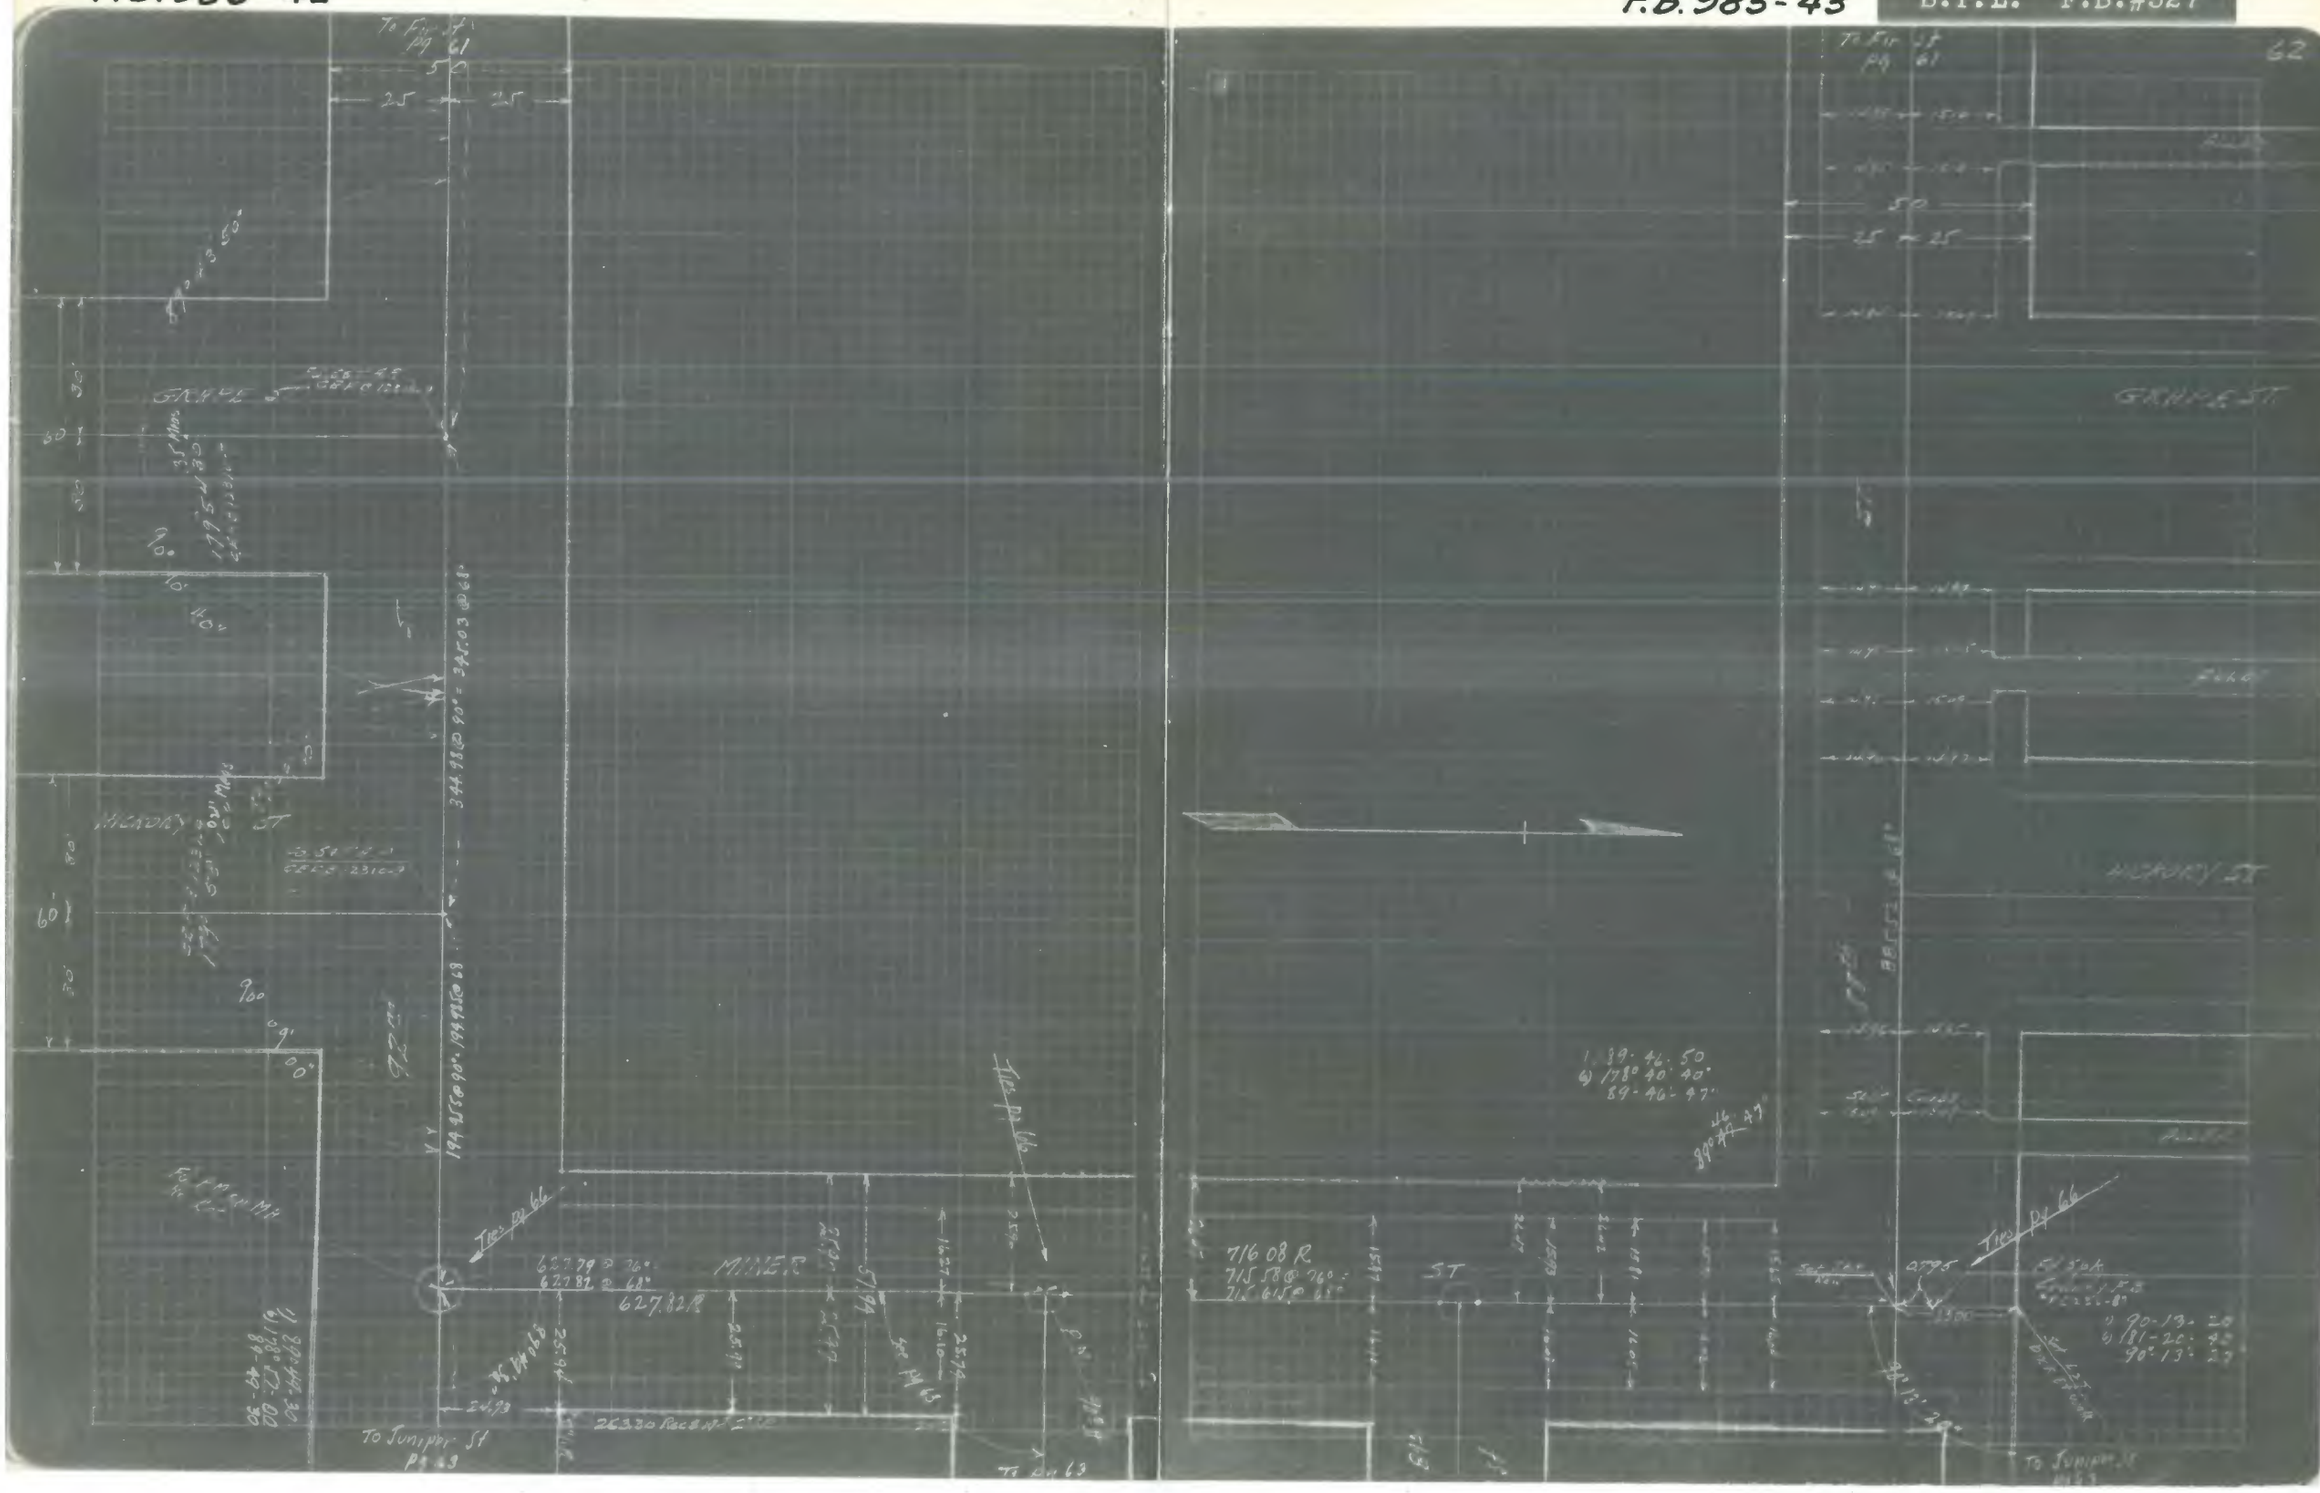

F.B. 985-44

F.B. 985-45

B.P.L. F.B.#527

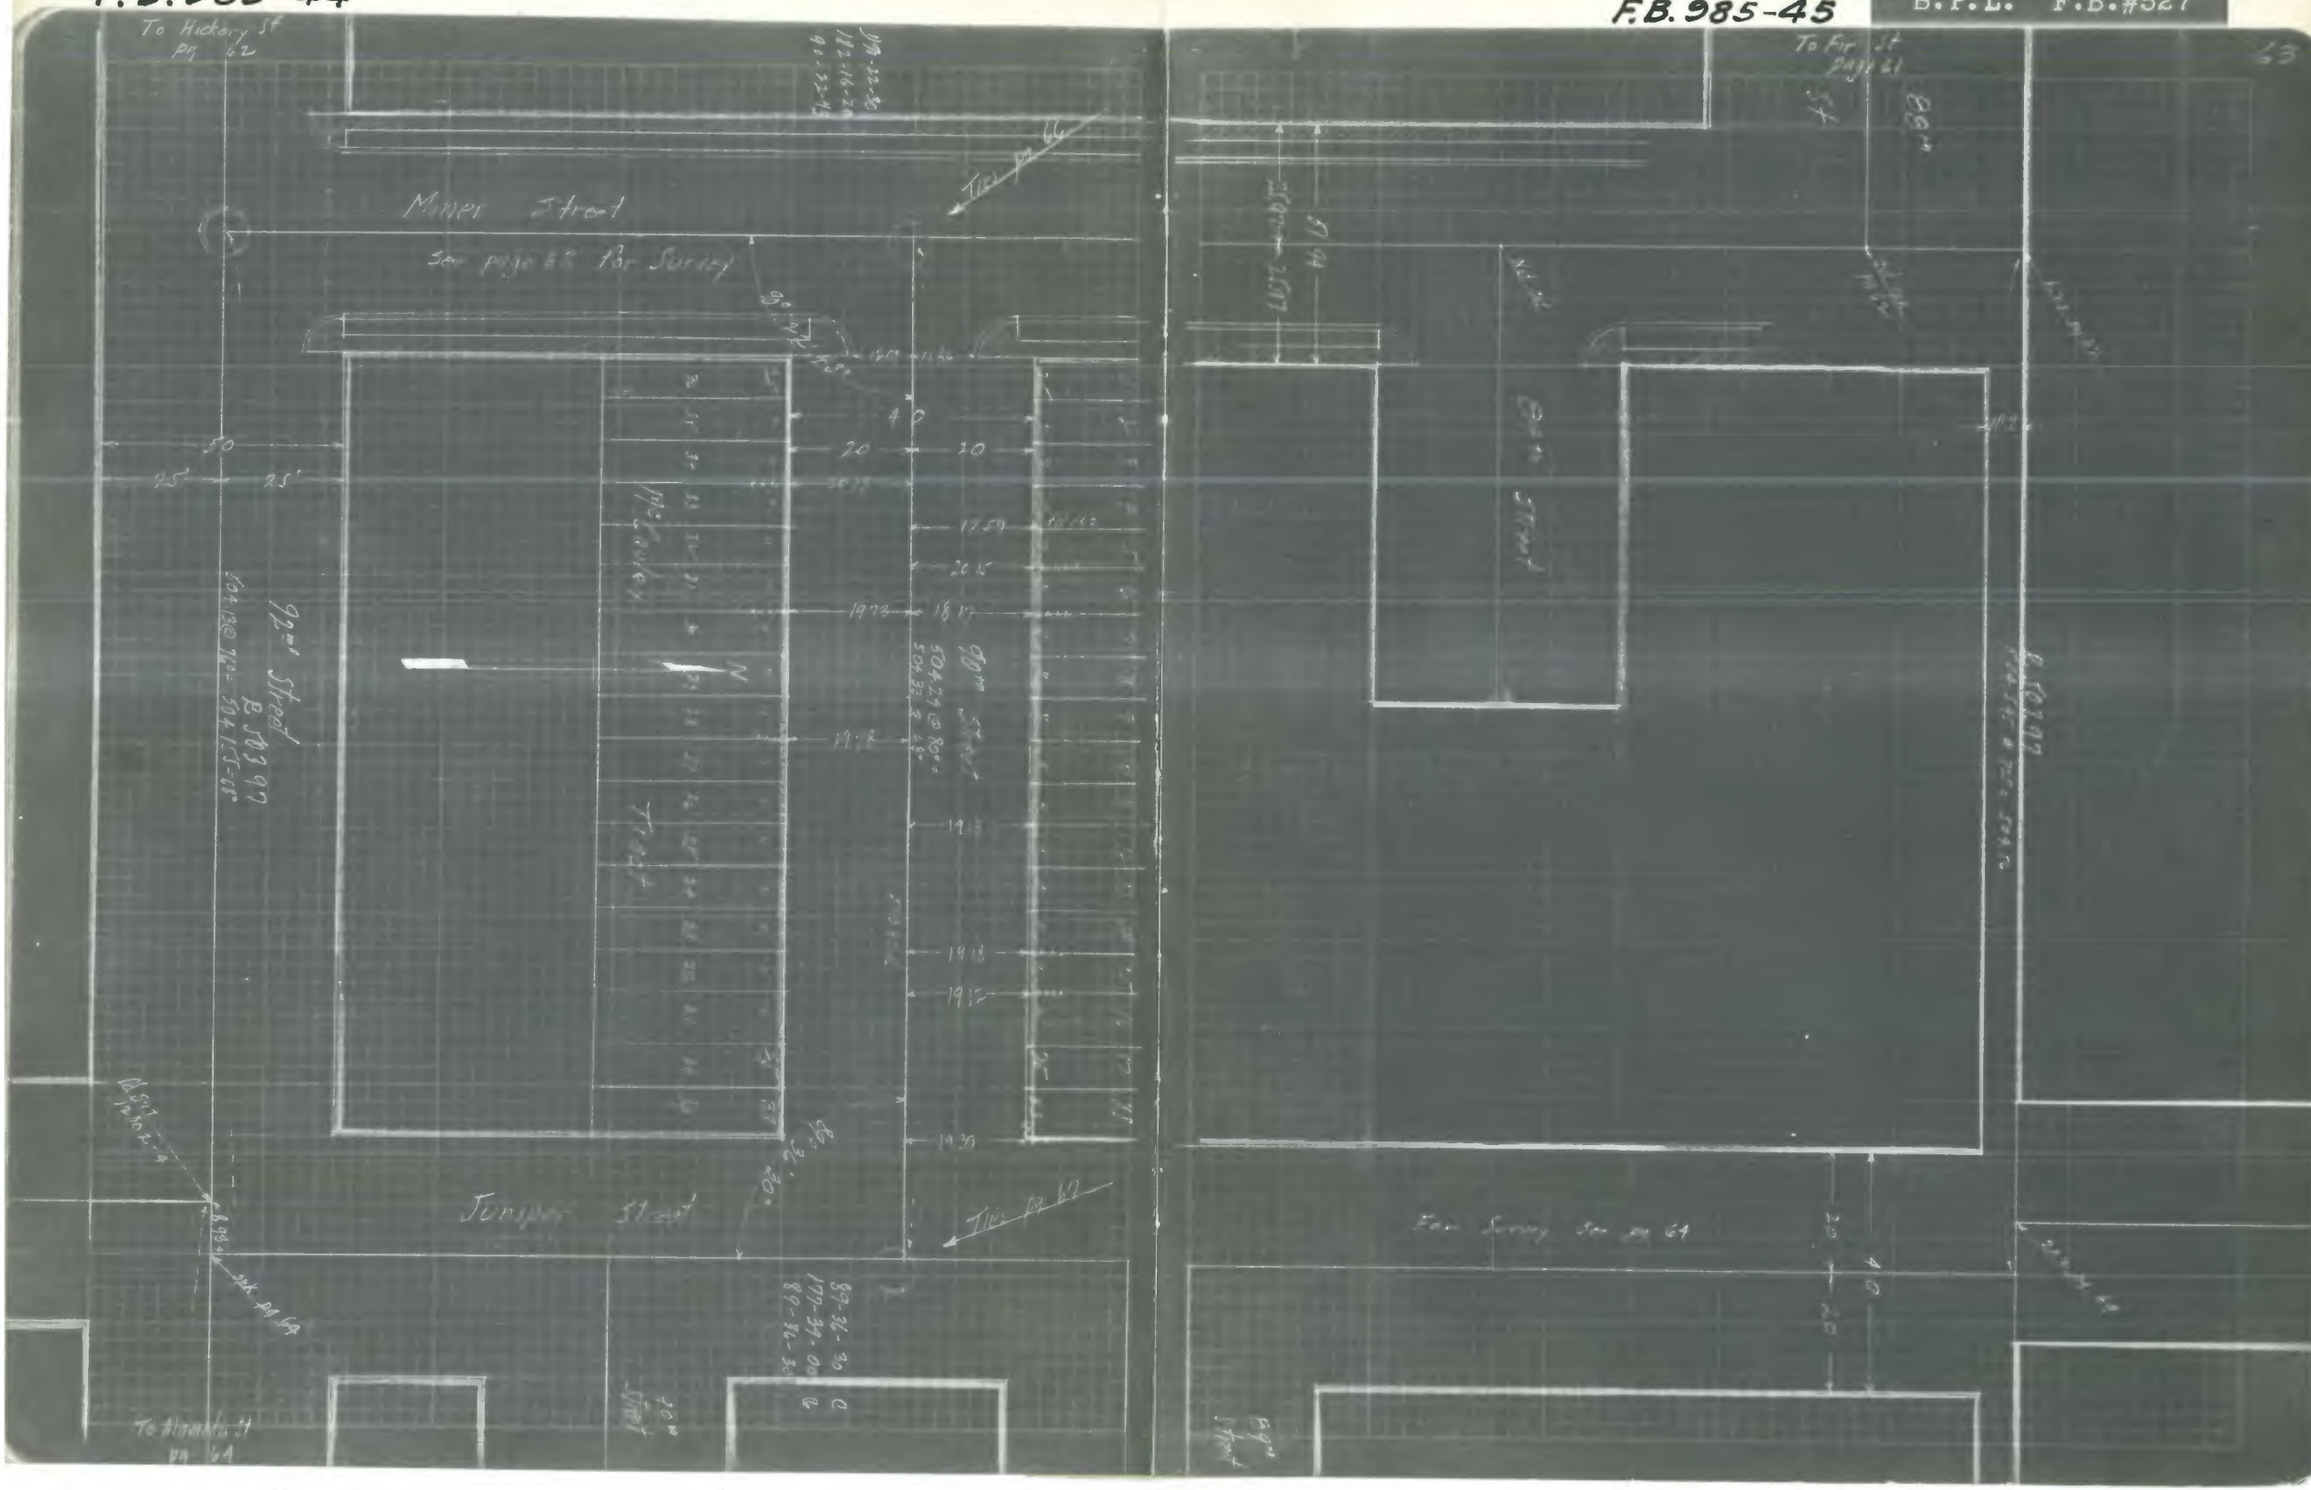
To Hickory St pg 62
Miner Street
See page 65 for Survey
To Fir St page 61
Bdy
Bdy
Bdy

F.B.985-46

F.B.985-47

B.P.L. F.B.#527

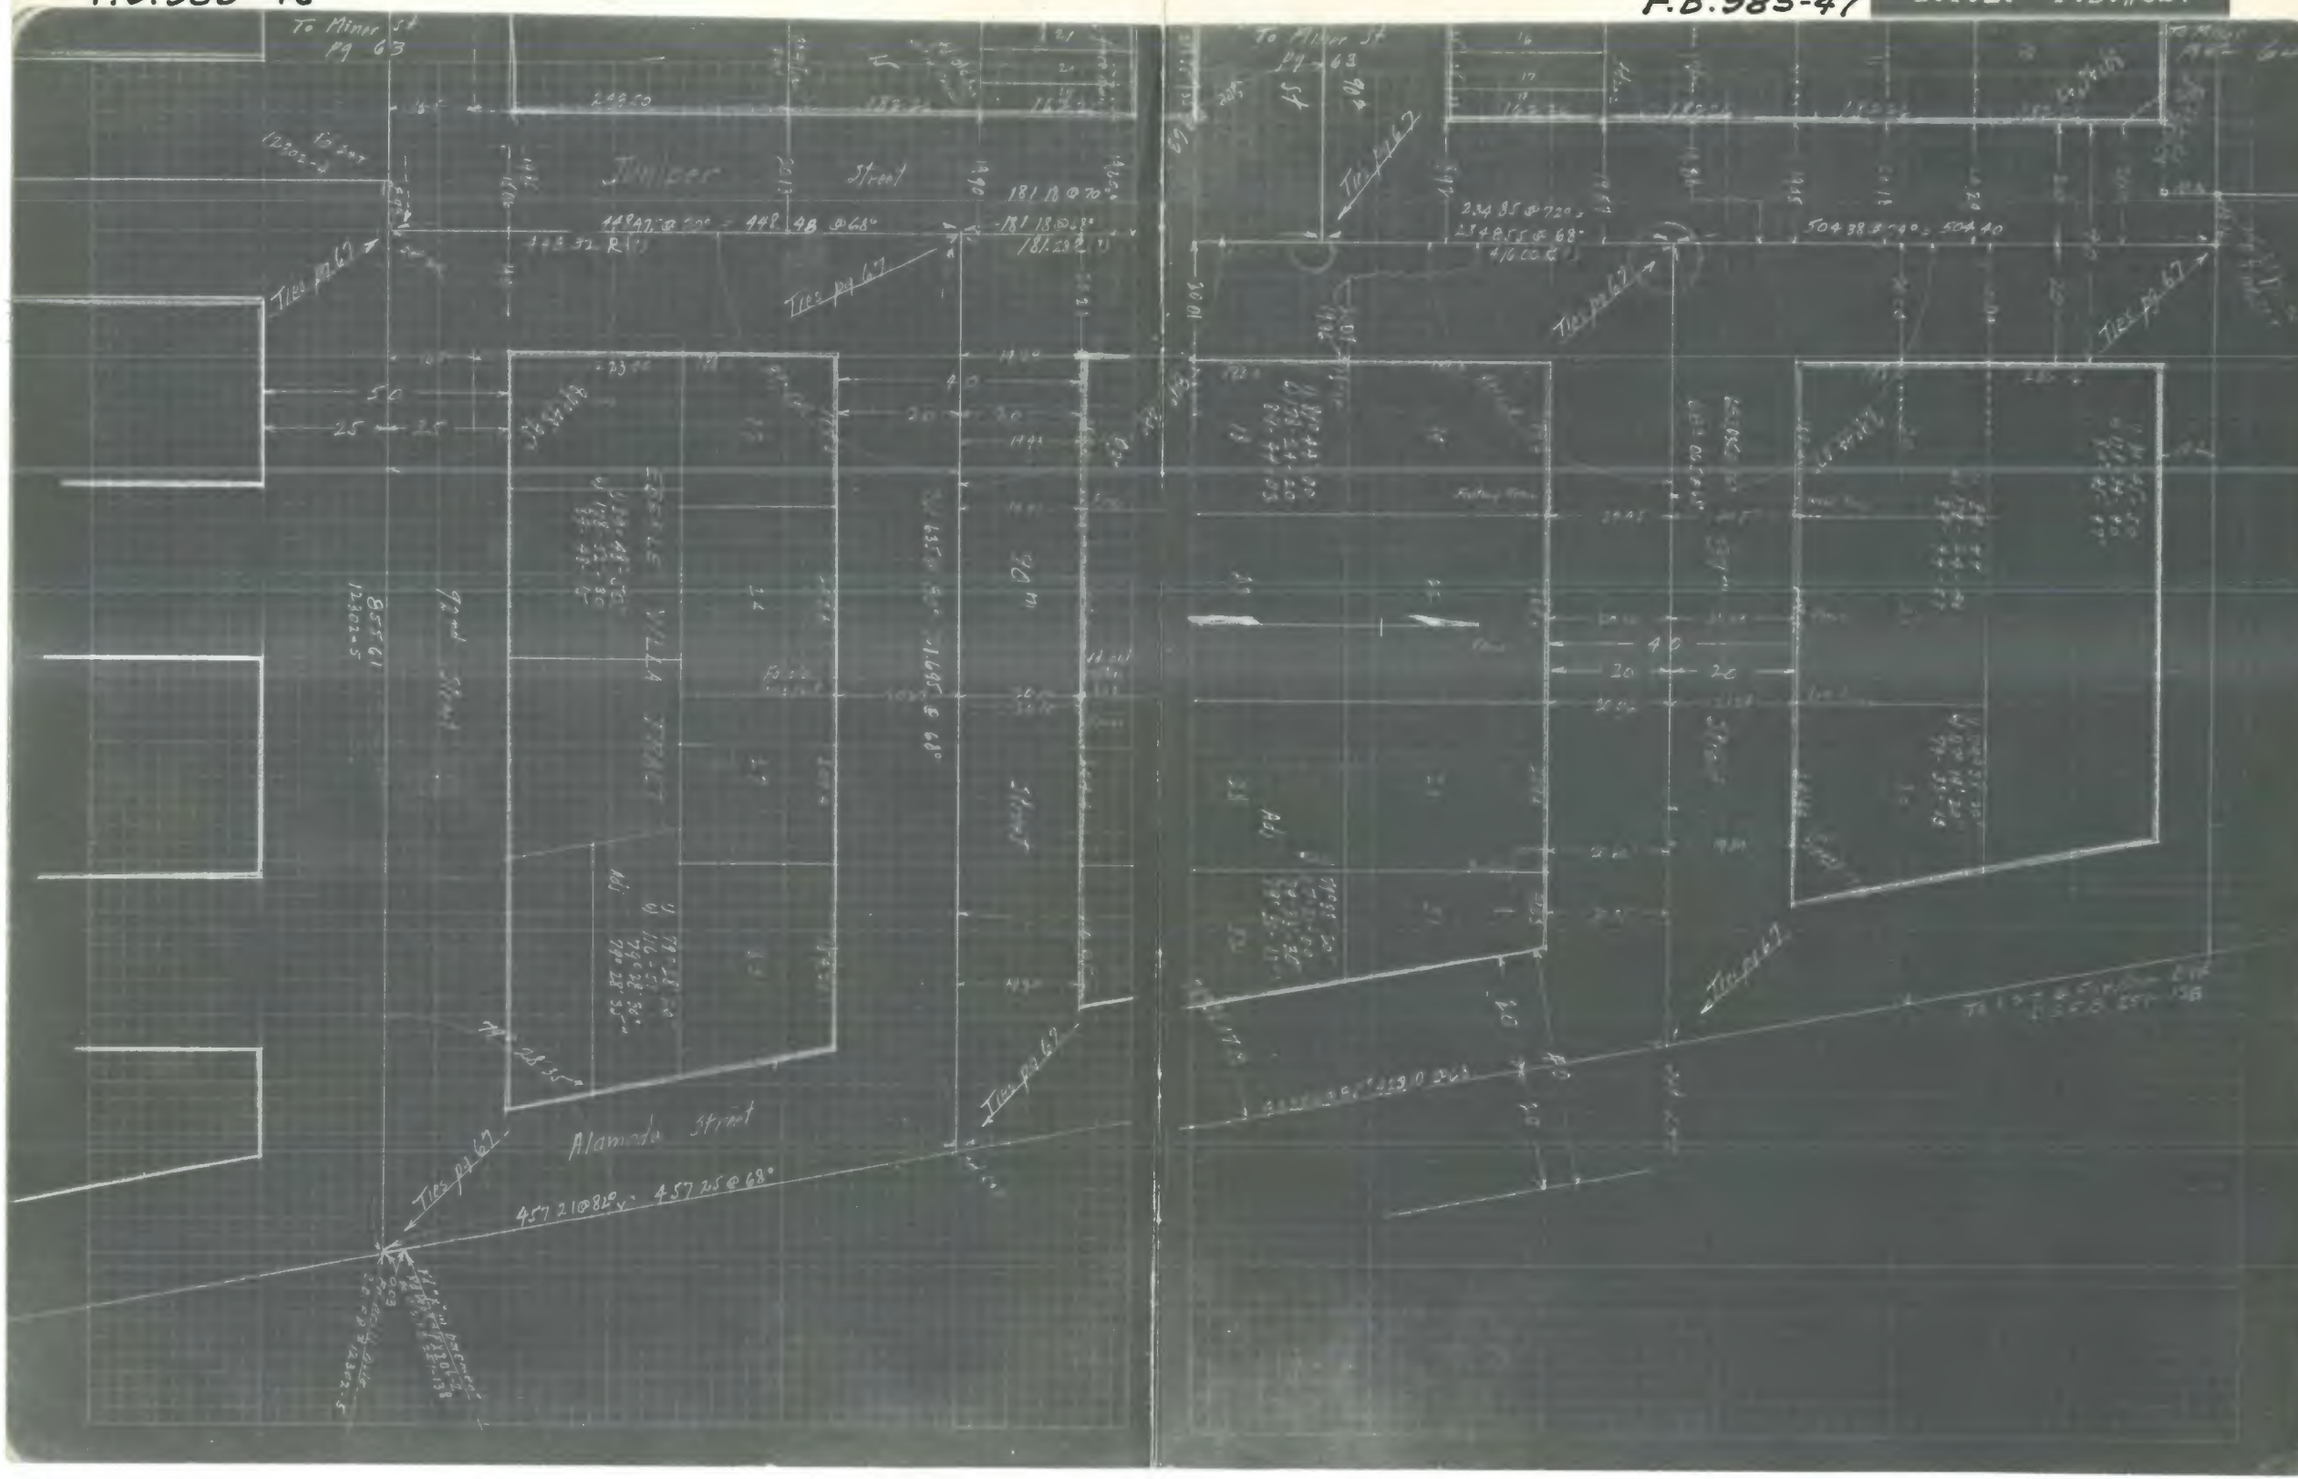
To Miner St Pg 63
Tiles pg 67
Tiles pg 67
Tiles pg 67

F.B. 985-48 -77

F.B. 985-49

B.P.L. F.B.#527

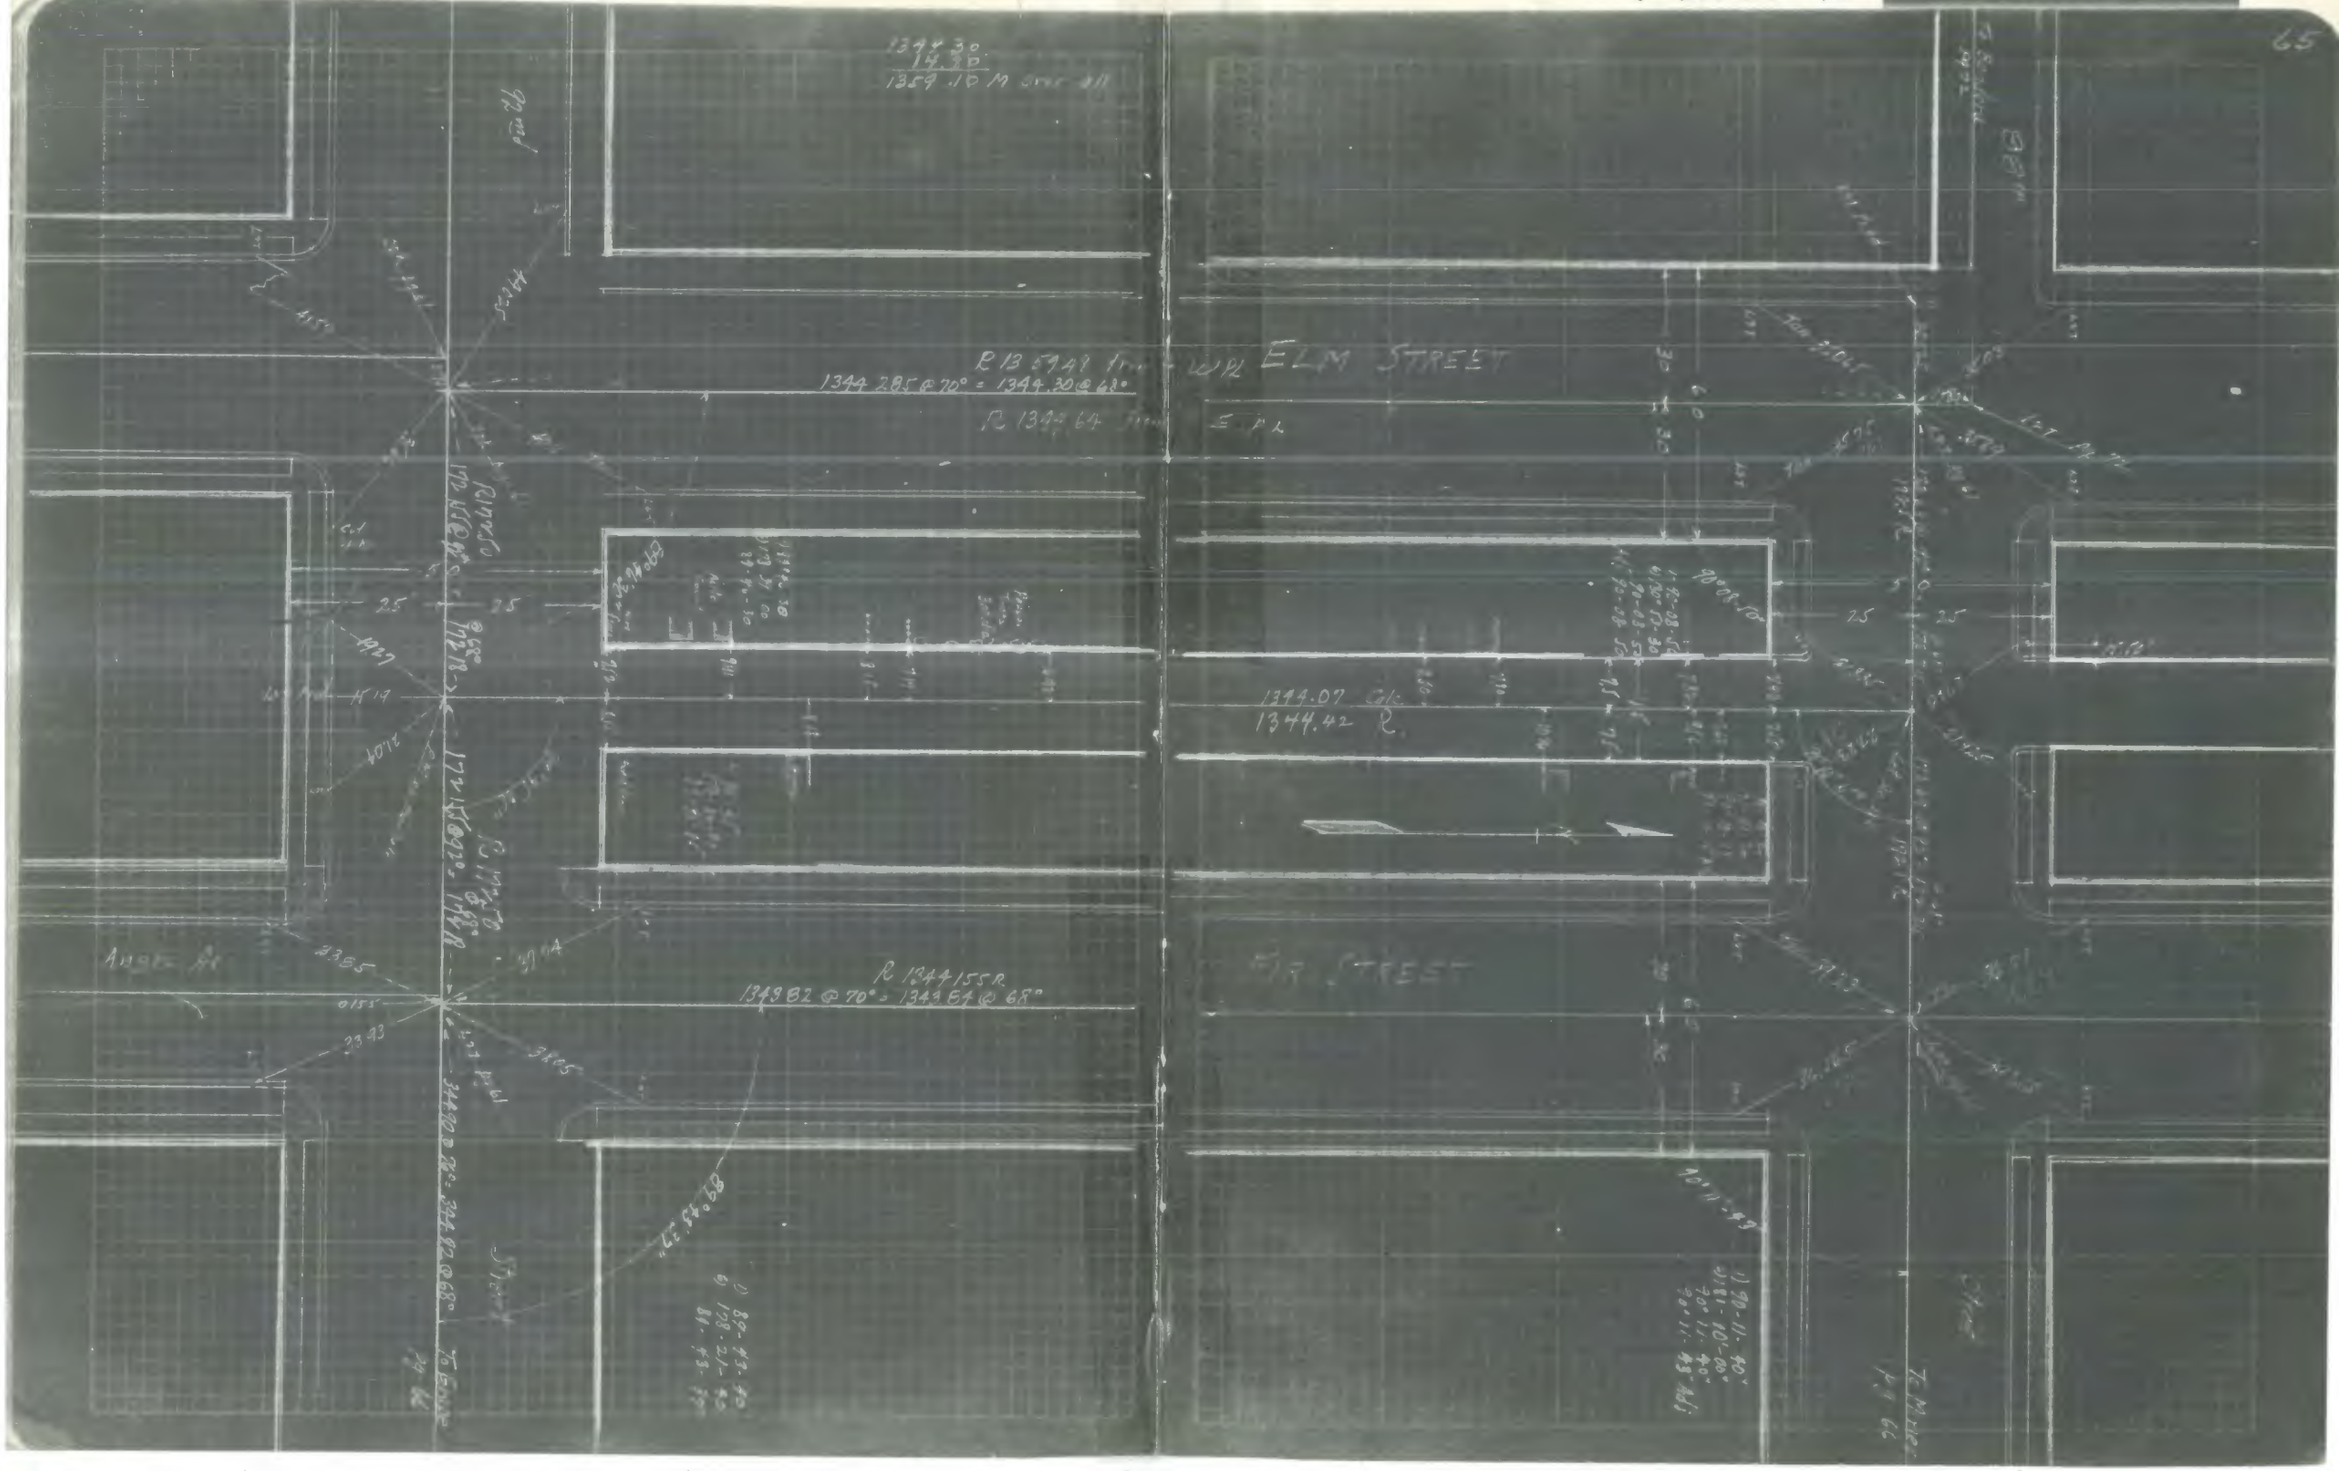

F.B. 985-50

F.B. 985-51

B.P.L. F.B.#527

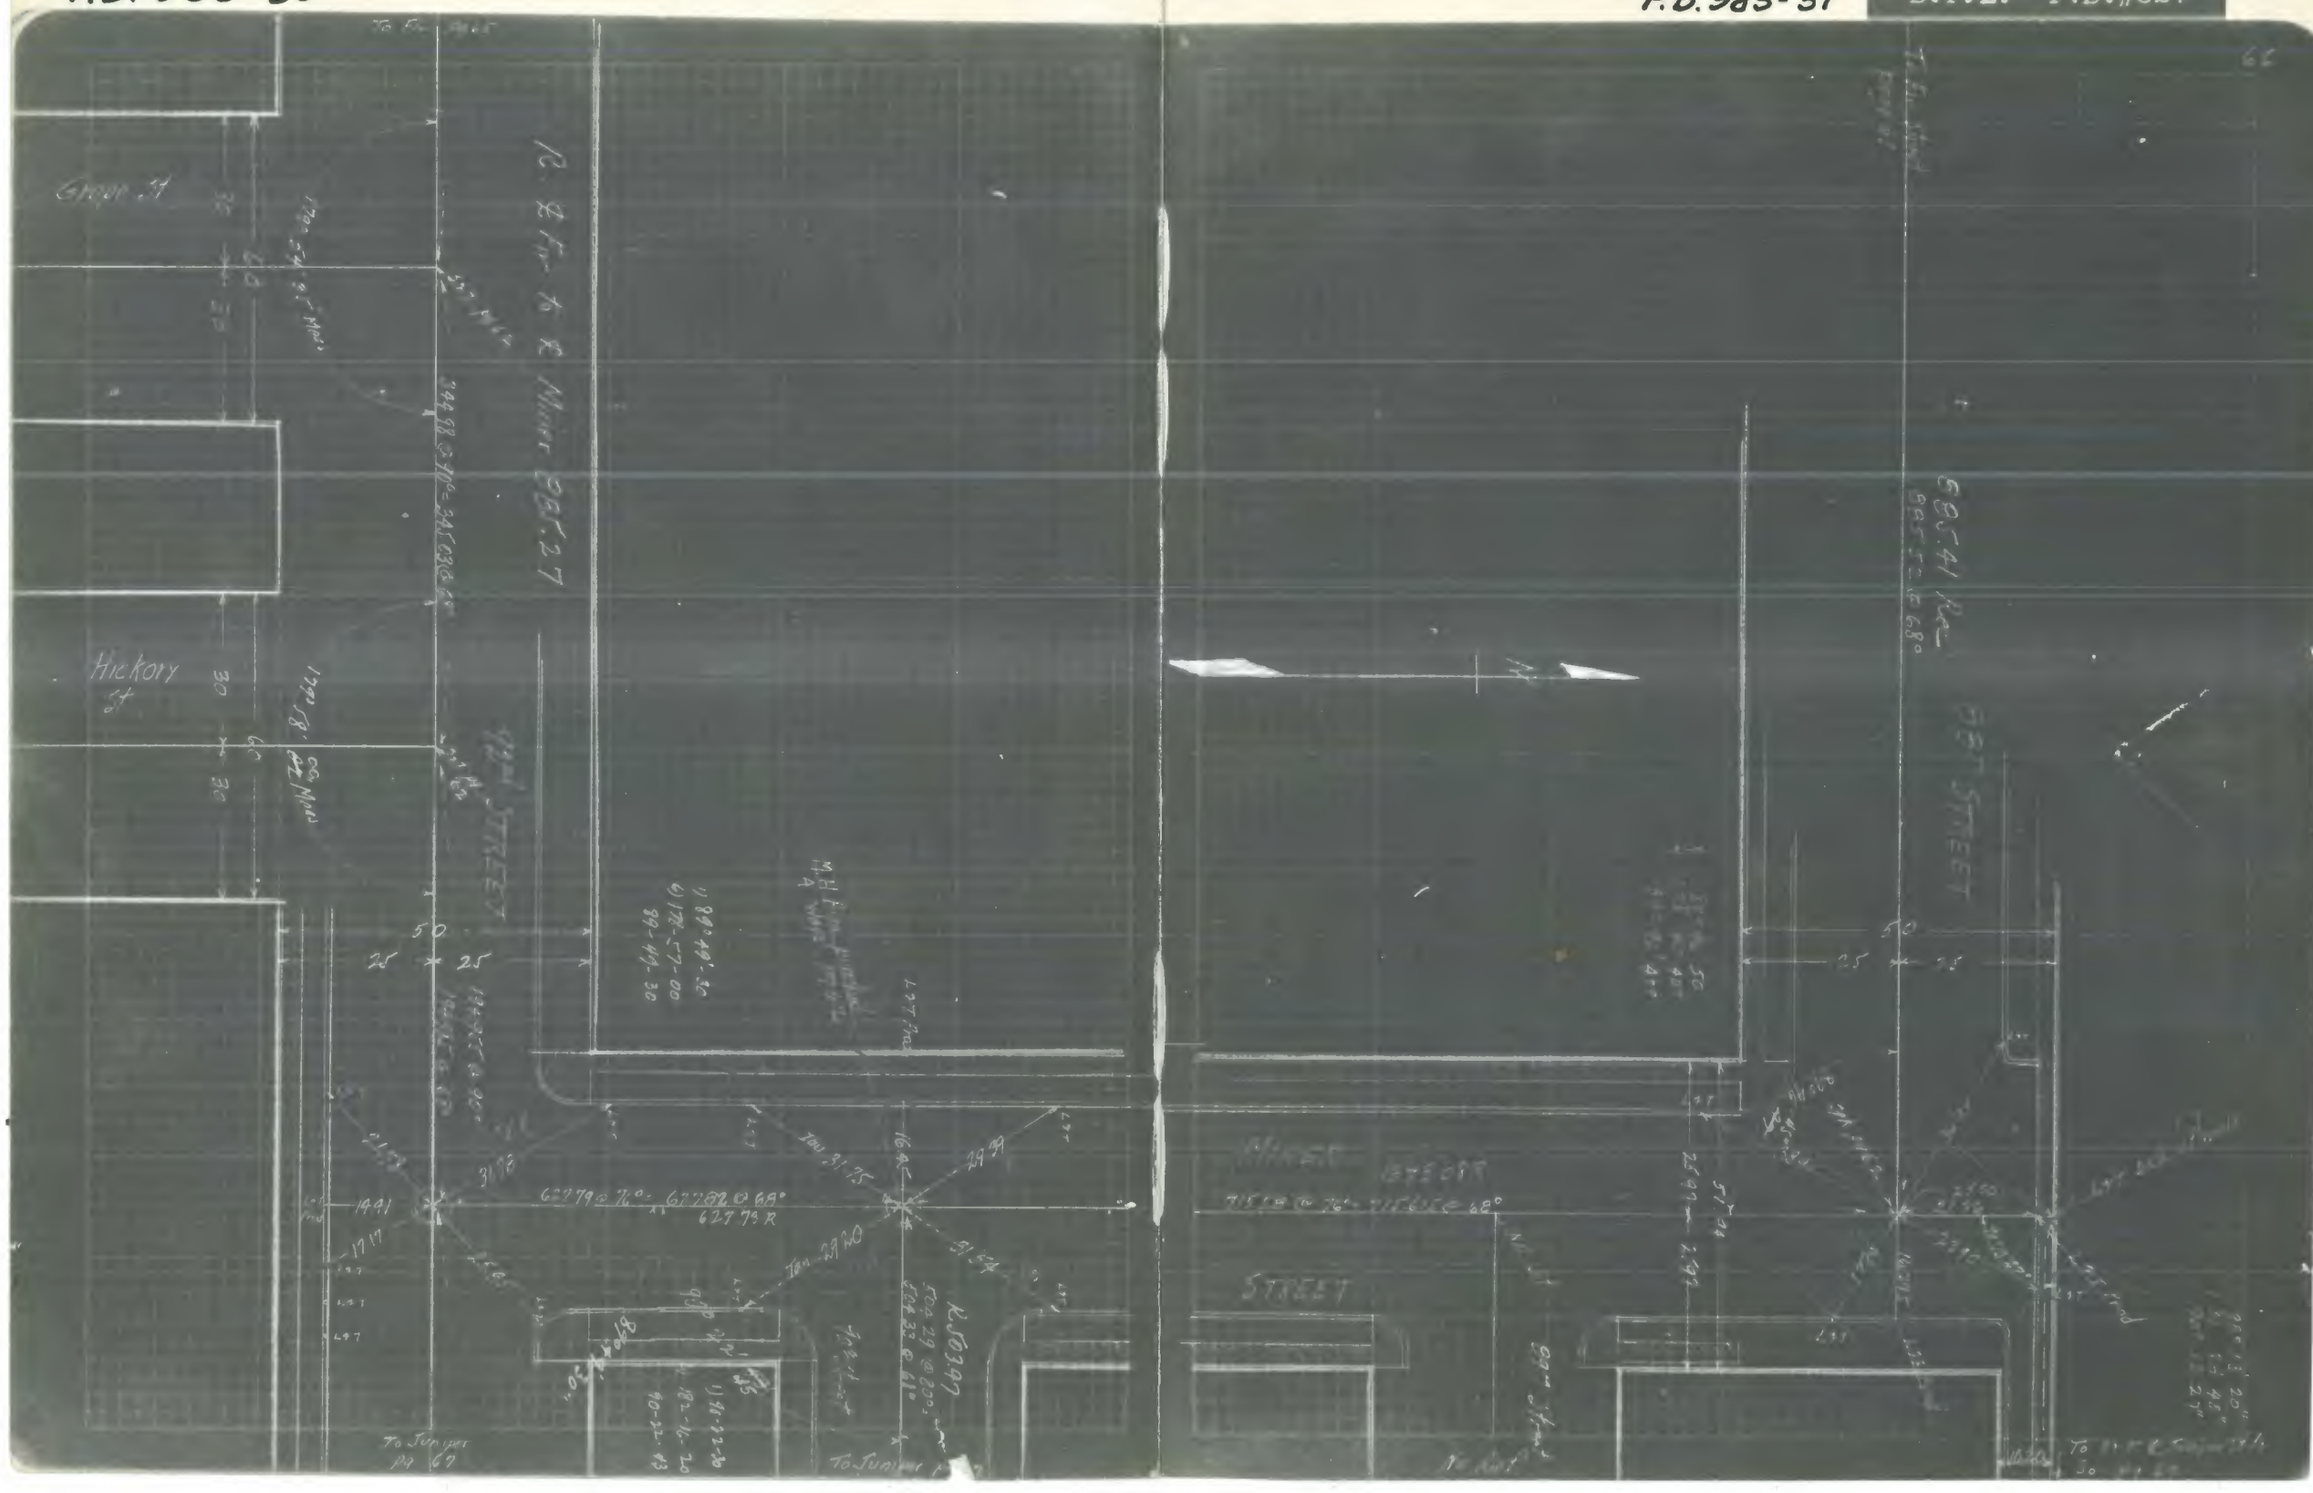
Hickory
37
Hickory
37
50
25
25
50
STREET
STREET
STREET
STREET
627.79
627.79
627.79

F.B.985-52

F.B.985-53

B.P.L. F.B.#527

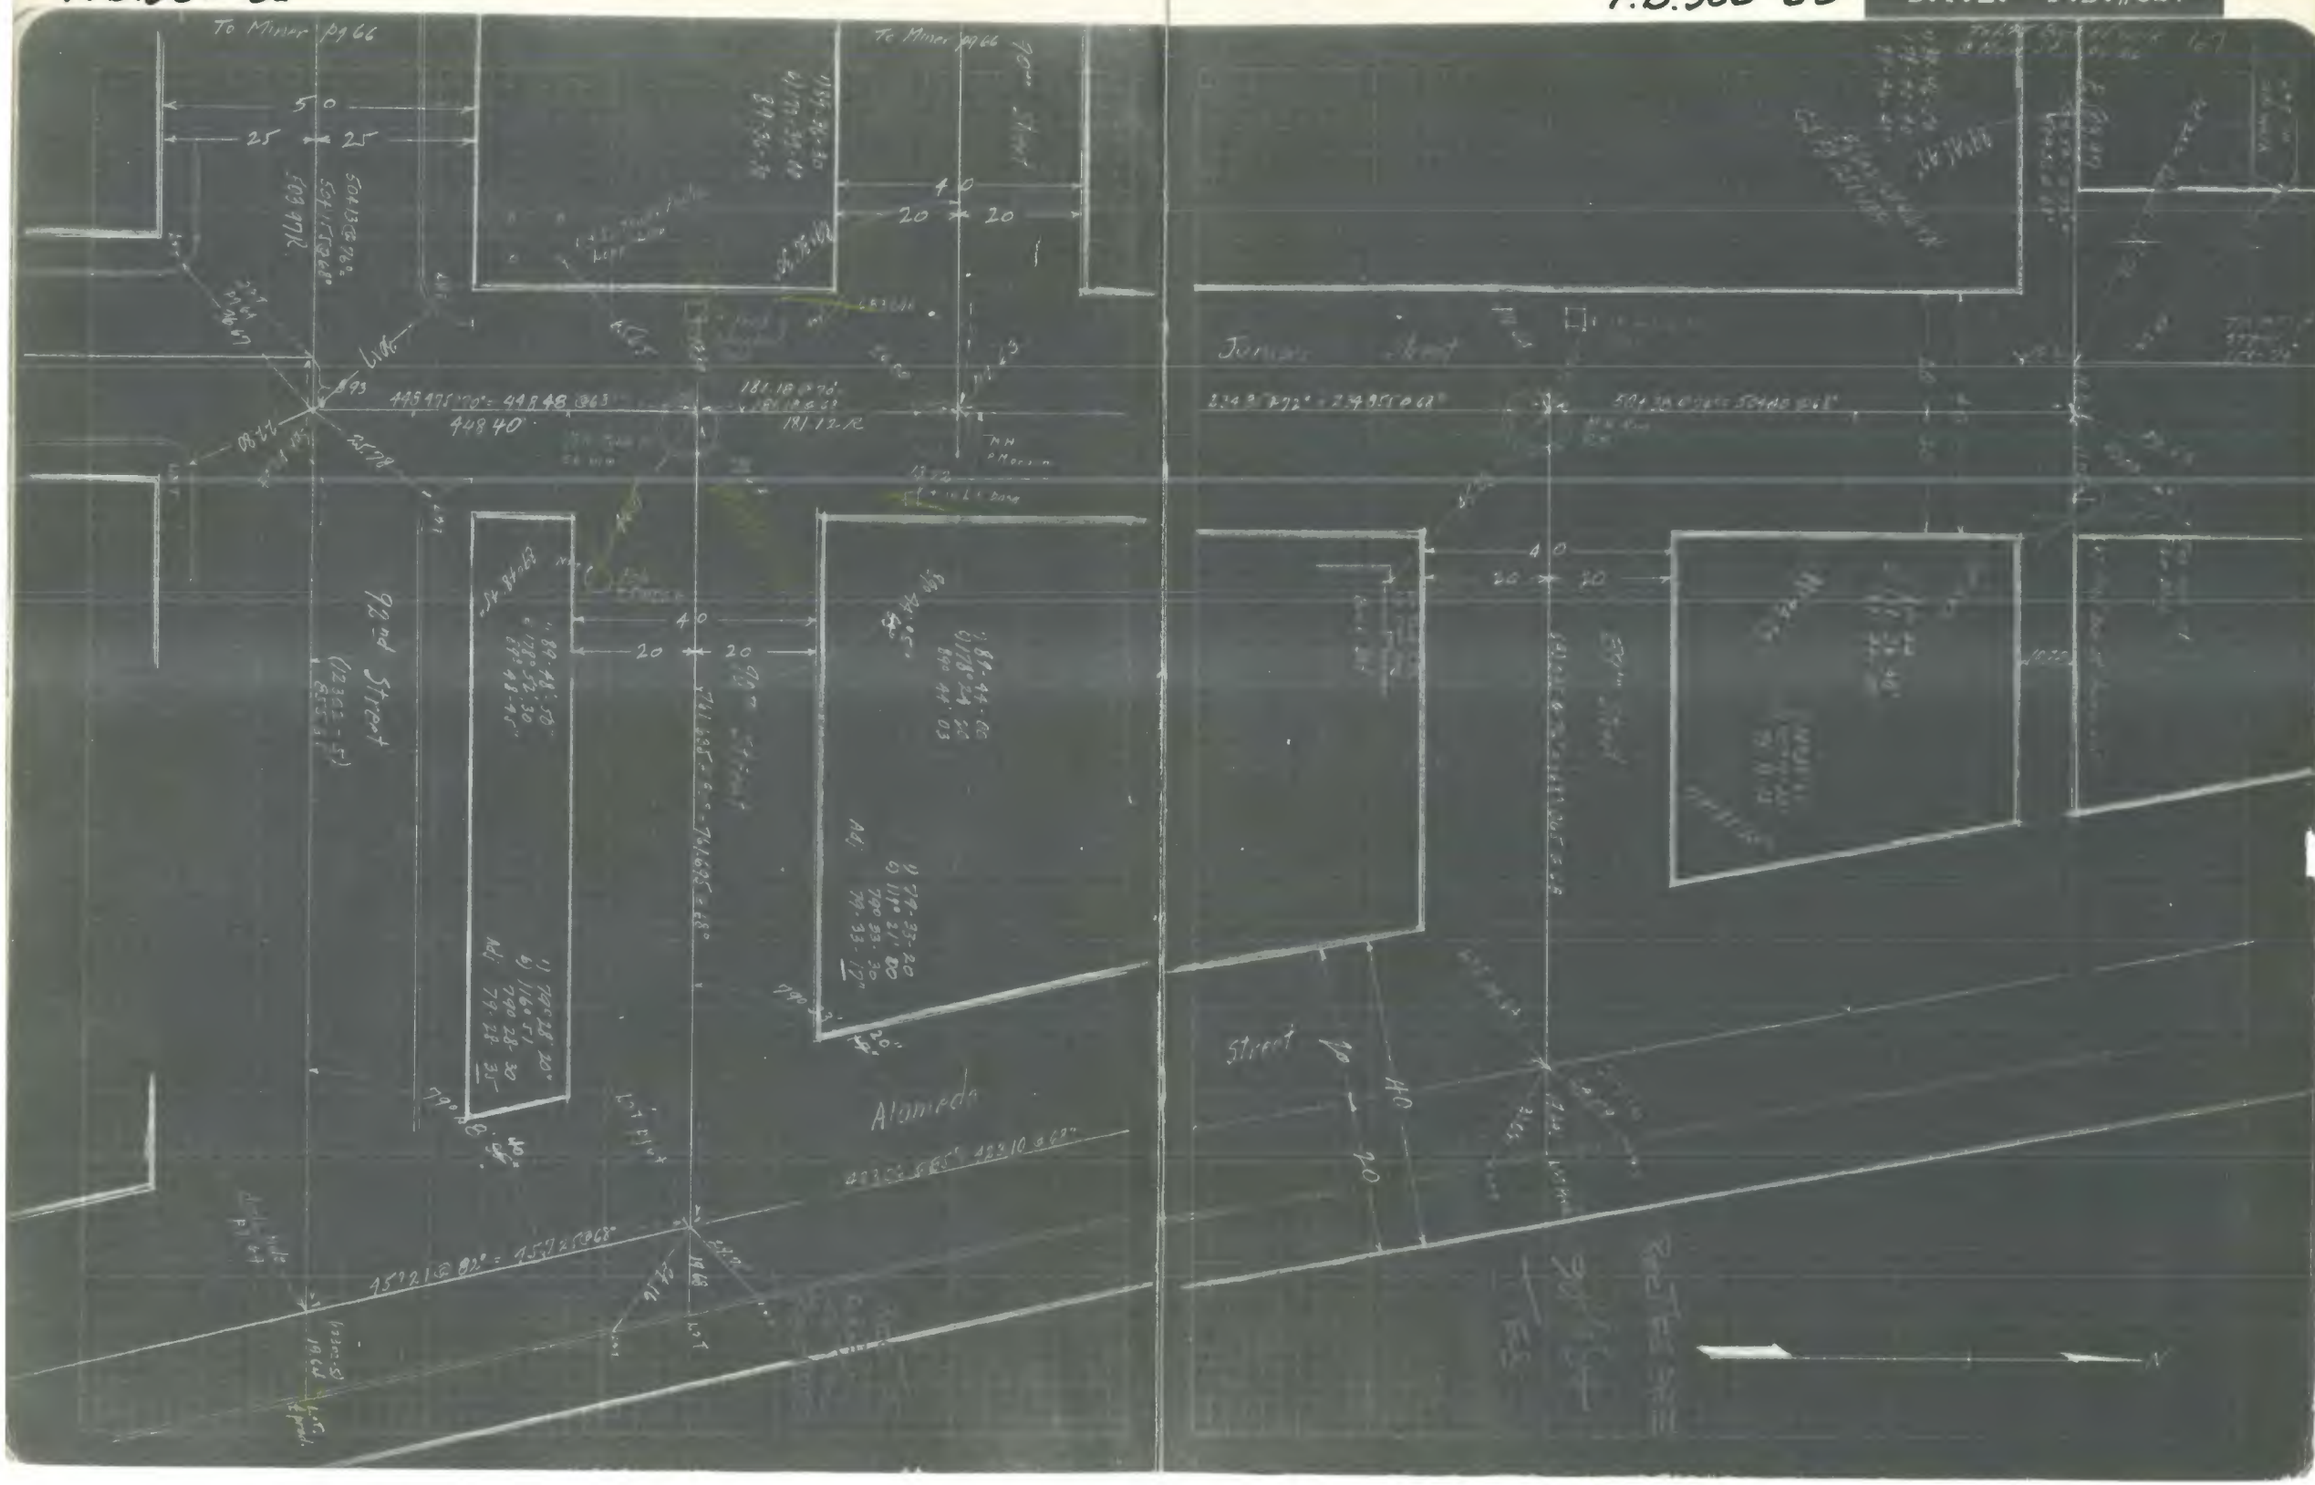
To Minor pg 66
To Minor pg 66
50
25
25
40
20
20
Lot
Lot
Lot

B.P.L. F.B.#527

Survey... Tie & Distances

12th Street to 68th Street

GRAHAM STREET To ELM STREET

References

City Eng. F.B. 12310 - 5, 9, 31

" " " 10382 - 2, 3

County Sur. F.B. 58 - 11, 15, 17

" " " 123 - 3


R. L. Mooney Surveyor

Jos. Watson Rod

Ed. Donahue Chainman

Chas. Brooks "

Walter Hamilton "

July 8th 1896 To July 18th 1896

F.B. 985-56

F.B. 985-57

B.P.L. F.B.#527

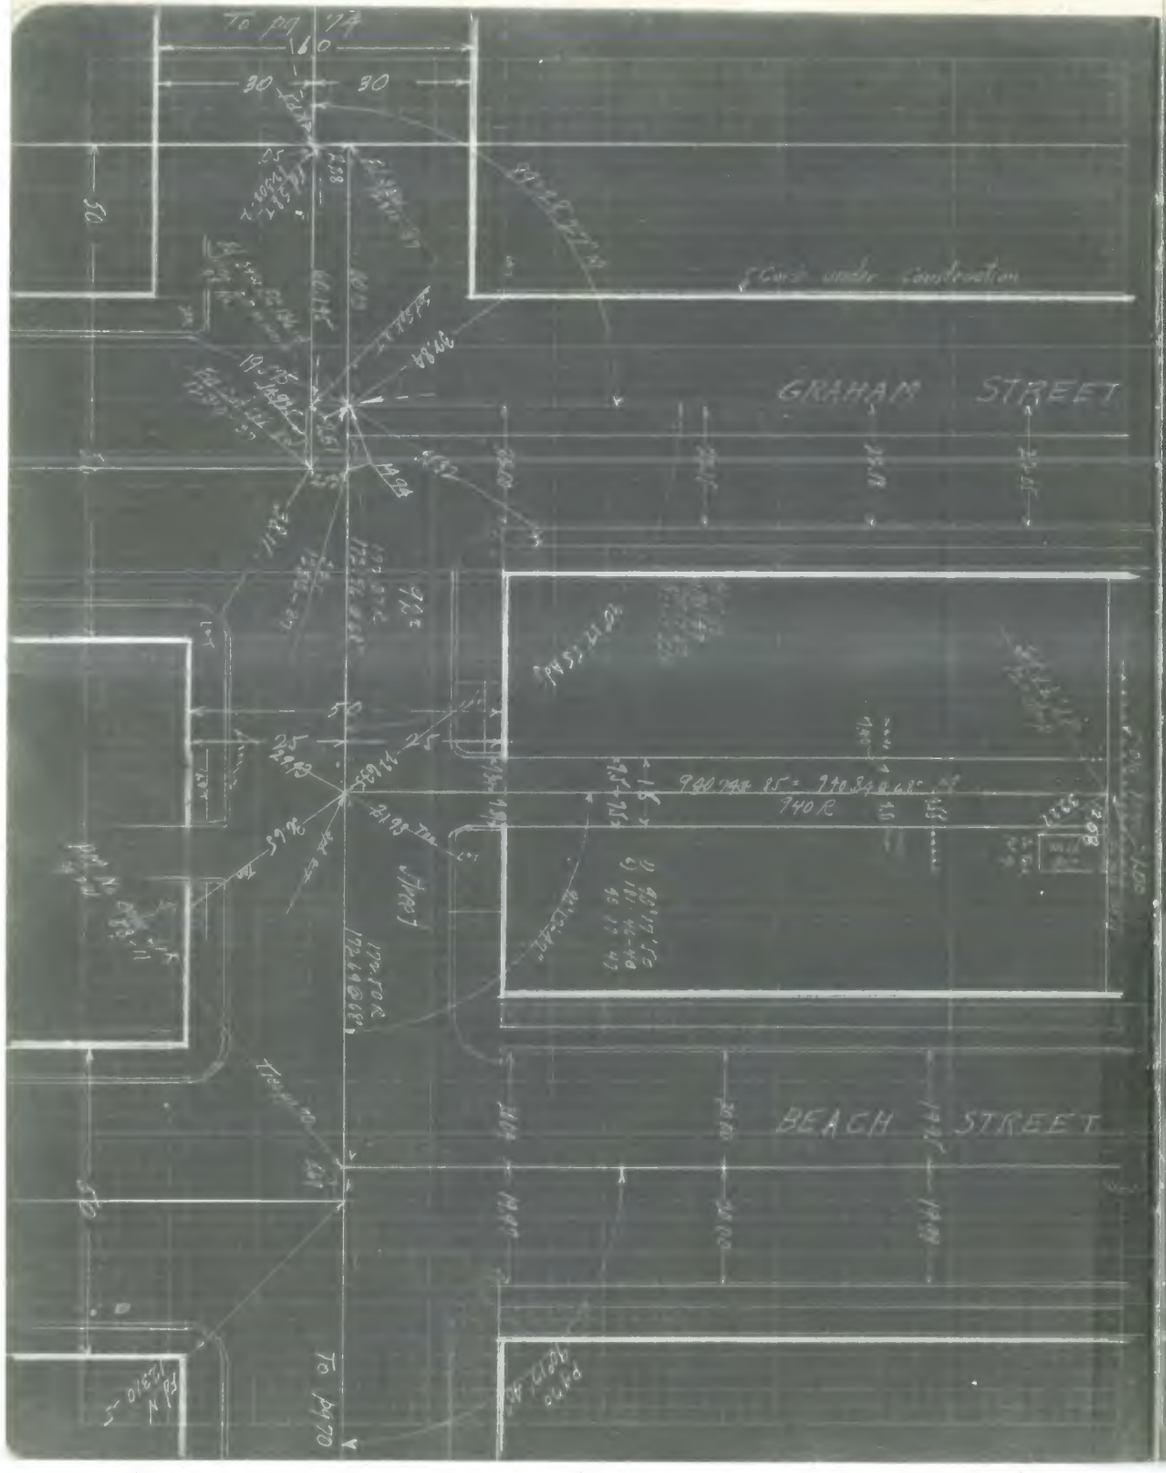

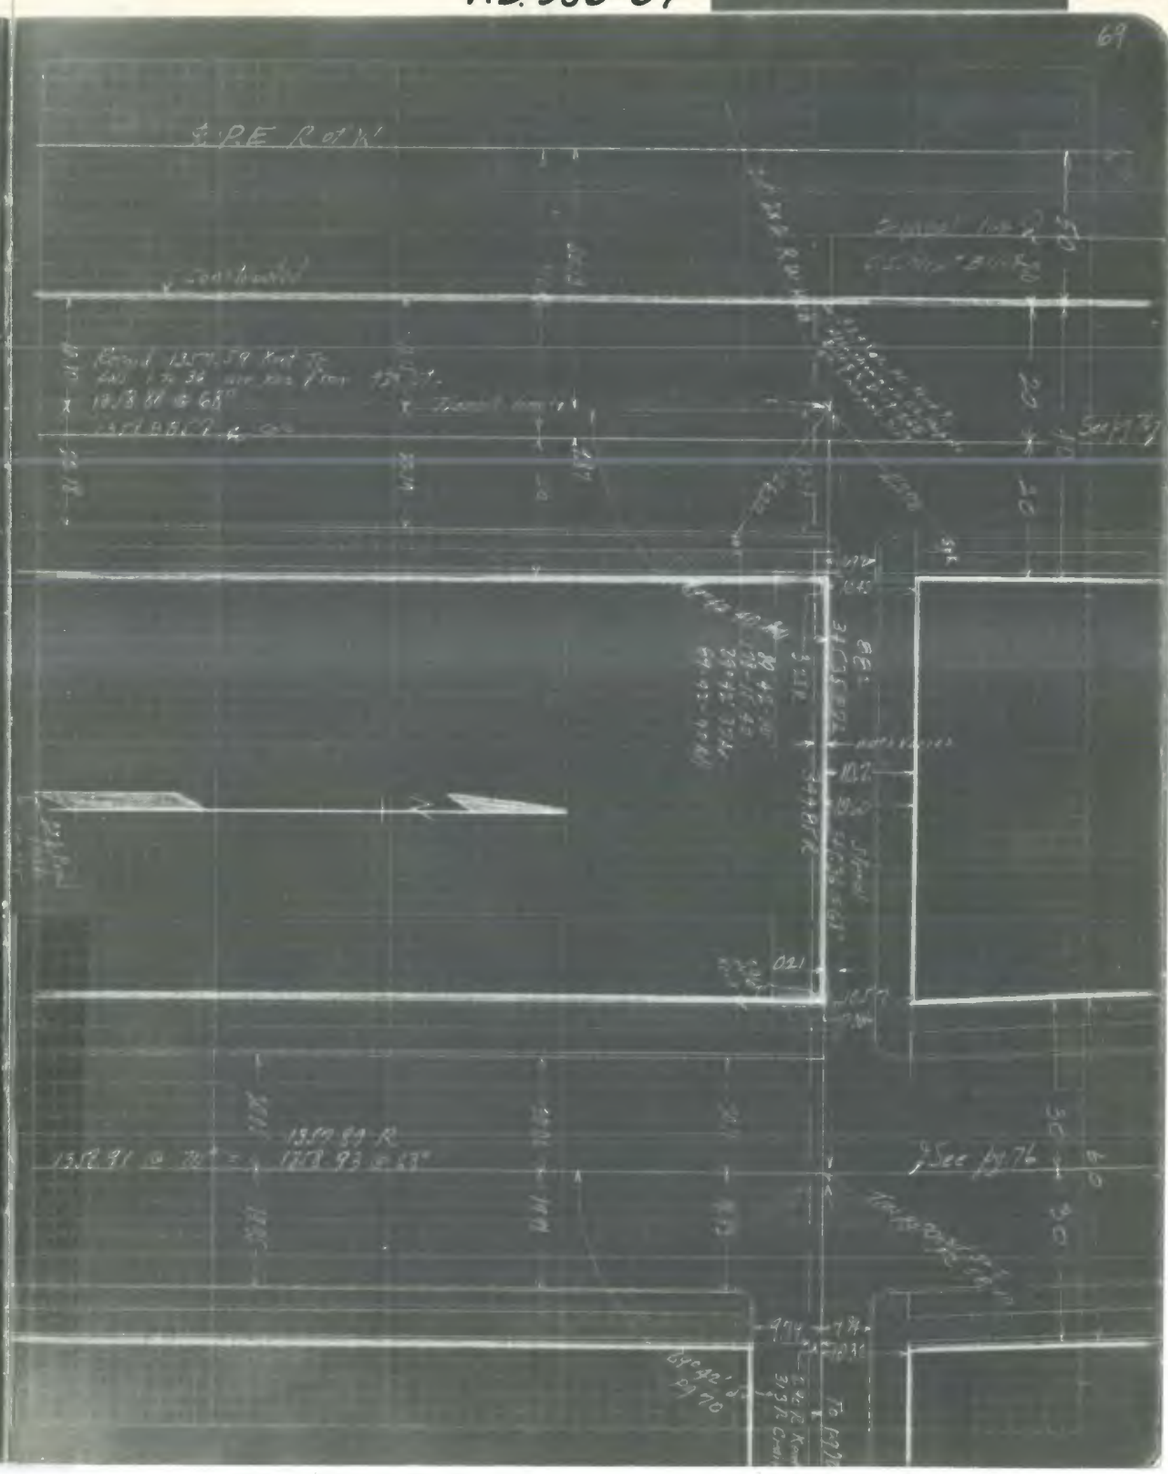

F.B. 985-58

F.B. 985-59

B.P.L. F.B.#527

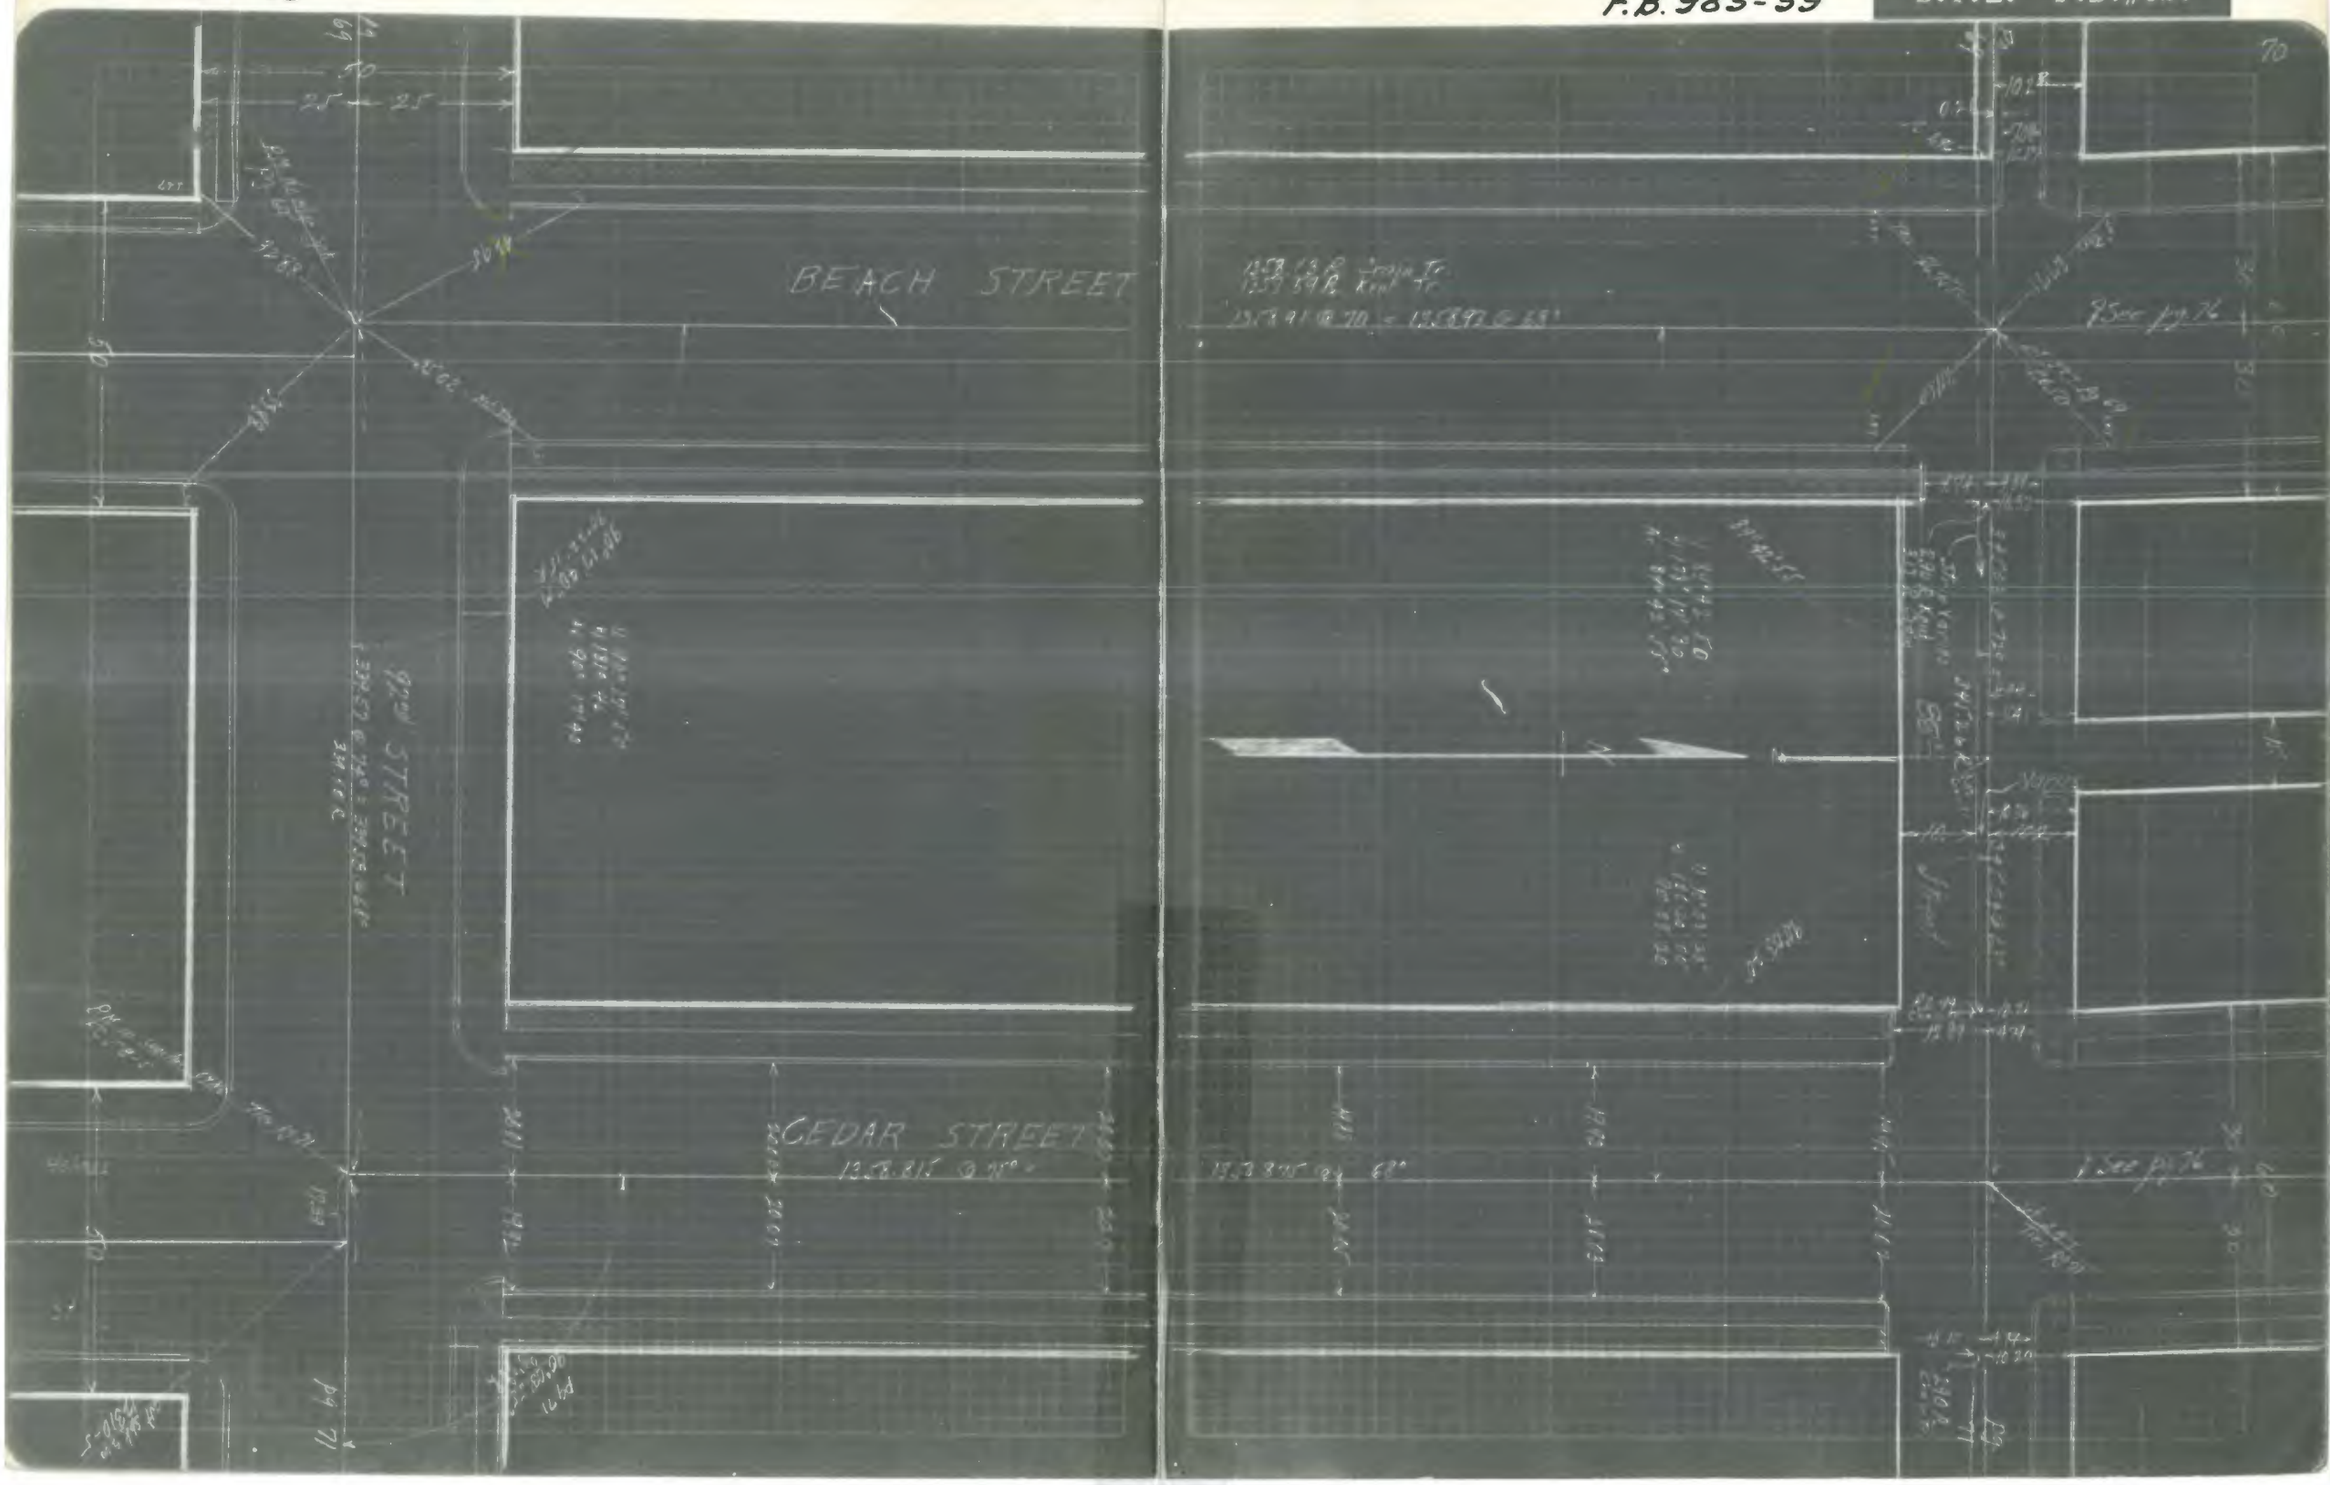

F.B. 985-60

F.B. 985-61

B.P.L. F.B.#527

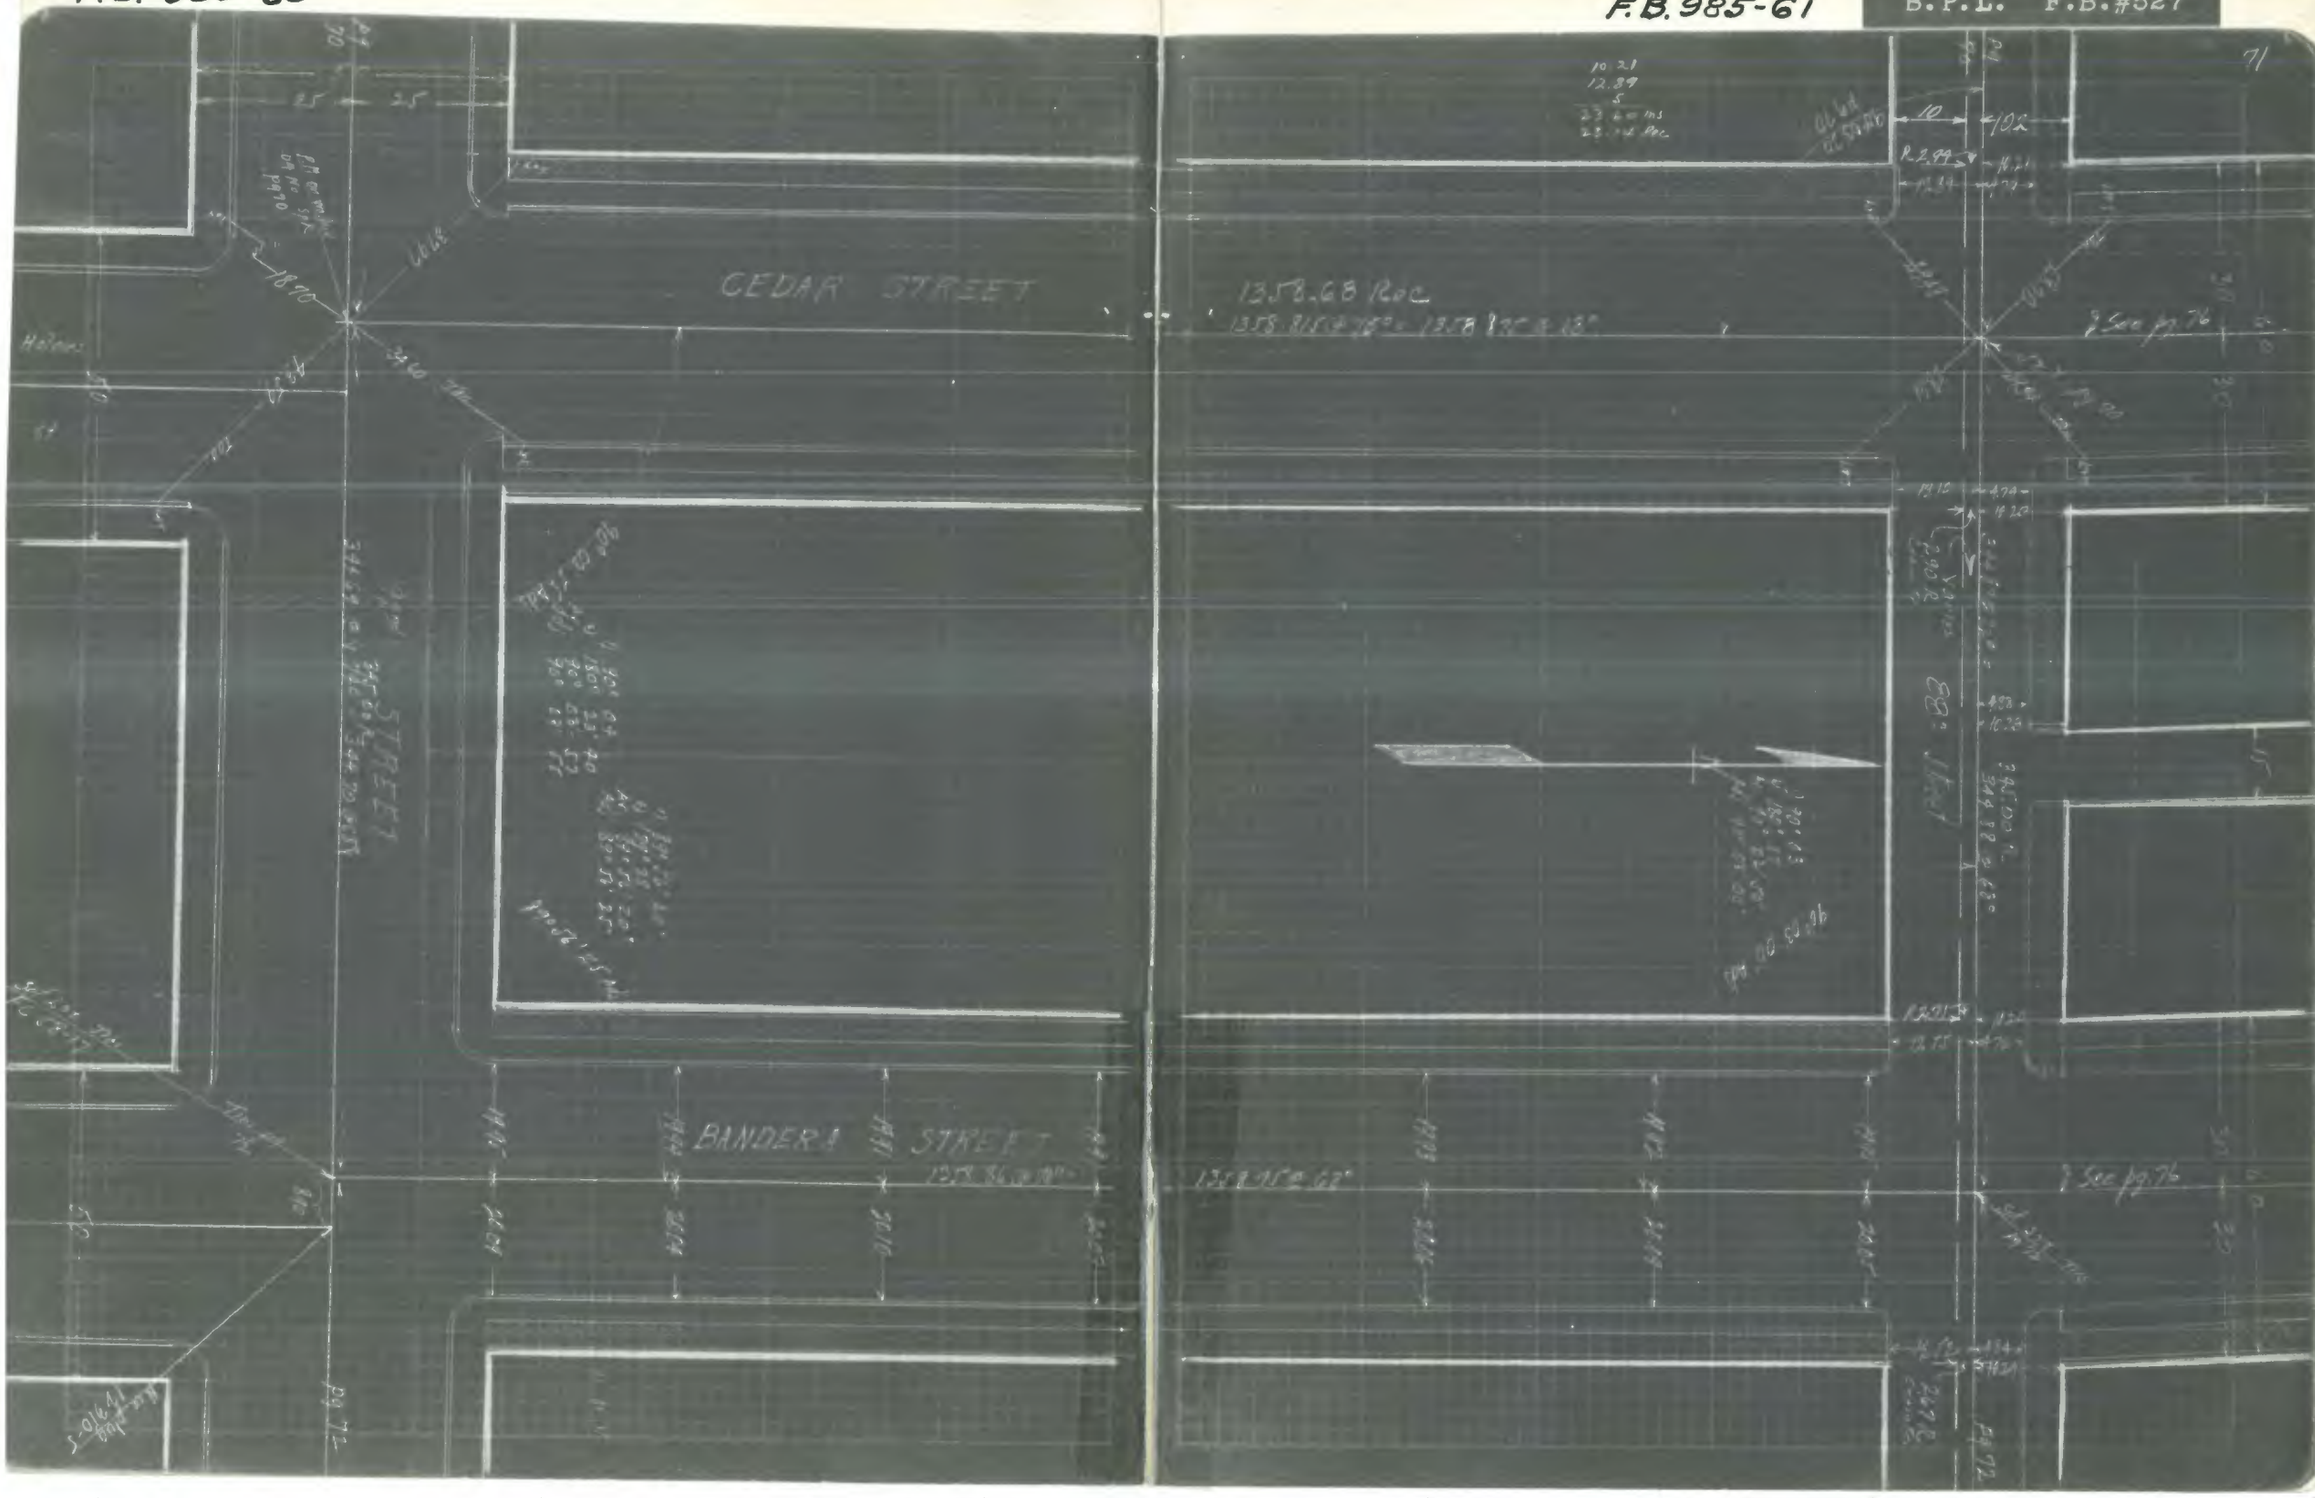

F.B. 985-62

F.B. 985-63

B.P.L. F.B.#527

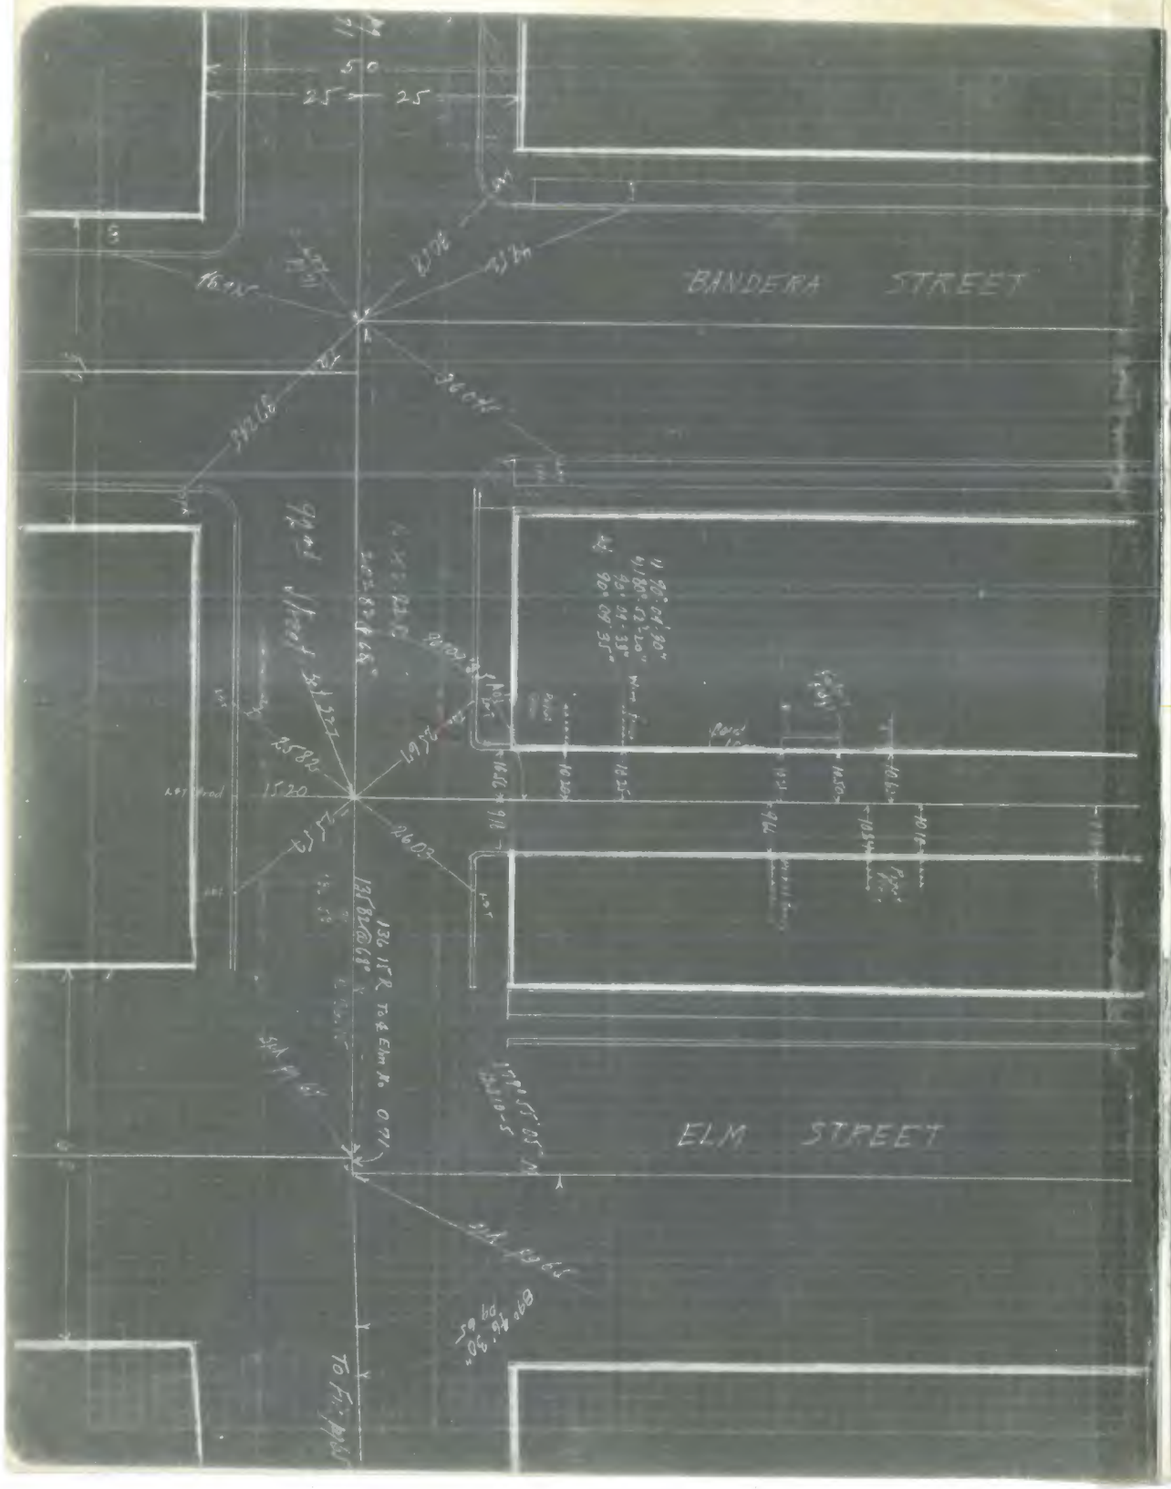

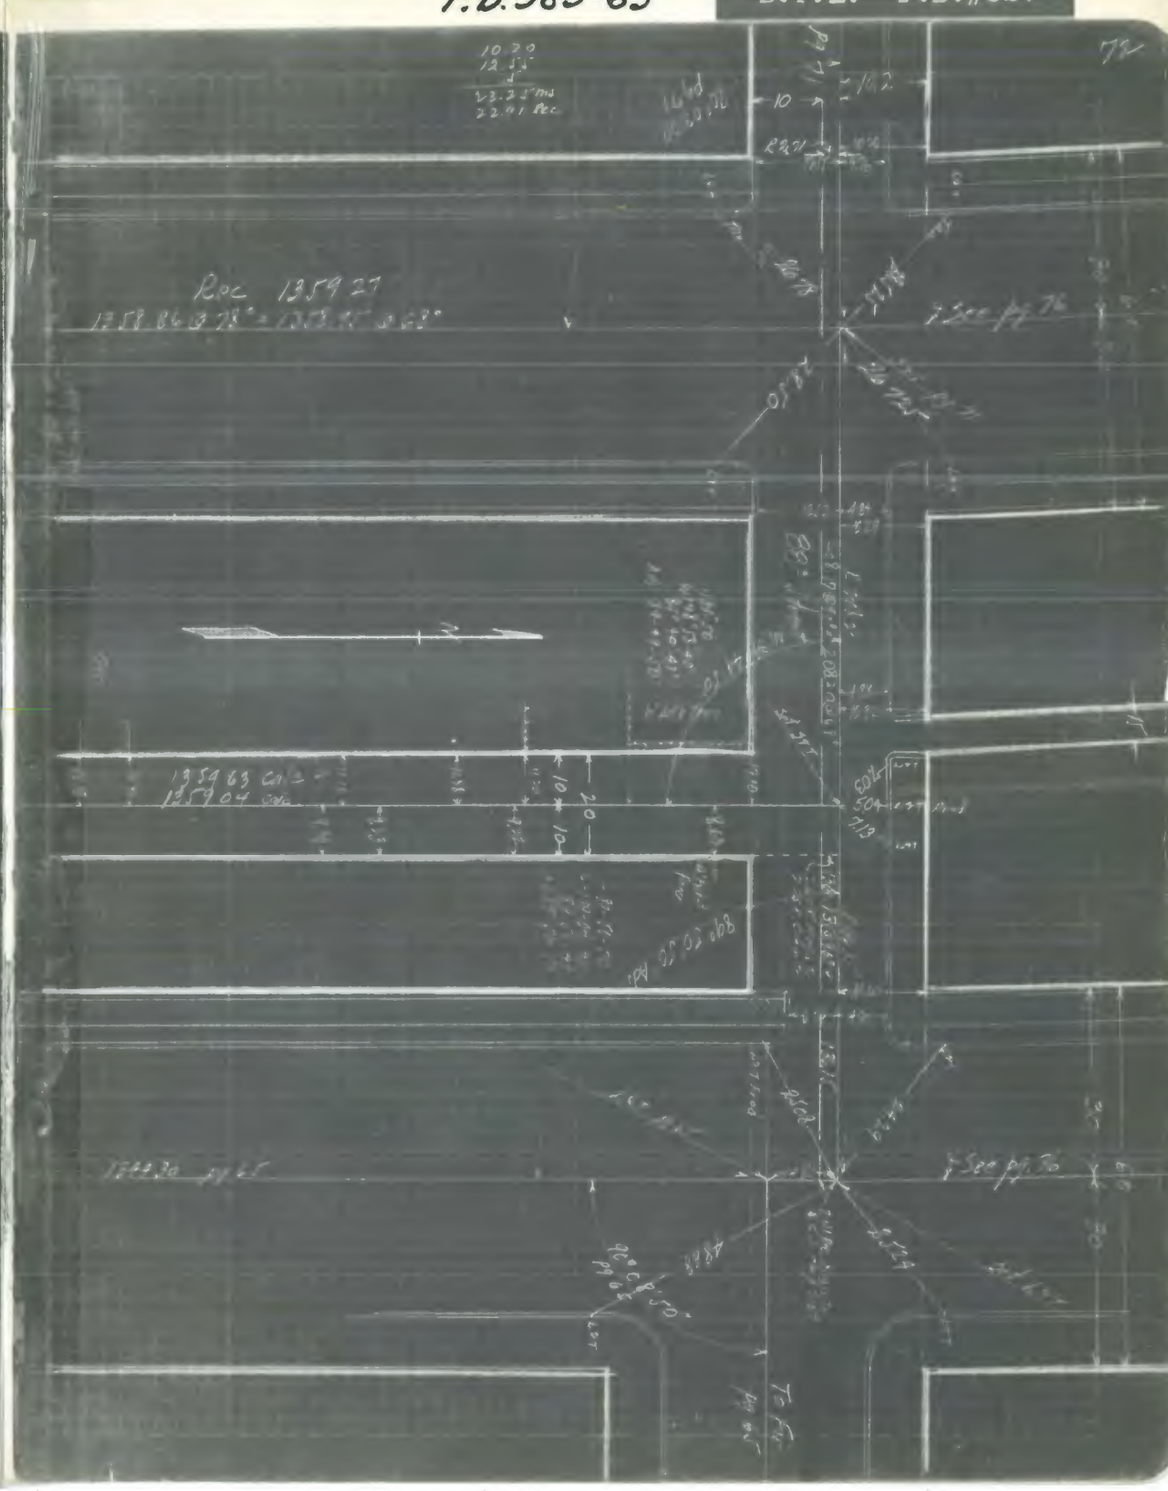

B.P.L. F.B.#527

L Survey of Tract

COMPTON STREET

to

MAIE STREET

92nd STREET to 87th STREET

References

City Surv 9695-87-88

1530-1

LA County 364-17


R.L. Hessy Surveyor

Roy Hatton Asst

Ed Hemberg Asst

Henry Hamilton Asst

Aug 5-10-1936 Sept 2-10 1936

F. B. 985-66

F. B. 985-67

B. P. L. F. B. #527

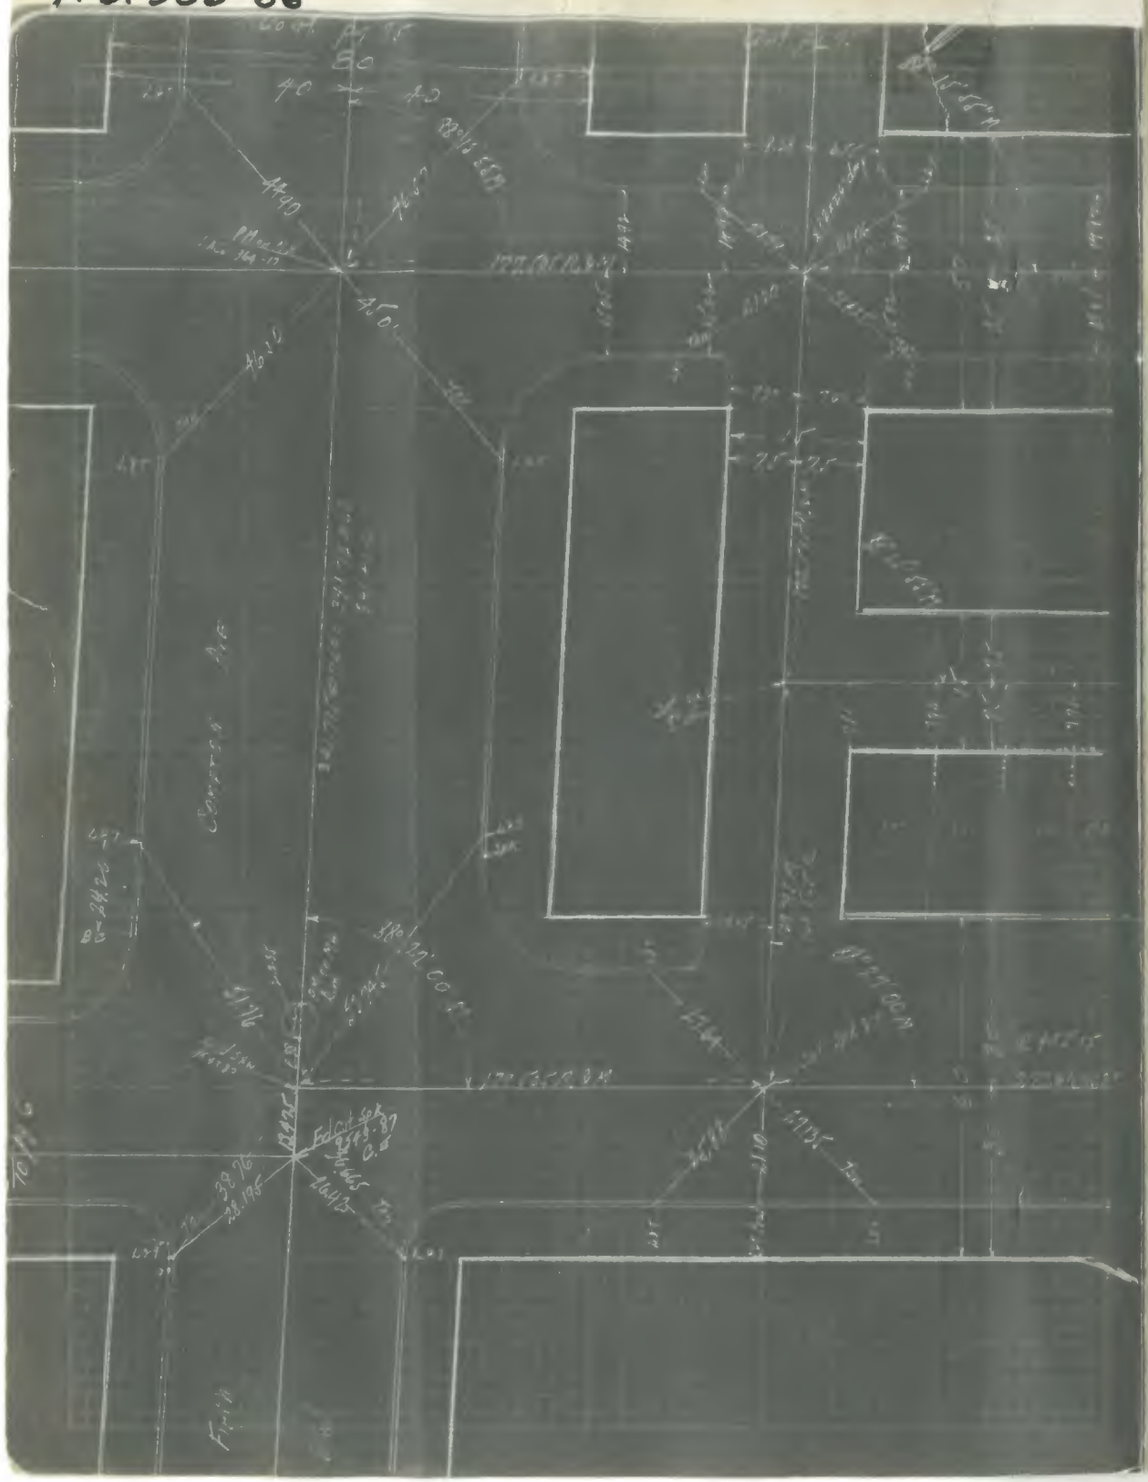

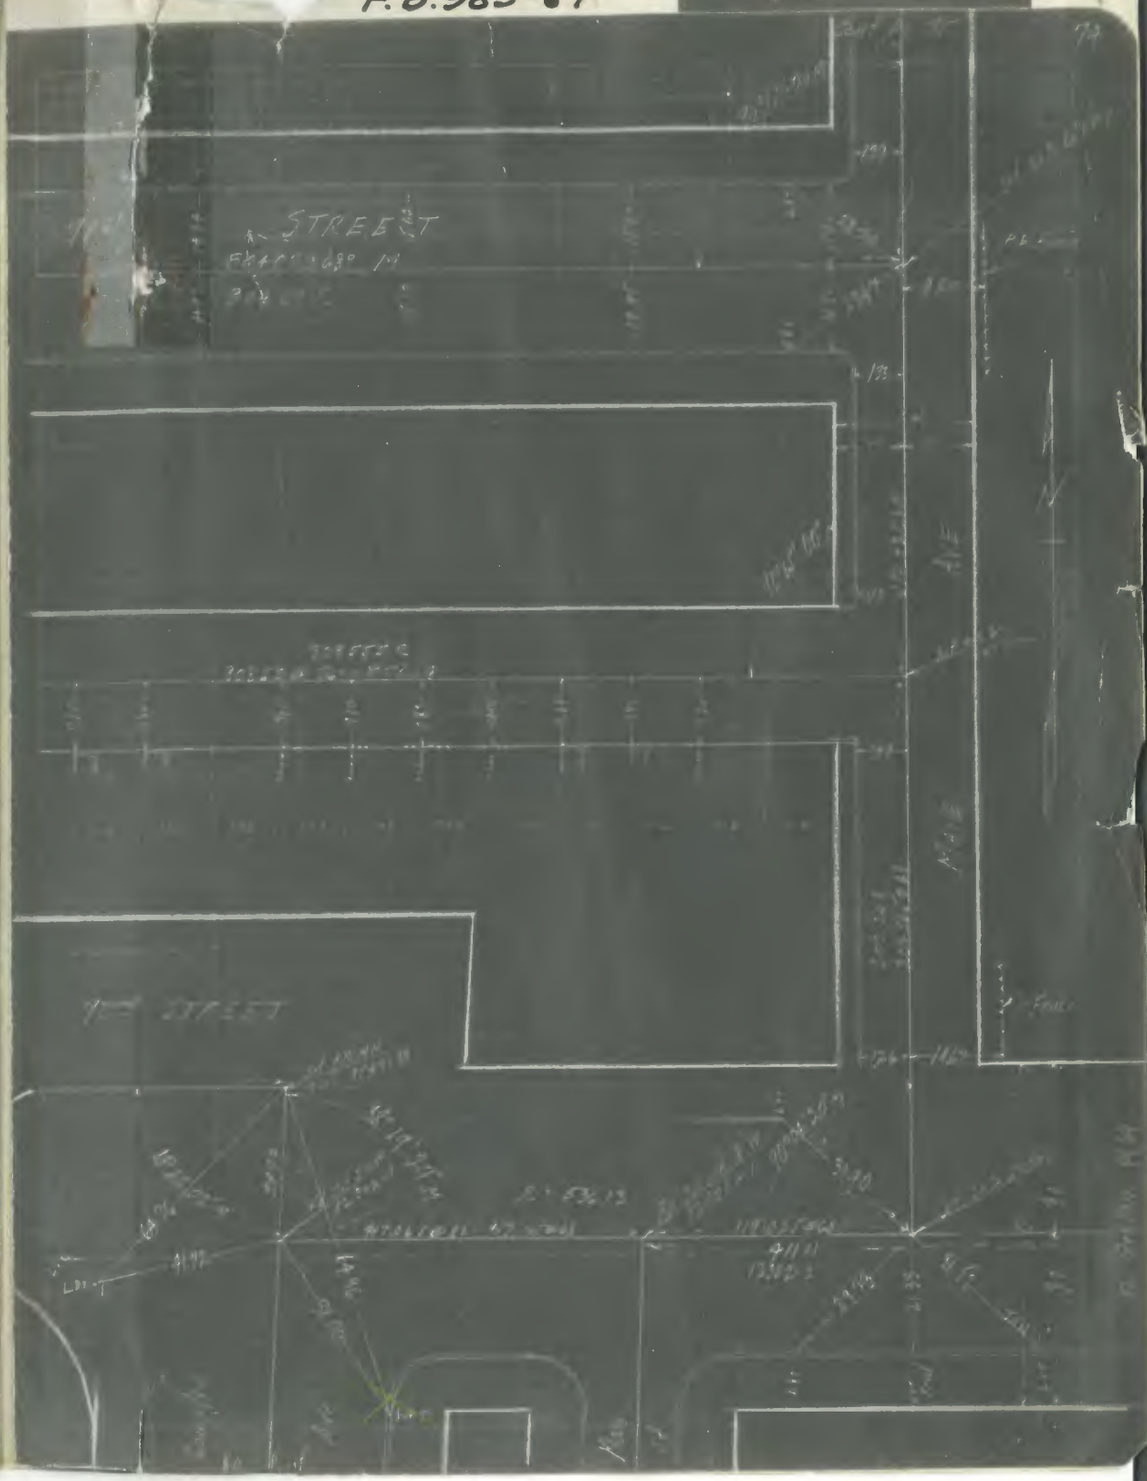

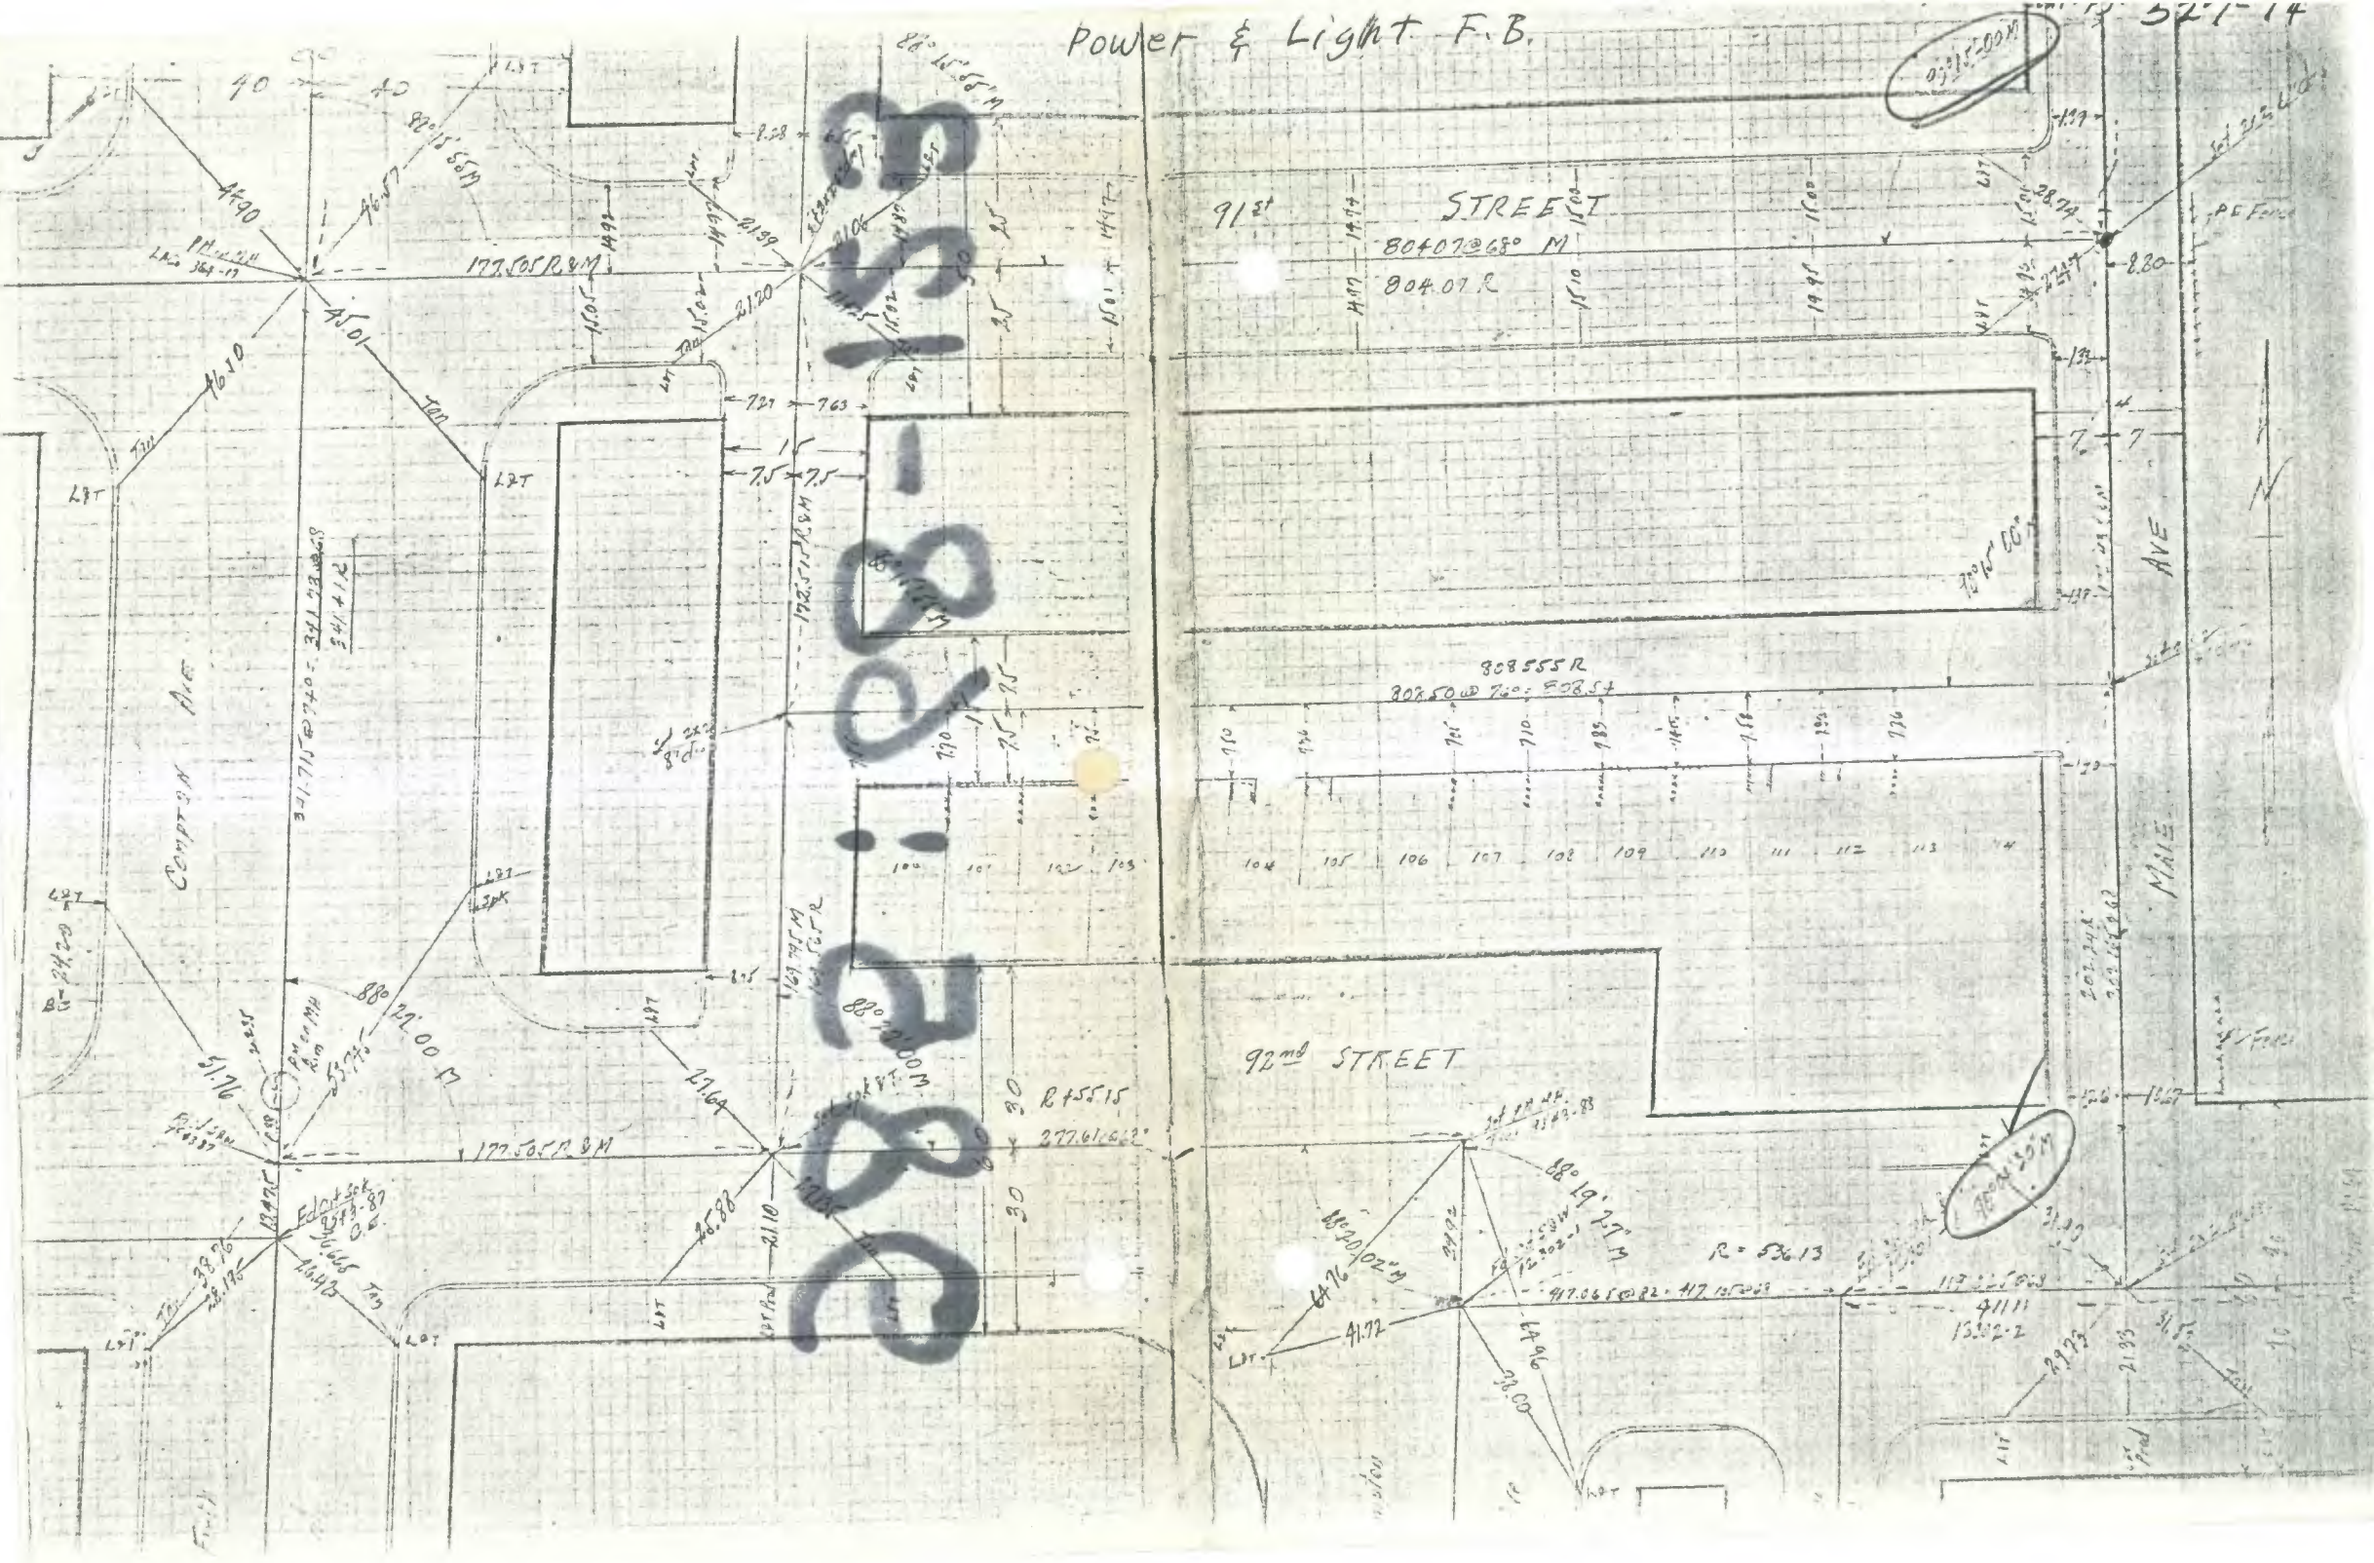
Power & Light F.B.
91st STREET
92nd STREET
COMPTON AVE
MAIE AVE
177.505 R & M
177.505 R & M
177.505 R & M

Power & Light F.B.

527-74

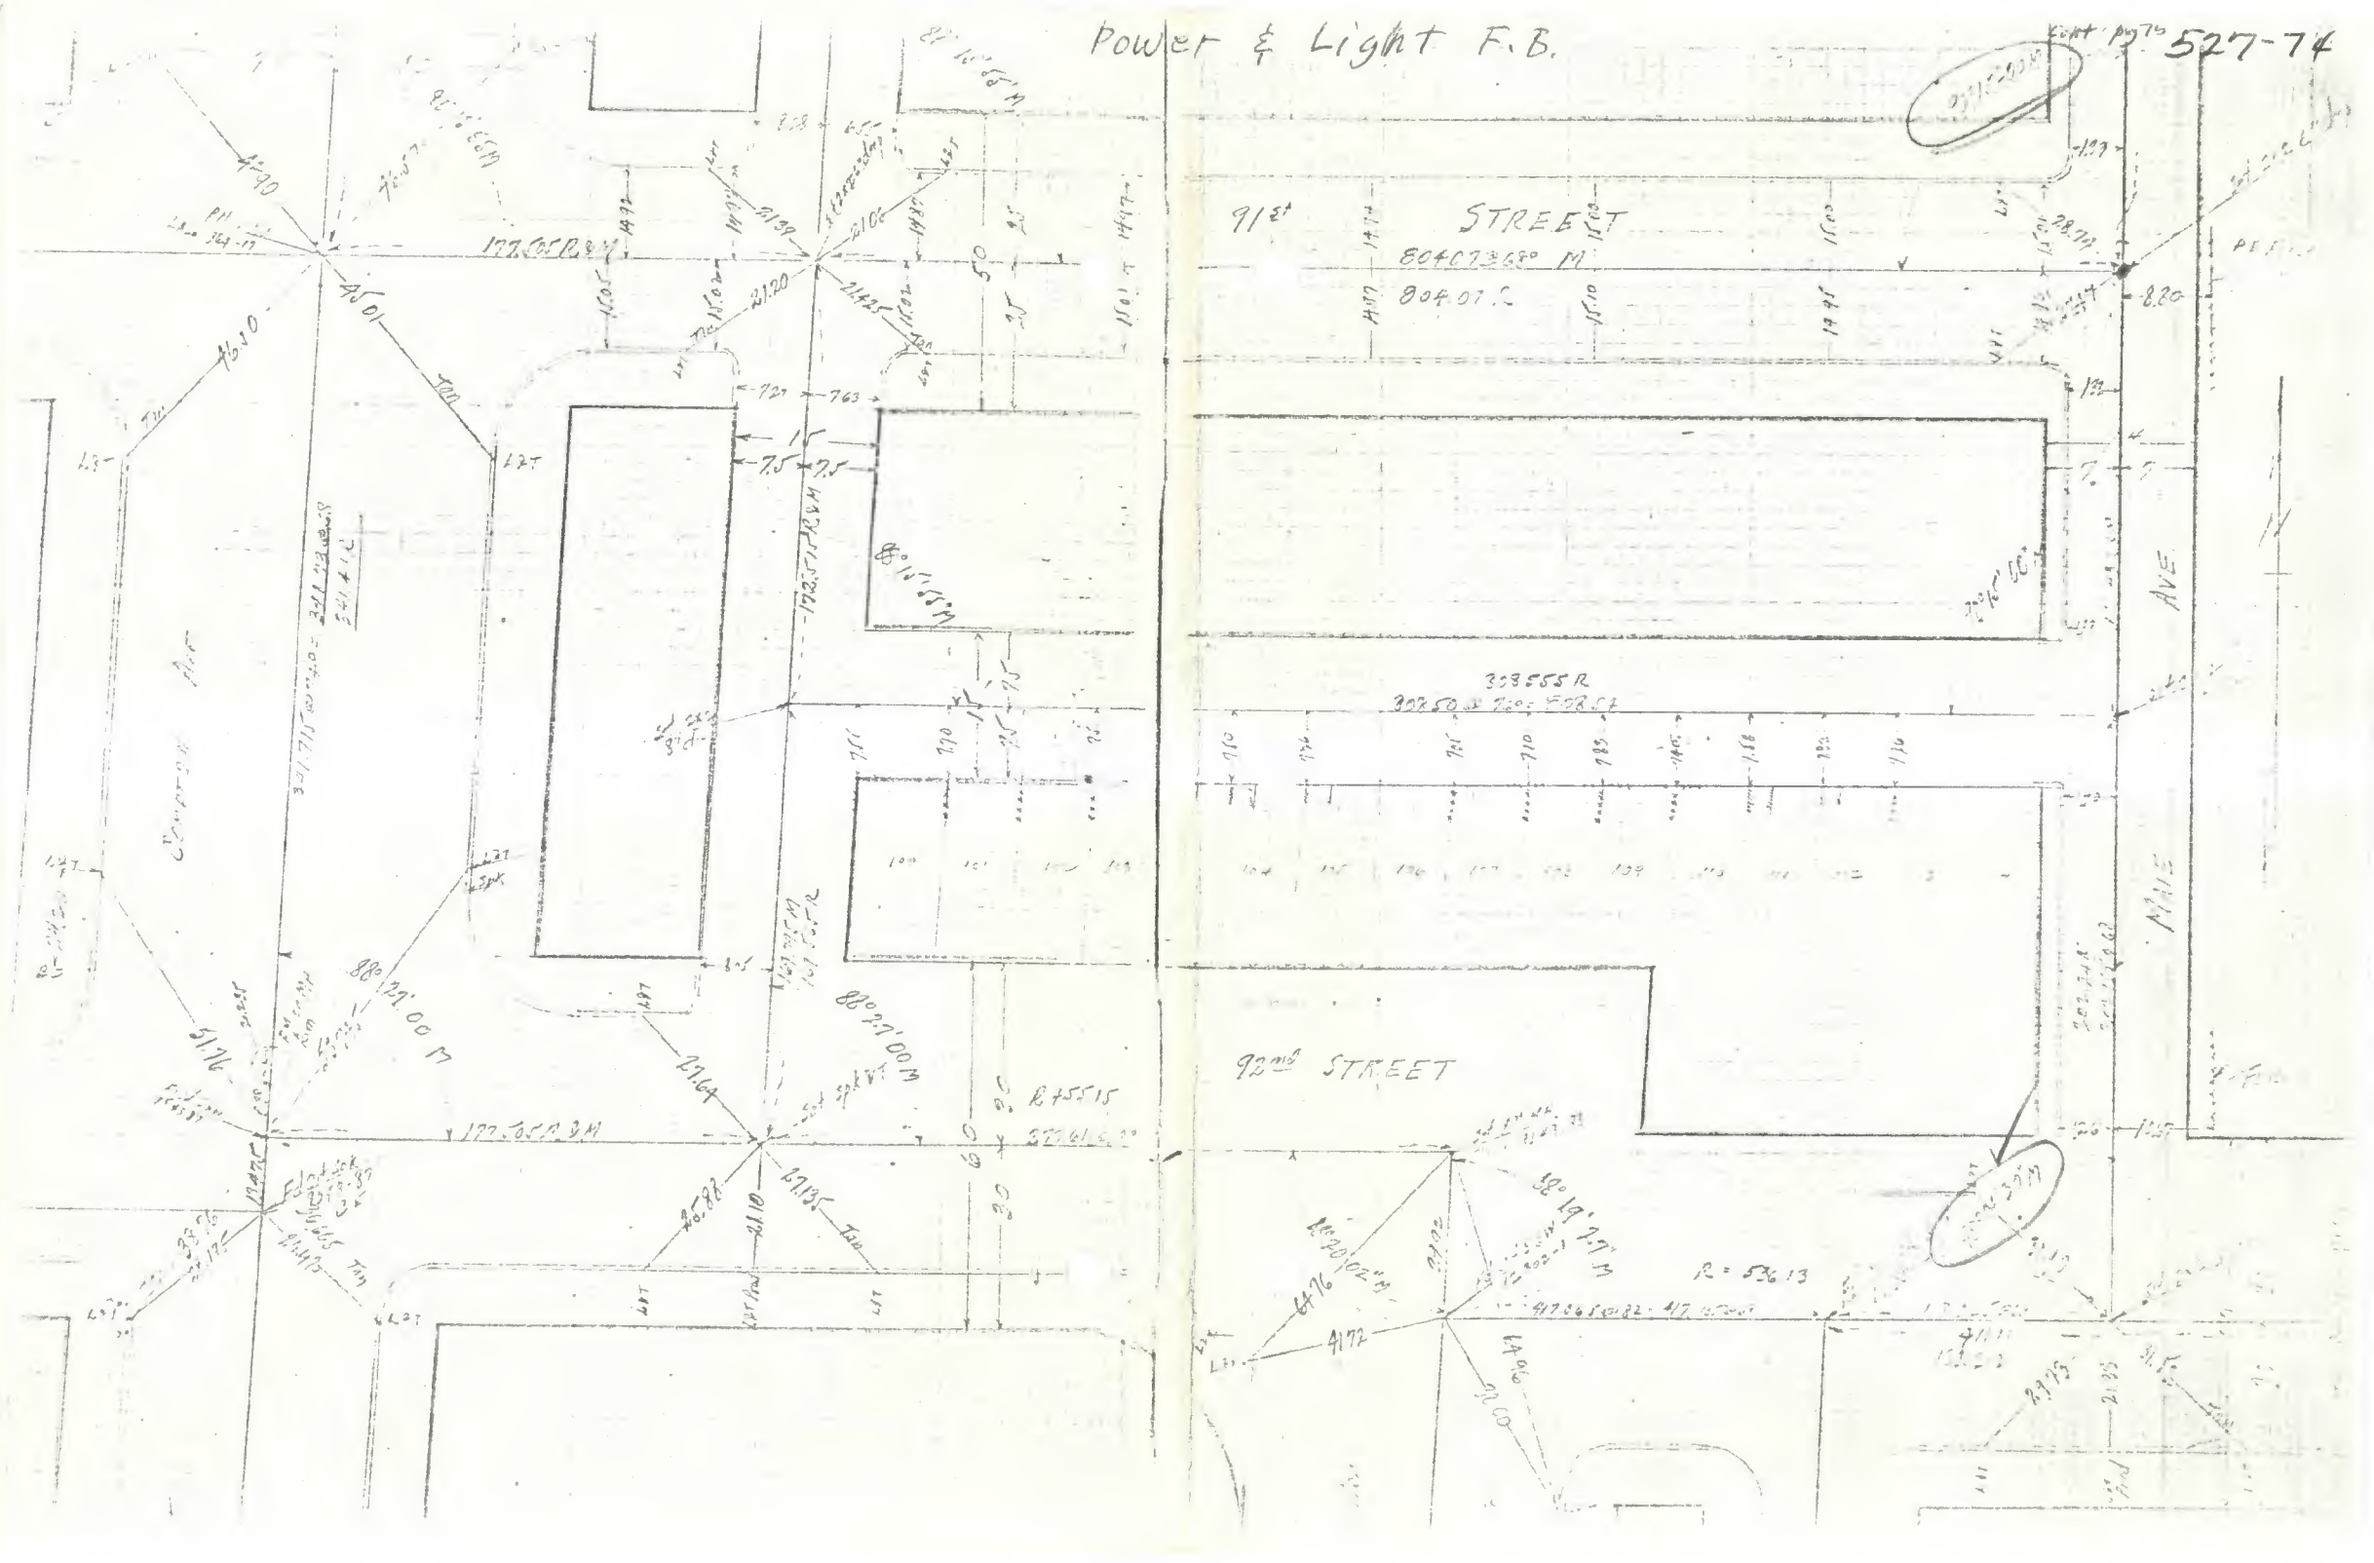

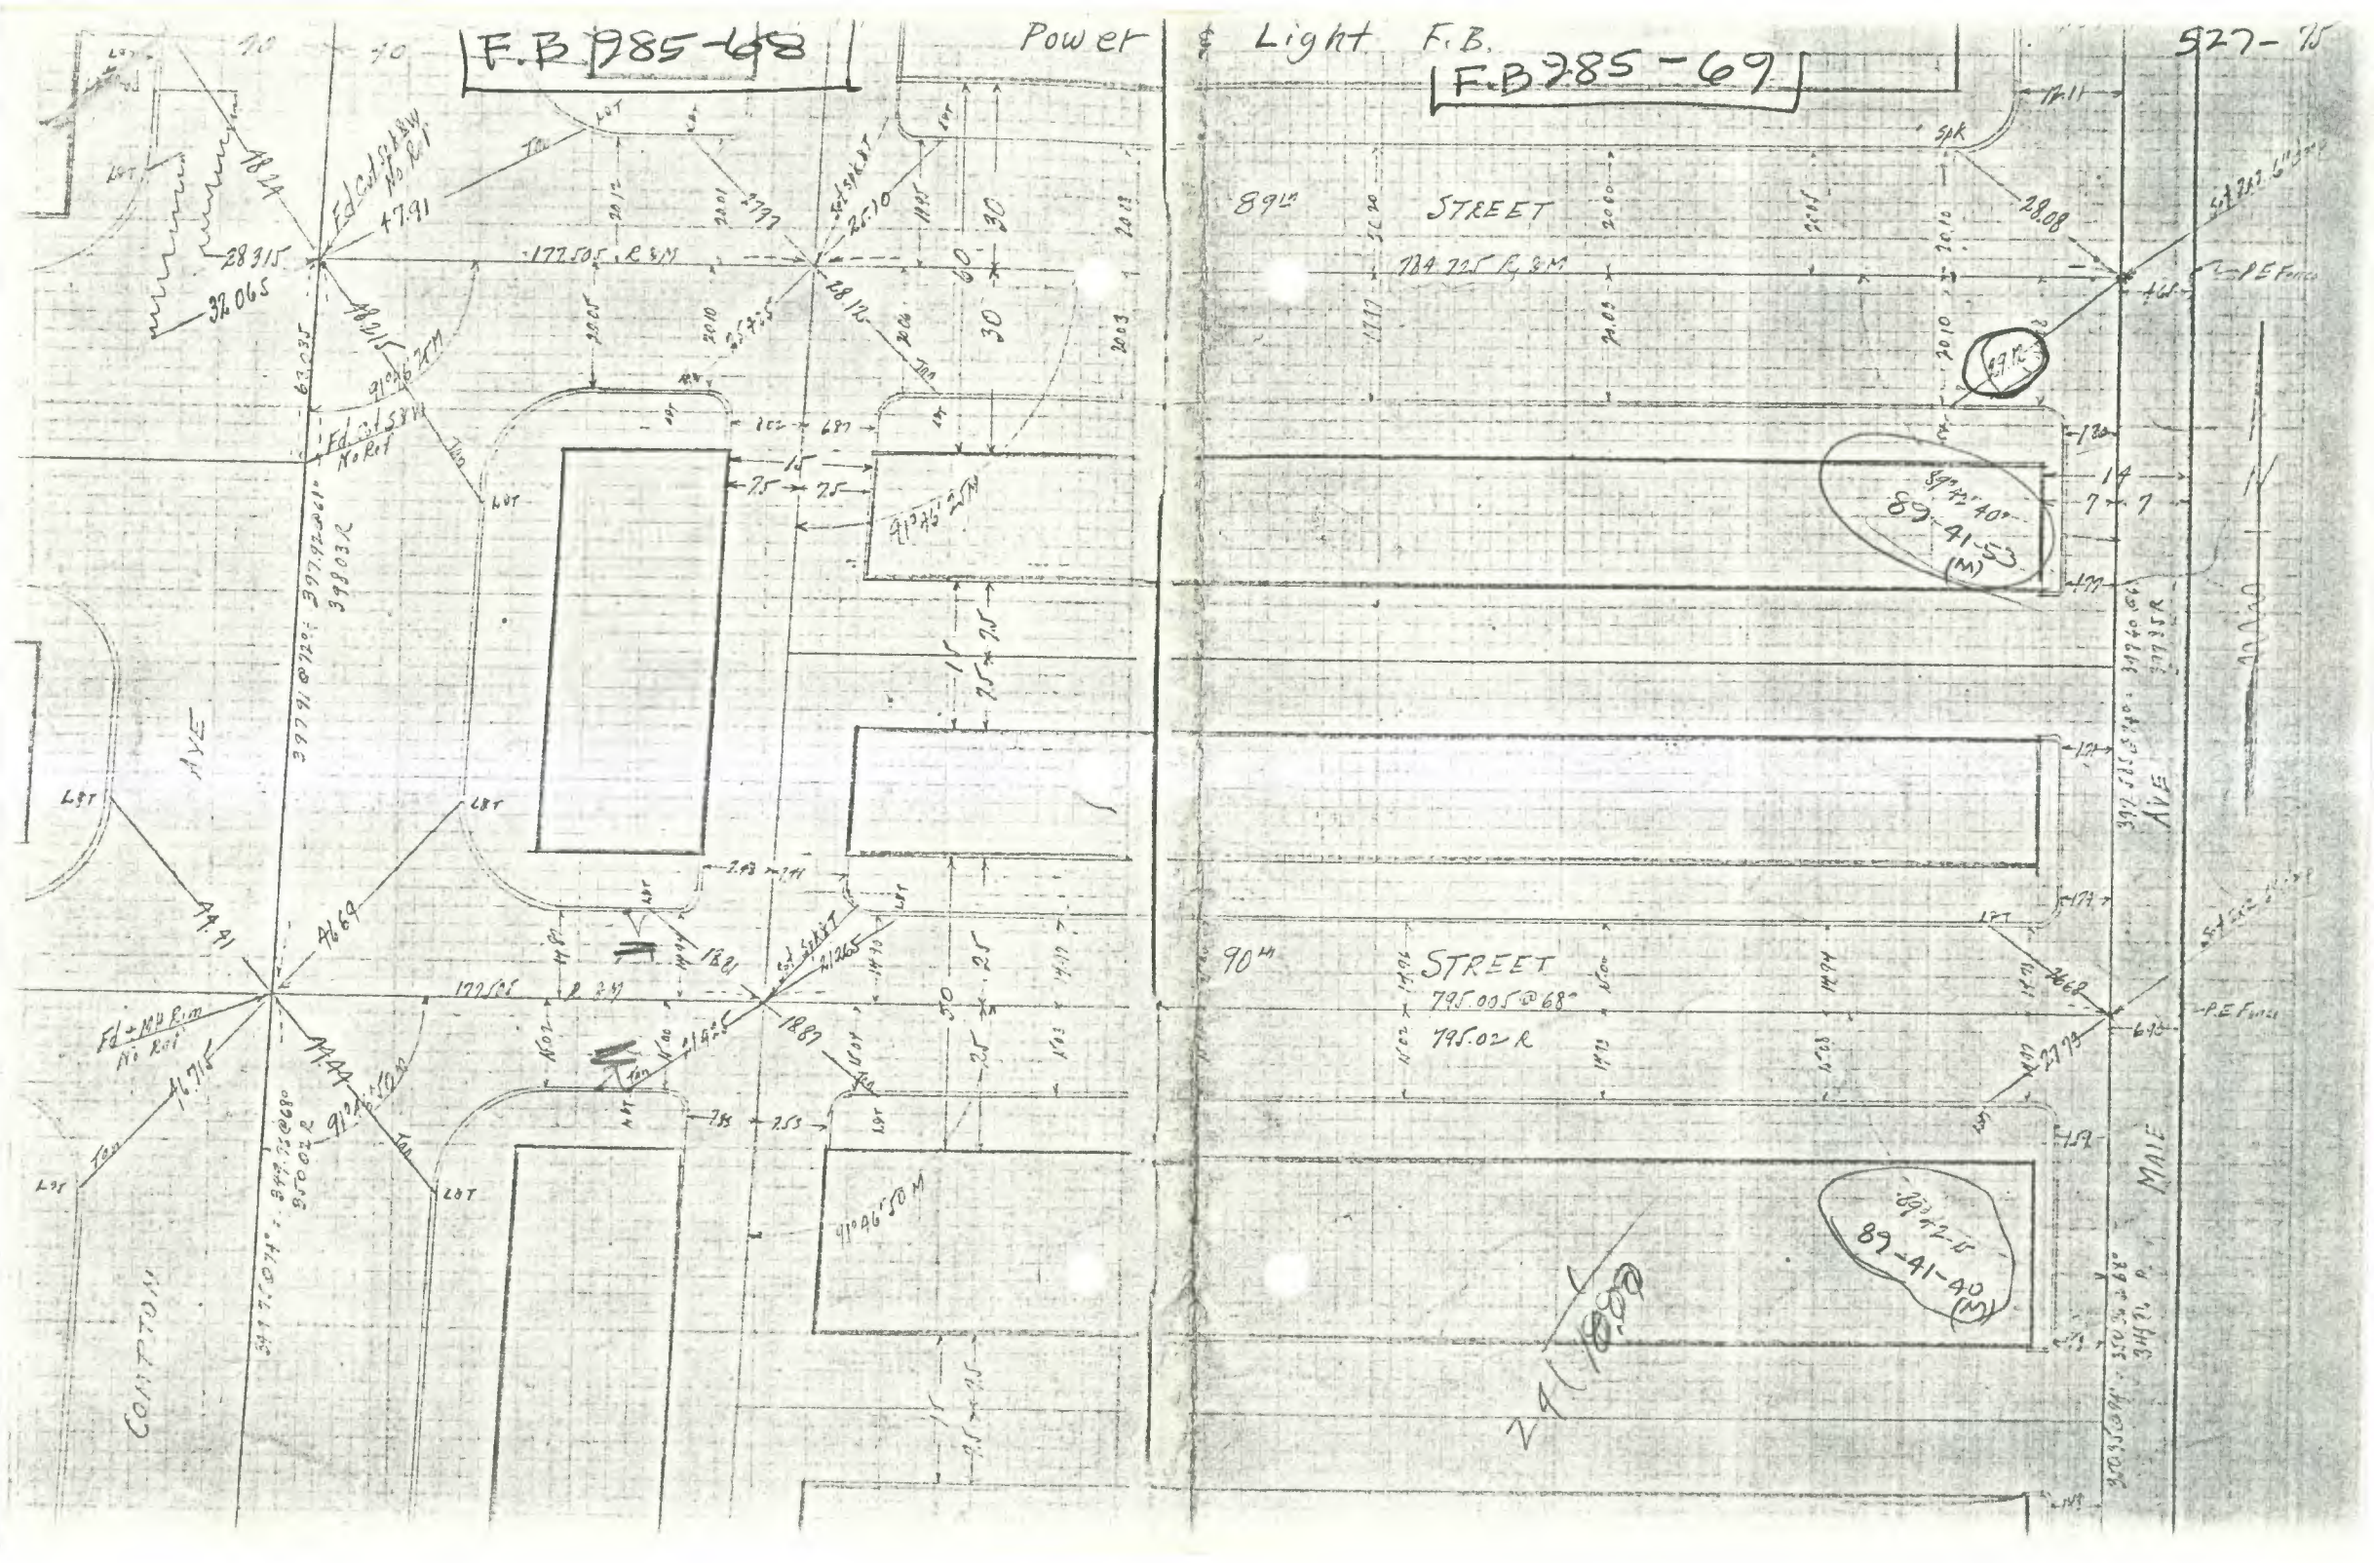
F.B 285-68
Power & Light F.B.
F.B 285-69
927-75
89th STREET
90th STREET
AVE
MILE

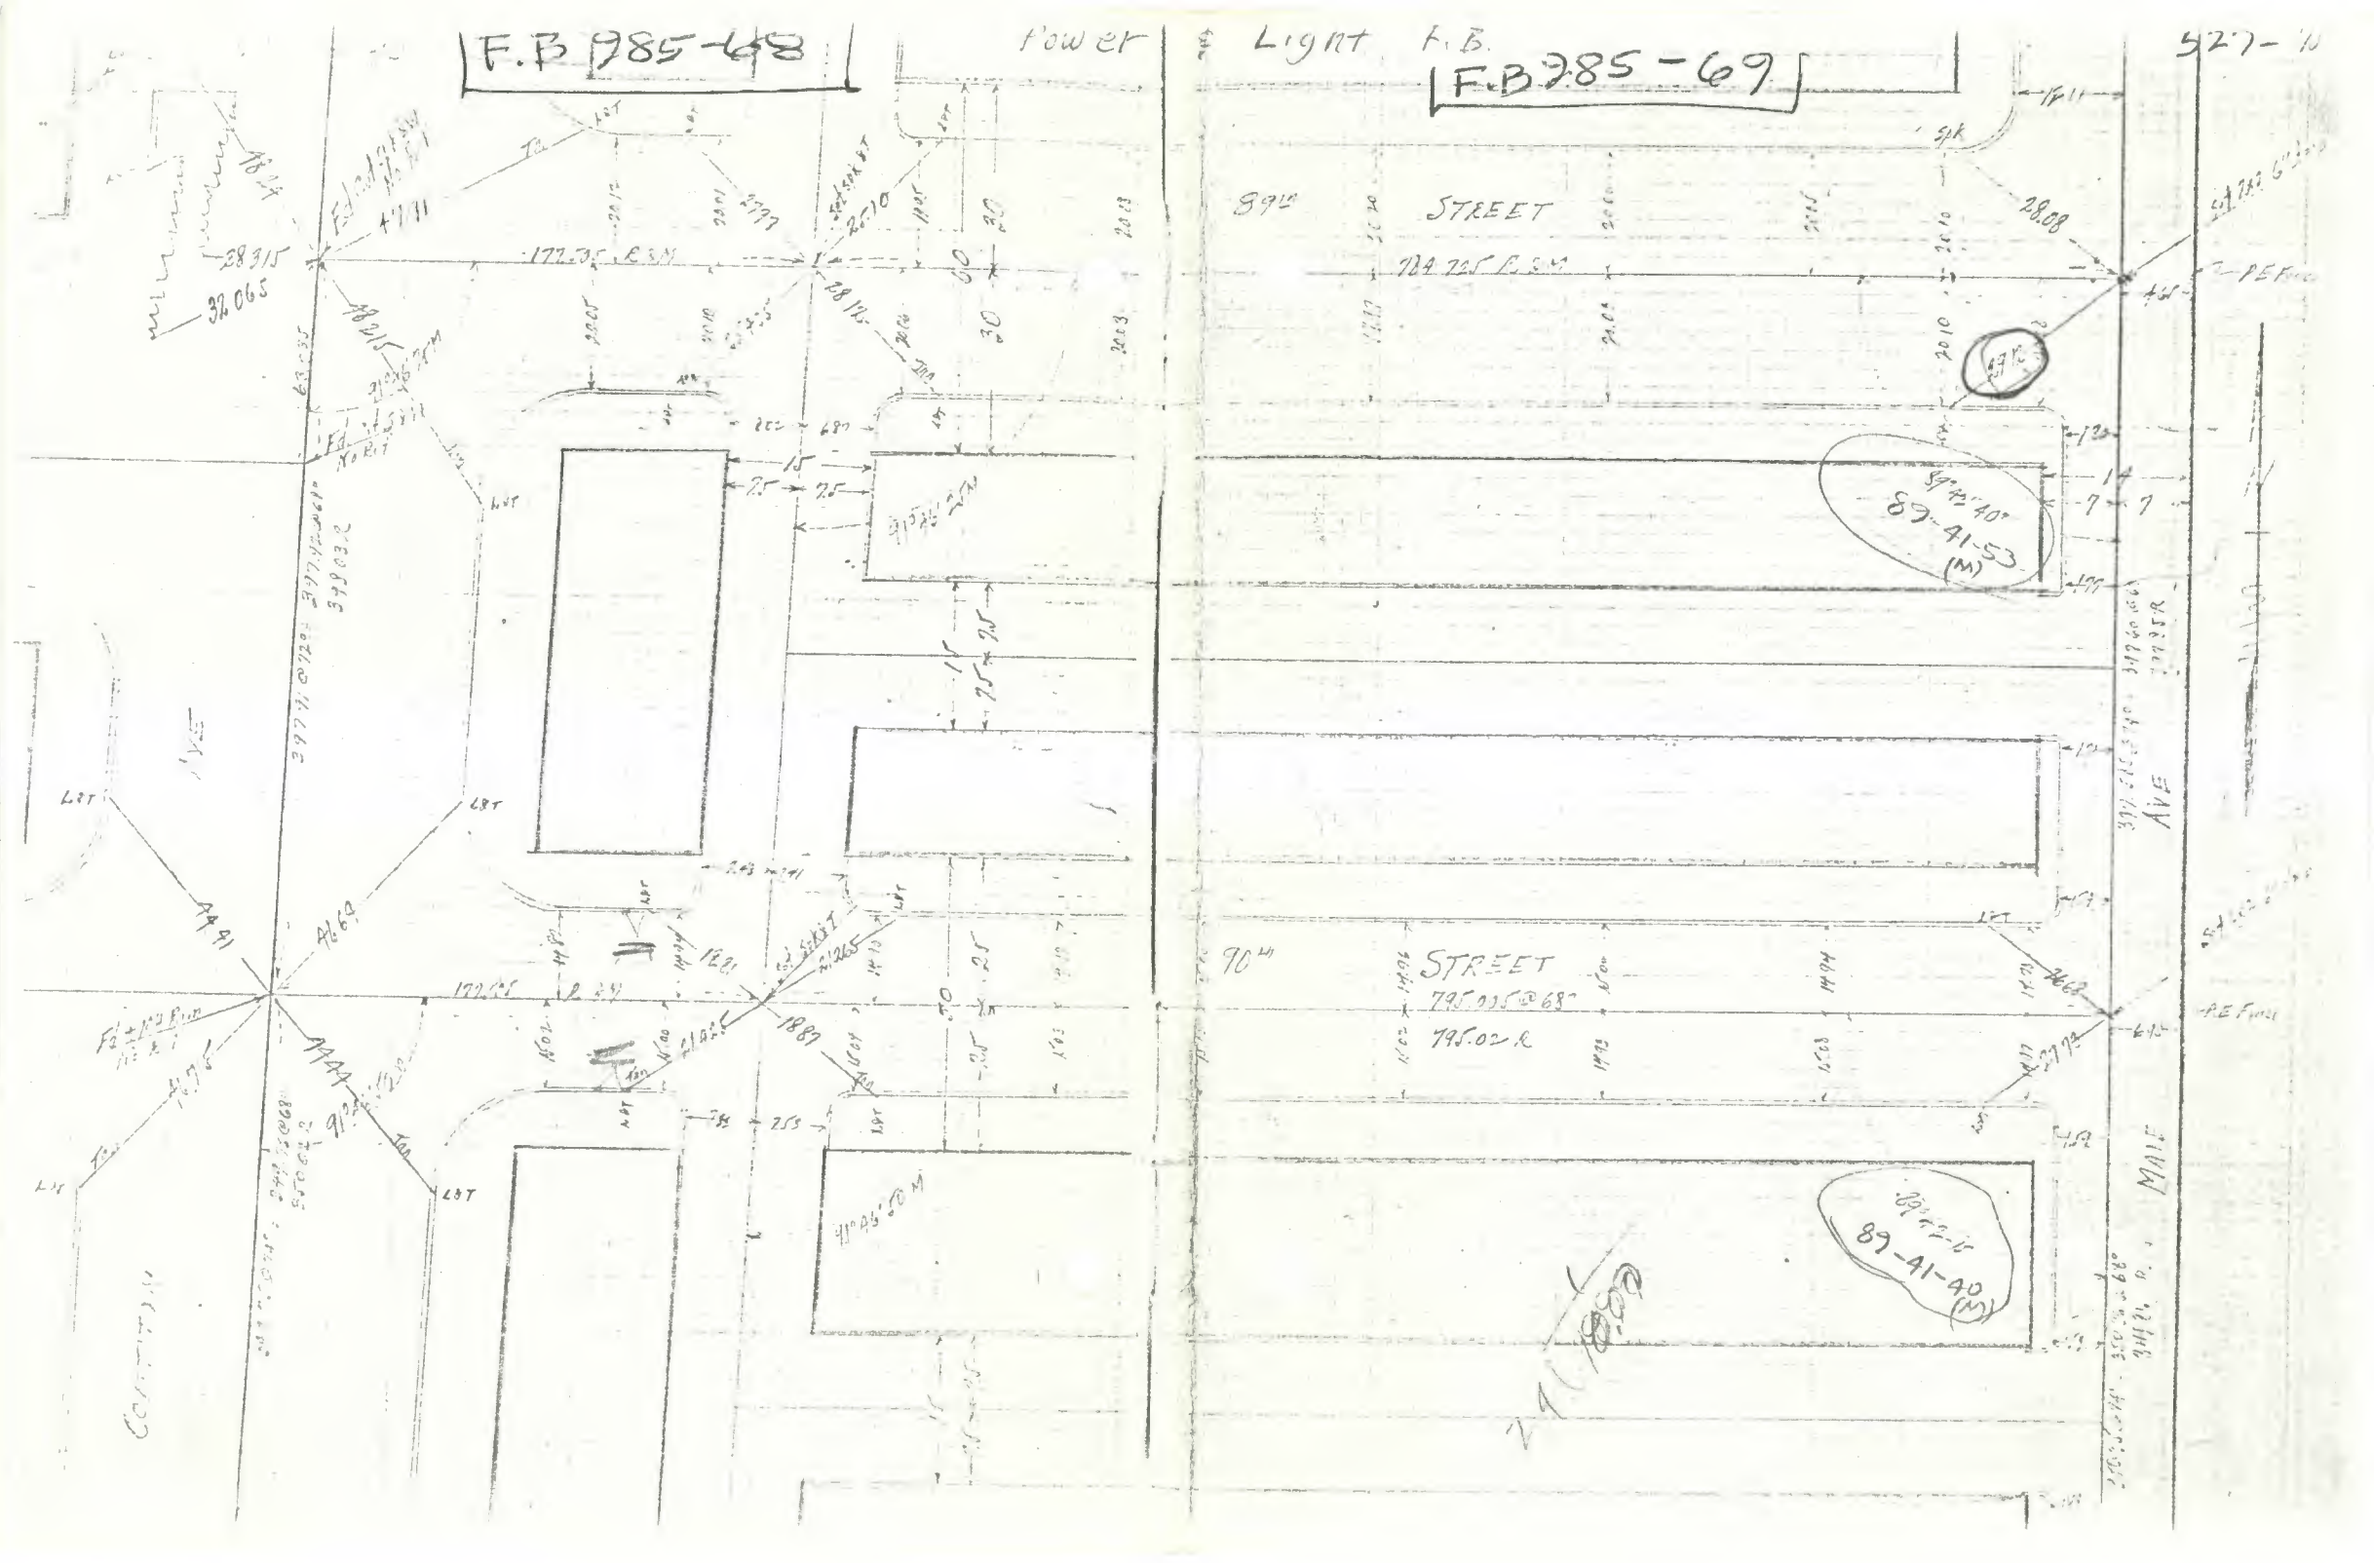
F.B 985-68
Power & Light F.B.
F.B 985-69
89th STREET
90th STREET
MAIN AVE
89-41-53 (M)
89-41-40 (M)

Power & Light F.B.

527 - 16





PACIFIC ELECTRIC RAILWAY CO.

BURKHART

GRAHAM ST.

BRANCH

HOME

ALLEY

BEECH ST.

88th

CEDAR ST.

TRACT

ALLEY

ST.

BANDERA ST.

M.B. 5-100

ALLEY

ST.

ELM ST.

Power & Light F.B. 527 - 16

R.L. Rowe for
G. Wilson last
E. Hinckley
W. Craig
H. Hamilton
11/23-25/36

℄ DISTANCES 87th ST to 88th ST
ELM ST to GRAHAM ST.
(For Check against Record)

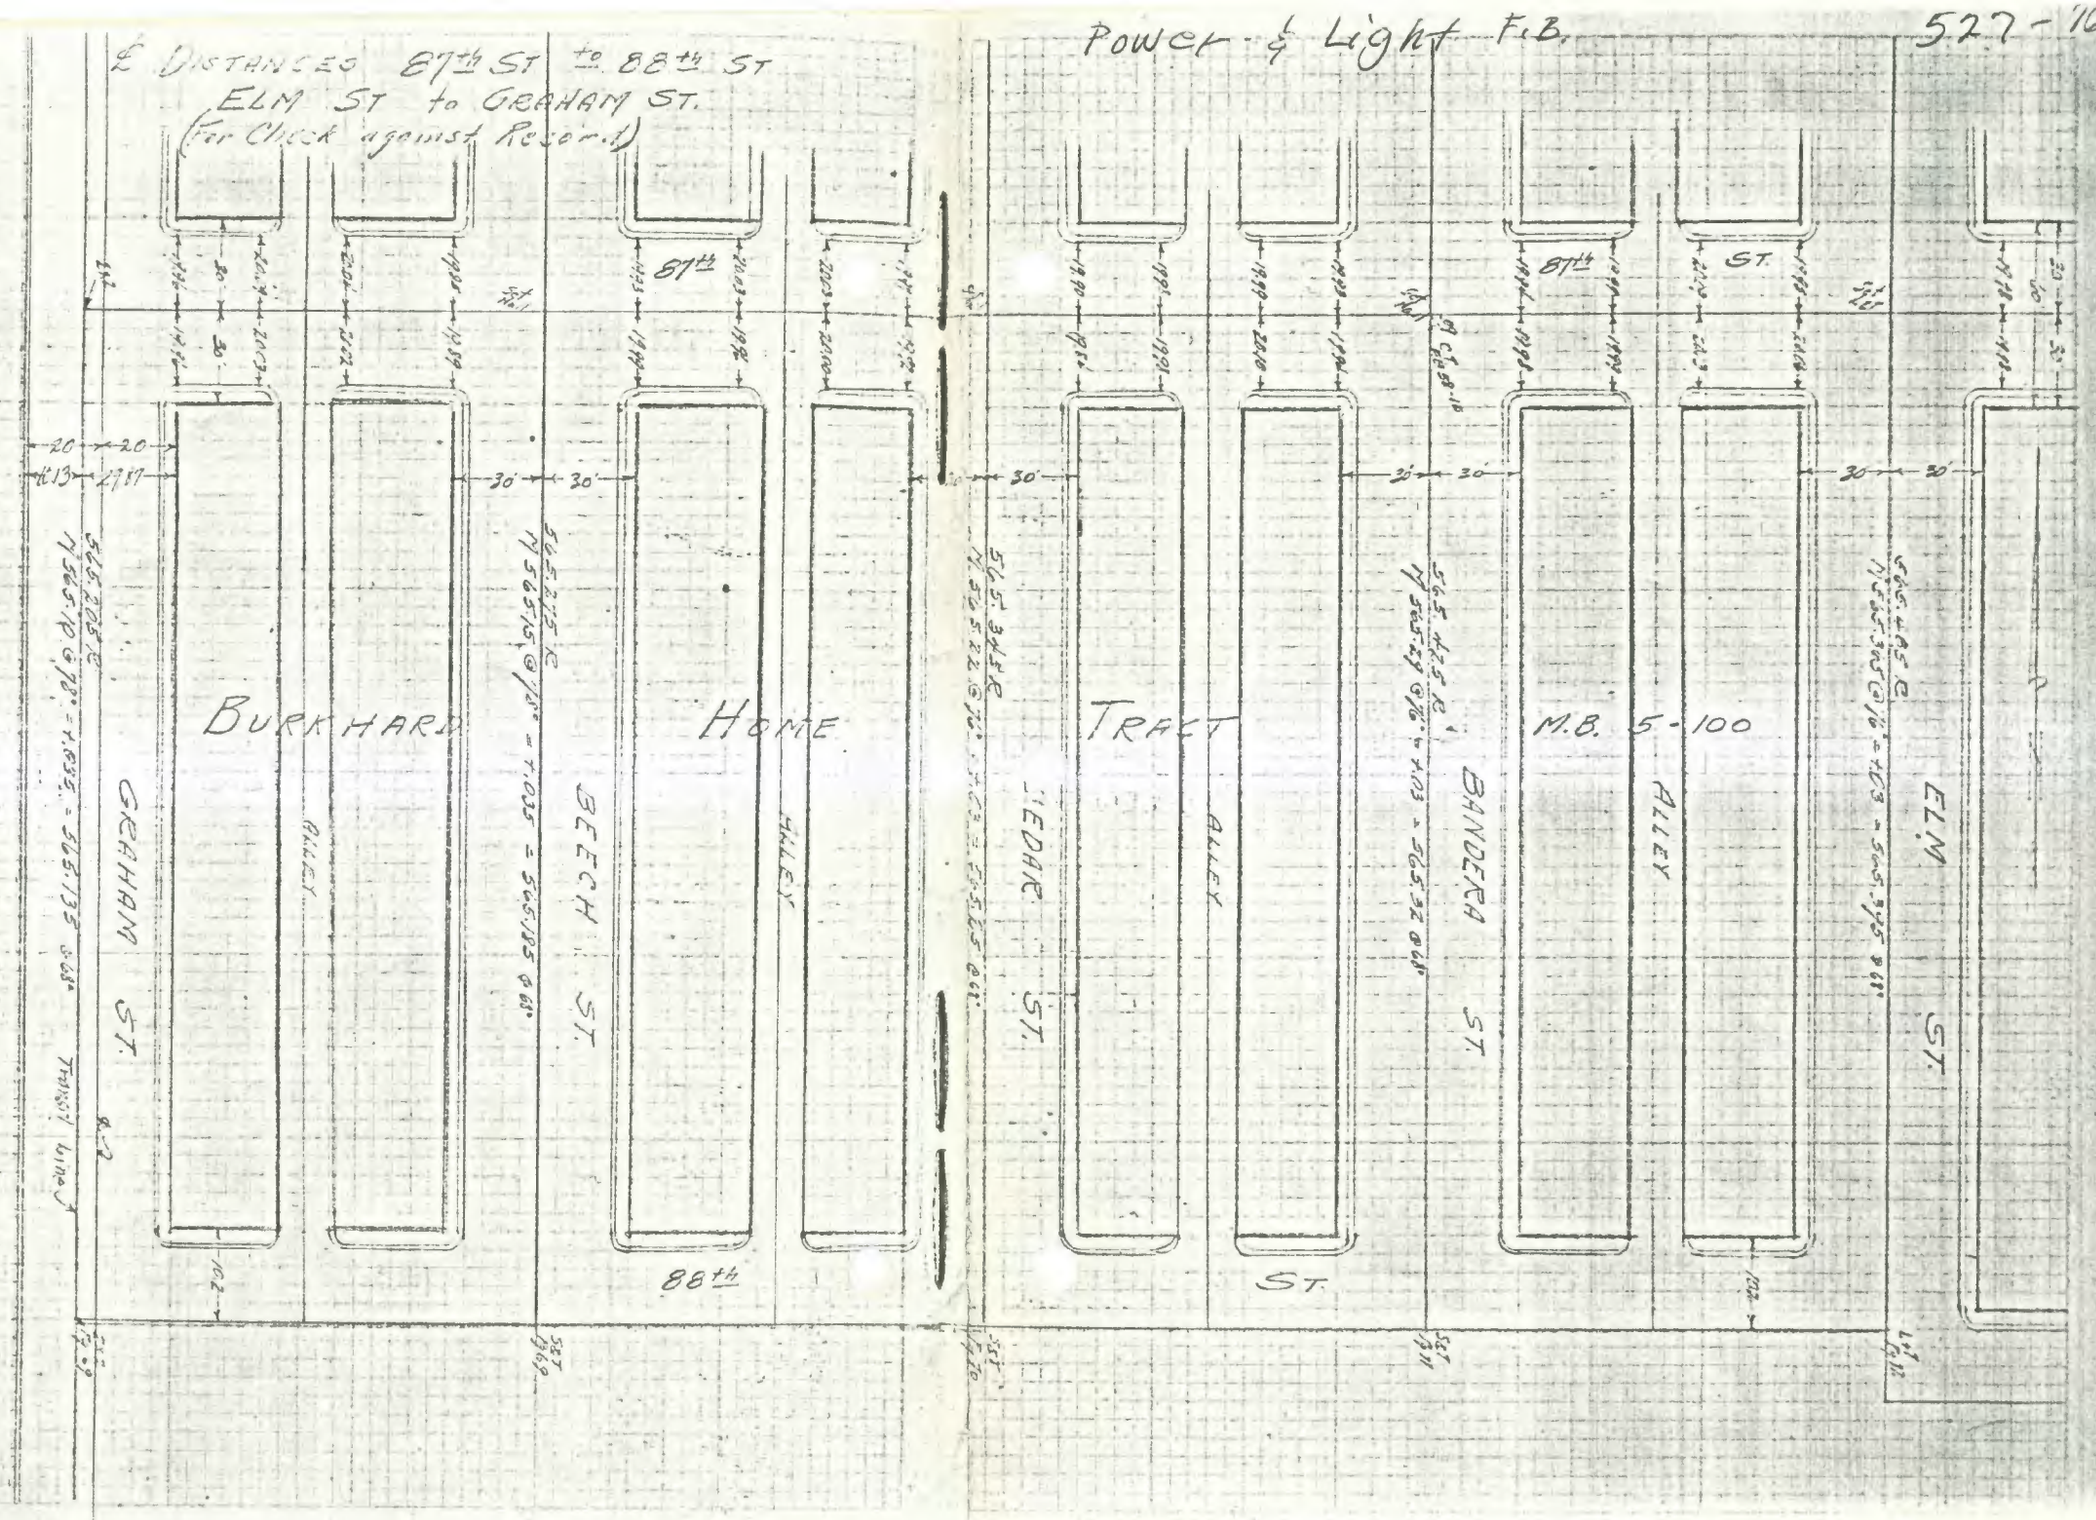

INDEXED DEC 31 1928

F.B. 985-72

92nd Street.

Compton Ave. to Alameda St

Survey to establish ℄

Engr's Dist. and Tie

Jan. 27, 1927.

Dierdorf
Horn
Nipper
Thompson

GE 46761

F.B. 985-73

1

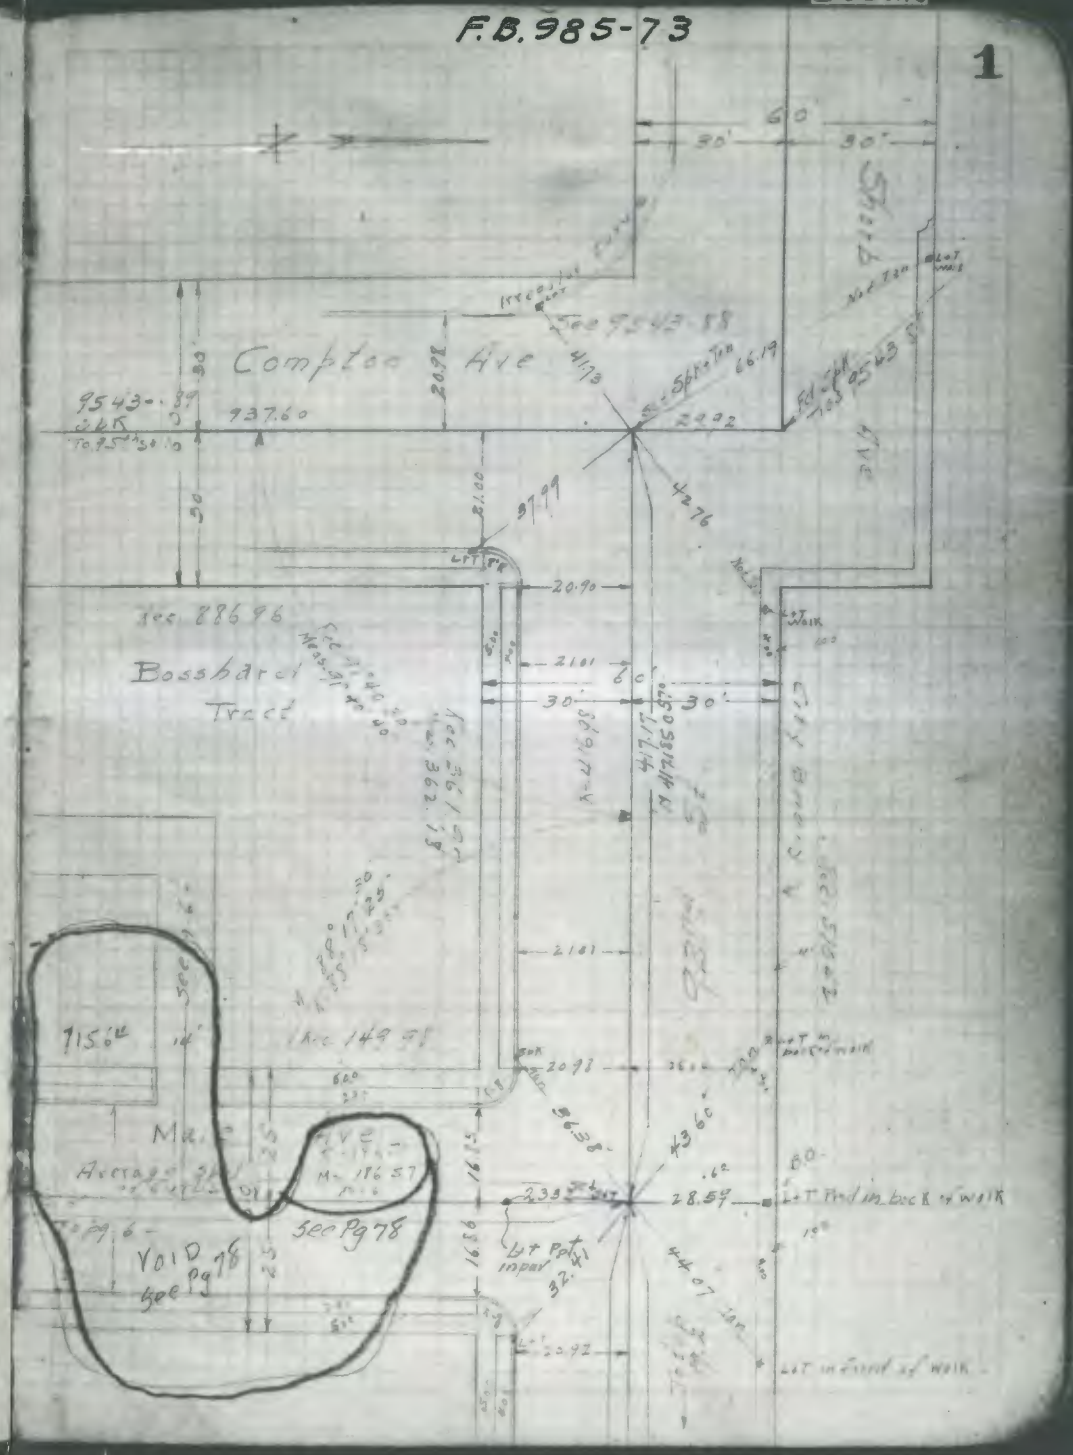

F.B. 985-74

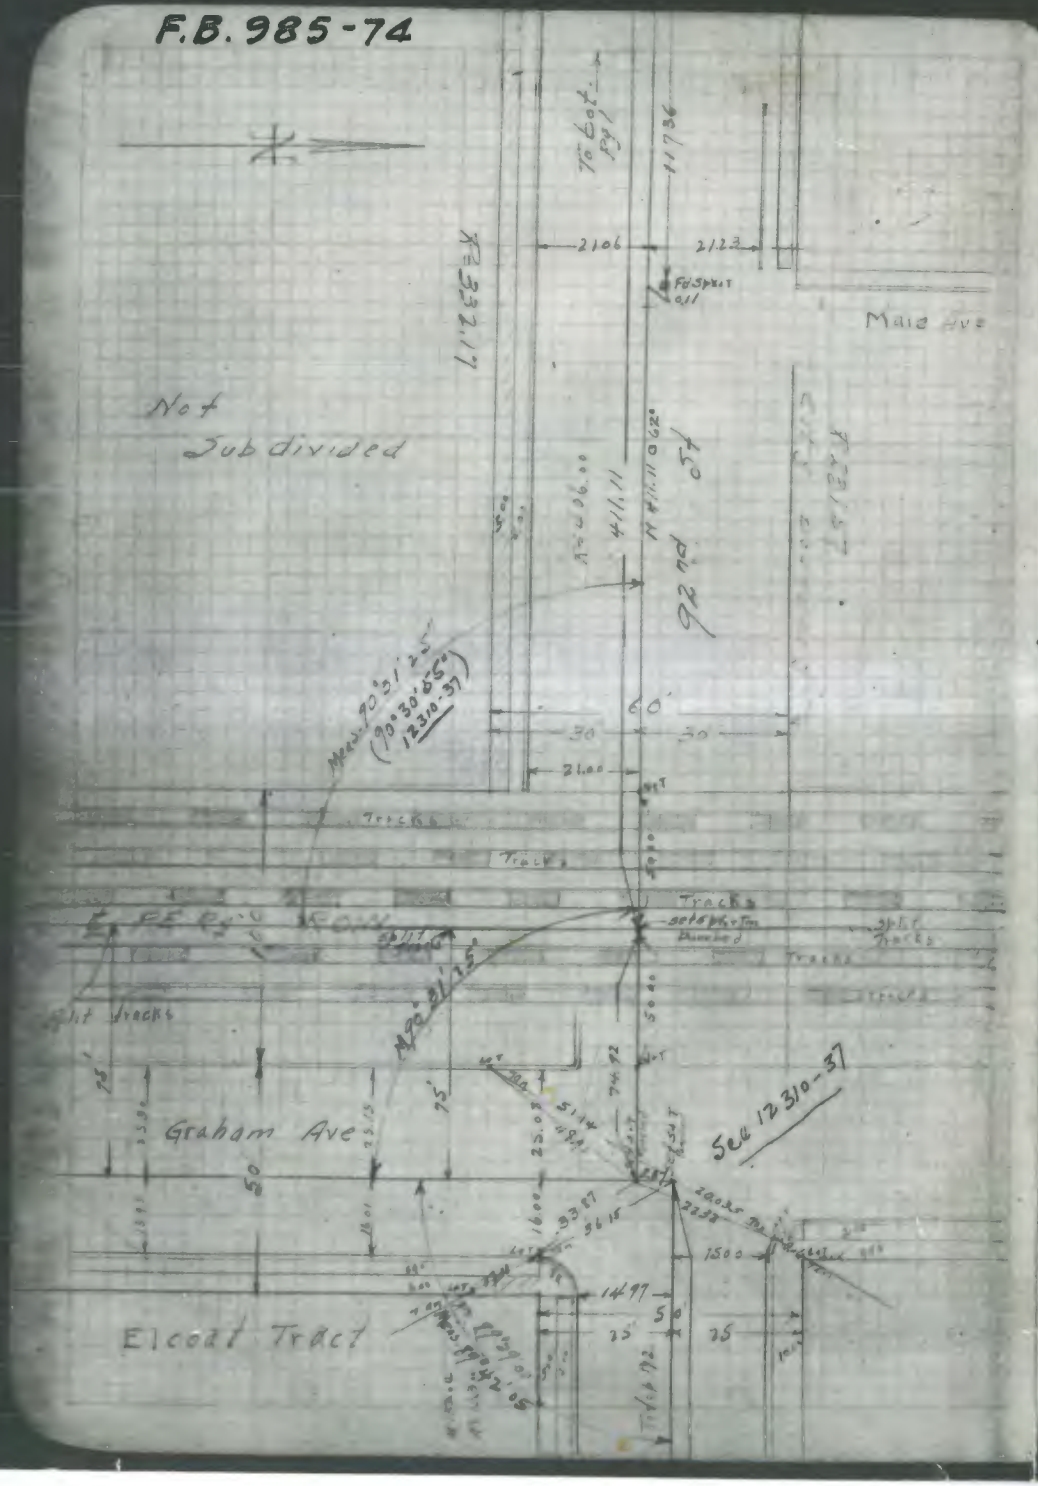

12302

F.B 985-75 2

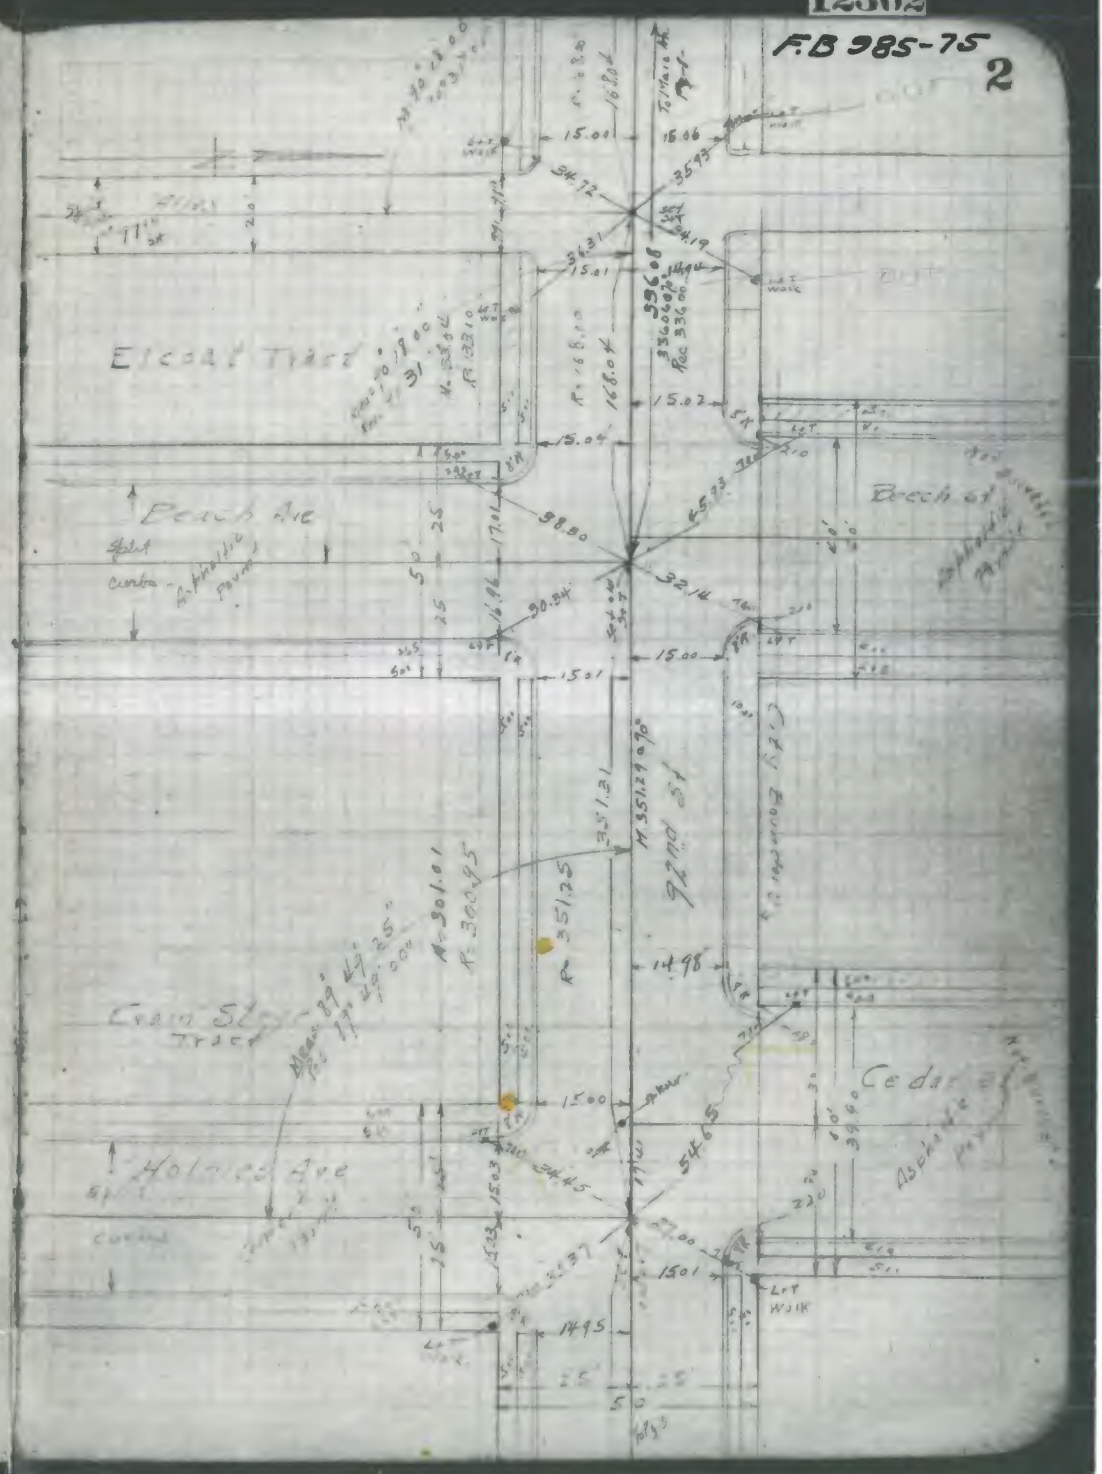

F.B. 985-76

F.B. 985-77

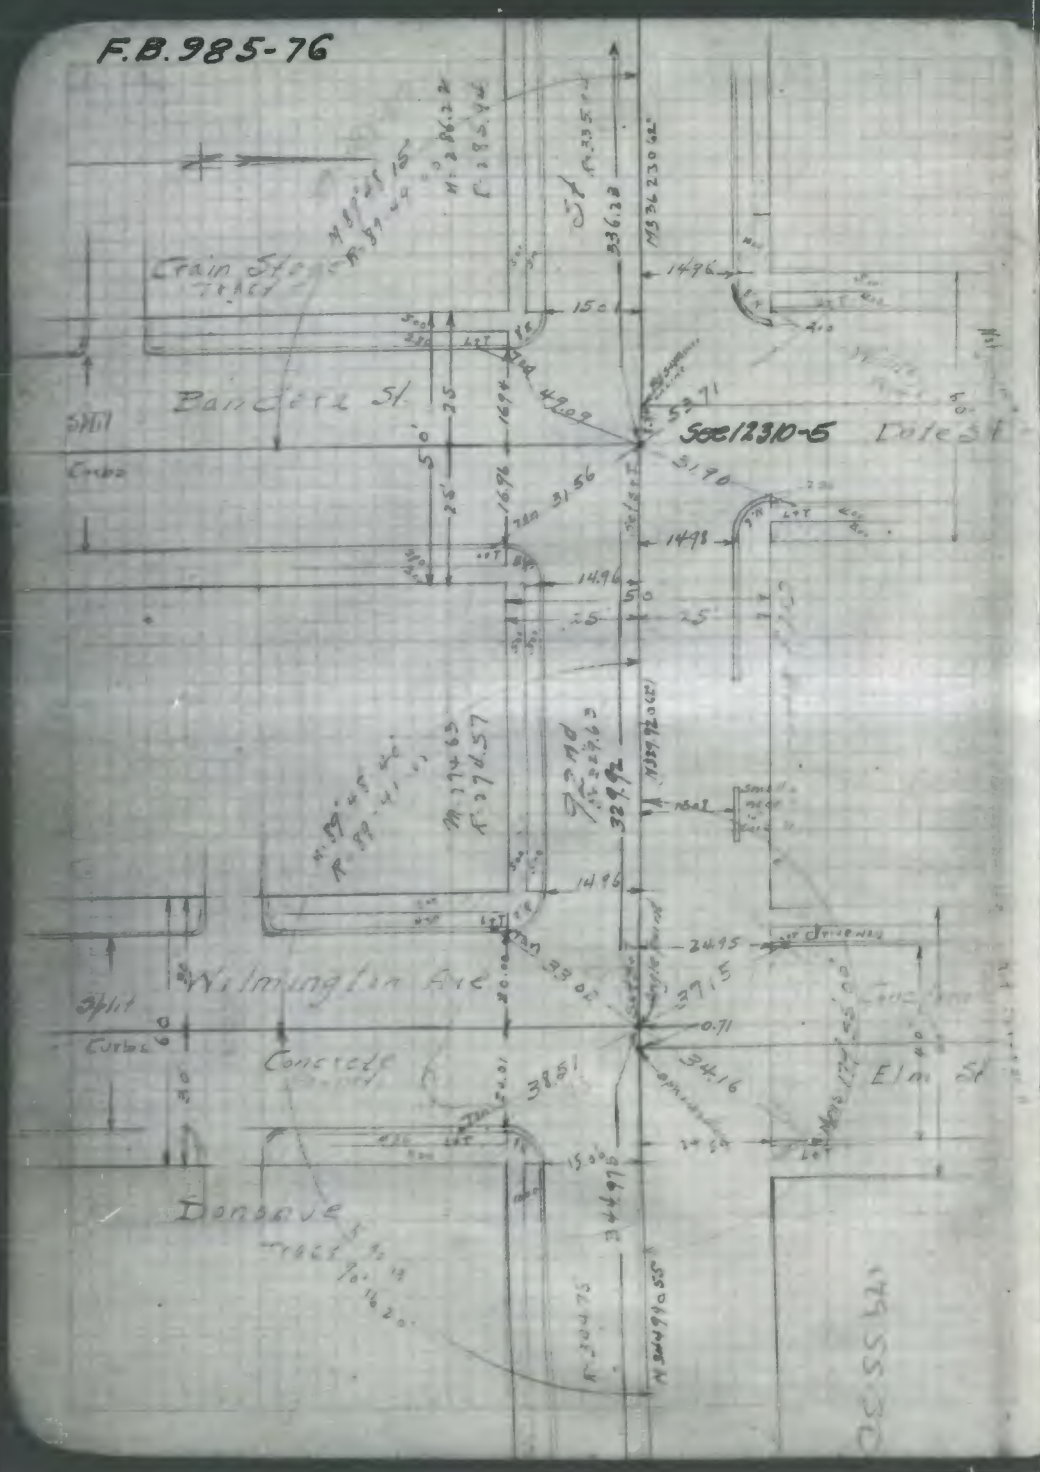

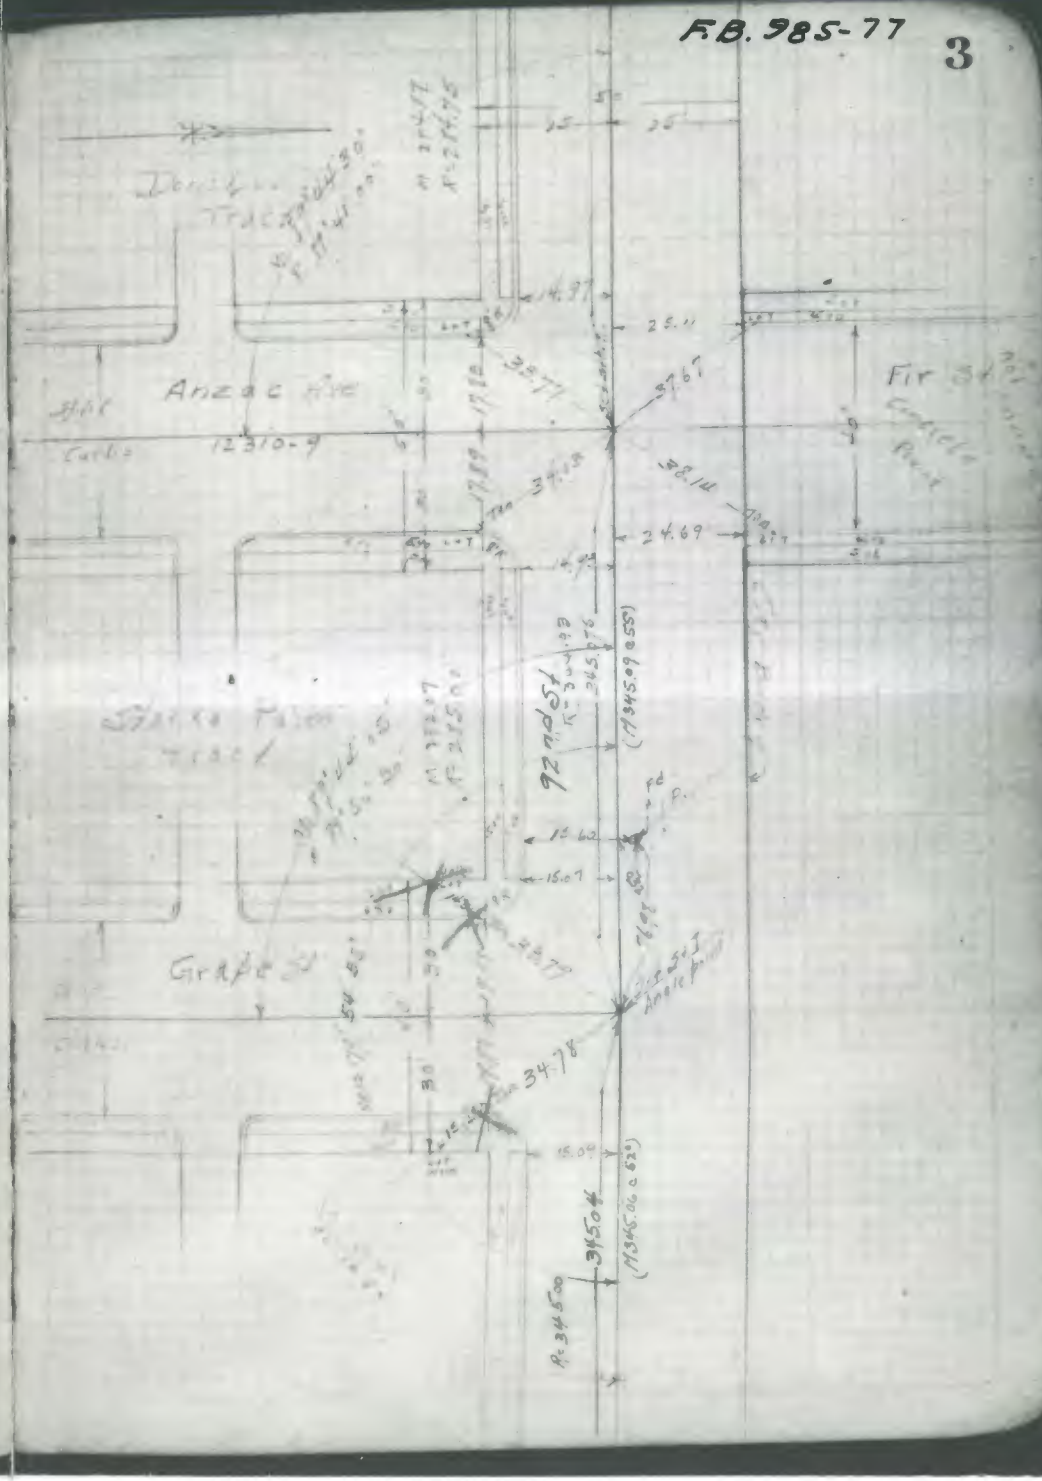

F.B. 985-78

12302

F.B. 985-79

4

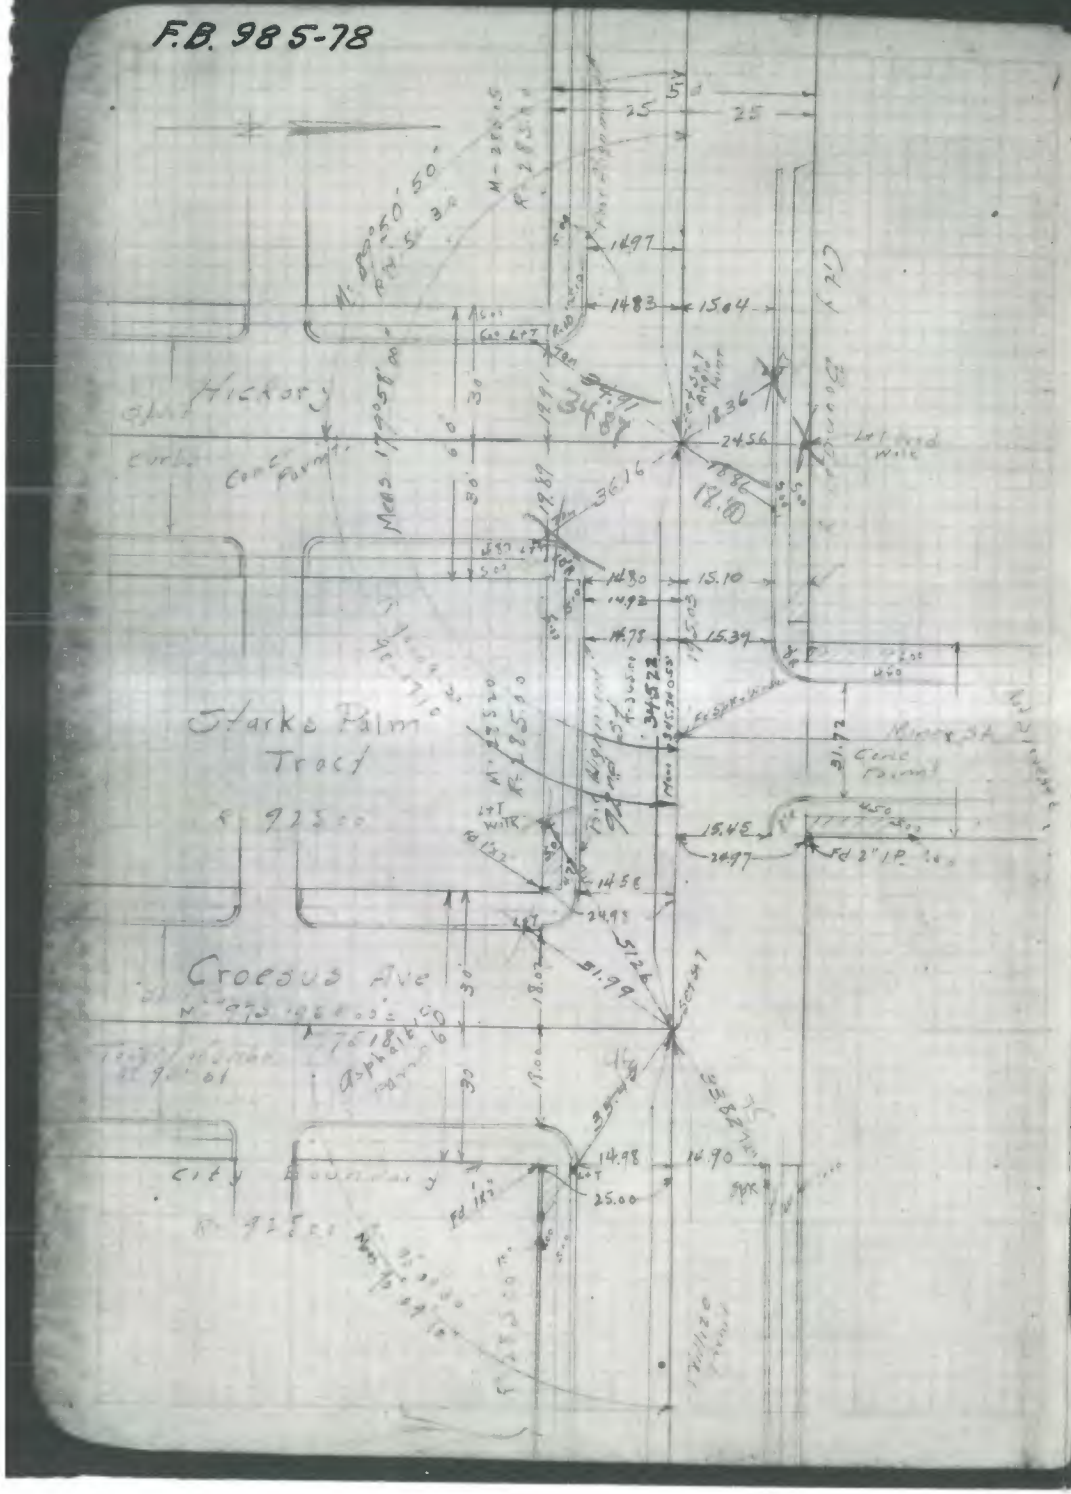

F.B. 985-80

INDEXED DEC 31 1928

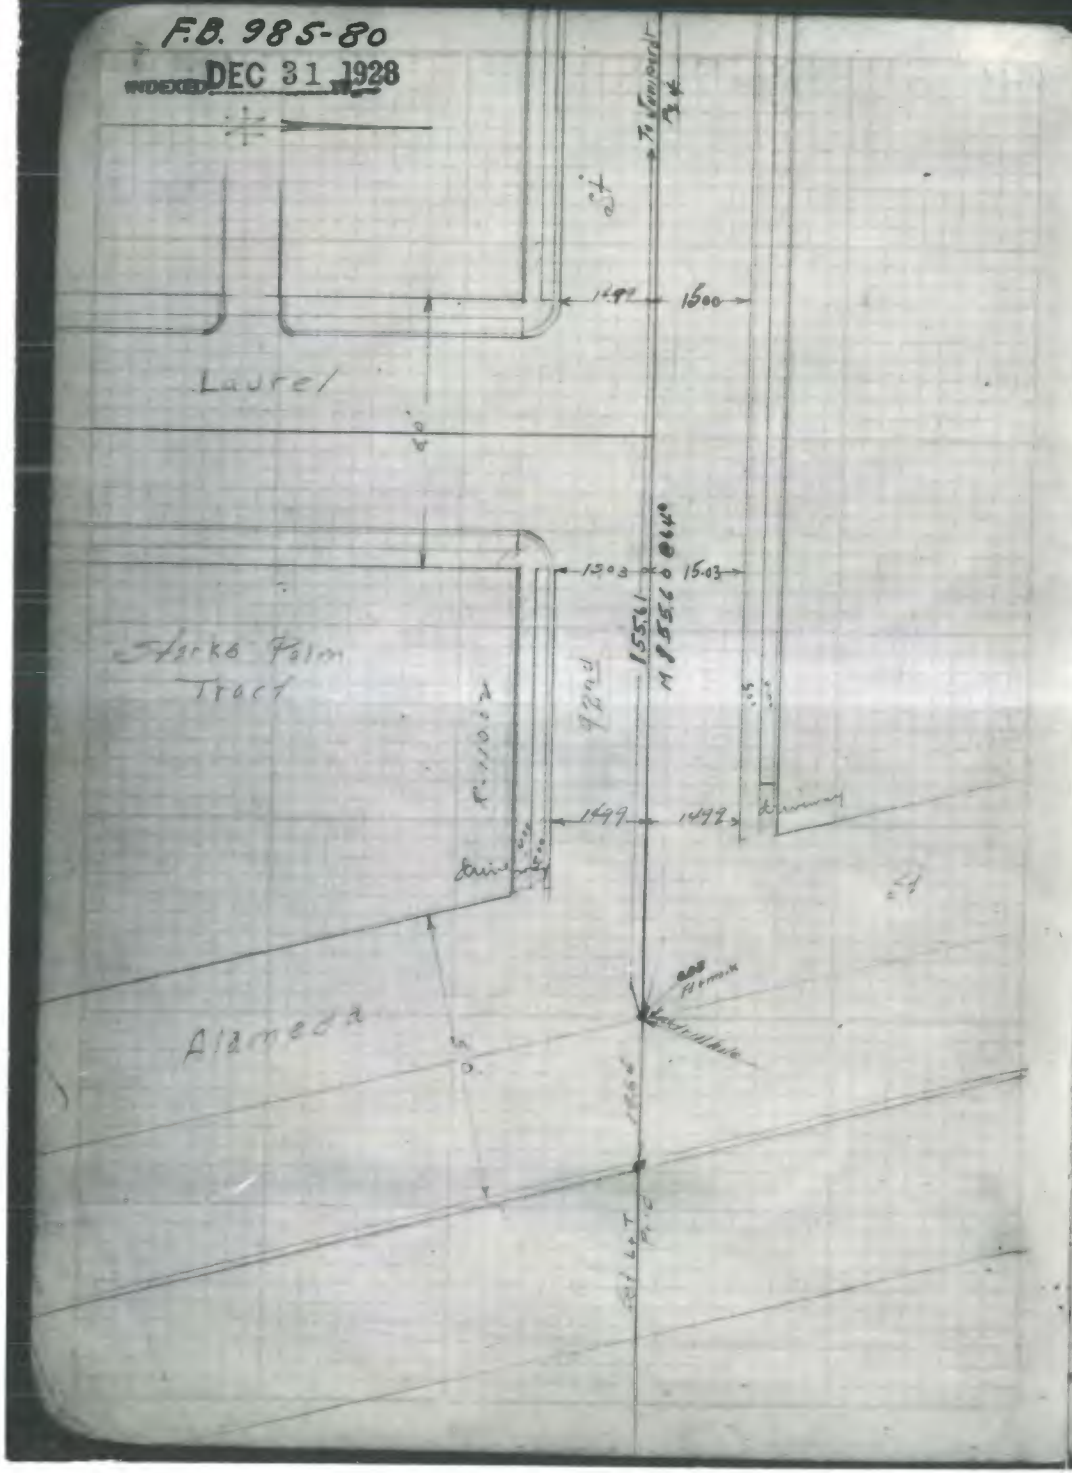

12302

F.B. 985-81 5

INDEXED DEC 31 1928

Survey to establish Z

Angles, Distances & Ties

Thomas
Horn
Nipper
Thompson

GE 46901 Fd. L. 7th Z P.

95th St.	Compton Ave	to	Maie Ave
95th Pl.	Maie Ave	"	Grandee Ave.
97th St.	Compton "	"	" "
Defiance Ave.	97th St.	"	95th St
Maie Ave	" "	"	" "
Grandee "	" "	"	152.61 N. of 95th Pl
1st Alley E. of Compton Ave.	95th St	"	742.67 N.
" " N "	95th St	Maie Ave	260.02 W.
" " E "	Maie Ave	97th St	152.53 N. of 95th Pl.

F.B. 985-82

New tie by Hickerson + party 4-24-1950

Rec = 993.2

VOID See 12310-46

Resurvey

F.B. 985-83

43

New tie by Hickerson + party 2-28-1950

887.81

Rec - 888.10

107th St.

930.23 @ 80° 12310-46

Rec - 870.56

870.31

Sam Houston Blvd.

F.B. 985-84

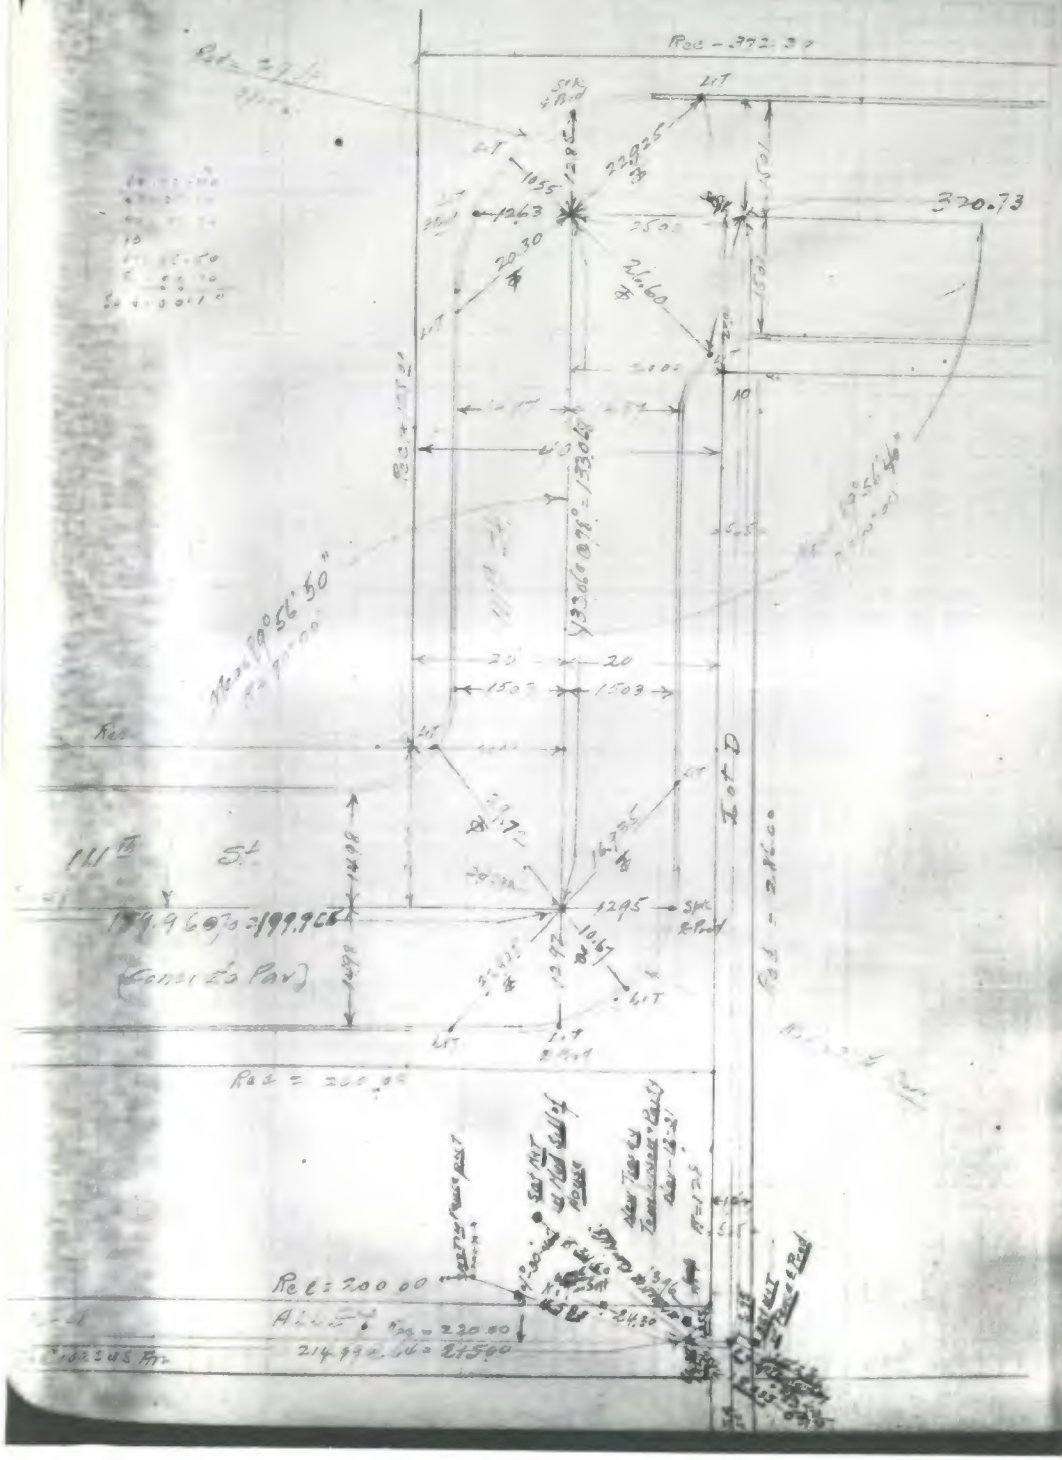

F.B. 985-85

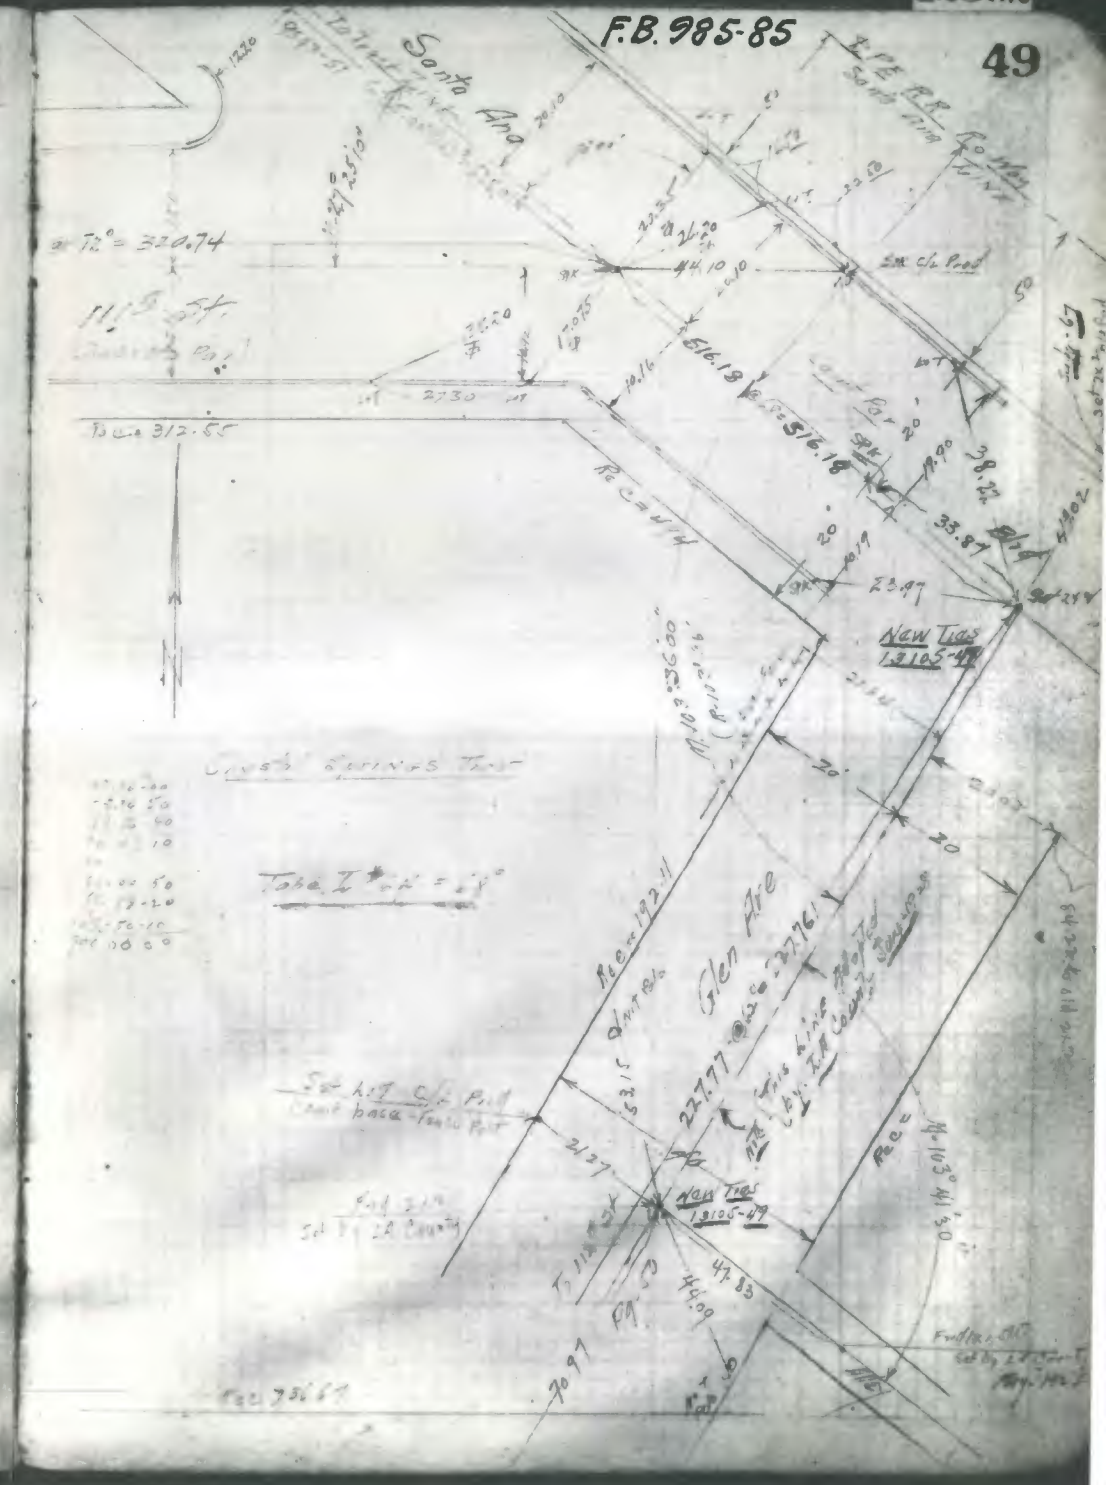

F.B. 985-86

F.B. 985-87

50

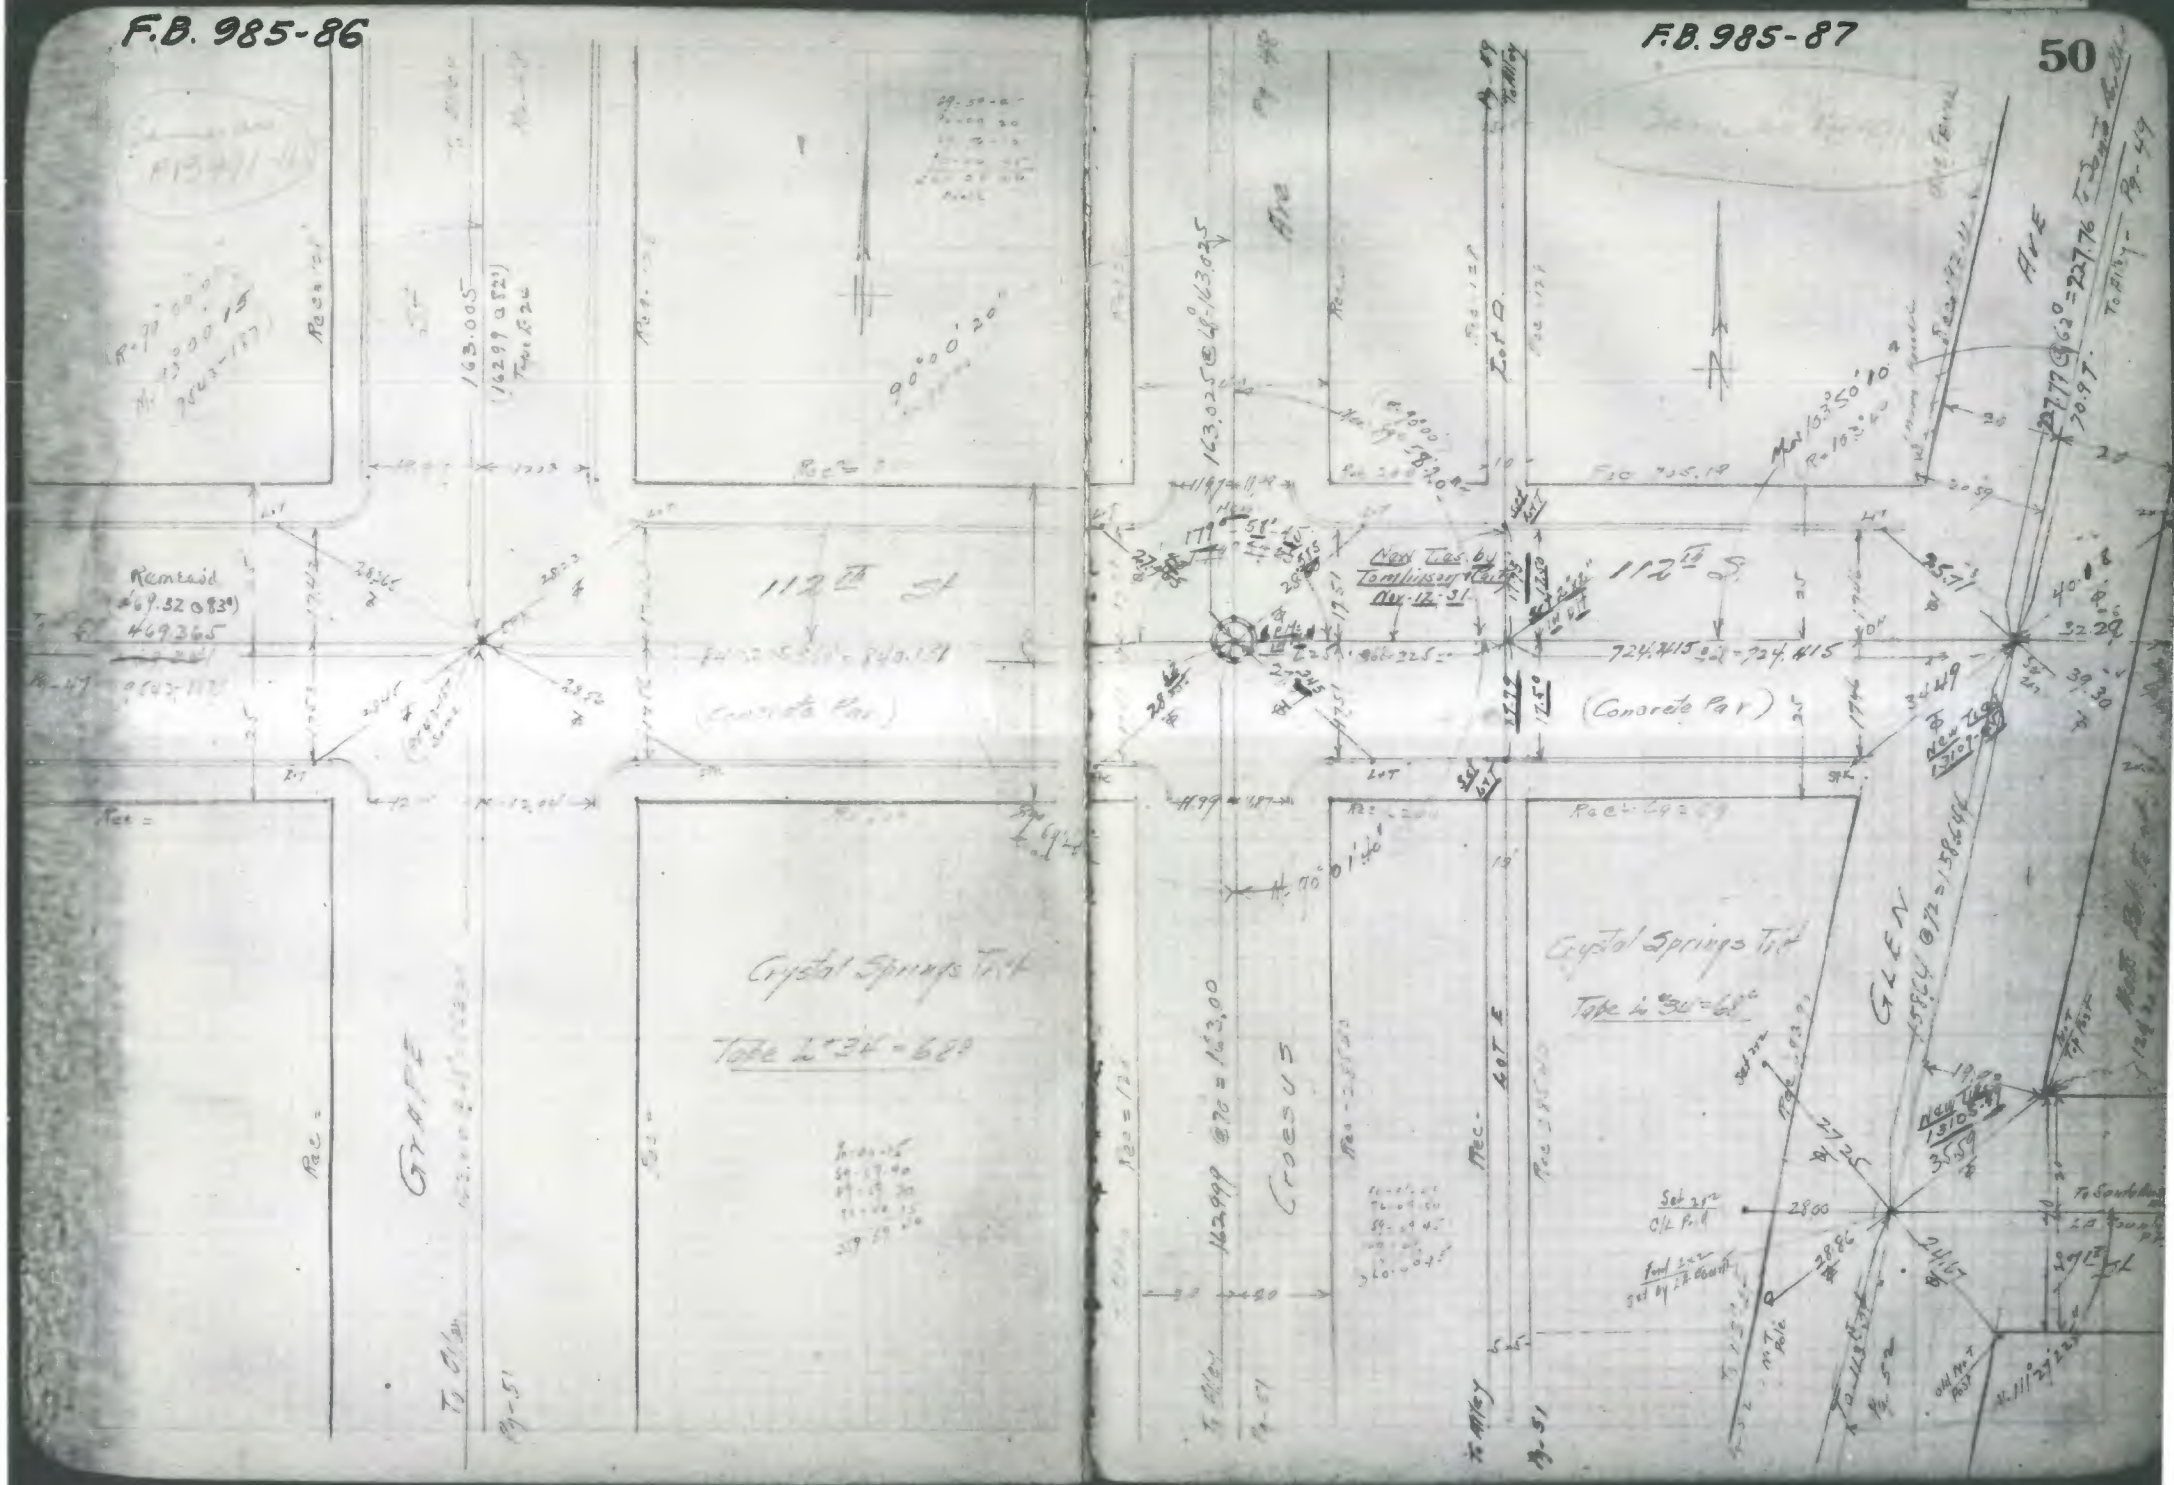

F.B. 985-88

12302

51

F.B. 985-89

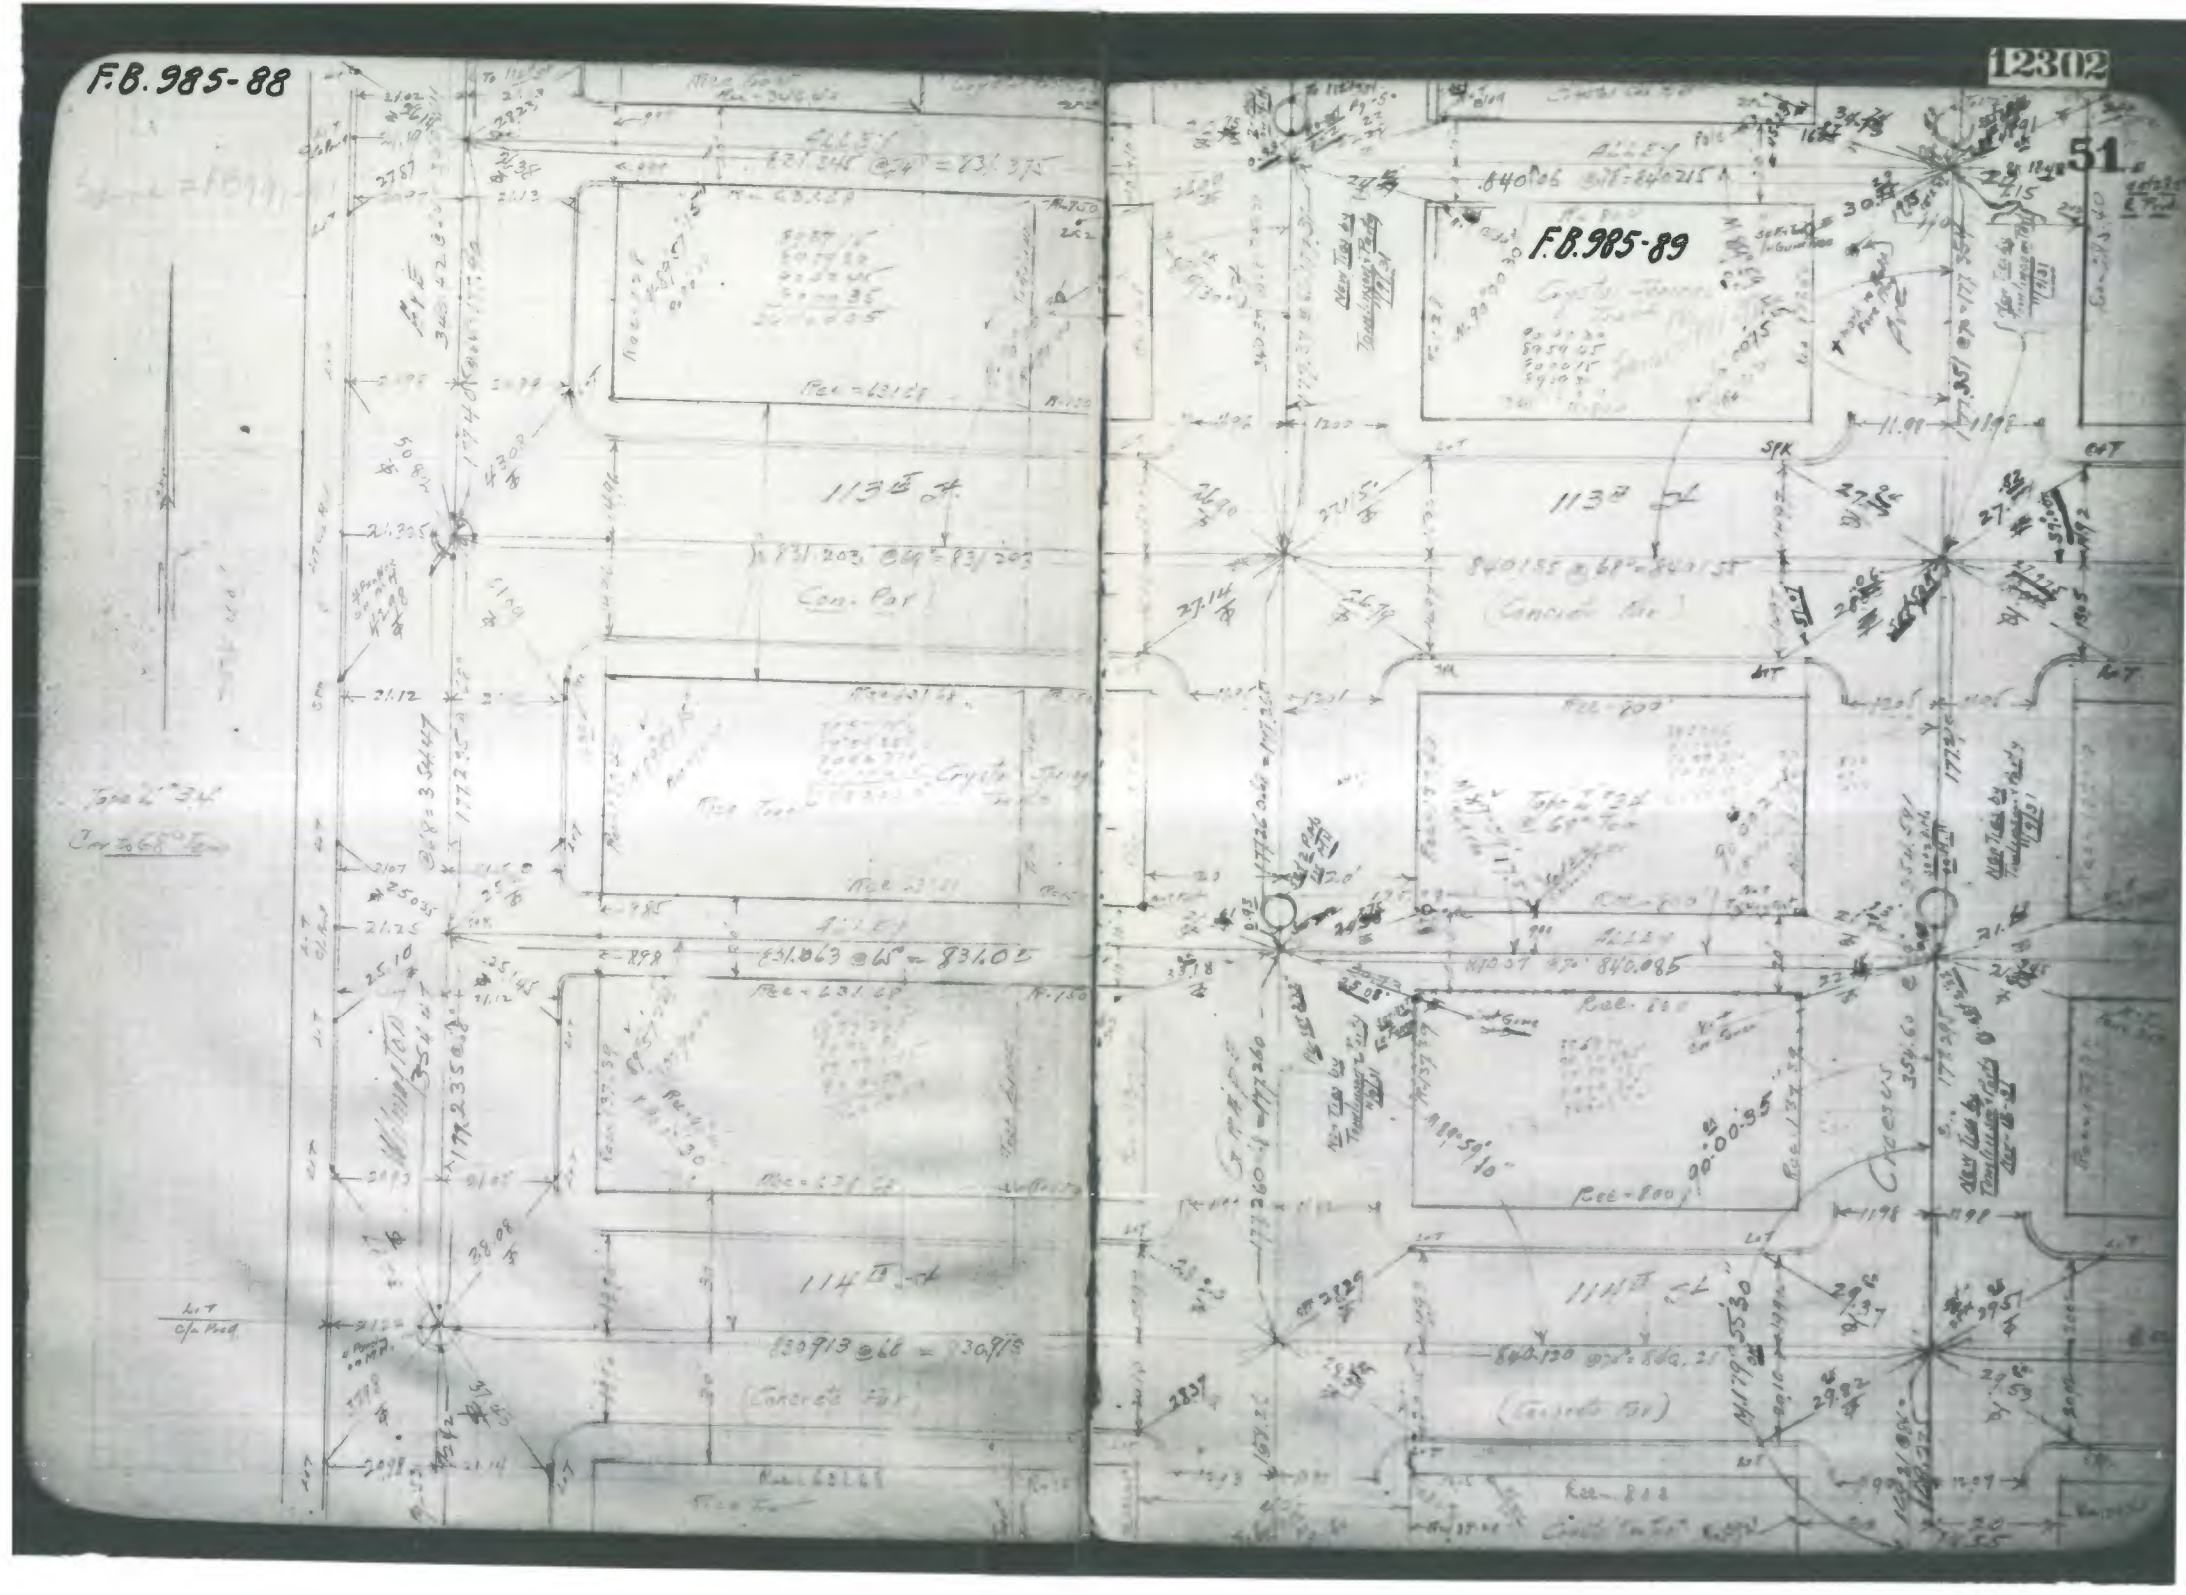

F.B. 985-90

Tope 2" 34 @ 48"

R=200

R=200

113 ft

Crystal Springs Tract

R=200

R=200

R=200

114 ft

R=200

Crystal Springs Tract

F.B. 985-91

INDEXED JAN 3 1929

12302

52

Crystal Springs Tract

ALLEY

Crystal Springs Tract

Crystal Springs Tract

F.B. 985-92

INDEXED JAN 3 1929

108th St

Glen Ave. to Juniper St.

107th St

Wilmington Ave To GLEN Ave

ALLEY

East of Wilmington Ave 107th St To South Line of

ERSKINE Ave

107th St To Santa Fe Blvd

ALLEY - East of Alameda

107th St To Santa Fe Blvd

GRAPE ST

107th St To Santa Fe Blvd

ALLEY - East of Grape St

107th St To Santa Fe Blvd

HICKORY ST

107th St To Santa Fe Blvd

ALLEY E of Hickory

107th St To Santa Fe Blvd

LOU DILLON ST

107th St To Santa Fe Blvd

ALLEY E of LOU DILLON ST

107th St To Santa Fe Blvd

CRESUS AVE

107th St To Santa Fe Blvd

ALLEY E of CRESUS AVE

107th St To JUNIPER ST

JUNIPER ST

107th St To Santa Fe Blvd

KALMIA ST

107th St To Santa Fe Blvd

GARVEN ST

107th St To Santa Fe Blvd

MEIGHAN ST

107th St To Santa Fe Blvd

Glen Ave

107th St To Santa Fe Blvd

12302

F.B. 985-93

Surveys To Establish Center Lines

McCabe Sur
Gunnels Inst
Fosdick Shaw
Fowler Chas

Sur. 1928

57

To Santa Ana Blvd

F.B. 985-94

F.B. 985-95

12302

58

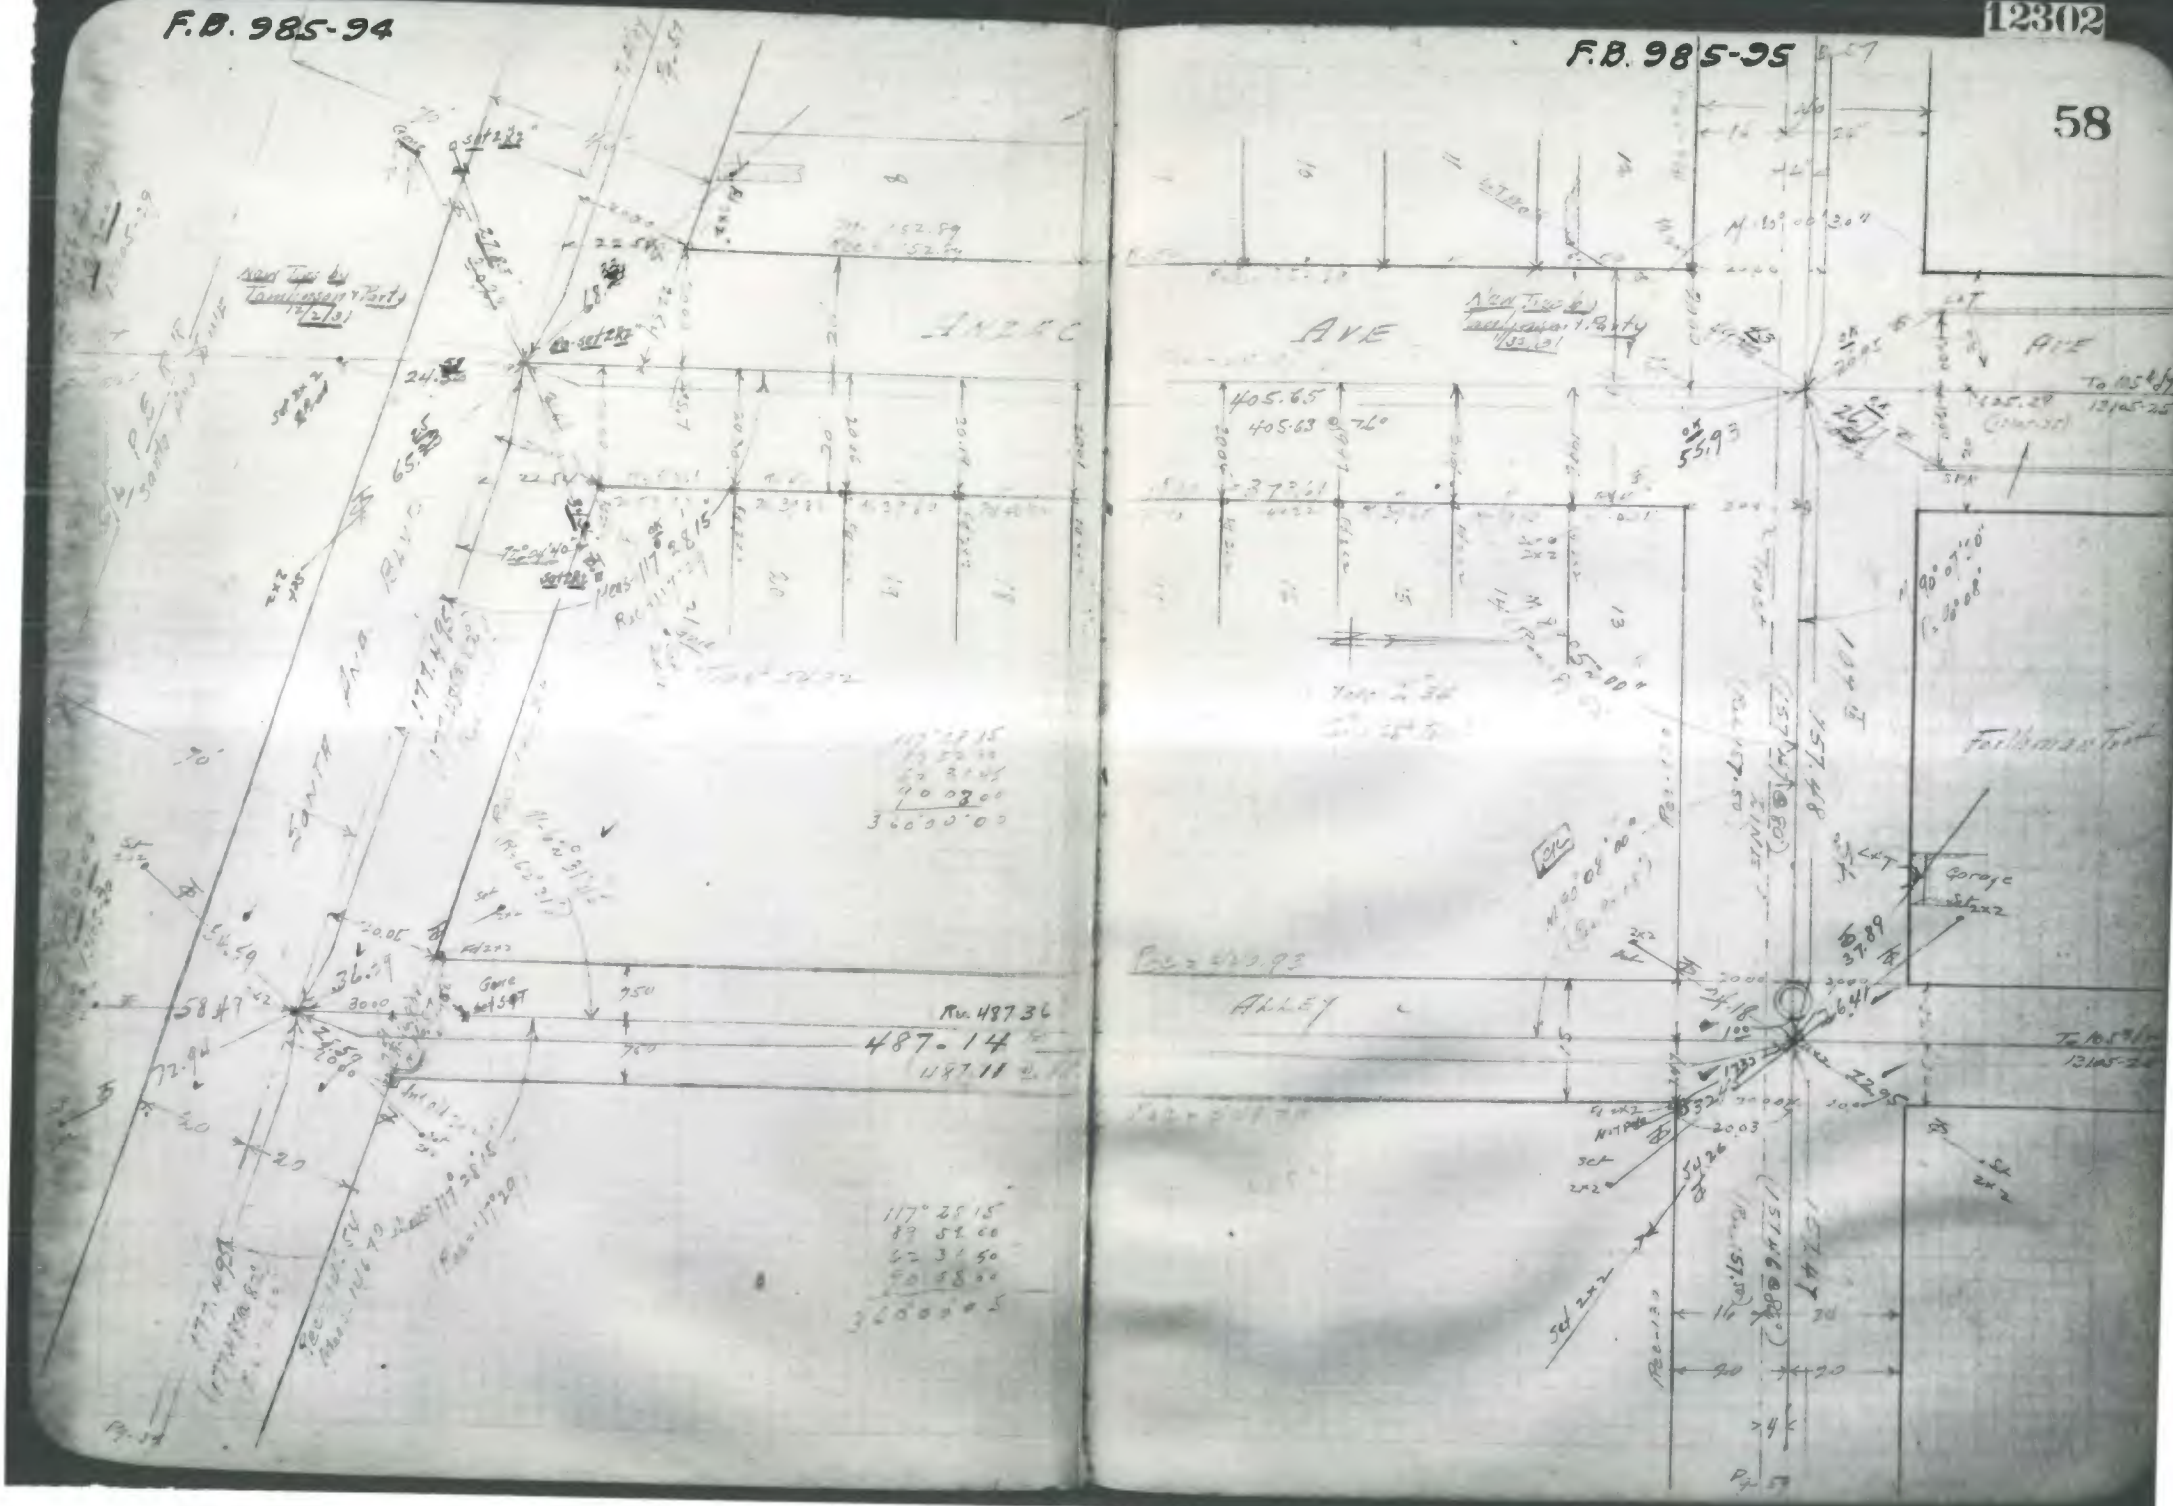

F.B. 985-96

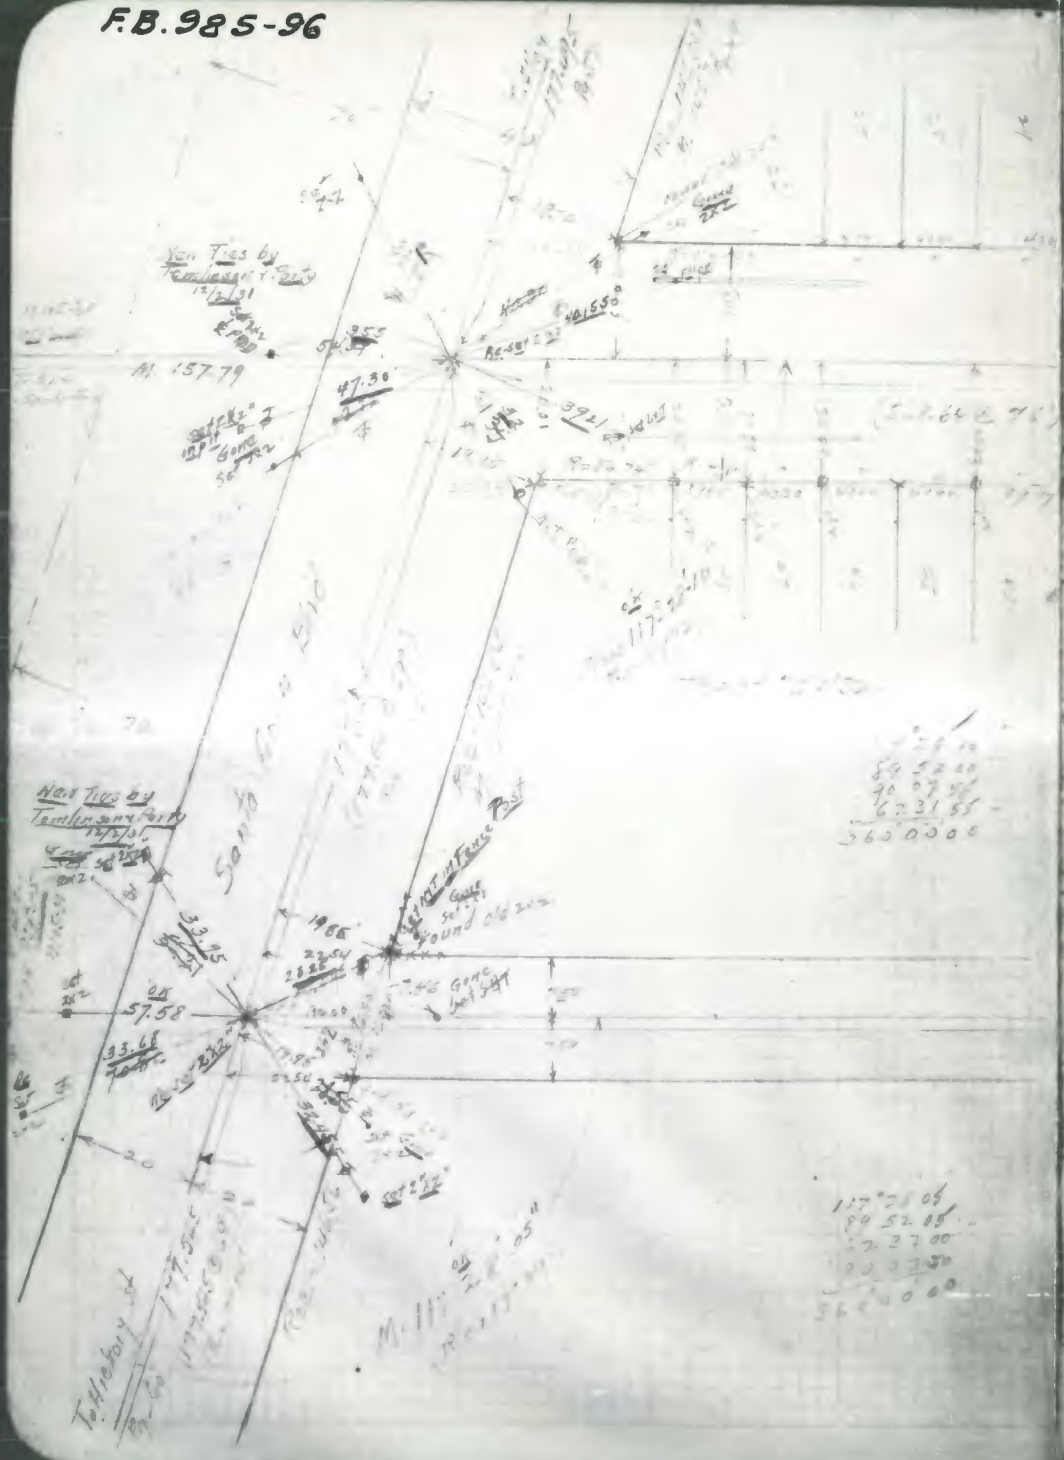

F.B. 985-97

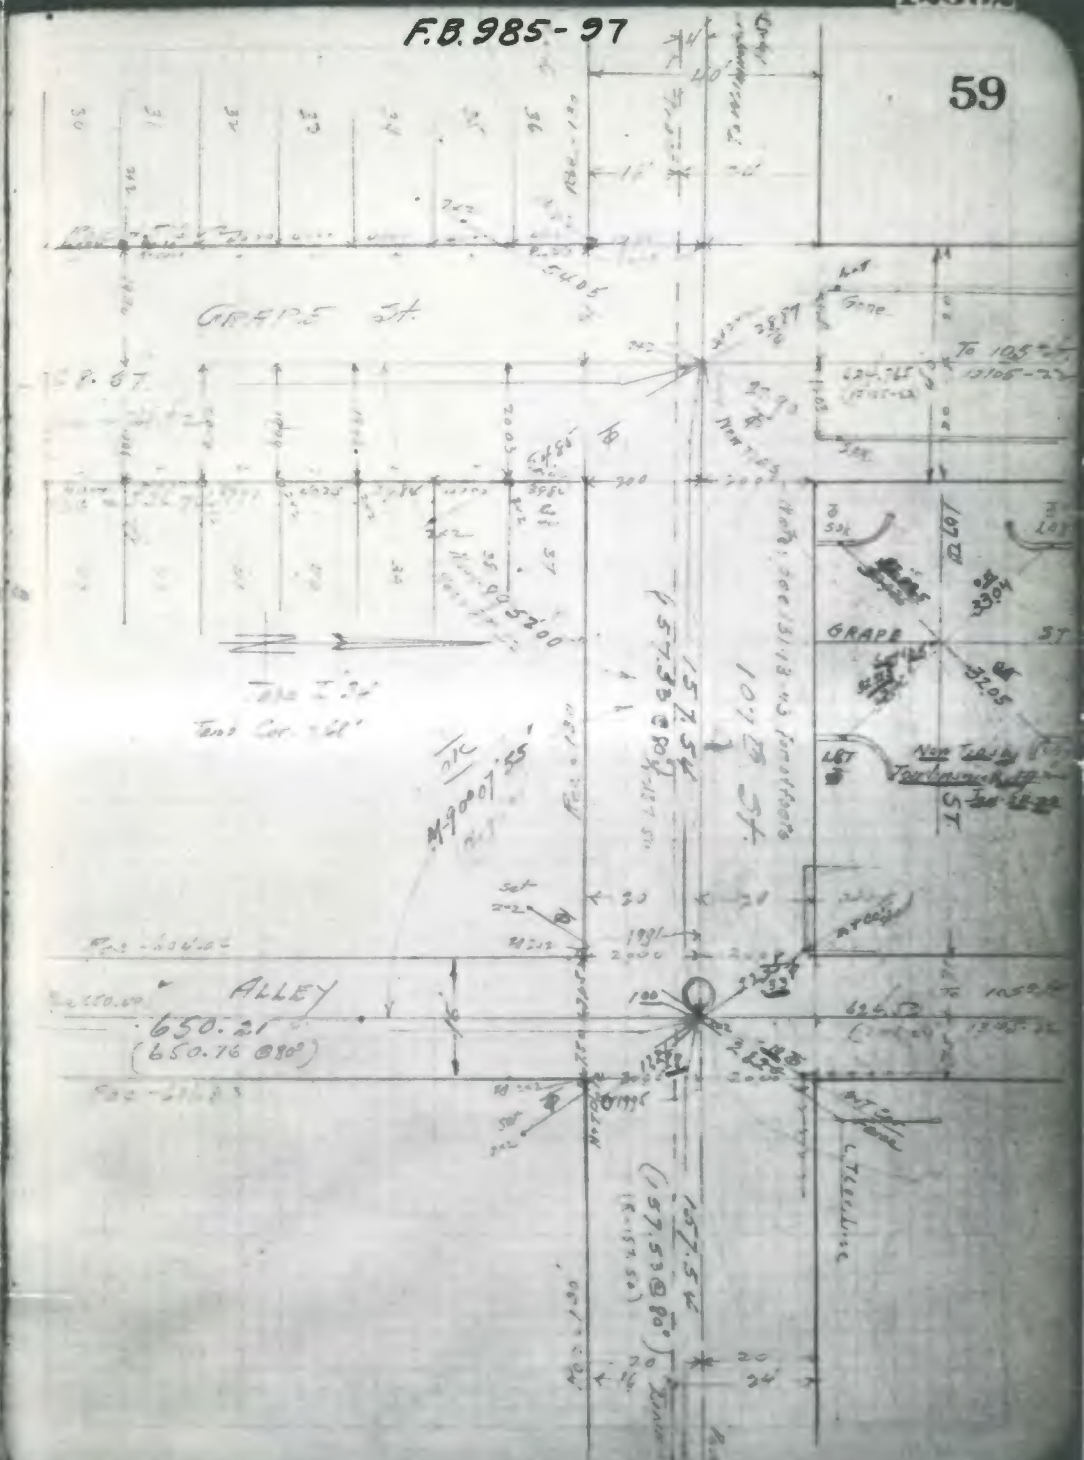

F.B. 985-98

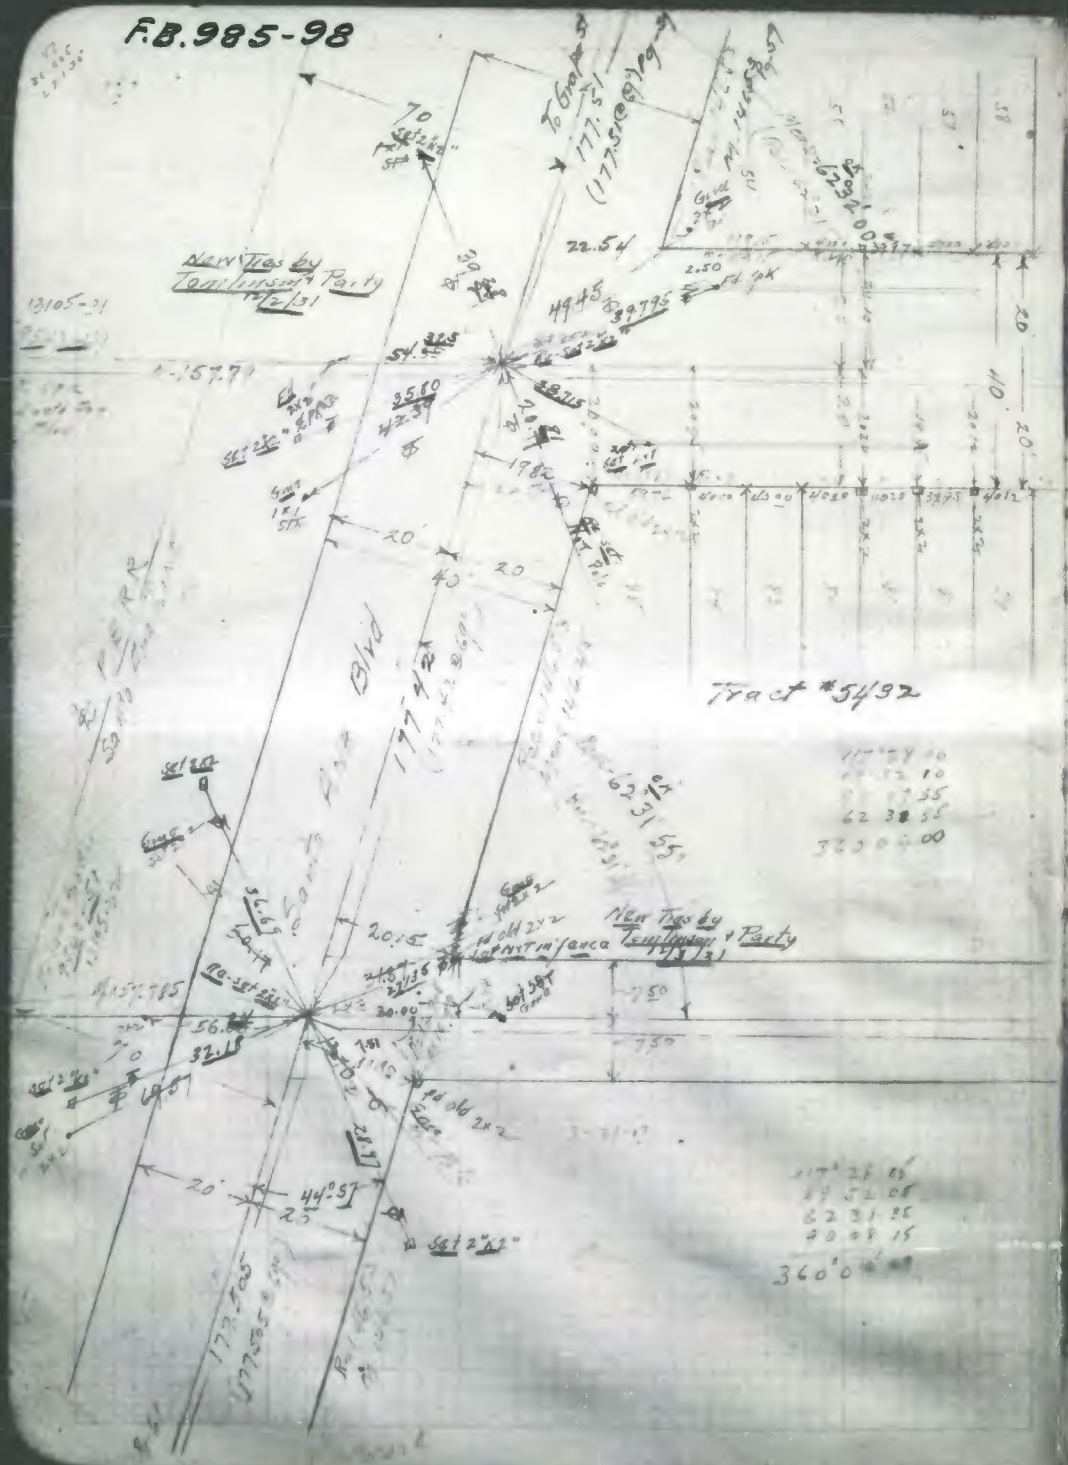

F.B. 985-99

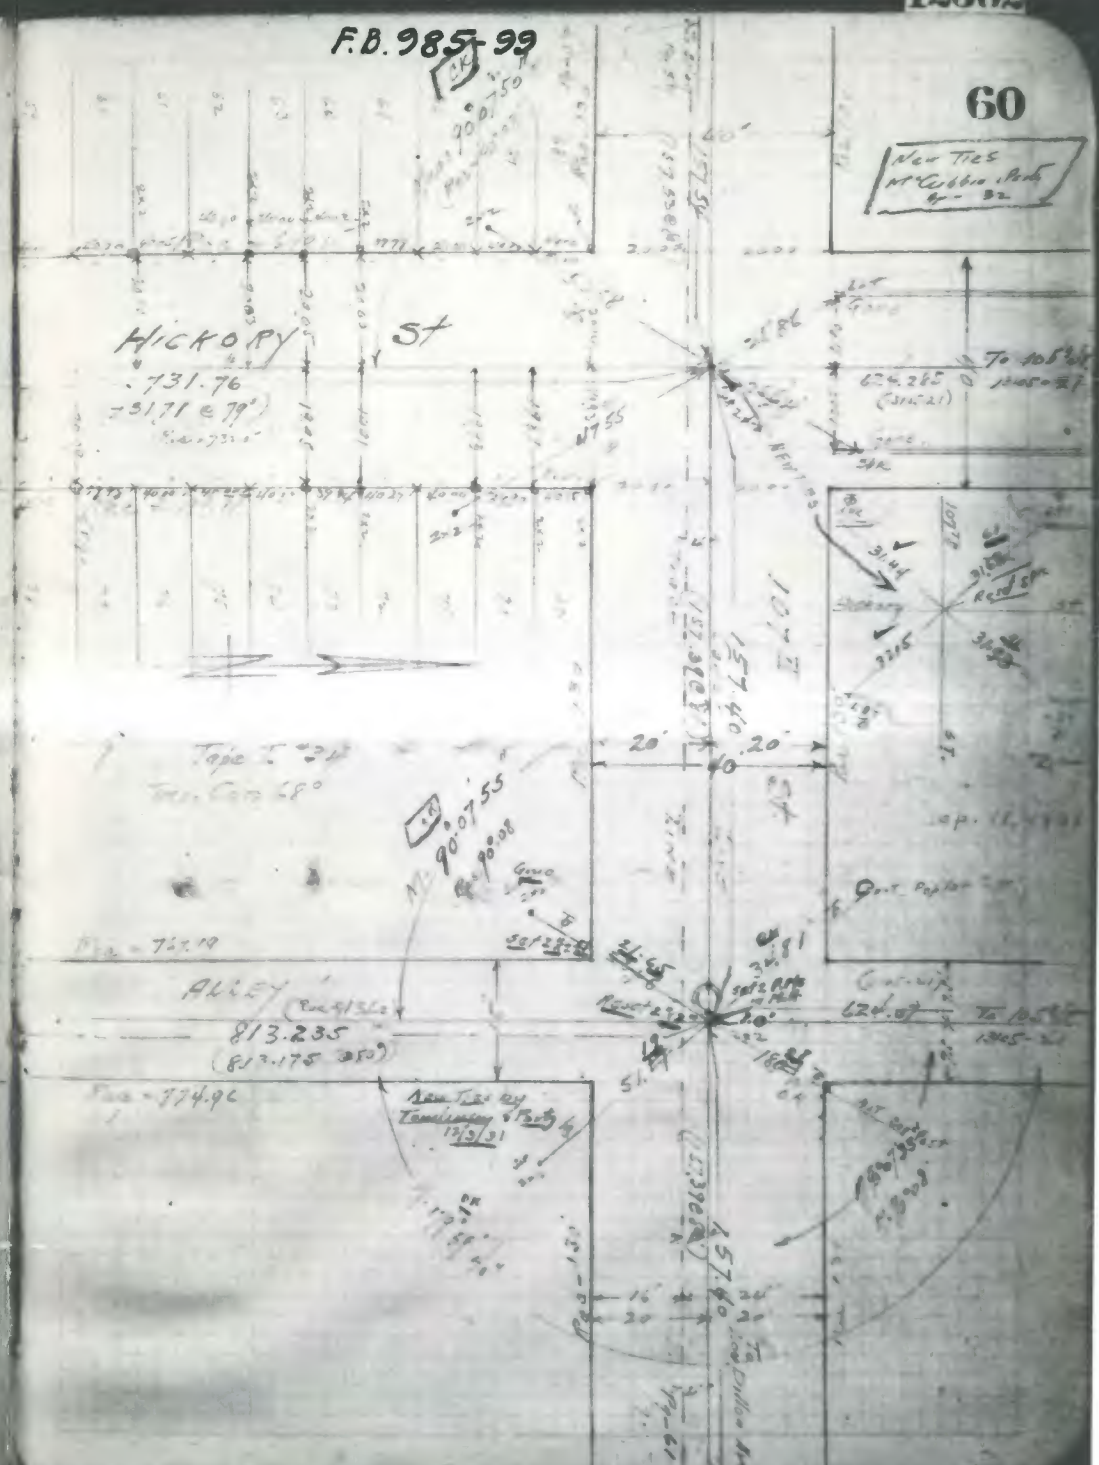

F.B. 985-100

F.B. 985-101

61

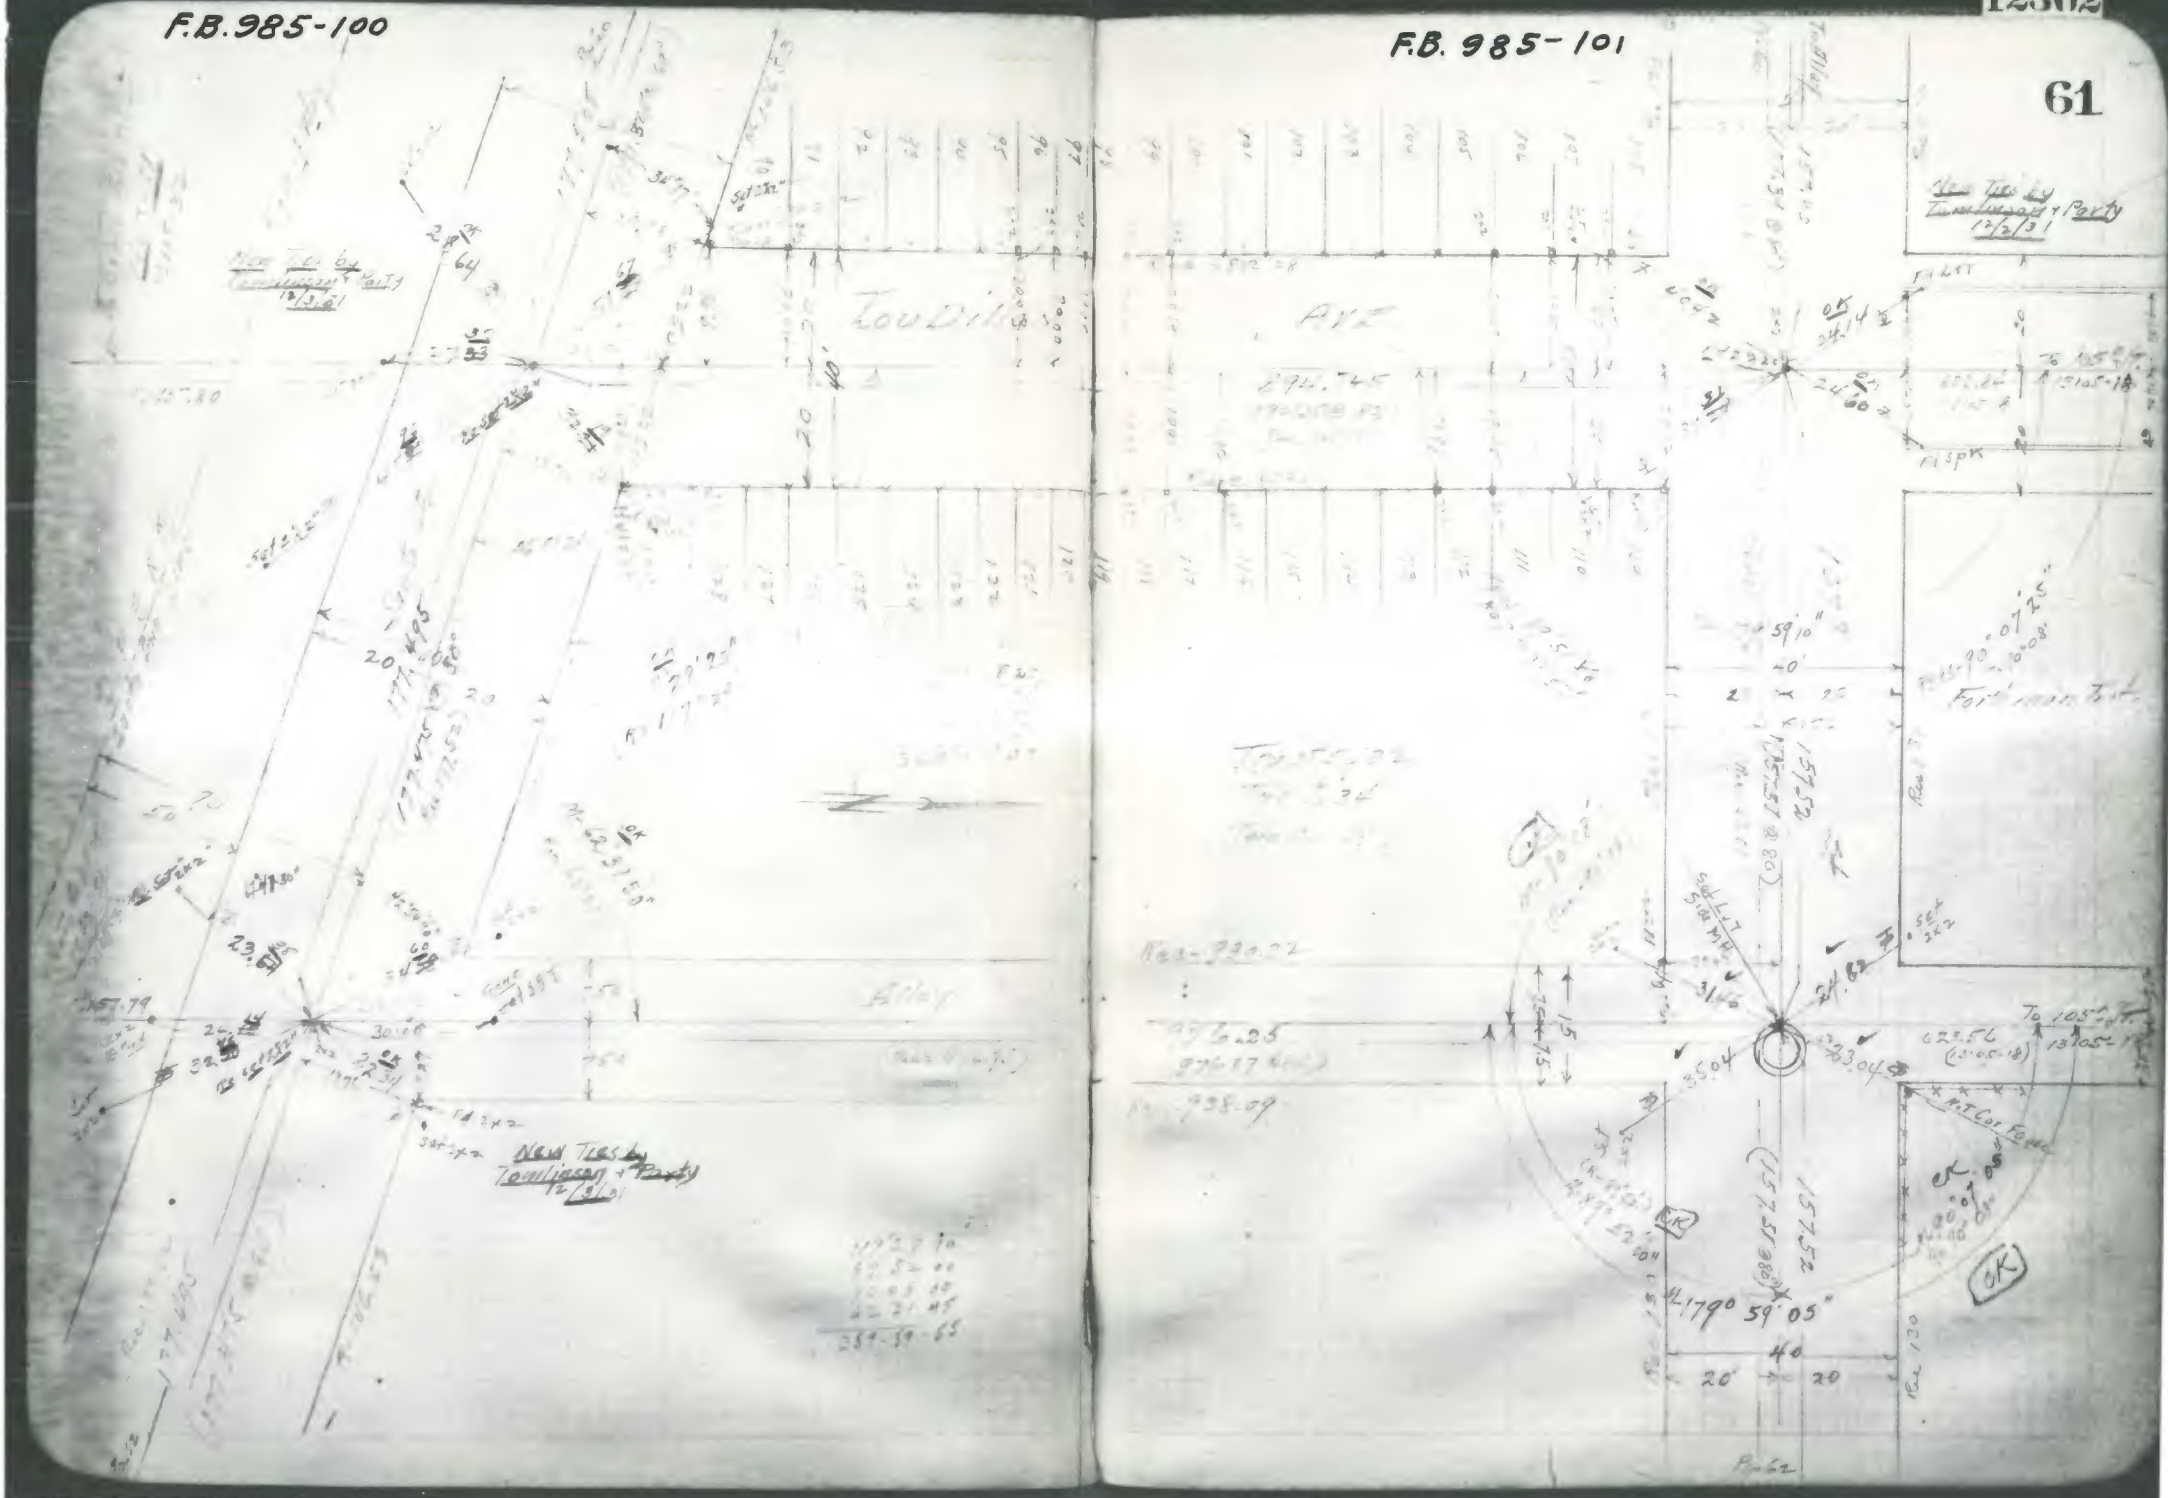
New Tie by Tomlinson + Party 12/31/51
Low Drk
Alley
20
40'
New Tie by Tomlinson + Party 12/31/51
New Tie by Tomlinson + Party 12/31/51
AYE
294.745
Fd 1/2 pk
Fd Nail
Fd 1/2 pk
Fd 1/2 pk
Fd 1/2 pk

F.B. 985-102

F.B. 985-103

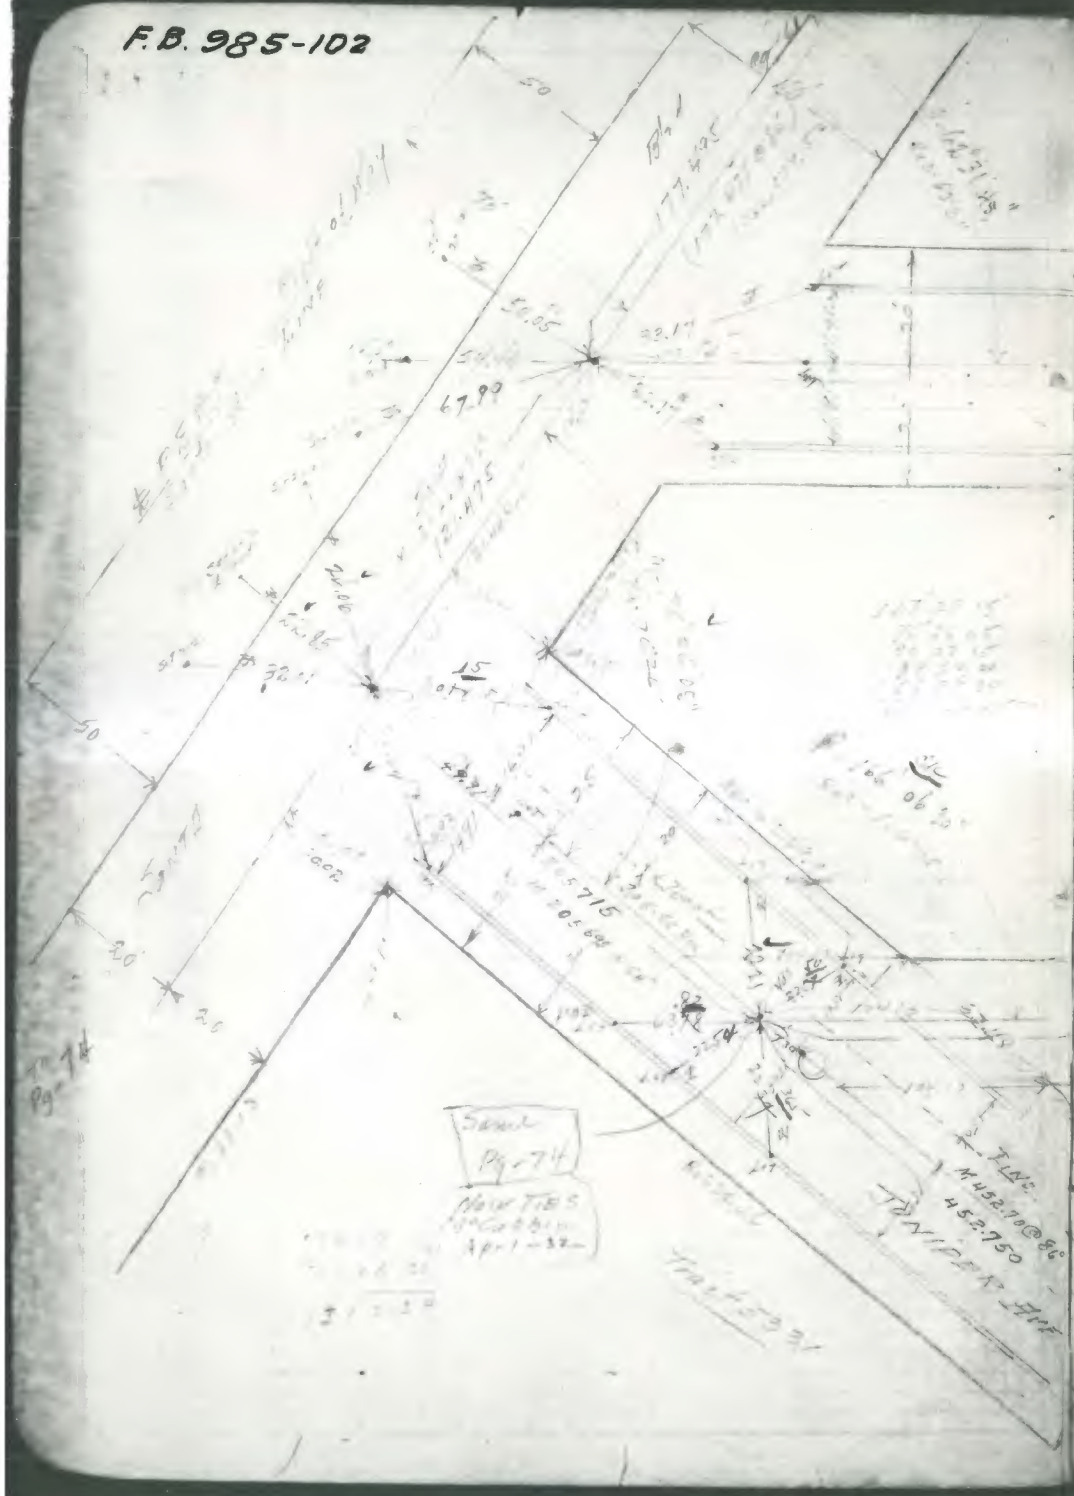
Sewer
Pg-74
New T&S
Cabin
Apr-1-32
T.N.C.
M452.750@86°
452.750
Trav-5715

F.B. 985-104

F.B. 985-105

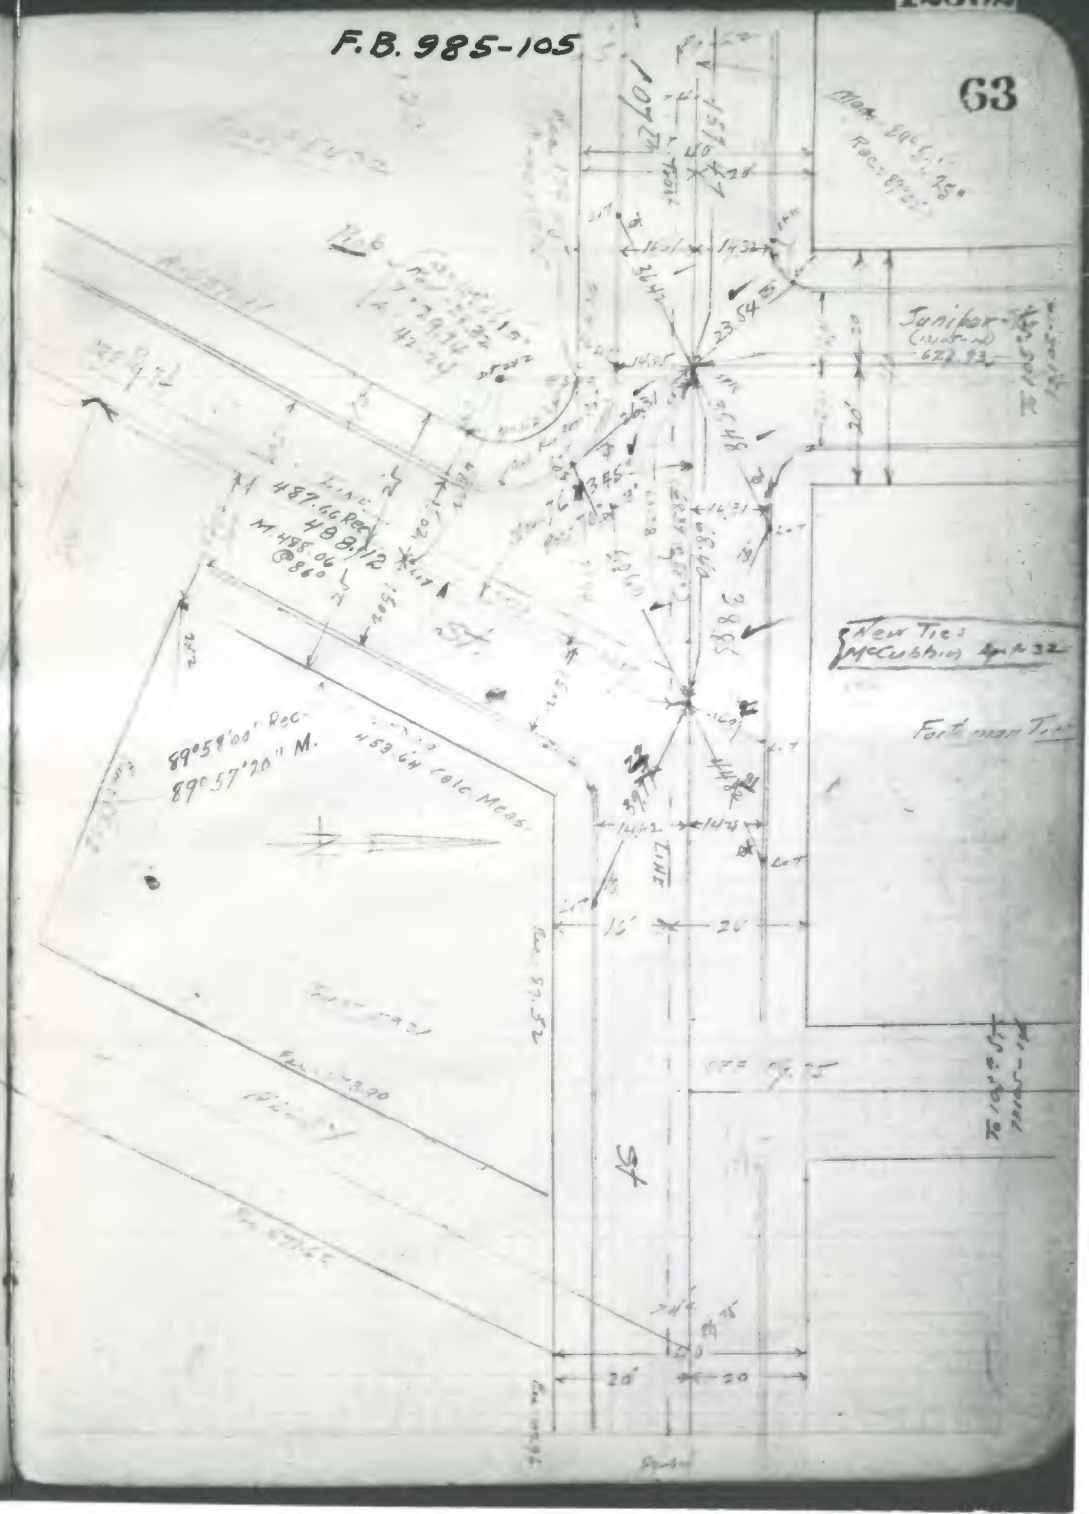

F.B. 985-106

F.B. 985-107

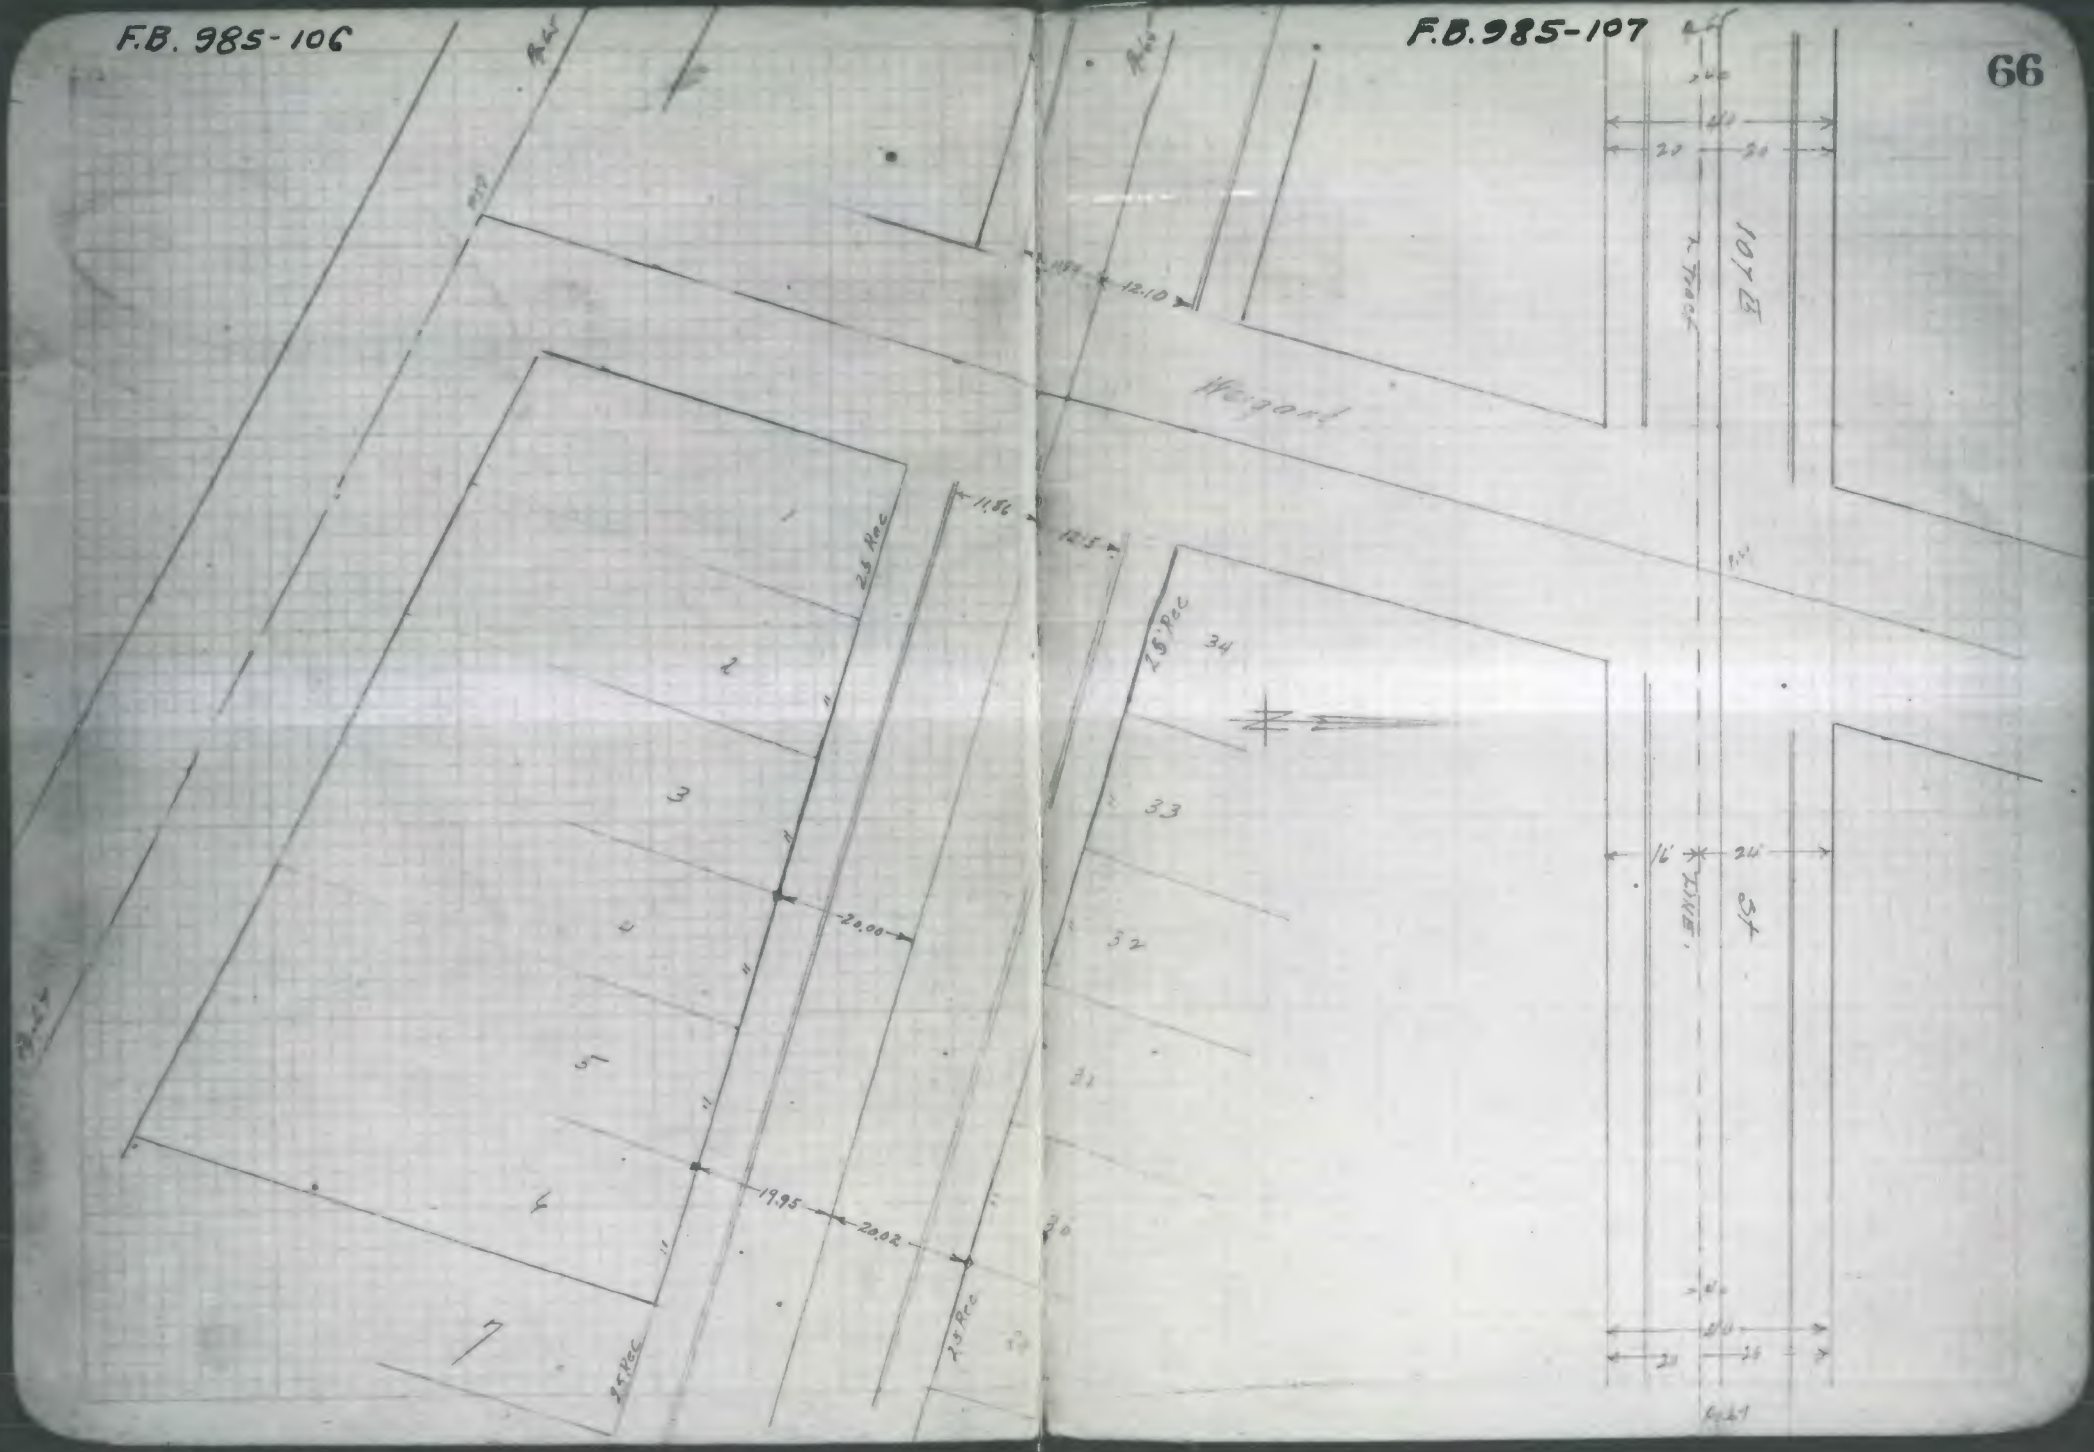

F.B. 985-108

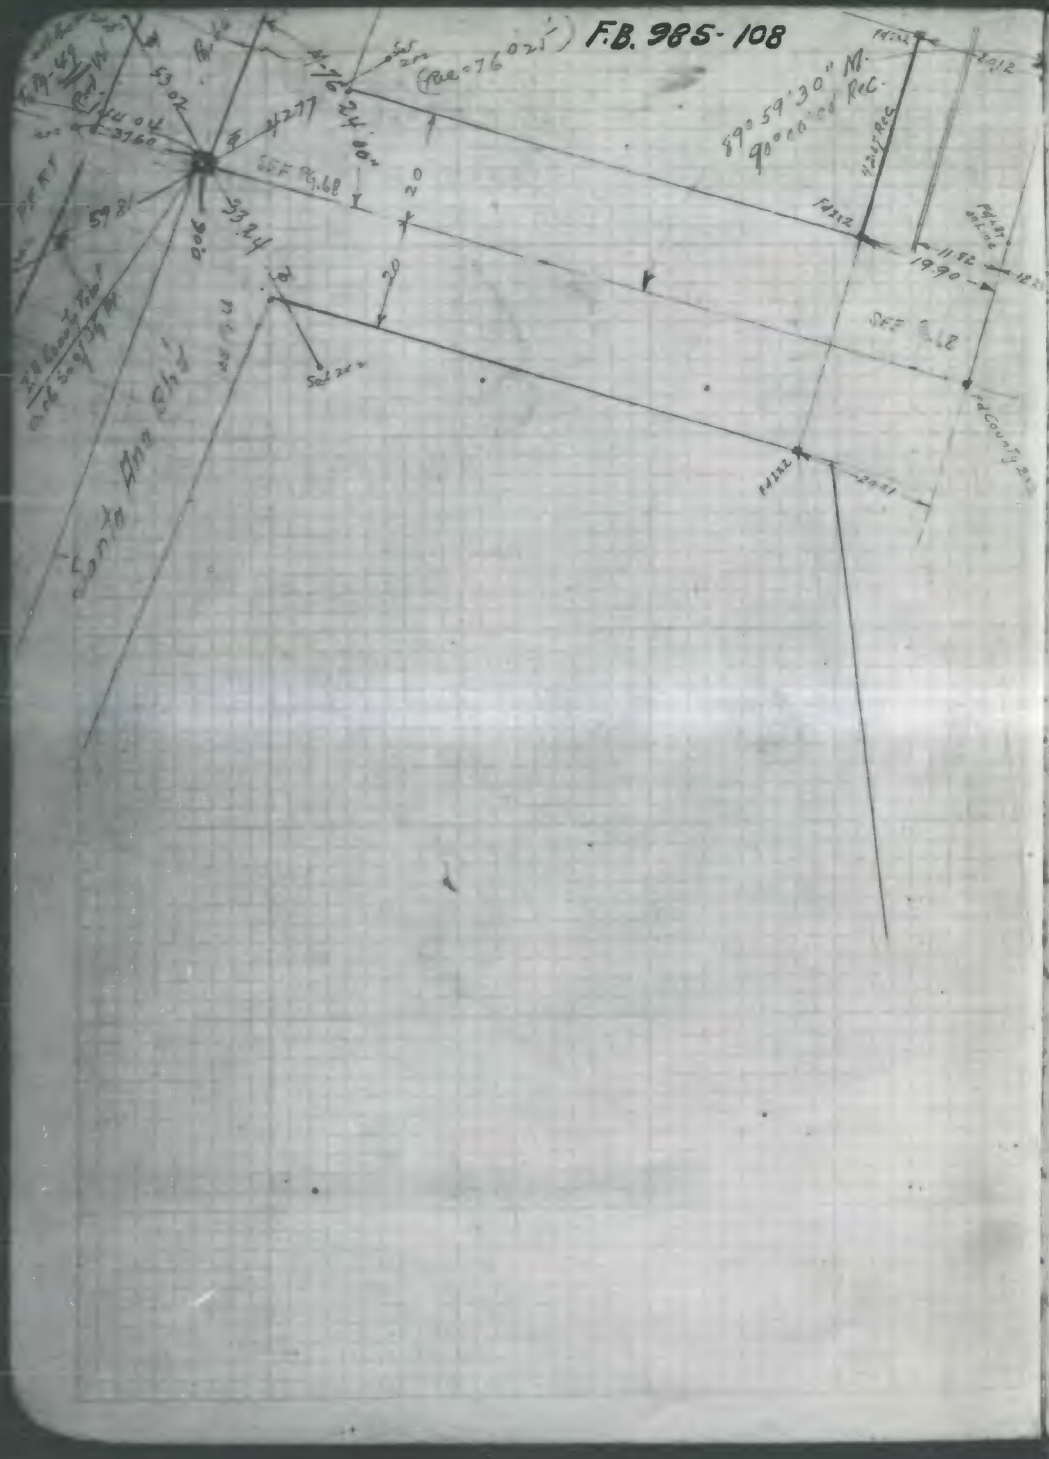

F.B. 985-109 Pg. 66

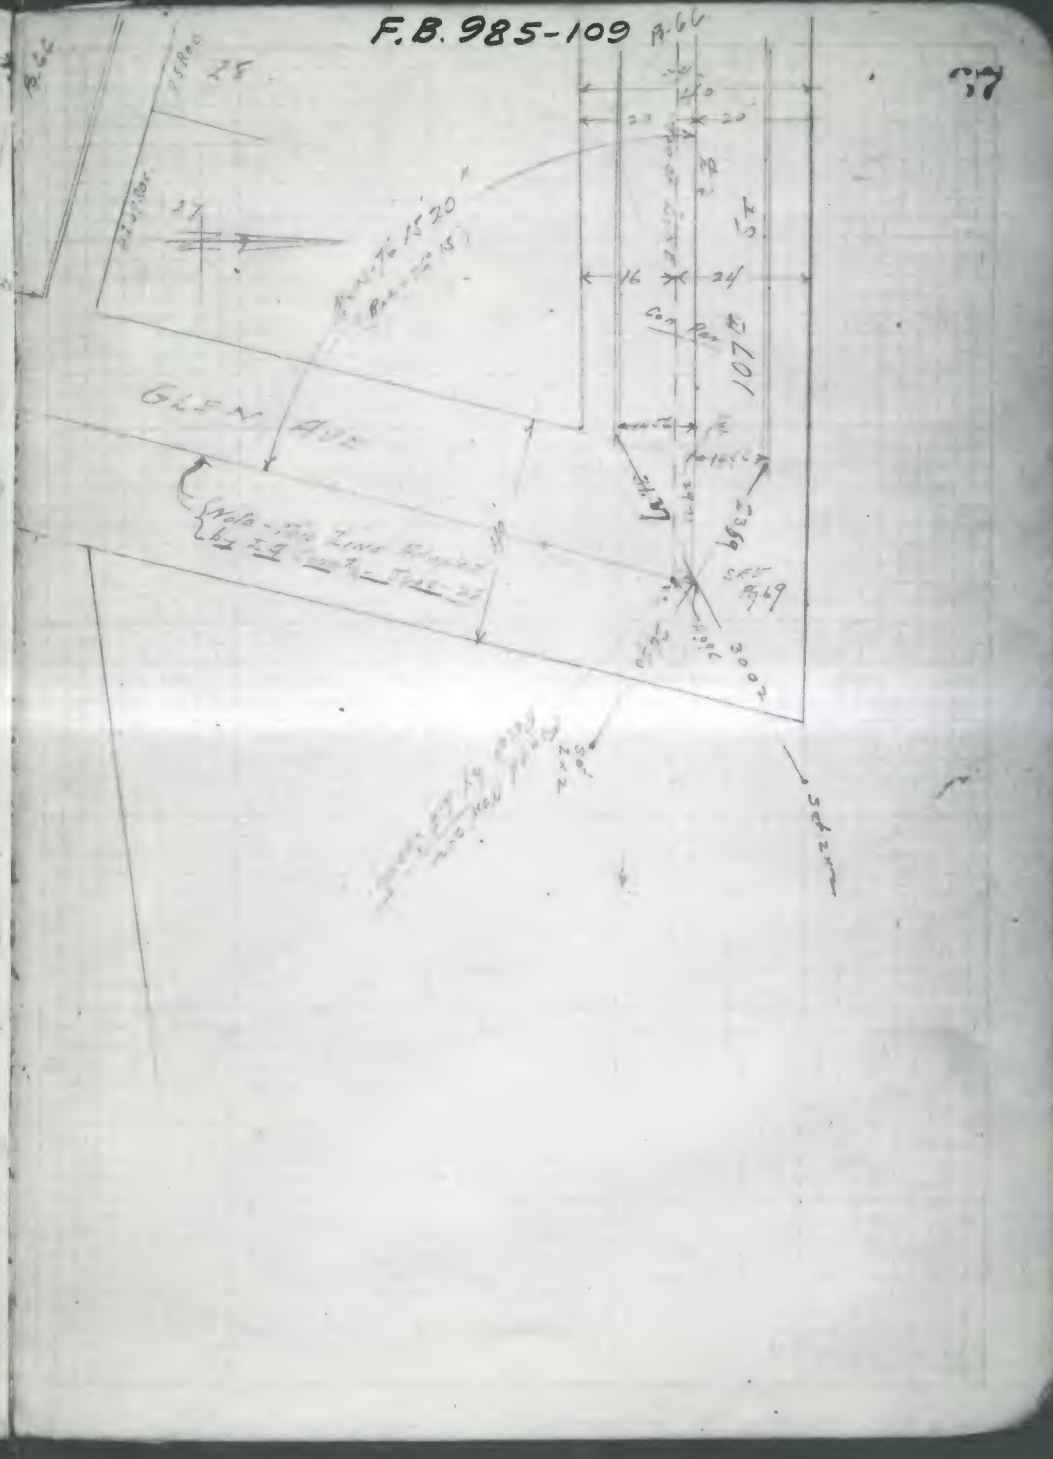

37

F.B. 985-100

F.B. 985-111

68

WEIGAND

WEIGAND AVE

SANTA ANA

GLEN AVE.

GLEN AVE

TELEGT

.5331

865.82 Rec.
865.91
865.92 @ 66°

830.28 Rec.
830.17 Meas

882.67 Rec.
882.85 Meas.

728.67 Rec
728.28
N 728.255 @ 72°

NEW TIES by Tom Lipscomb Party 1/29/92

To P. 69

To 107 E

To 107 E

F.B. 985-112

WEIGAND AVE.

697.07 Rec.
697.345
M 697.380 @ 18°

To 108 @ 31 Page 65

661.36 Rec
661.63 Meas

Total { 714.85 Rec
714.43 M (25)

GLEN AVE

740.13 Rec
740.155
M. 740.095 @ 20°

To 108 @ 41 Page 69

To Page 69

12302

F.B. 985-113

69

7

10

151.59 Rec.

WEIGAND AVE.

111.36 Rec.

ST.

New Ties McCubbin - Pb 4 Mch. 31-32

139.02 Rec
139.02 Rec

76°15'30" M (76°15' Rec)

139.65 Rec.

GLEN AVE

274.70 Meas
275.07 Rec

New Ties McCubbin - Pb 4 Mch. 31-32

To 105 @ 53 / 3105-9

Fd 2x2 Page 67

Set 2x2

F.B. 985-114

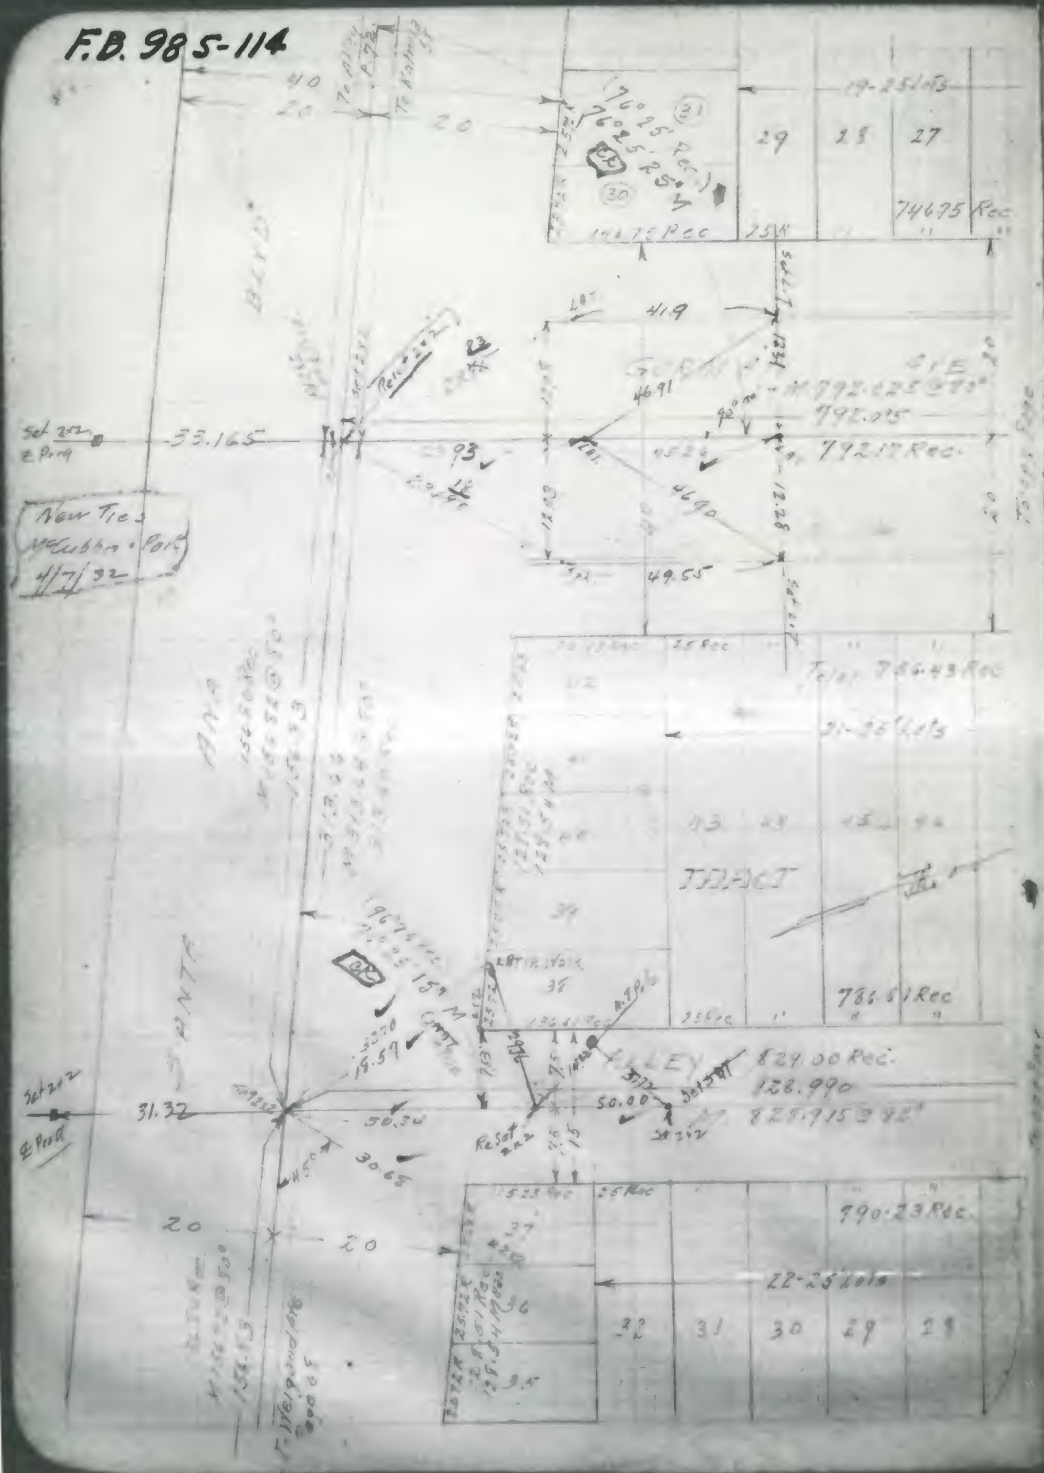

F.B. 985-115

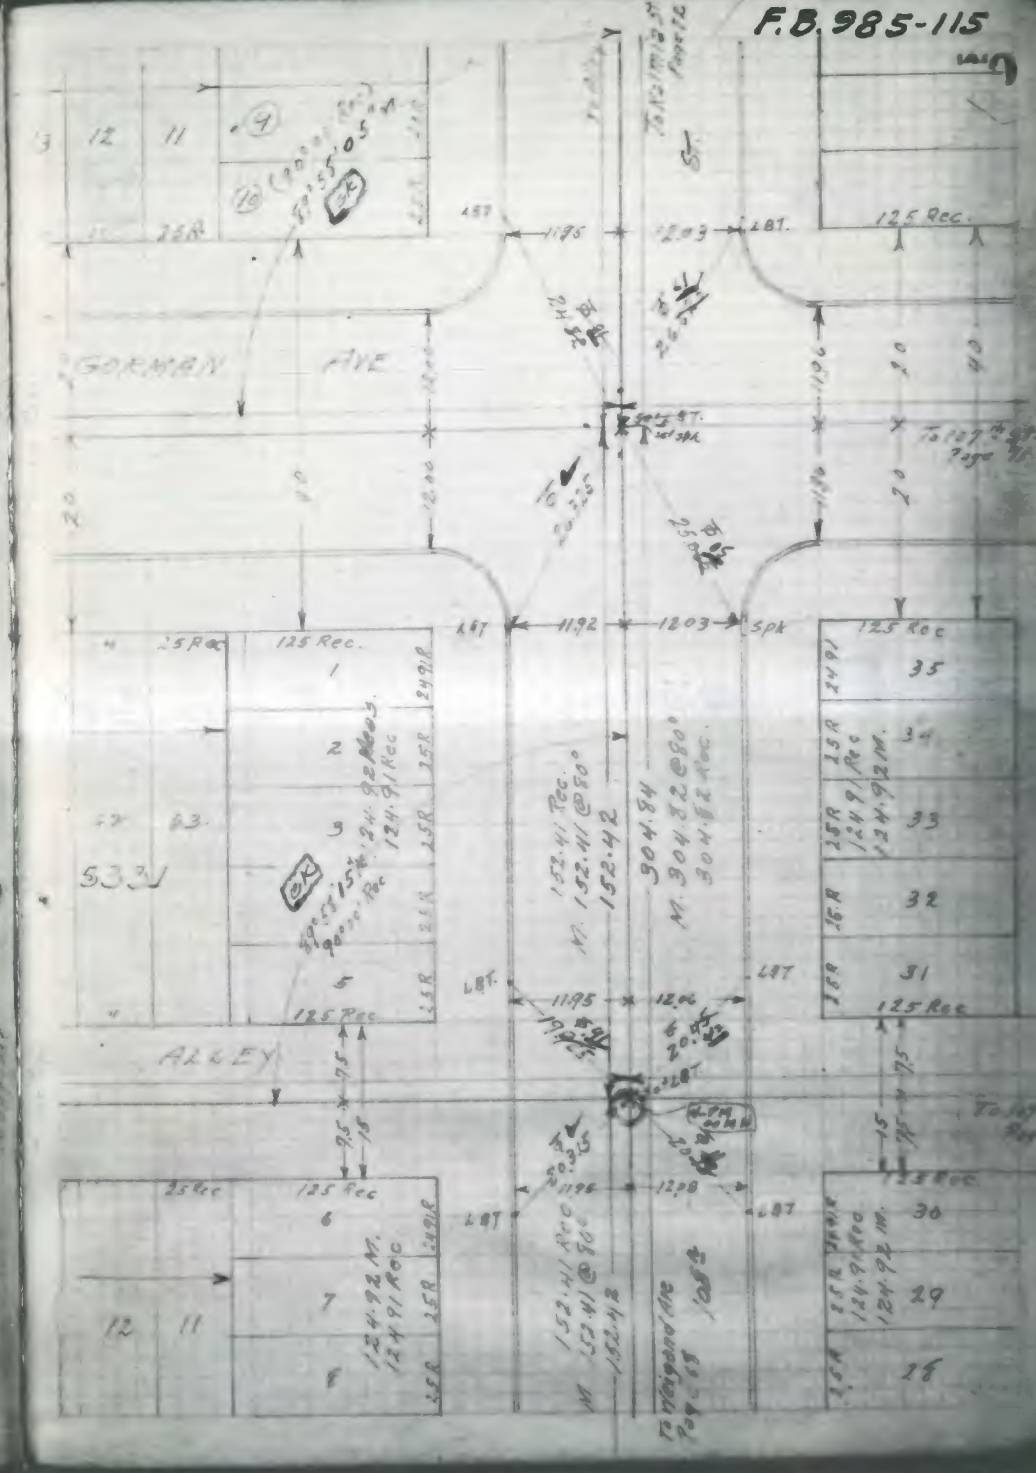

F.B. 985-116

12302

F.B. 985-117

F.B. 985-118

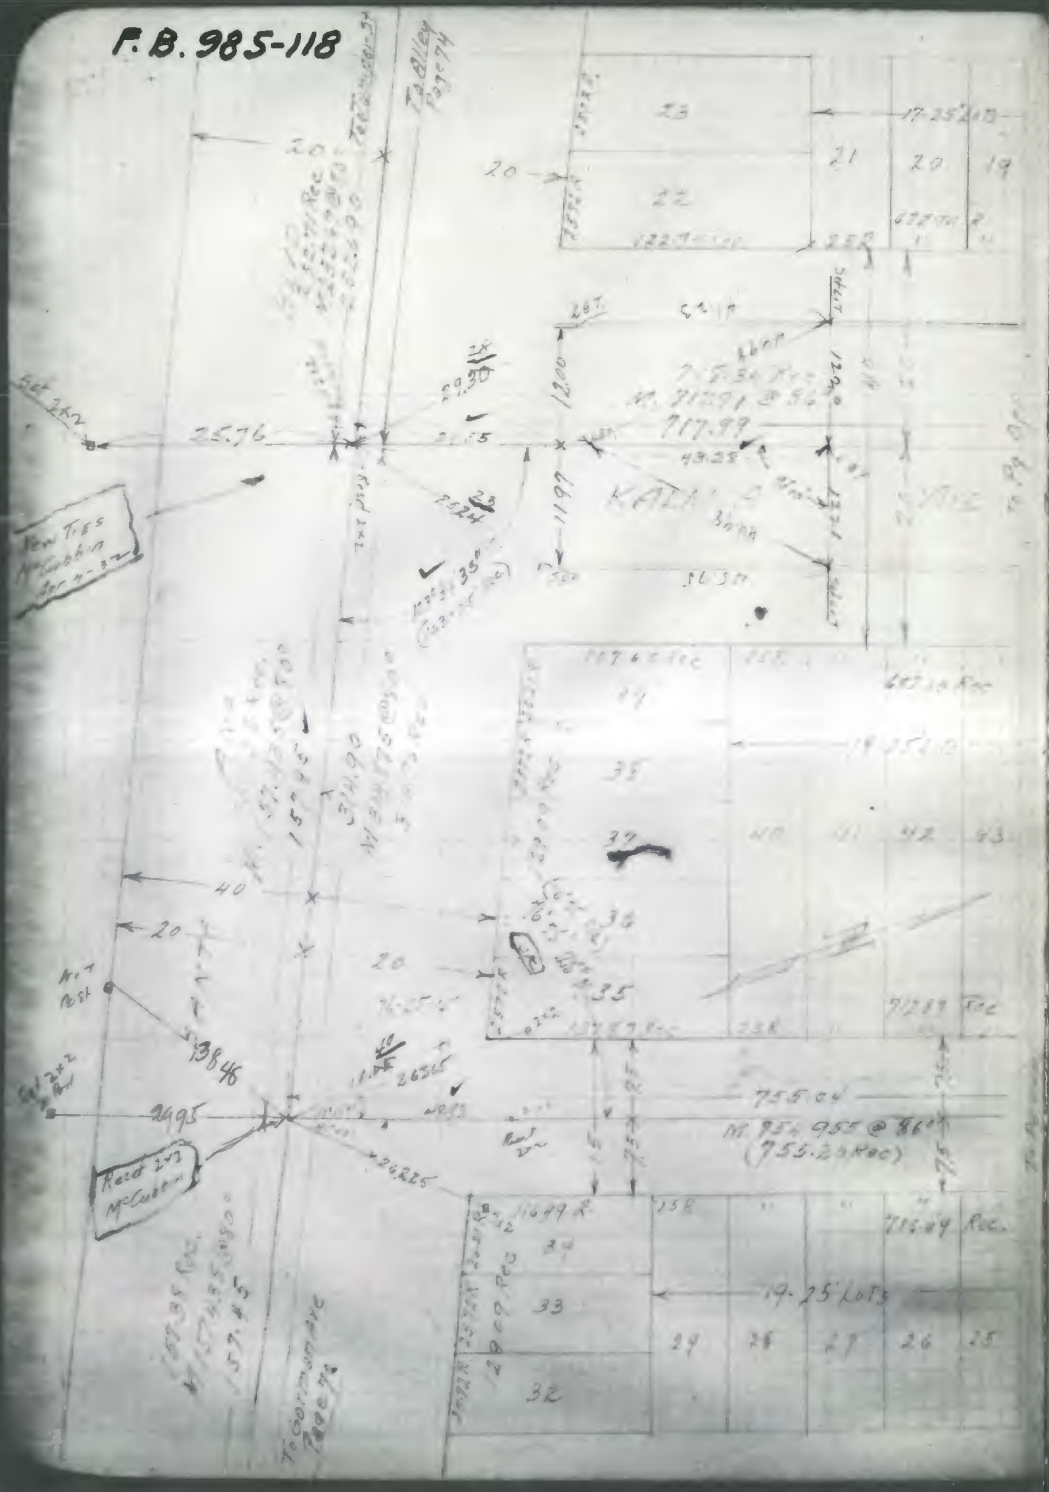

F.B. 985-119

72

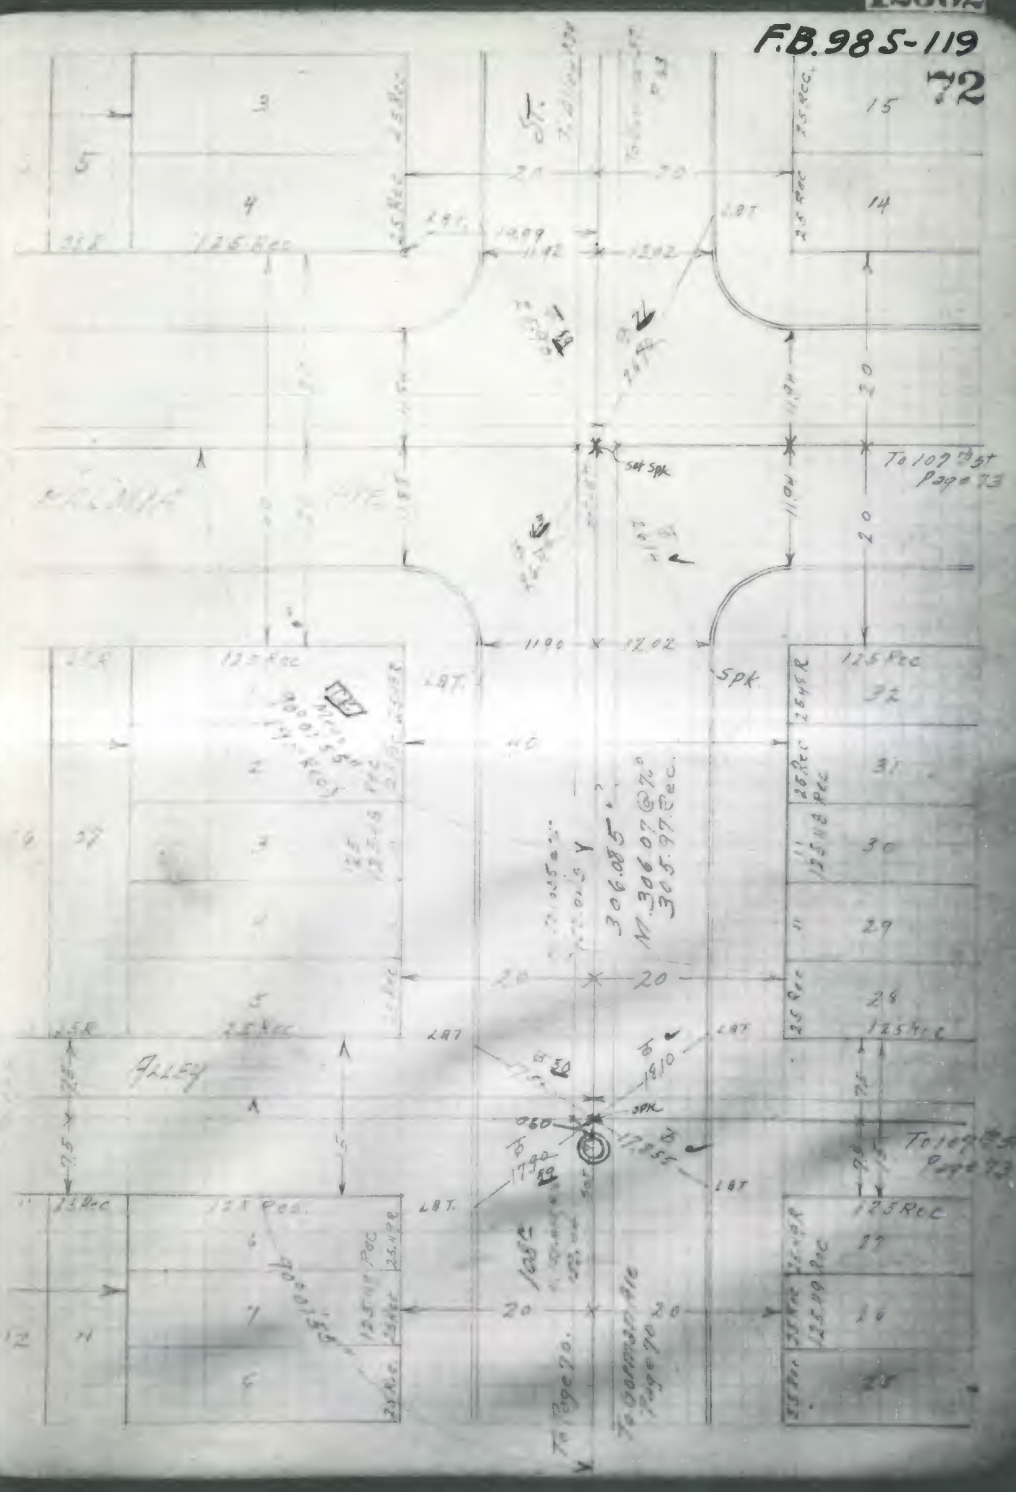

F.B. 985-120

F.B. 985-121

73



F.B. 985-123
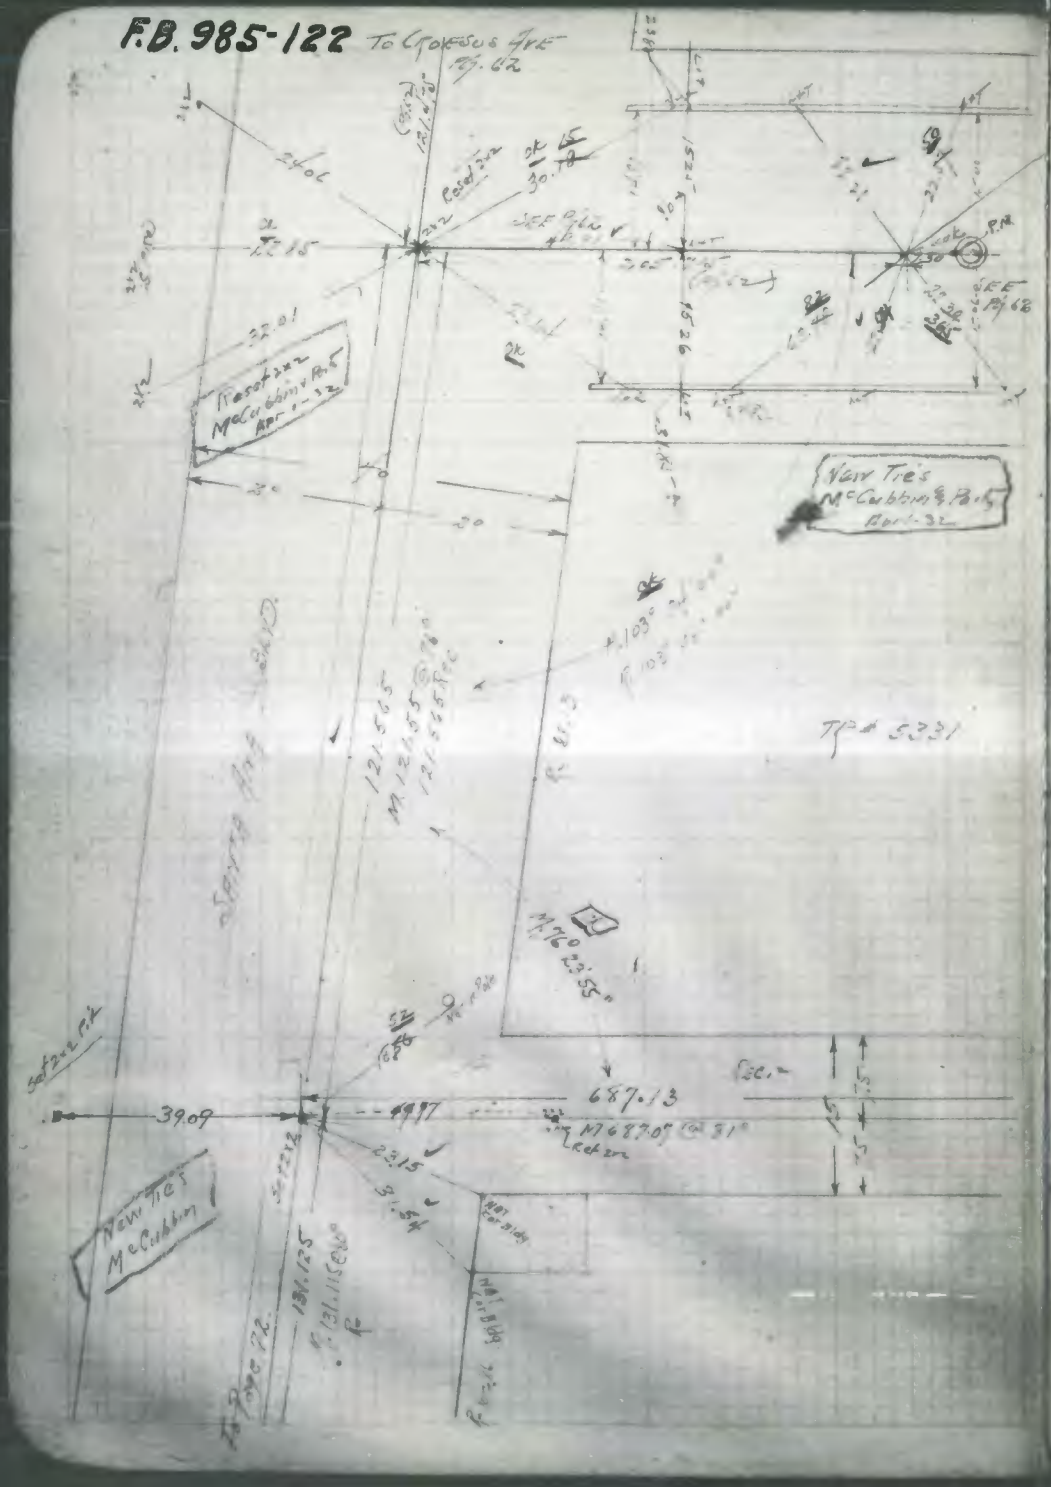
74