The original pages of this book are of poor quality. Care has been taken to make the best scans possible. If necessary you can arrange to see the original book at:

Department of Public Works

900 S. Fremont Ave

Survey Public Counter

Alhambra, CA 91803

F.B. 987-2

Bureau of Light + Power
Water + Power
F.B. 359

F.B. 987-3

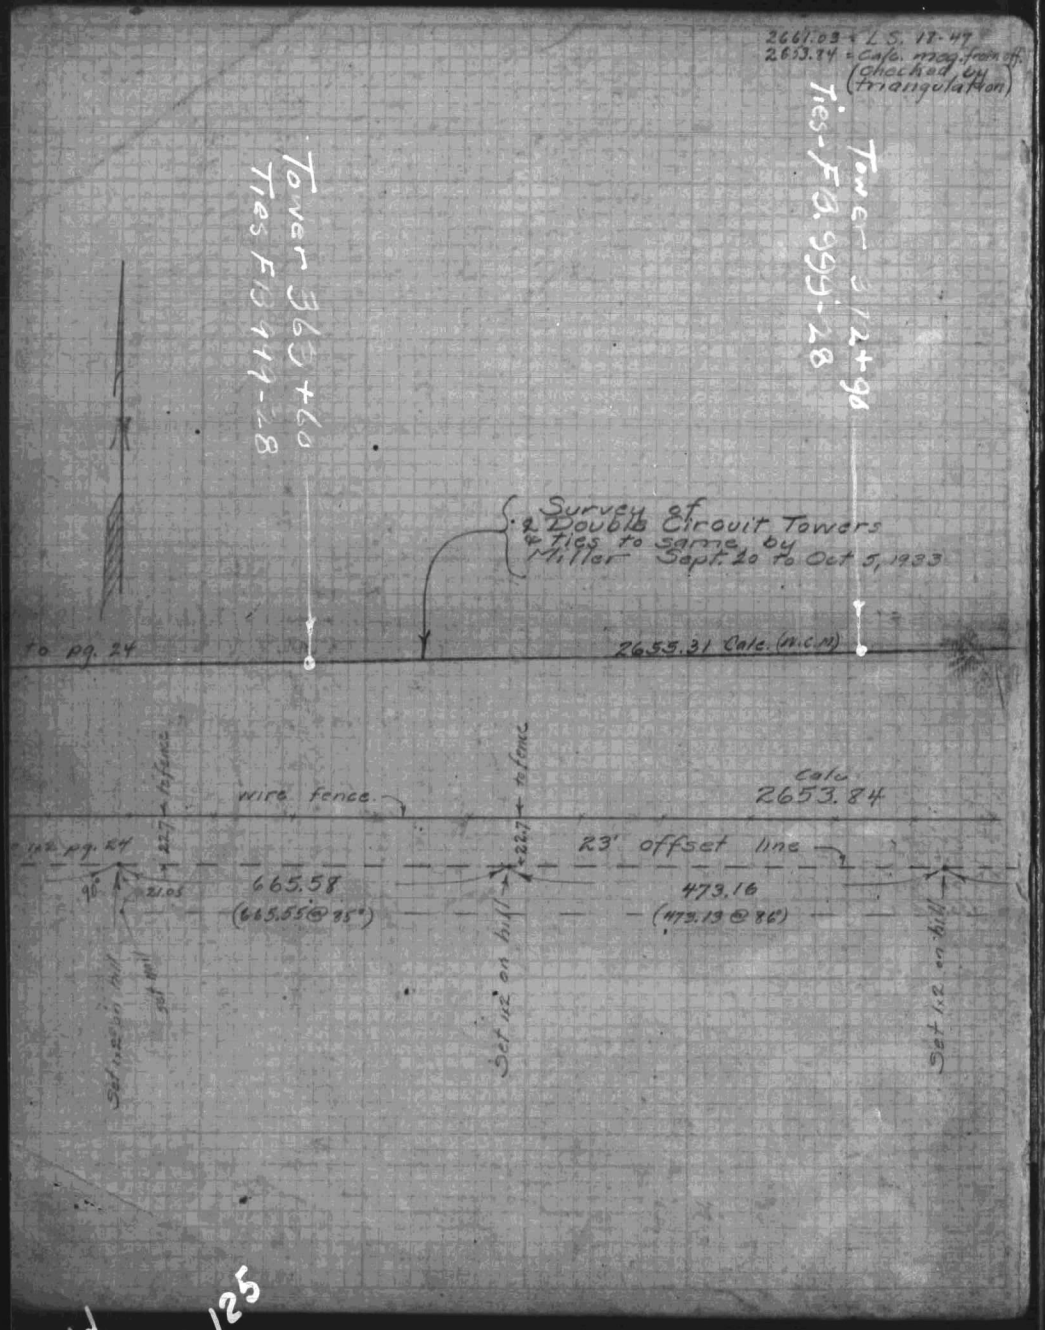

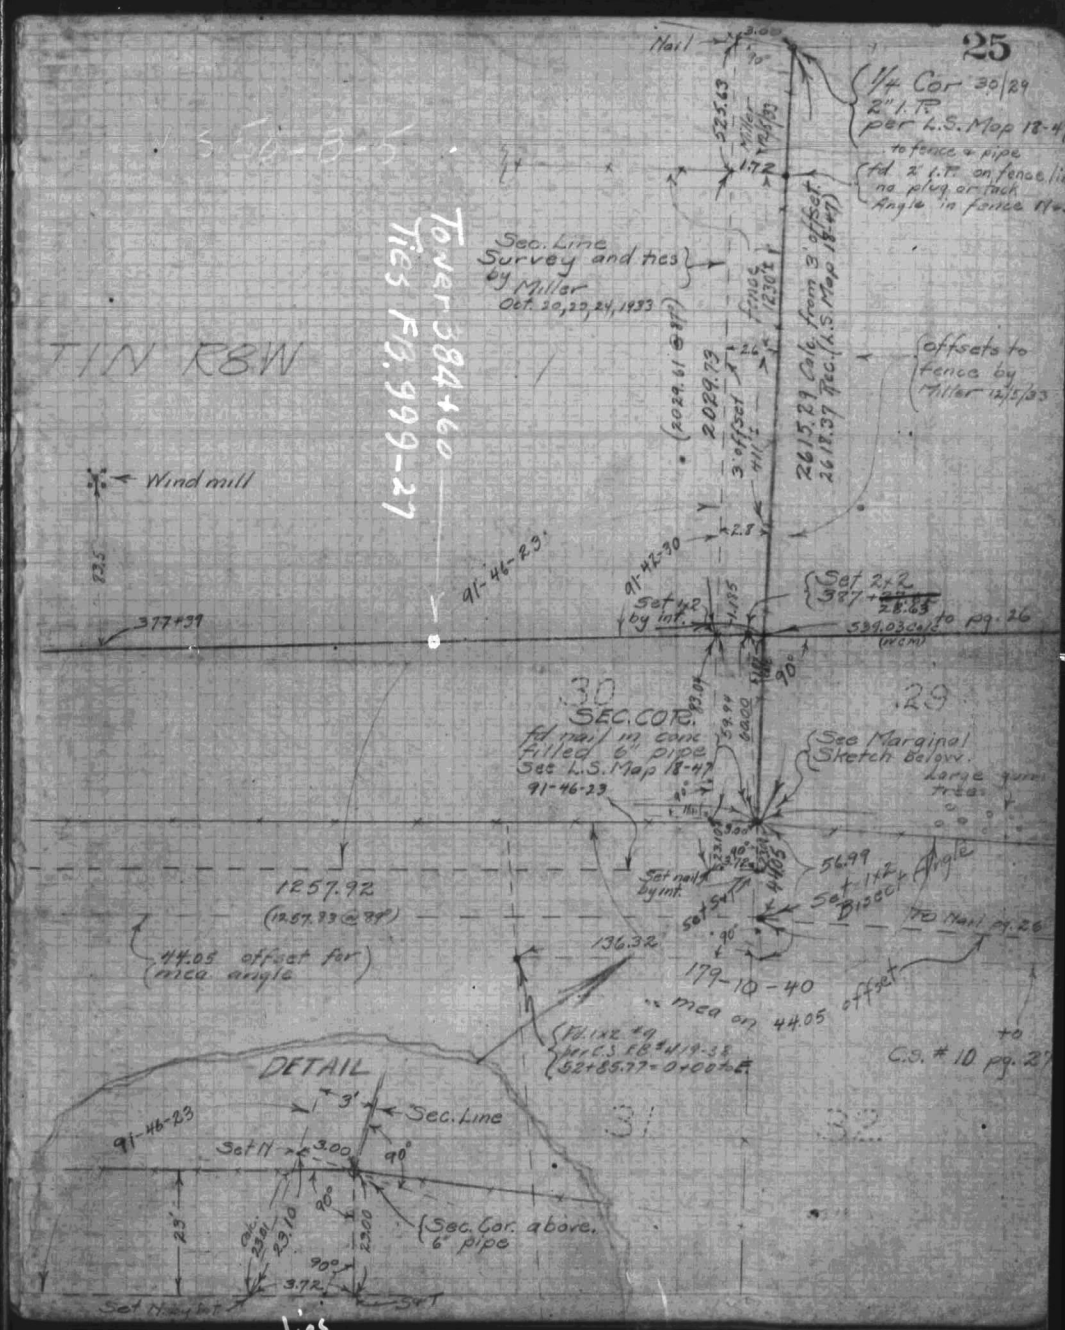

Contd From F.B. 987-125

For ties to R/W See F.B. 999-3

F.B. 987-4

B.W. & P. F.B. 359

F.B. 987-5

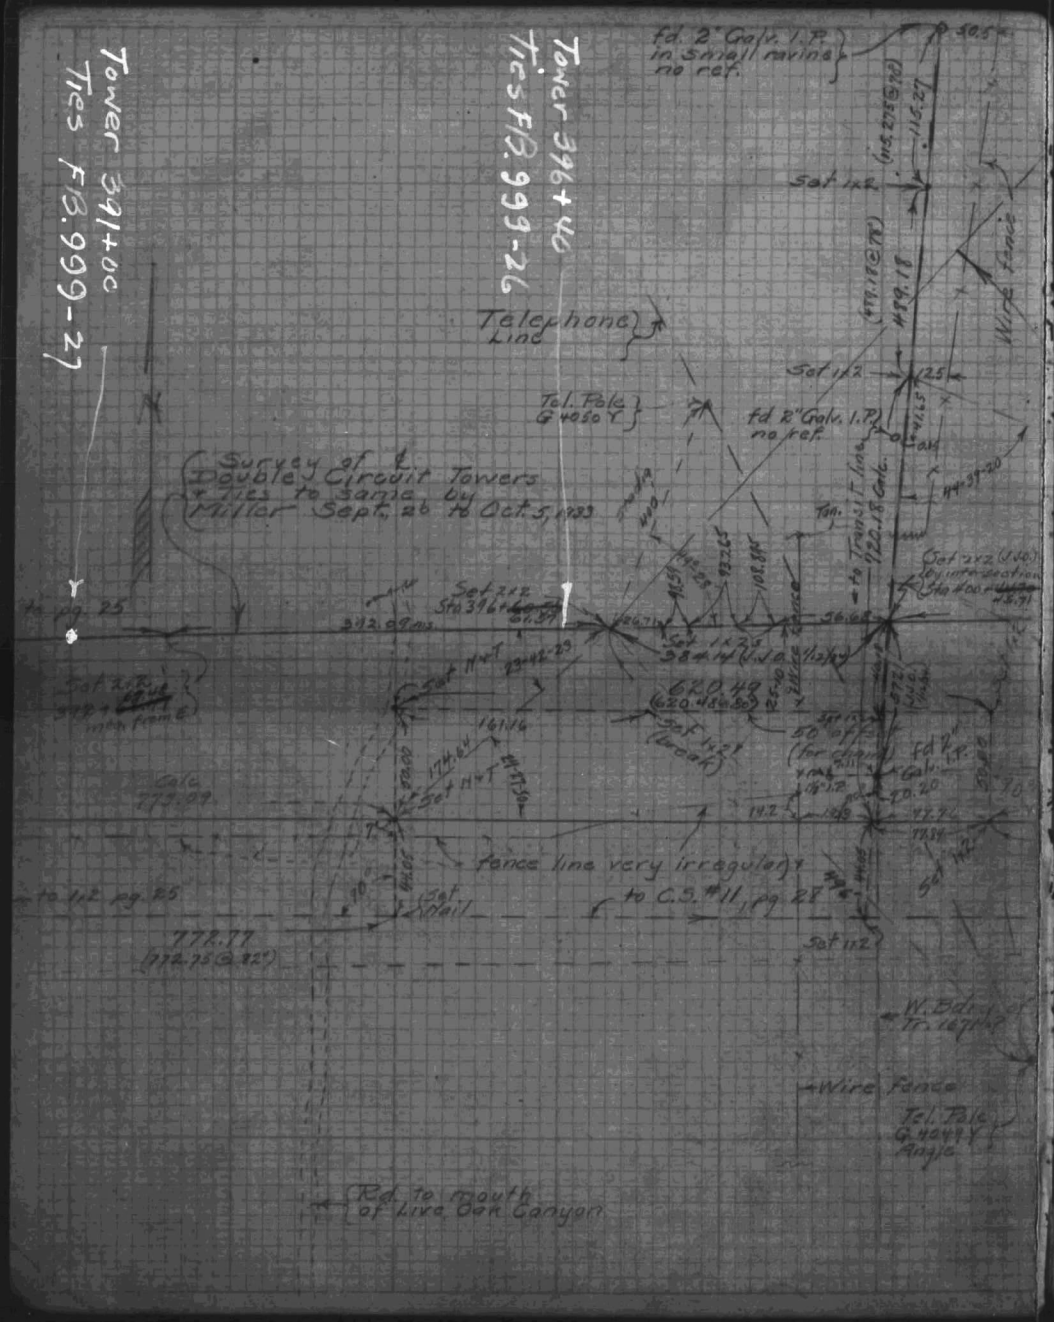

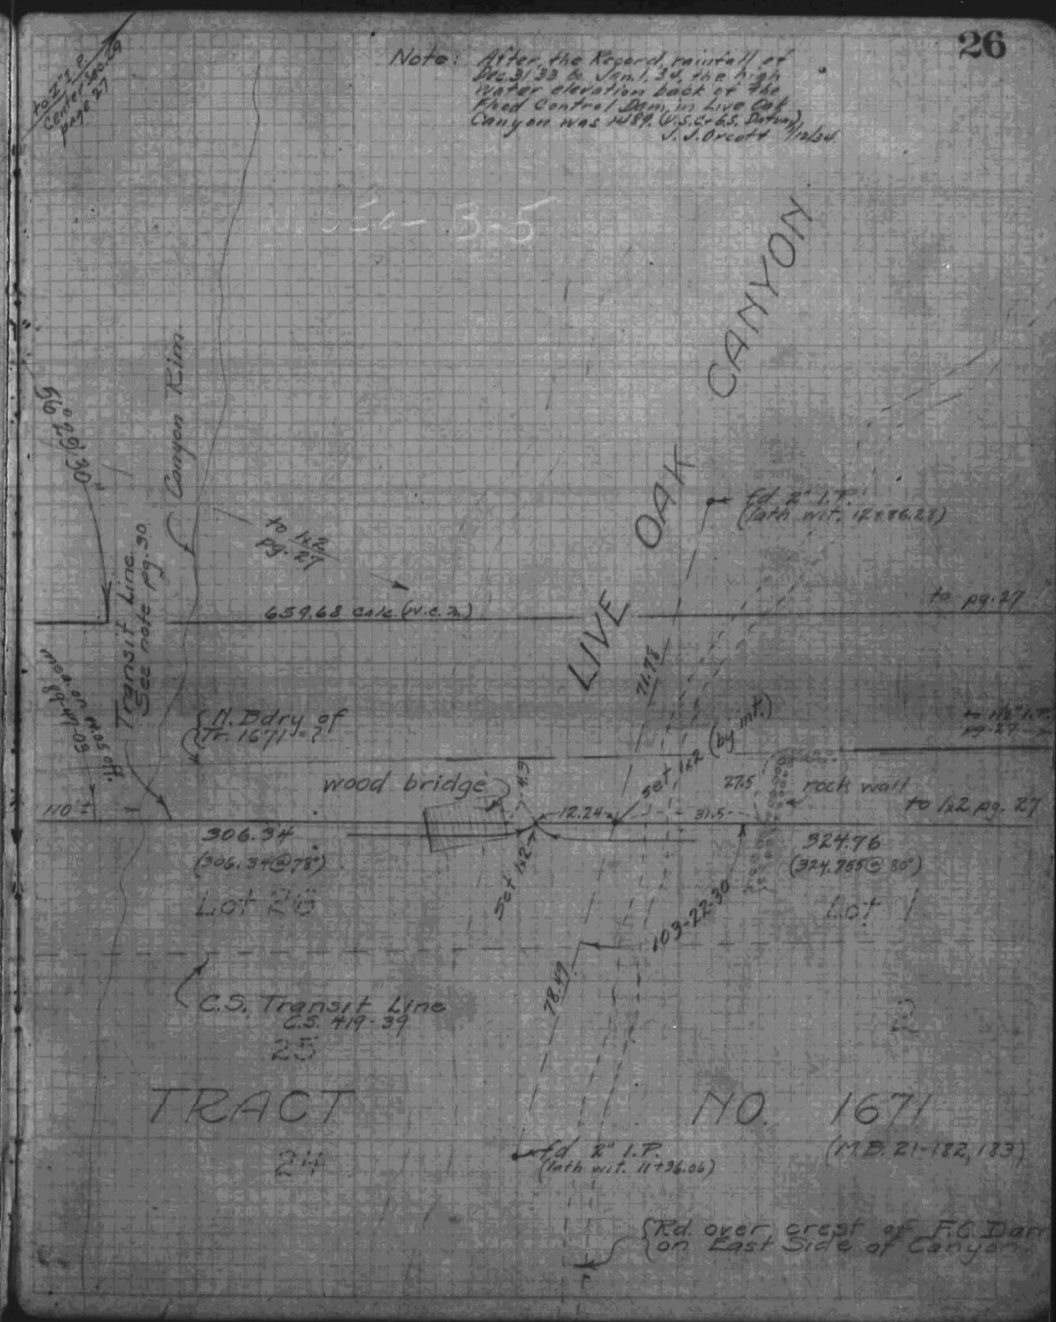

W.S. 50-B-5

Fd. 2" I.P. Center Sec 29 T1N R.5W. per L.S. 18-47

44°13'12"

93°15'31" Calc.

to Sta 396+60.56 2x7 page 26

1857.41"

Survey of ℄ Line made by Mason & Pratt Feb. 7 & 8 1934

Tower 40 Str. Tie to ℄ 41+72.26

Ridge

Canyon

Transit Line C.S. 419-39

to pg. 30

to pg. 26

Set 2x2 on stake at hub by intersection Sta. 407+ ~~95.39~~ 72.14 (J.J.O. in hub)

Set 3x3 Sta 407+ ~~79.53~~ 79.53

N. Bdry of Tr. 1671

(fd. 1½" I.P. N.E. Cor Tr. 1671

2" Gal. I.P. ℄ pg. 26

N 89°-30' E 334.61

105°-42'-17" Calc.

75-03-10

10.02

Set 1x2

19.95

32.25

to 1x2 pg. 26

88-20-00 (Calc. 88°-24'-55")

S 89-09-35 E 1322.22

E. Bdry of Tr. 1671

51.25

87-50-45"

90°

Set 1x2

536.98 (536.985 @ 76°)

582.33 Calc. (Ovem.)

90°14'59"

Set 2x2 by Intersection Sta. 413+ ~~33~~ 59.82

59°21'20"

116.68

79.64

51°06'47"

29°56'10"

570.01 (570.05 @ 58°)

Set 1x2

Fd. 1x2 #10 21+60.75 C.S. 419-39

Fd. 1½ I.P. in place of 3x3 Stk. as shown on Flood Control Map No. TO. 208 Sheet 3

Survey of ℄ Double Circuit Towers Tie to same by Miller Sept. 20 to Oct. 5, 1933

Set 2x2 P.O.T. Sta 413+ ~~59.49~~

Set 2x2 P.O.T. Sta 419+ ~~93.06~~

Set 1x2 P.O.T. Sta. 420+ ~~13.36~~ 13.36

79°17'18"

499.63 Calc. (N.C.M.)

43.57

110.30

64°40'

110.17

1½" Gal. I.P. Cor. 3' per F.B. 419-39

Pipe found to have been replaced with brass cap to conc. by Miller Hunt

Set 1x2

207.09 (207.07 @ 91°)

492.12 (492.07 @ 93°)

433.14 (433.12 @ 95°)

Set 1x2

Set 1x2

N&T Scrub Oak (Top cut off)

to 1x2 pg. 27

Canyon

Transit Line C.S. 419-39

Ridge

Ridge to pg. 28.

F.B. 987-8

B.W.&P.F.B. 359

F.B. 987-9

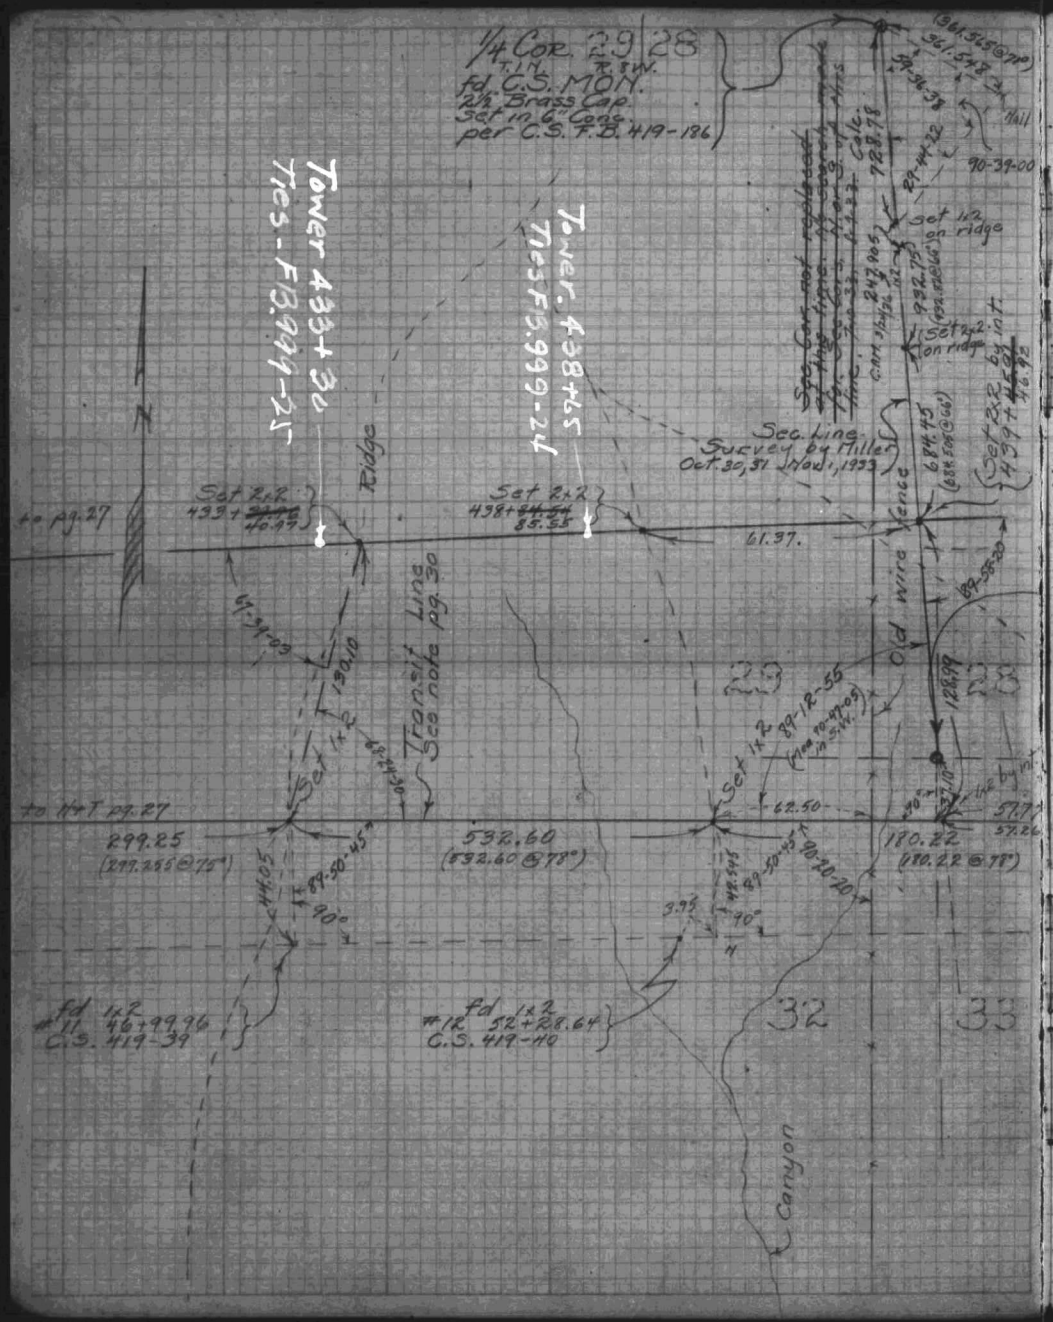

F.B. 987-10

B. W. & P. F.B. 359

F.B. 987-11

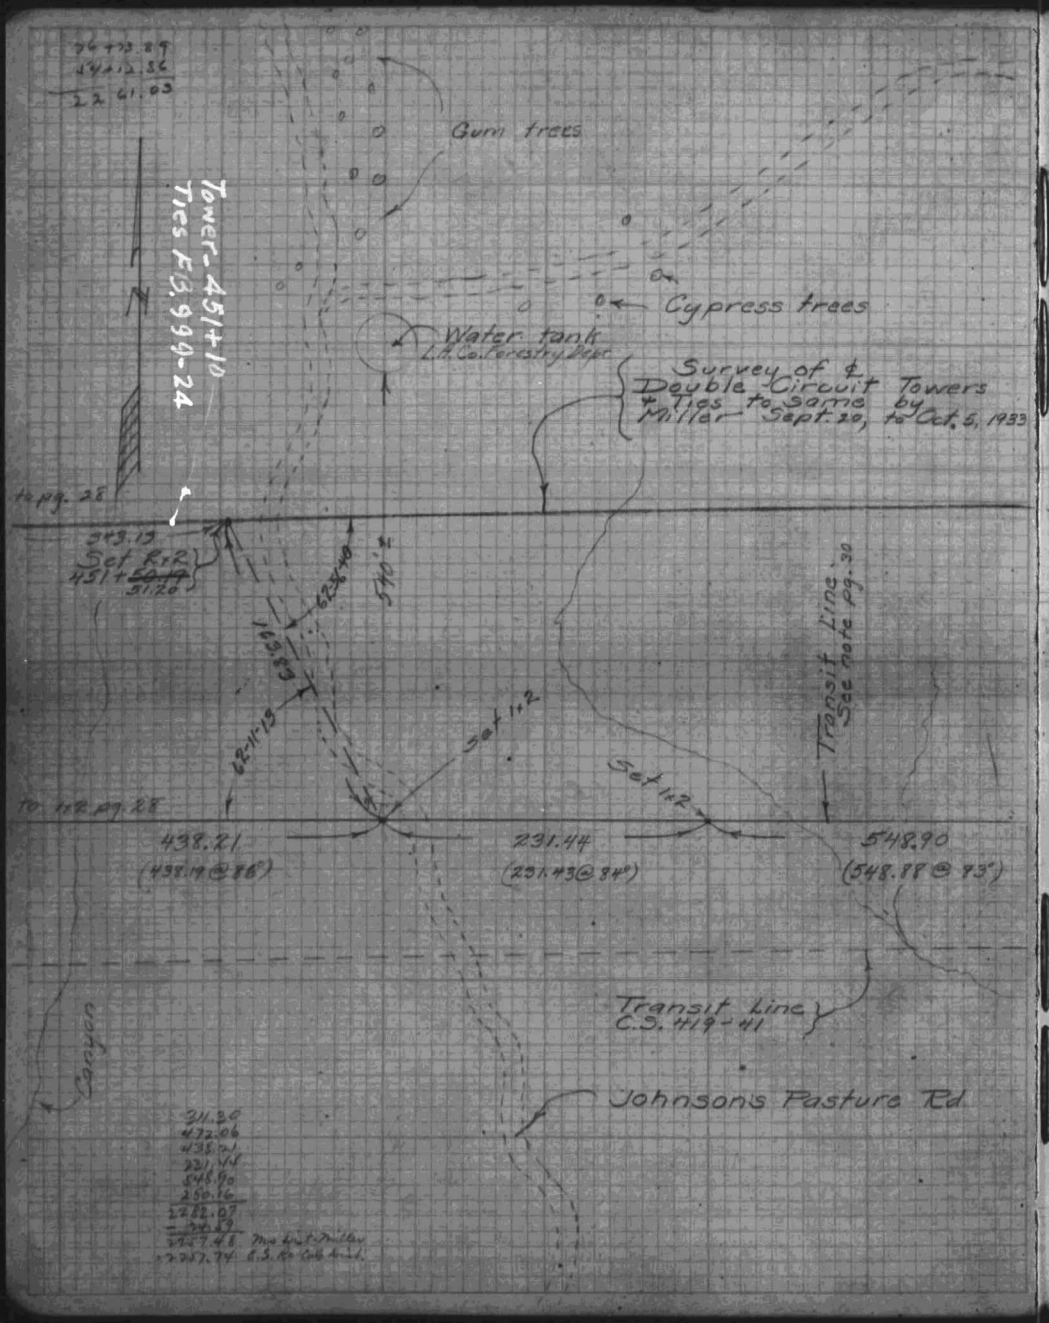

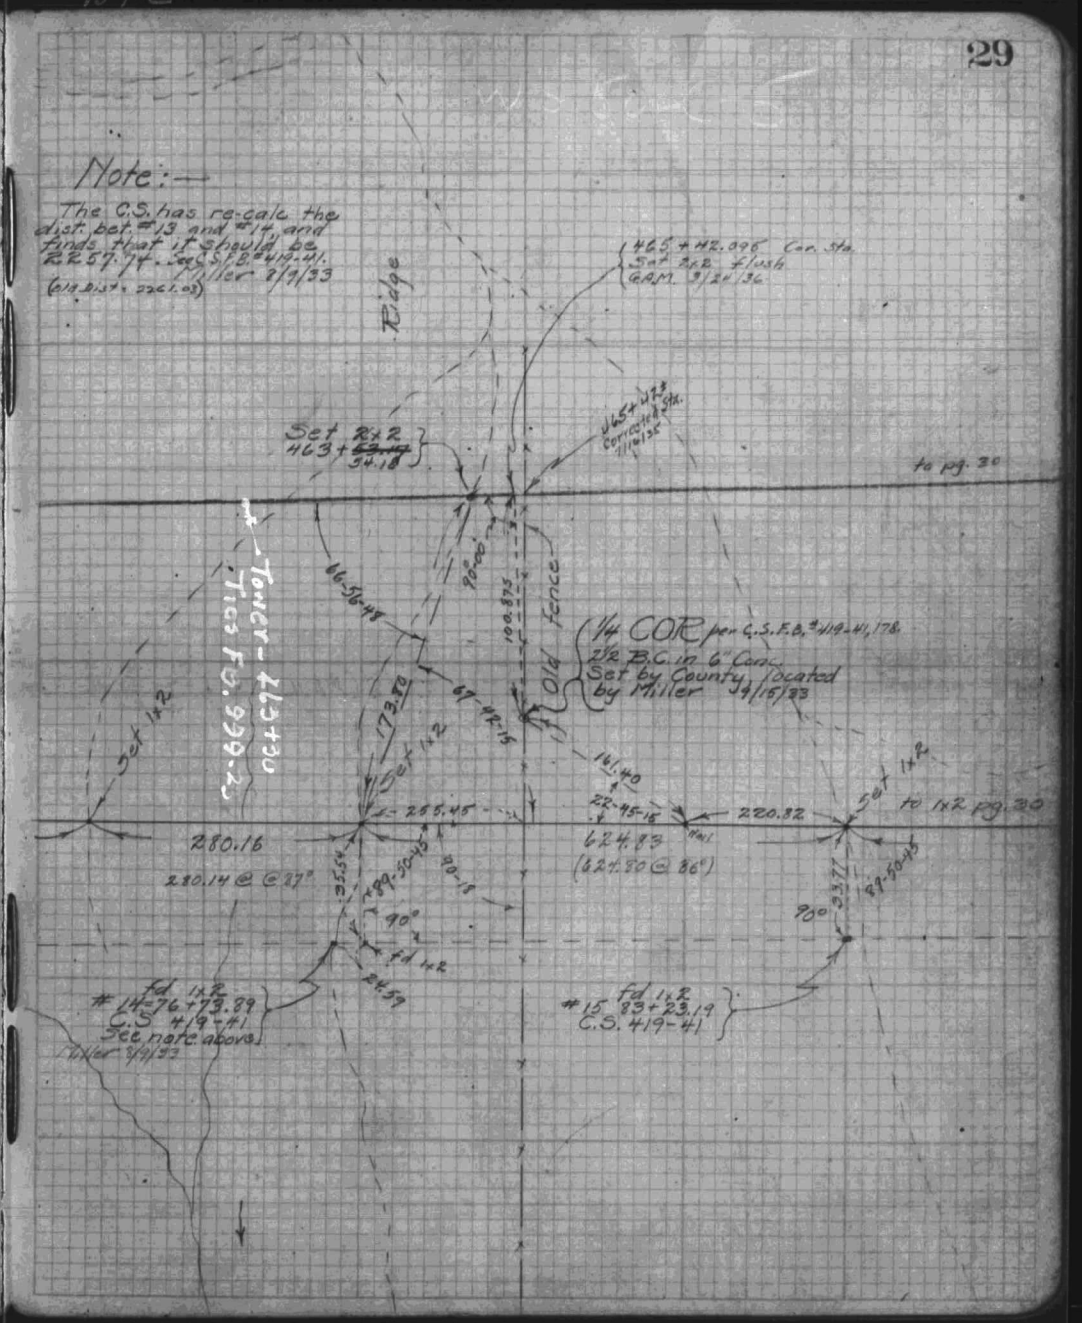

F.B. 987-12

B.W. & P. F.B. 359

BPL

F.B. 987-13

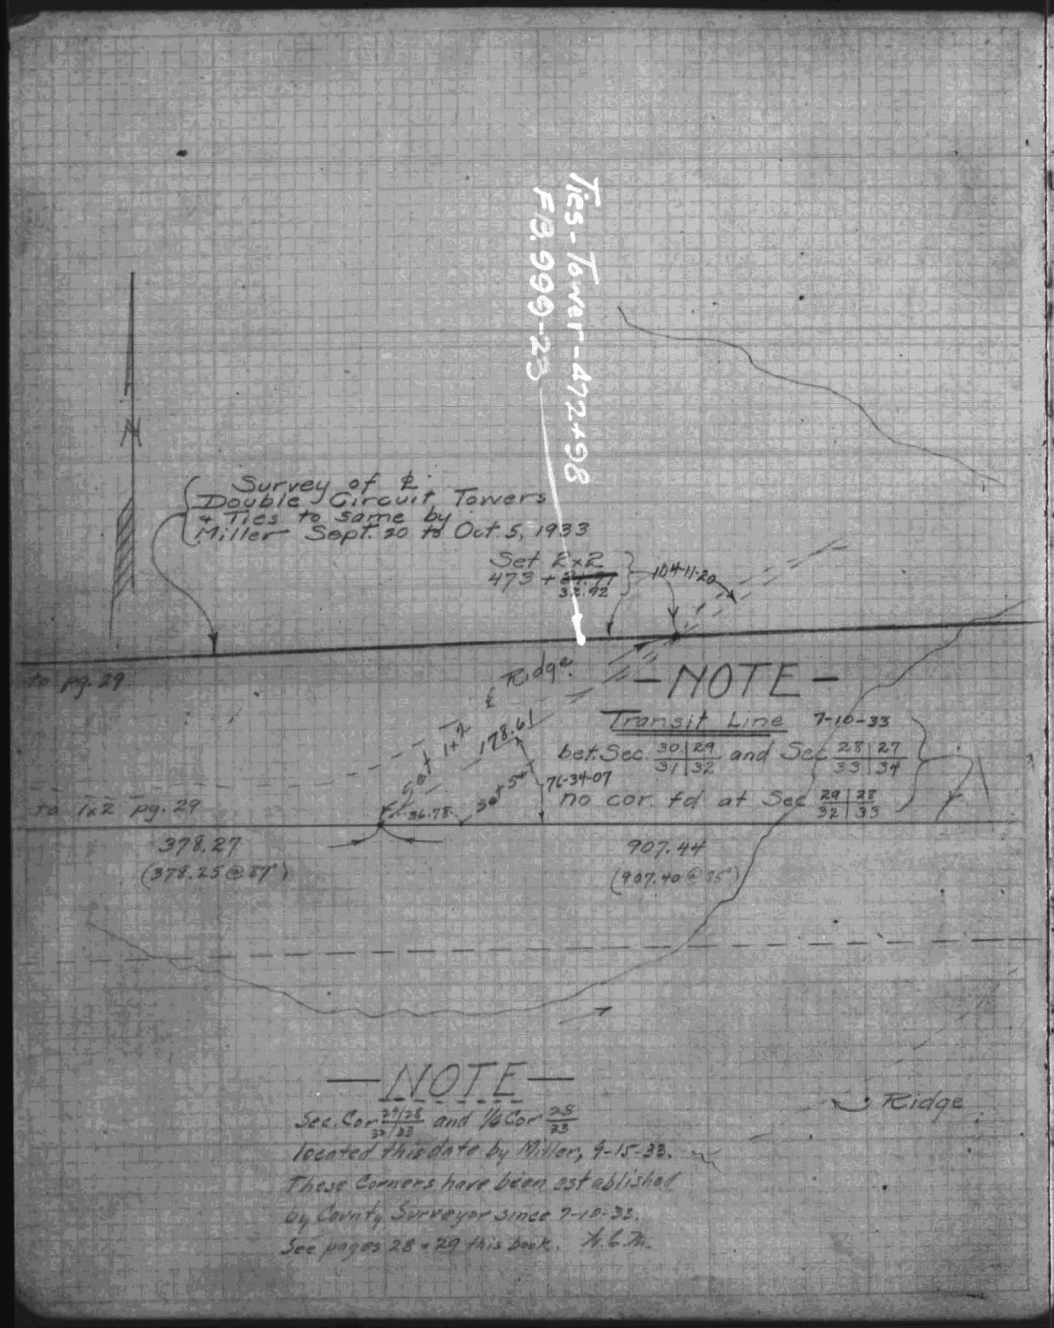

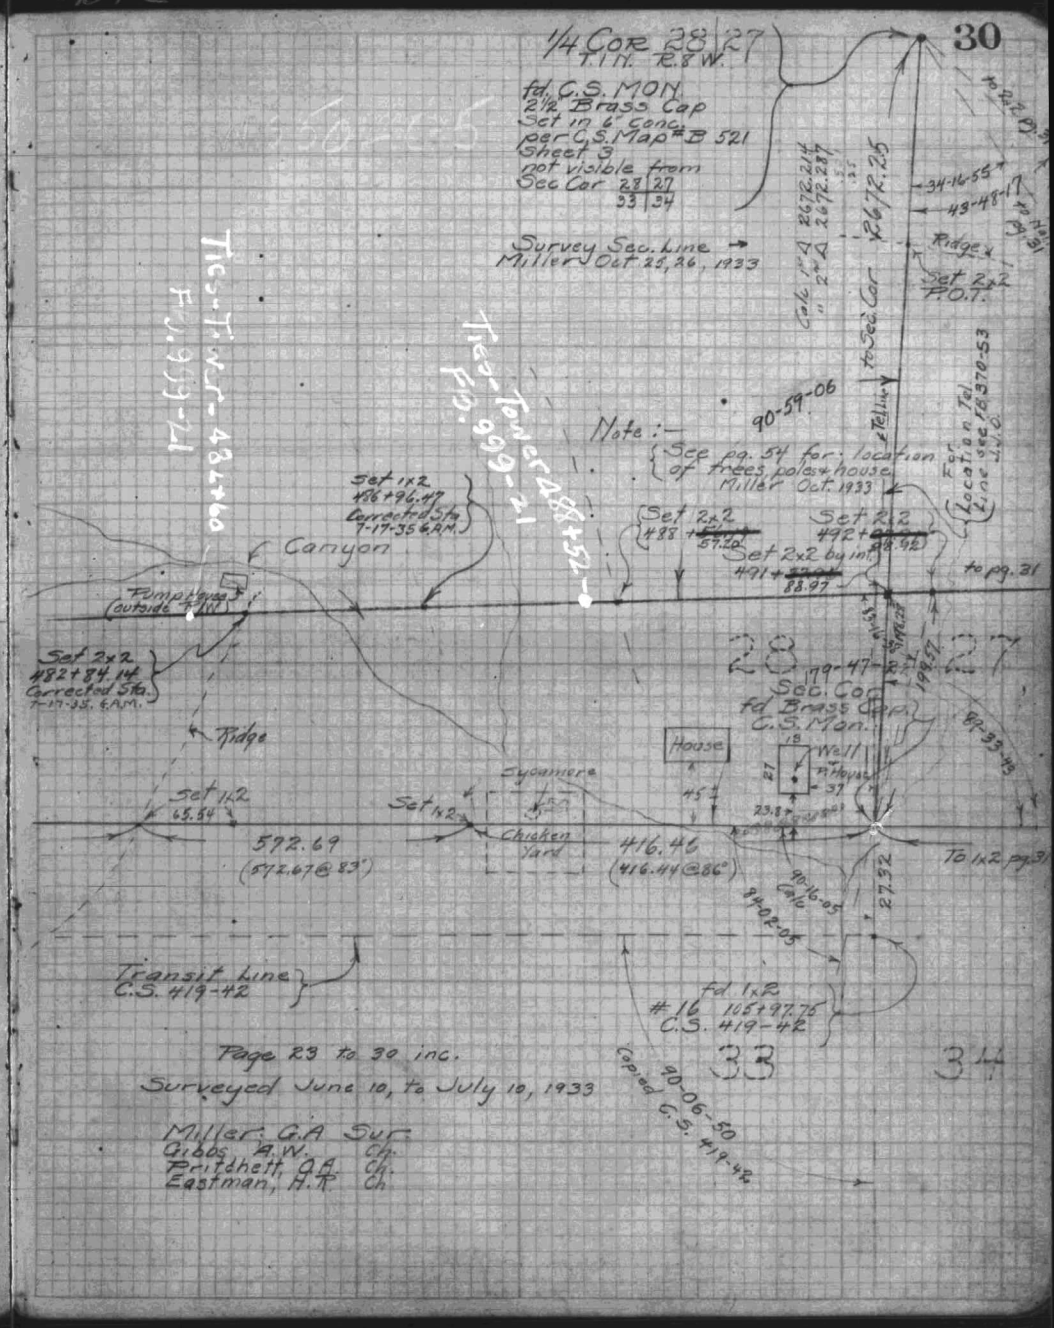

F.B. 987-14

B.W. & P. F.B. 359

F.B. 987-15

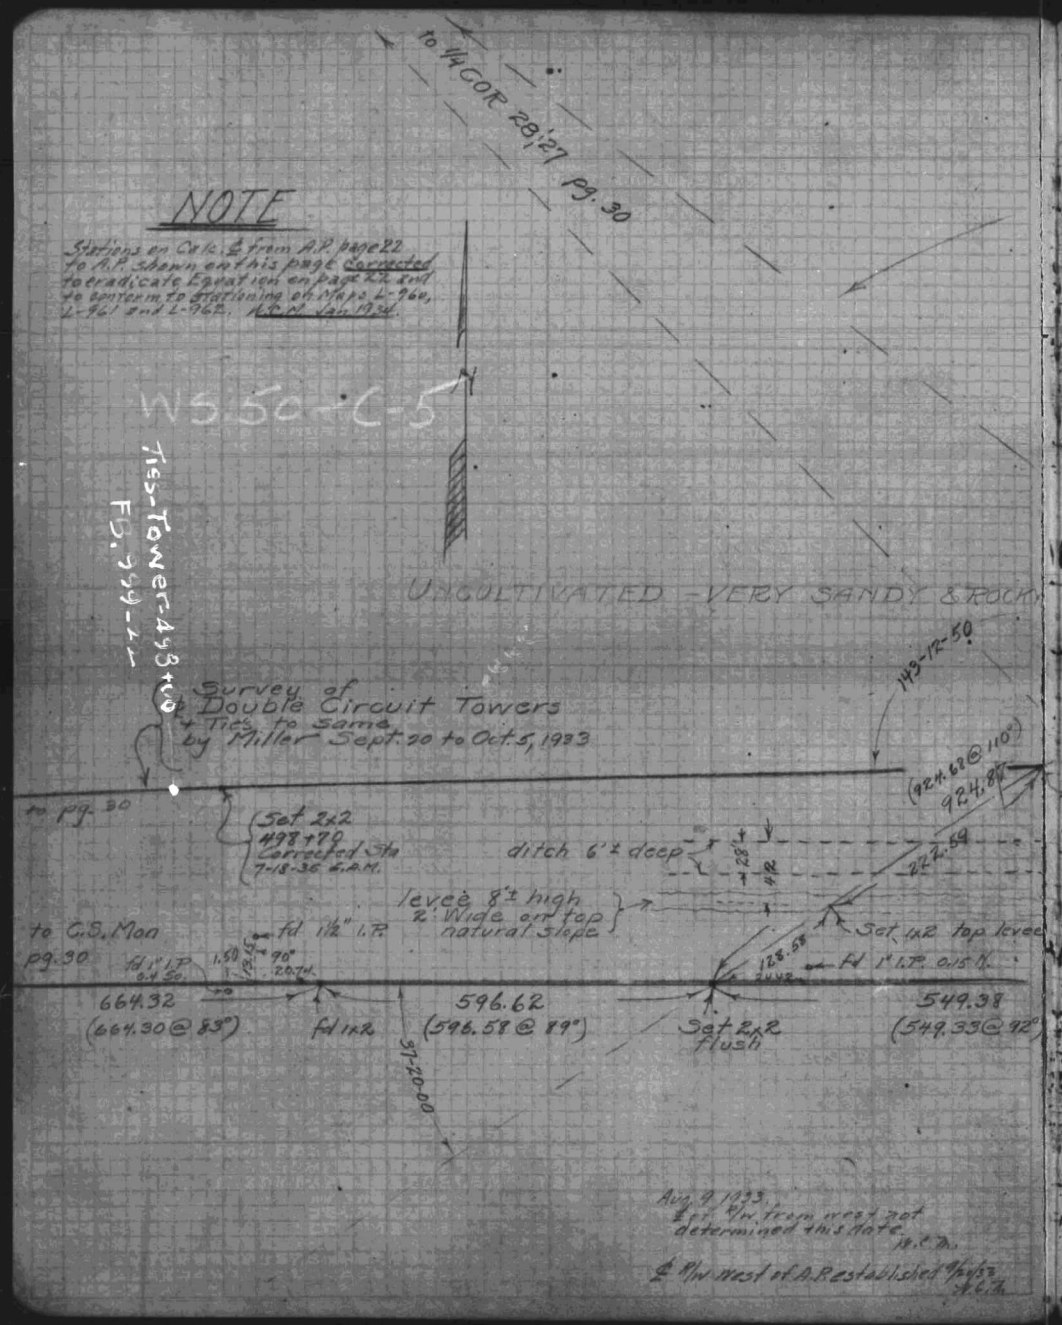

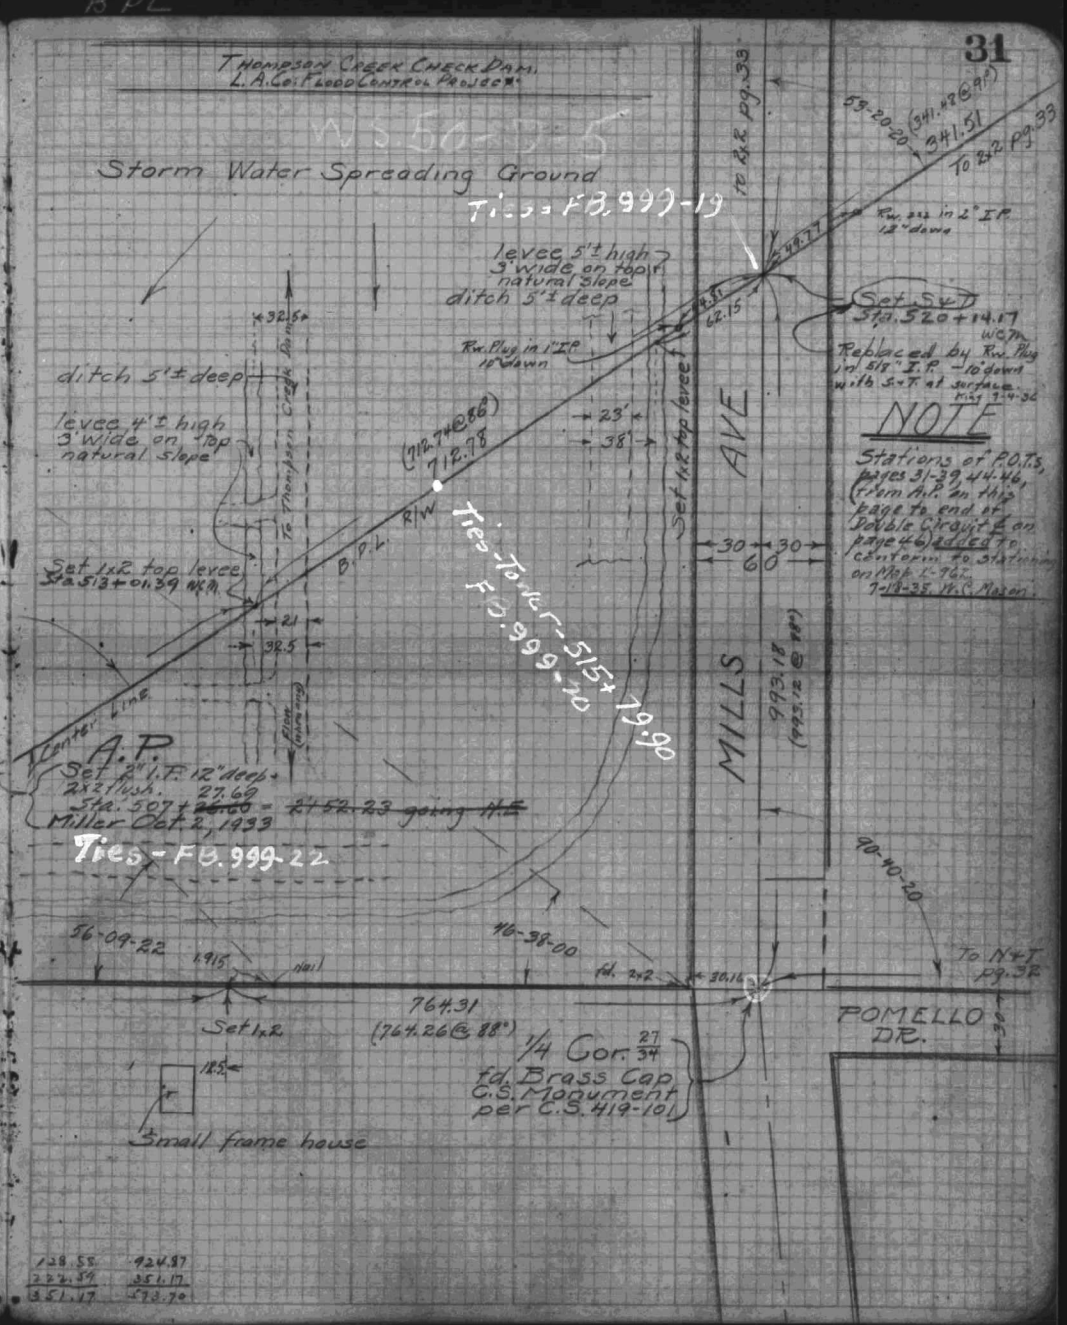

F.B. 987-16

B.W.+P.F.B. 359

BPC

F.B. 987-17

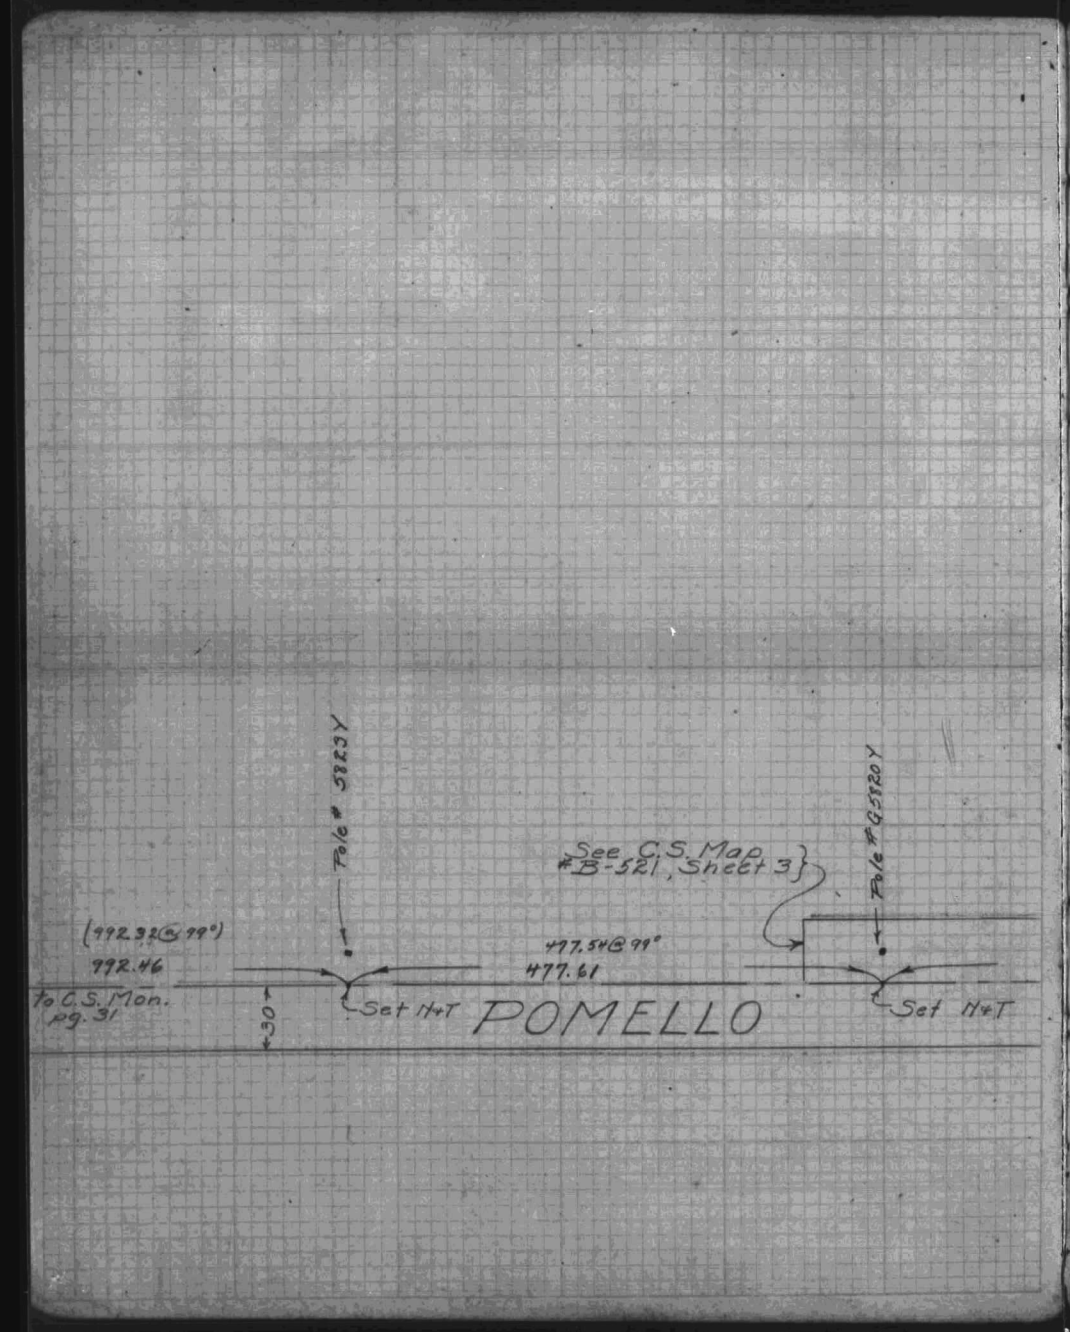

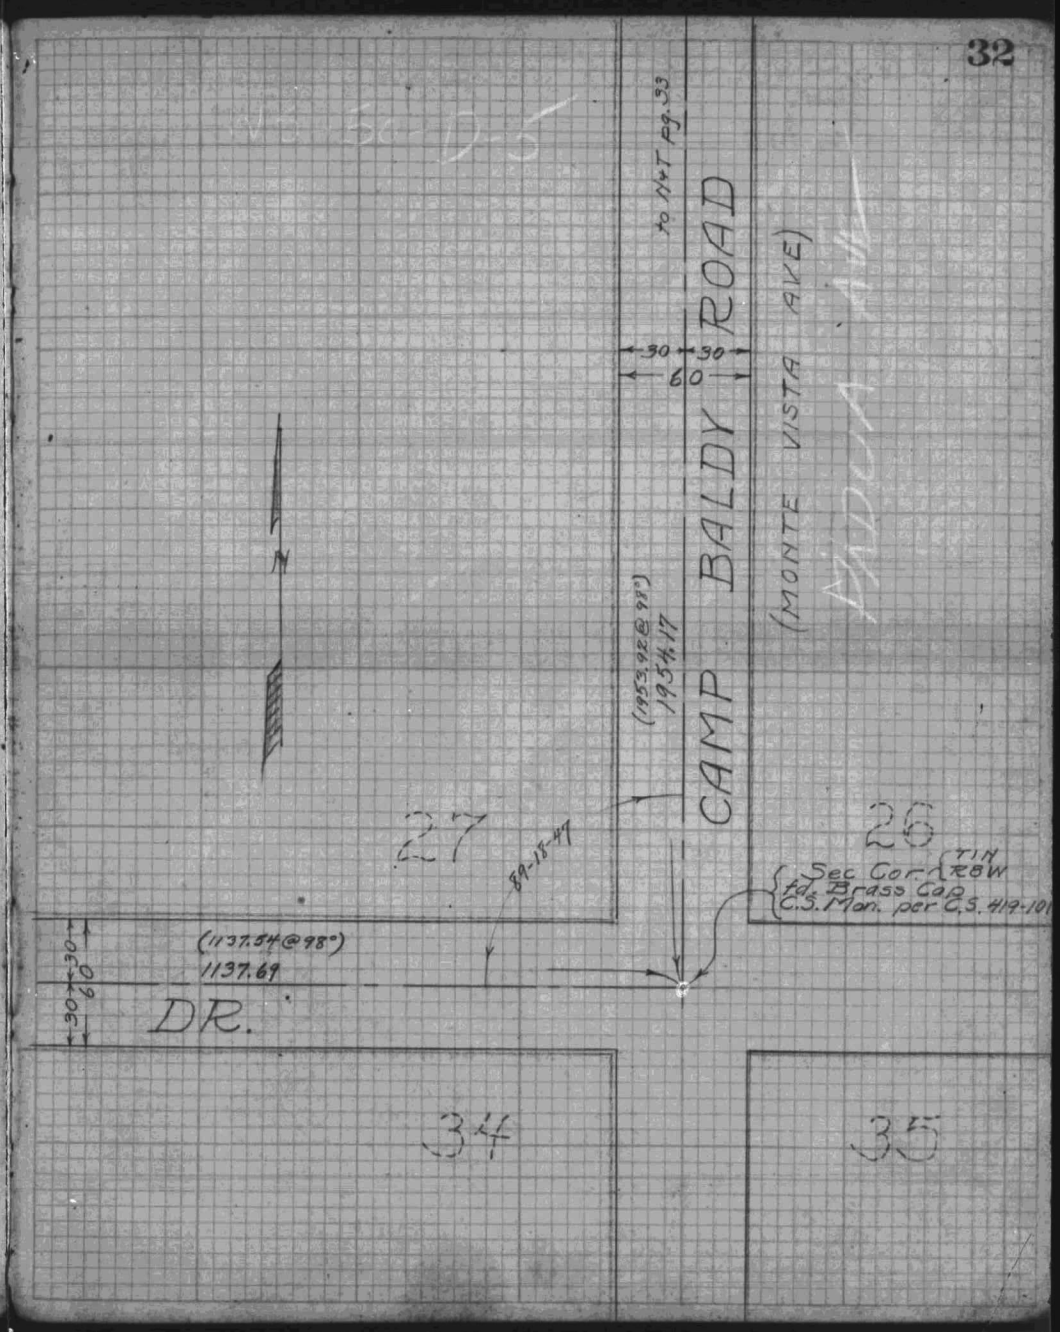

F.B. 987-18

B.W.& P. F.B. 359

BPL

F.B. 987-19

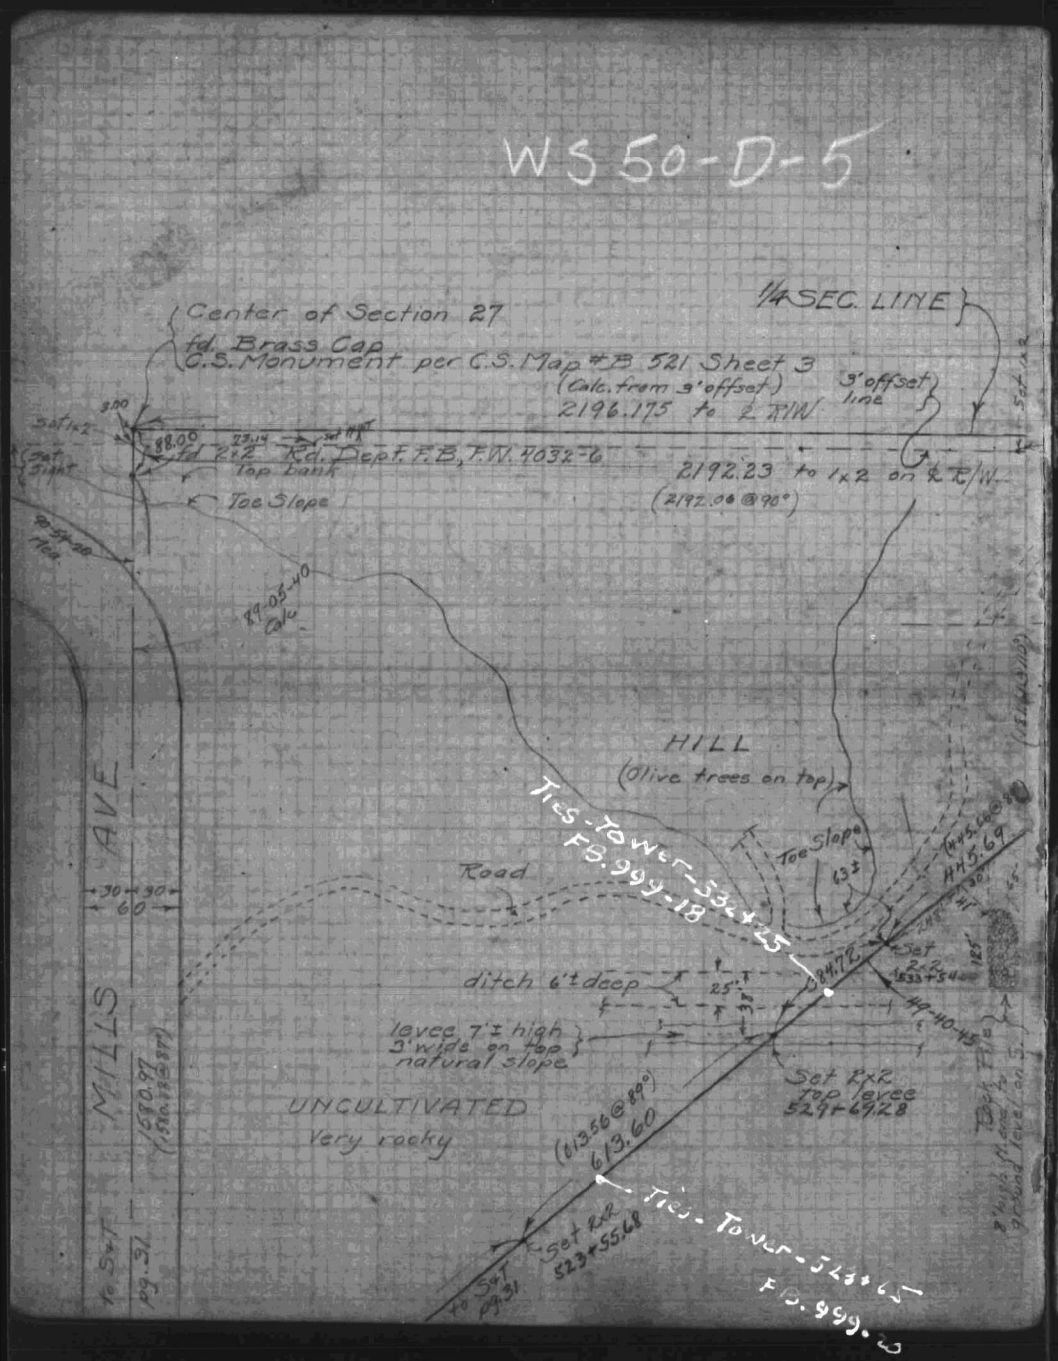

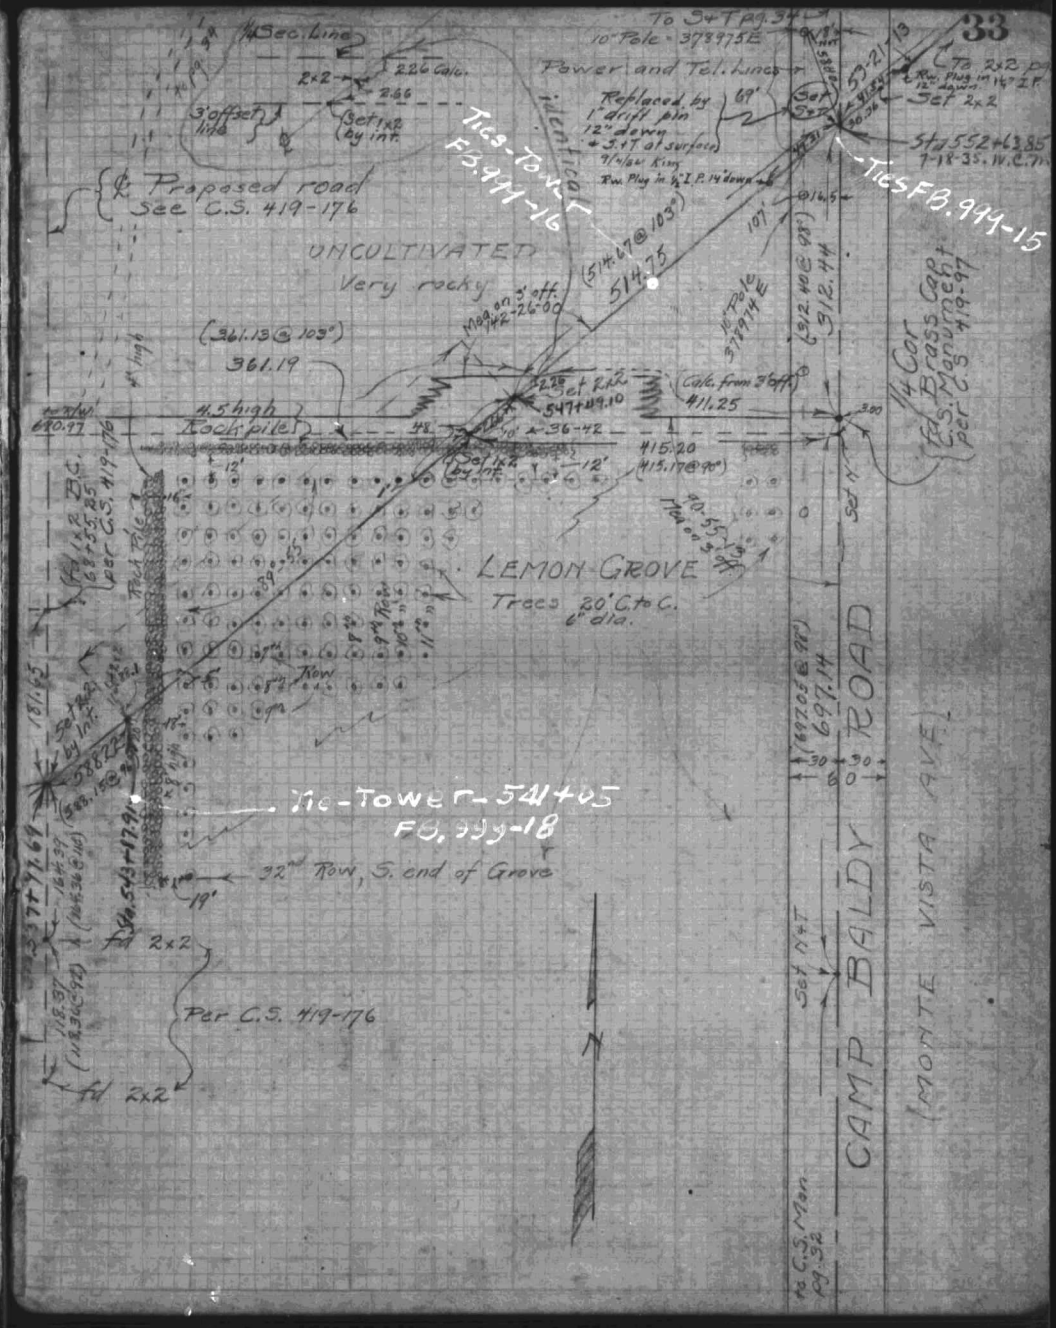

F.B. 987-20

B. W. & P. F.B. 359
B P L

F.B. 987-21

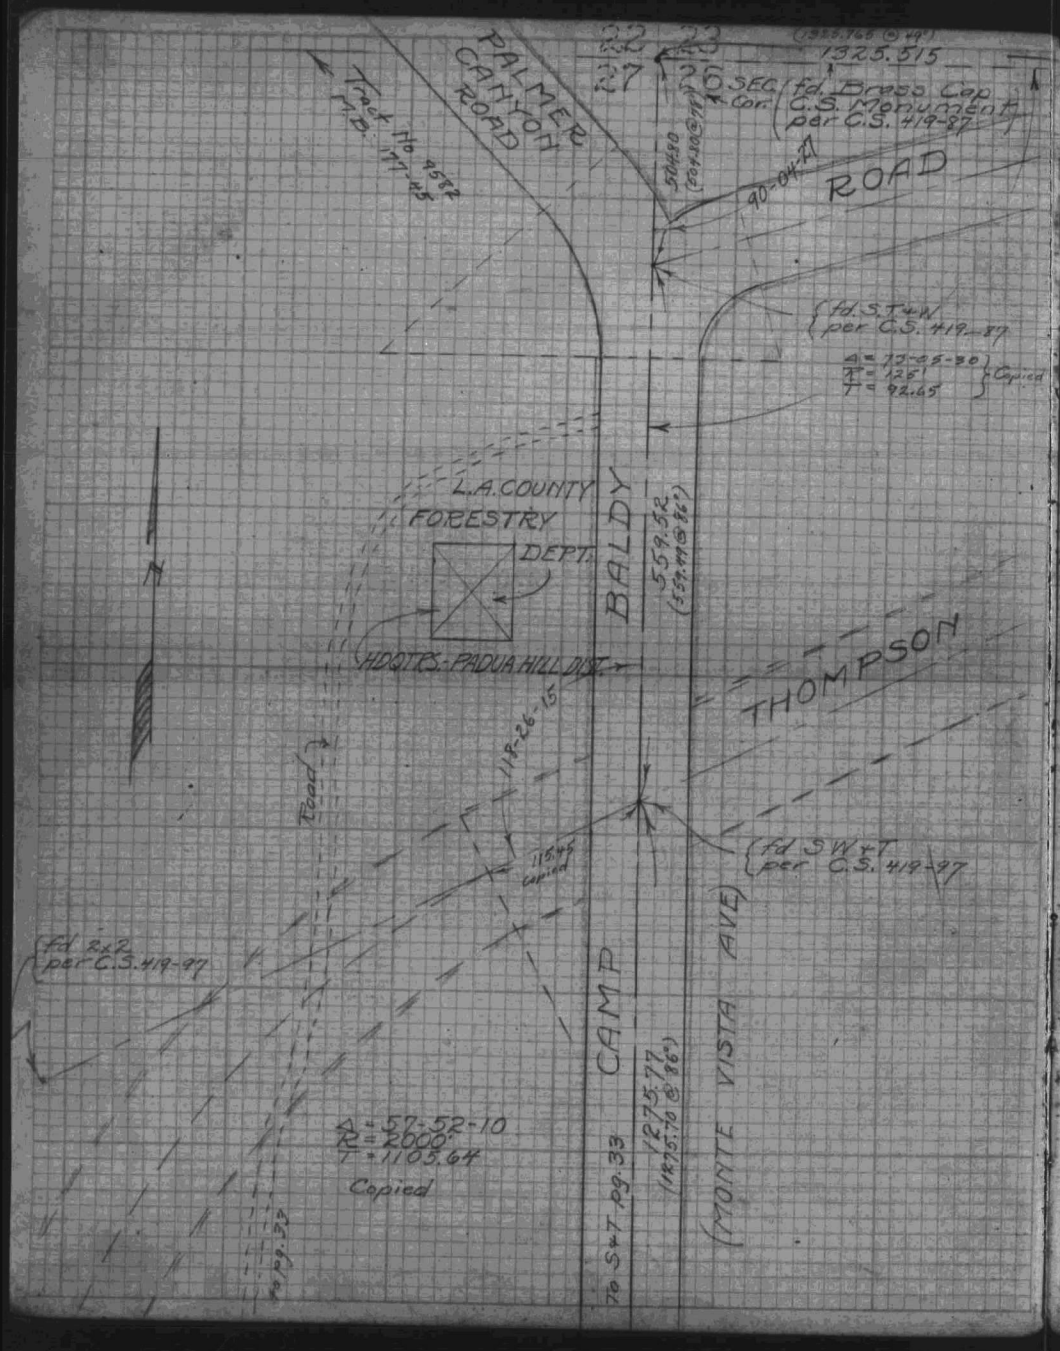

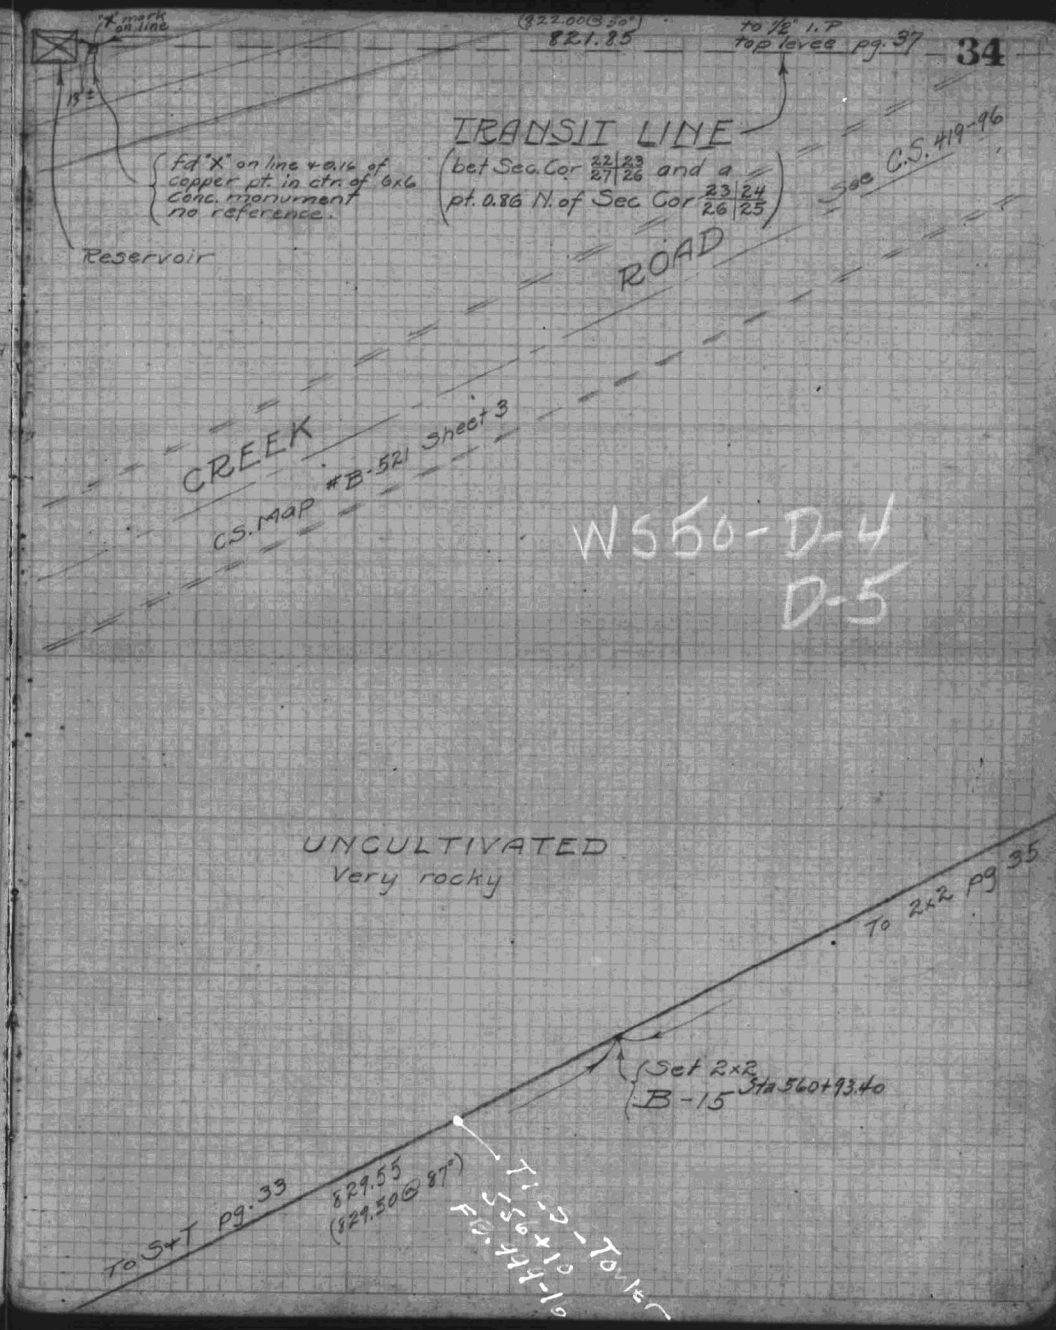

F.B. 987-22

B.W. & P. F.B. 359
B P L

F.B. 987-23

WS 50-D-5

UNCULTIVATED
Very rocky

To R×R pg. 34

492.66
(492.63 @ 86°)

Set R×R
B-14
Sta 565+86.06

417.19
(417.16 @ 89°)

Tie's-Tower-564+60
see F.B. 944-14

35

Approx. B.C.

Cem. irrigation pipe near surface App. parallel to levee. 16" Stand Pipe

B-13
Set R×R
Top levee
Sta 570+03.25

22'±

102'

73'±

Mat

52-47

top bank

41'

12'

76'

41'

28'

To R×R pg. 36

6'± deep

413.93
(413.91 @ 85°)

Levee 8'± high
natural slope

5'±

22'±

Top levee
Toe slope

Rock and Wire

bottom ditch

Tie's-Tower-572+95
F.B. 944-14

UNCULTIVATED
Storm water spreading ground.

F.B. 987-24

B. W. & P. F.B. 359
BPL

F.B. 987-25

UNCULTIVATED
Very rocky + sandy
Storm water spreading ground

to 2×2 pg. 35

492.97
(492.75 @ 83°)

Set 2×2
B-12
Sta. 574+17.18

Set 2×2
B-11
Sta 579+10.15

574+17.18

579+10.15

W 550-D-4

to 2×2 pg 37

435.05
(435.04 @ 81°)

420.10
(420.09 @ 71°)

Set 2×2
B-10
Sta. 583+45.20

Tie 3
Tower 580+60
See FB. 494-17

F.B. 987-26

B.W.& P. F.B. 359

BPL 3J7

F.B. 987-27

37

W.550-D-4

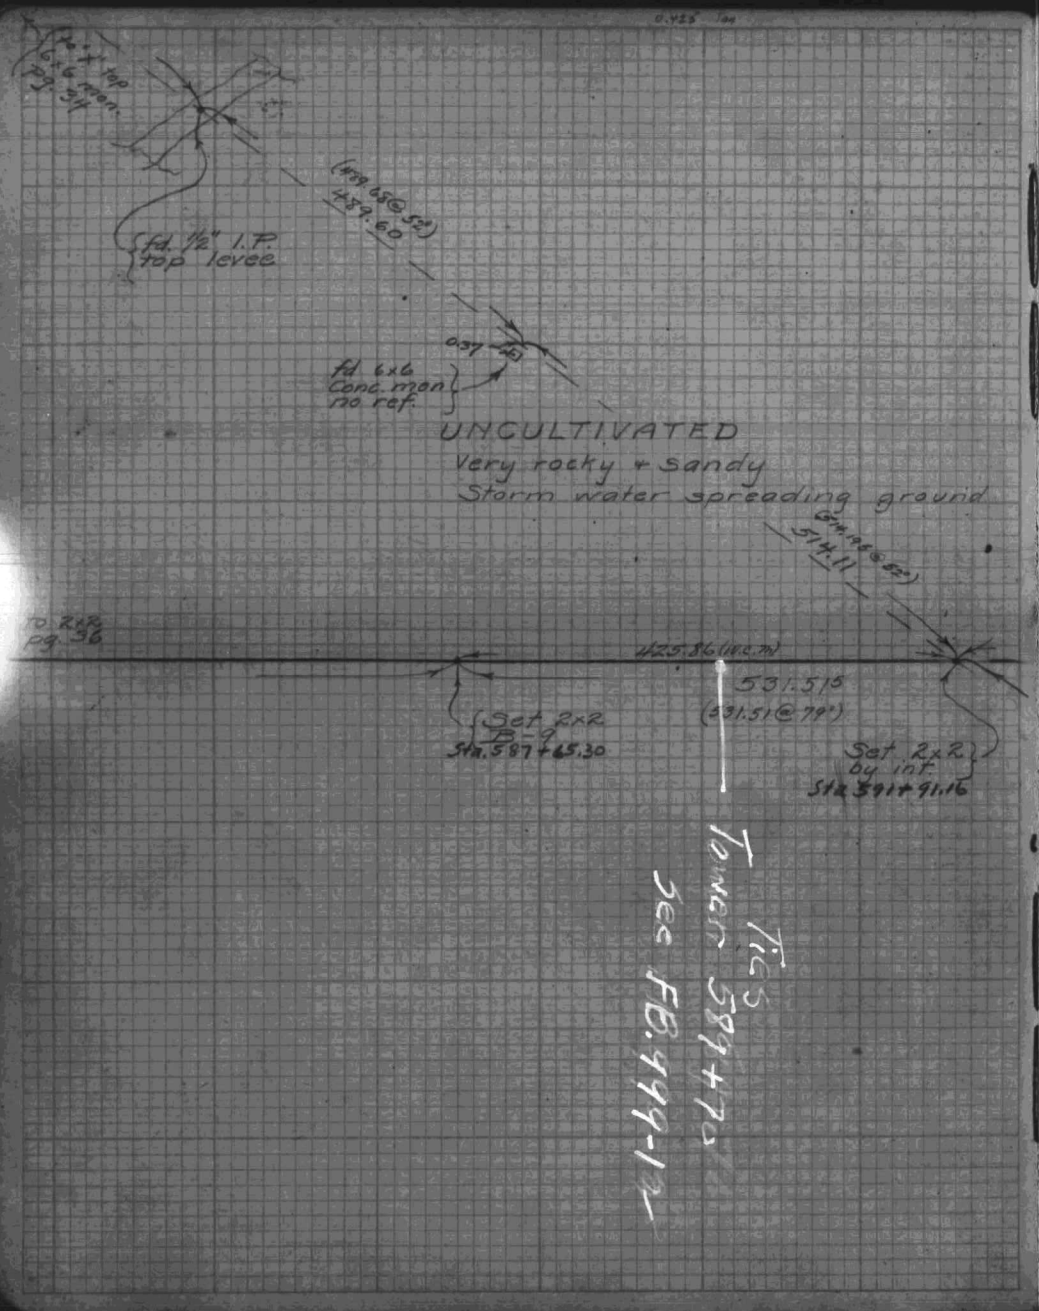

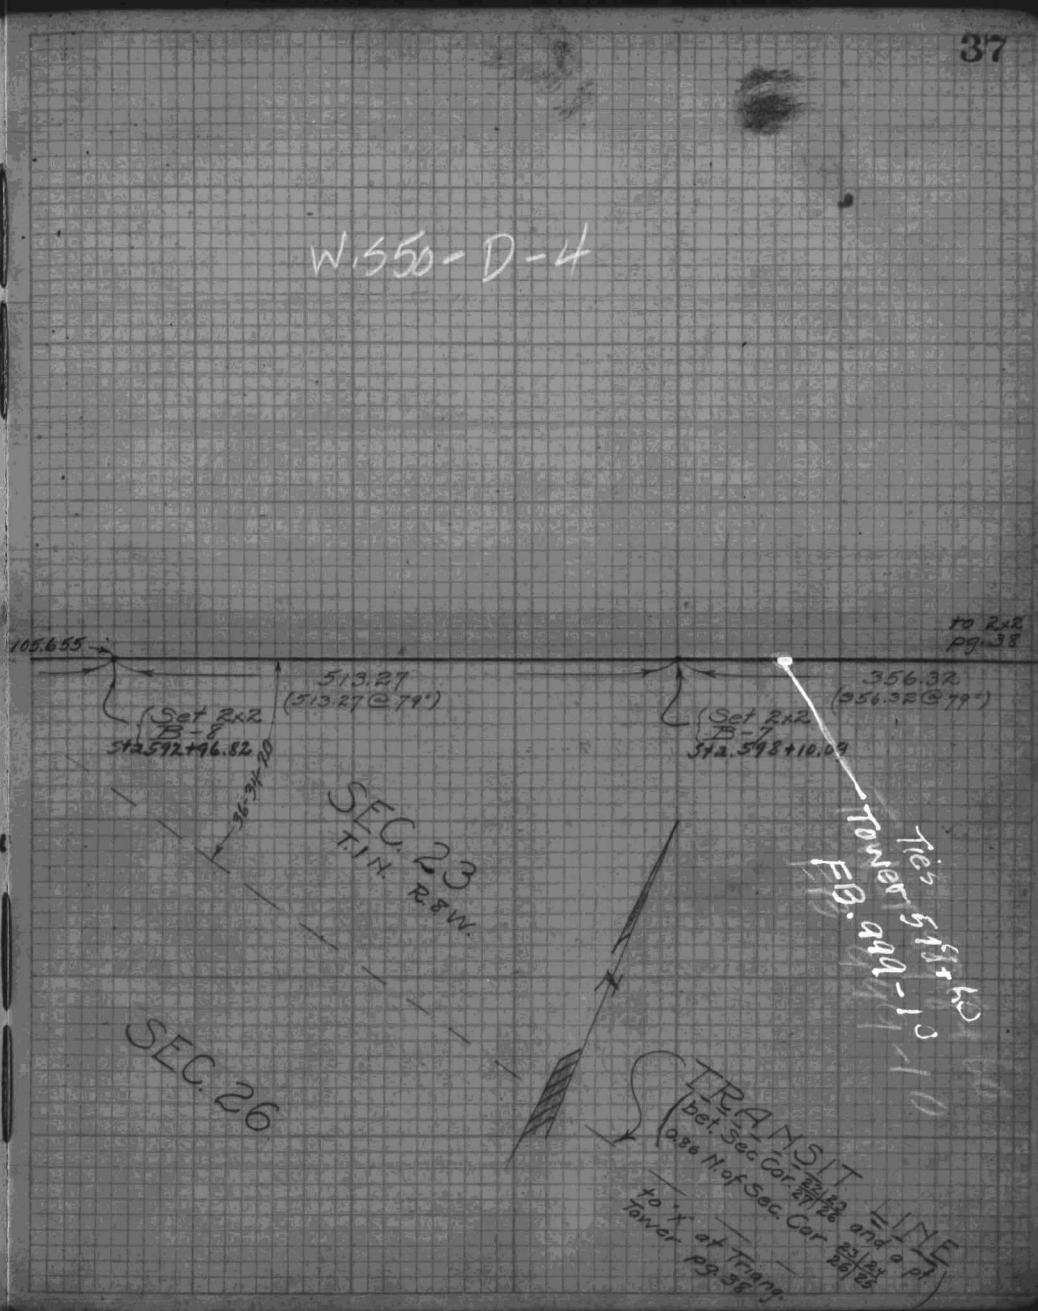

F.B. 987-28

D. W. & P. F.B. 359

BPL

F.B. 987-29

91-51-40

38

Pages 31 to 39 incl.
& B.P.L. R/W
Surveyed July 10 to Aug. 9.

G. A. Miller Sur.
O. A. Pritchett chn
H. R. Eastman chn
J. E. Roberts chn

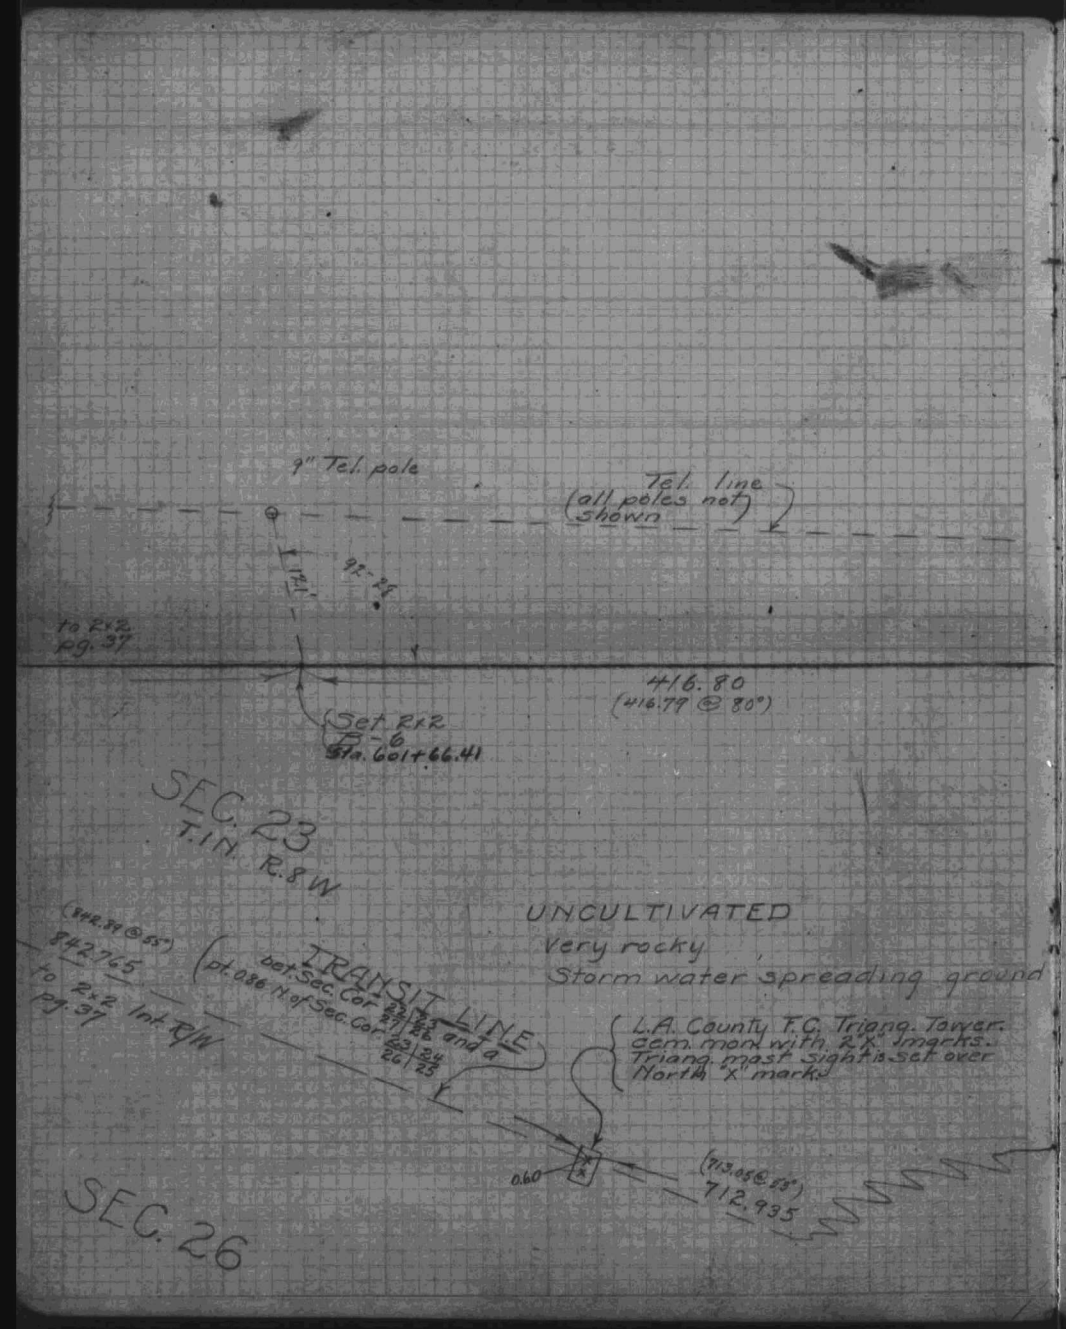

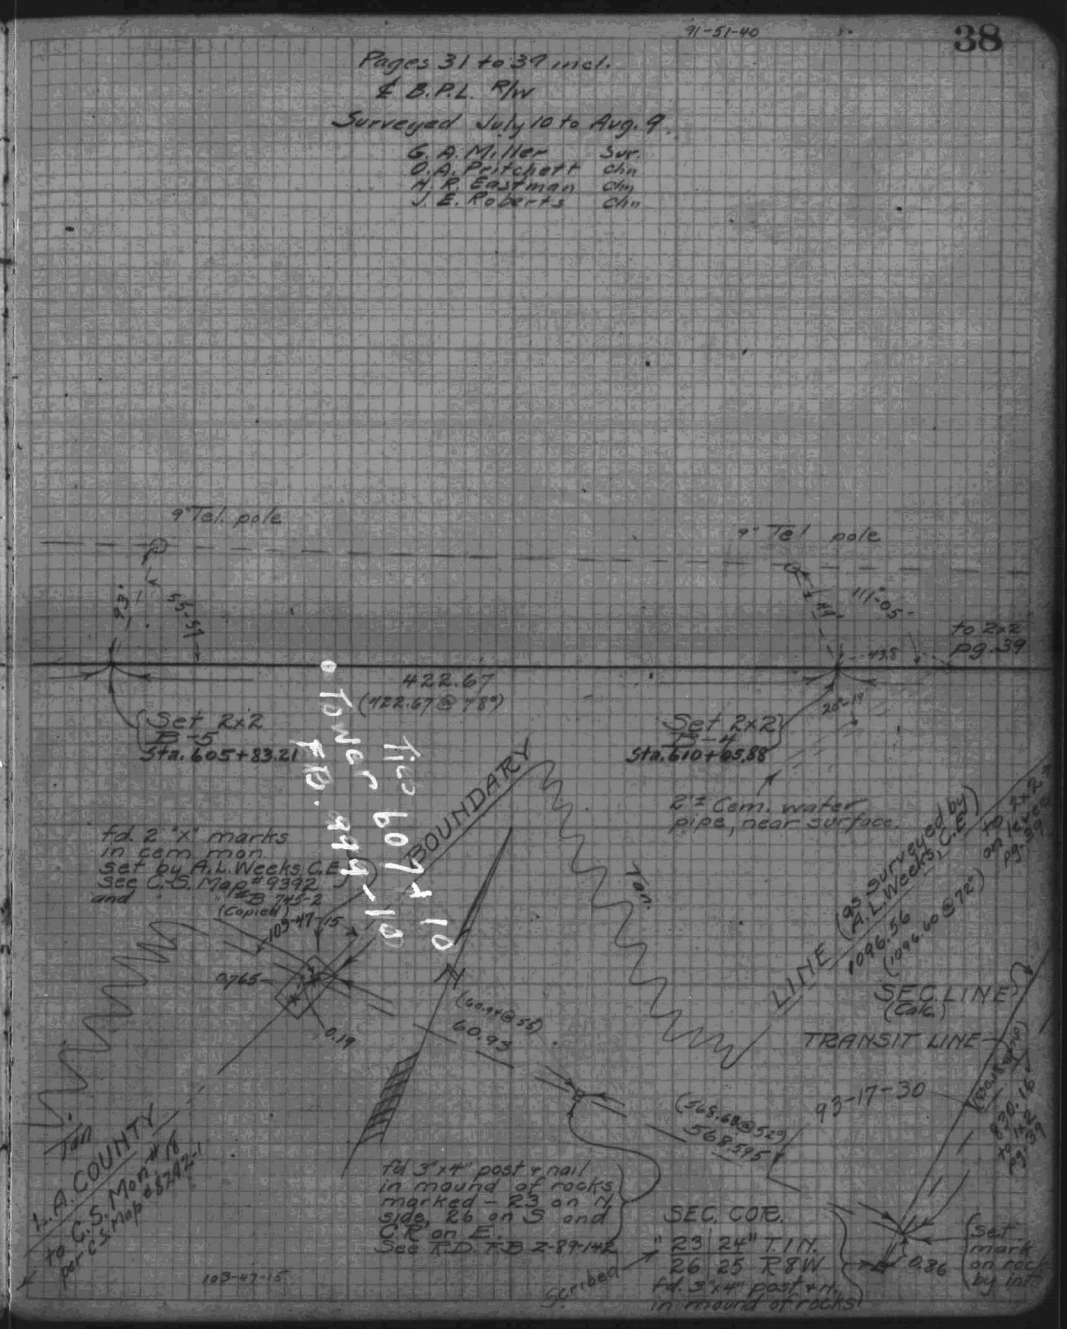

F.B. [illegible] 30

B. W. & P. F. B. 359

BPL

F.B. 987-31

WS. 50 - E - 4

39

F.B. 987-32

F.B. 987-33

B.L. & P

352

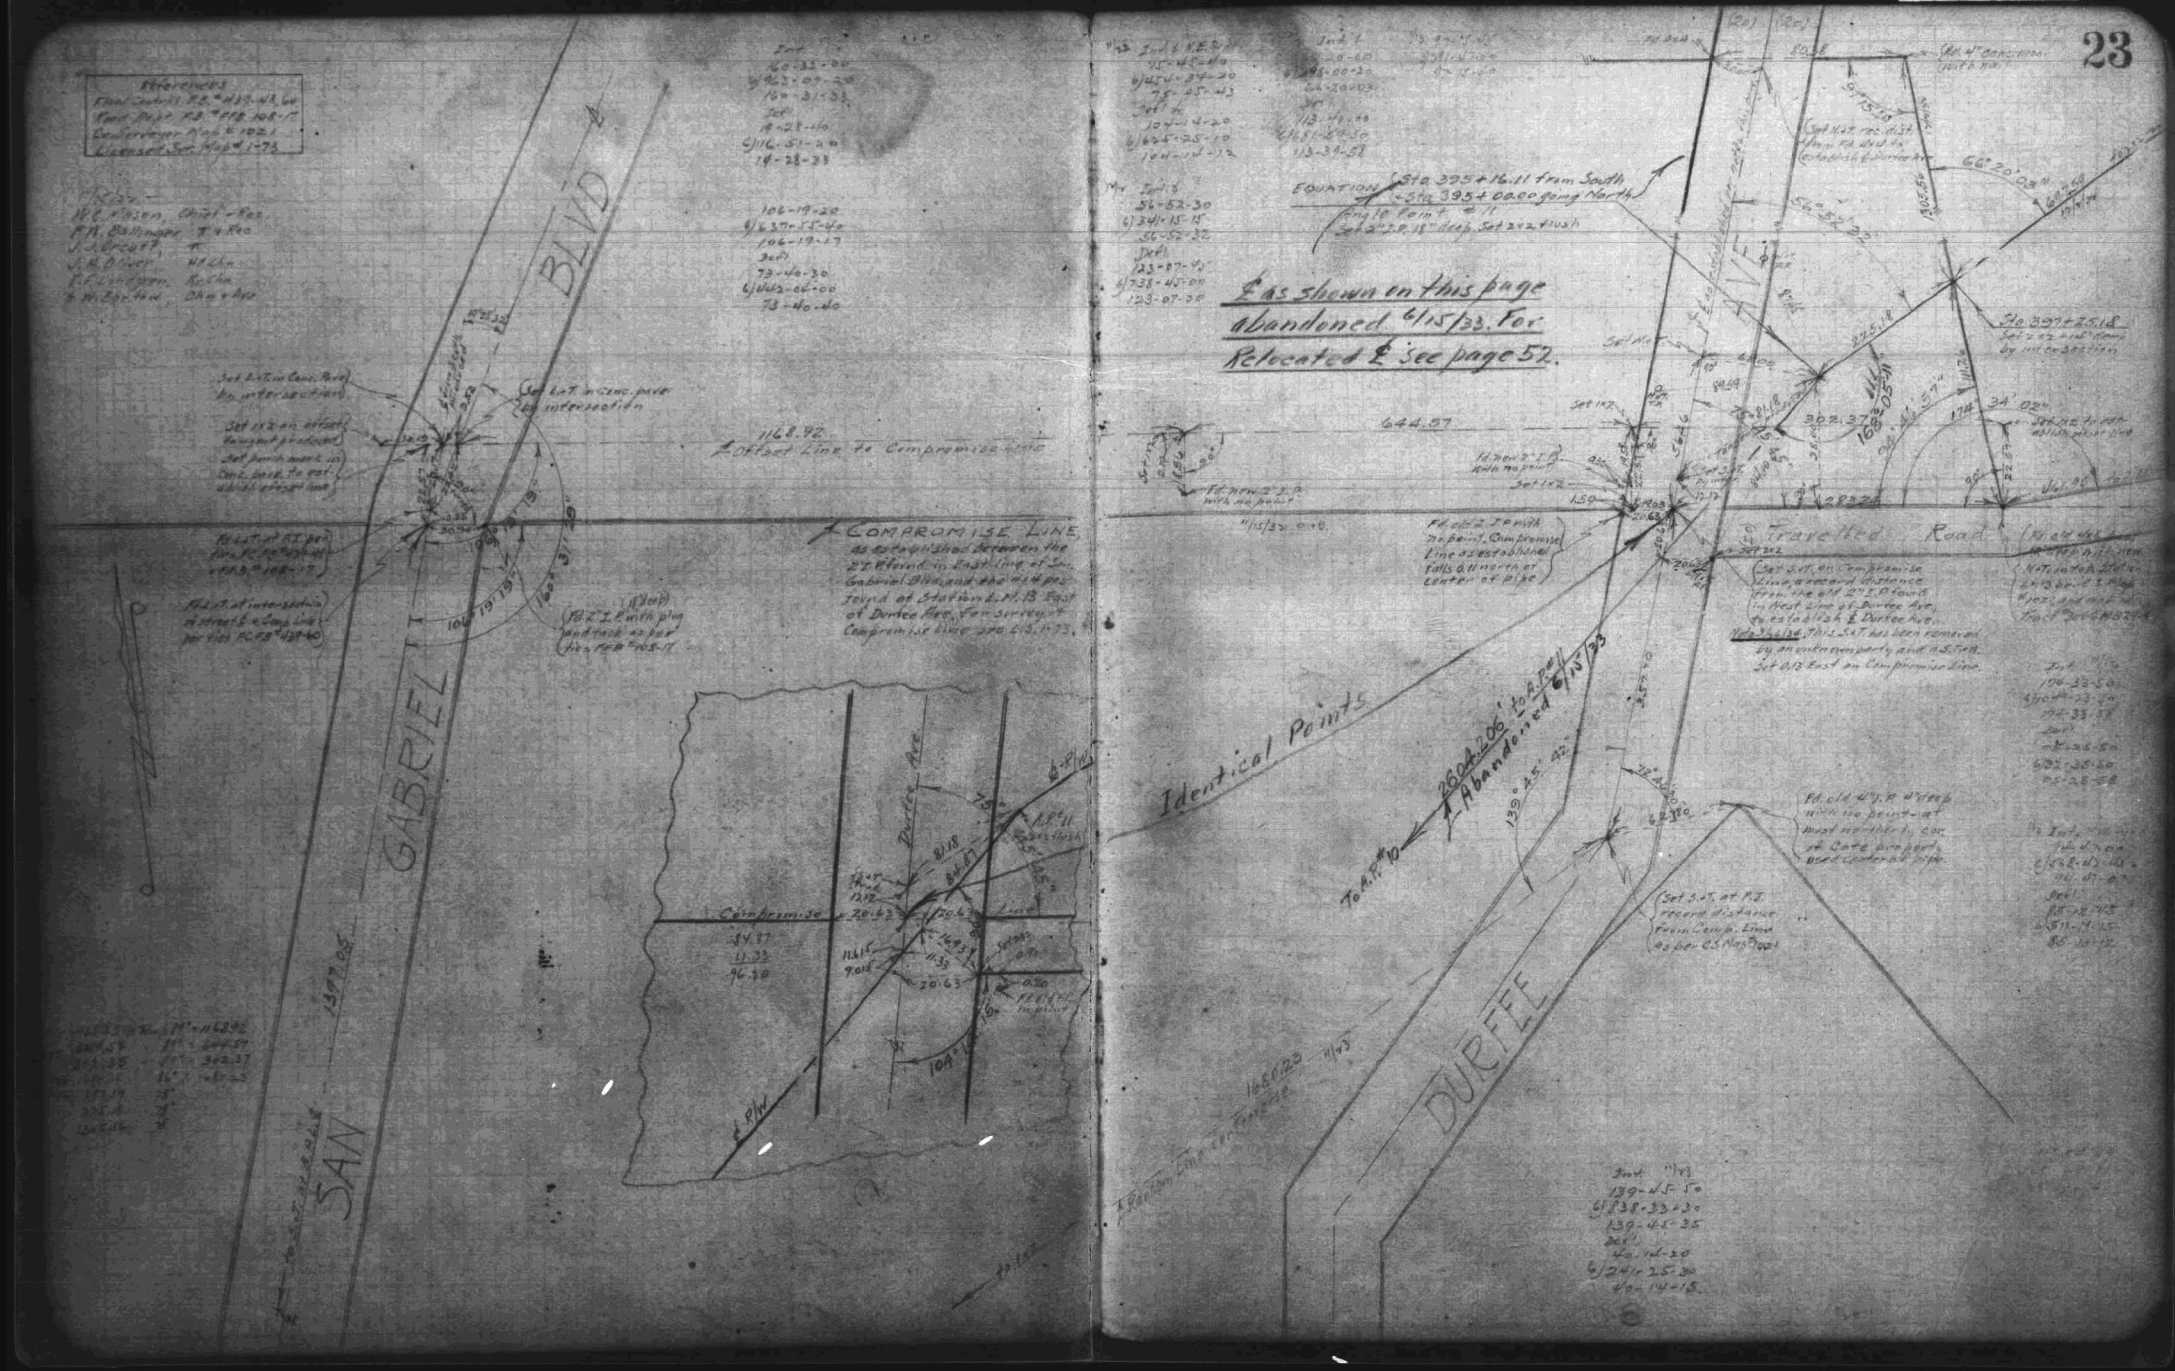
SAN GABRIEL BLVD
DURFEE
Travelled Road
Identical Points
Compromise
Sta 395+16.11 from South
Sta 395+00.00 going North
Sta 397+25.18
Set 2x2 at intersection by intersection
644.57
1168.92
Ft of East Line To Compromise Line
COMPROMISE LINE as established between the 2" I.P. found in East line of San Gabriel Blvd. and the 1/4" pin found at Station L.P. 13 East of Durfee Ave. for survey & Compromise Line per U.S. 1-73.
Set 1/2 on offset
Set Punch mark on Conc. base to establish offset line
Set L.S.T. in Conc. Pave. by intersection
Set L.S.T. in Conc. pave. by intersection
Fd. L.S.T. at P.I. per Rec. of Survey
Fd. 2" I.P. with plug and tack as per Rec. R.S.B. 108-17
Fd. 2" I.P. with no point. Compromise Line as established falls 0.11 north of center of pipe
Set 3/4" I.P. with no point
Fd. 2" I.P. with no point. Compromise Line as established falls 0.11 north of center of pipe
Set S.P.T. on Compromise Line, a record distance from the old 2" I.P. found in West line of Durfee Ave. to establish L Durfee Ave.
Note: Set this S.P.T. has been removed by an entrancompany and U.S.T.H.
Set 0.13 East on Compromise Line
Set 3/4" I.P. with no point - at most northerly cor. of Cote property used centerline pipe
Set 3/4" I.P. record distance from Comp. Line as per C.S. Map 3021
Fd. old 4" I.P. with no point - at most northerly cor. of Cote property used centerline pipe
Fd. 4" Conc. mon. with No.
Cal. Nat. rec. dist. 4.5m to and to establish Curve No.
Fd. 2" I.P. with no point
Fd. 2" I.P. with no point
Fd. 2" I.P. with no point

F. B. 987-34

B. L. & P.

F. B. 987-35

352

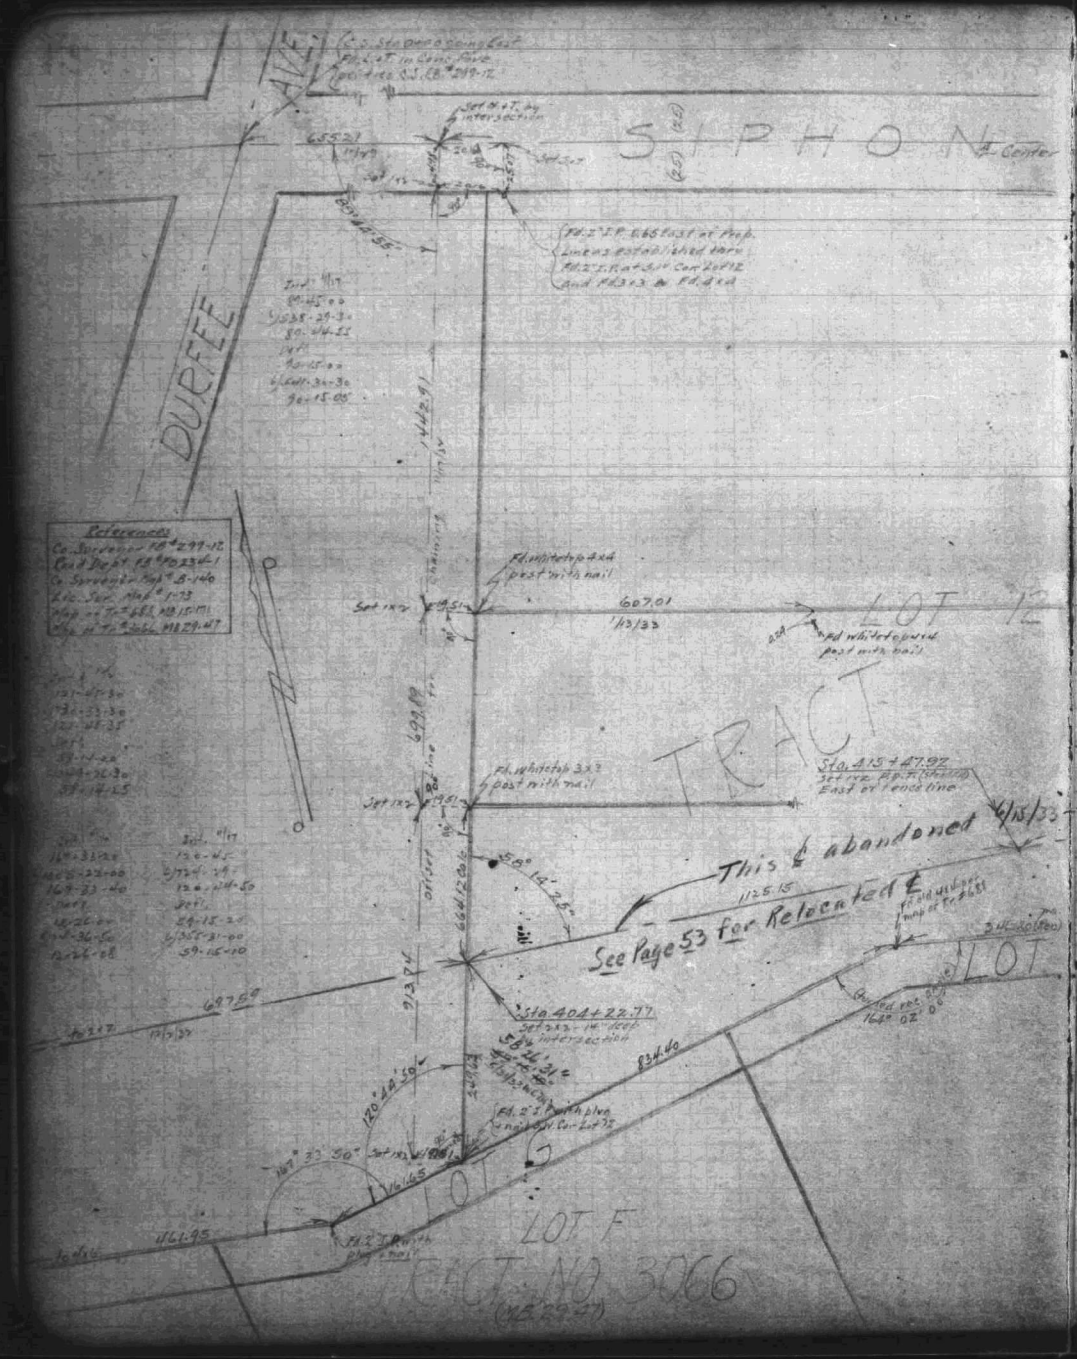

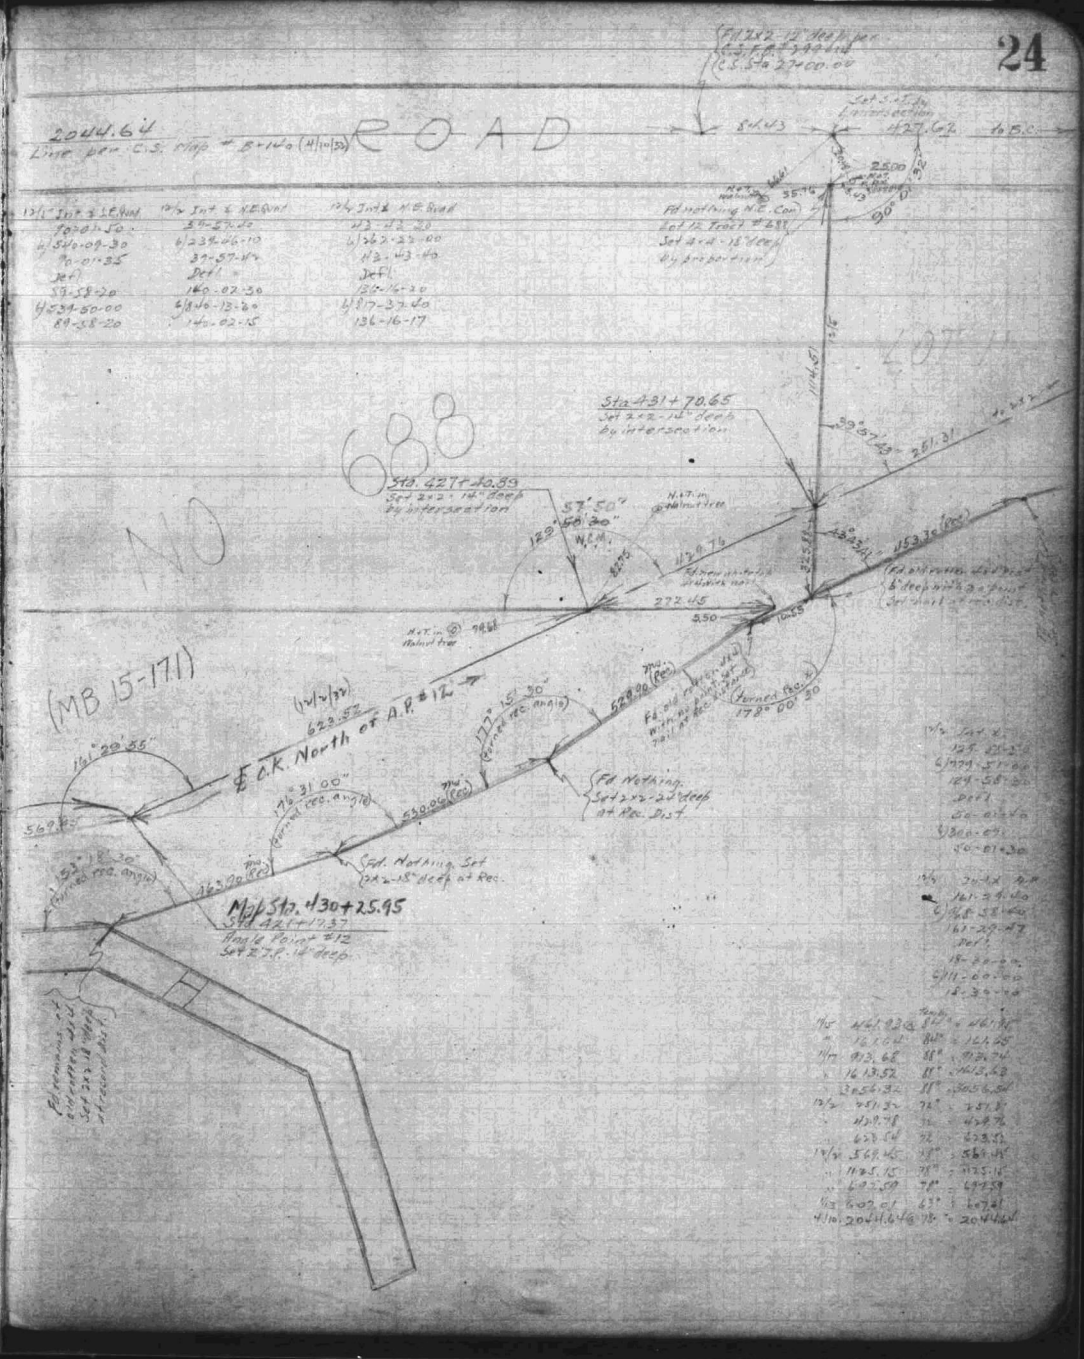

F.B. 987-36

F.B. 987-37

Bur. Li. & Pow.

352

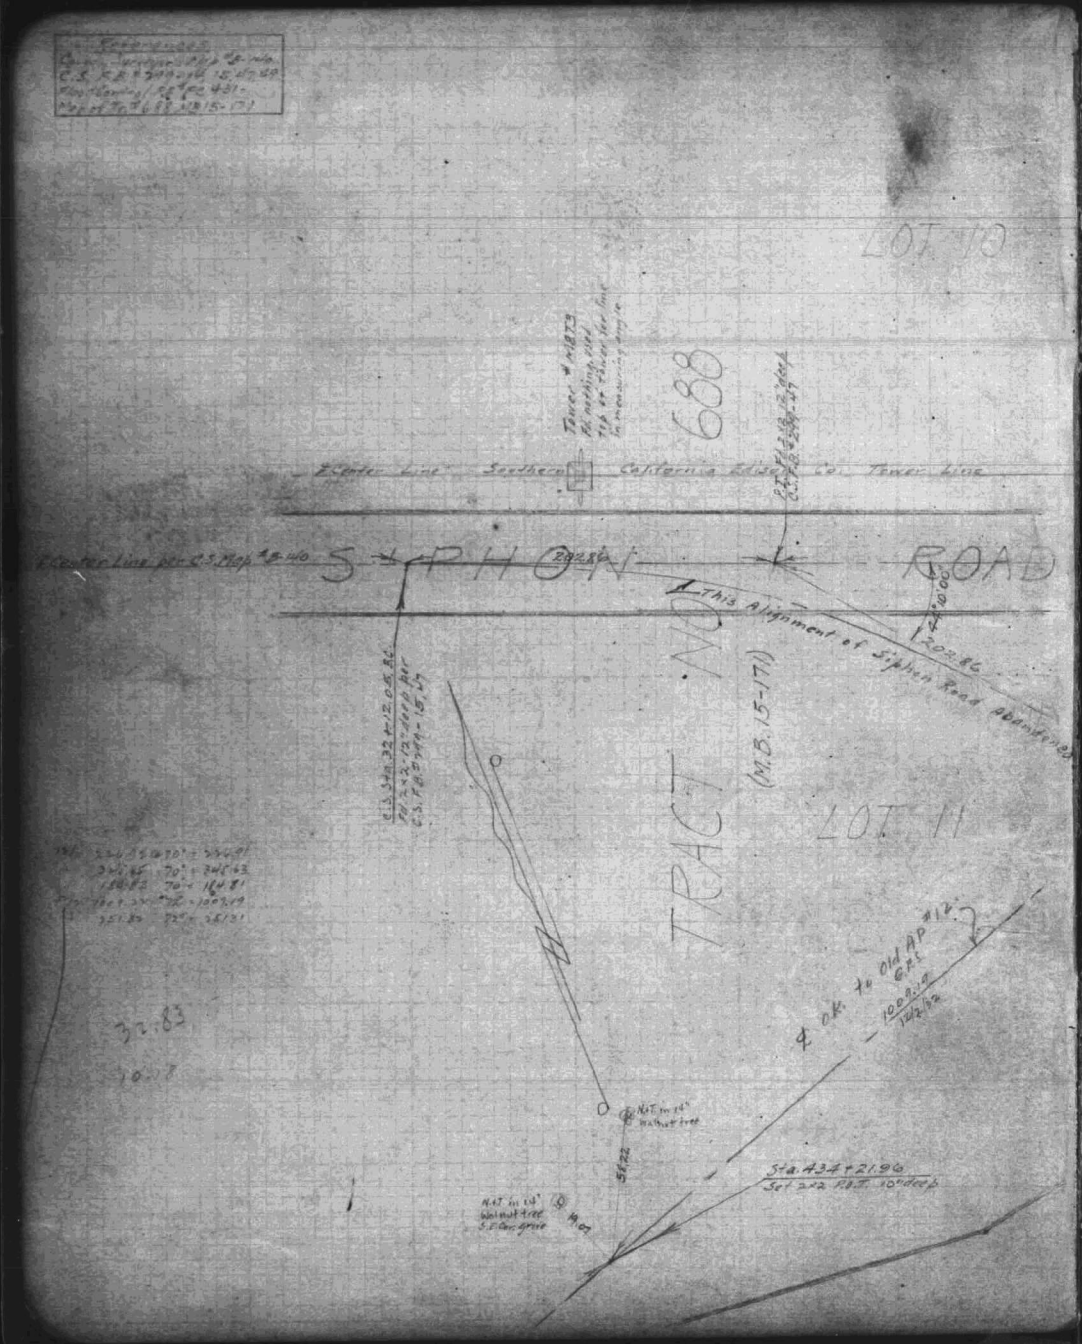

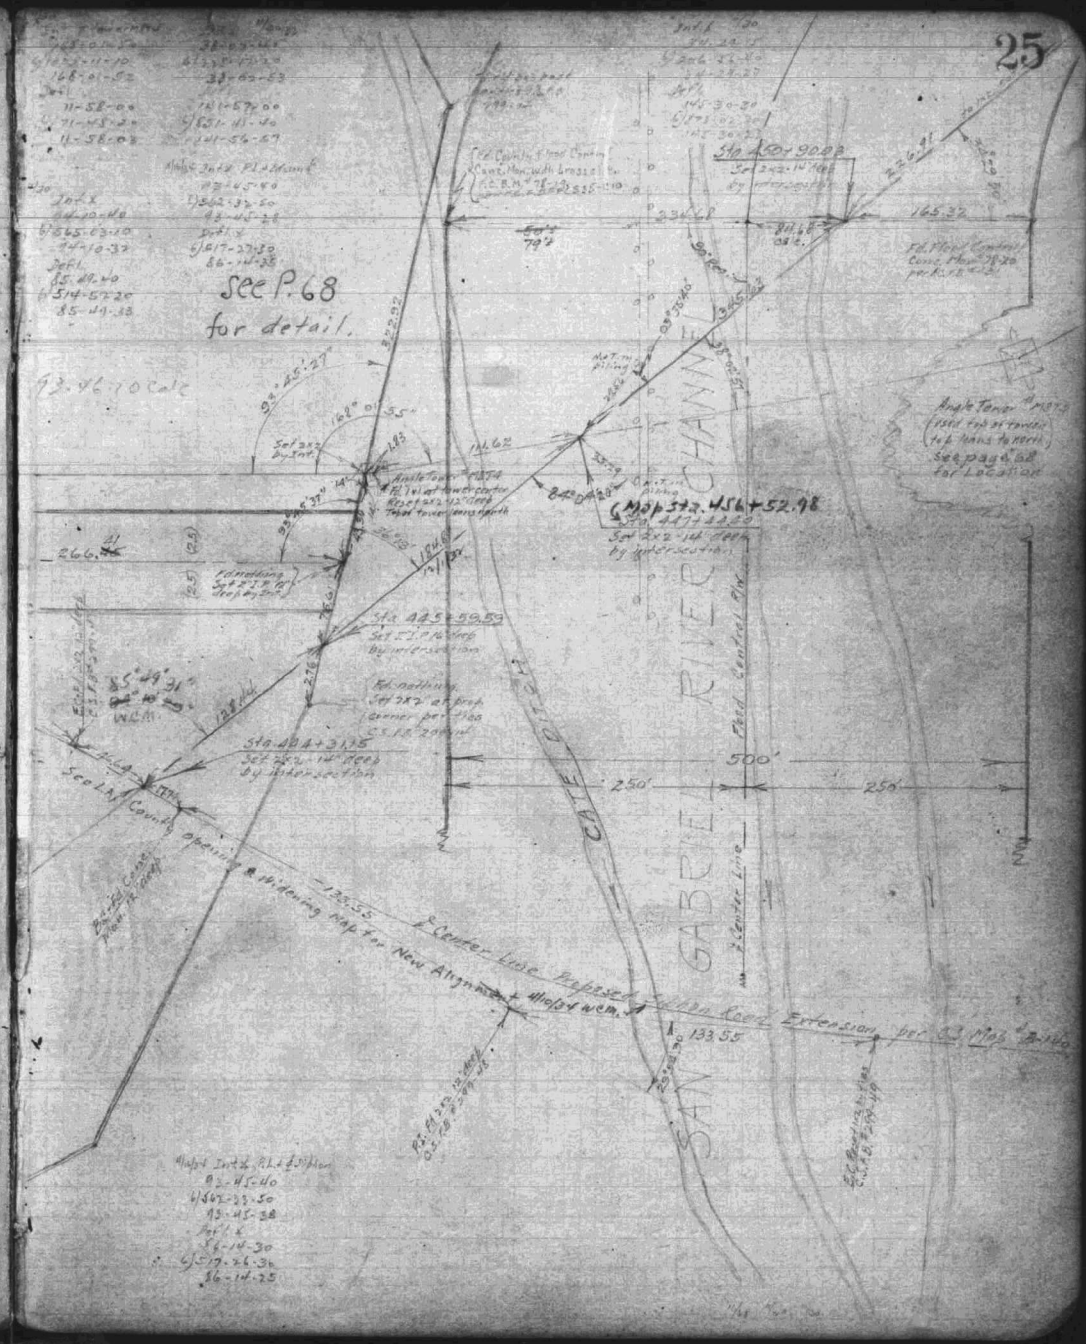

F.B. 987-38

F.B. 987-39

Bur. Li. & Pow.

352

26

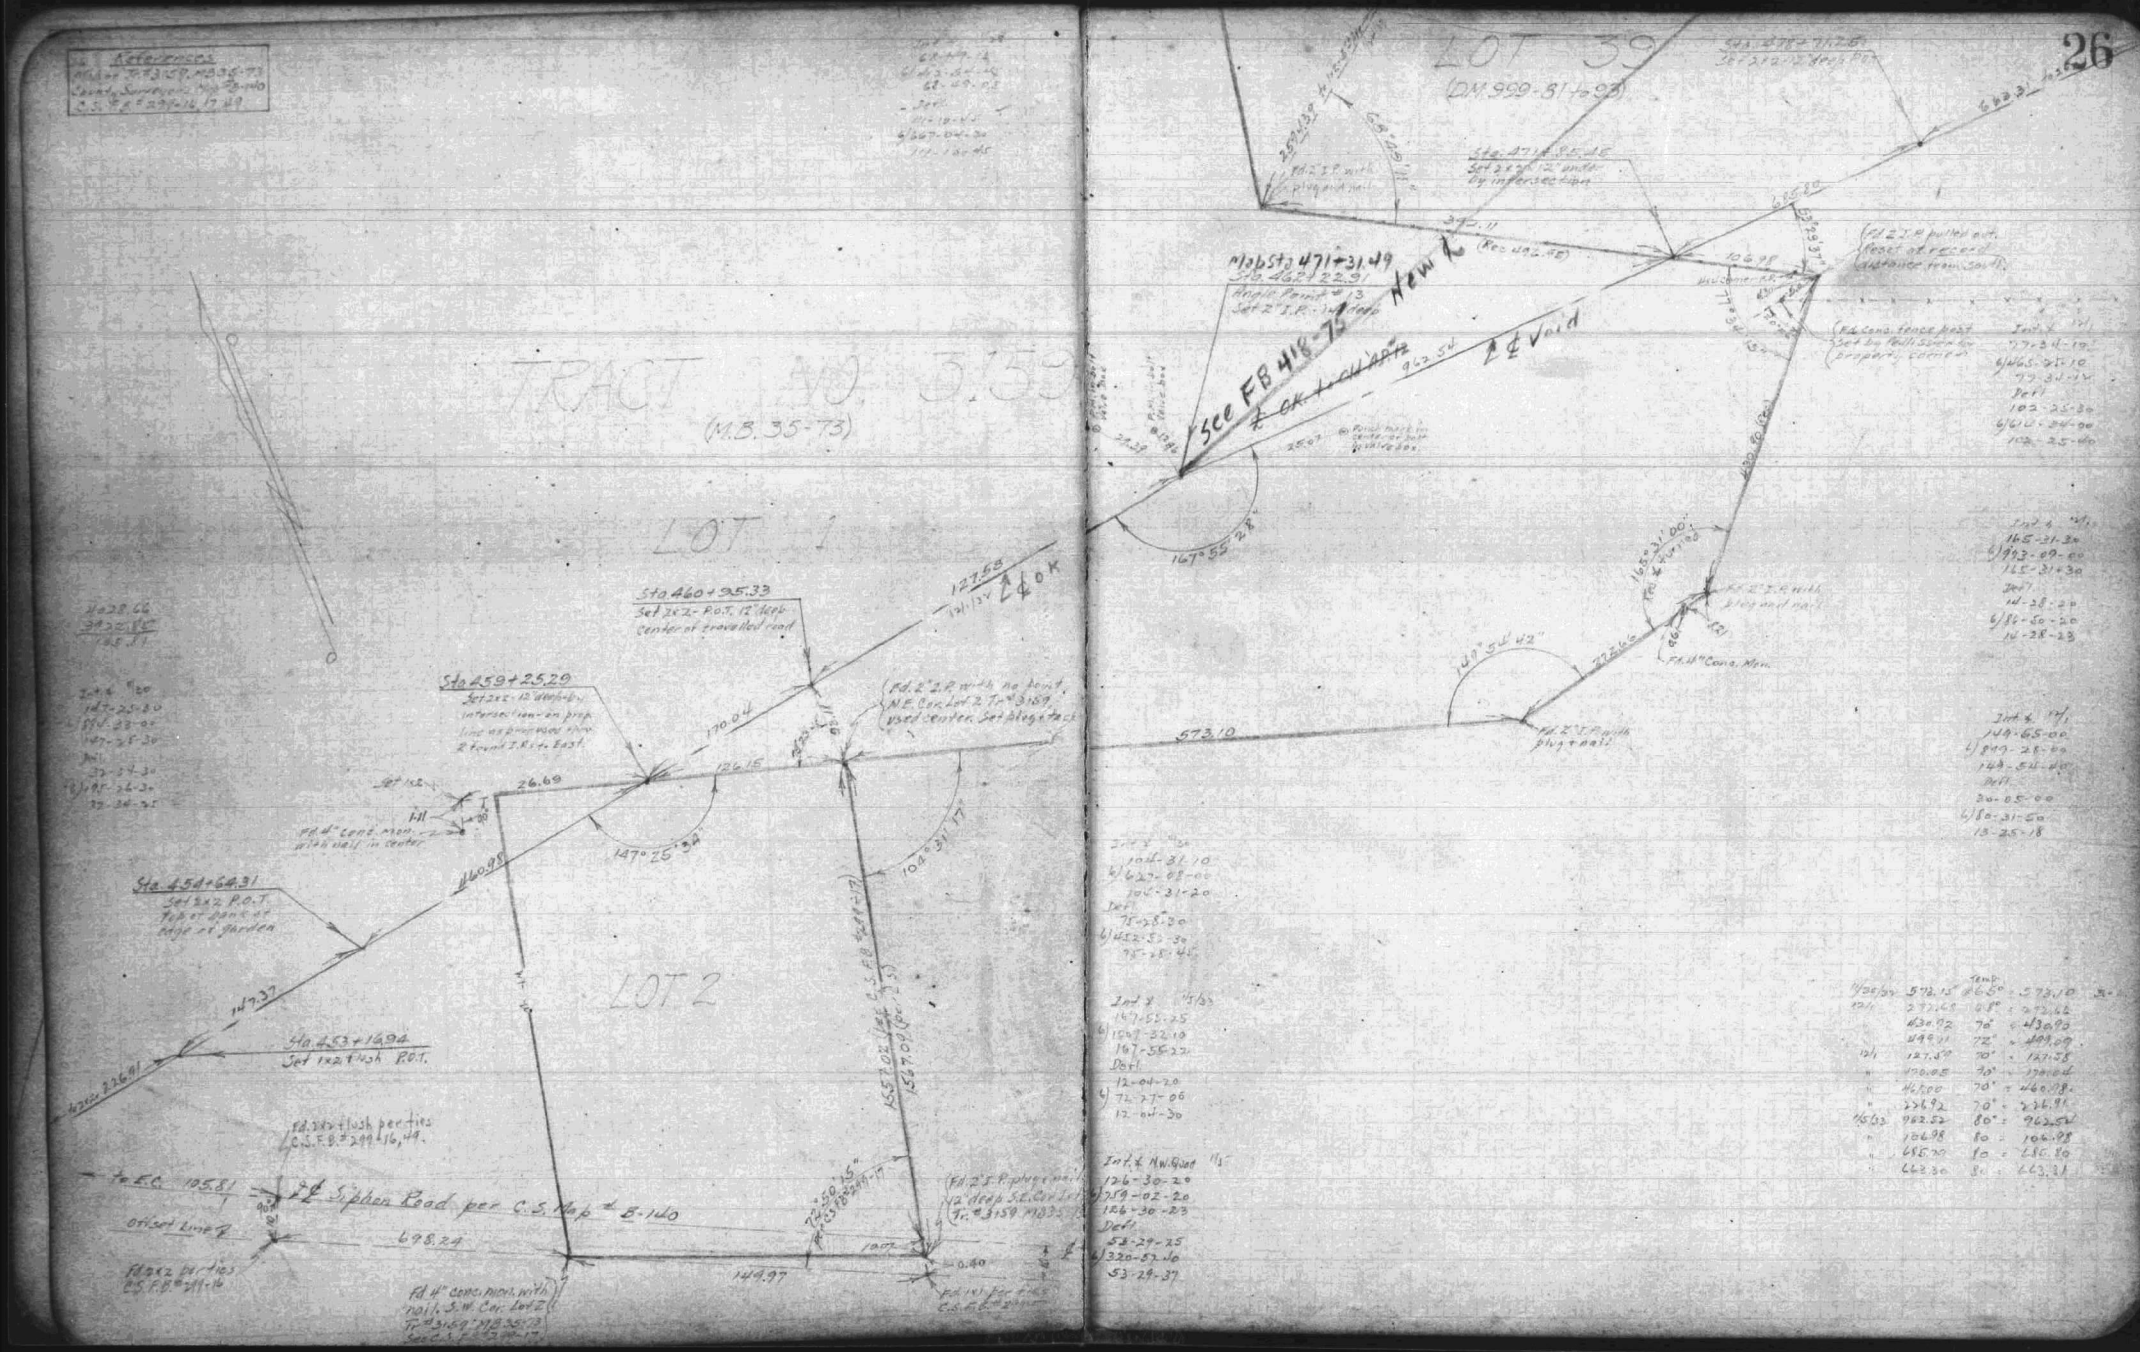
TRACT NO. 3159
(M.B. 35-73)
LOT 1
LOT 2
LOT 39
(D.M. 909-81+98)
Sta. 460+35.33
Set 2x2- P.O.T. 12" deep
center of travelled road
Sta. 459+25.20
Set 2x2- 12" deep
intersection on prop.
line as previously shown
2 found I.R.'s. East.
Sta. 451+64.31
Set 2x2 P.O.T.
Tip or point of
edge of garden
Sta. 453+14.94
Set 1x2 Lush P.O.T.
Sta. 471+31.49
Set 2x2 P.O.T.
Angle Point #13
Set 2" I.P. in top
Sta. 469+22.91
Sta. 471+85.46
Set 2x2 - 12" deep
by intersection
Fd. 2" I.P. with
plug and nail
Fd. 2" I.P. with no dent,
N.E. Cor. Lot 2 Tr. #3159
used center. Set Bldg. tack
Fd. 4" conc. mon. - 2
with bolt in center
Fd. 2" I.P. with
plug and nail
Fd. 4" Conc. Mon.
Fd. 2x2 Lush per ties
C.S. F.B. #299-16, 19.
Fd. 2x2 per ties
C.S. F.B. #299-16
Fd. 4" conc. mon. with
nail. S.W. Cor. Lot 2
Tr. #3159 "MBS5-73
See C.S. F.B. #299-17
Fd. 2" I.P. pipe, nail
1/2" deep S.E. Cor. Lot 1
Tr. #3159 MB35-73
Fd. 1/2" pipe for line
C.S. F.B. #299-17
Siphon Road per C.S. Map # B-140
Set 2x2 Lush P.O.T.
Fd. 2x2 Lush per ties
C.S. F.B. #299-16, 19.
Fd. 2" I.P. pulled out.
(reset at record
distance from corner)
Fd. Conc. fence post
Set by Null System to
(prop. corner)
Fd. 2" I.P. with
plug and nail
Fd. 4" Conc. Mon.
See FB 418-75
New R
L & Void
L & OK + CW 4-07
L & OK
Int. & 12'
Int. & 12'
Int. & 12'

F.B. 987-40

F.B. 987-41

Bur. Li. & Pow.

WS 37-A-3

352

Cont'd on 1302-128

52

7/13/33
Orauff & Rec.
Lundgren - Ch.
Barlow - Ch.

See Calc. Book #36-24.

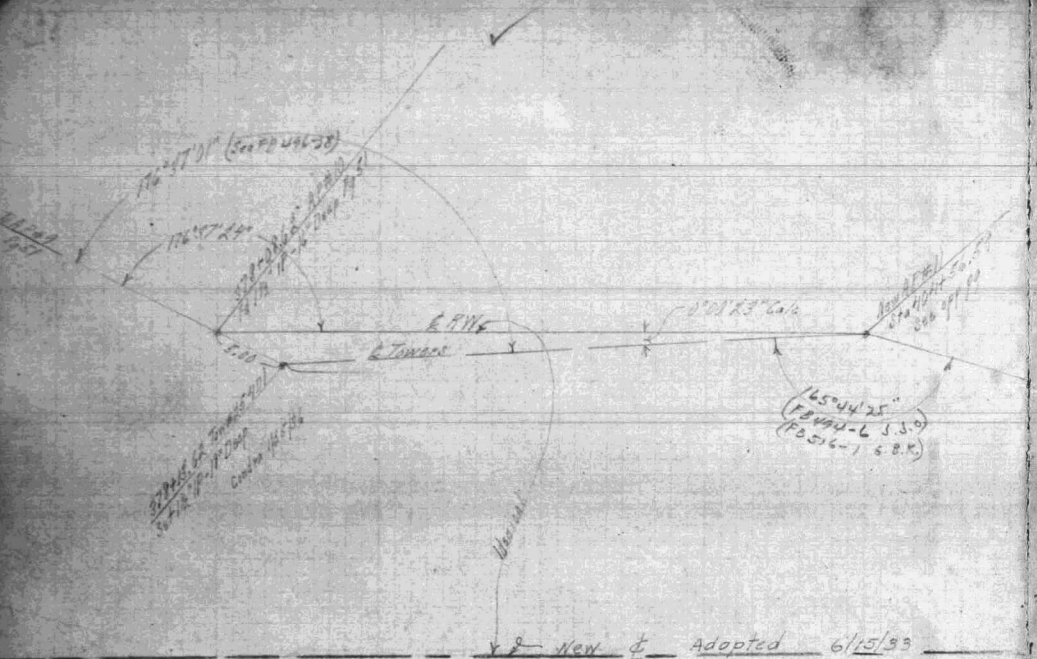

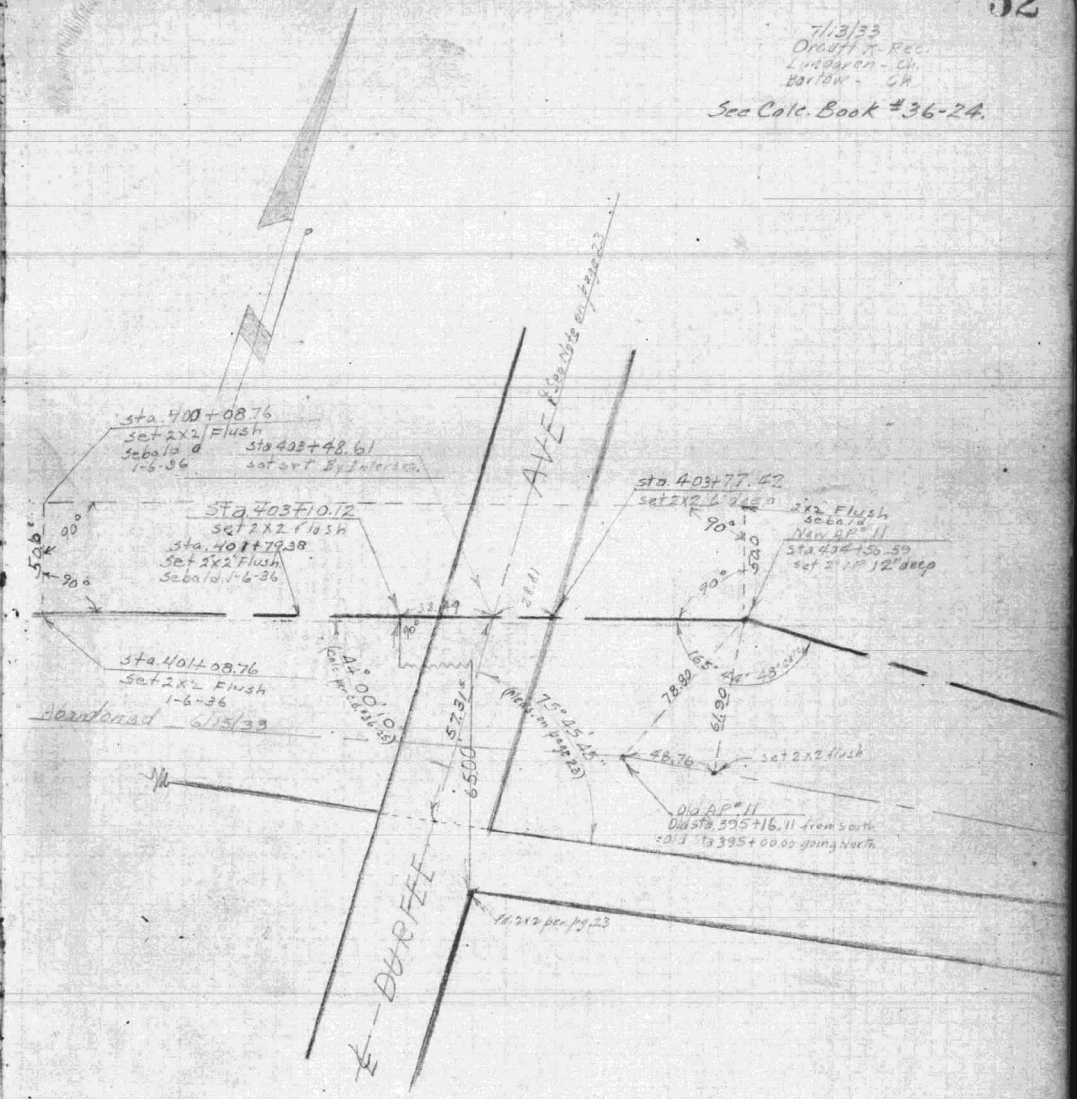

Continued F.B. 1302-128

F.B. 987-42

F.B. 987-43

Bur. Li. & Pow.

WS 32-A-3

352

53

7/13/33

See Calc. Book #36-24,25,26.

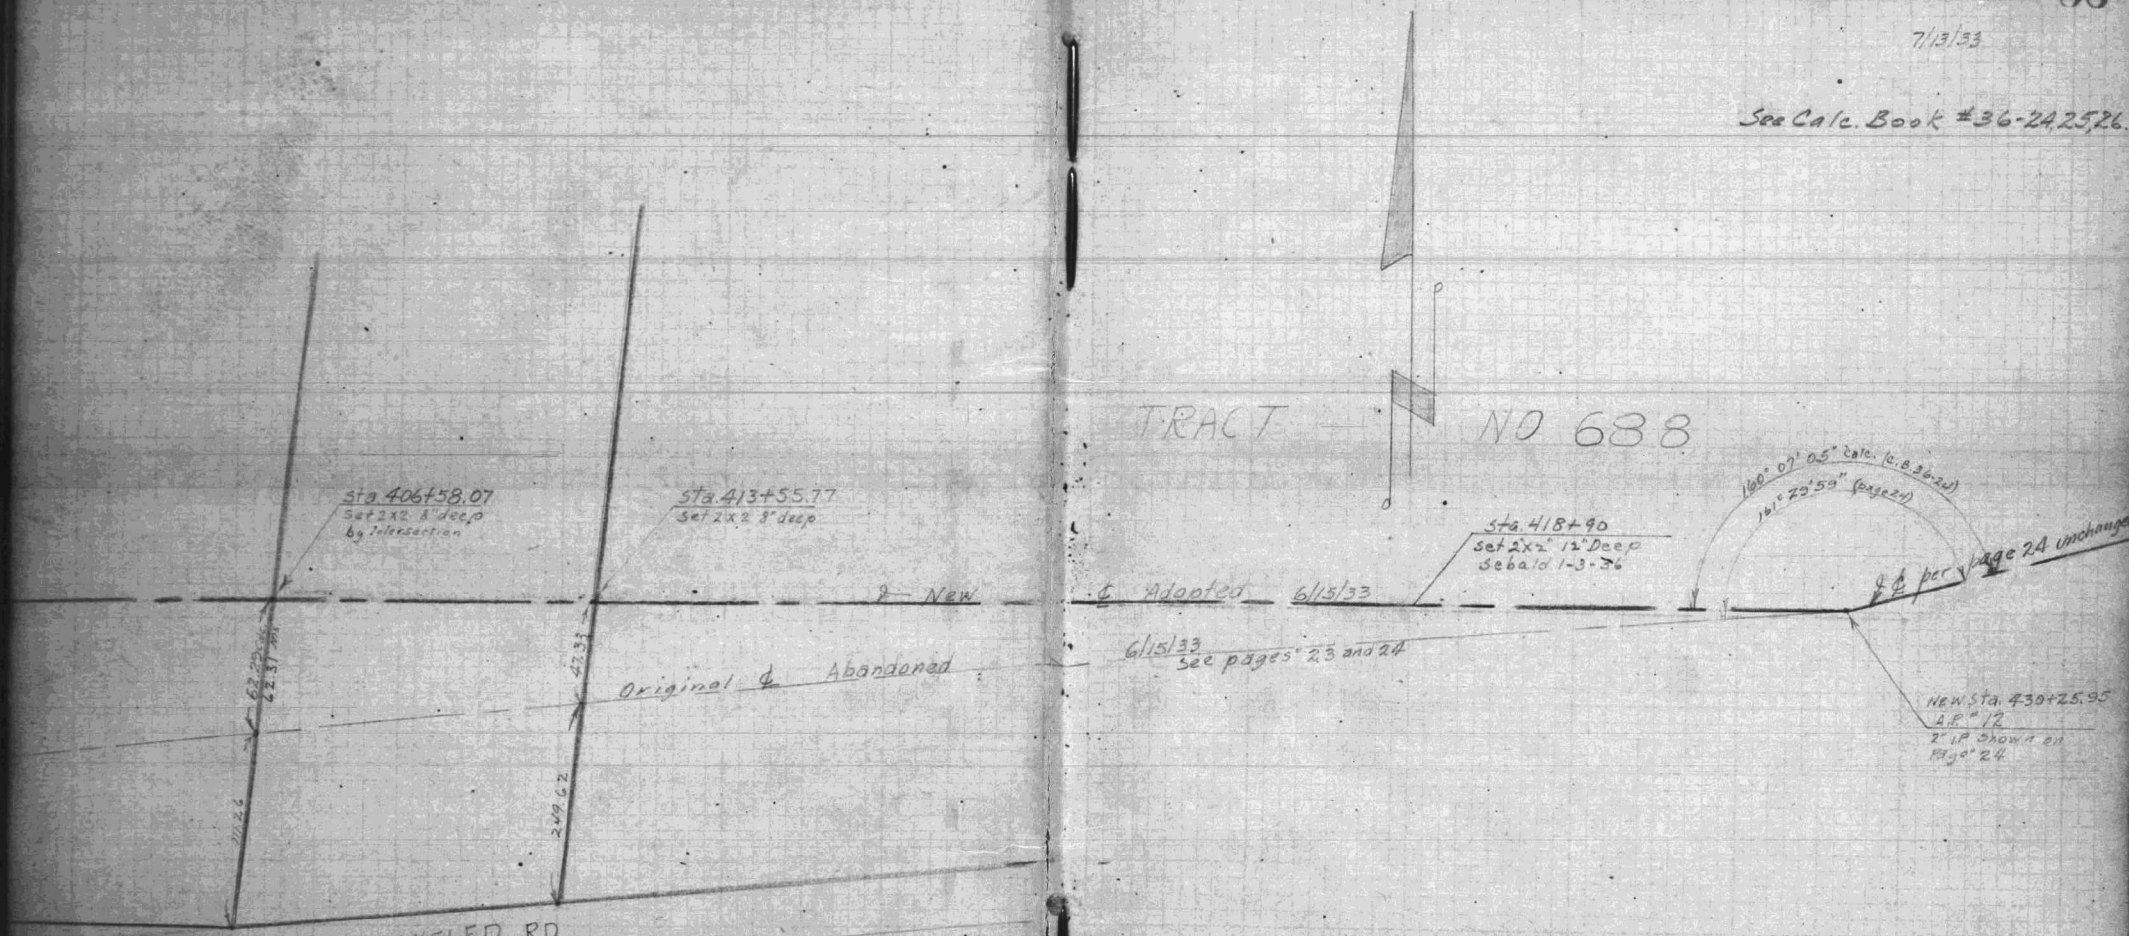

F.B. 987-44

Bur. Li. & Pow.

F.B. 987-45

WS 46-C-3

WS 46-D-3

352

58

See Calc. Book #36-21,29.

8/4/33 Calc. & Established Indiana New & Established

1/22/34 Traverse
170-17-30
6/1021-44-30
170-17-25
Defl. L
09-42-40
6/58-16-10
09-42-42
1/26/34 Not car 3 angles
30-21-20
9 542-07-20
90-21-13
Defl.
89-38-40
6/537-52-50
89-38-48

1/26/34 Traverse
34-48-10
6/308-44-50
34-48-18
Sum L
145-32-40
6/891-10-00
145-11-40

Sum R + L Sum
125-16-00
6/751-35-00
125-15-50
Defl.
54-44-00
6/328-23-30
54-43-50

1/30/33
SE Quad Mercedes Olive
89-22-00
6/536-13-00
89-22-10
Defl.
90-38-00
6/543-46-30
90-37-45

1/26/34
L + Calc. 854+80.66
125-15-40
6/751-35-40
125-16-38
Defl.
54-44-30
6/328-24-00
54-46-20

1/30/33
SE Quad Mercedes Olive
89-30-50
6/537-05-10
89-30-52
Defl.
89-32-30
537-14-50
89-32-28

1/22/34
SW Cor Ingels Pine
89-30-50
6/537-05-10
89-30-52
Defl.
90-29-20
9 542-53-40
90-28-53

1/30/33
SE Quad Mercedes Olive & Pine
90-27-30
9 542-45-00
90-27-30
Defl.
89-32-30
537-14-50
89-32-28

Old Sta 848+87.54
Fd 2x2 4" deep per page 40

Calc. Sta. 857+46.16
Set 2" I.P. 6" under

Old Sta 845+65.37
Fd 2x2 x 1.51 per page 40

844+12.75 } EQ.
=842+82.72 }

Set 2" I.P. 6" deep by Intersection

This Location Abandoned May 15 1934 M.C.W.

Tie to F.B. 944-46

This ℄ on

See New ℄ in F.B. #418-5

New Sta. 854+66.30
Set 2x2 4" deep

Fd 2x2 4" deep

New Sta. 861+80.24
Set 2x2 4" deep

See F.B. 418-3

Sta. 848+19.79
Set 2x12 6" deep
P.O.T.

Tie to F.B. 944-46

Tie to F.B. 944-46

Tie to F.B. 944-46

F.B. 987-46

F.B. 987-47

Bur. Lt. & Pow.

Contd in FB 997-352

See Calc Book #36-21

59

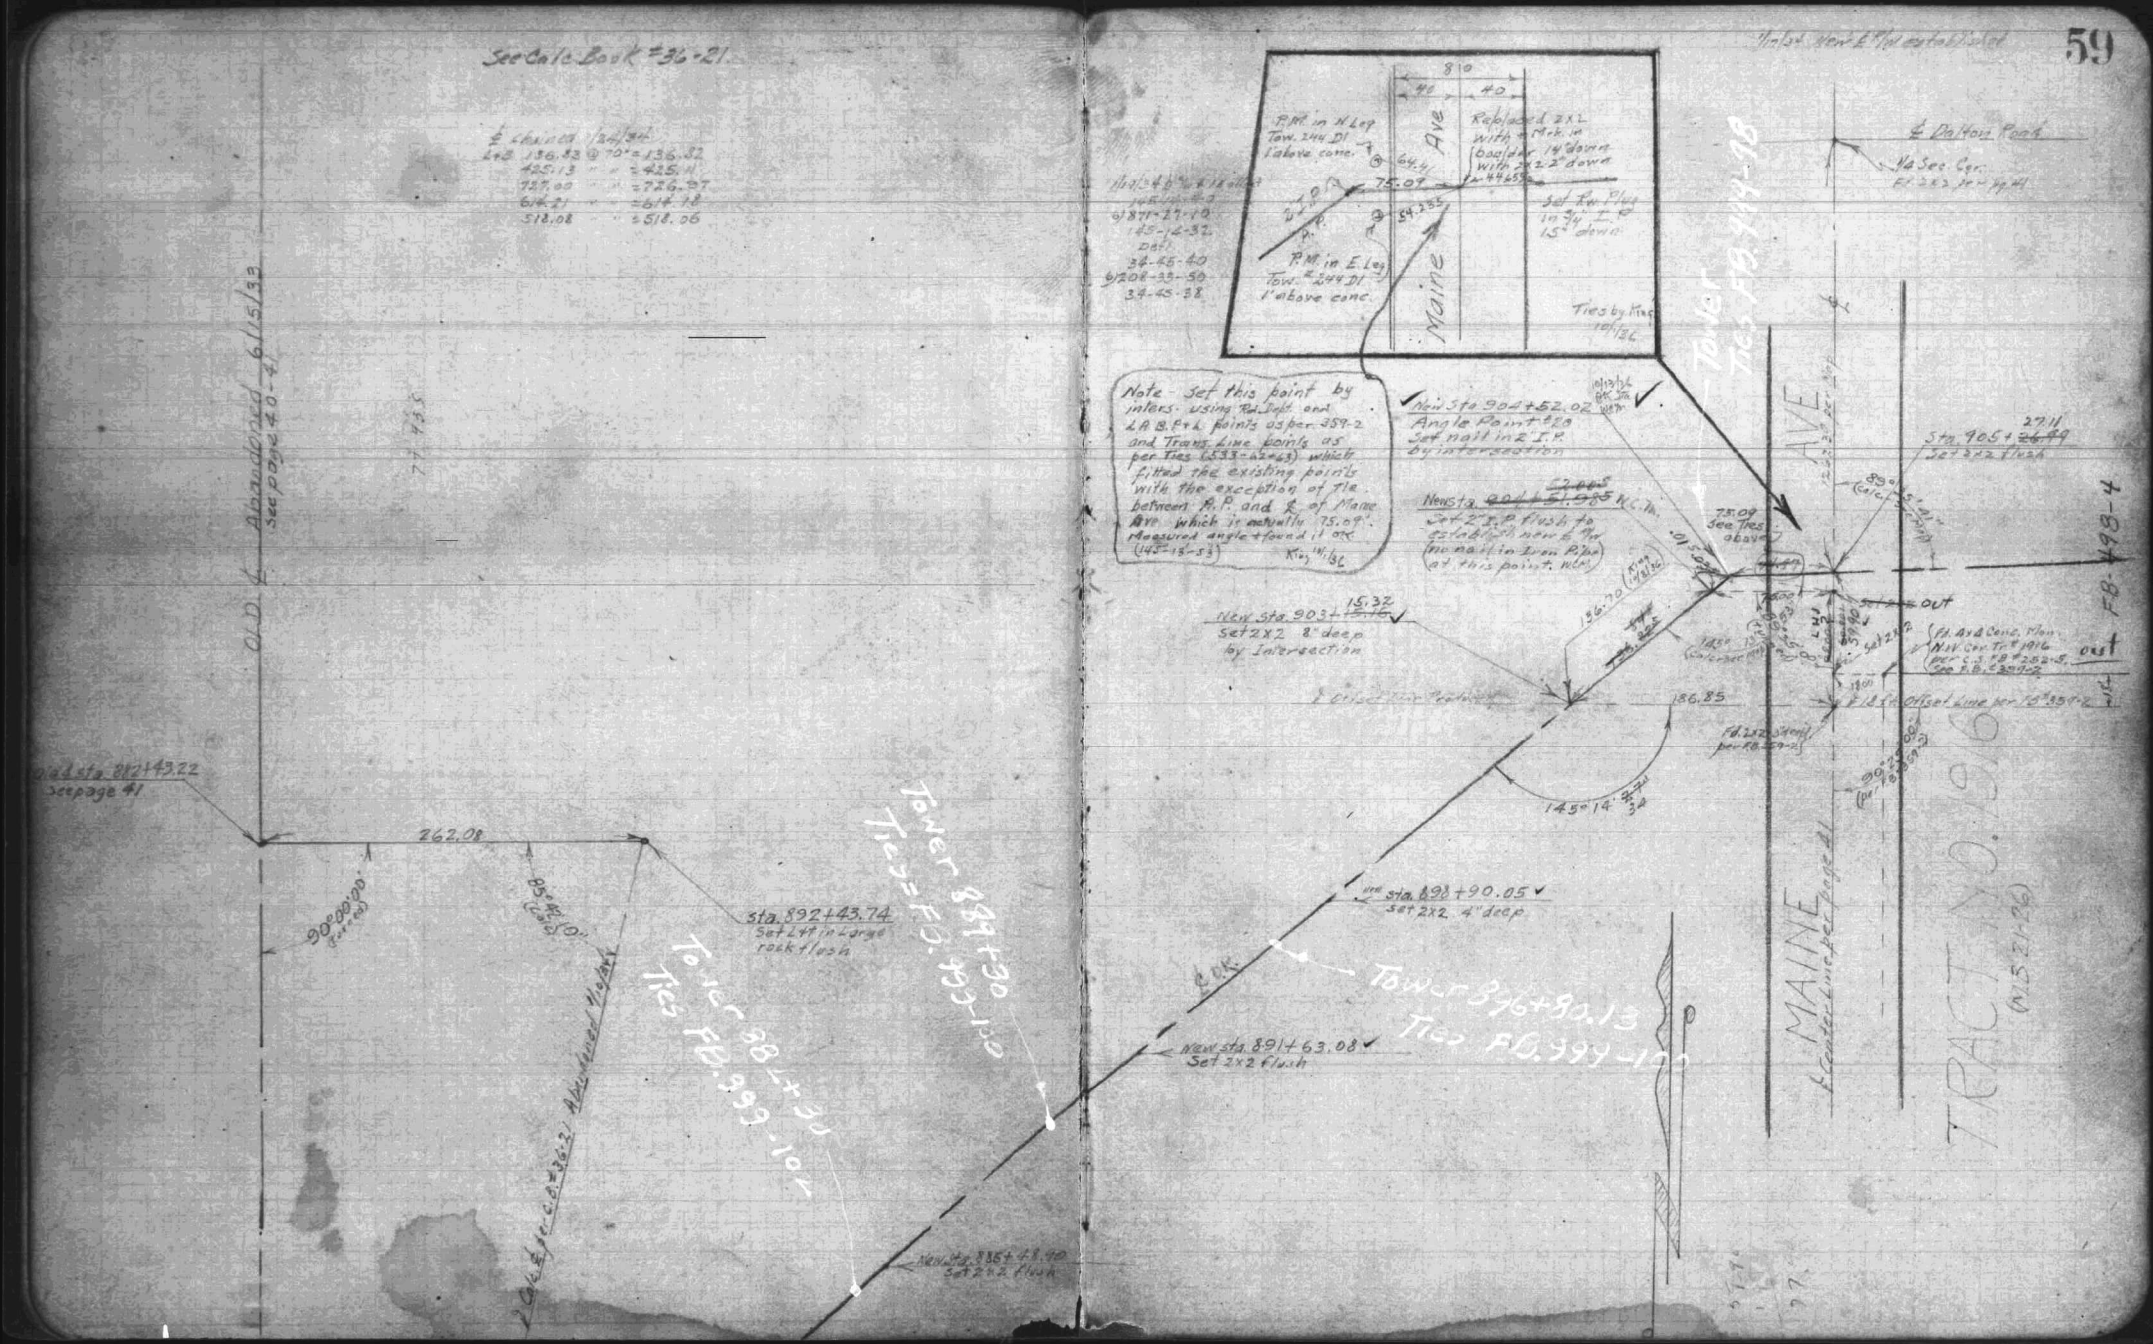

F.B. 987-48

Bur. Li. & Pow.

W3.46-D-3

F.B. 987-49

419

May 16/1934
G.D. Miller C.P. + Rec.
A.W. Gibbs "
W.R. Eastman Chn
L.H. Schuerman Chn
L.R. Fiatte Asc

NOTE:-
See F.B. 352-58
for complete notes. (original)

Calc. from Sta. 499.58

2×2 4" deep F.B. 352-58

Calc. from Sta. 448.39

℄ per F.B. 352-58

to 2" I.P. pg. 4

3

ARROW

HIGHWAY

8"×T 6"deep F.B. 352-58

25+25+50 100

50

25.00

25.00

S-T F.B. 352-58

390.58

2×2 4" deep F.B. 352-58

Calc. from Sta. 673.70

L+T in curb

2+77

2+78

Cont. F.B. 352-58 L+T in curb

S+T F.B. 352-58

2232.56

30

30

STEWART AVE

to 1" I.P. of Olive St F.B. 352-39,58

F.B. 987-50

Bur. Pow. & Li.

F.B. 987-51

418

4

NOTE :—
See F.B. 352-58
for complete notes (original)

fd 2" I.P. 6" deep
Old A.P. #19
F.B. 352-58

Calc. from Sta.
646.51

90.065

2×2 6" deep

℄ per F.B. 352-58

To A.P.
pg. 5

2×2 flush
F.B. 352-58

Calc. from Sta.
214.36

2" I.P. 8" deep
F.B. 352-58

to 2×2 pg. 3

125.15 - 40
#5

To Arrow Hwy F.B. 352-58

1310.82

To N+T 425 W of
℄ int of Olive St.
and Merced Ave
F.B. 352-58

F.B. 987-52

Bur. Pow. & Li.

F.B. 987-53

W 346-C3

419

5

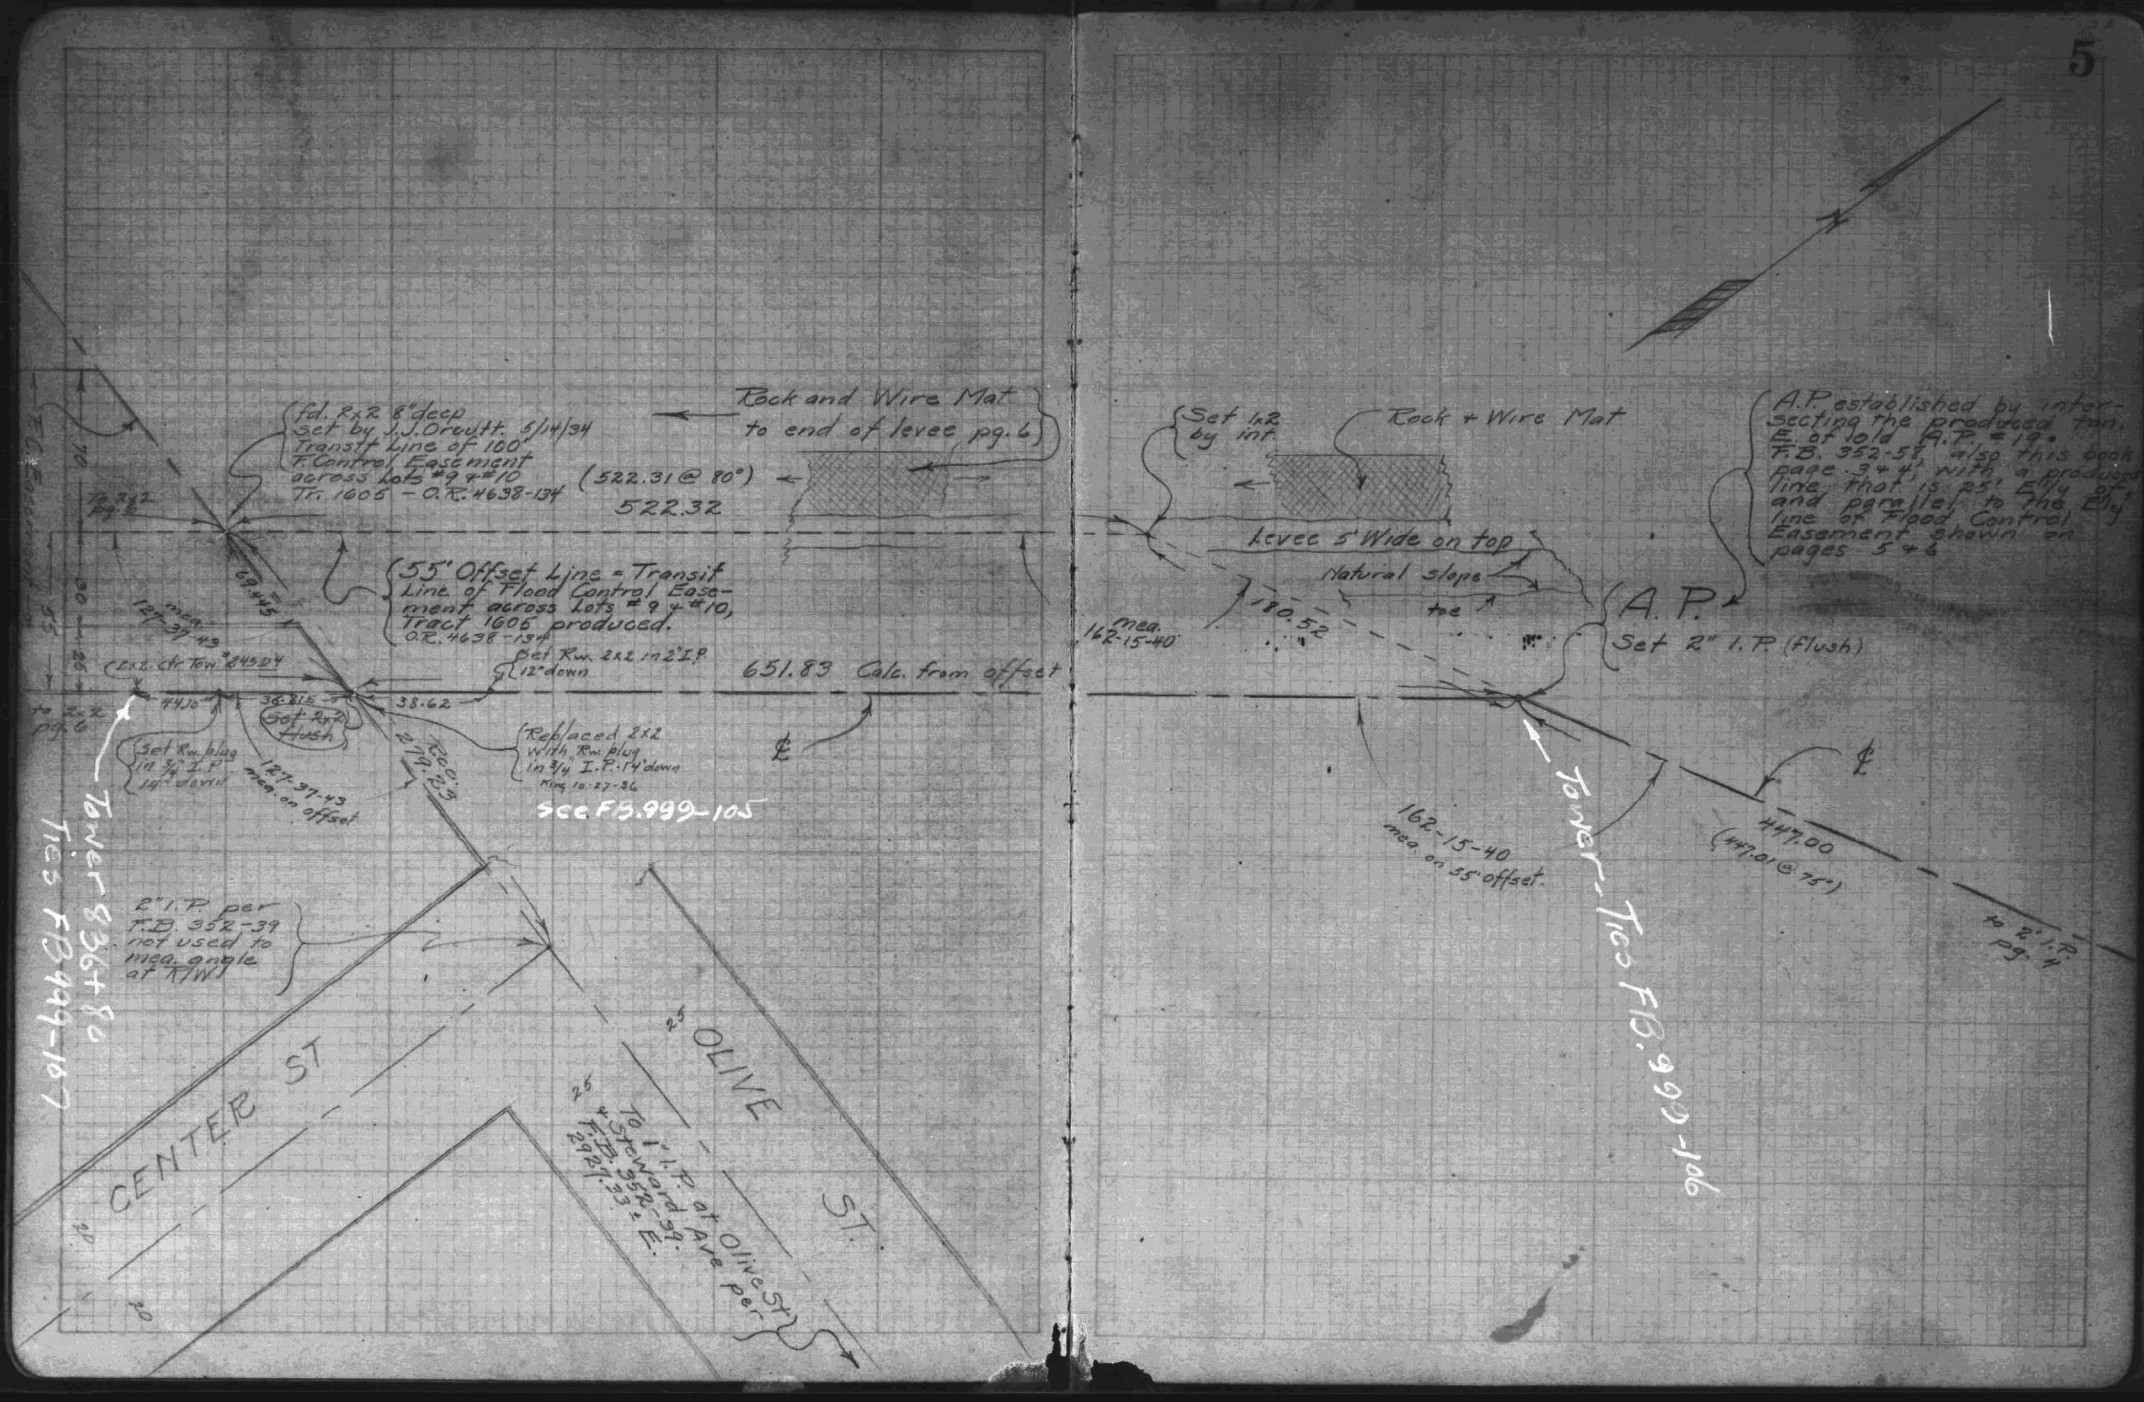

F.B. 987-54

Bur. Pow. & Li.

F.B. 987-55

WS. 41-C-3

419

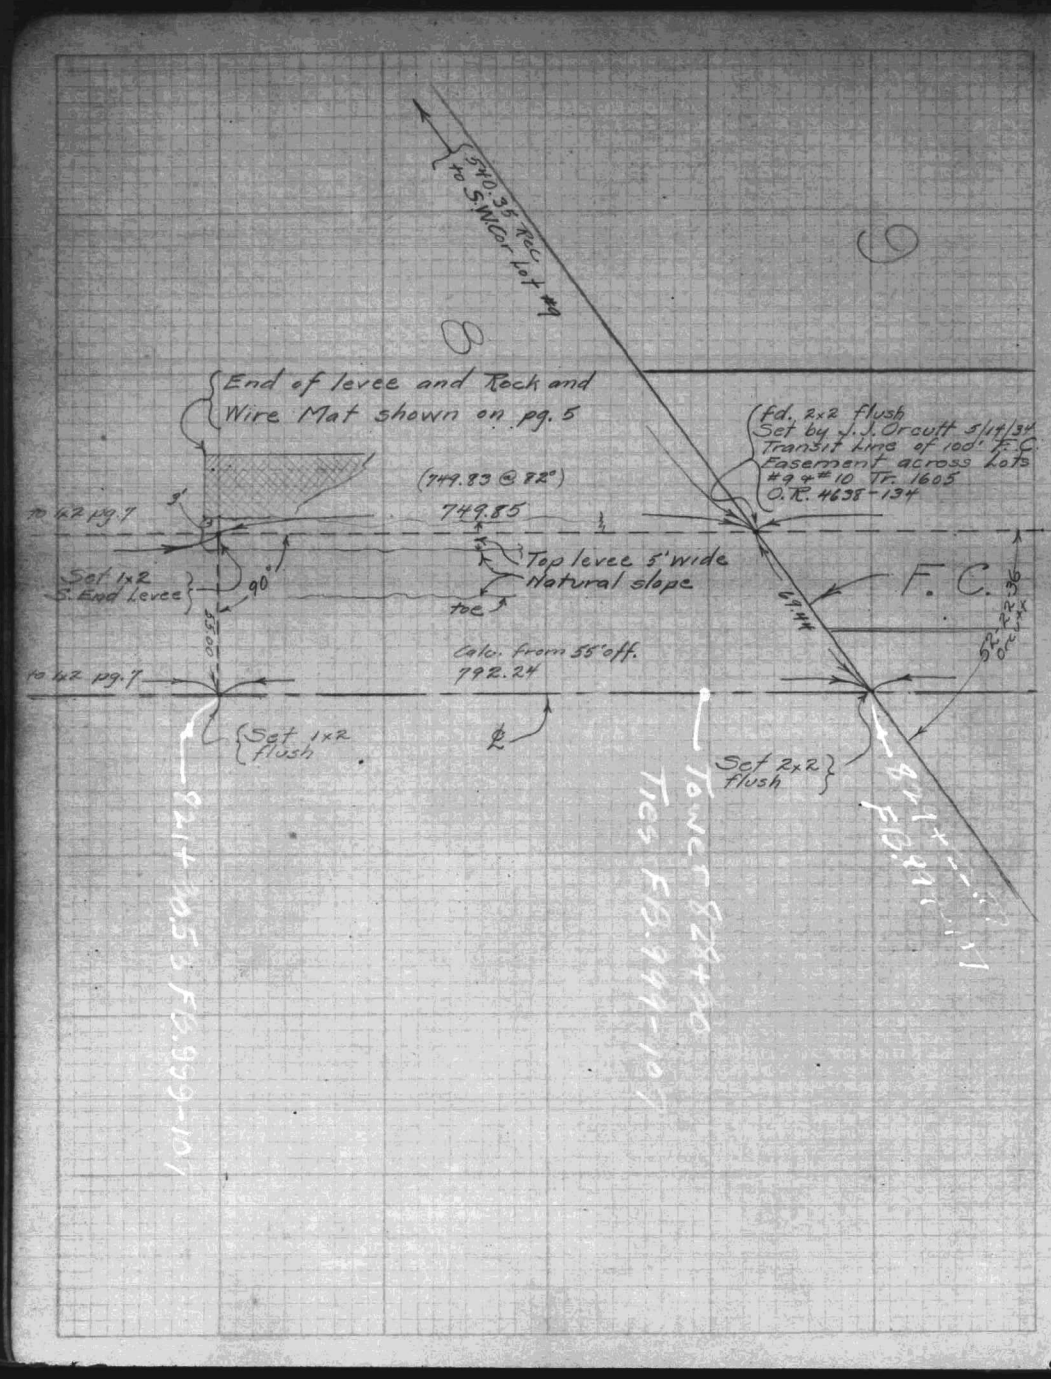

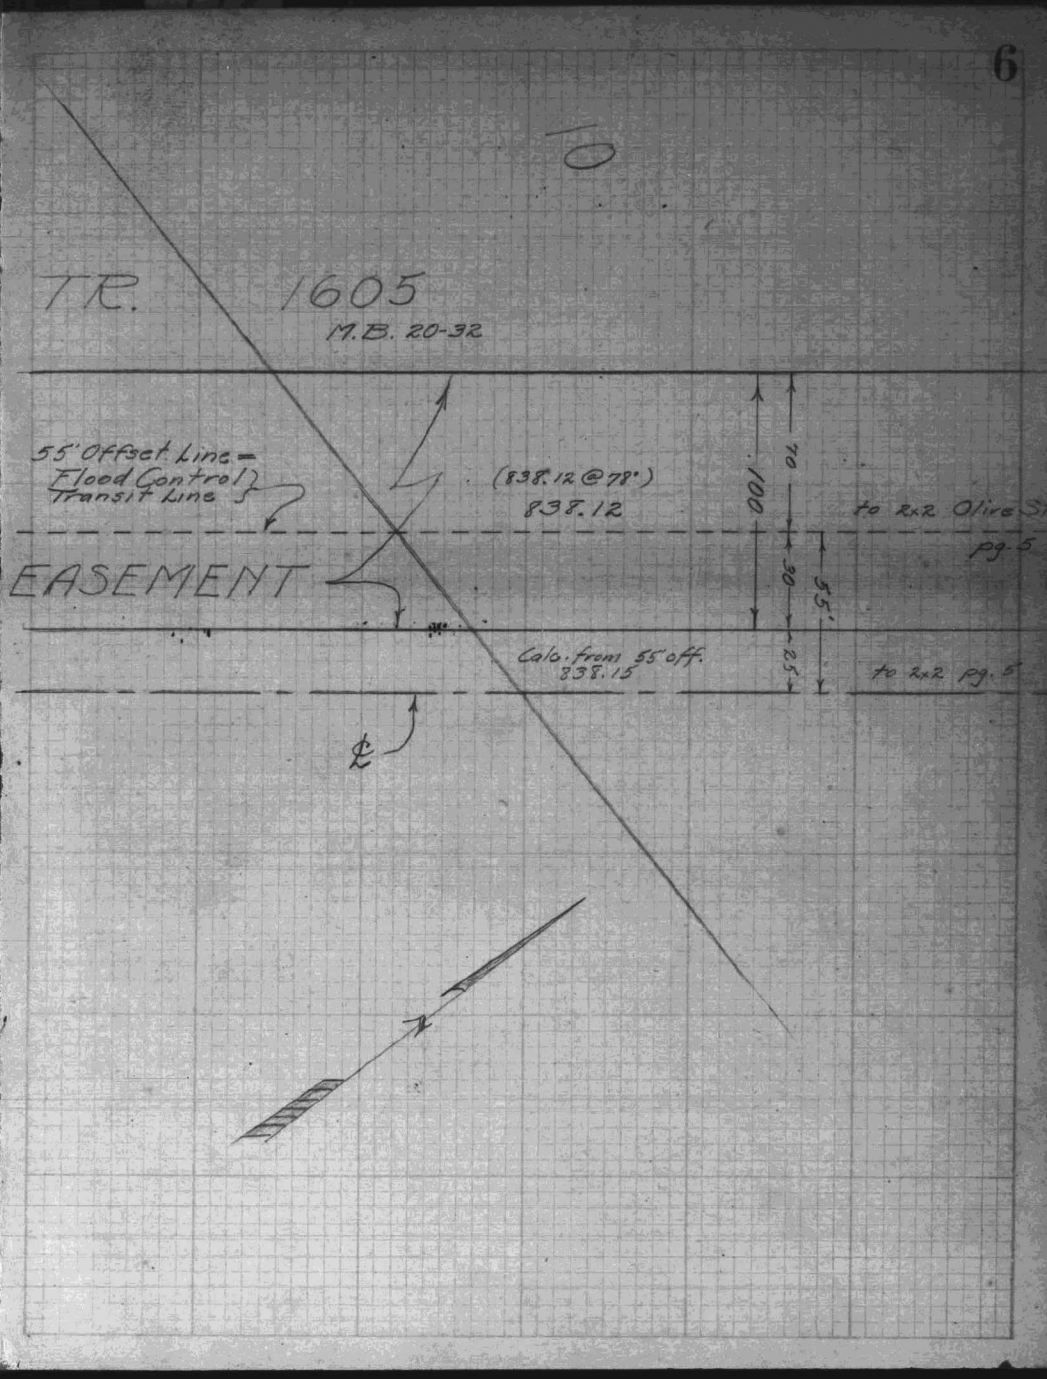

F.B. 987-56

Bur. Pow. & Li.

F.B. 987-57

W3.46-C-3

418

7

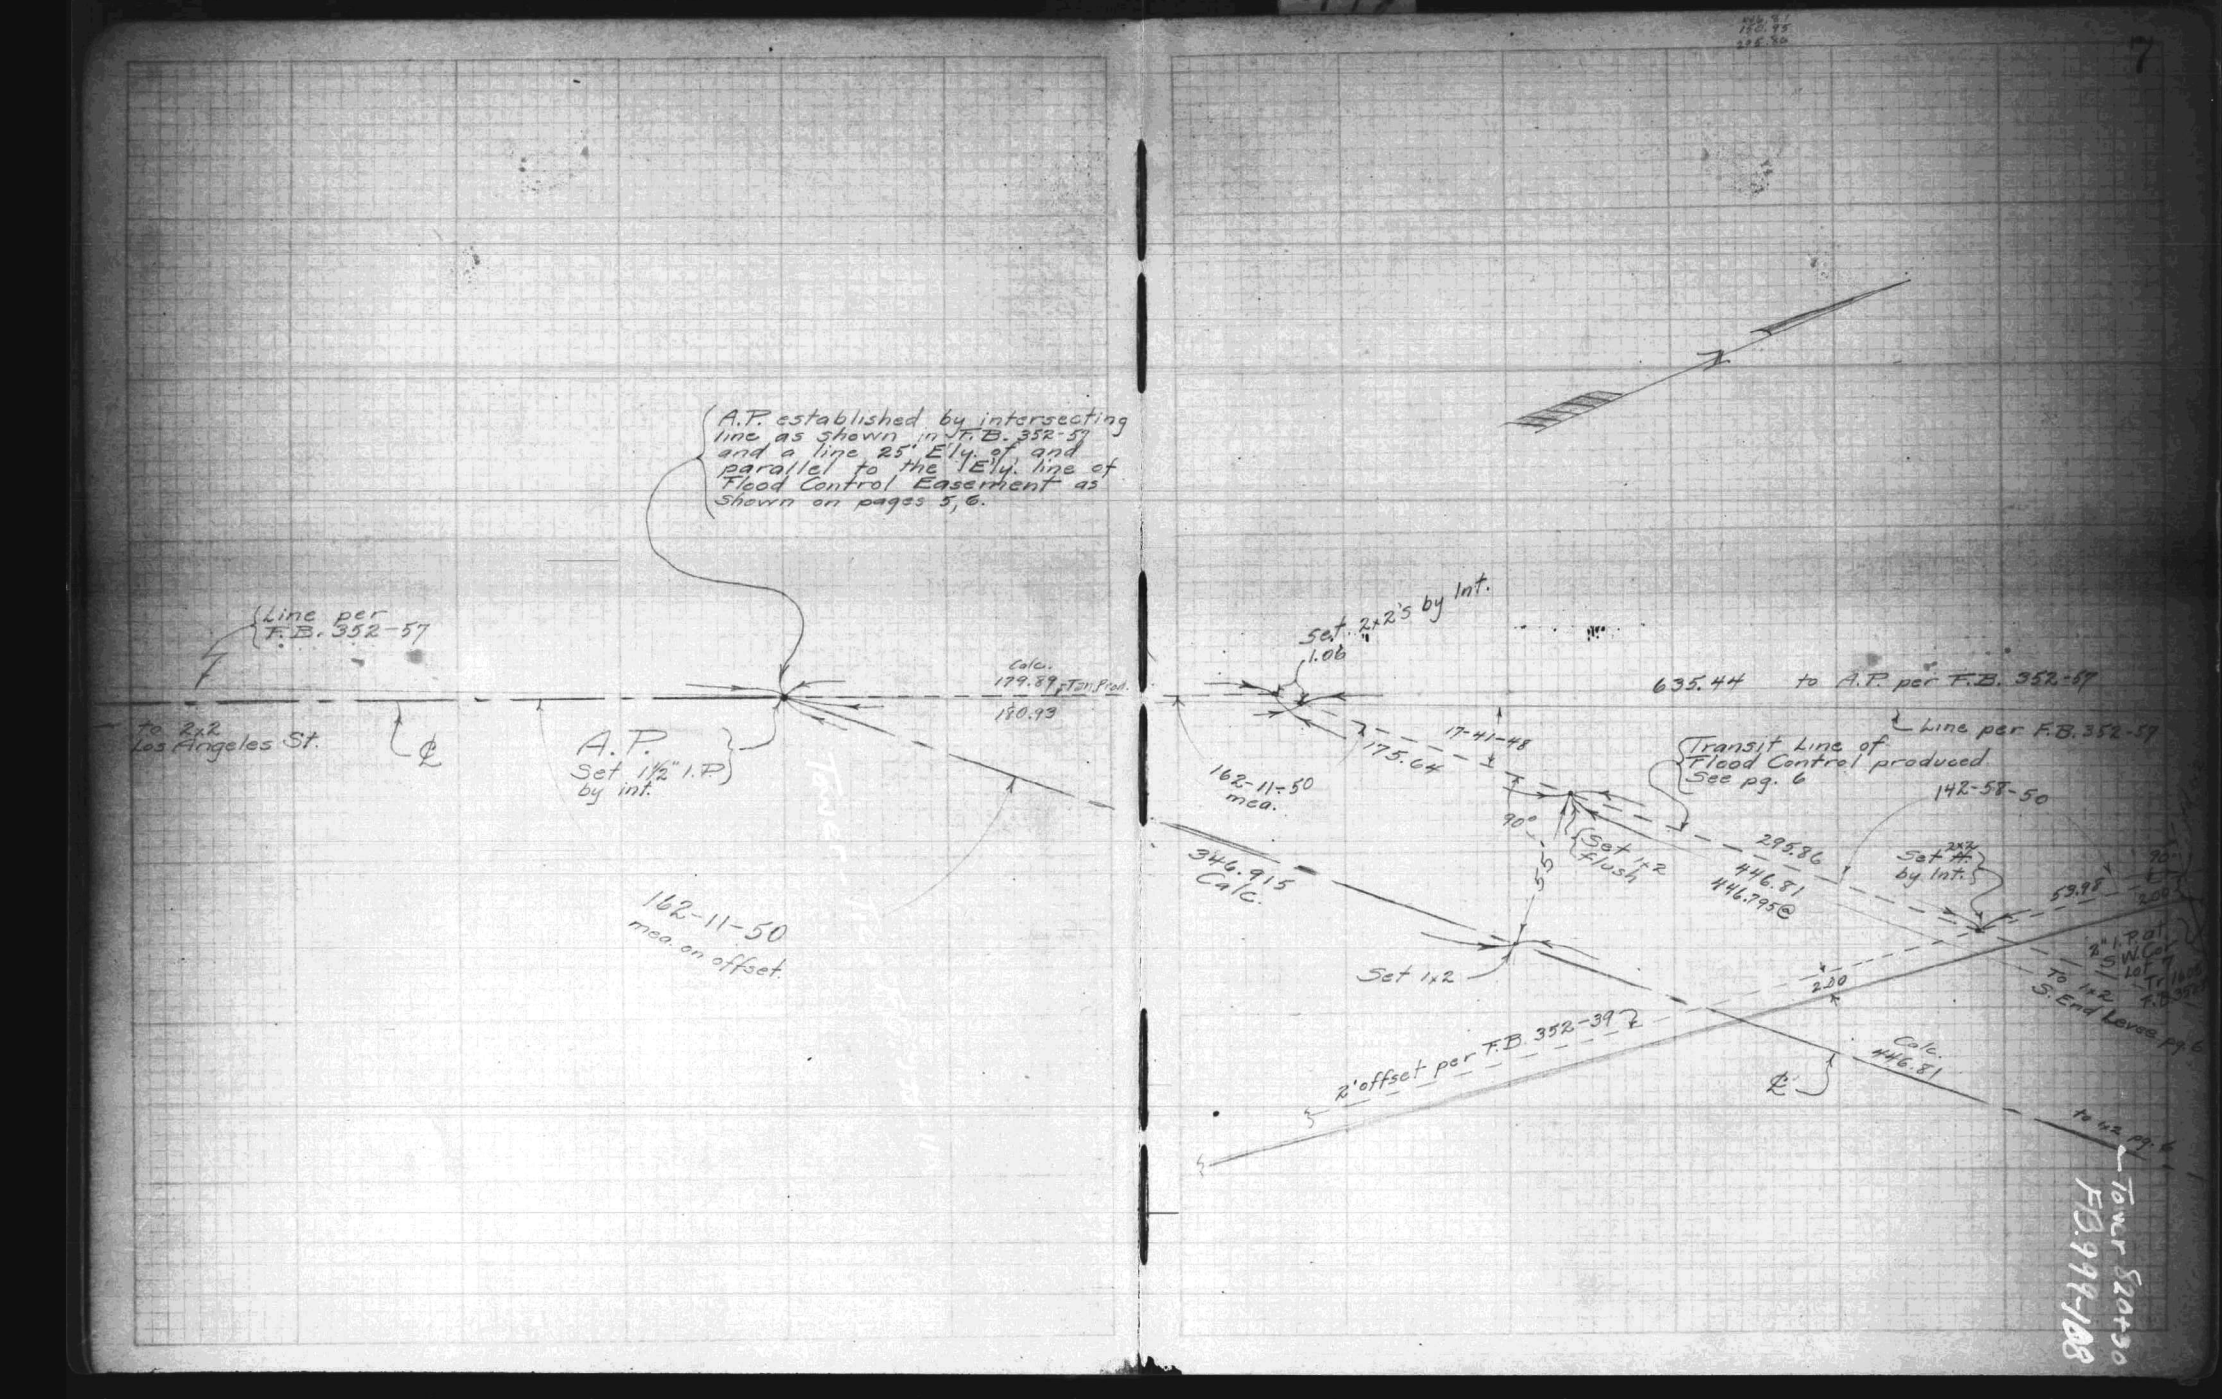

F.B. 987-58

Bur.Pow.&Li.
418
WS.46-C-4

F.B. 987-59

(870.265 @ 83°)
870.29

(501.305 @ 80°)
501.31

to 1x2 pg. 9

℄

P.O.T.
Set 1x2 flush

Tower 749+70
Ties F.B. 999-112

8

LOS ANGELES

25

25

Fd. 2x2 14" deep
F.B. 352-56

Set Rw 2x2 in
2" I.P. -12° down

(768.135 @ 78°)

1.35

768.135 to 1½" I.P. Agt

35.97

101.29

℄

Set 2x2
14" deep

Replaced with
Rw plug in ¾" I.P.
16" down

Ties 12-30-26
King

Copied F.B. 352-56

70-12.28
Meas.

Replaced 2x2
Ck. Tow. 246 D1
with Rw 2x2 in
¾" I.P. 19" down

Ties = F.B. 999-111

ST

to N. at 2' offset
F.B. 352-38

F.B. 987-60

Bur. Pow. & Li.

F.B. 987-61

419

W3.42-E-4

5/20/34 9

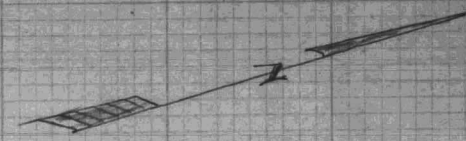

(325.31 @ 86°)
325.33

(565.28 @ 84°)
565.30

to 2x8 pg. 10

℄

P.O.T. Set 1x2 flush

Tower 178+10 Tie 3 FB. 987-114

(667.98 @ 84°)
668.005

Set 1"x4" T. Pole

Q 12.8

6.0'

5'-25'

(Set 5"x T. 6.0' Gum tree

P.O.T. Set 1x2 flush

℄

P.O.T. Set 1x2 flush

Tower 175+70 Tie 3 FB. 993-113

to 1x2 pg. 8

Tower 172+70 Tie 3 FB. 993-113

F.B. 987-62

Bur. Pow. & Li.

419

F.B. 987-63

10

NOTE — 5/22/34
See F.B. 352-37 for survey of Holt Ave and P.E. Ry.

8/2/35 - Tie to P.E. Ry. Switches and Culvert made. W.C.M.

Tower 76+10
Ties F.B. 995-115

Tower 76+60
Ties F.B. 995-114

ST ALBANS SPUR

PACIFIC ELECTRIC RY. TRACKS

HOLT AVE

WEST

RAMONA

FRANCISQUITO ST

BLVD

(721.08 @ 84°)
721.11

(995.45 @ 86°)
995.50

P.O.T. Set 1x2 flush

P.O.T. Set 2x2 flush

See Bal. Opp. Page

to 2" I.P. pg. 11

to 1x2 pg. 9

Set L+T by int.

(Fd. S+T F.B. 352-56)

(Fd. S+T F.B. 352-37)

(115.50 @ 82°)

115.50

1.475

11.12

5.10

6.95

6.22

55-51-30 mea.

71.875 mea.

55-44-30 mea.

838+15.86

471.1 mea.

Set L+T

3.36 Corrugated Iron Pipes

Inner edge rail 3

(COVINA-SAN DIMAS LINE)

To See F.B. 352-37

Line Correction (See opp. Page)

West

P.E. Ry

Detail Insert

Ramona

Francisquito Ave.

Blvd.

St.

50.77

46.73

35.85

68.73

111.75

76.35

111.75

0.135

1.485

0.115

0.08

Set Rail 2x2 in 2'I.P.

Set Rail 2x2 in 2'I.P.

Set Rail 2x2 in 2'I.P.

Note - Made careful check of angle points P.11+7 and of the line between, found point at ℄ of N. Ramona Blvd. off as shown and pts. in Ry R/W off correspondingly. All other points on this tangent o.k. Made changes as shown above and put in pipes & Surface Tie. This line change will affect the line to and of pts. shown opp. P.

King
11-3-36

F.B. 987-64

Bur. Pow. & Lit

F.B. 987-65

5/24/34
A.D. Miller
Gibbs
Eastman
Schuerman
Platte

copied F.B 352-36
164-55-13

82-27-36½

164-55-00
F.B. 352-36

82-27-36½

Fd 2" I.P.
F.B. 352-36

to 2" I.P.
S.E. Cor. Tr. #1010 4
500. F.B. 352-36

meas
175-49-00

60.52

93-21-00

To 1+2
pg. 12

Tower
Ties F.B. 999 .116

A.P. 2" I.P. 10" deep
Set by J.J. Orcutt: 5/15/34

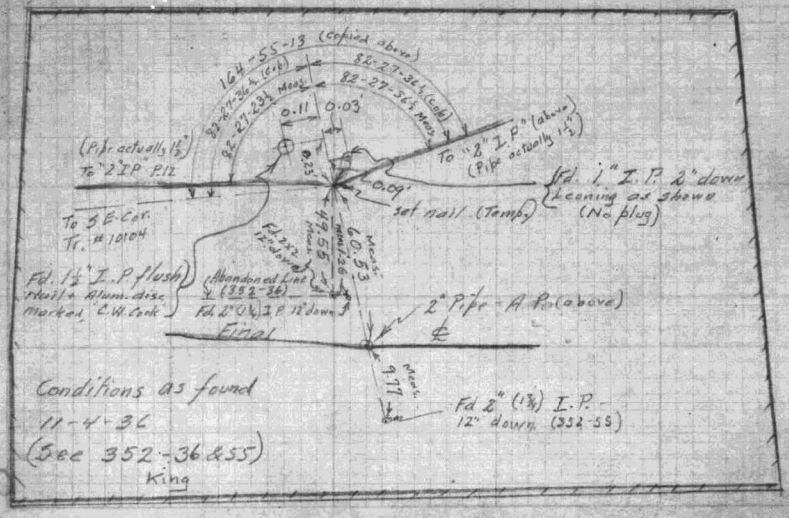

Conditions as found
11-4-36
(See 352-36 & 55)
King

11

W. ARIZONA AVE.

Copied F.B 352-37
66-45-22

N. 90° E.

Copied F.B. 352-37
1002.08

Fd. ½" I.P.
per F.B. 352-37

to L+T pg. 10

(1186.02 @ 82°)
1186.05

to L+T pg. 10

℄

Tower 753+30
F.B. 999-116
Ties

F.B. 987-66

Bur. Pow. & Li.
410
W 24-C-5

F.B. 987-67

TRACT

10104
M.B. 142-62-64

SEXTON ST.

CHELSFIELD ST.

See F.B. 352-36 to 2" I.P. at N.E. Cor. Barnes Ave

{fd ½" I.P. Tr. 10104 Sheet 2 See F.B. 352-36

to 2" I.P. Pg. 11

99-28-27

61.05

(378.79 @ 82°)
378.80

(406.11 @ 82')
405.12

(1132.72 @ 82°)
1132.51

to 2"I.P. pg. 11

to R×R pg. 13

{fd. R×R flush

℄

℄

fd. R×R 10" deep on North Line Chelsfield St. produced to ℄

{fd. I×R flush

Tower Station Tie's F.B. 999-118

Tower Station Tie's F.B. 999-118

F.B. 987-68

F.B. 987-69

418

13

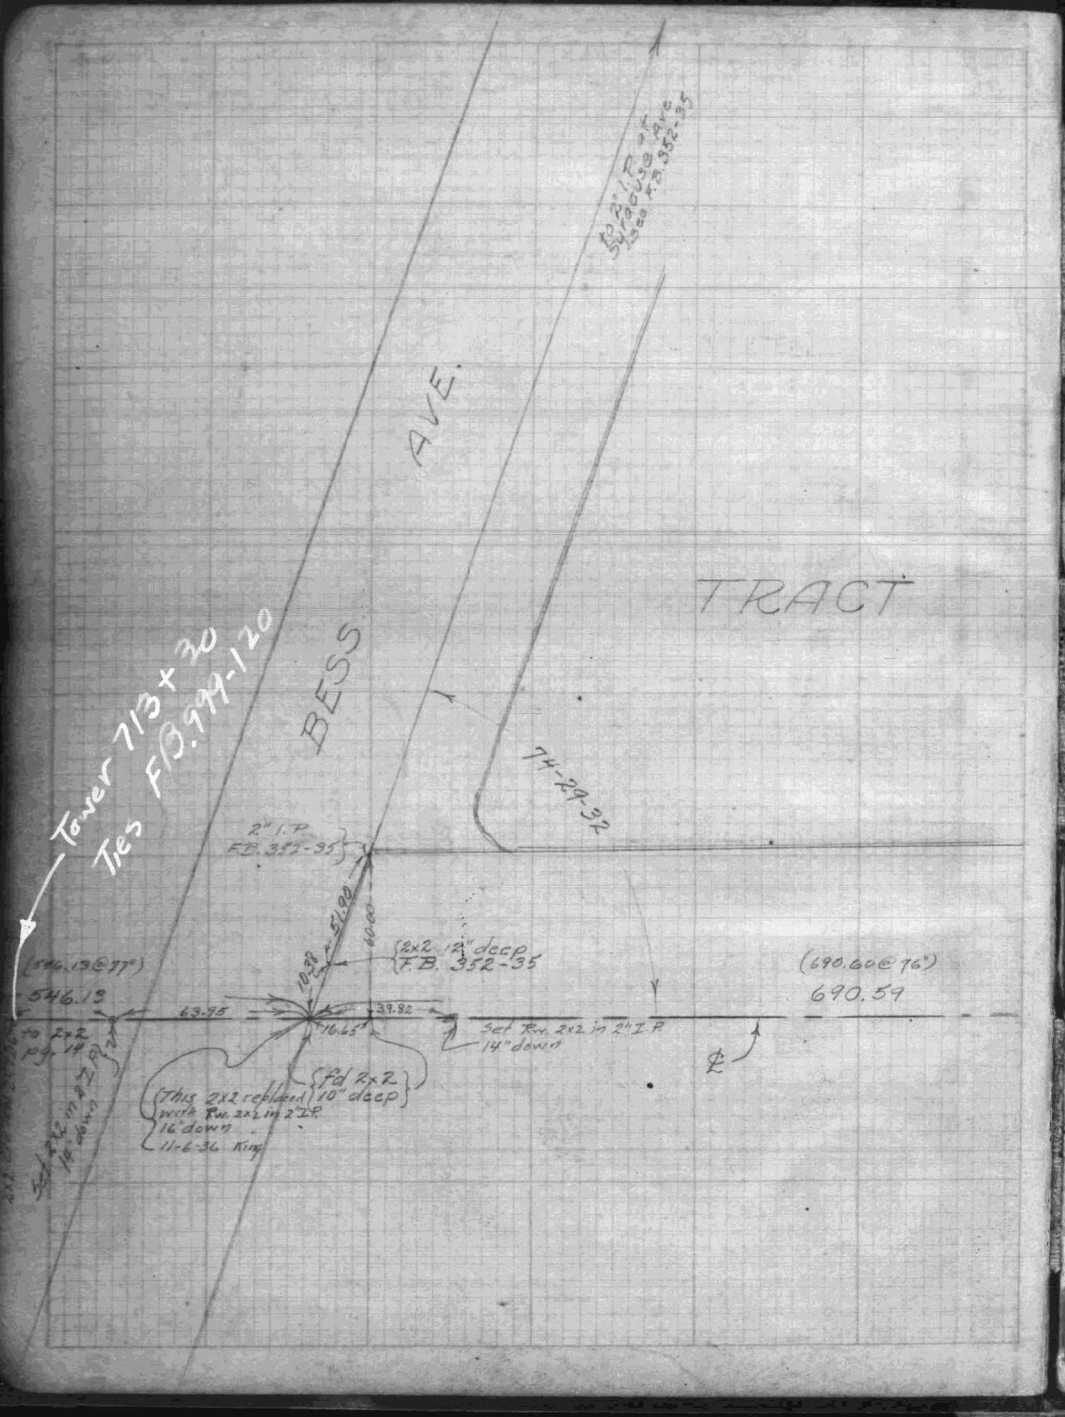

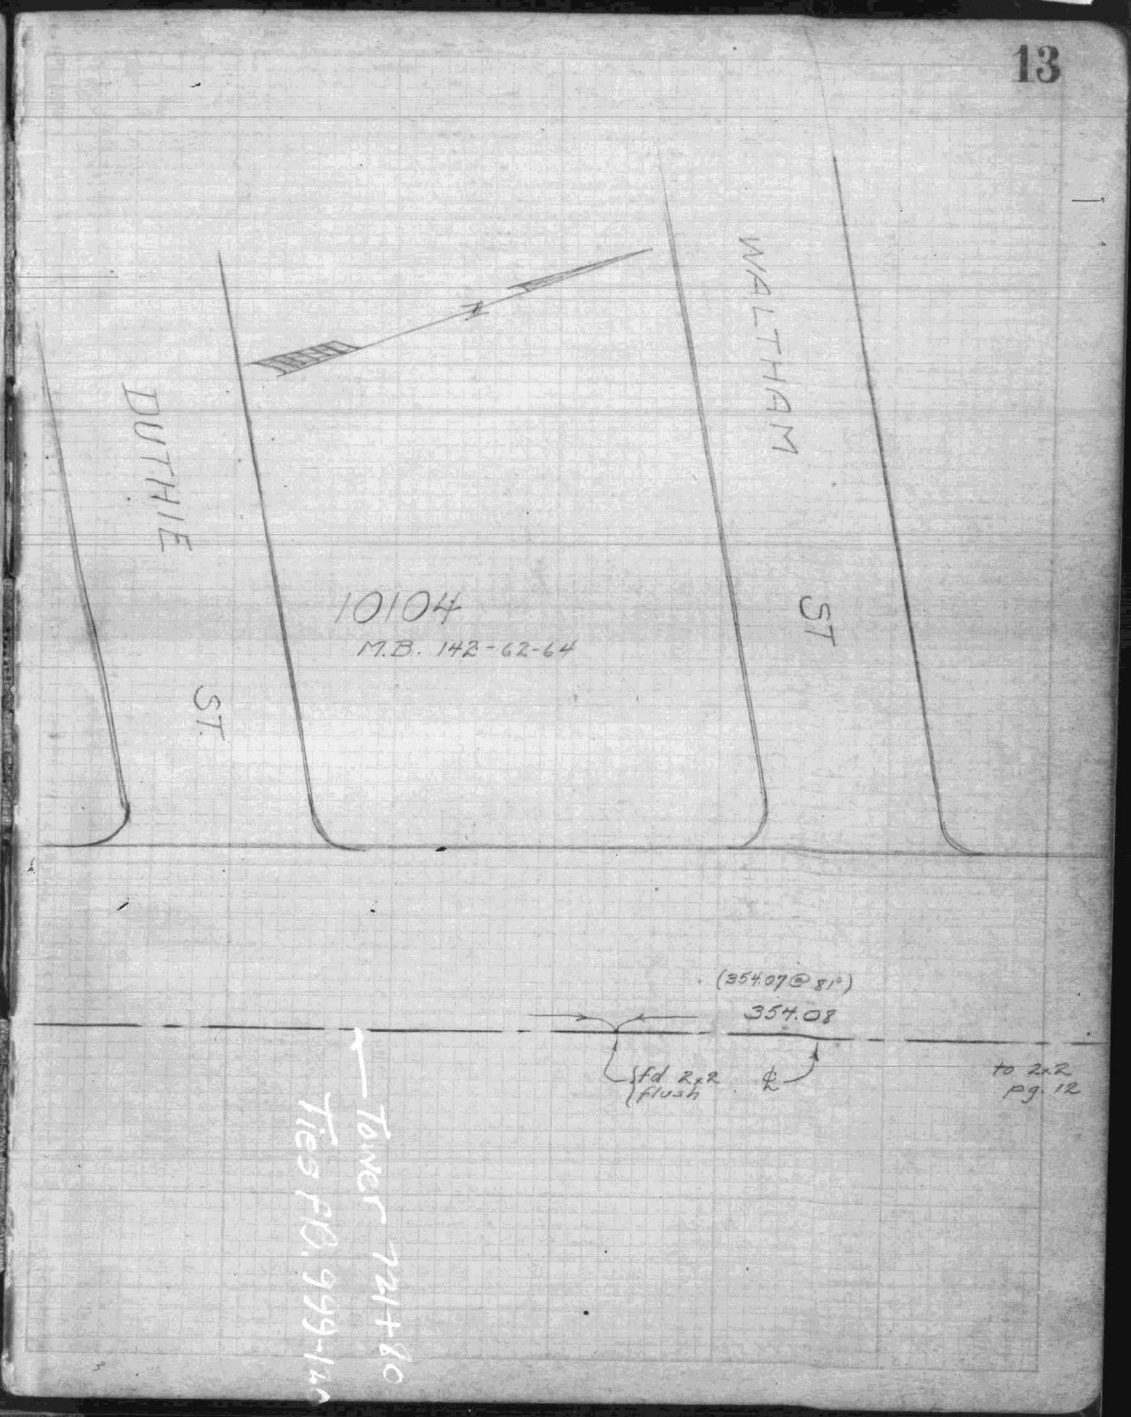

F.B. 987-70

F.B. 987-71

418

14

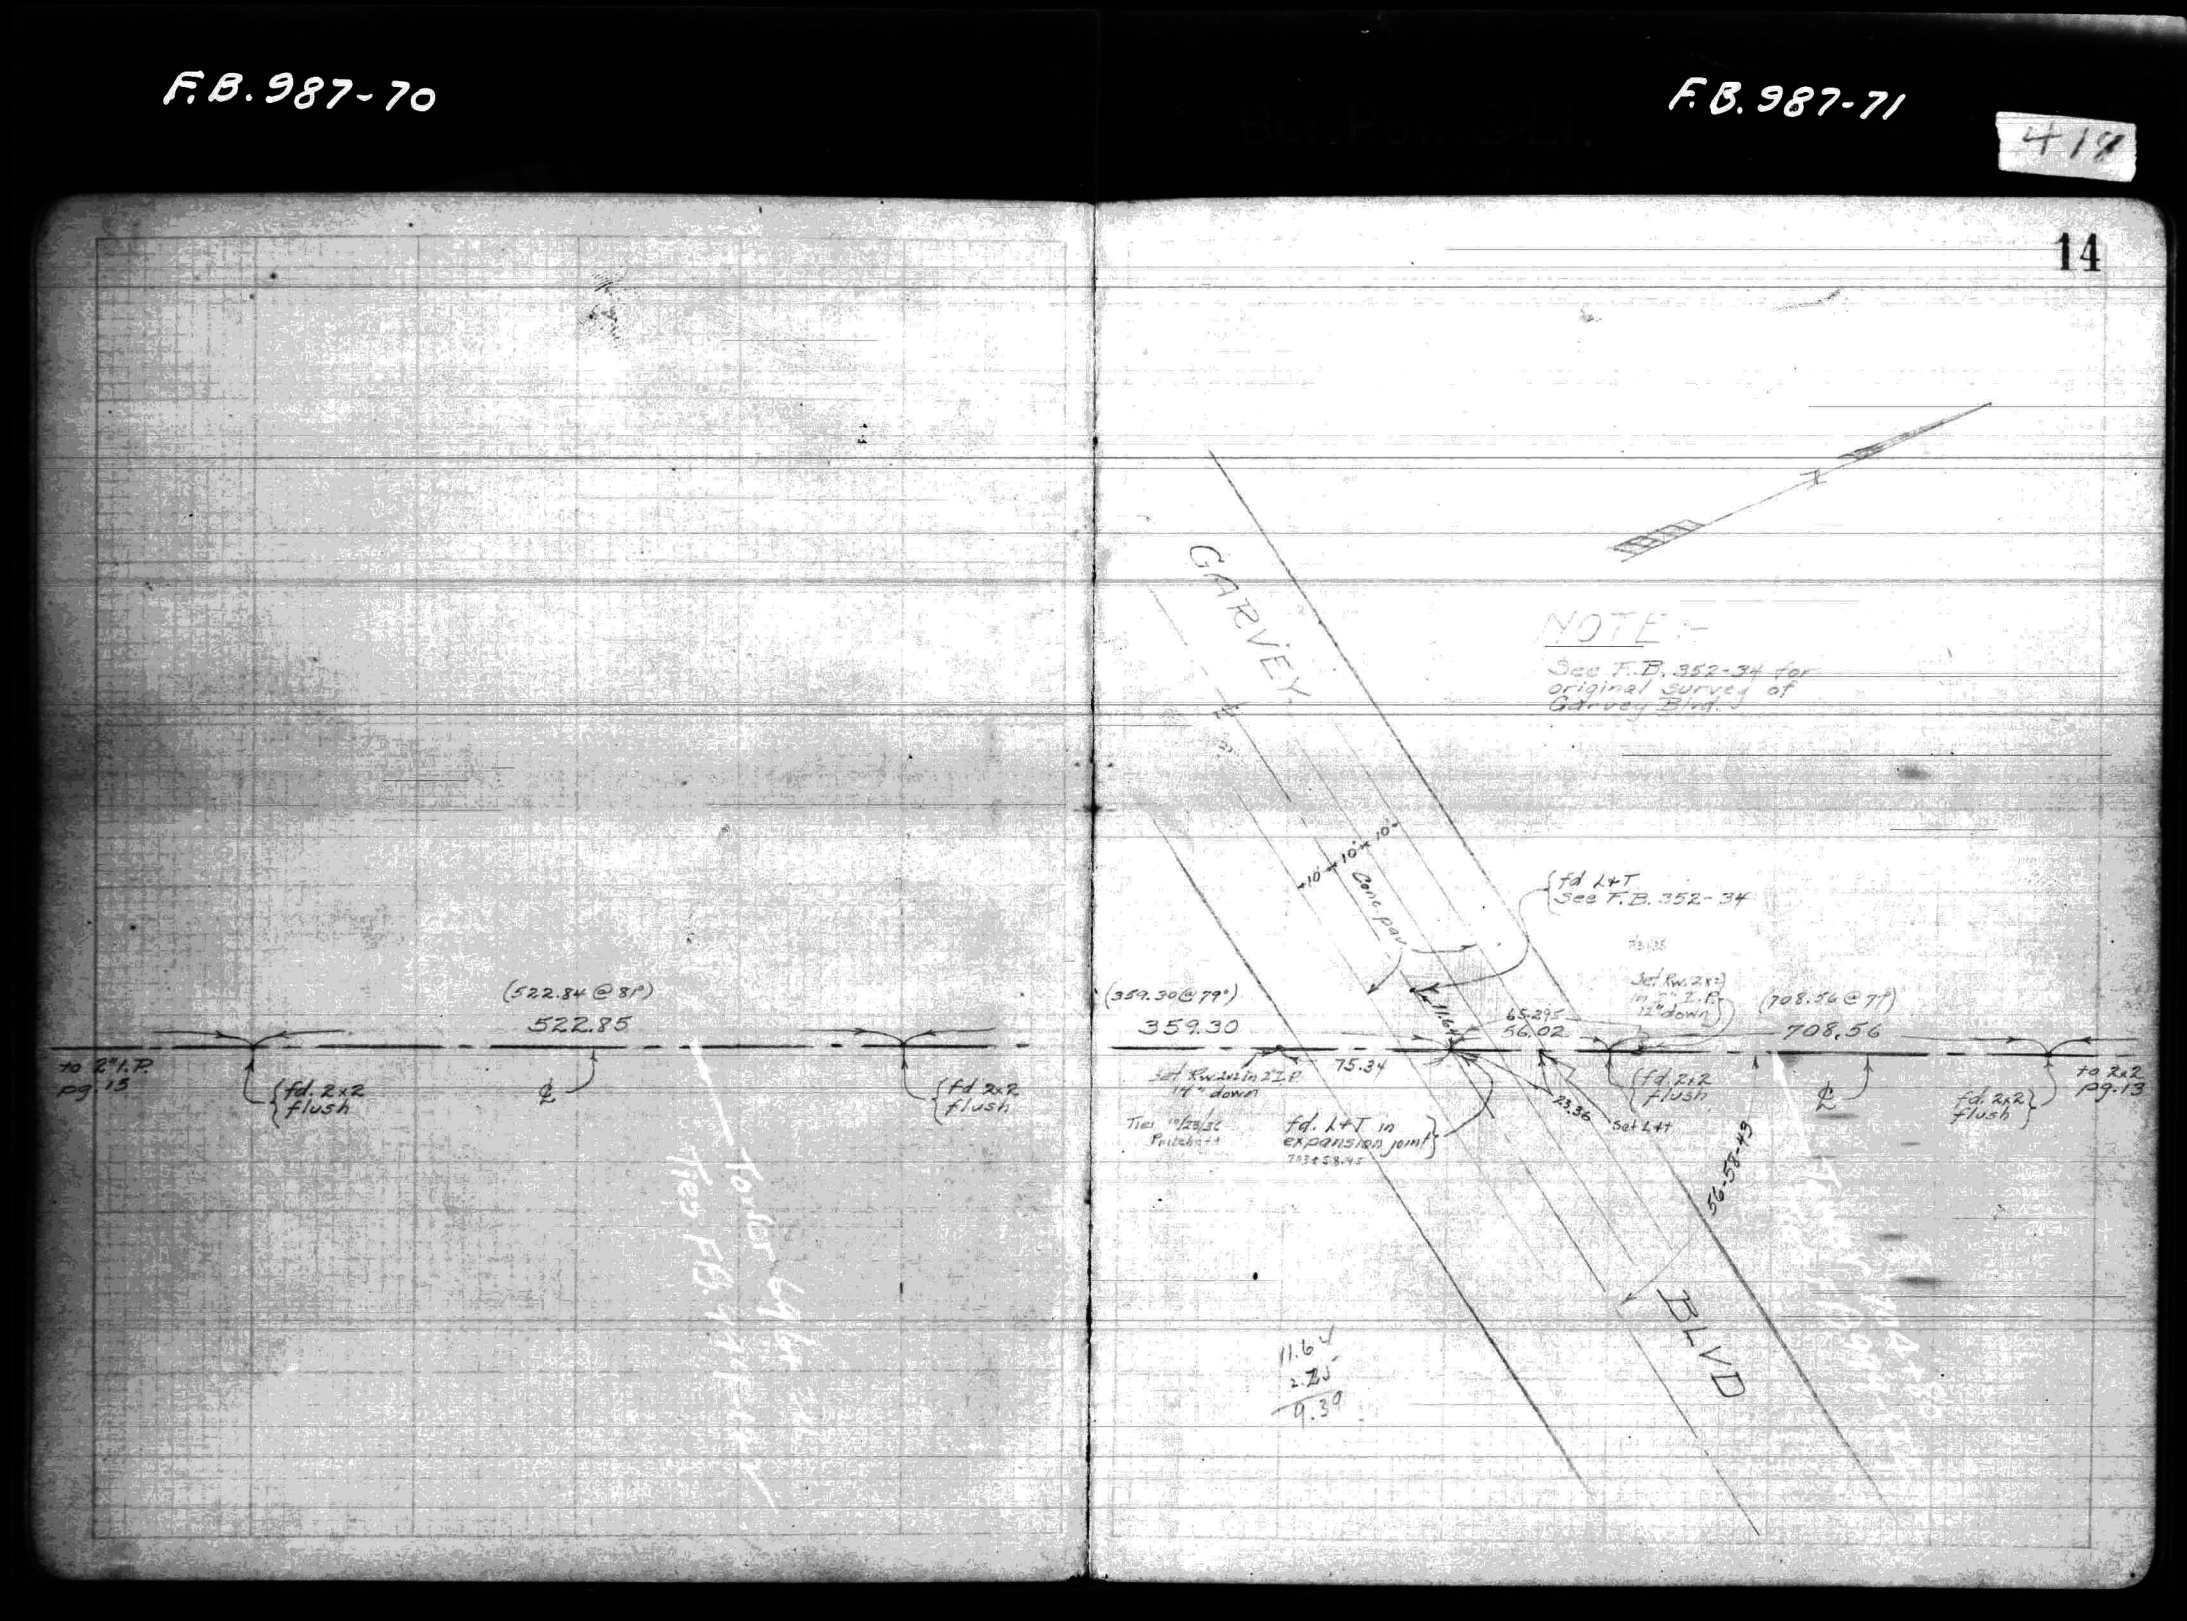

F.B. 987-72

F.B. 987-73

418

15

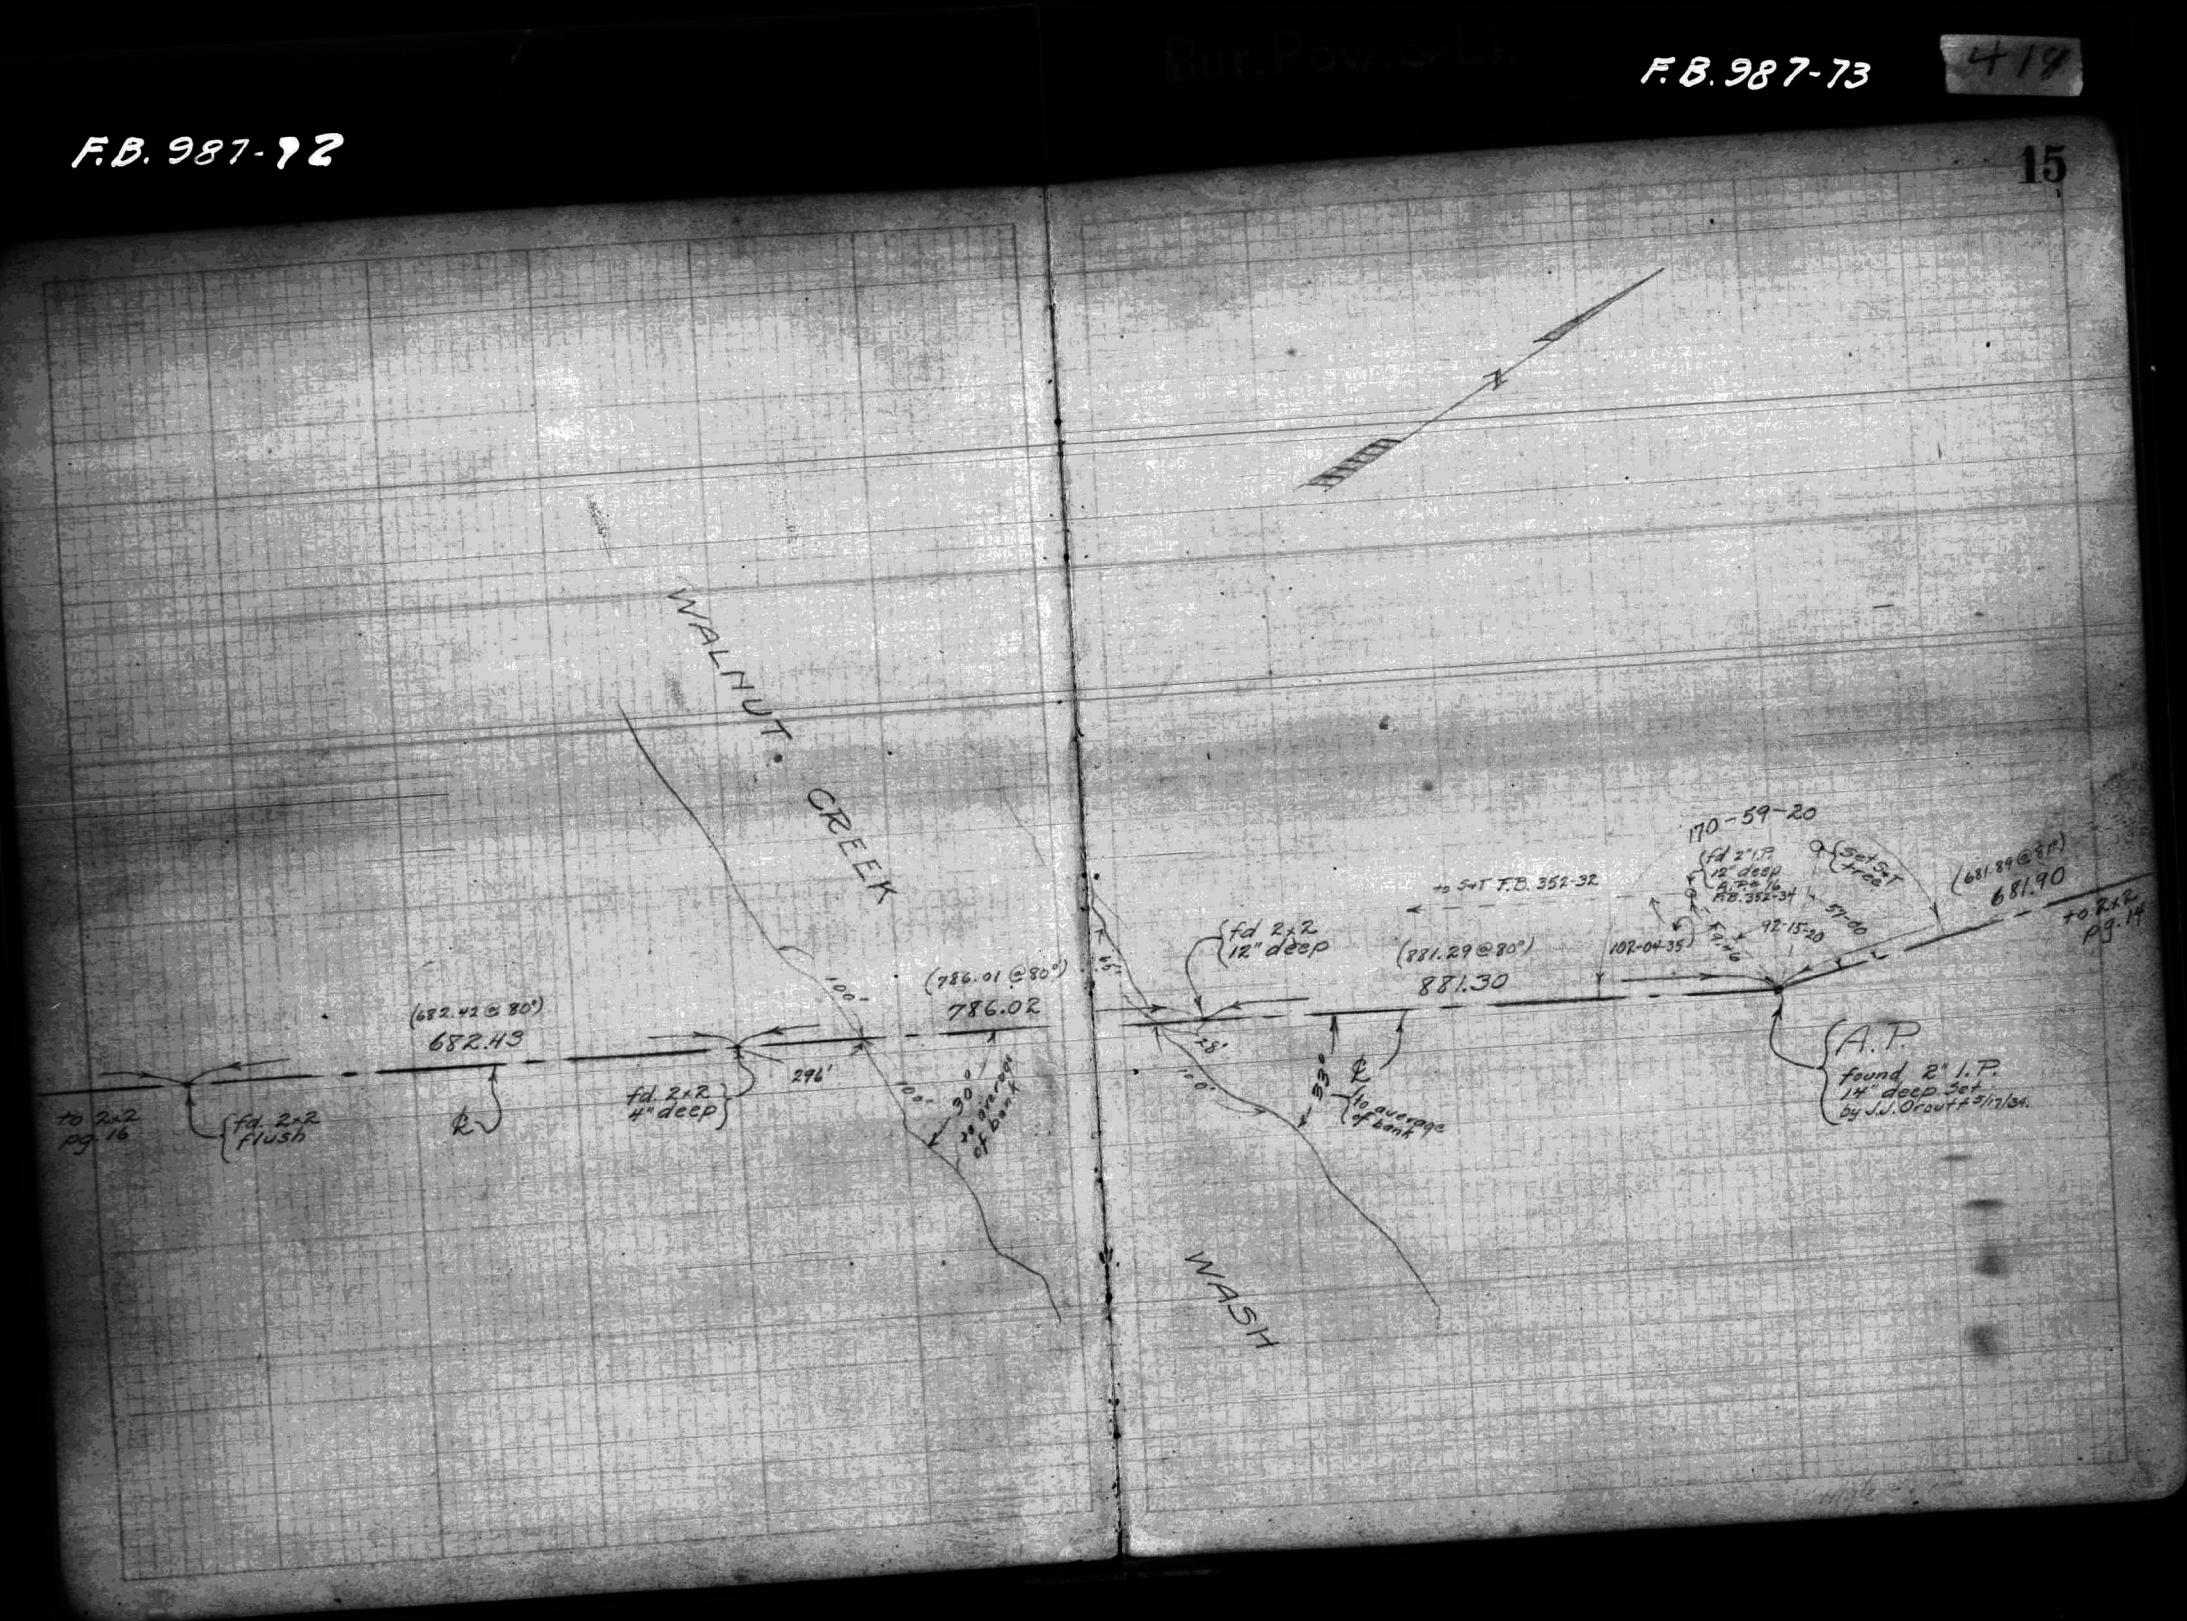

F.B.987-74

Bur. Pow & Li. F.B. 987-75

418

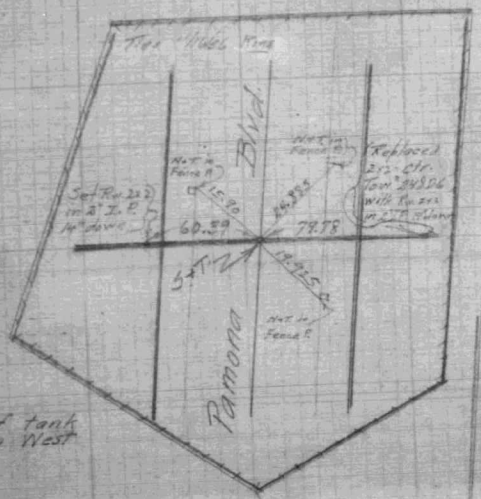

5¼ top edge of tank at Hog Ranch on West bank of river

Fd 5x7 F.B. 352-32

POMONA BLVD.

Tan 2000 ± road

114-51-30

(755.025 @ 70°)

755.00

55.655

18.89

Fd 2x2 flush

94-59-27

P 2x14 2" I.P. 2" deep

31.49

40

770.54

460

308.0

39.97

fd. 5x7

NT flume

Set 1x2 toe slope

157-26-20

Set 2x2 flush

3.40 above I.P.

68.5

340

400

169.0

275.20

279.0

277.7

280.2

277.80

Set 2x2 3' above toe slope

290.98

18.0

290.0

229.0

290.2

287.70

Toe of bank

Top of bank

All offsets are 90° from ℄

NOTE.—

See F.B. 352-32 for original survey of Pomona Blvd. and Southern Pacific Ry.

SOUTHERN PACIFIC RY

(75.68 @ 79°)

75.68

See insert Off. P.

(221.49 @ 79°)

221.49

fd 2x2 flush

Set Rw 2x2 in 2" I.P. 14" down

58.195

6.67

4.99

67.635

(612.29 @ 79°)

612.29

Set Rw plug in 3/4" I.P. 14" down on rail split

Set Rw 2x2 in 2" I.P. 14" down

to 2x2 pg. 15

fd 2x2 flush

7/31/36

Removed 2x2 and set 2x2 at Tower Location 0.87' South

T = 121 Sta 656+10.00

JJO

Note - Tower location later moved 5' E. to Sta. 656+15.

King 7/16/36

97°21'

Ties 10-22-36 Pentzbell

R = 1.5

F.B. 987-76

W 38.2-2

Bur. Pow. & Lt.

F.B. 987-77

W 38.2-2-1

418

17

5/29/34

A. Miller
A. Gibbs
H. Eastman
J. Schuerman
L. Florto

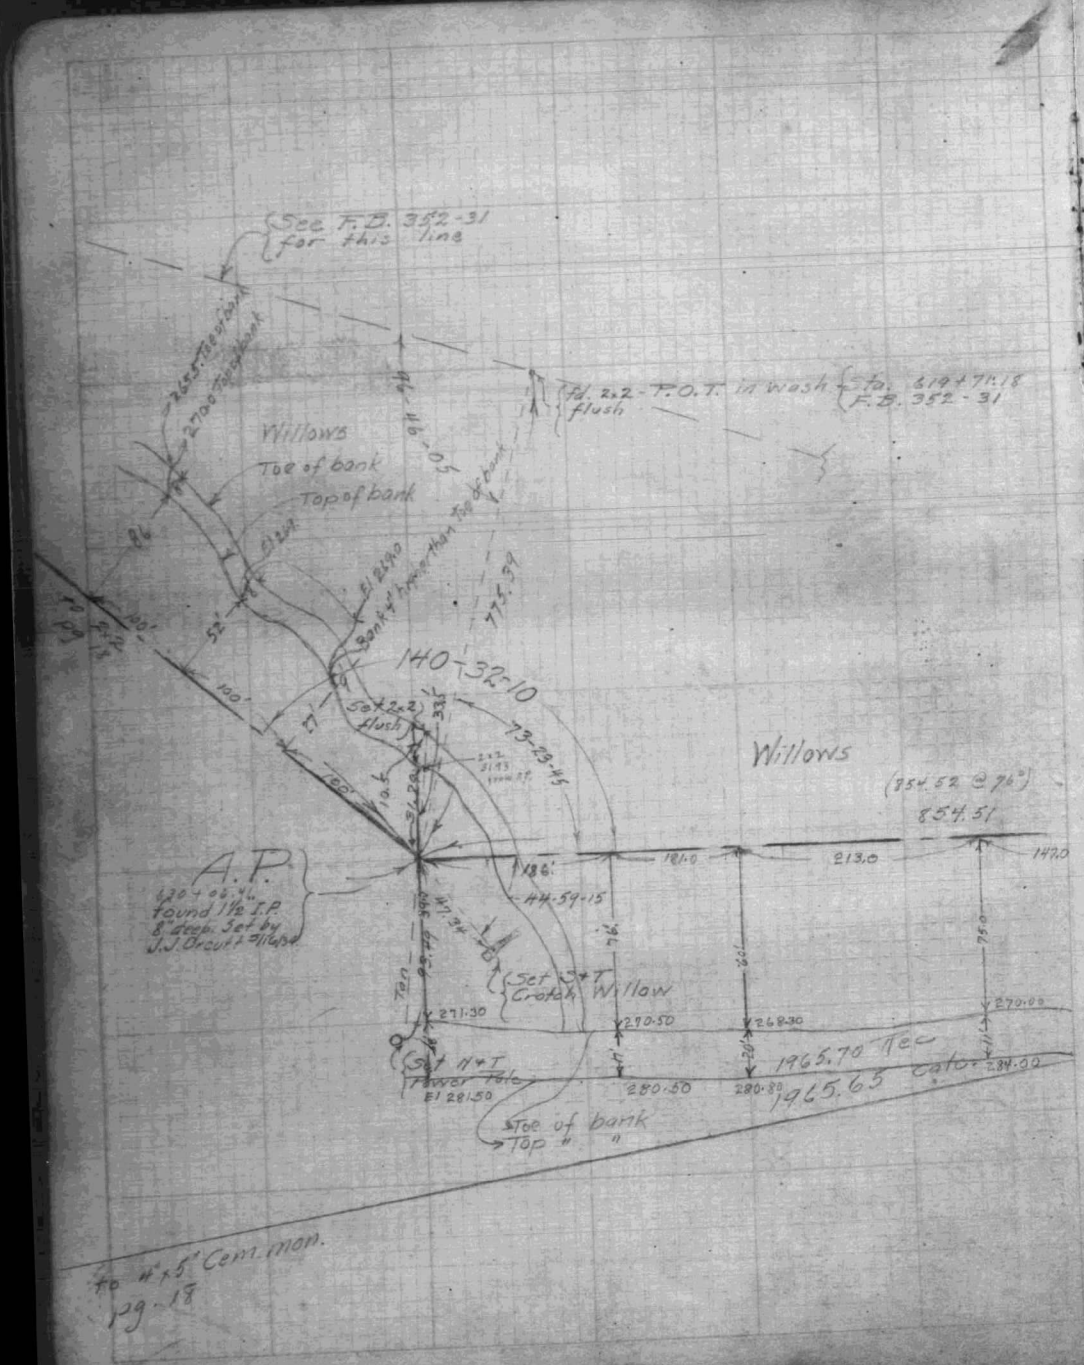

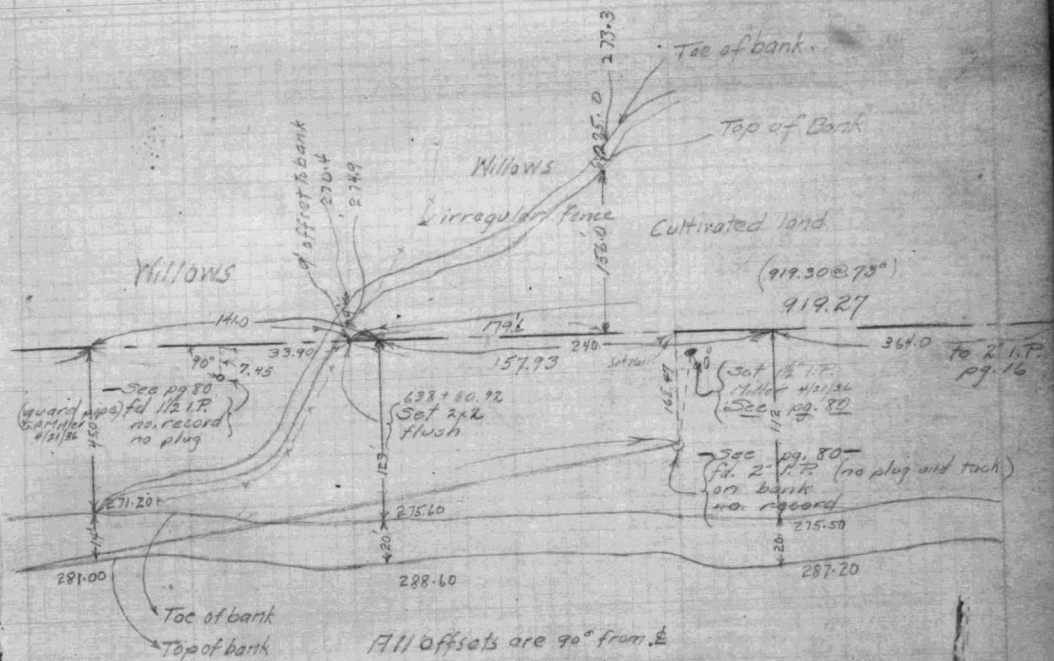

F.B. 987-78

Bur. Pow. & L.

F.B. 987-79

418

18

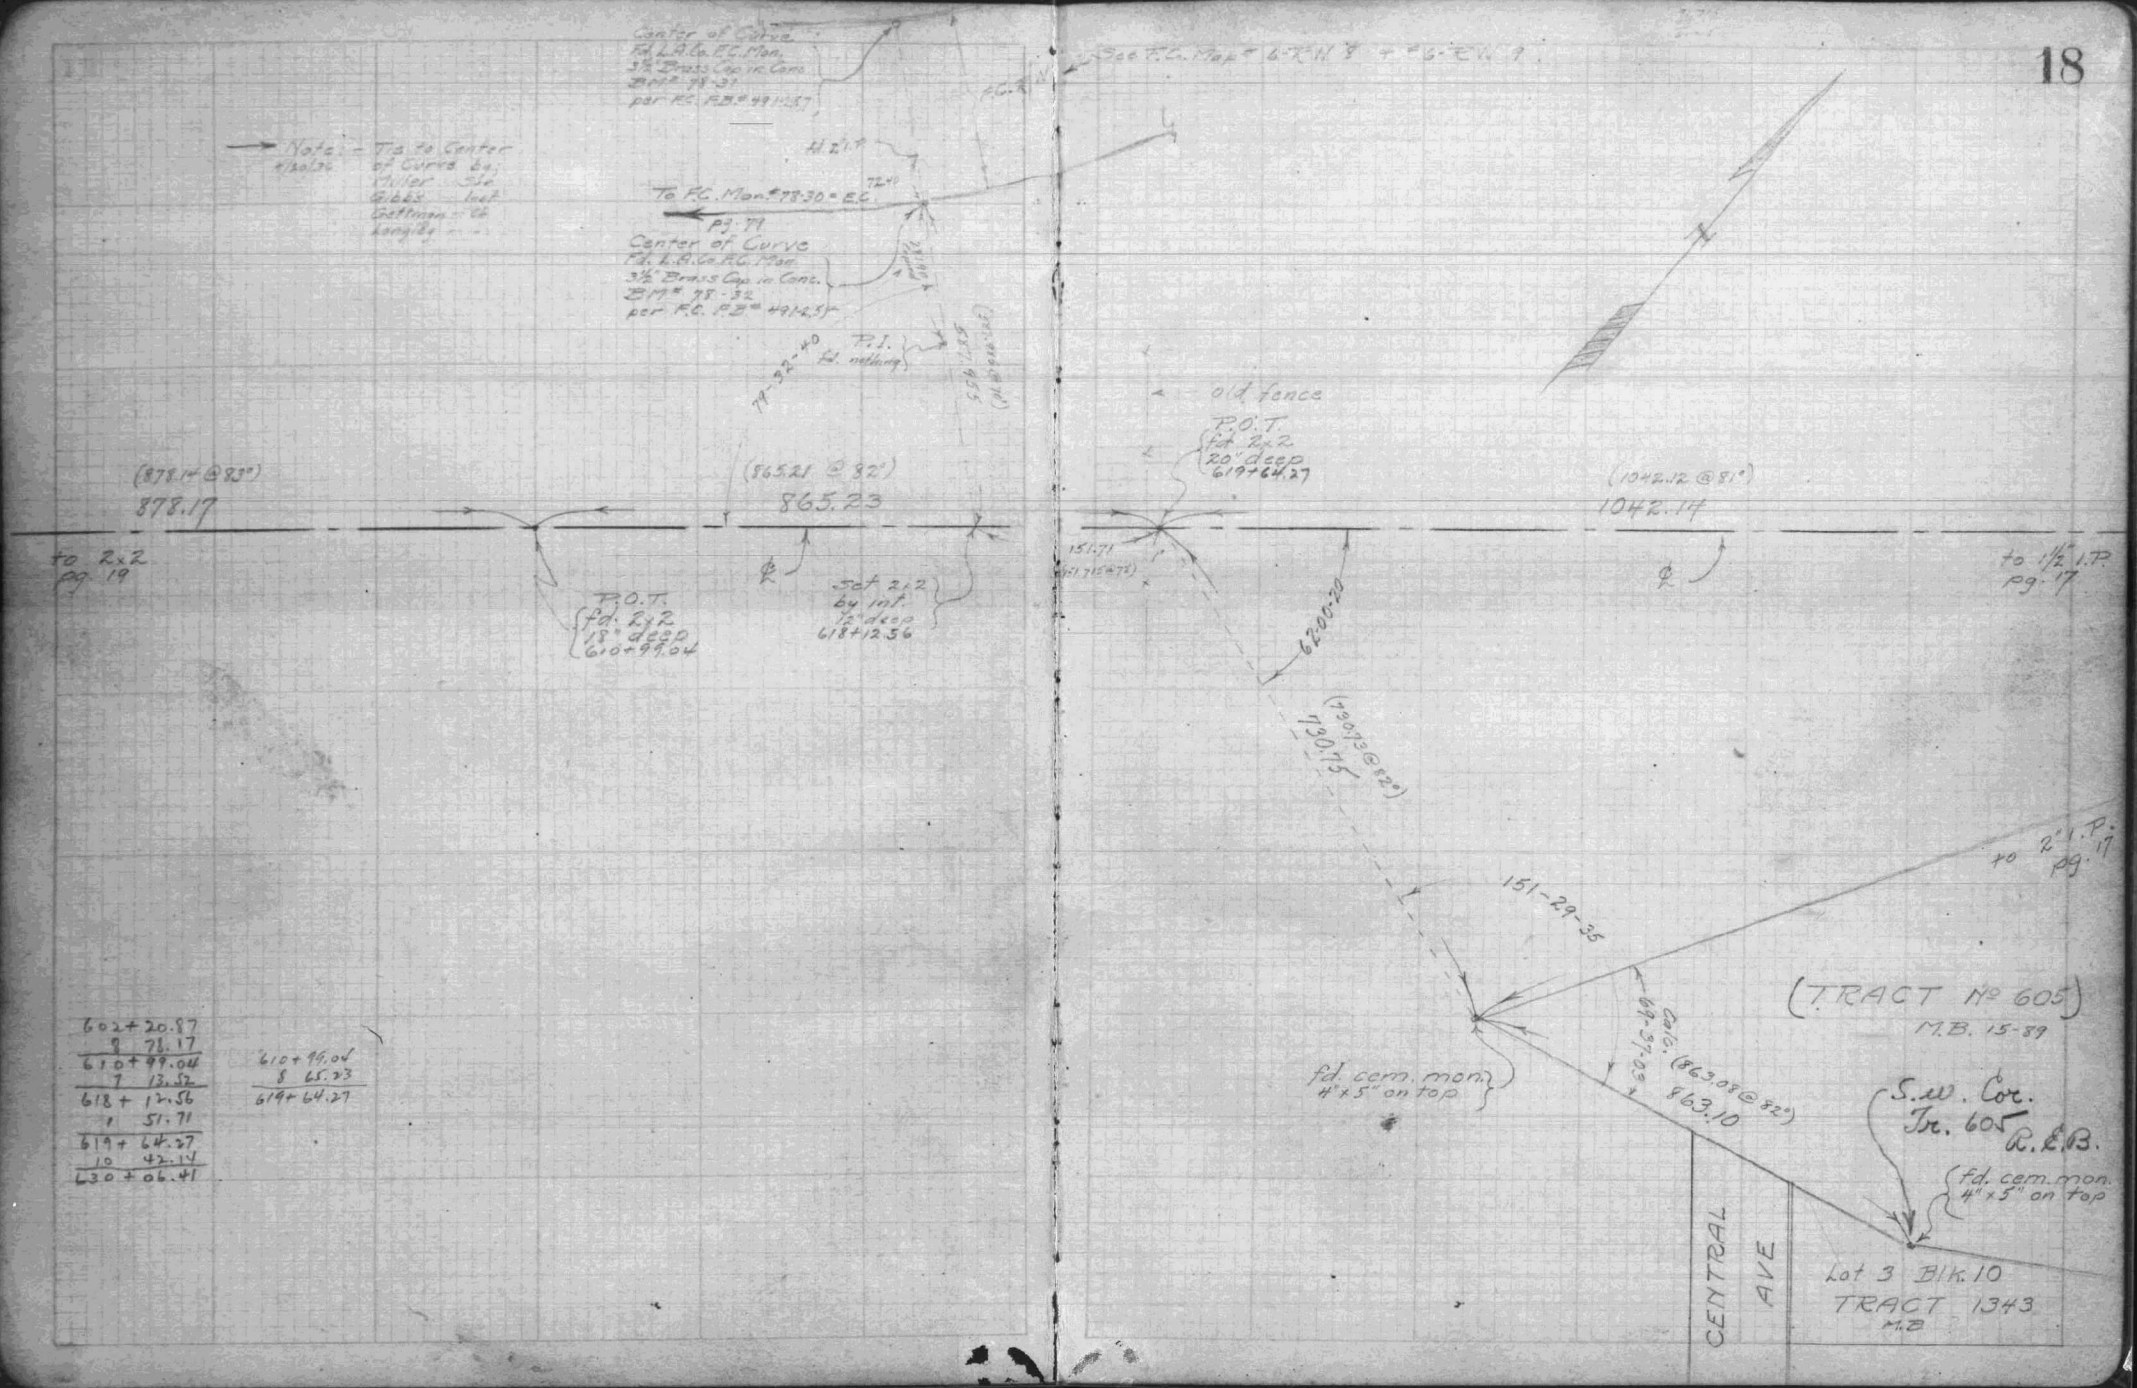

602+20.87	
9	78.17
610+99.04	
7	13.52
618+12.56	
1	51.71
619+64.27	
10	42.14
630+06.41	

610+99.04	
8	65.23
619+64.27	

F.B. 987-80

F.B. 987-81

418

19

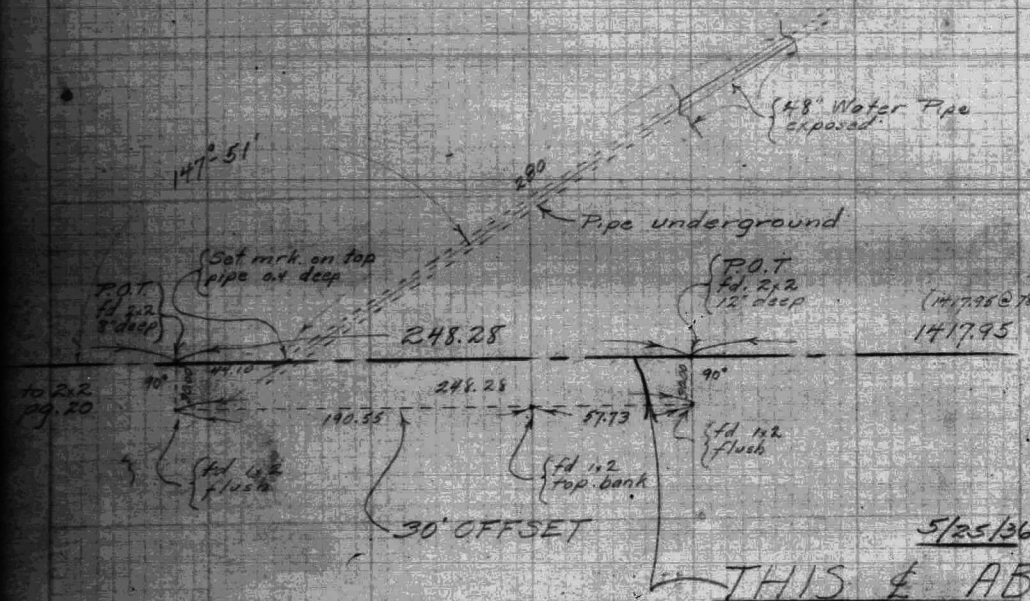

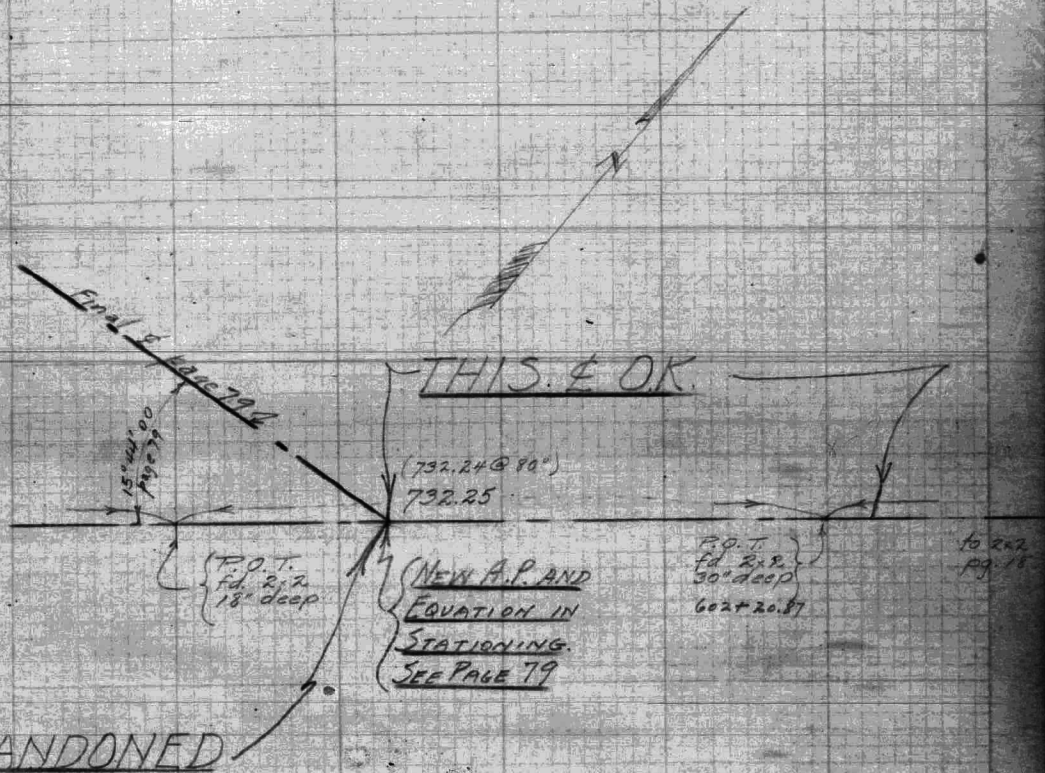

F.B. 987-82

F.B. 987-83

417

RELOCATION OF ℄ OF R/W

from

LONE HILL AVE

to

CENTRAL AVE.

(PAGES 23 TO 33 INCL.)

Surveyed 6/8/34 to 6/18/34 (pg 23 to 27 inc.) G.A. Miller — Sur.
" 6/20/34 to 7/9/34 (pg. 27 to 33 inc.) A. Gibbs — Asst.
H. Eastman — Chain
J. Schuerman — "
L. Fiatte — Axe

Previous ℄ in F.B. 359-14 to 20, 52, 43
Profile in F.B. 419-

23

Continued F.B. 359-43

Tower 1984-50
Tie-1984-50

℄ per F.B. 359-43

LONE HILL AVE

S+T F.M. in N leg of above Cmc T 29 R 3

fd 1½" I.P. 2' deep Map Sta 132+02.00 set by Orcutt

℄

75.00

67.52

79.89

81.06

27.47

61.46

159-54-10 mea.

Set F.M. in B. leg of above Cmc

fd S+T F.B. 359-43

Line per F.B. 337-43

Replaced by Kw. plug in ½" I.P. 10' distant with S+T at surface 9-18-36 o.a.a. Set 1½" I.P. flush by Yates, S.N.D.

Set Kw. plug in 2" I.P. 12" down

Set Kw. plug in 2" I.P. 12" down

30.53

℄

748.54

(748.54 @ 78°)

Tel. Pole G 4270 Y

46.5

60.

40.5

Tel. line

to R+R pg. 24

Tel. Pole G 4269 Y

90-02-06 Copied F.B. 359-43

LOT 18 MR. 60-E

LOT 37 MR. 60-E

SAN DIMAS

WASH

F.B. 987-84

F.B. 987-85

417

24

SAN DIMAS WASH

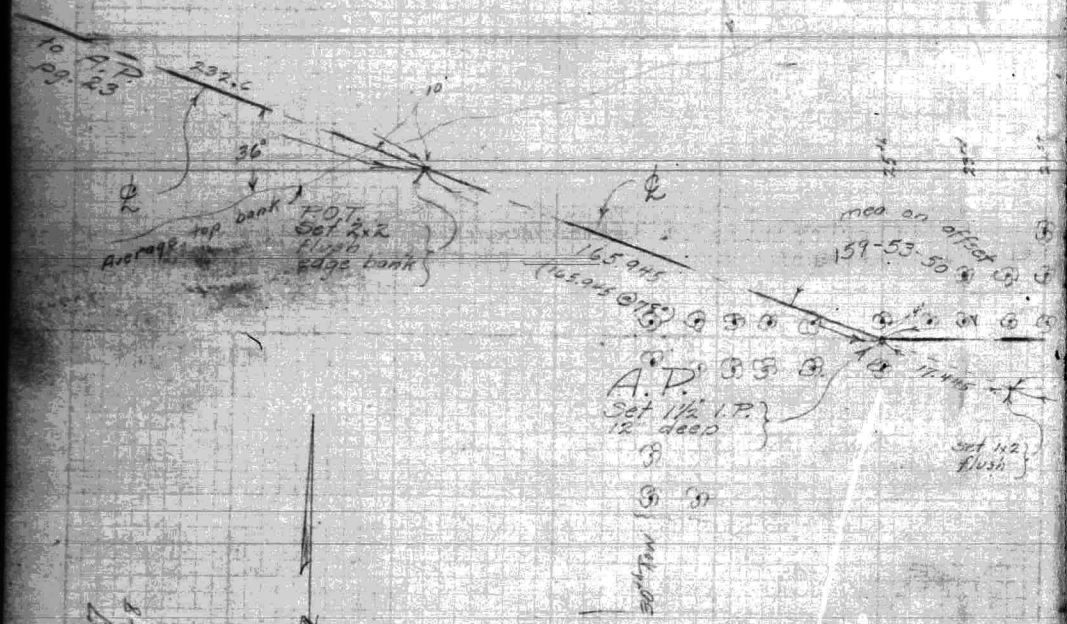

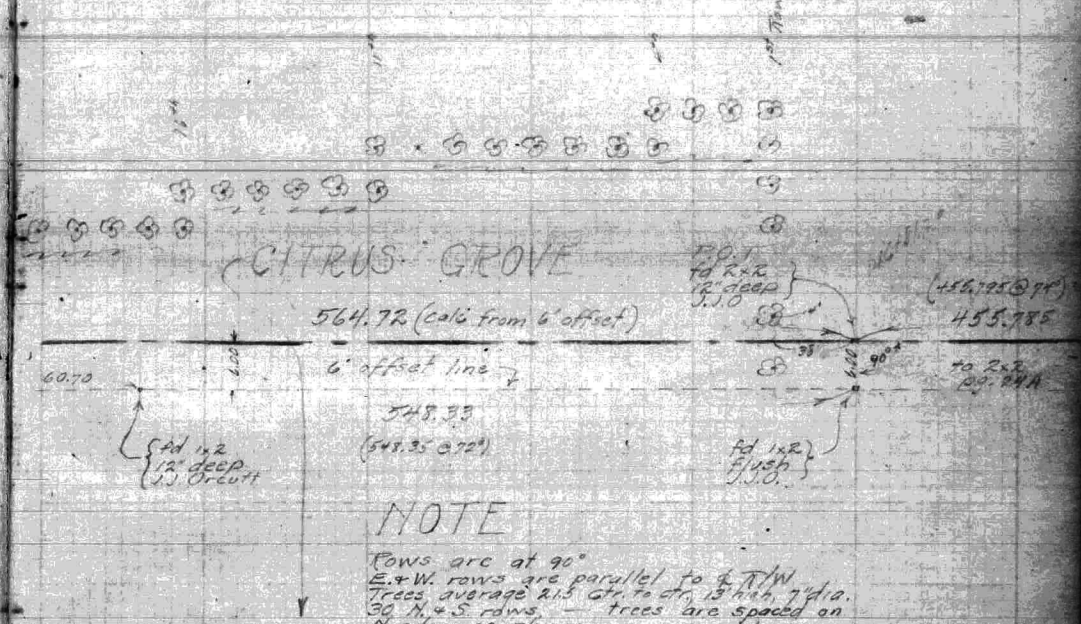

NOTE

Rows are at 90°
E. & W. rows are parallel to ℄ R/W
Trees average 21.5 Ctr. to Ctr, 13' high, 7" dia.
30 N. & S. rows. — trees are spaced on N. edge as shown.

LOT 37
M.R. 60-8

LOT 36
M.R. 60-8

Town of Glendora
Tract 6

F.B. 987-86

WS 49-C-3

Bur. Pow. & Li.

F.B. 987-87

418

24A

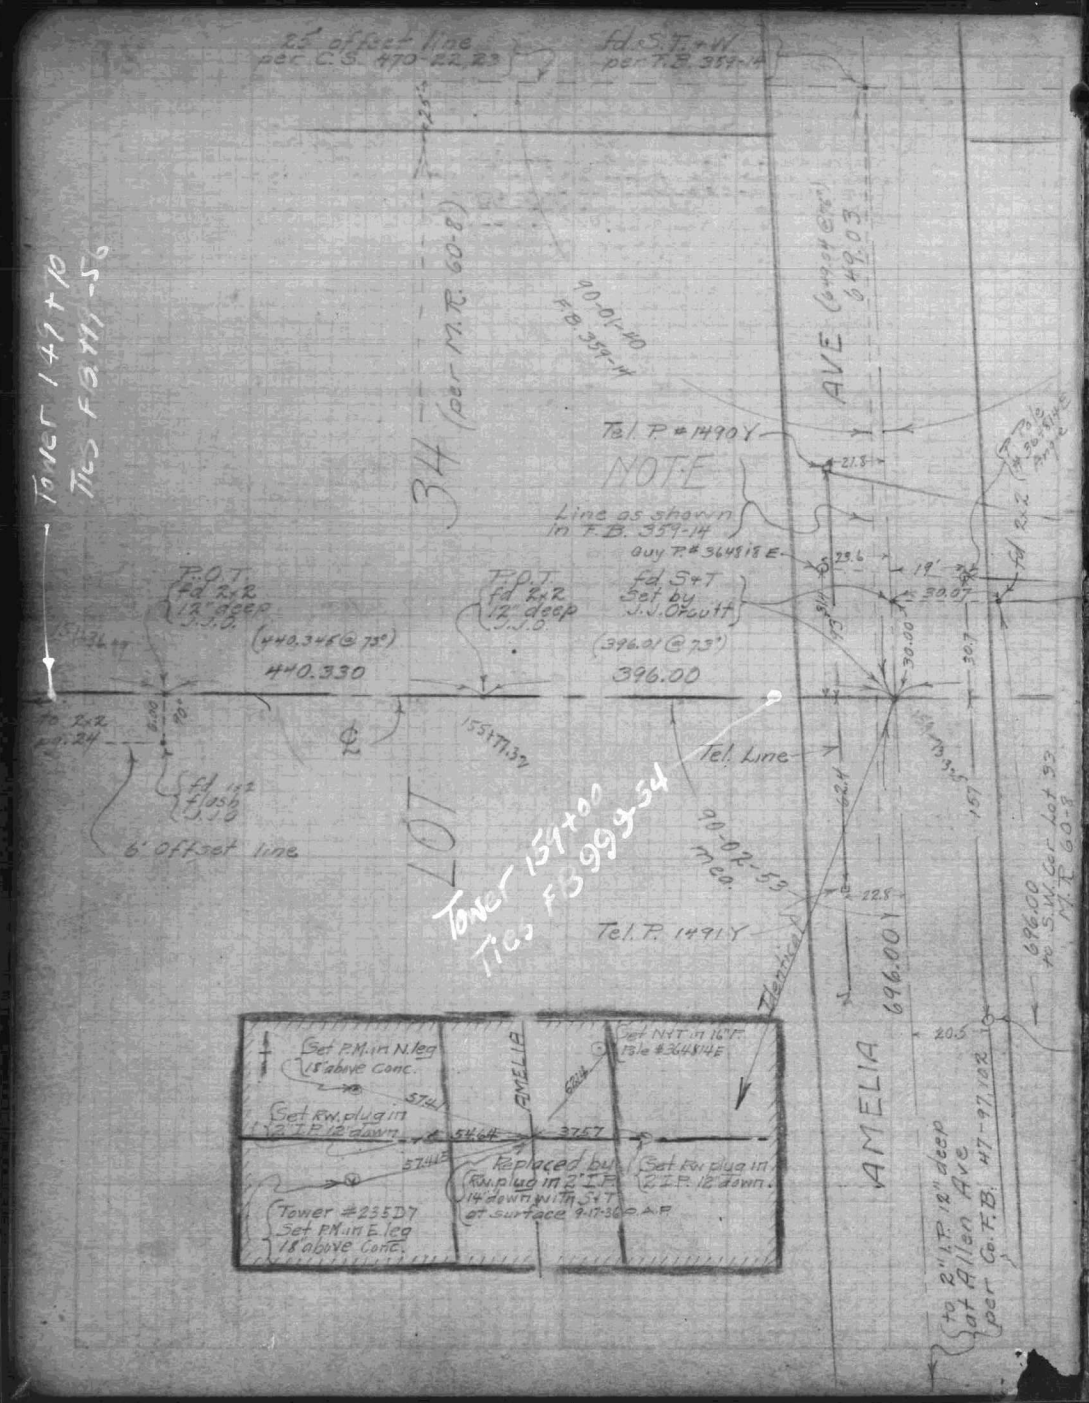

F.B. 987-88

F.B. 987-89

419

25

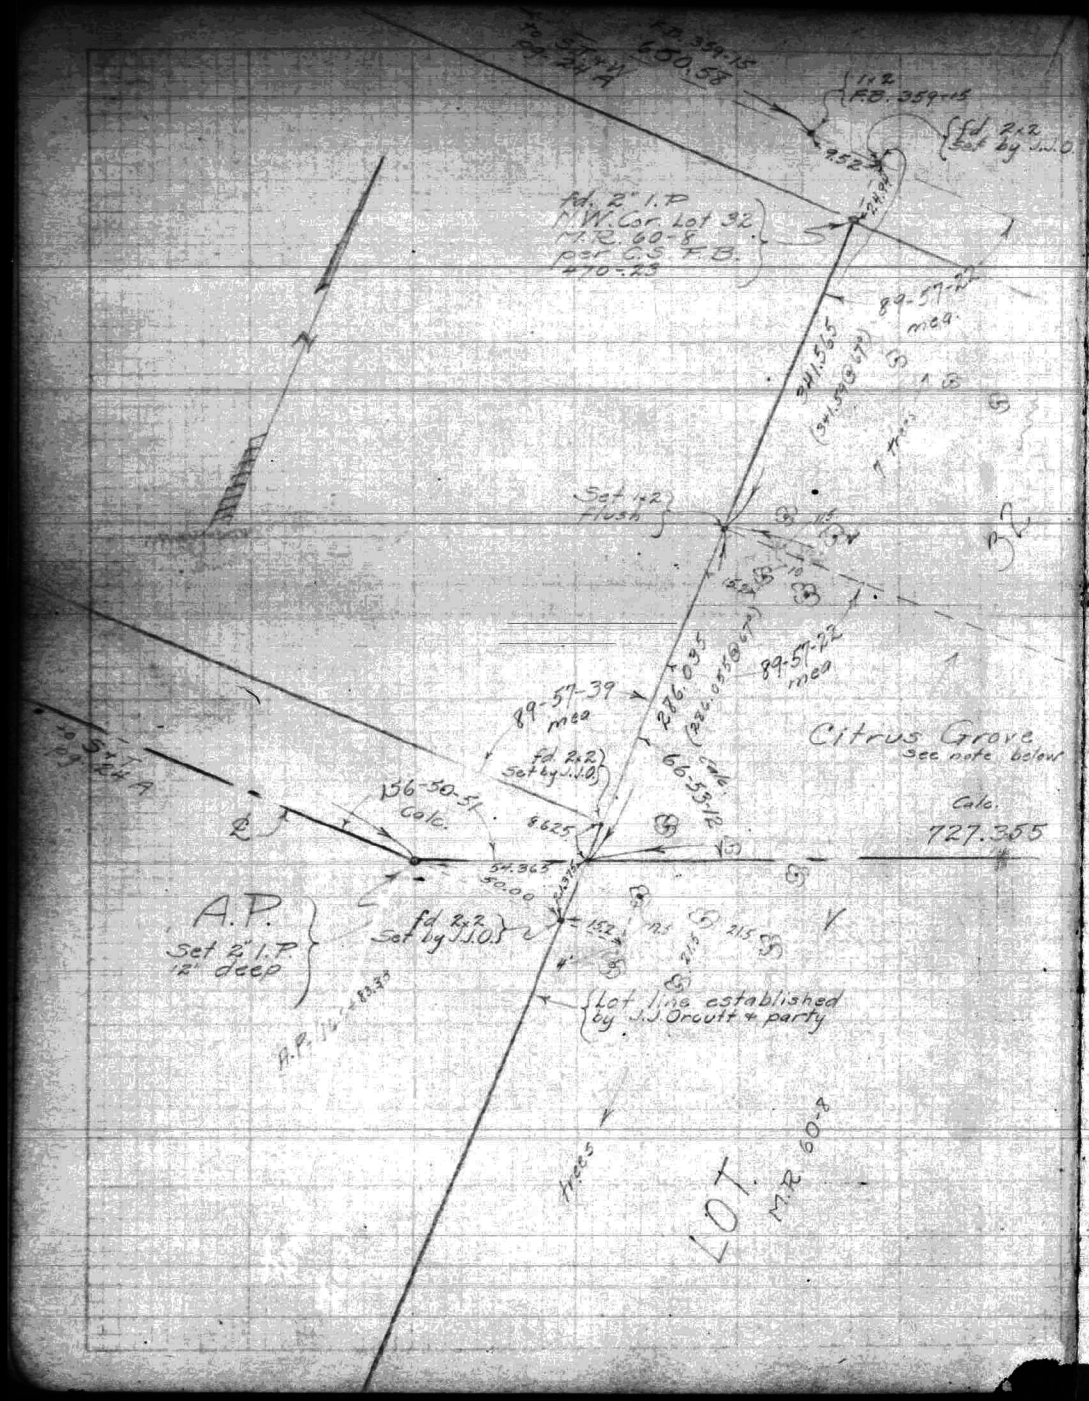

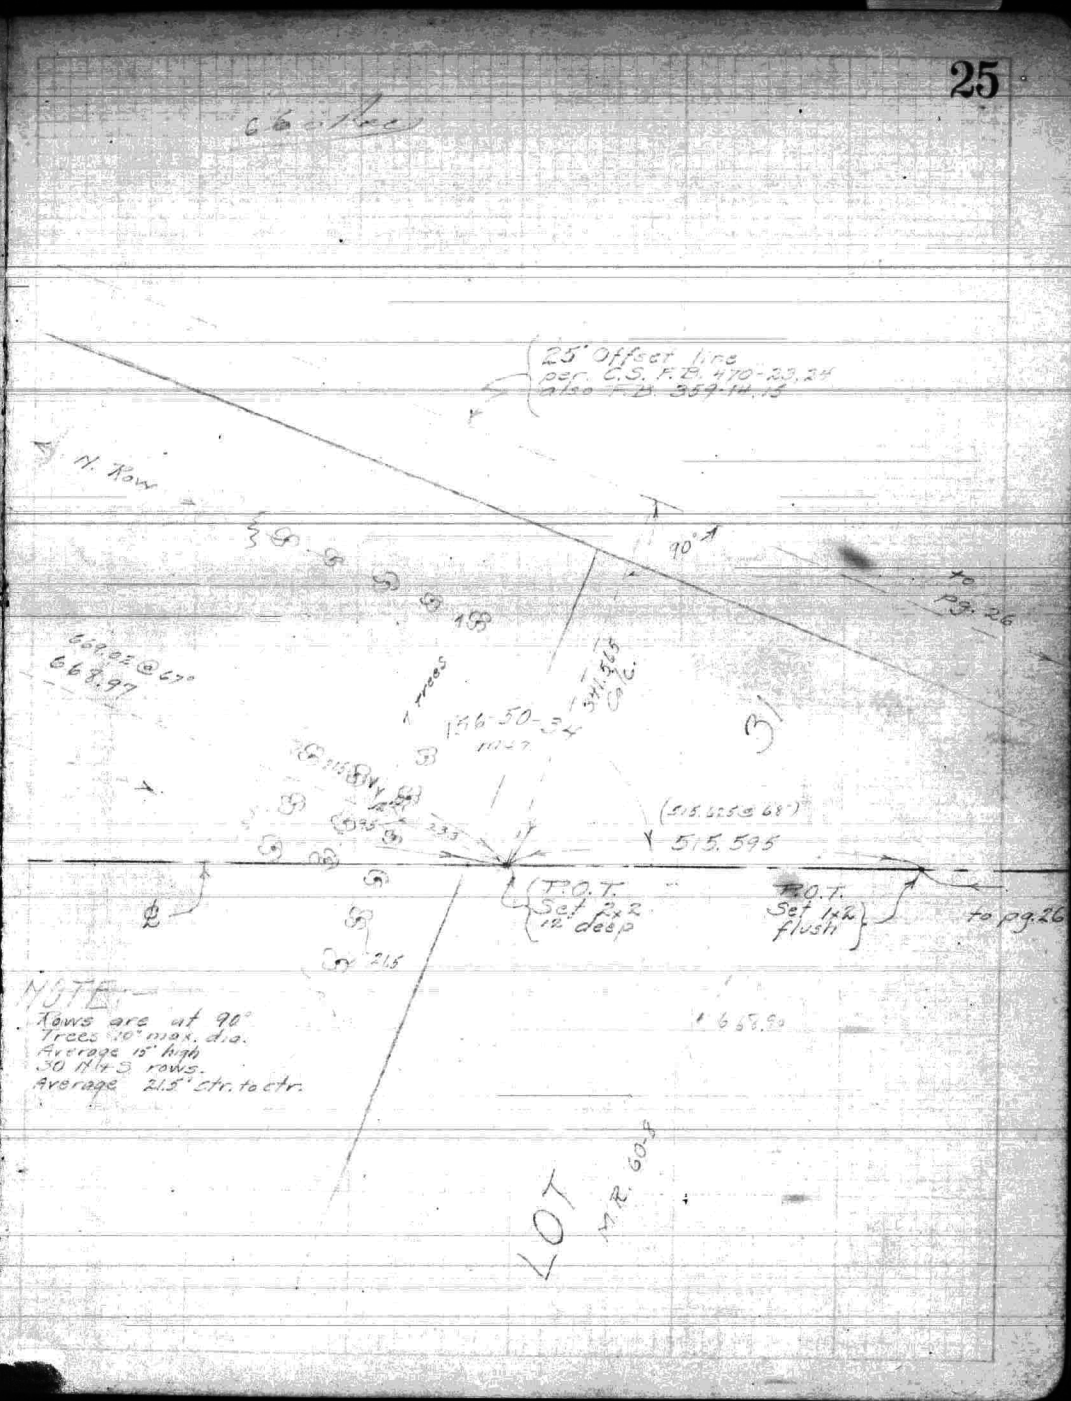

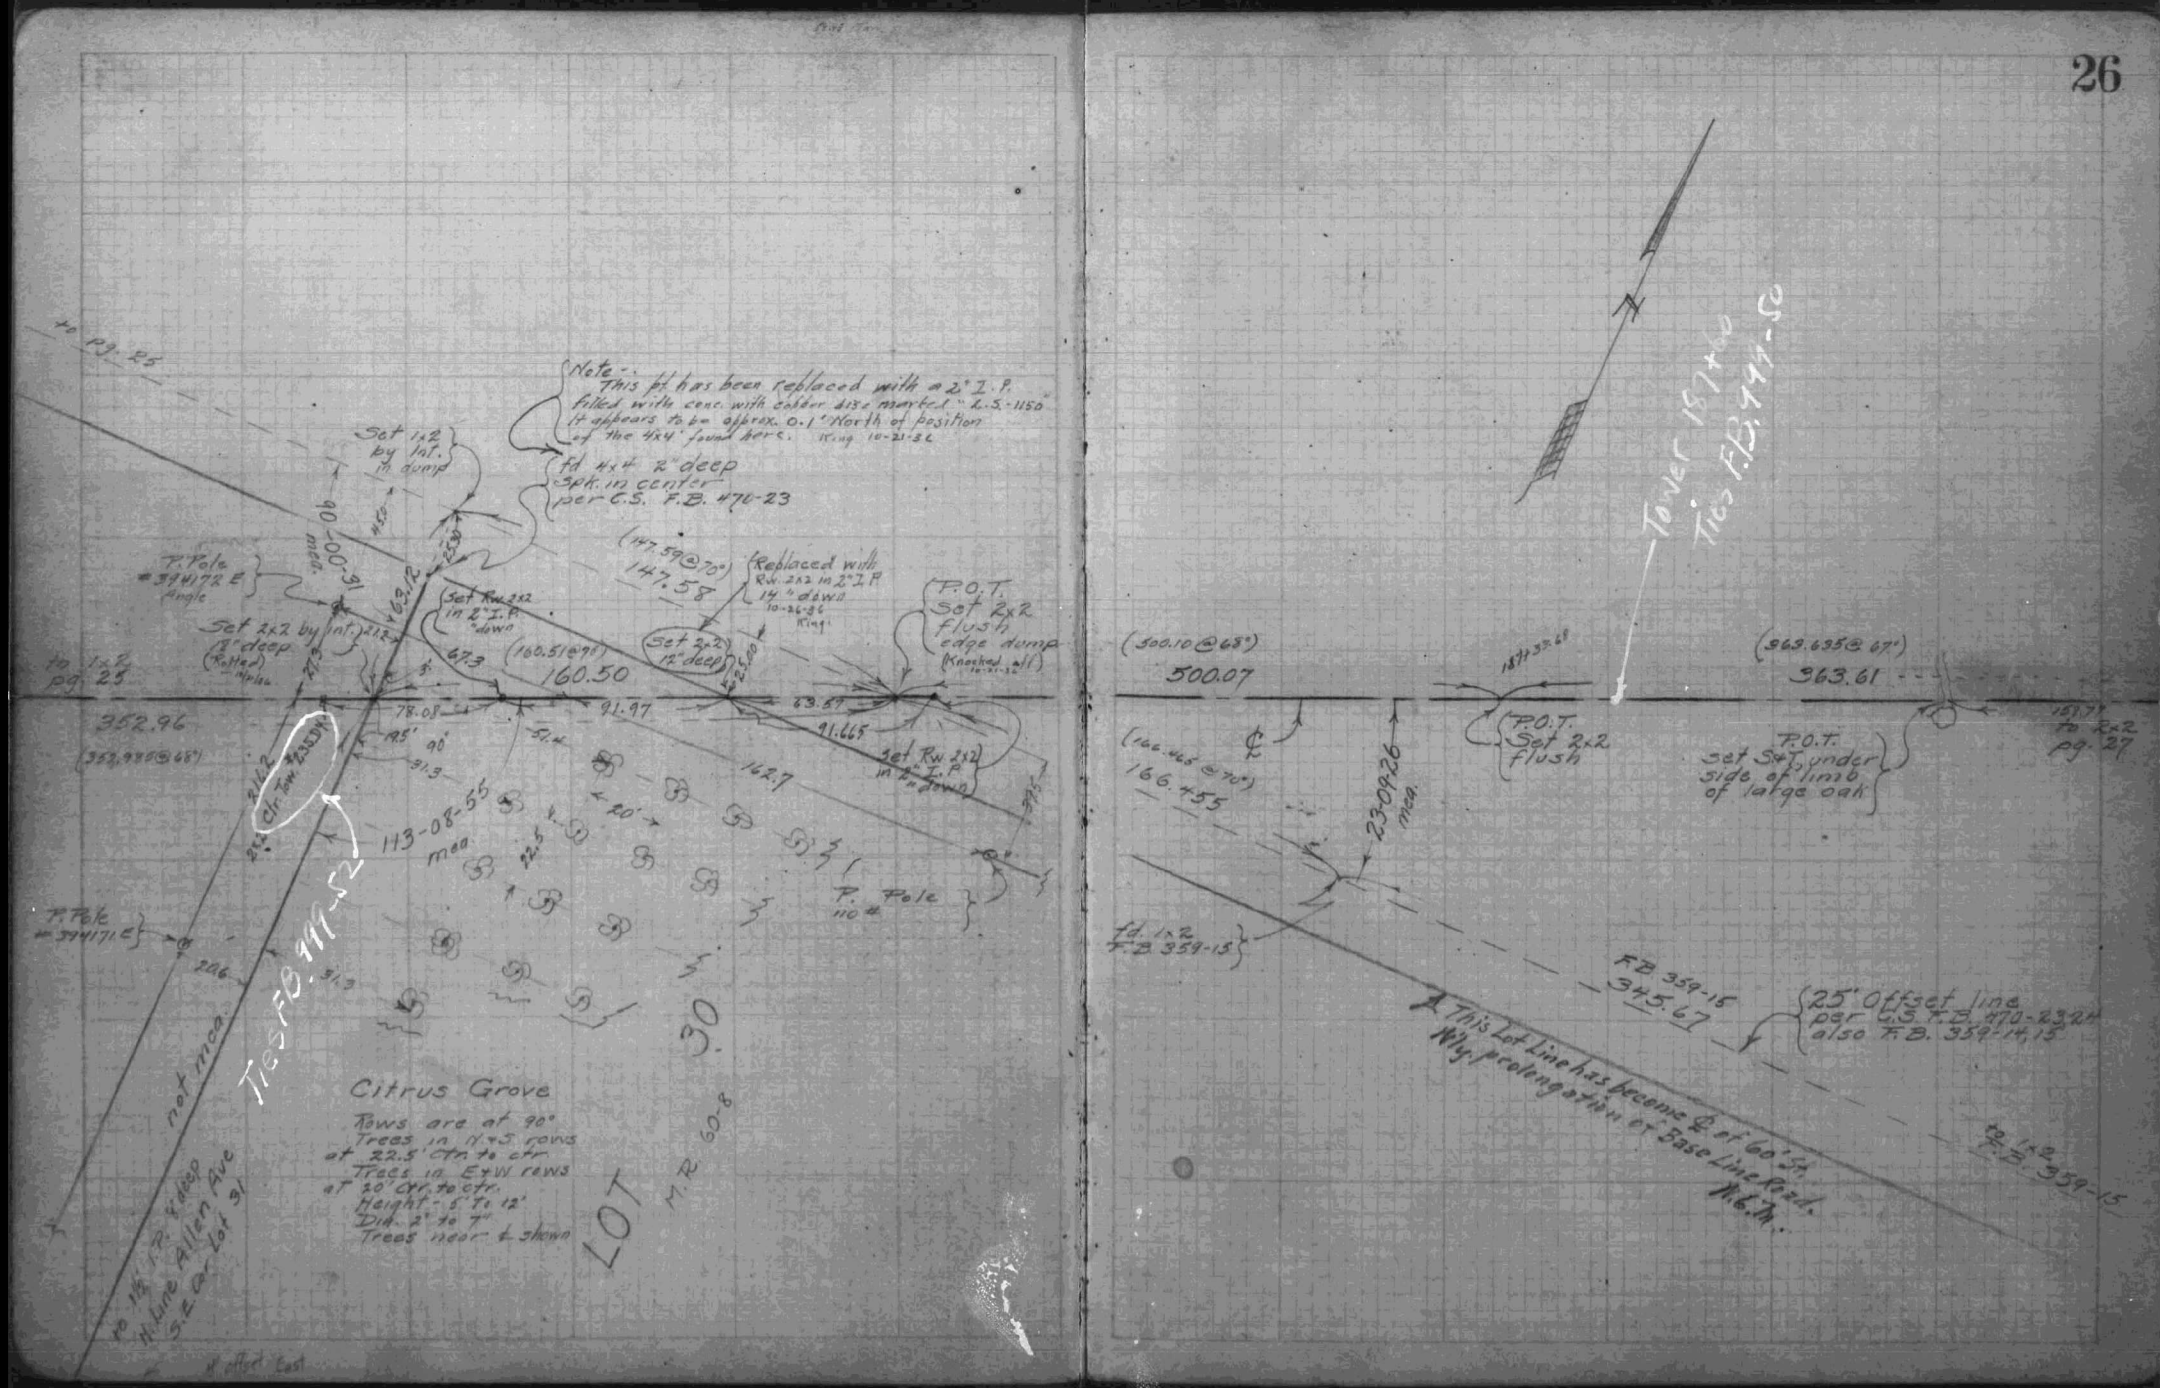
to pg. 25
Note: This pt has been replaced with a 2" I.P. filled with conc. with cable size marked "L.S.-1150" It appears to be approx. 0.1' North of position of the 4x4' found here. King 10-21-32
Set 1x2 by Int. in dump
Fd 4x4 2" deep Spk. in center per C.S. F.B. 470-23
T. Pole #394172 E
Set 2x2 by Int. 2" deep (Knotted) Triple
90-00-91 mea.
463.12
459
213
273
673
Set Rw 2x2 in 2" I.P. 12" down
(147.59 @ 70°)
147.58
Replaced with Rw. 2x2 in 2" I.P. 14" down 10-26-32 King
Set 2x2 12" deep
225.00
P.O.T. Set 2x2 flush edge dump (Knocked off) 10-21-32
(160.51 @ 71°)
160.50
to 1x2 pg. 25
352.96
(352.93 @ 68°)
78.05
91.97
63.67
91.665
Set Rw 2x2 in 2" I.P. 12" down
45° 90°
51.4
91.3
162.7
375
Clr. Tw 25 DBH
2x2
2x2
113-08-55 mea.
20'
22.5
T. Pole 110 #
T. Pole #394171 E
24.6
91.3
not mea.
to 1½" I.P. & dep N. Line Allen Ave S.E. Cor Lot 31
4 offset East
Citrus Grove
Rows are at 90°
Trees in N & S. rows at 22.5' ctr. to ctr.
Trees in E & W rows at 20' ctr. to ctr.
Height - 5' To 12'
Dia. 2" to 7"
Trees near & shown
LOT 30
M.R. 60-8
Tower 187 ± mo
187 33-60
(363.635 @ 67°)
363.61
187.7 to 1x2 pg. 27
P.O.T. Set 2x2 flush
P.O.T. Set S & T under side of limb of large oak
℄
(166.465 @ 70°)
166.455
2.30926 mea.
fd. 1x2 F.B. 359-15
F.B. 359-15
345.67
25' Offset line per C.S. F.B. 470-23 2H also F.B. 359-14, 15
This Lot Line has become ℄ of 60' St. N'ly prolongation of Base Line Road. M.B.M.
℄ F.B. 359-15

F.B. 987-92

Bur. Pow. & Li. F.B. 987-93

418

27.

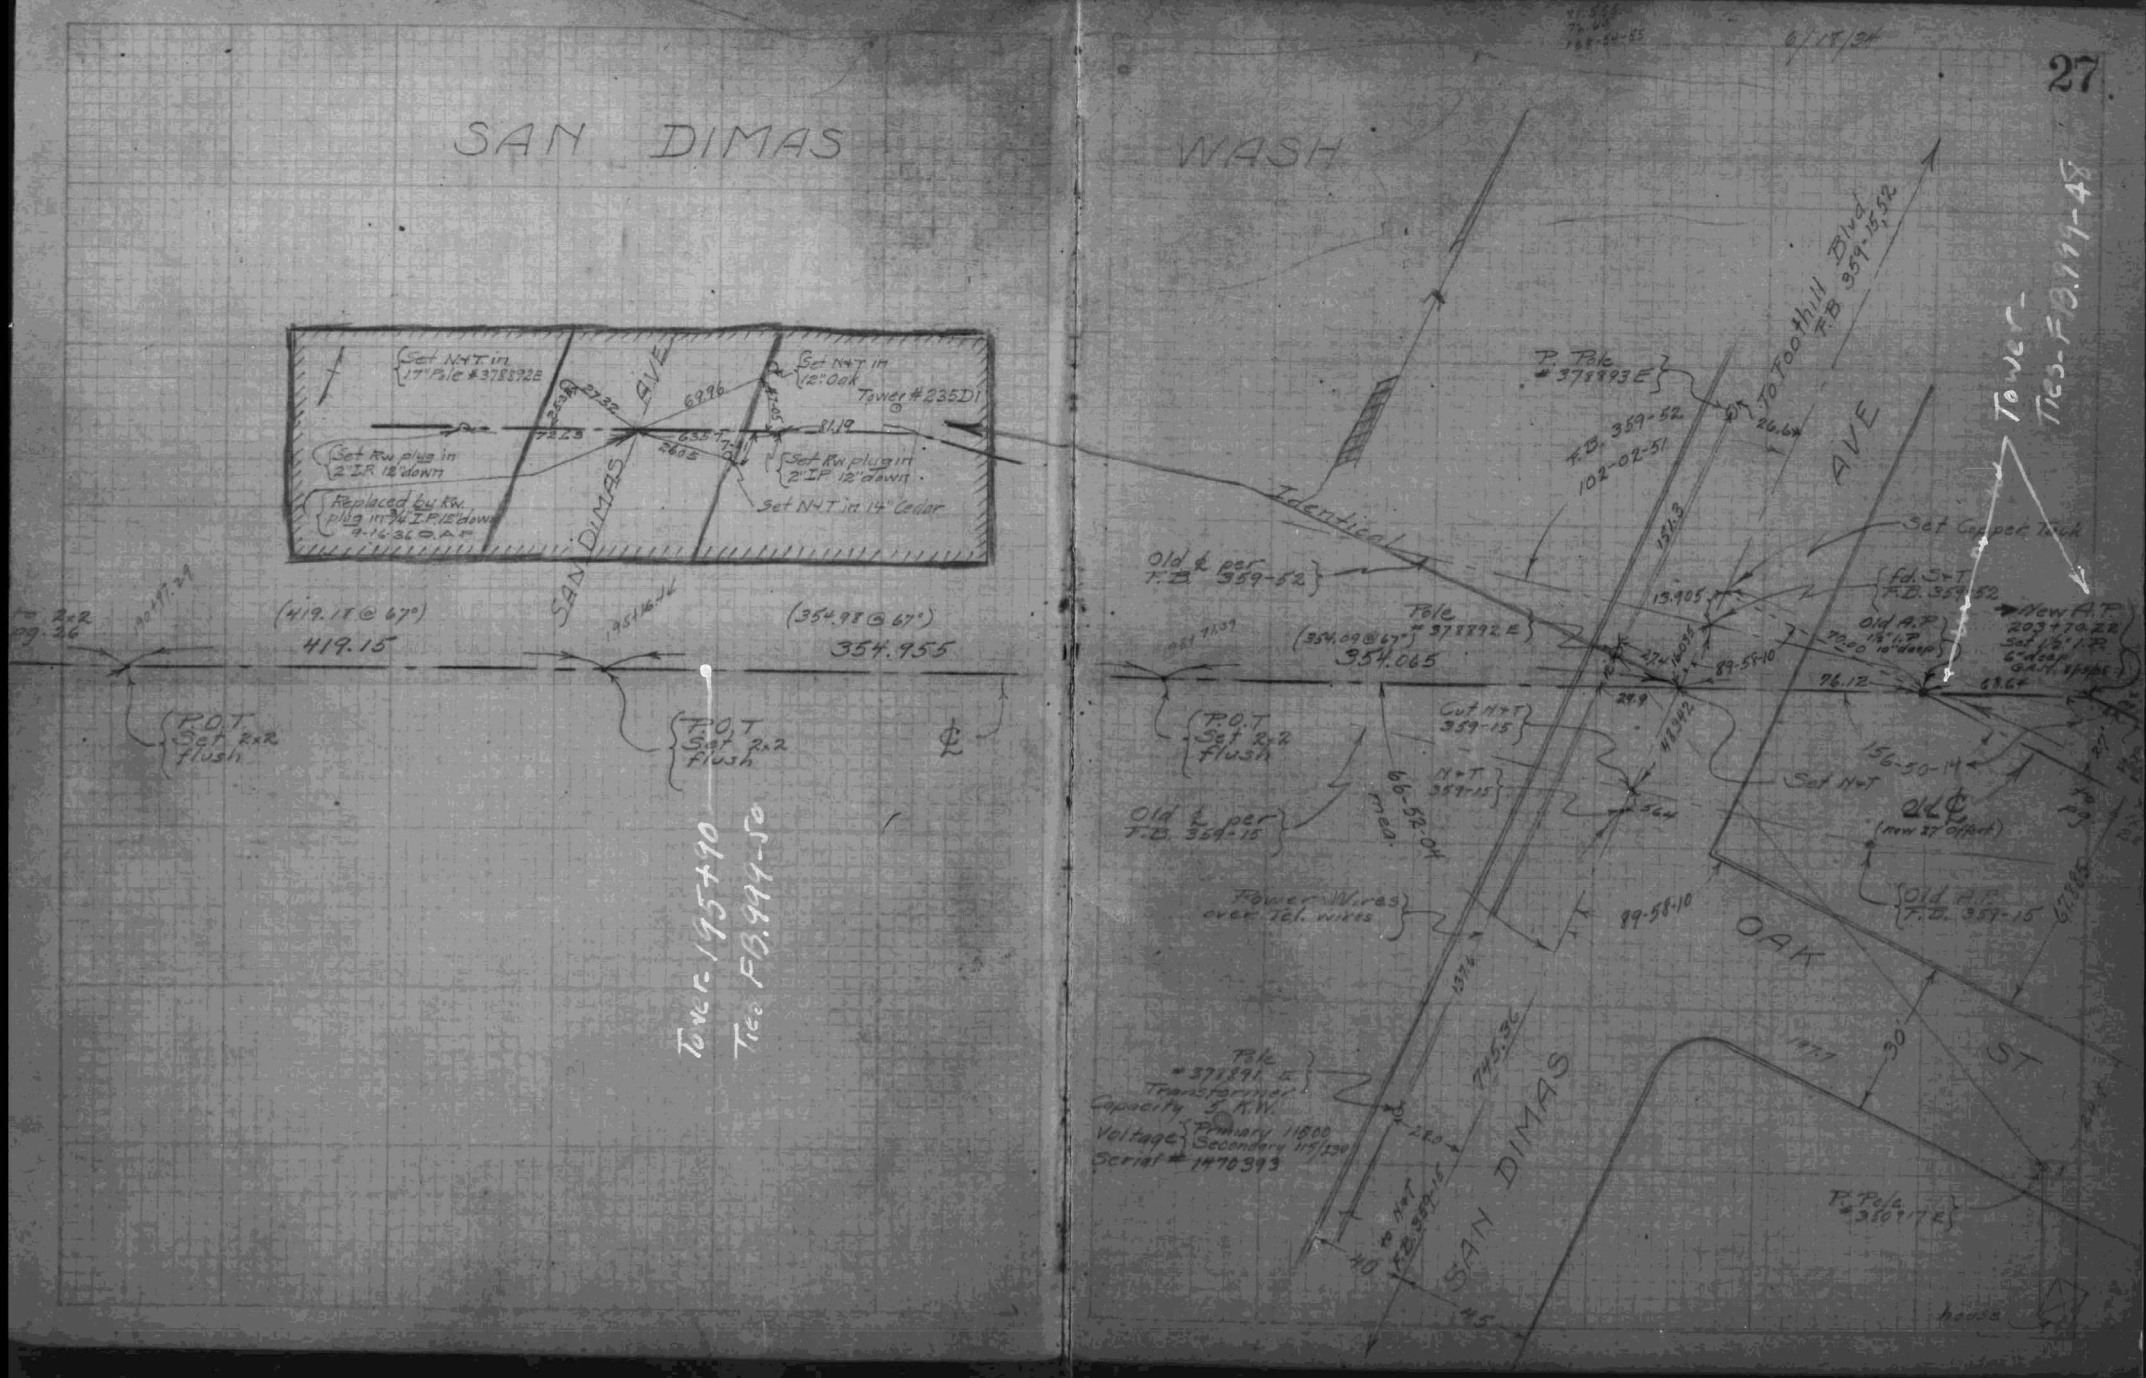

F.B. 987-94

Bur. Pow. & Li.

F.B. 987-95

418

28

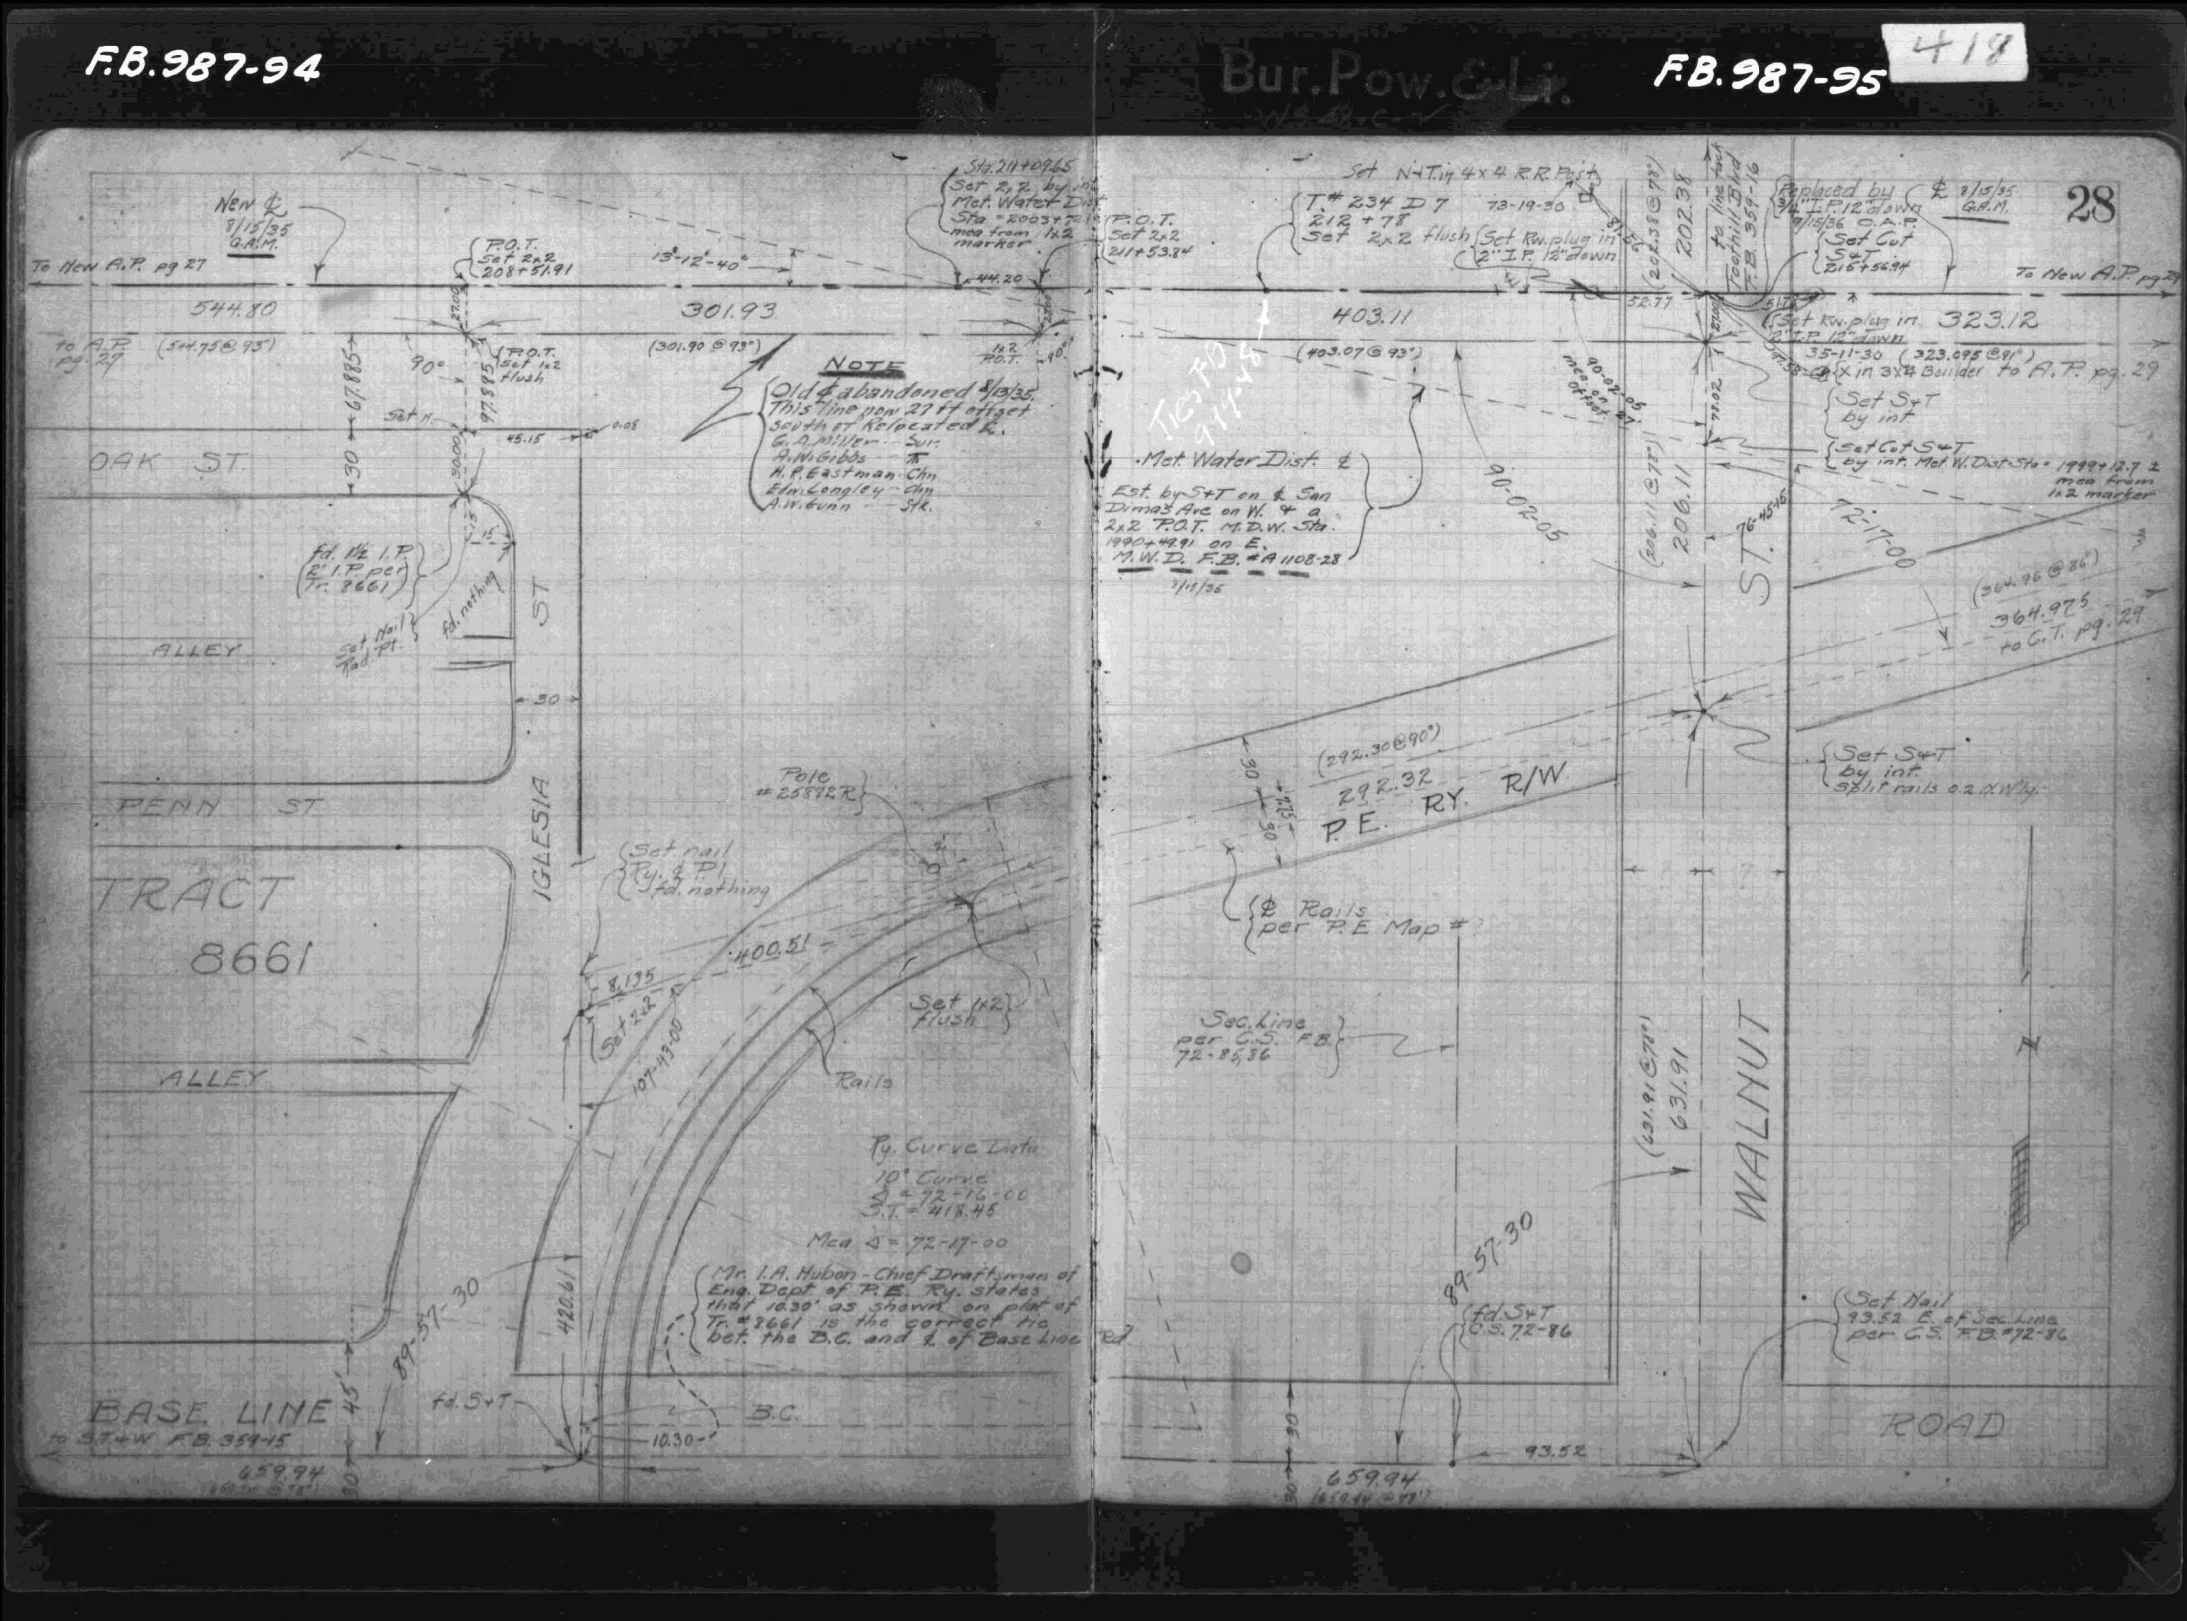

F.B. 987-96

Bur. Pow. & Li.

F.B. 987-97

29

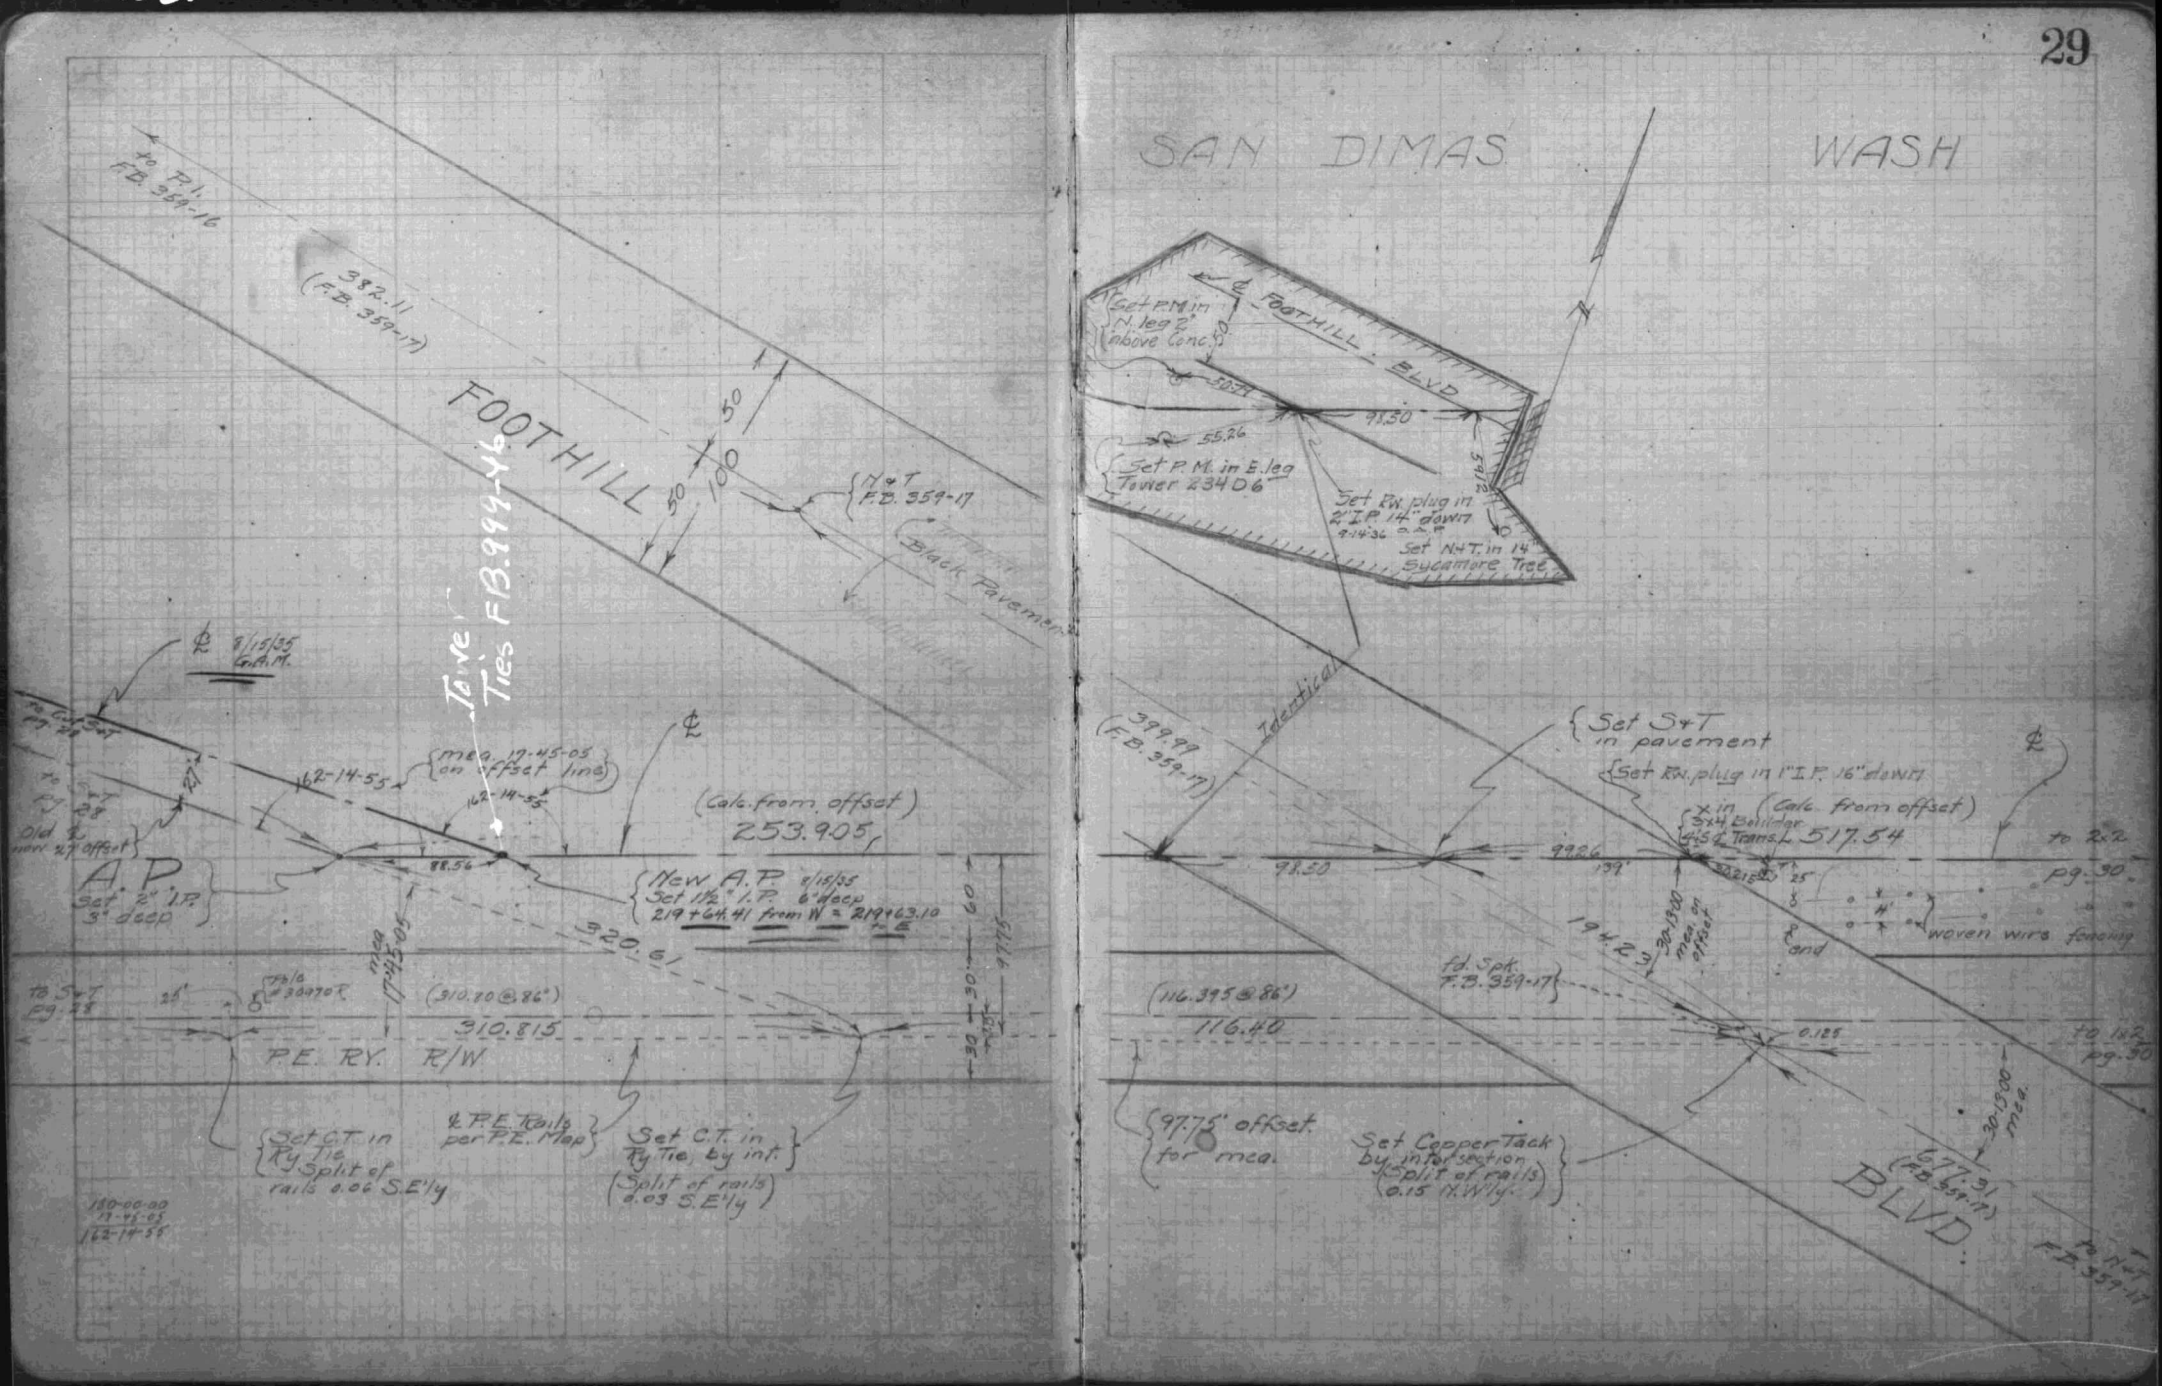

F.B.987-98

W5.18-D-2

Bur. Pow. & Li.

418

F.B.987-99

30

SAN DIMAS

Tower 225+12
Ties FB 999-46

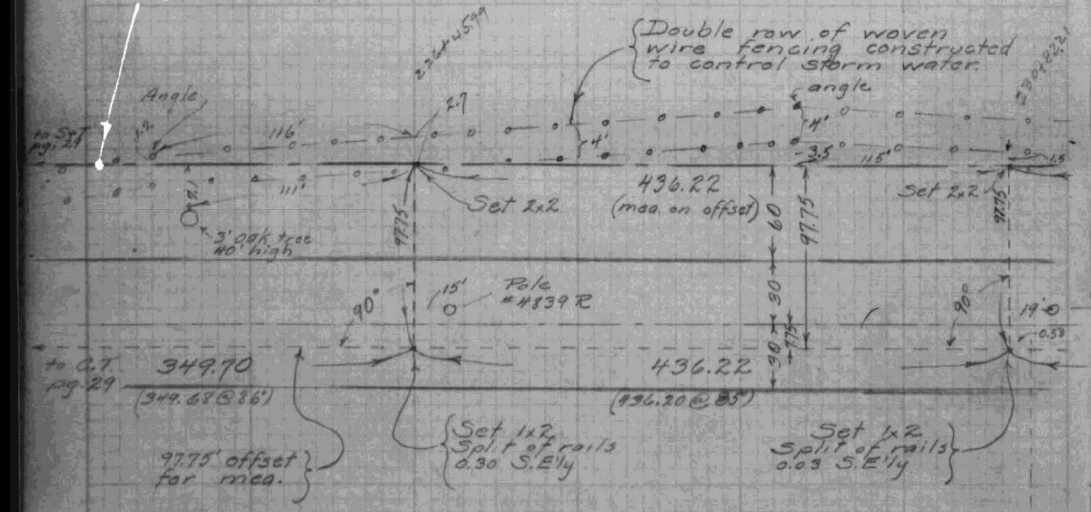

Tower 232+90
Ties FB. 999-44

WASH

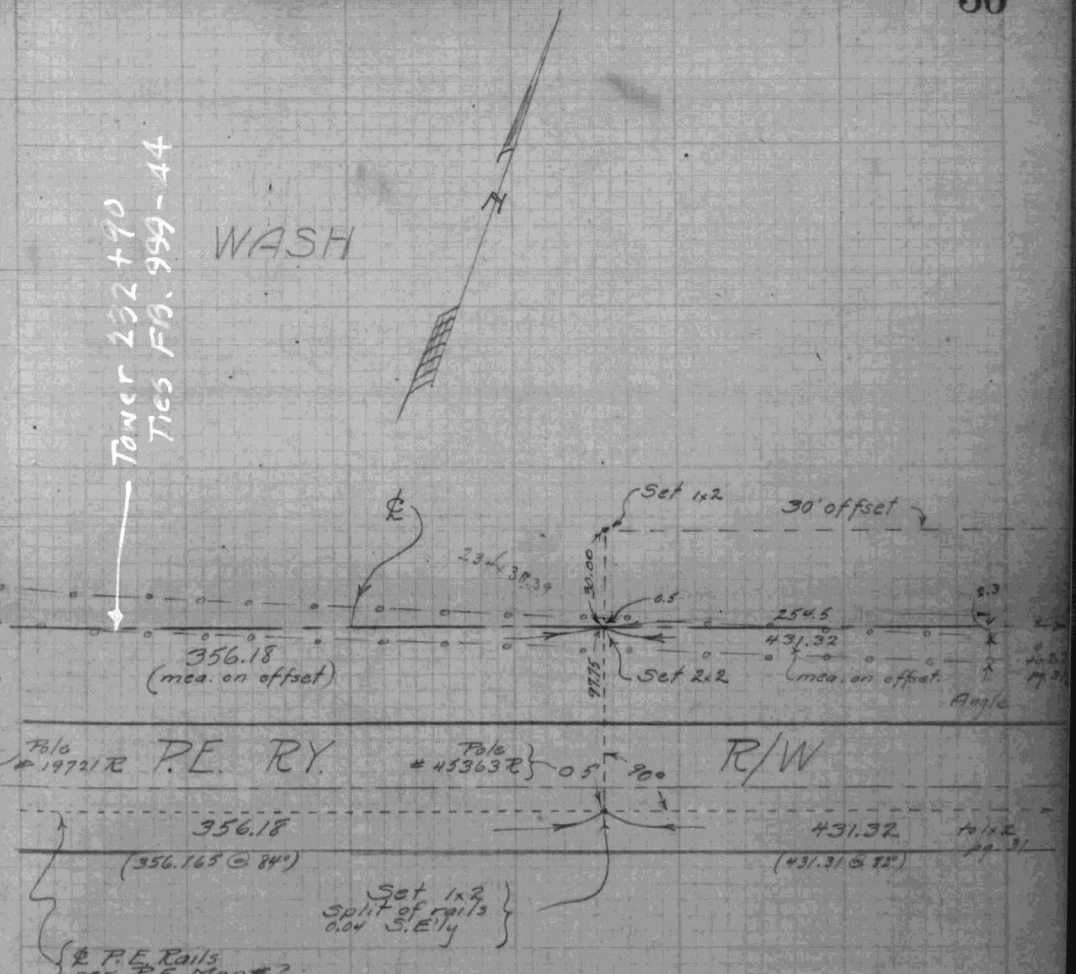

F.B. 987-100

W5.48-D-7

Bur. Pow. & Li.

418

F.B. 987-101

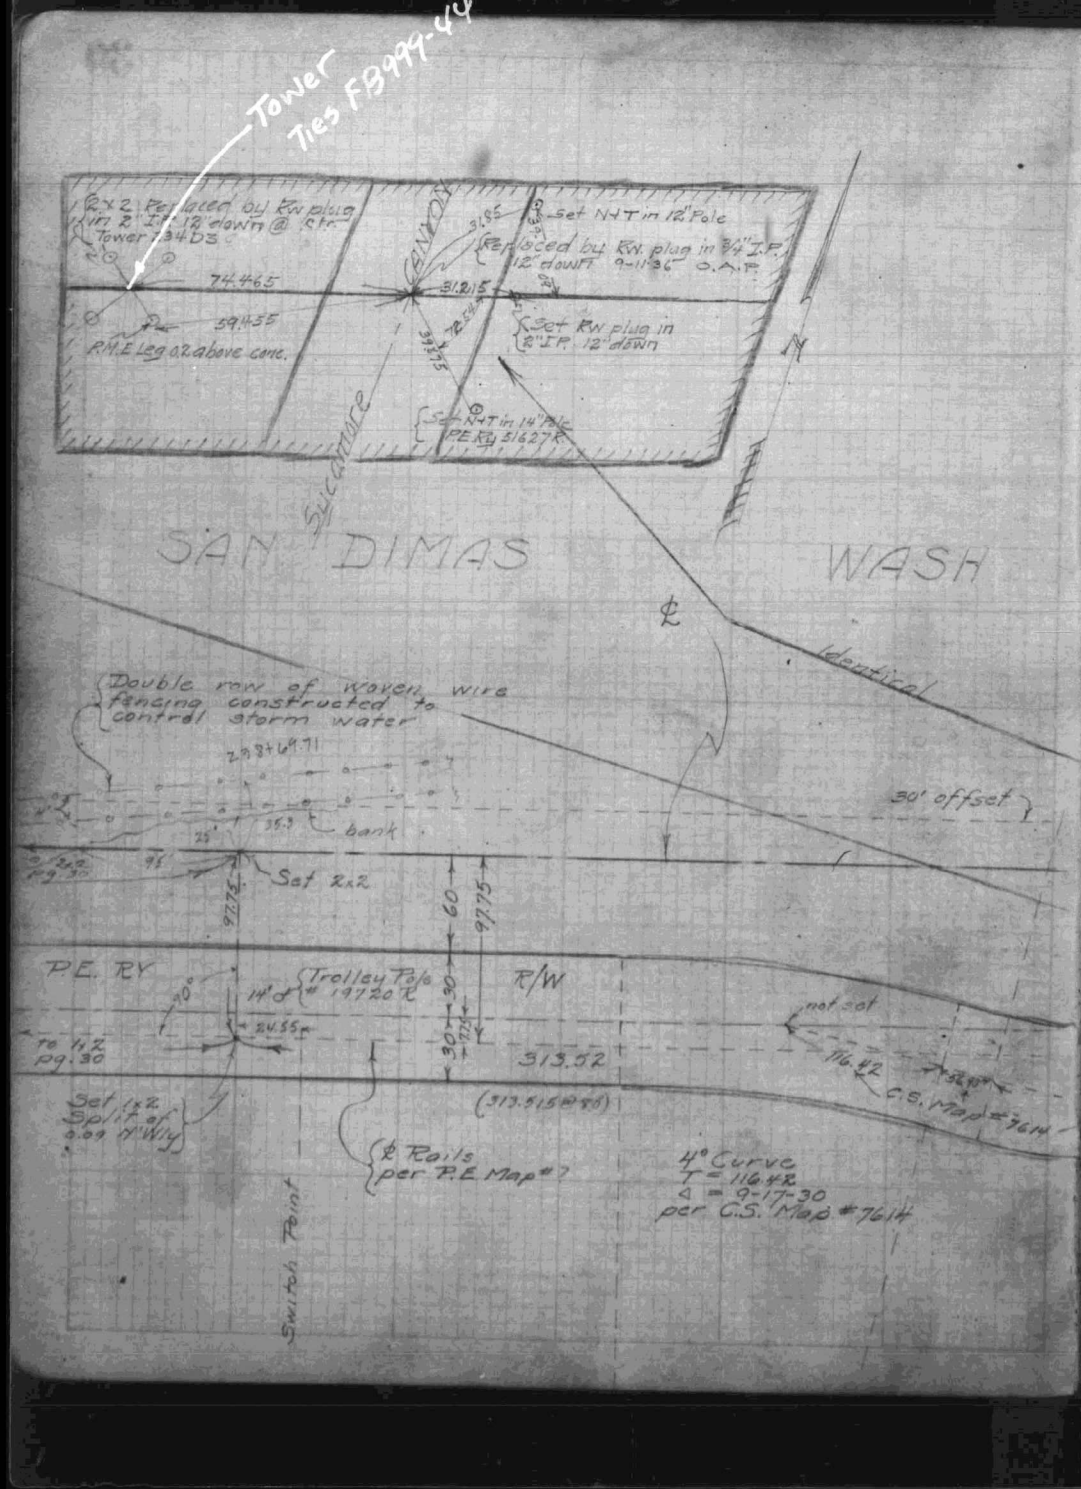

F.B. 987-102

Bur. Pow. & Li.

418

F.B. 987-103

32

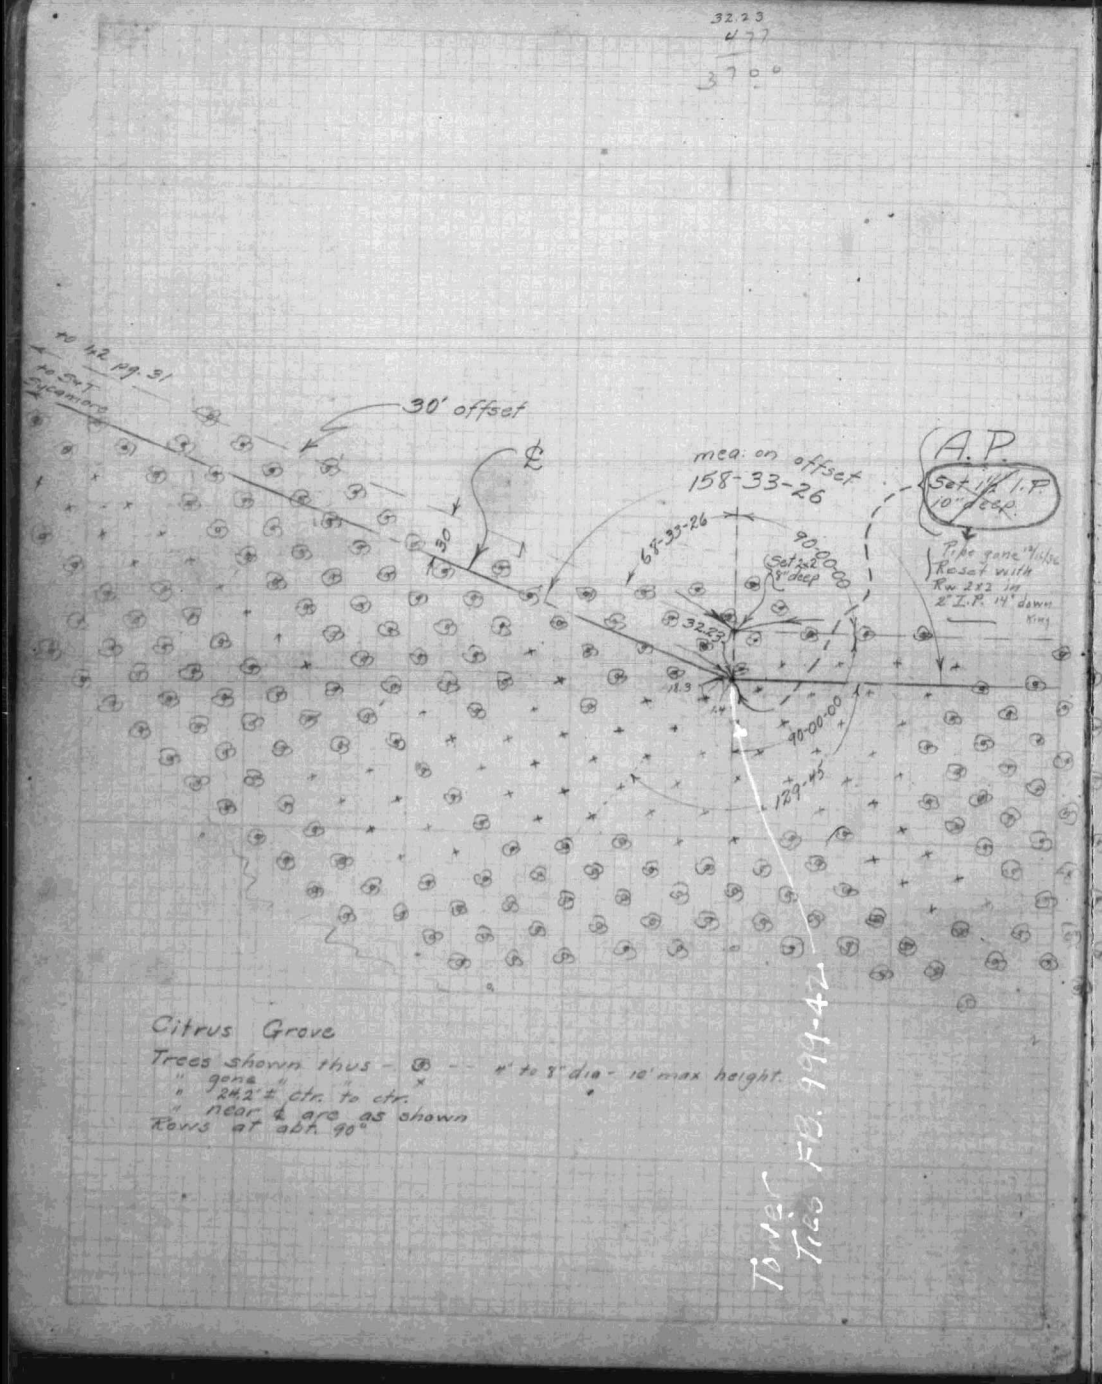

SAN DIMAS WASH

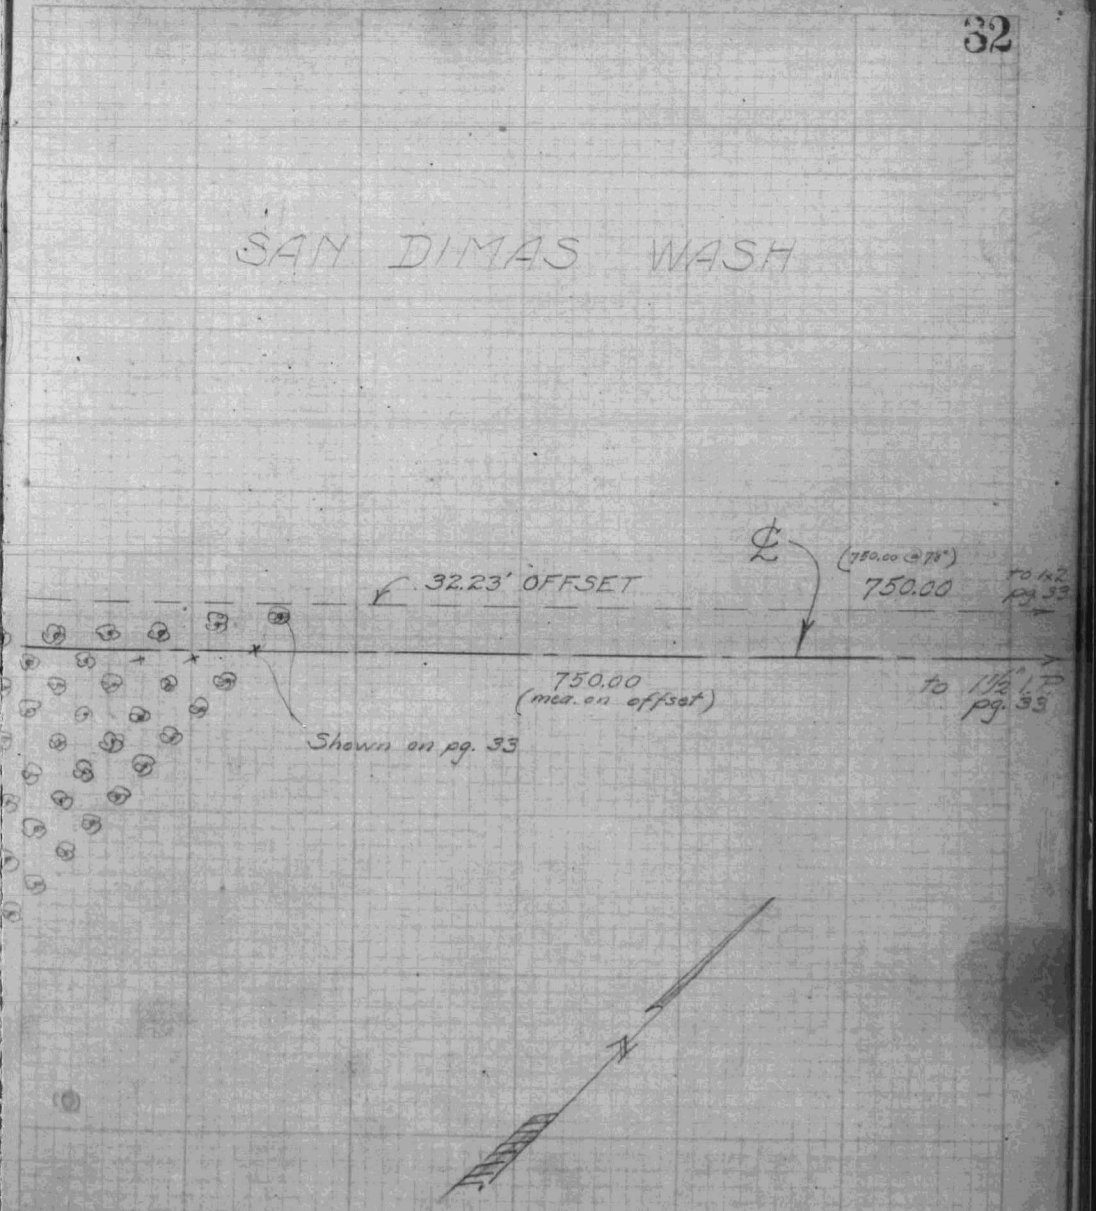

F.B. 987-104

Bur. Pow. & L.I.
W&U-D-7

418

F.B. 987-105

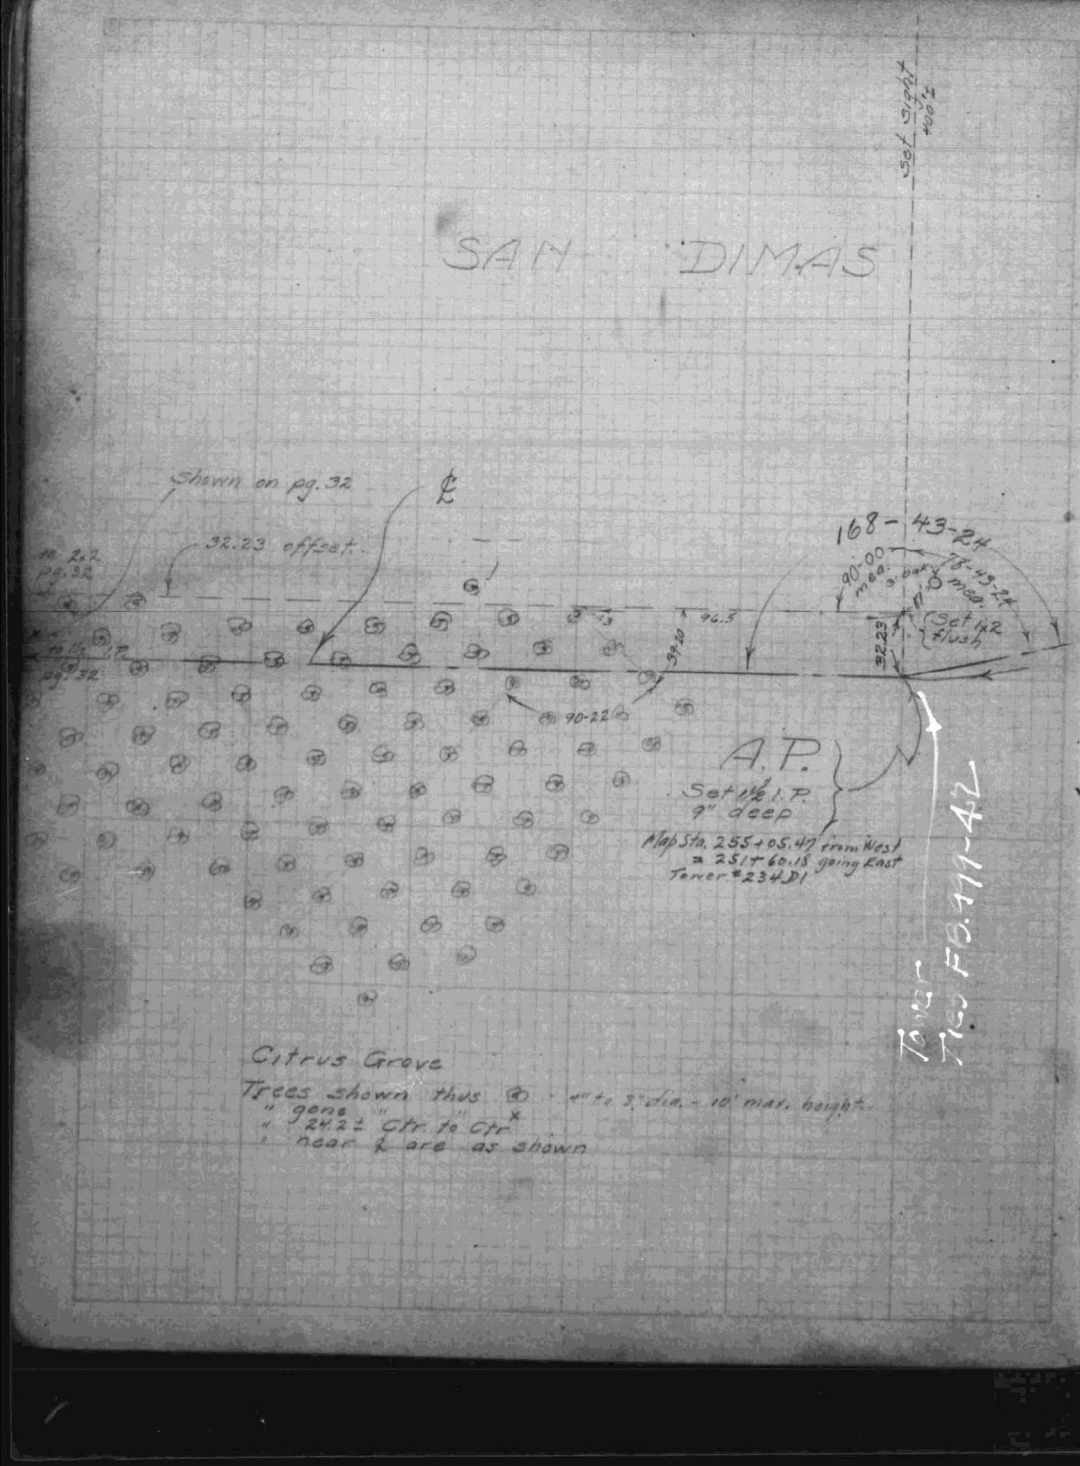

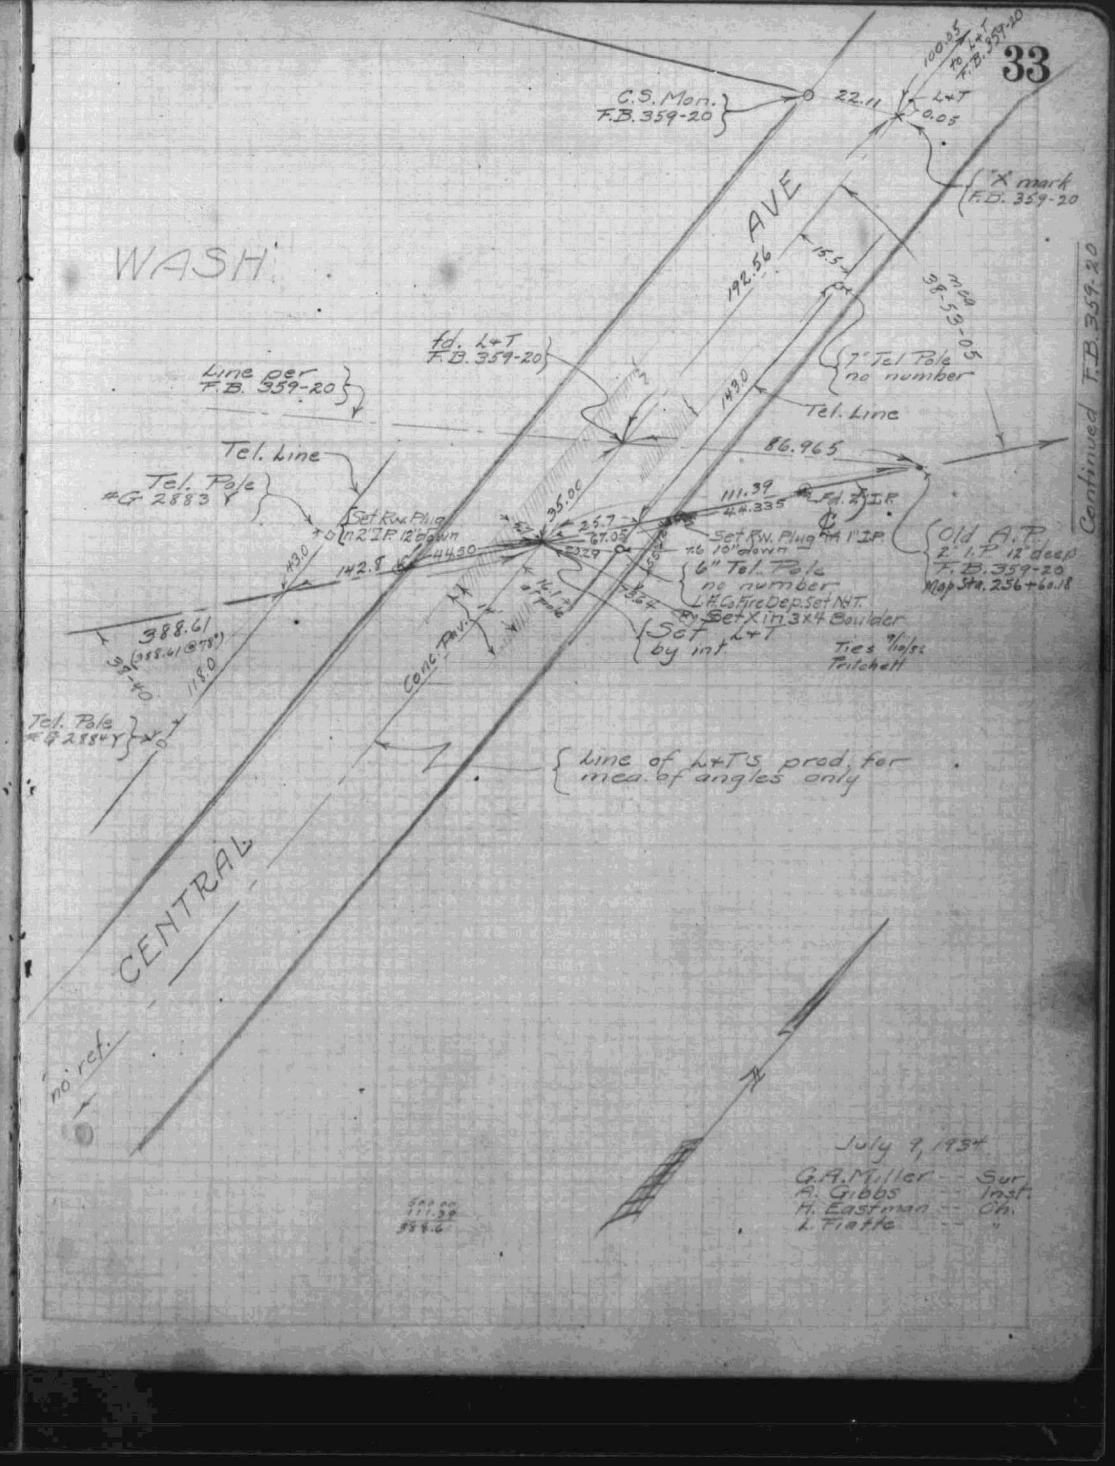

F.B. 987-106

Bur. Pow. & Li.

F.B. 987-107

75

~~FINAL~~ ~~PROPOSED~~ RELOCATION OF ℄ OF R/W

from

A.P. # 13 - 471+31.49 to T # 249 D 8 = 598+00

April 2 to 6, 1936

Miller	Sur
Gibbs	Inst
Schuerman	Ch
Longley	"
Gettman	Inst.

Note:- For Profile see F.B. # 498-40

Ref. pg 19,20
F.B. # 352-26,27

TR. NO. 3159
M.B. 35-73

A.P. # 13
471+31.49
fd. 2" I.P. 18" deep.
per F.B. # 352-26

Cont. F.B. 352-26

Final ~~Proposed~~ ℄

167-55-28
F.B. # 352-26

21-42-13 mea.

℄ Per F.B. # 352-26 Abandoned 5/25/36

167-55-28
21-42-13
189-37-41
170-22-19

E.C. 209+48.31 P.C.

L.A.Co. F.C. R/W

E.C. L.A.C.F.C.D. Mon. # 78-21 per F.C. F.B. # FC 535-C16.

E.C. L.A.C.F.C.D. Mon. # 78-22 per F.C. F.B. # FC 535-C16

Note:- Tie to F.C. R/W 4/21/36 by J.J. Broutt + party Notes copied by Miller

To F.C. Mon. # 78-24 pg. 77

85+20.5

fd. 2" I.P. F.B. # 362-26

482+40.05 Set 2x2 by int. 14" deep

82-33-10

P.O.T. 485+35.485 set 2x2 14" deep

23.98 mea.

308.2'

to pg. 76

479+31.81 Set 2x2 by int. 12" deep

P.O.T. 492+36.735 Set 2x2 14" deep

342.11 F.B. # 352-26

75-11-50 mea

LOT 39

126.98 F.B. # 352-26

fd 2" I.P. F.B. # 352-26

Cont. F.B. # 352-26

F.B. 987-108

Bur. Pow. & Li.

F.B. 987-109

Hot + Cont.

℄ Proposed 5th AVE
per C.S. F.B.# 404-14,15,
See F.B. # 352-27

Curve Data
per C.S. F.B. #404-15
Δ = 51-56-20
T = 1000.00
T = 487.07
L = 906.50

LOT 1
T.R. 3159

P.O.T.
496 + 07.665
Set 2x2 14" deep
2"

P.O.T.
500 + 55.89
Set 2x2 14" deep

P.O.T.
507 + 99.855
Set 2x2 14" deep

to Pg 75

to Pg 77

Final ℄

504 + 56.66
Set 2x2 by int.
18" deep

79-53-30
mea

175.15

R = 1000

P.I. Fd. 4x4
+ boat spike
per F.B. 352-27

LOT 39

Part of
LOT 35

51-56-20
F.B. # 352-27

℄ Proposed 5th AVE.
F.B. # 352-27

Cont. F.B. # 352-27

F.B. 987-110

WS 37-B-2

Bur. Pow. & Li.

418

F.B. 987-111

77

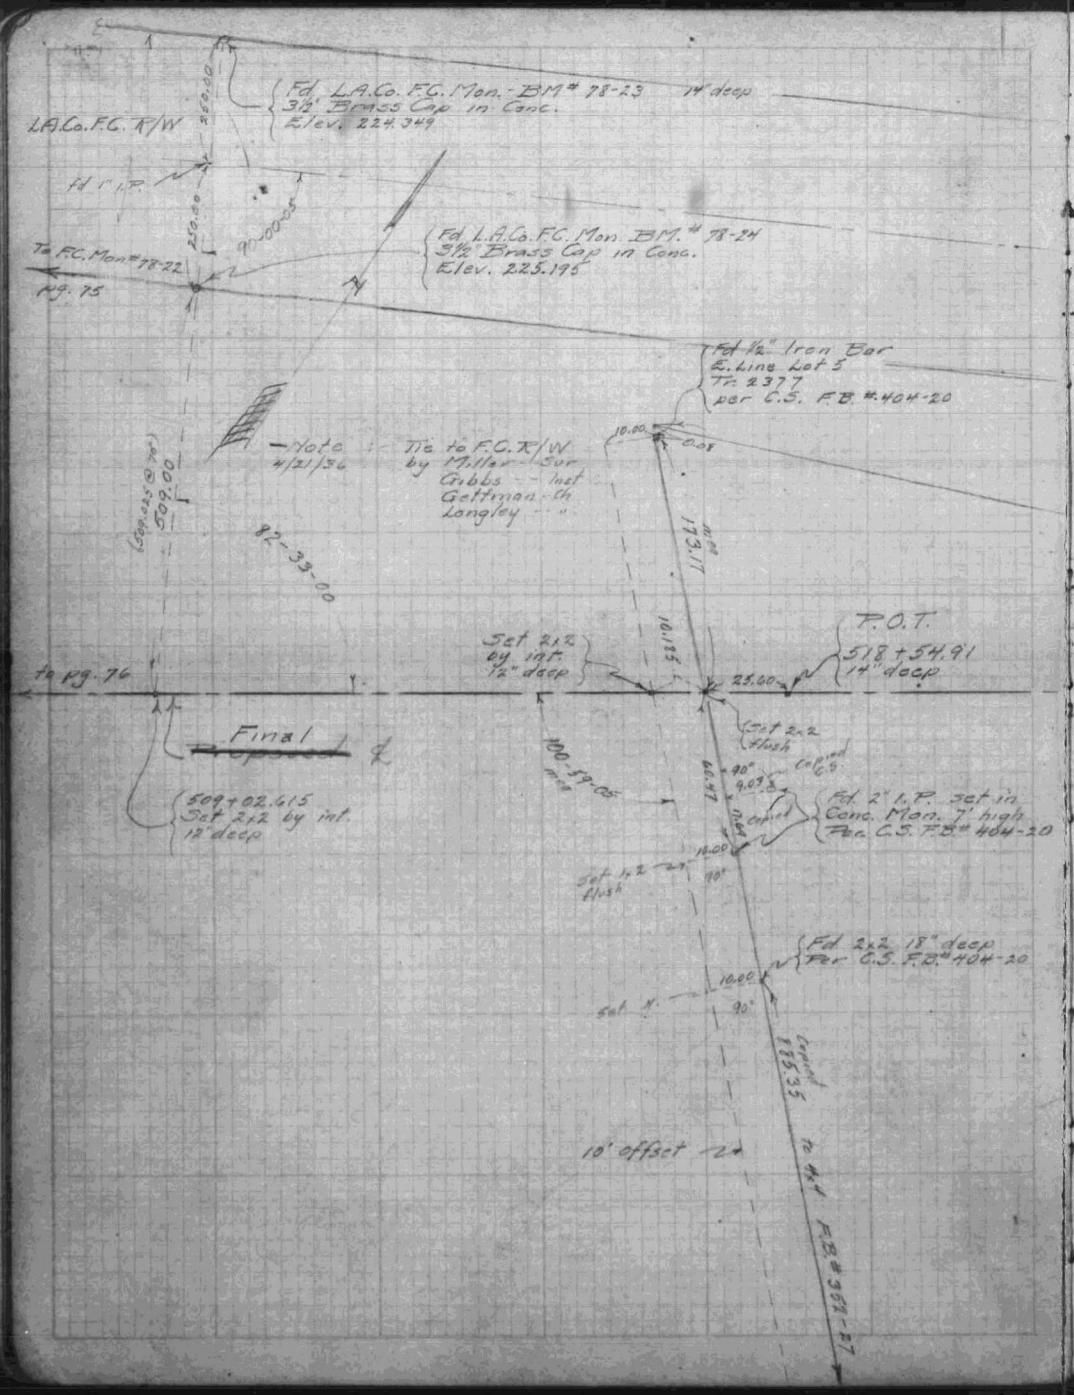

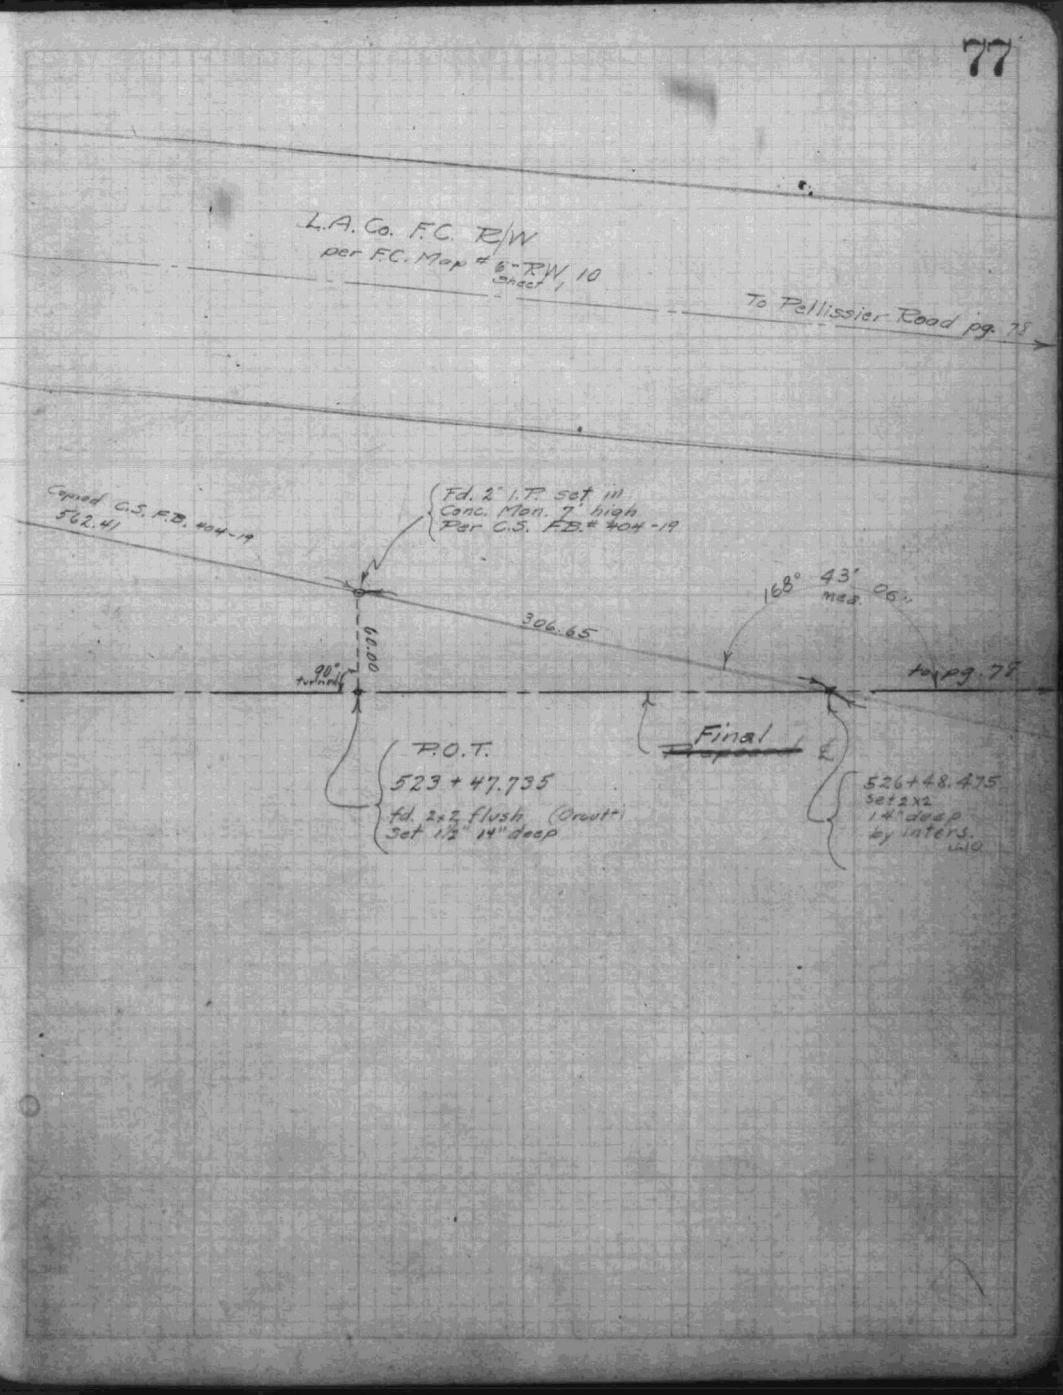

F.B. 987-112

#359

F.B. 987-113

78

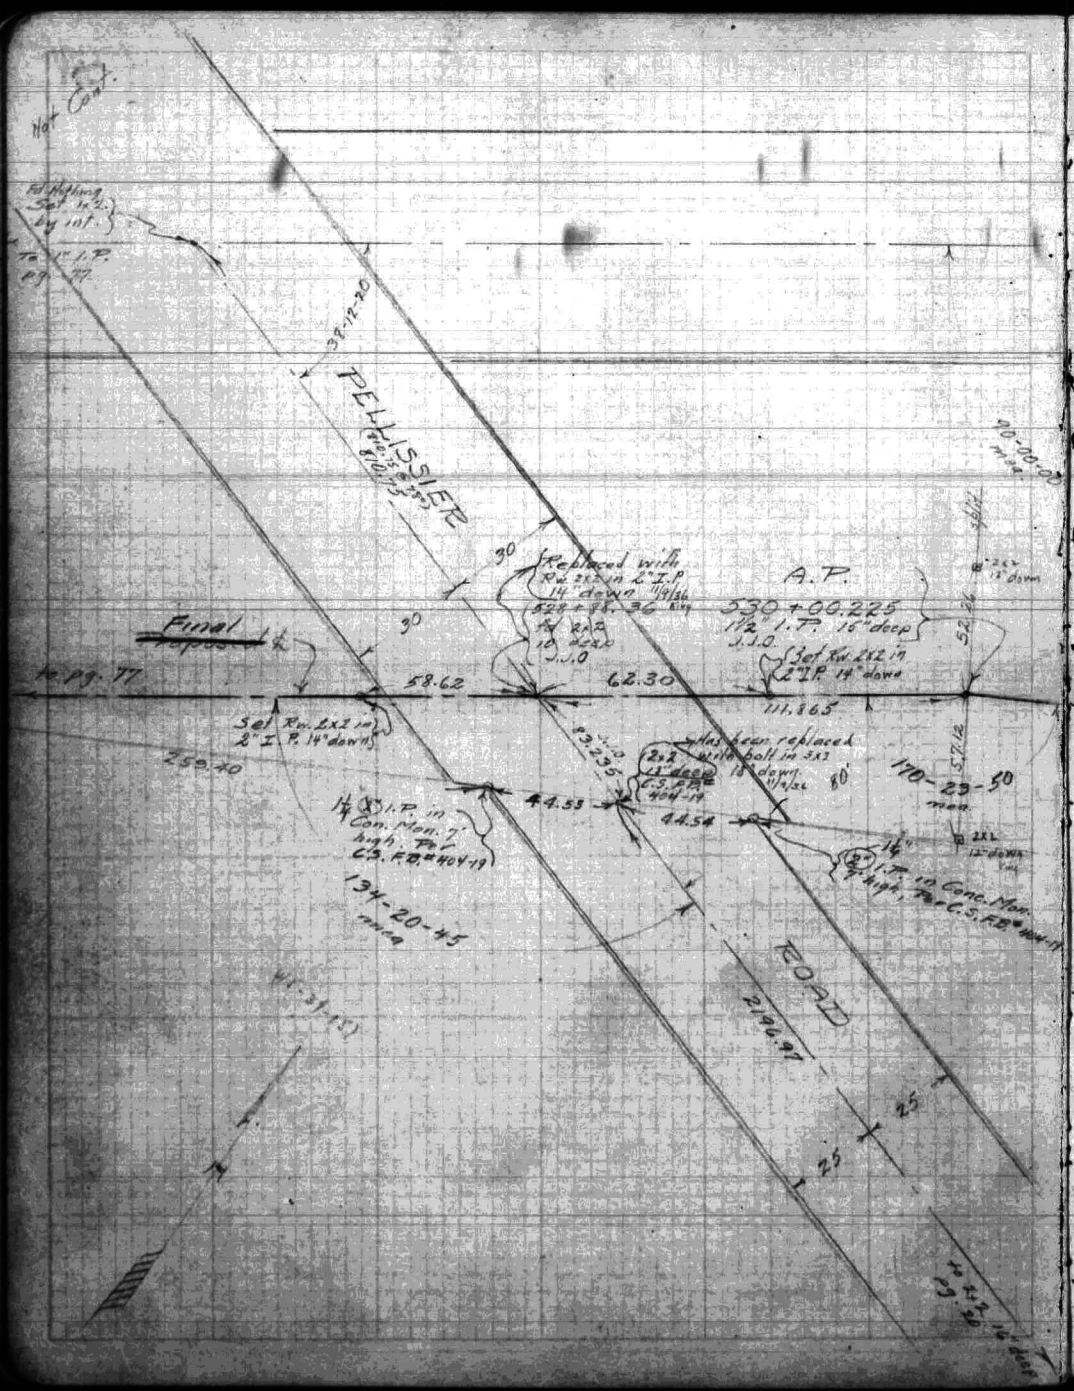

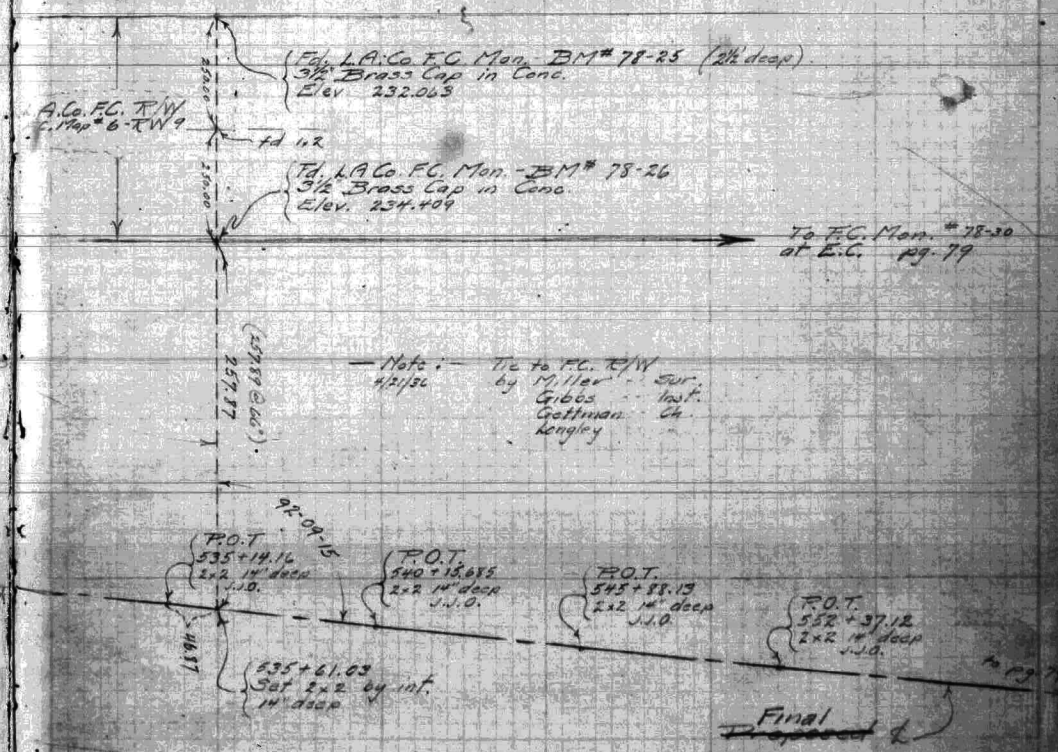

L.A.Co. F.C. R/W
F.C. Map # 6-RW 9 Sheet 1

500'

To F.C. Mon # 78-26
pg. 78

87-50-40

P.O.T.
581+16.175
2x2 14" deep
J.J.O.

P.O.T.
559+23.065
2x2 14" deep
J.J.O.

P.O.T.
564+23.87
2x2 14" deep
J.J.O.

P.O.T.
572+05.535
2x2 14" deep
J.J.O.

P.O.T.
577+12.075
2x2 14" deep
J.J.O.

to pg. 78

Final

℄

36" Pipe Line

132-02-30
J.J.O.

℄ per pg. 19, 20 abandoned 5/25/36

Cont. pg. 19, 20

E.C.
Fd. L.A.Co.F.C. Mon.-BM # 78-29
3½" Brass Cap in Conc.
Elev. 256.07
See F.C. Map # 6-RW 9 Sheet 1

To F.C. Mon. # 78-32
Center of Curve
pg. 18

Title pg. 75

Note:- Tie to F.C. R/W
by Miller + party
4/20/36

E.C.
Fd. L.A.Co.F.C. Mon-BM # 78-30
3½" Brass Cap in Conc.
Elev. 253.11
See F.C. Map # 6-RW 9 Sheet

1142.595
(N 19° 13' W)

P.O.T.
586+09.665
2x2 14" deep
J.J.O.

P.O.T.
591+68.545
2x2 14" deep
J.J.O.

Cont. pg. 19

584+97.465
Set 2x2 by 18"
14" deep
15-44-00
J.J.O.

A.P. - T. # 249 D8
595+63.175 = 588+80
1½" I.P.
12" deep

F.B. 987-116

Bur. Pow. & Li. #359

F.B. 987-117

359

20

NOTE
See page 80 for Traverse of E. of macadam pavement up San Dimas Canyon
8-11-33 W.C.M.

Fd. C.S. Monument, Brass Cap in Conc. Per Flood Control F.C. 63-83, 85, 93

Fd. L+T per Flood Con. F.C. 63-83, 85

20.00 — 20 — 20

10.00

Pole

Set X

660.56
(660.52 @ 88°)

90-54-05

100.05

AVE

CENTRAL

441.04
(441.08 M)

Fd. L+T per Flood Control F.C. 63-83, 85

Fd. C.S. Mon. Brass Cap in Conc. Per Flood Control F.C. 63-83, 85

22.11

0.05

Set X

T.P. 0

657

165-21-55

This E.O.K. see FB. 418-33

Sta 256+60.18
Set 2" I.P. 12" deep

708.07
(708.11 @ 70°)

64-41-50

192.56
(192.57 @ 70°)

Conc. Faire

86.97

8.2

Set L+T Sta. 255+73.21

89.77

0

Set N+T Pole

167-54-50

2' offset

To C.S. Mon. [illegible]

16

15

17

4

F. [illegible] R. [illegible] C.S. Map B-601

[illegible] 0' R/W

6/18/34

This E abandoned

For Reported final Location see F.B. # 418-33 W.C.M.

To 2" I.P. pg. 19

Line of L+T's prod. for meas. of angles only

Tower 267+40
Ties F.B. 999-40

To 11+T pg. 21

850.06
(850.09 @ 372')

TRACT 3232
M.B. 35-91

Set 2x2

89-59-55

1320.12 (Calc. from offset)

To 1/2" I.P. pg. 21

1/4 Cor
(fd. 2" I.P. plug + tack) Set in conc. Per Flood Control F.C. 63-93, 93, 94, 95

10.00

Set 1x2

fd. no pt.

659.72 10' offset
(659.68 @ 8.8°)

Set 1x2

Tower 258+40
Ties F.B. 999-40

20

1

WESTERN WATER & POWER COMPANY'S TRACT
M.B. 14-9

3

SAN DIMAS CANYON ROAD

84-963

F.B. 987-118

W3.49-U-2

Bur. Pow. & Li. #359

F.B. 987-119

21

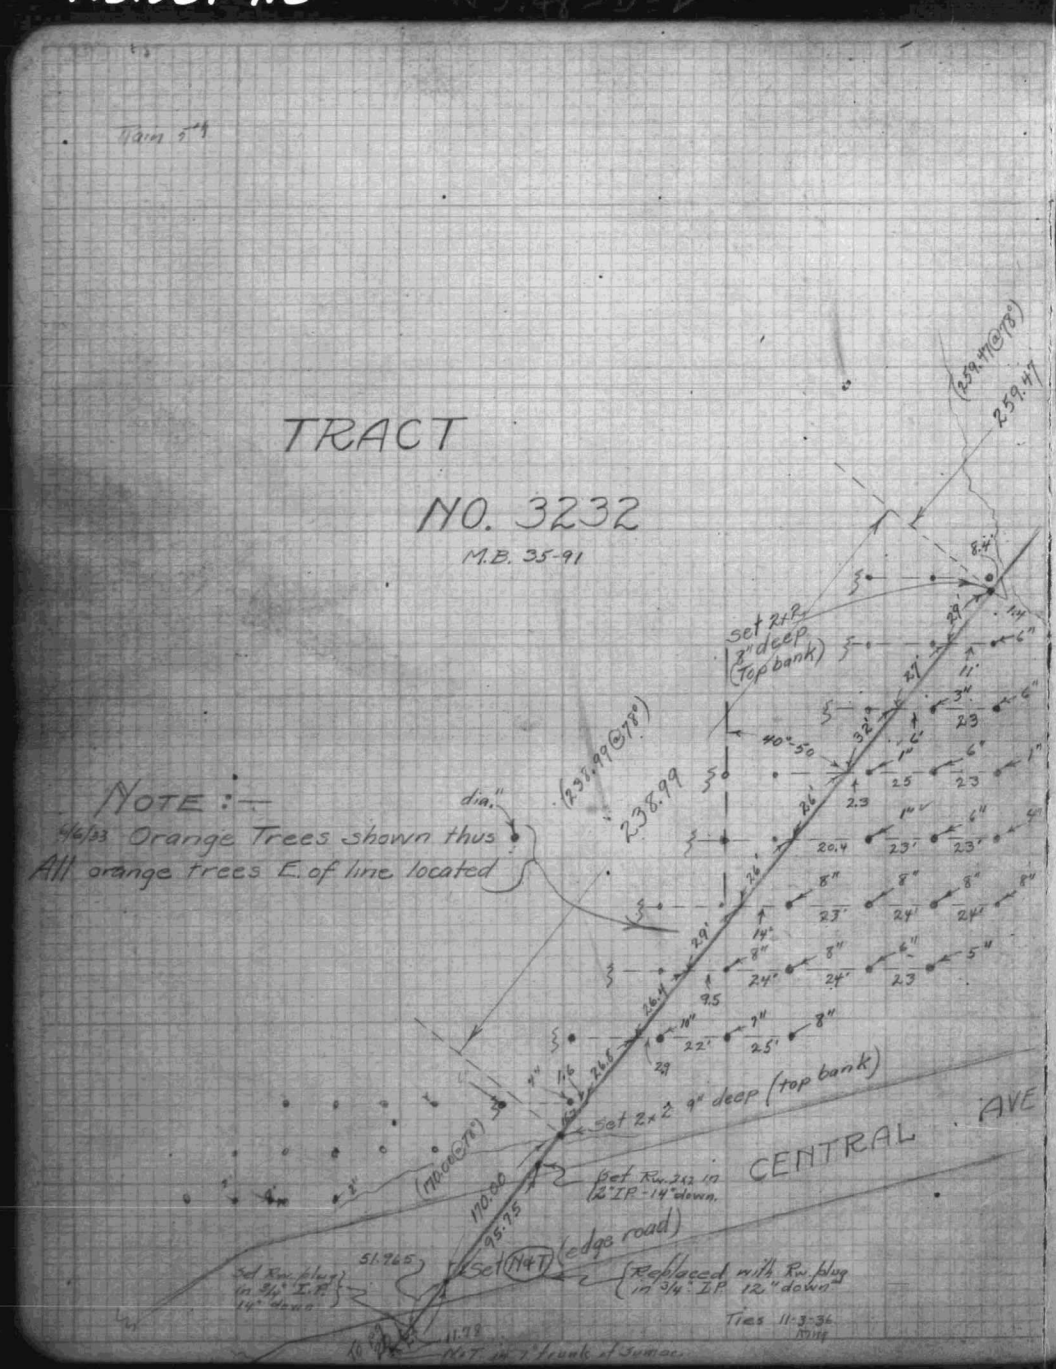

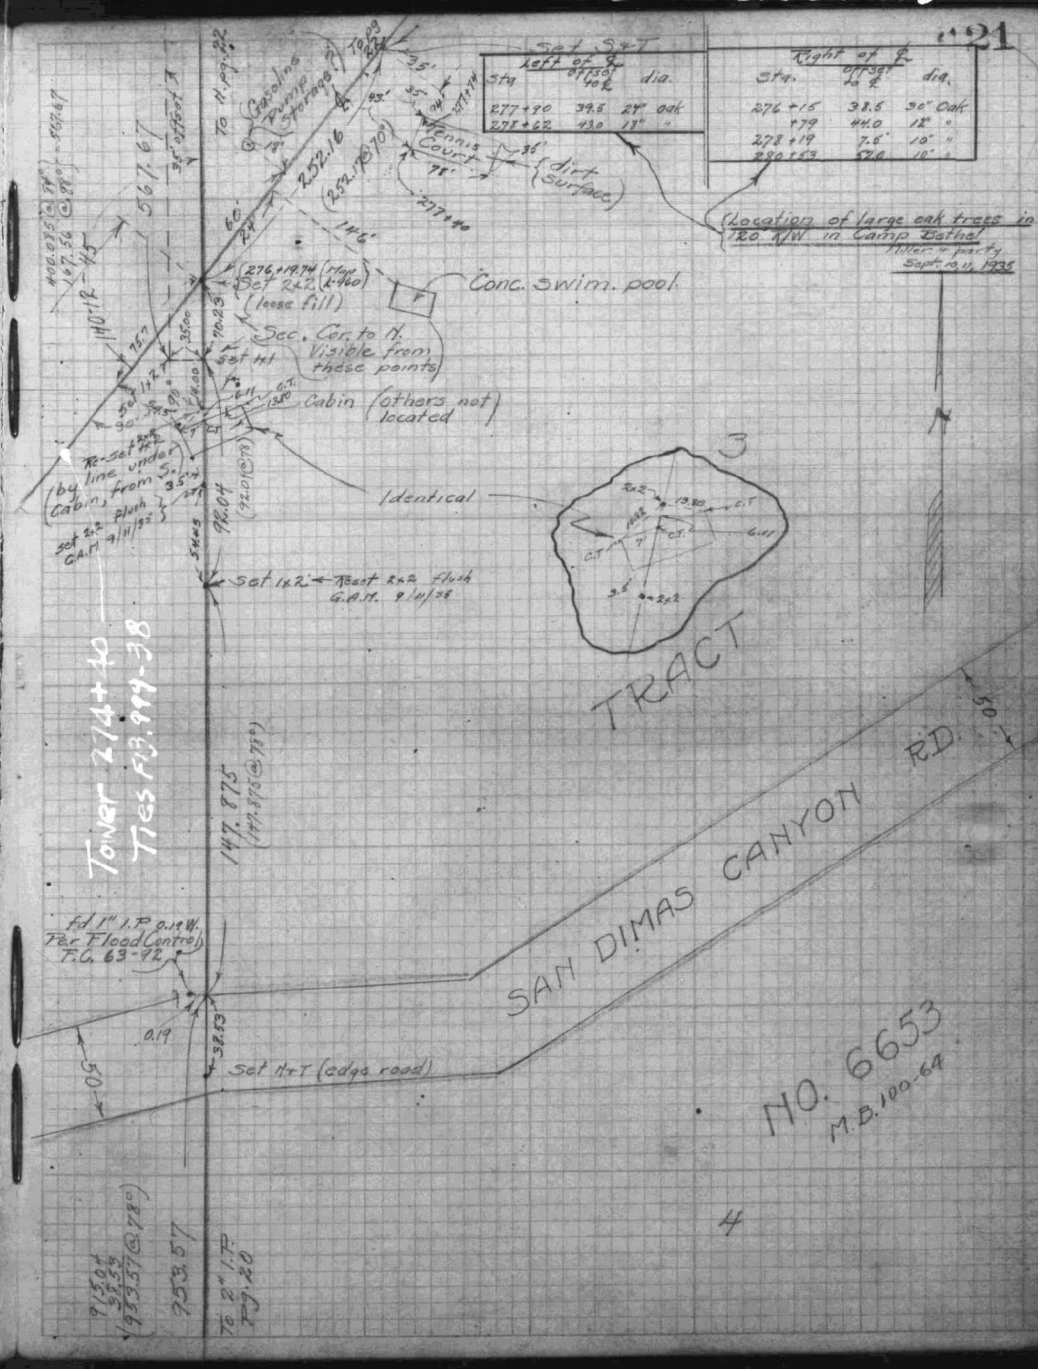

F.B. 987-120

Bur. Pow. & Land #359 F.B. 987-121

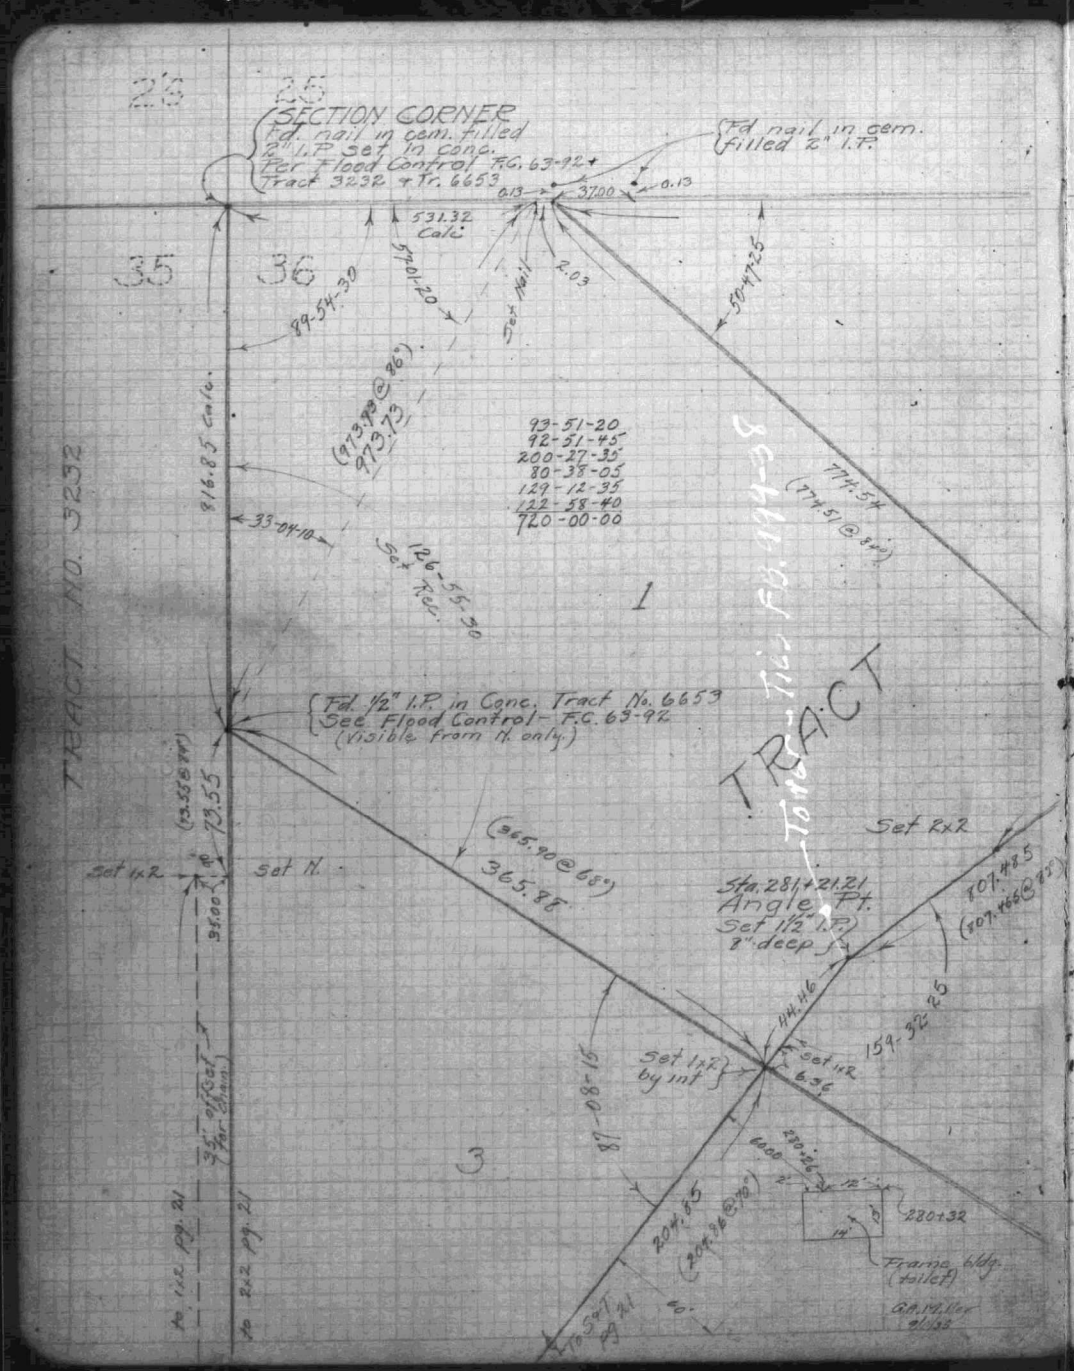

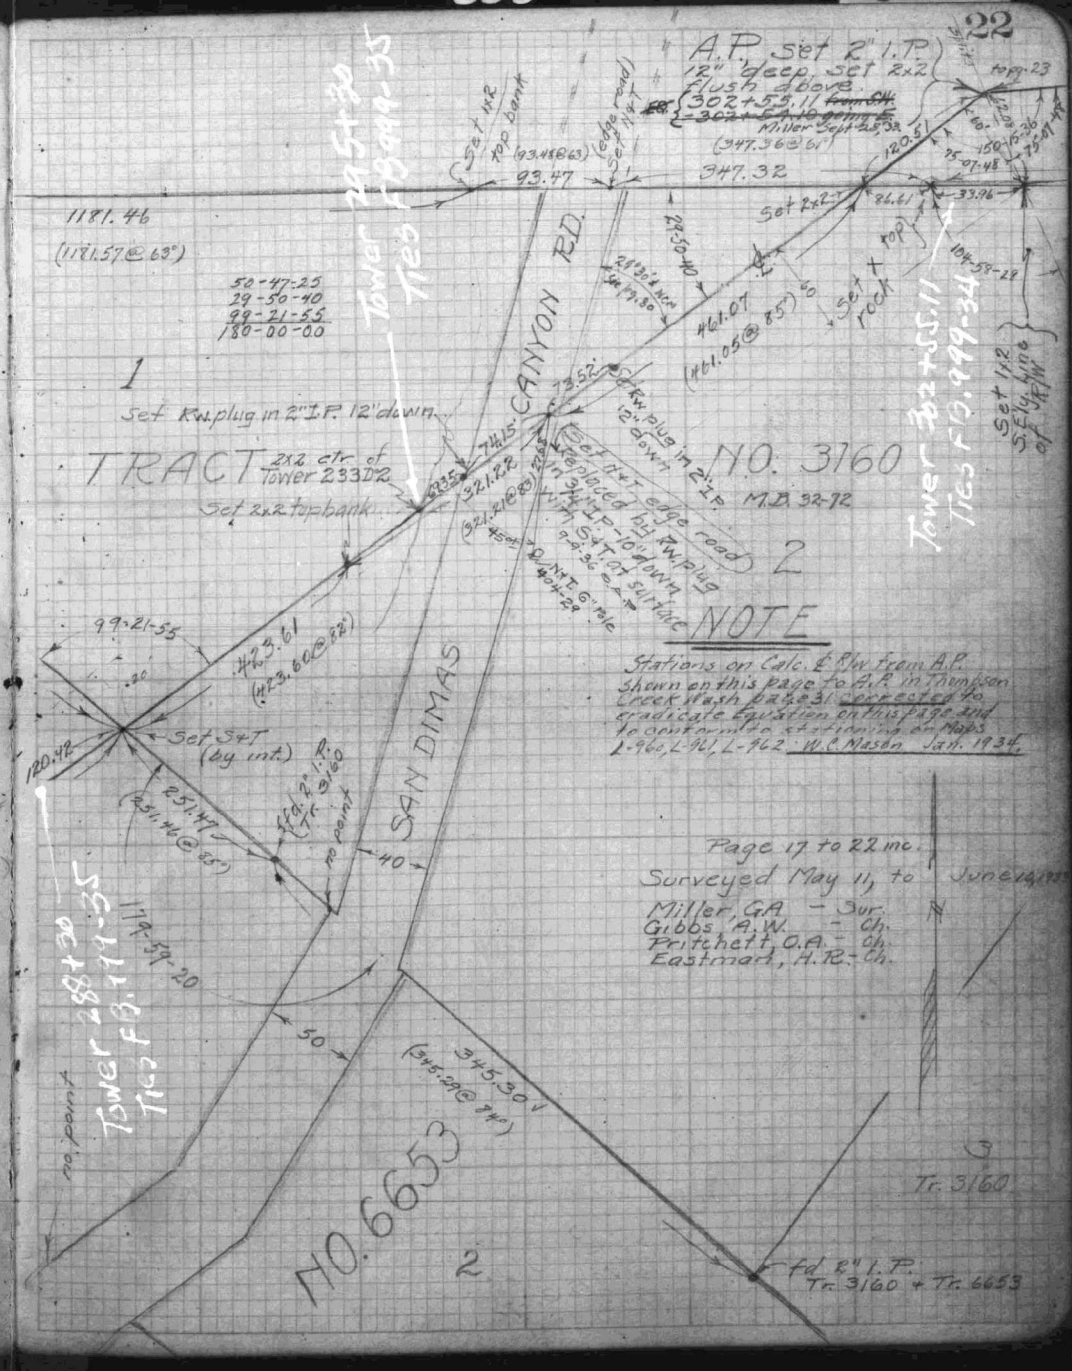

NOTE

Stations on Calc. & R/w from A.P. shown on this page to A.P. in Thompson Creek Wash pg 231 corrected to eradicate Equation on this page and to conform to stationing on Maps L-960, L-961, L-962. W.C. Mason Jan. 1934.

F.B. 987-122

Bur. Pow... 359 F.B. 987-123

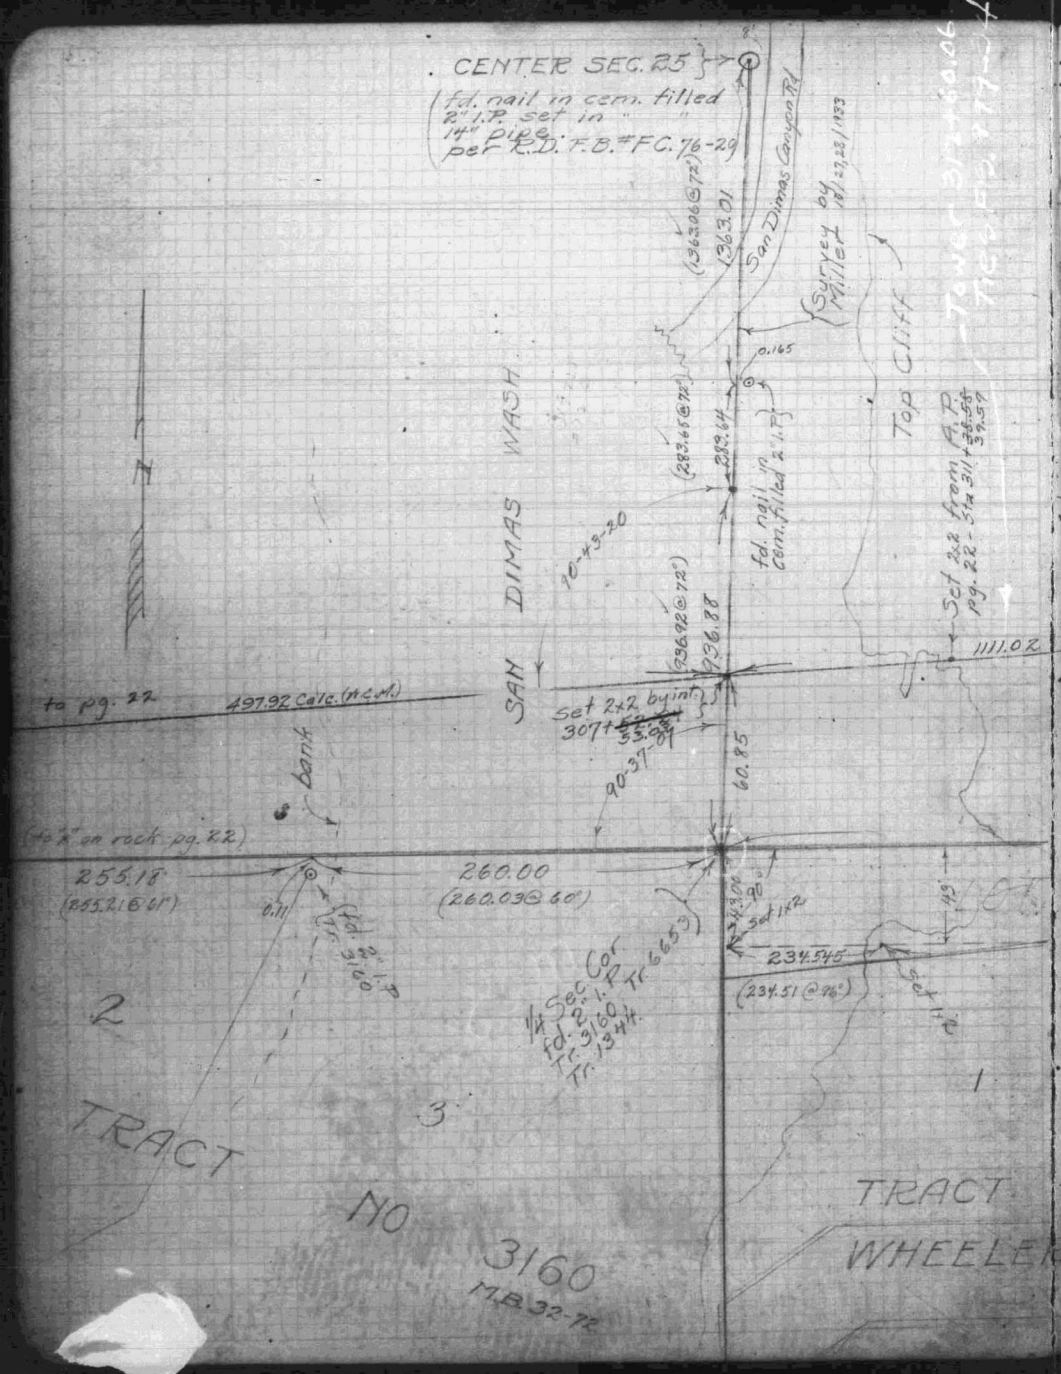

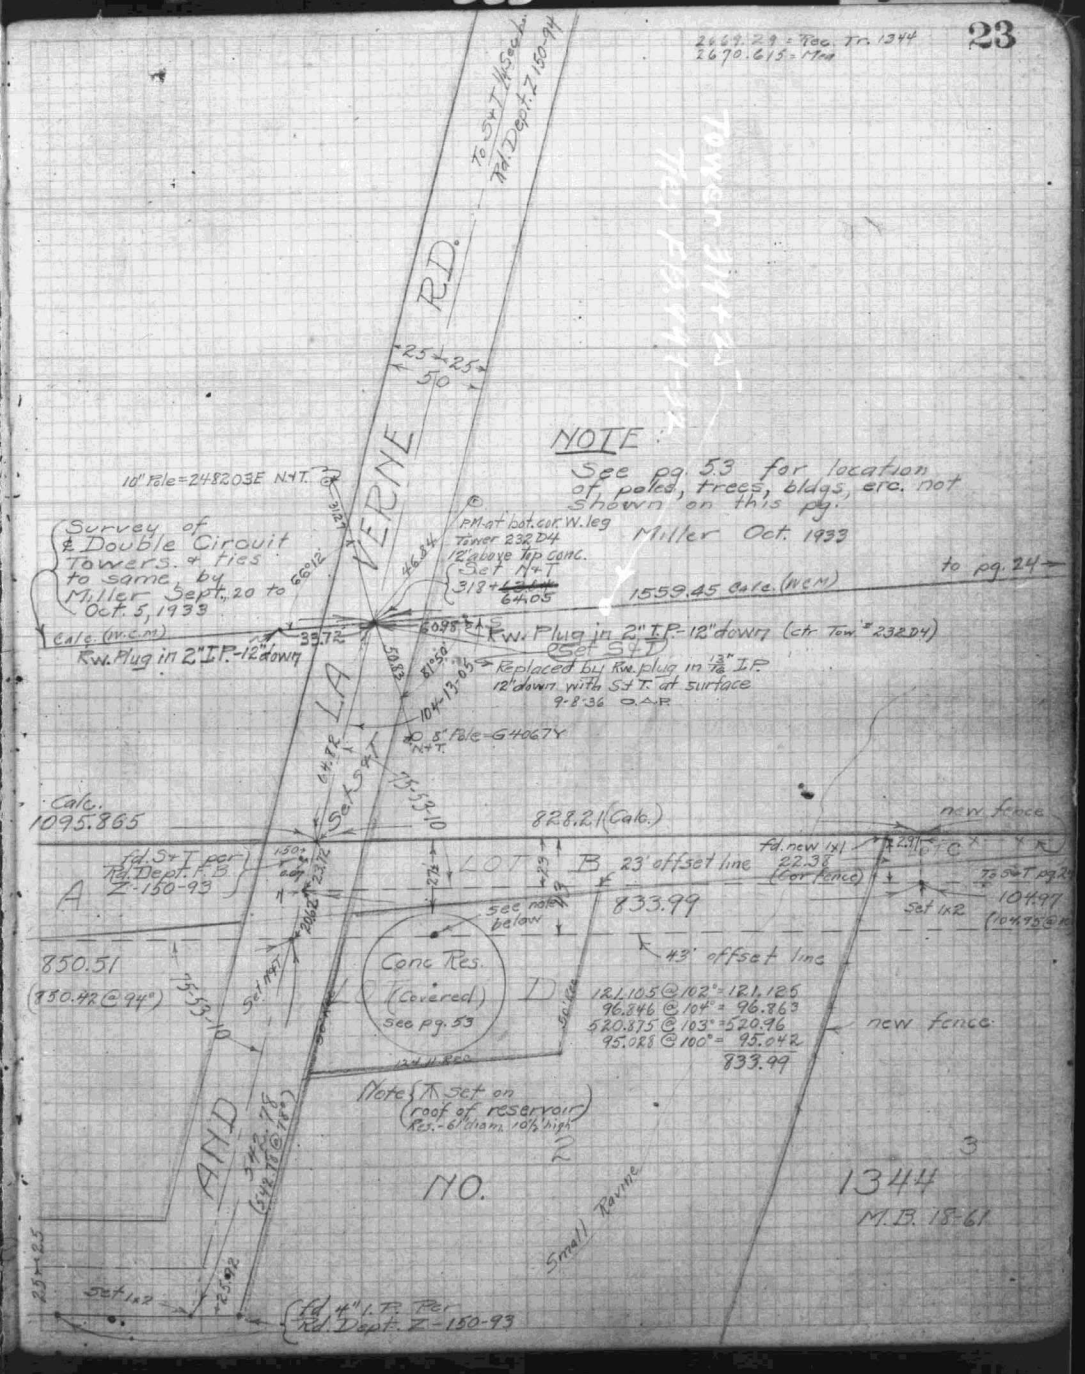

F.B. 987-124

1580.57

Bur. Pow. & ... 359 F.B. 987-125
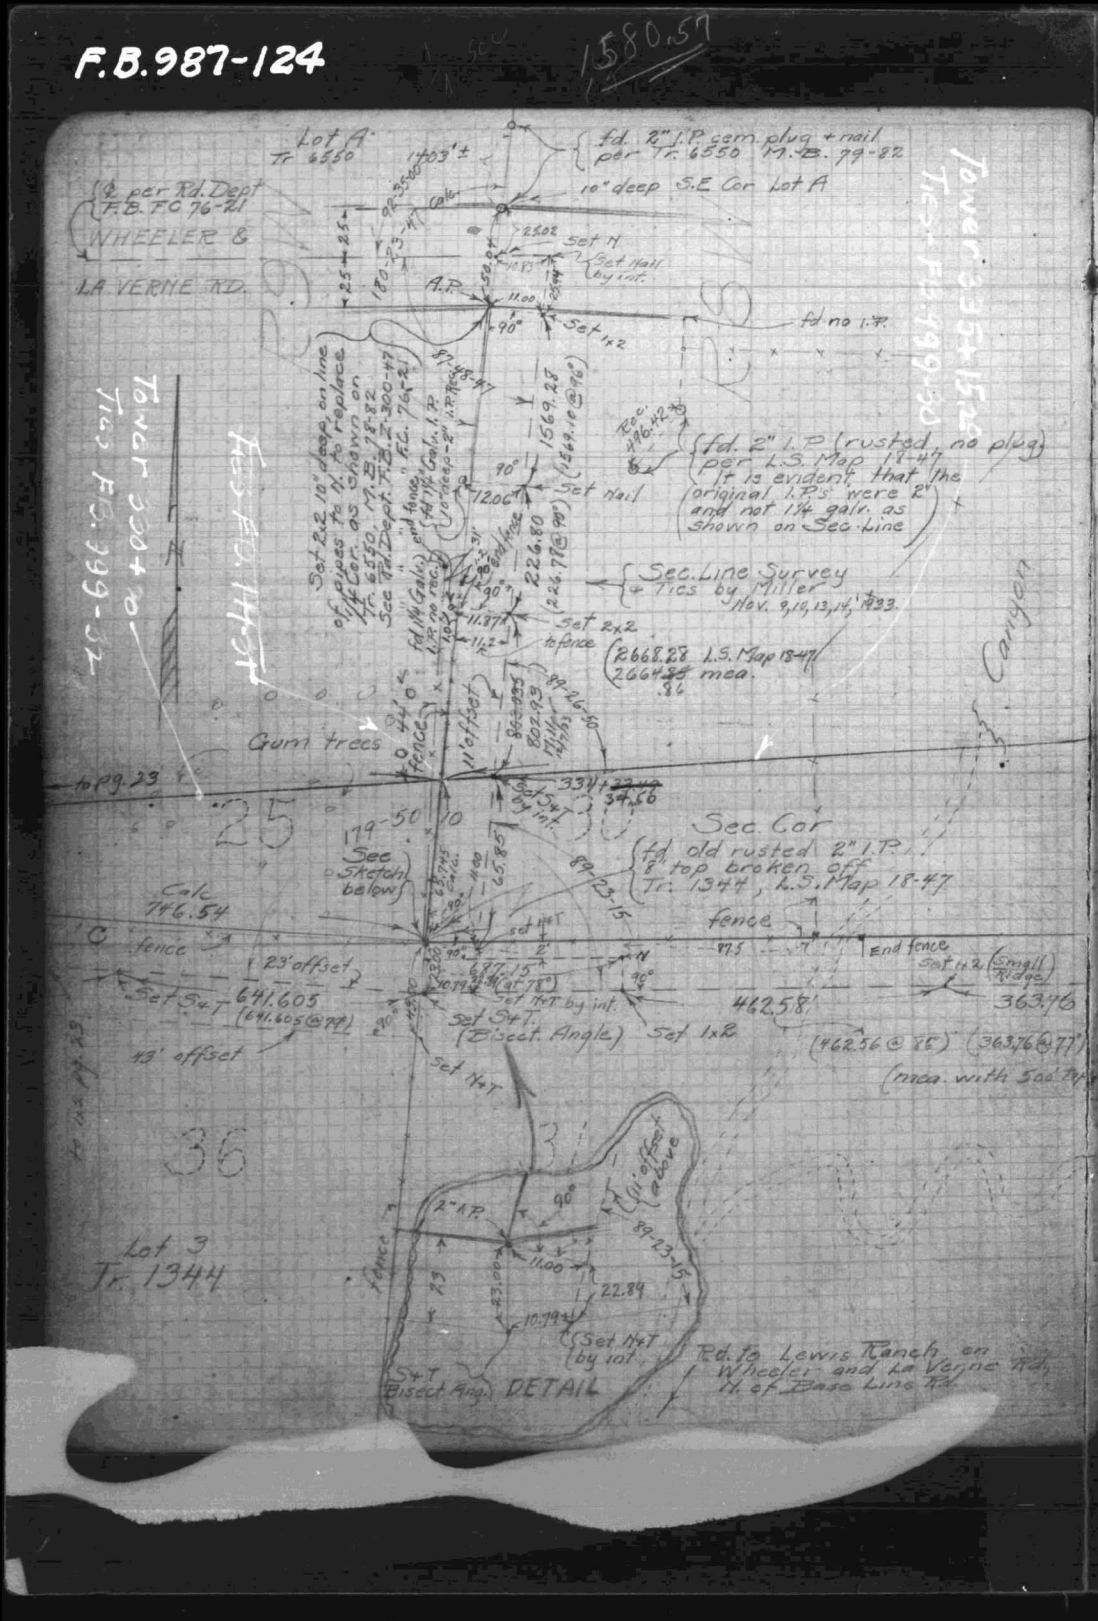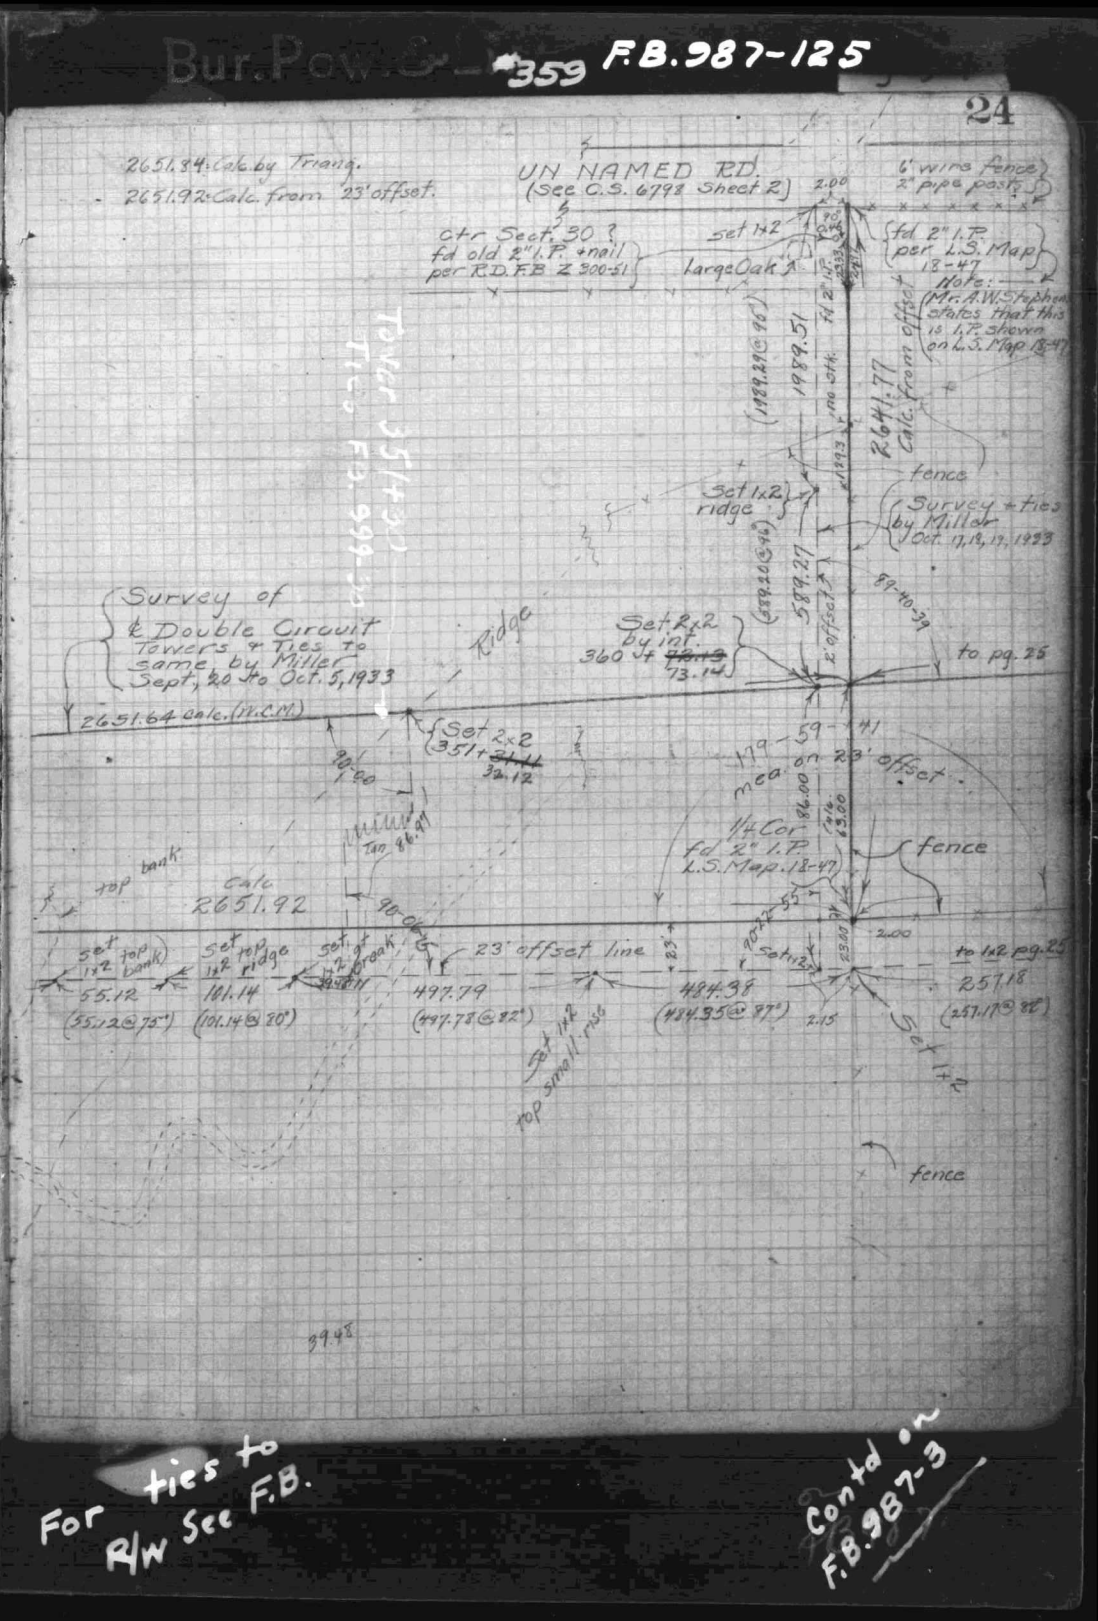
24