The original pages of this book are of poor quality. Care has been taken to make the best scans possible. If necessary you can arrange to see the original book at:

Department of Public Works

900 S. Fremont Ave

Survey Public Counter

Alhambra, CA 91803

(1) F.B. 1022-38
F.B. 1327-79

(2) F.B. 990-49
F.B. 1327-77

(3) F.B. 990-50
F.B. 1327-78

(4) F.B. 1022-33. F.B. 844-235
F.B. 1327-75. F.B. 147-40
F.B. 1553-80

(5) F.B. 1022-34. F.B. 844-238
F.B. 1327-76

(6) F.B. 1022-35. F.B. 844-238
F.B. 1327-73

(7) F.B. 990-33,34. F.B.1327-71,72
F.B. 844-236,237. F.B.147-30,31

(8) F.B. 990-56

(9) F.B. 990-57
F.B. 844-239

(10) F.B. 990-59

(11) F.B. 990-76
F.B. 1022-39

(12) F.B. 990-77
F.B. 1022-40

(13) F.B. 990-78
F.B. 1022-40

(14) F.B. 990-46

(15) F.B. 990-44

(16) F.B. 990-43
F.B. 791-15,282

(17) F.B. 1327-46
F.B. 990-42. F.B. 791-14

(18) F.B. 990-41

(19) F.B. 990-32. F.B. 844-234

(20) F.B. 990-31. F.B. 147-84,85
F.B. 844-233. F.B. 791-13

(21) F.B. 990-30
F.B. 844-232

(22) F.B. 990-39

(23) F.B. 990-39

(24) F.B. 990-40

(25) F.B. 990-29
F.B. 844-232

(26) F.B. 990-38

(27) F.B. 990-28
F.B. 844-231

(28) F.B. 990-27
F.B. 844-231

(29) F.B. 990-26

(30) F.B. 990-26

(31) F.B. 990-25

(32) F.B. 990-23

(33) F.B. 990-24

(34) F.B. 990-79
F.B. 1022-41

(35) F.B. 990-80

(36) F.B. 990-81
F.B. 1022-42

(37) F.B. 990-82
F.B. 1022-42

(38) F.B. 990-83

(39) F.B. 990-84
F.B. 1022-43

(40) F.B. 1022-22

(41) F.B. 1022-23

(42) F.B. 1022-24

(43) F.B. 1022-25

(44) F.B. 1022-26
F.B. 247-95

(45) F.B. 1022-27
F.B. 247-95

(46) F.B. 1022-28. F.B.844-223
F.B. 791-195. F.B.247-97

(47) F.B. 1022-29. F.B.791-194
F.B. 844-222

(48) F.B. 1022-30
F.B. 844-221
F.B. 791-11,193
F.B. 1022-30

(49) F.B. 1553-180
F.B. 791-11
F.B. 147-4

(50) F.B. 990-53
F.B. 247-99

(51) F.B. 1022-67

(52) F.B. 1022-65

(53) F.B. 1022-64

(54) F.B. 1022-63

(55) F.B. 990-54

(56)

(57) F.B. 990-85
F.B. 1022-46

(58) F.B. 990-86
F.B. 1022-45

(59) F.B. 990-87,88. F.B. 1022-47
F.B. 1327-56

(60) F.B. 1327-58

(61) F.B. 1327-57

(62) F.B. 1327-60

(63) F.B. 1022-5,6. F.B. 1327-62

(64) F.B. 990-52. F.B. 1022-7,8
F.B. 1327-63,64
F.B. 1022-9,10

(65) F.B. 1327-66
F.B. 247-100
F.B. 147-80
F.B. 1022-12

(66) F.B. 1327-65
F.B. 247-100
F.B. 147-70,
80,135

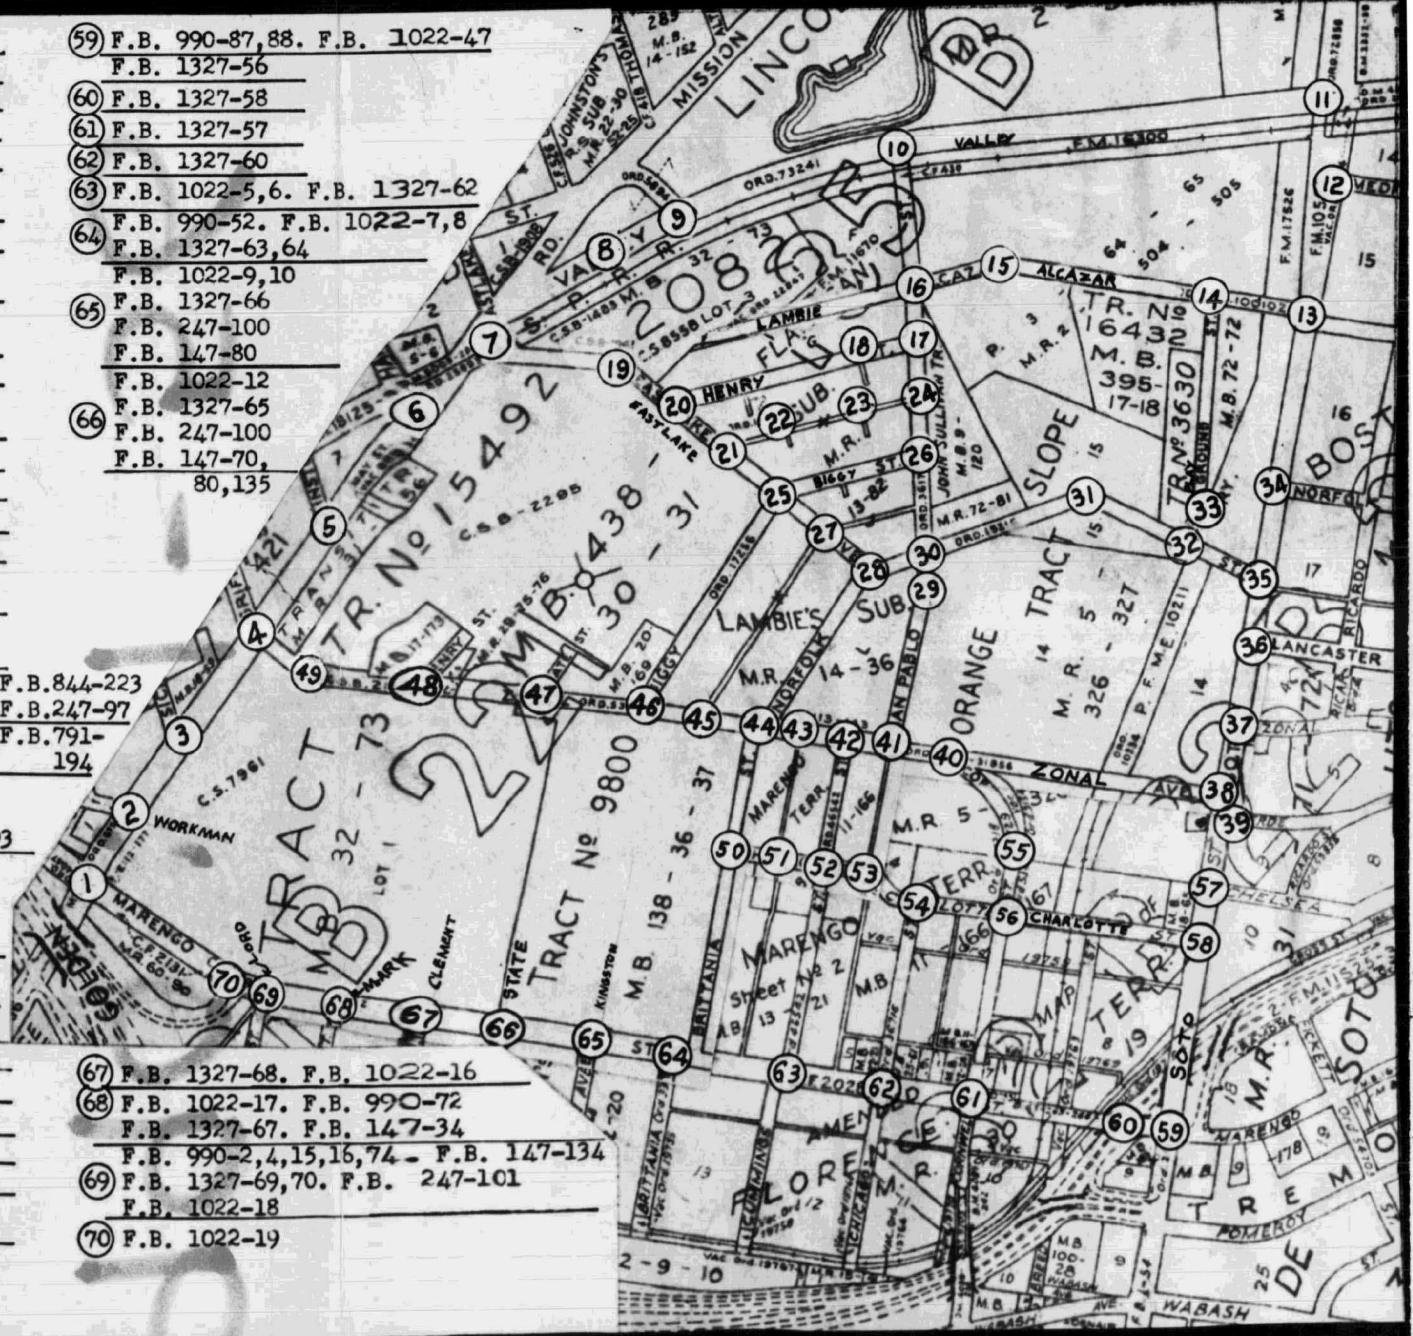

(67) F.B. 1327-68. F.B. 1022-16

(68) F.B. 1022-17. F.B. 990-72
F.B. 1327-67. F.B. 147-34
F.B. 990-2,4,15,16,74 - F.B. 147-134

(69) F.B. 1327-69,70. F.B. 247-101
F.B. 1022-18

(70) F.B. 1022-19

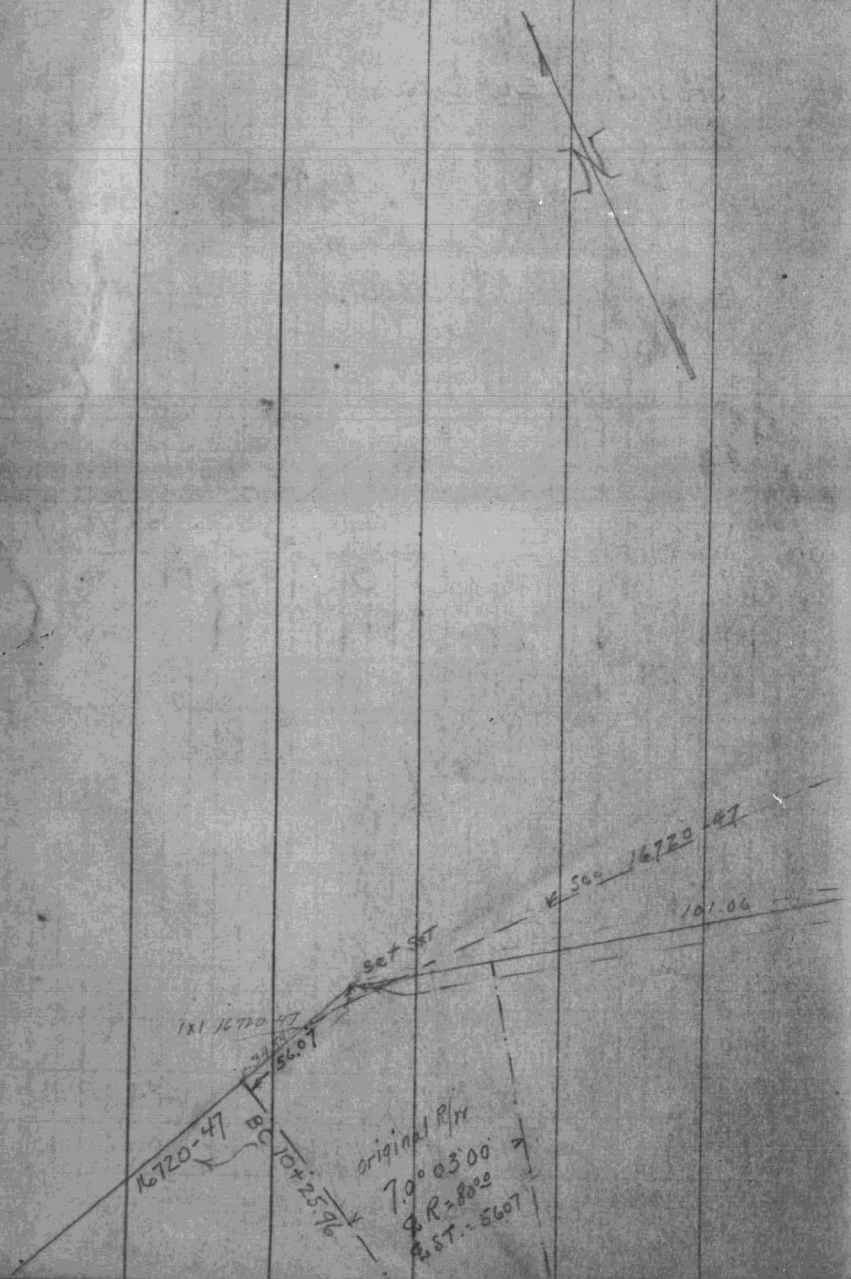
16720-47
101.06
set SKT
1x1 16720-47
56.07
16720-47
BC
10+25.96
original R/W
7°03'00"
R=80.0
ST.=56.07

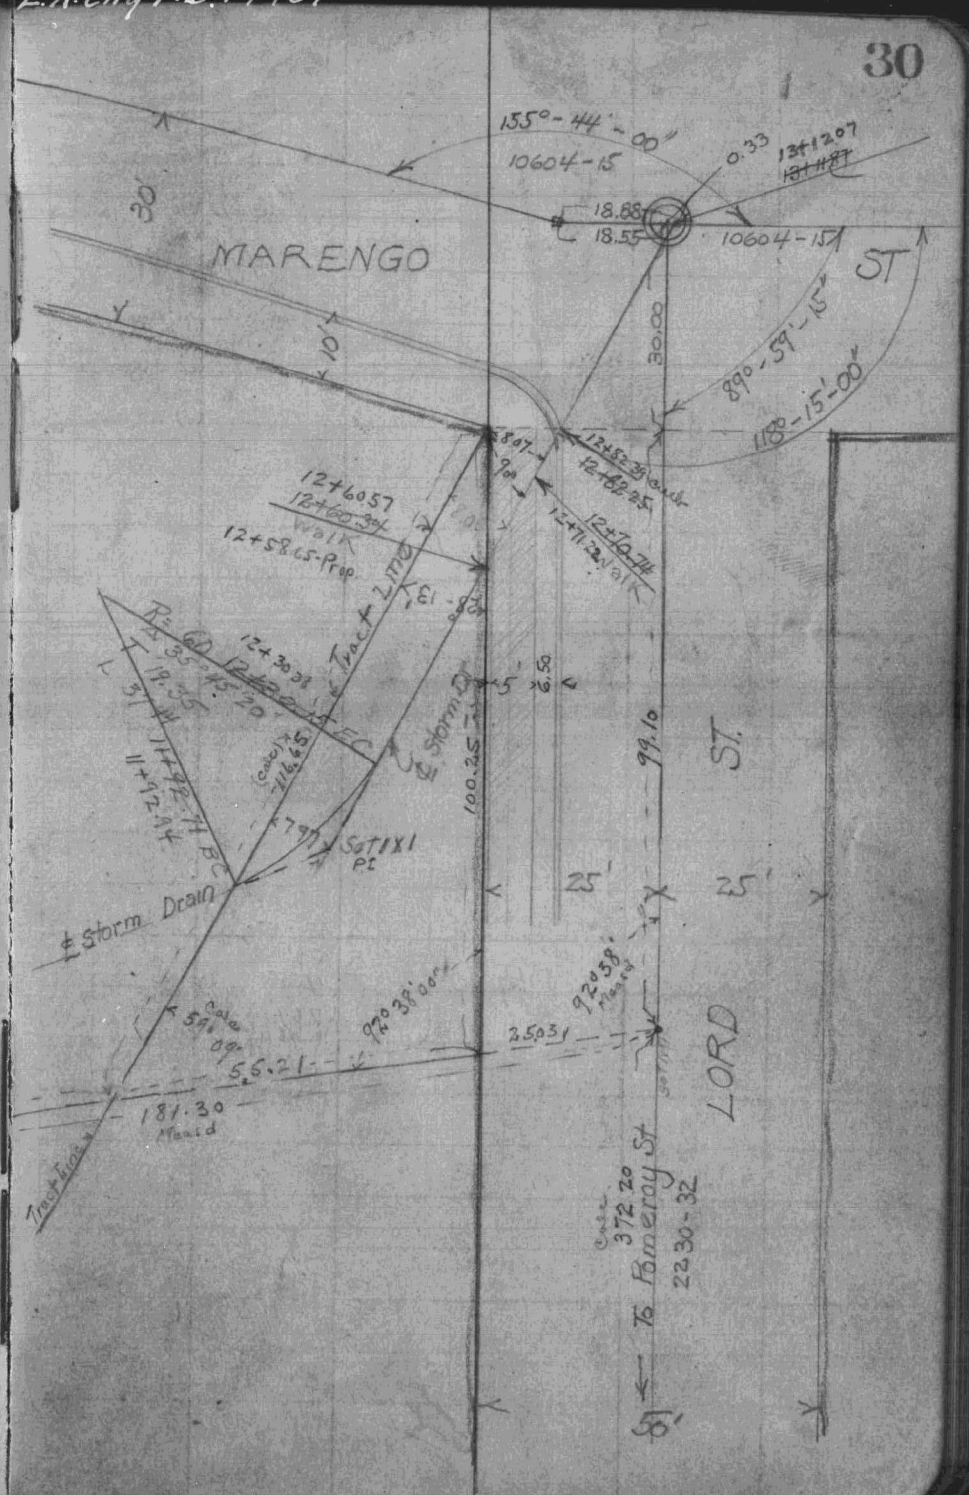
155°-44'-00"
10604-15
0.33
13+12.07
18.88
18.55
10604-15
MARENGO
ST
30
30.00
89°-59'-15"
118°-15'-00"
12+60.57
12+60.34
12+58.65-Prop.
Walk
Tract Line
R=60.0
L=51.19
11+42.71 BC
11+92.44
EC
Storm Drain
SET 1x1 PE
100.25
99.10
25'
25'
ST.
LORD
92°38'
181.30
Meas'd
Tract line
To Pomeroy St
372.20
2230-32

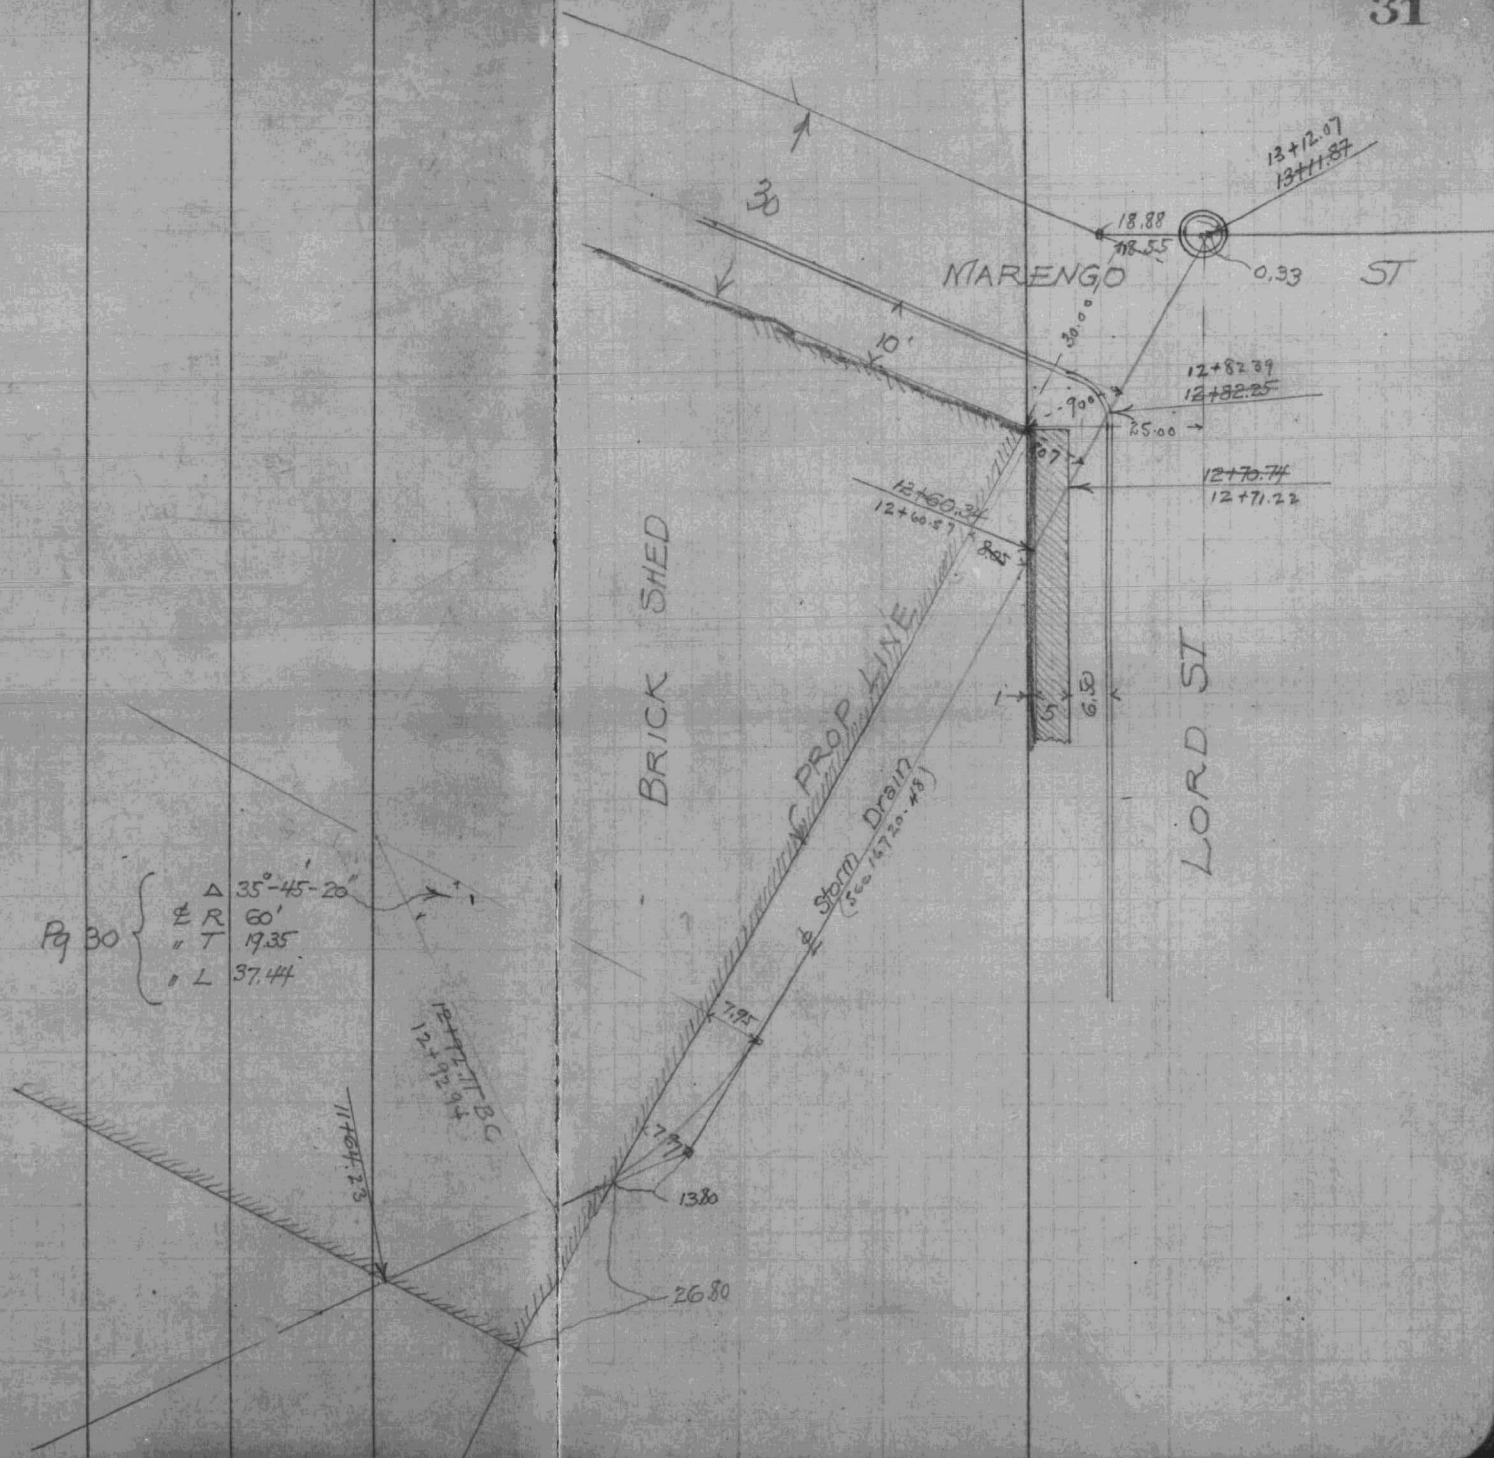
30
10'
MARENGO ST
LORD ST
BRICK SHED
PROP LINE
℄ Storm Drain
(See 16720-48)
13+12.07
13+11.87
18.88
18.55
0.33
30.00
12+82.39
12+82.25
90°
25.00
12+70.74
12+71.22
12+60.34
12+60.57
8.05
6.50
1
5
7.95
7.97
13.80
26.80
Pg 30
Δ 35°-45'-20"
℄ R 60'
" T 19.35
" L 37.44
12+92.94
11+64.23

INDEXED JUL 10 1934

SEE. D.3606

R. OF W.

WEST OF LORD ST

~~DRAINAGE RELIEF~~

RAMONA BLD. to MARENGO ST

S.D. PROFILE

W.O. 45620
C 1872

July-5-34

Douthitt
Oetting
Kipke
Evrist

℄ Refs. 10604-14-15-2230-27-32

Sta. New

B.Ms. Pg 2-11075-22

Levels Pg. 49
" continued 14451-29

U.S.G.S. DATUM

SEE 11075-20 To 23 & 11061-59
FOR. MARENGO & LORD STS

Pole LOCATION PG. 43
RAIL " " 44

THESE ELEVATIONS ARE BASED ON U.S.G.S. DATUM
ADOPTED JULY 1st. 1925 — ORDINANCE No. 52.222

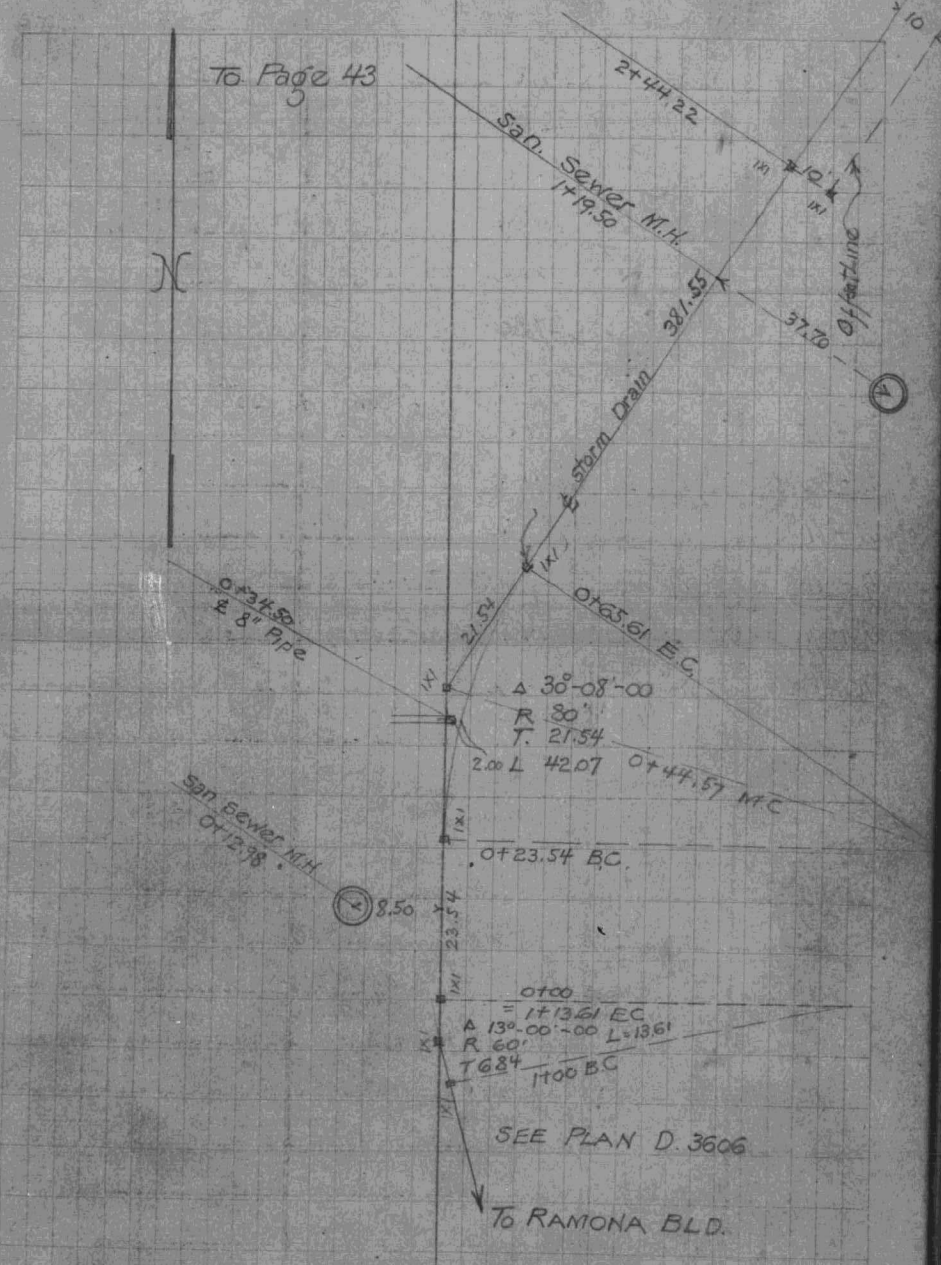

		W. of ℄.	
0+83	Pole	20.50	
1+40	"	22.00	
2+12	"	26.10	
2+75	"	30.00	
3+30	"	28.00	
3+94	"	29.50	
4+57	"	27.20	
5+07			24" Cem Pipe 22.00 W of ℄
5+75	"	14.00	
6+30	"	10.50	
6+71	"	13.50	
7+80	"	33.00 off S.T.	
8+90	"	19.70	
10+02	"	6.90	

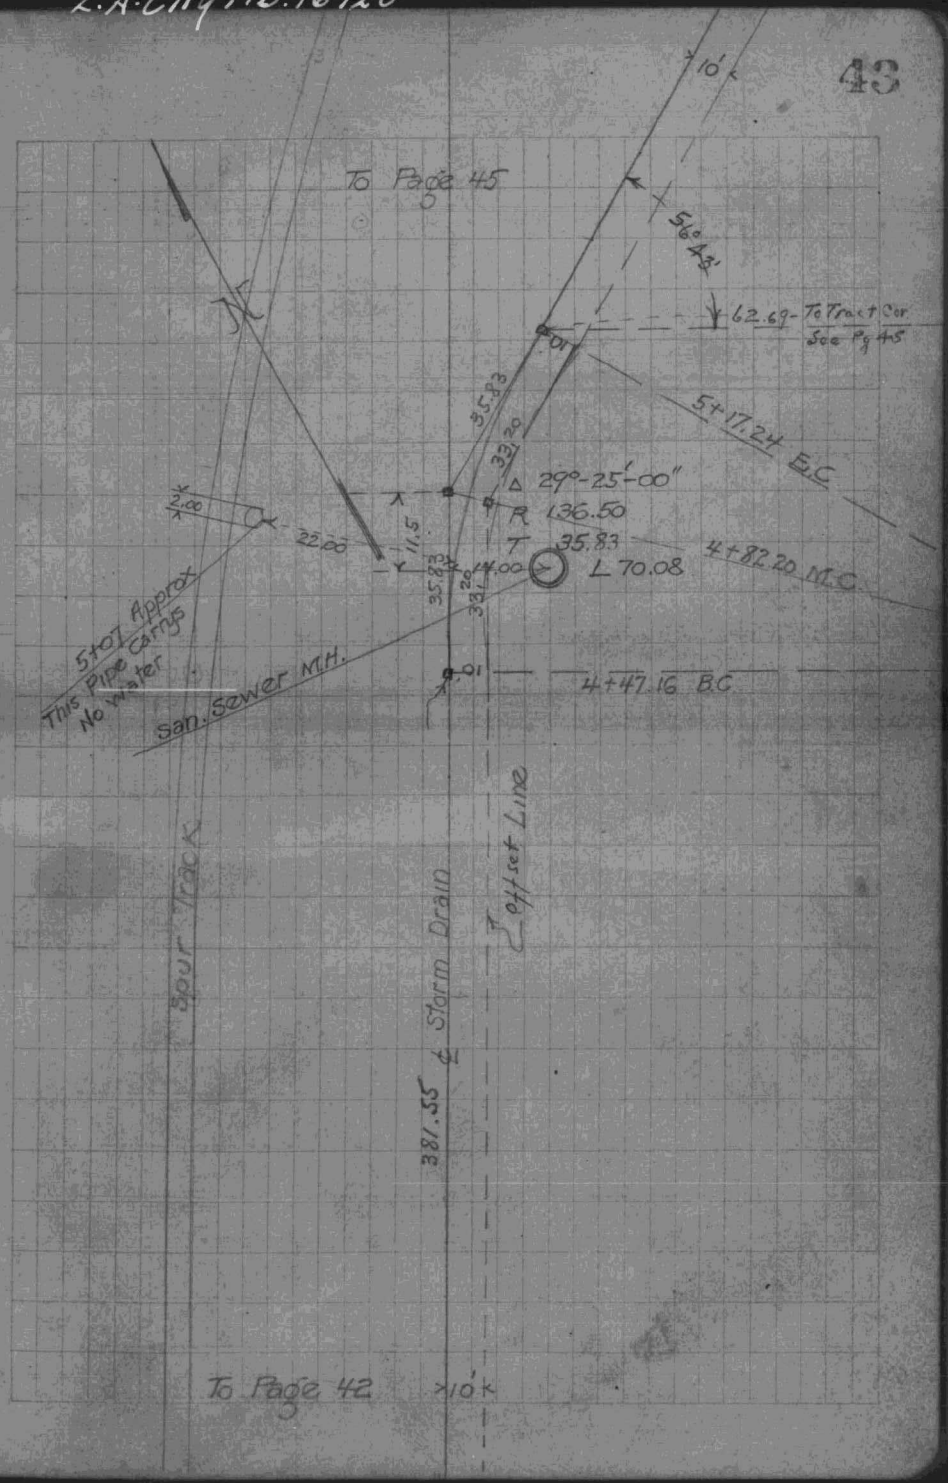

F. B. 990-9

L.A. City FB 16720

F. B. 990-10

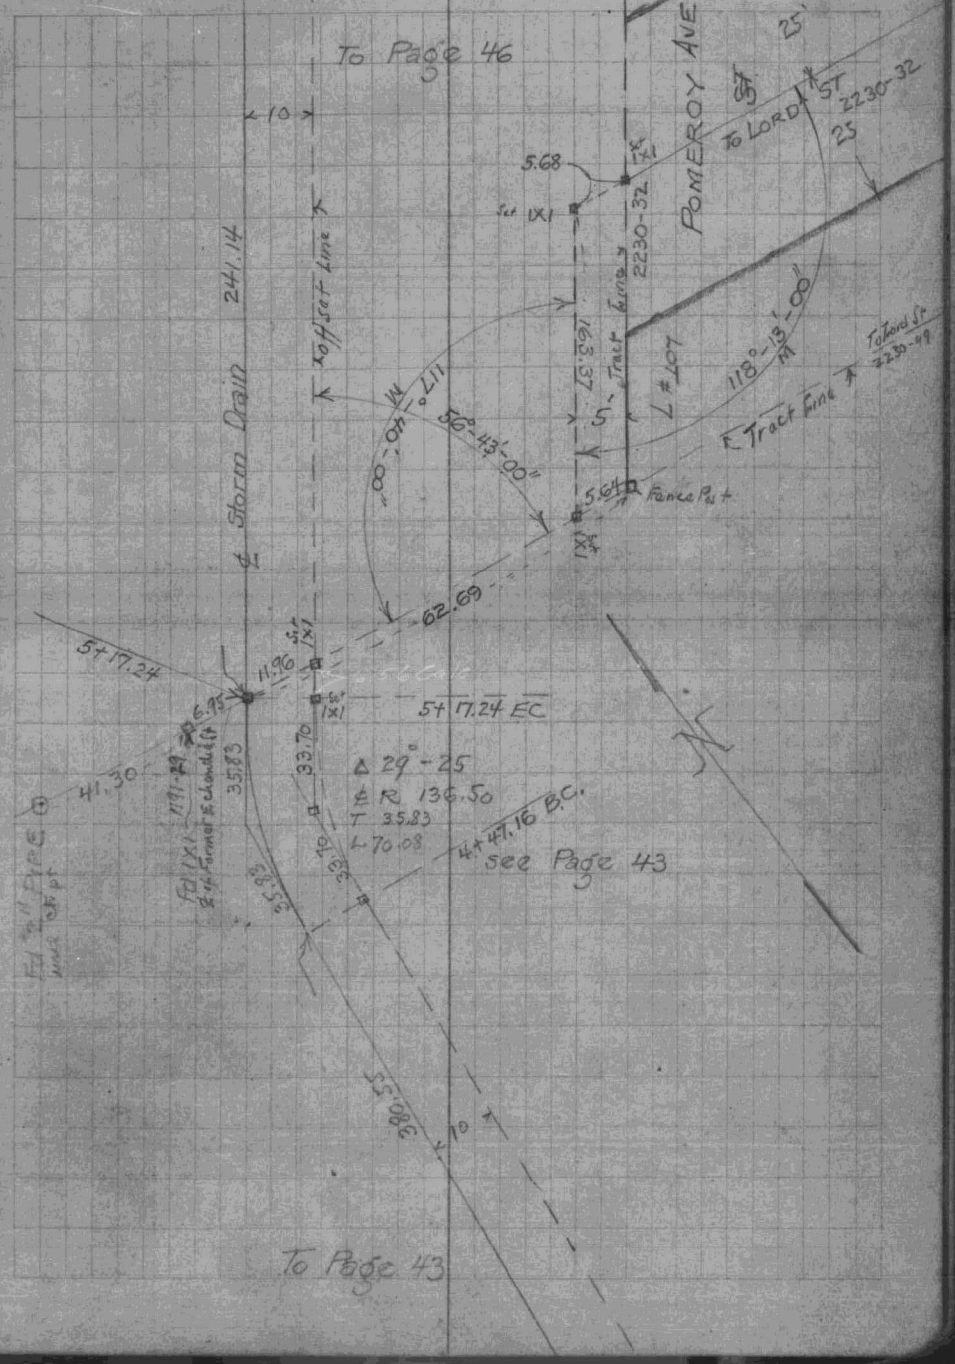

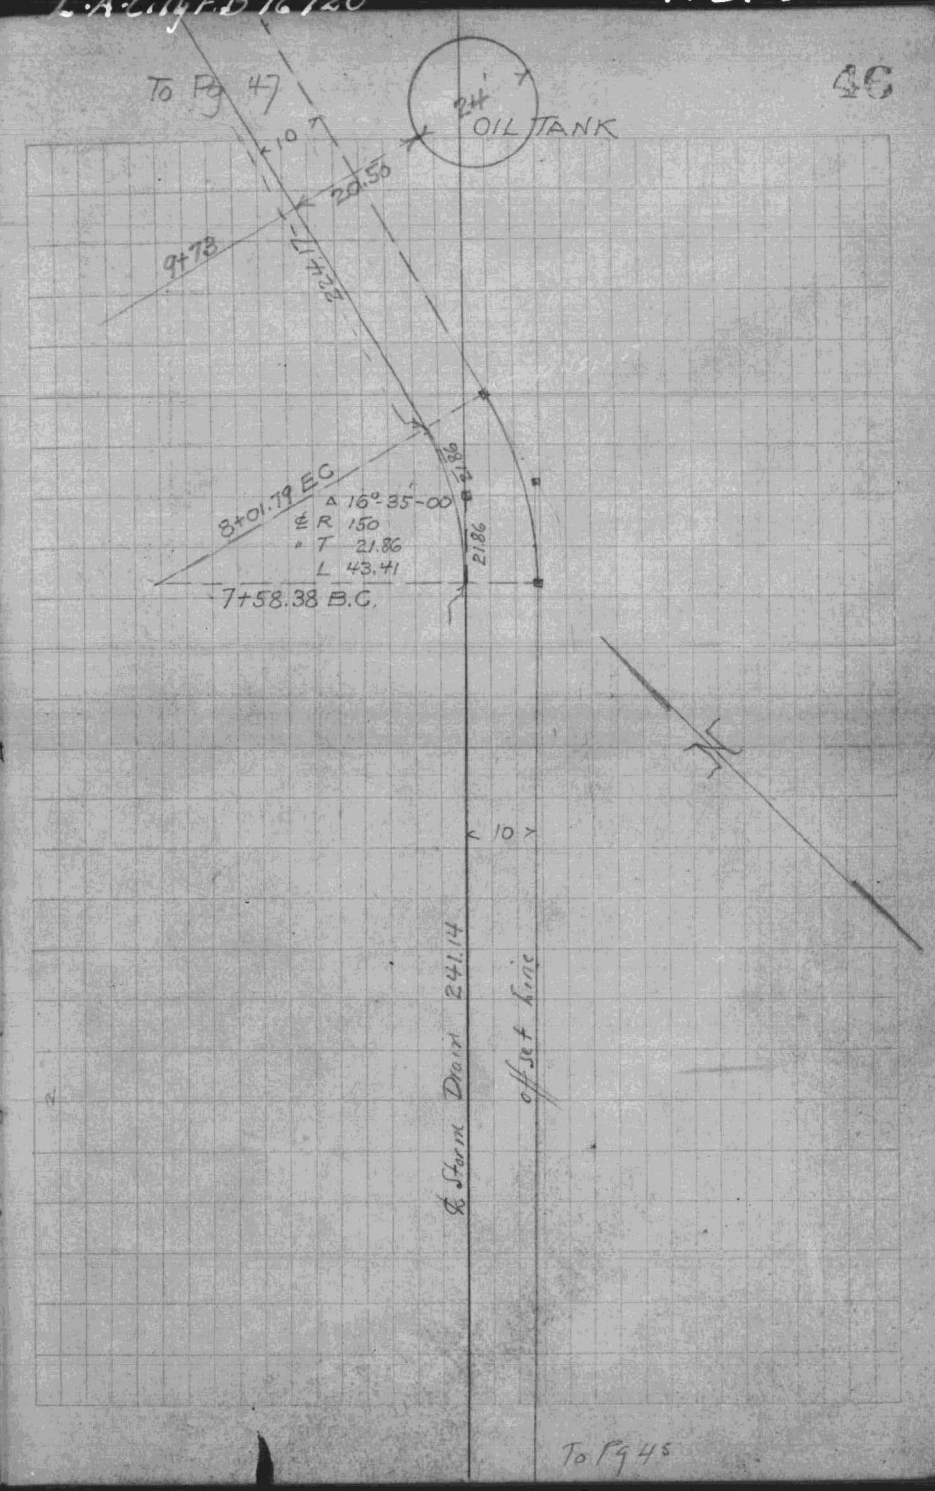
To Pg 47
24'
OIL TANK
10
20.50
9+73
22+17
8+01.79 E.C.
Δ 16°-35-00
℄ R 150
" T 21.86
L 43.41
21.86
21.86
7+58.38 B.C.
10
℄ Storm Drain 241.14
offset line
To Pg 45

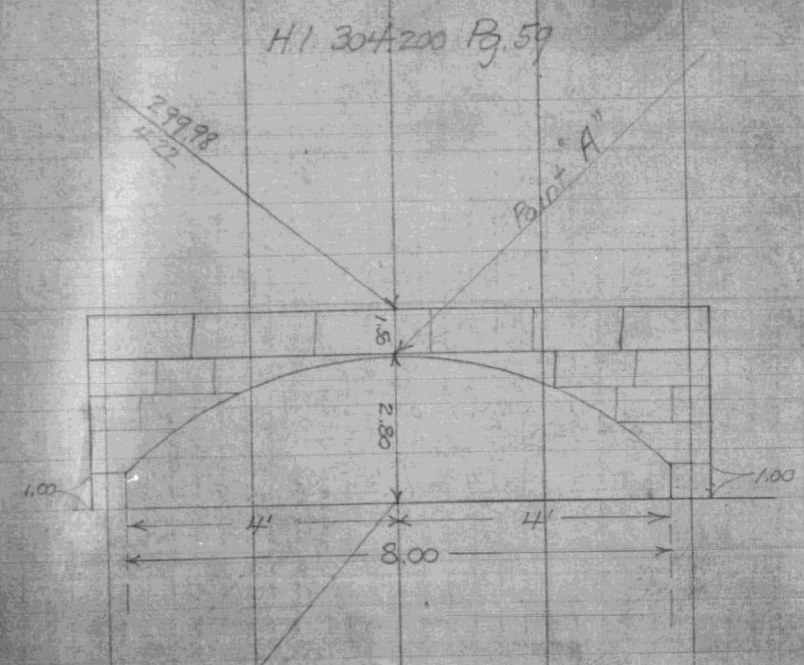

THESE ELEVATIONS ARE BASED ON U.S.C. & G. DATUM
ADOPTED JULY 1st. 1925 — ORDINANCE No.

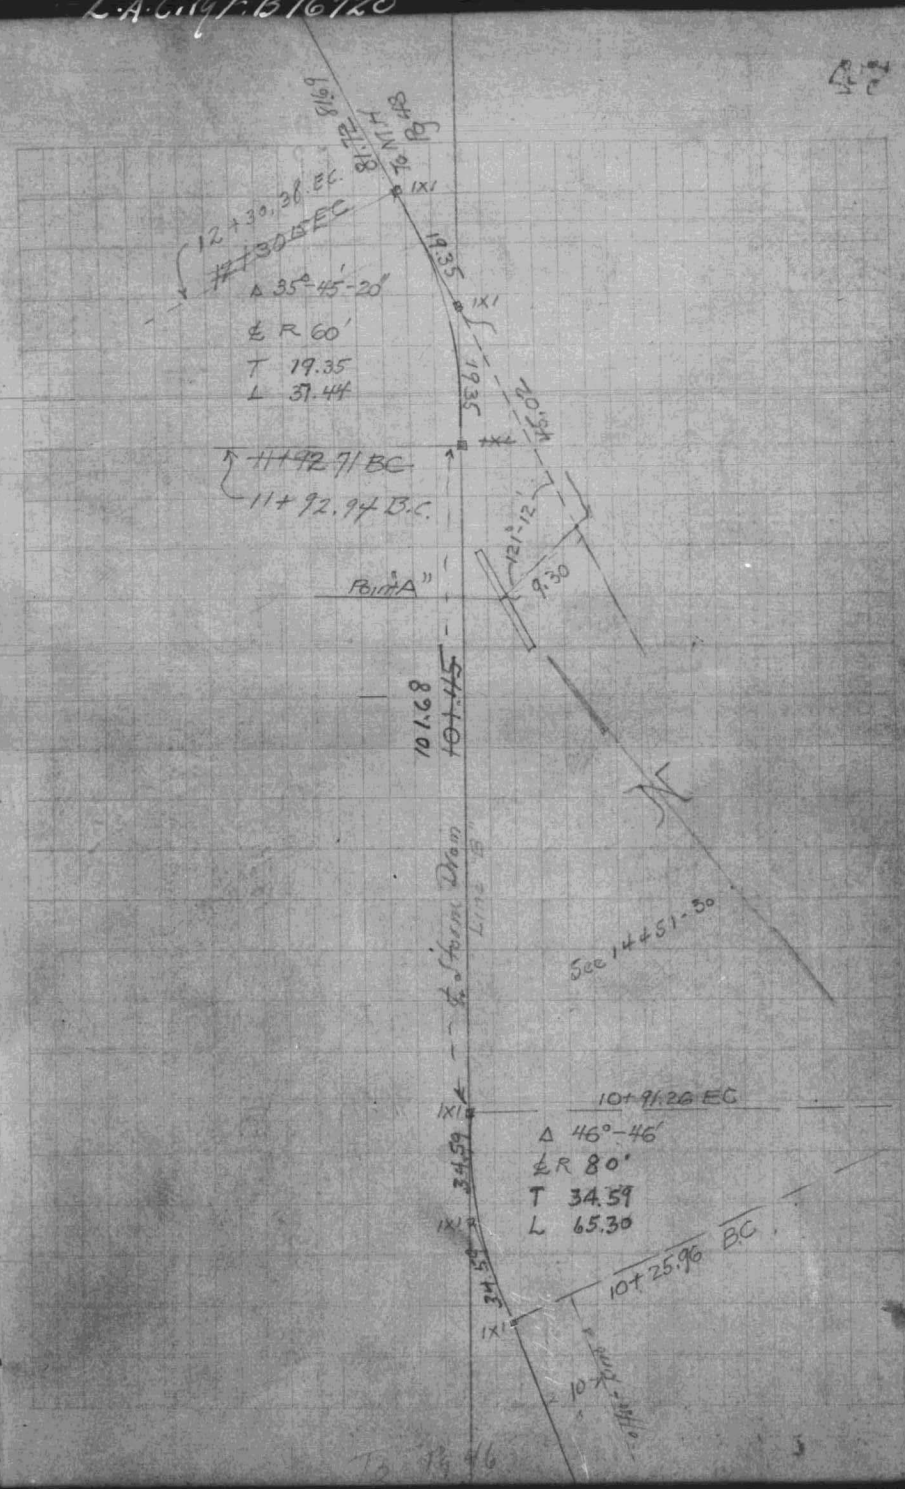

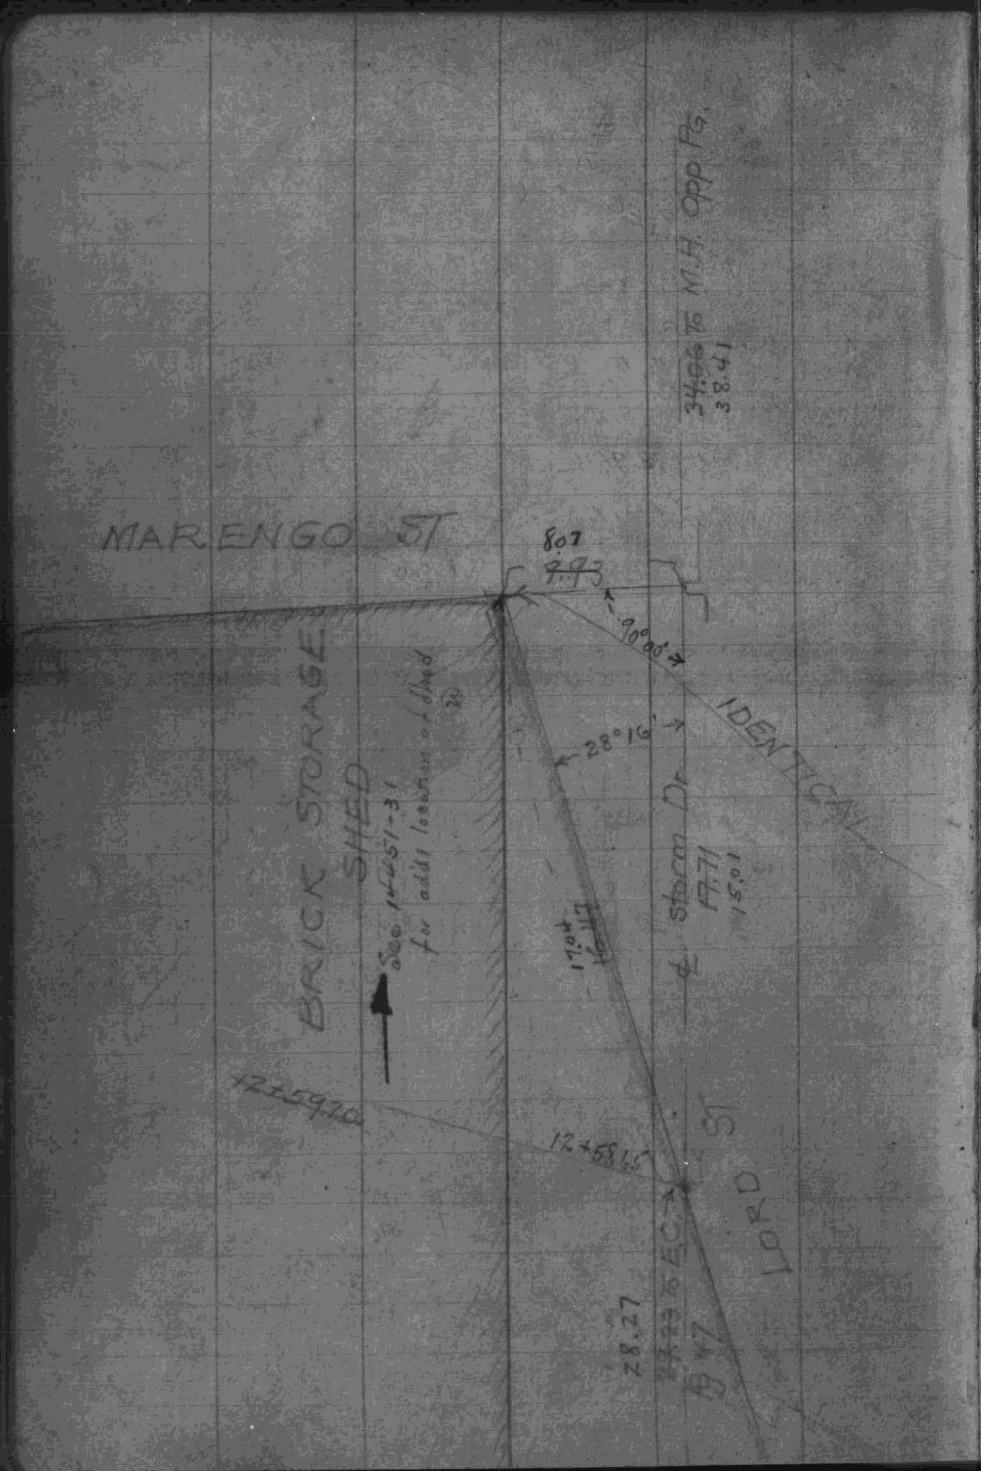
MARENGO ST
8.07
7.93
90°00'
28°16'
IDENTICAL
BRICK STORAGE SHED
See 14251-31 for addl loss on Lind
℄ storm Dr
F.F. 71
15.01
17.01
12+59.70
12+58.65
LORD ST
28.27
34.06 To M.H. Opp Pg.
38.41

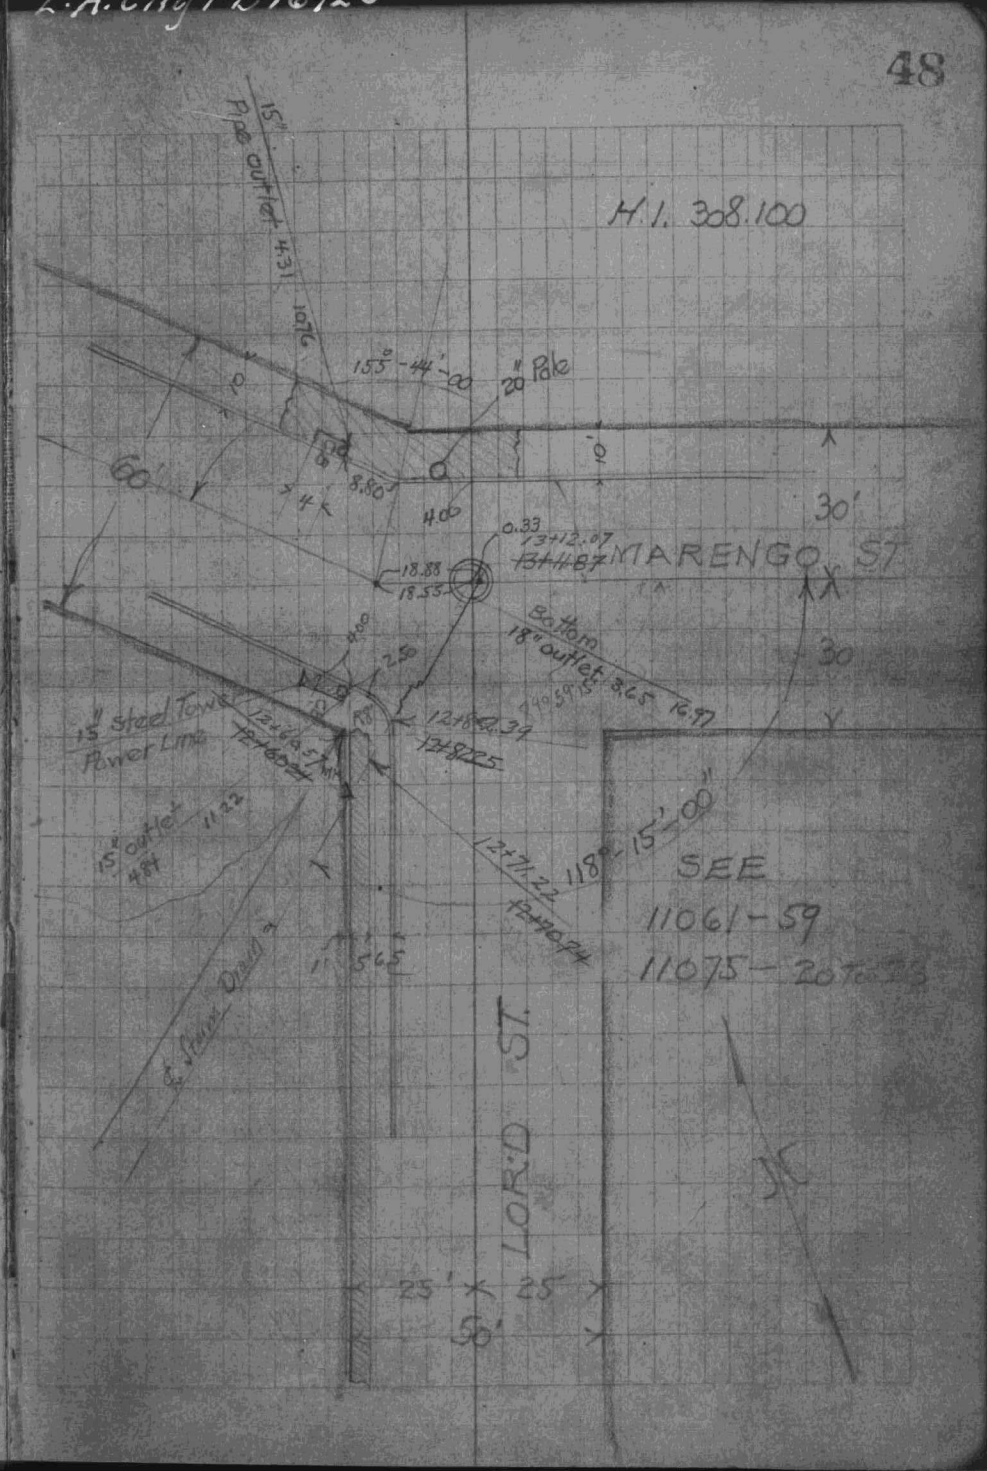
H.I. 308.100
15" Pipe outlet 4.31
10.76
155°-44'-00"
20" Pole
60'
8.80
4.00
0.33
13+12.07
13+14.87
MARENGO ST
30'
18.88
18.55
Bottom 18" outlet 3.65
16.77
30
15" steel Tower Power Line
12+64.57
12+60.27
12+80.39
12+80.25
15" outlet 4.87
11.22
12+71.22
12+70.94
118°-15'-00"
SEE 11061-59
11075-20 to 23
℄ Storm Drain
11.56.5
LORD ST
25' × 25'
50'

F.B.990-17

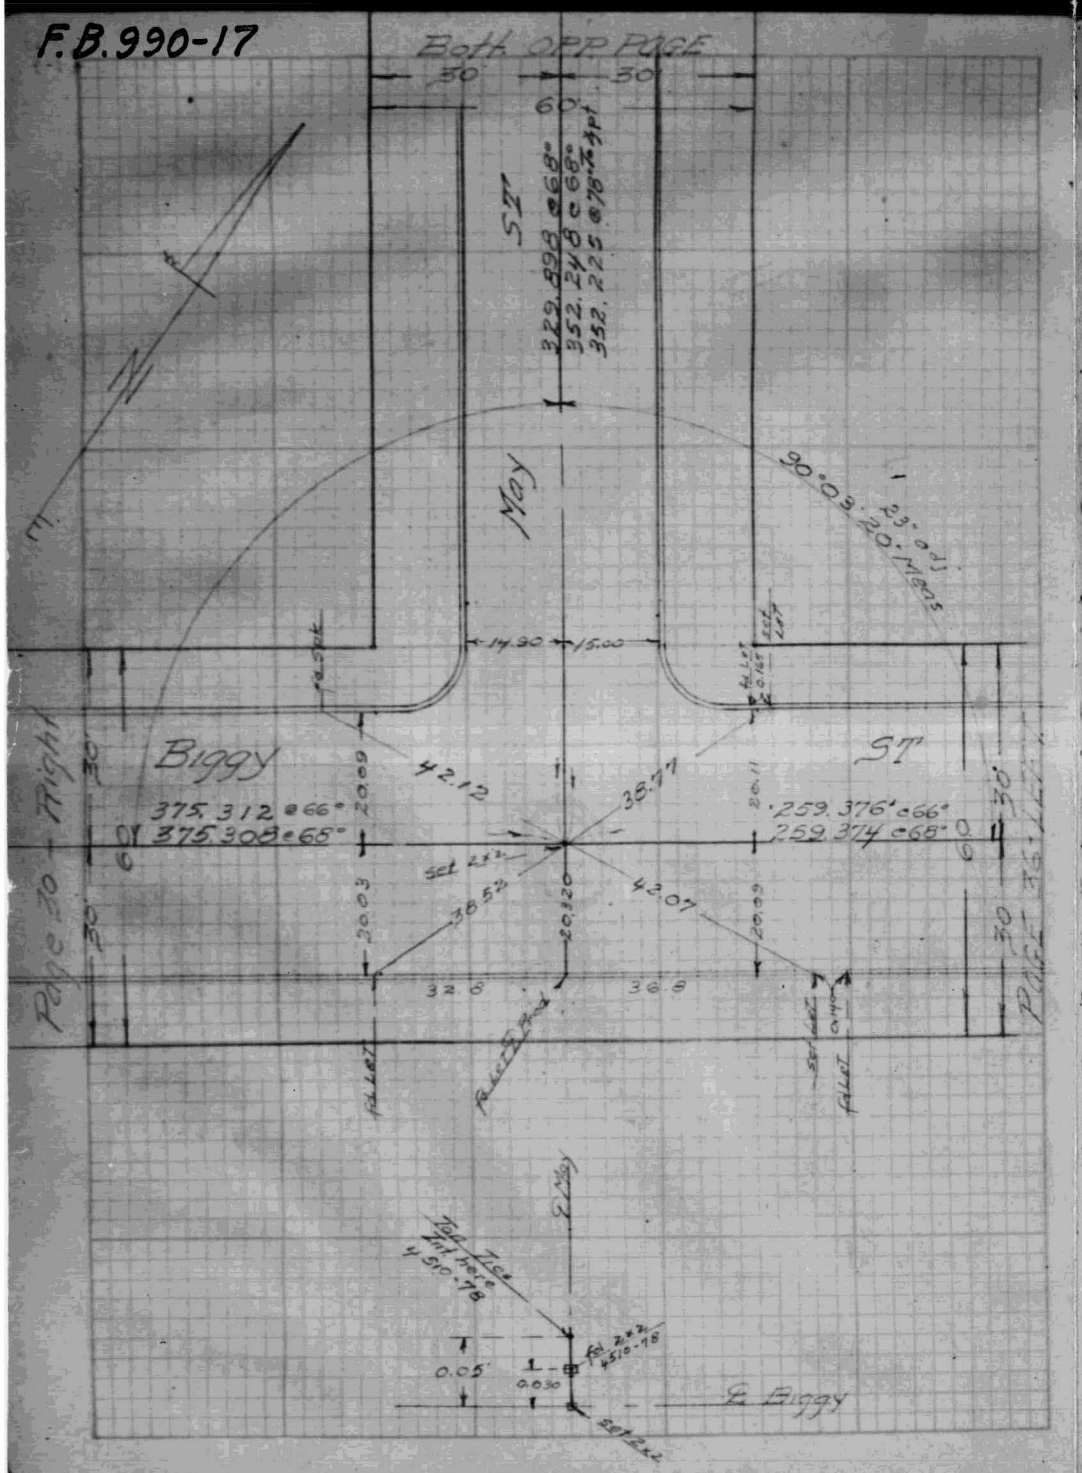

F.B.990-18

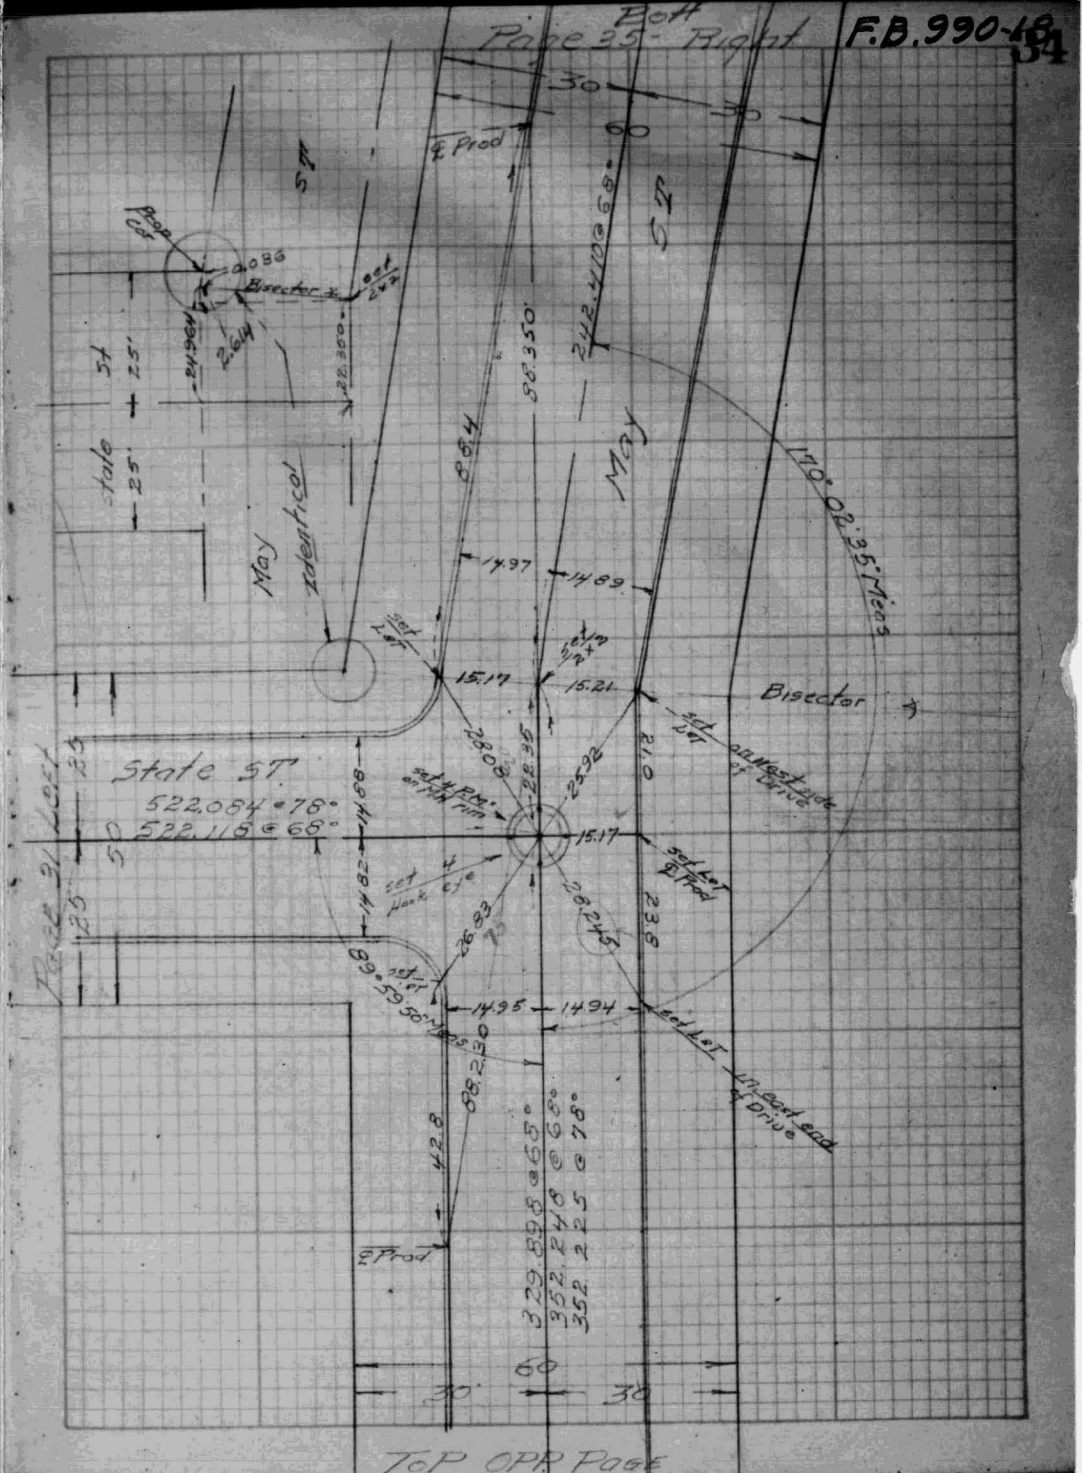

F.B. 990-19

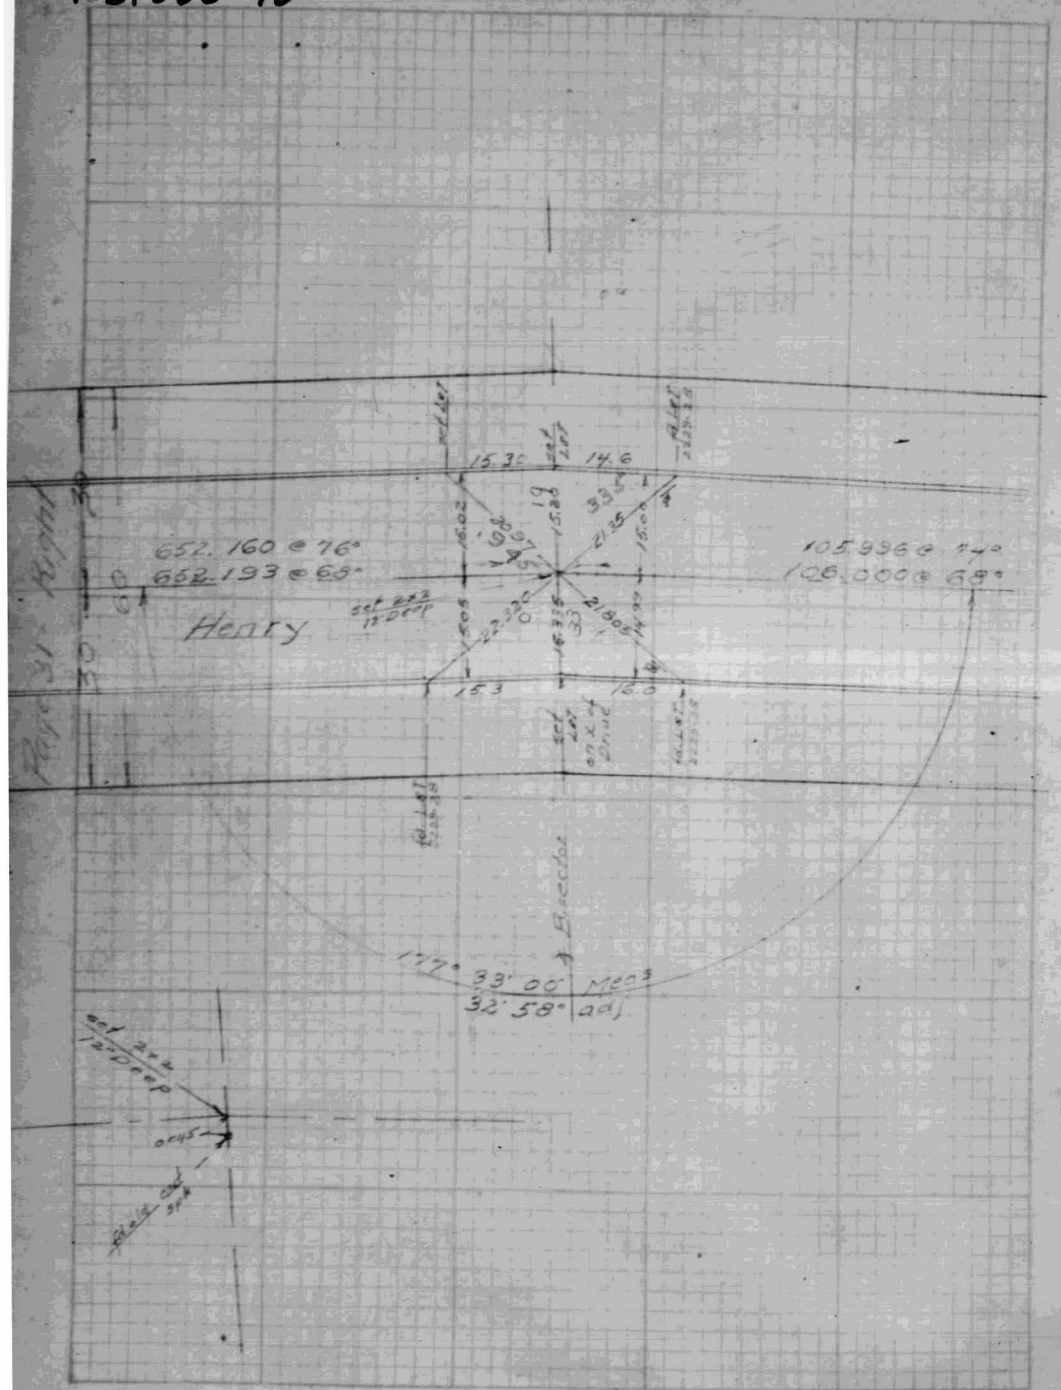

F.B. 990-20

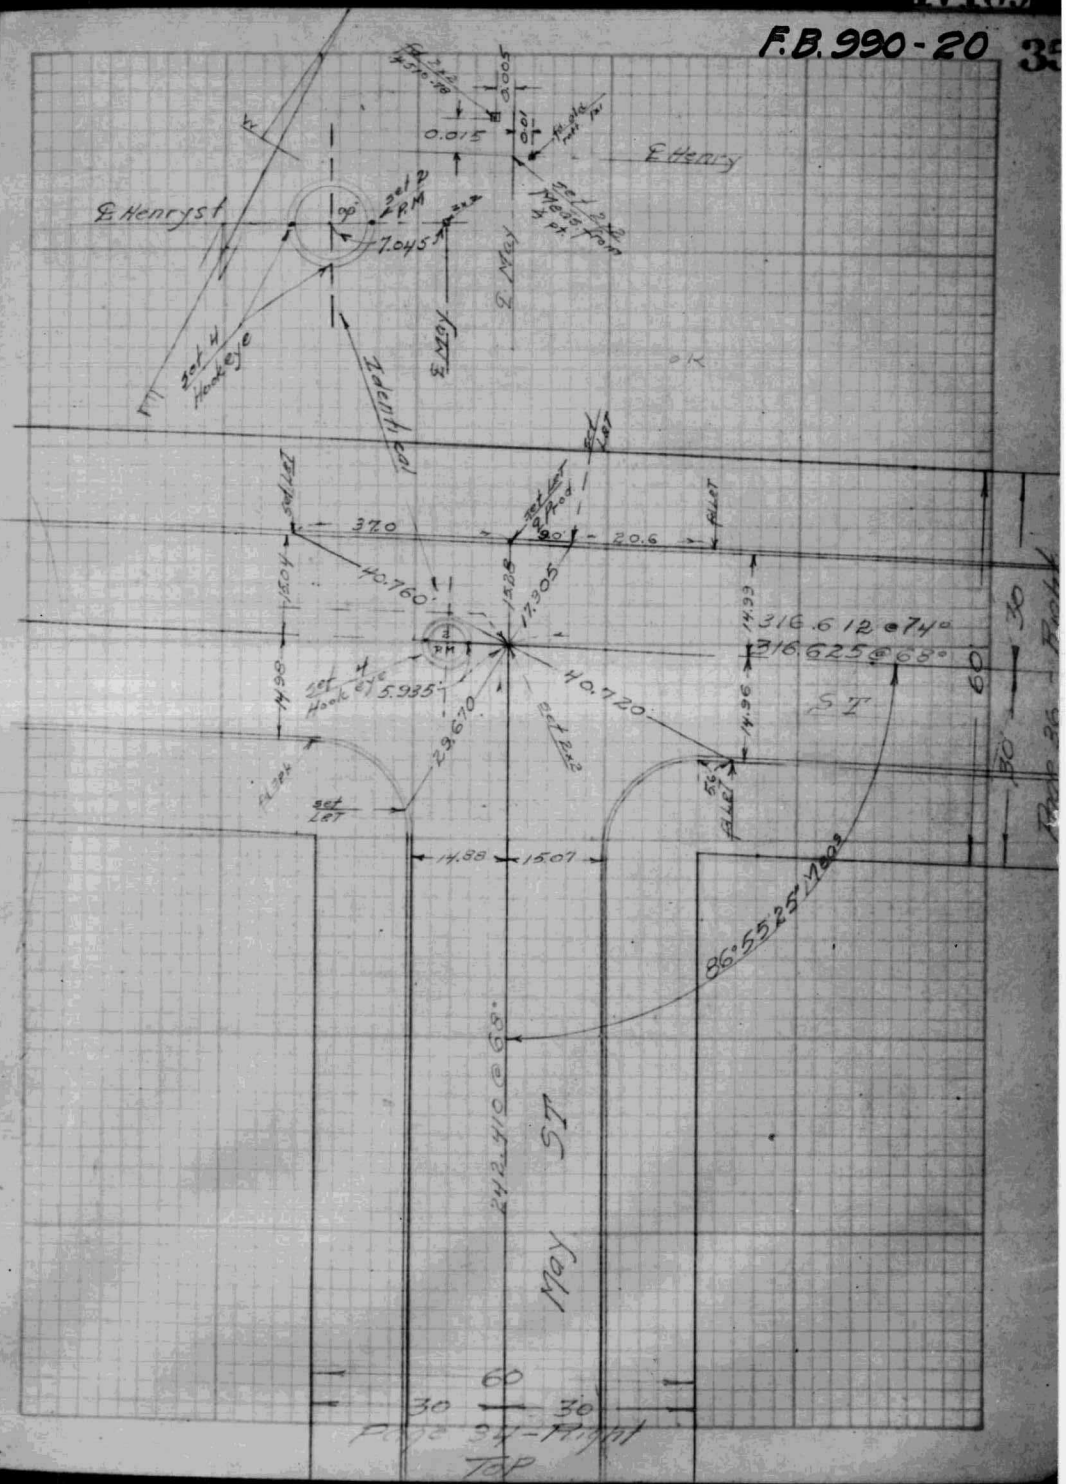

F.B. 990 - 21

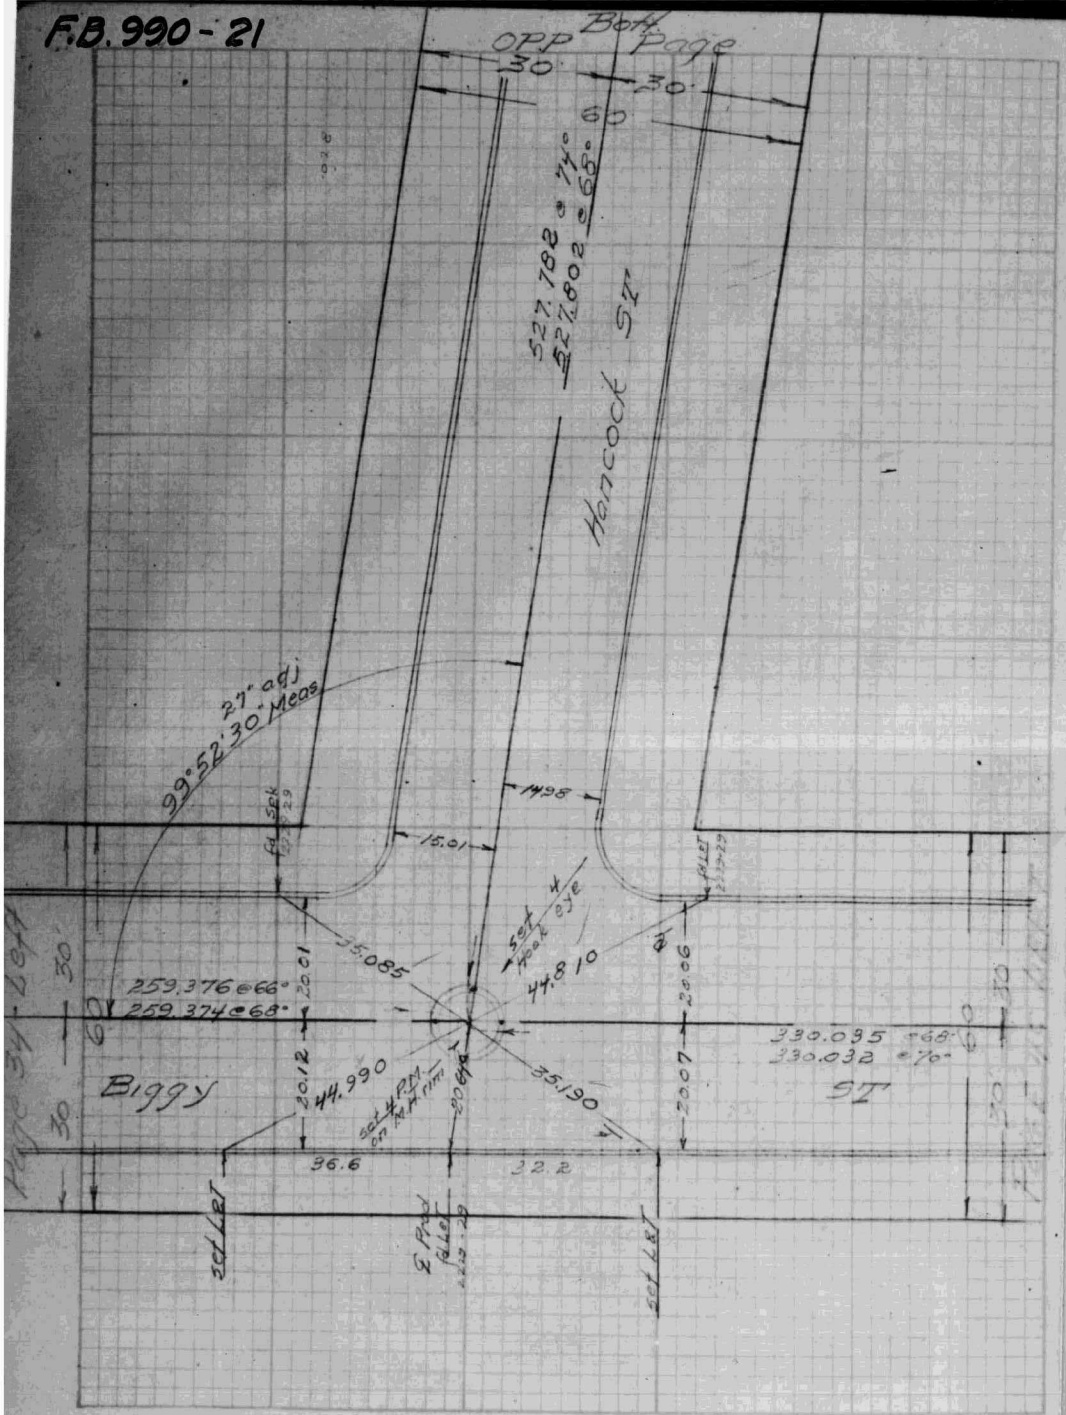

F.B. 990 - 22

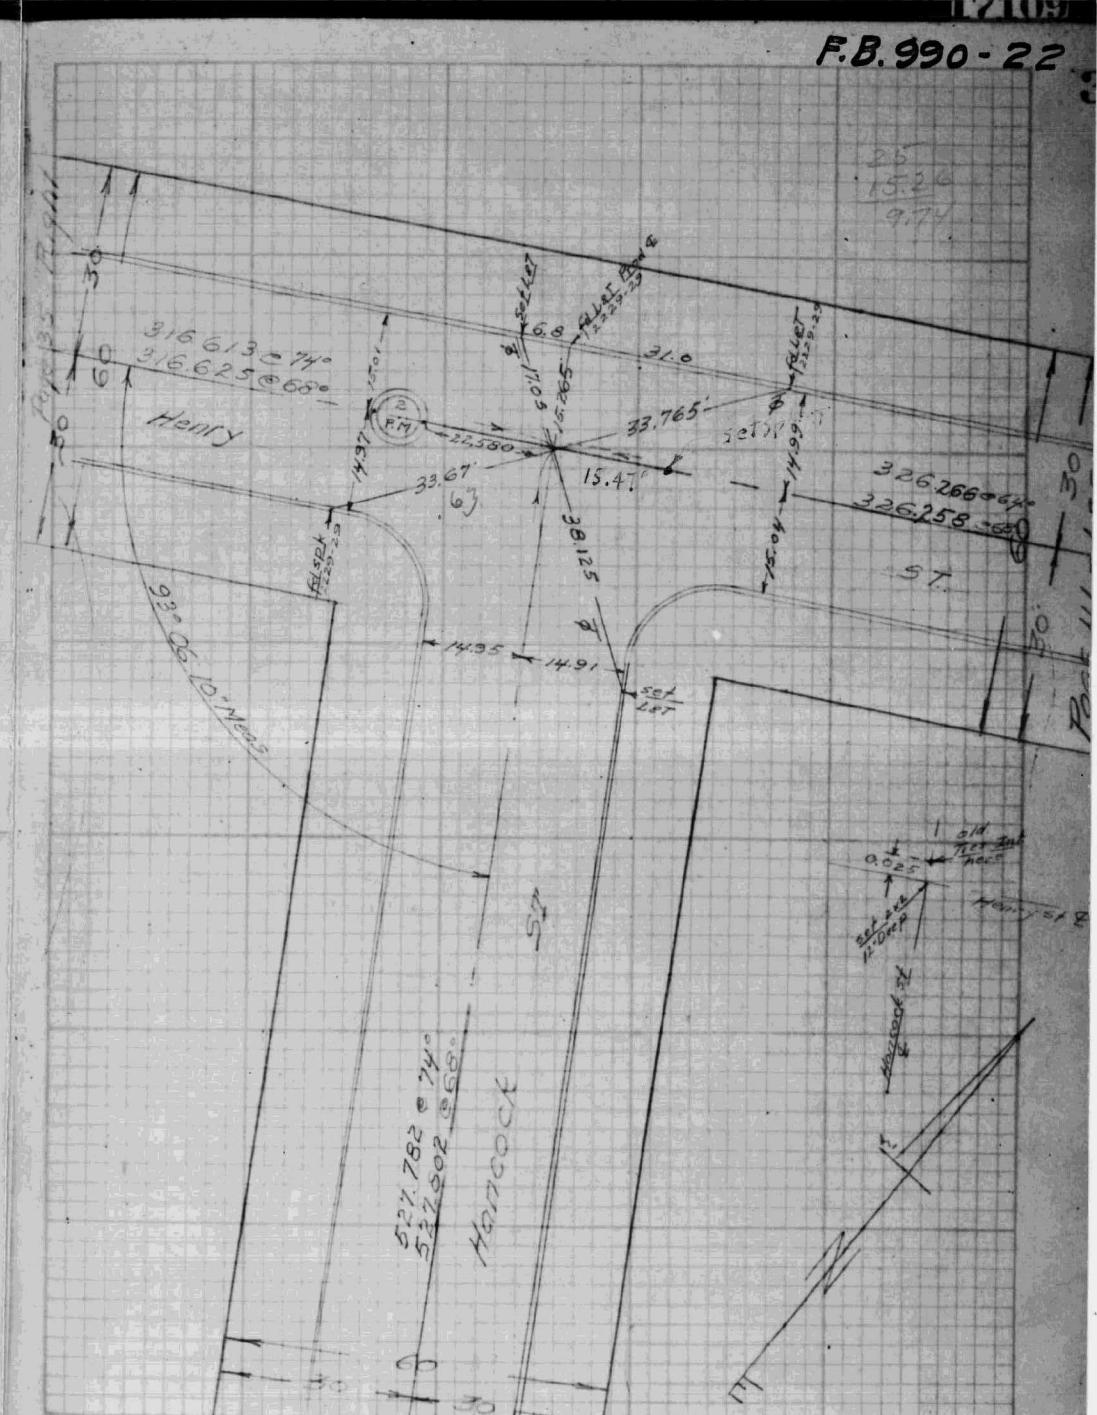

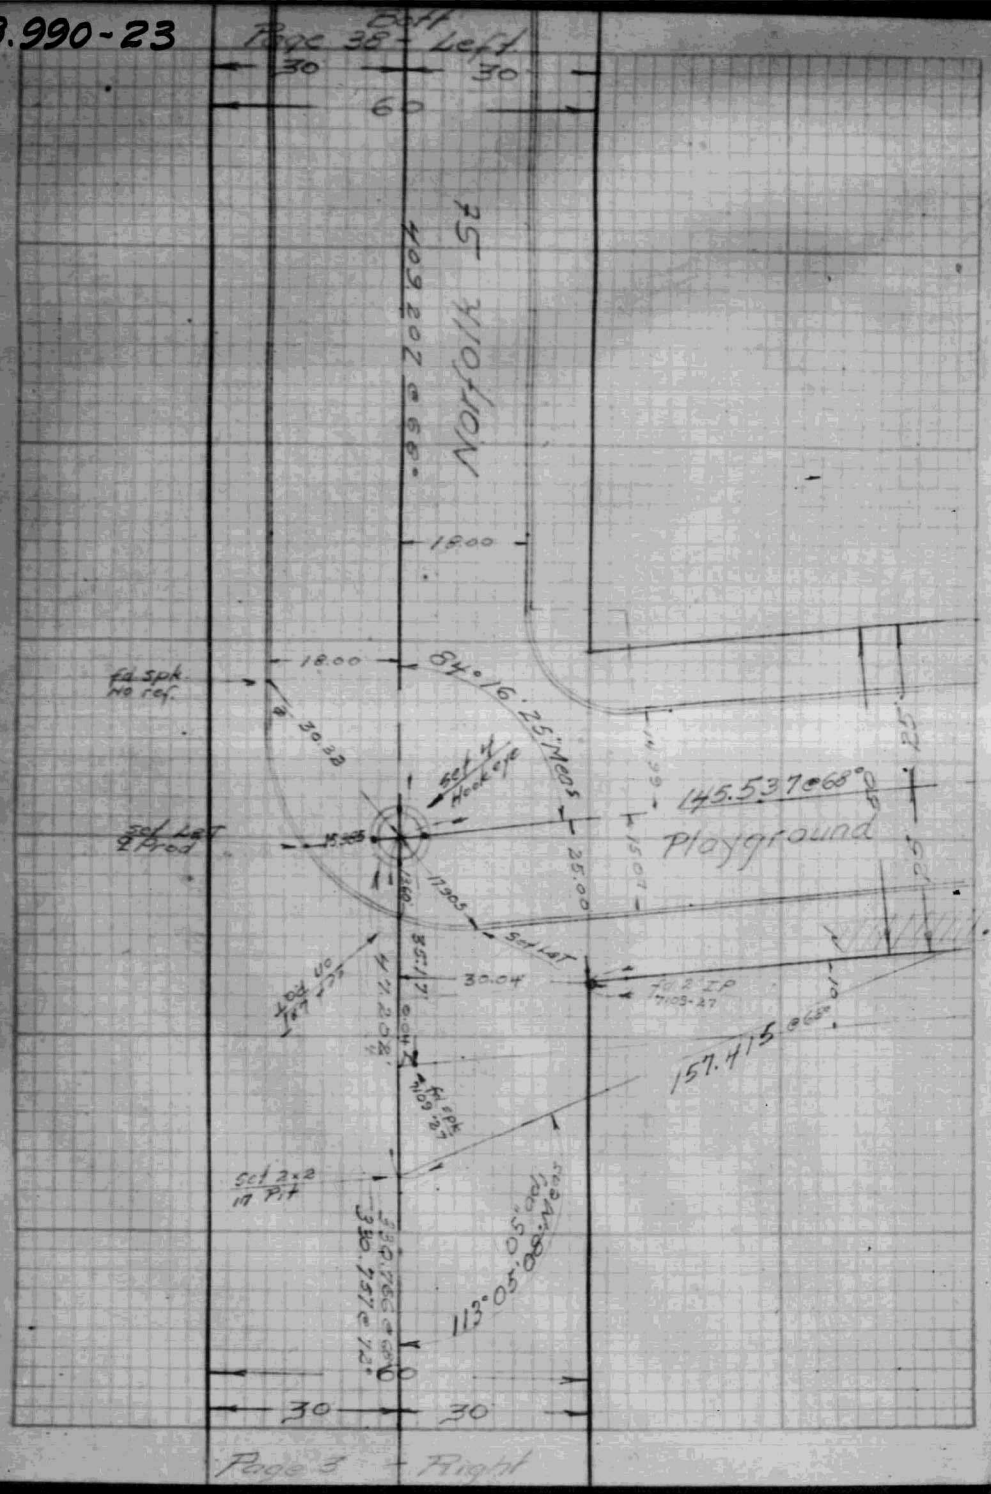
Page 38 - Left
30
30
60
Norfolk St
409.207 @ 68°
18.00
18.00
84°16'25" Meas
Set 4 Hookeye
Set Lat ℄ Prod
145.537 @ 68°
Playground
25.00
30.04
157.415 @ 68°
Set 2x2 in Pit
113°05'08" Meas
330.757 @ 72°
60
30
30
Page 3 - Right

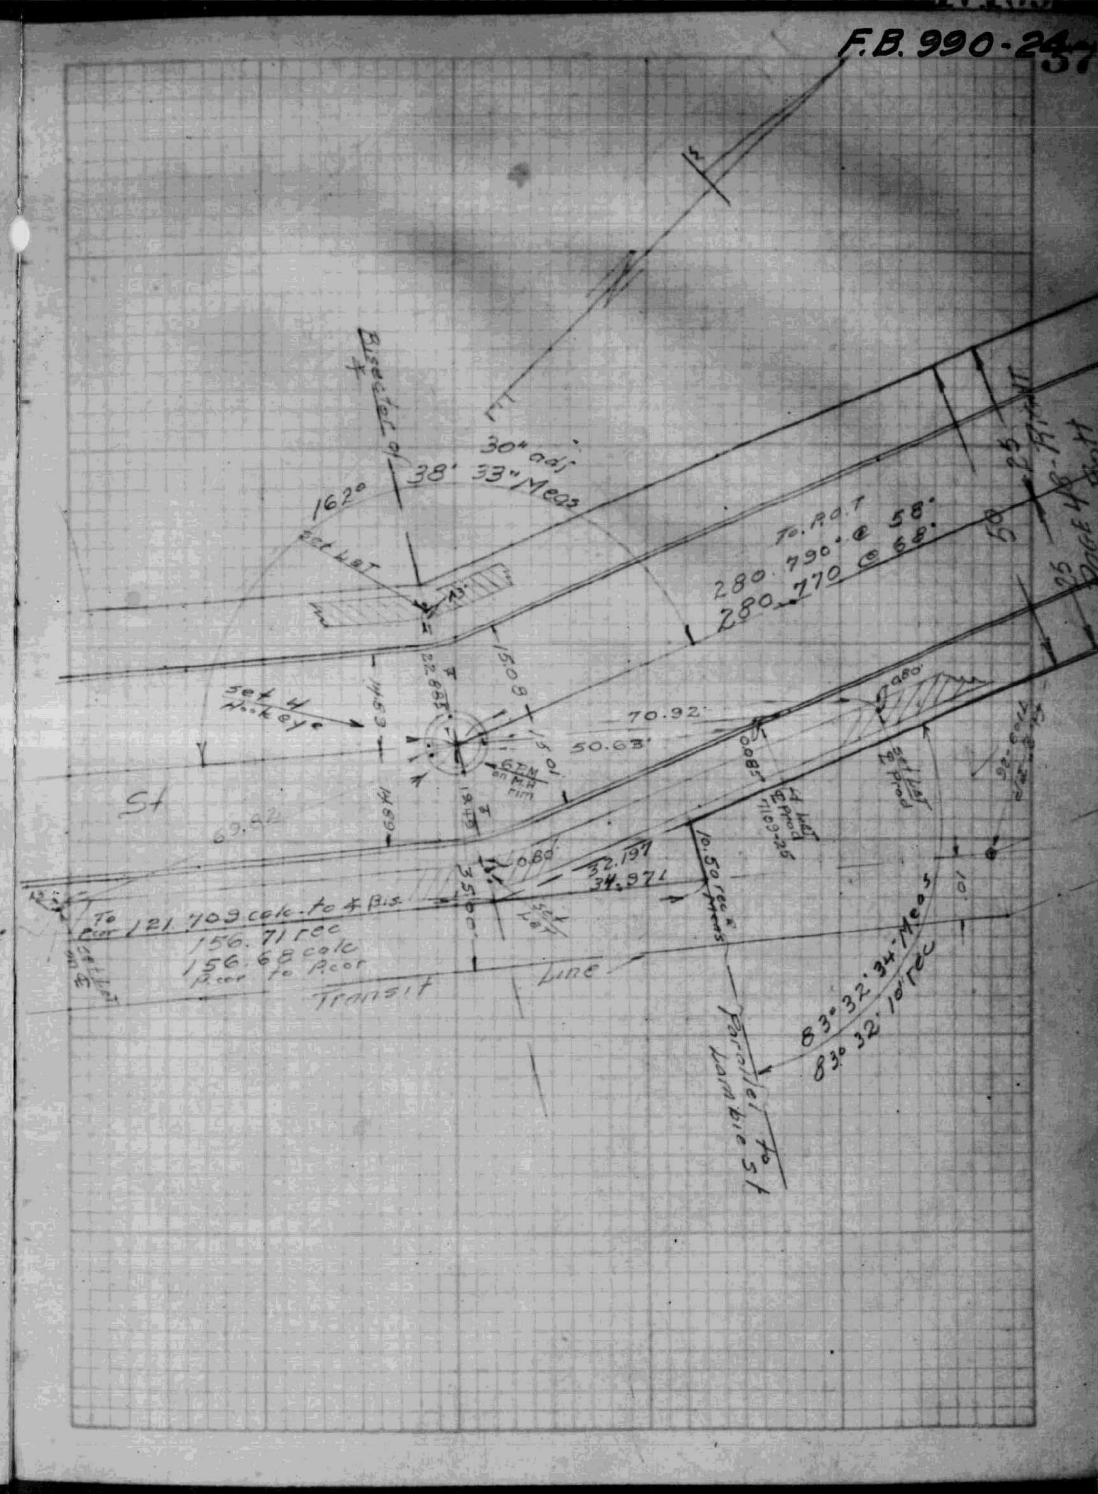
30" adj
38' 33" Meas
162°
Set Lat
To P.O.T
280.790 @ 58°
280.770 @ 68°
Set 4 Hookeye
70.92
50.63
St
69.82
121.709 calc. to ℄ Bis.
156.71 rec
156.68 calc
Transit
Line
83°32'34" Meas
83°32'10" rec
Parallel to Lambie St

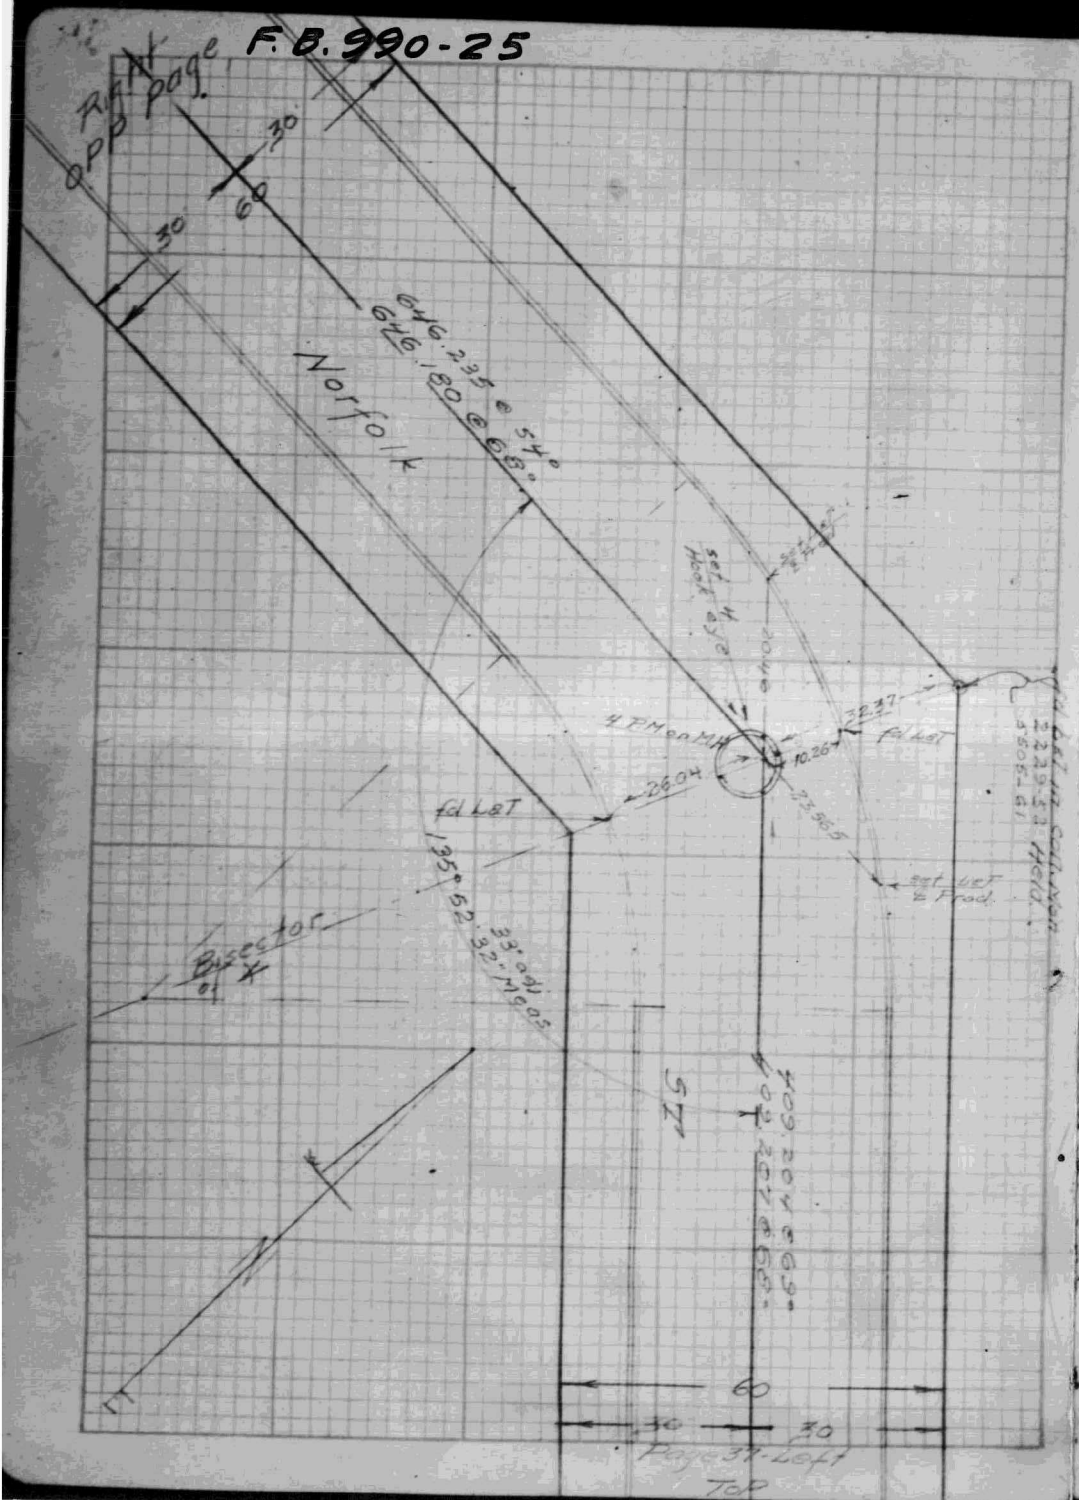
F.B. 990-25
Right OPP page
Norfolk
646.235 @ 54°
646.180 @ 68°
Bisector
ST
Page 37-Left
Top

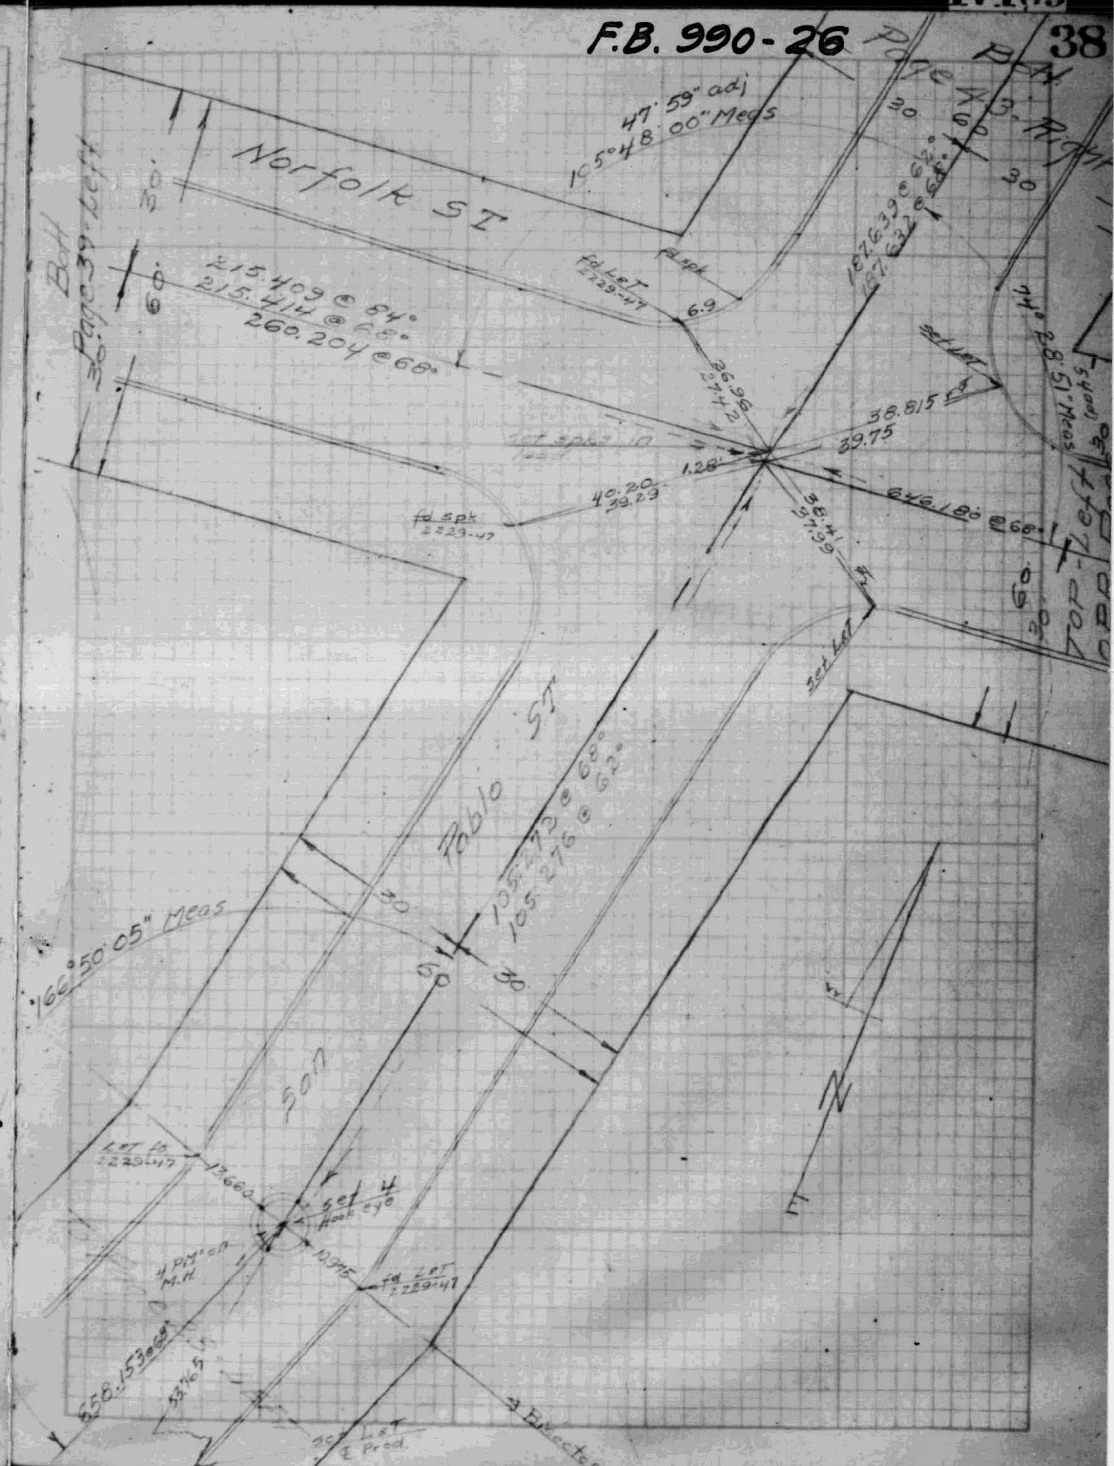
F.B. 990-26
Norfolk ST
47.59" adj
105°48'00" Meas
215.409 @ 84°
215.414 @ 68°
260.204 @ 68°
Page 39-Left
Pablo ST
166°50'05" Meas
Son
Bisector

F.B. 990-27

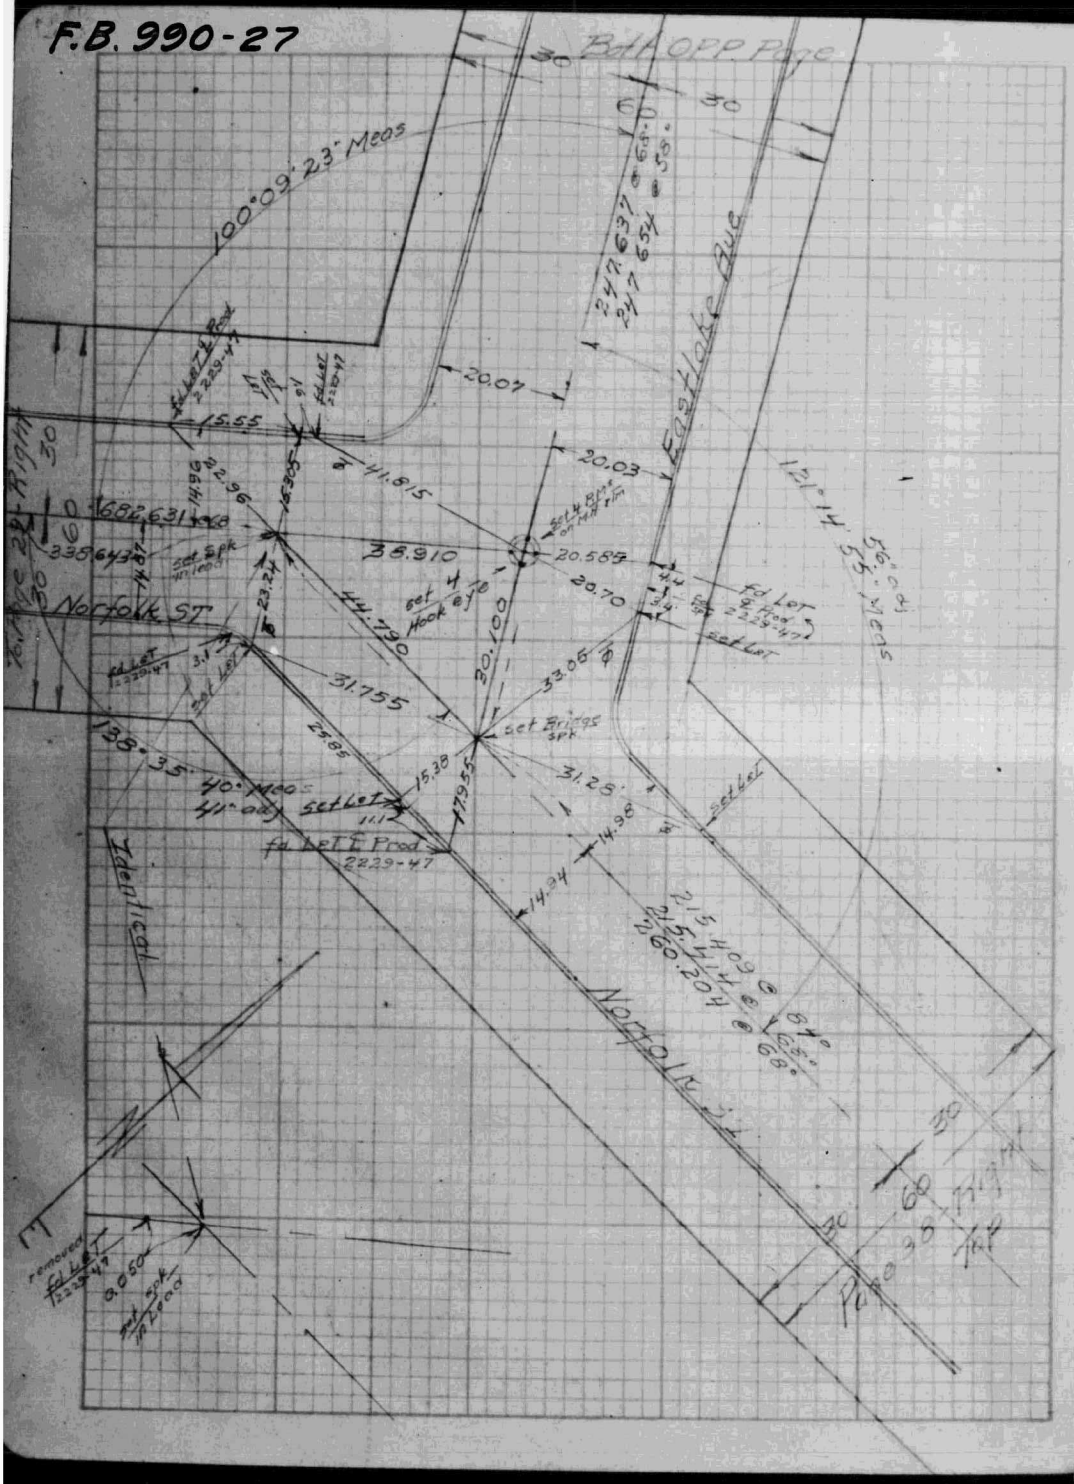

F.B. 990-28

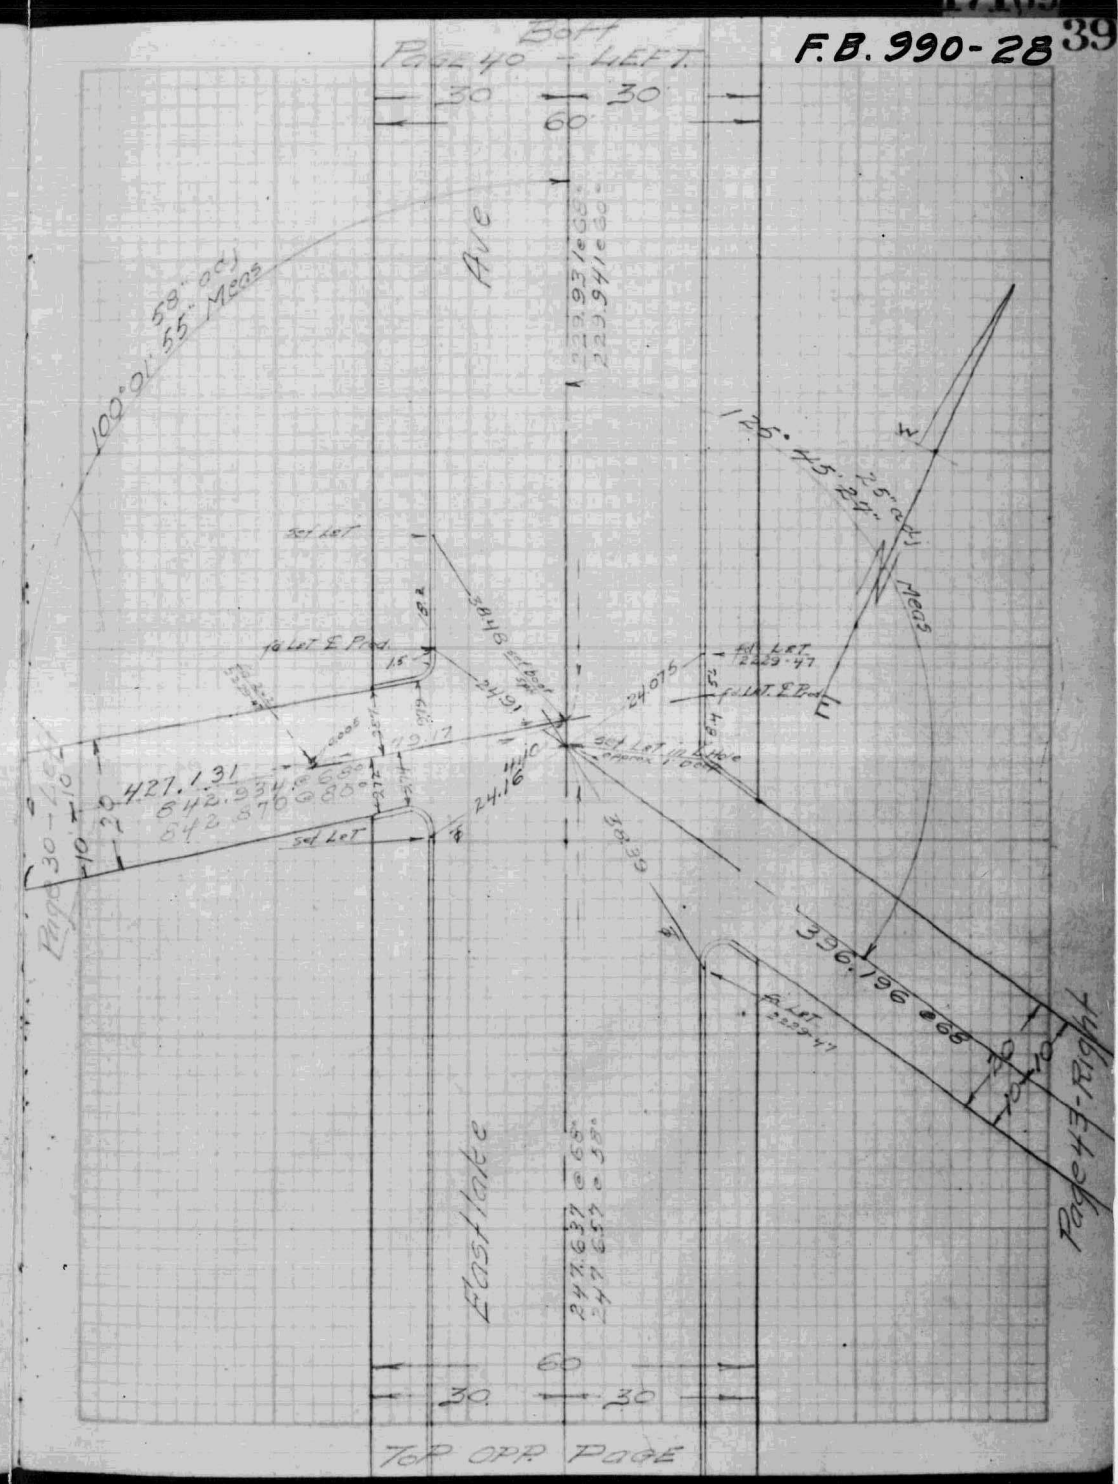

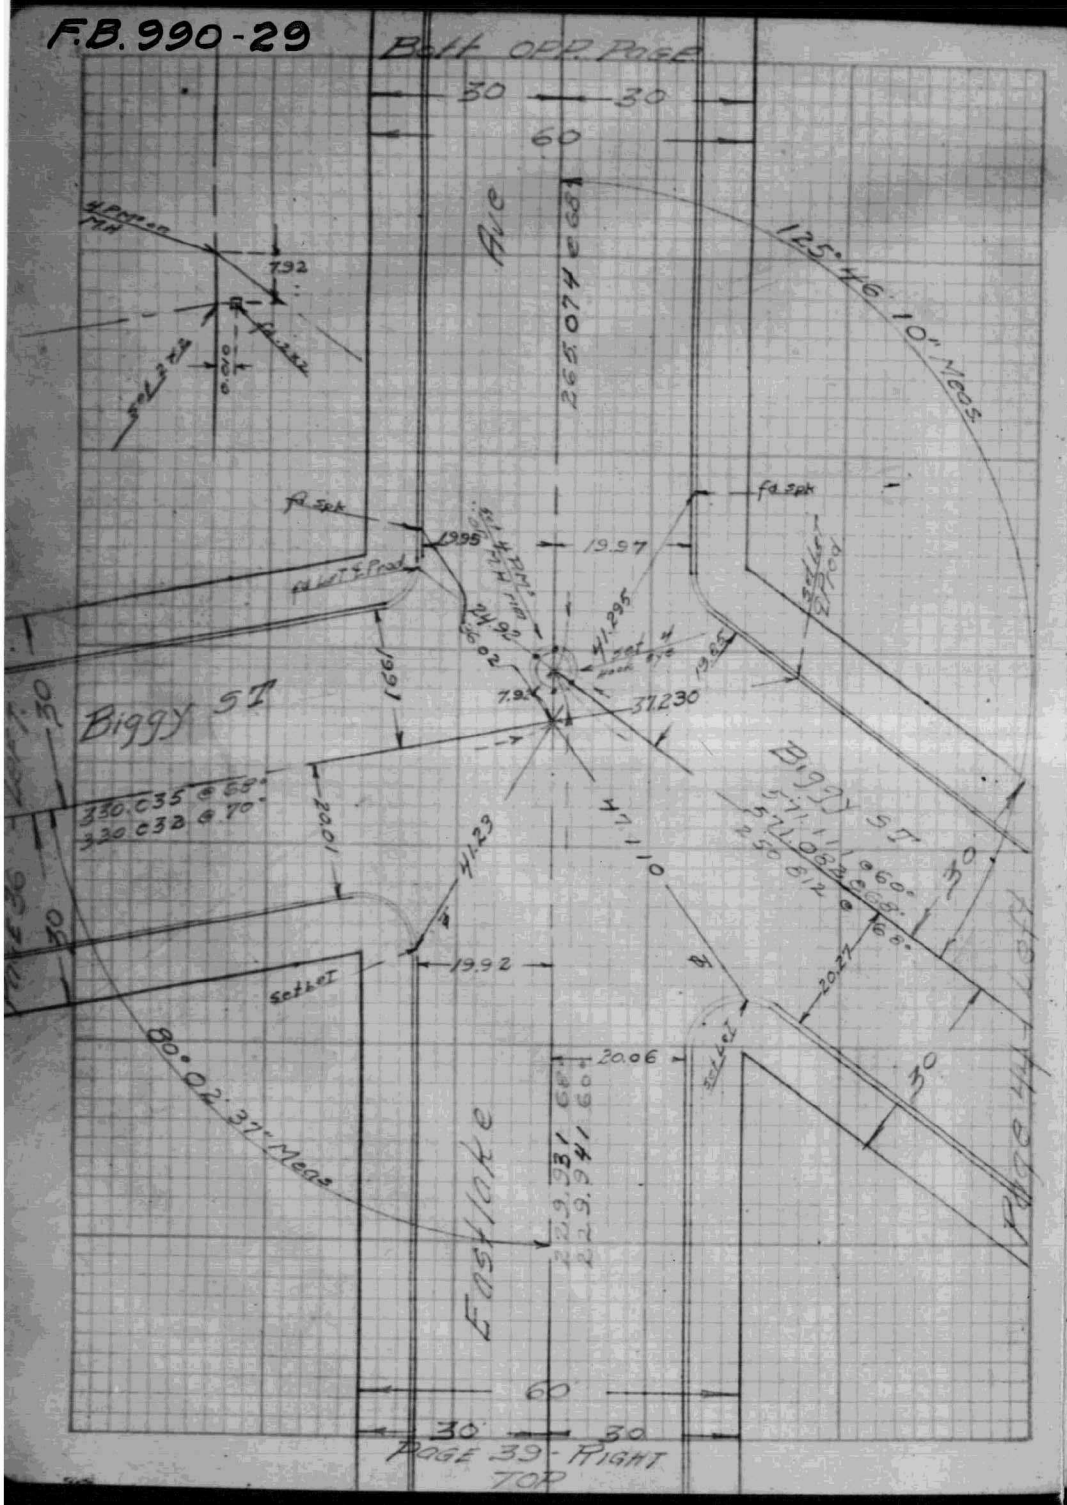
Bott OPP. Page
30
30
60
Ave
265.074 @ 68°
125° 46' 10" Meas
Biggy ST
330.035 @ 68°
320.032 @ 70°
Biggy ST
571.111 @ 60°
571.082 @ 68°
250.812 @ 68°
80° 02' 37" Meas
Eastlake
229.931 68°
229.941 60°
Page 44 Left
60
30
30
Page 39 - Right
Top

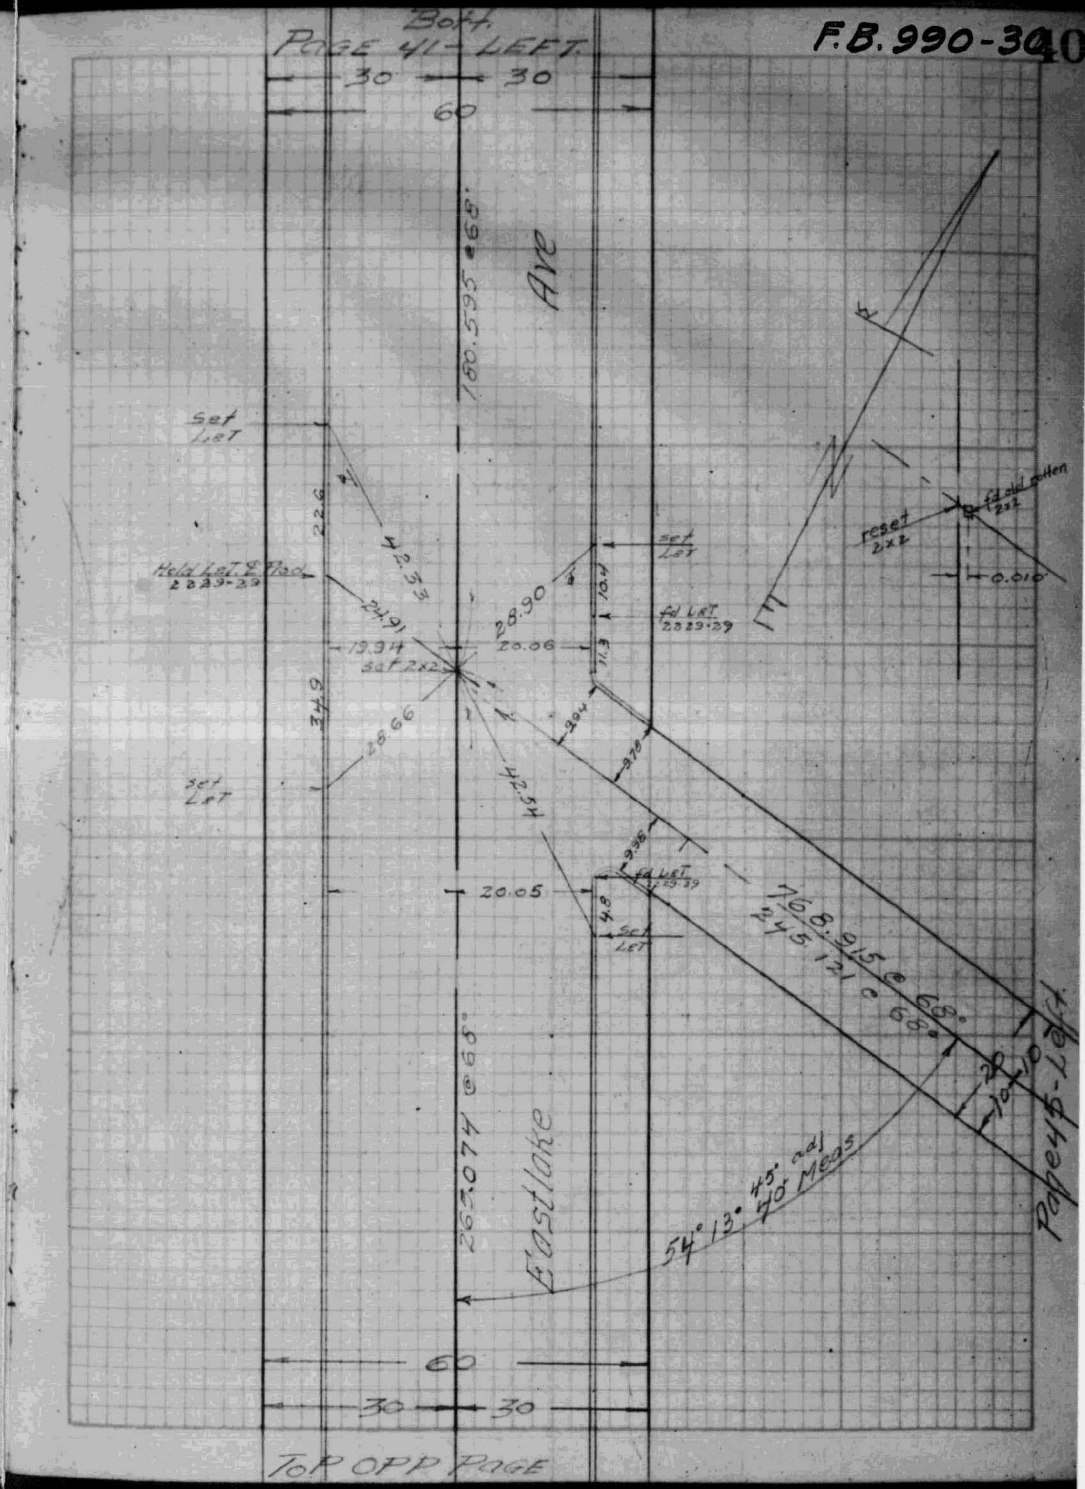
Bott.
Page 41 - Left
30
30
60
Ave
180.595 @ 68°
Set Let
Hold Let & Prod
2229-29
Set Let
Set Let
Set Let
Eastlake
265.074 @ 68°
768.915 @ 68°
245.121 @ 68°
54° 13' 45" adj
40' Meas
Page 45 - Left
60
30
30
Top Opp Page

F.B. 990-31

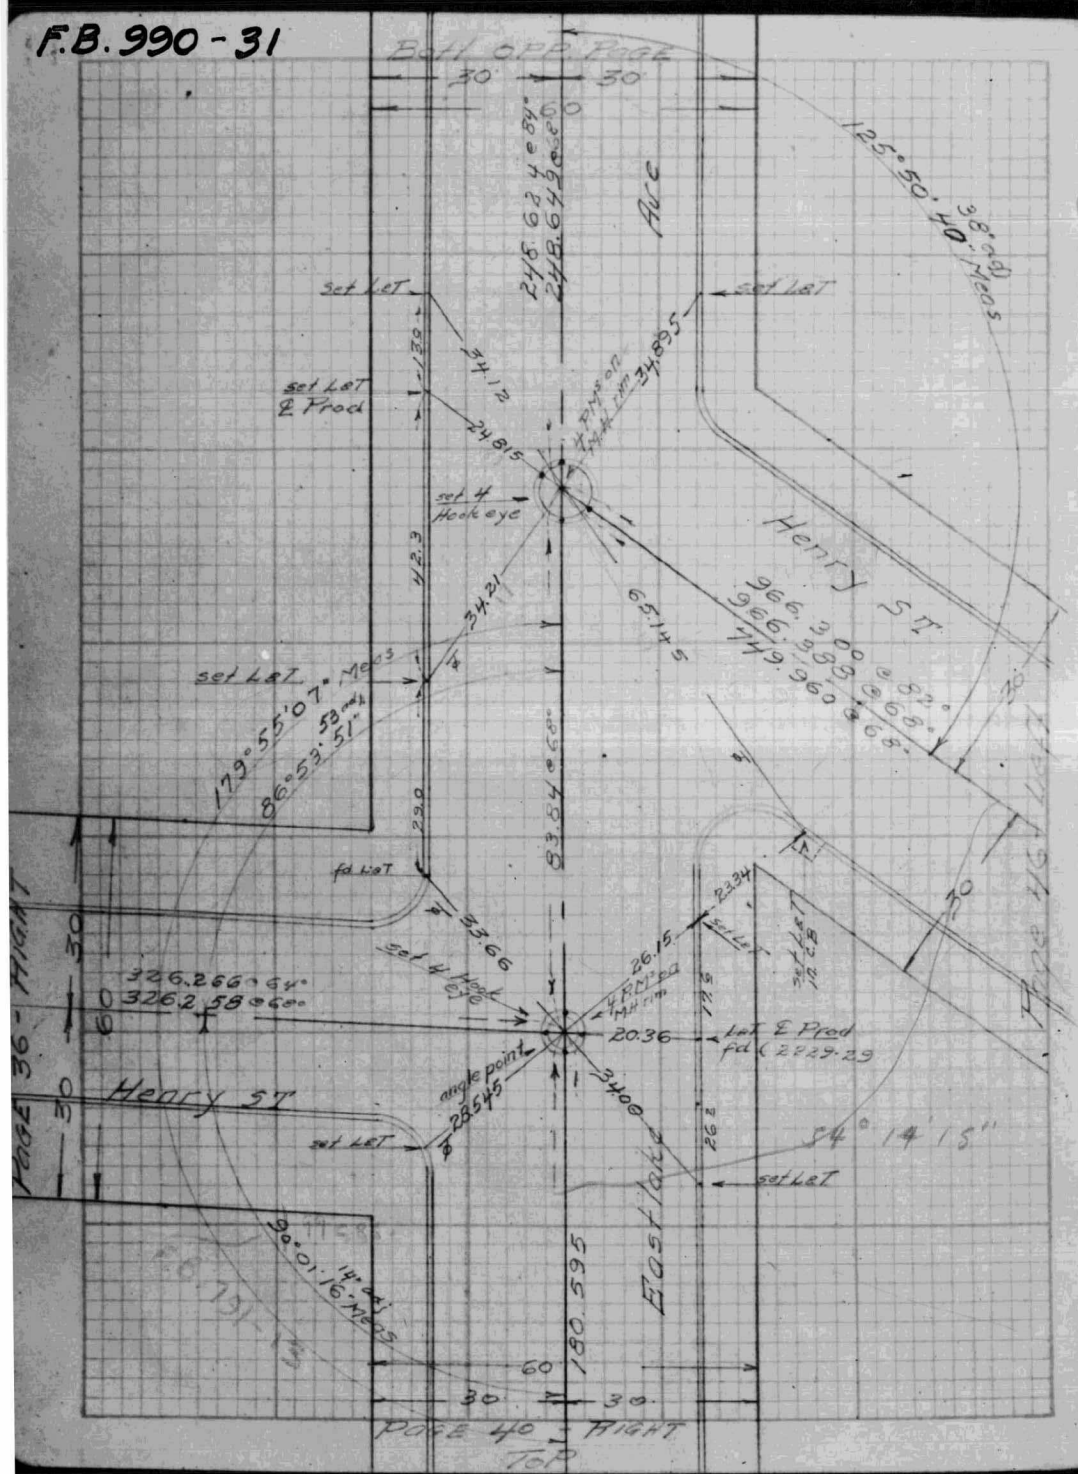

F.B. 990-32

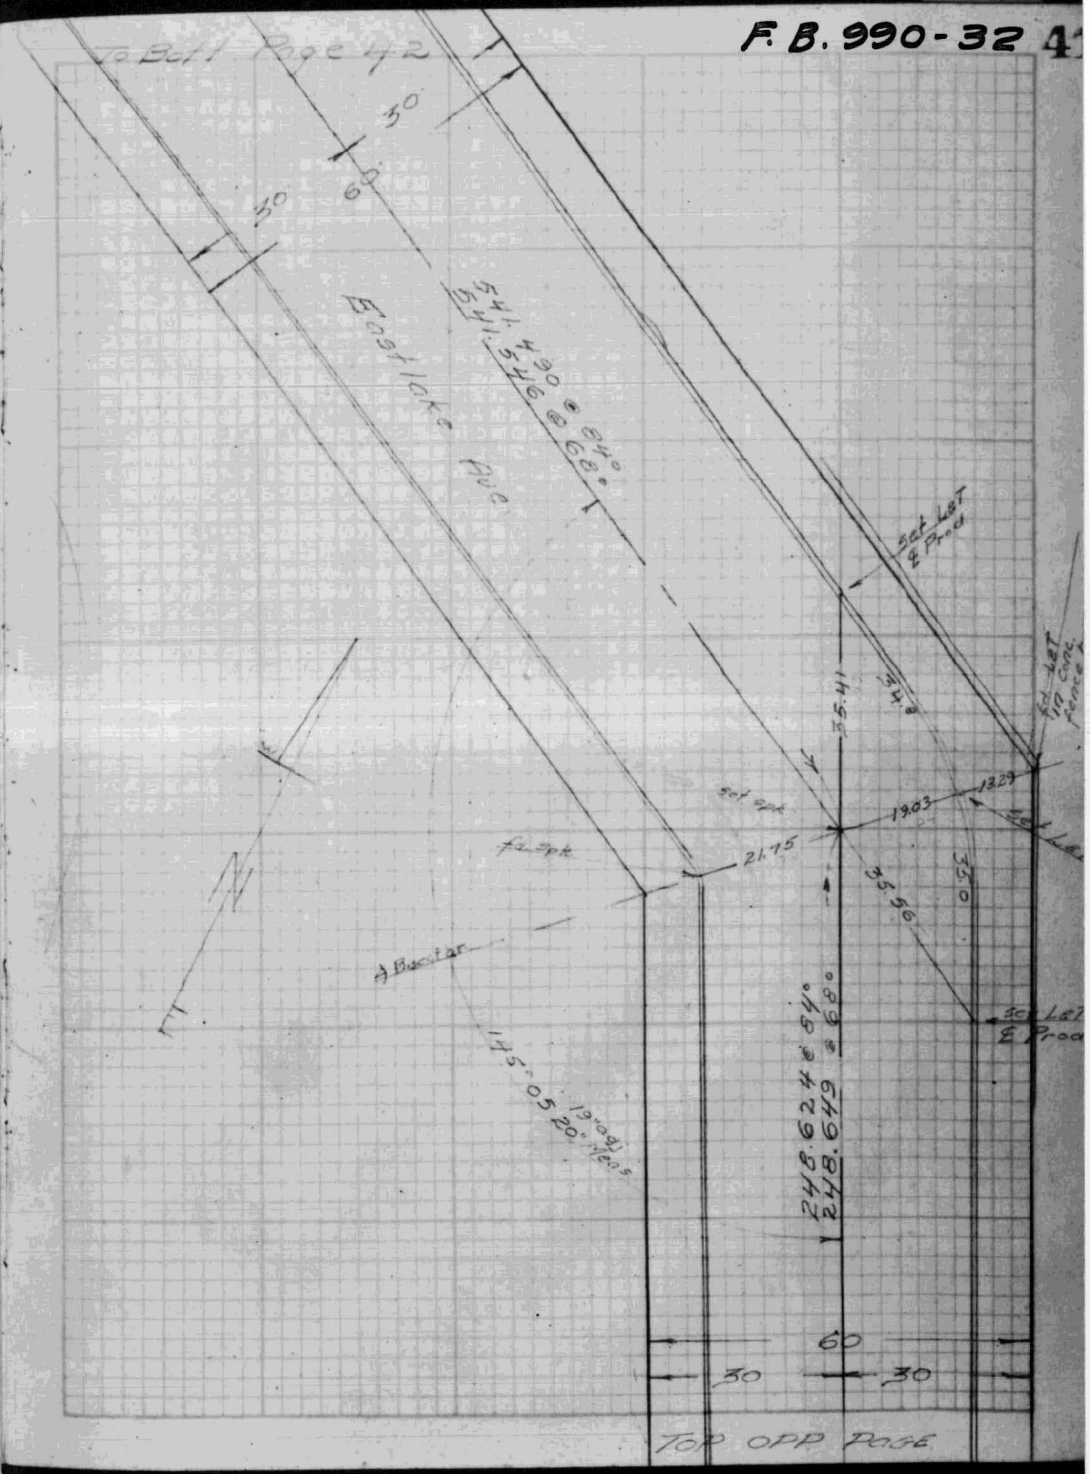

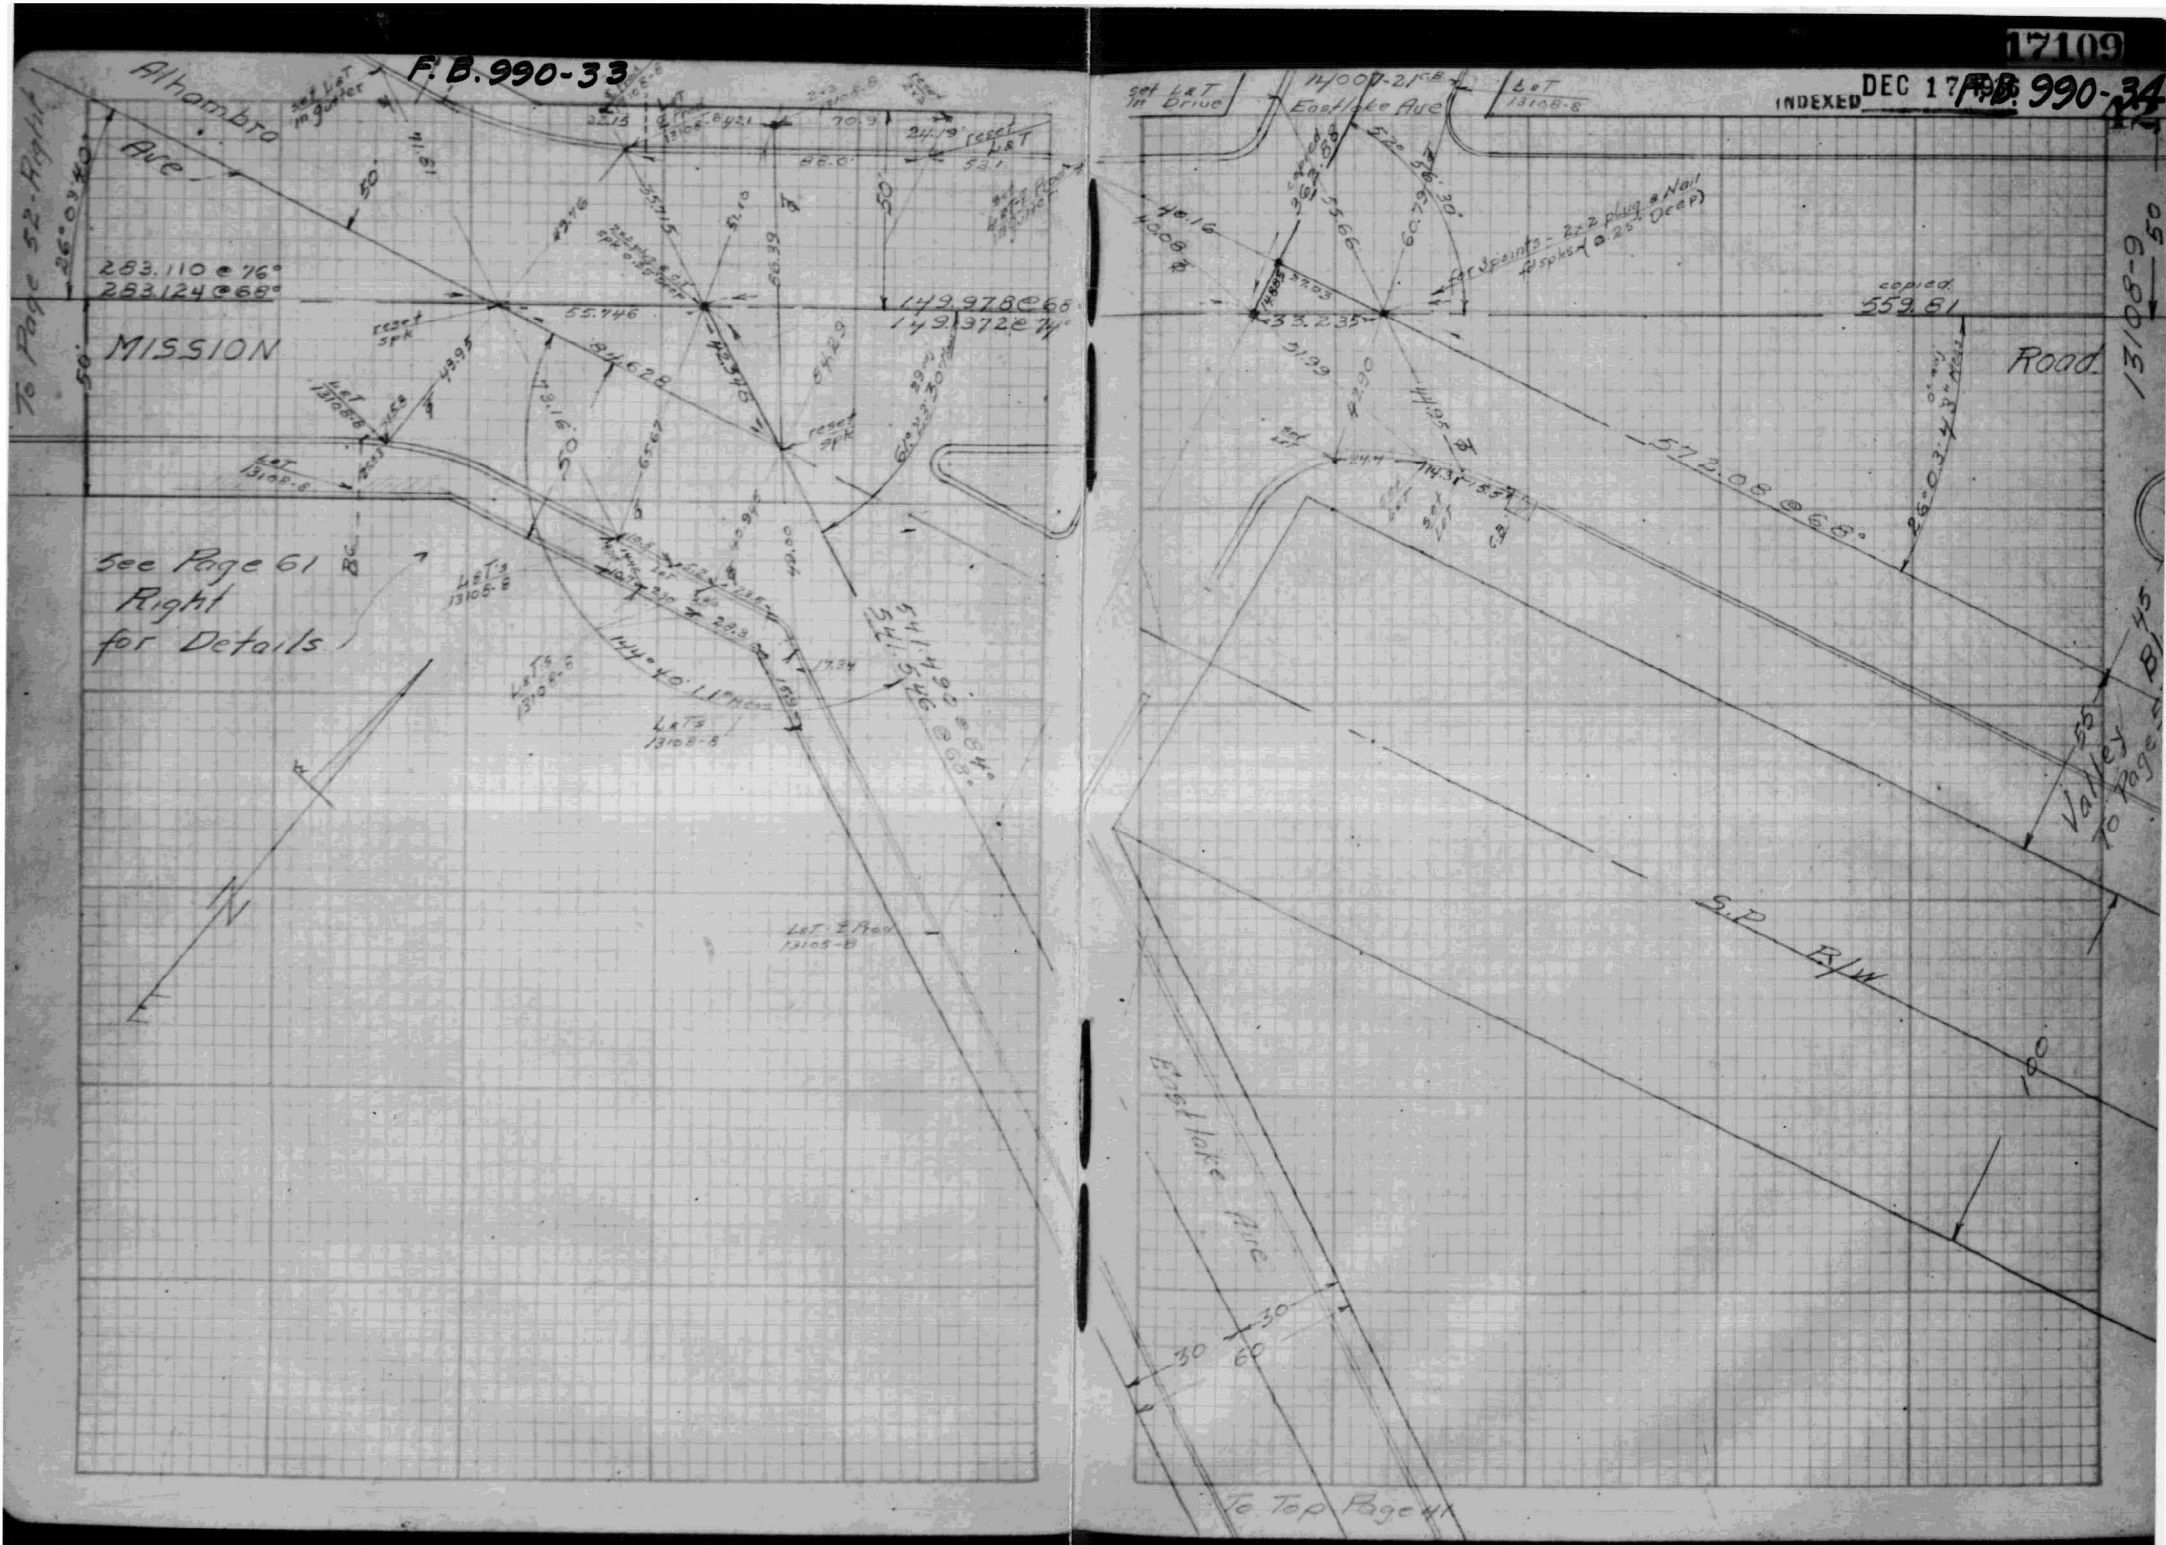
F.B. 990-33
Alhambra Ave
MISSION
To Page 52-Right
283.110 @ 76°
283.124 @ 68°
149.978 @ 68°
149.972 @ 74°
See Page 61 Right for Details
F.B. 990-34
INDEXED DEC 17
Eastlake Ave
Road
13108-9
572.08 @ 68°
559.81
S.P. R/W
Valley
To Page
East lake Ave
To Top Page 41

F.B. 990-35

DEC 17 1936

INDEXED

SAN PABLO ST (Page {28, 38, 55} {43 to 47 inc})

Valley Blvd to Zonal Ave

LAMBIE ST (Page 47, 48, 2)

Soto St to San Pablo St.

(Page 44) Alley W. of San Pablo St - Biggy to 100± S'ly

(Page 45) 1st " " " " " " - Alley N'ly Biggy St to 100± S'ly

(Page 45) 2nd " " " " " " - " " " " " 70± "

(Page 46) " " " " " " - Henry St to 100± S'ly

(Page 40, 45) Alley N'ly Biggy St - San Pablo St to Eastlake Ave

C-1939
C-1940

Center Line - Angles - Distances - Ties
July 28 1936

Boysen A.H.
Winters J.C.
Beals E.R.
Saffell F.B.

℄ Ref

1609-30, 31
2409-43
1035-70

17109

F.B. 990-3643

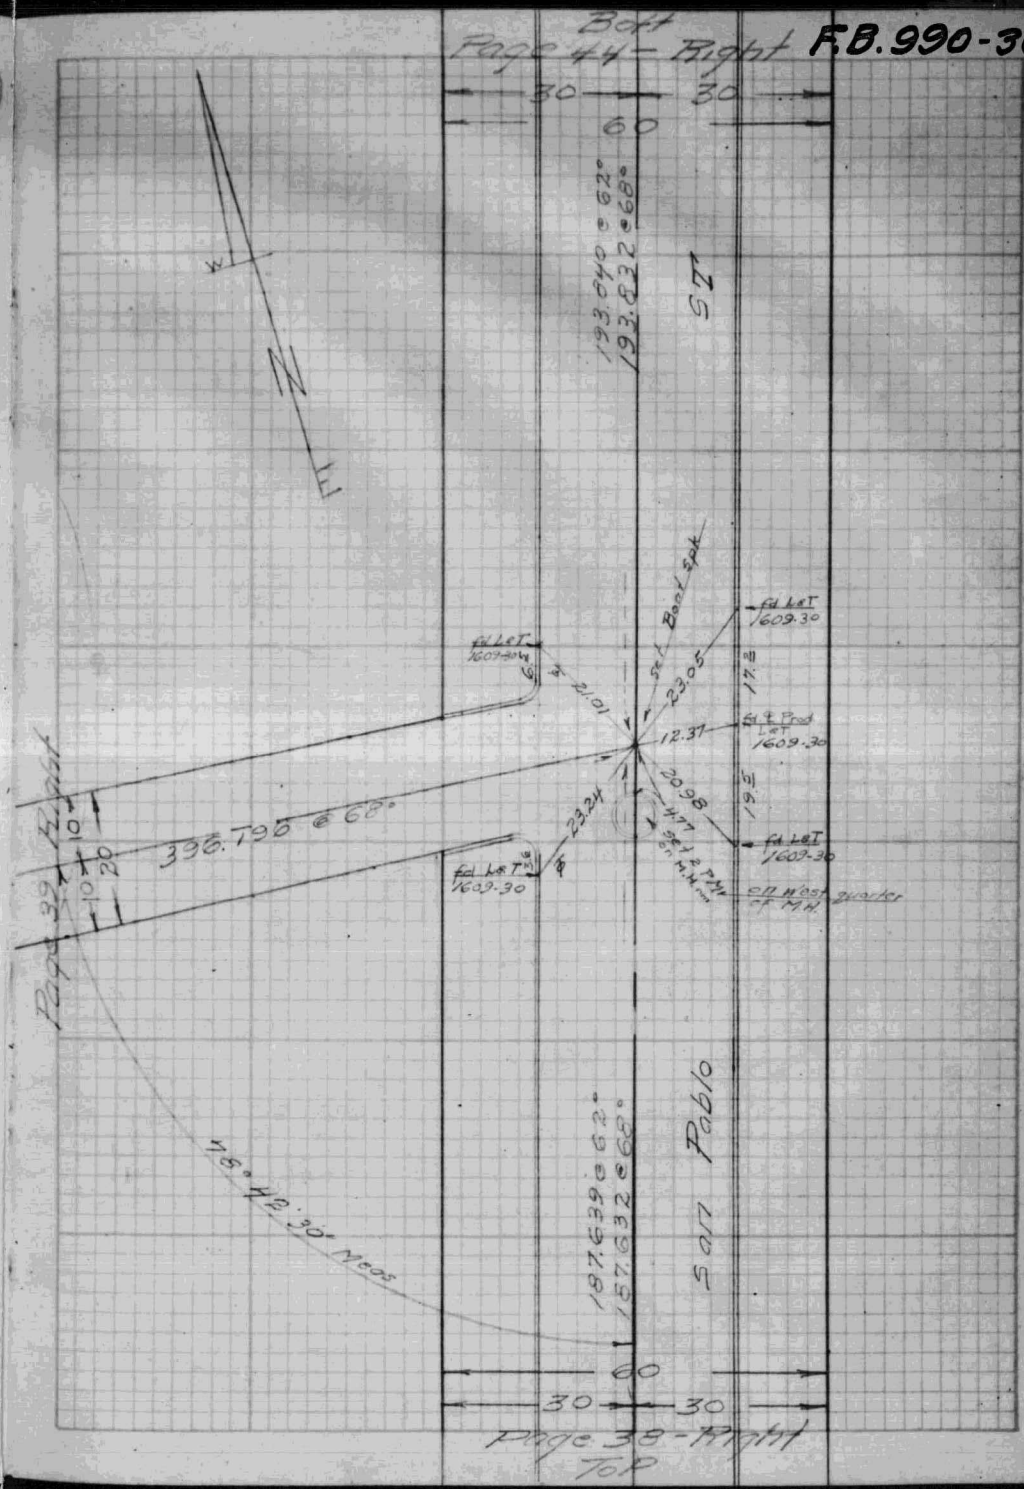

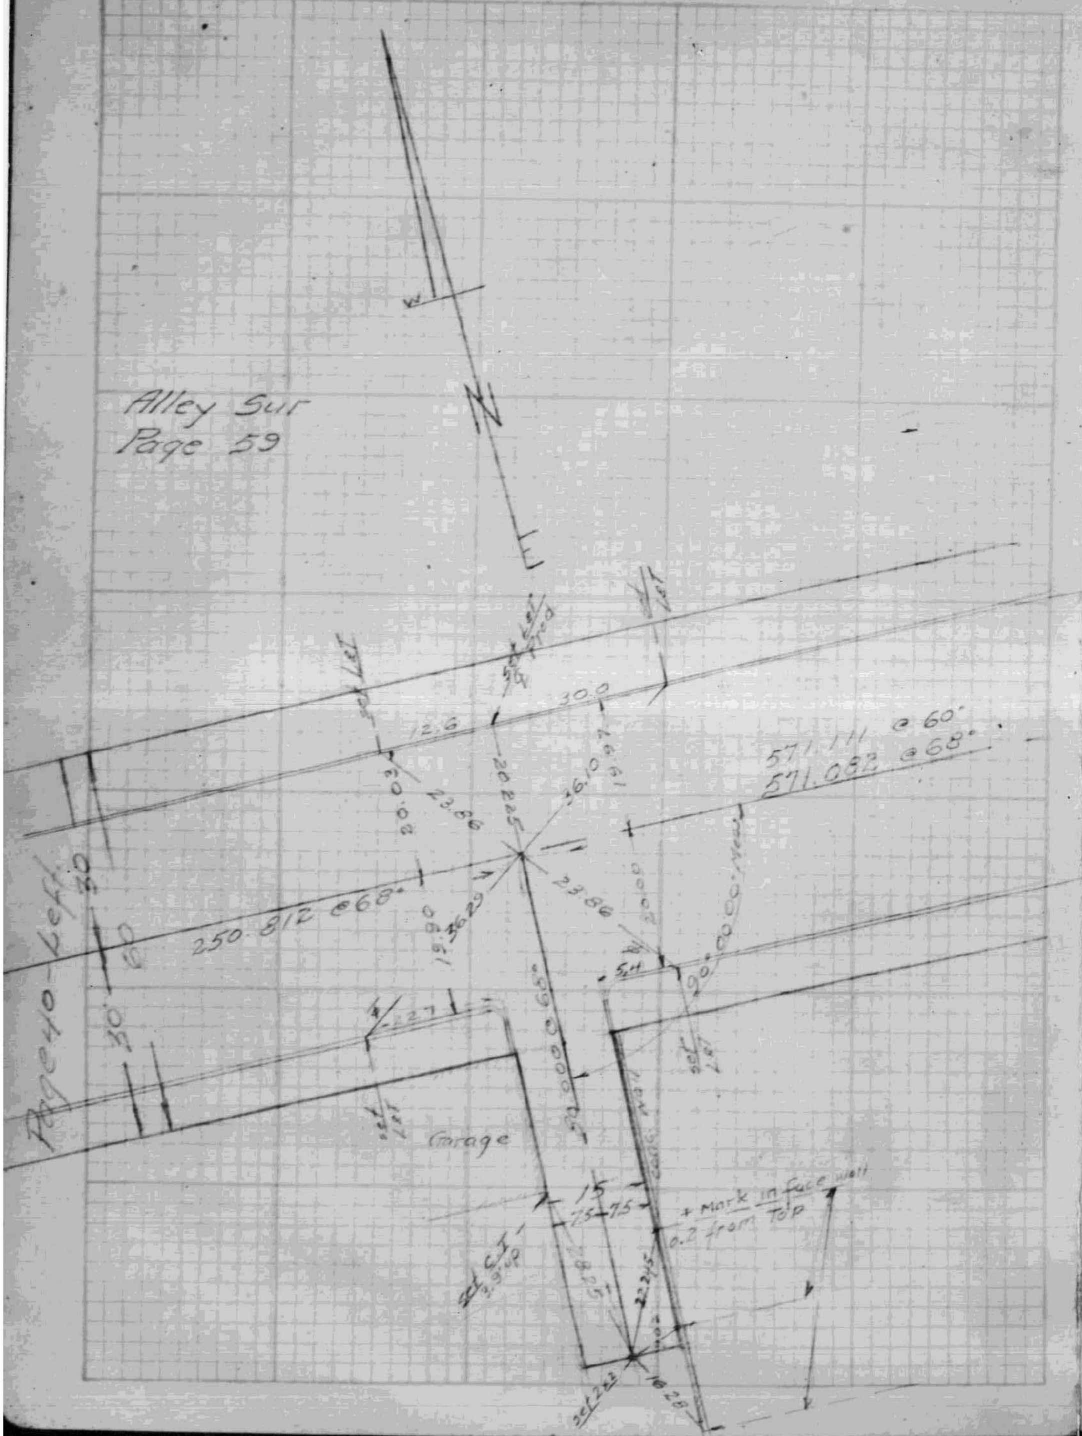
Alley Sur
Page 59
N
Page 40 - Left
30
60
30
250.812 @ 68°
571.111 @ 60°
571.082 @ 68°
30.0
12.6
20.03
23.86
20.225
36.0
26.61
19.80
36.29
23.86
Garage
15
7.5
7.5
+ Mark in face wall
0.2 from Top

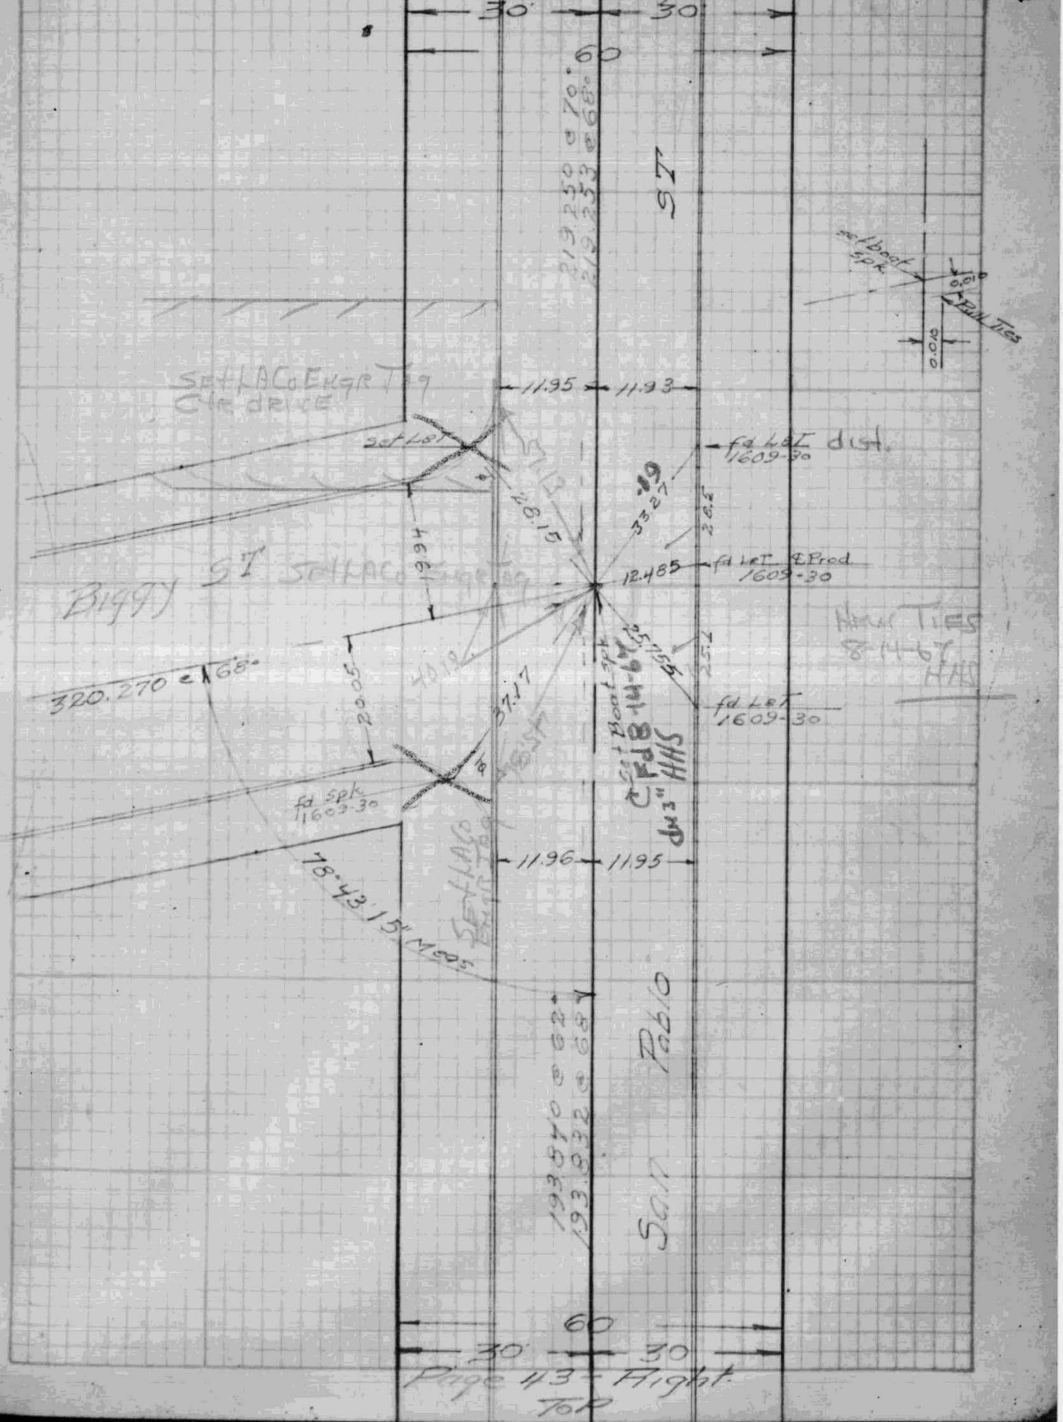
Both
Page 45 - Right
30
30
60
219.250 @ 70°
219.253 @ 68°
ST
Set LACo Engr Tag
C/L drive
set Lot
11.95
11.93
fd L&T dist.
1609-30
28.15
33.27
28.5
12.485
fd L&T ℄ Prod
1609-30
Biggy ST
320.270 @ 68°
40.19
37.17
25.155
25.2
fd L&T
1609-30
New Ties
8-14-67
HHS
fd spk
1609-30
11.96
11.95
78°43'15" Meas
Pablo
San
193.870 @ 62°
193.832 @ 68°
60
30
30
Page 43 - Right
Top

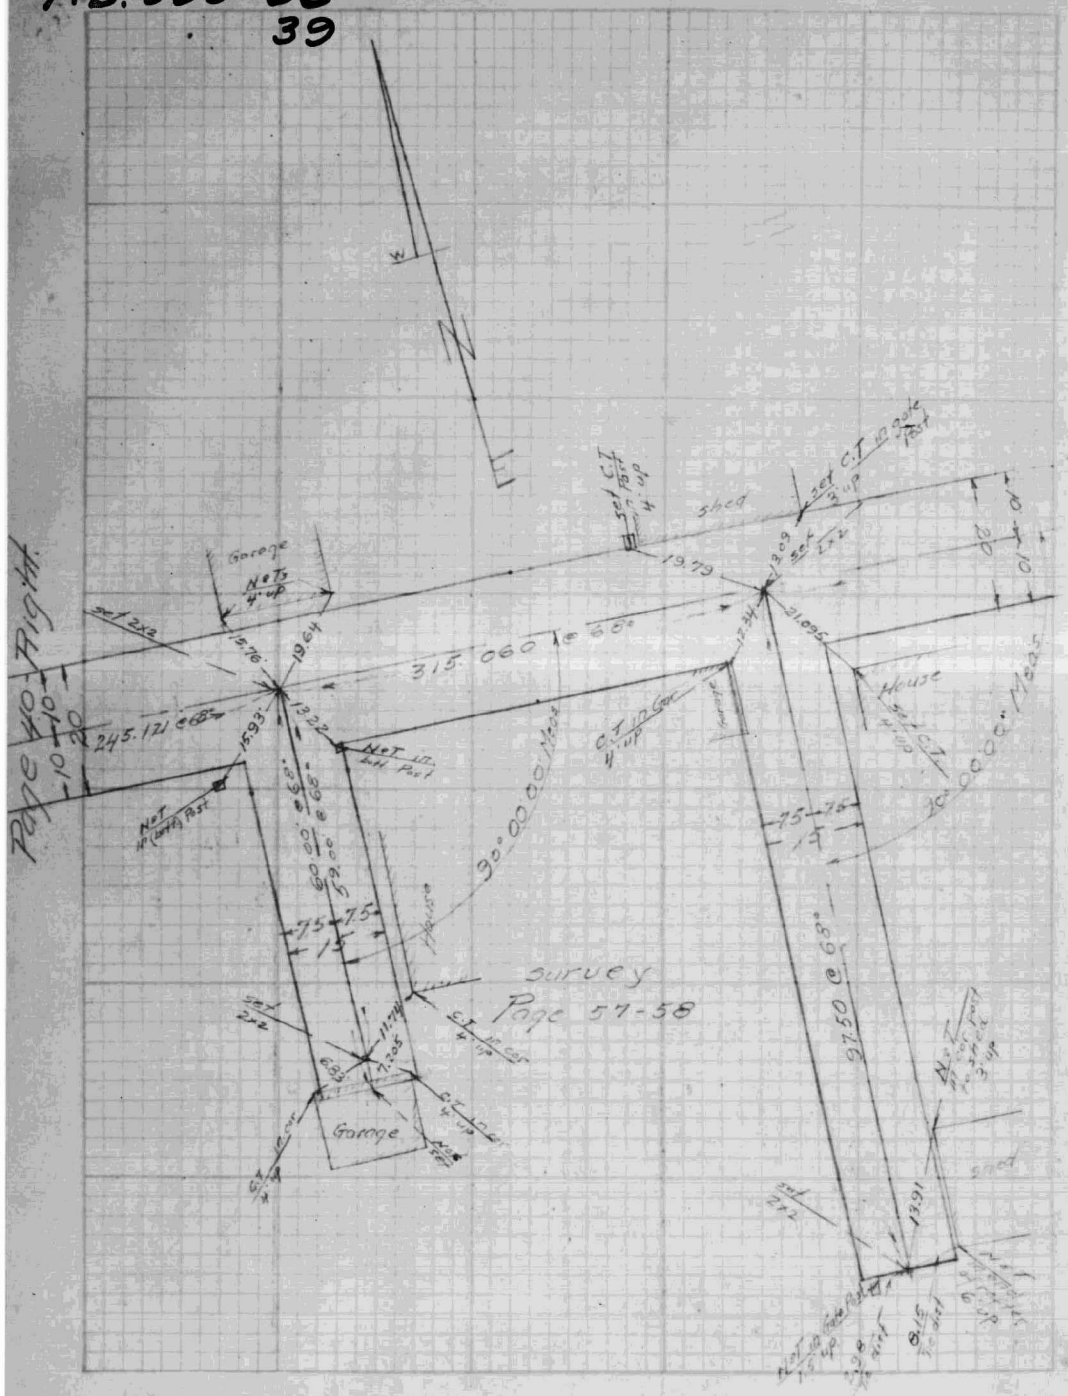
Page 40-Right
Garage
Shed
House
315.060 @ 68°
245.121 @ 68°
90°00'00" Meas
97.50 @ 68°
Survey
Page 57-58
Garage

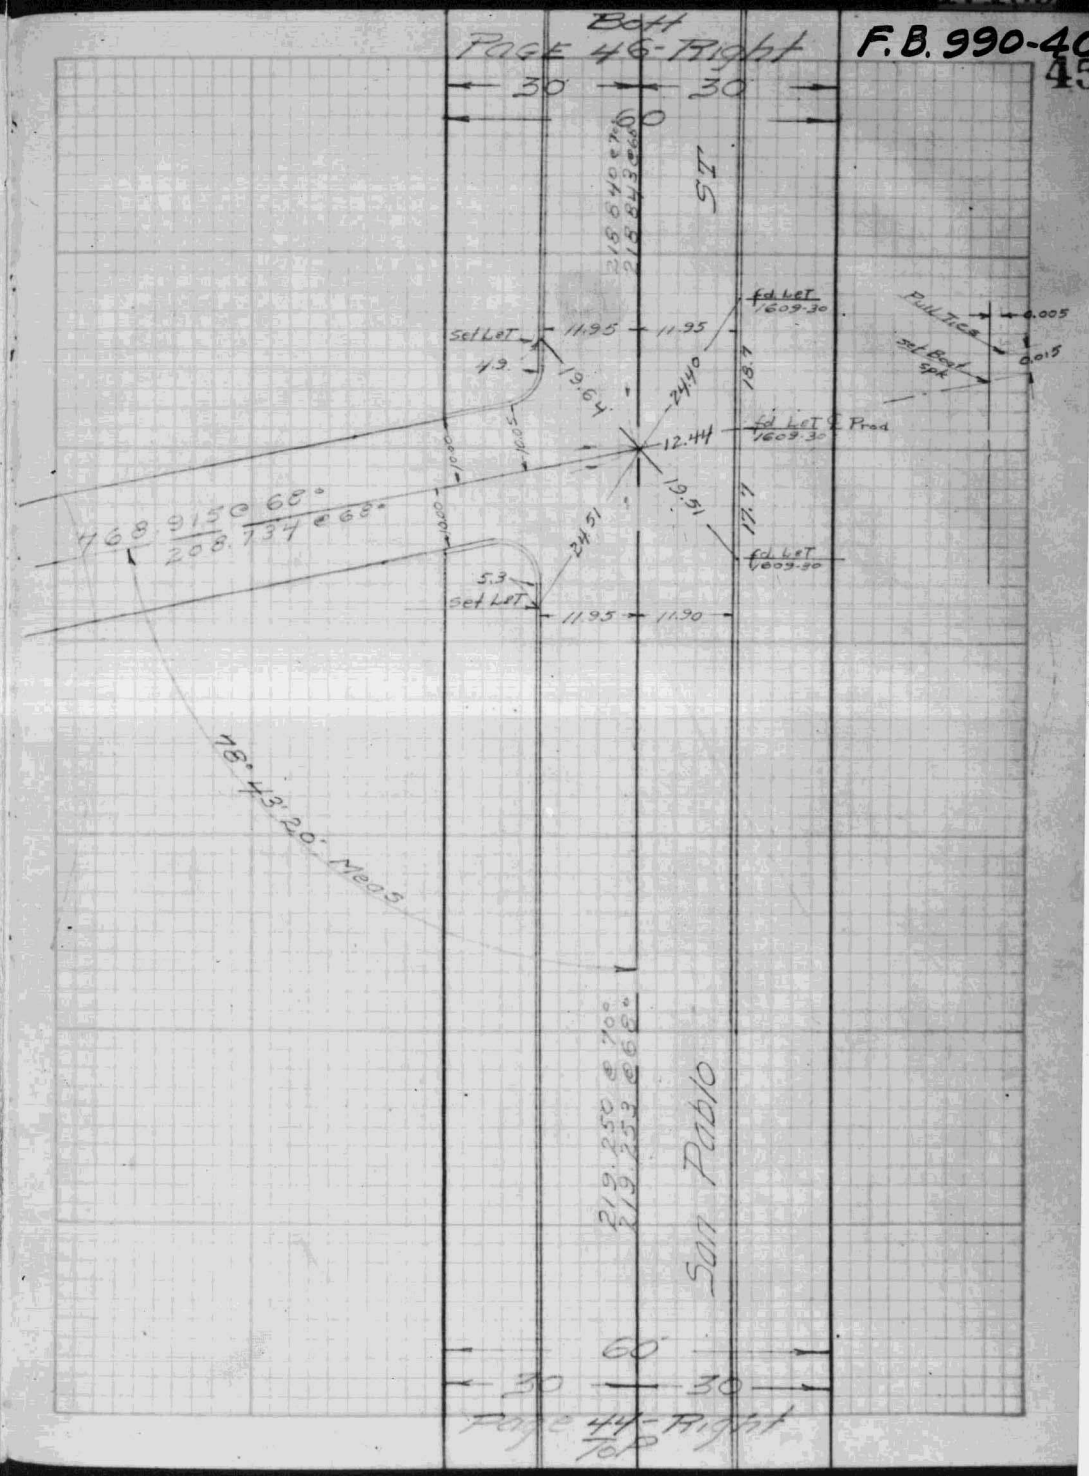
Bott
Page 46-Right
30
30
60
ST
768.915 @ 68°
208.734 @ 68°
78°43'20" Meas
San Pablo
Page 44-Right
Top

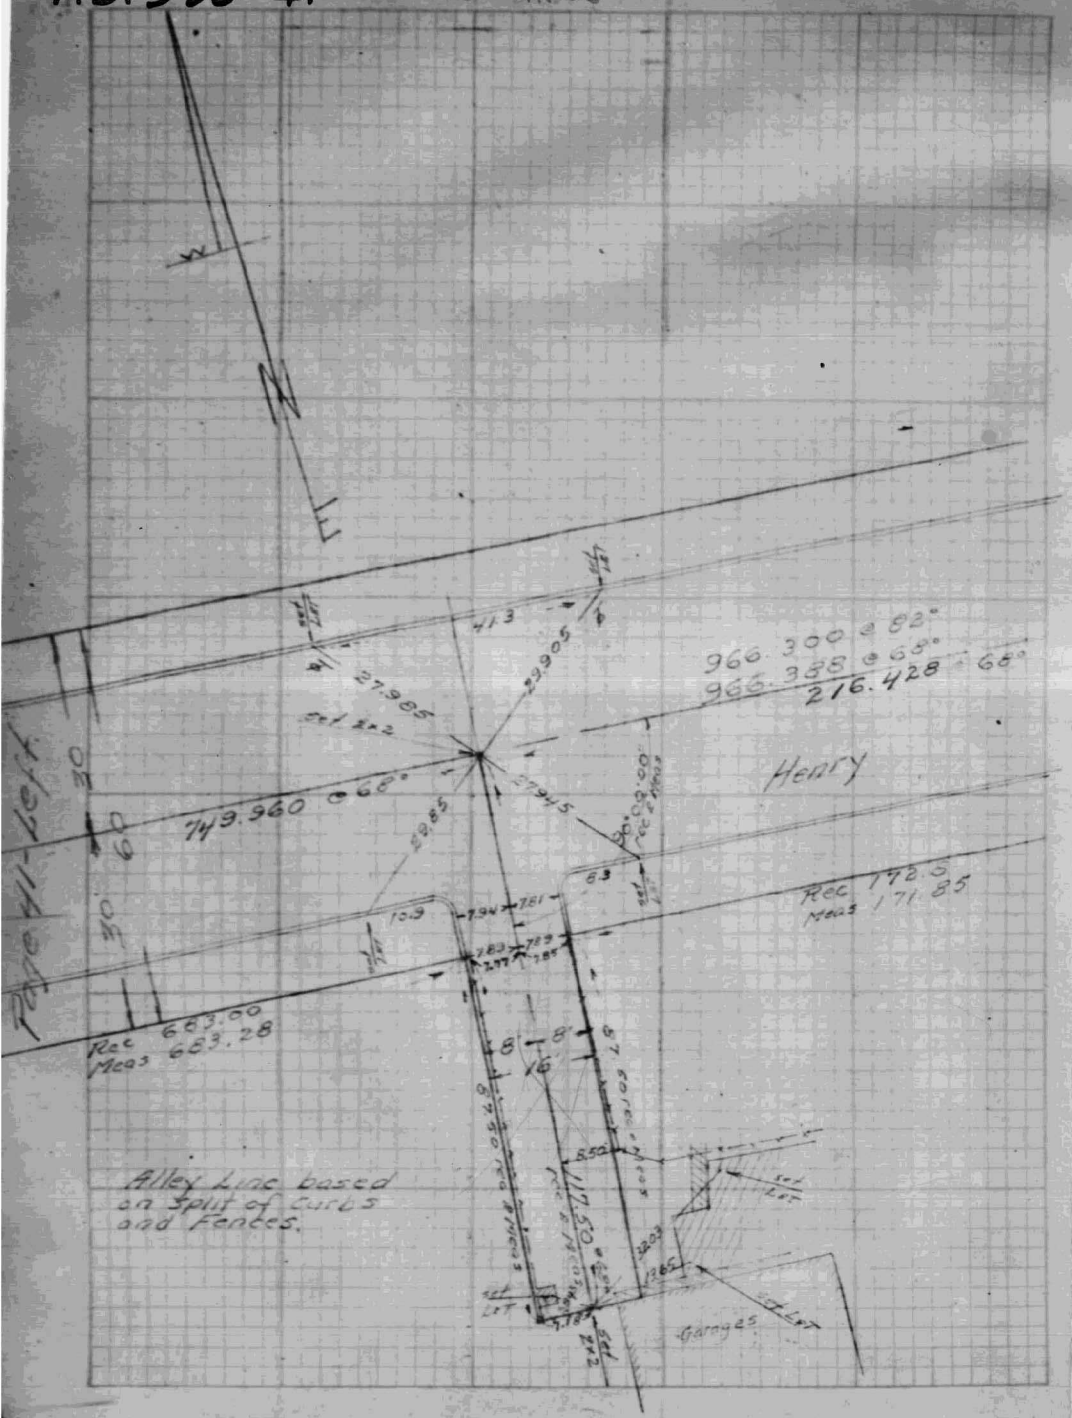
Page 41-Left
Henry
966.300 @ 82°
966.385 @ 68°
216.428 68°
749.960 @ 68°
Rec 172.5
Meas 171.85
Rec 683.00
Meas 683.28
Alley Line based on Split of Curbs and Fences.
Garages

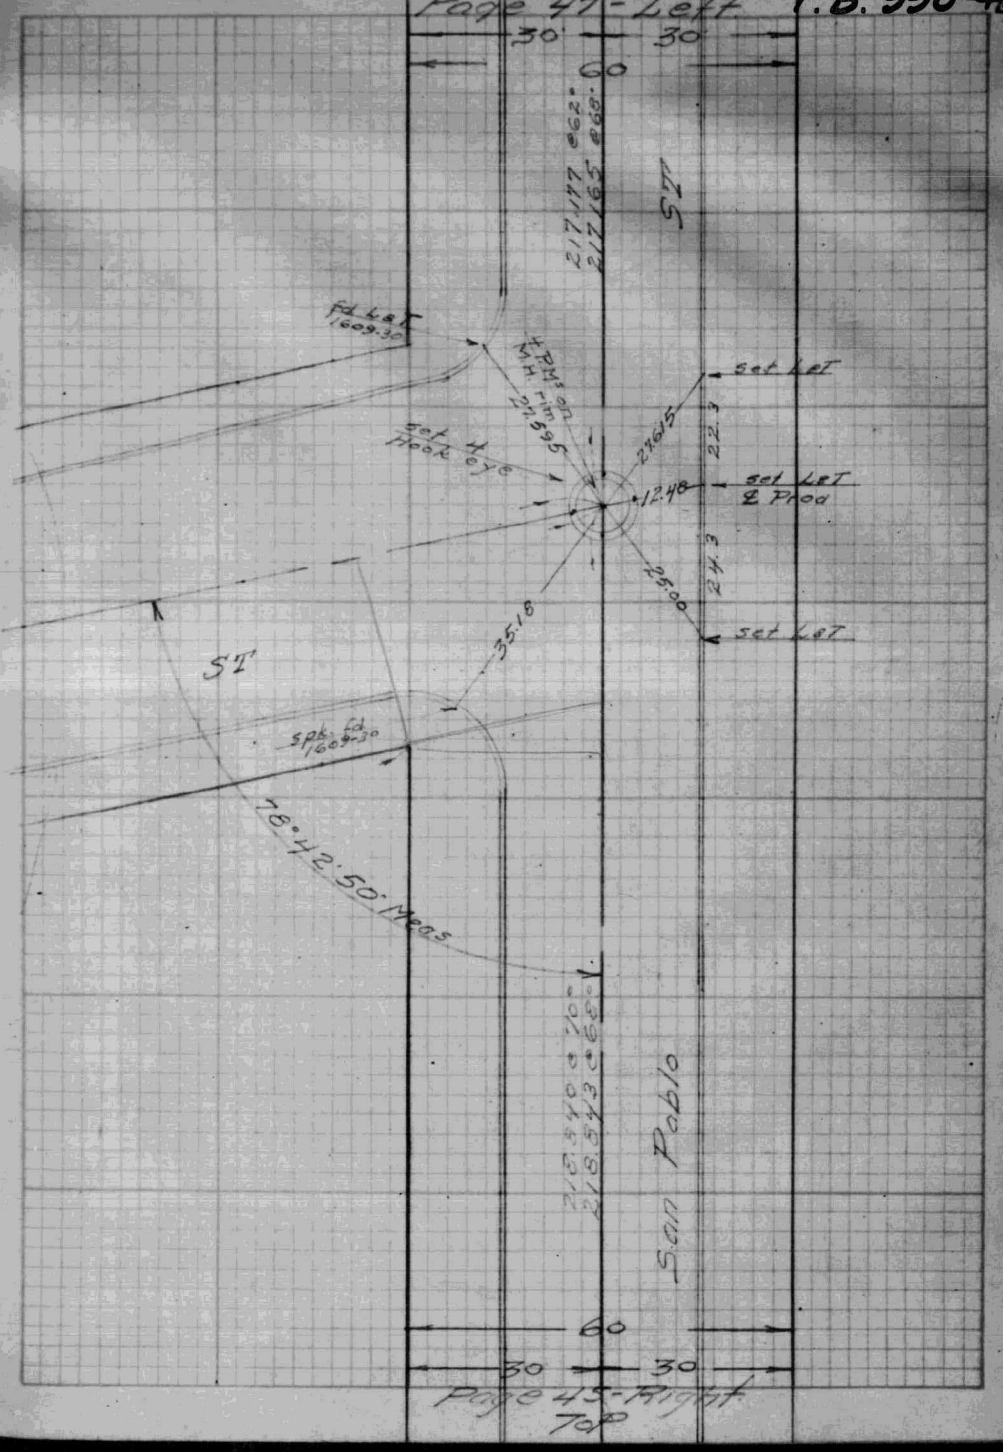
Both
Page 47-Left
ST
ST
San Pablo
78°42'50" Meas
Page 45-Right
Top

F.B. 990-43

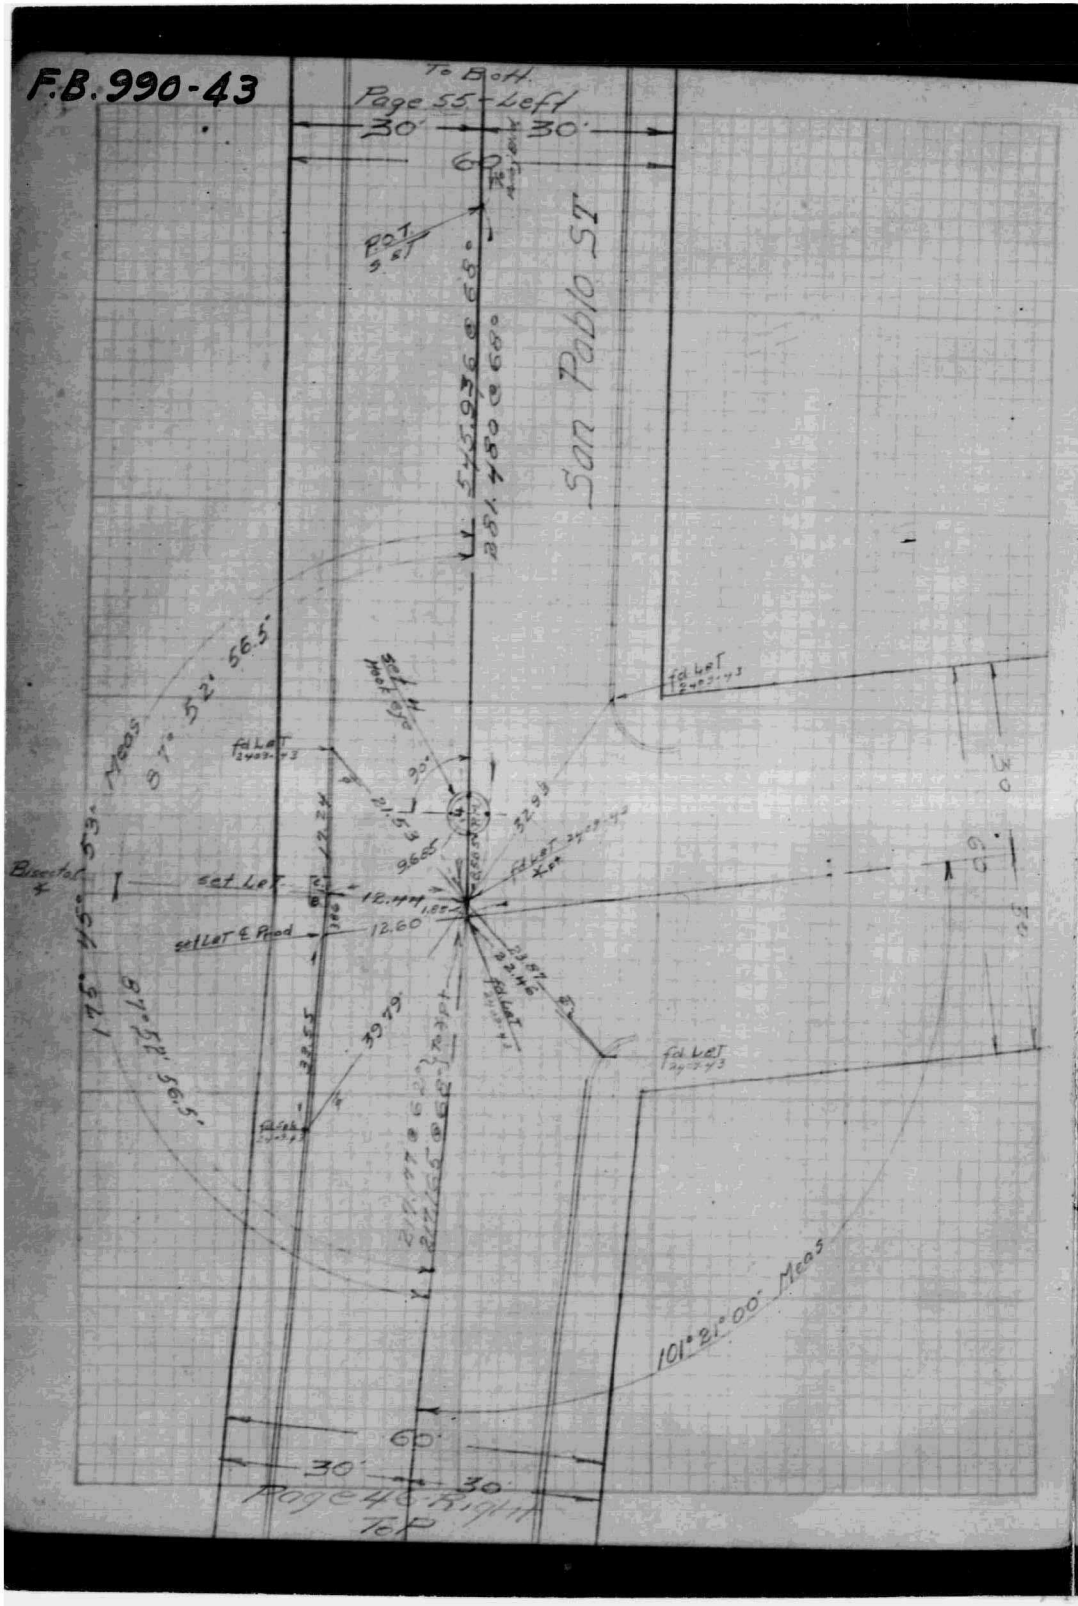

F.B. 990-44

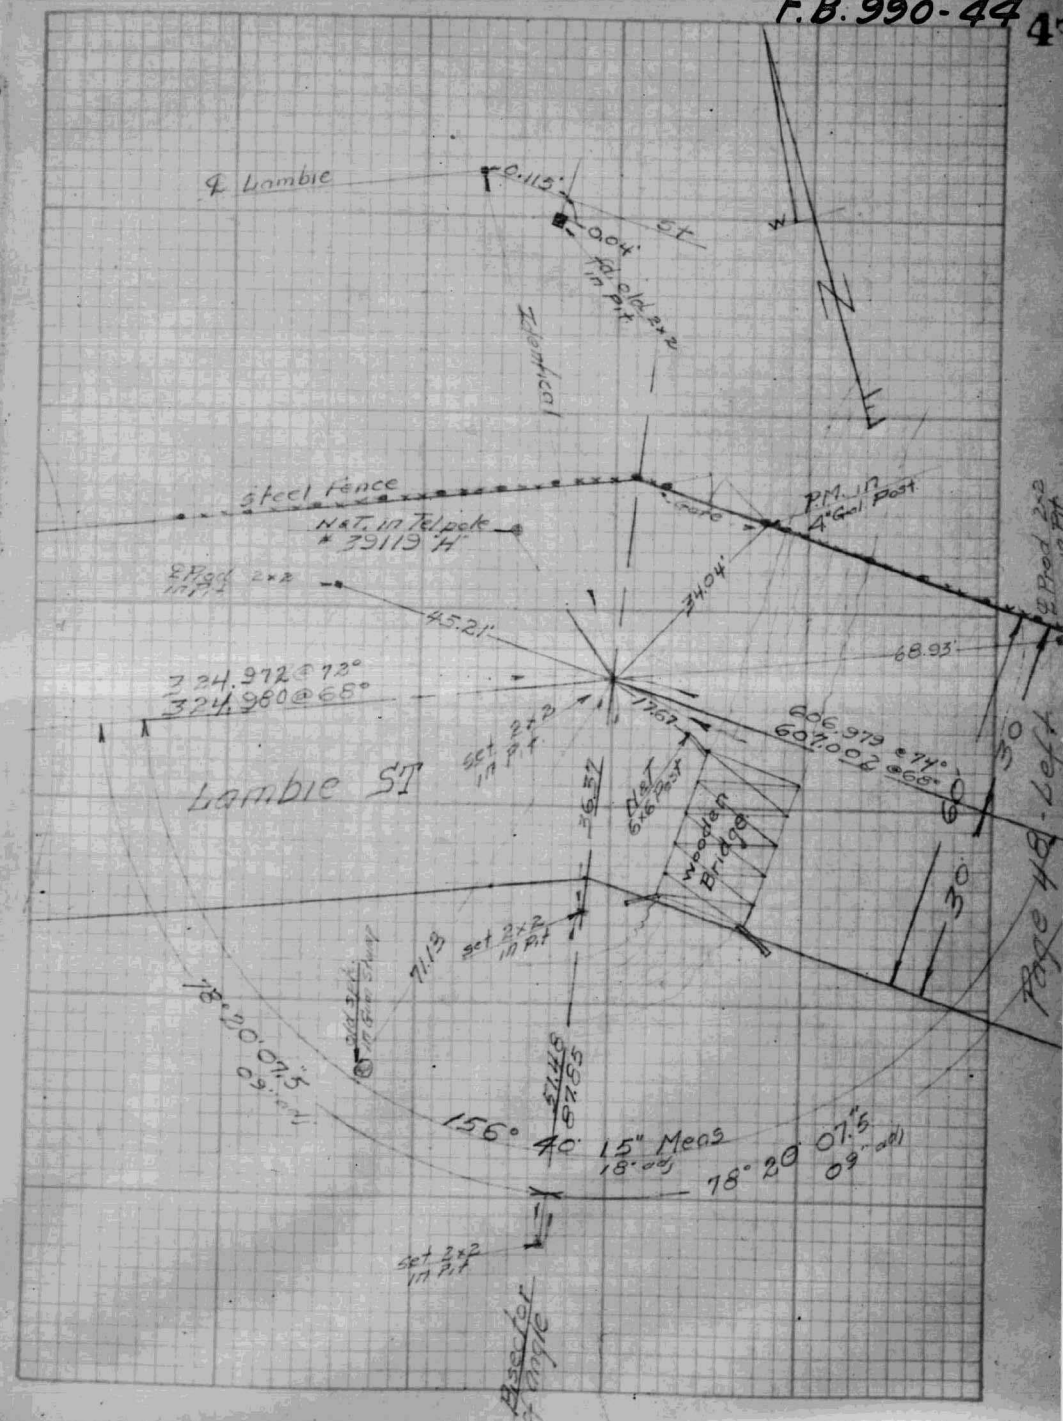

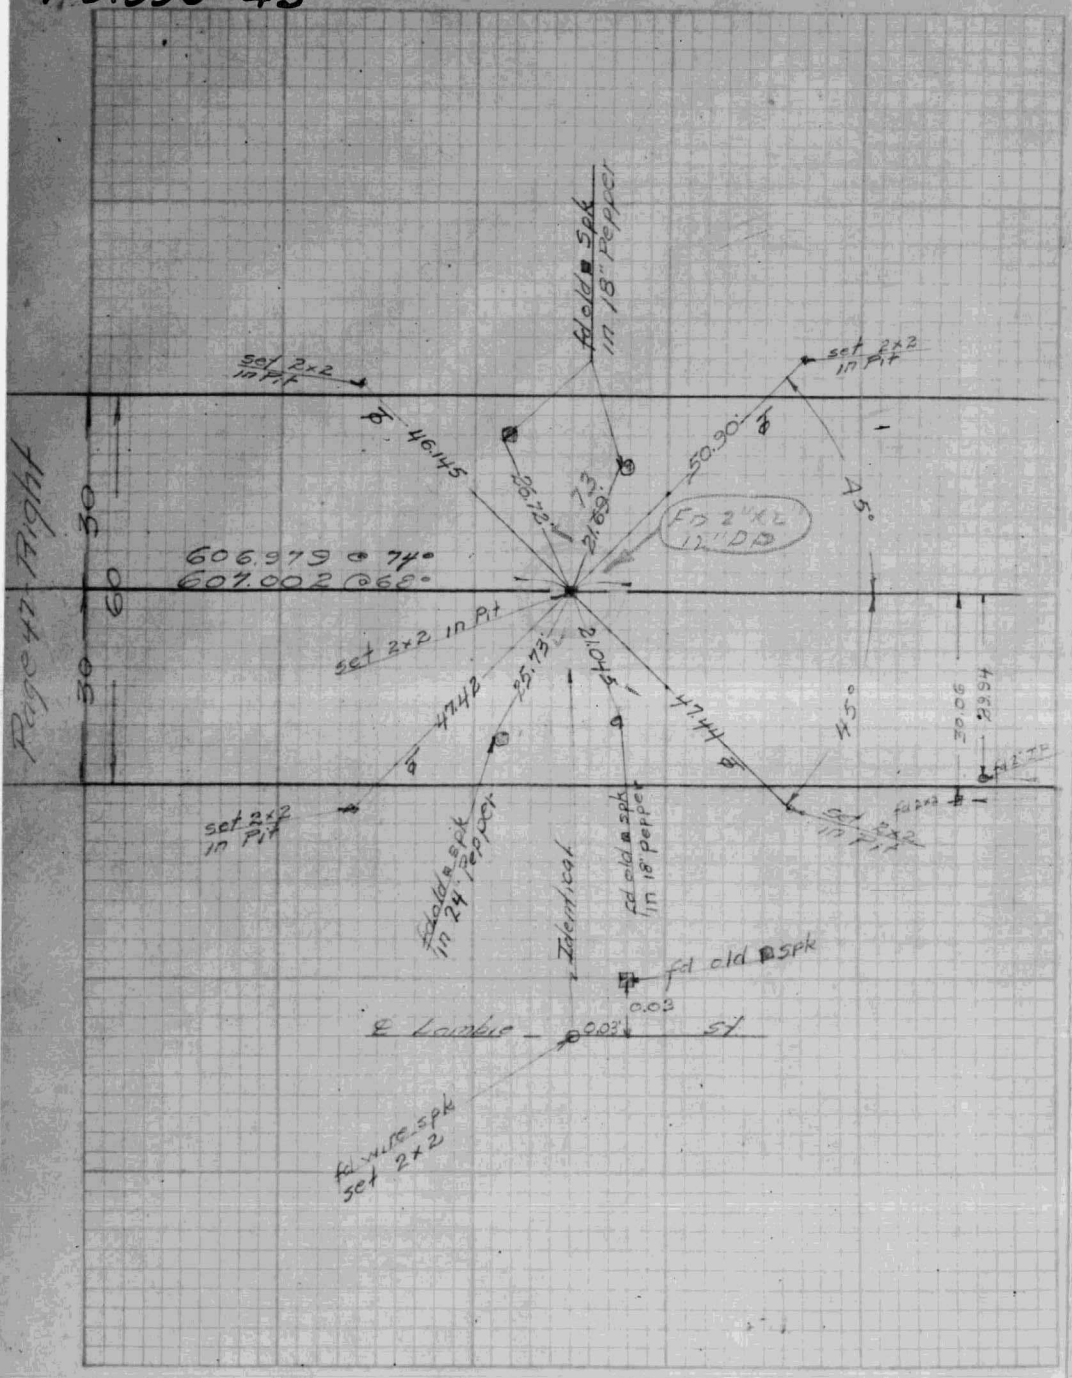

INDEXED DEC 17 1936

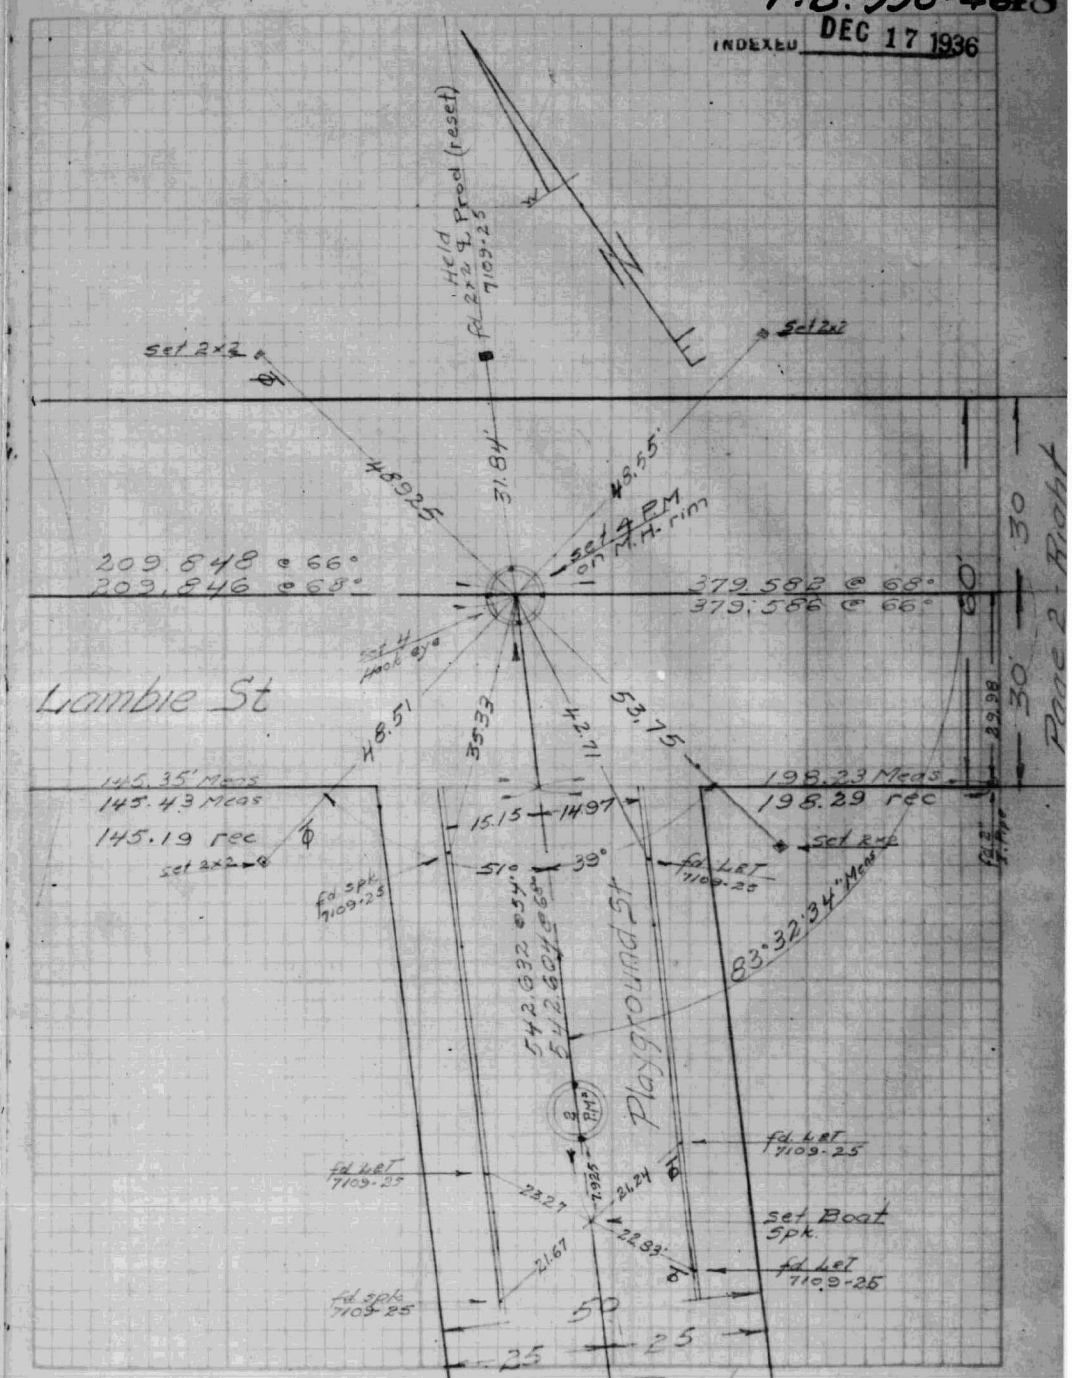

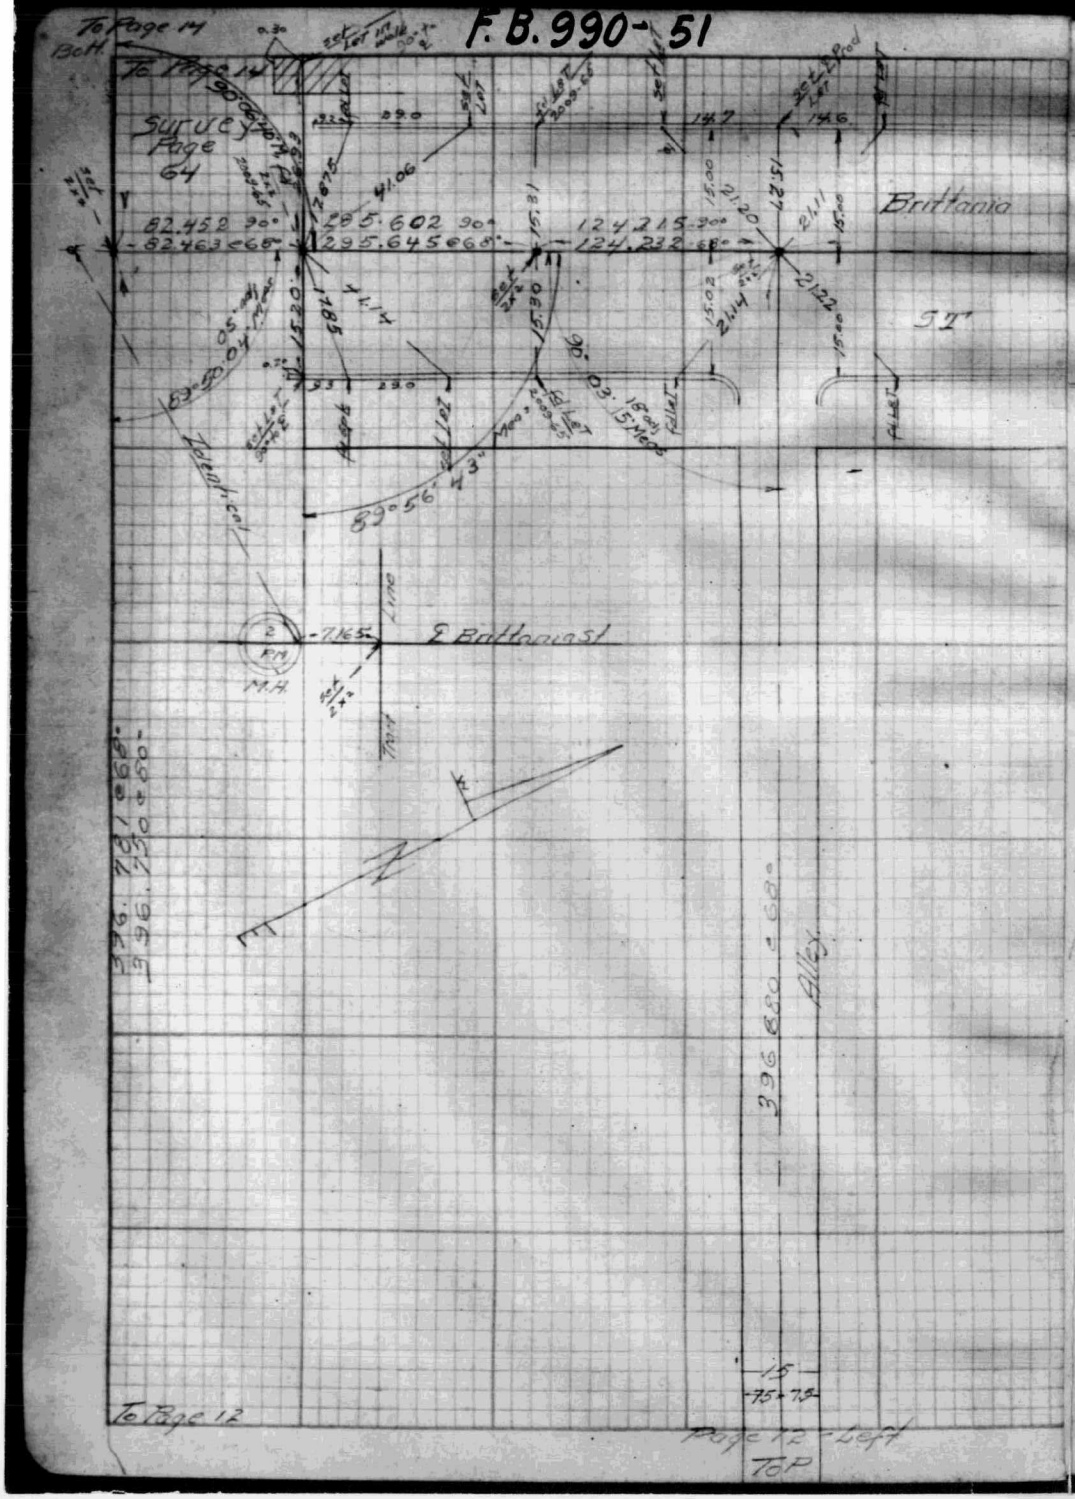
F.B. 990-51
To Page 14
Bott.
Survey Page 64
Brittania
ST
℄ Brittania St
Alley
To Page 12
Page 12 - Left
TOP

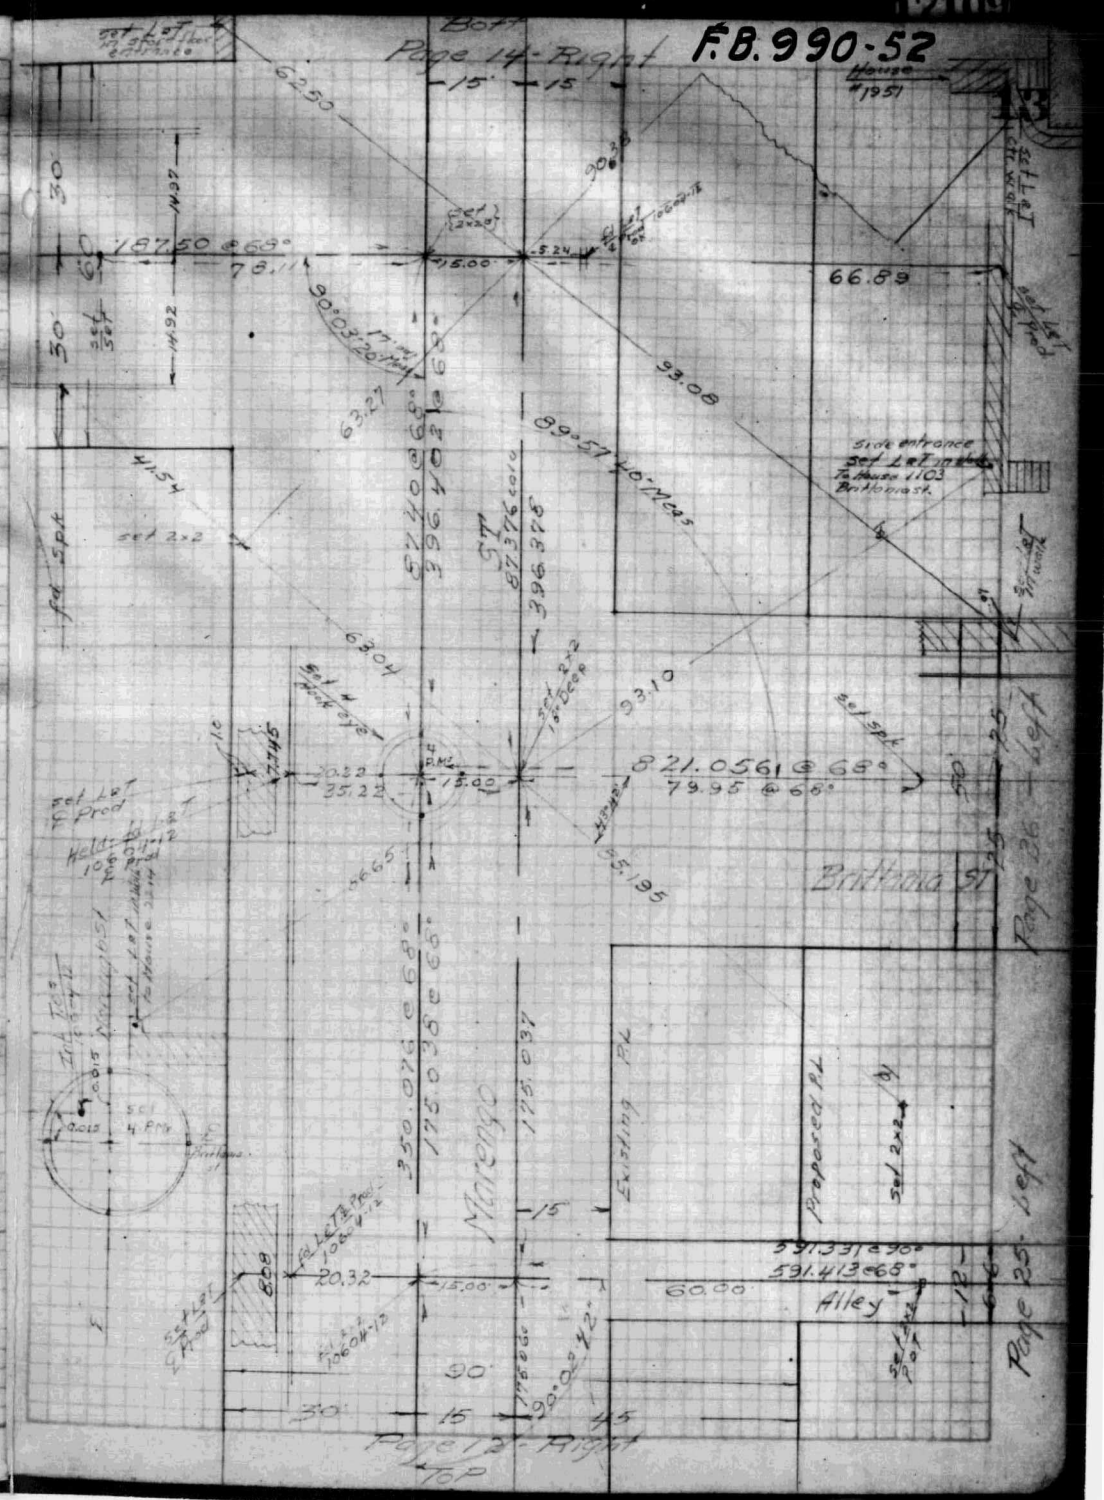
F.B. 990-52
Page 14 - Right
House #1951
Side entrance
Brittania St
Marengo
Existing P.L.
Proposed P.L.
Alley
Page 25 - Left
Page 12 - Right
TOP

DEC 17 1936
INDEXED

MISSION ROAD

Marengo ST to Valley Blvd

Center Line - Ties - Distances - Angles

C 1939
C 1940

July 28 1936

Boysen A.H
Oetting V.W
Beals E.R
Leonhardt H.A
Kipkie L.P.

Ref 13108-6 to 13 inc

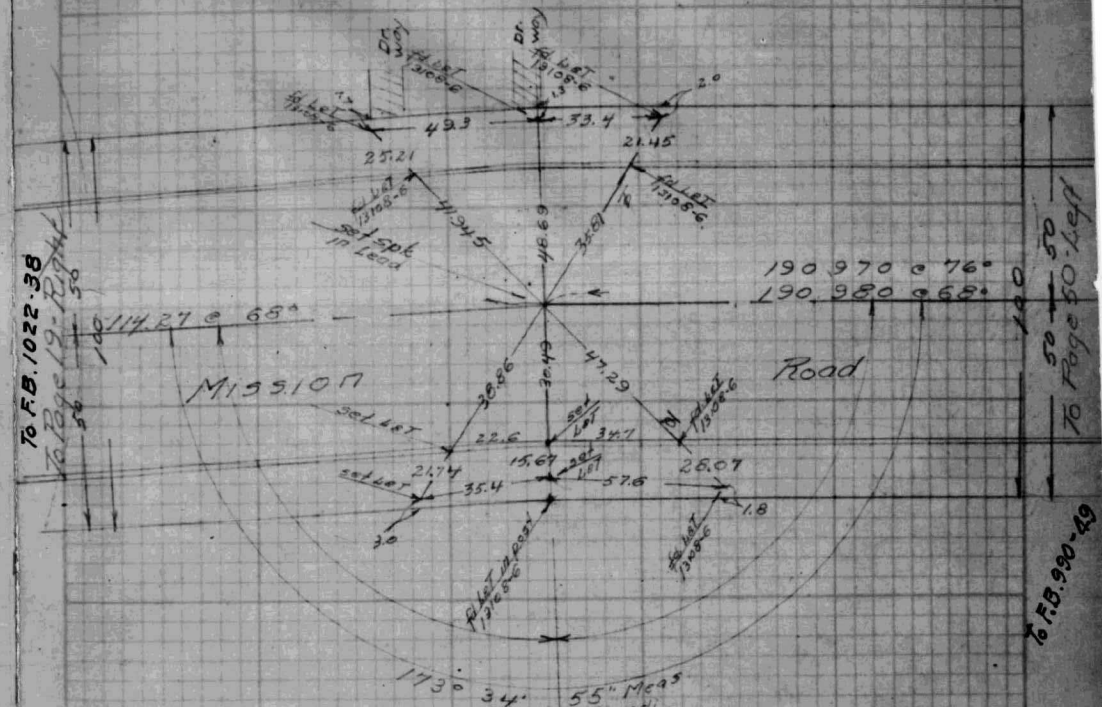

F.B. 990-49

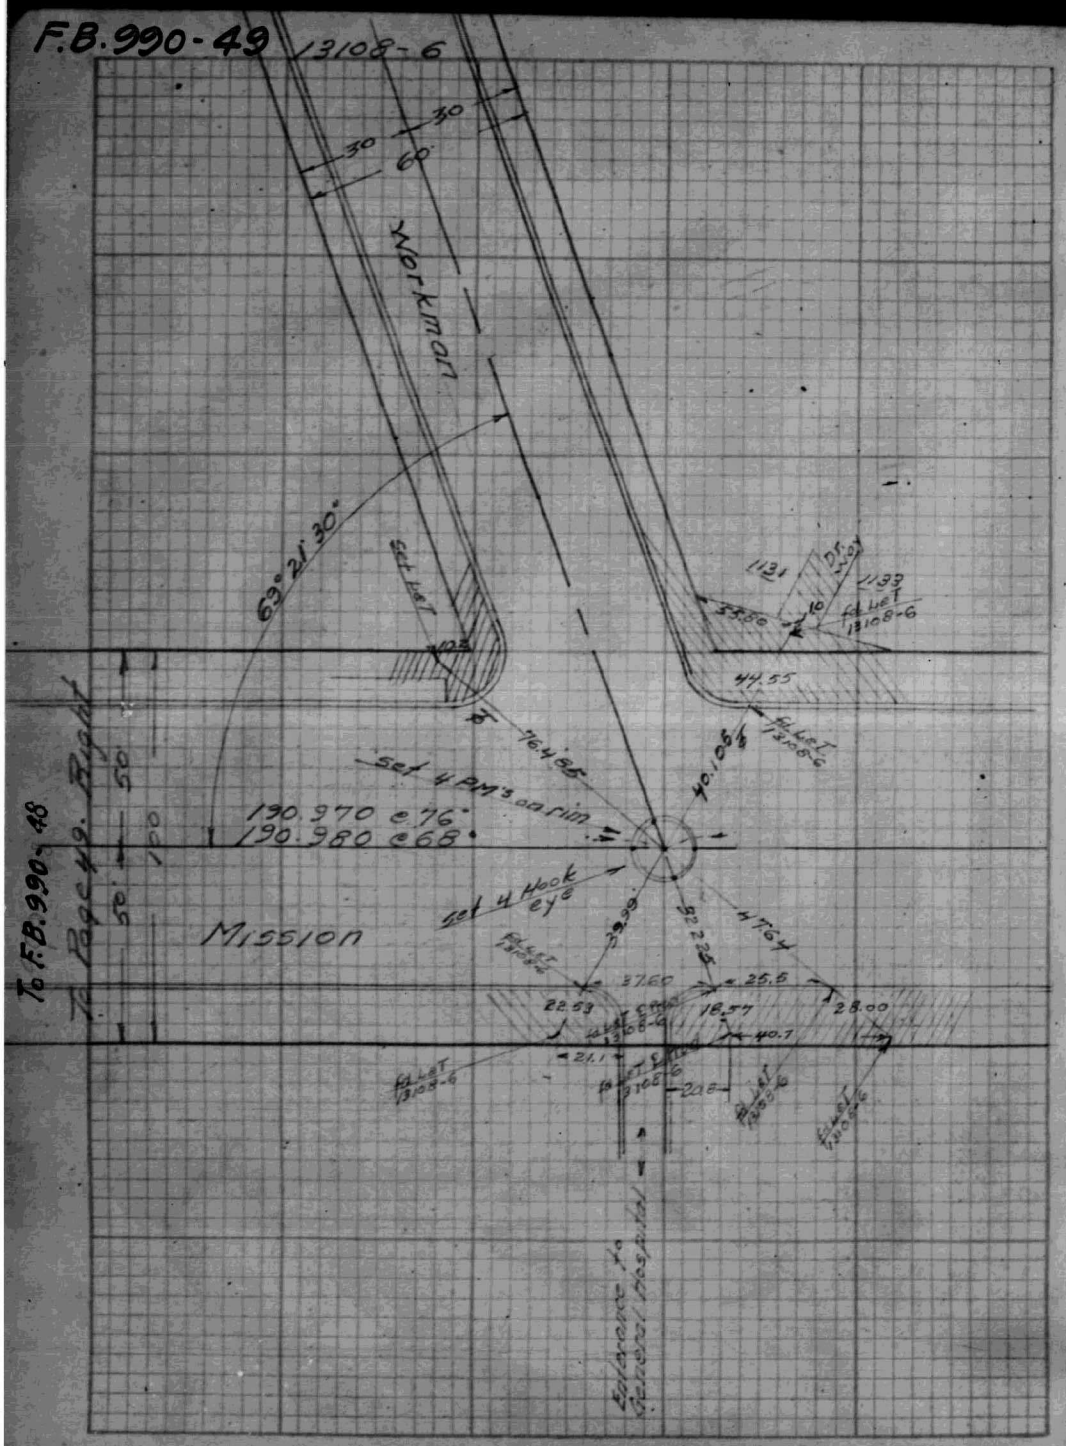

F.B. 990-50

50

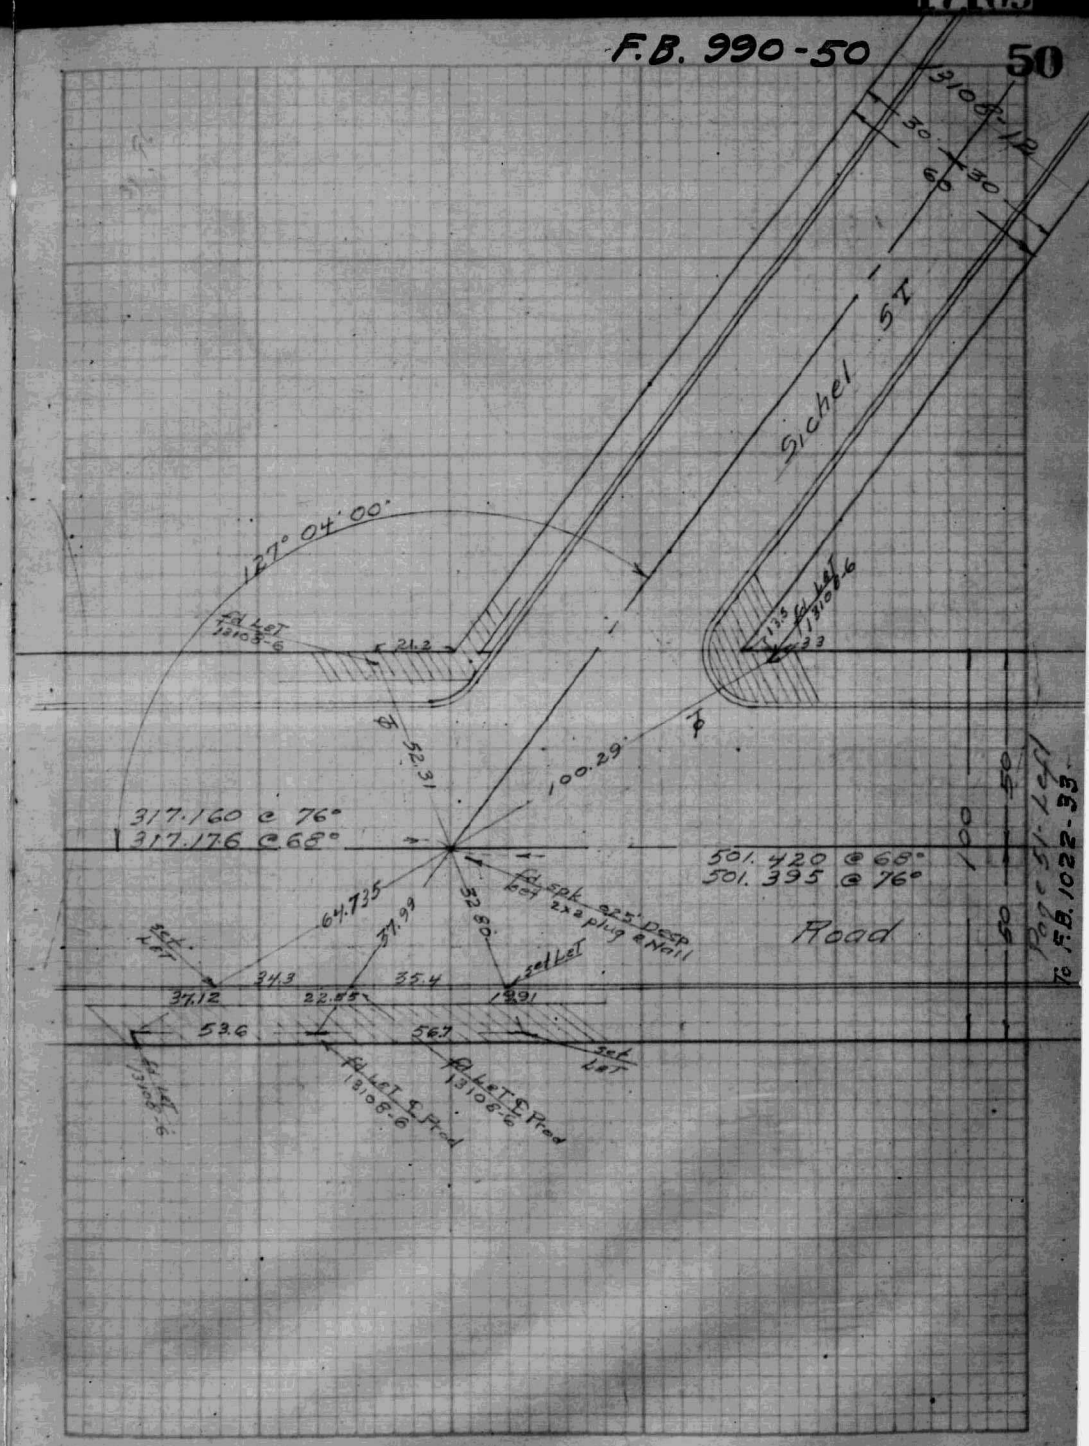

F.B. 990-53

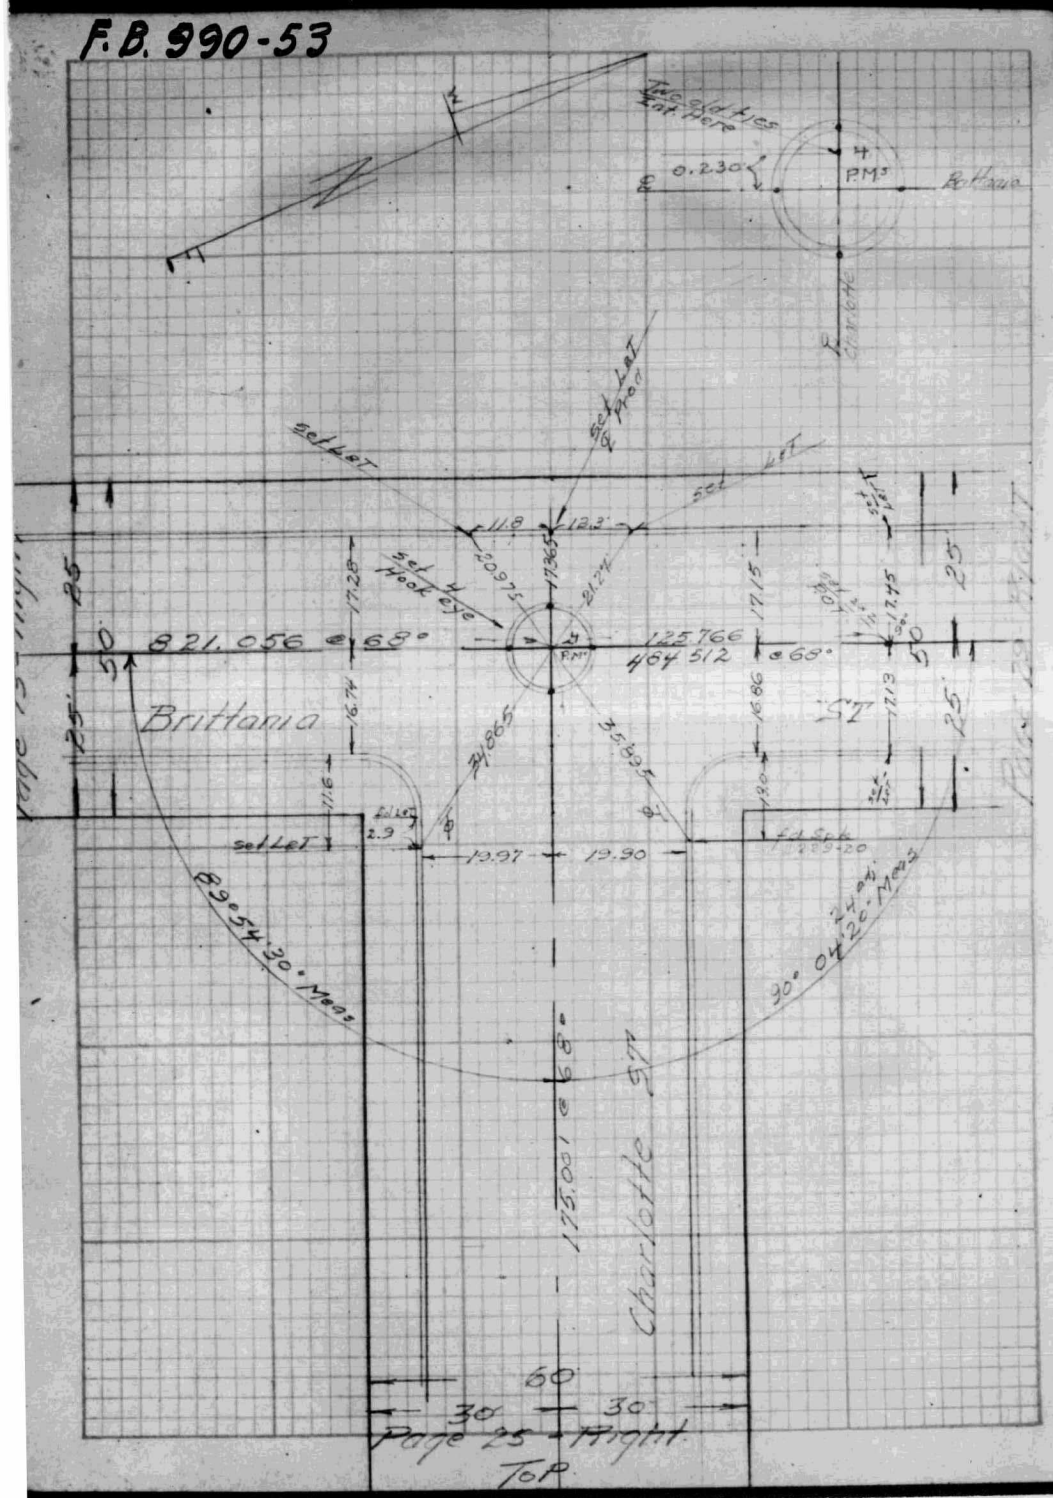

F.B. 990-54

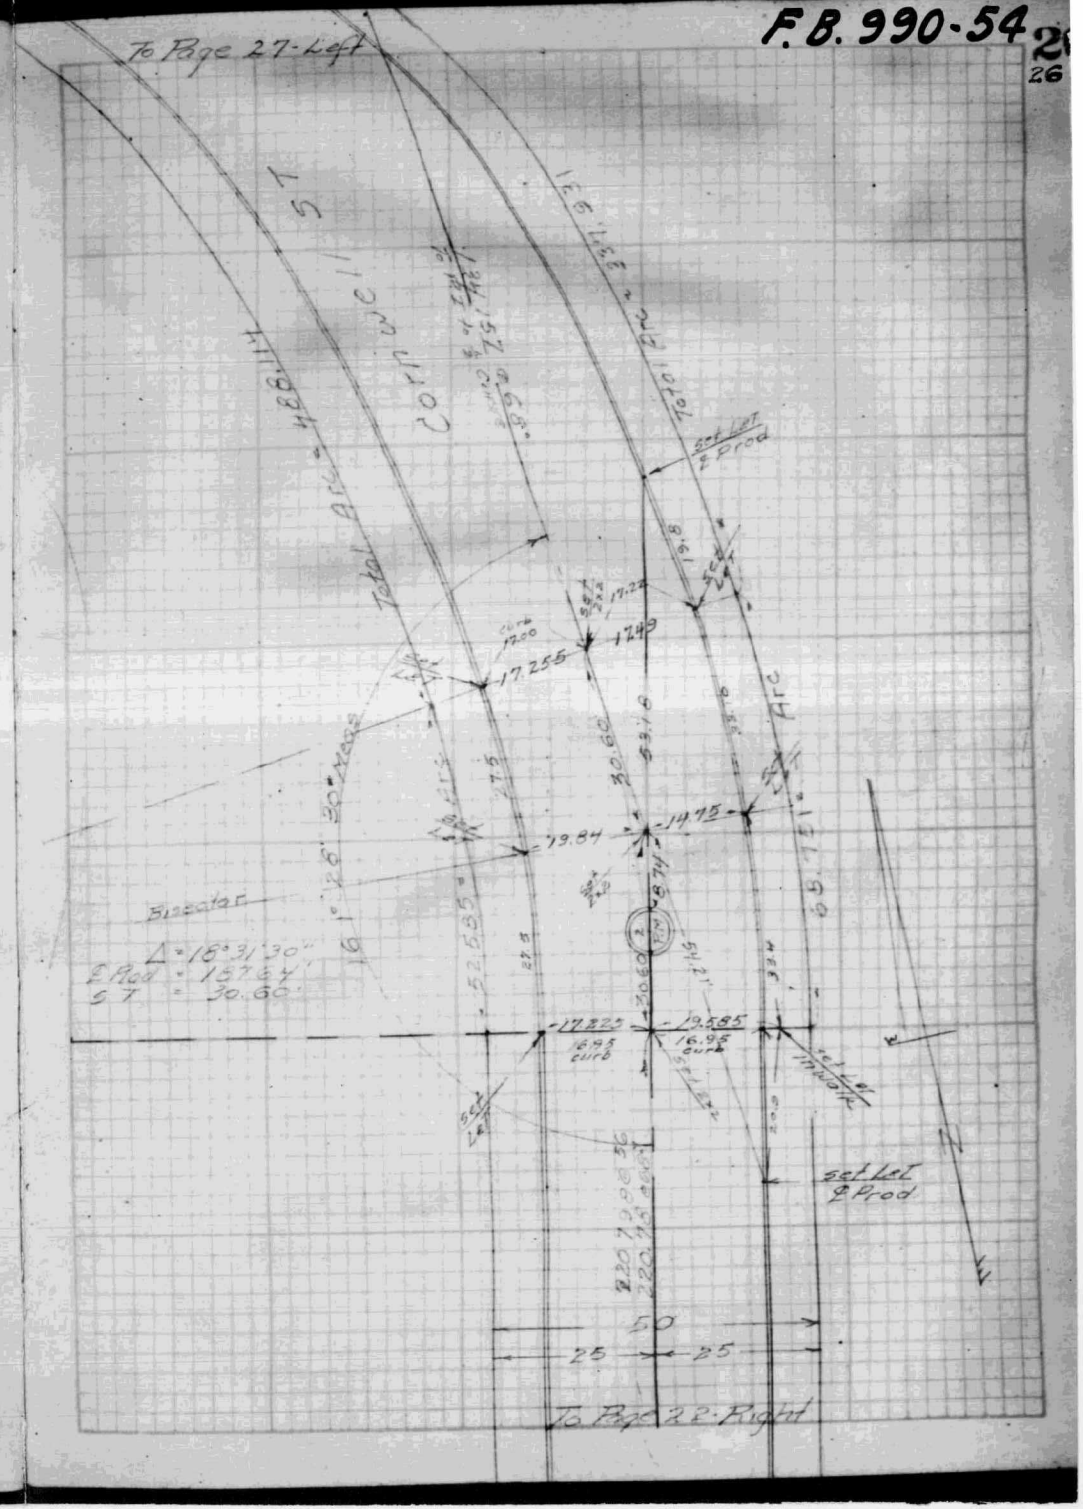

INDEXED DEC 17 1936 F.B. 990-55

VALLEY BLVD

Mission Rd to Soto St

Center Line - Ties - Distances - Angles

C-1939
C-1940

July 28, 1936

Boysen A H
Gunn T.R
Oetting V.W

Beals E.R
Foglesong F
Saffell F.B

Ref
2229-58-59-60-61
1035-70

F.B. 990-56

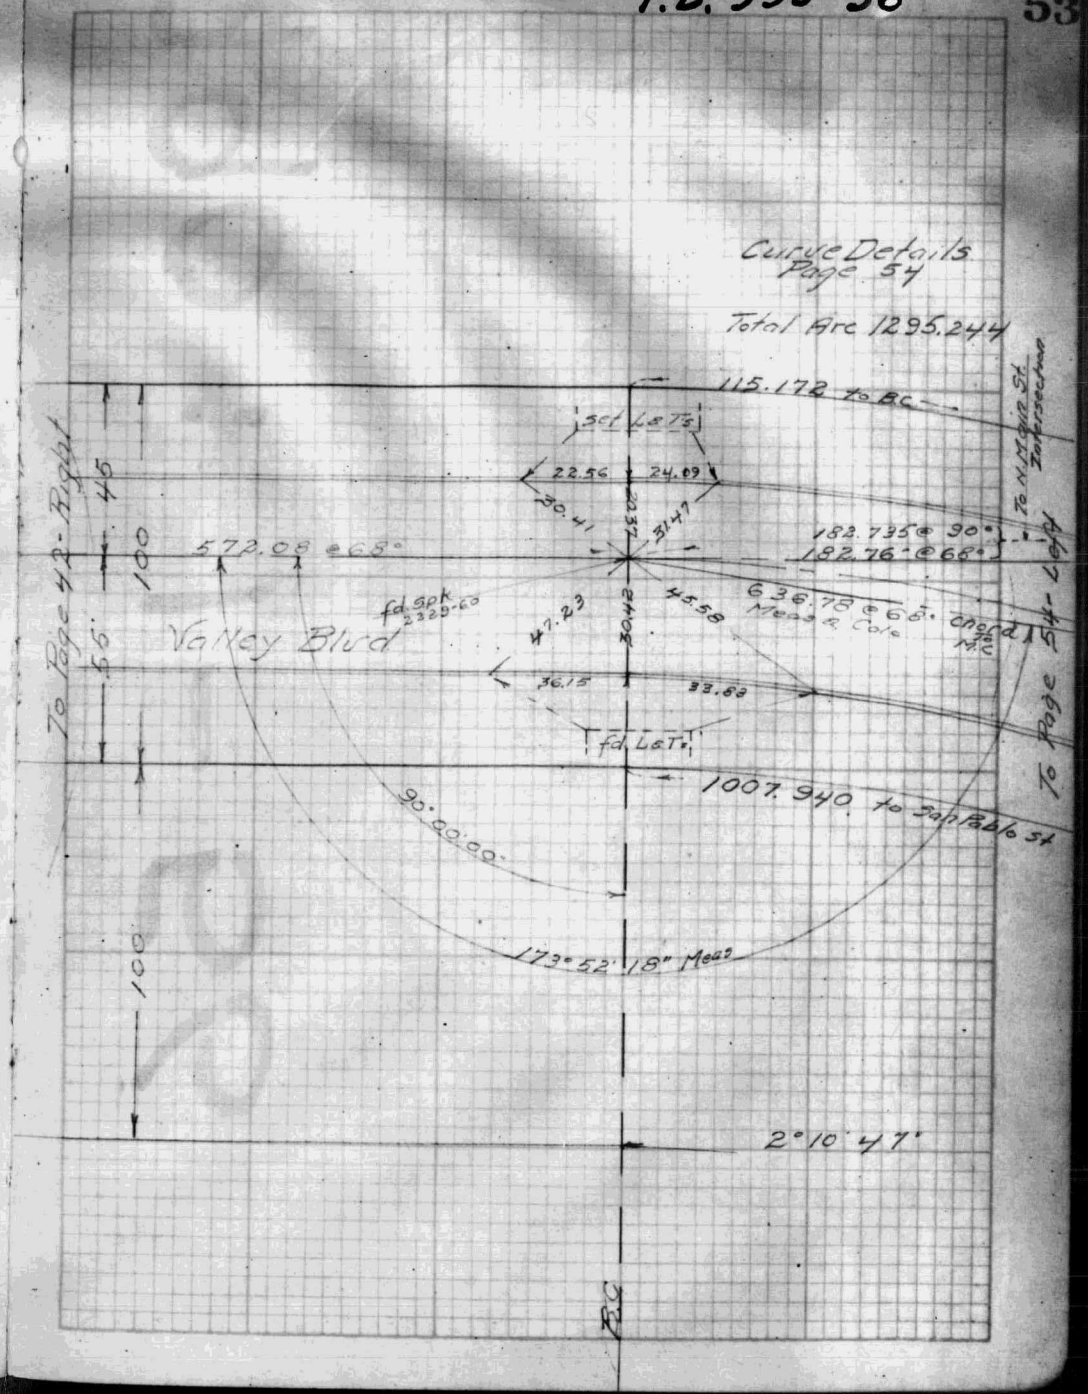

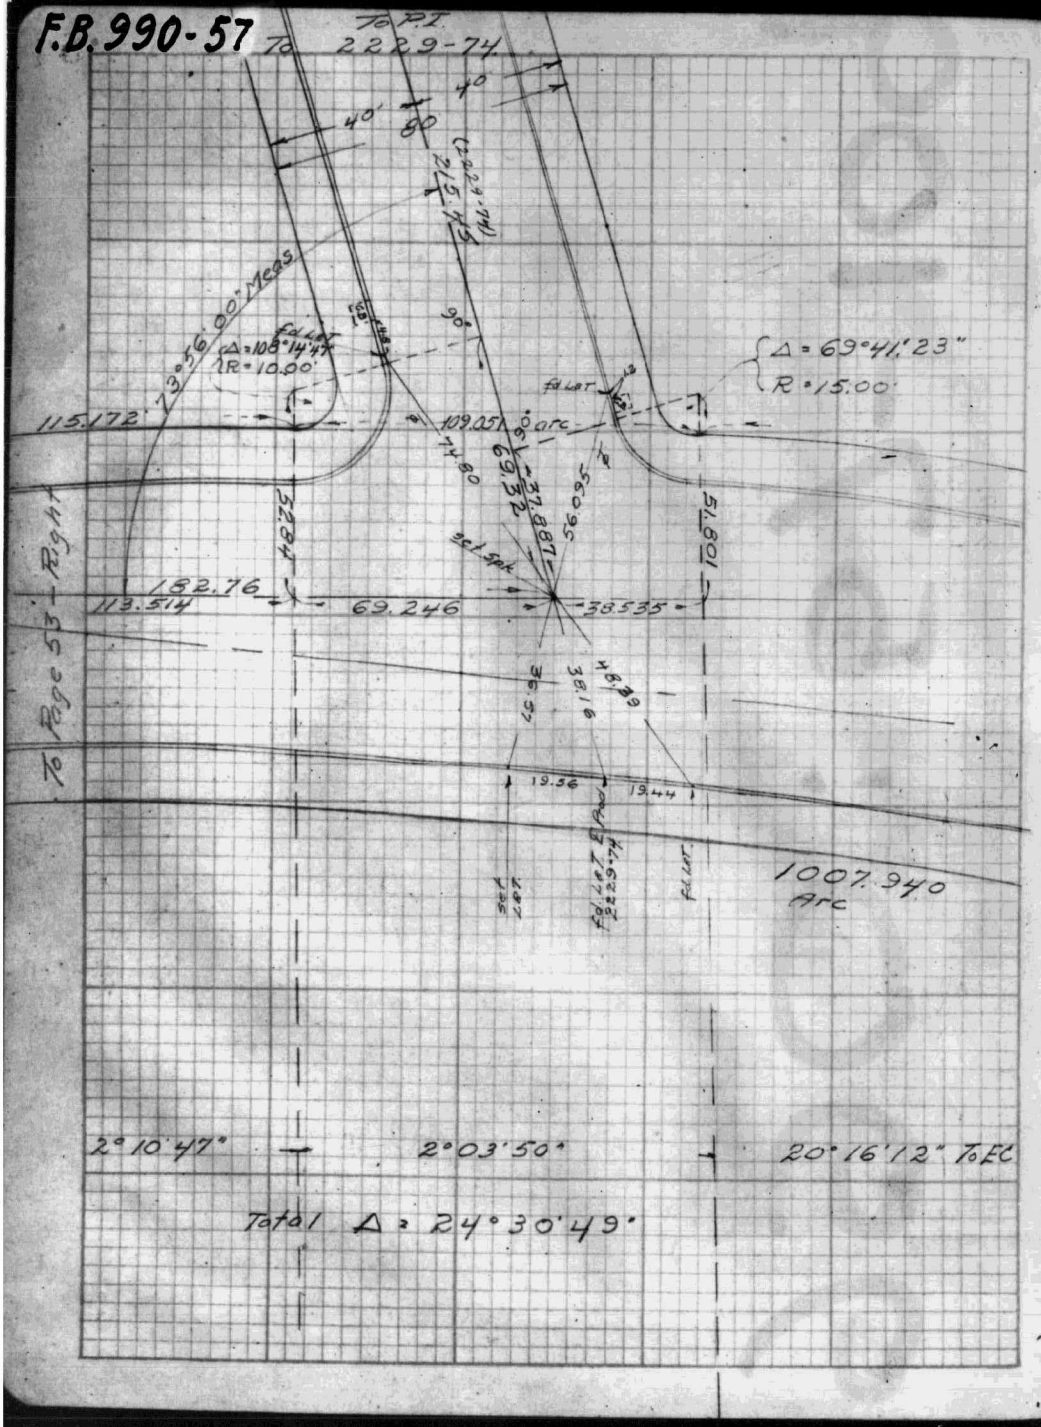

To Page 53 - Right

Total Curve
Δ = 24°30'49"
ST = 647.910
Transit Line R = 2982.38
Cord for ½ curve = 636.78

Total Arc (long) = 1295.244
" " (short) = 1252.460

P.I. to Curve inaccessible } falls in Lake

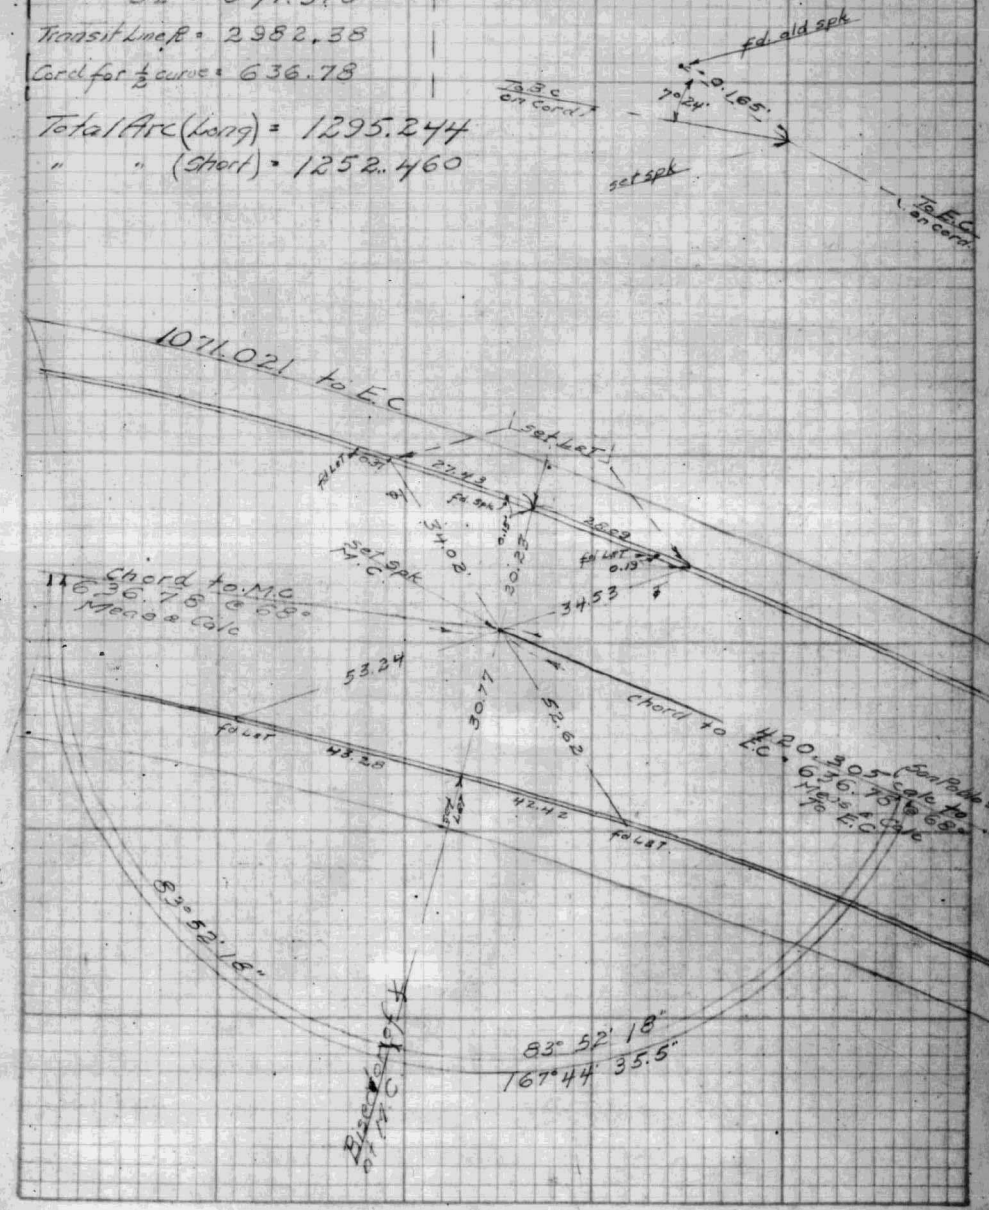

To Page 55 - Left

F.B. 990-59

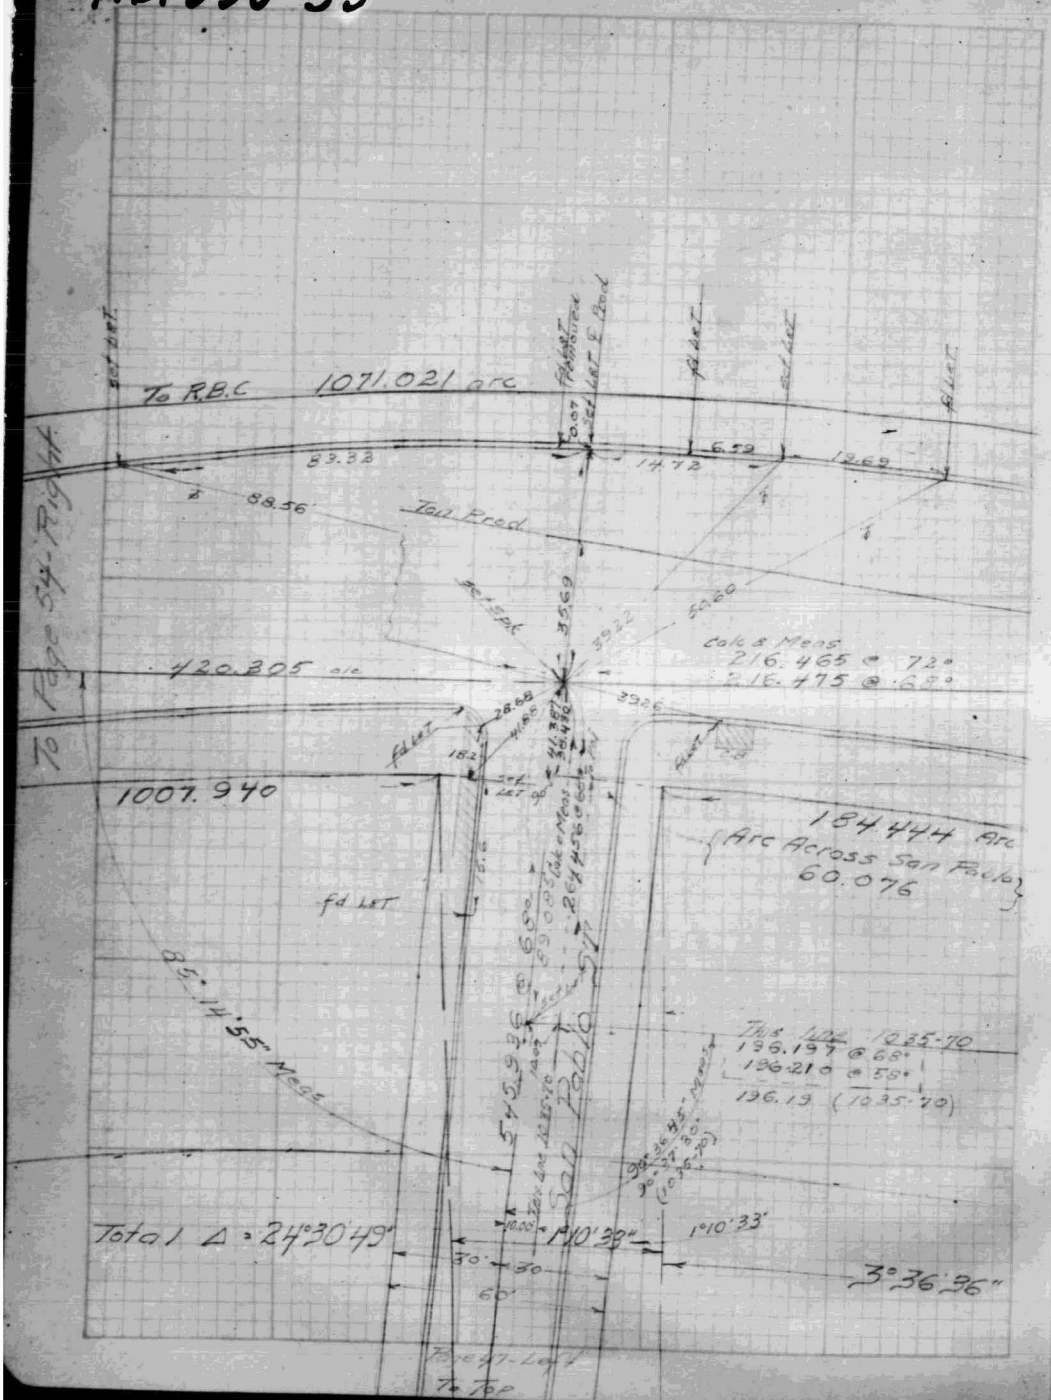

F.B. 990-60

17109
INDEXED DEC 17 1936

P.I. to Curve inaccessible } falls in Lake

Curve Details
Page 54

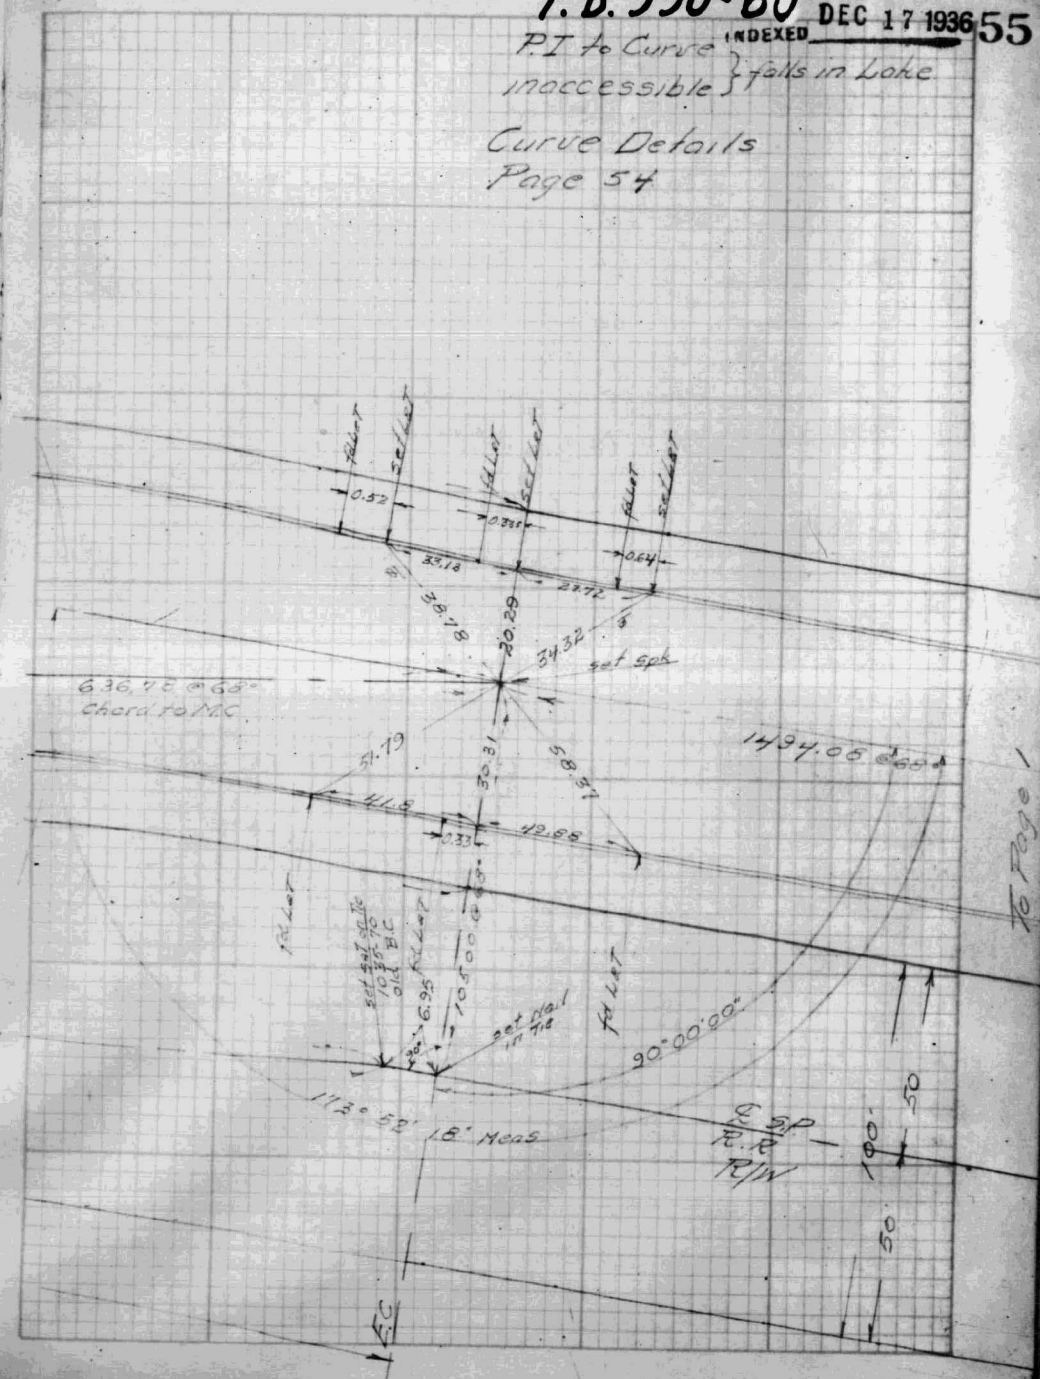

City Eng. F.B. 16,008

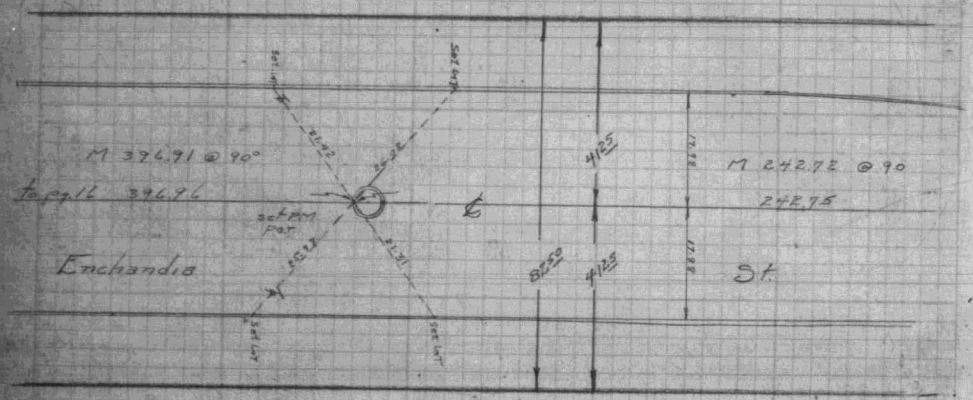

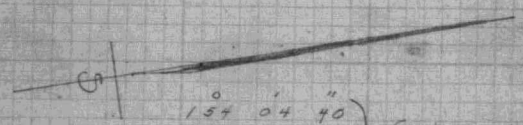

°	'	"	
154	04	40	Judson
192	08	35	Enchandia-60°
173	47	00	Enchandia-82½°
50	56	50	Finchart
231	20	28	Lord
? → 97	41	24	
89	50	00	
90	06	00	
1079	59	57	

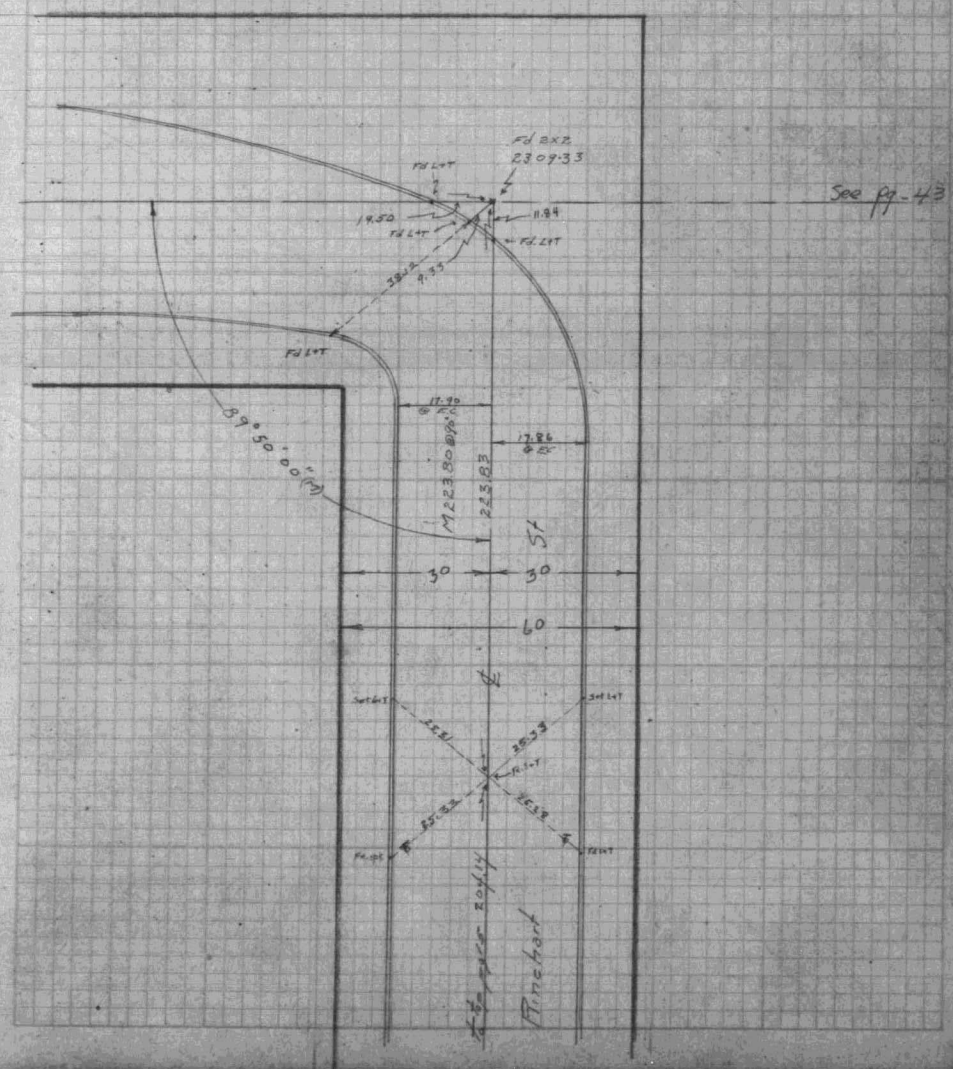

L.A. City Engrs FB 16008

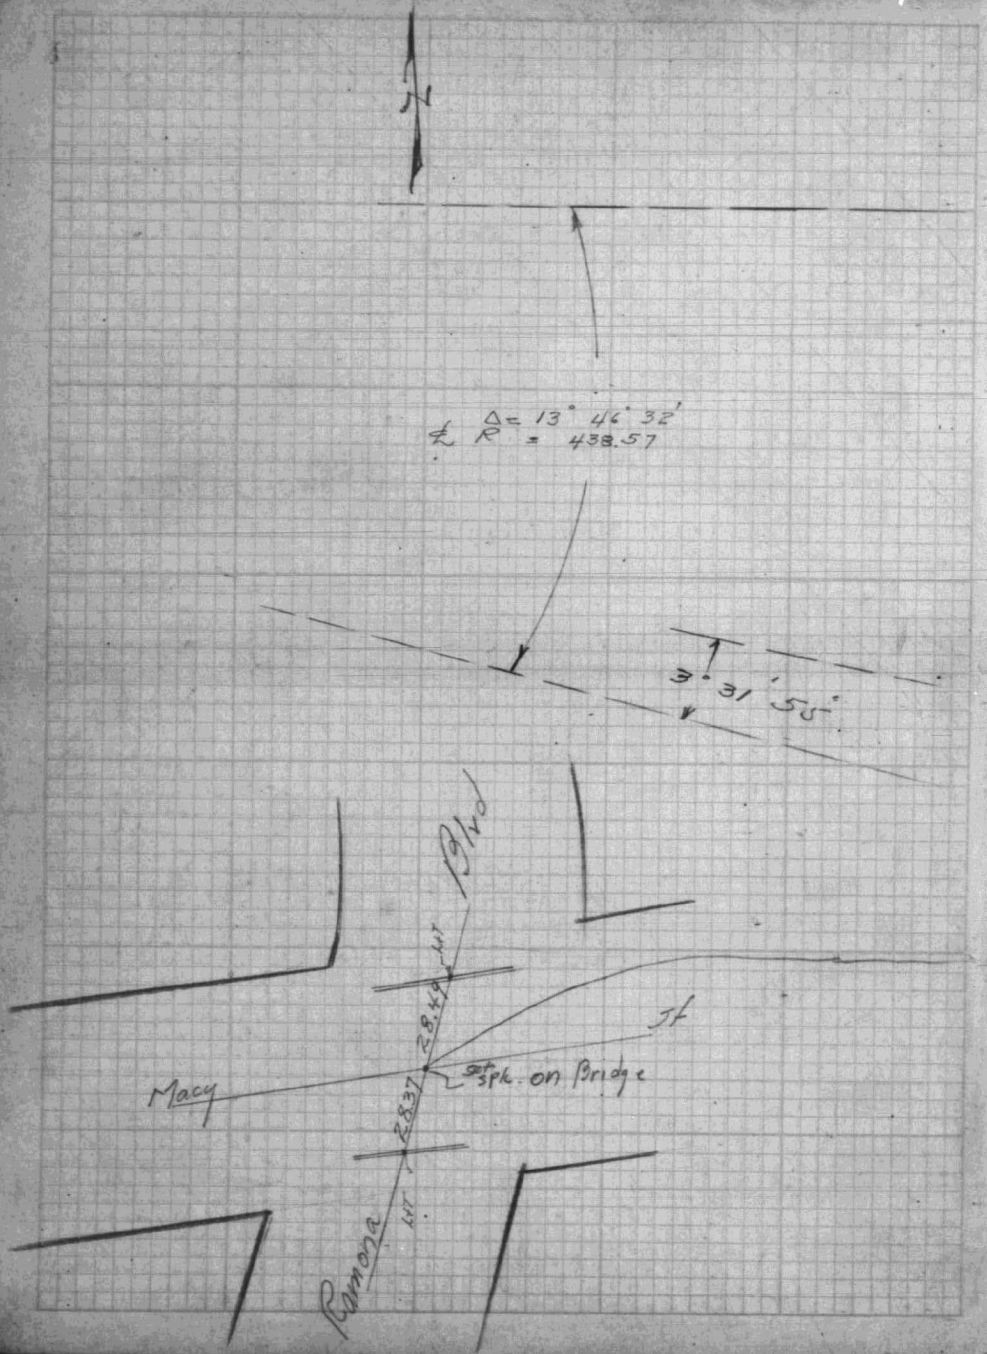

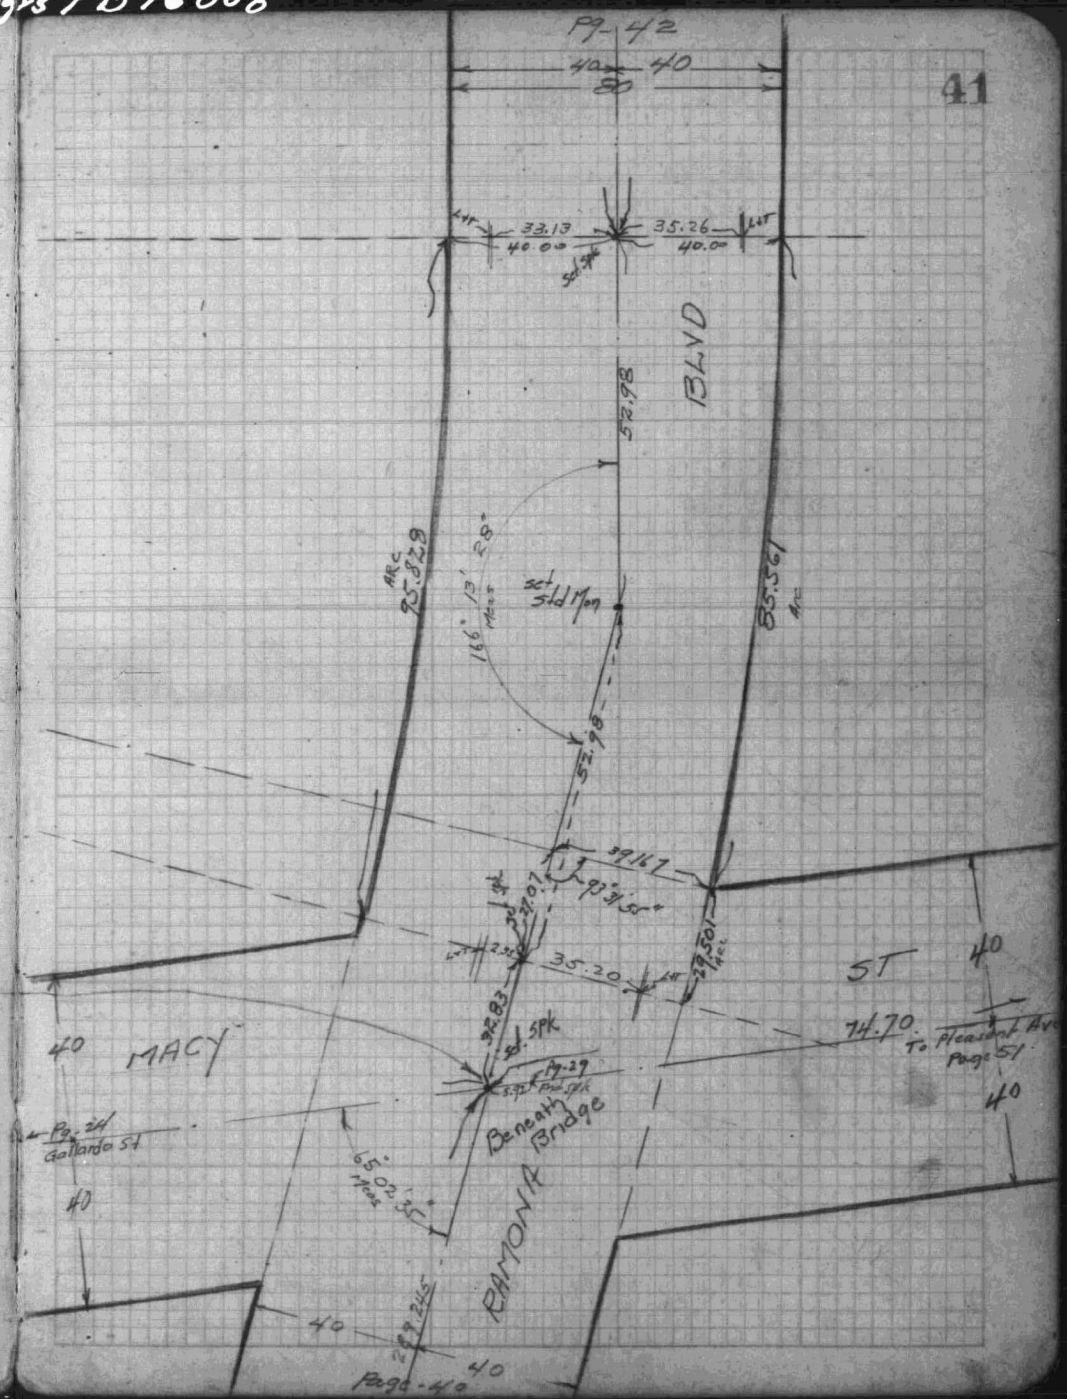

L.A. City Engrs F-B16008

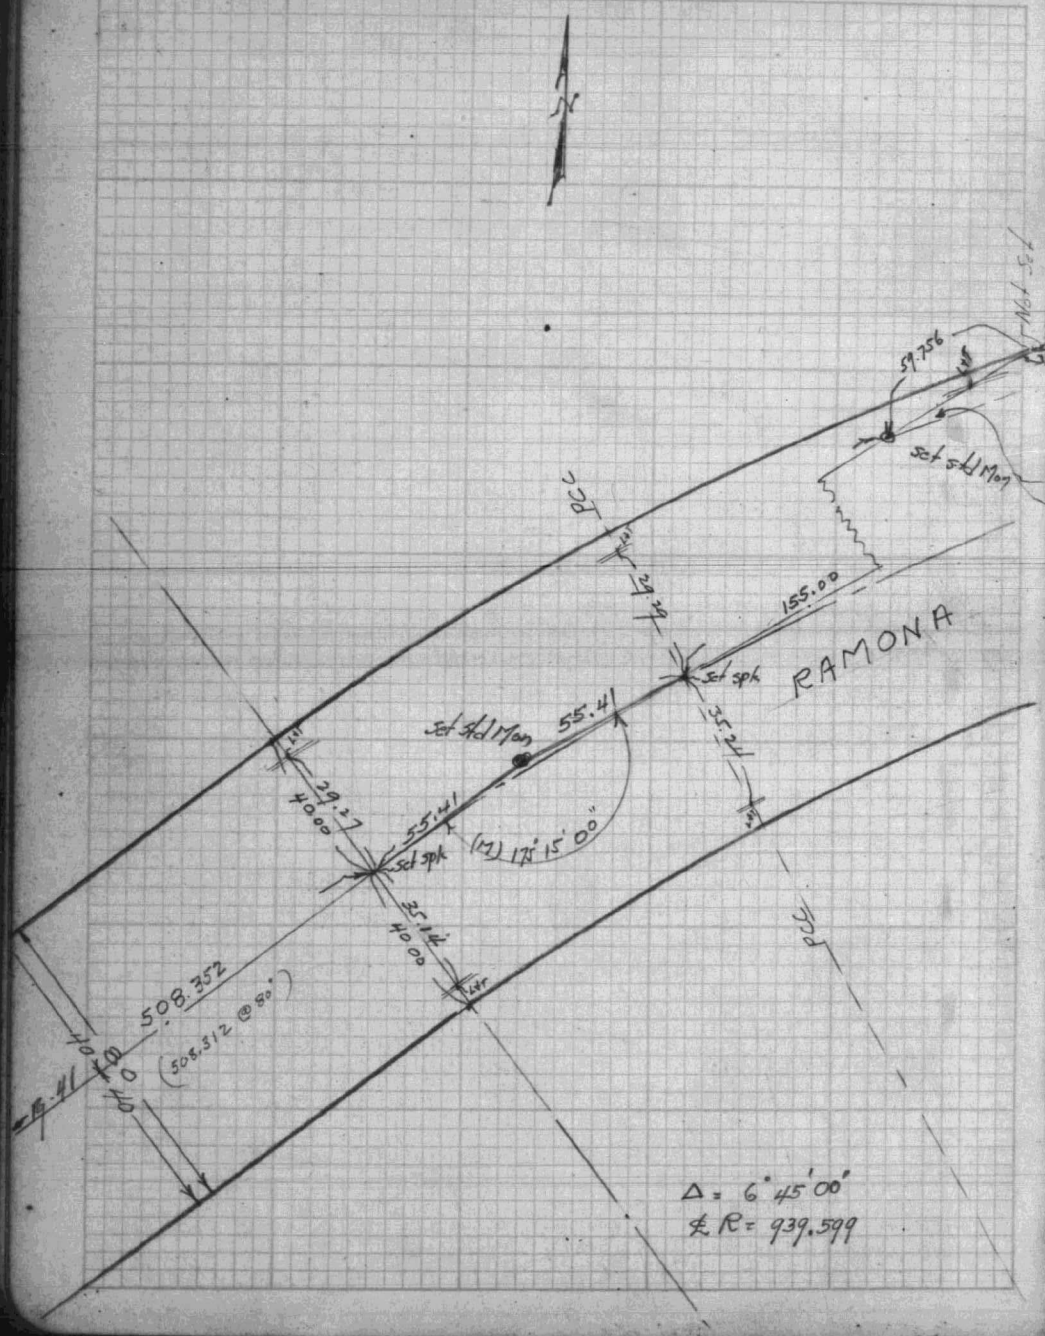

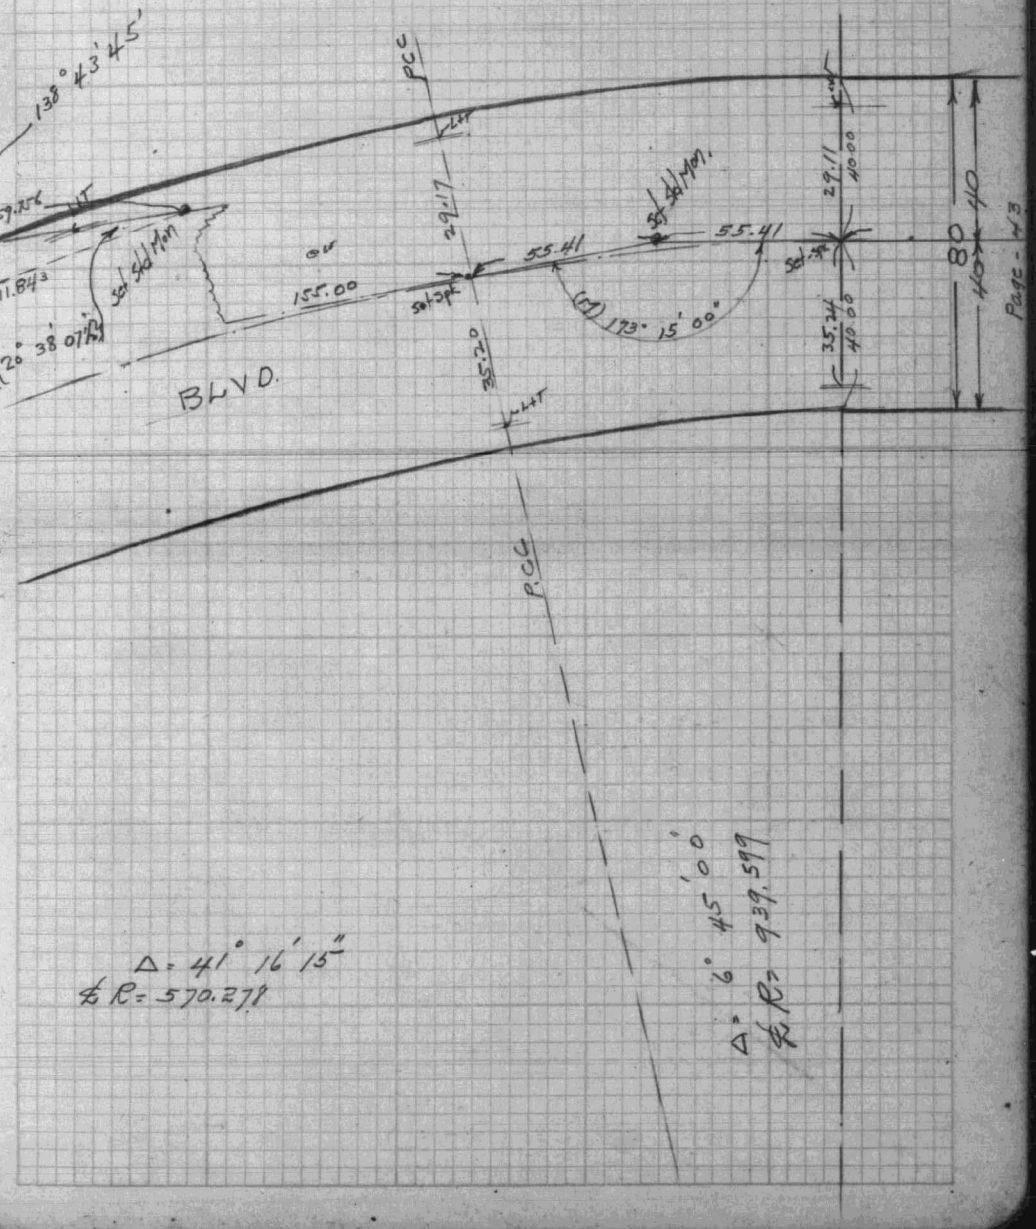

L.A. City Engrs F.B 16008

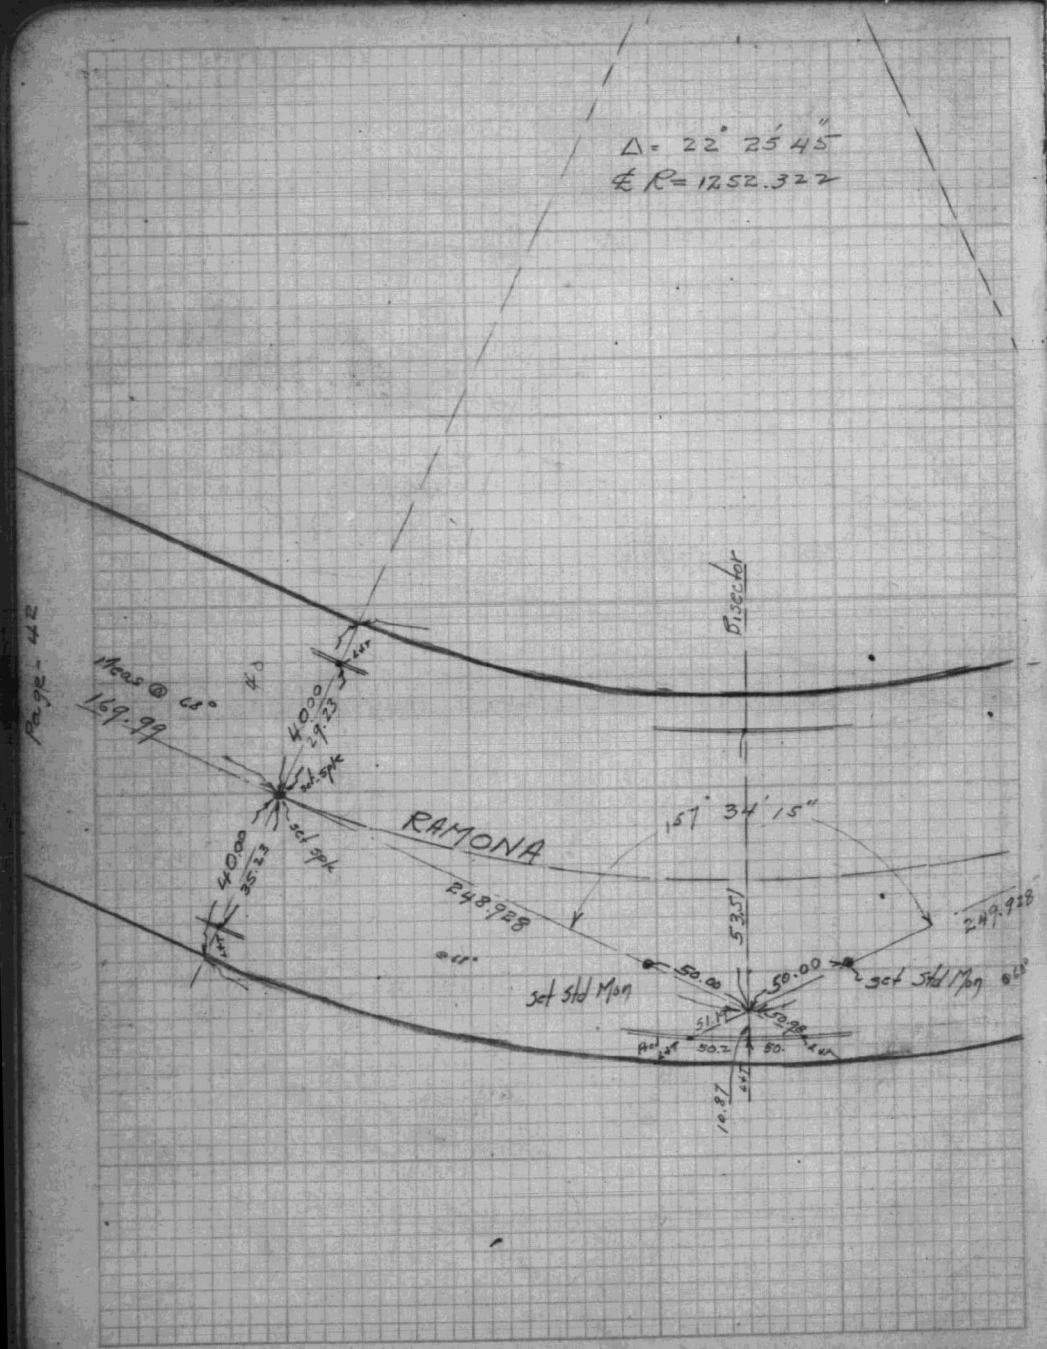

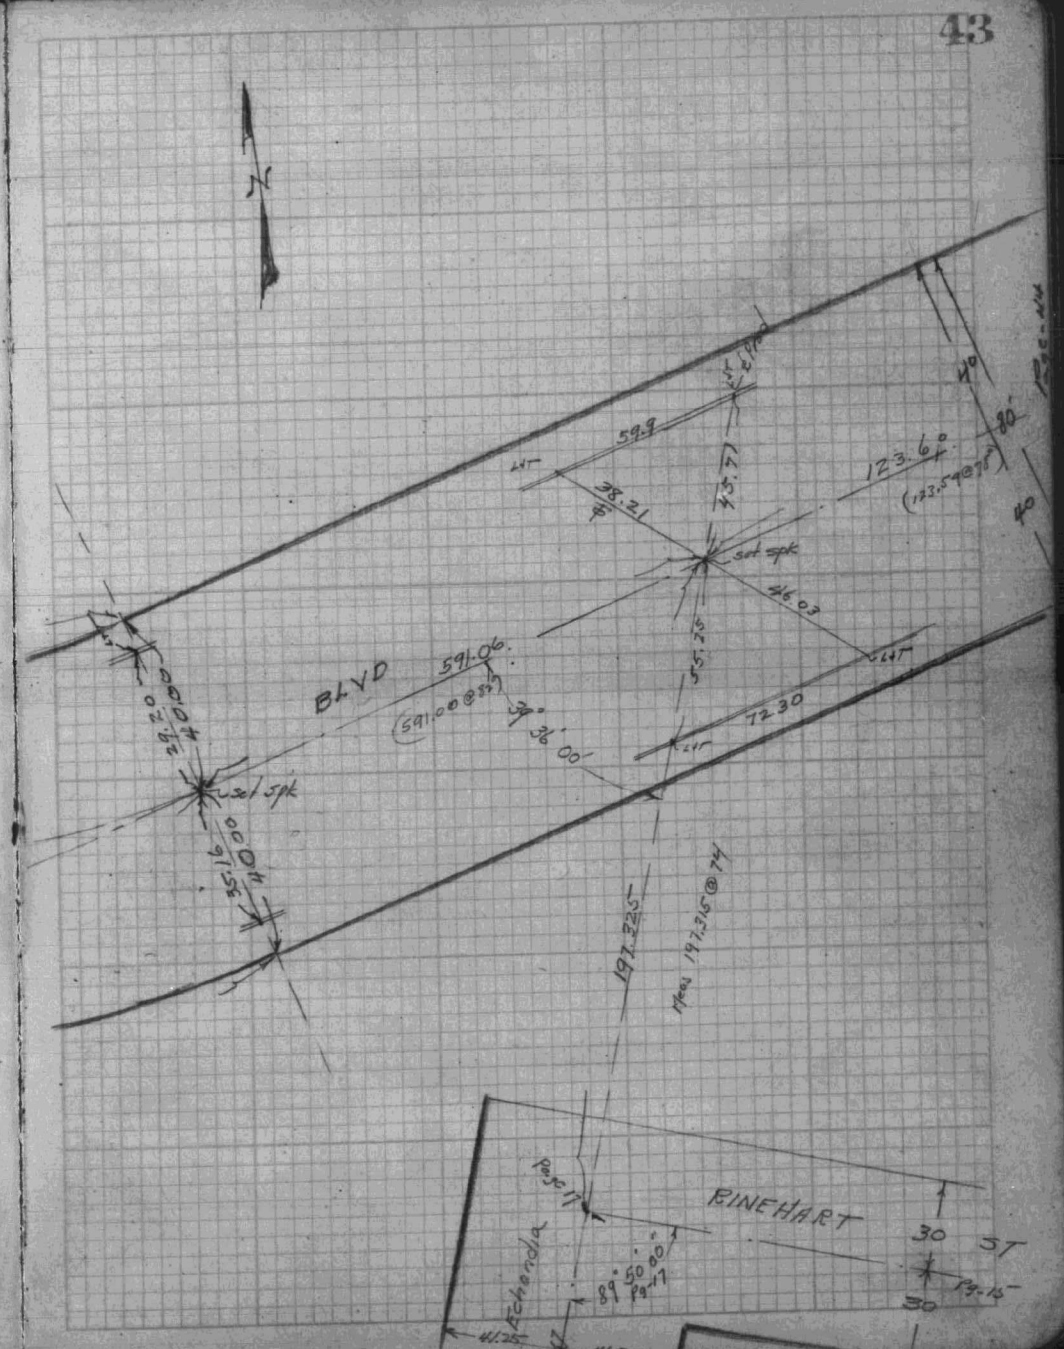

L A City Engrs F.B. 16008

N.P. Line { Δ = 49° 44' 45"
R = 880.00
L =

Top Ditch Wall
+ Mark
curb

R = 880.00 Arc 438.662

Identical

set Std Mon. Back of Curb

@ 66

214.00

Pg. 33
168.88

Note This Mon. seem to be less c.

151° 24' 53"

Ramona Blvd

Page 43

R = 800.00 - Arc 366.33

26° 14' 13"

28° 35' 07"

9° 01' 28"

LORD - ST

To D. McAllister Pg. 13

PCC

130° 15' 15"

PI - Page 33

PCC

LORD - ST

To E. T. Tract Line 22 Sq. Ft.

Identical

Top Bridge

68° 06' 57"

Set Std Mon.

158° 50' 22"

Varies

R = 880.00 - Arc 261.57

R = 651.69 - Arc = 208.83

4° 07' 48"

2° 53' 01"

18° 21' 37"

17° 01' 50"

21° 09' 38"

Page 46

FB990-71

City Eng FB17109

FB990-72

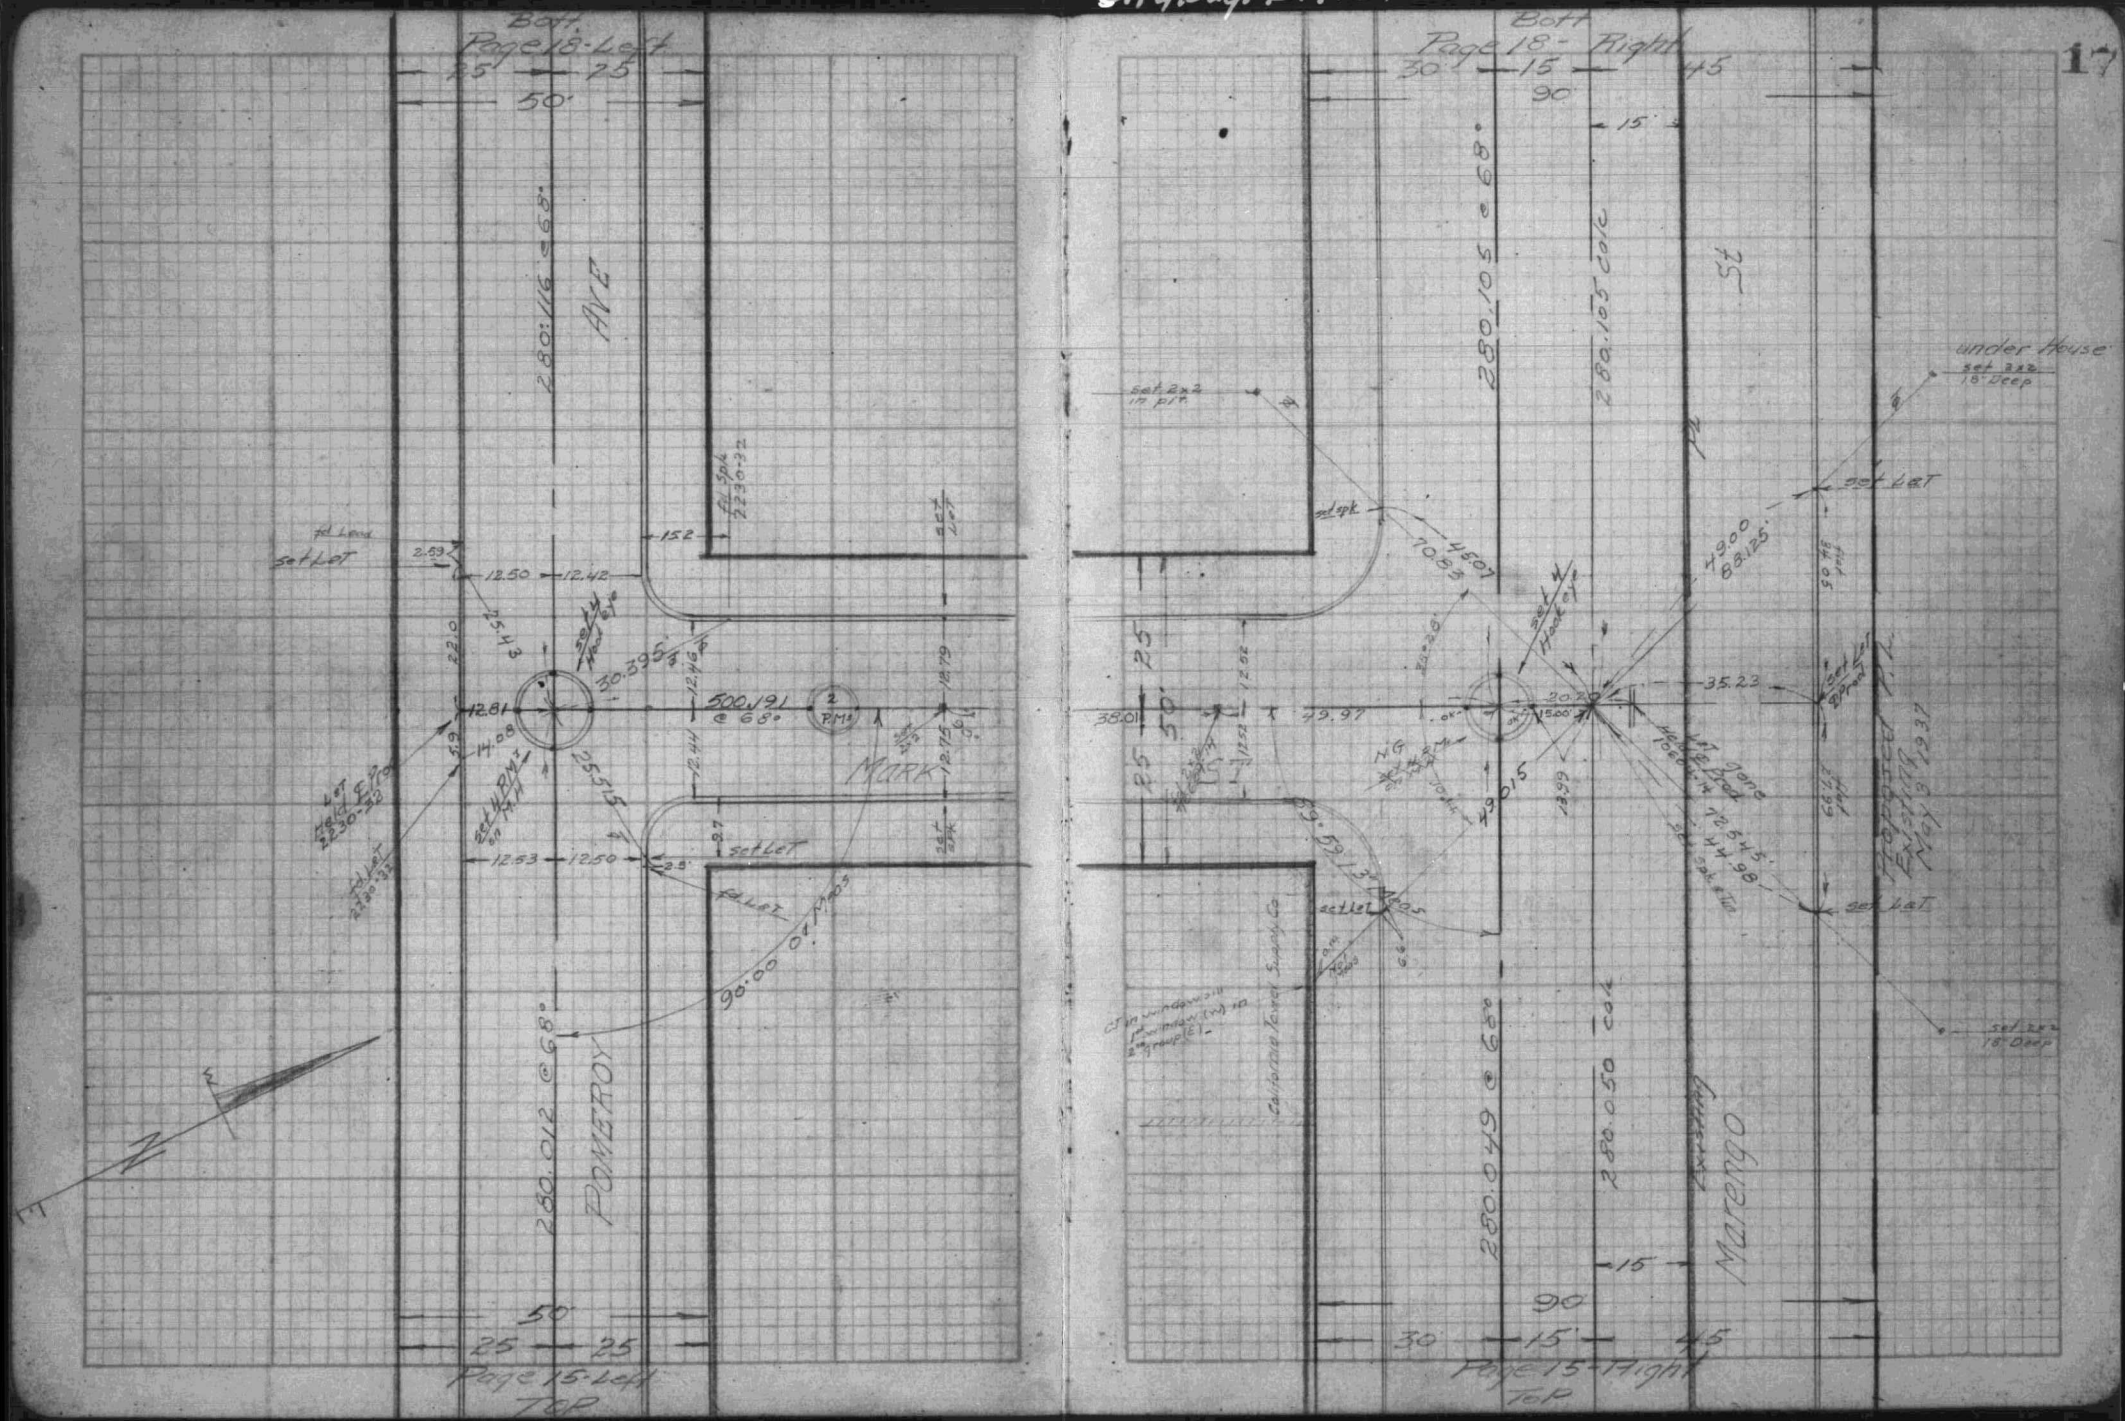

FB 990-73

City Eng FB17109

FB 990-74

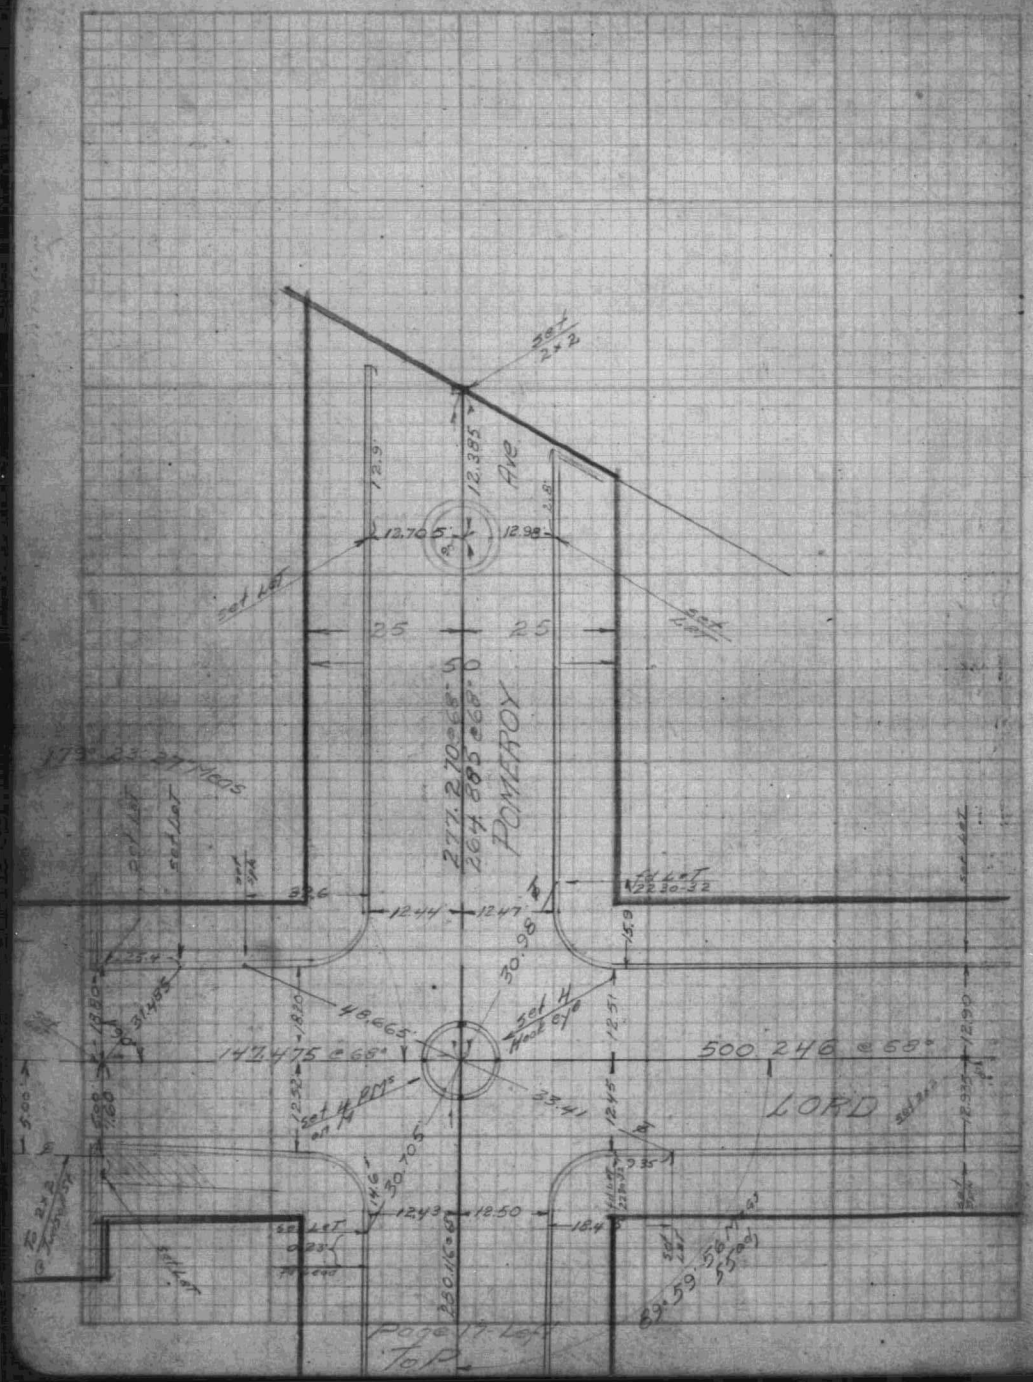

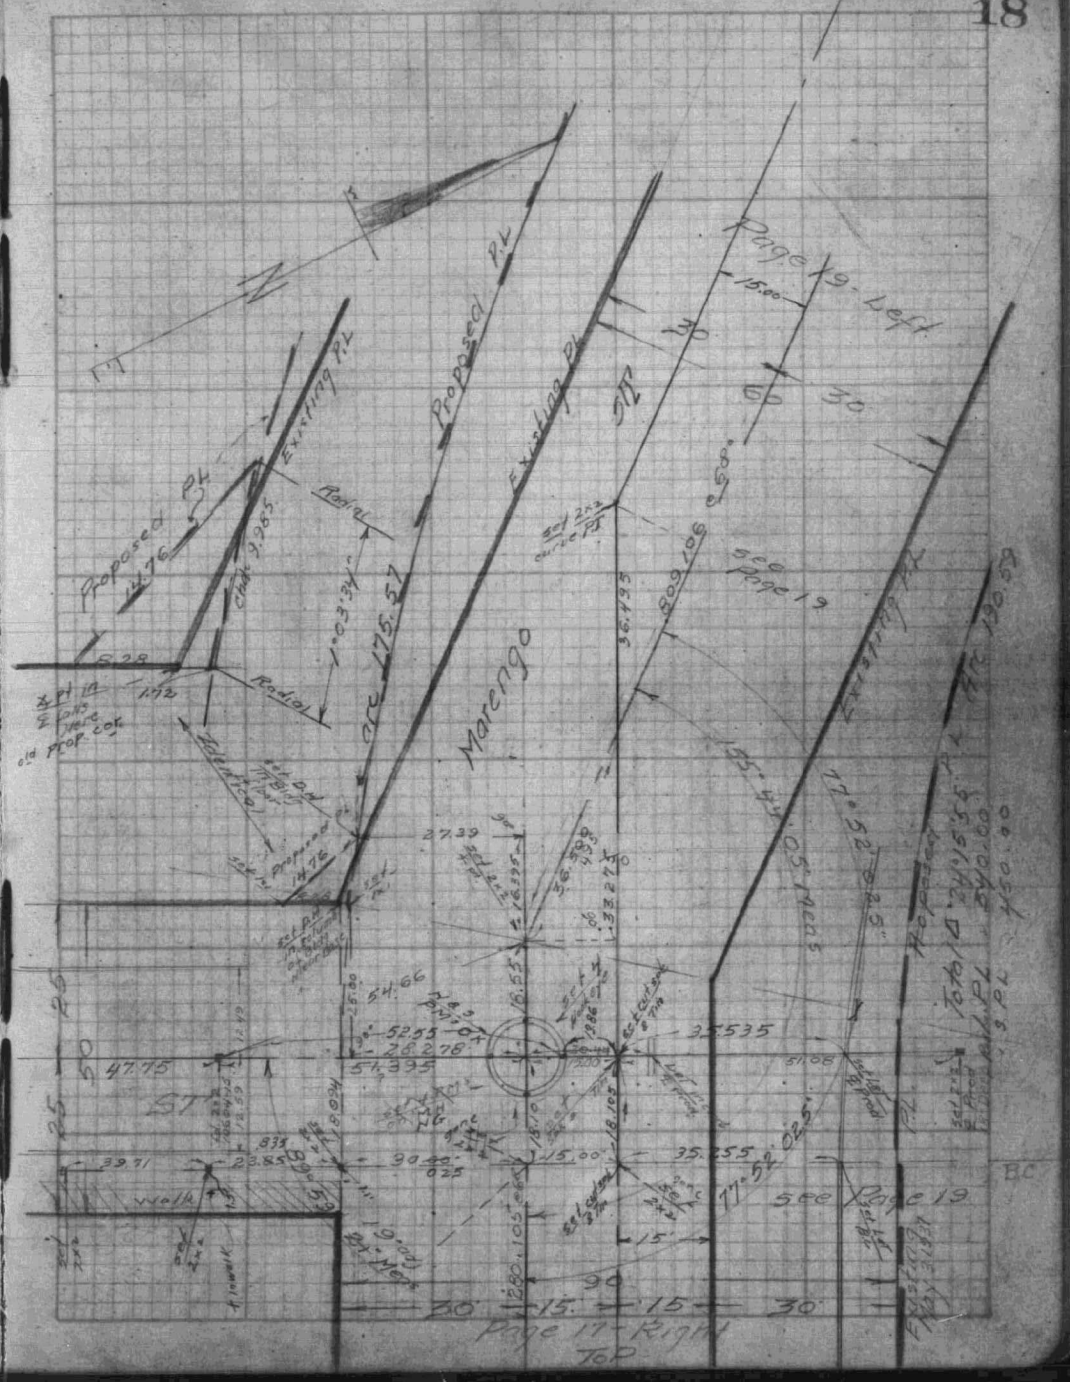

INDEXED DEC 17 1936

SOTO ST.

Alhambra Ave to Marengo St

Centerline - Ties, Distances, Angles

C-1939
C-1940

July 28 1936

Boysen A.H.
Elmore L.B.
Steger F.J.
Kipke L.P.
Horn J.A.
Friedman C.

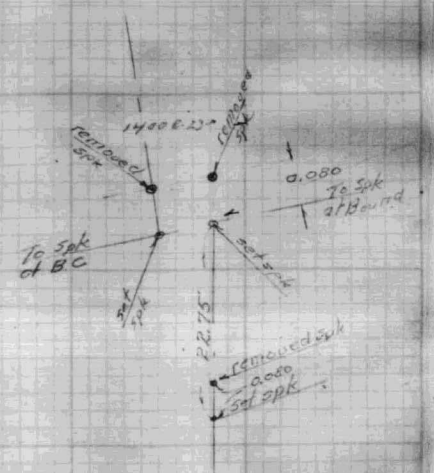

℄ Ref 10606 - 10 to 16 inc.
10604 - 9
2229 - 40 - 41
7109 - 17 18 19

2409 - 61 to 64 inc.

Tape L 236 Standard @ 68°

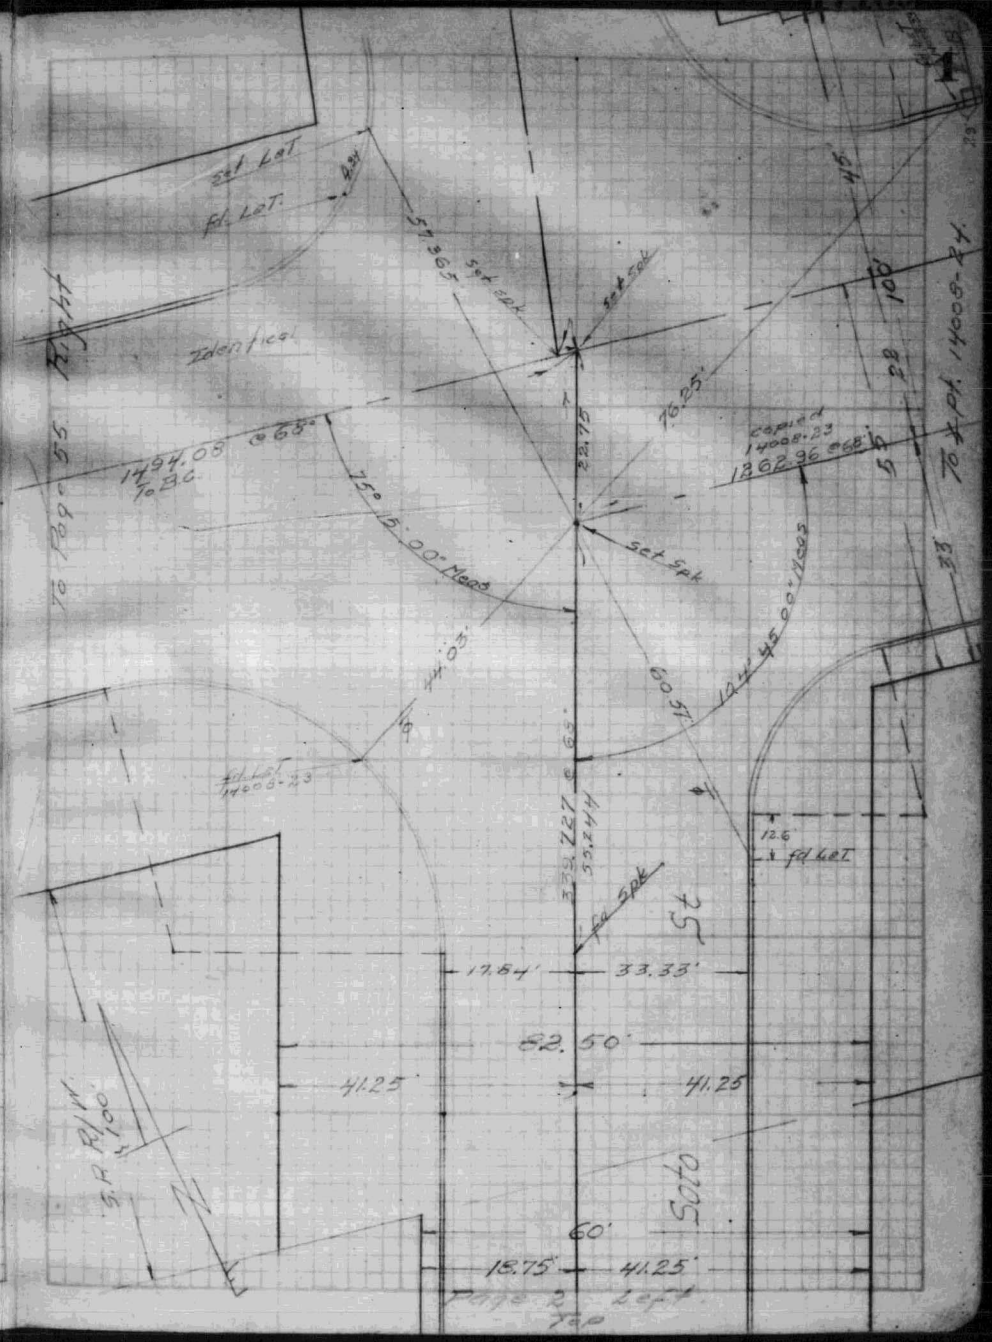

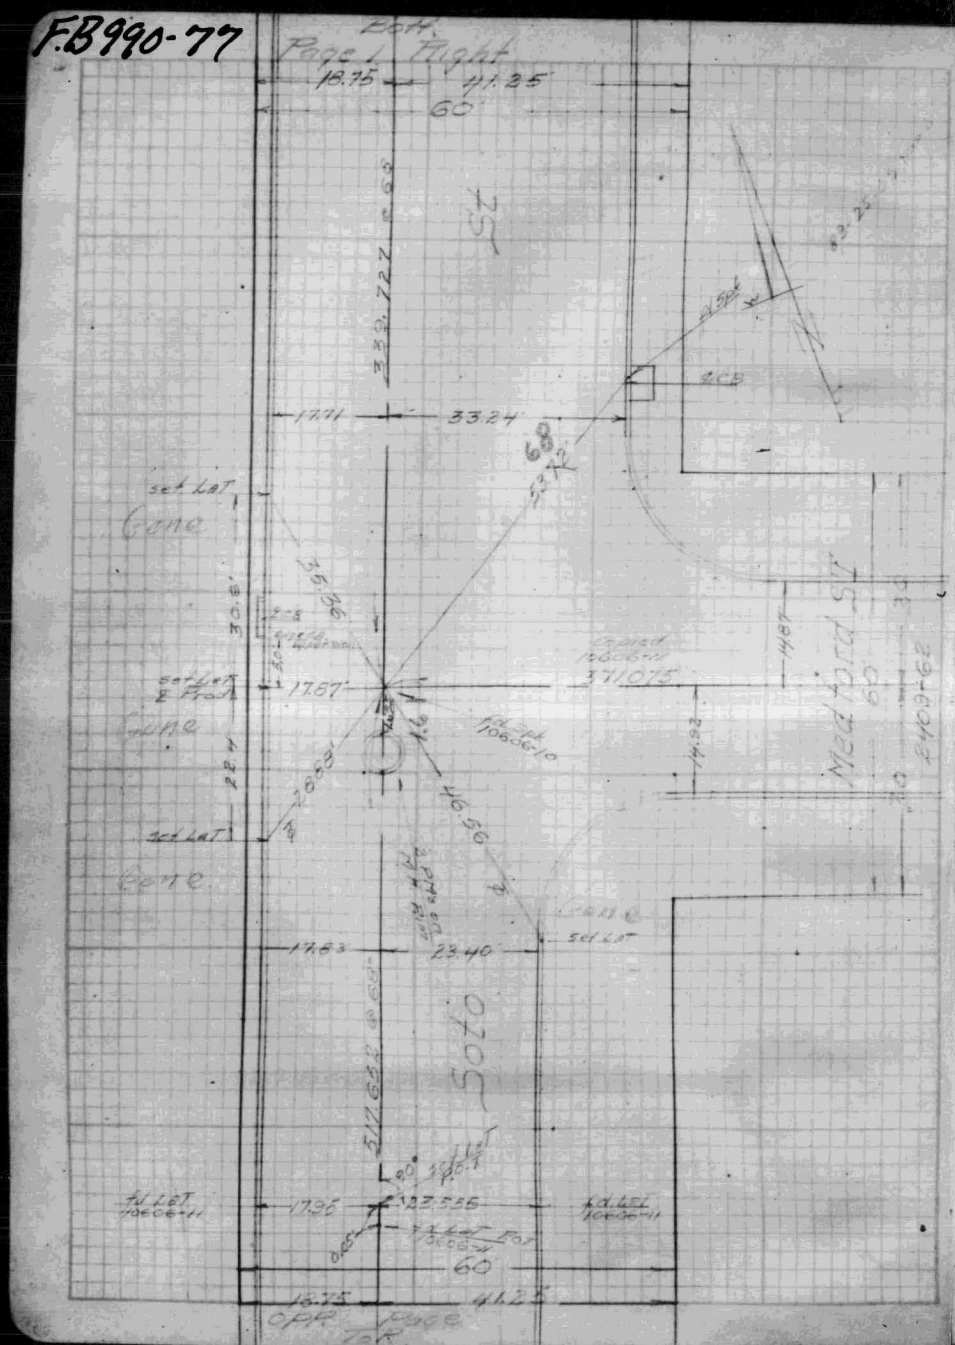
F.B990-77
Page 1 Right
Bott.
18.75
41.25
60
339.727 @ 68
17.71
33.24
68
53.72
set LaT
Gone
Gone
Gone
set LaT
17.87
371.075
Copied 10606-11
fd. Spk 10606-10
46.56
Medford ST
60
2409-62
17.83
23.40
Soto
517.652 @ 68
fd. LaT 10606-11
17.95
23.555
fd. LaT 10606-11
60
18.75
41.25
OPP. Page
Top

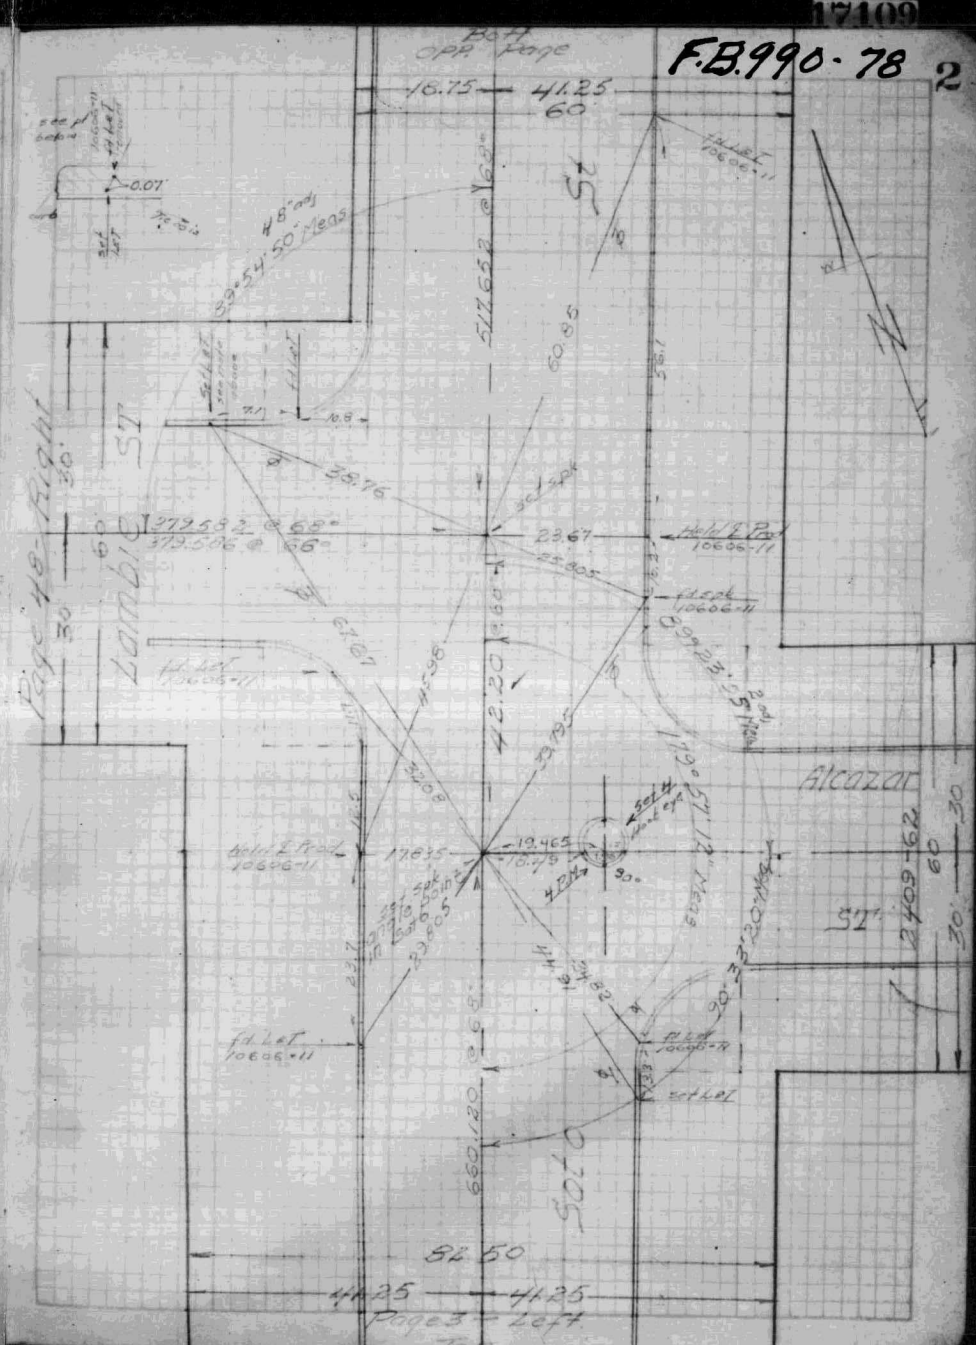
F.B.990-78
2
Bott.
OPP. Page
18.75
41.25
60
0.07
48" adj
89°54'50" Meas
517.652 @ 68
60.85
Page 48 Right
Lambie ST
38.76
379.582 @ 68°
379.586 @ 66°
23.67
Hold ℄ Prod 10606-11
fd. Spk 10606-11
fd. LaT 10606-11
42.20
Alcazar
ST
2409-62
60
30
Hold ℄ Prod 10606-11
17.835
19.465
fd. LaT 10606-11
fd. LaT 10606-11
Soto
82.50
41.25
41.25
Page 3 - Left
Top

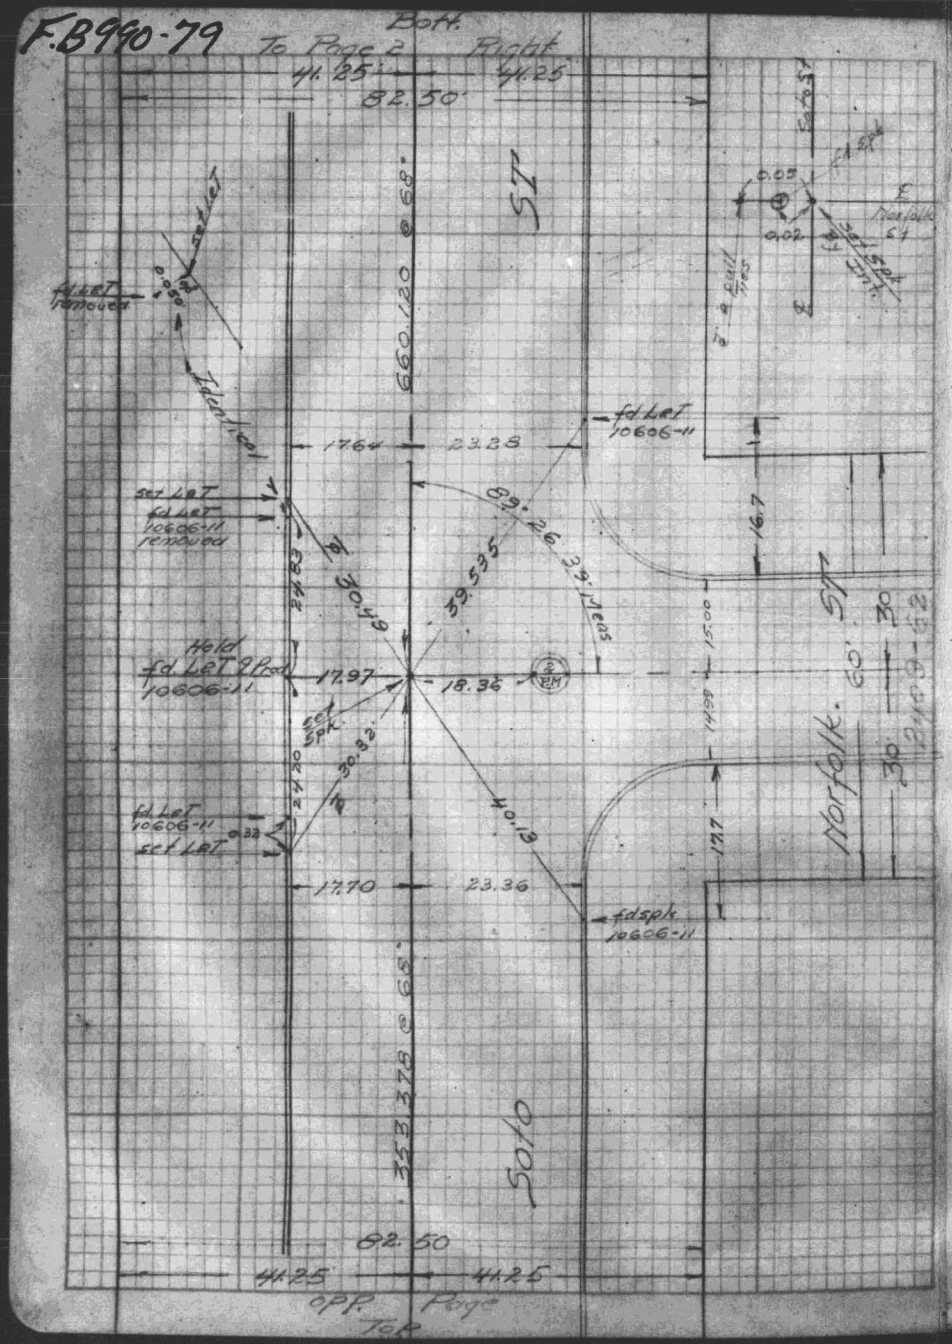
F.B 990-79
Bott.
To Page 2 Right
41.25
41.25
82.50
ST
660.120 @ 68°
Identical
fd LeT 10606-11
17.64
23.28
set LeT
fd LeT 10606-11 removed
89°26'39" Meas
30.49
39.535
Hold fd LeT & Prod 10606-11
17.97
18.36
set spk
30.32
40.13
fd LeT 10606-11
set LeT
17.70
23.36
fd spk 10606-11
353.378 @ 68°
Soto
Norfolk
60'
30
30
82.50
41.25
41.25
OPP. Page
Top

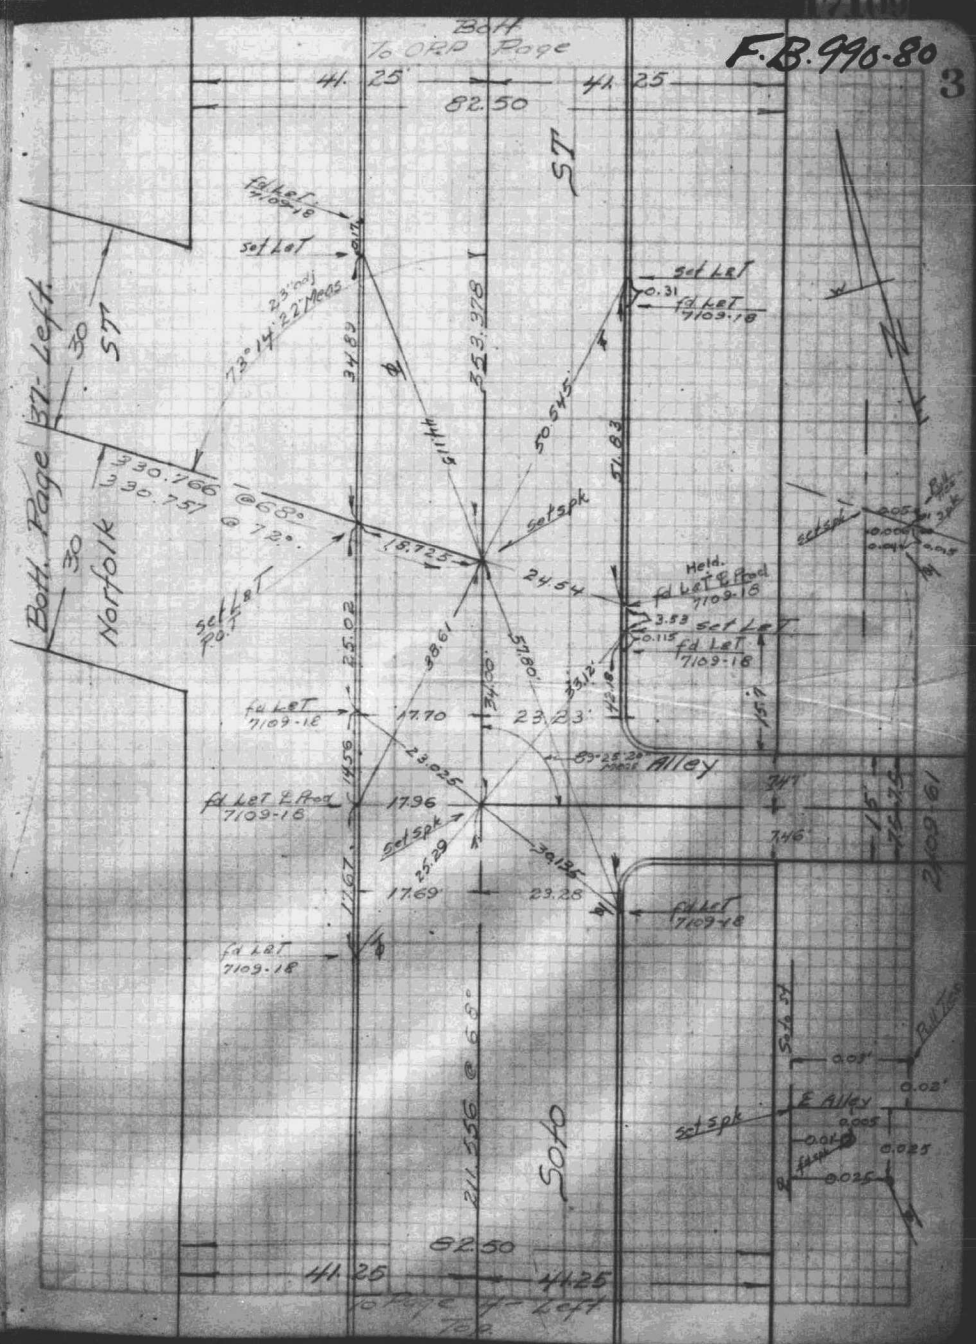
F.B. 990-80
3
Bott
To OPP Page
41.25
41.25
82.50
ST
fd LeT 7109-18
set LeT
73°14'22" Meas
23" adj
353.378
50.545
51.83
set LeT
fd LeT 7109-18
Bott. Page 37 Left
30
ST
Norfolk
330.766 @ 68°
330.757 @ 72°
18.725
set spk
24.54
set LeT P.O.T.
Held. fd LeT & Prod 7109-18
3.53
set LeT
fd LeT 7109-18
fd LeT 7109-18
17.70
23.23
Alley
fd LeT & Prod 7109-18
17.96
set spk
25.29
17.69
23.28
fd LeT 7109-18
fd LeT 7109-18
211.556 @ 68°
Soto
Soto St
Pull Tees
E Alley
set spk
82.50
41.25
41.25
To Page 4 Left
Top

17109

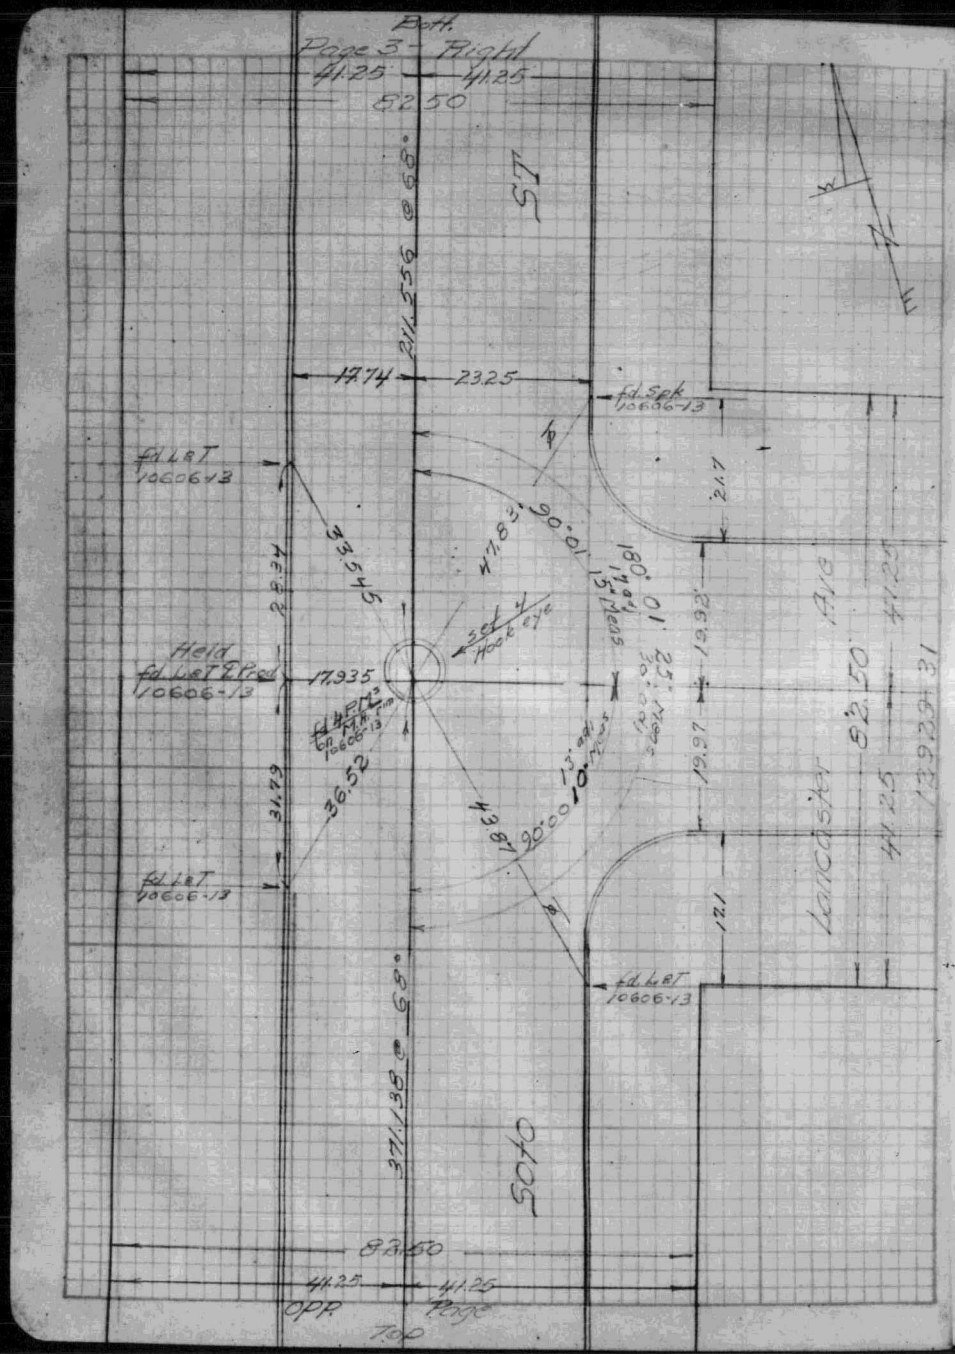

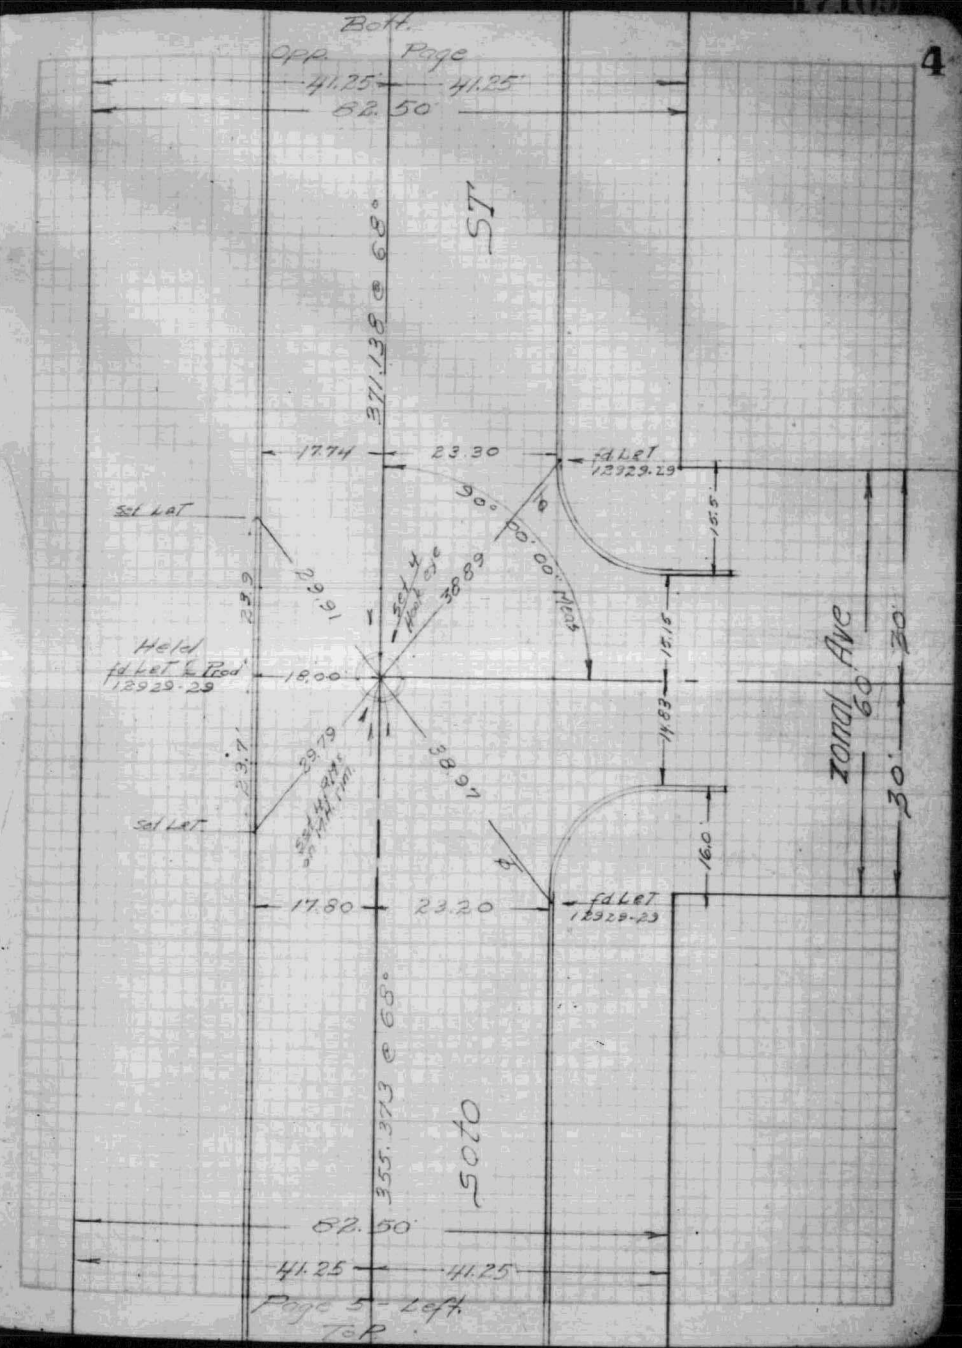

APR 1 1937

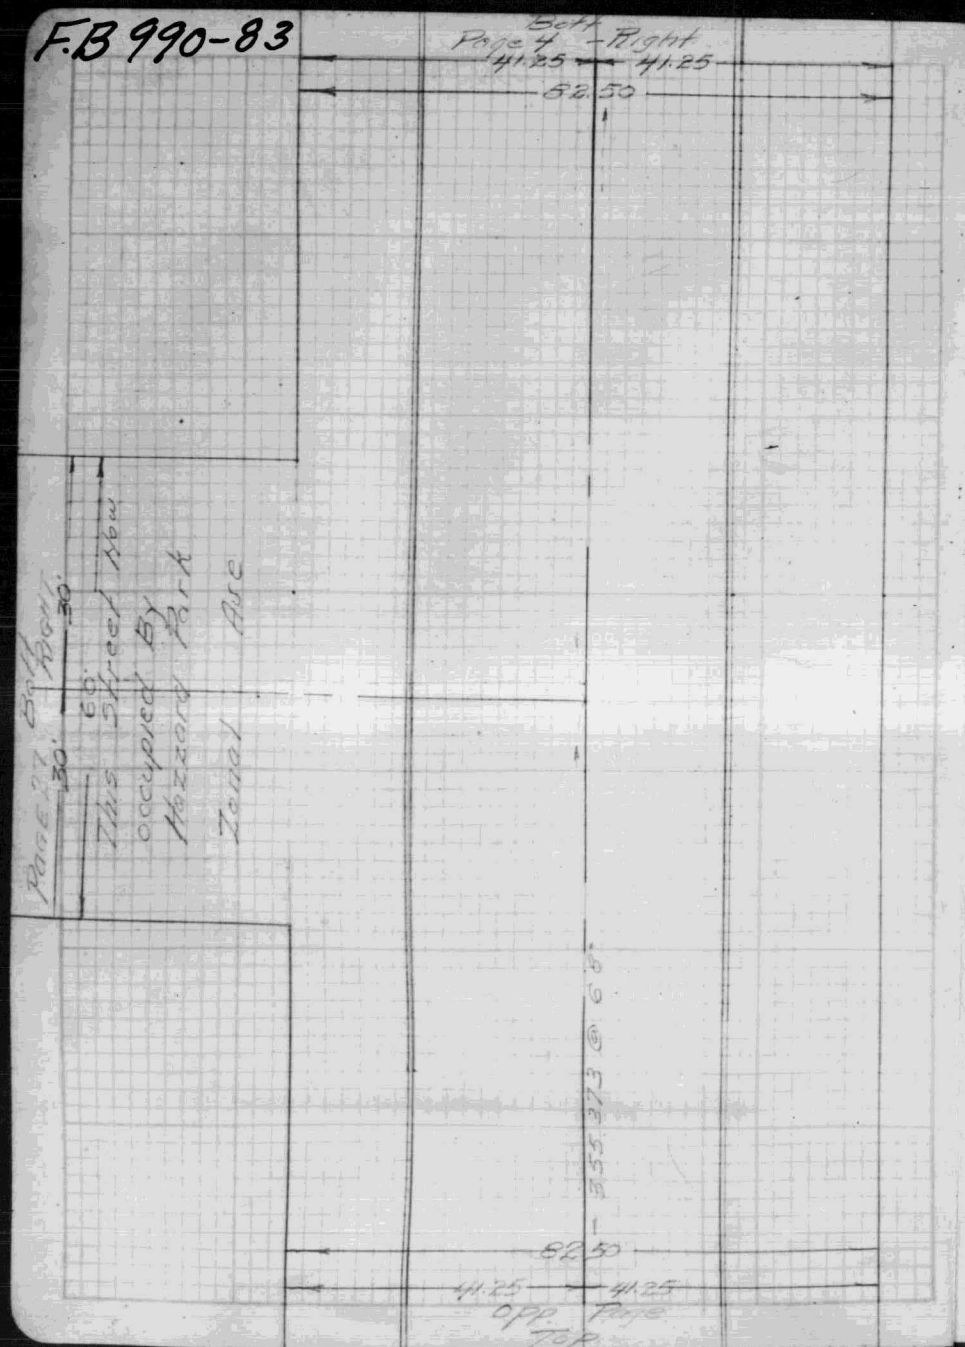
F.B 990-83
Bott
Page 4 - Right
41.25
41.25
82.50
Page 27 Bott Right
30'
30'
60'
This Street Now occupied By Hazzard Park Zonal Ave
355.373 @ 68°
82.50
41.25
41.25
Opp. Page
Top

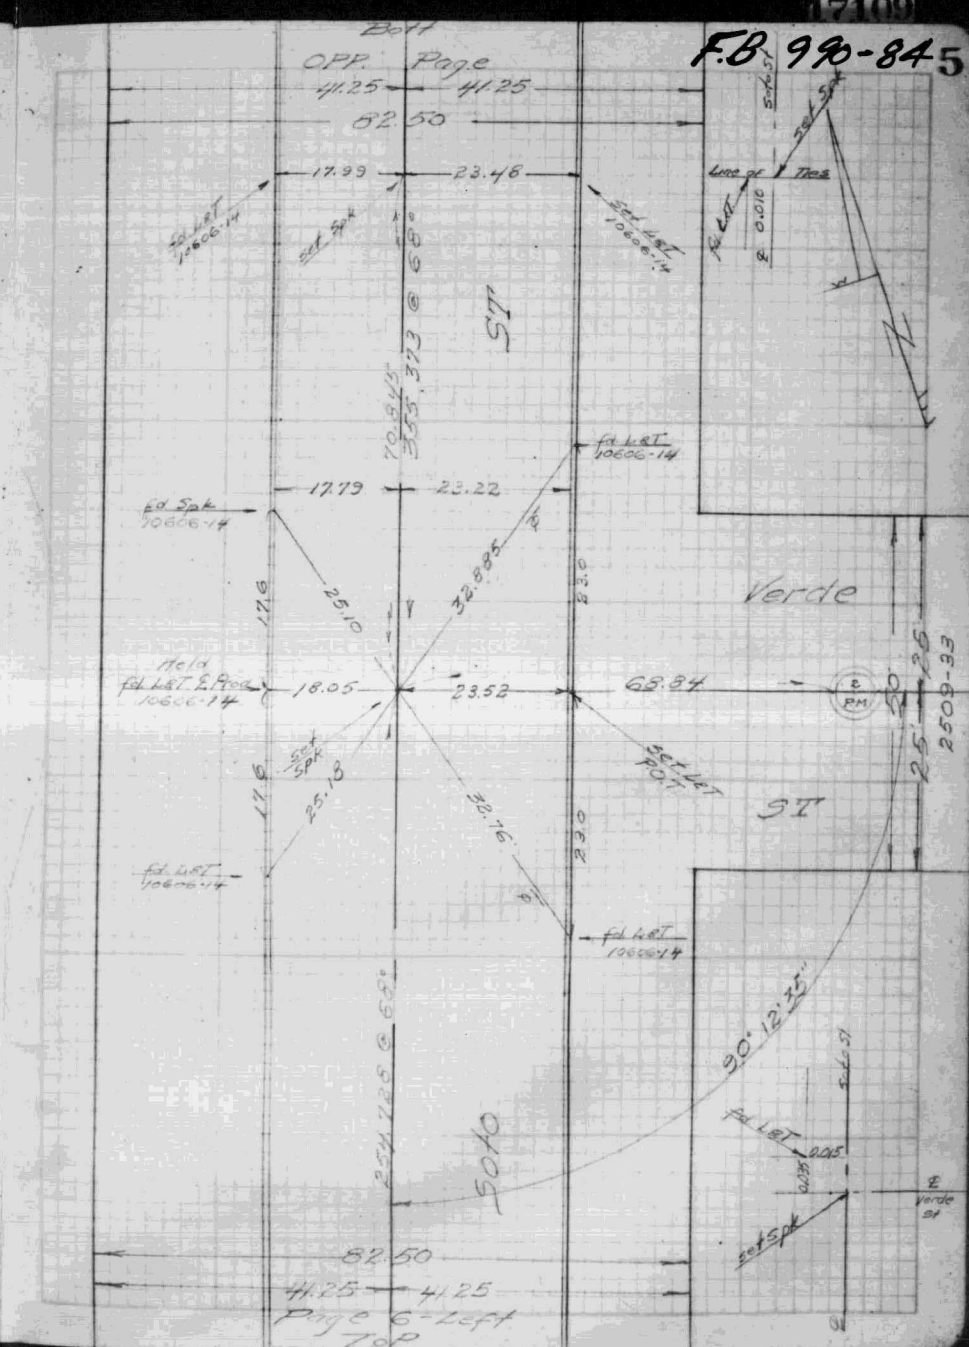
F.B 990-84
17109
Bott
Opp. Page
41.25
41.25
82.50
17.99
23.48
fd LRT 10606-14
set Spk
set LRT 10606-14
70.845
355.373 @ 68°
ST
fd LRT 10606-14
17.79
23.22
fd Spk 10606-14
25.10
32.885
17.6
23.0
Verde
Held fd LRT & Prod 10606-14
18.05
23.52
68.84
PM
2509-33
25'
25'
set Spk
25.18
32.76
set LRT P.O.T
ST
fd LRT 10606-14
fd LRT 10606-14
90° 12' 35"
254.728 @ 68°
Soto
fd LRT
0.015
set Spk
Verde St
82.50
41.25
41.25
Page 6 - Left
Top
Line of Ties
fd LRT
0.010
set Spk
Soto St

APR 1 1937

F.B 990-85

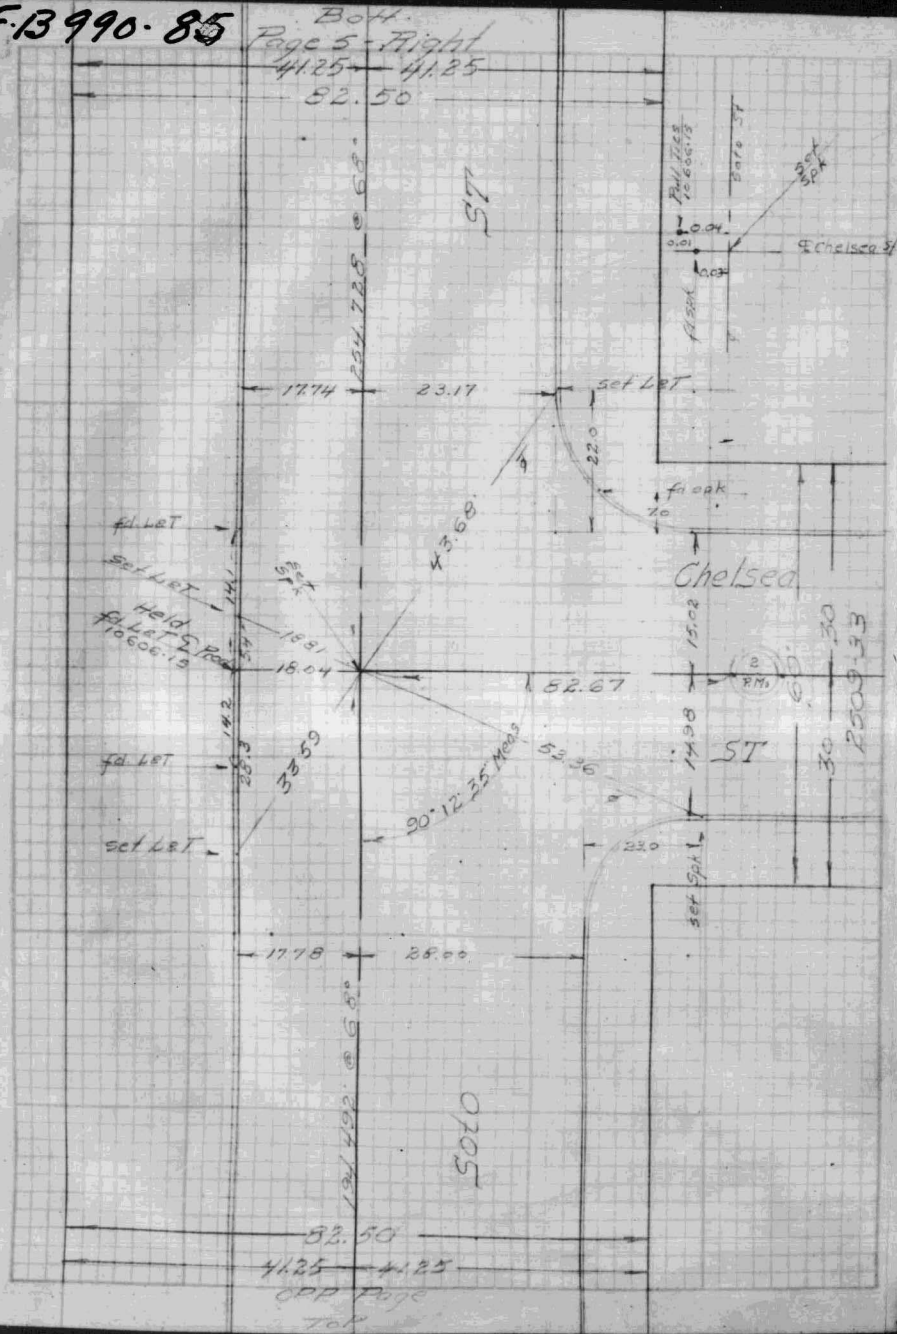

F.B 990-86

6

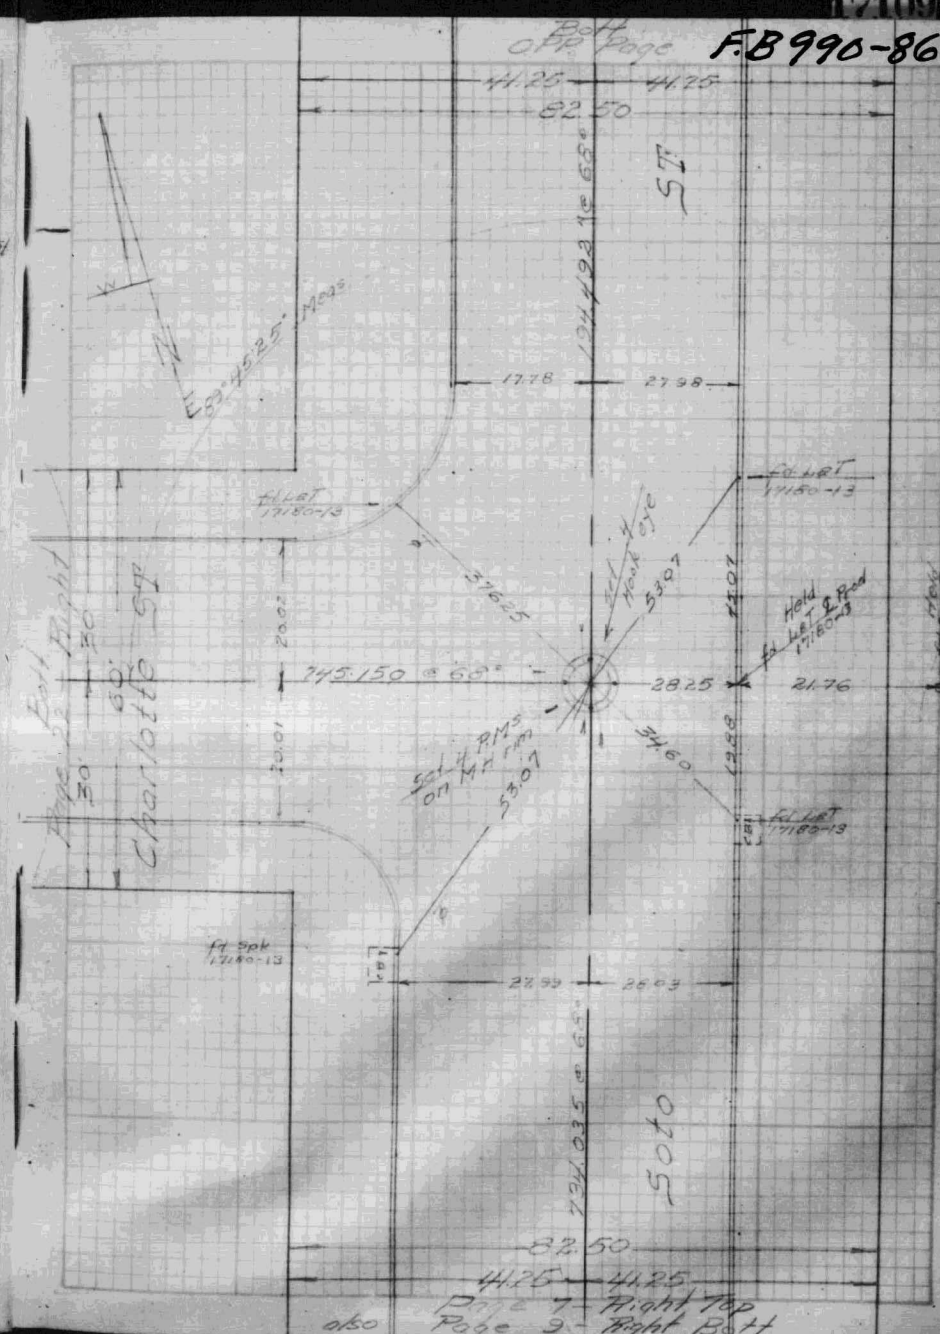

17109

Copied from
15109-15-16
except ties & ∡
at Marengo St
S of to ST

New E. Marengo St
To State St

old E. Marengo St
To State St

To Chloride St

S of to ST

Set spk

Set spk
Ties to this pt.

15.00'
14.79

252.730

298.77

These points on bridge
for ties below bridge see
page 9

see FB
15109-15
copied from
89° 43' 32" Meas

Arc = 18.650

Arc = 10.813

Marengo St

3° 08' 00"

2° 27' 01"

51.22

44.35

51.04

To 15109-15

These Point on bridge
for ties below bridge
see page 9

To Page 6 Bott Right

Ties From 15109-16
Arc = 163.974

Set Lots

24.46

26.98

31.3

31.792

123° 21' 25"

157° 13' 17"

52.75

Total Arc to B.C. = 251.94

Arc = 140.364

4° 26' 52"

3° 53' 51"

1° 42' 00"

Δ = 1° 04' 48"
R = 2401.69

45.27

57 298.77

To 15109-16

2 R = 1483.18

INDEXED DEC 17 1930

Lambie St
San Pablo St to Private Right-way East
Sewer Profile
Medford St Sewer Dist
April 30 - 14

Jessup
Clark
Stilwell
Prudhomme

San Pablo St ℄ 2409-43 2224-60
Lambie St 2409-43

Previous Profile ~~4751~~
3731-1

Bm's 4751-1

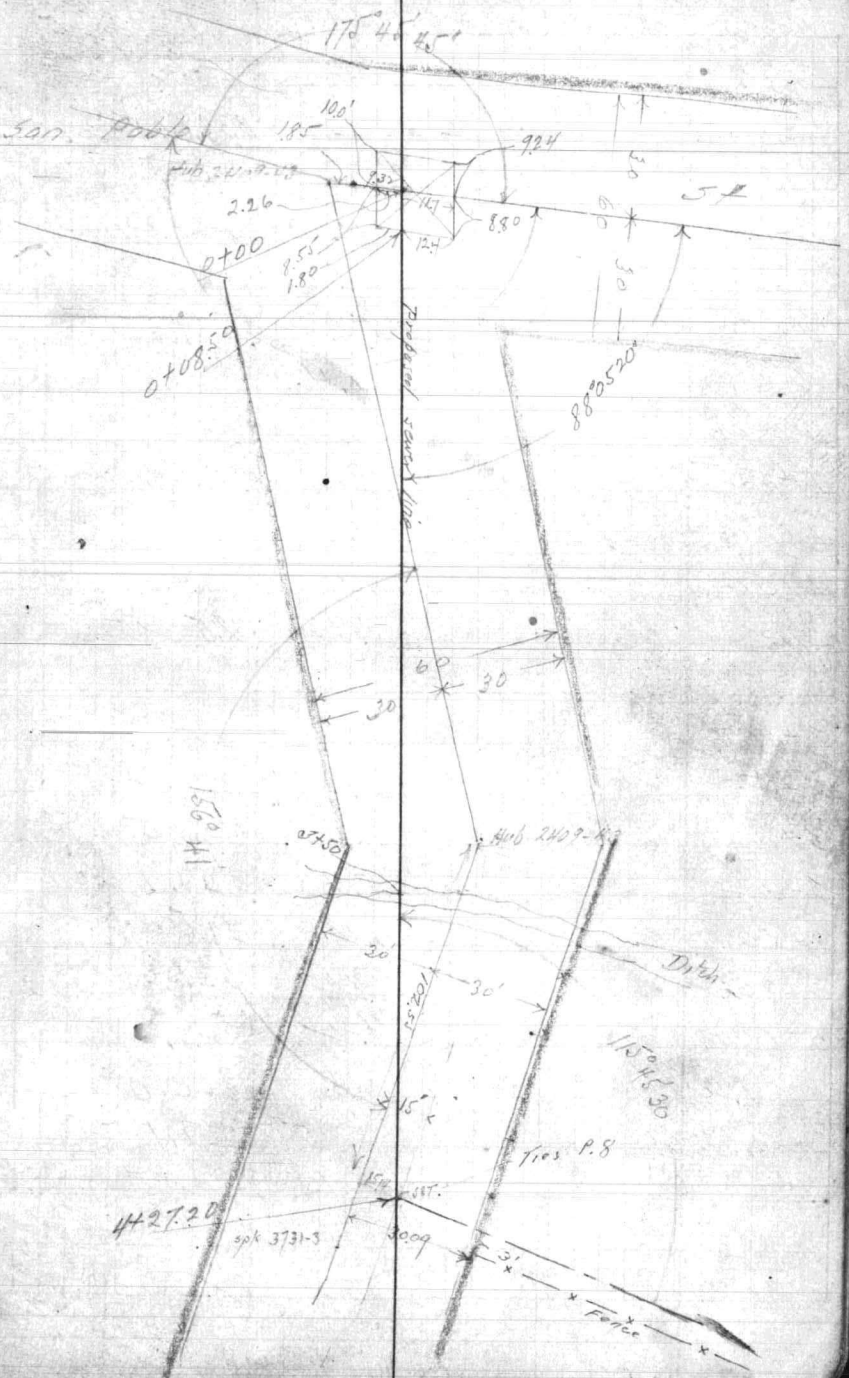

Private Property
East of San Pablo St
Lambie St to P.E.R.R. R/W of Way:
Sewer Profile
May - 8 - 14
Medford St Sewer Dist
Tessup
Clark
Stilwell
Prudhomme

Perious line Profile 3731-1

Levels page 10

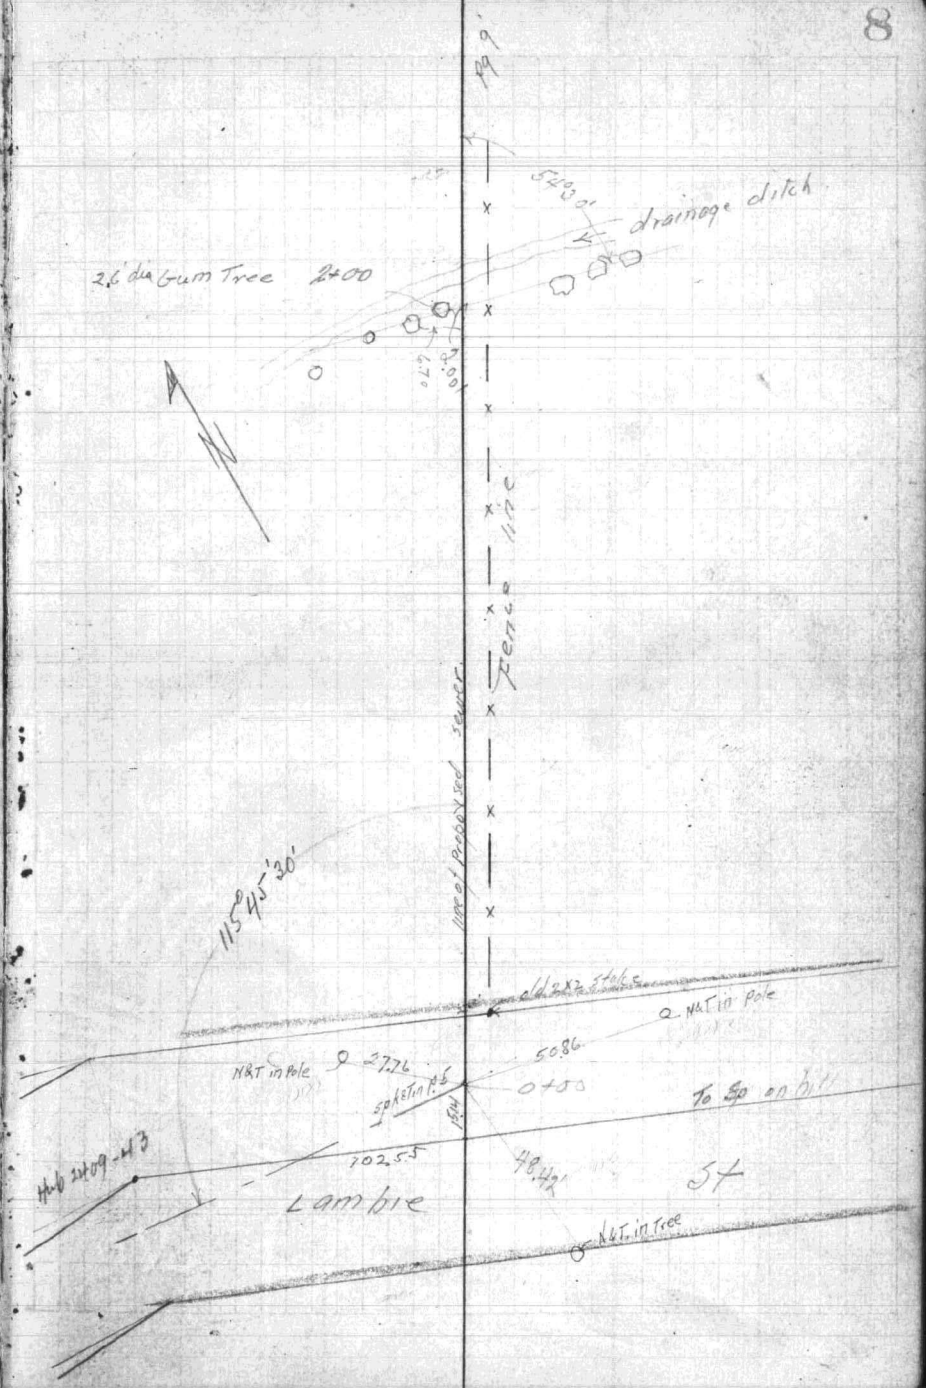

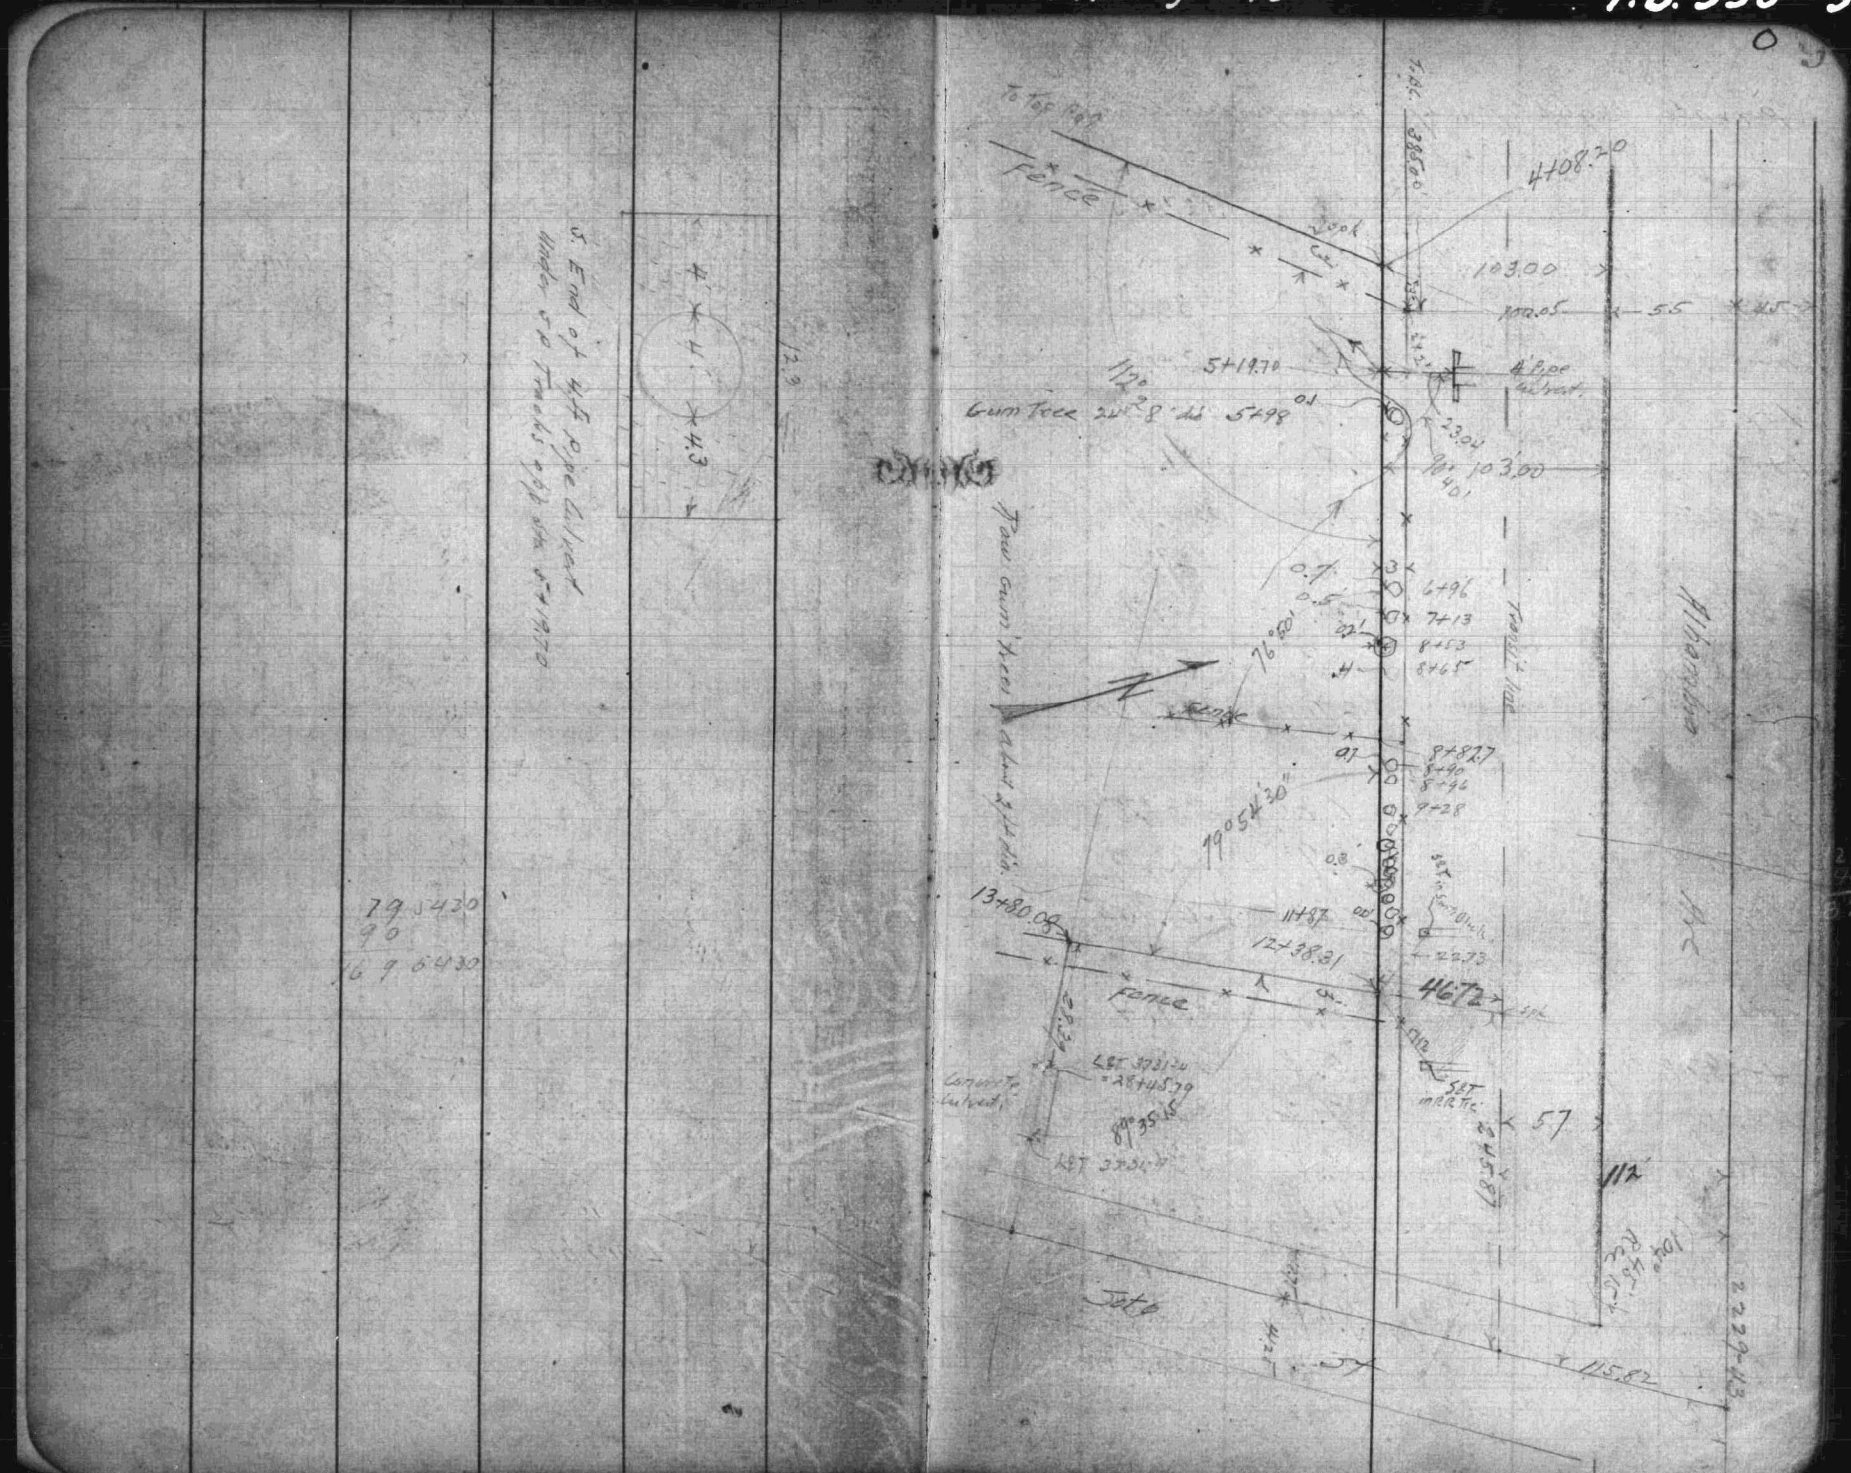
To Top Rail
Fence
4708.20
103.00
102.05
5.5
4.5
5+19.70
4' 8.00 culvert
Gum Tree
5+98
23.04
103.00
Paw Gum Tree
Trail Line
6+96
7+13
8+53
8+65
8+827
8+90
8+96
9+28
19°54'30"
13+80.08
11+87
12+38.31
4672
Fence
Concrete culvert
LET 3731.24
=28+45.79
LET 3731.79
Albertson
Jute
57
112'
115.82
229.43
79.5430
90
69.6430
12.3
S. End of 4.5' pipe culvert under 5 Tracks 4.00 sta. 5+19.70

Lambie St
San Pablo St to Soto St
Run Sewer Profile
May 1914

Jessup
Clark
Stilwell
Prudhomme.

℄ 2409-43

Bm^s Pg 6

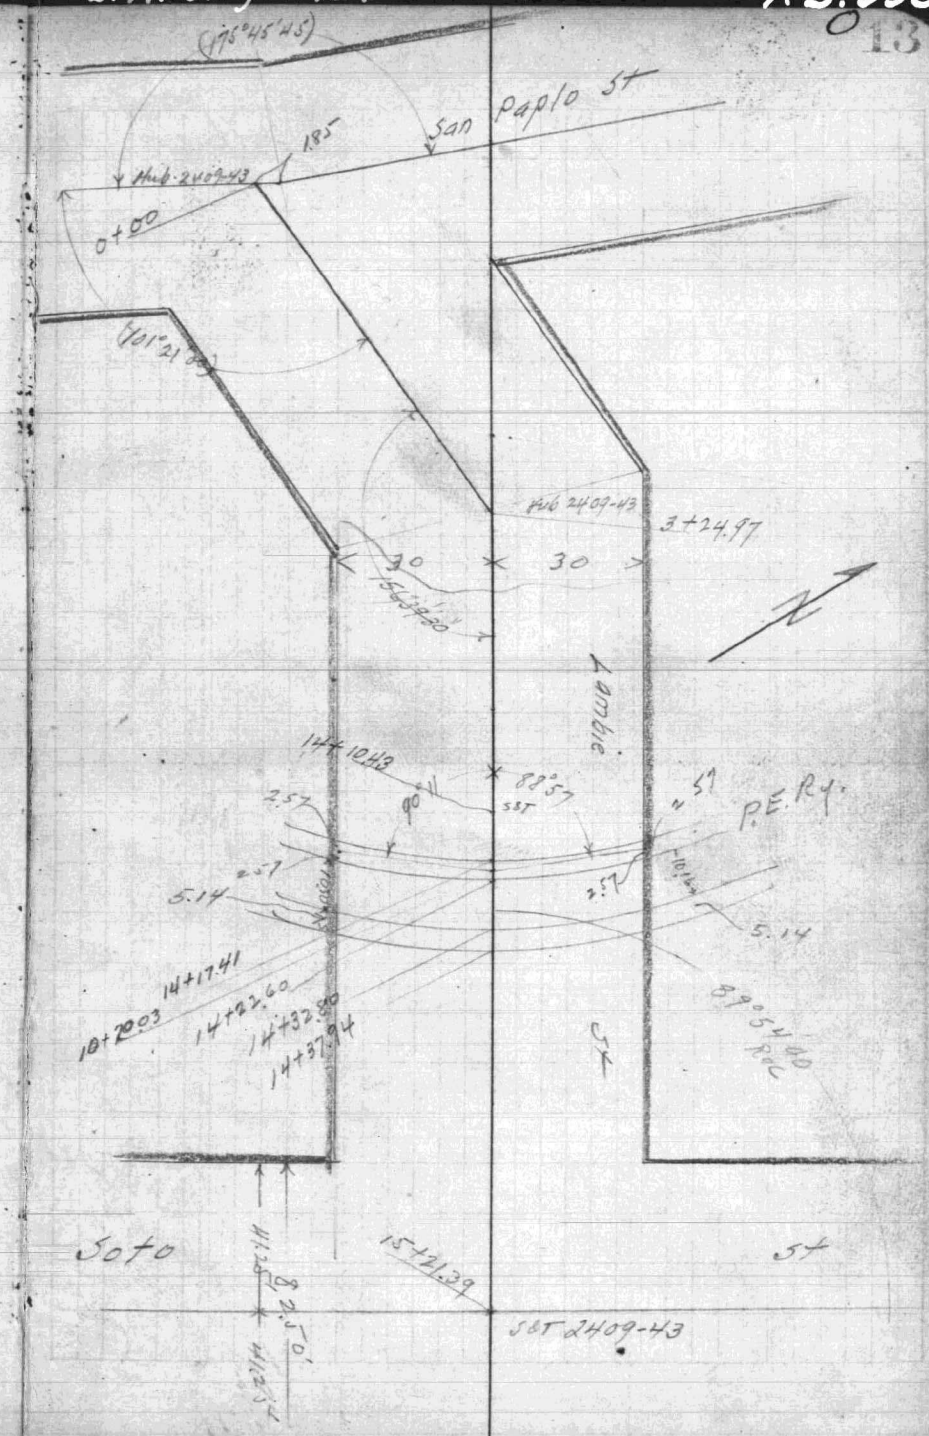

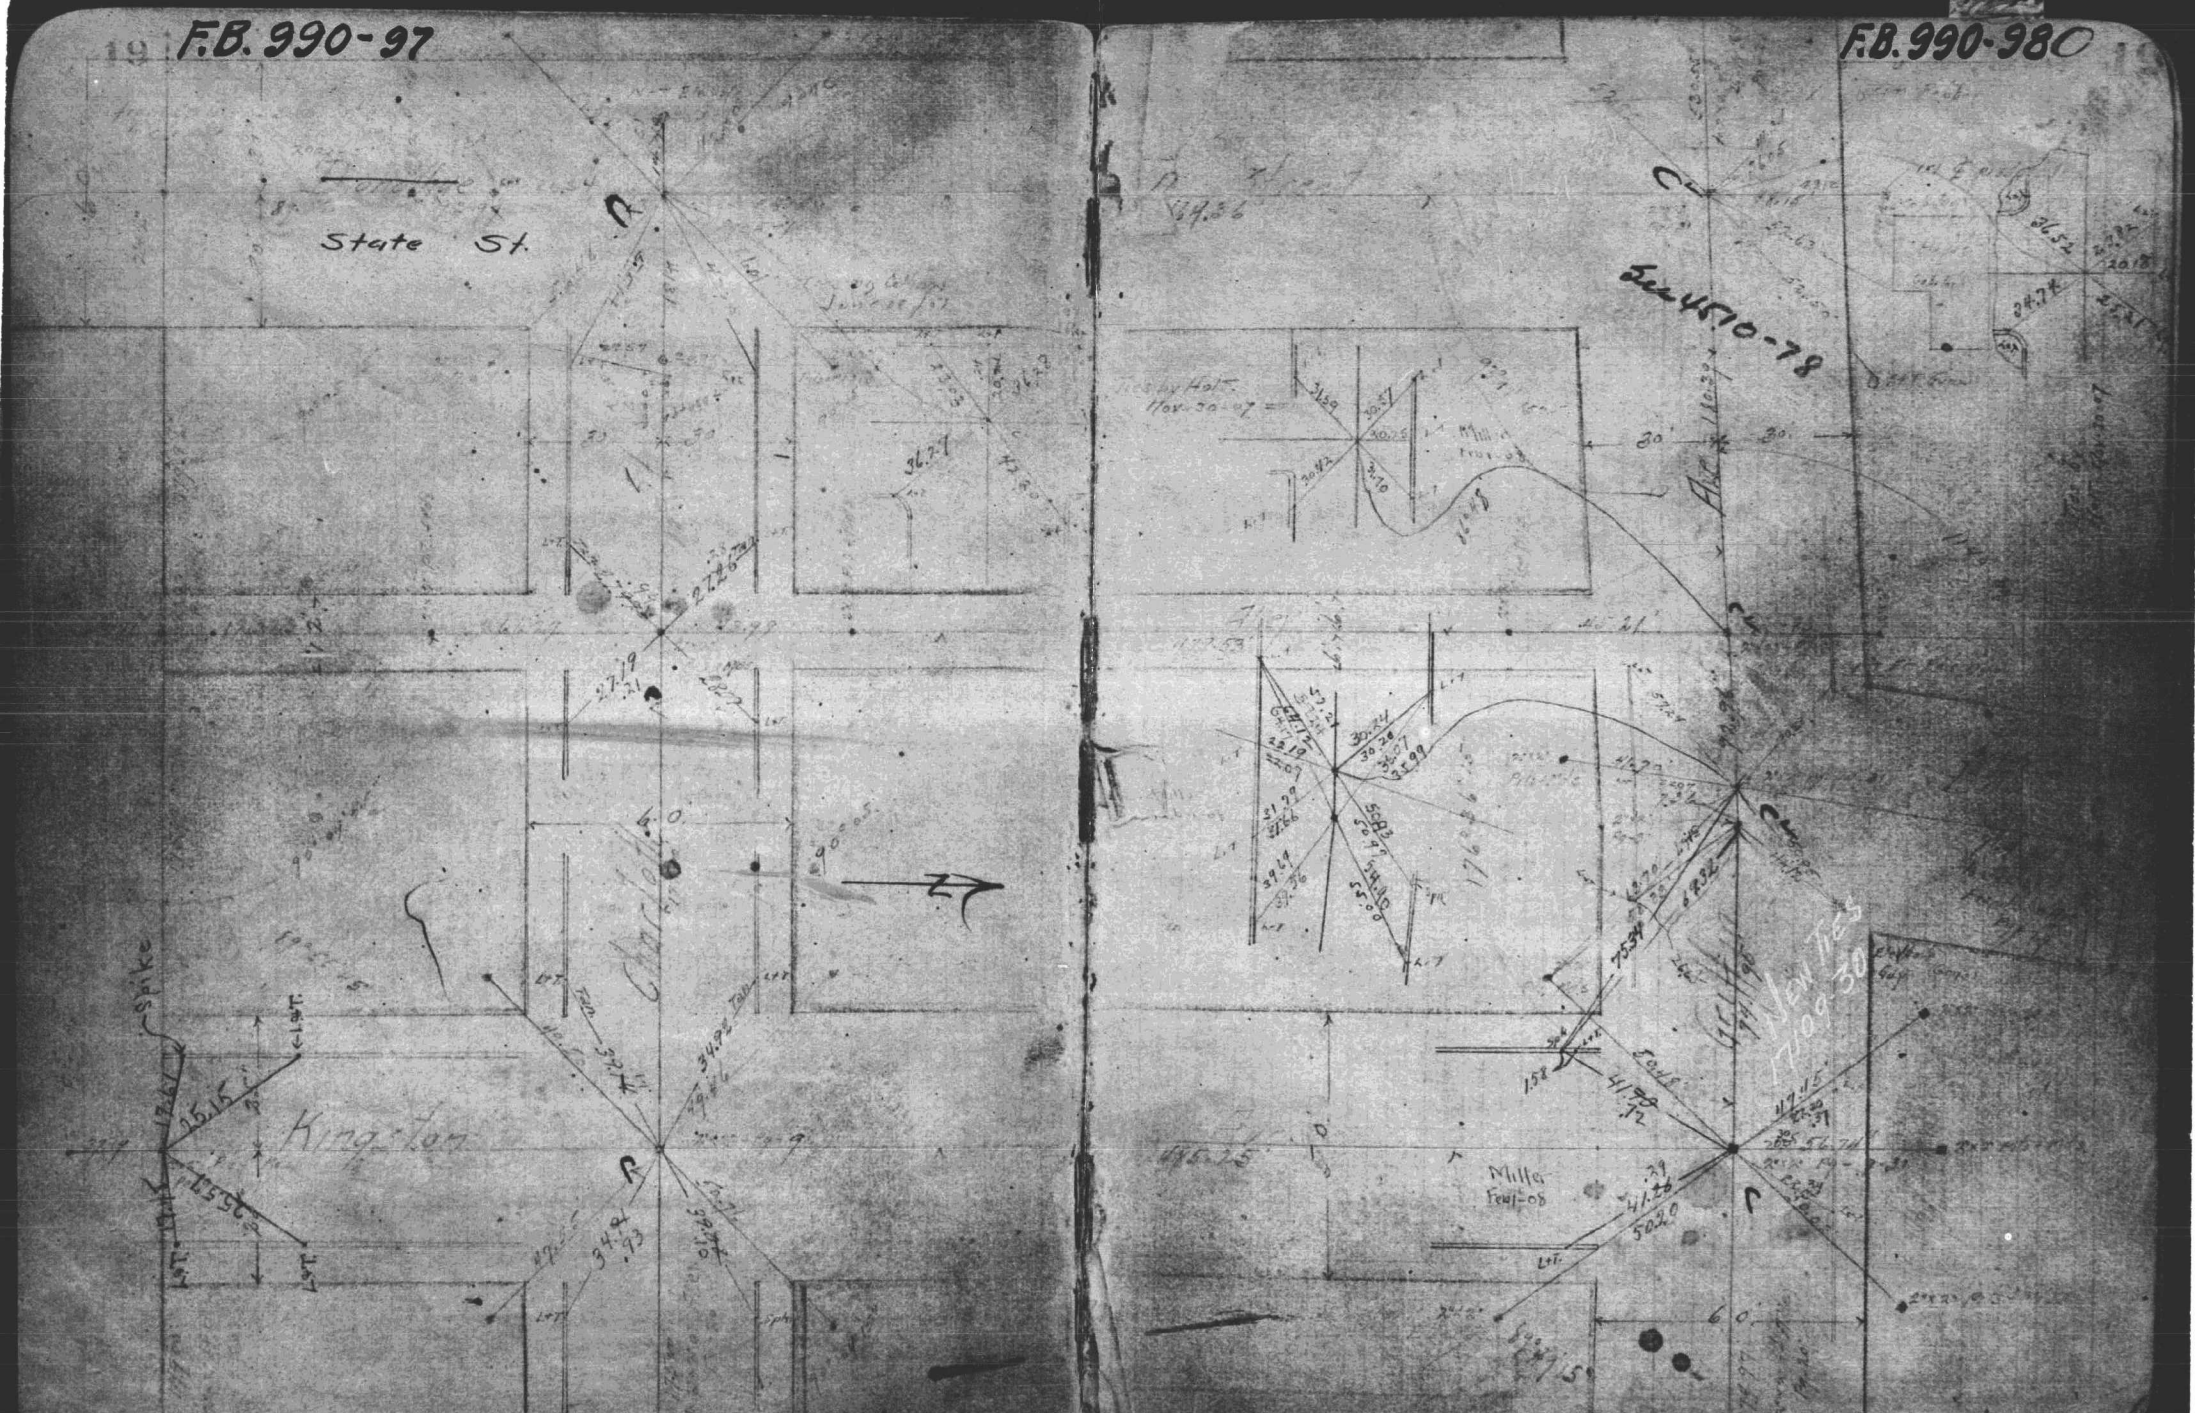
F.B. 990-97
State St.
Spike
Kingston
F.B. 990-98
Sec 4510-78
Miller
Feb 1-08
New Ties
17 Aug 30

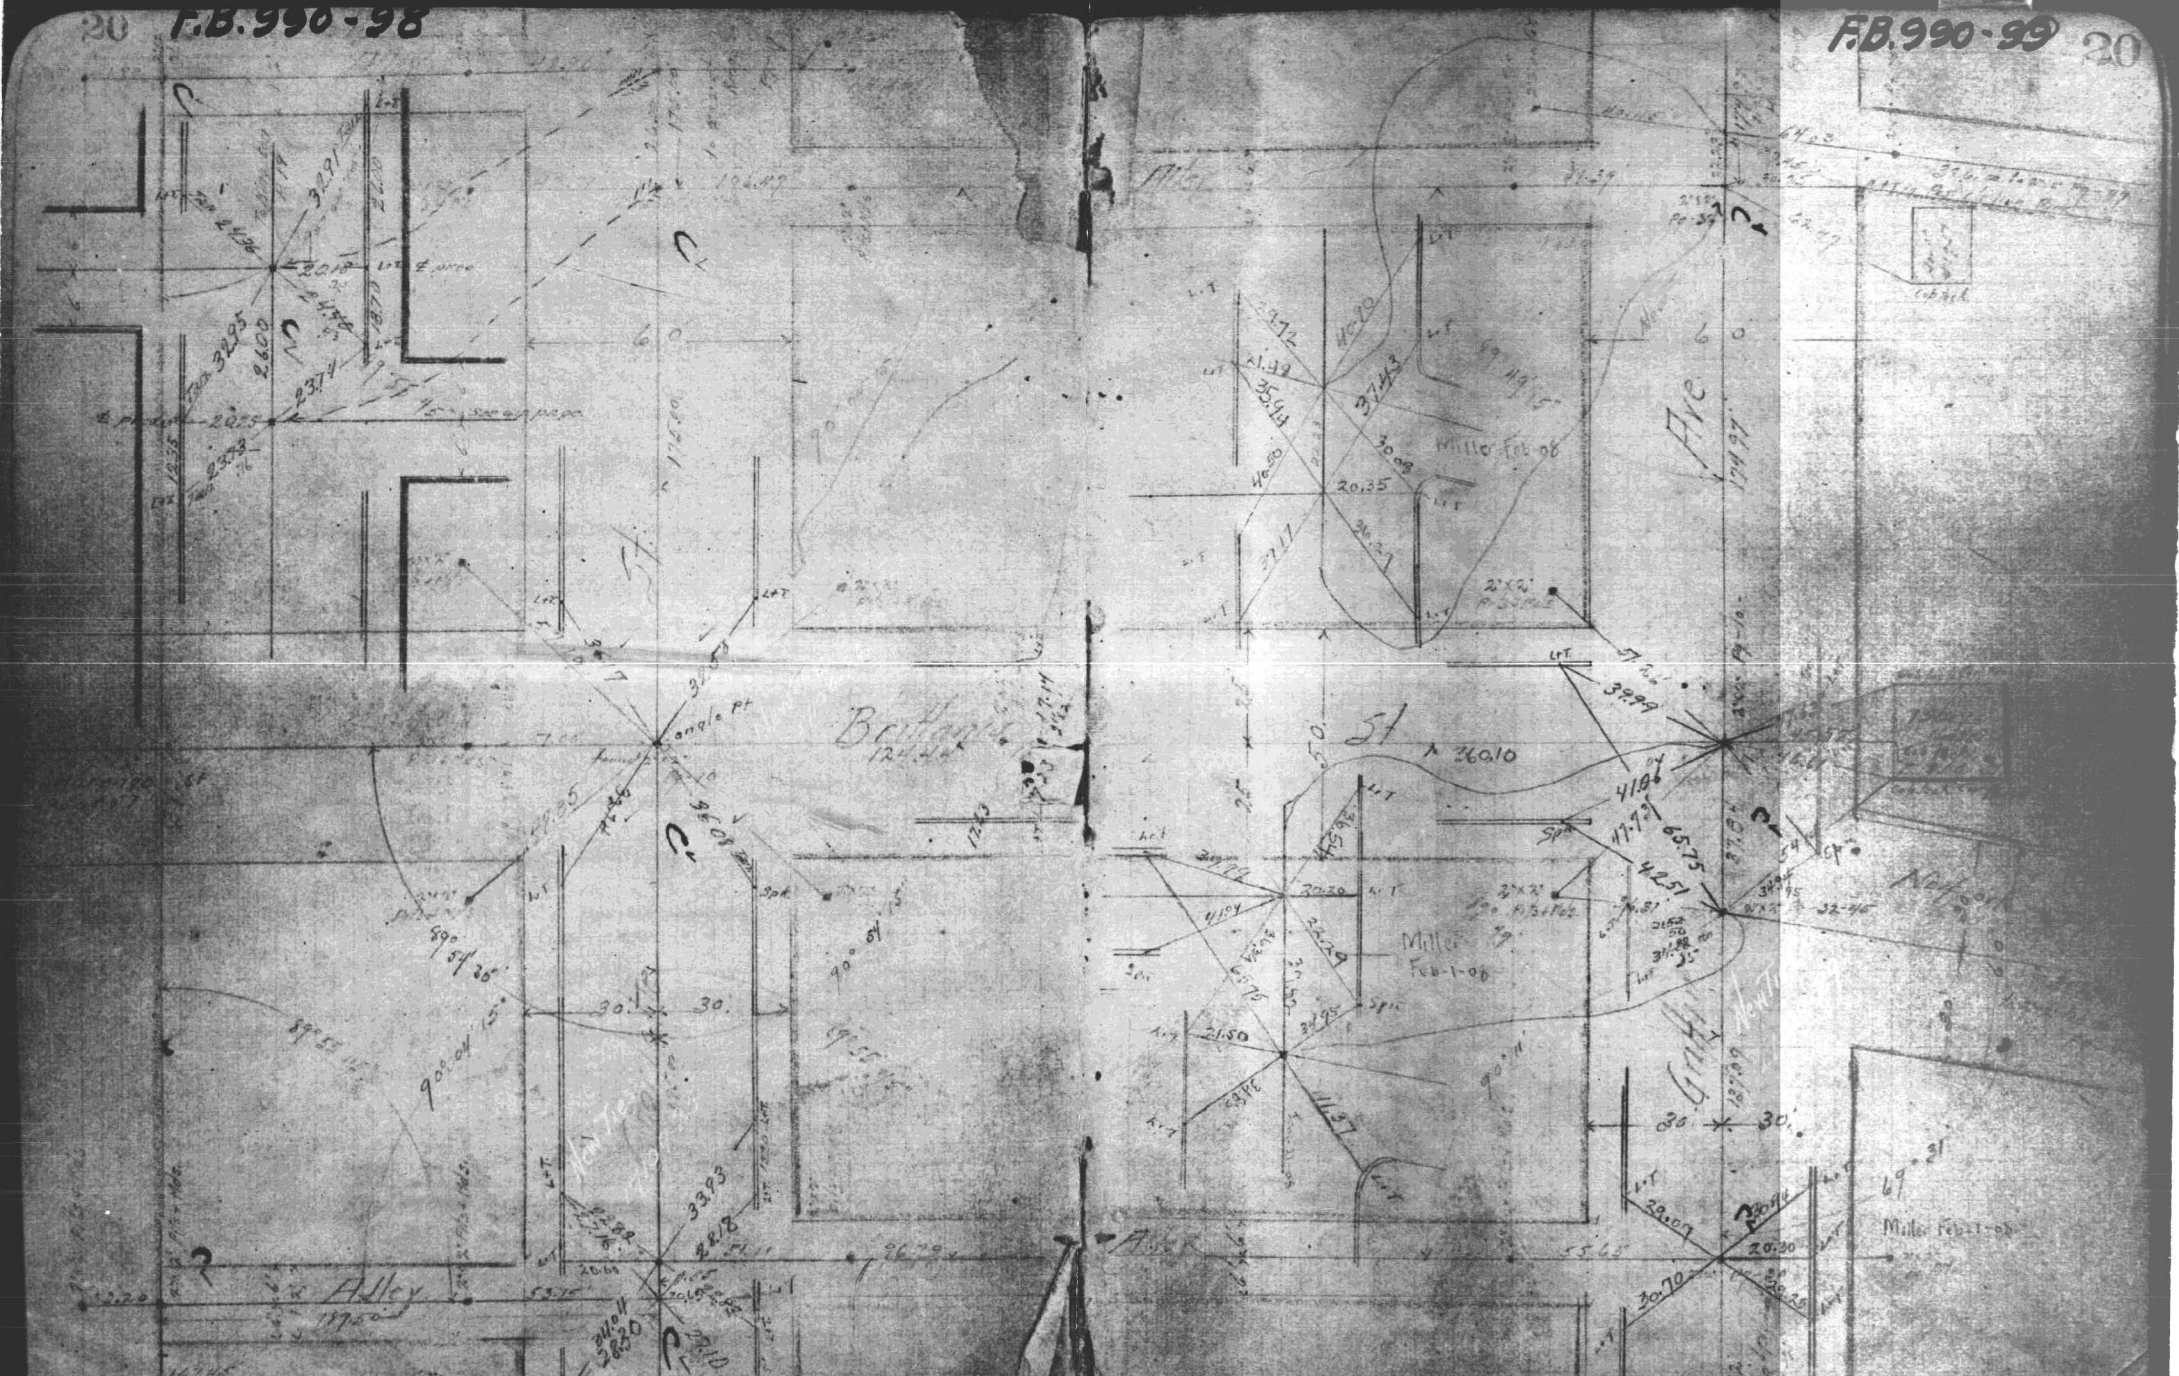
Alley
Miller Feb-08
Miller Feb-1-08
Miller Feb-1-08
Ave
St
Alley

F.B. 990-100

F.B. 990-101

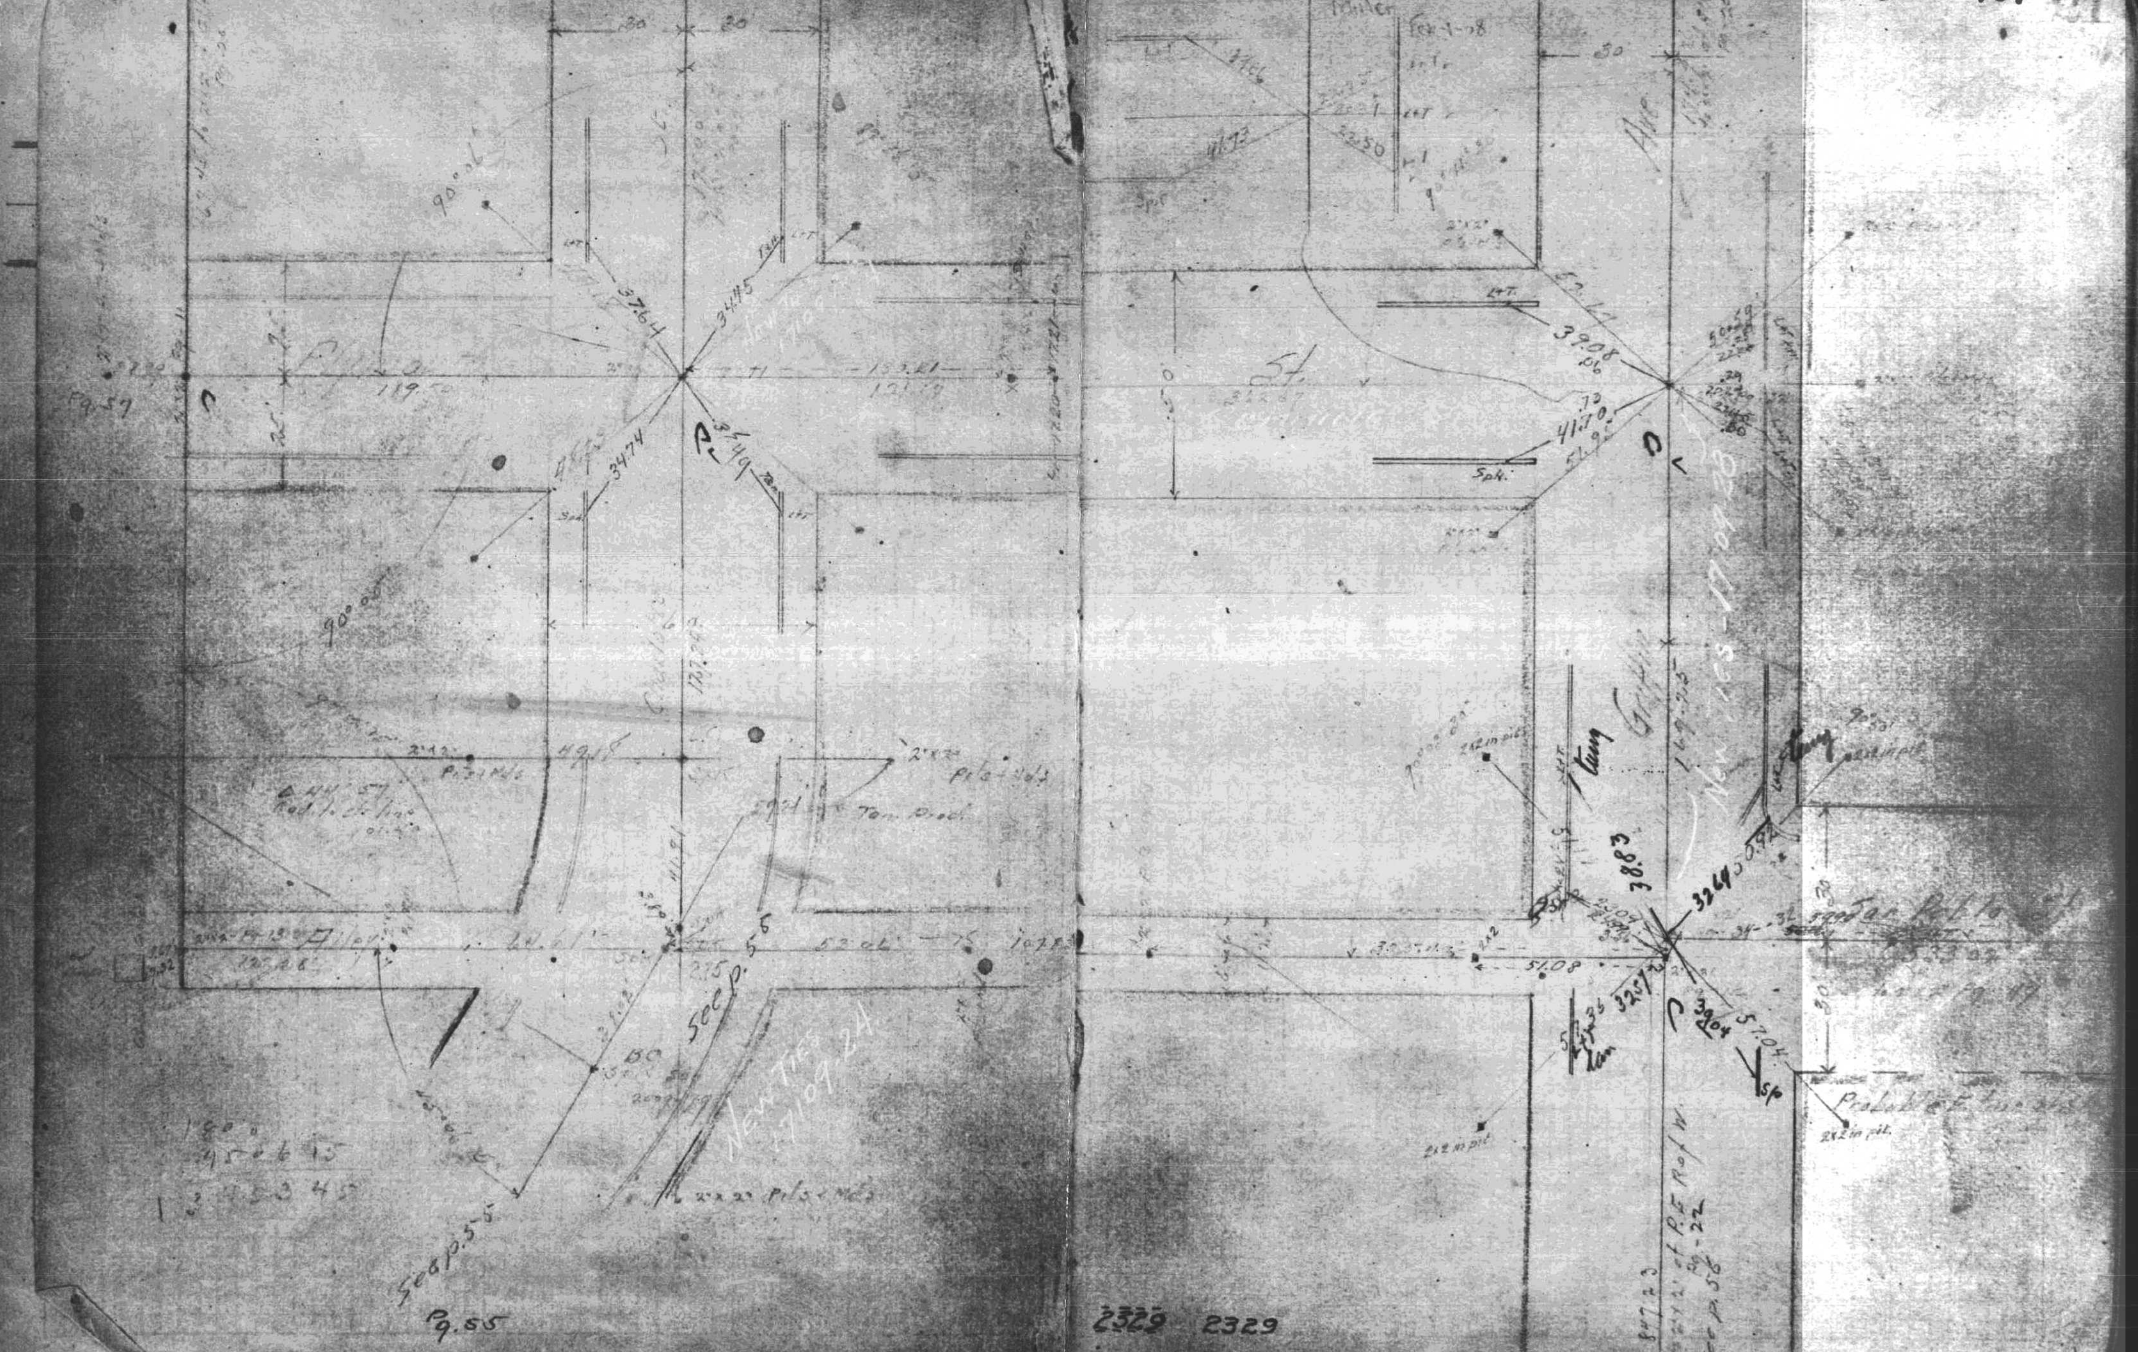

Henry Street

Griffin Ave to Eastlake Avenue

Ctr line ties

Gibson Sur { Hayes Inst
Locke Chain Feb - Mar 07
Boal do

Ctr line Survey Pg - 33

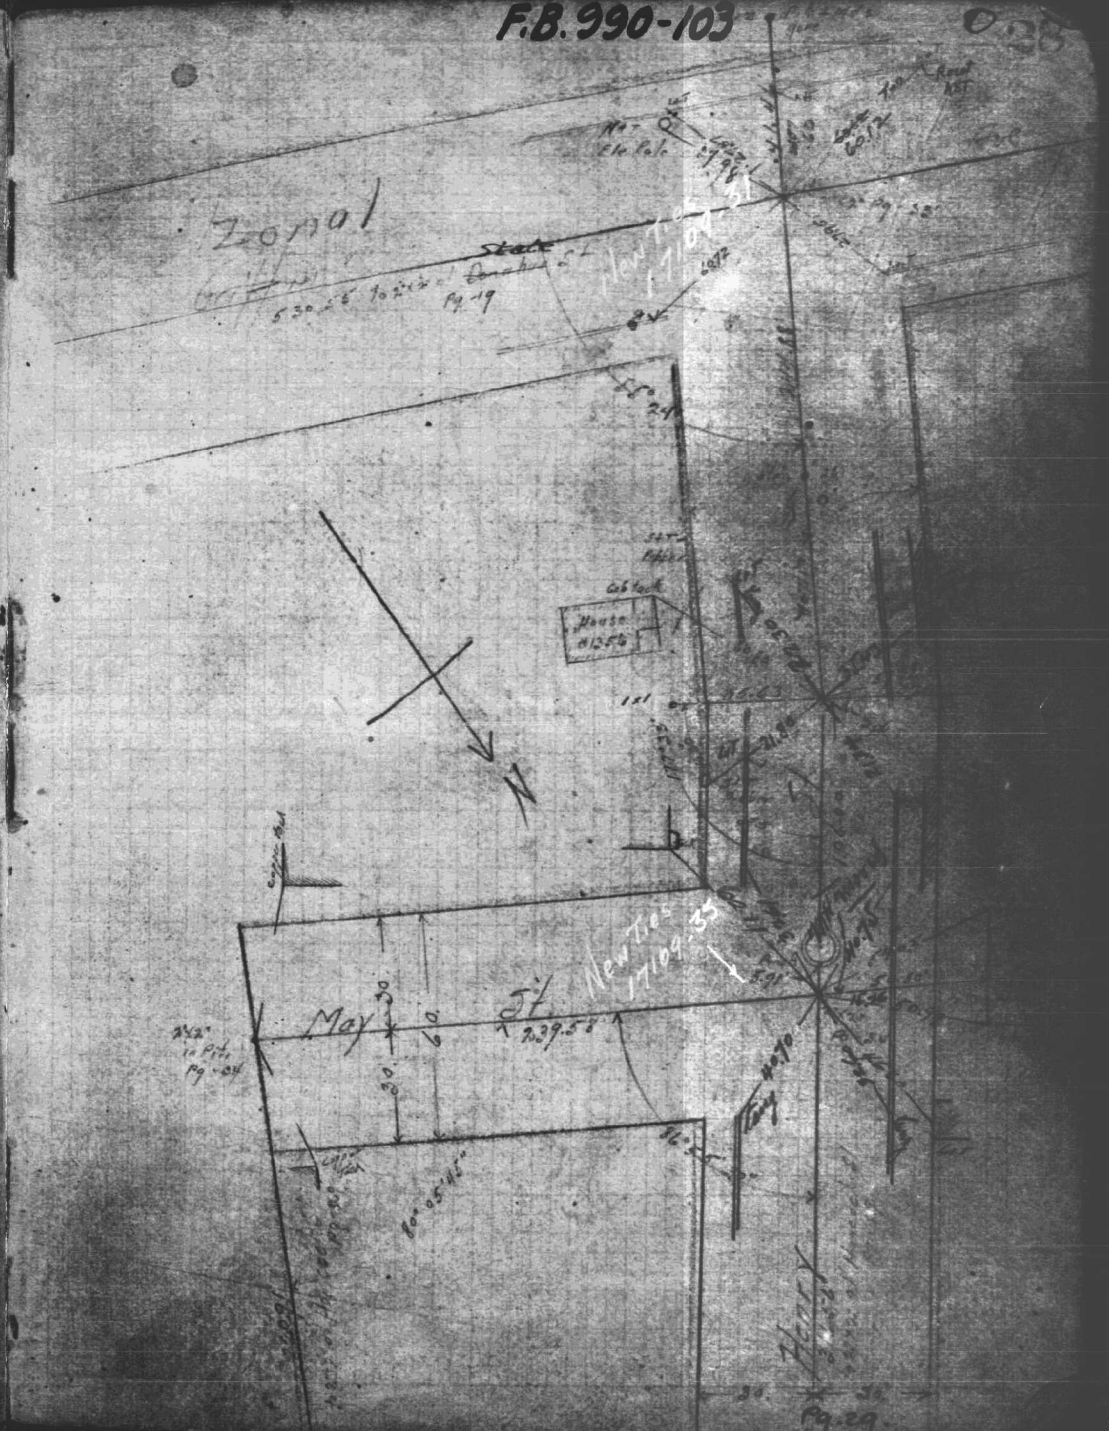

F.B. 990-104

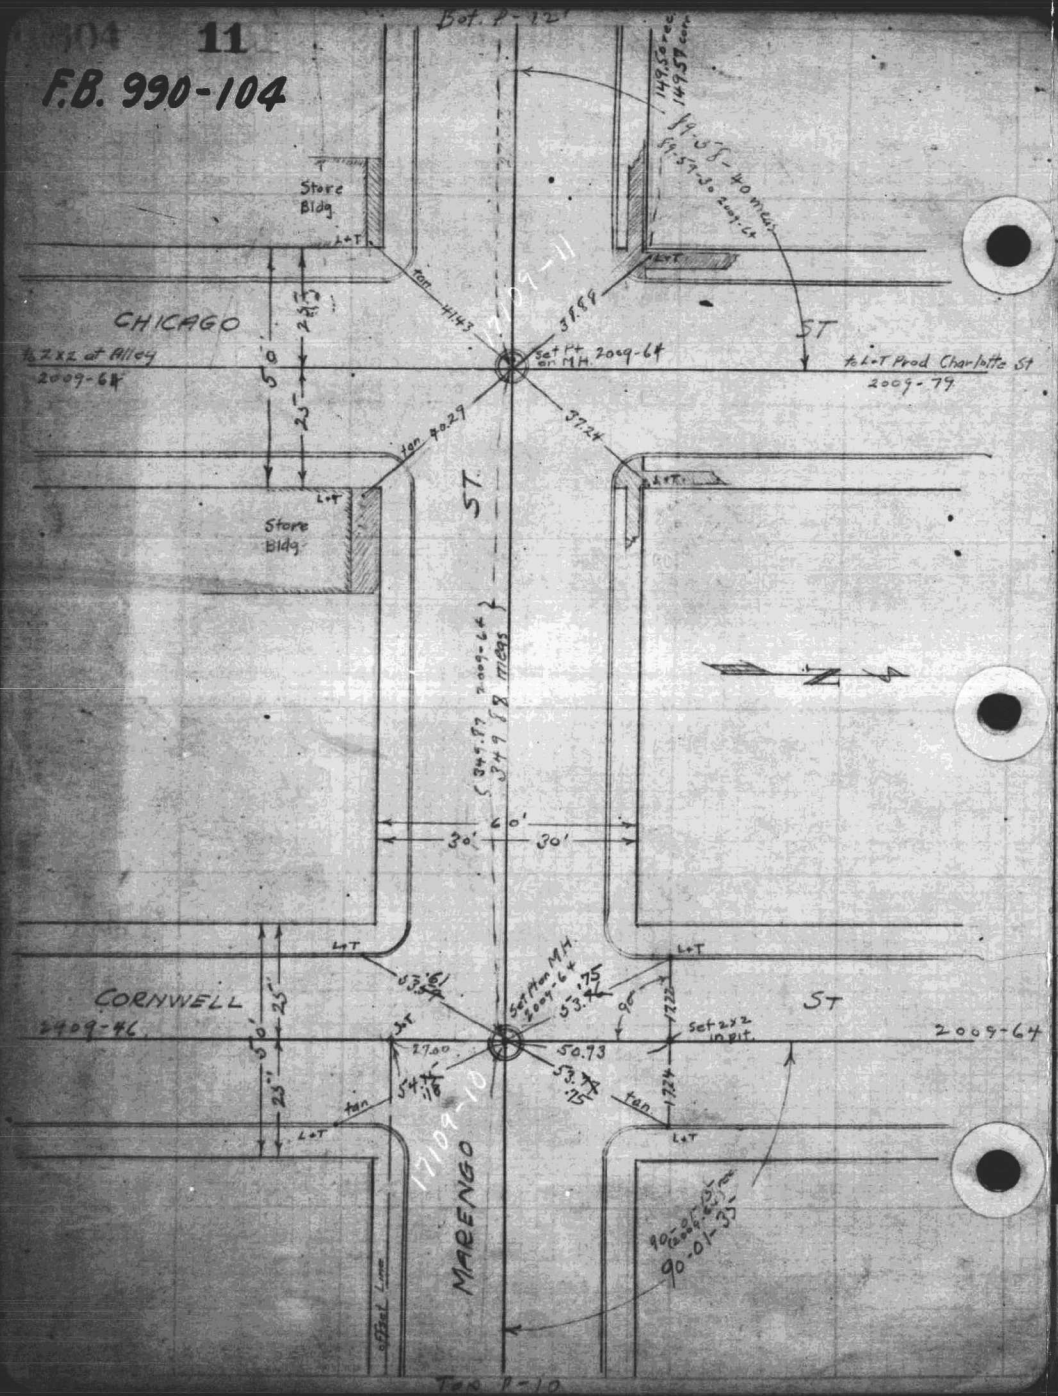

F.B. 990-105

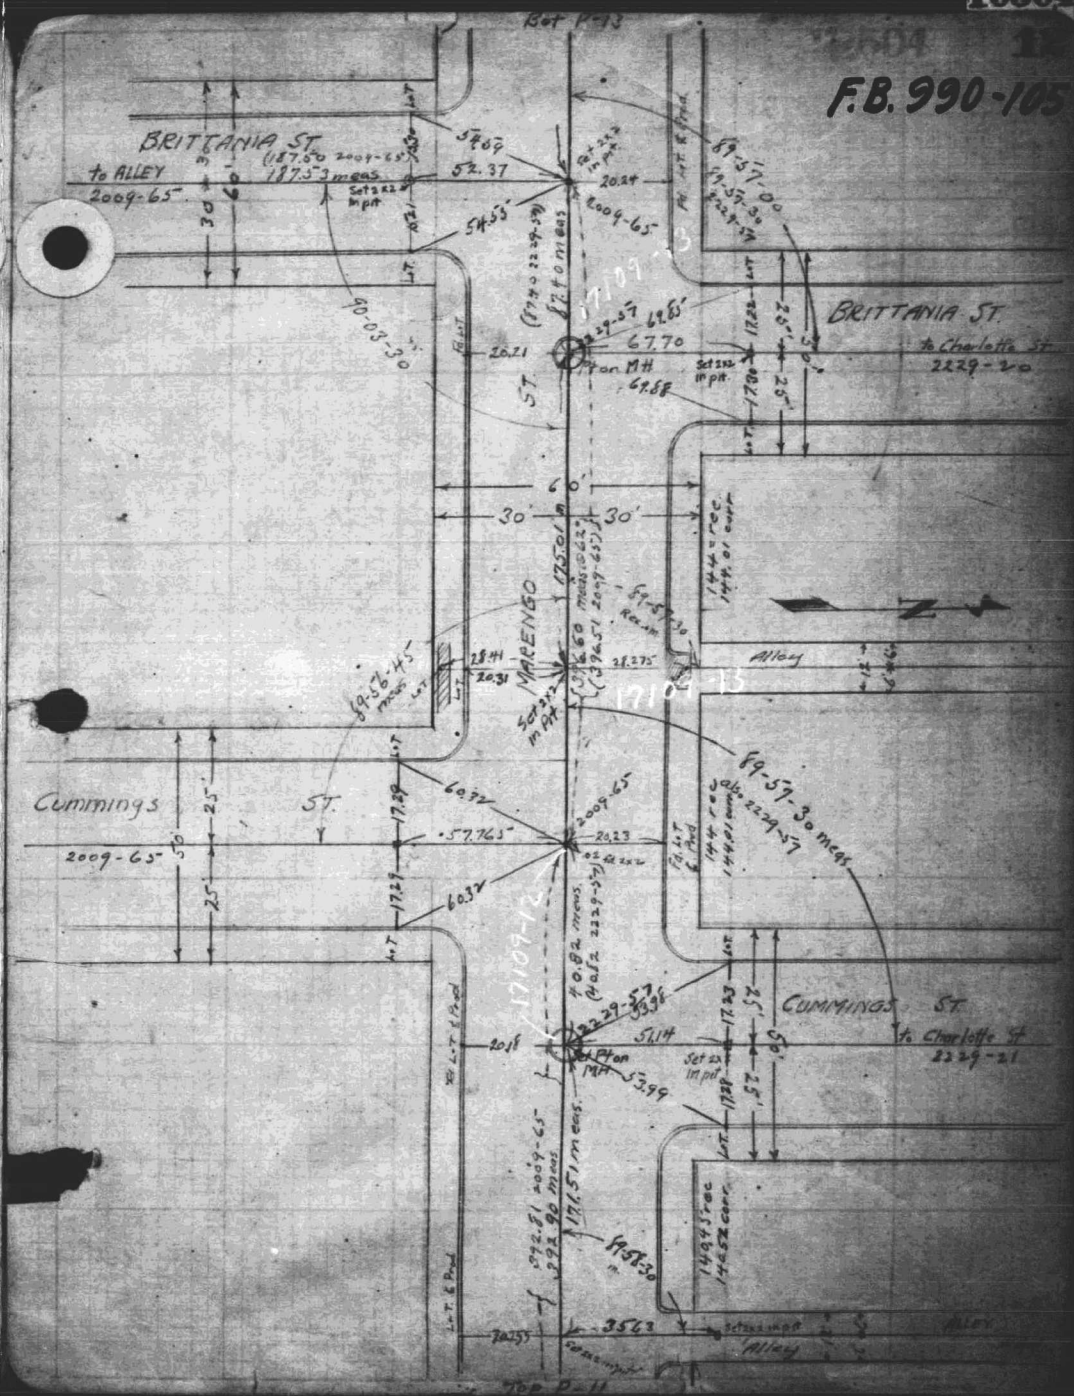

F.B. 990-106

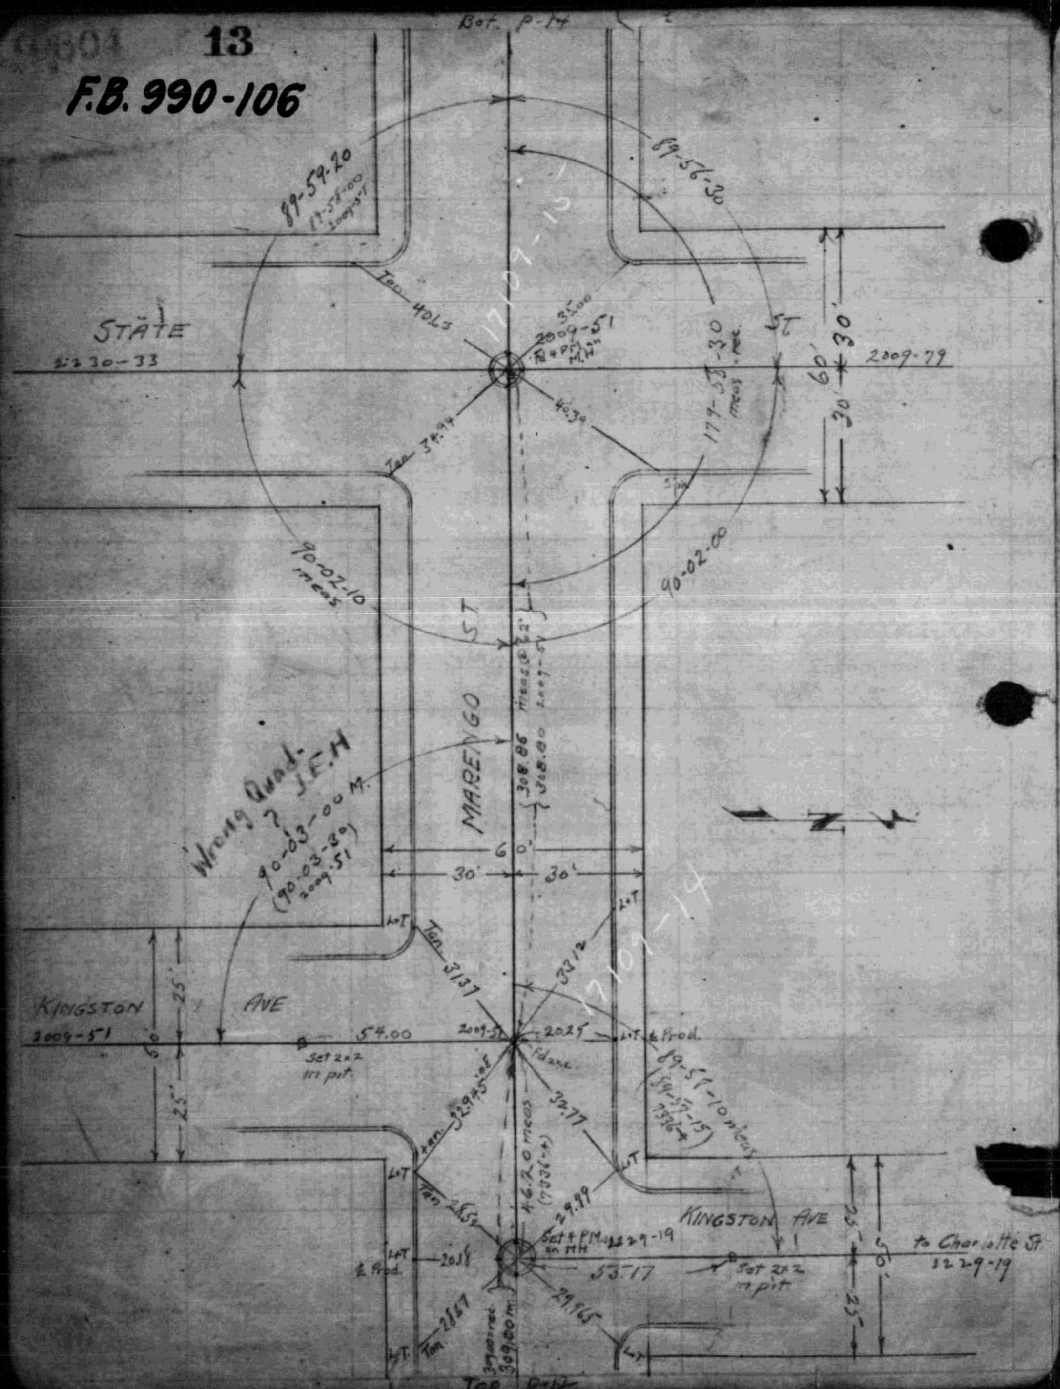

F.B. 990-107

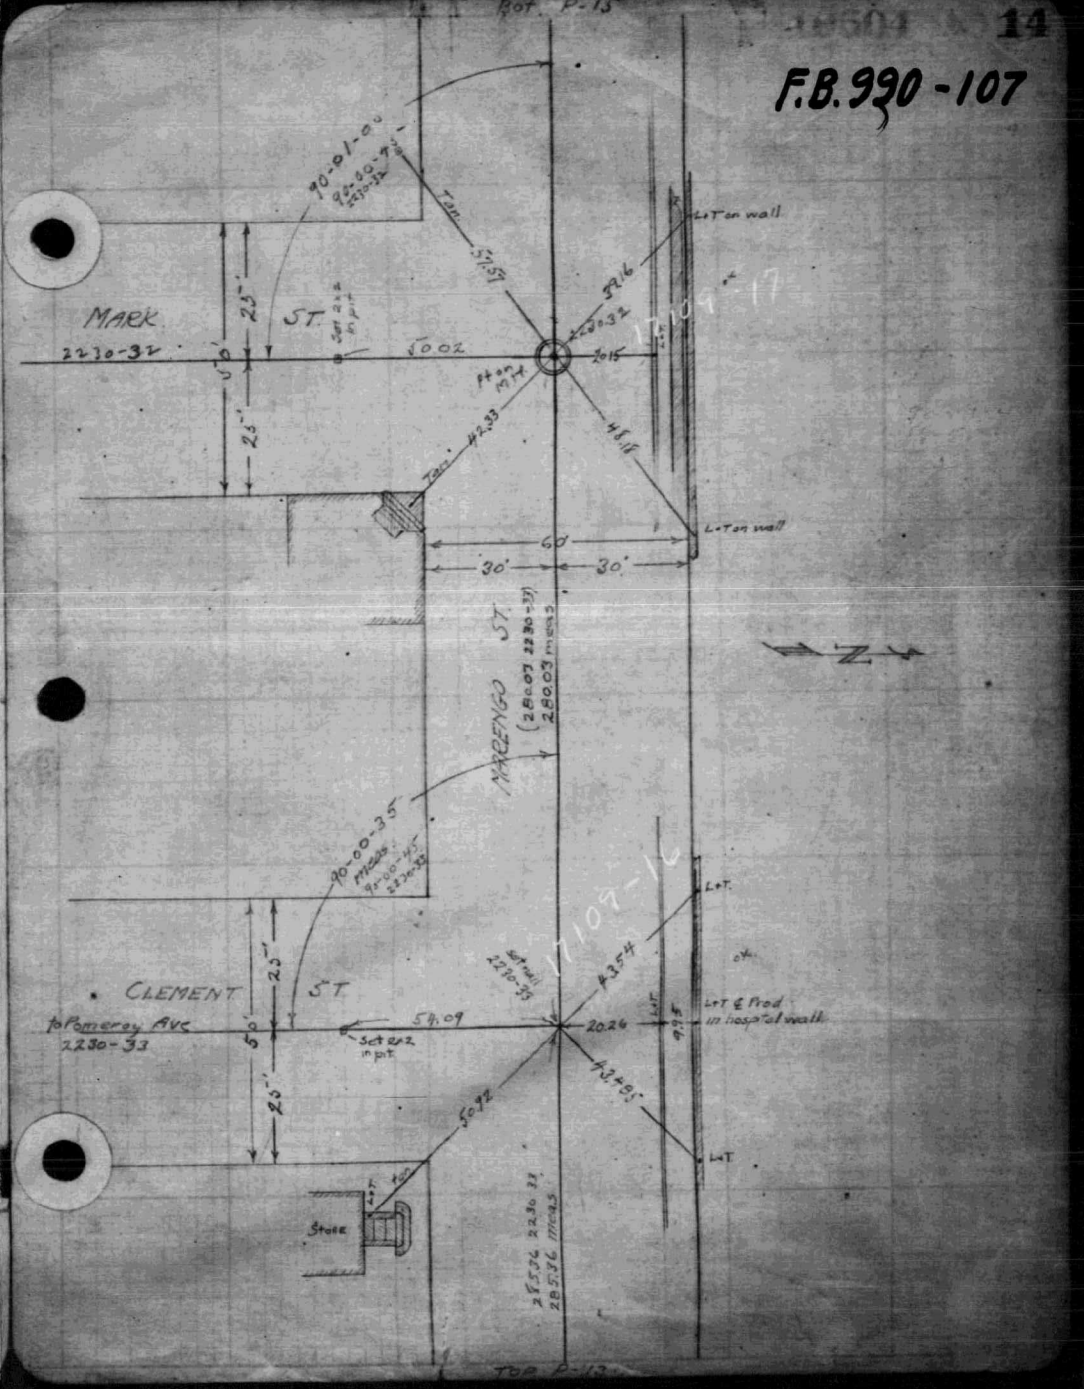

F.B. 990-108

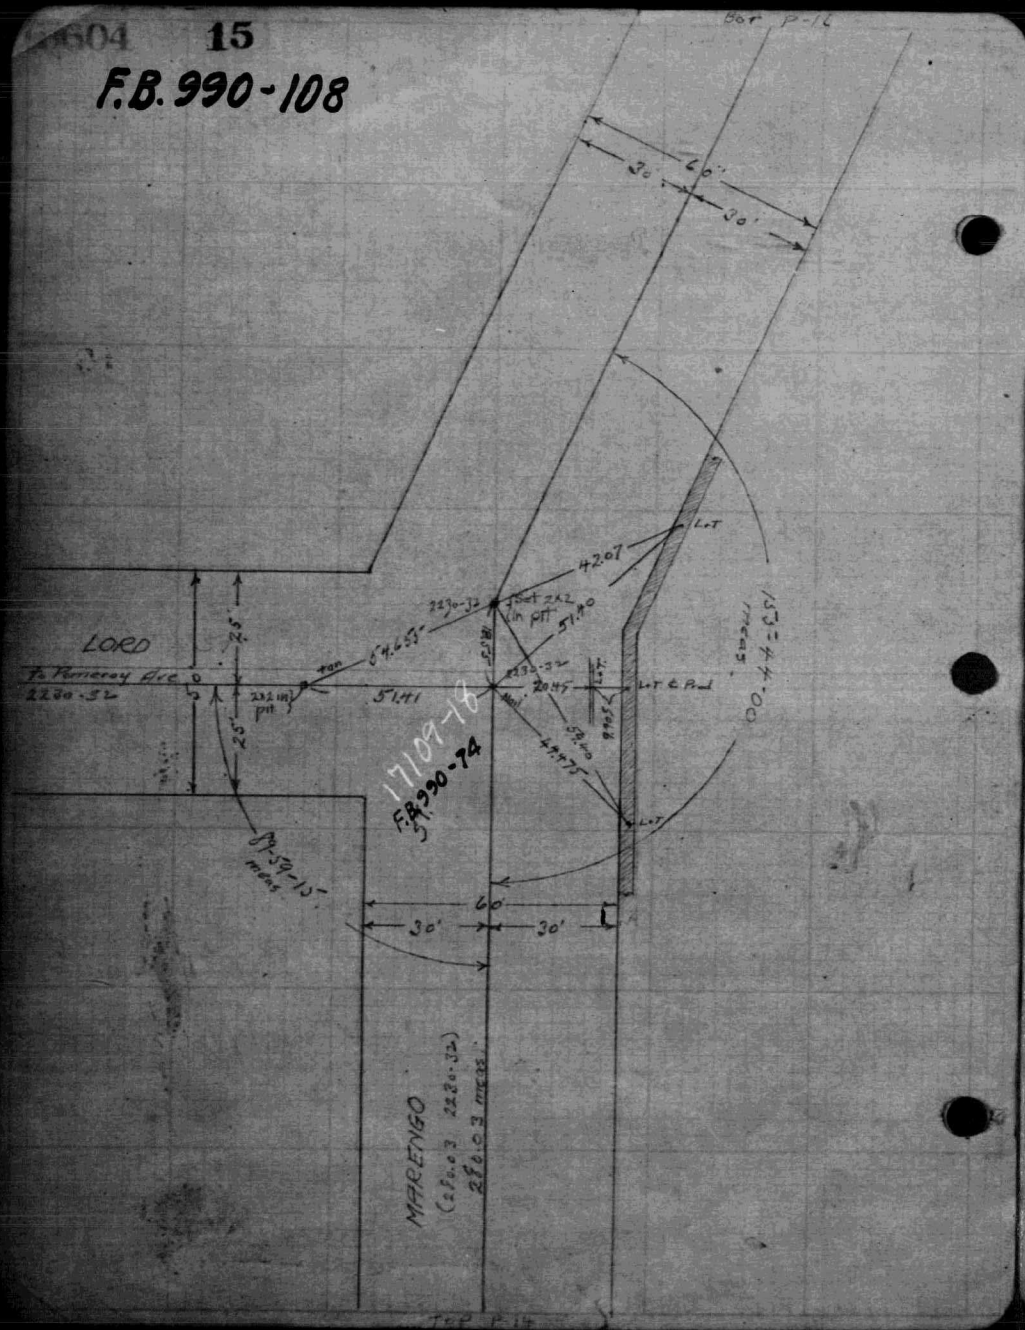

F.B. 990-74
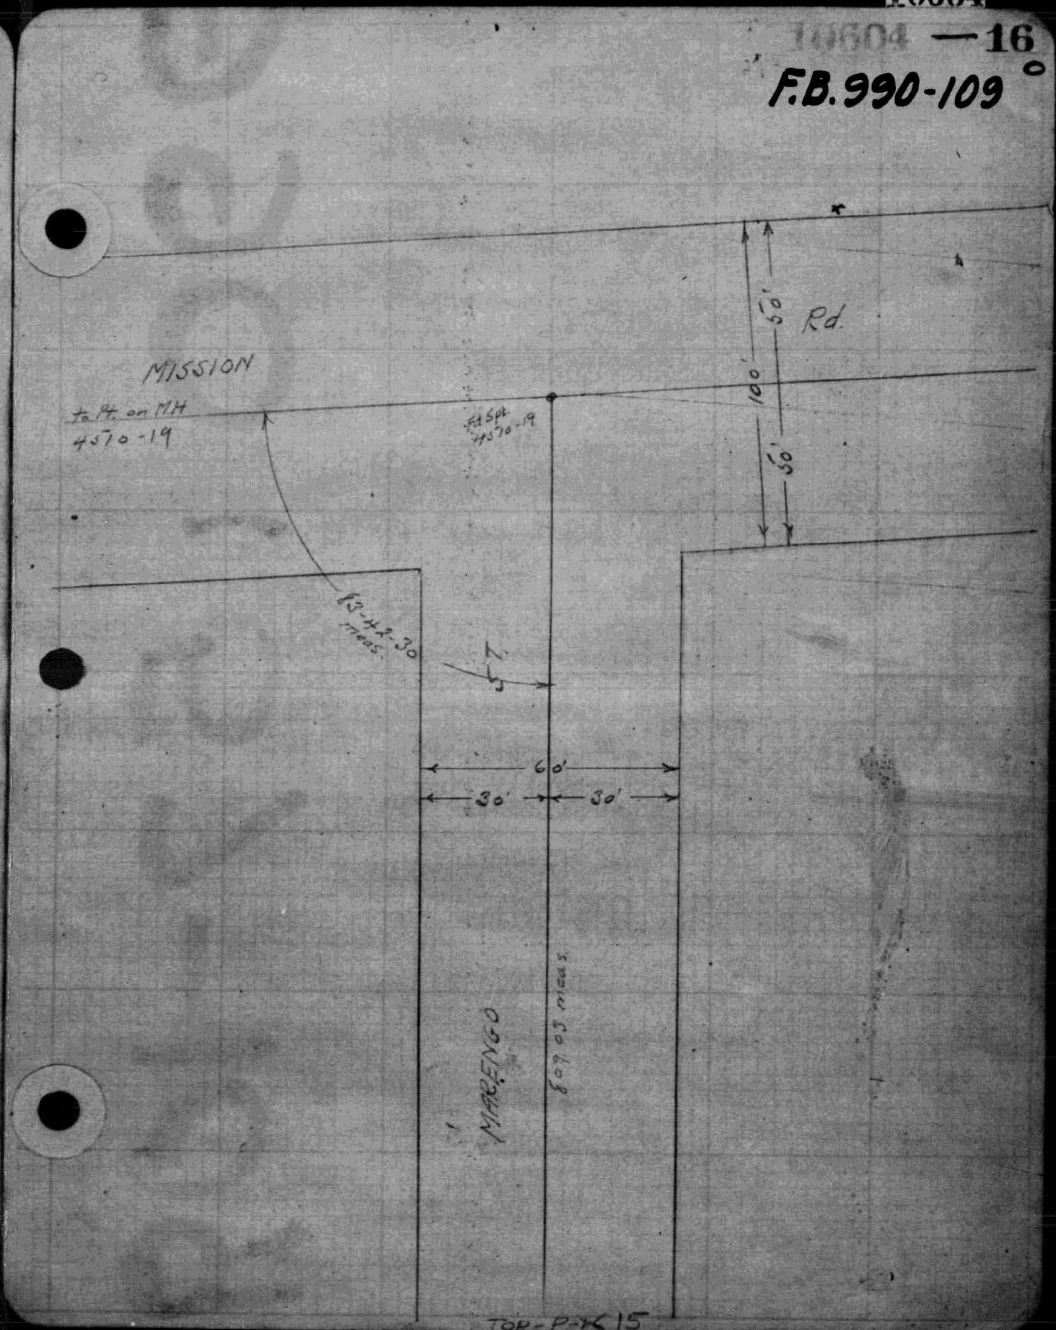
F.B. 990-109