PLEASE RETURN TO
LOS ANGELES COUNTY ENGINEER
403 Los Angeles County Engineering Bldg.

Note: Any Additions or Changes on this Sheet Must be Made or Circled in Red Ink With Date and Name of Person Making Change

Do not extend this side of this line.

F.B. Pg

Notes Ck'd by
Map No.
Office Work
Checked
Date

Survey of
JN Tape Std °F
Surveyed by
Notes Date
Indexed

F.B. 1159 Pg. 1139

Page	Job	Description
		SAN JUAN WAY J.N. 8339
7-16	C.L.	Align. Arroyo Seco Blvd. to Gould & Michigan Avenues.
17-28	Topo.	Loc. Imp. fr. Arroyo Seco Blvd. to Gould & Michigan Avenues.
		WINDSOR AVE. 0075.46
[illegible]-32	Index	
33-[illegible]	C.L.	C.L. Survey fr. Woodbury Rd. to Altadena Dr.
[illegible]-84	C.L.	C.L. Survey-Windsor Ave. & intersecting Sts. fr. Chevron Ct. to Windsor Ave.
[illegible]-86	C.L.	Pick up Rd. Dept. alignment vicinity of Chevron Ct. & Windsor Ave.
87-118	C.L.	ALBERTA ST. J.N. 030300 ℄ & Monuments set

Microfilmed Jan '88

Survey of Foothill Blvd	F.B. 1159 Pg. 7
Mod No.	W. O. 5399 Topo No. 081 Std 68 °F
Office Work KRM	Surveyed by Porter
Checked	Notes Porter Date 6-45
Date	Indexed A. C. Johnson

SURVEY OF
FootHill Blvd (SAN JUAN WAY)

From the ARROYO SECO Westerly
to MICHIGAN AVE West
of Gould AVE

June 45

Note - FootHill Blvd
changed to San Juan Way
J.N. 8399

Porter
Brock
Bardoff
Hand

H.C.: 8-84
C.S. B-1920

Note: Any Additions or Changes on This Sheet Must be Made or Circled in Red Ink With Date and Name of Person Making Change.

RETURN TO
LOS ANGELES COUNTY SURVEYOR
700 HALL OF RECORDS

Do not extend notes this side of this line.

FORM 247 3M 12-40

F.B. 1159 Pg.

RETURN TO
LOS ANGELES COUNTY SURVEYOR
700 HALL OF RECORDS

Note: Any Additions or Changes Made This Sheet Must be Made in Red Ink With Dot and Name of Person Making Change

Do not extend notes this side of this line.

Notes Ck'd by Drew	Survey of Foothill Blvd
Map No.	W. O. 8399 Tape No. 081 St'd 68 °F
Office Work K.R.M.	Surveyed by Porter
Checked	Notes Porter Date 6-28-45
Date	Indexed A. C. Johnson

F.B. 1159 Pg. 9

W.S.51-D-5

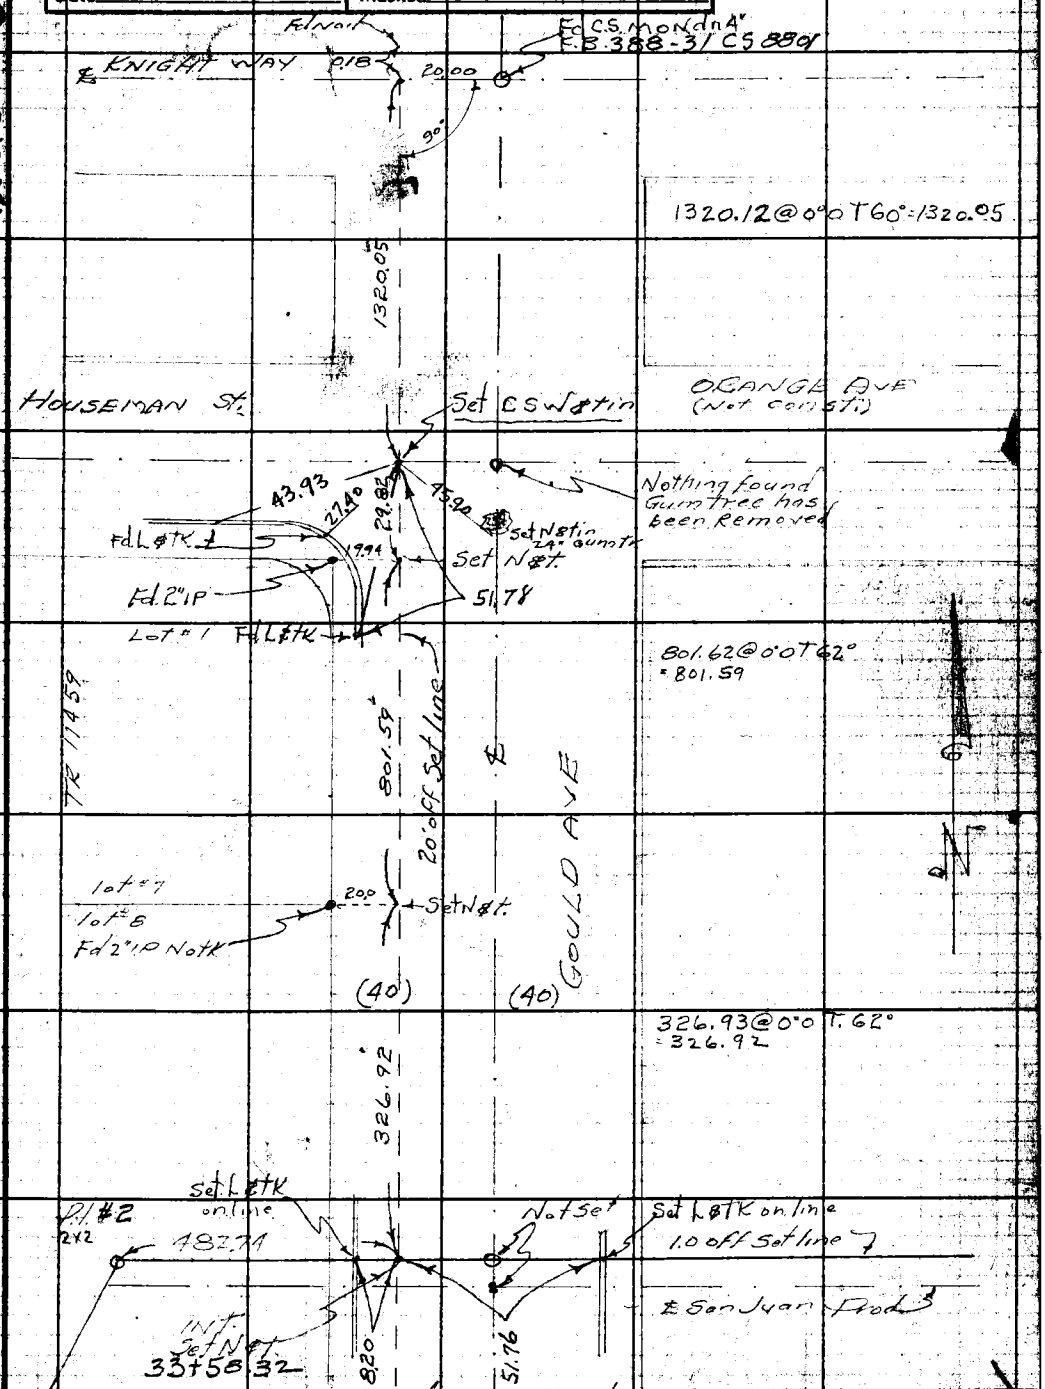

cont. Right Side Pg 10

Note: Any Additions or Changes on This Sheet Must be Made or Circled in Red Ink With Date and Name of Person Making Change

Do not extend notes this side of this line.

RETURN TO
LOS ANGELES COUNTY SURVEYOR
700 HALL OF RECORDS

FORM 247 5M 12-40

RETURN TO
LOS ANGELES COUNTY SURVEYOR
700 HALL OF RECORDS

Note: Any Additions or Changes on This Sheet Must be Made or Circled in Red Ink With Date and Name of Person Making Change.

Do not extend notes this side of this line.

W.S. 51+D-5

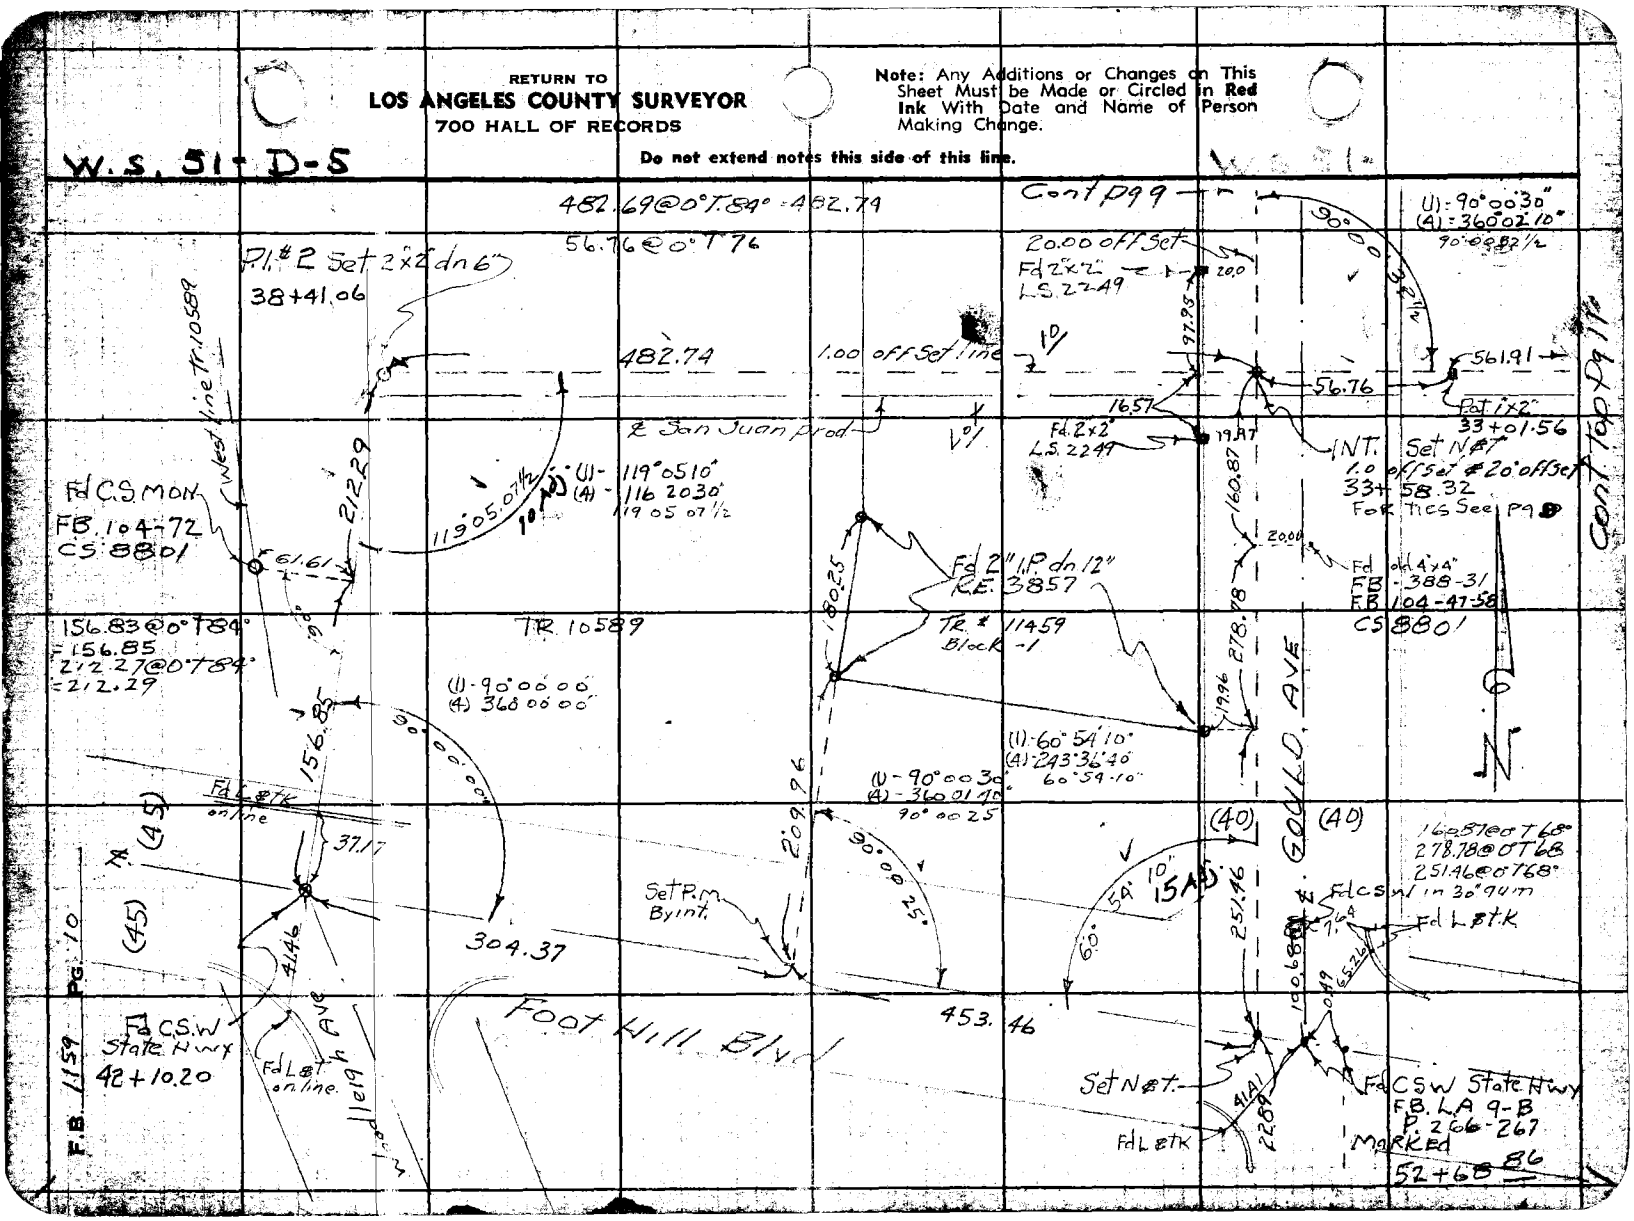

Notes Ck'd by Drew	Survey of Foot Hill Blvd
Map No.	W. O. 8399 Tape No. 081 St'd 68 °F
Office Work K.R.M.	Surveyed by Porter
Checked	Notes Porter Date 6-
Date	Indexed A. C. Johnson

F.B. 1159 Pg. 11

W.S. 56-A-1

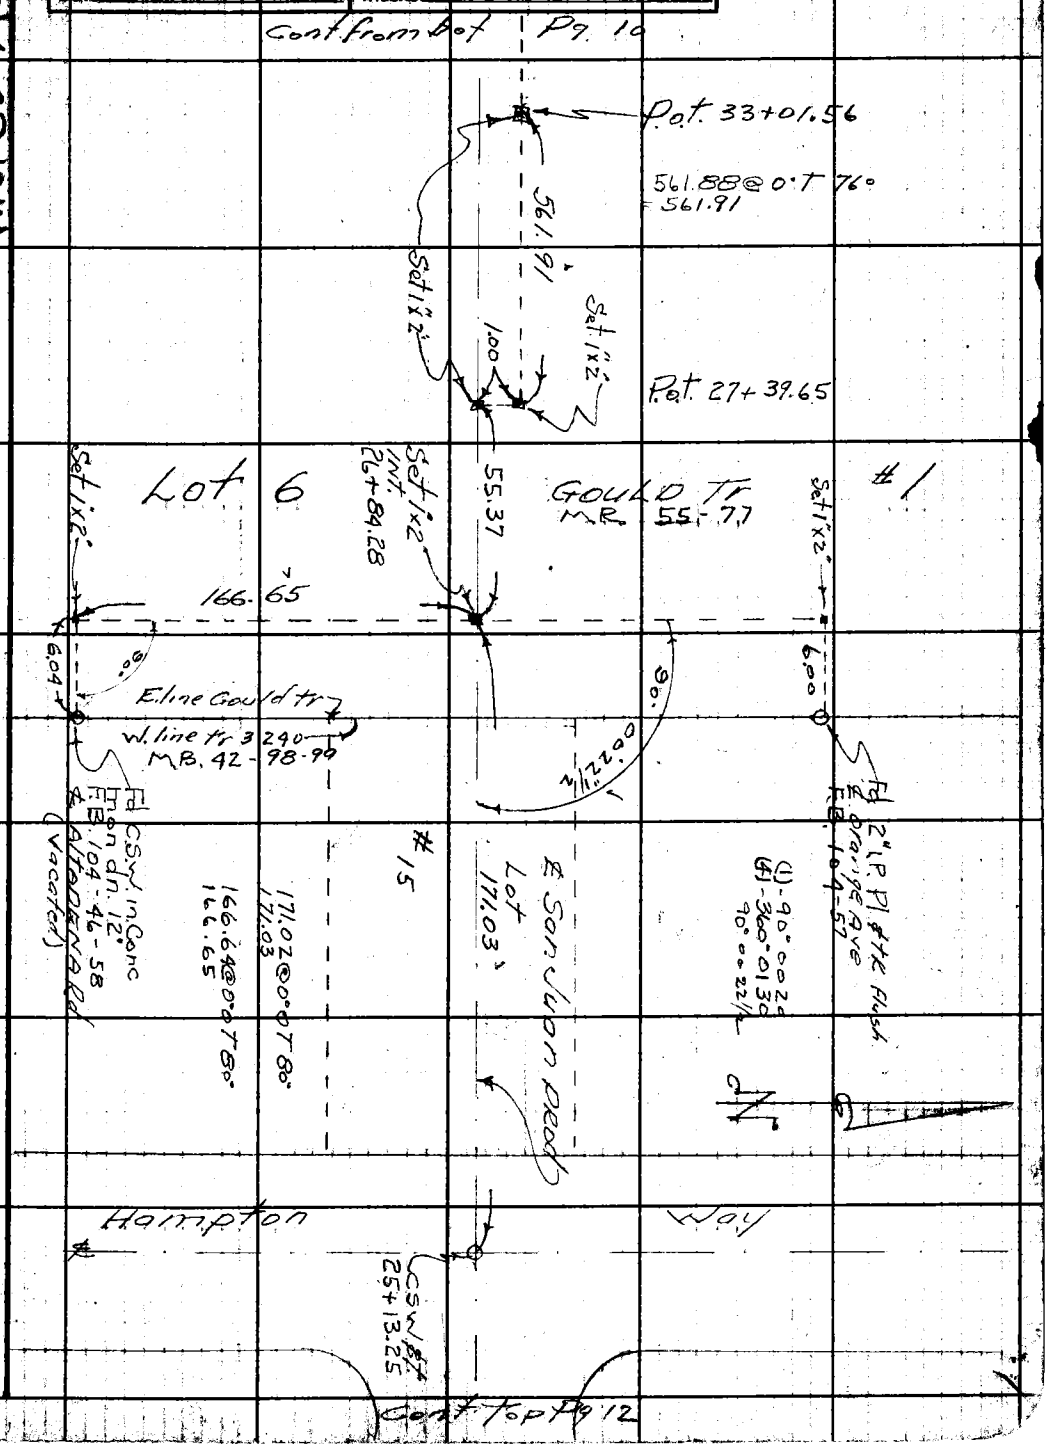

Note: Any Additions or Changes on This Sheet Must be Made or Circled in Red Ink With Date and Name of Person Making Change.

Do not extend notes this side of this line.

RETURN TO
LOS ANGELES COUNTY SURVEYOR
700 HALL OF RECORDS

FORM 247 5M 12-40

RETURN TO
LOS ANGELES COUNTY SURVEYOR
700 HALL OF RECORDS

Note: Any Additions or Changes on This Sheet Must be Made or Circled in **Red Ink** With Date and Name of Person Making Change.

Do not extend notes this side of this line.

WS, 50 - A-1

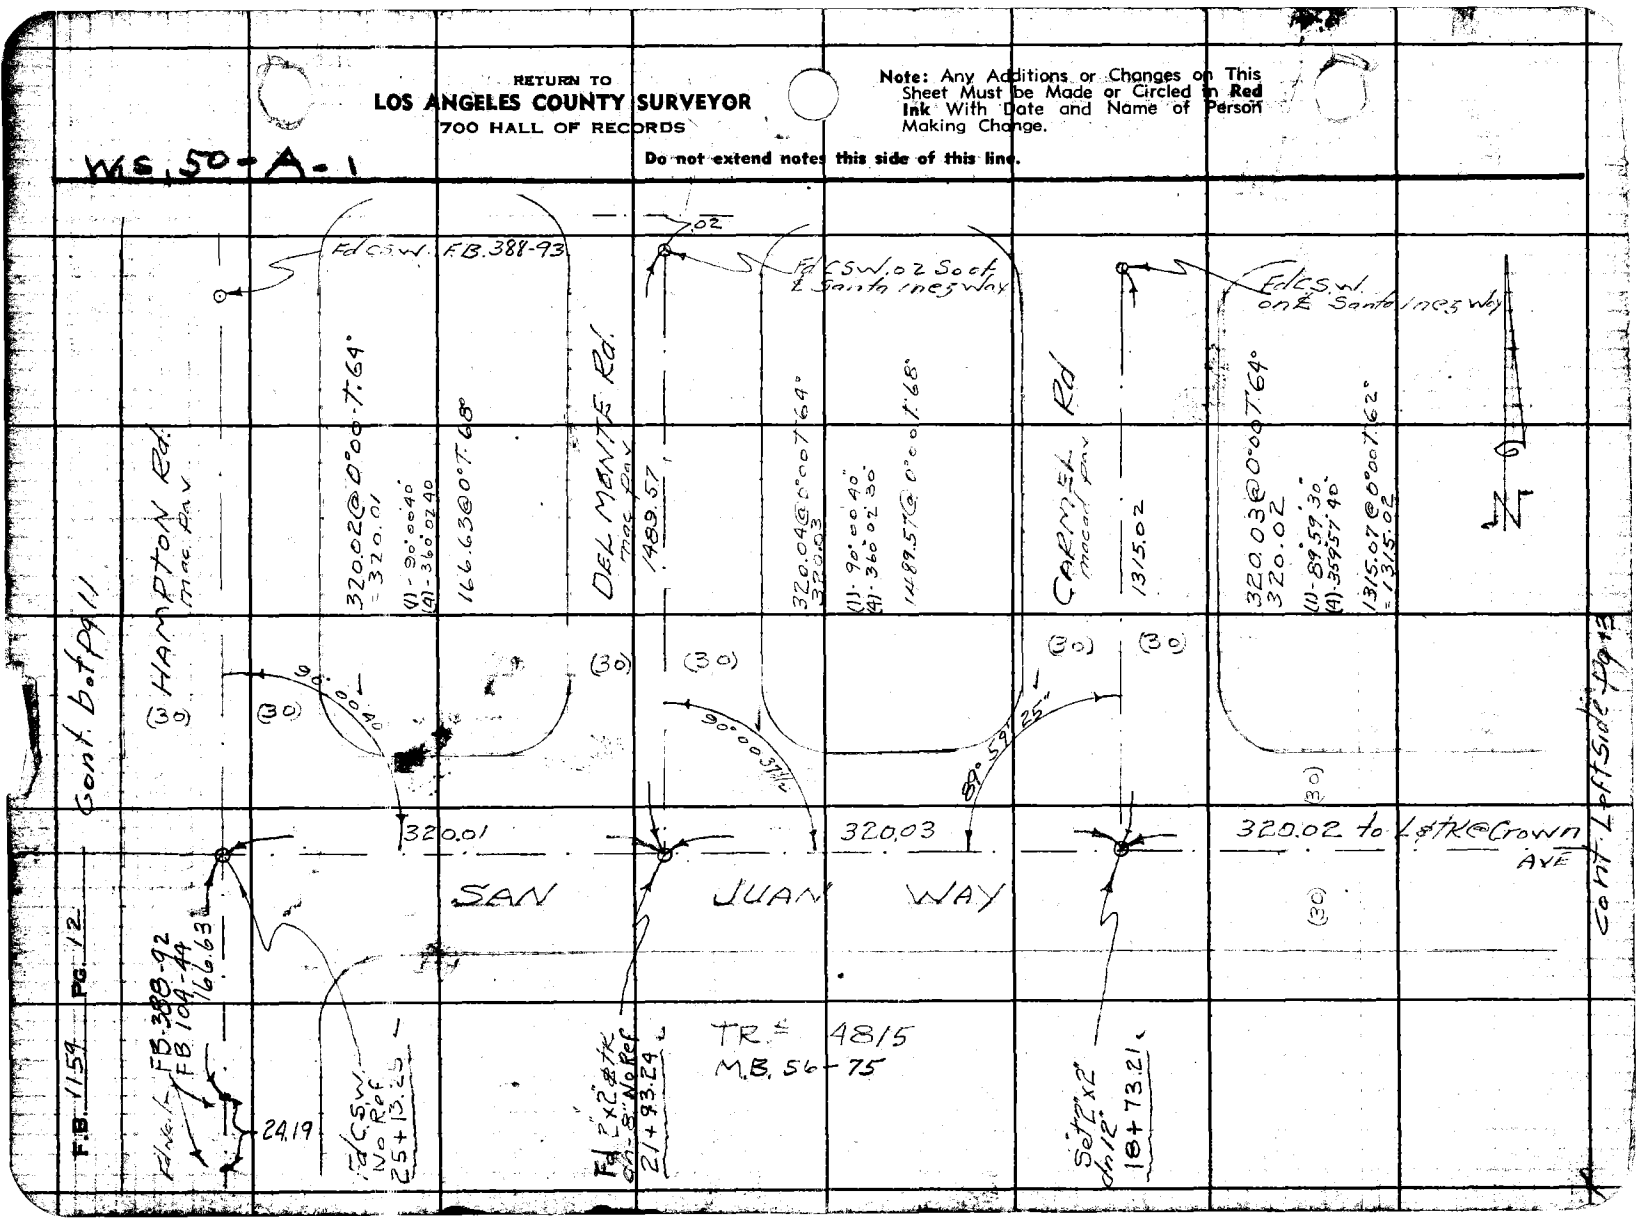

Notes Ck'd by Drew	Survey of Foothill Blvd
Map No.	W. O. 8399 Tape No. 081 Std 68 °F
Office Work KRM	Surveyed by Porter
Checked	Notes Porter Date 6
Date	Indexed A. C. Johnson

F.B. 1159 PG. 13

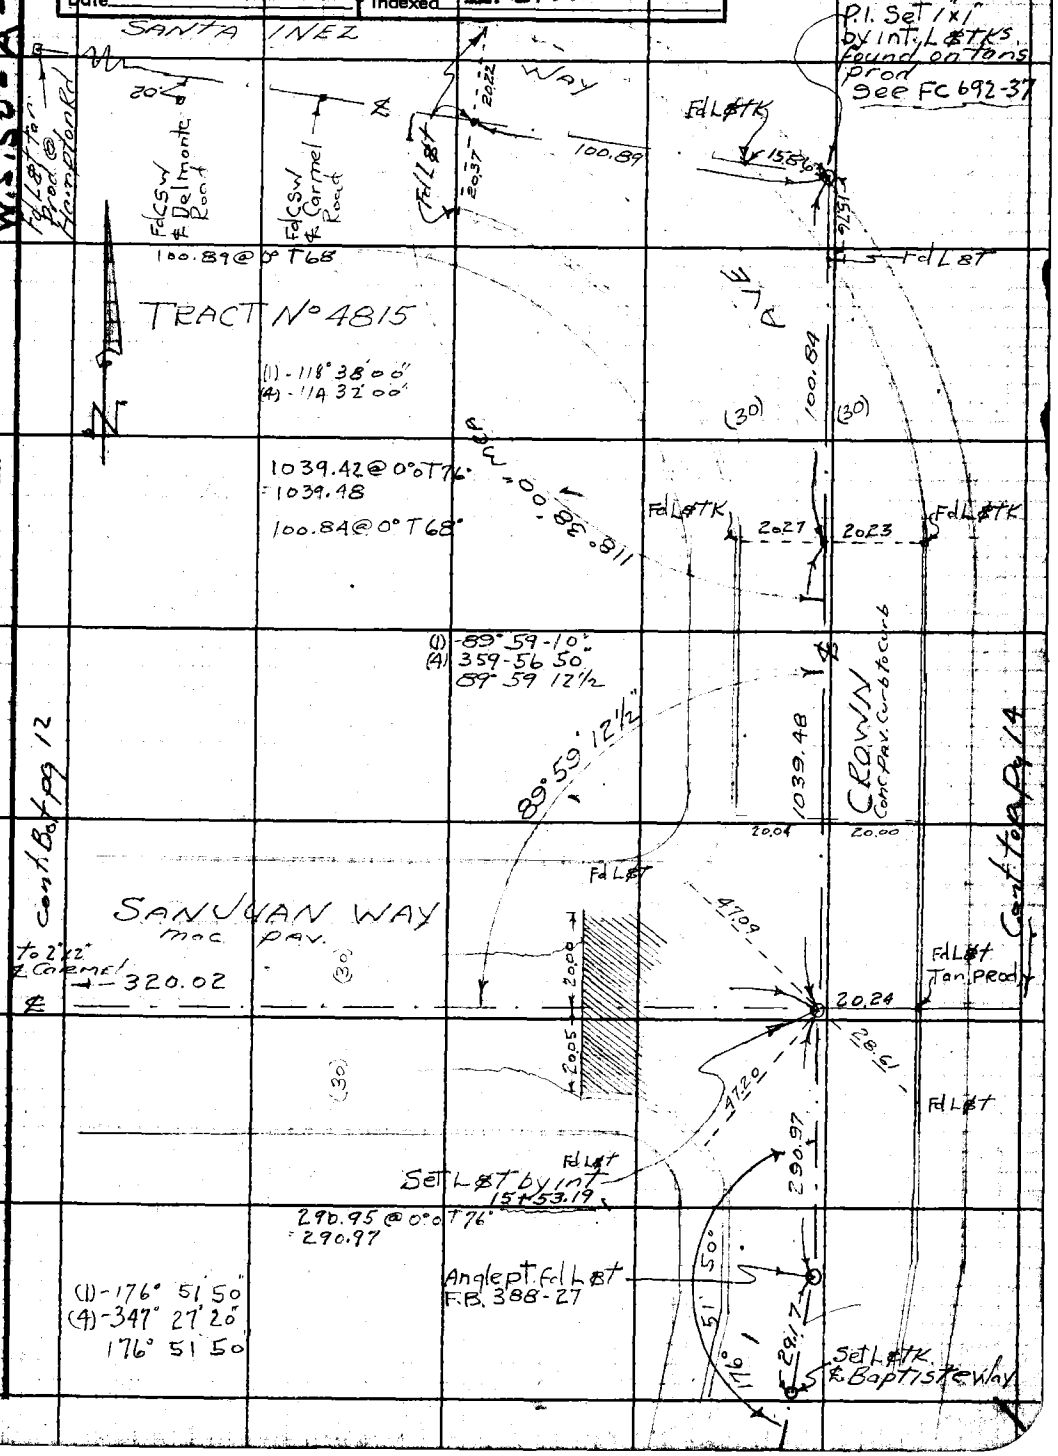

Note: Any Additions or Changes on This Sheet Must be Made or Circled in Red Ink With Date and Name of Person Making Change.

Do not extend notes this side of this line.

RETURN TO
LOS ANGELES COUNTY SURVEYOR
700 HALL OF RECORDS

FORM 247 3M 12-40

RETURN TO
LOS ANGELES COUNTY SURVEYOR
700 HALL OF RECORDS

Note: Any Additions or Changes on This Sheet Must be Made or Circled in Red Ink With Date and Name of Person Making Change.

Do not extend notes this side of this line.

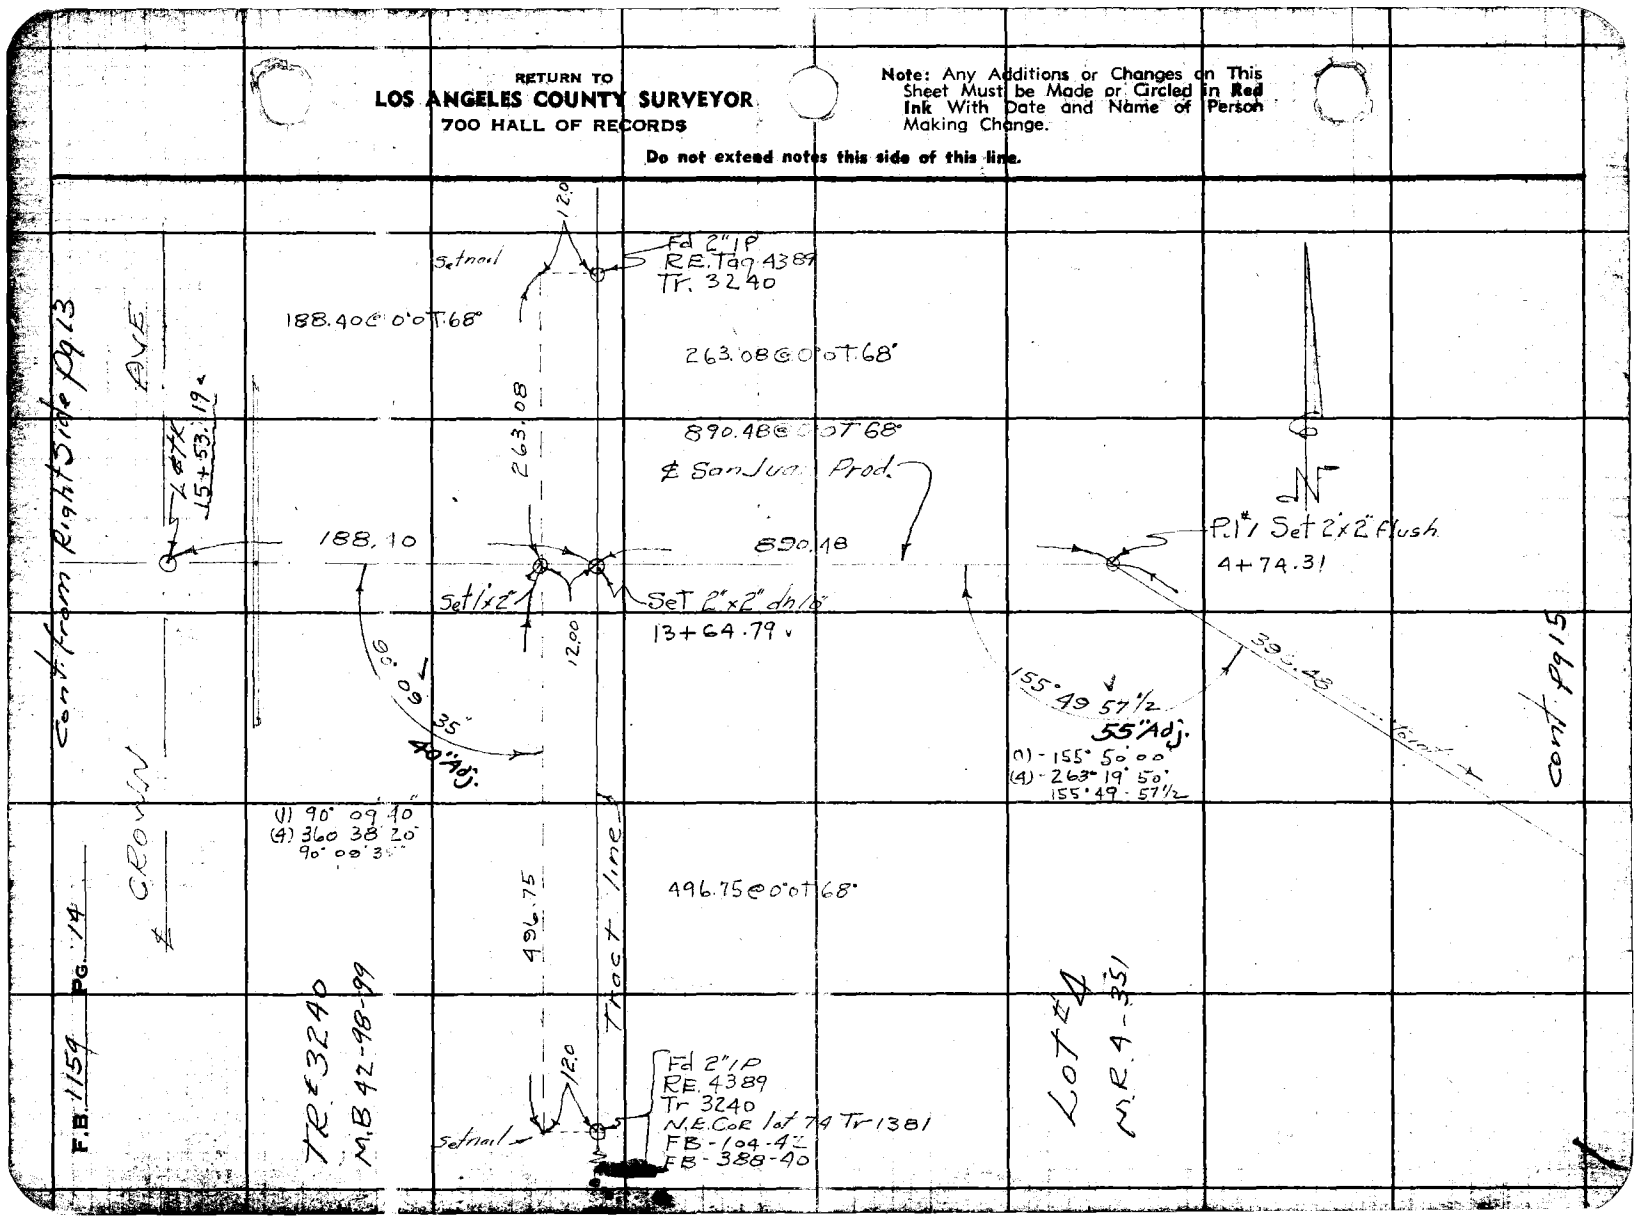

Notes Ck'd by Drew	Survey of Foothill Blvd
Map No.	W. O 8399 Tape No. 081 St'd 68 °F
Office Work KRM-	Surveyed by Porter
Checked	Notes Porter Date 6-
Date	Indexed A. C. Johnson

F.B. 1159 Pg. 15

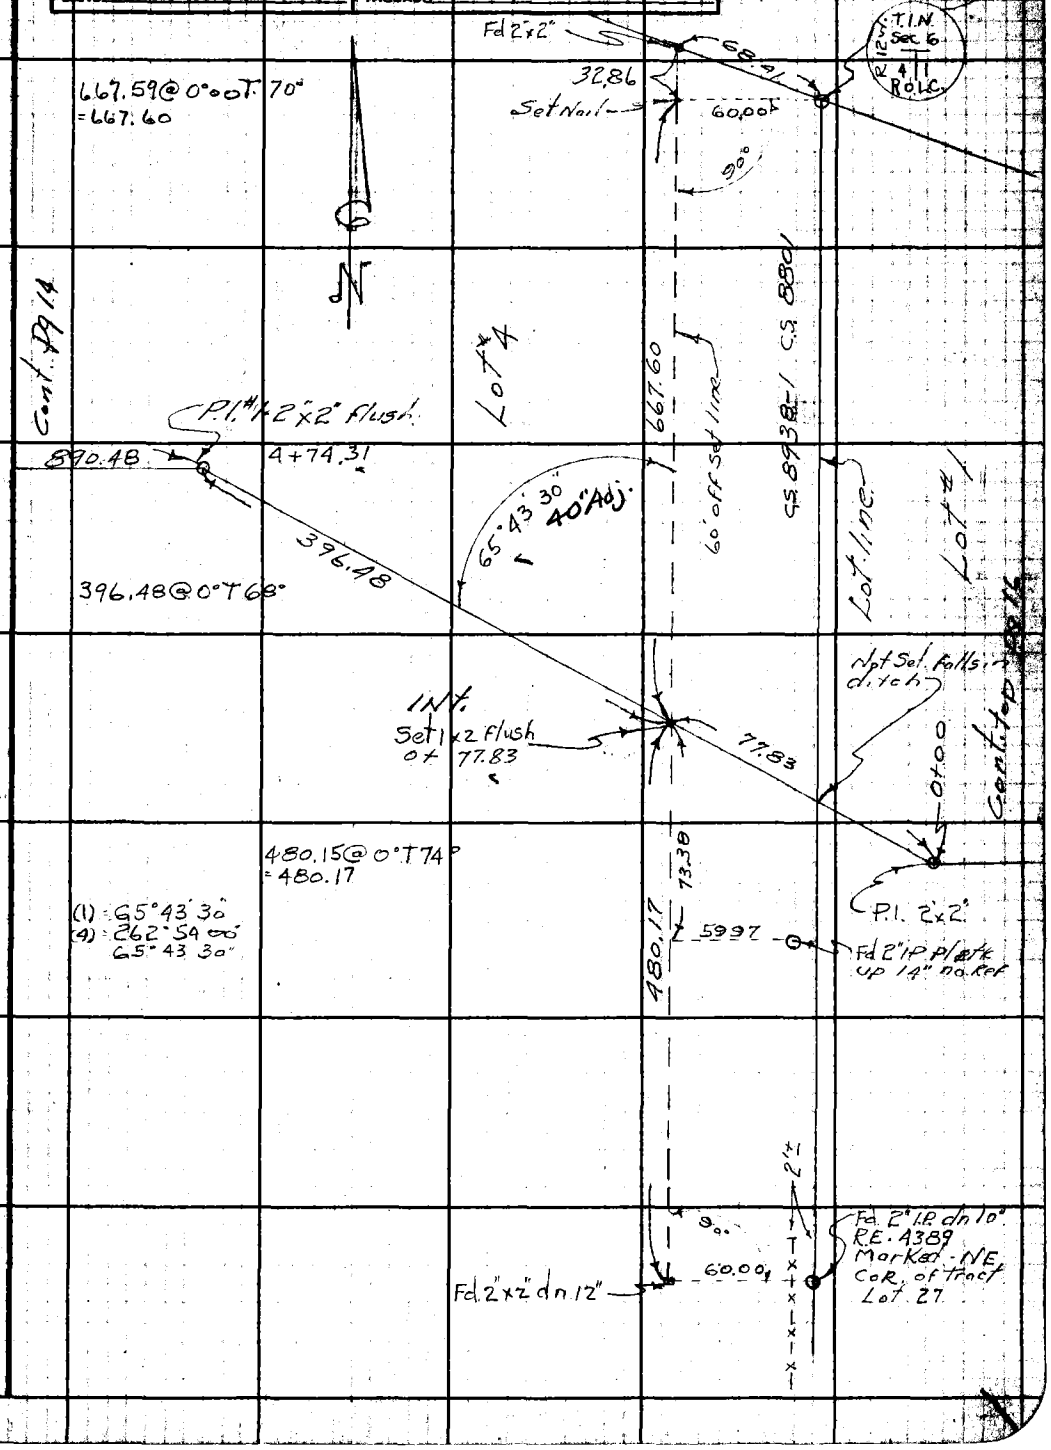

Notes: Any Additions or Changes on This Sheet must be Made or Circled in Red Ink with Date and Name of Person Making Change.

Do not extend notes this side of this line.

RETURN TO
LOS ANGELES COUNTY SURVEYOR
700 HALL OF RECORDS

FORM 247 5M 12-80

RETURN TO
LOS ANGELES COUNTY SURVEYOR
700 HALL OF RECORDS

Note: Any Additions or Changes on This Sheet Must be Made or Circled in **Red Ink** With Date and Name of Person Making Change.

Do not extend notes this side of this line.

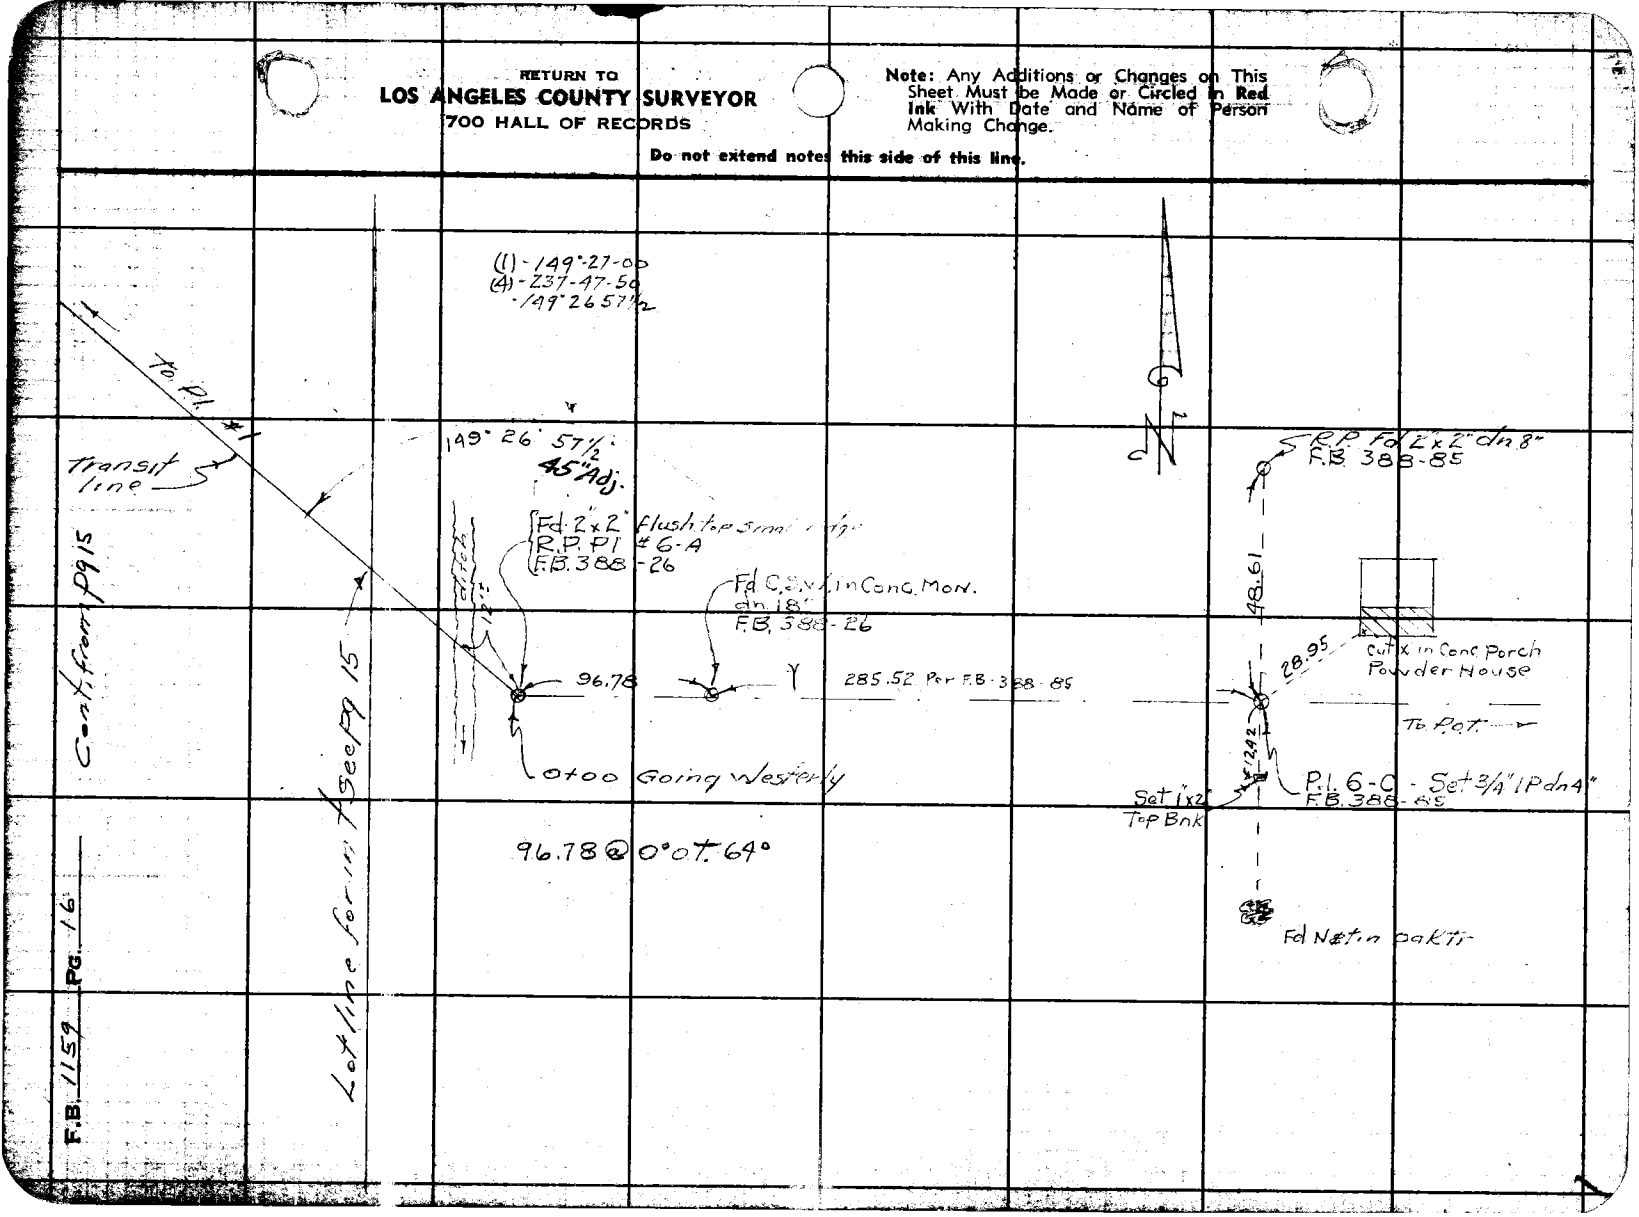

F.B. 1159 Pg. 16

Notes Ck'd by Porter	Survey of San Juan Way
Map No.	W. O. 8379 Tape No. Std °F
Office Work K.R.M.	Surveyed by Porter
Checked	Notes Porter Date 7-27-45
Date	Indexed A. C. Johnson 8-5-45

F.B. 1159 Pg. 17

Topography on San Juan Way

13+65 to 42+10.20

Note: Any Additions or Changes on This Sheet Must be Made or Circled in Red Ink With Date and Name of Person Making Change.

Do not extend notes this side of this line.

RETURN TO
LOS ANGELES COUNTY SURVEYOR
700 HALL OF RECORDS

FORM 247 3M 1-50

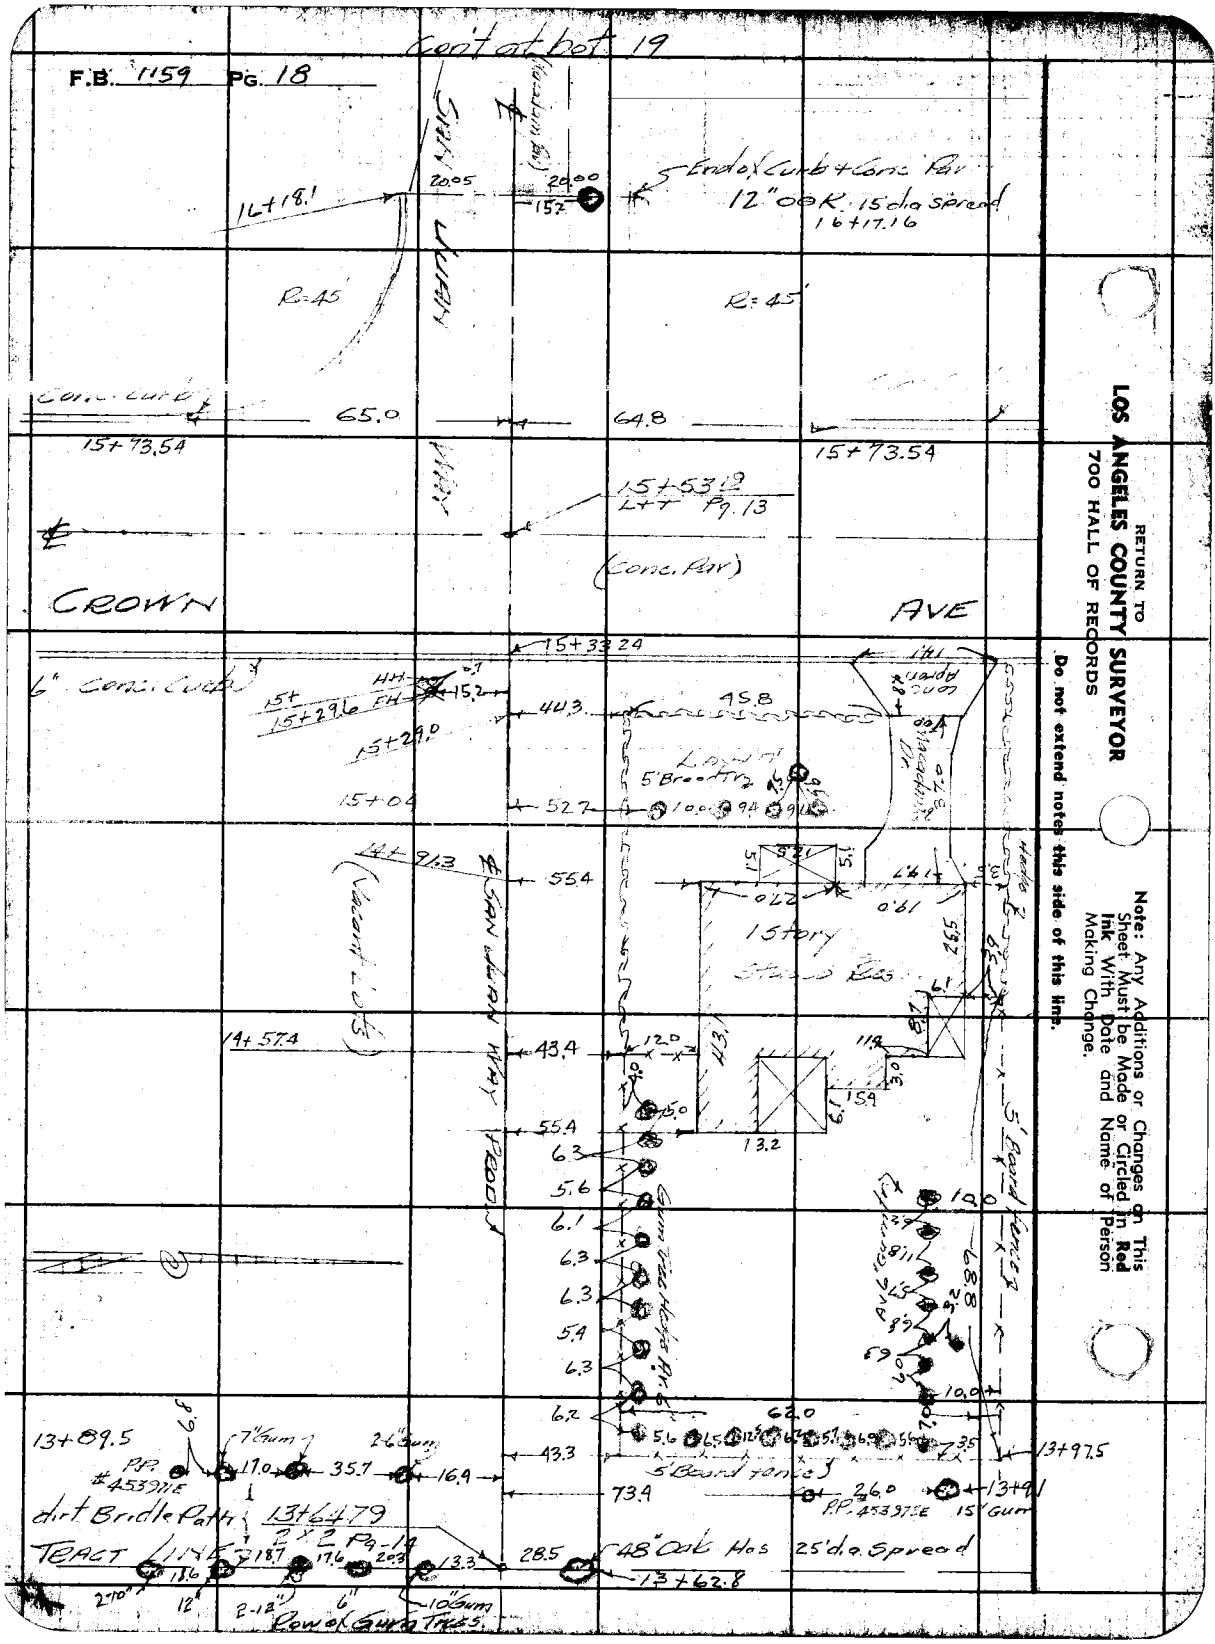

RETURN TO
LOS ANGELES COUNTY SURVEYOR
700 HALL OF RECORDS
Do not extend notes this side of this line.
Note: Any Additions or Changes on This Sheet Must be Made or Circled in Red Ink With Date and Name of Person Making Change.

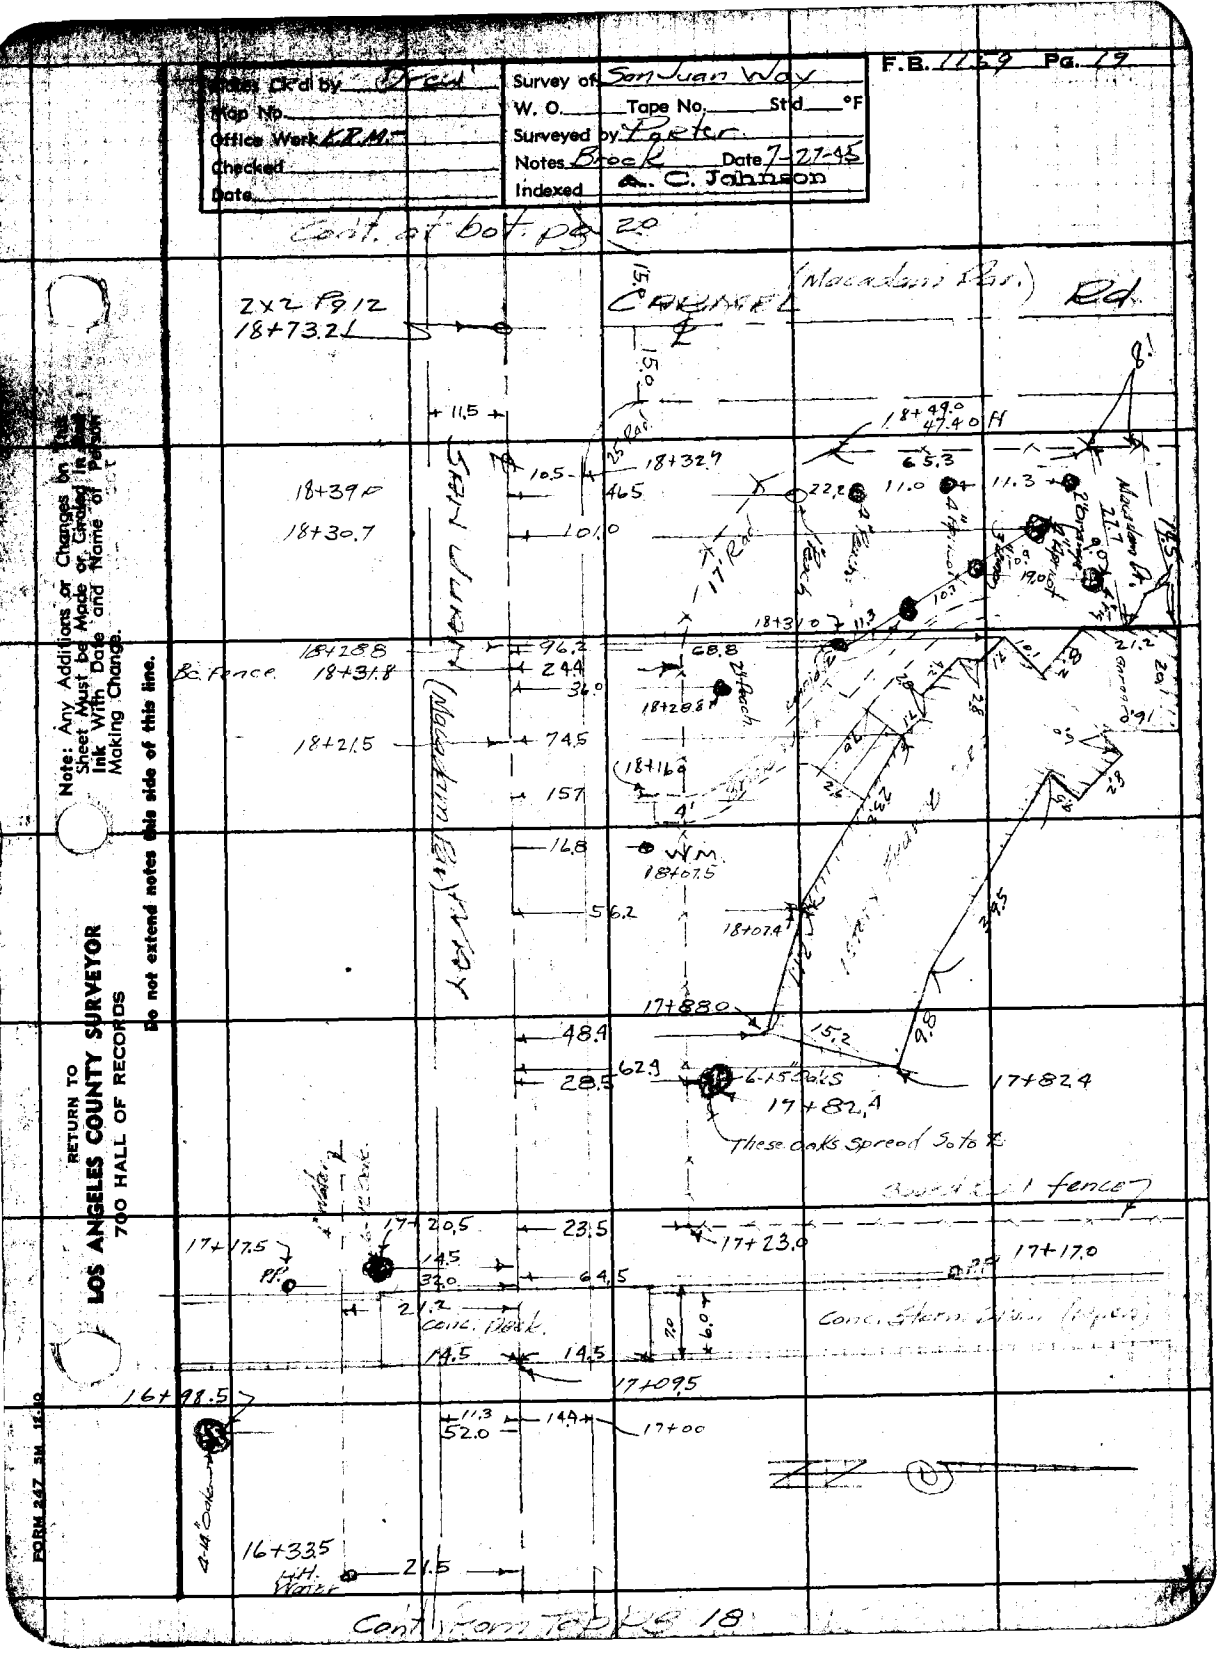

Notes Ck'd by Drew
Map No.
Office Work KRM
Checked
Date
Survey of San Juan Way
W. O. Tape No. Std °F
Surveyed by Porter
Notes Brock Date 7-27-45
Indexed A. C. Johnson
F.B. 1159 Pg. 19
Cont. at bot. pg 20
CARMEL Rd.
(Macadam Pav.)
2x2 Pg 12
18+73.2
18+39.0
18+30.7
18+28.8
18+31.8
Bc. Fence
18+21.5
18+49.0
47.40 H
18+32.9
18+31.0
18+28.8
18+16.0
18+07.5
18+07.4
17+88.0
17+82.4
These oaks spread 50 to ℄
17+20.5
17+17.5
17+23.0
17+17.0
Conc. Deck
Conc. Storm Drain (Open)
17+09.5
16+98.5
17+00
16+33.5
Lift Water
Cont. from Tab pg 18
Note: Any Additions or Changes on this Sheet Must be Made or Circled in Red Ink With Date and Name of Person Making Change.
Do not extend notes this side of this line.
RETURN TO
LOS ANGELES COUNTY SURVEYOR
700 HALL OF RECORDS
FORM 247 5M 12-40

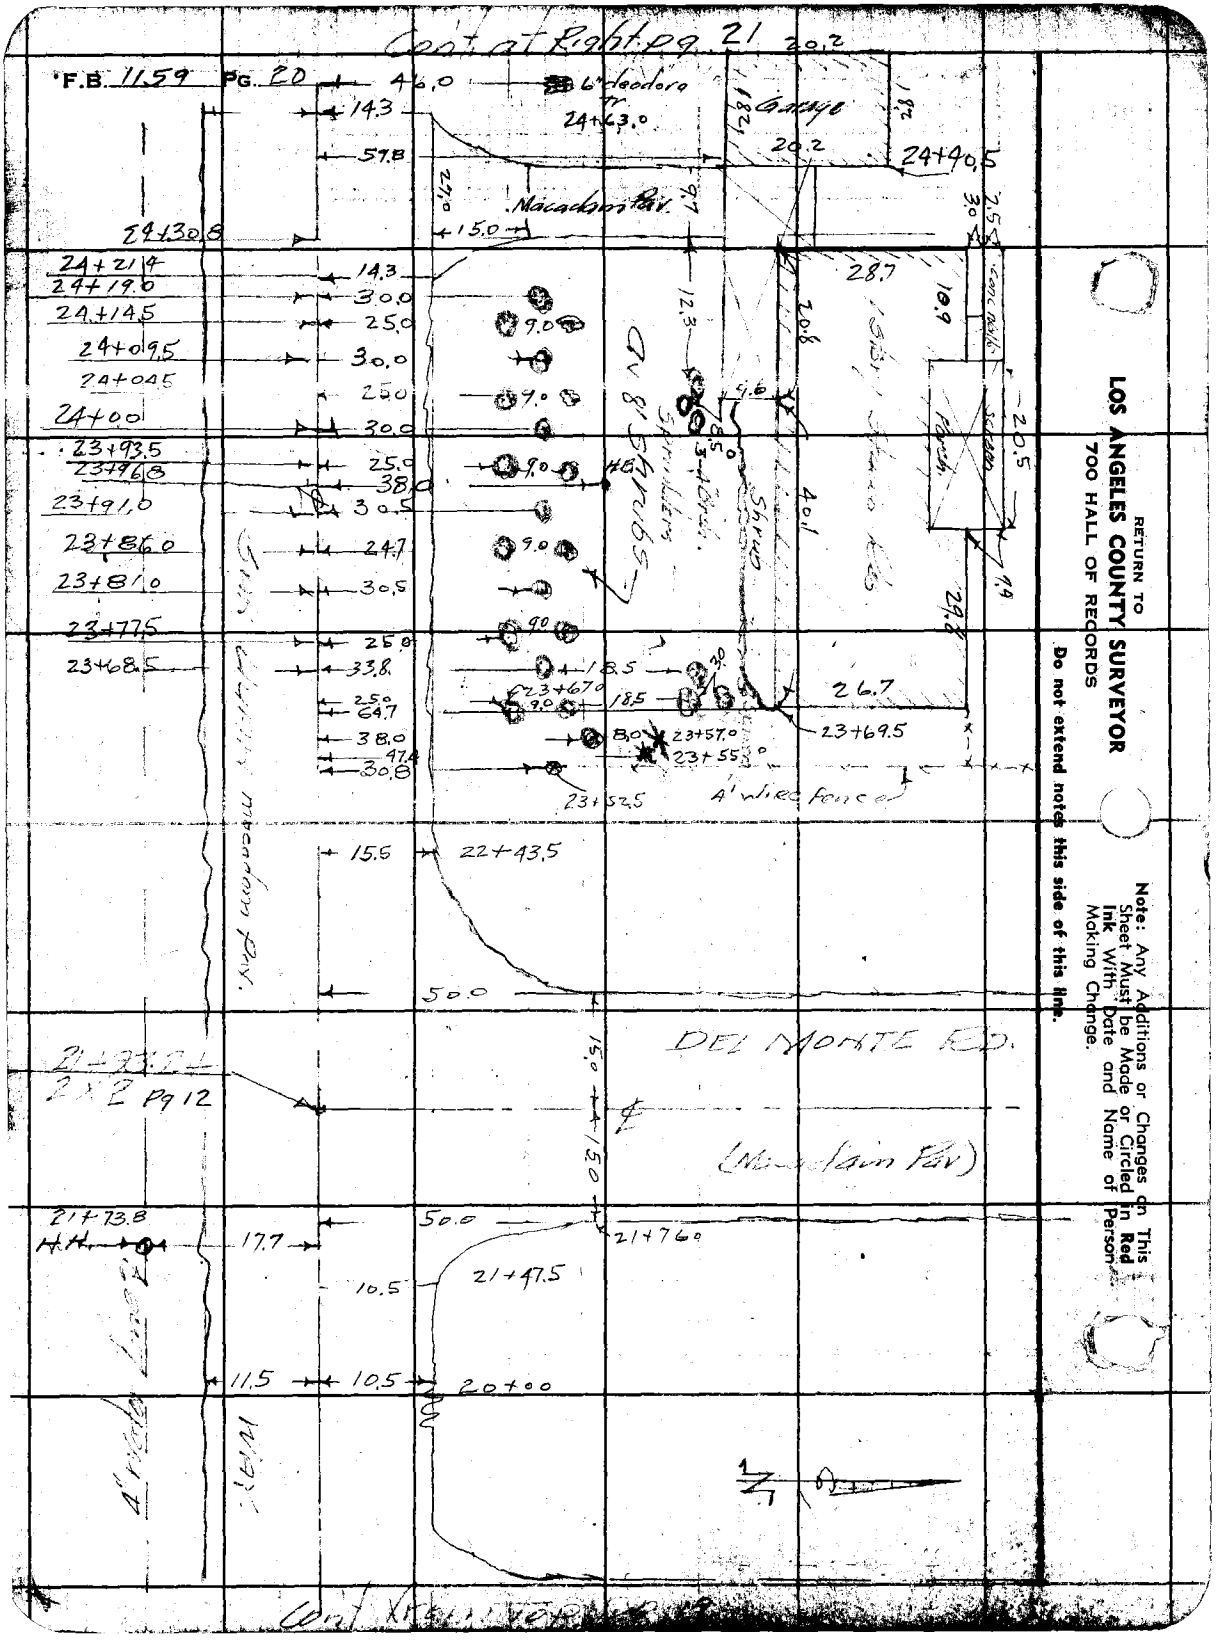

RETURN TO
LOS ANGELES COUNTY SURVEYOR
700 HALL OF RECORDS

Do not extend notes this side of this line.

Note: Any Additions or Changes on This Sheet Must be Made or Circled in Red Ink With Date and Name of Person Making Change.

Notes Ck'd by Drew	Survey of San Juan Way	F.B. 1159 Pg. 21
Map No.	W. 08399 Tape No. Std °F	
Office Work K.R.M.	Surveyed by Porter	
Checked	Notes Brock Date 7-26-45	
Date	Indexed A. C. Johnson	

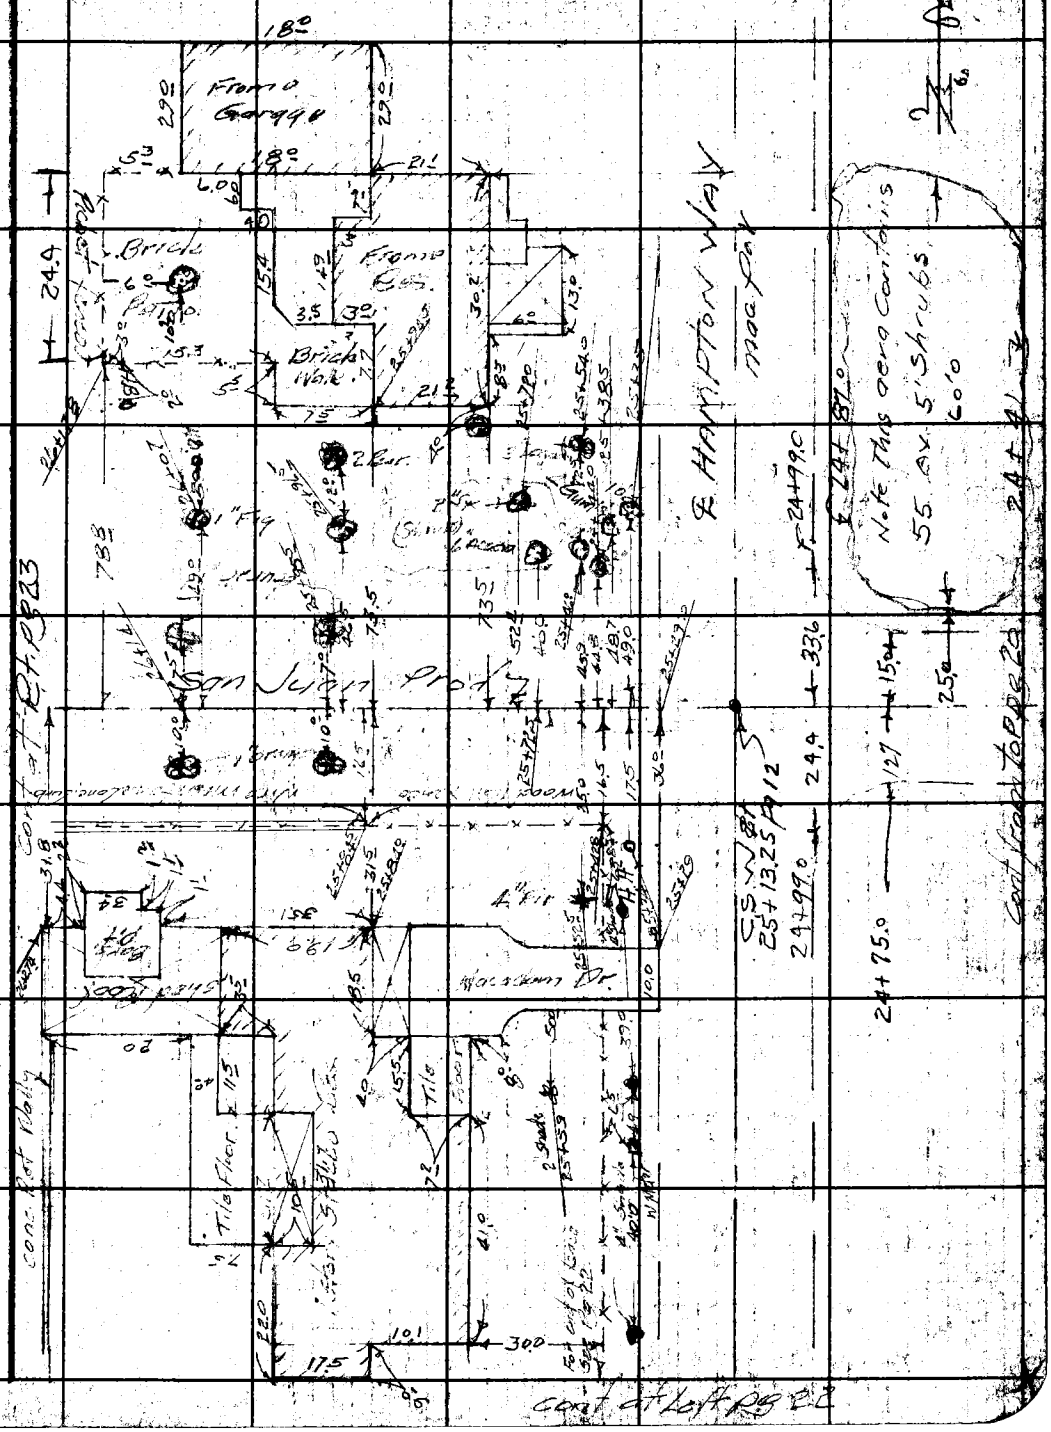

Note: Any Additions or Changes on This Sheet Must be Made or Circled in Red Ink With Date and Name of Person Making Change.

Do not extend notes this side of this line.

RETURN TO
LOS ANGELES COUNTY SURVEYOR
700 HALL OF RECORDS

FORM 247 5M 12-40

RETURN TO
LOS ANGELES COUNTY SURVEYOR
700 HALL OF RECORDS

Note: Any Additions or Changes on This Sheet Must be Made or Circled in **Red Ink** With Date and Name of Person Making Change.

Do not extend notes this side of this line.

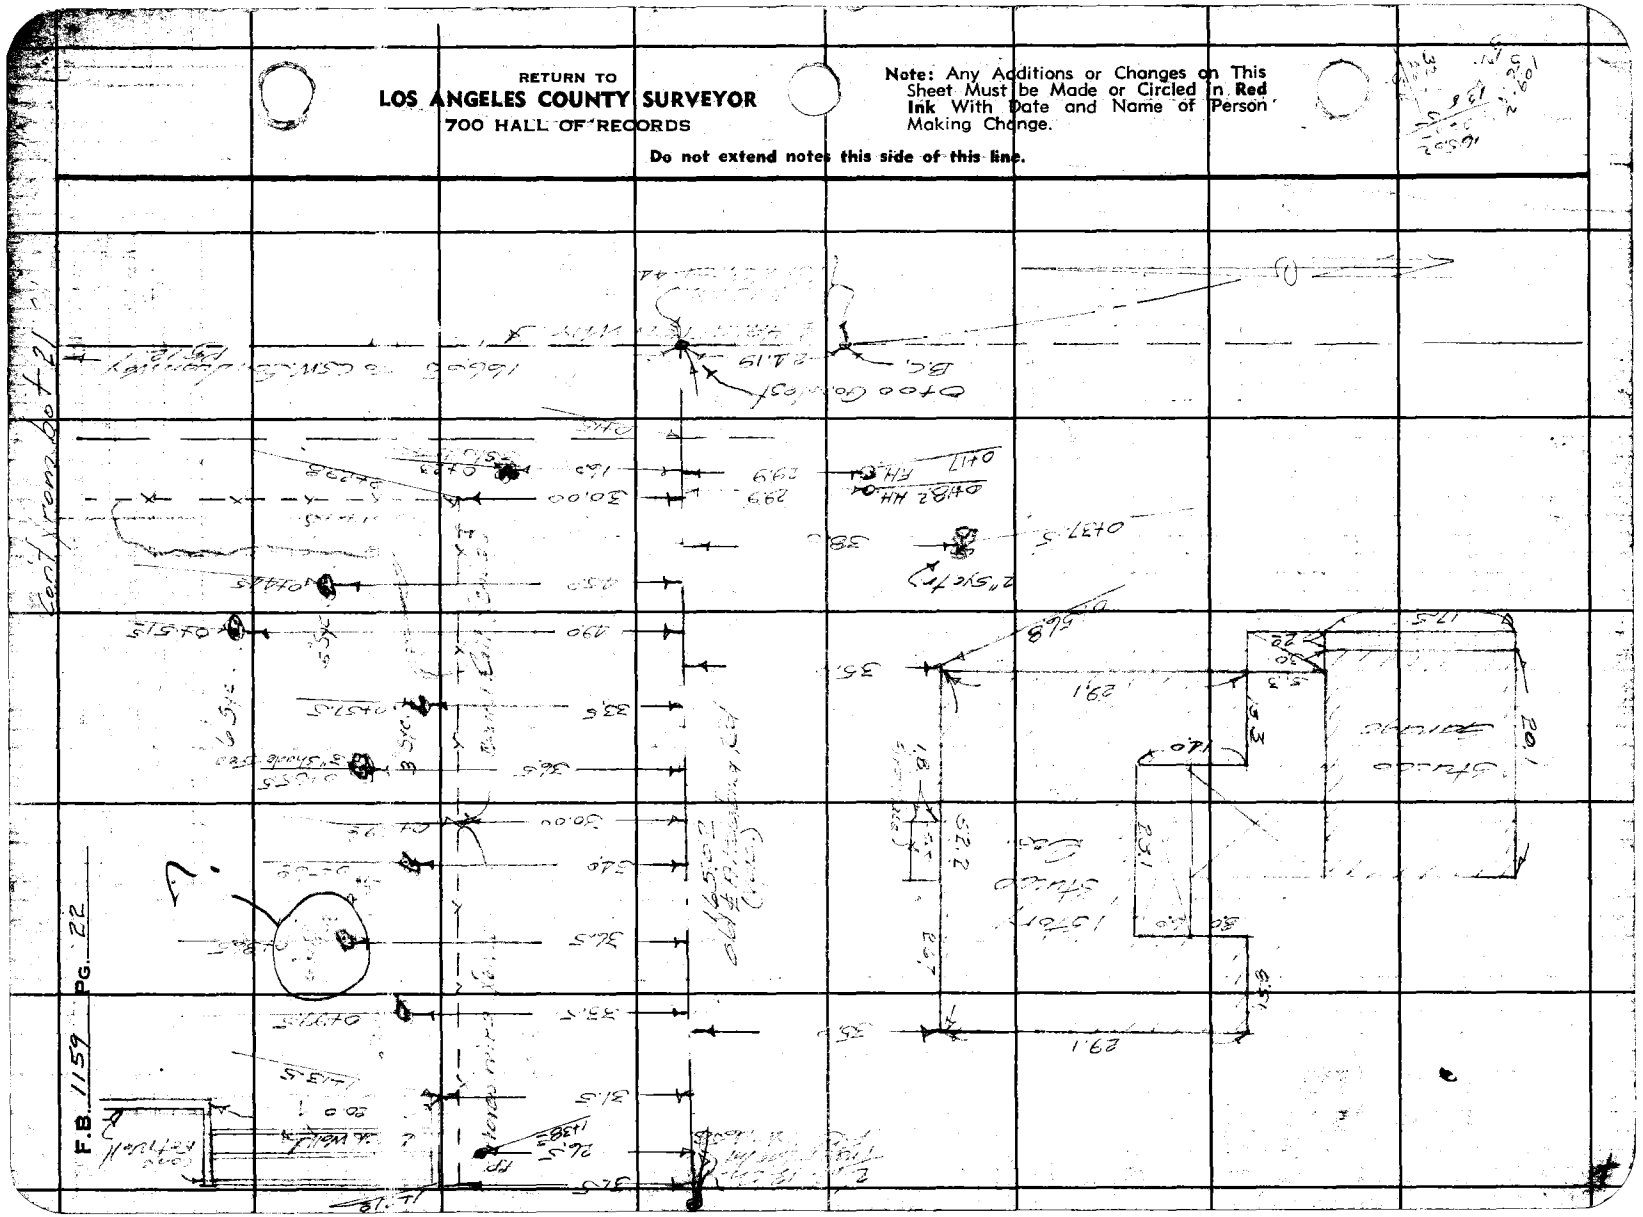

Notes Ck'd by Drew	Survey of San Juan Way	F.B. 1159 Pg. 23
Map No.	W. O. 8399 Tape No. Std °F	
Office Work K.R.M.	Surveyed by Porter	
Checked	Notes Brock Date 7-26-45	
Date	Indexed A. C. Johnson	

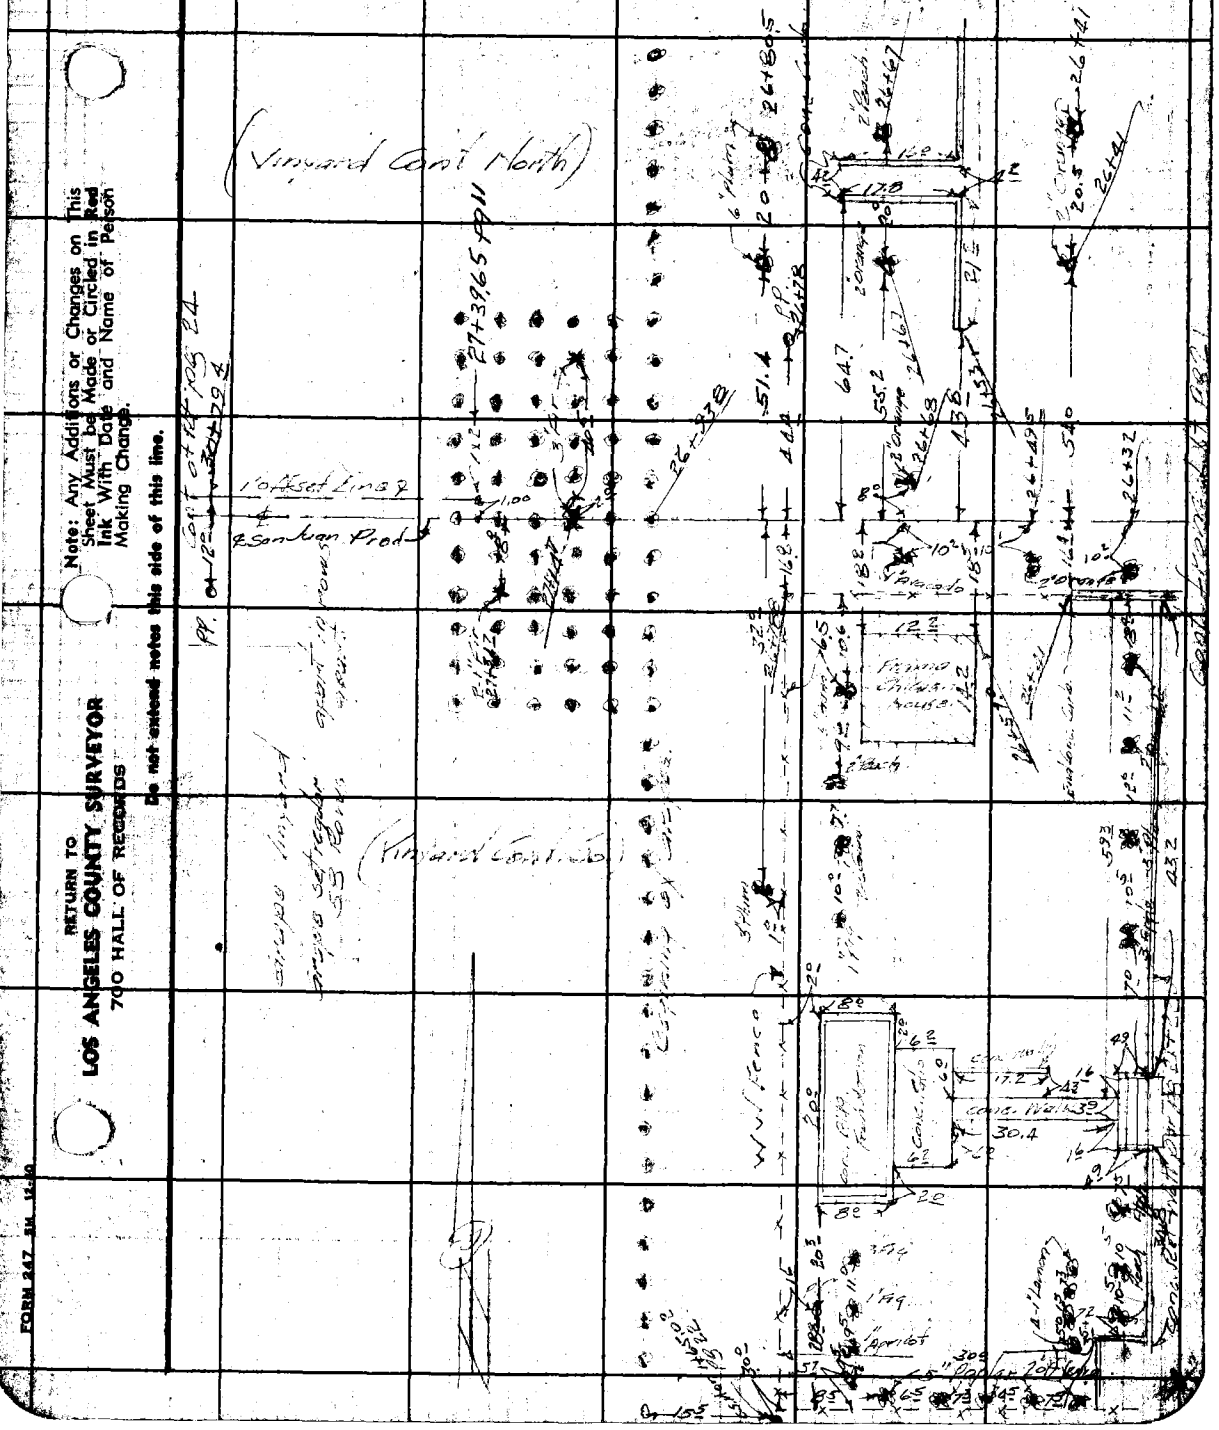

Note: Any Additions or Changes on This Sheet Must be Made or Circled in Red Ink With Date and Name of Person Making Change.

Do not extend notes this side of this line.

RETURN TO
LOS ANGELES COUNTY SURVEYOR
700 HALL OF RECORDS

FORM 247 SM 12-40

RETURN TO
LOS ANGELES COUNTY SURVEYOR
700 HALL OF RECORDS

Note: Any Additions or Changes on This Sheet Must be Made or Circled in **Red Ink** With Date and Name of Person Making Change.

Do not extend notes this side of this line.

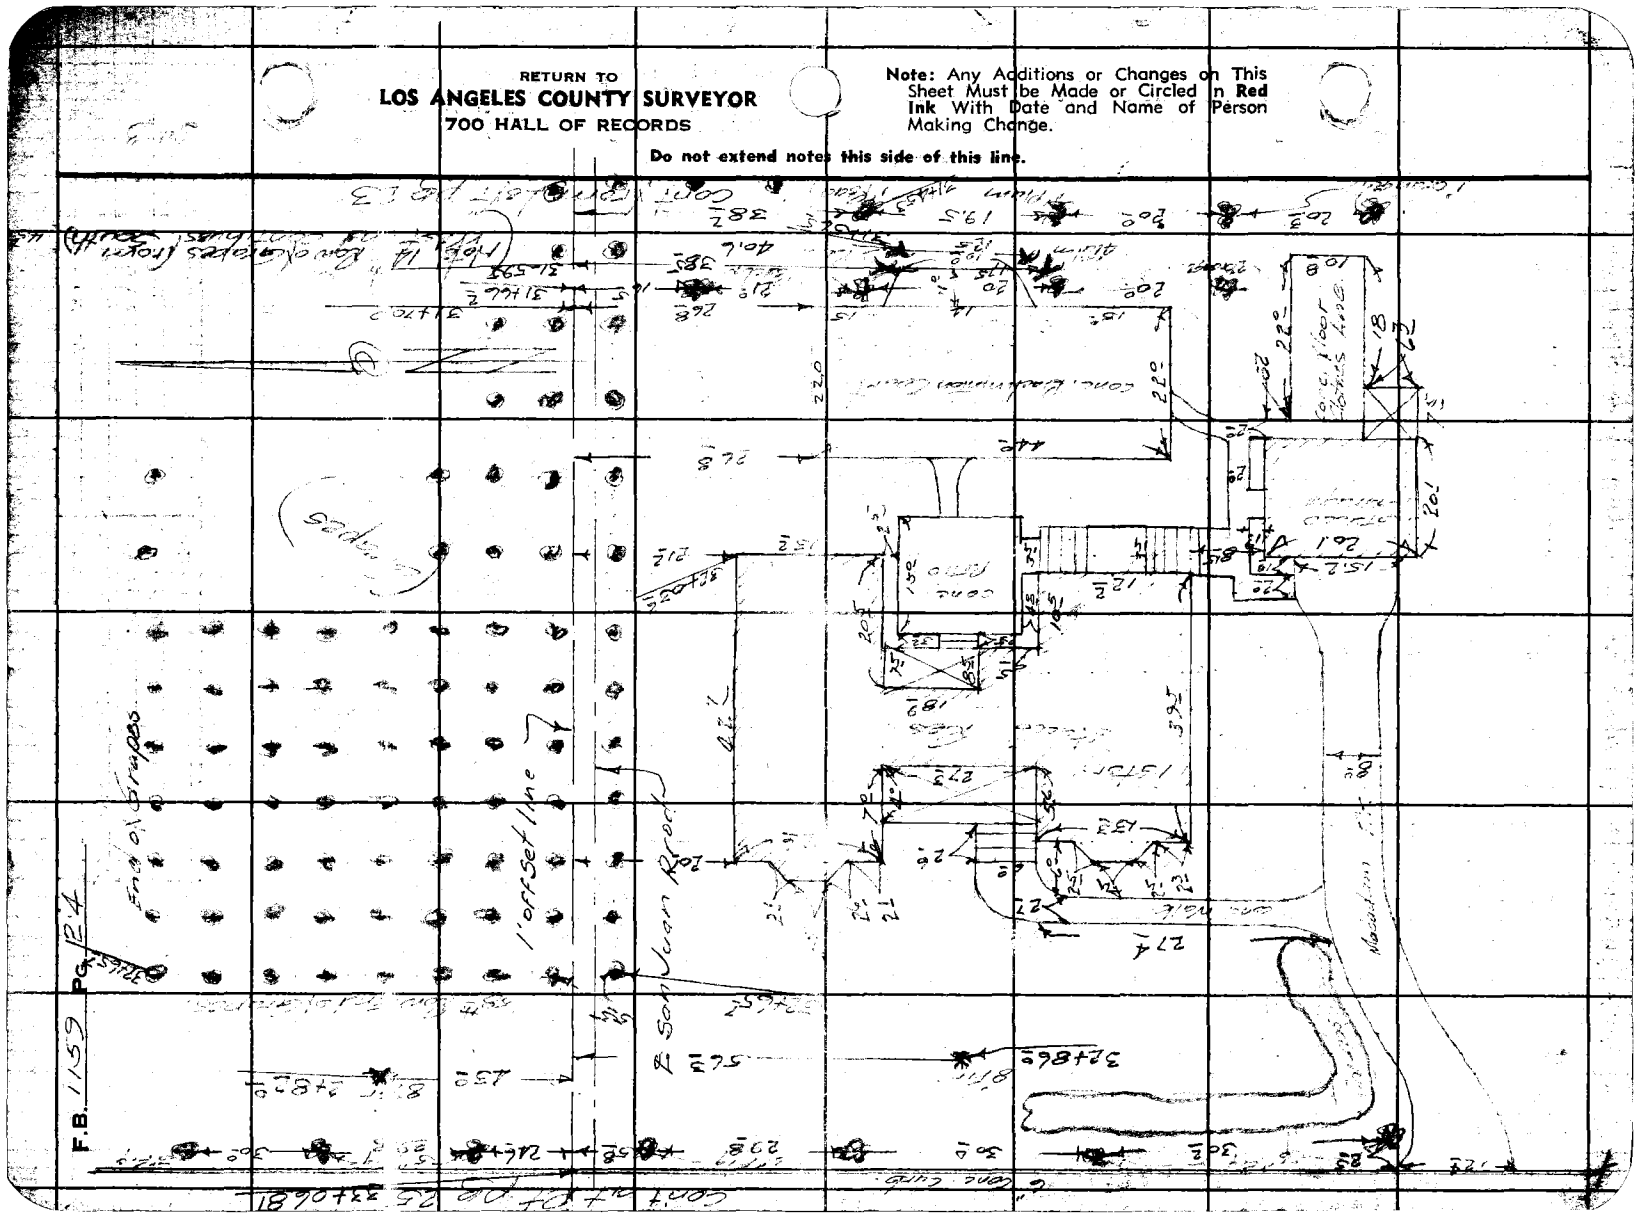

Notes Ck'd by Prew	Survey of San Juan Way
Map No.	W. O. 8399 Tape No. Std °F
Office Work K.R.M.	Surveyed by Porter
Checked	Notes Brock Date 7-27-45
Date	Indexed A. C. Johnson

F.B. 1159 Pg. 25

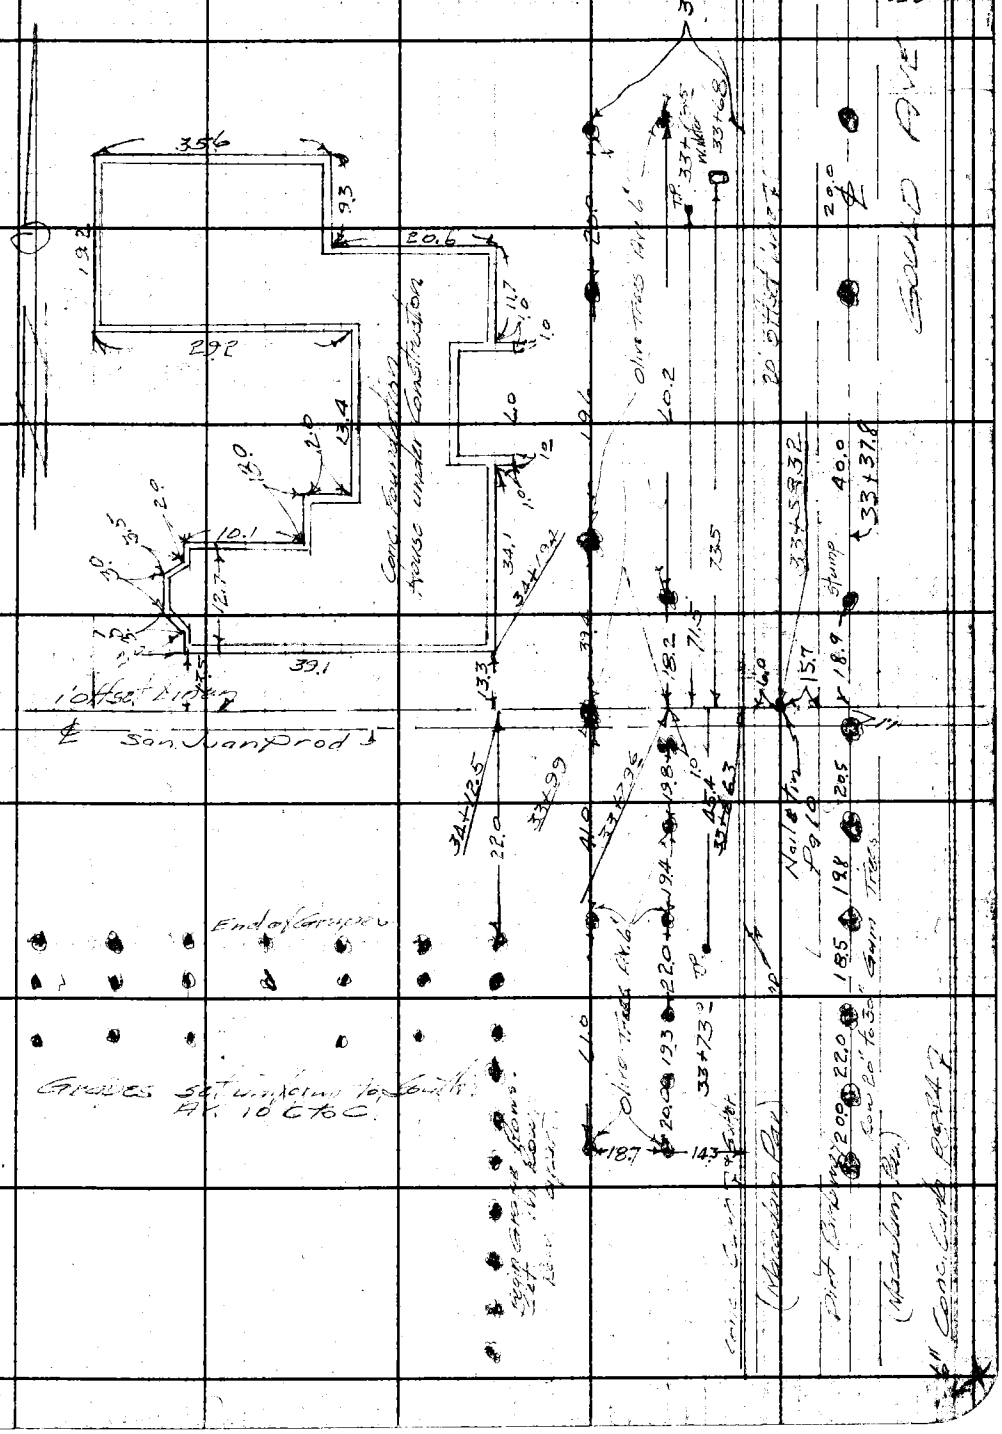

Note: Any Additions or Changes on This Sheet Must be Made or Circled in Red Ink With Date and Name of Person Making Change.

Do not extend notes this side of this line.

RETURN TO
LOS ANGELES COUNTY SURVEYOR
700 HALL OF RECORDS

FORM 247 5M 12-40

RETURN TO
LOS ANGELES COUNTY SURVEYOR
700 HALL OF RECORDS

Note: Any Additions or Changes on This Sheet Must be Made or Circled in **Red Ink** With Date and Name of Person Making Change.

Do not extend notes this side of this line.

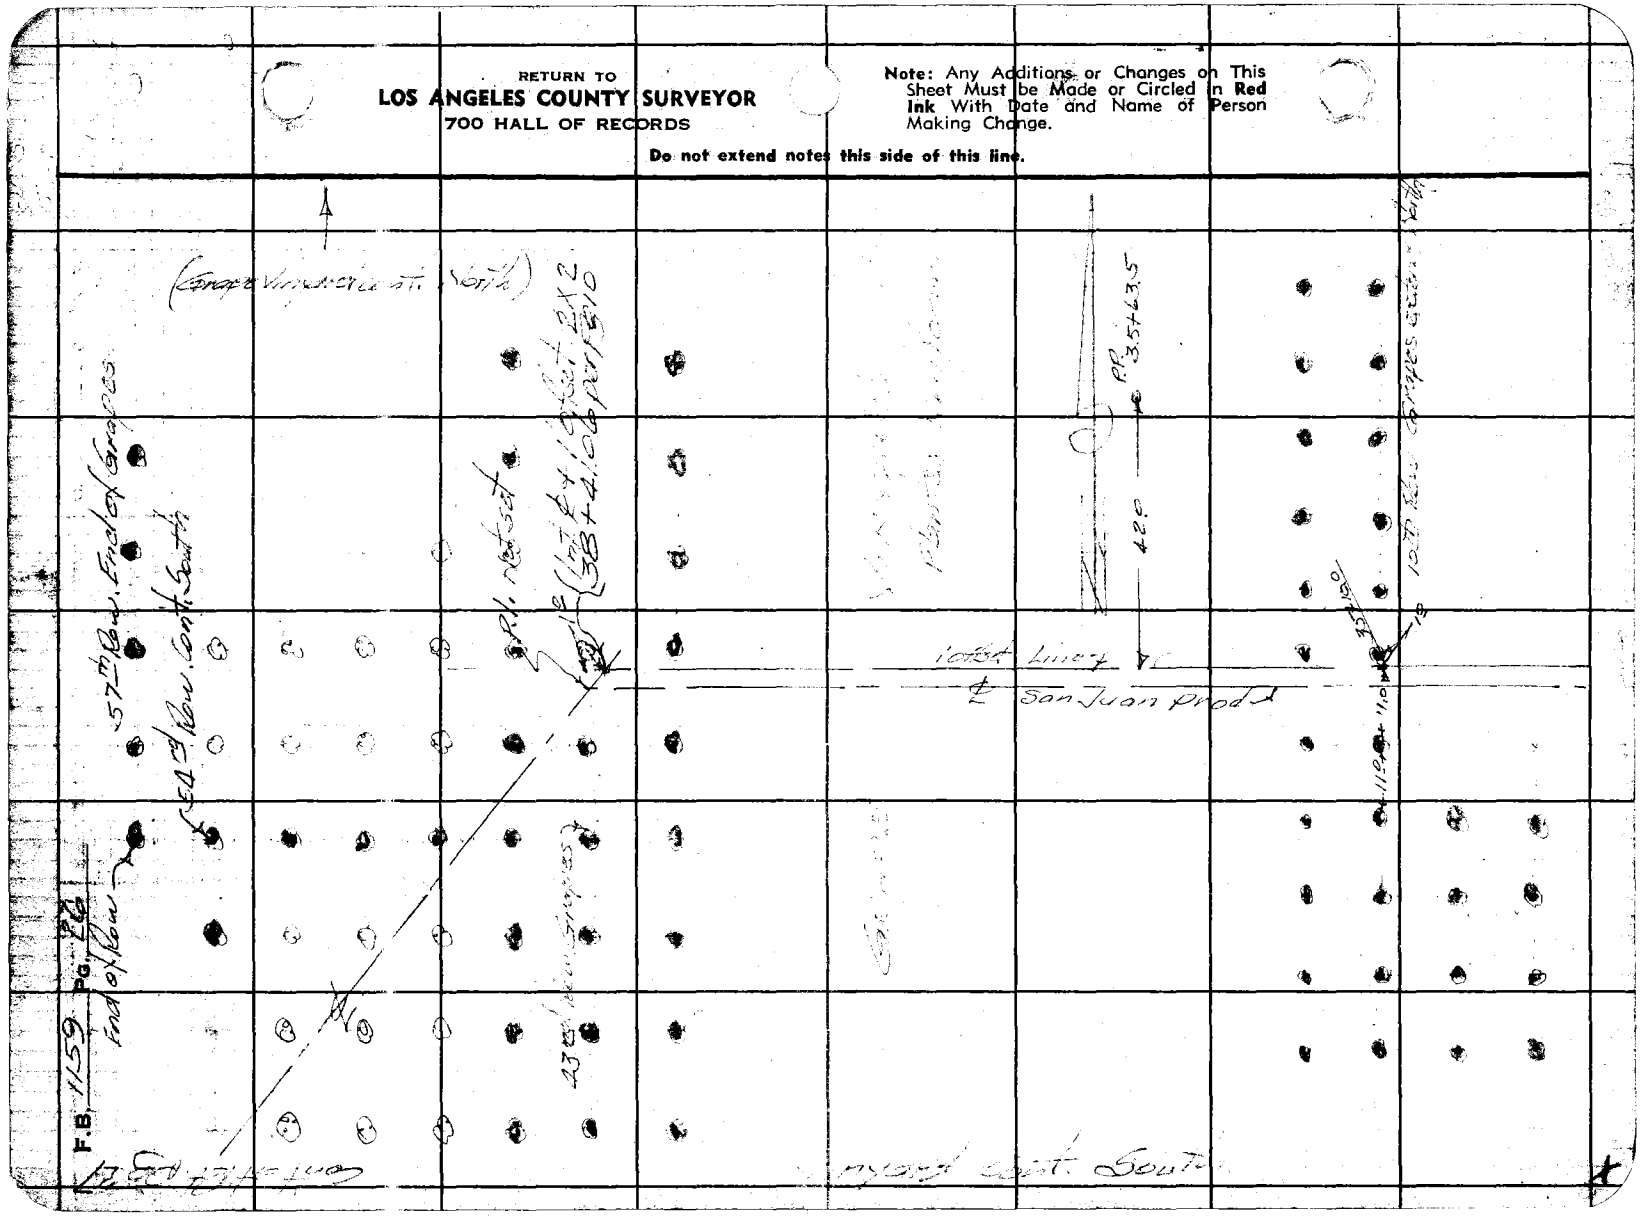

Notes Ck'd by Drew	Survey of Sandgate Way
Map No.	W. O. 8399 Tape No. Std °F
Office Work K.R.M.	Surveyed by Parker
Checked	Notes Brock Date 7-27-45
Date	Indexed A. C. Johnson

F.B. 1159

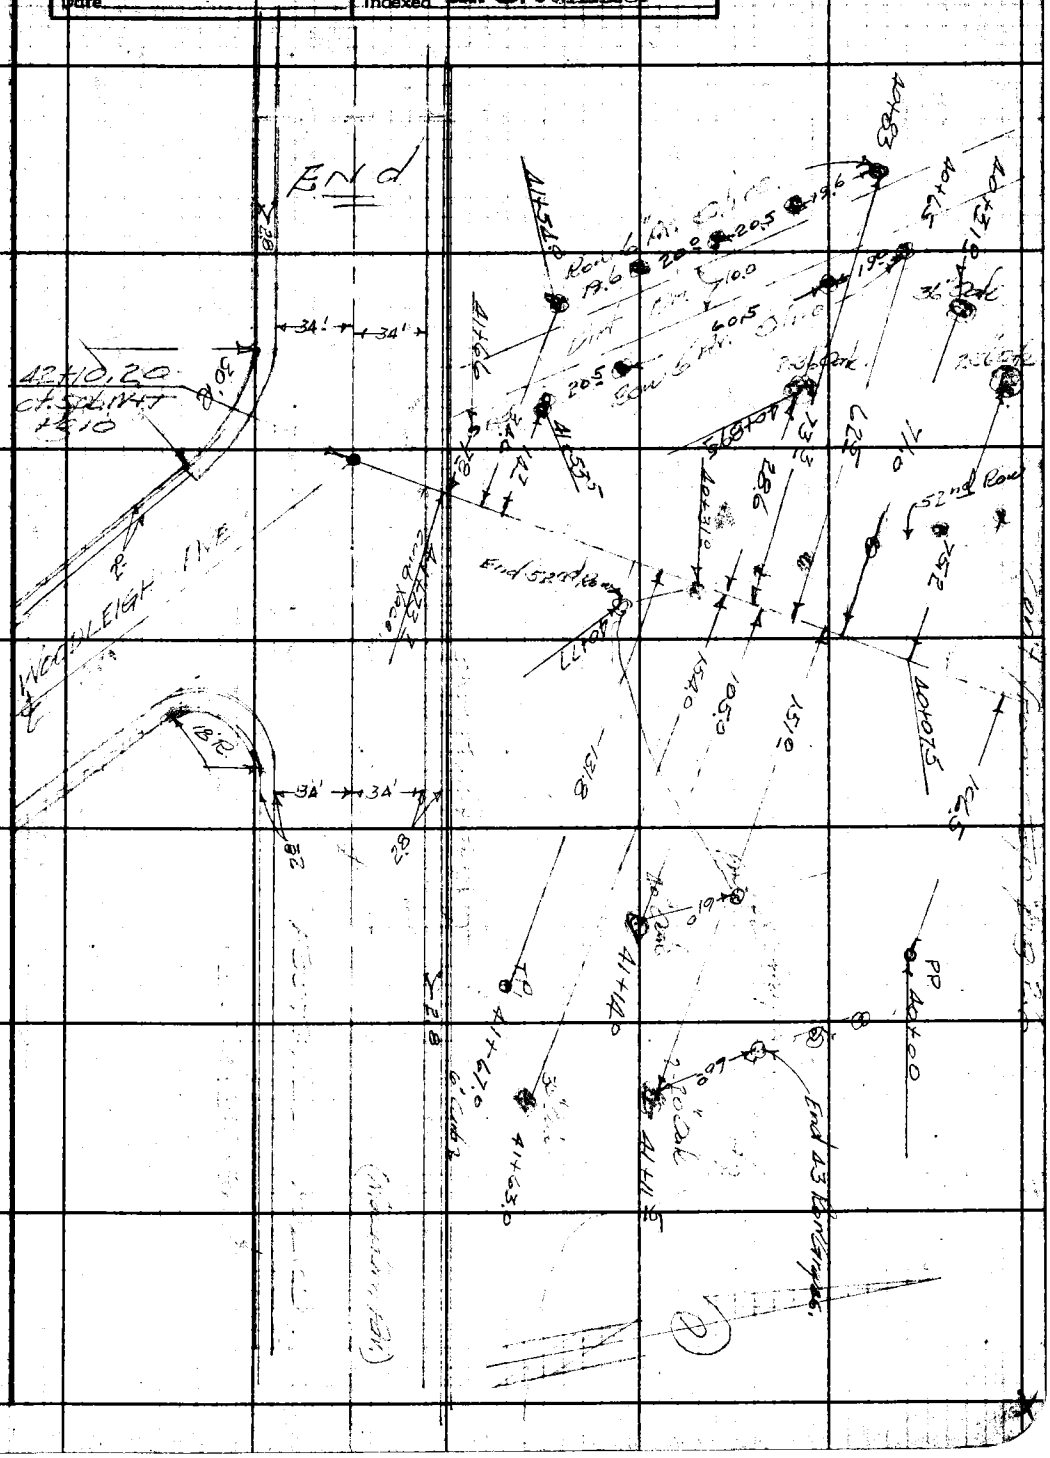

Note: Any Additions or Changes on This Sheet Must be Made or Circled in Red Ink With Date and Name of Person Making Change.

Do not extend notes this side of this line.

RETURN TO
LOS ANGELES COUNTY SURVEYOR
700 HALL OF RECORDS

FORM 247 5M 12-50

RETURN TO
LOS ANGELES COUNTY SURVEYOR
700 HALL OF RECORDS

Note: Any Additions or Changes on This Sheet Must Be Made or Circled in Red Ink With Date and Name of Person Making Change.

Do not extend notes this side of this line.

F.B. 1137 PG. 28

Notes Ck'd by	Survey of Windsor Ave.	F.B. 1159 Pg. 31
Map No.	JN 0075.46 Tape 0240 Std 68 °F	
Office Work	Surveyed by A.S. Curtis	
Checked	Notes Curtis Date 11/3/67	
Date	Indexed C. J. GALLI DEC 1 '67	

J.N. 0075.46
WINDSOR AVE.
Index.

WOODBURY RD. TO ALTADENA DR.

CURTIS
KAPP
RODRIGUEZ
LOMONT.

Note: Any Additions or Changes on this Sheet Must be Made or Circled in Red Ink With Date and Name of Person Making Change

PLEASE RETURN TO
LOS ANGELES COUNTY ENGINEER
403 LOS ANGELES COUNTY ENGINEERING BLDG.

Do not extend this side of this line.

76P3098 CK #310 5-66

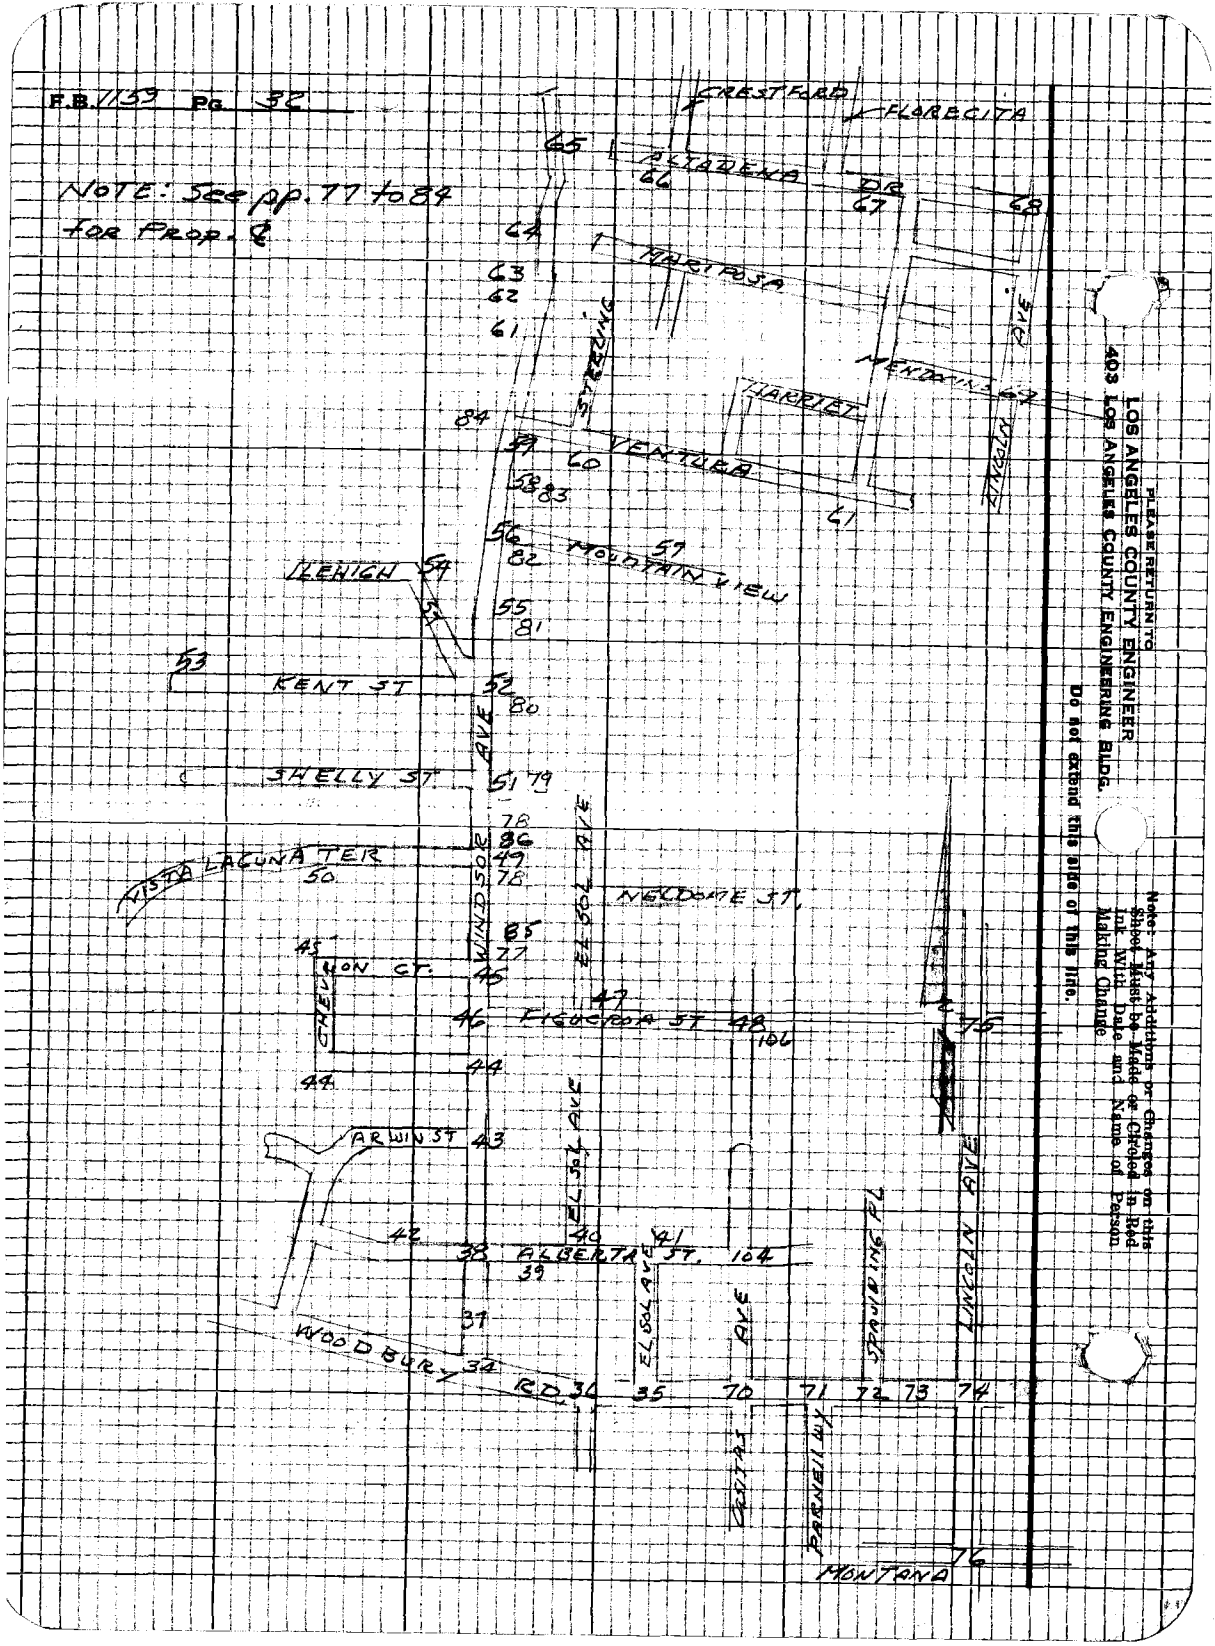
F.B. 1159 Pg. 32
NOTE: See pp. 77 to 84 for Prop. ℄
CRESTFORD
FLORECITA
ALTADENA DR
MARIPOSA
STERLING
MENDOCINO
HARRIET
VENTURA
LINCOLN AVE
MOUNTAIN VIEW
LEHIGH
KENT ST
SHELLY ST
VISTA LAGUNA TER
WINDSOR AVE
EL SOL AVE
NELDOME ST
HON CT
CHEVE
FIGUEROA ST
ARWIN ST
ALBERTA ST
WOODBURY RD
SPAULDING PL
CASITAS
PARNELL WY
MONTANA
PLEASE RETURN TO
LOS ANGELES COUNTY ENGINEER
403 LOS ANGELES COUNTY ENGINEERING BLDG.
Do not extend this side of this line.
Note: Any Additions or Changes on this Sheet Must be Made or Circled in Red Ink With Date and Name of Person Making Change

Notes Ck'd by J. A.	Survey of Windsor Ave.	F.B. 1159 Pg. 33
Map No.	JN 0075.46 Tape 0240 Std 68 °F	
Office Work T. ABE	Surveyed by D. S. Curtis	
Checked	Notes Curtis Date 11/3/67	
Date	Indexed C. J. GALLI	

JN. 0075.46
WINDSOR AVE.
Centerline

WOODBURY RD. TO ALTADENA DR.

Curtis
Kepp
Rodriguez
Lamont

Note: Any Additions or Changes on this Sheet Must be Made or Circled in Red Ink With Date and Name of Person Making Change

PLEASE RETURN TO
LOS ANGELES COUNTY ENGINEER
403 Los Angeles County Engineering Bldg.

Do not extend this side of this line.

76P3098 CE #310 5-66

F.B. 1150 Pg. 54
M.S. 88 A-2
WINDSOR AVE.
WOODBURY RD.
PLEASE RETURN TO
LOS ANGELES COUNTY ENGINEER
403 Los Angeles County Engineering Bldg.
Do not extend this side of this line.
Note: Any Additions or Changes on this Sheet Must be Made or Circled in Red Ink With Date and Name of Person Making Change.

Notes Ck'd by: [illegible]	Survey of Windsor Ave.	F.B. 1159 Pg. 35
Map No.	JN 0075.46 Tape 0240 Std 68 °F	
Office Work T. ABE	Surveyed by A.S. Curtis	
Checked	Notes Curtis Date 11/67	
Date	Indexed C. J. GALLI	

Cont. on Bot page-41 & Rt. pg-100

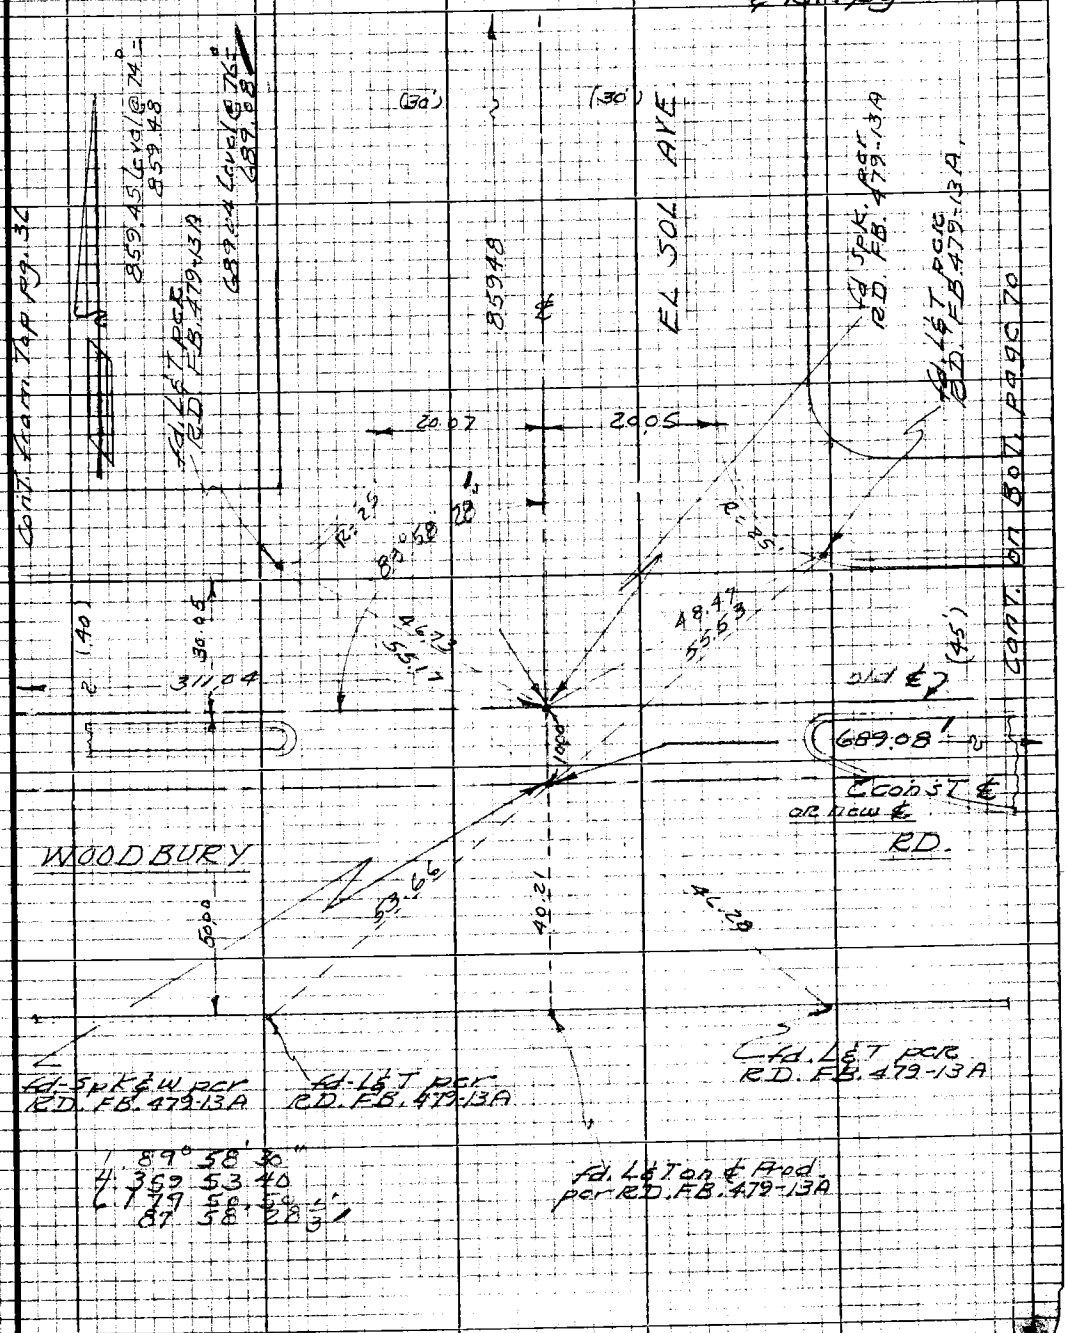

Note: Any Additions or Changes on this Sheet Must be Made or Circled in Red Ink With Date and Name of Person Making Change

Do not extend this side of this line.

PLEASE RETURN TO
LOS ANGELES COUNTY ENGINEER
403 LOS ANGELES COUNTY ENGINEERING BLDG.

76P2098 CE #310 5-66

PLEASE RETURN TO
LOS ANGELES COUNTY ENGINEER
403 LOS ANGELES COUNTY ENGINEERING BLDG.

Note: Any Additions or Changes on this Sheet Must be Made or Circled in Red Ink With Date and Name of Person Making Change

Do not extend this side of this line.

W.S. 88, A-6

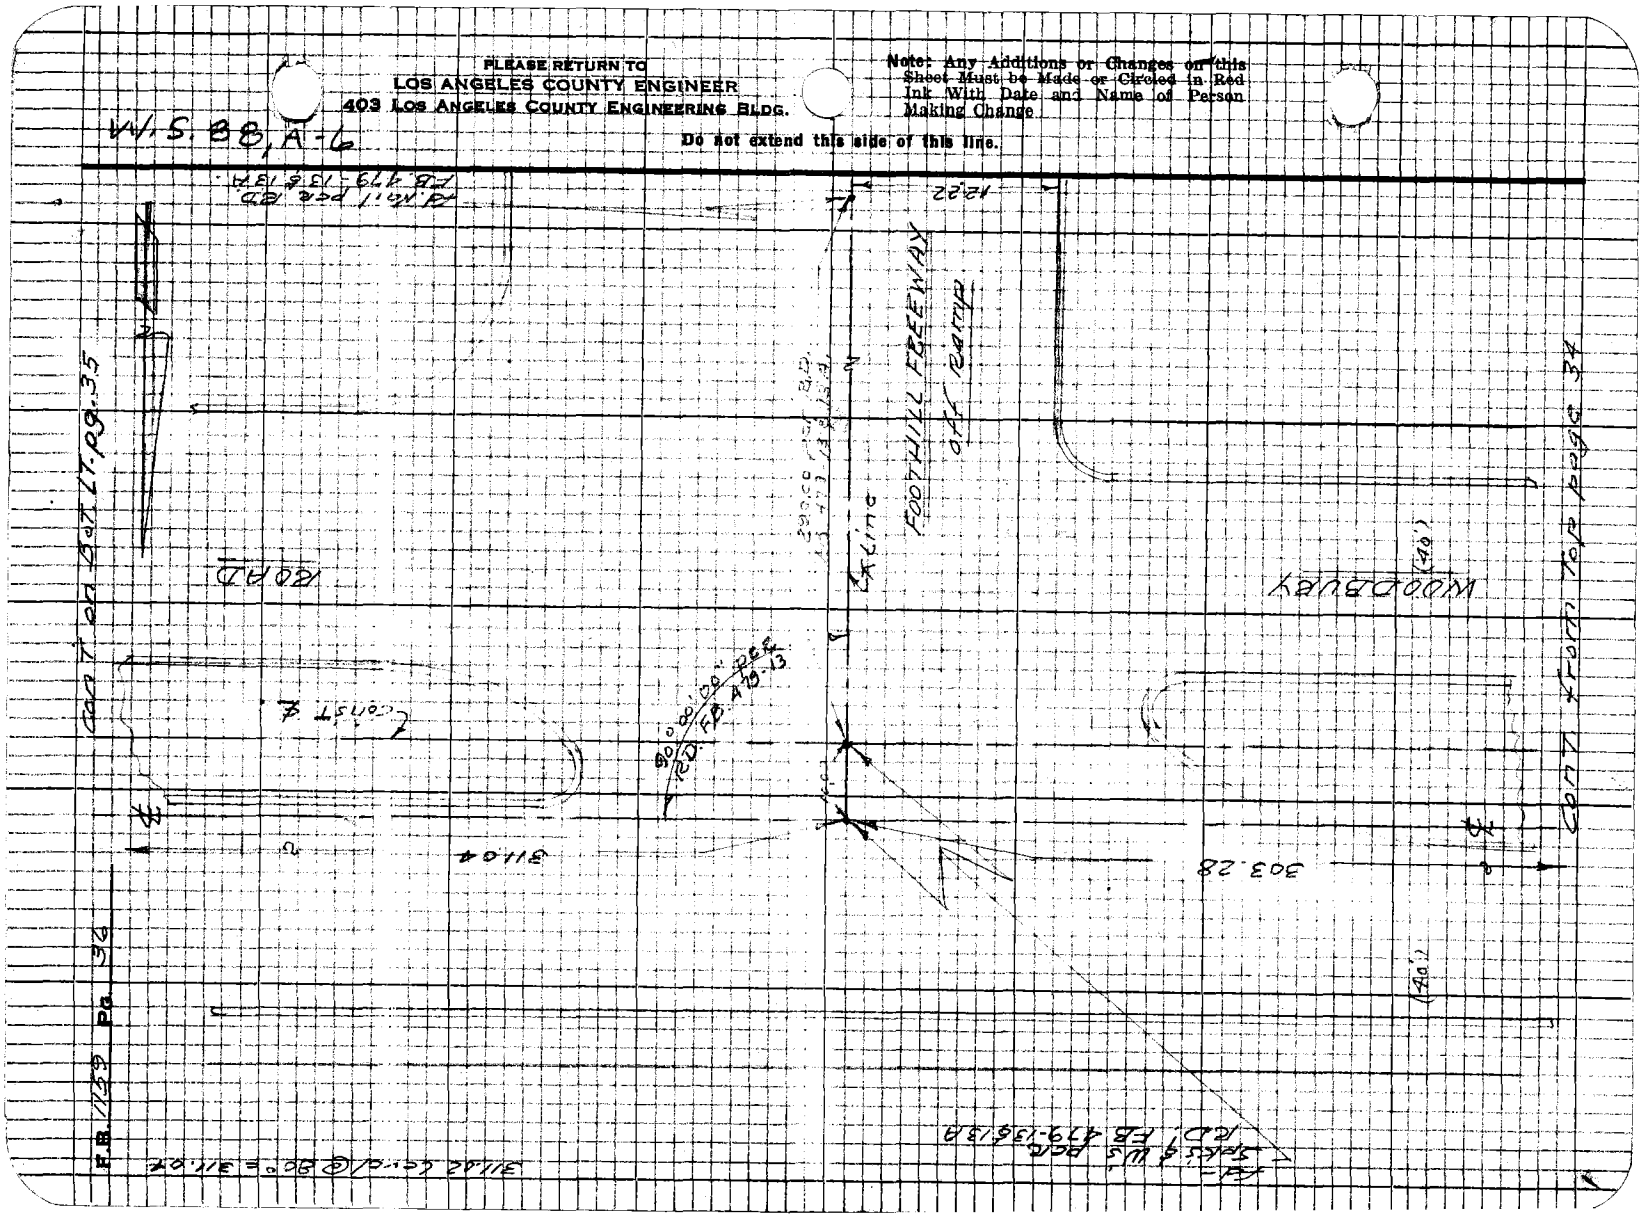

Notes Ck'd by [illegible]	Survey of Windsor Ave.	F.B. 1159 Pg. 37
Map No.	JN 0075.46 Tape 0240 Std 68 °F	Cont. on Bot. page 38
Office Work	Surveyed by A.S. Curtis	
Checked T. Ace	Notes Curtis Date 11/67	
Date	Indexed C. J. GALLI	

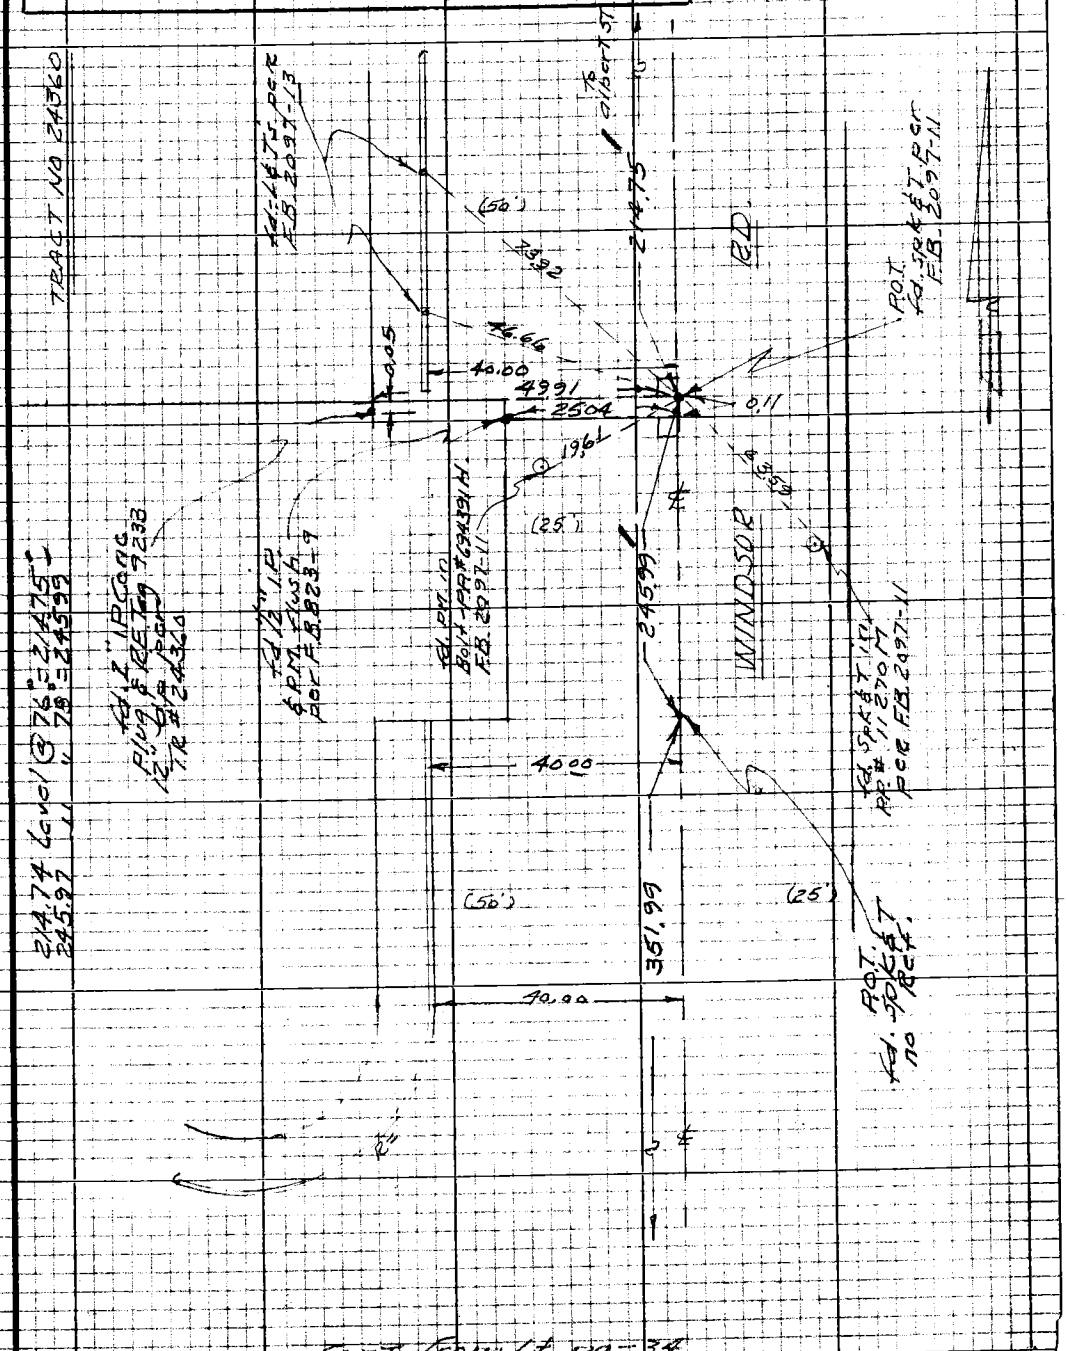

Cont. from Lt. pg-34

Note: Any Additions or Changes on this Sheet Must be Made or Circled in Red Ink With Date and Name of Person Making Change

Do not extend this side of this line.

PLEASE RETURN TO
LOS ANGELES COUNTY ENGINEER
403 LOS ANGELES COUNTY ENGINEERING BLDG.

76P3098 CE #310 5-66

PLEASE RETURN TO
LOS ANGELES COUNTY ENGINEER
403 LOS ANGELES COUNTY ENGINEERING BLDG.

Note: Any Additions or Changes on this Sheet Must be Made or Circled in Red Ink With Date and Name of Person Making Change

Do not extend this side of this line.

W.S. 88, A-2

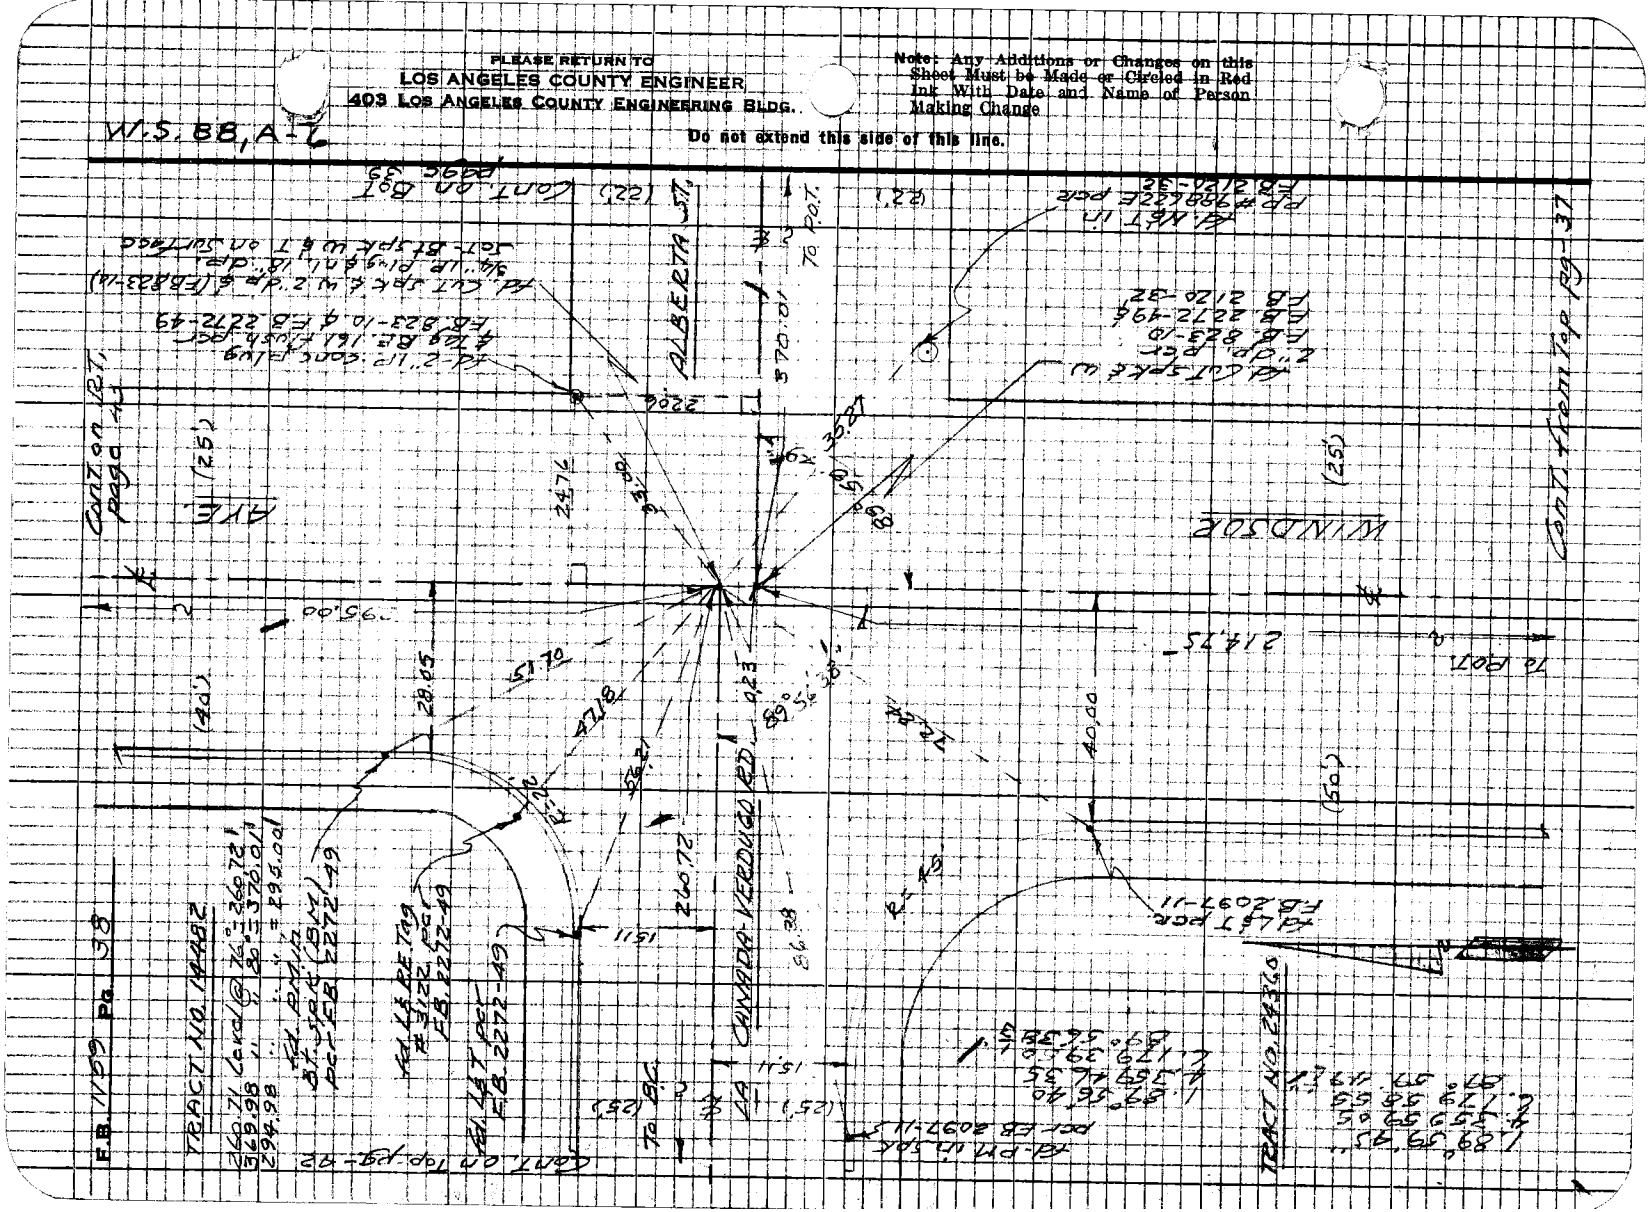

Notes Ck'd by [illegible]	Survey of WINDSOR AVE	F.B. 1159 Pg. 39
Map No.	JN 0075.46 Tape 0240 Std 68 °F	
Office Work T. ABE	Surveyed by A.S. CURTIS	
Checked	Notes CURTIS Date 11/67	
Date	Indexed C. J. GALLI	

(CONT. ON BOT. pg-40)

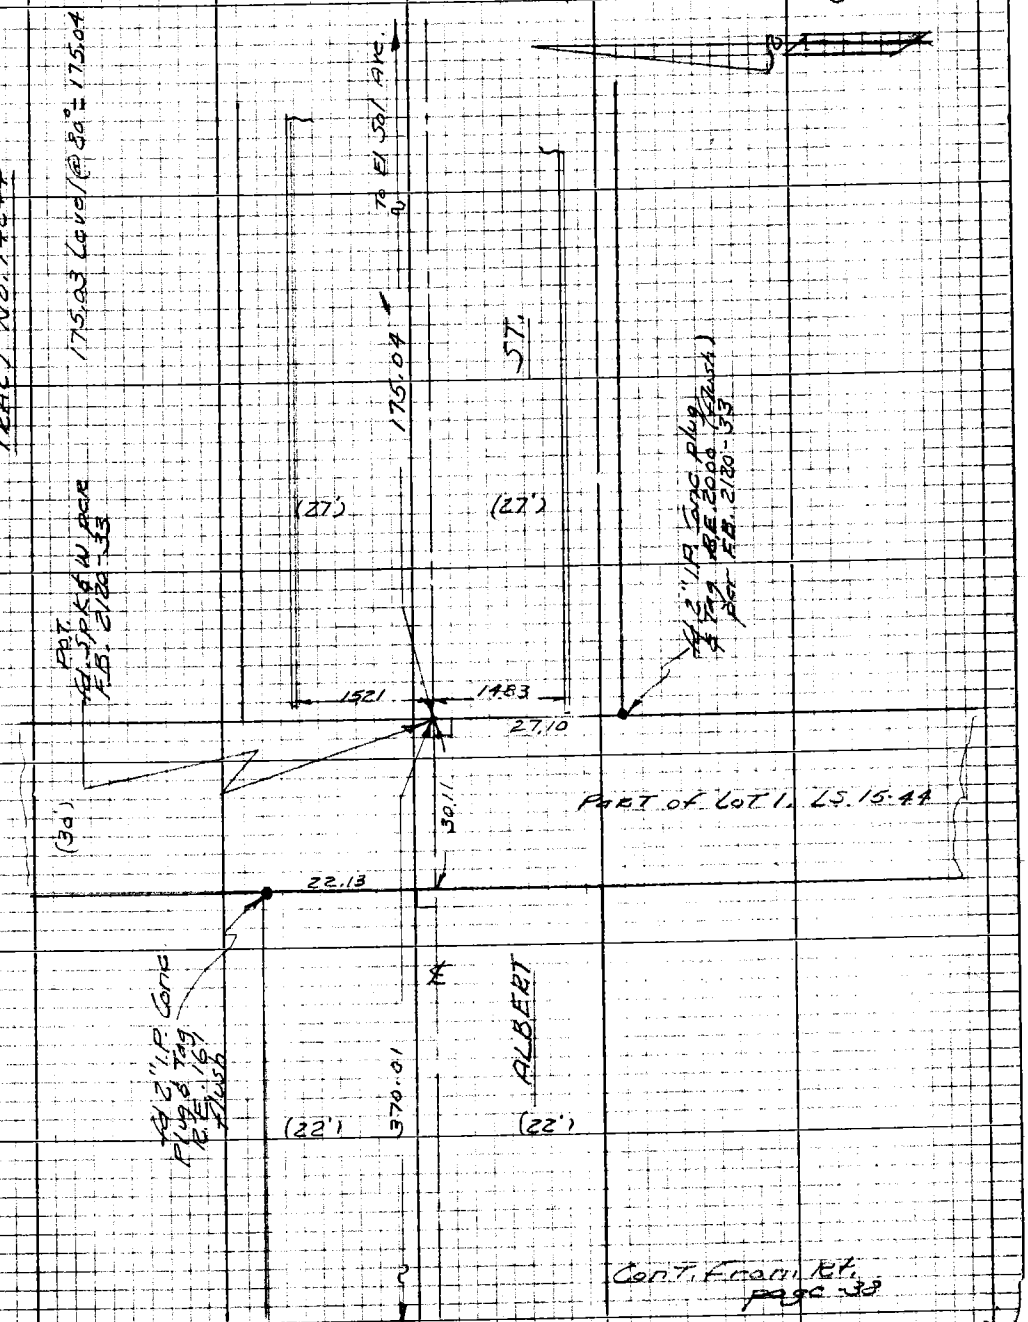

Cont. From Rt. page 38

Note: Any Additions or Changes on this Sheet Must be Made or Circled in Red Ink With Date and Name of Person Making Change

W.S. 88, A-6

Do not extend this side of this line.

PLEASE RETURN TO
LOS ANGELES COUNTY ENGINEER
403 LOS ANGELES COUNTY ENGINEERING BLDG.

76P3098 CE #310 5-66

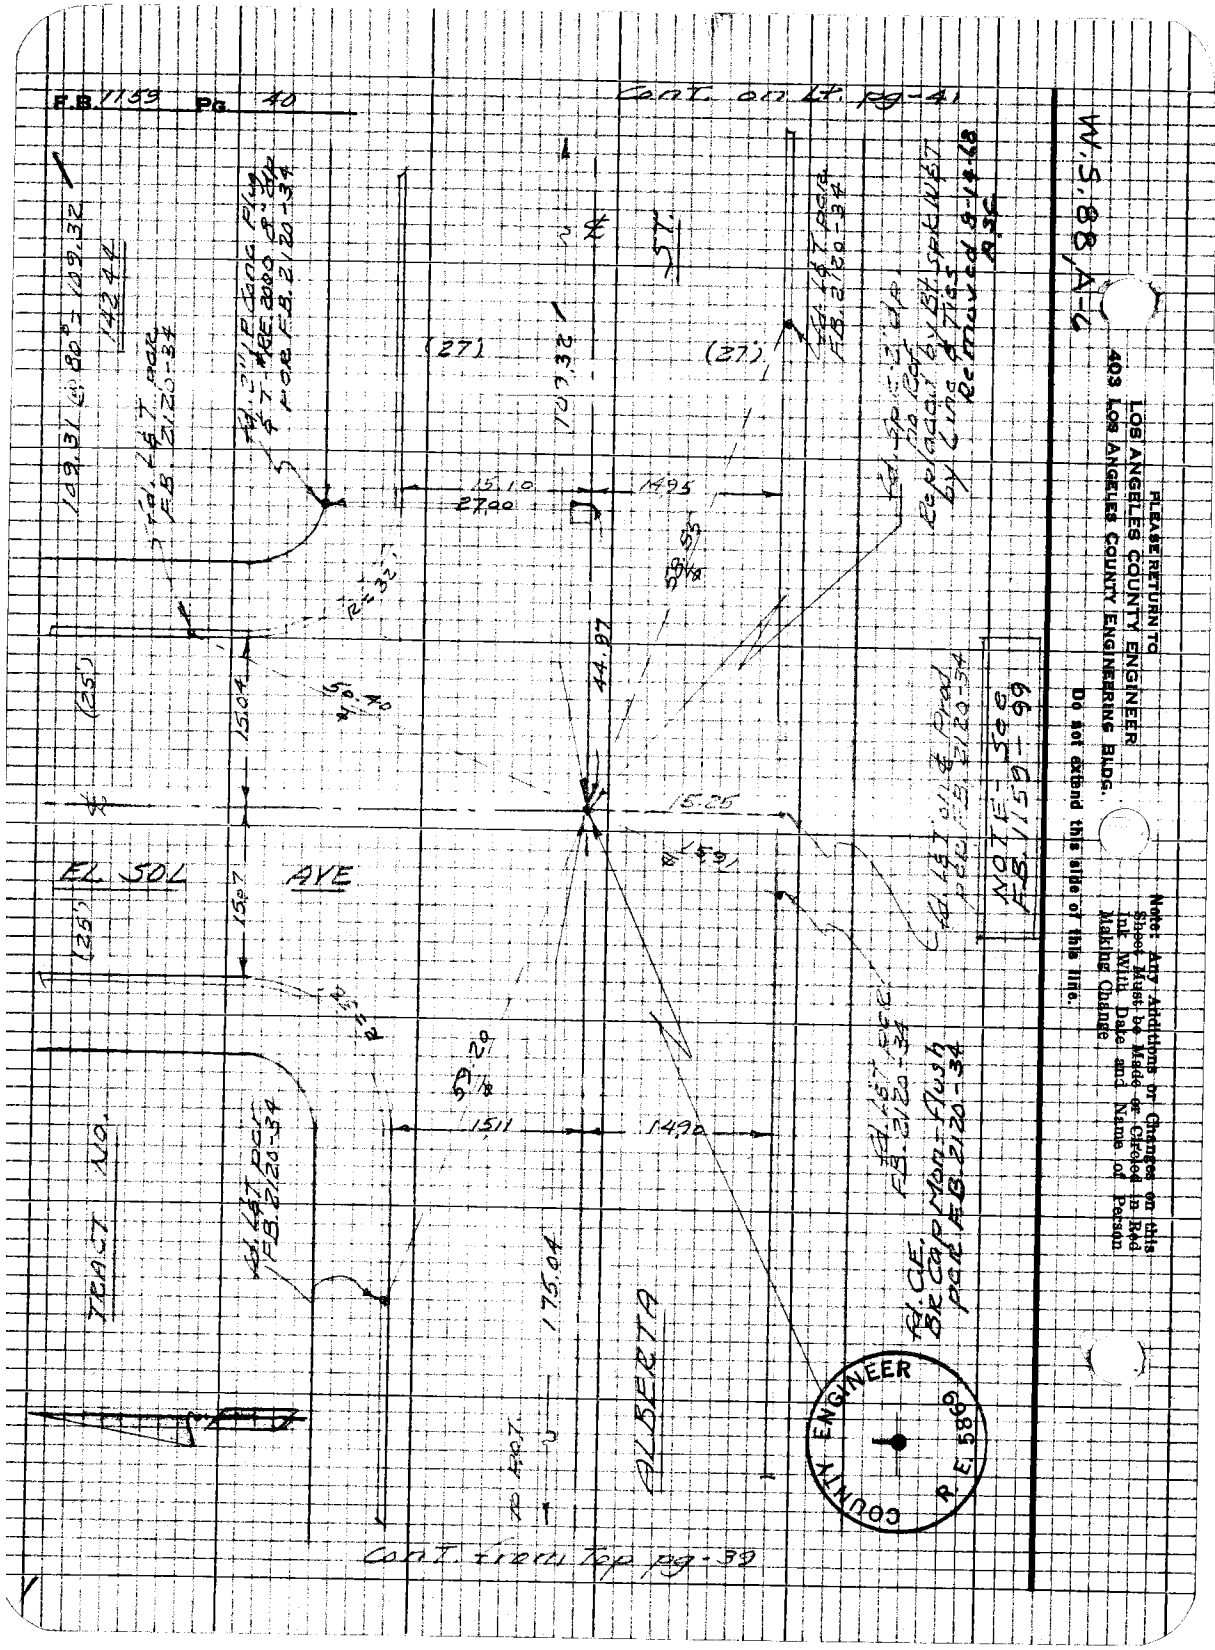
F.B. 1159 Pg. 40
Cont. on Lt. pg-41
W.S. 88, A-6
PLEASE RETURN TO
LOS ANGELES COUNTY ENGINEER
403 LOS ANGELES COUNTY ENGINEERING BLDG.
Do not extend this side of this line.
Note: Any Additions or Changes on this Sheet Must be Made or Circled in Red Ink With Date and Name of Person Making Change
EL SOL AVE
TRACT NO.
ALBERTA
ST.
NOTE - See F.B. 1159-99
COUNTY ENGINEER R.E. 5869
Cont. from Top pg-39

Notes Ck'd by		Survey of WINDSOR AVE.	F.B. 1159 Pg. 41
Map No.		JN 0075A6 Tape 0240 Std 68 °F	
Office Work	T. ABE	Surveyed by G.S. CURTIS	
Checked		Notes CURTIS Date 11/67	
Date		Indexed L. J. GALLI	

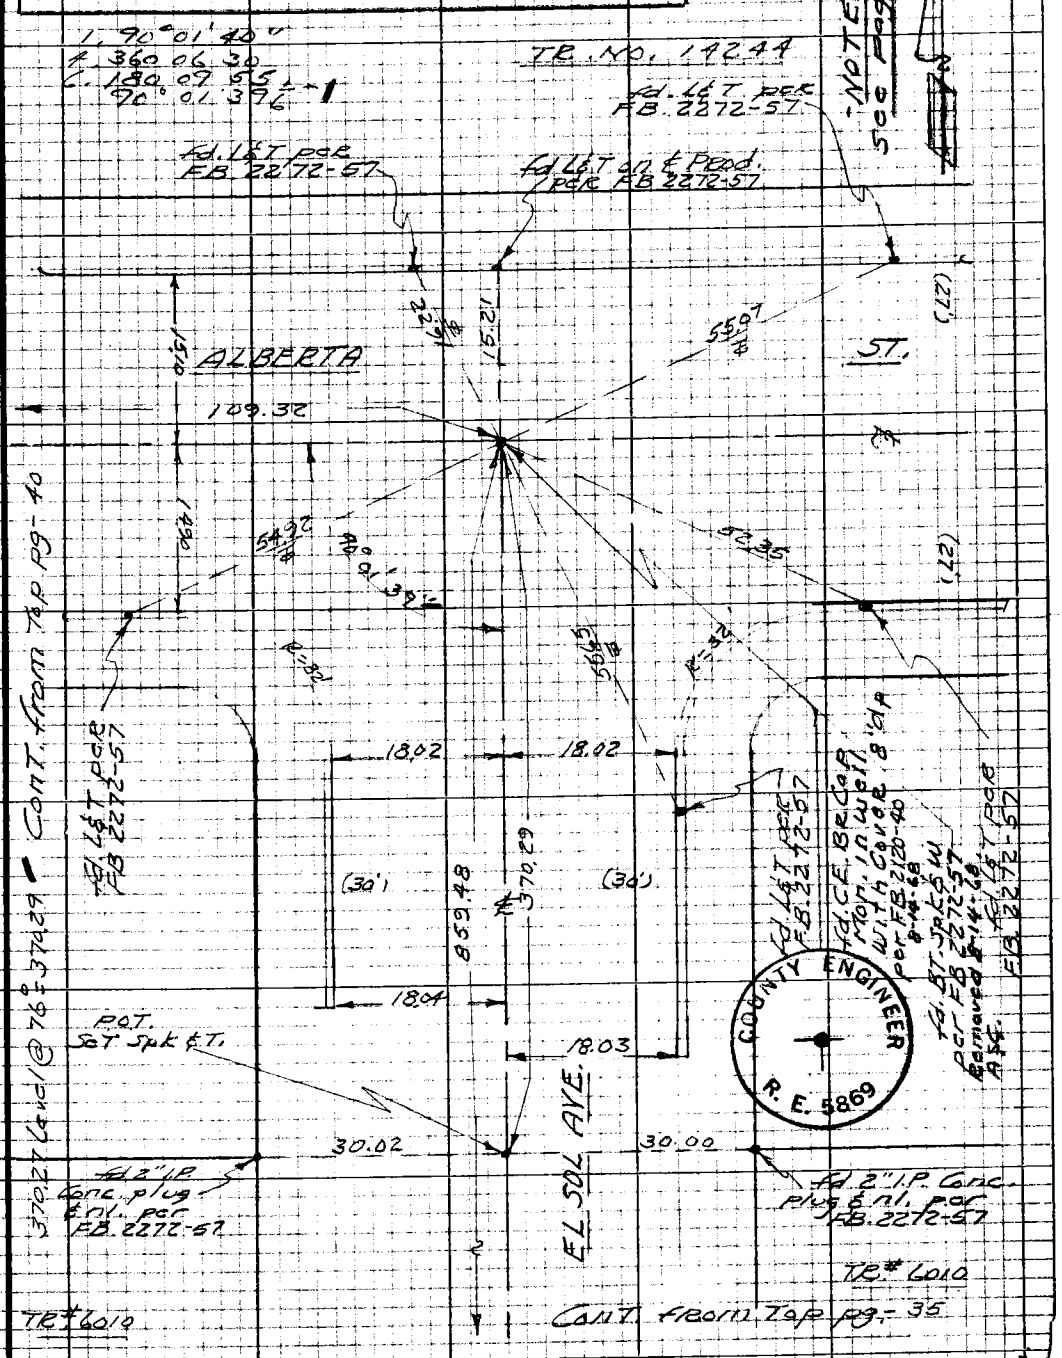

Note: Any Additions or Changes on this Sheet Must be Made or Circled in Red Ink With Date and Name of Person Making Change

W.S. 88, A-6

PLEASE RETURN TO
LOS ANGELES COUNTY ENGINEER
403 LOS ANGELES COUNTY ENGINEERING BLDG.

Do not extend this side of this line.

76P3095 CE #310 5-66

F.B. 1159 Pg. 42

Cont. from Lt. pg. 38

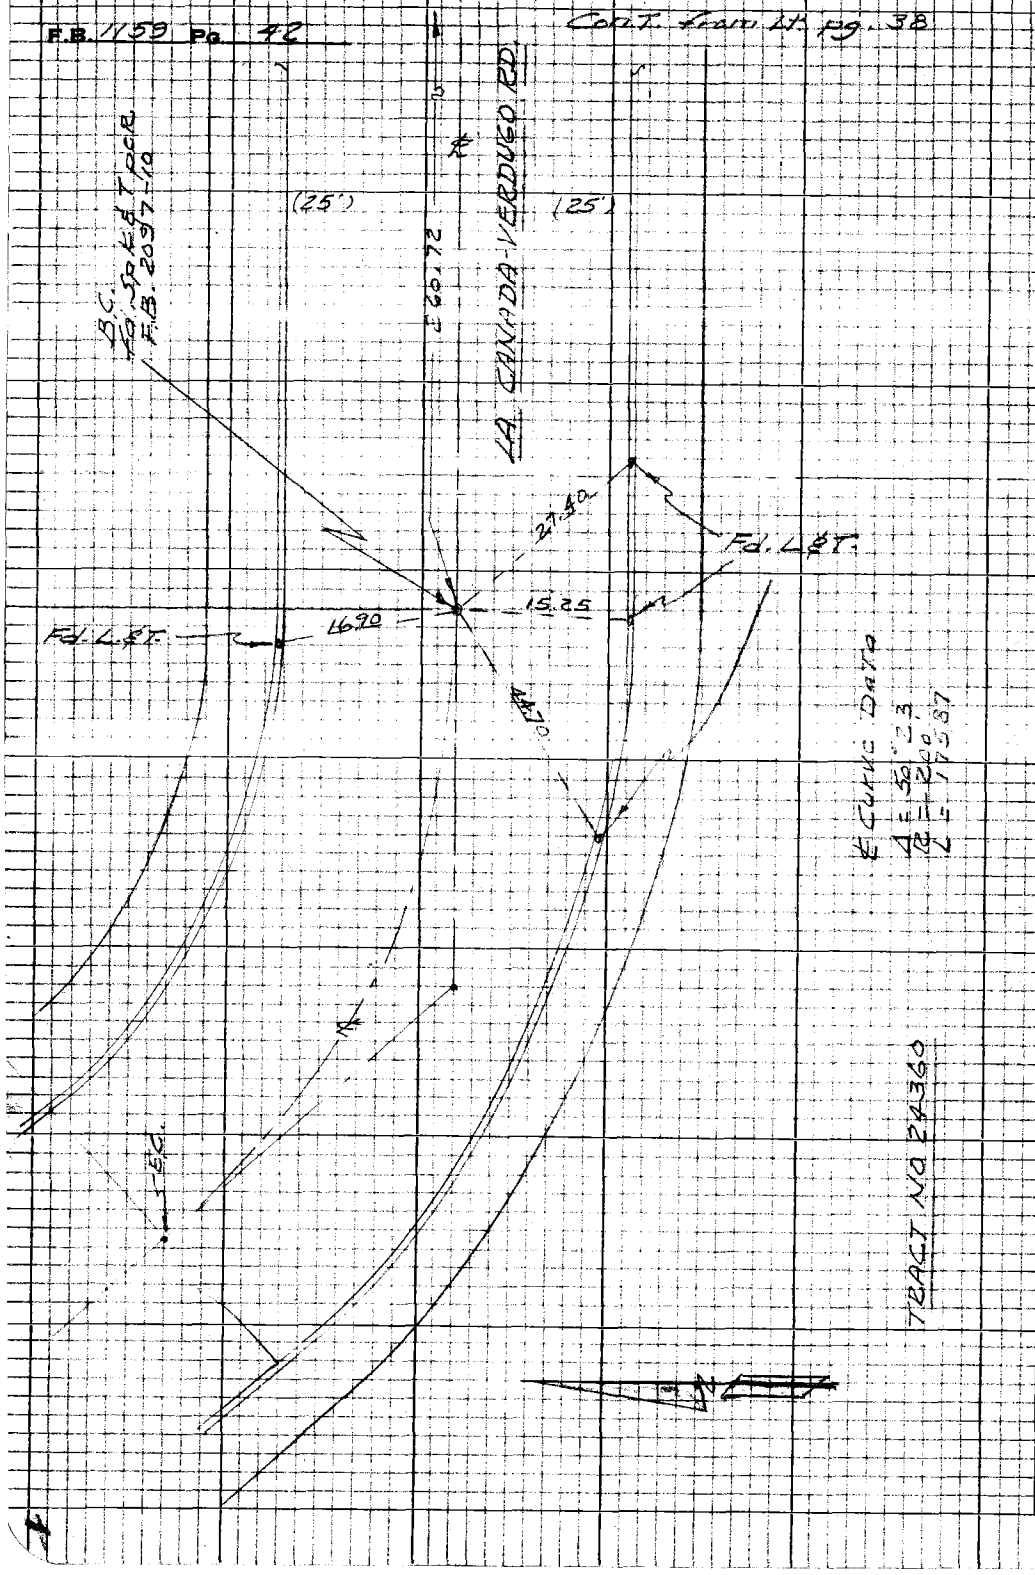

PLEASE RETURN TO
LOS ANGELES COUNTY ENGINEER
403 LOS ANGELES COUNTY ENGINEERING BLDG.

Note: Any Additions or Changes on this Sheet Must be Made or Circled in Red Ink With Date and Name of Person Making Change

Do not extend this side of this line.

Notes Ck'd by		Survey of WINDSOR AVE.	F.B. 1159 Pg. 43
Map No.		JN 0075.46 Tape 0240 Std 68 °F	
Office Work	T. AB	Surveyed by A.S. CURTIS	
Checked		Notes CURTIS Date 11/67	
Date		Indexed C. J. GALLY	

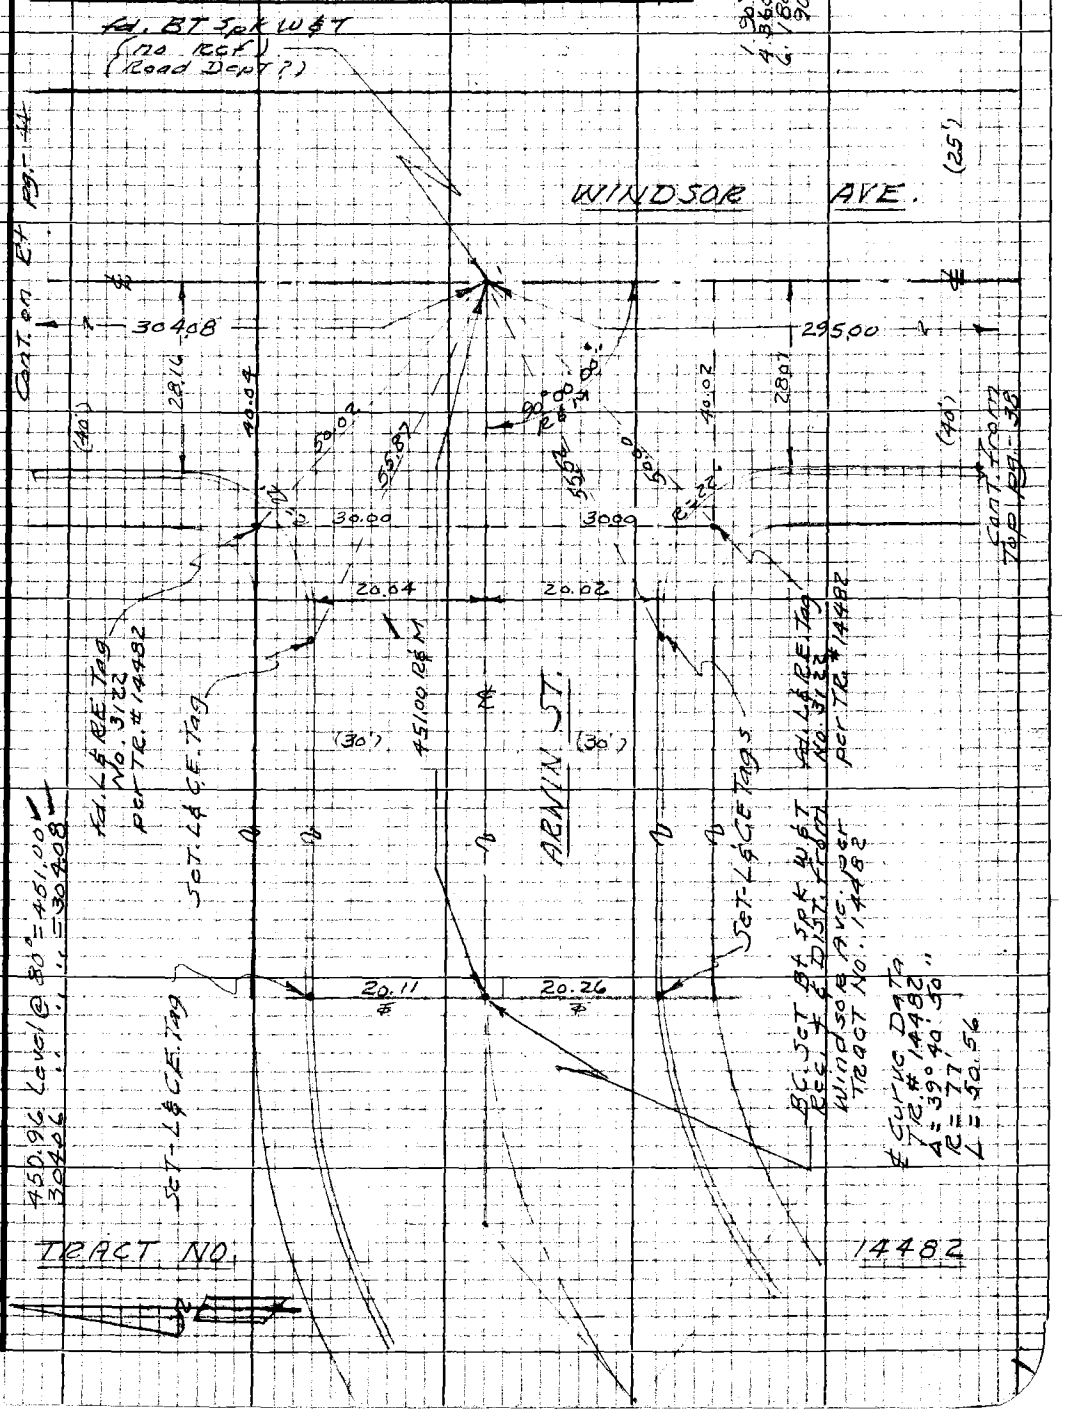

Note: Any Additions or Changes on this Sheet Must be Made or Circled in Red Ink With Date and Name of Person Making Change

W.S. 88, A-6

Do not extend this side of this line.

PLEASE RETURN TO
LOS ANGELES COUNTY ENGINEER
403 LOS ANGELES COUNTY ENGINEERING BLDG.

76P3098 CE #310 8-66

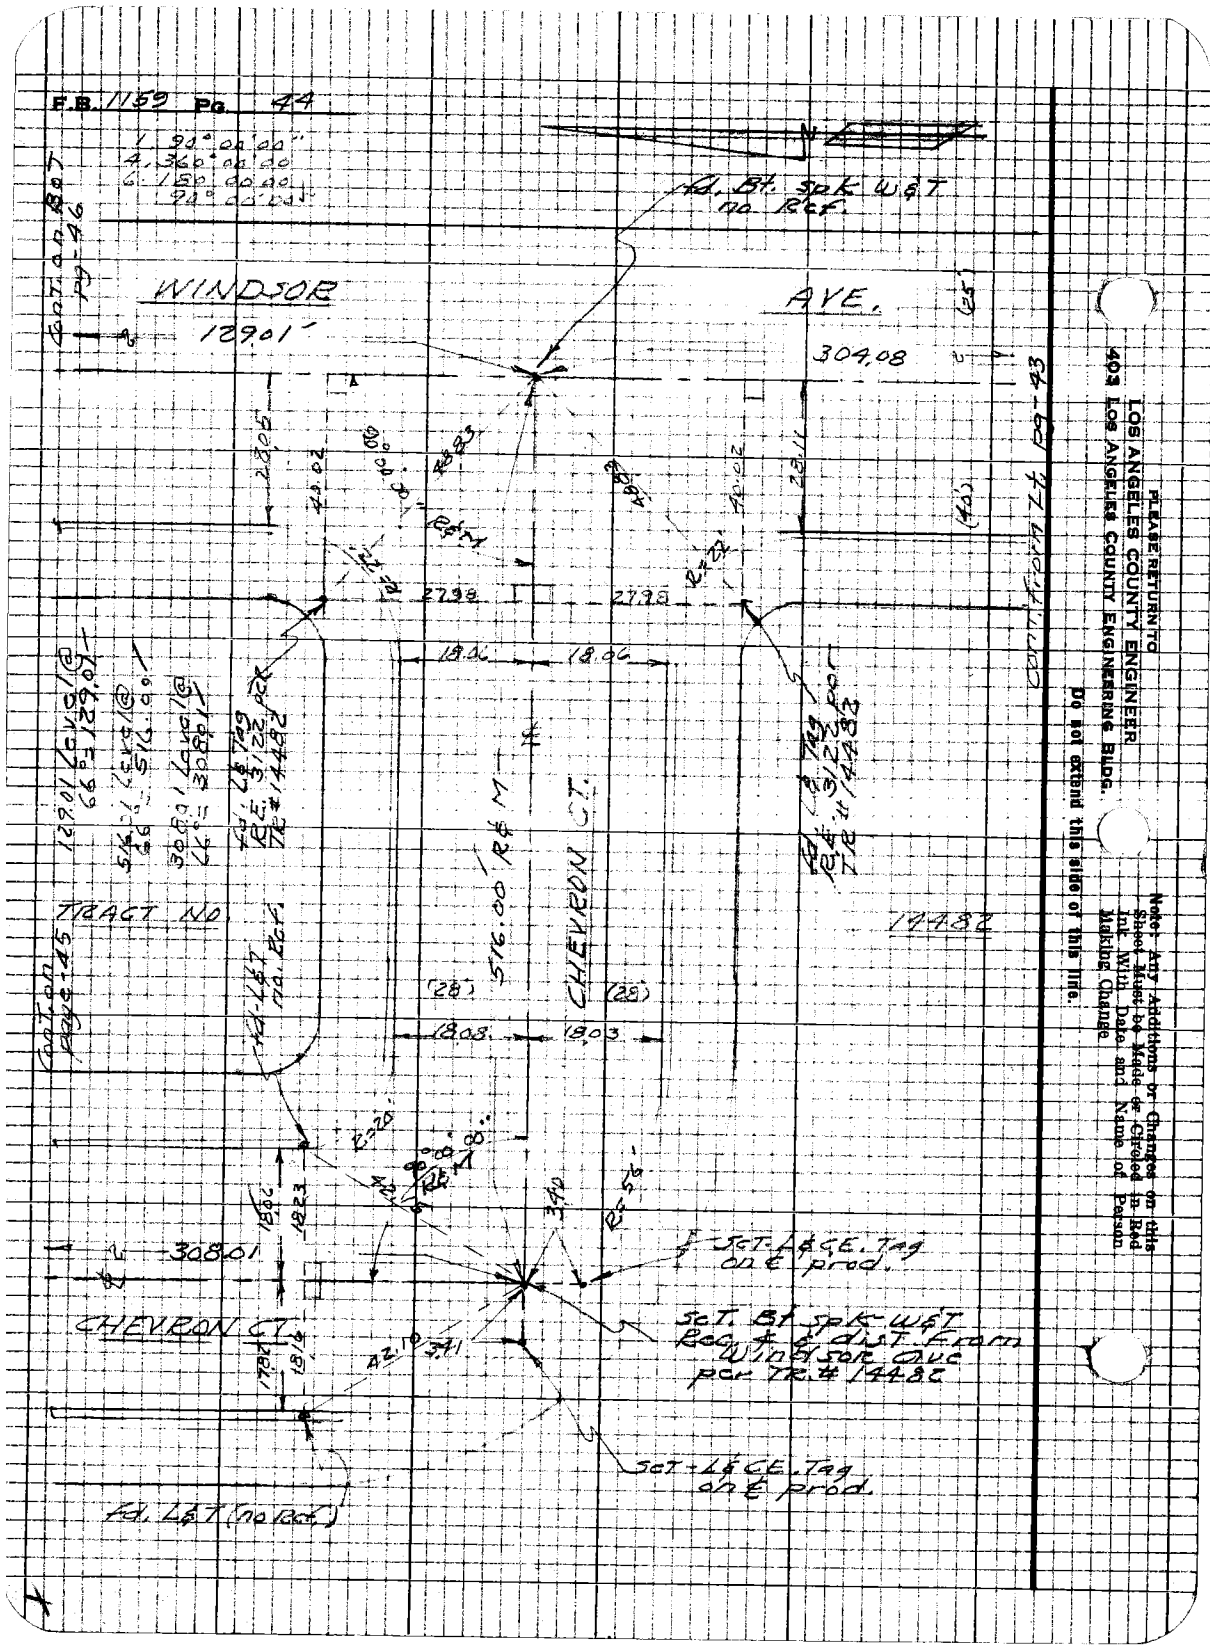

PLEASE RETURN TO
LOS ANGELES COUNTY ENGINEER
403 Los Angeles County Engineering Bldg.

Note: Any Additions or Changes on this Sheet Must be Made or Circled in Red Ink With Date and Name of Person Making Change

Do not extend this side of this line.

Notes Ck'd by A. A. CHURCH	Survey of WINDSOR AVE.	F.B. 1159 Pg. 45
Map No.	JN 0075.46 Tape 0240 Std 68 °F	
Office Work T. ABE	Surveyed by A.S. CURTIS	
Checked	Notes CURTIS Date 11/67	
Date	Indexed C. J. GALLI	

1. 90° 00' 00"
4. 360 00 00
6. 180 00 00
90° 00' 00"

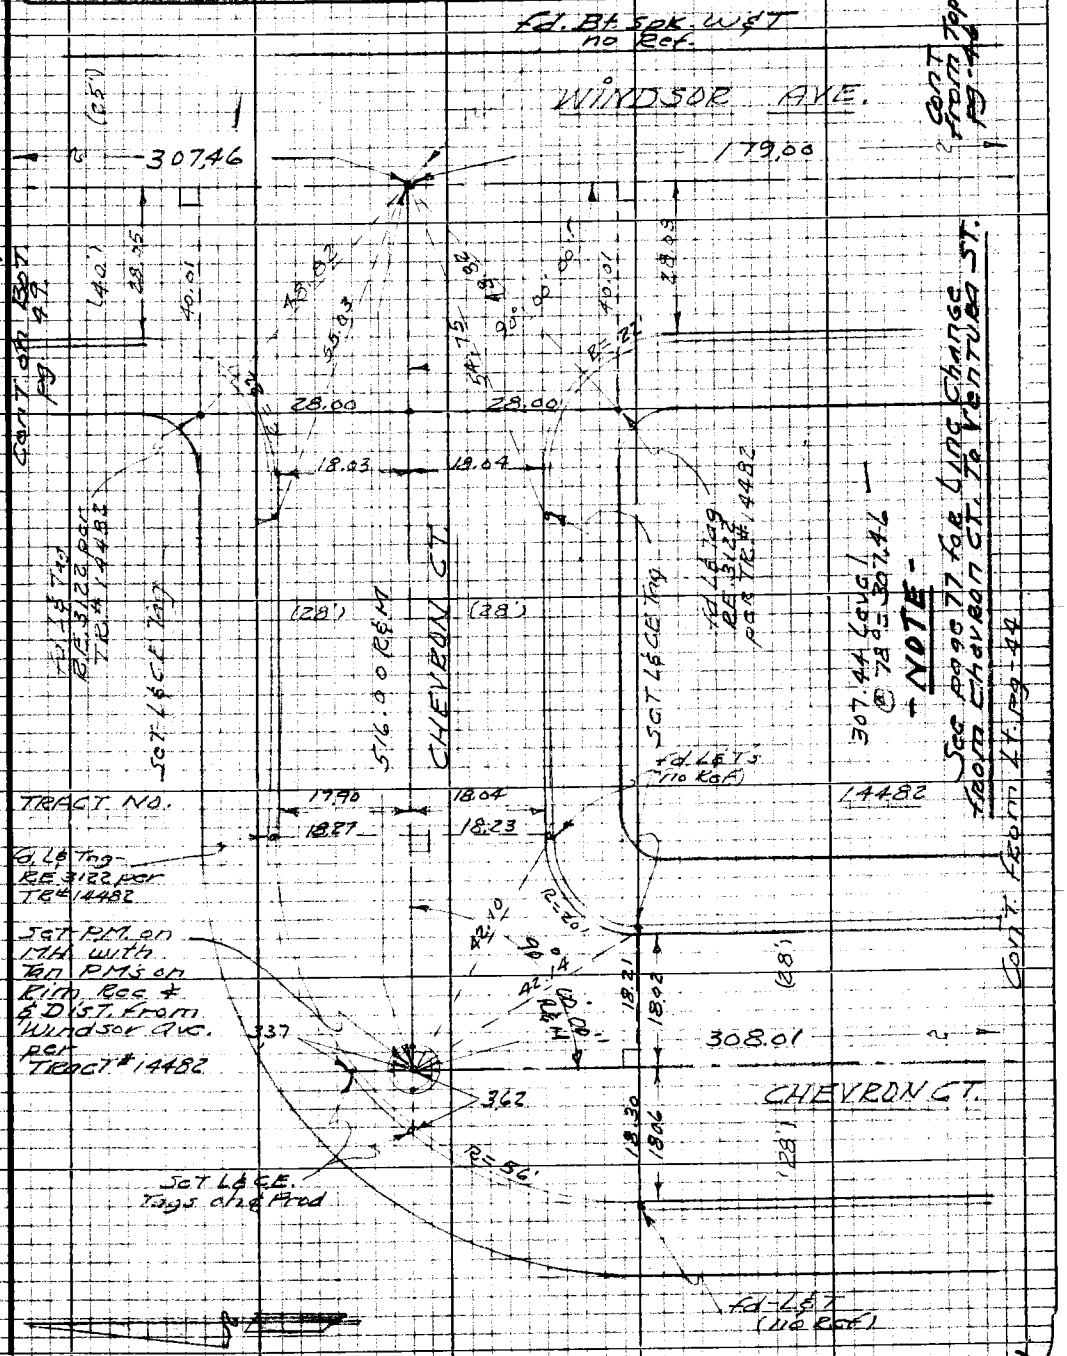

Note: Any Additions or Changes on this Sheet Must be Made or Circled in Red Ink With Date and Name of Person Making Change

W.S. 88, A-6

Do not extend this side of this line.

PLEASE RETURN TO
LOS ANGELES COUNTY ENGINEER
403 Los Angeles County Engineering Bldg.

7SP3098 CE #310 5-66

PLEASE RETURN TO
LOS ANGELES COUNTY ENGINEER
403 LOS ANGELES COUNTY ENGINEERING BLDG.

Note: Any Additions or Changes on this Sheet Must be Made or Circled in Red Ink With Date and Name of Person Making Change

Do not extend this side of this line.

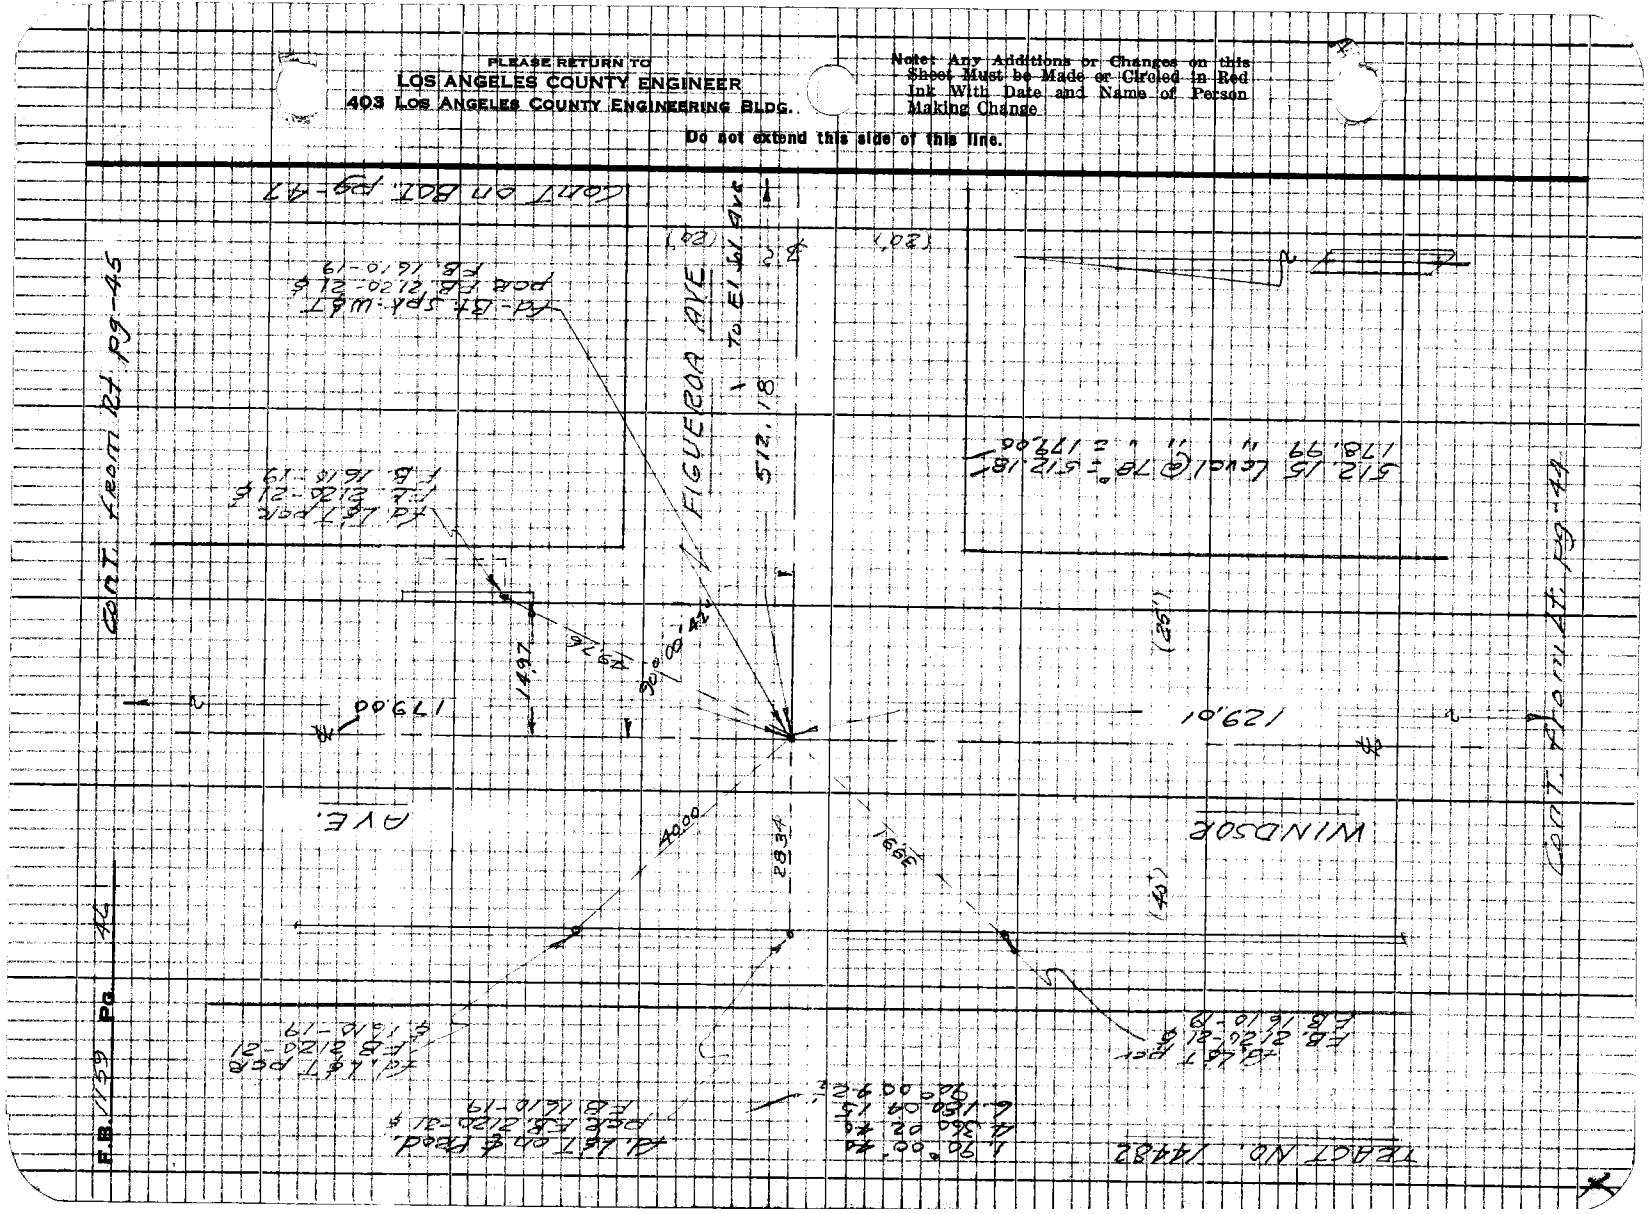

Notes Ck'd by		Survey of Windsor Ave.	F.B. 1159 Pg. 47
Map No.		JN 0075.46 Tape 0240 Std 68 °F	Cont. on Bot. Pg. 48
Office Work	T. ABE	Surveyed by A. S. Curtis	
Checked		Notes Curtis Date 11/67	
Date		Indexed C. J. GALLI	

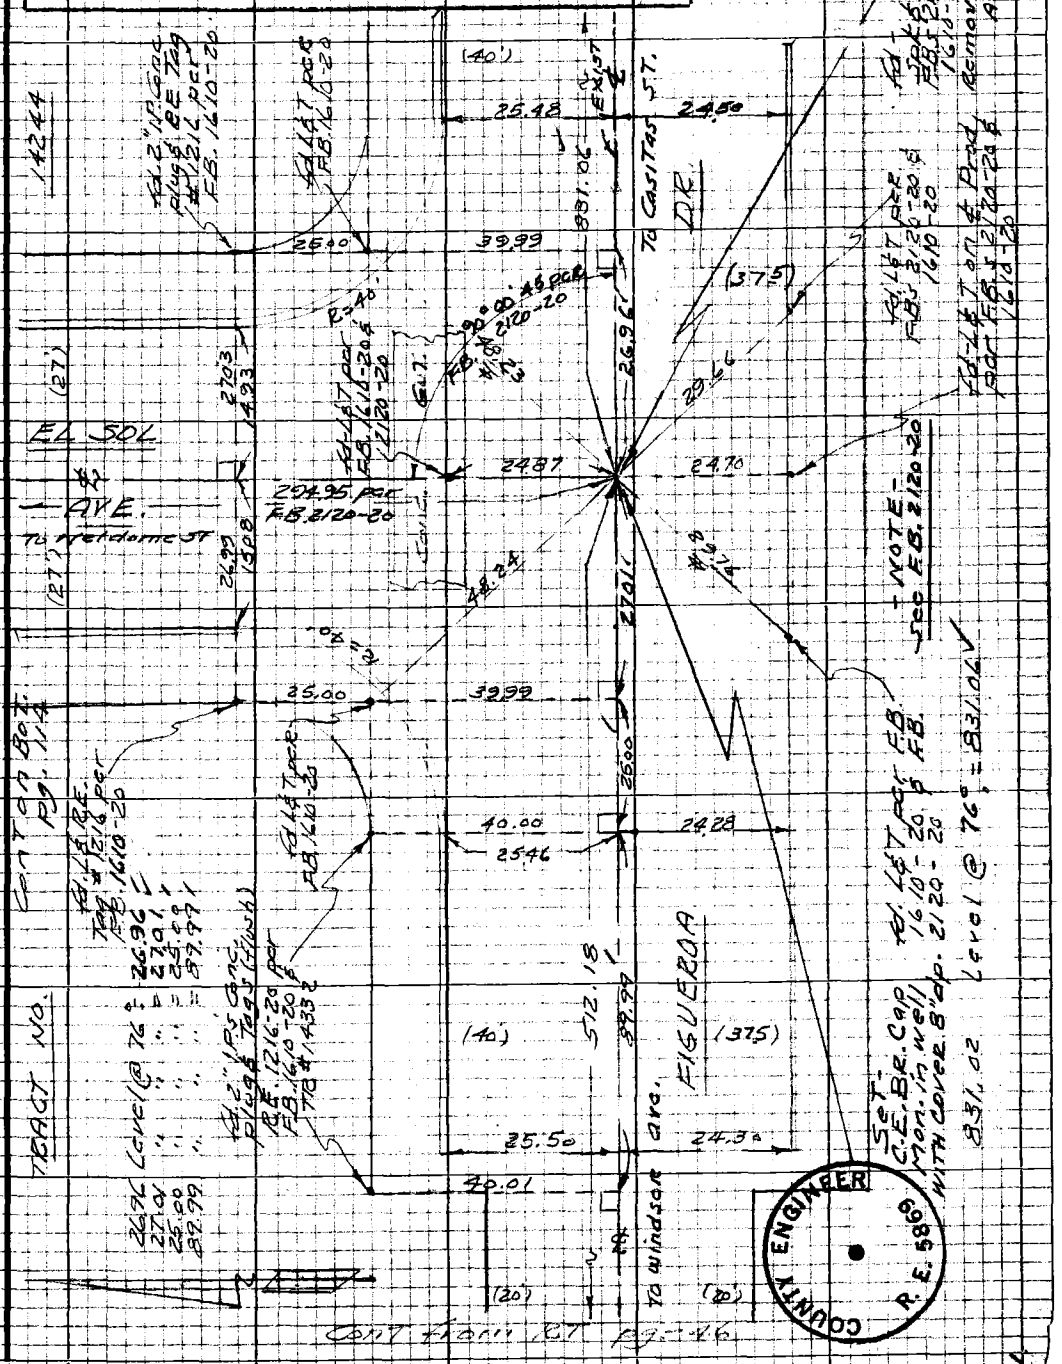

PLEASE RETURN TO
LOS ANGELES COUNTY ENGINEER
403 LOS ANGELES COUNTY ENGINEERING BLDG.

Note: Any Additions or Changes on this Sheet Must be Made or Circled in Red Ink With Date and Name of Person Making Change

Do not extend this side of this line.

W.S. 88, A-6

76P3098 CK #310 5-66

PLEASE RETURN TO
LOS ANGELES COUNTY ENGINEER
403 LOS ANGELES COUNTY ENGINEERING BLDG.

Note: Any Additions or Changes on this Sheet Must be Made or Circled in Red Ink With Date and Name of Person Making Change

Do not extend this side of this line.

W.S. 88, A-6

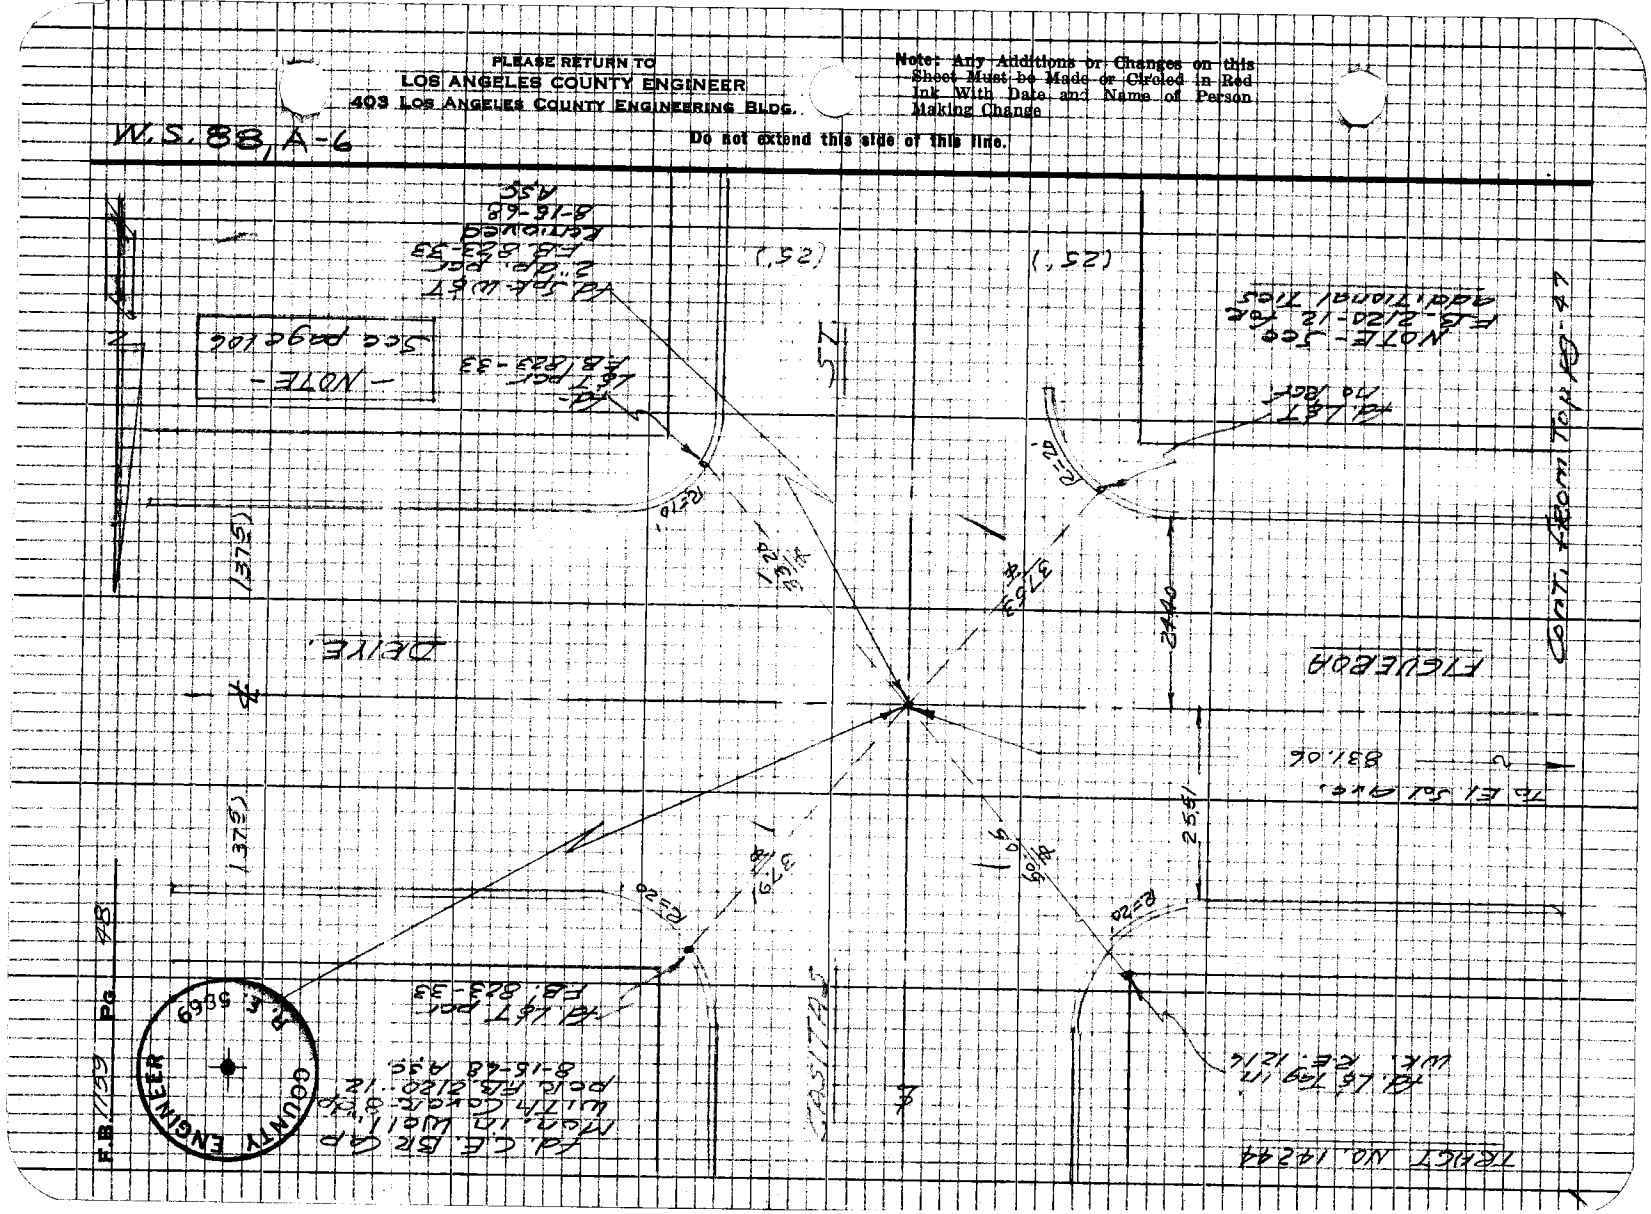

Notes Ck'd by		Survey of WINDSOR AVE.	F.B. 1159 Pg. 49
Map No.		JN 007546 Tape 0240 Std 68 °F	
Office Work	T. ABE	Surveyed by A. S. CURTIS	
Checked		Notes CURTIS Date 11/67	
Date		Indexed C. J. GALLI	

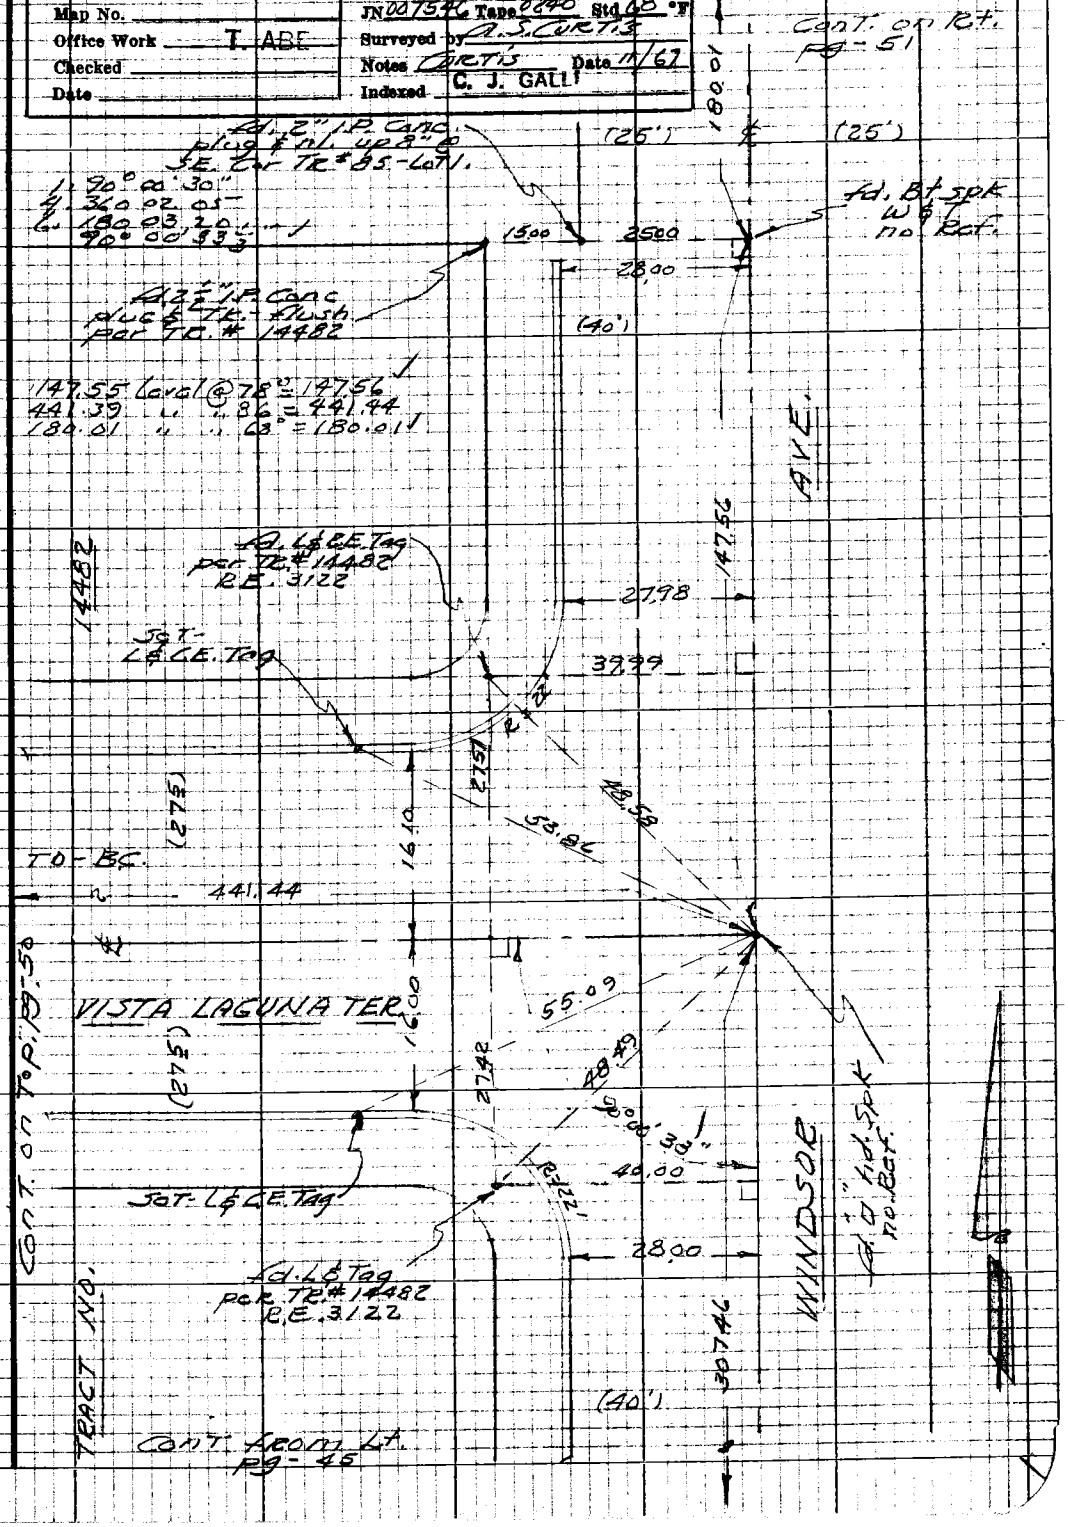

Note: Any Additions or Changes on this Sheet Must be Made or Circled in Red Ink With Date and Name of Person Making Change

W.S. 88, A-6

PLEASE RETURN TO
LOS ANGELES COUNTY ENGINEER
403 Los Angeles County Engineering Bldg.

Do not extend this side of this line.

76P3098 CE #310 5-66

PLEASE RETURN TO
LOS ANGELES COUNTY ENGINEER
403 LOS ANGELES COUNTY ENGINEERING BLDG.

Note: Any Additions or Changes on this Sheet Must be Made or Circled in Red Ink With Date and Name of Person Making Change

Do not extend this side of this line.

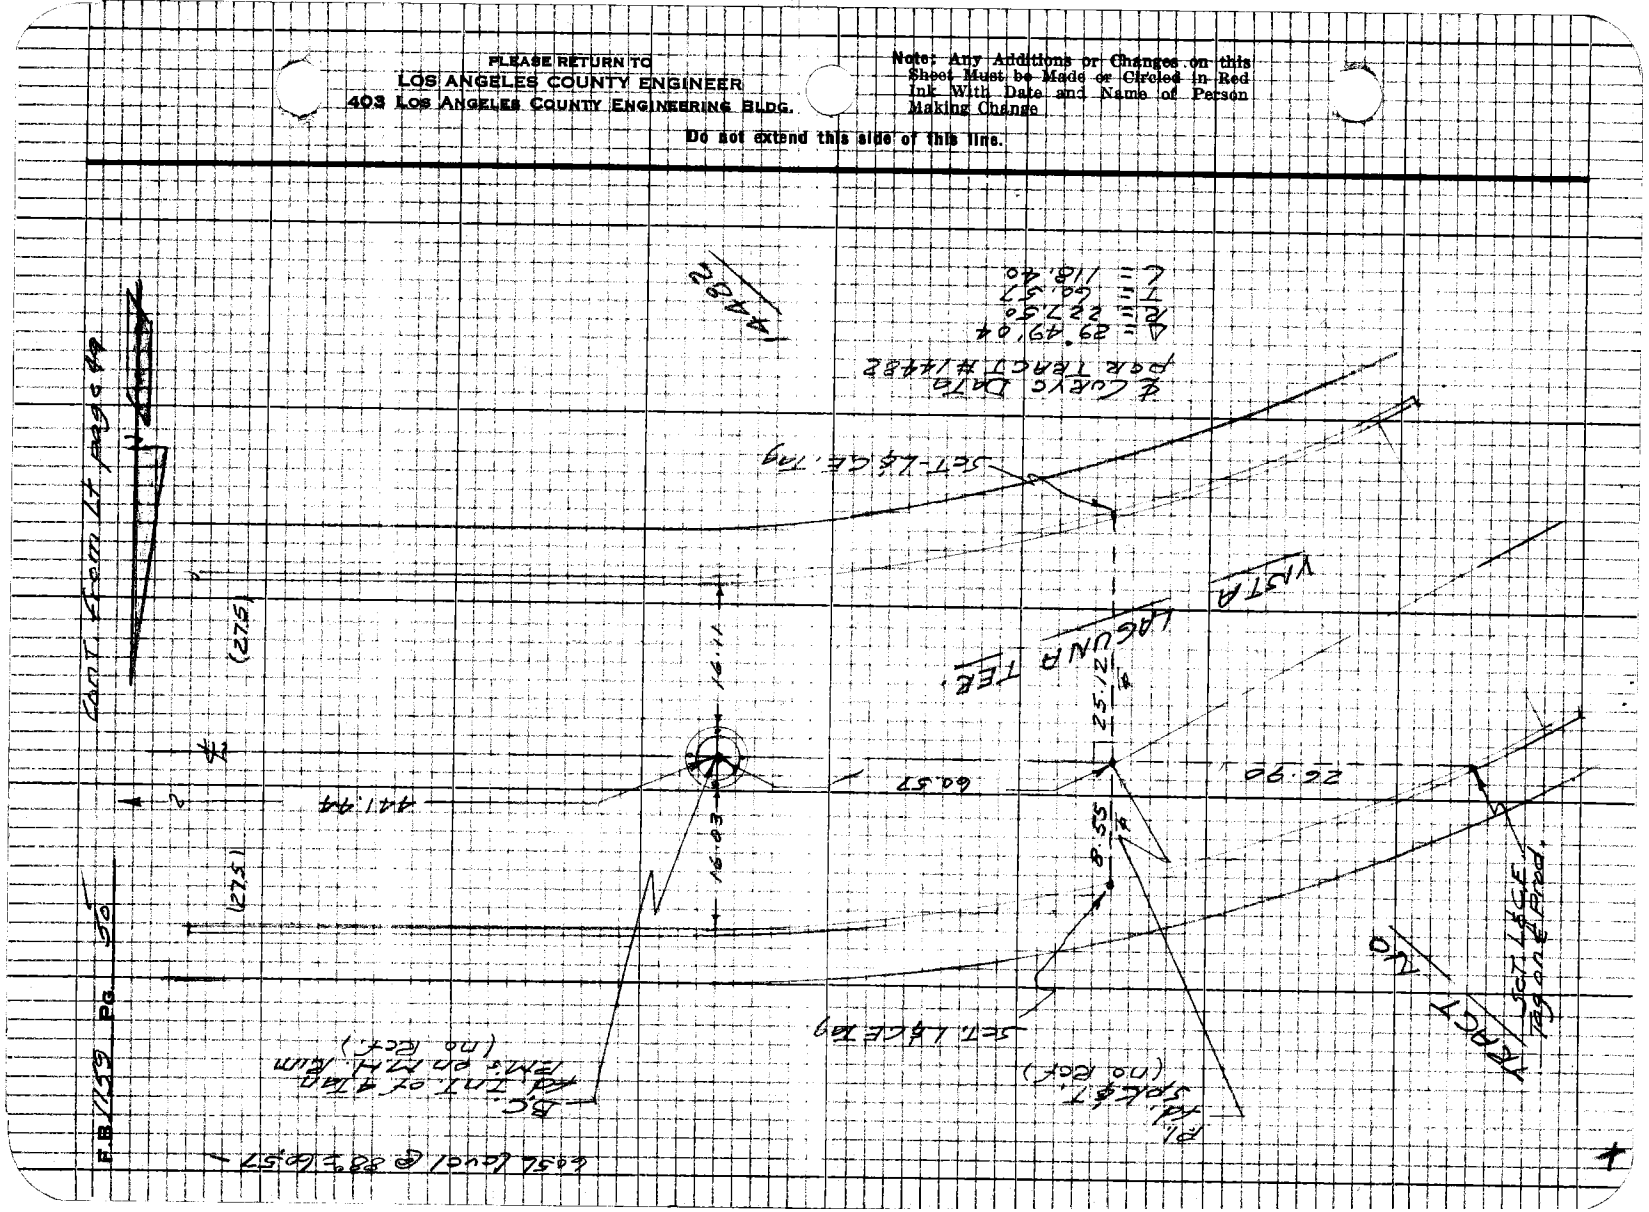

Notes Ck'd by		Survey of WINDSOR AVE.	F.B. 1159 Pg. 51
Map No.		JN 007546 Tape 0240 Std 68 °F	
Office Work T. AE.		Surveyed by A.S. CURTIS	
Checked		Notes CURTIS Date 11/67	
Date		Indexed C. J. GALLI	

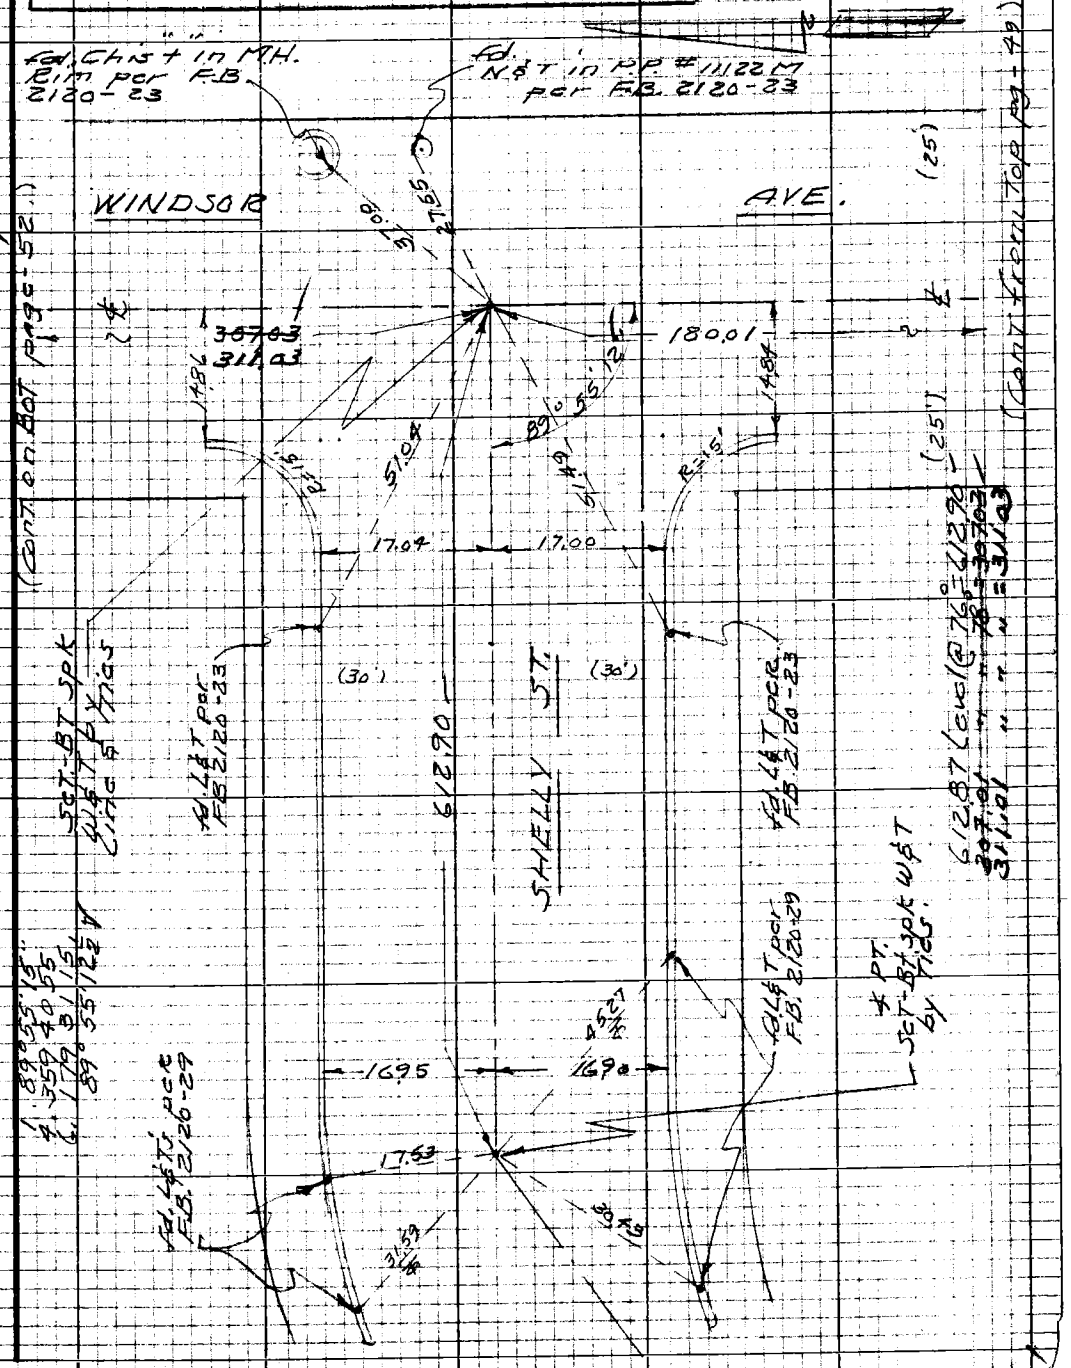

Note: Any Additions or Changes on this Sheet Must be Made or Circled in Red Ink With Date and Name of Person Making Change

W.S. 88 A-6

PLEASE RETURN TO
LOS ANGELES COUNTY ENGINEER
403 Los Angeles County Engineering Bldg.

Do not extend this side of this line.

76P309S CE #310 5-66

PLEASE RETURN TO
LOS ANGELES COUNTY ENGINEER
403 LOS ANGELES COUNTY ENGINEERING BLDG.

Note: Any Additions or Changes on this Sheet Must be Made or Circled in Red Ink With Date and Name of Person Making Change

Do not extend this side of this line.

W.S.88, A 5

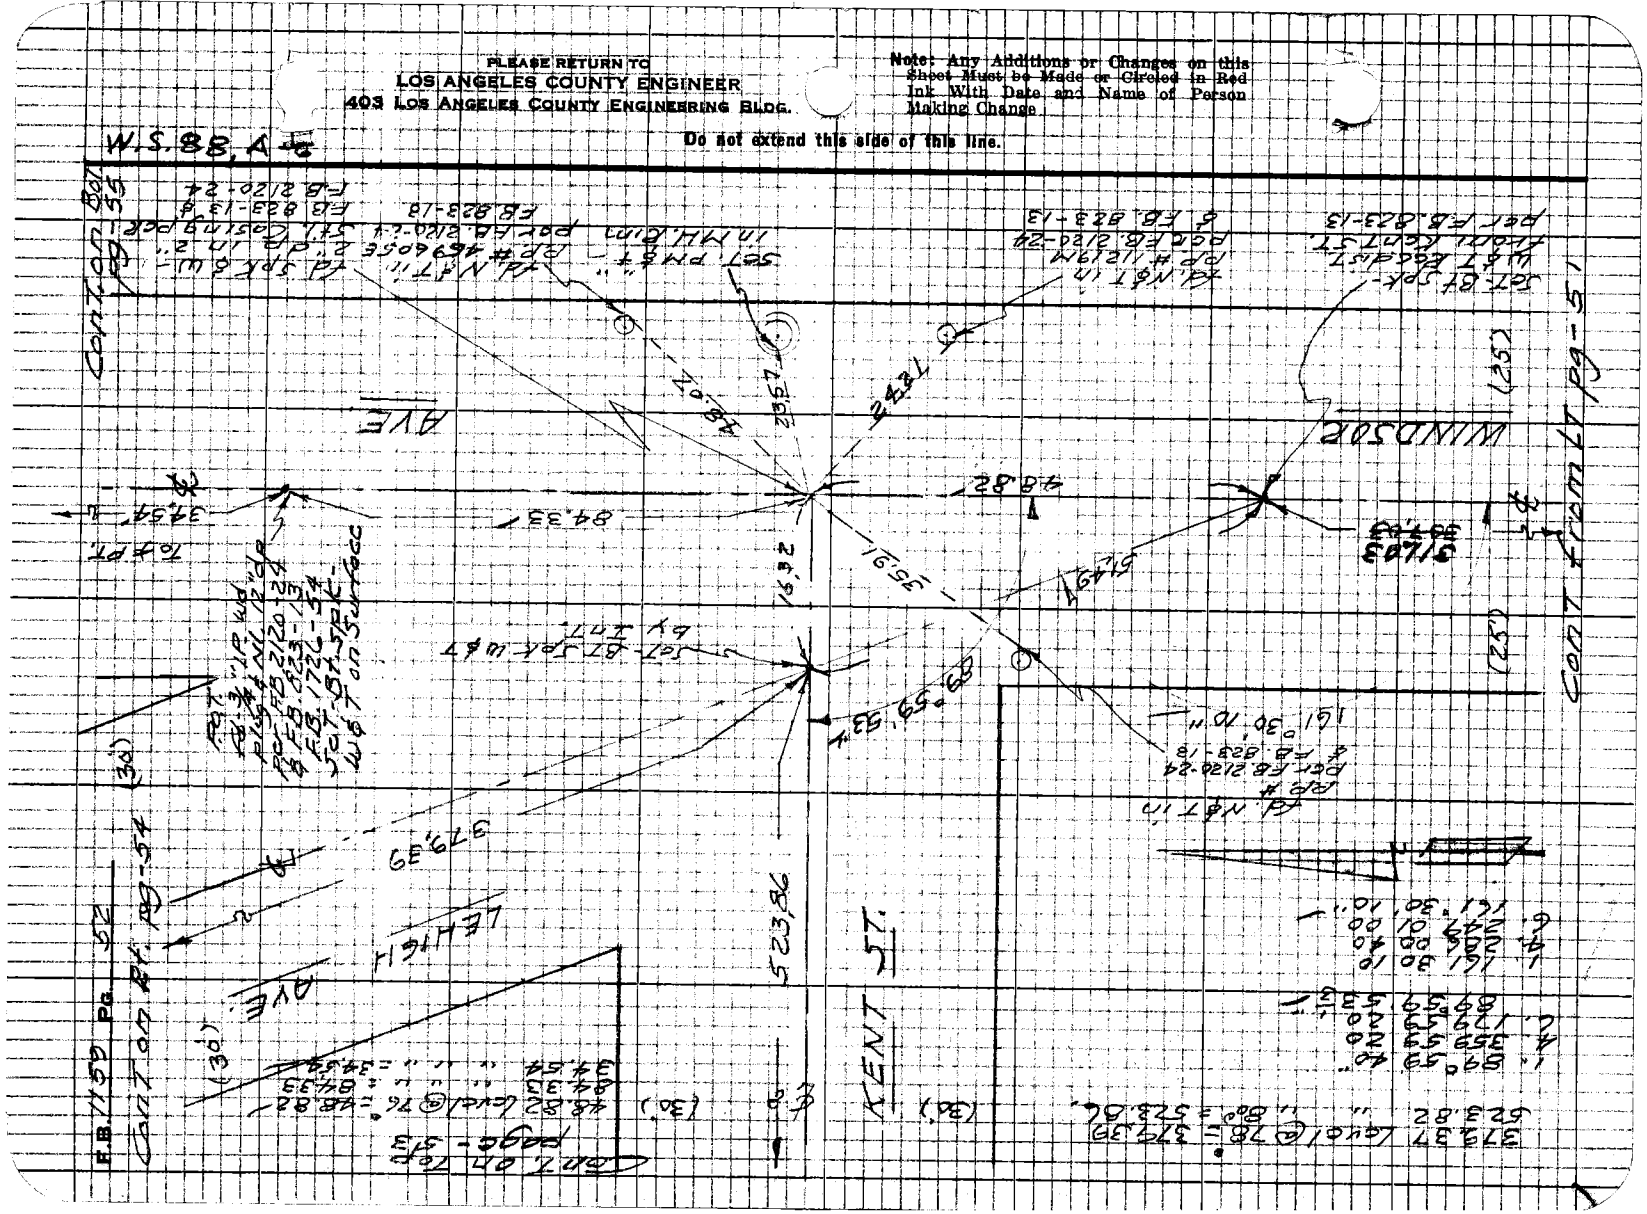

Notes Ck'd by A. CHURCH	Survey of WINDSOR AVE.	F.B. 1159 Pg. 53
Map No.	JN 0075.46 Tape 0240 Std 68 °F	
Office Work T. ABE	Surveyed by A. S. CURTIS	
Checked	Notes CURTIS Date 11/67	
Date	Indexed C. J. GALLI	

Cont from LT. pg. 52

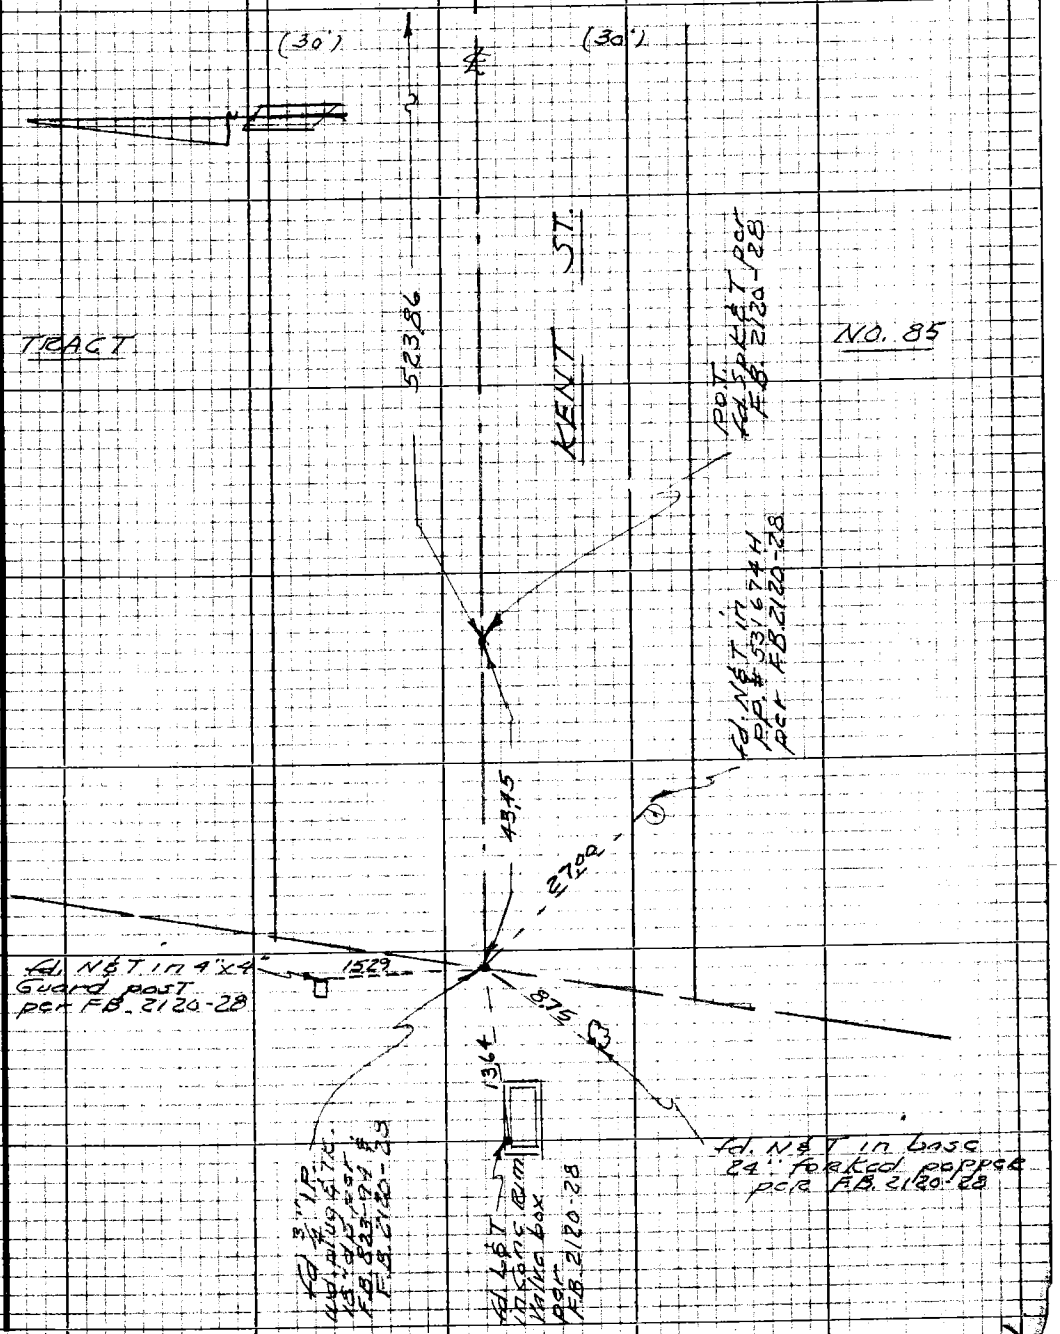

W.S. 88, A-6

Note: Any Additions or Changes on this Sheet Must be Made or Circled in Red Ink With Date and Name of Person Making Change

Do not extend this side of this line.

PLEASE RETURN TO
LOS ANGELES COUNTY ENGINEER
403 Los Angeles County Engineering Bldg.

76P3095 CE #310 5-66

PLEASE RETURN TO
LOS ANGELES COUNTY ENGINEER
403 LOS ANGELES COUNTY ENGINEERING BLDG.

Note: Any Additions or Changes on this Sheet Must be Made or Circled in Red Ink With Date and Name of Person Making Change

W.S. 88, A-6

Do not extend this side of this line.

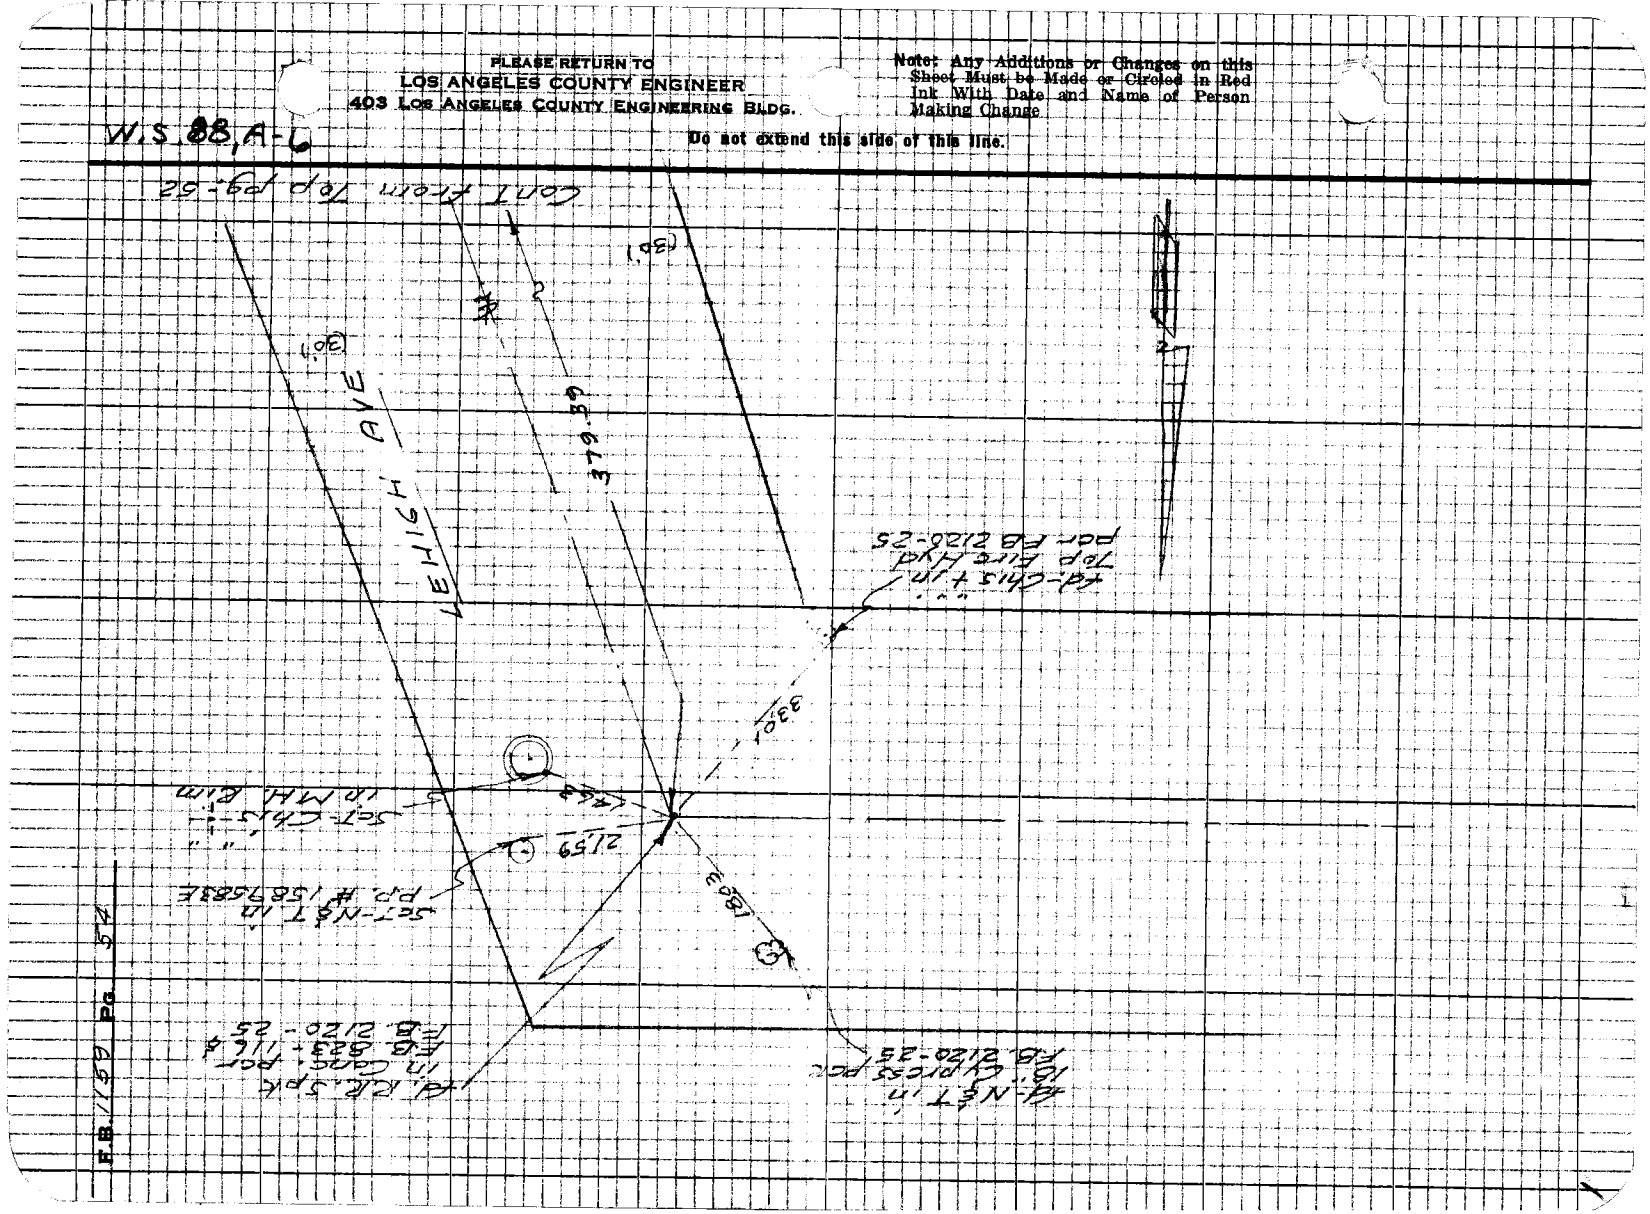

Notes Ck'd by [illegible]	Survey of WINDSOR AVE	F.B. 1159 Pg. 55
Map No.	JN 0075.46 Tape 2240 Std 68 °F	
Office Work T. ABE	Surveyed by A.S. CURTIS	CONT. on BOT. pg. 56
Checked	Notes CURTIS Date 11/67	
Date	Indexed C. J. GALLI	

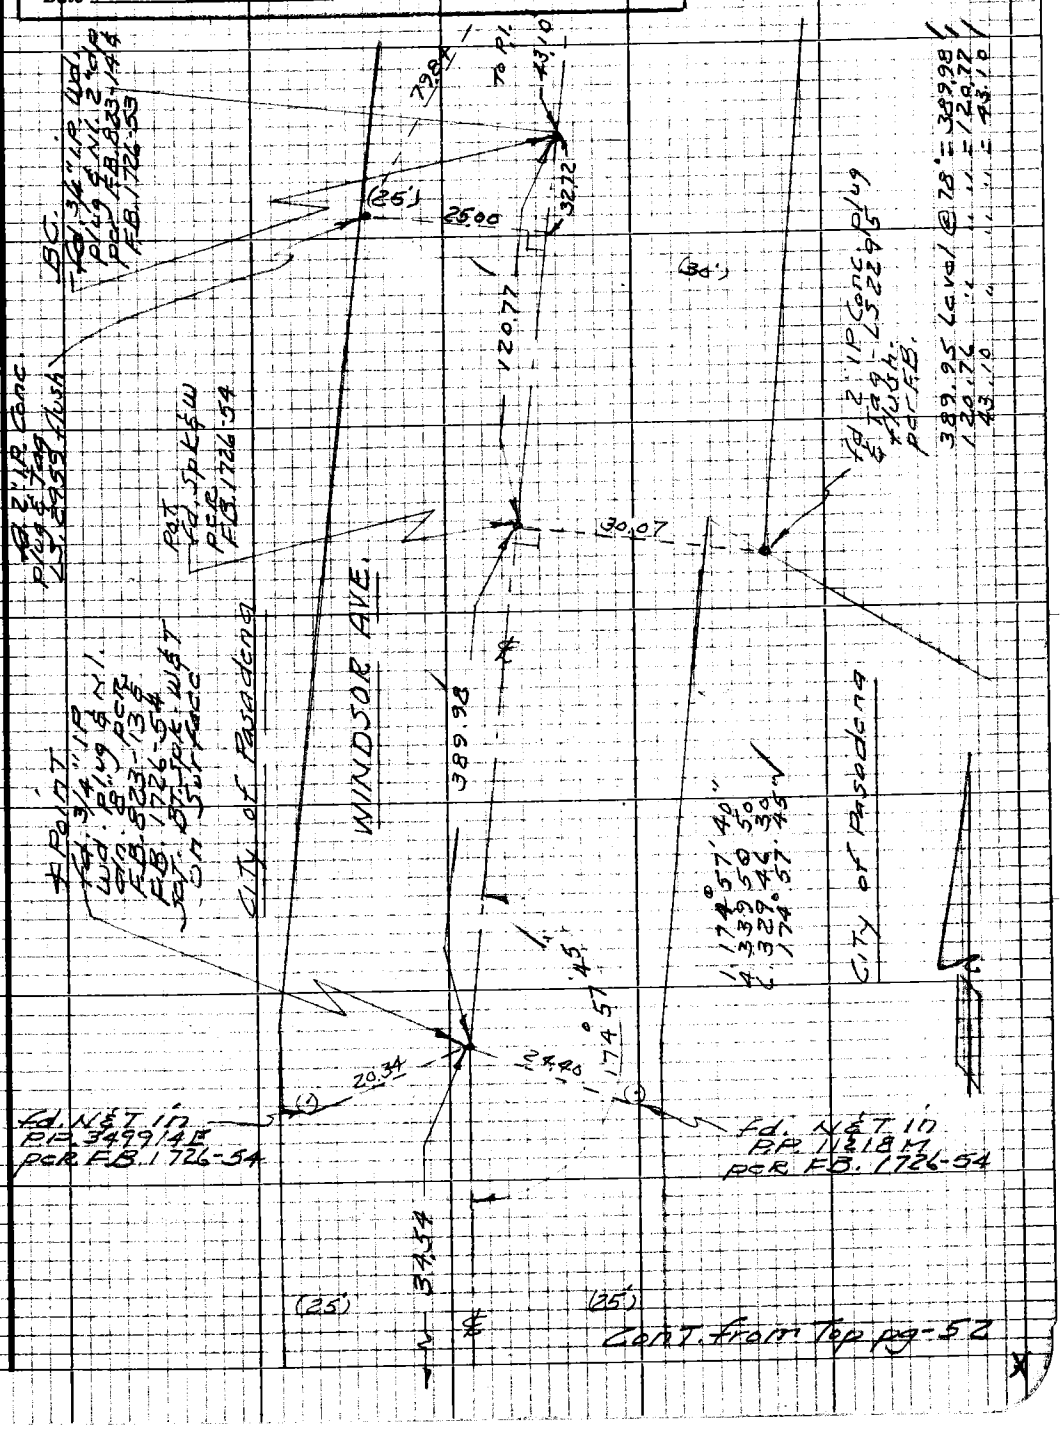

Cont. from Top pg-52

Note: Any Additions or Changes on this Sheet Must be Made or Circled in Red Ink With Date and Name of Person Making Change

Do not extend this side of this line.

PLEASE RETURN TO
LOS ANGELES COUNTY ENGINEER
403 LOS ANGELES COUNTY ENGINEERING BLDG.

76P3098 CK #310 8-66

PLEASE RETURN TO
LOS ANGELES COUNTY ENGINEER
403 LOS ANGELES COUNTY ENGINEERING BLDG.

Note: Any Additions or Changes on this Sheet Must be Made or Circled in Red Ink With Date and Name of Person Making Change

Do not extend this side of this line.

W.S. 88, A-6

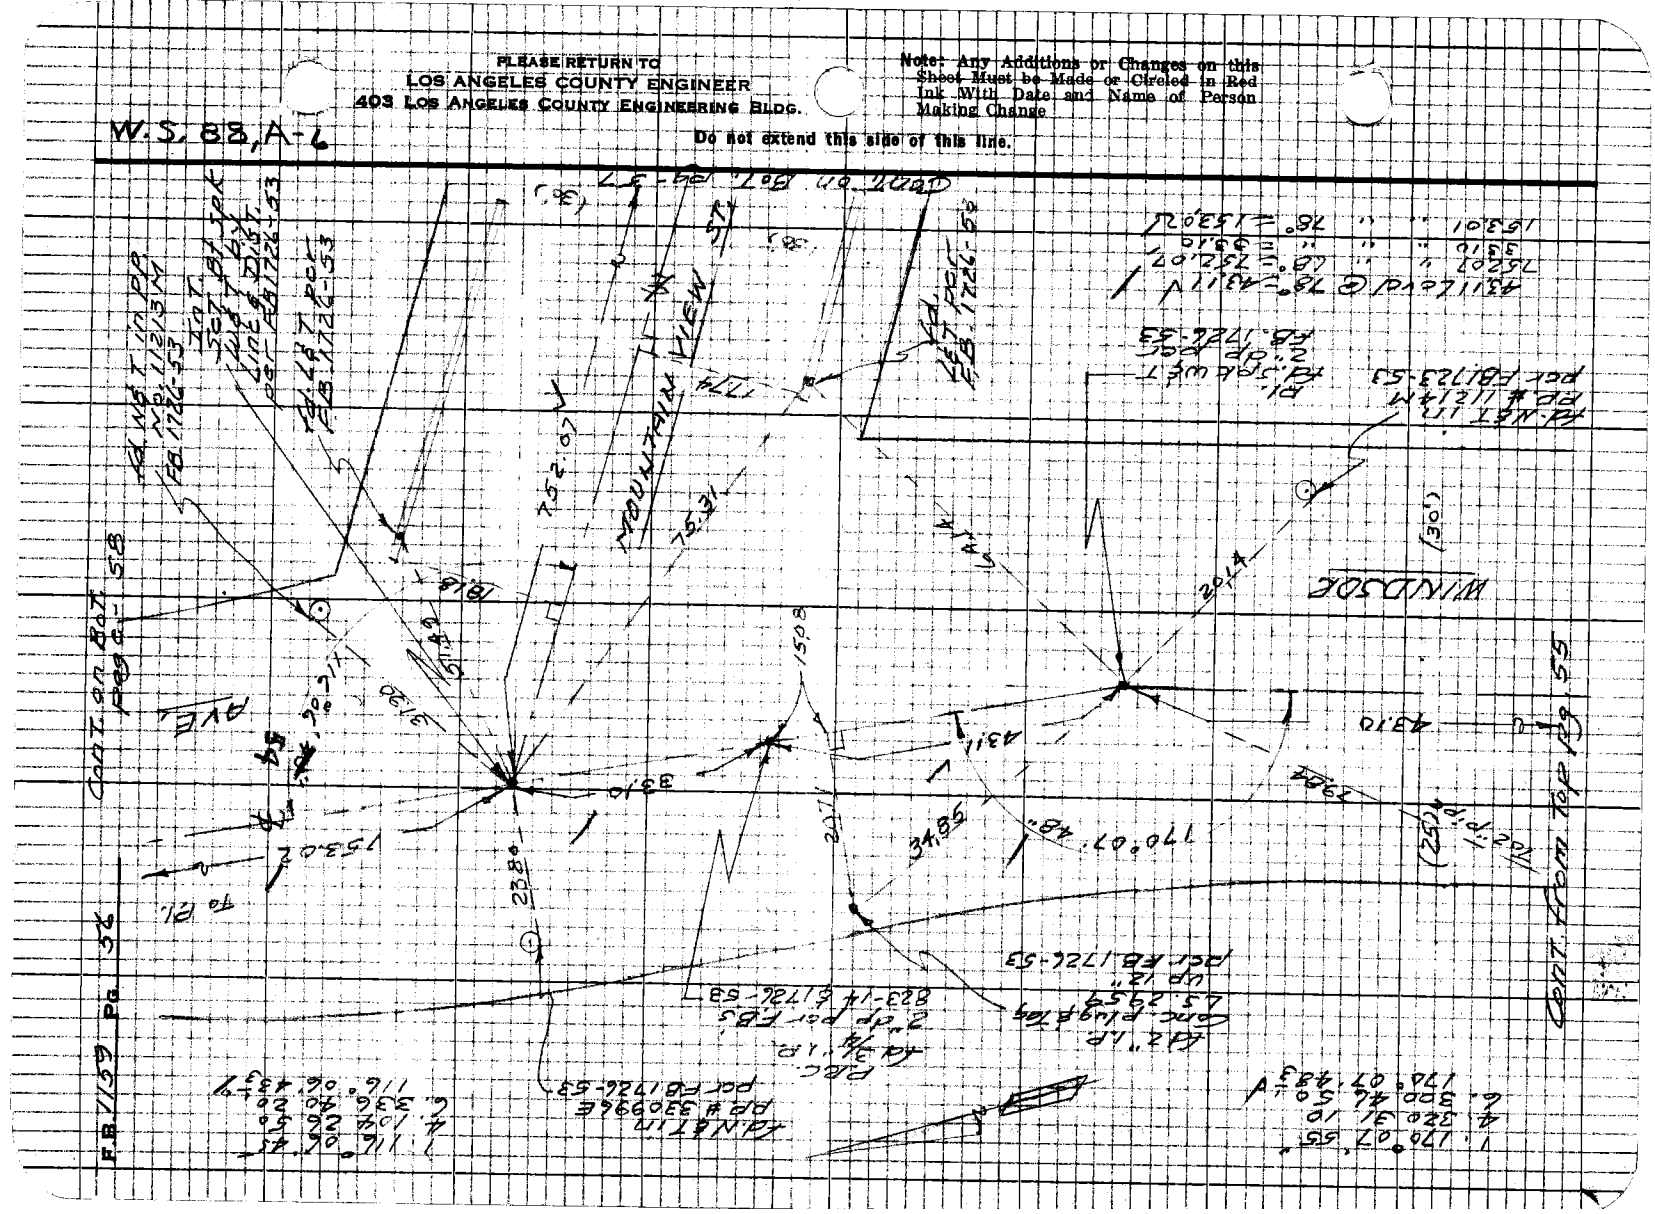

Notes Ck'd by:
Map No.
Office Work T. ABE
Checked
Date

Survey of Windsor Ave
JN 2075.46 Tape 0240 Std 68 °F
Surveyed by A. S. Curtis
Notes Curtis Date 11/67
Indexed C. J. GALLI

F.B. 1159 Pg. 57

Note: Any Additions or Changes on this Sheet Must be Made or Circled in Red Ink With Date and Name of Person Making Change

W.S. 88, A-6

Do not extend this side of this line.

PLEASE RETURN TO
LOS ANGELES COUNTY ENGINEER
403 LOS ANGELES COUNTY ENGINEERING BLDG.

Cont. from Rt. pg. 56

76P3098 CE #210 5-66

PLEASE RETURN TO
LOS ANGELES COUNTY ENGINEER
403 LOS ANGELES COUNTY ENGINEERING BLDG.

Note: Any Additions or Changes on this Sheet Must be Made or Circled in Red Ink With Date and Name of Person Making Change

W.S. 88, A-6

Do not extend this side of this line.

Notes Ck'd by	Survey of Windsor Ave
Map No.	JN 0075.46 Tape 0240 Std 68 °F
Office Work T. ABE	Surveyed by A. S. Curtis
Checked	Notes Curtis Date 11/67
Date	Indexed C. J. GALLI

F.B. 1159 Pg. 59

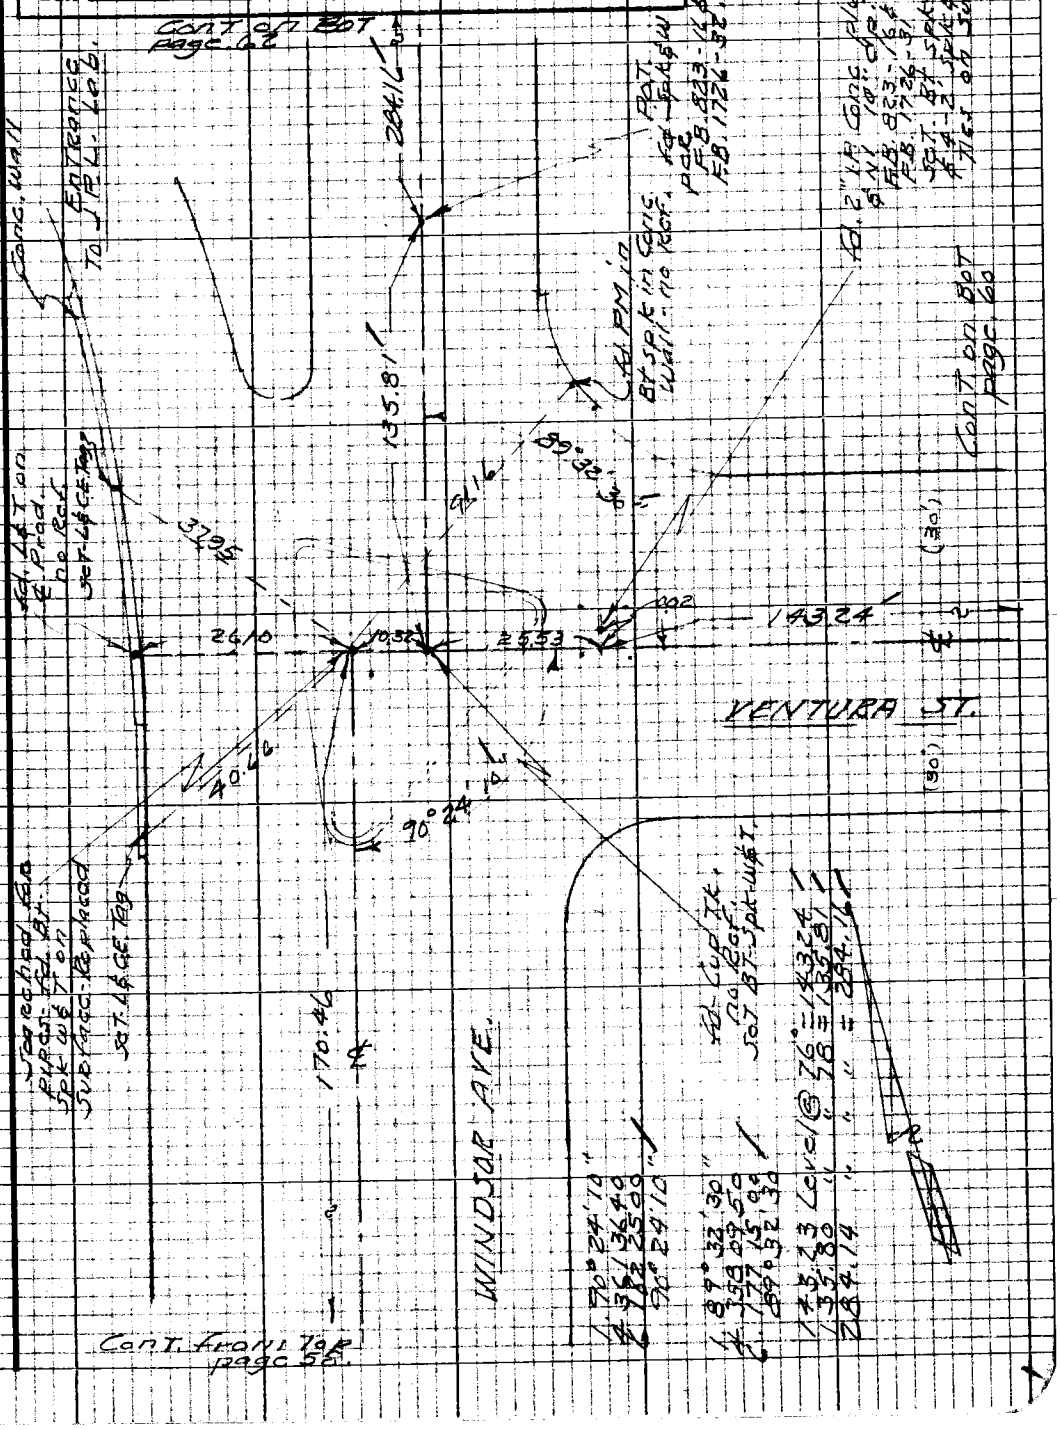

Note: Any Additions or Changes on this Sheet Must be Made or Circled in Red Ink With Date and Name of Person Making Change

Do not extend this side of this line.

W.S. 88, A-6

PLEASE RETURN TO
LOS ANGELES COUNTY ENGINEER
403 LOS ANGELES COUNTY ENGINEERING BLDG.

76P3095 CE #310 5-66

PLEASE RETURN TO
LOS ANGELES COUNTY ENGINEER
403 LOS ANGELES COUNTY ENGINEERING BLDG.

Note: Any Additions or Changes on this Sheet Must be Made or Circled in Red Ink With Date and Name of Person Making Change

Do not extend this side of this line.

W.S. 88, A-6

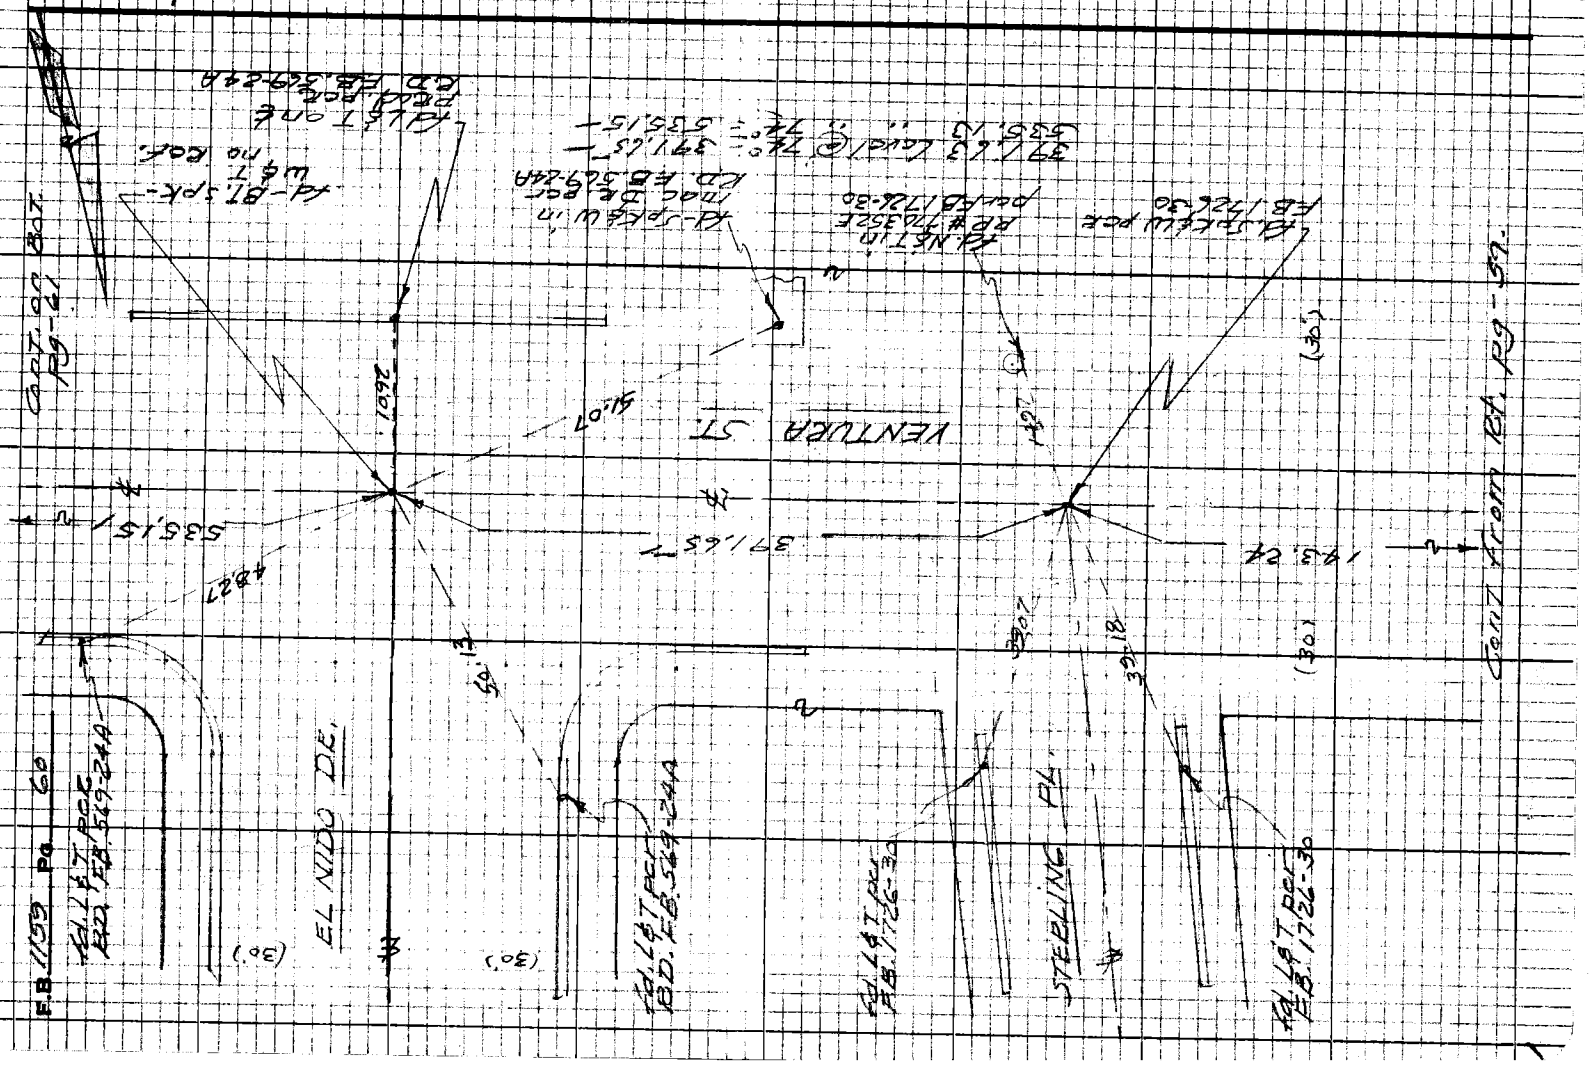

Notes Ck'd by	Survey of Windsor Ave
Map No.	JN 007546 Tape 0240 Std 68 °F
Office Work T. ABE	Surveyed by A.S. Curtis
Checked	Notes Curtis Date 11/67
Date	Indexed C. J. GALLI

F.B. 1159 Pg. 61

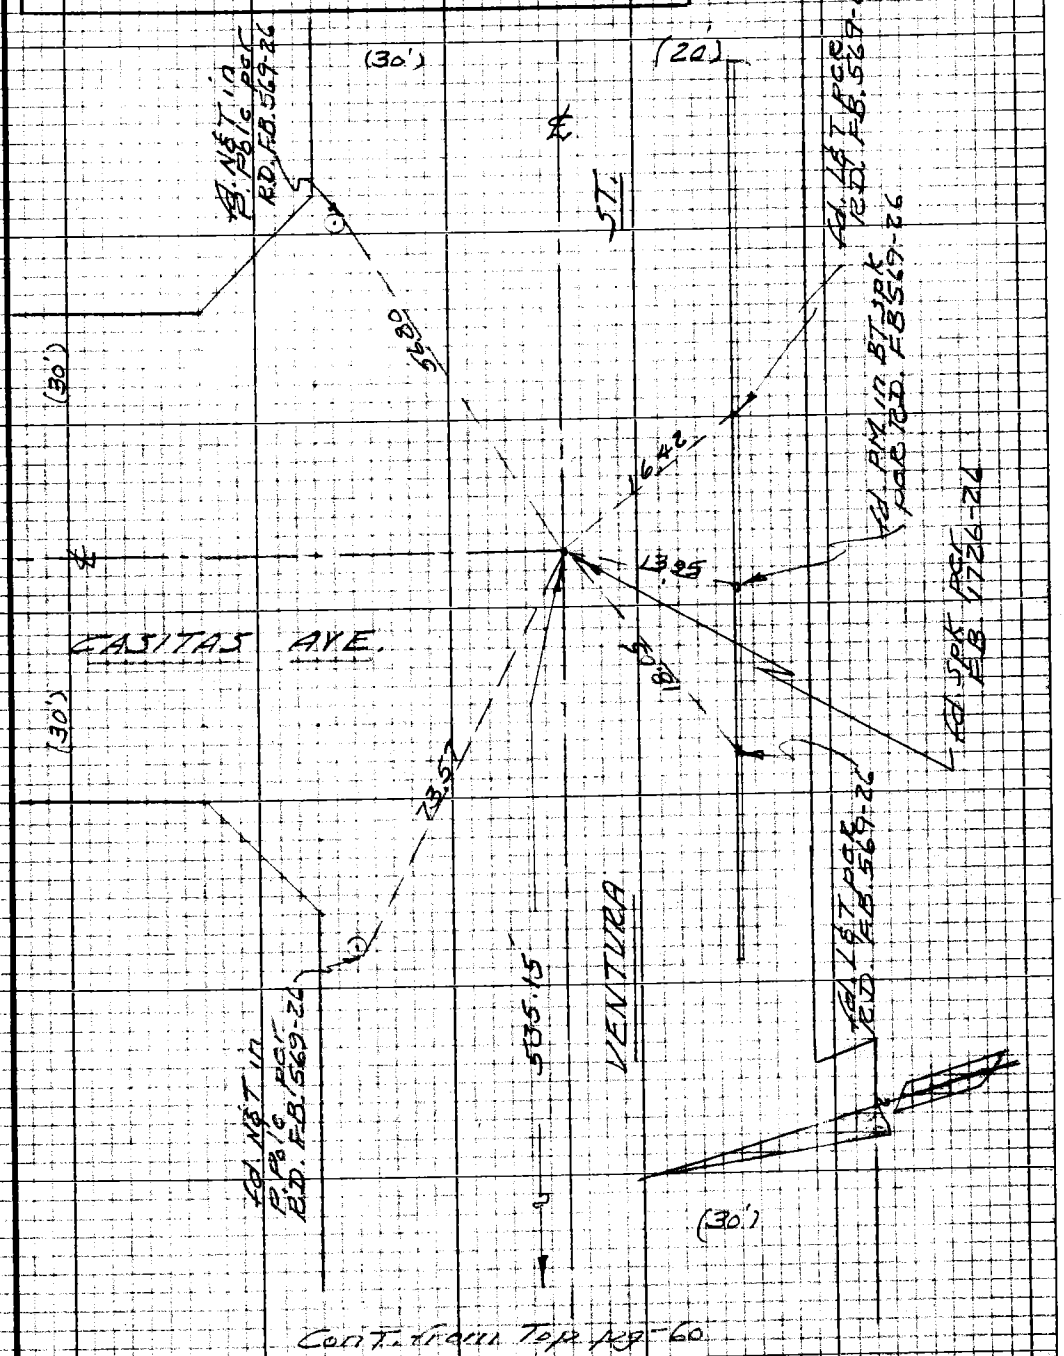

Cont. from Top pg-60

Note: Any Additions or Changes on this Sheet Must be Made or Circled in Red Ink With Date and Name of Person Making Change

Do not extend this side of this line.

W.S. 88, A-6

PLEASE RETURN TO
LOS ANGELES COUNTY ENGINEER
403 Los Angeles County Engineering Bldg.

76P3098 CE #310 5-66

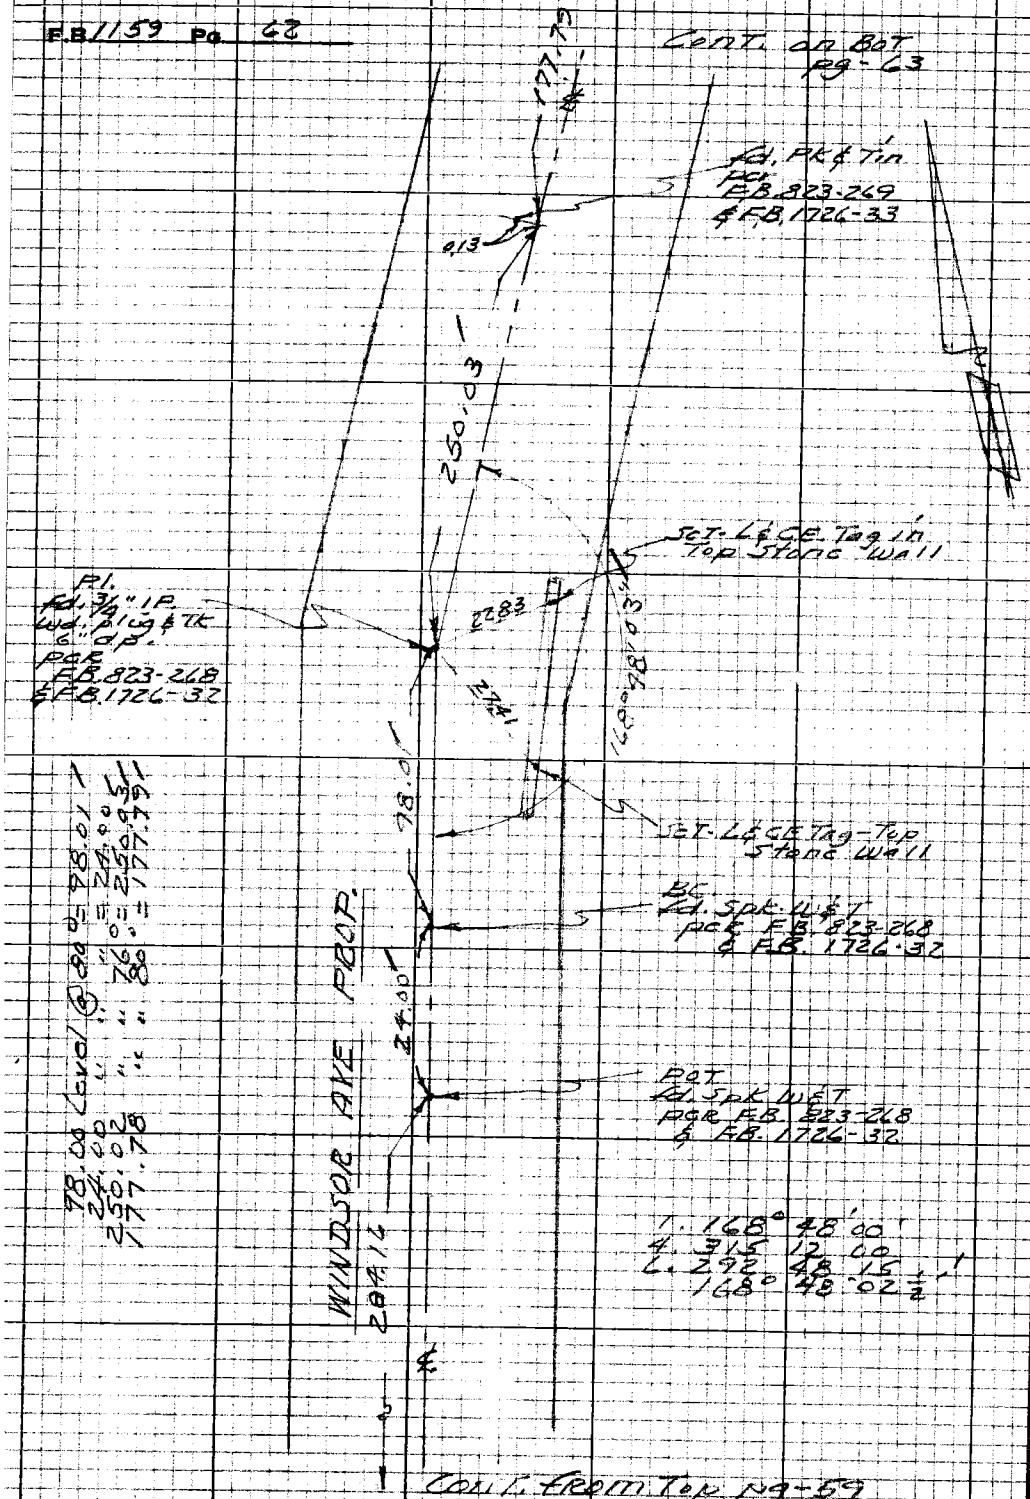

W.S. 88, A-6

PLEASE RETURN TO
LOS ANGELES COUNTY ENGINEER
403 LOS ANGELES COUNTY ENGINEERING BLDG.

Do not extend this side of this line.

Note: Any Additions or Changes on this Sheet Must be Made or Circled in Red Ink With Date and Name of Person Making Change

Notes Ck'd by	Survey of Windsor Ave
Map No.	JN 007546 Tape 0240 Std 68 °F
Office Work T. ABE	Surveyed by A.S. Curtis
Checked	Notes Curtis Date 11/67
Date	Indexed E. J. GALLI

F.B. 1159 Pg. 63

Cont. on Bot pg-64

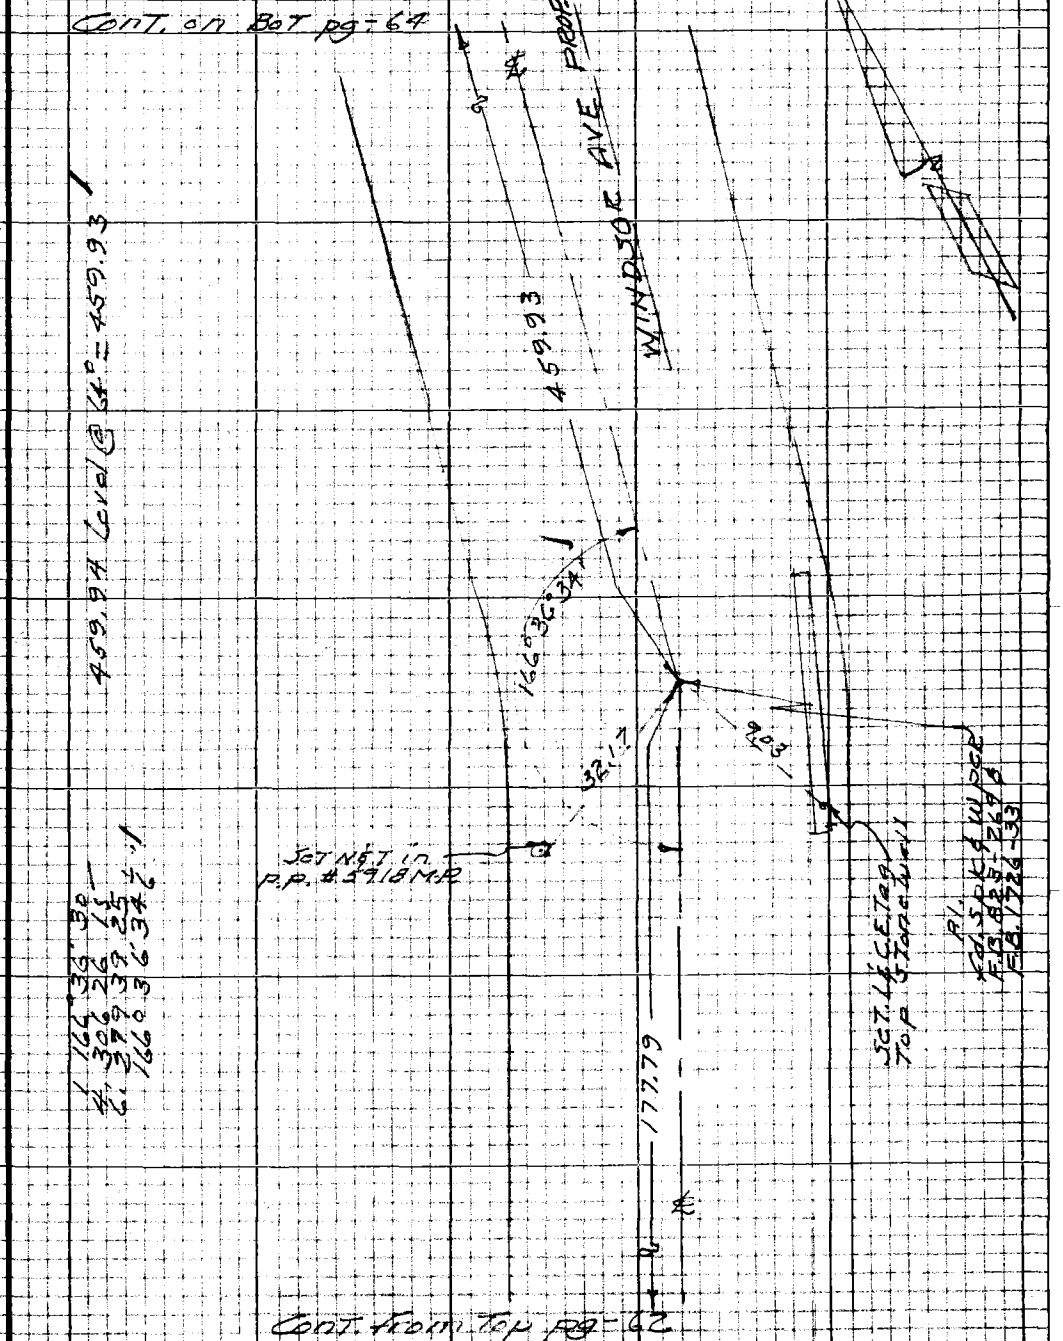

Cont. from Top pg-62

Note: Any Additions or Changes on this Sheet Must be Made or Circled in Red Ink With Date and Name of Person Making Change

Do not extend this side of this line.

PLEASE RETURN TO
LOS ANGELES COUNTY ENGINEER
403 Los Angeles County Engineering Bldg.

76P3098 CK #310 8-66

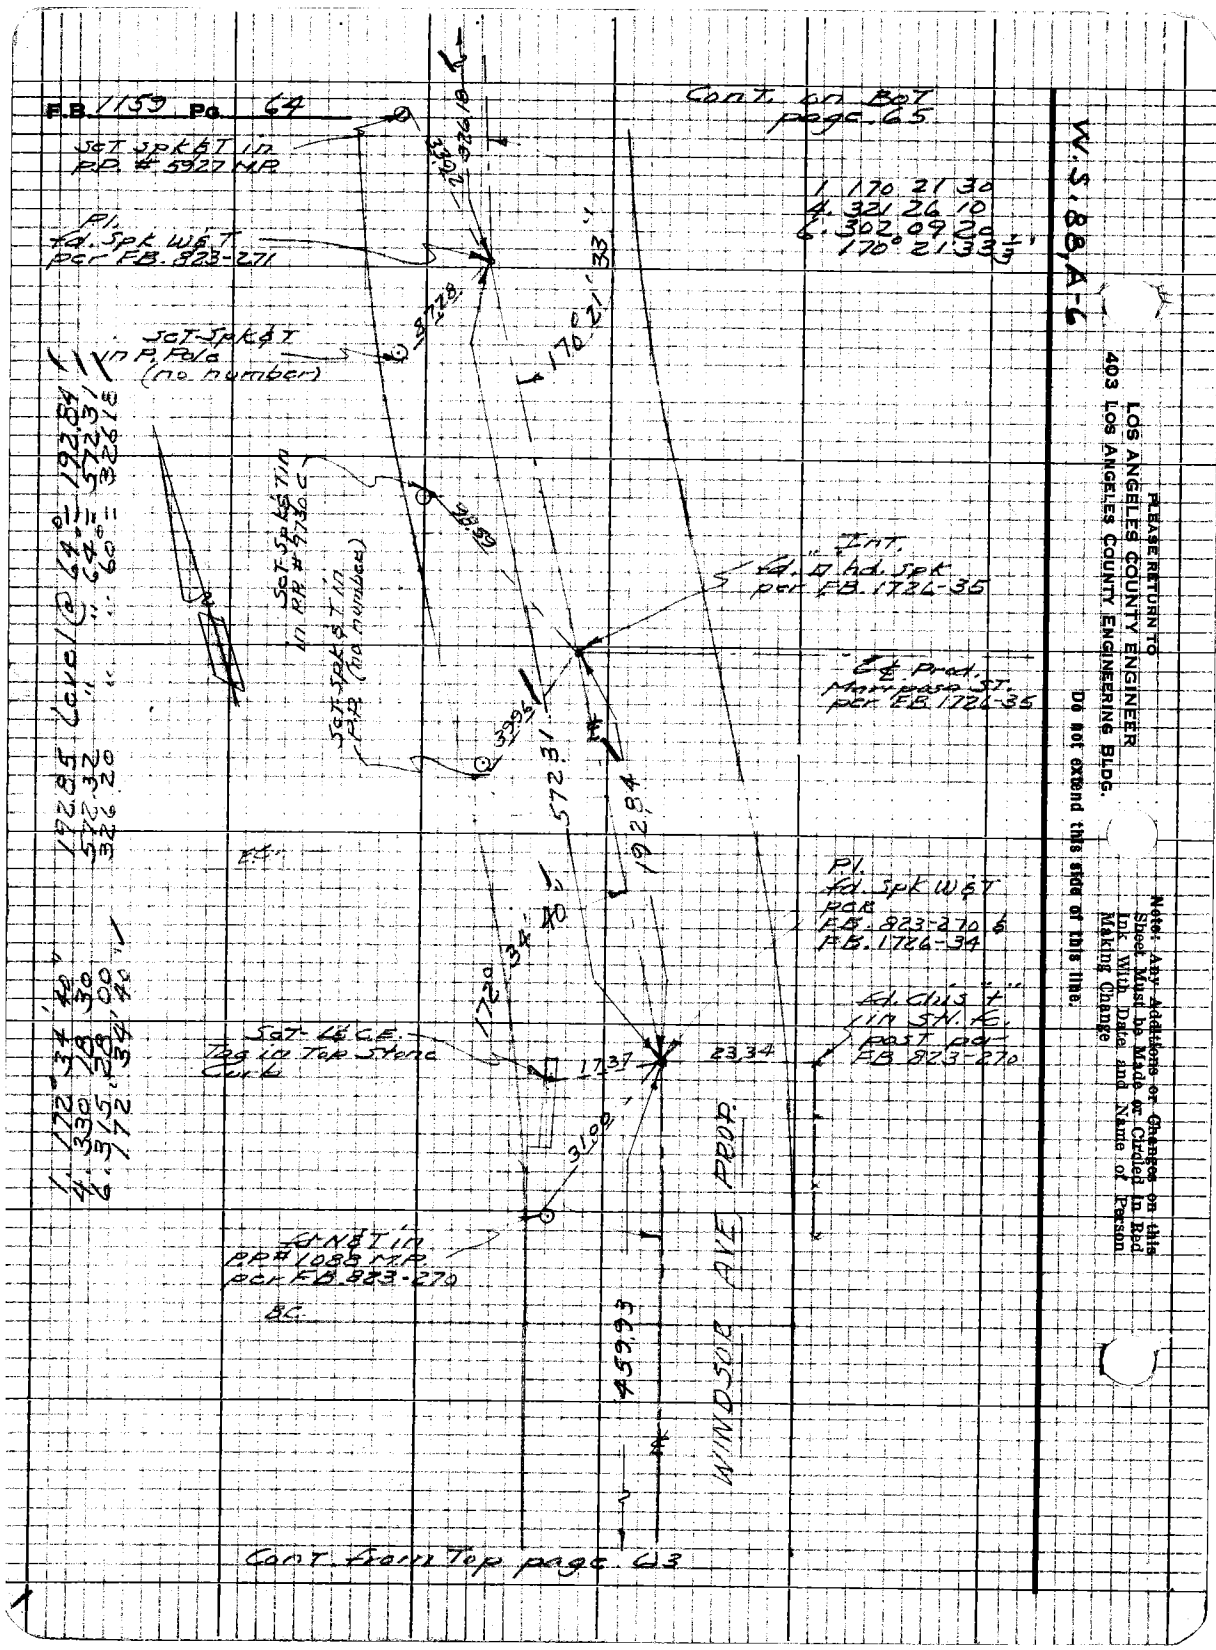
F.B. 1159 Pg. 64
Cont. on Bot page 65
W.S. 88, A-6
Set Spk & T in P.P. # 5927 M.P.
Pl. fd. Spk W & T per F.B. 823-271
Set Spk & T in P. Pole (no number)
Set Spk & T in P.P. # 9730 C
Set Spk & T in P.P. (no number)
Int. fd. □ hd. Spk per F.B. 1726-35
℄ Prod. Mariposa St. per F.B. 1726-35
Pl. fd. Spk W & T per F.B. 823-270 & F.B. 1726-34
Fd. Chis "t" in Sh. Fc. post per F.B. 823-270
Set L & C.E. Tag in Top Stone Curb
Fd. N & T in P.P. # 1088 M.P. per F.B. 823-270
WINDSOR AVE PROP.
Cont. from Top page 63
PLEASE RETURN TO
LOS ANGELES COUNTY ENGINEER
403 LOS ANGELES COUNTY ENGINEERING BLDG.
Do not extend this side of this line.
Note: Any Additions or Changes on this Sheet Must be Made or Circled in Red Ink With Date and Name of Person Making Change

Notes Ck'd by	Survey of Windsor Ave.	F.B. 1159 Pg. 65
Map No.	JN 0075.46 Tape 0240 Std. 68 °F	T = 70°
Office Work T. AB.	Surveyed by A. S. Curtis	120.45 @ 27°54' = 106.44'
Checked	Notes Curtis Date 11/67	120.84 " 28°15' = 106.44'
Date	Indexed C. J. GALLI	

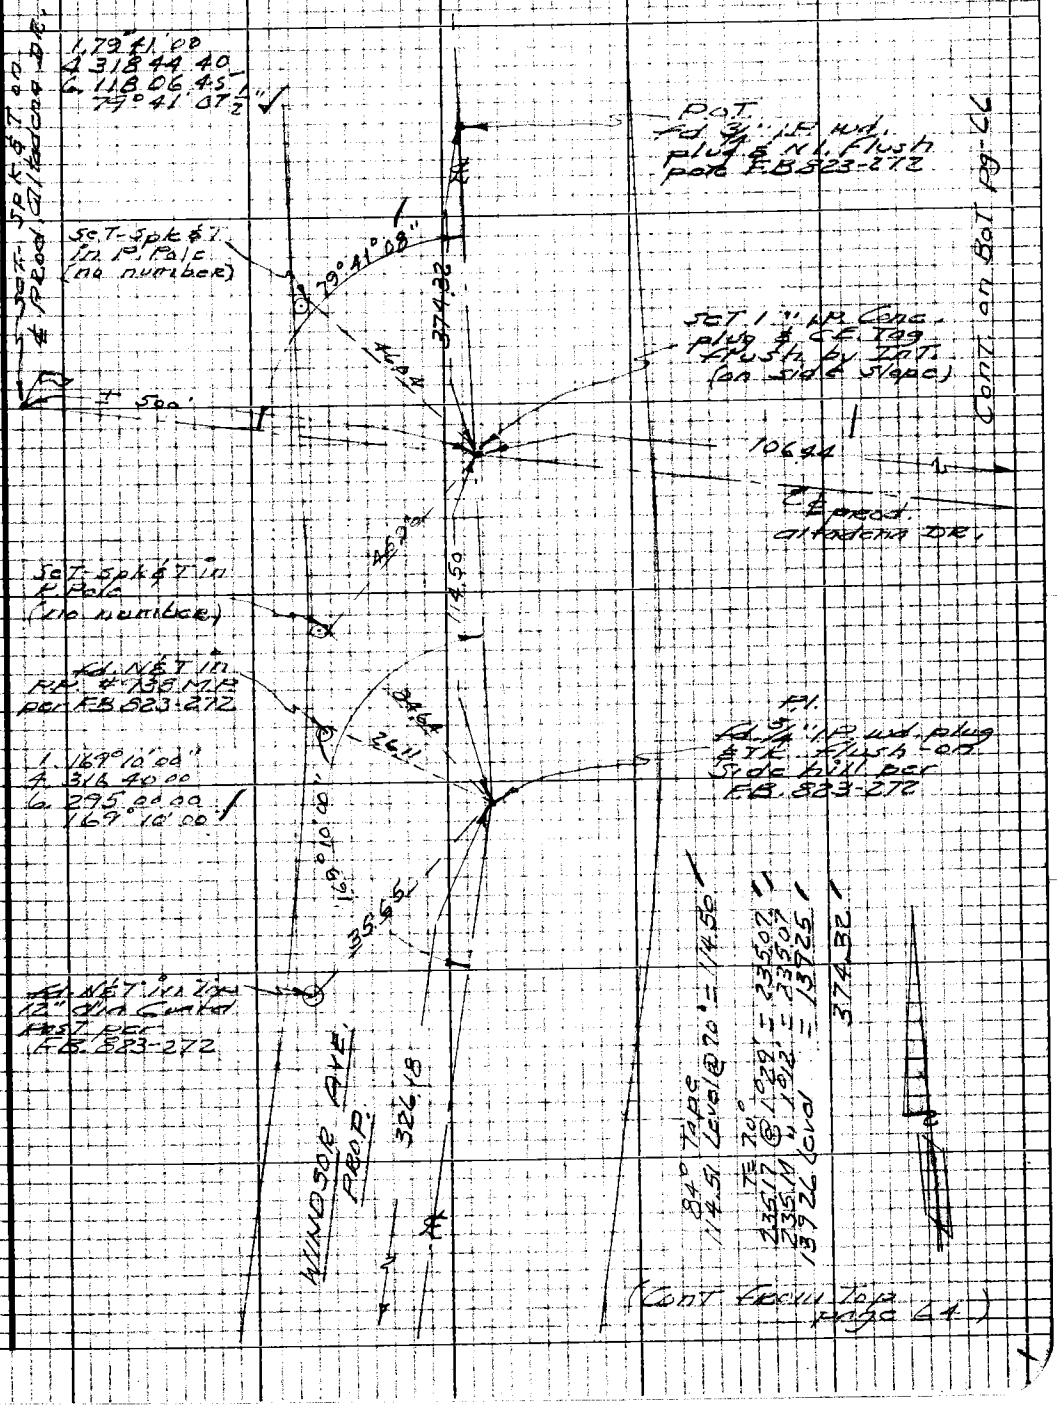

Note: Any Additions or Changes on this Sheet Must be Made or Circled in Red Ink With Date and Name of Person Making Change.

Do not extend this side of this line.

W.S. 88, A-6

PLEASE RETURN TO
LOS ANGELES COUNTY ENGINEER
403 LOS ANGELES COUNTY ENGINEERING BLDG.

76P3095 CE #310 5-66

F.B. 1159 Pg. 66

Cont. on Bot. pg-67

W.S. 88, A-5 & B-5

PLEASE RETURN TO
LOS ANGELES COUNTY ENGINEER
403 LOS ANGELES COUNTY ENGINEERING BLDG.

Do not extend this side of this line.

Note: Any Additions or Changes on this Sheet Must be Made or Circled in Red Ink With Date and Name of Person Making Change.

Cont. From Bt. pg-65

Notes Ck'd by	[illegible]	Survey of	WINDSOR AVE
Map No.		JN 007546	Tape 0240 Std 68 °F
Office Work	T. AD	Surveyed by	A.S. Curtis
Checked		Notes	Curtis Date 11/67
Date		Indexed	C. J. GALLI

F.B. 1159 Pg. 67

Cont on Lt page 68

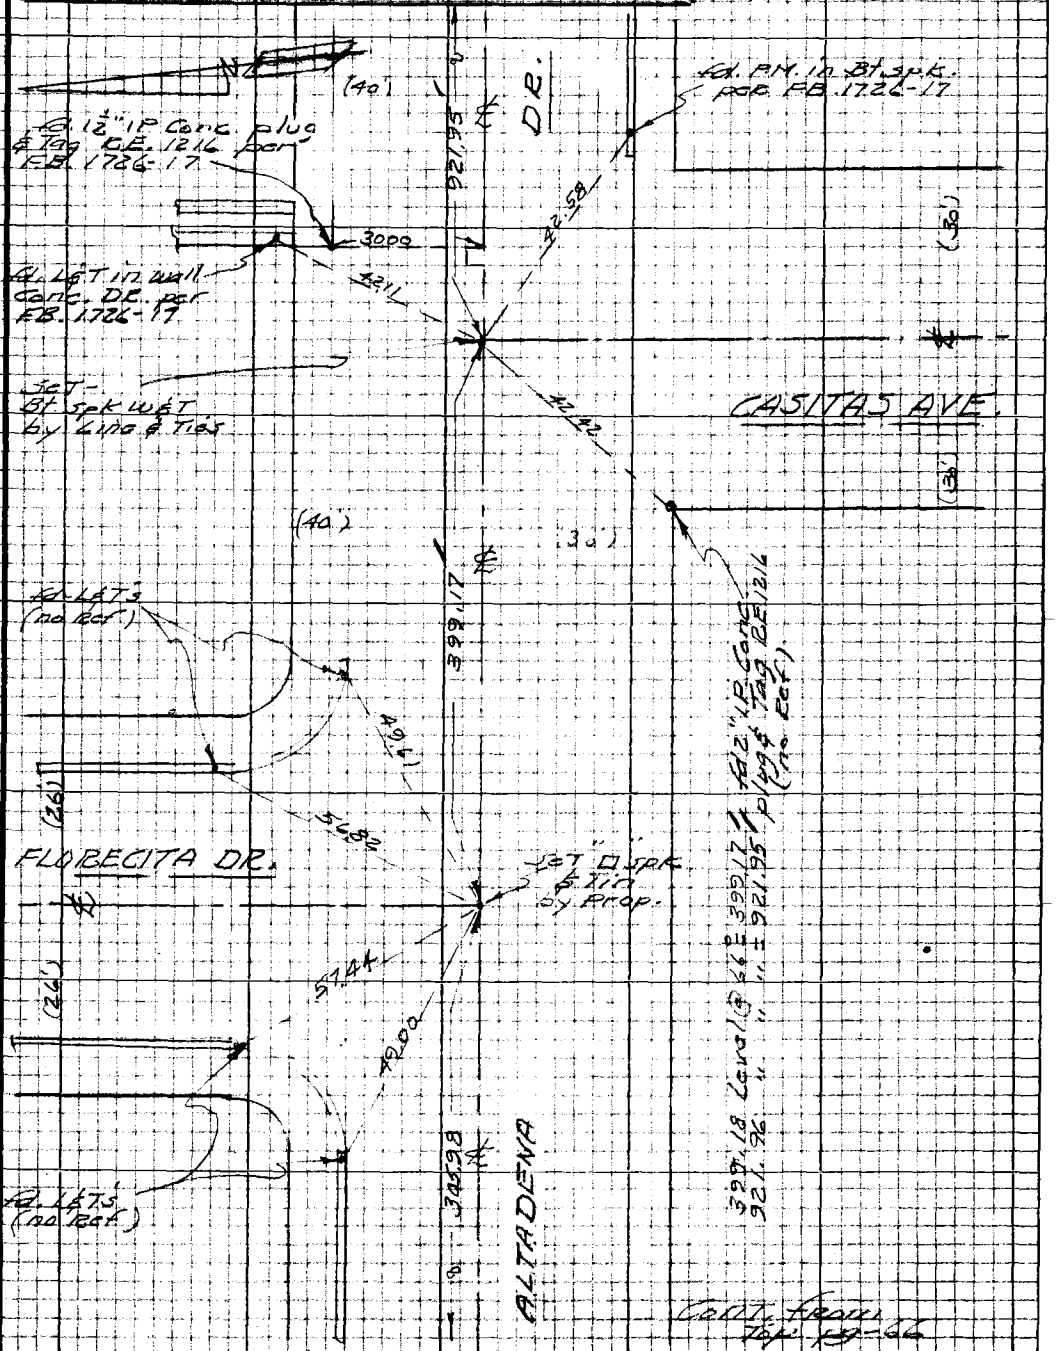

Cont. from Top pg-66

Note: Any Additions or Changes on this Sheet Must be Made or Circled in Red Ink With Date and Name of Person Making Change

Do not extend this side of this line.

W.S. 88, 8-6

PLEASE RETURN TO
LOS ANGELES COUNTY ENGINEER
403 LOS ANGELES COUNTY ENGINEERING BLDG.

76P3098 CE #310 8-66

PLEASE RETURN TO
LOS ANGELES COUNTY ENGINEER
403 LOS ANGELES COUNTY ENGINEERING BLDG.

Note: Any Additions or Changes on this Sheet Must be Made or Circled in Red Ink With Date and Name of Person Making Change

Do not extend this side of this line.

W.S. 88, B-6

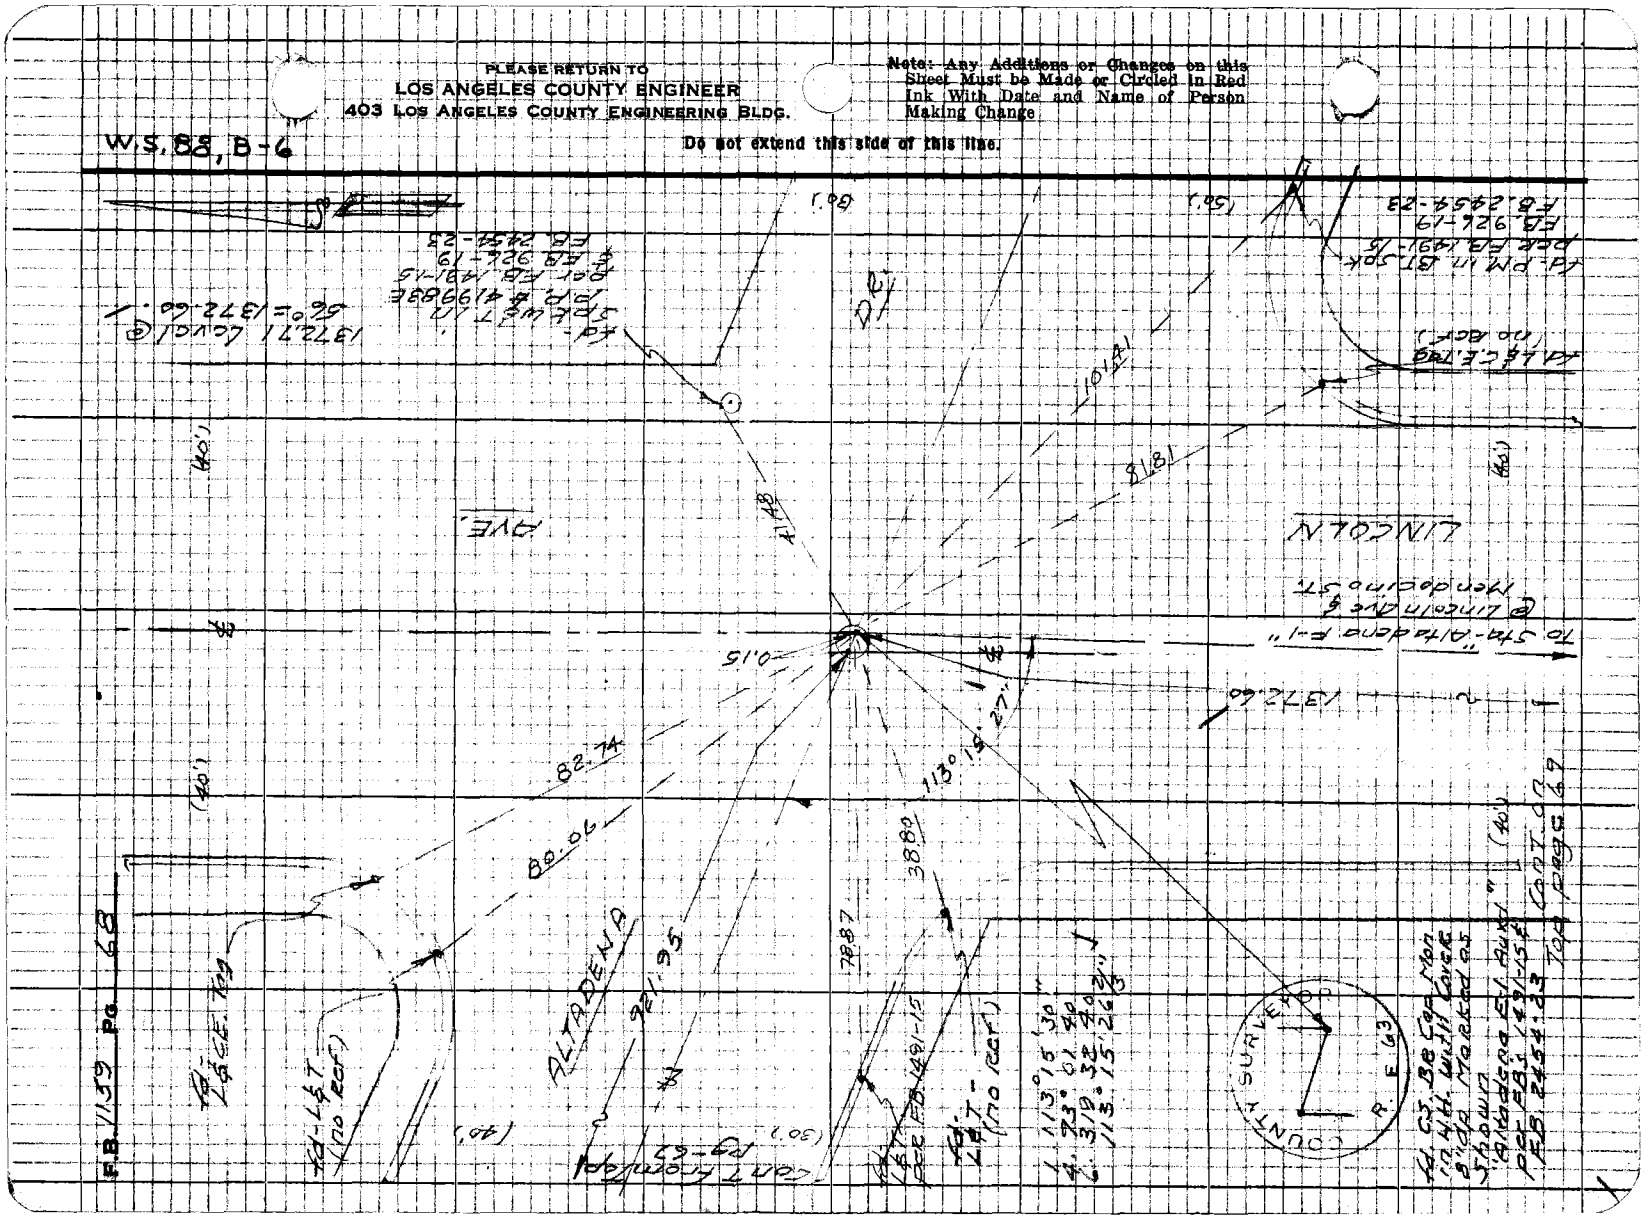

Notes Ck'd by	Survey of Windsor Ave	F.B. 1159 Pg. 69
Map No.	JN 0075-46 Tape 0240 Std 68 °F	
Office Work T. ABE	Surveyed by A. S. Curtis	
Checked	Notes Curtis Date 11/67	
Date	Indexed C. J. GALL	

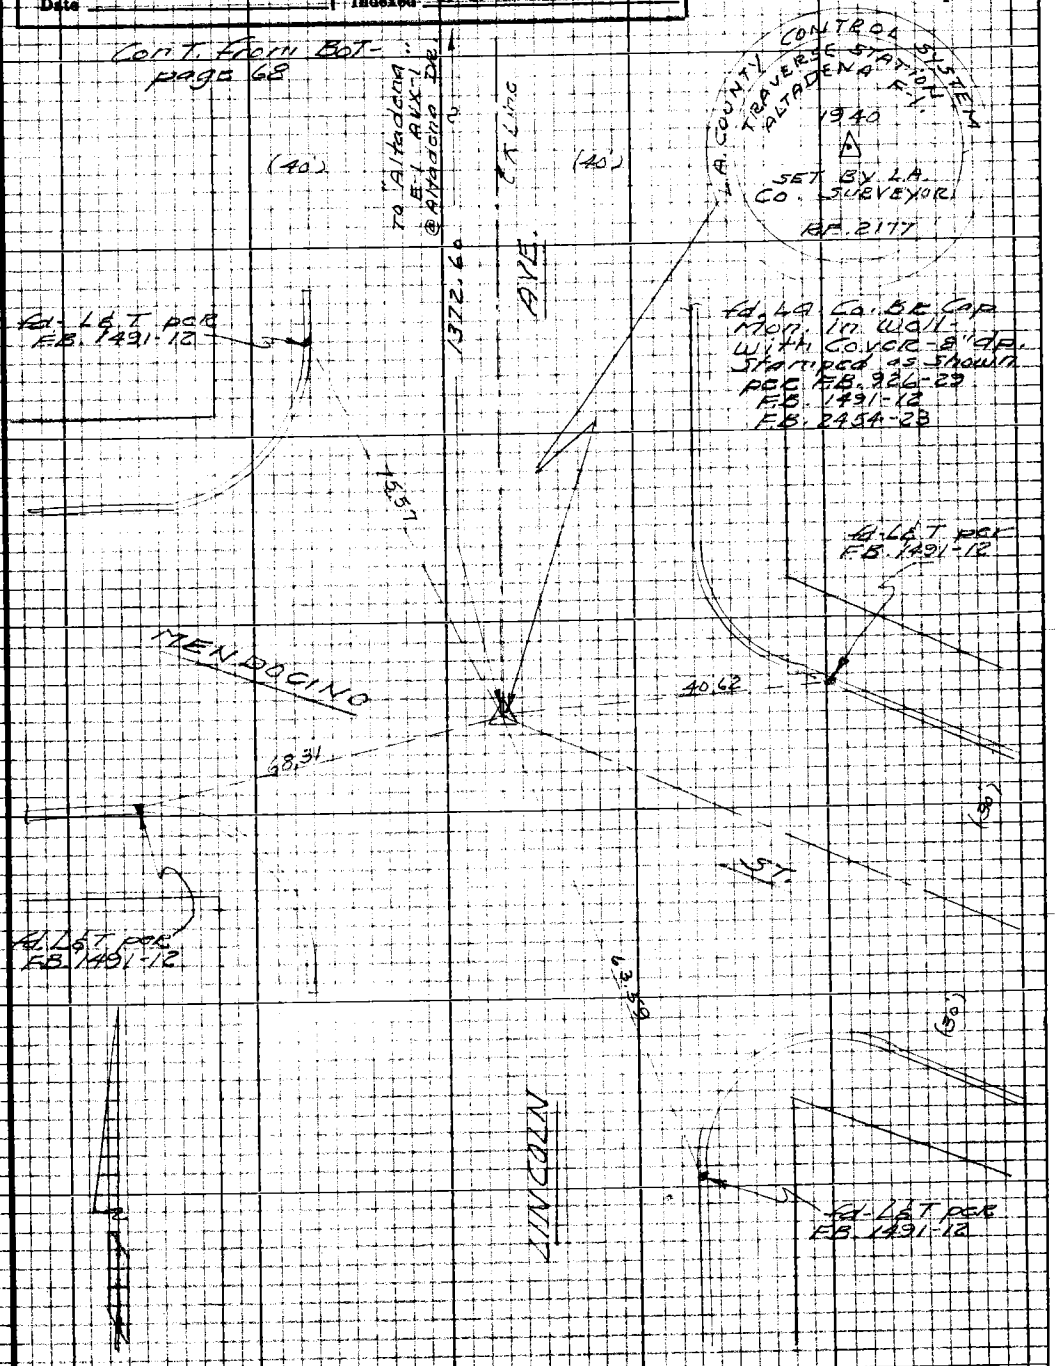

Note: Any Additions or Changes on this Sheet Must be Made or Circled in Red Ink With Date and Name of Person Making Change

W.S. 88, B-6

Do not extend this side of this line.

PLEASE RETURN TO
LOS ANGELES COUNTY ENGINEER
403 LOS ANGELES COUNTY ENGINEERING BLDG.

75P3093 CE #310 5-66

PLEASE RETURN TO
LOS ANGELES COUNTY ENGINEER
403 LOS ANGELES COUNTY ENGINEERING BLDG.

Note: Any Additions or Changes on this Sheet Must be Made or Circled in Red Ink With Date and Name of Person Making Change

W.S. 88, A-6

Do not extend this side of this line.

Notes Ck'd by	Survey of Windsor Ave	F.B. 1159 Pg. 71
Map No.	JN 0075.46 Tape 0240 Std 68 °F	
Office Work T. A.	Surveyed by A.S. Curtis	Cont. on Bot. pg-72
Checked	Notes Curtis Date 11/67	
Date	Indexed E. J. GALLI	

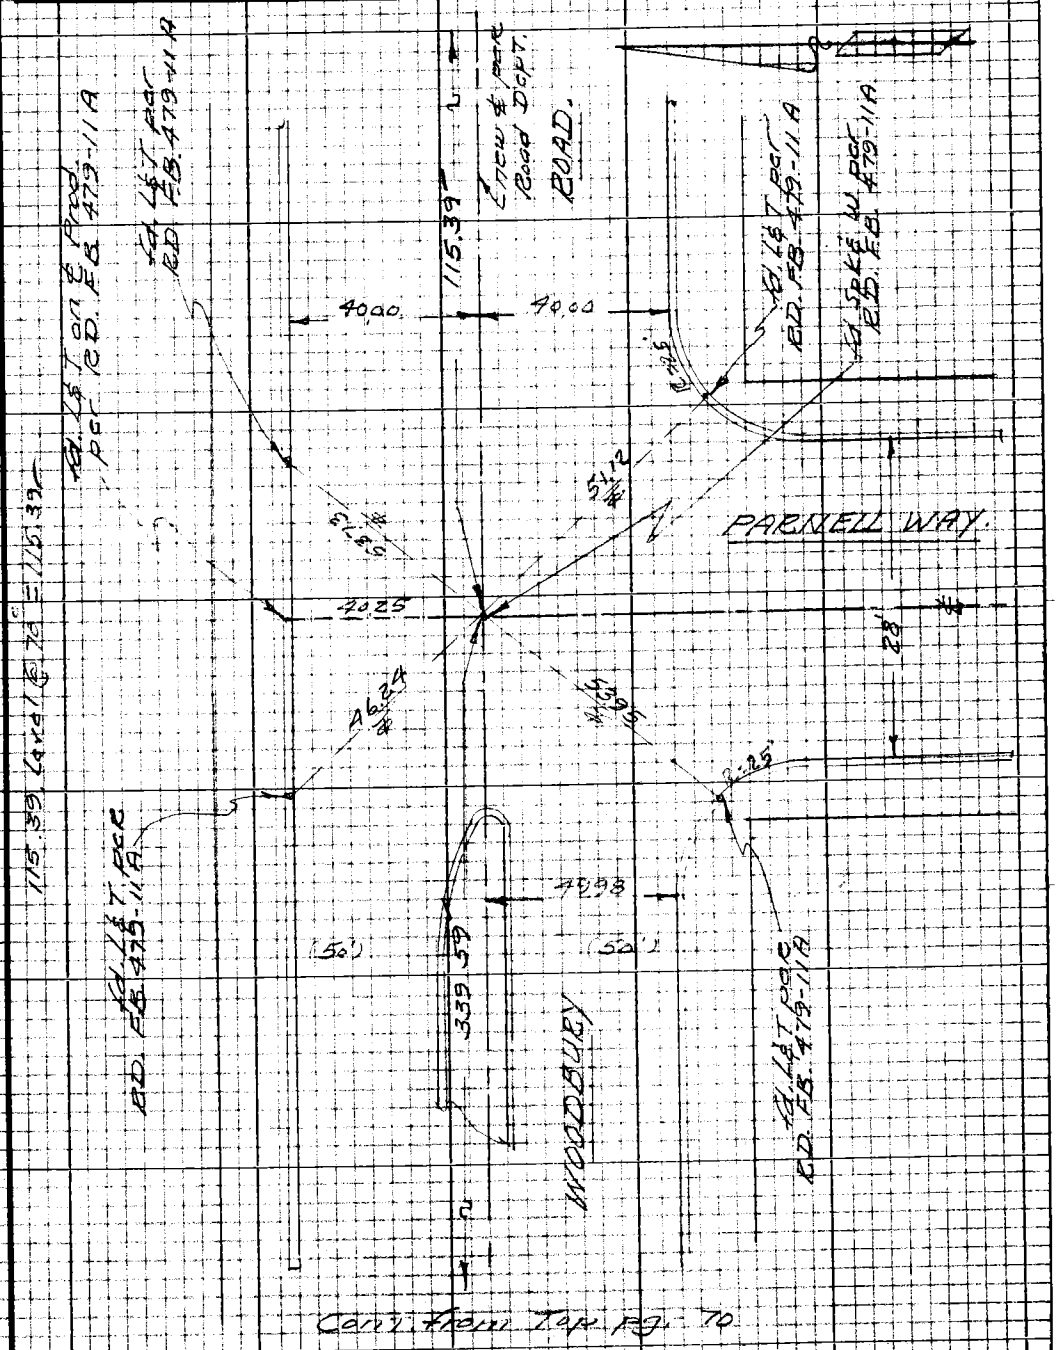

Cont. from Top pg. 70

Note: Any Additions or Changes on this Sheet Must be Made or Circled in Red Ink With Date and Name of Person Making Change

Do not extend this side of this line.

W.S. 88, B-6

PLEASE RETURN TO
LOS ANGELES COUNTY ENGINEER
403 Los Angeles County Engineering Bldg.

76P3095 CE #310 5-66

PLEASE RETURN TO
LOS ANGELES COUNTY ENGINEER
403 LOS ANGELES COUNTY ENGINEERING BLDG.

Note: Any Additions or Changes on this Sheet Must be Made or Circled in Red Ink With Date and Name of Person Making Change

Do not extend this side of this line.

W.S. 88, B-6

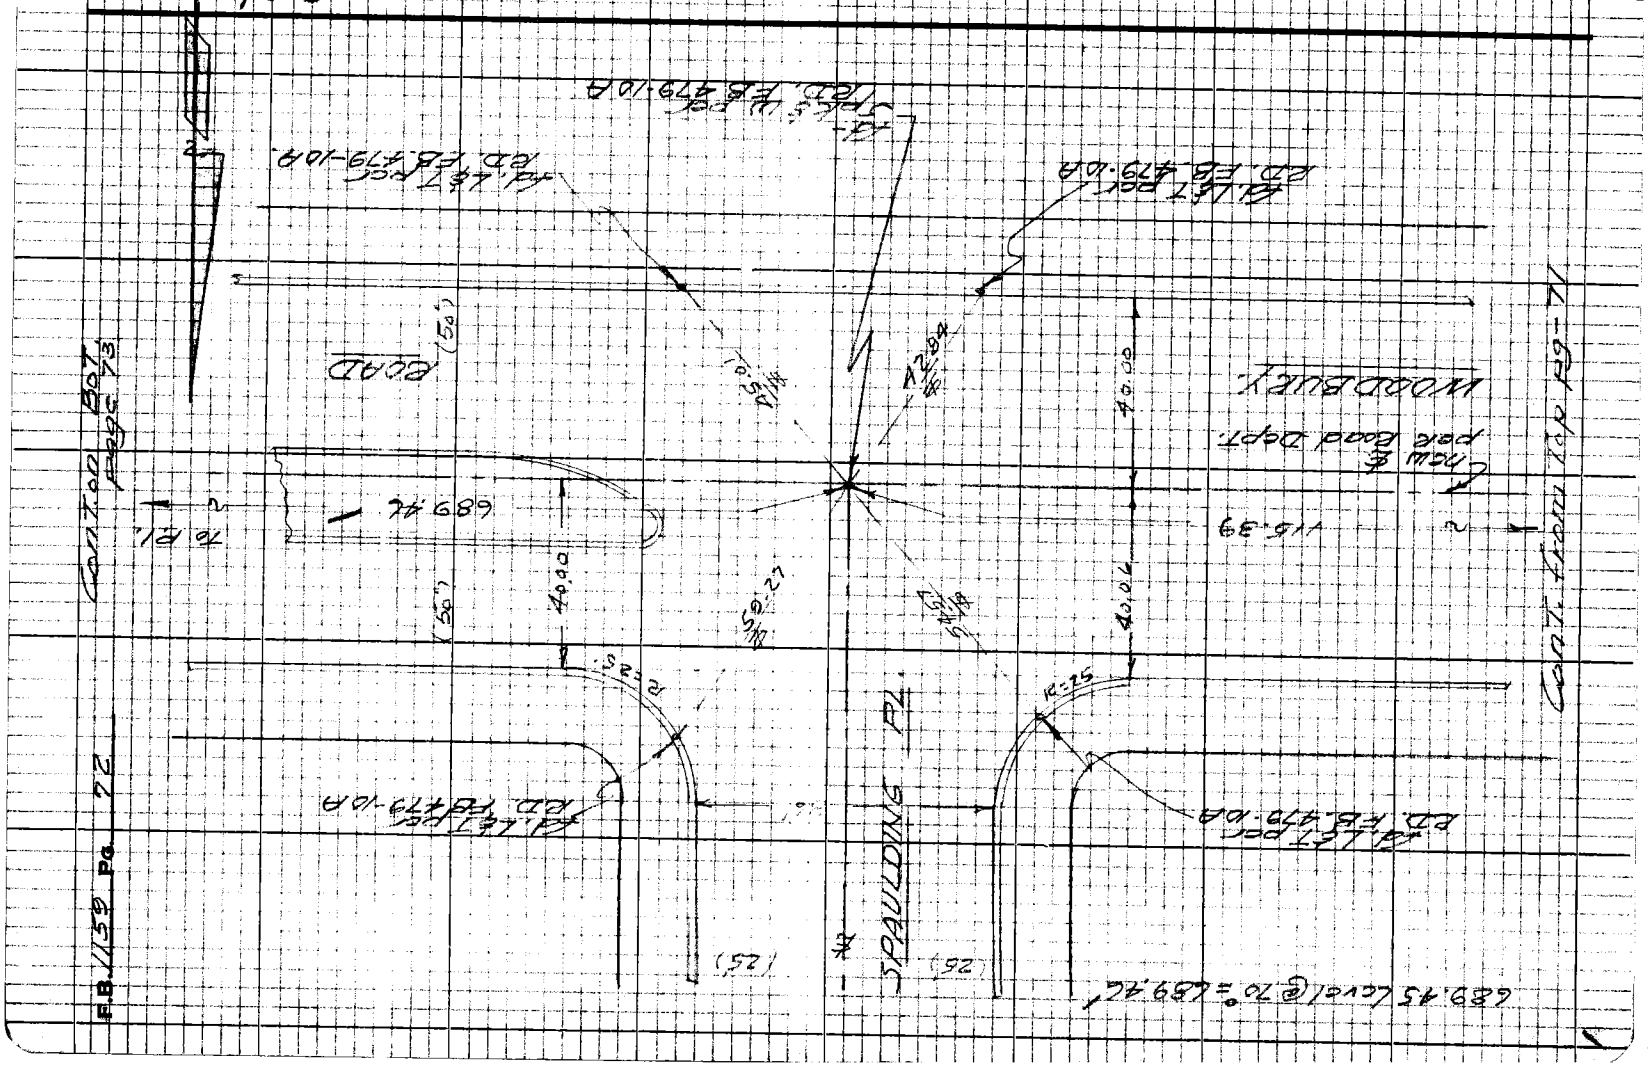

Notes Ck'd by		Survey of Windsor Ave	F.B. 1159 Pg. 73
Map No.		JN 0075.46 Tape 0240 Std 68 °F	
Office Work	T. AB	Surveyed by A.S. Curtis	
Checked		Notes Curtis Date 11/69	
Date		Indexed C. J. GALLI	

Cont. on Bot. page 74

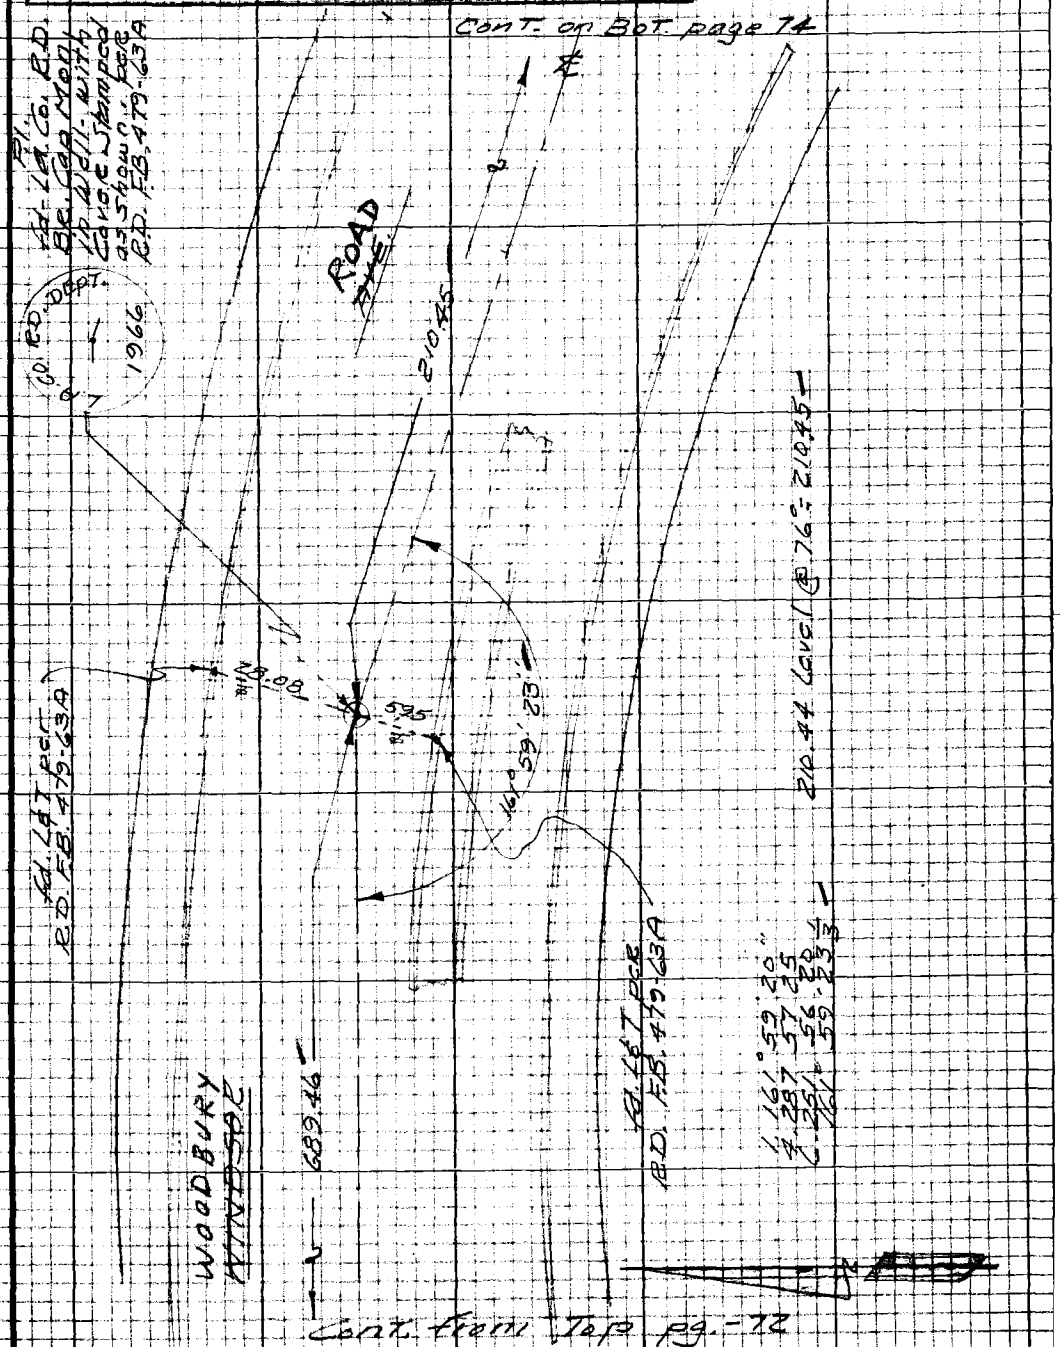

Cont. from Top pg. -72

Note: Any Additions or Changes on this Sheet Must be Made or Circled in Red Ink With Date and Name of Person Making Change

Do not extend this side of this line.

PLEASE RETURN TO
LOS ANGELES COUNTY ENGINEER
403 LOS ANGELES COUNTY ENGINEERING BLDG.

76P309B CE #310 5-66

PLEASE RETURN TO
LOS ANGELES COUNTY ENGINEER
403 LOS ANGELES COUNTY ENGINEERING BLDG.

Note: Any Additions or Changes on this Sheet Must be Made or Circled in Red Ink With Date and Name of Person Making Change

Do not extend this side of this line.

WS-88, B-6

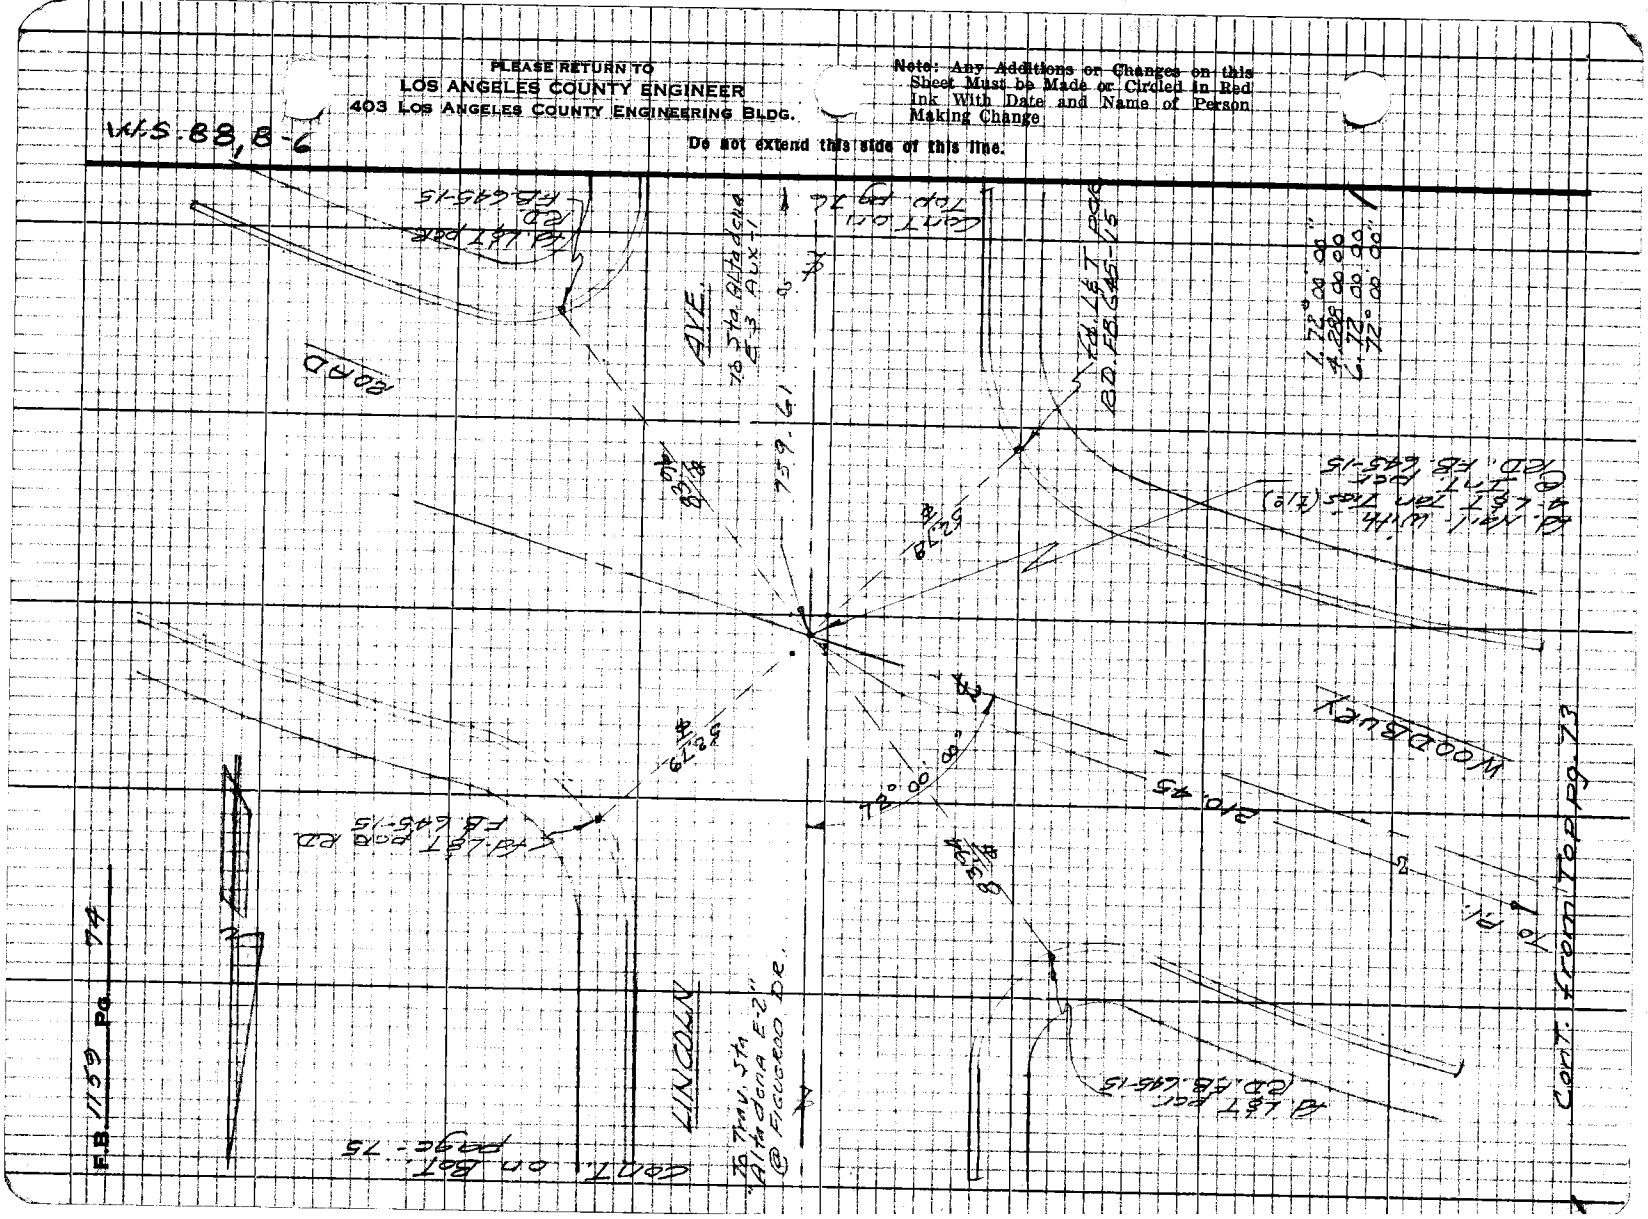

Notes Ck'd by		Survey of Windsor Ave.	F.B. 1159 Pg. 75
Map No.		JN 0075.46 Tape 0240 Std 68 °F	
Office Work	T. AB	Surveyed by A.S. Curtis	
Checked		Notes Curtis Date 11/67	
Date		Indexed C. J. GALLI 1/67	

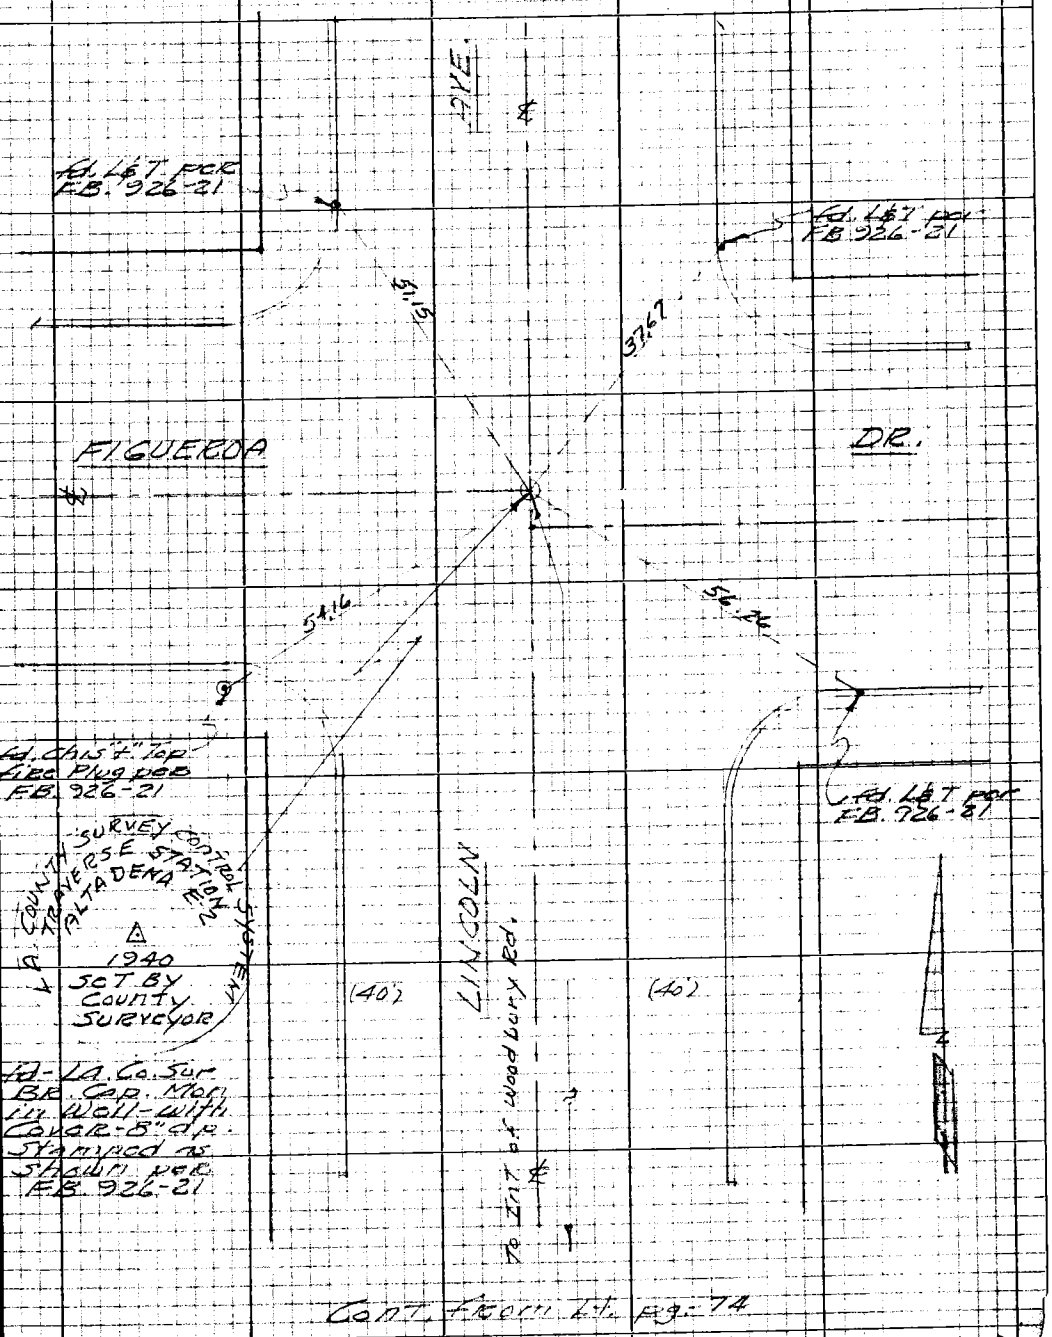

Cont. from Lt. pg. 74

W.S. B8, B-6

Note: Any Additions or Changes on this Sheet Must be Made or Circled in Red Ink With Date and Name of Person Making Change

Do not extend this side of this line.

PLEASE RETURN TO
LOS ANGELES COUNTY ENGINEER
403 Los Angeles County Engineering Bldg.

76P3098 CE #310 8-66

PLEASE RETURN TO
LOS ANGELES COUNTY ENGINEER
403 LOS ANGELES COUNTY ENGINEERING BLDG.

Note: Any Additions or Changes on this Sheet Must be Made or Circled in Red Ink With Date and Name of Person Making Change

Do not extend this side of this line.

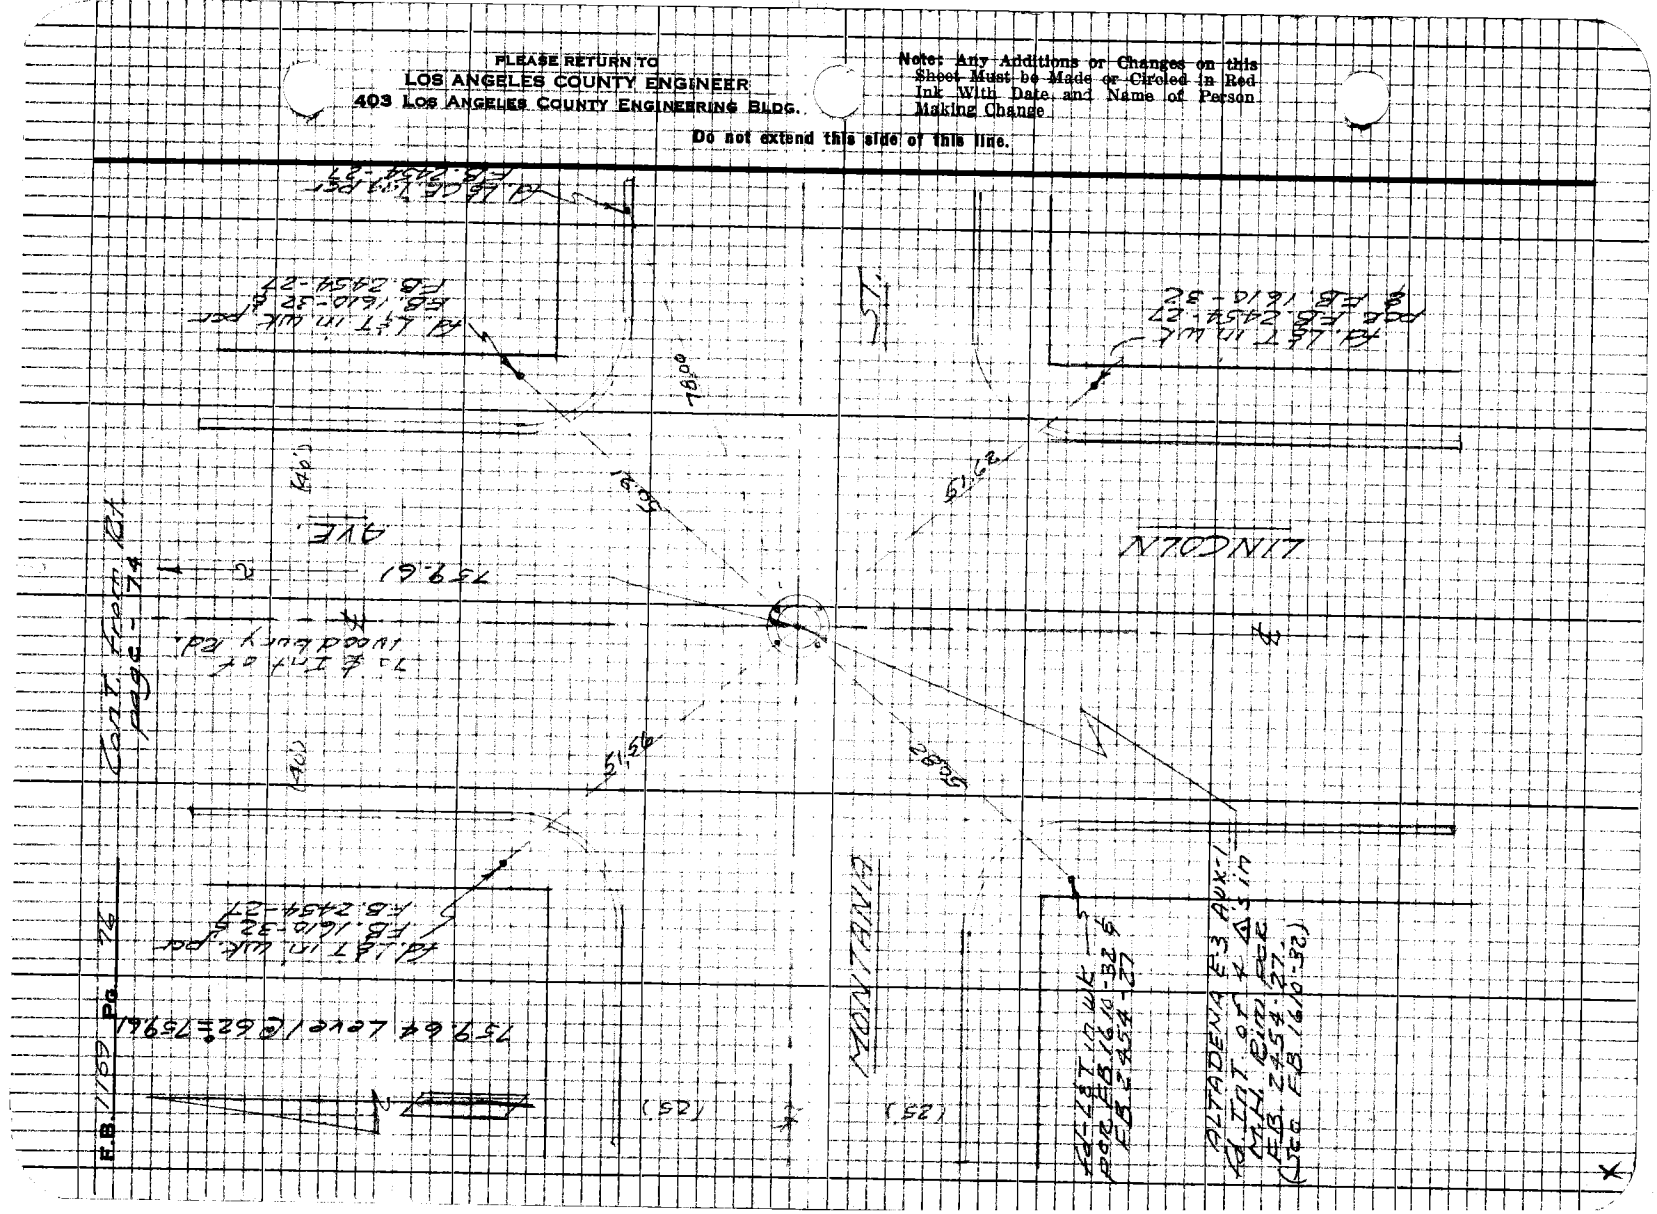

Notes Ck'd by [illegible]	Survey of Windsor Ave.	F.B. 1159 Pg. 77
Map No.	JN 0075.46 Tape 0240 Std 68 °F	
Office Work T. ABE	Surveyed by A.S. Curtis	
Checked	Notes Curtis Date 12/67	
Date	Indexed [illegible] GALLI DEC 3 '67	

Cont. on page 78

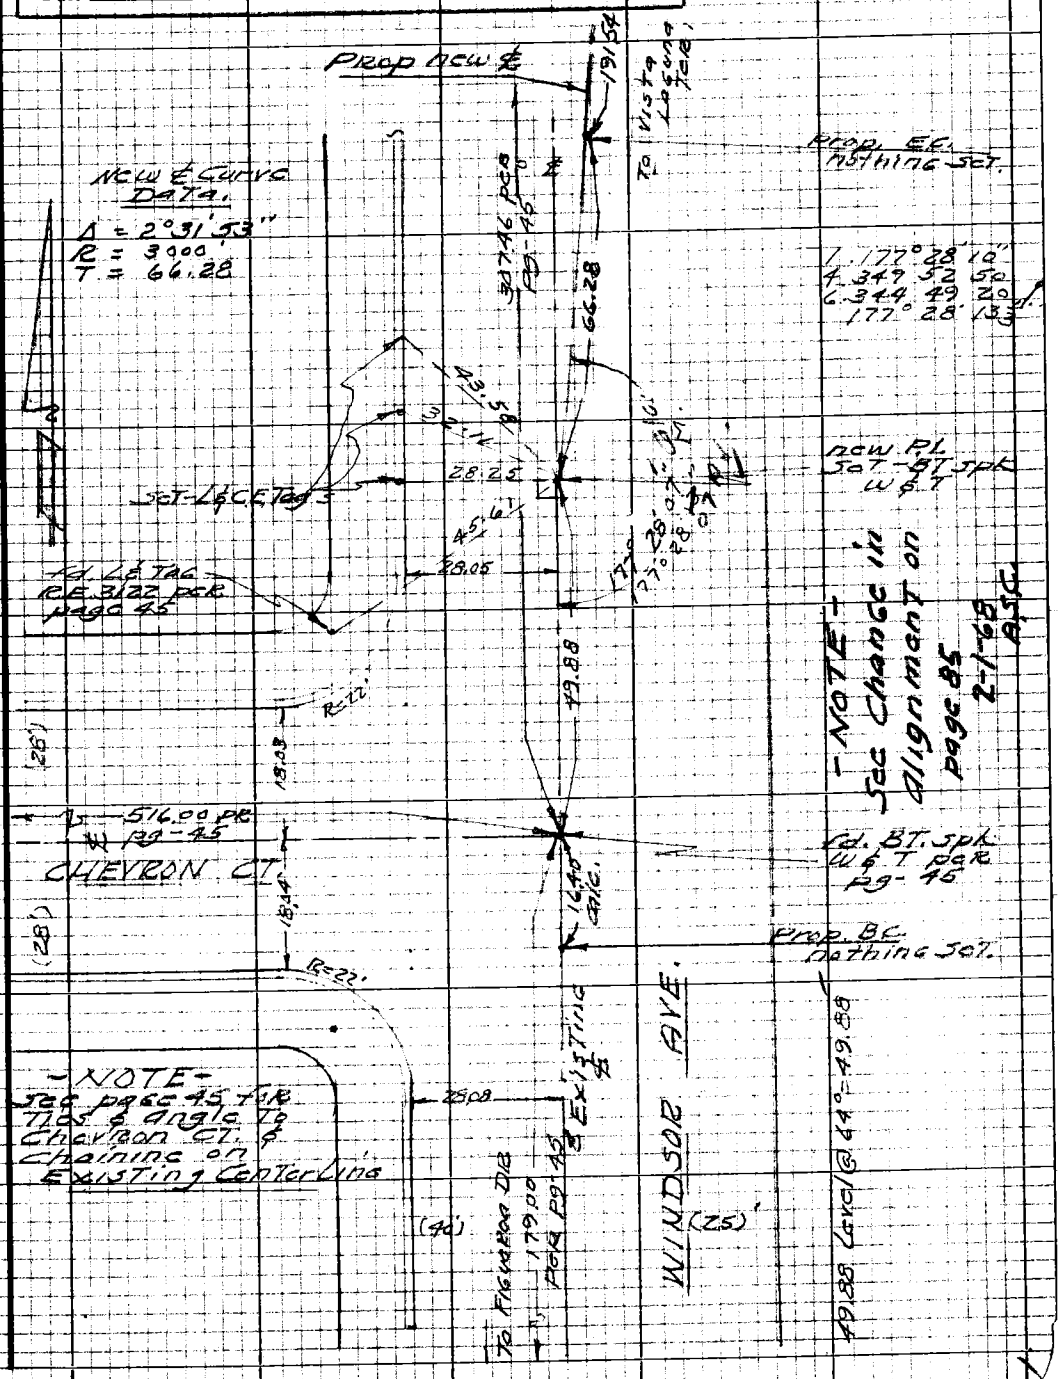

- NOTE - See Change in Alignment on page 85 2-1-68 A.S.C.

- NOTE - See page 45 for Ties & angle to Chevron Ct. & Chaining on Existing Centerline

W.S. 88, A-6

Note: Any Additions or Changes on this Sheet Must be Made or Circled in Red Ink With Date and Name of Person Making Change

Do not extend this side of this line.

PLEASE RETURN TO
LOS ANGELES COUNTY ENGINEER
403 Los Angeles County Engineering Bldg.

76P3098 CE #310 5-66

F.B. 1159 Pg. 78

W.S. 88, A-6

PLEASE RETURN TO
LOS ANGELES COUNTY ENGINEER
403 LOS ANGELES COUNTY ENGINEERING BLDG.

Do not extend this side of this line.

Note: Any Additions or Changes on this Sheet Must be Made or Circled in Red Ink With Date and Name of Person Making Change.

Notes Ck'd by	Survey of Windsor Ave.	F.B. 1159 Pg. 79
Map No.	JN 0075.46 Tape 0240 Std 68 °F	
Office Work T. ABE	Surveyed by A. S. Curtis	Cont. on Bot. page 80
Checked	Notes Curtis Date 12/67	
Date	Indexed C. J. GALLI	

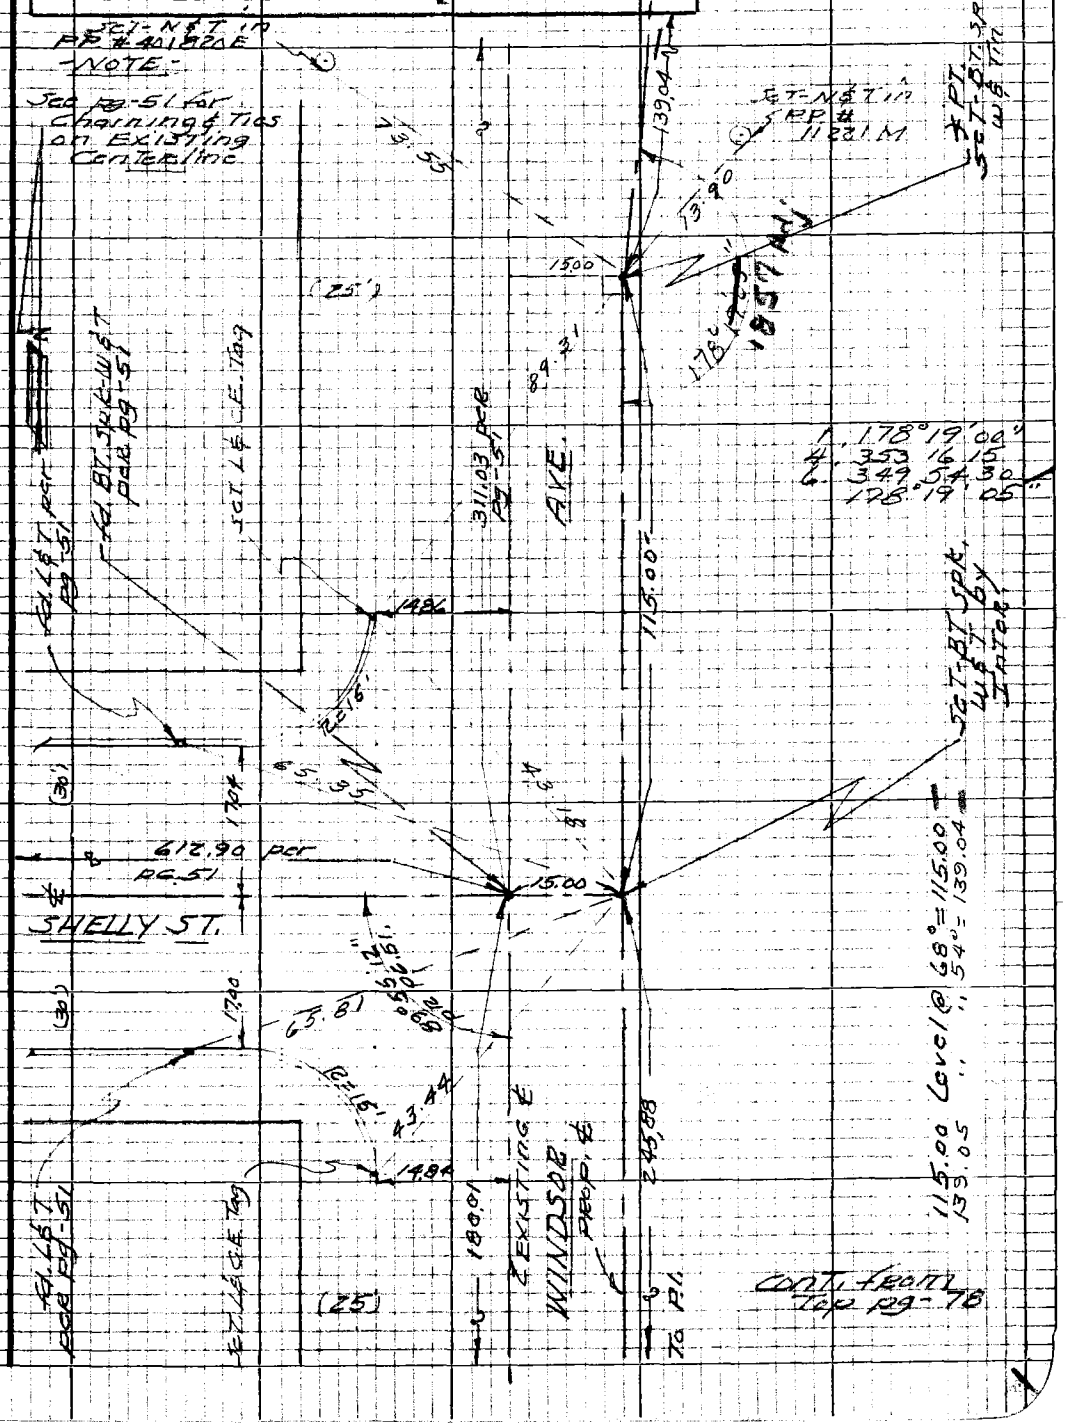

Note: Any Additions or Changes on this Sheet Must be Made or Circled in Red Ink With Date and Name of Person Making Change

Do not extend this side of this line.

PLEASE RETURN TO
LOS ANGELES COUNTY ENGINEER
403 LOS ANGELES COUNTY ENGINEERING BLDG.

76P309S CE #310 5-66

F.B. 1159 Pg. 80

To Rt. Pg. - 54

Cont. on Bot. Pg. 81

Cont. from Top Pg - 79

W.S. 88, A-6

PLEASE RETURN TO
LOS ANGELES COUNTY ENGINEER
403 LOS ANGELES COUNTY ENGINEERING BLDG.

Do not extend this side of this line.

Note: Any Additions or Changes on this Sheet Must be Made or Circled in Red Ink With Date and Name of Person Making Change.

Notes Ck'd by J. A. CHURCH	Survey of Windsor Ave.	F.B. 1159 Pg. 81
Map No.	JN 007546 Tape 0240 Std 68 °F	
Office Work T. AD	Surveyed by A. S. Curtis	Cont. on Bot page 82
Checked	Notes Curtis Date 12-67	
Date	Indexed C. J. GALLI	

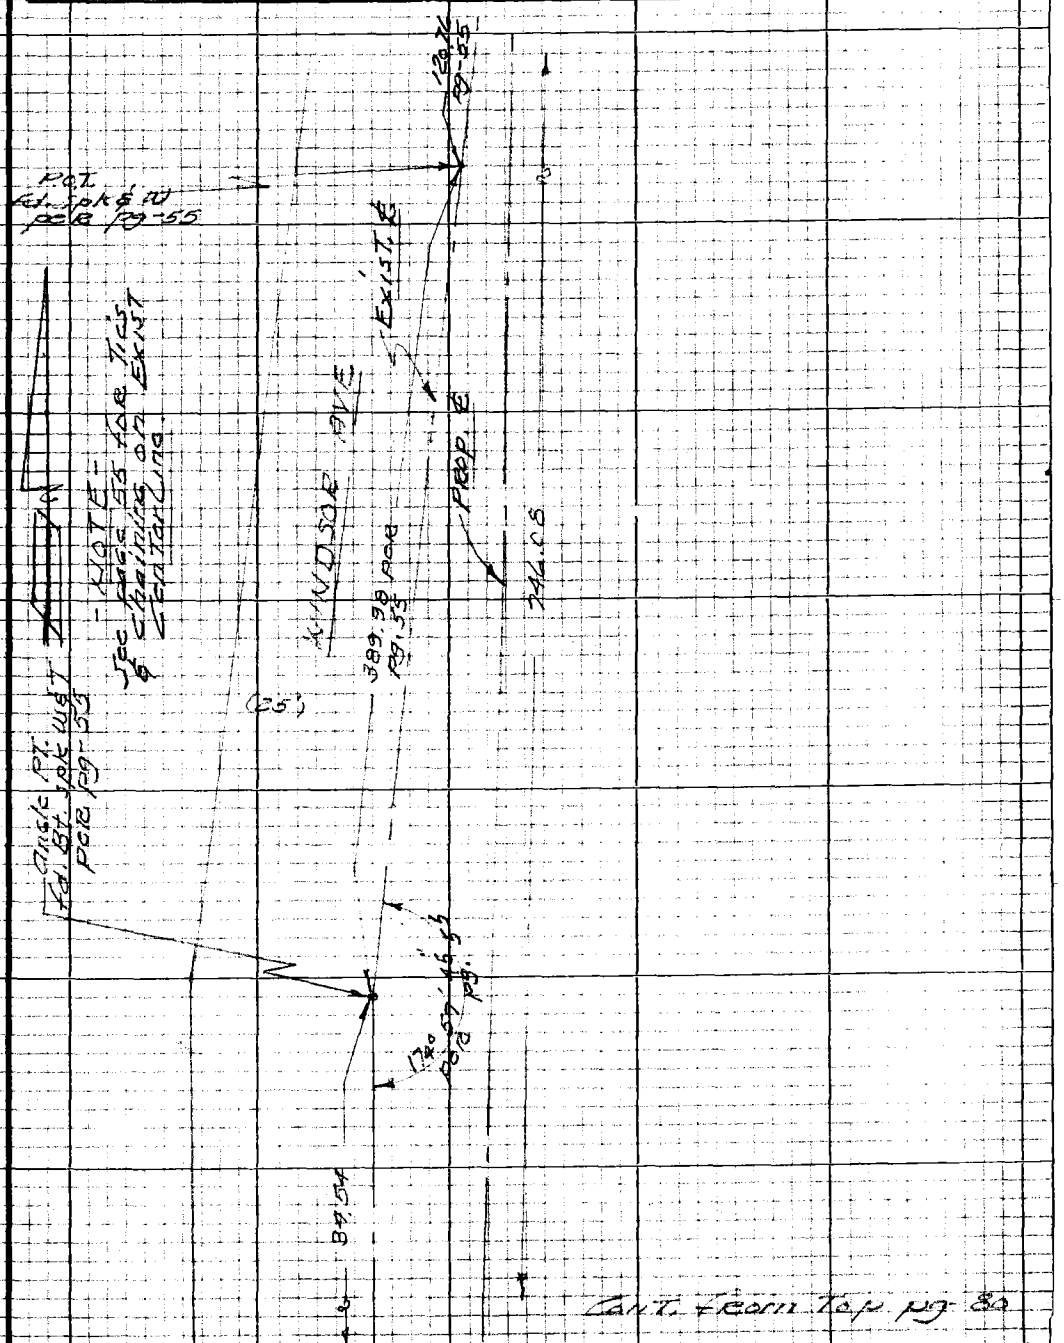

Cont. from Top pg 80

Note: Any Additions or Changes on this Sheet Must be Made or Circled in Red Ink With Date and Name of Person Making Change

PLEASE RETURN TO
LOS ANGELES COUNTY ENGINEER
403 Los Angeles County Engineering Bldg.

Do not extend this side of this line.

76P3095 CE #310 5-66

PLEASE RETURN TO
LOS ANGELES COUNTY ENGINEER
403 LOS ANGELES COUNTY ENGINEERING BLDG.

Note: Any Additions or Changes on this Sheet Must be Made or Circled in Red Ink With Date and Name of Person Making Change

Do not extend this side of this line.

W.S. 88, A-6

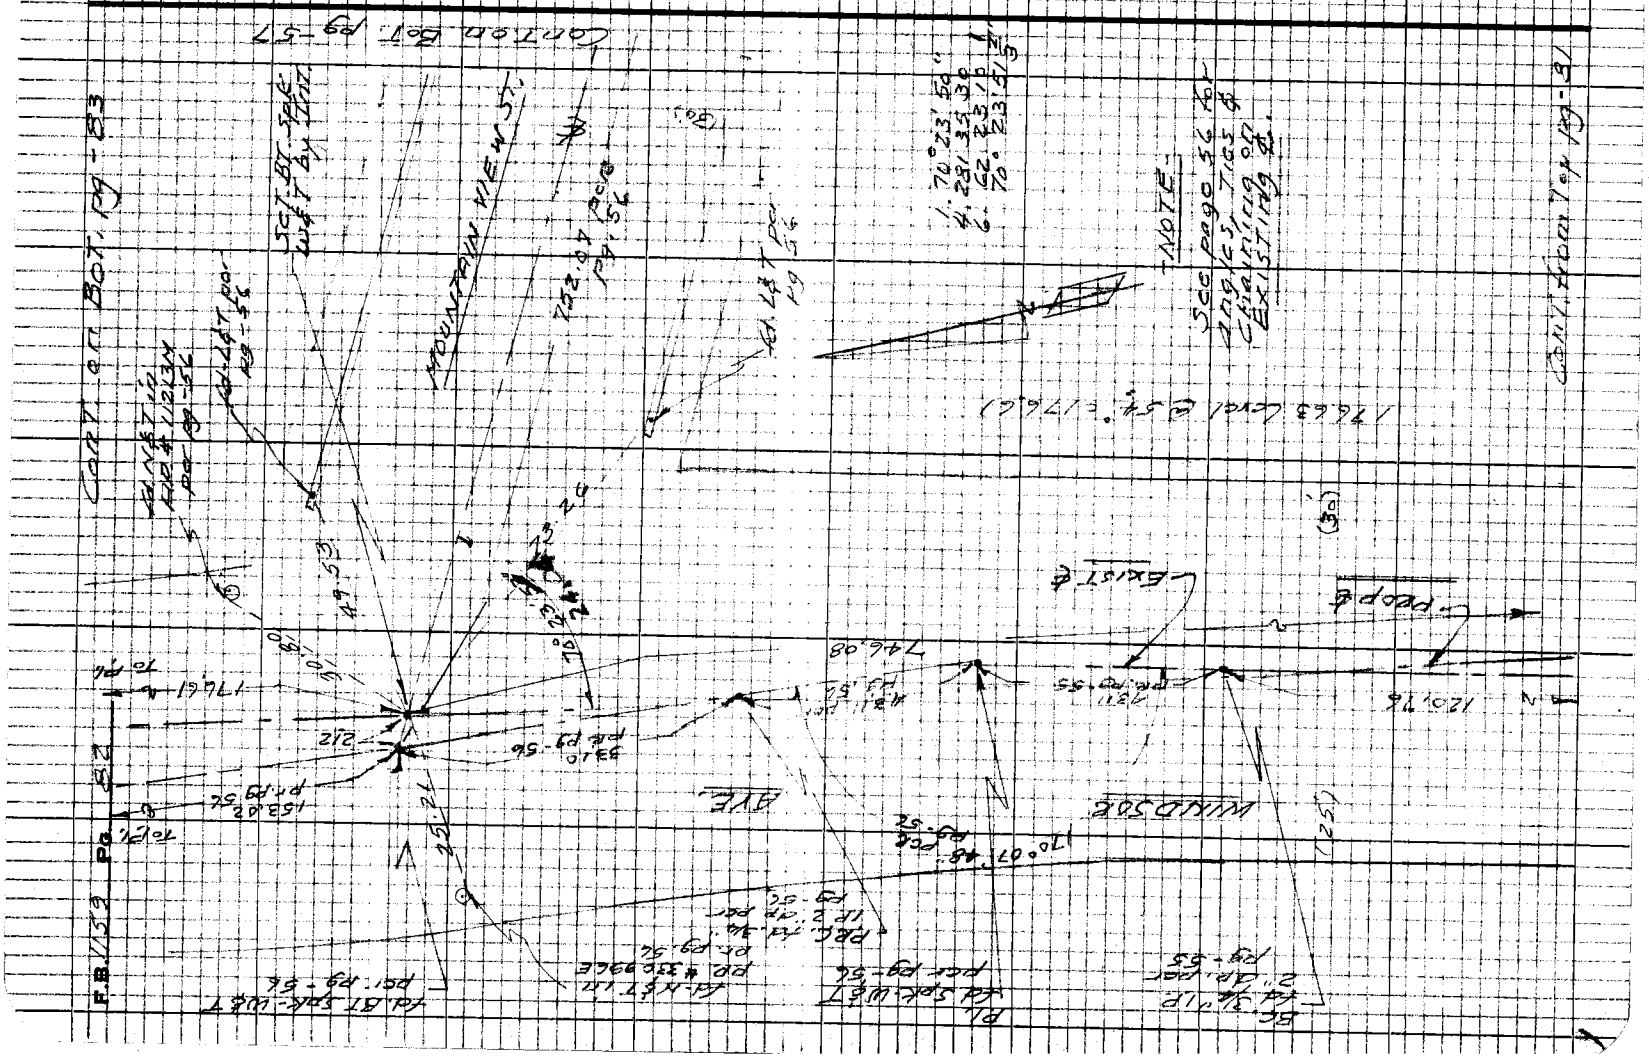

Notes Ck'd by J. A. CHURCH
Map No.
Office Work T. ABE
Checked
Date

Survey of WINDSOR Ave.
JN 0075.41 Tape 2840 Std 68 °F
Surveyed by A. J. CUR 113
Notes CURTIS Date 12/67
Indexed C. J. GALLI DEC 1967

F.B. 1159 Pg. 83

Cont on Rt page 84

Note: Any Additions or Changes on this Sheet Must be Made or Circled in Red Ink With Date and Name of Person Making Change

W.S. 88, A-C

Do not extend this side of this line.

PLEASE RETURN TO
LOS ANGELES COUNTY ENGINEER
403 LOS ANGELES COUNTY ENGINEERING BLDG.

76P2038 CK #310 5-66

PLEASE RETURN TO
LOS ANGELES COUNTY ENGINEER
403 LOS ANGELES COUNTY ENGINEERING BLDG.

Note: Any Additions or Changes on this Sheet Must be Made or Circled in Red Ink With Date and Name of Person Making Change

Do not extend this side of this line.

W.S. 88, A-6

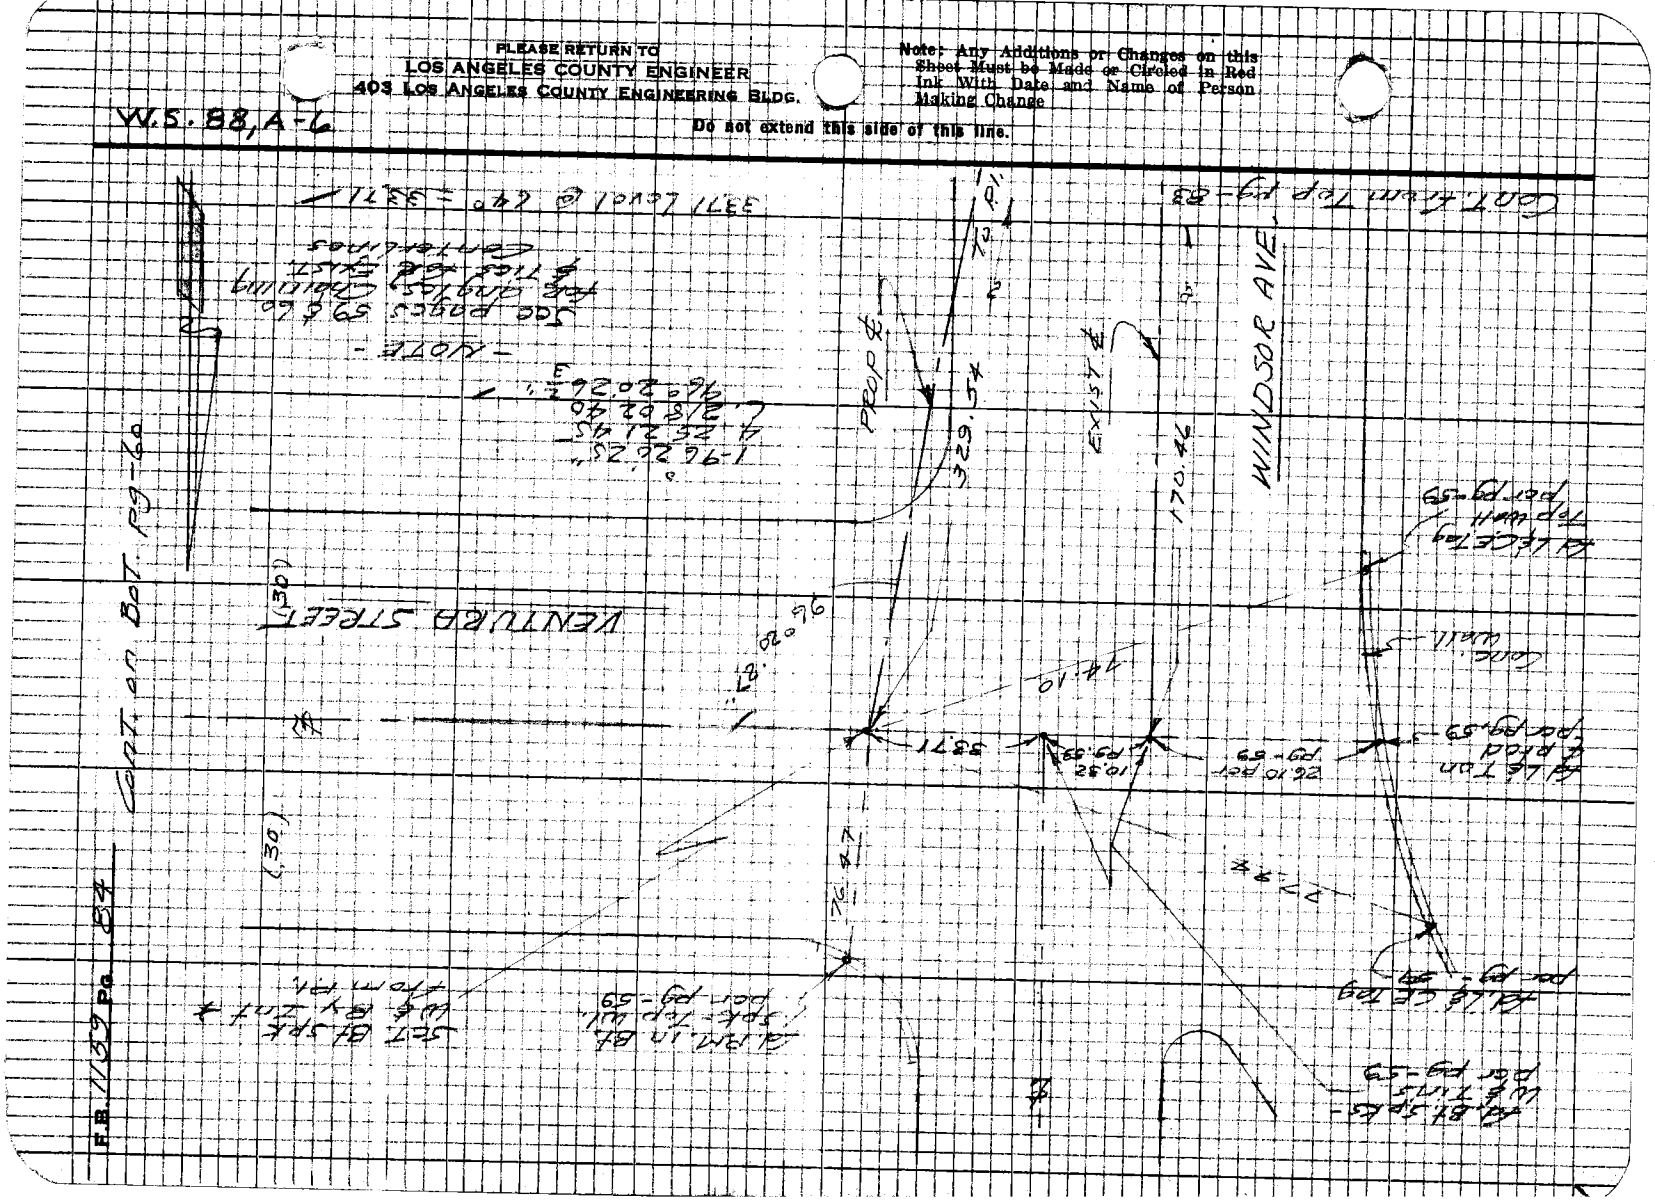

Notes Ck'd by	Survey of Windsor Ave.	F.B. 1159 Pg. 85
Map No.	JN 0075.46 Tape 0240 Std 68 °F	
Office Work T. ABE	Surveyed by A.S. Curtis	Cont. on Bot. pg-86.
Checked	Notes Curtis Dated 3/1/68	
Date	Indexed C.J. GALLI FEB 2 '68	

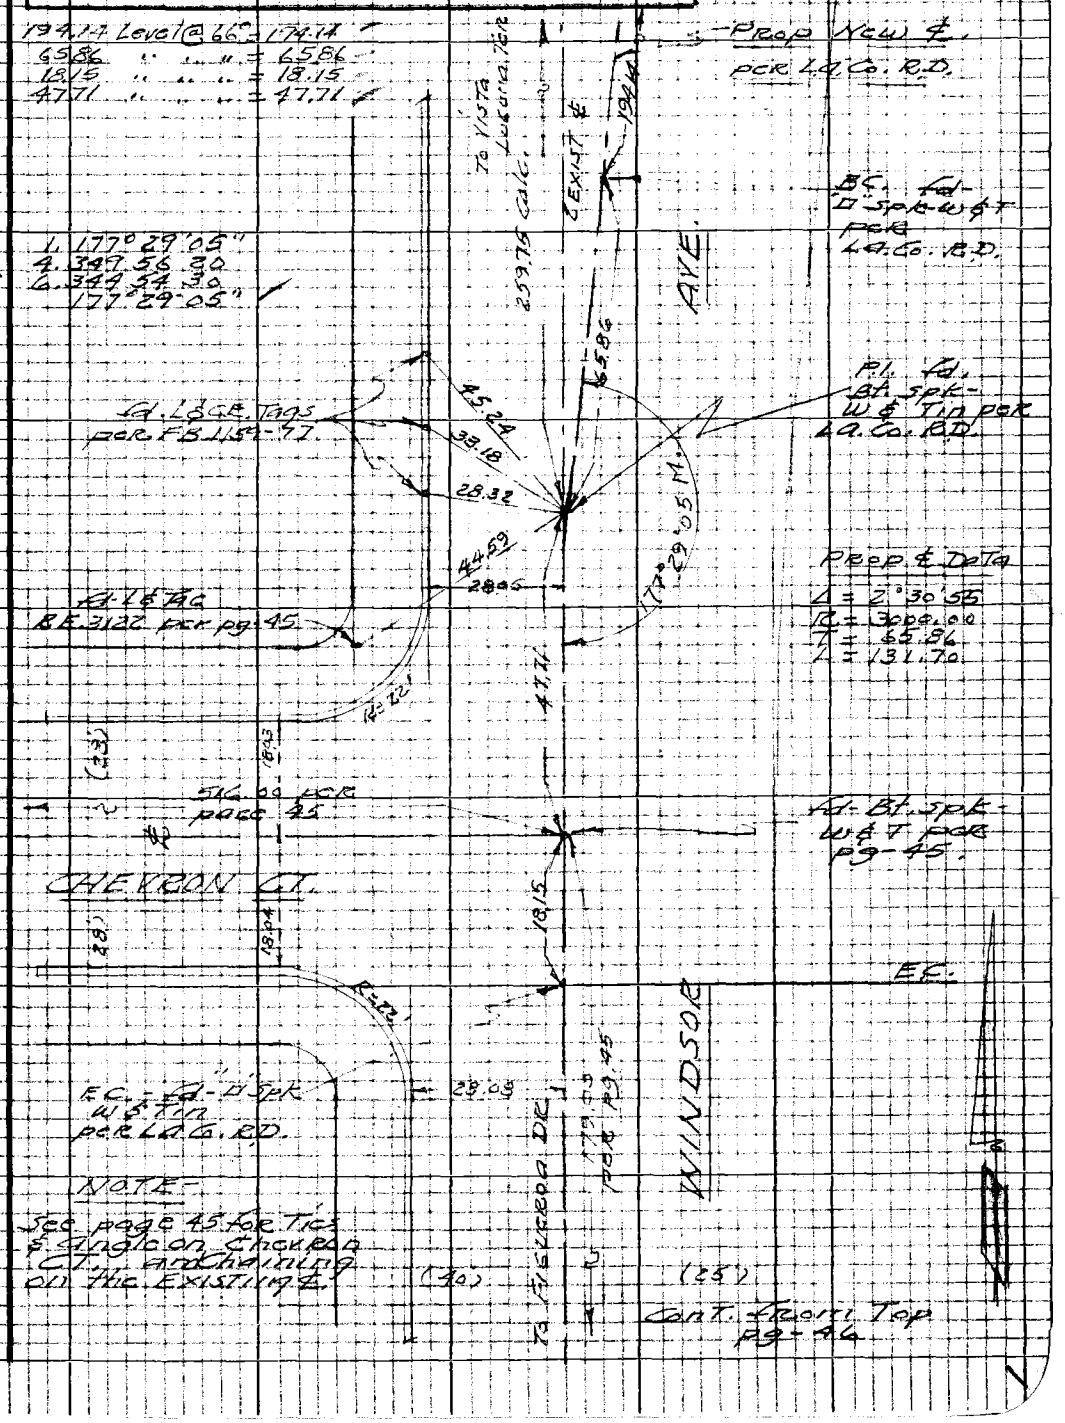

Note: Any Additions or Changes on this Sheet Must be Made or Circled in Red Ink With Date and Name of Person Making Change

Do not extend this side of this line.

W.S. 88, A-6

PLEASE RETURN TO
LOS ANGELES COUNTY ENGINEER
403 LOS ANGELES COUNTY ENGINEERING BLDG.

7BP3098 CE #310 2-68

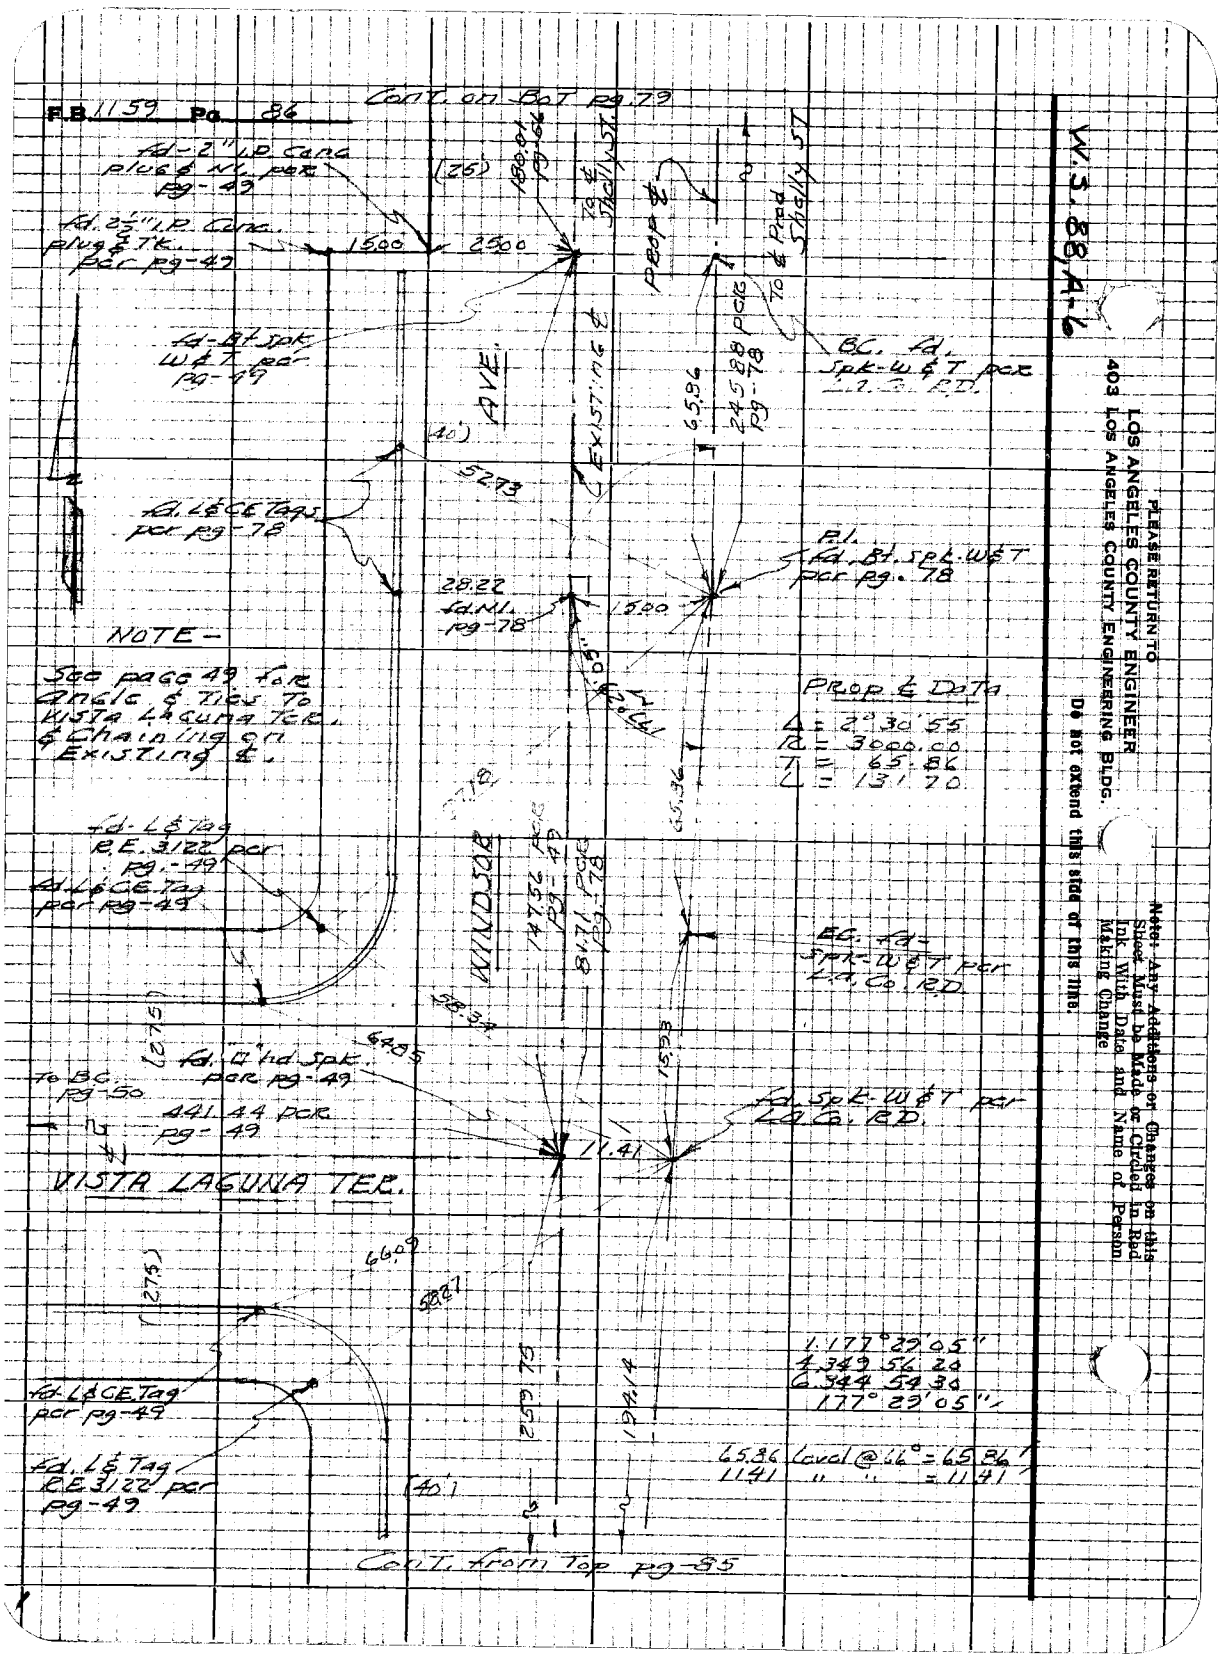

W.S. 88, A-6

PLEASE RETURN TO
LOS ANGELES COUNTY ENGINEER
403 LOS ANGELES COUNTY ENGINEERING BLDG.

Note: Any Additions or Changes on this Sheet Must be Made or Circled in Red Ink With Date and Name of Person Making Change

Do not extend this side of this line.

Notes Ck'd by
Map No.
Office Work
Checked
Date

Survey of Alberta ST
JN 0303.00 Tape 207 Std 84 °F
Surveyed by A.S. Curtis
Notes Curtis Date 8-68
Indexed [illegible] SEP 27 '68

F.B. 1159 Pg 97

INDEX SHEET.
ALBERTA ST.
ALTADENA AREA
Monuments Set & Centerline
& Index.

Curtis
Kapp
Rodriguez
Ohashi

Ref. F.B. 2120

Note: Any Additions or Changes on this Sheet Must be Made or Circled in Red Ink With Date and Name of Person Making Change.

Do not extend this side of this line.

PLEASE RETURN TO
LOS ANGELES COUNTY ENGINEER
403 LOS ANGELES COUNTY ENGINEERING BLDG.

16F3098 CE#310 9-67

F.B. 1159 Pg. 98

PLEASE RETURN TO
LOS ANGELES COUNTY ENGINEER
408 LOS ANGELES COUNTY ENGINEERING BLDG.

Do not extend this side of this line.

Note: Any Additions or Changes on this Sheet Must be Made or Circled in Red Ink With Date and Name of Person Making Change.

W.S. 88, A-6

Notes Ck'd by	Survey of Alberta St.
Map No.	JN 0303.00 Tape 207 Std 84°F
Office Work	Surveyed by A.S. Curtis
Checked	Notes Curtis Date 8-68
Date	Indexed C.L. GALLI 9 27 '68

F.B. 1159 Pg. 99

Cont. on Bot. page - 100

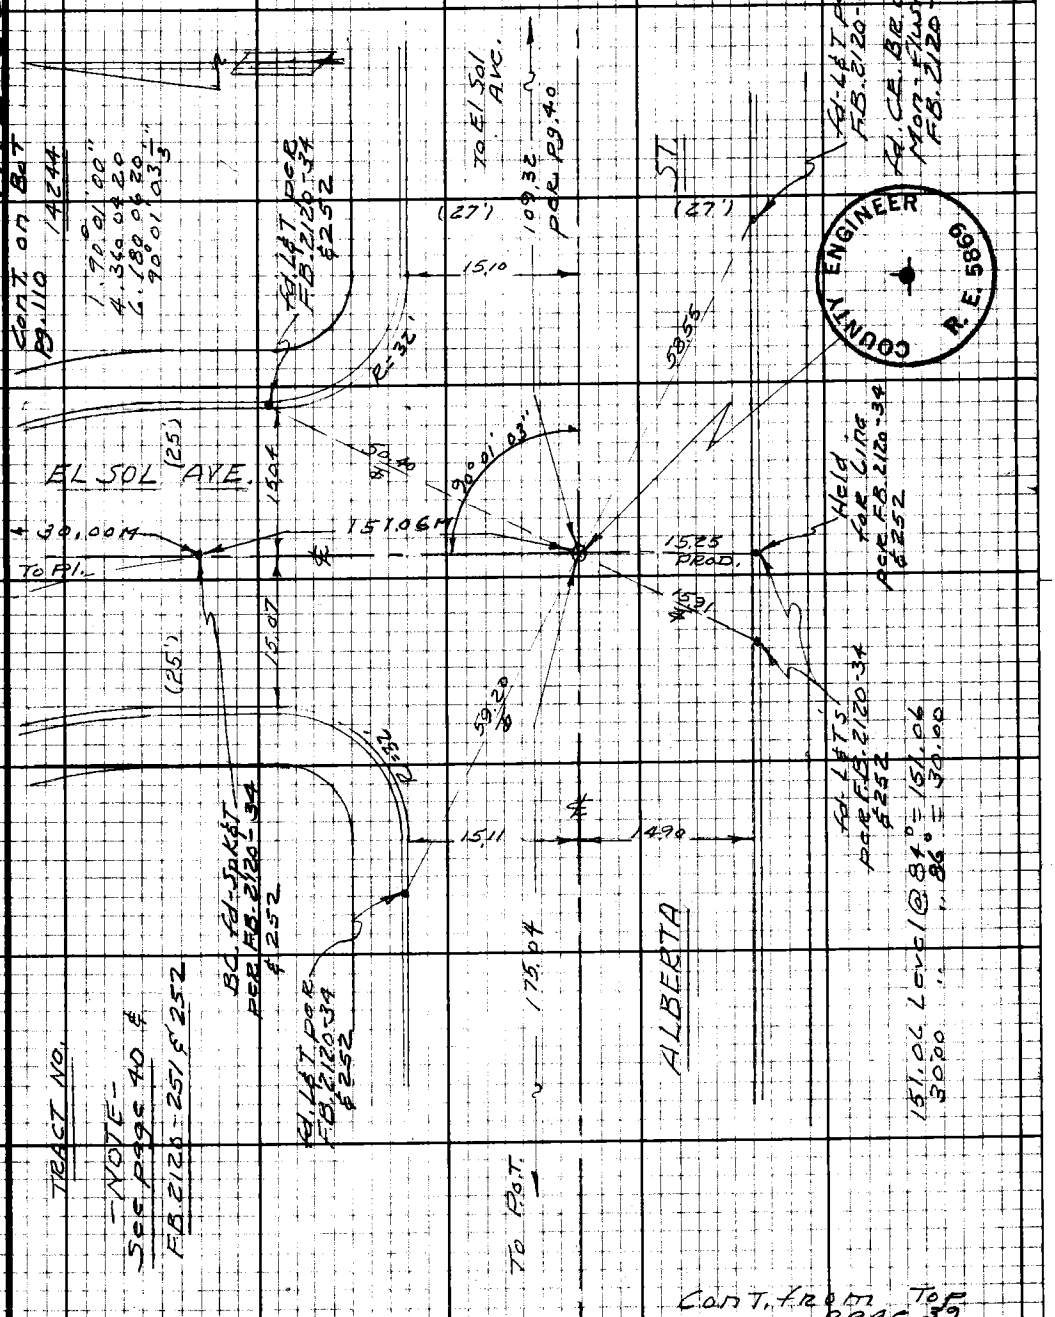

Cont. from Top page 39

COUNTY ENGINEER R.E. 5869

Note: Any Additions or Changes on this Sheet Must be Made or Circled in Red Ink With Date and Name of Person Making Change.

Do not extend this side of this line.

PLEASE RETURN TO
LOS ANGELES COUNTY ENGINEER
403 LOS ANGELES COUNTY ENGINEERING BLDG.

16F3098 CF #310 9-67

F.B. 1159 Pg. 100

Cont. on Bot. pg-101

Cont. from Top page-99

W.S. 88, A-6

Notes Ck'd by	Survey of Alberta St.
Map No.	JN 0303.00 Tape 207 Std 84 °F
Office Work	Surveyed by A.S. Curtis
Checked	Notes Curtis Date 8-68
Date	Indexed C.J. Gall

F.B. 1159 Pg 101

Cont. on Bot. page - 103

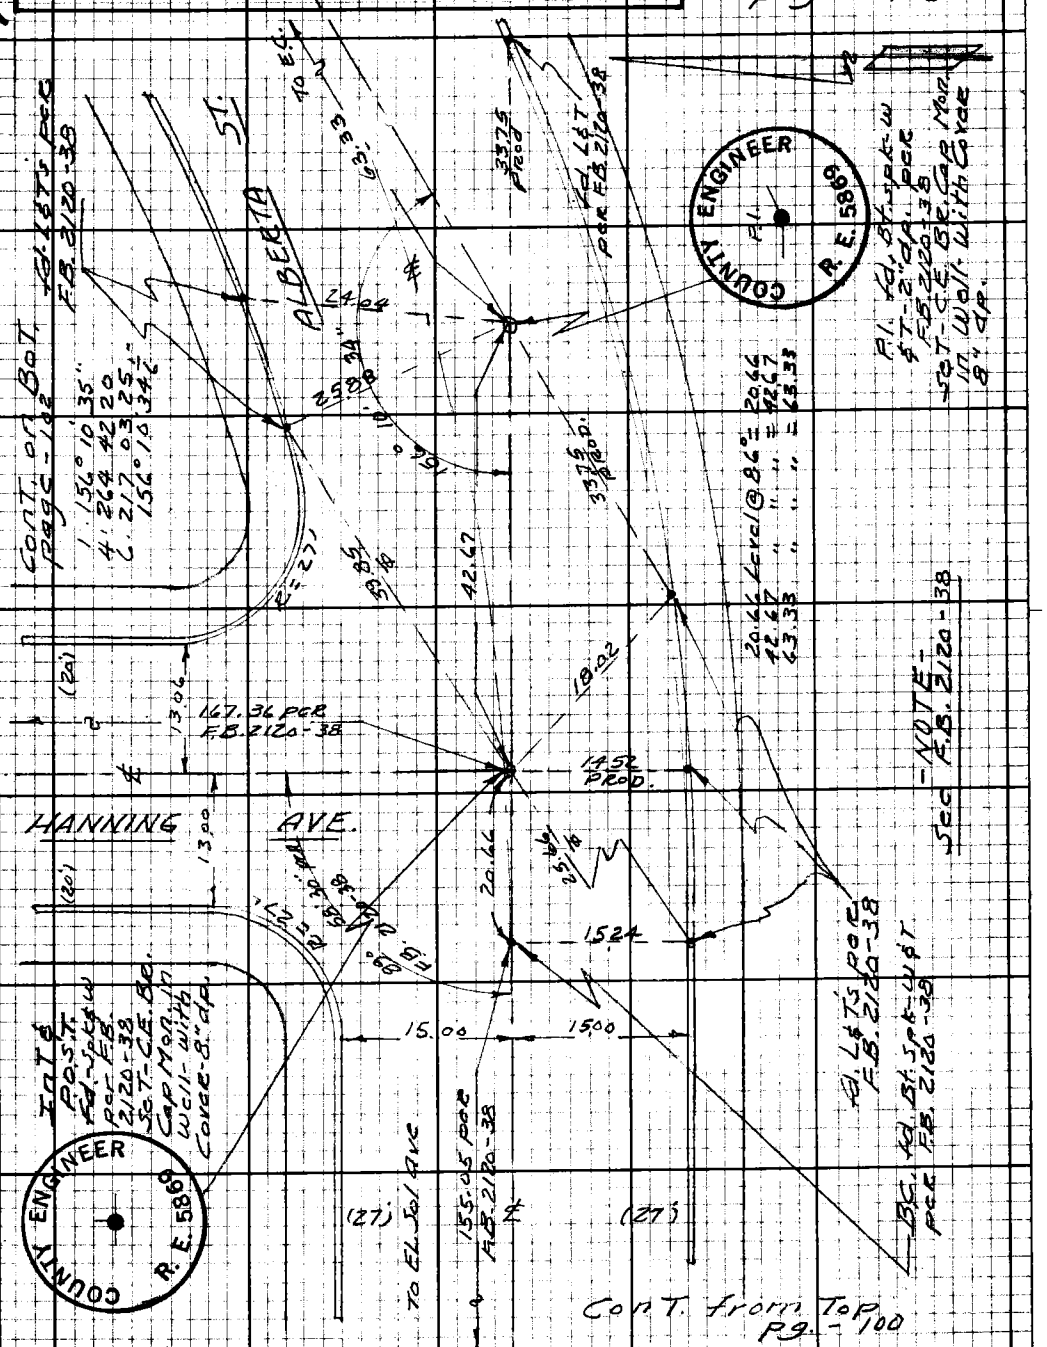

Note: Any Additions or Changes on this Sheet Must be Made or Circled in Red Ink With Date and Name of Person Making Change.

Do not extend this side of this line.

PLEASE RETURN TO
LOS ANGELES COUNTY ENGINEER
403 Los Angeles County Engineering Bldg.

76F3098 CE #310 9-67

F.B. 1159 Pg. 102

Cont. from Lt. page - 101

W.S. 88.4-6

PLEASE RETURN TO
LOS ANGELES COUNTY ENGINEER
408 LOS ANGELES COUNTY ENGINEERING BLDG.

Do not extend this side of this line.

Note: Any Additions or Changes on this Sheet Must be Made or Circled in Red Ink With Date and Name of Person Making Change.

W.S. 88, A-6

Notes Ck'd by	Survey of Alberta St.
Map No.	JN 030300 Tape 207 Std 84 °F
Office Work	Surveyed by G.S. Curtis
Checked	Notes Curtis Date 8-68
Date	Indexed [illegible]

F.B. 1159 Pg. 103

Cont on Bot Pg- 104

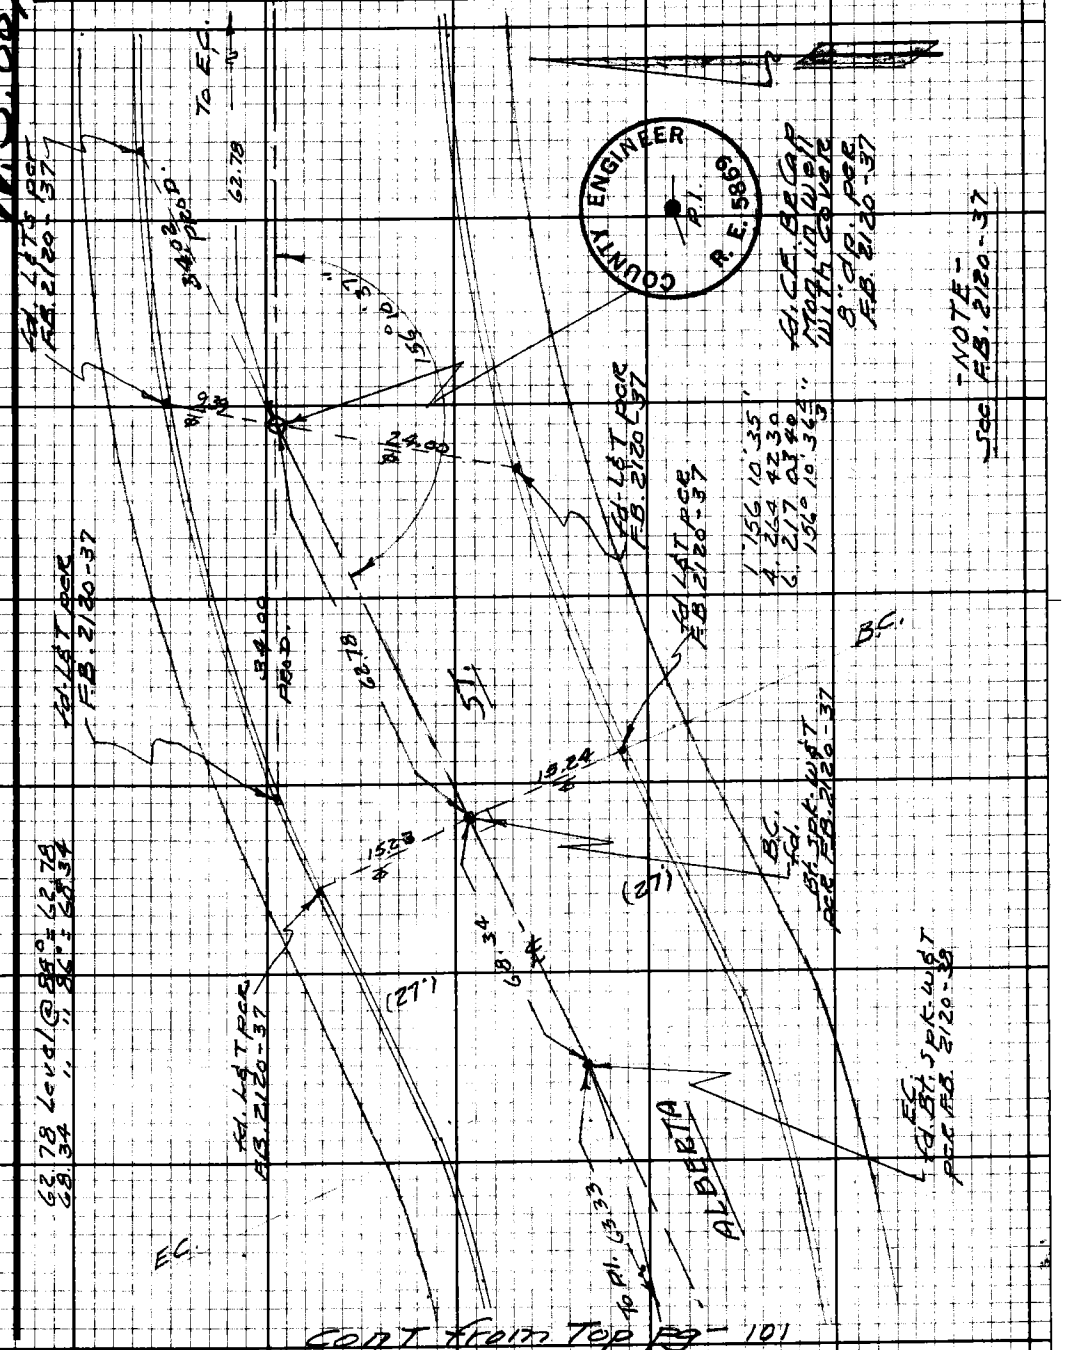

Cont from Top Pg- 101

Note: Any Additions or Changes on this Sheet Must be Made or Circled in Red Ink With Date and Name of Person Making Change.

Do not extend this side of this line.

PLEASE RETURN TO
LOS ANGELES COUNTY ENGINEER
403 Los Angeles County Engineering Bldg.

1653098 CE #310 9-67

PLEASE RETURN TO
LOS ANGELES COUNTY ENGINEER
403 LOS ANGELES COUNTY ENGINEERING BLDG.

Note: Any Additions or Changes on this Sheet Must be Made or Circled in Red Ink With Date and Name of Person Making Change.

Do not extend this side of this line.

W.S. 88, A-6

F.B. 1159 Pg. 104

W.S. 88, A-6

Notes Ck'd by	Survey of Alberta St.
Map No.	JN 303.00 Tape 207 Std 84 °F
Office Work	Surveyed by A.S. Curtis
Checked	Notes Curtis Date 8-15-68
Date	Indexed D.L. GALLI

F.B. 1159 Pg. 105

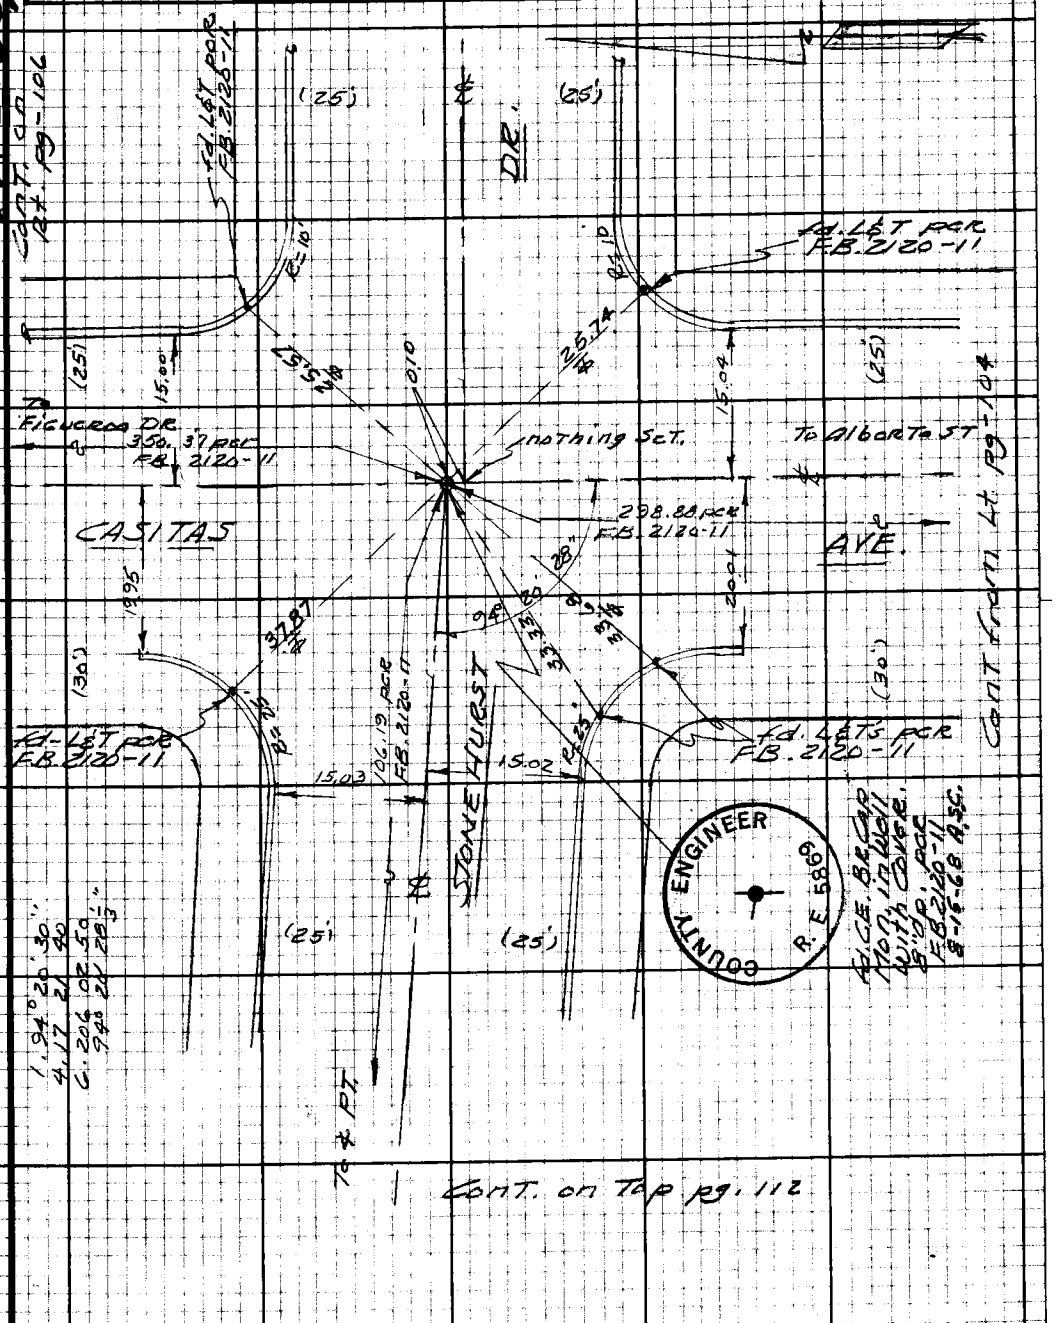

Note: Any Additions or Changes on this Sheet Must be Made or Circled in Red Ink With Date and Name of Person Making Change.

Do not extend this side of this line.

PLEASE RETURN TO
LOS ANGELES COUNTY ENGINEER
403 LOS ANGELES COUNTY ENGINEERING BLDG.

76F3098 CF #310 9-67

PLEASE RETURN TO
LOS ANGELES COUNTY ENGINEER
403 LOS ANGELES COUNTY ENGINEERING BLDG.

Note: Any Additions or Changes on this Sheet Must be Made or Circled in Red Ink With Date and Name of Person Making Change.

Do not extend this side of this line.

W.S. 88, A-6

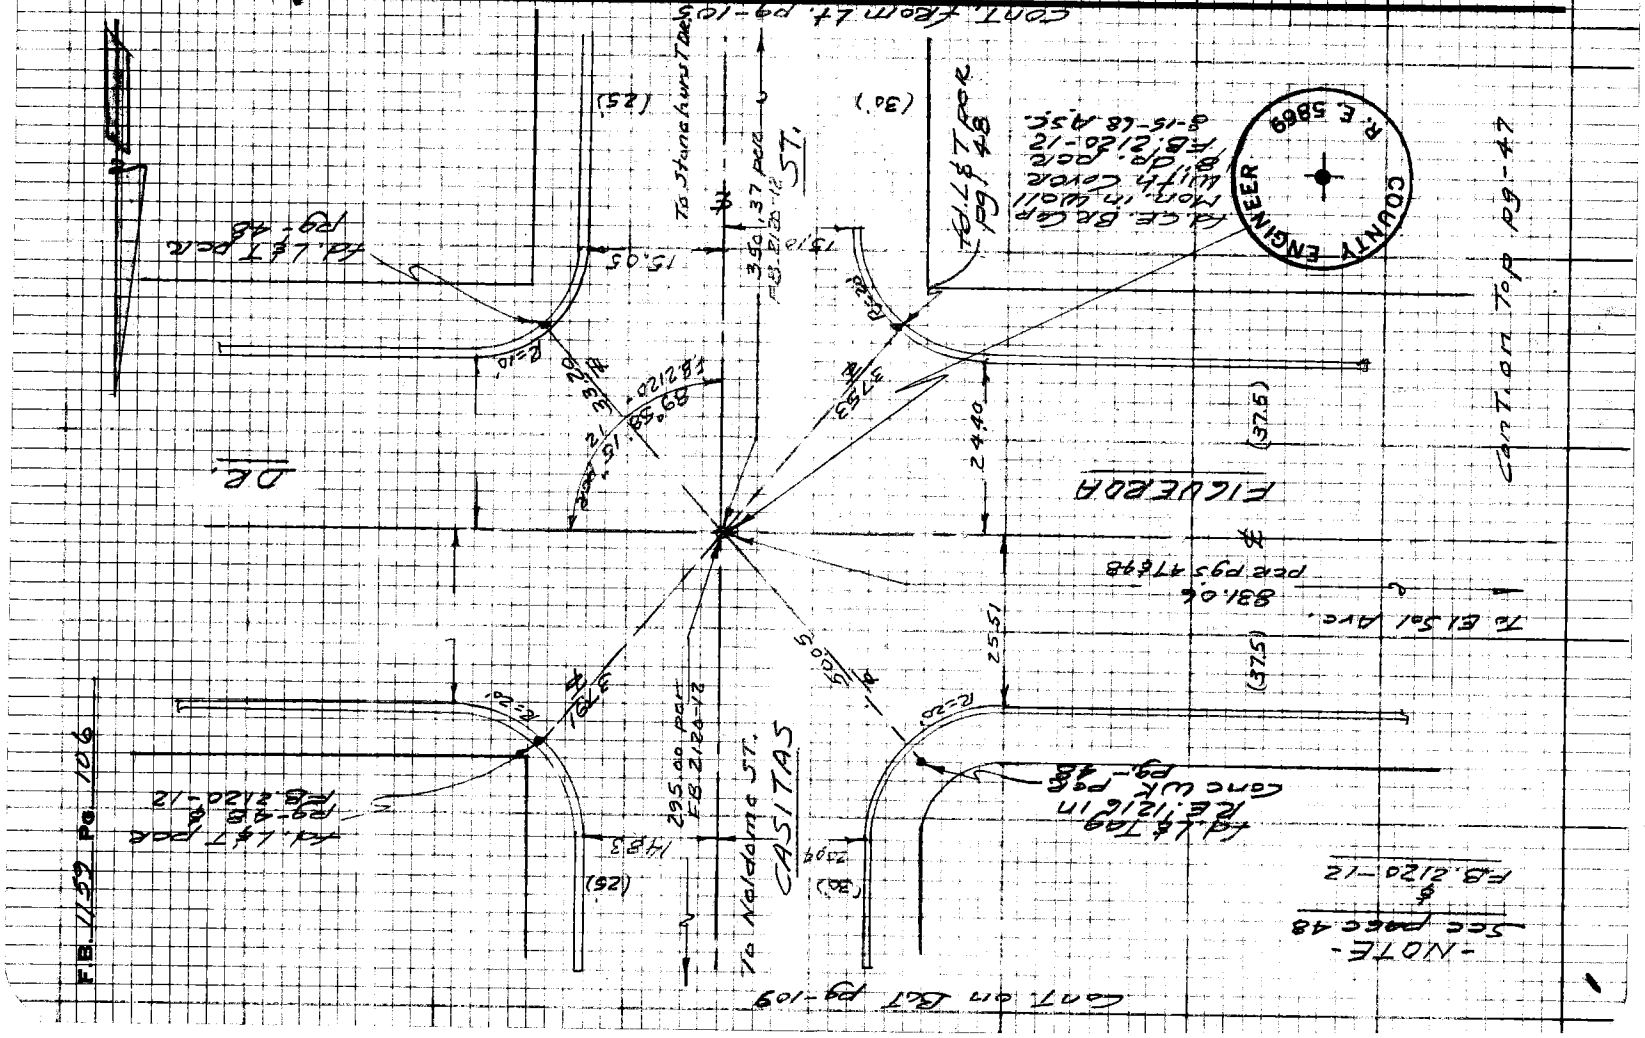

W.S. 88, A-6

Notes Ck'd by	Survey of Alberta St.
Map No.	JN 0303.00 Tape 207 Std 84 °F
Office Work	Surveyed by A.S. Curtis
Checked	Notes Curtis Date 9-68
Date	Indexed R.R. Galli

F.B. 1159 Pg. 107

Cont. on Bot. pg. 108

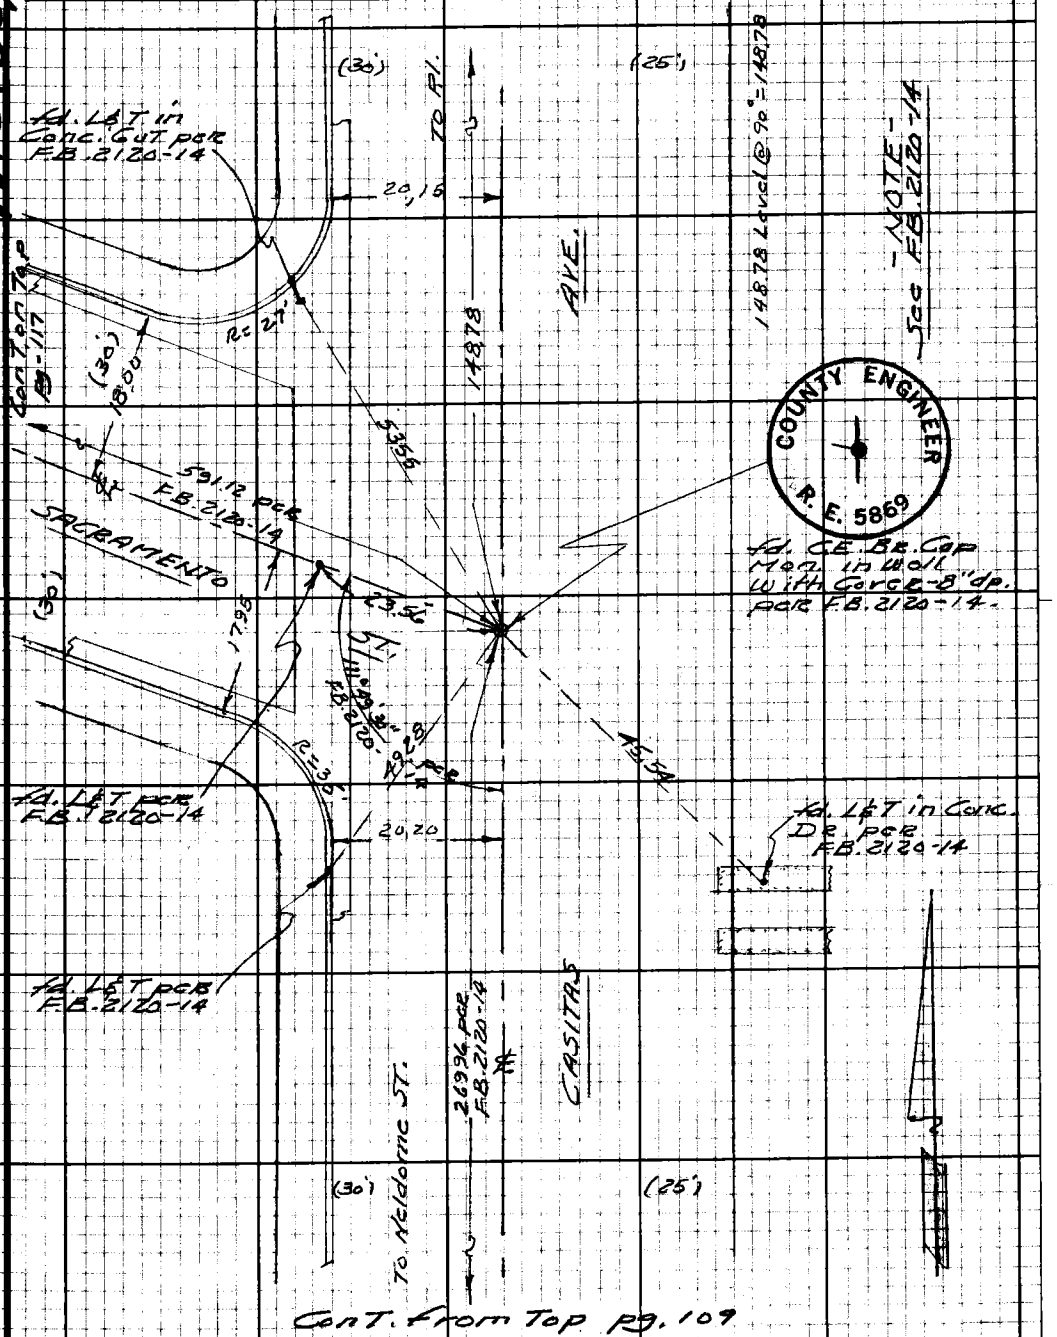

Cont. from Top pg. 109

Note: Any Additions or Changes on this Sheet Must be Made or Circled in Red Ink With Date and Name of Person Making Change.

Do not extend this side of this line.

PLEASE RETURN TO
LOS ANGELES COUNTY ENGINEER
403 Los Angeles County Engineering Bldg.

76F3098 CE #310 9-67

F.B. 1159 Pg. 108

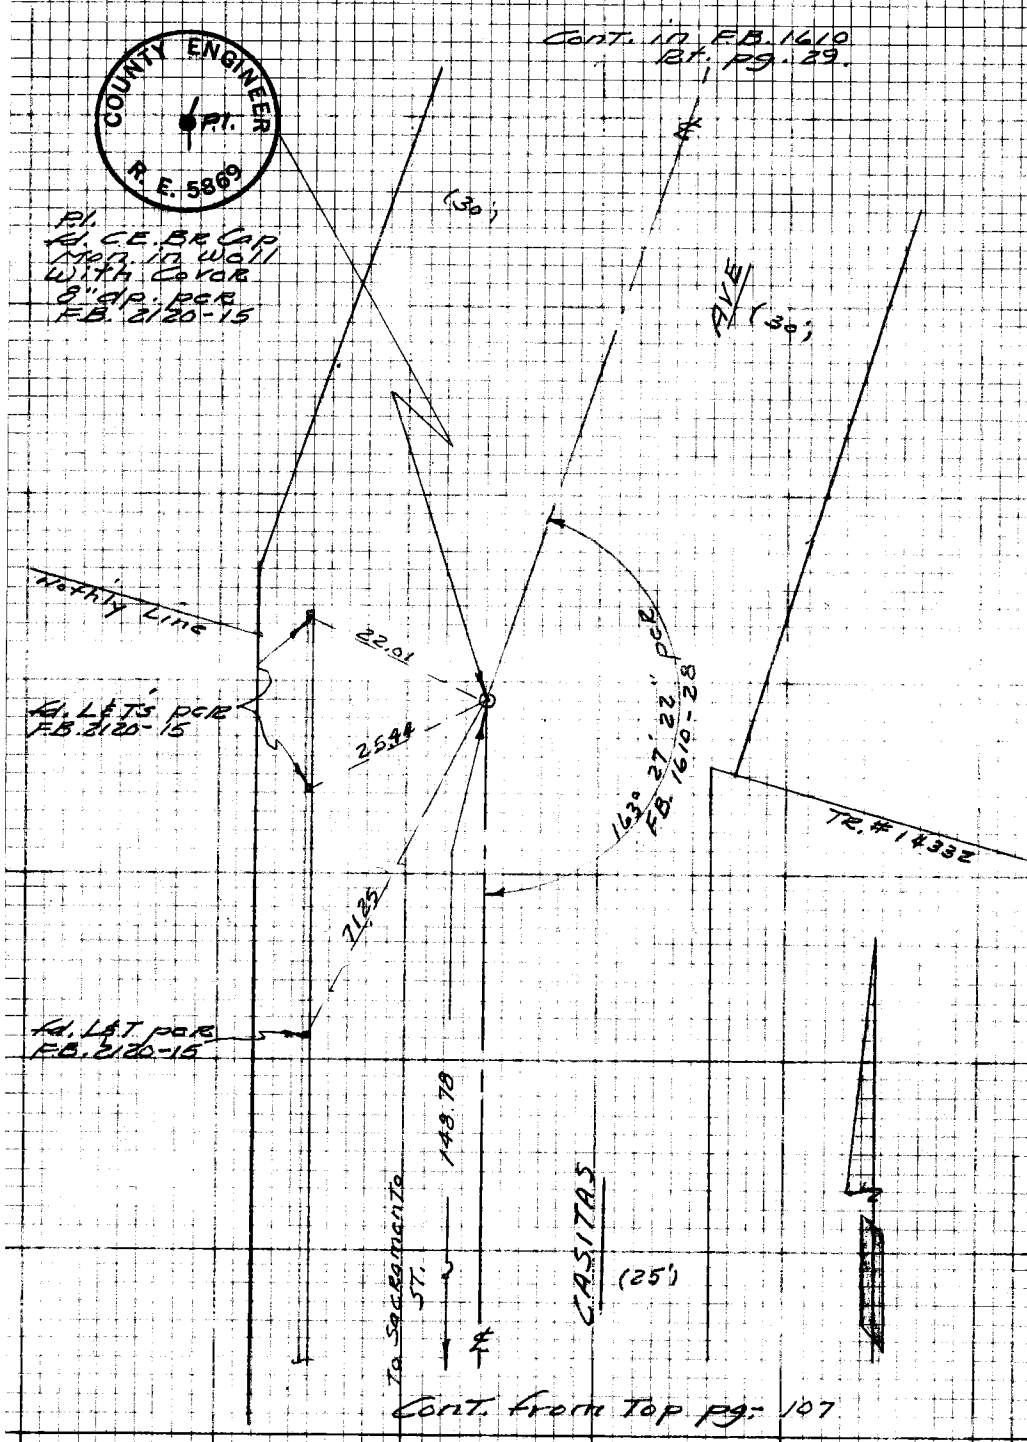

W.S.88, A-6

PLEASE RETURN TO
LOS ANGELES COUNTY ENGINEER
403 LOS ANGELES COUNTY ENGINEERING BLDG.

Do not extend this side of this line.

Note: Any Additions or Changes on this Sheet Must be Made or Circled in Red Ink With Date and Name of Person Making Change.

W.S.88,A-6

Notes Ck'd by	Survey of Alberta ST.
Map No.	JN 0303.00 Tape 207 Std 84 °F
Office Work	Surveyed by A.S. Curtis
Checked	Notes Curtis Date 9-68
Date	Indexed R.L. GALLI

F.B. 1159 Pg. 109

Cont. on Bot pg 107

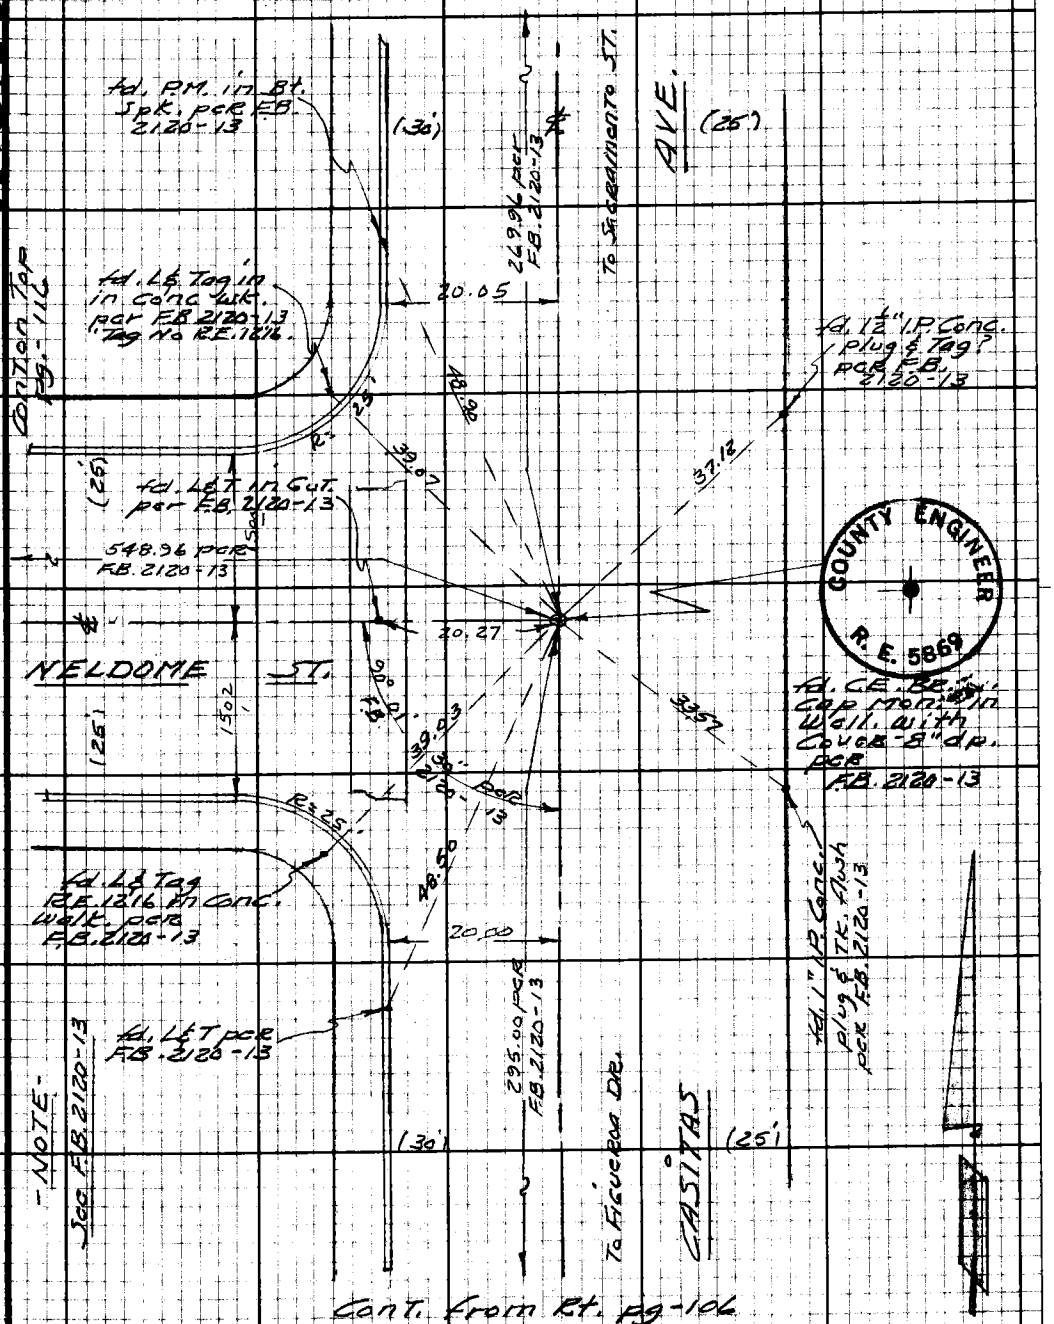

Cont. from Rt. pg-106

COUNTY ENGINEER R.E. 5869

Note: Any Additions or Changes on this Sheet Must be Made or Circled in Red Ink With Date and Name of Person Making Change.

Do not extend this side of this line.

PLEASE RETURN TO
LOS ANGELES COUNTY ENGINEER
403 LOS ANGELES COUNTY ENGINEERING BLDG.

76F3098 CE#310 9-67

PLEASE RETURN TO
LOS ANGELES COUNTY ENGINEER
403 LOS ANGELES COUNTY ENGINEERING BLDG.

Note: Any Additions or Changes on this Sheet Must be Made or Circled in Red Ink With Date and Name of Person Making Change.

Do not extend this side of this line.

W.S. 88, A-6

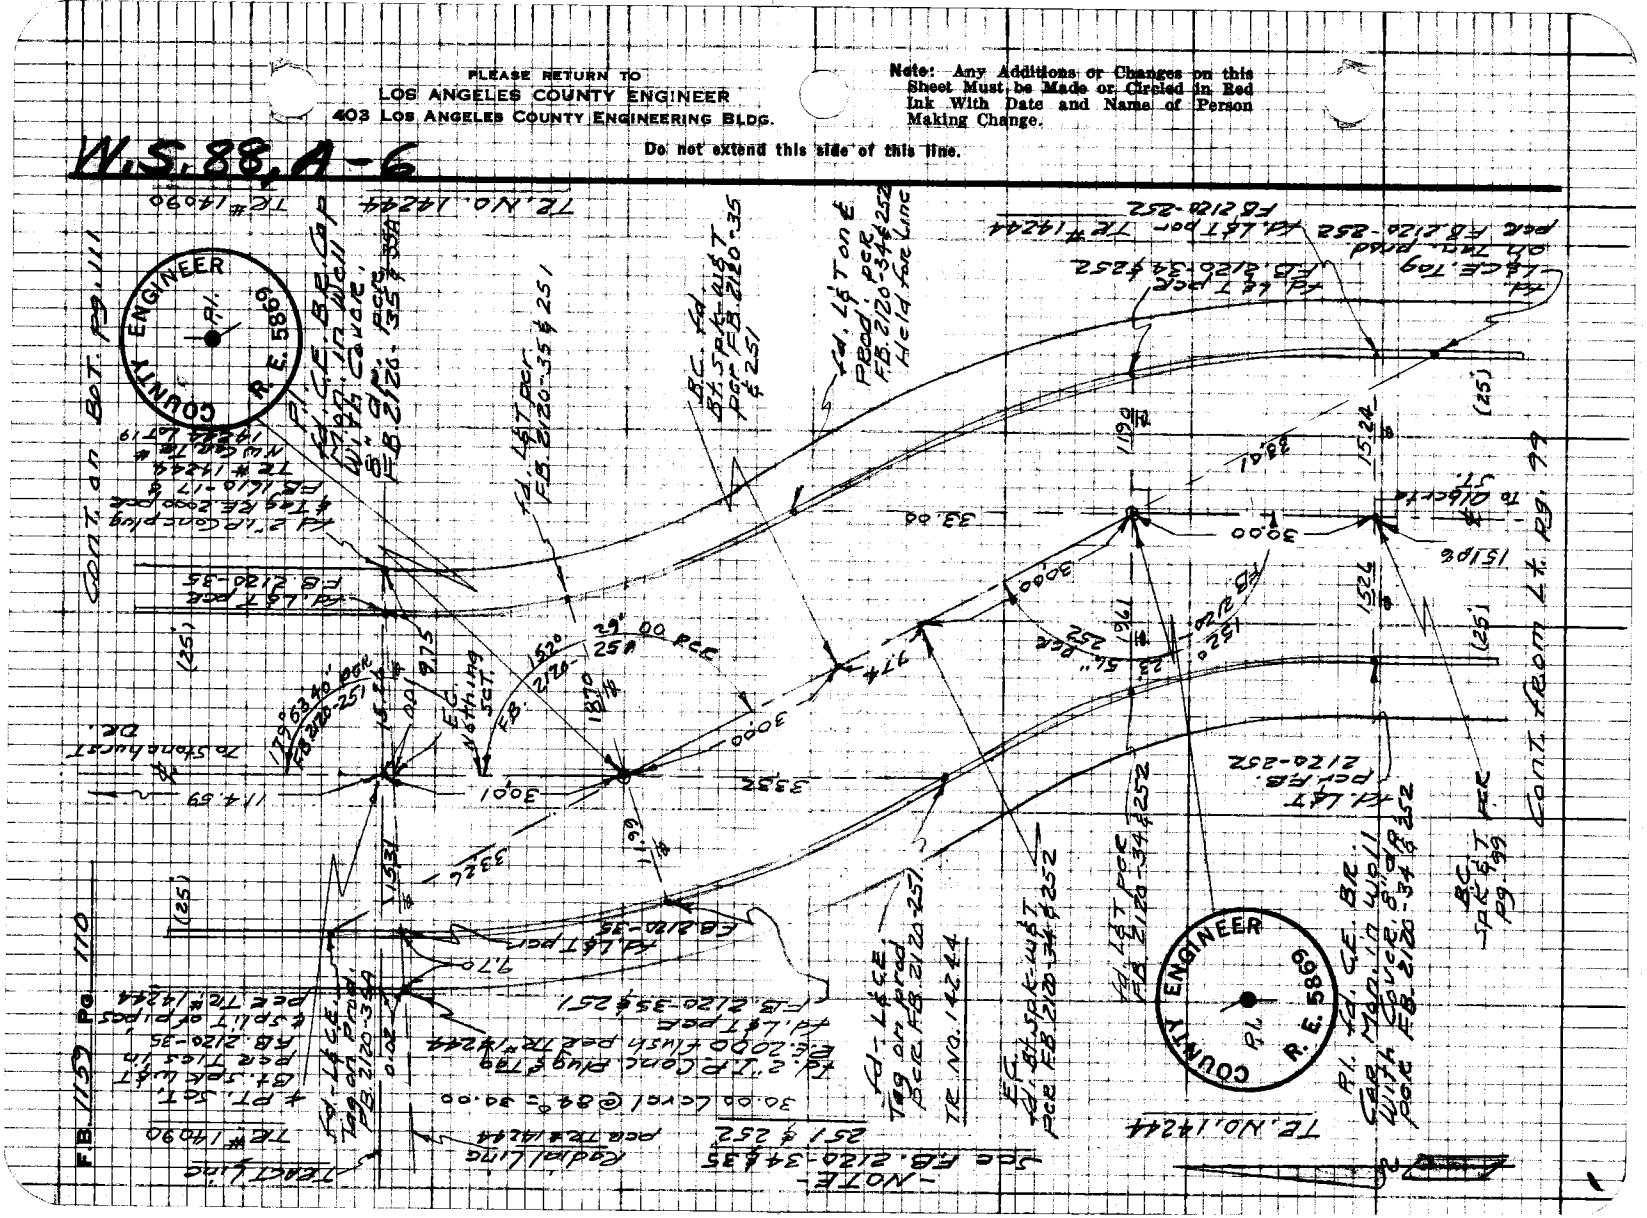

W.S.88,A-6

Notes Ck'd by
Map No.
Office Work
Checked
Date

Survey of Alberta St.
JN 0303.00 Tape 207 Std 84 °F
Surveyed by A.S. Curtis
Notes Curtis Date 9-68
Indexed R.L. Galli

F.B. 1159 PG 111

COUNTY ENGINEER R.E. 5869

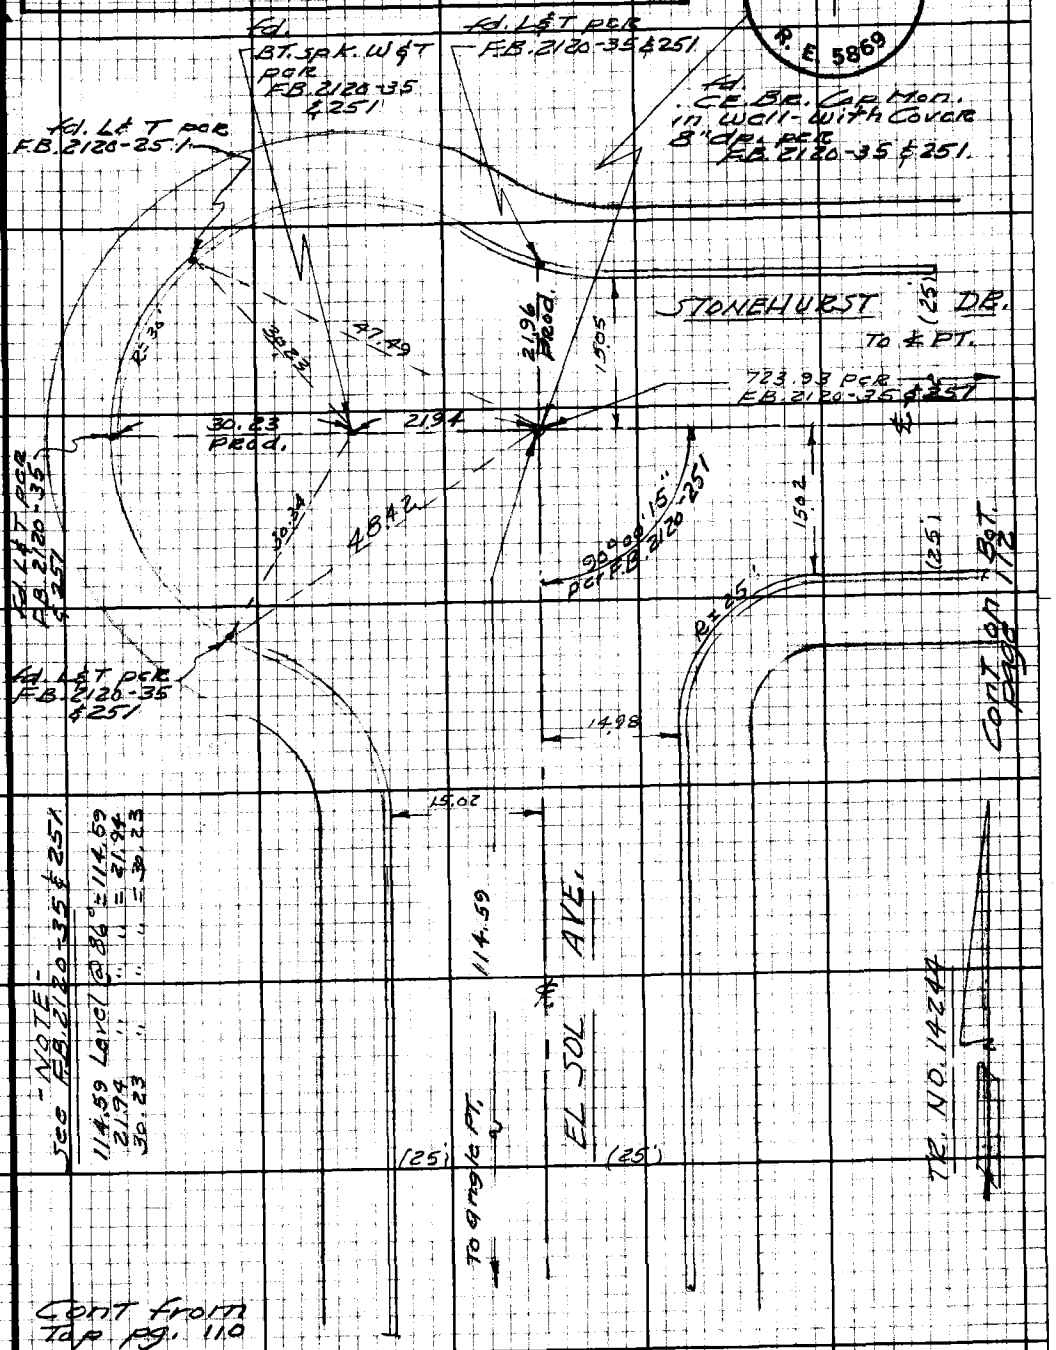

Cont from Tap pg. 110

Note: Any Additions or Changes on this Sheet Must be Made or Circled in Red Ink With Date and Name of Person Making Change.

Do not extend this side of this line.

PLEASE RETURN TO
LOS ANGELES COUNTY ENGINEER
403 LOS ANGELES COUNTY ENGINEERING BLDG.

16F3098 CF #310 9-67

PLEASE RETURN TO
LOS ANGELES COUNTY ENGINEER
403 LOS ANGELES COUNTY ENGINEERING BLDG.

Note: Any Additions or Changes on this Sheet Must be Made or Circled in Red Ink With Date and Name of Person Making Change.

Do not extend this side of this line.

W.S. 88, A-6

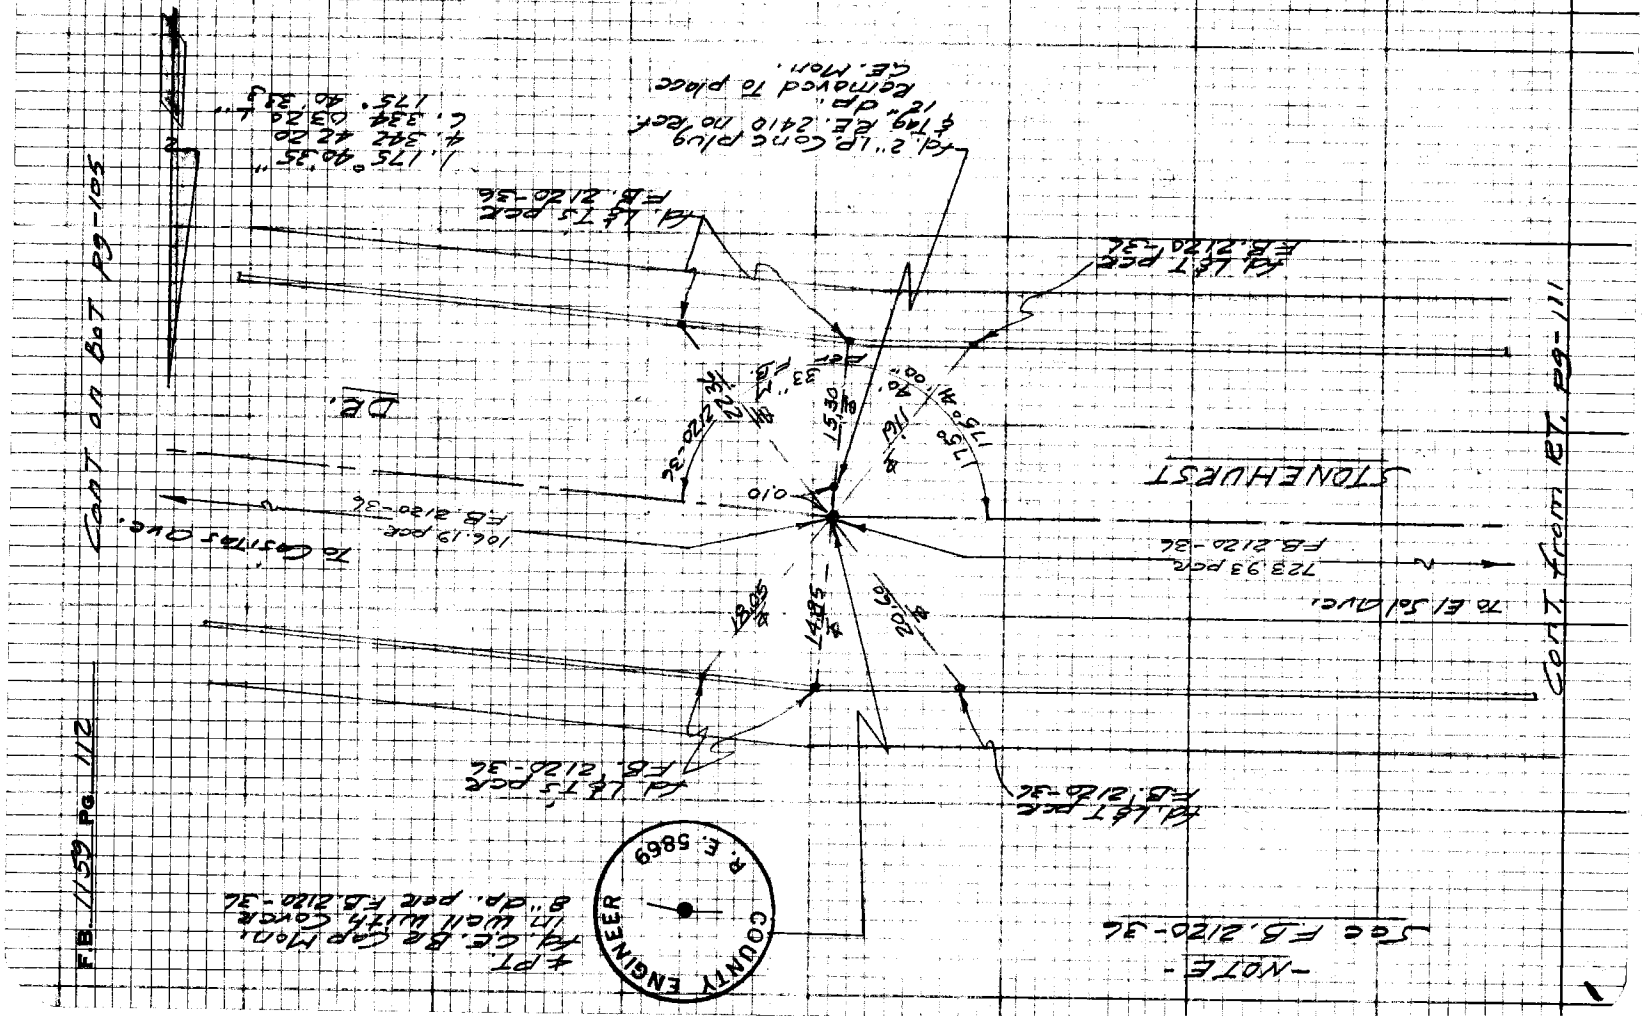

W.S. 88, A-6

Notes Ck'd by	Survey of Alberta St.
Map No.	JN 0303.00 Tape 207 Std 84 °F
Office Work	Surveyed by A.S. Curtis
Checked	Notes Curtis Date 9-68
Date	Indexed [illegible]

F.B. 1159 Pg. 113

Cont. from Rt. pg. 104

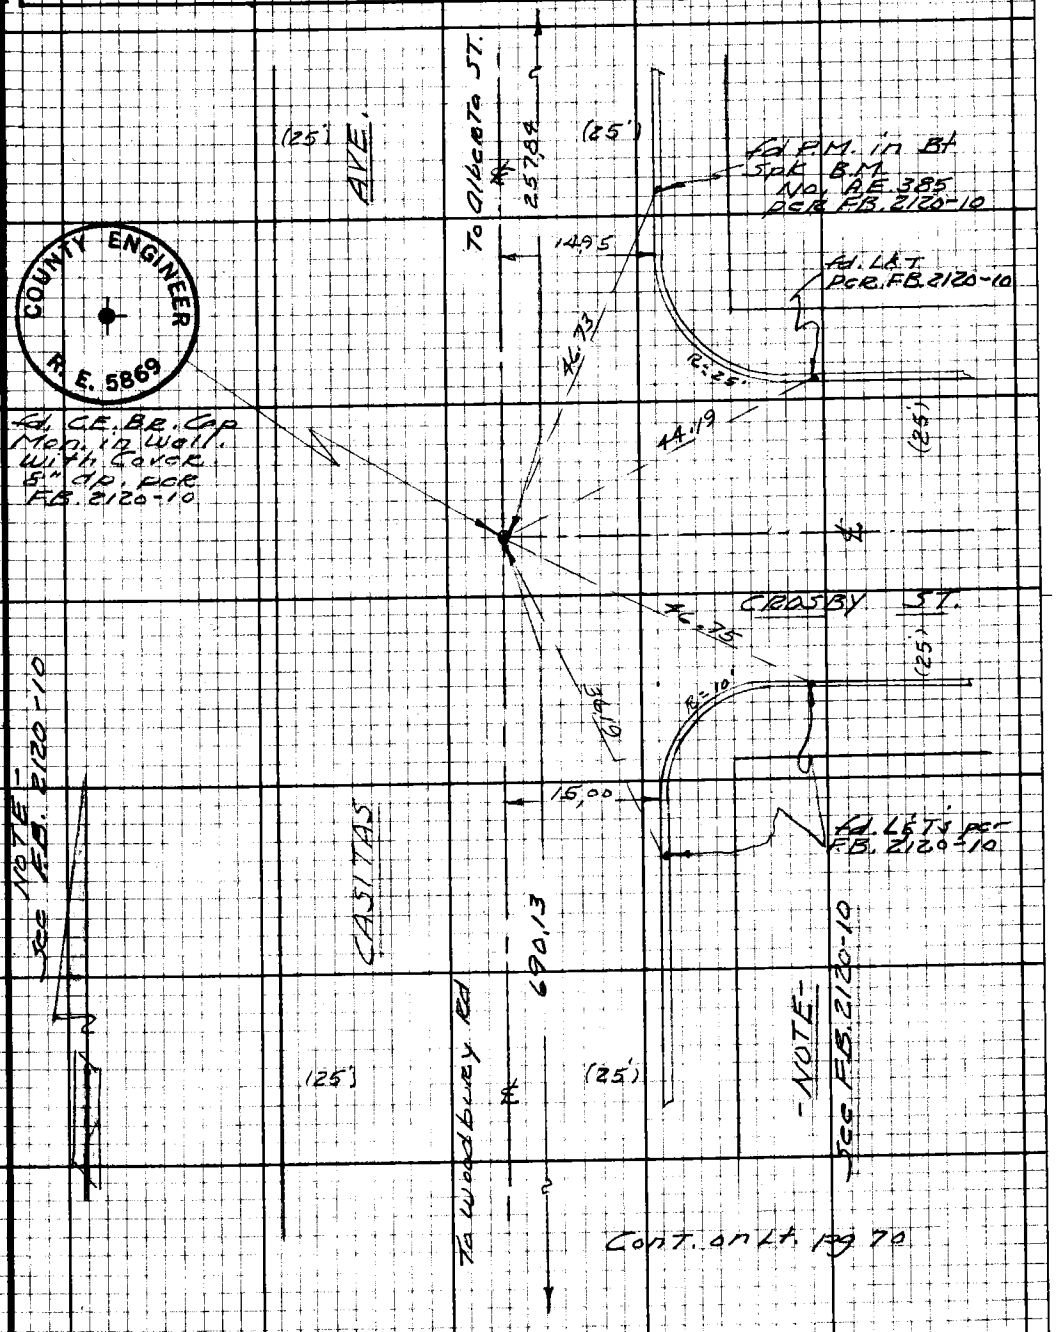

Cont. on Lt. pg 70

COUNTY ENGINEER R. E. 5869

Note: Any Additions or Changes on this Sheet Must be Made or Circled in Red Ink With Date and Name of Person Making Change.

Do not extend this side of this line.

PLEASE RETURN TO
LOS ANGELES COUNTY ENGINEER
403 LOS ANGELES COUNTY ENGINEERING BLDG.

76F3098 CE#310 9.67

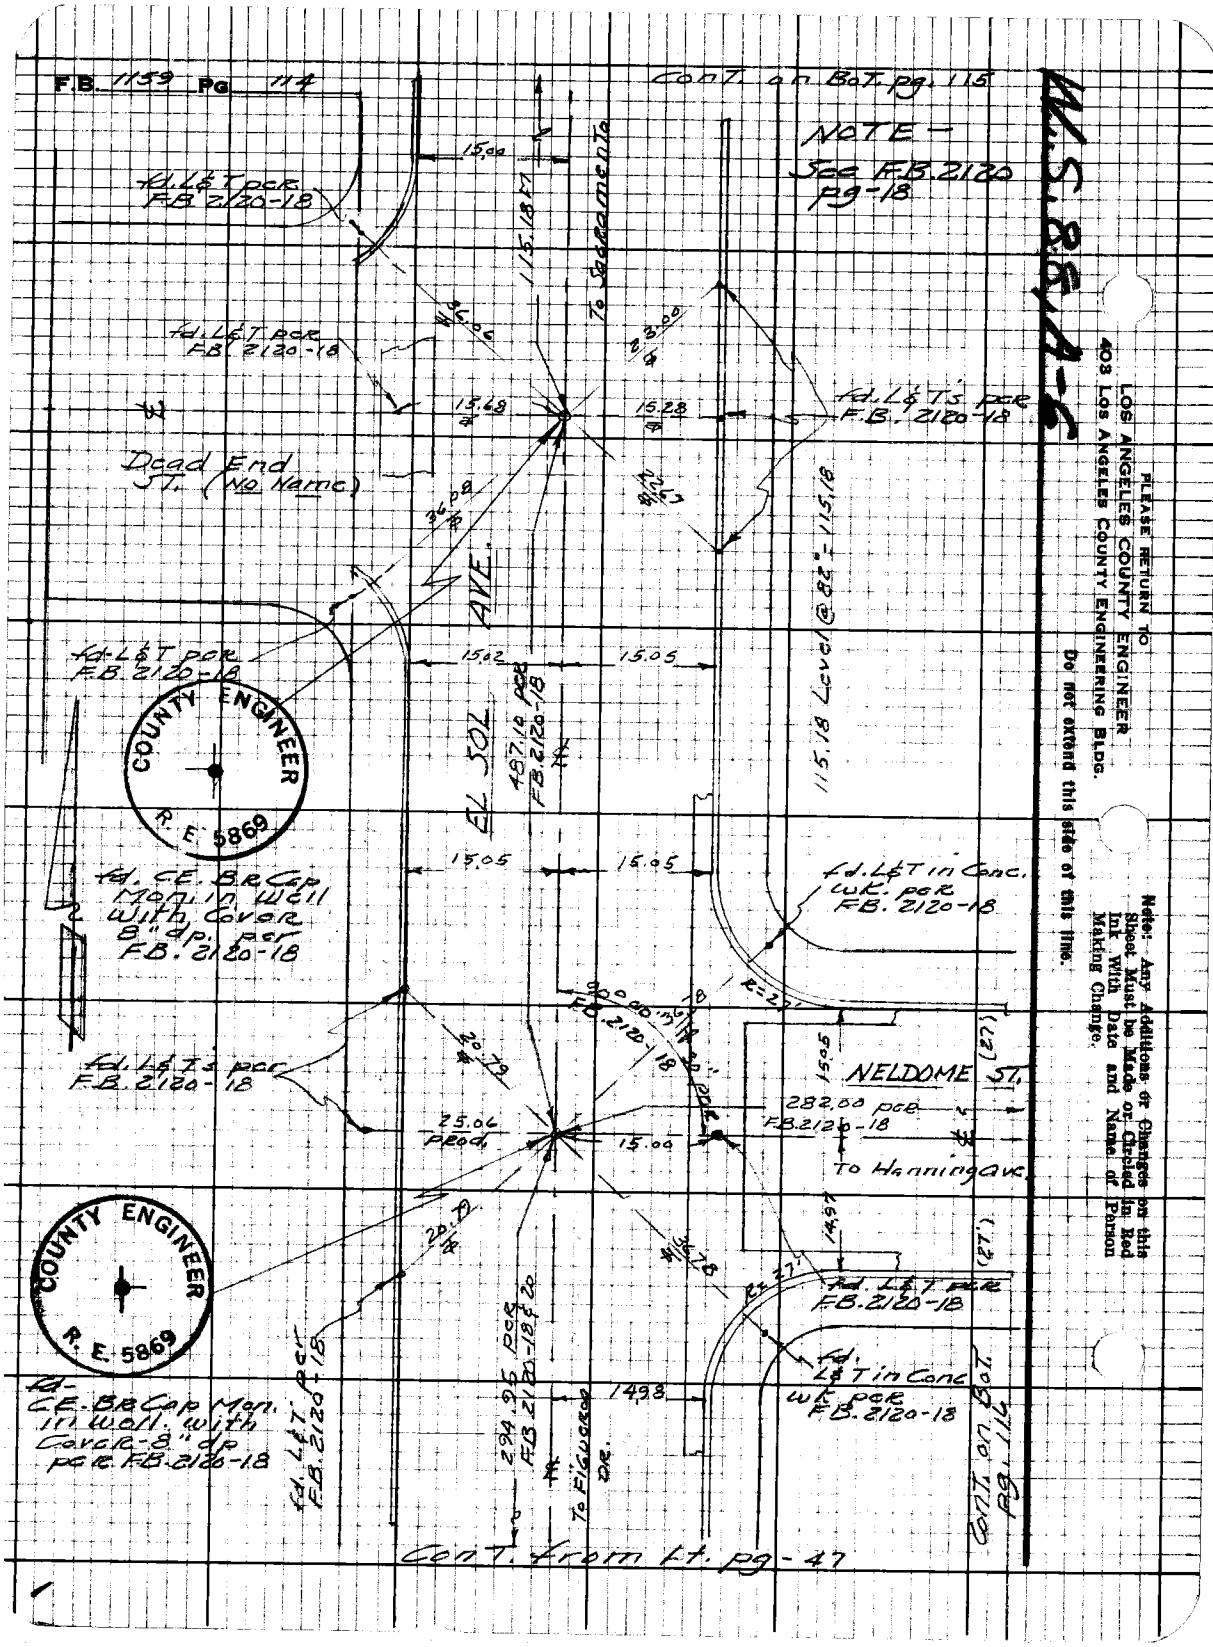

PLEASE RETURN TO
LOS ANGELES COUNTY ENGINEER
403 LOS ANGELES COUNTY ENGINEERING BLDG.

Do not extend this side of this line.

Note: Any Additions or Changes on this Sheet Must be Made or Circled in Red Ink With Date and Name of Person Making Change.

W.S.88.A-6

Notes Ck'd by	Survey of Alberta ST.
Map No.	JN 030390 Tape 207 Std 84° F
Office Work	Surveyed by A.S. Curtis
Checked	Notes Curtis Date 9-68
Date	Indexed R.E. GALLI

F.B. 1159 PG. 115

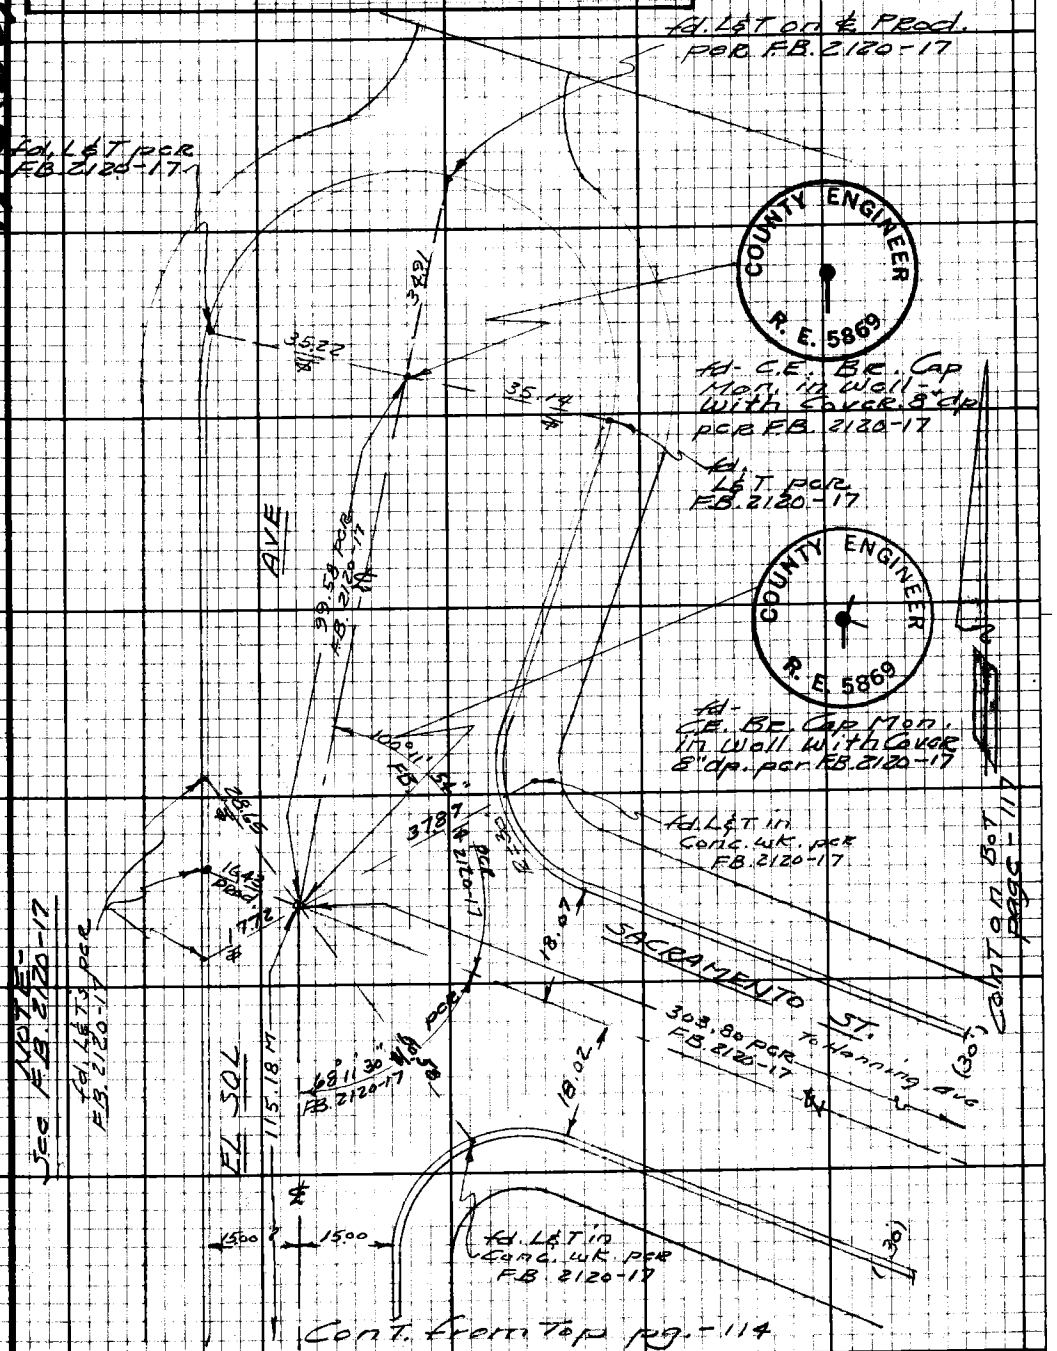

Note: Any Additions or Changes on this Sheet Must be Made or Circled in Red Ink With Date and Name of Person Making Change.

Do not extend this side of this line.

PLEASE RETURN TO
LOS ANGELES COUNTY ENGINEER
403 Los Angeles County Engineering Bldg.

76E3098 CE #310 9-67

F.B. 1159 Pg. 116

Cont. from Lt. pg. 109

WS 88 A-6

PLEASE RETURN TO
LOS ANGELES COUNTY ENGINEER
403 LOS ANGELES COUNTY ENGINEERING BLDG.

Do not extend this side of this line.

Note: Any Additions or Changes on this Sheet Must be Made or Circled in Red Ink With Date and Name of Person Making Change.

Cont. from Rt. pg. 114

1

W.S.88, A-6

Notes Ck'd by	Survey of Alberta St.
Map No.	JN 0303.00 Tape 207 Std 84 °F
Office Work	Surveyed by A. S. Curtis
Checked	Notes Curtis Date 9-68
Date	Indexed R.L. Galli

F.B. 1159 Pg. 117

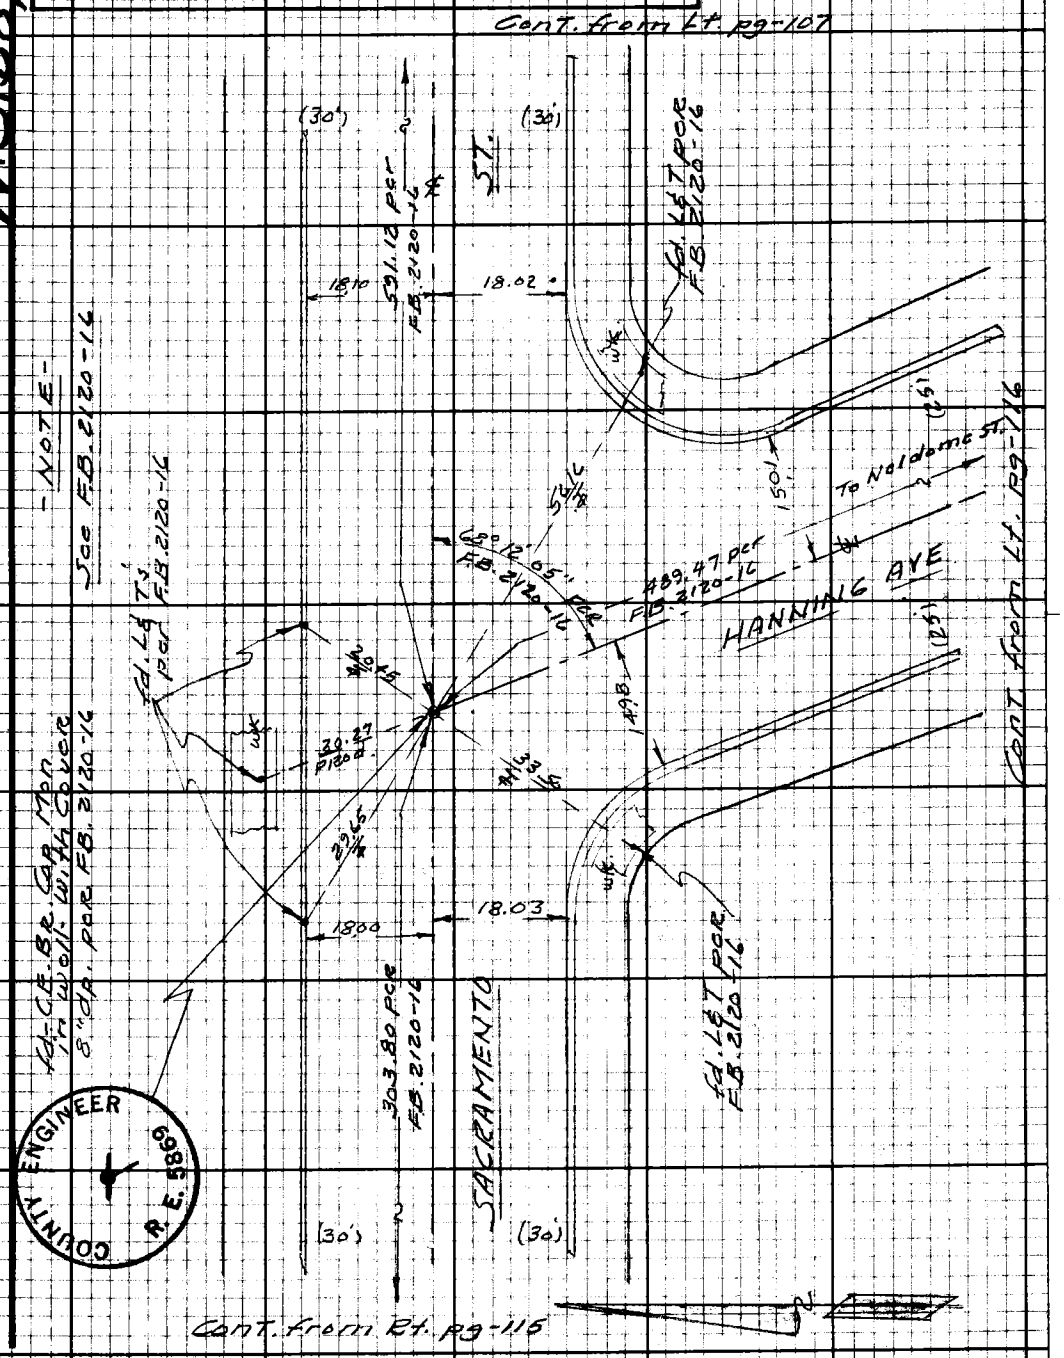

Note: Any Additions or Changes on this Sheet Must be Made or Circled in Red Ink With Date and Name of Person Making Change.

Do not extend this side of this line.

PLEASE RETURN TO
LOS ANGELES COUNTY ENGINEER
403 LOS ANGELES COUNTY ENGINEERING BLDG.

COUNTY ENGINEER R.E. 5869

76F3098 CE#310 9.67

PLEASE RETURN TO
LOS ANGELES COUNTY ENGINEER
403 LOS ANGELES COUNTY ENGINEERING BLDG.

Note: Any Additions or Changes on this Sheet Must be Made or Circled in Red Ink With Date and Name of Person Making Change.

Do not extend this side of this line.

F.B. 1159 Pg. 118

Notes Ck'd by _____	Survey of _____	F.B. _____ PG. _____
Map No. _____	JN _____ Tape _____ Std _____ °F	
Office Work _____	Surveyed by _____	
Checked _____	Notes _____ Date _____	
Date _____	Indexed _____	

Note: Any Additions or Changes on this Sheet Must be Made or Circled in Red Ink With Date and Name of Person Making Change.

PLEASE RETURN TO
LOS ANGELES COUNTY ENGINEER
403 LOS ANGELES COUNTY ENGINEERING BLDG.

Do not extend this side of this line.

76F309B CE #310 9-67

PLEASE RETURN TO
LOS ANGELES COUNTY ENGINEER
403 LOS ANGELES COUNTY ENGINEERING BLDG.

Do not extend this side of this line.

Note: Any Additions or Changes on this Sheet Must be Made or Circled in Red Ink With Date and Name of Person Making Change.

FILE PG

Notes Ck'd by _____
Map No. _____
Office Work _____
Checked _____
Date _____

Survey of _____
JN _____ Tape _____ Std _____ °F
Surveyed by _____
Notes _____ Date _____
Indexed _____

F.B. _____ PG _____

Note: Any Additions or Changes on this Sheet Must be Made or Circled in Red Ink With Date and Name of Person Making Change.

Do not extend this side of this line.

PLEASE RETURN TO
LOS ANGELES COUNTY ENGINEER
403 LOS ANGELES COUNTY ENGINEERING BLDG.

76F3098 CE#310 9-67

PLEASE RETURN TO
LOS ANGELES COUNTY ENGINEER
403 LOS ANGELES COUNTY ENGINEERING BLDG.

Do not extend this side of this line.

Note: Any Additions or Changes on this Sheet Must be Made or Circled in Red Ink With Date and Name of Person Making Change.

FB PG

Notes Ck'd by	Survey of	F.B. Pg.
Map No.	JN Tape Std °F	
Office Work	Surveyed by	
Checked	Notes Date	
Date	Indexed	

Note: Any Additions or Changes on this Sheet Must be Made or Circled in Red Ink With Date and Name of Person Making Change

Do not extend this side of this line.

PLEASE RETURN TO
LOS ANGELES COUNTY ENGINEER
403 LOS ANGELES COUNTY ENGINEERING BLDG.

76P3098 CK #310 5-66

PLEASE RETURN TO
LOS ANGELES COUNTY ENGINEER
403 LOS ANGELES COUNTY ENGINEERING BLDG.

Note: Any Additions or Changes on this Sheet Must be Made or Circled in Red Ink With Date and Name of Person Making Change

Do not extend this side of this line.

P.B. Pg