Survey of Sierra Madre Villa Area F.B. 1238 Pg. 6
W. O. 8446 Tape No. 962 St'd. 62 °F
Surveyed by A.N.H.
Notes A.N.H. Date 10-10-46
Indexed A. C. Johnson 10-14-46

PARTY
A.N. Hellstrom
H.E. Frank R.M.
M.G. Salazar H.C.
J.C. Pike R.C.

VACATED Pg. 11

VILLA AVE

Pg. 16 VOSBURG ST. Pg. 14

Pg. 15 BARHITE ST. Pg. 13

FAIRPOINT ST.

SIERRA MADRE

Pg. 7

SIERRA MADRE VILLA AREA
J.N. 8446
BETWEEN
FAIRPOINT ST.
AND
VOSBERG ST.

INDEX

PAGES SHOWN ARE FROM F.B. 1238
TO PGS. ON PAGES 19 TO 28

C.S.B-1958.
H.C. 42-20

Photographic Record 85

RETURN TO
LOS ANGELES COUNTY SURVEYOR
700 HALL OF RECORDS

Note: Any Additions or Changes on This Sheet Must be Made or Circled in Red Ink With Date and Name of Person Making Change.

Do not extend notes this side of this line.

F.B. 12338 PG. 6

Notes Ck'd by K.R.Miller
Map No. B-1958
Office Work McP.-McA.
Checked DREW
Date July 47

Survey of Sierra Madre
W. O. 8446 Tape No. 269 St
Surveyed by Hellstrom
Notes A.M.H. Date 7-23-46
Indexed C. Johnson

238 PG. 7

W.S. 44C-1

① 120-55-45
④ 123-41-00
120-55-15

324.68 @ T98 = 321.74
761.20 @ T98 = 761.35
226.61 @ T94 = 226.65
137.20 @ T94 = 137.22
93.66 @ T94 = 93.48
457.55

Fd. Nail & Tin 321.74 going N. For Topog.

761.35 To Rock with LETT

(20)

Cont. on pg 8

AVE

NBT. in 24" Pepper 321.74

For Topog. 0+00 going N.

Pl. Fd. 2" I.P. Filled with cement and Spk & W in cntr. Pr. Z-379-125

19.56

L&T. in Stone Wall

10.38

11.62

S. Nail in St. Wall

Fd. Iron Axel with pncl. mrk at Int. of Trav. Rd. To West

SEE C.S. MAP B-541-2

NBT. in Pepper

27.86

457.55

120'

Δ = 59°04'-25
R = 99.99
T = 56.65
L = 103.08
C.S. B-541-2

76+99.73 EC.

137.22

Fd. Iron Axel with pncl. mrk at Int. of Trav. Rd. To East

3.68

Set NBT. in pvmnt

VILLA

MADRE

425.84

E.C. 68+73.13

Δ = 35°-16'-20"
R = 250.07
T = 79.50
L = 153.95
C.S. Map B-541-2

B.C. 67+19.18

Fd. NBT.

Set NBT. in 28" Eucal. Tree 4' above grd.

79.49

23.27

Pl. Fd. 1½" I.P. filled with cement and nail in cntr. 6" dp. Pr. Z-379-125

100.51

10.26

N.B. Small Tin in 3" limb stump in 20" Cedar (Stump)

NBT. in P.P. "201985E"

425.77 @ T94 = 425.84

SIERRA

(20)

(20)

SEE C.S. B-541 SHT. 2.

RETURN TO
LOS ANGELES COUNTY SURVEYOR
700 HALL OF RECORDS

Note: Any Additions or Changes on This Sheet Must Be Made or Circled in Red Ink With Date and Name of Person Making Change

Do not extend notes this side of this line.

FORM 247 SM (1-41)

F.B. 1238 PG. 8

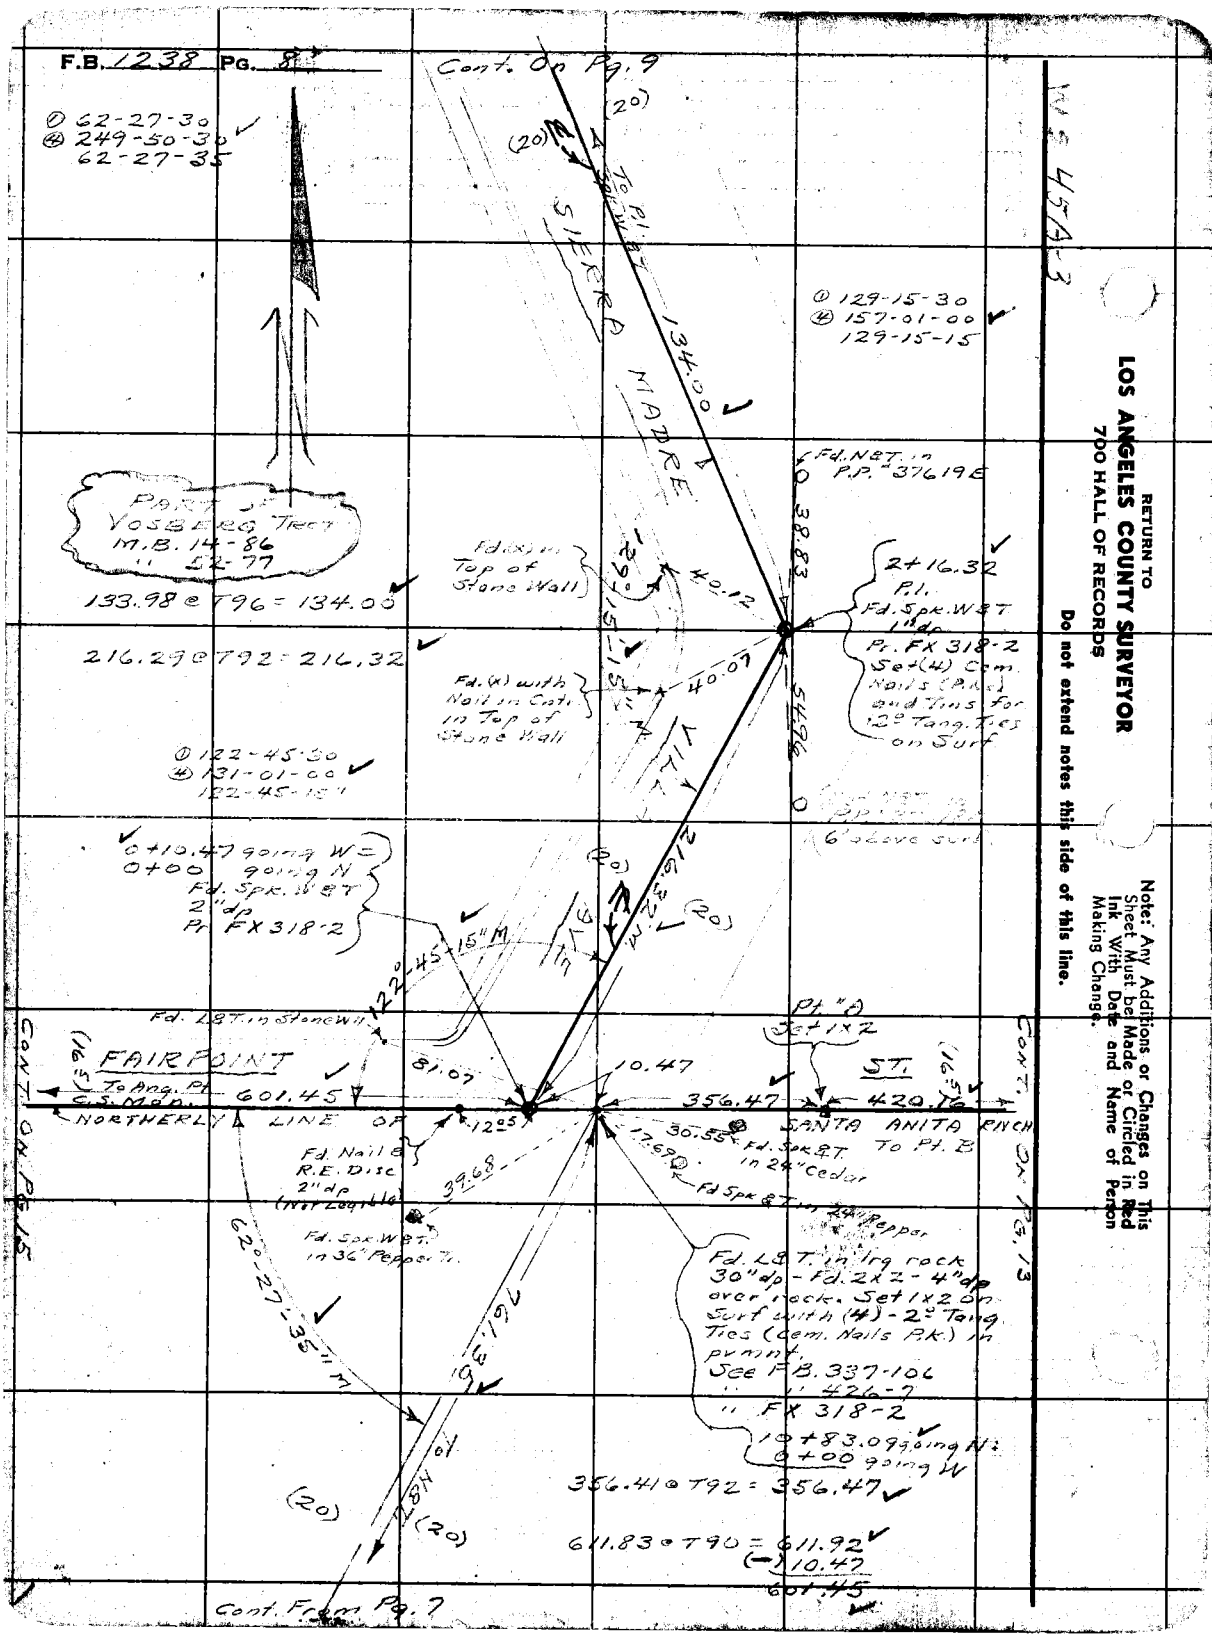

RETURN TO
LOS ANGELES COUNTY SURVEYOR
700 HALL OF RECORDS

Do not extend notes this side of this line.

Note: Any Additions or Changes on This Sheet Must be Made or Circled in Red Ink With Date and Name of Person Making Change.

Notes Ck'd by	Survey of Sierra Madre Villa Ave
Map No. B-1958	W. O. 8844 Tape No. 069 St'd 68 °F
Office Work M.P. - M.A.	Surveyed by Hellstrom
Checked Drew	Notes A.N.H Date 9-23-46
Date July 47	Indexed A. O. Johnson

F.B. 1238 PG. 7

M.S. 459-3

① 163-45-30
④ 295-00-00
163-45-00

① 95-44-30
④ 22-58-45
95-44-40

Cont. On Pg. 10

4+84.01
P.I.
Fd. Remains of 2x2 - 8" dp
Pr. Ex 318-3
Reset 2½" I.P. - 8" dp
at Rec 4 Dist From Inters
Barhite St.

Fd. 1" I.P. pl. & tck Flush in Pvmt.

Chis(x) in Top of Stone Wall

(20)

134.47 To P.I.

21.68

25.45

N&T. in PP "376.21E

BARHITE ST.

23.34

61.28

37.75

163°45'00"

20.10

To Spk W&T. Range Line

627.02

23.70

4+63.91
INTERS
Fd. Spk. W&T. - 3" dp
Pr. F.X. 318-3
Set (4) 2" Tang. Ties
(Boat Spk & T) on
Surf. on E's

Cont. On Pg. 13

21.57

41.77

29.26

20.08

Chis(x) in Top of Stn Wall

0.03

Fd. N&T.
Pr. Ex 318-3
0.03 E. of Line
4+43.83

95-44-00
22-56-45
95-44-10

4+04.27

VILLA AVE

INTERS
Set Boat Spk W&T by Int.

Set L&T. in Top of Stone Wall

26.24 proj.

Fd. (x)

BARHITE ST.

427.14 To Nail

Cont. On Pg. 13

SIERRA MADRE

N&T. in Guy Pole "480685E

93.50 = T84 = 93.51

53.95 = T68 = 53.95

93.51

53.95

37.00

N&T. in P.P. "376.20E

PART OF VOSBERG TRACT
M.B. 14-86
" 52-77

P.I.
Fd. Spk. W&T. - 1" dp
Pr. F.X. 318-3
Set (4) 2" Tang. Ties
(Boat Spk & T) on Surf.

Chis(x) in Top of Stone Wall

24.74

40.74

167°45'30"

134.00 W&T. Spk. P.I.

3+50.32

① 167°46'00"
④ 311-02-00
167-45-30

Cont. From Pg. 8

Note: Any Additions or Changes on This Sheet Must be Made or Circled in Red Ink With Date and Name of Person Making Change.

Do not extend notes this side of this line.

RETURN TO
LOS ANGELES COUNTY SURVEYOR
700 HALL OF RECORDS

FORM 247 SM 1-51

F.B. 1238 PG. 10

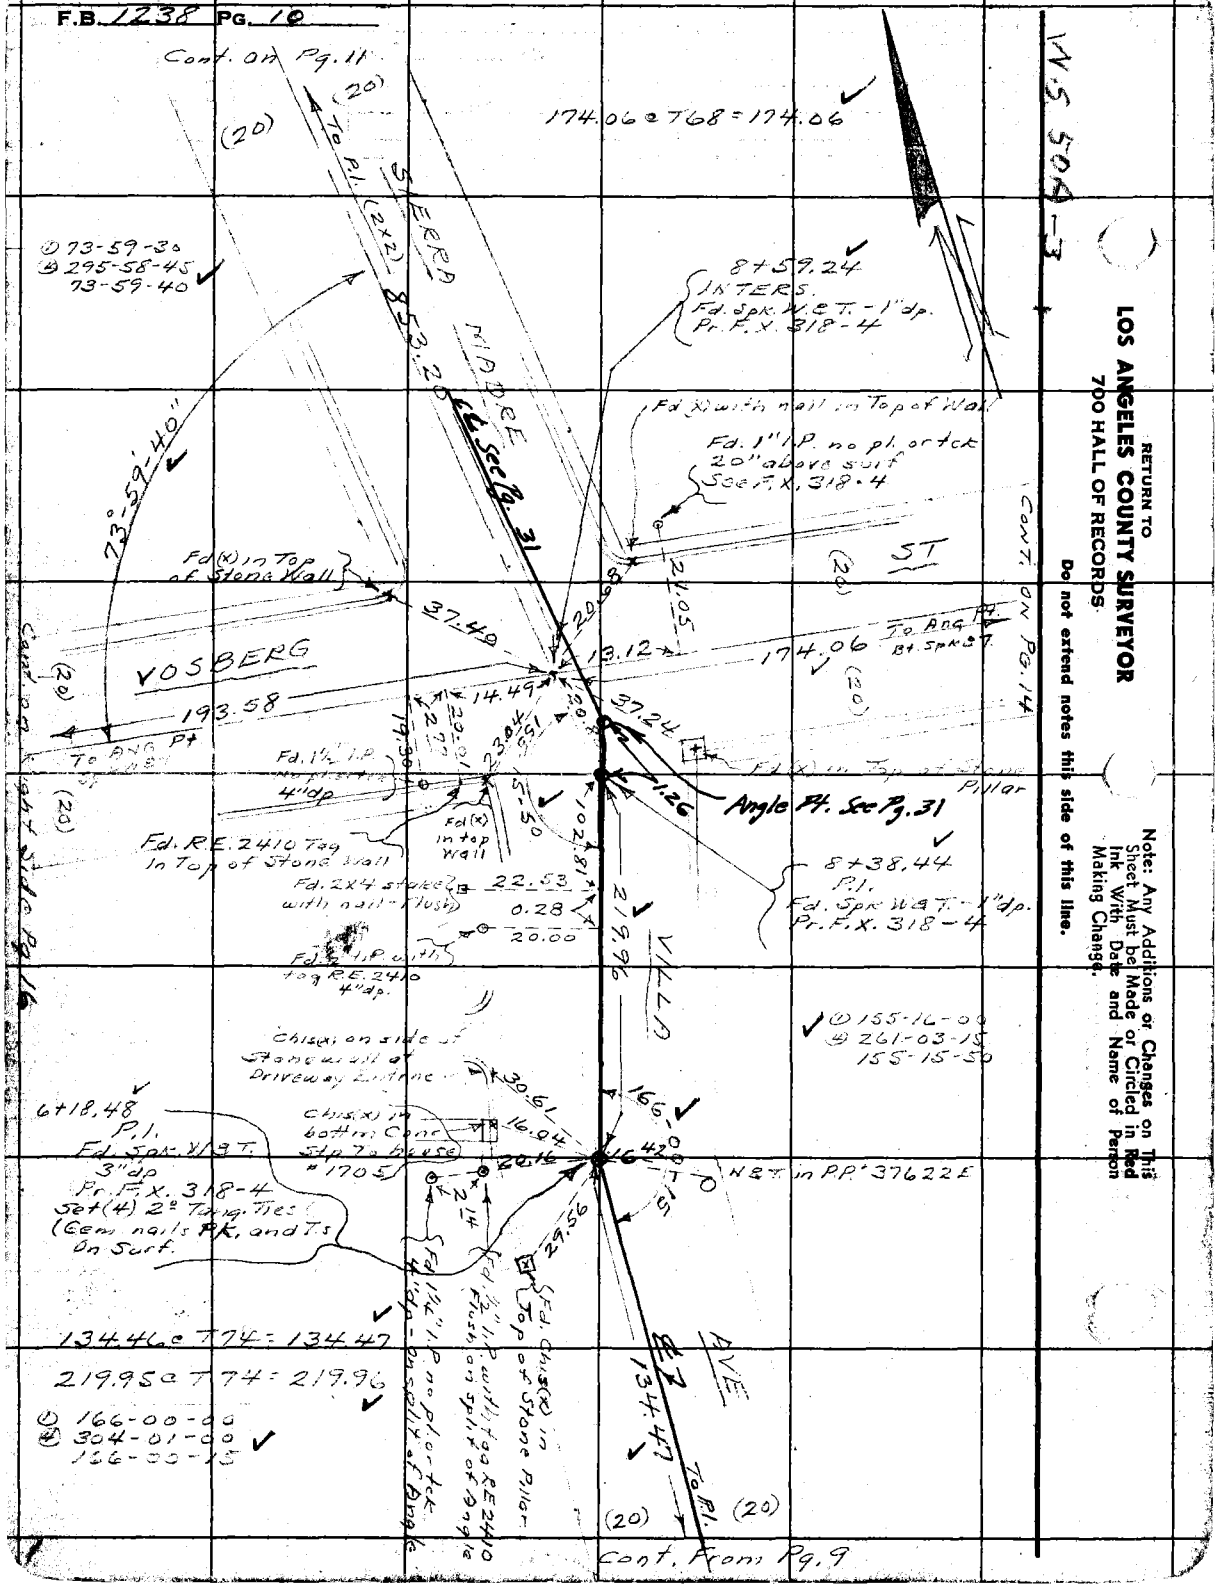

RETURN TO
LOS ANGELES COUNTY SURVEYOR
700 HALL OF RECORDS

Do not extend notes this side of this line.

Note: Any Additions or Changes on This Sheet Must be Made or Circled in Red Ink With Date and Name of Person Making Change.

Notes Ck'd by K.E.M.
Map No. B-1958
Office Work M.P. - M.A.
Checked Drew
Date July 47

Survey of Sierra Madre Villa Ave F.B. 1238 Pg. 11
W. O. 844 Tape No. 069 St'd. 68 °F
Surveyed by Hellstrom
Notes A.N.H. Date 9-27-36
Indexed L. O. Johnson

W.S. 45-A-2

Note: Any Additions or Changes on This Sheet Must Be Made or Circled in Red Ink With Date and Name of Person Making Change.

Do not extend notes this side of this line.

RETURN TO
LOS ANGELES COUNTY SURVEYOR
700 HALL OF RECORDS

FORM 247 SM 11-41

For Curve Data See M.373-1024 & F.X. 316-5
SEE ALSO C.S. Map 2 B 306

(Rd Dpt.)

Set N&T. in guy Pole #465292H

65.81

17+12.44
P.I.
Fd. 2x2 with nail - 6" dp
Pr. F.X. 316-5
" 2-373-102

See S-1134 (Rd. Dpt.) (Vacated)

5.85

20.53

Set N&T in 48" Pepper Tree

Set Chis(X) in Iron Gate Post.

Set Chis(X) in Top of Stone Wall near end

SIERRA MADRE VILLA AVE

853.21 @ TLC - 853.20

853.20

E. Sec. 317

To Inter. Vosberg St.

PART OF VOSBERG TRCT M.B. 14-86

PART OF VOSBERG TRCT MB 14-86

(20) (20)

Cont. From Pg. 10

RETURN TO
LOS ANGELES COUNTY SURVEYOR
700 HALL OF RECORDS

Note: Any Additions or Changes on This Sheet Must be Made or Circled in Red Ink With Date and Name of Person Making Change.

Do not extend notes this side of this line.

F.B. 12338 PG. 12

Notes Ck'd by K.R.McA. | Survey of Sierra Madre Villa Ave F.B. 1238 Pg. 13
Map No. B.1958 | W. O. 8446 Tape No. 069 St'd 68 °F
Office Work M's P. - M's A. | Surveyed by Hellstrom
Checked Drew | Notes A.N.H. Date 9-24-46
Date July 47 | Indexed A. O. Johnson

Ms 45-8

Note: Any Additions or Changes on This Sheet Must Be Made or Circled in Red Ink With Date and Name of Person Making Change.

Do not extend notes this side of this line.

RETURN TO LOS ANGELES COUNTY SURVEYOR. 700 HALL OF RECORDS

FORM 247 BM 11-41

CONT. FROM PG. 9

Fd. 1½" I.P. - Flush with Tag R.E. 2410

Fd. 1x2

TRACT "2927

BAR HITE

0.18

Fd. 2" I.P. - 20" high with 2x2 and Nail sticking out 6"

20.87

Fd. 1x2

427.14 — 14 — 20.00 — 340.95 — (20) — 261.14 — 5.18

Fd. 1" I.P. - Flush with Tag R.E. 2410

To Int Sierra Madre Villa Ave

ST

(20)

1995

15.87

Lot "94"

Fd. 2" I.P. plstck - Flush

Fd. Nail

Fd. Nail & Tin

TRACT "4932

N&T in 24" Pepper

20.15

340.95

45.70

27.80

N&T in 10" Avocado

N&T in 6 prong Euc

PART OF YOSEMITE TR. M.B. 14-86 " 52-77

TRACT "2927

261.14 @ T68 = 261.14

340.95 @ T68 = 340.95

427.14 @ T68 = 427.14

Edg. of brk. Fd. old 2x2 with nail leans 0.4± East. Angle Point in W. Line Lot 102 TR 2927

420.09 @ T94 = 420.16

103.56 @ T94 = 103.58

77.65 @ T96 = 77.66

46+81.30 Fd Remains of old 1x2 Pr. R.E. 426-7

N&T in 8 prong 48" Eucal

(7.35) N&T in 50" Euc.

60.29

31.81

190.81

0.51

Fd. 2" I.P. plstck 8" high at Fnc Cor. 0.93 N. of Line 0.08 W. " ¾" I.P.

FAIR POINT ST

Pt. "B" Set 1x1

Set 1x1

(16.5)

420.16

103.58

74.16

77.66

RNCH

NORTHERLY LINE OF SANTA ANITA SEE C.S. MAP B523-2

12.58

Set 3" I.P. Flush S.E. Cor. Tr. 2927 Pr. C.S. Map B-523-2 at Fnc. Cor.

RETURN TO
LOS ANGELES COUNTY SURVEYOR
700 HALL OF RECORDS

Note: Any Additions or Changes on This Sheet Must be Made or Circled in Red Ink With Date and Name of Person Making Change.

Do not extend notes this side of this line.

WS 45-A-3

TRACT # 2927

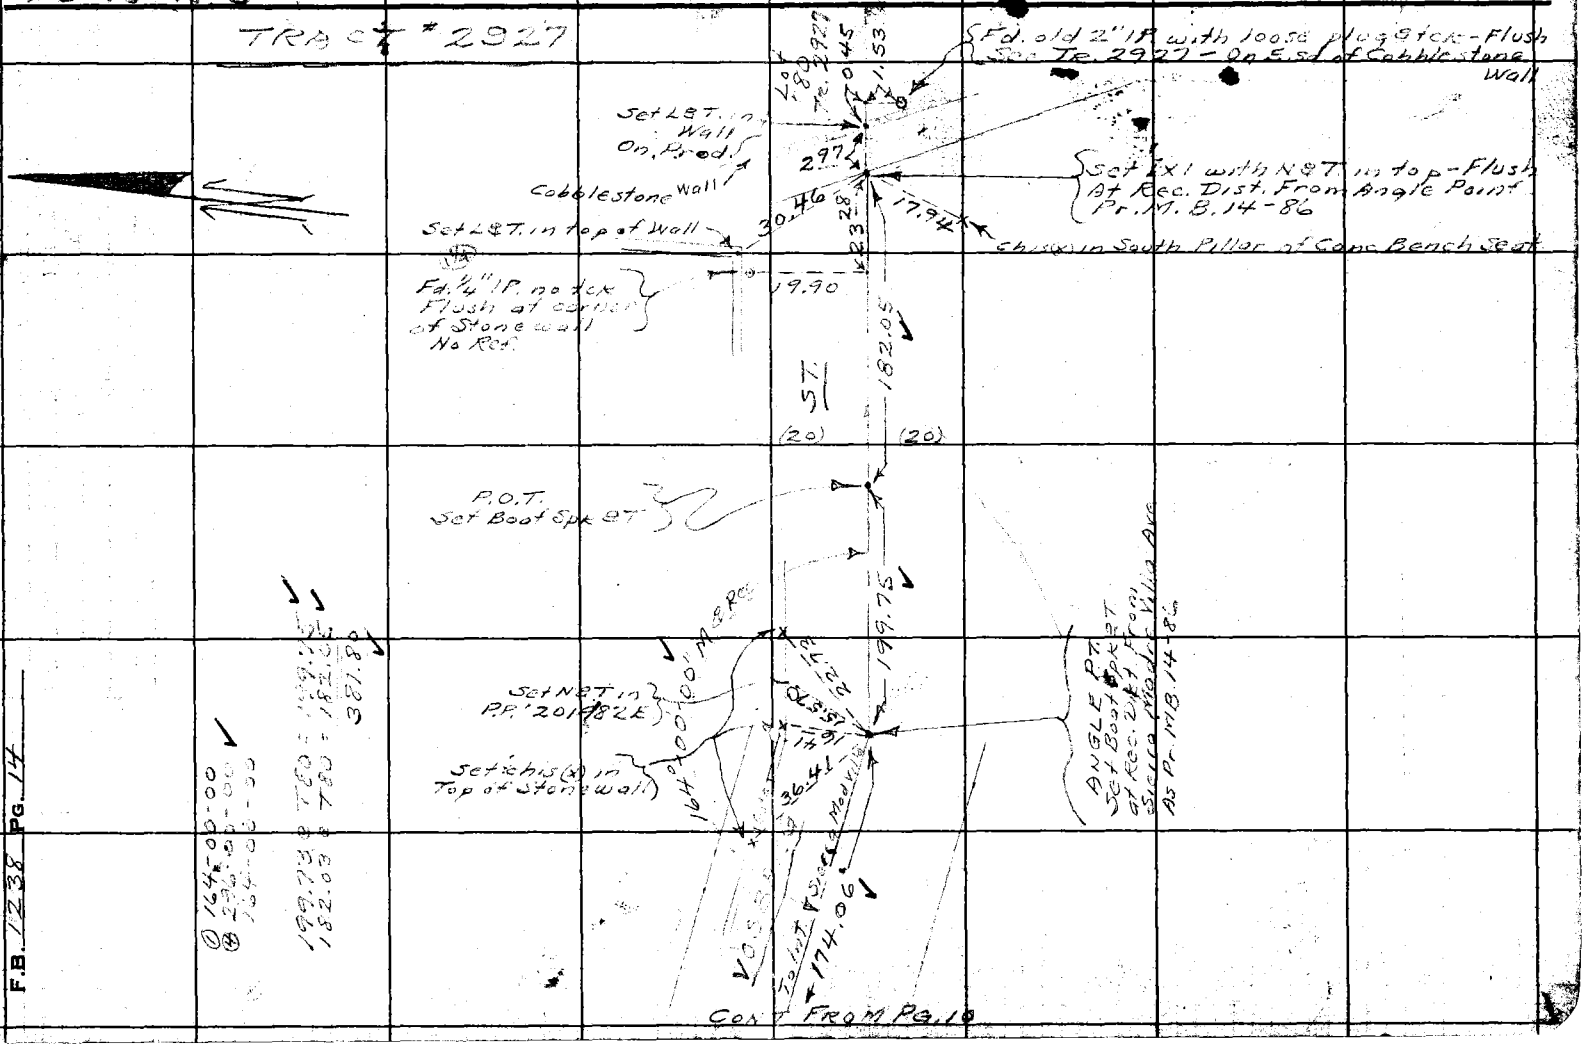

F.B. 1238 PG. 14

Notes Ck'd by L.R.M.S.M.	Survey of Sierra Madre Villa Ave F.B. 1238 Pg. 15
Map No. C.S.B-1958	W. O. 8446 Tape No. 669 St'd 68 °F
Office Work M.S.P-M.S.A.	Surveyed by Hellstrom
Checked Drew	Notes A.N.H. Date 9-26-46
Date July 47	Indexed A. C. Johnson

W 45 A-3

Cont. on Pg. 16

Sec. Ex. 318 - 8-9-14

(20)?

Fd. 1½" I.P. with tag R.E. 2825

Fd. 1½" I.P. with tag R.E. 2410

Fd. 1½" I.P. with tag R.E. 2410 - 6"up.

Fd. 1½" I.P. - Flush Filled with Conc. with tag R.E. 1216

Fd. N&T in P.P. 363227E (21.24 Disk)

Fd. 1½" I.P. with tag R.E. 2410 6"up

Fd. 1½" I.P. with tag R.E. 2410 3"up

Fd. 1x1 - Flush

Fd. 2x2 - Flush

Cont. from Pg. 9

INTERS Fd. Spx. W&T 2"dp Pr. F.X. 318-9

2.20

19.99

10.19

19.99

201.42

20.00

99.98

19.98

100.00 To Int Sierra Madre Villa Ave

20.02

3.34

19.97

627.02

(20)

BARHITE ST.

Set N&T in 48" Euc Tr

31.35

Chis(x) in 4" iron elbow going in to Large Wier Box

626.98 c T78 = 627.02

RANGE

F.X. 318-9 & 14

PRIVATE (Abandoned?)

Chis(x) in end of Wall

See

63.15

(20)

28.07

9 N&T in P.P. 376475E

FAIRPOINT (ST.)

601.45 To Spx W.&T. Int Sierra Madre Villa Ave going

Cont. from Pg. 8

NORTHERLY LINE OF SANTA ANITA RANCH

(S 9°E)

15.04

26.07

Set N&T in 24" Pepper

N&T in P.P. 363231E

ANGLE PT. Fd. C.S. Conc. Mon. With Brass Cap 24"dp Pr. F.B. 426-7 & F.X. 318-8 Set 1x2 on Surf. also (2) 2° Ties in pvmnt. (N&T's)

Note: Any Additions or Changes on This Sheet Must be Made or Circled in Red Ink With Date and Name of Person Making Change.

Do not extend notes this side of this line.

RETURN TO
LOS ANGELES COUNTY SURVEYOR
700 HALL OF RECORDS

FORM 247 SM 1-41

F.B. 1238 PG. 16

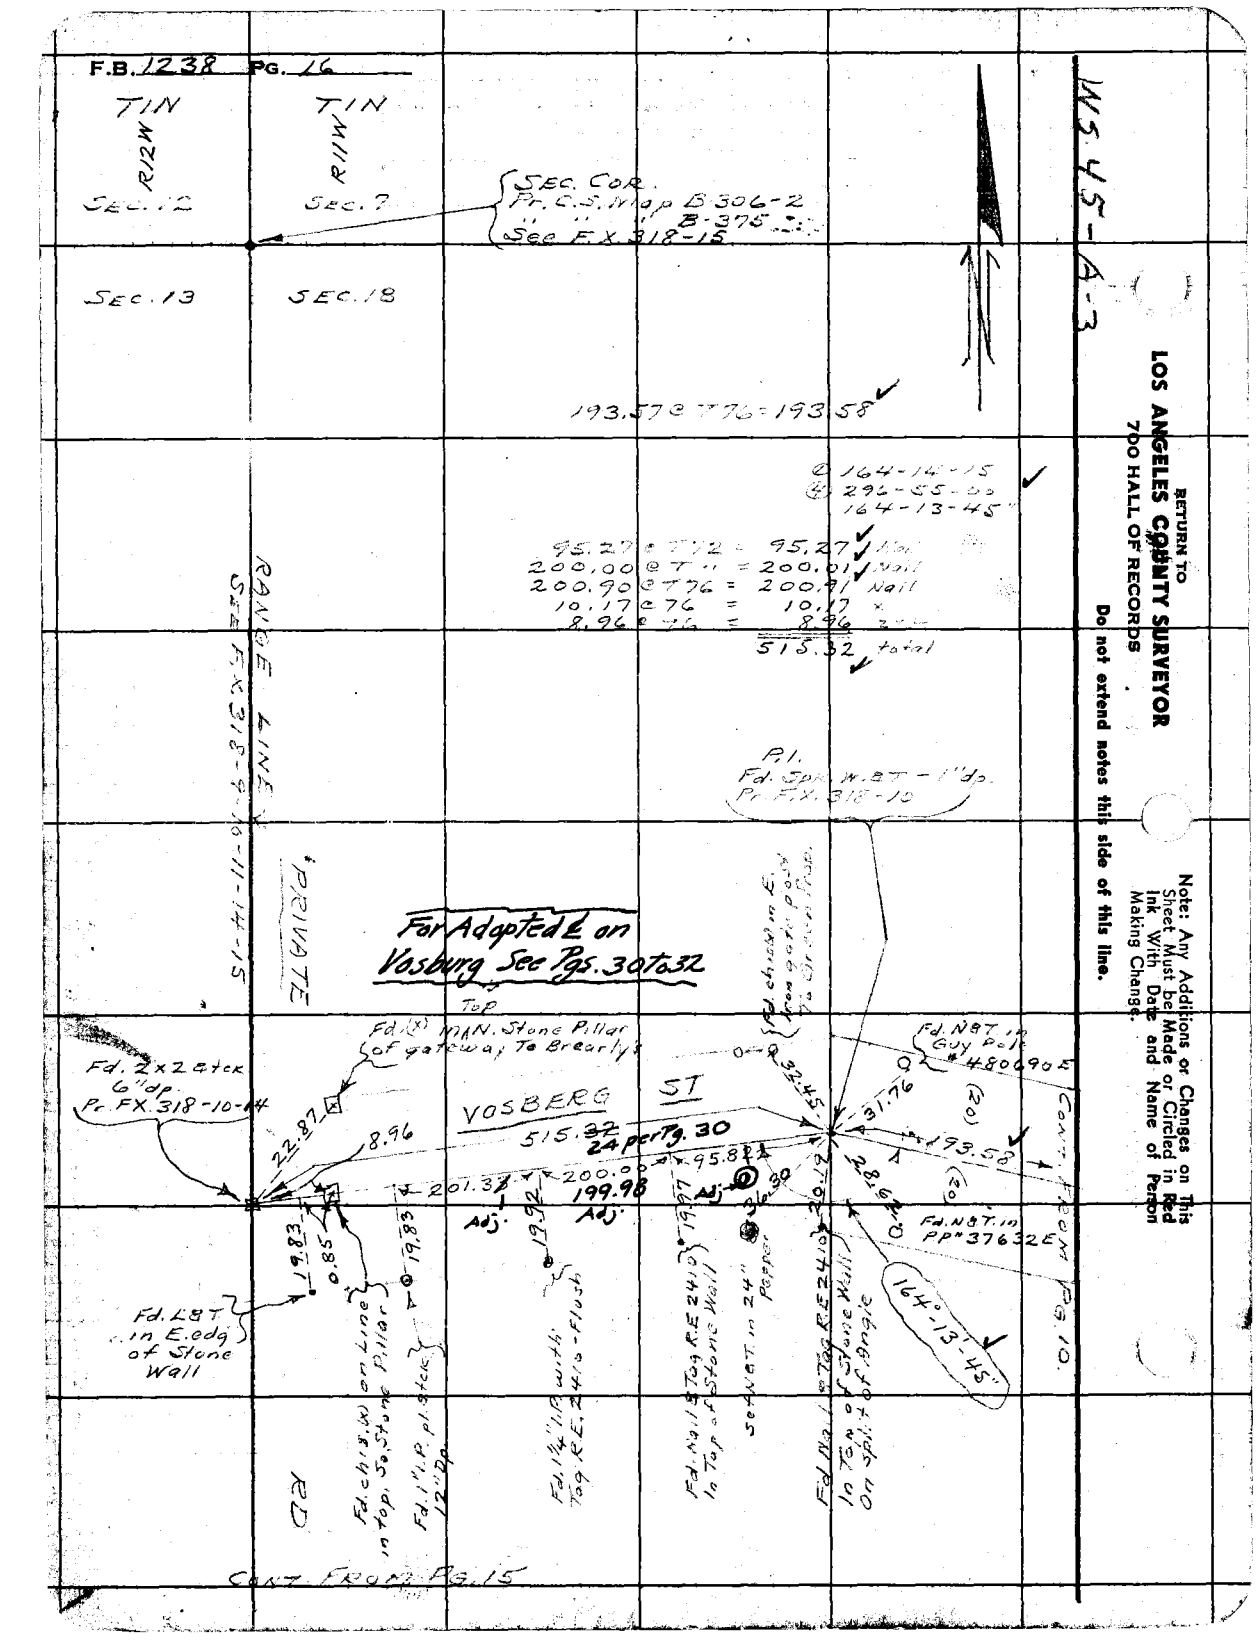

WS 45-A-3

RETURN TO
LOS ANGELES COUNTY SURVEYOR
700 HALL OF RECORDS

Do not extend notes this side of this line.

Note: Any Additions or Changes on This Sheet Must be Made or Circled in Red Ink With Date and Name of Person Making Change.

FORM 247 5M 11-41

RETURN TO
LOS ANGELES COUNTY SURVEYOR
700 HALL OF RECORDS

Note: Any Additions or Changes on This Sheet Must be Made or Circled in Red Ink With Date and Name of Person Making Change.

Do not extend notes this side of this line.

Notes Ck'd by
Map No. R-1858
Office Work M&P - M&A
Checked
Date

Survey of
W. O. Tape No. St'd °F
Surveyed by
Notes Date
Indexed

F.B. 1233 Pg. 17

1" = 20'

RETURN TO
LOS ANGELES COUNTY SURVEYOR
700 HALL OF RECORDS

Note: Any Additions or Changes on This Sheet Must be Made or Circled in Red Ink With Date and Name of Person Making Change.

Do not extend notes this side of this line.

OPEN

F.B. 1238 PG. 18

Notes Ck'd by
Map No. B-1958
Office Work McP. - McA.
Checked DRE
Date July 47

Survey of Sierra Madre Villa Ave F.B. 1238 Pg. 19
W. O. 8446 Tape No. 069 St'd 68 °F
Surveyed by Hellstrom
Notes A.N.H. Date 10-8-46
Indexed A. O. Johnson 10-14-46

× Cont on Pg. 20 ×

6+47.5 P.P. 13.5
8" Peppr. 6+24.5
41
6+18 30" Peppr. 10.5
6+00 8 8 16 5
5+52.5
2" Water Hydt
5+33.5
46
Galv. 12" Water Trough 5+46.5
41.5
5+35.0 36" Peppr Tr 12.0
5+00 7.5 8 15
4+96.0 4+96.0 P.P. 14.2
Small 6" Peppr Tr
Small 8" Peppr Tr 4+36.0 26.5
2.5 2.0
Water Meter 1X2
Water Hand Valve in 6" Conc. Pipe
4+00 6 10 14 7
Small 10" Peppr 14.5
3+93.5
3+44.0 P.P. 14
BEGINNING OF TOPOG. ON SIERRA MADRE VILLA AVE
3+25.3
Small 8" & 10" Peppr Trs 10.4 17
10 14
3+21.74 NET or pg. 7
3+00 16 21.5
Beginning of Topog.
120.00
0+00 going N. P.I. - 2" IP filled with conc. and Spike W Pr. Pg. 7
See Pg. 7

Sierra Madre Villa Ave
Fnce
Sierra Madre Villa
Ave
Edge Pvmt
Edge Wtr
Edge Pvmt
Edge Wtr
Edge Pvmt
Edge Wtr

F.B. 1238 Pg. 20

Cont. on Pg. 21

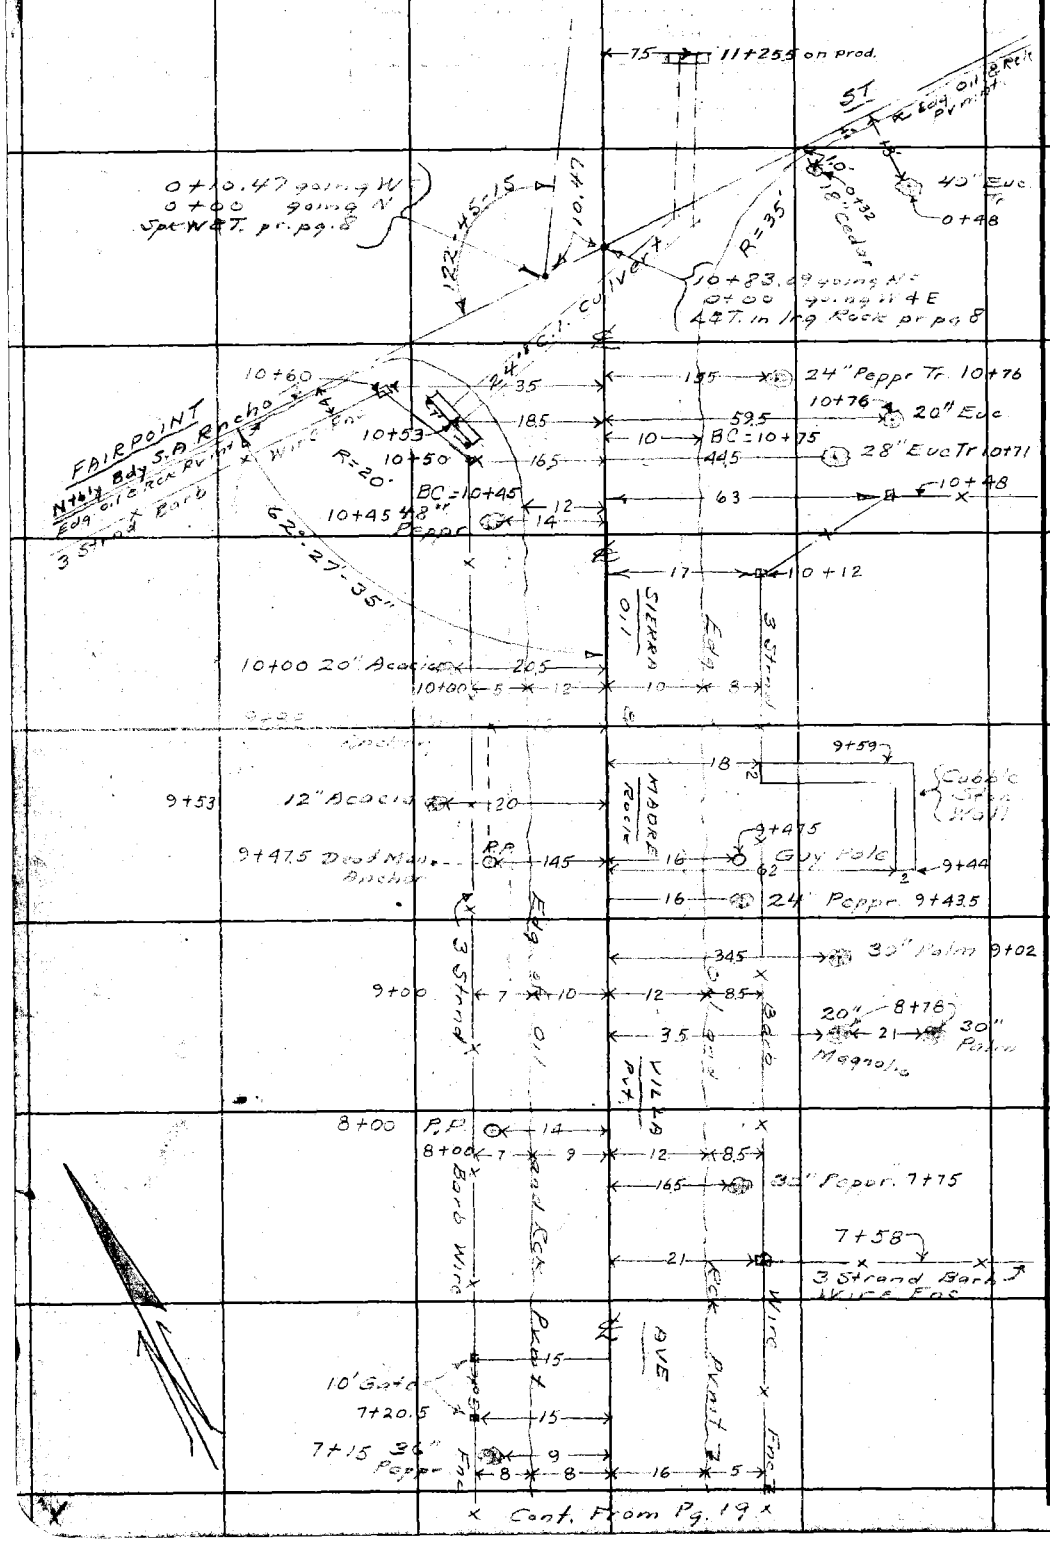

RETURN TO
LOS ANGELES COUNTY SURVEYOR
700 HALL OF RECORDS

Do not extend notes this side of this line.

Notes Any Additions or Changes on This Sheet Must be Made or Circled in Red Ink With Date and Name of Person Making Change.

Notes Ck'd by
Map No. B-1958
Office Work Mc P. - Mc A.
Checked Drew
Date July 47

Survey of Sierra Madre Villa Ave F.B. 1238 Pg. 21
W. O 8944 Tape No. 269 St'd 68°F
Surveyed by Hellstrom
Notes A.N.H. Date 10-8-46
Indexed A. O. Johnson

CONT. ON PG. 22

Note: Any Additions or Changes on This Sheet Must Be Made or Circled in Red Ink With Date and Name of Person Making Change.

Do not extend notes this side of this line.

RETURN TO LOS ANGELES COUNTY SURVEYOR 900 HALL OF RECORDS

FORM 247 RN 11-41

H.H. = Hand Hole

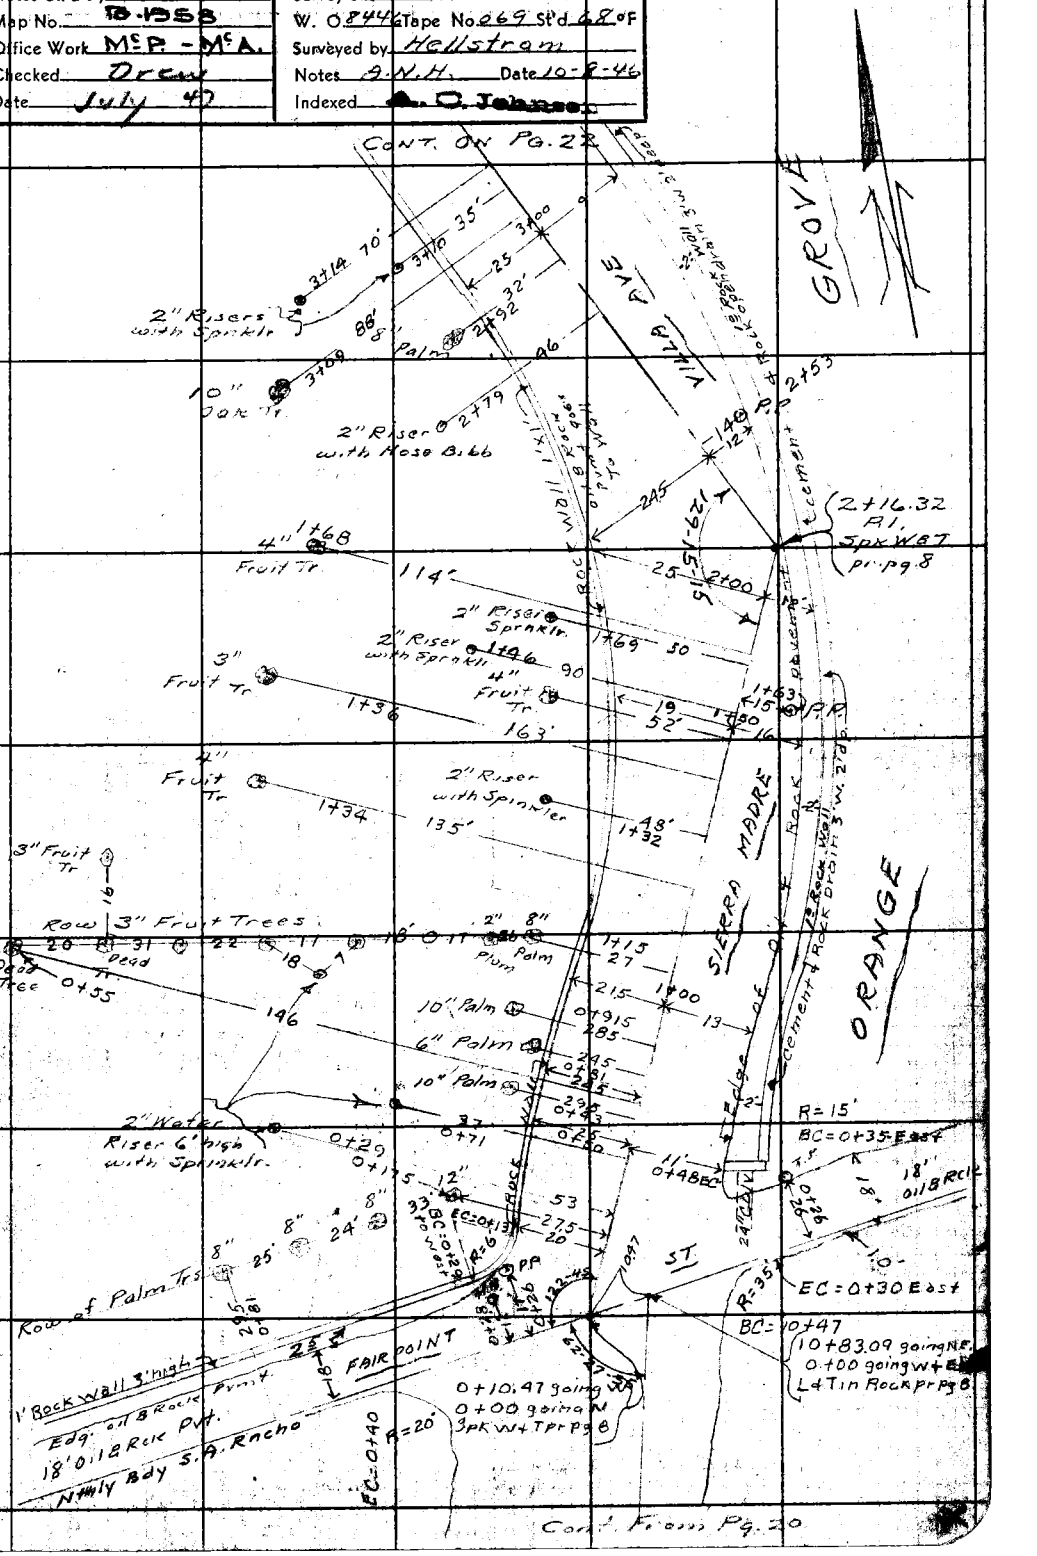
GROVE
SIERRA MADRE VILLA
ORANGE
SIERRA MADRE
3714
3710
3700
2792
2779
2753
3769
2+53
2+16.32 Al
Spk WBT
pi. pg 8
1768
Fruit Tr
114'
2+00
2" Riser Sprinkl.
1769
50
2" Riser with Sprinkl.
1746
90
4" Fruit Tr
1736
163'
1+63
1+80
1+48
1734
135'
1+32
3" Fruit Tr
Row 3" Fruit Trees
Dead Tree
0+55
146
1715
27
215
1+00
10" Palm
0+91.5
285
6" Palm
0+91
245
10" Palm
0+83
295
2" Water Riser 6' high with Spinklr.
0+29
0+71
0+76
0+48 BC
R=15'
BC=0+35 East
EC=0+30 East
R=35'
BC=10+47
10+83.09 going NE
0+00 going W+E
L4 Tin Rock Pr Pg 8
Edge of 4' Rock Wall
Cement Rock Drain 3' W. 27.0
Rock Wall
Rock Wall 1'x1'
Rock Wall 1'x1'
Rock Wall 1'x1'

F.B. 1238 PG. 22

Cont'd On Pg. 23

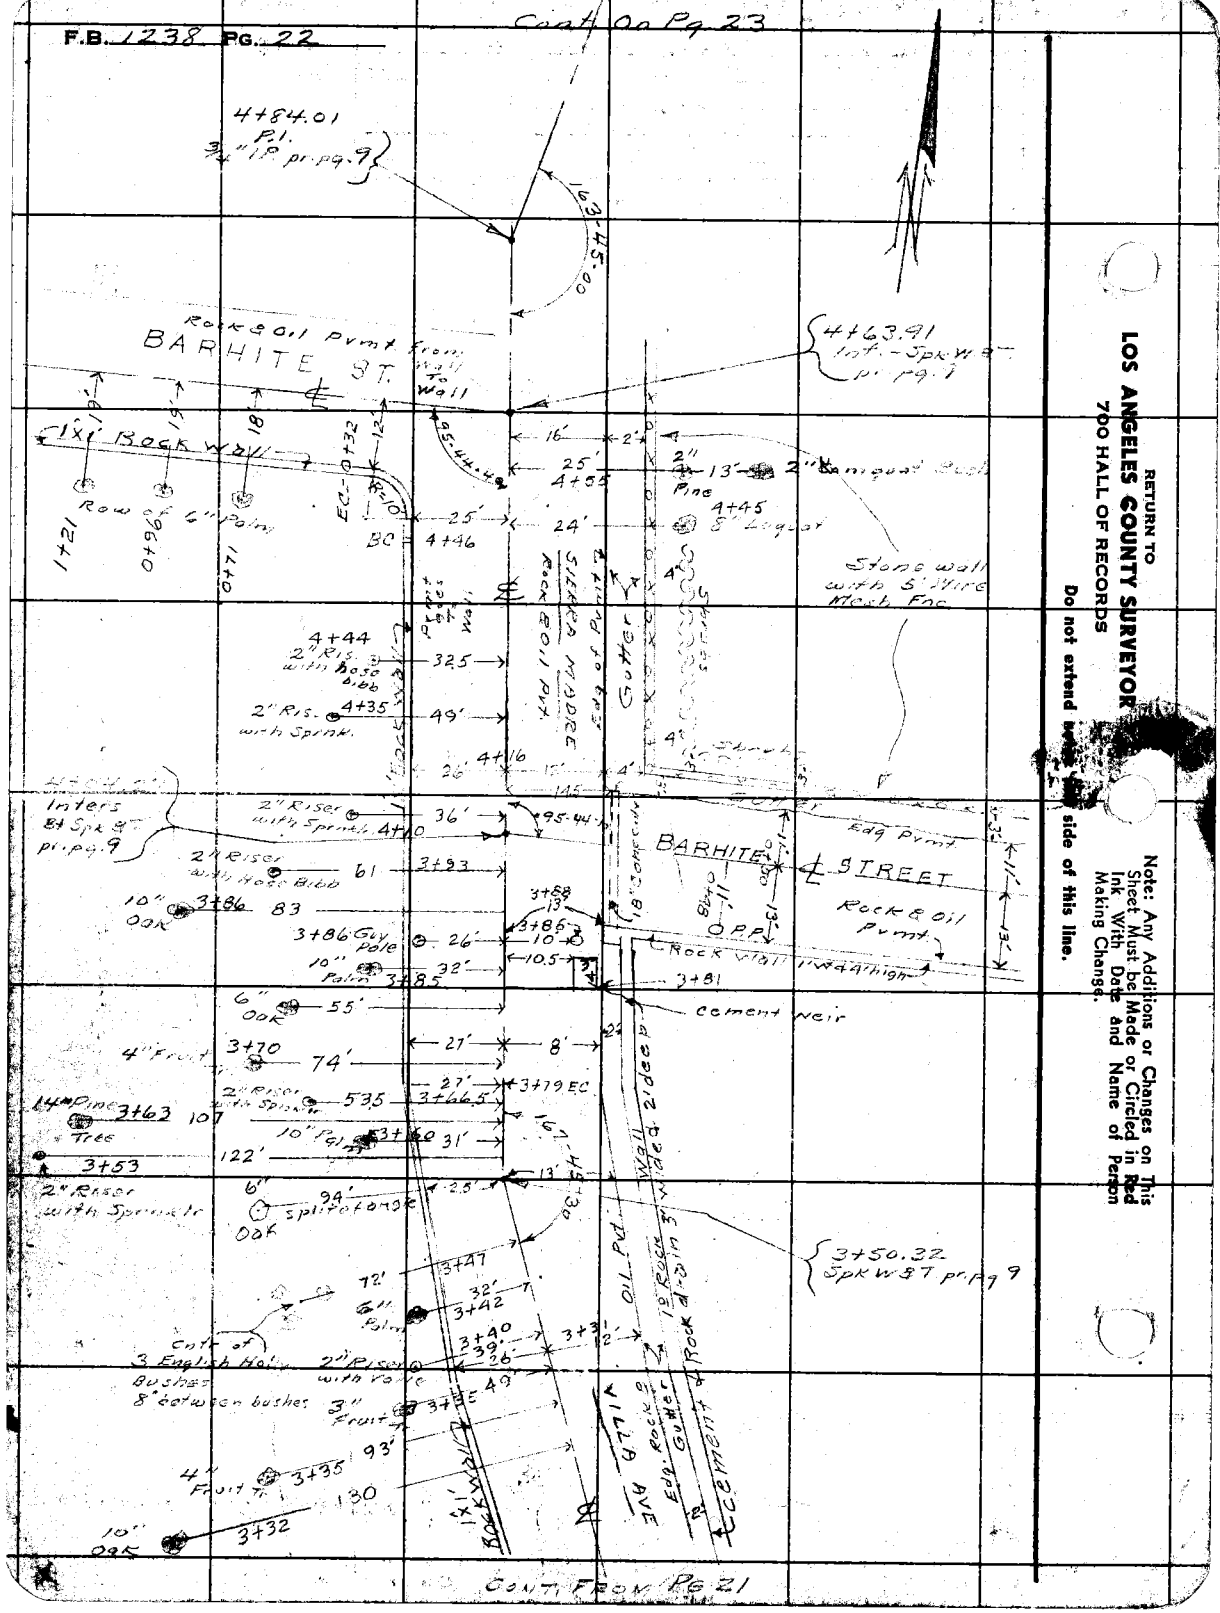

CONT'D FROM PG 21

RETURN TO
LOS ANGELES COUNTY SURVEYOR
700 HALL OF RECORDS

Do not extend beyond this line.

Note: Any Additions or Changes on This Sheet Must be Made or Circled in Red Ink With Date and Name of Person Making Change.

FORM 247 5M 11-41

RETURN TO
LOS ANGELES COUNTY SURVEYOR
700 HALL OF RECORDS

Note: Any Additions or Changes on This Sheet Must be Made or Circled in Red Ink With Date and Name of Person Making Change.

Do not extend notes this side of this line.

Notes Ck'd by R-1958
Map No. Office Work M&P - M&A
Checked Drawn
Date July 47

Survey of Sierra Madre Villa Area F.B. 1238 Pg. 23
W. O. 8444 Tape No. 962 Std. Deg. °F
Surveyed by Hellstrom
Notes A.N.H. Date 10-7-47
Indexed A. C. Johnson

Cont. on pg 24

2'Sq. Pillar 5+94

Small Trees Shrubs 3/4" Water Hyds and Rock Lined small Walks in this area

18" Palm

16" Palm 18' 5+80 37'

Palm 16" 30"

20.5 5+69

Pal 16" 10" 5+57.5 41'

3" Mag 5+55 29

4" Mag 24' 5+53

12" Palm 24' 5+49 15'

1'x2' Stone wall 20.5

5+46

10" Palm

18" Pine 57' 5+34

18" Palm 5+25 37'

Small Trees Shrubs and 3/4" Water Hyds in this Area

4+89 18" Palm 22' 38' 225'

4+84.01 Fl. 3/4" IP pr. pg. 9)

EC = 4+84.0

R=80

2'Sq. Pillar

Stone Wall 1'-2' high

BARHITE STREET

0+19.47'

0+84

0+86

13'

18'

185 6+00 13' 17' 19'

22 5+90

38

155 5+85

5+92

Driveway (Dirt)

Stonewall with 5' Wire Mesh Fnc

6+03

(5+91 = N side House)

48'

92'

2 Story Frame #1694

27'

20' 4' 14' 4' 14'

9'

20" Sycamore

5+41

Rock Wall

Shrubs

Edge Pavement

Curb & Gutter

17' 5+02 PI

22' 5+00 17' 61'

1" Peach 5+00

2" Kumquat 4+73

3' wide 2' deep Stone wall with 5' Wire Mesh Fnc Steel Posts

4+63.91 Inter Sprwlt pr. pg. 9

12" DIVE

CONT. FROM T.O.A. PG. 22

House

Walk

Curb

Steps

Drive

RETURN TO
LOS ANGELES COUNTY SURVEYOR
700 HALL OF RECORDS

Note: Any Additions or Changes on This Sheet Must be Made or Circled in Red Ink With Date and Name of Person Making Change.

Do not extend notes this side of this line.

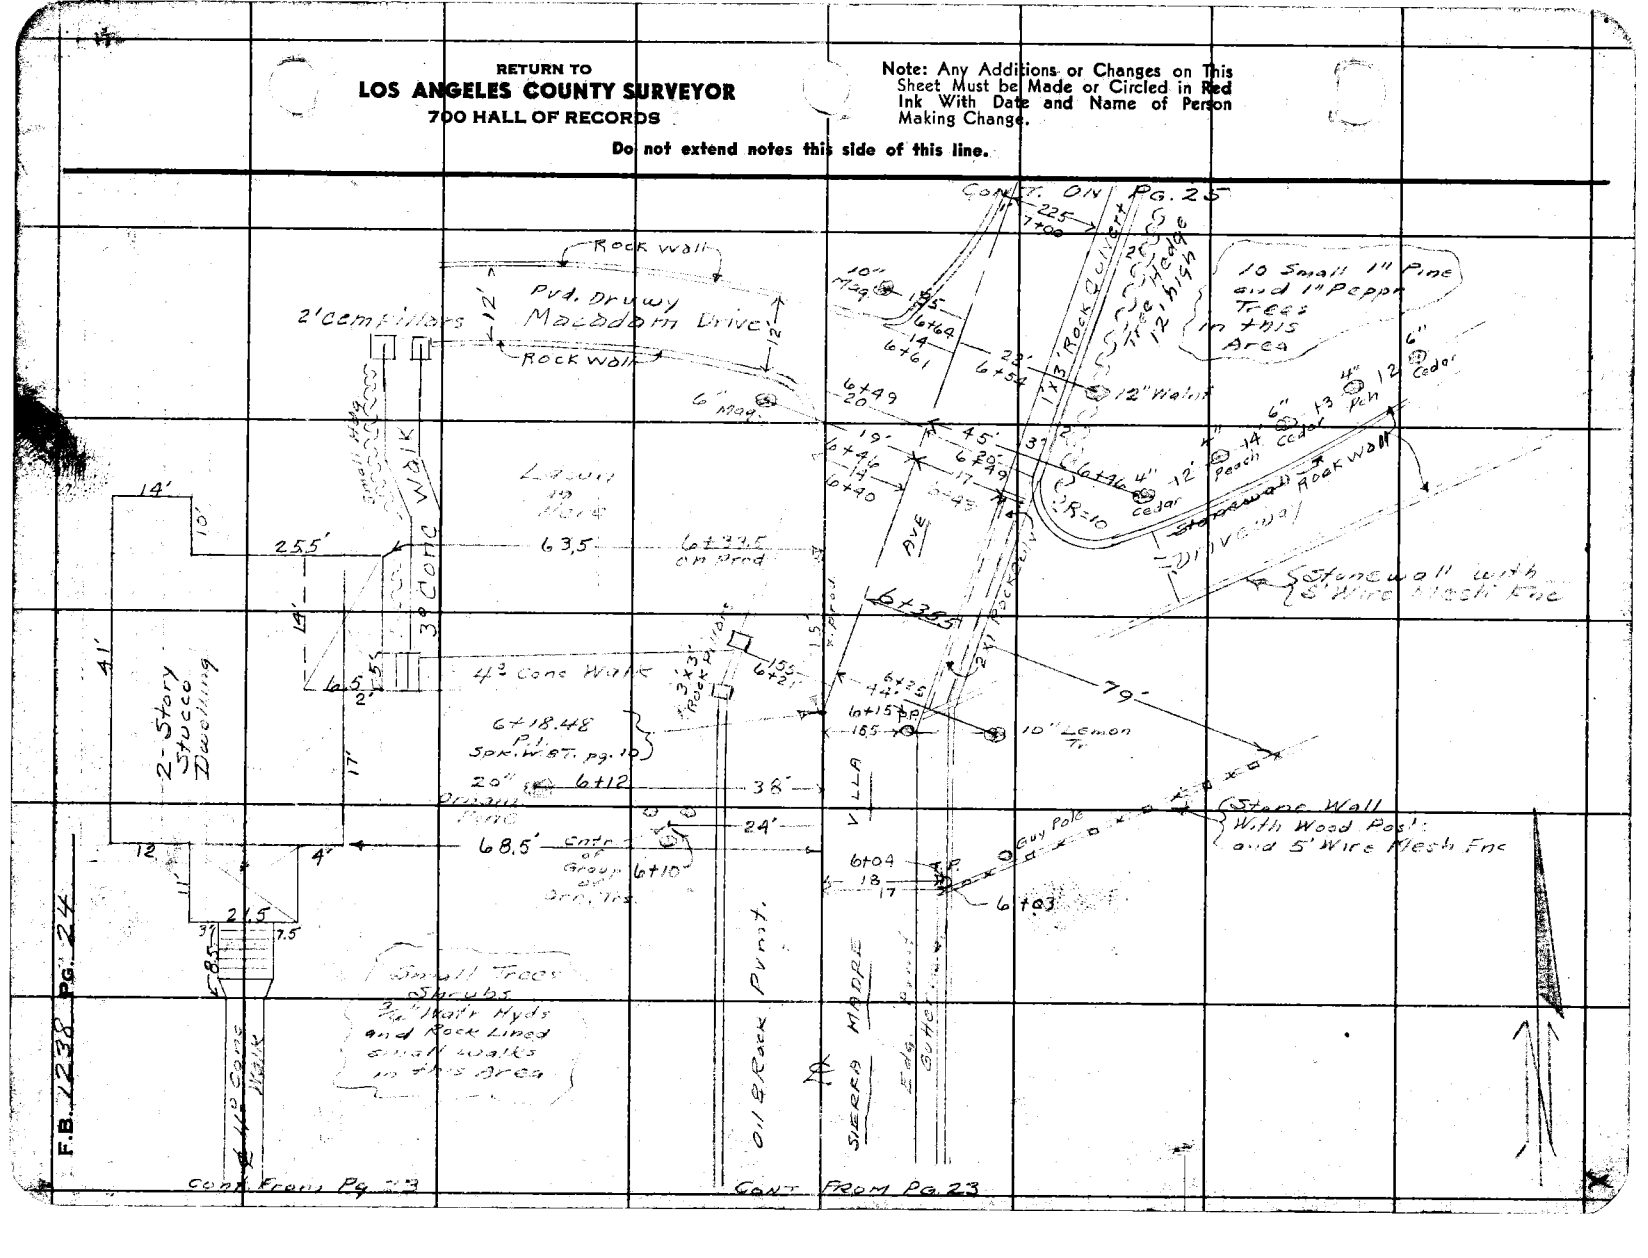

Notes Ck'd by
Map No. B-1958
Office Work M:P. - M:A.
Checked Drew
Date July 47

Survey of Sierra Madre Villa Ave F.B. 1238 Pg. 25
W. O. 8440 Tape No. 069 St'd 68 °F
Surveyed by Hellstrom
Notes A.M.H. Date 10-10-46
Indexed A. O. Johnson

CONT. ON LEFT SIDE PG. 26

8+00 16" Spruce 56'
7+95 30" Palm 55'
7+79 30" Palm
7+78 24" Orn. Shade Tr. 23' 45'
14" Oak 83'
7+61 30" Palm 5'
7+53 10" Fir 41'
7+45 30" Palm 4'
7+28 30" Pine 80'
7+20 10" Mulberry Tr. 23'
7+12 30" Palm 45'
Engl. Holly Bush 51'
6+95 30" Palm 6'
6+93 18" Orn. Shade Tr. 48'
6+86 16" Cactus Tr. 8'
30" Palm 9'
Iron Post Fnc Cor
6+72 30" Palm 28'
24" Orn. Mantal Chinese Tr. 36'
6+70
6+76
6+18.48 P.I. Spk W.B.T. prpg 10

34' 8" Shade Tr. 8+10
8+05 53' 2" Lemon
7+89 49' 2-1" Avocado
36' 12' 6" Quince
26' Dead Man Anchor 7+61
7+60 Walnut
51' 12" Walnut 7+33
23.5' P.P. 7+30
225'
Fence
Mesh
Rock Wall
Oil & Rock Pvmt.
Sierra Madre Villa Ave
Hdrg.
Gutter
Stone Wall
Trees

R = 766.00'

CONT. FROM PG. 24

RETURN TO
LOS ANGELES COUNTY SURVEYOR
700 HALL OF RECORDS

Note: Any Additions or Changes on This Sheet Must Be Made or Circled in Red Ink With Date and Name of Person Making Change.

Do not extend notes this side of this line.

FORM 247 5M 11-41

RETURN TO
LOS ANGELES COUNTY SURVEYOR
700 HALL OF RECORDS

Note: Any Additions or Changes on This Sheet Must be Made or Circled in Red Ink With Date and Name of Person Making Change.

Do not extend notes this side of this line.

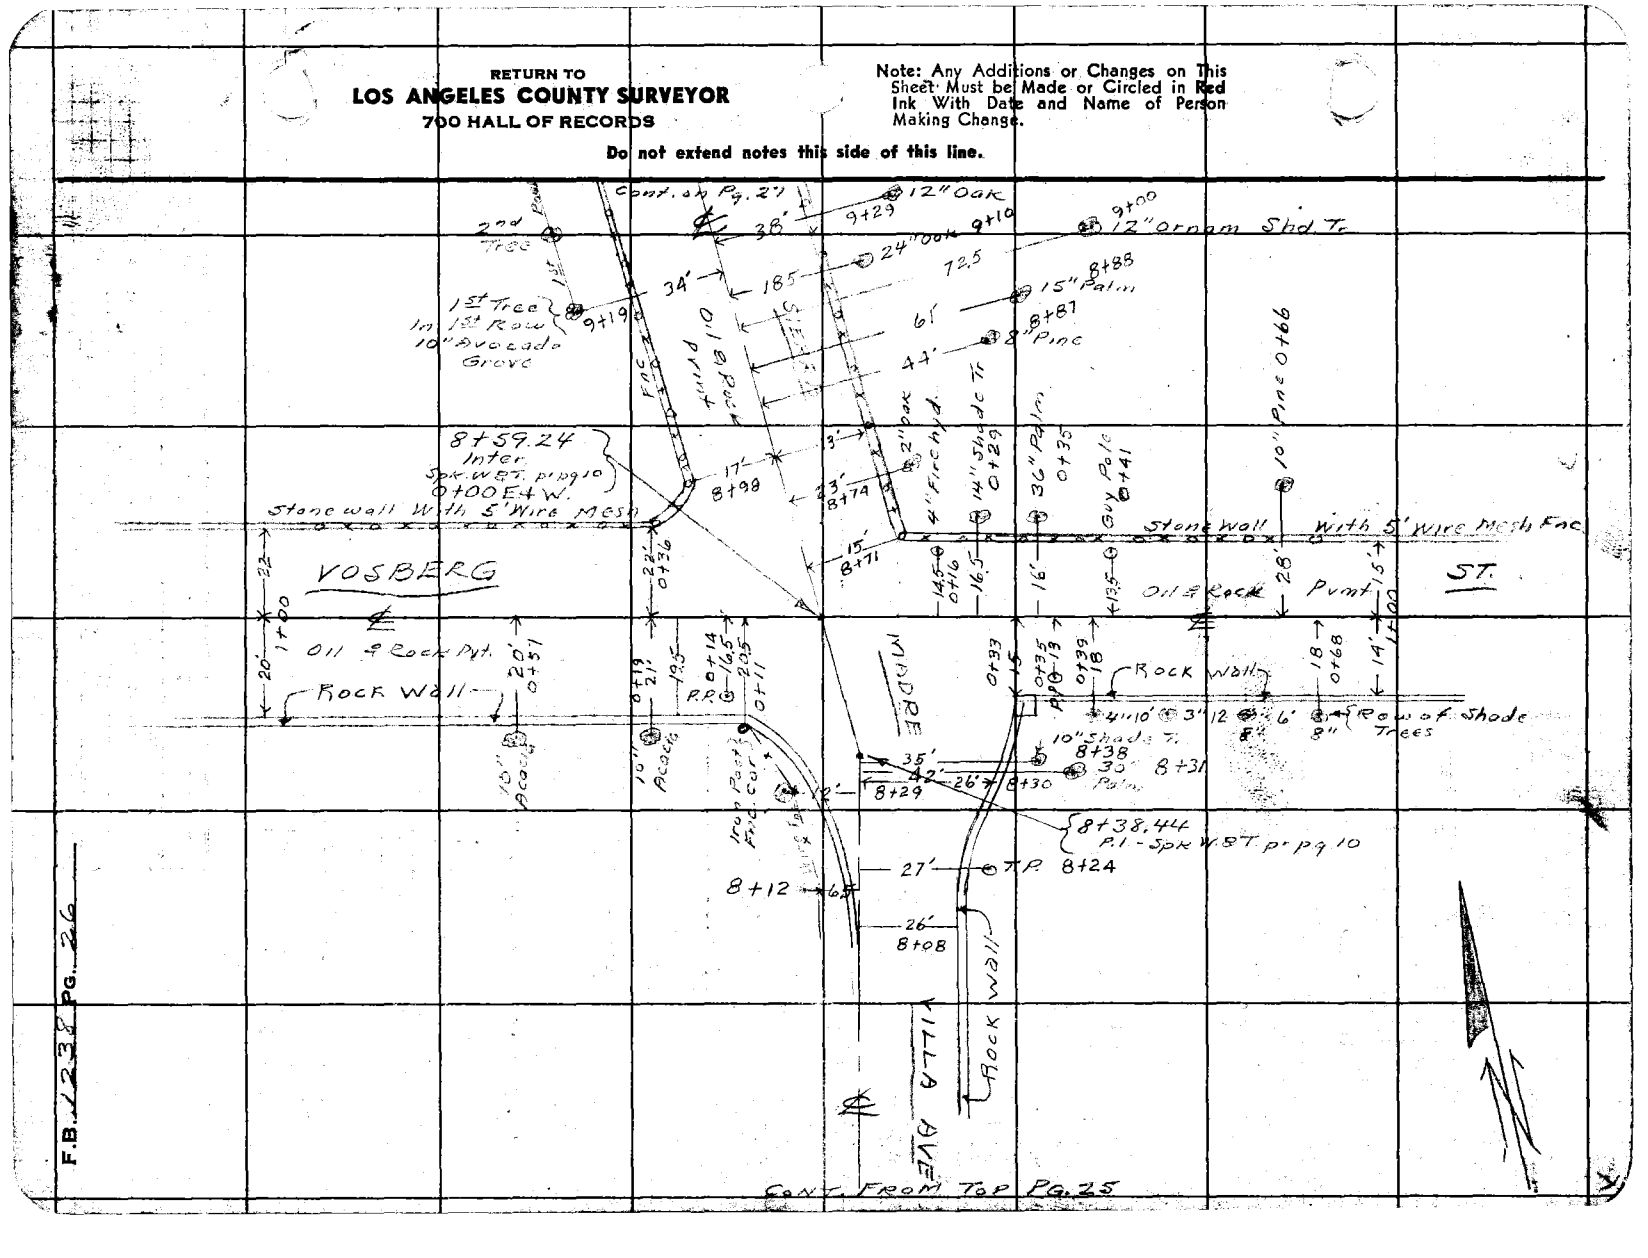

Notes Ck'd by
Map No. D-1958
Office Work Mc P. - Mc A.
Checked Drew
Date July 47

Survey of Sierra Madre Villa Ave F.B. 1238 Pg. 27
W. O 8446 Tape No. 269 St'd 68 °F
Surveyed by Hallstrom
Notes A.N.H. Date 10-10-46
Indexed A. O. Johnson

Note: Any Additions or Changes on This Sheet Must be Made or Circled in Red Ink With Date and Name of Person Making Change.

Do not extend notes this side of this line.

RETURN TO
LOS ANGELES COUNTY SURVEYOR
700 HALL OF RECORDS

17+12.44 P.I. 2x2 pr. pg. 11

Driveway to House #1782

SIERRA MADRE VILLA AVE

16' 135 10+99 6" Orang Tr. in 1st Row
21'
34' 10+97
7" Tr. in 1st Row of 10" Avos.

1st Row of 10" Avos.

16' 12" Palm 10+33

1st Row of 6.38" O.C. Trees Evenly Spaced

10+05 P.A. 16'

1st Tree in 1st Row of 6" Orang Grove

23' 9+59

Stone wall

13' 9+44

40

VOSBERG

23-59

8+59.24 Inter. Spk. W.8T. pr pg. 10

155-15-50

8+38.44 P.I. Spk. W.8T. pr pg. 10

CONT. FROM RT SIDE PG 26

FORM 247 SM 11-41

RETURN TO
LOS ANGELES COUNTY SURVEYOR
700 HALL OF RECORDS

Note: Any Additions or Changes on This Sheet Must be Made or Circled in Red Ink With Date and Name of Person Making Change.

Do not extend notes this side of this line.

F.B. 12338 PG. 28

Notes Ck'd by		Survey of Sycamore Villa Av	F. B 1238 Pg 29
Map No. D-1958		W. O. 5441 Tape No. 081 St'd 68 °F	
Office Work McP-McA		Surveyed by Porter	
Checked Drew		Notes Porter Date 4-15-47	
Date July 47		Indexed A. C. Johnson 5-3-50	

ADOPTED E. OF YOSEMITE ST.

[illegible] OF SYCAMORE VILLA AV.

4-15-47

Inf 8446

Porter
Snyder
Steel
Drawer

Note: Any Additions or Changes on This Sheet Must be Made or Circled in Red Ink With Date and Name of Person Making Change.

Do not extend notes this side of this line.

RETURN TO
LOS ANGELES COUNTY SURVEYOR
700 HALL OF RECORDS

FORM 247 5M 5-48

F. B. 1238 PG. 30

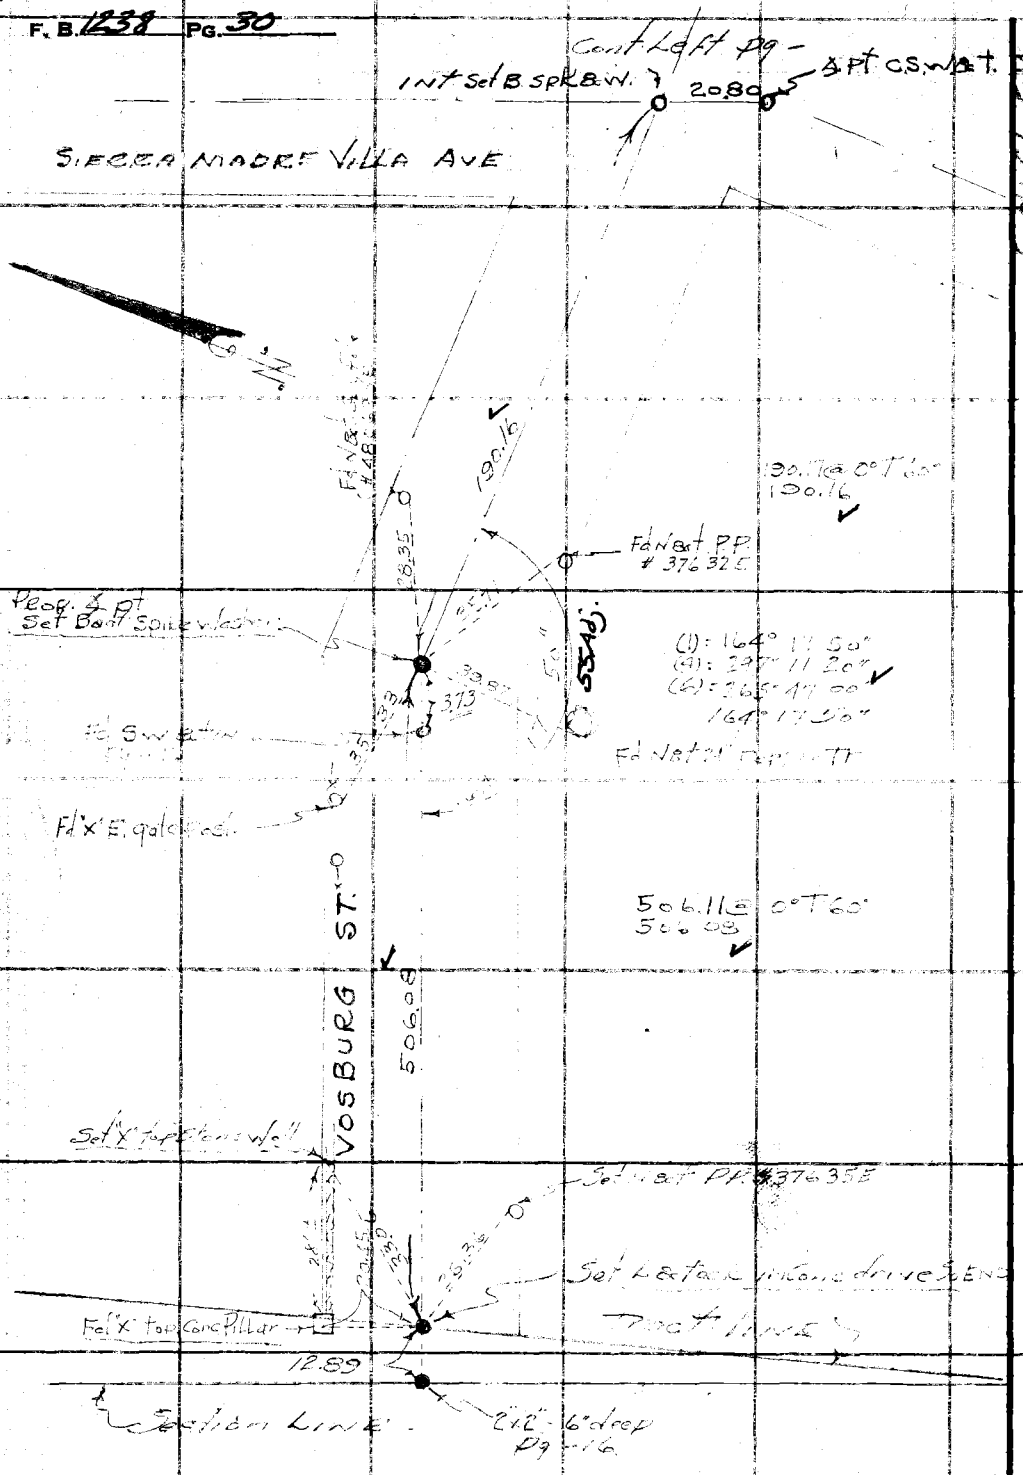

RETURN TO
LOS ANGELES COUNTY SURVEYOR
7DO HALL OF RECORDS

Do not extend notes this side of this line.

Note: Any Additions or Changes on This Sheet Must be Made or Circled in Red Ink With Date and Name of Person Making Change.

Notes Ck'd by	Survey of Sierra Madre Villa Ave
Map No. B-1958	W. O. 8440 Tape No. 681 St'd 68 °F
Office Work McP - McA.	Surveyed by Porter
Checked Drew	Notes Porter Date 1-15-47
Date July #7	Indexed A. C. Johnson

F. B. 1238 Pg. 31

LOS ANGELES COUNTY SURVEYOR
700 HALL OF RECORDS
RETURN TO

Note: Any Additions or Changes on This Sheet Must be Made or Circled in Red Ink With Date and Name of Person Making Change.

Do not extend notes this side of this line.

FORM 247 5M 5-46

WS 45A-3

Fd N&T Guy Pole # 465272 M Pg-11

Fd 2"x2" & Nail 6" deep FB 1238-11

Fd "X" in Iron Gate Post Pg-11

Fd Nail & Tag 45 Pepper Pg-11

Fd "X" in Stone Wall

852.02 @ 0°T 60' = 851.98

(1) = 74° 01' 30"
(41) = 296° 06' 20"
(61) = 84° 09' 30"
74° 01' 35"

Cont. from Pg-1

Fd "X" top Stone Wall Pg-10

Set Boat Spike Flush

Fd Nail in "X" Top Stone Wall Pg-10

VOSBURG ST

Set Cs w/ Station for intersect ℄ PT in Sierra Madre Villa

Fd Nail in lead R.L. 2410 Top Conc. Wall

Fd "X" top Conc. Wall

(3) = 155° 13' 40"
(4) = 260° 54' 30"
(5) = 211° 22' 00"
155° 13' 40"

Fd "X" top conc. pillar Pg-10

Fd S.W. & T Pg-10

SIERRA MADRE VILLA AVE

173.46 @ 0°T 60'
173.45
173.42 @ 0°T 86'
173.44
221.21 @ 0° T 60'
221.20

Fd Station Pg-10

F. B. 1238 Pg. 32

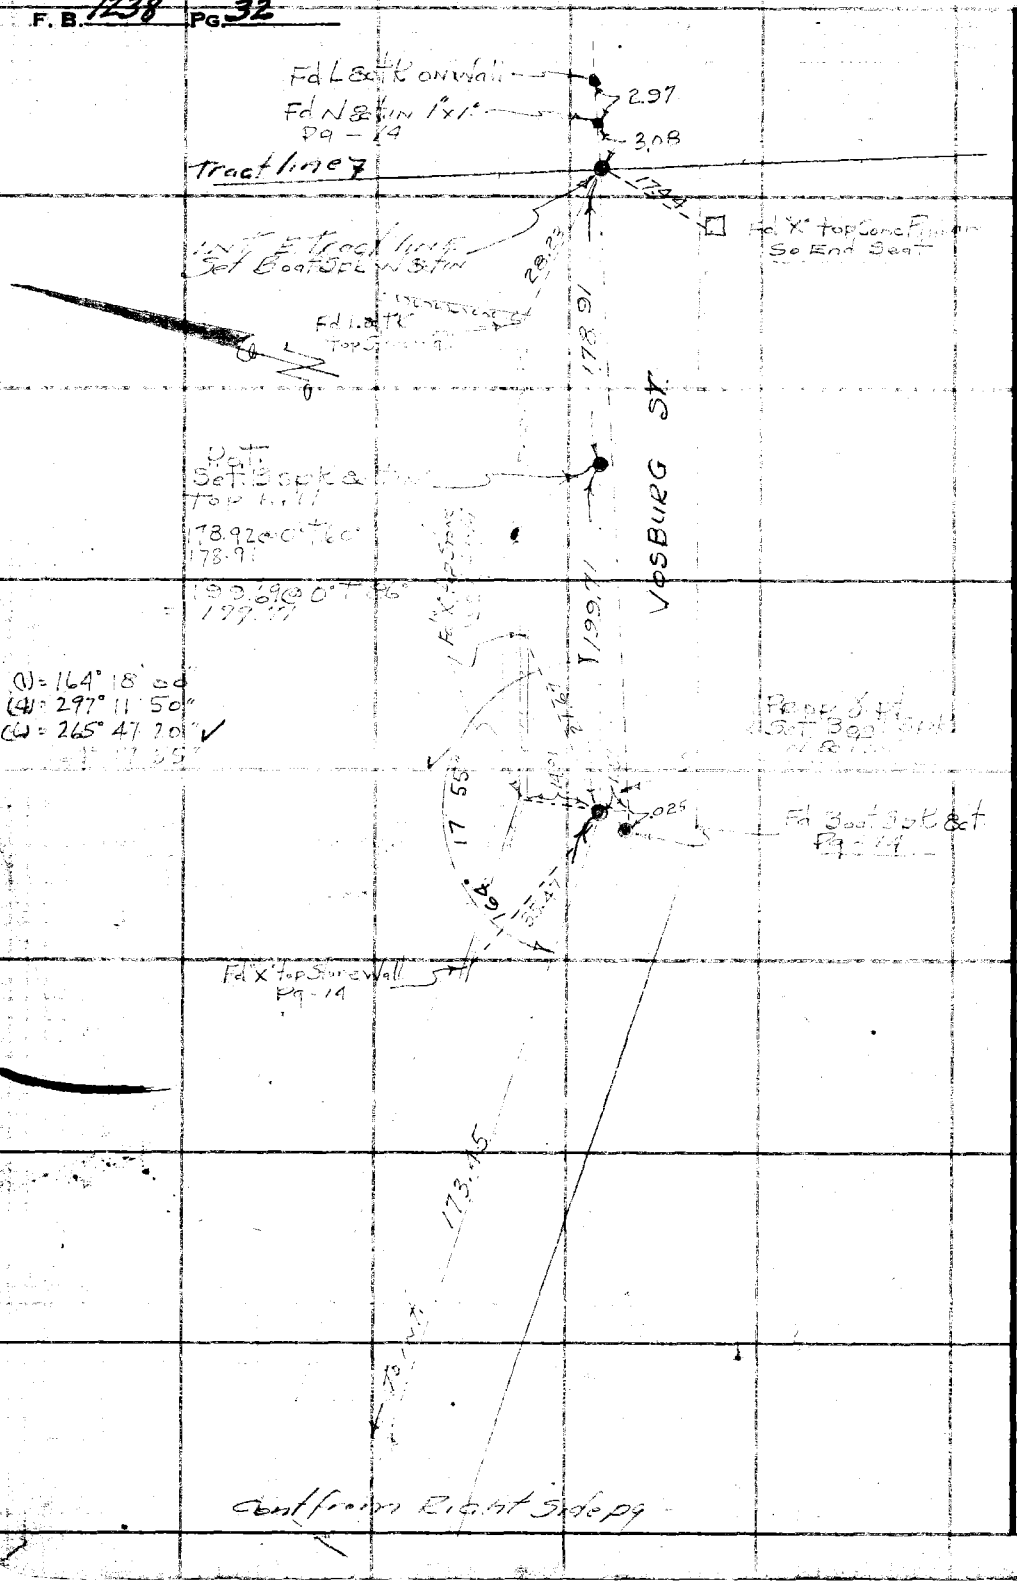

RETURN TO
LOS ANGELES COUNTY SURVEYOR
700 HALL OF RECORDS

Do not extend notes this side of this line.

Note: Any Additions or Changes on This Sheet Must be Made or Circled in Red Ink With Date and Name of Person Making Change.

Notes Ck'd by KMM	Survey of Eaton Park
Map No. B-2208	W. 0442 Tape No 811e St'd. 68 °F
Office Work OES	Surveyed by Snyder
Checked McPherson	Notes Snyder Date 10-13-49
Date Nov 1949	Indexed A. C. Johnson 10-18-49

F. B. 1238 Pg. 33

EATON PARK
(Pasadena)

Notes: Any Additions or Changes on This Sheet Must be Made or Circled in Red Ink With Date and Name of Person Making Change.

Do not extend notes this side of this line.

RETURN TO
LOS ANGELES COUNTY SURVEYOR
726 LOS ANGELES COUNTY
ENGINEERING BLDG.

C.S. B-2208
H.C. 33-50

76F3098 247 10M 5-49

F. B. 1238 Pg. 34

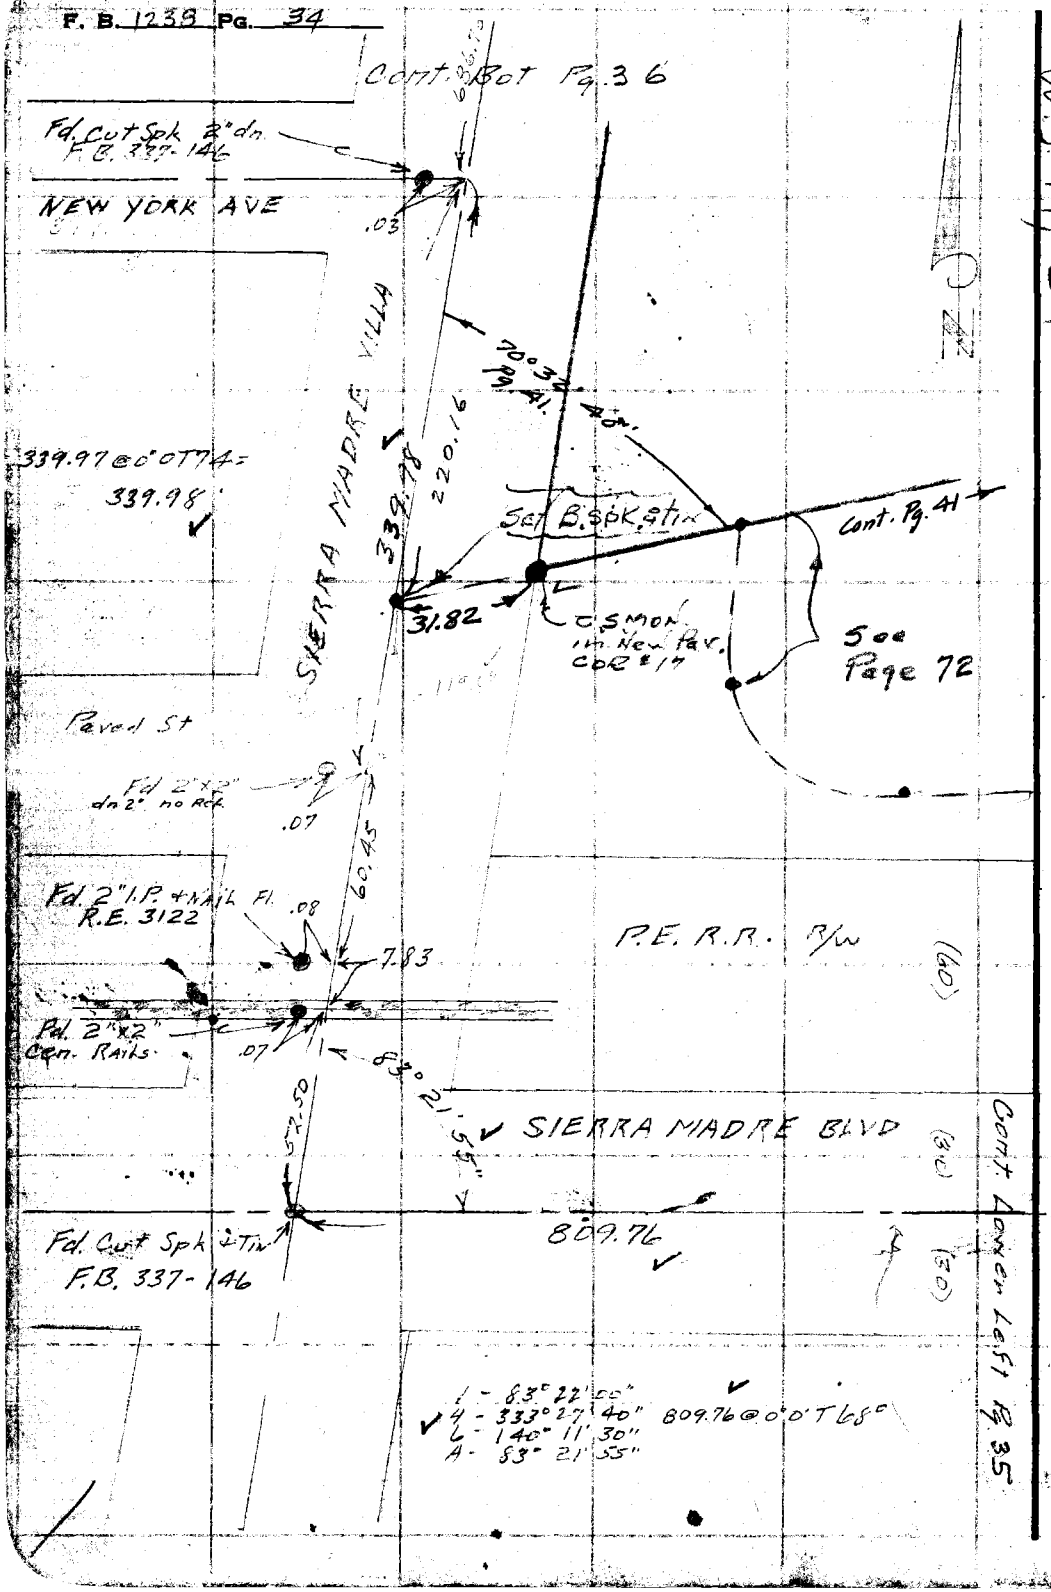

W.S. 44, C-1

RETURN TO
LOS ANGELES COUNTY SURVEYOR
726 LOS ANGELES COUNTY
ENGINEERING BLDG.

Do not extend notes this side of this line.

Note: Any Additions or Changes on This Sheet Must Be Made or Circled in Red Ink With Date and Name of Person Making Change.

Notes Ck'd by KRM	Survey of Eaton Park
Map No. B-2208	W. O. 4424 Tape No. 81 St'd 84 °F
Office Work O.E.S	Surveyed by Snyder
Checked McPherson	Notes Snyder Date 10-14-49
Date Nov. 1949	Indexed

F. B. 1238 Pg. 35

W.S. 44, C-1

Note: Any Additions or Changes on This Sheet Must be Made or Circled in Red Ink With Date and Name of Person Making Change.

Do not extend notes this side of this line.

RETURN TO
LOS ANGELES COUNTY SURVEYOR
726 LOS ANGELES COUNTY
ENGINEERING BLDG.

Cont Bot Pg. 37

Set 1"x2" o.u.
P.C.T. #3
T 84
115.10 @ 5°56' = 114.48
114.90 @ 4°58' = 114.47

114.47

463.58 To C@ #1

See Page 42

Set 1"x2" o.u.
P.C.T. #2

166.20 @ 0°0' T 96 = 166.19

166.19

Set 1"x2"
P.C.T. #1

o.u.

P.E.R.R. R/W

(60)

Cont From Right Pg. 34

9.41

Fd. Cone Mon + Spk Above
F.C. 413-3

105° 54' 25"

63.73

SIERRA MADRE BLVD.

3500'

809.76

892.44

Set Bolt Spk
W.4T.

30.00'

Set B.S.W. 4T

1 - 105° 54' 20"
4 - 63° 37' 40"
6 - 275° 26' 30"
A - 105° 54' 25"

Fd. Cone Mon + Spk Above
F.C. 413-3

892.43 @ 0°0' T 70 = 892.44
(Tape "D" 110 Stand 68°)

76F309S 247 10M 1-49

F. B. 1238 PG. 36

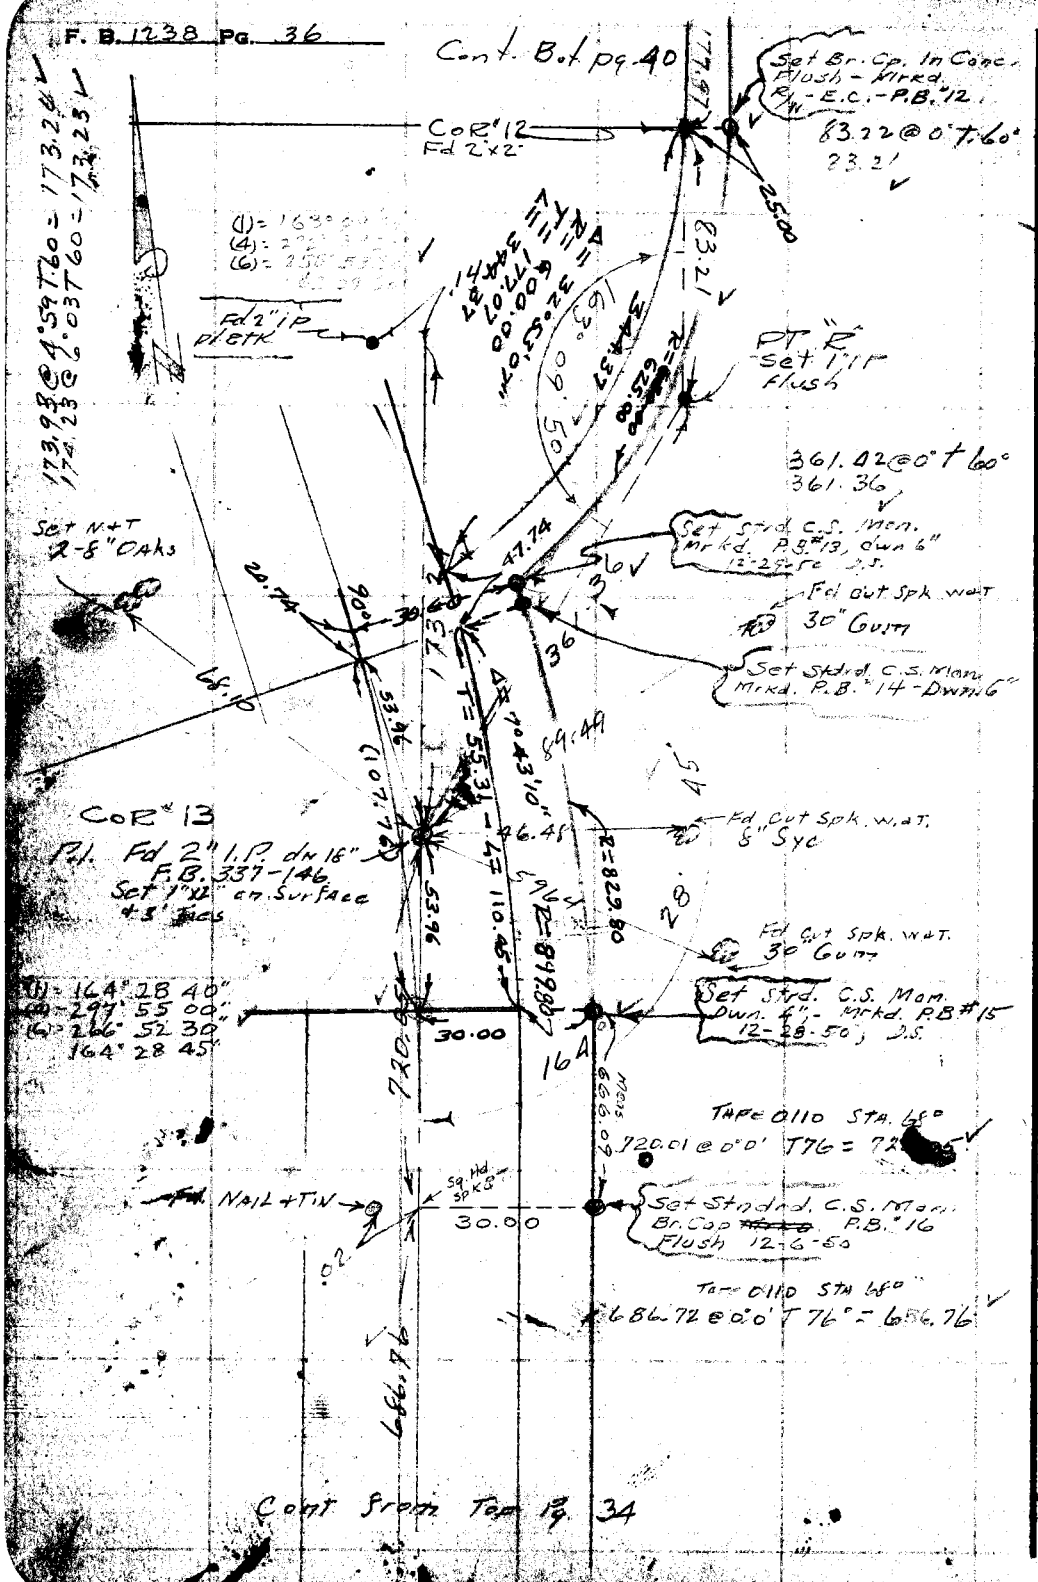

RETURN TO
LOS ANGELES COUNTY SURVEYOR
726 LOS ANGELES COUNTY
ENGINEERING BLDG.

Do not extend notes this side of this line.

Note: Any Additions or Changes on This Sheet Must be Made or Circled in Red Ink With Date and Name of Person Making Change.

Notes Ck'd by KMM	Survey of Eaton Park
Map No. B-2208	W. O. 4424 Tape No. 81 St'd 84 °F
Office Work O.E.S.	Surveyed by Snyder
Checked McPhearson	Notes Snyder Date 10-14-49
Date Nov. 1949	Indexed R. C. Johnson

F. B. 1238 PG. 37

W.S.44, C-1

Cont Bk Pg. 38

Mon = Covered by 3' f.ll 7-29-58 L.P.

T Sc 100.99 @ 0°0

Cor #4

Set Strd C.S. Mon. Mrkd. P.B. #4 up 2" 12-27-50 D.S.

1 132° 31' 10"
4 130° 05' 00"
L 15° 07' 30"
A 122° 31' 15"

Not = Cor #2 Mon. under concrete Post 1.0 W 7-29-58 L.P.

100.99

122° 31' 15" 20 Rds.

Cor #3

Set C.S. Br. Cp. in conc. Mrkd P.B. #3 Flush, 12-27-50 D.S.

Fd mon. flush 7-29-58

200.96

Set N&T 12" on K.T.

Cor #2

Set C.S. Br. Cp. in conc. Mrkd. P.B. #2 Flush 12-26-50, D.S.

4862.
1 - 118° 40'
4 - 114° 39'
L - 35° 39'
A - 118° 39'

200.96 @ 0°0' T86

See Pg 198 for ties to this mon. 12-19-58 R.B.H.

118.39

55° 50' Rad.

163.15 @ 1°41' = 163.08
72.95 @ 0°0' = 72.95
16.95 @ 0°0' = 16.95
252.98 T84

252.98

Set N&T 18" on K.T.

282.32

Set 1" x 2" P.O.T. #4 Top Ridge

29.34

Set N&T 6" on K.T.

690 ± T84°

150.87 @ 10°0' = 148.52
151.21 @ 10°47' = 148.54

See Pg. 41

Cor #1

Set C.S. Br. Cp. in conc. up 2" - Mrkd P.B. #1 12-26-50, D.S.

148.53

96

Set N&T 5" E Nerberry

Cont from Top Pg. 35

Note: Any Additions or Changes on This Sheet Must be Made or Circled in Red Ink With Date and Name of Person Making Change.

Do not extend notes this side of this line.

RETURN TO
LOS ANGELES COUNTY SURVEYOR
726 LOS ANGELES COUNTY
ENGINEERING BLDG.

76F308S 247 10M 1-49

Cont. Bot pg - 39

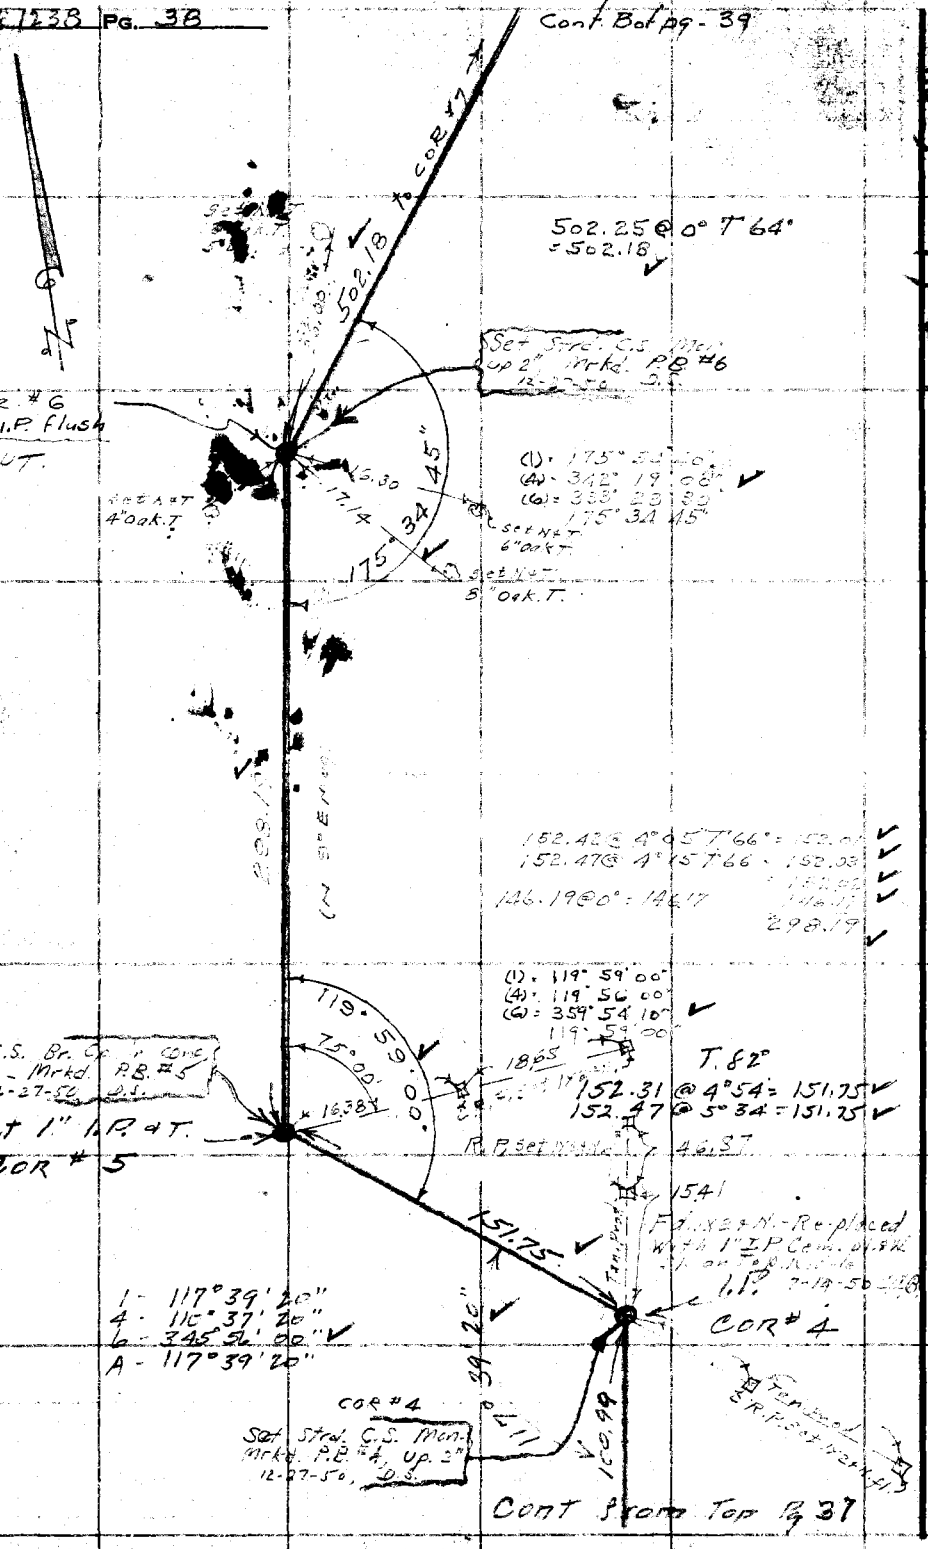

RETURN TO
LOS ANGELES COUNTY SURVEYOR
726 LOS ANGELES COUNTY
ENGINEERING BLDG.

Do not extend notes this side of this line.

Note: Any Additions or Changes on This Sheet Must be Made or Circled in Red Ink With Date and Name of Person Making Change.

Notes Ck'd by K.R.M.	Survey of Eaton Park
Map No. B-2208	W. O. 1426 Tape No. 81 St'd 84 °F
Office Work O.E.S.	Surveyed by Porter
Checked McKinnon	Notes Porter Date 12-7-49
Date Nov. 1949	Indexed C. Johnson

F. B. 1238 Pg. 39

W. S. 49, C-1

Cont. R. sht pg 40

169.63 @ 0°16'
169.61

Rad Pt
Fd 2"x2"

Pat. Set 1"x8"

R = 00.002 = Δ

R = 00.522 = Δ

25.00

COR #8
Set Std. C.S. Mon.
Flush - Mrkd P.B. #8
12-28-50 L.S.

Pat. Set 1"x8"

232.31

Set Std. C.S. Mon.
L.S. Mrkd P.B. #7
12-28-50 L.S.

COR #7
Set 1" I.P. Flush

2°23'

6.37
6.82

Set N.T.
28" on K.

171° 09' 50"

502.18

Certificate to pg 38

Note: Any Additions or Changes on This Sheet Must be Made or Circled in Red Ink With Date and Name of Person Making Change.

Do not extend notes this side of this line.

RETURN TO
LOS ANGELES COUNTY SURVEYOR
726 LOS ANGELES COUNTY
ENGINEERING BLDG.

76F3098 247 10M 1-49

RETURN TO
LOS ANGELES COUNTY SURVEYOR
726 LOS ANGELES COUNTY
ENGINEERING BLDG.

Note: Any Additions or Changes on This Sheet Must be Made or Circled in Red Ink With Date and Name of Person Making Change.

Do not extend notes this side of this line.

W.S. 44, C-1

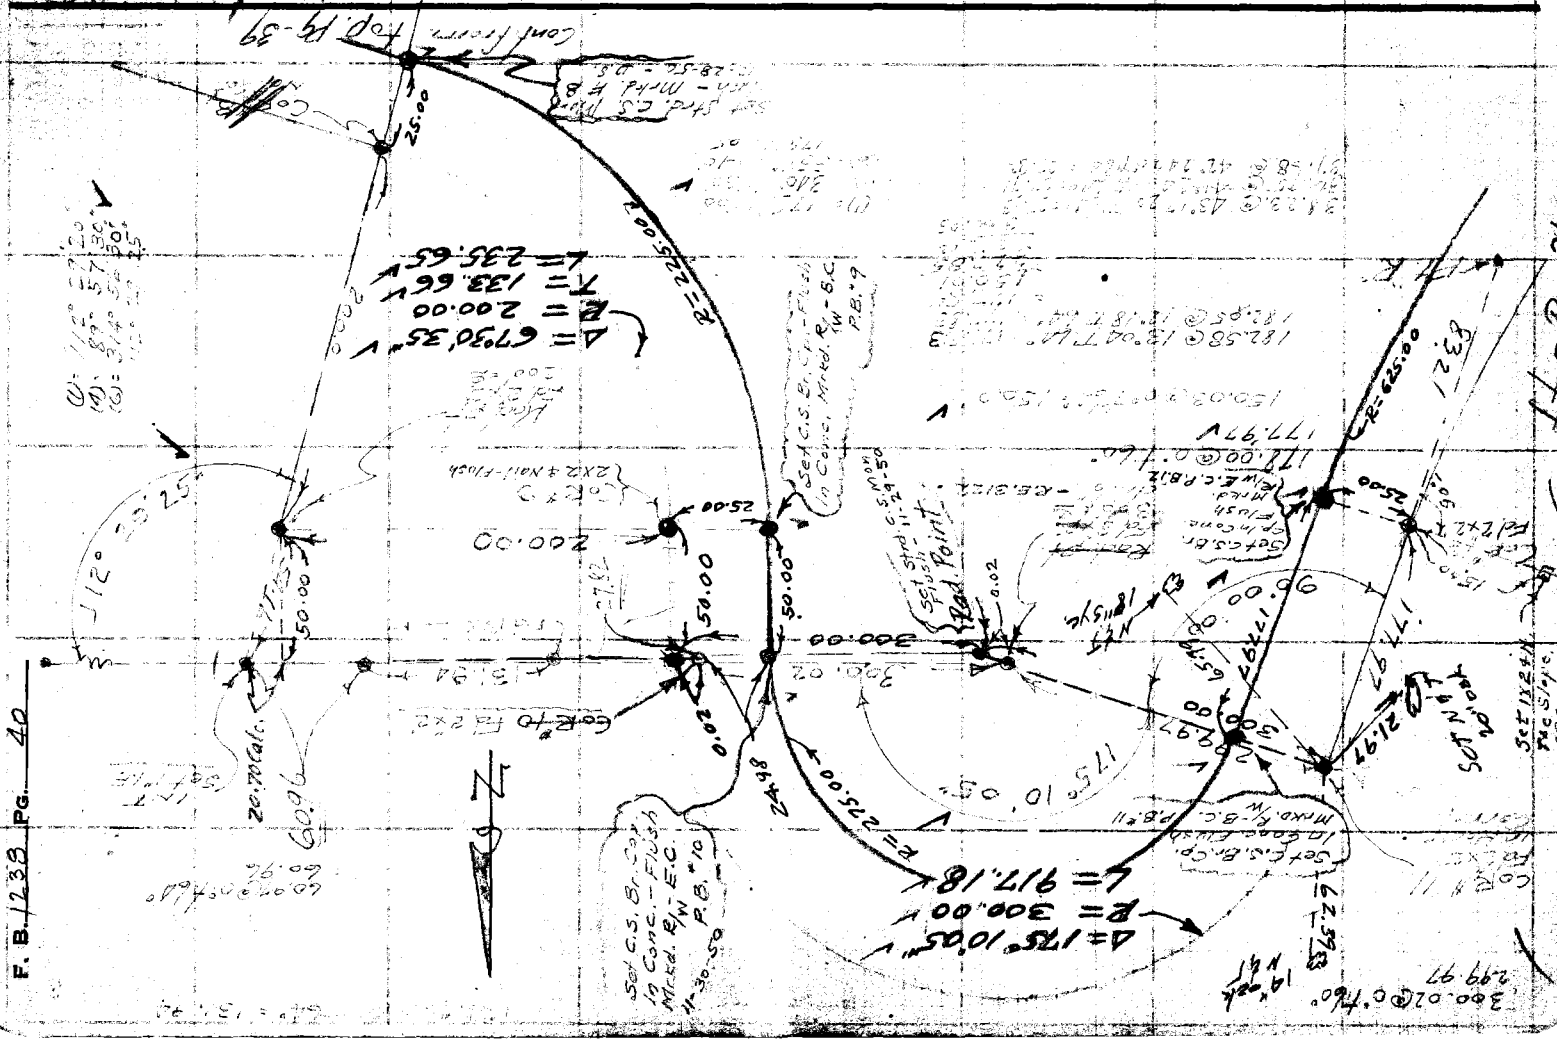
Cont. from Hor. Pg. 39
Hor. Pg. 36
Set C.S. Br. in Conc. Mkd. P.B. 9
Set C.S. Br. in Conc. Flush
Set Stnd. C.S. Mon. in Conc. Flush
Set C.S. Br. in Conc. Flush Mkd. R/W E.C.
Set C.S. Br. in Conc. Flush Mkd. P.B. 11
Set C.S. Br. in Conc. Flush Mkd. P.B. 10
Set C.S. Br. in Conc. Flush Mkd. P.B. 8
Set C.S. Br. in Conc. Flush Mkd. R-B.C.

76F3098 247 10M 1-49

RETURN TO
LOS ANGELES COUNTY SURVEYOR
726 LOS ANGELES COUNTY
ENGINEERING BLDG.

Note: Any Additions or Changes on This Sheet Must be Made or Circled in Red Ink With Date and Name of Person Making Change.

Do not extend notes this side of this line.

W.S 44, C-1

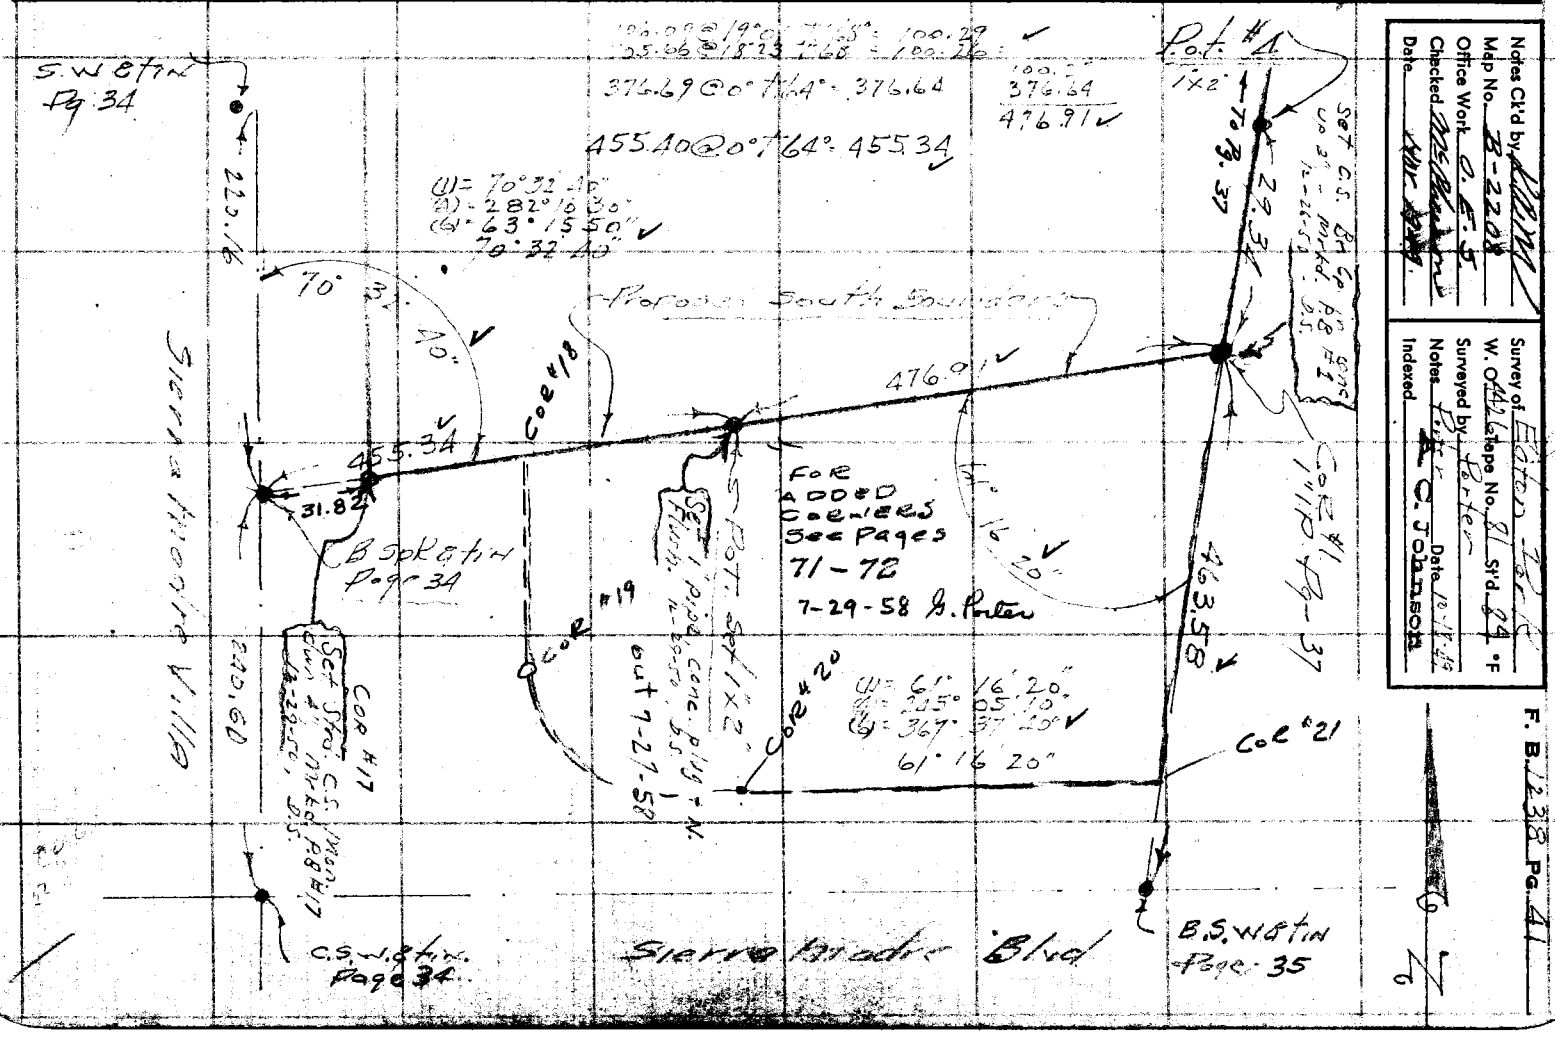

Notes Ck'd by [illegible]
Map No. B-2208
Office Work [illegible]
Checked [illegible]
Date [illegible]



RETURN TO
LOS ANGELES COUNTY SURVEYOR
726 LOS ANGELES COUNTY
ENGINEERING BLDG.

Note: Any Additions or Changes on This Sheet Must be Made or Circled in Red Ink With Date and Name of Person Making Change.

Do not extend notes this side of this line.

F. B. 1238 PG. 42

Notes Ck'd by	Survey of Eaton Canyon Park
Map No.	W. O. 0209 Tape No. St'd. 68 °F
Office Work	Surveyed by Benson
Checked	Notes " Date 7-12-50
Date	Indexed A. C. Johnson 7-20-50

F. B. 1238 PG. 43

J.N. 0203

C.P. 3950.

EATON CANYON PARK.

FENCE.

East of Sierra Maire Villa Ave & North of New York Ave.

7-13-50
C.A. Benson
W.S. Cortez
J.W. Edwards
R.N. Blanchet

Note: Any Additions or Changes on This Sheet Must be Made or Circled in Red Ink With Date and Name of Person Making Change.

Do not extend notes this side of this line.

RETURN TO
LOS ANGELES COUNTY SURVEYOR
726 LOS ANGELES COUNTY
ENGINEERING BLDG.

76F3098 247 10M 1-49

RETURN TO
LOS ANGELES COUNTY SURVEYOR
726 LOS ANGELES COUNTY
ENGINEERING BLDG.

Note: Any Additions or Changes on This Sheet Must be Made or Circled in Red Ink With Date and Name of Person Making Change.

Do not extend notes this side of this line.

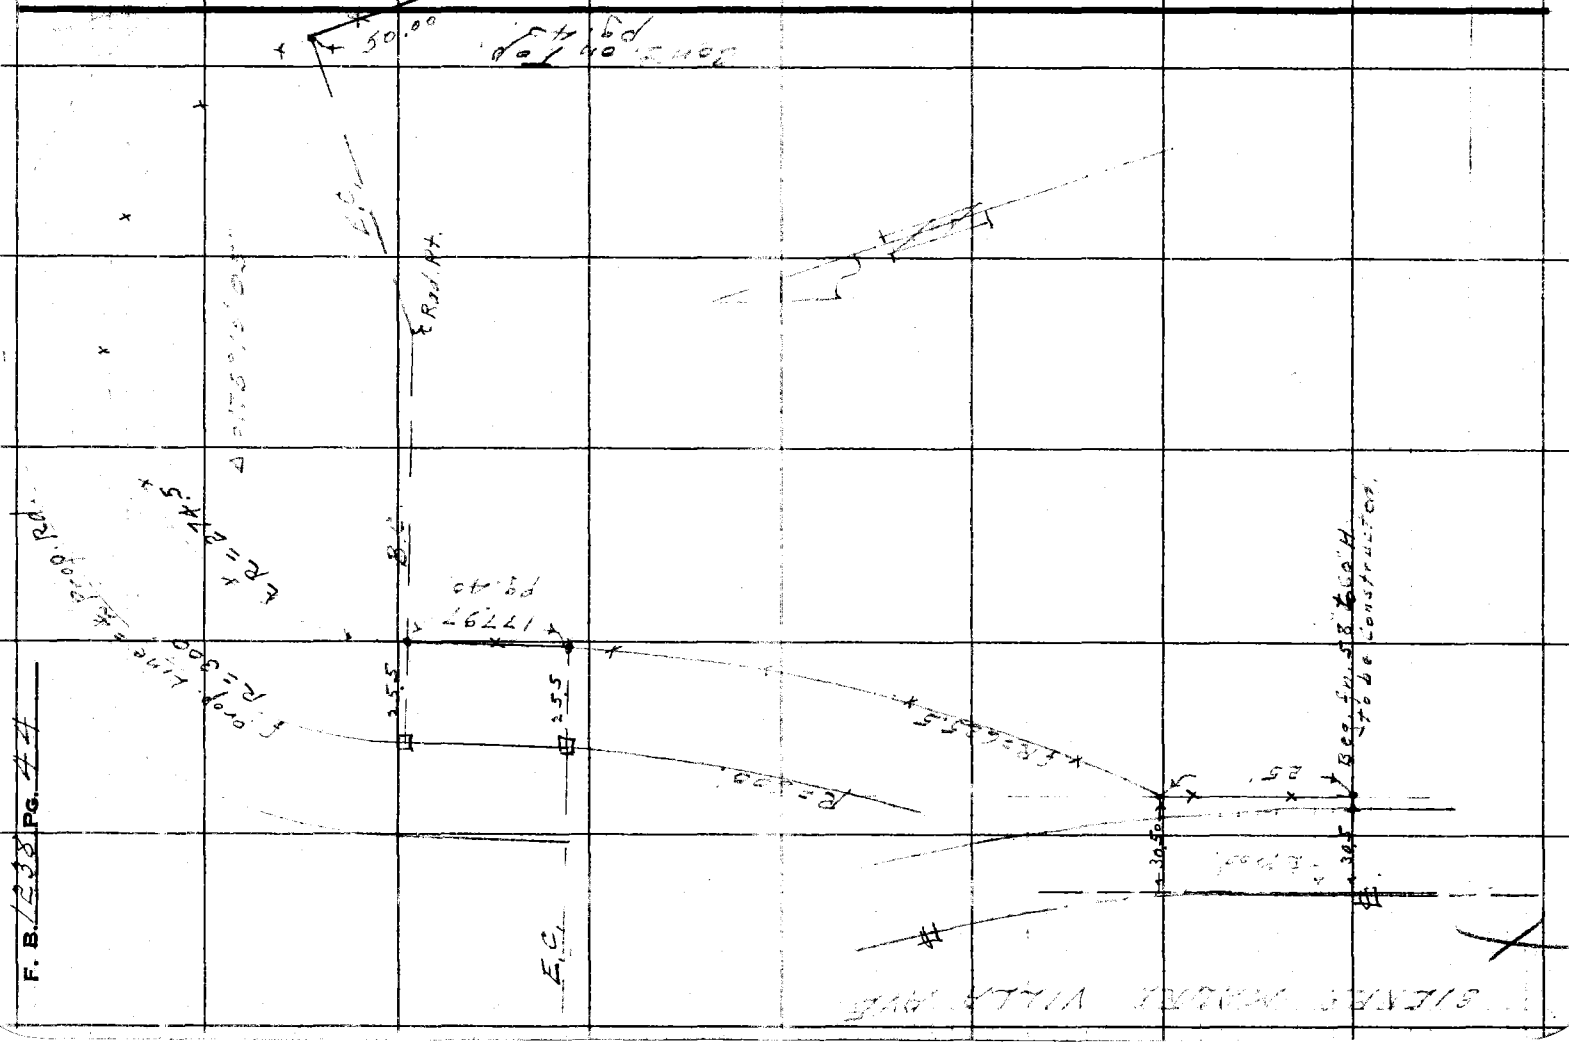
50.00
Rad. Pt.
Rad. Line
Pt. on
Pt. on
Pt. on

Notes Ck'd by	Survey of Eaton Canyon Park
Map No.	W. O. 0229 Tape No. St'd. 68 °F
Office Work	Surveyed by Benson
Checked	Notes " Date 7-13-50
Date	Indexed E. C. Johnson

F. B. 1235 Pg. 45

Con't. from R/S 3106 pg. 44.

5000 E Fd. Leg

Rad. Pt.

P.T. + L Data.
Δ = 67°30.3.5'
R = 200.00

P.T. Fd. Eaton pg. 39.

Δ = 67°30.3.5'

Set IX on Bot. Shank

Set IX on Top Slope

Set IX on Bisection

Cor. of Fd 1" I.P. pg. 39.

Con't. on top pg. 46

Note: Any Additions or Changes on This Sheet Must be Made or Circled in Red Ink With Date and Name of Person Making Change.

Do not extend notes this side of this line.

RETURN TO
LOS ANGELES COUNTY SURVEYOR
726 LOS ANGELES COUNTY
ENGINEERING BLDG.

76F3095 247 10M 1-49

F. B. 1238 PG. 46

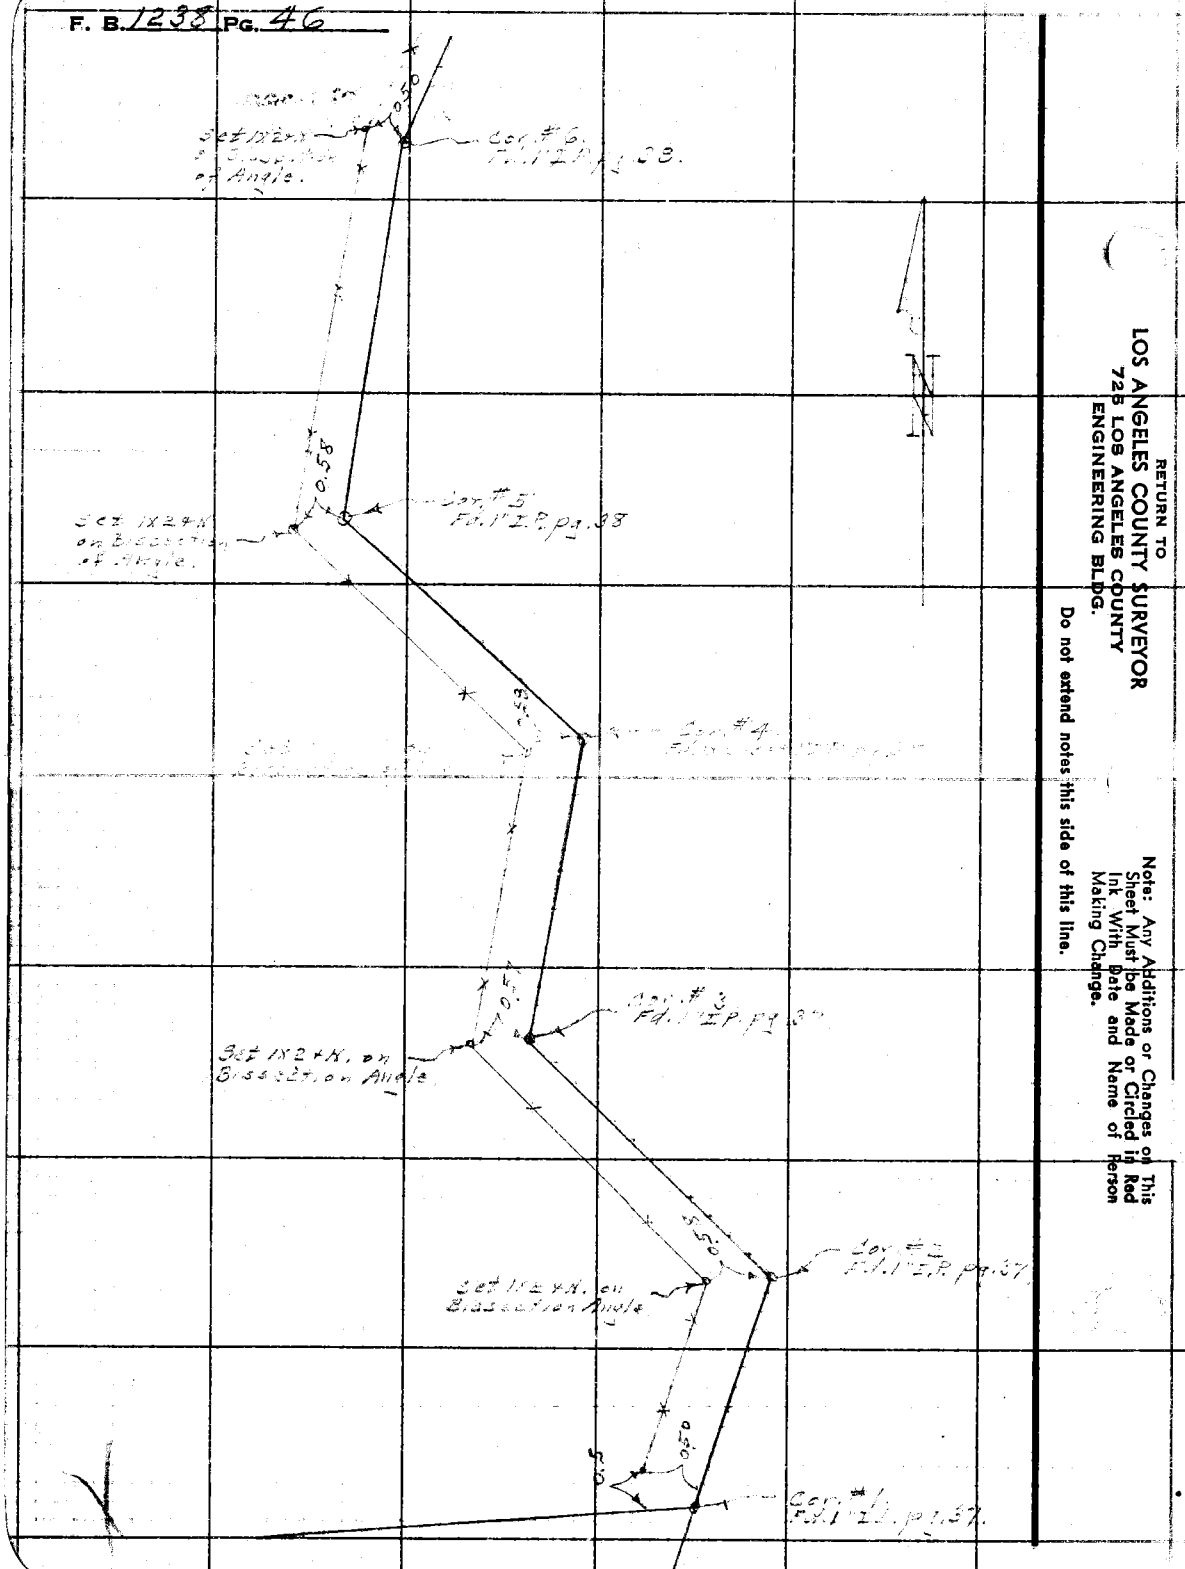

RETURN TO
LOS ANGELES COUNTY SURVEYOR
725 LOS ANGELES COUNTY
ENGINEERING BLDG.

Do not extend notes this side of this line.

Note: Any Additions or Changes on This Sheet Must be Made or Circled in Red Ink With Date and Name of Person Making Change.

Profile No. | Notes Red. | Plotted | Job No. 8596 | Division No. | F. B. 1238 | Pg. 47

X-Sec. No. | Notes Chkd. | Checked | Survey of Eaton Cp Port

Date | Date | Survey by D.S. | Notes D.S. | Date 8-14-51

Date | Date | Map No. | Indexed A C Johnson | Date 8-21-51

NOTE: ANY ADDITIONS OR CHANGES ON THIS SHEET MUST BE MADE OR CIRCLED IN RED INK, WITH DATE AND NAME OF PERSON MAKING CHANGE.

PLEASE RETURN TO
LOS ANGELES COUNTY SURVEYOR
726 Los Angeles County Engineering Bldg.

Do not extend notes this side of this line.

STATION	B. S.	H. I.	F. S.	ELEV.	
				D. Sappell J.A. Vrsalovich E.R. Vollnogle	ESTABLISHMENT OF ELEVATIONS ON C.S. BRASS CAP. MON. SET FOR PARK BOUNDARIES UPPER HASTINGS RANCH AREA. J.N. 8596

76L298 307 4-50

76L298 307 4-50

PLEASE RETURN TO
LOS ANGELES COUNTY SURVEYOR
726 LOS ANGELES COUNTY ENGINEERING BLDG.

NOTE: ANY ADDITIONS OR CHANGES ON THIS SHEET MUST BE MADE OR CIRCLED IN RED INK, WITH DATE AND NAME OF PERSON MAKING CHANGE.

Do not extend notes this side of this line.

F.B. 1238 Pg. 48 | Job No. 8596 Division No. | Profile
Survey of Eaton Cn. Park. | No. | Plotted | Notes Red. | No.
Survey by L.C. Johnson Notes D.S. | Date | Checked | Notes Chkd. M.H.E.D. | X-Sec.
Indexed | Date | Date 8-23-51 | Date | No.

STATION	B. S.	H. I.	F. S.	ELEV.	Fd 24"down 7-27-58 Porter
BM-53 U				878.950	BM 53 U - on the Sierra Madre Spur of Pacific Electric R.R. 19' N. of tracks 17' N. of trolley line pole #158996 R in N.E. Cor. of Conc. Viaduct - A stnd. Bronz Disk Metropolitan Water District of S.C. Elev. 878.953 F.B. 1144 - 147. Note: tracks and pole out. See Page 72
	9365	888.315			
T.P.			0.760	887.555	T.P. Rock in horse trail
	12050	899.605			
T.P.			0.730	898.875	T.P. 1x2
	10955	909.830			
T.P.			3.540	906.290	T.P. 1x2
	11730	918.020			
T.P.			0.405	917.615	T.P. 1x2
	4380	921.995			
P.B. #1			12.015	909.980	P.B. #1 - C.S. Brass Cap in conc. - up 2" Mrkd. P.B. #1, F.B. 1238-41
	11850	921.830			
T.P.			0.065	921.765	T.P. 1x2
	11160	932.925			
T.P.			0.160	932.765	T.P. Trunk of 8" oak tree.
	4555	937.320			
P.B. #2			4.105	933.215	P.B. #2 C.S. Brass Cap in conc. - Flush Mrkd. P.B. #2, F.B. 1238-37
	8490	941.705			
P.B. #3			8.370	933.335	P.B. #3 C.S. Brass Cap in conc. - Flush Mrkd. P.B. #3, F.B. 1238-37

764.298 307 4-50

PLEASE RETURN TO
LOS ANGELES COUNTY SURVEYOR
726 LOS ANGELES COUNTY ENGINEERING BLDG.

NOTE: ANY ADDITIONS OR CHANGES ON THIS SHEET MUST BE MADE OR CIRCLED IN RED INK, WITH DATE AND NAME OF PERSON MAKING CHANGE.

Do not extend notes this side of this line.

Profile Notes Red. Plotted Job No. 8536 Division No.
No. Date Date Survey of Eaton Canyon Park F.B. 1238 Pg. 40
X-Sec. Notes Chkd. H.H.E.D. Checked Survey by D.S.C. Notes D.S. Date 8-25-51
No. Date 8-28-51 Date Map No. Indexed Johnson Date

STATION	B. S.	H. I.	F. S.	ELEV.		
P.B. #3				933.335	P.B. #3,	for description see pg. 194
	7.705	941.040				
P.B. #4			3.610	937.430	P.B. #4,	Strd. C.S. Brass Cap Mon. - up 2" Mrkd. P.B. #4, F.B. 1238-37+38
	10.580	948.010				
T.P.			0.840	947.170	T.P.	rock on side h
	11.940	959.110				
P.B. #5			4.845	954.265	P.B. #5	C.S. Brass Cap in Conc. - up 1" Mrkd. P.B. #5, F.B. 1238-38
	11.195	965.460				
T.P.			0.620	964.840	T.P.	1x2
	9.745	974.585				
P.B. #6			0.585	974.000	P.B. #6	Strd. C.S. Brass Cap Mon. - up 2" Mrkd. P.B. #6, F.B. 1238-38
	9.780	983.780				
T.P.			0.195	983.585	T.P.	1x2
	9.840	993.425				
T.P.			0.640	992.785	T.P.	1x2
	10.210	1002.995				
P.B. #7			0.760	1002.235	P.B. #7	Strd C.S. Brass Cap Mon. - up 1" Mrkd. P.B. #7, F.B. 1238-39
	8.900	1011.135				
T.P.			0.870	1010.265	T.P.	1x2 ± 200' N. of P.B. #7, 4' E of fence
	7.850	1018.115				
T.P.			3.075	1015.040	T.P.	1x2 for ridge, 4' E of fence

76L298 307 4-50

PLEASE RETURN TO
LOS ANGELES COUNTY SURVEYOR
726 LOS ANGELES COUNTY ENGINEERING BLDG.

NOTE: ANY ADDITIONS OR CHANGES ON THIS SHEET MUST BE MADE OR CIRCLED IN RED INK, WITH DATE AND NAME OF PERSON MAKING CHANGE.

Profile ____ Plotted ____ No. ____
X-Sec. ____ Date ____ No. ____
Notes Chkd. [redacted] Checked ____
Date 8-23-[redacted] Date ____
Notes Red. ____ Date ____
Job No. 8596 Division No. ____
Survey of Zone 2A Parcels
Survey by 2 Squads Notes D.S.
Indexed K. C. Johnson Date ____
F.B. 1238 Pg. 50

Do not extend notes this side of this line.

STATION	B. S.	H. I.	F. S.	ELEV.		
T.P.	3.945	1018.985		1015.040	T.P.	See pg. 19
P.B. #8			11.930	1007.055	P.B. #8	Std. C.S. Brass Cap Mon. - Flush Mrkd. P.B. #8, F.B. 1238-39
	12.160	1019.215				
T.P.			0.230	1018.985	T.P. 1x2	
	3.185	1022.170				
T.B.M. #9			11.205	1010.965	T.B.M. #9	Bt spk. in Root of 30" Gum Tree N. side, 12' W. fence corner - 850' E of Sierra Madre Villa Ave. N. side of Rd. W.y. F.B. 1144-150, El. 1010.965
	0.100	1011.055		1010.955	Corrected Elev.	
P.B. #9			9.5[illegible]	1001.[illegible]	P.B. #9	C.S. Brass Cap in conc. - Flush Mrkd. R/W. B.C., F.B. 1238-40
	6.395	1007.940				
P.B. #10			4.63[illegible]	1003.[illegible]	P.B. #10	C.S. Brass Cap in conc. - Flush Mrkd R/W E.C., F.B. 1238-40
	1.555	1004.865				
T.P.			7.465	997.400	T.P.	
	4.250	1001.650				
P.B. #11			7.390	994.260	P.B. #11	C.S. Brass Cap in conc. - Flush. Mrkd. R/W B.C., F.B. 1238-40
	2.445	996.705				
P.B. #12			11.465	985.240	P.B. #12	C.S. Brass Cap in conc. - Flush. Mrkd. R/W. E.C. F.B. 1238-40
	1.065	986.305				
T.P.			11.050	975.255	T.P.	
	0.850	976.105				
P.B. #13			10.440	965.665	P.B. #13	Std. C.S. Brass Cap Mon., Mrkd P.B. #13 dwn 6", F.B. 1238-36

76L298 307 4-50

PLEASE RETURN TO
LOS ANGELES COUNTY SURVEYOR
726 LOS ANGELES COUNTY ENGINEERING BLDG.

NOTE: ANY ADDITIONS OR CHANGES ON THIS SHEET MUST BE MADE OR CIRCLED IN RED INK, WITH DATE AND NAME OF PERSON MAKING CHANGE.

Do not extend notes this side of this line.

STATION	B. S.	H. I.	F. S.	ELEV.		
P.B.#13				965.665	P.B.#13	See pg. 196
	5.500	971.165				
P.B.#14			5.805	965.360	P.B.#14 - Strd. C.S. [illegible] Mkrd. P.B.#14	
	1.575	966.935				
P.B.#15			7.620	959.315	P.B.#15	Strd. C.S. Brass Cap Mon. - drill 4" Mkrd. P.B.#15, F.B. 1238-36, Note: use W. edge of cap for elev.
	0.320	959.635				
T.P.			12.150	947.485	T.P. 1x2	
	0.620	948.105				
T.P.			11.500	936.605	T.P. 1x2	
	0.100	936.705				
T.P.			11.925	924.780	T.P. 1x2	
	1.685	926.465				
P.B.#16			6.090	920.375	P.B.#16	Strd. C.S. Brass Cap Mon. - Flush. F.B. 1238-36 Note: Not stamped.
	0.075	920.450				
T.P.			11.690	908.760	T.P. 1x2	
	0.660	909.420				out 7-29-58
T.B.M.#15			6.030	903.390	T.B.M.#15	Set spk. E. side of 36" Gum - 10' E. of E. edge print Sierra Madre Villa - 45' S. of P.R.# 3750A-E., El. 903.393 F.B. 1144-152
	0.115	903.505				
T.P.			11.300	892.205	T.P. 1x2	
	0.485	892.690				
T.P.			11.360	881.330	T.P. 1x2.	

Profile No. _____ Notes Red. _____ Plotted _____ Job No. 8596 Division No. _____ F.B. 1238 Pg. 97

X-Sec. No. _____ Date _____ Date _____ Survey of Eaton Canyon Park Date 8-16-51

Notes Chkd. H.H.E. Date _____ Survey by D.S. Notes Johnson Date _____

Date 8-23-51 Date _____ Map No. _____ Indexed _____

76L298 307 4-50

PLEASE RETURN TO
LOS ANGELES COUNTY SURVEYOR
726 Los Angeles County Engineering Bldg.

NOTE: ANY ADDITIONS OR CHANGES ON THIS SHEET MUST BE MADE OR CIRCLED IN RED INK, WITH DATE AND NAME OF PERSON MAKING CHANGE.

Do not extend notes this side of this line.

F. B. 1238 Pg. 52 | Job No. 8596 Division No. | Plotted | Profile
Survey of Exter Co. Park | Inked Red. | No.
Survey by D. Segrell Notes | Date | Date | X-Sec.
Indexed E. C. Johnson Date | Notes Chkd. H.H.E.D. Checked | No.
Date 8-23-51

STATION	B. S.	H. I.	F. S.	ELEV.		
T.P.				830	T.P.	See pg. 197
	0.05	881 365				
T.P.			7425	873.940	T.P.	112
	0.50	874 630				
P.B. 11-17			8.890	865.740	P.B. 11-17	Stkd. C.S. Brass Cap mon. found, Mrkd. P.B. 11-17, PB. 1238-41
	9.45	896 220				
T.P.			3.50	862.670	T.P.	rock
	10.065	872 975				
T.P.			0.175	872 900	T.P.	rock
	9.50	882 340				
B.M. "53-U			3.390	878.950	B.M. "53-U	El. 878.953, for description see pg. 194

Notes Ck'd by KRM	Survey of Eaton Canyon Park
Map No. B-2335	W. O. 8628 Tape No. 0122 St'd. 68 °F
Office Work Wilson	Surveyed by D.E. Holmes
Checked McPherson	Notes D.E.H. Date 12-31-51
Date Apr. '52	Indexed E. C. Johnson 1-8-52

F. B. 1238 Pg. 53

J.N. 8628

EATON CANYON PARK.

PARK BDY. SURVEY

Per Deed #

Holmes
Bamford
Bowles

See Pgs 64-66 for Line Change & monumenting of Bdry.

C.S. Mon. Shown Thus →●
Marked as below

COUNTY SURVEYOR
R.E. 63

Notes: Any Additions or Changes on This Sheet Must be Made or Circled in Red Ink With Date and Name of Person Making Change.

Do not extend notes this side of this line.

RETURN TO
LOS ANGELES COUNTY SURVEYOR
726 LOS ANGELES COUNTY
ENGINEERING BLDG.

A.C. 32-67
J.N. 8628
C.S. B-2335

X

76F3098 247 10M 1-49

RETURN TO
LOS ANGELES COUNTY SURVEYOR
726 LOS ANGELES COUNTY
ENGINEERING BLDG.

Note: Any Additions or Changes on This Sheet Must be Made or Circled in Red Ink With Date and Name of Person Making Change.

Do not extend notes this side of this line.

W.S. 88, E-7, D-7

1. 209.1 @ 10°-05' T-70° = 205.91
2. 209.52 @ 10°-36' T-70° = 205.93
1. 256.1 @ 25-02 T-74° 232.03
2. 255.98 @ 24-58 T-74° 232.04
Av. Total 437.95

300' Tape @ 98

Note
So. Cal. Edison Mon.'s at R/W Angle Pts. (E&W Side) as shown on CS 8.-846-1 have been Plowed out

Contd bot. Pg. 56

Fd. So. C. Edison Co. B. Cap mon. F.B. 380-132

Fd/ So. C. Edison Co. B. Cap mon. F.B. 380-132 (Used for line)

0.4±

86°-24'-30" 345-38-20 158-27-20 86-24-35

86°-24'-35"

(145°-28'-10" Rec. Per CS 8-846-1) 145°-28'-35" (Meas)

(S 64°-22'-30" E Rec. per CS 8-846-1) S 64°-22'-30" E (Meas)

286.03 (Rec.) 286.03 (Meas)

275.53

275.53 T 54° = 275.53

64°22'30" 257-29-40 26-14-30 64-22-35

All Cont'd Bot. Pg. 55

Fd. Spk. So. Cal. Edison Co.

26.47

150

373.57

21.81

Fd/ So. C. Edison Co. B. Cap mon. F.B. 380-131 (Ist N. of line)

Replaced with CS Mon. RE. 23 Dia. 14" 2.18-52 286.03 S 64°-22'-30" E = 286.03

51.96

Fd. So. C. Edison Co. B. Cap. mon. (Fd) F.B. 380-132-49-151 (Used for line)

Set Nail 145°-28'-10" 221-58-20 152-31-40 145°-28'-35"

Angle Stn. So. Cal. Edison Co. Set 1/4" Pipe & Tag (Illegible) Rec. Angle CS 8-846-1 Fd. Nail & Tag (Illegible)

373.57 T 58° = 373.57

F. B. 1238 PG. 54

F. B. 1238 PG. 55

Notes Ck'd by KRM	Survey of Eaton Canyon Park
Map No. B-2335	W. O. 8628 Tape No. 0122 St'd 68 °F
Office Work Wilson	Surveyed by D.E. Holmes
Checked McPherson	Notes D.E.H. Date 12-22-51
Date April '52	Indexed A. C. Johnson

W.S. 88 D-7

Note: Any Additions or Changes on This Sheet Must be Made or Circled in Red Ink With Date and Name of Person Making Change.

Do not extend notes this side of this line.

RETURN TO
LOS ANGELES COUNTY SURVEYOR
726 LOS ANGELES COUNTY
ENGINEERING BLDG.

Set 1"x2" 90° Tr. Mon.

422.26@0-00 T-90 = 422.25

150

422.25

Fd. So. Cal. Edison Co. B. Cap. Mon. (in 8") F.B. 380-130-141

Cont'd. Fr. Pg. 58

R/W

KINNELOA

265.55

Set S.W.I. Tr. Rec. (Per deed) From Angle Pt. To So.

1 131-52-20
4 167-59-20
6 71-14-00
Av. 131-52-20

265.56@0-00 T-60° = 265.55

Set P.M. in Small Spk.

P.I. #3
Fd. 2" I.P. P.K. Tk. (in 12") F.B.

150
150
0.18
Fd. Spk. Tk.

160.12

131° 52' RD

See Pg. 64 For Adopted Line etc.

E.W. Sys. So. Cal. Edison Co.

68.22

68.23@0-00 T-48° = 68.22

NEW YORK DR.

160.14@0-00 T-48° = 160.12

Set small spk. & Tk. by inter.

216.59@0-00 T-48° = 216.56

216.56

E.C.

Fd. P.M. in Small spk. (used for line)

Cont'd. Pg. 60

42.00

Line per Pg's 56 & 57

373.57

See Pg. 60 for inter.

P.I. #4 (out)

B.C. R/W Fd. C.S. Mon. Dia. 12" F.B. 380-130

20° 42' 20"

1 20-42-20
4 82-49-10
6 124-13-50
Av. 20-42-20

Cont'd. From Top Pg. 54

76F3095 247 10M 1-49

F. B. 1238 PG. 56

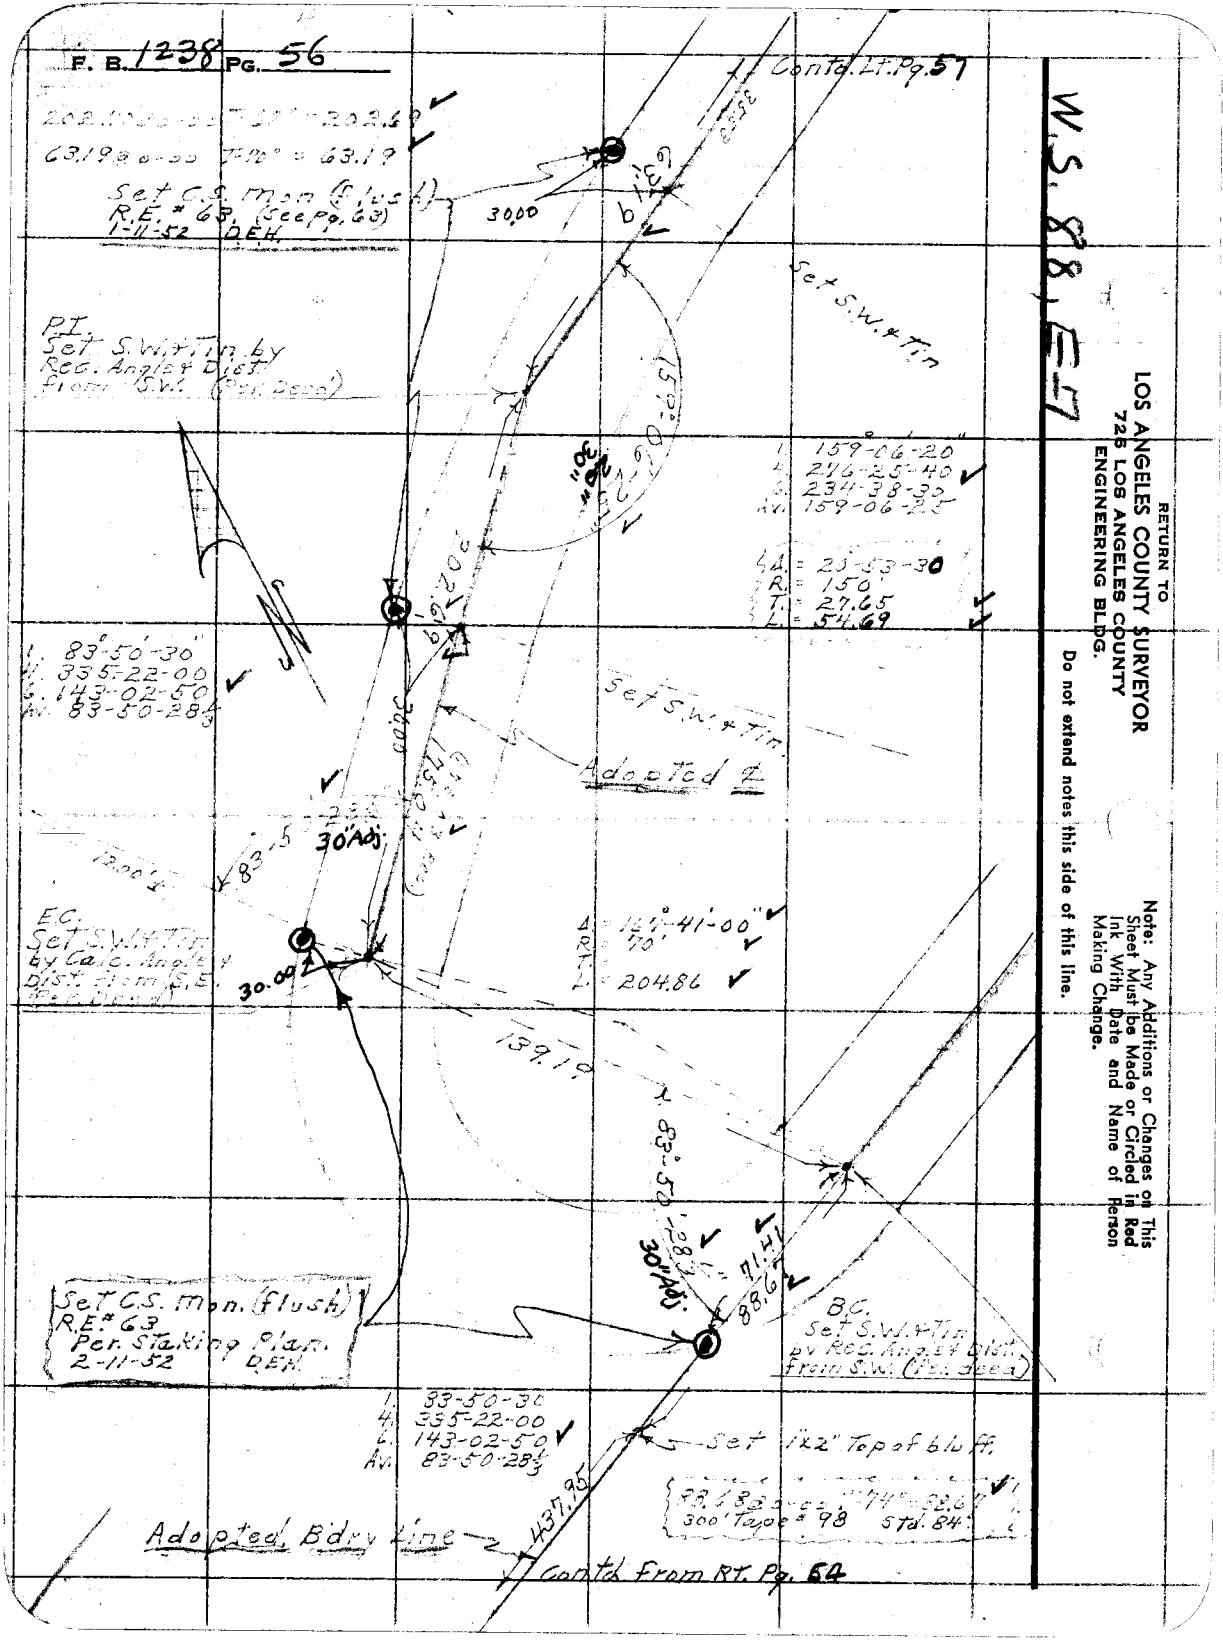

W.S. 88, E-7

RETURN TO
LOS ANGELES COUNTY SURVEYOR
725 LOS ANGELES COUNTY
ENGINEERING BLDG.

Do not extend notes this side of this line.

Note: Any Additions or Changes on This Sheet Must be Made or Circled in Red Ink With Date and Name of Person Making Change.

Notes Ck'd by K.R.McPh
Map No. B-2335
Office Work Wilson
Checked McPherson
Date Apr. 1952

Survey of Eaton Canyon Park
W. O. 8628 Tape No. 0122 St'd. 68 °F
Surveyed by D.E. Holmes
Notes D.E.H. Date 2-27-51
Indexed A. C. Johnson

F. B. 238 Pg. 57

Contd. bot. Pg. 58

W. S. 88 E 7

See Pg's 64-66 for Adopted line

POST Set S.W.# Tin by Calc. Dist. from P.O.S.T. E. (Per Deed) Removed 2-7-52 D.E.H.

130.68 @ 0-00 T 56° = 130.67

P.I. not set

138°-00'-30" 192-02-00 168-03-00 Av 138-00-30

Δ = 94-39-00 R = 60' T = 66.08 L = 99.12

POST Set Tin 2' N.E. by Rec. Angle from E. (Per Deed) Removed 2-7-52 D.E.H. See Pg. 66

52°-39'-30" 210-38-00 315-57-00 Av 52-39-30

Note: Any Additions or Changes on This Sheet Must be Made or Circled in Red Ink With Date and Name of Person Making Change.

Do not extend notes this side of this line.

Contd. From Top Pg. 56

113.22 @ 0-00 T 68° = 113.22

1. 140°-49'-00" 4. 203-22-30 6. 134-34-00 Av 140-49-00

Δ = 39-11-00 R = 75' T = 26.63 L = 37.39

52°-39'-30

POST Set S.W.# Tin by Rec. Angle & Dist. from S.E. (Per Deed) Removed 2-7-52 D.E.H.

See Pg. 66

109.00 @ 0-00 T 68° = 109.00

L. 122-36-30 R. 50' T. 91.03 L. 106.85

109.01

63.19

11°-56'-46"-45

118°-46'-45

87.65

E.C. Set S.W.# Tin by Calc. Angle & Dist. from S.E. (Per Deed) Removed 2-7-52 D.E.H.

1. 118°-46'-45" 4. 115-07-00 6. 352-40-30 Av 118-46-45

87.65 @ 0-00 T 64° = 87.65

B.C. Set S.W.# Tin by Rec. Angle & Dist. from S.W. Per Deed. Removed 2-8-52 D.E.H. See Pg. 66

P.I. not set

RETURN TO
LOS ANGELES COUNTY SURVEYOR
726 LOS ANGELES COUNTY
ENGINEERING BLDG.

76F3095 247 10M 1-49

RETURN TO
LOS ANGELES COUNTY SURVEYOR
726 LOS ANGELES COUNTY
ENGINEERING BLDG.

Note: Any Additions or Changes on This Sheet Must be Made or Circled in Red Ink With Date and Name of Person Making Change.

Do not extend notes this side of this line.

W.5.88 E-7

Contd. R.T. Pg 59

EC Set S.W.& T.in. by Int. Angle & dist. from So. (Per. Deed) Removed 2-7-52 D.E.H.

P.I. not set.

Fd. 1" I.P.-P47K. R.E. 1.216 (Fish)

BC Set S.W.& Tin by Calc. Angle & Dist. from S.E. (Per. Deed) Removed 2-7-52 D.E.H.

Set S.W.& T. by Inter. of Rec. Angle from S.W. & Calc. Angle from E. (Per. Deed) Removed 2-7-52 D.E.H.

Fd. N.& T.

51.83

165.13

(47.75 Rec.) 47.90

146°-36'-15" 20" Adj.

Δ = 66-47-30
R. = 150'
T. = 98.89
L. = 174.84

1. 89°-59'-00"
4. 359-56-10
6. 179-54-20
Av. 89-59-03

89°-59'-05" 0.15

0.49

223.62

47.90 @ 0-00 T-52° = 47.90

223.64 @ 0-00 T-52° = 223.62

146°-36'-15" 20" Adj.

130.61

Contd. From Top Rt. Pg. 57

See Pg's 65 To 66 for Adopted Line

51.83 @ 0-00 T-54° = 51.83

Δ = 31-26-22
R. = 150.
T. = 98.89
L. = 174.84

1. 148°-33'-40"
4. 234-14-30
6. 171-21-50
Av. 148-33-38

N 8°-33'-38" W

P.I. Set S.W.& Tin by Rec. Angle & Dist. from S.W. (Per. Deed)

265.55

165.14 @ 0-00 T-56° = 165.13

1. 146°-36'-20"
4. 213-23-20
6. 146-36-15
Av. 146-36-18

1. 146°-36'-20"
4. 213-23-20
6. 146-36-15
Av. 146-36-18

Contd. From Top Rt. Pg. 55

F. B. 238 Pg. 58

76F309S 247 10M 1-49

RETURN TO
LOS ANGELES COUNTY SURVEYOR
726 LOS ANGELES COUNTY
ENGINEERING BLDG.

Note: Any Additions or Changes on This Sheet Must be Made or Circled in Red Ink With Date and Name of Person Making Change.

Do not extend notes this side of this line.

Notes Ck'd by Ellsworth
Map No. T-2335
Office Work Wilson
Checked MS Hudson
Date 1-15-52

Survey of Eaton Canyon Park
W. O. 8628 Tape No. 0225 Ck'd 68 °F
Surveyed by D.E. Holmes
Notes
Indexed E. C. Johnson Date 1-2-52

F. B. 238 Pg. 59

Fd. 4" I.P.-P.K. (dn. 8")
F.B. 380-130
I.S. 31-22
(Used for Control of line West.

Fd. 4" I.P.-P.K. flush.
F.B. 380-130

1x2" Pg. 3
1.02
15.0
15.03
Set 1x2" by inter.

35.03

249.71

35.0
23.93
24.93
27.76
Set P.K. in small spk. & by inter.

Set 1x2" 90° to I.P.

So. Cal. Edison Co.
B. Cap mon.
See pg. 3

69°25'10"

93°-53'-45"

1.	93°-53'-40"	1	69°-25'-10"
4.	15°-35'-00	4	277°-40'-30
6.	203°-22'-30	6	56°30'-50
Av.	93°-53'-45	Av.	69°-25'-10

249.73 @ 0°-00'-54" = 249.71

R (4°22'25")

150' off Set 1x2 pg. 55

Ely. R/W So. Cal. Edison Co.
Line Prod. From So.

Contd. From Top RT. Pg. 58

F. B. 1238 Pg. 60

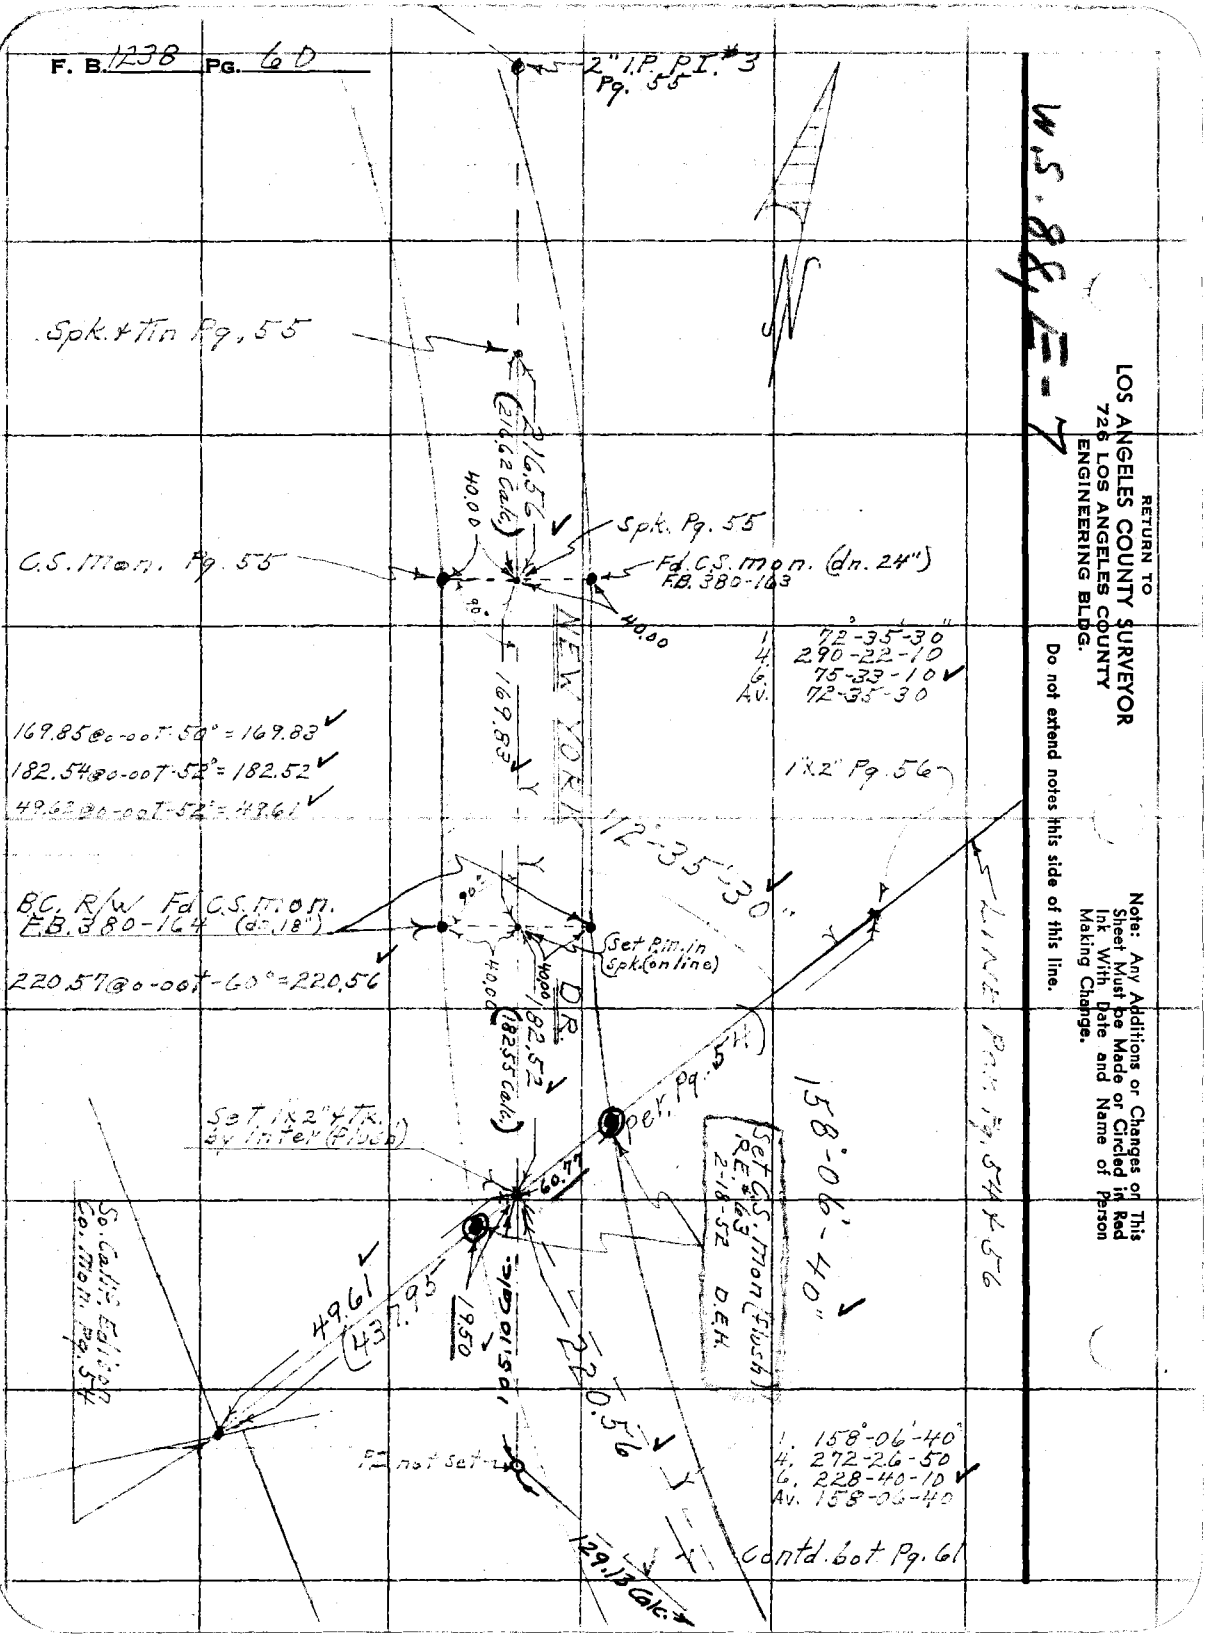

1. 72°-35'-30"
4. 290-22-10
6. 75-33-10
Av. 72-35-30

1. 158°-06'-40"
4. 272-26-50
6. 228-40-10
Av. 158°-06'-40"

W. S. 88, E. 7

RETURN TO
LOS ANGELES COUNTY SURVEYOR
726 LOS ANGELES COUNTY
ENGINEERING BLDG.

Do not extend notes this side of this line.

Note: Any Additions or Changes on This Sheet Must be Made or Circled in Red Ink With Date and Name of Person Making Change.

Notes Ck'd by KRM&RA	Survey of Eaton Canyon Park
Map No. B-2335	W. O. 8628 Tape No. 6122 St'd. 68 °F
Office Work Wilson	Surveyed by D.E. Holmes
Checked McPherson	Notes D.E.H. Date 1-18-52
Date April '52	Indexed E. C. Johnson

F. B. 1238 PG. 61

W 3 44 15-1

Note: Any Additions or Changes on This Sheet Must be Made or Circled in Red Ink With Date and Name of Person Making Change.

Do not extend notes this side of this line.

RETURN TO
LOS ANGELES COUNTY SURVEYOR
726 LOS ANGELES COUNTY
ENGINEERING BLDG.

Fd Nail FB. 1640-140 (used for line)

DR.

C.S. mon, F.B. 1611-140 — 2

40.00

40.00

6"x6" ± B+ spk. F.B. 1611-143

YORK

(139.73 FB. 1611-142)

Fd Nail. FB. 1611-140 (used for line)

C.S. Mon. FB. 1611-142

40.00

NEW

29.36

Fd. Roofing Nail FB. 1611-[illegible] (on line Prod)

129.26 @ 0-00-7.56" = 129.25

129.25

Set 1" I.P. P+T.K. (Flush) on line Prod from E.

	° ' "
1	162-20-10
4	289-21-00
4	254-01-30
Av	162-20-15

162°-20'-15" (Adj.)

220.56

129.13 Calc.

1+ Cont'd. From bot. Pg. 60

76F3095 247 10M 1-49

RETURN TO
LOS ANGELES COUNTY SURVEYOR
726 LOS ANGELES COUNTY
ENGINEERING BLDG.

Note: Any Additions or Changes on This Sheet Must be Made or Circled in Red Ink With Date and Name of Person Making Change.

Do not extend notes this side of this line.

F. B. 1231 PG. 67

Notes Ck'd by KRM	Survey of Eaton Canyon Park
Map No. B-2335	W. O. 8628 Tape No. 0122 St'd. 68 °F
Office Work Wilson	Surveyed by D.E. Holmes
Checked McPherson	Notes D.E.H. Date 2-7-52
Date Apr. 1952	Indexed A. C. Johnson 2-15-52

F. B. 1238 PG. 63

J.N. 8628

EATON CANYON PARK

MONUMENTING PARK Bdry.

Holmes
Barilotti
Bowles
Whitaker

G.S. Mon. Shown Thus. → ●
marked as

COUNTY SURVEYOR
R.E. 63

Note: Any Additions or Changes or This Sheet Must be Made or Circled in Red Ink With Date and Name of Person Making Change.

Do not extend notes this side of this line.

RETURN TO
LOS ANGELES COUNTY SURVEYOR
726 LOS ANGELES COUNTY
ENGINEERING BLDG.

76F3098 247 10M 1-49

X

RETURN TO
LOS ANGELES COUNTY SURVEYOR
726 LOS ANGELES COUNTY
ENGINEERING BLDG.

Note: Any Additions or Changes on This Sheet Must be Made or Circled in Red Ink With Date and Name of Person Making Change.

Do not extend notes this side of this line.

WS 88, D-7

Cont. Top Lt. Pg. 65

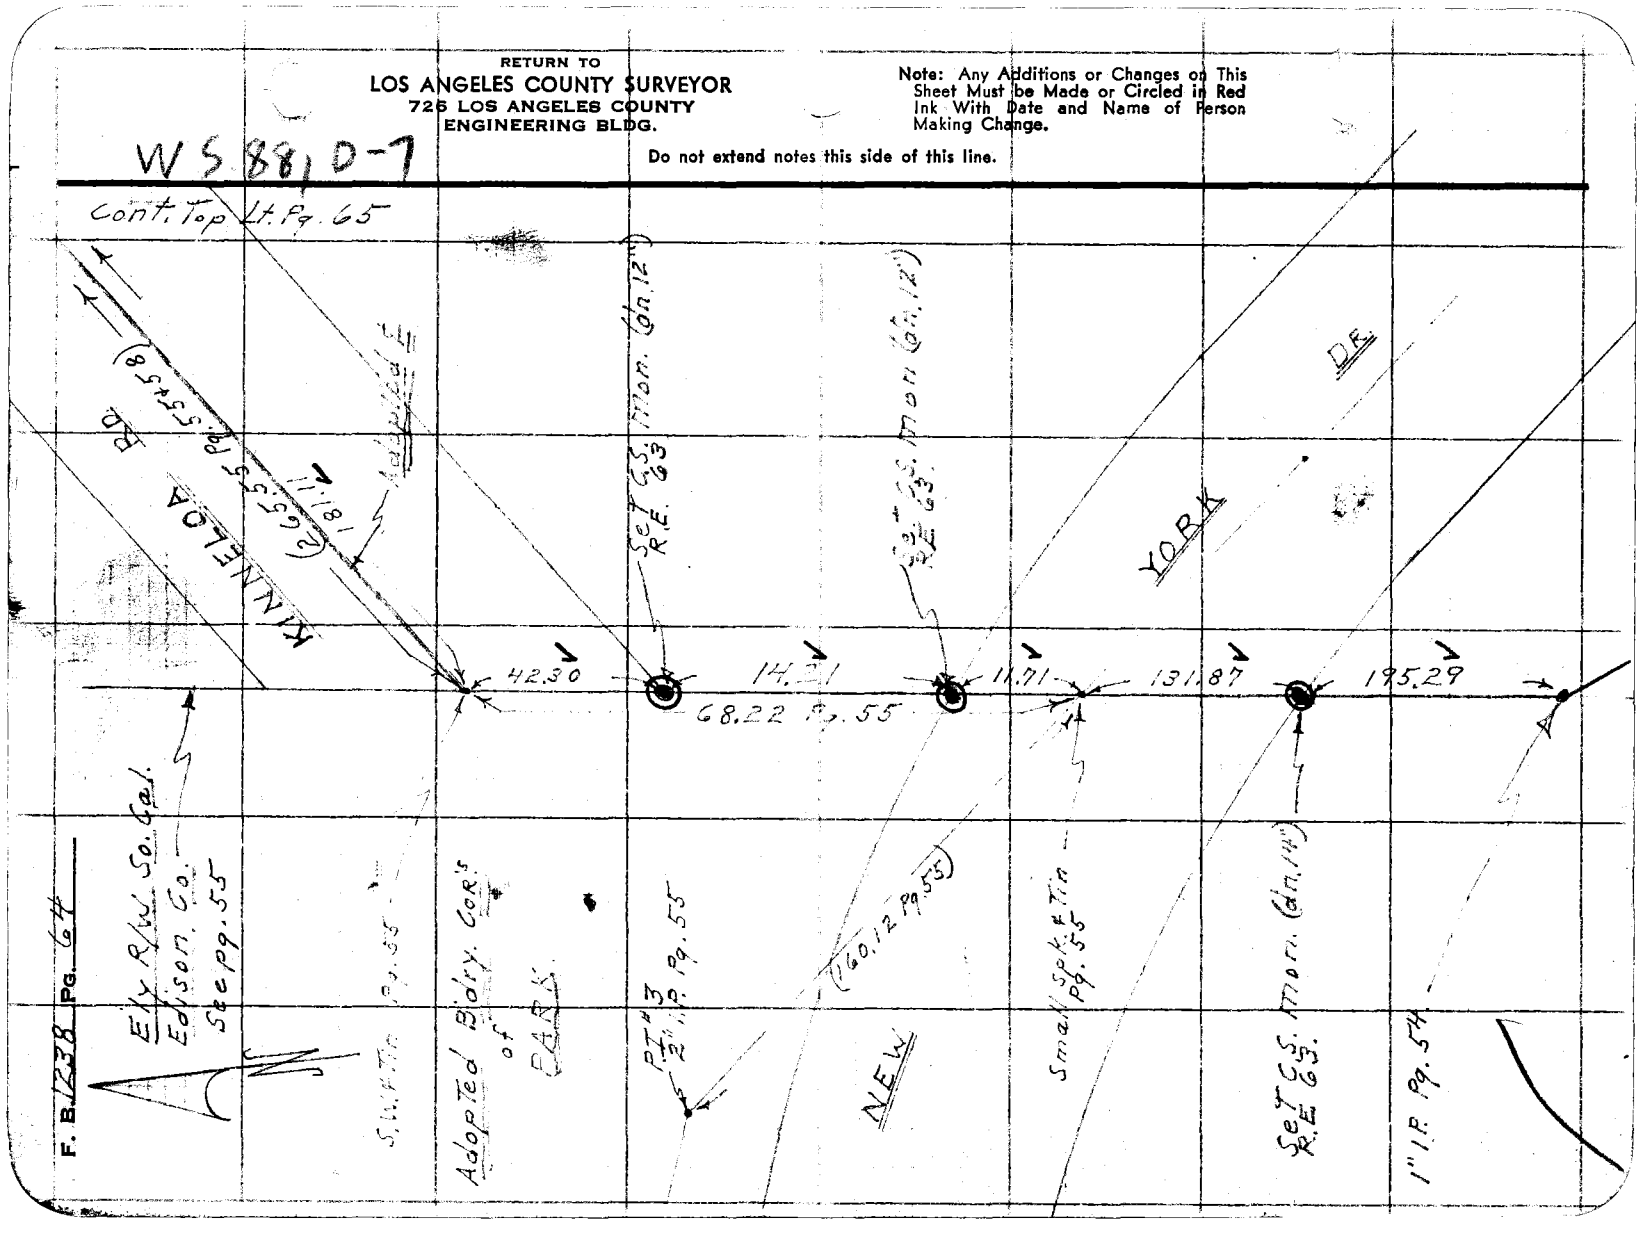

Notes Ck'd by. KRM	Survey of Eaton Canyon Park
Map No. B-2335	W. O. 8628 Tape No. 0122 St'd. 68 °F
Office Work Wilson	Surveyed by D.E. Holmes
Checked McPherson	Notes D.E.H. Date 2-8-52
Date Apr. 1952	Indexed R. C. Johnson

F. B. 1238 PG. 65

W 5, 8 E-7

Note: Any Additions or Changes on This Sheet Must be Made or Circled in Red Ink With Date and Name of Person Making Change.

Do not extend notes this side of this line.

RETURN TO
LOS ANGELES COUNTY SURVEYOR
726 LOS ANGELES COUNTY
ENGINEERING BLDG.

KINNELOA RD.

Set small spk. & Tin

Contd. from Tab Lt. Pg. 64

(265.55 Pg.)

Δ = 31-26-22
R. = 300.00
T. = 84.44
L. = 164.62

55+58
84.44
31.50

Set C.S. Mon. marked as Shown (Flush)

P.I. S.W. & Tin Pg. 58

Set small spk. & Tin

S.W. & Tin Pg. 58 Removed

Set S.W. & Tin Per. Staking Plan.

223.62

Pg. 58

84.44

30.00

0.05

0.05

109.23

90°

16.25

Set C.S. Mon. dn. 12" marked as Shown Pg. 63.

(44.90 Pg. 58)

41.45

Set S.W. & Tin Per. Staking Plan

30.00

0.15

0.06

Δ = 66-47-35
R. = 150.00
T. = 98.89
L. = 174.86

S.W. & Tin Pg. 58 Removed.

(165.13 Pg. 58)

56°-37-00" (Calc. from Tab. Lt.)

Adopted ℄

Set C.S. Mon. (Flush)

P.I. Not Set.

30.00

S.W. & Tin Pg. 58 Removed.

0.17

Set S.W. & Tin Per. Staking Plan

BOYNE RD.

93.66

0.05

cont'd. Top Pg. 66.

76F3095 247 10M 1-49

F. B. 1238 PG. 66

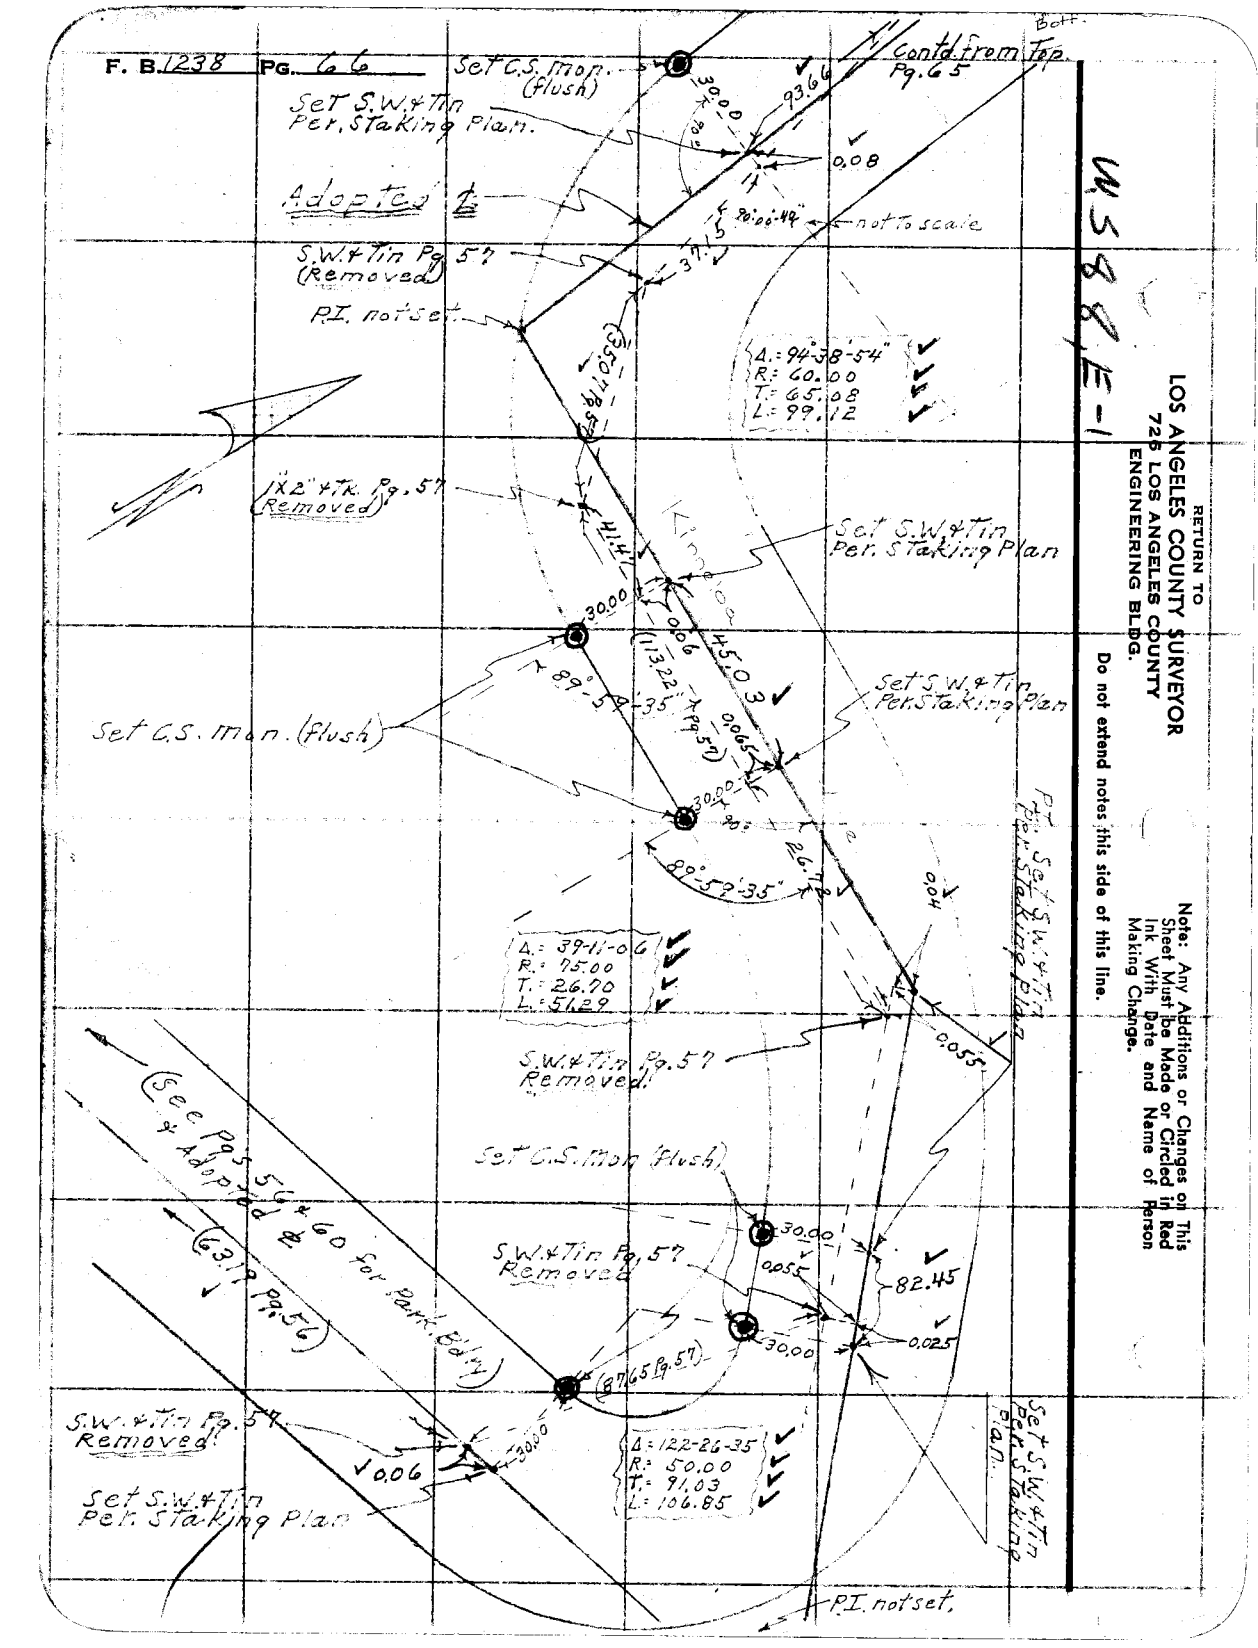

RETURN TO
LOS ANGELES COUNTY SURVEYOR
725 LOS ANGELES COUNTY
ENGINEERING BLDG.

Do not extend notes this side of this line.

Note: Any Additions or Changes on This Sheet Must be Made or Circled in Red Ink With Date and Name of Person Making Change.

W.S.8.E-1

Notes Ck'd by KRM	Survey of EATON CANYON PARK.
Map No.	W. O 8628 Tape No. 98 St'd. 84° °F
Office Work	Surveyed by D.E. Holmes
Checked	Notes D.E.H. Date 9-11-52
Date	Indexed A. C. Johnson

F. B. 1238 PG. 67

J.N. 8628
EATON CANYON PARK.
SURVEY of PRO. NEW E/y Bdry of
KINNELOA ADDITION

Note: Any Additions or Changes of This Sheet Must be Made or Circled in Red Ink With Date and Name of Person Making Change.

Do not extend notes this side of this line.

RETURN TO
LOS ANGELES COUNTY SURVEYOR
726 LOS ANGELES COUNTY
ENGINEERING BLDG.

76F3095 247 2-51

F.B. 1238 PG. 68

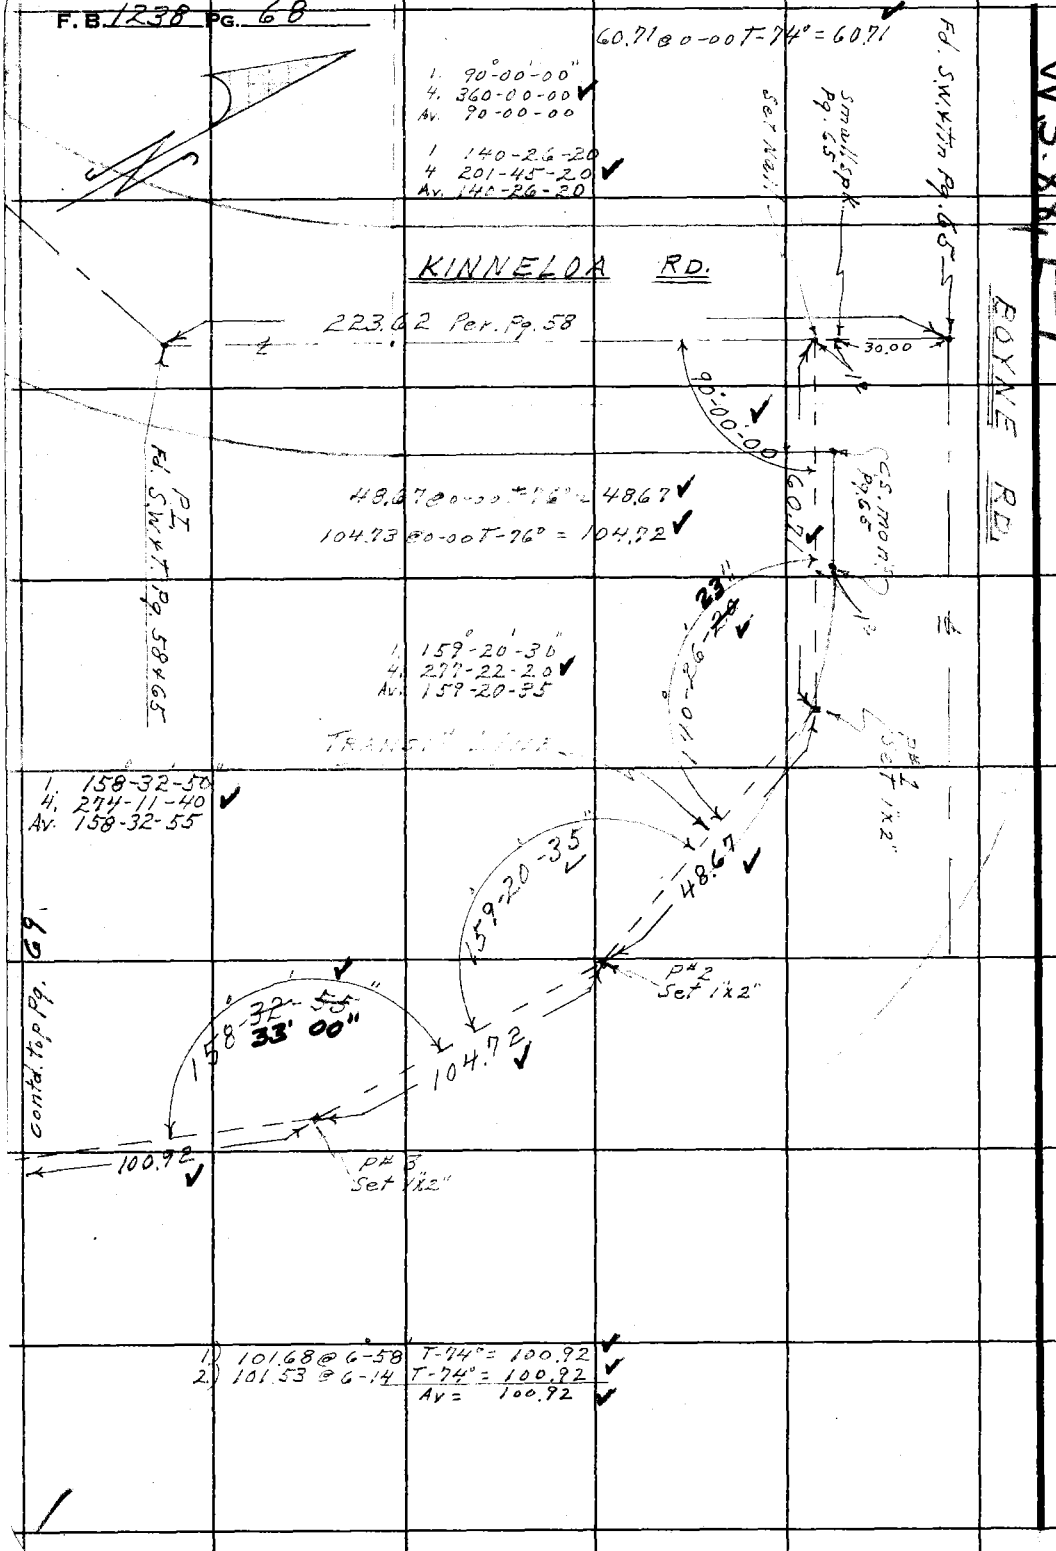

W.S. 88 F-7

BOYNE RD.

RETURN TO
LOS ANGELES COUNTY SURVEYOR
726 LOS ANGELES COUNTY
ENGINEERING BLDG.

Do not extend notes this side of this line.

Note: Any Additions or Changes on This Sheet Must be Made or Circled in Red Ink With Date and Name of Person Making Change.

Notes Ck'd by KRM.
Map No.
Office Work
Checked
Date

Survey of EATON CO PARK
W. O. Tape No. 98 St'd. 84° °F
Surveyed by D.E. Holmes
Notes D.E.H. Date 9-11-52
Indexed C. Johnson

F.B. 1238 Pg. 69

Contd from bot. Lt. pg. 68

W. S. 88, E-7

Note: Any Additions or Changes or This Sheet Must be Made or Circled in Red Ink With Date and Name of Person Making Change.

Do not extend notes this side of this line.

RETURN TO
LOS ANGELES COUNTY SURVEYOR
726 LOS ANGELES COUNTY
ENGINEERING BLDG.

1. 185.43 @ 5-01 T-76° = 184.71
2. 185.50 @ 5-14 T-76° = 184.72
Av = 184.71

1. 85.13 @ 8-13 T-76° = 84.26
2. 84.95 @ 7-22 T-76° = 84.25
Av. = 84.25

1. 171.08 @ 3-36 T-74° = 170.73
2. 171.02 @ 3-18 T-74° = 170.73
Av. = 170.73

66.55 @ 0-00 T-74° = 66.55
1. 180.32 @ 5-02 T-74° = 179.61
2. 180.25 @ 4-47 T-74° = 179.61
Av. Total = 246.16

1. 154°-12'-00"
4. 256-48-00
Av. 154-12-00

P#3-A Set 1"x2"

100.92

184.71

154°-12'-00"

84.25

P#4 Set 1"x2"

P#5 Set 1"x2"

1. 175-23-40
4. 341-34-40
Av. 175-23-40

175°-23'-40"

1. 152°-29'-30"
4. 249-58-00
Av. 152-29-30

170.73

TRANSIT LINE

1. 22-44-50
4. 90-59-10
Av. 22-44-50

P#6 Set 1"x2"

152°-29'-30"

22°-44'-50"

246.16

E'ly R/W So. Cal. Edison Co.

E'ly Bdry Pcl

Pg. 54+66

Fd. 1½" I.P. flush Pg. 60

NEW YORK DR.

Fd small spk. & tin Pg. 55

123.21 @ 0-00 T-74° = 123.20

BG Fd small spk. pg. 60

123.20

Set small spk. & tin

76FS09S 247 2-51

RETURN TO
LOS ANGELES COUNTY SURVEYOR
726 LOS ANGELES COUNTY
ENGINEERING BLDG.

Note: Any Additions or Changes on This Sheet Must be Made or Circled in Red Ink With Date and Name of Person Making Change.

Do not extend notes this side of this line.

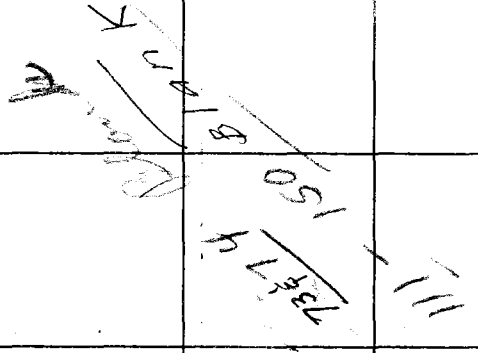

F.B. 1138 PG. 70

Notes Ck'd by	Survey of Eaton Canyon Park
Map No.	JN005430 Tape 069 Std 68 °F
Office Work	Surveyed by G. Porter
Checked	Notes Porter Date 7-28-58
Date	Indexed M. E. OII AUG 10 '60

F. B. 1238 Pg. 71

EATON CANYON PARK

COE's 18-19-20 & 21 added 7-28-58

Porter & Party

Note: Any Additions or Changes on This Sheet Must be Made in Red Ink With Date and Name of Person Making Change.

Do not extend notes this side of this line.

RETURN TO
LOS ANGELES COUNTY ENGINEER
700 LOS ANGELES COUNTY ENGINEERING BLDG.

70F3095 CE #247—3

X

RETURN TO
LOS ANGELES COUNTY ENGINEER
700 LOS ANGELES COUNTY ENGINEERING BLDG.

Note: Any Additions or Changes on This Sheet Must be Made or Circled in Red Ink With Date and Name of Person Making Change.

Do not extend notes this side of this line.

W.S. 44 C-4

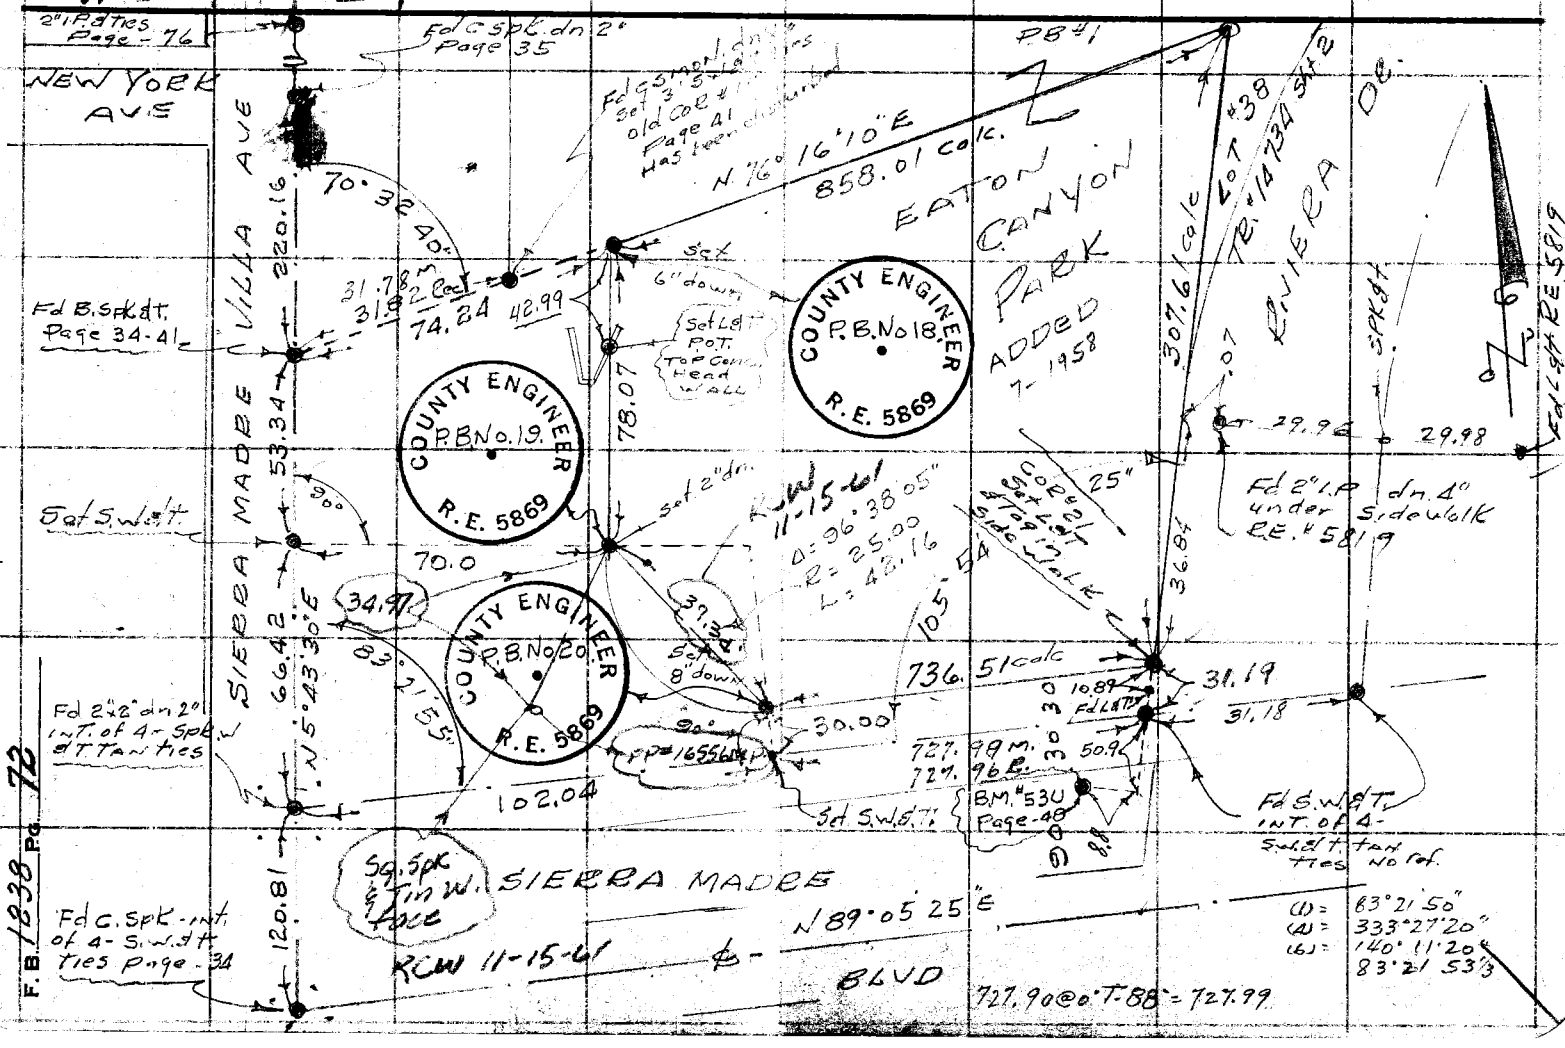

Notes Ck'd by	Survey of New York Ave
Map No.	W. 7757 Tape No. 0108 St'd. 68 °F
Office Work	Surveyed by Dougherty
Checked	Notes Dougherty Date 7-23-53
Date	Indexed A. C. Johnson 8-12-53

F. B. 1238 Pg. 75

Survey of

New York Ave

J.N. 7757

℄ Change from P.I. #7 S.E.
To a point at the Intersection
of Sierra Madre Ave ℄ Sierra
Madre Villia.

7-23-53.

Dougherty
Sta
Sa

Note: Any Additions or Changes on This Sheet Must be Made or Circled in Red Ink With Date and Name of Person Making Change.

Do not extend notes this side of this line.

RETURN TO
LOS ANGELES COUNTY SURVEYOR
720 LOS ANGELES COUNTY
ENGINEERING BLDG.

76F3098 247 4-58

X

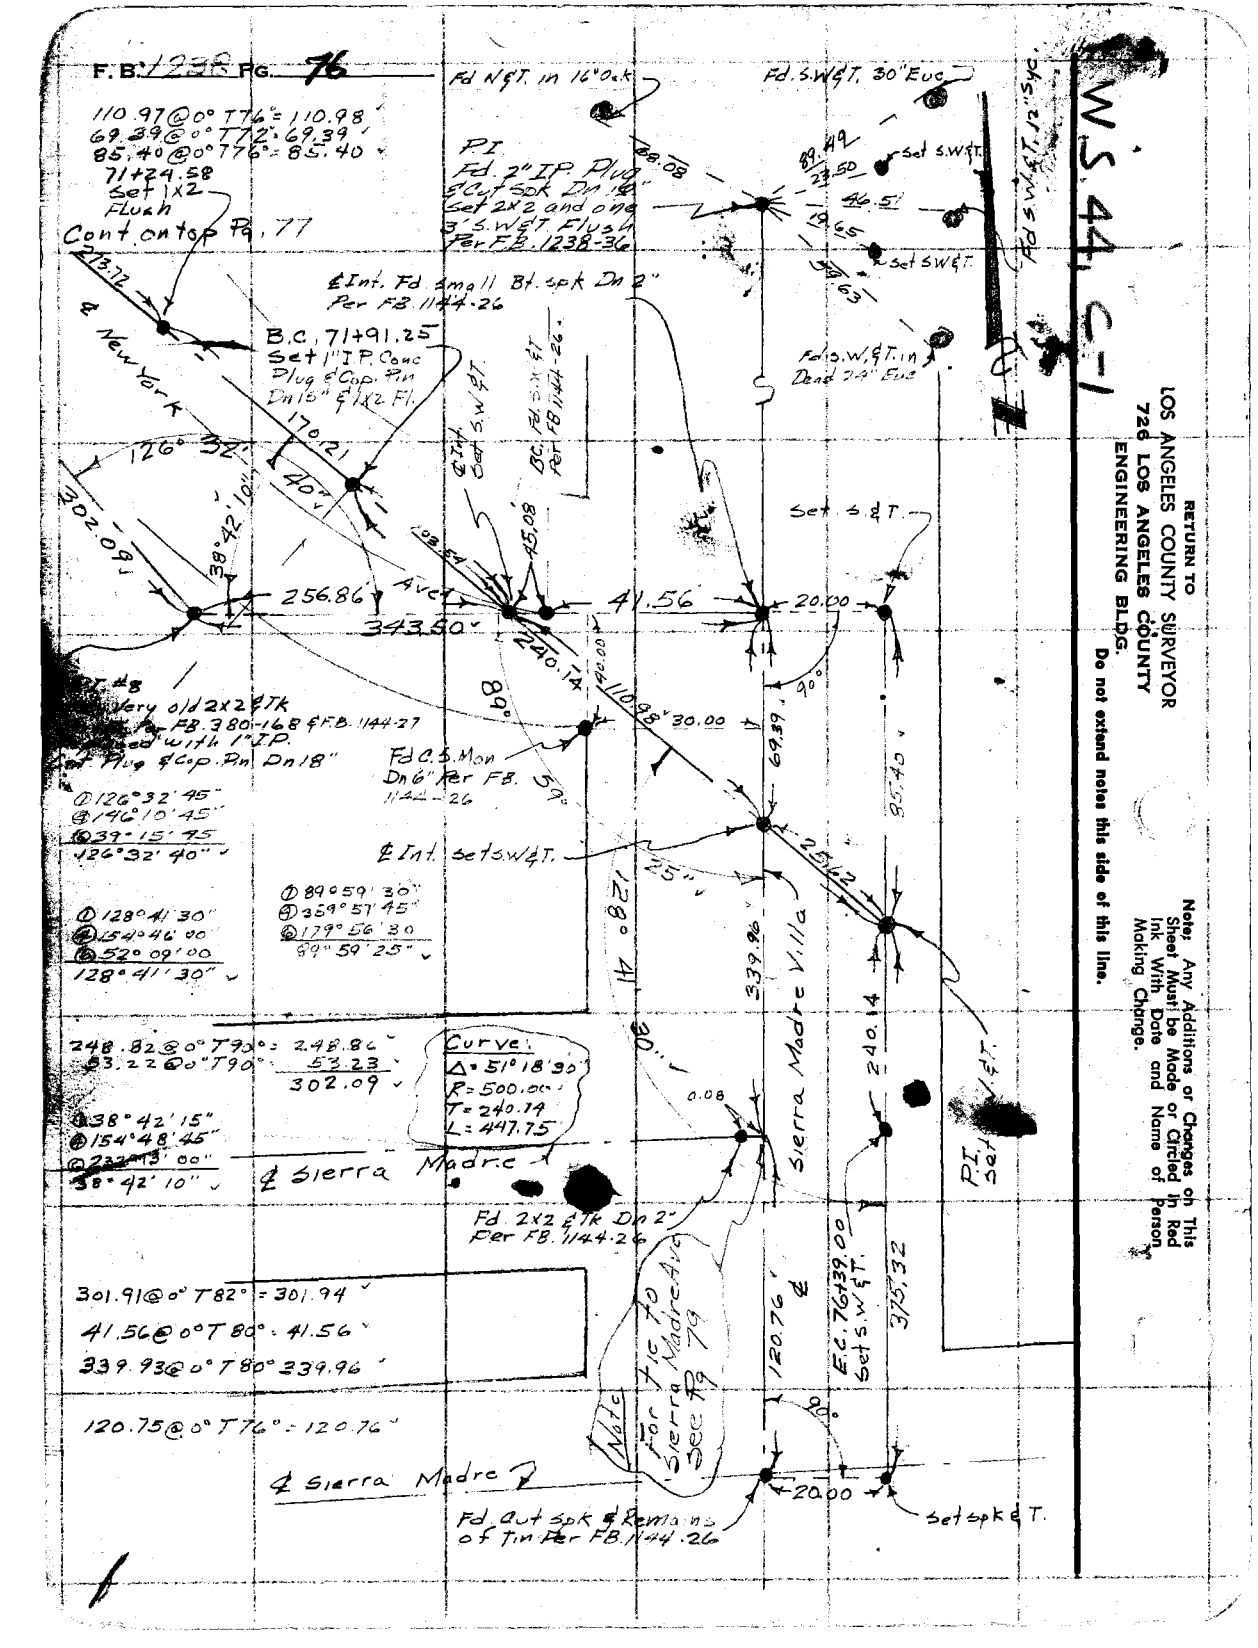
F.B. 1238 Pg. 76
W.S. 44, C-1
RETURN TO
LOS ANGELES COUNTY SURVEYOR
726 LOS ANGELES COUNTY
ENGINEERING BLDG.
Do not extend notes this side of this line.
Note: Any Additions or Changes on This Sheet Must be Made or Circled in Red Ink With Date and Name of Person Making Change.
Fd N&T. in 16"Oak
Fd. S.W&T. 30" Euc
Fd S.W&T. 12" Syc.
110.97@0°T76°=110.98'
69.39@0°T72°=69.39'
85.40@0°T76°=85.40'
71+24.58
Set 1x2
Flush
Cont. on top Pg. 77
PI
Fd. 2" IP. Plug
5/8 Cut Spk Dn 1/2"
Set 2x2 and one
3' S.W&T. Flush
Per F.B. 1238-36
Set S.W&T.
Set S.W&T.
Fd S.W&T. in
Dead 24" Euc
℄ Int. Fd. small Bt. spk Dn 2"
Per F.B. 1144-26
B.C. 71+91.25
Set 1" I.P. Conc
Plug & Cap. Pin
Dn 15" & 1x2 Fl.
℄ Int.
Set S.W&T.
BC. Fd. S.W&T.
Per F.B. 1144-26
℄ New York
126° 32' 40"
170.21
40'
302.09'
38° 42' 10"
256.86
℄ Ave.
343.60'
45.08
Set S.&T.
41.56
20.00
℄ Int. Fd. 3/4" I.P.
Very o/d 2x2 & Tk
F.B. 380-168 & F.B. 1144-27
Stamped with 1" I.P.
or Plug & Cap. Pin Dn 18"
Fd C.S. Mon
Dn 6" Per F.B.
1142-26
℄ Int. Set S.W&T.
Ⓓ 126° 32' 45"
Ⓔ 196° 10' 45"
Ⓕ 39° 15' 75"
126° 32' 40"
Ⓓ 89° 59' 30"
Ⓔ 359° 57' 45"
Ⓕ 179° 56' 30"
89° 59' 25"
Ⓓ 128° 41' 30"
Ⓔ 154° 46' 00"
Ⓕ 52° 09' 00"
128° 41' 30"
248.82@0°T90°=248.86'
53.22@0°T90°=53.23'
302.09'
Ⓓ 38° 42' 15"
Ⓔ 154° 48' 45"
Ⓕ 232° 43' 00"
38° 42' 10"
Curve:
Δ = 51° 18' 30"
R = 500.00'
T = 240.14
L = 447.75
℄ Sierra Madre
Fd 2x2 & Tk Dn 2"
Per F.B. 1144-26
301.91@0°T82°=301.94'
41.56@0°T80°=41.56'
339.93@0°T80°=239.96'
120.75@0°T76°=120.76'
℄ Sierra Madre
Fd Cut Spk & Remains
of Tin Per F.B. 1144-26
Set Spk & T.
Note: Fig. to ℄ Sierra Madre Ave. See Pg. 79
Sierra Madre Villa
℄ Int.
Set S.W&T.
℄ Int.
Set S.W&T.
P.I. Set ℄ Int.
℄ Int.
Set S.W&T.
℄ Int.
Set S.W&T.
℄ Int.
Set S.W&T

Notes Ck'd by
Map No.
Office Work
Checked
Date

Survey of New York Ave. F
W. 07757 Tape No. 0100 St'd. 68 F
Surveyed by Dougherty
Notes Dougherty Date 7-27-53
Indexed A. C. Johnson

B 1238 PG. 77

W. 5, 94, C-1

Cont. from 27 | Pg 76

Note: Any Additions or Changes on This Sheet Must be Made or Circled in Red Ink With Date and Name of Person Making Change.

Do not extend notes this side of this line.

RETURN TO
LOS ANGELES COUNTY SURVEYOR
726 LOS ANGELES COUNTY
ENGINEERING BLDG.

Note These Dist. Filled with 300' Tape #93 Std @ 84°

121.76 @ 0°00' T74 = 121.76'
151.97 @ 12°20 T72° =
151.72 @ 11°54 T72° = 148°45'
170.21

273.72'

275.12 @ 5°49 T92° = 273.72'
274.98 @ 5°30 T92°
68+50.86 Set 1X2 Flush

86.29 @ 11°10 T92°
86.71 @ 12°30' T92° = 84.66'

283.55 @ 6°22' T88° = 281.82'
283.41 @ 6°06' T88°
366.48

Fd. Nail Dn 1" No Ref.
0.01
302.09
0.02
BC Fd Small Bt Spk Flush Per 1144-27
39.99

Fd. C. S. Mon Dn 16" Per FB. 1144-27

81.63

Fd S, W & T Dn 1" Per 1144-27

169.15 @ 0° T90° = 169.17'
81.62 @ 0° T90° = 81.63'

169.17

E.C.
Fd Small Bt Spk Dn 1"
FB 1144-28
246.85 @ 0° T90° = 246.89'

246.89
0.04
39.99

Fd. C. S. Mon. Dn 18" Per F.B. 1144-28

Fd. Nail Dn 1" No Ref.

366.48

P.I. #7
Fd. W & T Wire Spk ET. Per FB 1144-28 Dn 2"
Fd. Remains of Old 2x2. No Tk. Dn 15" Per FB 380-167
Cont. 2x2 Checked Nail Replaced Nail with 1" I.P. Cmt. Plug & Cop. Pin Dn 12" 1X2 T3 S. W & T. Flush
℄ Sta = 64+84.38

768'

45°

① 165° 14' 30"
② 300° 59' 00"
③ 271° 28' 30"
165° 14' 45" /

14

77.73

77.73 @ 0° T 76° = 77.73'

165°

40.00 39.99

Fd. C. S. Mon. Dn 20" Per 1144-28
Sta 64+06.65 Per F.B 380-167

Fd. 2" IP Plug & Tk Dn 5" Per 1144-28

BC Nothing Set.

1342.08' New York Ave

1341.94 @ 0° T84 = 1342.08'

Cont. on Top Pg. 78

76FSOS 247 4-53

F.B. 1223 PG. 78

Cont from Bot Pg. 77

W.S 49 B-1

1342.08'

Fd. 2X2 & TK Dn 2'
Per FB. 1144-29

0.015

83.96'

83.96 @ 0°T 76°-83.96

Fd. C.S. Mon Dn 20"
FB. 380-167

40.00

Nothing set.

591.65'

591.59 @ 0°T 84 = 591.65'

Fd. C.S. Mon Flush
FB 1144-29

39.97

E.C.
Fd. Nail 0.02 No of line FB 1144-29
Fd. old 2X2 & TK Dn. 18" Except for Line Per FB 380-166. Replaced 2X2 with 1" IP. Cmt plug & Cop Pin Dn 17" 1X2 & 3'S W&T Flush

P.I. # 6
Fd. Nothing.

Note 1" IP. May have been Destroyed to Put in Guardrail

RETURN TO
LOS ANGELES COUNTY SURVEYOR
720 LOS ANGELES COUNTY
ENGINEERING BLDG.

Do not extend notes this side of this line.

Note: Any Additions or Changes on This Sheet Must be Made or Circled in Red Ink With Date and Name of Person Making Change.

Notes Ck'd by	Survey of New York Ave.
Map No.	W. O. 7757 Tape No. 0100 St'd. 68
Office Work	Surveyed by Dougherty
Checked	Notes Dougherty Date 8-3-53
Date	Indexed E. C. Johnson

F. B. 1230 Pg. 49

M.S. 49, C-1

Note: Any Additions or Changes on This Sheet Must be Made or Circled in Red Ink With Date and Name of Person Making Change.

Do not extend notes this side of this line.

RETURN TO
LOS ANGELES COUNTY SURVEYOR
726 LOS ANGELES COUNTY
ENGINEERING BLDG.

76F3098 247 4-53

P.I. Set S.W.T. Pg. 76

E.C. Set S.W.T. Pg. 76

Int. Set S.W.T.

Set S.W.T. Pg. 76

240.14

12.08

375.32

2.56

℄ Sierra

96°

20.13

Madre Villa

120.76

0.08

20.0

90°

Prop. ℄ Change Sec Pg. 76

℄ Int. Set S.W.T.

① 96° 37' 30"
② 26° 30' 30"
③ 21° 45' 30"
96° 37' 35" ✓

℄ Sierra Madre Ave (North)

19.52 Rec.

Fd 2x2 Dn 2" Per 1144-26

Fd cut sq. Per FB 1144-26

Sierra Madre Ave (South)

Fd S.W.T. Per 1144-37

69.43'

Fd Nail Per 1144-37

69.426 0°00'T84° = 69.43 ✓

RETURN TO
LOS ANGELES COUNTY SURVEYOR
726 LOS ANGELES COUNTY
ENGINEERING BLDG.

Note: Any Additions or Changes on This Sheet Must be Made or Circled in Red Ink With Date and Name of Person Making Change.

Do not extend notes this side of this line.

F.B. 1232 PG. 80

Notes Ck'd by	Survey of New York Ave
Map No.	W. O. 7757 Tape No. St'd. °F
Office Work	Surveyed by Dougherty
Checked	Notes Dougherty Date 7-31-53
Date	Indexed E. C. Johnson 8-12-53

F. B. 1228 PG. 31

New York Ave

IN 7757

Location of Improvements on Sierra Madre Vista from 125± South of Sierra Madre Ave to New York Ave.

7-31-53

Dougherty
Stangeland
Sawaya
Chandler

Note: Any Additions or Changes on This Sheet Must be Made or Circled in Red Ink With Date and Name of Person Making Change.

Do not extend notes this side of this line.

RETURN TO
LOS ANGELES COUNTY SURVEYOR
726 LOS ANGELES COUNTY
ENGINEERING BLDG.

76FSOB 247 4-53

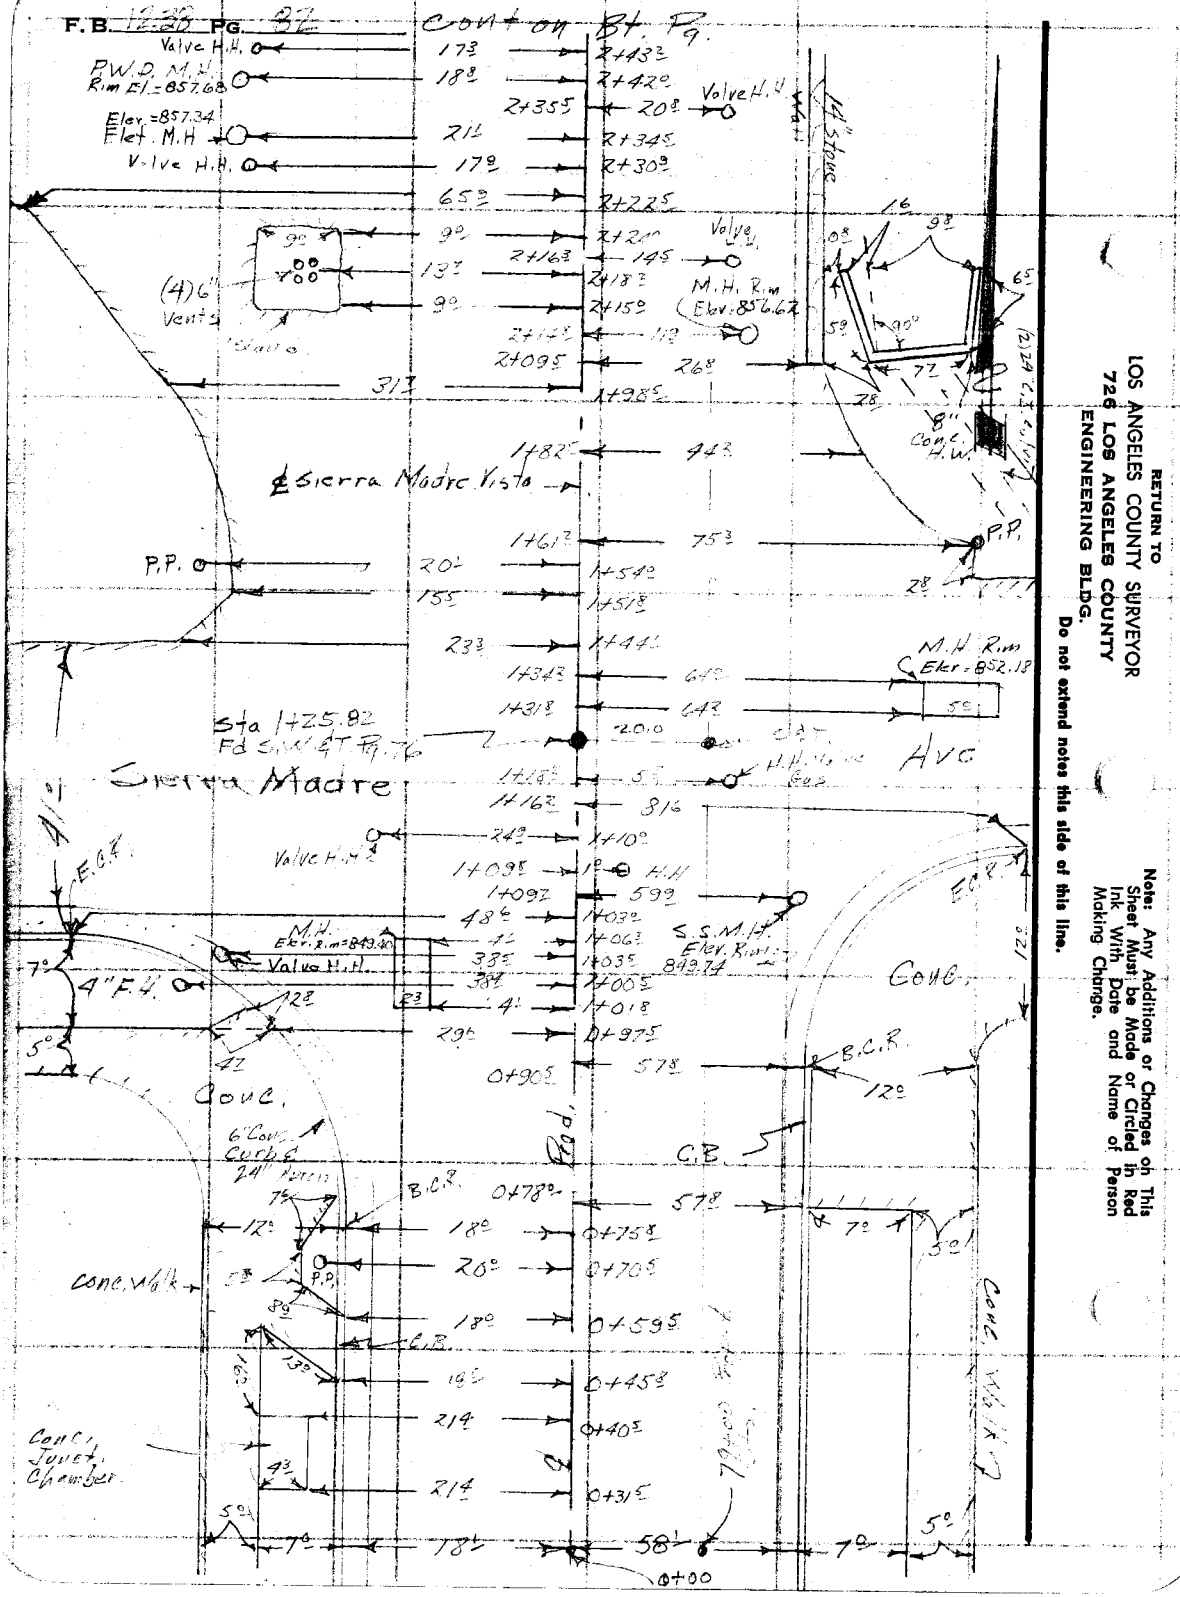

RETURN TO
LOS ANGELES COUNTY SURVEYOR
726 LOS ANGELES COUNTY
ENGINEERING BLDG.
Do not extend notes this side of this line.

Note: Any Additions or Changes on This Sheet Must be Made or Circled in Red Ink With Date and Name of Person Making Change.

F.B. 1238 PG. 83

Notes Ck'd by
Map No.
Office Work
Checked
Date

Survey of New York Ave
W. O. 7757 Tape No. St'd. °F
Surveyed by Dougherty
Notes Dougherty Date 7-31-52
Indexed K. C. Johnson

New York Ave — Cont. on Bot. Pg.

5+55 P.P. 0
65 19 9 26 14 13 36 35 15 8
5+72 27 5+66 27 5+58 5+41 39 5+42 5+39 5+25 5+17 26 39 4+62 4+63 4+62 4+59
24" Euc. Dead. T.P. 24" Euc Dead.
30" Euc. Bor Channel Rock Side of 30" Euc. Dead. 15 INCHES 15 INCHES
5+00 30" Euc. Dead.
30" Euc. Dead. 48" Euc. Dead.
14 14
4+45 27 4+29 4+21 4+16 60 4+13 26
T.P. Dead 9° 12" Euc 8" Euc
P.P. 0 10
4+14 8 26 3+91 23 3+84 57
4+00 10" Paper 24" Euc Dead.
30" Euc.
15
3+38 27 3+27
36" Euc.
40" Euc. Dead. 145
3+15 40 3+03
20" Euc.
℄ Sierra Madre Villa
2+91 28 2+89 25
24" Euc.
79 8" Conc C.B. 5 7 3 46
14
14" Rock Wall.
3 2+81
P.P. 0 10 2+81 29
P.P.
2+78 33
Conc Signal Box 31
9 2+70
4 4 1/3 2+67
49 2+61
Valve H.H.
2+58 23 2+58 33
15" C.I.P.
Sierra Madre Ave

Cont. from Top Pg.

RETURN TO
LOS ANGELES COUNTY SURVEYOR
726 LOS ANGELES COUNTY
ENGINEERING BLDG.

Note: Any Additions or Changes on This Sheet Must be Made or Circled in Red Ink With Date and Name of Person Making Change.

Do not extend notes this side of this line.

76F3008 247 4-53

F.B. 1238 Pg. 84

RETURN TO
LOS ANGELES COUNTY SURVEYOR
726 LOS ANGELES COUNTY
ENGINEERING BLDG.
Do not extend notes this side of this line.

Notes: Any Additions or Changes on This Sheet Must be Made or Circled in Red Ink With Date and Name of Person Making Change.

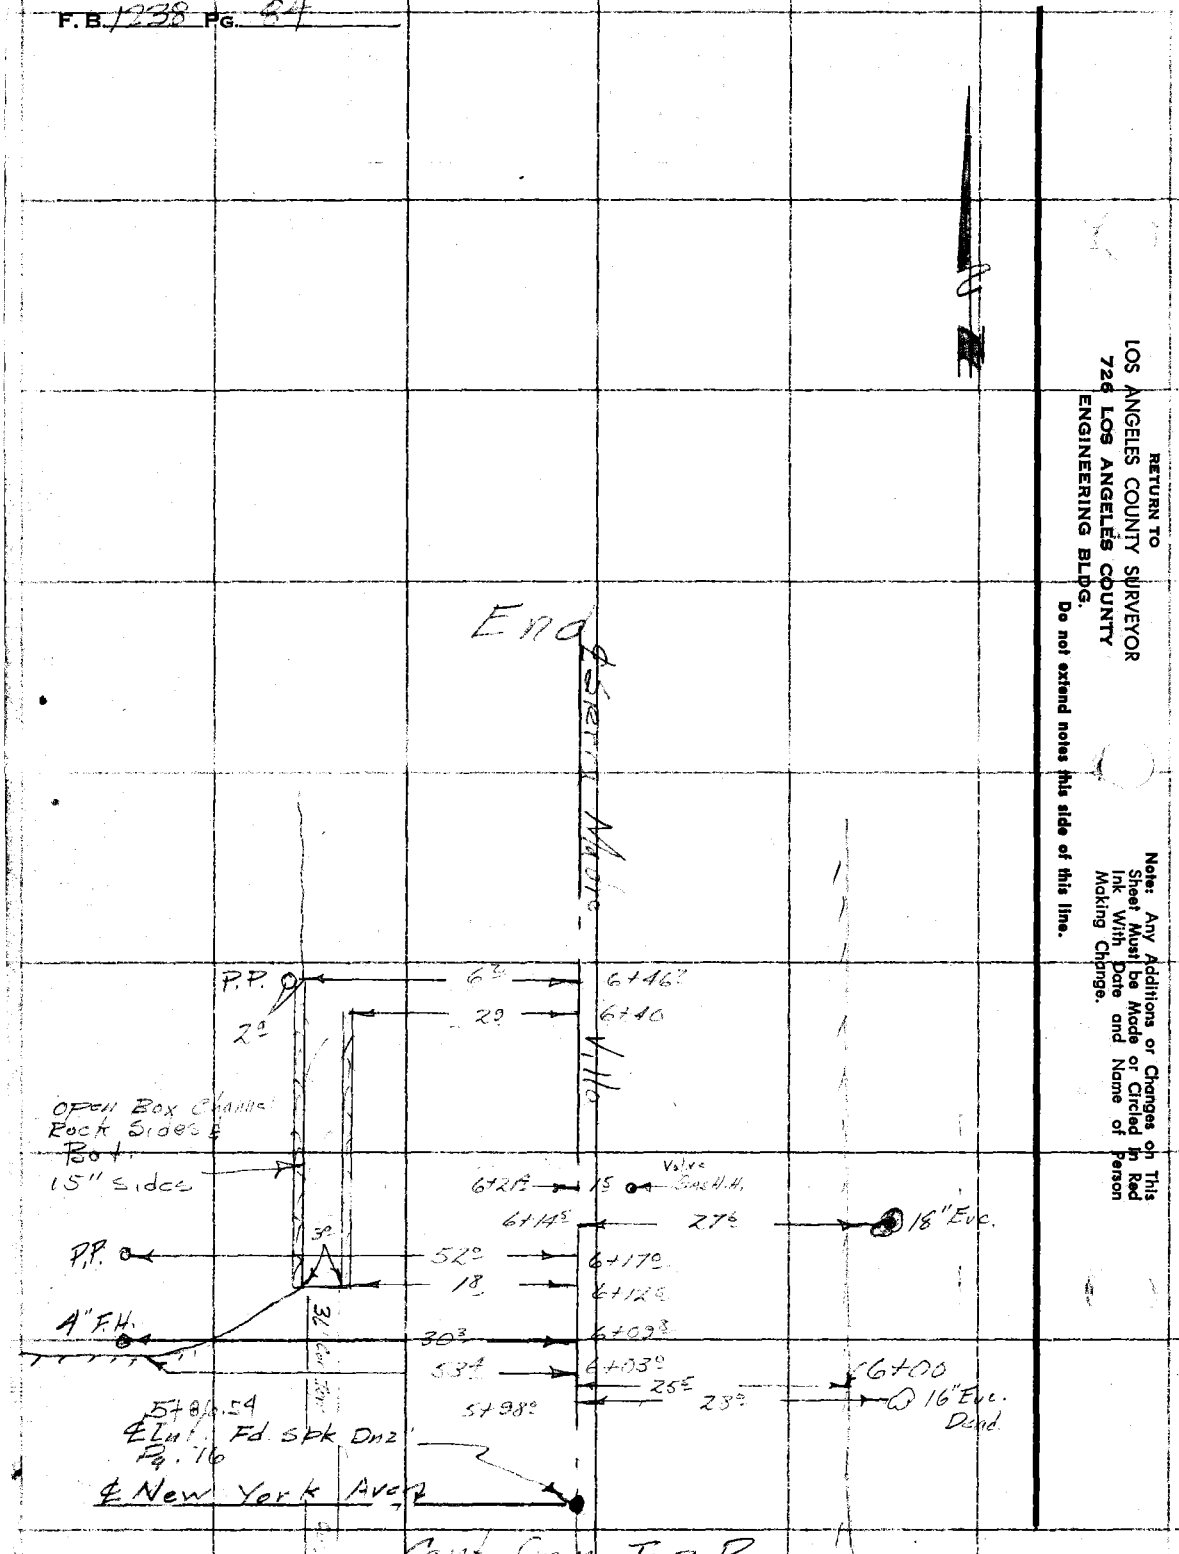

Profile No. | X-Sec. No.

Notes Red. | Plotted | Job No. 7757 | Division No. | F.B. 1238 Pg. 85
Date | Date | Survey of New York Ave
Notes Chkd. C.J.G. | Checked | Survey by Dougherty Notes same Date 7-28-53
Date 8-17-53 | Date | Map No. | Indexed K.C. Johnson Date 8-12-53

NOTE: ANY ADDITIONS OR CHANGES ON THIS SHEET MUST BE MADE OR CIRCLED IN RED INK, WITH DATE AND NAME OF PERSON MAKING CHANGE.

Do not extend notes this side of this line.

PLEASE RETURN TO
LOS ANGELES COUNTY SURVEYOR
726 LOS ANGELES COUNTY
ENGINEERING BLDG.

STATION

B.S.

H.I.

F.S.

ELEV.

New York Ave

J.N. 7757

Profile & Cross Sections

over

Proposed ℄ from P.I. #7 S.E.
To Intersection of Sierra Madre Ave
& Sierra Madre Villa.

7-28-53

Dougherty
Stangeland
Sandoval

Also

Profile & Cross Sec on Sierra Madre Villa
from Sierra Madre Ave No to 400 ± No of
New York Ave

And

Profile & Cross Sec. on New York Ave
from a Point 134 ± West of P.I. #7 East
To BC. PI #7

76L298 307 10-51

76L298 307 10-51

PLEASE RETURN TO
LOS ANGELES COUNTY SURVEYOR
726 LOS ANGELES COUNTY
ENGINEERING BLDG.

NOTE: ANY ADDITIONS OR CHANGES ON THIS SHEET MUST BE MADE OR CIRCLED IN RED INK, WITH DATE AND NAME OF PERSON MAKING CHANGE.

Do not extend notes this side of this line.

F.B. 1238 PG. 86 | Job No. 7257 | Division No. | Notes Red | Plotted | No. | Profile
Survey of New York Ave | Date | Date | No. | X-Sec.
Survey by Dougherty | Notes Dougherty | Notes Chkd C.J.G. | Checked
Indexed A. C. Johnson | Date | Date 8-17-53 | Date | No.

STATION	B. S.	H. I.	F. S.	ELEV.		
T.B.M. #17				858.141 ✓	T.B.M. #17 – 40'± West of Sierra Madre Villa & 100'± No. of RR E. Fd. Chisled □ Per. FB. 1144-154	in Conc. Base of Mail Box
	12 22	870 96 ✓				
T.P.			075	870 21 ✓		
	679	87700 ✓				out 7-29-58
T.B.M. #16			099	876 01 ✓	T.B.M. #16 Elev: 876.018 Arc on West Side Sierra Madre Villa Fd Chisled □ in Top Storm Drain Wall	50'± So. of New York Per FB. 1144-154
T.B.M #16				876 018 ✓	"	"
	7198	883216 ✓				
T.P.			9941	873 275 ✓		
	0238	873 513 ✓				
T.P.			12 006	861 507 ✓		
	0537	862 044 ✓				
T.P.			12 087	849 957 ✓		
	0656	850 613 ✓				
T.P.			11 951	838 662 ✓		
	0467	839 129 ✓				
T.P.			9944	829 185 ✓		
	4321	833 506 ✓				
B.M. #1			7676	825 830 ✓	BM #1 – 77.73' W of PI #7 & 40.'± Sou. & New York Ave Fd. C.S. Mon	Dn 28" See Pg. 77
	12 268	838 098 ✓				

76L298 307 10-51

PLEASE RETURN TO
LOS ANGELES COUNTY SURVEYOR
726 LOS ANGELES COUNTY
ENGINEERING BLDG.

NOTE: ANY ADDITIONS OR CHANGES ON THIS SHEET MUST BE MADE OR CIRCLED IN RED INK, WITH DATE AND NAME OF PERSON MAKING CHANGE.

Do not extend notes this side of this line.

STATION	B. S.	H. I.	F. S.	ELEV.		
		838.098'				
64+06.65		833.10'	1005	828.05	℄ B.C. P.I. #7 New York Ave Pg. 77	
"			1090	2720	Rt. 14.7' edge Mac. Pav.	
"			94	267	Rt. 21.5' top Bank	
"			129	252	Rt. 70' field	
"			924	2886	Lt. 16' edge Mac. Pav.	
"			44	337	Lt. 40' Ground. Prop. Line	
64+06.65			1.0	371	Lt. 70' Ground.	
64+16.8					Rt. 24.8. Power Pole	
64+50.			904	29.06	℄	
"			995	2815	Rt. 15.6' Edge Pav.	
"			90	291	Rt. 23.5' Top Bank.	
"			105	276	Rt. 30.5' Brk. Ground	
"			123	258	Rt. 70' field.	
"			822	2988	Lt. 13.2' Edge Pav.	
"			39	342	Lt. 40.8 Ground	
64+50			1.0	371	Lt. 70' Ground.	
65+00			699	3111	℄	
"			817	2993	Rt. 21.9. Edge Pav.	
"			78	303	Rt. 33' Top Bank.	
65+00		838.098'	93	8288	Rt 37.2' Bot. Bank.	

Profile
Notes Red _____ Plotted _____ Job No. 7757 Division No. _____ F.B. 1238 Pg. 67
No. _____ Date _____ Survey of New York Ave
X-Sec. _____ Date _____ Survey by Lambert Notes Same Date 7-28-53
Notes Chkd C.J.G. Checked _____ Survey by Andrew Johnson Date _____
No. _____ Date 8-17-53 Date _____ Map No. _____ Date _____

76L298 307 10-51

PLEASE RETURN TO

LOS ANGELES COUNTY SURVEYOR
726 LOS ANGELES COUNTY
ENGINEERING BLDG.

NOTE: ANY ADDITIONS OR CHANGES ON THIS SHEET MUST BE MADE OR CIRCLED IN RED INK, WITH DATE AND NAME OF PERSON MAKING CHANGE.

Do not extend notes this side of this line.

F.B. 12238 Pg. 88 | Job No. 7257 | Division No. | Notes Red | Plotted | Profile
Survey of New York Ave | Date | No. | X-Sec.
Survey by Dougherty | Notes Dougherty | Notes Chkd. C.J.G. | Checked | No.
Indexed A. C. Johnston | Date | Date 8-17-53 | Date

STATION	B. S.	H. I.	F. S.	ELEV.	
		838 098			
65+00		838 10	99	838 2	Rt. 70' field.
"			665	31 45	Lt. 65' Edge Pavement
"			65	31 6	Lt. 22.4 Brk. Ground.
65+00			31	350	Lt. 70' Ground
65+41.0					℄ Edge Pav.
65+50			39	8342	℄ Top Bank
"			502	3308	Rt. 3' No. Edge Pave
"			615	31 25	Rt. 32.6 So. Edge Pav.
"			62	319	Rt. 41.4' Top Bank
"			73	309	Rt. 47.6 Bot. Bank
"			73	308	Rt. 61.0 Prop. Line (field.
"			29	352	Lt. 10' Brk.
"			00	836 1	Lt. 40.5
65+50					℄ Elev +7.9 @ Lt 70' (Hand Lev) = 842.1
T.P.			3935	834163	IXZ Sta 65+50
	10 143	844 306			
		844 31			
66+00			606	838 25	℄
"			948	3483	Rt. 15.4 N Edge Pav.
"			986	3445	Rt. 45.5 S. Edge Pav.
66+00			103	8340	Rt. 70.0

76L298 307 10-51

PLEASE RETURN TO
LOS ANGELES COUNTY SURVEYOR
726 LOS ANGELES COUNTY
ENGINEERING BLDG.

NOTE: ANY ADDITIONS OR CHANGES ON THIS SHEET MUST BE MADE OR CIRCLED IN RED INK, WITH DATE AND NAME OF PERSON MAKING CHANGE.

Do not extend notes this side of this line.

Profile Notes Red No. Date Plotted Job No. 7757 Division No.
X-Sec. No. Date Date Survey of New Work 4/53
Notes Chkd C.J.G. Date 8-17-53 Checked Date Survey by Douglas Notes Same Date 7-29-53
Map No. Indexed Tab Date

F.B. 1238 Pg. 89

STATION	B. S.	H. I.	F. S.	ELEV.		
		844.306				
		44 31			= 857.3 ✓	
66+00					℄ Elev. + 19.0 @ 95.0 Lt.	Top Brk (Hand Lev)
66+50			247	841.84	℄	
"			49	394	Rt. 0.3 Brk.	
"			692	3739	Rt. 26.8 NE Edge Pave	
"			667	3764	R. 39.0 S. Edge Pav.	
"			65	378	Rt. 70	
					= 859.8 ✓	
66+50					℄ Elev. + 18.0 @ Lt. 93.3	Brk. Toe Slope (H.L.)
66+77.0			23	420	℄ +2 @ Lt. 16.0 Toe	Slope (H.L.)
66+86			36	407	℄ Brk. - Bot. Ravine	
67+00			228	4203	℄ Brk. Toe Slope.	
"			432	3999	Rt. 40.2 NEdge Pav.	
"			356	4075	Rt. 72.0 E. Edge Pav.	
					= 875.0 ✓	= 883.0 ✓ (H.L.)
67+00					℄ Elev. +33.0 @ Lt. 63' Brk Slope;	+41.0 @ Lt. 95.4 Hinge
T.P.			2 286	842020	1X2 Sta 67+00	
	11 622	853642				
67+07			98	843.8	℄ Toe Slope Cross ℄	
T.P.			0252	853390		

76L298 307 10-51

PLEASE RETURN TO
LOS ANGELES COUNTY SURVEYOR
726 LOS ANGELES COUNTY
ENGINEERING BLDG.

NOTE: ANY ADDITIONS OR CHANGES ON THIS SHEET MUST BE MADE OR CIRCLED IN RED INK, WITH DATE AND NAME OF PERSON MAKING CHANGE.

Do not extend notes this side of this line.

F.B. 1238 Pg. 90 Job No. 7257 Division No. Profile
Survey of Van Nuys Ave. Notes Red Plotted
Survey by D. Doherty Notes Date Date No. X-Sec.
Indexed Date Notes Chkd C.L.G. Checked
Date 8-17-53 Date No.

STATION	B. S.	H. I.	F. S.	ELEV.		
67+35				853.38	T.P. ℄ Side H.11	
	11.825	865.215				
67+50		65.23	3.75	851.47	℄ Elev. -14.0 @ Rt. 28 Toe Slope, = 845.5 ✓	-16.5 @ 52 Rt. Edge Pav. = 843.0 ✓
67+50					℄ Elev. +34.0 @ 76 Lt. Brk. = 893.5 ✓	Top Edge Flat Ridge, +60.0 @ Lt 120' (H.L.) = 919.5 ✓
67+66			1.3	863.9	℄ Top Ridge	
67+89.0					67+50 ℄ Elev +60.0 @ 107 Lt. Top Brk. Left Ridge = 919.5 ✓	+42.0 @ 60' Lt. Top Slope Brk (Hand Level) = 901.5 ✓
T.P.			1.278	862.937		
	9.995	873.932				
67+79		73.93	1.05	863.4	℄ Elev -12.0 @ 21 Rt. Toe Slope, = 851.4 ✓	-16.7 @ 45 Rt. Brk (H.L.) = 846.7 ✓
68+00			11.66	862.27	℄ Bot. Draw	
"					℄ Elev -7.7 @ 15 Rt Brk = 854.6 ✓ Bot Draw, -14.6 @ 48 Rt Brk. = 848.3 ✓, -13.5 @ 63 Rt Brk = 848.8	
68+06					℄ Elev. -15.9 @ 68 Rt. Edge Pav. = 846.4 ✓	℄ Side Slope (H.L.)
T.P.			0.531	873.401		
	10.570	882.971				
68+18					68+50.86 ℄ Elev +16.2 @ 51 Lt. Top Edge Flat Ridge = 895.9 ✓ (Note Flat Ridge Used for Pt.), +20.6 @ 67 Lt Top Edge Flat Ridge = 900.3 ✓	
68+18					68+50.86 ℄ Elev +21.7 @ 92 Lt. = 901.4 ✓	Side H.11 Meets Fill
68+42.			3.3	880.7	℄ Top Slope.	

75L298 307 10-51

PLEASE RETURN TO
LOS ANGELES COUNTY SURVEYOR
726 LOS ANGELES COUNTY
ENGINEERING BLDG.

NOTE: ANY ADDITIONS OR CHANGES ON THIS SHEET MUST BE MADE OR CIRCLED IN RED INK, WITH DATE AND NAME OF PERSON MAKING CHANGE.

Do not extend notes this side of this line.

Profile Notes Red ____ Plotted ____ Job No. 7757 Division No. ____ F.B. 1238 Pg. 91
No. ____ Date ____ Date ____ Survey of New York Ave
X-Sec. ____ Notes Chkd C.J.G. Checked ____ Survey by Dougherty Notes Same Date 7-29-53
No. ____ Date 8-17-53 Date ____ Map No. ____ Index Johnson Date ____

STATION	B. S.	H. I.	F. S.	ELEV.	Lt.	℄	Rt.
		883 971			+884.0	+878.7	+883.2	+887.7	+876.2	+876.9	+859.1	+858.4	+858.0
68+47.			46	8794	℄ Edge Rd.								
68+50.86			429	879.68	+4.3 / 80'	-1.0 / 68'	+3.5 / 46.0'	+8.0 / 29.0'	-3.5 / 11'	-2.8 / 18'	-20.4 / 50'	-20.6 / 60'	-29.1 / 72' Edge Pav.
T.P.			4294	879677									
	0163	879 840											
68+63.0			04	879 4	℄ Top Bank.								
T.P.			11 68	868172									
	0231	868 403											
T.B.M. #1			4942	863461	T.B.M. #1 600'± W of Sierra Madre Villa & 50'± No. of New York Ave Set spk & Tin in W. Crotch of 40" 6-Leader Oak.								
	0400	863 861											
T.P.			4549	859 312									
	6870	866 182											
		866 18							+6.3 / 35'				
68+75			33	8629									
68+86.5					Rt. 58.0. 40" Oak.								
68+91			15	647	℄								
"			84	578	Rt. 64' Toe Slope								
"			98	564	Rt. 80' Top Bank								
68+91			1225	5393	Rt 87' Bot. Bank Edge Pav.								
								=871.7 / +6.8 / 92'		868.4 / +3.5 / 55'			
69+00			13.	8649									

76L298 307 10-51

PLEASE RETURN TO
LOS ANGELES COUNTY SURVEYOR
726 LOS ANGELES COUNTY
ENGINEERING BLDG.

NOTE: ANY ADDITIONS OR CHANGES ON THIS SHEET MUST BE MADE OR CIRCLED IN RED INK, WITH DATE AND NAME OF PERSON MAKING CHANGE.

Do not extend notes this side of this line.

F.B. 1238 Pg. 92 | Job No. 7757 | Division No. V | Profile | No. | X-Sec. | No.
Survey of New York Ave | Notes Red. | Plotted
Survey by Dougherty | Notes Dougherty | Date | Notes Chkd. C.J.G. | Checked
Indexed | Date | Date 8-17-53 | Date

STATION	B. S.	H. I.	F. S.	ELEV.	Lt.	℄	Rt.
		866 182				=874.6	=868.3
69+50			1 21	864 97	Top Shoe	+9.6 93'	+3.3 52'
"			33	629	Rt 40'		
"			54	608	Rt. 73. Brk.		
69+50			85	8377	Rt. 88 Edge Road.		
T.P.			1209	864 973	IXI Sta 69+50		
	5 119	870092					
					+869.9	894.8	883.9	872.4
70+00			387	866 22	+3.7 706'	+28.6 82'	+17.7 60'	+6.2 33'
"			45	656	Rt 30'		
"			60	641	Rt. 78'		
70+00			855	6154	Rt. 87' Edge Mac Ave.		
70+00					Rt. 850 20" Oak		
70+21			20	681	Top Slope ℄		
T.P.			0577	864 515			
	11 814	881329					
T.P.			0236	[illegible] 293			
	11553	892 646					
					+916.3	918.0	906.4	+903.0	901.5	889.0				
70+50			962	883 03	+13.3 19'	+13.4 83'	+13.4 70'	+20.0 61'	+18.5 39'	+6.0 9'	℄ =879.2 12'	-3.8 32'	-14.5 75'	-15.3 81'	-17.2 Edge Ave.

76L298 307 10-51

PLEASE RETURN TO
LOS ANGELES COUNTY SURVEYOR
726 LOS ANGELES COUNTY
ENGINEERING BLDG.

NOTE: ANY ADDITIONS OR CHANGES ON THIS SHEET MUST BE MADE OR CIRCLED IN RED INK, WITH DATE AND NAME OF PERSON MAKING CHANGE.

Do not extend notes this side of this line.

Profile No. ____ Notes Red ____ Plotted ____ Job No. 7757 Division No. V
X-Sec. No. ____ Date ____ Date ____ Survey of Newberry Park Area
Notes Chkd. C.J.G. Checked ____ Survey by Dougherty Notes S.M.E. Date 7-30-53
Date 8-17-53 Date ____ Map No. ____ Indexed Johnson Date ____

F.B. 1238 Pg. 93

STATION	B. S.	H. I.	F. S.	ELEV.	Lt.	℄	Rt.
T.P.		892.646	0965	891681			
	11645	903326					
70+65			87	894.6	℄ Brk		
70+85			113	8920			
T.P.			0108	903213			
	10705	913923					
		13 92					
70+93					7 x 10.0 ℄ Elev	=918.07 +13.0 @ 29.5 Lt. T-P	
					=916.1 +10.4 116.5	917.7 +12.0 111'	917.9 +12.2 67'
71+10			82	9057			
71+24.57			511	0881	18" ℄		
						912.5 +2.0 86'	918.0 +9.5 57'
71+31			54	085			
71+39			45	094	70+85 ℄ Elev.		
T.P.			11843	902080			
	0364	902444					
71+55.0			87	8937	Brk 2.11	-889.5 -4.2 100'	-897.7 +4.0 52'
T.P.			11239	891205			
	0277	891482					
71+69.5			36	8879	℄ Toe Slope.		

℄	Rt.
= 891.3 -0.7 18'	= 880.0 -12.0 39'
= 881.3 -10.7 32'	880.0 -12.0 39'
= 894.7 +1.0 7'	= 891.0 -2.7 19'
	-896.7 -7.0 28'
	878.2 = -15.5 37.8
	874.9 = -18.8 60'
	873.0 = -20.7 64'
	874.5 = -19.2 92'
= 871.0 -21.0 58'	= 870.2 -21.8 76'
= 881.7 -10.3 44'	= 877.5 -14.5 50'
	872.0 -20.0 68'
	873.7 -18.8 96'

-23.5 82' Rv.
-15.2 65'

76L298 307 10-51

PLEASE RETURN TO

LOS ANGELES COUNTY SURVEYOR
726 LOS ANGELES COUNTY
ENGINEERING BLDG.

NOTE: ANY ADDITIONS OR CHANGES ON THIS SHEET MUST BE MADE OR CIRCLED IN RED INK, WITH DATE AND NAME OF PERSON MAKING CHANGE.

Do not extend notes this side of this line.

F.B. 1288 Pg. 94 | Job No. 7757 | Division No. V | Notes Red | Plotted | No. | Profile
Survey of New York Ave | Date | Date | No. | X-Sec.
Survey by Dougherty | Notes Dougherty | Notes Chkd C.J.G. | Checked
Indexed K. C. Johnson | Date | Date 8-17-53 | Date | No.

STATION	B. S.	H. I.	F. S.	ELEV.	Lt.	℄	Rt.
		891 482					
71+69.5			19	889 6	Rt. 10' Brk Ridge		
"			27	888	Lt. 19'		
"			31	874	Lt. 52'		
71+69.5			29	886	Lt. 72'		
71+87.5			56	859			
71+92					Rt. 20.5 Power Pole		
T.P.			5799	885683			
	1461	E 87144 87 14					
72+00			146	885 68			
"			09	882	Rt. 12' Top Bk.		
"			54	881	Rt. 30 Brk		
"			124	747	Rt. 40' Edge Rd.		
"			13	858	Lt. 40		
72+00			03	869	Lt. 72'		
72+50			89	732	℄		
"			1056	7658	Rt. 5' Edge Pav		
"			904	7810	Rt. 47.5 ℄ Edge Pav		
"			83	788	Rt. 53.5 Top Bank		
72+50			97	8774	Rt. 89'		

+2.0 = 887.9 ✓ (9')
-9.2 = 876.7 ✓ (32')
-11.7 = 874.2 ✓ (50')
-10.0 = 875.9 ✓ (82')

76L298 307 10-51

PLEASE RETURN TO
LOS ANGELES COUNTY SURVEYOR
726 LOS ANGELES COUNTY
ENGINEERING BLDG.

NOTE: ANY ADDITIONS OR CHANGES ON THIS SHEET MUST BE MADE OR CIRCLED IN RED INK, WITH DATE AND NAME OF PERSON MAKING CHANGE.

Do not extend notes this side of this line.

Profile Notes Red ____ Plotted ____ Job No. 7757 Division No. V
No. ____ Date ____ Date ____ Survey of New York Ave
X-Sec. Notes Chkd C.J.G. Checked ____ Survey by Dougherty Notes Same Date 7-30-53
No. ____ Date 8-17-53 Date ____ Map No. ____ Date ____

F.B. 1238 Pg. 95

STATION	B. S.	H. I.	F. S.	ELEV.		
72+50		887 144	48	8823	Lt. 9' Top Bank	
"			32	839	Lt 23'	
72+50			34	837	Lt. 90'	
73+00			808	7906	℄ S Edge Mac Fa	
"			89	782	Rt. 35'	
"			107	764	Rt. 76'	
"			869	7845	Lt. 24' cent. Mac Fa	
"			868	7846	Lt. 50' N Edge Fa	
"			52	819	Lt. 65' Top B	
73+00			54	817	Lt. 75'	
T.P.			8085	879059		
	0883	879 942				
72+50			389	7605	℄	
"			37	762	Rt. 35'	
"			49	750	Rt. 70'	
"			38	761	Lt. 36'	
"			18	781	Lt. 41'	
"			240	775	Lt. 46'	
73+50			155	7839	Lt 72' curb Inter. Sierra Vista & New York Ave	
74+00			725	7269	℄	
74+00			65	734	Rt 35'	

76L298 307 10-51

PLEASE RETURN TO
LOS ANGELES COUNTY SURVEYOR
726 LOS ANGELES COUNTY
ENGINEERING BLDG.

NOTE: ANY ADDITIONS OR CHANGES ON THIS SHEET MUST BE MADE OR CIRCLED IN RED INK, WITH DATE AND NAME OF PERSON MAKING CHANGE.

Do not extend notes this side of this line.

F.B. 1238 Pg. 96 | Job No. 7757 | Division No. | Notes Red. | Plotted | No. | Profile
Survey of New York Ave | Date | Date | No. | X-Sec.
Survey by Dougherty | Notes | Notes Chkd. C.J.G. | Checked
Indexed C. Johnson | Date | Date 8-17-53 | Date

STATION	B. S.	H. I.	F. S.	ELEV.		
		879 942				
74+00		79 91	75	872.4	Rt. 75'	
"			55	74.4	Lt. 26'	
"			635	72.59	Lt. 32' Top W. Wall Open Conc. Channel	
"			831	71.63	Bot. Channel	
"			559	74.35	Lt. 26' Top E. Wall Open Conc. Channel	
"			595	72.99	Lt. 38' W Edge Pav.	
"			499	74.95	Lt. 66' E Edge Pav.	
74+00			57	74.2	Lt. 76'	
74+50			948	70.46	℄	
"			97	70.2	Rt. 35'	
"			100	69.3	Rt. 75'	
"			947	70.47	Lt. 7' Edge Pav.	
"			1012	69.82	Lt. 12' Flow Line	
"			857	71.37	Lt. 28' Cent. Pav.	
"			853	71.41	Lt. 42' F.L.	
"			795	71.99	Lt. 45' Edge Pav.	
"			93	70.6	Lt. 55'	
"			78	72.1	Lt. 60'	
74+50			84	71.5	Lt. 70'	
T.P.			9728	67.214		
	0741	870 955				

76L298 307 10-51

PLEASE RETURN TO
LOS ANGELES COUNTY SURVEYOR
726 LOS ANGELES COUNTY
ENGINEERING BLDG.

NOTE: ANY ADDITIONS OR CHANGES ON THIS SHEET MUST BE MADE OR CIRCLED IN RED INK, WITH DATE AND NAME OF PERSON MAKING CHANGE.

Do not extend notes this side of this line.

STATION	B. S.	H. I.	F. S.	ELEV.	
		870 955			
75+00			365	867 31	℄
"			402	66 94	Rt. 5' F.L.
"			370	67 26	Rt. 10' Edge Pav.
"			48	662	Rt. 28'
"			42	668	Rt 70'
"			283	68 13	Lt. 10' Cut Pav.
"			282	68 14	Lt. 23 Brk Pav.
"			233	68 63	Lt. 26' Edge Pav
"			18	692	Lt. 33'
75+00			19	691	Lt. 70'
T.P.			6418	864 537	
	3455	867 992			
75+50			310	864 89	℄ Crown Pavement.
"			436	6363	Rt. 16' F.L.
"			406	6393	Rt. 22' Edge Pav.
"			40	640	Rt. 42'
"			38	642	Rt. 80'
"			206	6493	Lt. 14' Edge Pav.
"			37	643	Lt. 35'
75+50			33	647	Lt. 70'
76+00			624	861 75	℄

Note
Area to Right of ℄ is
Grape Vineyard Between
New York And Sierra
Madre Ave

Profile
Notes Red _____ Plotted _____ Job No. 7757 Division No. 4 F.B. 1238 Pg. 97
No. _____ Date _____ Date _____ Survey of New York Ave
X-Sec.
No. _____ Notes Chkd C.J.G. Checked _____ Survey by J.N.D. Notes J.N.D. Date 7-30-53
Date 8-17-53 Date _____ Map No. _____ Checked J. Johnson Date _____

76L298 307 10-51

PLEASE RETURN TO
LOS ANGELES COUNTY SURVEYOR
726 LOS ANGELES COUNTY
ENGINEERING BLDG.

NOTE: ANY ADDITIONS OR CHANGES ON THIS SHEET MUST BE MADE OR CIRCLED IN RED INK, WITH DATE AND NAME OF PERSON MAKING CHANGE.

Do not extend notes this side of this line.

F.B. 1238 Pg. 98 | Job No. 7757 | Division No. | Notes Red | Date | Plotted | Date | Profile | No. | X-Sec. | No.

Survey of New York Ave

Survey by Dougherty Notes | Notes Chkd. C.J.G. | Checked | Date | 8-17-53 | Date

Indexed C. Johnson | Date

STATION	B. S.	H. I.	F. S.	ELEV.		
		867 992				
76+00		67 99	619	961 80	Rt 7' Crown Pav.	
"			710	60 [illegible]	Rt. 19'	
"			780	60 19	Rt. 24' F.L.	
"			685	61 14	Rt 29' Edge Pav.	
"			55	625	Rt. 35'	
"			68	61 2	Rt. 47'	
"			64	61 6	Rt 70'	
"			633	61 66	Lt. 6' Edge Pav.	
"			72	60 8	Lt. 17'	
"			53	627	Lt. 23'	
"			66	61 4	Lt 50'	
76+00			65	61 5	Lt. 70'	
E.C. 76+39.00			877	59 22	℄ S.W. St.	
"			833	59 66	Rt. 9' Crown Pav.	
"			949	59 50	Rt. 23' Pav.	
"			1071	57 28	Rt. 55' Edge Pav.	
"			904	59 75	Lt. 6' Bot. Curb, top	859.55 +0.6
"			114	566	Lt. 12' Bot Wash	
"			82	593	Lt 25' Top.	
"			927	58 72	Lt 40.1 Rim S.S.M.H.	
E.C.			86	594	Lt. 70'	

76L298 307 10-51

PLEASE RETURN TO
LOS ANGELES COUNTY SURVEYOR
726 LOS ANGELES COUNTY
ENGINEERING BLDG.

NOTE: ANY ADDITIONS OR CHANGES ON THIS SHEET MUST BE MADE OR CIRCLED IN RED INK, WITH DATE AND NAME OF PERSON MAKING CHANGE.

Do not extend notes this side of this line.

STATION	B. S.	H. I.	F. S.	ELEV.		
T.B.M.#17		867 992	9 260	858 732	T.B.M. #17 Elev. 858.741	See Pg. 86
T.B.M.#17	0 47	859 21		858 741	" "	" "
76+60			1.22	57.99	Lt.	
"			100	58 21	Rt. 9'	
"			153	57.68	Rt. 39'	
76+60			272	5649	Rt. 77' Conc. Pav. Sierra Madre Ave N.	
76+60			235	5686	Rt. 22' Pav. Bot. Vert. Edge	
"			13	579	Rt. 36.0 Center Top. Vert. Pipe Retd.	
"			225	5696	Rt. 42' Pav. Bot. Vert. Pipe. Stand.	
76+80			350	5571	Rt. 84' Edge Mac. Pav. S. side S.M. Ave.	
76+82			283	5638	Lt. 5.7' Bot. Curb., Mixture + 0.60	
"			624	5297	Lt. 14' Bot. Open Catch Basin	
76+85			348	5573	Lt. 18' Top Open Catch Basin	
77+00			325	5596	Lt.	
"			357	5564	Rt. 24'	
"			265	5556	Rt. 55' Bot. Mac.	
"			269	5652	Lt. 58' Top. Edge Mac.	
77+00			43	549	Rt. 75'	
"			322	5599	Lt. 7.5' Mac.	
77+00			235	85686	Lt. 10' Top, Edge Mac.	

Profile
No. ____ Notes Red ____ Plotted ____ Job No. 7757 Division No. V
X-Sec. ____ Date ____ Date ____ Survey of New York Ave
No. ____ Notes Chkd C.J.G. Checked ____ Survey by N.D. Notes N.D. Date 3-31-53
Date 8-17-53 Date ____ Map No. ____ Indexed J. Johnson Date ____

F.B. 1238 Pg. 99

76L298 307 10-51

PLEASE RETURN TO

LOS ANGELES COUNTY SURVEYOR
726 LOS ANGELES COUNTY
ENGINEERING BLDG.

NOTE: ANY ADDITIONS OR CHANGES ON THIS SHEET MUST BE MADE OR CIRCLED IN RED INK, WITH DATE AND NAME OF PERSON MAKING CHANGE.

Do not extend notes this side of this line.

F.B. 1238 Pg. 100 Job No. 7257 Division No. Notes Red. Plotted
Survey of New York Ave Date Date No.
Survey by Dougherty Notes " Notes Chkd C.J.G. Checked X-Sec.
Indexed R. C. Johnson Date Date 8-17-53 Date Profile No.

STATION	B. S.	H. I.	F. S.	ELEV.		
		859.21				
77+00			33	8559	Lt. 20'	
77+00			26	56.6	Lt 60'	
77+44			379	5342	℄	
"			660	5261	Rt. 36' Bot, Nic.	
"			515	5546	Rt. 39' Top, Nic.	
"			5 —	525	Rt. 39'	
"			514	5347	Lt. 22'	
77+44			513	5248	Lt. 51', +1.3 @ Sta 77+41 Top Nic.	=54.78
77+75			818	5103	℄	
"			881	5040	Rt 50'	
77+75			779	5142	Lt. 50'	
78+22			1146	4775	℄	
"			1227	4684	R738 F.L. Cutter + 0.45 Top Curb	
"			1151	4770	Rt. 50.5 Nic	
"			1153	4768	Lt. 28' Top Curb — 1.05 F.L. Cutter	=46.63
78+22			404	4813	Lt 50' Back Walk	
T.P.			1232	4699		
	140	849.39				
79+00			582	8425.7	℄	
"			659	4180	R738 F.L. Cutter + 0.45 Top Curb	=42.45
79+00			558	8428.1	Rt. 50' Back Walk	

76L298 307 10-51

PLEASE RETURN TO
LOS ANGELES COUNTY SURVEYOR
726 LOS ANGELES COUNTY
ENGINEERING BLDG.

NOTE: ANY ADDITIONS OR CHANGES ON THIS SHEET MUST BE MADE OR CIRCLED IN RED INK, WITH DATE AND NAME OF PERSON MAKING CHANGE.

Do not extend notes this side of this line.

STATION	B. S.	H. I.	F. S.	ELEV.		
		940 39				=42.59
79+00			645	841 94	Lt. 38'	F.L. +0.05 Top Curb
79+00			556	4283	Lt. 50'	Back Walk
T.P.			216	846 23		
	1235	958 58				
T.P.			263	855 92		
	642	962 34				
T.B.M.#17			361	858.73	T.B.M.#17 Elev. 858.72	See Pg. 86

Profile & Cross Sec. of Sierra Madre Villa North from Sta 4+00 to 400' North of New York Ave

Note

This Profile will be taken on existing ℄ of Sierra Madre Villa. Sta 0+00 to North = Sta 79+00 of Proposed New York Ave and is 125.82 South of ℄ Int. of S.M. Ave & S.M. Villa See Pg. 82

T.B.M.#16				876 018	T.B.M.#16	See Pg. 86
	136	877 38				
4+00			1002	867.36	℄	
4+00			914	868.24	Rt. 16'	

Profile
Notes Red ____ Plotted ____ Job No. 7757 Division No. V
No. ____ Date ____ Date ____ Survey of New York Ave
X-Sec. ____ Notes Chkd C.J.G. Checked ____ Survey by J.N.D. Notes J.N.D. Date 7-21-53
No. ____ Date 8-17-53 Date ____ Map No. ____ Plotted ____ Notes C. Johnson Date ____
F.B. 12238 Pg. 101

76L298 307 10-51

PLEASE RETURN TO
LOS ANGELES COUNTY SURVEYOR
726 LOS ANGELES COUNTY
ENGINEERING BLDG.

NOTE: ANY ADDITIONS OR CHANGES ON THIS SHEET MUST BE MADE OR CIRCLED IN RED INK, WITH DATE AND NAME OF PERSON MAKING CHANGE.

Do not extend notes this side of this line.

F.B. 1238 PG. 102 Job No. 7757 Division No. Notes Red. Plotted
Survey of New York Ave Date Date No.
Survey by Dougherty Notes T.N.D Notes Chkd. C.J.G. Checked X-Sec.
Indexed C. Johnson Date Date 8-17-53 Date No.
Profile

STATION	B. S.	H. I.	F. S.	ELEV.		
4+00		877 38'	9 43	867 95	Rt 26'	
"			8 90	866 48	Rt 28' Edge Pav.	
"			90	868 4	Rt 43'	
"			10 26	67 12	Lt 3.5 F.L.	
"			9 83	67 55	Lt 8.5 Edge Pav.	
4+00			10 5	66 9	Lt 29.0	
5+00			3 76	73 62	℄	
"			3 28	74 10	Rt 15'	
"			3 56	73 82	Rt 25	
"			2 34	74 04	Rt 27' Edge Pav	
"			48	72 6	Rt 39'	
"			3 81	73 57	Lt 3' Bot. Curb	
"			3 29	74 09	Lt 3.5 Top Channel wall	
"			585	71 53	Bot. Channel	
"			1 02	73 36	Lt 6.5 Top Channel Wall	
"			31	74 3	Lt 14'	
5+00			39	73 5	Lt 16'	
T.B. M#16			1 36	876 02	T.B. M#16 876.018' Sec Fly. 86	
T.B. M#16	11 11	887 13		876 02	" " " "	
5+38			11 21	75 92		
"			10 77	76 36	Lt 2' Top Box channel wall, -0.5 Flow Line.	75.86

76L298 307 10-51

PLEASE RETURN TO
LOS ANGELES COUNTY SURVEYOR
726 LOS ANGELES COUNTY
ENGINEERING BLDG.

NOTE: ANY ADDITIONS OR CHANGES ON THIS SHEET MUST BE MADE OR CIRCLED IN RED INK, WITH DATE AND NAME OF PERSON MAKING CHANGE.

Do not extend notes this side of this line.

Profile Notes Red Plotted Job No. 7157 Division No. F.B. 1238 Pg. 103
No. Date Date Survey of New York Ave
X-Sec. Notes Chkd C.V.G. Checked Survey by Dougherty Notes J.W.P. Date 8-3-53
No. Date 8-17-53 Date Map No. Andrew Johnson Date

STATION	B. S.	H. I.	F. S.	ELEV.		
		887				
5+38			11 4/2	875.70	Lt. 7' Top Channel	=873.1 ✓
5+70			9 02	781.1	℄	-2.6 Bot.
5+76			8 14	789.9	Rt. 64' Edge	
6+00			7 33	798.0	℄	
			7 42	797.1	Rt 24' Edge	
			7 09	800.4	Rt 28' Top Bank	
			8 6.	785.	Rt 34' Bot. "	
			80	791.	Rt 46	
			7 35	797.8	Lt. 11	
			8 18	789.5	Lt 40'	
6+00						
6+14			5 97	811.6	Rt. 2' Top Culv. Wall	=77.16 ✓
			6 72	804.1	Rt 7' "	-4.0 Bot.
6+45			5 97	811.6	Rt. 2' Top end E. Culv. Wall	
6+47			5 56	815.7	Rt. 2' Bot end W. Culv. Wall, +12 Top	=82.9 ✓
7+00			1 54	859.	℄	
			1 10	860.3	Rt 16' Crown Rd.	
			45	856.8	Rt. 24' Edge	
			19	852.	Rt 40	
			1 69	854.4	Lt. 3' F.L.	
			1 25	858.8	Lt. 3' Top	
7+00			0 5	866.	Lt. 48'	

76L298 307 10-51

PLEASE RETURN TO
LOS ANGELES COUNTY SURVEYOR
726 LOS ANGELES COUNTY
ENGINEERING BLDG.

NOTE: ANY ADDITIONS OR CHANGES ON THIS SHEET MUST BE MADE OR CIRCLED IN RED INK, WITH DATE AND NAME OF PERSON MAKING CHANGE.

Do not extend notes this side of this line.

F.B. 1238 Pg 104 | Job No. 7757 | Division No. | Notes Red. | Plotted | Profile
Survey of New York Ave | Date | Date | No. | X-Sec.
Survey by Dougherty | Notes Same | Notes Chkd. C.J.G. | Checked
Indexed C. Johnson | Date | Date 8-17-53 | Date | No.

STATION	B. S.	H. I.	F. S.	ELEV.		
		887 13'				
7+00			00	8871'	Lt. 30'	
T.P.			1 30	886 13'		
	1130	897 43'				
8+00			556	89137'	℄	
"			490	92 53'	Rt. 17' Crown Pv.	
"			531	92 12'	Rt. 21' Edge Pav	
			63	91 1'	Rt. 24'	
			56	91 8'	Rt. 40'	
			579	9 64'	Lt. 47½'	
			306	92 37'	Lt. 6' Toe Slope	
			54	92 0'	Lt. 30'	
			52	92 2'	Lt. 50'	
8+00			39	925'	Lt. 122' Toe Slope	
T.P.			1 21	89 13'		
	1219	908 31'				
9+00			1034	897.97'	℄	
			977	898 54'	Rt. 16' Crown Pav	
			1010	898 21'	Rt. 24' Edge Pav.	
			95	896 3'	Rt. 40'	
			1062	897 69'	Lt. 43' = ℄	
9+00			1521	896 10'	Lt. 5' Toe Bank	

76L298 307 10-51

PLEASE RETURN TO
LOS ANGELES COUNTY SURVEYOR
726 LOS ANGELES COUNTY
ENGINEERING BLDG.

NOTE: ANY ADDITIONS OR CHANGES ON THIS SHEET MUST BE MADE OR CIRCLED IN RED INK, WITH DATE AND NAME OF PERSON MAKING CHANGE.

Do not extend notes this side of this line.

Profile No. ____ Notes Red ____ Plotted ____ Job No. 7737 Division No. ____ F.B. 1238 Pg. 105
X-Sec. No. ____ Date ____ Date ____ Survey of New York Ave
Notes Chkd C.J.G. Checked ____ Survey by Dunnerty Notes by Jones Date 8-3-53
Date 8-17-53 Date ____ Map No. ____ Added by Johnson Date ____

STATION	B. S.	H. I.	F. S.	ELEV.		
		906 31				
9+00			102	898 1	Lt. 40	
9+			99	898 4	Lt. 116' Toe Slope	
9+79			509	903 22	Lt. 5' Top Bank	
"			71	901 2	Lt. 57'	
"			64	901 9	Lt. 74'	
9+79			68	901 5	Lt. 118' Toe Slope	
10+00			122	904 09	[illegible]	
			385	904.46	[illegible]	
			405	904 26	[illegible]	
			42	904 1	Rt 40'	
			434	903 97	Lt. 3' F.L.	
			559	904.72	Lt. 7' Brk. Drive Way	
			293	905 48	Lt. 40'	
			172	906 59	Lt. 8'	
T.P.			1220	896 11		
	0 37	896 48				
T.P.			1166	884 82		
	0 83	885 65				
T.B.M. #16			964	876 01	T.B.M. #16 Elev. = 876.02	See Pg. 86

76L298 307 10-51

PLEASE RETURN TO
LOS ANGELES COUNTY SURVEYOR
726 LOS ANGELES COUNTY
ENGINEERING BLDG.

NOTE: ANY ADDITIONS OR CHANGES ON THIS SHEET MUST BE MADE OR CIRCLED IN RED INK, WITH DATE AND NAME OF PERSON MAKING CHANGE.

Do not extend notes this side of this line.

F.B. 1238 Pg. 106 | Job No. 7757 Division No. | Notes Red. | Plotted | Profile
Survey of New York Ave. | Date | Date | No.
Survey by Daugherty Notes Same | Notes Chkd. C.J.G. Checked | X-Sec.
Indexed C. Johnson Date | Date 8-17-53 Date | No.

STATION	B. S.	H. I.	F. S.	ELEV.		
Profile & Cross Sec. New York Ave from a Point 1342'± West P.I.#7 East To B.C. P.I.#7						
B.M.#1				823 83	B.M.#1 See Pg. 86	
	4 16	830 31				
T.P.			9 03	821 28		
	2 95	82 423				
T.P.			2 92	821 31		
	11 49	83 2 80				
T.P.			0 24	83 2 56		
	10 43	84 299				
52+00			2 79	840 20	℄	
53+00			5 90	837 09	℄	
"			6 41	836 55	Rt. 16' Edge Pav.	
"			56	837 4	Rt. 73'	
"			59	837 1	Rt. 45'	
"			6 22	836 77	Lt. 14' Edge Pav.	
"			4 5	838 5	Lt. 22'	
53+00			3 0	840 0	Lt. 50'	
54+00			9 79	833 20	℄	
"			10 14	832 85	Rt. 11' Edge Rd	

76L298 307 10-51

PLEASE RETURN TO

LOS ANGELES COUNTY SURVEYOR

726 LOS ANGELES COUNTY
ENGINEERING BLDG.

NOTE: ANY ADDITIONS OR CHANGES ON THIS SHEET MUST BE MADE OR CIRCLED IN RED INK, WITH DATE AND NAME OF PERSON MAKING CHANGE.

Do not extend notes this side of this line.

Profile No.____ Notes Red____ Plotted____ Job No. 7757 Division No.____ F.B. 1238 Pg. 107

X-Sec. No.____ Date____ Date____ Survey of New York Ave

Notes Chkd C.J.G. Checked____ Survey by JND Notes JND Date 8-13-53

Date 8-17-53 Date____ Map No.____ Checked Johnson Date____

STATION	B. S.	H. I.	F. S.	ELEV.		
		842.99				
54+00			92	833.8	Rt 22'	
"			120	31.0	Rt 41'	
"			91	33.9	Lt 14' Edge Pav.	
54+00			80	35.0	Lt 50'	
T.P.			1045	822.54		
	047	833.01				
55+00			436	828.65	℄	
			459	28.42	Rt 15' Edge Pav.	
			35	29.5	Rt 21'	
			41	28.9	Rt 33'	
"			64	26.6	Rt 41'	
"			437	28.64	Lt 14' Edge Pav.	
55+00			46	28.4	Lt 50'	
56+00			859	24.42	℄	
			874	24.27	Rt 15' Rt. Edge Pav.	
"			70	26.0	Rt 22'	
"			72	25.8	Rt 34'	
"			107	22.3	Rt 41'	
"			884	24.17	Lt 14'	
"			82	24.8	Lt 21'	
56+00			50	8280	Lt 25'	

76L298 307 10-51

PLEASE RETURN TO
LOS ANGELES COUNTY SURVEYOR
726 LOS ANGELES COUNTY
ENGINEERING BLDG.

NOTE: ANY ADDITIONS OR CHANGES ON THIS SHEET MUST BE MADE OR CIRCLED IN RED INK, WITH DATE AND NAME OF PERSON MAKING CHANGE.

Do not extend notes this side of this line.

F.B. 1228 Pg. 108 Job No. 7757 Division No. Profile No. X-Sec. No.
Survey of New York Ave
Survey by Daugherty Notes Same Notes Chkd. C.J.G. Checked
Indexed C. Johnson Date Date 8-17-53 Date Plotted Date Notes Red. Date

STATION	B. S.	H. I.	F. S.	ELEV.	Lt.	&	Rt.
		833.01					
56+00			31	829.9	Lt. 50'		
T.P.			1170	831			
	221	823.52					
57+00			255	820.97	827.47 ✓ +6.5 = 50	823.97 ✓ +3.0 = 25	
"			282	2067	Rt. 14' Edge Pav.		
"			04	231	Rt. 22'		
"			09	226	Rt. 33'	817.8 ✓ − 3.2 = 40	
"			274	2078	Lt. 145 Edge Pav.		
57+00			19	216	Lt. 21'		
58+00			4??	19.10	?		
"			476	19.76	Rt. ? Edge ?		
"			55	180	Rt. 31'		
"			450	1902	Lt. 14' Edge ?		
"			36	199	Lt. 21'		
58+00			23	203	Lt. 45'		
59+00			468	1884	?		
"			506	1844	Rt. 14' Edge Pav.		
"			42	193	Rt. 22'		
"			59	176	Rt. 29'		
"			62	173	Rt. 39'		
59+00			478	81874	Lt. 14' Edge Pav.		

76L298 307 10-51

PLEASE RETURN TO
LOS ANGELES COUNTY SURVEYOR
726 LOS ANGELES COUNTY
ENGINEERING BLDG.

NOTE: ANY ADDITIONS OR CHANGES ON THIS SHEET MUST BE MADE OR CIRCLED IN RED INK, WITH DATE AND NAME OF PERSON MAKING CHANGE.

Do not extend notes this side of this line.

Profile No. ____ Notes Red ____ Plotted ____ Job No. 7250 Division No. 4
X-Sec. No. ____ Date ____ Date ____ Survey of New York Ave
Notes Chkd C.J.G. Checked ____ Survey by JND Notes JND Date 8-3-53
Date 8-17-53 Date ____ Map No. ____ Traced Johnson Date ____

F.B. 1238 Pg. 109

STATION	B. S.	H. I.	F. S.	ELEV.	Lt.	℄	Rt.
		823 52					
59+00			45	8190	Lt. 30' Toe Slope		
59+00			08	22.7	Lt. 43'	826.7 ✓	824.5 ✓
						+6.7	+4.5
60+00			357	1995	℄	44	24
"			386	1966	Rt. 13.5 Edge Pav.		
"			30	205	Rt. 20'		
"			59	176	Rt. 28'		
60+00			62	173	Rt. 39'		
60+00			368	1984	Lt. 15' Edge Pav.		
TP.			346	8200			
	8 64	828 70					
61+00			683	82187	℄		
"			720	2150	Rt. 14' Edge Pav.		
"			75	212	Rt. 23'		
"			109	178	Rt. 29'		
"			106	181	Rt. 40'		
			692	2178	Lt. 13' Edge Pav.		
			39	248	Lt. 21'		
			28	259	Lt. 30'		
			05	28.2	Lt. 35'		
61+00			27	26.0	Lt. 42'		
62+00			492	82378	℄		

76L298 307 10-51

PLEASE RETURN TO
LOS ANGELES COUNTY SURVEYOR
726 LOS ANGELES COUNTY
ENGINEERING BLDG.

NOTE: ANY ADDITIONS OR CHANGES ON THIS SHEET MUST BE MADE OR CIRCLED IN RED INK, WITH DATE AND NAME OF PERSON MAKING CHANGE.

Do not extend notes this side of this line.

F.B. 1238 Pg. 110 Job No. 7757 Division No. Profile
Survey of New York Ave
Survey by Dougherty Notes Same Notes Red. Plotted No. X-Sec.
Indexed C. Johnson Date Date Notes Chkd. C.J.G. Checked Date 8-17-53 Date No.

STATION	B. S.	H. I.	F. S.	ELEV.	Lt.	℄	Rt.
62+00		828 70	547	823 23	Rt. 10' Edge Pav.		
"			54	23 3	Rt. 21'		
"			84	20 3	Rt. 28'		
"			80	20 7	Rt. 41'		
"			301	2369	Lt. 15' Edge Pav.		
"			33	254	Lt. 33'		
62+00			08	279	Lt. 54'		
63+00			276	294			
"			323	2547	Rt. 14' Edge Pav.		
"			26	261	Rt. 26'		
"			23	254	Rt. 23'		
"			38	249	Rt. 40'		
63+00			29	259	Lt. 16' Edge Pav.		
T.P.			337	825 33			
	658	831 91					
B.M. #1			607	825 84	B.M. #1 Elev. 825.83		

831.4 −820.74 828.9
F6.5 +48 +3.9
50 41 23

76298 S & E #307—7-55

PLEASE RETURN TO

LOS ANGELES COUNTY ENGINEER

700 Los Angeles County Engineering Bldg.

NOTE: ANY ADDITIONS OR CHANGES ON THIS SHEET MUST BE MADE OR CIRCLED IN RED INK, WITH DATE AND NAME OF PERSON MAKING CHANGE.

Do not extend notes this side of this line.

STATION	B. S.	H. I.	F. S.	ELEV.		

Profile Notes Red. Plotted Job No. Division No. F. B. Pg.

No. Date Survey of

X-Sec. Notes Chkd. Checked Survey by Notes Date

No. Date Map No. Indexed Date

F. B. Pg. | Job No. Division No. Notes Red. Plotted Profile

Survey of Date Date No.

Survey by Notes Notes Chkd. Checked X-Sec.

Indexed Date Date Date No.

STATION	B. S.	H. I.	F. S.	ELEV.

76298 S & E #307—7-55

PLEASE RETURN TO

LOS ANGELES COUNTY ENGINEER

700 Los Angeles County Engineering Bldg.

NOTE: ANY ADDITIONS OR CHANGES ON THIS SHEET MUST BE MADE OR CIRCLED IN RED INK, WITH DATE AND NAME OF PERSON MAKING CHANGE.

Do not extend notes this side of this line.

Notes Ck'd by DCW	Survey of DALTON Canyon Road F.B. 1238 Pg. 15
Map No. B-1971	W. O. 8440 Tape No. 081 St'd 68 °F
Office Work Corr.	Surveyed by Porter
Checked Screw	Notes Porter Date 10-1-46
Date Mar. 1947	Indexed 10-21-46

DALTON CANYON ROAD

From Glendora Mt Rd Easterly to Forest Boundary

Sec 21 T.1.N. R.9.W.

J.N. 8440

Ref.-

C.S.B. # 8829

" " 745-2

Ed dept Survey Map # T-14-1

" " " " # T-48-1

Oct. 1946

Porter

Holmes

O.T.

Ochsner

Hand

PROP. R/W = 40'

Note: Any Additions or Changes on This Sheet Must be Made or Circled in Red Ink With Date and Name of Person Making Change.

Do not extend notes this side of this line.

RETURN TO
LOS ANGELES COUNTY SURVEYOR
700 HALL OF RECORDS

FORM 247 SM. 11-41

Sec 21 T.1.N. R.9W.

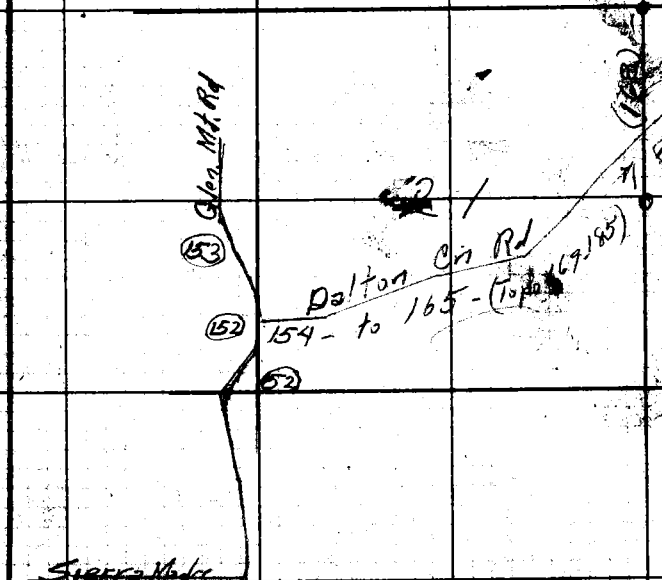

Surface Mods Acc

C.S.B-1971
H.C. 19-85

F.B. 1238 PG. 152

Cor. of Pg 153

BC Not Found

Δ = 30°37'30" ✓
R = 500
T = 136.90
L = 267.25

Fd 2" I.P. plug & tk
Set By A.B. DeMott
Glendora Calif.
His F.B. 3-33

To 1/4 Cor

P.I. #3
Fd 2x2
Top Broken off
Set 3½" I.P.
dh. 20"

DALTON

CANYON Rd

Fd wire Stk
Washer & tin
Z-354-2
Z-368-23

Fd decayed 2x2 Nail

BC

U.S. FOREST Service

Ranger Station

B.C. Fd Roof Nail Set

GLENDORA MT.

Fd C.S.M.
Z-354-2

100' Tape S 7°68°
1145.31 @ 0°0'64"
1145.28

Δ = 36°12'20" ✓
R = 392.02
T = 128.15 ✓
L = 247.72

(I) = 143°47'50"
(M) = 215°10'00"
143°47'40"

P.I. #2
Fd C.S. MON
dh 24"
F.B. 470-42-99
F.B. 112-116

300' Tape S 8°84°
296.87 @ 1°33'51" = 296.72
296.90 @ 1°43'64" = 296.73
53.50 @ 0°0'69" = 53.49
350.22

255.57 @ 0°0'60"
255.56

Found
C.S. Mon dh
18" 4 Nail
Tan ties

Fd 2" x 2"
Flush
F.B. 112-4-116
F.B. 470-98

Replaced
With 2" I.P. & B.C.
Marked as Shown

Sec. Cor
Fd ¾" Iron
Pin out
L.S. 2-8-4
F.B. 470-42-110

T. 1 N.
20 21
E. 29 28
Sec Cor

W.S. 4 & 3-1

RETURN TO
LOS ANGELES COUNTY SURVEYOR
700 HALL OF RECORDS

Do not extend notes this side of this line.

Note: Any Additions or Changes on This Sheet Must be Made or Circled in Red Ink With Date and Name of Person Making Change.

Notes Ck'd by Drew
Map No. B-1971
Office Work Cox
Checked Drew
Date Mar 1947

Survey of Dalton Canyon Road
W. O. 8442 Tape No. 08 Std. 68 °F
Surveyed by Foster
Notes Ford Date 10-1-46
Indexed A. C. Johnson

F.B. 1238 Pg. 15

W.S. 48B-1

Tics Pl #3 & #4

Fd Nail PP

123.01

Pl #4 Not Pt Set 2"x2" Flush on Rec Angle Sta 1st

4709

Fd CS W 12" oak

71.37

Fd Nail PP
& 408527E

305.98@0°T68°

305.98 M.T. Road

To 11" Coc

Fd 2" IP Flush

Fd CS W 20" oak

Fd Nail PP

(1) = 149° 22' 00"
(4) = 237° 30' 00"
149° 22' 00"

90°79'

52.95

38.82

Pl #3 Fd 2"x2" Top Broken off Set 3/4" IP dist 20"

136.90

(30) (30)

Bc 1"x

To Pl #2

Note: Any Additions or Changes on This Sheet Must be Made or Circled in Red Ink With Date and Name of Person Making Change.

Do not extend notes this side of this line.

RETURN TO
LOS ANGELES COUNTY SURVEYOR
700 HALL OF RECORDS

FORM 247 SM 11-41

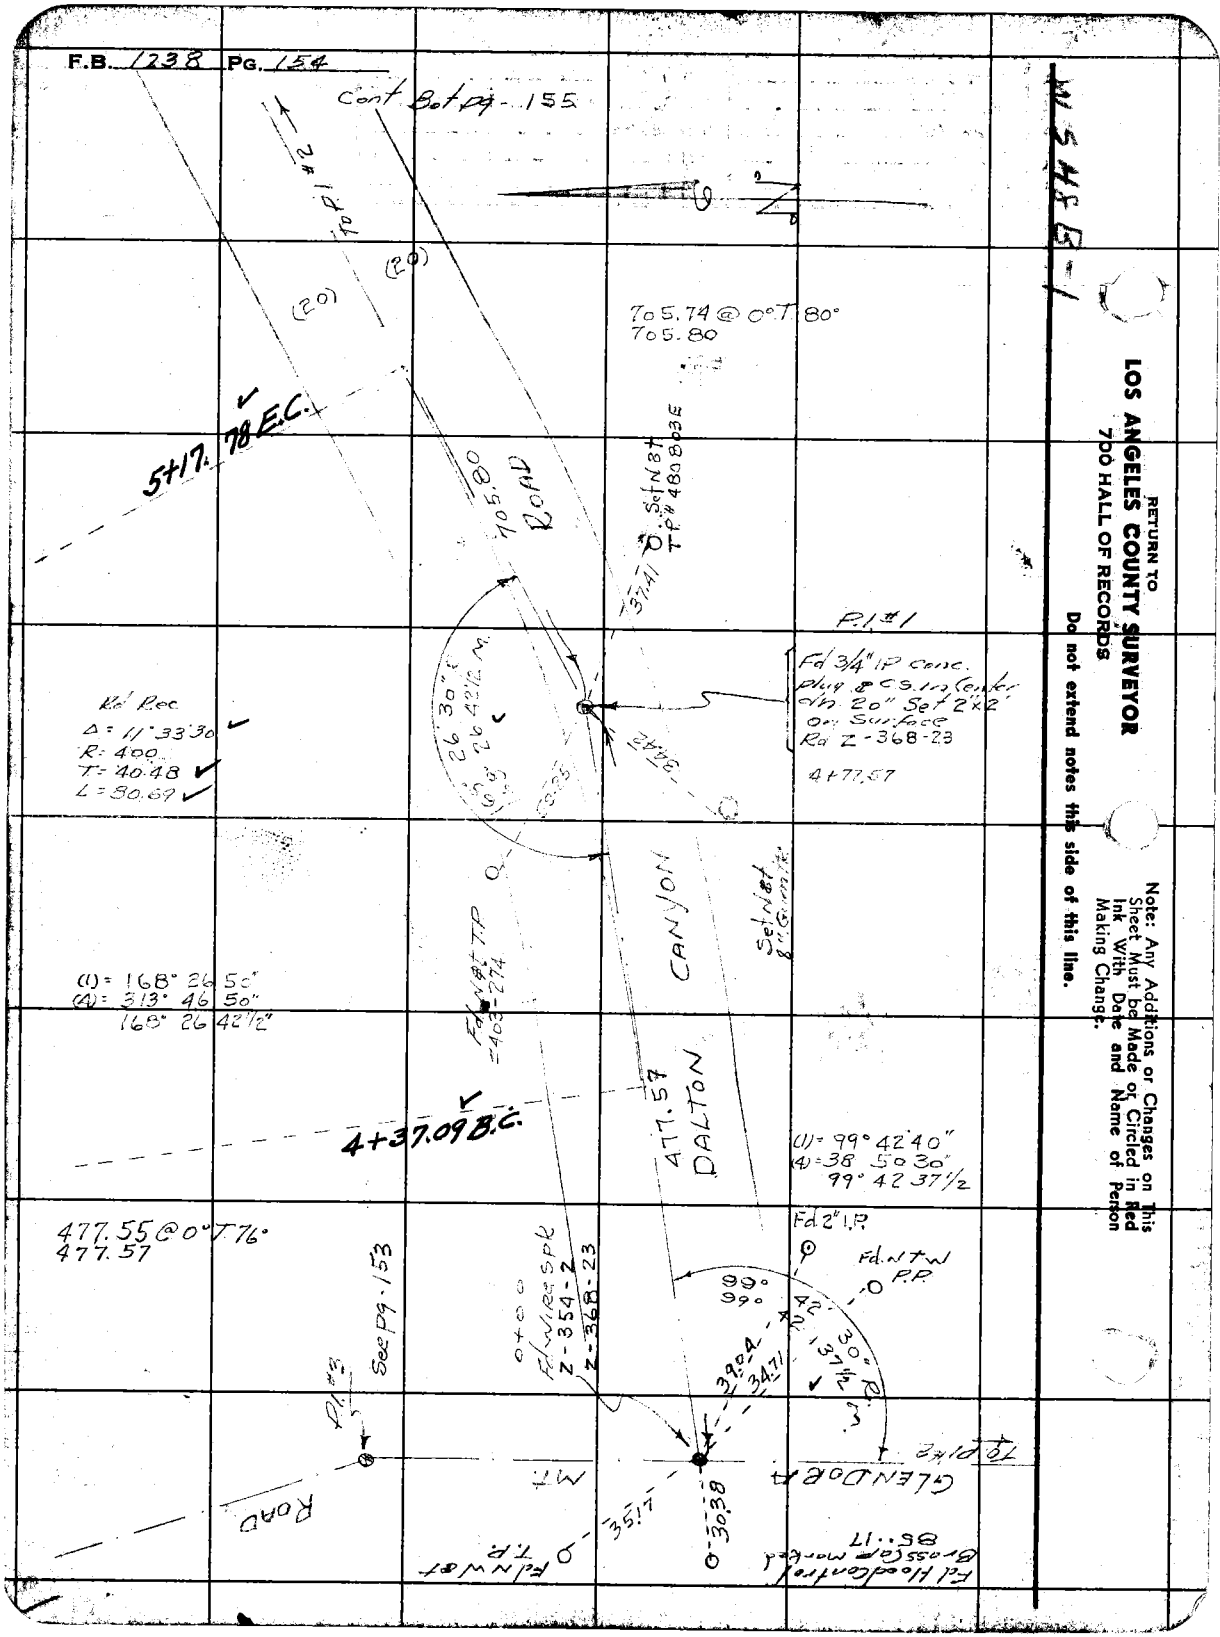
F.B. 1238 Pg. 154
Cont Bot pg. 155
To P.I. #2
(20)
(20)
To 5.74 @ 0°T 80°
To 5.80
5+17.78 E.C.
105.80
Road
3.71' S. of N & TP #48 & 63E
P.I. #1
Fd 3/4" IP conc. plug & CS in Center in 20" Set 2"x2" on Surface Rd Z-368-23
4+77.57
Rad Rec
Δ = 11°33'30"
R = 400
T = 40.48
L = 80.69
(1) = 168° 26' 5"
(4) = 313° 46' 50"
168° 26' 42½"
Fd Nail TP
Z-403-274
CANYON
Set Nail & Tag in C.
477.59
DALTON
4+37.09 B.C.
(1) = 99° 42' 40"
(4) = 38° 50' 30"
99° 42' 37½"
477.55 @ 0°T 76°
477.57
See Pg. 153
Fd 2" I.P.
Fd. N T W P.P.
Fd Wire Spk Z-354-2 Z-368-23
99°
99°
N 42° 37½" E
39.04
34.71
P.I. #2
ROAD
MT
GLENDORA
To pipe
35.17
0.30.38
Fd Nail & Tag Z-403-274
Fd Nail & Tag Brass Cap Marked 85°17'
RETURN TO
LOS ANGELES COUNTY SURVEYOR
700 HALL OF RECORDS
Do not extend notes this side of this line.
Note: Any Additions or Changes on This Sheet Must be Made or Circled in Red Ink With Date and Name of Person Making Change.

Notes Ck'd by Drew
Map No. B-1971
Office Work Cox
Checked Drew
Date Mar. 1947

Survey of Dalton Cyn Rd
W. O. 8440 Tape No. 087 St'd. 66°F
Surveyed by Porter
Notes Porter Date 10-7-46
Indexed A. C. Johnson

F.B. 1238 Pg. 155
cont Bot Pg 156

WLS 48B-1

(20) (20)

276.94 @ 0°T 82°
276.97

12+60.82 E.C.

Δ = 17°57'46" ✓
R = 500 ✓
T = 79.02 ✓
L = 156.74 ✓

ROAD
276.97

Fd C.S. w/ BC
10' S/C 1/2

curb & conc. Step Portecho Bldg

15" Rec Conc

N 0° 22' E
53.15

170.73

P.I. #2
Fd 3/4" I.P. Conc Plug & C.S. in Center dn 20"
Bd - Z 368-24
Set 2½ on Curb

11+83.37

(1) = 162° 02' 20"
(4) = 288° 09' 20"
162° 02' 20"

S 27° 57' 14" E

11+04.08 BC

Canyon

45.81

Fd X in Top of Conc. Wall dn 0.4'

Dalton

705.80

(20) P.I. #1 (20)

Cont from for. Pg 154

81-307

Note: Any Additions or Changes on This Sheet Must Be Made or Circled in Red Ink With Date and Name of Person Making Change.

Do not extend notes this side of this line.

RETURN TO
LOS ANGELES COUNTY SURVEYOR
700 HALL OF RECORDS

FORM 247 BM 11-41

F.B. 1238 PG. 156

Cont. To Pg 157

(20) (20) 16+24.09 E.C.

Set N&T 12" Syc. Tr

Rec
Δ = 25°04'05"
R = 200
T = 44.46
L = 87.56

89.10 Rad

211.89

180.0'

71.04

P.I. #4
Fd 1½" I.P. Conc
Dug 8" C.S. in
Center dip 15"
Rd. R-368-24
Set Tack in Conc
15+82.07

211.89 @ C° T 65°

(1) = 154° 56' 00"
(4) = 259° 43' 40"
154° 55' 55"

Set N&T 14" oak

Set N&T PP
480808E

15+36.59 B.C.

122.72 @ 0° T 80°
122.73

122.73

KCN

14+97.55 E.C.

Set N&T PP
480809E

P.I. #3
Fd 1½" I.P. on Line
Rd. R-368-24
Set Tack in Conc Surface

Fd c & w 24" oak

Rd Rec
Δ = 14° 53 55"
R = 300
T = 39.23
L = 78.01

14+60.34

57.93

1680

Set N&T 10" oak

(1) 165° 06' 10"
(4) 300° 24' 50"
165° 06' 05"

14+19.54 B.C.

276.97

DALTON

(20) (20)

Cont. from Top Pg 155

RETURN TO
LOS ANGELES COUNTY SURVEYOR
700 HALL OF RECORDS

Do not extend notes this side of this line.

Note: Any Additions or Changes on This Sheet Must be Made or Circled in Red Ink With Date and Name of Person Making Change.

W.S. 4F R.

Notes Ck'd by DRC
Map No. B-1971
Office Work CAD
Checked Dunn
Date McPherson

Survey of Dalton Canyon Road
W. O. 8440 Tape No. 081 St'd 68°F
Surveyed by Perici
Notes Perici Date 10-8-46
Indexed A. C. Johnson

F.B. 1238 PG. 157
Cont. Bef Pg - 158

U.S. 4F8-1

21+63.32 E.C.

Δ = 19°08'55" ✓
R = 500
T = 84.32 ✓
L = 167.00 ✓

ROAD

437.98 P.I. ✓

Set Nail PP
0.48 0 BLE

437.97 @ 0°7'76"
437.98

160°51'15" Rt
160°51'02½" M ✓

P1#6
Fd 1/2" IP dn 1/6"
Rad 7-368.25
Set 1x2 on Surface

32.42' O

2+84.99.

Set Nail 10" Syc. Tr

19+96.22 B.C. ✓

(1) = 160°51'00"
(4) = 283°24'10"
160°51'02½

290.036 @ 0°7'76"

CANYON

290.03

18+41.74 E.C. ✓

P1#5
Fd 3/4 in 1½"
P1#6 dis. from
Rad 7-368-24
Set 2x2 on Surf.

17+94.96

Δ = 19°22'20" ✓
R = 300
T = 51.21 ✓
L = 101.43 ✓

75.64'

160°37'40" M
160°37'45"

Set Nail PP
4.50 0.9E

(1) = 160°37'40"
(4) = 282°36'40"
160°37'40

DALTON

Set Nail Cut Cross

to P1 54 211.83

17+40.31 B.C. ✓

Cont from Top Pg 156

Note: Any Additions or Changes on This Sheet Must be Made or Circled in Red Ink With Date and Name of Person Making Change.

Do not extend notes this side of this line.

RETURN TO
LOS ANGELES COUNTY SURVEYOR
700 HALL OF RECORDS

FORM 247 SM 11-41

F.B. 1238 Pg. 158

Cont Bof pg 159

(20) (20)

363.53 @ 00° 17' 16" = 363.55

28+51.19 E.C.

Set N&T TP #30

Δ = 4° 23' 40"
R = 1000
T = 38.37
L = 76.70

Fd 2" IP plug & tack in 12" Set 1/2 on Surface Z-368-25

28+18.82

Set N&T Brass

(1) = 175° 36' 20"
(4) = 342° 25' 10"
175° 36' 17"

27+74.49 B.C.

295.89 @ 00° 17' 16"
295.91

DAYTON CANYON ROAD

25+30.37 E.C.

Δ = 1° 32' 15"
R = 1000
T = 13.42
L = 26.83

Fd 3/4" IP Wood plug & tack in Center Very Loose dn 13" Reset 1/2" on Surface Z-368-25

25+22.97

(1) = 1° 13' 27' 50"
(4) = 353° 51' 00"
178° 27' 45"

25+03.54 B.C.

(20) (20)

cont from top pg 157

LOS ANGELES COUNTY SURVEYOR
700 HALL OF RECORDS
RETURN TO

Do not extend notes this side of this line.

Note: Any Additions or Changes on This Sheet Must be Made or Circled in Red Ink With Date and Name of Person Making Change.

Notes Ck'd by Drew
Map No. B-1971
Office Work Cory
Checked McPherson
Date Mar. 1947

Survey of Dalton Canyon Rd
W. O. 8440 Tape No. 081 St'd. 68 °F
Surveyed by Porter
Notes Porter Date 10-8-46
Indexed C. Johnson

F.B. 1238 PG. 159

Cont Bot pg -160

W.S. 4V4-2

(20) (20)

Big Dalton Creek

ROAD

270.27 @ 0° T 72°
270.28

34+56.06 E.C.

Δ = 10°38'20"
R = 500
T = 46.55
L = 92.84

270.28

Set NET T.P. #35

19.19 S 69° 21' 40" E

22.00

Fd C.S.W. 12"S.V.C.

30.26

(1) = 169° 21' 40"+
(4) = 317° 56' 40"
169° 21' 40"

33+63.22 B.C.

Pl. #10
Fd 1½" I.P. conc.
Plug & C.S. in
Center dn 12"
Set 1½" on
Surface
Rd. T. 368-25

34+15.96

43.74

Set N&T T.P. #34

233.52 @ 0° T 76°
233.53

Dalton Canyon Rd

Set N&T T.P. #33

Pl. #9
Fd 2" I.P. Conc.
Plug & C.S. in
Center dn 11"
Set 1½" on Surface
T-368-25
31+82.43

Fd C.S.W.
24" OAK

32+33.05 E.C.

Δ = 6°30'10"
R = 1000
T = 56.81
L = 113.49

31+19.56 B.C.

(1) = 173° 29' 50"
(4) = 353° 59' 20"
173° 29' 50"

363.55

(20) (20)

To Pl. #8

Cont from top Pg 158

Note: Any Additions or Changes on This Sheet Must be Made or Circled in Red Ink With Date and Name of Person Making Change.

Do not extend notes this side of this line.

RETURN TO
LOS ANGELES COUNTY SURVEYOR
700 HALL OF RECORDS

FORM 247 SM 11-41

F.B. 1238 PG. 160

cont / B.t pg. 161

WS 1440-2

255.01 @ 0°7'68"

255.01 to P.I. #13

P.I. #12
Fd 1½" I.P. conc
plug & C.S. in
Cen for Stn 18"
Set 1x2" on Surf
Z-3-E-26
394+55.75

E.C. 3979.82 ✓

Δ = 9°48'50" ✓
R = 500
T = 42.78 ✓
L = 85.35 ✓

RETURN TO
LOS ANGELES COUNTY SURVEYOR
700 HALL OF RECORDS

Do not extend notes this side of this line.

Note: Any Additions or Changes on This Sheet Must be Made or Circled in Red Ink With Date and Name of Person Making Change.

269.51 @ 0°7'66"
269.51

Q = 170°13'10"
(4) = 347°46'50"
170°13'10"

DALTON CANYON ROAD

B.C. 3940.51 ✓

E.C. 3946.69 ✓

Fd 5/8" rd iron oak

36+86.24

DALTON
269.51

P.I. #11
Fd 1½" I.P.
conc. plug &
C.S. in Center
dr. 5" E-368-36
44.62
Set Nail & Tin #36

Δ = 3°05'00" ✓
R = 1060
T = 28.98 ✓
L = 57.08 ✓

176°55'00"
54.45

210.28

(1) = 176°55'00"
(4) = 347°46.00"
176°55'00"

(20) (20)

36+52.88 B.C. ✓

To P.I. #10

Cont from top pg 159

Notes Ck'd by: DRC	Survey of: Dalton Canyon Road	F.B. 1238	Pg. 161
Map No. 13-1771	W. O. 5440 Tape No. 081 St'd 68 °F		
Office Work: [illegible]	Surveyed by: Porter		
Checked: Dunn	Notes: Porter Date: 10-9-46		
Date: Mar. 1947	Indexed: A. O. Johnson		

WS 14-2

cont Bot Pg 162

46+76.85 E.C.

306.77 R.P.

Δ = 34°31'00"
R = 400
T = 124.27
L = 240.97

Set N&T 30" oak

45+75.96
R.I. #14
Fd 1½" I.P.
on line 0.9' S. of N.-S.
on 14" Z-368-27

37.93

145°28'40"
145°28'29"

Set N&T 18" Pine

306.76 @ 0°T.12°
306.77

44+35.88 B.C.

(1) = 145°28'40"
(2) = 221°59'40"
145°28'40"

Fd 4 S. & T. set 14" Sycamore

Road

365.20 @ 0°T.10°
365.20

365.20

43+05.01 E.C.

Set L&T in Red Rock

42+10.76
R.I. #13
Fd 1½" I.P.
on Side Hill
Z-368-26

56.93

50.71

Fd 6 S. & T. 16" oak Tr.

Δ = 40°18'40"
R = 300
T = 110.06
L = 210.98

(1) 139°42'20"
(2) 198°49'10"
139°42'17½"

59.0

Set N&T 24" oak

255.01

40+94.03 B.C.

(20) (20)

R.I.#15

Cont from top Pg 160

Note: Any Additions or Changes on This Sheet Must be Made or Circled in Red Ink With Date and Name of Person Making Change.

Do not extend notes this side of this line.

RETURN TO
LOS ANGELES COUNTY SURVEYOR
700 HALL OF RECORDS

FORM 247 BM 11-41

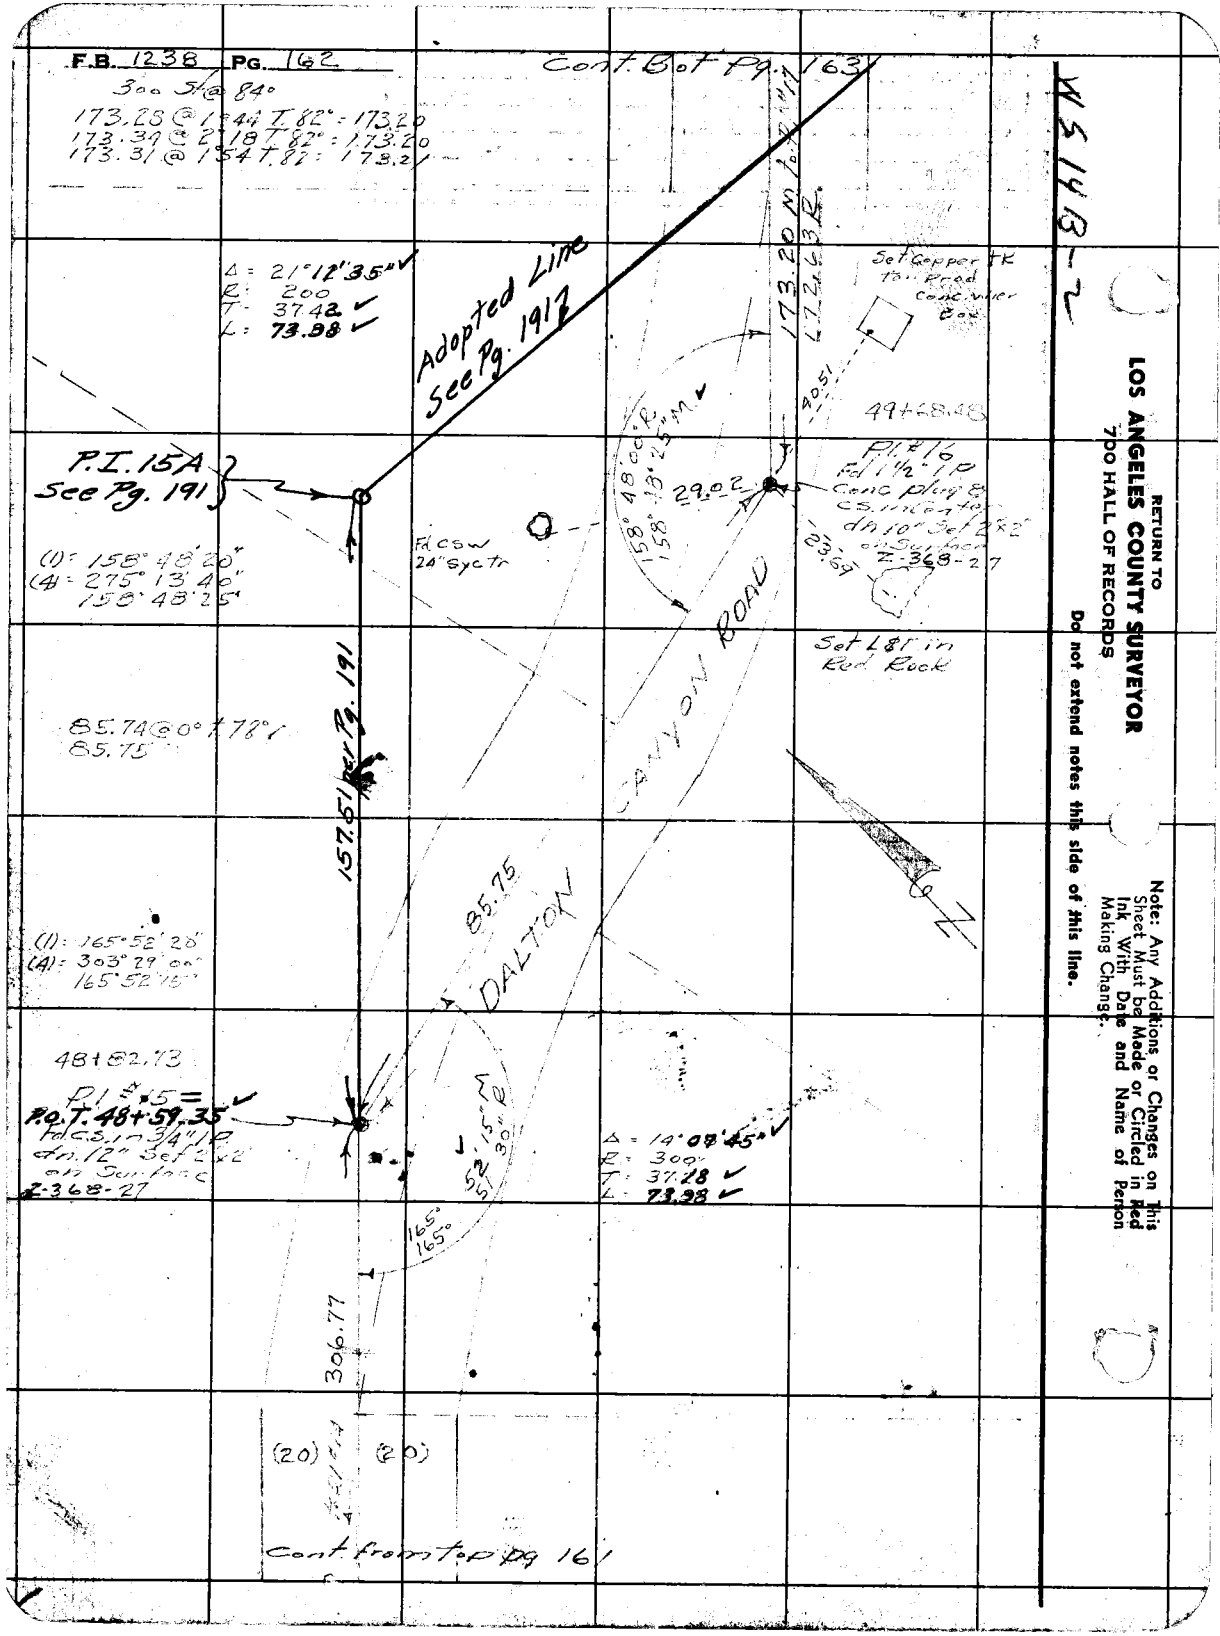
F.B. 1238 PG. 162
Cont. to of Pg. 163
300 St @ 84°
173.28 @ 1°44' T 82° = 173.20
173.39 @ 2°18' T 82° = 173.20
173.31 @ 1°54' T 82° = 173.20
Δ = 21°12'35"
R = 200
T = 37.42
L = 73.98
Adopted Line
See Pg. 191
173.20 M.
S 14 E
Set Copper Tk in Road
Conc. Water Box
40.5'
49+68.48
P.I. 15A
See Pg. 191
(1) = 158° 48' 20"
(4) = 275° 13' 40"
158° 48' 25"
Fd Cow
24" Syc Tr
158° 48' 20" P
158° 13' 40" M
29.02
Pt #16
Fd 1½" IP
Conc plug & CS in center
dn 10" Set 2x2"
on Survey
Z-368-27
23.69
CANYON ROAD
Set L&T in Red Rock
85.74 @ 0° 1' 78"
85.75
157.61 Per Pg. 191
85.75
DALTON
(1) = 165° 52' 20"
(4) = 303° 29' 00"
165° 52' 15"
48+82.73
P.I. 15
P.O.T. 48+59.35
Fd C.S. in 3/4" IP
dn 12" Set 2x2
on Survey
Z-368-27
52° 15' 40" E
30'
Δ = 14° 07' 45"
R = 300'
T = 37.28
L = 73.98
165°
165°
306.77
(20)
(20)
Cont. from top Pg 161
RETURN TO
LOS ANGELES COUNTY SURVEYOR
7DO HALL OF RECORDS
Do not extend notes this side of this line.
Note: Any Additions or Changes on This Sheet Must be Made or Circled in Red Ink With Date and Name of Person Making Change.

Notes Ck'd by Dr Cy
Map No. B-1971
Office Work Cpy
Checked Dunn
Date May 1947

Survey of Dalton Canyon Rd
W. O. 8444 Tape No. 081 St'd. 68 °F
Surveyed by Foster
Notes Foster Date 10-9-46
Indexed A. O. Johnson

F.B. 123 Pg. 165
Cont B of pg 164

MS 1418-2

Note: Any Additions or Changes on This Sheet Must be Made or Circled in Red Ink With Date and Name of Person Making Change.

Do not extend notes this side of this line.

RETURN to
LOS ANGELES COUNTY SURVEYOR
700 HALL OF RECORDS

FORM 247 BM 11-41

Δ = 58°21'65" ✓
R = 100
T = 55.83 ✓
L = 101.84 ✓

F.d. St. nail L'S Y.C.

385.37
P.T. 18A + Sec 3.192
30.00 per 3.192

To R.I.P. To

Fd St. nail L'S Y.C.

32.60

29.50

19.97

Fd nail & S Y.C.

(1) = 121°39'00"
(4) = 126°35'40"
121°38'55"

385.38 @ 0°7'66"
385.37

Fd. n. tw 12" oak

121.38
121.38
29.73

53+78.74
P.I. #18
Set 2"x2" by Yates Rd. Z-368-28

51+41.68
P.I. #17
Fd 1½" IP
Corr. Plug & Nail
on 6"
Z-368-27

237.06

DALTON CANYON ROAD

237.07 @ 0°7'62"
237.06

Adopted Line Sec 3.192

(1) = 122°14'50"
(4) = 122°59.00"
122°14'45"

122°13'45"R.

Δ = 57°45'15" ✓
R = 200
T = 110.30 ✓
L = 201.66 ✓

173.50

(20) (20)

To R.I.P. To

Cont. from top pg 162

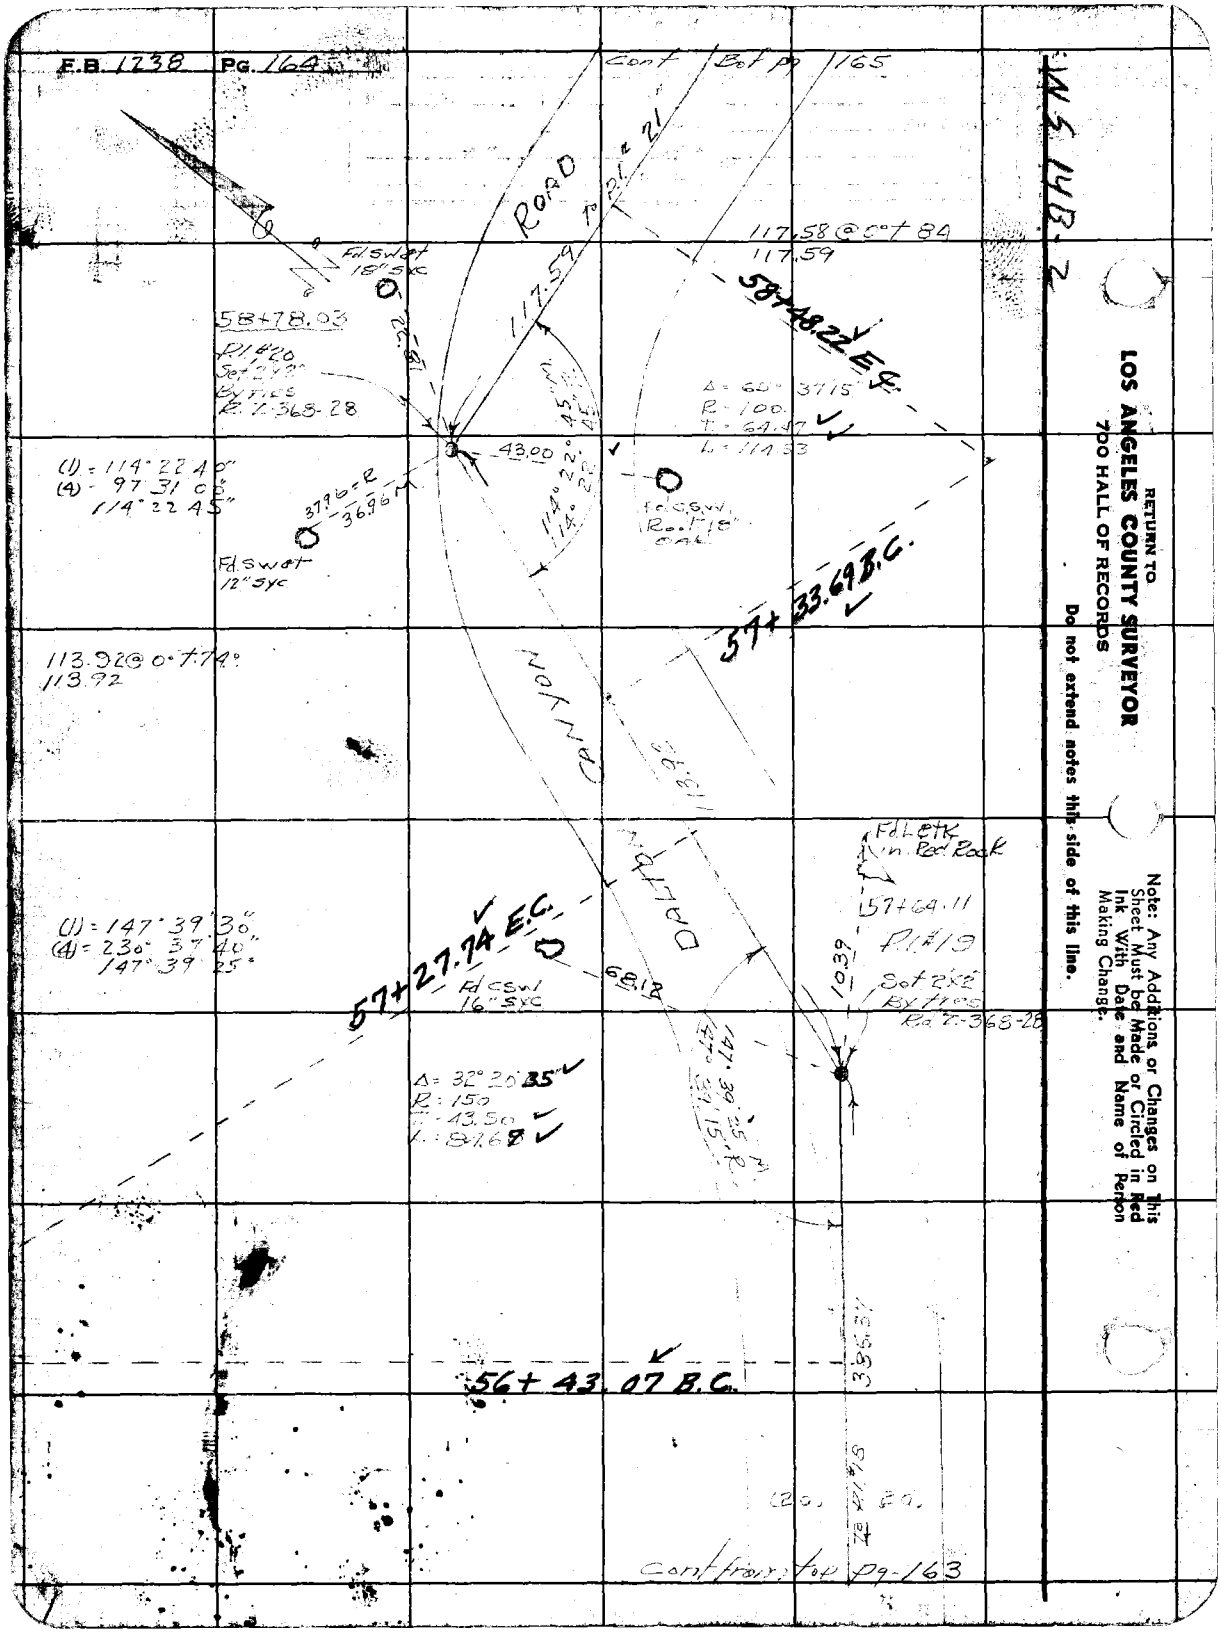

RETURN TO
LOS ANGELES COUNTY SURVEYOR
700 HALL OF RECORDS

Note: Any Additions or Changes on This Sheet Must be Made or Circled in Red Ink With Date and Name of Person Making Change.

Do not extend notes this side of this line.

W.S. 14 B-2

Notes Ck'd by DTC
Map No. B-1971
Office Work Cox
Checked Drew
Date Mar. 1947

Survey of Dalton Canyon Rd
W. O. 8140 Tape No. 081 St'd 68°F
Surveyed by Porter
Notes Porter. Date 10-11-46
Indexed A. O. Johnson

F.B. 1238 Pg. 165

Note: Any Additions or Changes on This Sheet Must be Made or Circled in Red Ink With Date and Name of Person Making Change.

Do not extend notes this side of this line.

RETURN TO
LOS ANGELES COUNTY SURVEYOR
700 HALL OF RECORDS

FORM 247 BM 11-41

Cont. Bal pg 166

157.17@0°T82°
157.18

60+98.89 E.C.

(1) = 163° 11' 40"
(2) = 292° 47' 00"
163° 11' 45"

157.18 P.I.

P.I. #2 61+49.96

Fd 3/4" Bolt dn 20" Rd 2.368.29

Δ = 16° 48' 15"
R = 300
T = 44.31
L = 87.99

11.45 R

N 89° 30' E

ROAD

60+10.90 B.C.

32.87 CANYON

32.87 @ 0° T 82°
121.46 @ 0° T 82°
121.47

Set Lot Conc Valve Box

Set ⊙ on side to Redrock
61+17.09

57.35 INT. Set C.S.W.L. & T.I.N.
P.O.S.T. See Page - 168

ANGELAS
To SEC Cor

Max 40.10

106.590

Set N&T Walnut Tr.

23.01

50.00

DEC 21

(1) = 106° 50' 00"
(2) = 67° 20' 00"
106° 50' 00

59+31.45 EC

Δ = 17° 23' 10"
R = 200
T = 30.58
L = 60.69

20.01

DALTON

121.47

Forest
To 1/4 Sec. Cor.

Bdy

Set N&T 10" Syc.

58+70.76 B.C.

E/S N&T 12" Syc.

36° 36' 50" R
162° 36' 50"

17.34

14.65

59+95.62

P.I. #21

Set 2"x2" by int of Rec. Ang. & Tres Z-3

(1) = 162° 36' 00"
(2) = 290° 27' 20"
162° 36' 50"

(20)

11.59 R 20

Cont. from top pg 164

F.B. 1238 PG. 166

Cont B.T. pg 167

215.29 @ 0° T. 82°
215.31

(1) = 166° 36' 00"
(4) = 306° 23' 50"
166° 35' 57 1/2

63+89.26 E.C.

Set L&T Red Rock

Δ = 13°24'00"
R = 500
T = 58.74
L = 116.94

62+72.32 B.C.

119.58 @ 0° 1' 82"
119.58

62+59.31 E.C.

Δ = 10°55'50"
R = 500
T = 47.84
L = 95.39

61+63.92 B.C.

(1) = 169° 04' 10"
(4) = 316° 16' 40"
169° 04' 10"

(20)

(20)

cont. from top pg 165

N 25° 14' E

225.14

N 14° 12' E

N 36° 00' E

244 L

Dalton Canyon Wash

Dalton Canyon

62+26.75
P.I. #24
3/4" Bolt
dn. 18" E-368-29

1427
Set Nail
14" oak

4625

Fd CSM
16" Syc

Fd CSM
Base 12" oak

22.0

1431
Set Nail
10" oak

63+07.14
P.I. #23
Rd 3/8" Bolt
dn. 12" E-368-29

45.07

Fd CSM
12" oak

157.18

N 45° 00' E

N 14° 12' E

RETURN TO
LOS ANGELES COUNTY SURVEYOR
700 HALL OF RECORDS

Do not extend notes this side of this line.

Note: Any Additions or Changes on This Sheet Must be Made or Circled in Red Ink With Date and Name of Person Making Change.

Notes Ck'd by Drew
Map No. B-1951
Office Work Log
Checked Drew
Date Mar 1947

W. O. 8441 Tape No. 081 St'd 68 °F
Surveyed by Porter
Notes Porter Date 10-19-46
Indexed A. O. Johnson

F.B. 1238 PG. 147

W.S.M.B. 2

Note: Any Additions or Changes on This Sheet Must be Made or Circled in Red Ink With Date and Name of Person Making Change.

Do not extend notes this side of this line.

RETURN TO
LOS ANGELES COUNTY SURVEYOR
700 HALL OF RECORDS

FORM 247 SM 11-41

BNL of Survey


65+45.83
P/ #25
Fd C.S. w/ dia 14"
R.Z. 363-29

Fd 4"x4" Conc. MON. Marked U.S. Forest Survey
T. 1 N. R. 9 W.
16 | 15
21 | 22
822'

31.29
25.66
23.26
24.66
47.98
7.14
S 87° 47' 30" E 47.98

Δ = 30° 15' 00"
R = 200
T = 59.06
L = 105.59

(1) = 30° 19' 40"
(2) = 120° 58' 10"
30° 14' 32 1/2

30° 14' 32"
7.03'

Fd 1 1/2" I.P. Flush. C.S. in Conc. center
R.Z. 368-29

U.S. Forest Service Gate.
Note This Gate moved to location shown on M.B. 191 1-15-47

215.31

(20) (20)

to 21+24

Cont. from Top Pg. 166

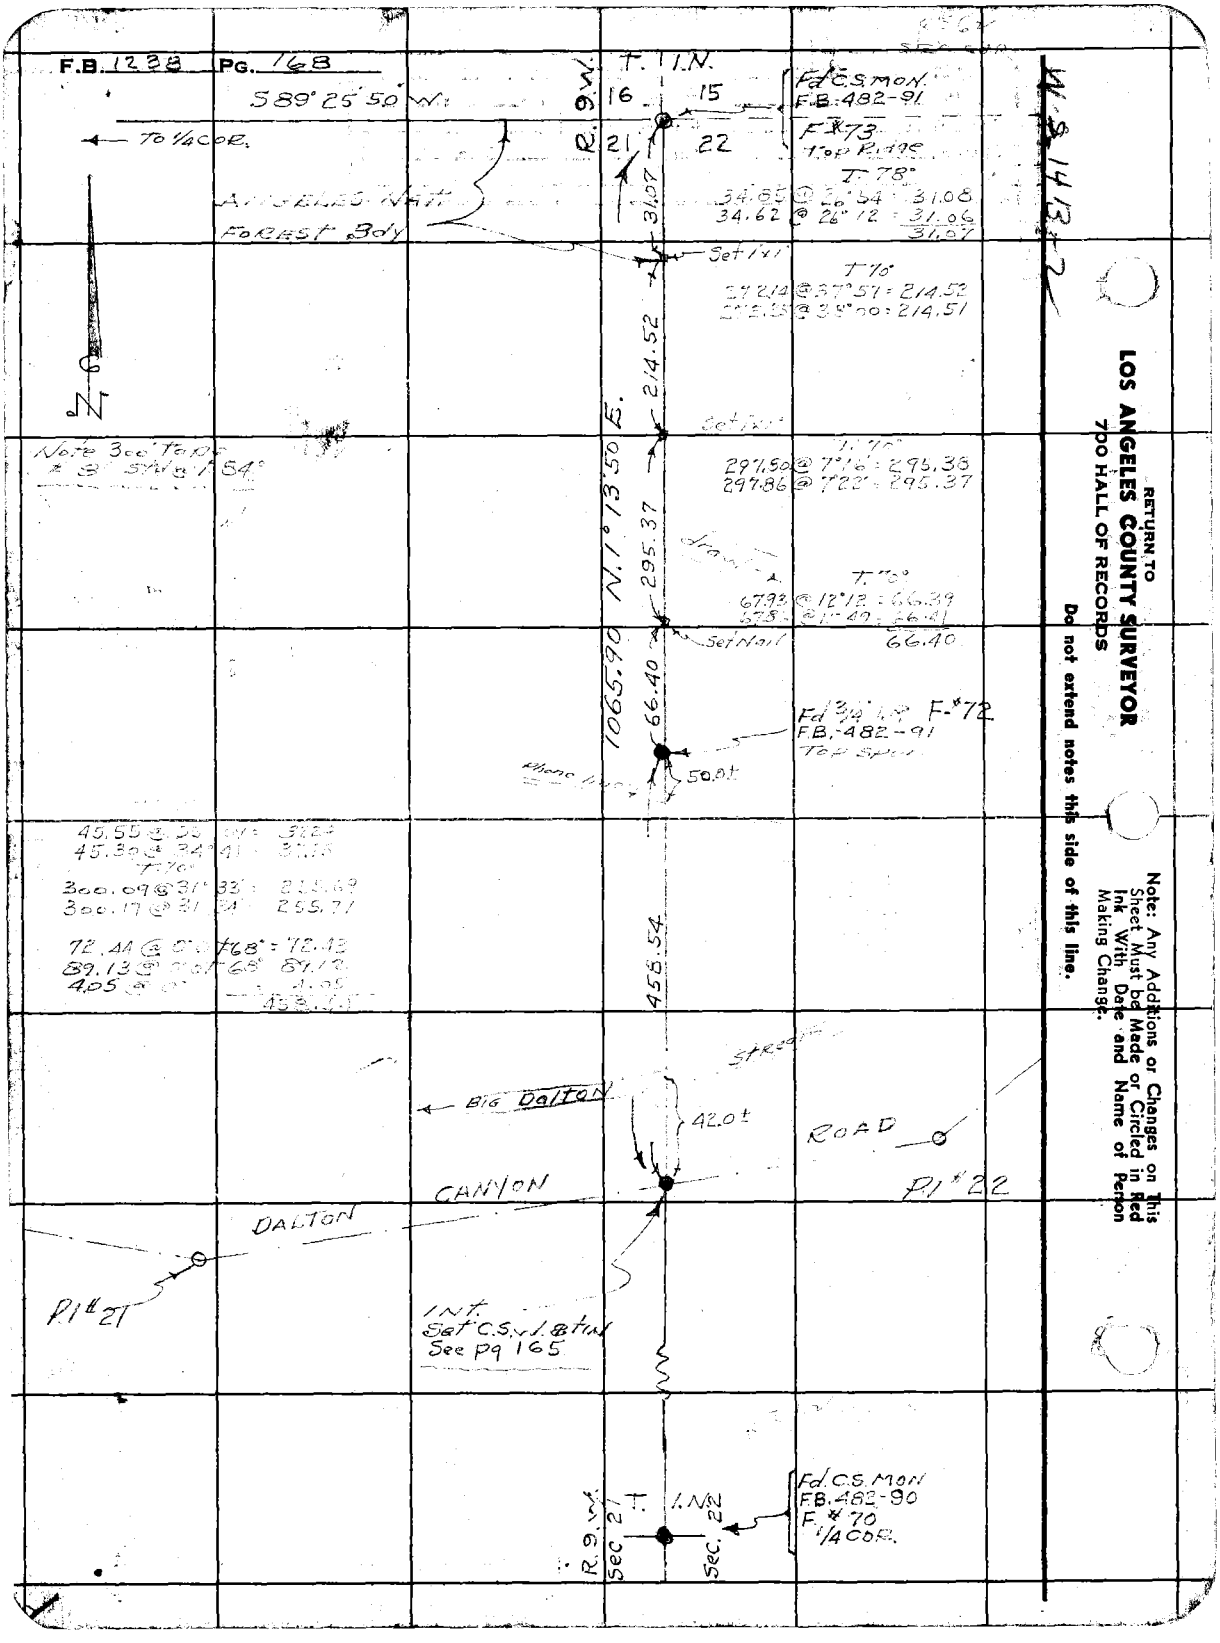
F.B. 1238 PG. 168
S 89° 25' 50" W.
To 1/4 COR.
T. 11 N.
R. 9 W.
16
15
21
22
Fd C.S. MON.
F.B. 482-91
F. # 73
Top Pipe
T 78°
34.85 @ 26° 54 = 31.08
34.62 @ 26° 12 = 31.06
31.07
LOS ANGELES NAT'L FOREST Bdy
Set 1x1
T 76°
214.52
N. 1° 13' 50" E.
295.37
T. 76°
297.50 @ 7° 16' = 296.38
297.86 @ 7° 22' = 296.37
T. 78°
67.93 @ 12° 12' = 66.39
66.40
Set Nail
1065.90
66.40
Fd 3/4" I.P. F. # 72
FB. 482-91
Top Spike
50.0±
458.54
BIG DALTON CANYON
42.0±
ROAD
PI # 22
DALTON
PI # 21
INT.
Set C.S. Mon
See pg 165
Fd C.S. MON
FB. 482-90
F. # 70
1/4 COR.
R. 9 W.
Sec. 21
Sec. 22
T. 11 N.
RETURN TO
LOS ANGELES COUNTY SURVEYOR
700 HALL OF RECORDS
Do not extend notes this side of this line.
Note: Any Additions or Changes on This Sheet Must be Made or Circled in Red Ink With Date and Name of Person Making Change.

Notes Ck'd by
Map No. B-1971
Office Work Copy
Checked Draw
Date Mar. 1947

Survey of Dalton Cyn Rd
W. O. 8446 Tape No. 281 St'd 68 °F
Surveyed by Porter
Notes Porter Date 10-19-46
Indexed A. O. Johnson 10-21-46

F.B. 1238 PG. 169

Topo - DALTON CANYON ROAD

0+00 Int. Glendora Mt Rd

to P.I. * 25 = 66+42.04

Porter
Holmes
Stock
Ochsner
Hand

Note: Any Additions or Changes on This Sheet Must be Made or Circled in Red Ink With Date and Name of Person Making Change.

Do not extend notes this side of this line.

RETURN TO
LOS ANGELES COUNTY SURVEYOR
700 HALL OF RECORDS

FORM 247 5M 11-41

F.B. 1238 Pg. 170

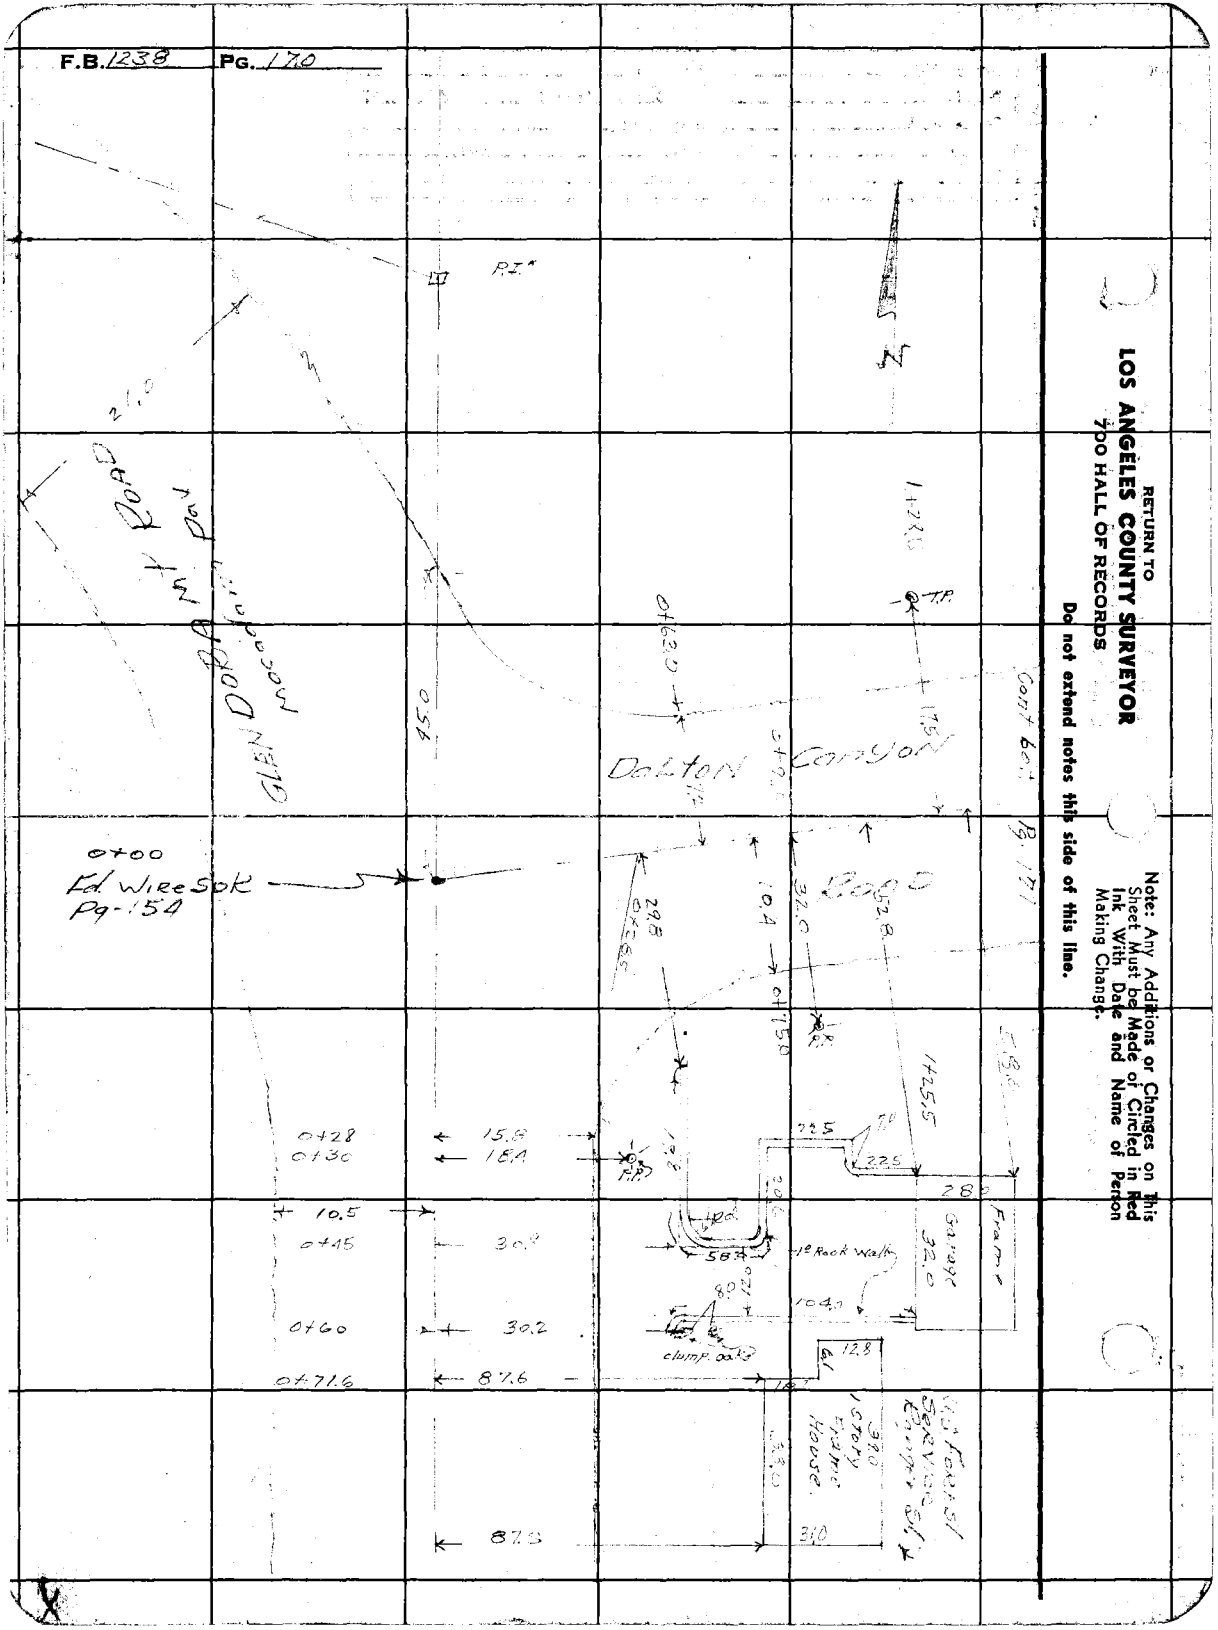

Notes Ck'd by
Map No. B-1971
Office Work Cox
Checked Dunn
Date May 1947

Indexed A. C. Johnson

F.B. 1238 Pg. 171

Note: Any Additions or Changes on This Sheet Must be Made or Circled in Red Ink With Date and Name of Person Making Change.

Do not extend notes this side of this line.

RETURN TO
LOS ANGELES COUNTY SURVEYOR
700 HALL OF RECORDS

FORM 247 BM 11-41

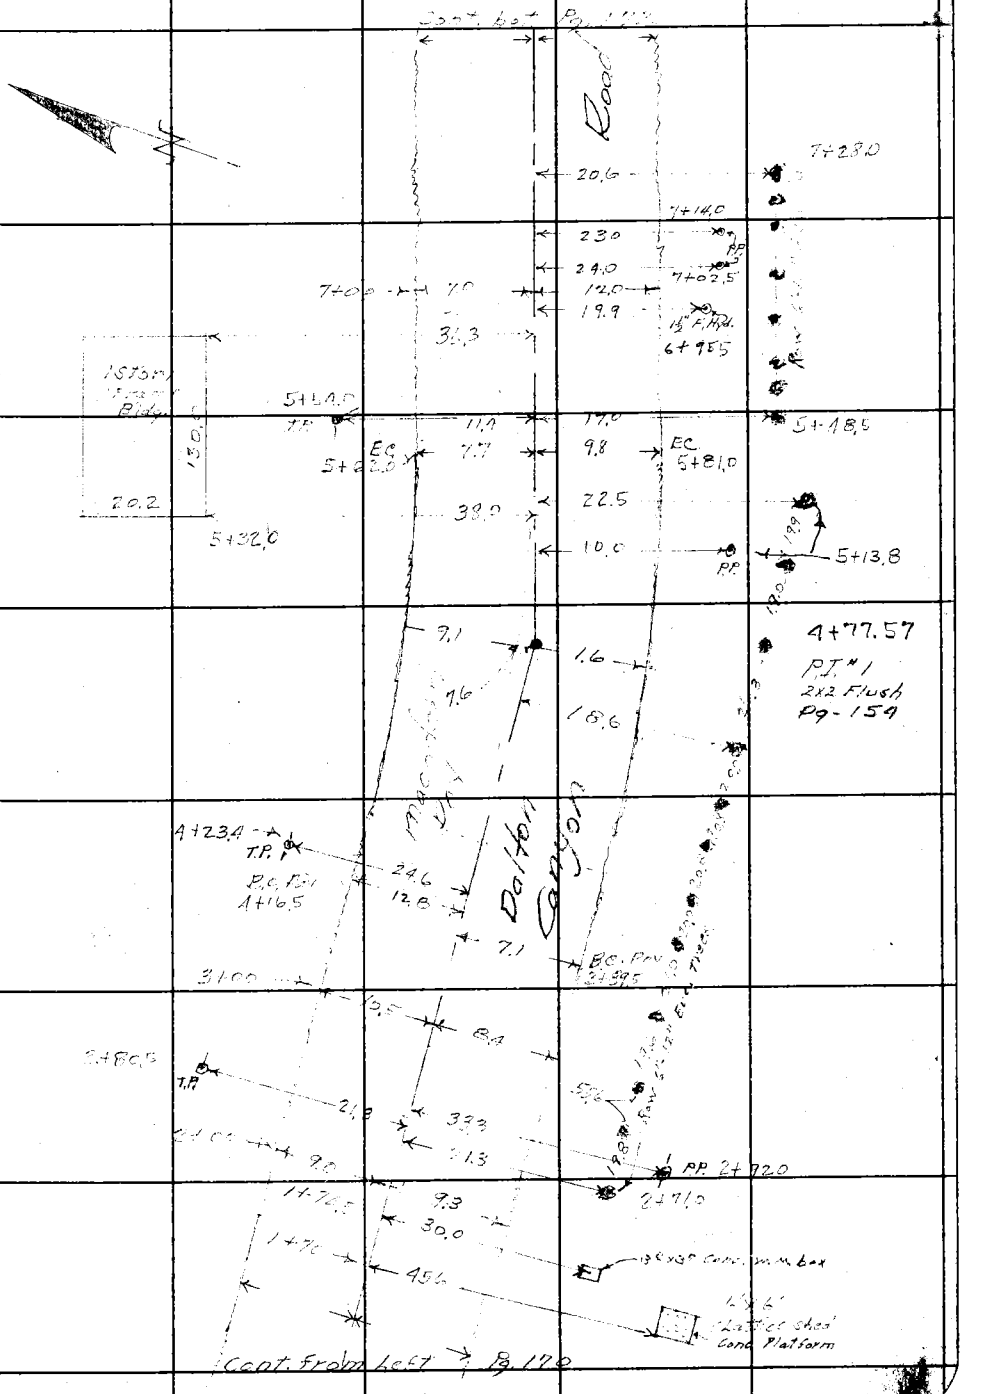

F.B. 1238 Pg. 172

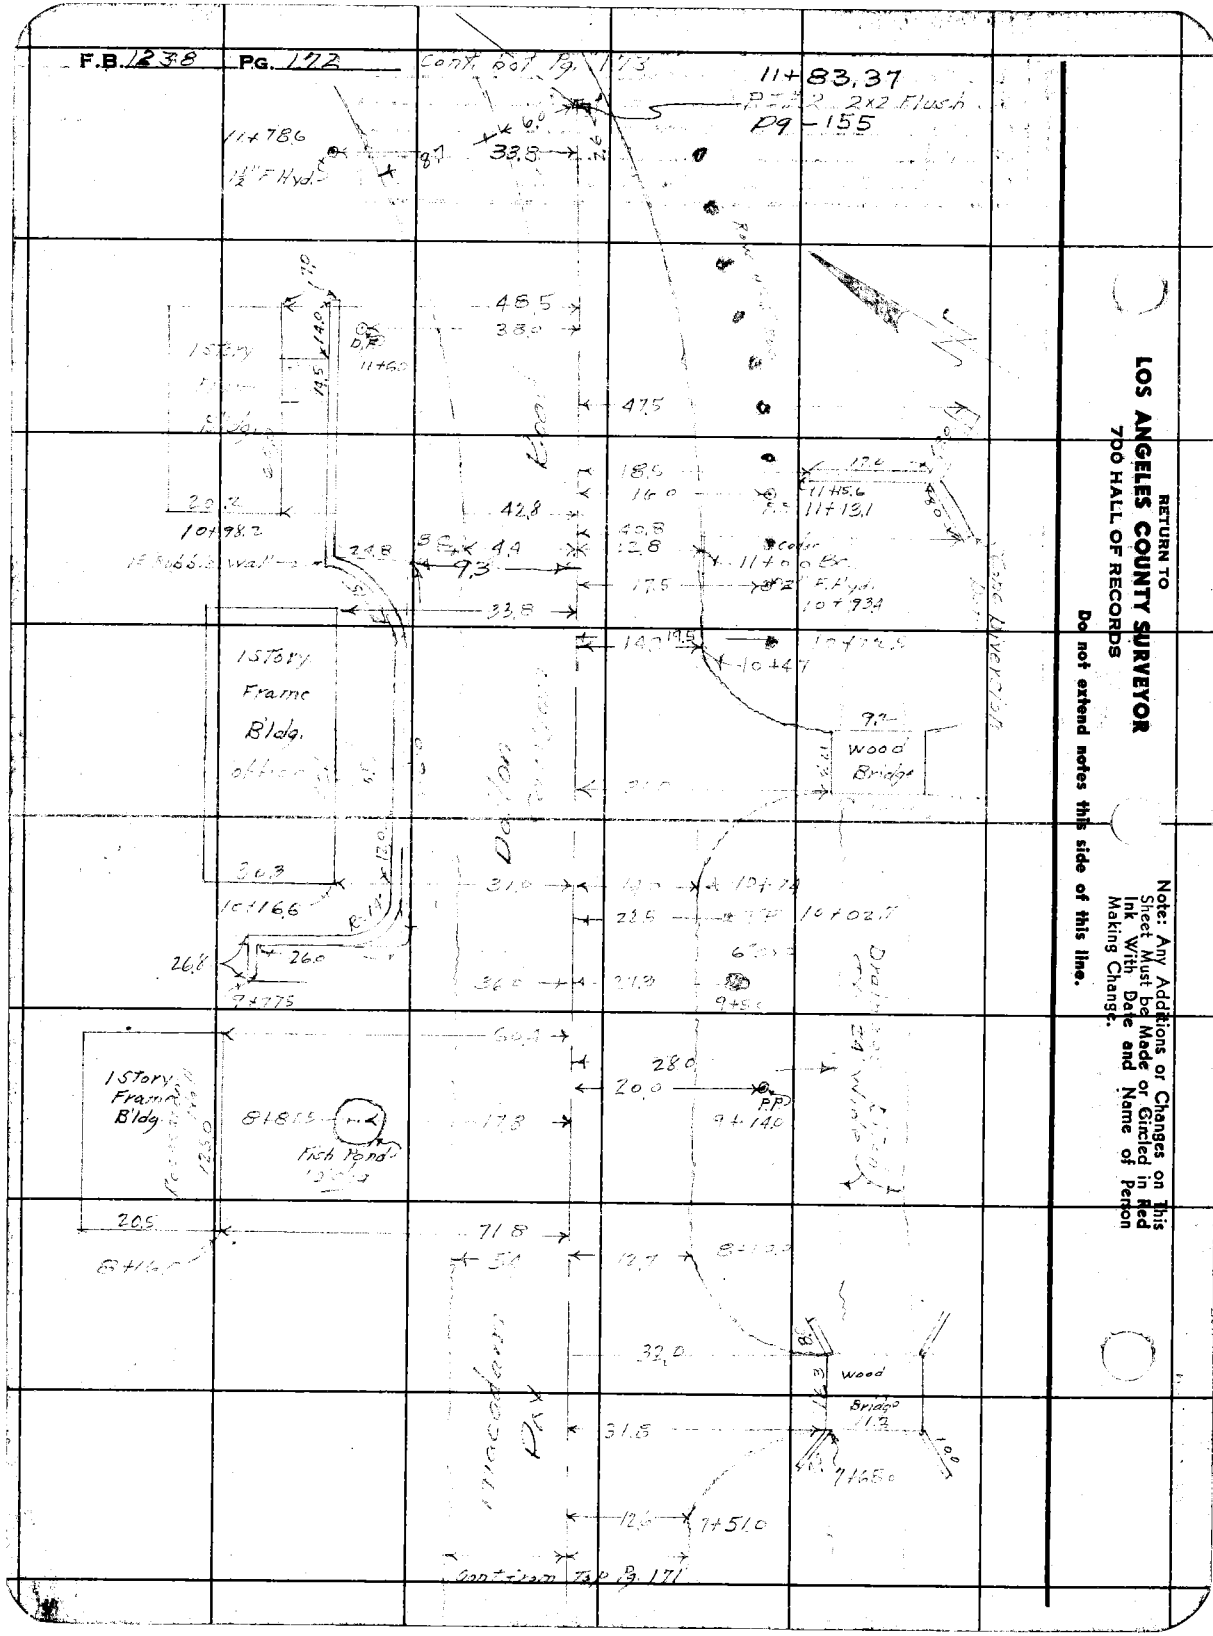

RETURN TO
LOS ANGELES COUNTY SURVEYOR
700 HALL OF RECORDS

Do not extend notes this side of this line.

Note: Any Additions or Changes on This Sheet Must be Made or Circled in Red Ink With Date and Name of Person Making Change.

Notes Ck'd by
Map No. B-1971
Office Work Cop
Checked Drew
Date Mar. 1947

Survey of Dalton Canyon Rd
W. O. 8440 Tape No. 181 St'd 62 °F
Surveyed by Poole
Notes Holmes-Foster Date 11-15-46
Indexed A. C. Johnson

F.B. 1256 Pg. 173

15+83.07

Cont. Lot Pg. 174

Pt. Tan. 2x2 Flush
Pg - 156

Road

15+19.0

16.2

15+14.0

14+79

6.6

11A

14+62.0

17.0

4.5

8.7

14+60.34

Pt. 3 2x2 Flush
Pg - 156

14+44.5
BC
10.7
27.2

W. Valve Shed

9.5

9.3

BC
14+00

14+26.0

27.4

13+62.0

18.5

Concrete Diversion Dam

13+11.0

16.9

PT

13+01

30.5

17.5

14.6

Cons. Diversion Dam

50.5

9.0

9.5

12+71
EC

12+85.2

12+19.5

Fence

14+17.0

16.6

18.5

6.9

12+18.0

Dalton

Steel Platform Bridge

12+03.3

11+83.37

Pt. 2 2x2 Flush
Pg - 155

From Top Pg. 172

RETURN TO
LOS ANGELES COUNTY SURVEYOR
700 HALL OF RECORDS

Do not extend notes this side of this line.

Note: Any Additions or Changes on This Sheet Must be Made or Circled in Red Ink With Date and Name of Person Making Change.

FORM 247 5M 11-41

F.B. 1238 Pg. 144

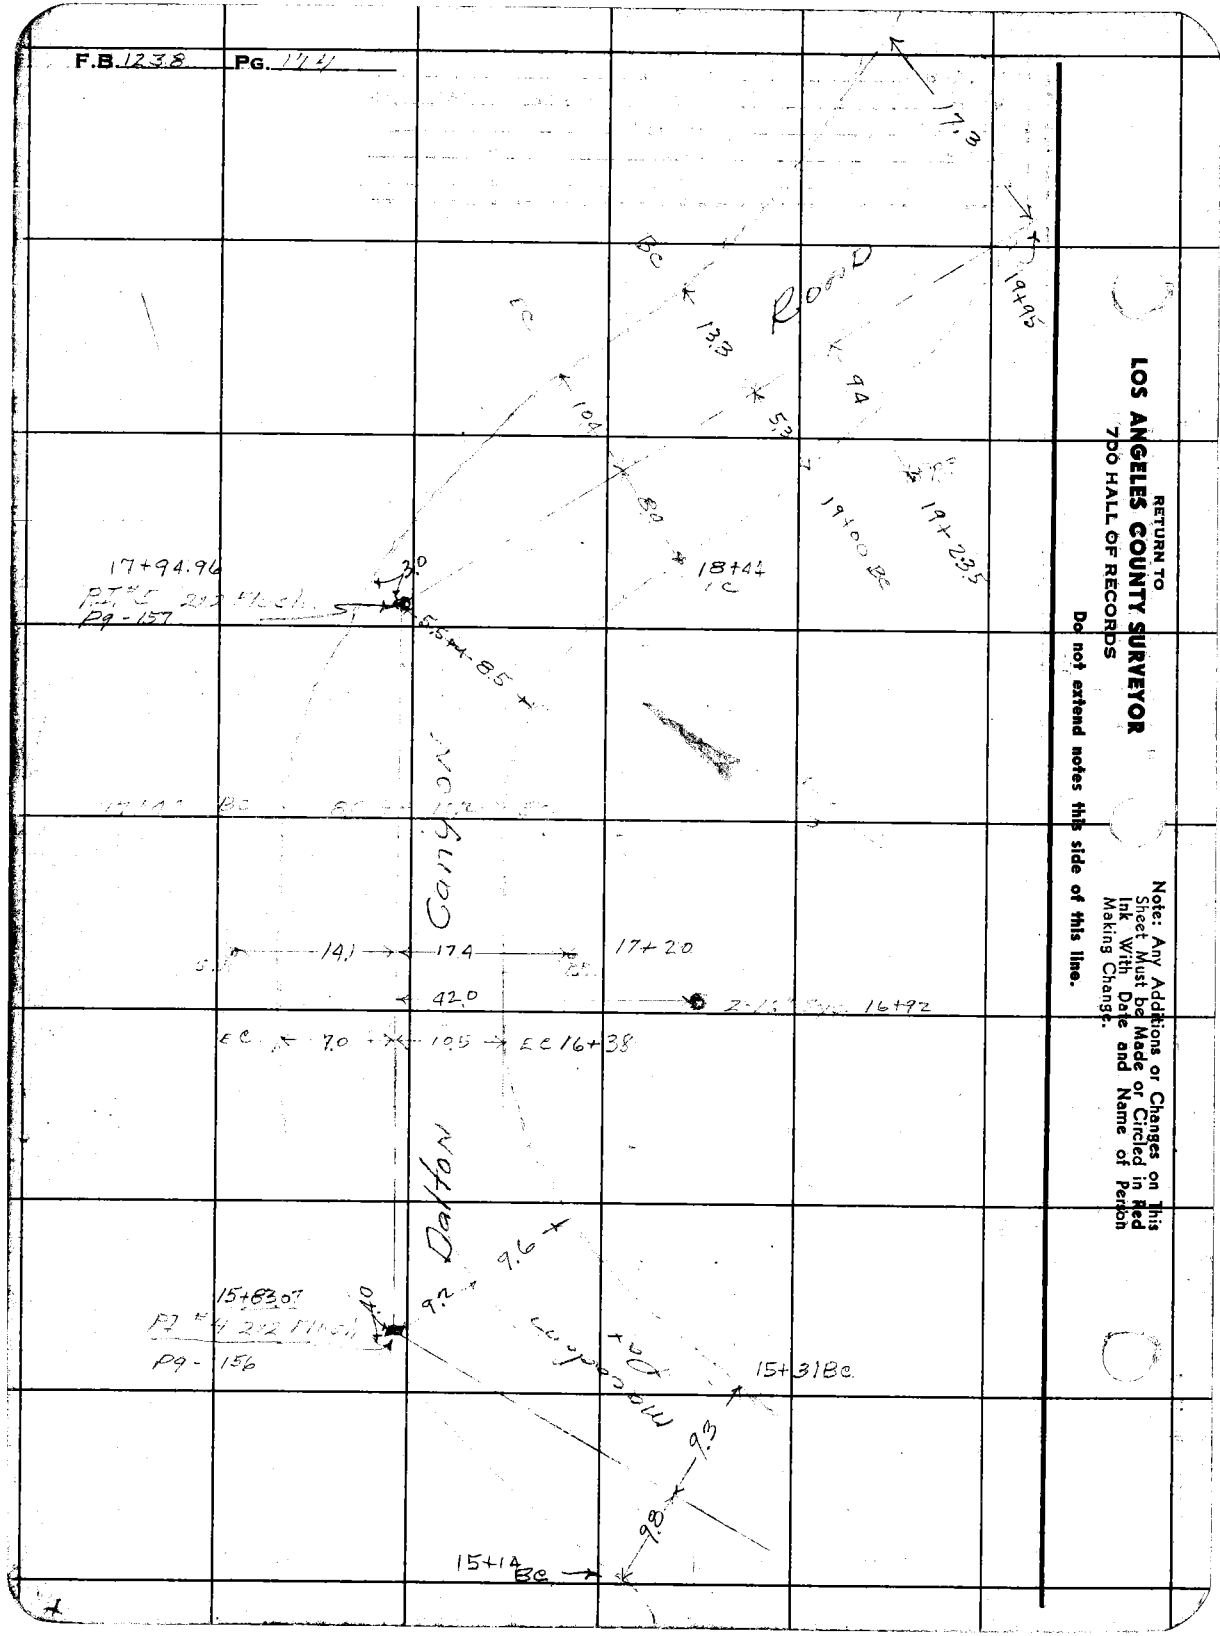

RETURN TO
LOS ANGELES COUNTY SURVEYOR
700 HALL OF RECORDS

Note: Any Additions or Changes on This Sheet Must be Made or Circled in Red Ink With Date and Name of Person Making Change.

Do not extend notes this side of this line.

Notes Ck'd. by
Map No. B-1971
Office Work
Checked
Date Mar 1949

Survey of Dalton Canyon Rd
W. O. 8112 Tape No. 08 St'd. 62 °F
Surveyed by Foster
Notes Mol Mesa Terr. Date 12-16-48
Indexed A. C. Johnson

F.B. 1238 Pg. 175

Cont. bet. Pg 176 & 175

DALTON CANYON ROAD

25+22.97
P.I. # 7
2x2 Flush h.
Pg - 158

10.5 — 9.0

59.0

62.2

30.0
2 story
33.0
33.0
30.0
24+49.0

23+58.5
P.P.
23+00

22+76.2 2" Asphalt

22+57.5

22+43.8

16.3
10.0
9.0
26.1
27.6
23.1

22+26.5

21.0

22+39

29.0

7.8.8

135.5
2.0
21+92.0
Conc. Flood Cont. Rain.

EC 14.8 5.8 EC
22+00

Macadam Pav.

DALTON

20.0
21+33.0
53
21+23.0
P.T.

9.2
9.2
7.8

20+81.99

P.I. # 8 2x2 F. Block
Pg-157

17.3

19+95

Cont. from Pg. 174

Note: Any Additions or Changes on This Sheet Must be Made or Circled in Red Ink With Date and Name of Person Making Change.

Do not extend notes this side of this line.

RETURN TO
LOS ANGELES COUNTY SURVEYOR
700 HALL OF RECORDS

FORM 247 BM. 11-41

F.B. 1238 PG. 176

Cont. bot. Pg 177

31+82.43

PI. # 9

Pg - 159

31+50°

31+41°

31+38°

31+00

30+93.8

30+92.9

30+00.

29+61.0

28+92.0

28+85

28+18.88

27+95

27+80

27+54

27+00

26+00

25+22.97

PI. # 30

Pg - 158

Pg. 125

RETURN TO
LOS ANGELES COUNTY SURVEYOR
7DO HALL OF RECORDS

Do not extend notes this side of this line.

Note: Any Additions or Changes on This Sheet Must be Made or Circled in Red Ink With Date and Name of Person Making Change.

Notes Ck'd by
Map No. B-1971
Office Work Cook
Checked Dent
Date Mar. 1947

Survey of Dalton Canyon Rd
W. O. 5940 Tape No. 081 St'd 68 °F
Surveyed by Porter
Notes Haines & Porter Date 10-16-46
Indexed A. O. Johnson

F.B. 1838 Pg. 177

Note: Any Additions or Changes on This Sheet Must be Made or Circled in Red Ink With Date and Name of Person Making Change.

Do not extend notes this side of this line.

RETURN TO
LOS ANGELES COUNTY SURVEYOR
700 HALL OF RECORDS

FORM 247 5M 11-46

36+86.24

Cont. bott. Pg. 178

P.I. # 11
1½" I.P. dn. 5"
Pg - 160

DALTON CANYON ROAD

Exposed 4" steel water line

Conc. APRON Stream Crossing

P.I. # 10 1"x2"
Pg - 159
34+15.96

P.I. # 9 1x2 Flush
Pg - 159
31+82.43

80" C.M. Iron pipe Rubble Head wall

macadam

Cont. from top Pg. 176

F.B. 1238 PG. 178

Cont. bot Pg. 179

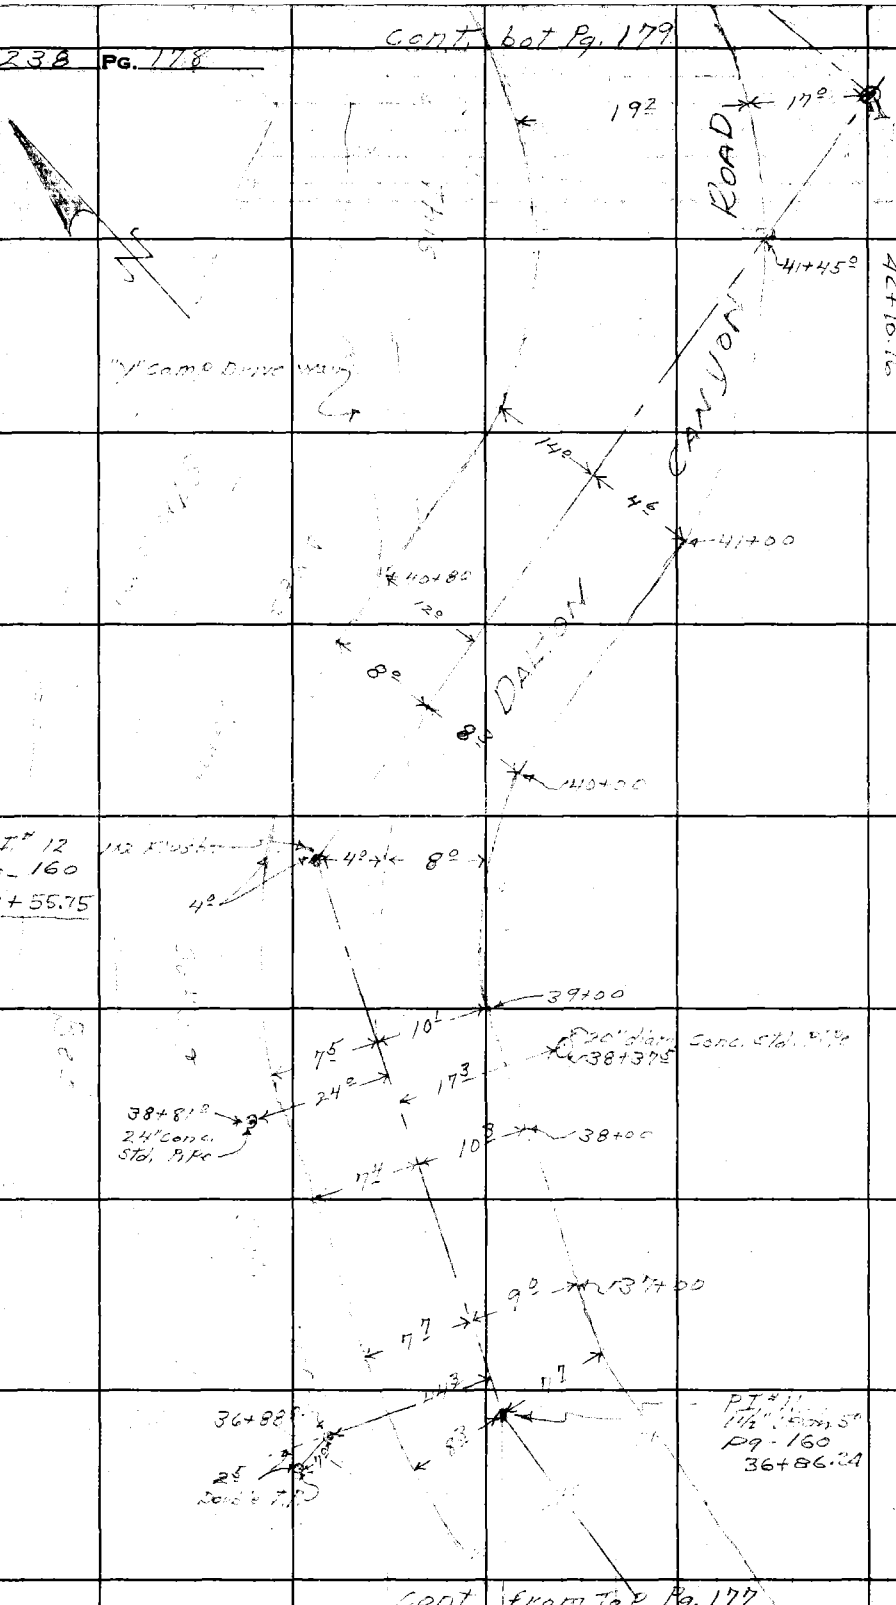

Cont. from Top Pg. 177

RETURN TO
LOS ANGELES COUNTY SURVEYOR
700 HALL OF RECORDS
Do not extend notes this side of this line.

Note: Any Additions or Changes on This Sheet Must be Made or Circled in Red Ink With Date and Name of Person Making Change.

Notes Ck'd by
Map No. B-1971
Office Work Cop
Checked Dunn
Date May 1947

Survey of Dalton Canyon Rd.
W. O. 8115 Tape No. 081 St'd. 68°F
Surveyed by Porter
Notes Holmes & Porter Date 10-17-46
O. Johnson
Indexed

F.B. 1238 Pg. 179

Note: Any Additions or Changes on This Sheet Must be Made or Circled in Red Ink With Date and Name of Person Making Change.

Do not extend notes this side of this line.

RETURN TO
LOS ANGELES COUNTY SURVEYOR
700 HALL OF RECORDS

FORM 247 RM 12-41

Cont. bot. Pg. 180

45+75.96
P.I. "M"
Pg-161

3" I.P. dn. 12"

46+05.5

95

22.4

45+23.2

17.6

30" Oak
46+08.6

30.7

Road

Dalton Canyon

16°

45+00

10°

44+00

11.8

7.2

This Area

Rubble drain basin

1°
2°
2°
30°
10.7

14.6

15.9

43+35.9

Planted

100 ft

with
4" - 12

43+1.0

Pine trees

34°

16°

2.5

43+00

DALTON

42+7.5°

42+10.76

P.I. "L"
Pg.-161

Cont. From Top Pg. 178

F.B. 1238 PG. 180

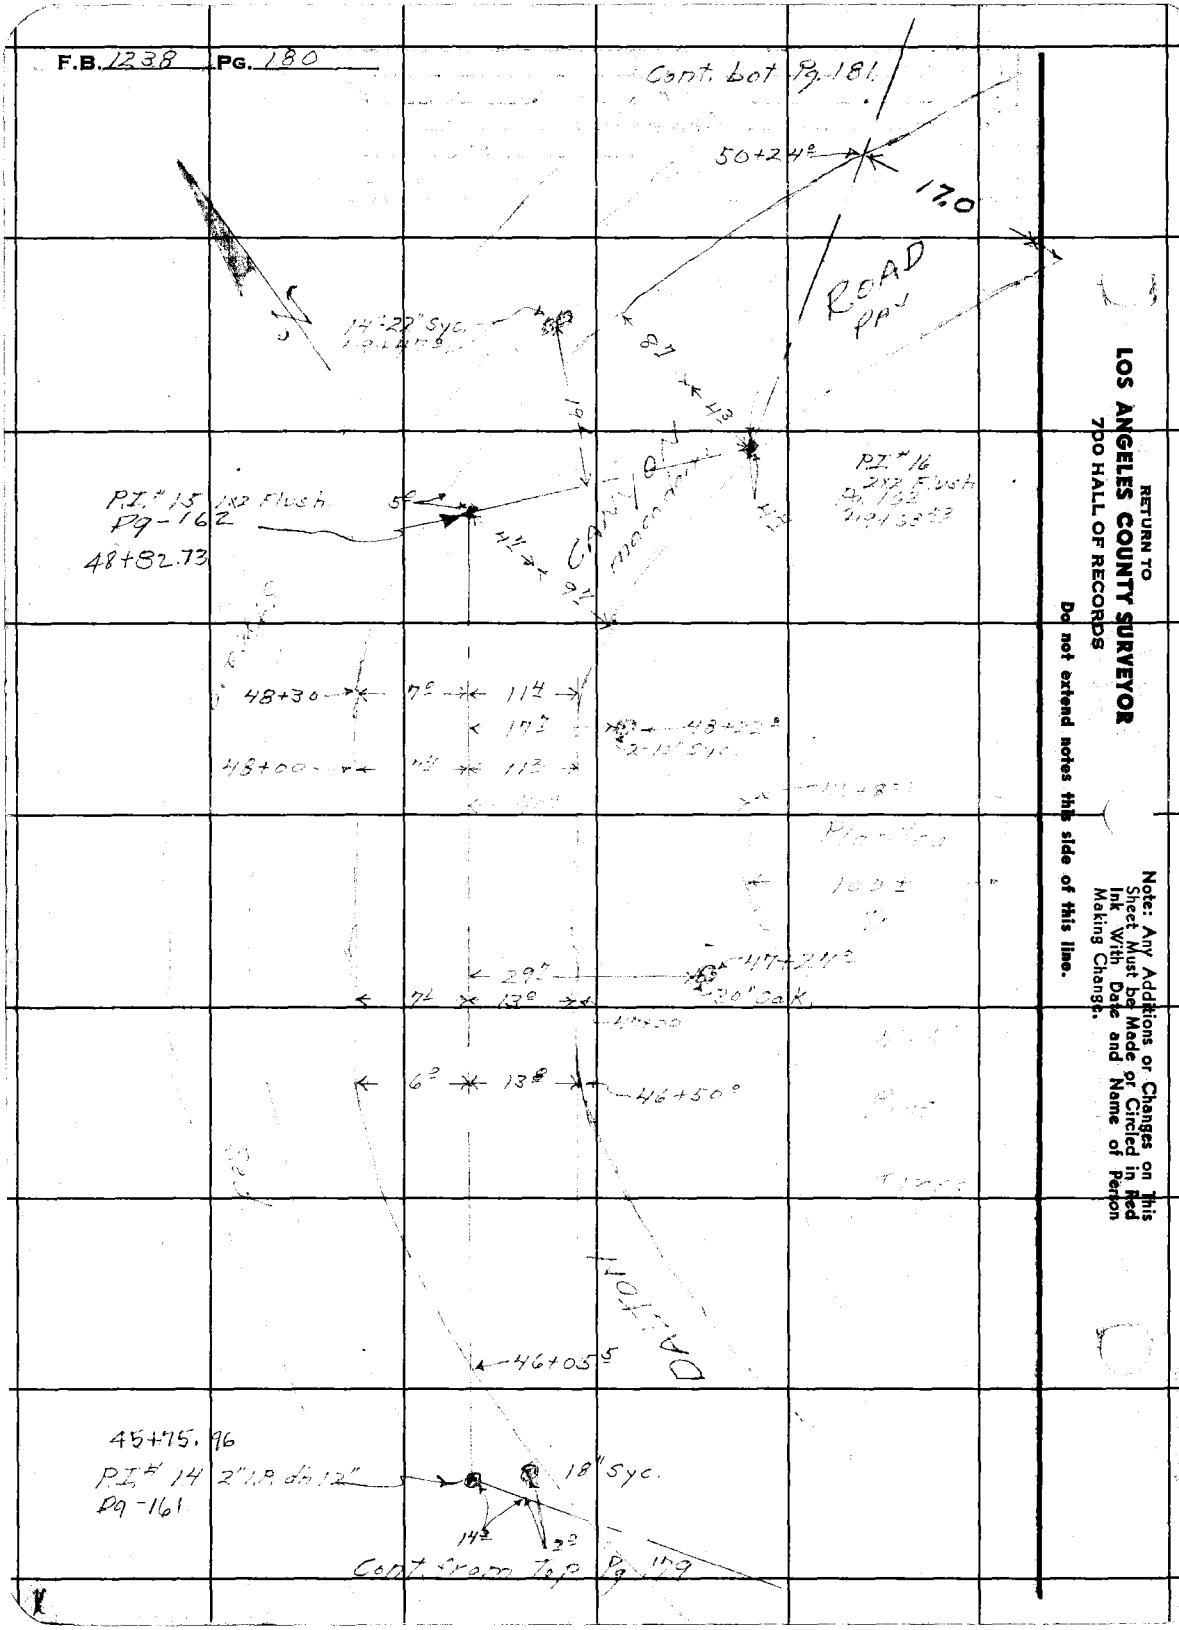

RETURN TO
LOS ANGELES COUNTY SURVEYOR
700 HALL OF RECORDS

Do not extend notes this side of this line.

Note: Any Additions or Changes on This Sheet Must be Made or Circled in Red Ink With Date and Name of Person Making Change.

Notes Ck'd by
Map No. B-1971
Office Work Cox
Checked Dent
Date Mar. 1947

Survey of Dalton Canyon Road
W. O. 8440 Tape No. 681 St'd 68 °F
Surveyed by Foote
Notes Holmes Date 10-7-46
Indexed A. O. Johnson

F.B. 1238 PG. 181

Cont. fot. Pg. 182

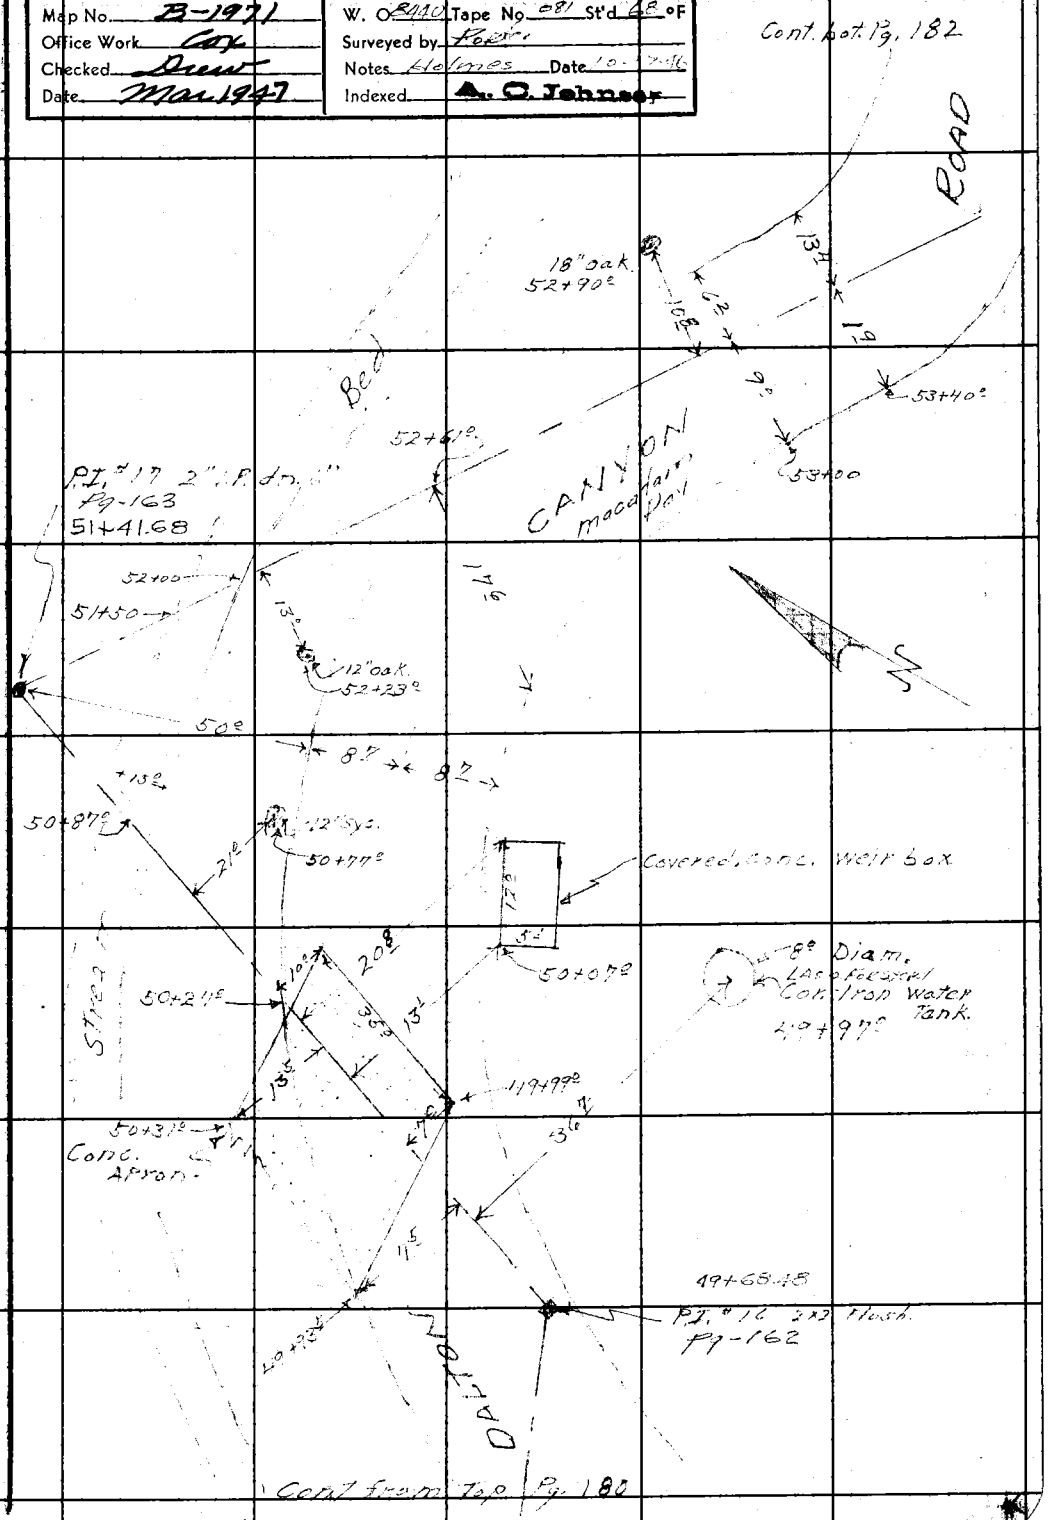

Note: Any Additions or Changes on This Sheet Must be Made or Circled in Red Ink With Date and Name of Person Making Change.

Do not extend notes this side of this line.

RETURN TO
LOS ANGELES COUNTY SURVEYOR
700 HALL OF RECORDS

FORM 247 RM. 11-41

F.B. 1238 PG. 93

Cont bot. Pg. 183

Pt. #19 2x2 Flush
Pg-164
57+64.11

13²

→ 13² → 57+00

56+77² ← 14⁸ ← 13² → 3² → 56+76²

56+41⁵ ← 14⁶ → 5² → 56+61⁰

6² → 56+25²

← 14⁶ → 1⁹ → 56+00

← 14⁵

← 8⁶ → 5⁵ → 55+00

← 11⁸ → 4⁹ → 54+50

12"14 Syc
53+93²

← 25⁸ → ROAD

54+20⁰

53+78.74
Pt. #18 2x2 Flush
Pg-168

DALTON

Cont from Top Pg 181

RETURN TO
LOS ANGELES COUNTY SURVEYOR
700 HALL OF RECORDS
Do not extend notes this side of this line.

Note: Any Additions or Changes on This Sheet Must be Made or Circled in Red Ink With Date and Name of Person Making Change.

Notes Ck'd by
Map No. B-1971
Office Work CAL
Checked Dunt
Date Mar 1949

Survey of Dalton Canyon Rd
W. O. 849 Tape No. 081 St'd 68 °F
Surveyed by Porter
Notes Nov 1948 Date 12-15-48
Indexed A. C. Johnson

F.B. 1238 Pg. 183

Cont'd on Pg 184

Note: Any Additions or Changes on this Sheet Must be Made or Circled in Red Ink With Date and Name of Person Making Change.

Do not extend notes this side of this line.

RETURN TO
LOS ANGELES COUNTY SURVEYOR
700 HALL OF RECORDS

59+86°
59+37°
59+50°
59+40
59+06°
59+28°
58+52°
58+29
57+89°
57+39°
78+41.2°

ROAD
DALTON CANYON
Exposed 4" Steel Water Line
P.I. #21 2x2 Flush. Pg-165 59+95.62
P.I. #20 2x2 Flush Pg-169 58+78.03
P.I. #19 2x2 Flush Pg-169 57+64.11
SB
1B Oak

Cont'd on Pg 182

FORM 247 RM 1948

F.B. 1238 Pg. 184

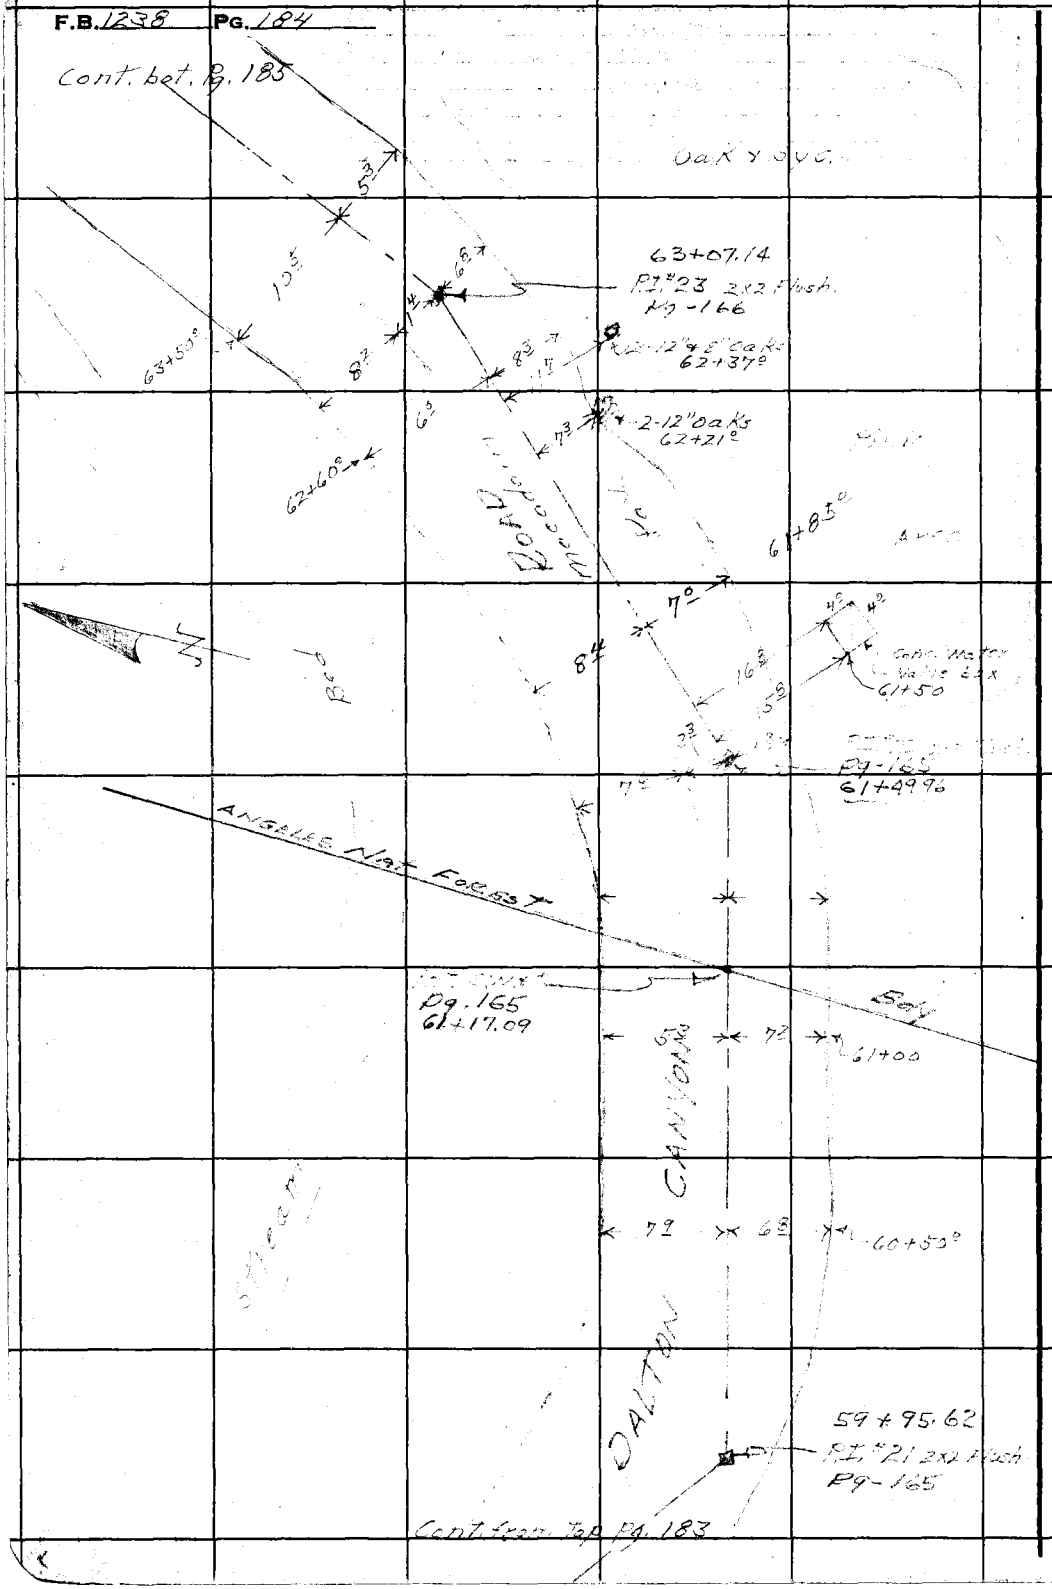
Cont. bet. Pg. 183
Oak Y Ave.
63+07.14
P.I. #23 2x2 Flush.
Pg-166
2-12" oaks
62+37°
2-12" oaks
62+21°
63+50°
62+60°
6'
8'
13'
5'
6'
8'
7'
7'
6'
6'
7'
6'
6'
7'
6'
6'
6

Notes Ck'd by	Survey of Dalton Canyon Road
Map No. B-1971	W. O. 8446 Tape No. 081 St'd 68 °F
Office Work Cox	Surveyed by Peace
Checked Drew	Notes For Stations Date 10-17-46
Date Mar. 1947	Indexed A. O. Johnson

F.B. 1238 Pg. 185

Note: Any Additions or Changes on This Sheet Must be Made or Circled in Red Ink With Date and Name of Person Making Change.

Do not extend notes this side of this line.

RETURN TO
LOS ANGELES COUNTY SURVEYOR
7100 HALL OF RECORDS

FORM 247 BM 1-41

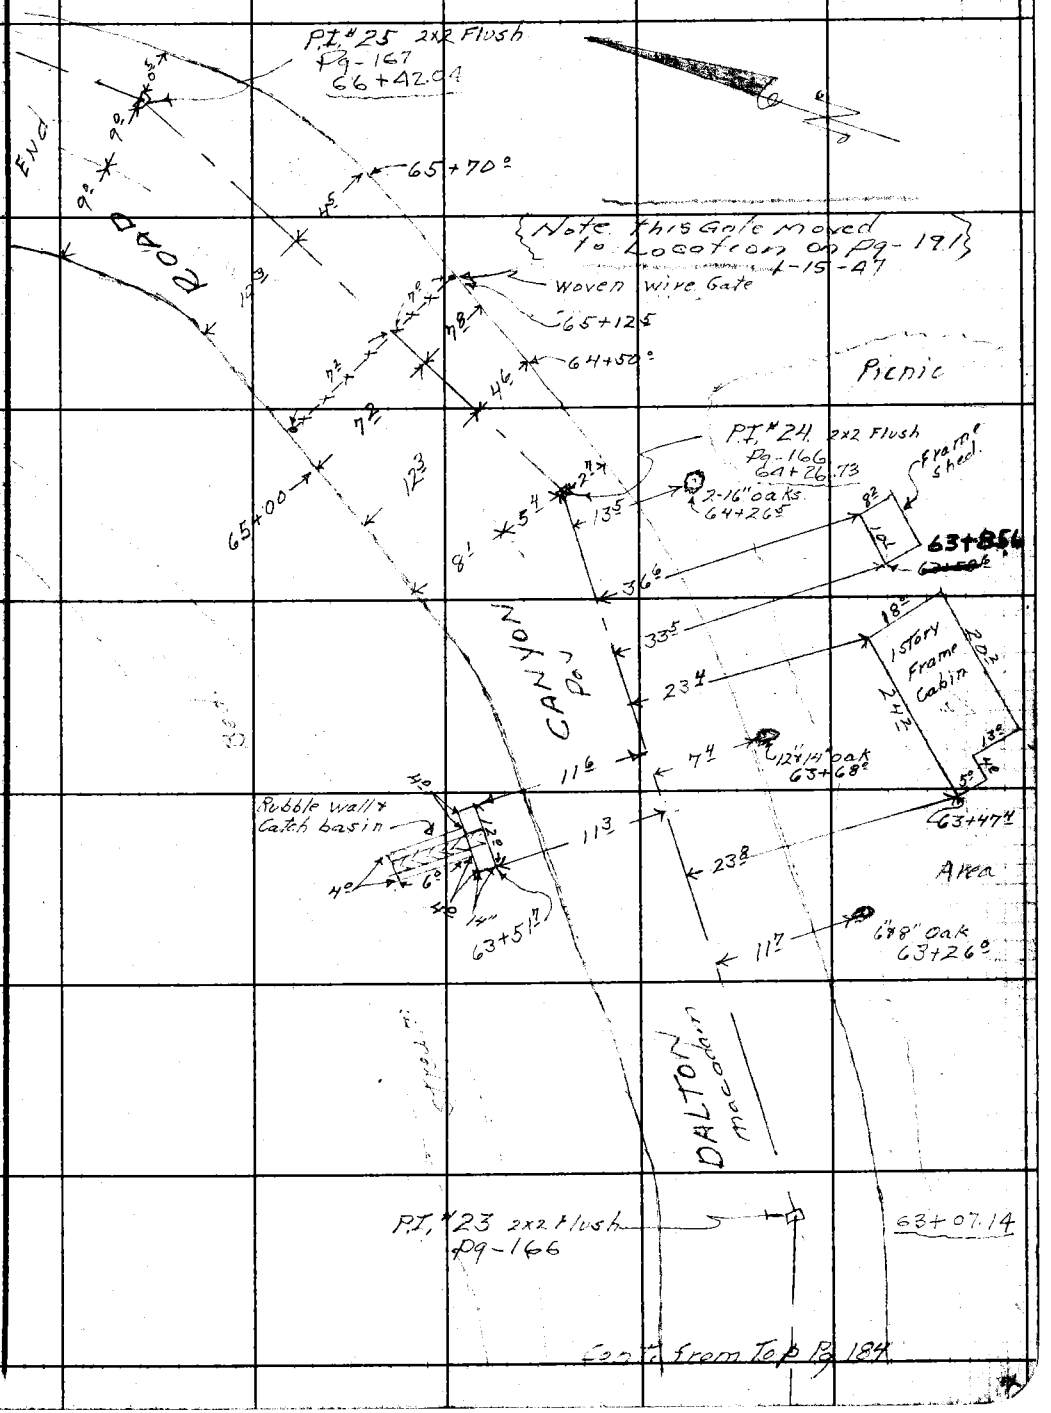
P.I. #25 2x2 Flush
Pg-167
66+42.0
END
65+70
Note this Gate moved to Location on Pg-191
4-15-47
Woven wire Gate
65+12.5
64+58
Picnic
P.I. #24 2x2 Flush
Pg-166
64+26.73
Frame Shed
2-16" oaks
64+26.5
63+85.6
1 Story Frame Cabin
20.2
24.2
13.5
63+47.4
Area
65+00
CANYON
Rubble wall & Catch basin
12"
14"
63+51.7
4"
6"
24"
12"
4"
4"
4

RETURN TO
LOS ANGELES COUNTY SURVEYOR
700 HALL OF RECORDS

Note: Any Additions or Changes on This Sheet Must be Made or Circled in Red Ink With Date and Name of Person Making Change.

Do not extend notes this side of this line.

F.B. 1233 Pg. 186

RETURN ORIGINAL TO
LOS ANGELES COUNTY SURVEYOR
700 HALL OF RECORDS

NOTE: ANY ARRANGEMENT OR CHANGES ON THIS SHEET MUST BE MADE OR CHECKED IN WITH DATE AND NAME OF PERSON MAKING CHANGE

Do not extend notes this side of this line

Location Stream Bed Dotson Canyon
Live Stream on 10' grade

Point on	Point on	Station Intervals	Slope Distance	Slope Rad—	Horizontal Angle 0° to 360° Right	Horiz. Distance	+ — Vertical Angle	Elevation of Point	+ Back Sight	— Difference Elevation	Height of Instrument	+ — Vertical Distance	REMARKS Station	Left	Right
			Location Stream Bed Dotson Canyon												
			Live Stream on 10' grade												
P.I.8	P.I.9	1092													
		9	192		104 50	189	7 13						Bot. Cn.		
		1128													
		9	228		50 40	227	3 36						" "		
P.I.9	P.I.10														
		1166													
		10	166		116 25	165	4 42						" "		
		1155													
		10	155		94 45	154	5 15						" "		
		1040													
		9	140		61 00	139	4 13						" "		
P.I.10	P.I.11														
		448													
		3	148		128 20	146	5 56						" "		
		1203													
		11	103		77 00	103	1 50						" " Lot.		
		1099													
		10	99		50 05	99	1 40						" "		
		1003													
		9	103		26 30	103	1 19						" "		
		1025													
		9	125		11 50	125	0 43						" "		
		1113													
		9	213		351 10	212	3 38						" "		
		10 11													
		7	311		339 45	310	2 37						" "		
P.I.13	P.I.14														
		1040													
		6	440		232 10	439	2 00						" " Lot		
		1039													
		7	330		231 45	326	6 45						" "		
		1022													
		8	222		238 40	219	7 14						" " Lot		
		1062													
		9	162		258 40	159	4 18						" "		

Form 301 10M 3-34

PLEASE RETURN TO
LOS ANGELES COUNTY SURVEYOR
700 HALL OF RECORDS

NOTE: ANY ADDITIONS OR CHANGES ON THIS SHEET MUST BE MADE OR CIRCLED IN RED INK, WITH DATE AND NAME OF PERSON MAKING CHANGE

Do not extend notes this side of this line

Transit at	Sight on	Stadia Intercepts	Stadia Distance	Stadia Rod→	Horizontal Angle 0° to 360° Right	Horiz. Distance	+ − Vertical Angle	Elevation of Point	+ Back Sight	+ − Difference Elevation	Height of Instrument	+ − Vertical Distance	REMARKS Station	Left	Right
Pl 13	Pl 14	1115													
		10	115		293 00	111	− 10 39						Bot Cyn		
		1142													
		10	142		334 35	141	− 4 28						"		
		1114													
		9	214		345 00	214	− 2 21						"		
Pl 14	Pl 15														
		580													
		5	80		195 15	79	− 6 16						"		
		1165													
		11	65		315 20	64	− 6 21						"	"	Lpt
		1196													
		10	195		324 35	195	− 0 32						"		
Pl 15	Pl 16														
		1108													
		10	108		223 25	108	− 2 20						"		
		1145													
		11	45		268 05	44	− 6 08						"		
		777													
		7	77		333 40	77	− 0 33								
		615													
		5	115		339 55	115	− 0 0						int. old channel & New old channel Brg		
		612													
		4	212		349 30	212	− 0 40						Bot New Channel		
		1197													
		10	197		3 55	197	+ 2 43						" old "		
		970													
		7	270		6 30	270	+ 2 12						" " "		
		1194													
		9	294		351 55	294	+ 1 58						" New "		
		1137													
		8	337		356 15	337	+ 2 00						" " "		
Pl 18	Pl 19														
		1197													
		11	97		208 25	97	− 0 25						Bot old Channel		
		701													
		6	101		291 10	101	− 0 0						" New "		
		954													
		9	54		129 45	54	− 0 0						" old "		

Form 682-2000 3-34

PLEASE RETURN TO
LOS ANGELES COUNTY SURVEYOR
700 HALL OF RECORDS

NOTE: ANY ADDITIONS OR CHANGES ON THIS SHEET MUST BE MADE OR CIRCLED IN RED INK, WITH DATE AND NAME OF PERSON MAKING CHANGE

Do not extend notes this side of this line

Transit at	Sight on	Stadia Intercepts	Stadia Distance	Stadia Red—	Horizontal Angle 0° to 360° Right	Horiz. Distance	+ − Vertical Angle	Elevation of Point	+ Back Sight	+ − Difference Elevation	Height of Instrument	+ − Vertical Distance	REMARKS Station	Left	Right
P.118	P.119				° '		° '		1						
		915													
		8	115		333 45	113	8 45		2				Ept New channel (old dirt dam Broken)		
		520													
		4	120		70 00	120	0 00		3				Bot old channel		
		1156													
		10	156		42 00	155	3 57		4				" " "		
									5						
P.119	P.120								6						
		1112													
		9	212		203 40	212	0 00		7				Bot old channel		
		1121													
		9	221		244 30	221	0 00		8				" NEW "		
		882													
		8	82		243 30	82	0 00		9				" old "		
		1173													
		11	73		280 55	73	3 45		10				" " "		
		11153													
		10	153		249 05	153	0 0		11				" NEW "		
		618													
		5	118		328 40	118	2 10		12				" old "		
		1121													
		10	121		292 55	121	3 15		13				" NEW "		
									14						
P.120	P.121														
		1178													
		11	78		214 30	78	0 0		15				" " "		
		1160													
		11	60		246 25	60	0 0		16				Int old New channels		
		892													
		8	92		288 10	92	0 00		17				Bot channel		
		692													
		6	92		302 40	92	0 00		18				" "		
		1010													
		9	110		313 30	110	2 27		19				" "		
		1042													
		9	142		314 15	142	2 26		20				" "		
		1175													
		10	175		326 15	174	3 41		21				" "		

See B.M. Values

Date _____ Date _____ Date _____ Date _____

Survey of Potter Canyon Rd

Map No. _____ Notes Taken by Potter Date 11-3-49-46

Inked C. Johnson Date _____

Add'n'l Inform.

Form 301 1966 5-34

PLEASE RETURN TO
LOS ANGELES COUNTY SURVEYOR
700 HALL OF RECORDS

NOTE: ANY ADDITIONS OR CHANGES ON THIS SHEET MUST BE MADE OR CIRCLED IN RED INK. WITH DATE AND NAME OF PERSON MAKING CHANGE

Do not extend notes this side of this line

Transit at	Sight on	Stadia Intercepts	Stadia Distance	Stadia Rod—	Horizontal Angle 0° to 360° Right	Horiz. Distance	+ − Vertical Angle	Elevation of Point	+ Back Sight	+ − Difference Elevation	Height of Instrument	+ − Vertical Distance	REMARKS Station	Left	Right
P123	P124				° '		° '						Bot channel		
		1170													
		10	170		206 10	170	0 00								
		1202													
		12	102		212 15	102	0 00								
		1143													
		11	43		256 05	43	0 00								
		1051													
		10	51		318 05	51	0 00								
		1196													
		11	96		333 45	96	2 23								
P125	P124														
		1201													
		10	201		14 40	200	3 10								
		1150													
		10	150		23 10	149	4 01								
		1113													
		10	113		36 25	112	4 45								
		1177													
		11	77		77 10	77	3 11								
		1159													
		11	59		95 15	59	3 09								
		1178													
		14	94		128 25	94	0 00								
		1157													
		10	157		136 20	157	0 00								
		922													
		7	222		135 15	222	0 00								
		289													
		1	189		157 00	189	0 00								
		162													
		0	162		154 10	162	0 00								
		128													
		0	128		152 15	128	0 00								
		197													
		1	97		152 35	97	0 00								
		268													
		2	68		151 55	68	0 00								
		236													
		2	36		147 55	36	0 00								

END

Notes Ck'd by K.R.McPh.
Map No. C.S.B-1971
Office Work Cap
Checked Dunn
Date Mar. 1947

Survey of Dalton Canyon Rd
W. O. 8440 Tape No. 081 St'd 68 °F
Surveyed by PORTER
Notes PORTER Date 1-16-47
Indexed ALBERT E. TIMMONS 1-24-47

F.B. 1238 PG. 191

W.S. 14 B-1

LINE CHANGE AT P.I. #15 to P.I. #18

See Pgs 161-162-163

Cont Bot Pg 192

Note: Any Additions or Changes on This Sheet Must Be Made or Circled in Red Ink With Date and Name of Person Making Change.

Do not extend notes this side of this line.

RETURN TO
LOS ANGELES COUNTY SURVEYOR
700 HALL OF RECORDS

FORM 247 SM 1-41

40.82 to BC

ROAD

147.34

51+56.09
EC Set Boat Spk & Tin

DALTON CANYON

New P.I. #15-A
Set X" on Rock
in Stream Bed

385

147 09 40"

282

Proj

Δ = 32° 50' 20"
R = 500.00
T = 147.34
L = 286.57

15.4

GATE

147.34

87

(1): 147° 09 40"
(2): 228° 38 30"
147° 09 37½

147.36 @ 0° 1' 50" = 147.34

48+69.52
BC Set Boat Spk & Tin

10.17

Note: Ties to Edges of Gore Moved to This Location 1-15-47 Pg-185

P.O.T. 48+59.35
P.I. #15-¾" IP
Pg-162

306.77

P.I. #14-1½" IP
Pg-161

(20) (20)

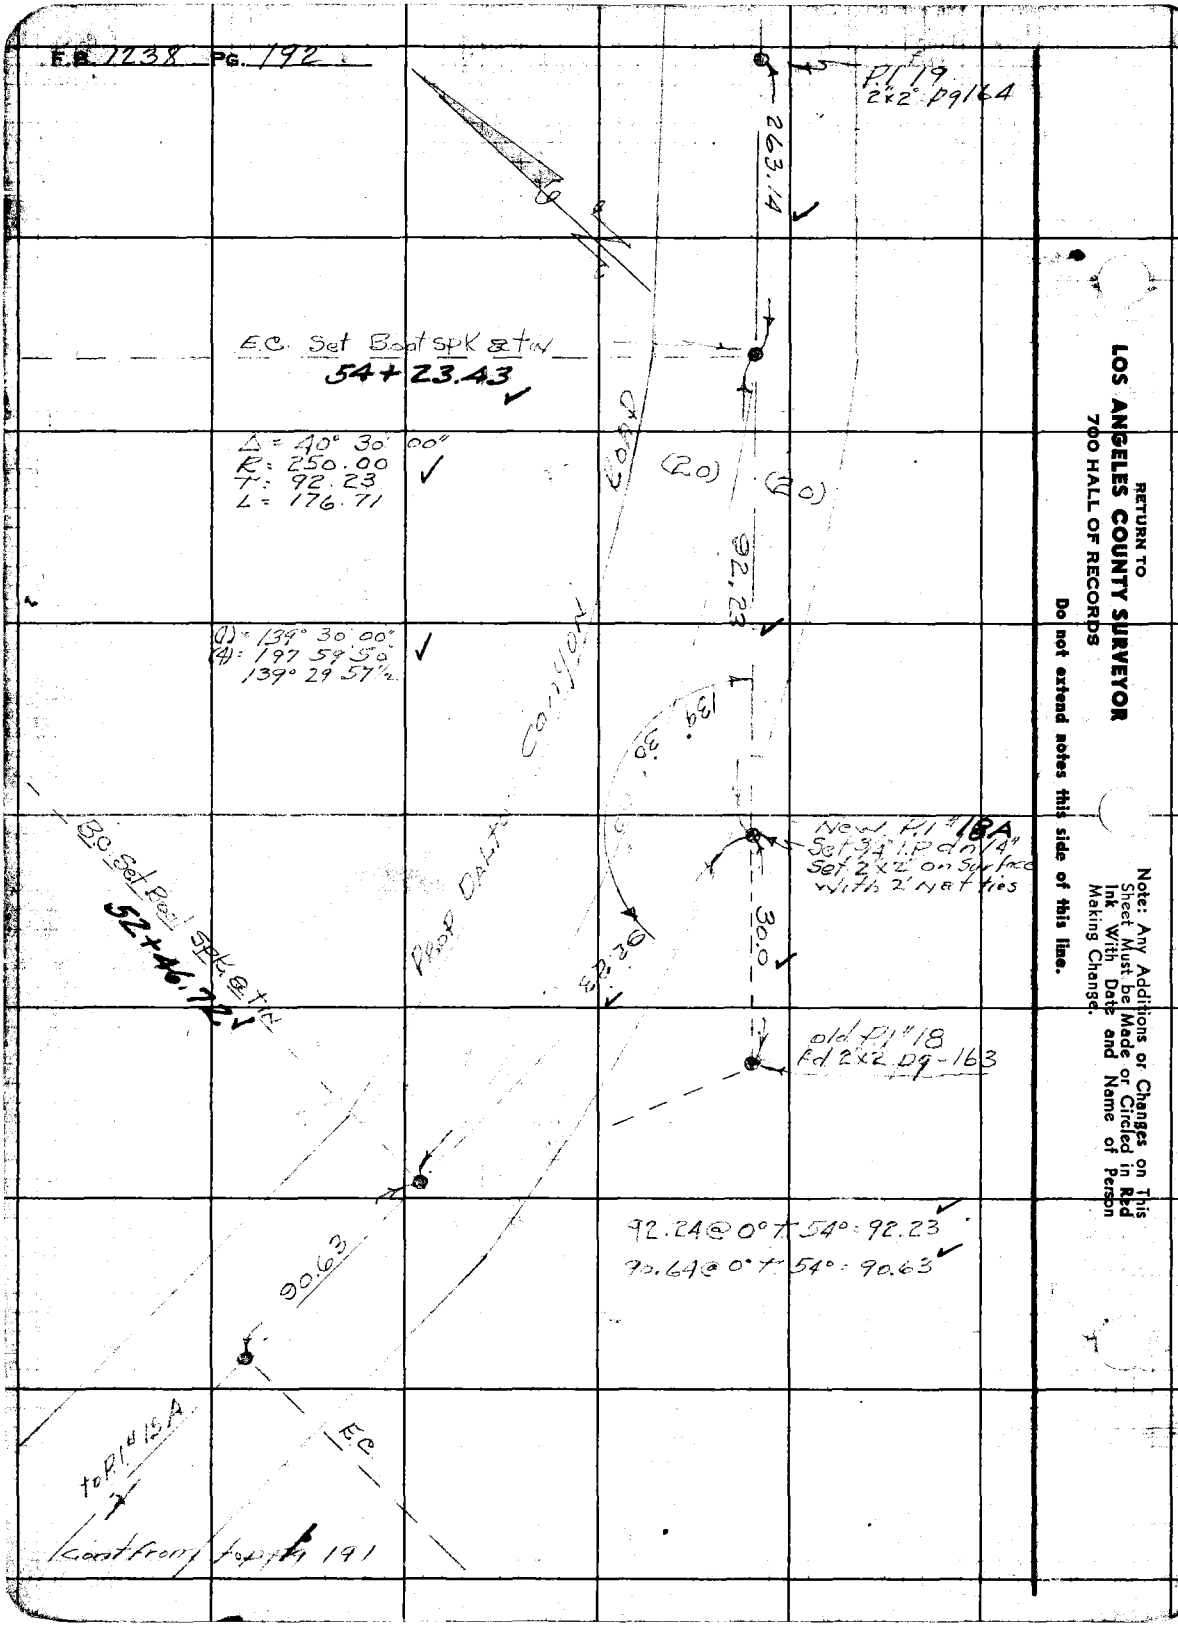
F.B. 1238 PG. 192
Pt 19
2x2" PP164
263.14
E.C. Set Boat Spk & Tin
54+23.43
Δ = 40° 30' 00"
R = 250.00
T = 92.23
L = 176.71
(20)
(20)
92.23
Δ = 139° 30' 00"
Δ = 197 59 50
139° 29 57½
Prop Dist Centerline
139° 30'
New Pt #18A
Set 3/4" I.P. on 1/4"
Set 2x2" on Surface
with 2' nail tie
30.00
BC set Boat Spk & Tin
52+46.77
Prop Dist
30.00
old Pt #18
Fd 2x2 PP-163
92.24@ 0° 7' 54" = 92.23
90.64@ 0° 7' 54" = 90.63
90.63
to Pt #18A
EC
1 East from Fourth 191
RETURN TO
LOS ANGELES COUNTY SURVEYOR
700 HALL OF RECORDS
Do not extend notes this side of this line.
Note: Any Additions or Changes on This Sheet Must be Made or Circled in Red Ink With Date and Name of Person Making Change.

Notes Ck'd by	Survey of EATON CN PARK
Map No. B-2208	JN 0054.30 Tape Std °F
Office Work T. M. ICHIEN	Surveyed by R.B. Hobson
Checked	Notes R.B.H. Date 12-19-58
Date May 58	Indexed L. C. Johnson 5-18-59

F.B. 1238 Pg. 193

DR

PINE BLUFF DR.

RIVIERA

Set chis."+" in W. side fnce. post up 1.1

HSE. #1075

Dashed line is roof line of hse.

Set 1"x1" & N. flush - also set copper nail directly overhead in roof facia.

12.90

41.18'

4'ch. link fence

P.O.T. Set 1"x1" & N.

25.49'

To Cor#5 151.75' (FB 1238-37)

Cor#4 Fd. Std. C.S. Mon. dwn. 3' per F.B. 1238-37

Set chis."+" in N.W. side fnce. post up 0.5

EATON

225.80'

D/L

192.90'

Cor# 3 Fd. std. C.S. Mon flush per F.B. 1238, pg. 37

See note for replacement

90° 00' 00" 158.40'

Set chis + on top brick wall

27.2'

R.D. Fd. 1"x2" & N. on line per F.B. 1238 pg. 37

13.81

200.96 (FB 1238-37)

Wall

Cor. # 2.

37.58'

94 00'

AZ 66'

R.D. Fd. 1"x2" & N. per F.B. 1238, pg 37 0.01' W. of line

CN.

PARK

Note: These ties made on Cor. # 3 on Dec. 19, 1958 ~~58~~ Mon was destroyed, thereafter and replaced with a C.E. mon. on Feb. 16th 1959. R.B.H. Feb 16TH, 1959

R.P. Set 1"x1" & N. dn. 0.1 on tang. prod.

RETURN TO
LOS ANGELES COUNTY ENGINEER
700 Los Angeles County Engineering Bldg.

Note: Any Additions or Changes on This Sheet Must be Made or Circled in Red Ink With Date and Name of Person Making Change.

Do not extend notes this side of this line.

76F309S CE #247—3 x 5

RETURN TO
LOS ANGELES COUNTY ENGINEER
700 LOS ANGELES COUNTY ENGINEERING BLDG.

Note: Any Additions or Changes on This Sheet Must be Made or Circled in Red Ink With Date and Name of Person Making Change.

Do not extend notes this side of this line.

F.B. 2221 PG. 194

Notes Ck'd by W. J. BRENNER	Survey of EATON CANYON PARK	F. B 1238 Pg. 195
Map No. S.D. 8-99	JN 005430 Tape 0146 Std 68 °F	
Office Work F. M. ICHIEN	Surveyed by J. H. BROWN	
Checked	Notes J.H.B. Date 7-61	
Date SEPT. 1961	Indexed H. E. OTT AUG 2 '61	

EATON CANYON PARK
SURVEY OF SOUTH BOUNDARY

for establishing a Legal description of 9.0' easement 17' in width & parallel with South Boundary of park for 525+ West from EATON CANYON HIKING TRAIL

J.N. 005430

July 20-26, 1961

PARTY: BROWN, J.H.
REED
NUNEZ
BRUSH

Note: Any Additions or Changes on This Sheet Must be Made or Circled in Red Ink With Date and Name of Person Making Change.

Do not extend this side of this line.

PLEASE RETURN TO
LOS ANGELES COUNTY ENGINEER
403 Los Angeles County Engineering Bldg.

76F3085 CE # 310 3-61

C

F. B. 1238 PG. 196

INDEX

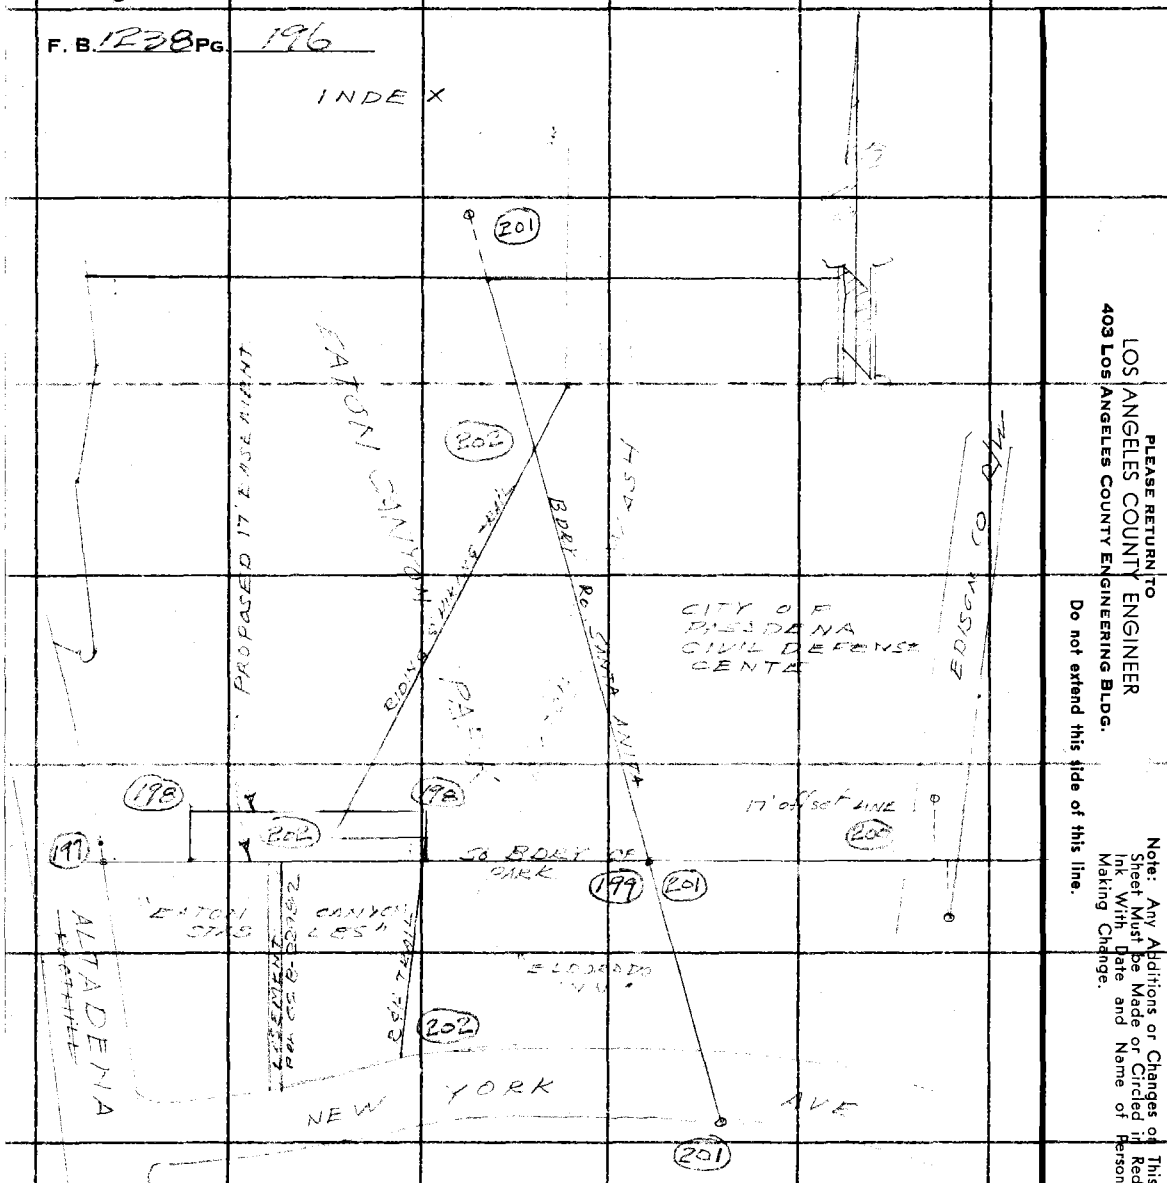

PLEASE RETURN TO
LOS ANGELES COUNTY ENGINEER
403 LOS ANGELES COUNTY ENGINEERING BLDG.

Do not extend this side of this line.

Note: Any Additions or Changes on This Sheet Must be Made or Circled in Red Ink With Date and Name of Person Making Change.

Notes Ck'd by W. J. BRENNER	Survey of EATON CANYON PARK
Map No. S.D. 8-99	JN 0054.30 Tape 9/96 Std 68 °F
Office Work T. M. ICHIEN	Surveyed by J. H. BROWN
Checked	Notes J. H. B. Date 7-24-61
Date SEPT. 1961	Indexed H. E. OTT

F. B. 1238 Pg. 127

EATON CANYON PARK

W.S. 88, D-7

END THIS SURVEY

DEVILS BLVD

ALTA DENA (FOOTHILL)

END 7.00 COURSE

2---Set nothing

2---Set nail @ 90° 49' 17.00 Usrd

S 0° 11' 30" W

25.01 meas

144.14 meas

15.33 meas

0.03 meas

1100 Set

SO BDRY EATON CANYON PARK

Cont. to Pg. 125

Fd. STD. C.S. MON. IN H.H. dn 1ft "RE 63" MARKED AS shown Below

Fd. STD. C.S. MON. flush MARKED AS shown FB 1144-82

COUNTY SURVEYOR RE 63

COUNTY SURVEYOR P.K. BDRY. RE 32

COUNTY SURVEYOR P.K. BDRY. PT 329

PLEASE RETURN TO
LOS ANGELES COUNTY ENGINEER
403 LOS ANGELES COUNTY ENGINEERING BLDG.

Note: Any Additions or Changes on This Sheet Must be Made or Circled in Red Ink With Date and Name of Person Making Change.

Do not extend this side of this line.

76F309S CE # 310 3-61

PLEASE RETURN TO
LOS ANGELES COUNTY ENGINEER
403 LOS ANGELES COUNTY ENGINEERING BLDG.

Note: Any Additions or Changes on This Sheet Must be Made or Circled in Red Ink With Date and Name of Person Making Change.

Do not extend this side of this line.

F. B. 1238 PG 198

F

Notes Ck'd by W. J. BRENNER
Map No. S.D. 8-99
Office Work T. M. ICHIEN
Checked
Date SEPT. 1961

Survey of EATON CANYON PARK
JN 00594 Tape 0146 Std 68 °F
Surveyed by J. H. Brown
Notes J.H.B Date 7-20-61
Indexed H. E. OT

F. B. 1238 Pg. 199

CITY OF PASADENA CIVIL DEFENSE CENTER

EATON CANYON PARK

(T= 84)
100.71 @ 9° 54' = 99.21 ✓
100.60 @ 9° 30' = 99.22 ✓
Avg = 99.21 ✓
Temp cor .01 ✓
99.22 /
.41
98.81 ✓

(T= 84)
100.32 @ 22° 09' 20 = 92.95 ✓
100.10 @ 21° 45' 00 = 92.77 /
Avg = 92.95 ✓

223.76 Lev
223.79 Lev } Avg = 223.79 ✓

71.37 @ 9° 16' = 70.63 ✓
71.50 @ 9° 01' = 70.62 ✓ Avg = 70.62 ✓

Sum = 387.39 ✓
Temp. cor .04 ✓
387.43 ✓
14.65 + 0.41 Lev (T= 84) = 15.06
402.49 ✓

E. A. Page 200 Park see page 201

Note: Any Additions or Changes on This Sheet Must be Made or Circled in Red Ink With Date and Name of Person Making Change.

Do not extend this side of this line.

PAGE 198

Eaton Wash

Sat nail in rock on L PARKING LOT

(T LINE 17.00 at 80. LEFT of Meas)

98.9 Meas
99.2

Set nail & tag - 2.1 - 50 + nails by 4 pts. set very on line

402.49 Meas

Z-00

17.00

99°

0.41 Meas

PAGE 201

Meas 91.39

Lev (T= 68) 76.87 Meas

66.87 Meas

10.80 Meas

0.02 Meas

0.02 Meas

Fd bl. Sq. Finish flush in R&G PARKING LOT. behind "EL DORADO INN."

Meas 82.21

Set Sq. Finish flush in R&G PARKING LOT behind "EL DORADO INN."

Fd 1/2" I. P. in conc. 0.39' "CITY ENG. PASADENA" (Believe C/L Eaton Canyon Wash) 83.40 on 80.

CONT LEFT

CONT RT

PAGE

NEW YORK AVE

PLEASE RETURN TO
LOS ANGELES COUNTY ENGINEER
403 Los Angeles County Engineering Bldg.

76F3095 CE # 310 3-61

PLEASE RETURN TO
LOS ANGELES COUNTY ENGINEER
403 LOS ANGELES COUNTY ENGINEERING BLDG.

Note: Any Additions or Changes on This Sheet Must be Made or Circled in Red Ink With Date and Name of Person Making Change.

Do not extend this side of this line.

F.B. 1238 Pg 200

Notes Ck'd W. J. BRENNER
Map No. S.D. 8-99
Office Work T. M. ICHIEN
Checked
Date SEPT. 1961

Survey of EATON CANYON PARK
JN 2059 30 Tape 246 Std 68 °F
Surveyed by J. H. BROWN
Notes J. N. B. Date 7-21-61
Indexed H. E. OTT

F. B. 1238 PG. 201

W.S. 8.0-7

Note: Any Additions or Changes on This Sheet Must be Made or Circled in Red Ink With Date and Name of Person Making Change.

Do not extend this side of this line.

PLEASE RETURN TO
LOS ANGELES COUNTY ENGINEER
403 LOS ANGELES COUNTY ENGINEERING BLDG.

76F3095 CE # 310 3-61

Fd STD C.S. MON 0.02 E of LINE
UP 6" PCA FB 1144-85
MARKED AS shown

Fd L F Nail 1in brass
of CORNER FENCE post
Rel FB-1144-85
(END THIS SURVEY)

COUNTY SURVEYORS MONUMENT
FD TOCOR
R.N.
R.E 32.9

PASADENA

Fd 1X2 (nail) (new)
on Rd. Line

17.00 N 71 18° 05' 07" E

1) 71 54 50
2) 287 39 40
3) 71 29 20
Avg 71 54 53½

CITY OF CIVIL DEFENSE CENTER

71 54 53 Meas

Fd 1X2 6" (new)
2.45 Meas

1X2 nail 0.41 EAST OF Nail shown
(T. 17' off set) per R.O.S.

calc

5.55
5.35 M

0.21 calc Meas

EATON

Set 1X2 S punch mark by this edge of bank

266.41 Set

473.95 Meas
474.15 Rec

CANYON

PARK

Meas 0.59

Set 1X2 S VAN by this

So. BDRY OF EATON CN. PARK (EXTENDED E'LY)

424.20
49.75
474.15

C.S. B-2295-2

0.62 calc'd Meas

DORY

Rd

SANTA ANITA

C.S. B-2295-2

Set nail & tin MON per R.O.S. page 6 over PASADENA CITY ENGR'S MON

S 53°08'53" W 1.00 Meas

0.59 CAL 18°05'07"

NEW YORK AVE

COUNTY SURVEYORS MONUMENT
RANCHO SANTA ANITA
LINE

Fd STD CS MON
MARKED AS SHOWN
DN 6" PER FB 1144-84

(END THIS SURVEY
FIRE STATION

F. B. 1238 PG. 202

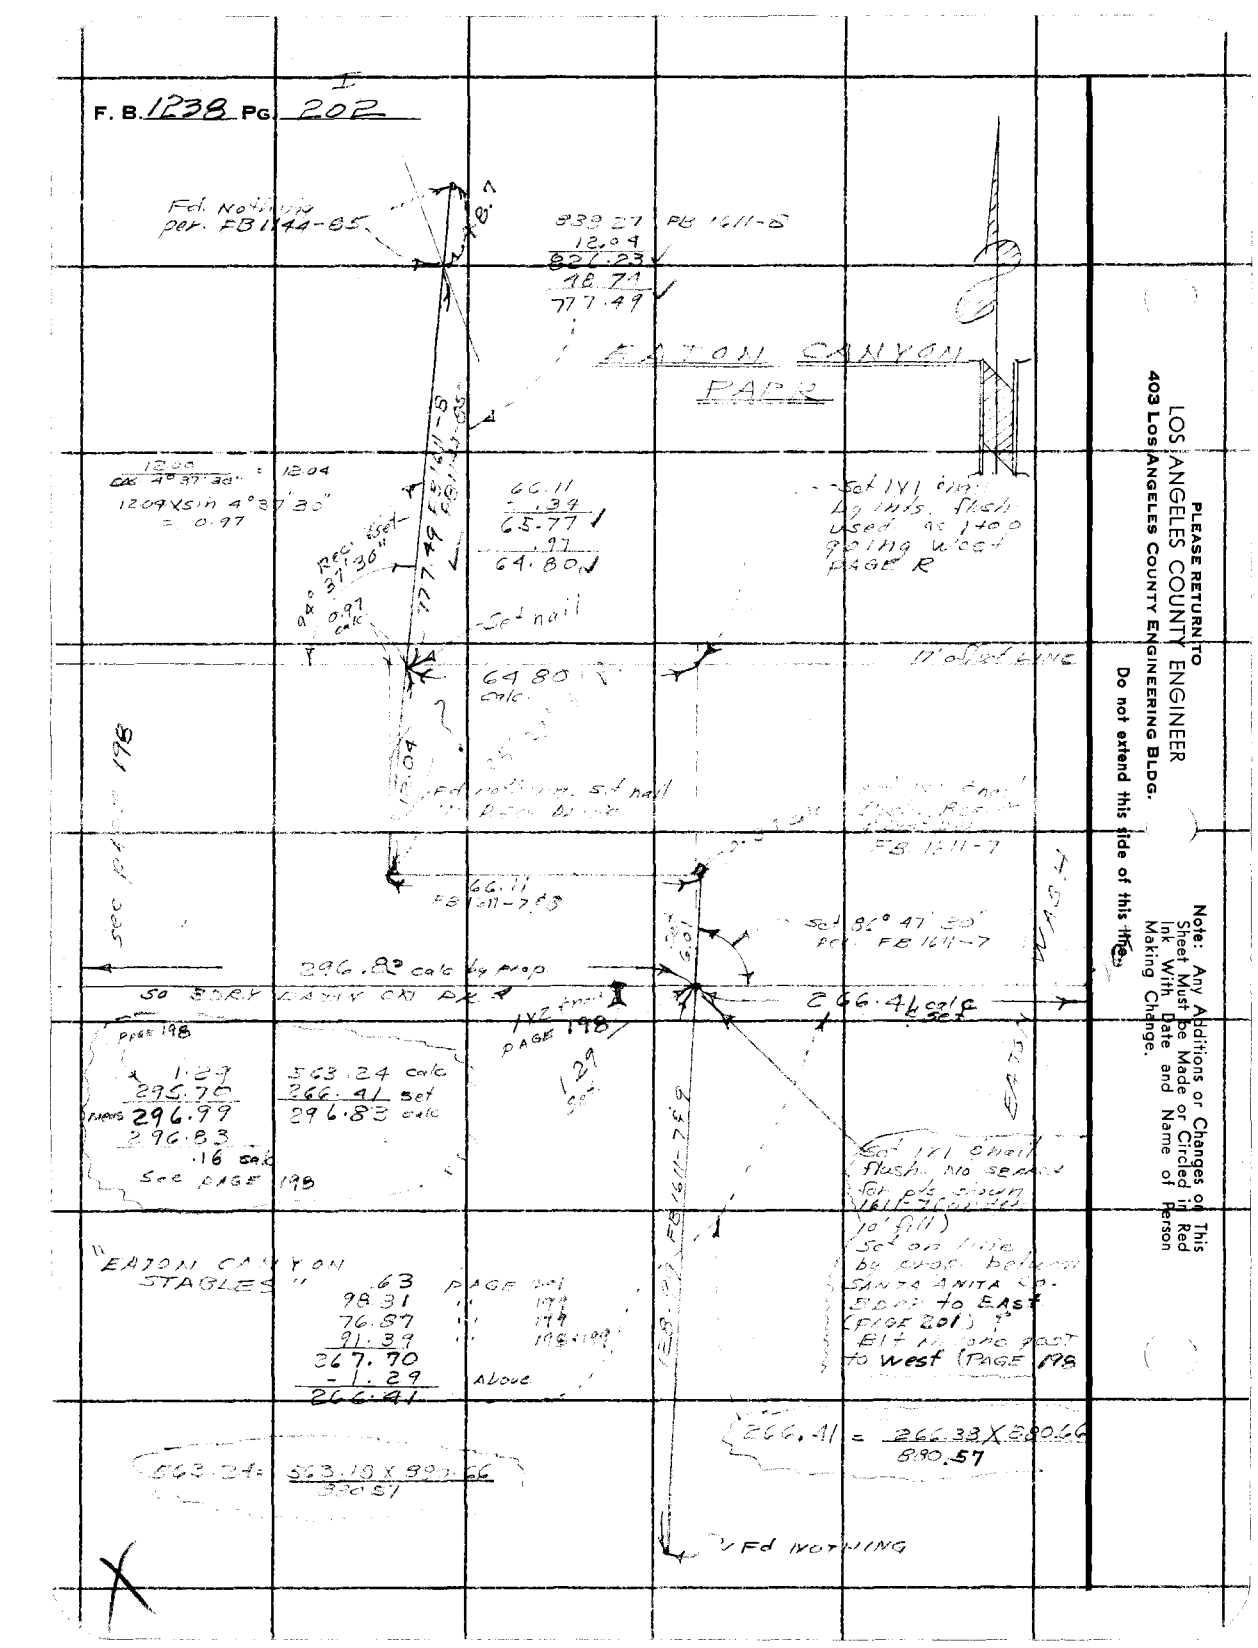

PLEASE RETURN TO
LOS ANGELES COUNTY ENGINEER
403 Los Angeles County Engineering Bldg.
Do not extend this side of this map.

Note: Any Additions or Changes on This Sheet Must be Made or Circled in Red Ink With Date and Name of Person Making Change.

Notes Ck'd by	Survey of EATON CANYON PARK
Map No. S.D. 8-99	JN 0054.30 Tape 0146 Std CE °F
Office Work T. M. ICHIEN	Surveyed by J. H. BROWN
Checked	Notes LB 5 CKMK Date 7-26-61
Date SEPT. 1961	Indexed H. E. OTT AUG 2 '61

F. B. 1238 PG. 203

LOCATING IMPROVMENTS IN PROPOSED TREATMENT ALONG SOUTH BOUNDARY OF EATON CANYON PARK

J. N. C 54.30 July 1961

Note: Any Additions or Changes on This Sheet Must be Made or Circled in Red Ink With Date and Name of Person Making Change.

PLEASE RETURN TO
LOS ANGELES COUNTY ENGINEER
403 Los Angeles County Engineering Bldg.

Do not extend this side of this line.

PARTY
J. H. BROWN
K. M. KAPP
B. NUNEZ
H. L. BIRLOW

76F3095 CE # 310 3-61

PLEASE RETURN TO
LOS ANGELES COUNTY ENGINEER
403 LOS ANGELES COUNTY ENGINEERING BLDG.

Note: Any Additions or Changes on This Sheet Must be Made or Circled in Red Ink With Date and Name of Person Making Change.

Do not extend this side of this line.

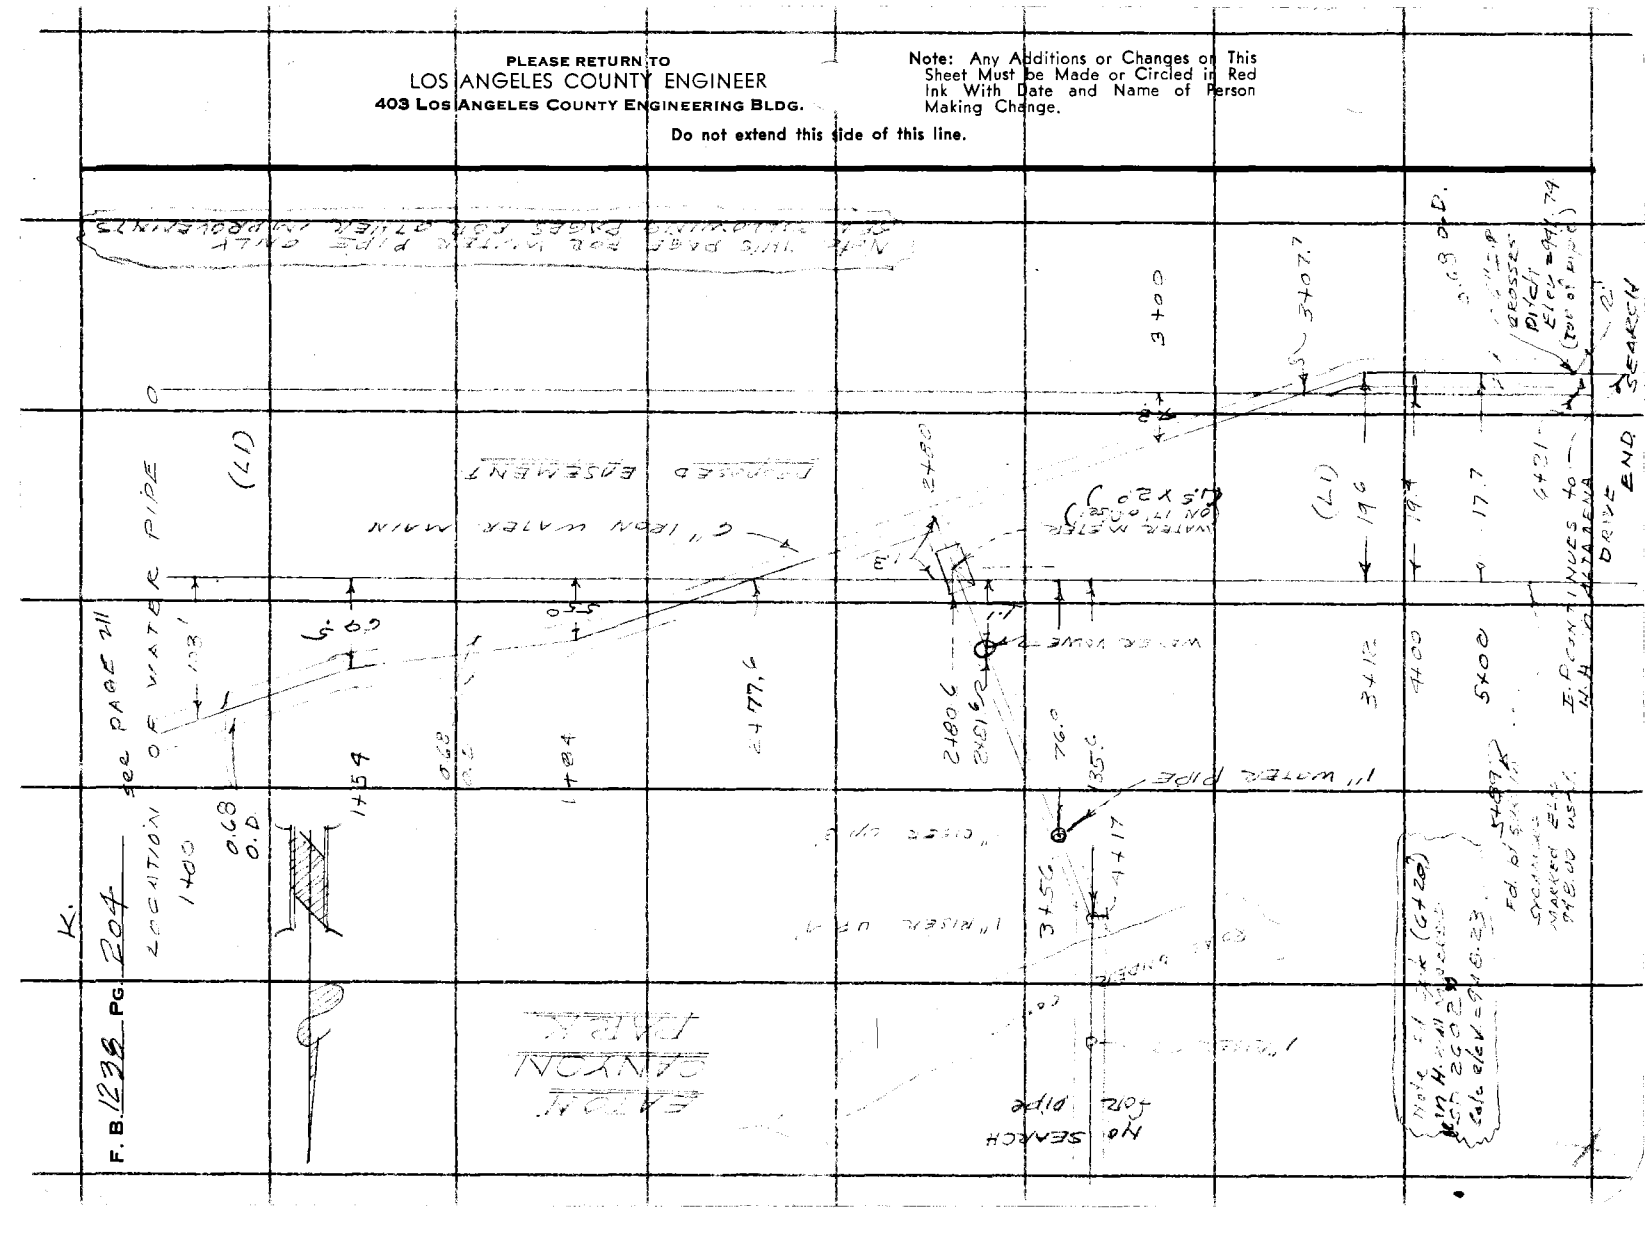

PLEASE RETURN TO
LOS ANGELES COUNTY ENGINEER
403 Los Angeles County Engineering Bldg.

Note: Any Additions or Changes on This Sheet Must be Made or Circled in Red Ink With Date and Name of Person Making Change.

Do not extend this side of this line.

F.B. 1238 PG 206

PG. 207

PG. 205

EATON CANYON

PARK

(PROPOSED) (17) EASEMENT

BAR X

ROCK & DIRT PASSAGE

CINDER BLK. RET. WALL

Ed. 1/2 Concrete Stk. Marked "947 Con. Flush"









76F3095 CE # 310 3-61

PLEASE RETURN TO
LOS ANGELES COUNTY ENGINEER
403 LOS ANGELES COUNTY ENGINEERING BLDG.

Note: Any Additions or Changes on This Sheet Must be Made or Circled in Red Ink With Date and Name of Person Making Change.

Do not extend this side of this line.

Notes Ck'd by
Map No. S.D. 8-99
Office Work T. M. ICHIEN
Checked
Date SEPT. 1961

Survey of EATON CANYON PARK
JN 2057 Tape 2146 Std. 66 °F
Surveyed by L. H. BROWN
Notes L. H. B. K. M. K. Date 7-26-61
Indexed H. E. C.

F. B. 1235 PG. 205

17.00
E.N.E. LOCATING IMPROVEMENTS

STEEP BANK RISES TO WEST

42" CHAIN LINK FENCE

(ROCK WALL)

EATON CANYON PARK

EXACT END OF EASEMENT NOT YET DETERMINED

DIRT

ACCESS RD UNDER CONST.

17.0' Offset Line

6+50 ℄
6+45 ℄
6+36.7
6+32.5
6+32.5
6+27.9
6+26.5
6+24.1

CONC. CULVERT 42" DIA. INSIDE

943.55

22.6
34.1
27.51
6.86
6+25.9
25
12
48" INSIDE DIA
INVERT ELEV = 947.8
HEADWALL
CONC. CULVERT
9.6
11.2
11.8
STONE & CONCRETE BARRIER
1.0

Sta. Barr. Eaton Canyon Road

19.89
18.12
6+15.5
6+14.0
7.4
6+08.6
BOTTOM OF CANYON
Fd IV2 Monad "1400 C. 3.22"
(drawn wrong + 0.1')
17+5+94.2 10" sycamore
6+02.2 12" sycamore
18.00
5+88.3
ROCK & OIL PASSAGE (Covered)
(PROPOSED 17' EASEMENT)
7.0
5+76.0

CONT. PAGE 206

Notes Ck'd by	Survey of EATON CANYON PARK
Map No. S.D. 8-99	JN 005430 Tape 0146 Std 68 °F
Office Work T. M. ICHIEN	Surveyed by J. H. BROWN
Checked	Notes JHB EKMK Date 7-26-61
Date SEPT. 1961	Indexed H. E. OTT

F. B. 1238 PG. 207

Note: Any Additions or Changes on This Sheet Must be Made or Circled in Red Ink With Date and Name of Person Making Change.

Do not extend this side of this line.

PLEASE RETURN TO
LOS ANGELES COUNTY ENGINEER
403 LOS ANGELES COUNTY ENGINEERING BLDG.

76F3095 CE # 810 3-61

PLEASE RETURN TO
LOS ANGELES COUNTY ENGINEER
403 LOS ANGELES COUNTY ENGINEERING BLDG.

Note: Any Additions or Changes on This Sheet Must be Made or Circled in Red Ink With Date and Name of Person Making Change.

Do not extend this side of this line.

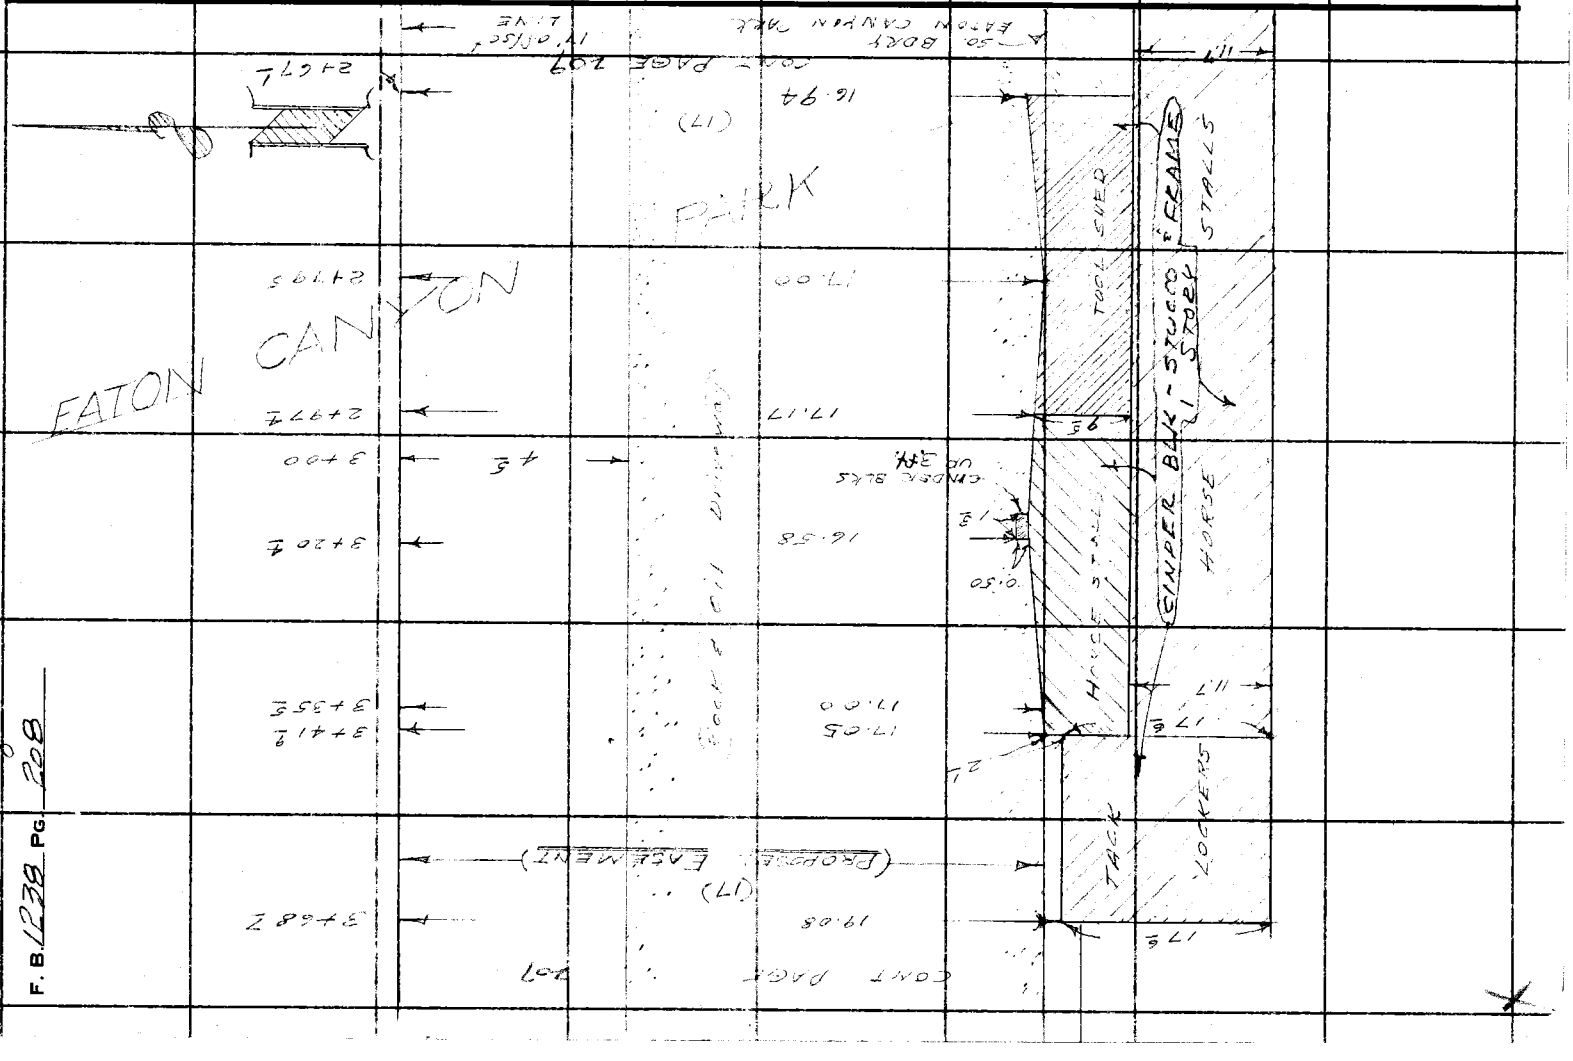

F. B. 1238 PG. 208

Notes Ck'd by	Survey of EATON CANYON PARK
Map No. S.D. 8-99	JN 00548.30 Tape 0196 Std. 68 °F
Office Work T. M. ICHIEN	Surveyed by J.H. BROWN
Checked	Notes J.H.B. Date 7-20-61
Date SEPT. 1961	Indexed H. E. OTT

F. B. 1238 PG. 209

Note: Any Additions or Changes on This Sheet Must be Made or Circled in Red Ink With Date and Name of Person Making Change.

Do not extend this side of this line.

PLEASE RETURN TO
LOS ANGELES COUNTY ENGINEER
403 LOS ANGELES COUNTY ENGINEERING BLDG.

76F3095 CE # 310 3-61

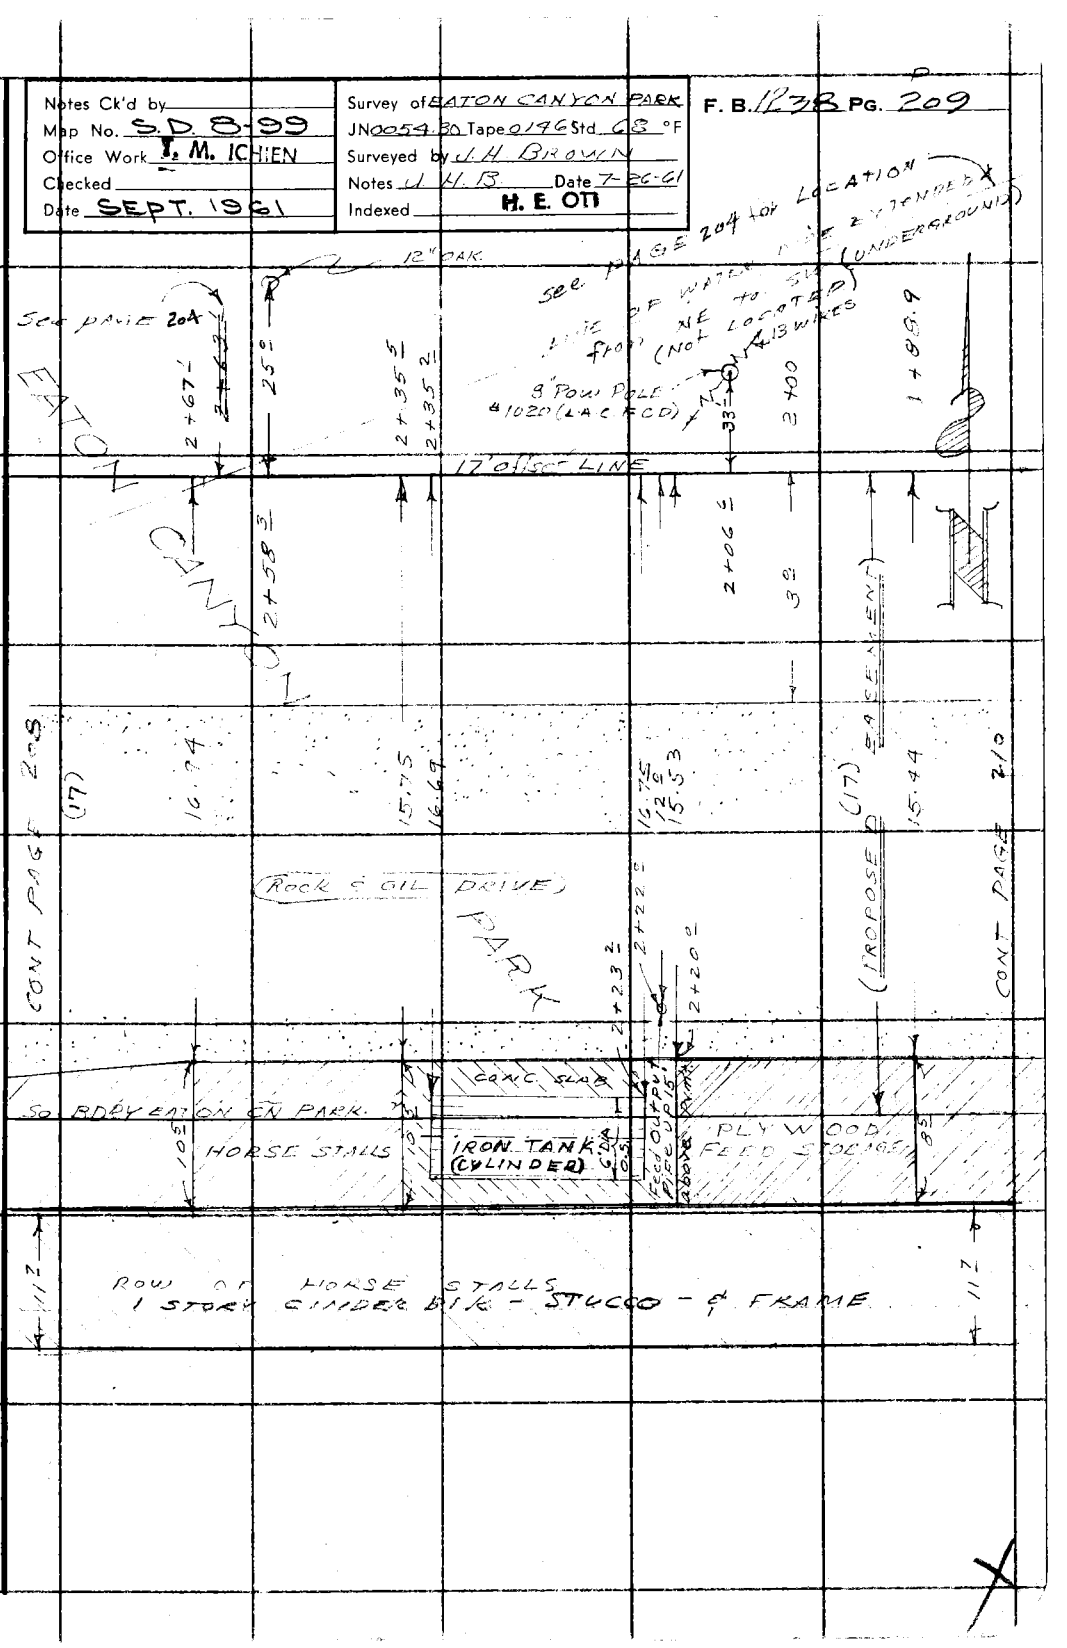

PLEASE RETURN TO
LOS ANGELES COUNTY ENGINEER
403 LOS ANGELES COUNTY ENGINEERING BLDG.

Note: Any Additions or Changes on This Sheet Must be Made or Circled in Red Ink With Date and Name of Person Making Change.

Do not extend this side of this line.

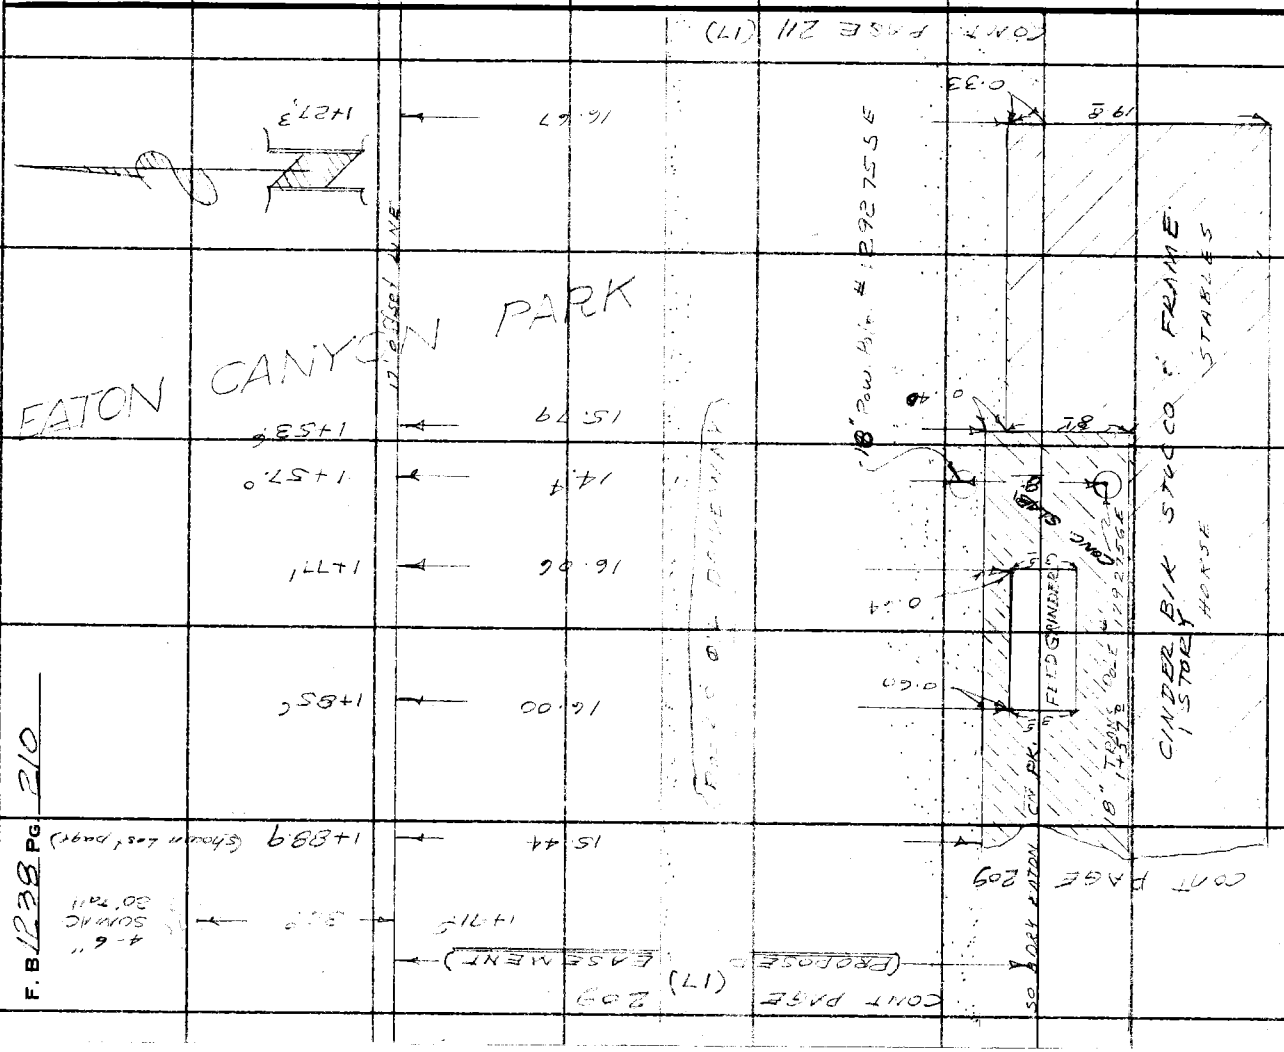

76F3095 CE # 310 3-61

PLEASE RETURN TO
LOS ANGELES COUNTY ENGINEER
403 LOS ANGELES COUNTY ENGINEERING BLDG.

Note: Any Additions or Changes on This Sheet Must be Made or Circled in Red Ink With Date and Name of Person Making Change.

Do not extend this side of this line.

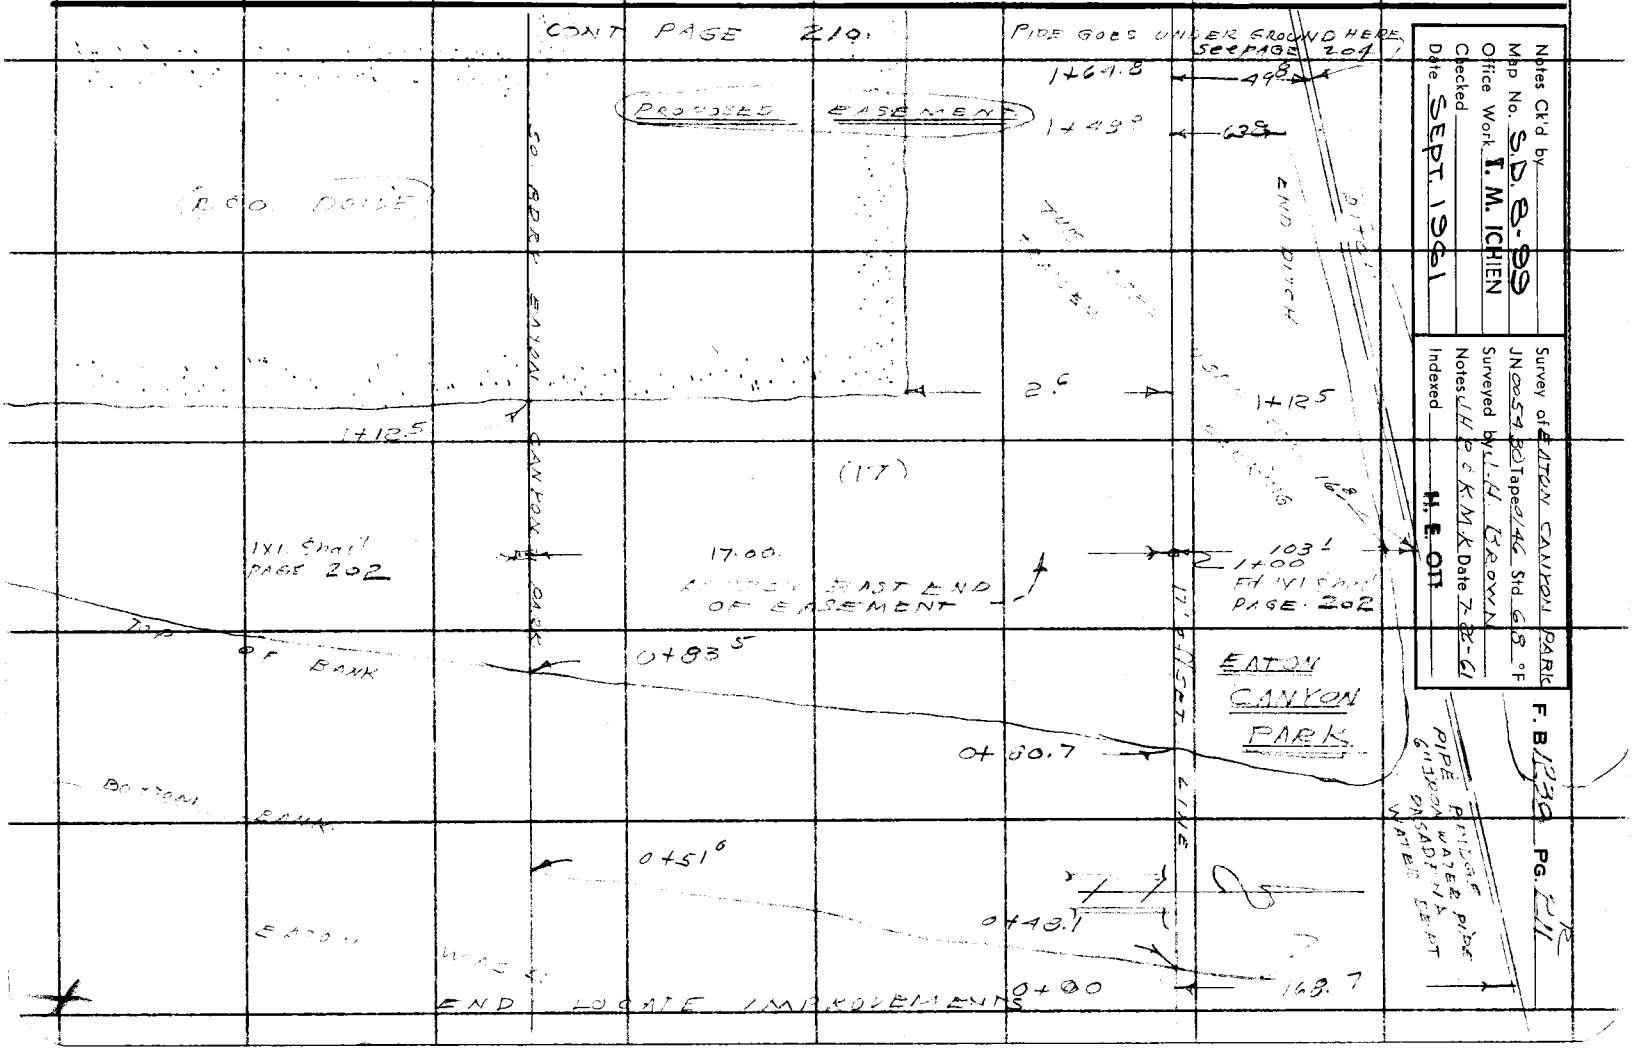

Notes Ck'd by
Map No. S.D. 8-99
Office Work T. M. ICHIEN
Checked
Date SEPT. 1961

Survey of EATON CANYON PARK
JN 0054 Bo Tape 146 Std 68 °F
Surveyed by L.H. & C.K.M.K Date 7-26-61
Notes L.H. & C.K.M.K
Indexed H. E. OTT

F. B. 12239 PG. 211

PLEASE RETURN TO
LOS ANGELES COUNTY ENGINEER
403 LOS ANGELES COUNTY ENGINEERING BLDG.

Note: Any Additions or Changes on This Sheet Must be Made or Circled in Red Ink With Date and Name of Person Making Change.

Do not extend this side of this line.

F. B. [redacted] PG [redacted]

Notes Ck'd by G. E. BARR	Survey of EATON CYN. PARK
Map No.	JN 0054.30 Tape 188 Std 84 °F
Office Work	Surveyed by J. P. MENNE
Checked	Notes J.P.M Date 8-25-66
Date	Indexed J. J. BALL

F. B. 1238 PG. 215

Note: Any Additions or Changes on This Sheet Must be Made or Circled in Red Ink With Date and Name of Person Making Change.

Do not extend this side of this line.

PLEASE RETURN TO
LOS ANGELES COUNTY ENGINEER
403 Los Angeles County Engineering Bldg.

BOUNDARY SURVEY
OF
EATON CANYON PARK
NEAR
PARK ENTRANCE ROAD
1750 No. ALTADENA DRIVE
FOX RIDGES SECTION
FOR
ENCROACHMENT CHECK

REF.

F.B. 1144

J.P. MENNE

C. ADAMS

B. JACKSON

R. NEVAREZ

76F3095 CE #310 6-62

PLEASE RETURN TO
LOS ANGELES COUNTY ENGINEER
403 LOS ANGELES COUNTY ENGINEERING BLDG.

Note: Any Additions or Changes on This Sheet Must be Made or Circled in Red Ink With Date and Name of Person Making Change.

Do not extend this side of this line.

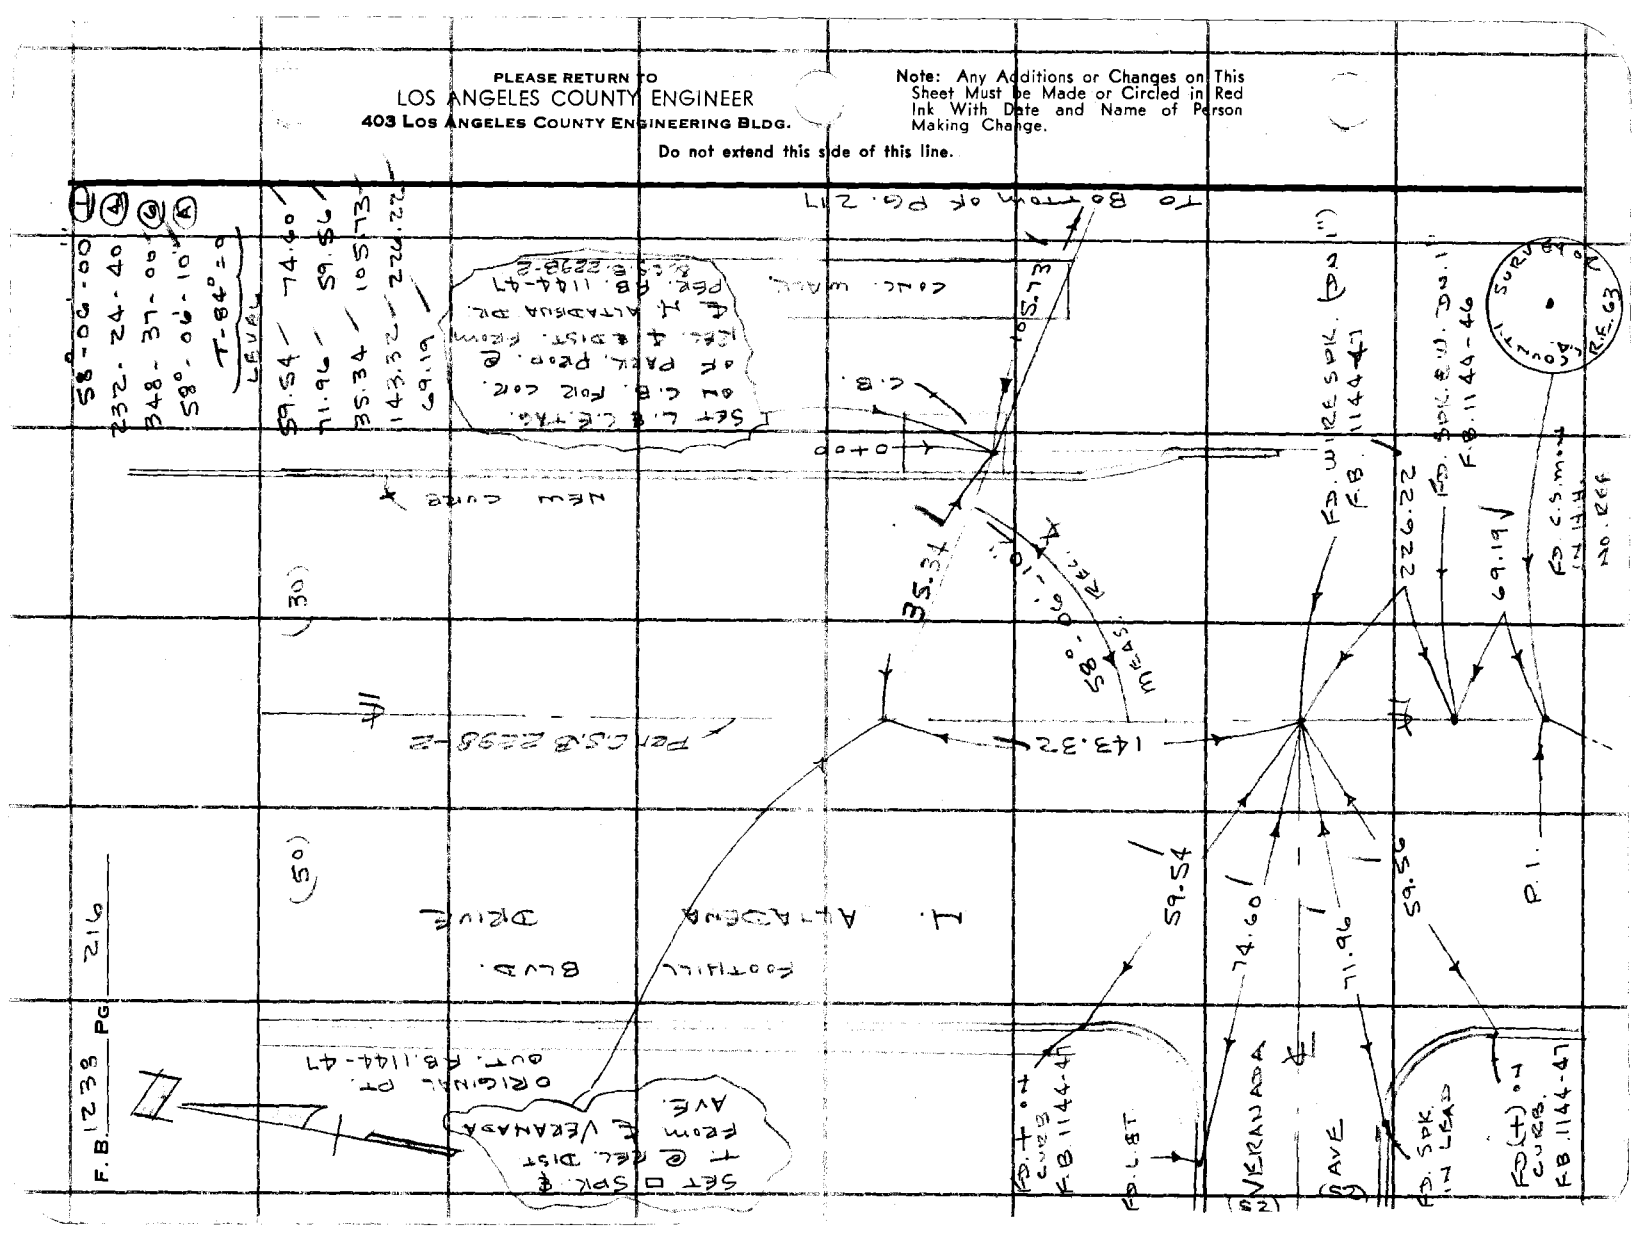

Notes Ck'd by G. E. BARR	Survey of EATON CYN. PARK
Map No.	JN 0054.39 Tape 188 Std 84 °F
Office Work	Surveyed by J. P. MENNIE
Checked	Notes S.O.M. Date 8-25-64
Date	Indexed

F. B. 1238 Pg. 7-11

Note: Any Additions or Changes on This Sheet Must be Made or Circled in Red Ink With Date and Name of Person Making Change.

Do not extend this side of this line.

PLEASE RETURN TO
LOS ANGELES COUNTY ENGINEER
403 Los Angeles County Engineering Bldg.

FD. C.S.MON.
DN. 2"
F.B. 1144-52

L.A. CO. SURV.
RE. 63

FD. 1" I.P. & N.
DN. 6"
F.B. 1144-52

E.C.

FD. 2" I.P. & R.E 1216
DN. 6"

4.00

F.B. 1144-52
95.85

29.25

B.C.

PRIVATE OWNERSHIP

S 39° 54' W
S.M. 94

R=40.06'

41.78

L.A. COUNTY SURVEY
RE. 63

T=84°=0
LEVEL

41.78
53.91
29.25
4.00

FD C.S.MON.
(FLUSH)
F.B. 1144-52

185.73 R.M.

PARK PROPERTY

SET LC. BT. SPK
W. & T ON
DRIVEWAY @
REC DIST FROM
SET C.L.C.E TAG.
PER F.B. 1144-52
& C.S.B. 2298-2

34° - 06' - 40" (1)
68 - 13 - 20 (2)
34° - 06' - 40" (3)

TO RIGHT OF PG. 216

76F3095 CE #310 6-63

PLEASE RETURN TO
LOS ANGELES COUNTY ENGINEER
403 LOS ANGELES COUNTY ENGINEERING BLDG.

Note: Any Additions or Changes on This Sheet Must be Made or Circled in Red Ink With Date and Name of Person Making Change.

Do not extend this side of this line.

F. B. 12238 PG 218

Notes Ck'd by	Survey of EATON CYN. PARK
Map No.	JN 0054.30 Tape 188 Std 84 °F
Office Work	Surveyed by J.D. MENNE
Checked	Notes C. ADAMS Date 8-25-66
Date	Indexed C. J. GALLI

F. B. 1238 PG. 219

Note: Any Additions or Changes on This Sheet Must be Made or Circled in Red Ink With Date and Name of Person Making Change.

PLEASE RETURN TO
LOS ANGELES COUNTY ENGINEER
403 LOS ANGELES COUNTY ENGINEERING BLDG.
Do not extend this side of this line.

LOCATION

OF

IMPROVEMENTS & TOPOG.

NEAR

PARK ENTRANCE ROAD

1700 NO. ALTADENA DRIVE

76F309S CE # 310 3-61
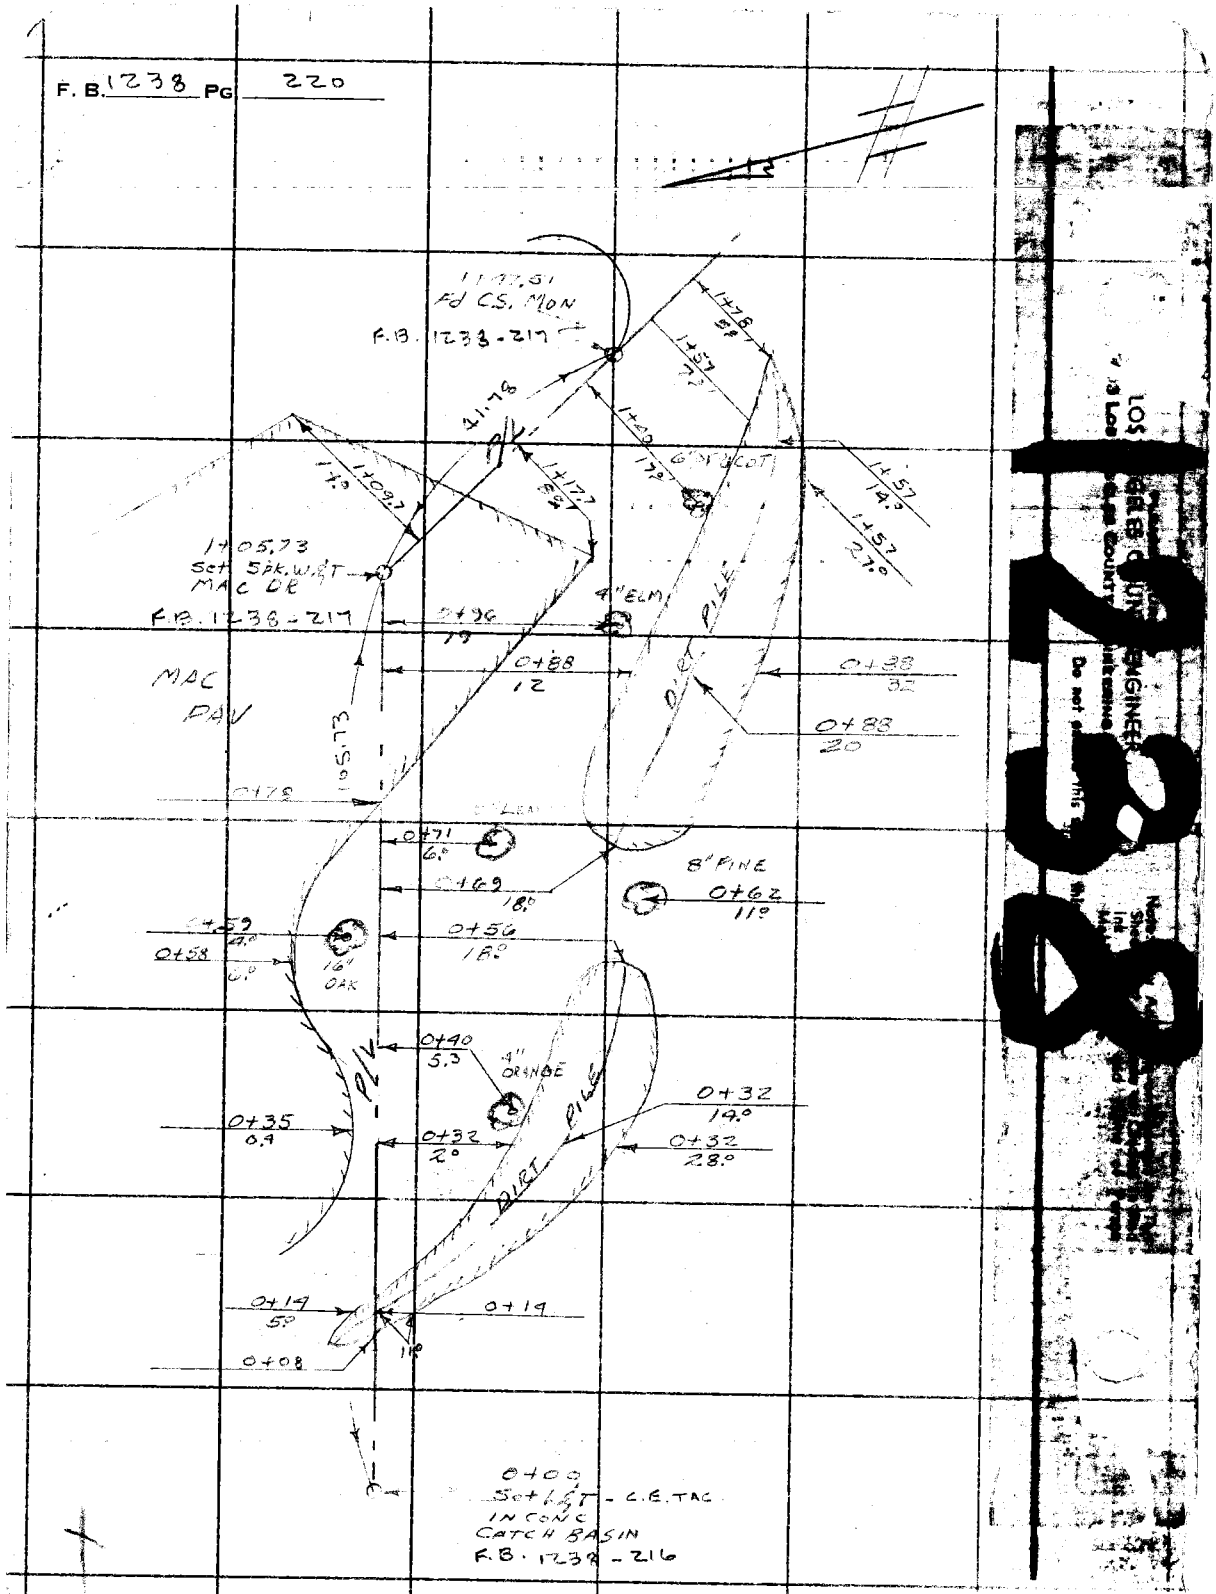
F. B. 1238 PG 220