Survey of
W. O. Tape No. St'd °F
Surveyed by ~~F. H. BLANCHARD~~
Notes Date
Indexed

F. B. 1262 Pg. 3

Resurveys of Section Lines

T5N-R8W See Index on Pg. 6
T5N-R8W See Index on Pg. 40
T5N-R9W See Index on Pg. 125
T5N-R10W See Index on Pg. 145
T5N-R11W See Index on Pg. 197.

Microfilmed Feb '88

Notes Ck'd by	Survey of T.5N. R.9W.
Map No.	W. O. 4999 Tape No. 77 St'd 68 °F
Office Work	Surveyed by Rosecrans
Checked	Notes Date 5-9-47
Date	Indexed A. C. Johnson 6-10-47

F. B. 1262 Pg. 5

SECTION LINES IN T.5N. R.9W.

J.N. 4999

E. A. Rosecrans
J. P. Pierce
J. C. Pierce
V. T. Gibbons
A. C. Folgate

Note: Any Additions or Changes on This Sheet Must be Made or Circled in Red Ink With Date and Name of Person Making Change.

Do not extend notes this side of this line.

RETURN TO
LOS ANGELES COUNTY SURVEYOR
700 HALL OF RECORDS

FORM 247 5M 5-46

F.B. 1262 PG. 6

T. 5 N. R. 9 W.

Index to lines measured on this survey

● = Monument set

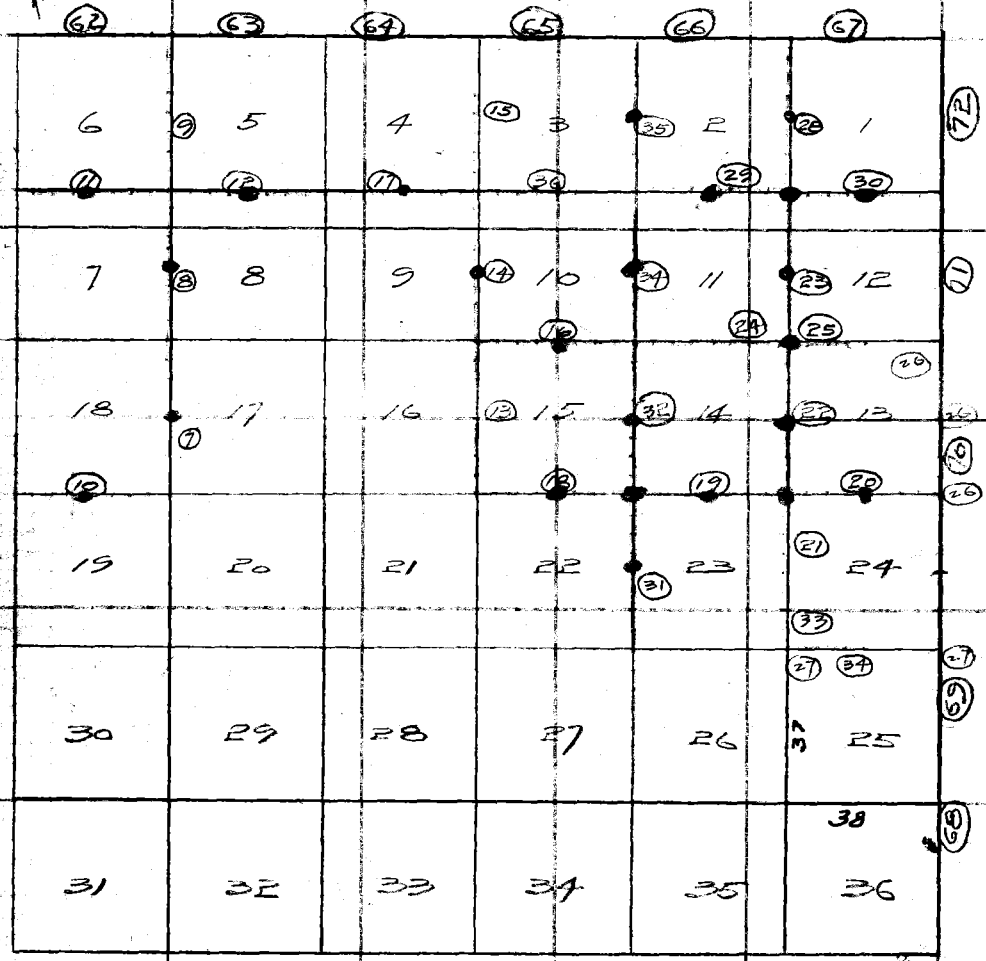

Platted on Sur. Div. 22-100

RETURN TO
LOS ANGELES COUNTY SURVEYOR
700 HALL OF RECORDS

Do not extend notes this side of this line.

Note: Any Additions or Changes on This Sheet Must be Made or Circled in Red Ink With Date and Name of Person Making Change.

W.S. 66 D-9S

Notes Ck'd by [illegible]	Survey of T. 5N. R. 9 W.
Map No.	W. O. 4999 Tape No. 77 St'd 68 °F
Office Work	Surveyed by Rosecrans
Checked	Notes R Date 3-3-47
Date	Indexed A. C. Johnson

F.B. 1262 Pg. 7

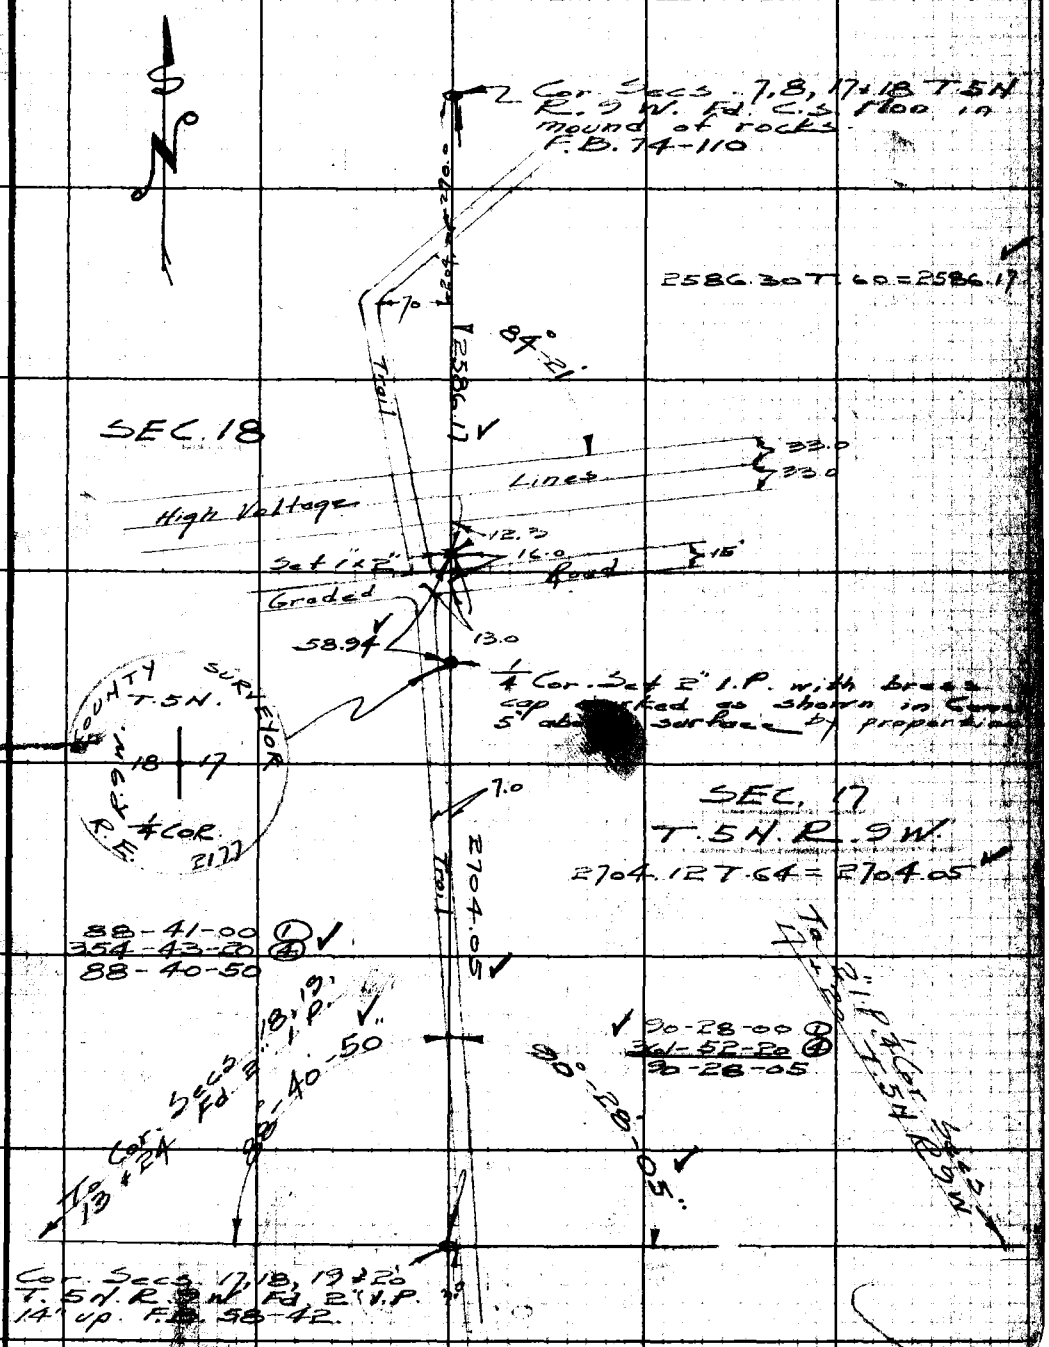

Note: Any Additions or Changes on This Sheet Must be Made or Circled in Red Ink With Name and Name of Person Making Change.

Do not extend notes this side of this line.

RETURN TO
LOS ANGELES COUNTY SURVEYOR
700 HALL OF RECORDS

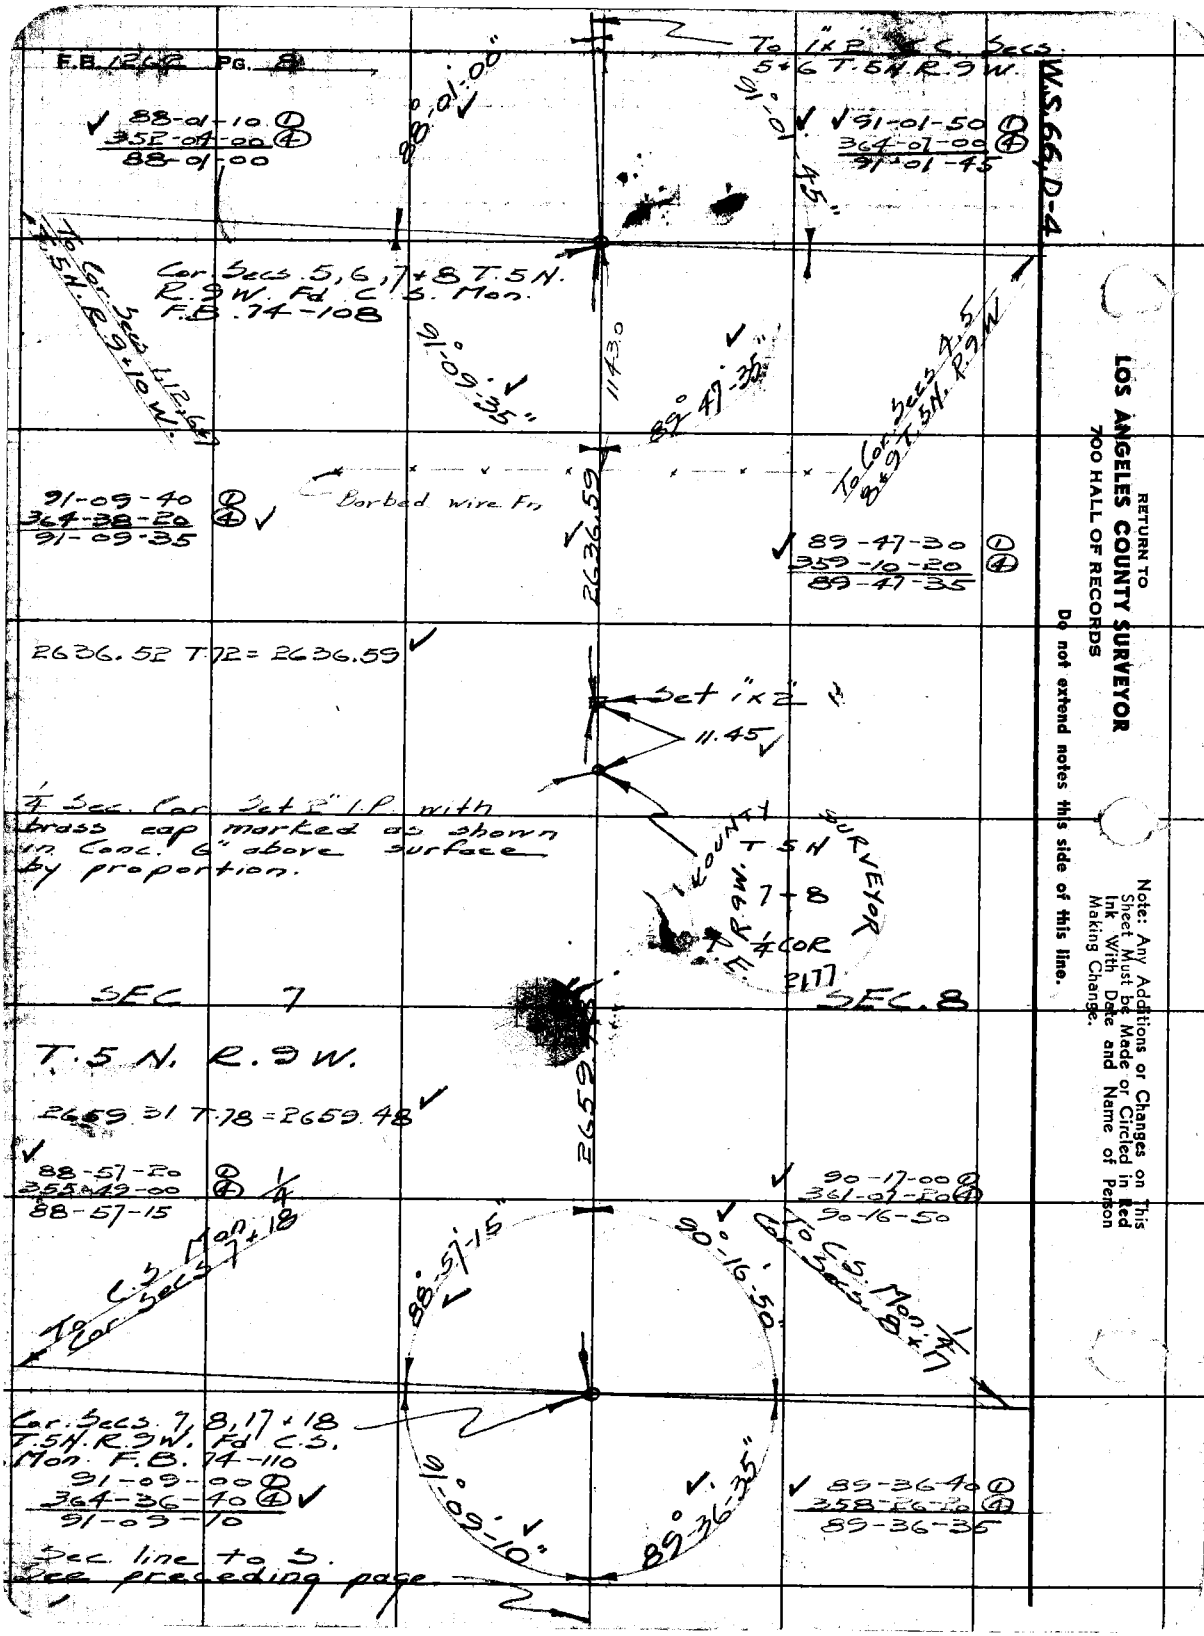
F.B. 1262 PG. 8
To 1"x2" C. Secs. 5+6 T.5N. R.9W.
W.S.66, D-4
88-01-10 ①
352-04-00 ④
88-01-00
88°-01'-00"
91°-01'-45"
91-01-50 ①
364-07-00 ④
91-01-45
To Cor. Secs. 1,12,6+7 T.5N. R.9+10 W.
Cor. Secs. 5,6,7+8 T.5N. R.9W. Fd. C.S. Mon. F.B. 74-108
91°-09'-35"
11430
89°-47'-35"
To Cor. Secs. 4,5 8+9 T.5N. R.9W.
91-09-40 ①
364-38-20 ④
91-09-35
Barbed wire Fn.
2636.59
89-47-30 ①
359-10-20 ④
89-47-35
2636.52 T.72 = 2636.59
Set 1"x2"
11.45
1/4 Sec. Cor. Set 2" I.P. with brass cap marked as shown in Conc. 6" above surface by proportion.
COUNTY SURVEYOR
T.5N. R.9W.
7+8
1/4 COR
R.E. 2177
SEC. 7
SEC. 8
T.5N. R.9W.
2659.31 T.78 = 2659.48
2659.48
88-57-20 ①
355-49-00 ④
88-57-15
1/4
90-17-00 ①
361-07-20 ④
90-16-50
To C.S. Mon. Cor. Secs. 7+18
88°-57'-15"
90°-16'-50"
To C.S. Mon. Cor. Secs. 8+17
1/4
Cor. Secs. 7,8,17+18 T.5N. R.9W. Fd. C.S. Mon. F.B. 74-110
91-09-00 ①
364-36-40 ④
91-09-10
91°-09'-10"
89°-36'-35"
89-36-40 ①
358-26-20 ④
89-36-35
See line to S.
See preceding page
RETURN TO
LOS ANGELES COUNTY SURVEYOR
700 HALL OF RECORDS
Do not extend notes this side of this line.
Note: Any Additions or Changes on This Sheet Must be Made or Circled in Red Ink With Date and Name of Person Making Change.

Notes Ck'd by KAMcAL	Survey of T.5N.R.9W.
Map No.	W. O. 4999 Tape No. 77 St'd 68 °F
Office Work	Surveyed by Rosecrans
Checked	Notes R Date 3-11-47
Date	Indexed A. C. Johnson

F.B. 262 Pg. 9

W.S. 66.D-3

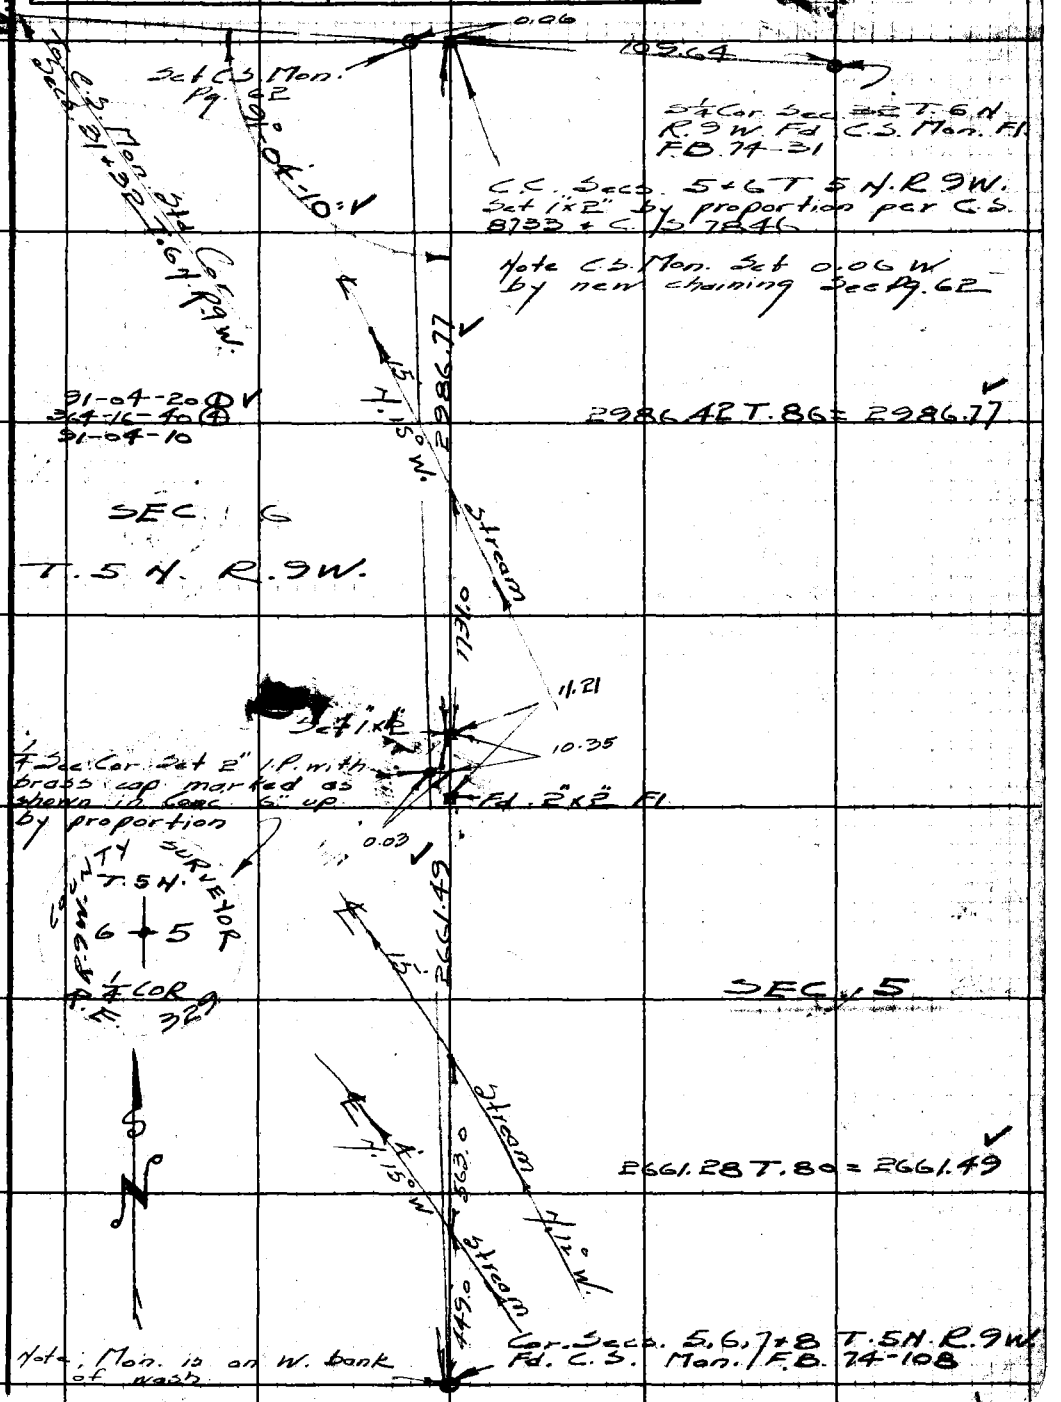

Note: Any Additions or Changes on This Sheet Must be Made or Circled in Red Ink With Date and Name of Person Making Change.

Do not extend notes this side of this line.

RETURN TO
LOS ANGELES COUNTY SURVEYOR
700 HALL OF RECORDS

FORM 247 5M 11-41

F.B. 1262 PG. 10

W.S. 66, D-5

Sec. line 7

Cor. Secs. 17, 18, 19 + 20
T. 5 N. R. 9 W. Fd. 2" I.P.
F.B. 58-42

88°-40'-50"

Sec Pg. 7

776.0

℄ 12' Stream

3122.95

3122.79 T.76 = 3122.95

SURVEYOR
T. 5 N. R. 9 W.
18 19
1/4 COR
R.E. 21.77

SEC 18

1/4 Cor. Set 2" I.P. with brass cap marked as shown in Conc. 5" above surface by proportion

SEC 19

T. 5 N. R. 9 W.

477.34

Set 1"x2"

2043.82 T76 = 2043.93

2043.93

90-53-30 (1)
363-33-40 (4)
90-53-25

7' Trail

90°-53-25"
90°-55-15" Rec.

To C.S. Mon. 1/4 Cor Secs. 13 + 18

271.0

Cor. Secs. 13, 24, 18 + 19
T. 5 N. R. 9 + 10 W. Fd.
2" I.P. in mound of rocks
3 base 1' high. Could not
find brass cap Mon. per
C.S. 8734

RETURN TO
LOS ANGELES COUNTY SURVEYOR
700 HALL OF RECORDS

Do not extend notes this side of this line.

Note: Any Additions or Changes on This Sheet Must be Made or Circled in Red Ink With Date and Name of Person Making Change.

W.S.66.D-4

Notes Ck'd by K.R. McPh	Survey of T 5 N R 9 W
Map No.	W. O. 4999 Tape No. 77 St'd 68 °F.
Office Work	Surveyed by Rosecrans
Checked	Notes R Date 3-18-47
Date	Indexed A. C. Johnson

F.B. 1262 Pg. 11

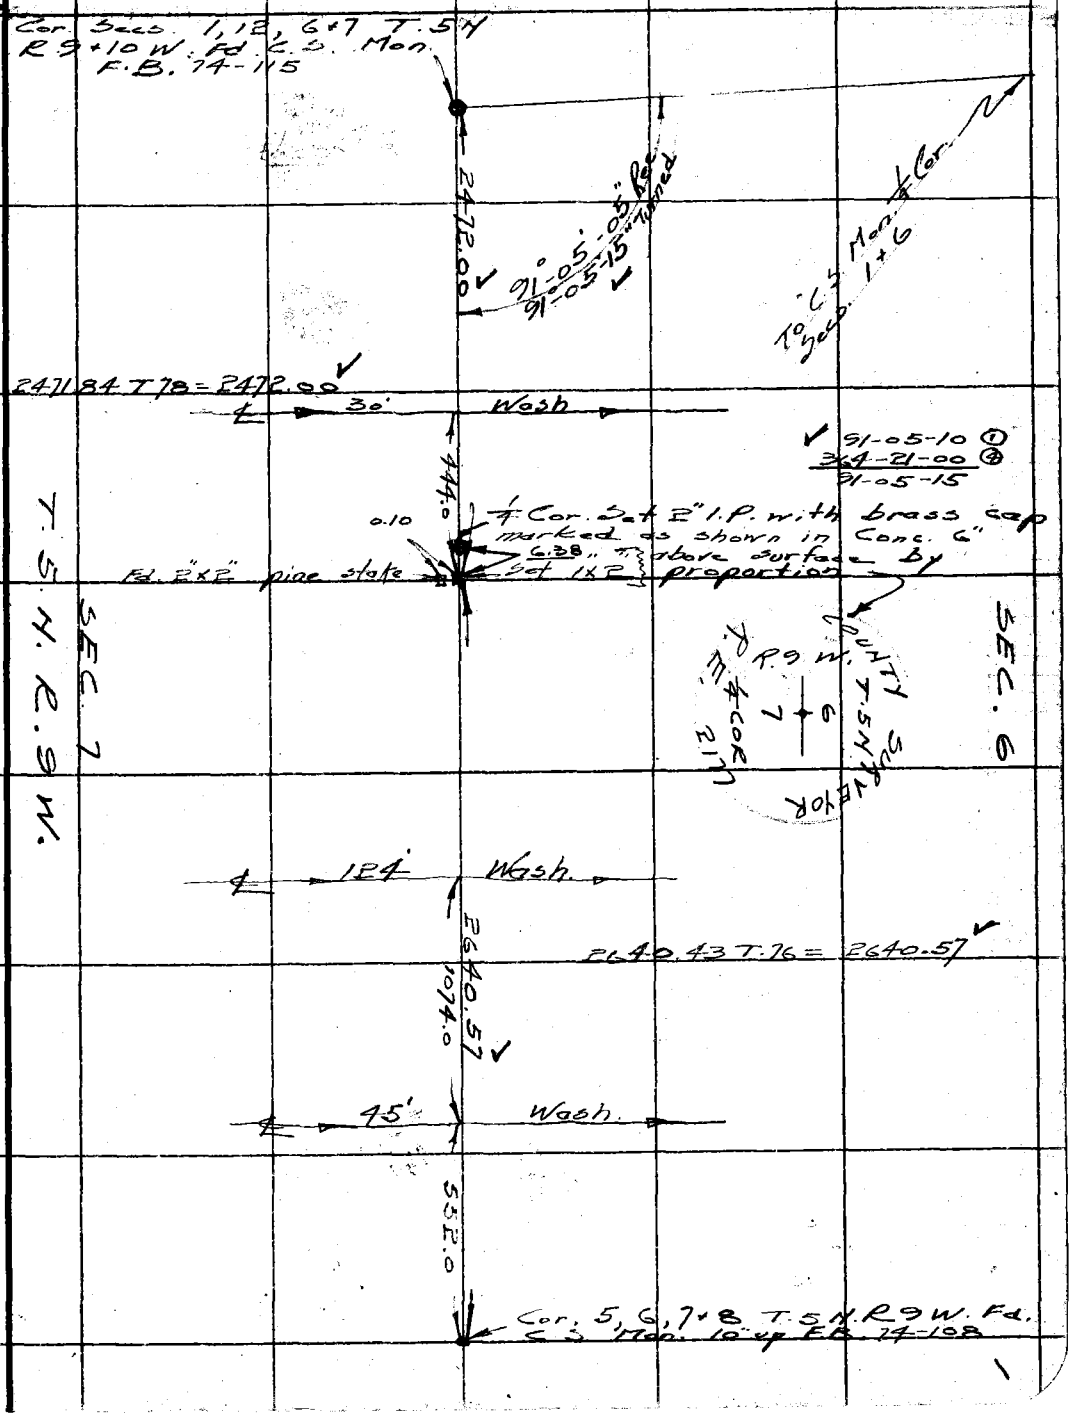

Note: ANY ADDITIONS OR CHANGES ON THIS SHEET MUST BE MADE OR CIRCLED IN Red Ink. WITH DATE AND NAME OF PERSON MAKING CHANGE.

RETURN TO
LOS ANGELES COUNTY SURVEYOR
700 HALL OF RECORDS
Do not extend notes this side of this line

FORM 247 10M 8-31

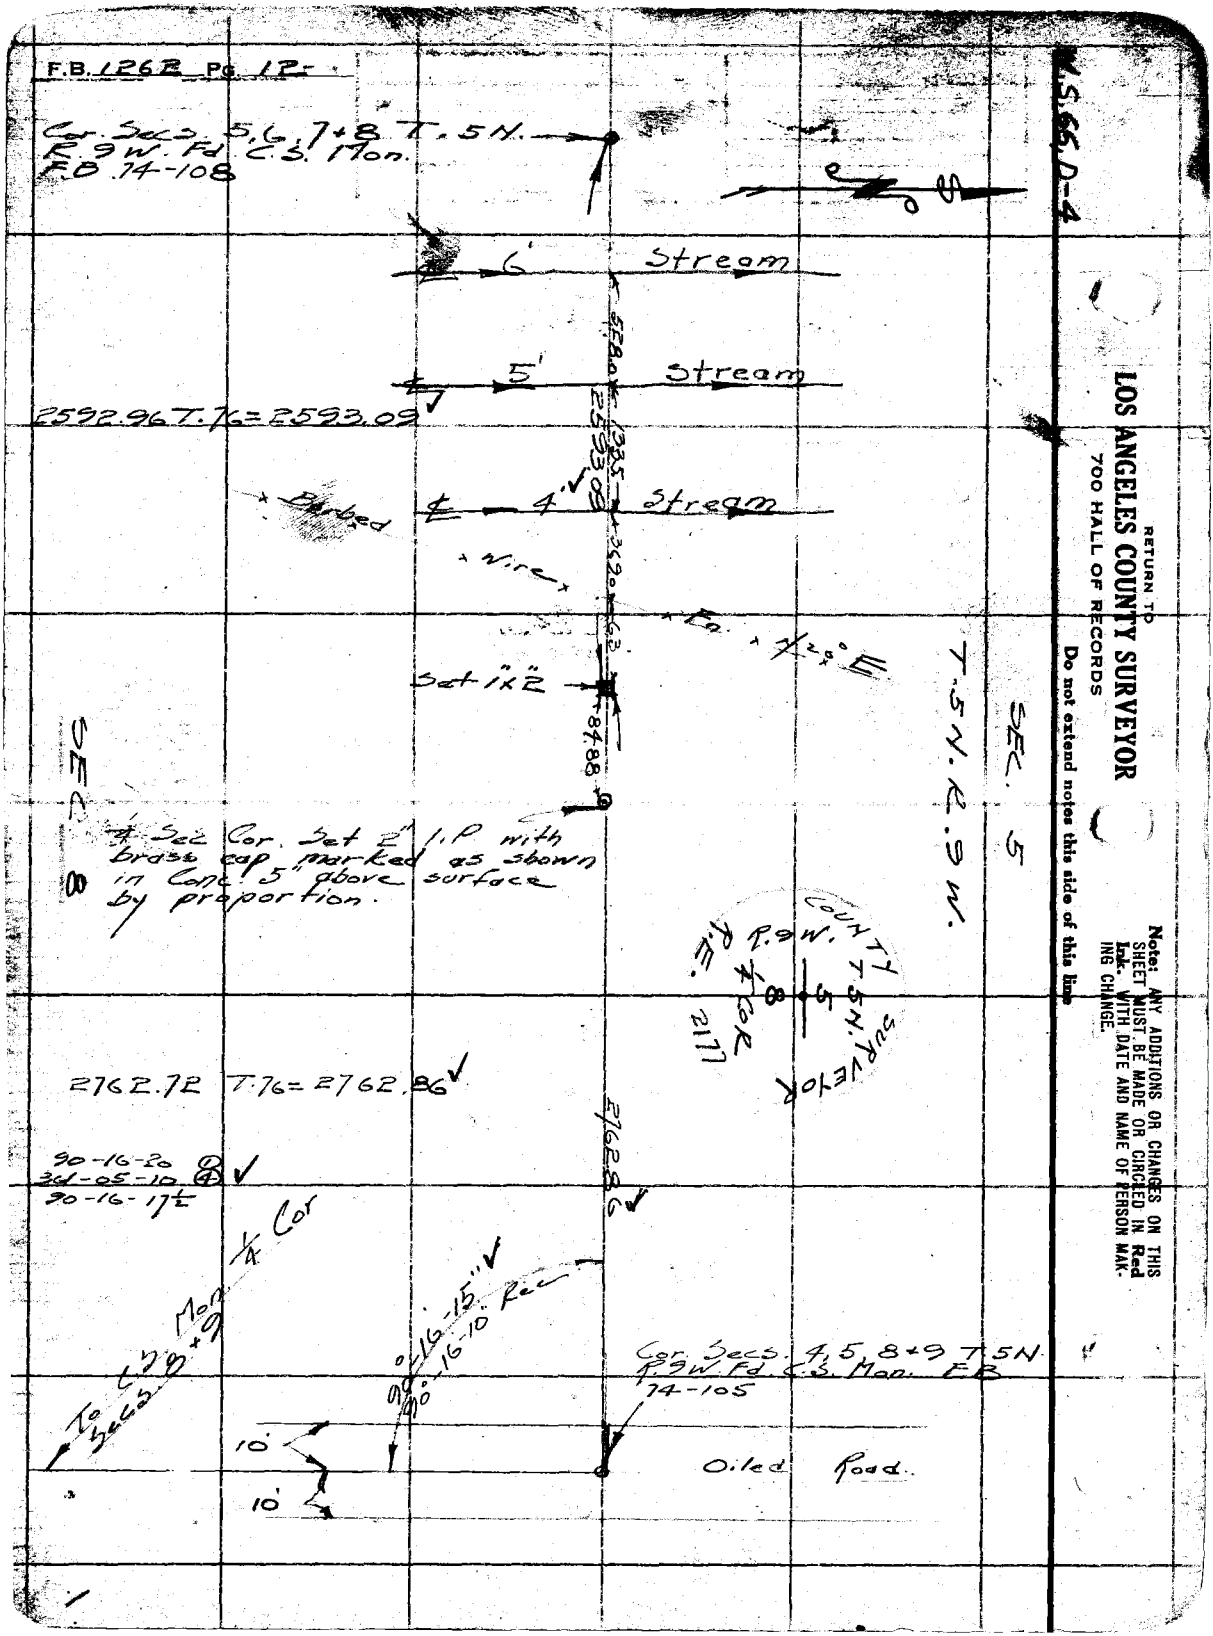

RETURN TO
LOS ANGELES COUNTY SURVEYOR
700 HALL OF RECORDS
Do not extend notes this side of this line
Note: ANY ADDITIONS OR CHANGES ON THIS SHEET MUST BE MADE OR CIRCLED IN Red Ink. WITH DATE AND NAME OF PERSON MAKING CHANGE.

W.S. 67-A-4,5

Notes Ck'd by K.R. McPh	Survey of T.5N. R9W.
Map No.	W. O. 4999 Tape No. 77 St'd 68 °F
Office Work	Surveyed by Rosecrans
Checked	Notes R Date 3-26-47
Date	Indexed A. C. Johnson

F. B. 1262 Pg. 13

Cont. bottom next page

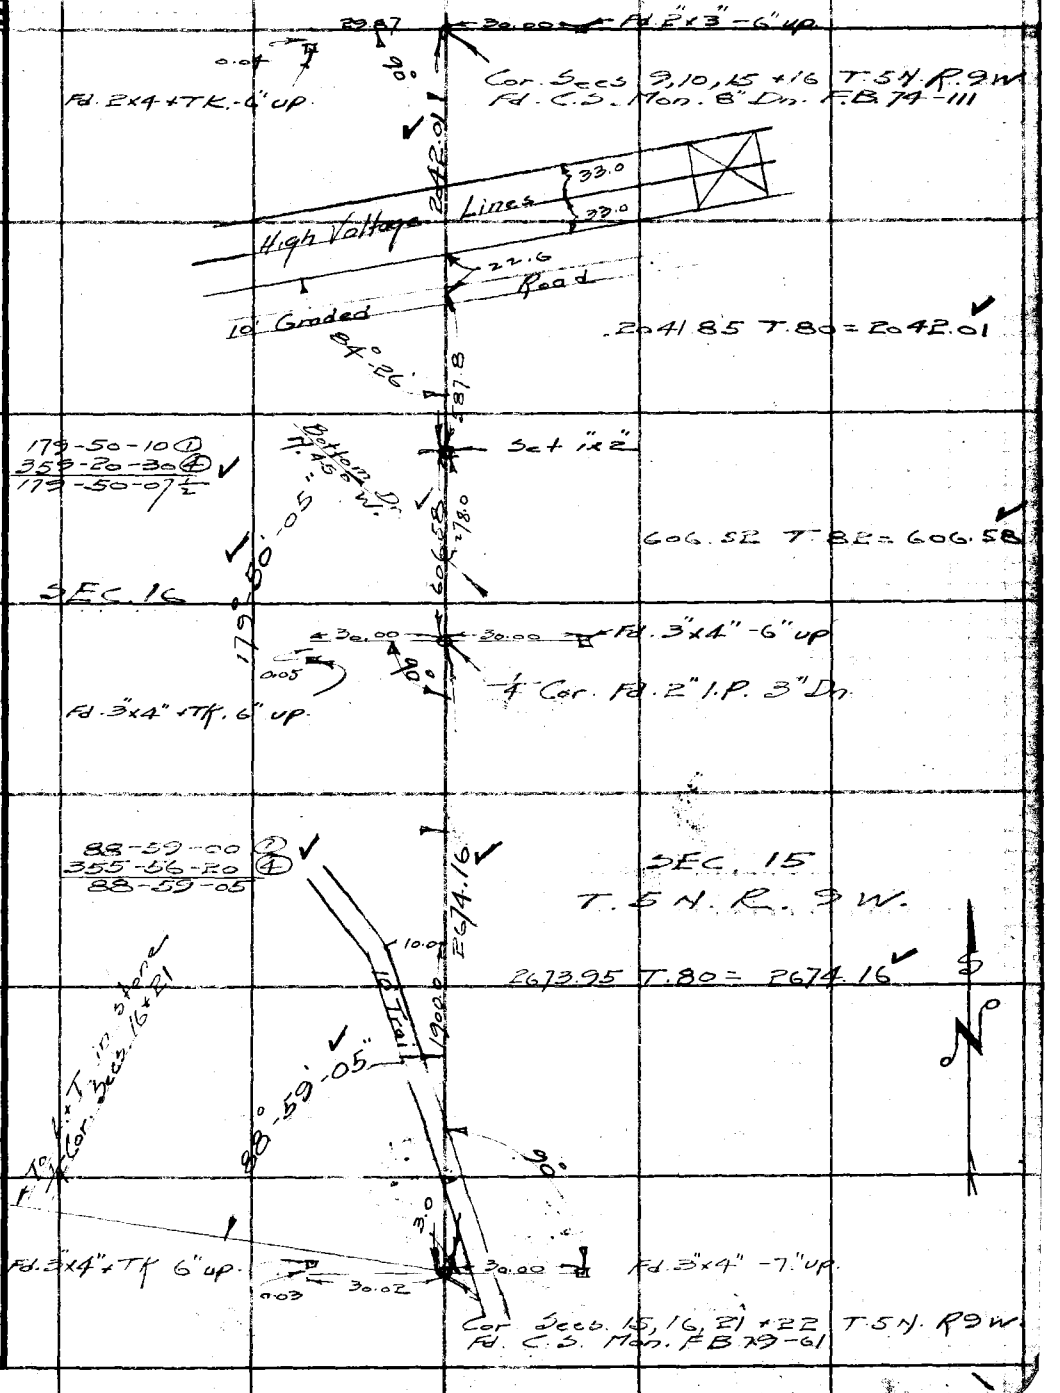

Note: Any Additions or Changes on This Sheet Must be Made or Circled in Red Ink With Date and Name of Person Making Change.

Do not extend notes this side of this line.

RETURN TO
LOS ANGELES COUNTY SURVEYOR
700 HALL OF RECORDS

FORM 247 5M 5-46

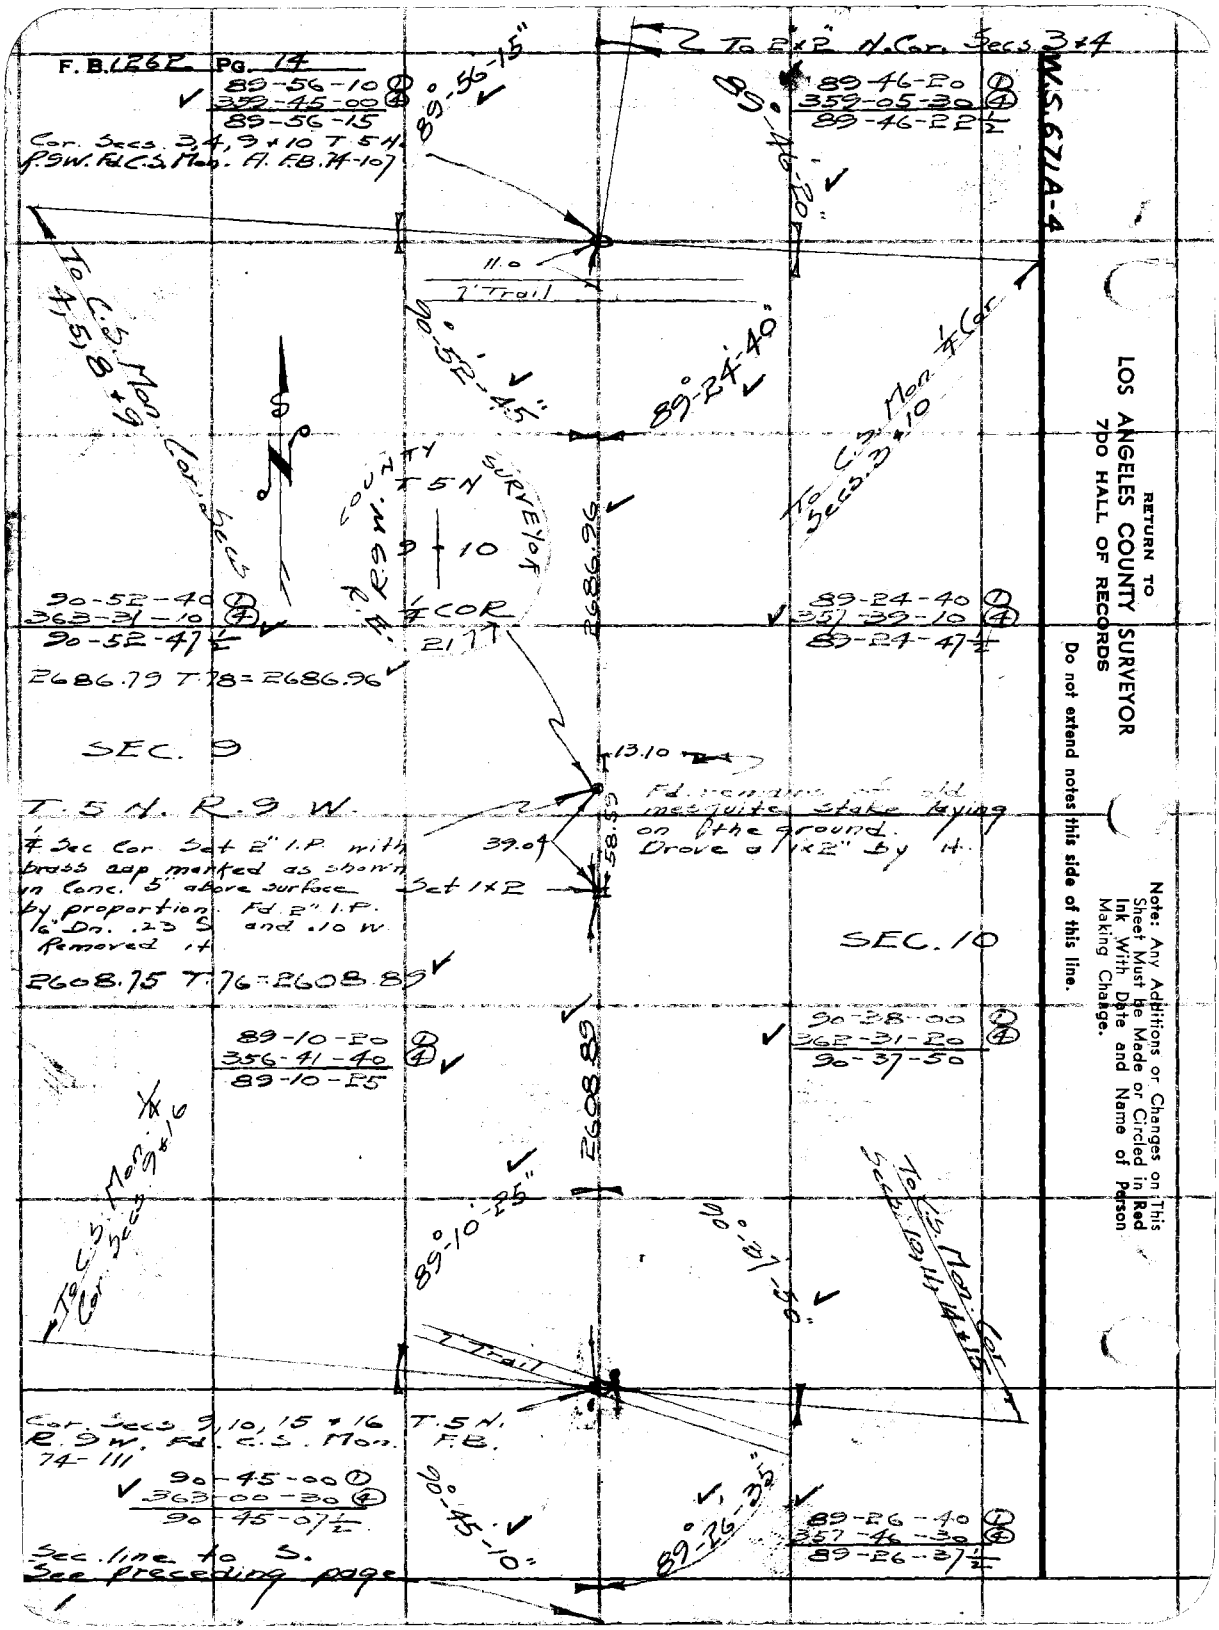
F. B. 1262 Pg. 14
To 2"x2" N. Cor. Secs 3 & 4
W.S. 671A-4
89-56-10 ①
359-45-00 ④
89-56-15
Cor. Secs. 3, 4, 9 & 10 T. 5 N. R. 9 W. Fd. C.S. Mon. A. F.B. 74-107
89°-56'-15"
89°-46'-20"
89-46-20 ①
359-05-30 ④
89-46-22½
11.0
7' Trail
To C.S. Mon. Cor. Secs 4, 5, 8 & 9
90°-52'-45"
89°-24'-40"
To C.S. Mon. ¼ Cor. Secs. 3 & 10
COUNTY SURVEYOR
T. 5 N.
R. 9 W.
9 10
¼ COR
21.77
2686.96
90-52-40 ①
363-31-10 ④
90-52-47½
89-24-40 ①
357-39-10 ④
89-24-47½
2686.79 T. 78 = 2686.96
SEC. 9
13.10
T. 5 N. R. 9 W.
Fd. remains of old mesquite stake laying on the ground. Drove a 1x2" by it.
¼ Sec Cor Set 2" I.P. with brass cap marked as shown in Conc. 5" above surface by proportion. Fd. 2" I.P. 16" Dn. .23 S and .10 W. Removed it
39.04
58.59
Set 1x2
SEC. 10
2608.75 T. 76 = 2608.89
89-10-20 ①
356-41-40 ④
89-10-25
90-38-00 ①
362-31-20 ④
90-37-50
2608.89
To C.S. Mon. ¼ Cor. Secs 9 & 16
89°-10'-25"
90°-37'-50"
To C.S. Mon. Cor. Secs 10, 11, 14 & 15
7' Trail
Cor. Secs 9, 10, 15 & 16 T. 5 N. R. 9 W. Fd. C.S. Mon. F.B. 74-111
90-45-00 ①
363-00-30 ④
90-45-07½
90°-45'-10"
89°-26'-35"
89-26-40 ①
357-46-30 ④
89-26-37½
Sec. line to S.
See preceding page
RETURN TO
LOS ANGELES COUNTY SURVEYOR
700 HALL OF RECORDS
Do not extend notes this side of this line.
Note: Any Additions or Changes on This Sheet Must be Made or Circled in Red Ink With Date and Name of Person Making Change.

W.S. 67A-3.4

Notes Ck'd by K.R. McPhe	Survey of T.5 N. R. 9 W.
Map No.	W. O. 4999 Tape No. 77 St'd 68 °F.
Office Work	Surveyed by Rosecrans
Checked	Notes R Date 3-28-47
Date	Indexed A. C. Johnson

F.B. 1268 Pg. 15

~~N. C.C. Secs 3+4 T.5N. R.9W.~~
~~Set 2"x2" by proportion.~~
~~C.S. 8734 + C.S. 7846~~

133.11

C.C. Set 2" I.P. with brass cap by proportion per new chaining See Pg. 4

89°-32'-45"

0.04

To C.S. Mon. Std. Cor. Secs. 33+34 T.6N. R.9W.

1523.62

S 1/4 Cor. Sec. 3+4 T.6N. R.9W. Fd. C.S. Mon. F.B. 74-32

89-32-50 ①
358-11-00 ④
89-32-45

1523.64 T.66 = 1523.62

1550.03 T.66 = 1550.01

Set 1"x2"

SEC. 4

SEC. 3

T. 5 N R. 9 W.

1550.01

Fd. 2"x4" + Ha. 5" up

Fd. 2"x4" + Ha. 5" up

30.04

30.01

38.47

0.36

0.39

90°

24.97

Set 1"x2"

1/4 Cor. Fd. 2" I.P. 3" Dn. with piece of old original mesquite stake laying by it. Replaced 2" I.P. with 2" I.P. with brass cap marked as shown in Conc. 6" above Surf.

COUNTY SURVEYOR

T.5N.

R.9W.

4 + 3

1/4 COR

R.E. 329

2615.58

2615.65 T 64 = 2615.58

Cor. Secs. 3, 4, 9 + 10 T.5N. R.9 W.
Fd. C.S. Mon. F.B. 74 - 107

Note: ANY ADDITIONS OR CHANGES ON THIS SHEET MUST BE MADE OR CIRCLED IN Red Ink. WITH DATE AND NAME OF PERSON MAKING CHANGE.

RETURN TO
LOS ANGELES COUNTY SURVEYOR
700 HALL OF RECORDS

Do not extend notes this side of this line

FORM 247 10M 5-31

F.B. 1262 Pg. 16

W.S. 67A-4

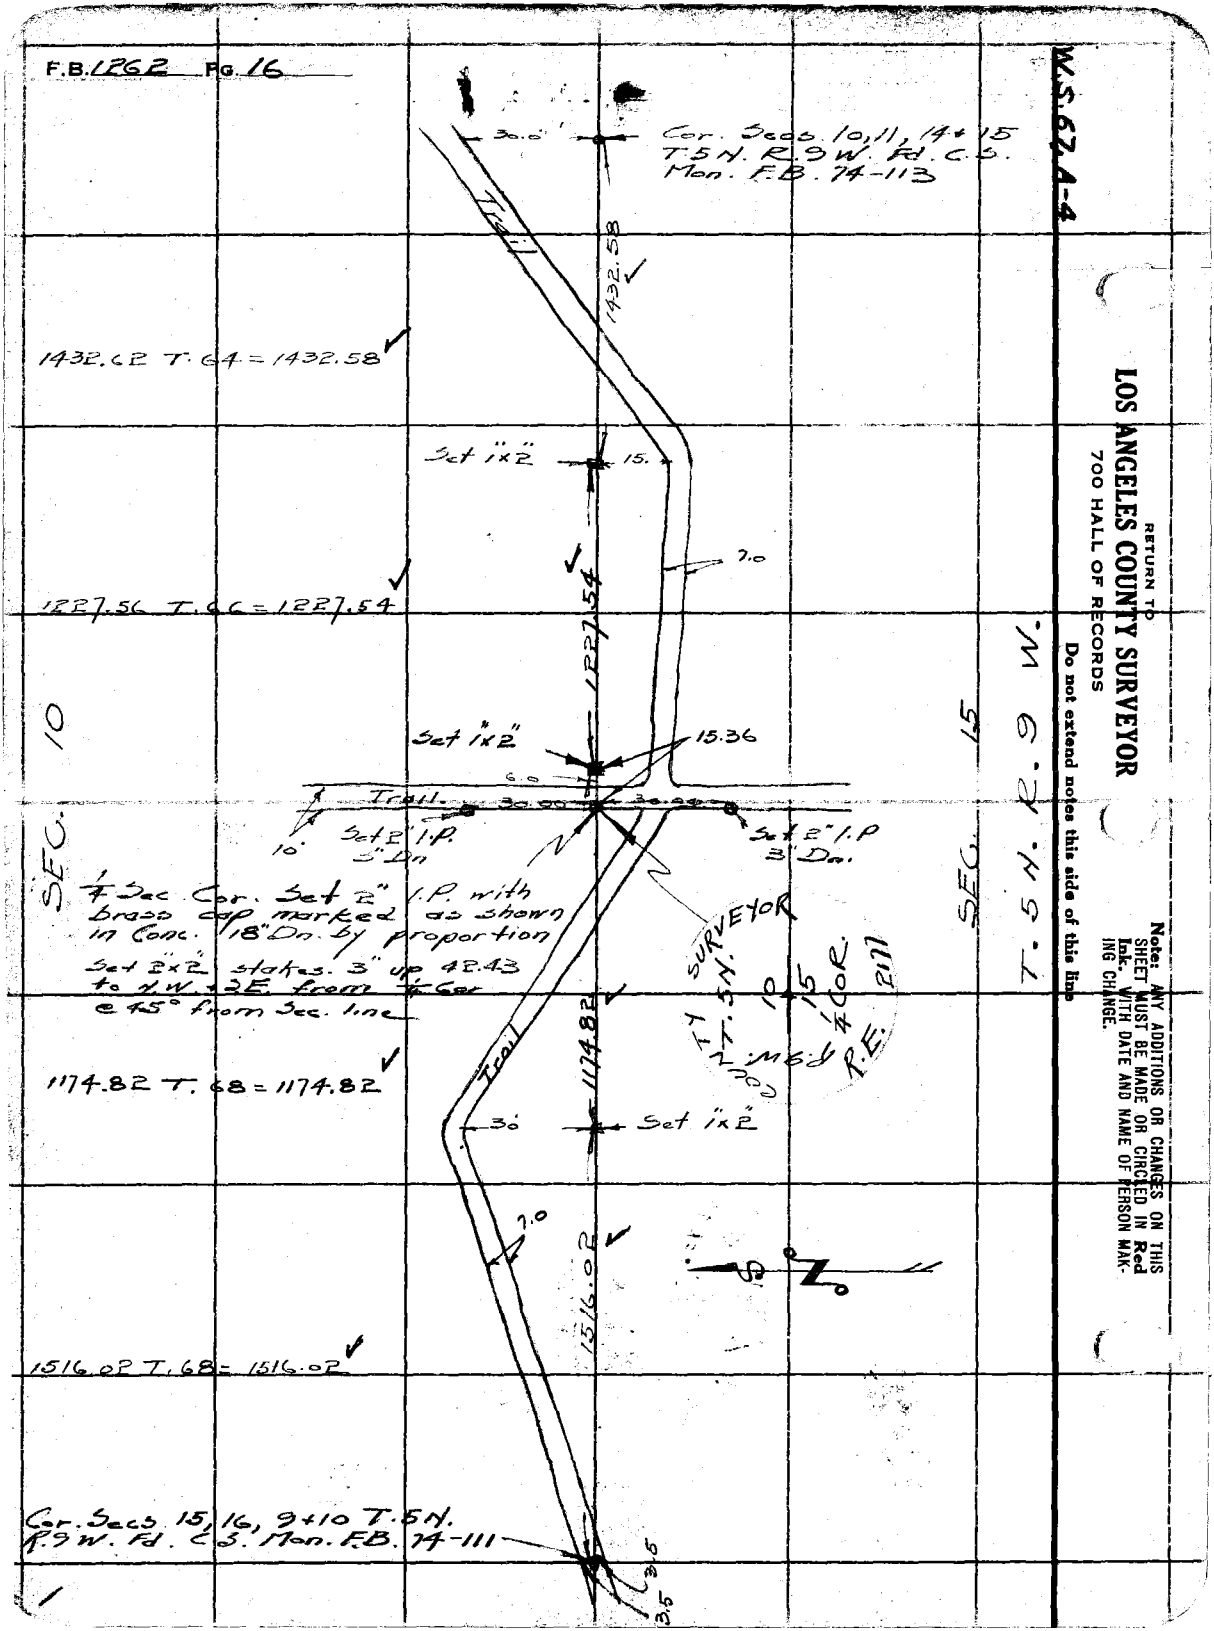

RETURN TO
LOS ANGELES COUNTY SURVEYOR
700 HALL OF RECORDS

Do not extend notes this side of this line

Note: ANY ADDITIONS OR CHANGES ON THIS SHEET MUST BE MADE OR CIRCLED IN Red Ink. WITH DATE AND NAME OF PERSON MAKING CHANGE.

W.S. 67A-4

Notes Ck'd by [illegible]	Survey of T.5N. R.9W.
Map No.	W. O. 4999 Tape No. 77 St'd 68 °F
Office Work	Surveyed by Rosecrans
Checked	Notes R Date 4-1-47
Date	Indexed C. C. Johnson

F. B. 1262 PG. 17

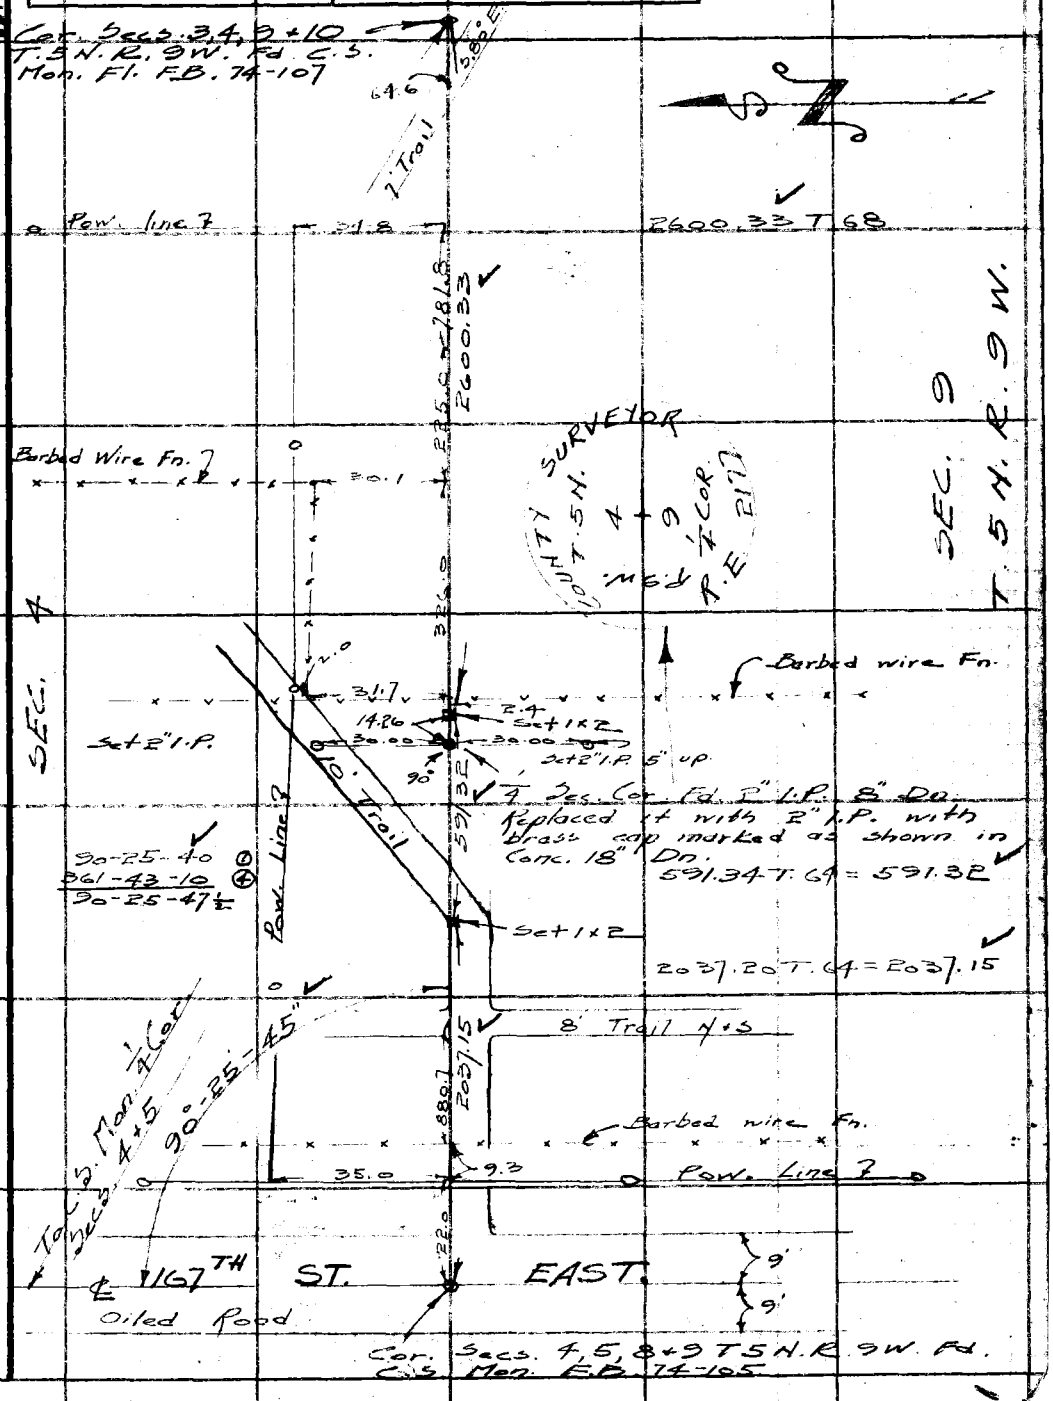

Note: Any Additions or Changes on This Sheet Must be Made or Circled in Red Ink With Date and Name of Person Making Change.

Do not extend notes this side of this line.

RETURN TO
LOS ANGELES COUNTY SURVEYOR
700 HALL OF RECORDS

FORM 247 5M 5-46

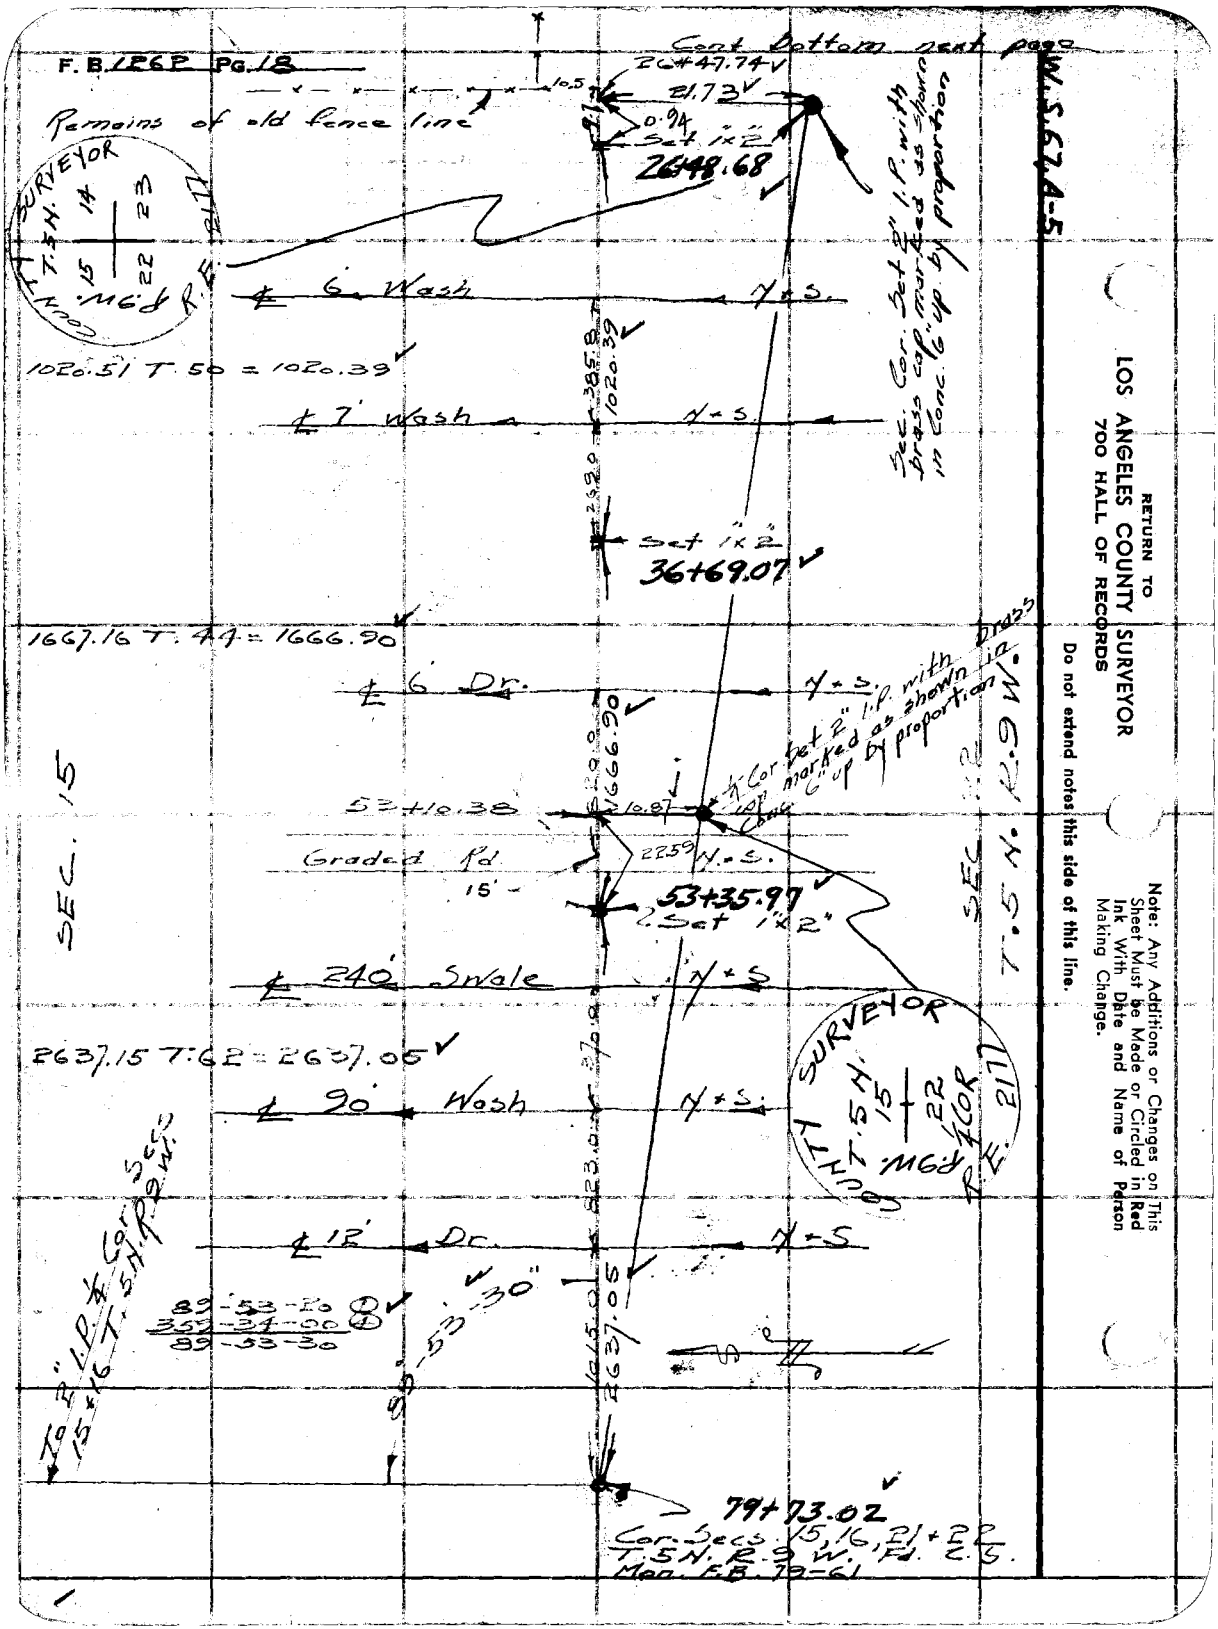
F. B. 1262 PG. 18
Cont. Bottom next page
W.S. 67 A-5
26+47.74
21.73
0.94
Set 1"x2"
26+48.68
Remains of old fence line
10.5
Sec. Cor. Set 2" I.P. with brass cap marked as shown in Conc. 6" up by proportion
COUNTY SURVEYOR
T.5N. R.9W. 14 15 22 23
R.E. 2177
℄ 6' Wash
N+S.
1020.51 T. 50 = 1020.39
385.8
1020.39
℄ 7' Wash
N+S.
Set 1"x2"
36+69.07
1667.16 T. 44 = 1666.90
℄ 6' Dr.
N+S.
1666.90
℄ Cor. Set 2" I.P. with brass cap marked as shown in Conc. 6" up by proportion
53+10.38
10.87
Graded Rd.
15'
22.59
N+S.
53+35.97
Set 1"x2"
SEC. 15
SEC. 22
T.5N. R.9W.
℄ 240' Swale
N+S
2637.15 T. 62 = 2637.05
℄ 90' Wash
N+S.
COUNTY SURVEYOR
T.5N. R.9W. 15 22 ¼ COR
R.E. 2177
℄ 12' Dr.
N+S
89-53-20
359-34-00
89-53-30
89-53-30"
1015.0
2637.05
To 2" I.P. ¼ Cor. Secs 15+16 T.5N. R.9W.
79+73.02
Cor. Secs. 15, 16, 21 + 22
T.5N. R.9W. Fd. C.S.
Mon. F.B. 79-61
RETURN TO
LOS ANGELES COUNTY SURVEYOR
700 HALL OF RECORDS
Do not extend notes this side of this line.
Note: Any Additions or Changes on This Sheet Must be Made or Circled in Red Ink With Date and Name of Person Making Change.

W.S. 67A-5

Notes Ck'd by [illegible]	Survey of T.5N. R9W.
Map No.	W. O. 4999 Tape No. 77 St'd 68 °F
Office Work	Surveyed by Rosecrans
Checked	Notes [illegible] Date 4-4-47
Date	Indexed A. C. Johnson

F.B. 1262 PG. 19

SURVEYOR
T.5N
14 | 13
23 | 24
COUNTY R.9W.
R.E. 2177

Cor. Secs. 13, 14, 23 + 24 T.5N. R.9W. Fd. mound of rocks 1' high 2' base with old 2"x3" x 24" juniper stake laying by it. Could not make out any scribing as the stake was in poor condition. No juniper growing in this vicinity. Drove a 2"x2" in the center of the mound. Replaced 2"x2" with 2" I.P. with brass cap marked as shown in Conc. 5" above surface.

2649.96

2649.82 T.76 = 2649.96

SEC. 23
T.5N. R.9W.

SURVEYORS
T.5N.
14 | 23
COUNTY R.9W.
¼ COR. MONUMENT
R.E. 2177

71°-28'-30"

168.30

Fd. fallen 10" Joshua Tree

¼ Sec. Cor. Fd. 1"x3"x36" juniper stake scribed ¼ S. on the N. standing in mound of rocks 1' high 2' base. Replaced it with 2" I.P. with brass cap marked as shown in Conc. 6" up

0+00 to W.

98.48

41°-15'

178-41-20 ①
354-45-00 ④
178-41-15

178°-44'-06"-30"

Fd fallen 8" Joshua Tree with old blaze

1270.24

1270.34 T.56 = 1270.24

SEC 14

Set 1x2 Top of Brk.

12+70.24

5.0

Remains of old Fn

560.0

1378.44

1378.55 T.56 = 1378.44

26+48.68

Set 1"x2" See preceding page

Note: Any Additions or Changes on This Sheet Must be Made or Circled in Red Ink With Date and Name of Person Making Change.

Do not extend notes this side of this line.

RETURN TO
LOS ANGELES COUNTY SURVEYOR
700 HALL OF RECORDS

FORM 247 5M 5-46

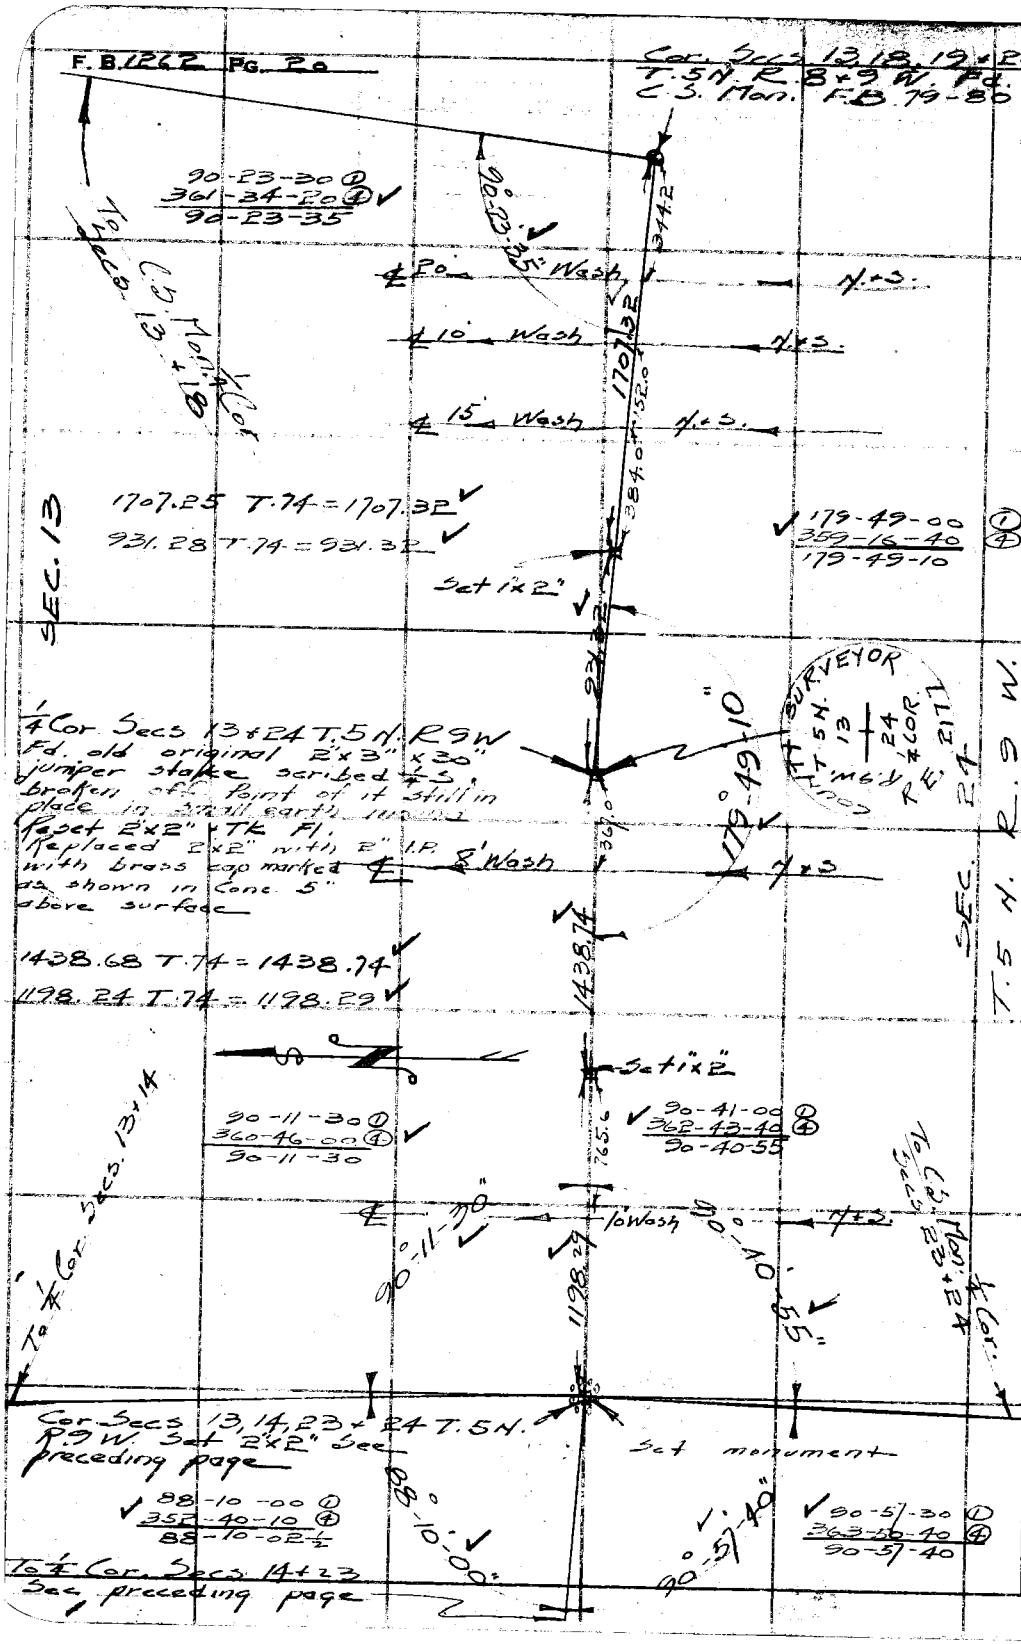

RETURN TO
LOS ANGELES COUNTY SURVEYOR
700 HALL OF RECORDS

Do not extend notes this side of this line.

Note: Any Additions or Changes on This Sheet Must be Made or Circled in Red Ink With Date and Name of Person Making Change.

Notes Ck'd by [illegible]	Survey of T. 5 N. R. 9 W.
Map No.	W. O. 4992 Tape No. 22 St'd 62 °F
Office Work	Surveyed by Rosecrans
Checked	Notes R Date 4-22-47
Date	Indexed A. C. Johnson

F. B. 1262 Pg. 21

W.S. 67 B-5

Cont. bottom next page

Cor. Secs. 13, 14, 23 + 24 T. 5 N. R. 9 W. Set 2"x2" replacing the original Sec. a preceding page

Set monument

2058.35
2649.41

SEC. 23 SEC. 24

T. 5 N. R. 9 W.

Toe of slope

2058.46 T.60 = 2058.35

Set 1x2 - T.R.

591.09 T.60 = 591.06

591.06

179-34-20

4 Cor. Secs. 23 + 24 T. 5 N. R. 9 W. Fd. C.S. Mon. F.B. 79-62

Rec. Per C.S. 8734 = 2649.82
Chained 2642.75

179-34-20
358-17-50
179-34-27½

2642.75

For detail of this line See Pg. 32

To C.S. Mon. Cor. of Secs. 23, 24, 25 + 26 T. 5 N. R. 9 W.

Note: Any Additions or Changes on This Sheet Must be Made or Circled in Red Ink With Date and Name of Person Making Change.

Do not extend notes this side of this line.

RETURN TO
LOS ANGELES COUNTY SURVEYOR
700 HALL OF RECORDS

FORM 247 5M 5-46

F. B. 1262 PG. 122

Cont. bottom next page

W.S. 67, B-4

Cor. Secs. 11, 12, 13 + 14 T.5N. R.9W. Fd. base of 2x3" juniper stake in mound of earth and rocks 3' base 1' high Set 10d Na in old stake Set 5' reference 1x2's Replaced juniper stake with 2" I.P. with brass cap marked as shown in Conc. 5" above surface.

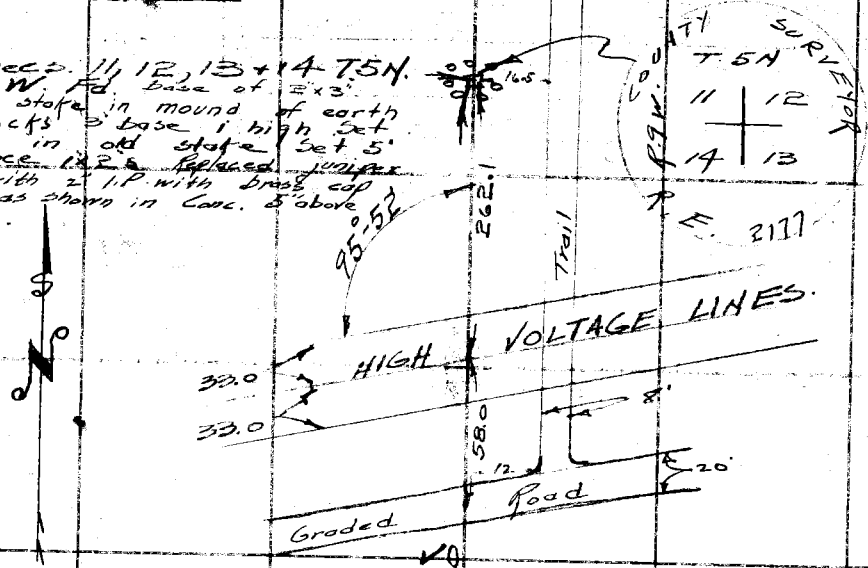

2644.42 T.90 = 2644.80

SEC. 14

2644.80

SEC. 13

T.5N. R.9 W.

4 Cor. Secs. 13 + 14 T.5N. R.9W. Fd. old mound of earth 3' base ½' high with old 2x3 x 30" juniper post with traces of scribing laying by the mound. Drove a 2x2" in the center of the mound. Replaced 2x2" with 2" I.P. with brass cap marked as shown in Conc. 6" above surface

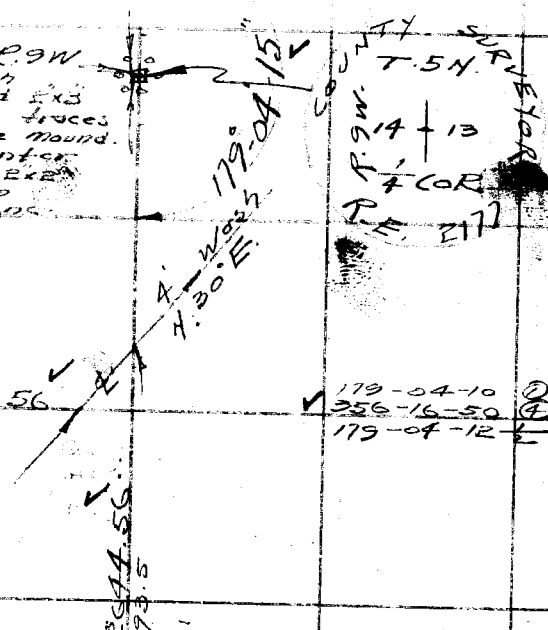

2644.22 T.88 = 2644.56

179-04-10 ②
356-16-50 ④
179-04-12 ½

2644.56
1693.5

2x2 Cor. Secs. 13, 14, 23 + 24 T.5N. R.9W. See preceding Pg.

Set a C.S. Mon.

RETURN TO
LOS ANGELES COUNTY SURVEYOR
700 HALL OF RECORDS

Do not extend notes this side of this line.

Note: Any Additions or Changes on This Sheet Must be Made or Circled in Red Ink With Date and Name of Person Making Change.

W.S.67.B-4

Notes Ck'd by K.R.McPh.	Survey of Sec. lines T.5N.R.9W.
Map No.	W. O. 4992 Tape No. 77 St'd 68 °F
Office Work	Surveyed by Rosecrans
Checked	Notes R Date 4-22-47
Date	Indexed A. C. Johnson

F.B. 1262 PG. [illegible]

Cor. Secs. 1, 2, 11 + 12 T.5N.R.9W.
Fd. mound of rocks 4' base 2' high. Drove a 2" I.P. in center of the mound. Dug in and around the mound but could not find the original stake. No other rocks in this vicinity.

N. 39° W.

2645.63

2645.46 T.78 = 2645.63

179-38-40 ①
358-34-40 ④
179-38-40

SEC. 11

179-38-40"

1253.0

12

8' Trail

15.0

¼ Cor. Secs. 11 + 12 T.5N.R.9W.
Fd. bottom end of a charred 2"x3" juniper stake 4" Dn. in center of a mound of earth and stones 3' base 0.5' high. Replaced stake with ¾" I.P. Fl. Replaced ¾" I.P. with 2" I.P. with brass cap marked as shown in Conc. 6' above surface

SEC. 12

T. 5N. R. 9W.

COUNTY SURVEYOR

T.5N.

R.9W.

11 + 12

¼ COR.

R.E. 2177

2643.13 T.76 = 2643.27

89-35-00 ①
358-20-40 ④
89-35-10

2643.27

8' Trail

89-16-00 ①
357-03-20 ④
89-15-50

To C.S. Mon ¼ Cor. Secs. 12 + 13

To C.S. Mon ¼ Cor. Secs. 11 + 14

89-35-10"

7' Trail

20.5

89-15-50"

8' Trail

25.0

Set C.S. Mon

Cor. Secs. 11, 12, 13 + 14 T.5N.R.9W. Set 10d Na in old stake see preceding page.

90-07-30 ①
360-30-30 ④
90-07-37½

90-07-40"

91-01-20"

91-01-20 ①
364-05-20 ④
91-01-20

To ¼ Cor. Secs. 13 + 14

Note: Any Additions or Changes on This Sheet Must be Made or Circled in Red Ink With Date and Name of Person Making Change.

Do not extend notes this side of this line.

RETURN TO
LOS ANGELES COUNTY SURVEYOR
700 HALL OF RECORDS

FORM 247 5M 11-41

F.B. 1262 Pg. 24

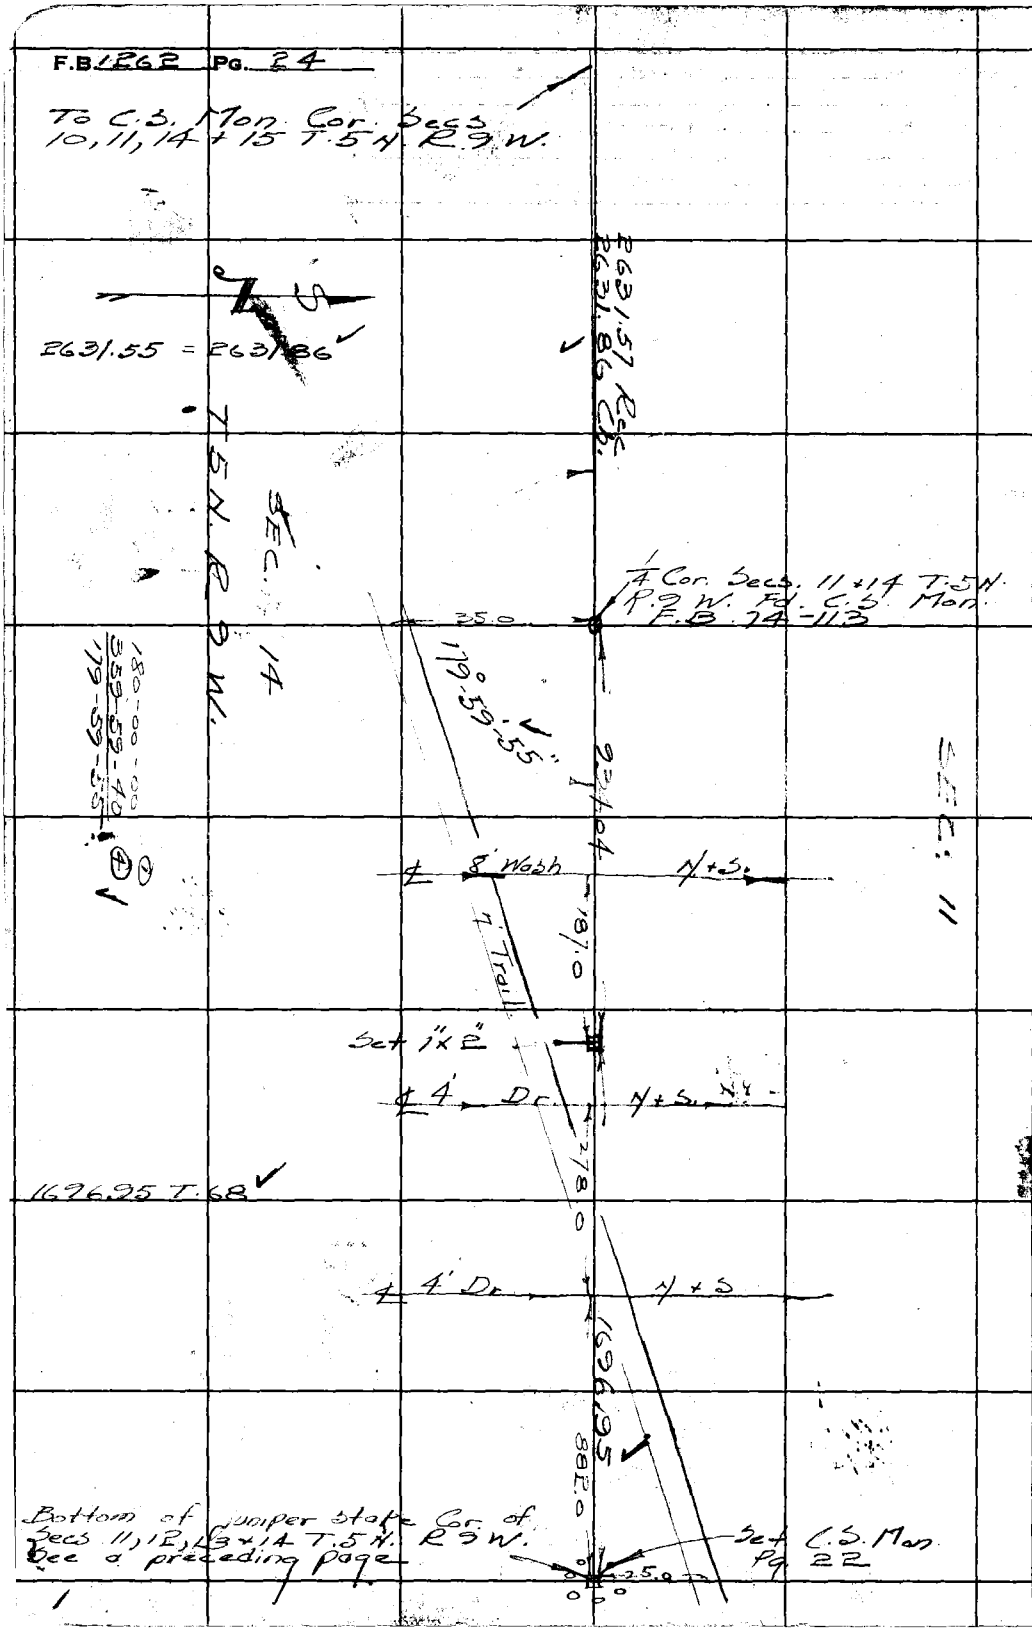

W.S.67.B-4

RETURN TO
LOS ANGELES COUNTY SURVEYOR
700 HALL OF RECORDS

Do not extend notes this side of this line.

Note: Any Additions or Changes on This Sheet Must be Made or Circled in Red Ink With Date and Name of Person Making Change.

Notes Ck'd by R.R. McPhee	Survey of T. 5N R9W.
Map No.	W. O. 4999 Tape No. 77 St'd 68 °F
Office Work	Surveyed by Rosecrans
Checked	Notes R Date 4-22-47
Date	Indexed A. C. Johnson

F.B. 1262 PG. 25

W.S. 67, B-4

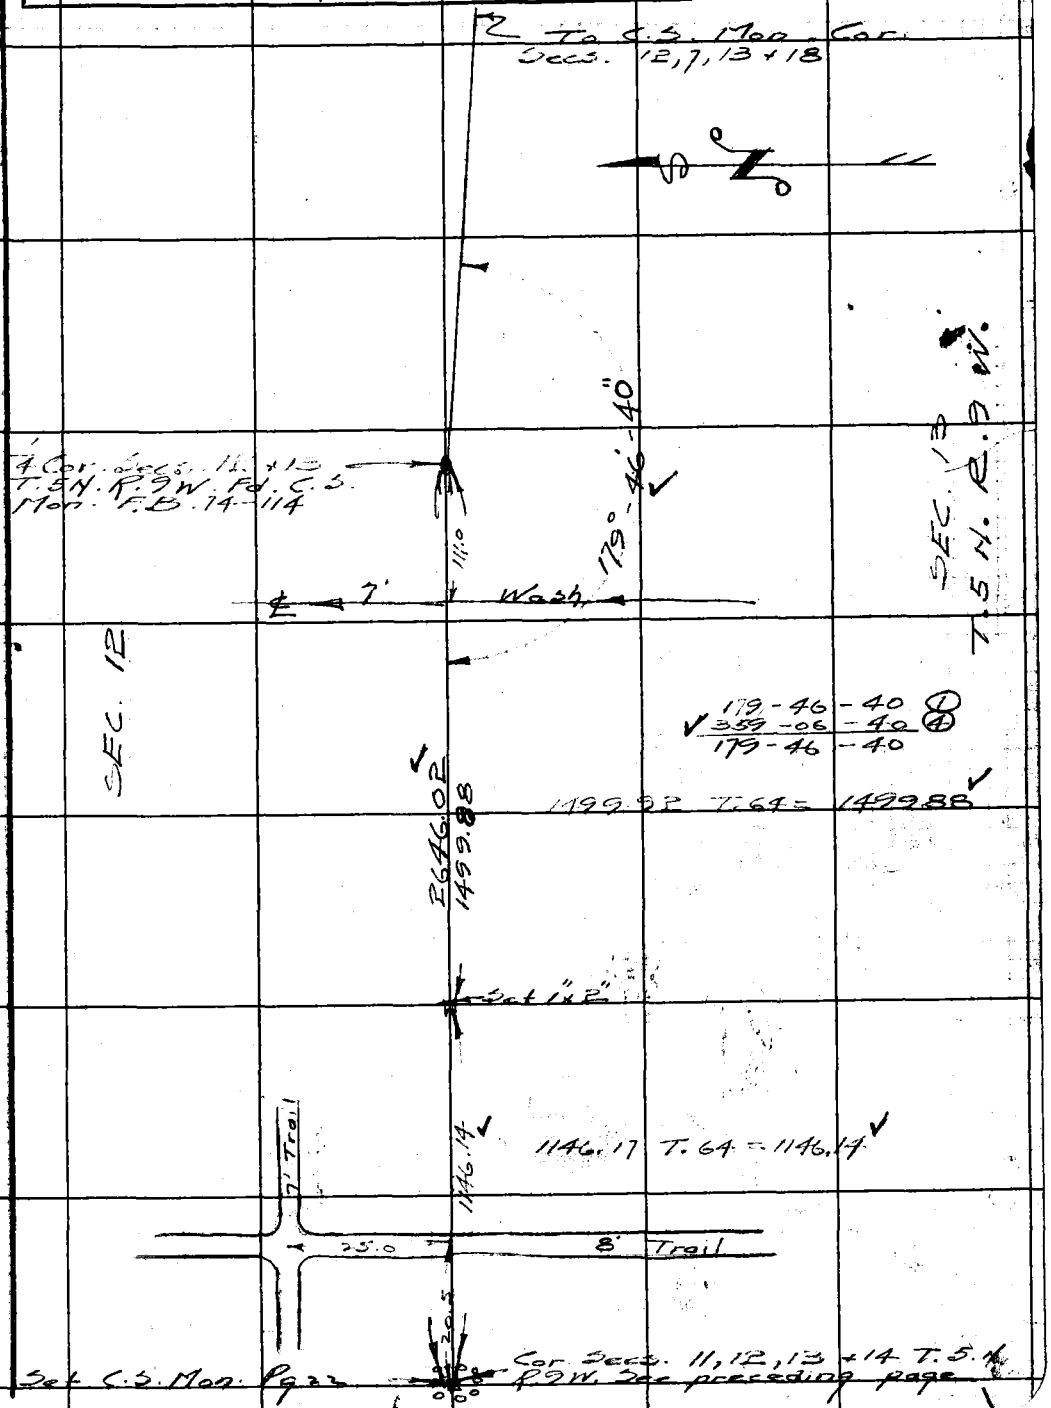

Note: Any Additions or Changes on This Sheet Must be Made or Circled in Red Ink With Date and Name of Person Making Change.

Do not extend notes this side of this line.

RETURN TO
LOS ANGELES COUNTY SURVEYOR
700 HALL OF RECORDS

FORM 247 5M 11-41

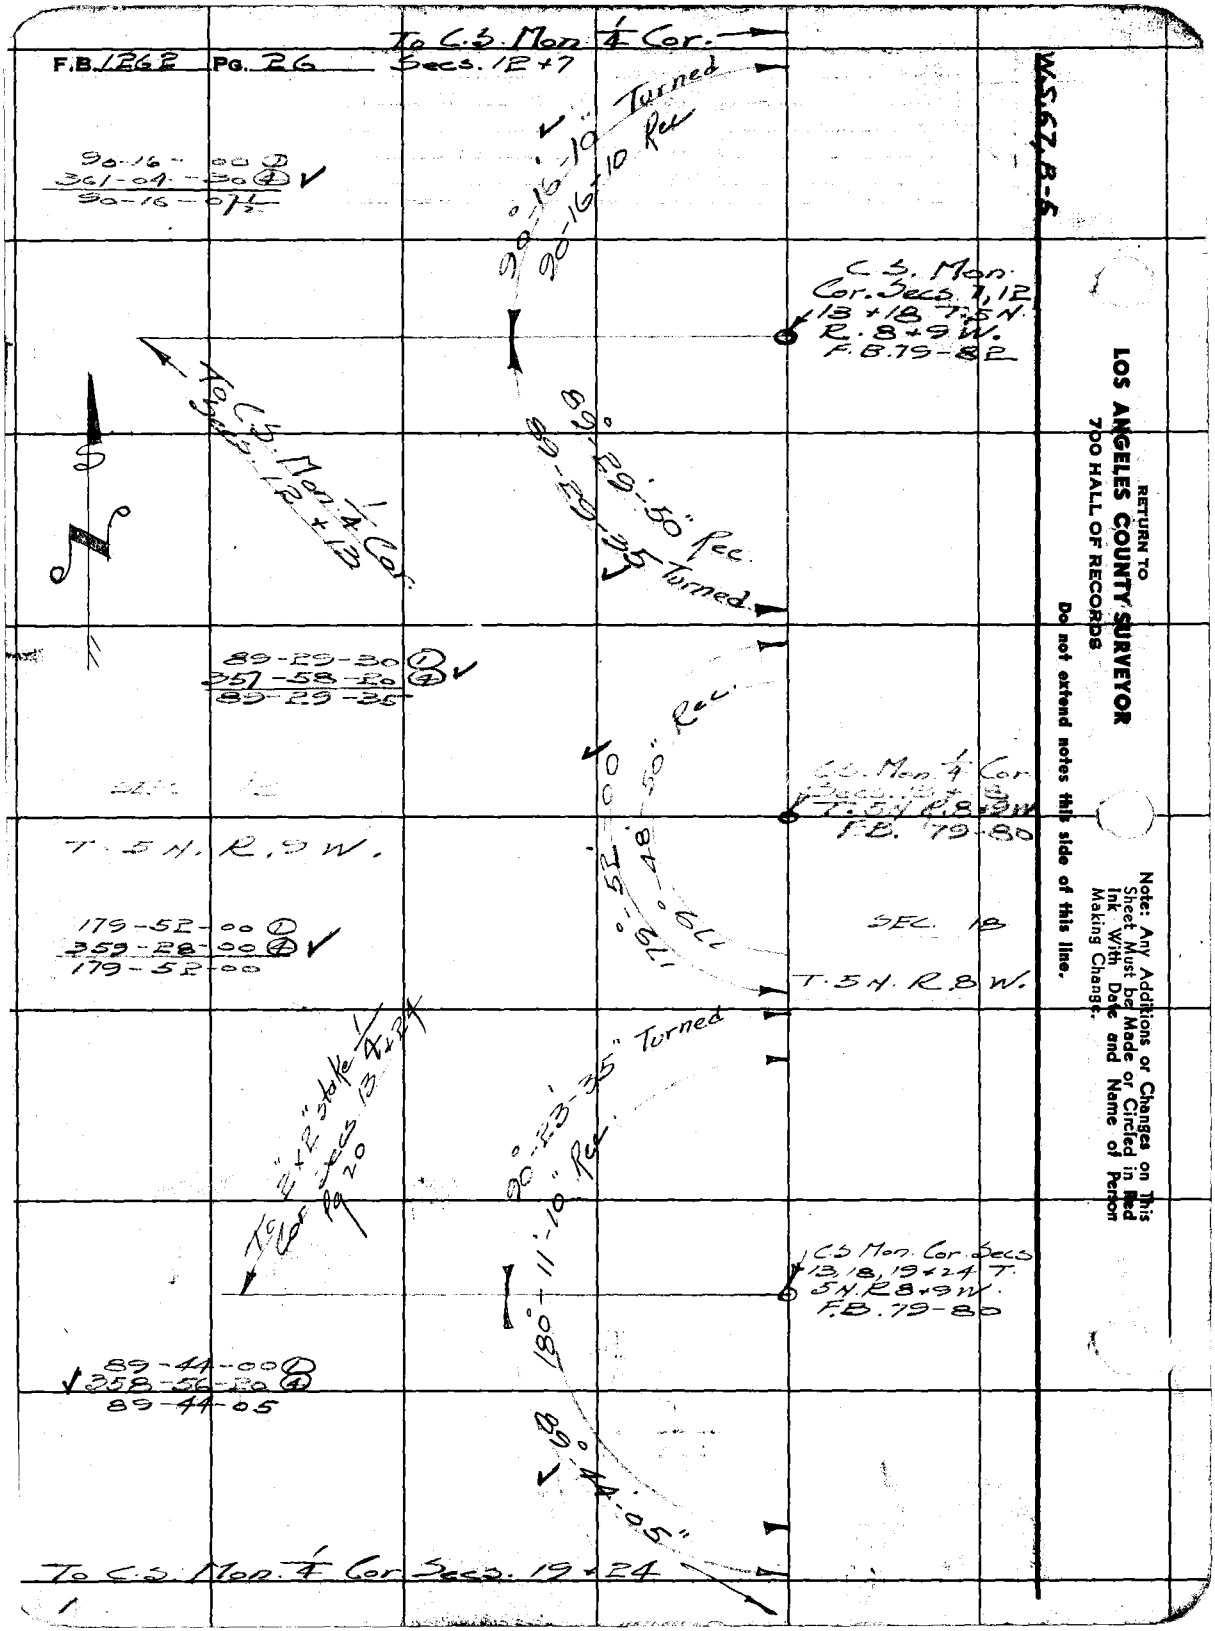
F.B. 1262 PG. 26
To C.S. Mon. 1/4 Cor. Secs. 12+7
90-16-00 ①
361-04-30 ④
90-16-01 1/2
90°-16'-10" Turned
90-16-10 Rec
C.S. Mon. Cor. Secs. 7, 12, 13+18 T.5N. R.8+9W. F.B. 79-82
To C.S. Mon. 1/4 Cor. Secs. 12+13
89°-29'-50" Rec.
89-29-35 Turned
89-29-30 ①
357-58-20 ④
89-29-35
C.S. Mon. 1/4 Cor. Secs. 13+18 T.5N. R.8+9W. F.B. 79-80
T.5N. R.9W.
179°-52'-00"
179°-48'-50" Rec.
179-52-00 ①
359-28-00 ④
179-52-00
SEC. 18
T.5N. R.8W.
To 2"x2" stake 1/4 Cor. Secs. 13+24 Pg 20
90°-23'-35" Turned
180°-11'-10" Rec.
C.S. Mon. Cor. Secs. 13, 18, 19+24 T.5N. R.8+9W. F.B. 79-80
89-44-00 ①
358-56-20 ④
89-44-05
89°-44'-05"
To C.S. Mon. 1/4 Cor. Secs. 19+24
W.S. 67, B-5
RETURN TO
LOS ANGELES COUNTY SURVEYOR
700 HALL OF RECORDS
Do not extend notes this side of this line.
Note: Any Additions or Changes on This Sheet Must be Made or Circled in Red Ink With Date and Name of Person Making Change.

Notes Ck'd by [illegible]	Survey of T. 5 N. R. 9 W.
Map No.	W. O. 4797 Tape No. 27 St'd 68 °F
Office Work	Surveyed by Rodgers
Checked	Notes R Date 7-29-47
Date	Indexed A. C. Johnson

F. B. 1862 Pg. 27

W.S. 67 B-5

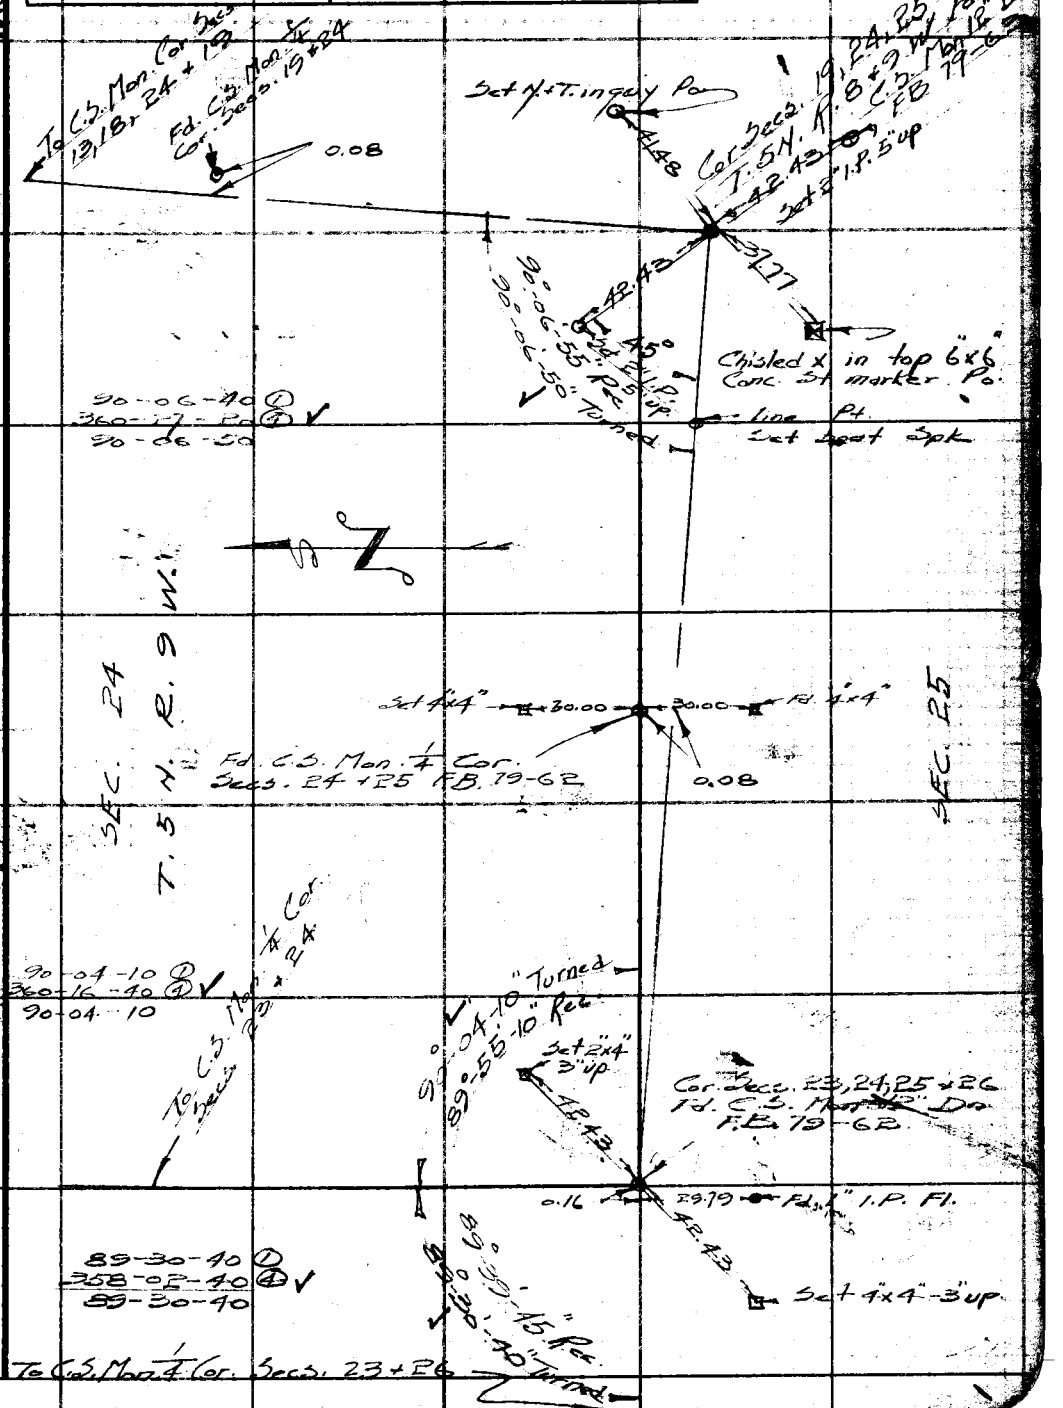

FORM 247 5M 8-46

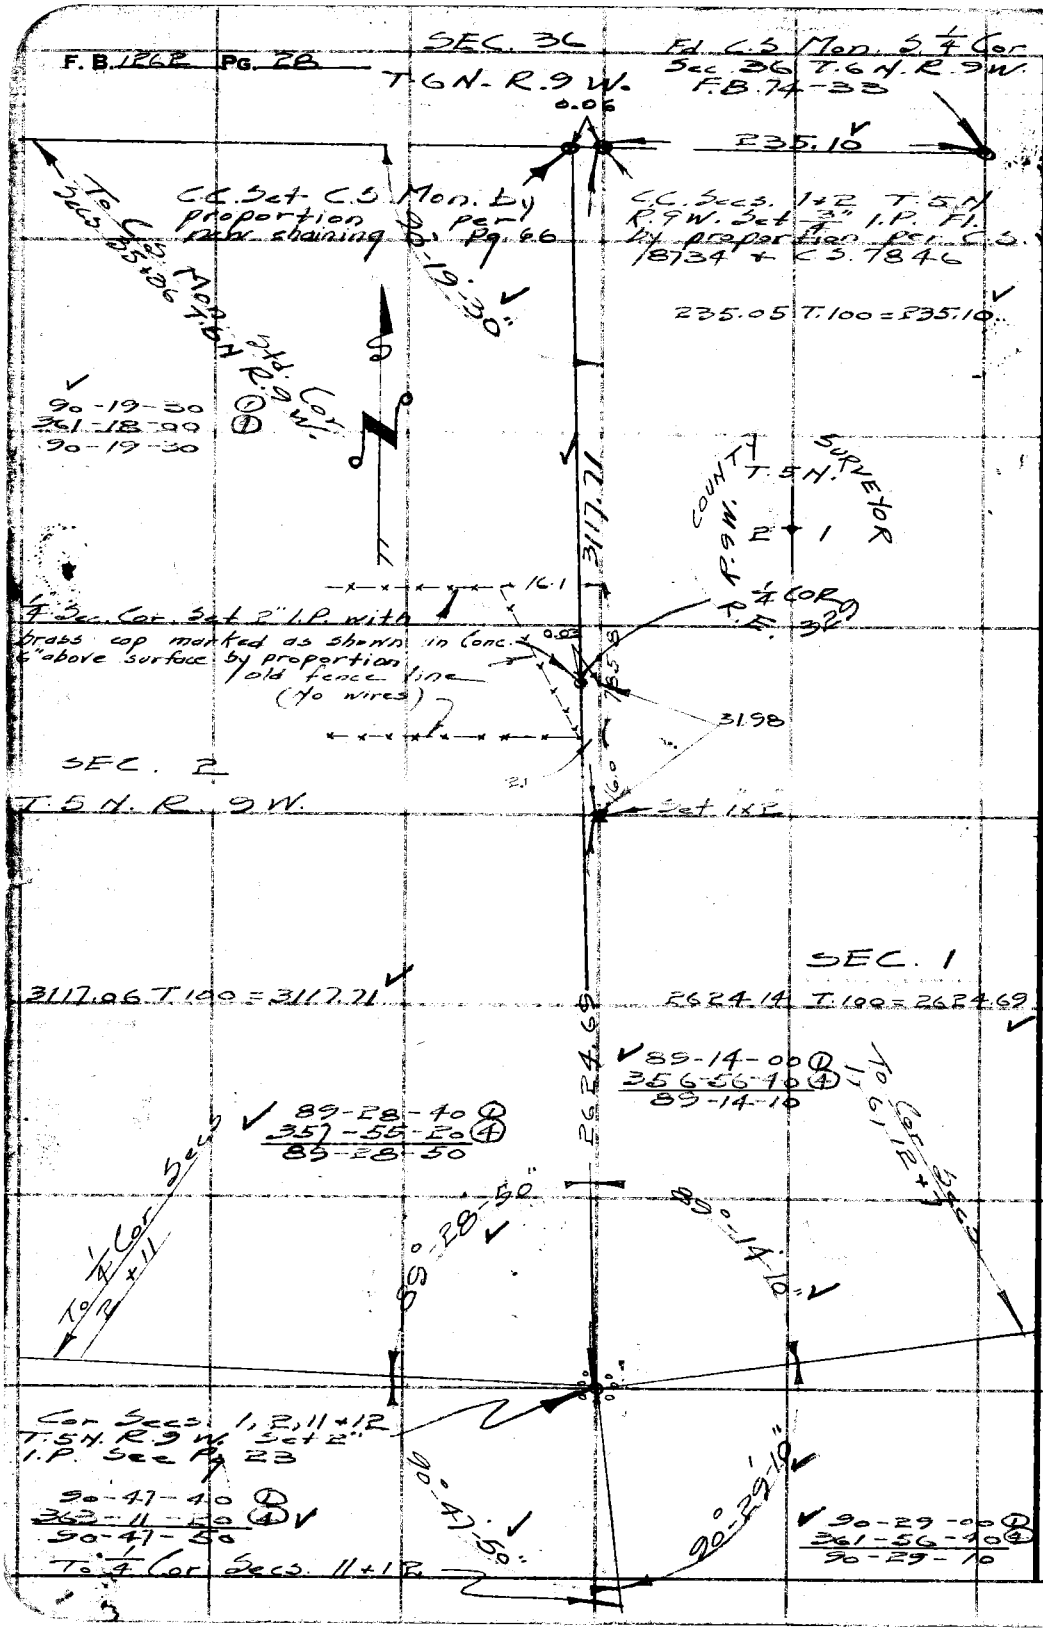

RETURN TO
LOS ANGELES COUNTY SURVEYOR
700 HALL OF RECORDS

Do not extend notes this side of this line.

Note: Any Additions or Changes on This Sheet Must be Made or Circled in Red Ink With Date and Name of Person Making Change.

W.S.67.AB-4

Notes Ck'd by K.R. McPhee	Survey of T.5 N. R 9 W.
Map No.	W. O. 4999 Tape No. 77 St'd 68 °F
Office Work	Surveyed by Rosecrans
Checked	Notes R Date 5-5-47
Date	Indexed A. C. Johnson

F. B. 1262 Pg. 29

Cor. Secs. 2, 3, 10 + 11 T. 5 N. R 9 W. Fd. C.S. Mon. 6" up. F.B 74-120

713.38

713.28 T. 90 = 713.38

Set 1"x2"

1916.18

179-58-20 ①
359-54-00 ④
179-58-30

℄ 6' Wash N+S

1915.91 T. 90 = 1916.18

179°58'-30"

3180

COUNTY SURVEYOR

T. 5 N. R 9 W.

2 + 11

1/4 COR. E. 2,77

T. 5 N. R. 9 W.

SEC. 11

1/4 Cor. Secs. 2 + 11 T. 5 N. R 9 W. Fd. stub of 2" juniper stake in mound of rocks 2 1/2' base 1/2' high. Fd 3"x4" pine stake 5' long marked S.W. 1/4 of S.E. 1/4 2 on one side V.W. on another side, laying by the mound. Replaced juniper stake with a 1x2". Replaced 1x2" with 2" I.P. with brass cap marked as shown in Conc. 5" above surface

500'

℄ 6' Wash N+S.

453.

℄ 6' Wash N+S.

2615.98

2615.44 T. 100 = 2615.98

Cor. Secs 1, 2, 11 + 12 T. 5 N. R. 9 W. Set 2" I.P. See preceding page

Note: Any Additions or Changes on This Sheet Must be Made or Circled in Red Ink With Date and Name of Person Making Change.

Do not extend notes this side of this line.

RETURN TO
LOS ANGELES COUNTY SURVEYOR
700 HALL OF RECORDS

FORM 247 5M 5-46

F. B/262 PG. 30

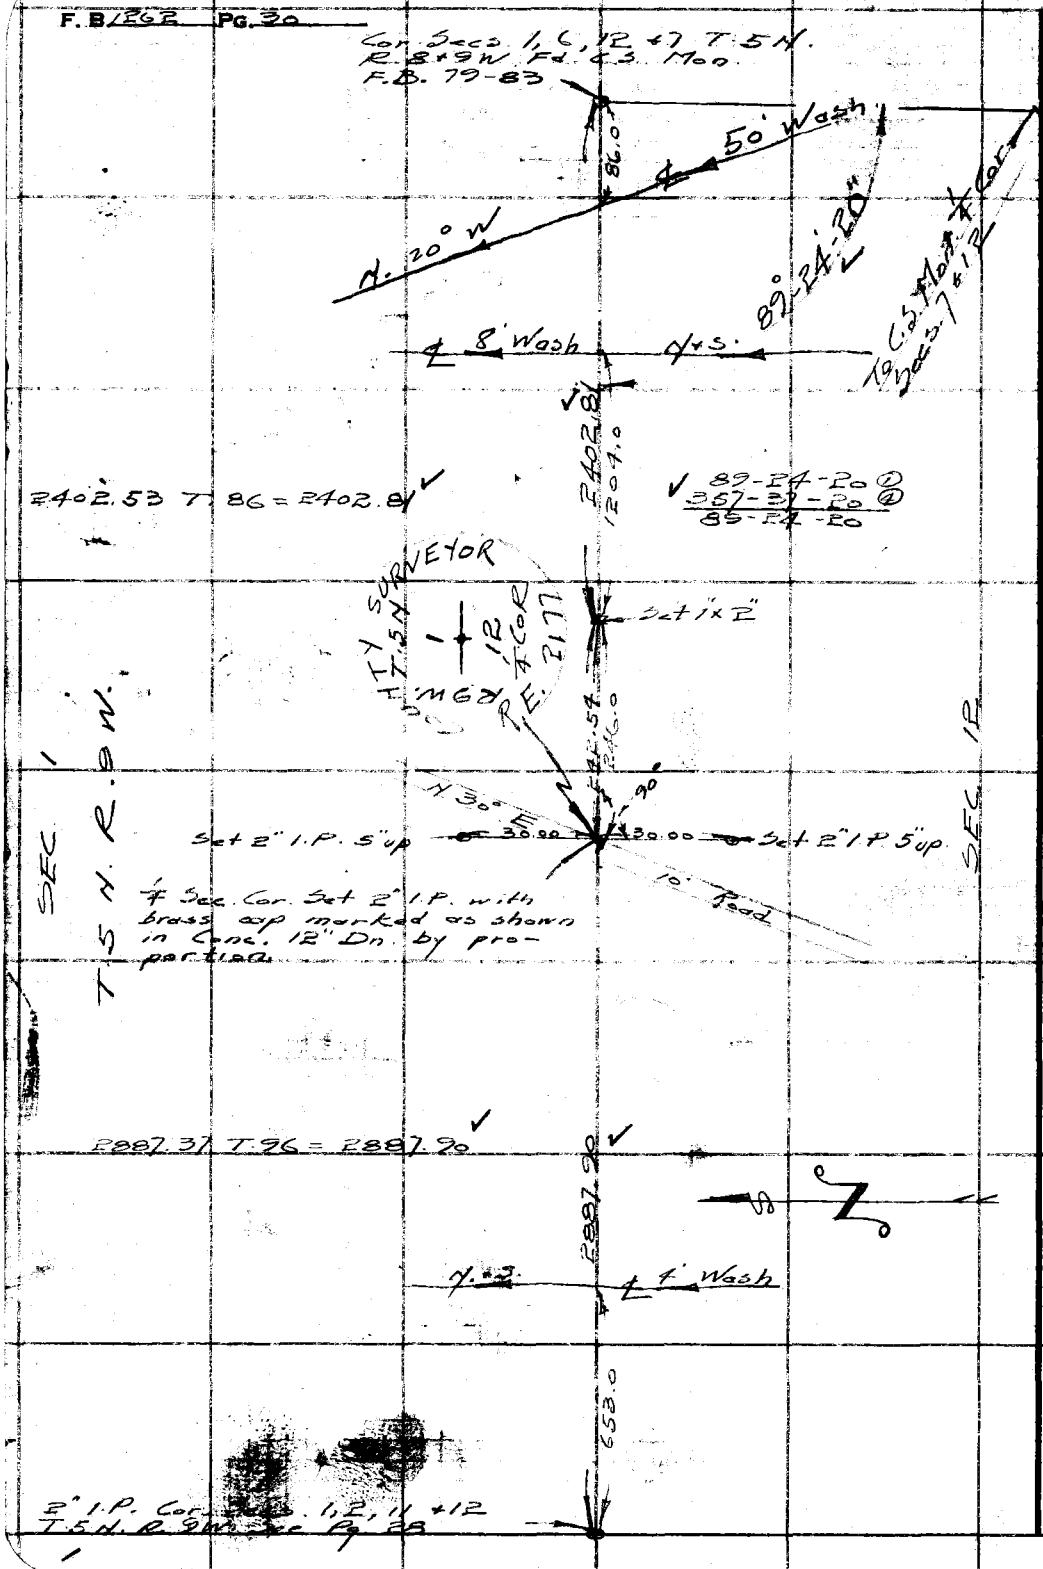

RETURN TO
LOS ANGELES COUNTY SURVEYOR
7DO HALL OF RECORDS

Do not extend notes this side of this line.

Note: Any Additions or Changes on This Sheet Must be Made or Circled in Red Ink With Date and Name of Person Making Change.

Notes Ck'd by [illegible]	Survey of T.5N. R.9W.
Map No.	W. O. 4999 Tape No. 77 St'd 68 °F
Office Work	Surveyed by Rosecrans
Checked	Notes R Date 5-7-47
Date	Indexed A. C. Johnson

F. B. 1262 Pg. 31

W.S. 67 A-5

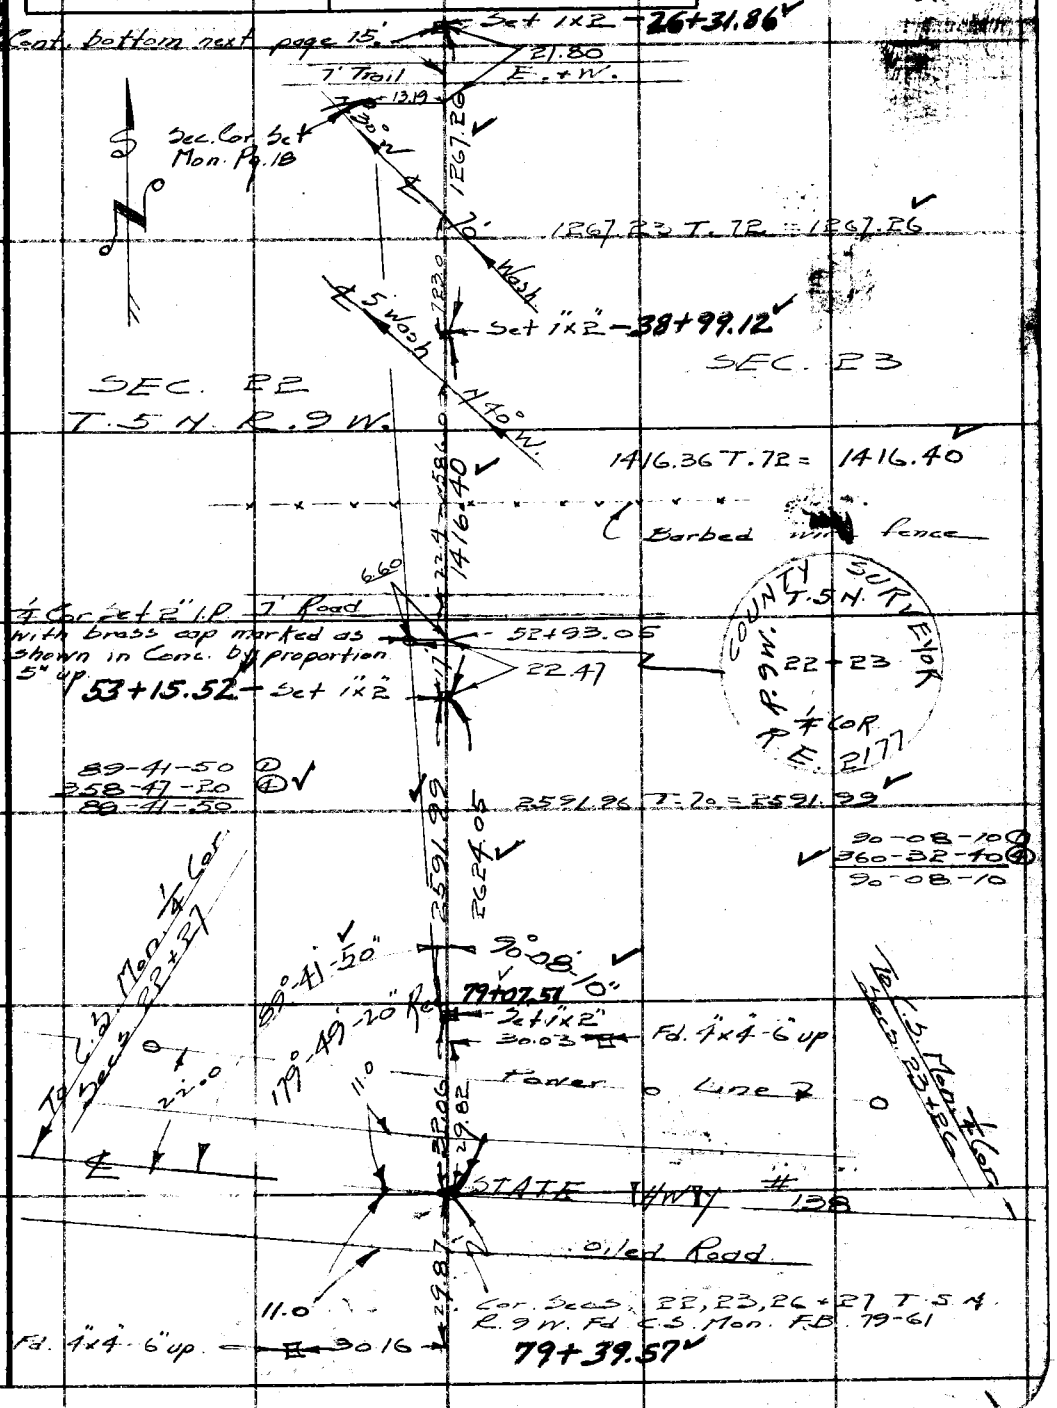

Note: Any Additions or Changes on This Sheet Must be Made or Circled in Red Ink With Date and Name of Person Making Change.

Do not extend notes this side of this line.

RETURN TO
LOS ANGELES COUNTY SURVEYOR
700 HALL OF RECORDS

FORM 247 5M 5-46

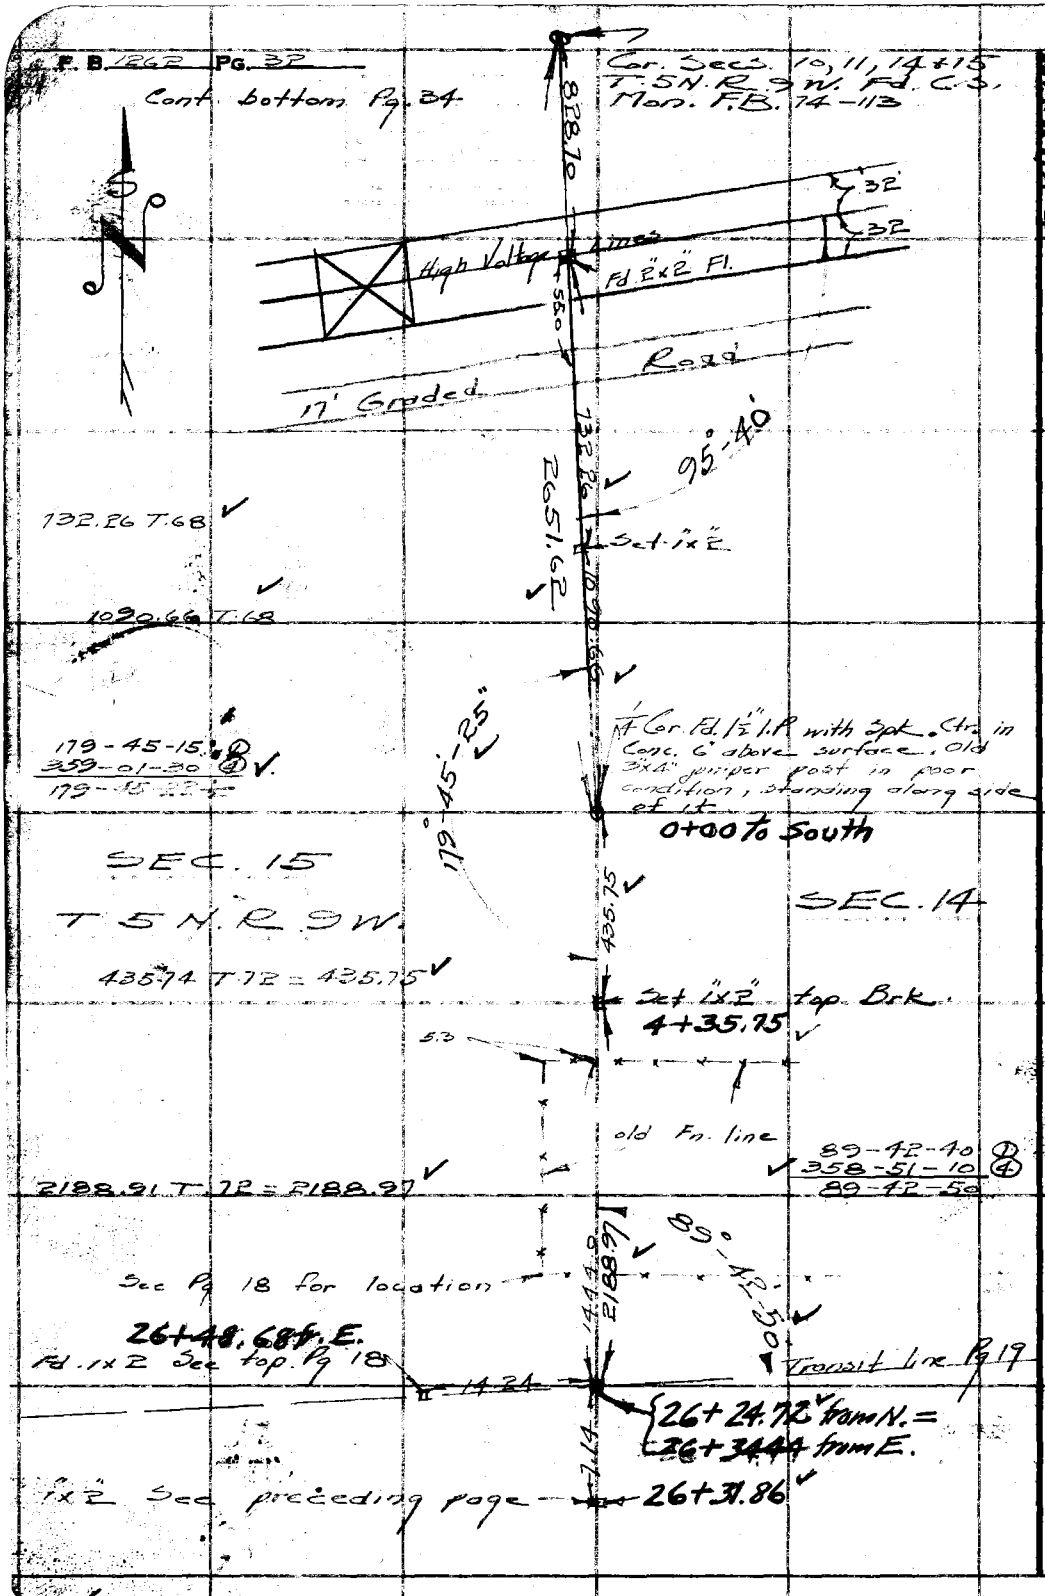

RETURN TO
LOS ANGELES COUNTY SURVEYOR
700 HALL OF RECORDS

Do not extend notes this side of this line.

Note: Any Additions or Changes on This Sheet Must be Made or Circled in Red Ink With Date and Name of Person Making Change.

W.S. 67, B-5

Notes Ck'd by KRM	Survey of T.5N. R.9W.
Map No.	W. O. 4999 Tape No. 27 St'd 68 °F
Office Work	Surveyed by Rosecrans
Checked	Notes R Date 5-9-47
Date	Indexed A. C. Johnson

F. B. 1262 PG. 33

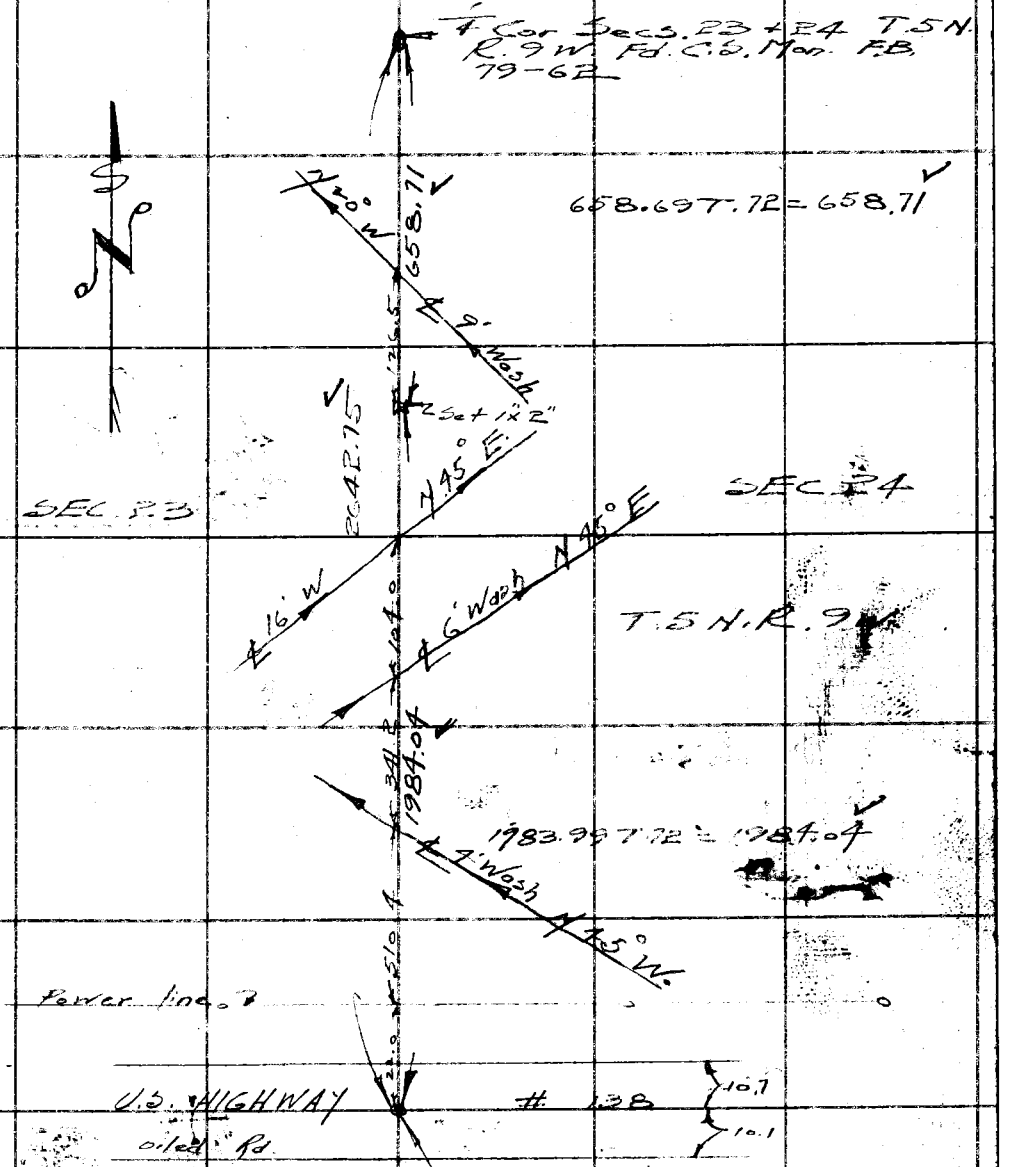

Note: Any Additions or Changes on This Sheet Must be Made or Circled in Red Ink With Date and Name of Person Making Change.

Do not extend notes this side of this line.

RETURN TO
LOS ANGELES COUNTY SURVEYOR
700 HALL OF RECORDS

FORM 247 5M 5-46

F. B. 1262 PG. 34

W.S.67.A-4

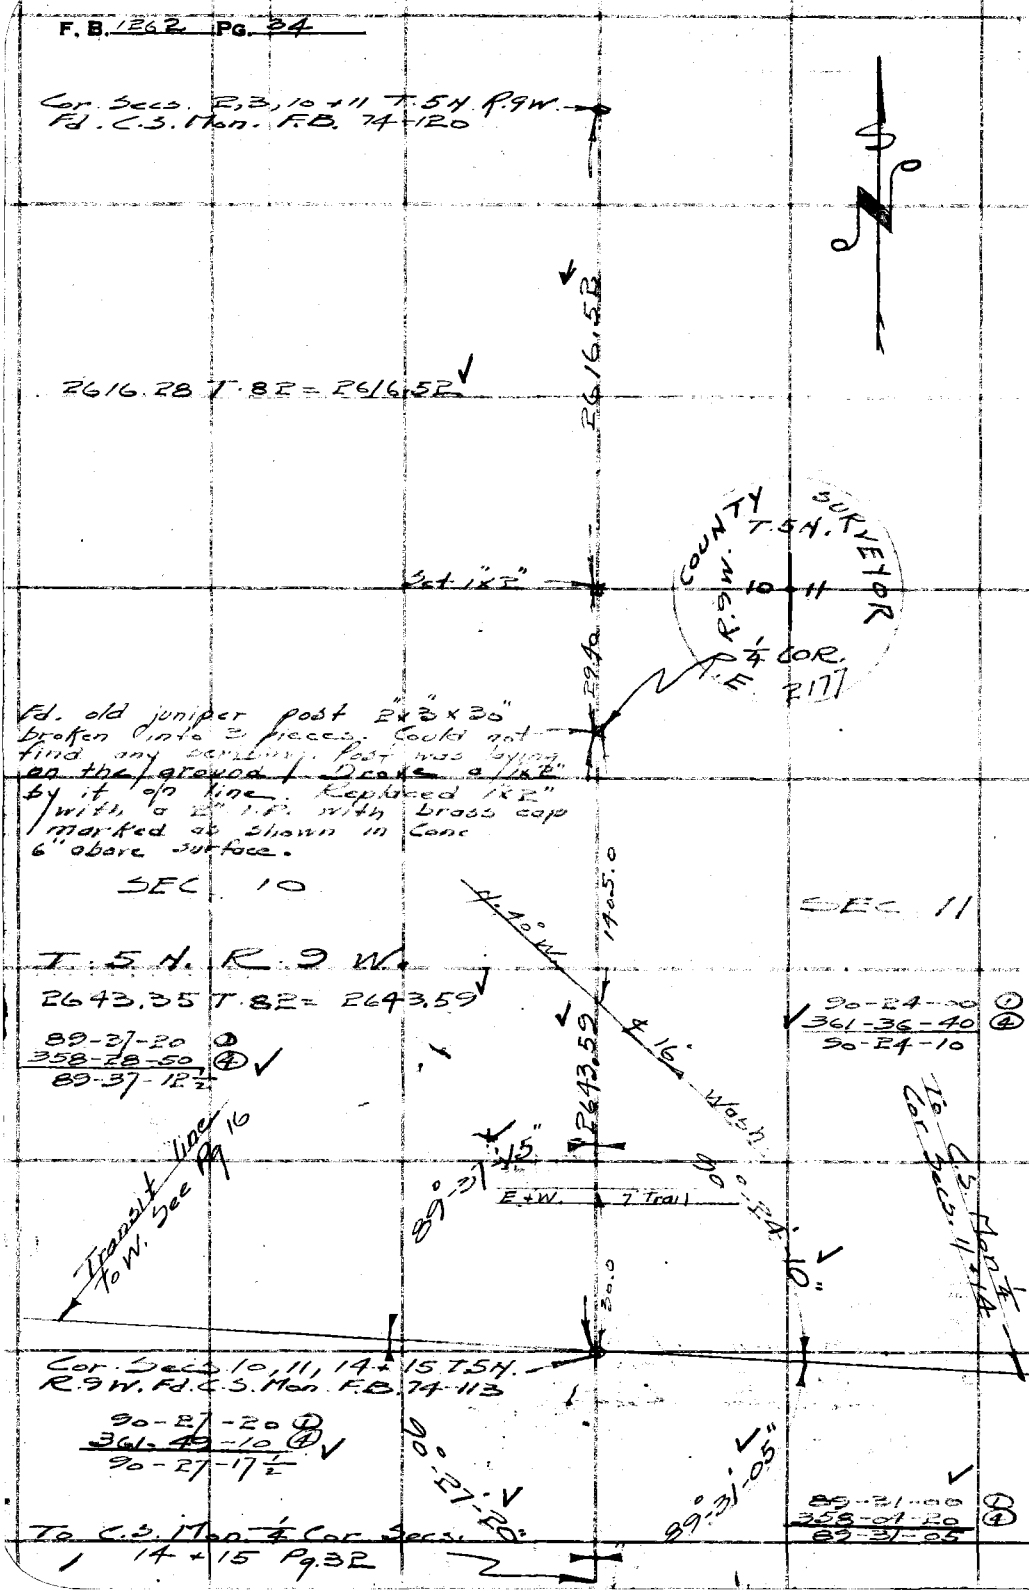

RETURN TO
LOS ANGELES COUNTY SURVEYOR
700 HALL OF RECORDS

Do not extend notes this side of this line.

Note: Any Additions or Changes on This Sheet Must be Made or Circled in Red Ink With Date and Name of Person Making Change.

W.S. 67, A-3

Notes Ck'd by KRMcPh	Survey of T5N R9W
Map No.	W. O. 4999 Tape No. 72 St'd 68 °F
Office Work	Surveyed by Rosecrans
Checked	Notes R Date 5-13-47
Date	Indexed A. C. Johnson

F. B. 1262 Pg. 35

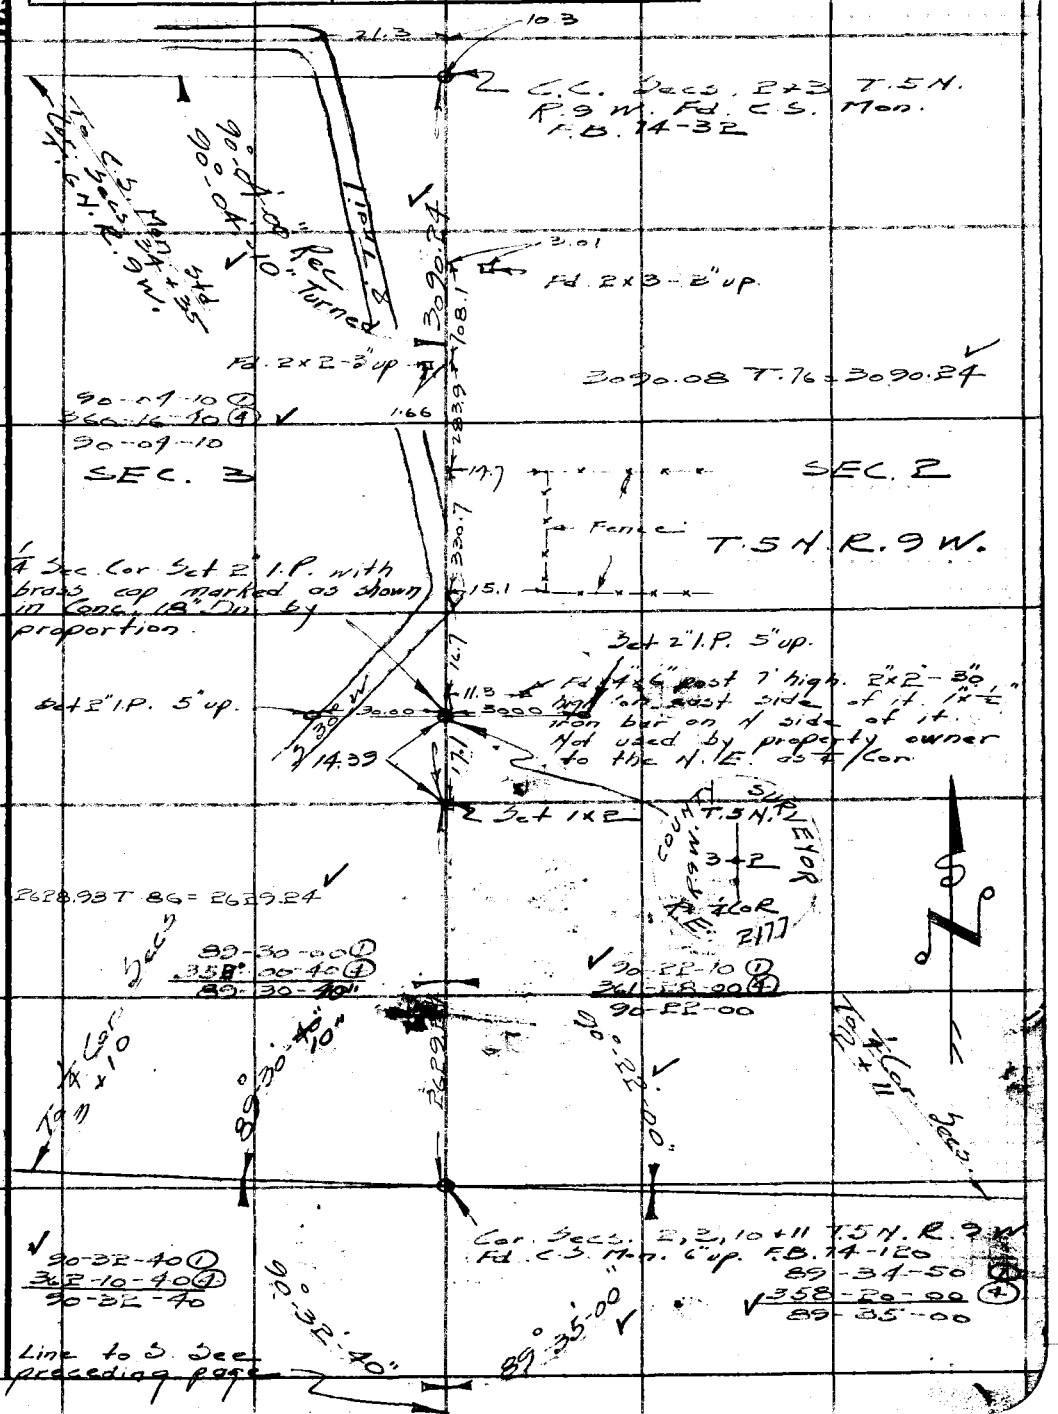

Note: Any Additions or Changes on This Sheet Must be Made or Circled in Red Ink With Date and Name of Person Making Change.

Do not extend notes this side of this line.

RETURN TO
LOS ANGELES COUNTY SURVEYOR
700 HALL OF RECORDS

FORM 247 5M 5-46

F. B. 1262 PG. 36

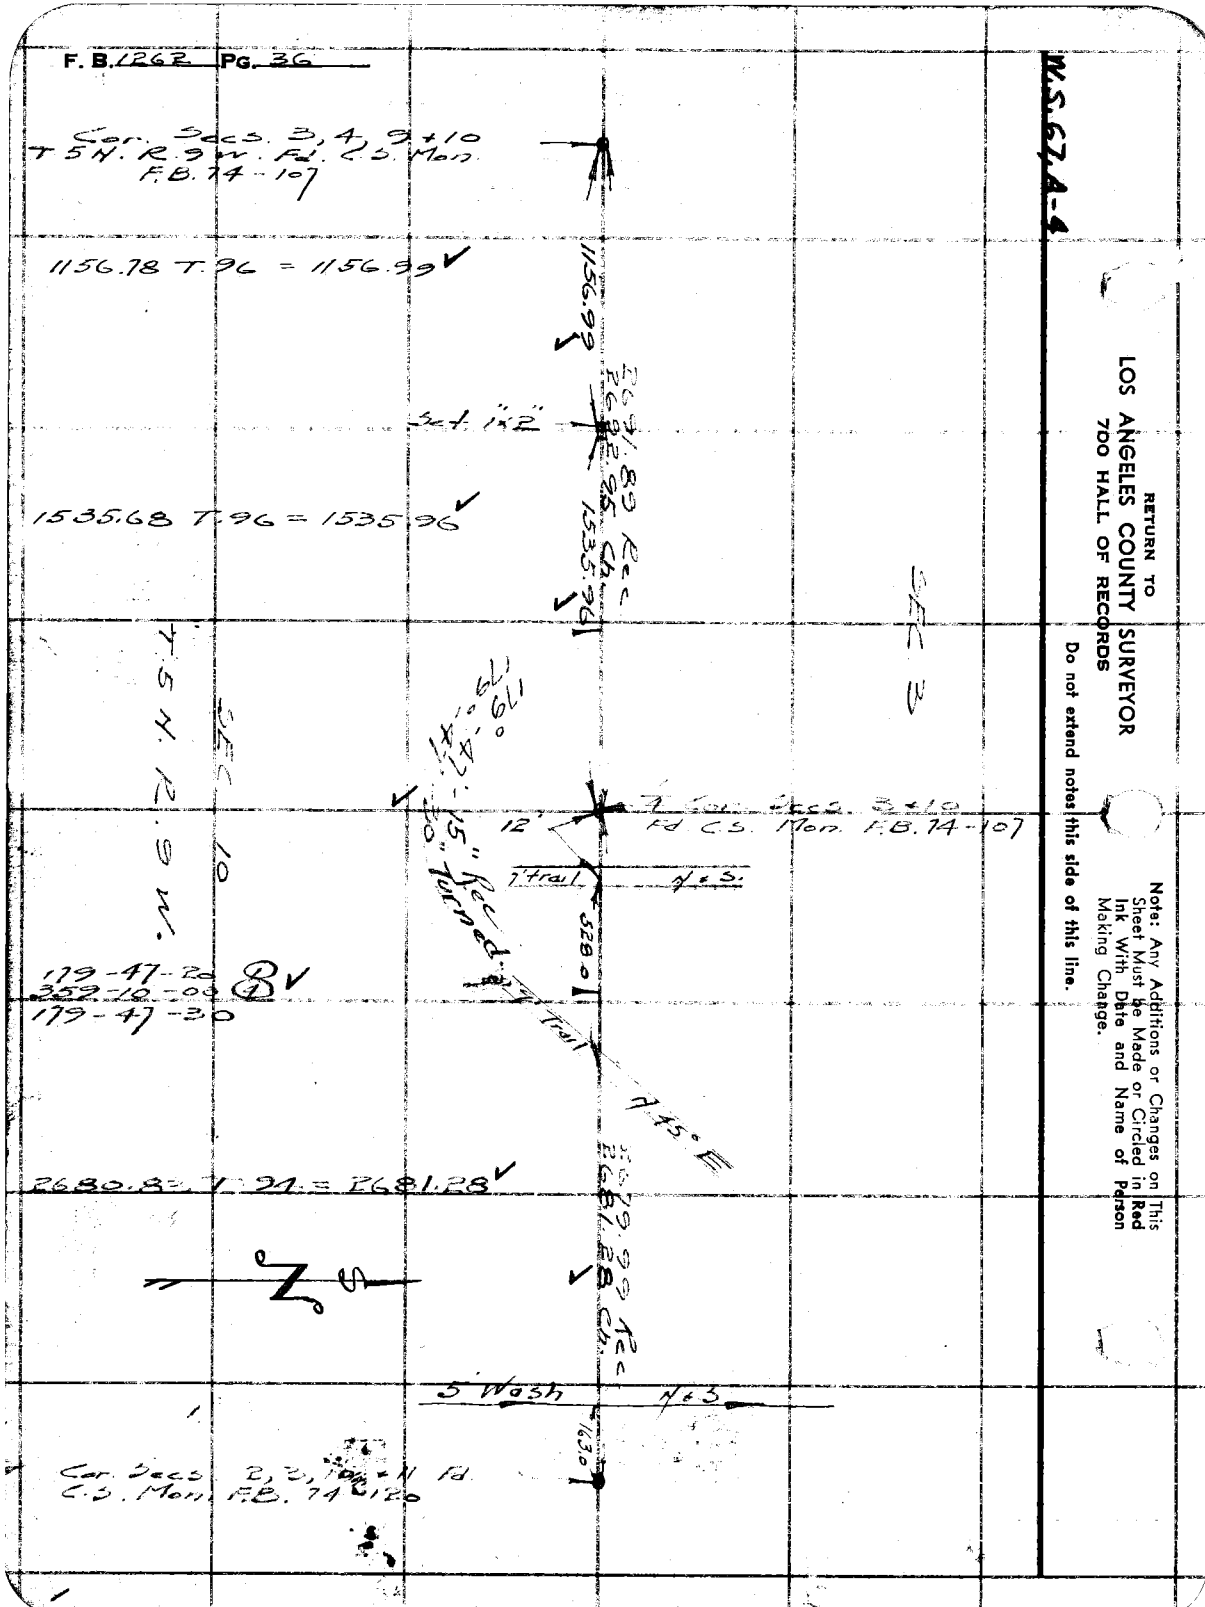

W.S. 67, A-4

RETURN TO
LOS ANGELES COUNTY SURVEYOR
700 HALL OF RECORDS

Do not extend notes this side of this line.

Note: Any Additions or Changes on This Sheet Must be Made or Circled in Red Ink With Date and Name of Person Making Change.

W.S. 67 R-5

Notes Ck'd by R.R. McPh	Survey of T.5N. R.9W.
Map No.	W. O. 4999 Tape No. 60 St'd 84 °F
Office Work	Surveyed by Rosecrans
Checked	Notes R Date 5-29-47
Date	Indexed A. C. Johnson

F. B 1262 PG. 37

Cor. Secs. 23, 24, 25 + 26 T.5N. R.9W. Fd. C.S. Mon. F.B. 79-62

To C.S. Mon. 1/4 Cor. Secs. 23 + 26

90°-16'-10" Rec. 90°-16'-10" Turned

90°-08'-55" Rec. 90°-09'-15" Turned

To C.S. Mon. 1/4 Cor. Secs. 24 + 25

2650.29

90-16-00 ①
361-04-40 ④
90-16-10

2650.39 T.78 = 2650.29

90-09-20 ①
360-37-10 ④
90-09-17 1/2

1/4 Cor. Secs. 25 + 26 T.5N. R.9W. Fd. C.S. Mon. F.B. 79-62

179°-54'-00"

SEC. 26

SEC 25

T.5N. R.9W.

940.09

558.0

39.07
300.58 @ 2-30 = 300.29
300.72 @ 1-30 = 300.62
300.46 @ 2-45 = 300.11
940.09

T 84

Set 1x2

179-54-00 ①
359-36-00 ④
179-54-00

205.03 @ 1-00 = 205.00
300.19 @ 2-15 = 299.96
300.63 @ 2-15 = 300.40
300.30 @ 1-41 = 300.17
300.19 @ 2-23 = 299.93
300.83 @ 2-28 = 300.55
1706.01

T 84

1706.01

Cor. Secs. 25 26, 35 + 36 T.5N. R.9W. Fd. C.S. Mon. F.B. 537-165

Note: Any Additions or Changes on This Sheet Must Be Made or Circled in Red Ink With Date and Name of Person Making Change.

Do not extend notes this side of this line.

RETURN TO
LOS ANGELES COUNTY SURVEYOR
700 HALL OF RECORDS

FORM 247 5M 11-46

F. B. 1262 PG. 38

To C.S. Mon. Cor. Secs. 25, 36, 30 + 31 T.5 N. R 8 + 9 W.

W.S. 67, B-5

179-38-30 (1)
358-33-40 (4)
179-38-25

179°-38'-25"

¼ Cor. Secs. 25 + 26 T.5 N. R.9 W. Fd. C.S. Mon. F.B. 77-75

SEC. 25 T.5 N. R. 9 W.

SEC. 36

℄ 12' Wash N.+S.

℄ 40' Wash N.+S.

86.0

107.0

1557.19 T.76 = 1557.11
1081.59 T.76 = 1081.53

Set 1"x2"

89-47-50 (1)
359-12-00 (4)
89-48-00

¼ Cor. Secs. 25+26

90-18-00 (1)
361-12-00 (4)
90-18-00

90°-18'-00"

89°-48'-00"

¼ Cor. Secs. 25+26

Cor. Secs. 30, 31, 25 + 36 T.5 N. R. 8 W. Fd. C.S. Mon. F.B. 537-165

89-51-10 (1)
359-25-00 (4)
89-51-15

89°-51'-15"

90-02-15
90-02-50
turned

90-02-40 (1)
360-11-20 (4)
90-02-50

To ¼ Cor. Secs 26 + 35

RETURN TO
LOS ANGELES COUNTY SURVEYOR
700 HALL OF RECORDS

Do not extend notes this side of this line.

Note: Any Additions or Changes on This Sheet Must Be Made or Circled in Red Ink With Date and Name of Person Making Change.

Notes Ck'd by Miller	Survey of T5N.R8W.	F.B. 1262 Pg. 39
Map No.	W. O. 4999 Tape No. 60 St'd 84 °F	
Office Work	Surveyed by Rosecrans	
Checked	Notes R Date	
Date	Indexed A. C. Johnson 3-3-48	

SECTION LINES

T. 5N. R. 8W.

J.H. 4999

E.A. Rosecrans
J.P. Pierce
J.C. Pierce
D.C. Folgate
V.T. Gibbons.
H.H. Howard — New chainmen
L. Vejar — Alternates for Folgate & Gibbons.

Note: Any Additions or Changes on This Sheet Must be Made or Circled in Red Ink With Date and Name of Person Making Change.

Do not extend notes this side of this line.

RETURN TO
LOS ANGELES COUNTY SURVEYOR
700 HALL OF RECORDS

FORM 247 SM 11-46

F. B. 1262 PG. 40

T. 5 N. R. 8 W.

Index to lines surveyed
● = Monuments set

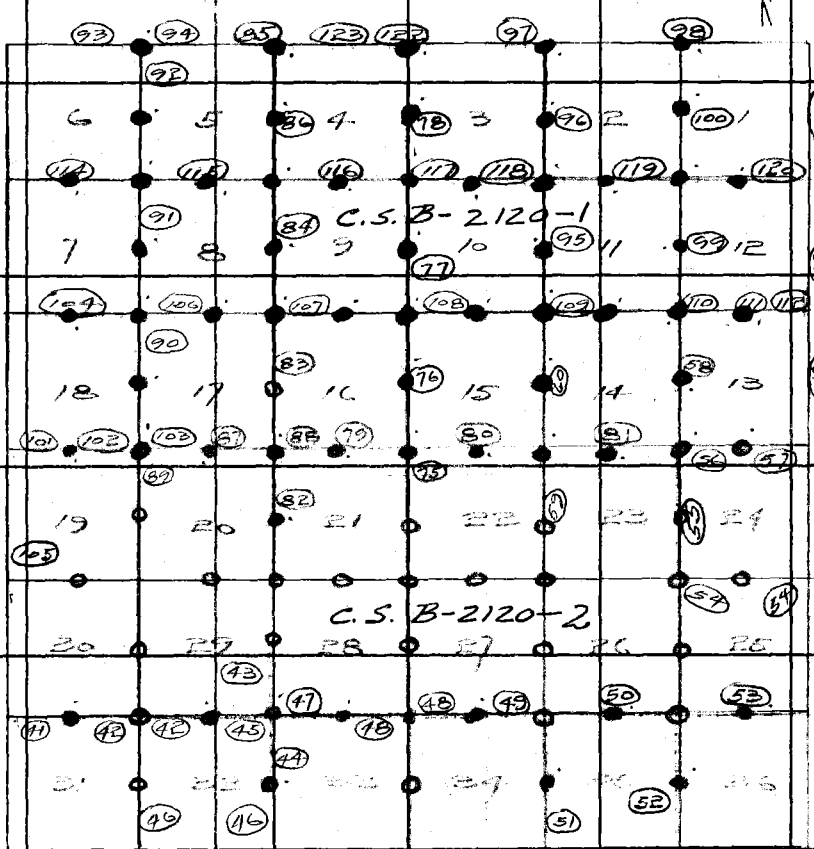

H.C. 52-21-1&2
C.S. B-2120-1&2

RETURN TO
LOS ANGELES COUNTY SURVEYOR
700 HALL OF RECORDS

Do not extend notes this side of this line.

Note: Any Additions or Changes on This Sheet Must Be Made or Circled in Red Ink With Date and Name of Person Making Change.

Notes Ck'd by Miller	Survey of T 5 N R 8 W	F. B. 1262 Pg. 41
Map No. B-2120-2	W. O. 4999 Tape No. 60 St'd 84 °F	
Office Work Ito	Surveyed by Rosecrans	
Checked Miller	Notes R Date 6-9-47	
Date April 1949	Indexed A. C. Johnson	

W.S. 67 B-5

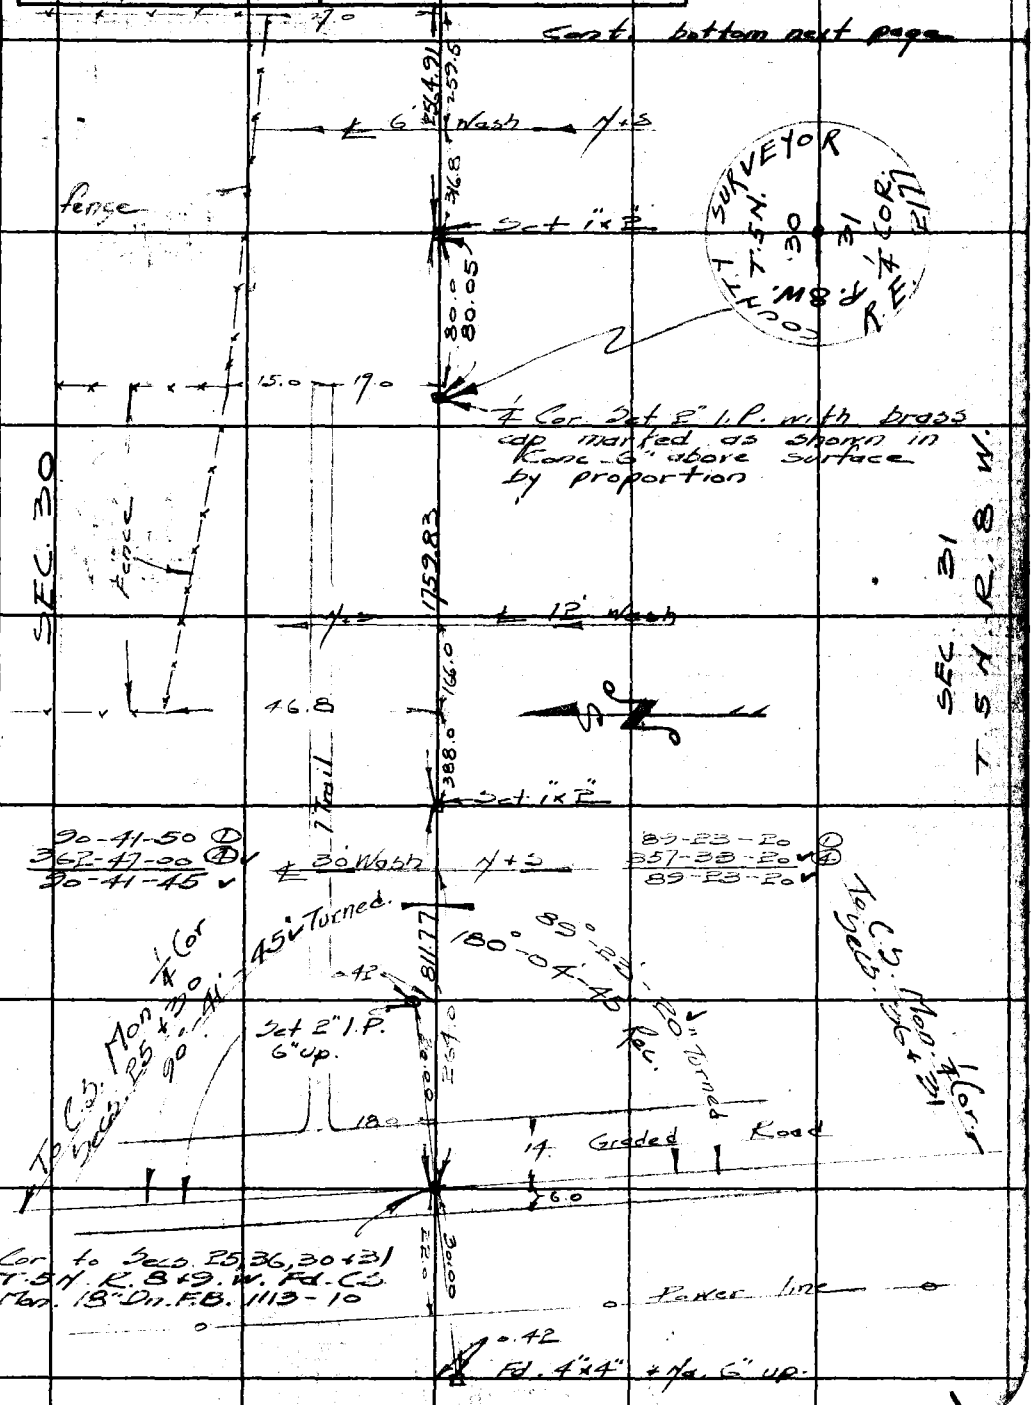

Note: Any Additions or Changes on This Sheet Must be Made or Circled in Red Ink With Date and Name of Person Making Change.

Do not extend notes this side of this line.

RETURN TO
LOS ANGELES COUNTY SURVEYOR
700 HALL OF RECORDS

FORM 247 BM 11-46

F. B. 1262 PG. 42

Cont. bottom page 45

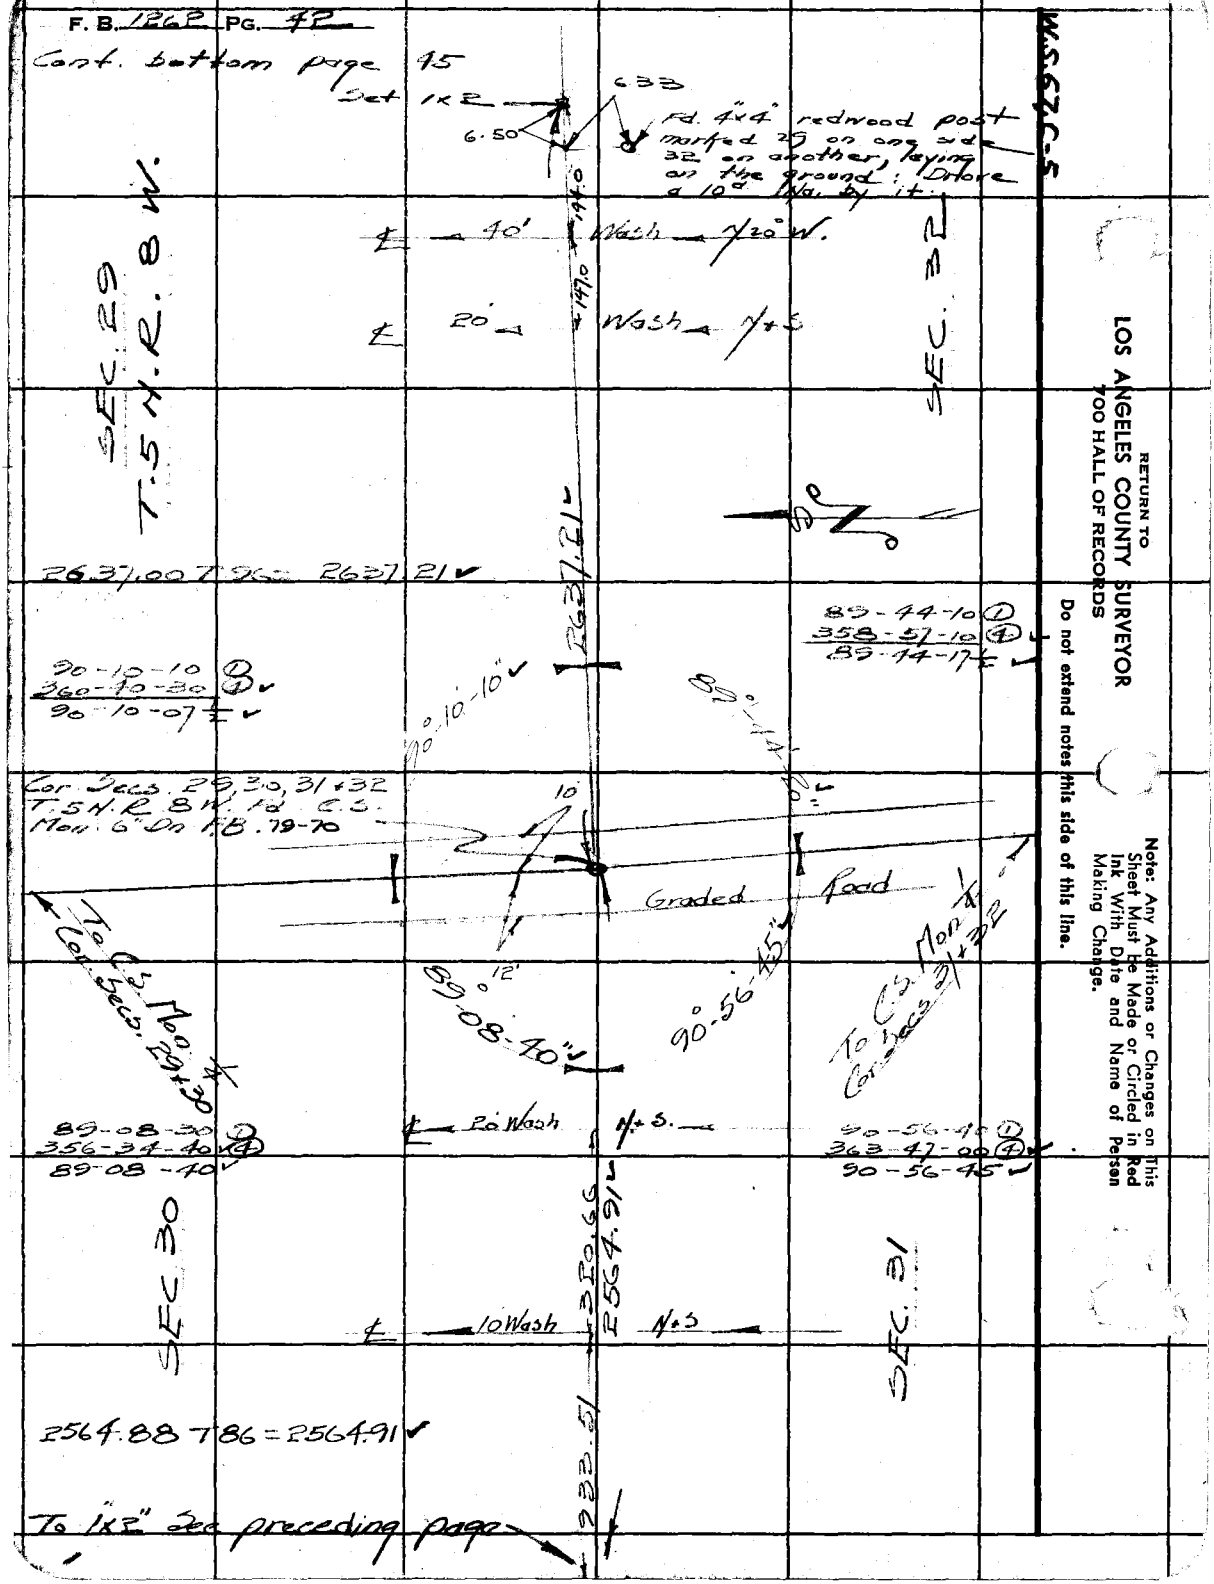

RETURN TO
LOS ANGELES COUNTY SURVEYOR
700 HALL OF RECORDS

Do not extend notes this side of this line.

Note: Any Additions or Changes on This Sheet Must Be Made or Circled in Red Ink With Date and Name of Person Making Change.

W.S. 67, C-5

Notes Ck'd by Miller	Survey of T. 5 N. R 8 W.	F. B. 1262 PG. 43
Map No. B-2120-2	W. O. 4999 Tape No. 60 St'd 84 °F	
Office Work Ito	Surveyed by Rosecrans	
Checked Miller	Notes R Date 6-11-47	
Date April 1949	Indexed A. C. Johnson	

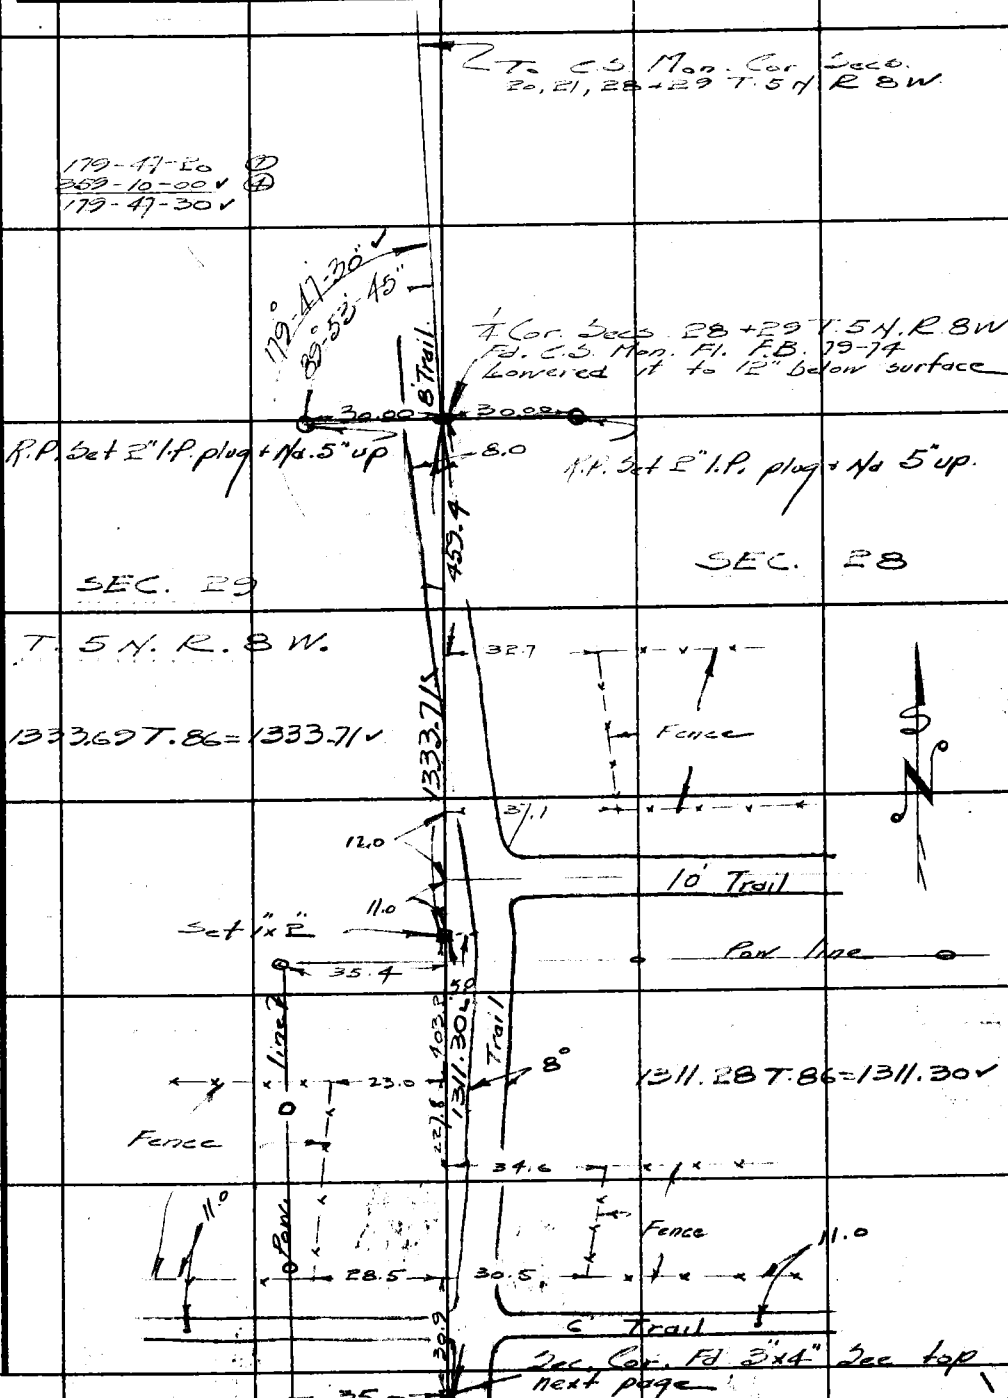

Note: Any Additions or Changes on This Sheet Must be Made or Circled in Red Ink With Date and Name of Person Making Change.

Do not extend notes this side of this line.

RETURN TO
LOS ANGELES COUNTY SURVEYOR
700 HALL OF RECORDS

FORM 247 SM 11-46

F. B. 1262 PG. 44

Cont. bottom of preceding page

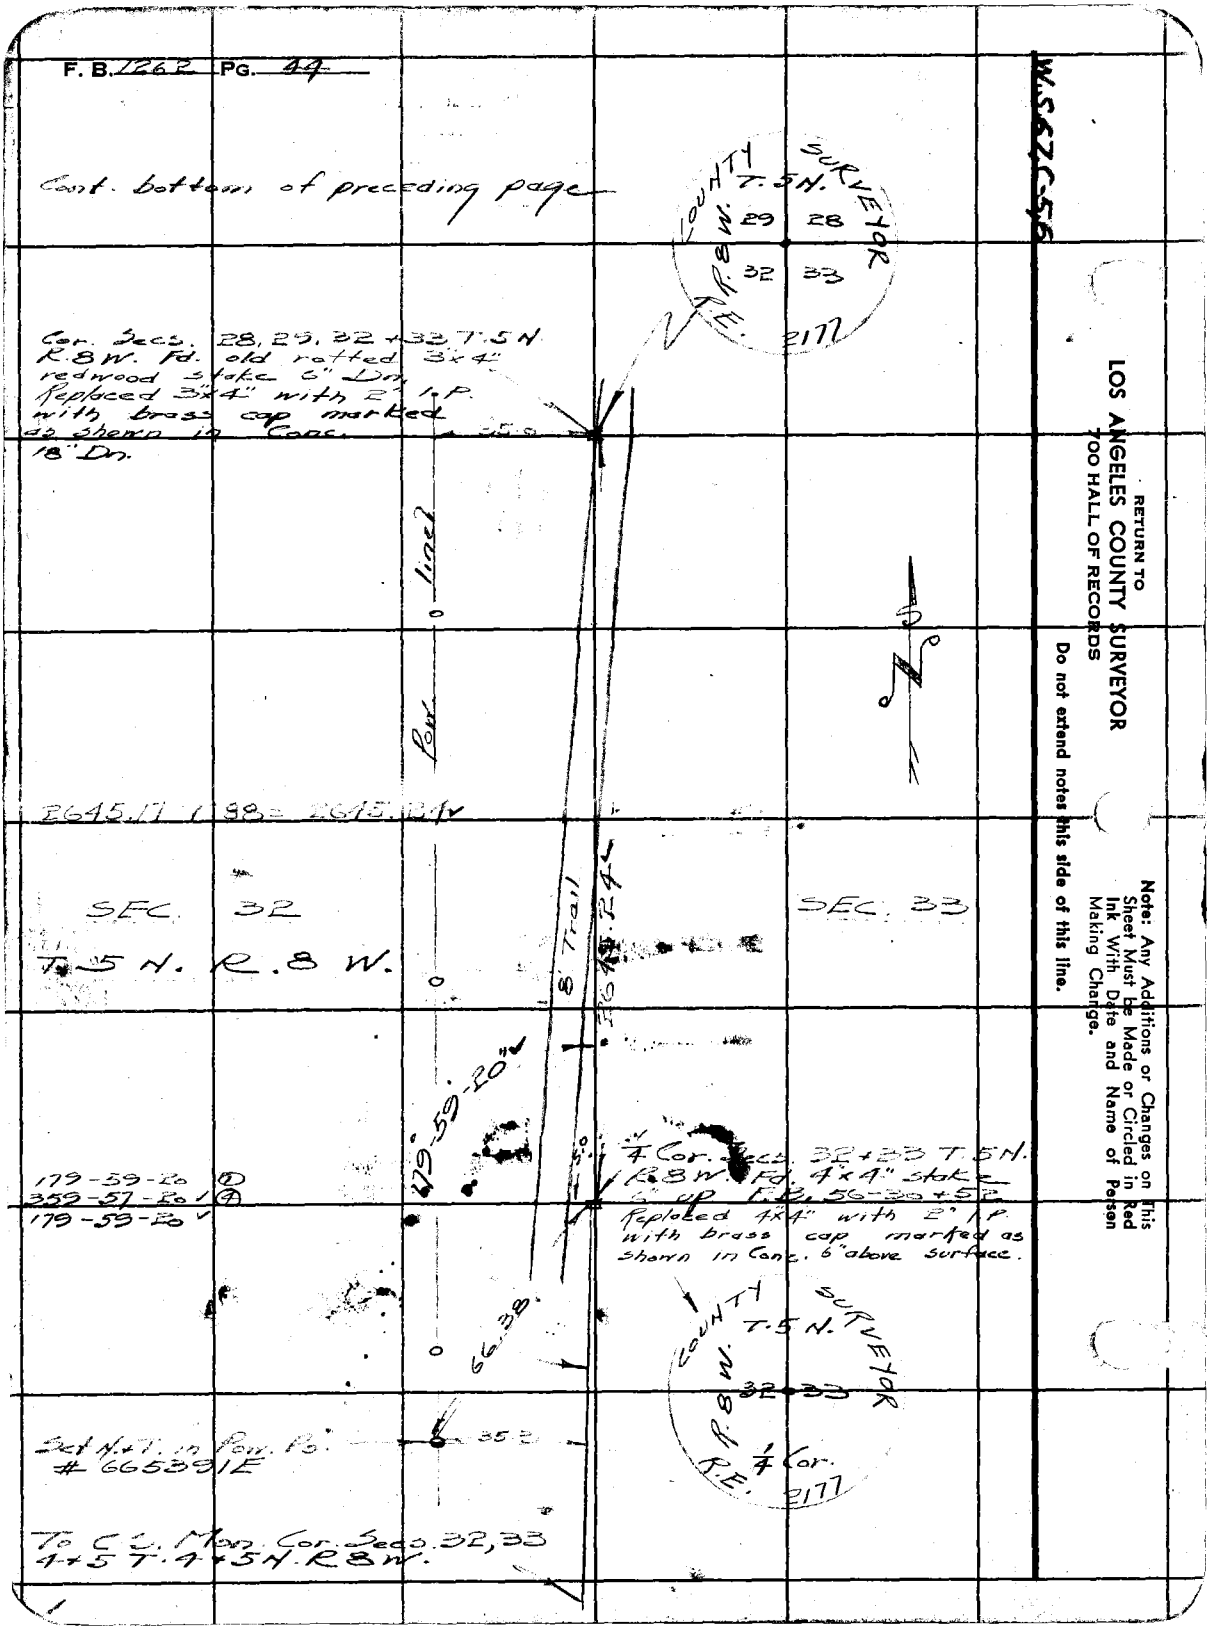

W.S.67C-56

RETURN TO
LOS ANGELES COUNTY SURVEYOR
700 HALL OF RECORDS

Do not extend notes this side of this line.

Note: Any Additions or Changes on This Sheet Must be Made or Circled in Red Ink With Date and Name of Person Making Change.

W.S.67, C-5

Notes Ck'd by Miller	Survey of T.5N. R 8W.
Map No. B-2120-2	W. O. 4999 Tape No. 60 St'd 84 °F
Office Work Ito	Surveyed by Rosecrans
Checked Miller	Notes R Date 6-13-47
Date Apr. 1949	Indexed A. C. Johnson

F. B. 1262 PG. 45

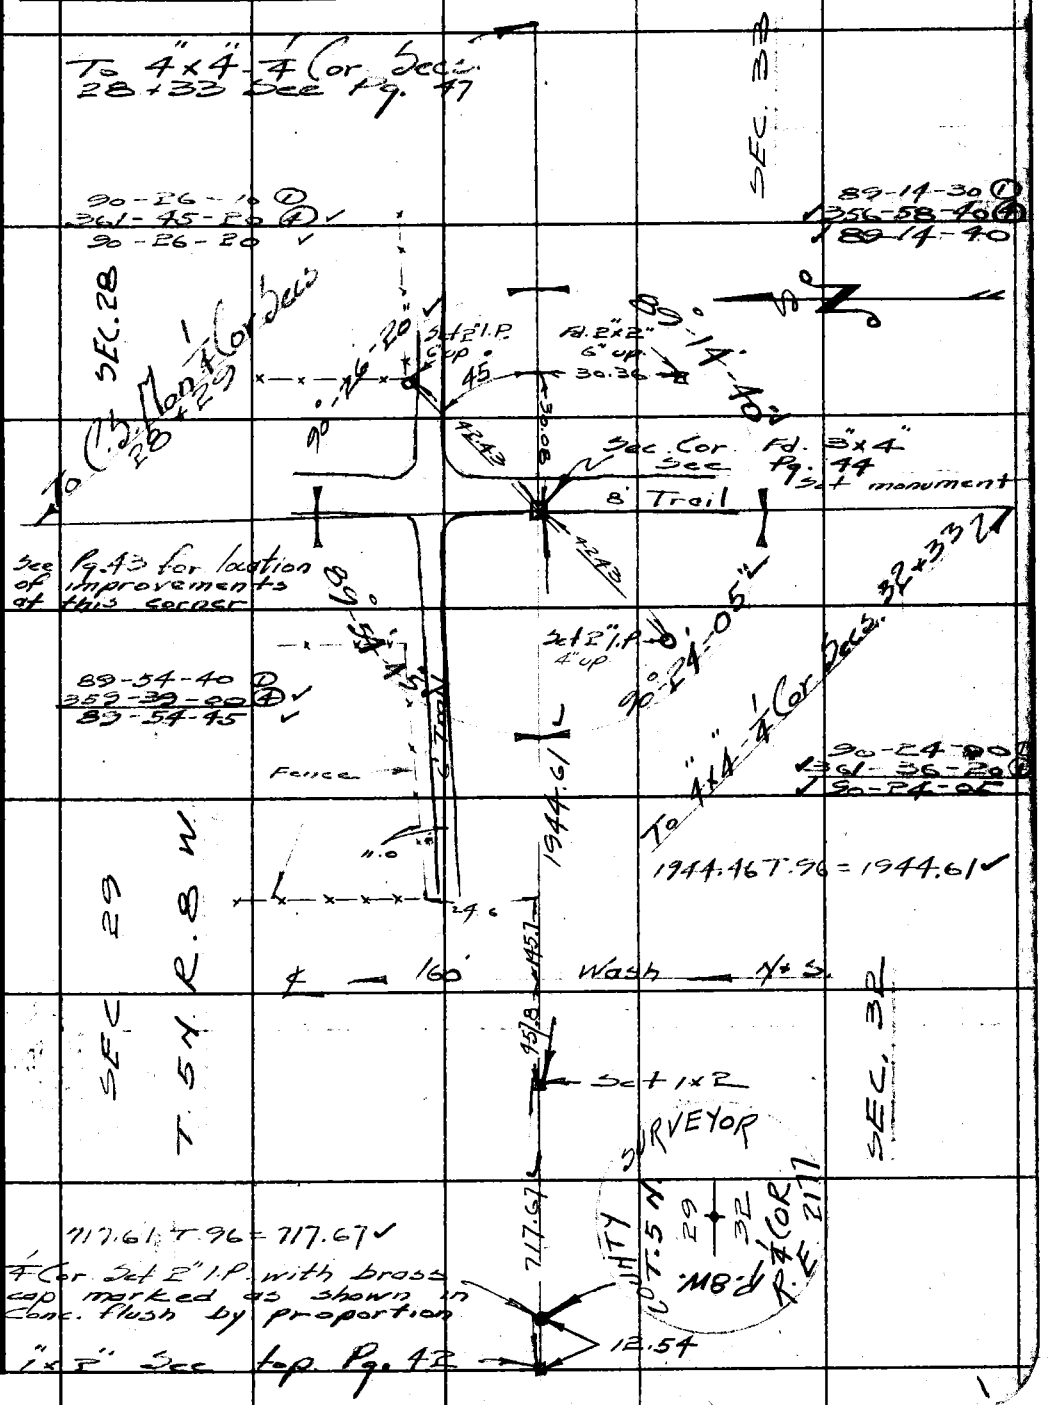

Note: Any Additions or Changes on This Sheet Must Be Made or Circled in Red Ink With Date and Name of Person Making Change.

Do not extend notes this side of this line.

RETURN TO
LOS ANGELES COUNTY SURVEYOR
700 HALL OF RECORDS

FORM 247 5M 11-46

RETURN TO
LOS ANGELES COUNTY SURVEYOR
700 HALL OF RECORDS

Note: Any Additions or Changes on This Sheet Must be Made or Circled in Red Ink With Date and Name of Person Making Change.

Do not extend notes this side of this line.

W.S.15, C-1
W.S.67, C-6

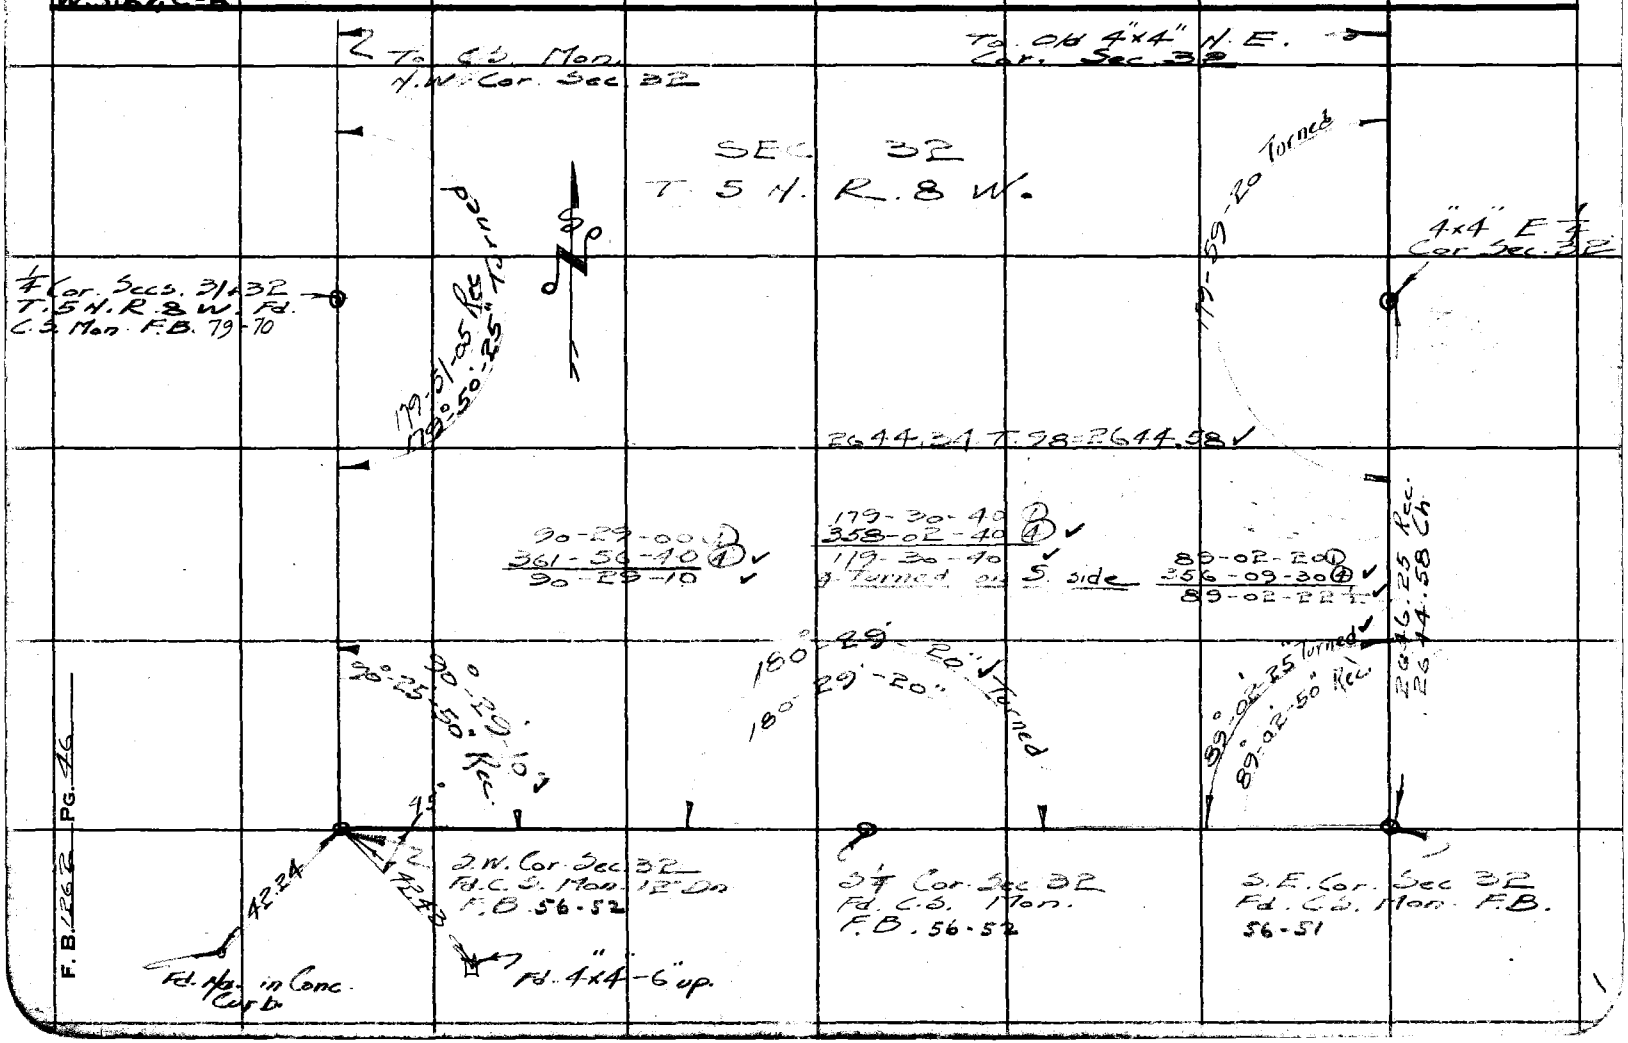

F.B. 1262 PG. 46

W.S. 67.6-5

Notes Ck'd by Miller	Survey of T. 5 N. R. 8 W.
Map No. B-2120-2	W. O. 4994 Tape No. 60 St'd 84 °F
Office Work T.to	Surveyed by Rosecrans
Checked Miller	Notes R Date 6-18-47
Date Apr. 1949	Indexed A. C. Johnson

F. B. 1262 Pg. 47

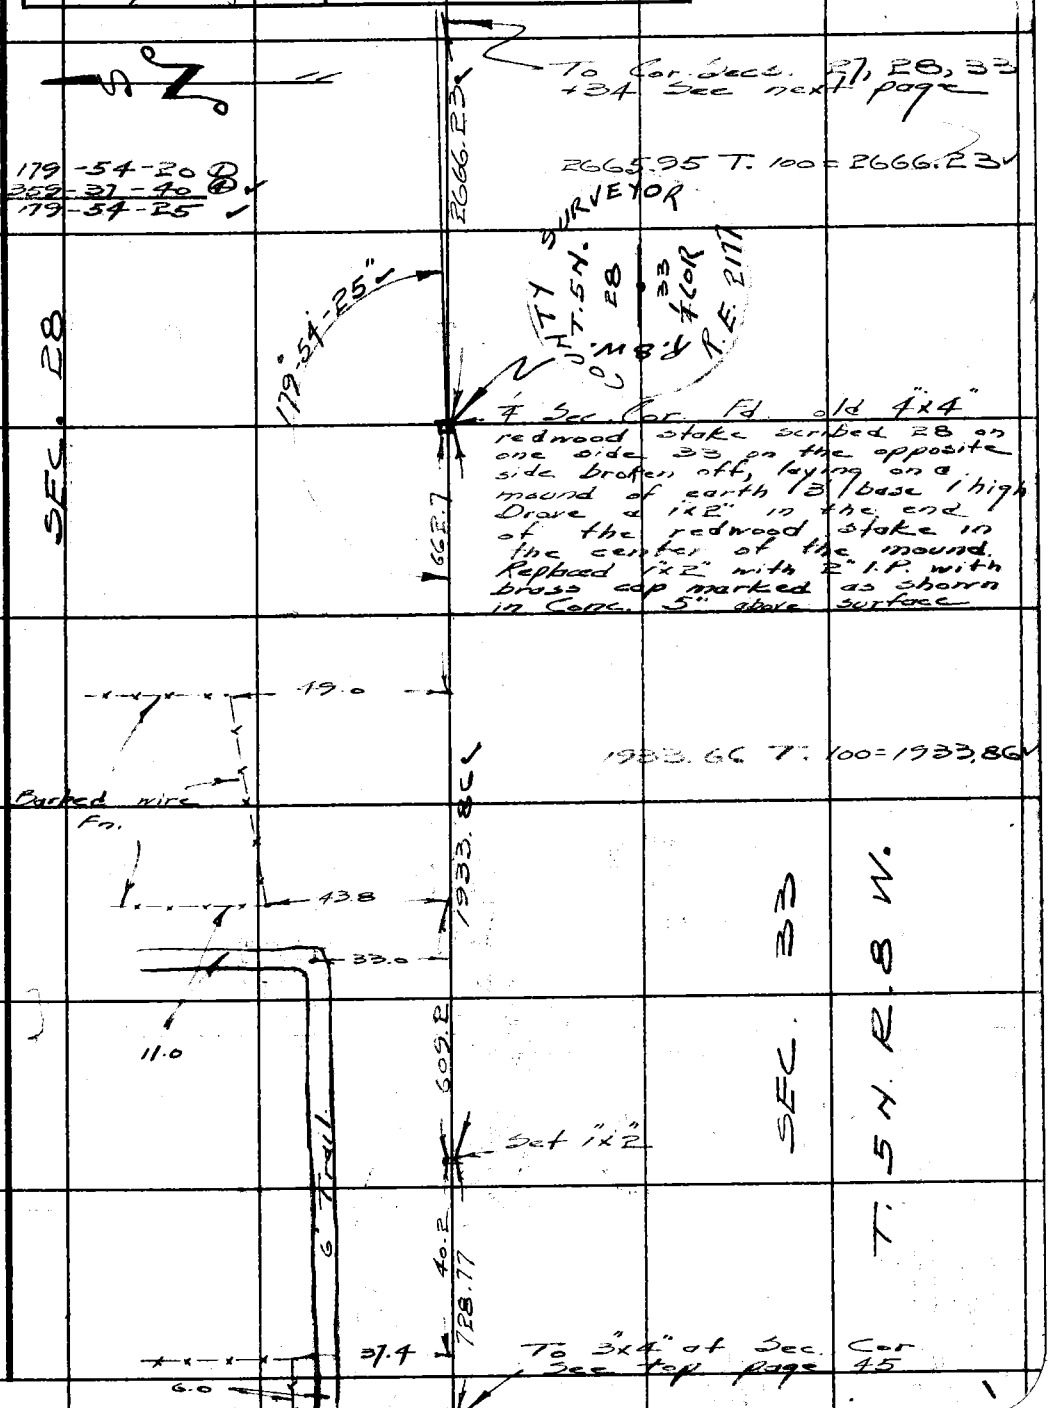

Note: Any Additions or Changes on This Sheet Must Be Made or Circled in Red Ink With Date and Name of Person Making Change.

Do not extend notes this side of this line.

RETURN TO
LOS ANGELES COUNTY SURVEYOR
700 HALL OF RECORDS

FORM 247 SM 11-46

F. B. 1262 PG. 48

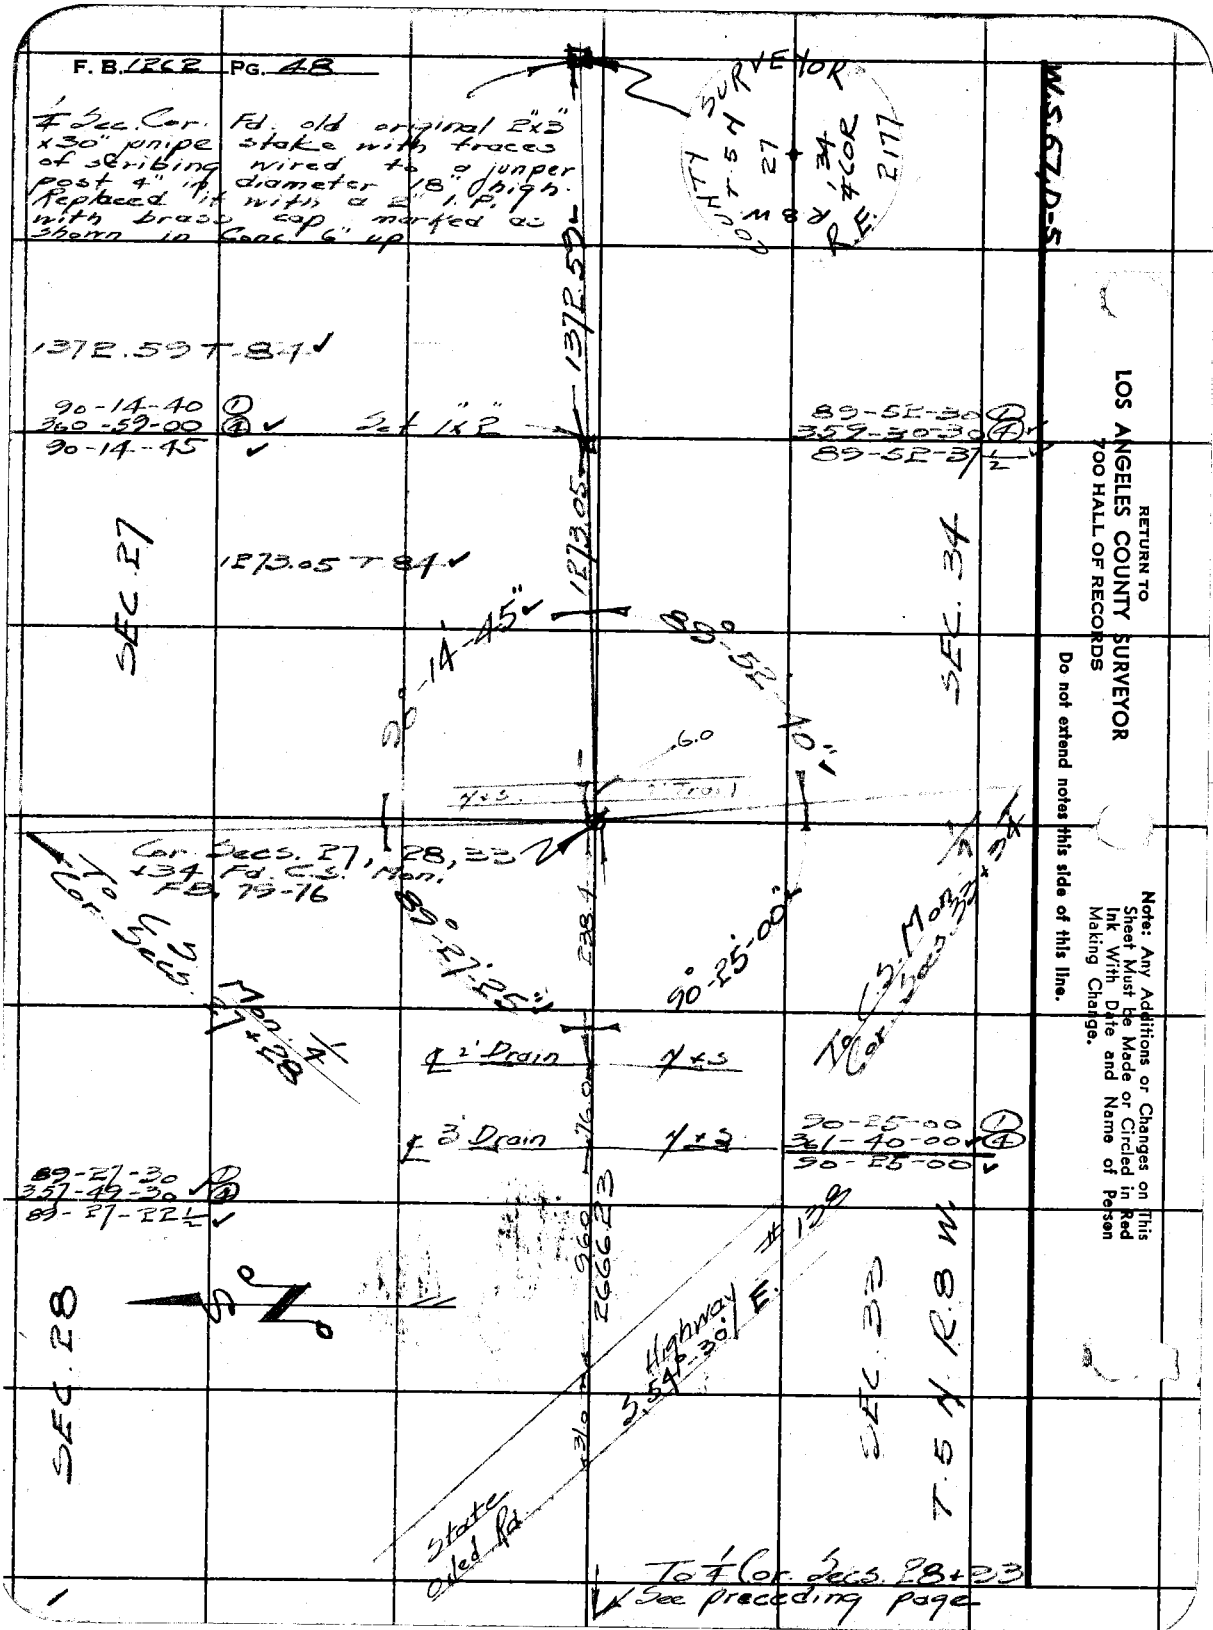

RETURN TO
LOS ANGELES COUNTY SURVEYOR
700 HALL OF RECORDS

Do not extend notes this side of this line.

Note: Any Additions or Changes on This Sheet Must Be Made or Circled in Red Ink With Date and Name of Person Making Change.

W.S. 67, D-5

Notes Ck'd by Miller	Survey of T.5N. R.8W.
Map No. C.S. B-2120-2	W. O. 4999 Tape No. 60 St'd 84 °F
Office Work Ito	Surveyed by Rosecrans
Checked Miller	Notes R Date 6-23-47
Date Apr. 1949	Indexed A. C. Johnson

F. B. 1262 Pg. 49

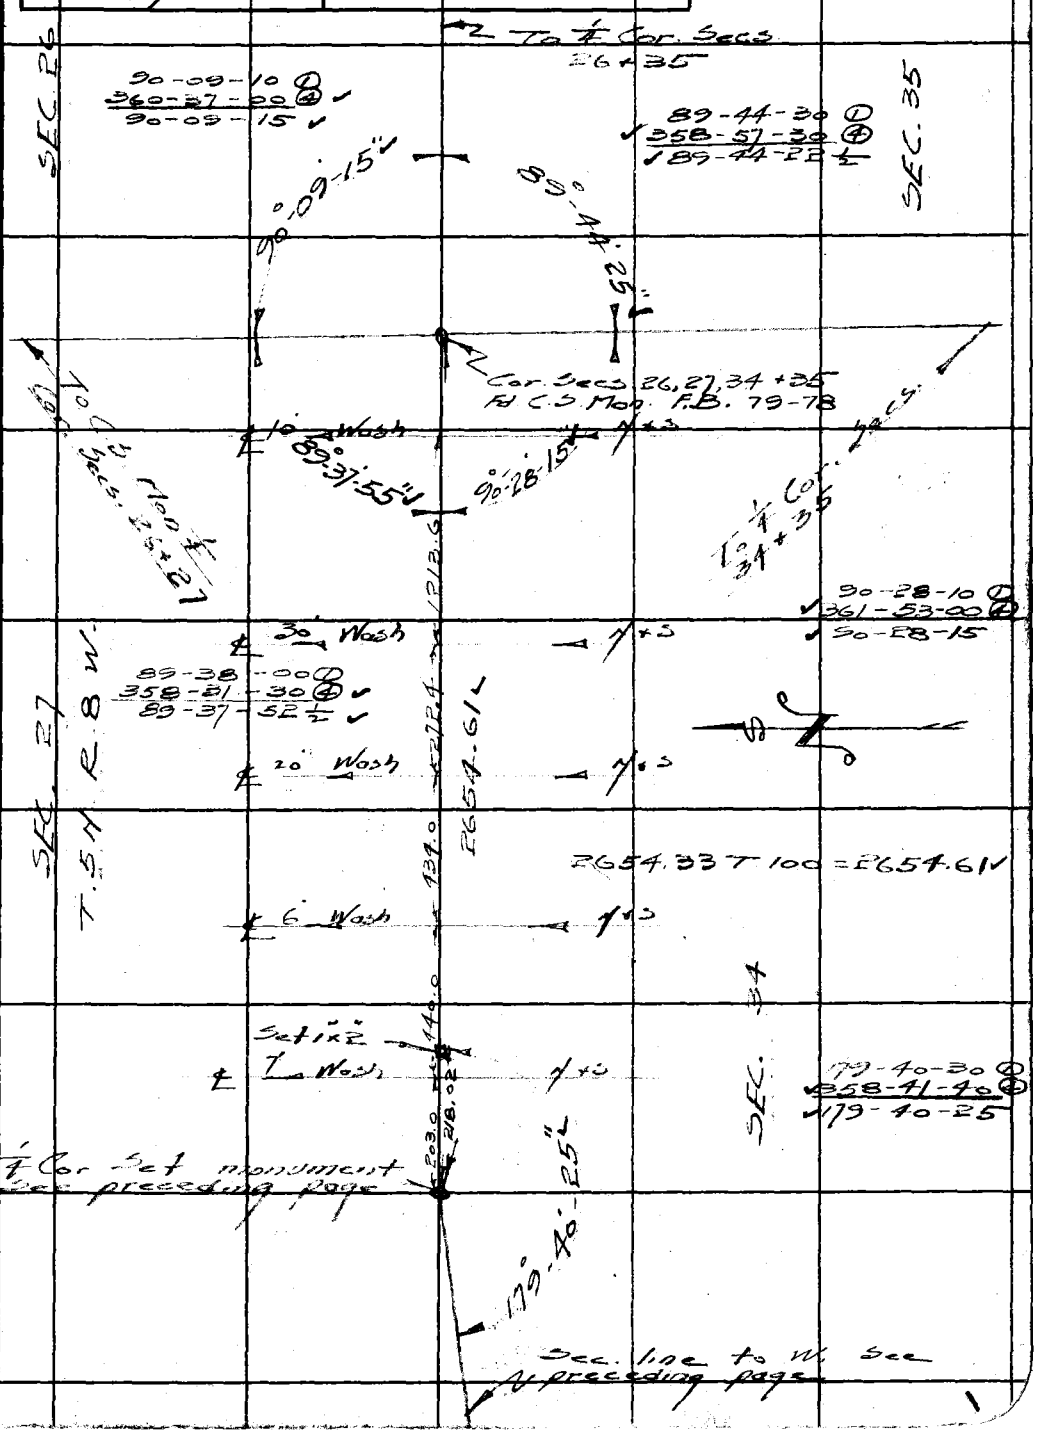

Note: Any Additions or Changes on This Sheet Must be Made or Circled in Red Ink With Date and Name of Person Making Change.

Do not extend notes this side of this line.

RETURN TO
LOS ANGELES COUNTY SURVEYOR
700 HALL OF RECORDS

FORM 247 5M 11-46

F. B. 1262 PG. 50

Cor. Secs 25, 26, 35 & 36
T. 5 N. R 8 W. Fd. C.S. Mon.
8" up F.B. 79-79

W.S. 67, D-5

℄ 20' Wash N & S.

2650.53 T 88 = 2650.60 ✓

7' Trail N 10° E

179-54-20
359-37-30
179-54-22½ ✓

0.17

Fd. piece of 1½" x ¼" strap iron in small rock mound

Fd. 12" joshua blazed on S.W. face

℄ 15' Wash N & S.

℄ 15' Wash N & S.

SEC. 26

SURVEYOR

COUNTY T. 5 N. R. 8 W. 26 35 ¼ COR. 2177

179°-54'-25"

N. 87°-30' E 48.20

4 Sec. Cor. Fd 3x4 redwood stake 6" above surface with old original 2"x3" x30" hewn juniper stake laying on the ground by it. Replaced redwood with 2' I.P. with brass cap marked as shown in Conc. 6" above surface.

℄ 6' Wash N & S.

Note found remains of old bearing tree N 16° W. 59' from ¼ Cor.

SEC. 35 T. 5 N. R. 8 W.

℄ 4' Wash N & S

1639.33 T. 96 = 1639.46 ✓

Set 1x2

℄ 4' ditch N & S.

1007.99 T. 96 = 1008.07 ✓

℄ 5' Wash N & S.

C.S. Mon. Cor. Secs 26, 27 34 & 35 See preceding page

W.S. 67, D-5

RETURN TO
LOS ANGELES COUNTY SURVEYOR
700 HALL OF RECORDS

Do not extend notes this side of this line.

Note: Any Additions or Changes on This Sheet Must Be Made or Circled in Red Ink With Date and Name of Person Making Change.

W.S. 67D-6

Notes Ck'd by Miller	Survey of T.5N. R.8W.	F.B. 1262 PG. 51
Map No. B-2120-2	W. O. 4999 Tape No. 60 St'd 84 °F	
Office Work Ito	Surveyed by Rosecrans	2644.52 T.88 = 2644.59
Checked Miller	Notes R Date 6-26-47	
Date Apr. 1949	Indexed A. C. Johnson	

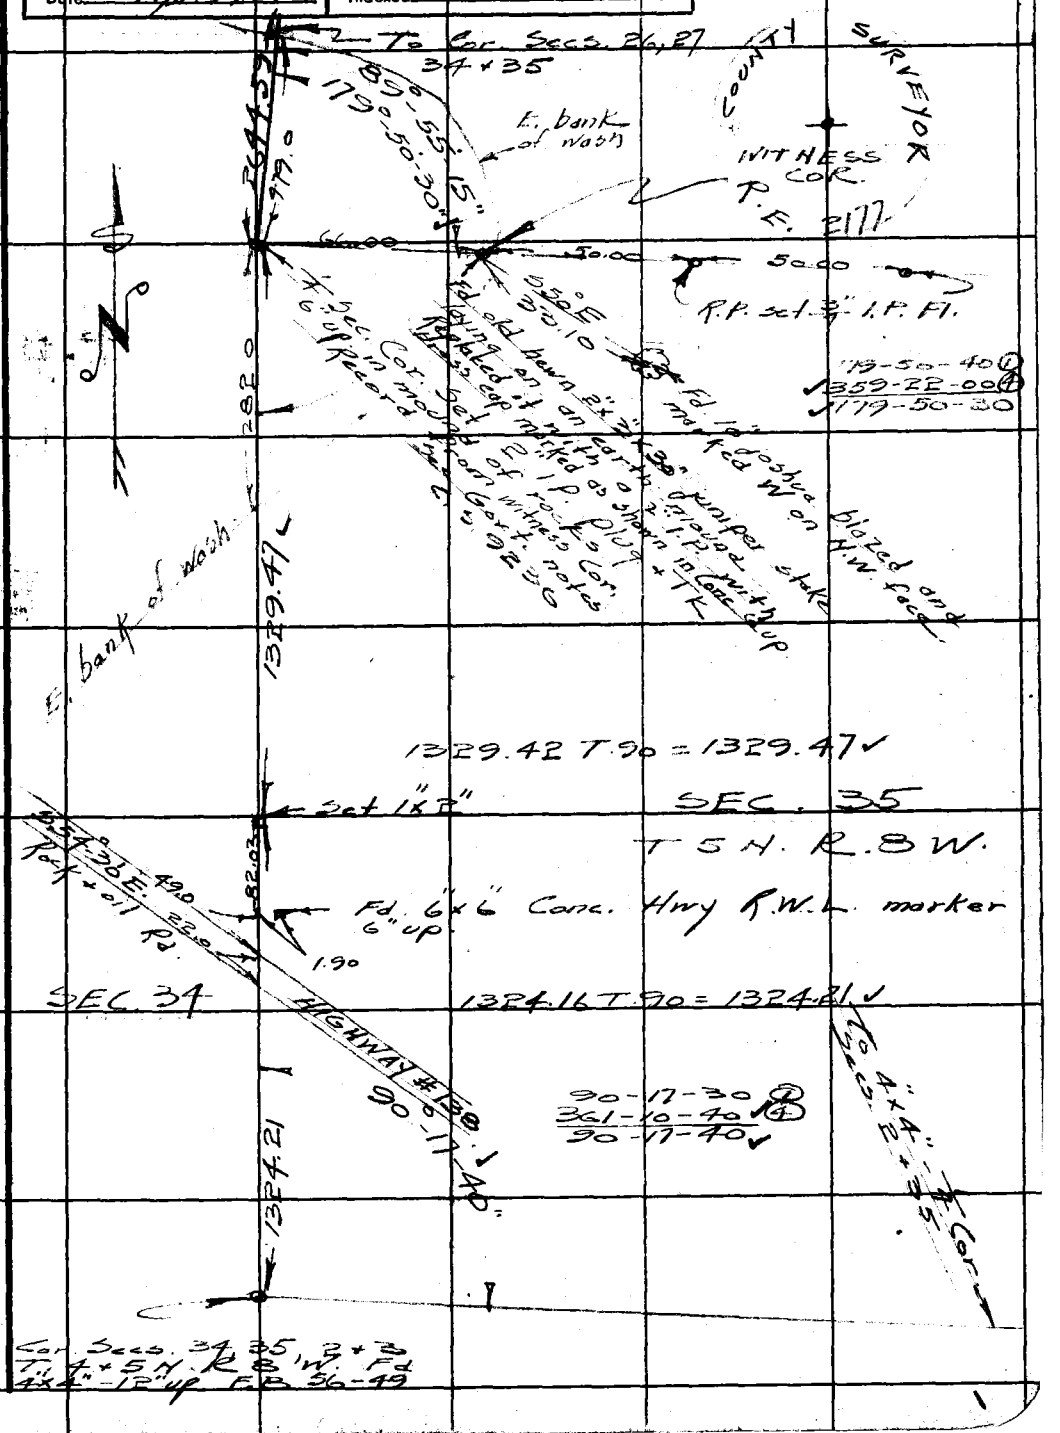

Note: Any Additions or Changes on This Sheet Must be Made or Circled in Red Ink With Date and Name of Person Making Change.

Do not extend notes this side of this line.

RETURN TO
LOS ANGELES COUNTY SURVEYOR
700 HALL OF RECORDS

FORM 247 BM 11-46

F. B. 1262 PG. 52

89-53-10 (1)
359-33-00 (4) ✓
89-53-15 ✓

89°-53'-15" ✓

To C.S. Mon. 1/4 Cor. Secs 25-26

89°-30'-40"

89-30-40 (1)
358-02-40 (4)
89-30-40

W.S. 27 D-6

Cor. Secs. 25, 26, 35 + 36 Fd. C.S. Mon. F.B. 79-79

To 1/4 Cor. Secs. 26 + 35

90°-28'-25"

90°-07'-20"

To 1/4 Cor. Secs. 25 + 36

90-28-30 (1)
361-53-40 (4) ✓
90-28-25 ✓

2642.58

90-07-20 (1)
360-29-20 (4)
90-07-20 ✓

2642.41 T.94 = 2642.58 ✓

SEC. 35

COUNTY SURVEYOR T.5N. R.8W. 35-36 1/4 COR. R.E. 2177

179°-45'-35" ✓

1/4 Cor. Fd. old hewn 2"x3"x30" juniper stake laying on small mound of earth. Set a 2" I.P. with brass cap marked as shown in Conc. 4" above surface in the center of the mound.

179-45-30 (1)
359-02-10 (4) ✓
179-45-32 1/2 ✓

SEC. 36

T.5N. R.8W.

2643.58 T.100 = 2643.85 ✓

2643.85

89-54-30 (1)
359-37-20 (4)
89-54-20 ✓

To 4"x4" 1/4 Cor. Secs 35 + 2

89°-54'-20" ✓

Cor. Secs 1, 2, 35 + 36 T.4+5 N. R.8W. Fd. 4"x4" Set over C.S. Mon. F.B. 56-48

RETURN TO
LOS ANGELES COUNTY SURVEYOR
700 HALL OF RECORDS

Do not extend notes this side of this line.

Note: Any Additions or Changes on This Sheet Must be Made or Circled in Red Ink With Date and Name of Person Making Change.

Notes Ck'd by Miller	Survey of T.5N. R8W.	F.B. 1262 PG. 53
Map No. B-2120-2	W. O. 4999 Tape No. 60 St'd 84 °F	
Office Work Ito	Surveyed by Rosecrans	
Checked Miller	Notes R Date 7-7-47	
Date Apr. 1949	Indexed A. C. Johnson	

W.S. 67, D.E.-5

SAN BERNARDINO COUNTY

Cor. Secs. 25, 36, 30+31 T.5N. R7+8W. Fd C.S. Mon. 12" Dn. F.B. 79-66

Y+S. ℄ 20' Rd.

To C.S. Mon. 1/4 Cor. Secs. 25+30

90°-27'-45" ✓

℄ 6' Wash

Y+S.

179°-55'-25" Rec.

89°-27'-45" ✓

To C.S. Mon. 1/4 Cor. Secs. 31+36

℄ 6' Wash

Y+S.

LOS ANGELES COUNTY

℄ 7' Wash

Y+S.

89-27-50 ①
✓ 357-51-00 ④
✓ 89-27-45

90-27-40 ①
361-51-00 ④ ✓
90-27-45 ✓

2666.00 T.98 = 2666.24 ✓

℄ 10' Wash

Y+S.

179°-52'-30"

1/4 Sec. Cor. Fd. old 2"x3"x30" hewn juniper stake with traces of scribing laying on the ground Set 1/2" I.P. with brass cap marked as shown in Conc. by it. 6" up.

COUNTY SURVEYOR T.5N. R8W. 25 36 1/4 COR R.E. 2177

SEC. 25

SEC. 36

179-52-30 ①
359-30-00 ④ ✓
179-52-30 ✓

1842.97 T.94 = 1843.09 ✓

T.5N. R.8W.

Set 1"x2"

818.72 T94 = 818.77 ✓

Cor. Secs. 25, 26, 35+36 T.5N. R.8W. Fd. C.S. Mon. 6" up. F.B. 79-79

Note: Any Additions or Changes on This Sheet Must be Made or Circled in Red Ink With Date and Name of Person Making Change.

Do not extend notes this side of this line.

RETURN TO LOS ANGELES COUNTY SURVEYOR 700 HALL OF RECORDS

FORM 247 5M 11-46

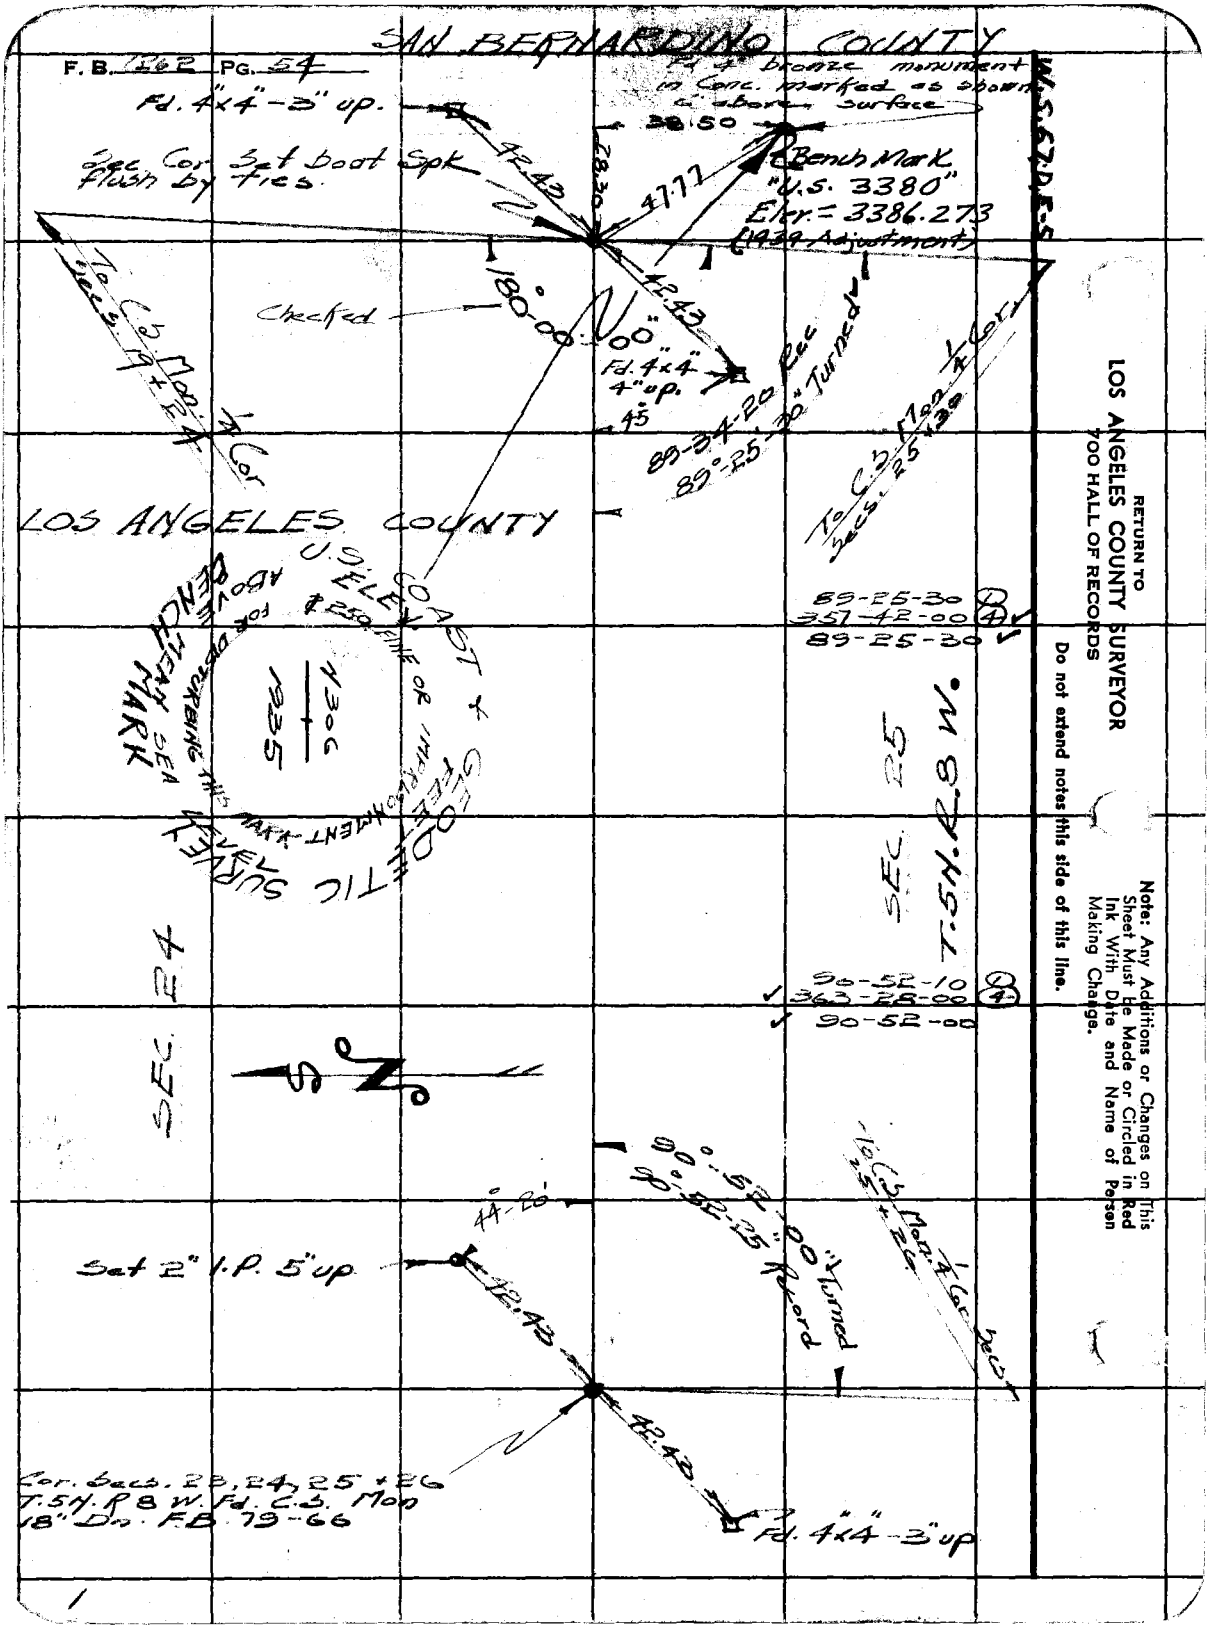
SAN BERNARDINO COUNTY
F. B. 1262 PG. 54
Fd. 4"x4"-3" up.
Fd. 4" bronze monument in Conc. marked as shown 6" above surface
38.50
Sec. Cor. Set boat Spk flush by ties.
42.43
28.30
47.77
Bench Mark "U.S. 3380" Elev. = 3386.273 (1939 Adjustment)
W.S. 67 D.E.S.
Checked
180°-00'-00"
Fd. 4"x4" 4" up.
45°
89-34-20 Rec
89°-25'-30" Turned
To C.S. Mon. 1/4 Cor. Secs. 19 + 24
To C.S. Mon. 1/4 Cor. Secs. 25 + 30
LOS ANGELES COUNTY
U.S. COAST + GEODETIC SURVEY
ELEV. ABOVE MEAN SEA
BENCH MARK
FOR DISTURBING THIS MARK - A FINE OR IMPRISONMENT - 1935
N306
1935
89-25-30
357-42-00
89-25-30
SEC. 25
T.5N. R.8 W.
90-52-10
363-28-00
90-52-00
SEC. 24
90°-52'-00" Turned
90°-52'-25" Record
To C.S. Mon. 1/4 Cor. Secs. 25 + 26
44°-20'
Set 2" I.P. 5" up
42.43
42.43
Cor. Secs. 23, 24, 25 + 26 T.5N. R.8 W. Fd. C.S. Mon 18" Dn. F.B. 79-66
Fd. 4"x4"-3" up
RETURN TO
LOS ANGELES COUNTY SURVEYOR
700 HALL OF RECORDS
Do not extend notes this side of this line.
Note: Any Additions or Changes on This Sheet Must Be Made or Circled in Red Ink With Date and Name of Person Making Change.

W.S. 67.D-5

Notes Ck'd by Miller	Survey of T.5N. R.8W.	F.B. 1262 Pg. 55
Map No. B-2120-2	W. O. 4999 Tape No. 60 St'd 84 °F	
Office Work Tto	Surveyed by Rosecrans	
Checked Miller	Notes R Date 7-11-47	
Date Apr. 1949	Indexed A. C. Johnson	

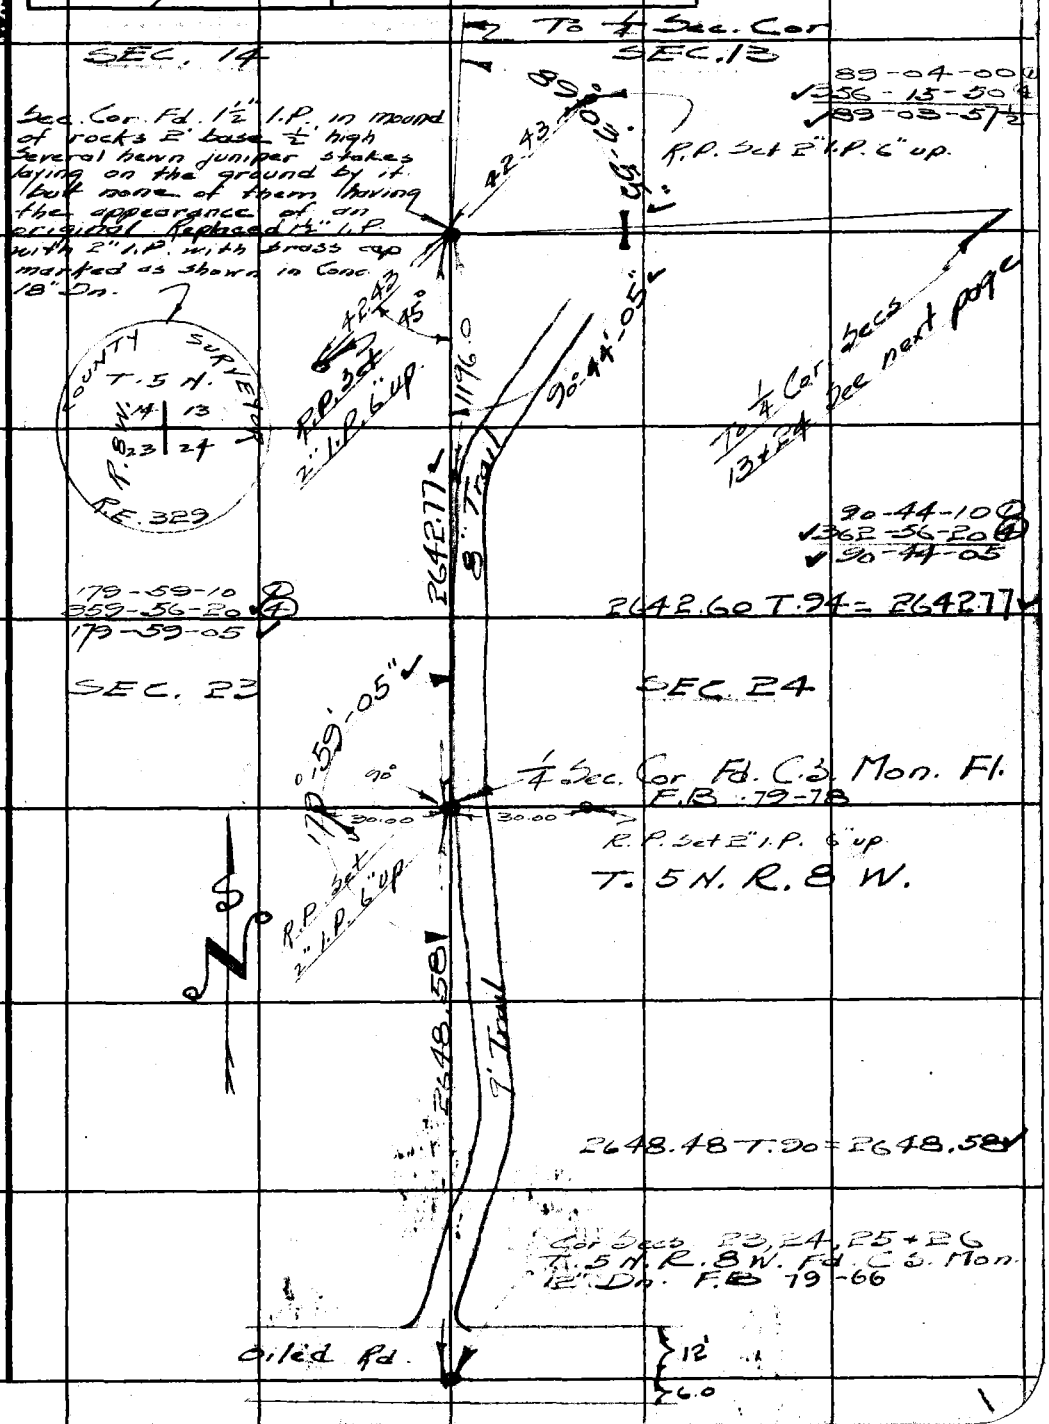

Note: Any Additions or Changes on This Sheet Must be Made or Circled in Red Ink With Date and Name of Person Making Change.

Do not extend notes this side of this line.

RETURN TO
LOS ANGELES COUNTY SURVEYOR
700 HALL OF RECORDS

FORM 247 5M 11-46

F. B. 1262 PG. 56

℄ 8' Wash N 4° E

1018.0

Fd. 2" I.P. plug + TK. 1" up.

¼ SEC COR. Replaced 2" I.P. with 2" I.P. with brass cap marked as shown in Conc. 6" up.

COUNTY SURVEYOR
T.5N. R.8W.
13 | 24
¼ COR
R.E. 3292

663.53

Fd. 2" I.P. 6" up

664.01

2654.77

SEC 13

SEC 24

T.5N. R.8W.

Fd. 2" I.P. 2" up.

663.50

2654.77 T 84 ✓

Fd. 2" I.P. 1" up.

N

121.94

Set 1"x2" Fl.

N 15° E

47.5

℄ 8' Trail

541.80

Mon. at Sec. Cor. See top preceding page

W.S. 67-D-E-5

RETURN TO
LOS ANGELES COUNTY SURVEYOR
700 HALL OF RECORDS

Do not extend notes this side of this line.

Note: Any Additions or Changes on This Sheet Must be Made or Circled in Red Ink With Date and Name of Person Making Change.

Notes Ck'd by Miller	Survey of T.5N.R8W.
Map No. B-2120-2	W. O. 4999 Tape No. 60 St'd 84 °F
Office Work Ito	Surveyed by Rosecrans
Checked Miller	Notes R Date 7-28-47
Date April 1949	Indexed A. C. Johnson

F. B. 1262 Pg. 57

W.S. 67, E-5

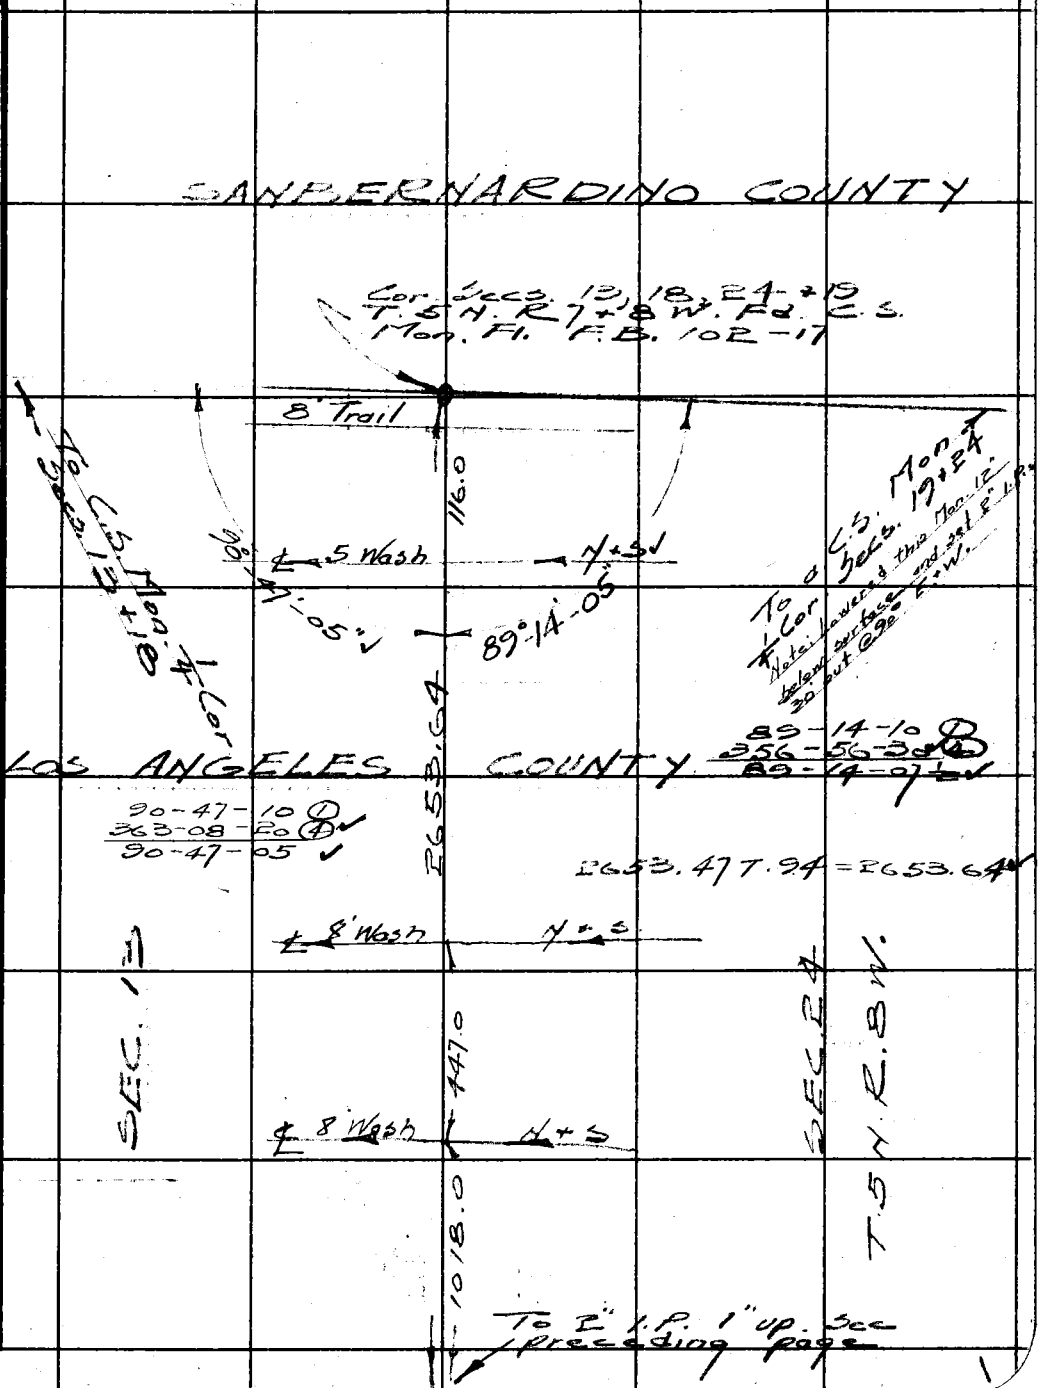

Note: Any Additions or Changes on This Sheet Must be Made or Circled in Red Ink With Date and Name of Person Making Change.

Do not extend notes this side of this line.

RETURN TO
LOS ANGELES COUNTY SURVEYOR
700 HALL OF RECORDS

FORM 247 SM 11-46

Cont. on Pg. 99

F. B. 1262 PG. 58

Cor. Secs. 11, 12, 13 + 14 T. 5 N. R. 8 W. Fd. 2" I.P. plug + TK 4" up. Could not find old bearing trees.

Set C.S. Mon. See Pg. 99

W.S. 67 D-5

664.23

664.17 T.98 = 664.23

0.16

Fd. 2" I.P. 5" up

664.06

664.00 T.98 = 664.06

0.23

Fd. 2" I.P. 5" up.

664.64

2657.06

664.58 T.98 = 664.64

SEC. 13

0.02

Fd 2" I.P. 5" up.

664.13

664.07 T.98 = 664.13

¼ Sec. Cor. replaced 2" I.P. with 2" I.P. with brass cap marked as shown in Conc. 18" Dn.

R.P. Set 2" I.P. 6" up

Fd. 2" I.P. plug + TK 5" up.

30.00

30.00

R.P. Set 2" I.P. 6" up.

SEC. 14

T. 5 N. R. 8 W.

664.19

664.13 T.98 = 664.19

0.05

Fd. 2" I.P. 6" up

664.05

2656.91

663.99 T.98 = 664.05

COUNTY SURVEYOR

T. 5 N.

R. 8 W.

14 | 13

¼ COR

R.E. 329

℄ 6 Wash

0.05

Fd. 2" I.P. 5" up

664.28

103.0

664.19 T 104 = 664.28

N. 10° W.

664.39

664.30 T 104 = 664.39

Cor. Secs. 13, 14, 23 + 24 T. 5 N. R. 8 W. Fd. pipe set monument See Pg. 55

RETURN TO
LOS ANGELES COUNTY SURVEYOR
700 HALL OF RECORDS

Do not extend notes this side of this line.

Note: Any Additions or Changes on This Sheet Must be Made or Circled in Red Ink With Date and Name of Person Making Change.

W.S. 67 D-5

Notes Ck'd by Miller	Survey of T.5N. R8 W.
Map No. B-2120-2	W. O. 4999 Tape No. 60 St'd 84 °F
Office Work Ito	Surveyed by Rosecrans
Checked Miller	Notes R Date 9-22-47
Date April 1949	Indexed A. C. Johnson

F. B. 1262 Pg. 59

Cont. bottom next page

Fd. 4"x4" redwood post 9' high.

5.48

N. 30° E

Trail

19.22

10'

Set 1x2

7'

8' Trail

77.0

17.0

Sec. line

SEC. 22

SEC. 23

T.5N. R.8W.

2587.70

2587.36 T.104 = 2587.70 ✓

N. 50° W.

179-48-40 (1)
359-15-00 (4) ✓
179-48-45 ✓

179°-48'-45" ✓

556.0

Trail

Cor. Secs. 22 + 23 T.5N. R.8W. Fd. C.S. Mon. 6" up F.B. 79-77

To C.S. Mon. Cor. Secs. 22, 23 26 + 27 T.5N. R8W

Note: Any Additions or Changes on This Sheet Must be Made or Circled in Red Ink With Date and Name of Person Making Change.

Do not extend notes this side of this line.

RETURN TO
LOS ANGELES COUNTY SURVEYOR
700 HALL OF RECORDS

FORM 247 5M 11-46

F. B. 1262 PG. 60

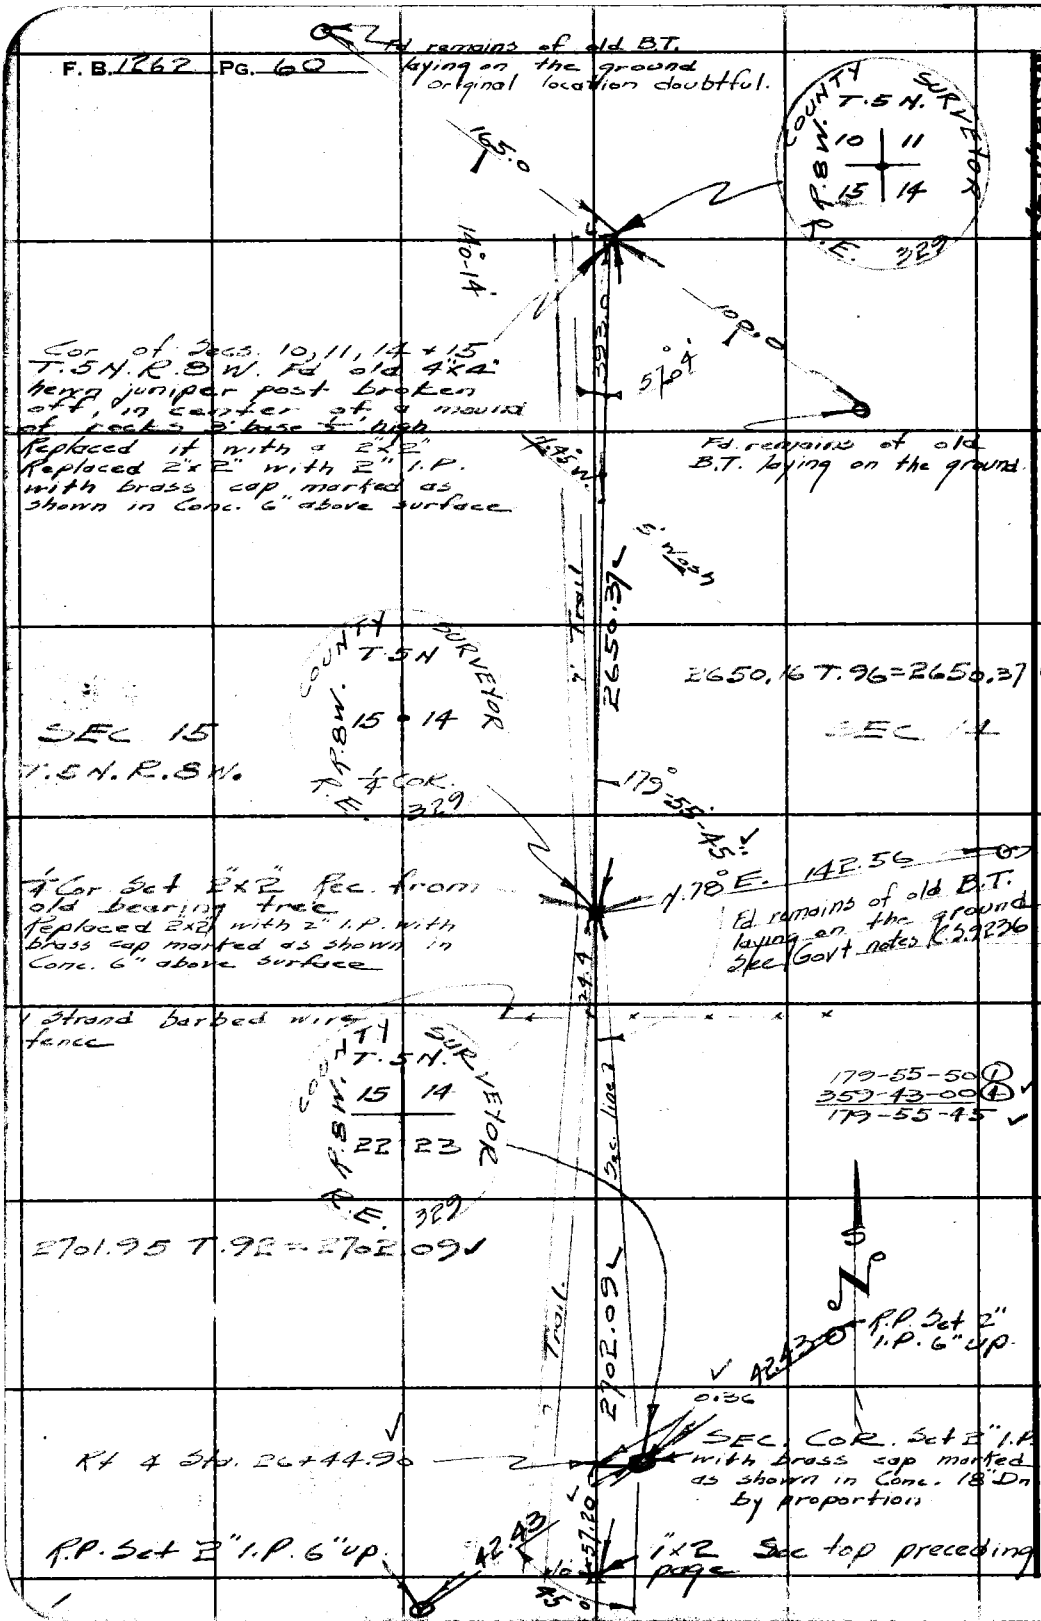

W.S. 67D-95

RETURN TO
LOS ANGELES COUNTY SURVEYOR
700 HALL OF RECORDS

Do not extend notes this side of this line.

Note: Any Additions or Changes on This Sheet Must be Made or Circled in Red Ink With Date and Name of Person Making Change.

Notes Ck'd by RRM.	Survey of T.5 N R 9 W.
Map No. B-2120-1	W. O. 4999 Tape No. 60 St'd. 84 °F
Office Work Drawn	Surveyed by Rosecrans
Checked McPherson	Notes R Date 10-10-47
Date Apl. 1949	Indexed A. C. Johnson 10-27-47

F. B. 186 R Pg. 61

RECHAIN OF NORTH AND EAST BOUNDARYS OF T. 5 N. R. 9 W.

J. N. 4999

Party E. A. Rosecrans
J. P. Pierce
J. C. Pierce
H. H. Howard
L. Vejar.

Note: Any Additions or Changes on This Sheet Must Be Made or Circled in Red Ink With Date and Name of Person Making Change.

Do not extend notes this side of this line.

RETURN TO
LOS ANGELES COUNTY SURVEYOR
700 HALL OF RECORDS

FORM 247 SM 11-46

F. B. 1262 PG. 62

W.S. 66, D-3

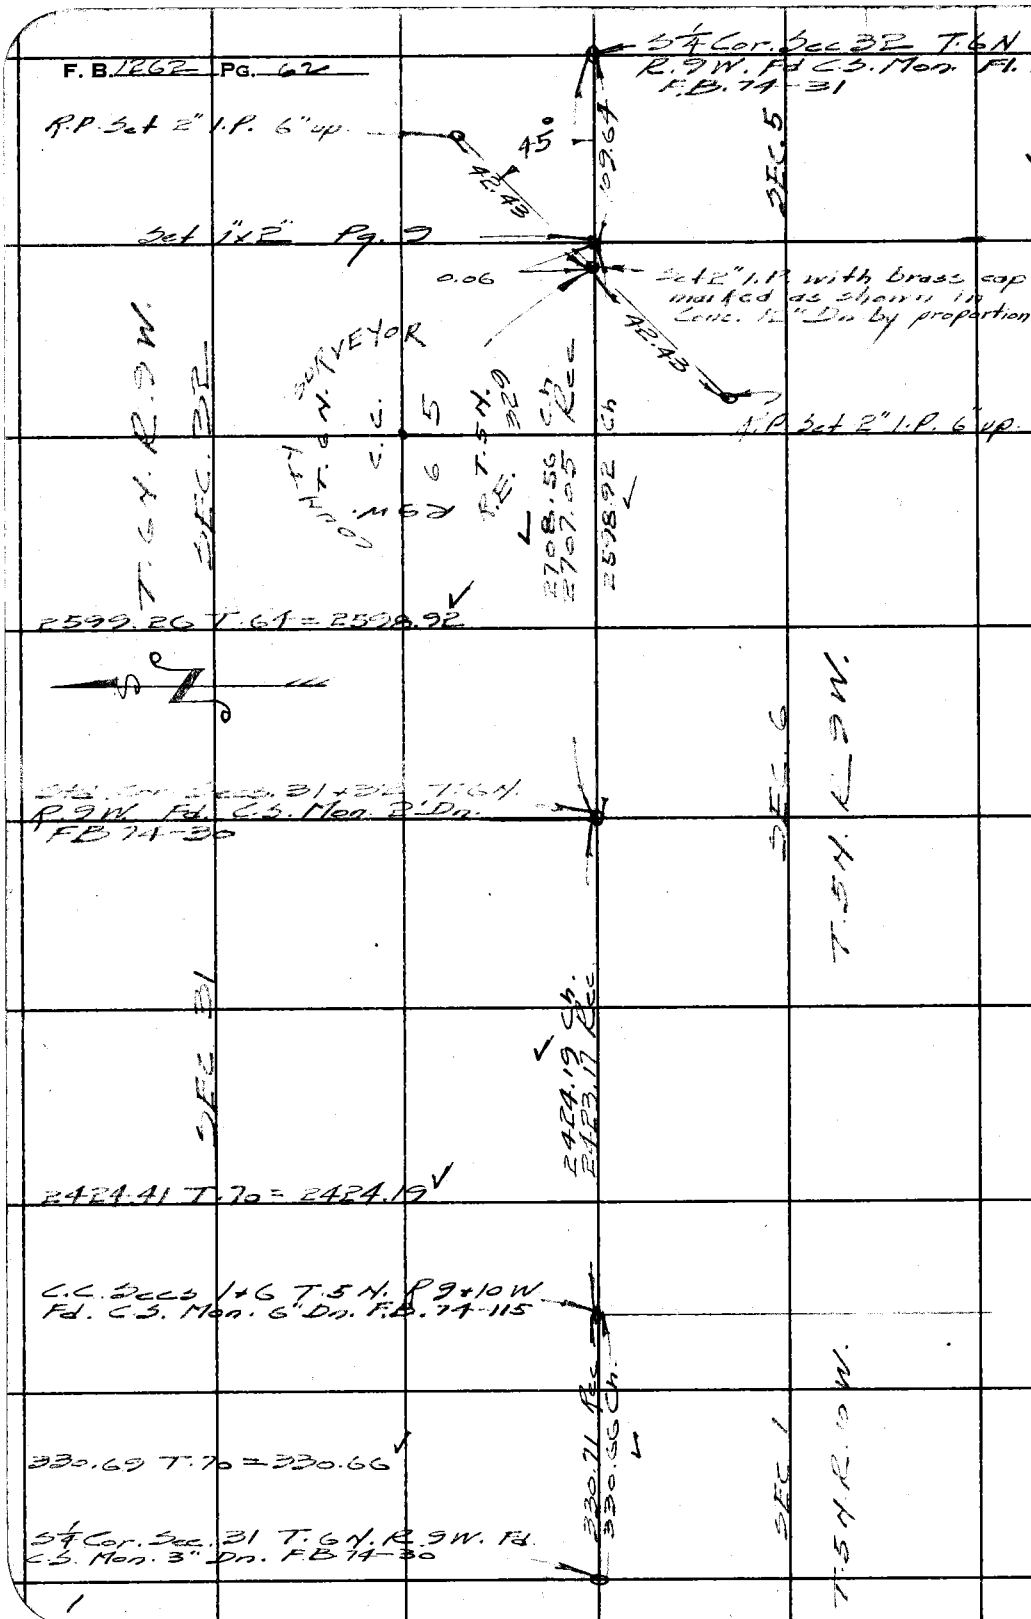

RETURN TO
LOS ANGELES COUNTY SURVEYOR
700 HALL OF RECORDS

Do not extend notes this side of this line.

Note: Any Additions or Changes on This Sheet Must be Made or Circled in Red Ink With Date and Name of Person Making Change.

FORM 247 5M 11-46

RETURN TO
LOS ANGELES COUNTY SURVEYOR
700 HALL OF RECORDS

Note: Any Additions or Changes on This Sheet Must be Made or Circled in Red Ink With Date and Name of Person Making Change.

Do not extend notes this side of this line.

W.S.66.D-3

Notes Ck'd by LWM
Map No. B-2120-1
Office Work Drawn
Checked [illegible]
Date Dec. 1949

Survey of T.5N.R.9W.
W. O. [illegible] Tape No. 60 Std. [illegible]
Surveyed by [illegible]
Notes [illegible] Date 6-10-47
Indexed R. C. Johnson

F. B. 1262 Pg. 63

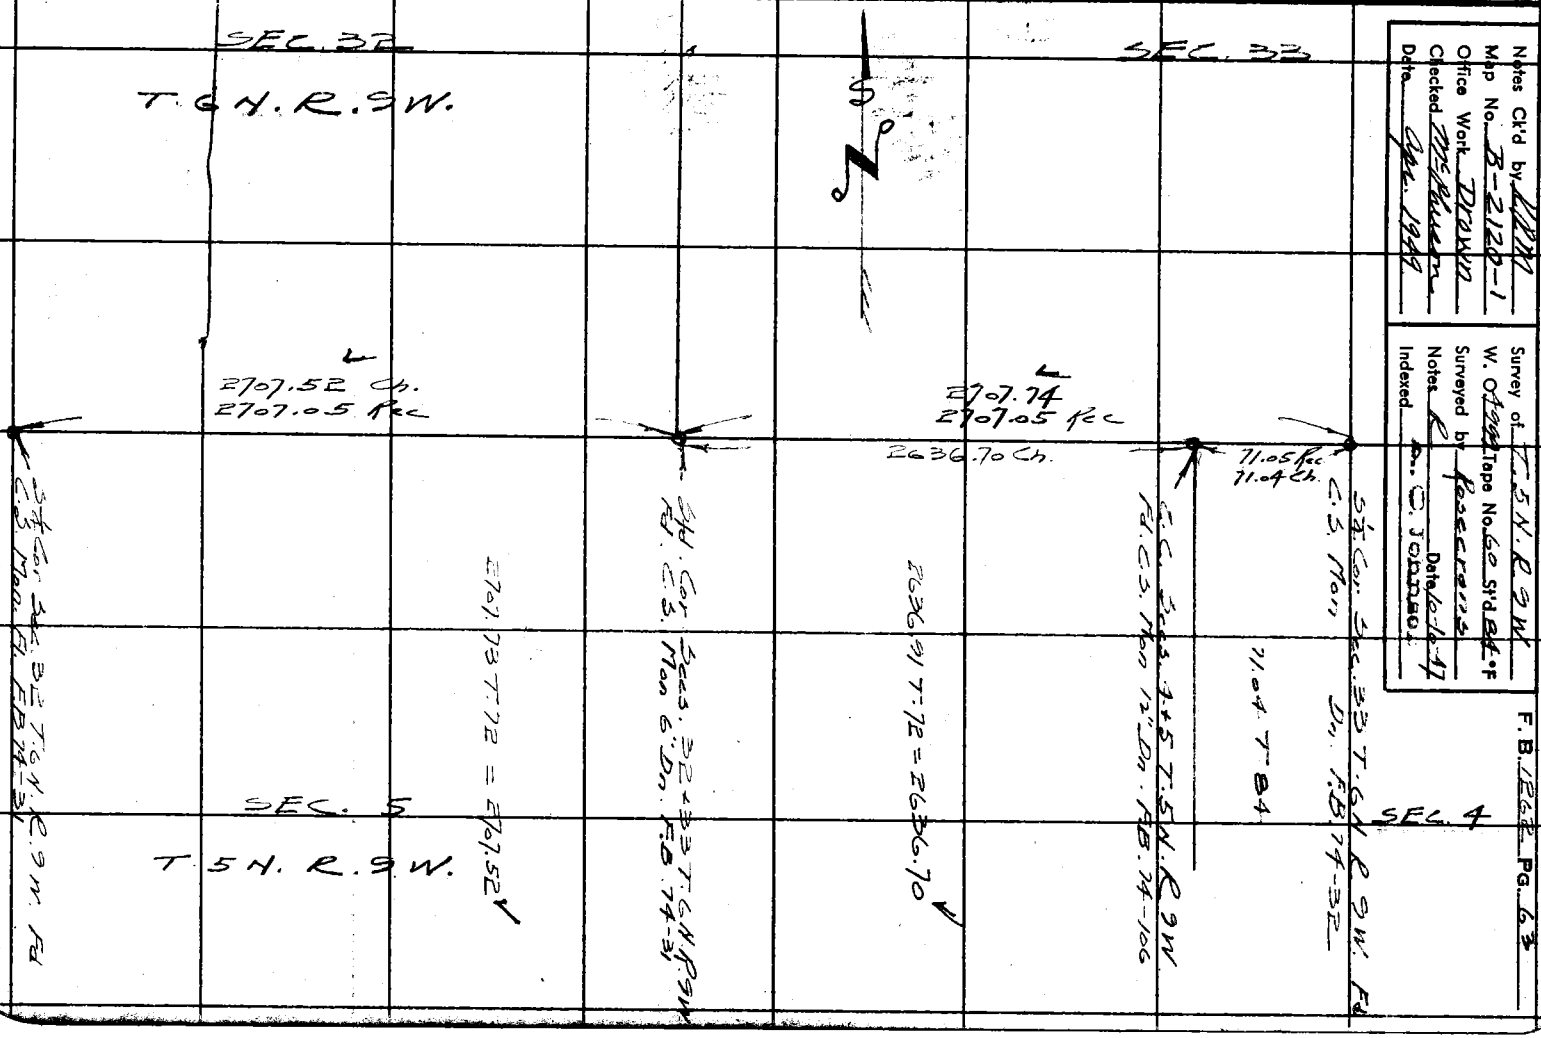

F. B. 1262 PG. 64

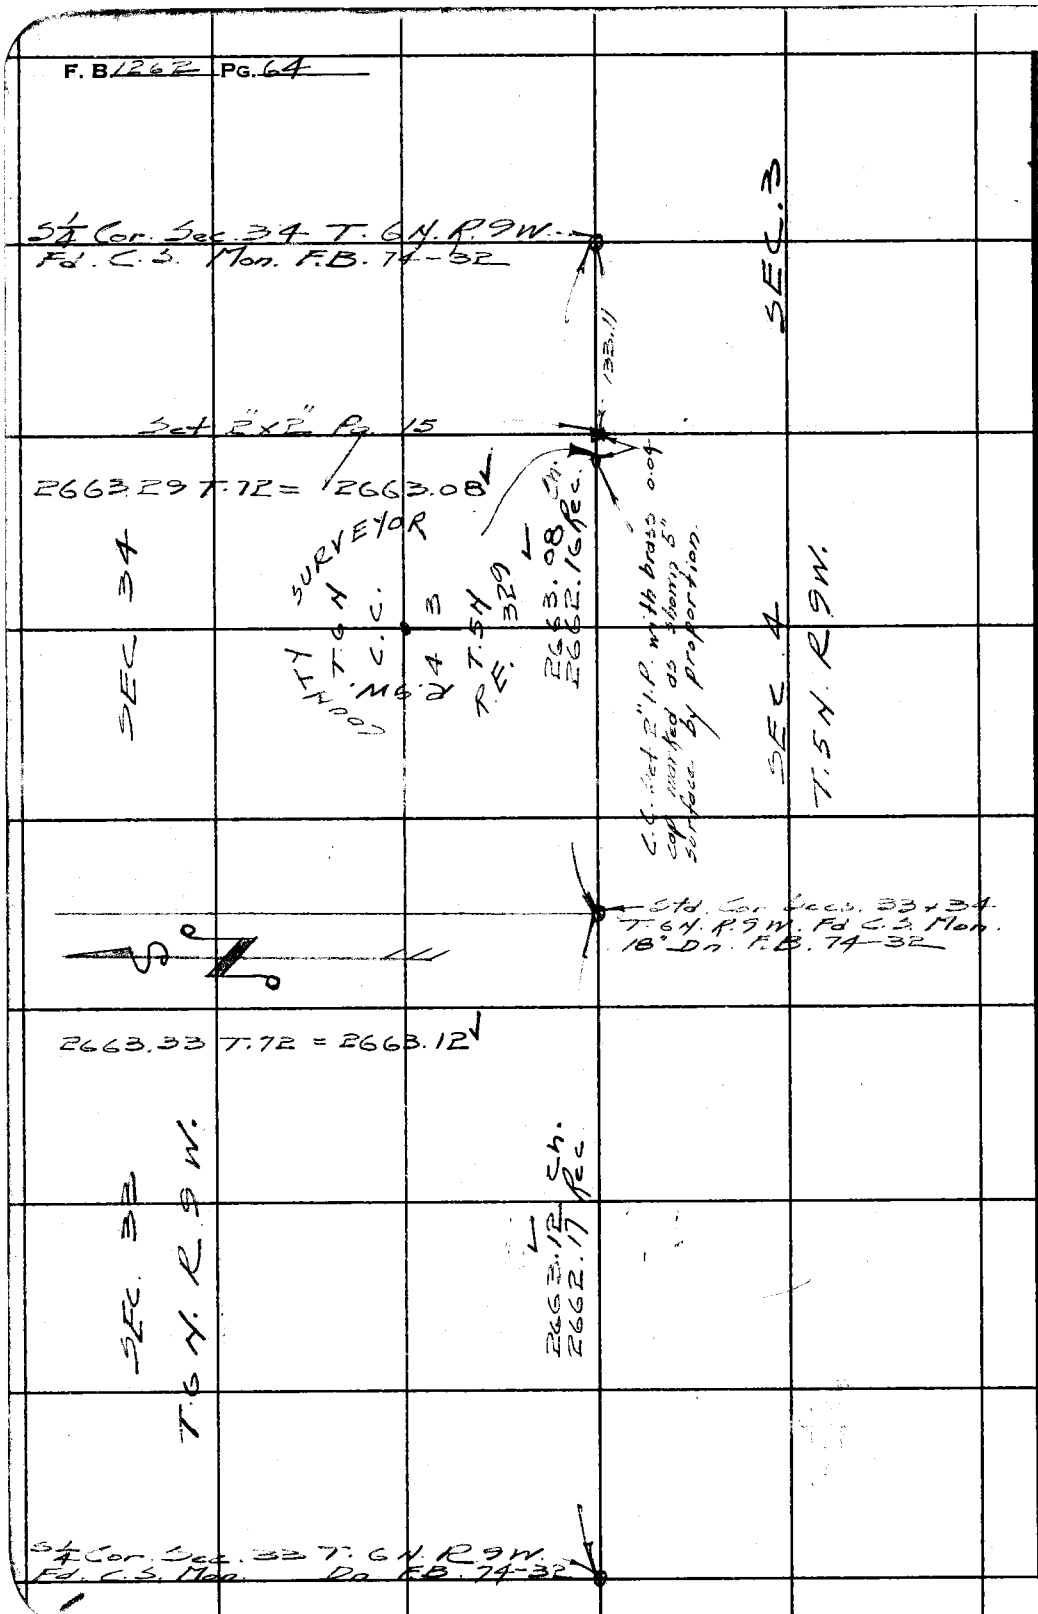

W.S. 67, A-3

RETURN TO
LOS ANGELES COUNTY SURVEYOR
700 HALL OF RECORDS

Do not extend notes this side of this line.

Note: Any Additions or Changes on This Sheet Must Be Made or Circled in Red Ink With Date and Name of Person Making Change.

Notes Ck'd by KRM	Survey of T.5N. R.9W.
Map No. B-2120-1	W. O. 4999 Tape No. 60 St'd 84°F
Office Work Drown	Surveyed by Rosecrans
Checked McPherson	Notes R Date 10-14-47
Date Apr. 1949	Indexed A. C. Johnson

F. B. 1262 Pg. 65

W.S. 67 A-3

SEC. 2

S¼ Cor. Sec 25 T.6N. R 9W. Fd. C.S. Mon F.B. 74-33

138.23 T.74 = 138.22

138.32 Rec
138.22 Ch

C.C. Secs 2+3 T.5N. R.9W. Fd C.S. Mon. F.B. 74-32

2663.27 Ch
2662.16 Rec

2525.05 Ch

SEC. 35

SEC. 3

T. 5N. R 9 W.

2525.25 T.72 = 2525.05

Std. Cor. Secs 34+35 T.6N. R.9W. Fd C.S. Mon. F.B. 74-32

2663.13 T.72 = 2662.92

SEC. 34

T.6N. R. 9W.

2662.92
2662.17 Rec

S¼ Cor. Sec. 34 T.6N. R.9W. Fd. C.S. Mon. F.B. 74-32

Note: Any Additions or Changes on This Sheet Must Be Made or Circled in Red Ink With Date and Name of Person Making Change.

Do not extend notes this side of this line.

RETURN TO
LOS ANGELES COUNTY SURVEYOR
700 HALL OF RECORDS

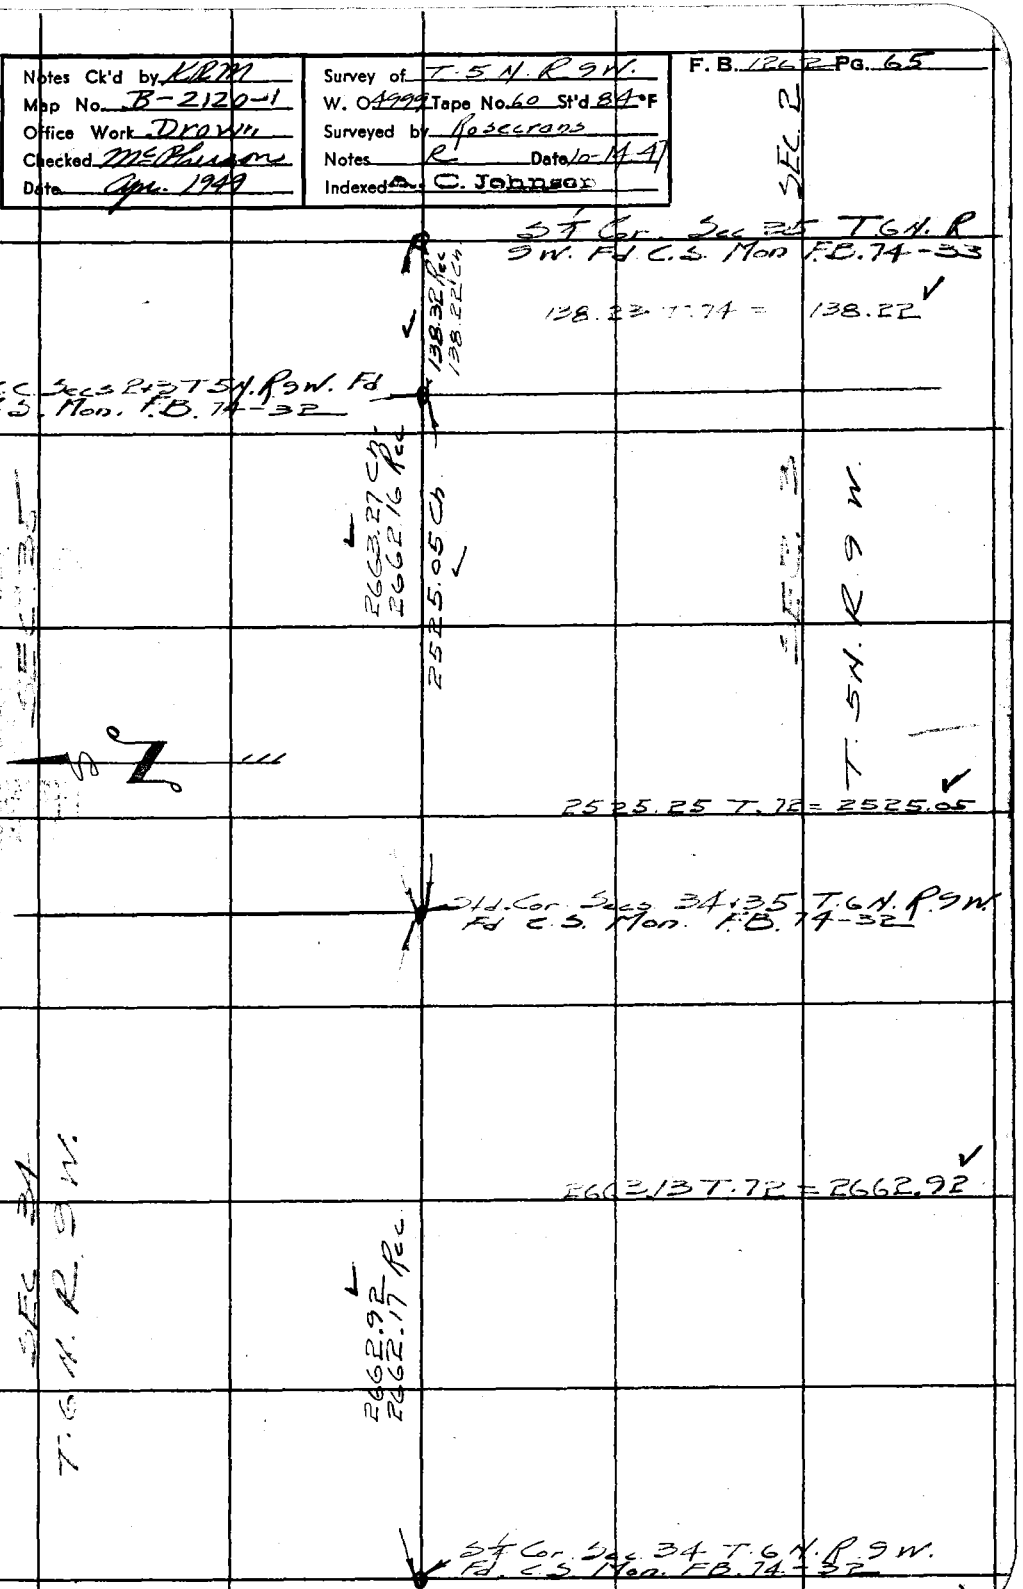

FORM 247 SM 11-46

F. B. 1262 PG. 66

W.S.67.A.B-3

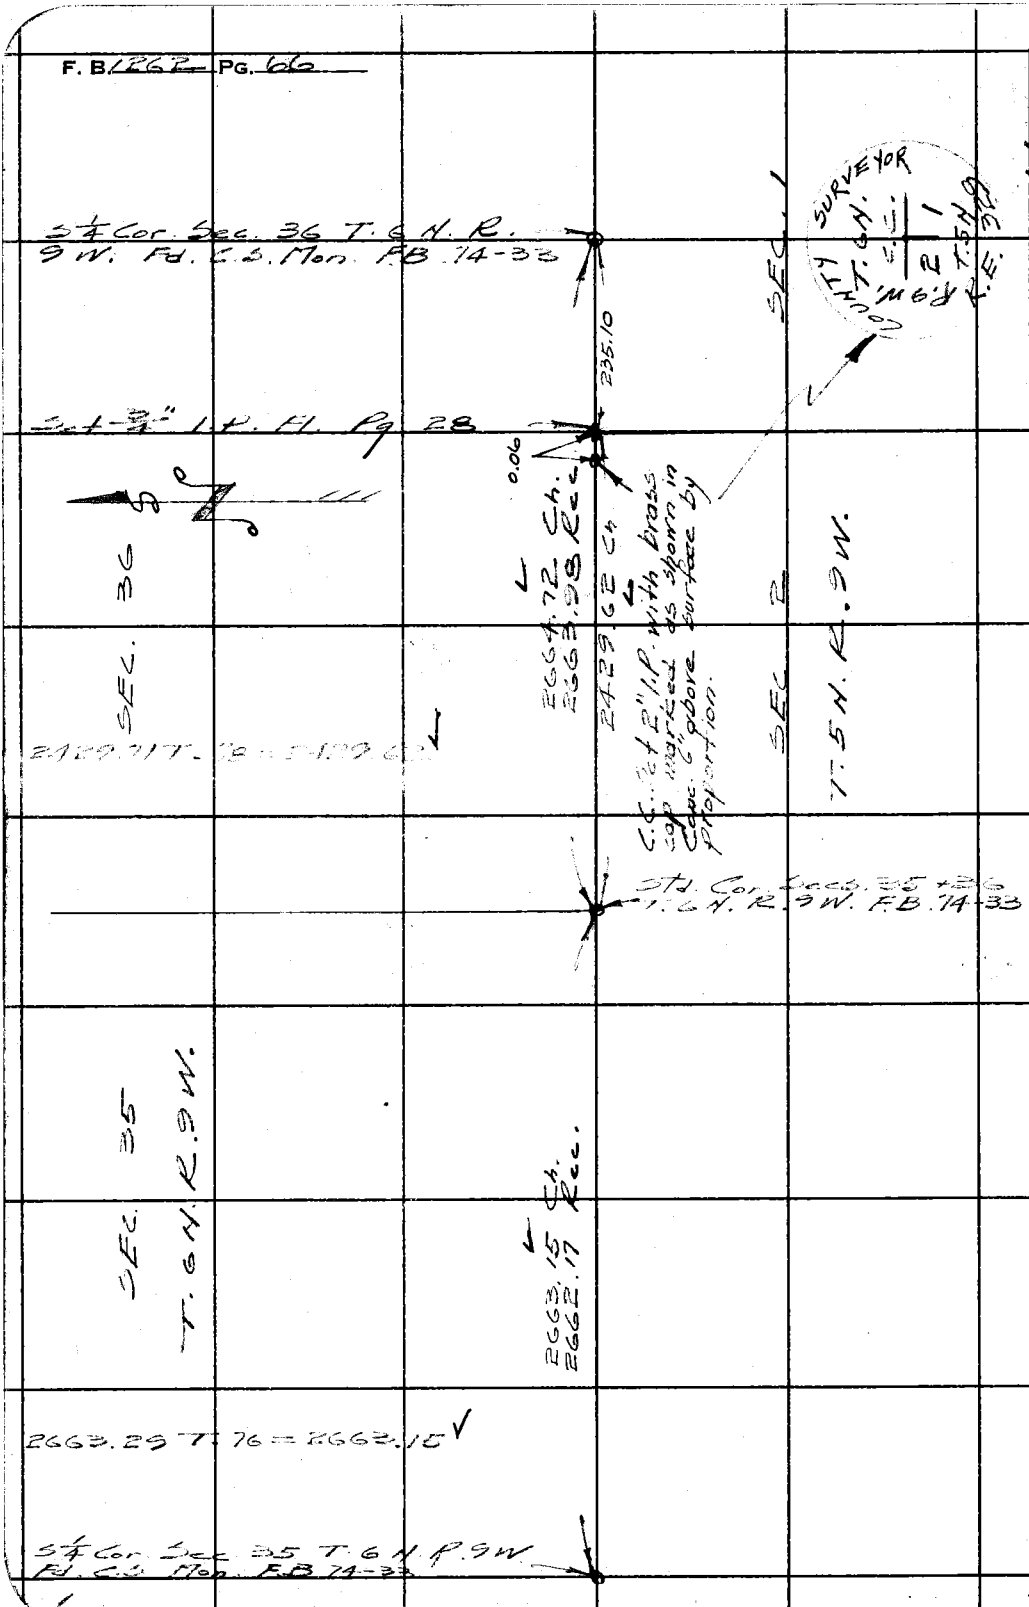

RETURN TO
LOS ANGELES COUNTY SURVEYOR
700 HALL OF RECORDS

Do not extend notes this side of this line.

Note: Any Additions or Changes on This Sheet Must be Made or Circled in Red Ink With Date and Name of Person Making Change.

Notes Ck'd by KAM	Survey of T. 5N. R. 9W.
Map No. B-2120-1	W. O. 4999 Tape No. 60 St'd 84 °F
Office Work Drawn	Surveyed by Rosecrans
Checked McPherson	Notes R Date 10-15-47
Date Apr. 1949	Indexed A. C. Johnson

F. B. 1262 PG. 67

W.S. 67, R-3

SEC. 6

S¼ Cor. Sec. 31 T. 6N. R. 8W.
Fd. C.S. Mon. F.B. 74-33

293.04 Rec.
293.01 Ch.

293.02 T78 = 293.01 ✓

Cor. Secs. 46 T. 5N. R. 9W.
Fd. C.S. Mon. F.B. 79-83

2372.40 T.78 = 2372.31 ✓

SEC. 31
T. 6N. R. 8W.

2665.82 Ch.
2663.98 Rec.

2372.31 Ch.

SEC. 1
T. 5N. R. 9W.

Std. Cor. Secs. 36 + 31 T. 6N.
R. 8 + 9W. Fd. C.S. Mon. F.B. 74-33

SEC. 36
T. 6N. R. 9W.

2665.40 Ch.
2663.98 Rec.

2665.50 T.78 = 2665.40 ✓

S¼ Cor. Sec. 36 T. 6N. R. 9W.
Fd. C.S. Mon. F.B. 74-33

Note: Any Additions or Changes on This Sheet Must Be Made or Circled in Red Ink With Date and Name of Person Making Change.

Do not extend notes this side of this line.

RETURN TO
LOS ANGELES COUNTY SURVEYOR
700 HALL OF RECORDS

FORM 247 SM 11-46

F. B. 1262 PG. 68

W.S. 67 B-5.6

1/4 Cor. Secs. 25+30 T. 5 N. R. 8+9 W. Fd. C.S. Mon. 18" Dn. F.B. 1113-10

SEC. 25

2655.69 Ch.
2654.76 Rec.

SEC. 30

2656.00 T. 66 = 2655.69

Cor. Secs. 25, 36, 30+31 T. 5 N. R. 8+9 W. Fd. C.S. Mon. 18" Dn. F.B. 1113-10

2650.75 T. 68 = 2650.47

2650.47 Ch.
2649.84 Rec.

SEC. 36
T. 5 N. R. 9 W.

SEC. 31
T. 5 N. R. 8 W.

1/4 Cor. Secs. 31+36 T. 5 N. R 8+9 W. Fd. C.S. Mon. 18" Dn. F.B. 79-81

2652.83 T. 76 = 2652.69

2652.69 Ch.
2651.84 Rec.
2654.60 Rec.

Cor. Secs. 31, 36, 1+6 T. 4+5 N. R 8+9 W. Fd. 4"x4" iron post filled with Conc. 36" Dn. F.B. 77-72

TIES

Set N+T in Pow. Po.

Set 2" I.P. plug + TK. 6" up

37.50

Sec. line

15°

42.43

Set 2" I.P. plug + T. 6" up

42.43

Set 2"x2" Dn. over 4" iron post

Identical

RETURN TO
LOS ANGELES COUNTY SURVEYOR
700 HALL OF RECORDS

Do not extend notes this side of this line.

Note: Any Additions or Changes on This Sheet Must Be Made or Circled in Red Ink With Date and Name of Person Making Change.

W.S.67,B-5

Notes Ck'd by K.R. McPhee	Survey of T.5N. R9W.	F.B. 1262 PG. 69
Map No. B-2120-2	W. O. 4999 Tape No. 60 St'd 84 °F	
Office Work Ito	Surveyed by Rosecrans	
Checked Miller	Notes R Date 10-17-47	
Date Apr. 1949	Indexed A. C. Johnson	

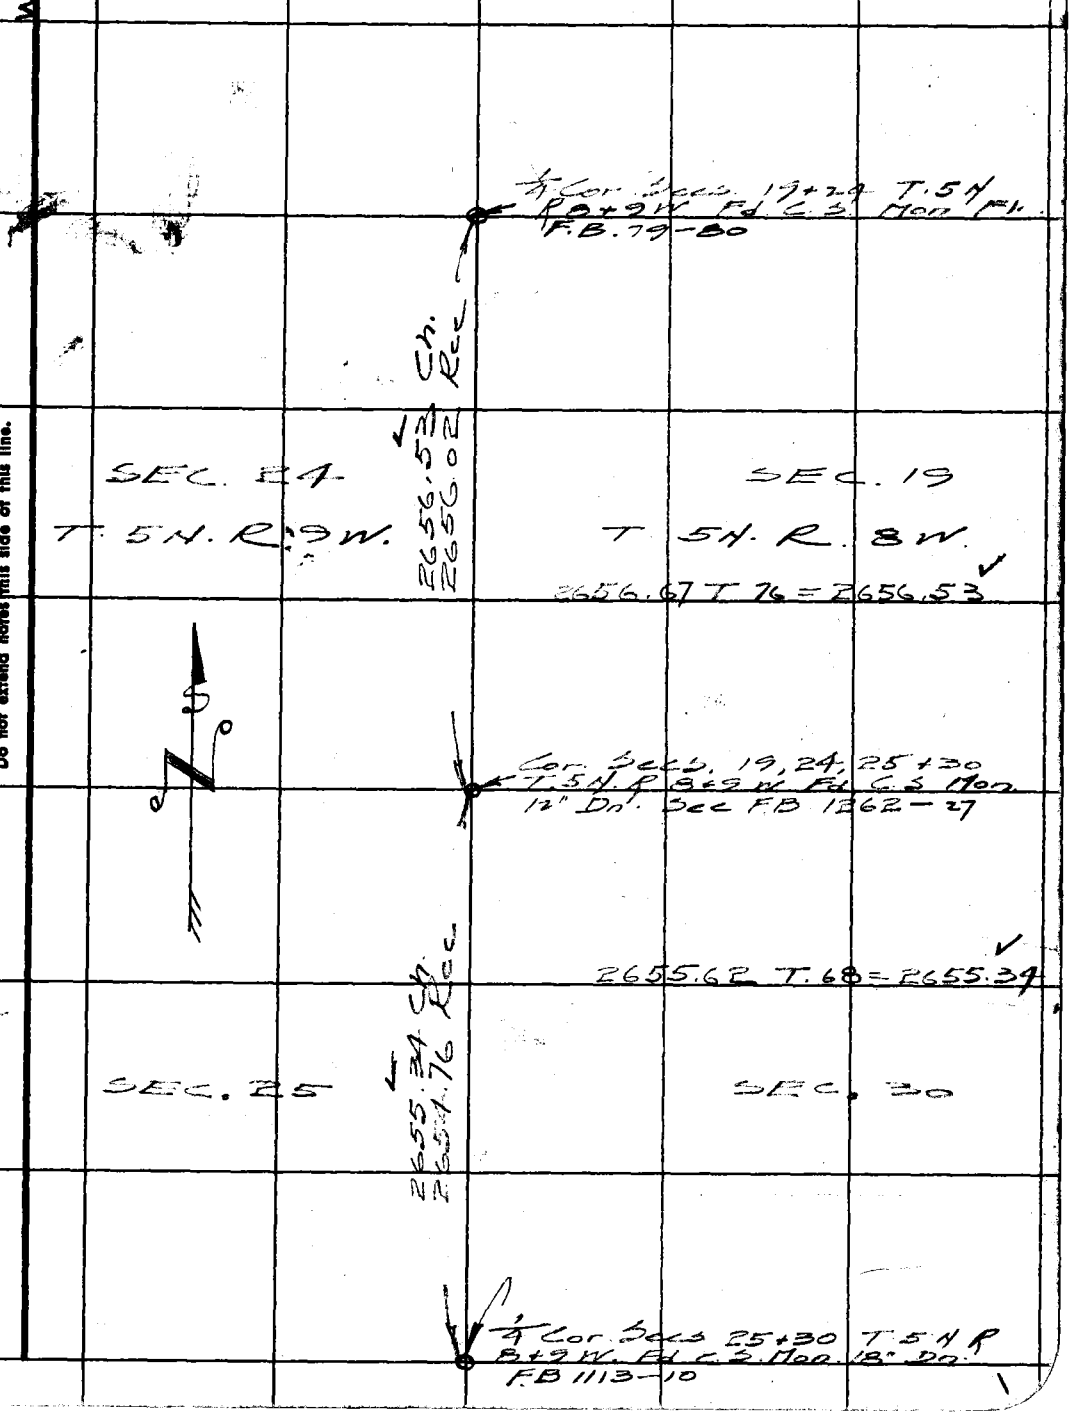

Note: Any Additions or Changes on This Sheet Must be Made or Circled in Red Ink With Date and Name of Person Making Change.

Do not extend notes this side of this line.

RETURN TO
LOS ANGELES COUNTY SURVEYOR
700 HALL OF RECORDS

FORM 247 5M 11-46

F. B. 1262 PG. 70

W.S. 67-R-4.5

SEC 12

Cor. Secs 7, 12, 13 + 18 T. 5N. R. 8 + 9W Fd. C.S. Mon. F.B. 79-82

SEC 7

2072.52 T. 84

2656.35 Ch.
2655.65 Rec

2072.52 Ch

Set 1x2

583.83

583.83 T. 84

¼ Cor. Secs 13 + 18 T. 5N R. 8 + 9 W Fd. C.S. Mon. F.B. 79-80

T. 5N. R. 9W.

T. 5N R. 8W

2655.85
2655.55 Rec

SEC. 13

2655.99 T. 76 = 2655.85

SEC. 18

Cor. Secs. 13, 18, 19 + 24 T. 5N R. 8 + 9W. Fd. C.S. Mon. F.B. 79-80

2656.63 T. 78 = 2656.53

SEC 24

2656.53 Ch.
2656.02 Rec

SEC 19

¼ Cor. Secs 19 + 24 T. 5N. R. 8 + 9W Fd. C.S. Mon. See preceding page

RETURN TO
LOS ANGELES COUNTY SURVEYOR
700 HALL OF RECORDS

Do not extend notes this side of this line.

Note: Any Additions or Changes on This Sheet Must be Made or Circled in Red Ink With Date and Name of Person Making Change.

W.S.67, B-4

Notes Ck'd by KRMcPh	Survey of T.5N R9W
Map No. B-2120-1	W. O. 4999 Tape No. 60 St'd 84 °F
Office Work Drawn	Surveyed by Rosecrans
Checked McPherson	Notes R Date 10-17-47
Date Apr. 1949	Indexed

F. B. 1262 PG. 71

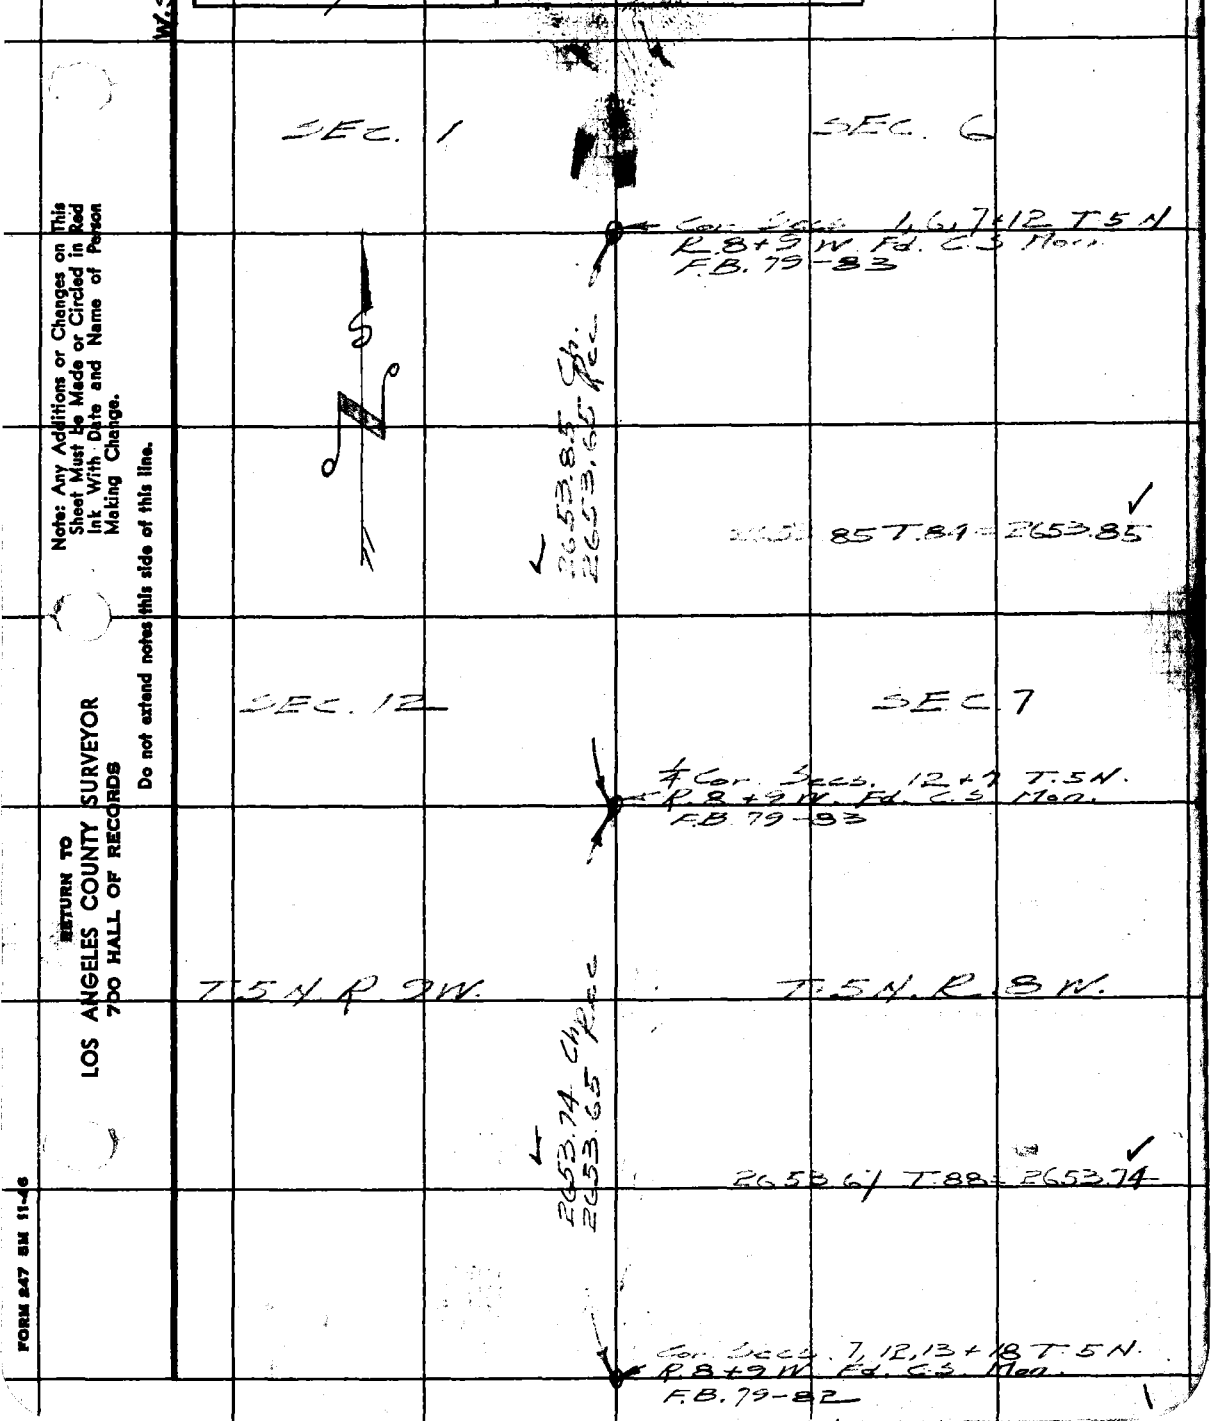

Note: Any Additions or Changes on This Sheet Must be Made or Circled in Red Ink With Date and Name of Person Making Change.

Do not extend notes this side of this line.

RETURN TO
LOS ANGELES COUNTY SURVEYOR
700 HALL OF RECORDS

FORM 247 5M 11-46

F. B. 1262 PG. 72

SEC. 31

T. 6 N. R. 8 W.

G.C. Secs 1+6 T.5N. R. 8+9 W. Fd. C.S. Mon.
F.B. 79-83

2985.85 T.70 = 2985.58

2985.58 Ch.
2985.85 Rec.

Cor. Secs 1+6 T.5N. R. 8+9 W. Fd. C.S. Mon.
F.B. 79-83

SEC. 1

SEC. 6

T. 5 N. R. 9 W.

T. 5 N. R. 8 W.

2654.29 T.68 = 2654.01

2654.01 Rec.
2653.95

Cor. Secs. 6, 7, 1+12 T. 5 N. R. 8+9 W. Fd. C.S. Mon.
F.B. 79-83

SEC. 12

SEC. 7

W.S. 67-B-3

RETURN TO
LOS ANGELES COUNTY SURVEYOR
700 HALL OF RECORDS

Do not extend notes this side of this line.

Notes: Any Additions or Changes on This Sheet Must Be Made or Circled in Red Ink With Date and Name of Person Making Change.

Notes Ck'd by	Survey of T.5N. R.8W.
Map No.	W. O. 4999 Tape No. 60 St'd. 84 °F
Office Work	Surveyed by Rosecrans
Checked	Notes R Date 10-21-47
Date	Indexed A. C. Johnson

F. B. 1262 Pg. 73

Note: Any Additions or Changes on This Sheet Must be Made or Circled in Red Ink With Date and Name of Person Making Change.

Do not extend notes this side of this line.

RETURN TO
LOS ANGELES COUNTY SURVEYOR
700 HALL OF RECORDS

FORM 247 SM 11-46

RETURN TO
LOS ANGELES COUNTY SURVEYOR
700 HALL OF RECORDS

Note: Any Additions or Changes on This Sheet Must be Made or Circled in Red Ink With Date and Name of Person Making Change.

Do not extend notes this side of this line.

F. B. 1262 PG. 74

Notes Ck'd by Miller	Survey of T.5N. R.8W.
Map No. B-2124-2	W. O. Tape No. 60 St'd 84 °F
Office Work Ito	Surveyed by Rosecrans
Checked Miller	Notes P Date 10-22-49
Date Apr. 1949	Indexed C. Johnson

F. B. 1262 PG. 25

W. S. 67- D-5

Note: Any Additions or Changes on This Sheet Must Be Made or Circled in Red Ink With Date and Name of Person Making Change.

Do not extend notes this side of this line.

RETURN TO LOS ANGELES COUNTY SURVEYOR 700 HALL OF RECORDS

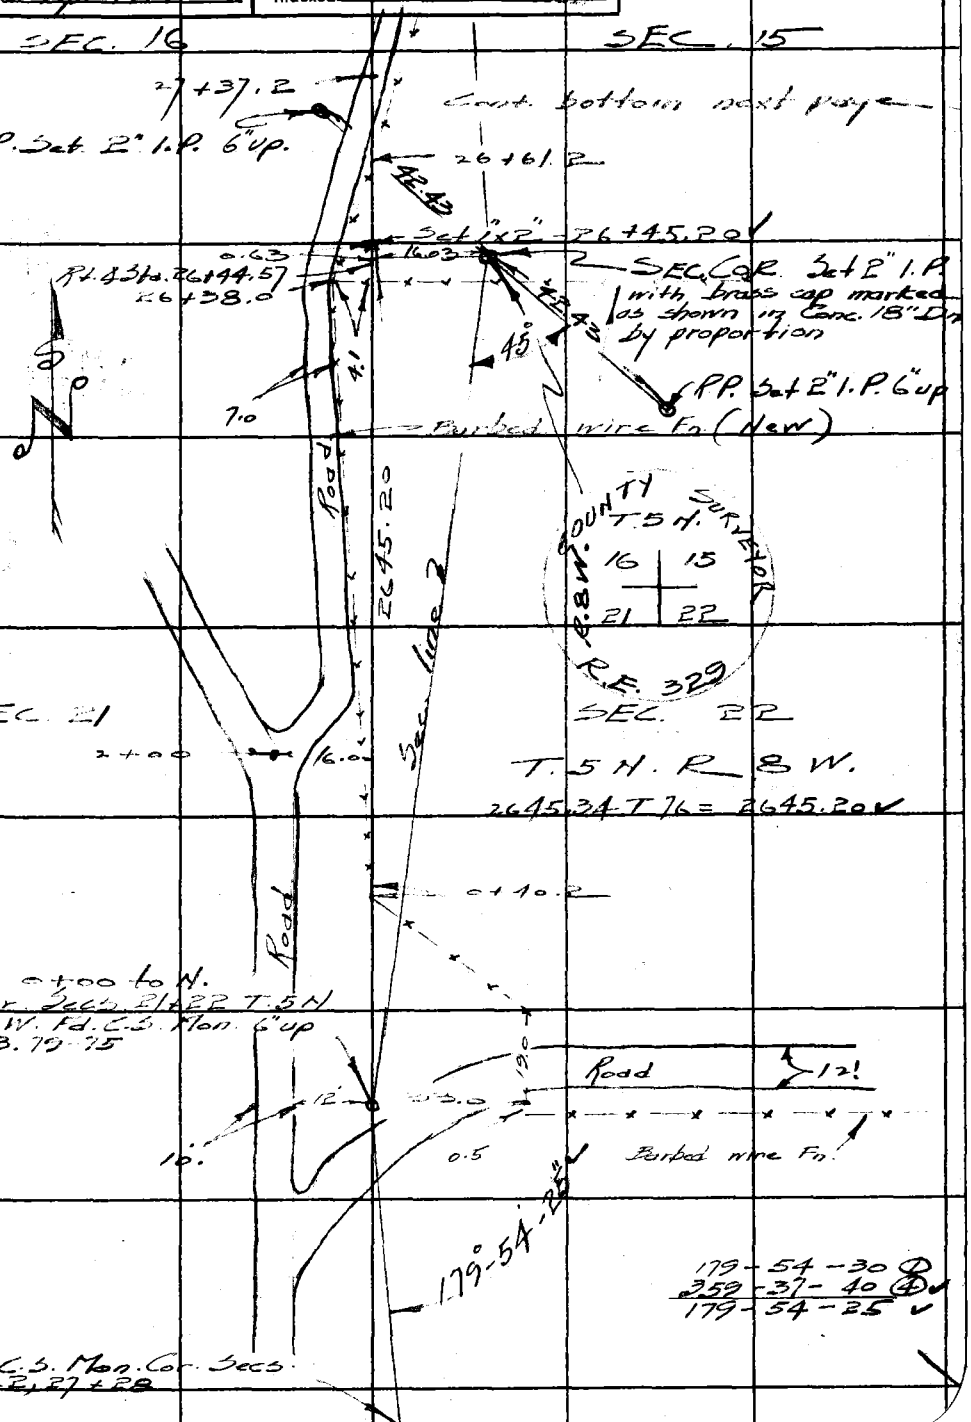

FORM 247 SM 11-46

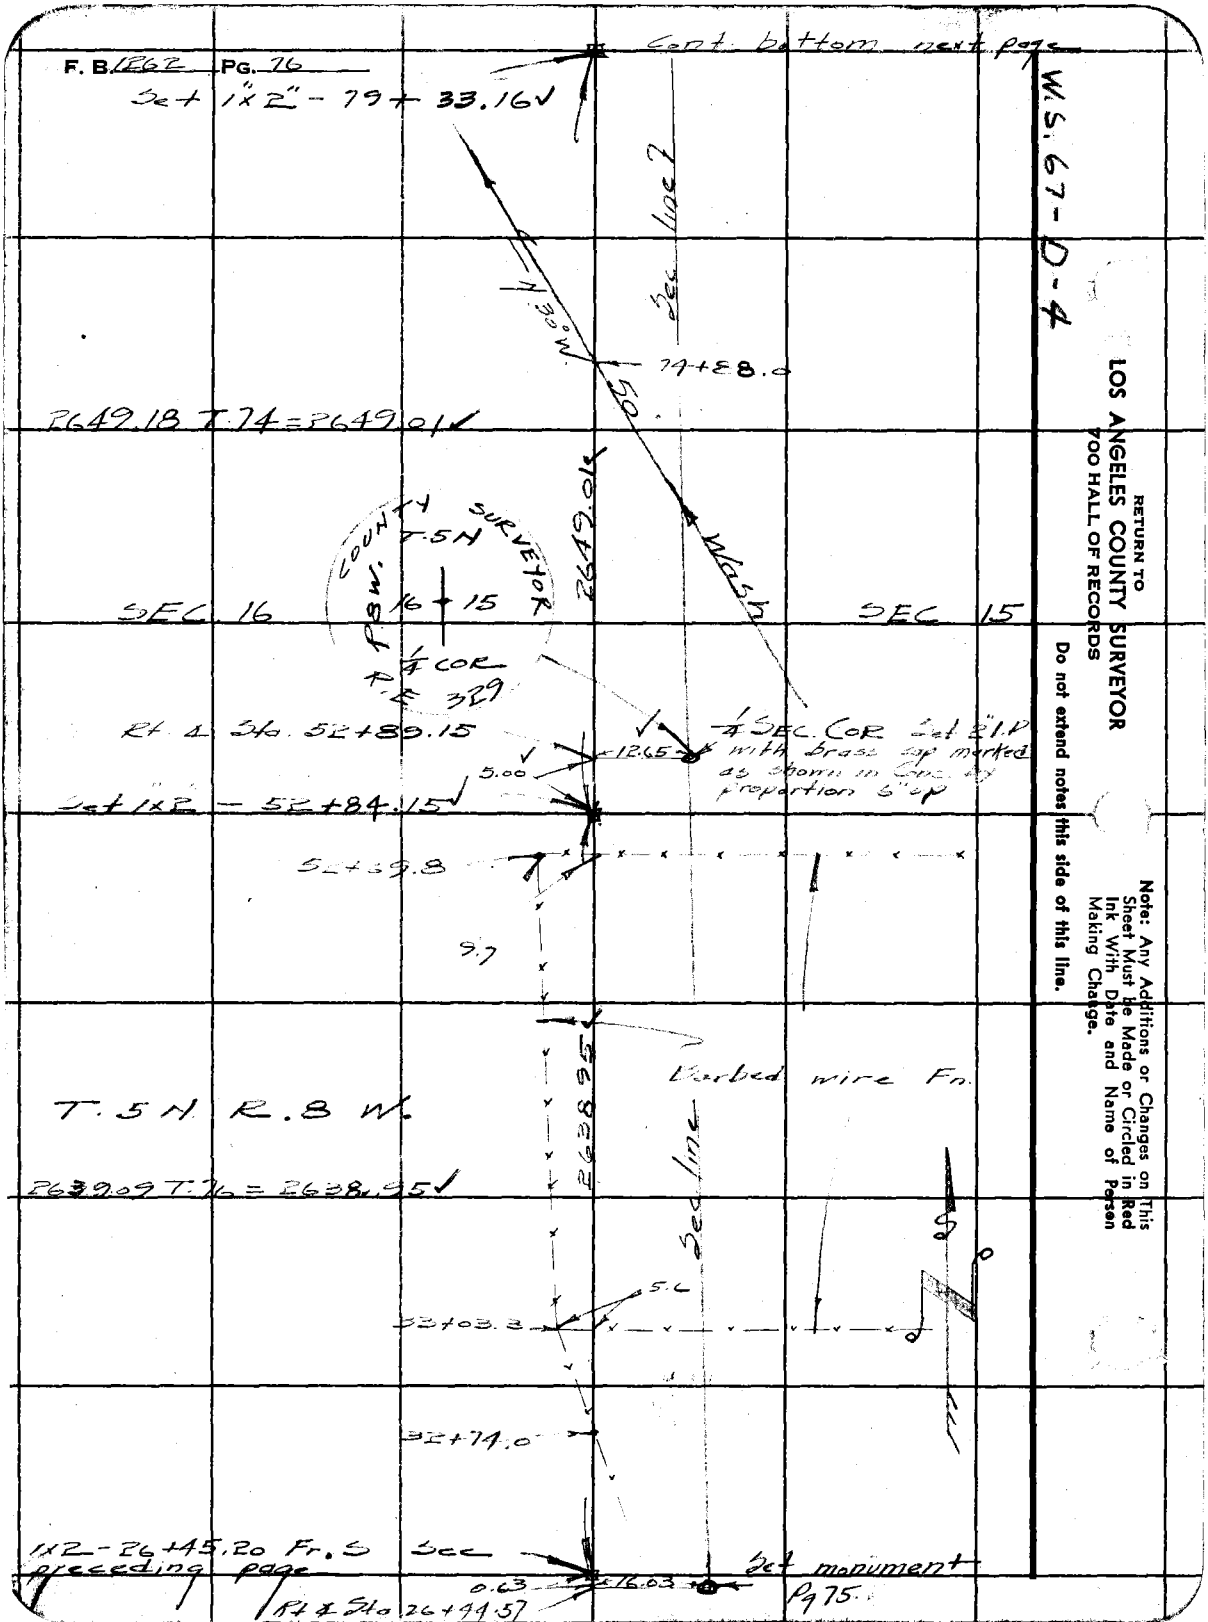

RETURN TO
LOS ANGELES COUNTY SURVEYOR
700 HALL OF RECORDS
Do not extend notes this side of this line.
Note: Any Additions or Changes on This Sheet Must be Made or Circled in Red Ink With Date and Name of Person Making Change.

Notes Ck'd by Miller	Survey of T.5N.R.8W.	F.B. 1262 PG. 77
Map No. B-2120-1	W. O. 4999 Tape No. 60 St'd 84 °F	
Office Work Drawn	Surveyed by Rosecrans	
Checked McPherson	Notes R Date 10-23-47	
Date Apr. 1949.	Indexed A. C. Johnson	

W.S. 67-D-4

Note: Any Additions or Changes on This Sheet Must be Made or Circled in Red Ink With Date and Name of Person Making Change.

Do not extend notes this side of this line.

RETURN TO
LOS ANGELES COUNTY SURVEYOR
700 MALL OF RECORDS

132+40.48 ✓
Fd. old charred 2"x3" redwood stake in mound of rocks 3' base 1' high. Replaced stake with 2" I.P. with brass cap marked as shown in Conc 6" above surface

Set 1"x2" - 132+44.14 ✓
3.66
11.90
1966.50
12' Rd N 30° E.
Sec. line?

COUNTY SURVEYOR
T.5N.
R.8W.
4 3
9 10
R.E. 329

121+86.0

114+02.4 Fd. old stump of 20" joshua
11.4

1966.58 T.78 = 1966.50 ✓

112+94.04
Fd. 24" joshua tree blazed on the north side See Govt. notes C.S. 9236
Note this tree does not check very well for plus.

16.40
Set 2"x2" - 112+77.64 ✓
Set 1x2
2.00

℄ 8' Wash 110+98.3

701.61 T.70 = 701.55 ✓

S4 SEC. COR Set 2" I.P. with brass cap marked as shown in Conc. 18" Dn. by proportion R.P. Set 2" I.P. 6" up ✓
2.00
30.00
30.00
11.01 ✓
2.32
701.55
Rt 4 Sta. 105+87.10
R.P. Set 2" I.P. 6" up.
Set 1x2 - 105+76.09 ✓

84° 18'
752.34 T.70 = 752.27 ✓

℄ 25' Wash. 102+26

98+99.4
High Voltage Lines?
98+66.6
98+33.8
2.00
Set 1x2" - 98+23.82 ✓
Graded Road
Set 1x2
98+04.8

COUNTY SURVEYOR
T.5N.
R.8W.
9 10
1/4 COR
15' R.E. 329

SEC. 9
SEC. 10
T.5N R.8W.

1890.83 T.70 = 1890.66 ✓

1890.66
Sec. line?

9.26
79+33.73
Fd. mound of stones 1/2' high 2' base Drove a 1x2 in center of the mound. Replaced 1"x2" with monument See Pg. 108

0.57
1x2 - 79+33.16 See preceding page

FORM 247 SM 11-46

F. B. 1262 PG. 78

57+17.56 Fr. S.
C.C. Secs. 3+4 T 5 N
R 8 W. Set 1" I.P. Fl.
by proportion (Removed.)
578.75

C.C. Set C.S.
Mon Sec Pg. 122

0.26

To C.S. Mon. Std. Cor.
Secs 3+4
R. 8 W.

90°-28'-55"

1965.23

5 1/4 Cor Sec. 3+4 T. 6 N
R. 8 W. Fd. C.S. Mon.
6" up F.B. 74-37

90°-29'-00" ①
361-55-40 ④
90-28-55

Toe of slope 39+00

1965.31 T 78 = 1965.23

Set No 37+52.33 Top
E+W. rocky spur

Toe of slope 36+32

SEC. 4

SEC 3
T 5 N. R. 8 W.
995.34 T 76 = 995.29

COUNTY SURVEYOR
T 5 N.
R. 8 W.
4 3
1/4 COR
R.E. 329

Sec. line 7

995.29

Set 1x2 — 27+57.04

116.13

R.P. Set 2" I.P. 6" up.
30.00
90°
30.00
R.P. Set 2" I.P. 6" up.

Rt. ∡ Sta. 26+40.91

0.12

1/4 SEC. COR. Set 2" I.P.
with brass cap marked
as shown in Conc. 18" Dn.
by proportion.

2757.04

2757.18 T 76 = 2757.04

0+00 to N.
Cor. Secs 3, 4, 9+10 T. 5 N. R
8 W. Fd. old charred stake in
rock mound. See preceding
page. Set monument

W.S. 67-D-3

RETURN TO
LOS ANGELES COUNTY SURVEYOR
700 HALL OF RECORDS

Do not extend notes this side of this line.

Note: Any Additions or Changes on This Sheet Must be Made or Circled in Red Ink With Date and Name of Person Making Change.

Notes Ck'd by Miller	Survey of T5N. R. 8W.	F. B. 1262 Pg. 79
Map No. B-2120-1	W. O. 4999 Tape No. 60 St'd 84°F	
Office Work Drawn	Surveyed by R. Seerans	
Checked McPherson	Notes R Date 10-28-47	
Date Apr. 1949	Indexed C. Johnson	

W.S. 67-C-5

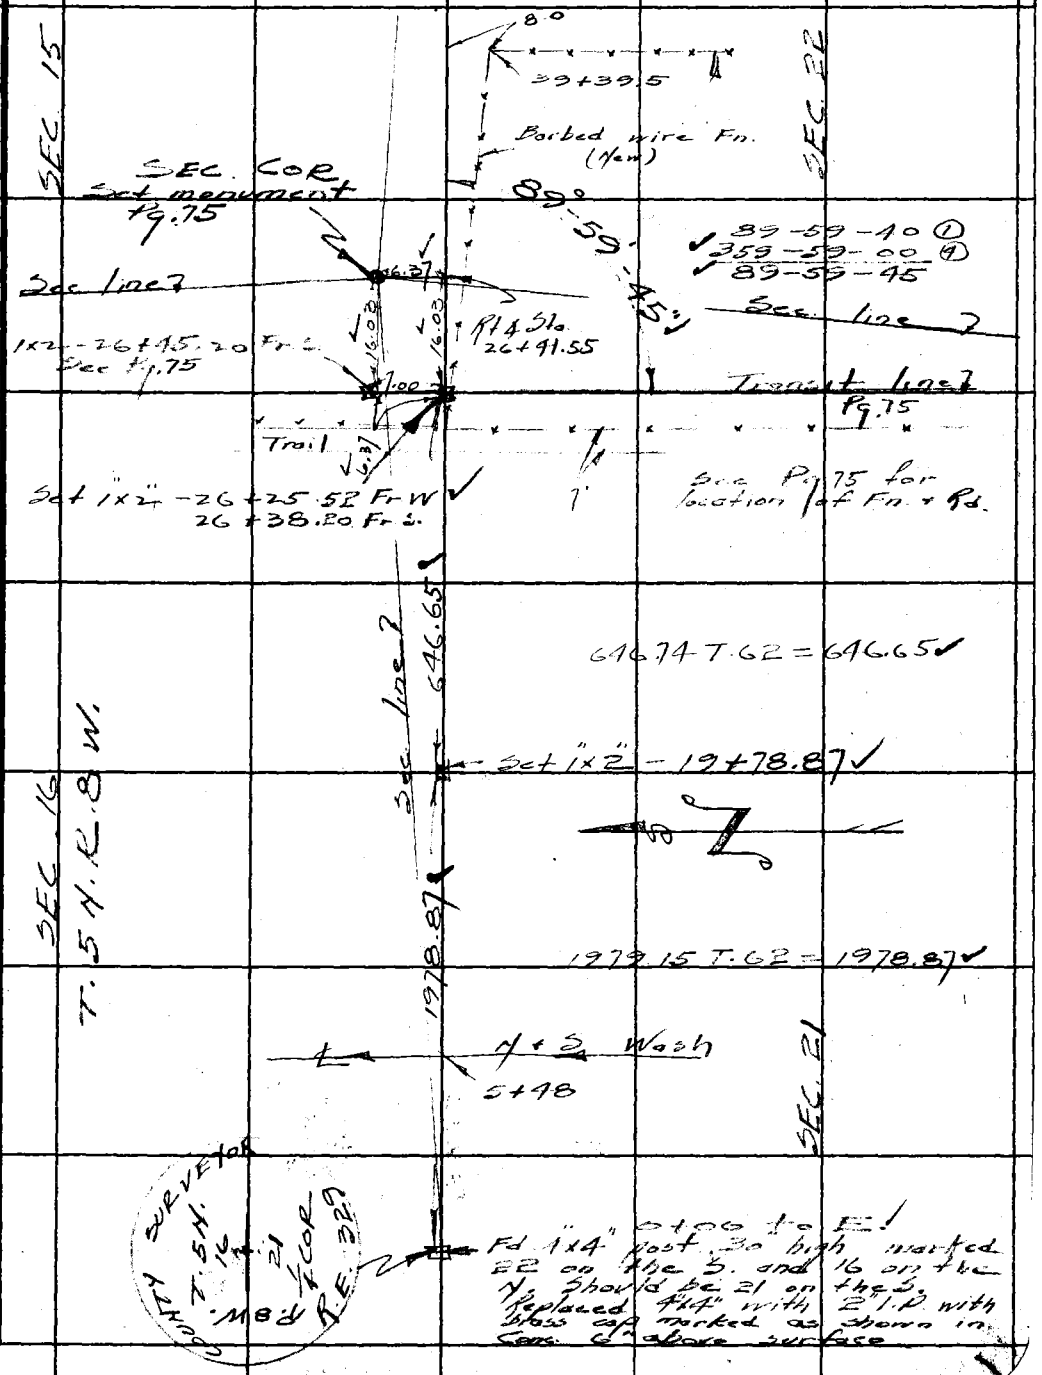

Note: Any Additions or Changes on This Sheet Must be Made or Circled in Red Ink With Date and Name of Person Making Change.

Do not extend notes this side of this line.

RETURN TO
LOS ANGELES COUNTY SURVEYOR
700 HALL OF RECORDS

FORM 247 5M 11-46

F. B. 1262 PG. 80

89-47-00 ①
359-08-20 ④
89-47-05 ✓
Turned in S.E.

8' Trail

N. 30° E.

90°-12'-55"

Set 1"x2" - 79+60.33 ✓

11.96

6.20 ✓

Transit line ? Pg. 60

Rt 4 Sta 79+48.75

63.40

SEC COR Set C.S. Mon. Pg 60

0.38

8.0

6' Trail

N + S

Int. Set 1"x2" - 79+48.37 ✓
26+51.10 Fr S

Fd. 1x2 - 25+87.70 Fr S
See Pg. 59

W.S. 67-D-5

2663.58 T68 = 2663.30 ✓

2663.30

SEC. LINE ?

SURVEYOR
COUNTY T.5 N. 15
22
1/4 COR
R.E. 329

T.5 N. R.8 W.

SEC 15

N 20° W.

35 Wash

56+37

52+85.07 ✓

1/4 Sec Cor Fd. old hewn juniper stake 2" x 3" x 24" laying on the ground a new juniper post 1/2" in diameter Driven by it. Replaced it with a 2x2 Ft. Replaced 2x2" with 2" I.P. with brass cap marked as shown in Cone 6" above surface

67.44

54°

179°-52'-15"

Fd. remains of old joshua B.T. See C.S. 9236

179-52-00 ①
359-29-00 ④
179-52-15 ✓

7' Trail

51+54.1

N 45° E

2659.90 T.64 = 2659.55 ✓

2659.55

40' Wash

N + S

46+41.0

To 1"x2" - 26+25.52 Fr. W.
See preceding page

RETURN TO
LOS ANGELES COUNTY SURVEYOR
700 HALL OF RECORDS

Do not extend notes this side of this line.

Note: Any Additions or Changes on This Sheet Must be Made or Circled in Red Ink With Date and Name of Person Making Change.

Notes Ck'd by Miller	Survey of T 5 N. R 8 W.	F.B. 1262 Pg. 81
Map No. B-2120-1	W. O. 4999 Tape No. St'd °F	
Office Work Drawn	Surveyed by Rosecrans	
Checked McPherson	Notes R Date 11-26-41	
Date April 1949	Indexed A. C. Johnson	

Cor. Secs. 13, 14, 23 + 24 T.5N. R.8W. Fd. 2" I.P. See Pg 55
132+42.30

Set monument Pg. 55

No. 2" I.P. 1/4 Cor. Secs. 13+14

89°-58'-00"

90°-14'-20"

To C.S. Mon. 1/4 Cor. Secs. 23+24

89-58-00 ①
359-52-00 ④
89-58-00

90-14-30 ①
360-57-20 ④
90-14-20

2678.31 T.72 = 2678.10

2678.10

3.20

20° W.

110+07.2

20 Wash

Rt ∡ Sta. 105+95.52

3/32

∡ SEC. COR. Set 2" I.P. with brass cap marked as shown in Conc. 6" above surface by proportion
Set 1x2 - 105+64.20

SEC. 14 T.5N. R.8W.

SEC. 23

Barbed wire Fn.

105+46.4

10 Wash N.+S.

100+77

SURVEYOR

COUNTY T.5N. R.8W. 14 23 1/4 COR. R.E. 329

2604.07 T.72 = 2603.87

2603.87

SEC. LINE 2

15 Wash N.+S.

81+23

1x2" - 79+60.33 Fr. W
See preceding page

Note: Any Additions or Changes on This Sheet Must be Made or Circled in Red Ink With Date and Name of Person Making Change.

Do not extend notes this side of this line.

RETURN TO
LOS ANGELES COUNTY SURVEYOR
700 HALL OF RECORDS

FORM 247 5M 11-46

F. B. 1262 PG. 82

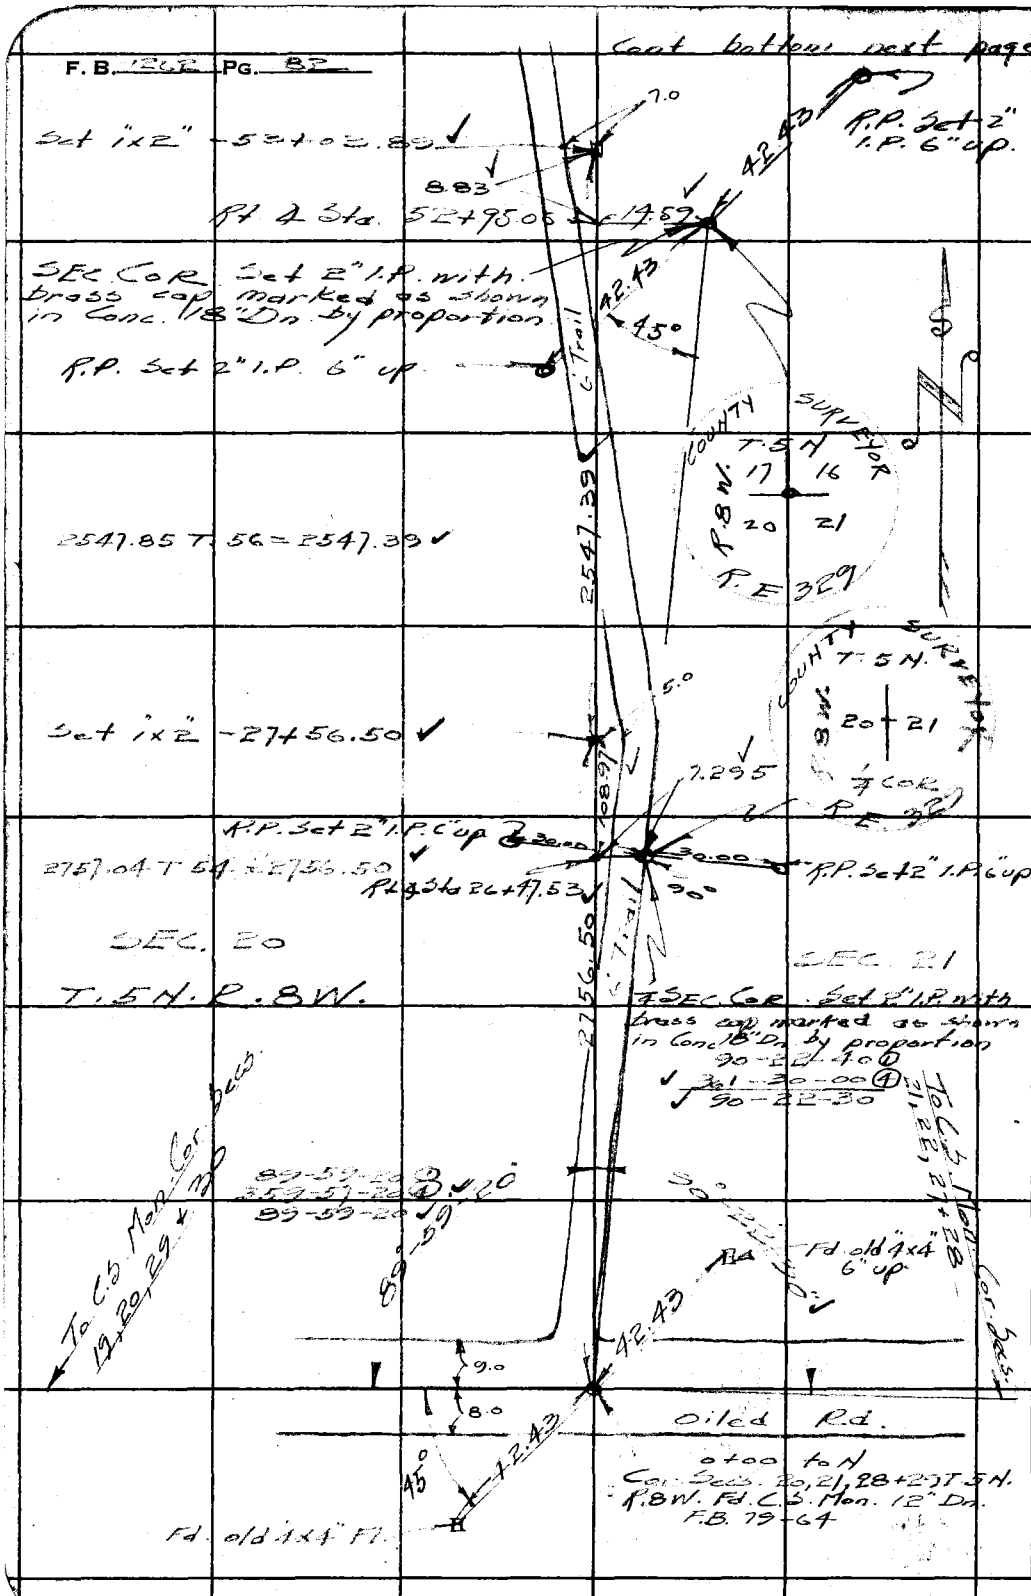

W.S. 67-C-5

RETURN TO
LOS ANGELES COUNTY SURVEYOR
700 HALL OF RECORDS

Do not extend notes this side of this line.

Note: Any Additions or Changes on This Sheet Must Be Made or Circled in Red Ink With Date and Name of Person Making Change.

Notes Ck'd by Miller	Survey of T.5N. R.8W.	F.B. 1262 PG. 83
Map No. B-2120-1	W. O. 4999 Tape No. 60 St'd 84 °F	
Office Work Drown	Surveyed by Rosecrans	Cont. bottom next page
Checked McPherson	Notes R Date 12-1-47	
Date Apr. 1949	Indexed A. C. Johnson	

W.S. 67-C-4

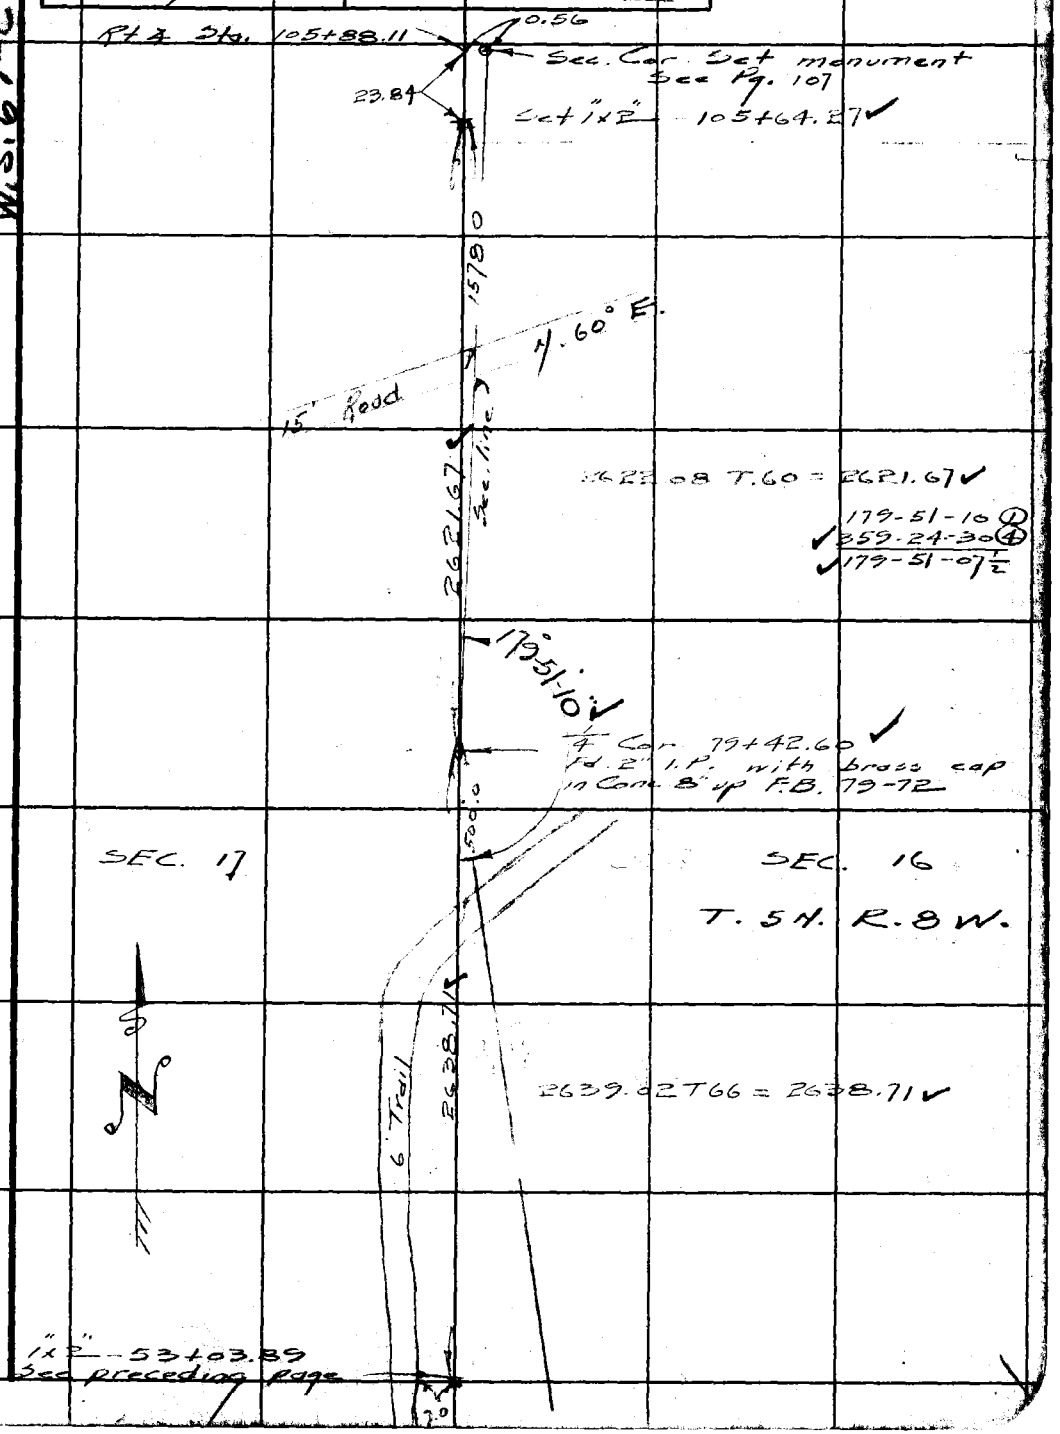

Note: Any Additions or Changes on This Sheet Must be Made or Circled in Red Ink With Date and Name of Person Making Change.

Do not extend notes this side of this line.

RETURN TO
LOS ANGELES COUNTY SURVEYOR
700 HALL OF RECORDS

FORM 247 SM 11-46

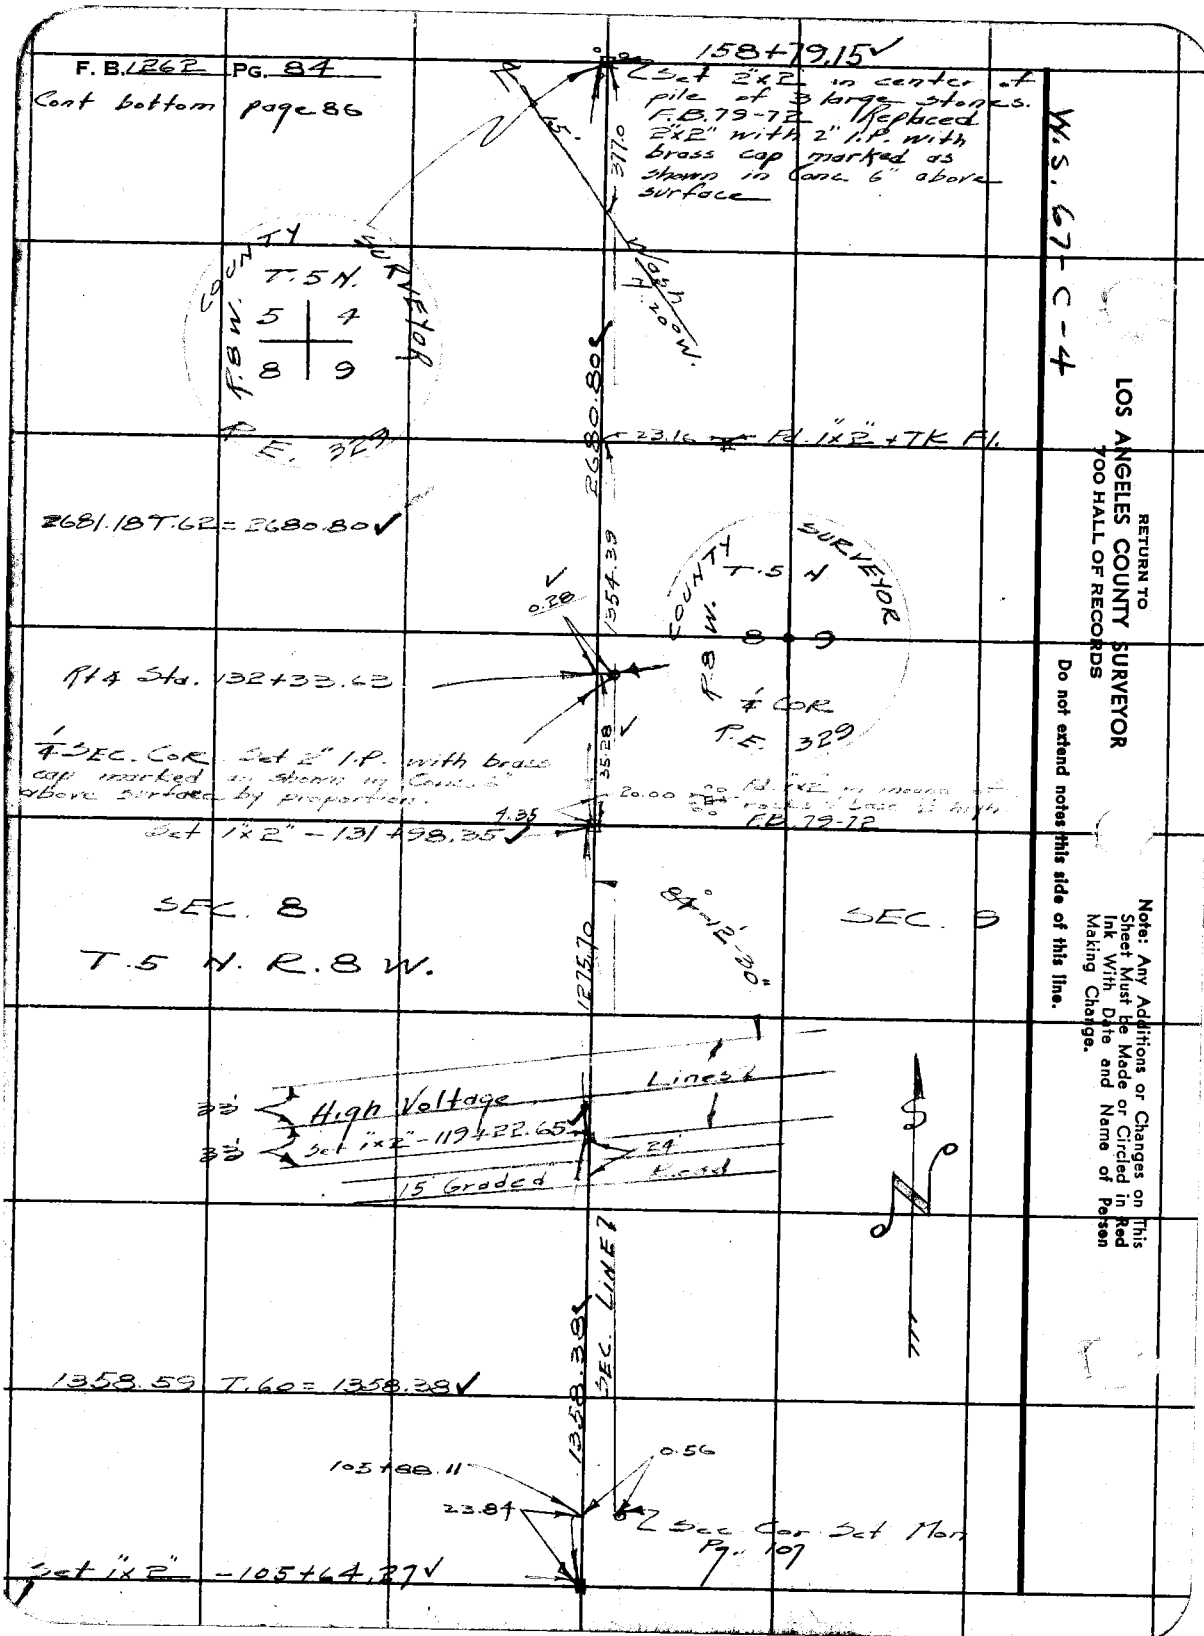
F. B. 1262 PG. 84
Cont bottom page 86
158+79.15
Set 2"x2" in center of pile of 3 large stones. F.B. 79-72 Replaced 2"x2" with 2" I.P. with brass cap marked as shown in Conc. 6" above surface
W.S. 67-C-4
COUNTY SURVEYOR
T.5 N.
R.8 W.
5 4
8 9
Wash
P.E. 329
2680.80
23.16 Fd. 1"x2" + TK Fl.
2681.18 T.62 = 2680.80
1354.39
0.28
Rt 4 Sta. 132+33.63
1/4 SEC. COR. Set 2" I.P. with brass cap marked as shown in Conc. 6" above surface by proportion.
35.28
20.00
4.35
Set 1"x2" - 131+98.35
F.B. 79-72
SEC. 8
T.5 N. R.8 W.
SEC. 9
1275.70
84°-12'-30"
High Voltage
Lines
Set 1"x2" - 119+22.65
24'
15' Graded Road
SEC. LINE
1358.38
1358.59 T.60 = 1358.38
105+88.11
0.56
23.84
Sec. Cor. Set Mon Pg. 107
Set 1"x2" - 105+64.27
RETURN TO
LOS ANGELES COUNTY SURVEYOR
700 HALL OF RECORDS
Do not extend notes this side of this line.
Note: Any Additions or Changes on This Sheet Must be Made or Circled in Red Ink With Date and Name of Person Making Change.

Notes Ck'd by Miller	Survey of T.5N.R.8W.	F. B. 1862 Pg. 85
Map No. B-2120-1	W. O. 1999 Tape No. 60 St'd 84 °F	
Office Work Drown	Surveyed by Rosecrans	
Checked McPhum	Notes R Date 12-3-41	
Date April 1949	Indexed A. C. Johnson	

W.S. 67-C-3

Note: Any Additions or Changes on This Sheet Must be Made or Circled in Red Ink With Date and Name of Person Making Change.

Do not extend notes this side of this line.

RETURN TO LOS ANGELES COUNTY SURVEYOR 700 HALL OF RECORDS

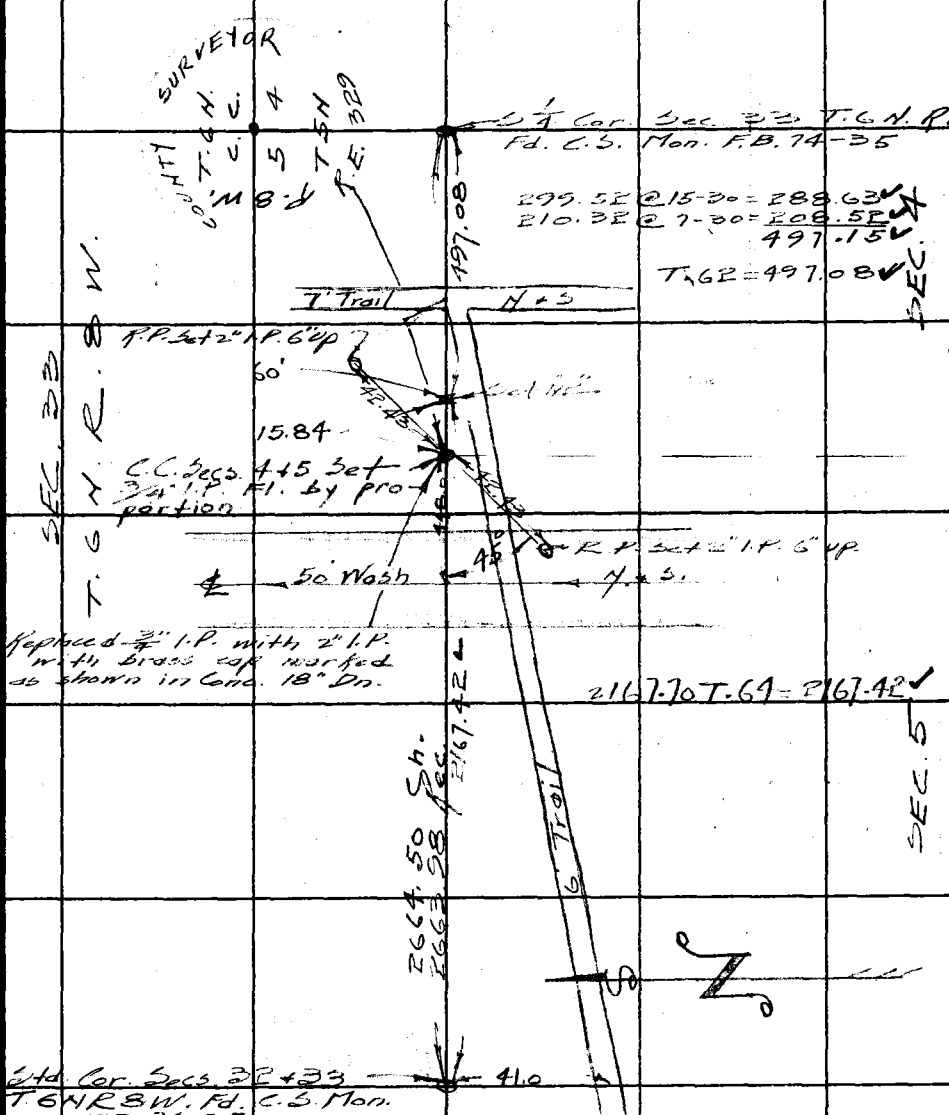

FORM 247 5M 11-46

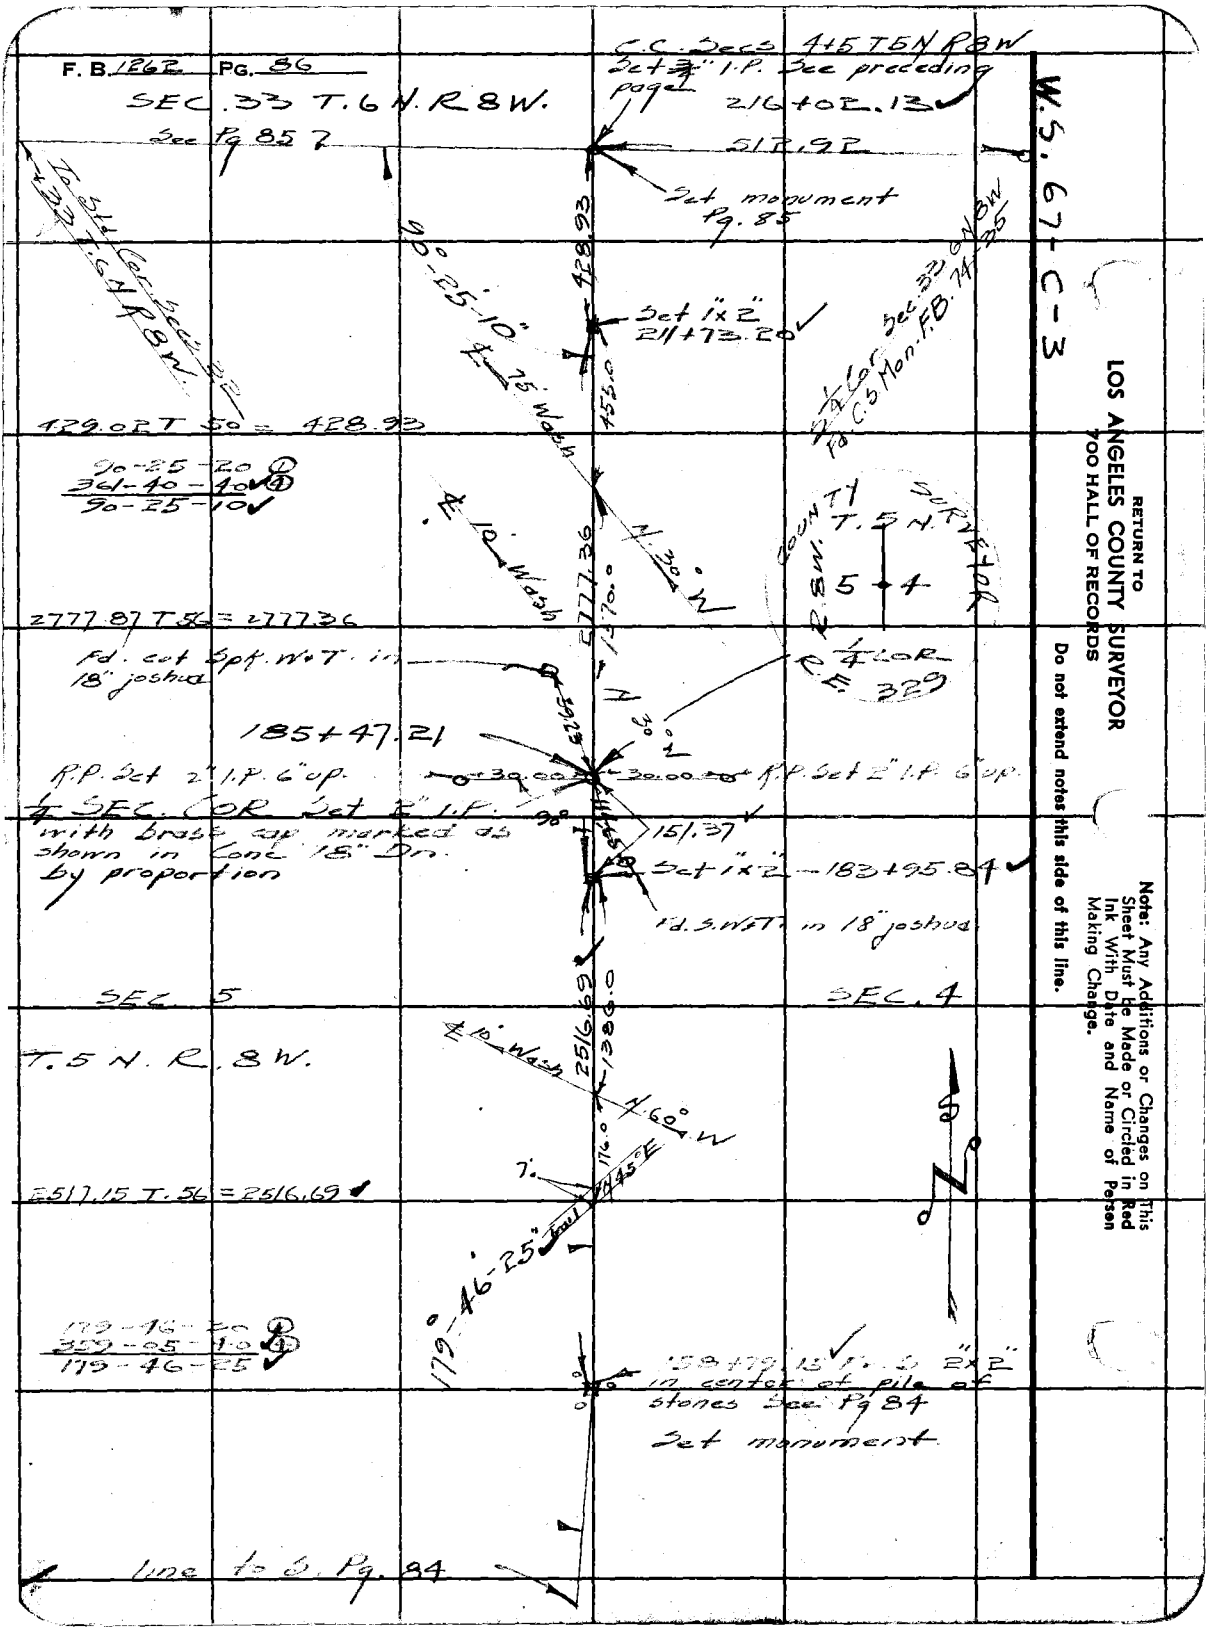

RETURN TO
LOS ANGELES COUNTY SURVEYOR
700 HALL OF RECORDS

Do not extend notes this side of this line.

Note: Any Additions or Changes on This Sheet Must be Made or Circled in Red Ink With Date and Name of Person Making Change.

Notes Ck'd by Miller	Survey of T.5N.R.8W.	F.B. 1262 Pg. 87
Map No. B-2120-1	W. O. 4999 Tape No. 60 St'd 84 °F	
Office Work Drawn	Surveyed by Rosecrans	
Checked McPherson	Notes R Date 12-9-47	
Date April 1949	Indexed A. C. Johnson	

W.S. 67 - C-5

Cont. bottom next page

SEC. 21

90-24-20 ①
361-37-40 ①
90-24-25

90°-24-25"

15' Wash N 20° W 29+46

N 20° W

10' Wash 90° 27+34

Sec. Cor. Set monument Pg. 82

28.31

Int. Set 1"x2" Fl. 26+50.78 Fr. W 52+66.85 Fr. S

37.04

℄ Transit line Pg 82

7' Trail N+S 26+44.8

1"x2" Fr. S Pg 82 53+03.89

996.48

N 30° W

25+41

N 30° W

10' Wash 24+112

996.67 T.54 = 996.48

10' Wash N 45° W

21+38

Set 1x2 - 16+54.30

15' Wash N 50° W

14+55

12' Wash 1654.30

N 20° W

50' Wash 7+91

1654.62 T.54 = 1654.30

5+09 N+S

10' Wash

SEC. 17

SEC. 20

T.5N.R.8W.

N+S 7+12 25' Wash

8' Wash

0+08.0

N 30° W

1/4 Sec Cor 0+00 to E

Fd. 4"x4" pine stake broken off + a 3"x4" x 24" hewn juniper post laying by it. Reset a 1"x2" Fl. Replaced 1"x2" with a 2" I.P. with brass cap marked as shown in Conc. 6" above surface.

Fd remains of old joshua tree with ax marks laying on the ground. See C.S. 9236

N 41° W. 111.90

COUNTY SURVEYOR T.5N R.8W. 17 20 1/4 COR. R.E. 329

Note: Any Additions or Changes on This Sheet Must be Made or Circled in Red Ink With Date and Name of Person Making Change.

Do not extend notes this side of this line.

RETURN TO
LOS ANGELES COUNTY SURVEYOR
700 HALL OF RECORDS

FORM 247 5M 11-46

F. B. 1262 PG. 88

W.S. 67-C-5

RETURN TO
LOS ANGELES COUNTY SURVEYOR
700 HALL OF RECORDS

Do not extend notes this side of this line.

Note: Any Additions or Changes on This Sheet Must be Made or Circled in Red Ink With Date and Name of Person Making Change.

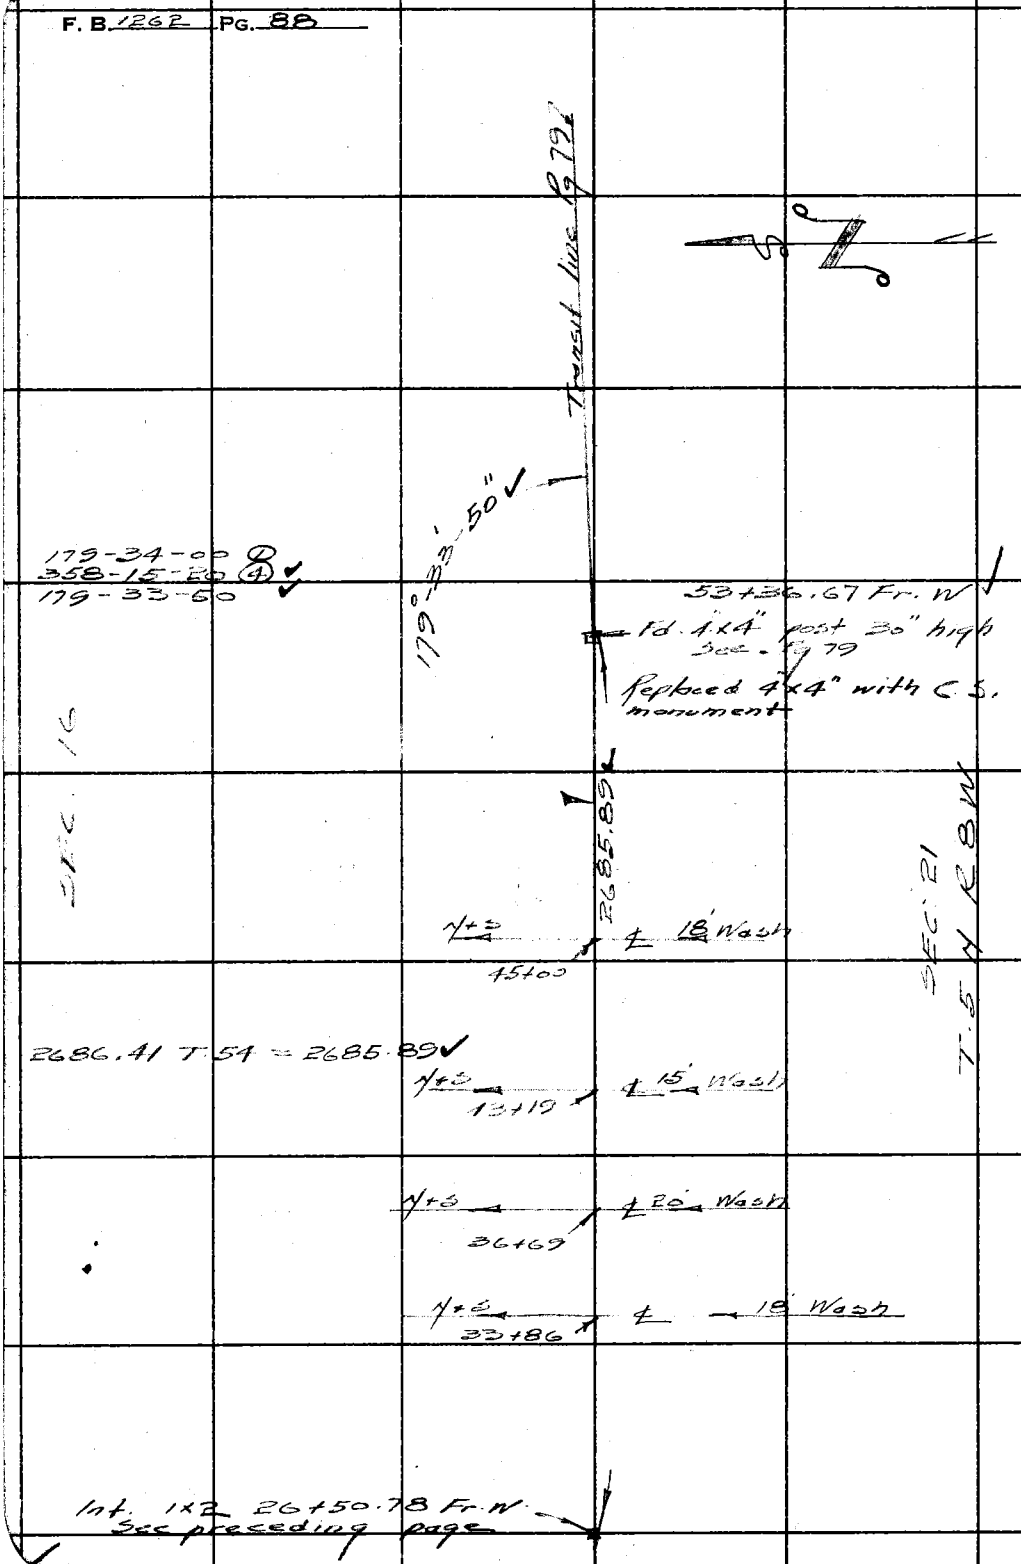

Notes Ck'd by MILLER	Survey of T.5N. R.8W.	F. B. 1262 PG. 89
Map No. B-2120-1	W. O. 4999 Tape No. 60 St'd 84 °F	Cont bottom next page
Office Work Drawn	Surveyed by Rosecrans	
Checked McPherson	Notes R Date 12-15-47	
Date April 1949	Indexed A. C. Johnson	

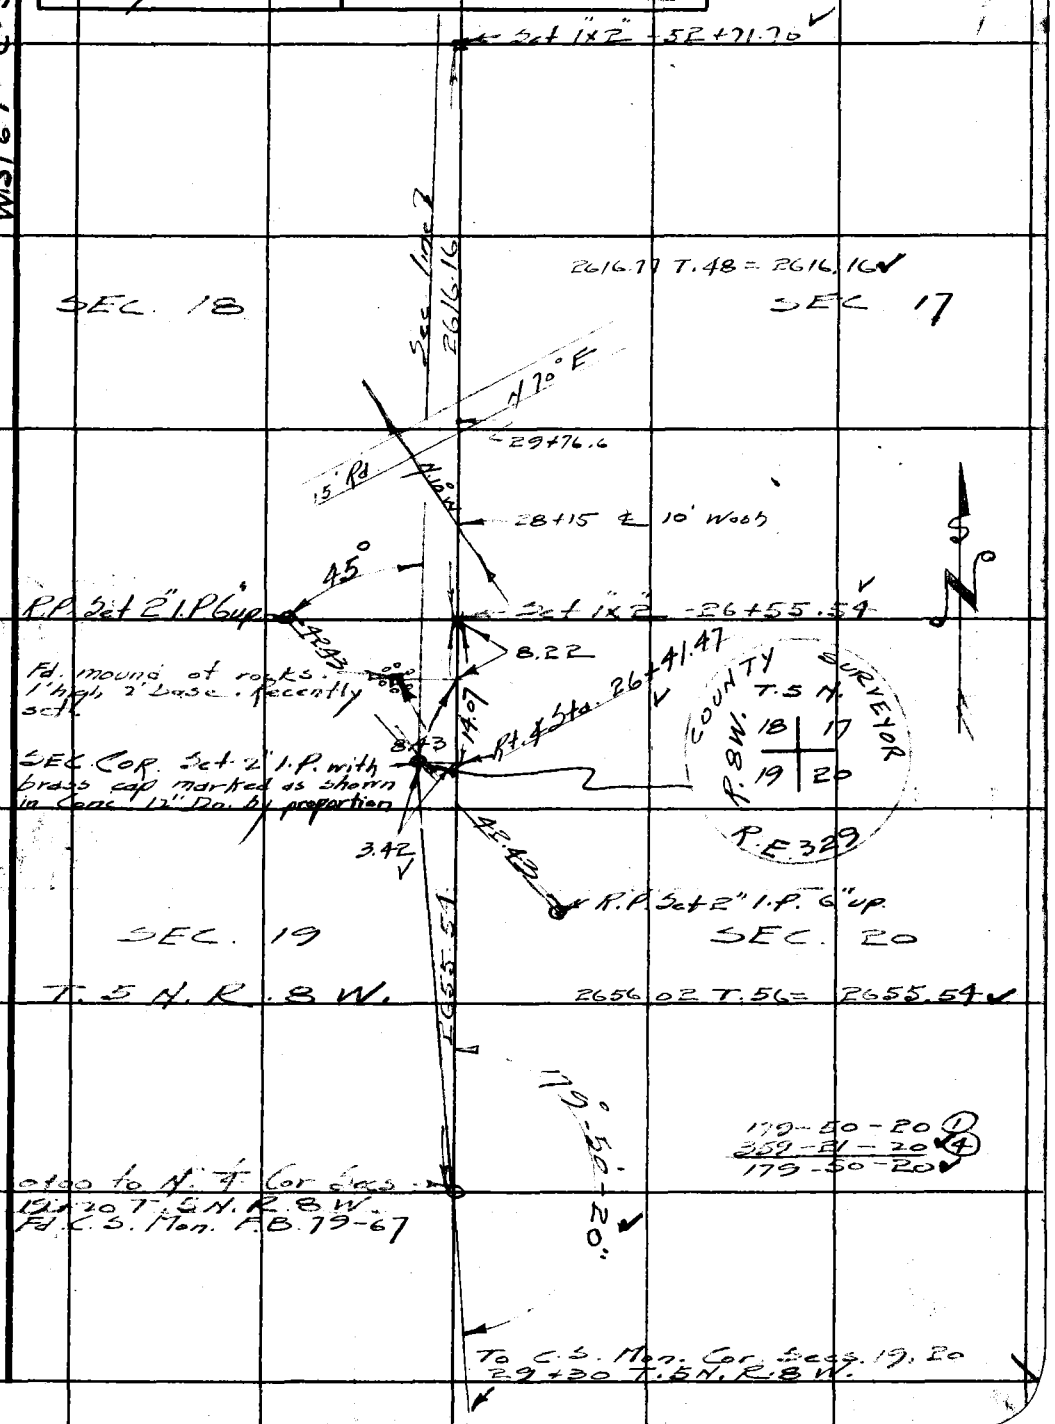

Note: Any Additions or Changes on This Sheet Must be Made or Circled in Red Ink With Date and Name of Person Making Change.

Do not extend notes this side of this line.

RETURN TO
LOS ANGELES COUNTY SURVEYOR
700 HALL OF RECORDS

FORM 247 5M 11-46

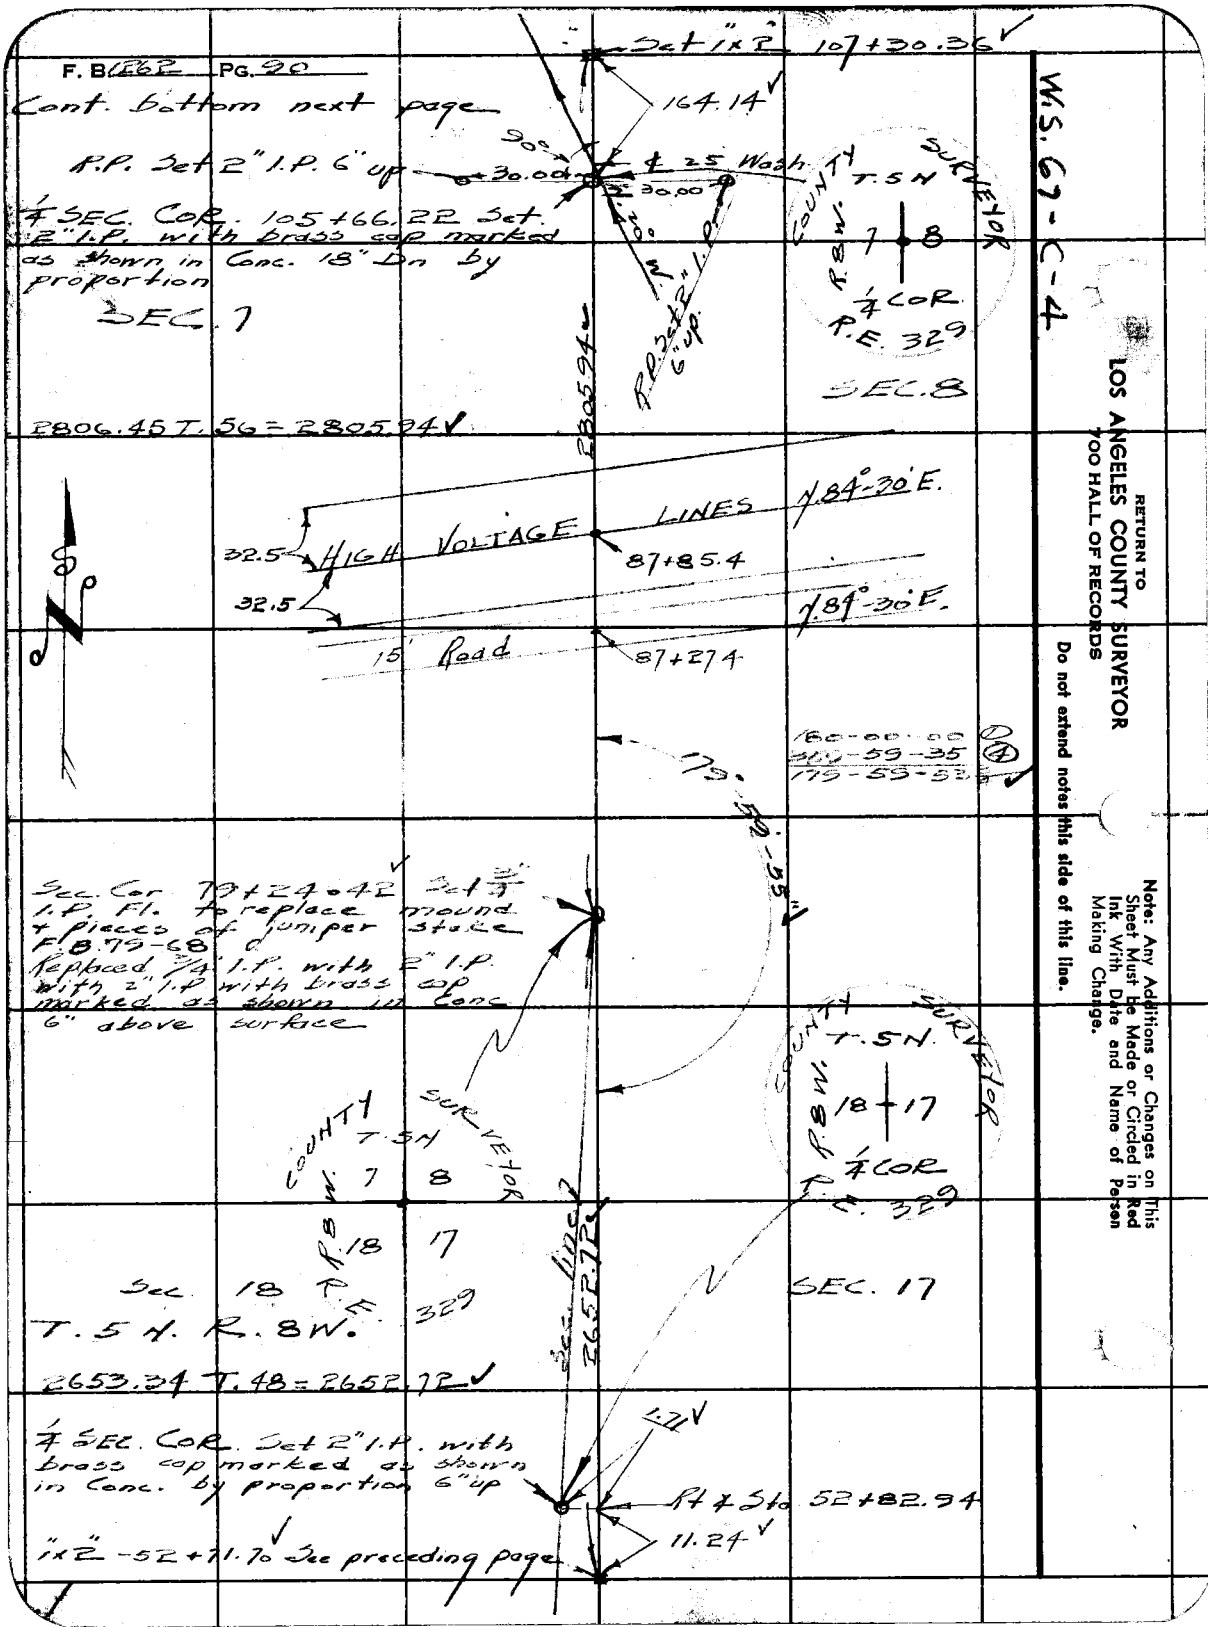
F. B. 1262 PG. 90
Cont. bottom next page
R.P. Set 2" I.P. 6" up
1/4 SEC. COR. 105+66.22 Set 2" I.P. with brass cap marked as shown in Conc. 18" Dn by proportion
SEC. 7
Set 1"x2" 107+30.36
164.14
90°
30.00
℄ 25 Wash
30.00
R.P. Set 2" I.P. 6" up
COUNTY SURVEYOR
T. 5 N
R. 8 W.
7
8
1/4 COR
R.E. 329
SEC. 8
2805.94
2806.45 T. 56 = 2805.94
HIGH VOLTAGE LINES
N. 84°-30' E.
32.5
87+85.4
32.5
N. 84°-30' E.
15' Road
87+27.4
180-00-00
359-59-35
179-59-53
179-59-35
Sec. Cor 79+24.42 Set 3/4" I.P. Fl. to replace mound + pieces of juniper stake F.B. 79-68
Replaced 3/4" I.P. with 2" I.P. with 2" I.P. with brass cap marked as shown in Conc 6" above surface
COUNTY SURVEYOR
T. 5 N.
R. 8 W.
18
17
1/4 COR
R.E. 329
SEC. 17
COUNTY SURVEYOR
T. 5 N
R. 8 W.
7
8
18
17
Sec. 18
R.E. 329
T. 5 N. R. 8 W.
Sec. line
2652.72
2653.34 T. 48 = 2652.72
1/4 SEC. COR. Set 2" I.P. with brass cap marked as shown in Conc. by proportion 6" up
1.71
Rt ℄ Sta 52+82.94
11.24
1"x2" -52+71.70 See preceding page
W.S. 67-C-4
RETURN TO
LOS ANGELES COUNTY SURVEYOR
700 HALL OF RECORDS
Do not extend notes this side of this line.
Note: Any Additions or Changes on This Sheet Must Be Made or Circled in Red Ink With Date and Name of Person Making Change.

Notes Ck'd by MILLER	Survey of T.5N.R.8W
Map No. B-2120-1	W. O. 4999 Tape No. 60 St'd 84 °F
Office Work Drown	Surveyed by Rosecrans
Checked McPherson	Notes R Date 12-31-47
Date April 1949	Indexed C. Johnson

F. B. 1262 PG. 91

W.S. 67-C-4

158+57.81 ✓ ¼ Cor 3.61

Cont. bottom next page

Fd. several small pieces of juniper within a radius of 3 feet
Drove a 1x2 in center 8.59

157.43
165.95

Set 1"x2" - 157+00.38 ✓

SEC. Line

SEC. 6

SEC. 5

N 50° W.

137+37

10 Wash

2492.58 T. 10 = 2492.35 ✓

2492.35 ✓

COUNTY SURVEYOR
T.5N.
R.8W.
6 5
7 8
R.E. 329

179-33-00
358-12-20
179-33-05

179°-33'-05" ✓

Sec. Cor. 132+08.03 ✓
Set 3/4" I.P. in center of small mound of rocks
F.B. 79-68
Replaced 3/4" I.P. with 2" I.P. with brass cap marked as shown in Conc. 6" above surface

2477.67 ✓

2478.19 T.52 = 2477.67 ✓

SEC. 7
T.5N.R.8W.

SEC. 8

1"x2" - 107+30.36 ✓ See preceding page

Note: Any Additions or Changes on This Sheet Must Be Made or Circled in Red Ink With Date and Name of Person Making Change.

Do not extend notes this side of this line.

RETURN TO
LOS ANGELES COUNTY SURVEYOR
700 HALL OF RECORDS

FORM 247 5M 11-46

F. B. 1262 PG. 92

W. S. 67-C-3

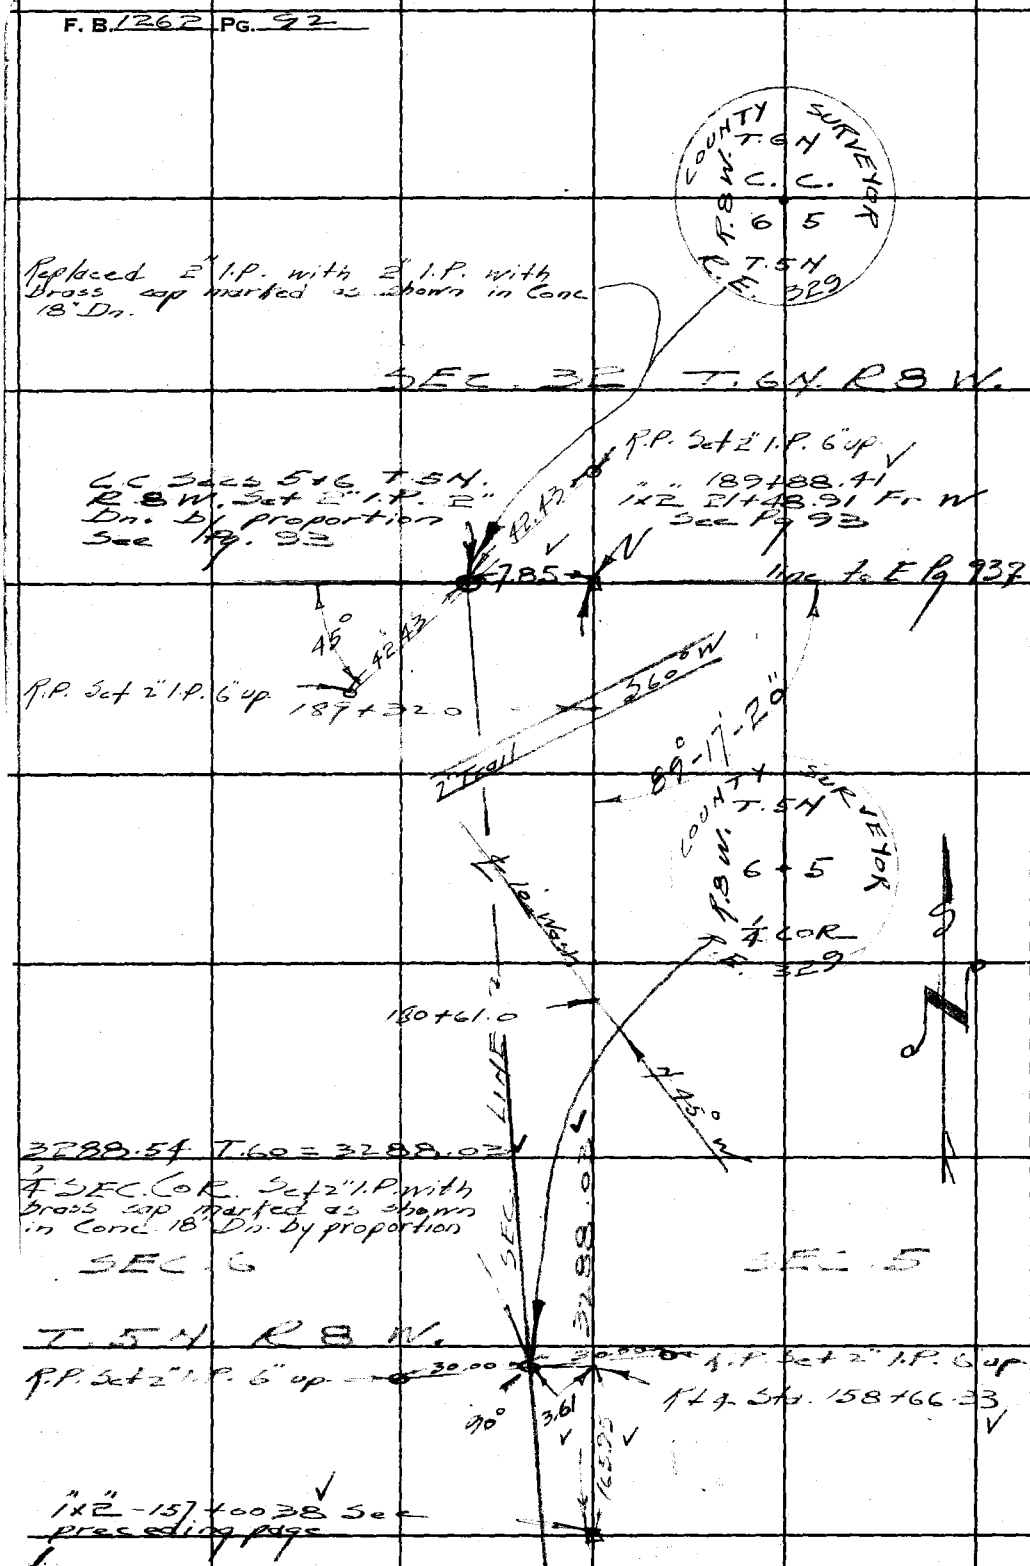

RETURN TO
LOS ANGELES COUNTY SURVEYOR
700 HALL OF RECORDS

Do not extend notes this side of this line.

Note: Any Additions or Changes on This Sheet Must Be Made or Circled in Red Ink With Date and Name of Person Making Change.

Notes Ck'd by MILLER	Survey of T.5N. R.8W.	F.B. 1262 PG. 92
Map No. B-2120-1	W. O. 4999 Tape No. 60 St'd 84 °F	
Office Work Drawn	Surveyed by Rosecrans	
Checked McPherson	Notes R Date 1-8-48	
Date April 1949	Indexed A. C. Johnson	

W.S. 67-C-3

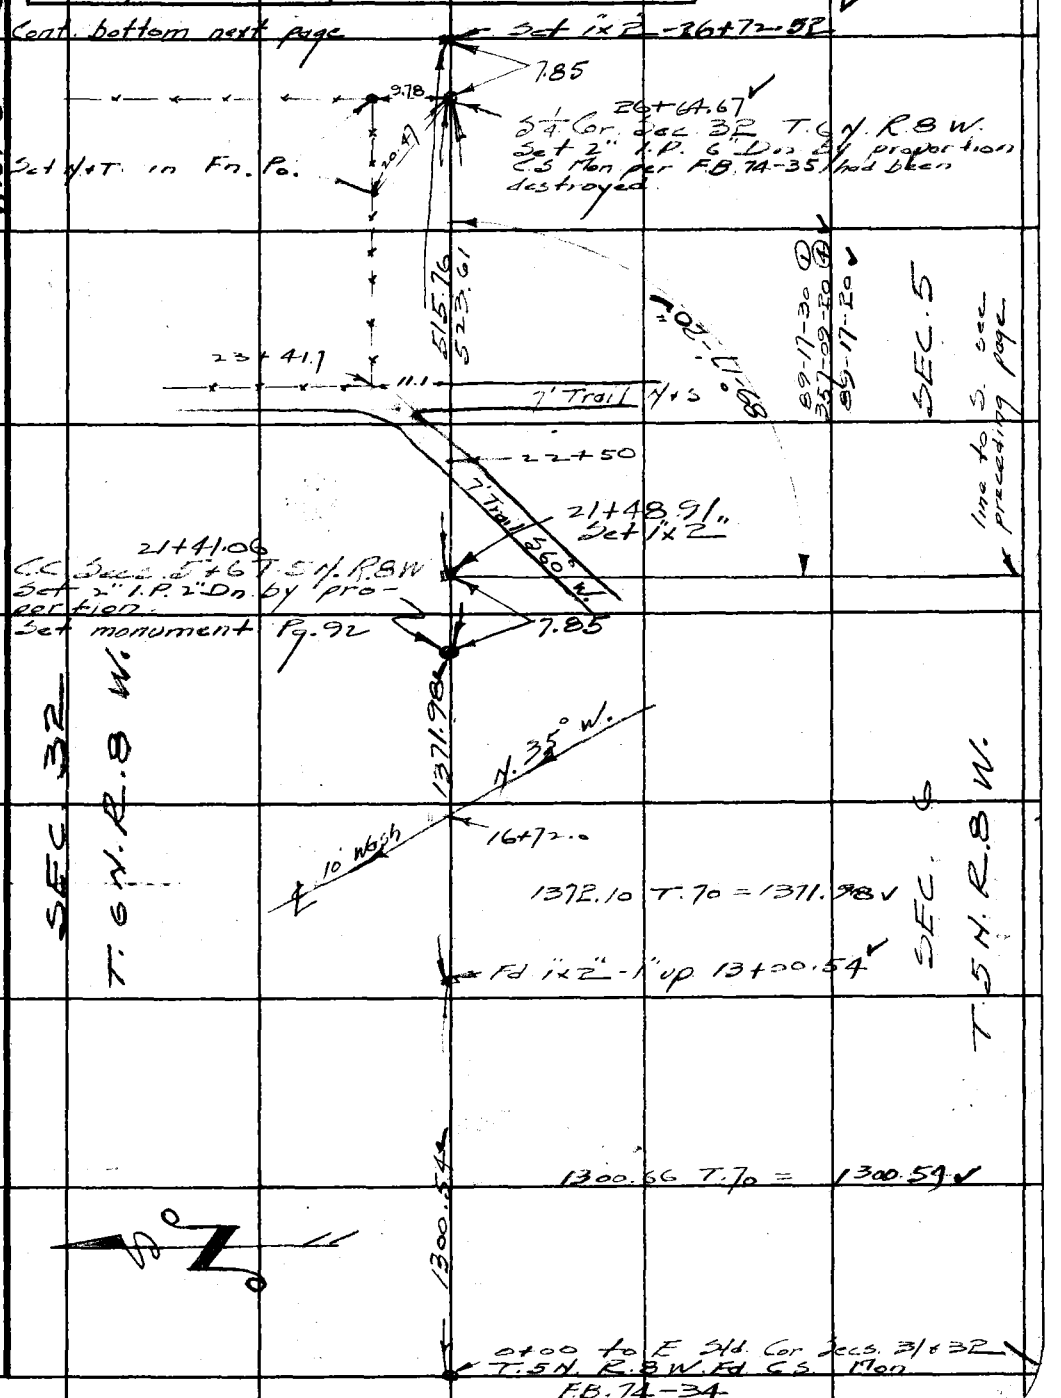

Note: Any Additions or Changes on This Sheet Must be Made or Circled in Red Ink With Date and Name of Person Making Change.

Do not extend notes this side of this line.

RETURN TO
LOS ANGELES COUNTY SURVEYOR
700 HALL OF RECORDS

FORM 247 5M 11-46

F. B. 1262 PG. 94

W.S. 67-C-3

RETURN TO
LOS ANGELES COUNTY SURVEYOR
700 HALL OF RECORDS

Do not extend notes this side of this line.

Note: Any Additions or Changes on This Sheet Must Be Made or Circled in Red Ink With Date and Name of Person Making Change.

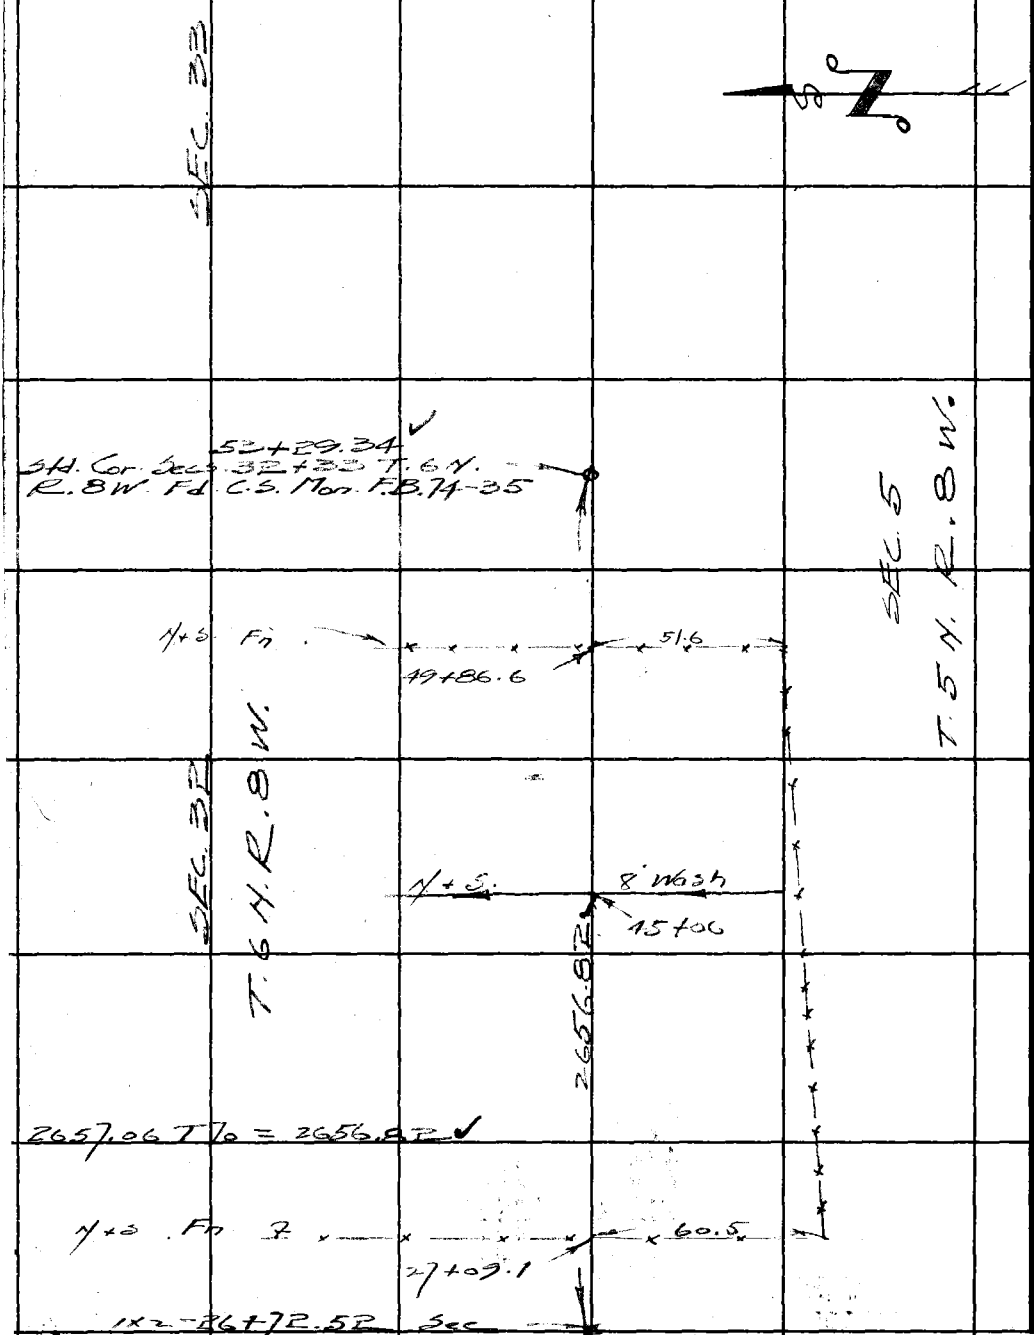

Notes Ck'd by MILLER	Survey of T.5N.R.8W.
Map No. B-2120-1	W. O. 1999 Tape No. 60 St'd 84 °F
Office Work Drawn	Surveyed by Rosecrans
Checked McPherson	Notes R Date 12-16-47
Date Apr. 1949	Indexed A. C. Johnson

F. B. 1262 PG. 95

W.S. 67-D-4

Note: Any Additions or Changes on This Sheet Must be Made or Circled in Red Ink With Date and Name of Person Making Change.

Do not extend notes this side of this line.

RETURN TO
LOS ANGELES COUNTY SURVEYOR
700 HALL OF RECORDS

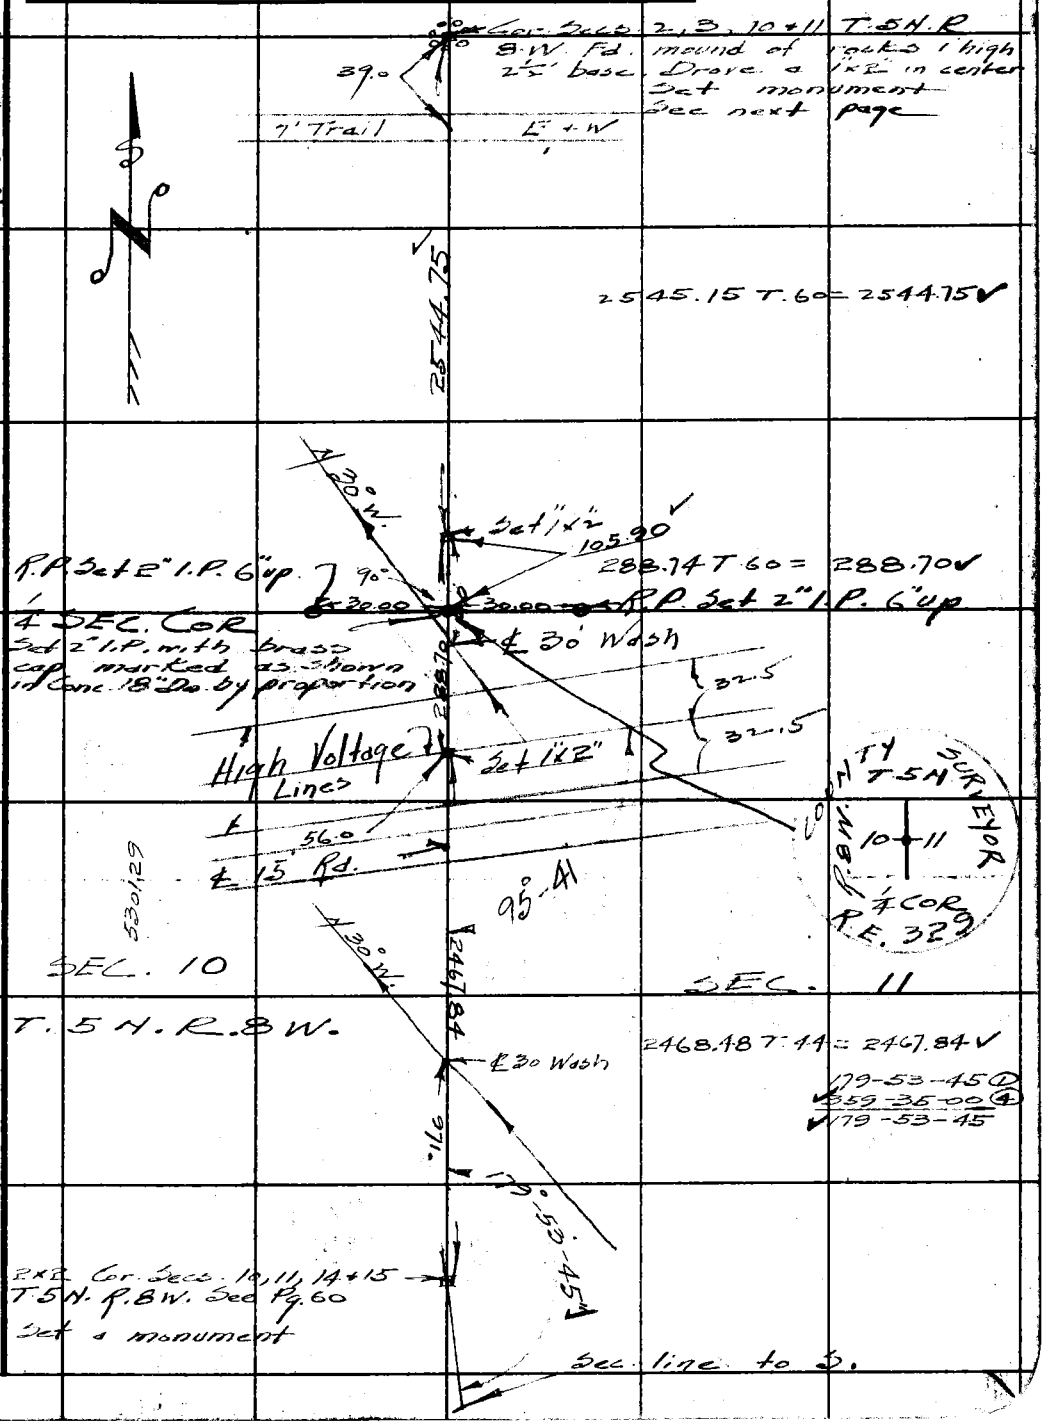

FORM 247 5M 11-46

F. B. 1262 PG. 96

Cont. on next page

W.S. 67-D-3, D-4

RETURN TO
LOS ANGELES COUNTY SURVEYOR
700 HALL OF RECORDS

Do not extend notes this side of this line.

Note: Any Additions or Changes on This Sheet Must be Made or Circled in Red Ink With Date and Name of Person Making Change.

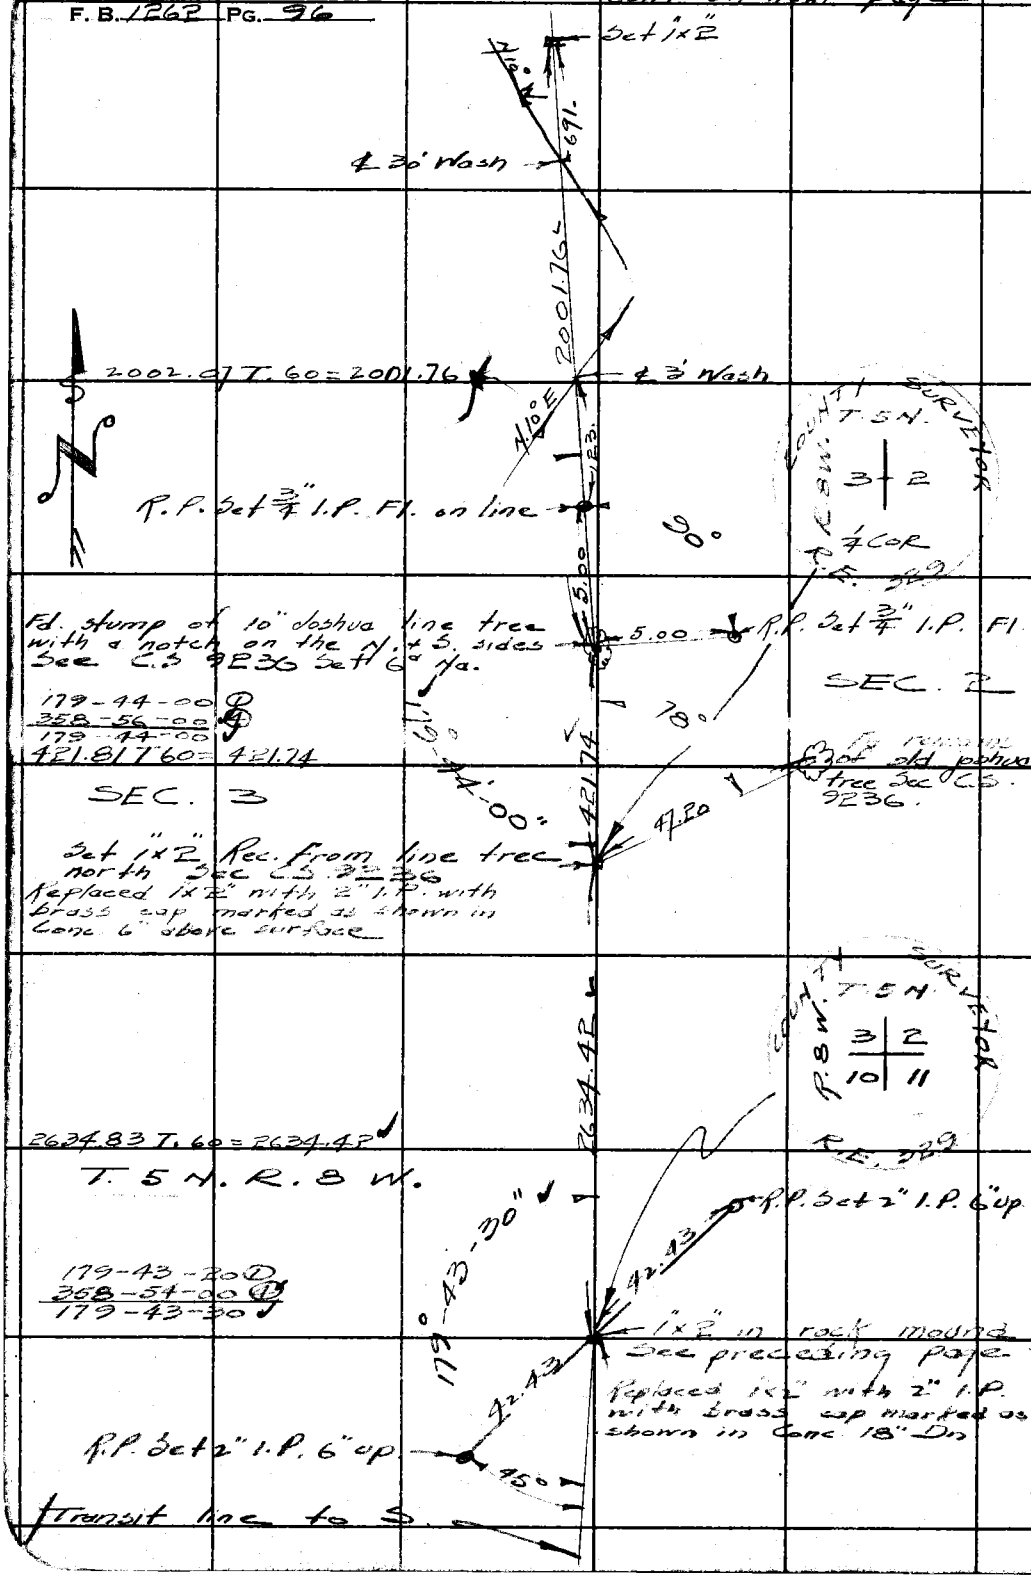

Notes Ck'd by MILLER	Survey of T.5N. R.8W.
Map No. B-2120-1	W. O. 4999 Tape No. 60 St'd 84 °F
Office Work Drawn	Surveyed by Rosecrans
Checked McPherson	Notes R Date 12-18-47
Date Apr. 1949	Indexed A. C. Johnson

F.B. 1262 PG. 97

W.S. 67-D-3

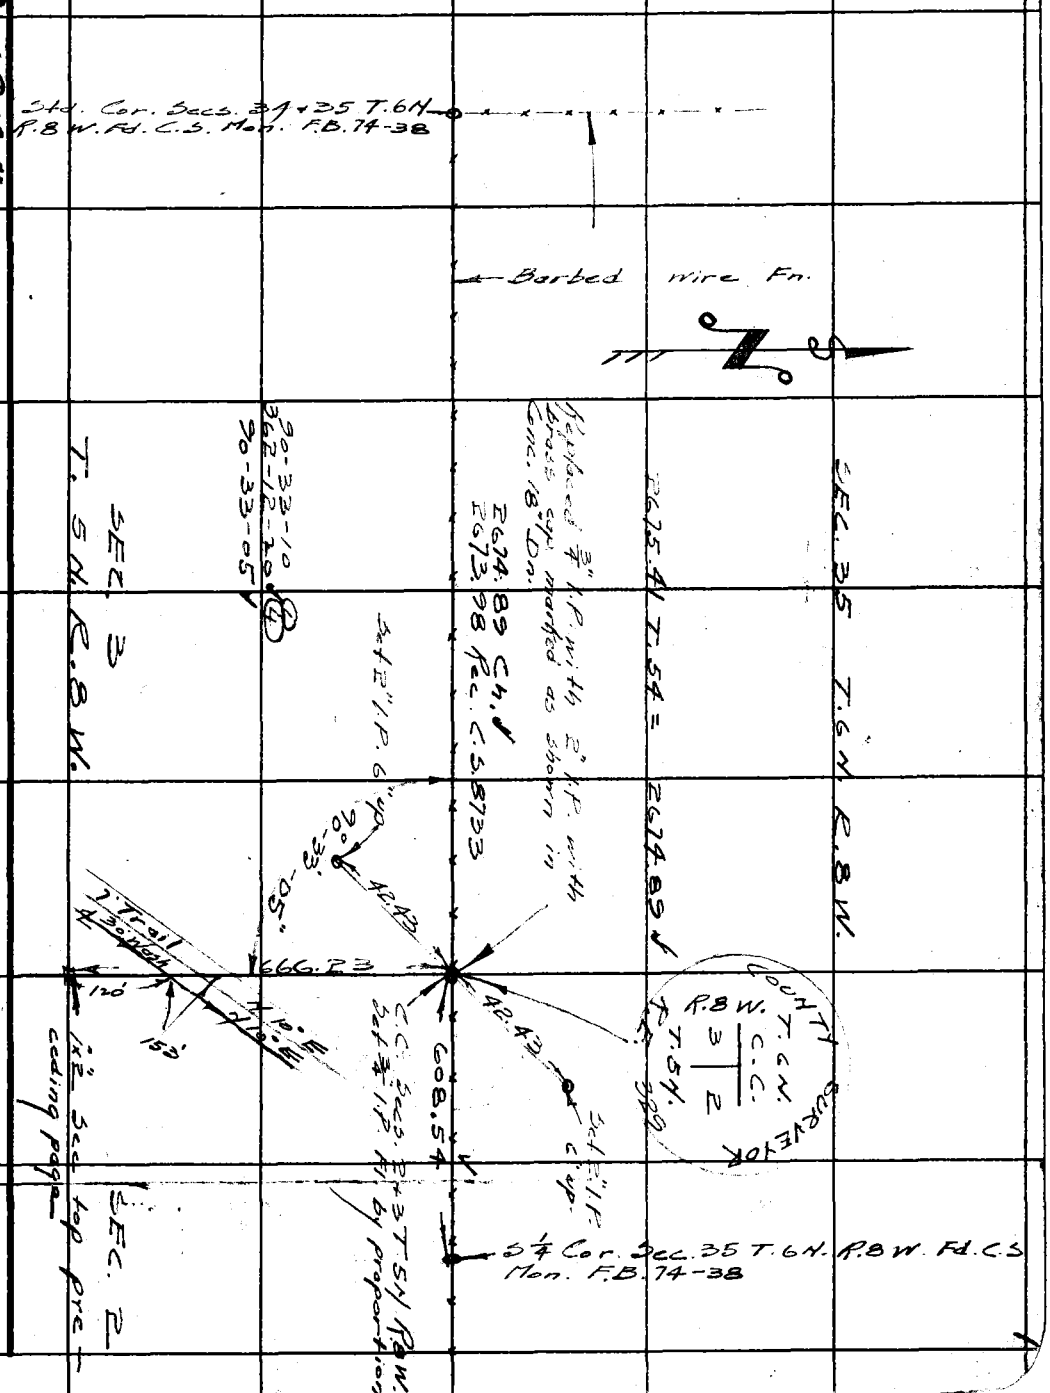

Note: Any Additions or Changes on This Sheet Must be Made or Circled in Red Ink With Date and Name of Person Making Change.

Do not extend notes this side of this line.

RETURN TO
LOS ANGELES COUNTY SURVEYOR
700 HALL OF RECORDS

FORM 247 5M 11-46

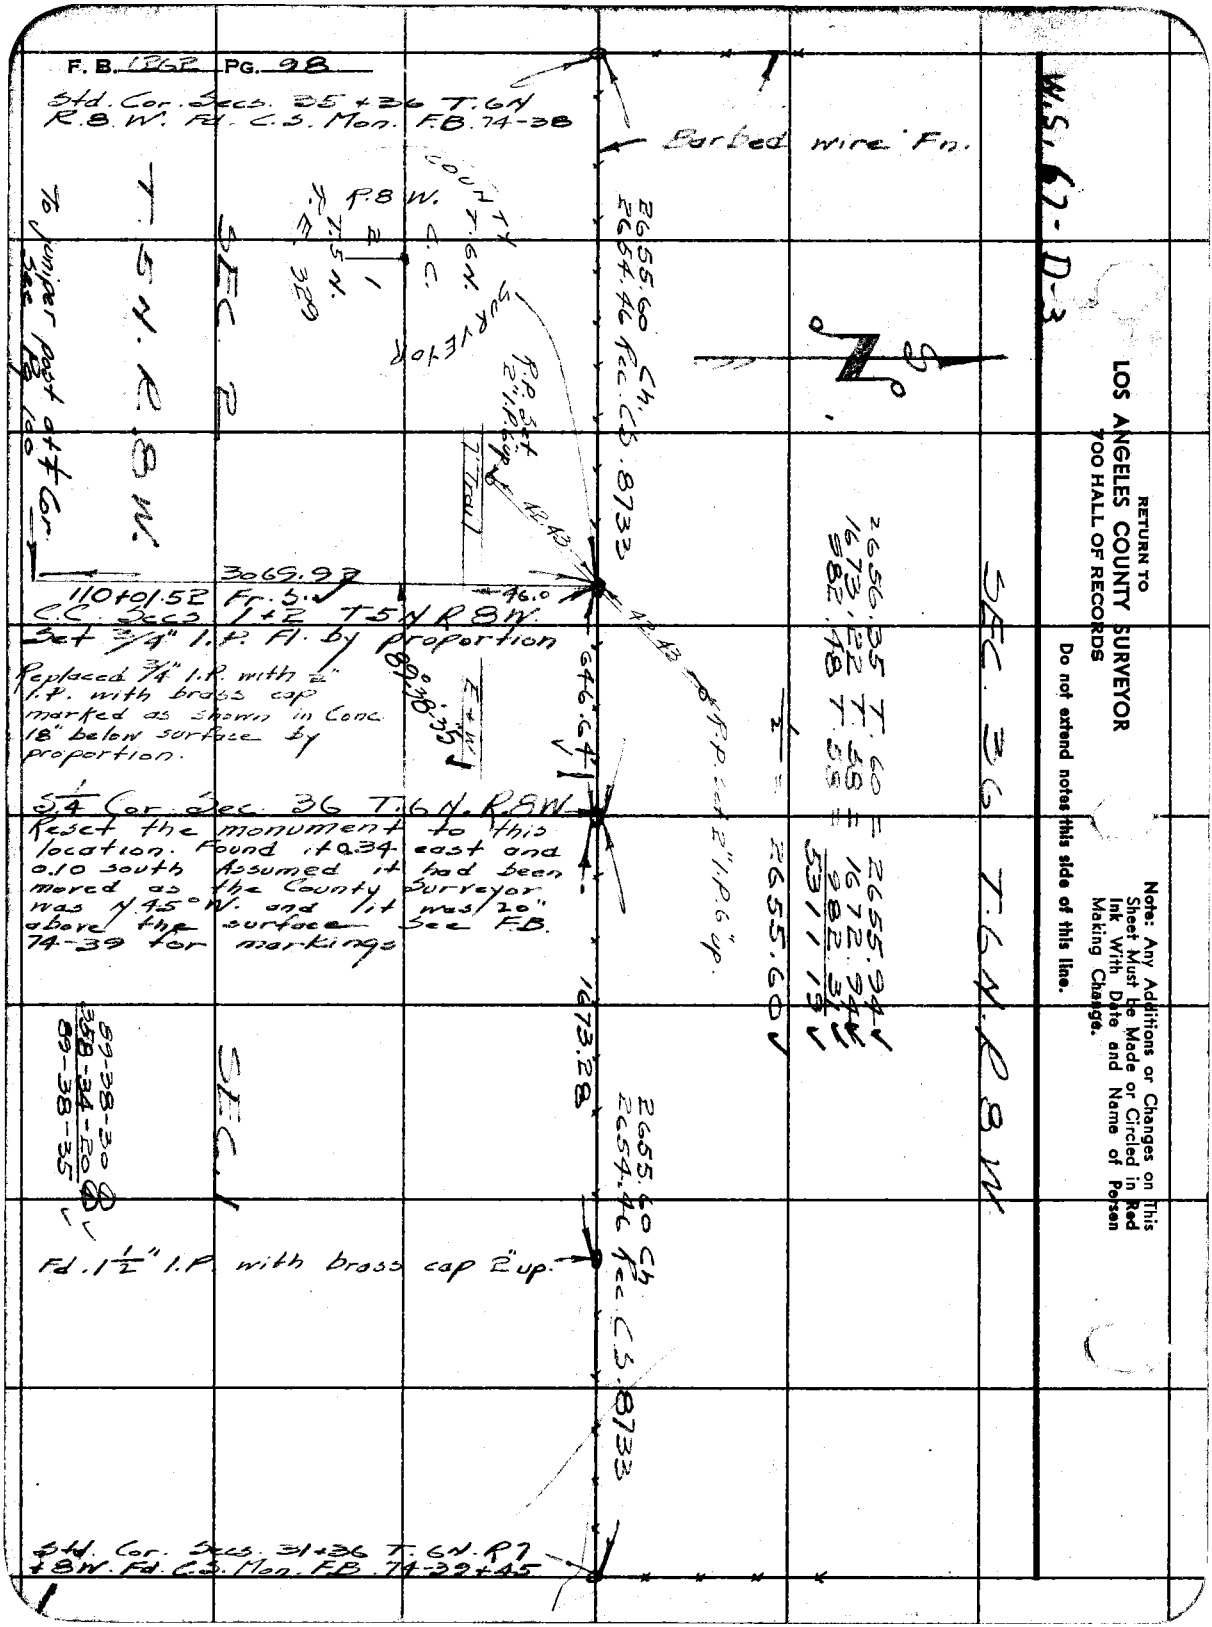
F. B. 1262 PG. 98
Std. Cor. Secs. 35 + 36 T. 6N R. 8 W. Fd. C.S. Mon. F.B. 74-38
Barbed wire Fn.
W.S. 67-D-3
RETURN TO
LOS ANGELES COUNTY SURVEYOR
700 HALL OF RECORDS
Do not extend notes this side of this line.
Note: Any Additions or Changes on This Sheet Must be Made or Circled in Red Ink With Date and Name of Person Making Change.
T. 5 N. R. 8 W.
SEC. 2
SEC. 1
SEC. 36 T. 6 N. R. 8 W.
COUNTY SURVEYOR
R. 8 W.
T. 6 N.
C.C.
T. 5 N.
F.E. 329
To juniper post at ¼ Cor. See Pg 100
2655.60 Ch.
2654.46 Rec. C.S. 8733
R.P. Set 2" I.P. 6" up
T. Trail
42.43
3069.92
110+01.52 Fr. S.
46.0
C.C. Secs. 1+2 T5N R8W.
Set 3/4" I.P. Fl. by proportion
Replaced 3/4" I.P. with 1/2" I.P. with brass cap marked as shown in Conc. 18" below surface by proportion.
89°38'35"
E+W
646.64
S 1/4 Cor. Sec. 36 T. 6 N. R. 8 W.
Reset the monument to this location. Found it 0.34 east and 0.10 south Assumed it had been moved as the County Surveyor was N 45° W. and it was 20" above the surface See F.B. 74-39 for markings
2656.35 T. 60 = 2655.94
1673.22 T. 58 = 1672.94
982.48 T. 58 = 982.31
5311.19
1/2 = 2655.60
1673.28
89-38-30
358-34-20
89-38-35
Fd. 1 1/2" I.P. with brass cap 2" up.
2655.60 Ch.
2654.46 Rec. C.S. 8733
Std. Cor. Secs. 31+36 T. 6N. R7 + 8W. Fd. C.S. Mon. F.B. 74-39+45

Notes Ck'd by MILLER	Survey of T.5N. R.8W.	F.B. 1262 Pg. 99
Map No. B-2120-1	W. O. 4999 Tape No. 60 St'd 84 °F	
Office Work Drawn	Surveyed by Rosecrans	
Checked McPherson	Notes R Date 1-9-48	
Date Apr. 1949.	Indexed A. C. Johnson	

W. S. 69-D-4

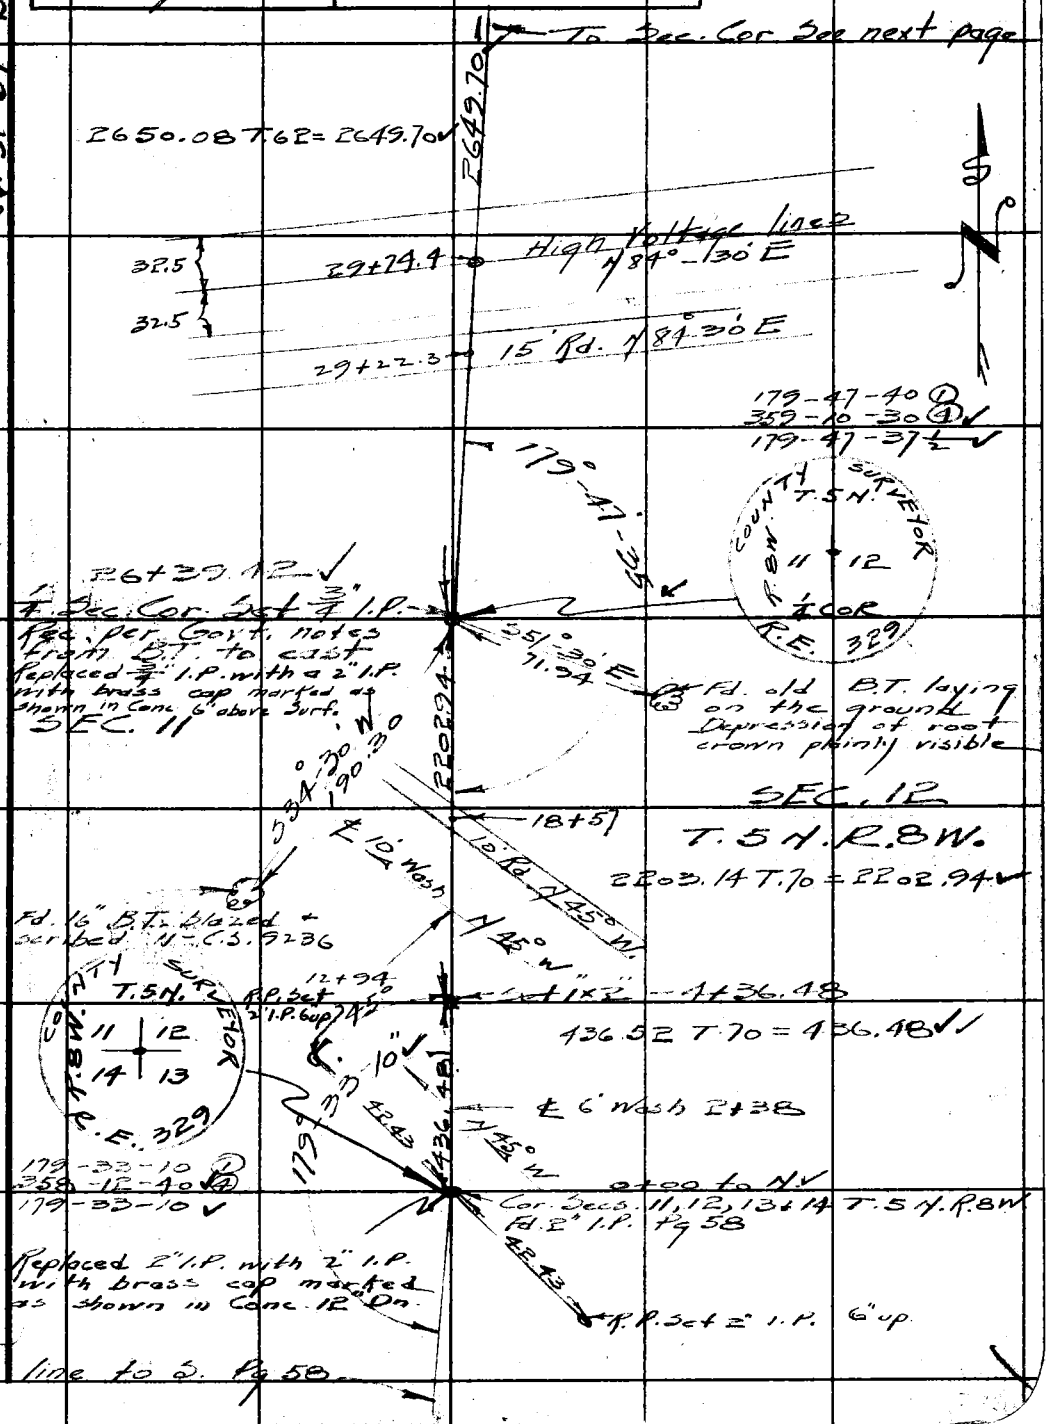

Note: Any Additions or Changes on This Sheet Must be Made or Circled in Red Ink With Date and Name of Person Making Change.

Do not extend notes this side of this line.

RETURN TO
LOS ANGELES COUNTY SURVEYOR
700 HALL OF RECORDS

FORM 247 5M 11-46

F. B. 1262 PG. 100

To C.C. See Pg 98

WIS. 67-D-3, D-4

℄ 8' Wash E+W

3070.36 T.62 = 3069.92 ✓

3069.92

COUNTY SURVEYOR T.5N R.8W. 2 1 ¼ Cor R.E. 329

179°-57'-45

R.P. Set 2" I.P. 6" up.

30.00

90°

30.00

¼ Sec Cor 79+31.60 ✓ Fd. 4x4" hewn juniper post 20" out of the Ground with traces of scribing on the north side. This stake has been set comparatively recent. Does not look old enough to be an original. Set 1x2" R.P. stakes 5.00 to S and W. Replaced 4x4" juniper post with 2" I.P. with brass cap marked as shown in Conc. 18" Dn.

R.P. Set 2" I.P. 6" up.

179-57-40 ①
359-51-00 ④
179-57-45

N 35° W

67+84.0

N 35° W

℄ 10' Wash

2642.82 T.64 = 2642.48 ✓

2642.48

65+60

SEC. 1

SEC. 2

T.5.N. R.8W.

N 45° W

℄ 20' Wash

62+02

℄ 10' Wash

COUNTY SURVEYOR T.5N. R.8W. 2 1 11 12 R.E. 329

5' Trail E+W

53+77

179°-57'-50"

N 73° W. 87'

179-57-50 ①
359-51-20 ④
179-57-50 ✓

Sec Cor 52+89.12 ✓ Fd old decayed 1x4" stake in mound at rock 1½ base ½ high. Reset ¾" I.P. Fl. Replaced ¾" I.P. with a 2" I.P. with brass cap marked as shown in Conc. 6" above Surf.

Fd. remains of old joshua B.T. See Govt notes C.S. 9236

S 87° W. 41.0

N 30°

S 54°-30' E 155'

52+53.0 ℄ 15' Wash.

N 45° W.

2649.70

℄ 25' Wash. 48+86.

Fd. remains of old joshua B.T.

To ¼ Cor See preceding page

RETURN TO
LOS ANGELES COUNTY SURVEYOR
700 HALL OF RECORDS

Do not extend notes this side of this line.

Note: Any Additions or Changes on This Sheet Must be Made or Circled in Red Ink With Date and Name of Person Making Change.

Notes Ck'd by MILLER	Survey of T. 5 N. R. 8 W.
Map No. B-2120-1	W. O. 4999 Tape No. 60 St'd 84 °F
Office Work Drawn	Surveyed by Rosecrans
Checked McPherson	Notes R Date 1-15-48
Date April 1949	Indexed A. C. Johnson

F. B. 1262 Pg. 101

W.S. 67, B-5

To 1"x2" - 24+64.19
See next page

Proposed State Hwy Diag.
Pd 1"x1" stakes at 50 intervals

771.15

771.23 T. 68 = 771.15

Int. Set 1"x2"
18+54.28

38-52-00 ①
277-44-20 ②
138-52-10

73.47

161.24

161.25 T. 70 = 161.24

Fd. 2"x2" Fl.

Set 1"x2" - 16+93.04

73.48 T. 70 = 73.47

SEC. 19

SEC. 18

T. 5 N. R. 8 W.

N 45° W

8 Wash

12+30

1693.04

8 Wash

N 45° W

8+40

1693.22 T. 68 = 1693.04

4+01

90-12-20 ①
360-49-50 ④
90-12-27½

N+S

25 Wash

2+71.5

N+S.

6 Wash

8 Wash

N+S.

1+64.5

To C.S. Mon. 1/4 Cor. Secs. 13+18

90°-12'-30"

Sec. line

0+00 To E. Cor. Secs. 13, 24
18+19 T. 5 N. R. 8+9 W. Fd
C.S. Mon. F.B. 79-80

179-52-00 ①
359-28-00 ④
179-52-00

See notes on T. 5 N. R. 9 W.

Note: Any Additions or Changes on This Sheet Must be Made or Circled in Red Ink With Date and Name of Person Making Change.

Do not extend notes this side of this line.

RETURN TO
LOS ANGELES COUNTY SURVEYOR
700 HALL OF RECORDS

FORM 247 5M 5-46

F. B. 1262 PG. 102

Cont. bottom next page

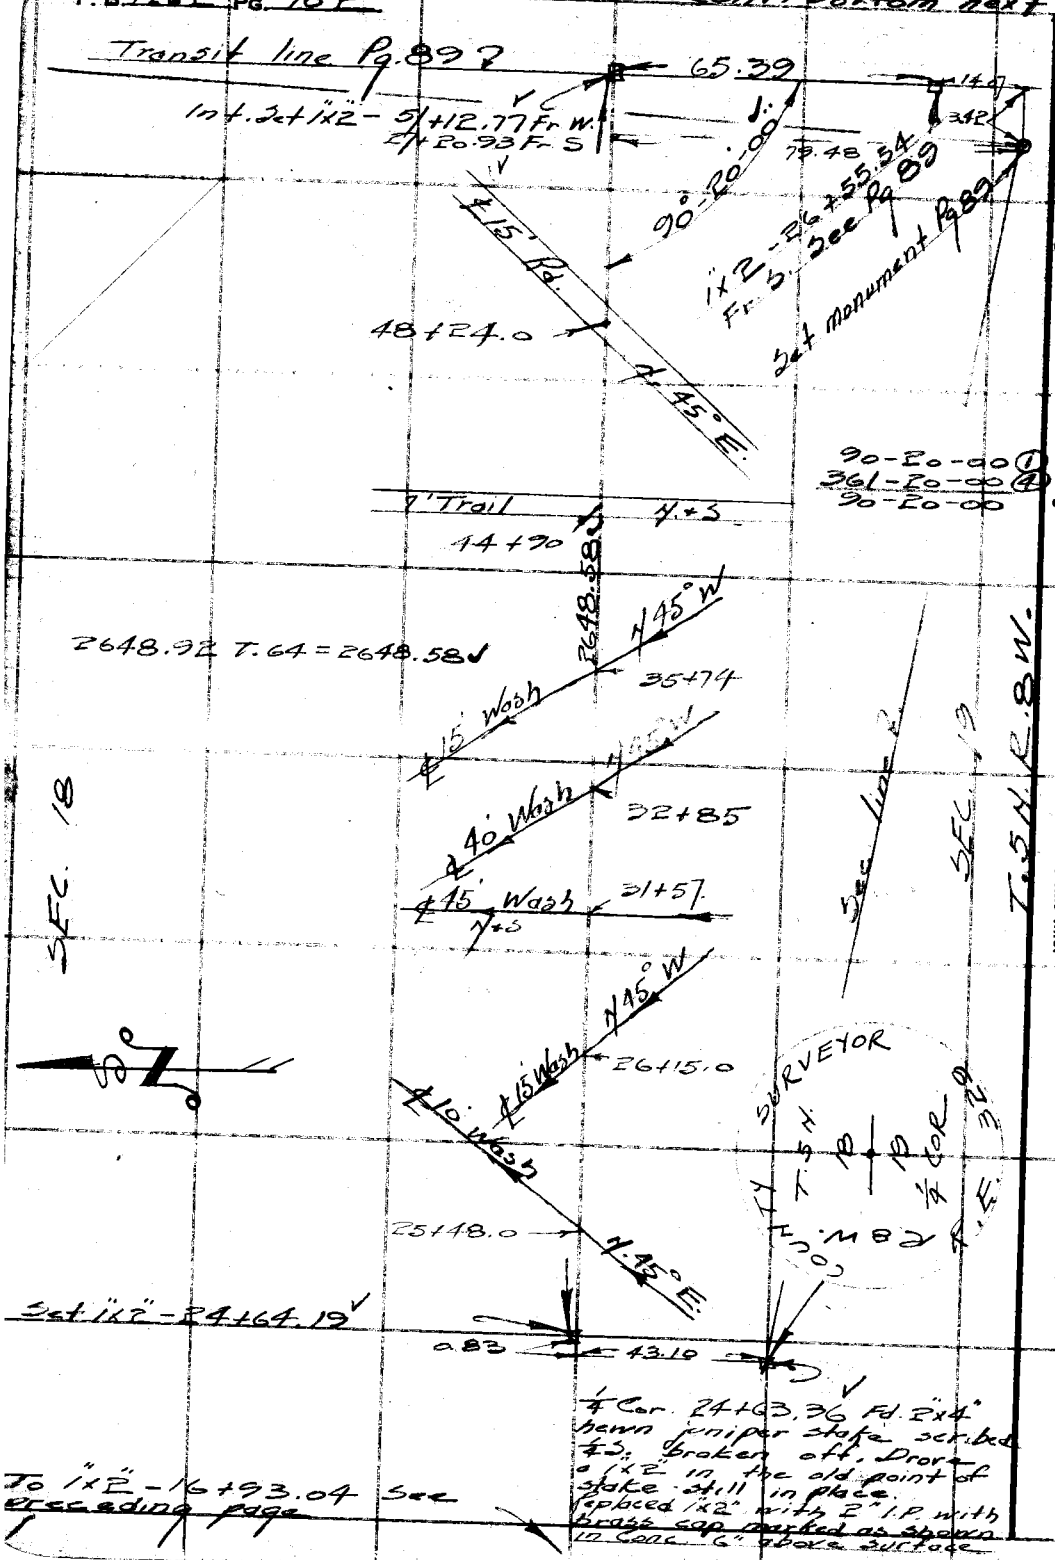

W.S. 67 - B-5

RETURN TO
LOS ANGELES COUNTY SURVEYOR
700 HALL OF RECORDS

Do not extend notes this side of this line.

Note: Any Additions or Changes on This Sheet Must be Made or Circled in Red Ink With Date and Name of Person Making Change.

Notes Ck'd by MILLER	Survey of T.5N R.8W.
Map No. B-2120-1	W. O. 4999 Tape No. 60 St'd 84 °F
Office Work Drawn	Surveyed by Rosecrans
Checked McWilliams	Notes R Date 1-15-48
Date April 1949	Indexed A. C. Johnson

F. B. 1262 Pg. 103

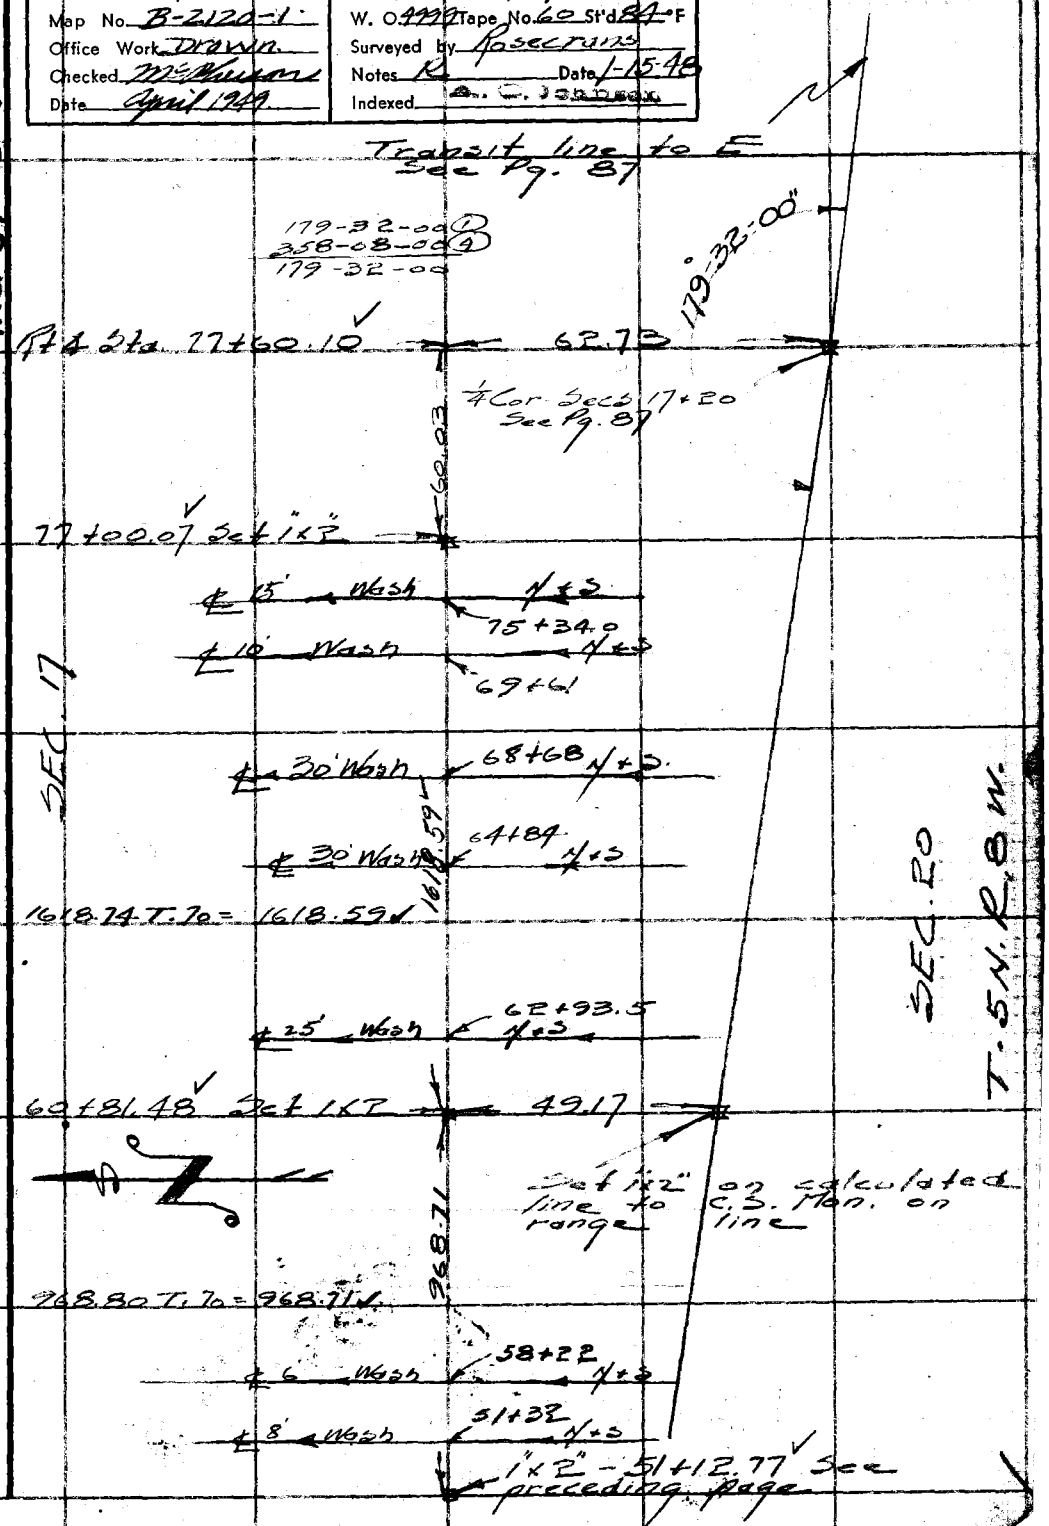

W.S. 67-E-5

Note: Any Additions or Changes on This Sheet Must be Made or Circled in Red Ink With Date and Name of Person Making Change.

Do not extend notes this side of this line.

RETURN TO
LOS ANGELES COUNTY SURVEYOR
700 HALL OF RECORDS

FORM 247 5M 5-46

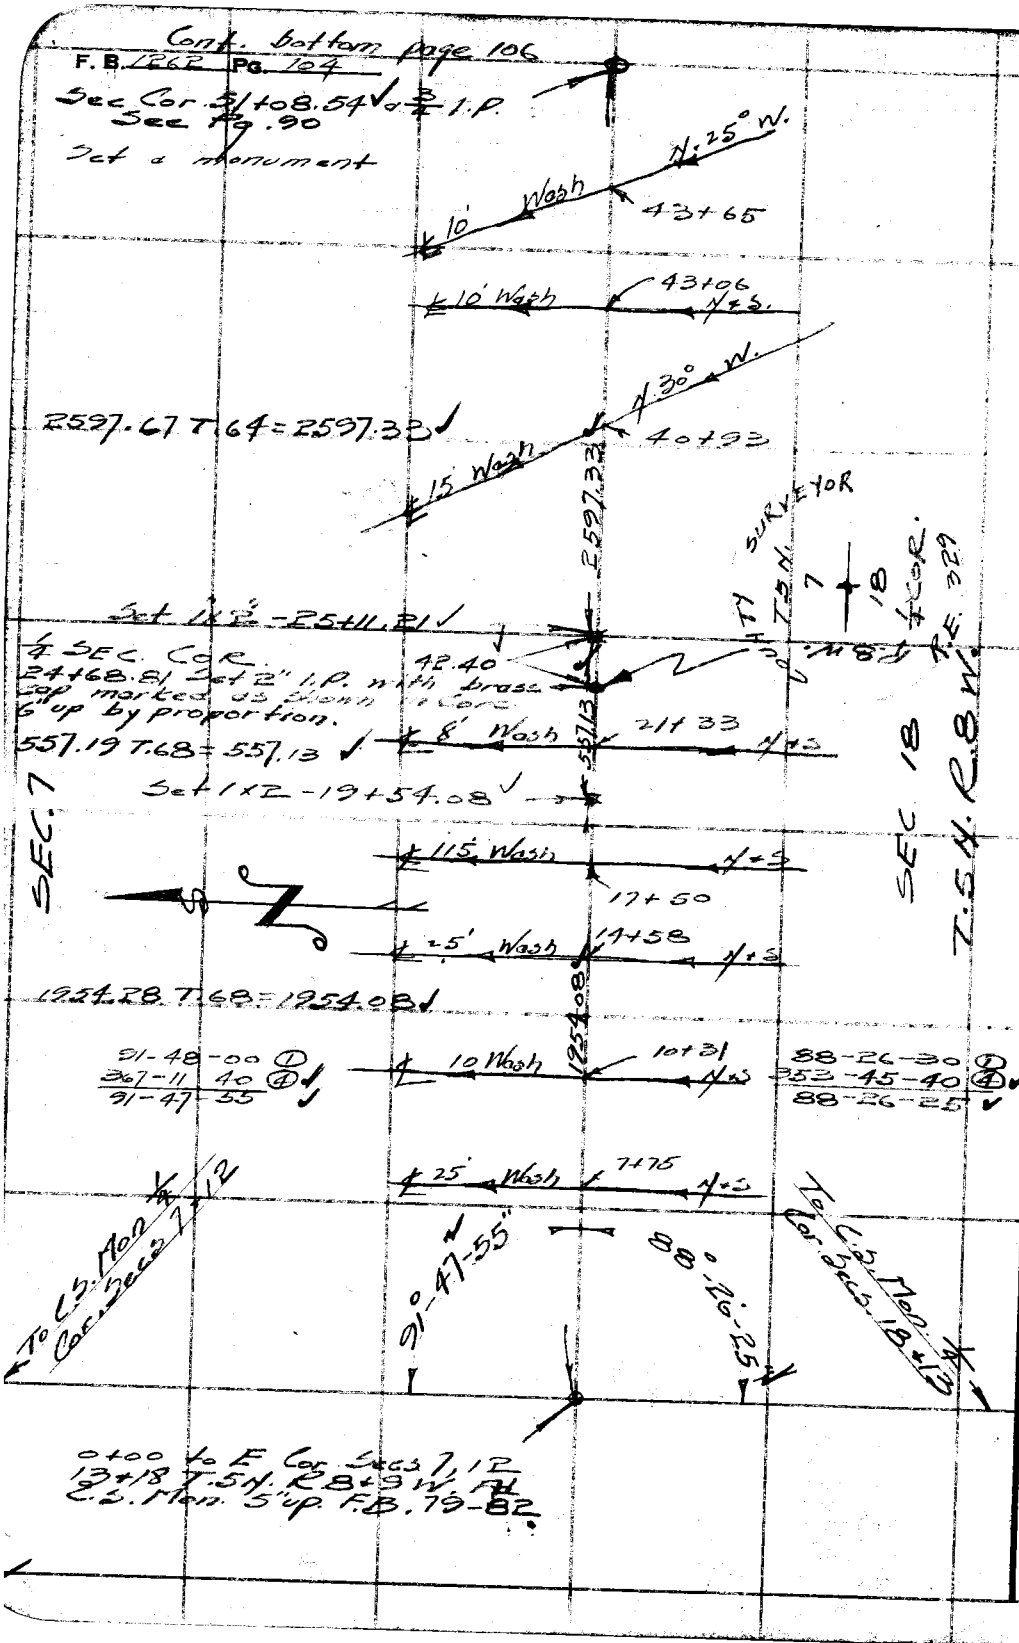

W.S. 67-B-4

RETURN TO
LOS ANGELES COUNTY SURVEYOR
700 HALL OF RECORDS

Do not extend notes this side of this line.

Note: Any Additions or Changes on This Sheet Must be Made or Circled in Red Ink With Date and Name of Person Making Change.

Notes Ck'd by MILLER	Survey of T.5N. R.8W.
Map No. B-2120-1	W. O. 4999 Tape No. 60 St'd 84 °F
Office Work Drawn	Surveyed by Rosecrans
Checked McPherson	Notes R Date 1-19-48
Date Apr. 1949	Indexed A. C. Johnson

F. B. 262 PG. 105

W.S. 67-B-5

Cor. Secs 13, 18, 24 + 19 T.5N. R.8 + 9 W. F.B. Mon. F.B. 79-80

Transit line to Pg. 101

89°39'25"

89-39-30 ①
358-21-10 ④
89-39-25 ✓

180°00'15"

SEC. 19
T. 5N. R 8W.

Cor Secs. 19 + 24 Fd. C.S. Mon. F.B. 79-80

SEC. 24
T. 5N. R 8 W.

180-00-10 ①
360-01-00 ④
180-00-15 ✓

90-55-20 ①
363-41-00 ④
90-55-15 ✓

90°55'15"

Fd. C.S. Mon. Cor. Secs 19, 20, 29 + 30 T.5N. R.8W.

Cor Secs. 19, 24, 25 + 30 T.5N. R.8 + 9 W. Fd. C.S. Mon. F.B. 79-60

Note: Any Additions or Changes on This Sheet Must be Made or Circled in Red Ink With Date and Name of Person Making Change.

Do not extend notes this side of this line.

RETURN TO
LOS ANGELES COUNTY SURVEYOR
700 HALL OF RECORDS

FORM 247 5M 5-46

F. B. 1862 PG. 106

Transit line to E. See next page

℄ 30' Wash N+S.

81+69.0

179°-58'-45" ✓

SURVEYOR
COUNTY
T.5 N.
R.8 W.
8
17
¼ COR
R.E. 329

¼ Sec. Cor. 77+53.57 Rd ✓ old hewn 2x3" juniper stake laying on the ground, broken into several pieces. Drove a 1x2 in the center of them. Replaced 1x2 with 2" I.P. with brass cap marked as shown in Conc. 6" above surface

179-58-40 ①
359-55-00 ④
179-58-45 ✓

℄ 8' Wash N+S

1471.09

1471.36 T. 56 = 1471.09 ✓

66+29

℄ 7' Rd. N+S

SEC. 8

SEC. 17

T.5 N. R.8 W.

℄ 5' Wash N+S

65+82

Set 1x2 - 62+82.48 ✓

N 30° W.

℄ 15' Wash

60+12

1174.15 T. 56 = 1173.94 ✓

89-58-00 ①
359-52-30 ④ ✓
89-58-07½ ✓

1173.94

℄ 50' Wash N+S.

56+58

N 30° W.

89°-58'-10" ✓

℄ 20' Wash

54+69

179°-59'-55" Pg. 90

90-01-45 Calc

Sec. line to N. See Pg. 90

Sec. line to S. See Pg. 90

Sec. Cor. ¾ I.P. 51+08.54 Fr. W.
79+24.42 Fr. S Pg. 90

SEC. 7

88-26-30 ①
353-46-10 ④ ✓
88-26-32½ ✓

88°-26'-35" ✓

Set monument Pg. 90

91-33-30 Calc

SEC. 18

Sec. line to W. Pg. 104

W.S. 67-C-4

RETURN TO
LOS ANGELES COUNTY SURVEYOR
700 HALL OF RECORDS

Do not extend notes this side of this line.

Note: Any Additions or Changes on This Sheet Must be Made or Circled in Red Ink With Date and Name of Person Making Change.

Notes Ck'd by MILLER	Survey of T.5N. R.8W.
Map No. B-2120-1	W. O. 4999 Tape No. 60 St'd 84 °F
Office Work Drown	Surveyed by Rosecrans
Checked McPherson	Notes R Date 1-21-48
Date Apr. 1949	Indexed A. C. Johnson

F. B. 1262 PG. 107

Cont. bottom next page

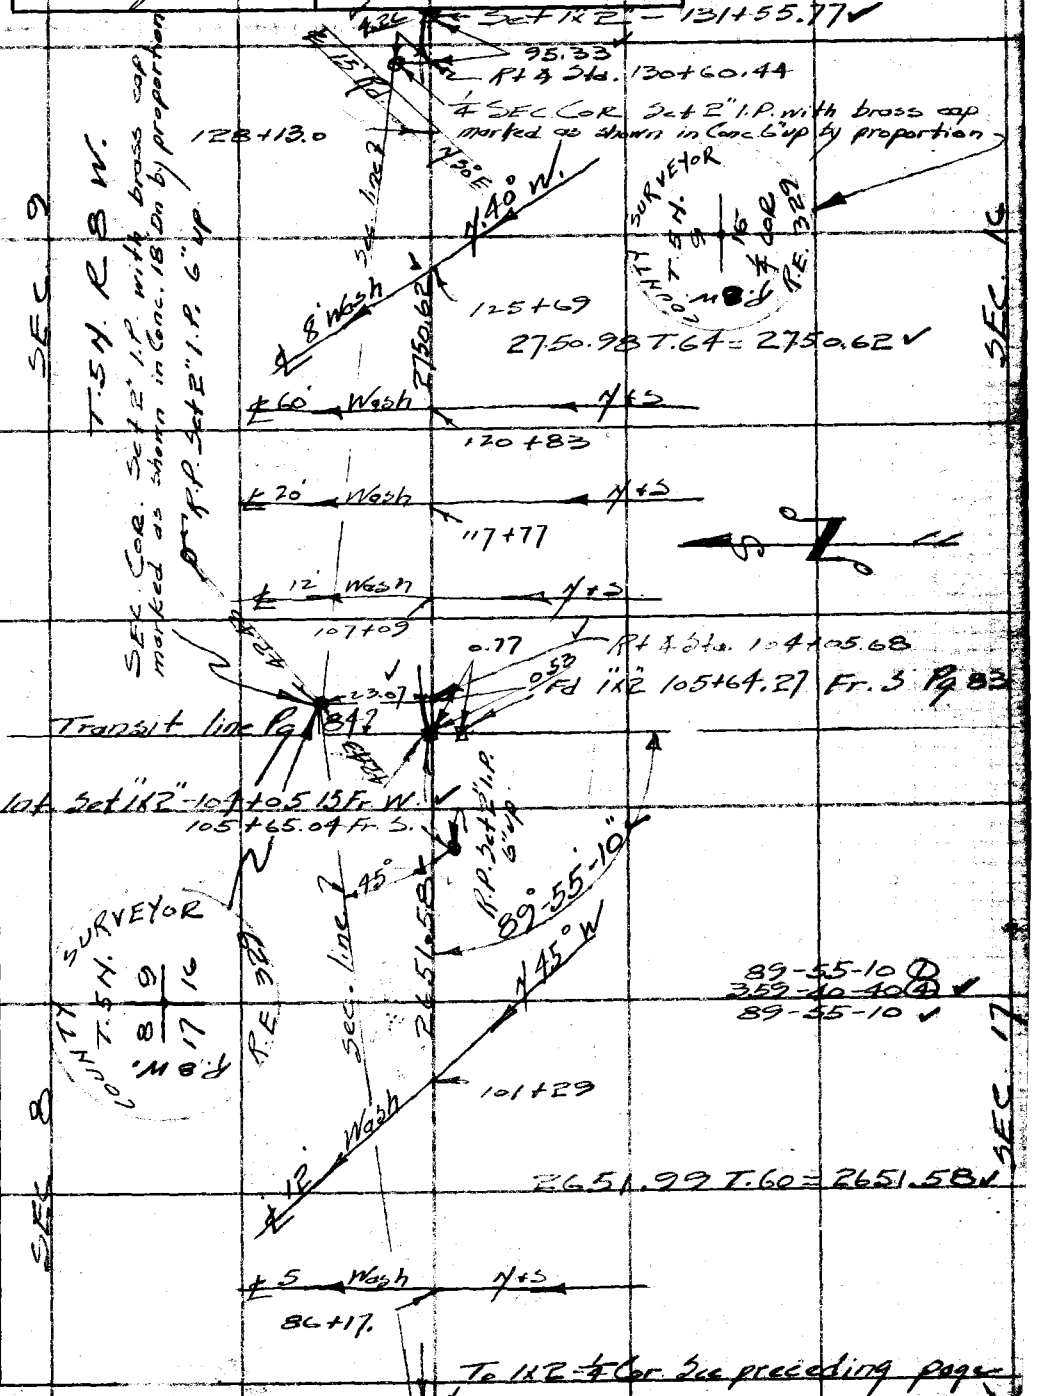

Note: Any Additions or Changes on This Sheet Must be Made or Circled in Red Ink With Date and Name of Person Making Change.

Do not extend notes this side of this line.

RETURN TO
LOS ANGELES COUNTY SURVEYOR
700 HALL OF RECORDS

FORM 247 5M 5-46

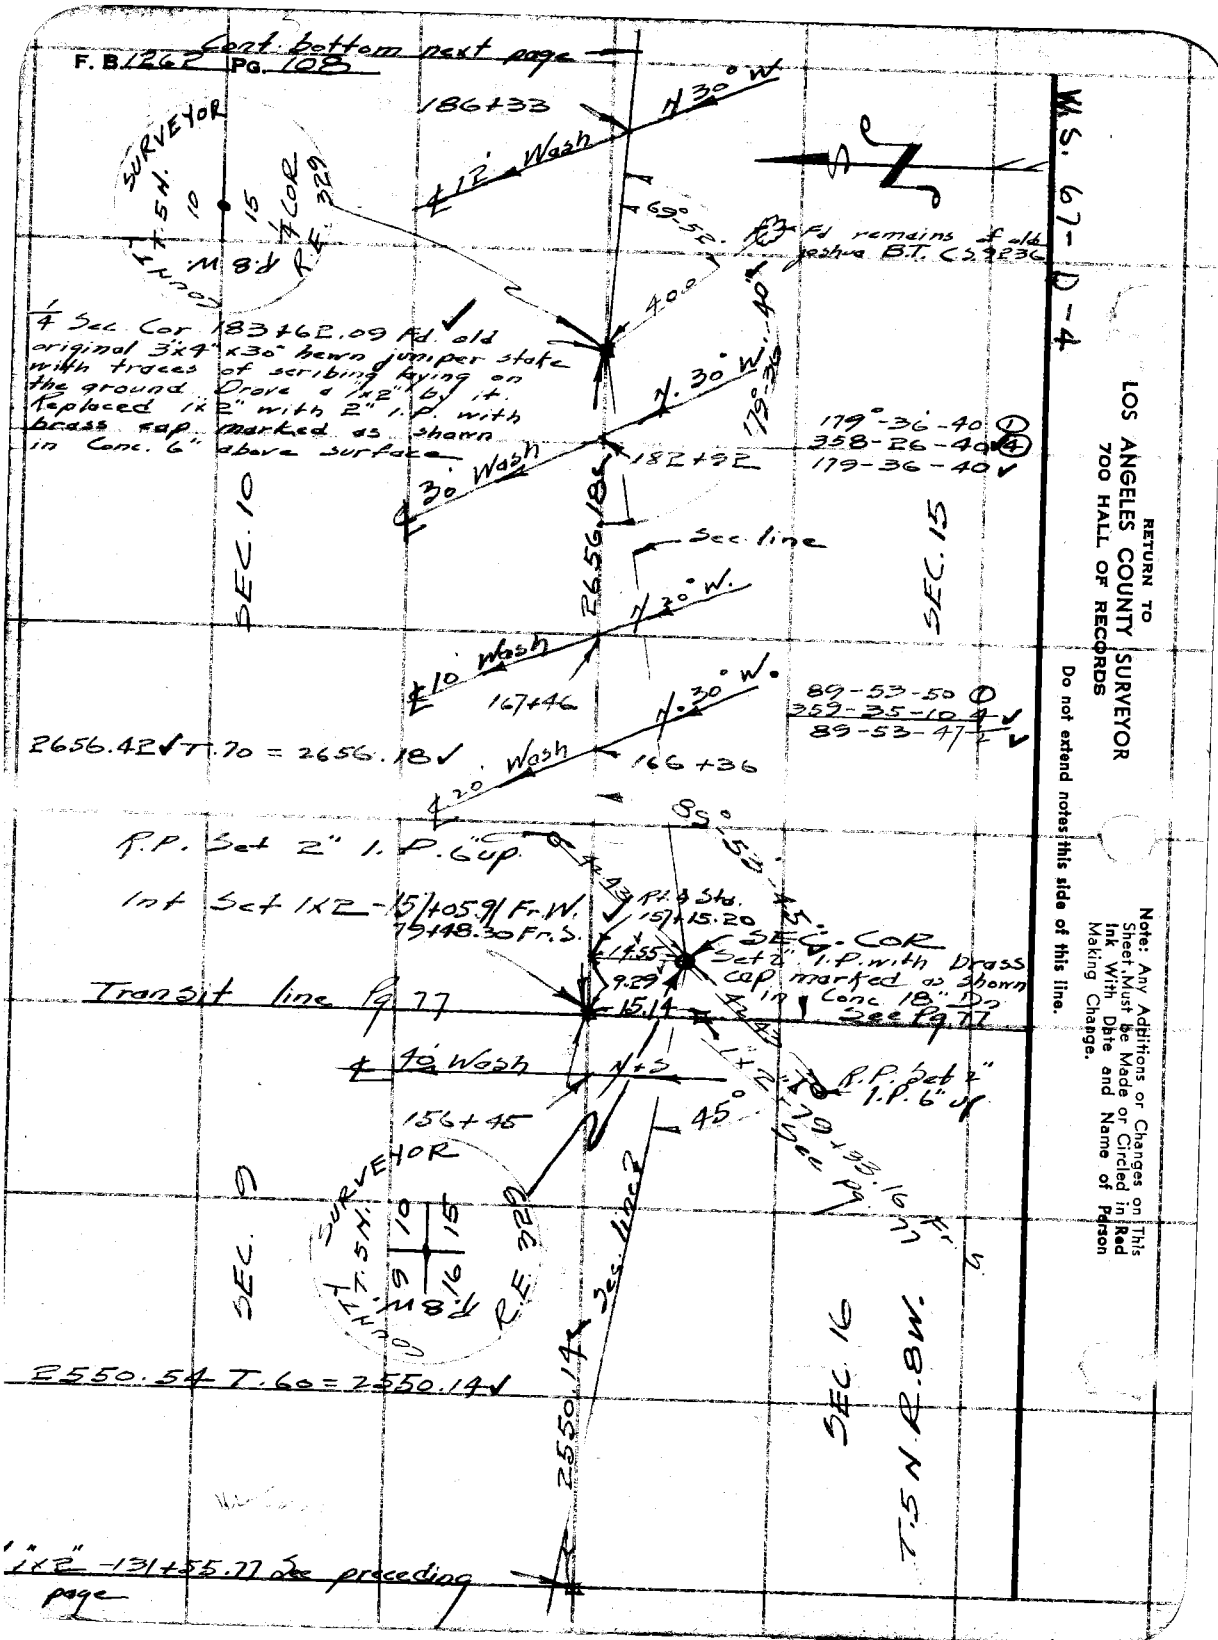

F. B. 1262 PG. 108
Cont. bottom next page
W.S. 67-D-4
RETURN TO
LOS ANGELES COUNTY SURVEYOR
700 HALL OF RECORDS
Do not extend notes this side of this line.
Note: Any Additions or Changes on This Sheet Must be Made or Circled in Red Ink With Date and Name of Person Making Change.
186+33
N 30° W
12' Wash
69°-52'
Fd remains of old Joshua B.T. CS 9236
SURVEYOR
COUNTY T.5N.
R.8W.
10
15
1/4 COR
R.E. 329
40.0
1/4 Sec. Cor 183+62.09 Fd. old original 3"x4"x30" hewn juniper stake with traces of scribing laying on the ground. Drove a 1"x2" by it. Replaced 1"x2" with 2" I.P. with brass cap marked as shown in Conc. 6" above surface
N. 30° W.
179°-36'-40
358-26-40
179-36-40
30' Wash
182+92
2656.18
Sec. line
SEC. 10
SEC. 15
N 30° W.
10' Wash
167+46
89-53-50
359-35-10
89-53-47
2656.42 T.70 = 2656.18
20' Wash
166+36
89°-53'-45"
R.P. Set 2" I.P. 6" up
Int Set 1x2 - 157+05.91 Fr.W.
79+48.30 Fr.S.
Rt. 3 Sta.
157+15.20
SEC. COR
Set 2" I.P. with brass cap marked as shown in Conc. 18" Dn
See Pg. 77
14.55
9.29
15.14
Transit line Pg. 77
40' Wash
N+S
R.P. Set 2" I.P. 6" up
156+45
45°
1"x2" 79+33.16 Fr. S.
See Pg. 77
SURVEYOR
COUNTY T.5N.
R.8W.
R.E. 329
SEC. 9
Sec. line 2
2550.14
SEC. 16
T.5N. R.8W.
2550.54 T.60 = 2550.14
1"x2" - 131+55.77 See preceding page

Notes Ck'd by MILLER	Survey of T.5N.R.8W.
Map No. B-2120-1	W. O. 4999 Tape No. 60 St'd 84 °F
Office Work Drawn	Surveyed by Rosecrans
Checked McPherson	Notes R Date 1-30-48
Date April 1949.	Indexed A. C. Johnson

F. B. 1262 Pg. 109

W.S. 67-D-4

Cont. bottom next page

Set 1"x2" - 233+01.02

SEC. 14

℄ 8' Rd. 231+27

N 25° E.

2276.27 T. 52 = 2275.80 ✓

SEC. 11

2275.80

N 30° W.

℄ 35' Wash 219+80

90-06-40 ①
✓ 360-26-30 ④
✓ 90-06-37½

90°-06-35"

179°-53'-45" Pg 95

line to N. Pg 95 ↗

line to S. Pg. 60 ↗

210+25.22 Fr W.
Cor. Secs. 10, 11, 14 + 15 T.5N
R.9W. Fd. 2x2 Pg. 60

Set a monument

℄ 12' Wash 90°-30'-05" N+S

209+00

2663.13

90-30-00 ①
362-00-20 ④
90-30-05 ✓

℄ 10' Wash N+S

202+23

2663.65 T 54 = 2663.13 ✓

SEC. 10

T. 5 N. R. 8 W.

℄ 6' Wash N+S

195+58

Set 1"x2" - 193+22.26

SEC. 15

960.17

To ¼ Cor. 183+62.09 See preceding page

Note: Any Additions or Changes on This Sheet Must be Made or Circled in Red Ink With Date and Name of Person Making Change.

Do not extend notes this side of this line.

RETURN TO
LOS ANGELES COUNTY SURVEYOR
700 HALL OF RECORDS

FORM 247 5M 5-46

F. B. 1262 PG. 110

Cont. bottom next page

Fd. 2" I.P. 5" up - 269+95.05

41.56 T.52 = 41.55

269+53.50 Set 1x2 Fl.

89-36-20 ①
358-25-20 ④ ✓
89-36-20 ✓

620.26 T.52 = 620.13

Set C.S. Mon Sec Pg. 99

Sec. line to N. Pg 99

Sec. Cor. 2" I.P. Pg. 58
263+33.37 Fr. W

Line to S7 Pg 58

℄ 5 Wash

89°-46'-55" ✓

N. ± S.

261+33

482.36 T.56 = 482.27 ✓

Set 1"x2" - 258+51.10

89-47-00 ①
359-07-50 ④ ✓
89-46-57½ ✓

N 30° W

5' Wash

254+83

250+53

℄ 30' Wash

N. ± S.

2224.86 T.56 = 2224.46 ✓

℄ 30' Wash

N. ± S.

242+67

52.16 ✓

¼ SEC. COR. 236+78.80 Set 2" I.P. with brass cap marked as shown in Conc 6" up by proportion

Set 1"x2" - 236+26.64

325.68 T.56 = 325.62 ✓

1"x2" - 233+01.02 See preceding page

SEC. 12

SEC. 11

SEC. 13

SEC. 14

T. 5 N. R. 8 W.

COUNTY SURVEYOR
T. 5 N.
R. 8 W.
11
14
¼ COR
R.E. 329

W.S. 67-D-4

RETURN TO
LOS ANGELES COUNTY SURVEYOR
700 HALL OF RECORDS

Do not extend notes this side of this line.

Note: Any Additions or Changes on This Sheet Must be Made or Circled in Red Ink With Date and Name of Person Making Change.

Notes Ck'd by MILLER	Survey of T. 5 N. R. 8 W.
Map No. B-2120-1	W. O. 4999 Tape No. 60 St'd 84°F
Office Work Drown	Surveyed by Rosecrans
Checked McPherson	Notes R Date 2-3-48
Date April 1949.	Indexed A. C. Johnson

F. B. 1262 Pg. 111

W.S. 67-E-4

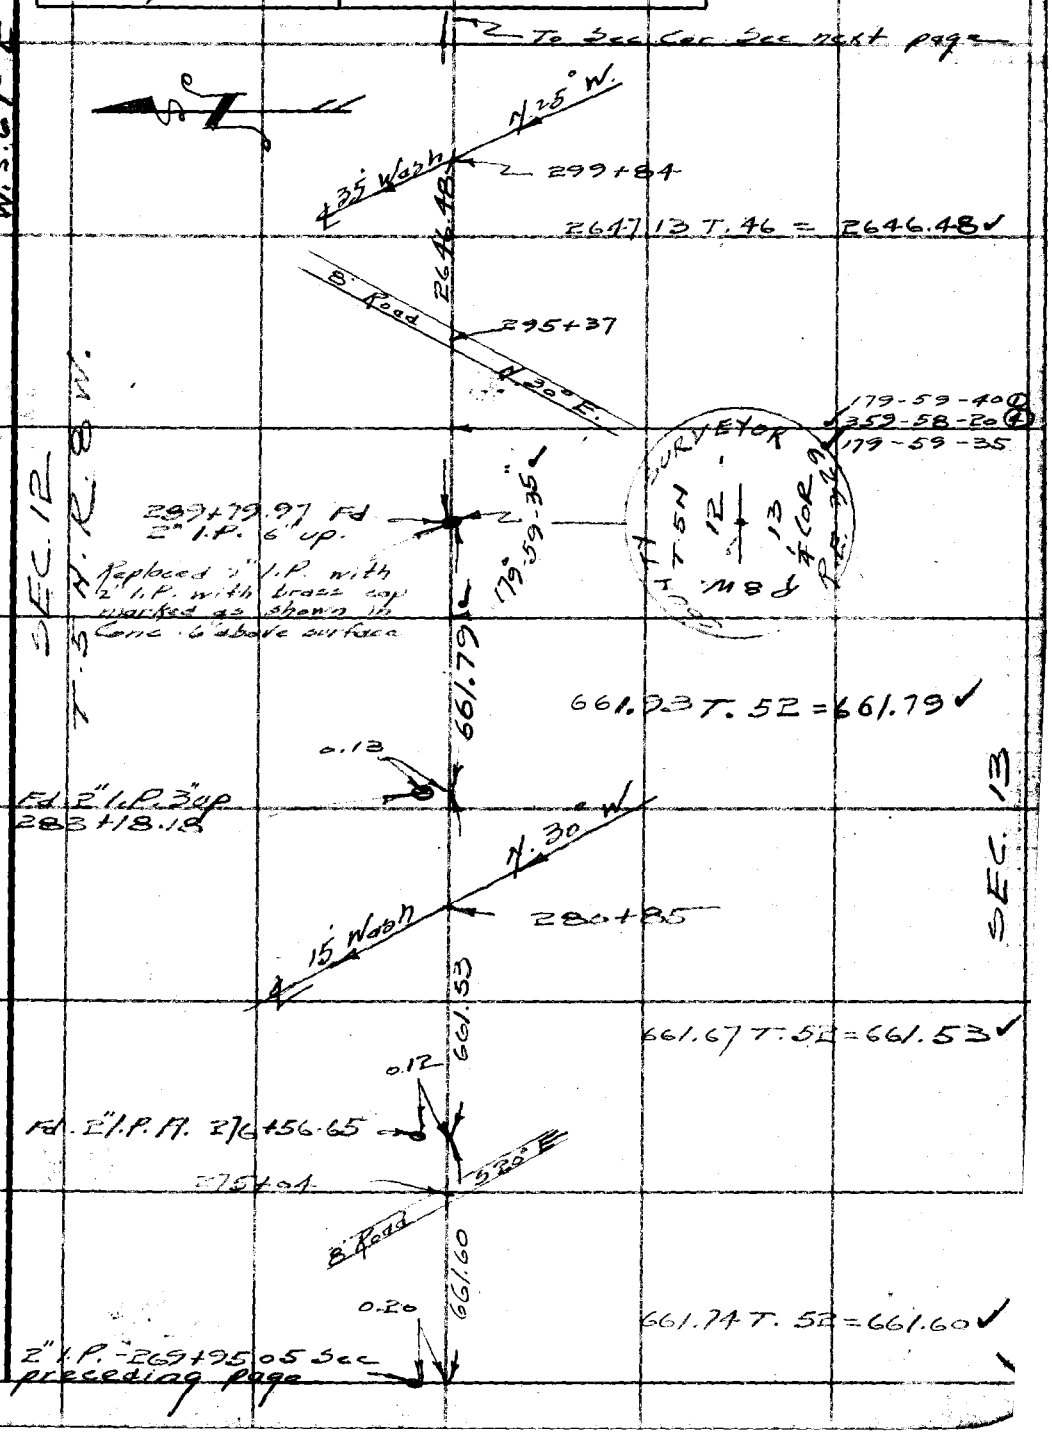

Note: Any Additions or Changes on This Sheet Must be Made or Circled in Red Ink With Date and Name of Person Making Change.

Do not extend notes this side of this line.

RETURN TO
LOS ANGELES COUNTY SURVEYOR
700 HALL OF RECORDS

FORM 247 5M 5-46

F. B. 126 E PG. 112

W.S. 62-E-4

RETURN TO
LOS ANGELES COUNTY SURVEYOR
700 HALL OF RECORDS

Do not extend notes this side of this line.

Note: Any Additions or Changes on This Sheet Must be Made or Circled in Red Ink With Date and Name of Person Making Change.

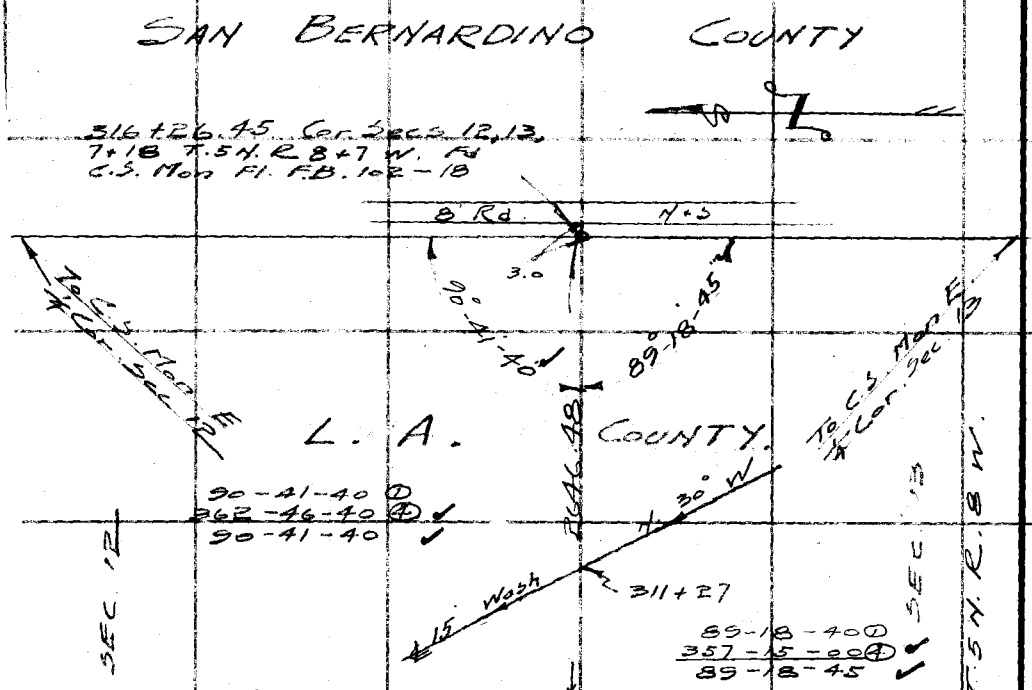

Notes Ck'd by MILLER	Survey of T. 5 N. R. 8 W.
Map No. B-212-1	W. O. 4999 Tape No. 60 St'd 84 °F
Office Work Drawn	Surveyed by Rosecrans
Checked McPherson	Notes R Date 2-3-48
Date April 1949	Indexed A. C. Johnson

F. B. 1262 Pg. 113

W.S. 67-E-4

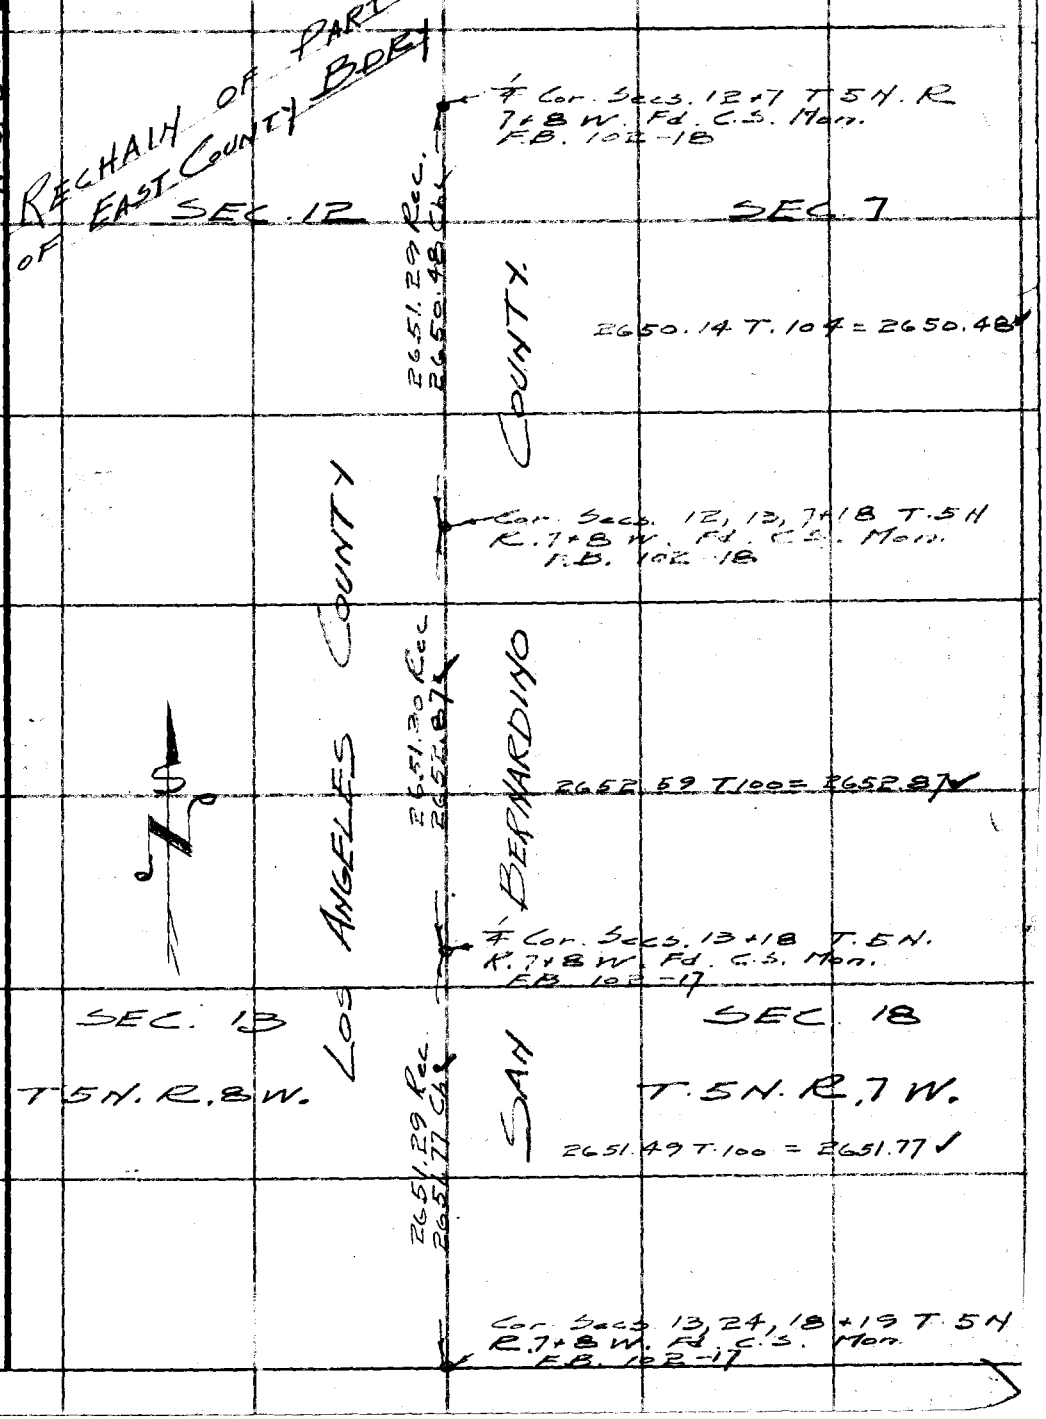

Note: Any Additions or Changes on This Sheet Must be Made or Circled in Red Ink With Date and Name of Person Making Change.

Do not extend notes this side of this line.

RETURN TO
LOS ANGELES COUNTY SURVEYOR
700 HALL OF RECORDS

FORM 247 5M 5-46

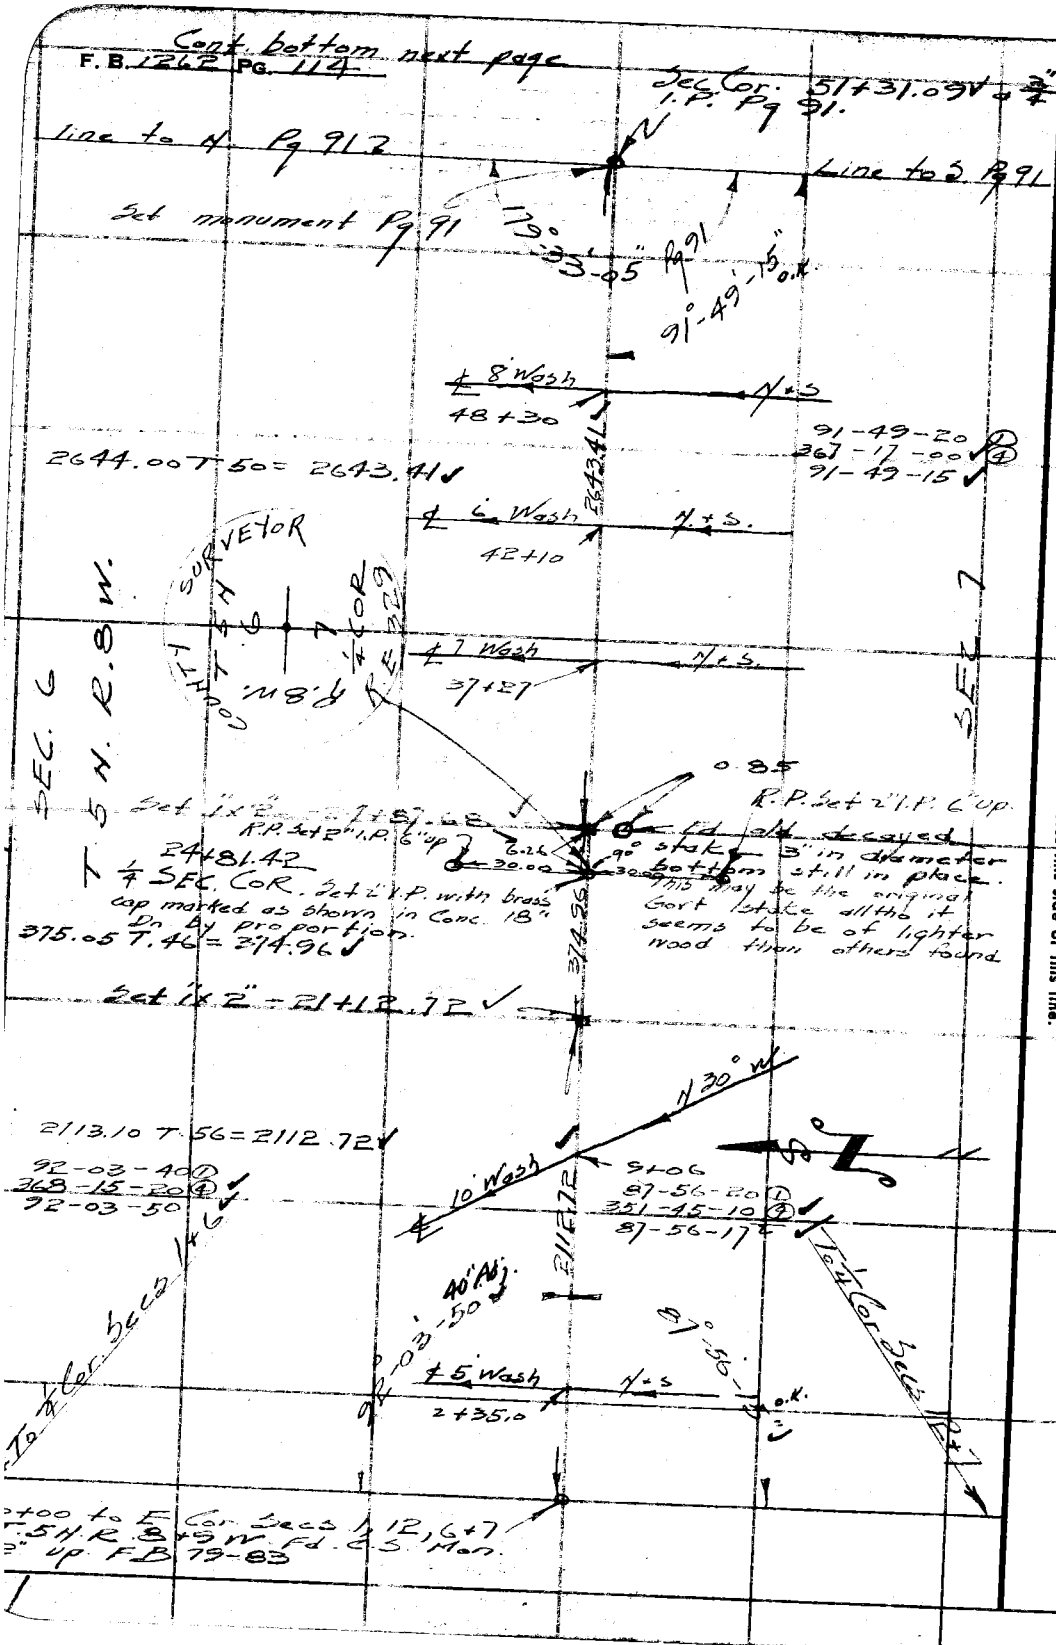

RETURN TO
LOS ANGELES COUNTY SURVEYOR
700 HALL OF RECORDS
Do not extend notes this side of this line.
Note: Any Additions or Changes on This Sheet Must be Made or Circled in Red Ink With Date and Name of Person Making Change.

Notes Ck'd by MILLER	Survey of T. 5 N. R. 8 W.
Map No. B-2120-1	W. O. 4999 Tape No. 60 St'd 84°F
Office Work Drawn	Surveyed by Rosecrans
Checked McPherson	Notes R Date 2-4-48
Date April 1949	Indexed A. C. Johnson

F. B. 1262 Pg. 115

W.S. 62-C-4

line to N. Pg. 86 2

line to S. Pg 84 2

104+34.29 Cor Secs. 4, 5, 8 + 9 T. 5 N. R 8 W & 2 x 2 See Pg 84

Set a monument

179°-46'-25"

89°-34'-35" 40" Adj.

10' Wash

92+40

N. 30° E

89-34-30 (1)
358-18-20 (4)
89-34-35

SURVEYOR

T. 5 N. R. 8 W.

5 8

1/4 COR

2701.17

2701.73 T. 52 = 2701.17

1/4 SEC. COR. 77+82.69 Set 2" I.P. with brass cap marked as shown in Conc. 18" Dn. by proportion.

P.P. Set 2" I.P. 6" up

30.00 30.00

P.P. Set 2" I.P. 6" up.

90°

49.57

Set 1"x2" - 77+33.12

SEC. 5

SEC. 8 T. 5 N. R. 8 W.

584.34

584.46 T. 52 = 584.34

Set 1"x2" - 71+48.78

15' Wash N + S

2018.06 T. 56 = 2017.69

69+03

10' Wash N + S

62+29
58+58

7' Rd N + S

90-21-00 (1)
361-24-10 (4)
90-21-02 1/2

90°-21'-05" 15" Adj.

2017.69

Sec. Cor. 51+31.09 Fr. W
3/4" I.P. See preceding page
Replaced with C.S. Mon.
Line to N

line to S. Pg 91 2

Note: Any Additions or Changes on This Sheet Must be Made or Circled in Red Ink With Date and Name of Person Making Change.

Do not extend notes this side of this line.

RETURN TO
LOS ANGELES COUNTY SURVEYOR
700 HALL OF RECORDS

FORM 247 5M 5-46

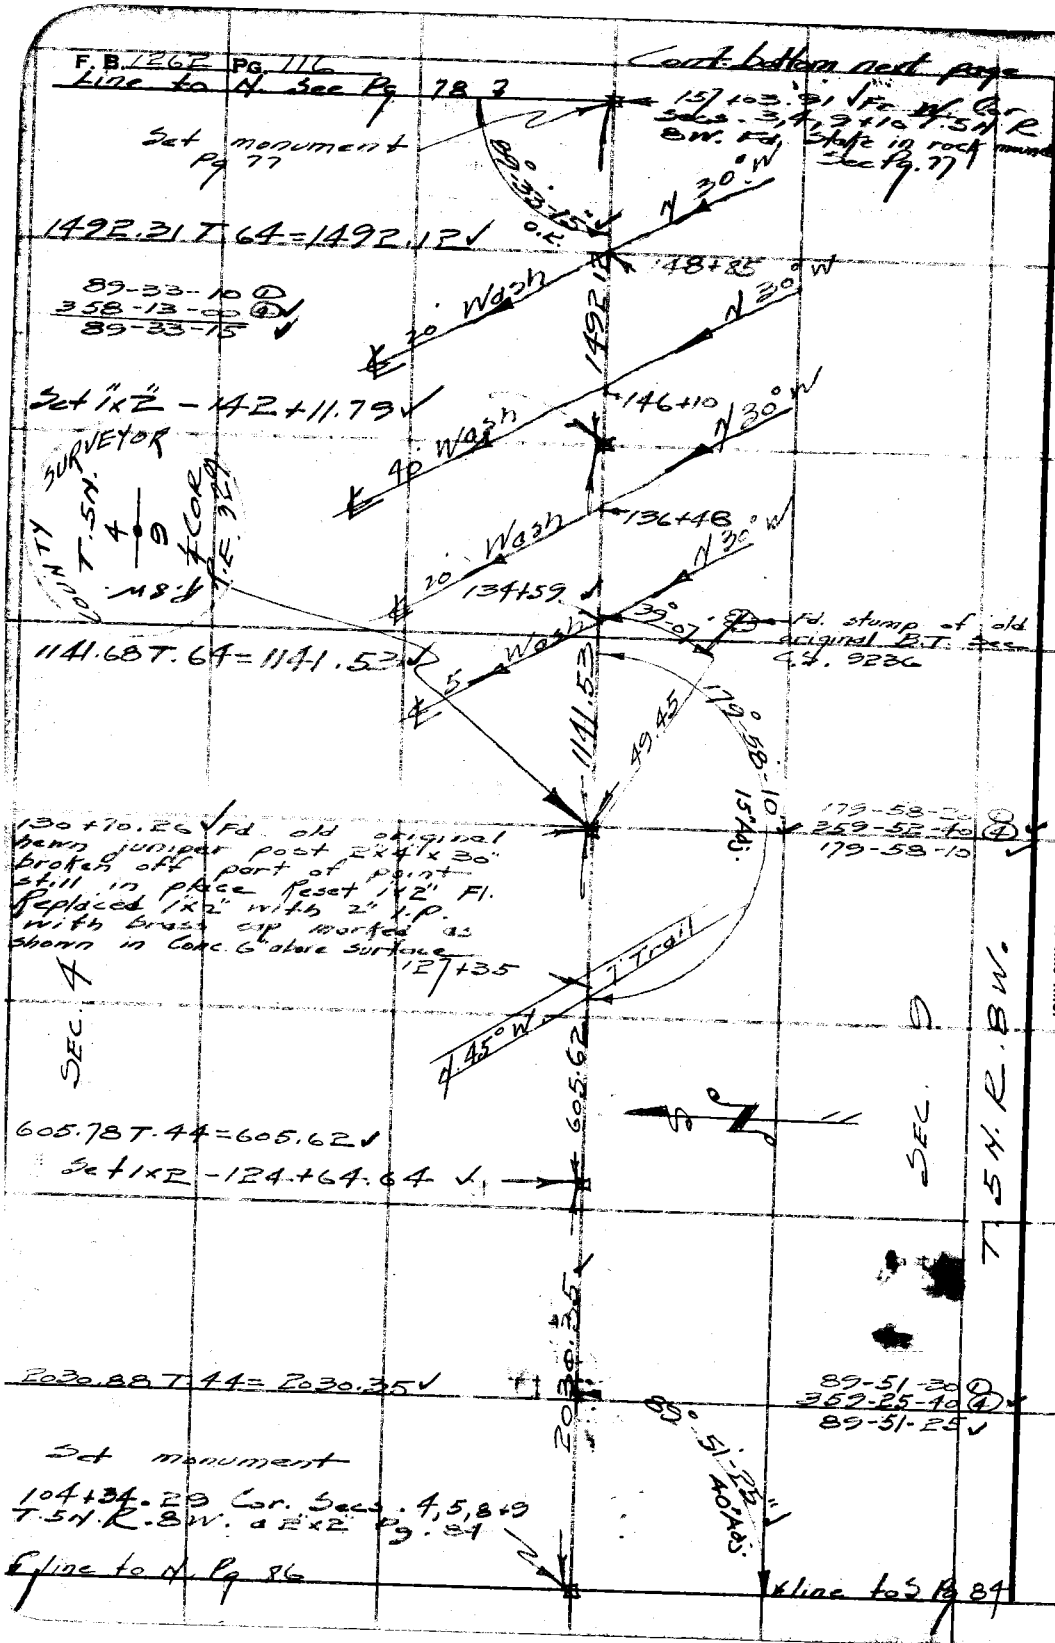

W.S. 67-C-4

RETURN TO
LOS ANGELES COUNTY SURVEYOR
7DO HALL OF RECORDS

Do not extend notes this side of this line.

Note: Any Additions or Changes on This Sheet Must be Made or Circled in Red Ink With Date and Name of Person Making Change.

Notes Ck'd by MILLER	Survey of T.5 N. R. 8 W.
Map No. B-2120-1	W. O. 4999 Tape No 85 St'd 84 °F
Office Work Drown	Surveyed by Rosecrans
Checked McPherson	Notes R. Date 2-13-48
Date April 1949	Indexed A. C. Johnson

F.B. 1262 Pg. 117

W.S. 67-D-4

To 1"x2" Int. See next page

1871.61 ✓
300.47 @ 5-07 = 299.27 ✓
2170.88 ✓
T 56 = 2170.48 ✓

2170.48

Toe of slope 189+83

Set 1"x2" Top N.S. ridge 188+75.24 ✓

Base of hill 187+40

427.06

SEC. LINE 7

126.82 @ 4-56 = 126.35 ✓
300.86 @ 1-23 = 300.77 ✓
427.12 ✓
T. 64 = 427.06 ✓

Set 1"x2" - 184+48.18 ✓

73.34

4.45

Rt. ∠ Sta. 183+74.84

SURVEYOR
COUNTY
T.5 N
R.8 W.
3
10
1/4 COR
R.E. 329

SEC. 10
T.5 N. R.8 W.

SEC. 3

1/4 SEC. COR
Set 2" I.P. with brass cap marked as shown in Conc. 6 above surface by proportion
2732.73 T 64 = 2732.37 ✓

2732.37

N 10° E
9 Road
162+17.

89-54-00 ①
359-35-40 ④
89-53-56 5

89°-53'-50" O.K.

90-12-00 ①
360-47-20 ④ ✓
90-11-50 ✓

O.K.
90°-11'-50" ✓
3.66

1x2 - 132+44.14
Fr. S Pg 77

Line to S. Pg 77 ✓

Int. Set 1"x2" - 157+15.81 Fr. W ✓
132+40.48 Fr. S

11.90

157+03.91 ✓ Stake in rock mound
See Pg. 77 set monument.

line to N Pg 78 ✓

Note: Any Additions or Changes on This Sheet Must be Made or Circled in Red Ink With Date and Name of Person Making Change.

Do not extend notes this side of this line.

RETURN TO
LOS ANGELES COUNTY SURVEYOR
700 HALL OF RECORDS

FORM 247 5M 5-48

F. B. 1262 PG. 78

Cont. bottom next page

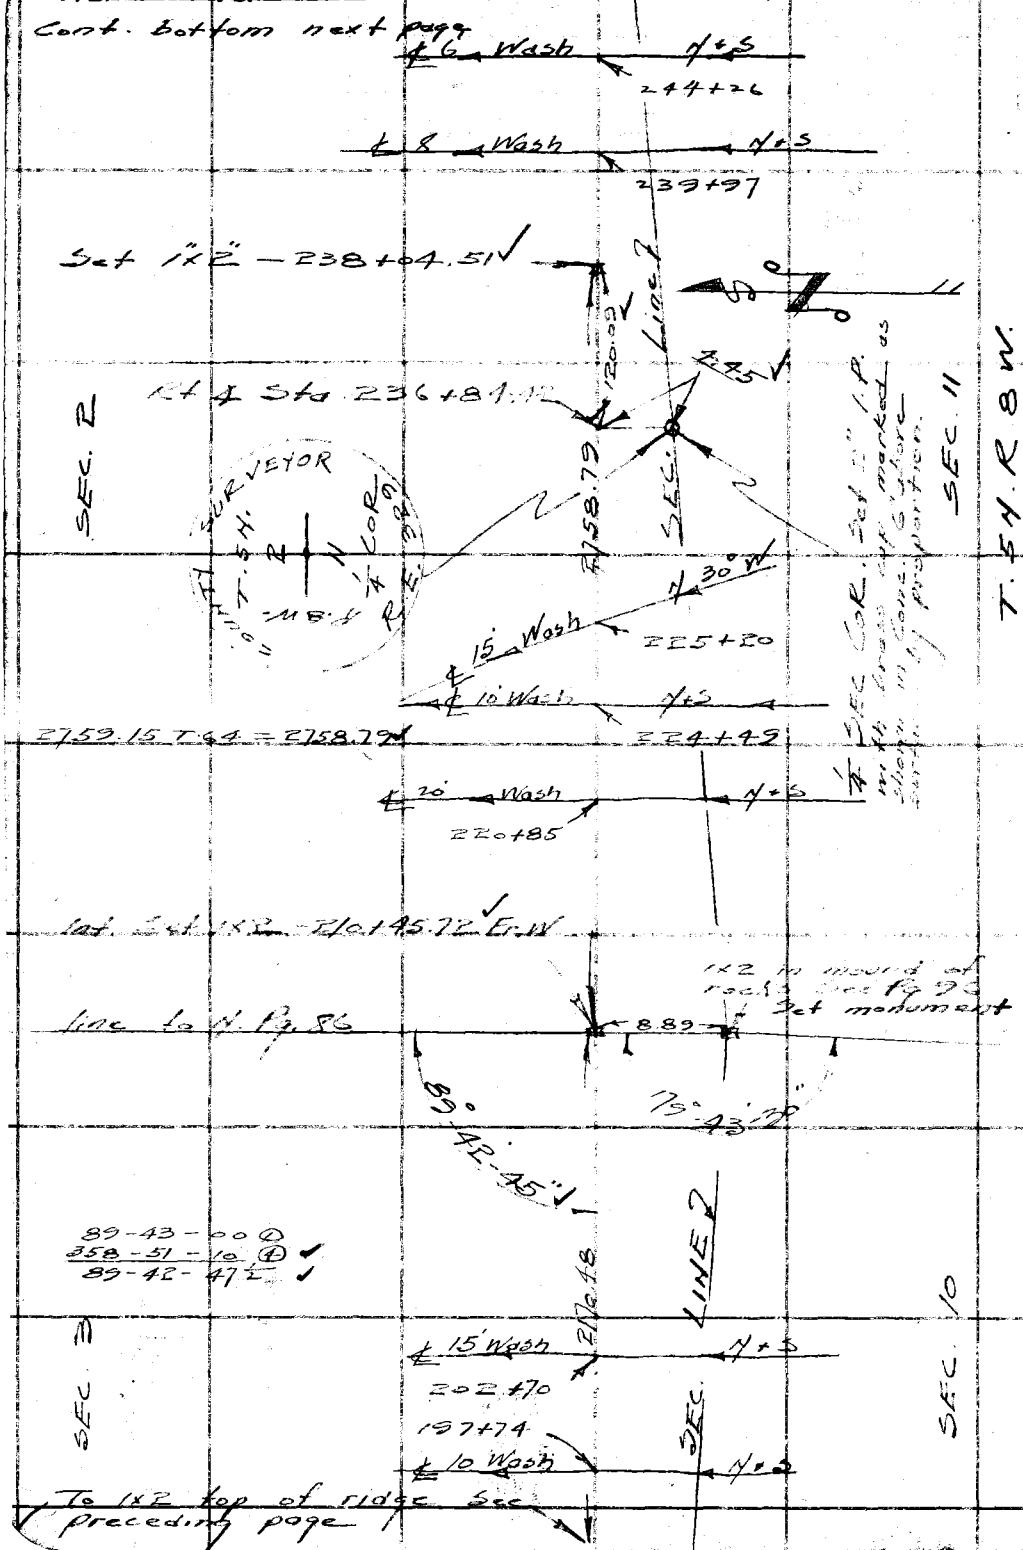

W.S. 67-D-4

RETURN TO
LOS ANGELES COUNTY SURVEYOR
700 HALL OF RECORDS

Do not extend notes this side of this line.

Note: Any Additions or Changes on This Sheet Must be Made or Circled in Red Ink With Date and Name of Person Making Change.

Notes Ck'd by MILLER	Survey of T.5N.R.8W.
Map No. B-2120-1	W. O. 4999 Tape No. 85 St'd 84°F
Office Work Drawn	Surveyed by Rosecrans
Checked McPherson	Notes R Date 2-17-48
Date April 1949.	Indexed A. C. Johnson

F.B. 1262 Pg. 119

W.S. 67-D-4

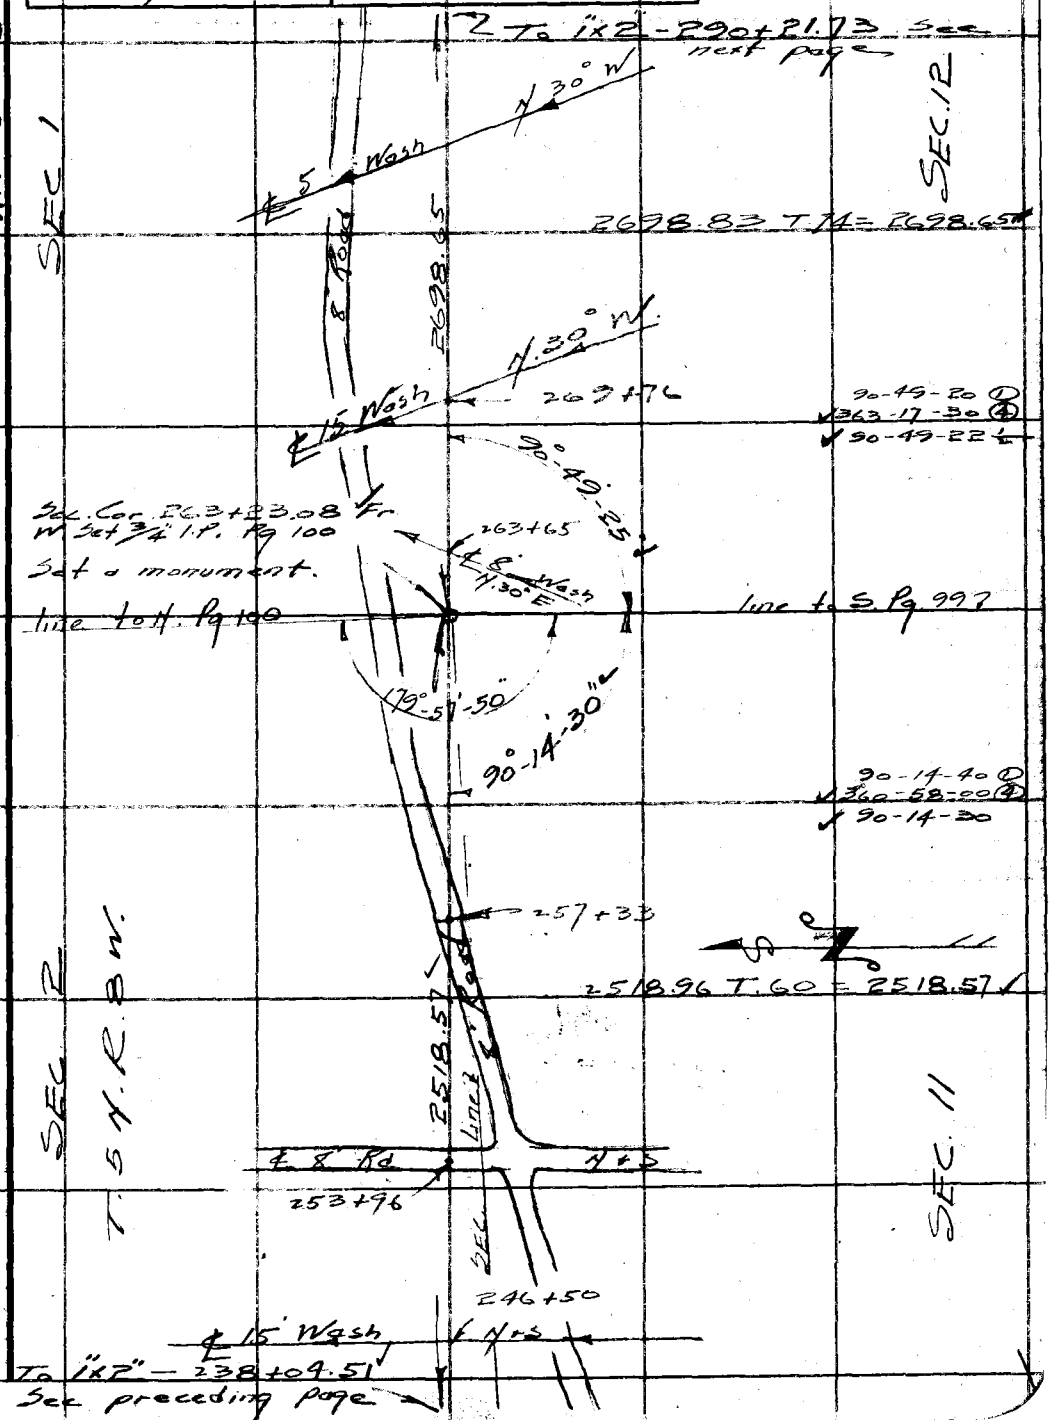

Note: Any Additions or Changes on This Sheet Must be Made or Circled in Red Ink With Date and Name of Person Making Change.

Do not extend notes this side of this line.

RETURN TO
LOS ANGELES COUNTY SURVEYOR
700 HALL OF RECORDS

FORM 247 5M 5-46

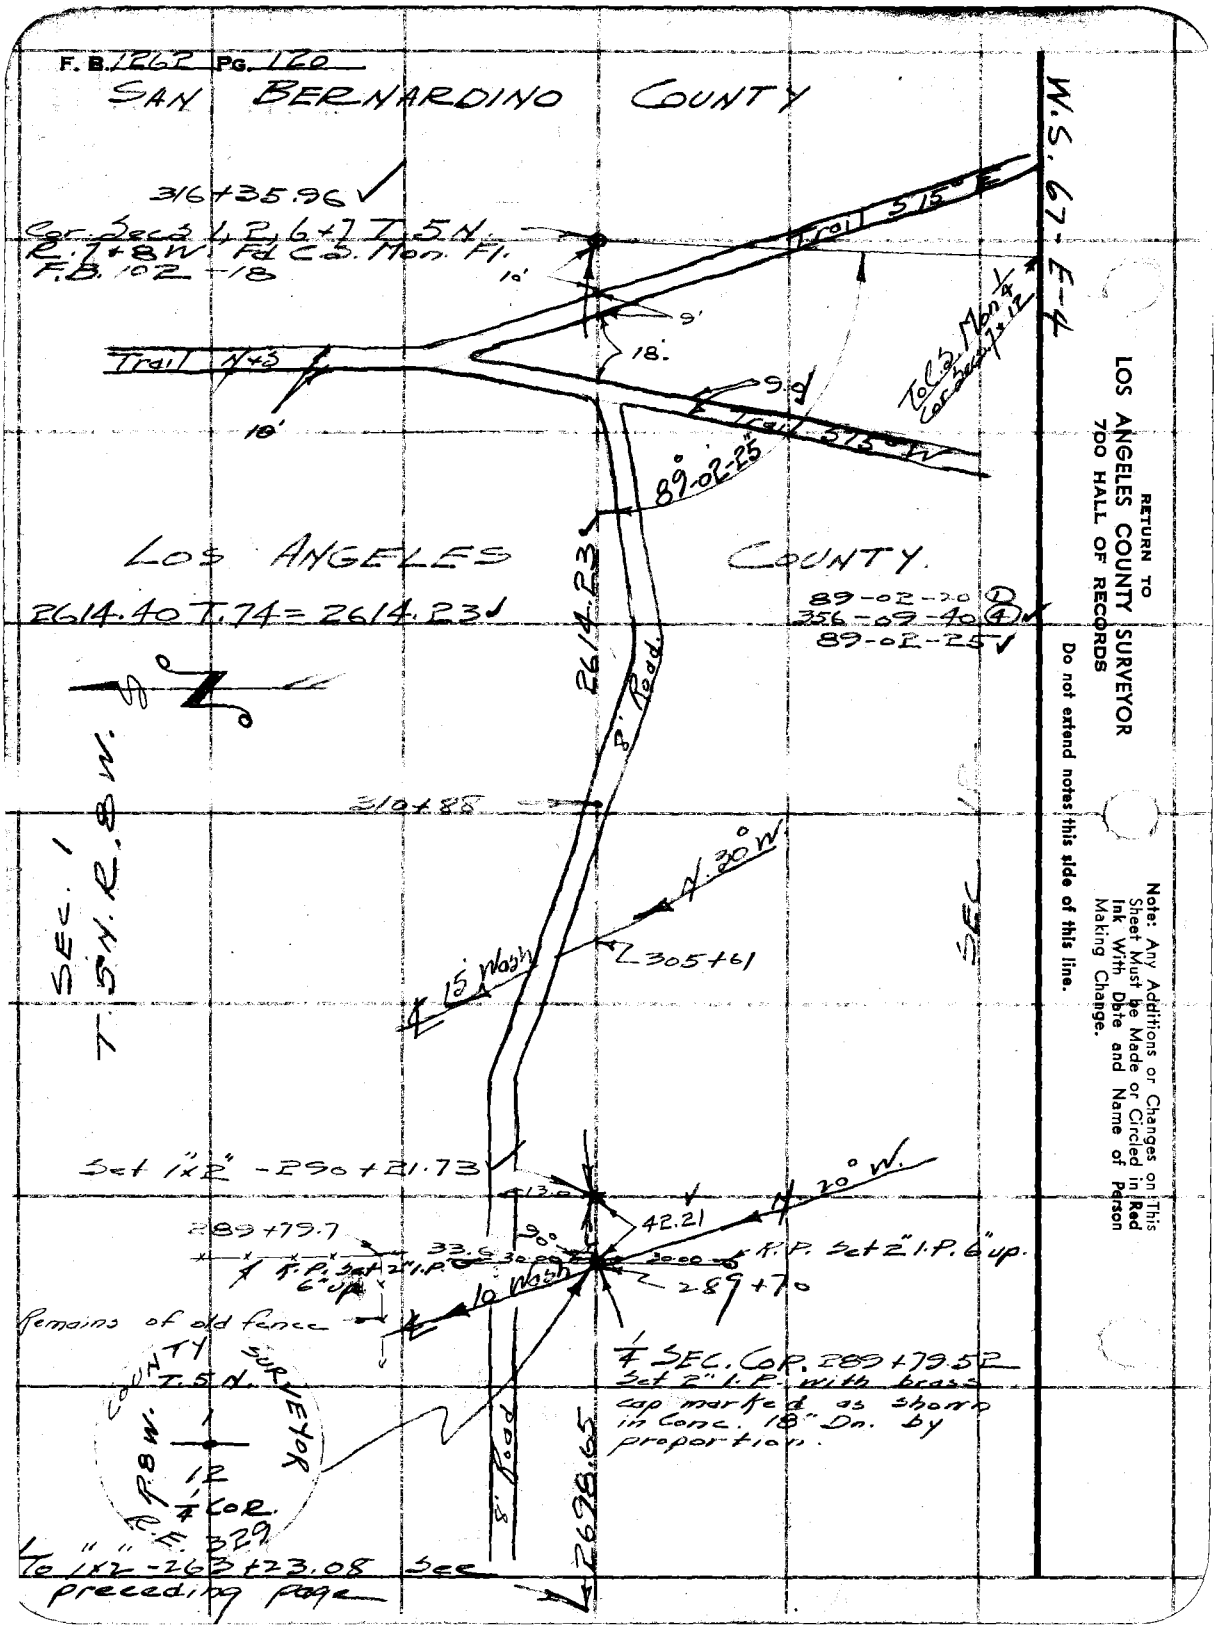
F. B. 1262 PG. 120
SAN BERNARDINO COUNTY
W.S. 67-E-4
316+35.96
Cor. Secs 1, 2, 6+7 T. 5 N. R. 7+8 W. Fd C.S. Mon. Fl. F.B. 102-18
Trail S 15° E
Trail N+S
Trail S 75° W
To C.S. Mon. 1/4 Cor. Secs 7+12
89°-02-25"
LOS ANGELES COUNTY.
2614.40 T. 74 = 2614.23
89-02-20 (1)
356-09-40 (4)
89-02-25
2614.23
8' Road
310+88
N. 30° W.
305+61
15' Wash
SEC. 1 T. 5 N. R. 8 W.
Set 1"x2" -290+21.73
N. 20° W.
42.21
289+79.7
R.P. Set 2" I.P. 6" up.
R.P. Set 2" I.P. 6" up.
289+70
10' Wash
Remains of old fence
1/4 SEC. COR. 289+79.52 Set 2" I.P. with brass cap marked as shown in Conc. 18" Dn. by proportion.
COUNTY SURVEYOR
T. 5 N.
R. 8 W.
1/4 COR.
R.E. 329
8' Road
2698.65
To 1"x2" -263+23.08 See preceding page
RETURN TO
LOS ANGELES COUNTY SURVEYOR
700 HALL OF RECORDS
Do not extend notes this side of this line.
Note: Any Additions or Changes on This Sheet Must be Made or Circled in Red Ink With Date and Name of Person Making Change.

F. B 1262 PG. 121

Notes Ck'd by MILLER	Survey of T.5N. R.8W.
Map No. B-2120-1	W. 04999 Tape No. 85 St'd 84 °F
Office Work Drawn	Surveyed by Rosecrans
Checked McPhaum	Notes R Date 2-17-48
Date Apr. 1949.	Indexed A. C. Johnson

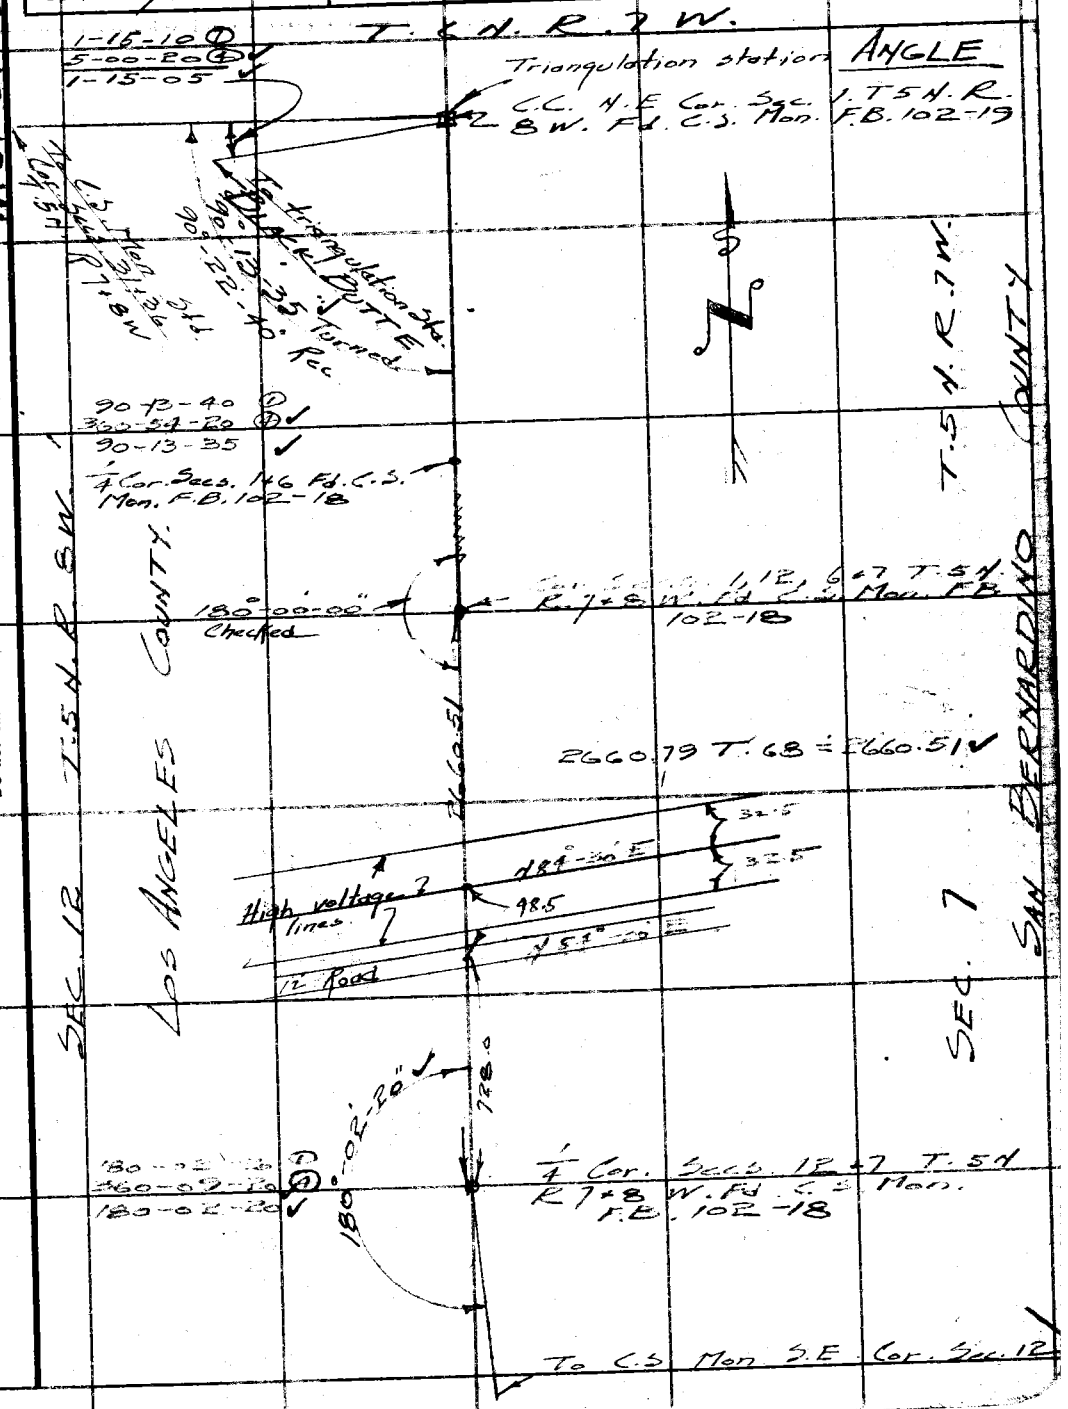

Note: Any Additions or Changes on This Sheet Must be Made or Circled in Red Ink With Date and Name of Person Making Change.

Do not extend notes this side of this line.

RETURN TO
LOS ANGELES COUNTY SURVEYOR
700 HALL OF RECORDS

FORM 247 5M 5-46

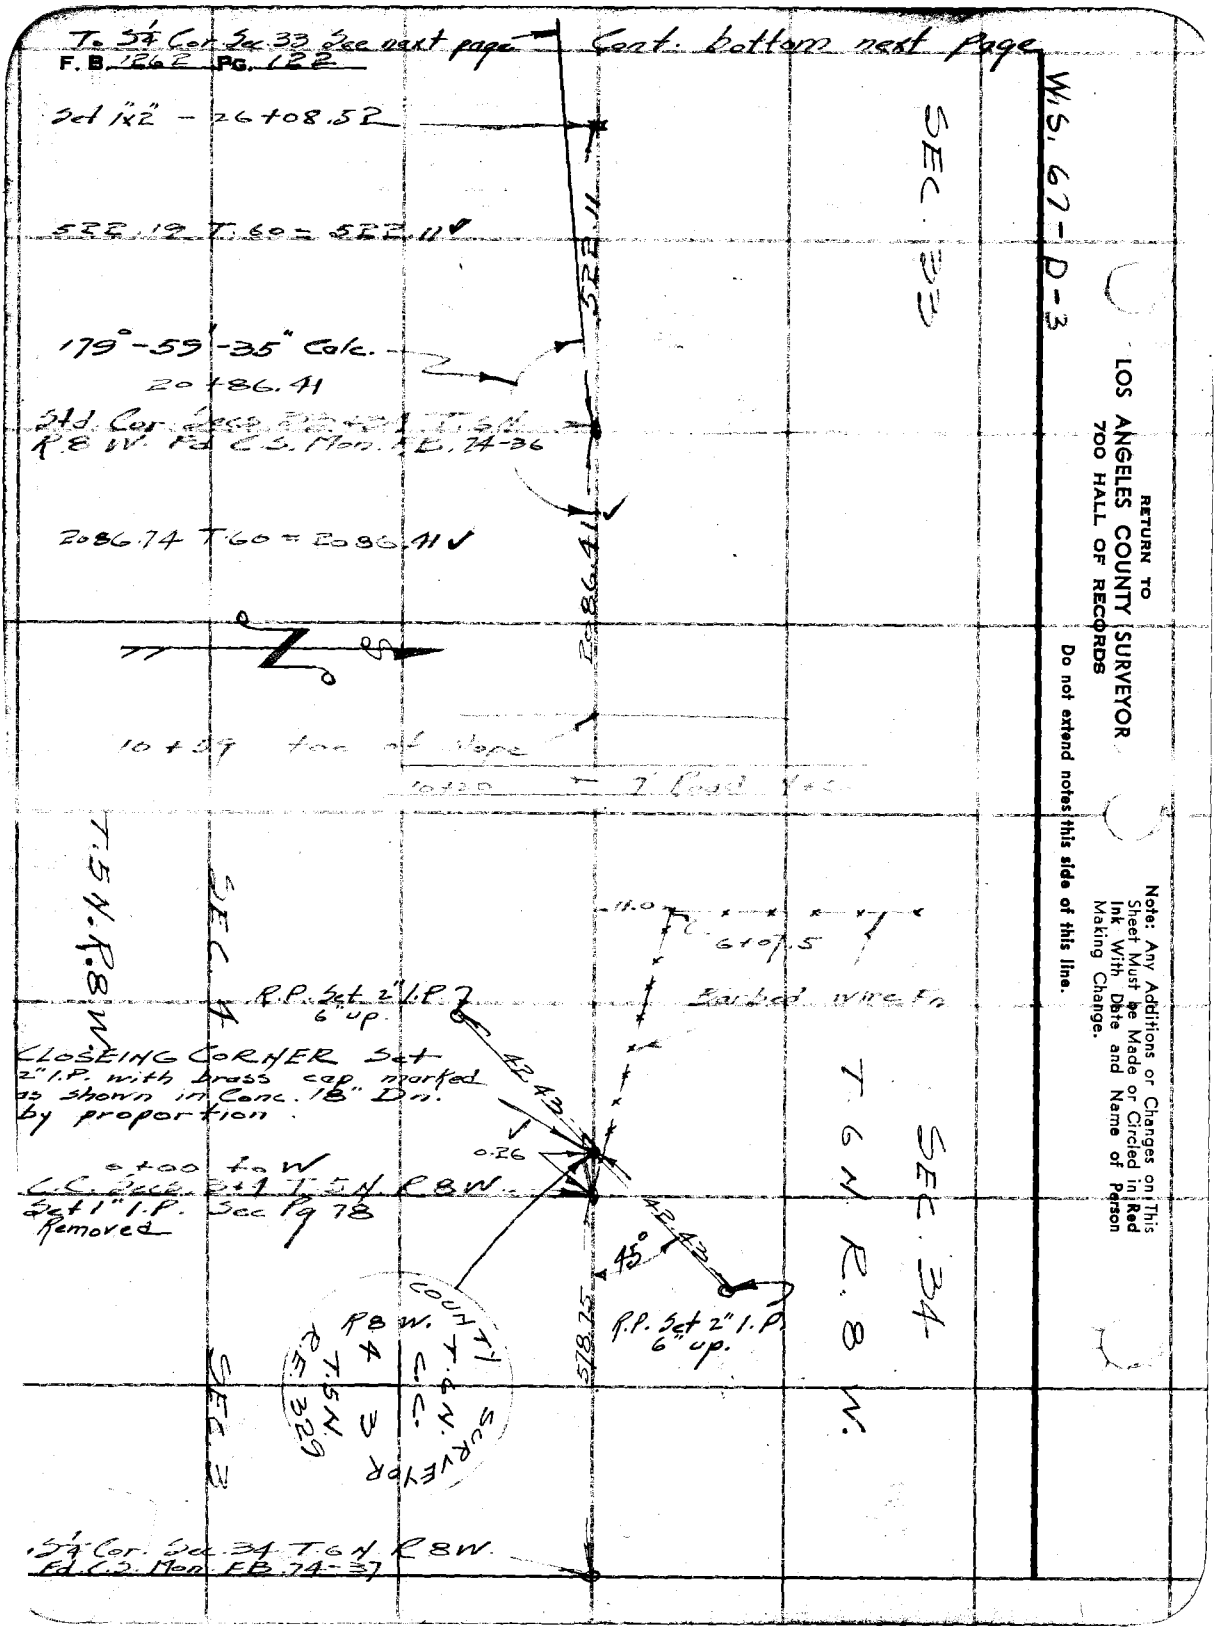

RETURN TO
LOS ANGELES COUNTY SURVEYOR
700 HALL OF RECORDS

Do not extend notes this side of this line.

Note: Any Additions or Changes on This Sheet Must be Made or Circled in Red Ink With Date and Name of Person Making Change.

Notes Ck'd by MILLER	Survey of T.5N.R.8W.
Map No. B-2120-1	W. O. 1999 Tape No. 85 St'd 84 °F
Office Work Drawn	Surveyed by Rosecrans
Checked McPherson	Notes R Date 2-19-48
Date Apr. 1949	Indexed A. C. Johnson

F. B. 1262 Pg. 123

To C.S. Mon. Std. Cor. Secs. 32 + 33 T.6N R.8W.
179°-59'-40" ✓

47+51.15

0.30

W.S. 67-C-3

S¼ Cor Sec. 33 T.6N. R. 8W. Fd. C.S. Mon. F.B. 74-35

179-59-40 ①
359-58-40 ④ ✓
179-59-40 ✓

511.25

260.21 @ 22-24 = 240.58 ✓
298.83 @ 25-02 = 270.76 ✓
511.34 ✓
T.58 = 511.25 ✓

Set 1"x2" -42+39.90

240.53

259.94 @ 22-16 T.64 = 240.53 ✓

Set 1"x2" -39+99.37

SEC. 33

T. 5N. R. 8W.

SEC. 4

566.79

63.85 @ 10-21 = 62.81 ✓
283.07 @ 5-07 = 281.94 ✓
228.93 @ 14-02 = 222.10 ✓
566.85 ✓
T.68 = 566.79 ✓

Set 1"x2" -34+32.58

T. 6N. R. 8W.

695.48

33.12 ✓
99.32 @ 14-32 = 96.14 ✓
270.06 @ 8-53 = 266.82 ✓
300.27 @ 4-11 = 299.47 ✓
695.55 ✓
T.68 = 695.48 ✓

Set 1"x2" -27+37.10

128.58

130.25 @ 9-07 T.60 = 128.58 ✓

1"x2" -26+08.52 See preceding page

To Std. Cor. Secs. 33 + 34

Note: Any Additions or Changes on This Sheet Must be Made or Circled in Red Ink With Date and Name of Person Making Change.

Do not extend notes this side of this line.

RETURN TO
LOS ANGELES COUNTY SURVEYOR
700 HALL OF RECORDS

FORM 247 5M 5-46

F. B. 1262 PG. 124

W.S. 67-E-5

SAN BERNARDINO COUNTY

LOS ANGELES COUNTY

RETURN TO
LOS ANGELES COUNTY SURVEYOR
700 HALL OF RECORDS

Do not extend notes this side of this line.

Note: Any Additions or Changes on This Sheet Must Be Made or Circled in Red Ink With Date and Name of Person Making Change.

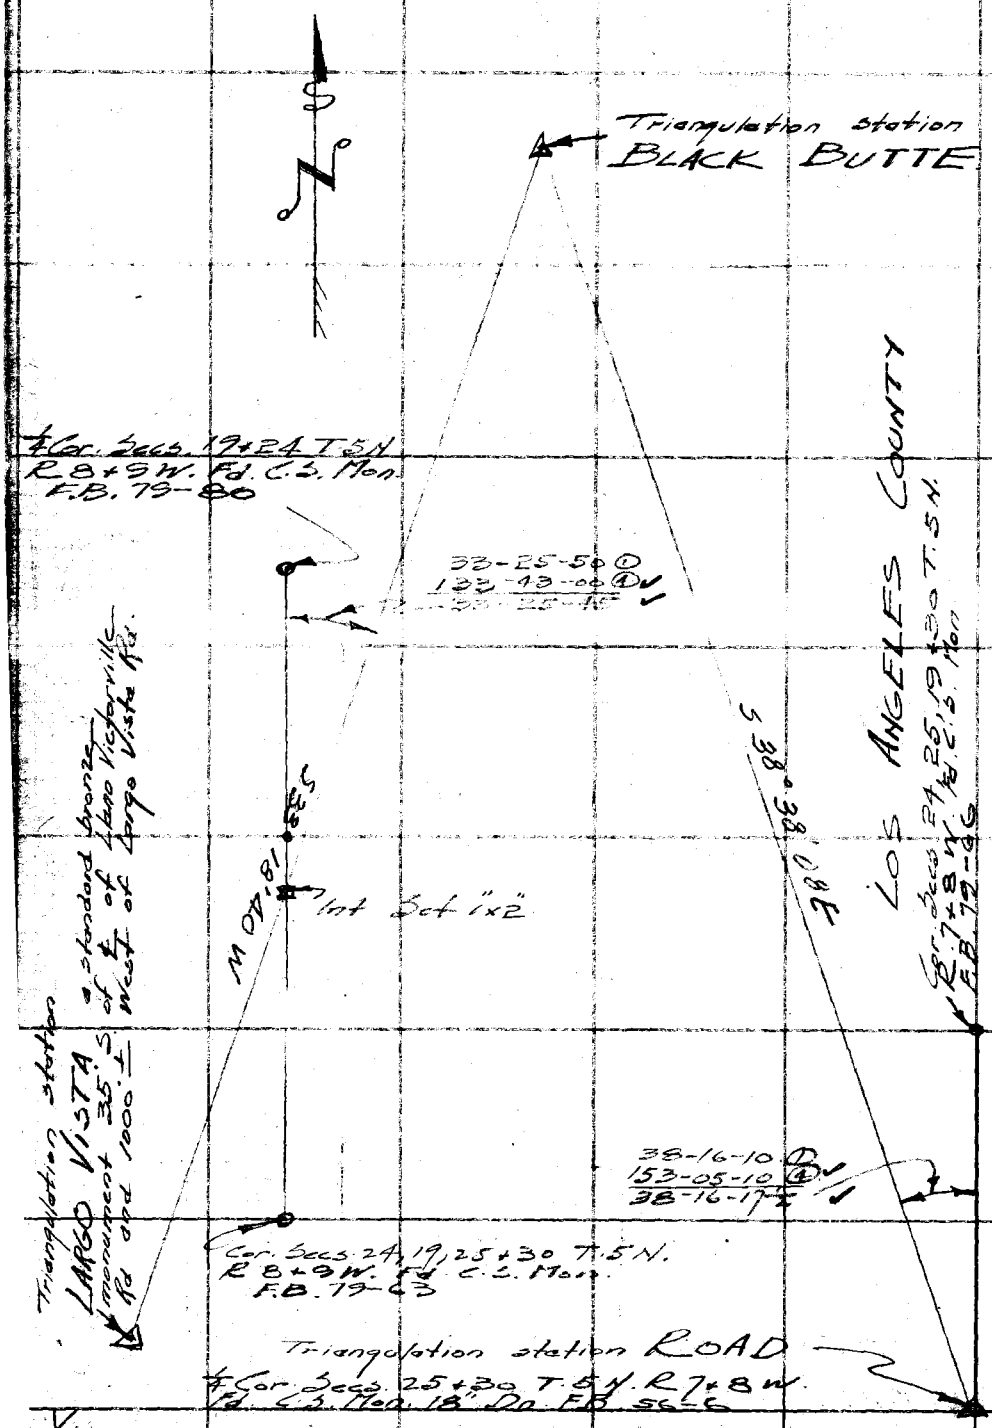

Notes Ck'd by	Survey of T.4N.R.9W.
Map No.	W. O. 4999 Tape No. 85 St'd 84 °F
Office Work	Surveyed by Rosecrans
Checked	Notes R Date 5-14-46
Date	Indexed E. C. Johnson 2-9-49

F.B. 1262 Pg. 125

SECTION LINES IN. T.4N. R.9W.

J. N. 4999 Party E.A. Rosecrans, J.P. Pierce, J.C. Pierce, L. Vejer, H.H. Howard

Index to notes

6 (190)	5 (141) (140) (139)	4 (138)	3	2 (135) (136) (131)	1
7 (144) (141)	8	9	10 (131) (132)	11 (127) (128) (133) (134)	12
18	17 (142) (143)	16	15 (130)	14 (129) (191)	13 (194)
19	20	21	22	23	24
30	29	28	27	26	25
31	32	33	34	35	36

F.B. 1113-14

Note: Any Additions or Changes on This Sheet Must be Made or Circled in Red Ink With Date and Name of Person Making Change.

Do not extend notes this side of this line.

RETURN TO
LOS ANGELES COUNTY SURVEYOR
700 HALL OF RECORDS

FORM 247 5M 5-46

RETURN TO
LOS ANGELES COUNTY SURVEYOR
700 HALL OF RECORDS

Note: Any Additions or Changes on This Sheet Must be Made or Circled in Red Ink With Date and Name of Person Making Change.

Do not extend notes this side of this line.

F. B. 1262 PG. 126

Notes Ck'd by [illegible]	Survey of T.4N.R.9W.
Map No.	W. O. 4999 Tape No. 85 St'd 84°F
Office Work	Surveyed by Rosecrans
Checked	Notes R Date 3-8-48
Date	Indexed A. C. Johnson

F. B. 1262 PG. 127

W.S. 15-0-1

0+00 to S. — Cor. Secs. 2,3,10+11 T.4N.R.9W. Fd. C.S. Mon. F.B.

0.47

Transit line Pg 135 7

Int. 0+00.47 Set 10d Na.

89°51'-15"

89-51-20 ①
359-25-00 ②
89-51-15

237.91

Set 1"x2" - 2+38.38

177.89 @ 9-27 = 175.48
63.14 @ 8-25 = 62.46
237.94
T.64 = 237.91

537.57

300.43 @ 6-58 = 298.21
240.80 @ 6-08 = 239.42
537.63
T. 64 = 537.57

Set 1x2 - 7+75.95

299.82 @ 4-56 = 298.71
95.08 @ 5-02 = 94.71
393.42
T. 68 = 393.38

393.38

SEC. 10

T. 4N. R. 9 W.

Top of ridge N. side 10+80

Set 1"x2" - 11+69.33

137.84 T.68 = 137.83

137.83

SEC. 11

1.90

Set 1x2 - 13+07.16

13+21.50
Fd. mound of stones 3' base 1' high. Top of ridge S. side

65.99 @ 9-25 = 65.10
232.38 @ 17-42 = 221.38
296.73 @ 9-05 = 293.01
86.64 @ -- = 86.64
192.71 @ 6-22 = 191.52
251.85 @ 1-05 = 251.80
191.71 @ 6-45 = 190.38
1299.83
T.68 = 1299.69

1299.69

To 1"x2" - 26+06.85 See top next page

Note: Any Additions or Changes on This Sheet Must be Made or Circled in Red Ink With Date and Name of Person Making Change.

Do not extend notes this side of this line.

RETURN TO
LOS ANGELES COUNTY SURVEYOR
700 HALL OF RECORDS

FORM 247 5M 5-46

F. B. 1262 PG. 128

To 1"x2" -13+07.16 See preceding page

W.S. 15-C-1

25+85.41

Fd. 1x3 redwood stake in mound of rocks 2' base ½' high

Replaced 3/8" iron pin with 2" I.P. with brass cap marked as shown in Conc. 6" above surface

130.05 Calc.

21.44 Calc.

131.81

80°38'20"

41.90

10.32

Set 1"x2" 26+06.85

Fd. 3/8" iron pin in mound of stones 3' base 1' high. See R.S. 59-6

25+96.53

COUNTY SURVEYOR T4N R9W 10 11 ¼ COR R.E. 329

88.44 Calc.

92.48

16°-59'-30"

26+95.29

Fd. 3/4" I.P. in mound of stones 2½' base 1' high.

12' Wash S80° W.

26+94.0

27.03 Calc.

300.31 @ 1-27 = 300.21

46.85 @ 10-06 = 46.12

346.33

T.58 = 346.27

Set 1"x2" top E+W ridge 29+53.12

SEC. 10

30+69 Swale toe of slopes

232.51 @ 2-46 = 232.24

223.61 @ 7-32 = 221.68

453.92

T.58 = 453.84

7' Road E+W

32+74

SEC. 11

T.4N. R.9W.

Set 1"x2" top E+W. spur 34+06.96

299.82 @ 1-35 = 299.71

85.64

142.52

121.80

299.96 @ 3-28 = 299.41

299.71 @ 2-58 = 299.31

247.53 @ 3-27 = 247.08

224.11 @ 2-19 = 223.93

1719.40

T.56 = 1719.09

Toe of slope 34+97

45+60

To 1x2 See top of next page

RETURN TO
LOS ANGELES COUNTY SURVEYOR
700 HALL OF RECORDS

Do not extend notes this side of this line.

Note: Any Additions or Changes on This Sheet Must be Made or Circled in Red Ink With Date and Name of Person Making Change.

Notes Ck'd by KRMcPh	Survey of T.4N. R.9W.
Map No.	W. O. 4999 Tape No. 85 St'd 84 °F
Office Work	Surveyed by Rosecrans
Checked	Notes R Date 3-9-48
Date	Indexed A. C. Johnson

F.B. 1262 Pg. 129

W.S. 15-C-1

To 1x2 - 34+06.96 see bottom of preceding page

SEC. 10

SEC. 11

1719.09

Set 1"x2" - 51+26.05

51+30.8

163.00 @ 2-22 T.36 = 162.83

47.0

162.83

Fd. mound of stones 3' base 1' high?

3.5

13.43

5.46

Sec. Cor. Fd 1x4" hewn pine post 24" high marked R.9W. S.14 on S.E. S.15 on S.W. T.4N. S.11 on N.E., S.10 on N.W. in mound of stones 2' base 1' high. Set a monument See Pg. 132

Set 1x2 - 52+88.88

52+83.42

old fence line (Juniper posts: No wires)

262.90 @ 2-15 = 262.70
221.46 @ 3-44 = 220.99
300.64 @ 2-19 = 300.28
80.61
233.08 @ 2-30 = 232.86
170.27 @ 2-20 = 170.13
300.60 @ 4-15 = 299.77
211.85 @ 3-03 = 211.55
163.54 @ 3-25 = 163.25
275.69 @ 1-30 = 275.60
300.35 @ 3-12 = 299.88
126.00 @ 7-50 = 124.82
2642.44
T. 52 = 2641.89

23.70

61+53.4

66+33

SEC. 14

T.4N. R.9W.

SEC. 15

2641.89

30' Wash

N.200 W.

7.60 E.

71+13

℄ 20' Gully

79+28.36

1/4 Cor. Secs. 14+15 T.4N. R.9W. Fd C.S. Mon. F.B. 488-144

19.21

19.36

2.41

Set 1"x2" - 79+30.77

W.C. to Cor. Secs. 14, 15, 22+23 T.4N. R.9W. Fd. C.S. Mon. F.B. 488-143

22.86

Note: Any Additions or Changes on This Sheet Must be Made or Circled in Red Ink With Date and Name of Person Making Change.

Do not extend notes this side of this line.

RETURN TO
LOS ANGELES COUNTY SURVEYOR
700 HALL OF RECORDS

FORM 247 5M 5-46

F. B. 1262 PG. 130

W.S. 15-C-1

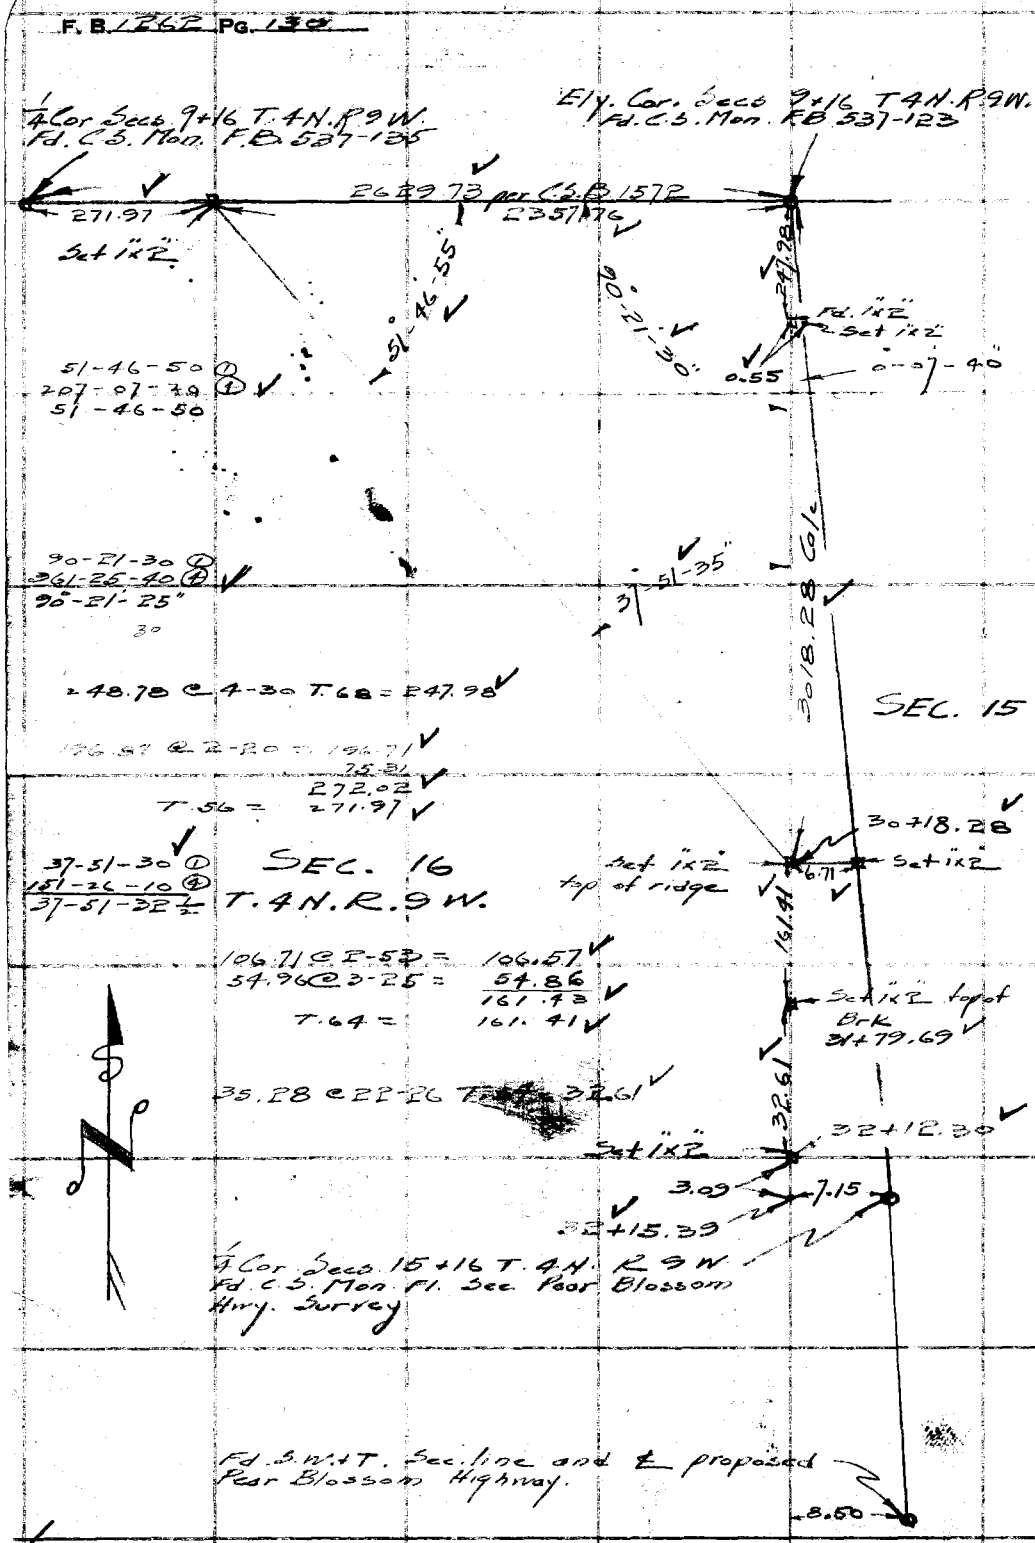

RETURN TO
LOS ANGELES COUNTY SURVEYOR
700 HALL OF RECORDS

Do not extend notes this side of this line.

Note: Any Additions or Changes on This Sheet Must be Made or Circled in Red Ink With Date and Name of Person Making Change.

Notes Ck'd by K.R.M. & P.H.	Survey of T. 4 N. R. 9 W.
Map No.	W. O. 4992 Tape No. 85 St'd 84 °F
Office Work	Surveyed by Rosecrans
Checked	Notes R Date
Date	Indexed A. C. Johnson

F.B. 1262 Pg. 121

Note: Any Additions or Changes on This Sheet Must be Made or Circled in Red Ink With Date and Name of Person Making Change.

Do not extend notes this side of this line.

RETURN TO LOS ANGELES COUNTY SURVEYOR 700 HALL OF RECORDS

Cont. bottom next page

Fd. 1x2 Fl. 26+63.11

Replaced 3/4" I.P. with 2" I.P. with brass cap marked as shown in Conc. 6" up. 26+60.90

2.01

2.20

SEC. 15

Fd. 3/4" I.P. tagged R.E. 4750 by old, original 4x4 hewn sycamore post with traces of scribing in mound of stones 2' high. 26+[illegible]

26+33.7

SURVEYOR 10 15 T. 4 N. R. 9 W. 1962 C.C. R.E. 3289

544.69

Barbed wire Fn.

SEC. 15 T. 4 N. R. 9 W.

288.22 @ 9-21 = 284.25 260.56

T. 50 = [illegible] 4.81 [illegible] 69

16.1 23+18.5

23+11.5 toe of slope

SEC. 10

Set 1x2 top N+S. spur 21+18.42

196.19 @ 9-56 = 193.25

274.65 @ 5-02 = 273.58

206.51 @ 5-18 = 205.63

672.46

T. 50 = 672.31

672.31

Set 1x2 T.R. Bear S 45° E 14+46.11

75.7 @ 6-25 = 75.20

300.51 @ 10-14 = 295.73

286.63 @ 1-30 = 286.53

181.15 @ 3-41 = 180.78

300.17 @ 4-52 = 299.09

74.44 @ 6-32 = 73.96

1211.29

T. 50 = 1211.02

90-18-10 ①

361-12-40 ④

90-18-10

1211.02

SURVEYOR 10 15 T. 4 N. R. 9 W. 1962 C.C. R.E. 3289

Set 1x2 top N+S. ridge 2+35.09

To C.S. Mon. Sec. 15 +10

300.30 @ 15-13 = 289.77

24.36

314.12

T. 48 = 314.04

90-18-10

264.89 @ 27-25 = 236.09

Closing Cor. Set 2" I.P. with brass cap marked as shown in Conc. flush by intersection.

Mon. E. Cor. 9+16

10 C.S. Mon. Sec. 15

Set 1x2 Sec preceding Pg. 0+00 to E Set 1x2"

314.04

Transit line 7

1.02

41.81

Point falls on low E+W spur

247.98

Fd. 1x2

4.81

Fd. hewn 4x4" sycamore post with traces of scribing in mound of stones 4' base 2' high. See Govt. notes.

FORM 247 5M 5-46

F. B. 1262 PG. 132

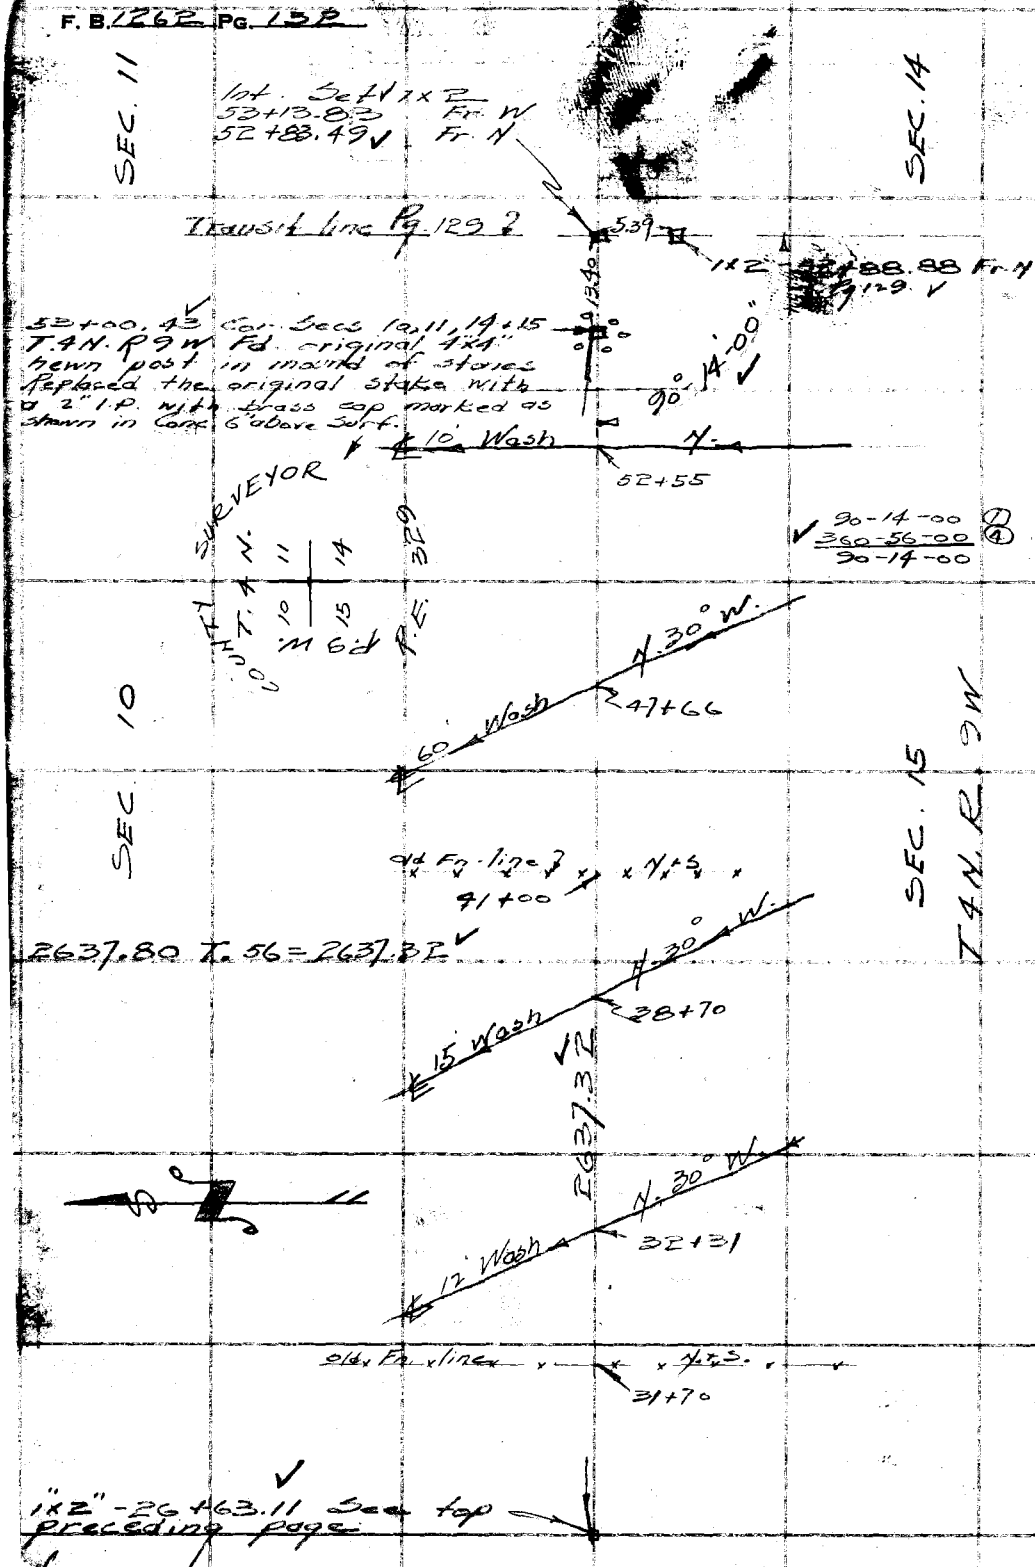

W.S. 15-D-1

RETURN TO
LOS ANGELES COUNTY SURVEYOR
700 HALL OF RECORDS

Do not extend notes this side of this line.

Note: Any Additions or Changes on This Sheet Must be Made or Circled in Red Ink With Date and Name of Person Making Change.

Notes Ck'd by [illegible]
Map No.
Office Work
Checked
Date

Survey of T. 4 N. R. 9 W.
W. O. 4999 Tape No. 85 St'd 84 °F
Surveyed by Rosecrans
Notes R Date 3-16-98
Indexed E. C. Johnson

F. B. 1168 Pg. 133

SURVEYOR T. 4 N. 11 14 R. 9 W. COR. R.E. 329

Cont. bottom next page

Set 1"x2" bottom of angle 79+49.29

0.19 6.44 8.11 273.17 — Replaced 3"x4" hewn juniper post with 2" I.P. with brass cap marked as shown in Conc. 6" above surface 225.00 @ 10-55

230.75
42.48
273.23
T.50 = 273.17

Fd 3" I.P.

1/4 SEC. COR.
79+40.55 Fd hewn 3"x4" juniper post scribed 1/4 S 11 Cont. 4.514 ens standing in mound of stones 1½ base 1½ high.

Set 1"x2" T.P. Bear N 30° W. 76+76.09

65.51 @ 9-50 T.46 = 64.54

2°-02' 64.54 560.67

168.96 @ 6-23 = 167.90
209.91
182.96 @ 0-49 = 182.96
560.77
T.56 = 560.67

Fd. 3" I.P. in mound of stones 2' base 1' high

B.D. N. 15° W. 74+25

72+82.55 Fd 3" I.P. in mound of stones 2' base 1' high. 12.13

71+15.42 Set 1"x2" T.P. Bear N 45° W.

67+66 Toe of slope

SEC. 14

66+29.8 Fd. mound of stones 2½ base 1 high.

66+19.4 Fd. 4" juniper post in mound of stones 2' base 1' high.

2[illegible]13 @ 7-44 = 230.02
2[illegible]1 @ 11-33 = 273.36
2[illegible]30 @ 4-06 = 276.59
3[illegible]76 @ 2-30 = 300.41
300.43 @ 3-16 = 299.74
261.99
159.41
1801.78
T.68 = 1801.59

1801.59

T. 4 N. R. 9 W.

SEC. 11

57+55 7"[illegible] 4+5

Old Fr. line 52+51 4+5

1"x2" - 53+12.83 Fr. W.
52+83.49 Fr. N.
See preceding page

Note: Any Additions or Changes on this Sheet Must be Made or Circled in Red Ink With Date and Name of Person Making Change.

Do not attach notes this side of this line.

RETURN TO
LOS ANGELES COUNTY SURVEYOR
700 HALL OF RECORDS

FORM-247 5M 5-46

F. B 1262 PG. 134

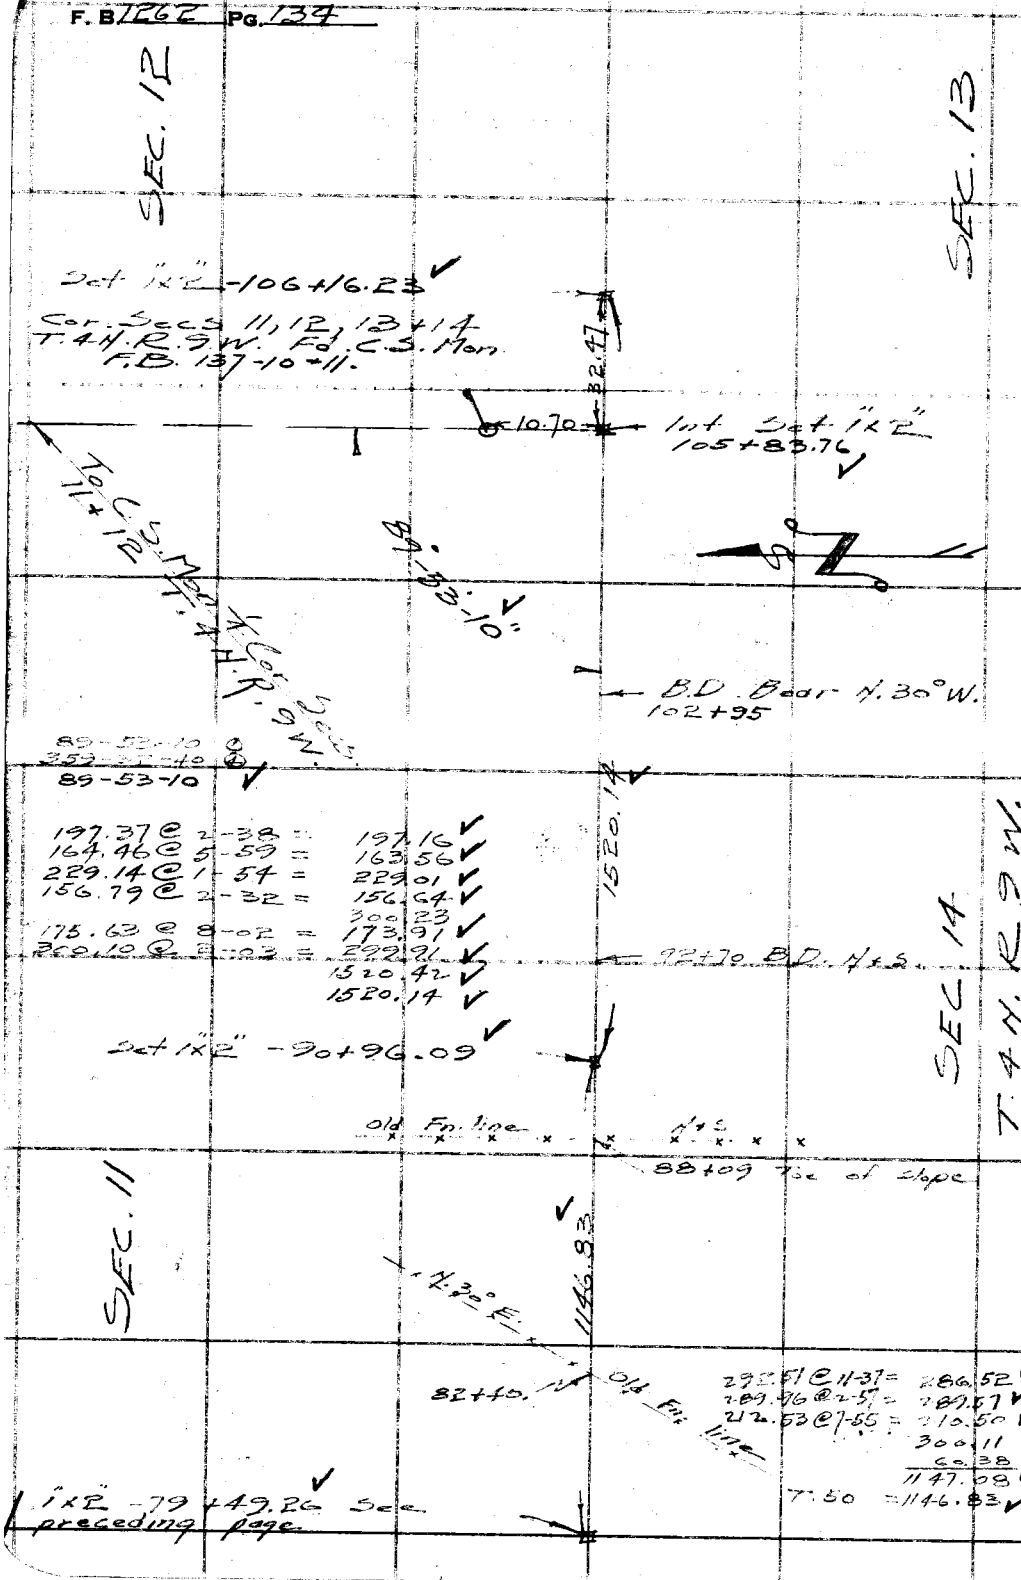

W.S. 15-C-1

RETURN TO
LOS ANGELES COUNTY SURVEYOR
700 HALL OF RECORDS

Do not extend notes this side of this line.

Note: Any Additions or Changes on This Sheet Must be Made or Circled in Red Ink With Date and Name of Person Making Change.

Notes Ck'd by KRMW	Survey of T.4N.R.9W.
Map No.	W. O. 4997 Tape No. 85 St'd 84 °F
Office Work	Surveyed by Rosecrans
Checked	Notes Date 2-26-48
Date	Indexed A. C. Johnson

F. B. 1262 Pg. 138

W.S. 15-d-1

Note: Any Additions or Changes on This Sheet Must be Made or Circled in Red Ink With Date and Name of Person Making Change.

Do not extend notes this side of this line.

RETURN TO
LOS ANGELES COUNTY SURVEYOR
100 HALL OF RECORDS

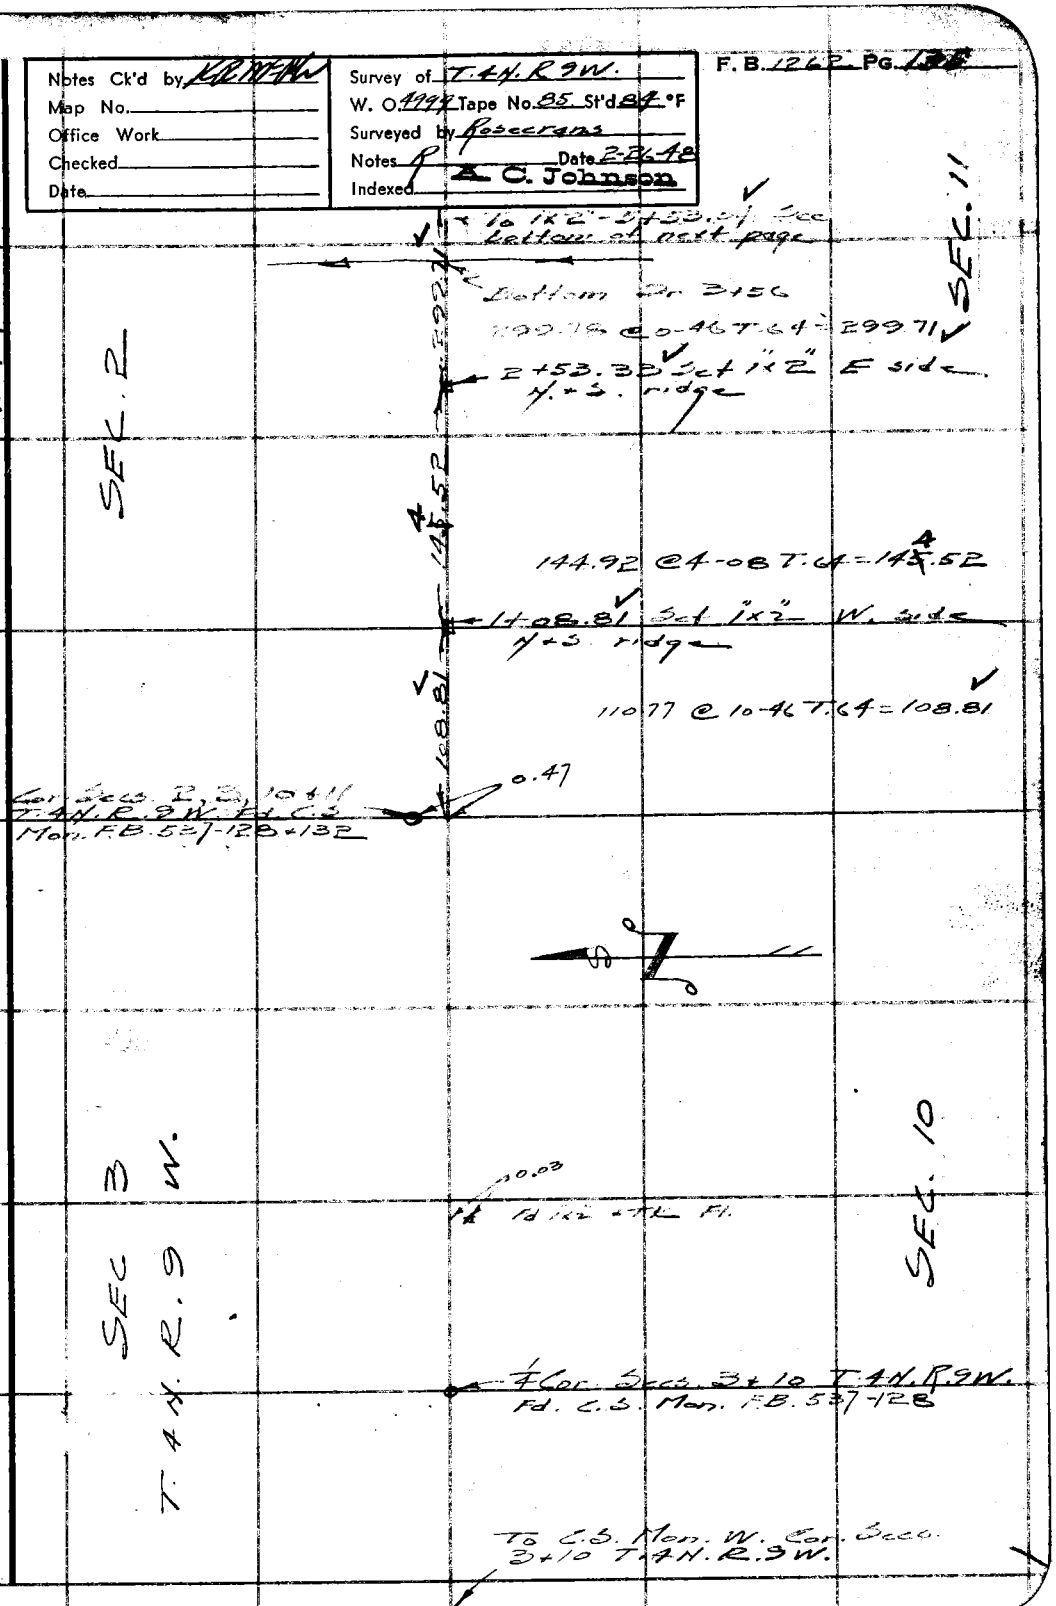

FORM 247 5M 5

F. B 1262 PG. 136

Cont. bottom next page

W.S. 15-C-1

Set 1"x2" - 30+79.14

COUNTY SURVEYOR T.4N. R.9W. 2 11 1/4 COR. R.E. 329

300.44

300.49 T.60 = 300.44

Set 1x2 Brk top W. slope 27+78.70

148.47

148.65 @ 2-35 T.58 = 148.47

Fd. mound of stones 3' base 1½' high.

2.0

2.10

5.66

1/4 SEC. COR

Fd 4"x4"x30" hewn juniper post scribed 1/4 S11 on one side, 1/4 S2 on opposite side laying on south side of rock mound Reset a 1"x2" Point falls on break top of east slope. Replaced 1x2 with 2" I.P with brass cap marked as shown in Conc. 6" up.

Set 1"x2" - 26+30.23

SEC. 11

517.66

102.85 @ 4-25 = 102.54
114.33
300.88
517.75
T.58 = 517.66

Set 1"x2" - 21+12.57

SEC. 2 T.4N. R.9W.

730.39

202.46 @ 1-20 = 202.41
55.14 @ 9-34 = 54.37
299.95
173.77
730.50
T.60 = 730.39

Set 1"x2" - 13+82.18

829.14

271.82 @ 2-17 = 271.61
258.12
299.54
829.27
T.60 = 829.14

Set 1"x2" - 5+53.04

To 1"x2" - 2+53.33 Sec preceding page

229.71

RETURN TO
LOS ANGELES COUNTY SURVEYOR
700 HALL OF RECORDS

Do not extend notes this side of this line.

Note: Any Additions or Changes on This Sheet Must be Made or Circled in Red Ink With Date and Name of Person Making Change.

Notes Ck'd by [illegible]	Survey of T.4N. R.9W.
Map No.	W. O. 4999 Tape No. 85 St'd 84 °F
Office Work	Surveyed by Rosecrans
Checked	Notes R Date 3-19-48
Date	Indexed A. C. Johnson

F. B. 1262 PG. 137

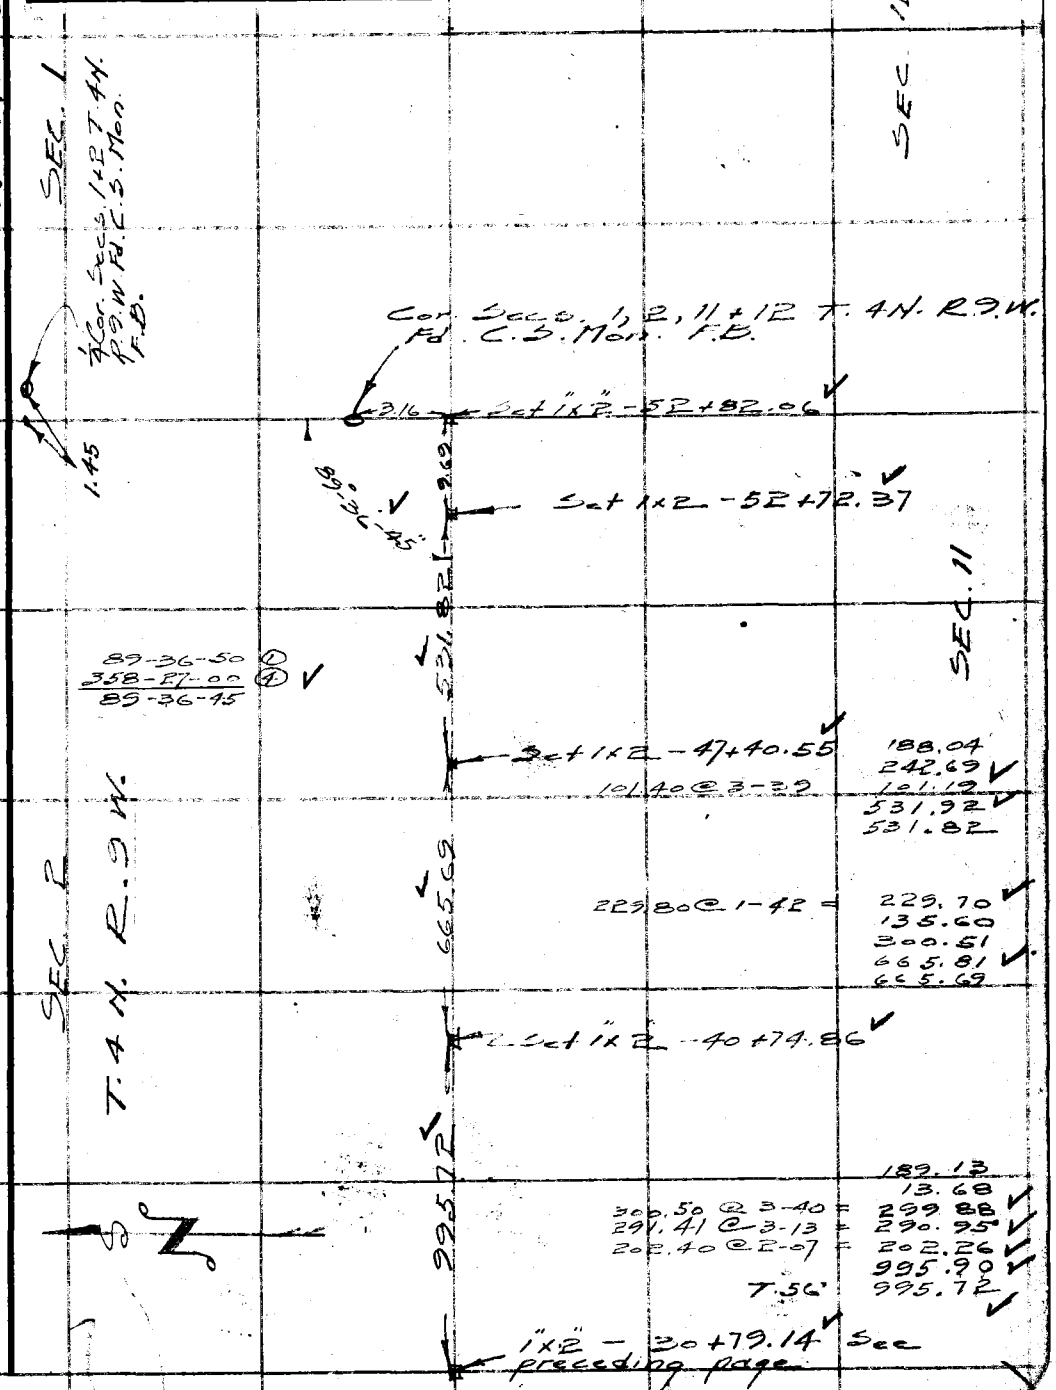

Note: Any Additions or Changes on This Sheet Must be Made or Circled in Red Ink With Date and Name of Person Making Change.

Do not extend notes this side of this line.

RETURN TO
LOS ANGELES COUNTY SURVEYOR
700 HALL OF RECORDS

FORM 247 5M 5-46

F. B. 1262 PG 138

SEC 32

T. 5 N. R. 9 W.

53+05.78

COR. SECS 4, 5, 32 + 33
T. 4+5 N. R 9 W. Fd 2" I.P.
set in Conc. 6" above the
surface F.B. 58-21+24

To C.S. Mon Cor
Secs 32+33 T. 5 N. R
9 W.

SEC. 33

90-15-00 (1)
361-00-20 (4)
90-15-05

89-20-00 (1)
357-20-40 (4)
89-20-10

To C.S. Mon 1/4 Cor
Secs 33+4 T 4+5 N
R 9 W.

W.S. 15-C-1

N+S

7' trail

90°-15-05"

89°-20-10"

2654.24

292.97 @ 4-13 = 292.18
300.27 @ 5-15 = 299.03
300.52 @ 4-54 = 299.42
80.54
300.08 @ 4-54 = 298.98
300.67 @ 4-17 = 299.82
300.86 @ 5-14 = 299.61
279.51 @ 4-45 = 278.55
300.62 @ 5-45 = 299.11
208.22 @ 5-22 = 207.31
2654.55
T66 = 2654.24

1/4 SEC. COR.
26+41.01 set 2" I.P. with
brass cap marked as
shown in Conc. 12" Dn.
by proportion.

Set 1"x2" - 26+51.54

R.P. Set 2" I.P. 6" up.

10.53

30.00

30.00

R.P. Set 2" I.P. 6" up

SEC. 5

90°

COUNTY SURVEYOR
T. 4 N.
R. 9 W.
5 4
R.E. 329

154.80 @ 6-35 = 153.78
293.08 @ 6-10 = 291.38
134.73 @ 5-42 = 134.06
286.05 @ 5-52 = 284.55
300.50 @ 5-50 = 298.94
300.95 @ 5-27 = 299.59
300.53 @ 6-20 = 298.70
300.20 @ 6-55 = 298.01
293.59 @ 11-08 = 288.06
204.27 @ 8-02 = 202.27
2549.34
T 72 = 2549.14

15 Rd

N. 65° E.

18+75

2549.14

SEC. 4

T 4 N. R 9 W.

Set 1"x2" T.P. Bear
N. 60° W. 1+02.40

179-37-20 (1)
358-29-00 (4)
179-37-15

102.40

102.56 @ 3-04 T. 72 = 102.40
0+00 to N.

COR. SECS. 4, 5, 8 + 9
T. 4 N. R. 9 W. Fd. C.S.
Mon. 6" up. F.B.
537-13 + 136

179°-37-15"

To C.S. Mon Cor Secs 8, 9
16+17 T. 4 N. R 9 W.

Note, could not wiggle
to 1/4 Cor.

RETURN TO
LOS ANGELES COUNTY SURVEYOR
700 HALL OF RECORDS

Do not extend notes this side of this line.

Note: Any Additions or Changes on This Sheet Must be Made or Circled in Red Ink With Date and Name of Person Making Change.

Notes Ck'd by KRMcG	Survey of T.4N. R.9W.
Map No.	W. O. 4999 Tape No. 85 St'd 84 °F
Office Work	Surveyed by Rosecrans
Checked	Notes R Date 5-7-48
Date	Indexed A. C. Johnson

F. B. 1262 Pg. 139

Cont on next page

W.S. 15-2-1

Note: Any Additions or Changes on This Sheet Must be Made or Circled in Red Ink With Date and Name of Person Making Change.

Do not extend notes this side of this line.

RETURN TO
LOS ANGELES COUNTY SURVEYOR
700 HALL OF RECORDS

T.4N. R.9W.

SEC. 8.

Set 1x2 Top N+S spur
39+15.57

233.01 @ 6-37 =		295.39
276.26 @ 3-29 =		231.46
300.26 @ 3-00 =		275.75
172.98 @ 6-08 =		299.86
		176.26
		1279.41
	T.74.	1279.33

1279.33

T.4N. R.9W.
Set 1x2
Corner
LOS ANGELES COUNTY

0.37

1/4 SEC. COR. 26+40.32
Fd mound of stones 2' base & high with old original hewn 2"x4"x48" juniper stake laying by it. Traces of Cedar-an juniper stake Drove of 1"x2" in center of mound

Replaced 1x2 with 2" I.P. with brass cap marked as shown in Conc. 6" above Surf.
4.08

Set 1x2 - 26+36.24

38.38

S 30° W

3.62

Fd. 6" juniper tree scribed B.T. on west side

Bottom Draw 10+40

300.70	@ 3-40 =		300.09
160.59	@ 4-24 =		160.12
200.56	@ 3-12 =		200.48
245.86	@ 5-33 =		244.71
213.06	@ 3-26 =		212.68
			300.21
182.80	@ 3-07		182.53
299.37	@ 17-35 =		285.38
83.54	@ 12-05 =		81.69
			2067.44
		T.80 =	2067.44

2067.44

89-48-40
359-15-20
89-48-50

5+68.80 Set 1x2 top ridge Bear. S.E + N.W.

Lot 17 Map 16x17 Bear. 89-48-50

268.48	@ 11-14 =		25.18
281.37	@ 4-55 =		263.34
			280.32
			568.85
		T. 70	568.80

568.80

0+00 to W. Cor. Secs. 4, 5, 8 + 9
T.4N. R.9W. Fd. C.S. Mon.
F.B. 537-132+136

FORM 247 5M 5-46

F. B. 1262 PG. 140

107.60

Cor Secs 5, 6, 31+32 T4N R9W Fd C.S. Mon. F.B. 77-83

Calc 42.70

0-26-30 Dell. +

Cor Secs 5+6 T4N R9W Fd C.S. Mon. F.B. 106-81

R4 Sta. 26+26.62

20°-38-40" ①
41-17-30 ②
20-38-45

Calc 121.11 / 1333

Set 1x2 25+13.29

77.65

Set 1x2 top Brk 24+35.64

SEC 5

299.73

Set 1x2" top E+W. ridge 21+35.91

SEC 6 T.4N. R9W.

SEC. LINE

2135.91

0°-55'-50" Calc.

Cor Secs. 5, 6, 7+8 S2+64.58 Fr E 0+00 to N. Fd. C.S. Mon. 6" up. FB 106-135

180-00-00

1163.22

90-35-45

To C.S. Mon. + Cor. Secs 7+8 T.4N. R.9W.

108.87 @ 8-45 T.84 = 107.60

134.84 @ 26-05 T.84 = 121.11

82.52 @ 19-47 T.84 = 77.65

136.29 @ 5-30 = 135.66
164.82 @ 5-29 = 164.07
299.73

T.84

128.84 @ 10-48 =		27.95
300.02 @ 13-07 =		292.19
162.59 @ 18-08 =		159.91
300.44 @ 5-00 =		299.30
127.15 @ 1-05 =		127.13
205.43 @ 3-18 =		205.09
154.82 @ 3-30 =		154.54
235.76 @ 1-48 =		235.24
251.20 @ 5-44 =		249.94
258.57 @ 3-30 =		258.05
		135.97
T.80 =		135.91

299.29 @ 4-19 = 298.44
153.37 = 153.23
213.43 = 213.31
37.81 = 37.80
300.50 = 298.73
163.28 = 161.73
T.76 = 1163.22

Top N+S

134.51 @ 5-01 T.74 = 185.79

Set 1x2" 41+01.36

Tel. Pole

40+81.4

N22°E

1x2" 39+15.57 Fr E. See preceding page

185.79

90°-36'-40" ①
36°-22'-50" ②
90-35-42½

RETURN TO
LOS ANGELES COUNTY SURVEYOR
700 HALL OF RECORDS

Do not extend notes this side of this line.

Note: Any Additions or Changes on This Sheet Must be Made or Circled in Red Ink With Date and Name of Person Making Change.

W.S. 15-C-1

Notes Ck'd by KRM	Survey of T.4N. R.9W.
Map No.	W. O. 4999 Tape No. 85 St'd 84 °F
Office Work	Surveyed by Rosecrans
Checked	Notes R Date 5-14-48
Date	Indexed A. C. Johnson

F. B. 1262 Pg. 141

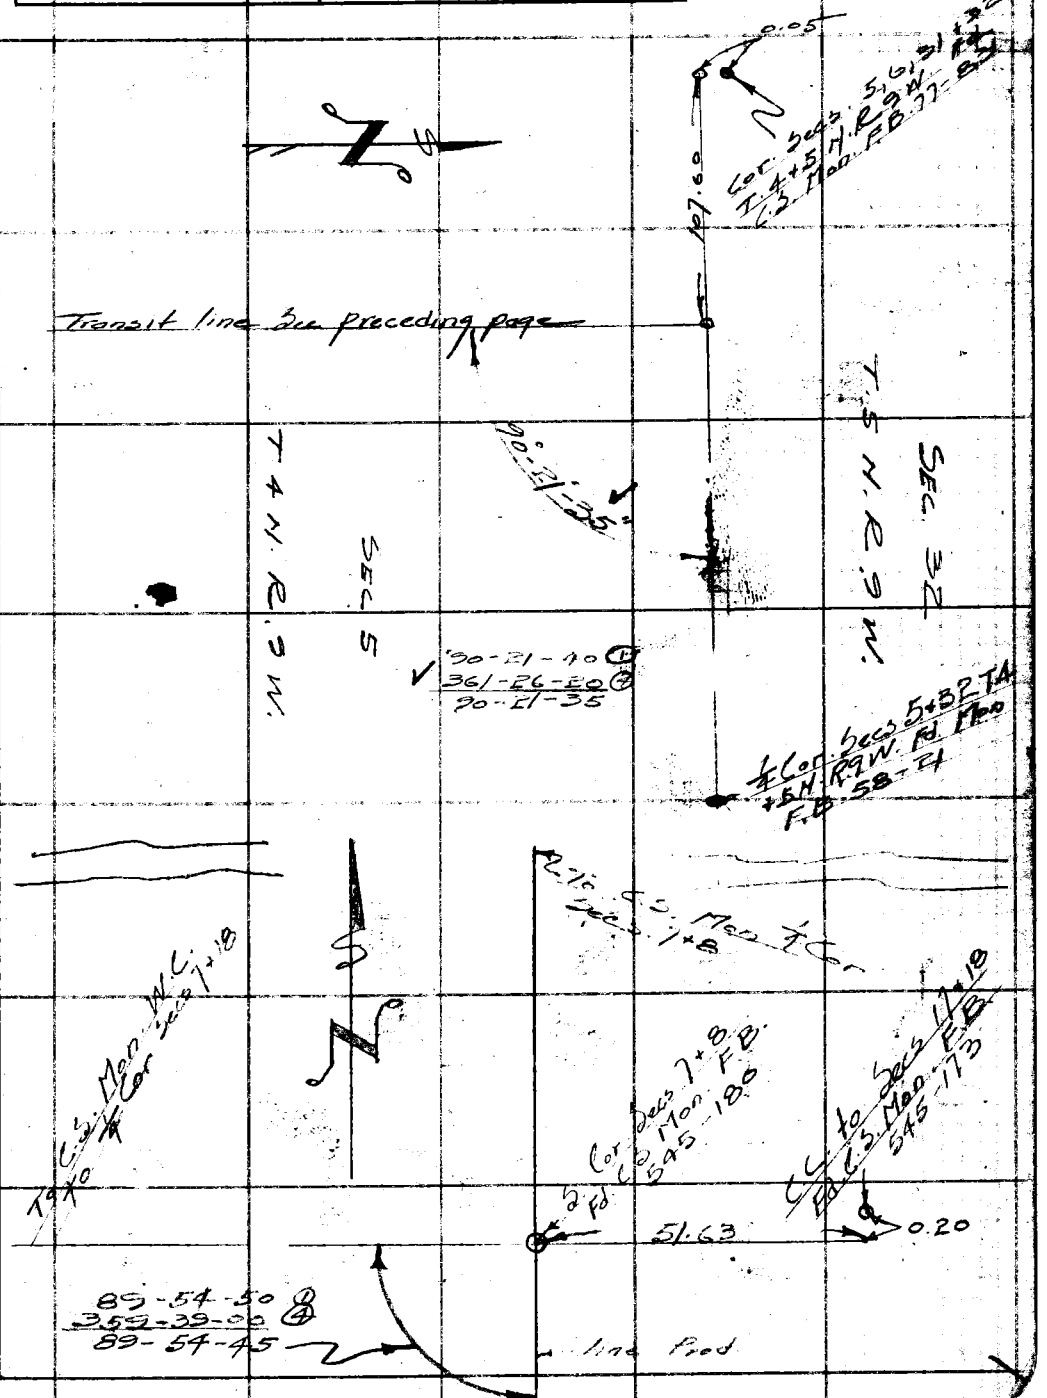

Note: Any Additions or Changes on This Sheet Must be Made or Circled in Red Ink With Date and Name of Person Making Change.

Do not extend notes this side of this line.

RETURN TO
LOS ANGELES COUNTY SURVEYOR
700 HALL OF RECORDS

FORM 247 5M 5-46

F. B. 1262 PG. 142

Cont. bottom next page

300.66 @ 5-36 = 299.23
101.49 @ 15-46 = 97.67
396.90
T. 76 = 396.88

Set 1x2 - 26+97.17

202.62
251.63
454.25
T. 76 = 454.23

Set 1"x2" top E+W ridge
22+42.94

Rechain
1245.96 T. 94 = 1246.04

~~65.40 @ 16-41 = 62.65~~
~~274.35 @ 25-19 = 248.00~~
~~281.36 @ 12-35 = 274.60~~
~~90.51 @ 27-32 = 80.26~~
~~36.01 @ 43-12 = 26.25~~
~~298.75 @ 21-14 = 278.47~~
~~300.54 @ 2-18 = 300.30~~
~~1270.53~~
T. 84

SEC. 17

68.82 @ 19-20 = 64.94
300.17 @ 9-15 = 296.27
361.21
T. 84

361.46

90-06-00 ①
360-23-40 ④
90-05-55

1/4 Cor.

Barbed wire Fn.
1+81.5

To C.S. Mon. Secs. 8+17

90-05-55

635.69

Set 1x2 on steep slope
30+94.05

396.88

454.23

1246.04
1270.53

SEC. 18
T. 4N. R. 9 W.

9+96.90 Ch. Pt. top
Spur Bears N 40° E

361.21

6+35.69 Set 1"x2"
top E.+W. spur

S 59° E

18" Conc. Irr. line 1+98.0

S 44° E

179-48-10 ①
359-12-20 ④
179-48-05
Turned on N. side

52.78 @ 23-38 = 48.35
300.08 @ 5-30 = 298.70
300.30 @ 16-01 = 288.64
635.69
T. 84

180-11-55

Rec.
51.63

0+00 to S. C.C. Secs. 17+18
T. 4N. R. 9W. Fd. C.S. Mon. 5" up
FB. 545-173+178

S. Cor. Secs. 7+8 T. 4N.
R. 9W. Fd. C.S. Mon.
6" up. FB. 545-180

W.S. 15-C-1

RETURN TO
LOS ANGELES COUNTY SURVEYOR
700 HALL OF RECORDS

Do not extend notes this side of this line.

Note: Any Additions or Changes on This Sheet Must be Made or Circled in Red Ink With Date and Name of Person Making Change.

Notes Ck'd by [illegible]	Survey of T.4N.R9W.
Map No.	W. O. [illegible] Tape No. 85 St'd. 84 °F
Office Work	Surveyed by Fosecrans
Checked	Notes R Date 6-18-48
Date	Indexed C. Johnson

F. B. 1262 PG. 145

Cor. Secs. 17, 18, 19 & 20 T.4N.R9W
Fd. C.S. Mon. F.B. 488-156

Set 1"x2" - 58+28.37
0.90 4.90

Int. Set 1"x2" - 58+27+47

89°47'35"

N

℄ 10 ga line 2"x2" 10 ga C.S. B. 145-4

4.70°W.

B.P. on north side of sand rocks 53+43

89-47-35
269-10-20
89-47-35

40+40.85 SEC. 18
Set 1"x2" top of Brk S. side of ravine

SEC. 17

T.4N. R.9W.

2628.95

299.95	@ 15-36 =	288.90
		179.62
153.31	@ 5-42 =	152.55
212.53	@ 5-16 =	211.62
299.23	@ 10-45 =	293.98
245.37	@ 27-01 =	214.57
65.78	@ 15-36 =	63.26
137.68	@ 5-21 =	131.07
58.47	@ 28-22 =	51.45
300.92	@ 25-16 =	272.77
81.64	@ 27-38 =	72.33
158.62	@ 31-35 =	135.12
262.12	@ 24-52 =	237.82
85.01	@ 30-15 =	73.43
250.74	@ 11-19 =	246.87
		2629.86
		-0.90
		2628.95

Bottom Cr. 34+72
4.70°W.

T.84

West 2.64

Fd. conglomerate boulder 3 in Diam. 2 high See Govt. notes

¼ SEC. COR 31+98.99
Set 1"x2" by ties to B.T. & rock per Govt. notes. Point is on top of break on N. side of deep ravine. Replaced 1"x2" with 2" I.P. with brass cap marked as shown in Conc. 6" above surface

4.85

0.47

Set 1"x2" - 31+98.52

8.88 N.10°E

104.47

Fd. 10" scrub oak scribed ¼ S 18 B.T. should be ¼ S 17 per Govt. notes.

104.85 @ 4.53 T84 = 104.47

Set 1"x2" - 30+94.05 See top preceding page

SURVEYOR ¼ COR. R.S.W. R.E. 829 COUNTY LI-81

Note: Any Additions or Changes on This Sheet Must be Made or Circled in Red Ink With Date and Name of Person Making Change.

Do not extend notes this side of this line.

RETURN TO LOS ANGELES COUNTY SURVEYOR 700 HALL OF RECORDS

FORM 2 SM 5-46

F. B. 1262 PG. 144

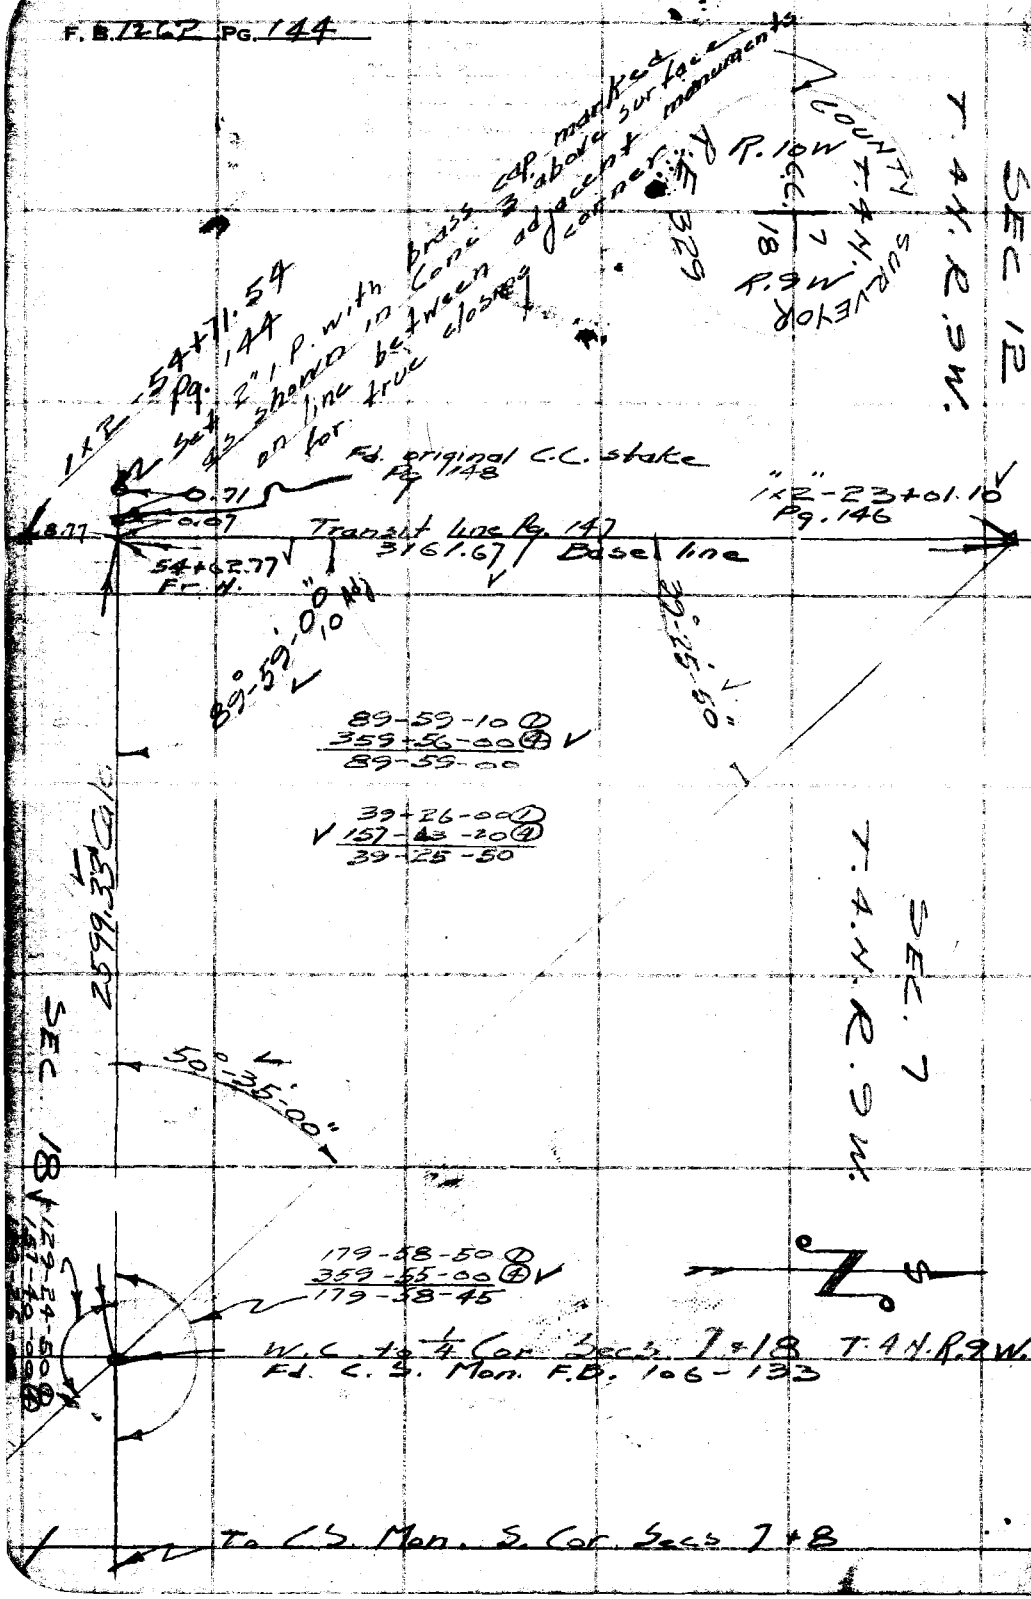

RETURN TO
LOS ANGELES COUNTY SURVEYOR
700 HALL OF RECORDS

Do not extend notes this side of this line.

Note: Any Additions or Changes on This Sheet Must be Made or Circled in Red Ink With Date and Name of Person Making Change.

Notes Ck'd by KRM	Survey of T. 4 N. R 10 W.
Map No.	W. O. 4999 Tape No. 85 St'd 84 °F
Office Work	Surveyed by Rosecrans
Checked	Notes R Date 5-13-48
Date	Indexed E. C. Johnson

R.B. 1262 Pg. 145

SECTION LINES
IN T. 4 N. R. 10 W.
J. N. 4999

Party E. A. Rosecrans
J. P. Pierce
J. C. Pierce
L. Vejar
H. H. Howard

Index to notes

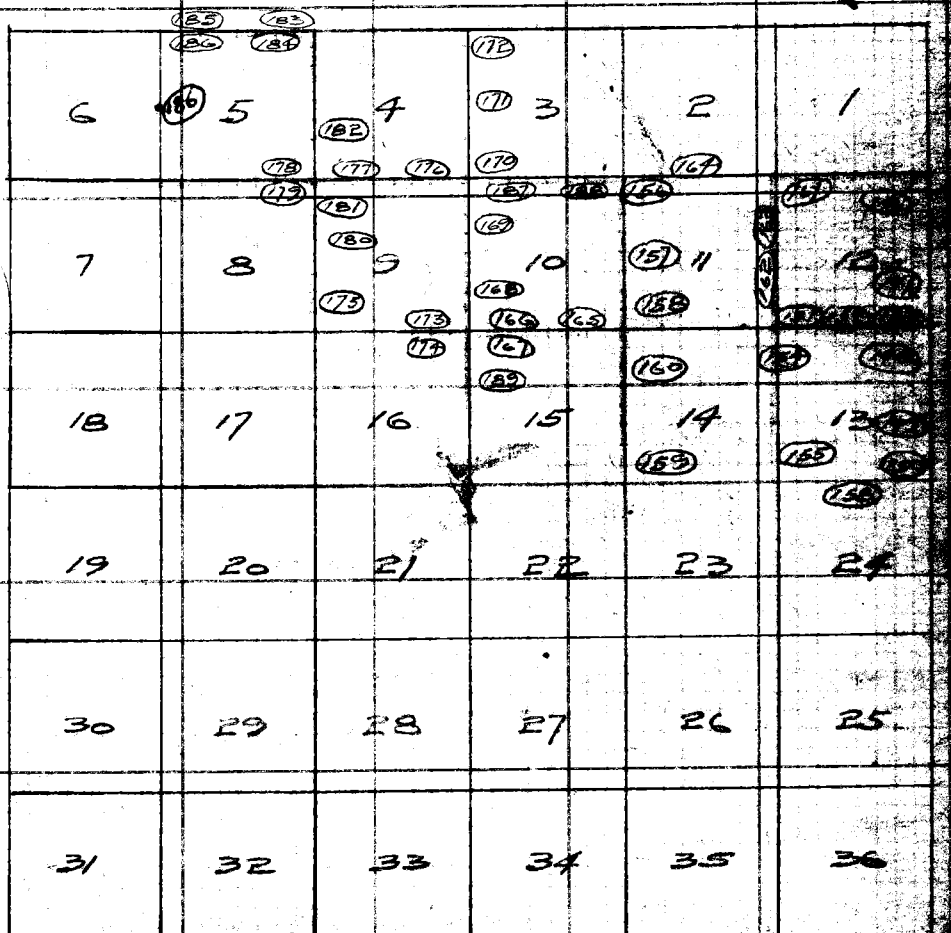

Note: Any Additions or Changes on This Sheet Must be Made or Circled in Red Ink With Date and Name of Person Making Change.

Do not extend notes this side of this line.

RETURN TO
LOS ANGELES COUNTY SURVEYOR
700 HALL OF RECORDS

FORM 247 5M 5-46

F.B. 1262 PG. 146

Cont. bottom next page

W.S. 15-B-1

Set 1"x2" top of spur Bear N60°W
23+01.10

N.45° E.

B.D. 16+44

44.59
287.28 @ 9-00 = 283.74
172.46 @ 4-00 = 172.04
300.10 @ 2-30 = 299.81
120.04 @ 2-34 = 119.92
300.50 @ 6-59 = 298.27
82.42
51.26
300.20
1652.25
T.90 = 1652.31

1652.31

B.D. 12+00

N.45° W.

Fd. ¼ iron in rock mound
2' base ½' high 6+48.79

SEC. 7

T. 4 N. R. 9 W.

217.55 @ 0-46 T 90 217.54

217.54

SEC. 12

Set 1"x2" - 4+31.25

T. 4 N. R. 10 W.

106.71 @ 8-14 T.90 = 105.61

105.61

Set 1"x2" top of Brk.
3+25.64

193.89 @ 21-37 = 180.25
150.23 @ 14-36 = 145.38
325.63
T 90 = 325.64

325.64

Cor. Secs. 1, 6, 7 + 12 T. 4 N. R.
9 + 10 W. 0+00 to S. Fd.
C.S. Mon. F.B. 960-137

0-01-20 (1)
0-05-00 (4)
0-01-15

SEC 6

SEC. 1

To C.S. Mon ¼ Cor. Secs.
1 + 6 T 4 N. R 9 + 10 W.

0-01-15

RETURN TO
LOS ANGELES COUNTY SURVEYOR
700 HALL OF RECORDS

Do not extend notes this side of this line.

Note: Any Additions or Changes on This Sheet Must be Made or Circled in Red Ink With Date and Name of Person Making Change.

Notes Ck'd by KRM	Survey of T.4N. R10W
Map No.	W. O. 4999 Tape No. 85 St'd 84 °F
Office Work	Surveyed by Rosecrans
Checked	Notes R Date 5-14-48
Date	Indexed A. C. Johnson

F.B. 1262 Pg. 147

Cont. bottom of next page

W.S. 15-B-1

52+66.43

Set 1"x2"-52+69.58

EAST COR. SECS 12+13

T.4N. R.10W. Fd. 4x4 [illegible] post 2 notches on the N 4 notches on the S. with traces of scribing. Standing on top of E+W ridge 110.06 @ 6-38 T.90 = 109.32

3.15

0.75

109.32

Original stake in poor condition and leaning. Drove a 1x2" at the base and used it as the section Cor. Replaced 1x2" with 2" I.P. with brass cap marked as shown in Conc. 6" above surface

Set 1"x2" on Brk N. side E+W ridge 51+60.26

R.E. 329

SURVEYOR R.9W. T.4N. R.10W. 12 13 COUNTY

B.D.

48+96

N 30° W

SEC. 7

B.D. N 30° W.

38+32

T.4N.R.9W.

36+40 Top E+W. spur

SEC. 12

T.4N.R.10W.

35+13

B.D. N 45° E.

28.04 @ 12-08 =		27.41
300.48 @ 24-59 =		272.36
86.97 @ 7-36 =		86.21
130.99 @ 20-41 =		122.55
228.58 @ 25-45 =		205.88
213.39 @ 9-54 =		210.21
		300.06
151.01 @ 8-12 =		149.47
242.03 @ 13-41 =		235.16
		197.43
		17.44
299.85 @ 12-07 =		293.17
285.75 @ 5-46 =		284.30
132.70 @ 5-15 =		132.14
		2533.79
	T.90 =	2533.89

33+53 top spur Bear N 45° E

2533.89

S 30° E old 7' trail

26+32

SURVEYOR R.9W. T.4N. R.10W. 12 7 COUNTY

R.E. 329

1/4 SEC. COR. 26+26.37

Fd. 4"x4" hewn junipe post Scribed 1/4 S 12 on west 1/4 S 7 on E in mound of rocks 2' base 1/2' high. Replaced 4"x4" hewn juniper post with 2" I.P. with brass cap marked as shown in Conc. 3" up.

52.40

40°-55'

Fd. 30" juniper one 8" branch scribed 1/4 S. B.T.

325.27

325.26 T.90 = 325.27

1"x2"-23+01.10 See preceding page

Note: Any Additions or Changes on This Sheet Must be Made or Circled in Red Ink With Date and Name of Person Making Change.

Do not extend notes this side of this line.

RETURN TO LOS ANGELES COUNTY SURVEYOR 700 HALL OF RECORDS

FORM 247 5M 5-46

F. B. 1262 PG. 148

Cont. bottom next page

W.S. 15-B-1

1/4 SEC. COR. 79+08.24 Fd. 1" I.P. with 2" brass cap marked as shown in mound of rocks 4' base 2' high See Govt notes C.S. 9178

1.11

67.11

Set 1"x2" top E+W. spur 78+41.13

70.09 @ 16-45 T.60 = 67.11

E+W.

B.D. 76+47

70+71 T.R. Bear E+W.

S 35° W.

B.D. 67+50

1834.66

93.07 @ 11-23 = 91.24
300.02 @ 3-11 = 299.56
280.50 @ 6-50 = 278.51
103.43 @ 14-19 = 100.22
172.93 @ 11-29 = 169.47
256.83 @ 10-52 = 252.23
91.86 @ 22-05 = 85.12
120.21 @ 18-01 = 114.32
185.48 @ 8-13 = 183.58
179.56 @ 9-28 = 177.11
84.09 @ 6-14 = 83.59
1834.95
T.60 = 1834.66

T.R. Bear S 70° E
S. side 60+66

Set 1"x2" - 60+06.47

T.R.N. Side

SEC 13

SEC. 18

T.4 N. R.10 W.

T.4 N. R.9 W.

534.93

225.65 @ 8-28 = 223.19
194.98 @ 2-20 = 194.82
119.19 @ 11-15 = 116.90
534.91
T.90 = 534.93

Set 1"x2" 54+71.54

2.7

8.77

0.07

54+62.77

Fd. dead 6" oak tree with traces of scribing

10.2

C.C. SECS. 7+18
Fd 3"x3" stake hewn + scribed. Could not read the scribing. 2 notches on N. 4 on th S. Standing on W. side of mound of rocks 4' base 2' high.
For C.S. Mon. See Pg. 144

Set C.S. Mon. 71 west of original stake See Pg. 144

201.96

B.D.

S. 80° E.

53+30.0

201.95 T.90 = 201.96

1"x2" 52+69.58 See top preceding page

RETURN TO
LOS ANGELES COUNTY SURVEYOR
700 HALL OF RECORDS

Do not extend notes this side of this line.

Note: Any Additions or Changes on This Sheet Must be Made or Circled in Red Ink With Date and Name of Person Making Change.

Notes Ck'd by KRM	Survey of T.4N R.10W.
Map No.	W. O. 4999 Tape No. 85 St'd 84 °F
Office Work	Surveyed by Rosecrans
Checked	Notes R Date 5-18-48
Date	Indexed R C. Johnson

FB 1262 Pg 149

W.S. 15-B-1

Cont bottom next page

91+75

S 45° W.

E+W.

B.D. 89+28

		103.27
121.89 @	6-00 =	121.22
246.56 @	5-55 =	245.25
126.10 @	5-31 =	125.52
195.05 @	1-55 =	194.94
273.92 @	6-43 =	272.04
231.84 @	1-14 =	231.79
278.80 @	1-13 =	278.74
		103.53
159.52 @	2-55	159.31
		1835.61
	T.66 =	1835.40

47-29

Fd. 20" pine blazed and scribed S18

37-12

1835.40

Set 1"x2" - 86+59.92

86+49.61

10.31

Fd. 3" pine stake with traces of scribing laying on mound of stones 3' base 2' high. Drove 3/4" I.P. in center of the mound

0.19

0.95

1/4 SEC. COR. Set 2" I.P. with brass cap marked as shown in Con.

R.10 W. T.4N. 18 COUNTY SURVEYOR

56.08

15-52

94.79

97.29 @ 12-59 T.60 = 94.79

Fd. 8" juniper blazed + scribed S18 B.T.

Set 1"x2" - 85+65.13

SEC. 13

T.4N. R.10W.

56.79 @ 9-of T.60 = 56.08

SEC. 18

T.4N. R.9W.

103.64

104.53 @ 7-25 T.60 = 103.64

Set boat Spk top E+W. ridge 84+61.49

N.50 W.

B.D. 83+18.0

620.36

Top. E+W. spur 80+53

279.95 @ 1-39	=	279.84
126.27 @ 7-15	=	125.26
215.83 @ 3-48	=	215.36
		620.46
	T.60 =	620.36

N.60° W.

B.D. 79+94

1"x2" - 78+41.13 See preceding page

Note: Any Additions or Changes on This Sheet Must be Made or Circled in Red Ink With Date and Name of Person Making Change.

Do not extend notes this side of this line.

RETURN TO
LOS ANGELES COUNTY SURVEYOR
700 HALL OF RECORDS

FORM 247 5M 5-46

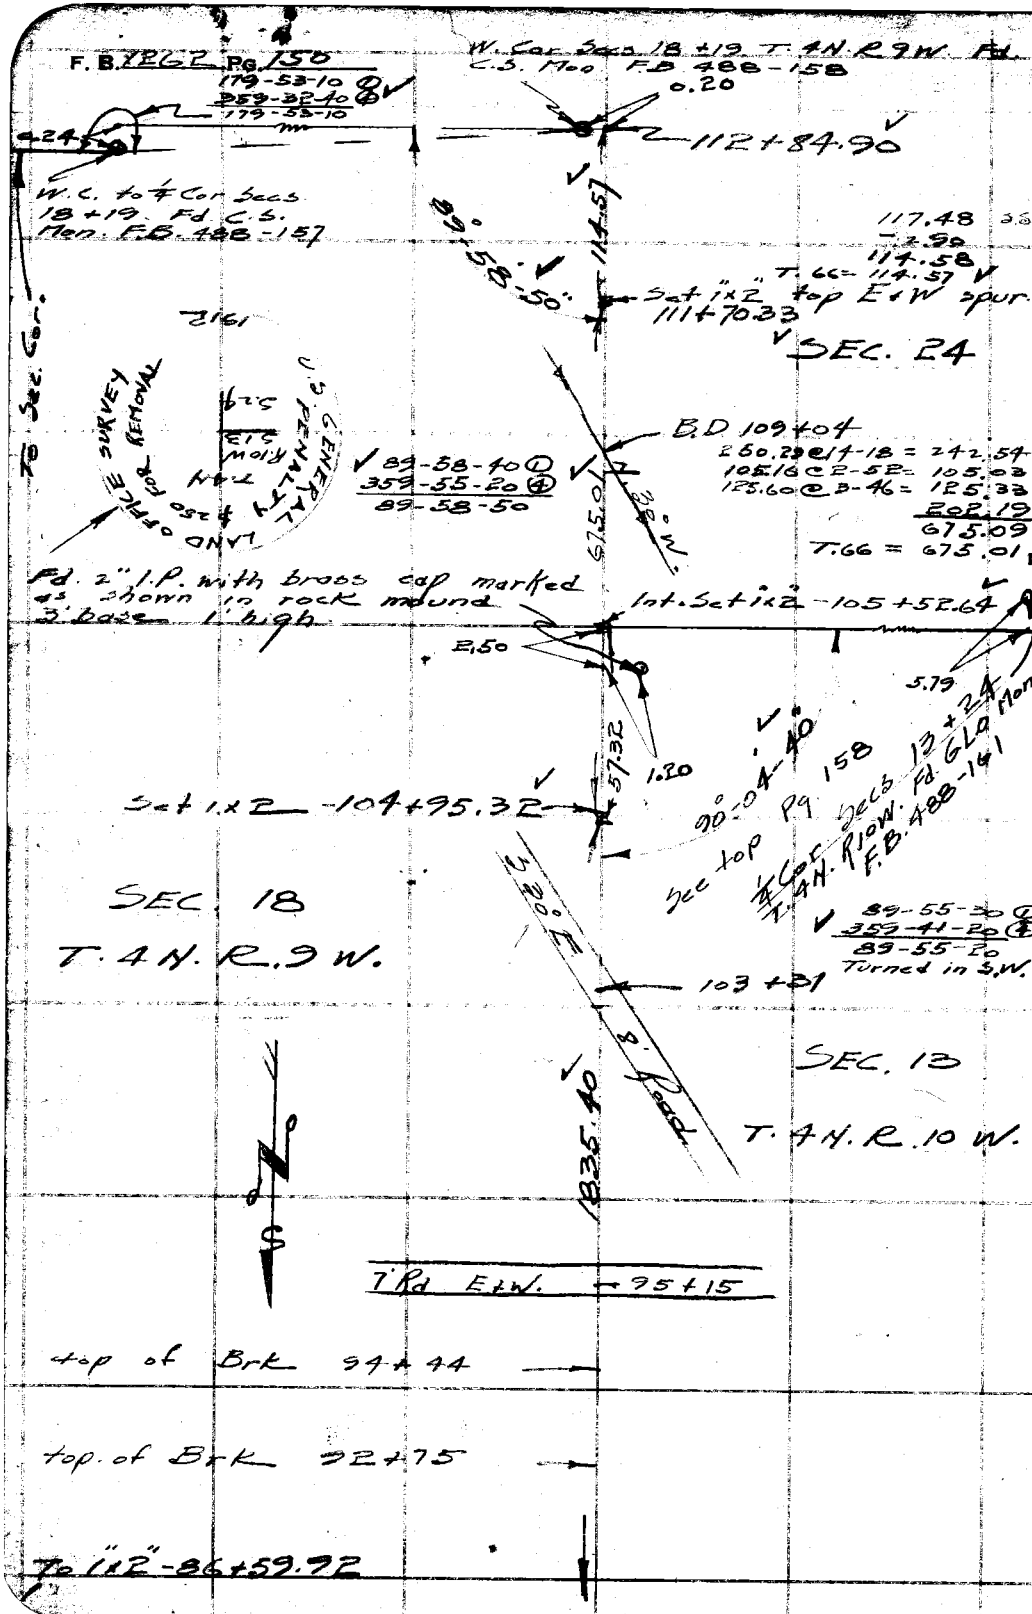

W.S. 15-B-1

RETURN TO
LOS ANGELES COUNTY SURVEYOR
700 HALL OF RECORDS

Do not extend notes this side of this line.

Note: Any Additions or Changes on This Sheet Must be Made or Circled in Red Ink With Date and Name of Person Making Change.

Notes Ck'd by RRM	Survey of T.4N.R.10W.
Map No.	W. O. 4999 Tape No. 85 St'd 84 °F
Office Work	Surveyed by Rosecrans
Checked	Notes R Date 5-20-48
Date	Indexed C. Johnson

F.B. 1262 Pg. 151

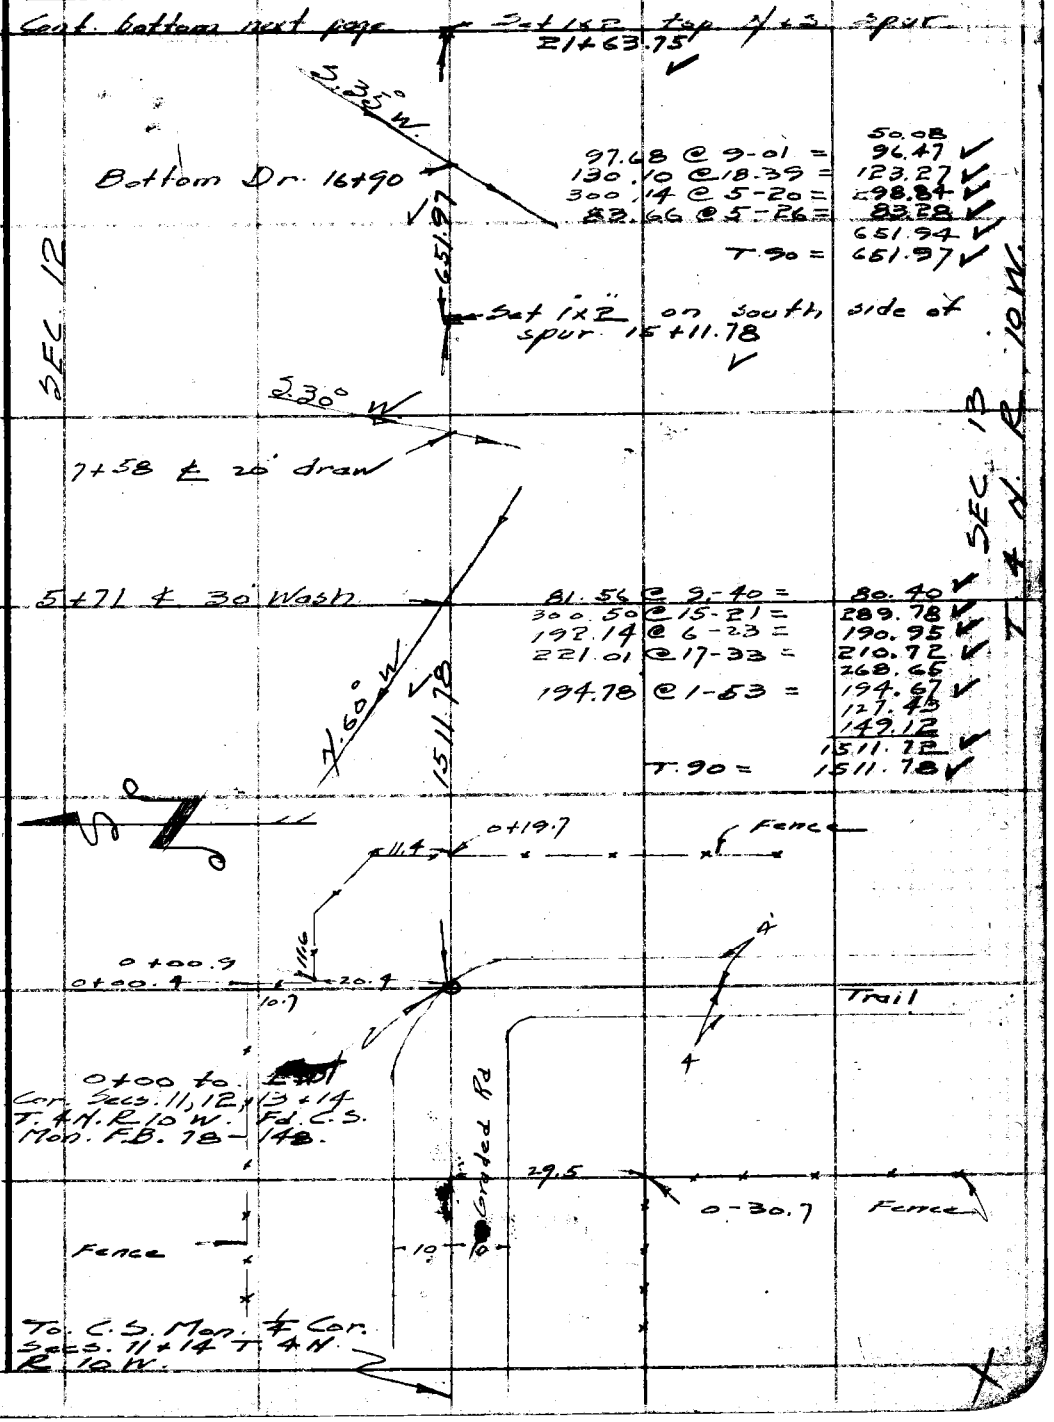

	50.08
97.68 @ 9-01 =	96.47
130.10 @ 18-39 =	123.27
300.14 @ 5-20 =	298.84
83.66 @ 5-26 =	83.28
	651.94
T.90 =	651.97

81.56 @ 9-40 =	80.40
300.50 @ 15-21 =	289.78
192.14 @ 6-23 =	190.95
221.01 @ 17-33 =	210.72
	268.65
194.78 @ 1-53 =	194.67
	127.43
	149.12
	1511.72
T.90 =	1511.78

Note: Any Additions or Changes on This Sheet Must be Made or Circled in Red Ink With Date and Name of Person Making Change.

Do not extend notes this side of this line.

RETURN TO
LOS ANGELES COUNTY SURVEYOR
700 HALL OF RECORDS

FORM 247 5M 5-46

Cont. bottom next page

F. B. 1262 PG. 152

Set 1x2 - 40+78.93

170.50 @ 2-10 = 170.38
300.27 @ 1-15 = 300.28
164.50 @ 1-16 = 164.47
635.05
" " T90 = 635.07

Set 1x2 - 34+43.86

201.13 @ 5-05 = 200.34
161.36 @ 4-04 = 160.95
361.29
T. 90 = 361.30

Set 1x2 Top N.+S. spur
30+82.56

SEC. 12

SEC. 13

T. 4 N. R. 10 W.

W.S. 15-B-1

SURVEYOR
COUNTY
T. 4 N.
R. 10 W.
12
13
1/4 COR
R.E. 329

178.58 @ 19-16 = 168.58
300.29 @ 11-45 = 294.00
62.29
524.87
T. 90 = 524.89

Bottom Dr. 27+20

Fd. dead 6" scrub oak stump
scribed 1/4 S.12 B.T.

1/4 SEC. COR 26+52.56
Fd. 3/4" I.P. 18" high in mound
of rocks 1. high 2' base
N. side Dr. Bear. N. 40° E.
Replaced 3/4" I.P. with 2" I.P. with
brass cap marked as shown in
Conc. 6" above surface

41.73 Calc

107.86 @ 16-03 T.90 = 103.66
23-44-20

Fd. 6" juniper scribed
1/4 S.13 B.T.

Set 1x2 S. Side N.+S. spur
25+57.67

23-44-00
47-28-40
23-44-20

300.24 @ 6-48 = 298.13
63.42 @ 16-00 = 60.96
393.90
T=90 - 393.92

N.+S. Dr.
23+23.0

1x2 - 21+63.75 See preceding page

RETURN TO
LOS ANGELES COUNTY SURVEYOR
700 HALL OF RECORDS

Do not extend notes this side of this line.

Note: Any Additions or Changes on This Sheet Must be Made or Circled in Red Ink With Date and Name of Person Making Change.

Notes Ck'd by RRM.	Survey of T.4N. R 10 W.
Map No.	W. O. 4999 Tape No. 85 St'd 84 °F
Office Work	Surveyed by Rosecrans
Checked	Notes R Date 5-25-47
Date	Indexed A. C. Johnson

F. B. 1262 Pg. 153

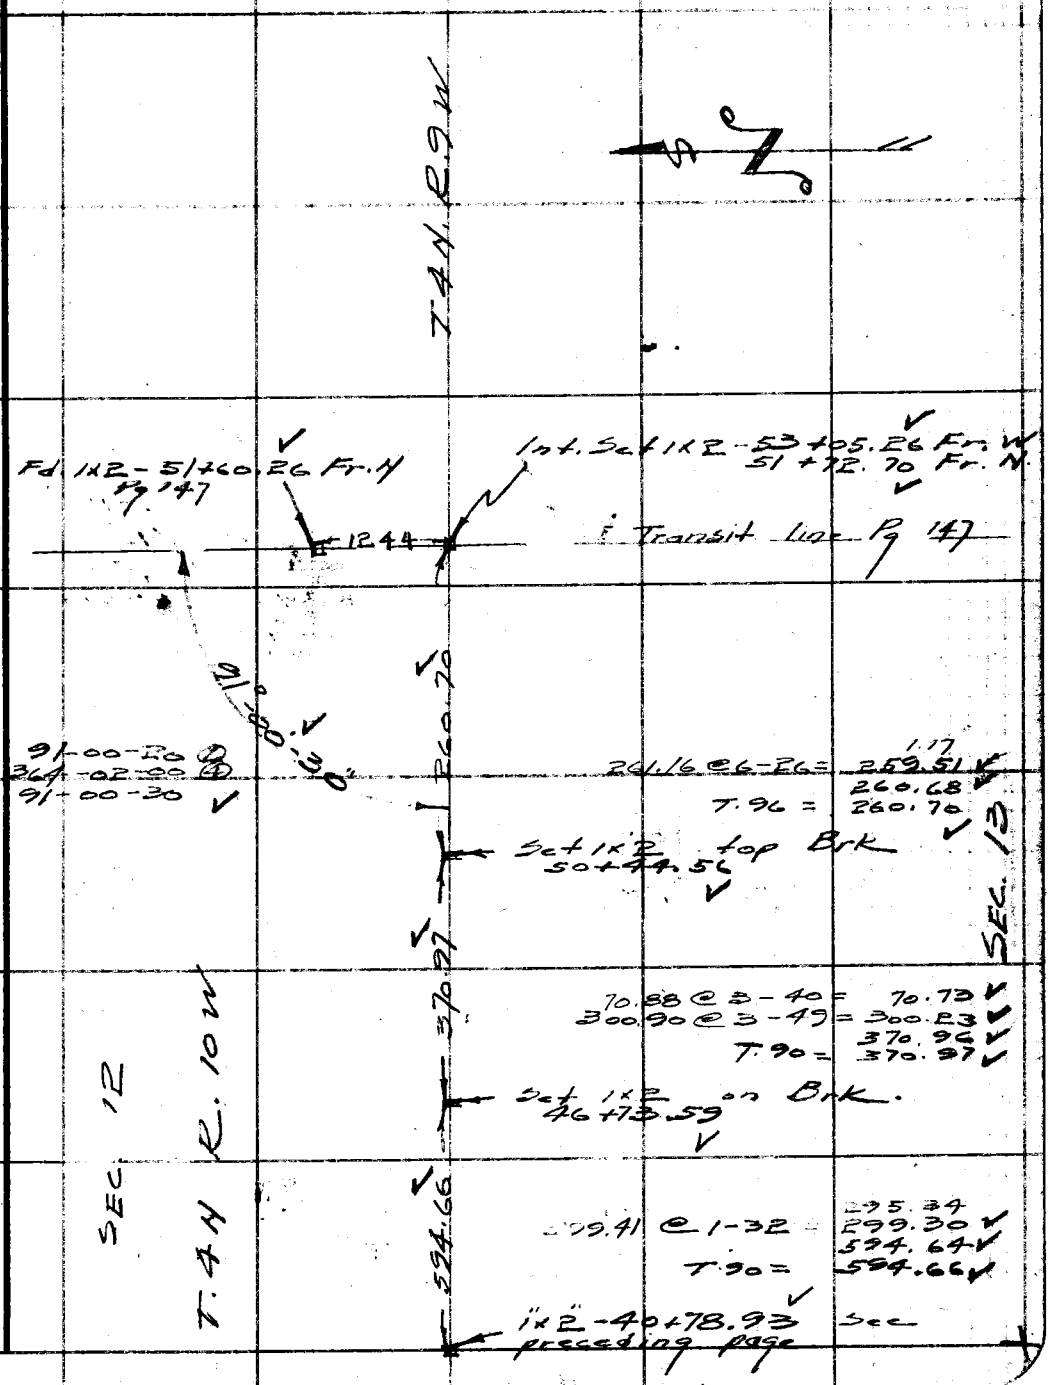

Note: Any Additions or Changes on This Sheet Must be Made or Circled in Red Ink With Date and Name of Person Making Change.

Do not extend notes this side of this line.

RETURN TO
LOS ANGELES COUNTY SURVEYOR
700 HALL OF RECORDS

FORM 247 5M 5-46

F.B. 262 PG. 154

To Sec. Cor. See next page

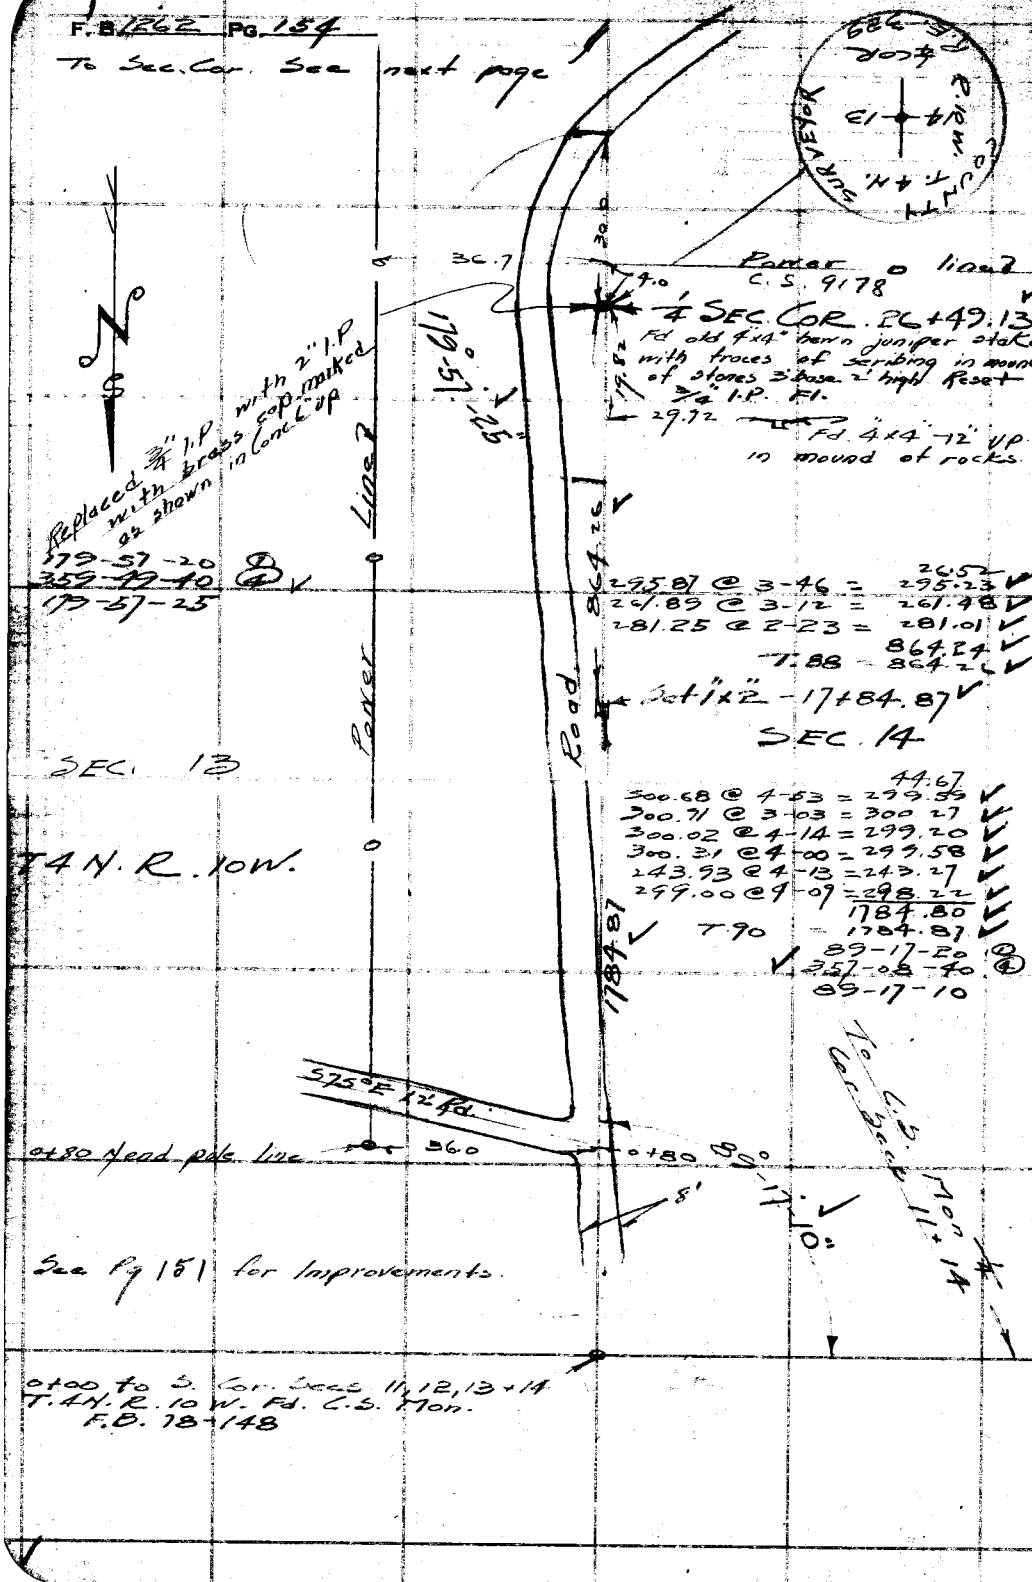

RETURN TO
LOS ANGELES COUNTY SURVEYOR
700 HALL OF RECORDS
Do not extend notes this side of this line.
Note: Any Additions or Changes on This Sheet Must be Made or Circled in Red Ink With Date and Name of Person Making Change.

W.S.15.C-1

Notes Ck'd by KRM	Survey of T.4N.R.10W.
Map No.	W. O. 4999 Tape No. 86 St'd. 84 °F
Office Work	Surveyed by Rosecrans
Checked	Notes R Date 6-21-48
Date	Indexed E. C. Johnson

F.B. 1262 Pg. 155

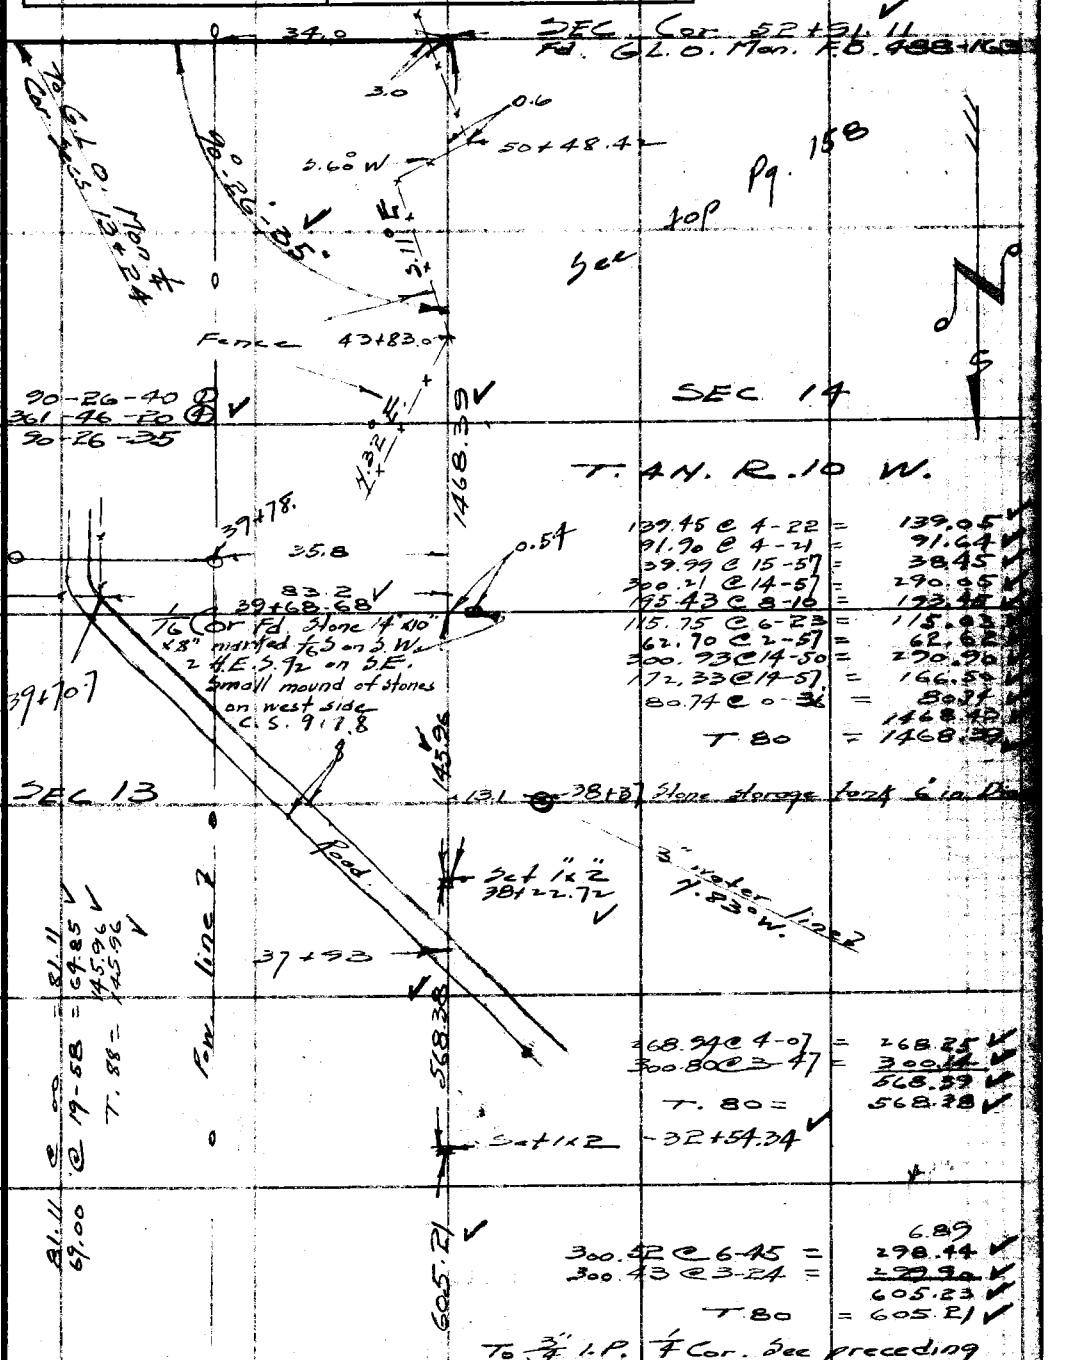

Note: Any Additions or Changes on this Sheet Must be Made or Circled in Red Ink With Date and Name of Person Making Change.

Do not extend notes this side of this line.

RETURN TO
LOS ANGELES COUNTY SURVEYOR
700 HALL OF RECORDS

FORM 247 5M 5-46

F. B. 1262 PG. 156
Cont. bottom next page

1164 Fd old 2"x2" in mound of rocks 3' base 1' high

1.41

Set 1"x2" - 35+32.47

28+52.0

8' Wash E+W

19.35

300.41 @ 4-06 = 299.64
299.47 @ 3-55 = 298.77
299.45 @ 13-00 = 291.78
909.54
T.96 = 909.62

909.62

4.18

26+23.30 Set 1"x2" Fd rock mound 2' base 1' high pieces of hewn juniper 0.45 laying on it

Set 1"x2" - 26+22.85

Set 2" I.P. with brass cap marked as shown in Conc. 4" up.

134.92

140.00 @ 15-30 T.98 = 134.92

Set 1x2 - 24+87.93

R.E. 329
P.10W.
¼ Cor
10 11
COUNTY SURVEYOR
T.4N.

298.20

300.70 @ 7-26 T.98 = 298.20

Set 1"x2" - 21+89.73

SEC. 10

T.4N.R.10W.

SEC. 11

N 60° E

15' Wash

19+03

1129.10

158.71 @ 17-33 = 151.32
282.50 @ 5-55 = 280.99
176.37 @ 6-41 = 175.17
300.40 @ 10-09 = 295.70
225.91 @ 1-38 = 225.82
1129.00
T.98 = 1129.10

14+72

6' Wash E+W

Set 1x2 - 10+60.63

6+48.04 Fd hewn juniper 3" in diam 2' high

1060.63

117.80 @ 10-30 = 115.83
299.95 @ 8-25 = 296.72
53.49 @ 10-55 = 52.52
300.08 @ 9-21 = 295.95
300.39 @ 4-26 = 299.49
1060.51
T.102 = 1060.63

89-43-20 ①
358-53-10 ④
89-43-20

2 NO

89°43'20"

E+W

Dr. 6 Wide

4+09

To C.S. Mon. ¼ Cor. Secs 2 + 11

0+00 to S. Cor. Secs 2-3-10-11 T.4N.R.10W. Fd. G.L.O. Mon. F.B. 78-115

W.S. 15-B-1

RETURN TO
LOS ANGELES COUNTY SURVEYOR
700 HALL OF RECORDS

Do not extend notes this side of this line.

Note: Any Additions or Changes on This Sheet Must be Made or Circled in Red Ink With Date and Name of Person Making Change.

Notes Ck'd by KRM	Survey of T.4N.R 10W.
Map No.	W. O. 4999 Tape No. 77 St'd 84 °F
Office Work	Surveyed by Rosecrans
Checked	Notes R Date 7-6-48
Date	Indexed C. Johnson

F. B. 1262 Pg. 157

Note: Any Additions or Changes on This Sheet Must be Made or Circled in Red Ink With Date and Name of Person Making Change.

Do not extend notes this side of this line.

RETURN TO
LOS ANGELES COUNTY SURVEYOR
700 HALL OF RECORDS

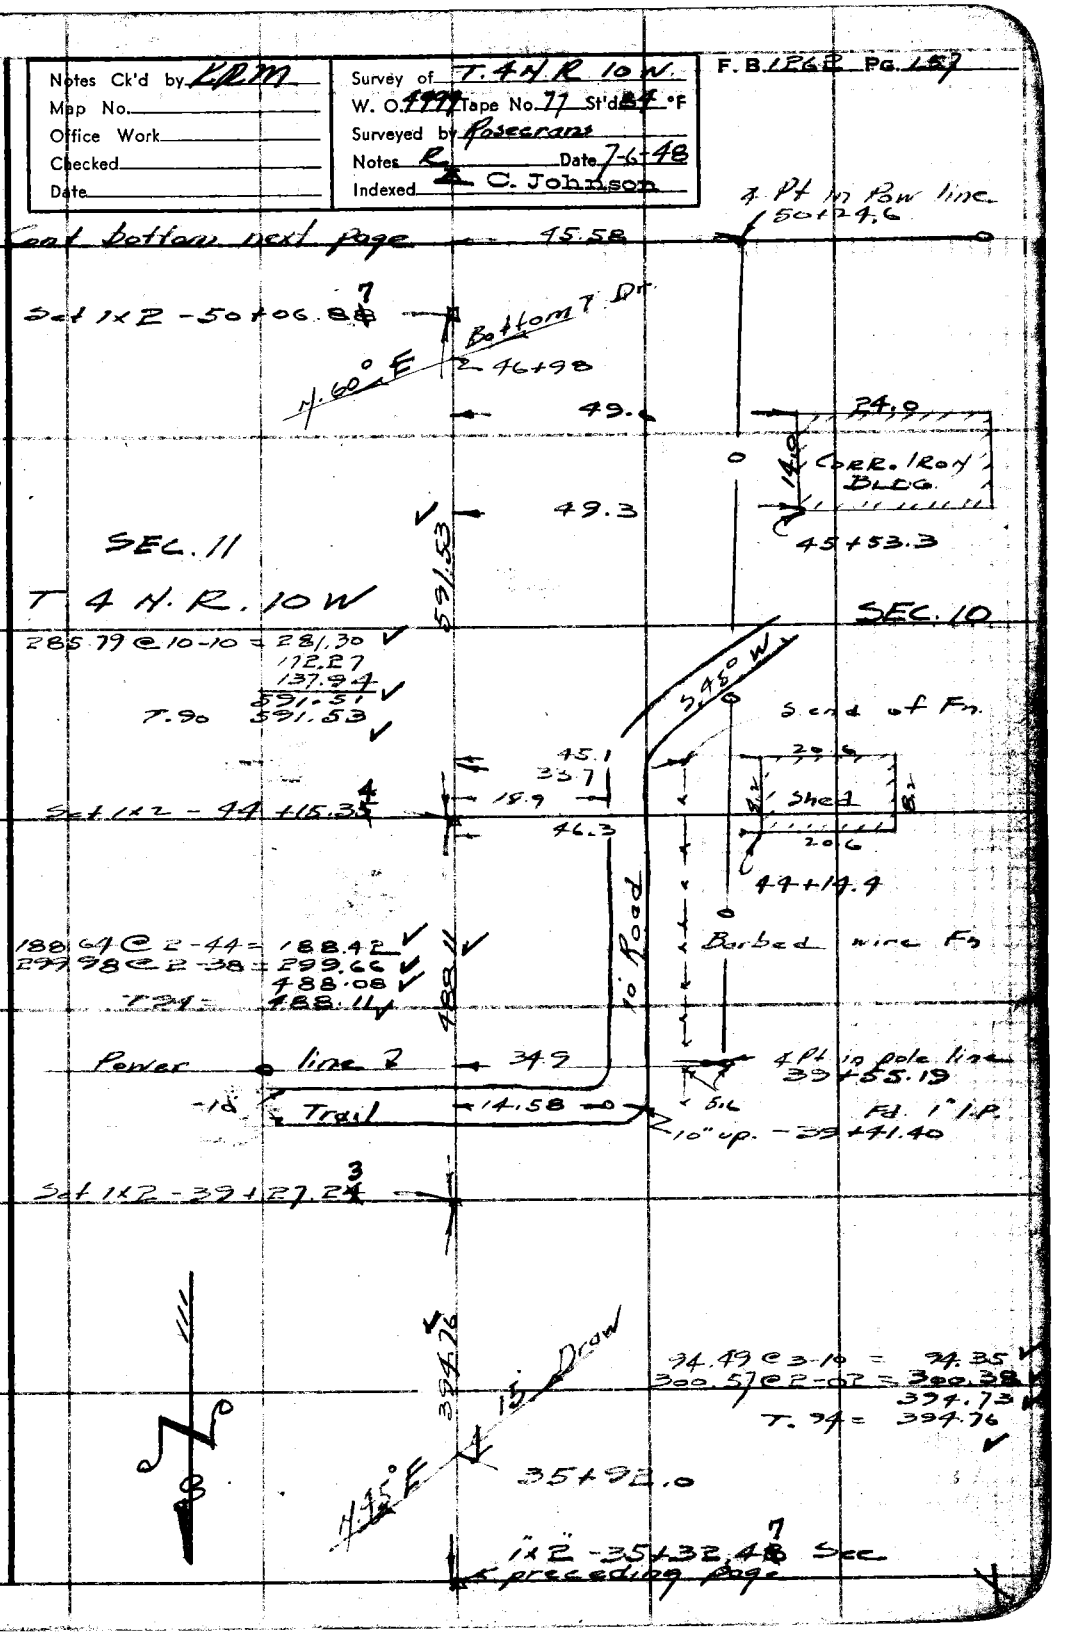

FORM 247 5M 5-46

F. B. 1262 Pg. 158

W.S. 15-B-1

ANGLE CHECK ON S. LINE SEC. 13

T. 4 N. R. 10 W.

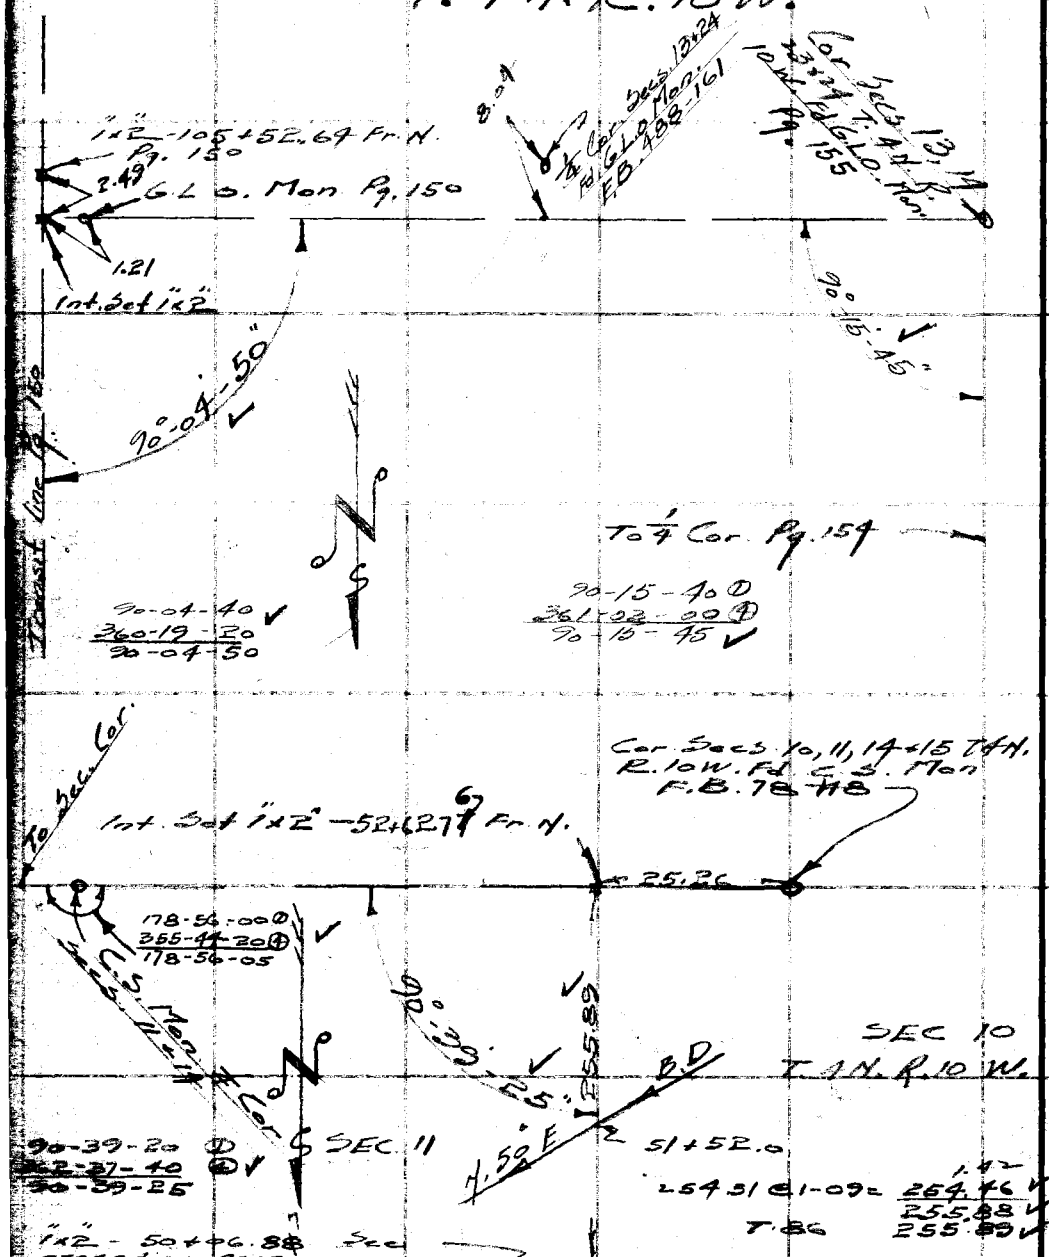

RETURN TO
LOS ANGELES COUNTY SURVEYOR
700 HALL OF RECORDS

Do not extend notes this side of this line.

Note: Any Additions or Changes on This Sheet Must be Made or Circled in Red Ink With Date and Name of Person Making Change.

Notes Ck'd by RLM	Survey of T.4N. R.10W.
Map No.	W. O. 4999 Tape No. 77 St'd 84 °F
Office Work	Surveyed by Rosecrans
Checked	Notes R Date 7-9-48
Date	Indexed C. Johnson

F.B. 126E PG. 159

W.S. 15-B-1

Cont bottom next page

LOUIS A. SUTTER SURVEYOR

T.4N. R.10W. 15 14 1/4 COR R.E. 329

Sec. C.S. 9178

Set "1x2" - 26+52.85

1/4 SEC. COR. Fd 3"x4"x30" known juniper post with traces of scribing wired to Cor. En. Po. Replaced juniper stake with 2" I.P. with brass cap marked as shown in Conc. 3" up.

11.05

4.15

Note Rock's scattered on the ground northwest of the Cor. makes it appear that the original was torn out at the fence Cor.

old fence line

107.87 @ 5-58 T.94 = 107.30

Set 1x2 - 25+45.55

107.30

7.3

SEC. 14

SEC. 15

279.04	@	3-54 =	278.39
300.35	@	4-03 =	299.60
300.08	@	3-50 =	299.41
299.98	@	3-27 =	299.44
300.52	@	3-56 =	299.81
300.62	@	3-45 =	299.98
175.40	@	4-03 =	174.74
297.00	@	5-03 =	295.80
299.67	@	6-02 =	298.01
			2543.38
		T.94 =	2545.55

T.4N. R.10W.

2545.55

90-00-20 (1)
360-01-20 (2)
90-00-20

Power line

0+41.0

90-00-20

0+20

0+13

Cor. Secs. 14, 15, 22 + 23 T.4N. R.10W. Fd. C.S. Mon. 12" Dn. F.B. 78-124

1.00

0+00 to N. Set N.+T.

Old Rd.

0-11

3.0

0-21.0

SEC. 22

SEC. 23

To Pallett Creek Rd

Note: Any Additions or Changes on This Sheet Must be Made or Circled in Red Ink With Date and Name of Person Making Change.

Do not extend notes this side of this line.

RETURN TO LOS ANGELES COUNTY SURVEYOR 700 HALL OF RECORDS

FORM 247 5M 5-46

F. B. 1267 PG. 160

W.S. 15-B-1

RETURN TO
LOS ANGELES COUNTY SURVEYOR
7DO HALL OF RECORDS

Do not extend notes this side of this line.

Note: Any Additions or Changes on This Sheet Must be Made or Circled in Red Ink With Date and Name of Person Making Change.

SEC. 10

SEC. 11

Cor. Secs. 10, 11, 14 & 15 T.4N. R.10W. Fd. C.S. Mon F.B. 78-148

1.00

Int. 52+80.33 Set 1"x1" & N/a

42.65

43.74 @ 12-49 T.96 = 42.65

Set 1"x2" - 52+37.68

247.0

N10°E 89°48'20"

To C.S. Mon. 1/4 Cor. Secs. 11 & 14

90-11-40 ①
360-46-40 ④
90-11-40
Turned in N.E.

Bottom 1 Dr.

SEC. 15

SEC. 14

98.00 @ 4-10 = 97.74
285.04 @ 6-04 = 283.44
271.89 @ 3-46 = 271.30
270.53 @ 2-55 = 270.18
245.40 @ 2-40 = 245.13
253.36 @ 1-56 = 253.22
162.21 @ 1-46 = 162.13
300.66 @ 2-23 = 300.40
300.98 @ 5-52 = 299.40
102.52
300.33 @ 5-07 = 299.13
2584.59
T98 2584.83

2584.83

T.4N. R.10W.

to 1"x2" - 26+52.85
See preceding page

FORM 247 5M 5-46

RETURN TO
LOS ANGELES COUNTY SURVEYOR
700 HALL OF RECORDS

Note: Any Additions or Changes on This Sheet Must be Made or Circled in Red Ink With Date and Name of Person Making Change.

Do not extend notes this side of this line.

W.S. 15-C-1

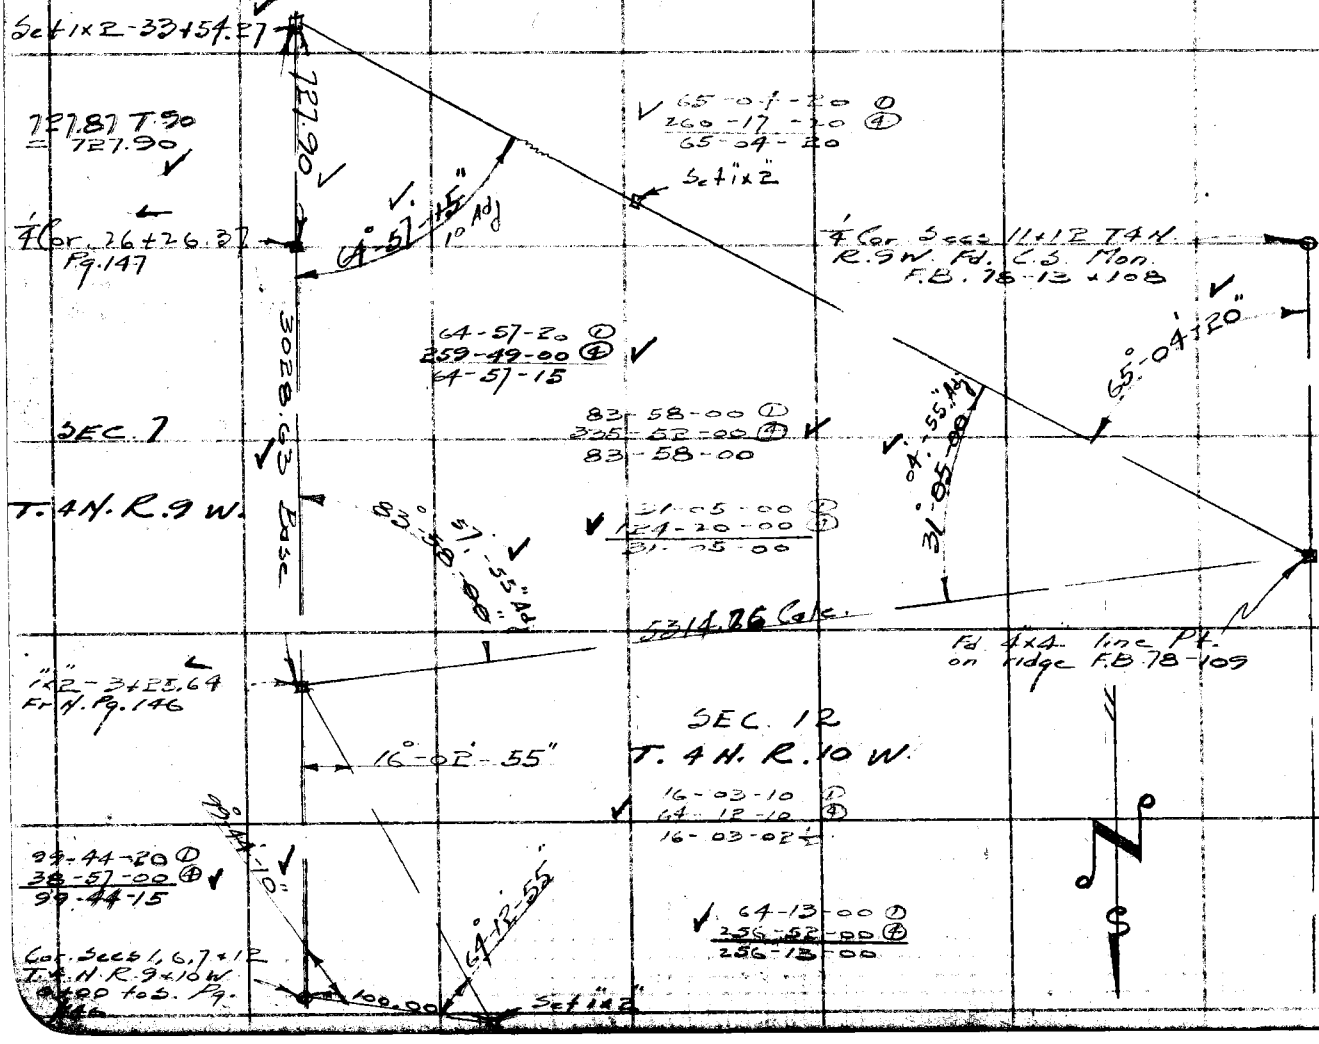

Notes Ck'd by KBM
Map No.
Office Work
Checked
Date

Survey of T. 4 N. R. 10 W.
W. O. 4999 Tape No. 77 St'd 84 °F
Surveyed by Rosecrans
Notes Date 7-13-48
Indexed C. Johnson

F.B. 1262 Pg. 161

F. B. 1262 PG. 162

Cont. bottom next page

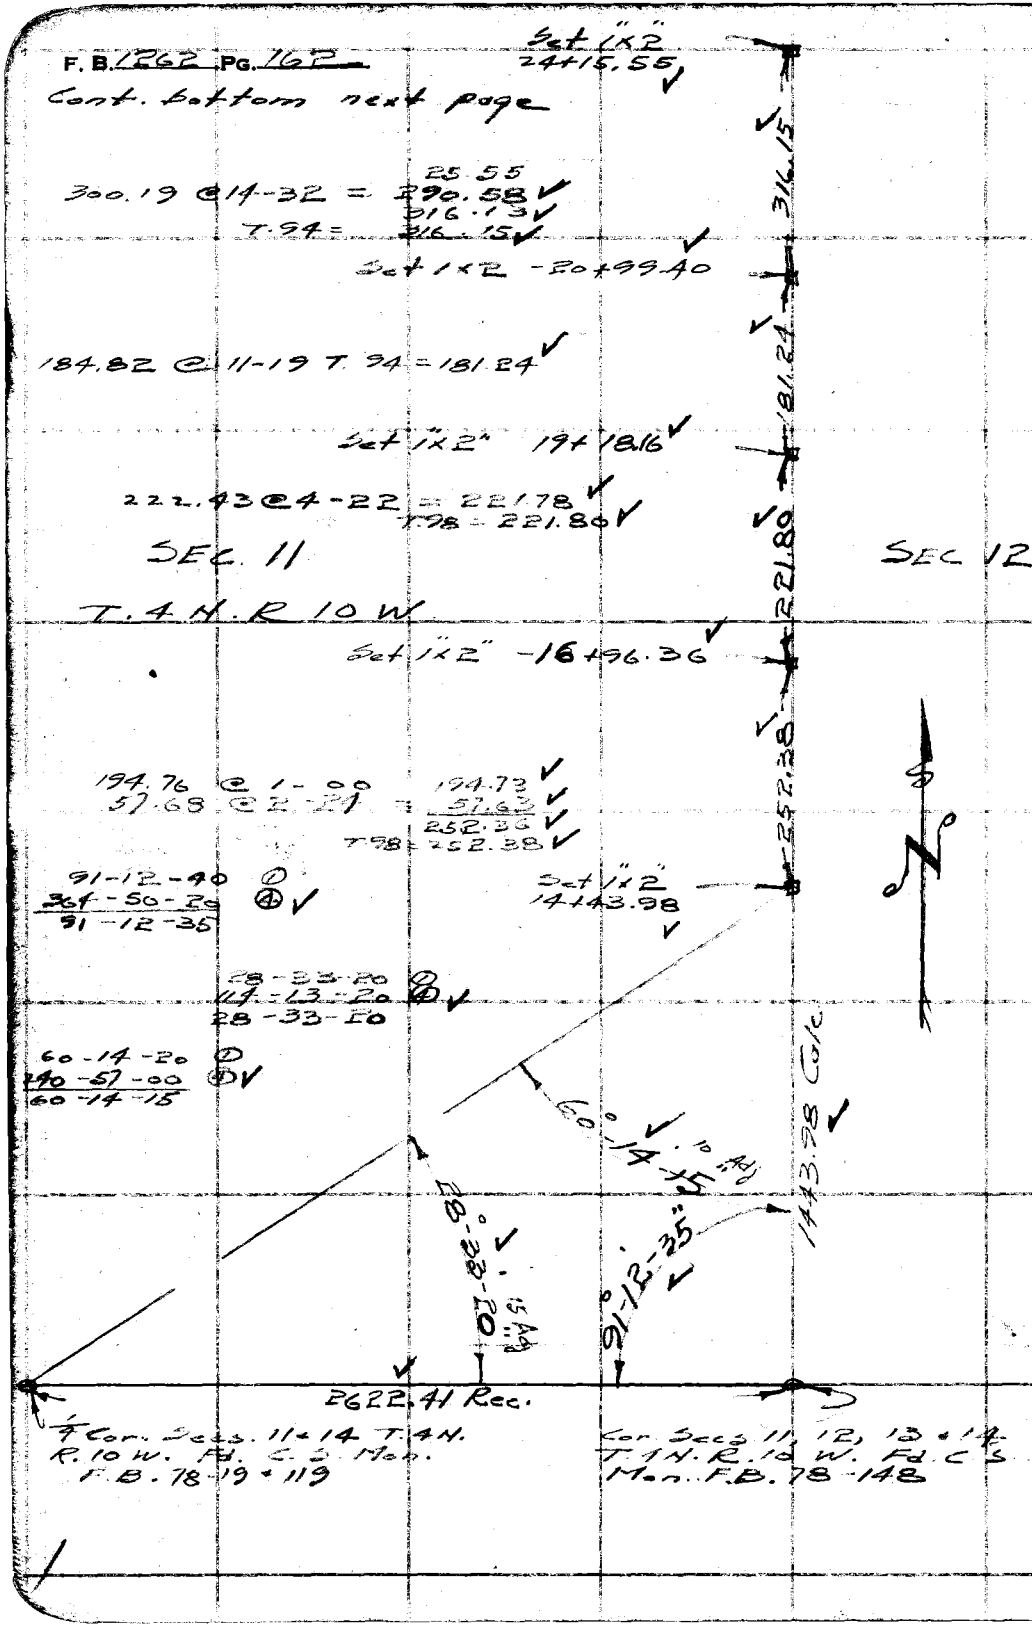

W.S. 15-B-1

RETURN TO
LOS ANGELES COUNTY SURVEYOR
700 HALL OF RECORDS

Do not extend notes this side of this line.

Note: Any Additions or Changes on This Sheet Must be Made or Circled in Red Ink With Date and Name of Person Making Change.

Notes Ck'd by KRM.	Survey of T.4N. R.10W.
Map No.	W. O. 4999 Tape No. 77 St'd 84 °F
Office Work	Surveyed by Rosecrans
Checked	Notes Date 7-15-48
Date	Indexed C. Johnson

F. B. 1262 PG. 162

W.S. 15-B-1

Note: Any Additions or Changes on This Sheet Must be Made or Circled in Red Ink With Date and Name of Person Making Change.

Do not extend notes this side of this line.

RETURN TO
LOS ANGELES COUNTY SURVEYOR
700 HALL OF RECORDS

2.69

Fd. 4"x4" line pt on ridge
See Pg 161

SEC 11 SEC 12

T. 4 N. R. 10 W.

5.56

25+98.32
¼ Cor. Secs. 11 + 12 T. 4 N R. 10 W.
Fd. C.S. Mon. F.B. 78-12 + 10B

8.88

Set 1"x2" - 25+89.44

173.89

106.93 @ Po-10 = 100.37
76.91 @ 17-06 = 73.51
173.88
T.94 = 173.89

1"x2" 24+15.55
See top preceding page

FORM 247 5M 5-46

RETURN TO
LOS ANGELES COUNTY SURVEYOR
700 HALL OF RECORDS

Note: Any Additions or Changes on This Sheet Must be Made or Circled in Red Ink With Date and Name of Person Making Change.

Do not extend notes this side of this line.

W.S. 15-B-1

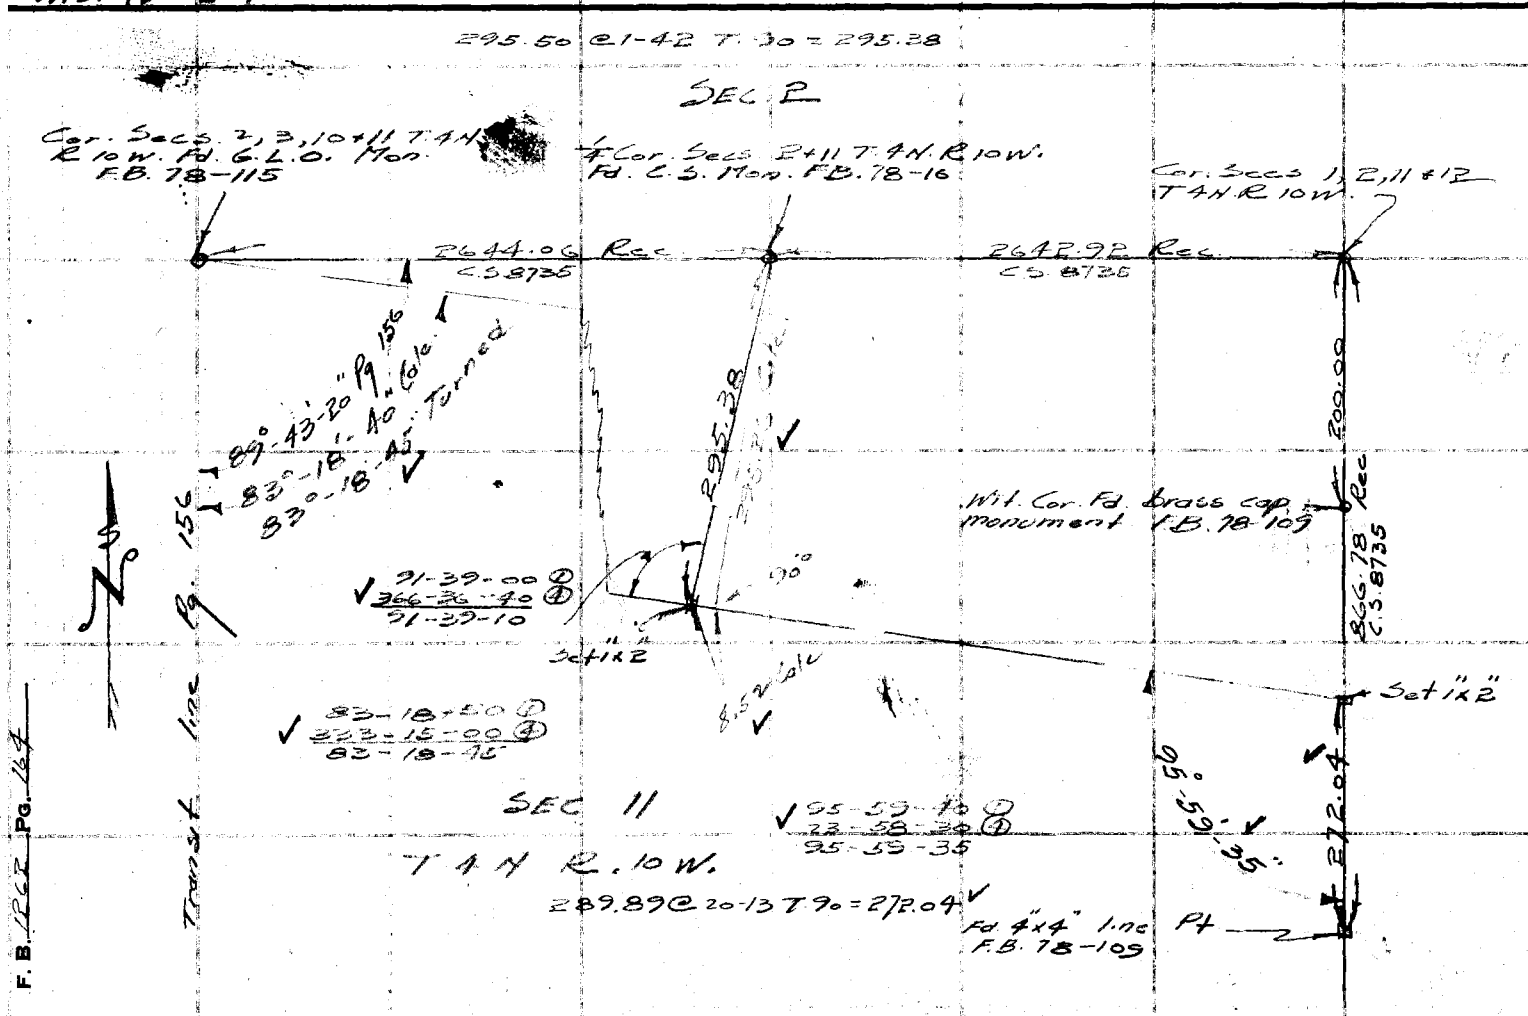

F. B. 1262 PG. 164

Notes Ck'd by KRM.	Survey of T.4N. R10W.
Map No.	W. O. 4999 Tape No. 77 St'd 84 °F
Office Work	Surveyed by Rosecrans
Checked	Notes R Date 8-5-48
Date	Indexed C. Johnson

F. B. 1262 Pg. 165

W.S. 15-8-1

Cont bottom next page

3.05

13+48.28

13+47.72 Fd. 2x2 - 4" up.

Iron Po Fn.

N 45° W.

1.94

B.D. 13+21

183.80 @ 0-36 = 183.79
249.51 @ 4-40 = 248.68
181.80 @ 1-20 = 181.75
209.38 @ 1-21 = 209.32
159.14
146.57
174.04 @ 2-13 = 173.91
1303.16
T.94 = 1303.24

1303.24

13+71.23 Fd. 6" post in mound of rocks 4' base 2½' high

1303.32 T.54 = 1303.07
Rechain

Set 10d Nd. 12+58.67

N 45° E.

10+18 B.D.

Trail

8+91.0 4 road

N 45° E

SEC. 15

SEC. 10

T.4N. R.10W.

758.14 T.54 = 758.01
Rechain

758.01

218.76 @ 1-50 = 115.66
153.52 @ 3-45 = 218.65
270.74 @ 2-35 = 153.19
270.46
757.76
T.94 = 758.01

B.D. 5+62

N 50° E

Set 1"x2" - 5+00.66

501.79 T.44 = 501.66
Rechain

89-48-20
359-13-40
89-48-25

2+74 B.D.

N 45° E.

501.66

0+00 to W. Cor. Secs 10, 11, 14 + 15 T.4N. R10W. Fd. C.S. Mon. F.B. 78-148

0+70 B.D.

N 45° E.

89-48-25

1 offset line Pg. 160

Set 1"x1"

1.00

300.36 @ 4-35 = 5.09
197.63 @ 3-50 = 299.34
197.19
501.62
T.94 = 501.65

SEC. 14

SEC. 11

Note: Any Additions or Changes on This Sheet Must be Made or Circled in Red Ink With Date and Name of Person Making Change.

Do not extend notes this side of this line.

RETURN TO
LOS ANGELES COUNTY SURVEYOR
700 HALL OF RECORDS

FORM 247 5M 5-46

F. B. 1262 PG. 766

Cont. bottom next page

Set 1"x2" - 39+79.57 09

10.92 9.28

Fd. new 2x2" 4" up

10 Dirt Rd

0.25

222.58 @ 2-31 T.94 =
222.88

39+59

222.34 T.60 = 222.31 Rechain
56.78
Set 1"x2" - 37+57.19

222.88

10' Dirt Rd

50.00
247.45 @ 4-06 = 246.82
273.32 @ 4-45 = 272.38
300.69 @ 2-21 = 300.44
286.44 @ 9-06 = 282.83
1152.47
T.94 = 1152.54

34+30

B.D. 33+01.92

1152.44 T.60 = 1152.26
Rechain

N.45° E.

Iron Po. Fn.

B.D. 30+21

N.45° E.

SEC. 15

U.S. GENERAL LAND OFFICE SURVEY
PENALTY $250 FOR REMOVAL
1912

R.P. 26+59.06
Set 2" I.P. 3" up.

26+97 B.D.

Fd. G.L.O. Mon. a 1" I.P. with 2" brass cap marked as shown in new mound of rocks 2' base 2' high. This monument appears to have been moved by road graders as it is just stood up and rocks piled around it.

1152.54

0.22

26+31.0

26+27.0

N.15° W. 16.0

26+29.06 ¼ COR Dirt Rd

0.45 24.54

0.7

Reset G.L.O. monument. Shown above to this location by proportion 12' Dn.

12.65

26+13.55 42

.52
Set 1x2" - 26+04.65

25+99.06 Set 2" I.P. R.P. 10" up.

42.79 T.54 =
Rechain

43.36 @ 6-55 = 42.75

42.75 78

Iron Po. Fn.

74
Set 1x2" - 25+61.90

22+62.0 B.D.

N.45° E.

1303.24 .07

N.45° E.

18+18.0 B.D.

W.S. 15-B-1

SEC. 10

T. 4 N. R. 10 W.

RETURN TO
LOS ANGELES COUNTY SURVEYOR
700 HALL OF RECORDS

Do not extend notes this side of this line.

Note: Any Additions or Changes on This Sheet Must be Made or Circled in Red Ink With Date and Name of Person Making Change.

F.B. 1262 PG. 167

Cont. bottom next page

Set 1"x2" - 21+43.71 ✓

300.91 @ 6-19 = 299.08 ✓
300.65 @ 6-05 = 298.96 ✓
598.04 ✓
T.80 = 298.02 ✓

231.03 @ 4-31 = 230.31 ✓
300.78 @ 4-30 = 299.85 ✓
300.30 @ 4-10 = 299.51 ✓
829.67 ✓
T.94 = 829.72 ✓

Set 1"x2" - 15+46.69 ✓

Note: Set 5 Rep. 1"x2"s to S.+W. as the pipe was missed.

12 ✓
S2+58.~~83~~ Fr. E
Cor. Secs 10 & 15 T. 4N. R 10 W.
Fd 2" I.P. with brass cap
marked as shown 18" up in
mound of rocks 2' base 1' high

SEC. 9

116.27 @ 5-22 = 115.76 ✓
229.10 @ 4-48 = 228.30 ✓
344.06 ✓
T.94 = 344.08 ✓

U.S. GENERAL LAND OFFICE SURVEY
PENALTY $250 FOR REMOVAL
T.4N. R.10 W.
510
515

U.S. GENERAL LAND OFFICE SURVEY
PENALTY $250 FOR REMOVAL
T.4N. R.10 W.
39
516

1912

0+00 to N.
Cor. Secs 9+16 T. 4N. R 10 W.
Fd 2" I.P. with brass cap
marked as shown 14" up

598.02

829.72

1279.24

Int. Set 1"x2" 7+15.97 ✓

0.98

0.85

6+00.2

371.89

Set 1"x2" - 3+71.89

Iron Po Fn.

SEC. 10

T.4N. R.10 W.

N.30° E

N.45° E

N.45° E

89°-54'-45"

B.O. 50+72.
85-57-50
355-47-00
89-54-45

B.O. 47+48.0

B.O. 43+63.2

299.75 @ 2-65 = 299.36 ✓
78.51
371.87 ✓
T.94 = 371.89 ✓

SEC. 15

281.79
300.24
113.01
1279.18
1275.26

281.89 @ 1-32 = 281.79
300.59 @ 2-45 = 300.24
300.42 @ 1-30 = 300.02
285.93 @ 1-35 = 283.82
T.94 = 1279.18
1277.23 T.60 = 1279.03 Feeding

1"x2" - 39+79.67 See preceding page

Survey of T. 4N. R 10 W.
W. of SBM Tape No. 22 Std. ~~B~~ °F.
Surveyed by Fosscars
Notes R. Date 8-4-48
Indexed A. C. Johnson

Notes Ck'd by KDM.
Map No.
Office Work
Checked
Date

W.S.15 - B-1

Do not extend notes this side of this line.

RETURN TO
LOS ANGELES COUNTY SURVEYOR
700 HALL OF RECORDS

Note: Any Additions or Changes on This Sheet Must be Made or Circled in Red Ink With Date and Name of Person Making Change.

FORM 247 5M 5-46

F. B. 1262 PG. 168

Cont. bottom next page

W.S. 15-B-1

Set 1"x2" - 37+24.95

8' Dr.

34+41

1.43

33+40.77

¼ Sec Cor Fd. G.L.O. monument a 1" I.P. with 2" I.P. with brass cap marked as shown, loosely set in mound of rocks

SEC. 9

T. 4 N. R. 10 W.

135.83 @ 4-46 = 135.36
299.82 @ 0-45 = 299.79
300.87 @ 6-28 = 298.96
197.91 @ 9-50 = 195.00
262.44 @ 9-52 = 258.56
1187.67
T.94 = 1187.75

1187.75

U.S. GENERAL LAND OFFICE PENALTY $250 FOR REMOVAL SURVEY

U.S. GENERAL LAND OFFICE PENALTY $250 FOR REMOVAL SURVEY

1912

N. 20° E.

191

Bottom Dr. 28+86

SEC. 10

¼ Sec Cor. 26+35.23 Fd. G.L.O. 1" I.P. with brass cap marked as shown laying in a mound of stones 3' base 1.5' high. Reset pipe in center of mound. Govt. notes call for mound west of corner but there is no evidence that the pipe was ever set on the east side of the mound, and other G.L.O. monuments found in this vicinity have been found standing in the center of rock mounds.

803.57

0.44

100.59 @ 12-57 T.84 = 98.03

98.03

Set 1"x2" - 25+37.20

300.92 @ 2-56 = 94.18
299.31
393.49
T.84

393.49

1"x2" - 21+43.71

See preceding page

RETURN TO
LOS ANGELES COUNTY SURVEYOR
700 HALL OF RECORDS

Do not extend notes this side of this line.

Note: Any Additions or Changes on This Sheet Must be Made or Circled in Red Ink With Date and Name of Person Making Change.

Notes Ck'd by KRM	Survey of T. 4N R. 10W
Map No.	W. O. 4999 Tape No. 77 St'd. 84°F
Office Work	Surveyed by Rosecrans
Checked	Notes K Date 8/10/48
Date	Indexed E. C. Johnson

F. B. 1262 Pg. 169

W.S. 15-B-1

SEC. 4 Cont. Bottom next page

Set 1x2 - 57+49.65

U.S. GENERAL LAND OFFICE PENALTY $250 FOR REMOVAL T4N. R.10W. S4 S9 SURVEY 1912

613.87

SEC. COR. 52+68.49 Fd. 2" I.P. with brass cap marked as shown 18" up. mound of rocks 4' base 2' high on W. side of pipe.

Bottom Dr. Bear N/40°E. 52+40

117.58 @ 5-03 = 117.12
238.11 @ 6-48 = 236.44
262.10 @ 6-46 = 260.27
613.83
613.87

140.16 @ 18-47 T.94 = 132.71

132.71

Set 1x2 51+35.78

(?)

76.78 @ 10-00 T.94 = 75.61

75.61

SEC. 9

Set 1x2 50+60.17 Top Spur bearing N.30°E

T. 4N. R. 10W.

E+W. B.D 46+11

Top. E+W. Spur 44+90

SEC. 10

B.D. 43+80

N.45E

1335.22

T. Spur Bear. N.45E 42+52

273.97 @ 2-36 = 273.69
296.27 @ 1-05 = 296.22
239.52 @ 1-38 = 239.42
156.12 @ 4-26 = 155.65
284.83 @ 4-30 = 283.95
86.98 @ 7-42 = 86.20
1335.13
T.94 = 1335.22

1x2 - 37+24.95 See preceding page

Note: Any Additions or Changes on This Sheet Must be Made or Circled in Red Ink With Date and Name of Person Making Change.

Do not extend notes this side of this line.

RETURN TO LOS ANGELES COUNTY SURVEYOR 700 HALL OF RECORDS

FORM 247 5M 5-46

F. B. 1262 PG. 170

W.S. 15-B-1

Cont bottom next page

Set "1x1" good for distance only. 78+11.41

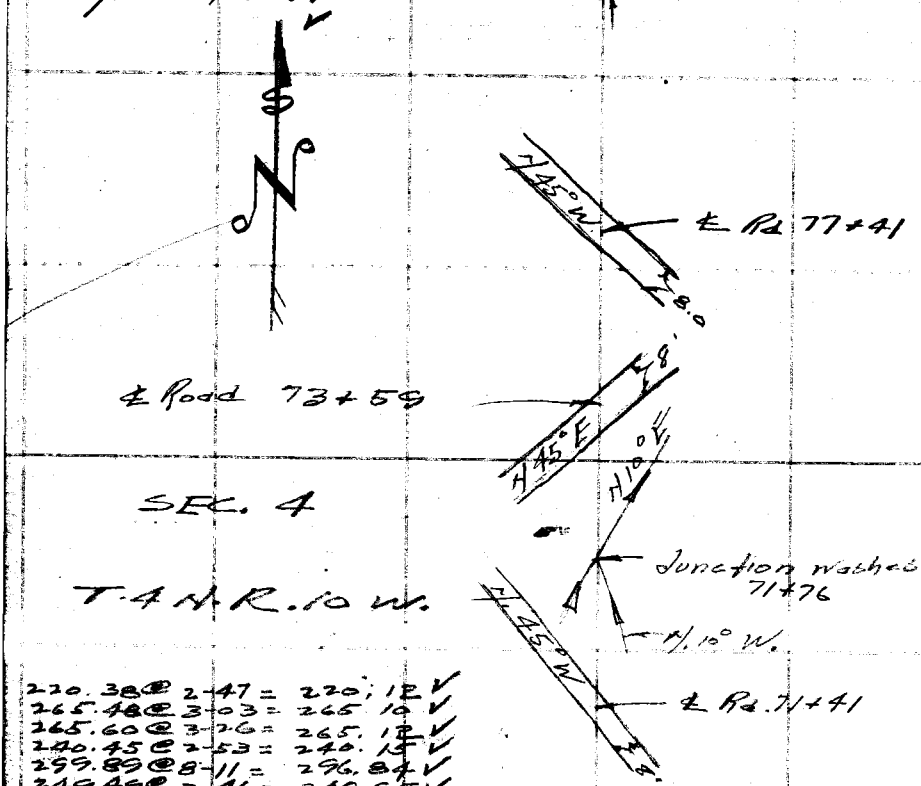

220.38 @ 2-47 = 220.12
265.48 @ 3-03 = 265.10
265.60 @ 3-26 = 265.12
240.45 @ 2-53 = 240.15
299.89 @ 8-11 = 296.84
249.49 @ 3-46 = 248.95
299.47 @ 0-51 = 299.44
231.00 @ 12-03 = 225.91
2061.63
T.94 = 2061.76

66+74 T.S.

SEC. 3

2061.76

GENERAL LAND OFFICE SURVEY
PENALTY $250 FOR REMOVAL
T.4N. R.10W.
S3
S10
U.S.
1912

1.74

59+75.80 Fd 2" I.P. with brass cap marked as shown 12" above surface. Rock mound 3' base 2' high W. of pipe

226.15

231.24 @ 12-03 T.94 = 226.15

1"x2" - 57+49.65 see preceding page

SEC. 10

RETURN TO
LOS ANGELES COUNTY SURVEYOR
700 HALL OF RECORDS

Do not extend notes this side of this line.

Note: Any Additions or Changes on This Sheet Must be Made or Circled in Red Ink With Date and Name of Person Making Change.

Notes Ck'd by KRM	Survey of T.4N. R 10W
Map No.	W. O. 4999 Tape No. 77 St'd 84°F
Office Work	Surveyed by Rosecrans
Checked	Notes R Date 8-16-48
Date	Indexed E. C. Johnson

F. B. 1262 PG. 171

W.S. 15-B-1

Cont bottom next page

3.56

86+26.16 Fd 1" I.P. with 2" brass cap marked as shown 12" above surface

10.91

Set 1"x2" - 86+15.25

OFFICE SURVEY FOR REMOVAL

U.S. GENERAL LAND PENALTY

250

1/4

S3

1912

N 45° E

SEC. 4

84+42 ℄ road

SEC. 3

T.4N. R 10W

80

26.5

17.7

529.27

Conc. Reservoir

229.99 @ 1-27 = 229.92

299.93 @ 3-41 = 299.31

529.23

T.96 = 529.27

15.

81+18.7

U.S. GENERAL LAND PENALTY

250

W.C.

1/4

S4

OFFICE SURVEY FOR REMOVAL

1912

Set 1x2 - 80+85.98

10.00

1.23

80+75.98 Fd. 1" I.P. with 2" brass cap marked as shown in mound of stones 3' base 1.5 high. Mound of earth 3' base 1/2 high W. of Cor

COUNTY SURVEYOR

T.4N.

R.10W.

4

1/4 COR

R.E.

329

165.00

N 15° W

79+38.4 ℄ road

79+10.98 Set 2" I.P. with brass cap marked as shown in Conc. 4" up.

274.91 @ 2-56 T. 96 = 274.57

274.57

1.27

1"x1" - 78+11.41 See preceding page

Note: Any Additions or Changes on This Sheet Must be Made or Circled in Red Ink With Date and Name of Person Making Change.

Do not extend notes this side of this line.

RETURN TO
LOS ANGELES COUNTY SURVEYOR
700 HALL OF RECORDS

FORM 247 5M 5-46

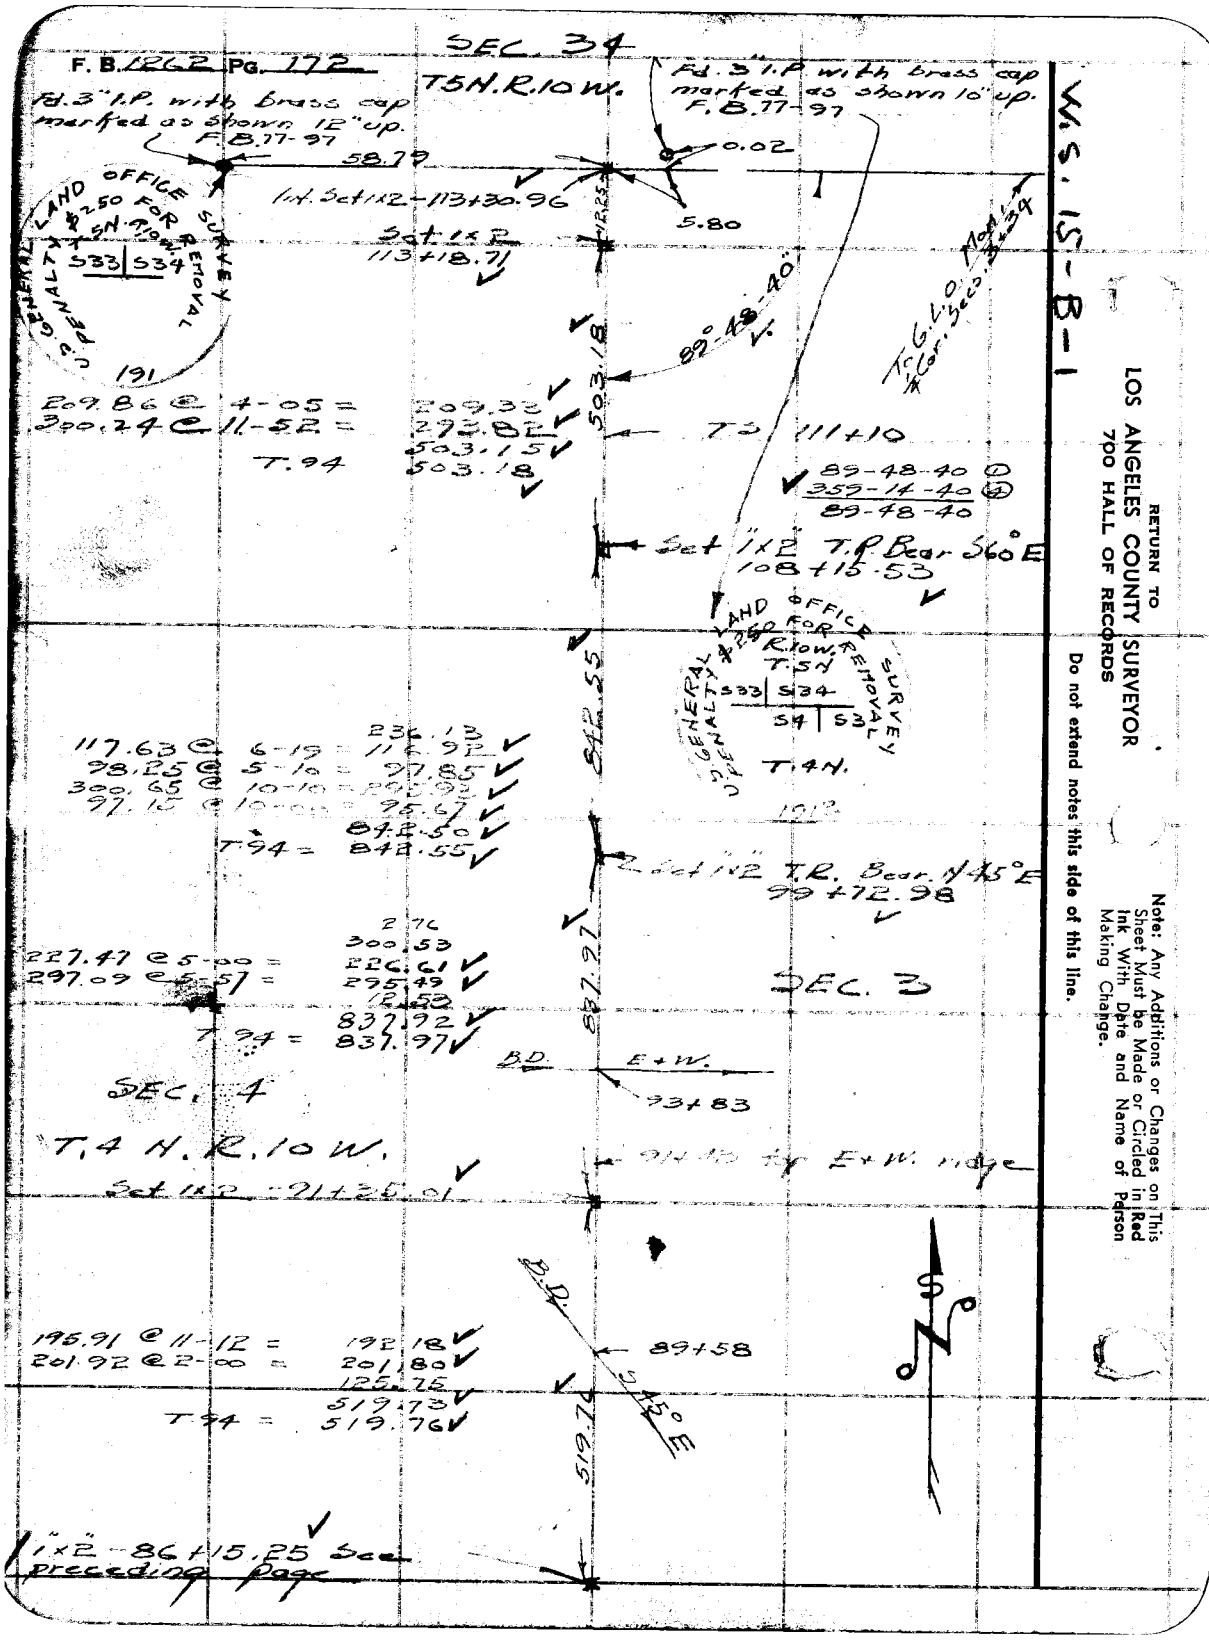

SEC. 34
F. B. 1262 PG. 172
T5N. R.10 W.
Fd. 3" I.P. with brass cap marked as shown 12" up. F.B. 77-97
Fd. 3" I.P. with brass cap marked as shown 10" up. F.B. 77-97
58.79
0.02
5.80
1st. Set 1x2 - 113+30.96
Set 1x2 113+18.71
U.S. GENERAL LAND OFFICE SURVEY
PENALTY $250 FOR REMOVAL
T5N. R10W.
S33 | S34
191
89°-48'-40"
503.18
209.86 @ 4-05 = 209.32
300.24 @ 11-52 = 293.82
503.15
T.94 503.18
T.S. 111+10
89-48-40 ①
359-14-40 ②
89-48-40
Set 1"x2" T.P. Bear S60°E 108+15.53
U.S. GENERAL LAND OFFICE SURVEY
PENALTY $250 FOR REMOVAL
R.10W. T.5N
S33 | S34
S4 | S3
T.4N.
1912
842.55
236.13
117.63 @ 6-19 = 116.92
98.25 @ 5-10 = 97.85
300.65 @ 10-10 = 295.92
97.15 @ 10-00 = 95.67
842.50
T.94 = 842.55
Set 1"x2" T.R. Bear N45°E 99+72.98
2.76
300.53
227.47 @ 5-00 = 226.61
297.09 @ 5-57 = 295.49
12.53
837.92
T.94 = 837.97
837.97
SEC. 3
B.D. E+W.
93+83
SEC. 4
T.4 N. R.10 W.
Set 1x2 - 91+25.01
91+43 for E+W. ridge
B.D.
89+58
S45°E
195.91 @ 11-12 = 192.18
201.92 @ 2-00 = 201.80
125.75
519.73
T.94 = 519.76
519.76
1"x2" - 86+15.25 See preceding page
W.S. 15-B-1
RETURN TO
LOS ANGELES COUNTY SURVEYOR
700 HALL OF RECORDS
Do not extend notes this side of this line.
Note: Any Additions or Changes on This Sheet Must be Made or Circled in Red Ink With Date and Name of Person Making Change.

W.S.15.B-1

Notes Ck'd by KRM	Survey of T.4 N R 10 W
Map No.	W. O. 4999 Tape No. 85 St'd 84 °F
Office Work	Surveyed by Rosecrans
Checked	Notes Pierce Date 9/2/48
Date	Indexed A. C. Johnson

F. B. 1262 PG. 173

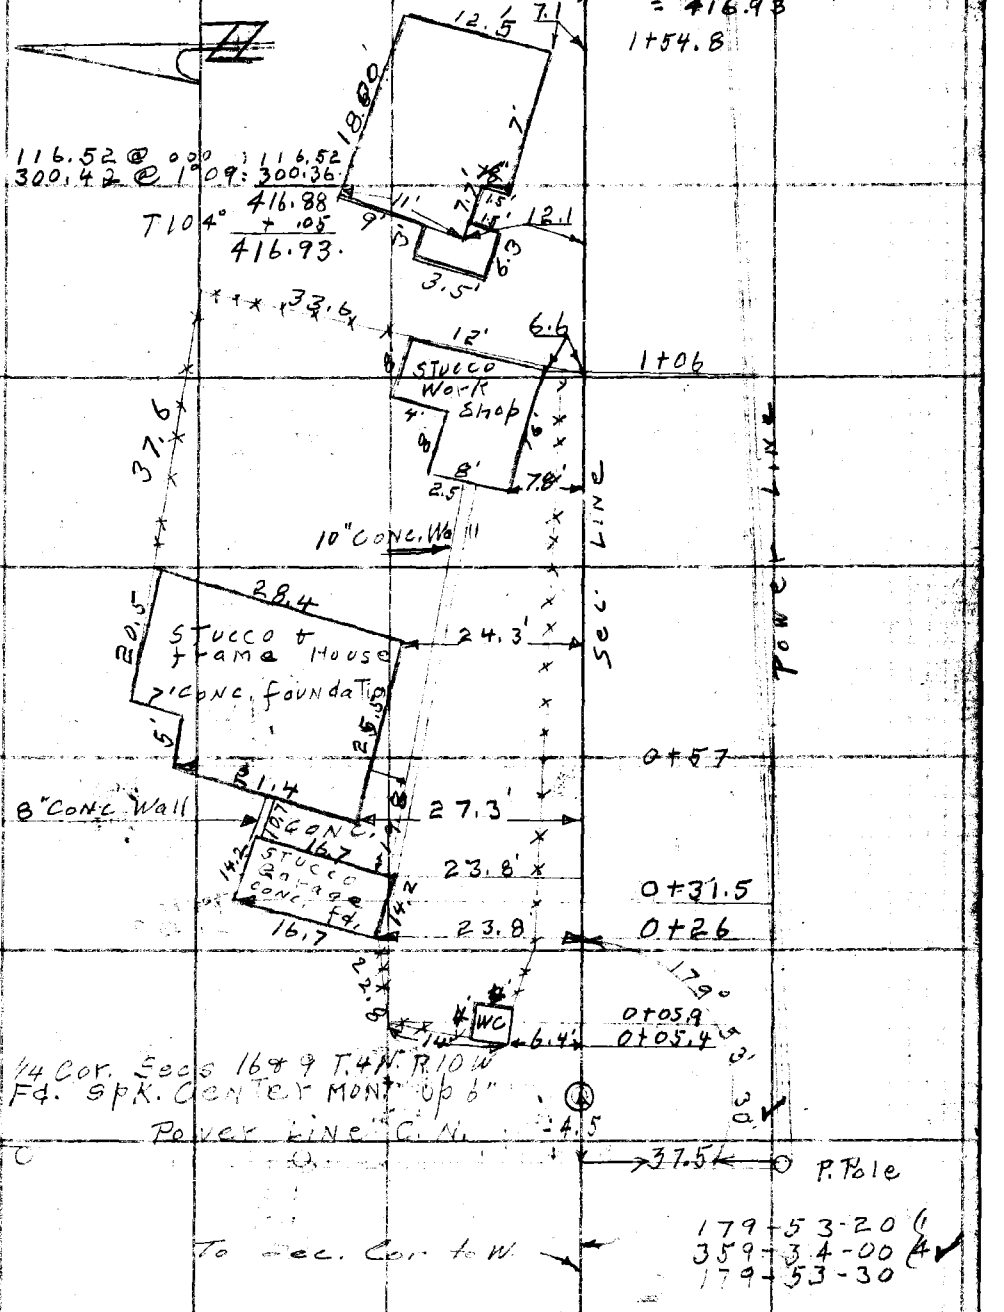

Note: Any Additions or Changes on This Sheet Must be Made or Circled in Red Ink With Date and Name of Person Making Change.

Do not extend notes this side of this line.

RETURN TO
LOS ANGELES COUNTY SURVEYOR
700 HALL OF RECORDS

FORM 247 5M 5-46

F. B 1262 PG. 174

To 1"x2" -3+71.89 Pg 167

S. Cor. of 9, 16, & 15

1½" I.P. Up 18" & Brass cap Mkd. C.S. Map #8735

89°-53'-05"

26+40.40 Fr. W.

General Land Office Survey
T.N. & N. R. 10 W.
S9 / S16

S.N.

℄ 3' Wash	N. & S.	25+71
℄ 6' Wash	N & S	23+18
℄ 2' Wash	N & S	20+24
℄ 3' Wash	N. & S.	18+32
Fenc cor.	x x x 2'	13+20.62
Power Line	N. & S.	13+17

Power Pole Lead in End of Line 6+52

℄ INT. 10' Rd. 6+30

220.45 @ 1°08' =	220.41 ✓	
179.10 @ 1°30' =	179.04 ✓	
99.83 @ 0°00' =	99.83 ✓	
240.00 @ 0°30' =	239.99 ✓	
243.14 @ 2°25' =	242.92 ✓	
112.07 @ 0°00' =	112.07 ✓	
283.65 @ 2°38' =	283.35 ✓	
300.34 @ 2°48' =	299.98 ✓	
300.10 @ 3°48' =	299.44 ✓	
235.82 @ 2°22' =	235.62 ✓	
10.65 @ 0°00' =	10.65 ✓	
T-96	2223.30 ✓	

2223.47

Water Tank METAL D. 4.3' = 2223.47 ✓ — 30.9 — 4+31.4 / 4+19.9

Set 1x2 fl. on line 4+16.93 ✓

31.2 — 4+08.90

Conc. pillars 2' base 46.5

INT. 10' rd + drive way 26.65 — 3+85.20

P. Pole Δ pt. & lead in 3.5 — 3+70.63

from Top of preceeding page

W.S. 15-B-1

RETURN TO
LOS ANGELES COUNTY SURVEYOR
7DO HALL OF RECORDS

Do not extend notes this side of this line.

Note: Any Additions or Changes on This Sheet Must be Made or Circled in Red Ink With Date and Name of Person Making Change.

Notes Ck'd by RRM.	Survey of TN.4N. R.10W.
Map No.	W. O. 4999 Tape No. 85 St'd 84 °F
Office Work	Surveyed by Rosecrans
Checked	Notes Pierce Date 9/3/48
Date	Indexed C. Johnson

F. B. 1262 Pg. 175

W.S. 15-B-1

GENERAL LAND OFFICE S.8 | S.9

N. Edg. Rd. 26+39 Λ
Fd. G.L.O. MON.
12" dN. F.B. 78-38
26+30.01 ✓
90°-09'-20"

T66° 785.05 ✓
-.09
785.14 ✓
193.00 @ 4°08' = 192.50 ✓
294.65 @ 4°26' = 293.77 ✓
300.28 @ 5°33' = 298.87 ✓
Fd 4X4 up 4"
B. wire fence 19.90
INT. Power Lines

26+12
S. Edg. Rd
26+09.98
26+10
26+05
90-09-20
360-37-20
90-09-20

℄ 8' dirt Rd. N.E. + S.W. 20+91 ✓

T66° 529.81 ✓
-.06
529.87 ✓
230.00 @ 2°50' = 229.72 ✓
300.55 @ 2°57' = 300.15 ✓

18+44.96 ✓
Set 1X2 on Line

E + W. barbed wire fence 15+29

529.81

Fd. 2" I.P. filled wi. conc.
Tack & Tab Mkd RE. 2000
0.10 E. of Line (Tottle)

13+15.15 ✓
0.1

T96° 1315.15 ✓
+.10
1315.05 ✓
122.18 @ 5-49' = 121.55 ✓
300.68 @ 5°34' = 299.26 ✓
300.66 @ 7°00' = 298.42 ✓
300.45 @ 6°15' = 298.67 ✓
300.26 @ 8°15' = 297.15 ✓

1315.15 ✓

COUNTY SURVEYOR
T.4N
R.10W.
8 | 9
17 | 16

Power Line + 8' Rd. 2+99.

To 1+2 on transit line opposite 1252 F.B. 48 171+174

90-09-40 ✓

89°51'45"

89-51-40
359-23-00
89-51-45

MONUMENT

Cor. Secs. 8, 9, 17, + 16 T.4N R.10W.
2" I.P. in conc. with Brass
Cap Mkd. 6" up - Md. stone

To 1/4 S. Cor.

90-09-40
360-38-40
90-09-40

Note: Any Additions or Changes on This Sheet Must be Made or Circled in Red Ink With Date and Name of Person Making Change.

Do not extend notes this side of this line.

RETURN TO
LOS ANGELES COUNTY SURVEYOR
700 HALL OF RECORDS

FORM 247 5M 5-46

F. B 1262 PG. 176

W.S. 15-B-1

RETURN TO
LOS ANGELES COUNTY SURVEYOR
700 HALL OF RECORDS

Do not extend notes this side of this line.

Note: Any Additions or Changes on This Sheet Must Be Made or Circled in Red Ink With Date and Name of Person Making Change.

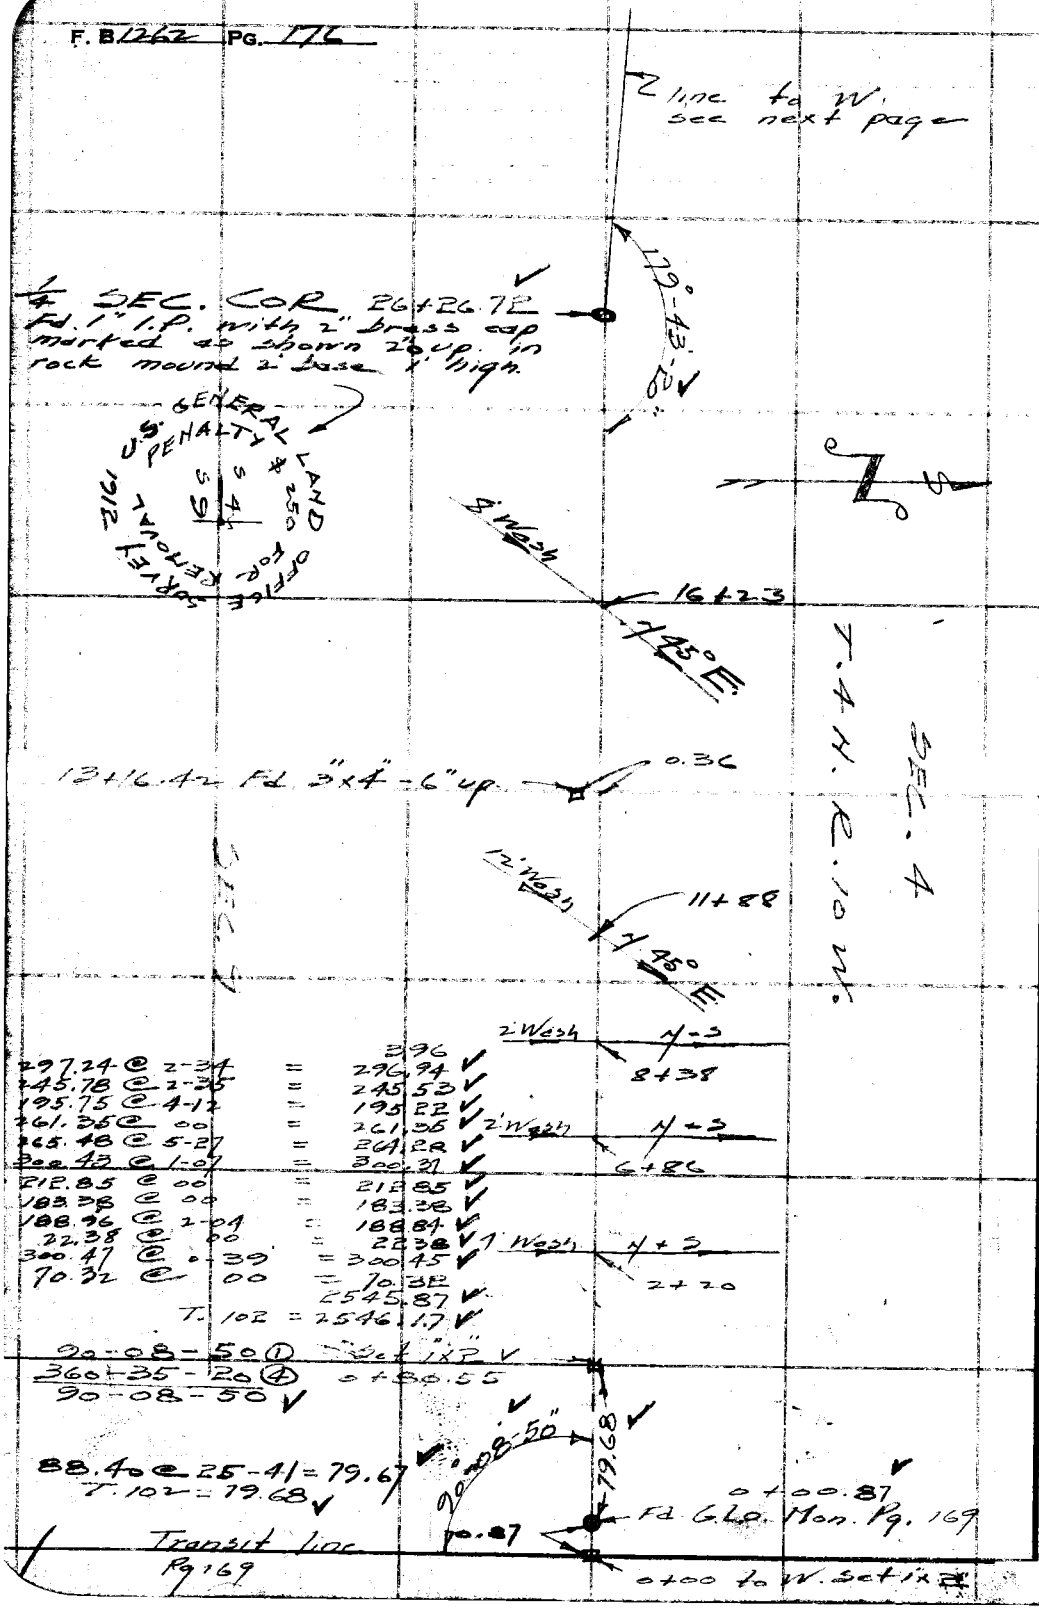

Notes Ck'd by KRM	Survey of T. 4 N. R 10 W.
Map No.	W. O. 4999 Tape No. 85 St'd 84 °F
Office Work	Surveyed by Rosecrans
Checked	Notes R Date 10-28-48
Date	Indexed ~~R. C. Johnson~~

F. B. 1262 Pg. 177

W.S. 15-B-1

Set 1"x2" top of spur
19+30.18

657.18

193.88 @ 3-40 = 193.48
213.21 @ 3-40 = 212.83
245.54 @ 3-55 = 245.97
T.60 = 657.28
657.18

Fd. 2"x2" + rock mound 3 base 8" high. 8.67

41.94

Calc. 41.03

43.63 @ 16-01 = 41.94

Set 1"x2" - 12+79.00

T. 4 N. R. 10 W.

SEC. 9

176.69

177.08 @ 3-38 T.60 = 176.69

Set 1"x2"
11+02.31

SEC 4

695.88

193.34
202.09
300.55
695.98
T.62 = 695.88

Set 1"x2" - 4+06.43

406.43

300.47 @ 2-16 = 300.24
106.25
406.49
T.60 = 406.43

0+00 to W.
1/4 C.R. Secs 4+9
Fd. G.L.O. monument

179-43-20 (2)
358-53-10 (4)
179-43-17½

Sec line to E see preceding page

Note: Any Additions or Changes on This Sheet Must be Made or Circled in Red Ink With Date and Name of Person Making Change.

Do not extend notes this side of this line.

RETURN TO
LOS ANGELES COUNTY SURVEYOR
700 HALL OF RECORDS

FORM 247 5M 5-46

F. B. 1262 PG. 178

W.S. 15-B-1

RETURN TO
LOS ANGELES COUNTY SURVEYOR
700 HALL OF RECORDS

Do not extend notes this side of this line.

Note: Any Additions or Changes on This Sheet Must be Made or Circled in Red Ink With Date and Name of Person Making Change.

Set 1"x 2" - 50+15.75 4

205.17
195.94 @ 5-03 = 195.18
263.84 @ 2-53 = 263.50
190 ± 17 m. N.S.
51.80
300.89
277.36
80.00
252.59
254.28 @ 2-53 = 253.96
1880.45
T. 76 = 1880.35

1880.35

N. + S. Dr.

145

Set 1"x 2" 31+35.40 4

SEC. 8

SEC. 5

T. 4 N. R. 10 W.

157.81 @ 2-56 = 157.60
193.48 @ 2-41 = 193.27
350.87
T 76 = 350.85

350.85

Set 1"x 2" - 27+87.55 37

183.26

Rt. 4 Std. 26+40.79
184.42 @ 6-25 T 76 = 183.26

Reset monument by proportion See Pg. 181

17.25

20.00

17.12

N. + S. Dr.

40.50

R.P. Set 1" I.P. 6" up on Sec. line

30'

Set 1"x 2" - 26+00.29

616.41

111.00
261.14
245.42 @ 5-30 = 244.29
616.43
T. 78 = 616.41

Set 1"x 2" 19+84.88 3

SEC. 9

SEC. 4

53.70 T. 82

53.70

1/2 See top preceding page
19+30.18

Notes Ck'd by KRM	Survey of T.4N. R.10W.
Map No.	W. O. 4993 Tape No. 85 St'd 84 °F
Office Work	Surveyed by Rosecrans
Checked	Notes R Date 11-18-48
Date ✓	Indexed Z C. Johnson

F. B. 1262 Pg. 179

W.S. 15-B-1

Lat. 79+32.60 1.70
Set boat Spk 3" Dn.

8.0

65.33

Graded Rd.

12.0

Cor Secs. 5, 6, 7 + 8 T.4N. R.10W.
Fd. C.S. Mon. F.B. 360-63

N. 10° W.

90°-22'-05"

N 30° W.

B.D. 74+50

To G.L.O. Mon. Cor. Secs 5+6

90-22-00 ①
361-28-20 ④
90-22-05

3.73

283.08 @ 3-32 = 282.54
259.17 @ 1-01 = 259.13
187.88 @ 1-34 = 187.81
197.81
180.40 @ 1-45 = 180.32
293.04 @ 0-32 = 293.03
220.42
1624.79
T.66 = 1624.60

B.D. 70+50

1624.60

Set 1"x2" - 63+08.10 7

1069.14

Bottom 4' Dr

SEC. 8

180.80 @ 2-32 = 180.62
89.60
300.36
298.34
201.00 @ 4-36 = 200.35
1069.27
T.66 = 1069.14

15'

Calc. 37.63

Calc. 46.49

4 SEC Cor
Fd G.L.O. Mon
F.B. 78-45
52+84.45

59.81

Set 1x2 - 52+38.96 7

141°01'

223.21

62.48 @ 16-49 = 59.81

223.66 @ 3-30 T.66 = 223.21

1"x2" - 50+15.75

T.4N. R.10W.

SEC 5

4

Note: Any Additions or Changes on This Sheet Must be Made or Circled in Red Ink With Date and Name of Person Making Change.

Do not extend notes this side of this line.

RETURN TO
LOS ANGELES COUNTY SURVEYOR
700 HALL OF RECORDS

FORM 247 5M 5-46

F. B. 1262 Pg. 180

W.S. 15-B-1

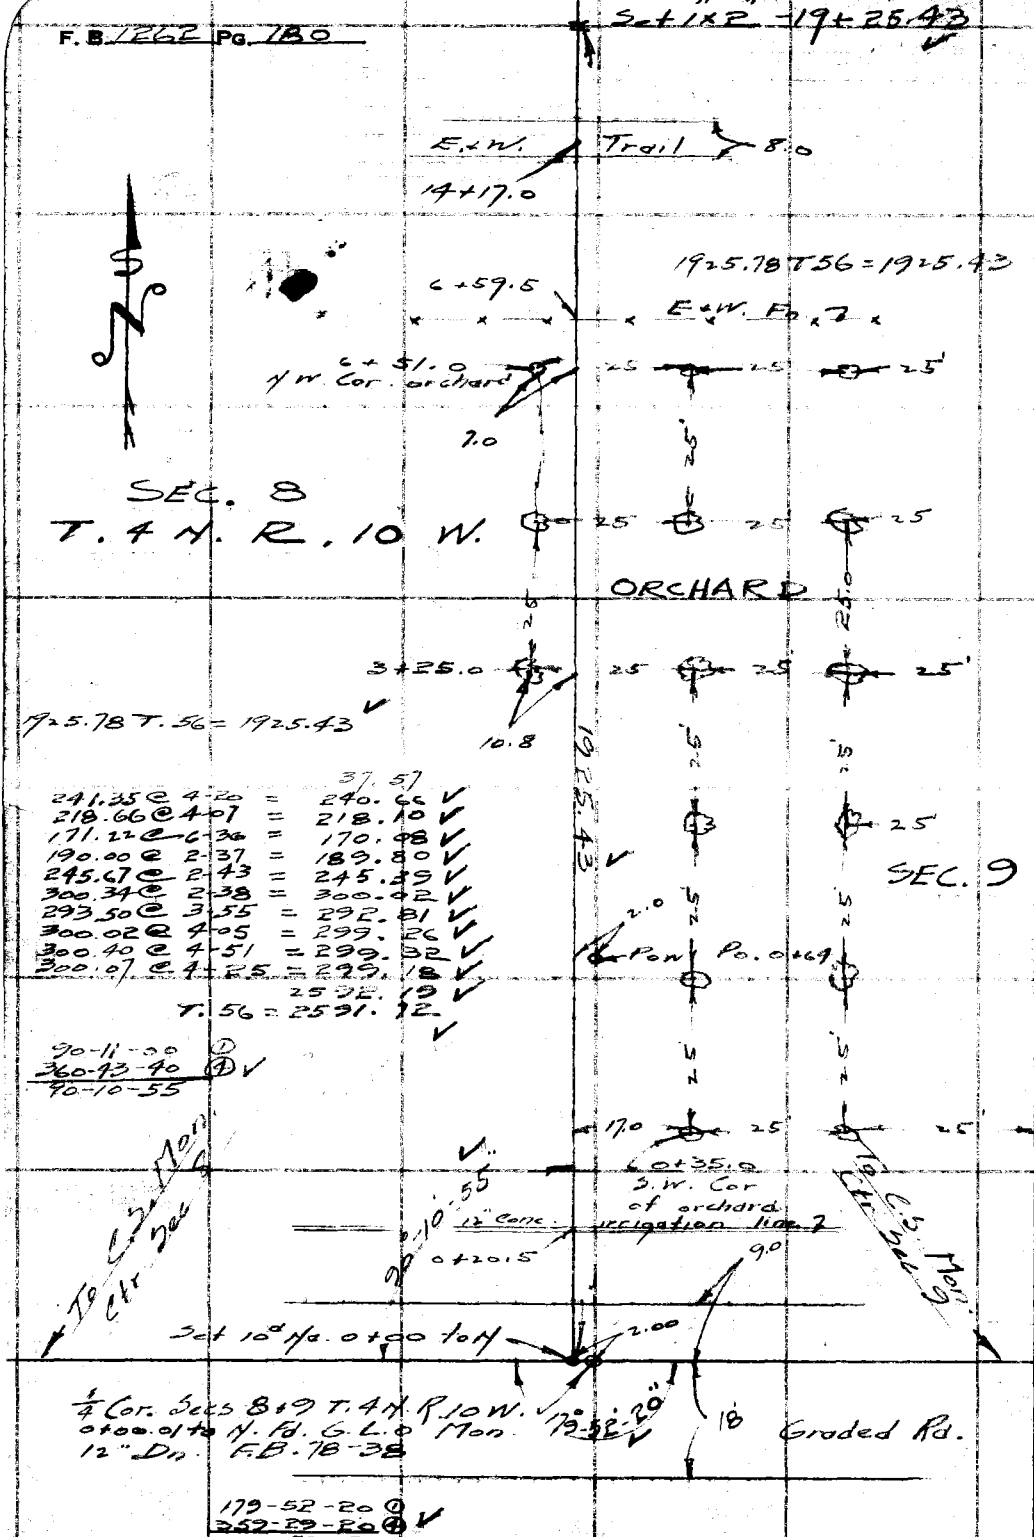

37.57

241.35 @ 4-20	=	240.66
218.66 @ 4-07	=	218.10
171.22 @ 6-36	=	170.08
190.00 @ 2-37	=	189.80
245.67 @ 2-43	=	245.39
300.34 @ 2-38	=	300.02
293.50 @ 3-55	=	292.81
300.02 @ 4-05	=	299.26
300.40 @ 4-51	=	299.32
300.07 @ 4-25	=	299.18
		2592.19
T. 56	=	2591.12

90-11-00 ①
360-43-40 ④
90-10-55

179-52-20 ①
359-29-20 ④
179-52-20

RETURN TO
LOS ANGELES COUNTY SURVEYOR
700 HALL OF RECORDS

Do not extend notes this side of this line.

Note: Any Additions or Changes on This Sheet Must be Made or Circled in Red Ink With Date and Name of Person Making Change.

Notes Ck'd by KBM	Survey of T4N. R10W
Map No.	W. O. 7499 Tape No. 85 St'd 84 °F
Office Work	Surveyed by Rosecrans
Checked	Notes Date 1-6-49
Date	Indexed C. Johnson

F.B. 1262 PG. 181

W.S. 15-B-1

To 10 4 See next page

c wash 47+85.0

SEC 5 SEC 4

T.4.N. R.10W.

36+59

35+15

℄ C Wash

34+99.0

2623.55

162.12	@ 2-34 =	161.96
241.37	@ 7-59 =	239.03
146.16	@ 3-14 =	145.93
156.99	@ 9-31 =	154.83
70.80	@ 25-28 =	63.92
93.80	@ 2-25 =	93.80
221.48	@ 1-50 =	221.37
224.51	@ 2-18 =	224.39
152.29	@ 3-03 =	152.07
204.44	@ 4-32 =	204.00
223.51	@ 6-37 =	222.03
225.70	@ 5-00 =	224.84
299.68	@ 2-41 =	299.34
216.52	@ 1-35 =	216.45
		2623.96
7.60	=	2623.55

Sec. Wash

S 37-30 E

27+22

1.46

Rt. 4 Sta. 26+40.79

Int Set 1"x2" 26+58.08 F.S.

26+43.25 Ec E.

Transit line

41.96

Pg 1787

Fd. 1"x2" 26+00.29 Pg 178

17.26

17.25

Rt 4 Sta 26+40.82

Wash

26+51

Fd. C.S. Mon. per FB 78-38 Washed out Reset it flush by proportion.

1.35

1.35

65.18 @ 15-24 = 62.84

66.89

66.37

7.40 =

29.11

Set 1"x2" 25+91.71

90-22-30

361-30-00

90-22-30

4 turned to short sights

R.P. Set 2" I.P. on Sec. line 6' up 20.00 So. of monument

SEC. 8

SEC. 9

666.41 T. 54 666.28

1"x2" 19+25.43 See top preceding page

Note: Any Additions or Changes on This Sheet Must be Made or Circled in Red Ink With Date and Name of Person Making Change.

Do not extend notes this side of this line.

RETURN TO LOS ANGELES COUNTY SURVEYOR 700 HALL OF RECORDS

FORM 247 5M 5-46

F.B. 1262 Pg. 182

W.S. 15-B-1

RETURN TO
LOS ANGELES COUNTY SURVEYOR
700 HALL OF RECORDS

Do not extend notes this side of this line.

Note: Any Additions or Changes on This Sheet Must be Made or Circled in Red Ink With Date and Name of Person Making Change.

N.C.C. Secs 4 & 5
T.4N. R.10W. Fd.
G.L.O. Mon 6" Dn
F.B. 78-40

300.55 @ 2-56 = 300.16 +170 ± 20W
300.33 @ 3-51 = 299.65
300.03 @ 3-22 = 299.51 +191 ± 7 Rd
294.78 @ 5-17 = 293.53
1192.85
T.50 = 1192.59

1192.75 Rechain 10-31-51

229.49 @ 13-24 = 223.24
T.50 = 223.19

223.24 Rechain 10-31-51

78.23 @ 2-43 = 78.14
240.81 @ 0-37 = 240.80
169.16 @ 13-24 = 164.56
148.58 @ 3-14 = 148.34
300.66 @ 1-45 = 300.52
226.62 @ 5-03 = 225.74
183.04 @ 10-25 = 180.02 +76 ± 5W
295.00 @ 8-35 = 291.70
169.40 @ 6-33 = 168.29
1798.77
T.48 = 1797.69

1797.87 Rechain 10-31-51

Secs 4 & 5 T.4N. R.10W.

0.6
Fd. 1/4" ∡ iron
marked L.S. 871 - 6" up

68.05 @ 10-24 T.50 = 66.92

Set 1"x2"

Set 1"x2"

0.05
Fd. 2" ∡ iron 12" up

26.59

1192.59

223.19

8735

Chained Rec. 1797.69

3419.45 Rechain 10-31-51

3419.00
3421.13

Set 1"x2"

179-58-00
359-58-00
179-58-00

205.53

179°-58'-00

205.63 @ 1-14 T.48 = 205.53

205.59 Rechain 10-31-51

2.00

52+81.63 Set 10d Nd on 2' offset line

52+81.63 Fr. S.

1/4 Cor. Secs 4 & 5
T.4N. R.10W. Fd.
G.L.O. Mon. F.B.
78-38

2623.55
TRUE LINE

T.4N. R.10W.

Notes Ck'd by KRM	Survey of T. 4 N. - R. 10 W.
Map No.	W. O. 4944 Tape No. 85 St'd 54 °F
Office Work	Surveyed by Rosecrans
Checked	Notes R. Date 2-7-48
Date	Indexed J. C. Johnson

F. B. 1262 Pg. 183

W. S. 15-B-1

Note: Any Additions or Changes on this Sheet Must be Made or Circled in Red Ink With Date and Name of Person Making Change.

Do not extend notes this side of this line.

RETURN TO
LOS ANGELES COUNTY SURVEYOR
700 HALL OF RECORDS

FORM 247 5M 5-46

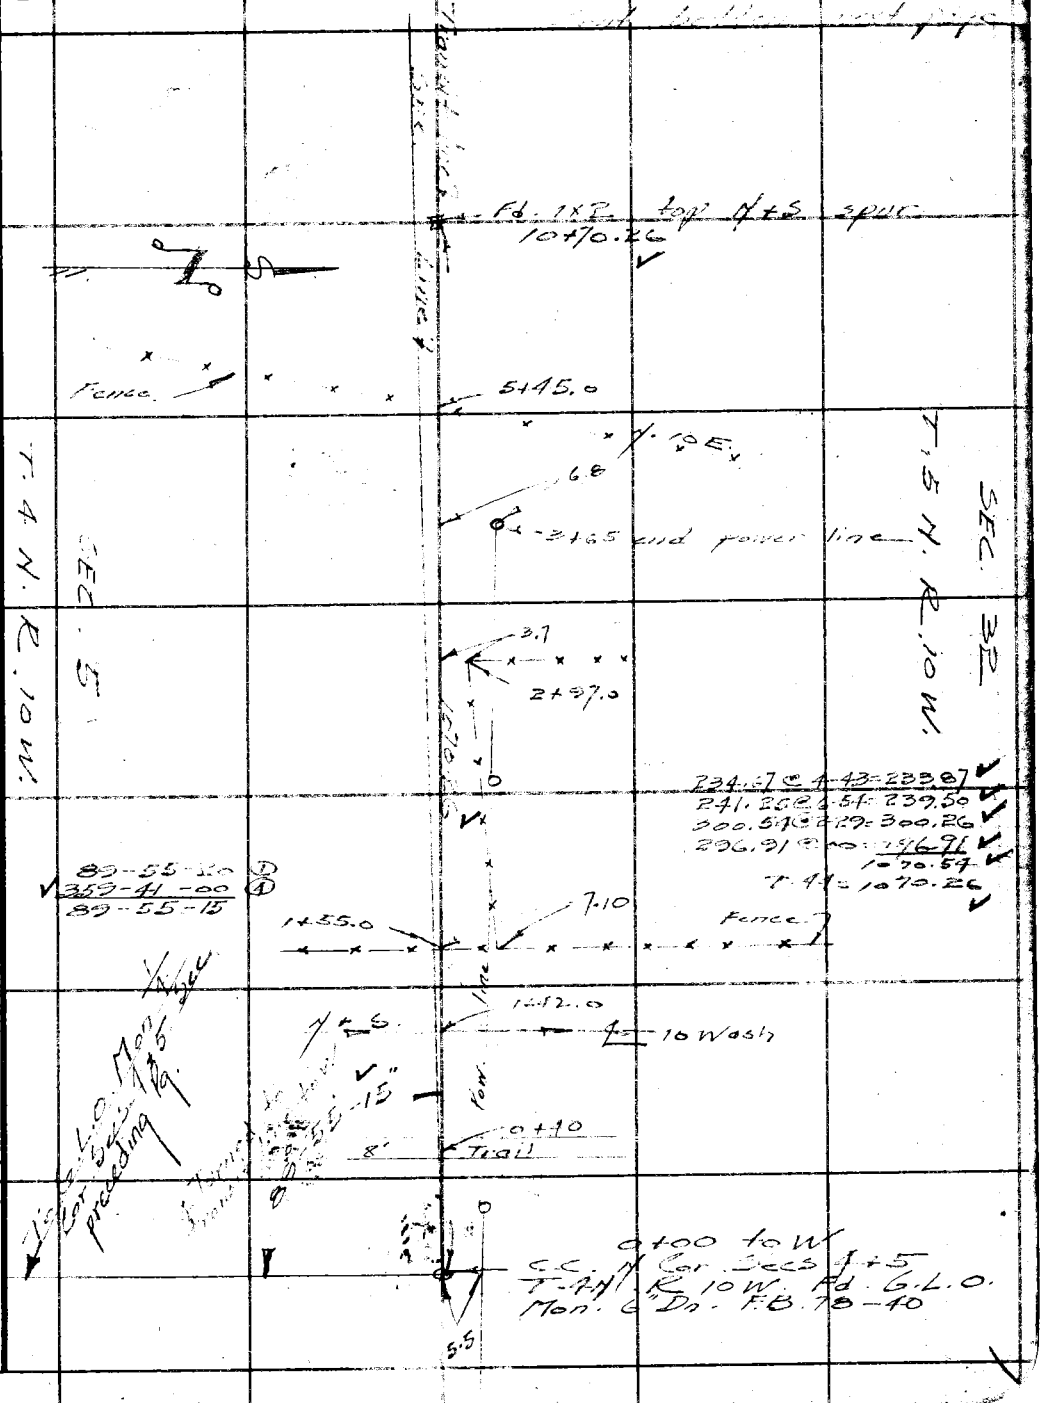

RETURN TO
LOS ANGELES COUNTY SURVEYOR
700 HALL OF RECORDS

Note: Any Additions or Changes on This Sheet Must be Made or Circled in Red Ink With Date and Name of Person Making Change.

W.S. 15-B-1

Do not extend notes this side of this line.

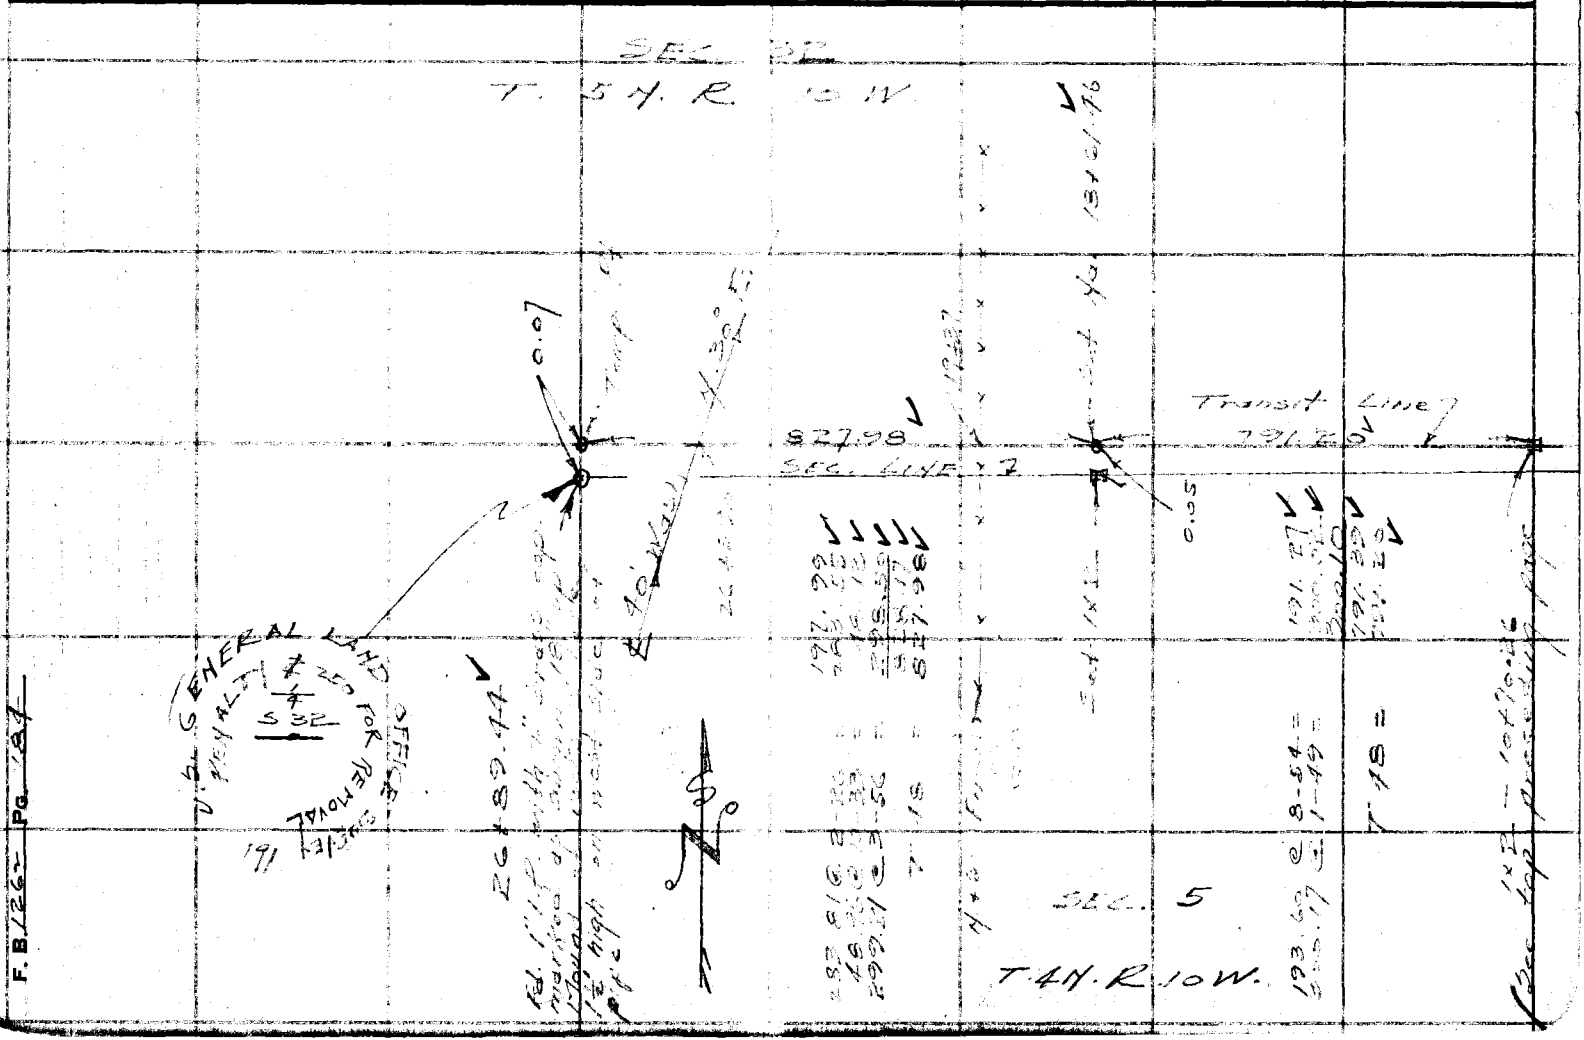

F.B. 1262 Pg. 184

Notes Ck'd by KRM	Survey of T 4 N R 10 W
Map No.	W. O. 4999 Tape No. 85 St'd 84°F
Office Work	Surveyed by Rosecrans
Checked	Notes R Date 2-8-48
Date	Indexed A. C. Johnson

F. B. 1262 Pg. 185

W.S. 15-B-1

Note: Any Additions or Changes on This Sheet Must be Made or Circled in Red Ink With Date and Name of Person Making Change.

Do not extend notes this side of this line.

RETURN TO
LOS ANGELES COUNTY SURVEYOR
700 HALL OF RECORDS

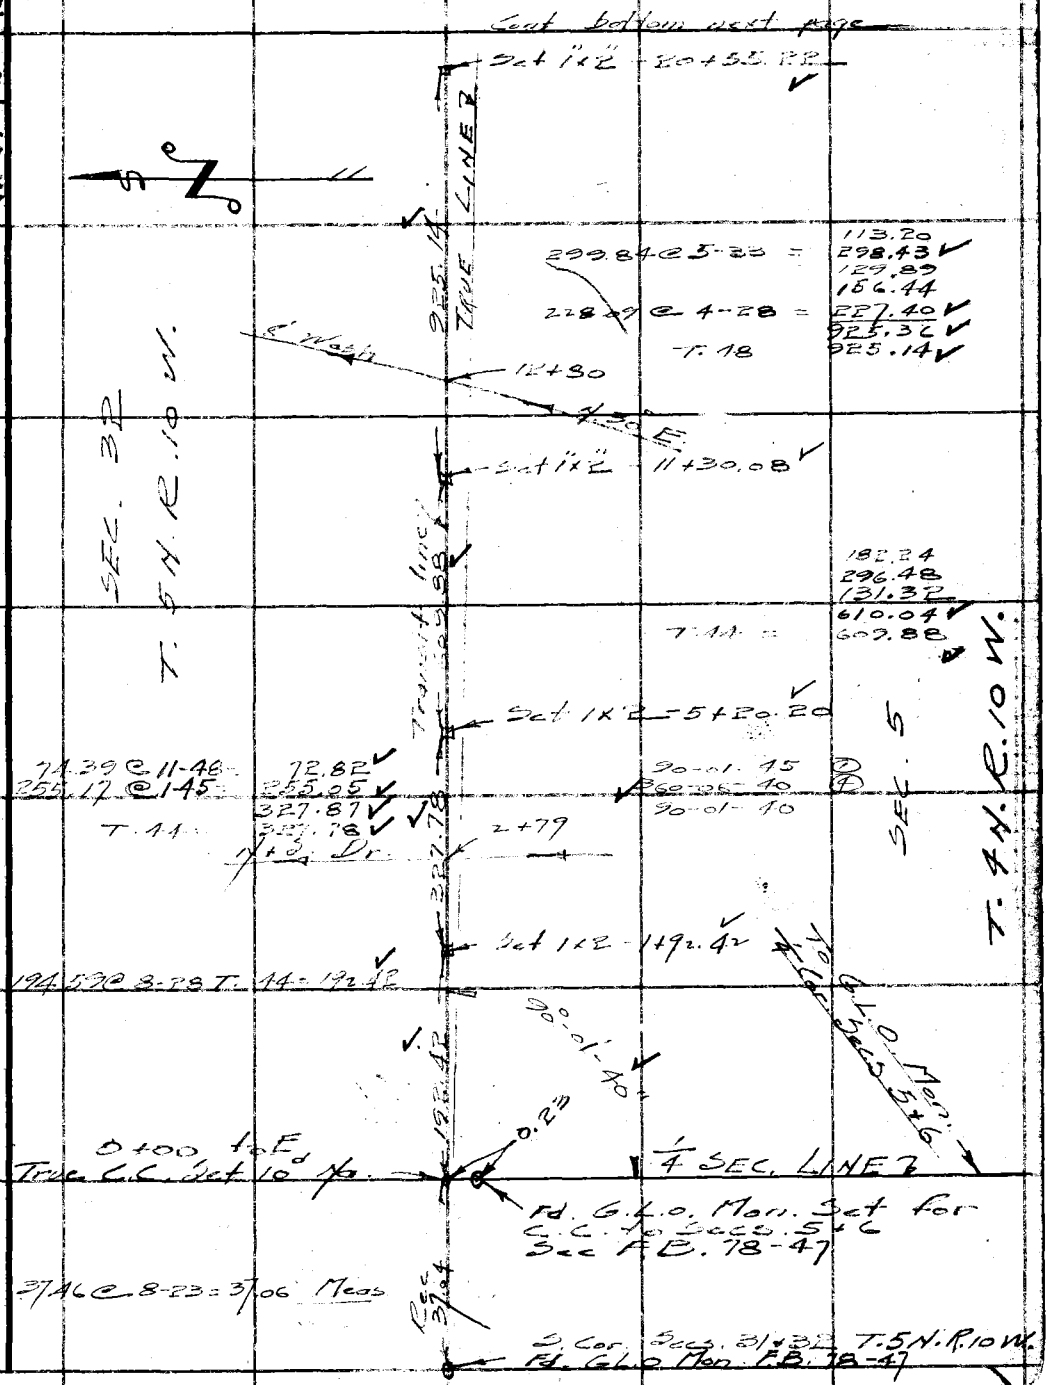

FORM 247 5M 5-46

F. B. 1262 PG. 186.

ANGLE CHECK ON W. LINE
SEC. 5 T. 4N. R. 10W.

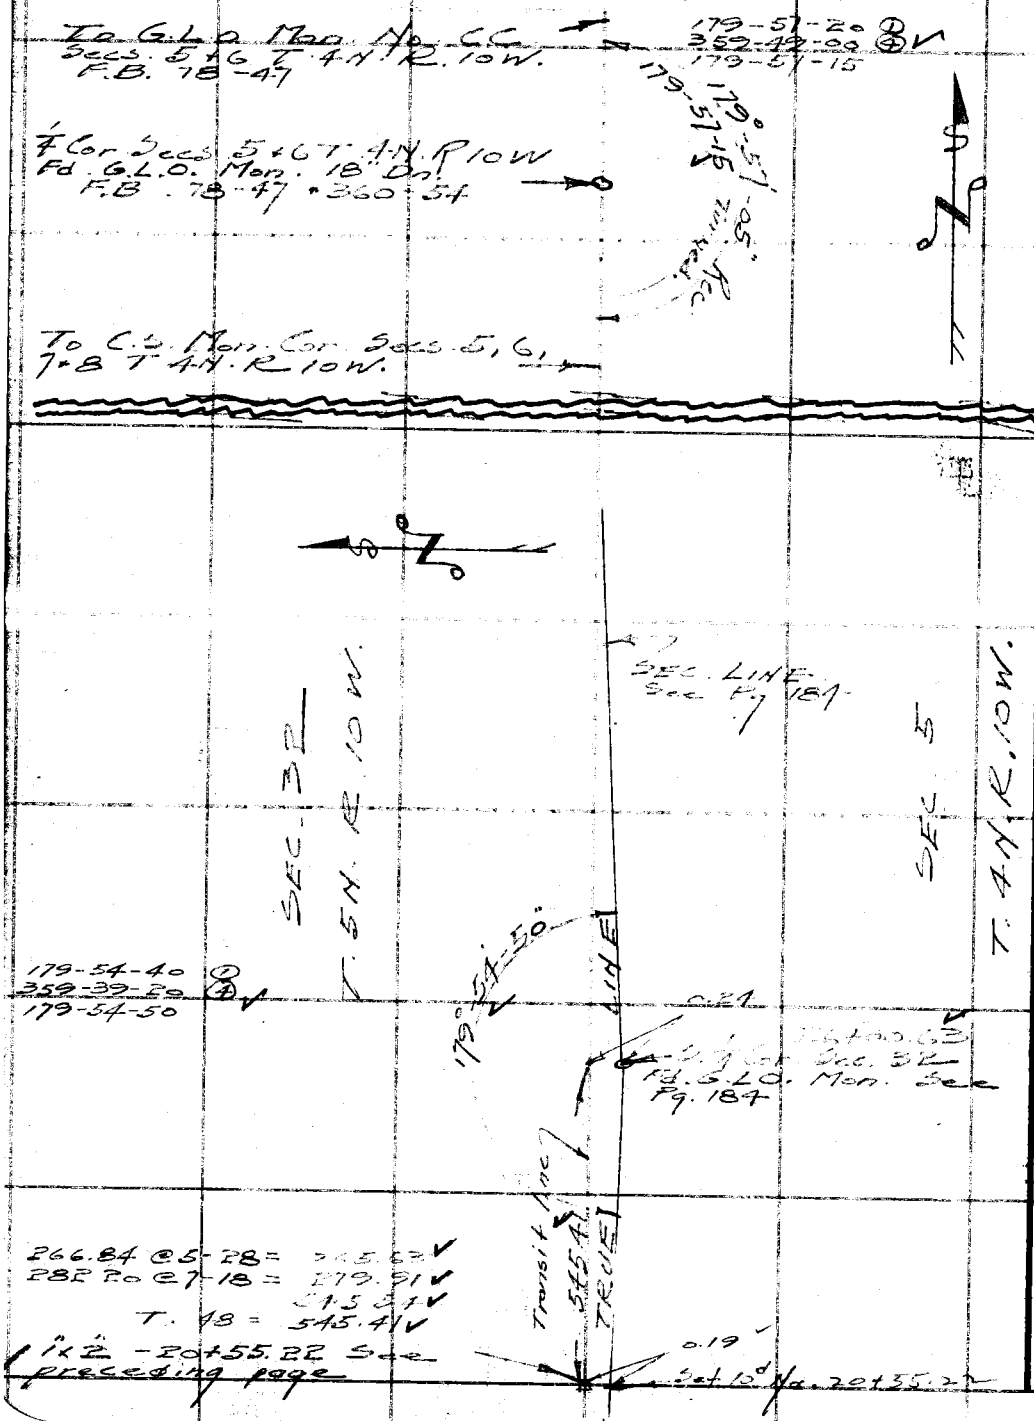

W.S. 15-B-1

RETURN TO
LOS ANGELES COUNTY SURVEYOR
700 HALL OF RECORDS

Do not extend notes this side of this line.

Note: Any Additions or Changes on This Sheet Must be Made or Circled in Red Ink With Date and Name of Person Making Change.

Notes Ck'd by KRM	Survey of T.4N.R10W.
Map No.	W. O. 4999 Tape No. 35 St'd 84 °F
Office Work	Surveyed by Rescrans
Checked	Notes R Date 2-10-49
Date	Indexed E. C. Johnson

F. B. 1212 Pg. 187

WS. 15-B-1

Set 1"x2" - 26+34.20 — 2.03 — Cont. bottom next page

10.69 — Fd. 1" I.P. with 3/4" brass cap marked as shown 18" up in mound of stones 2' base 0.5' high.

OFFICE SURVEY FOR REMOVAL OF GENERAL LAND OFFICE 1912 U.S. 250 S10

242.99

88.67 @ 13-53 = 86.08
157.35 @ 4-00 = 156.97
243.05
T. 48 = 242.99

Set 1"x2" - 23+91.21

298.21 @ 6-43 = 296.16
129.90 @ 9-50 = 127.77
188.12 @ 13-32 = 182.90
268.92 @ 8-24 = 266.04
258.60 @ 2-31 = 258.25
115.41
167.88
289.85 @ 2-20 = 289.61
281.16 @ 4-12 = 280.40
2002.84
T. 84

18.20

19+67.0 — 20' Wash — N.+S.

SEC. 3 T. 4 N. R. 10 W. SEC. 10

2002.84 Recheck 9-27-51

298.31 @ 6-49 = 296.23
280.97 @ 3-20 = 280.34
129.95 @ 8-54 = 128.39
187.95 @ 13-49 = 182.51
266.40 @ 8-59 = 266.09
115.38
167.83
258.42 @ 2-19 = 258.21
289.95 @ 2-17 = 289.62
2002.80
T. 54 = 2002.41

18.20

Note Rechained this line 9-27-51 and difference found between 3+88.80 & 23+91.21 as shown

12' Wash — N.+S. — 4+91

Set 1"x2" - 3+88.80

N.+S. — 20' W. — 2+05.

388.80

295.32 @ 13-37 = 287.02
100.10
1.74
388.86
T. 60 = 388.80

89-21-15"

0+01.74 Fd. G.L.O. Mon Pg. 170

1.74

226.15

Transit line Pg 170

Int. Set 1"x2" - 0+00 to E 59+75.80 Fr. S.

1"x2" - 5+49.65 Pg. 170

Note: Any Additions or Changes on This Sheet Must Be Made or Circled in Red Ink With Date and Name of Person Making Change.

Do not extend notes this side of this line.

RETURN TO LOS ANGELES COUNTY SURVEYOR 700 HALL OF RECORDS

FORM 247 5M 5-46

F.B. 1262 PG. 188

W.S. 15-B-1

RETURN TO
LOS ANGELES COUNTY SURVEYOR
700 HALL OF RECORDS

Do not extend notes this side of this line.

Note: Any Additions or Changes on This Sheet Must be Made or Circled in Red Ink With Date and Name of Person Making Change.

1"x2" - 10+60.63 Pg. 156

Int Set 1"x2" 52+27.78

179°-34'-00"

16.76

89°-59'-20"

C.S. Mon ¼ Cor. Secs. 2+3 T.4N.R. 10W. F.B. 78-113

G.L.O. Mon Cor. Secs. 2,3, 10+11 T4N.R. 10W. F.B. 78-115

51.23

51.24 T. 50 = 51.23

Set 1"x2" - 51+76-55

945.57

46.45
300.46 @ 3-15 = 299.98
300.15 @ 3-23 = 299.63
300.26 @ 3-27 = 299.72
945.78
T. 50 = 945.57

Set 1x2 - 42+30.98

SEC. 3

SEC. 10

T. 4N. R. 10 W.

1115.08

273.04 @ 3-49 = 272.43
300.76 @ 2-08 = 300.55
253.89 @ 3-08 = 253.51
289.00 @ 1-55 = 288.84
1115.33
T. 50 = 1115.08

Set 1"x2" - 31+15.90

160.51
145.24
74.78
101.79 @ 5-43 = 101.28
481.81
T. 48 = 481.70

481.70

1x2 - 26+34.20 See preceding page

Notes Ck'd by KRM	Survey of T4N. R.10W.
Map No.	W. O. 4999 Tape No. 85 St'd 84 °F
Office Work	Surveyed by Roseerans
Checked	Notes R Date
Date	Indexed A. C. Johnson

F. B. 1262 Pg. 189

W. S. 15-B-1

SEC. 9

To 1 [illegible] - 3+71.89 Pg. 167

Barbed wire Fn

26+38.95

E. Cor. Secs. 9+16 Fd. G.L.O. Mon. Sec. Pg. 167

179-58-20 ①
359-53-50 ④
179-58-27 ±

N 45° W

71.0

179°-58'-30"

Bottom Dr.

189.69 @ 2-01 = 189.57
291.95 @ 5-29 = 290.61
300.34 @ 4-18 = 299.50
300.34 @ 5-33 = 298.96
300.18 @ 5-02 = 299.02
299.38 @ 5-48 = 297.85
249.92 @ 5-14 = 248.88
1924.39
T.56 = 1924.04

SEC. 16

1924.04

W. ¼ Cor. Sec. 15
Fd 1" I.P. with 2" brass cap marked as shown 6" up in mound of stones 3' base 1' high.
F.B. 78-128
7+14.91

T. 4 N. R. 10 W.

0.06

2.0

2.0

U.S. GENERAL LAND OFFICE SURVEY PENALTY & 250 FOR REMOVAL 1912

¼ S15

266.86 @ 6-12 T.54 = 265.25

265.25

SEC. 15

Set 1x2 - 4+49.66

449.66

Barbed wire mon Pc Fn

265.37 @ 5-06 = 264.32
186.21 @ 5-15 = 185.43
449.75
T.54 = 449.66

179-59-00 ①
359-55-20 ④
179-58-50

0+00 to N.
E. ¼ Cor. Sec. 16 T. 4 N. R. 10 W. Fd. G.L.O. Mon.
F.B. 488-168

179°-58'-50"

To C.S. Mon W. Cor. Secs 15 + 22

Note: Any Additions or Changes on This Sheet Must be Made or Circled in Red Ink With Date and Name of Person Making Change.

Do not extend notes this side of this line.

RETURN TO
LOS ANGELES COUNTY SURVEYOR
700 HALL OF RECORDS

FORM 247 5M 5-46

F.B. 1262 PG. 190

W.S. 15-C-1

RETURN TO
LOS ANGELES COUNTY SURVEYOR
700 HALL OF RECORDS

Do not extend notes this side of this line.

Note: Any Additions or Changes on This Sheet Must be Made or Circled in Red Ink With Date and Name of Person Making Change.

Cor. Secs 5, 6, 7 + 8 T4N
R9W. Fd C.S. Mon.

SEC. 6
T 4N. R 9 W.

SEC. 7

2.67

¼ Cor. Secs 6 + 7 T4N.
R9W Fd. C.S. Mon.

This monument O.K.
Checked ties on it 6-21-51

2.13

Cor. Secs 1, 6, 7 + 12 T4N
R. 9 + 10 W. Fd. C.S. Mon.
F.B. 960-137. ½ of the brass cap has been torn off making the accuracy doubtful
6-1-51

Notes Ck'd by KRM	Survey of T 5 N R 8 W.
Map No. B-2120-2	W. O. 4999 Tape No. 85 St'd 84 °F
Office Work Brown	Surveyed by Rosecrans
Checked Miller	Notes C Date 10-4-48
Date Apr. 1949	Indexed A. C. Johnson 2-9-49

F.B. 1262 Pg. 191

W.S. 67-E-5

Note: Any Additions or Changes on This Sheet Must be Made or Circled in Red Ink With Date and Name of Person Making Change.

Do not extend notes this side of this line.

RETURN TO
LOS ANGELES COUNTY SURVEYOR
700 HALL OF RECORDS

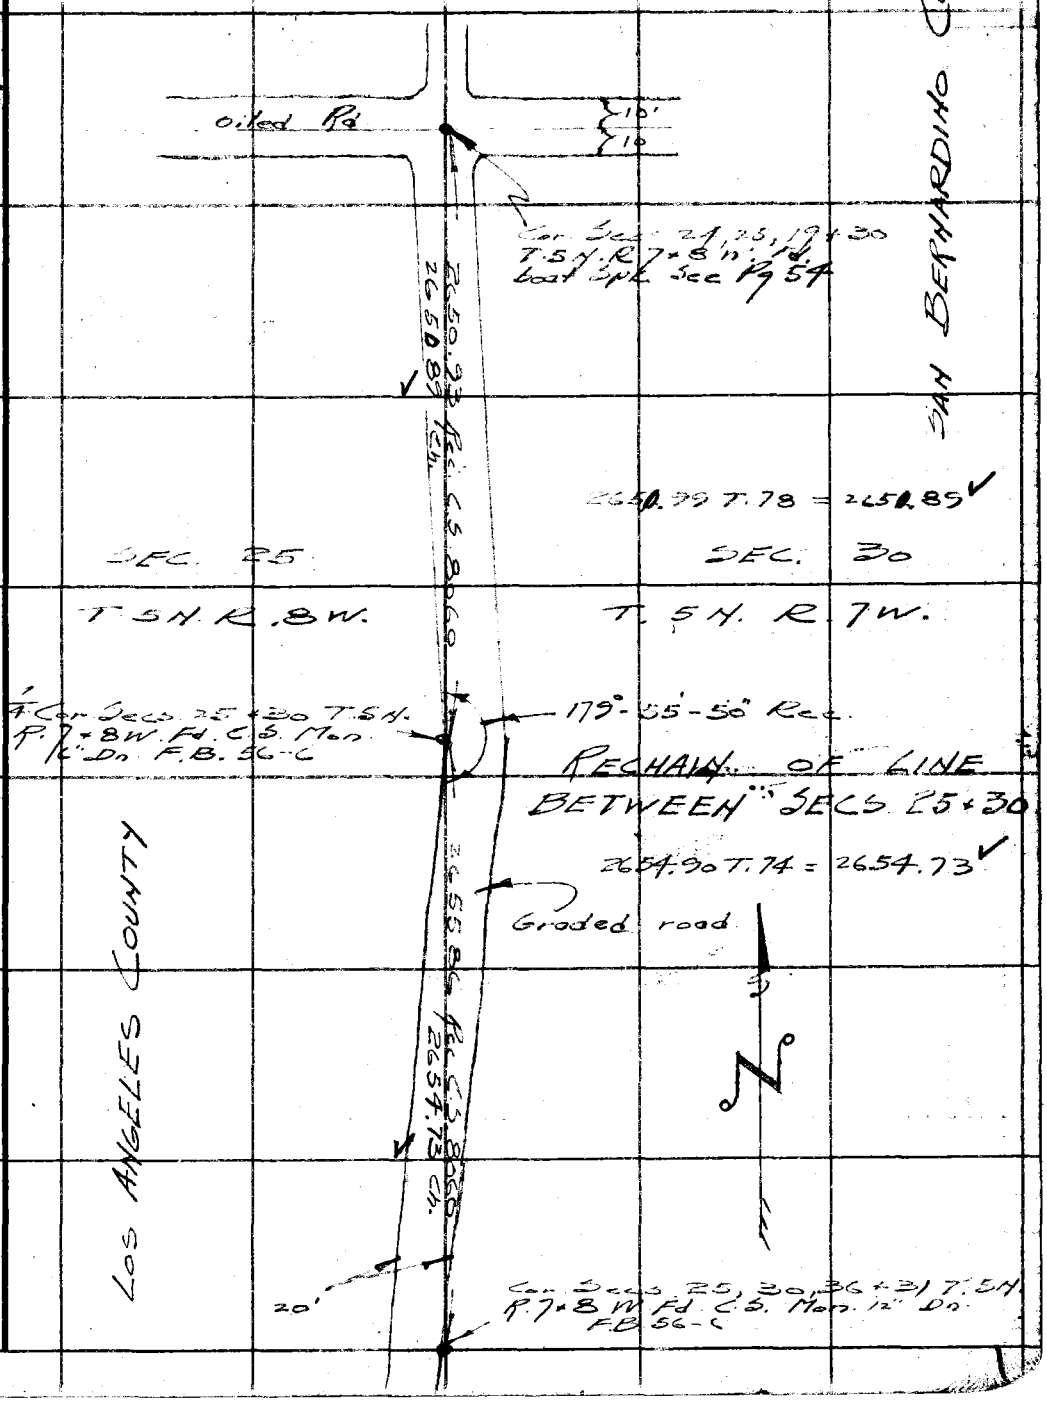

FORM 247 5M 5-46

RETURN TO
LOS ANGELES COUNTY SURVEYOR
700 HALL OF RECORDS

Note: Any Additions or Changes on This Sheet Must be Made or Circled in Red Ink With Date and Name of Person Making Change.

Do not extend notes this side of this line.

WS. 67-E-5

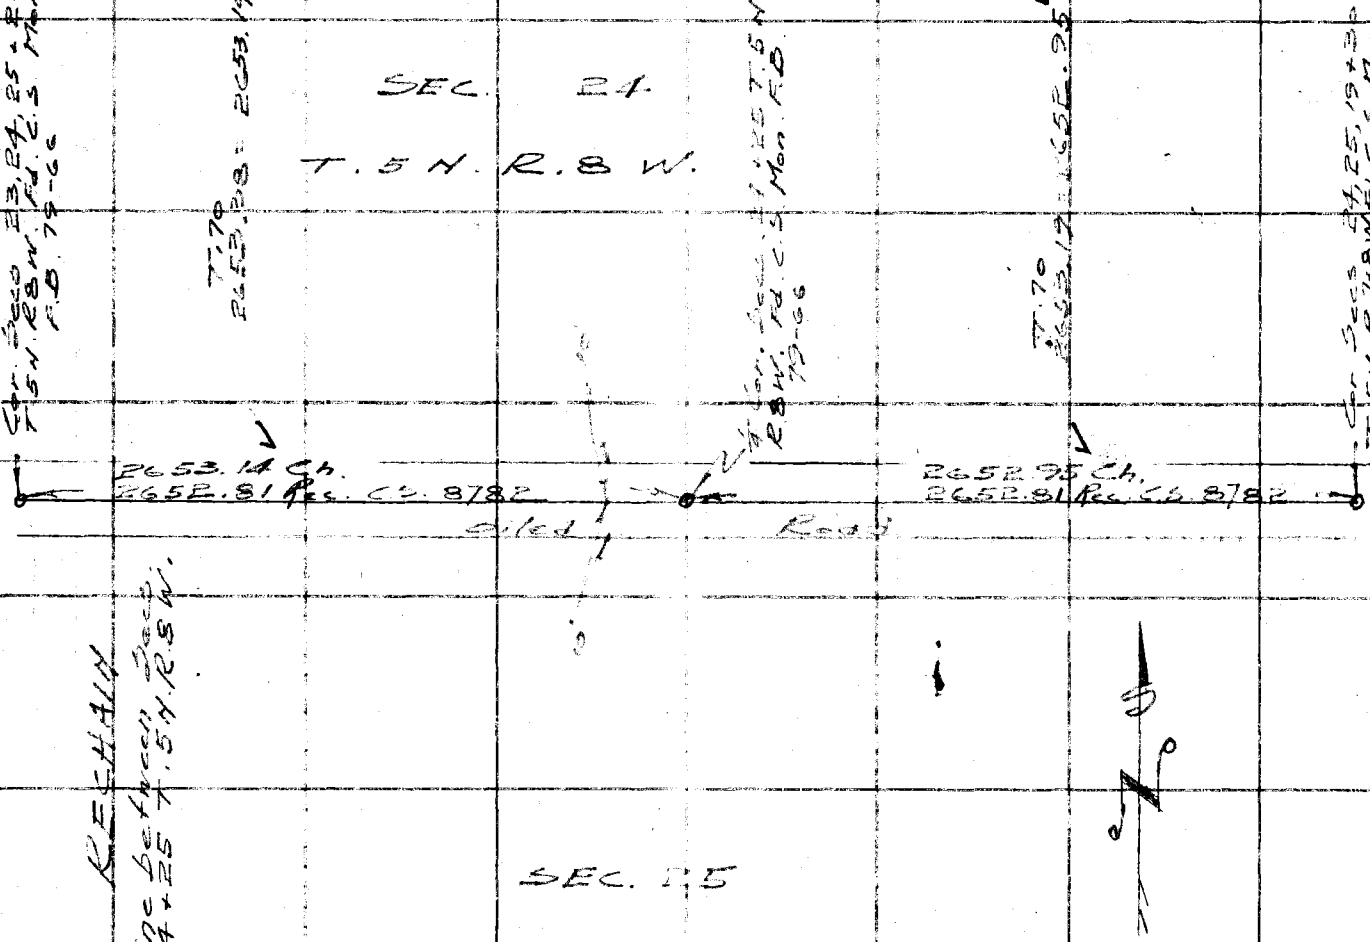

F.B. 1262 PG. 192

193

F.B. 1262 Pg.

Notes Ck'd by KRM	Survey of T.5N.R.8W.
Map No. B-2120-2	W. O. 4999 Tape No. 85 St'd 84°F
Office Work Ito	Surveyed by Rosecrans
Checked Miller	Notes R Date 10-21-48
Date Apr. '49	Indexed A. C. Johnson

W.S. 67-E-6

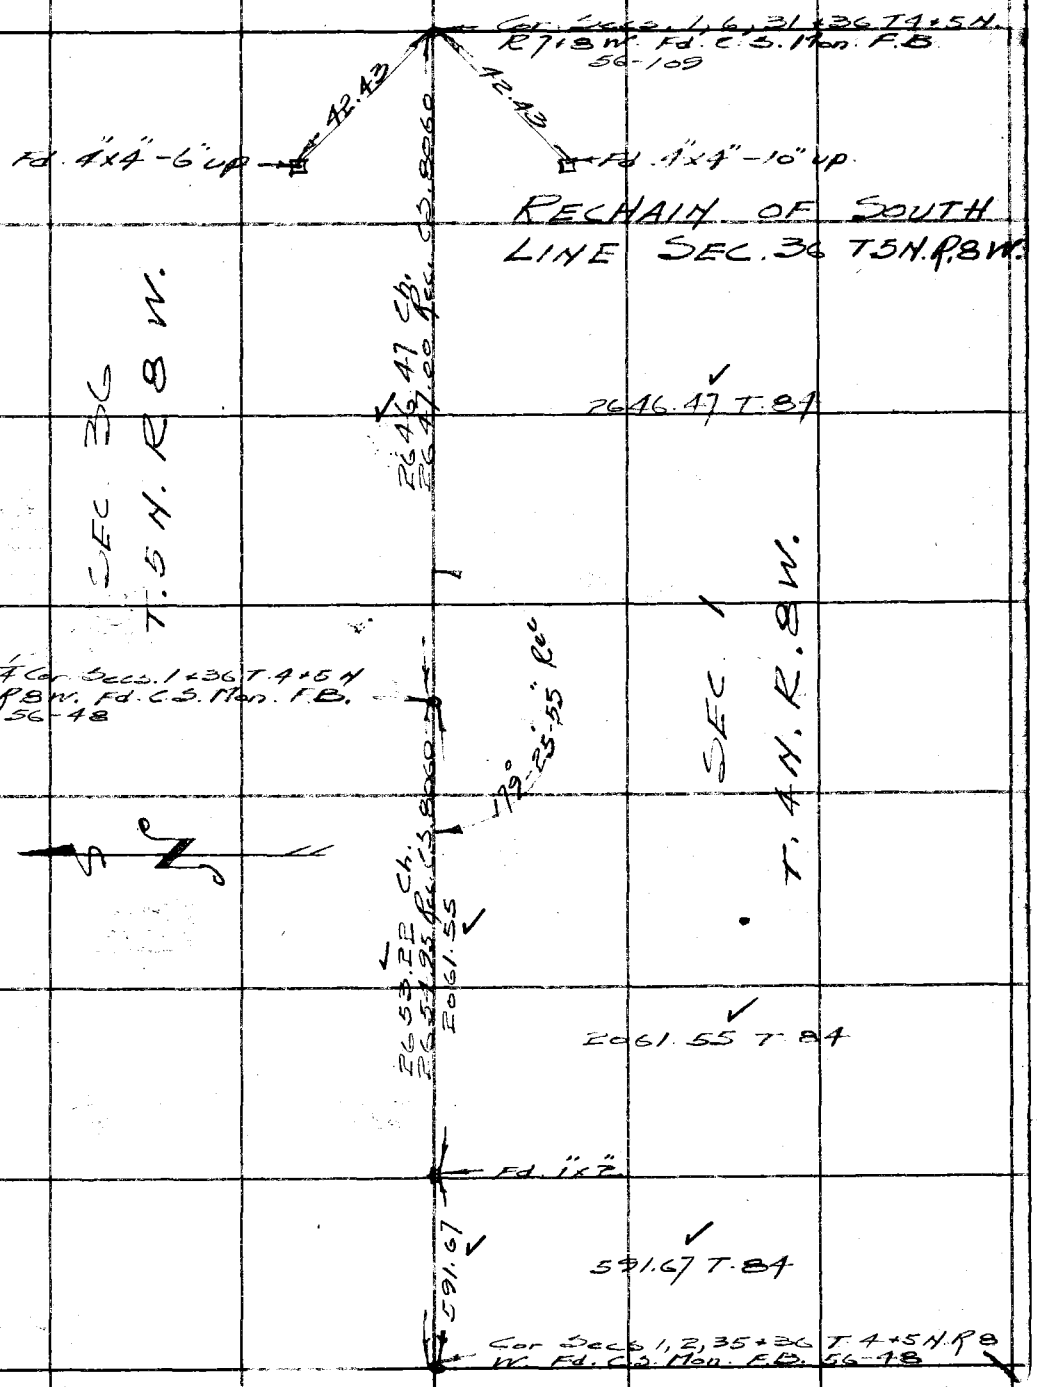

Note: Any Additions or Changes on This Sheet Must be Made or Circled in Red Ink With Date and Name of Person Making Change.

Do not extend notes this side of this line.

RETURN TO
LOS ANGELES COUNTY SURVEYOR
700 HALL OF RECORDS

FORM 247 5M 5-46

RETURN TO
LOS ANGELES COUNTY SURVEYOR
700 HALL OF RECORDS

Note: Any Additions or Changes on This Sheet Must be Made or Circled in Red Ink With Date and Name of Person Making Change.

Do not extend notes this side of this line.

F. B. 1962 PG. 194

Notes Ck'd by	Survey of T. 5 N. R 11 W.
Map No.	W. O. 4999 Tape No. 85 St'd 84 °F
Office Work	Surveyed by Rosecrans
Checked	Notes R Date
Date	Indexed A. C. Johnson 4-21-49

F. B. 1262 Pg. 1

SECTION LINES

T. 5 N. R. 11 W.

J. N. 4999

Party E. A. Rosecrans
J. P. Pierce
J. C. Pierce
L. Vejar
H. H. Howard.

Index to notes on lines surveyed

7	8	9	10	11 (204) (201) (203) (202)	12
18	17	16 (211)	15	14 (198)	13
19	20	21 (210) (209) (211)	22 (208) (201) (206)	23 (200) (199) (205)	24

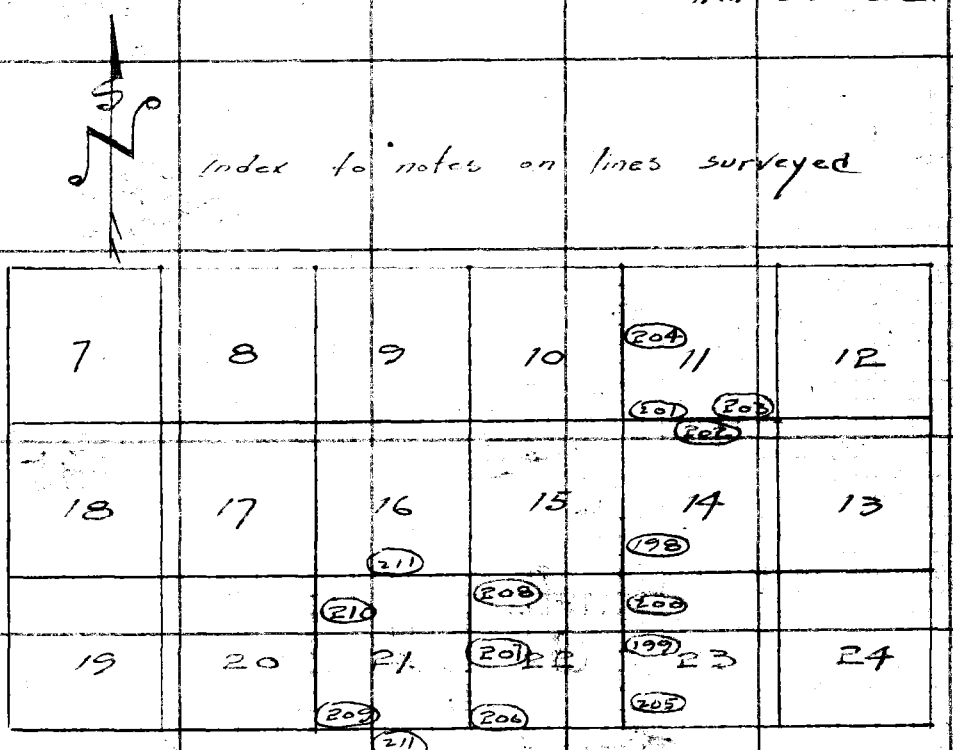

Note: Any Additions or Changes on This Sheet Must be Made or Circled in Red Ink With Date and Name of Person Making Change.

Do not extend notes this side of this line.

RETURN TO
LOS ANGELES COUNTY SURVEYOR
700 HALL OF RECORDS

FORM 247 5M 5-46

F. B. 1262 PG. 198

To C.S. Mon. Cor. Secs 10, 11, 14 + 15 T5N. R11W.

1/4 Cor Secs 14 + 15 T.5N. R.11W. Fd. C.S. Mon F.B. 85-137

171°-00'-45"

171-00-40 ①
324-03-00 ④
171-00-45

194.43 @ 2-55 = 194.18
196.33 @ 3-38 = 195.94
237.12 @ 4-35 = 236.36
190.48 @ 2-40 = 190.27
240.00 @ 12-34 = 234.25
246.77 @ 8-42 = 243.93
231.35 @ 6-07 = 230.03
1524.96
T.74 = 1524.86

1524.86

SEC. 15

SEC. 14

2654.81

T 5 N R. 11 W.

252.25 @ 3-22 = 251.81
300.[illegible] @ 5-00 = 299.22
141.40 @ 5-50 = 140.67
[illegible] @ 00 = [illegible]
[illegible] @ 9-55 = 89.87
[illegible].46 @ 00 = 48.46
1130.07
T.68 = 1129.95

Set 1"x2" T.R.

82-03-00 ①
328-12-20 ④
82-03-05

15/14
22/23
487-222
487-222

To C.S. Mon. 1/4 Cor Secs 14 + 23

W.C. to Cor Secs Fd C.S. Mon 6 up F.B. 487-222

82°-03'-05"

1129.95

Bottom Dr.

S 50° E

102.80
107.80 @ 2-04 = 107.73
210.53
T.70 = 210.51

300.0

210.51

0+00 to N.
Set 1"x2"

W.S. 67-D-4

RETURN TO
LOS ANGELES COUNTY SURVEYOR
700 HALL OF RECORDS

Do not extend notes this side of this line.

Note: Any Additions or Changes on This Sheet Must be Made or Circled in Red Ink With Date and Name of Person Making Change.

Notes Ck'd by	Survey of T. 5 N. R 11 W. [illegible] 1262 Pg. 199
Map No.	W. O. 4999 Tape No. 85 St'd 84 °F
Office Work	Surveyed by Rosecrans
Checked	Notes K Date 2-24-49
Date	Indexed A. C. Johnson

W.S. 67-D-5

Set 10d Na. 15+33.40 ✓ Cont. bottom next page

Top bluff S. bank little Rock wash

1161.48 ✓

42.06
300.31 @ 3-45 = 299.67 ✓
300.06 @ 7-35 = 297.43 ✓
162.63 @ 8-30 = 160.84 ✓
~~48~~.43 @ 3-48 = ~~101.21~~ ✓
101. 260.39 ✓
~~1167.60~~ ✓
T 68 = 1161.48 ✓

Bottom Dn 4+72

S 67° E

Graded Rd N 67° W 10

4+37.0

SEC. 22

Set 10d Na 3+71.92 ✓

T 5 N. R. 11 W.

SEC. 23

HIGH VOLTAGE LINES

33.0 33.0

To C.S. Mon ¼ Cor. Secs. 14+23

2+93.5

81°-23'

To 2"x2" A Pt See Pg. 200

47°-45'-30" ✓

41°-58'-00" ✓

371.92

47-45-30 ①
191-02-00 ④
47-43-30 ✓

41-58-00 ①
167-52-00 ④
41-58-00

78.82 @ 4-24 = 78.59 ✓
300.06 @ 12-06 = 293.39 ✓
371.98 ✓
T. 56 = 371.92 ✓

Fd 18" juniper B.T. scribed ¼ S. 22

66°-41'

97°-30'

T. 5 N.
22 — 23
¼ COR
329

COUNTY SURVEYOR
R.11 W.

21.9

22.0 @ 3-30 = 21.9

9.2

0+00 to N.

¼ Cor. Secs 22+23 T. 5 N. R 11 W. Fd. juniper post 6"x6" by 30" scribed ¼ S 22 on west side ¼ S 23 on E. side Replaced juniper post with 2" I.P. with brass cap marked as shown in Conc. flush.

Fd. 24" juniper B.T. scribed ¼ S 23

Note: Any Additions or Changes on This Sheet Must be Made or Circled in Red Ink With Date and Name of Person Making Change.

Do not extend notes this side of this line.

RETURN TO
LOS ANGELES COUNTY SURVEYOR
700 HALL OF RECORDS

FORM 247 5M 5-46

F.B. 1262 PG. 256

W.S. 67-D-5

RETURN TO
LOS ANGELES COUNTY SURVEYOR
700 HALL OF RECORDS

Do not extend notes this side of this line.

Note: Any Additions or Changes on This Sheet Must be Made or Circled in Red Ink With Date and Name of Person Making Change.

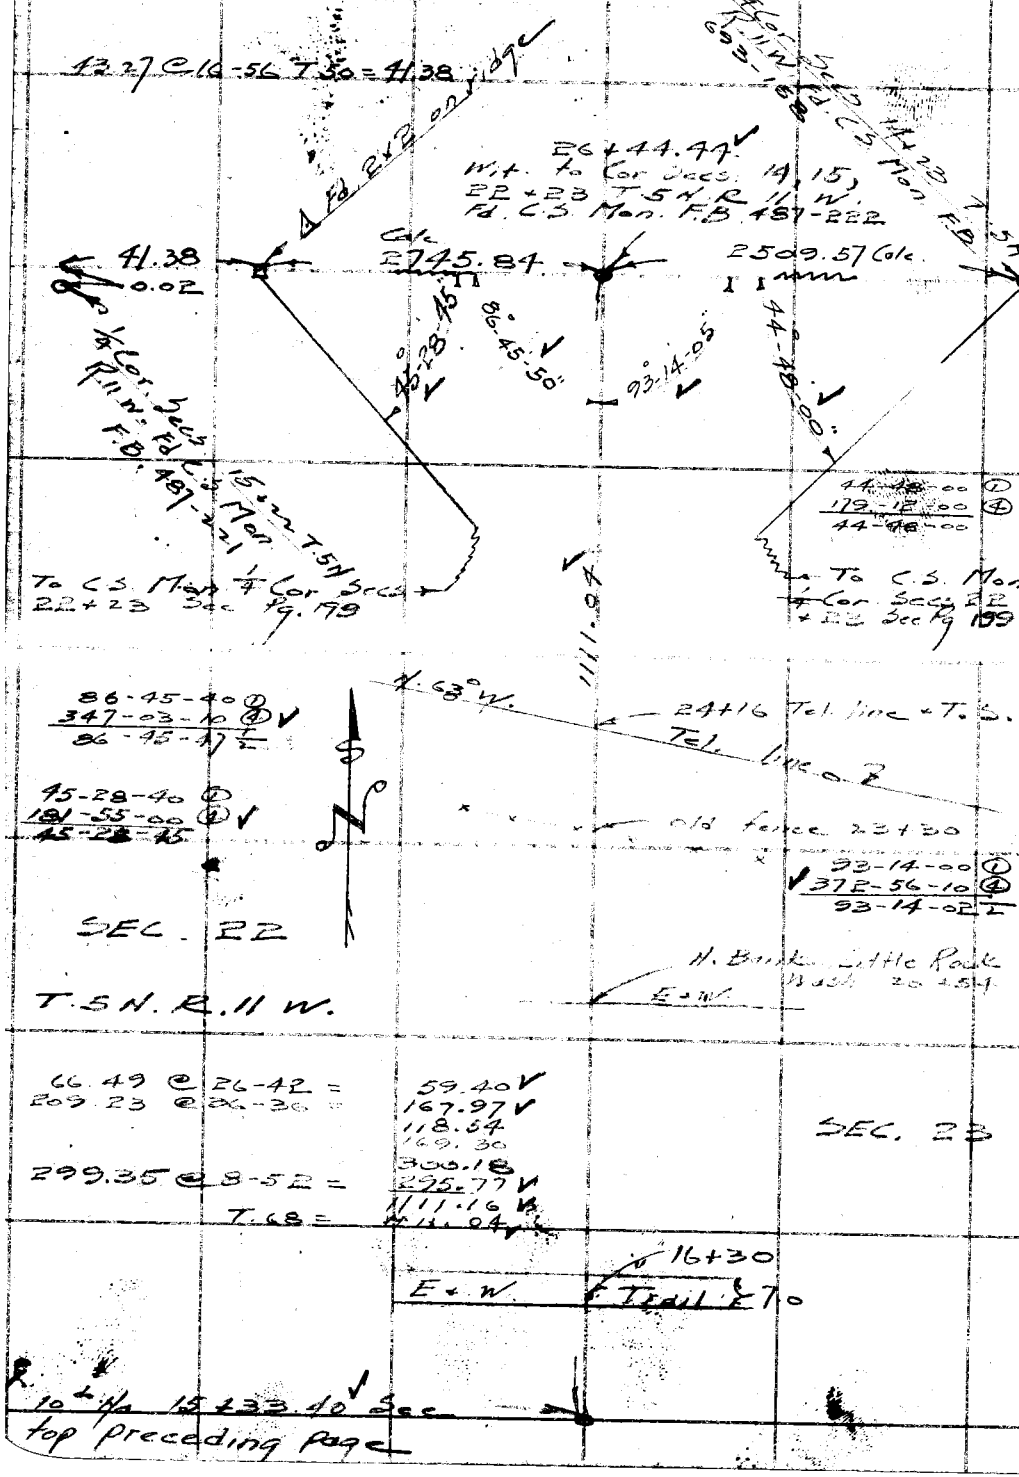

Notes Ck'd by	Survey of T 5 N R 11 W
Map No.	W. O. 4999 Tape No. 85 St'd 84 °F
Office Work	Surveyed by Rosecrans
Checked	Notes R Date 3-1-49
Date	Indexed A. C. Johnson

F. B. 1262 Pg. 201

W.S. 67-D-4

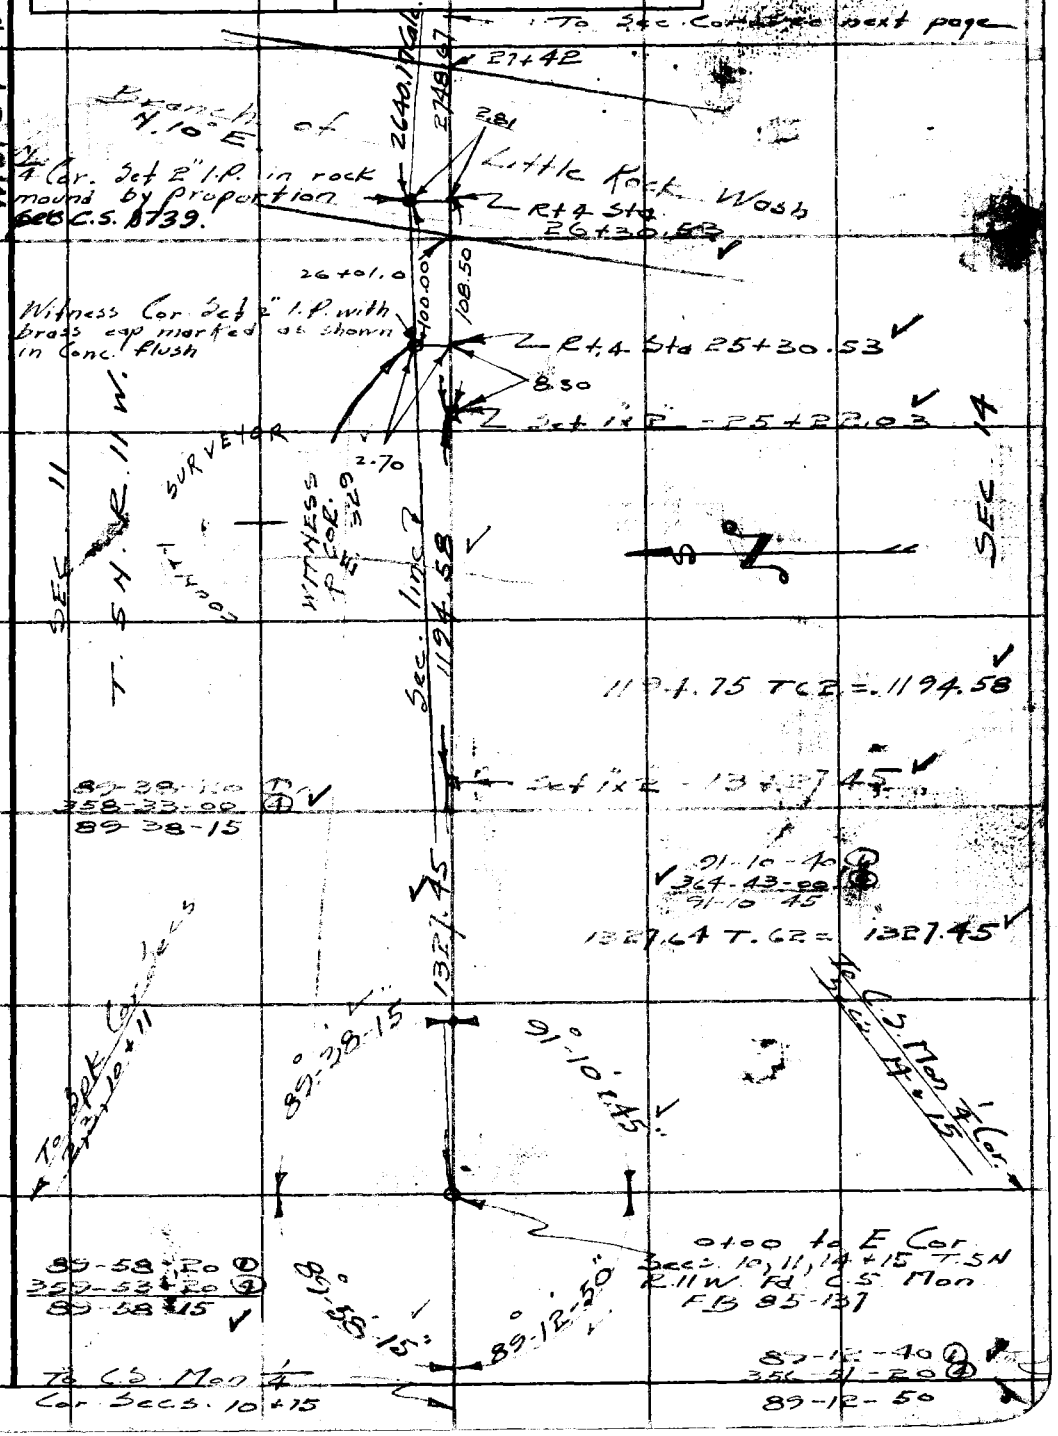

Note: Any Additions or Changes on This Sheet Must be Made or Circled in Red Ink With Date and Name of Person Making Change.

Do not extend notes this side of this line.

RETURN TO
LOS ANGELES COUNTY SURVEYOR
700 HALL OF RECORDS

FORM 247 5M 5-46

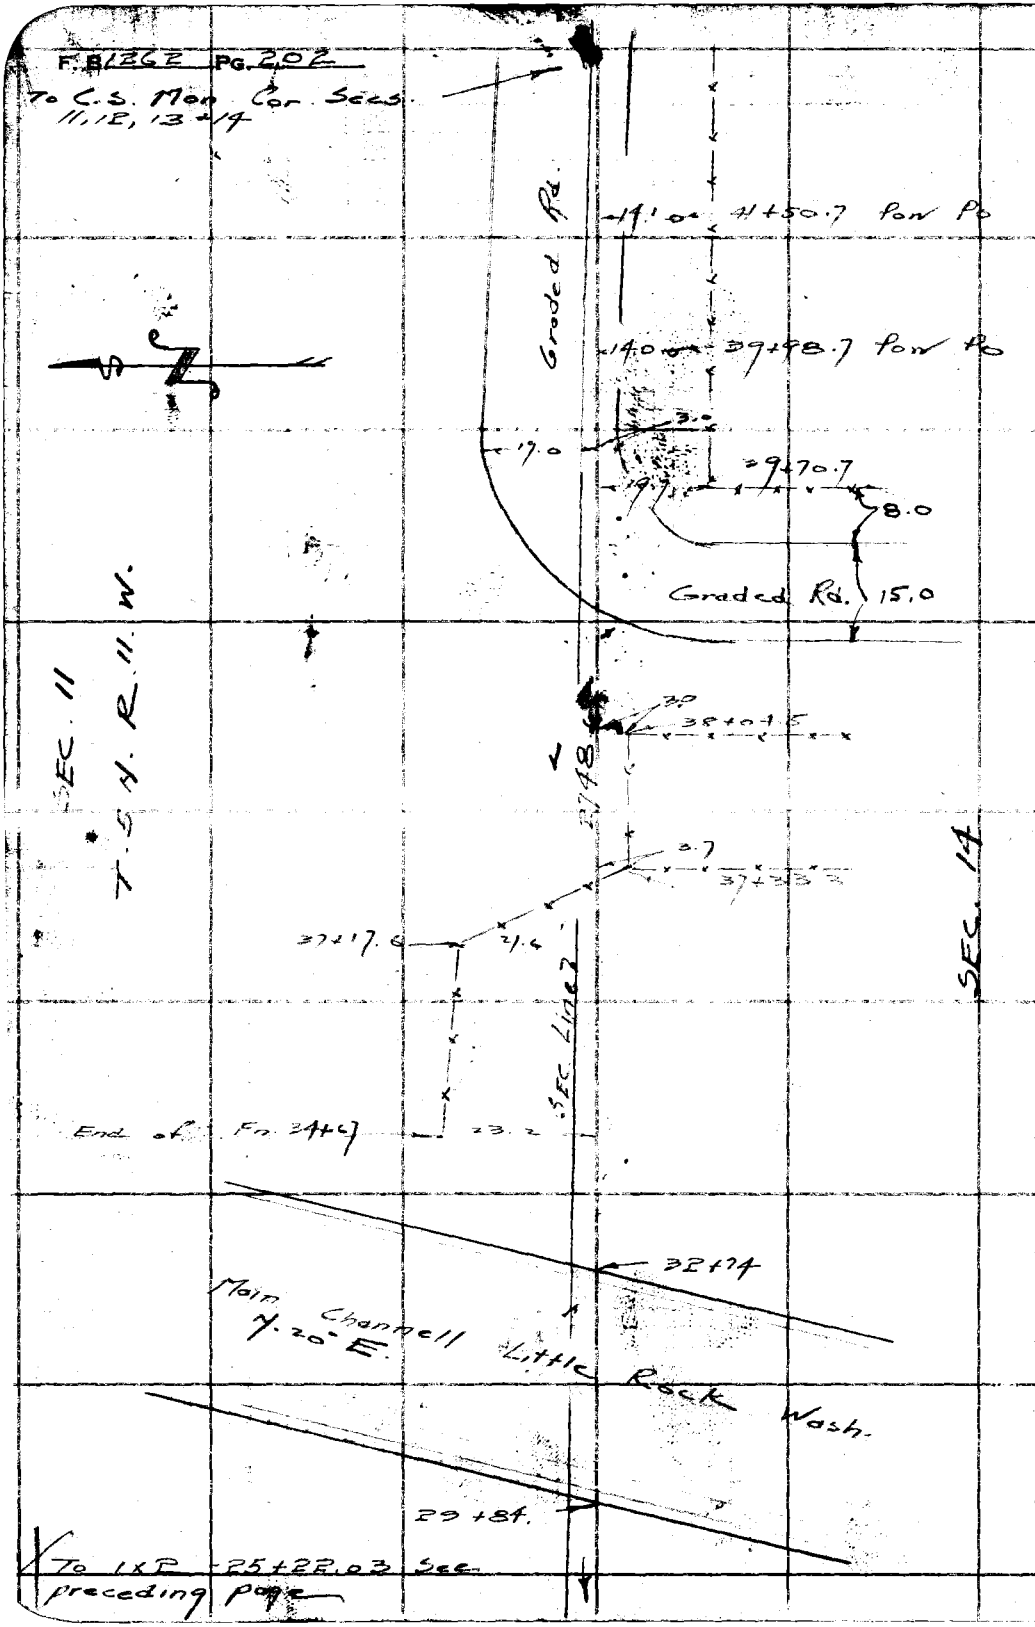

RETURN TO
LOS ANGELES COUNTY SURVEYOR
70 HALL OF RECORDS
Do not extend notes this side of this line.
Note: Any Additions or Changes on This Sheet Must be Made or Circled in Red Ink With Date and Name of Person Making Change.

Notes Ck'd by	Survey of T 5 N R 11 W
Map No.	W. O. 4999 Tape No. 85 St'd 84 °F
Office Work	Surveyed by Rosecrans
Checked	Notes R Date 2-1-49
Date	Indexed A. C. Johnson

F. B. 1262 Pg. 203

W. S. 65-D-4

Note: Any Additions or Changes on This Sheet Must Be Made or Circled in Red Ink With Date and Name of Person Making Change.

Do not extend notes this side of this line.

RETURN TO
LOS ANGELES COUNTY SURVEYOR
700 HALL OF RECORDS

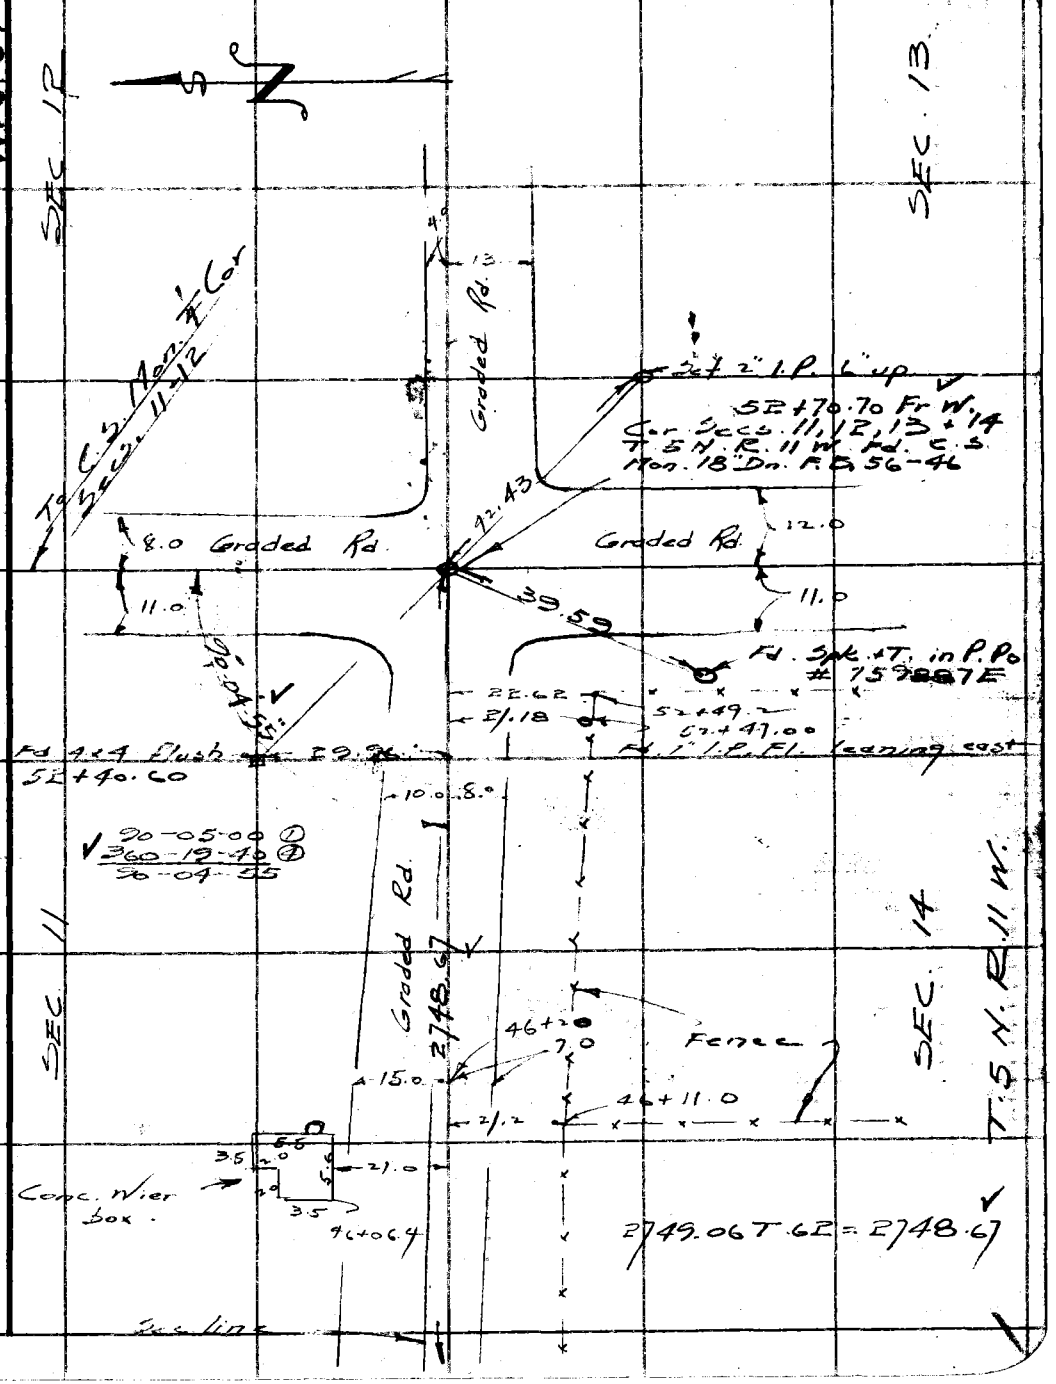

FORM 247 5M 5-46

F.B. 1262 PG. 204

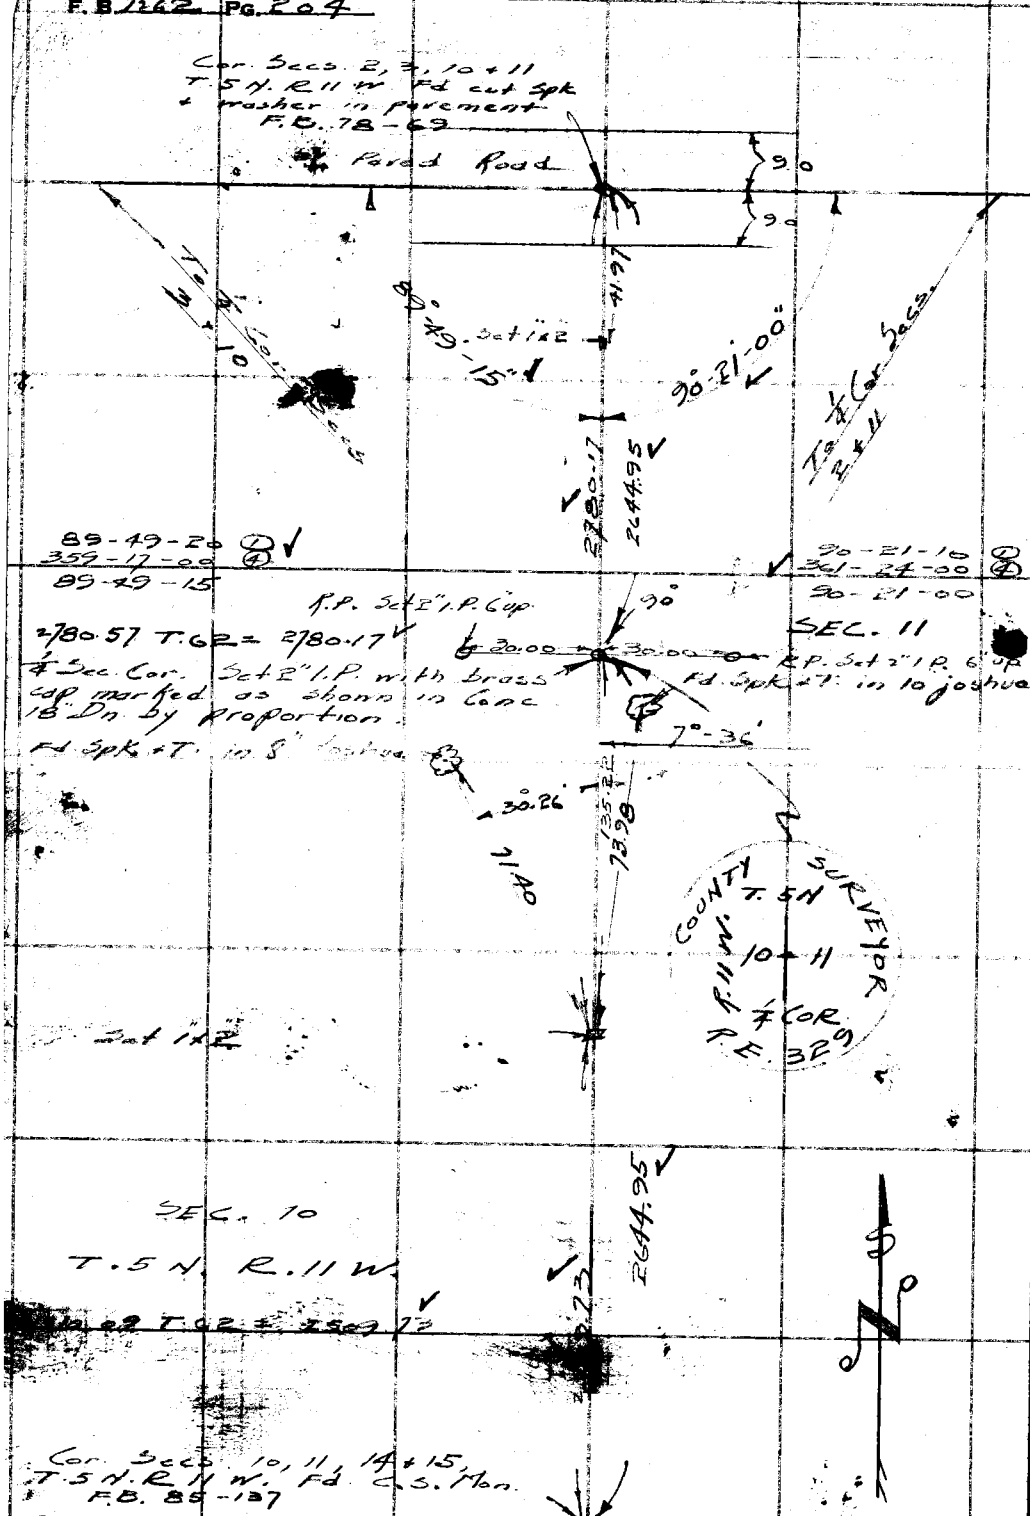

W.S. 67-D-4

RETURN TO
LOS ANGELES COUNTY SURVEYOR
700 HALL OF RECORDS

Do not extend notes this side of this line.

Note: Any Additions or Changes on This Sheet Must be Made or Circled in Red Ink With Date and Name of Person Making Change.

Notes Ck'd by	Survey of T.5N. R 11W.
Map No.	W. O. 4999 Tape No. 85 St'd 84 °F
Office Work	Surveyed by Rosecrans
Checked	Notes R Date 3-11-49
Date	Indexed A. C. Johnson

F. B. 1262 PG. 205

W.S. 67-D-5

89-56-10 (1)
359-44-50 (4)
89-56-12 (4)

17.48 — S. Cor. Secs. 22 & 23 Fd. G.L.O. Mon. F.B. 566-91

To 2"x2" K#358

N. Cor. Secs. 26 & 27 Fd. G.L.O. Mon. F.B. 566-91

0.13

111.80

Int. Set 1"x2" - 26+32.19

2.15
115.64 @ 1[illegible]-29 = 109.67
111.82
T.62 = 111.80

Set 1"x2" - 25+20.~~44~~ 39

47.73 T.62 = 47.72

Set 1"x2" - 2[illegible]2.67

74.82 @ [illegible] = 74.82
53.85 @ 8-27 = 53.27
300.21 @ 8-11 = 297.15
196.38 @ 13-02 = 191.32
616.56
T.62 = 616.47

23+98 T.R. N. 45° W

616.47

[illegible] 1"x2" - 18+56.[illegible]
top [illegible] ridge

208.08 @ 4-51 = 207.33
77.64 @ 2-41 = 77.55
63.29 @ 18-19 = 60.08
300.2[illegible] @ 00 = 300.23
202.26 @ 8-13 = 200.18
165.[illegible] @ 2-50 = 164.93
1010.3[illegible]
T.62 = 1010.[illegible]

13+50 Hd. Dr. to W.

1010.16

26.1 — 6' — Conc. religious monument — 6'
25.9
8.53

SEC. 23

SEC. 22

T. 5N. R. 11 W.

Set 1"x2" - 8+46.04
top E. & W. ridge

196.55 @ 14-29 190.30
61.00 @ 11-55 59.69
268.85 @ 16-19 258.02
254.33 @ 11-53 = 248.88
756.89
T.62 = 756.78

756.78

Set 1x2 - 0+89.26

95.26 @ 20-26 T.62 = 89.26

89.26

0+00 to S
¼ Cor. Secs. 22 & 23 Set
C.S. Mon. Pg. 198

3-15-20 (1)
13-01-20 (4)
3-15-20

Transit line to N.
See Pg. 198

3°-15'-20"

Note: Any Additions or Changes on This Sheet Must be Made or Circled in Red Ink With Date and Name of Person Making Change.

Do not extend notes this side of this line.

RETURN TO
LOS ANGELES COUNTY SURVEYOR
700 HALL OF RECORDS

FORM 247 5M 5-46

F. B. 1262 PG. 206

To 1½ I.P. See next page

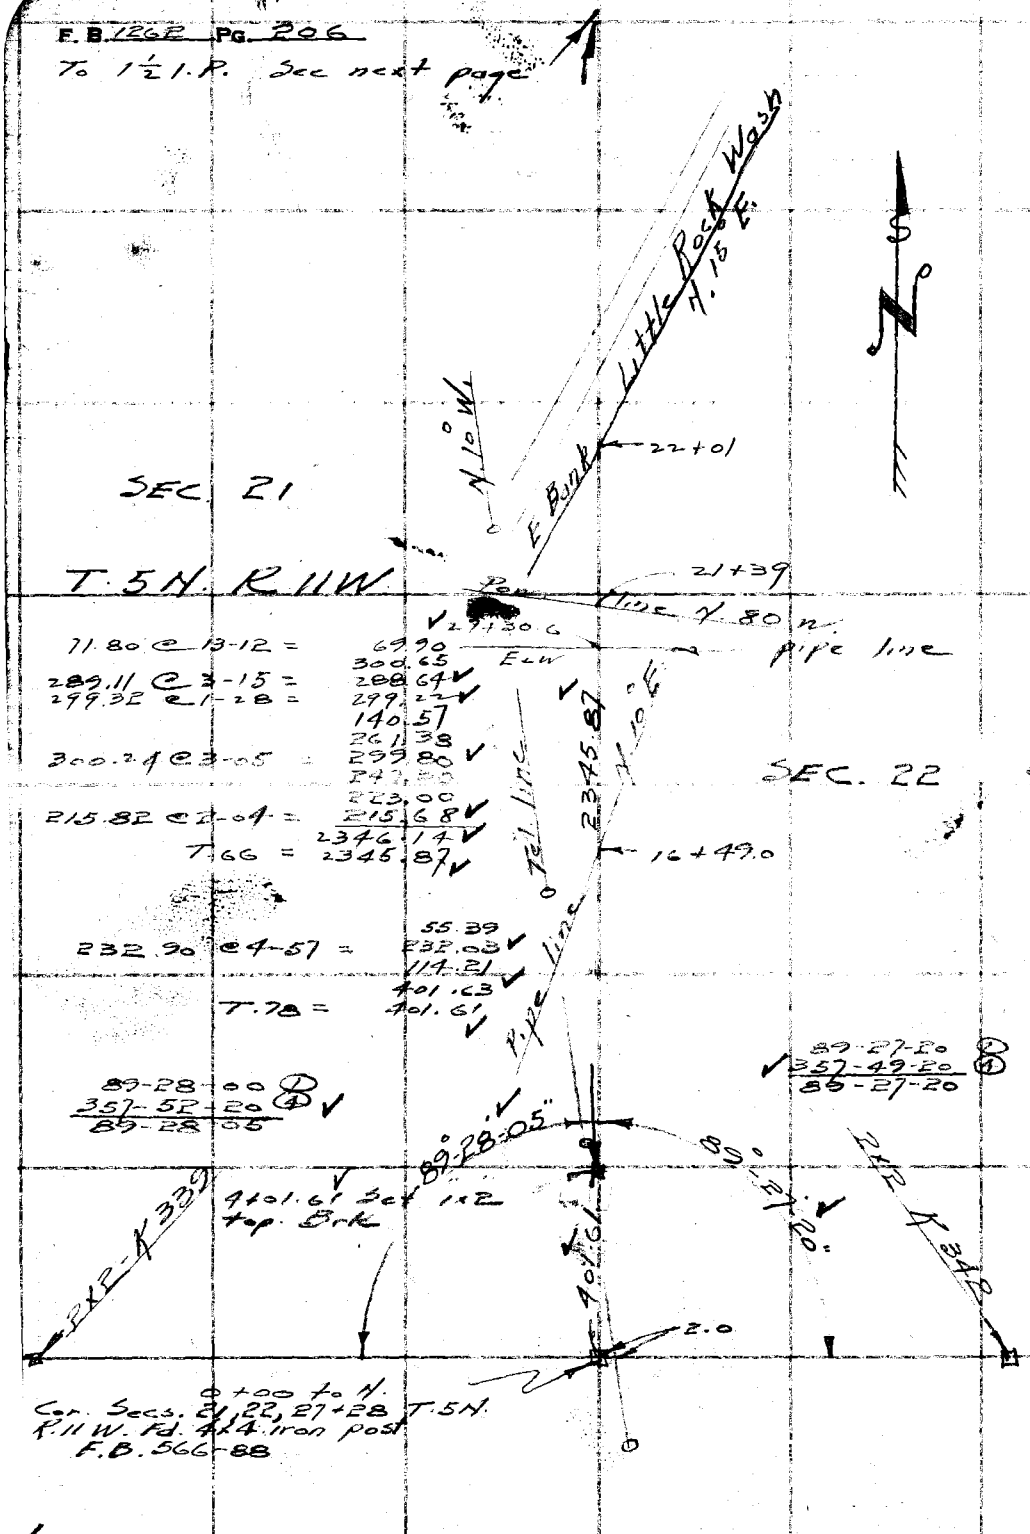

W.S. 67-D-5

RETURN TO
LOS ANGELES COUNTY SURVEYOR
700 HALL OF RECORDS

Do not extend notes this side of this line.

Note: Any Additions or Changes on This Sheet Must be Made or Circled in Red Ink With Date and Name of Person Making Change.

Notes Ck'd by KAM	Survey of T 5 N. R 11 W.
Map No.	W. O. 4999 Tape No. 85 St'd 84 °F
Office Work	Surveyed by Rosecrans
Checked	Notes R Date 3-16-49
Date	Indexed A. C. Johnson

F. B. 1262 Pg. 207

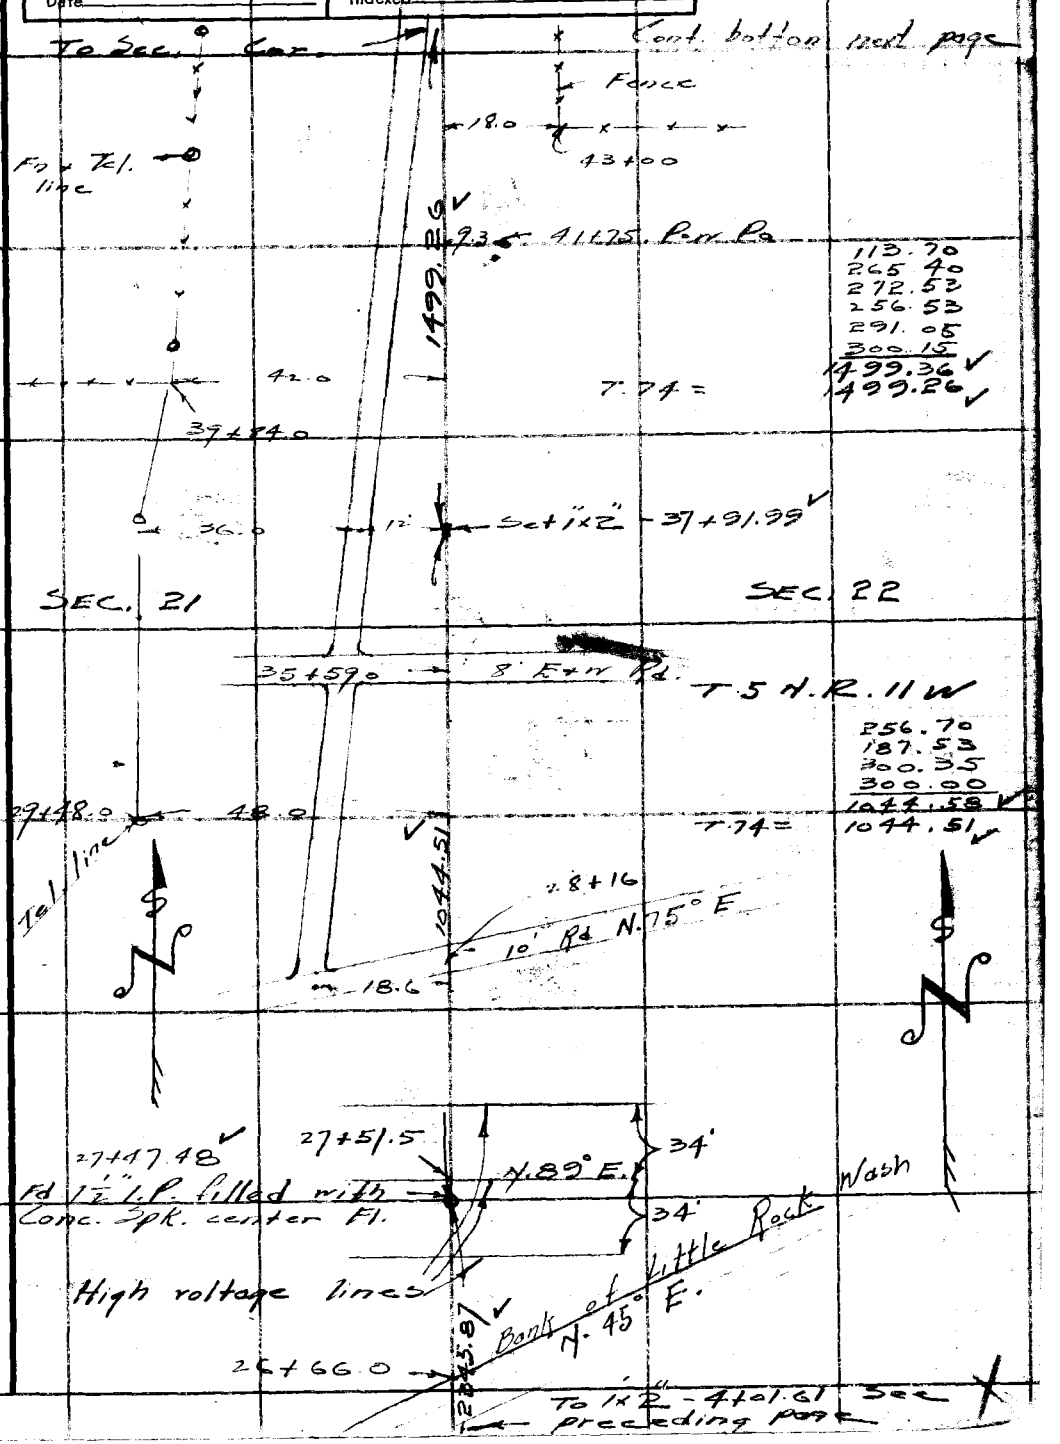

Note: Any Additions or Changes on This Sheet Must be Made or Circled in Red Ink With Date and Name of Person Making Change.

Do not extend notes this side of this line.

RETURN TO
LOS ANGELES COUNTY SURVEYOR
700 HALL OF RECORDS

FORM 247 5M 5-46

F.B. 1262 Pg. 208

W.S. 6 D-5

RETURN TO
LOS ANGELES COUNTY SURVEYOR
700 HALL OF RECORDS

Do not extend notes this side of this line.

Note: Any Additions or Changes on This Sheet Must be Made or Circled in Red Ink With Date and Name of Person Making Change.

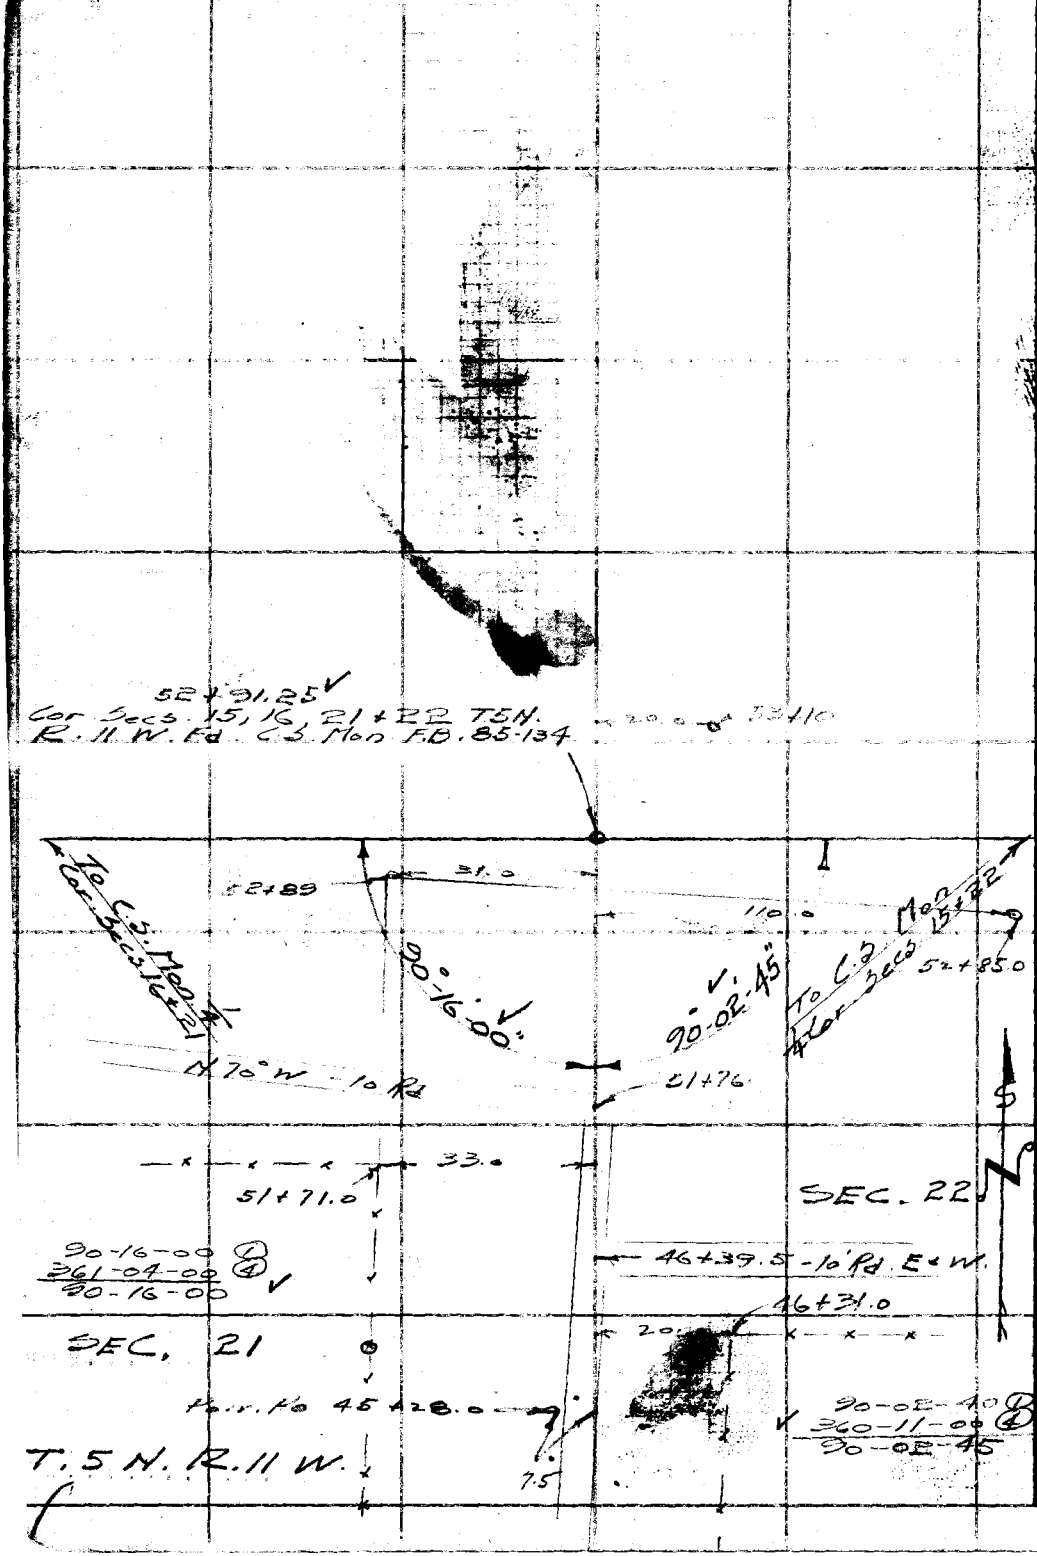

Notes Ck'd by KRM	Survey of T. 5N. R. 11W.
Map No.	W. O. 4999 Tape No. St'd 84 °F
Office Work	Surveyed by Rosecrans
Checked	Notes Pierce Date 3-8 '49
Date	Indexed A. C. Johnson

F.B. 1262 PG. 209

W.S. 65-C-5

See bottom next page

26+37.20

FOUND CS MON.
Up 4" in pile of
Rocks per C.S. 8739

COUNTY SURVEYOR MONUMENT
T.5N.
R11W.
2021
1/4 Sec. Cor.

0.10

3 strand b. wire fence 26+01

22+29 10' W. N 40° E

596.03

596.03
-.07
596.10

T 66°

22.17 @ 0°0	22.17
140.90 @ 0°0	140.90
134.93 @ 0°0	134.93
300.78 @ 7°39	298.10

21+90 : 3' W. N. 65° E

20+41.17
~~20+59.89~~
Set 1x2 flush
Top of spur
N. 90° E.

Set 10d N/a on true line

0.075

981.28

981.28
-.12
981.40

T 66°

140.57 @ 0°-0'	140.57
157.34 @ 0°-0'	157.34
235.41 @ 2°41	235.15
48.27 @ 0°-0'	48.27
300.27 @ 3°14	299.79
101.49 @ 8°51	100.28

SEC. 21

T 5N. R. 11W.

SEC. 20

10+59.89
Set 1x2 fl.

1059.89
-.12
1060.01

T 66°

186.96 @ 1°-22	186.91
250.10 @ 8°-33	247.32
300.90 @ 0°-0'	300.90
293.91 @ 16°39'	281.59
43.29 @ 00	43.29

3+49 : 12' W. N. 45 E.

89°-41'-15"

89°-51'-40"

1059.89

Note plugged this line to E + fall 0.12 N. of 1/4 Cor.

K 315
Fd. 2x2 + Tac.
4" up

1) 89°-41'-10"
4) 358-45-00
1) 89°-41-15"

GENERAL LAND OFFICE SURVEY
U.S. NAVY 250 FOR REMOVAL
T5N. R11W.
S21 S20
S29 S28

K 322
1) 89°-51'-50" Fd. 2x2 fl.
4) 359°-26'-40" No tack
1) 89°-51-40"

Fd U.S.G.L.O. MON. As described C.S.B. 745-5

Note: Any Additions or Changes on This Sheet Must be Made or Circled in Red Ink With Date and Name of Person Making Change.

Do not extend notes this side of this line.

RETURN TO
LOS ANGELES COUNTY SURVEYOR
700 HALL OF RECORDS

FORM 247 5M 11-41

F.B. 262 PG. 210

To C.S. Mon. 1/4 Cor. Secs 16+17 F.B. 85-132 + 139

0°-28'-40" ✓

0-28-40 ①
1-54-40 ④
0-28-40

89°-44'-05" ✓

89-44-00 ①
358-56-20 ④
89-44-05

W.S. 67-C-5

52+72.95 ✓
Cor. Secs 16, 17, 20 + 21 T.5N R.11 W. Fd. C.S. Mon. F.B. 85-132

67.32 @ 17-34 = 64.18 ✓
97.04 @ 6-36 = 96.40 ✓
160.58 ✓
T 74 = 160.57 ✓

Set 1"x2" -51+12.38 ✓

160.57

To C.S. Mon. 1/4 Cor Secs 16+21

SEC. 20

T.5N R.11W.

SEC. 21

58.74
176.55 @ 7-40 = 174.97 ✓
175.60 @ 7-28 = 174.11 ✓
175.81
256.68 @ 2-01 = 256.52 ✓
232.65 @ 2-15 = 232.47 ✓
300.55 @ 7-18 = 298.11 ✓
1.00
260.26 @ 6-49 = 258.42 ✓
123.40 @ 5-37 = 122.81 ✓
299.87 @ 3-03 = 299.44 ✓
2052.40 ✓
T. 70 = 2052.21 ✓

2052.21

Set 1"x2" -30+60.17 ✓

17.68
300.43
104.90
423.01 ✓
T. 68 = 422.97 ✓

422.97

N 20° E

26+71.0

179°-59'-15" ✓

7' Trail

179-59-15 ①
359-57-00 ④ ✓
179-59-15

26+37.20 ✓
C.S. Mon. 1/4 Cor. Secs 20 + 21 See preceding page

To 10th Na. 20+41.17 See preceding page

RETURN TO
LOS ANGELES COUNTY SURVEYOR
700 HALL OF RECORDS

Do not extend notes this side of this line.

Note: Any Additions or Changes on This Sheet Must be Made or Circled in Red Ink With Date and Name of Person Making Change.

Notes Ck'd by KRM.	Survey of T. 5N. R. 11W.
Map No.	W. O. 4999 Tape No. 85 St'd 84 °F
Office Work	Surveyed by Rosecrans
Checked	Notes R Date 3-23-49
Date	Indexed A. C. Johnson

F. B. 1262 Pg. 271

W.S. 67-C-5

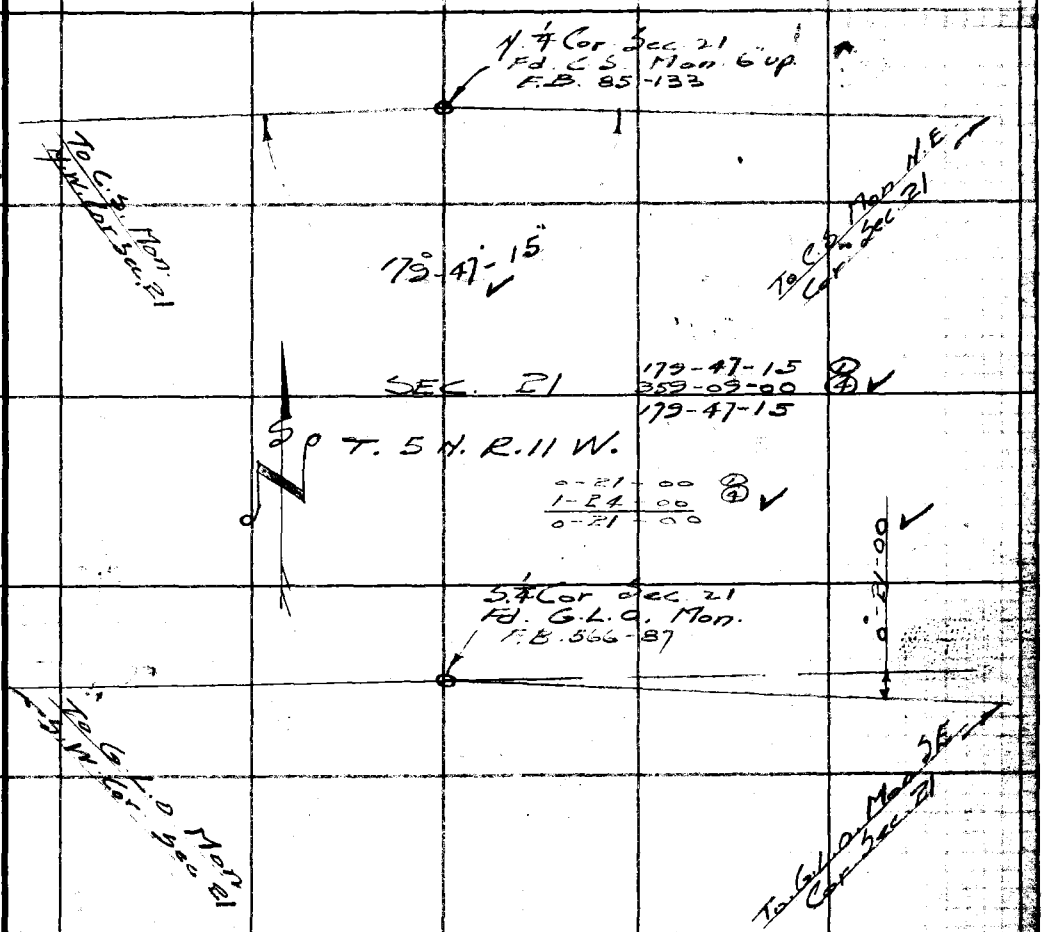

Note: Any Additions or Changes on This Sheet Must be Made or Circled in Red Ink With Date and Name of Person Making Change.

Do not extend notes this side of this line.

RETURN TO
LOS ANGELES COUNTY SURVEYOR
700 HALL OF RECORDS

FORM 247 5M 5-46

F. B 1262 PG. 212

213 + 214 Blank

RETURN TO
LOS ANGELES COUNTY SURVEYOR
700 HALL OF RECORDS

Do not extend notes this side of this line.

Note: Any Additions or Changes on This Sheet Must be Made or Circled in Red Ink With Date and Name of Person Making Change.

Notes Ck'd by KRM	Survey of T 5N R 12W
Map No. B-2611	W. O. 4999 Tape No. 85 St'd 64°F
Office Work G. BAILEY	Surveyed by Rosecrans
Checked	Notes R. Date 3-18-49
Date	Indexed A. C. Johnson 8-17-49

W.S. 65-A-4

Note: Any Additions or Changes on This Sheet Must be Made or Circled in Red Ink With Date and Name of Person Making Change.

Do not extend notes this side of this line.

RETURN TO
LOS ANGELES COUNTY SURVEYOR
700 HALL OF RECORDS

FORM 247

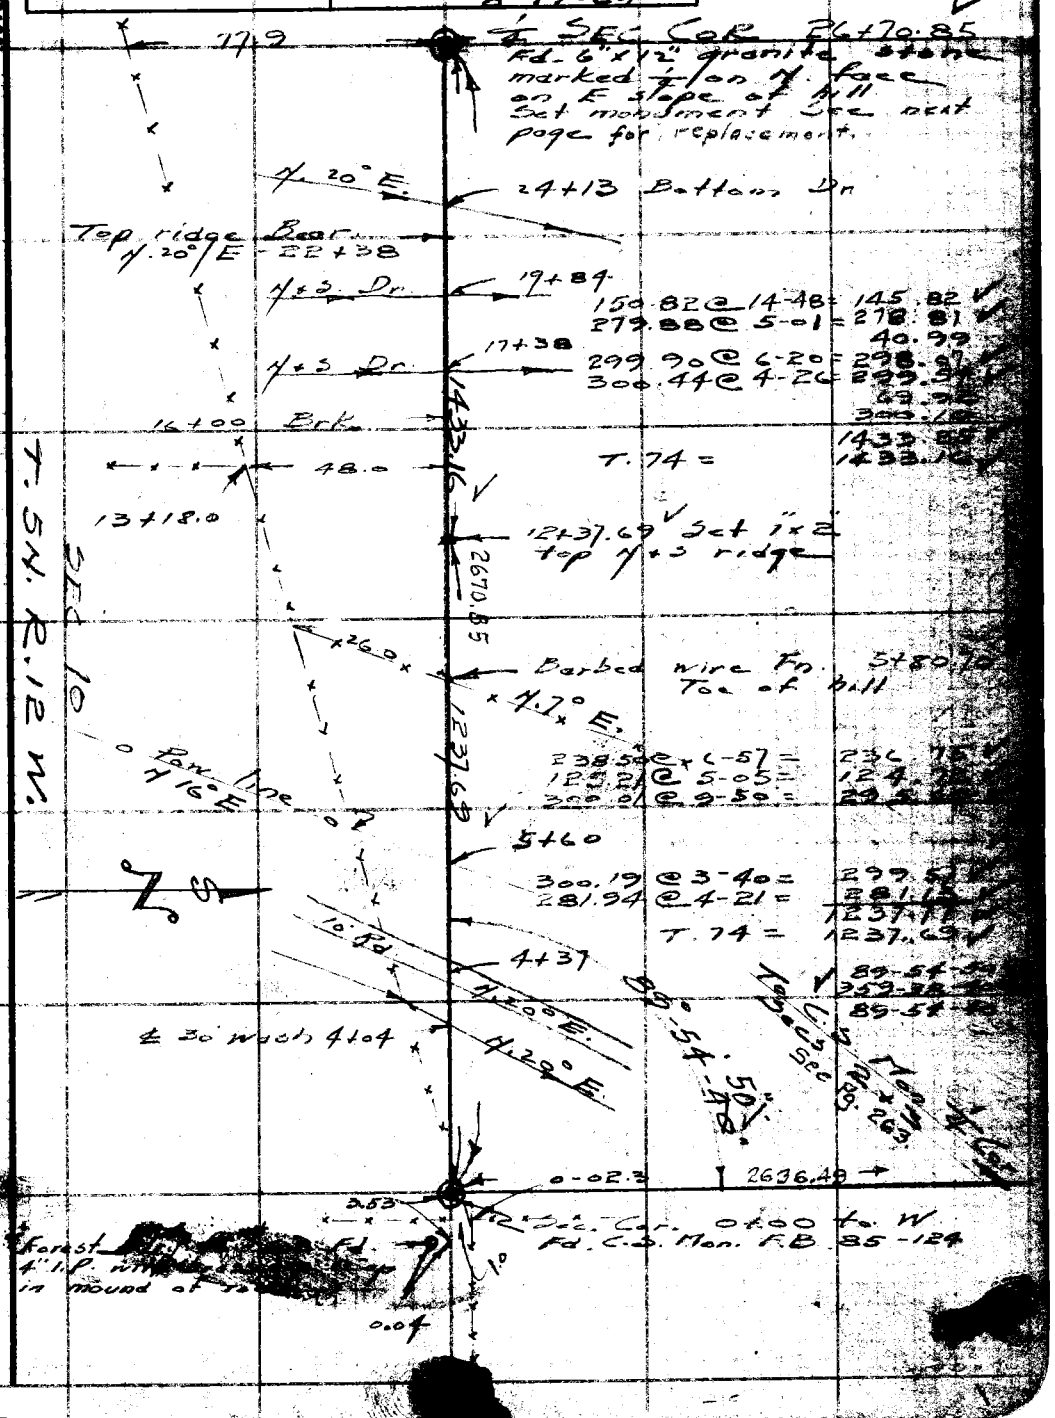

Cont. bottom next page

W.S. 65 A-4

Set 1"x2" - 49+83.32
top N+S. ridge

To S.W. Cor. Sec. 3

Dr. toe of slope 38+31.

N 10° E.

62.16 @ 5-32 =	61.87	
276.01 @ 12-21 =	269.62	
300.62 @ 3-55 =	299.92	
194.14 @ 18-37 =	183.98	
80.63 @ 23-30 =	73.94	
300.91 @ 22-15 =	278.50	
288.14 @ 2-38 =	287.83	
57.46 @ 6-43 =	57.07	
300.13 @ 3-53 =	299.44	
170.41 @ 11-53 =	166.76	
	30.60	
	2009.53	
T.72 =	2009.37	

37+09

8' Trail N 48° E.

Sec. Line

33+78

N 10° E.

Dr.

N 10° W

33+26

2009.37

26.9

Barbed wire Fn.

N 15°-20' E.

2645.08

0.05

Set 1"x2" - 29+73.95
top N+S. ridge

0°-00'-35" Calc.

102.04

108.04 @ 19-10 T.76 = 102.04

Set 1"x2" - 28+71.91

218.65 @ 23-08 T.76 = 201.06

201.06

SEC. COR. 26+70.85 Fr. E
Fd. marked stone. Replaced it with 2" I.P. with brass cap marked as shown in Conc. 3" above surface

SEE F.B. 2237-18

Sec. line to E See preceding page

SEC. 3

SEC. 10

T.5 N. R.12 W.

COUNTY SURVEYOR
T.5 N.
R.12 W.
3
10
4 Cor.
329

RETURN TO
LOS ANGELES COUNTY SURVEYOR
700 HALL OF RECORDS

Do not extend notes this side of this line.

Note: Any Additions or Changes on This Sheet Must be Made or Circled in Red Ink With Date and Name of Person Making Change.

W.S.65.A-4

Notes Ck'd by KRM	Survey of T.5N. R12W.
Map No. B-2611	W. O. 4999 Tape No. 85 Std. 84 °F
Office Work G. BAILEY	Surveyed by Rosecrans
Checked	Notes R Date 4-7-49
Date	Indexed A. C. Johnson

E.B. 1262 Pg. 217

Cont bottom next page

N+S Dr

74+38 103.66 @ 15-33 = 99.87 ✓
N+S Dr 187.90 @ 13-20 = 182.83 ✓
42.54
73+36 214.69 @ 8-05 = 212.56 ✓
262.56 @ 14-52 = 253.77 ✓
59.93 @ 11-49 = 58.27 ✓
64.04 @ 13-56 = 62.16 ✓
299.87 @ 7-55 = 297.01 ✓
300.02 @ 19-05 = 283.52 ✓
55.37 @ 5-52 = 55.08 ✓
1548.02 ✓
T.84

Top N+S. spur 70+70

Sec. Line 1548.02 ✓

Bottom Dr. 68+70

0°-18'-04" Calc. 19"

N 45° E

2618.92

Set 1"x2" - 63+70.84 ✓ on N. Slope

N+S. Dr

60+73

124.68 @ 14-15 = 53.28
120.84 ✓
299.46
68.78 @ 3-44 = 68.63 ✓
542.21 ✓
T. 70 = 542.16 ✓

542.16 ✓

Set 1"x2" - 58+28.68 ✓ top N+S. spur

84.24 @ 14-44 = 81.47 ✓
165.50 @ 23-50 = 151.39 ✓
300.23 @ 21-11 = 279.94 ✓
512.85 ✓
T. 68 = 512.75 ✓

Fd. 8" juniper scribed T.5N. R.12. W. S9 B.T.

R12W. 4 3 9 10 LOUNTY T.5N. SURVEYOR R.E. 329

512.80 75 ✓

57°30'

N+S. Dr.

136.0

53+15.93 ✓ SEC. COR. Set 2" I.P. with brass cap marked as shown in Cone 4" up Rec. from witness post. Fd. 3"x4"x20" juniper post with traces of scribing laying down.

3.96

53+11.97 ✓ Fd. 3" I.P. with 4" brass cap marked as shown 12" high. See government notes C.S. 92.06

See Pg. 226 & 243., see F.B. 1684-223

N S

2645.08 To 1/4 Cor. 328.65

Sec. Line

U.S. FOREST RESERVE

T.5N. S3 W.

RESERVE BOUNDARY POST No 107 1905 1911

R12W. S10 W

SEC. 10

166.72 @ 26-44 = 148.90 ✓
113.01 @ 24-42 = 102.67 ✓
81.86 @ 19-37 = 77.11 ✓
328.68 ✓
T. 68 = 328.65 ✓

1"x2" - 49+83.32 ✓ top of ridge. See preceding page

Note: Any Additions or Changes on This Sheet Must be Made or Circled in Red Ink With Date and Name of Person Making Change.

Do not extend notes this side of this line.

RETURN TO
LOS ANGELES COUNTY SURVEYOR
700 HALL OF RECORDS

FORM 247 5M 5-46

F.B. 1262 Pg. 218

Cont. bottom next page

W.S. 65 A-4

Set 1x2 - 97+82.28

old Fn. line 95+53.0

N 45° W

93+70

N 45° E

0°19'05"

91+69 Top N+S spur

1480.66

87+19.0

N 45° E

SEC 4

185.95 @ 15-53 = 178.86
142.10 @ 18-48 = 134.52
300.17 @ 3-30 = 299.61
287.32 @ 11-44 = 281.32
300.70 @ 6-08 = 298.98
287.55 @ 2-35 = 287.26
1480.54
T.96 = 1480.66

N+S Dr

84+96

Set 1x2 T.R. - 83+01.~~63~~ .58

58.65 @ 4-00 T84 = 58.51

58.51

2626.38

Sec. Line

Set 1x2 Top Brk 82+43.42 .07

324.21

33.66 @ 17-19 = 32.13
300.27 @ 13-25 = 292.08
324.21

T.84

N+S Dr

79+69.0

79+34.86

SEC. COR. Fd. granite stone 8"x9"x7"-10 in the ground marked ¼ on No. face. See cort notes C.S. 9206 Set 1x2" hubs 5.00 So and 5.00 E. Replaced stone with 2" I.P. with brass cap marked as shown in Cons. flush.

SEE F.B. 1684-224 a

13.76

Set 1x2 - 79+18.~~91~~ 86

N 44° E 52.45

41.38

S70 E

15.95

2618.92

Sec. Line

1548.02

Fd. 10" juniper scribed ¼ S B.T.

Fd. 10" juniper scribed ¼ S B.T.

Top N+S spur 75+93

To 1x2 - 63+70.89 See preceding page

COUNTY SURVEYOR
R.12 W. T5N 4
9
¼ COR
P.E. 329

SEC. 9

RETURN TO
LOS ANGELES COUNTY SURVEYOR
700 HALL OF RECORDS

Do not extend notes this side of this line.

Note: Any Additions or Changes on This Sheet Must be Made or Circled in Red Ink With Date and Name of Person Making Change.

Notes Ck'd by D. M. Finley	Survey of T. 5 N. R. 12 W.
Map No. B-2611	W. O. 4999 Tape No. 85 St'd 84 °F
Office Work G. BAILEY	Surveyed by Rosecrans
Checked	Notes R Date 6-28-49
Date	Indexed K. C. Johnson

F. B. 1262 Pg. 219

W.S. 65 A-4

SEP 14 '51

To 1"x2" - 119 + 49.96.91

Cont. bottom next page

26.00

106+60.63 .58 Fd 10" cedar blazed and marked. Could not read the markings.

SEC 8

R.12 W. COUNTY T.5 N. SURVEYOR 5 4 8 9 A.E. 329

SEC 5

Sec. Cor. Set 2" I.P. with brass cap marked as shown in Conc. 5" up. Rec. Fr. 4" I.P.

105+57.14 .00 Fd 4" iron pipe 18" above ground with brass cap marked as shown C.S. 9206

3.96

28.28

4.71

0.75

28.26

34.72

Set 1x2 - 105 + 56.39 4

0.80

105+55.59 4 Fd 6" scrub oak tree scribed T.5N. R.12 W S9 B.T.

Set 1x2 - 105+61.05 .05

FOREST RESERVE U.S. RESERVE BOUNDARY POST No. 106 1905 R.12 W. S9 T.5N. S4 W.S.

1323.07

206.48

0°-19'-00" .05

Sec. Line

212.99 @ 14-10 T.60 = 206.48

Set 1"x2" - 103 + 49.91 .86

124.93 @ 5-43 T.60 = 124.29

124.29

Set 1"x2" - 102 + 25.62 .57

2626.28 To ¼ Cor.

T. 5 N. R. 12 W.

SEC. 9

SEC. 4

326.75

300.30 @ 0-24' = 26.43 / 300.29 / 326.72

T.96 = 326.75

Set 1x2 - 98 + 98.87 2

116.58

116.95 @ 4-37 T.96 = 116.58

1"x2" - 97 + 82.29 4

See preceding page

Note: Any Additions or Changes on This Sheet Must be Made or Circled in Red Ink With Date and Name of Person Making Change.

Do not extend notes this side of this line.

RETURN TO
LOS ANGELES COUNTY SURVEYOR
700 HALL OF RECORDS

FORM 247 5M 5-48

F.B. 1262 Pg. 220

Cont. bottom next page

25"
0°-41'-29"
Calc.

To 1"x2" plugged ahead for 4 tie

W.S. 64D-4

0+00 to W.

1/4 Sec. Cor. Fd.
8" x 10" granite stone marked 1/4 on No. face and a X on top
Sec. C.S. 9206
Replaced stone with 2" I.P. with brass cap marked as shown in Conc. 5' up

79°26'-30"
52.02' Calc.

Rt 4 Sta 131+56.01

R. 12 W.
T. 5 N.
Sec. 9
Sec. 8
Sec. 5
Sec. 4
Sec. 3
Sec. 2
Sec. 1
Sec. 6
Sec. 7
82.18 @ 4-46 T.84 = 81.89'

Set 1"x2" - 130+92.77
T.R. Bear. N35°E.

85"
0°-31'-24"
Calc.

140-33-30 (1)
281-07-09 (2)
140-33-30'

Tel. line of 1°E.

125+62

Sec. 8

Sec. 5

300.56 @ 13-32 =	292.20'	
	223.91	10' Rd
125.86 @ 14-49 =	121.68'	
208.02 @ 14-16 =	201.61'	
204.63 @ 8-05 =	202.60'	
99.96 @ 9-18 =	99.36'	
	1143.35'	
T.80 =	1142.56'	

Set 1"x2" - 112+49.54
T-p spot bearing N 45°E

97.30 @ 17-11 =	28.49	
122.95 @ 18-35 =	92.96'	
275.15 @ 5-17 =	116.54'	
121.60 @ 13-58 =	274.02'	
128.65 @ 12-49 =	118.01'	
63.29 @ 1-59 =	125.44'	
293.70 @ 6-10 =	63.27'	
294.10 @ 6-00 =	292.90'	
	293.61'	
	1393.25'	
T.64 =	1393.07'	

Bottom Dr. 116+27

Top 1+6 Intr. 111+64

Bottom Dr. 109+55

To 1"x2" - 105+56.39

* See preceding page

RETURN TO
LOS ANGELES COUNTY SURVEYOR
700 HALL OF RECORDS

Do not extend notes this side of this line.

Note: Any Additions or Changes on This Sheet Must be Made or Circled in Red Ink With Date and Name of Person Making Change.

W.S. 64 D-4

Notes Ck'd by D. M. Finley	Survey of T. 5 N R 12 W
Map No. B-2611	W. O. 1999 Tape No. 73 St'd 84 °F
Office Work G. Bailey	Surveyed by Rosecrans
Checked	Notes R Date 5-25-50
Date	Indexed A. C. Johnson

F. B. 1262 Pg. 221

Cont. bottom next page

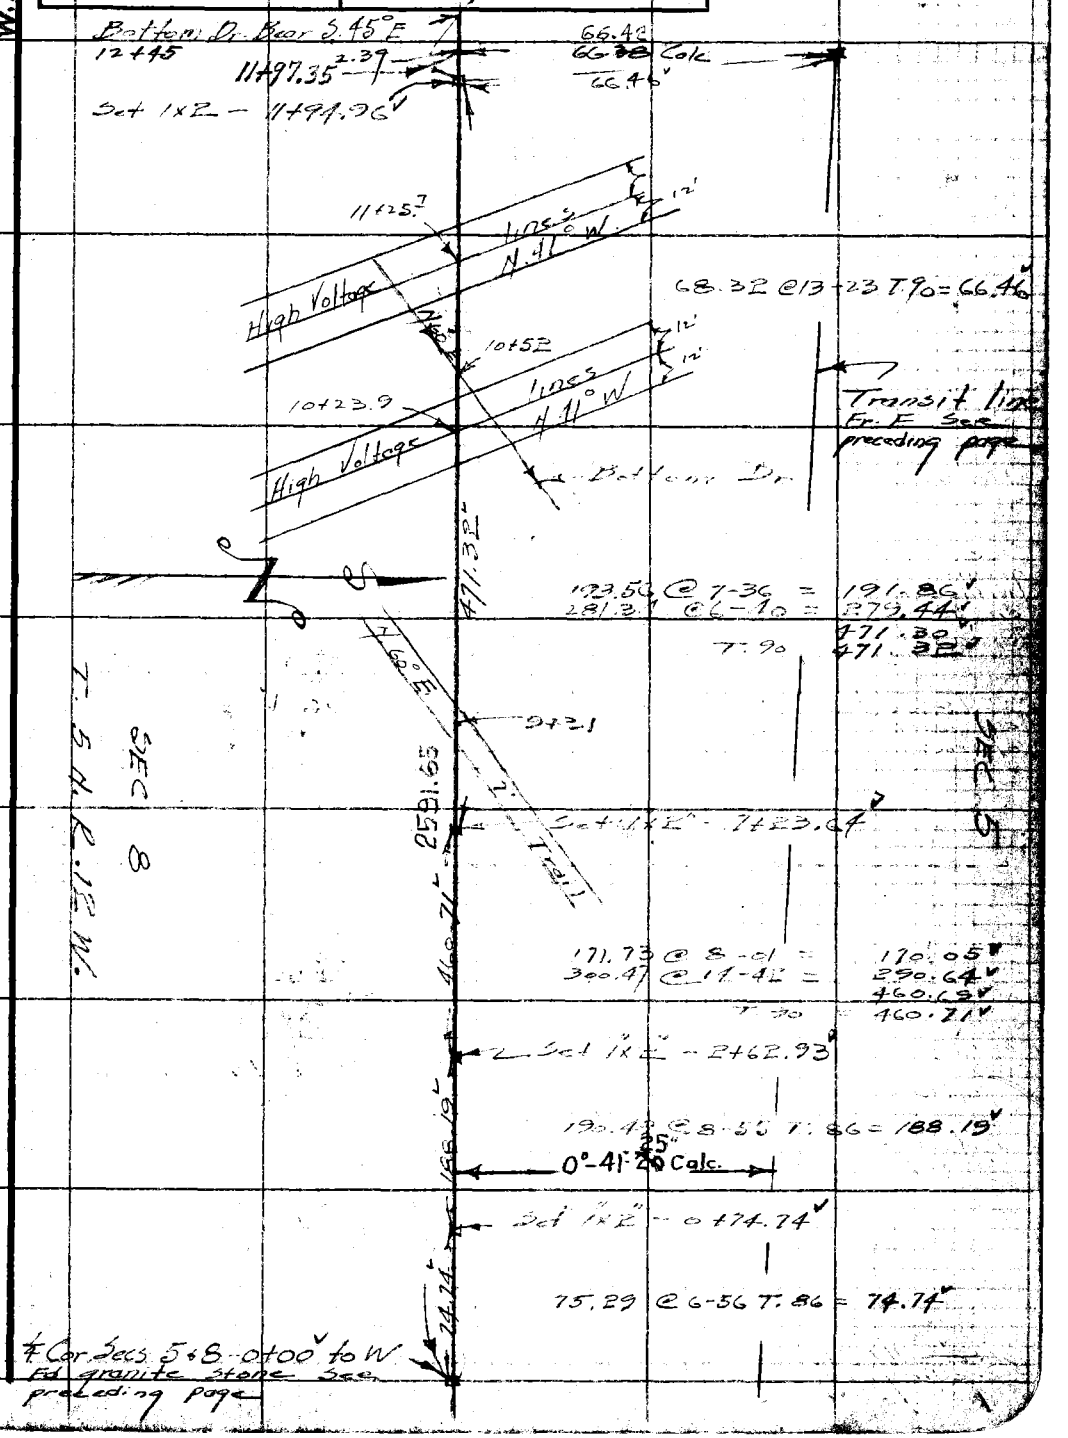

Note: Any Additions or Changes on This Sheet Must be Made or Circled in Red Ink With Date and Name of Person Making Change.

Do not extend notes this side of this line.

RETURN TO
LOS ANGELES COUNTY SURVEYOR
726 LOS ANGELES COUNTY
ENGINEERING BLDG.

76F3098 247 10M 1-49

F. B. 1262 PG. 223

Cont. bottom next page

W.S. 64 D-4

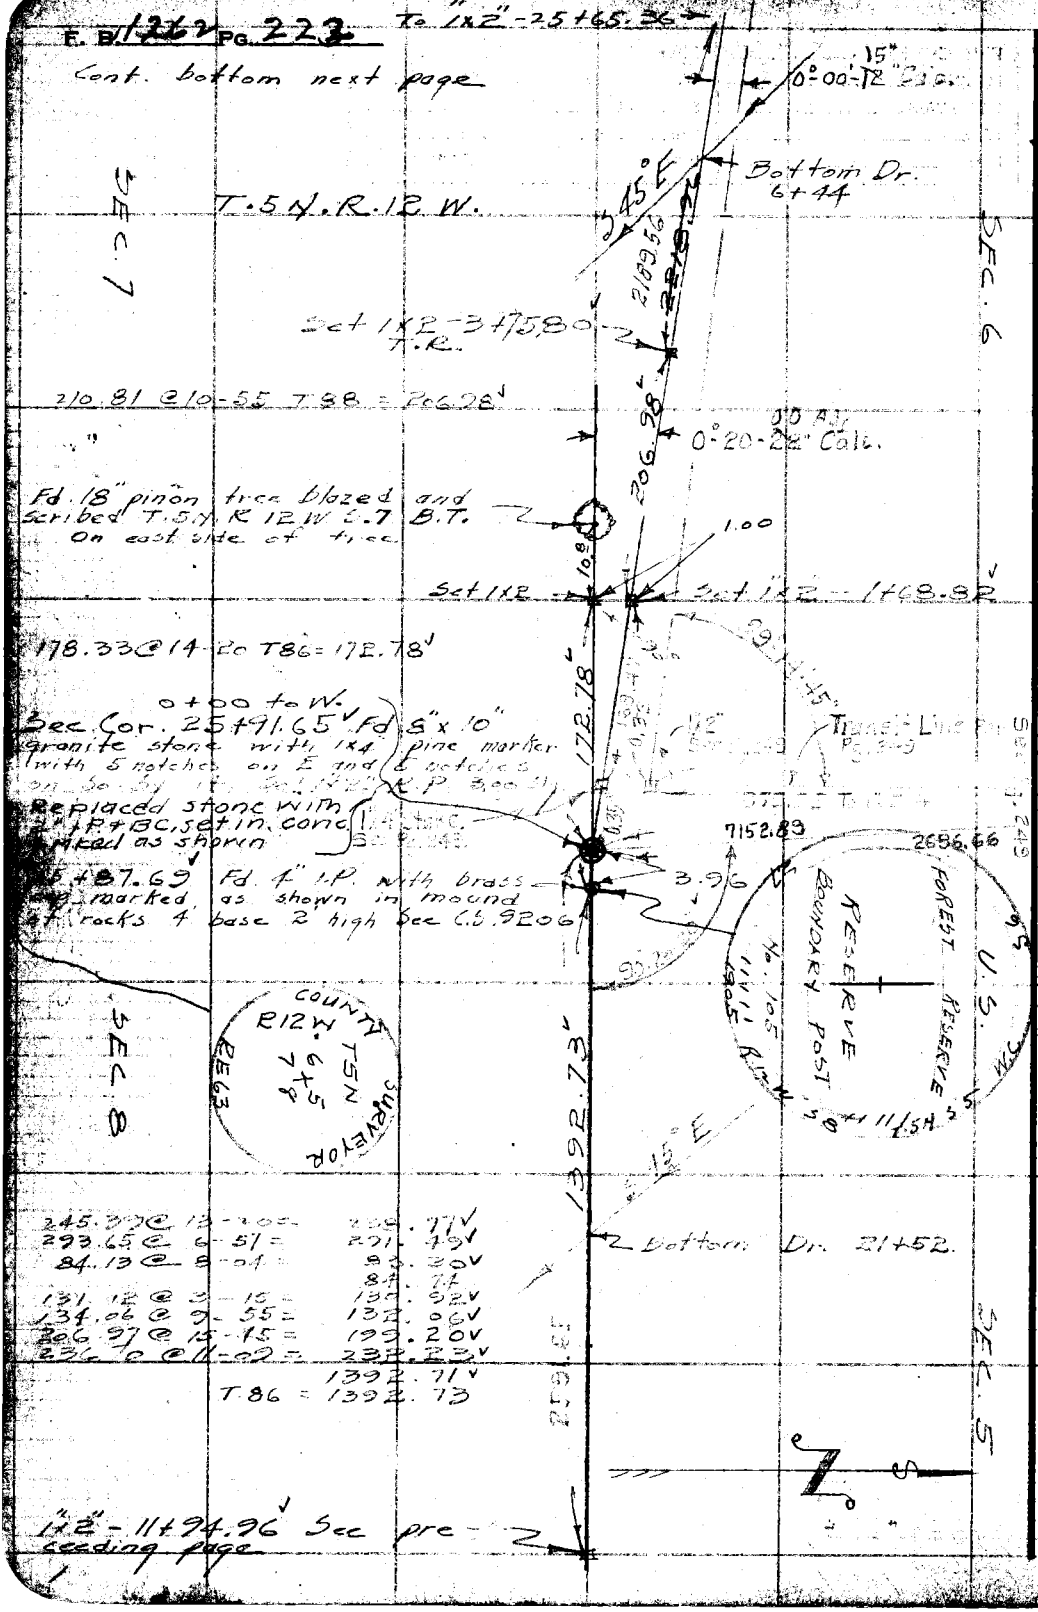

RETURN TO
LOS ANGELES COUNTY SURVEYOR
726 LOS ANGELES COUNTY
ENGINEERING BLDG.

Do not extend notes this side of this line.

Note: Any Additions or Changes on This Sheet Must be Made or Circled in Red Ink With Date and Name of Person Making Change.

W.S. 64 D-4

Notes Ck'd by D. M. Finley	Survey of T 5 N. R 12 W
Map No. B-2611	W. O. 1992 Tape No. 73 St'd. 84 °F
Office Work G. BAILEY	Surveyed by Lopez-Irans
Checked	Notes R Date 6-1-50
Date	Indexed A. C. Johnson

F. B. 1262 Pg. 229

Cont bottom next page — Set 1x2" top N+S ridge 43+05.33 V

To Sec. Cor.

1646.68 V

N+S. — 89.04 @ 23-00 — 81.96 V

25.27

B.D. 38+15

300.71 @ 20-36 = 281.48 V
297.52 @ 14-20 = 288.26 V
283.24 @ 4-12 = 282.48 V
115.65 @ 12-15 = 113.02 V
101.90 @ 7-02 = 101.13 V
300.62 @ 14-45 = 290.71 V
106.06
71.20
1641.77 V
T.76 = 1641.68 V

N+S.

B.D. 35+20

2775.91

SEC 7 T. 5 N. R. 12 W.

Set 1x2" 26+63.65 V
T. R. Bear N.E. & W.

02.88 @ 17-10 T 76 = 98.29

0°-56'55" Calc.

T 12 W
R 63
T 5 N
COUNTY SURVEYOR

2265.52

1/4 Sec Cor. 25+66.14 V
Fd. 8" x 8" granite stone
with X in top marked 1/4
on two faces say 1/4 face
found 3x3" hemlock juniper post
2' long lay'g by it

0.78 — 18.47

Replaced with 2" IP
& B.C. set in conc
marked as shown

Set 1x2
25+65.36 V

0°-24'45" Calc.

B.D. 18+02

55.35 @ 24-45 = 5.27 V
300.72 @ 19-52 = 282.83 V
233.22 @ 13-03 = 227.80 V
300.15 @ 12-55 = 292.85 V
162.65 @ 3-20 = 162.37 V
179.57 @ 2-52 = 179.35 V
69.39 @ 13-25 = 67.50 V
300.21 @ 11-24 = 294.44 V
175.29 @ 15-14 = 169.13 V
300.07 @ 9-51 = 296.65 V
94.41 @ 16-05 = 90.92
76.05
T. 84 — ~~2218.96~~ 2189.56 V

To Sec. Cor. Sec. 6

2189.56

Top N+S. ridge
13+69.49

Note: Any Additions or Changes on This Sheet Must be Made or Circled in Red Ink With Date and Name of Person Making Change.

Do not extend notes this side of this line.

RETURN TO
LOS ANGELES COUNTY SURVEYOR
726 LOS ANGELES COUNTY
ENGINEERING BLDG.

76F3098 247 10M 5-49

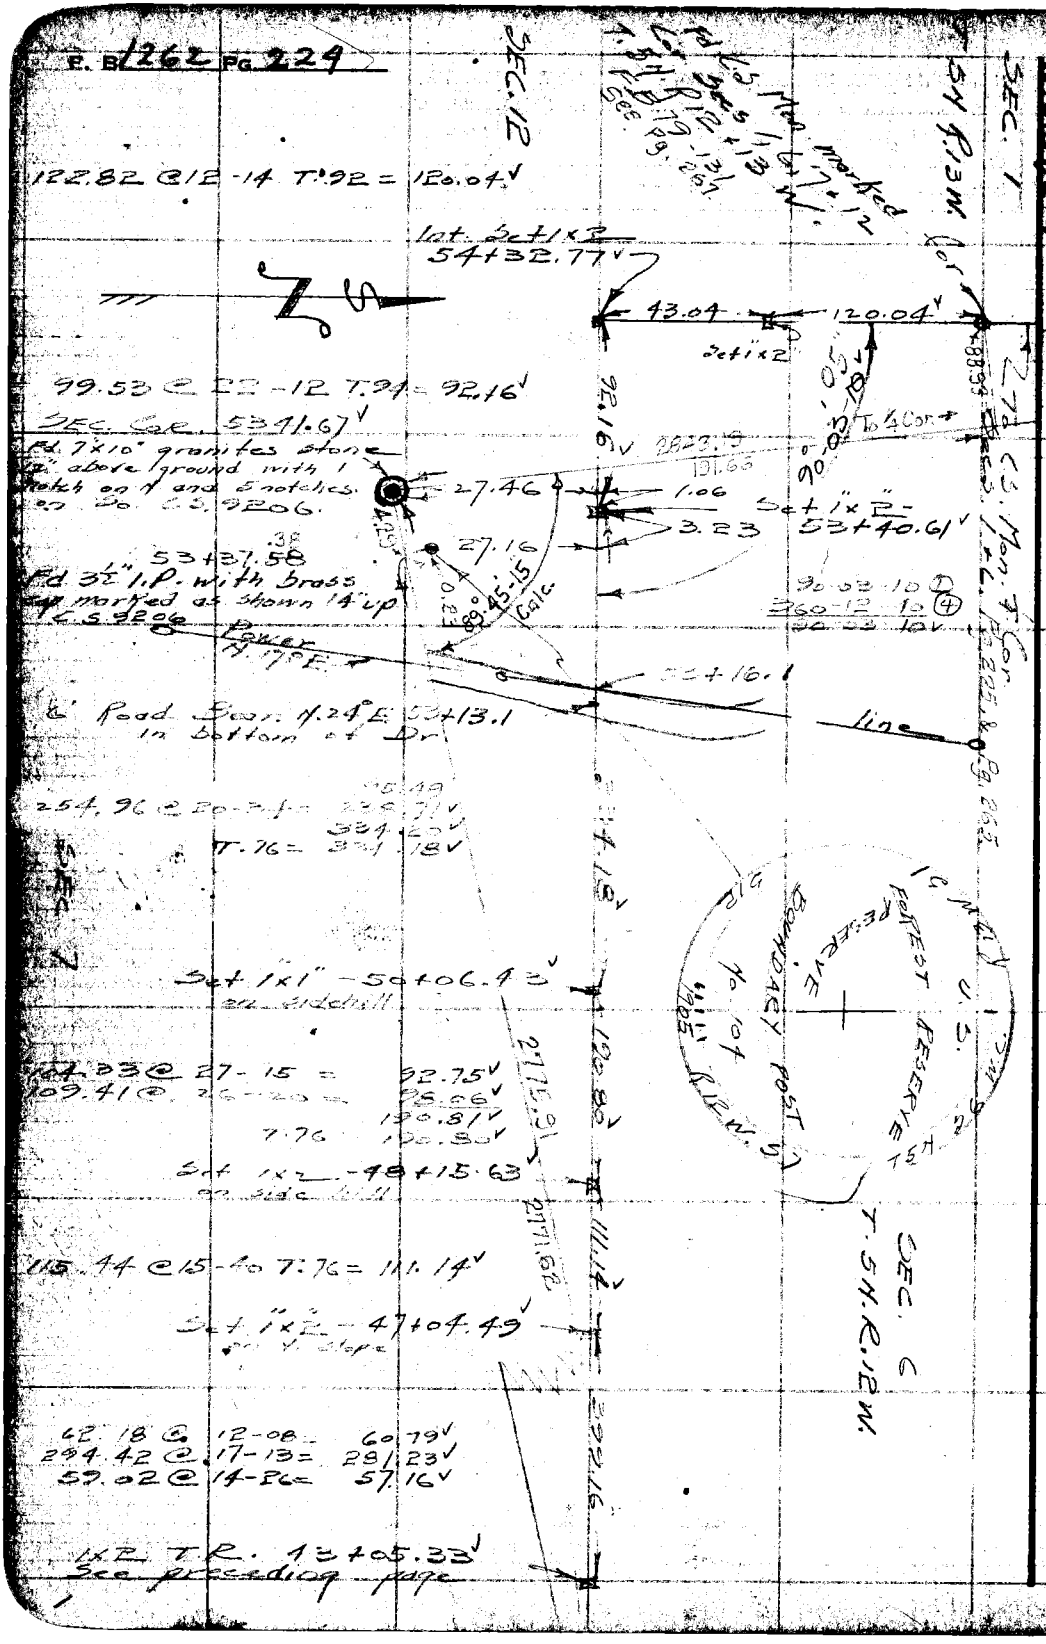

RETURN TO
LOS ANGELES COUNTY SURVEYOR
726 LOS ANGELES COUNTY
ENGINEERING BLDG.

Do not extend notes this side of this line.

Note: Any Additions or Changes on This Sheet Must be Made or Circled in Red Ink With Date and Name of Person Making Change.

W.S.64, C-4

Notes Ck'd by D. M. Finley	Survey of T 5 N. R 13 W.
Map No. B-2611	W. O. 4999 Tape No. 73 St'd. 84 °F
Office Work G. BAILEY	Surveyed by Rosecrans
Checked	Notes R Date 6-19-50
Date	Indexed A. C. Johnson

F. B 1262 Pg. 225

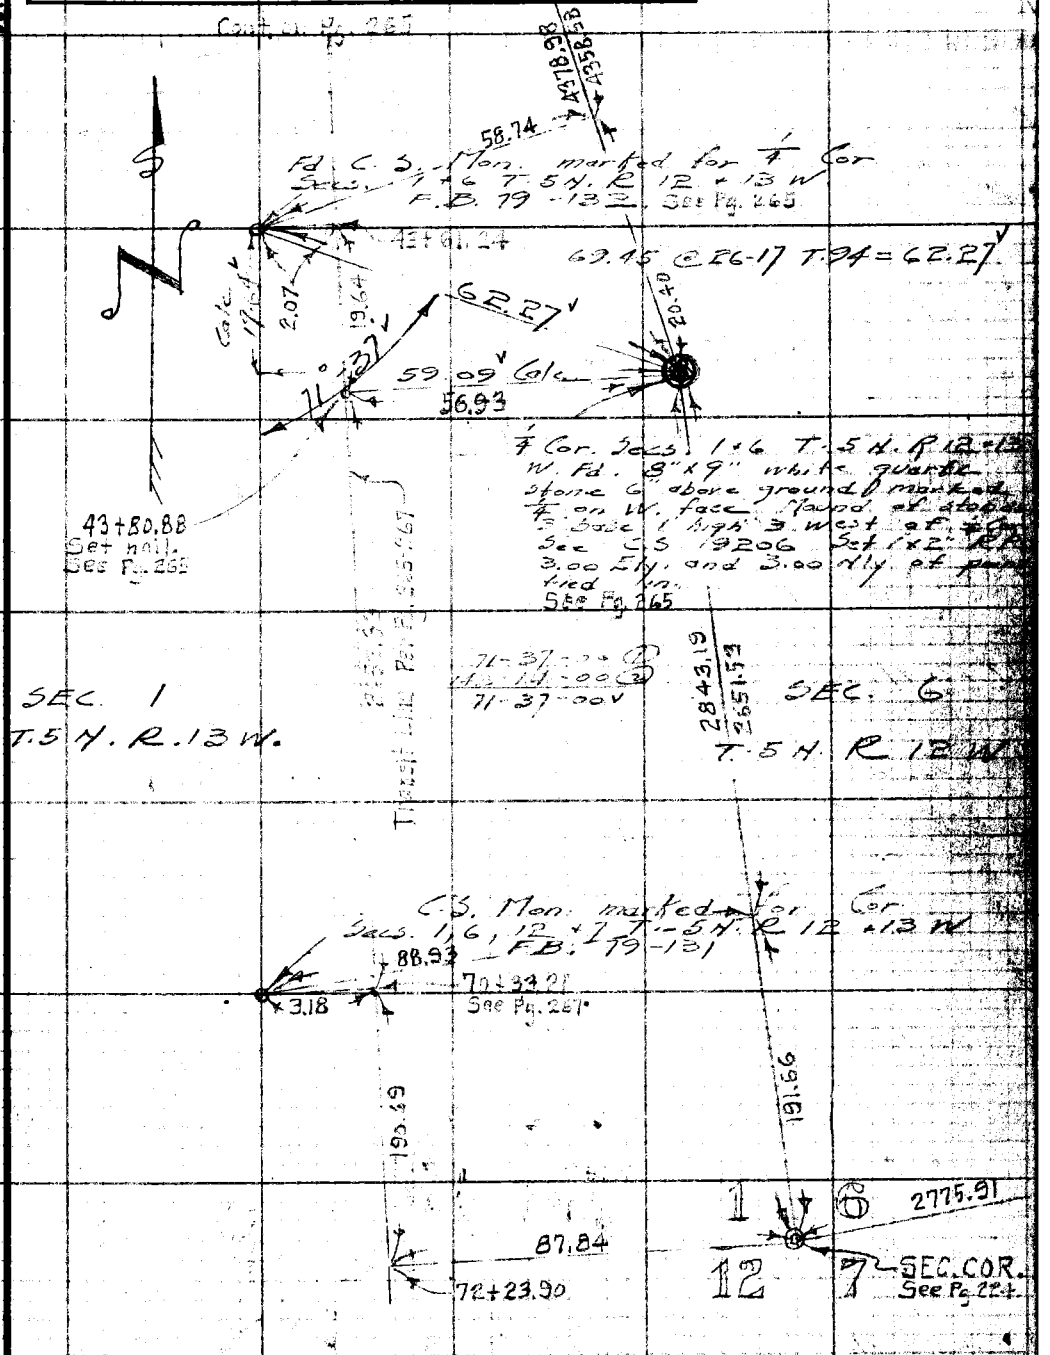

Note: Any Additions or Changes on This Sheet Must be Made or Circled in Red Ink With Date and Name of Person Making Change.

Do not extend notes this side of this line.

RETURN TO
LOS ANGELES COUNTY SURVEYOR
726 LOS ANGELES COUNTY
ENGINEERING BLDG.

76F309S 247 10M 5-49

F. B. 1262 Pg 226

Cont. bottom next page

To 1"x2" -26+~~57.82~~ 59.83

Bottom Dn. 14+58

1551.70

~~1549.68~~

78.0

13+64.

29.32

300.32 @ 3-26 = 299.78

300.65 @ 6-56 = 298.45

300.41 @ 9-31 = 296.28

NG 39.99

300.22 @ 11-35 = 294.10

195.34 @ 10-40 = 191.96

1549.88

T.64 = 1549.68

Set 1"x2" T.R. Bear N60° E. 11+08.13

216.54 @ 3-07 = 216.22

234.43 @ 6-00 = 233.16

211.83 @ 7-35 = 209.98

267.95 @ 9-52 = 263.99

226.40 @ 4-16 = 225.77

289.79 @ 11-48 = 283.67

120.67 @ 8-55 = 119.21

1552.00

T. 54 = 1551.70

Rechain 12-14-51

E.A.R.

7+56

Bottom draw

2642.40

5+59

T. 5 N. R. 12 W.

955.58

67.22

300.00 @ 1-38 = 299.88

300.23 @ 7-50 = 297.32

300.14 @ 13-56 = 291.31

955.73

T.60 = 955.58

3+02

Set 1"x2" - 14+52.55

0°-03'-20" Calc.

89-39-10

358-37-00

89-39-15

80.87

82.42 @ 11-05 T. 60 = 80.87

Set 1"x2" - 0+71.68

89°-39'-20"

71.68

71.69 @ 00 T. 60 = 71.68

Transit line 7

0+00 to N. Cor. Secs 3, 4, 9+10 T. 5 N. R. 12 W. Set C.S. Mon. F.B. 1262 - 217, 243

RETURN TO
LOS ANGELES COUNTY SURVEYOR
726 LOS ANGELES COUNTY
ENGINEERING BLDG.

Do not extend notes this side of this line.

Note: Any Additions or Changes on This Sheet Must be Made or Circled in Red Ink With Date and Name of Person Making Change.

W.S. 65.A.4

Notes Ck'd by D. M. Finley	Survey of T.5 N. R. 12 W.
Map No. B-2611	W. O. 4999 Tape No. 73 St'd 84 °F
Office Work G. BAILEY	Surveyed by Rosecrans
Checked	Notes R Date 10-2-50
Date	Indexed R. C. Johnson

F. B. 1262 Pa.

Cont. bottom this page

Ch. No. 52+17.30 — 30.81 V

53+13.7 +15

18.9

13.2

Per. line

Dirt Rd.

170.63 @ 3-00 = 170.40 V.
300.31 @ 2-15 = 300.09 V.
300.31 @ 3-11 = 299.9 V.
300.74 @ 2-50 = 300.87 V.
300.31 @ 2-15 = 300.08 V.
T.68 = 1370.66 V. 1370.52

3078.36

Sec. Line

1370.52

Road

71.80

SEC. 4

T. 5 N. R. 12 W.

1.190 +59.52 V
39+57.50 Fd. 3x3" + Tk. 2" up

0.10

Set 1x2 39+49.47 — 49.49 V

12.2

12'

0°-02'-00" Calc.

178.24 @ 3-15 = 177.95 V.
255.13 @ 1-50 = 255.00 V.
258.79 @ 3-51 = 258.21 V.
300.30 @ 3-26 = 299.76 V.
300.03 @ 5-03 = 298.87 V.
T. 68 = 1289.79 V. 1289.66 V.

4394.48

1277.84

SEC. 3

+81.68 26+79.60

Fd. old 3x4 redwood 3'6" + No. 2" up

0.32

0.36 70.02 68.07

2.91

Dirt Rd.

12.0

27.53

2.0

Fd. 2" I.P. 26+79.84 +81.34 V

Set 1x2 26+57.84 — 26+59.83 V

37.94

+43.40 V 26+41.38

1/4 SEC. COR.

Fd. 2 1/2" I.P. filled with Conc. + Nail 6" up

1/4 COR. BET. SECS. 3, 4 T5N, R12W

RE SET WITH CE. MON.

2" I.P. IN CONC.

18" DN. WITH BRASS CAP MARKED: T5N 4+3 1/4 COR.

FOR TIES SEE F.B. 2237-14

W. MACK 8-15-56

To 1x2 11+08.12 Sec. preceding page

COUNTY ENGINEER R.E. 5869

15.51.70

2.57

10° E.

Bottom Dr. 25+13 +15

To Dirt Rd.

2643.40

Note: Any Additions or Changes on This Sheet Must be Made or Circled in Red Ink With Date and Name of Person Making Change.

Do not extend notes this side of this line.

RETURN TO
LOS ANGELES COUNTY SURVEYOR
726 LOS ANGELES COUNTY
ENGINEERING BLDG.

76F3088 247 10M 1-48

F. B. 1262 PG. 228

W.S. 65 A-3

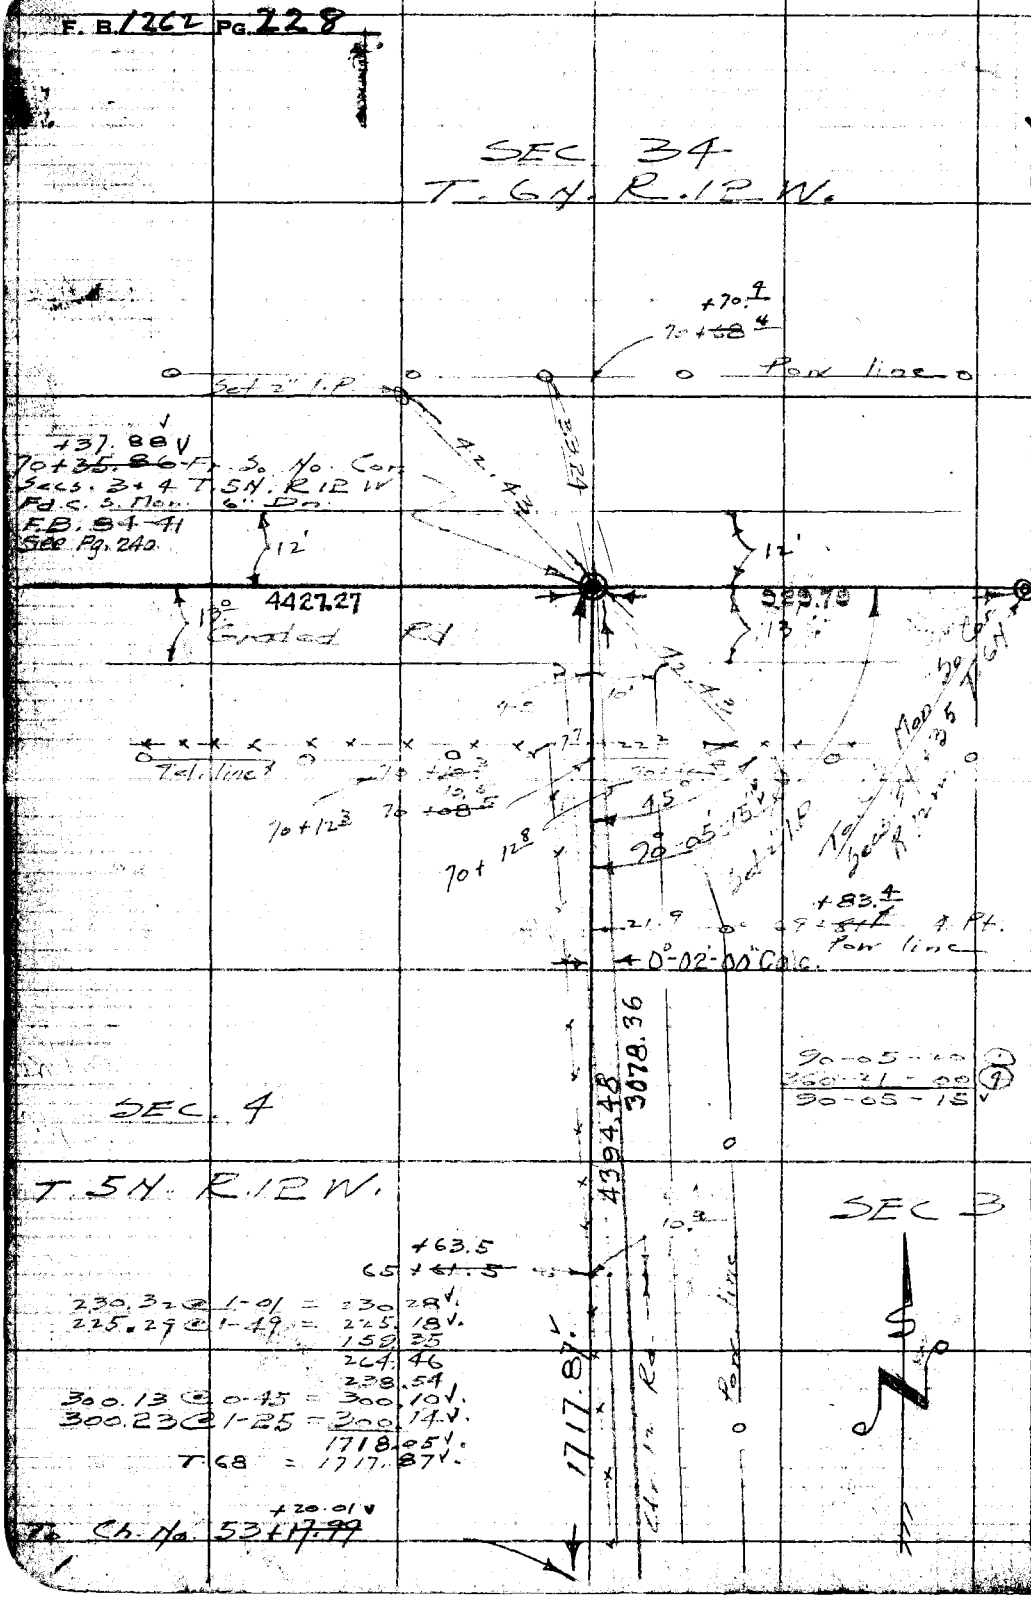

RETURN TO
LOS ANGELES COUNTY SURVEYOR
726 LOS ANGELES COUNTY
ENGINEERING BLDG.

Do not extend notes this side of this line.

Note: Any Additions or Changes on This Sheet Must be Made or Circled in Red Ink With Date and Name of Person Making Change.

F. B. 1262 PG. 229

Notes Ck'd by D. M. Finley	Survey of T. 5 S. R. 12 W.
Map No. B-2611	W. O. 1117 Tape No. 73 St'd. 84 °F
Office Work G. Bailey	Surveyed by Rosecrans
Checked	Notes R Date 11-14-50
Date	Indexed E. C. Johnson

W.S.65.A-3

Note: Any Additions or Changes on This Sheet Must be Made or Circled in Red Ink With Date and Name of Person Making Change.

Do not extend notes this side of this line.

RETURN TO
LOS ANGELES COUNTY SURVEYOR
726 LOS ANGELES COUNTY
ENGINEERING BLDG.

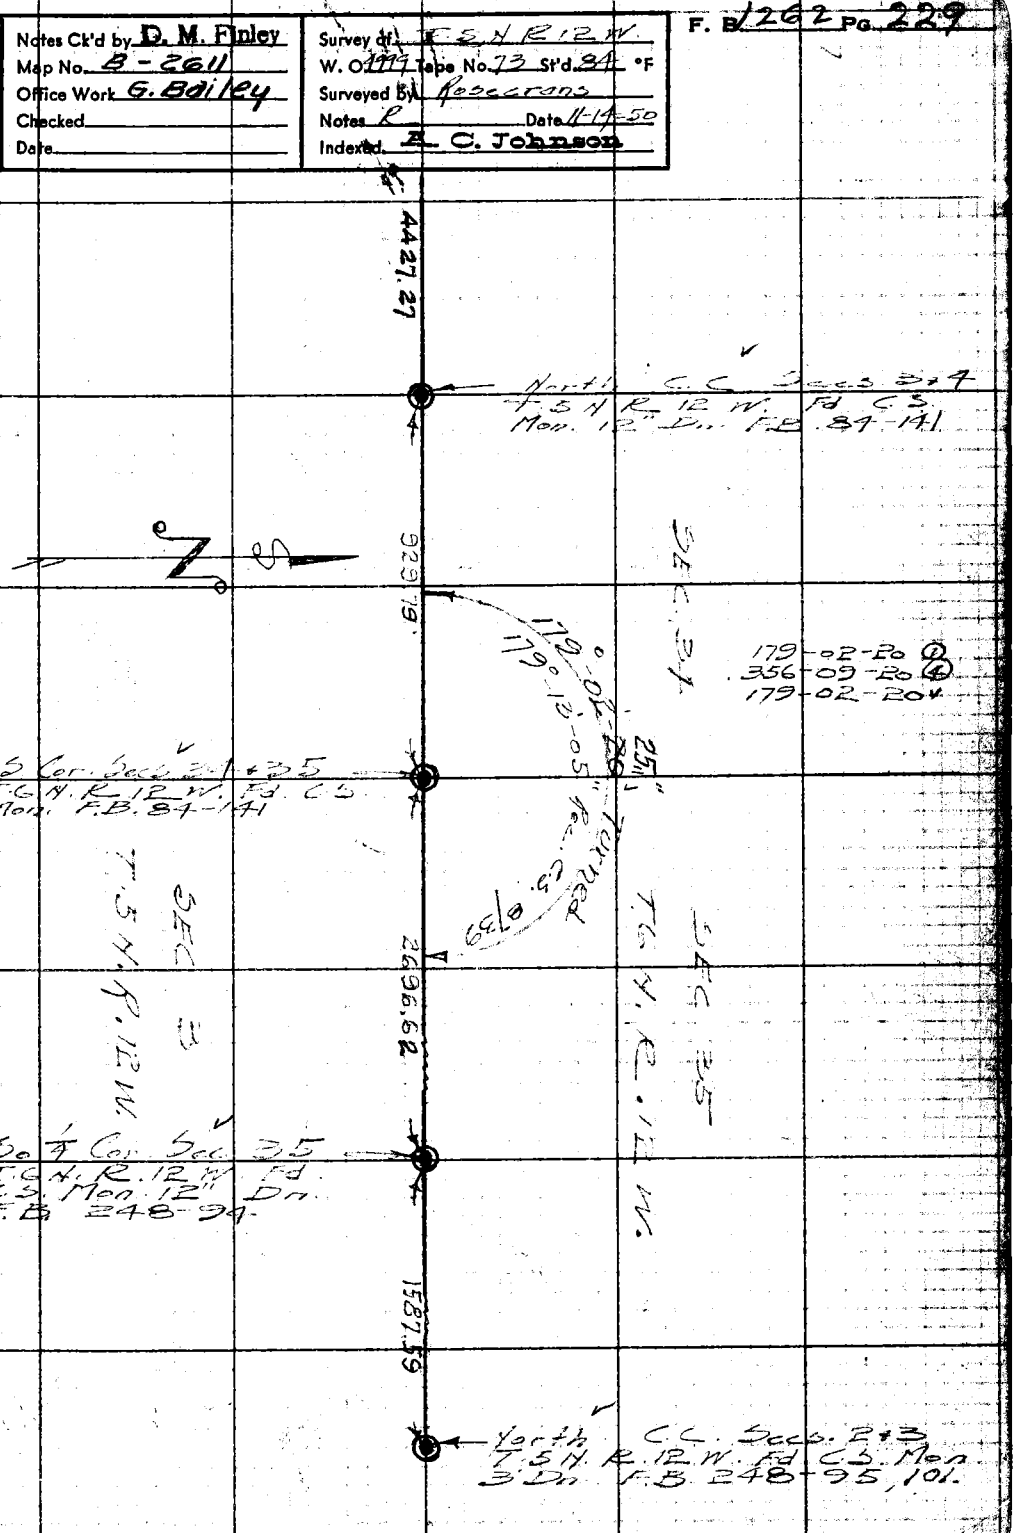

76F3098 247 10M 1-49

F.B. 1262 PG. 230

Cont bottom next page

W.S. 65 A-4

Set 1x2 T.R. E+W
26+73.30
1/4 Sec. Cor.
2.31
26+56.21 Fd. 1 I.P. 4 up.
28.33
2.28
26+27.88 Fd. 2x2 - 3 up at F.C.
Barbed wire Fn.
B.D. 25+13
1105.97
Sec. Line
Bottom Dr. 18+64
3°
18+60
Graded Rd.
11.0
2.47
So. end of Fn. 15+76.7
Set 1x2 T.R. Bear N. 60° E
15+67.33
1539.05
30° 2627.85 E
B.D. 5+65.
55'
90°-00-50
Transit line
Pg. 219
Int Fd. 1x2 - 0+28.28 to N.
105+61.10 Fr E.
28.28
otoo to N. Cor. Secs 4, 5, 8+9 T. 5 N. R 12 W & C.S. Mon.
F.B. 1262-219, 244

1/4 COR. BET. SECS 4, 5
T5N, R12W
RE SET WITH C.E. MON.,
2" I.P. IN CONC., 6" UP,
WITH BRASS
CAP MARKED
Wm MACK
8-15-56

COUNTY ENGINEER
T5N
R12W
5+4
1/4 COR
R.E. 5869

260.34 @	2-25	=	260.11
68.60 @	7-36	=	68.00
174.56 @	1-45	=	174.48
185.96 @	7-34	=	184.34
296.08 @	5-27	=	294.74
127.48 @	12-49	=	124.30
			1105.97

T.84

SEC 5

T 5 N. R 12 W.

SEC. 4

			281.59
292.05 @	5-27	=	290.73
299.01 @	11-14	=	293.28
78.45 @	6-33	=	77.94
298.50 @	10-37	=	293.39
193.21 @	18-54	=	182.79
126.23 @	19-02	=	119.33
			1539.05

T.84

90-01-00 (1)
360-03-20 (1)
90-00-50

RETURN TO
LOS ANGELES COUNTY SURVEYOR
726 LOS ANGELES COUNTY
ENGINEERING BLDG.

Note: Any Additions or Changes on This Sheet Must be Made or Circled in Red Ink With Date and Name of Person Making Change.

Do not extend notes this side of this line.

W.S. 65 A-3

Notes Ck'd by D. M. Finley	Survey of T. 5 N. R. 12 W.
Map No. 8-2611	W. O. 4999 Tape No. 101 St'd 84 °F
Office Work G. BAILEY	Surveyed by Rosecrans
Checked	Notes R Date 6-22-51
Date	Indexed E. C. Johnson

F. B. 1262 Pg. 231

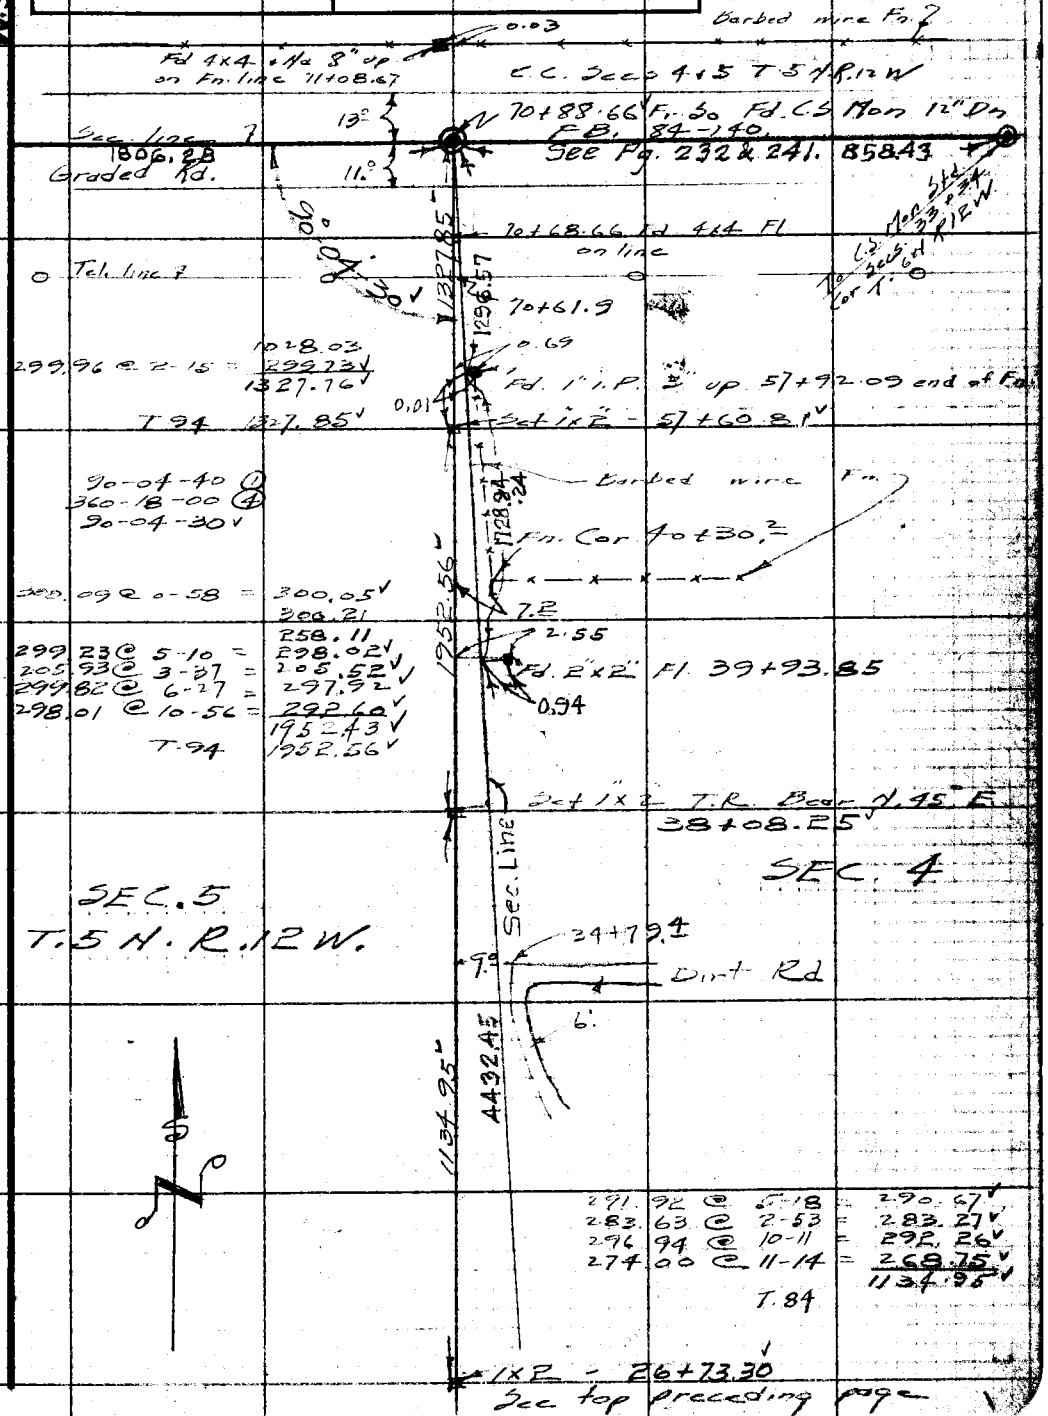

Note: Any Additions or Changes on This Sheet Must be Made or Circled in Red Ink With Date and Name of Person Making Change.

Do not extend notes this side of this line.

RETURN TO
LOS ANGELES COUNTY SURVEYOR
726 LOS ANGELES COUNTY
ENGINEERING BLDG.

76F3098 247 10M 1-49

F. B. 1262 Pg. 232

W.S. 64, D-3
W.S. 65, A-3

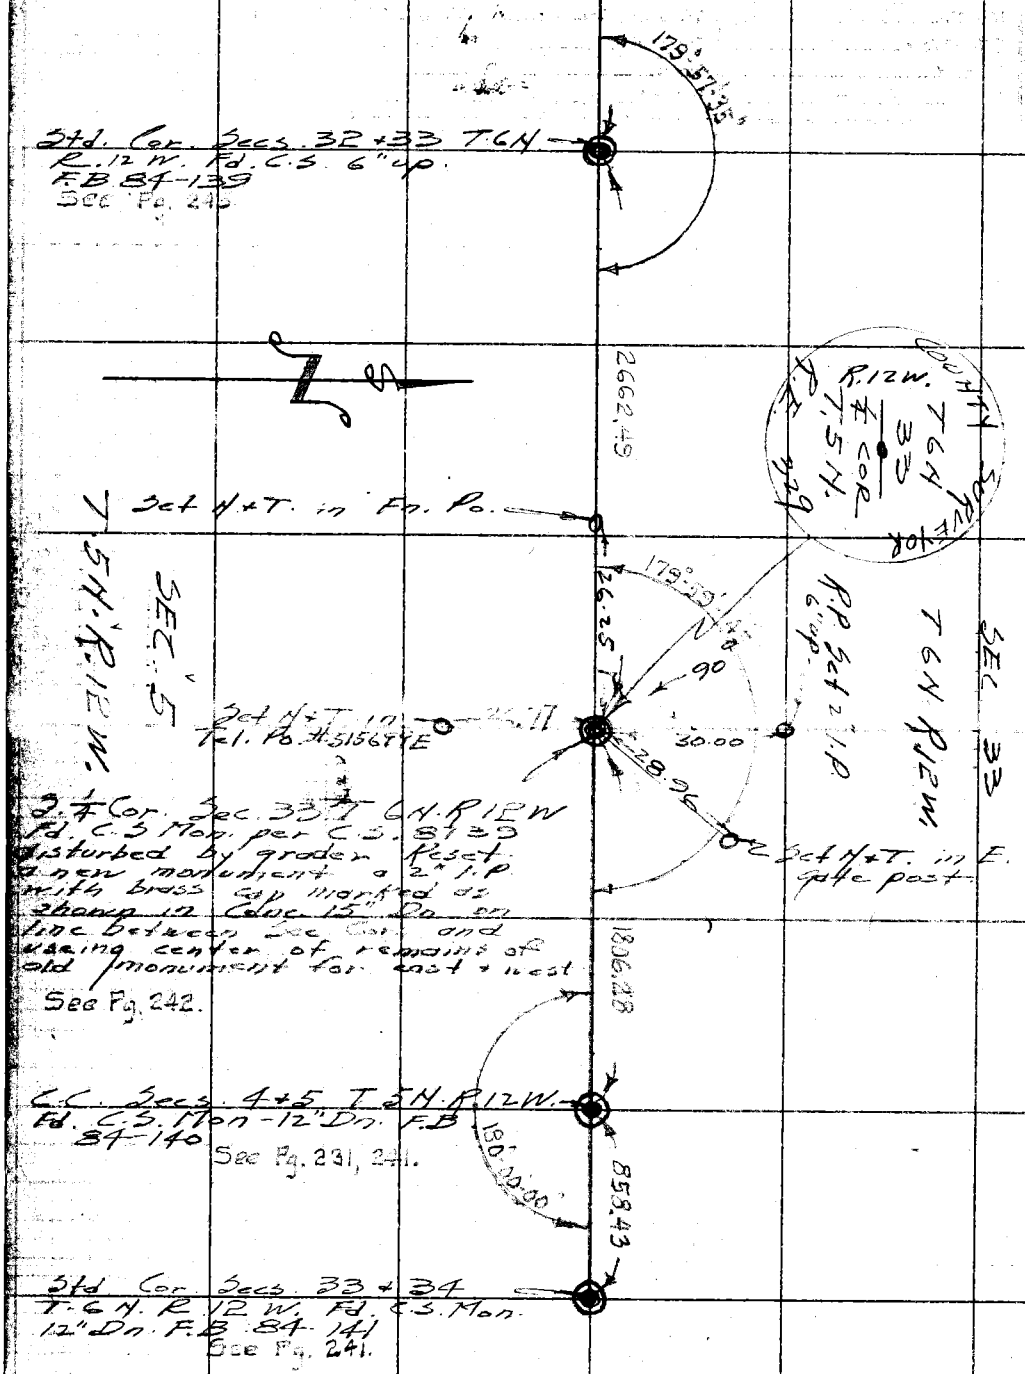

RETURN TO
LOS ANGELES COUNTY SURVEYOR
726 LOS ANGELES COUNTY
ENGINEERING BLDG.

Do not extend notes this side of this line.

Note: Any Additions or Changes on This Sheet Must be Made or Circled in Red Ink With Date and Name of Person Making Change.

1

W.S.64.D-3

Notes Ck'd by D. M. Finley	Survey of T. 5 N R 12 W
Map No. 8-2611	W. O. 4999 Tape No. 101 St'd. 84 °F
Office Work G. BAILEY	Surveyed by Rosecrans
Checked	Notes R Date 6-28-51
Date	Indexed A. C. Johnson

F. B. 1262 Pg. 233

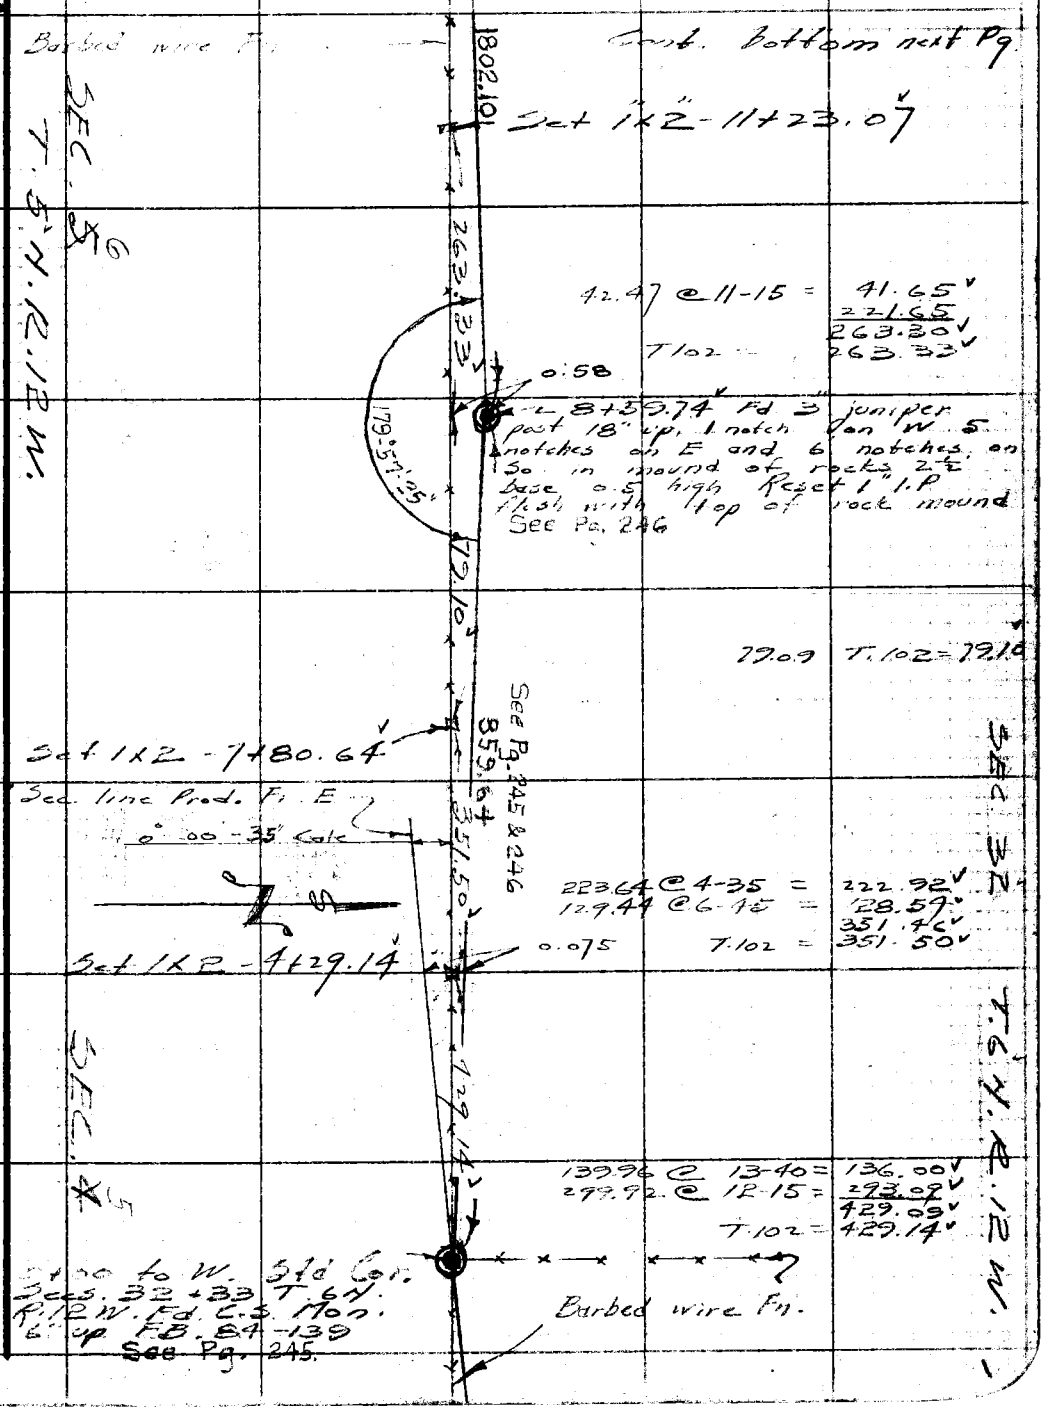

Note: Any Additions or Changes on This Sheet Must be Made or Circled in Red Ink With Date and Name of Person Making Change.

Do not extend notes this side of this line.

RETURN TO
LOS ANGELES COUNTY SURVEYOR
726 LOS ANGELES COUNTY
ENGINEERING BLDG.

76F3098 247 10M 1-49

F. B 1262 Pg 234

W.S. 64.D-3

RETURN TO
LOS ANGELES COUNTY SURVEYOR
726 LOS ANGELES COUNTY
ENGINEERING BLDG.

Do not extend notes this side of this line.

Note: Any Additions or Changes on This Sheet Must be Made or Circled in Red Ink With Date and Name of Person Making Change.

Barbed wire Fn.

26 +61.18

S. 1/4 Cor. Sec. 32 T.6N.
R.12W. Fd. C.S. monument.
6" up. F.B. 84-138
See Pg. 248.

119.32

120.75 @ 8-47 T 94 = 119.32

Set 1"x2" top N & S ridge
25 + 11.86

See Pg. 246-248
1802.10

SEC. 32 T.6N. R.12 W.

SEC. 5 6
T.5N. R.12 W.

1418.79

297.52 @	7-53 =	294.71
162.28 @	12-51 =	158.22
300.93 @	1-58 =	300.75
85.78 @	14-14 =	83.15
		53.27
195.69 @	1-48 =	195.59
269.05 @	9-10 =	265.61
69.00 @	12-22 =	67.40
		1418.70
	T. 94	1418.79

1"x2" - 11 + 23.07 See preceding page

F. B. 1262 PG. 235

Notes Ck'd by KRM.	Survey of T 5 N. R 12 W
Map No. C.S. 8739	W. O. 1111 Tape No. 101 St'd. 81 °F
Office Work McPherson	Surveyed by Rosecrans
Checked	Notes Rosecrans Date 5-29-51
Date June '51	Indexed E. C. Johnson 6-12-51

¼ COR SECS 27 + 28 T 5 N.
R. 12 W.

J.N. 4999

Party
E.A. Rosecrans
J.P. Pierce
D.H. Beers
S. Haliscky
L.E. Ritter

Note: Any Additions or Changes on This Sheet Must be Made or Circled in Red Ink With Date and Name of Person Making Change.

Do not extend notes this side of this line.

RETURN TO
LOS ANGELES COUNTY SURVEYOR
726 LOS ANGELES COUNTY
ENGINEERING BLDG.

76F3095 247 10M 1-49

F. B. 1262 PG. 236

W.S. 65 A-5

RETURN TO
LOS ANGELES COUNTY SURVEYOR
726 LOS ANGELES COUNTY
ENGINEERING BLDG.

Do not extend notes this side of this line.

Note: Any Additions or Changes on This Sheet Must be Made or Circled in Red Ink With Date and Name of Person Making Change.

248.98 @	9-41	=	245.43 ✓
182.84 @	0-49	=	182.82 ✓
299.68 @	5-16	=	298.42 ✓
162.13 @	5-50	=	161.29 ✓
			887.96 ✓

T. 84

DEC. 28

T. 5 N. R. 12 W.

888.02 per Rd Dept
887.96 Meas. ✓

Fd. 2"x2" Rd. W.O. 9465
Rd FB 188-81

SEC. 27

1/4 Cor. Fd 3/4" I.P. in mound of rocks Rd Dept FB 188-81
Replaced it with 2" I.P. with brass cap marked as shown in Conc. 5" up in mound of rocks.

COUNTY SURVEYOR
T 5 N
R. 12 W.
28-27
1/4 COR.
R.E. 329

Mon. added to H.C. 140-21
Also added to C.S. 8739

1

Notes Ck'd by	Survey of T5N R12W
Map No. B-2611	W. O. 4999 Tape No. 99 St'd. 84 °F
Office Work G. BAILEY	Surveyed by R L Willey
Checked	Notes Date 10-3-51
Date	Indexed A. C. Johnson

F. B. 1262 Pg. 237

NOV 2 '51

SEC LINES T5N R12W

JN 4999

10-4-51
R L Willey
L V Smith
J W S [illegible]
R C Bower Jr
A L York

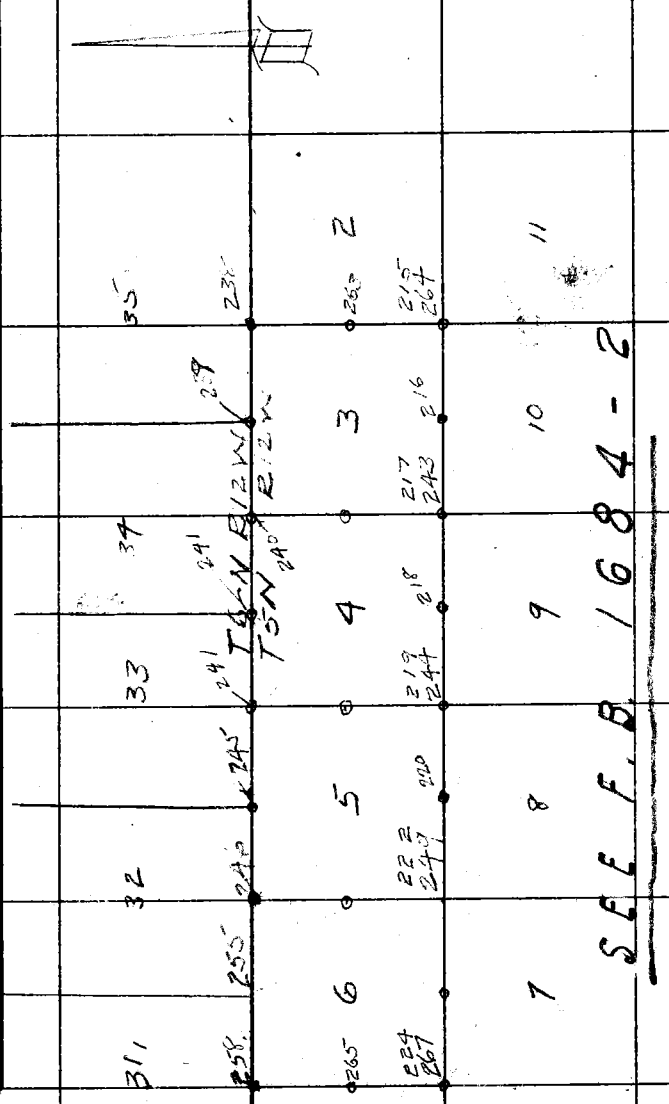

Note: Any Additions or Changes on This Sheet Must be Made or Circled in Red Ink With Date and Name of Person Making Change.

Do not extend notes this side of this line.

RETURN TO
LOS ANGELES COUNTY SURVEYOR
726 LOS ANGELES COUNTY
ENGINEERING BLDG.

76F309S 247 2-51

F.B. 1262 PG. 238

W.S. 65 A-3

Fd N&T. for closing cor sec 2 & 3 T5N R12W The mon is under a fill. Rosecrans checked the R.P.'s and fd them good. 0+00.00 To W

COUNTY SURVEYOR T6N 35 3 2 C.C. T5N R12W MONUMENT

Fd 4"x4" post

Fd 4"x4" post

3001

3001

4451.17 To E. 1/4 Cor. Sec. 3

56146

471.45

T6N R12W

90°00'30"
3620360
1830440

90°00'47"

40

790.90

T=80°= 790.90

300.78 @ 2°22' = 300.52
300.36 @ 226 = 300.09
190.41 @ 152 = 190.31
790.92

SEC 35

SEC 3 T5N R12W

cont Top pg 261

set bt spk & T.
7+90.90

T=80°= 796.77
238.50 @ 0°41' = 238.48
236.75 @ Lev = 236.75
300.63 @ Lev = 300.63
20.93 @ Lev = 20.93
796.79

.69

.69

.71

Fd 2x2 & N.

42.41

179°59'40" ①
359 59 40 ④
359 59 20 ⑥

Fd 2" IP & BC set in conc. 15" Mked as shown

15+87.67

.59

Fd 1/2 IP not plugged

42.3

2197.80

180°00'00"
179°59'53"

2696.62

COUNTY SURVEYOR T6N SEC 35 1/4 SEC COR T5N R12W MONUMENT

cont Top pg # 239

RETURN TO
LOS ANGELES COUNTY SURVEYOR
725 LOS ANGELES COUNTY
ENGINEERING BLDG.

Do not extend notes this side of this line.

Note: Any Additions or Changes on This Sheet Must be Made or Circled in Red Ink With Date and Name of Person Making Change.

W.S. 65.A-3

Notes Ck'd by D. M. Finley	Survey of T5N R12W
Map No. B-2611	W. O. 4999 Tape No. 99 St'd. 84 °F
Office Work G. BAILEY	Surveyed by R L Willey
Checked	Notes Date 10-4-50
Date	Indexed A. C. Johnson

F. B. 1262 Pg. 239

cont from bot pg # 238

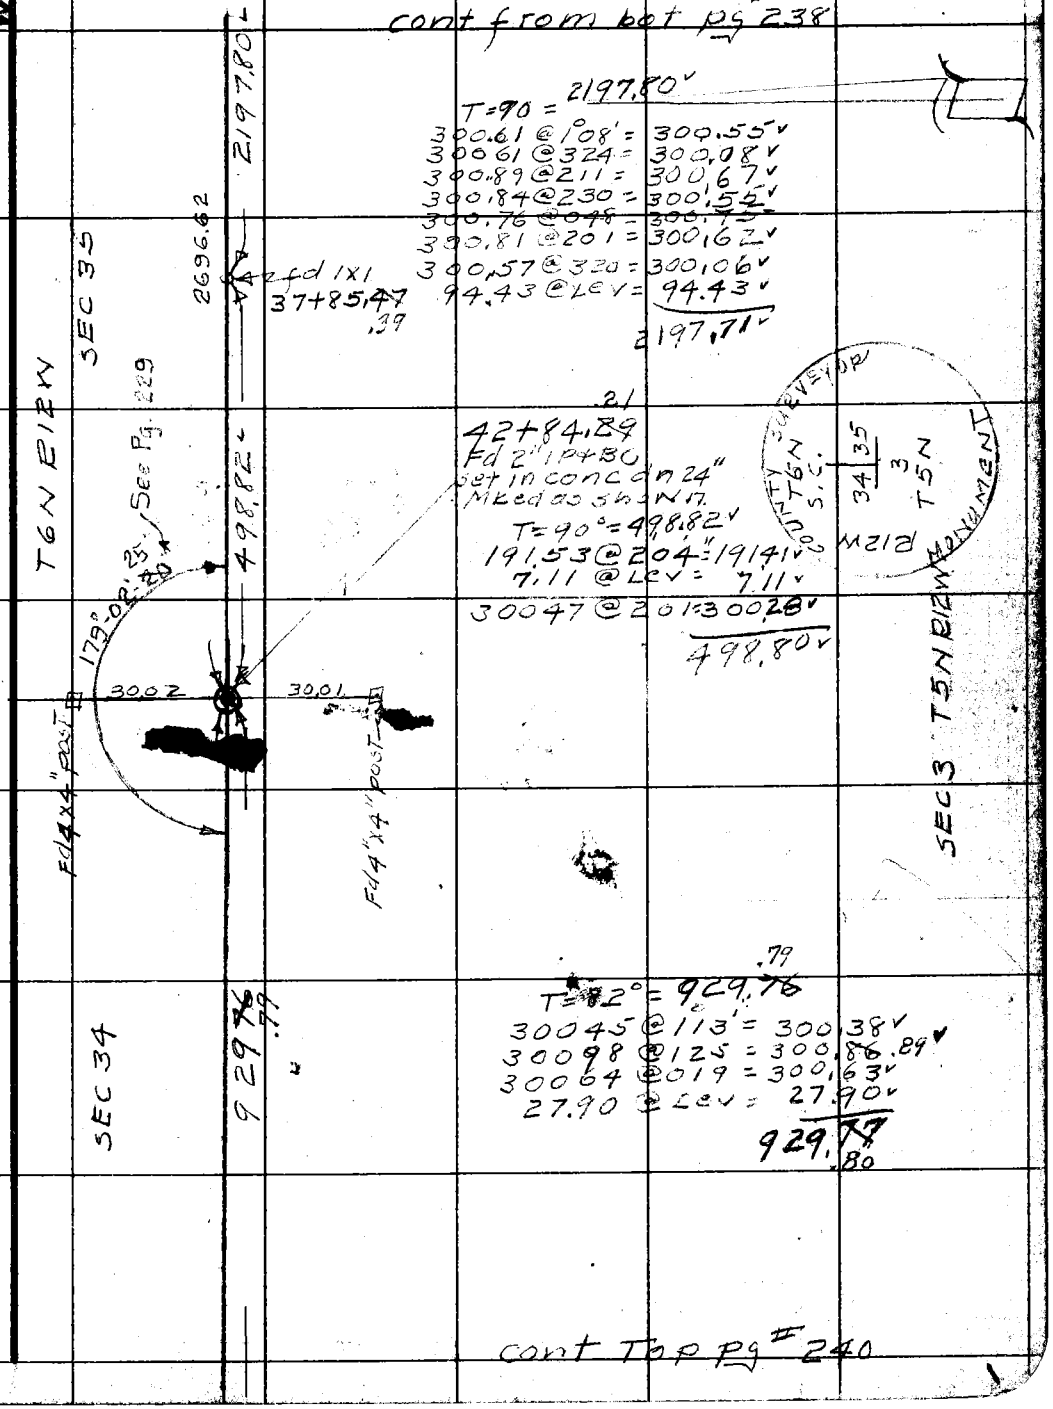

T=90 = 2197.80

300.61 @ 108' = 300.55
300.61 @ 324 = 300.08
300.89 @ 211 = 300.67
300.84 @ 230 = 300.55
300.76 @ 048 = 300.75
300.81 @ 201 = 300.62
300.57 @ 320 = 300.06
94.43 @ Lev = 94.43
2197.71

42+84.29 .21
Fd 2" IP+BC
set in conc dn 24"
Mked as shown.
T=90° = 498.82
191.53 @ 204 = 191.41
7.11 @ Lev = 7.11
300.47 @ 201 = 300.28
498.80

T=82° = 929.76 .79
300.45 @ 113' = 300.38
300.98 @ 125 = 300.86 .89
300.64 @ 019 = 300.63
27.90 @ Lev = 27.90
929.77 .80

cont Top pg # 240

Note: Any Additions or Changes on This Sheet Must be Made or Circled in Red Ink With Date and Name of Person Making Change.

Do not extend notes this side of this line.

RETURN TO
LOS ANGELES COUNTY SURVEYOR
726 LOS ANGELES COUNTY
ENGINEERING BLDG.

76F309S 247 2-51

F.B. 1262 PG. 240

cont from bot pg # 239

W.S. 654-3

180 00 20 ①
360 01 20 ②
360 02 00 ③

90° 05' 20" ①
360 20 40 ②
180 31 00 ③

90° 05' 20"

Fd 2" I.P. plug + N
5148410

SEC 3

Fd 2" I.P. + pin
5244403

42.44

42.43

7037.33 Meas. Dec 4 1951. See Pg. 226 240
~~7038.23~~ Calc.
~~8849.93~~ Calc. To SEC COR 43-9410
5214.05
Fd 2" I.P. + BC
set in conc. dn 6"
& tied as
shown.
See Pg. 228.
362740 ①
145100 ②
219620 ③

cont top pg 243

362.74

53 26 40

53 27 00 ①
213 47 00 ②
320 40 00 ③

SEC 34 T6N R12W

To SEC COR 43-9410

Fed Nerad
Fed RB 3118-259

4427.27
2642.85

T = 16 = 4427.27

300.61	@ Lev	=	300.61
300.93	@ 1.06	=	300.88
300.44	@ Lev	=	300.44
300.55	@ Lev	=	300.55
300.57	@ 0.36	=	300.55
300.95	@ Lev	=	300.95
300.72	@ Lev	=	300.72
301.12	@ 1.40	=	300.97
300.71	@ 1.01	=	300.66
300.86	@ 2.18	=	300.62
300.33	@ 1.22	=	300.25
300.54	@ 2.37	=	300.23
300.86	@ 2.18	=	300.12
300.77	@ 3.03	=	300.34
219.41	@ 1.48	=	219.30
			4427.21

ENGINEER
COUNTY
T6N SEC34 T SEC4 14 COR T5N R12W
FE5869

Set 2" I.P. + BC
in conc. stmpd
as shown. and
set in well
dn 12", with
cover, stmpd.
COUNTY ENGINEER
7845685

Fd Nail

1784.42

cont top pg # 241

SEC 4
T5N R12W

cont top pg # 244

RETURN TO
LOS ANGELES COUNTY SURVEYOR
725 LOS ANGELES COUNTY
ENGINEERING BLDG.

Do not extend notes this side of this line.

Note: Any Additions or Changes on This Sheet Must be Made or Circled in Red Ink With Date and Name of Person Making Change.

W.S. 65 A-3

Notes Cont. by D. M. Finley	Survey of T5N R12W
Map No. B-2611	W. O. 4999 Tape No. 99 St'd. 84 °F
Office Work G. BAILEY	Surveyed by R. L. Willey
Checked	Notes " Date 10-5-51
Date	Indexed R. C. Johnson

F. B. 1762 Pg. 241

Note: Any Additions or Changes on This Sheet Must be Made or Circled in Red Ink With Date and Name of Person Making Change.

Do not extend notes this side of this line.

RETURN TO
LOS ANGELES COUNTY SURVEYOR
726 LOS ANGELES COUNTY
ENGINEERING BLDG.

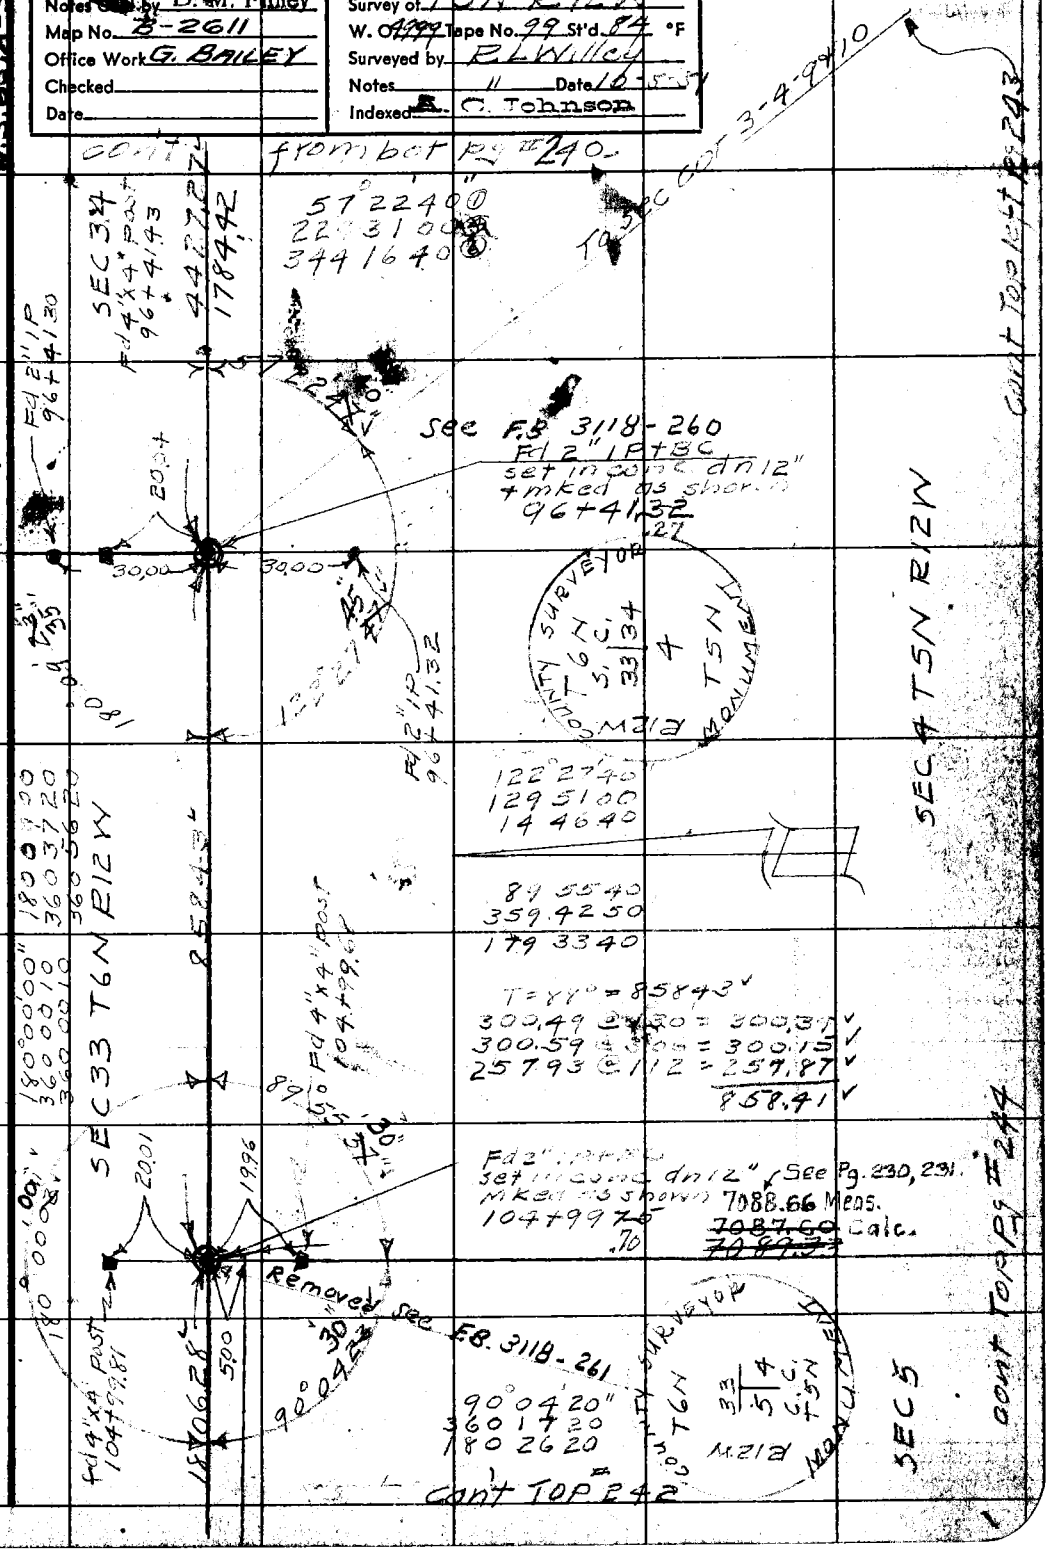

76F309S 247 2-51

F.B. 1262 PG. 242

cont from bot pg # 241

W.S. 64 D-3

T = 80° = 1806.28

300.66 @ 118' = 300.58
121.02 @ Lev = 121.02
300.06 @ 147 = 299.91
263.37 @ 340 = 262.83
300.68 @ 051 = 300.65
300.68 @ 147 = 300.53
220.83 @ 047 = 220.81

1806.33

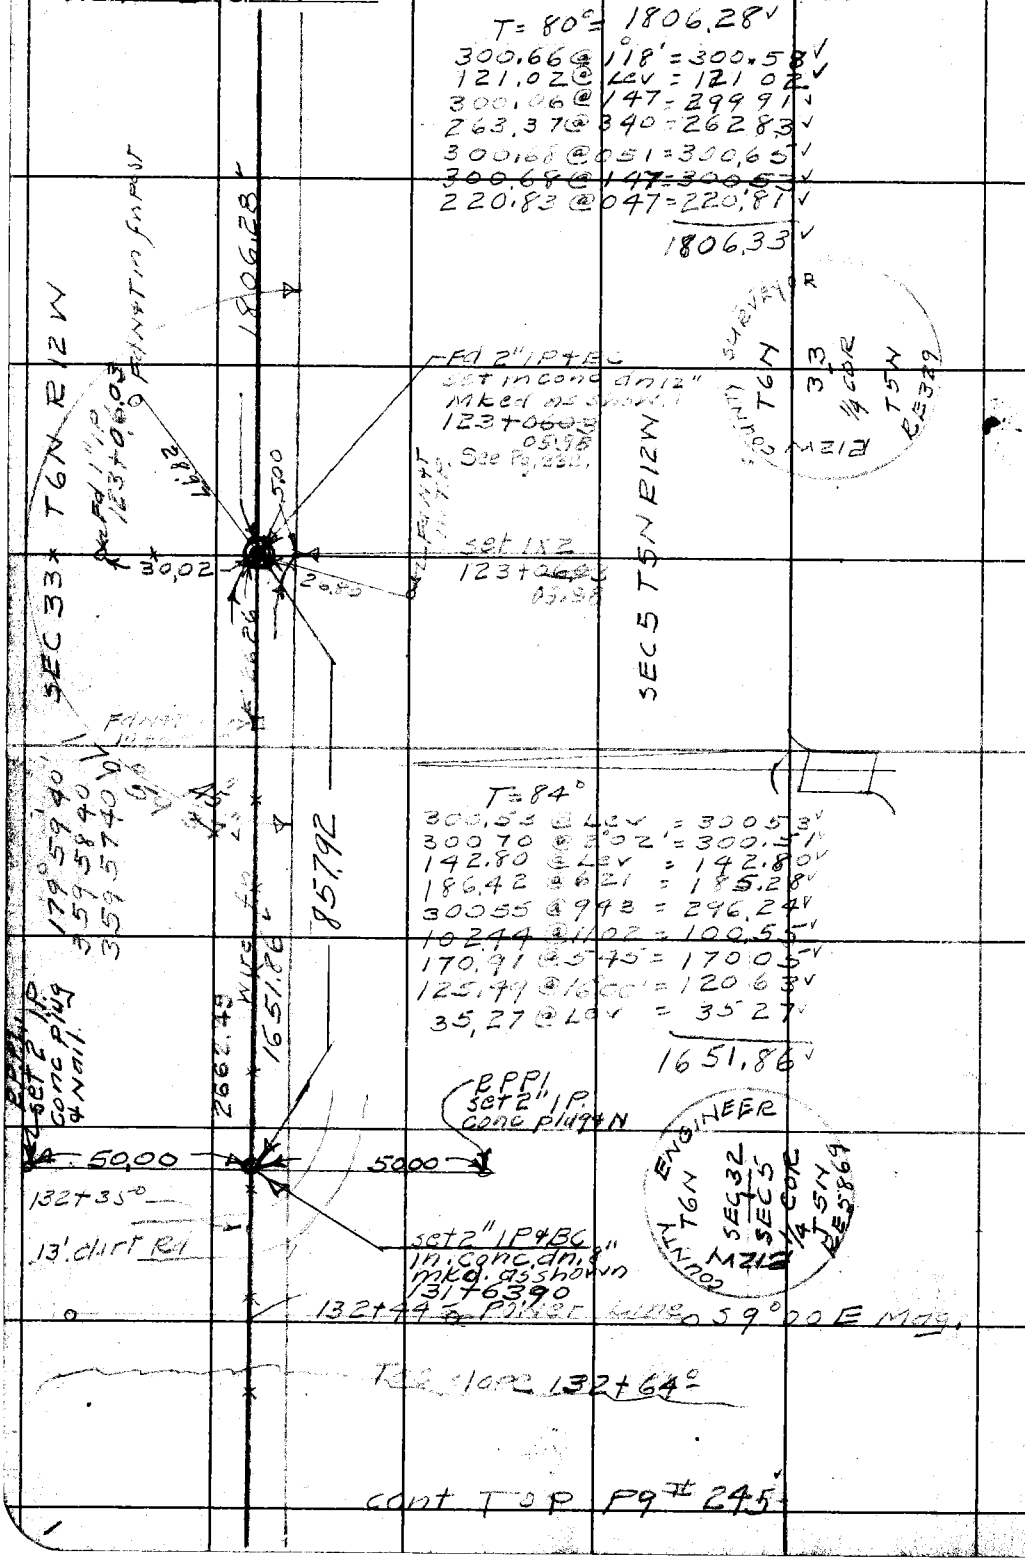

T = 84°

300.53 @ Lev = 300.53
300.70 @ 2°02' = 300.51
142.80 @ Lev = 142.80
186.42 @ 621 = 185.28
300.55 @ 943 = 296.24
102.44 @ 1102 = 100.55
170.91 @ 545 = 170.05
125.49 @ 16°00' = 120.63
35.27 @ Lev = 35.27

1651.86

cont TOP Pg # 245

RETURN TO
LOS ANGELES COUNTY SURVEYOR
725 LOS ANGELES COUNTY
ENGINEERING BLDG.

Do not extend notes this side of this line.

Note: Any Additions or Changes on This Sheet Must be Made or Circled in Red Ink With Date and Name of Person Making Change.

W.S. 65.A-4

Notes Ck'd by D. M. Finley	Survey of T5N R12W
Map No. B-2611	W. O. 4999 Tape No. 99 St'd. 84 °F
Office Work G. BAILEY	Surveyed by R L Willey
Checked	Notes " Date 10-51
Date	Indexed A. C. Johnson

F. B. 1262 Pg. 243

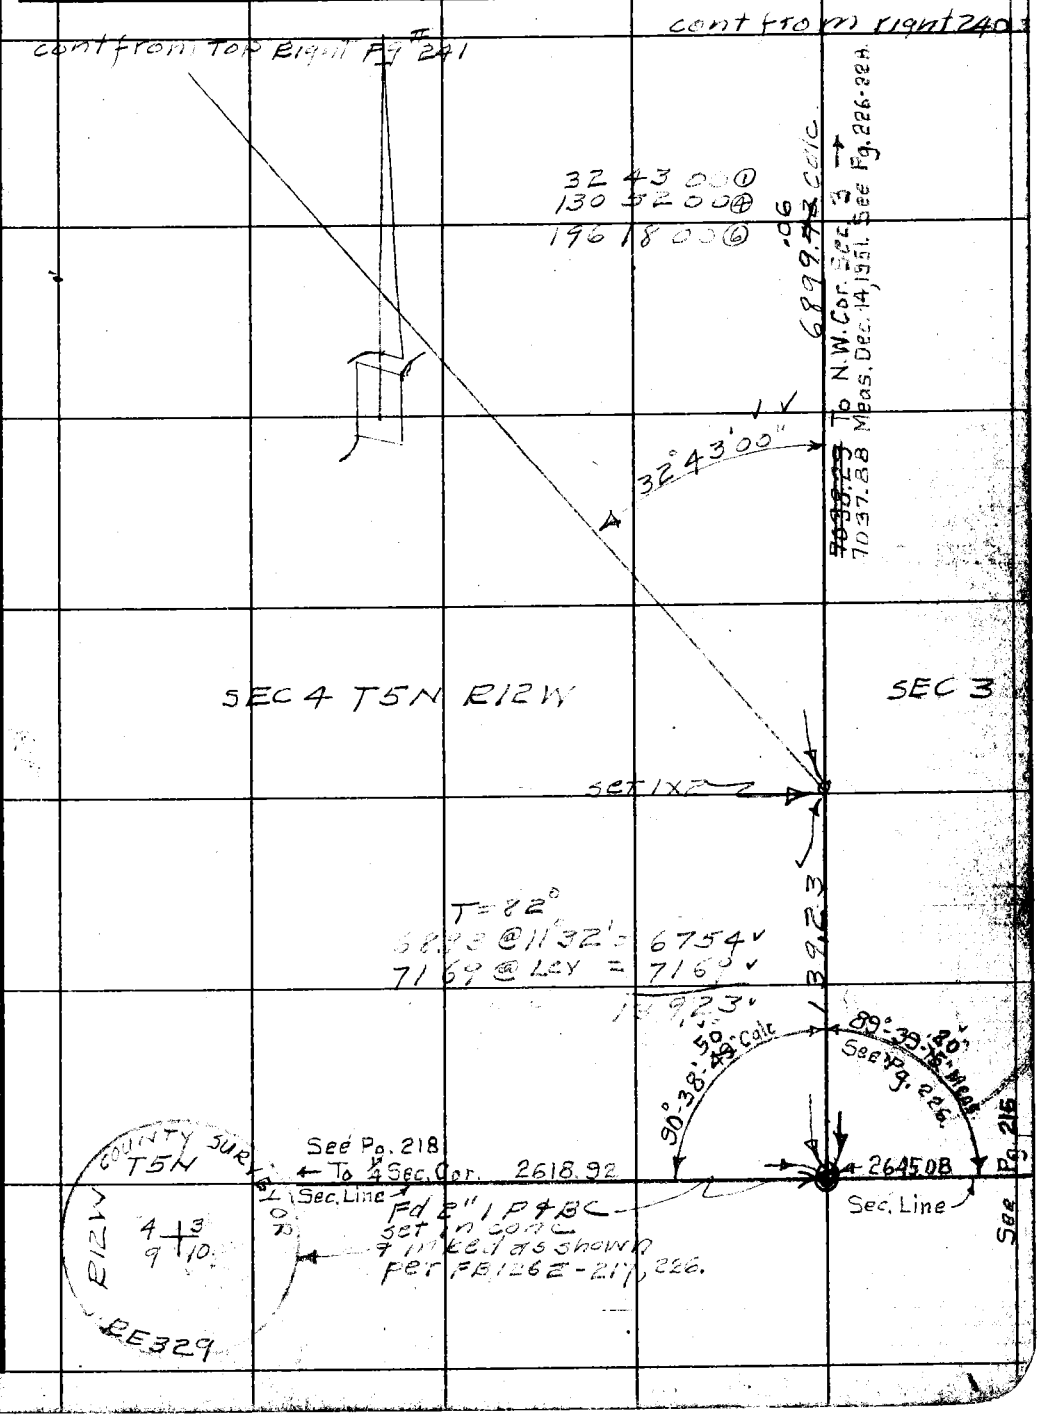

Note: Any Additions or Changes on This Sheet Must be Made or Circled in Red Ink With Date and Name of Person Making Change.

Do not extend notes this side of this line.

RETURN TO
LOS ANGELES COUNTY SURVEYOR
726 LOS ANGELES COUNTY
ENGINEERING BLDG.

76F3095 247 2-51

F. B. 1262 PG. 244

cont from bot right p 241

W.S.65, A-4

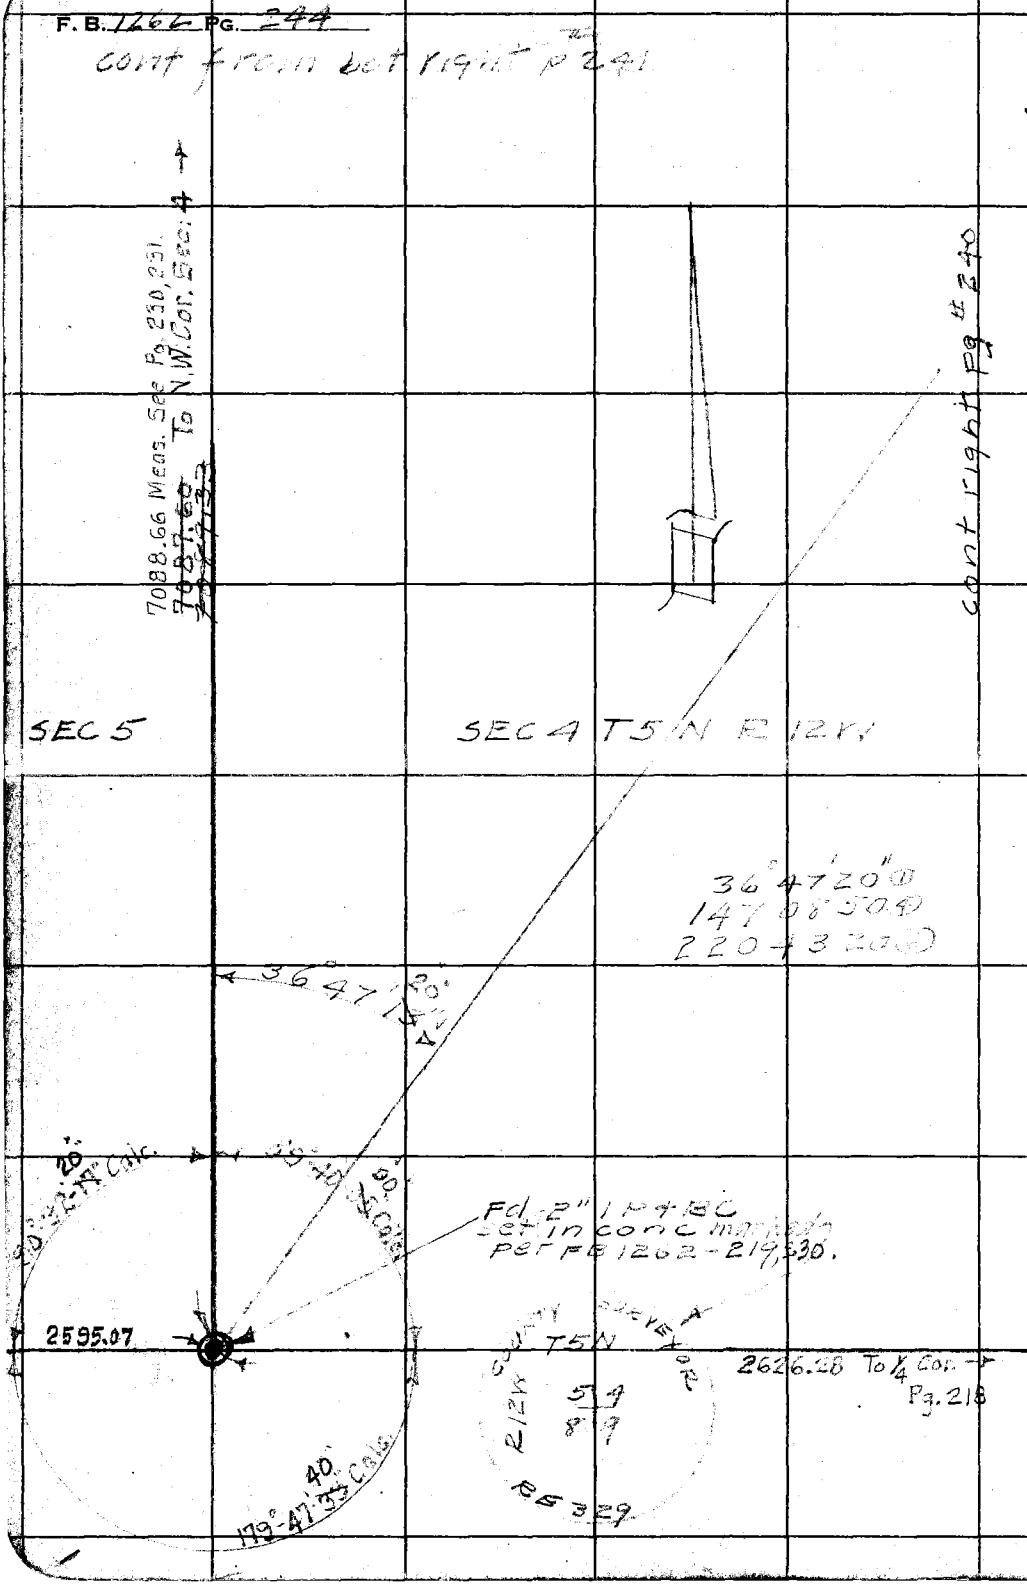

RETURN TO
LOS ANGELES COUNTY SURVEYOR
725 LOS ANGELES COUNTY
ENGINEERING BLDG.

Do not extend notes this side of this line.

Note: Any Additions or Changes on This Sheet Must be Made or Circled in Red Ink With Date and Name of Person Making Change.

W.S. 64.D-3

Notes Ck'd by D. M. Finley	Survey of T 5N R12W
Map No. B-2611	W. O. 4999 Tape No. 99 St'd. 84 °F
Office Work G. BAILEY	Surveyed by R L Willey
Checked	Notes Date 10-11-51
Date	Indexed A. C. Johnson

F. B. 1262 Pg. 245

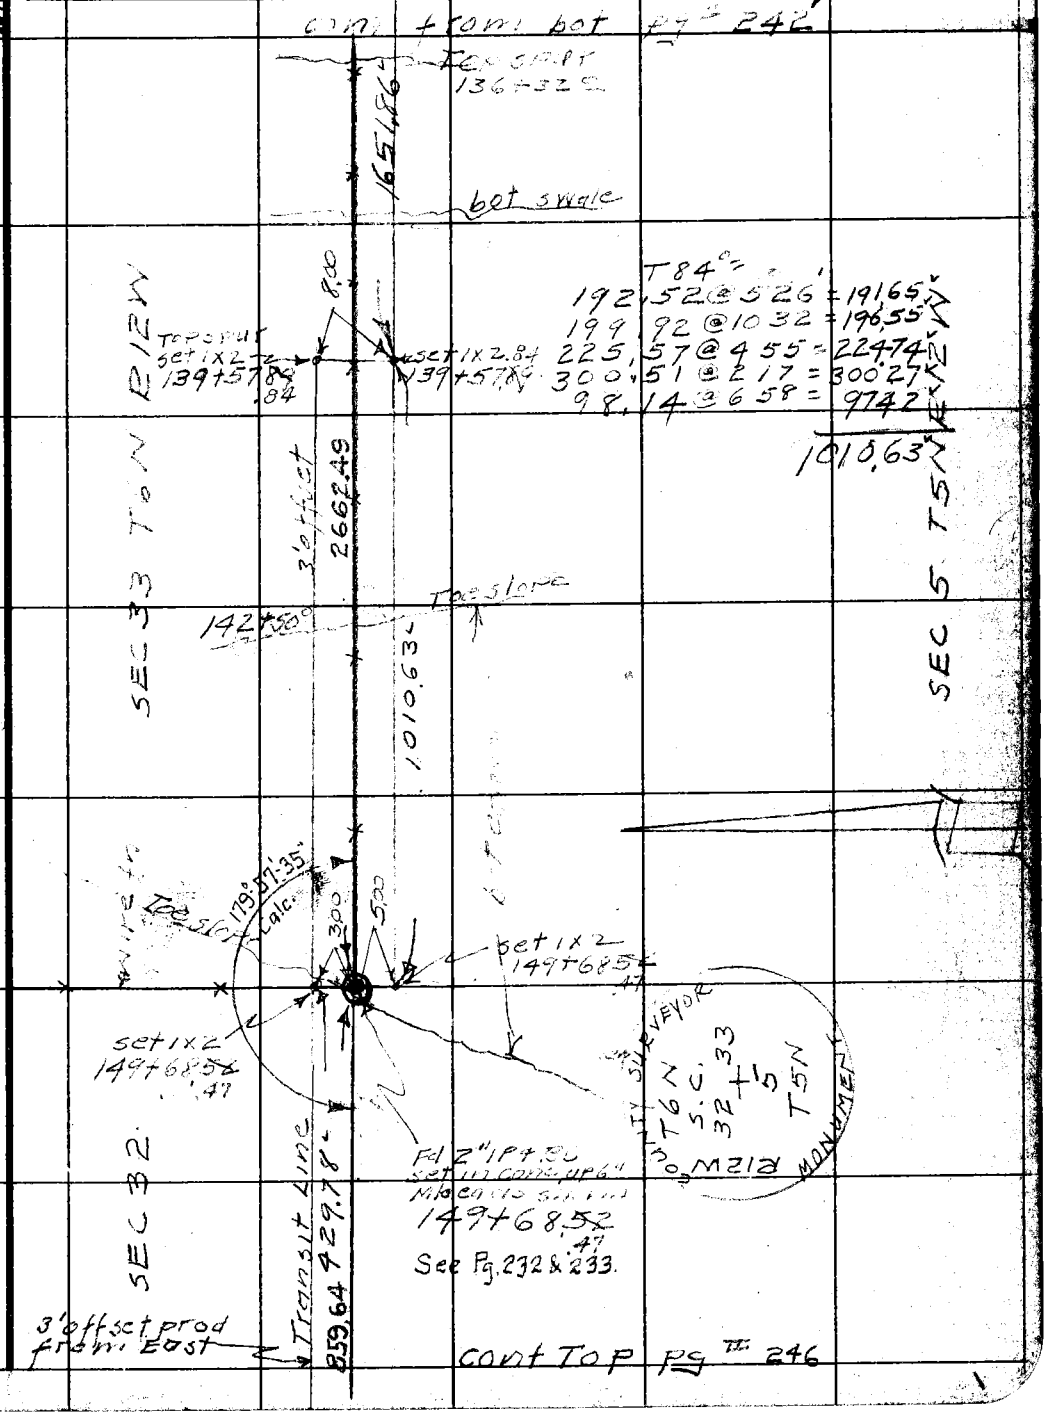

Note: Any Additions or Changes on This Sheet Must be Made or Circled in Red Ink With Date and Name of Person Making Change.

Do not extend notes this side of this line.

RETURN TO
LOS ANGELES COUNTY SURVEYOR
726 LOS ANGELES COUNTY
ENGINEERING BLDG.

76F3095 247 2-51

F.B. 1262 PG. 246

cont from bot pg # 245

W.S.65.D-3

RETURN TO
LOS ANGELES COUNTY SURVEYOR
726 LOS ANGELES COUNTY
ENGINEERING BLDG.

Do not extend notes this side of this line.

Note: Any Additions or Changes on This Sheet Must be Made or Circled in Red Ink With Date and Name of Person Making Change.

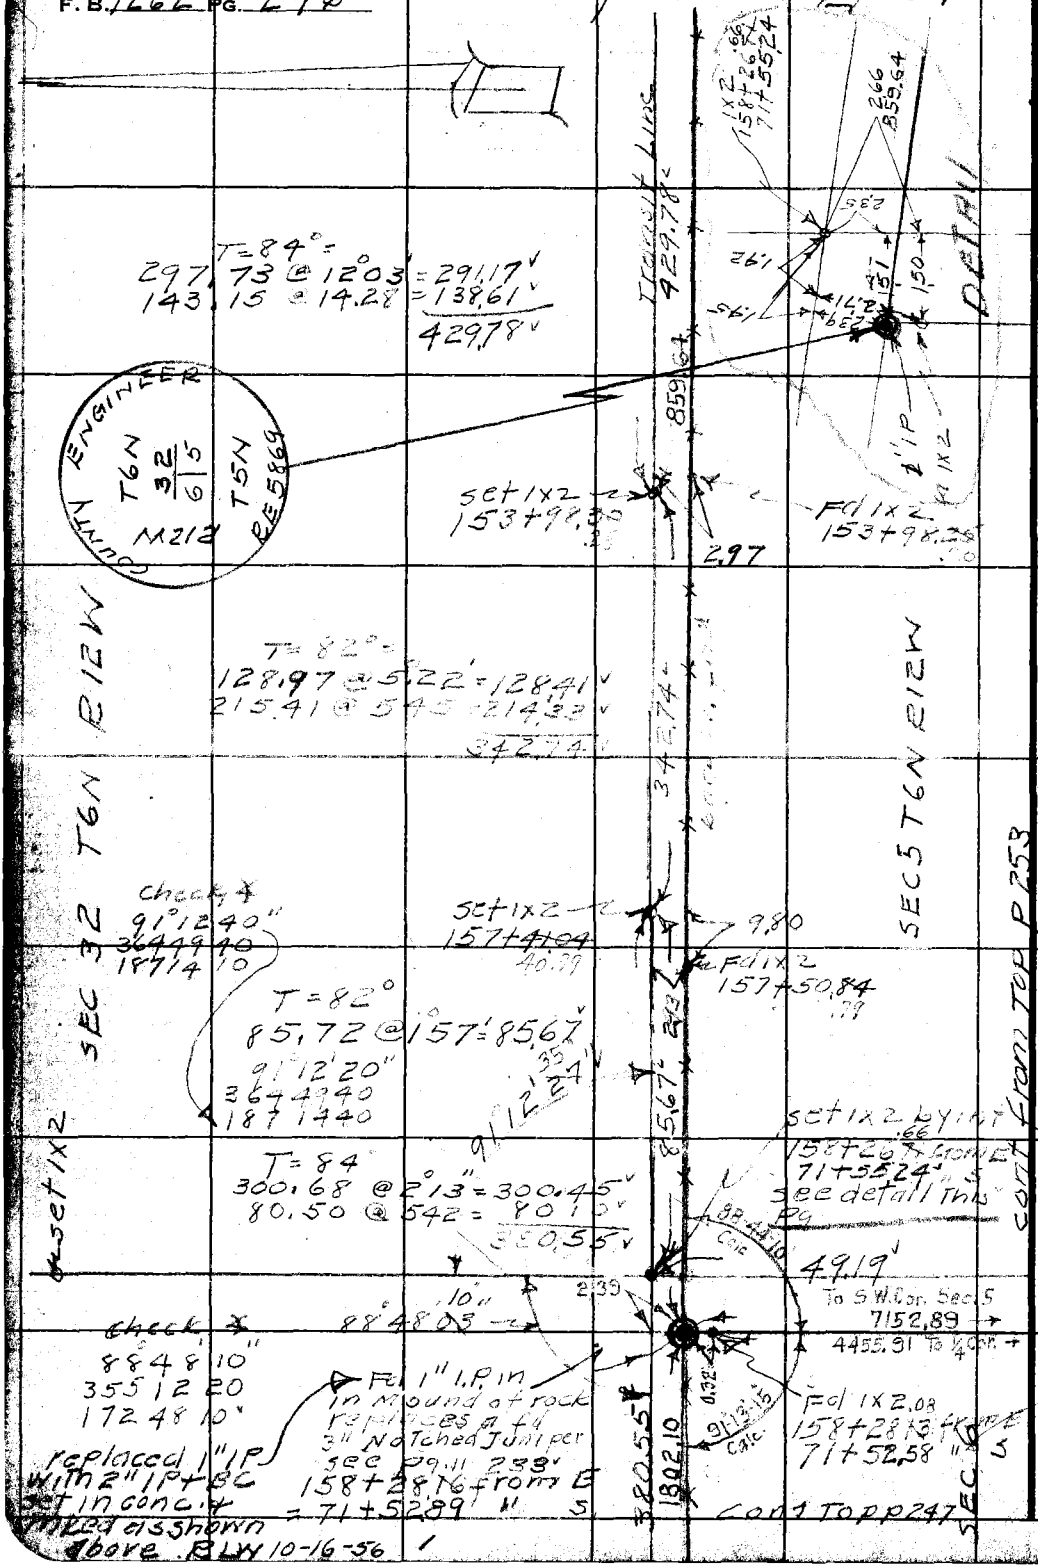

Notes Ck'd by D. M. Finley	Survey of T 5N R 12W
Map No. E-2611	W. O. 4999 Tape No. 99 St'd. 84 °F
Office Work G. Bailey	Surveyed by R L Willey
Checked	Notes Date 10-15-57
Date	Indexed A. C. Johnson

F. B. 1266 Pg. 247

cont from bot pg # 246

380.55

0.47

Top N+S spur
F 1 1x2 .29
160+91.34

2.90

30.25

Set 1x2
161+21.59
.54

T=84°
295.91 @ 10°19 = 291.13
203.61 @ Lev = 203.61
494.74

1802.10

494.74

Barb W fn

Top small spur
Set 1x2 .28
166+16.33

Bot small spur N+S

894.91

T=84°
89.28 @ 7°36' = 88.49
300.53 @ 2°13' = 300.30
57.04 @ 8°10' = 56.46
219.03 @ 9°45' = 215.87
238.03 @ 10°50' = 233.79
894.91

168+06

Cont. Top pg. 248

Note: Any Additions or Changes on This Sheet Must be Made or Circled in Red Ink With Date and Name of Person Making Change.

Do not extend notes this side of this line.

RETURN TO
LOS ANGELES COUNTY SURVEYOR
726 LOS ANGELES COUNTY
ENGINEERING BLDG.

76F309S 247 2-51

F.B. 1262 PG. 248

W.S. 64.D-3

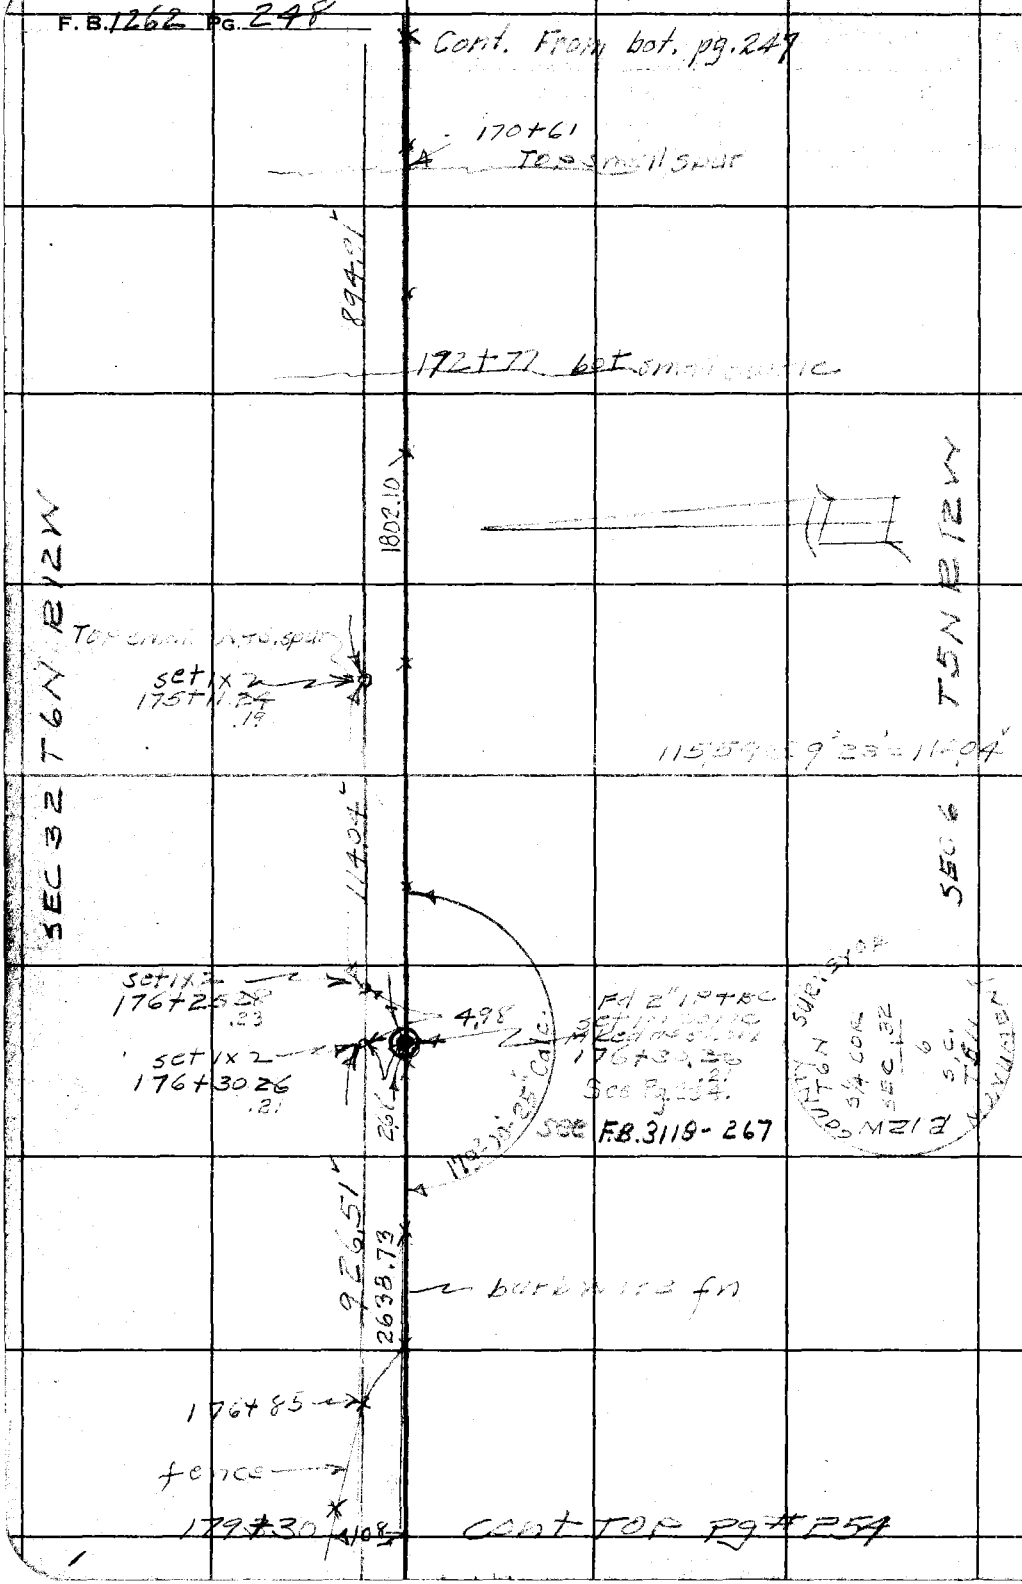

RETURN TO
LOS ANGELES COUNTY SURVEYOR
725 LOS ANGELES COUNTY
ENGINEERING BLDG.

Do not extend notes this side of this line.

Note: Any Additions or Changes on This Sheet Must be Made or Circled in Red Ink With Date and Name of Person Making Change.

W.S. 64 D-4

Notes Ck'd by D. M. Finley	Survey of T5N R12W
Map No. B-2611	W. O. 4999 Tape No. 99 St'd 84 °F
Office Work G. BAILEY	Surveyed by R L Willey
Checked	Notes Date 10-16-51
Date	Indexed A. C. Johnson

F.B. 1262 Pg. 249

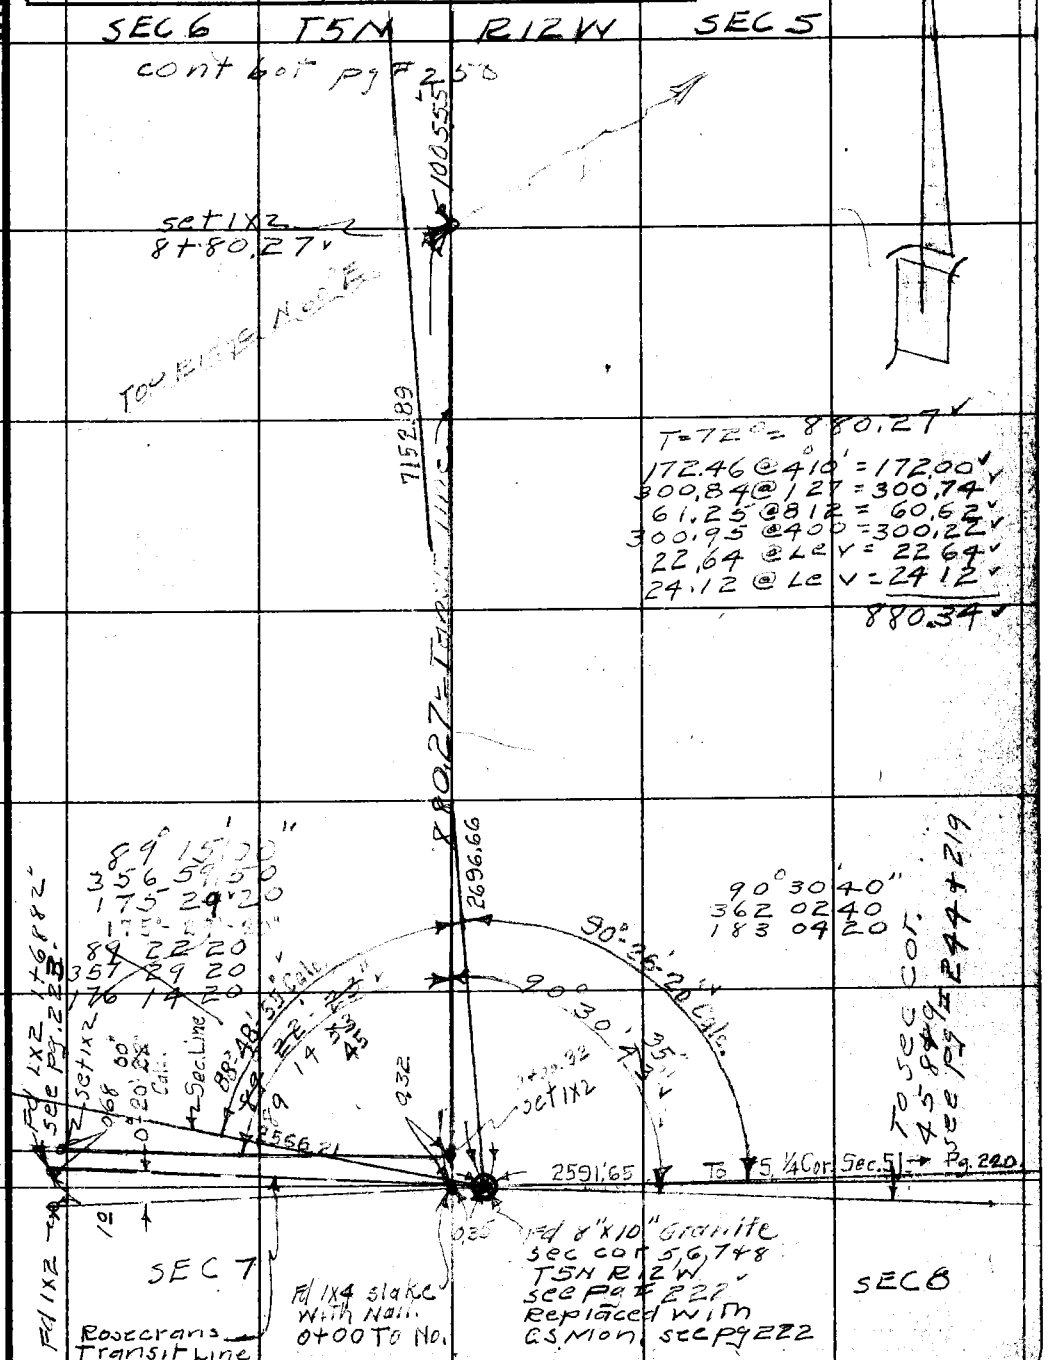

Note: Any Additions or Changes on This Sheet Must be Made or Circled in Red Ink With Date and Name of Person Making Change.

Do not extend notes this side of this line.

RETURN TO
LOS ANGELES COUNTY SURVEYOR
726 LOS ANGELES COUNTY
ENGINEERING BLDG.

76F3095 247 2-51

F.B. 1262 PG. 250

Cont bot pg # 251

SEC 6 T5 R12W SEC 5

Top ridge

26+70°

S 83° E

T = 74° = 1239.40

74.95 @ 9°11' = 7399

253.90 @ 1409 = 24620

265.36 @ 349 = 26477

200.38 @ 852 = 19799

127.61 @ 043 = 127.60

300.07 @ 652 = 29792

31.01 @ 22 = 31.01

1239.48

1239.40

Transit Line

7152.89

N 75° E

23+18

bot drain

2696.66

East

set 1x2

18+85.82

bot canyon

17+44°

1005.55

T = 68° = 1005.55

71.39 @ 1527 = 6881

120.55 @ 1716 = 11512

300.69 @ 1832 = 28510

129.62 @ 1047 = 12733

137.82 @ 246 = 137.66

271.64 @ 020 = 271.63

1005.65

Top small spur

16+14°

N 60° E

13+49°

bot canyon

Cont from Top p 249

X

RETURN TO
LOS ANGELES COUNTY SURVEYOR
726 LOS ANGELES COUNTY
ENGINEERING BLDG.

Do not extend notes this side of this line.

Note: Any Additions or Changes on This Sheet Must be Made or Circled in Red Ink With Date and Name of Person Making Change.

W.S. 64 D-4

Notes Ck'd by D. M. Finley	Survey of T5N R12W
Map No. 8-2611	W. O. 4999 Tape No. 99 St'd. 84 °F
Office Work G. BAILEY	Surveyed by E L Willey
Checked	Notes Date 10-17-51
Date	Indexed A. C. Johnson

F. B. 1262 Pg. 251

SEC 6 SEC 5 T5N R12W

cont bot pg # 252

bot cn

38+65°

12' dirt road

S72 E

38+27°

S72 E

T = 80° = 1561.14

121.16 @ 17°01' = 115.86

103.65 @ 19°15' = 97.86

247.72 @ 14°40' = 239.65

299.82 @ 7°27' = 297.29

120.55 @ 18°40' = 114.21

202.00 @ 54°5' = 200.98

300.42 @ 21°4' = 300.19

199.15 @ 11°31' = 195.14

1561.18

1561.14

4455.91

Transit line

Top ridge

set 1x2

31+25.22

S 85° E

6' dirt road

T5N

R12W COUNTY SURVEYOR

6+5

1/4 COR.

RE 63

T = 76 = 428.56

61.37 @ 63°1' = 60.97

269.33 @ 5°39' = 268.02

99.58 @ Lev 99.58

428.57

7152.89

123940

428.56

31+25.22

26+96.66

428.56

bot canyon

set 2" IP + BC in conc, + Mked as shown

S 75° E

1/4 SEC. COR.

Established by proportion between adjacent Section Corners per C.S. 9226-11 & 12.

26+96.66

0.35

cont from Top pg # 250

Note: Any Additions or Changes on This Sheet Must be Made or Circled in Red Ink With Date and Name of Person Making Change.

Do not extend notes this side of this line.

RETURN TO
LOS ANGELES COUNTY SURVEYOR
726 LOS ANGELES COUNTY
ENGINEERING BLDG.

76F309S 247 2-51

F.B. Pg. 252

cont bot pg # 253

SEC 6 T5N R12W SEC 5

Top ridge East

set 1x2
58+84.53

57+59° Bot draw N 85°E

56+34°

Top spur

7152.85

4455.91

N 70°E

54+06

Bot canyon

T = 72° = 1198.17
300.79 @ 13°47 = 292.13
138.20 @ 15°32 = 133.15
300.79 @ 10°33 = 295.71
232.74 @ 11°11 = 228.32
249.58 @ 4°04 = 248.95

1198.26

1198.17

47°37'20"
190 28 30
285 42 20

set 1x2
Top & nail
46+86.36

1561.14

47°37'03"

To sec cor 4, 5, 8 & 9
see pg # 244

cont from top p # 251

X

RETURN TO
LOS ANGELES COUNTY SURVEYOR
725 LOS ANGELES COUNTY
ENGINEERING BLDG.

Do not extend notes this side of this line.

Note: Any Additions or Changes on This Sheet Must be Made or Circled in Red Ink With Date and Name of Person Making Change.

Notes Ck'd by D. M. Finley	Survey of T 5N R 12W
Map No. 8-2611	W. O. 4499 Tape No. 99 St'd. 84 °F
Office Work G. BAILEY	Surveyed by R. L. Willey
Checked	Notes Date 10-19-51
Date	Indexed A. C. Johnson

F. B. 1262 Pg. 253

cont bot right pg #246

SEC 6 T5N R12W SEC 5

T=82°
51.40 @ 16°51' = 49.19

49.19

Top rage N 85°E

set 1x2
71+06.05

35° 56' 40"
143 47 00
215 41 00

35° 56' 50"

To sec cor 45.8.49
see pg #244

Bot draw S 84°E

7152.39

4455.91

67+39

Transit line

1221.52

T=82° = 1221.52
85.50 @ 12°49' = 83.37
300.27 @ 9 01 = 296.56
66.62 @ 4 21 = 66.43
167.91 @ 1548 = 161.57
255.23 @ 1435 = 247.01
203.39 @ 357 = 202.91
164.50 @ 541 = 163.69
1221.54

62+30

Top brk N 73°E

cont from Top pg #252

X

Note: Any Additions or Changes on This Sheet Must be Made or Circled in Red Ink With Date and Name of Person Making Change.

Do not extend notes this side of this line.

RETURN TO
LOS ANGELES COUNTY SURVEYOR
726 LOS ANGELES COUNTY
ENGINEERING BLDG.

76F309S 247 2-51

F.B. 1262 PG. 254

cont from bot pg #248

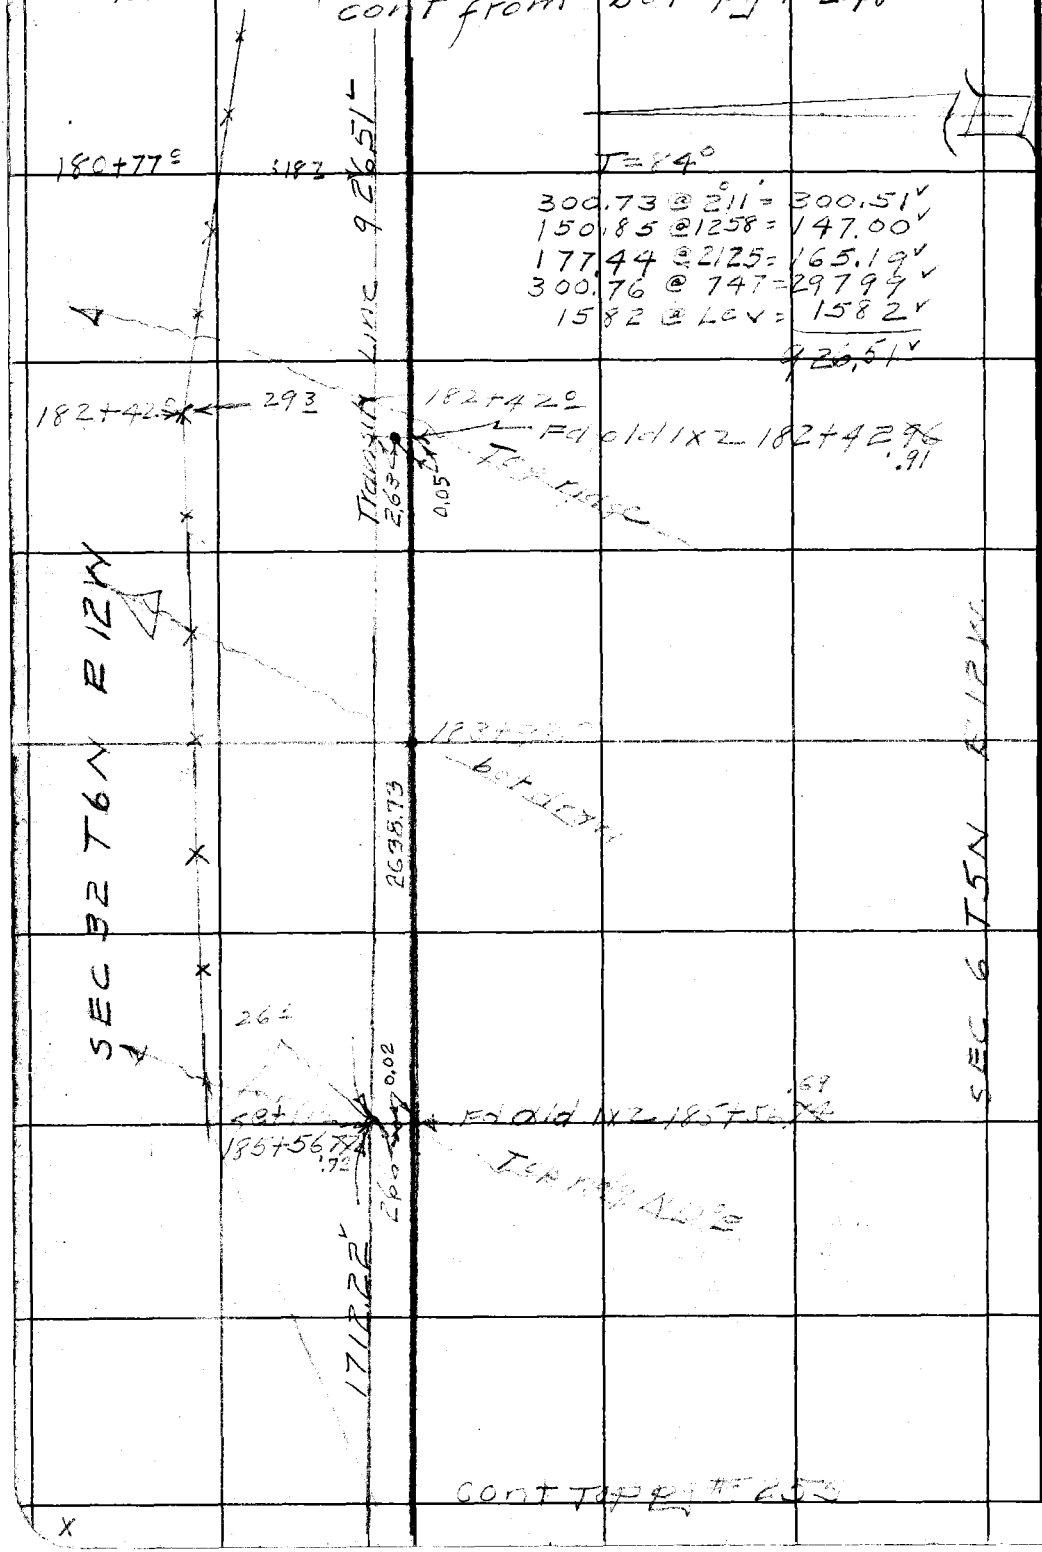

RETURN TO
LOS ANGELES COUNTY SURVEYOR
726 LOS ANGELES COUNTY
ENGINEERING BLDG.

Do not extend notes this side of this line.

Note: Any Additions or Changes on This Sheet Must be Made or Circled in Red Ink With Date and Name of Person Making Change.

Notes Ck'd by D. M. Finley	Survey of T5N R12W
Map No. B-2611	W. O. 4999 Tape No. 99 St'd. 84 °F
Office Work G. BAILEY	Surveyed by R L Willey
Checked	Notes Date 10-22-51
Date	Indexed A. C. Johnson

F. B. 1262 Pg. 255

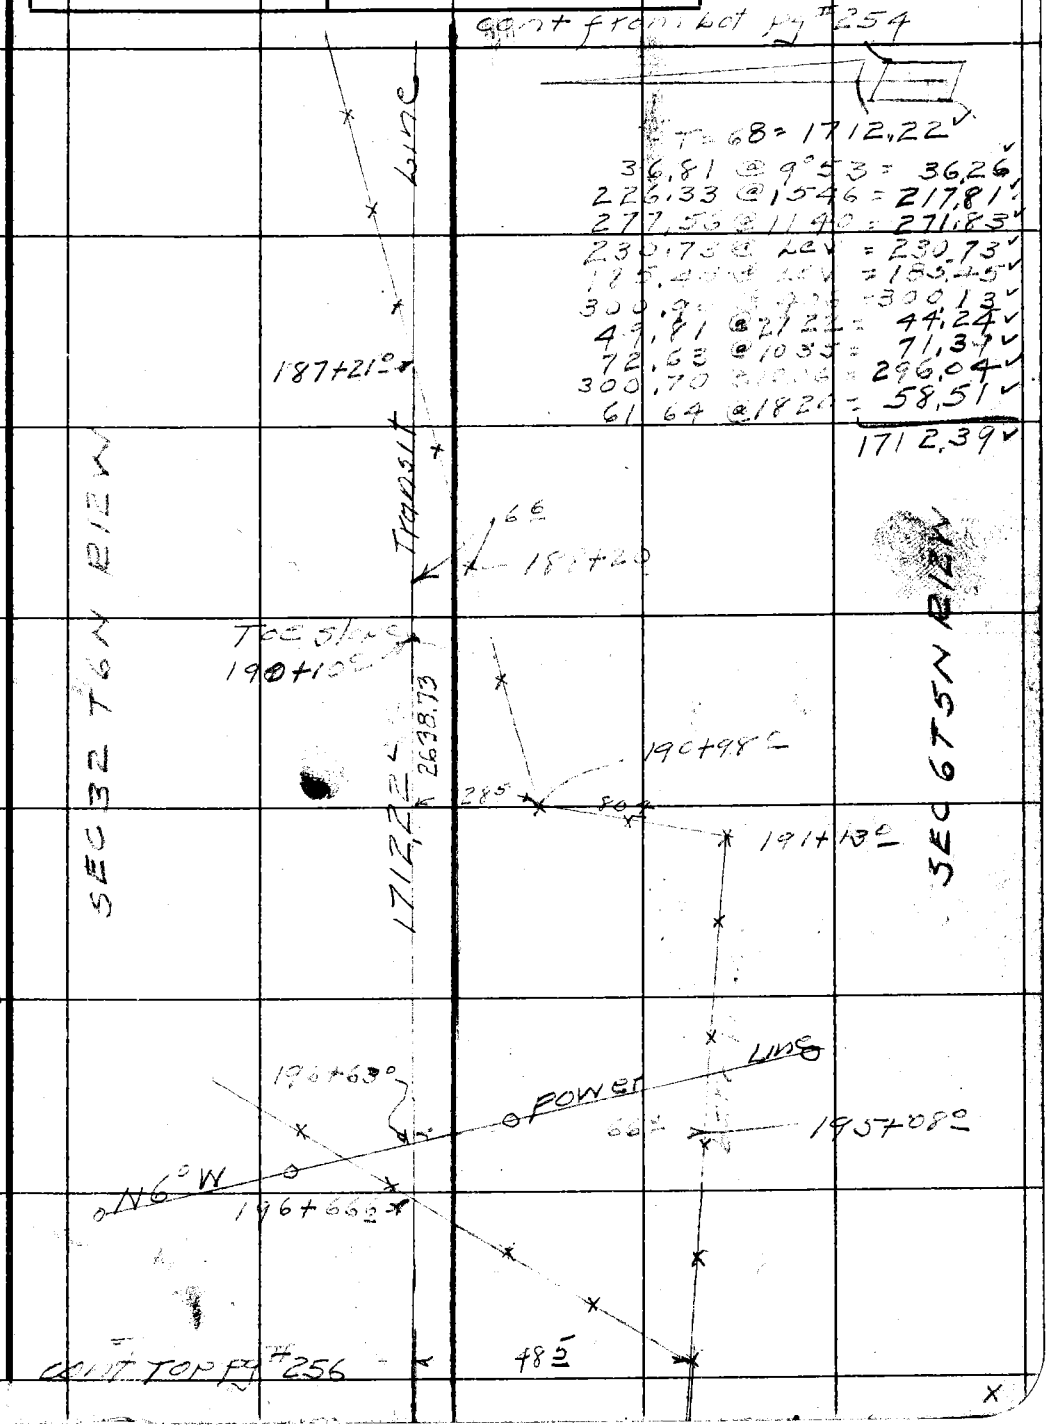

Note: Any Additions or Changes on This Sheet Must be Made or Circled in Red Ink With Date and Name of Person Making Change.

Do not extend notes this side of this line.

RETURN TO
LOS ANGELES COUNTY SURVEYOR
726 LOS ANGELES COUNTY
ENGINEERING BLDG.

76F309S 247 2-51

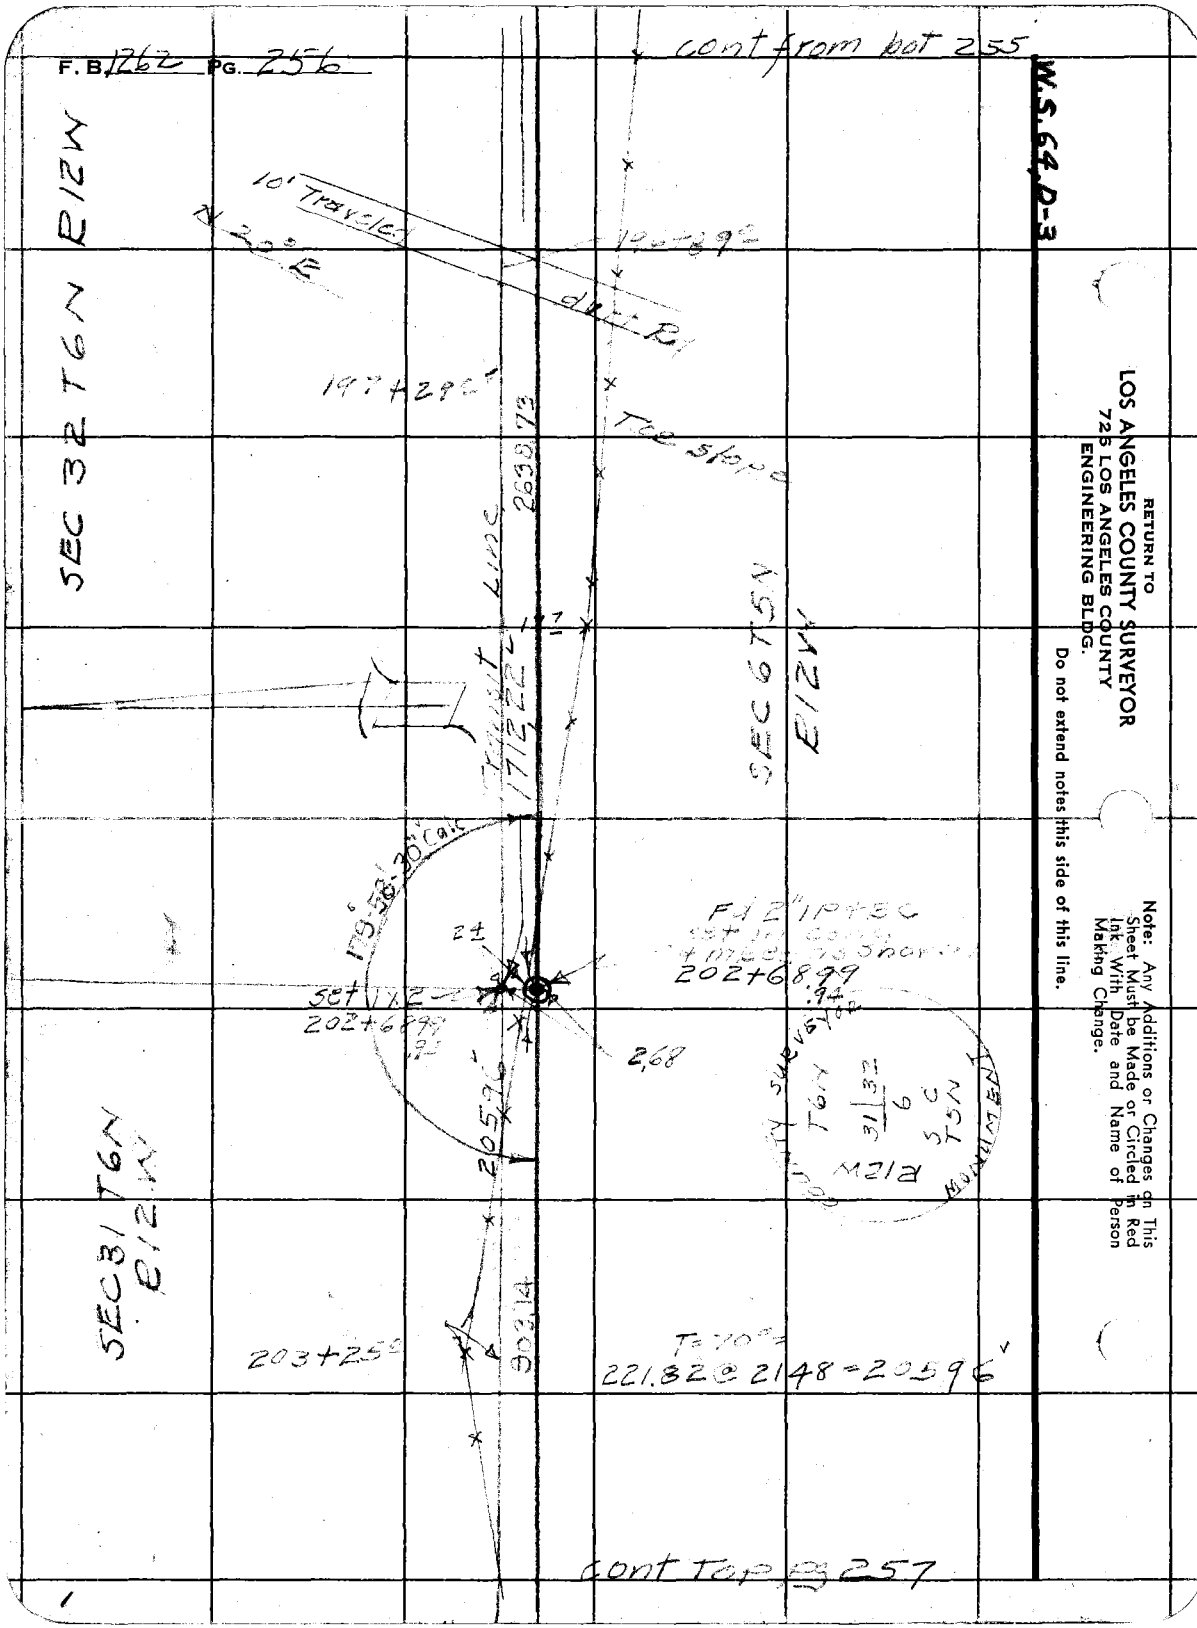
F.B. 1262 PG. 256
cont from bot 255
W.S. 64, D-3
SEC 32 T6N R12W
10' Traveled
N 20° E
dirt Rd
197+29.5
Toe slope
2638.73
Transit Line
1712.22
SEC 6 T5N R12W
Fd 2" IP+BC
202+68.99
.94
Set 1x2
202+68.99
.94
2.68
205.96
SEC 31 T6N R12W
203+25.5
903.14
T=70°=
221.82 @ 2148 = 205.96
cont Top pg 257
RETURN TO
LOS ANGELES COUNTY SURVEYOR
725 LOS ANGELES COUNTY
ENGINEERING BLDG.
Do not extend notes this side of this line.
Note: Any Additions or Changes on This Sheet Must be Made or Circled in Red Ink With Date and Name of Person Making Change.

Notes Ck'd by D. M. Finley	Survey of T5N R12W
Map No. B-2611	W. O. 4999 Tape No. 99 St'd. 84 °F
Office Work G. BAILEY	Surveyed by R.L. Willey
Checked	Notes " Date 10-22-57
Date	Indexed A. C. Johnson

F. B. 1262 Pg. 257

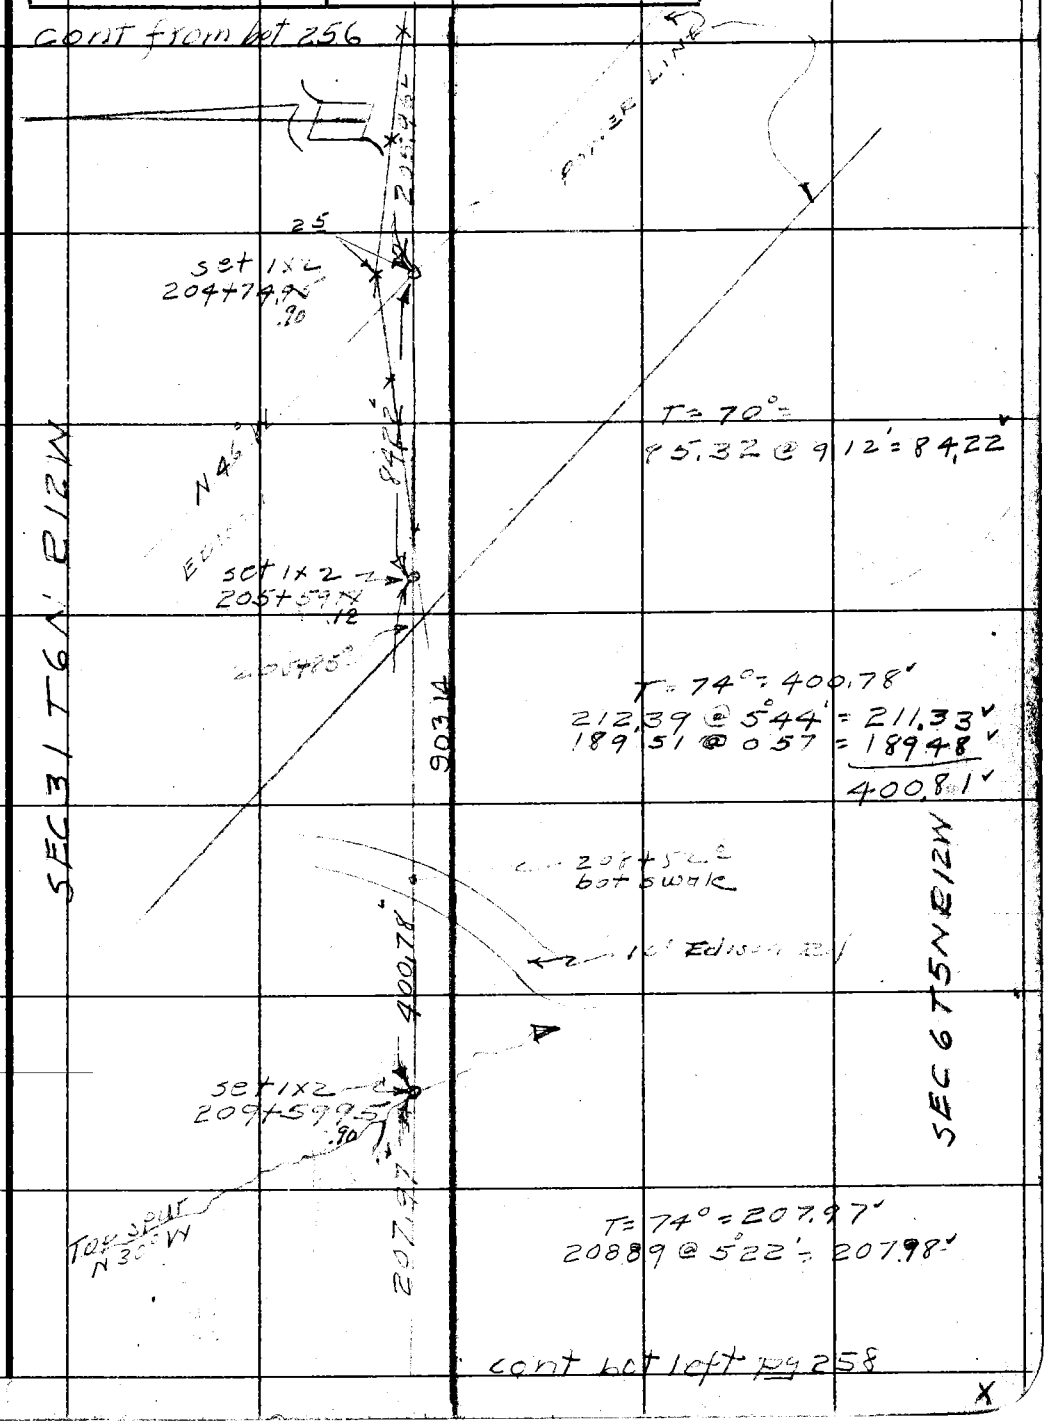

Note: Any Additions or Changes on This Sheet Must be Made or Circled in Red Ink With Date and Name of Person Making Change.

Do not extend notes this side of this line.

RETURN TO
LOS ANGELES COUNTY SURVEYOR
726 LOS ANGELES COUNTY
ENGINEERING BLDG.

76F309S 247 2-51

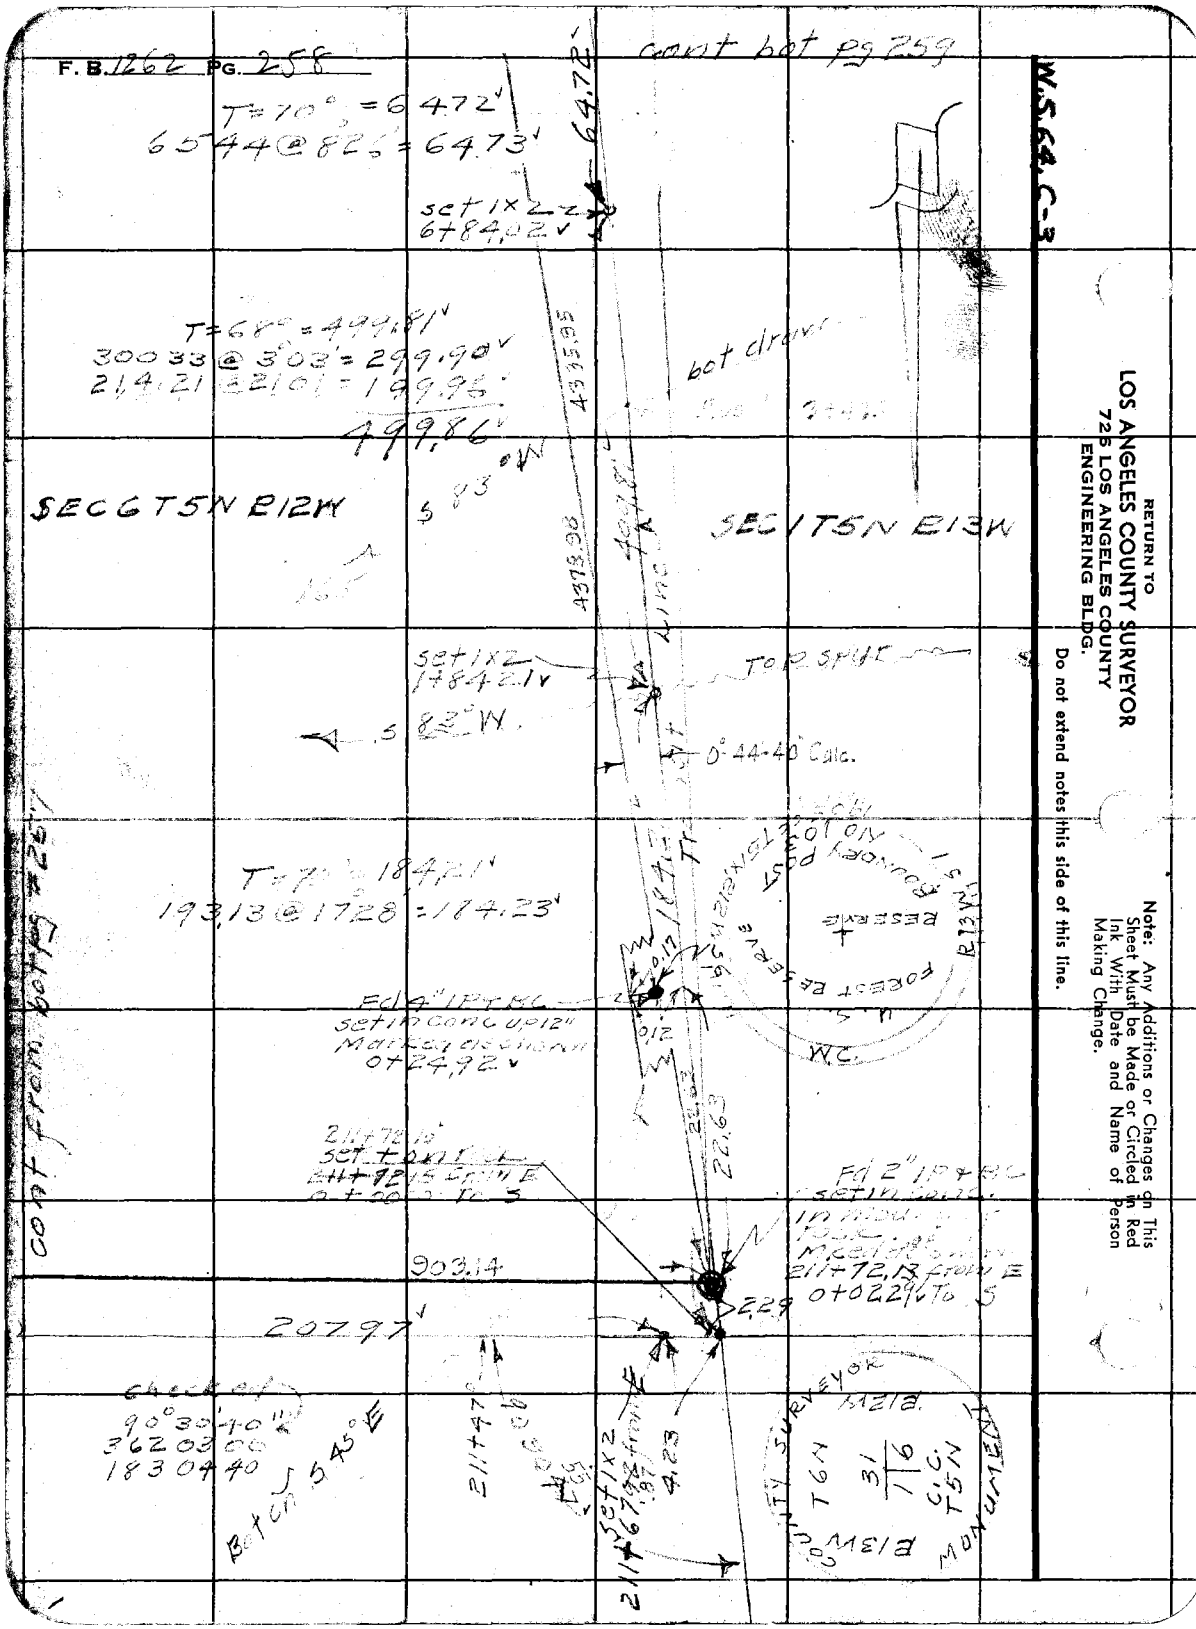

RETURN TO
LOS ANGELES COUNTY SURVEYOR
725 LOS ANGELES COUNTY
ENGINEERING BLDG.

Do not extend notes this side of this line.

Note: Any Additions or Changes on This Sheet Must be Made or Circled in Red Ink With Date and Name of Person Making Change.

Notes Ck'd by D. M. Finley	Survey of T5N R12W
Map No. B-2611	W. O. 4410 Tape No. 99 St'd. 84 °F
Office Work G. BAILEY	Surveyed by R. I. Willey
Checked	Notes " Date 10-24-51
Date	Indexed A. C. Johnson

F. B. 1262 Pg. 259

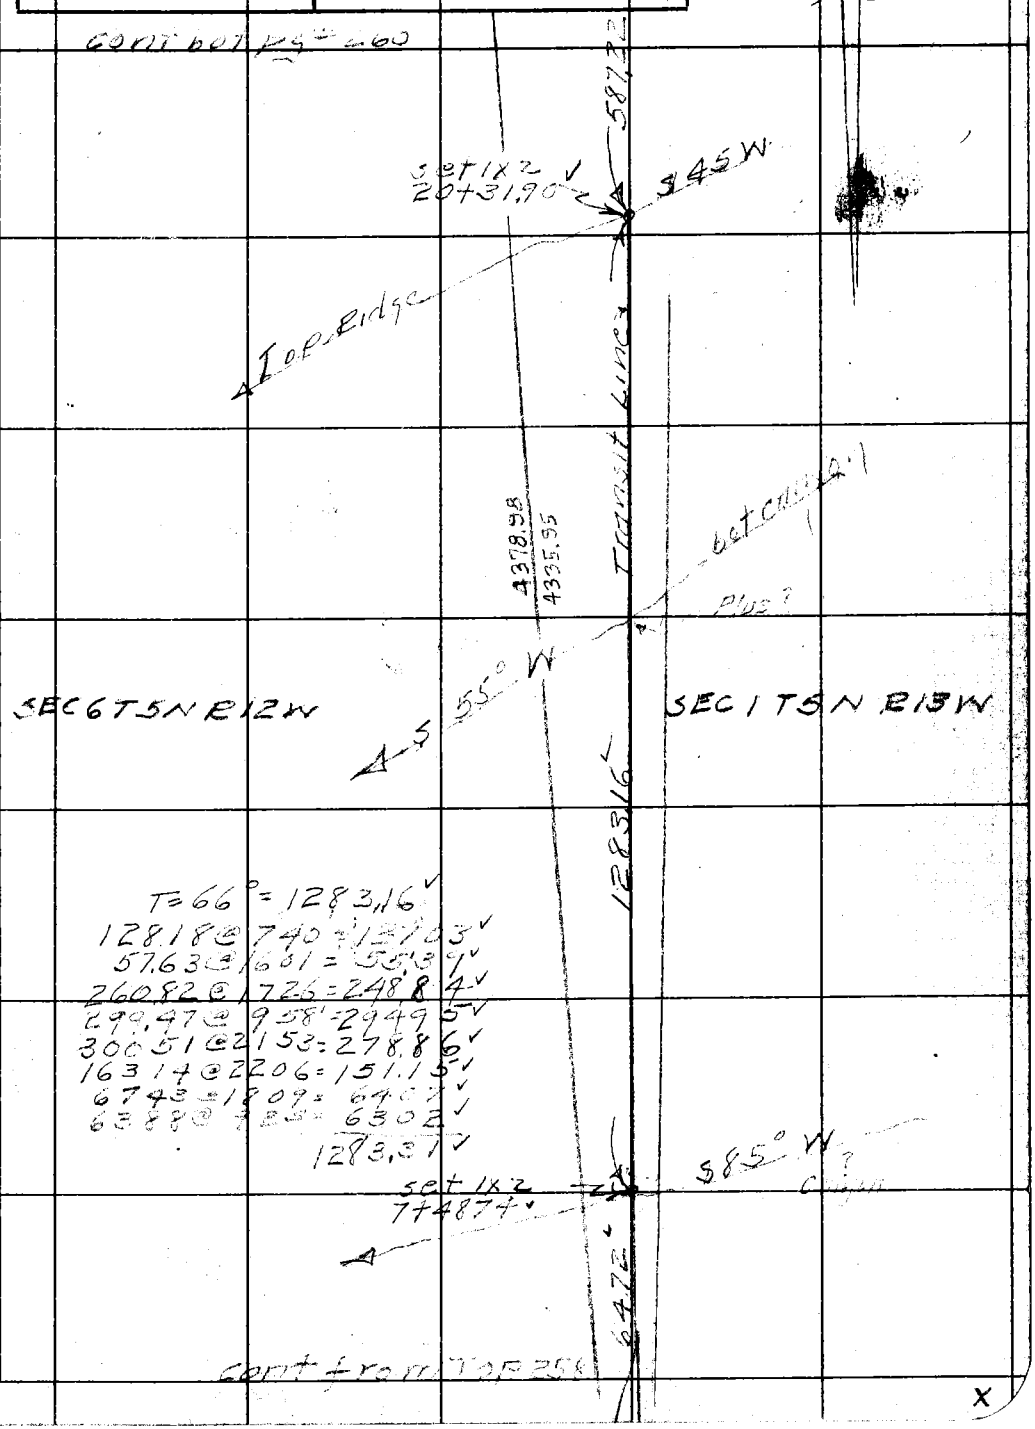

Note: Any Additions or Changes on This Sheet Must be Made or Circled in Red Ink With Date and Name of Person Making Change.

Do not extend notes this side of this line.

RETURN TO
LOS ANGELES COUNTY SURVEYOR
726 LOS ANGELES COUNTY
ENGINEERING BLDG.

76F309S 247 2-51

F. B. 1262 PG. 260

cont bot pg # 265

T = 68° = 871.67 Toe slope 32+98°

300.32 @ 14°55 = 290.20
127.41 @ 23 15 = 117.06
300 84 @ 9 27 = 296.76
156 89 @ 19 00 = 148.34
1940 @ Lev = 19.40

871.76

871.67

bot cr

set 1x2
31+75.84

58° W

T = 68 = 556.72

126.87 @ 5 09 = 126.36
140.20 @ 16 33 = 134.39
300.86 @ 10 17 = 296 03

556.78

Toe slope 30+20

556.72

SEC 6 T5N R12W

SEC 1 T5N R13W

+378.98
+335.95

set 1x2
26+19.12

T = 70 = 587.22 Top

93.24 @ 7°47' = 92.38
61.69 @ 17 14 = 58.92
66.27 @ 20 14 = 62.18
300.85 @ 10 29 = 285.88
82.88 @ 19 50 = 77.96

587.27

Transit

24+35
West

bot draw

cont from Top pg # 259

X

RETURN TO
LOS ANGELES COUNTY SURVEYOR
725 LOS ANGELES COUNTY
ENGINEERING BLDG.

Do not extend notes this side of this line.

Note: Any Additions or Changes on This Sheet Must be Made or Circled in Red Ink With Date and Name of Person Making Change.

Notes Ck'd by D. M. Finley	Survey of T5N R12W
Map No. B-2611	W. O. 4997 Tape No. 99 St'd. 84 °F
Office Work G. BAILEY	Surveyed by R L Willey
Checked	Notes 1 Date 10-25-51
Date	Indexed A. C. Johnson

F. B. 1262 PG. 261

cont from Top Pg #238

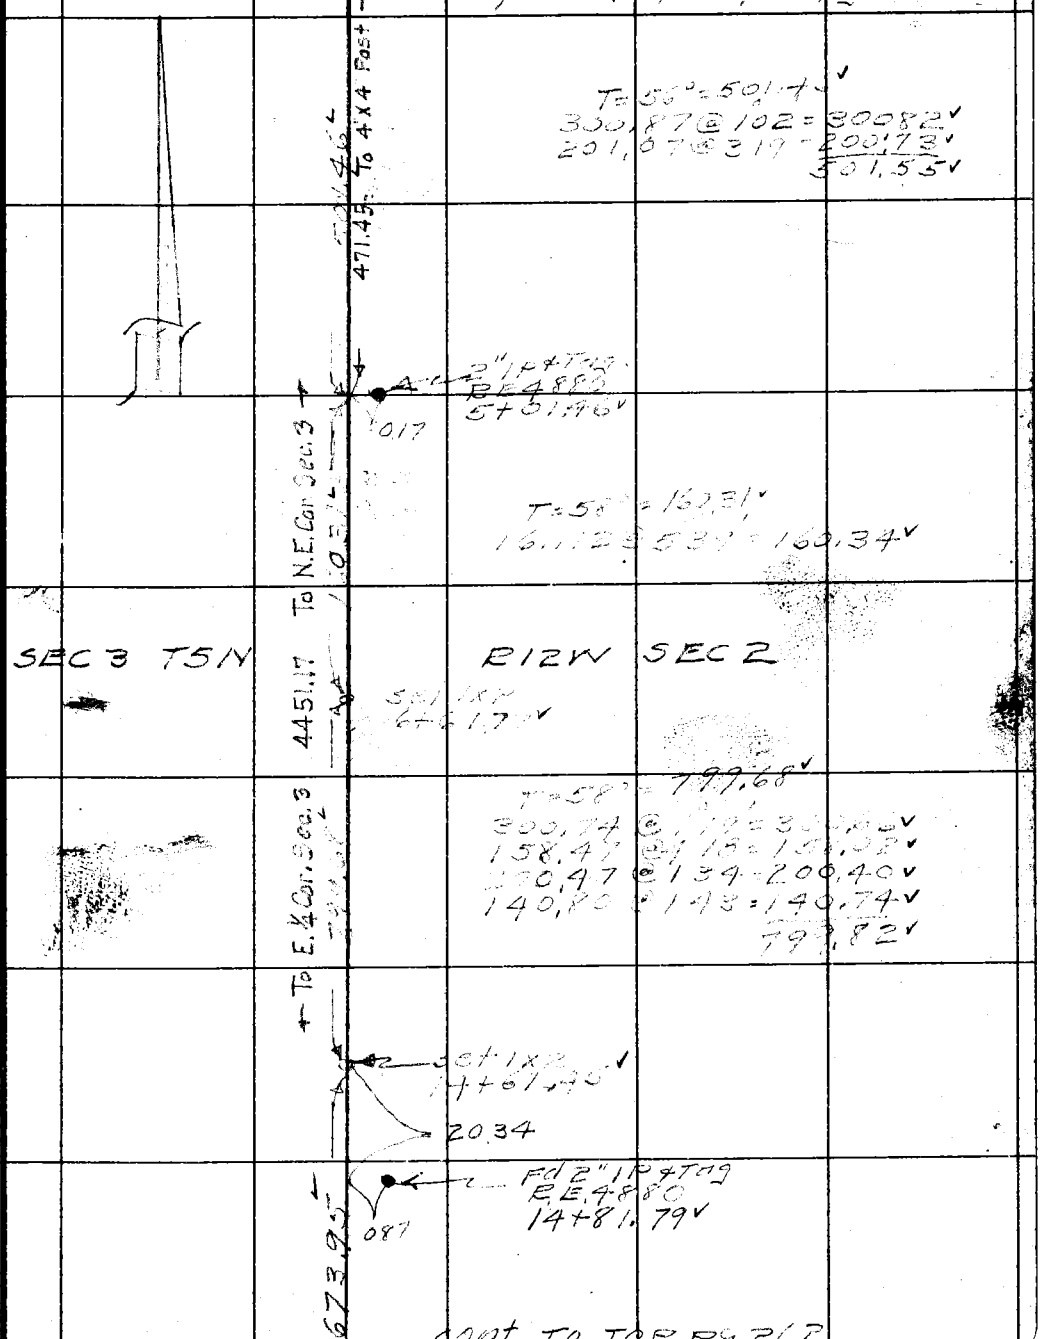

cont to Top Pg 262

X

Note: Any Additions or Changes on This Sheet Must be Made or Circled in Red Ink With Date and Name of Person Making Change.

Do not extend notes this side of this line.

RETURN TO
LOS ANGELES COUNTY SURVEYOR
726 LOS ANGELES COUNTY
ENGINEERING BLDG.

76F3095 247 2-51

F. B. 1262 PG. 262

cont from bot pg # 261

T = 60° = 673.95

272.49 @ 035 = 272.48
301.00 @ 041 = 300.98
101.15 @ 559 = 100.60
674.06

SEC 3 T5N R12W SEC 2

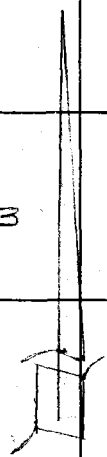

673.95

set 1x2
Top Palingus reservoir
21+35.40

T = 58° = 947.09
300.90 @ 540' = 299.43
[illegible] @ LCY = [illegible]
[illegible]
[illegible]
947.24

947.09

set 1x2
30+82.49

T = 62° = 415.57
200.60 @ 105 = 200.56
91.76 @ LCY = 91.76
65.40 @ " = 65.40
57.91 @ " = 57.91
415.63

415.57

set 1x2
34+98.06

cont Top # 263

X

RETURN TO
LOS ANGELES COUNTY SURVEYOR
725 LOS ANGELES COUNTY
ENGINEERING BLDG.

Do not extend notes this side of this line.

Note: Any Additions or Changes on This Sheet Must be Made or Circled in Red Ink With Date and Name of Person Making Change.

F.B. 1262 PG. 263

Notes Ck'd by D. M. Finley	Survey of T5N R12 W
Map No. B-2611	W. O. 4999 Tape No. 99 St'd. 84 °F
Office Work G. BAILEY	Surveyed by R. L. Willey
Checked	Notes Date 10-26-57
Date	Indexed A. C. Johnson

W.S. 65 A-4

cont from Top pg # 262

SEC. 3 T5N R12W SEC 2

T = 64° = 536.25

99.35 @ 1°42' = 99.31
171.94 @ LEV = 171.94
265.21 @ 153 = 265.07
536.32

Fd 3" I.P. conc plug + Nail
39+95.39

38.92

set 1x2
40+34.31

61.46

Fd 2" IP plug + Nail
40+95.77

3.36

4451.17 To N.E. Cor. Sec. 3

T = 68° = 416.86

259.63 @ 1°34' = 259.53
157.54 @ 2°40' = 157.37
416.90

179°08'40"
356 34 40
354 52 00

416.86

179°08'40"
179°-21'-45" Calc.

Fd 2" IP + BC
set in conc
Mked as shown
44+51.17

0°-13'-05" Adj. Calc.

T = 66° = 1291.02

279.21 @ 2°07' = 279.02
216.38 @ 3°10' = 216.05
279.47 @ 2°54' = 279.11
219.38 @ 3°48' = 218.90
298.45 @ 2°50' = 298.09
1291.17

1291.02

1291.01
2636.48
To S.E. Cor. Sec. 3

Transit line

R12 COUNTY SURVEYOR
T5N
3+2
1/4 SEC COR
MONUMENT

cont Top pg # 264

Note: Any Additions or Changes on This Sheet Must be Made or Circled in Red Ink With Date and Name of Person Making Change.

Do not extend notes this side of this line.

RETURN TO
LOS ANGELES COUNTY SURVEYOR
726 LOS ANGELES COUNTY
ENGINEERING BLDG.

76F3095 247 2-51

F.B. 1262 PG. 264

cont from bot pg # 263

W.S. 65.A-4

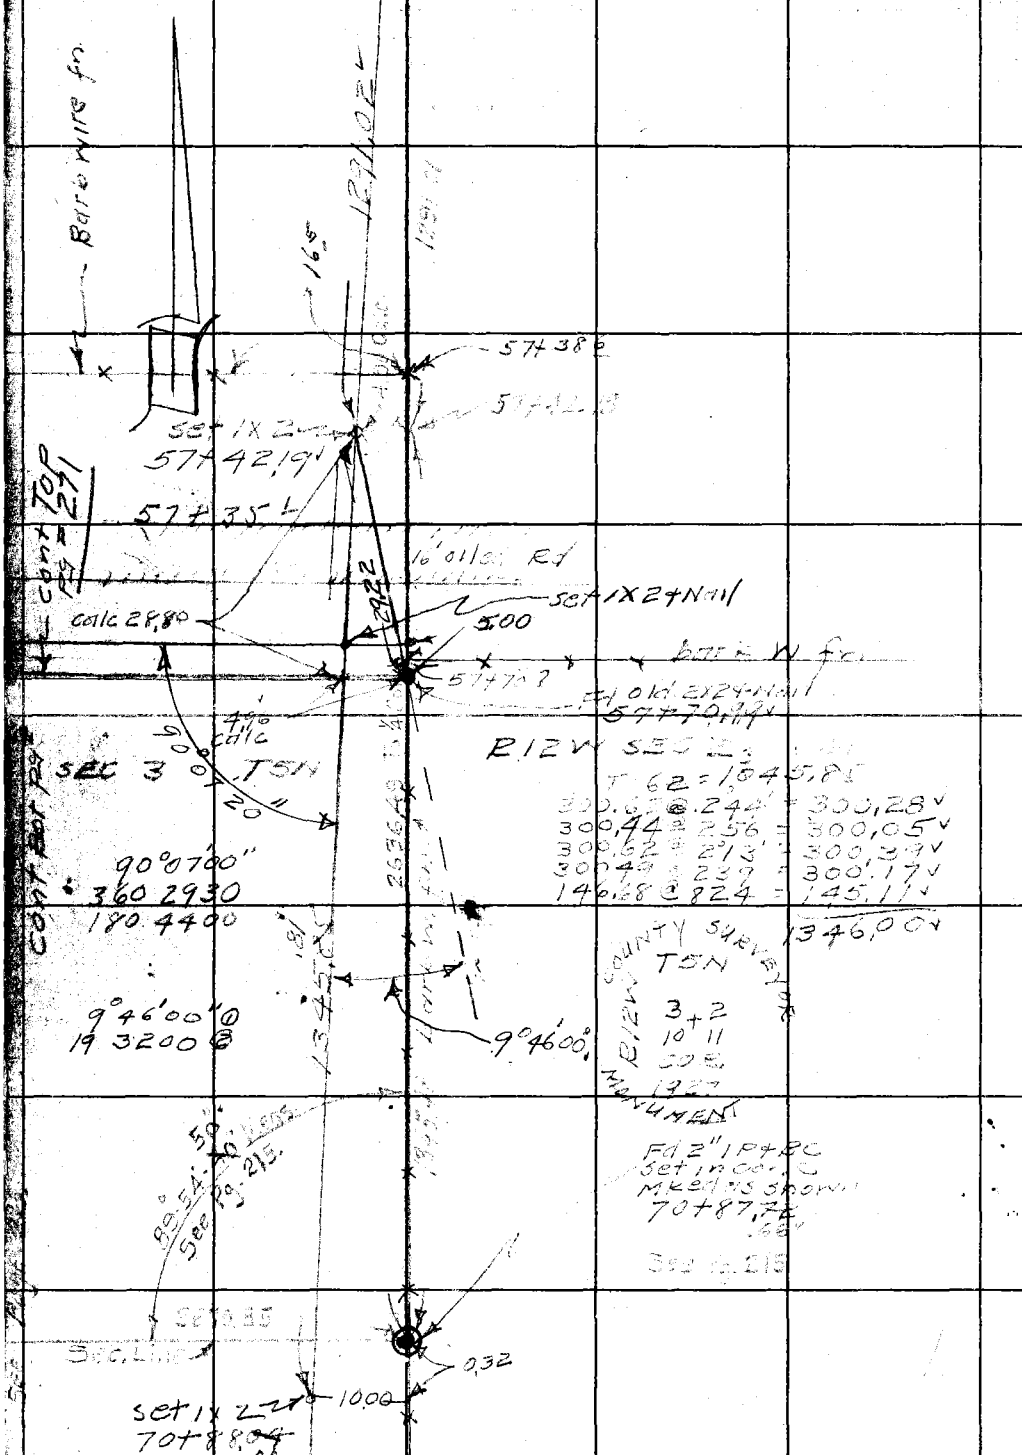

RETURN TO
LOS ANGELES COUNTY SURVEYOR
725 LOS ANGELES COUNTY
ENGINEERING BLDG.

Do not extend notes this side of this line.

Note: Any Additions or Changes on This Sheet Must be Made or Circled in Red Ink With Date and Name of Person Making Change.

W.S.64,C-4

Notes Ck'd by D. M. Finley	Survey of T5N R12W
Map No. B-2611	W. O. 4999 Tape No. 99 St'd. 84 °F
Office Work G. BAILEY	Surveyed by R L Willey
Checked	Notes " Date 10-30-57
Date	Indexed A. C. Johnson

F. B. 1262 Pg. 265

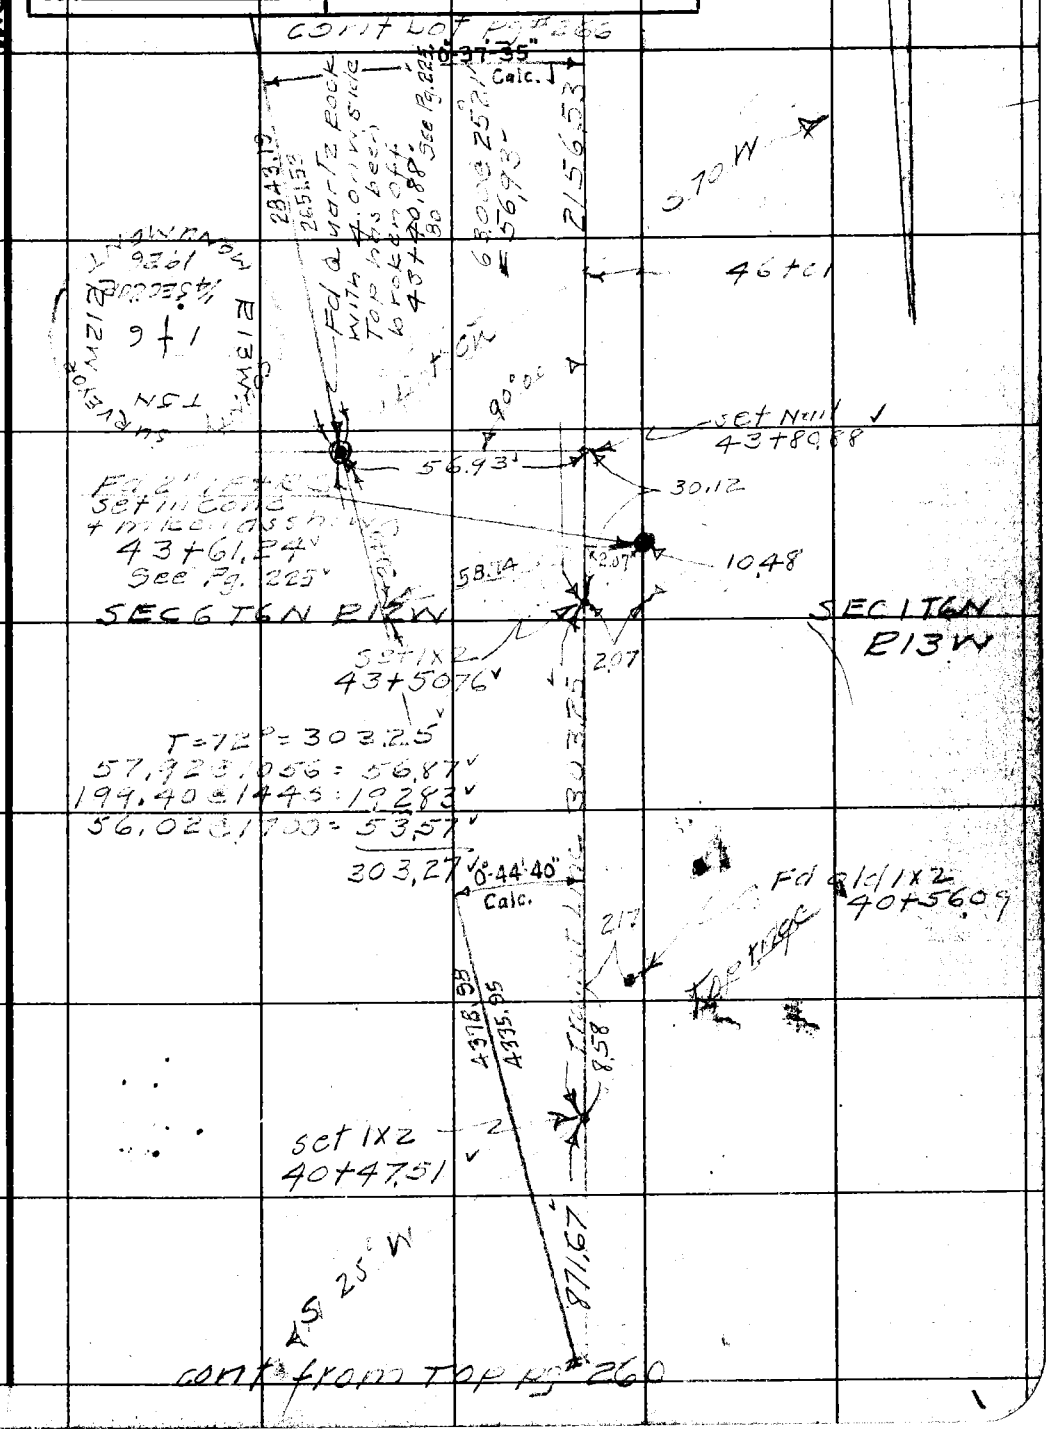

Note: Any Additions or Changes on This Sheet Must be Made or Circled in Red Ink With Date and Name of Person Making Change.

Do not extend notes this side of this line.

RETURN TO
LOS ANGELES COUNTY SURVEYOR
726 LOS ANGELES COUNTY
ENGINEERING BLDG.

76F309S 247 2-51

F.B. 1262 PG. 266

cont bot pg 267

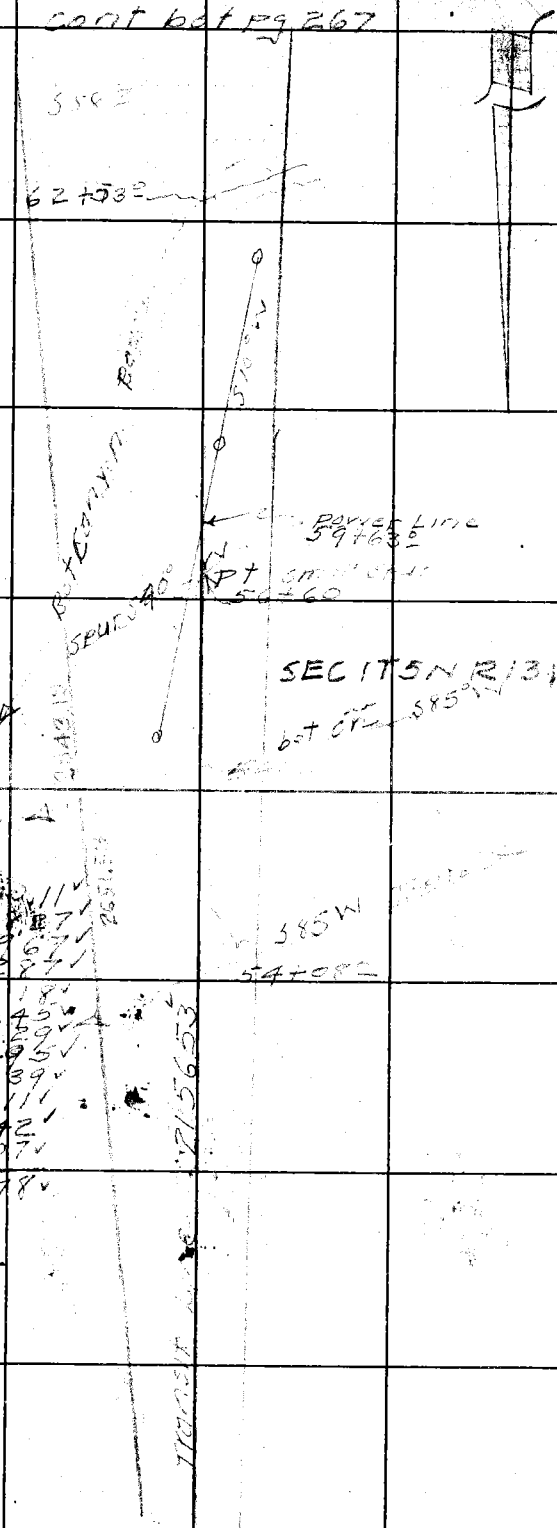

T= 66° = 2156.53

300.58 @ 312 = 300.11
241.35 @ 910 = 238.87
194.41 @ 1241 = 189.67
136.60 @ [illegible] = 132.87
143.54 @ 404 = 143.18
55.00 @ 303 = 54.45
257.50 @ 533 = 256.29
222.97 @ 044 = 222.95
166.51 @ 639 = 165.39
162.22 @ 1114 = 159.11
301.04 @ 2745 = 266.42
28.07 @ [illegible] = 28.07

2156.78

cont from TOP p 265

X

RETURN TO
LOS ANGELES COUNTY SURVEYOR
725 LOS ANGELES COUNTY
ENGINEERING BLDG.

Do not extend notes this side of this line.

Note: Any Additions or Changes on This Sheet Must be Made or Circled in Red Ink With Date and Name of Person Making Change.

W.S. 64-C-4

Notes Ck'd by D. M. Finley	Survey of T5N R12W
Map No. 8-2611	W. O. 4999 Tape No. 99 St'd. 84 °F
Office Work G. BAILEY	Surveyed by R.L. Willey
Checked	Notes A. C. Johnson Date 10-31-51
Date	Indexed

F. B. 1262 Pg. 267

For Transit To South see FB 1654-127

S.W. Cor. SEC. 6

T= 96.54 @ 22.49 = 88.99

To left pg 249

See 3.224

87.84

72+23.90

54+29.55 set 1x2 by int 71+96.32

88.94

3.22

Fd 1x2 54+29.55 per pg 224

90°04'20"
360 17 40
180 26 40

53+41.67 Fd 1x2 per pg 224

191.65

47.79

Fd 1x2 per pg #224 71+53.27

4.74

3.22

T 64° = 47.79
47.80 @ Lev

0°37'35" Calc.

set 1x2 71+48.53

T=64° = 113.19

115.80 @ 1209 = 113.21

SEC 7 T5N R12W

SEC 12 T5N R13W

set 1x2 70+35.34

2.13

88.94

Fd 2" IP & BC. set in conc & mk cards shown 70+33.21 see pg #224

T=58° = 528.05

3.18

40.86 @ 14.46 = 39.51
300.65 @ 7.11 = 298.29
95.20 @ 15.55 = 91.55
101.50 @ 13.16 = 98.79
528.14

528.05

40.86 @ 14.46 = 39.51
300.65 @ 7.11 =

S50E

65.48

SEC 6 T5N R12W

SEC 1

T5N R12W

set 1x2 65+07.29

Top Small

2156.53

cont from Top pg 266

Note: Any Additions or Changes on This Sheet Must be Made or Circled in Red Ink With Date and Name of Person Making Change.

Do not extend notes this side of this line.

RETURN TO
LOS ANGELES COUNTY SURVEYOR
726 LOS ANGELES COUNTY
ENGINEERING BLDG.

76F309S 247 2-51

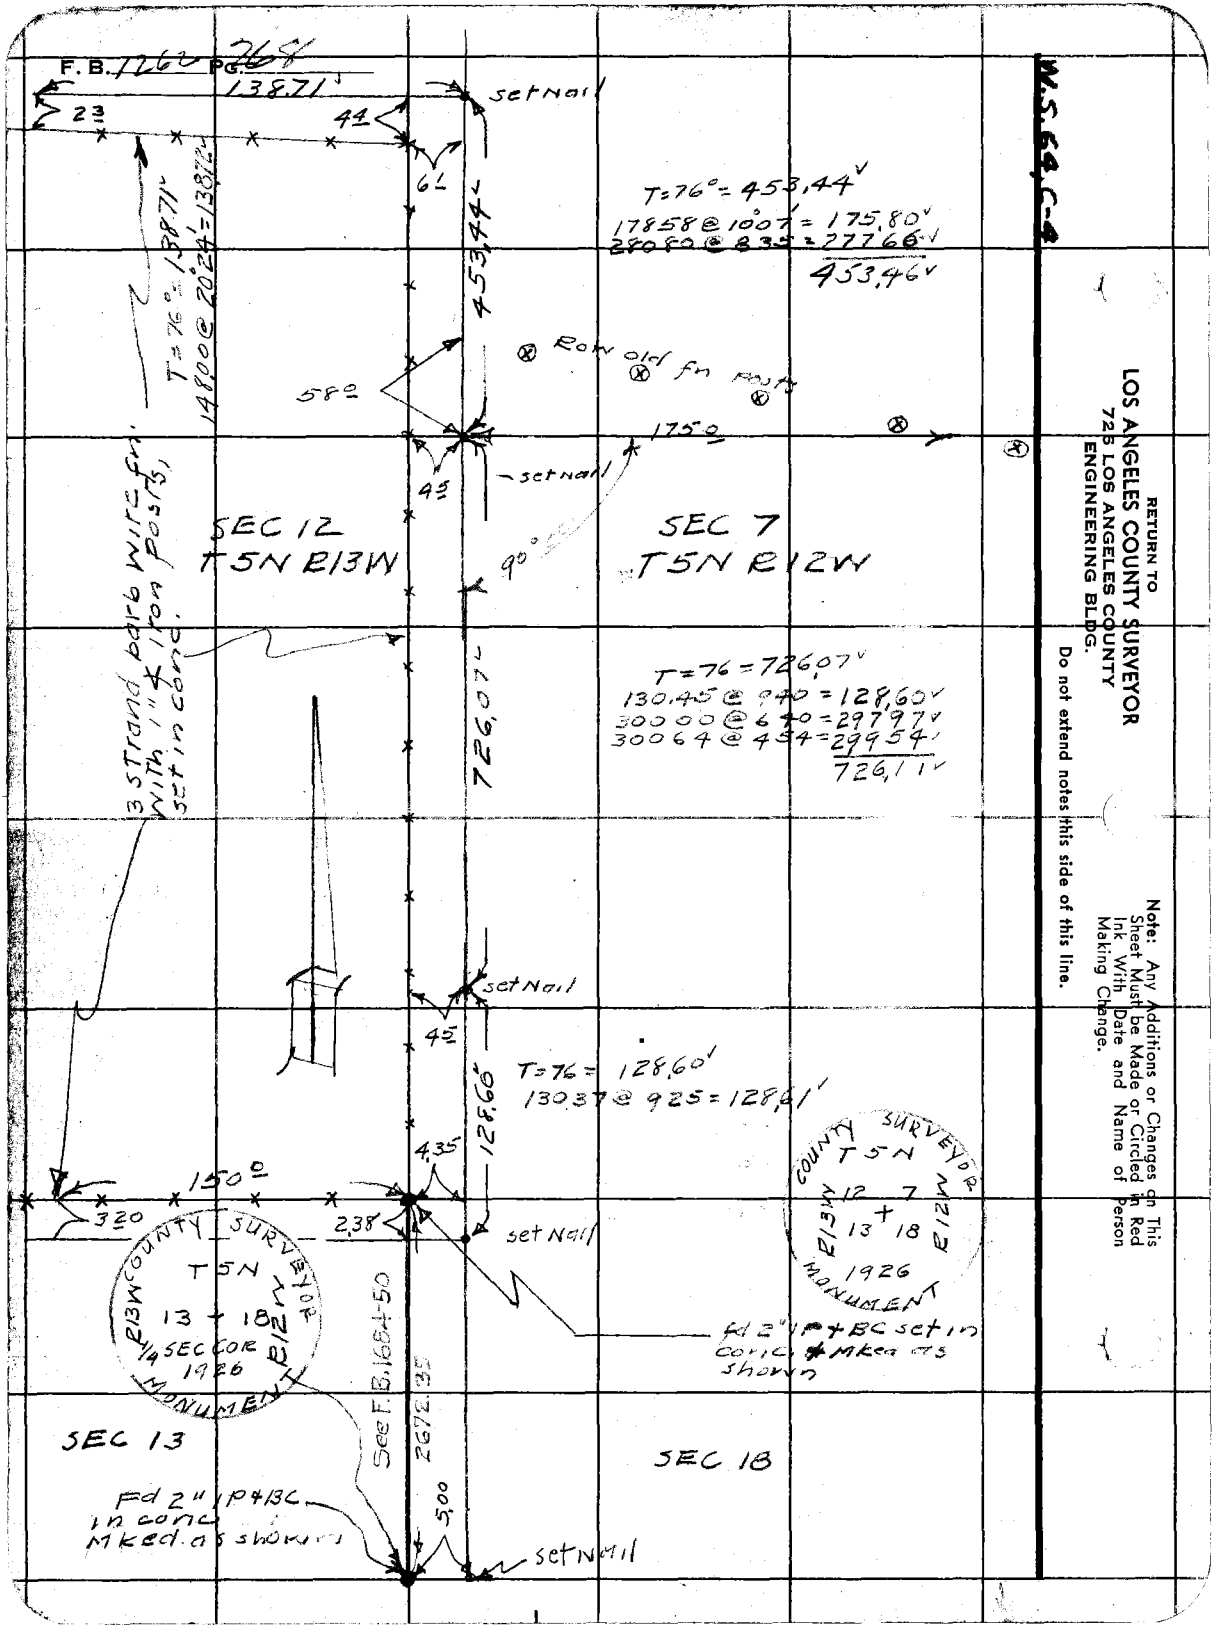
F. B. 1262 Pg. 268
138.71'
set Nail
23
44
6'
T=76°=453.44'
17858 @ 10°07' = 175.80'
28080 @ 8°35' = 277.66'
453.46'
453.44'
T=76°=138.71'
148.00 @ 20°24' = 138.72'
Row old fn posts
58°
175°
45
set Nail
SEC 12
T5N R13W
SEC 7
T5N R12W
90°
3 strand barb wire fn. with 1" ∡ iron posts, set in conc.
726.07'
T=76=726.07'
130.45 @ 9°40' = 128.60'
300.00 @ 6°40' = 297.97'
300.64 @ 4°54' = 299.54'
726.11'
set Nail
45
T=76=128.60'
130.37 @ 9°25' = 128.61'
128.60'
4.35
150°
3.20
2.38
set Nail
COUNTY SURVEYOR
T5N
13 + 18
R13W R12W
1/4 SEC COR
1926
MONUMENT
COUNTY SURVEYOR
T5N
12 7
13 + 18
R13W R12W
1926
MONUMENT
fd 2" IP + BC set in conc. & Mked as shown
See F.B. 1684-50
2672.35
SEC 13
SEC 18
Fd 2" IP + BC in conc Mked. as shown
5.00
set Nail
W.S. 64, C-4
RETURN TO
LOS ANGELES COUNTY SURVEYOR
725 LOS ANGELES COUNTY
ENGINEERING BLDG.
Do not extend notes this side of this line.
Note: Any Additions or Changes on This Sheet Must be Made or Circled in Red Ink With Date and Name of Person Making Change.

Notes Ck'd by D. M. Finley	Survey of T5N R12W
Map No. 8-2611	W. O. 4999 Tape No. 99 St'd. 84 °F
Office Work G. BAILEY	Surveyed by R. L. Willey
Checked	Notes Date 4-1-52
Date	Indexed A. C. Johnson

F. B. 1262 Pg. 269

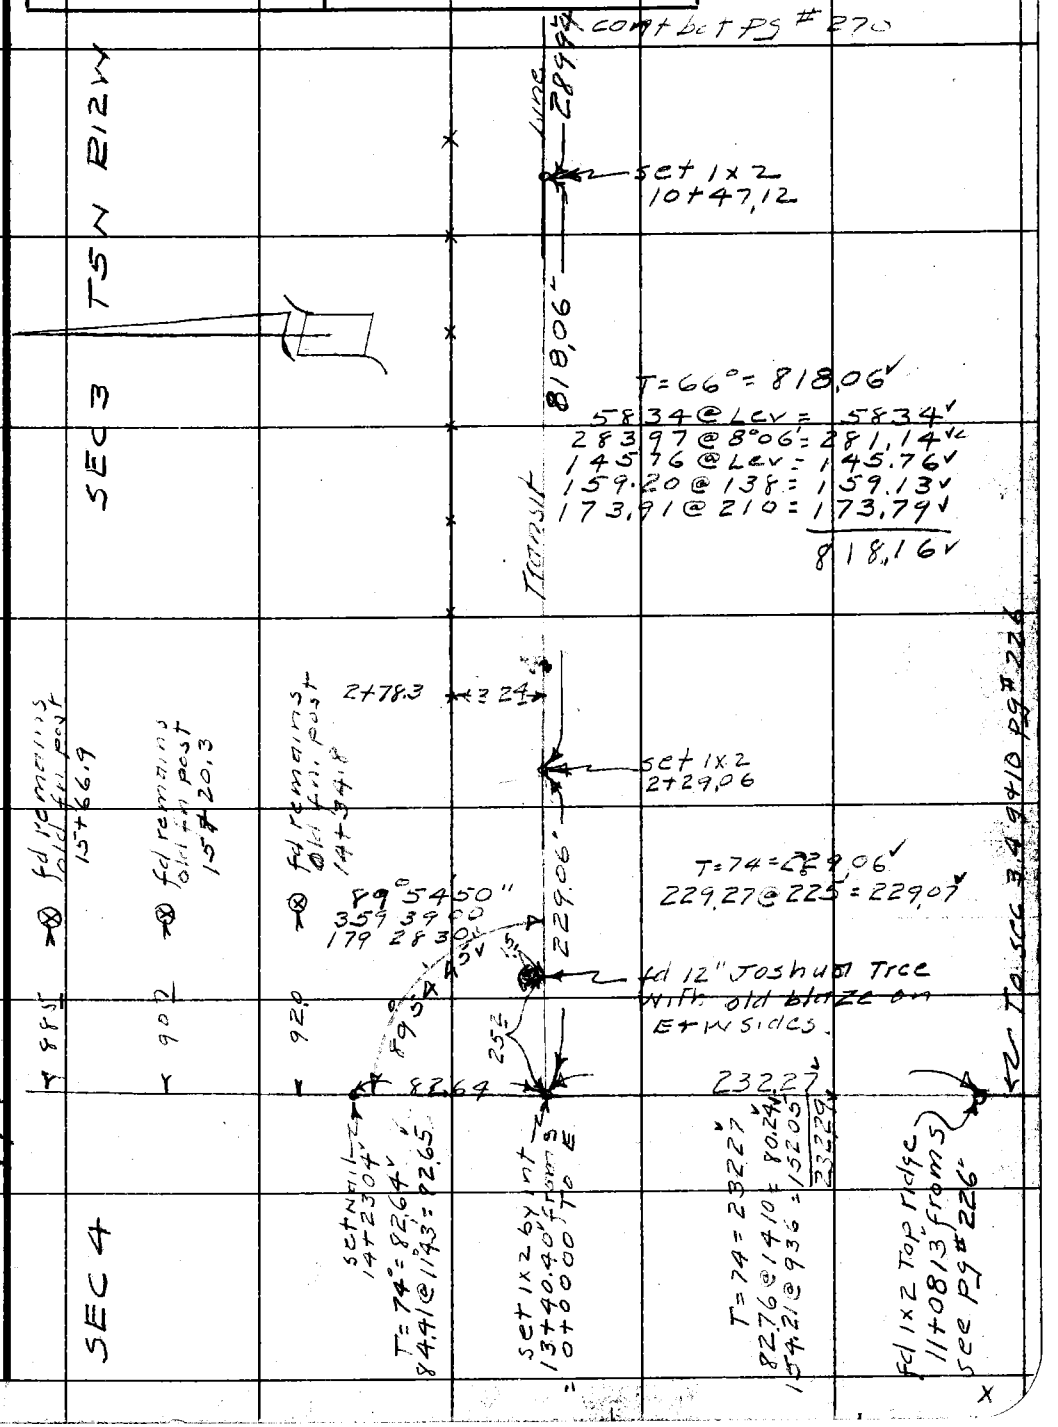

Note: Any Additions or Changes on This Sheet Must be Made or Circled in Red Ink With Date and Name of Person Making Change.

Do not extend notes this side of this line.

RETURN TO
LOS ANGELES COUNTY SURVEYOR
726 LOS ANGELES COUNTY ENGINEERING BLDG.

Pg 276

76F309S 247 2-51

F. B. 1262 Pg. 270

cont bot pg #271

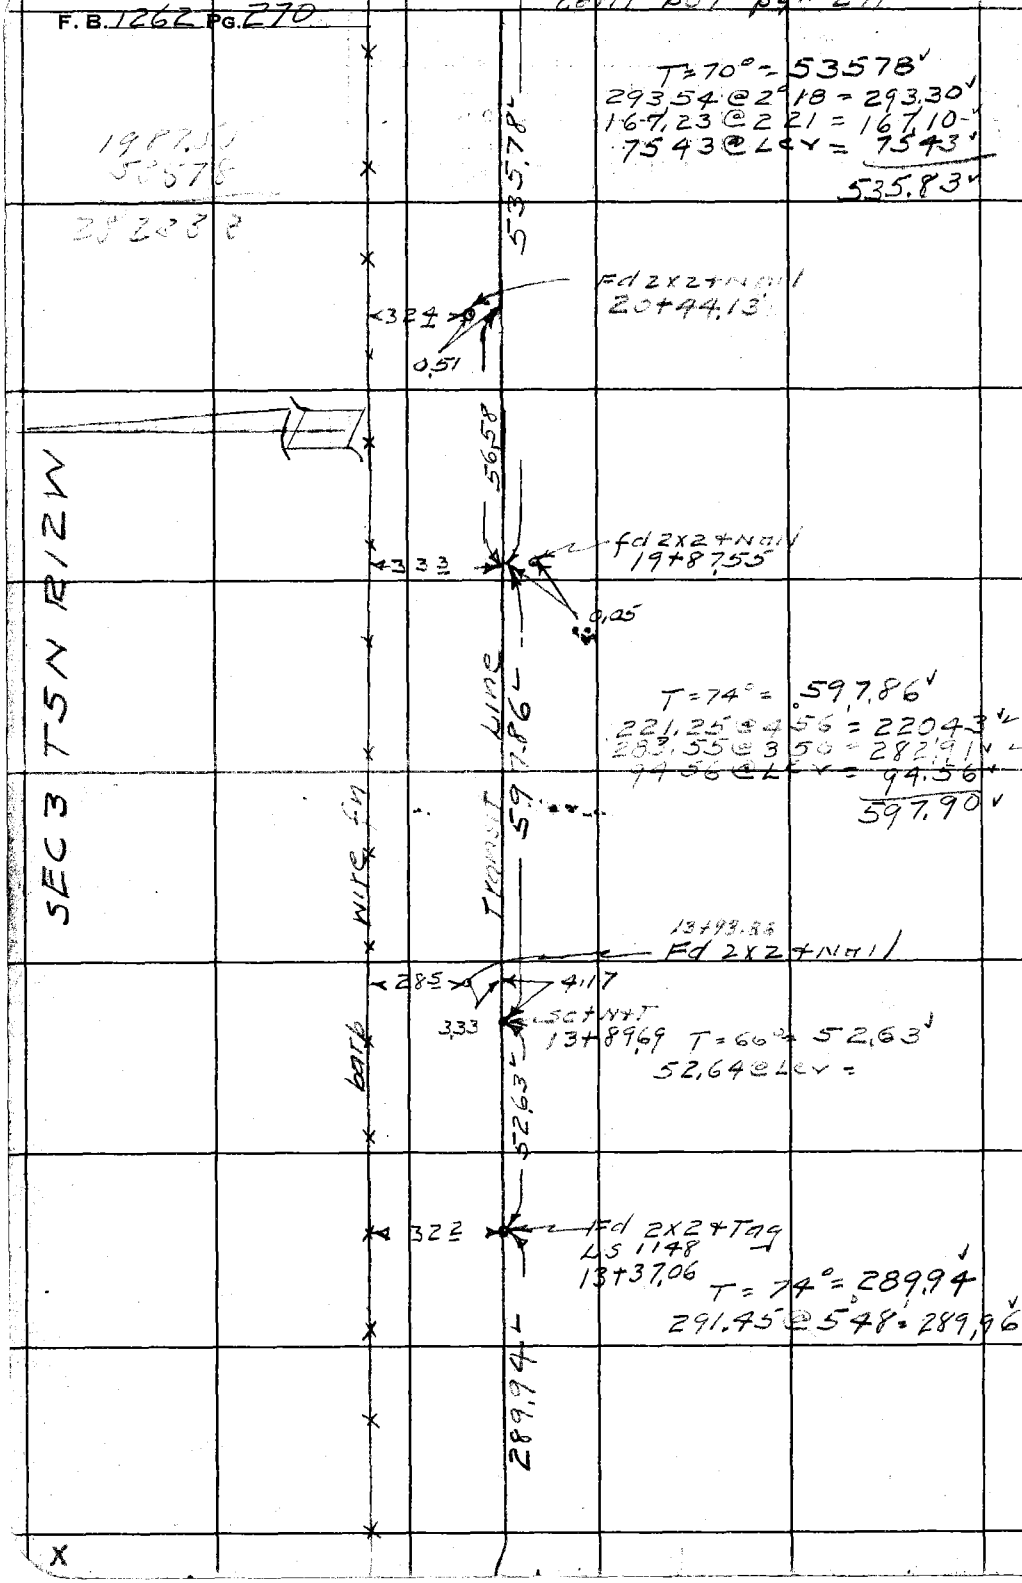

RETURN TO
LOS ANGELES COUNTY SURVEYOR
726 LOS ANGELES COUNTY
ENGINEERING BLDG.

Do not extend notes this side of this line.

Note: Any Additions or Changes on This Sheet Must be Made or Circled in Red Ink With Date and Name of Person Making Change.

Notes Ck'd by D. M. Finley	Survey of T5N R12W
Map No. B-2611	W. O. 4999 Tape No. 99 St'd. 84 °F
Office Work G. BAILEY	Surveyed by R L Willet
Checked	Notes " Date 4-1-52
Date	Indexed A. C. Johnson

F. B. 1262 Pg. 271

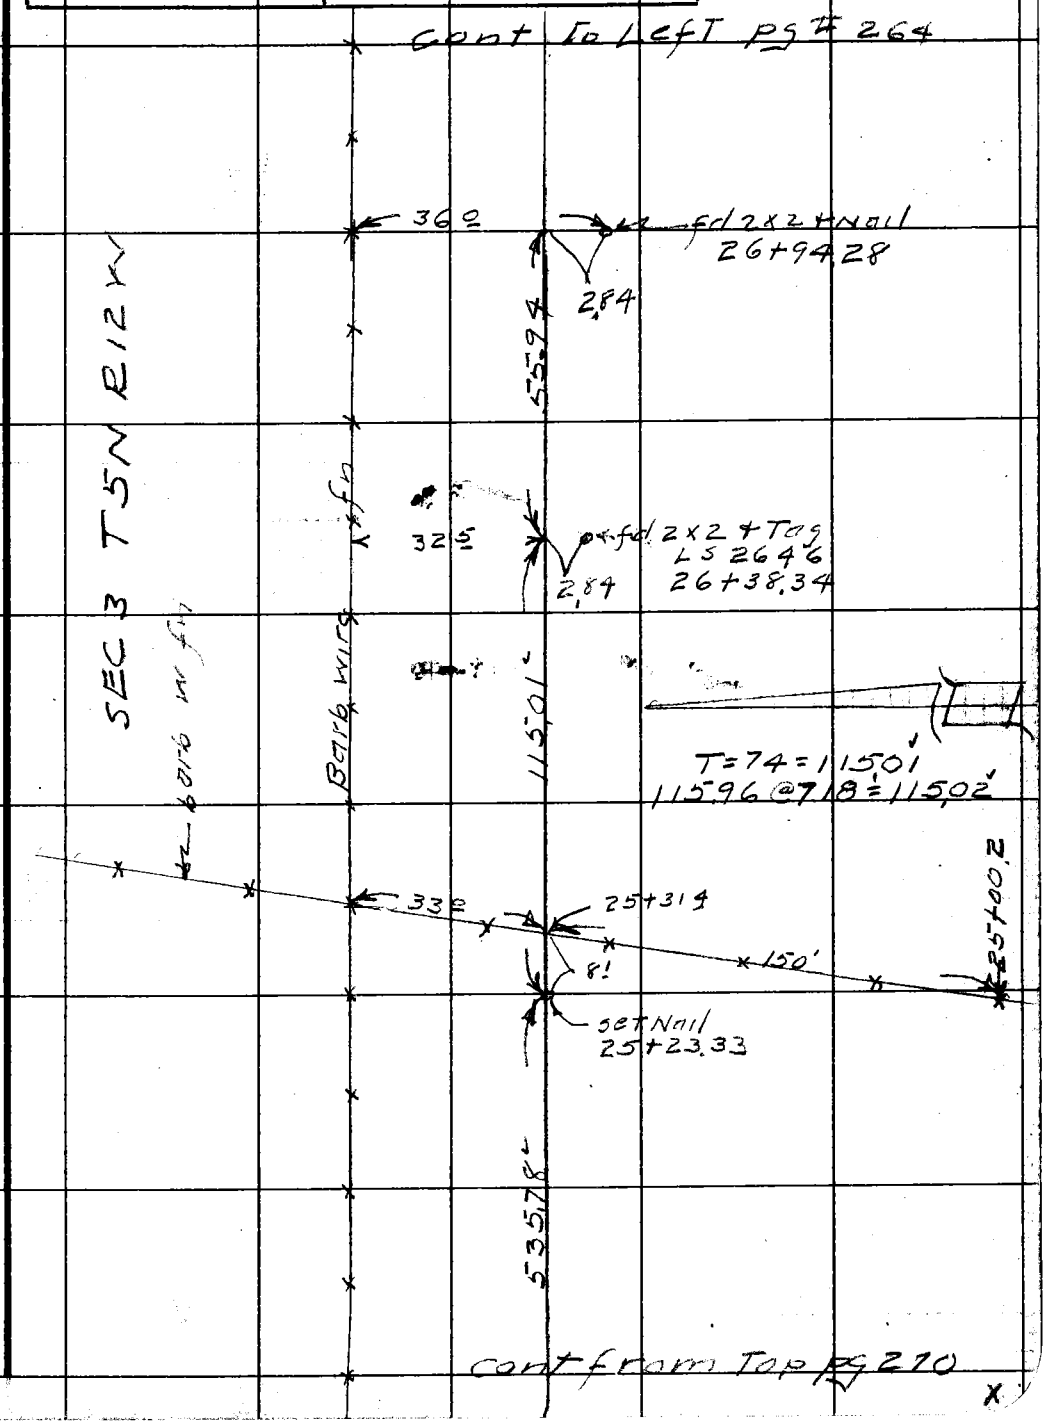

Note: Any Additions or Changes on This Sheet Must be Made or Circled in Red Ink With Date and Name of Person Making Change.

Do not extend notes this side of this line.

RETURN TO
LOS ANGELES COUNTY SURVEYOR
726 LOS ANGELES COUNTY
ENGINEERING BLDG.

76F309S 247 2-51

F.B. 1262 PG. 272

cont left pg #273

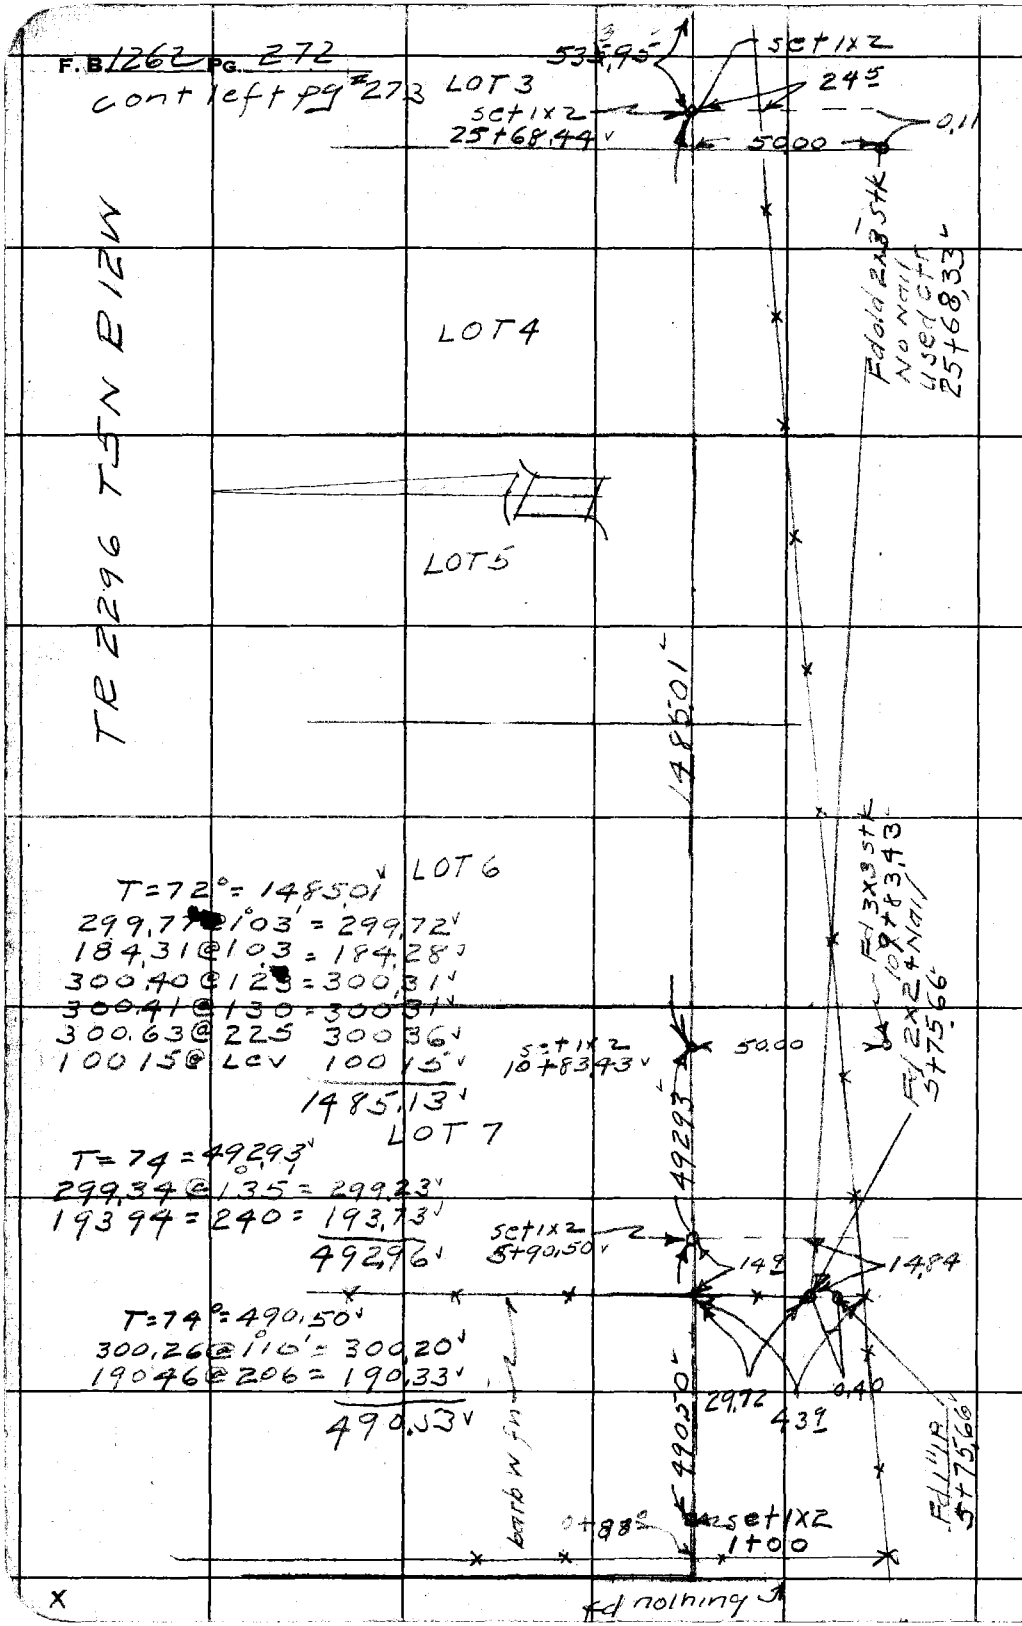

RETURN TO
LOS ANGELES COUNTY SURVEYOR
725 LOS ANGELES COUNTY
ENGINEERING BLDG.

Do not extend notes this side of this line.

Note: Any Additions or Changes on This Sheet Must be Made or Circled in Red Ink With Date and Name of Person Making Change.

W.S. 65A-3

Notes Ck'd by D. M. Finley	Survey of T5N R12W
Map No. B-26N	W. O. 1262 Tape No. 99 St'd. 84 °F
Office Work G. BAILEY	Surveyed by R.L. Willey
Checked	Notes " Date
Date	Indexed A. C. Johnson

F.B. 1262 PG. 273

70+37.88 From S.
N Cor secs
3+4 T5N R12W
see pg # 228
fd C5 Mon

T = 72° = 1709.10
300.46 @ 157 = 300.29
300.41 @ 028 = 300.40
300.51 @ 049 = 300.48
225.89 @ LEV = 225.89
300.47 @ 034 = 300.45
281.76 @ 057 = 281.72
1709.23

LOT 3 LOT 2 LOT 1

TR 2296 T5N R12W

T = 70 = 533.95
300.50 @ 215 = 300.27
233.78 @ 112 = 233.73
534.00

T = 72° = 513.21
242.71 @ 255 = 242.39
271.12 @ 231 = 270.86
513.25

T = 70 = 419.99
205.20 @ 219 = 205.03
215.11 @ 155 = 214.99
420.02

90°28'40"
361 54 20
182 51 40

1709.10

Set 1x2 3.1+0.39

Set 1x2 36+17.60

Set 1x2 by int 40+37.59 from W

90°28'30"

33+28.78 From S.

Transit Line

533.95 513.21 419.99

136

19'

Cont from Top pg #272

54.61

59.31

Fd old 2x3 stk No Nail. used ctr 30+69.24

Fd old 2x3 No Nail used ctr 35+66.68

53+20.01 Fd Nail ch. pt. see pg 227

Fd Nothing see pg 227

To 1x2, 26+59.83

Note: Any Additions or Changes on This Sheet Must be Made or Circled in Red Ink With Date and Name of Person Making Change.

Do not extend notes this side of this line.

RETURN TO
LOS ANGELES COUNTY SURVEYOR
726 LOS ANGELES COUNTY
ENGINEERING BLDG.

76F309S 247 2-51

F. B. 1262 PG. 274

See FB 1684

RETURN TO
LOS ANGELES COUNTY SURVEYOR
725 LOS ANGELES COUNTY
ENGINEERING BLDG.

Do not extend notes this side of this line.

Note: Any Additions or Changes on This Sheet Must be Made or Circled in Red Ink, With Date and Name of Person Making Change.

Notes Ch'd by D. M. Finley	Survey of T 5N R 12W
Map No.	W. O. 4999 Tape No. 99 St'd. 84 °F
Office Work	Surveyed by R L Willey
Checked	Notes RLW Date 4-8-52
Date	Indexed C. J. GALLI

F. B. 1262 Pg. 275

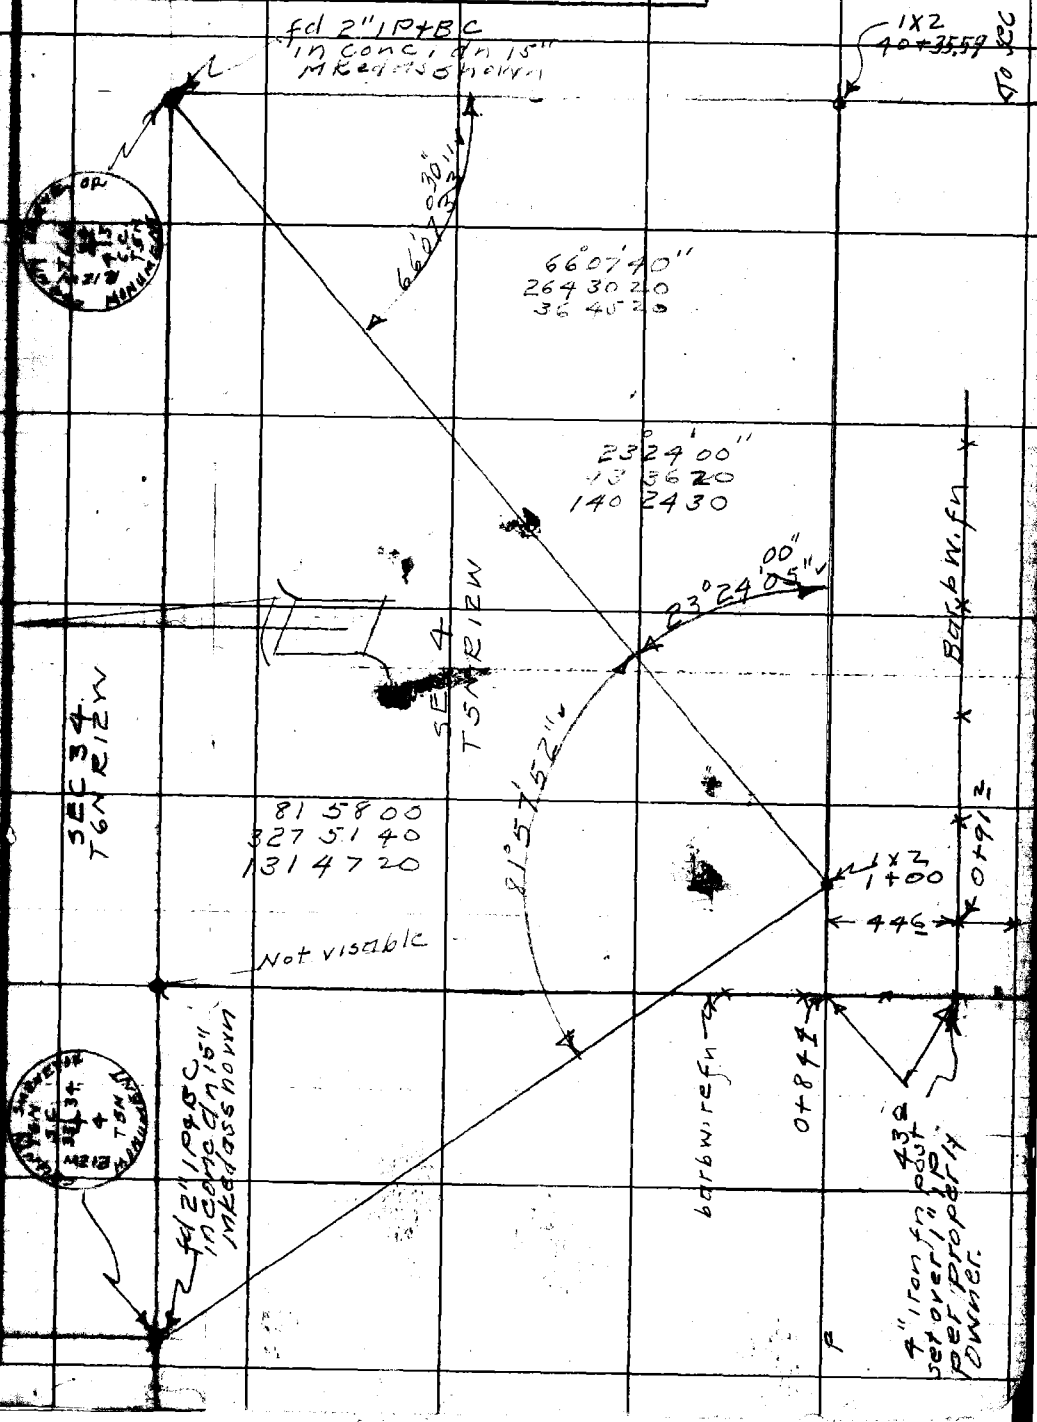

F. B._____ Pg._____