The original pages of this book are of poor quality. Care has been taken to make the best scans possible. If necessary you can arrange to see the original book at:

Department of Public Works

900 S. Fremont Ave

Survey Public Counter

Alhambra, CA 91803

FB.1301-1

FB.1301-2

B.P.&L.-F.B.325

INDEX

Center Line - Tower Tops.

Sta A - Sta B. Line

Tower #1 at Power St (Sta "A")		Page 2
Tower #25	(Where Line leaves L.A. Riv.)	" 14
Tower #35	(L.A. Riv & Downey Road)	" 19
Tower #44	Slauson Ave	" 24
Tower 71	Southern & Alameda	" 37+38
" 80	92nd & Success	" 42
" 85	Central Ave. (Sta "B")	" 44

Sta B - Sta C Line

Tower #1	Wadsworth + 98th St	46
" 25	McKinley + Rosecrans	57
" 32	Olive St.	61
" 44	Victoria (190th) St	66
" 59	Carson St.	71
" 71	Bonita + Rocha	78
" 80	Reyes St (Sta "C")	79
	INDEXED Indexed check 4/18/38	
" 37	EDISON CO - DW&P JOINT TOWER	58

FB.1301-3

FB.1301-4

B.P.&L.-F.B.325

TIES TO ℄ R/W & TOWER CENTERS LOOP LINE "A" TO "B"

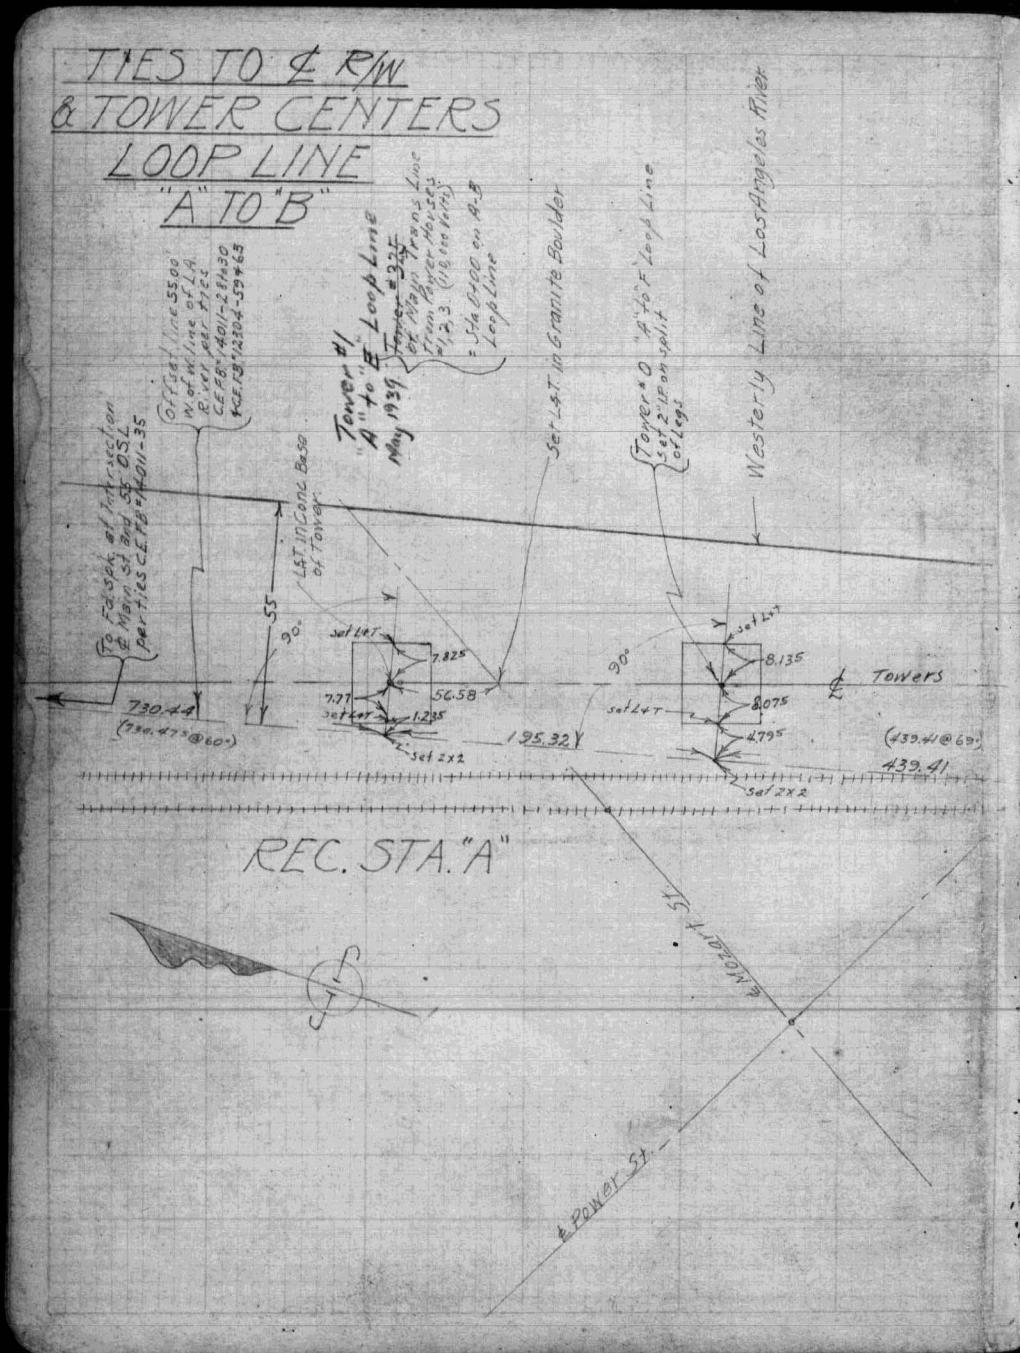

July 3, 1928.
Party L.G. Multhauf
O.B. Field
G.W. Barlow
F.W. Ballinger

2

Note —
Additional notes on pages 2 to 7 inc. ℄ dists., offset ties to towers, angles & etc. made may 22 to June 8, 1936 by —
Orcutt - sur
Oliver - A
Lundgren - Ch
Barlow - Ch

Ref. —
C.E. F.B. # 12304 - 59 to 67
" " " # 14011 - 28 to 35
" " " # 17110 - 14 to 17
B.P.L. Map # 188

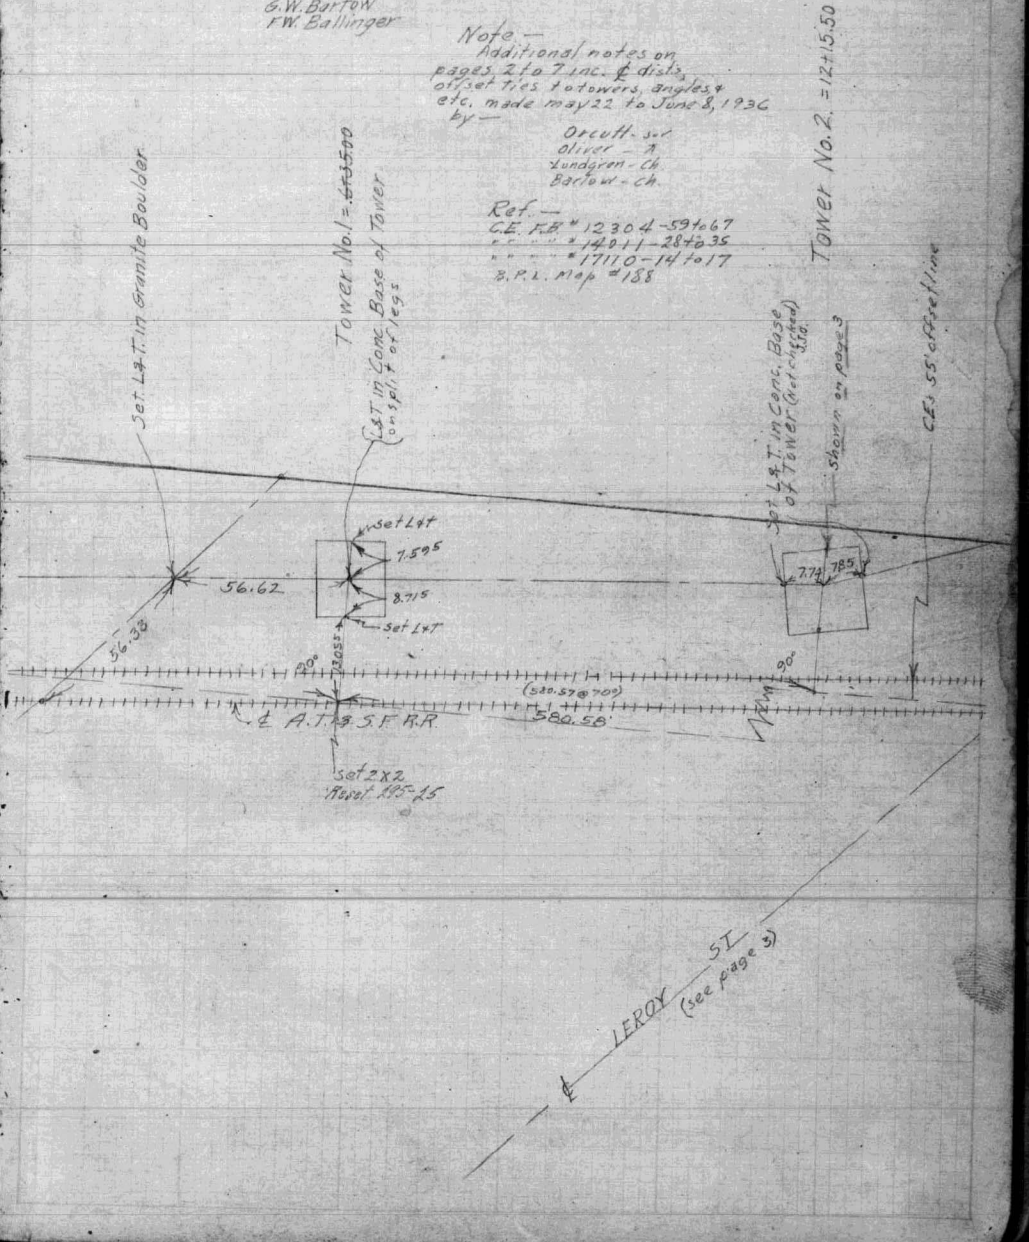

FB.1301-5

FB.1301-6

B.P.&L.-F.B.325

July 1928
L.G. Monthaut
& Party.

June 1936
J.J. Orcutt
& Party

To ℄ Mozart St. per Ties CE FB# 12304-64

49° 33' 33" NE
(49° 33' 35" CE)

Fd. 2X2 per ties CE FB# 12304-59

℄ E.A.T.& S.F.R.R.

Fd. 2X2 per ties CE FB# 14011-30

L&T in Bridge abutment set by City Engr.

Set N&T.

Towers

Fd. 5+T Reset F.N. 195-13

P.I. on CE 3 55' 04" Fd 2" I.P. 0.01 S+ 0.02" W. per ties CE FB 14011-30

153° 58' 00" (153° 58' 00" CE)

Offset line 23.00 W. of W. line of L.A. River per ties CE FB# 14011-30+32

23.00'

150.00

Set nail in RR tie

L&T in Conc. Base of Tower # 3

Shown on page 4

See 295-24

Westerly Line of Los Angeles River

150.00

L&T in Conc. Base of Tower #2 (Not checked 330)
Map Sta 12+15.50

Tower No 2 Map Sta 12+15.50
Constructed Ctr of Tow
3.00 W'ly of ℄ AP

See 295-23

154.51 -5°-11' 153.88

℄ Los Angeles River

Easterly Line of Los Angeles River

℄ Alhambra Ave.
S.P.R.R.

Fd. 3/4" on 20' o.s.l. per ties CE FB# 14011-30

Tower No. 3 Map Sta 18+93.66

150.00

FB.1301-7

FB.1301-8

B.P.&L.-F.B.325

4

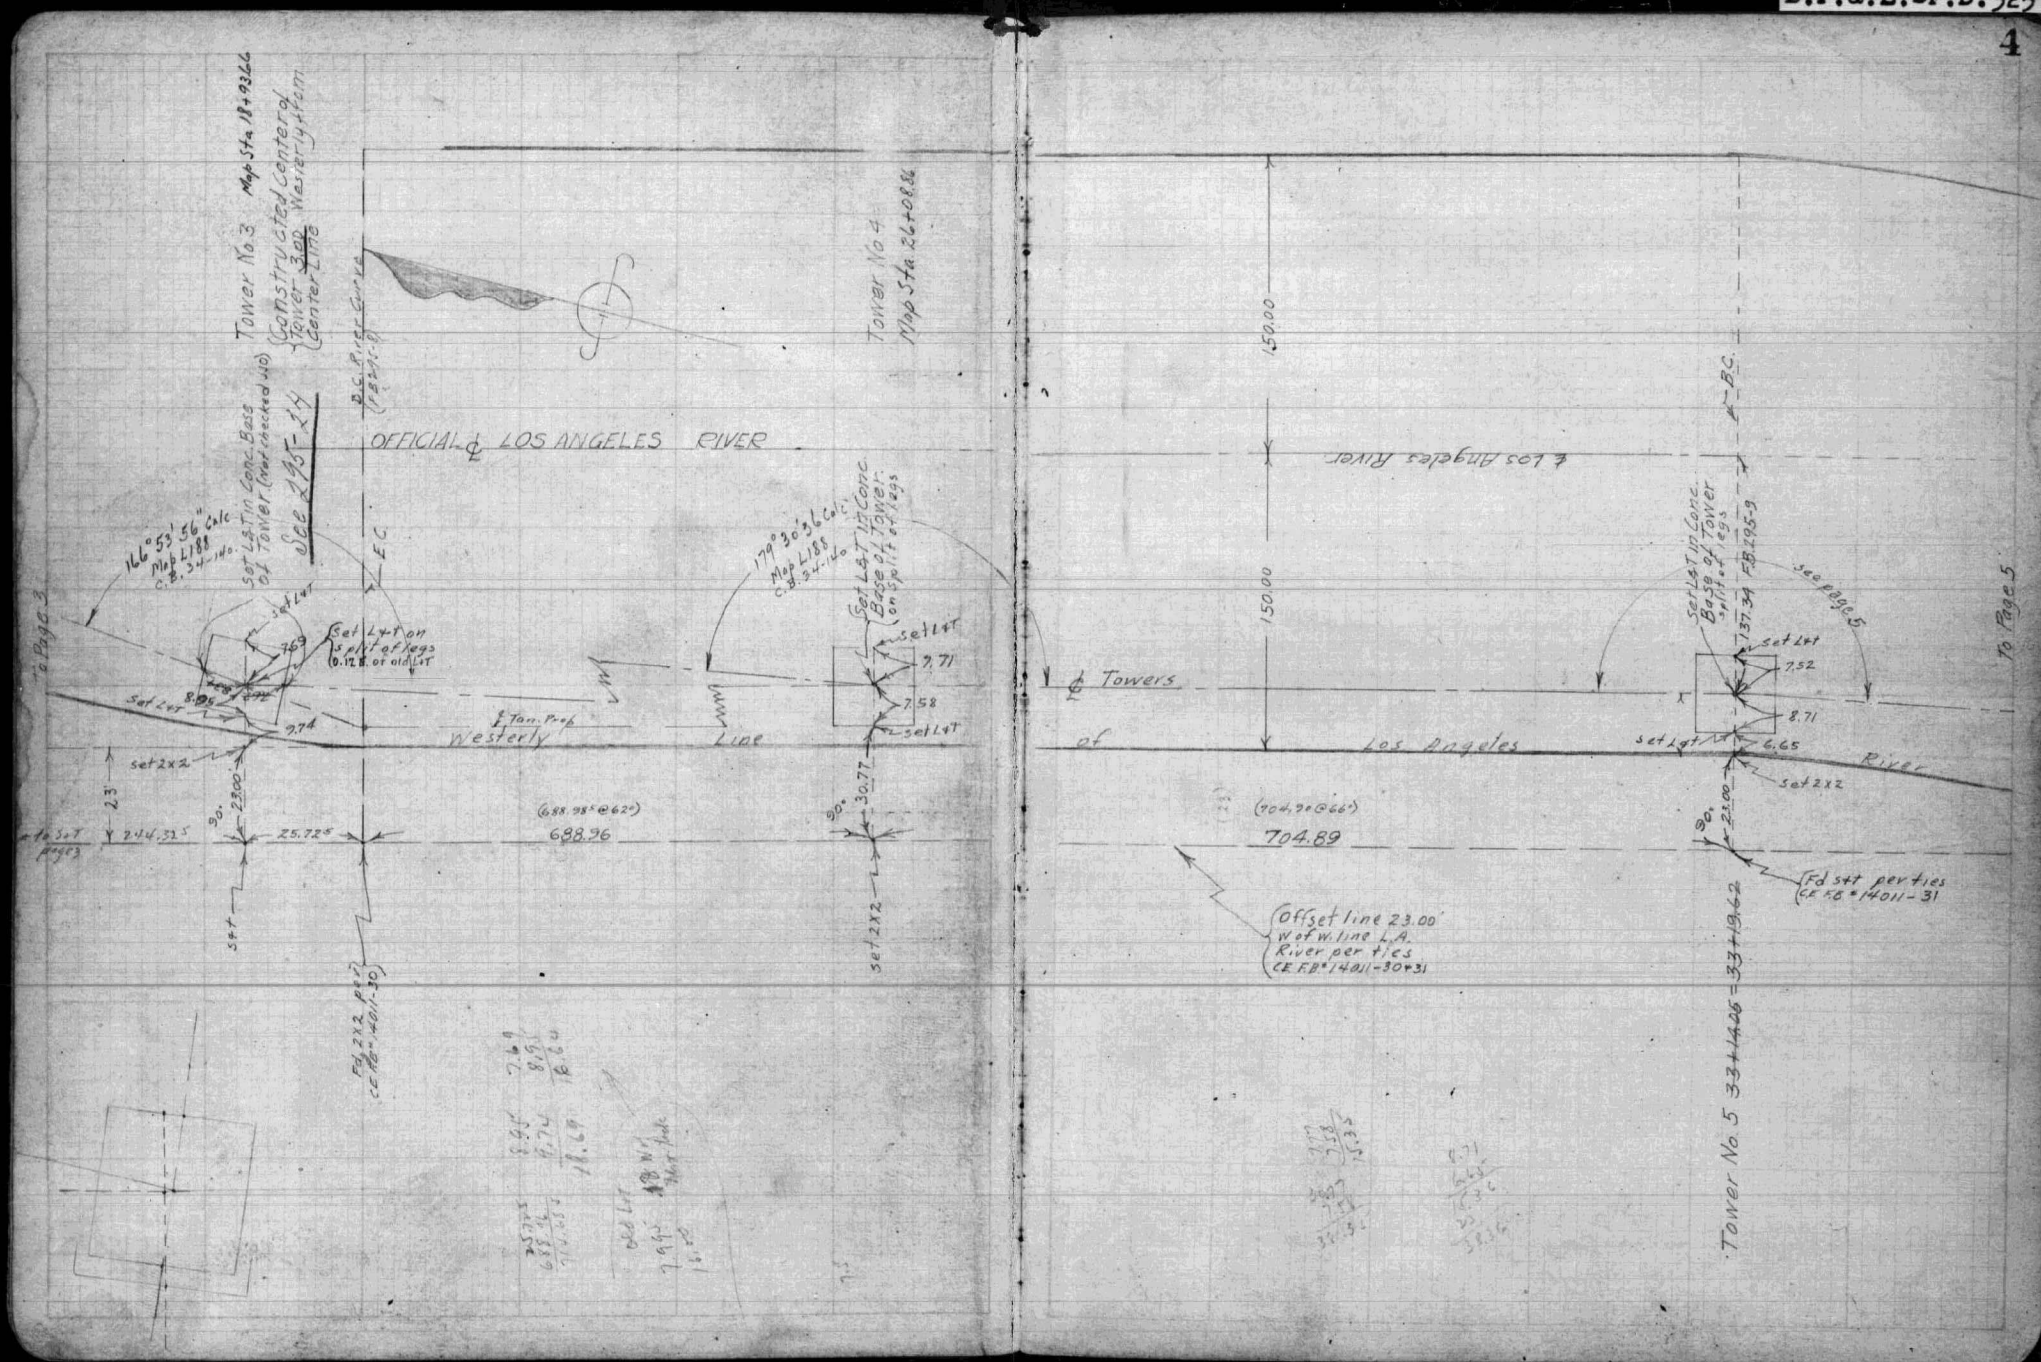

FB.1301-9

FB.1301-10

B.P.&L.-F.B.325

5

July 1928
L.E. Molthaut
& Party

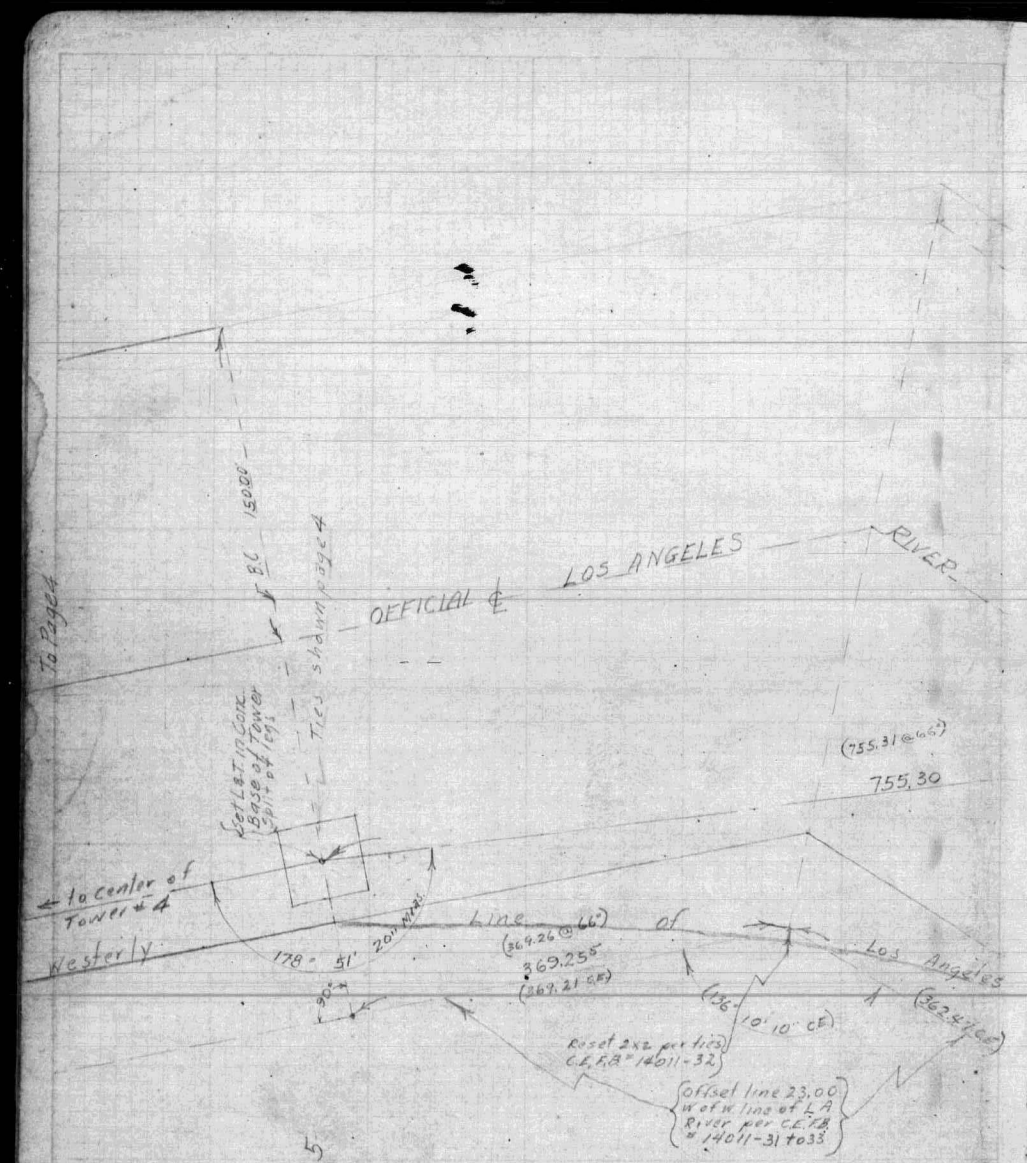

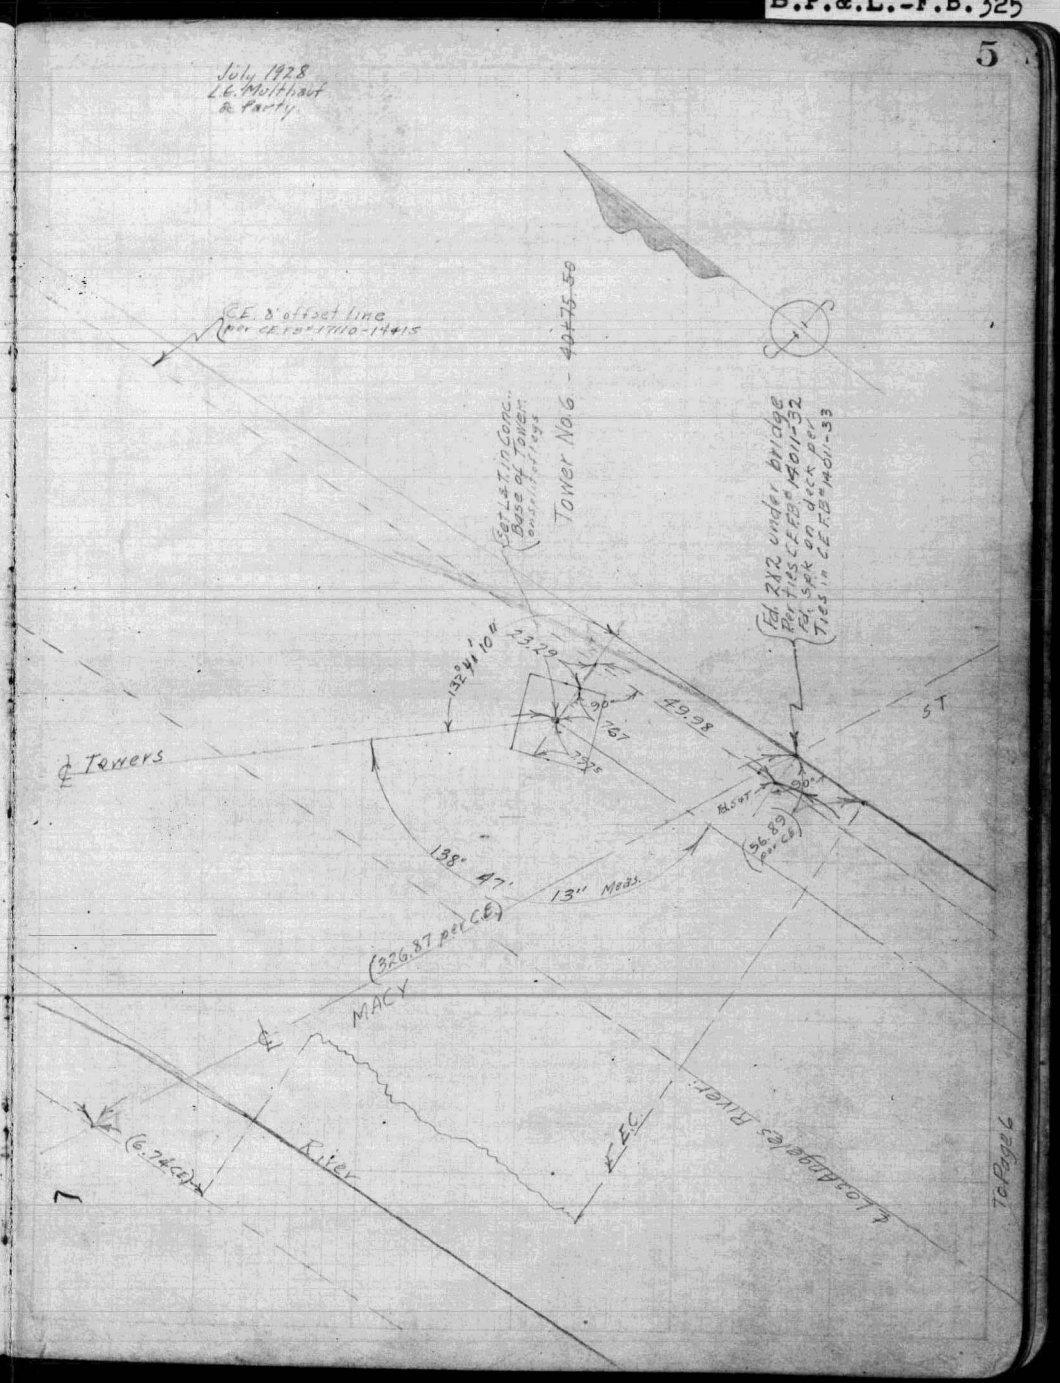

FB.1301-11

FB.1301-12

B.P.&.L.-F.B.325

6

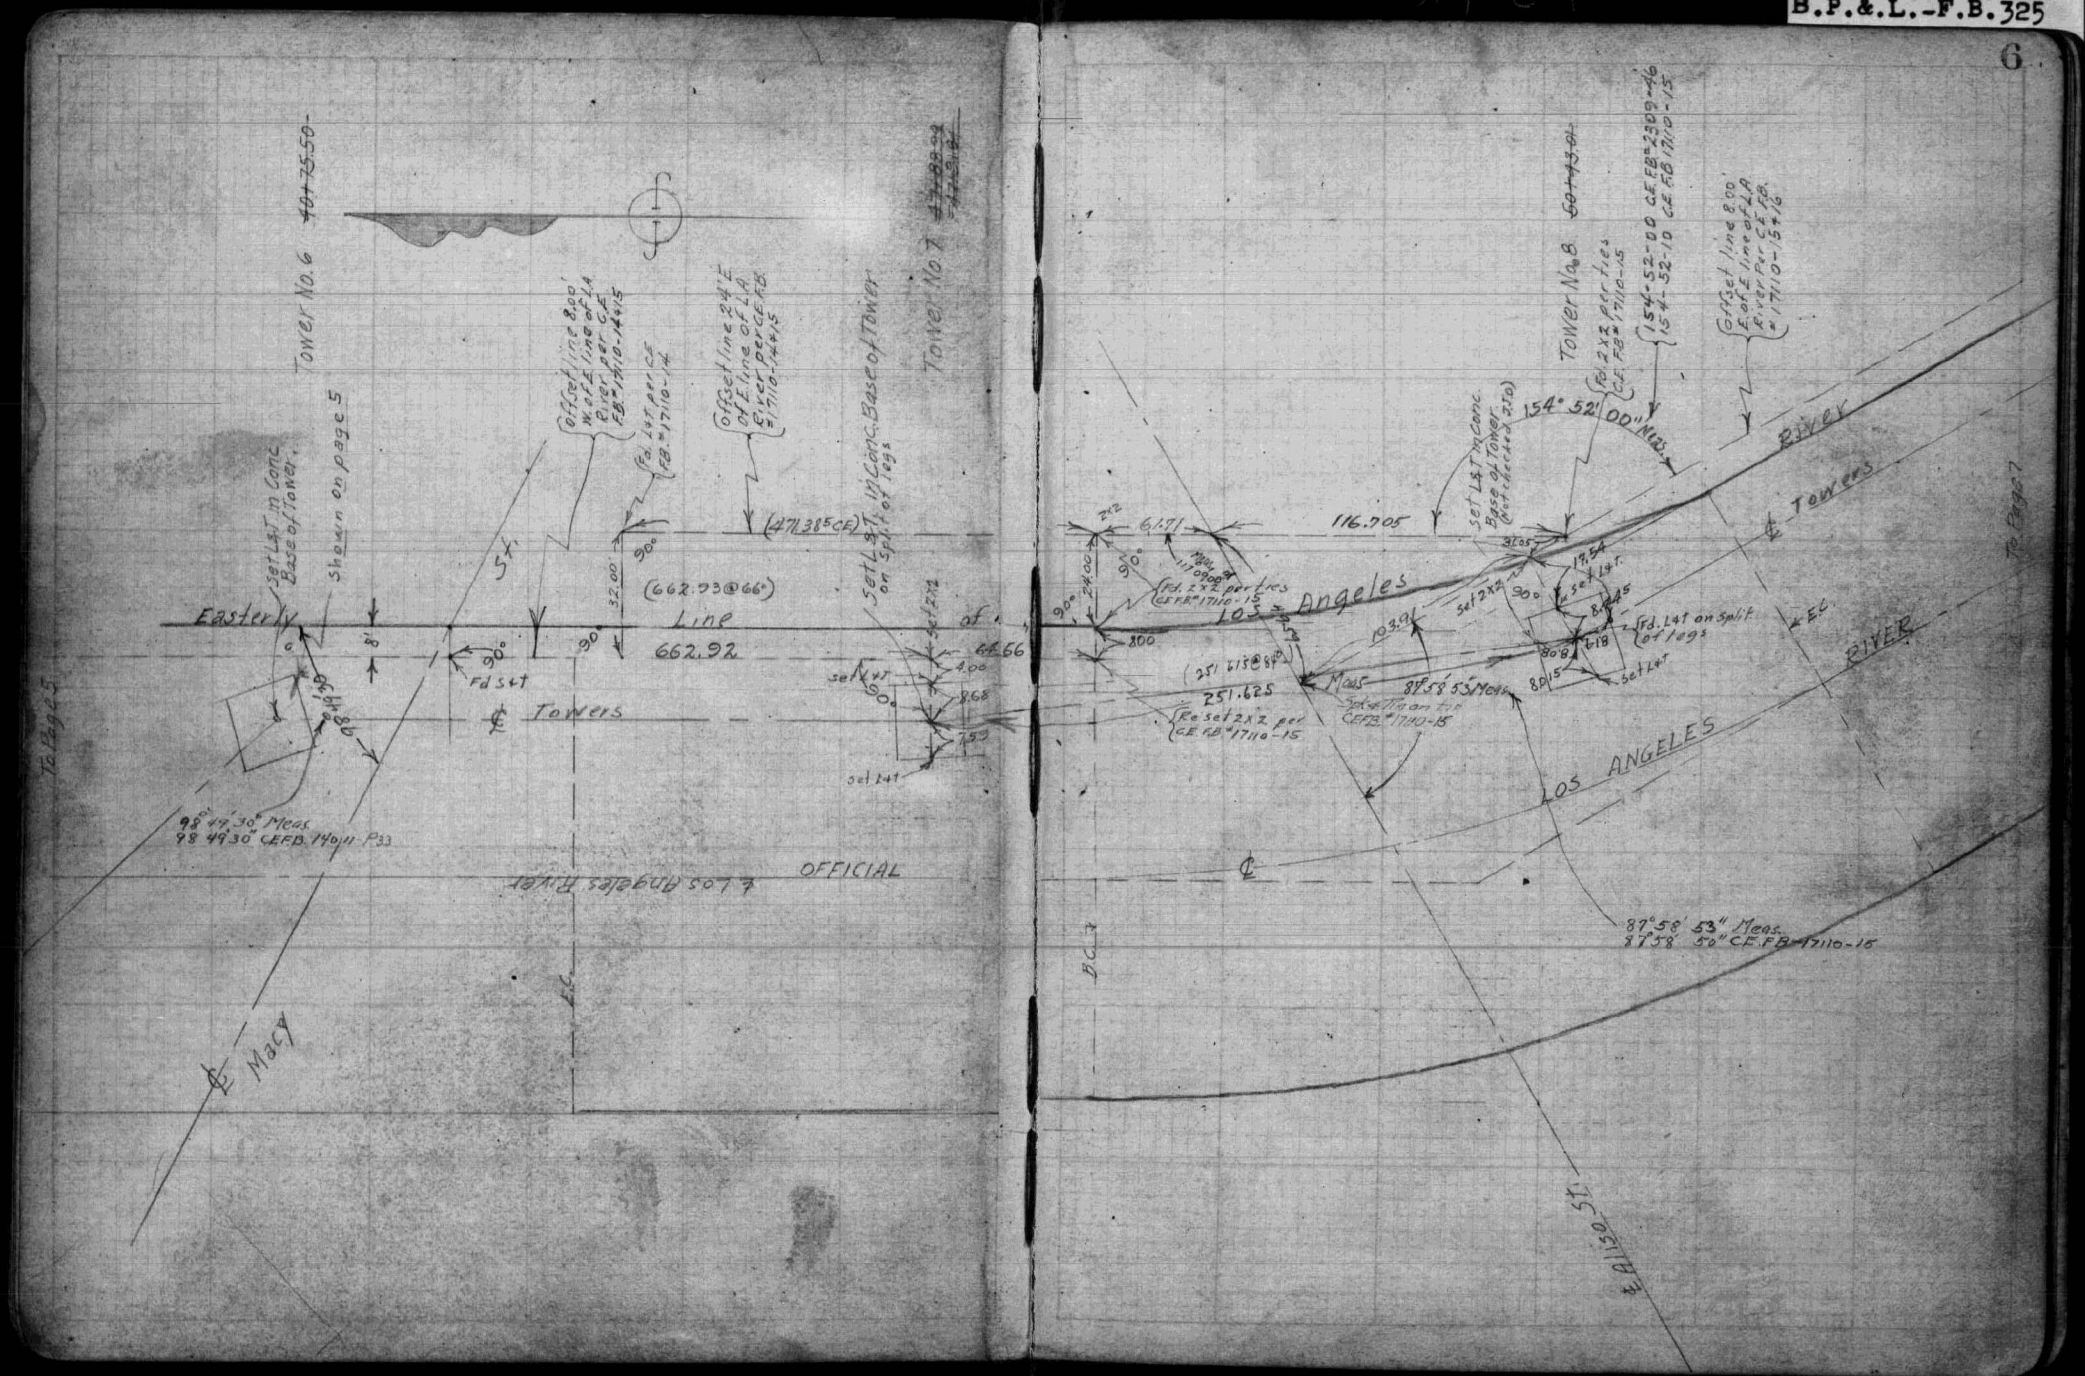

FB.1301-13

FB.1301-14

B.P.&.L.-F.B.325

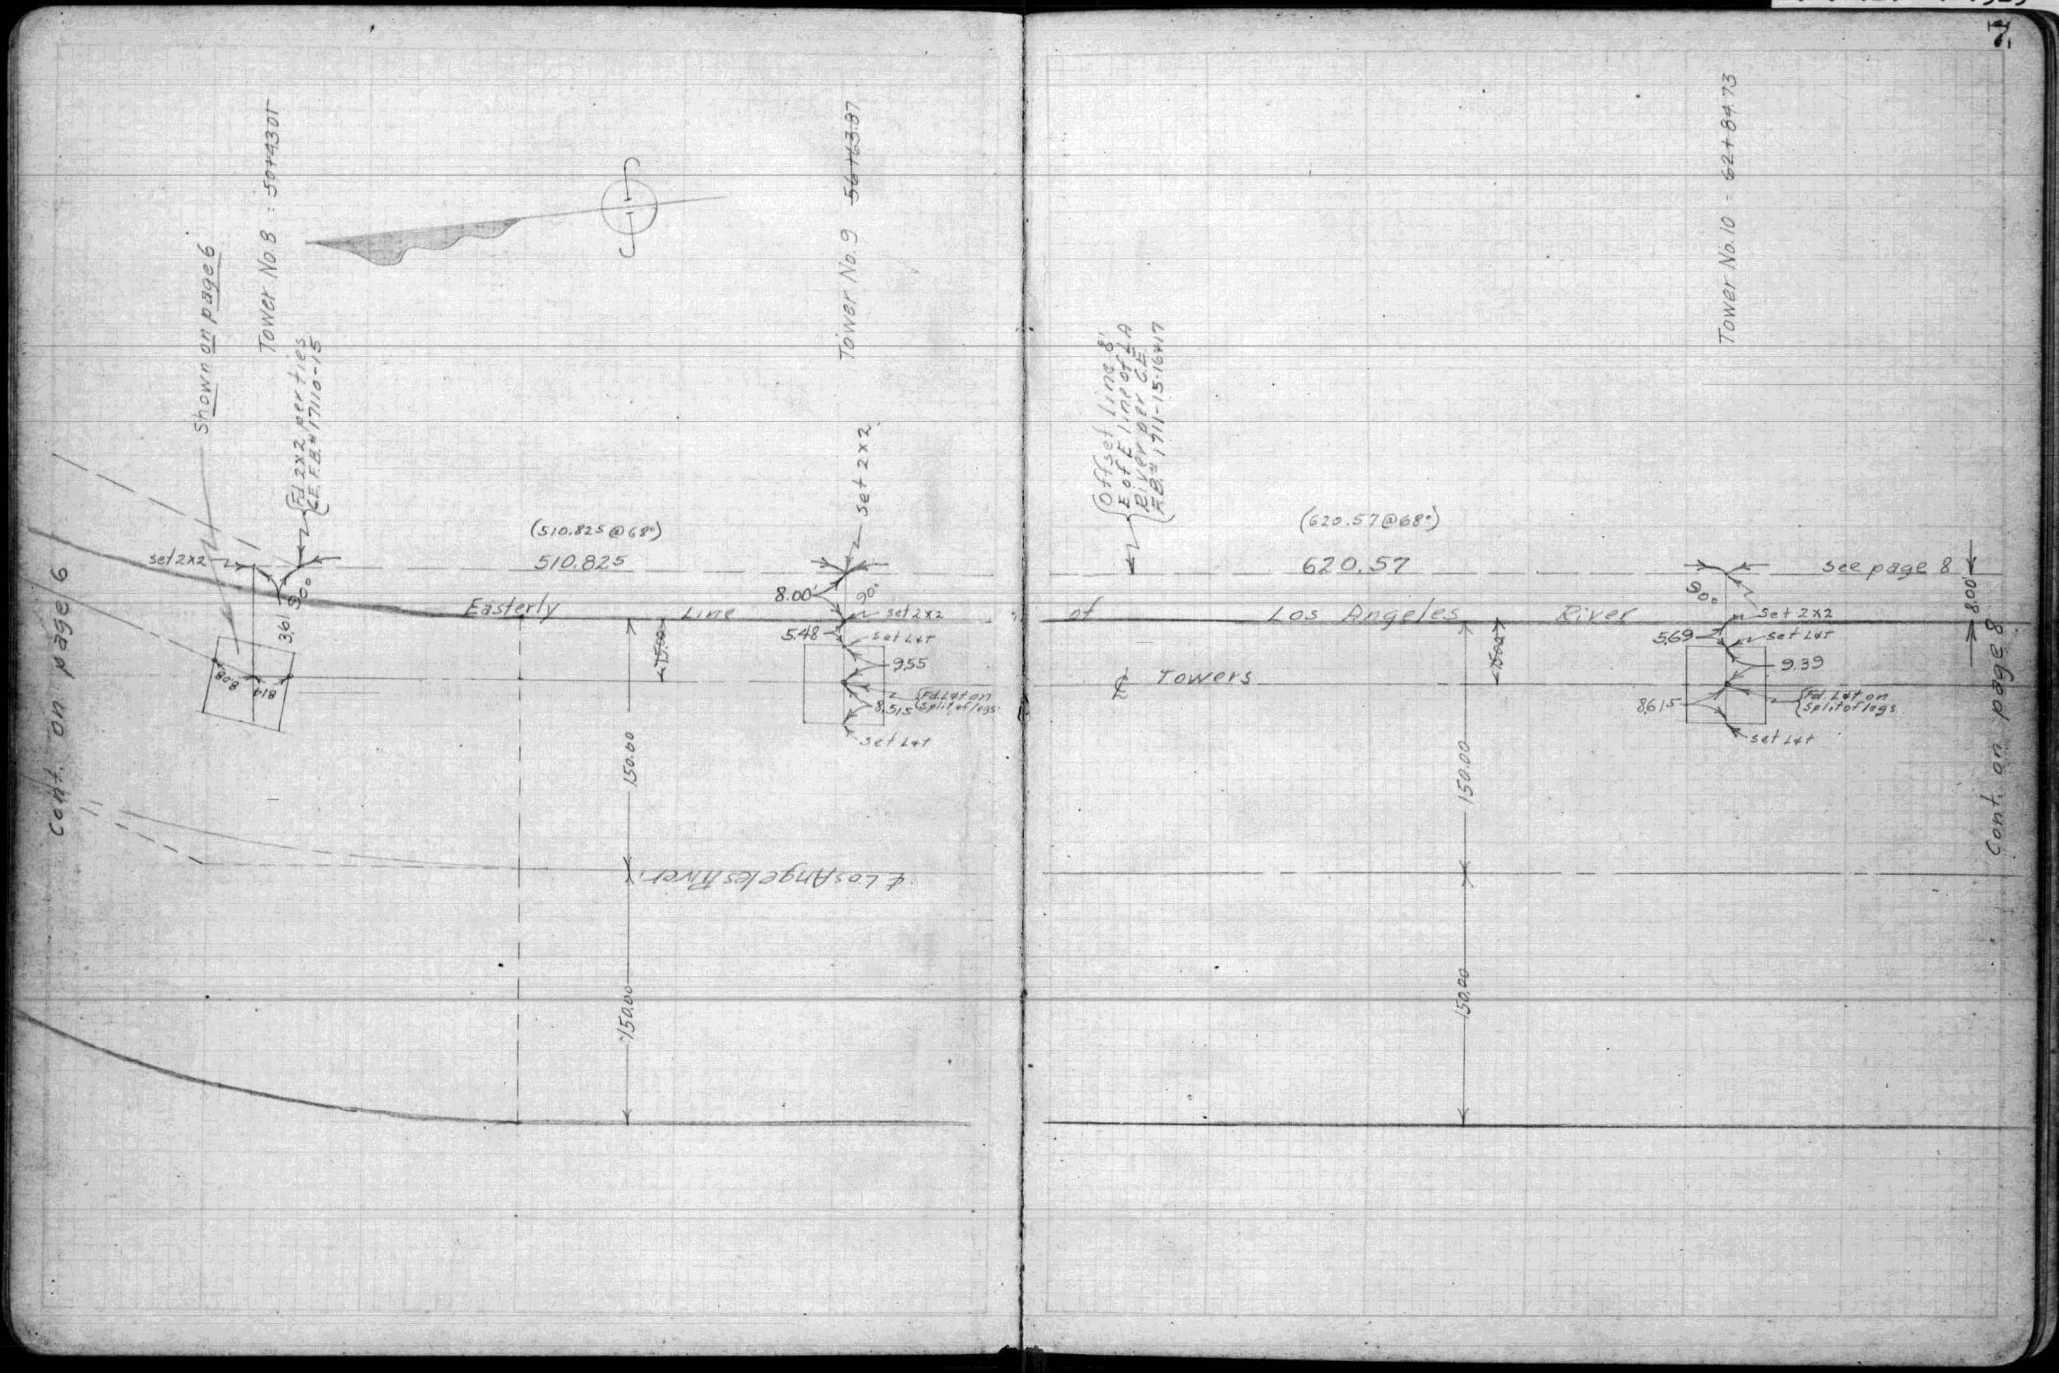

FB.1301-15

FB.1301-16

B.P.&L.-F.B.325

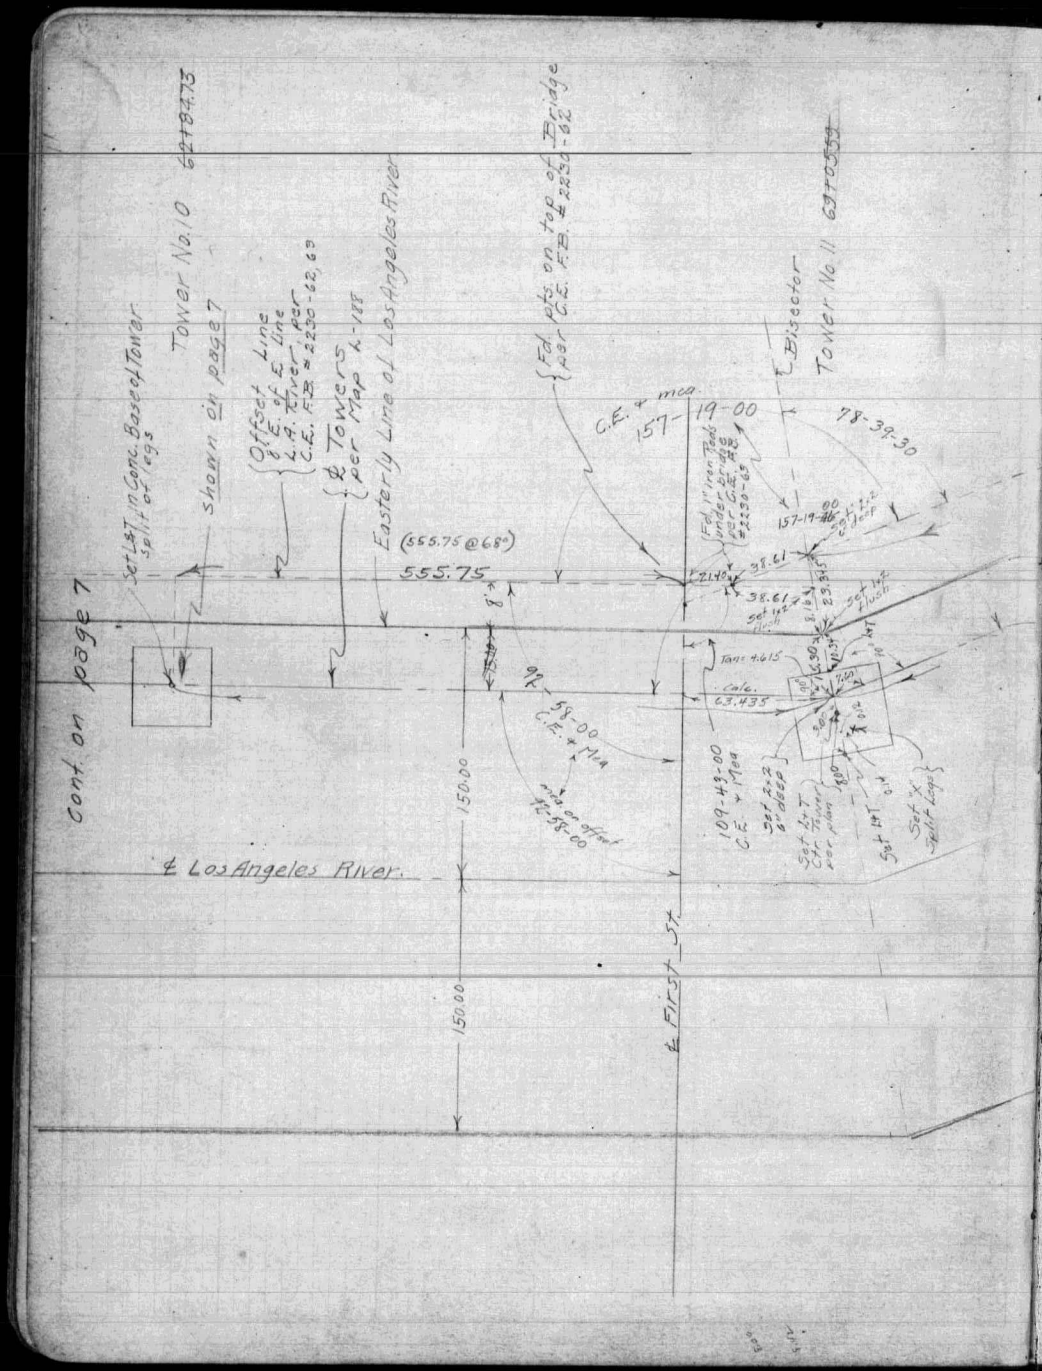

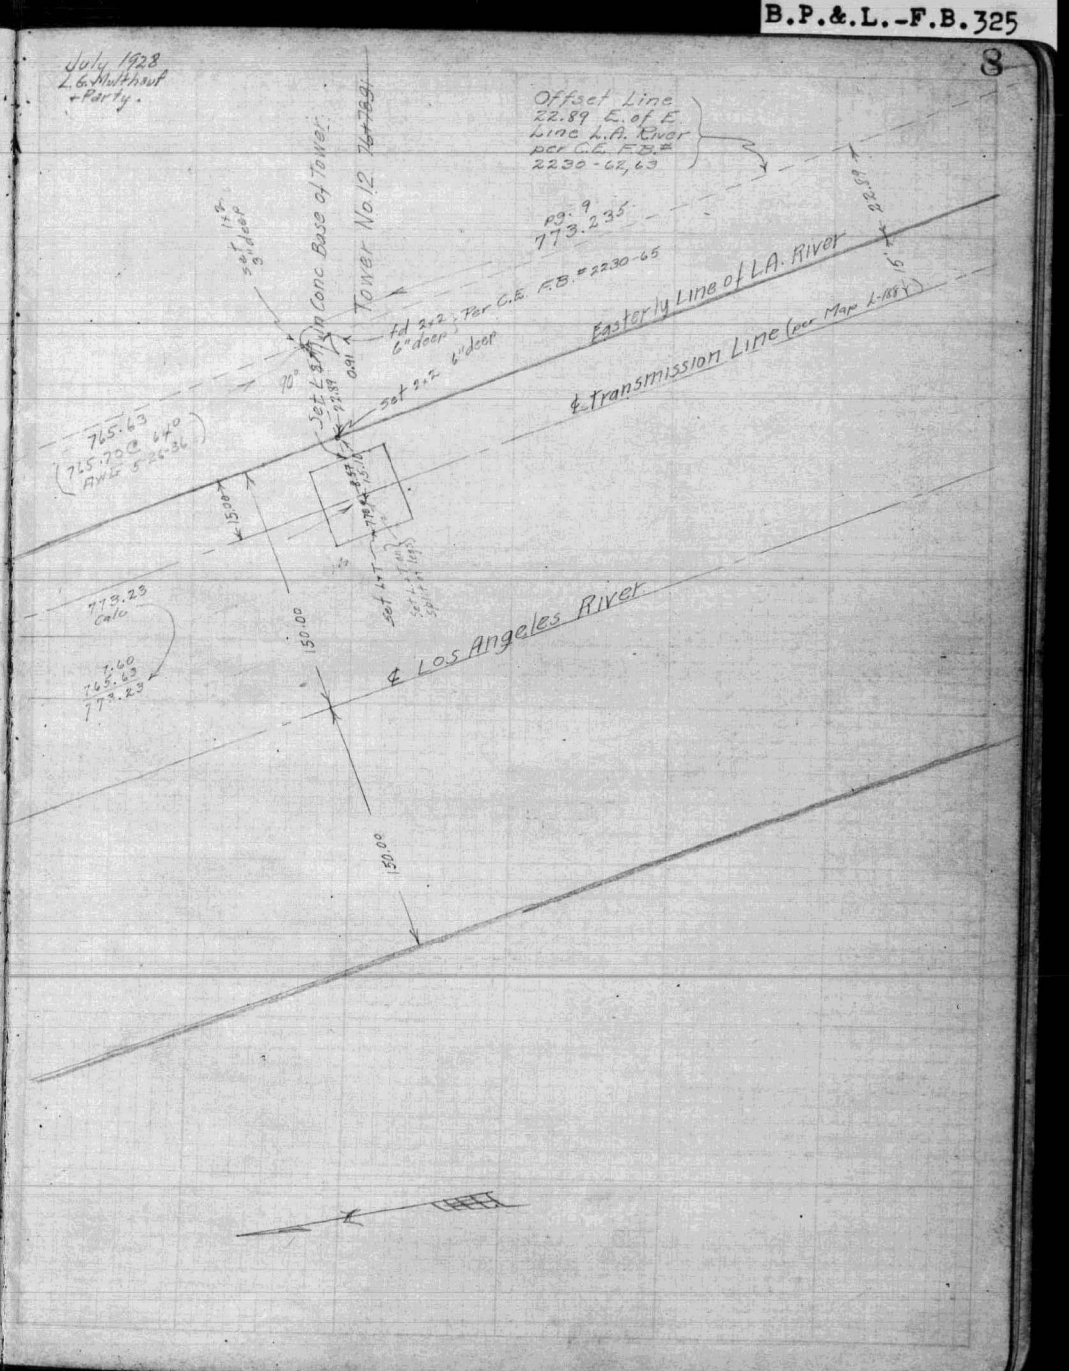

FB.1301-17

FB.1301-18

B.P.&L.-F.B.325

9

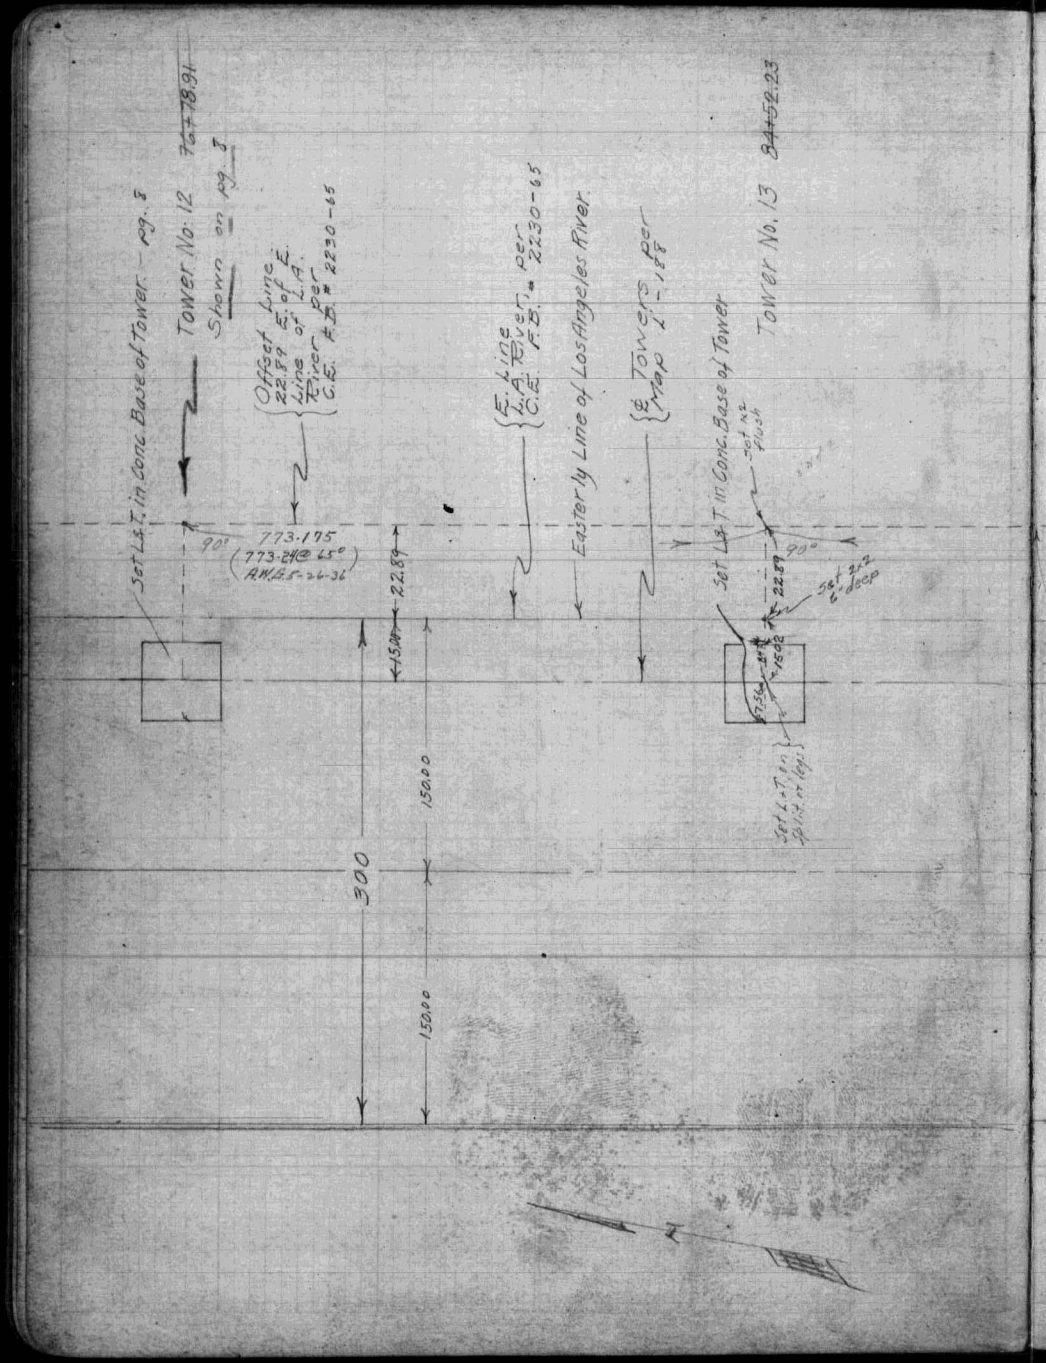

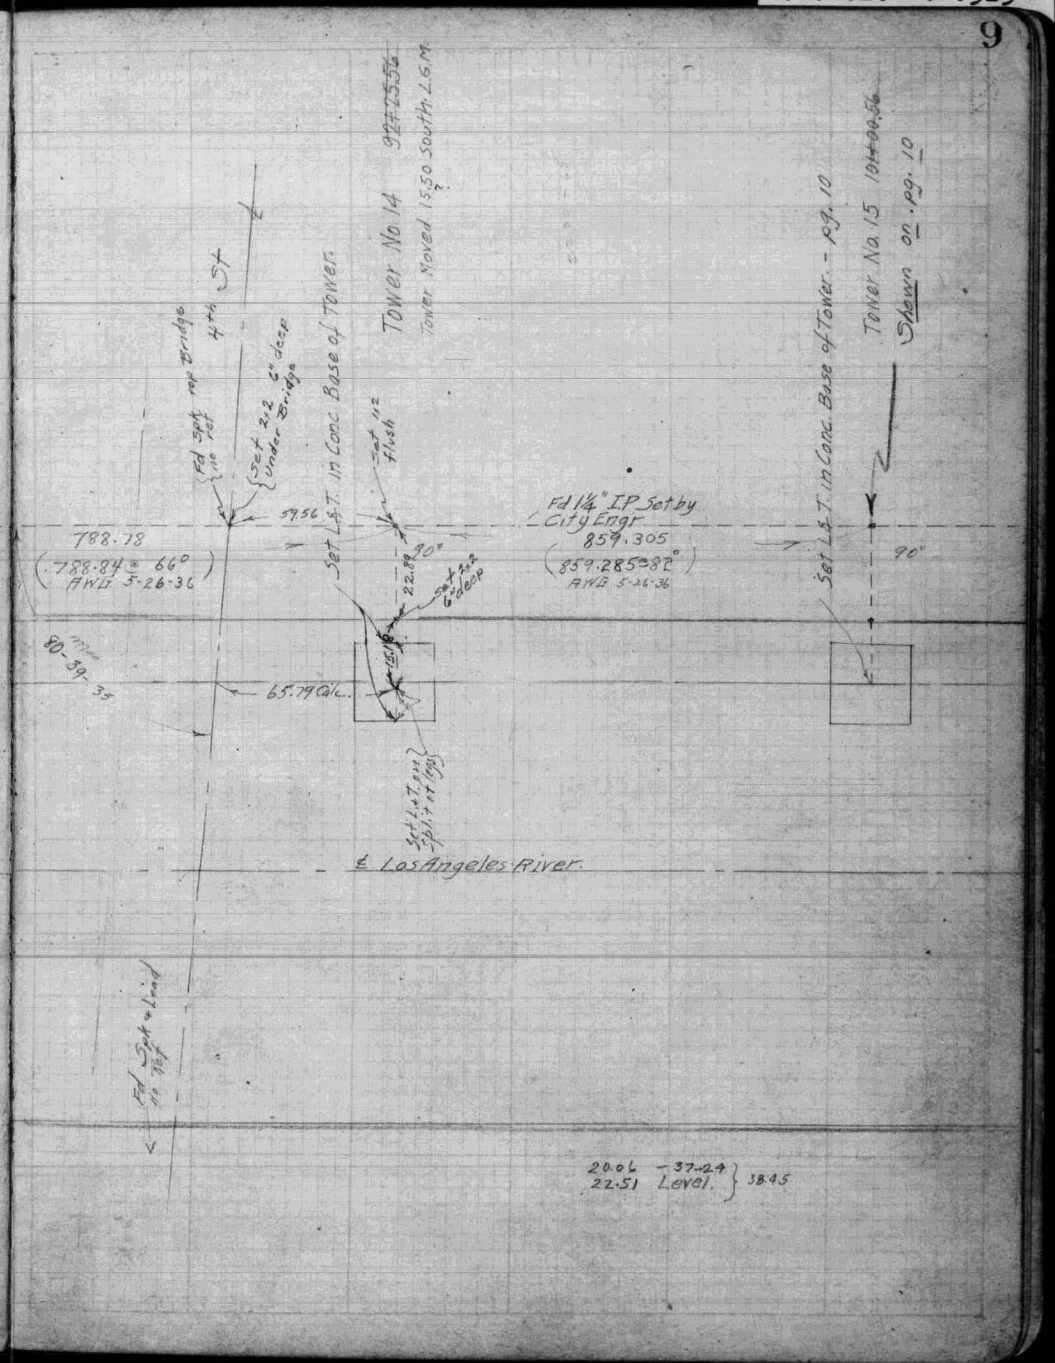

FB.1301-19

FB.1301-20

B.P.&.L.-F.B.325

10

Party L.G. Multhauf
O.B. Field
G.W. Bartow
F.W. Ballinger

To Page 9

Set L & T. in Conc. Base of Tower

Tower No. 15 1077+00.56

Set Nail Flush

22.89 90°

Set 6" deep

22.89

Set L & T. in Concrete Hub stacked 0.47' Found Bolt 1.63' N of line under bridge Found Spike Lead on top of bridge

Offset Line 22.89 E. of C.L. Line L.A. River per C.E. F.B. = 2230-66.70

East Line L.A. River per C.E. F.B. = 2230-66.70

874.925

874.91 RR83 RWB 5-26-36

(E. Towers Per Map L-188

Set L & T. in Conc. Base of Tower

Set Nail Flush

Tower No. 16 1091+56.56

22.89 90°

Set 6" deep

Set L & T. on Split of Pipes

6th St. Water Main

℄ Los Angeles River

Set L & T. on Split of Pipes

℄ Seventh St

Fd. at Top Bridge per C.E. F.B. = 2230-70

Fd. at Top Under Bridge per C.E. F.B. = 2230-66

70.54

90°

Pg 11

874.815

874.79 RR83 RWB 5-26-36

22.89

78° 45' 00" C.E. Mea

1.50

78.075 Calc.

150.00

135

150.00

Set L & T. in Conc. Base of Tower


Shown on Pg. 11

To Page 11

FB.1301-21

FB.1301-22

B.P.&L.-F.B.325

11

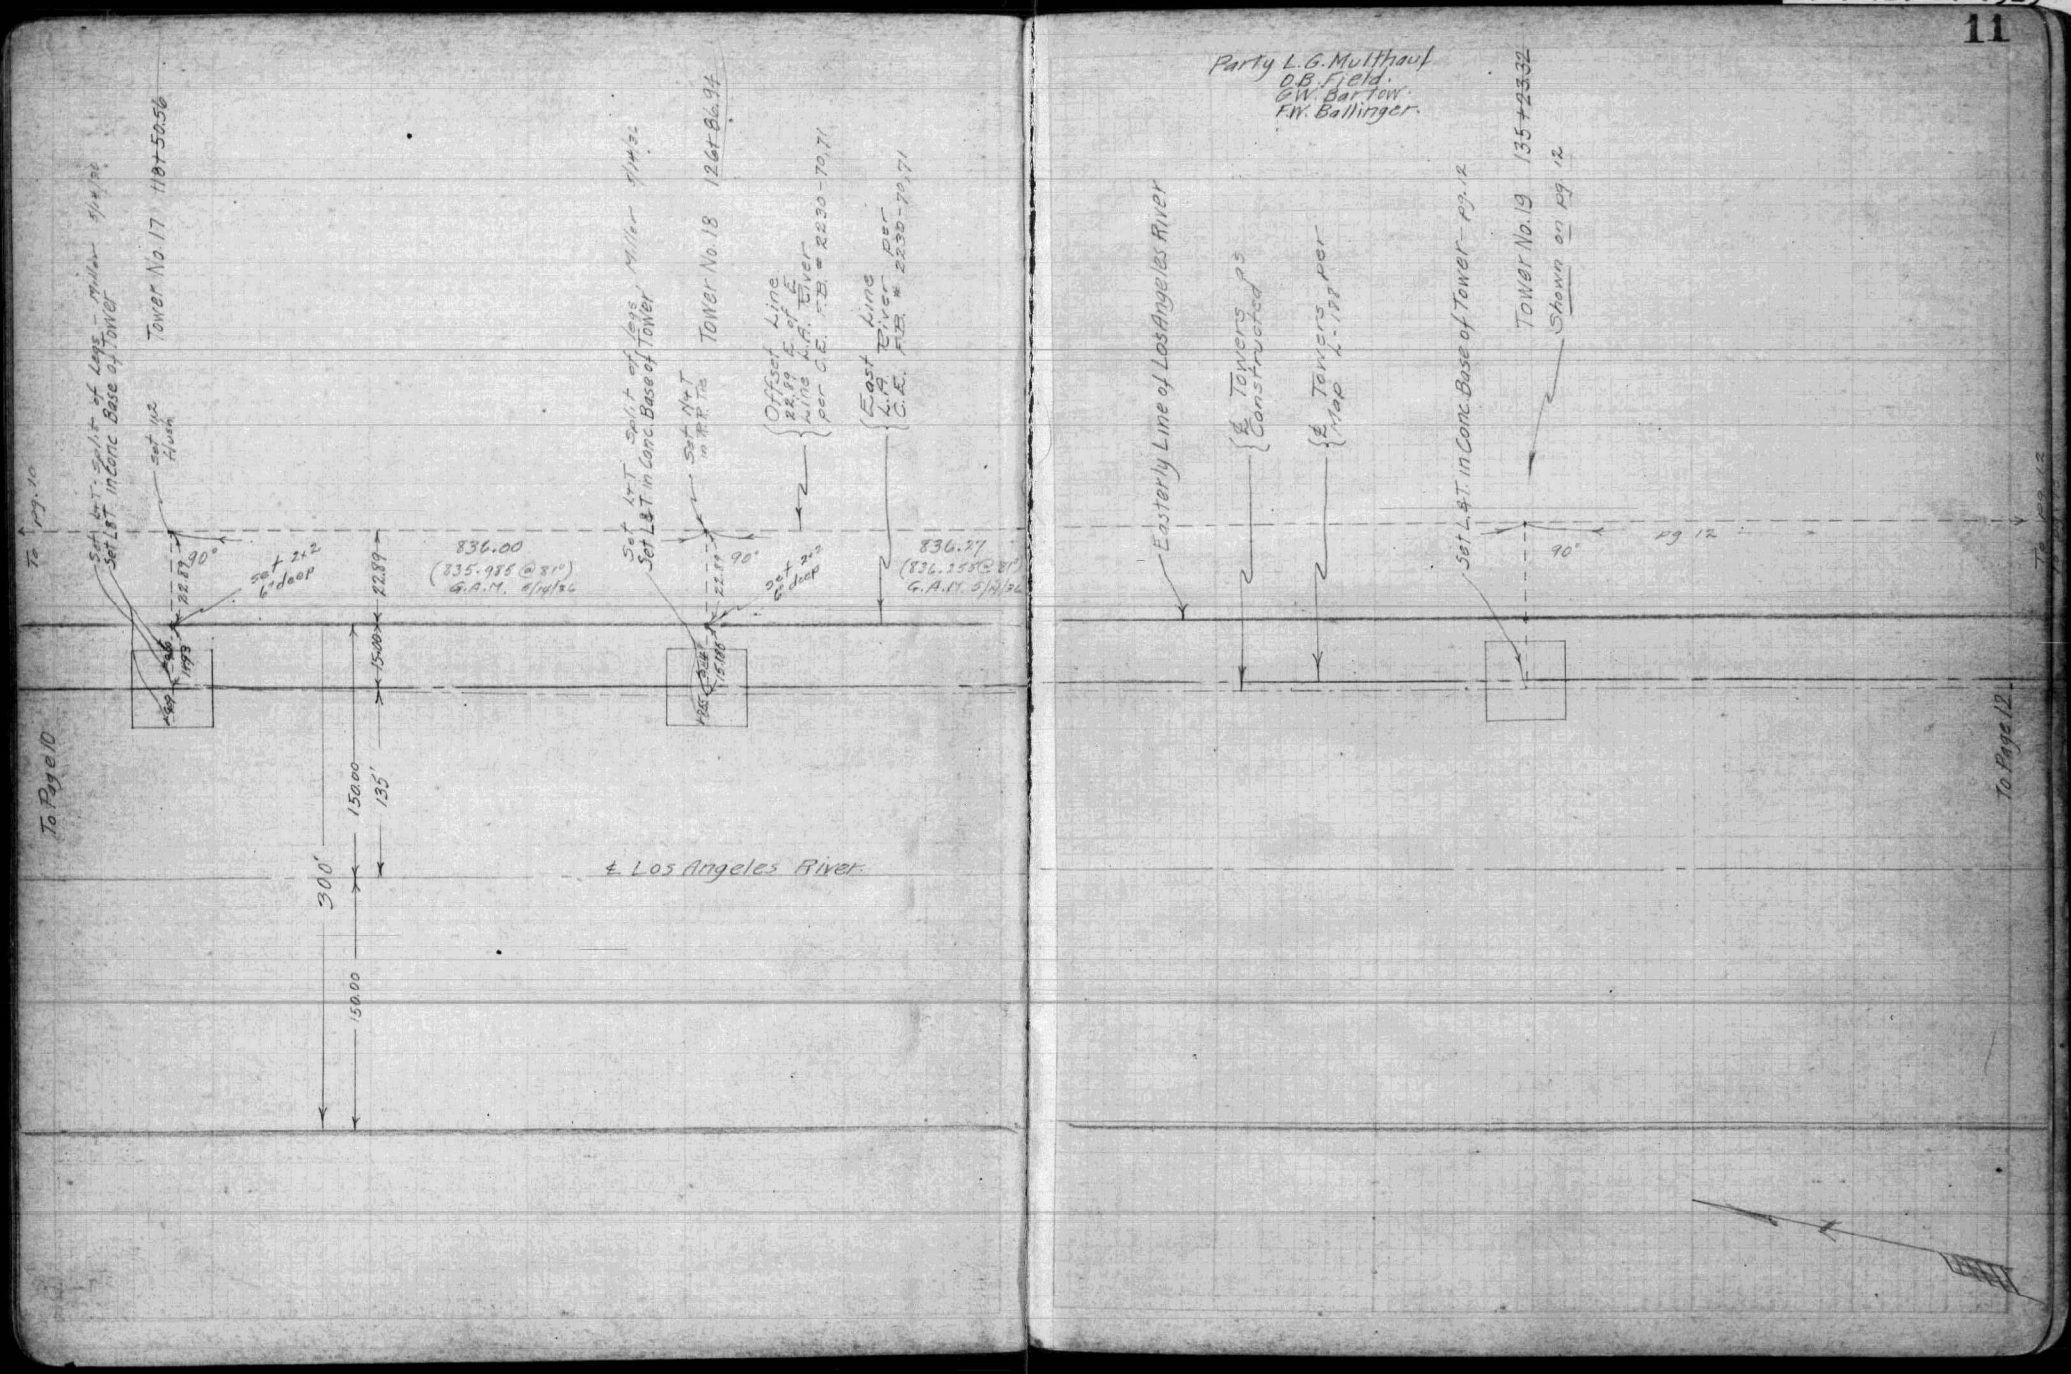

FB.1301-23

FB.1301-24

B.P.&L.-F.B.325

12

L.G. Multhaup
O.B. Field
G.W. Bartow
F.W. Ballinger

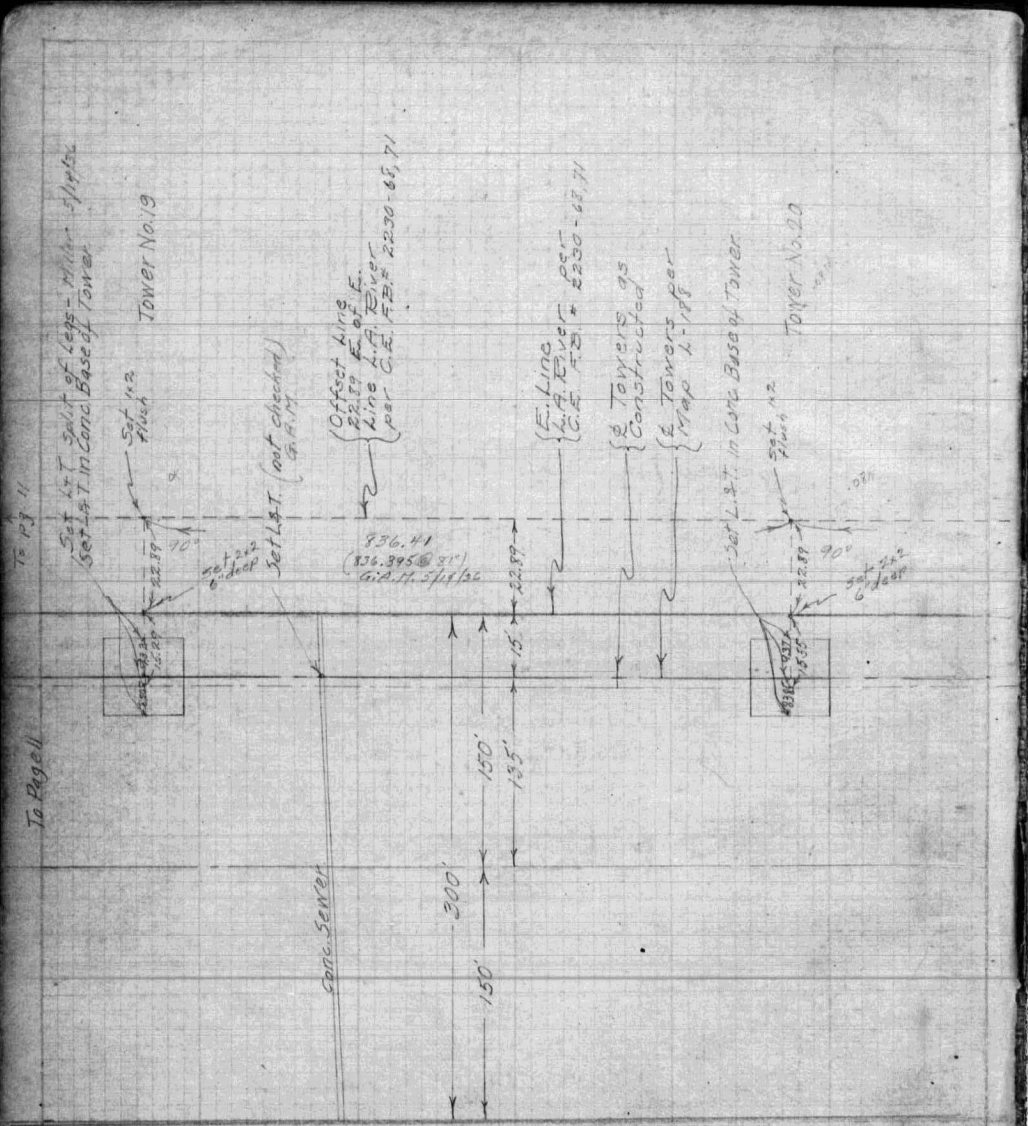

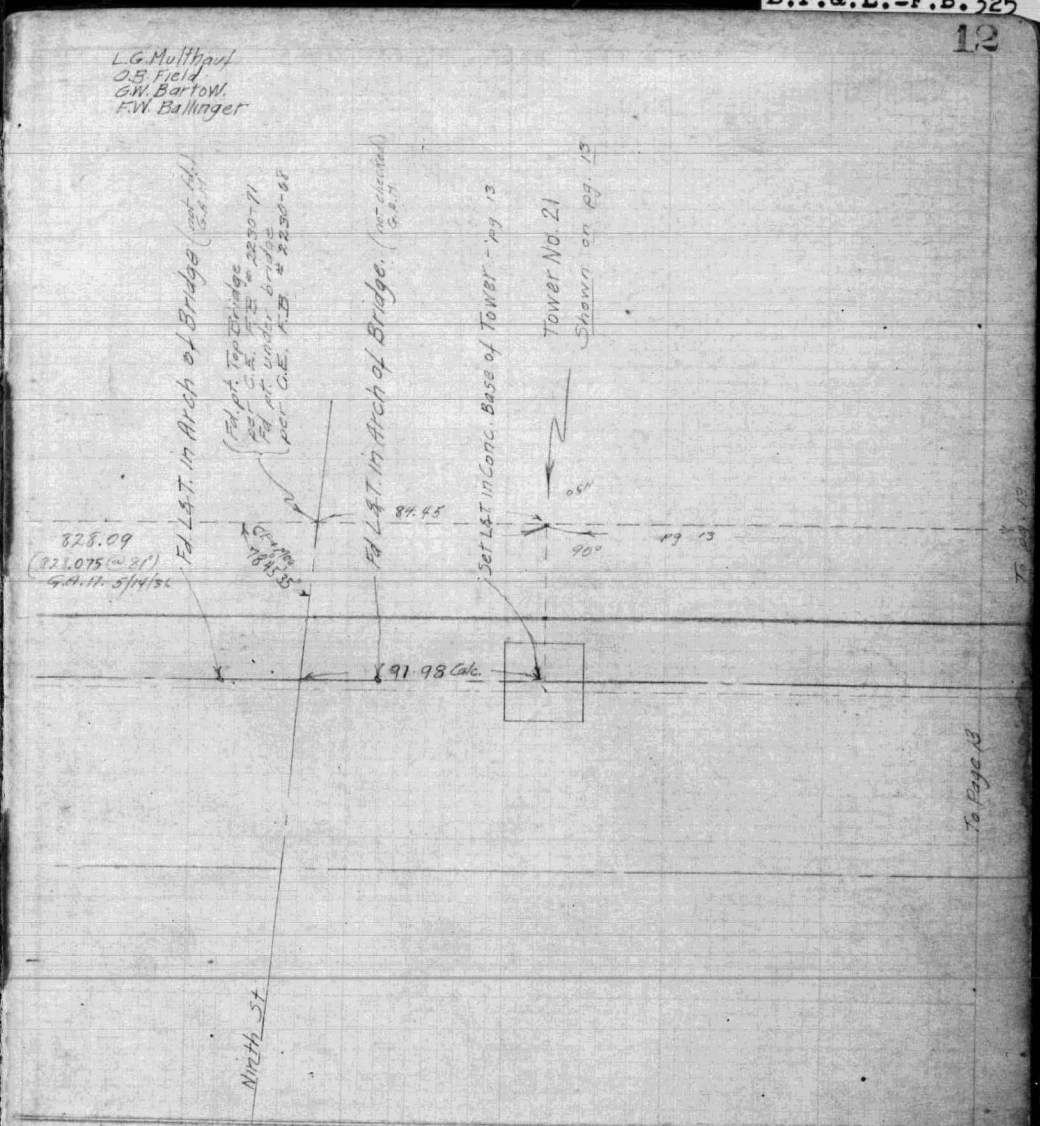

FB.1301-25

FB.1301-26

B.P.&L.-F.B.325

13

July 1928.
Party L.G. Multhauf.
O.B. Field.
G.W. Barlow.
F.W. Ballinger.

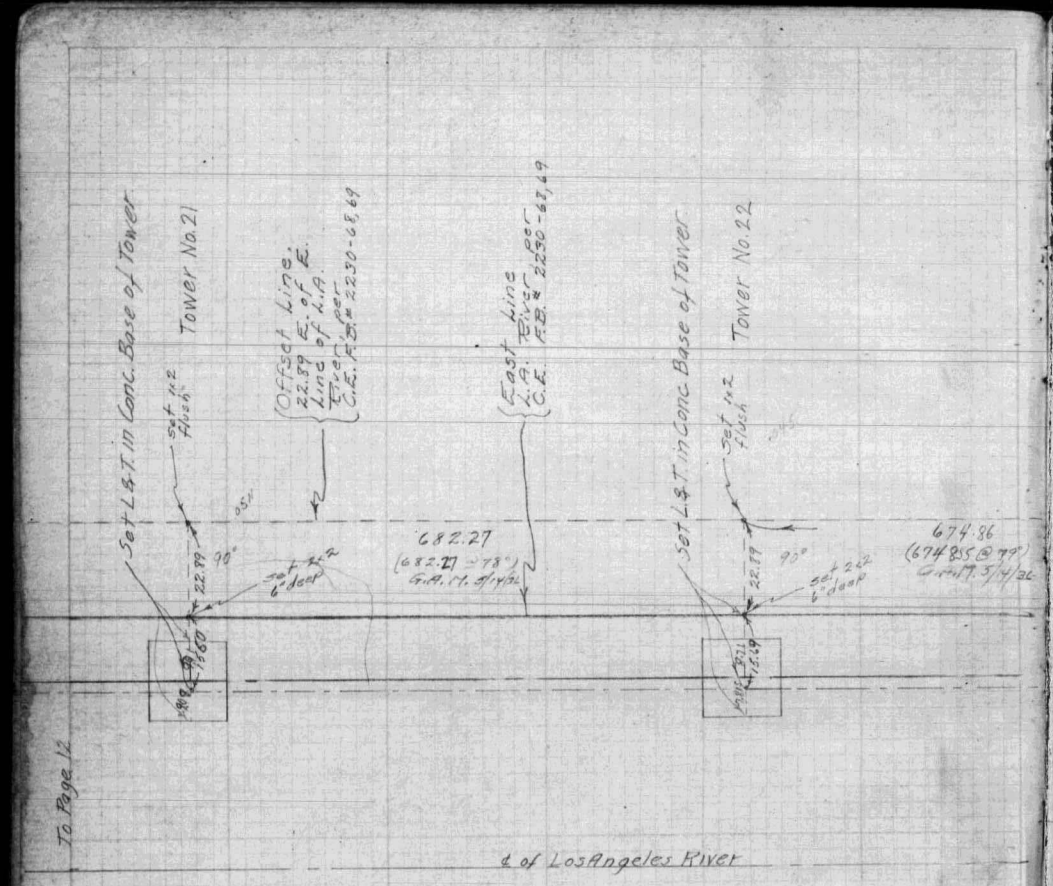

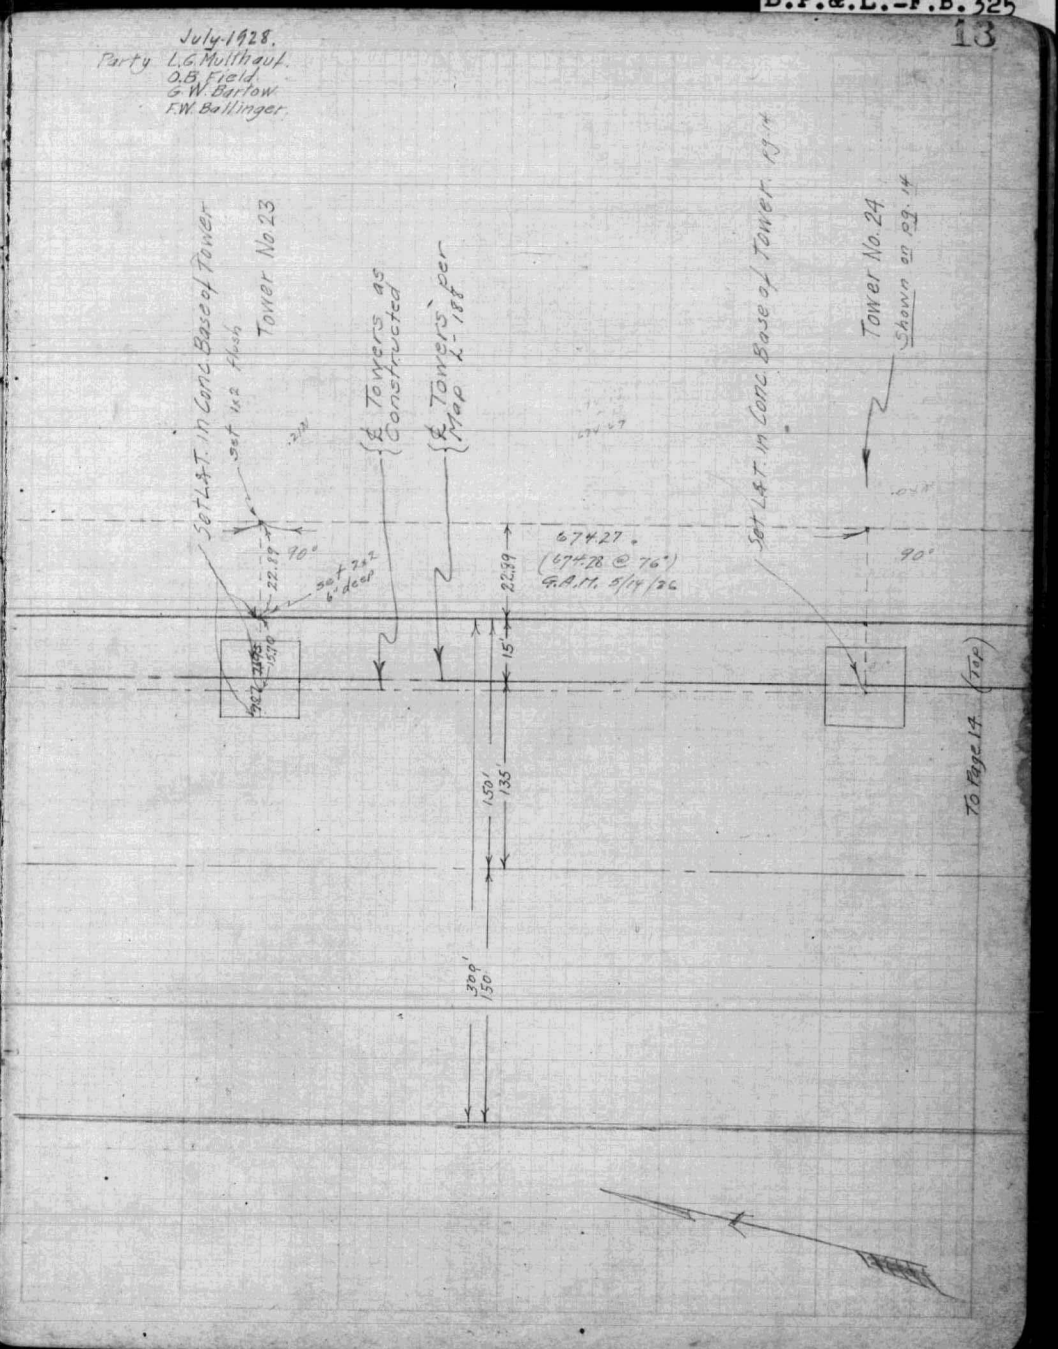

FB.1301-27

FB.1301-28

B.P.&.L.-F.B.325

14

To Page 13 (Right Side)

July 1928.
L.G. Multhauf.
O.B. Field
G.W. Bartow
F.W. Bullinger

Set L&T in Conc Base of Tower. (Fd. G.A.M. 5/11/36

22.89 — Set 1x2 Flush

90°

Tower No. 24
172+19.26

Set 2x2 6" deep

Offset Line 22.89 E. of E. line of L.A. River, per C.E. FB# 1292A-49 + FB# 2230-68

300'
135'
150'
15'
72.89
37.89

East Line L.A. River per C.E. FB# 2230-68

℄ Towers as Constructed

℄ R/w & ℄ Towers per Map L-188

℄ Los Angeles River

G.A.M. 5/13/36

per map L-188
100-37-5E
Check by Miller 5/13/36

Moved

Calc 38.63

38.55
39.305

Set 2x2 by 10" 6" deep G.A.M. 5/4/36

Angle Point in ℄ R/w Map Sta 178+93.66

Set L&T in Conc Base of Tower (Fd. G.A.M. in Spot of Destroyed Tower)
Tower No. 25 D.E.-A.P.

To Set ℄ Wall per C.E. FB# 1292A-49

39.305
38.55
0.755

12.18
-.745
11.435

10/8/40
Tower No. 25 moved East 21.37' & North 1.98' to allow for Construction of River Channel Wall
See Notes FB 515-50.
W.C.M.

New ties Tower #25
in F.B. 549-36

Note.
New Location Tower #25
moved Oct. 1940.
See F.B. 515-50

New ties 3/12/42.
See F.B. 549-36
J.H. Oliver & Party

To ℄ Towers

℄ R/w per Map L-188

10°-32'-58"

90°-00'-00"

Tower 25

Tower 26.

Set 2x2 6" deep

11.42 calc

1.98
8.75
7.14
6.44

℄ Towers

℄ R/w

231.41

2.355

493.89

to Pg. 15

Set L-T

A.P. in ℄ R/w Map Sta 178+93.66

Ctr. Old Tower #25

G.A.M. 5/11/36 N.S. 777.02 756.14 WCM 7/10/36

To Page 15.

178+93.66
7 56.14
186+49.80

777.02
20.88
756.14

FB.1301-29

FB.1301-30

B.P.&L.-F.B.325

15

Soto to 3rd
C.E.F.B. 10603-37
" 17260-33,37

Plat by Miller 5/11/36

Proposed property line per Soto St. Union Pacific R.R. Grade Separation. C.E. Job # W.O. 60584, Clerks File # 355-35

Proposed prop. line

Tie to P.T. of Proposed Blvd. C.E. F.B. # 12924-30

SOTO ST

100'

50 50

89.04 (89.04 @ Prop.)

Set 6"x18" conc. footing

Set 6"x18" conc. footing

18.50

86-57-40 mon.

0.02

0.05

To pg. 14

R.P. Set 2x2 10" deep ~~7 from~~ W. of Tower 84.12

T # 26 Set 2x2 24 1/2" deep Set by proportion bet. A.P.'s

Fd. 2x2 Nail & Tag Reset 2x2 on Line 26 Deep 0.93

Fd. Spk no ref.

89.04
109.94 W.C.M. Set D.H. in pave.

0.65

New ℄ per C.E. F.B. # 17260-33,37

Set 6"x18" conc. footing

267.31 (267.31 @ Prop.)

To L+T ℄ Washington Blvd per C.E. F.B. # 12924-48

ST

776.92 797.80 W.C.M. ~~Nail & Tag~~

Set 6"x18" conc. footing

Set 6"x18" conc. footing

New Ties Condrs 8/27/40

SOTO ST

Fd. 1/2" I.P. 0.04 Deep 0.05 W. of Line

Set 6"x18" conc. footing

10.90

Set 2"x2" 1" Deep

To pg. 16

L Towers

R.P. Set 2x2 6" deep 75.00 W. of Tower

Fd 1x2, 1.16 Nail & Tag Reset 2x2 on Line, 6" Deep 75.10 W of Tow

T. # 27 Fd 2x2 Flush Replaced with 2x2 6" deep by proportion bet. A.P.'s

11.16

R.P. Set 2x2 1" & " deep 75.00 E. of Tower

Fd 1x2, 0.02 Nail & Tag Reset 1x2 on Line, 1 Deep 75.00 E of Tow

776.92
20.88
797.80

89.06
20.88
109.94

75.00
2x2
24 1/2

FB.1301-31

FB.1301-32

B.P.&L.-F.B.325

16

Party L.G.Multhauf 7/18/28
O.B.Field
G.W.Bartow
F.W.Ballinger

To Page 15

G.A.M. 5/11/28
760.41

50

℄ South Line Tract No. 2495 - See F.B. 292-30.

Fd 1½" I.P. 12" Deep Set by Mason F.B. 292-30

Set Spk in Conc Footing

Fd 1½" I.P. 12" Deep Set by Mason FB 292-30

See 528-18&20

℄ Southerly Line of U.P.R.R. R of W.

Replaced 2"x2" With 2" I.P.

155-31-00 mean G.A.M.

℄ Towers

T24 El G.A.M. 3/4/28

Tower No. 29 208+37.12
See pg. 17

Set L.S.T. in Conc. Base of Tower.

2x2 pg. 17

Set L.S.T. in Conc Base of Tower

Set 2"x2" Flush

T. pg. 17

FB.1301-33

FB.1301-34

B.P.&.L.-F.B.325

17

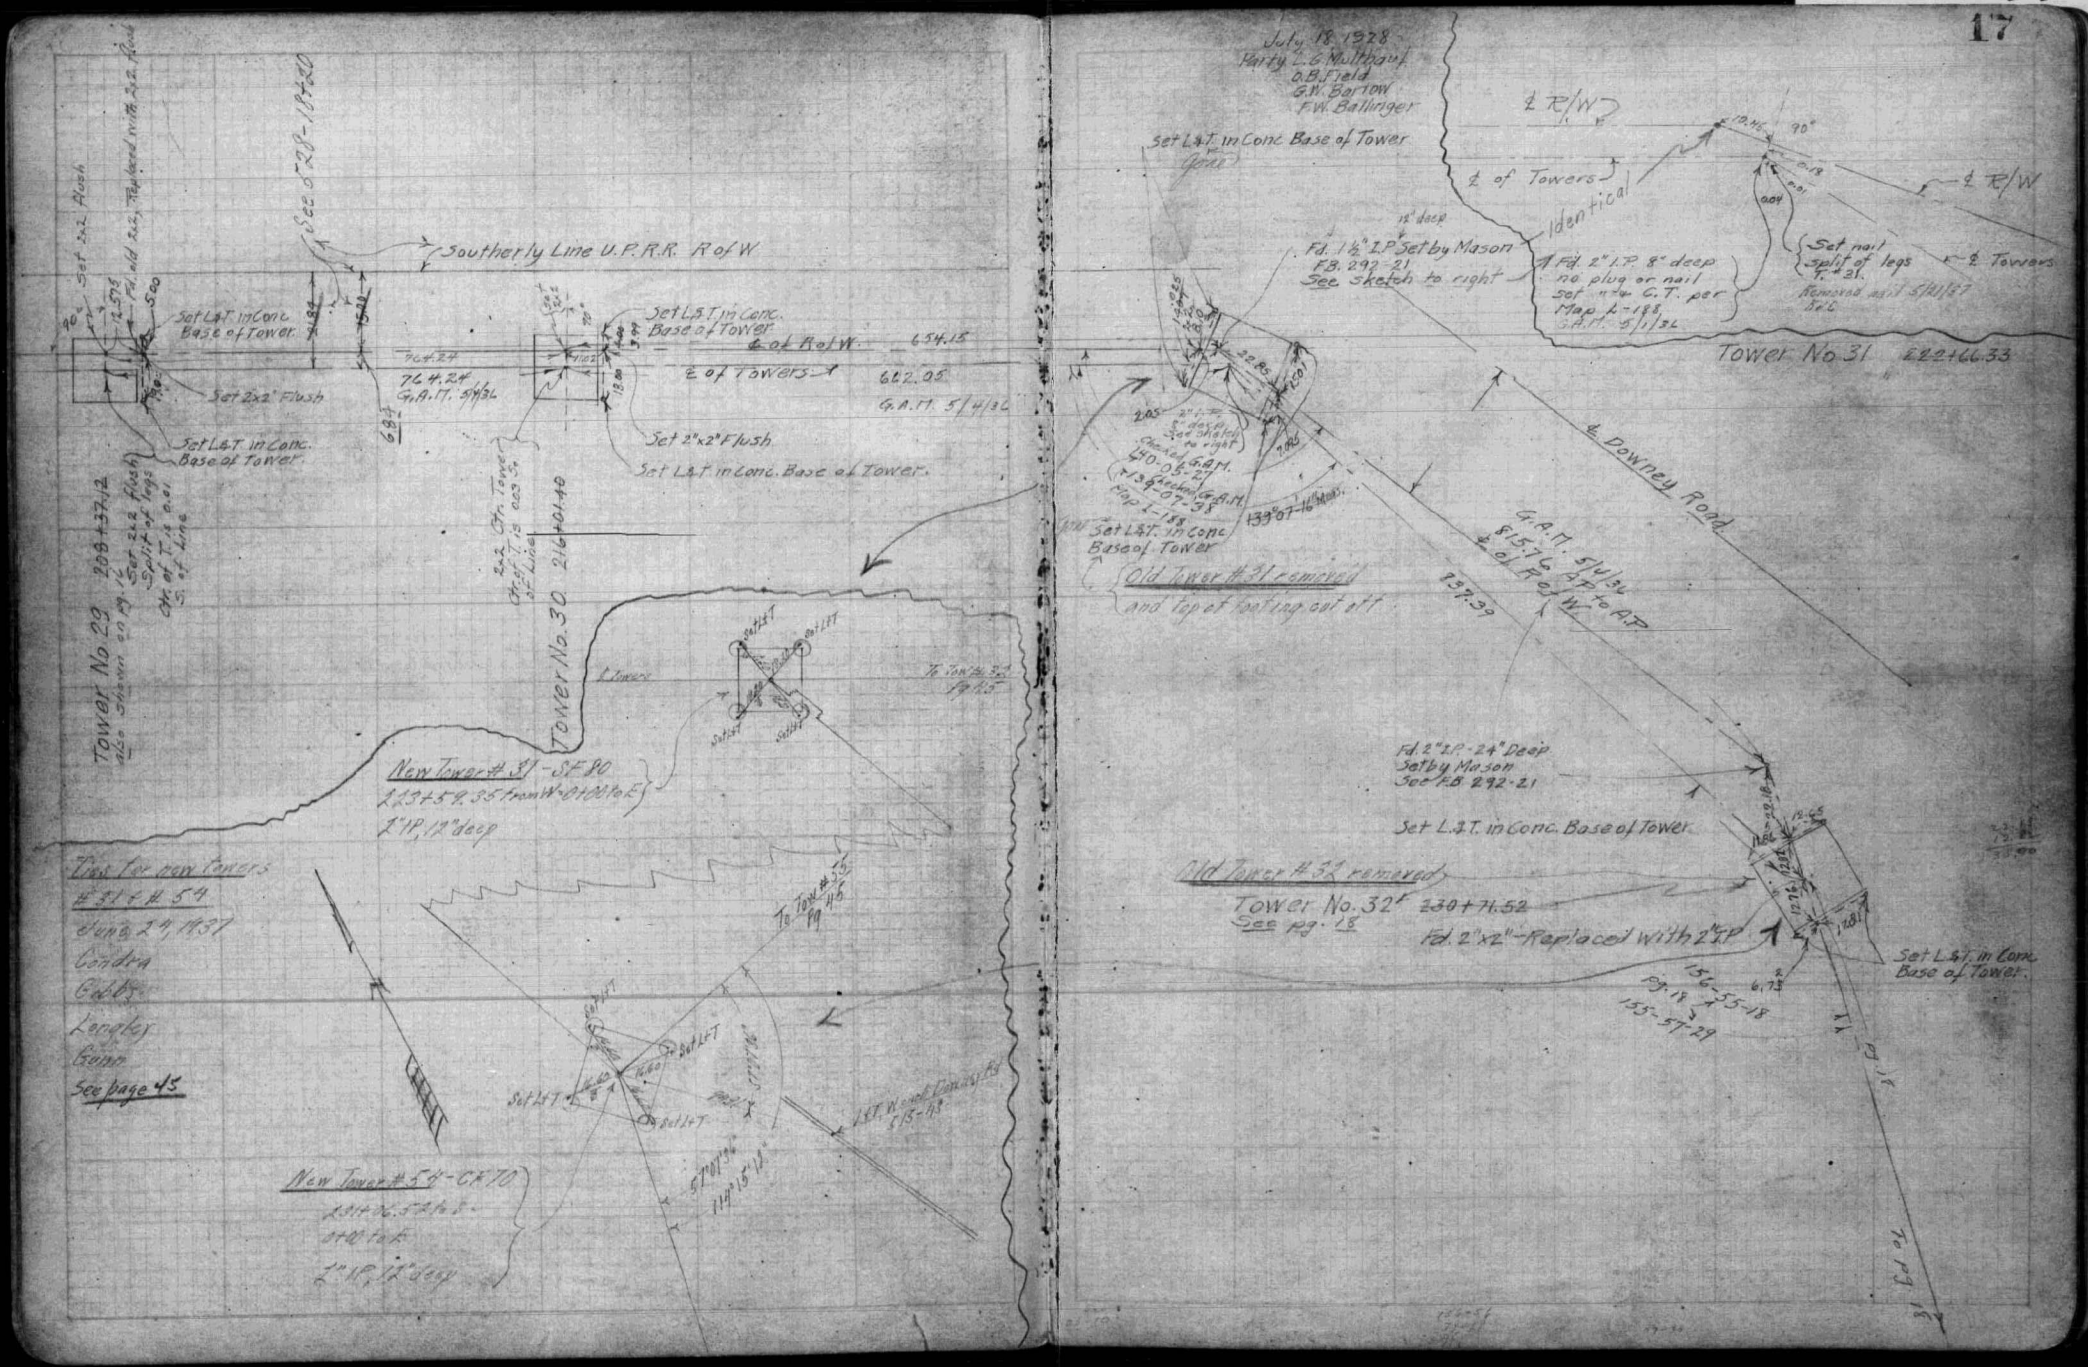

FB.1301-35

FB.1301-36

B.P.&.L.-F.B.325

18

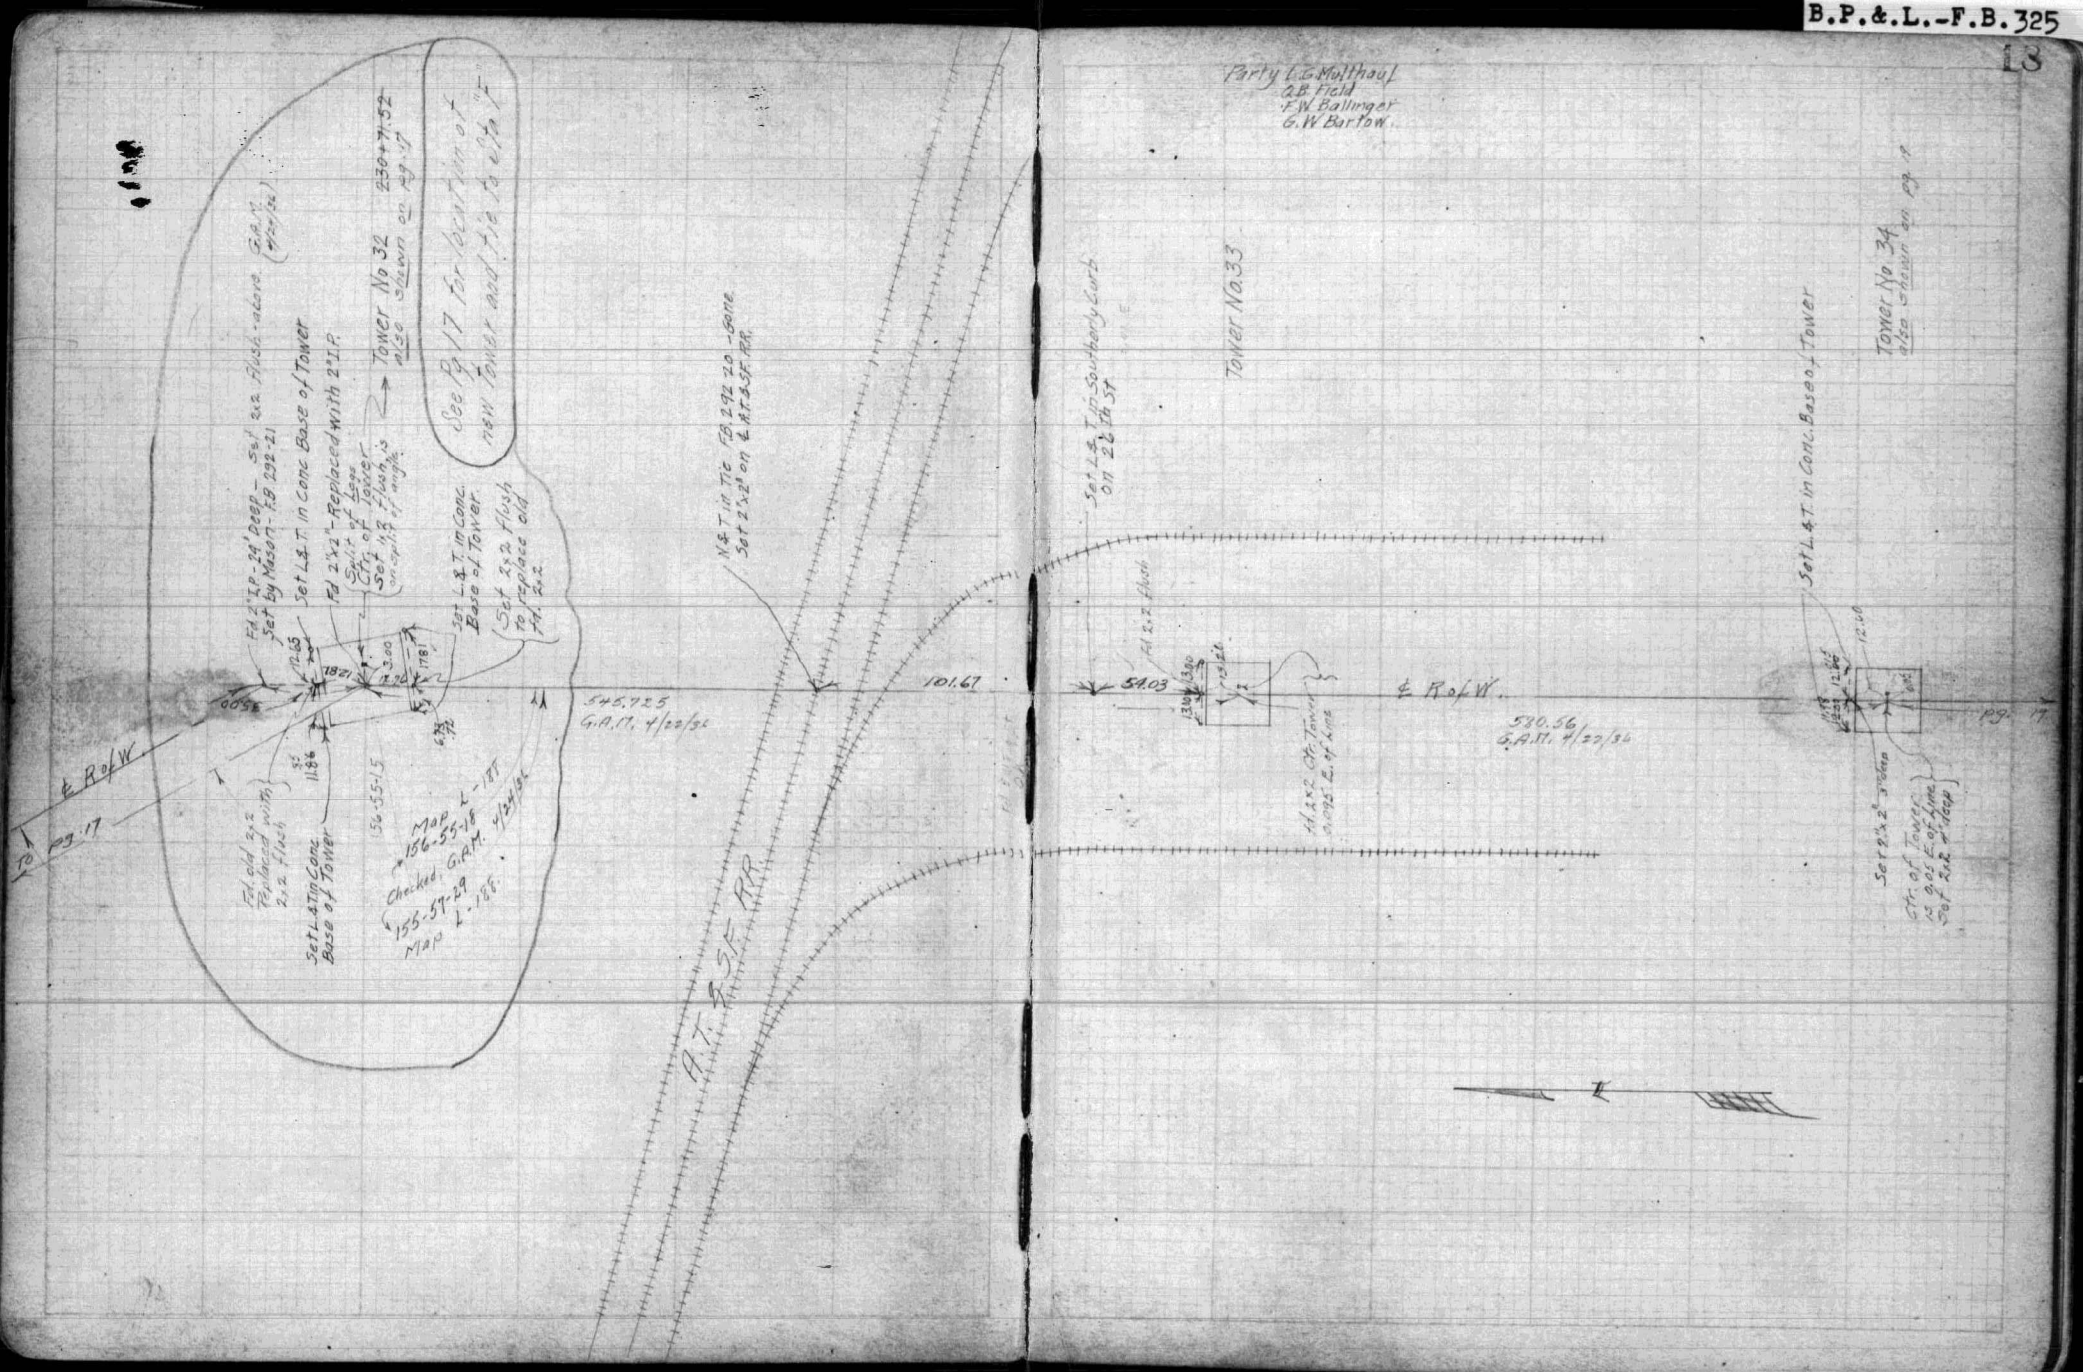

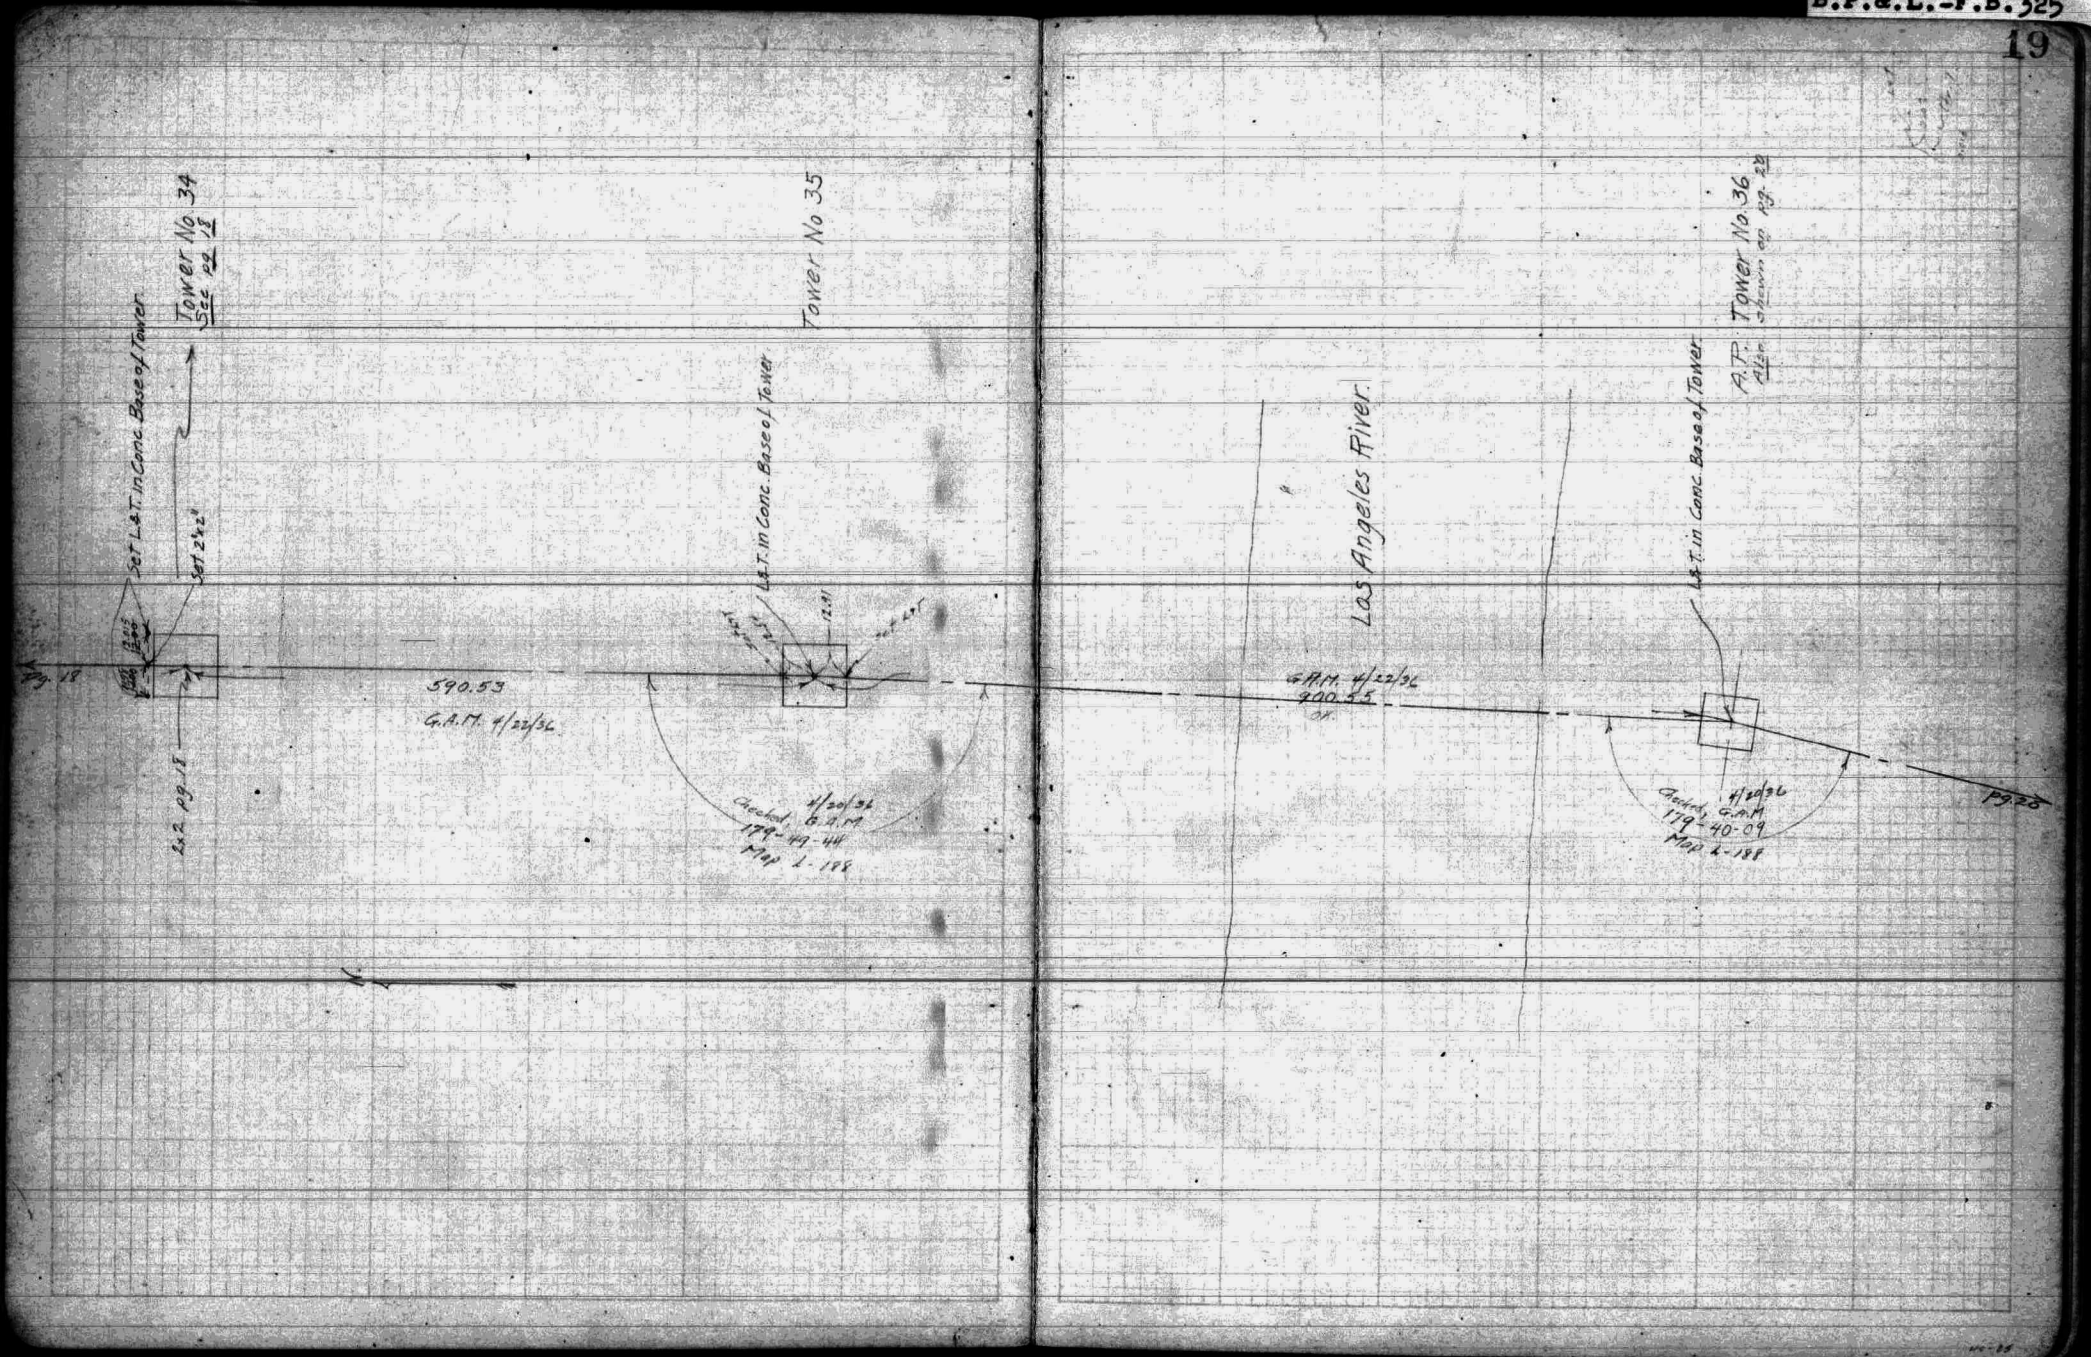
Tower No 34
See 22 18
Set L&T in Conc Base of Tower
Set 2x2'
Pg. 18
2.2 pg. 18
590.53
G.A.M. 4/22/36
Tower No 35
L&T in Conc. Base of Tower
12.91
Checked 4/20/36 G.A.M.
179-49-44
Map 2-198
Las Angeles River
G.A.M. 4/22/36
700.55
Tower No 36
A.P. Alien
L&T in Conc. Base of Tower
Checked 4/20/36 G.A.M.
179-40-09
Map 2-188
Pg 22

FB.1301-39

FB.1301-40

B.P.&.L.-F.B.325

20

Party L.G. Multhauf
O.B. Field
G.W. Bartow
F.W. Ballinger

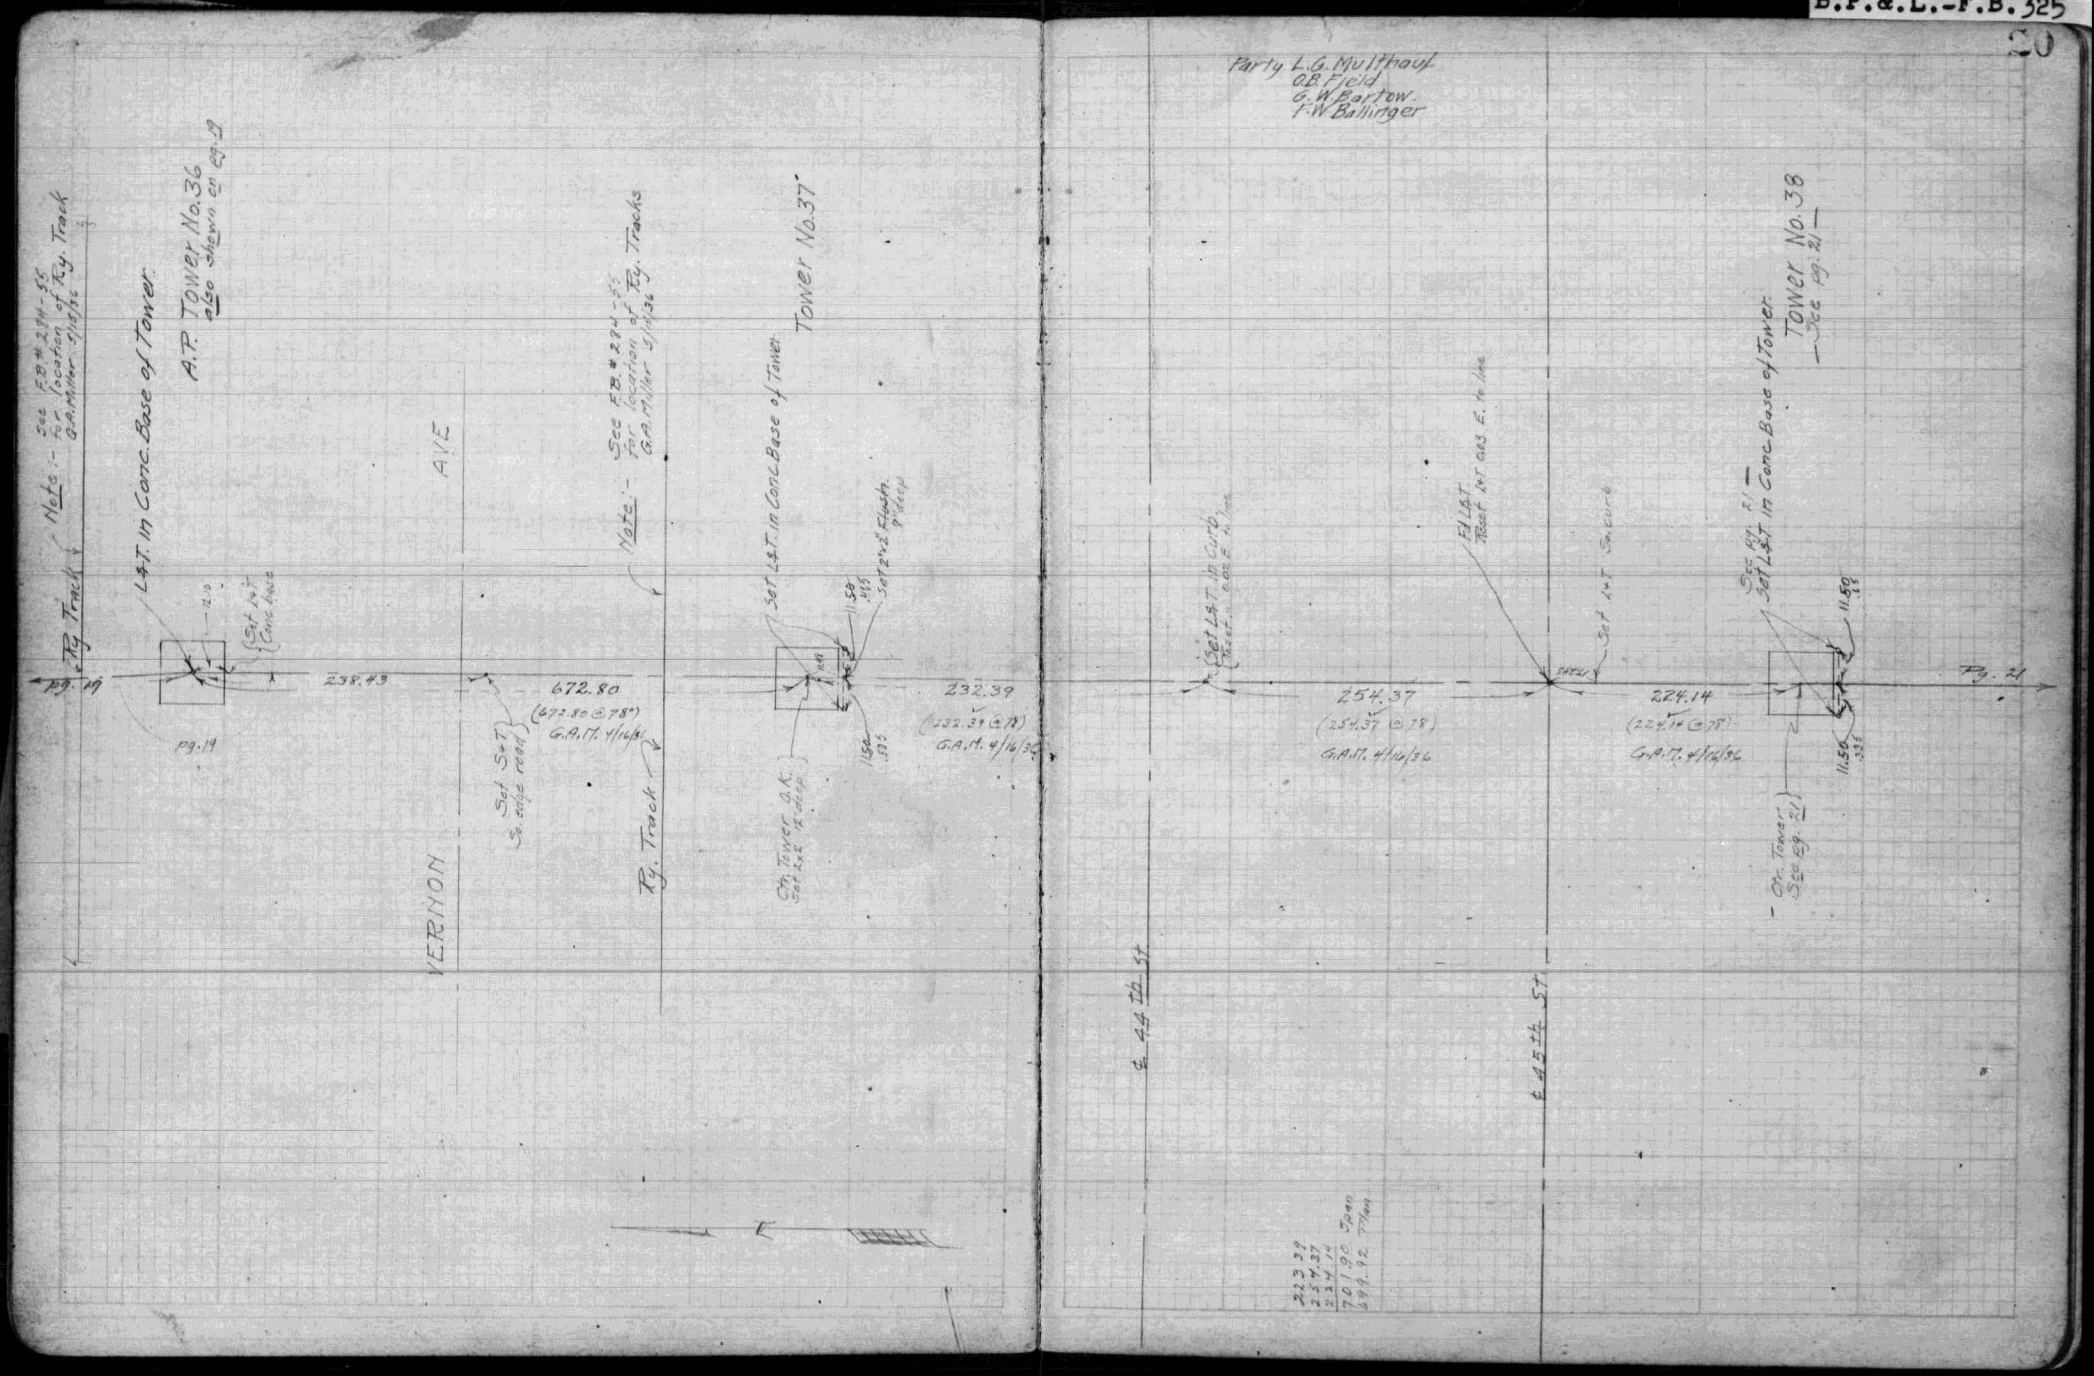

FB.1301-41

FB.1301-42

B.P.&L.-F.B.325

21

Party L.G. Multhauf 7/21/28
O.B. Field
G.W. Barlow
F.W. Bullinger

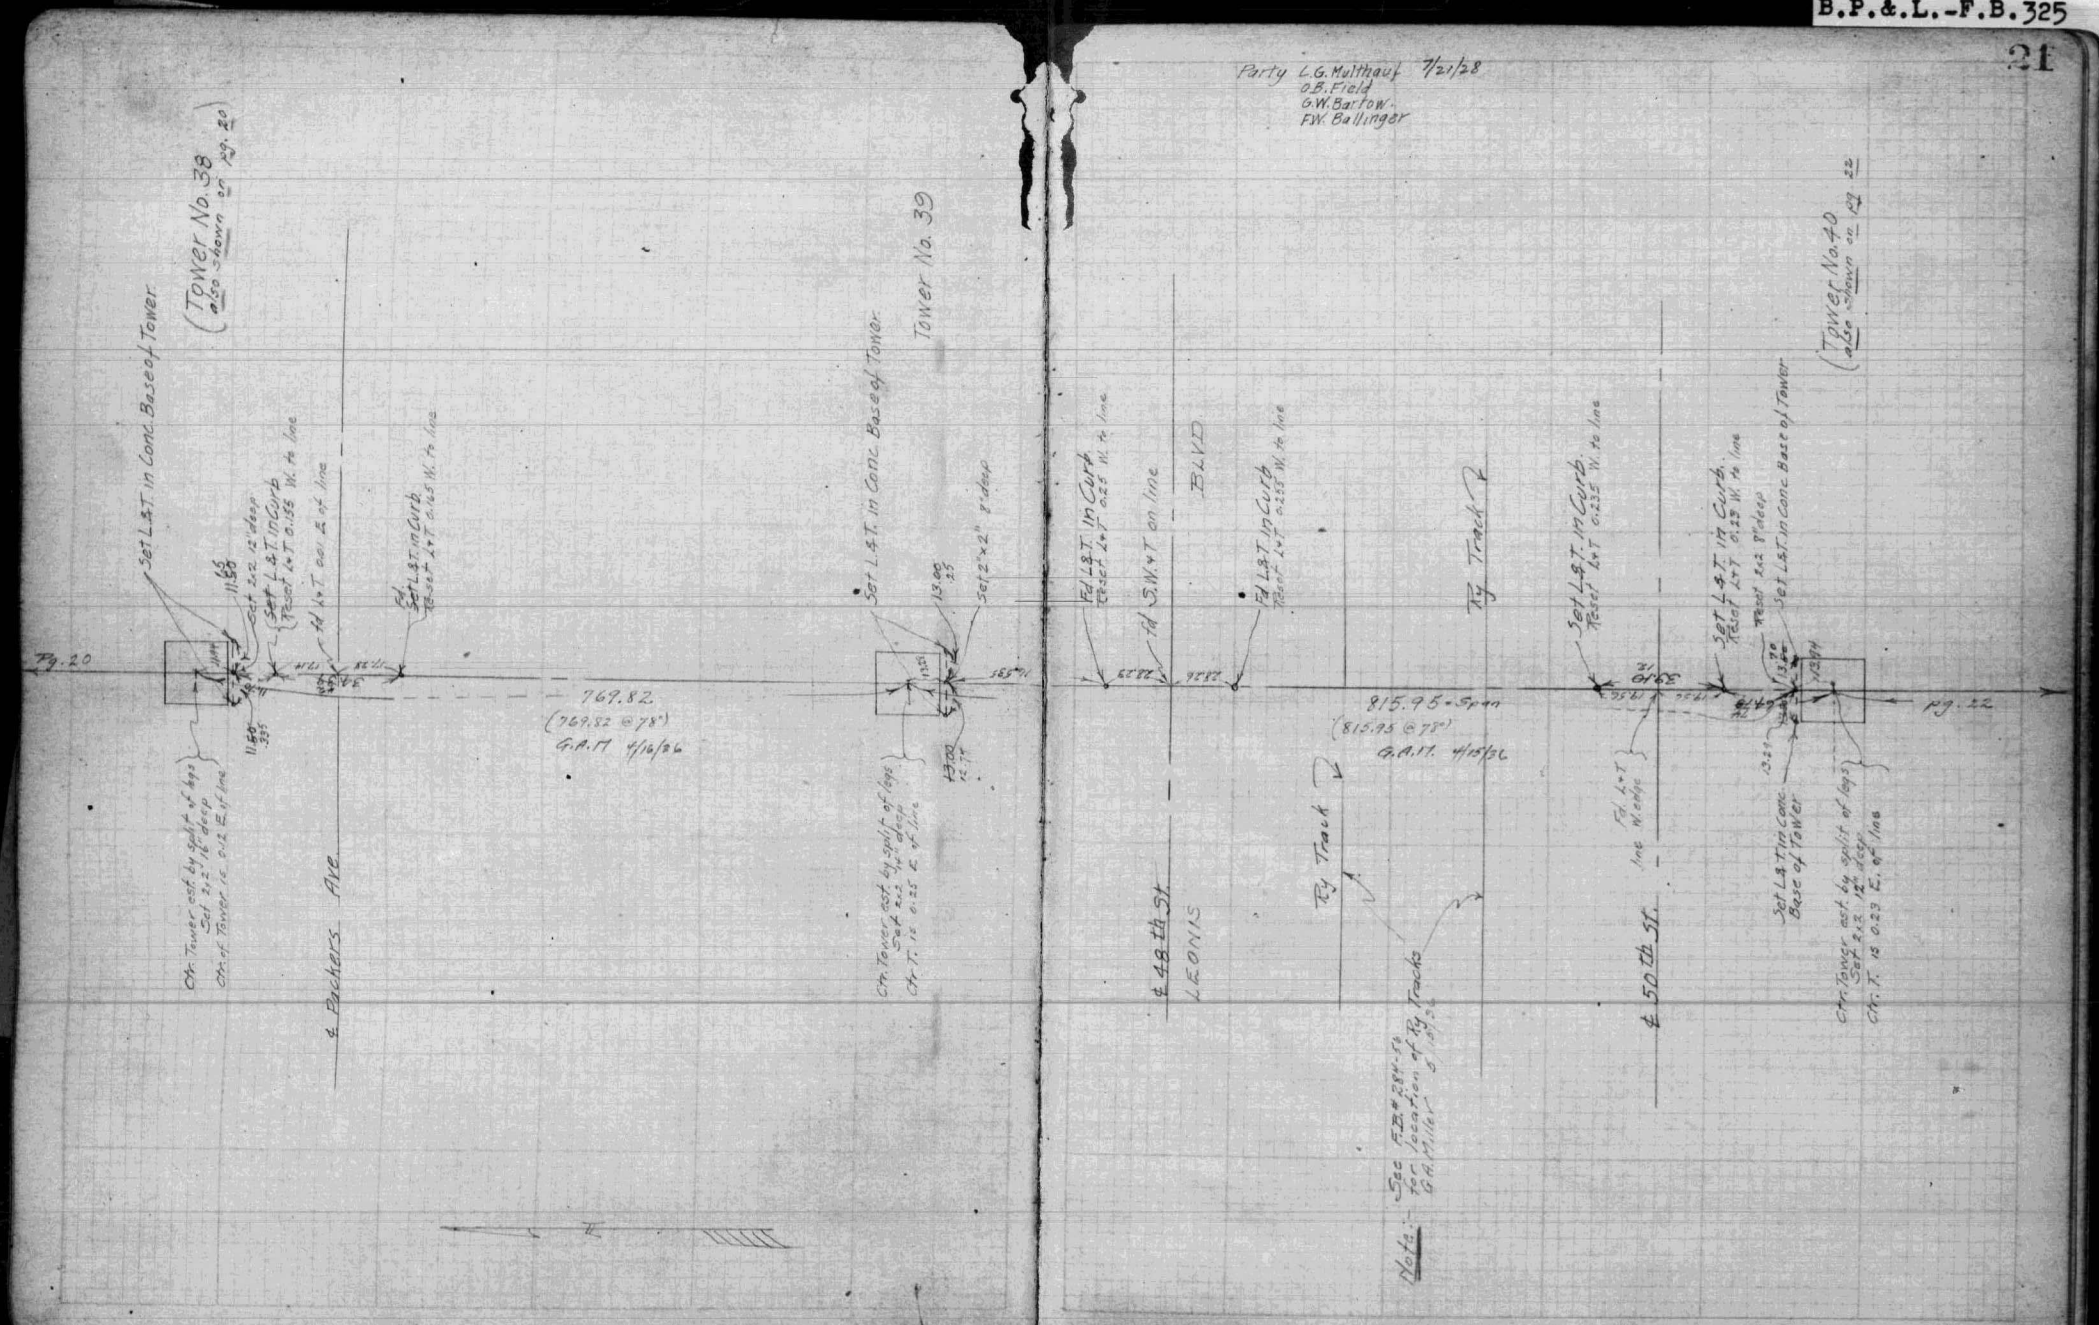

FB.1301-43

FB.1301-44

B.P.&L.-F.B.325

22

Party L.G. Multhauf
OB Field
F.W. Ballinger
G.W. Bartow.

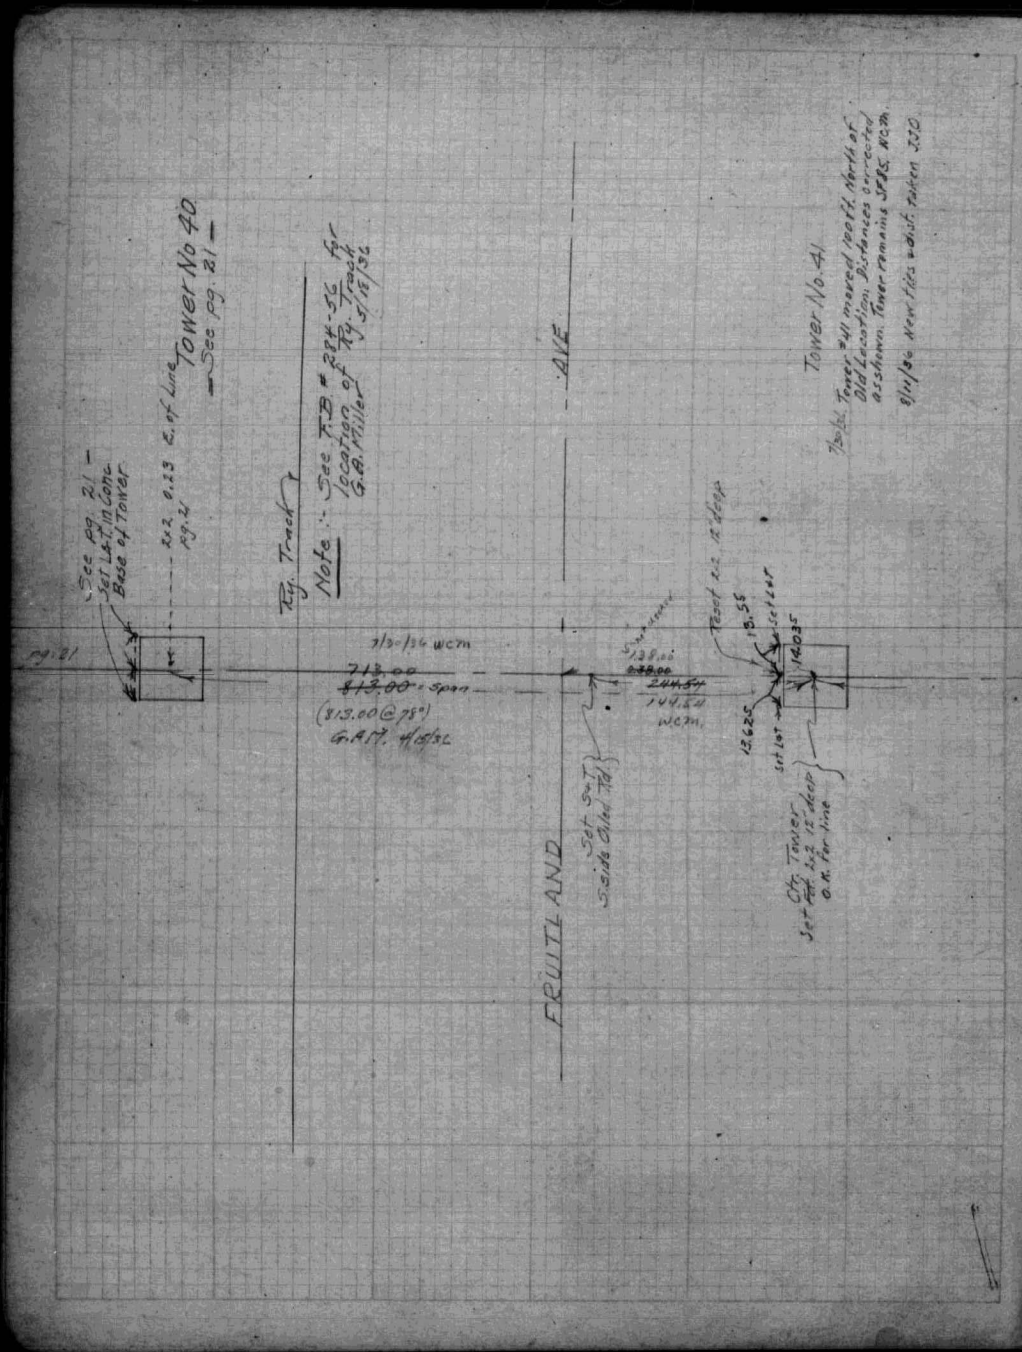

B.P.&L.-F.B.325

NOTE :—

Plat pg. 13 and additional note on pgs. 8 to 23 inc. ∠ dists, offsets to Towers, check of angles, etc. by

Miller
Gibbs
Goffman
Longley

April, May 1936

Party L.G. Multhauf 8/3/28
AB Field
G.W. Barrow
F.W. Ballinger

TOWER No 43

To T# 42
pg. 22

812.85 - Span
(812.85 @ 78°)
G.A.M. 4/8/36

763.53 - Span
(763.53 @ 78°)
G.A.M. 4/8/36

Set L&T in Conc Base of Tower

Set L&T in Conc Base of Tower

Fd 2"x2" - Replaced with 2" I.P.

Fd 1" I.P.

I.P. - Fd old 1" I.P. with N&T, Mark Point, Pine 1.5 ft. E. of C.L. of Tower

Set 1½" I.P.

Set L&T in Conc Base of Tower.

Set L&T in Conc Base of Tower

Set L&T in Curb

Set L&T in Conc. Base of Tower

Set 2"x2" Hub

℄ Simpson Ave.

(Also shown on sht. 21 TOWER No 44 - 318+8934)

8943

N

FB.1301-47

FB.1301-48

B.P.&L.-F.B.325

Party L.G. Multhauf
O.B. Field
F.W. Ballinger
G.W. Barrow

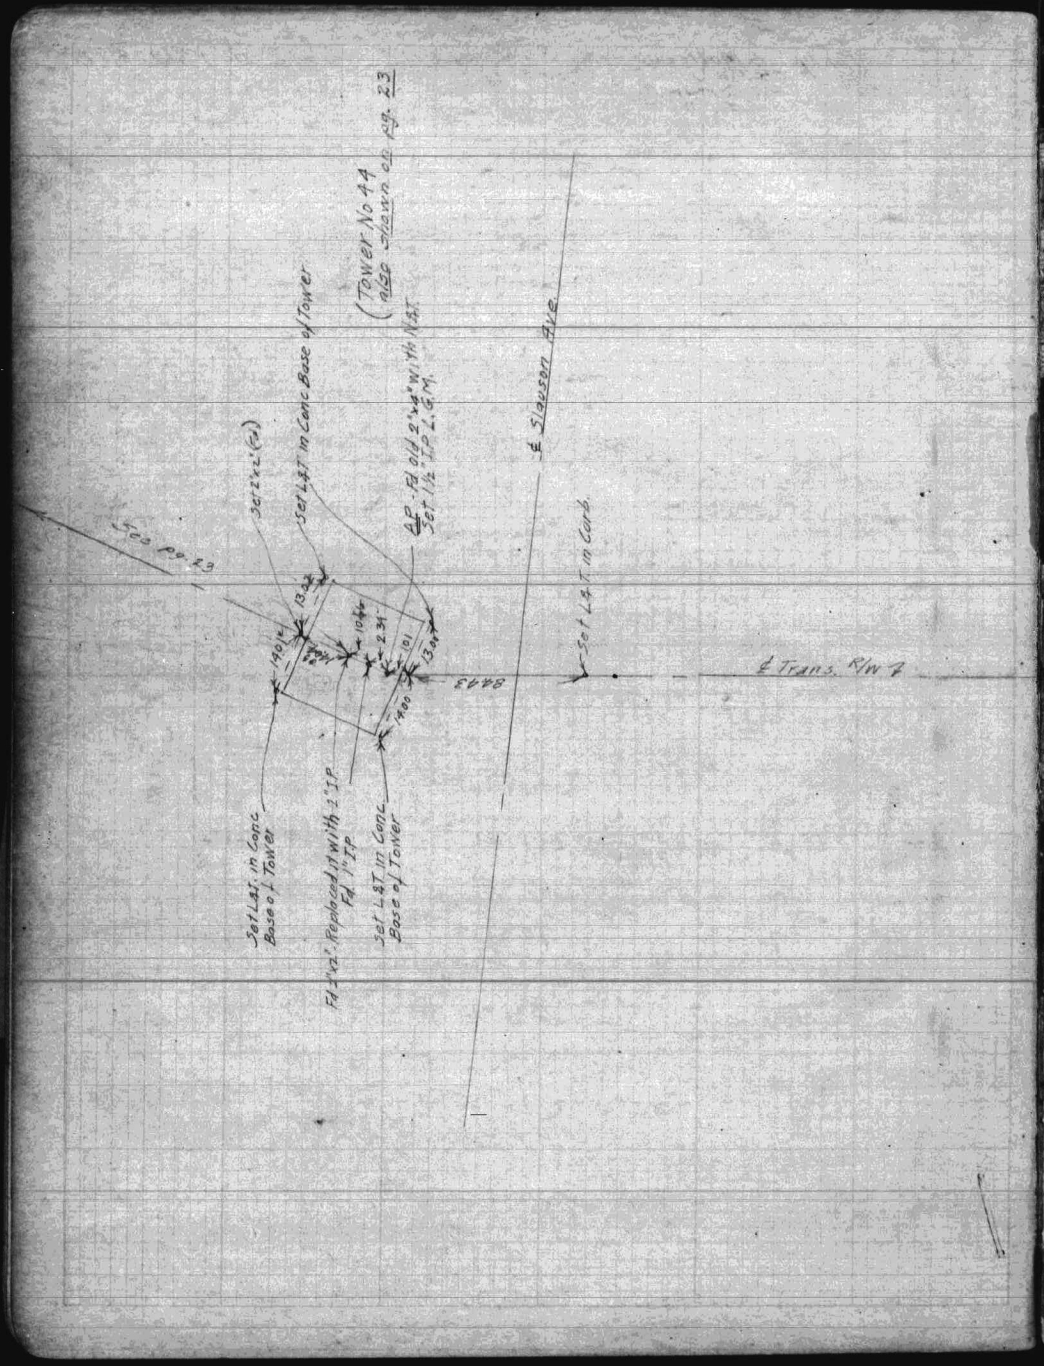

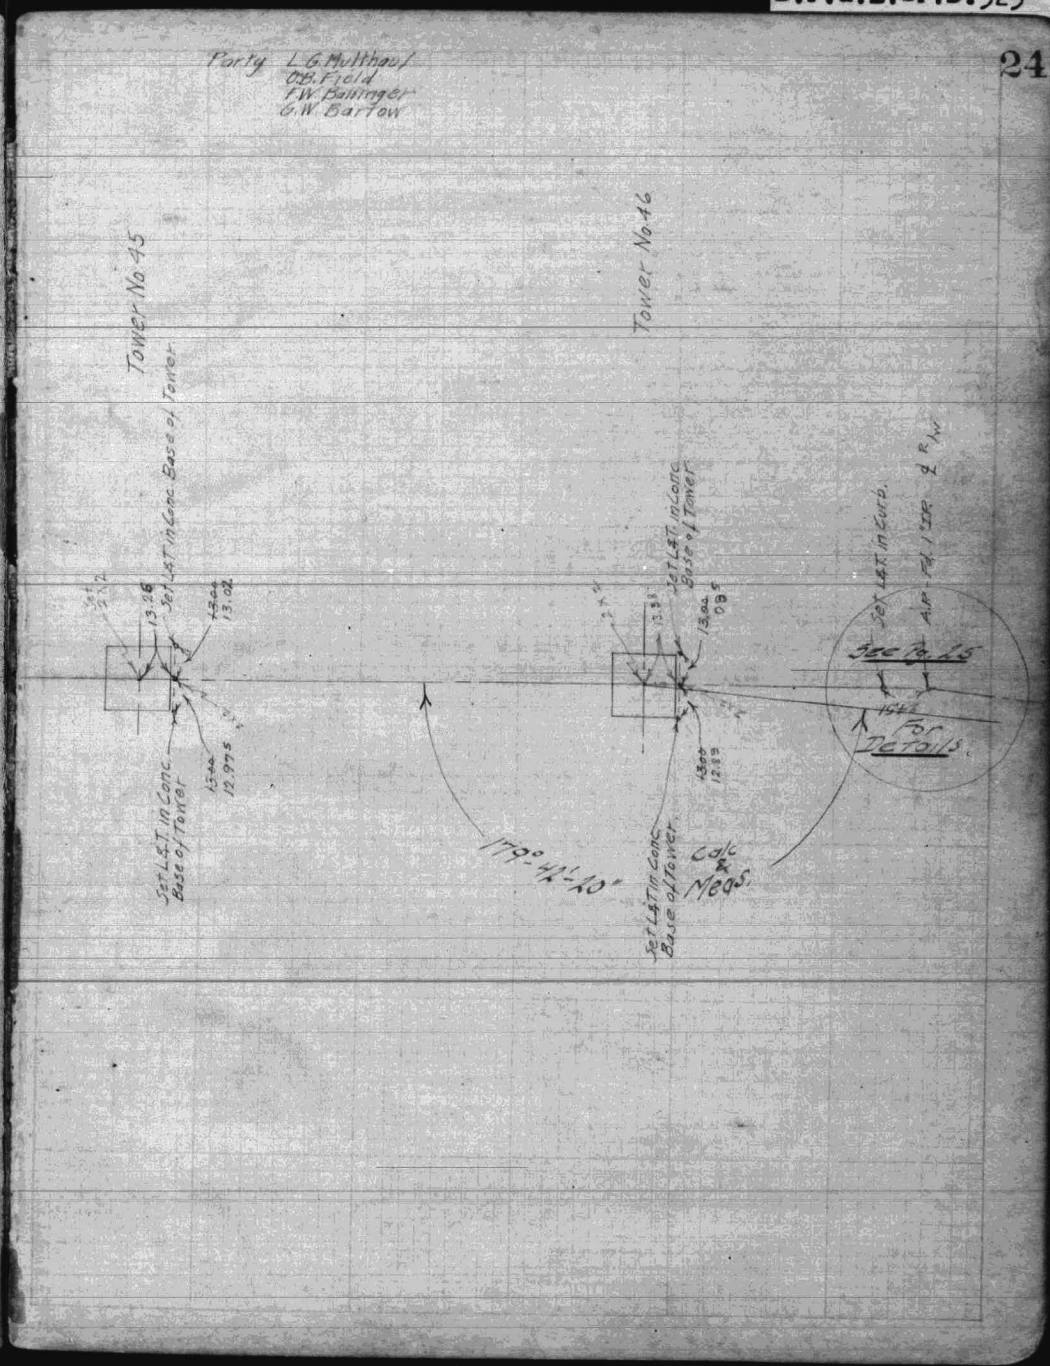

FB.1301-51

FB.1301-52

B.P.&.L.-F.B.325

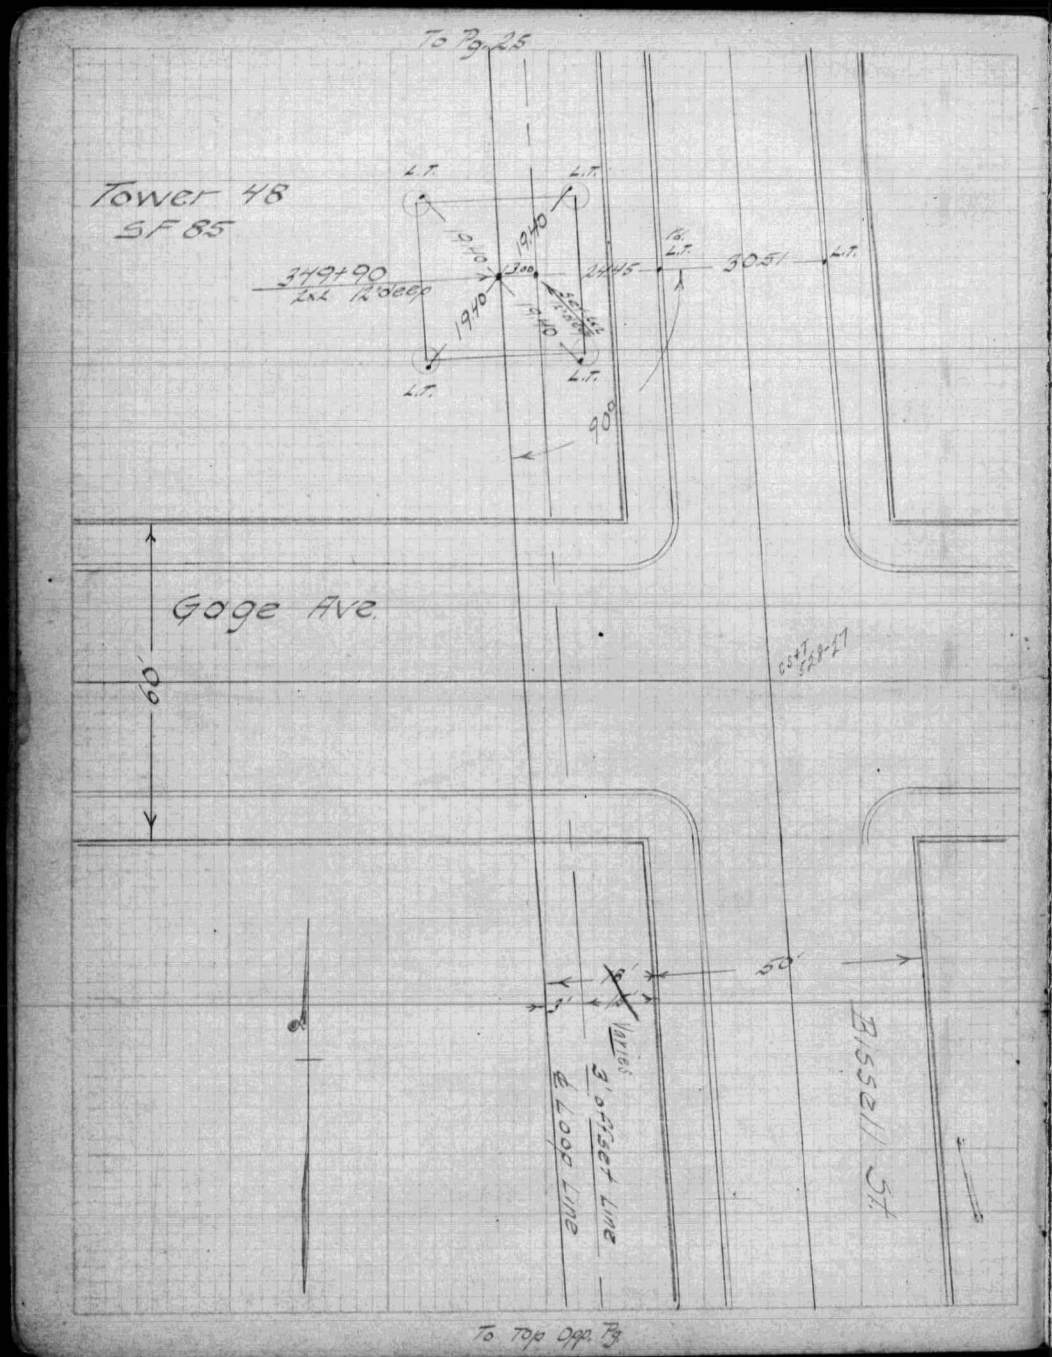

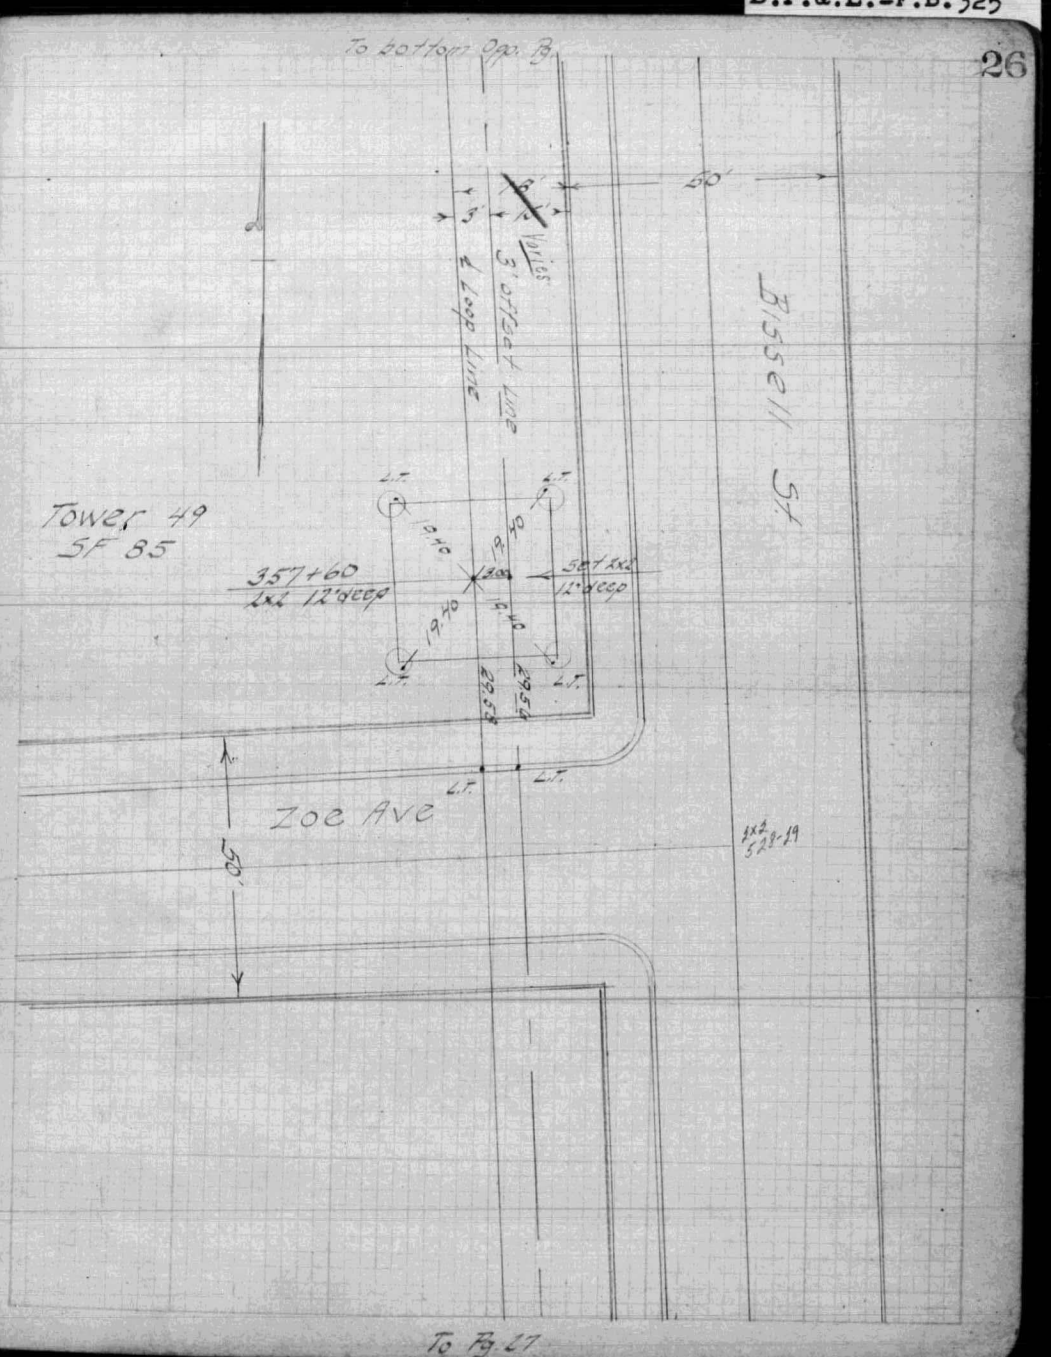

FB.1301-49

FB.1301-50

B.P.&.L.-F.B.325

25

Center Line Ties
on
Loop Line

Tower 47 Randolph St
to
Tower 62 Virginia Ave & Southern Ave

July 16, 1936

Knight GB
Gettman EL
Mansfield CB
Hathaway G
Buck F.C.

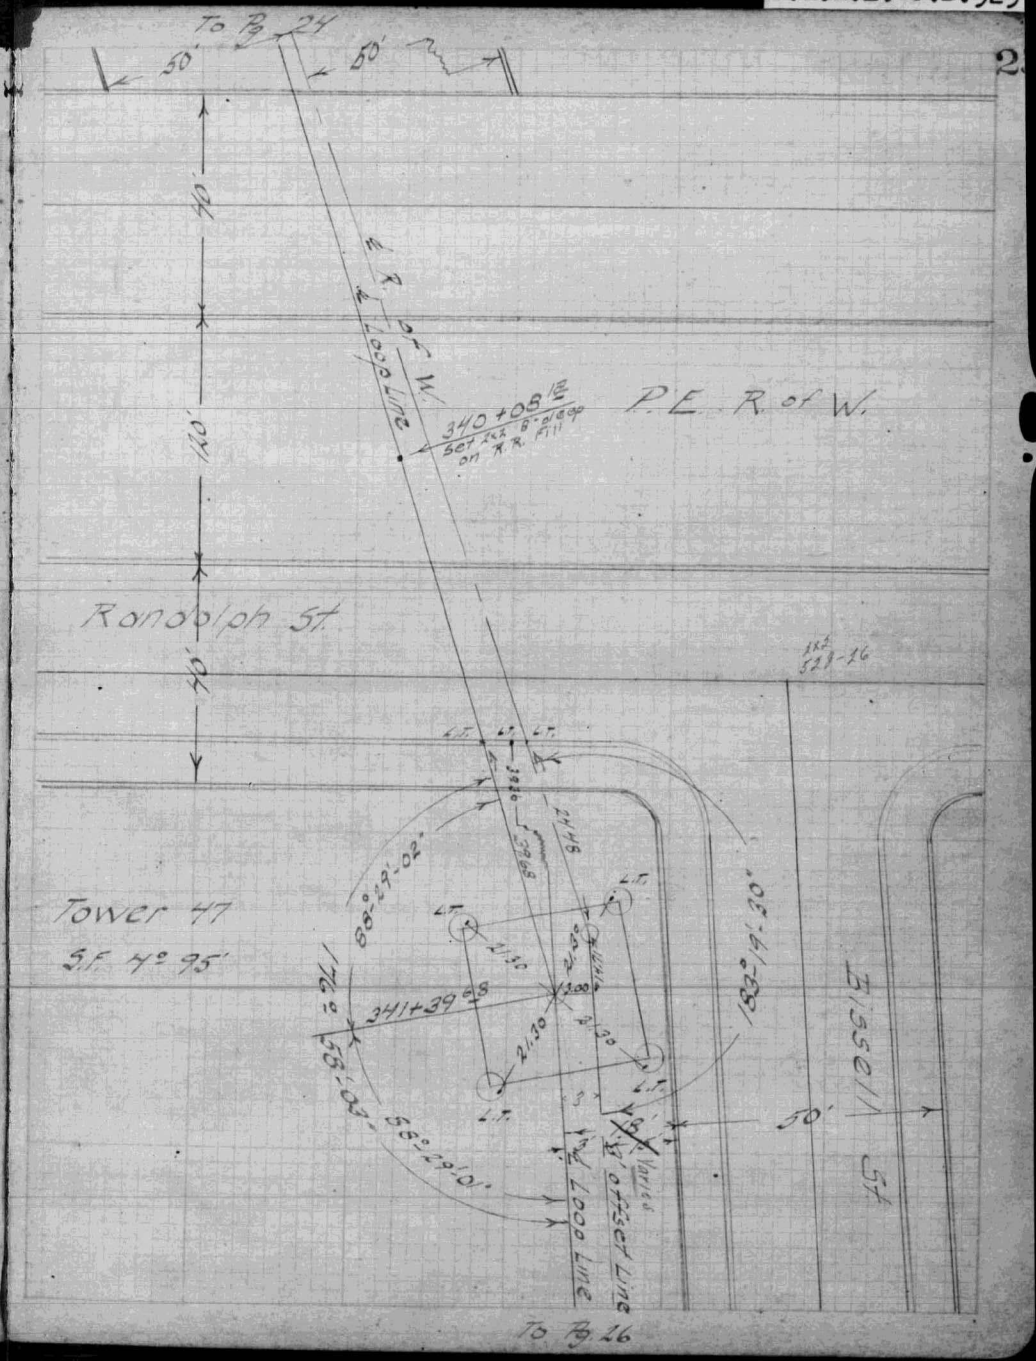

FB. 1301-53

FB. 1301-54

B.P.&L.-F.B. 325

27

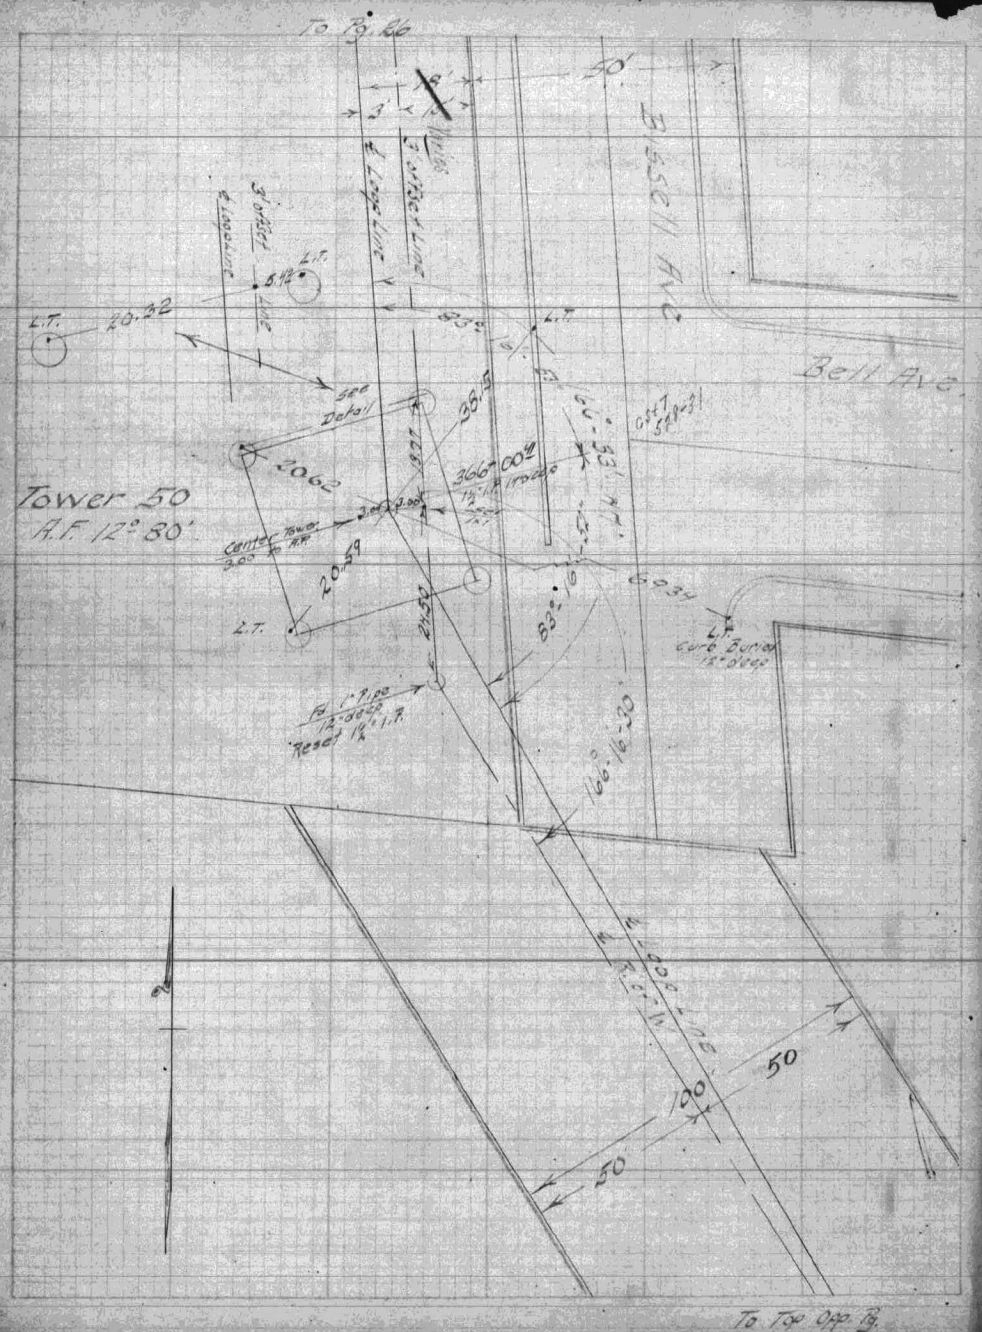

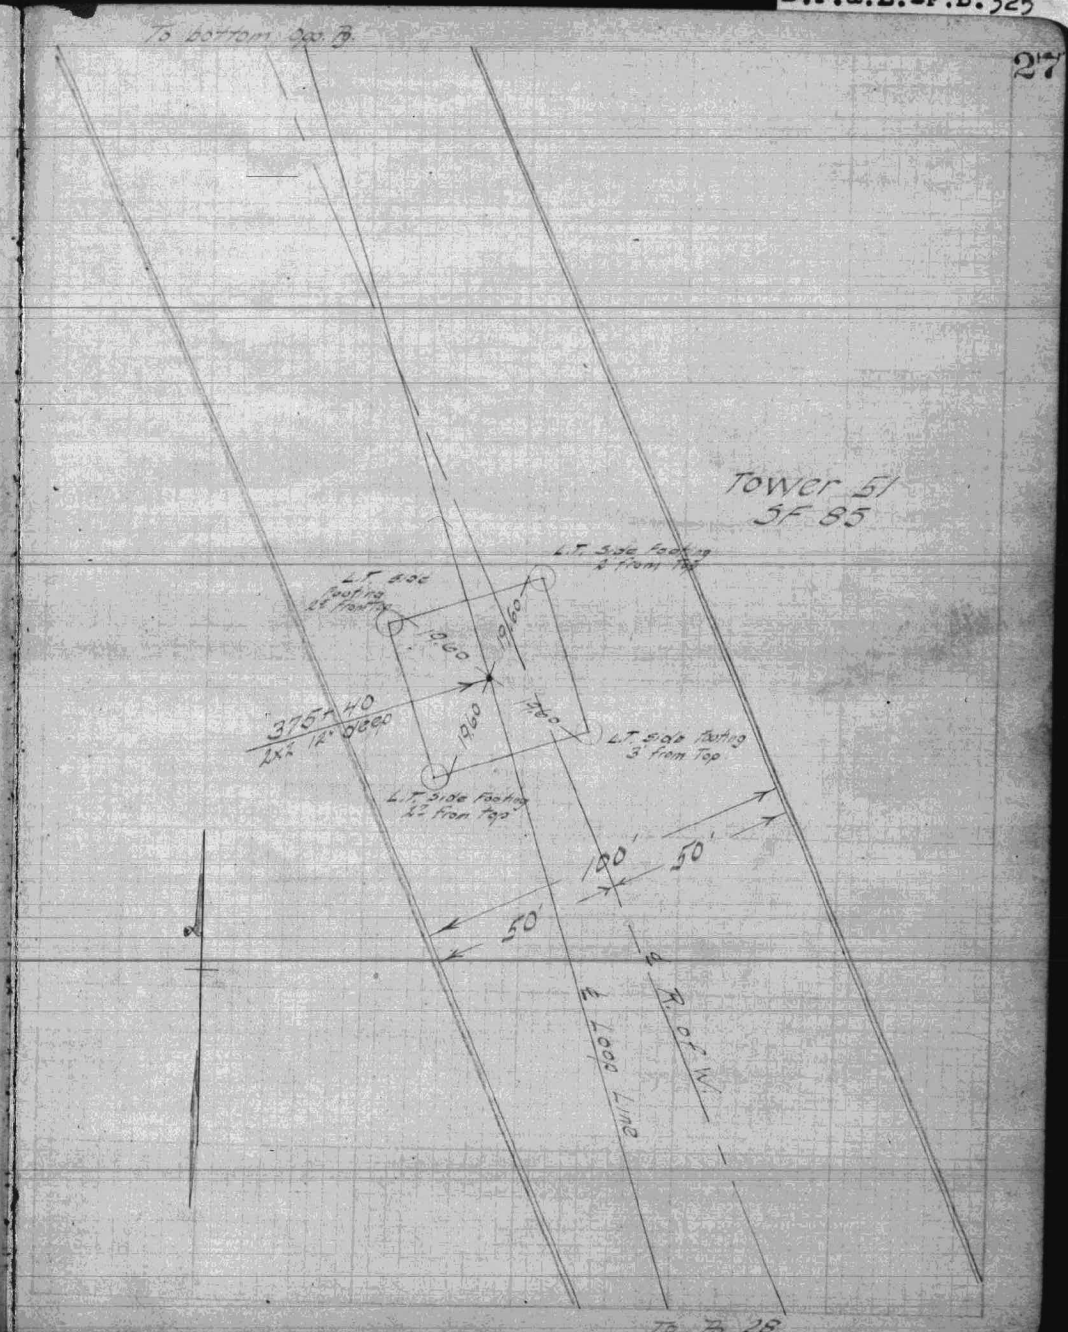

FB.1301-55

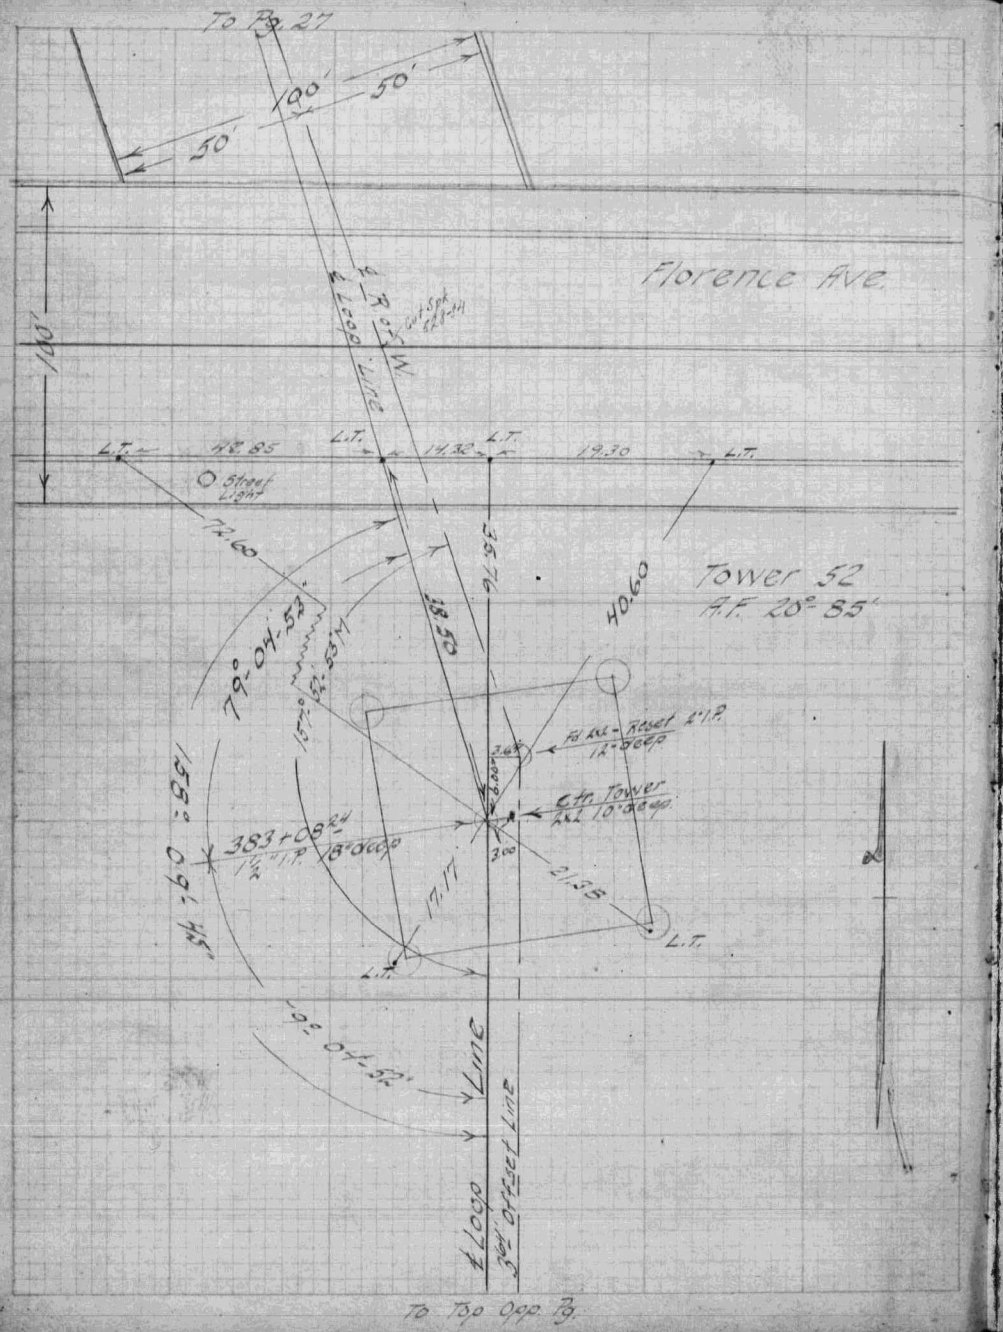

FB.1301-56

B.P.&L.-F.B.325

28

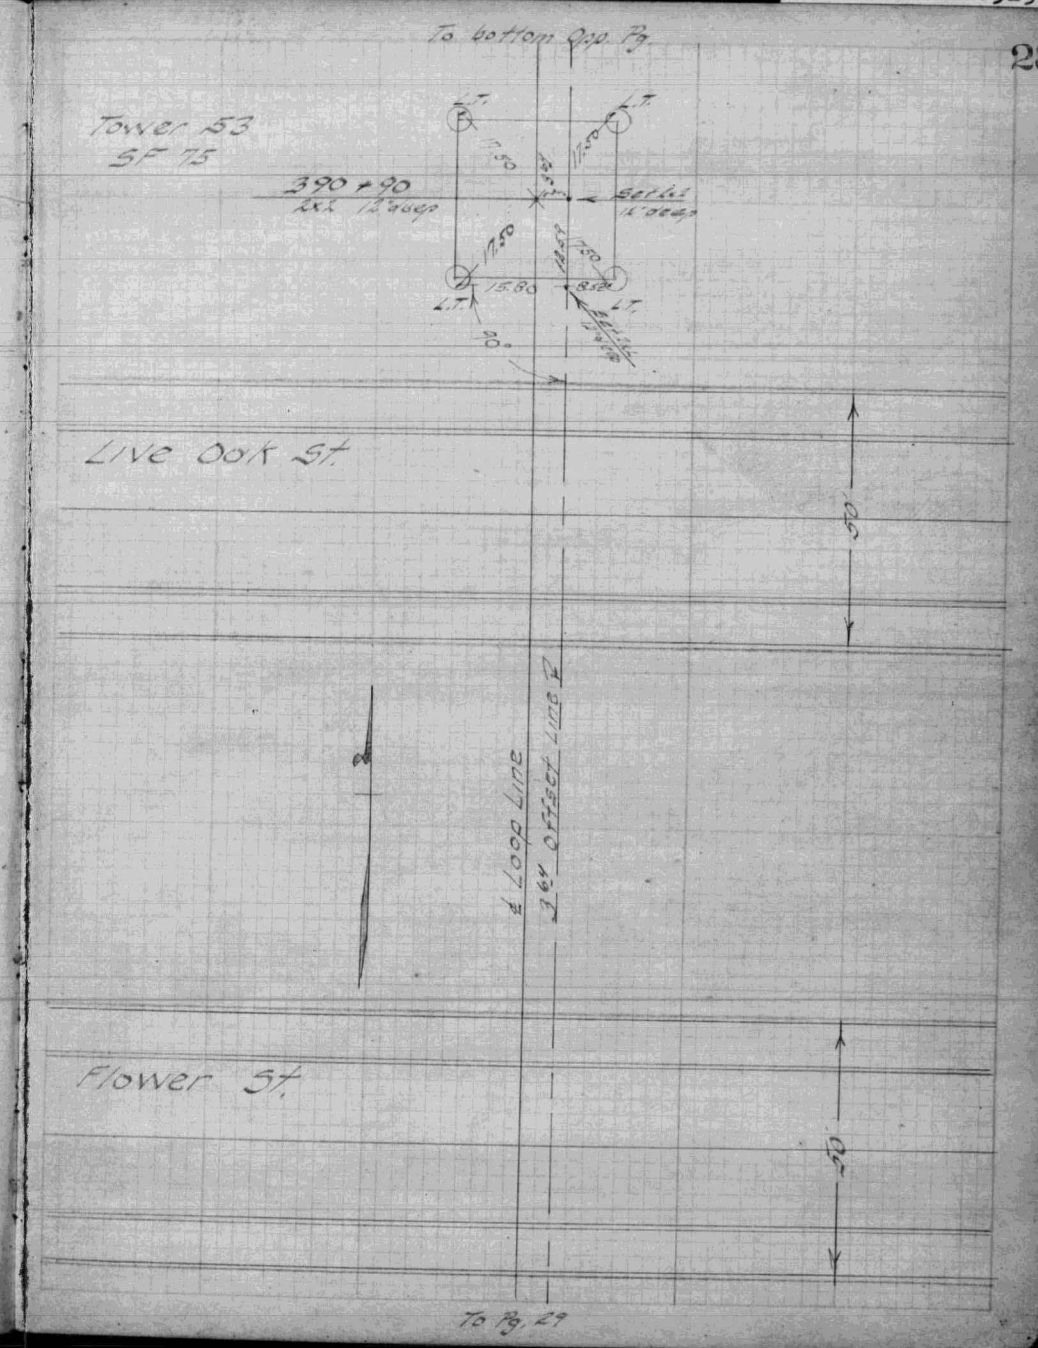

FB.1301-57

FB.1301-58

B.P.&L.-F.B.325

To Pg 28

To bottom opp. Pg

29














To Top Opp. Pg

To Pg 30

FB.1301-59

FB.1301-60

B.P.&L.-F.B.325

30

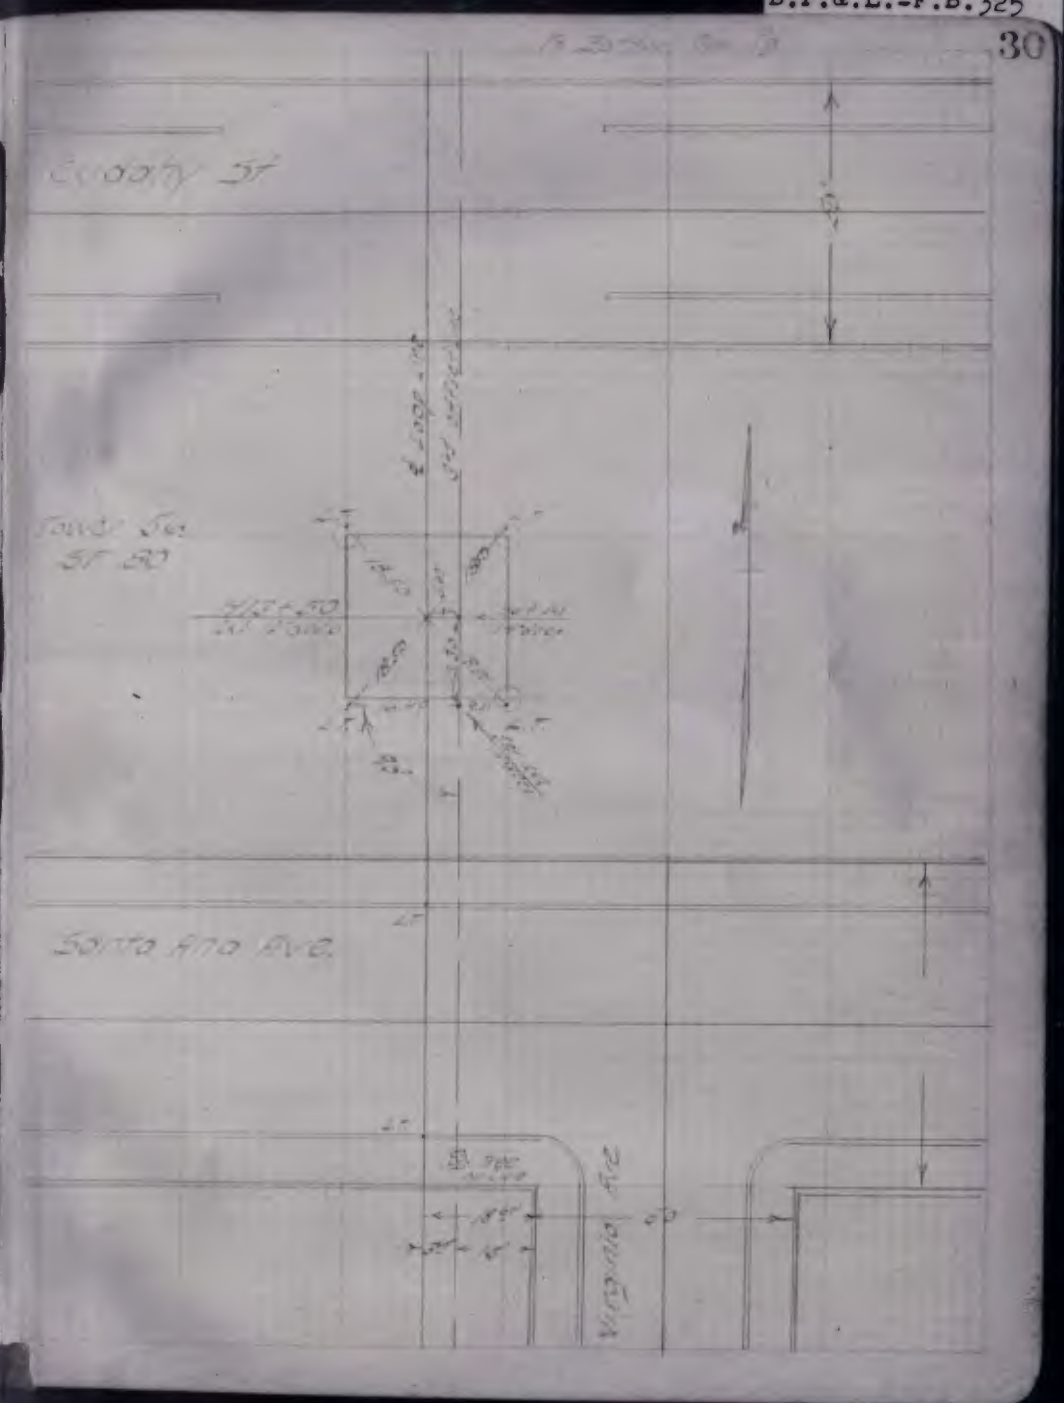

FB.1301-61

FB.1301-62

B.P.&.L.-F.B.325

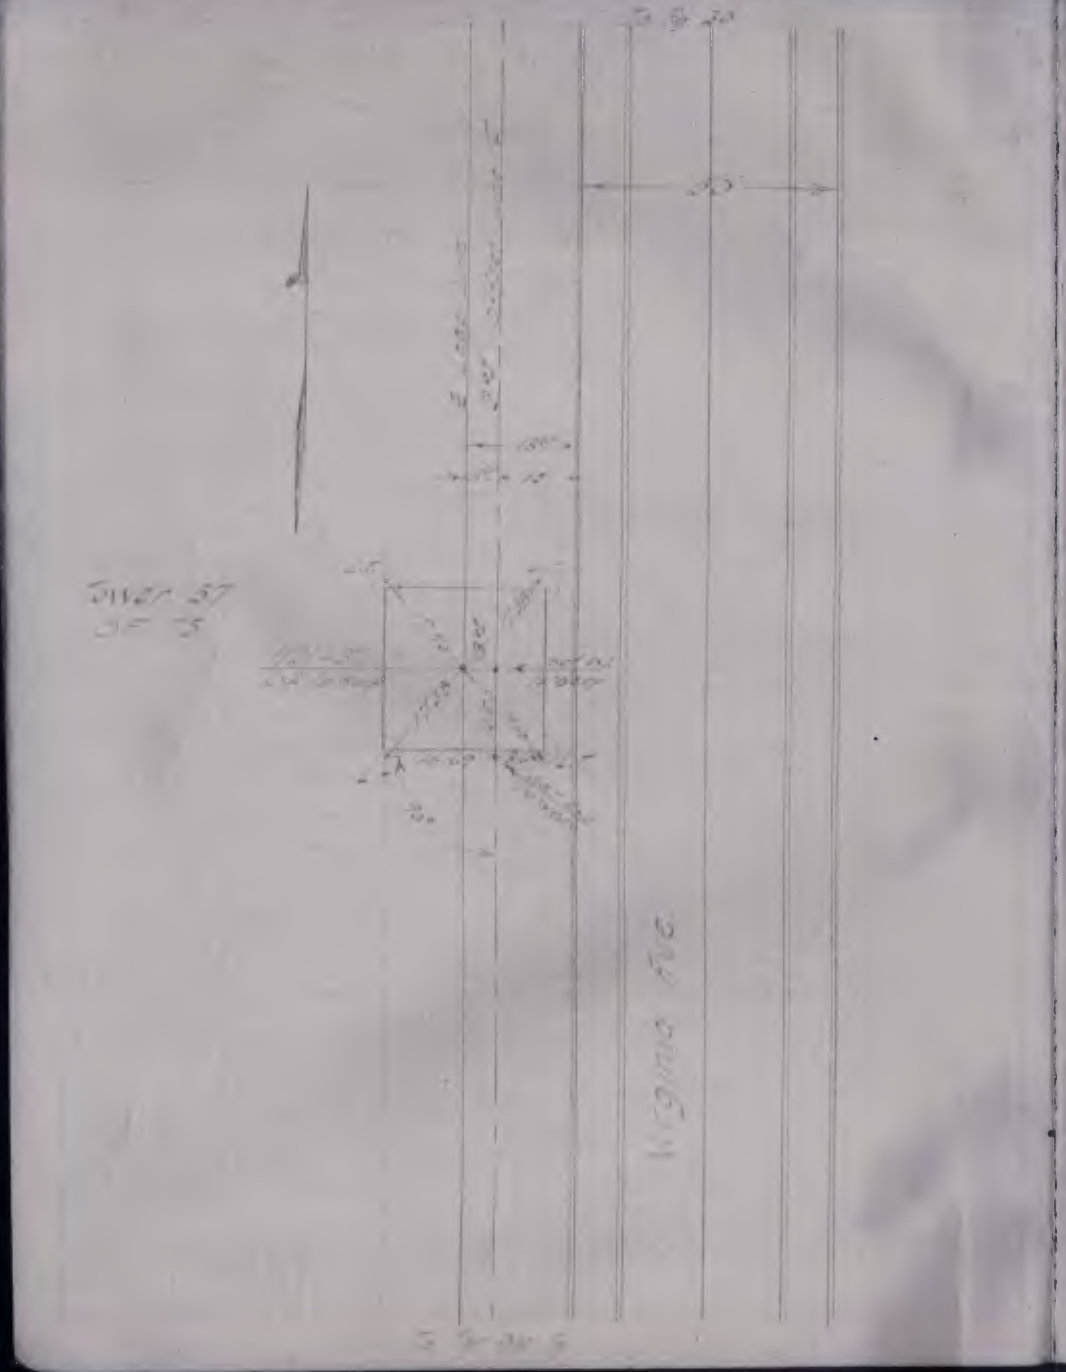

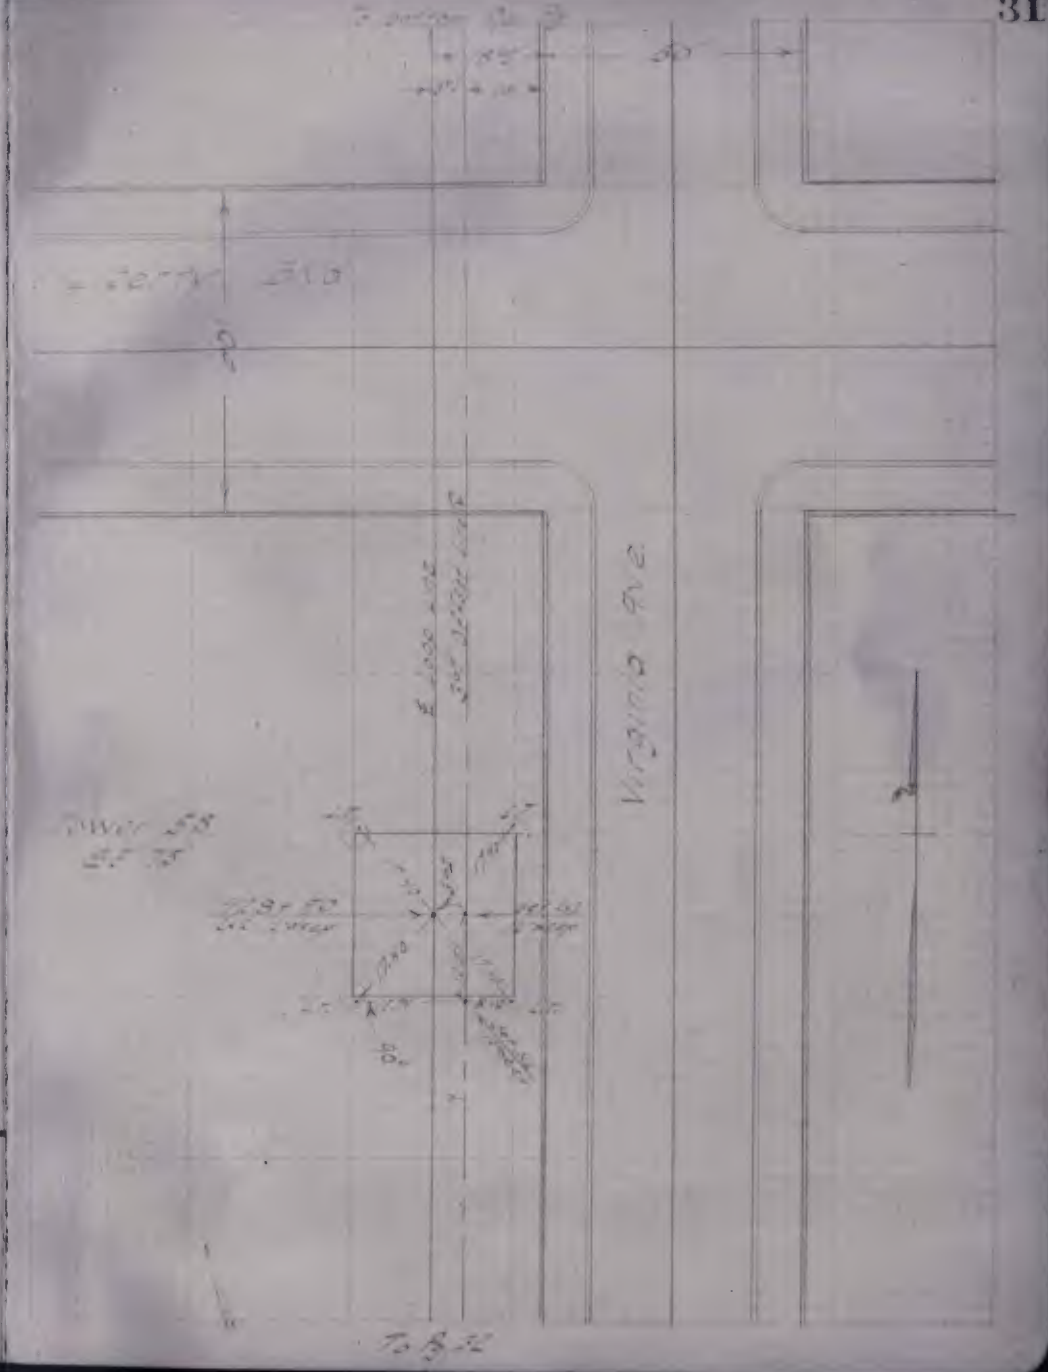

FB.1301-63

FB.1301-64

B.P.&L.-F.B.325

32

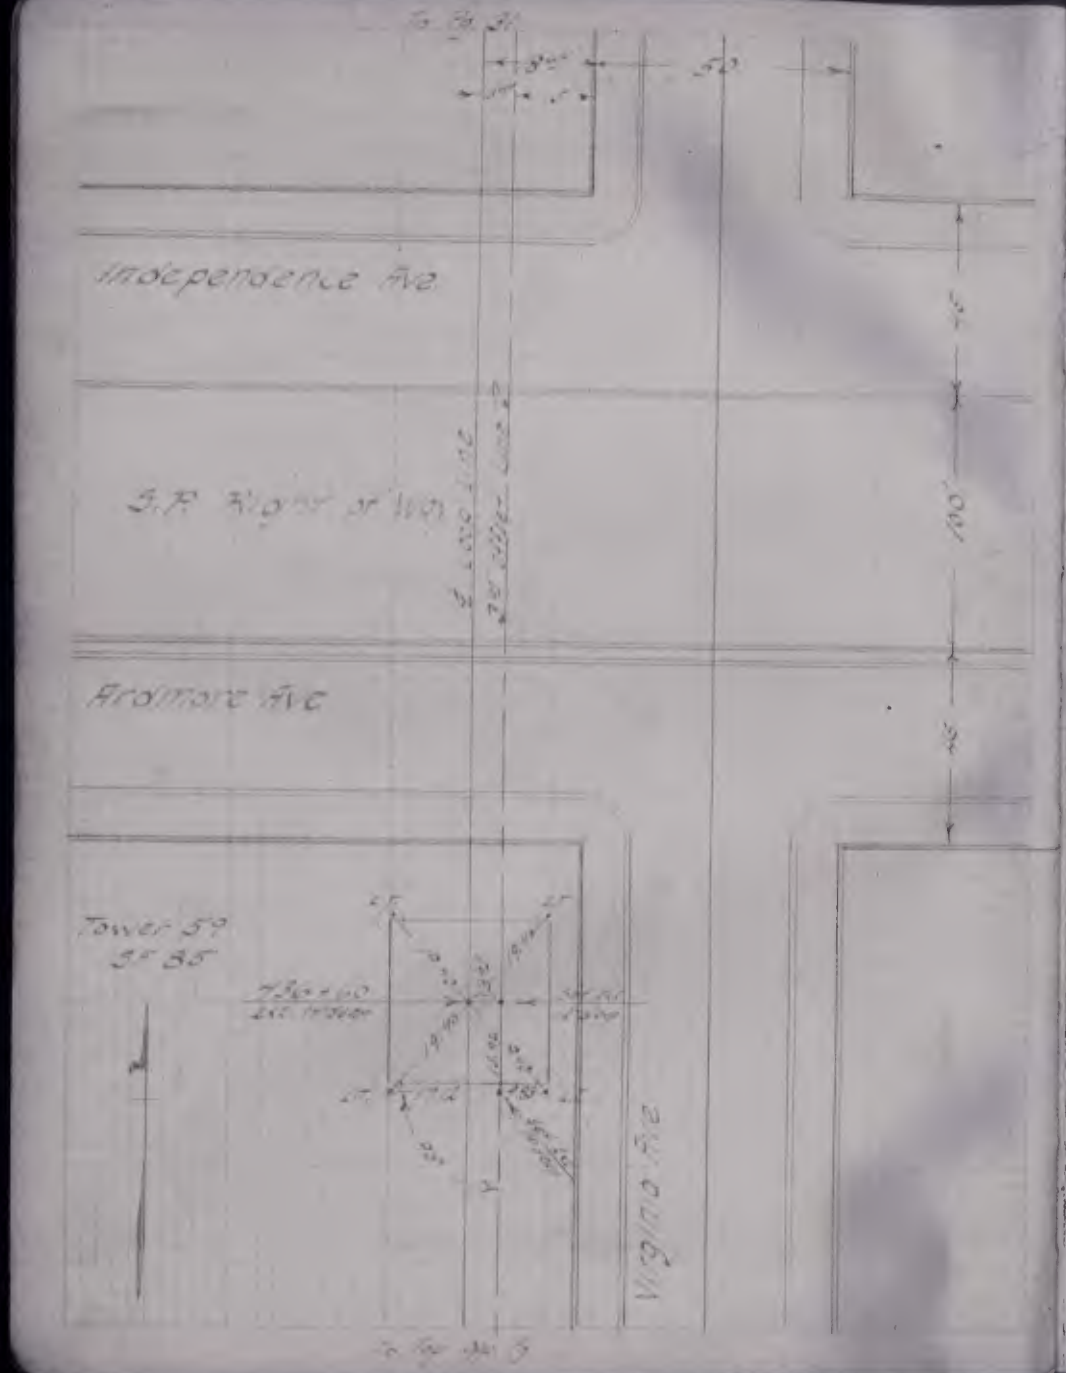

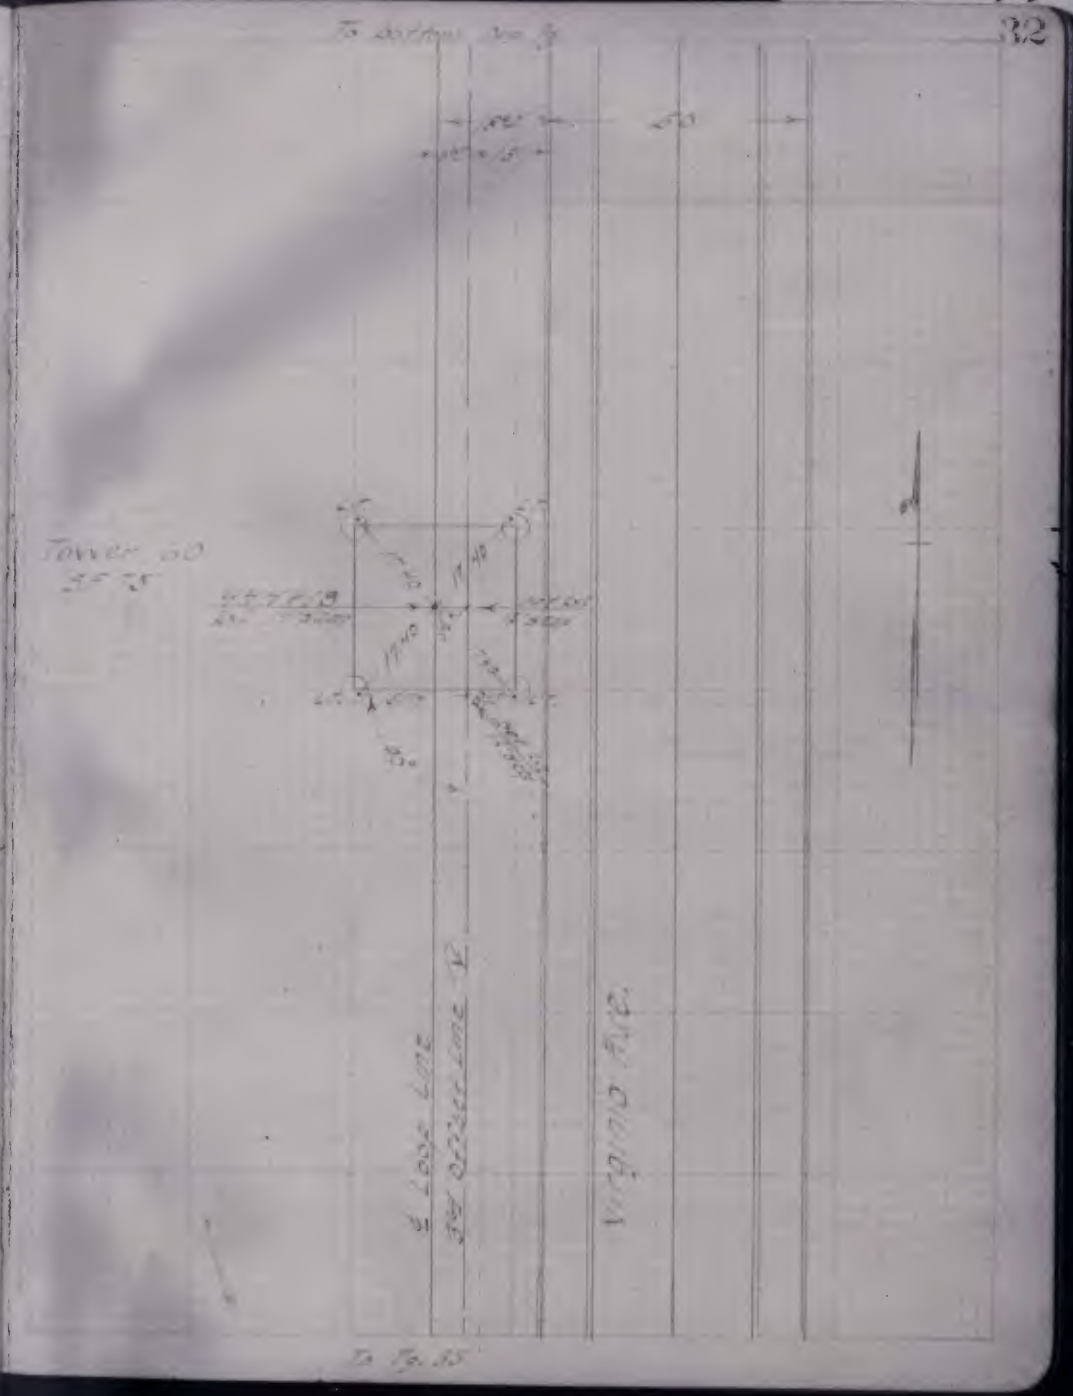

FB.1301-65

FB.1301-66

B.P.&.L.-F.B.325

33

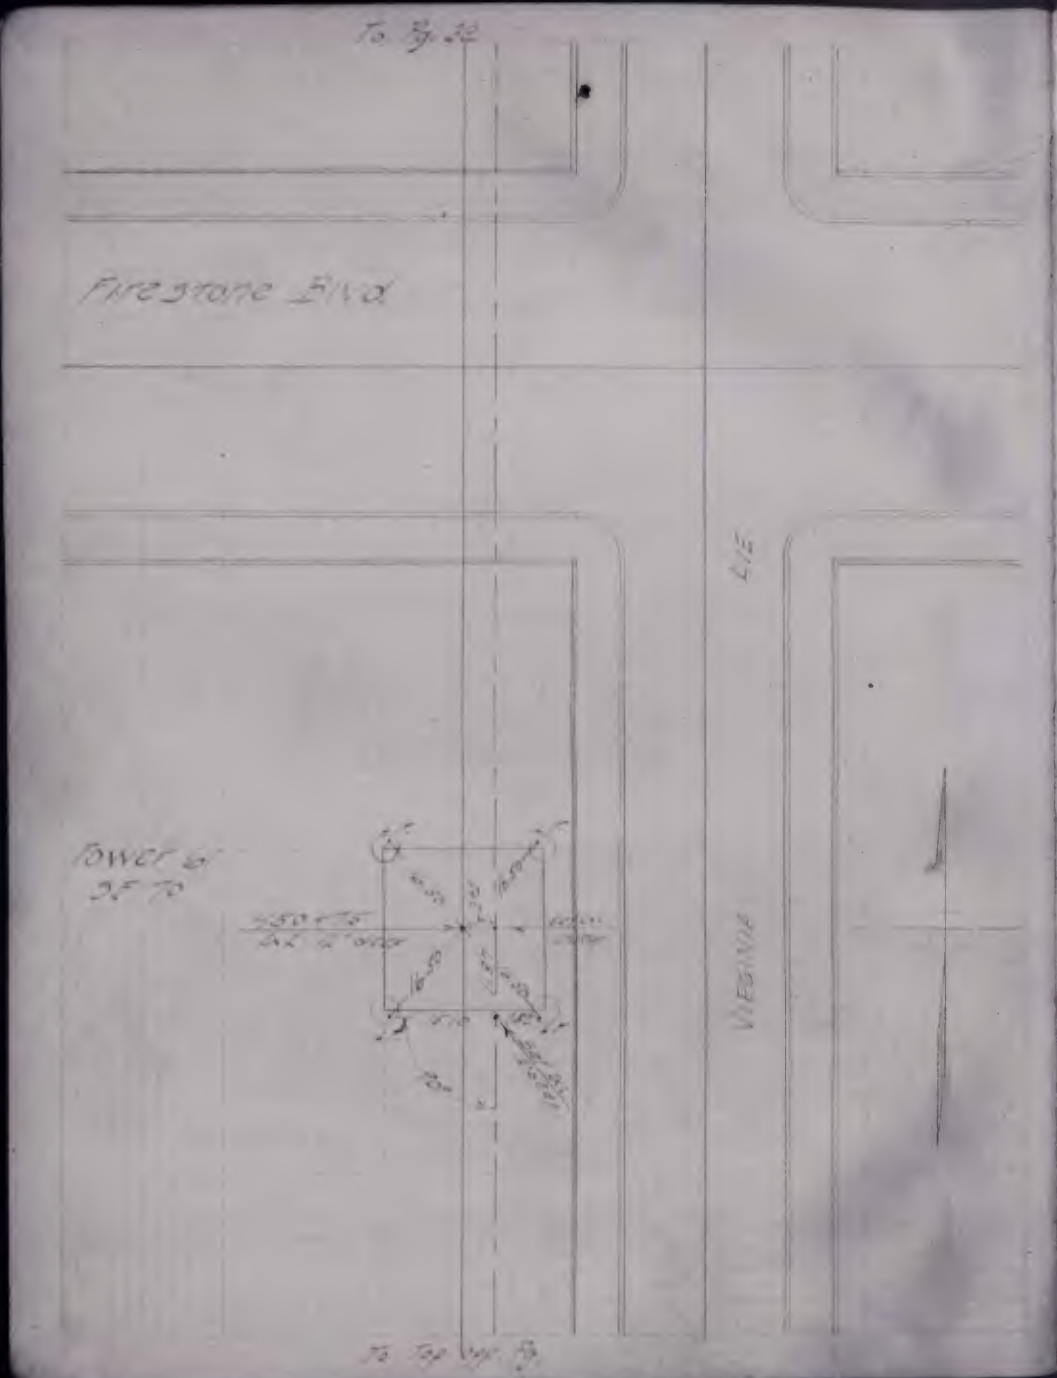

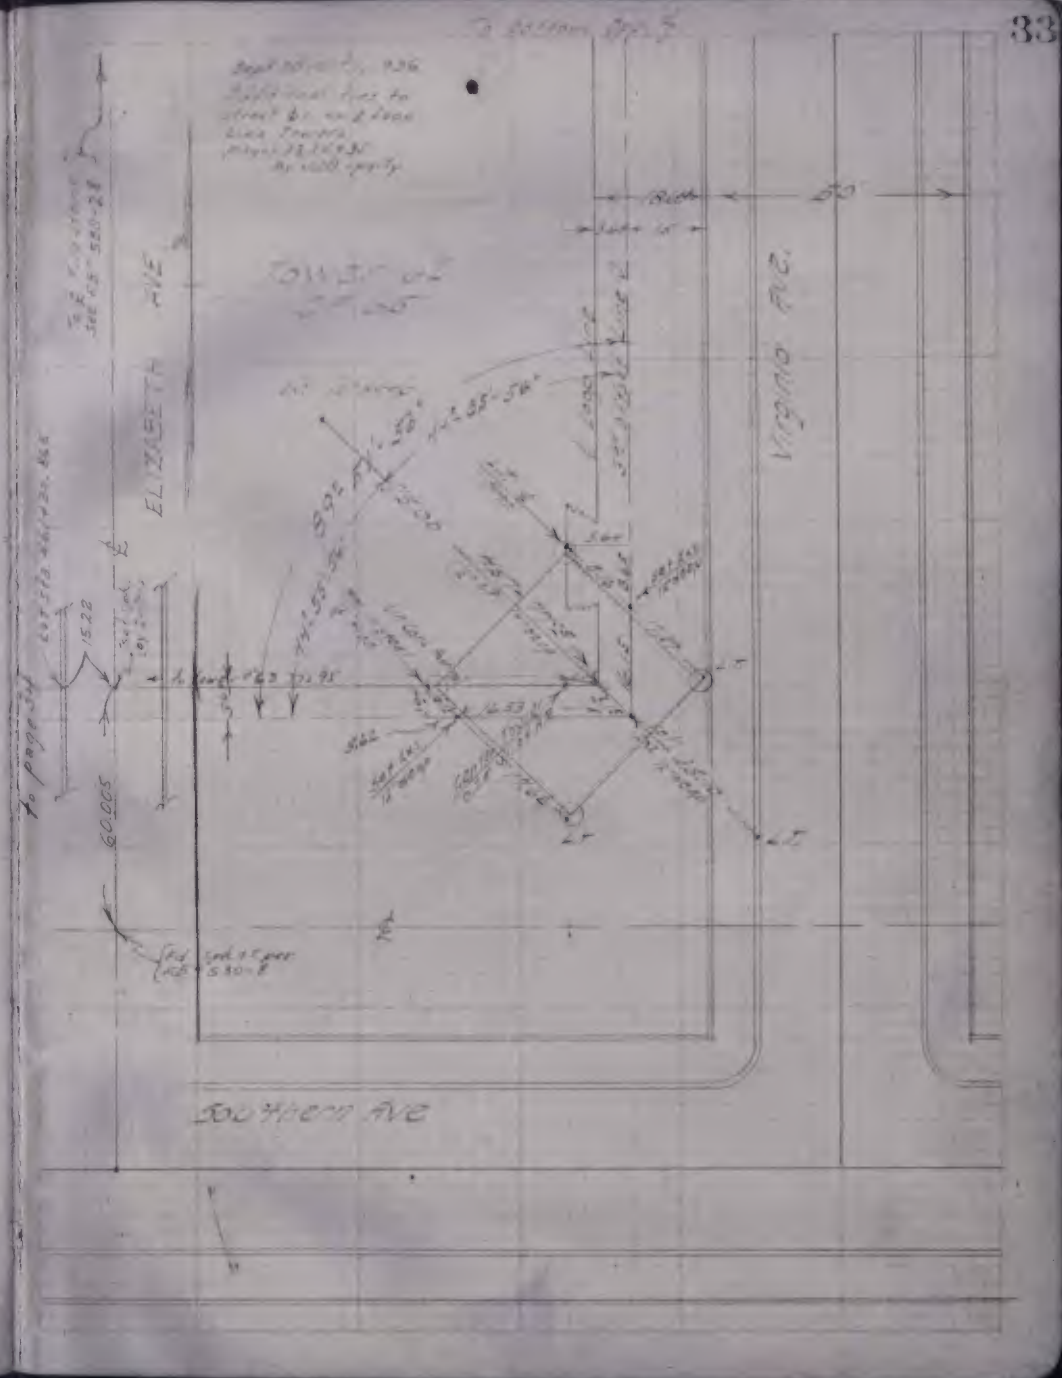

FB. 1301-67

FB. 1301-68

B.P.&.L.-F.B.325

34

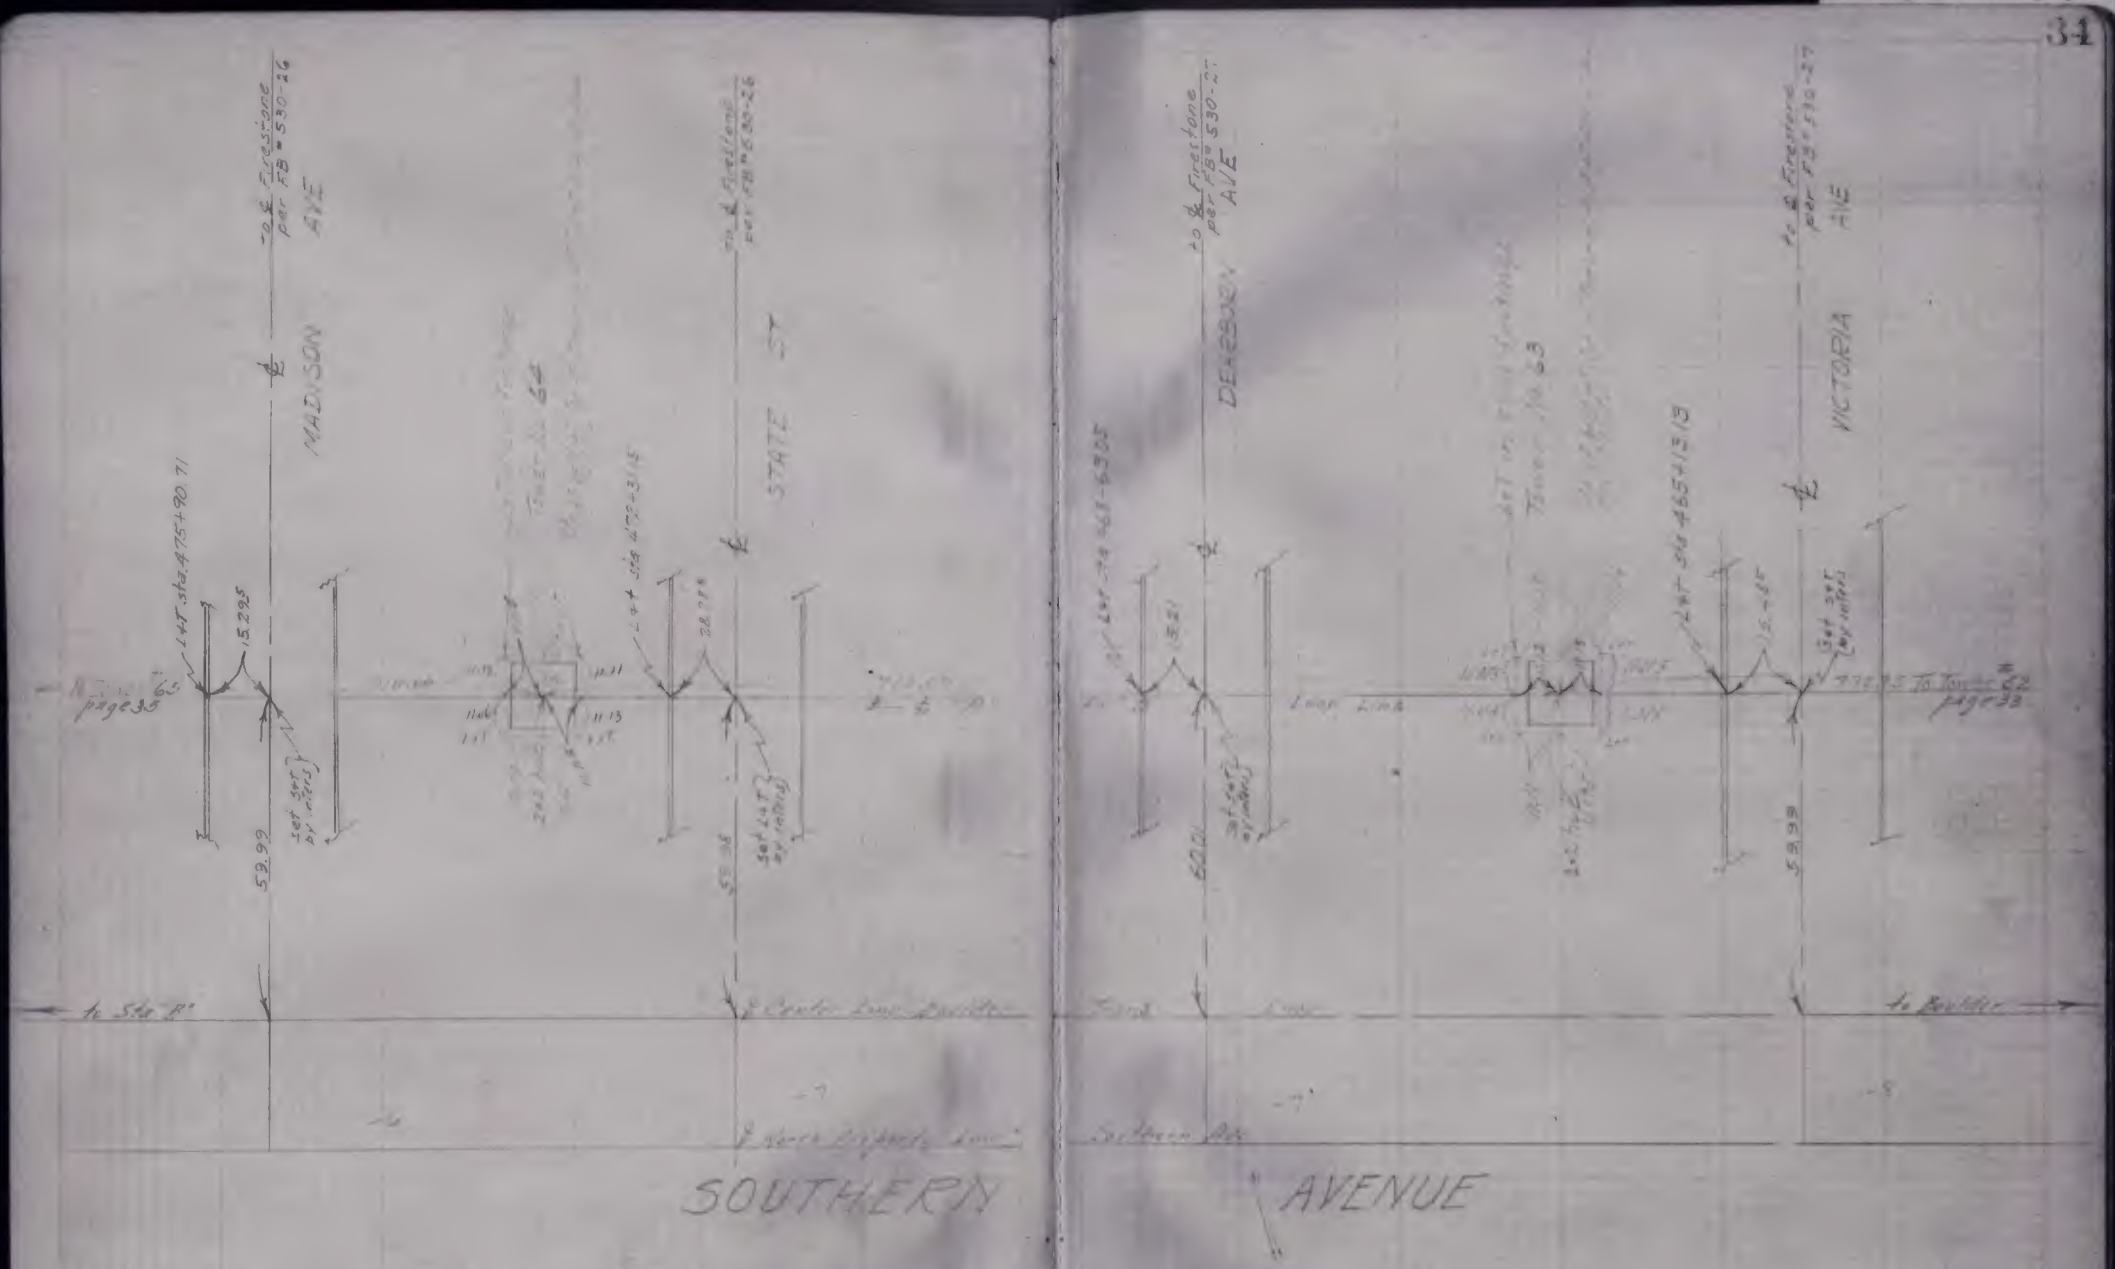

FB.1301-69

FB.1301-70

B.P.&.L.-F.B.325

35

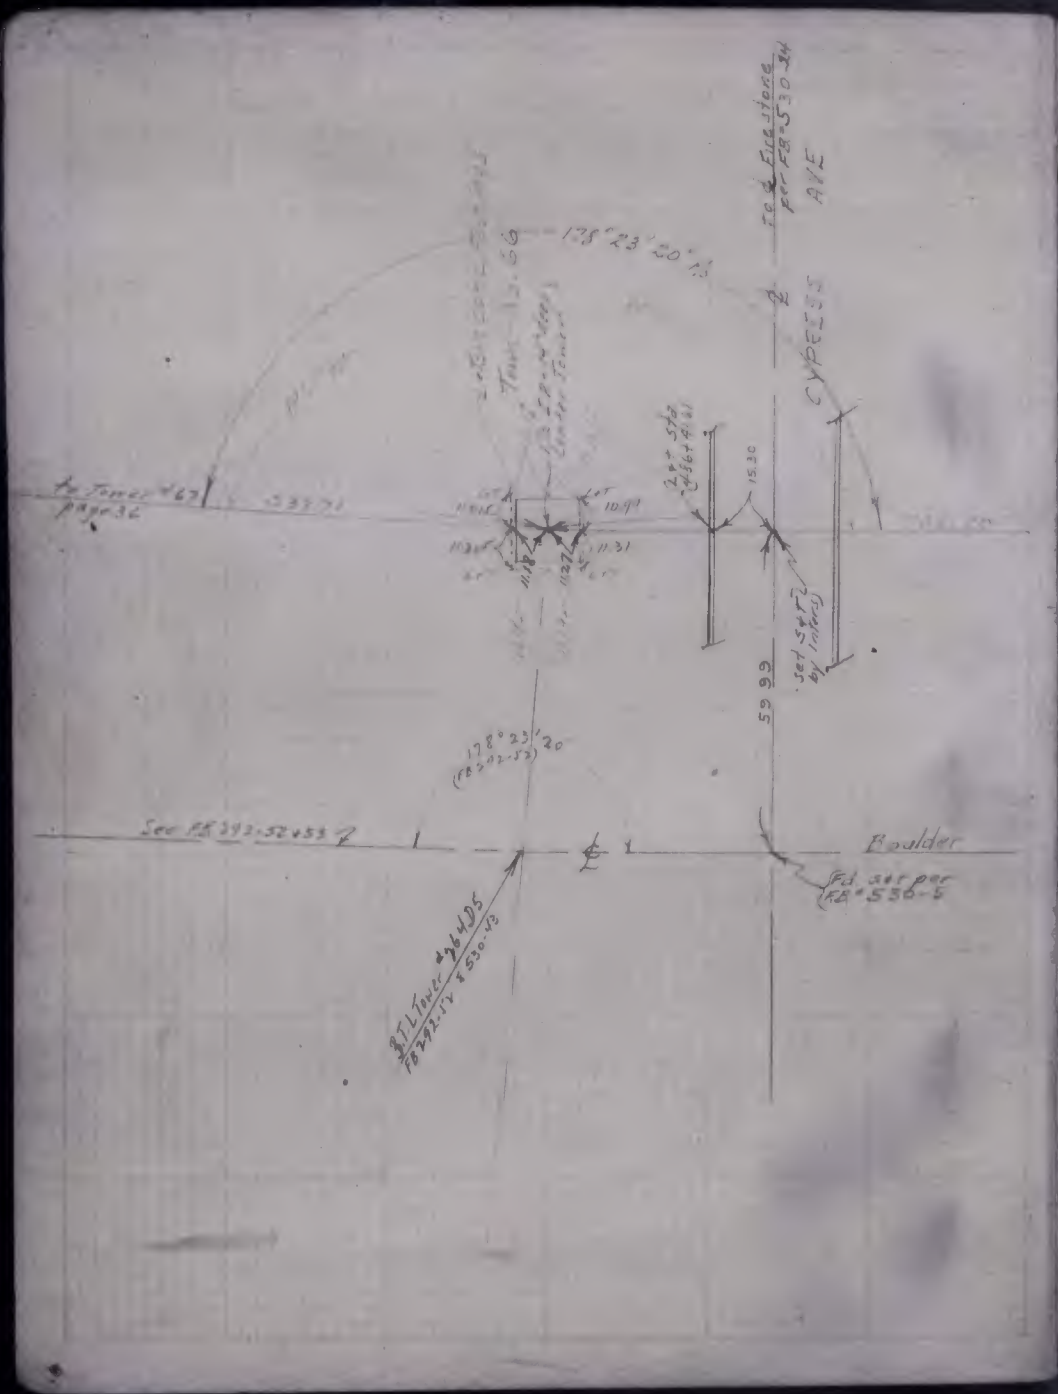

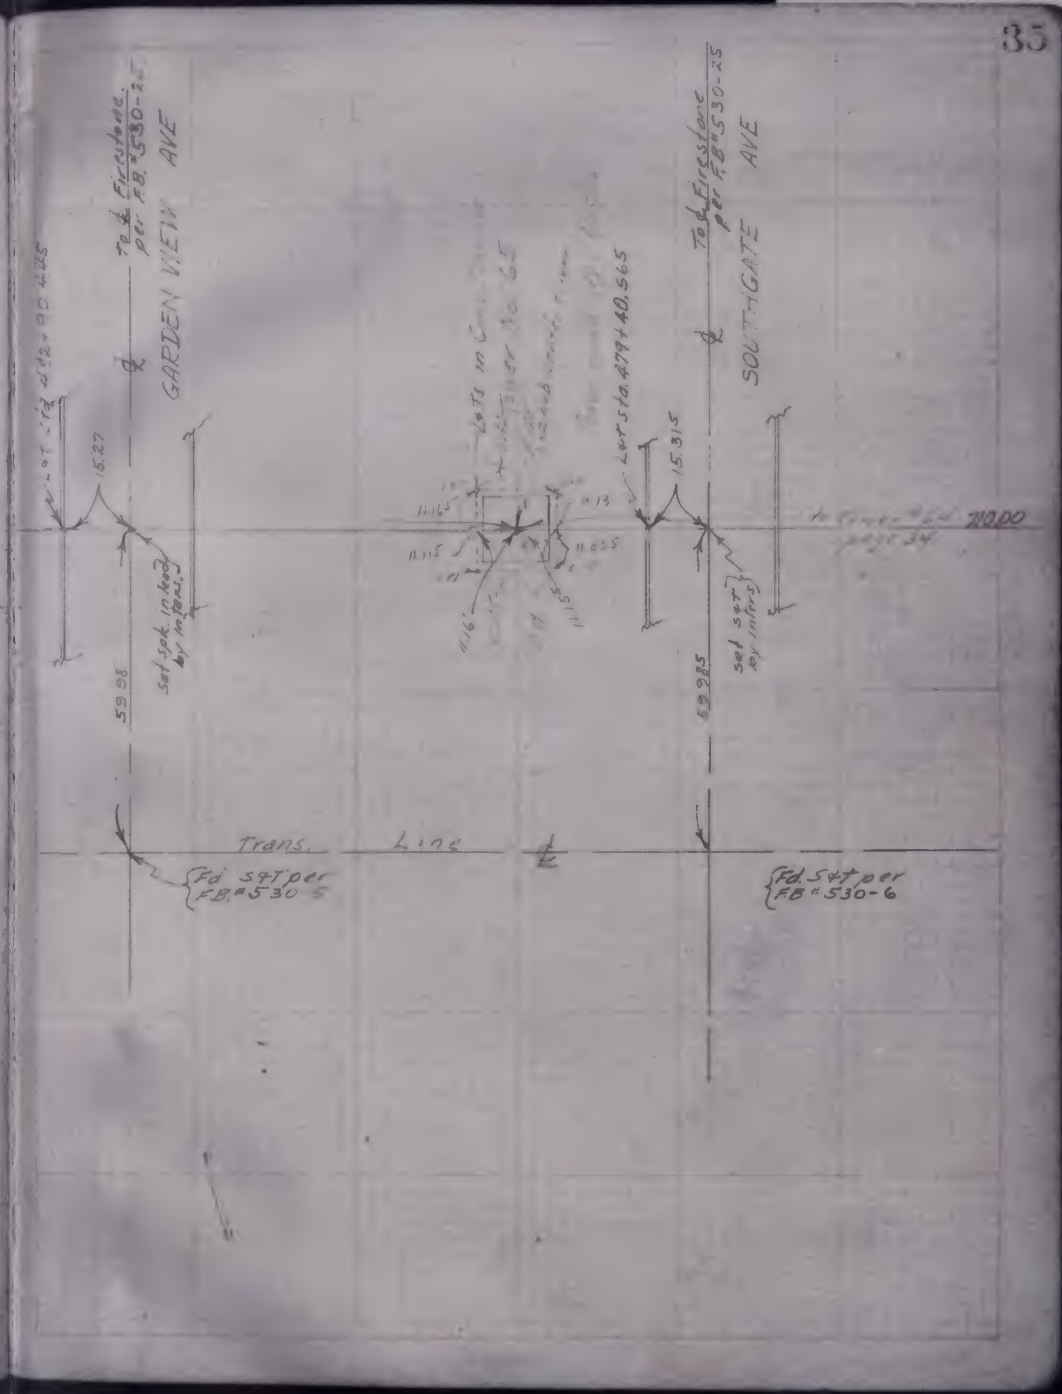

FB.1301-71

FB.1301-72

B.P.&L.-F.B.325

FB.1301-73

FB.1301-74

B.P.&.L.-F.B.325

37.

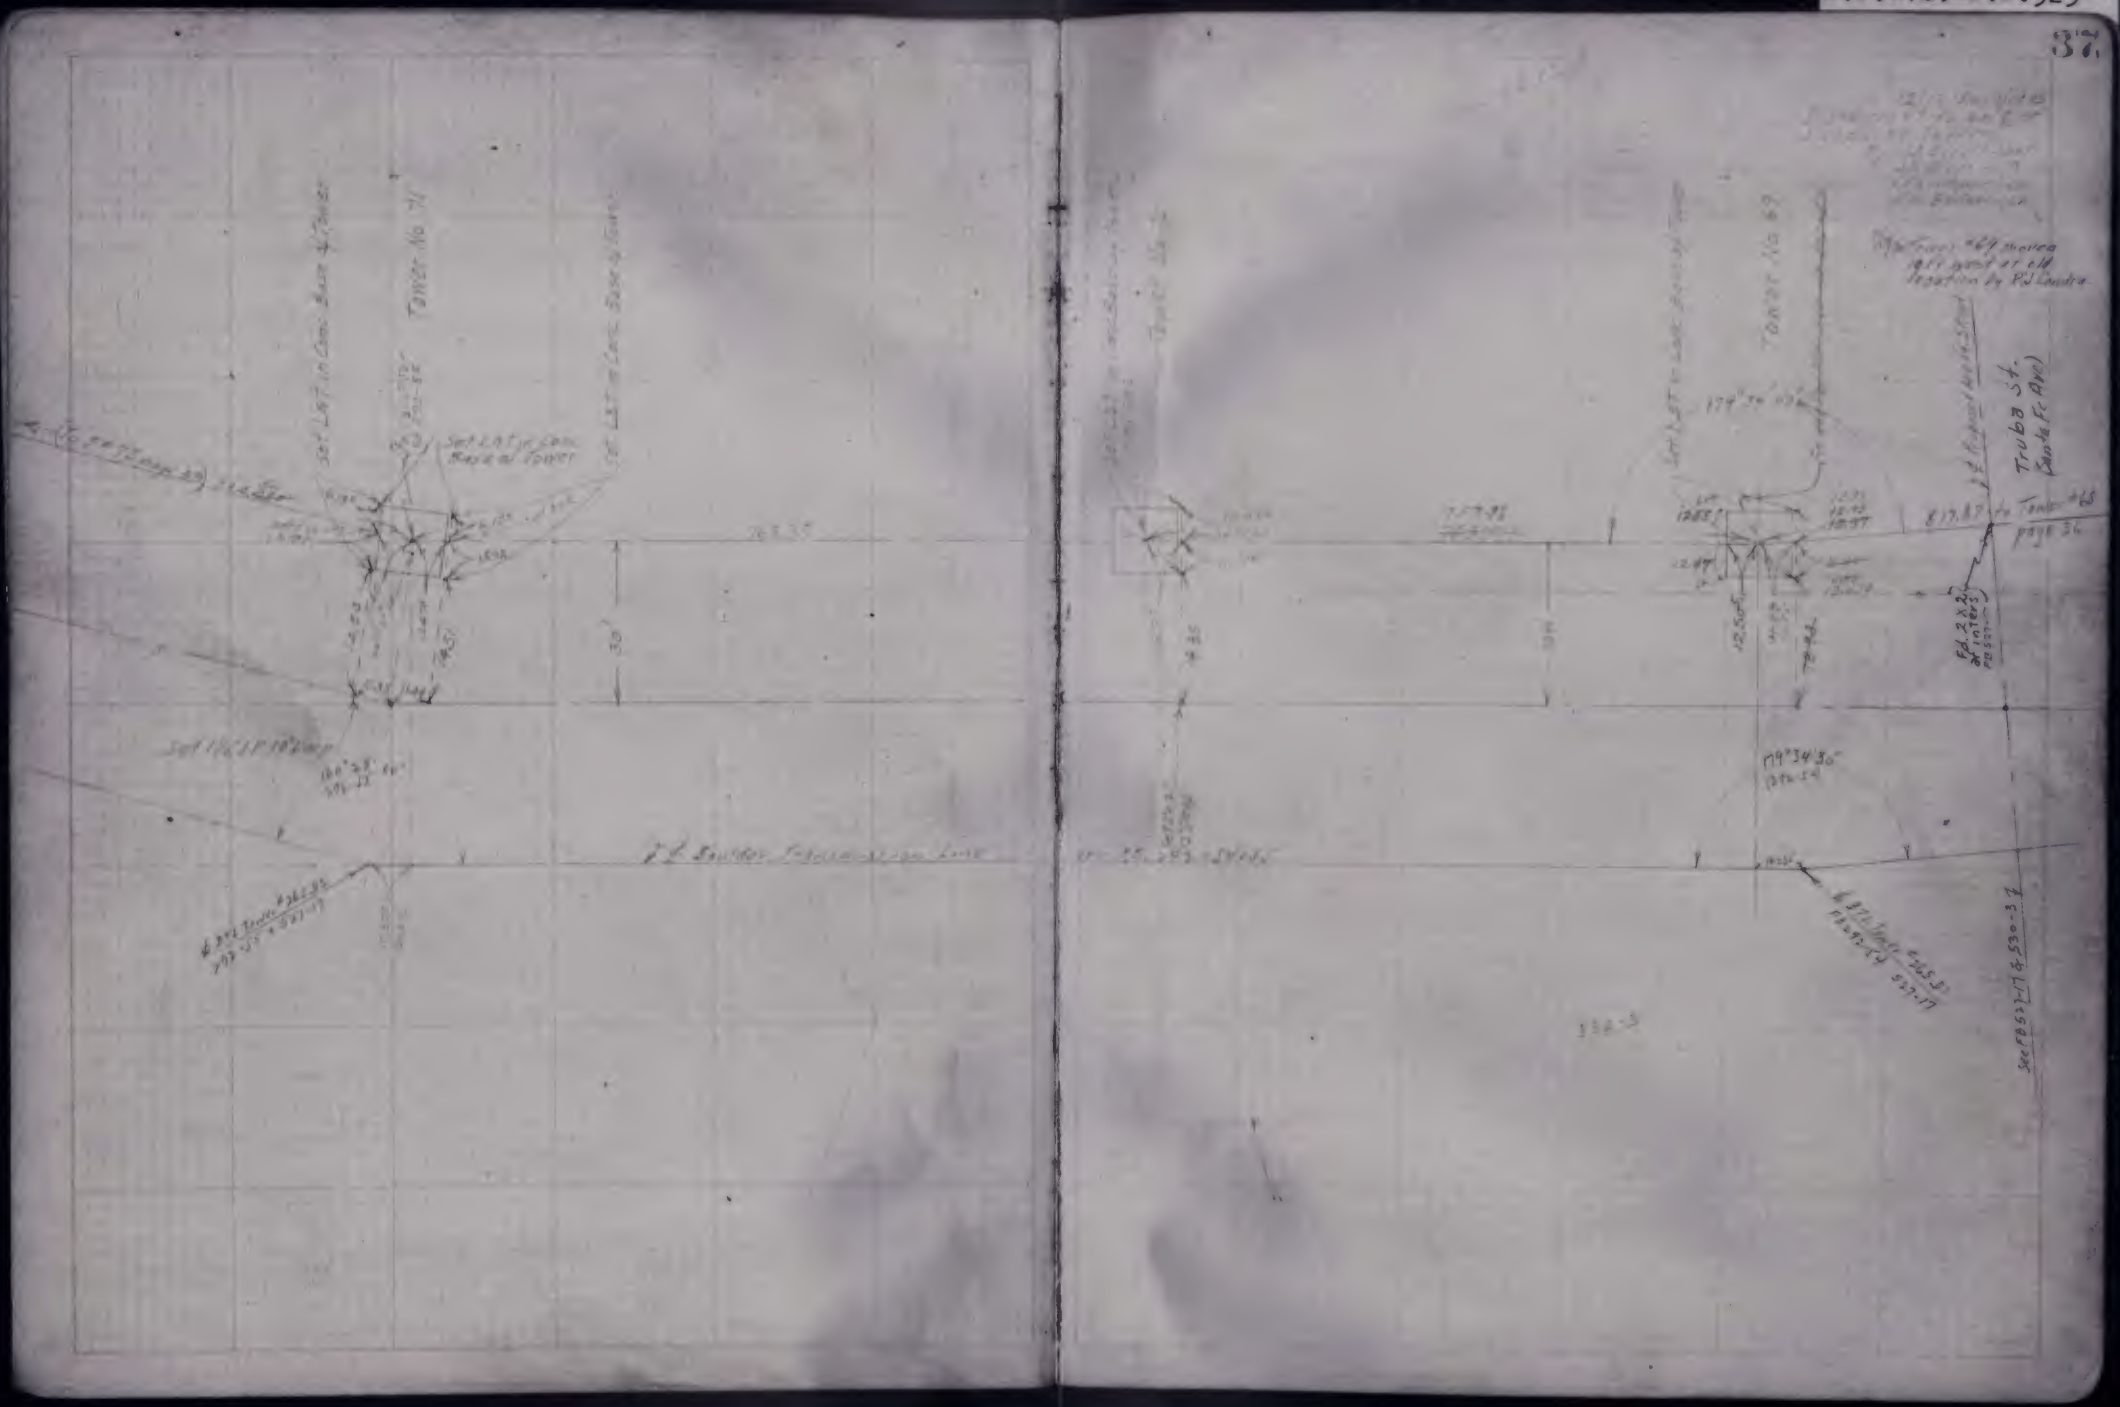

FB.1301-75

FB.1301-76

B.P.&.L.-F.B.325

38

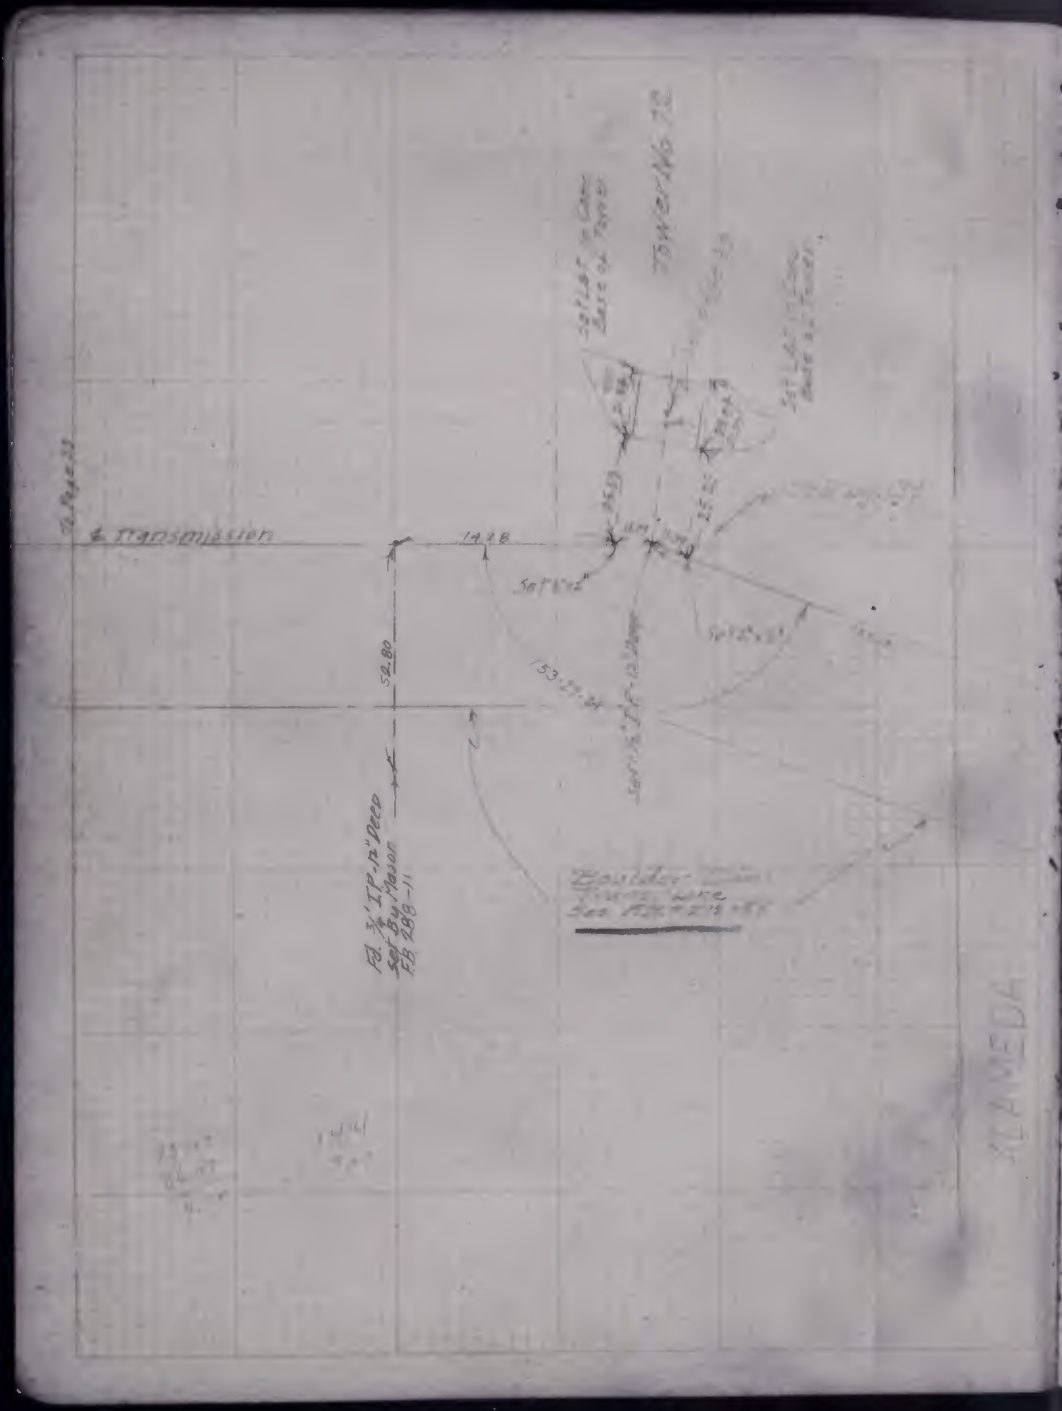

FB.1301-77

FB.1301-78

B.P.&.L.-F.B.325

39

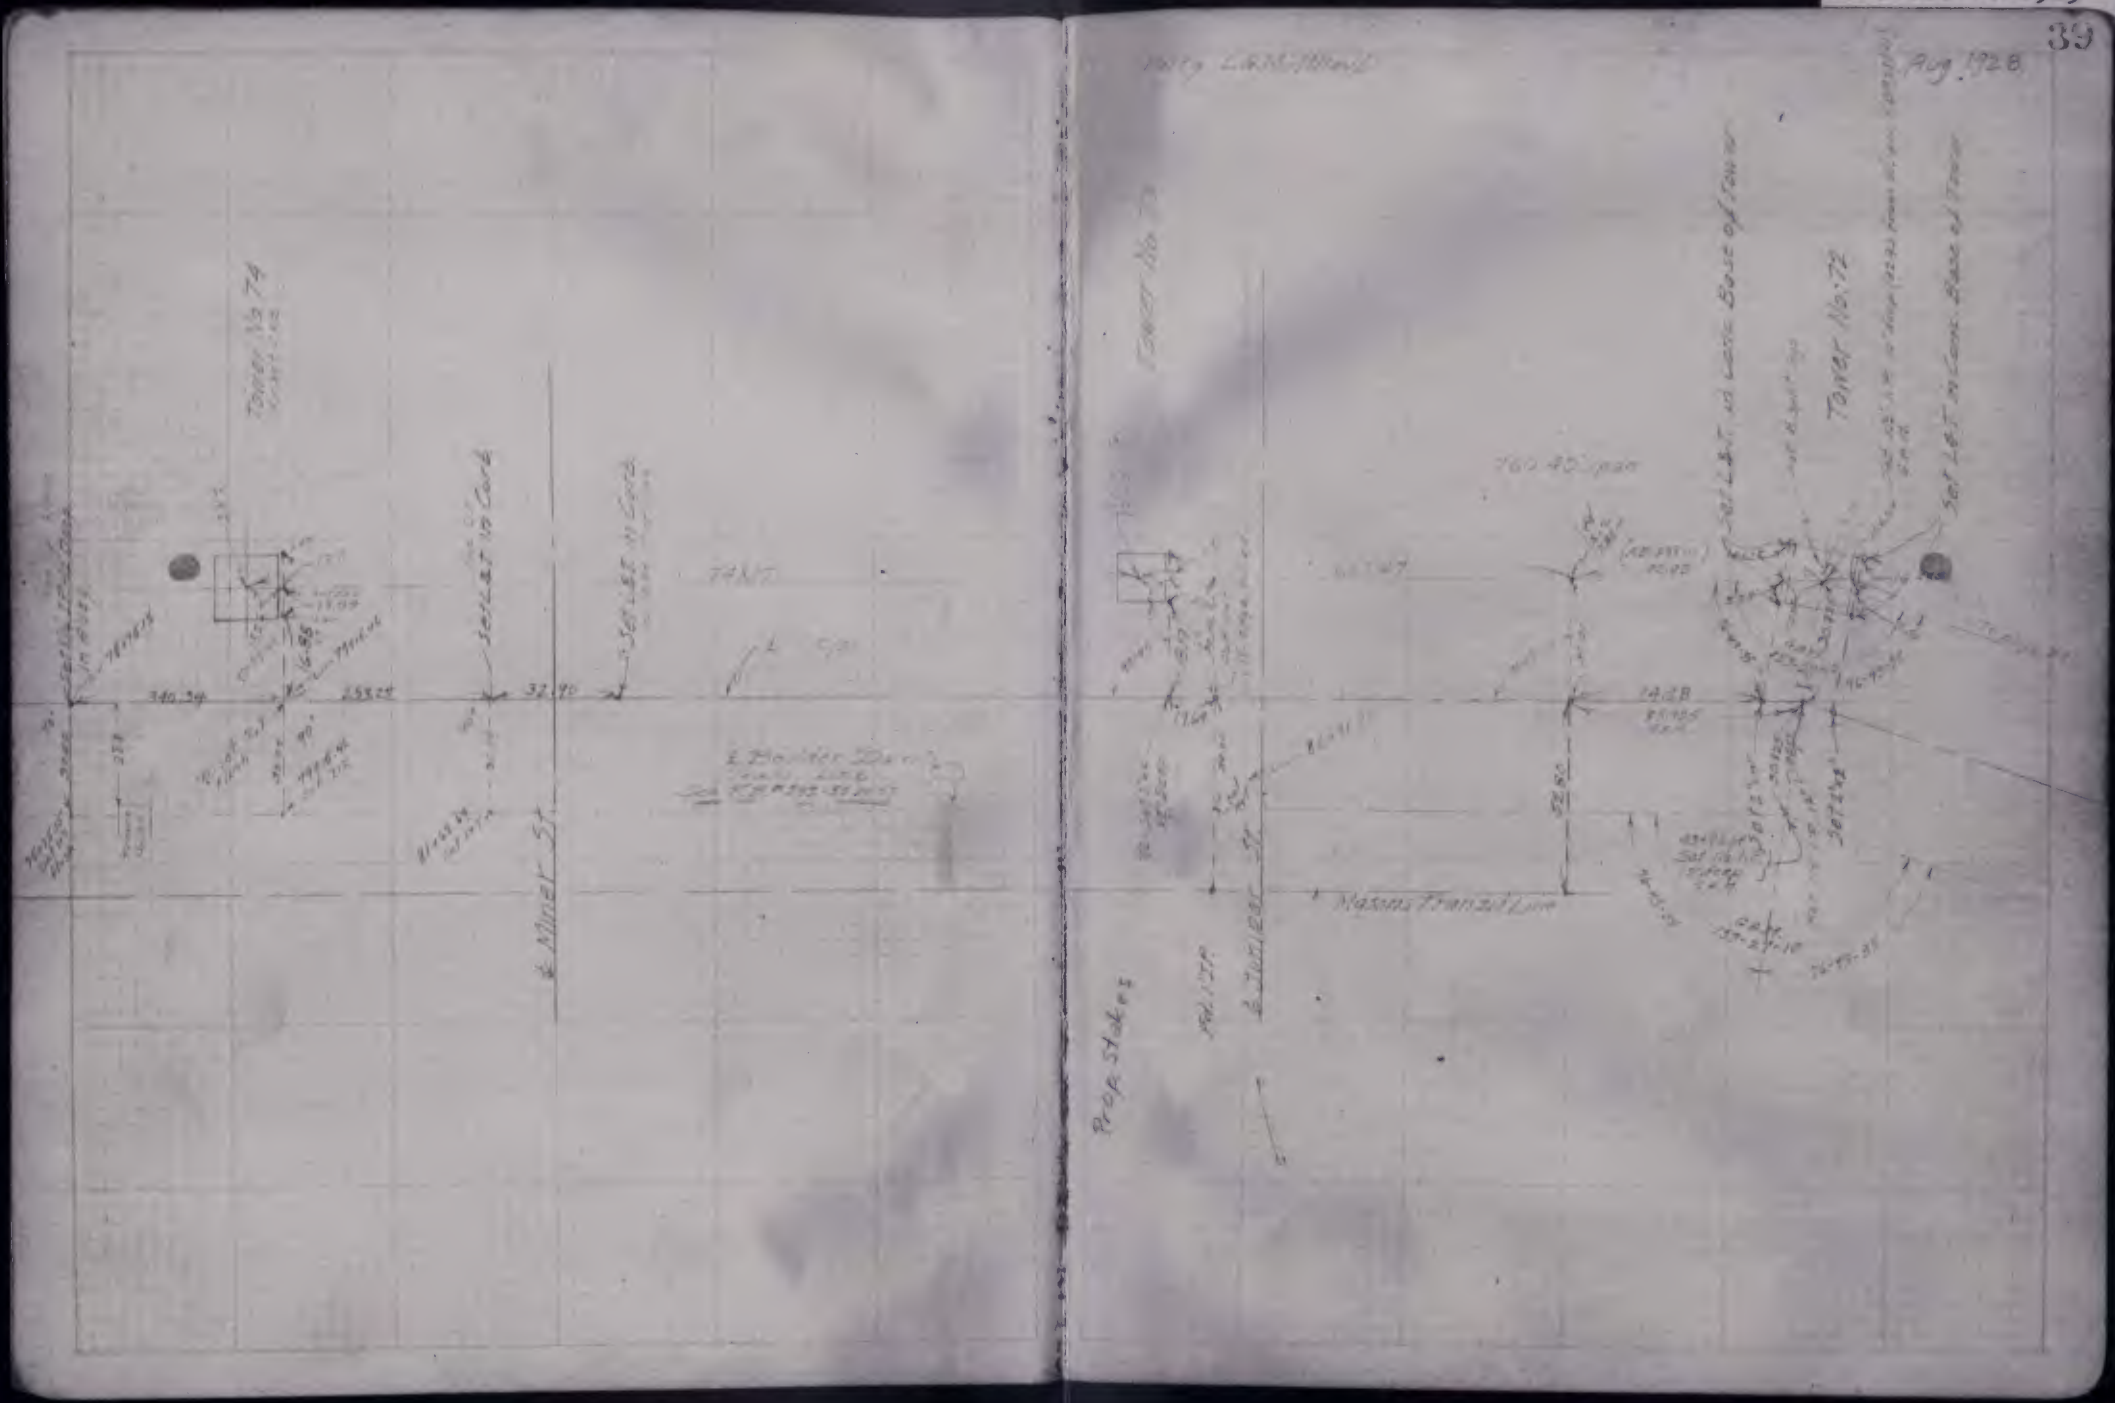

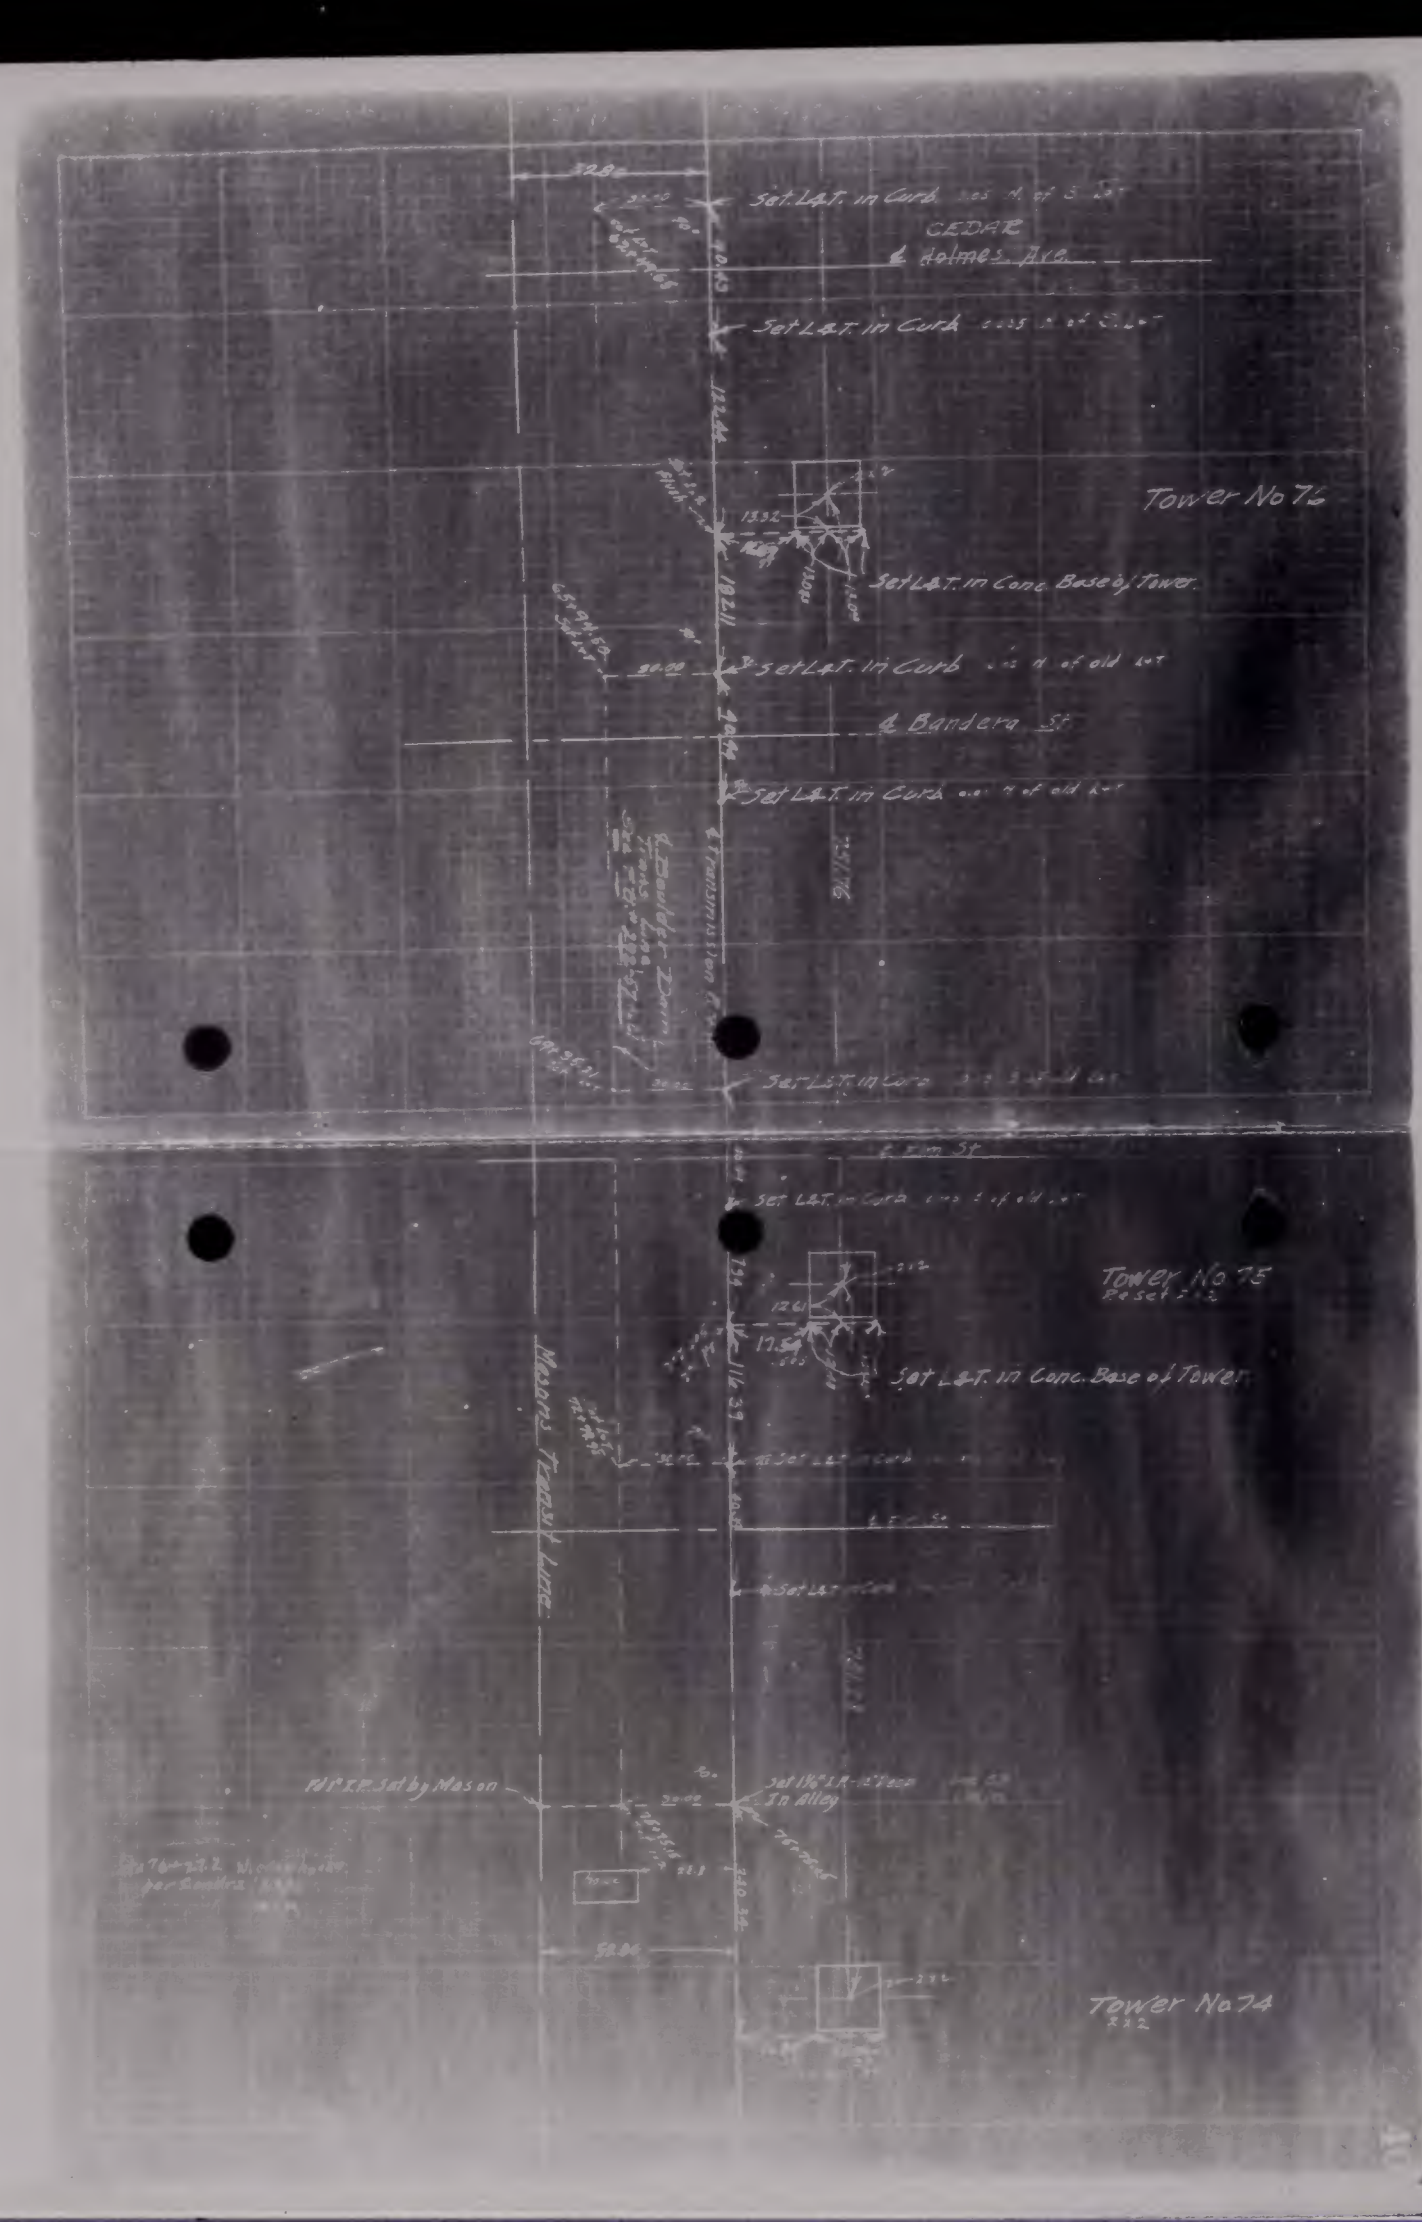
Set L&T. in Curb
CEDAR
& Holmes Ave
Set L&T. in Curb
Set L&T. in Conc. Base of Tower
Set L&T. in Curb
& Bandera St
Set L&T. in Curb
Set L&T. in Curb
& Elm St
Set L&T. in Curb
Tower No 75
Reset
Set L&T. in Conc. Base of Tower
Set 1½" I.P. Set by Mason
Set 1½" I.P. in Rock In Alley
Tower No 74

B.P.&L.-F.B.325

FB.1301-79

FB.1301-80

B.P.&.L.-F.B.325

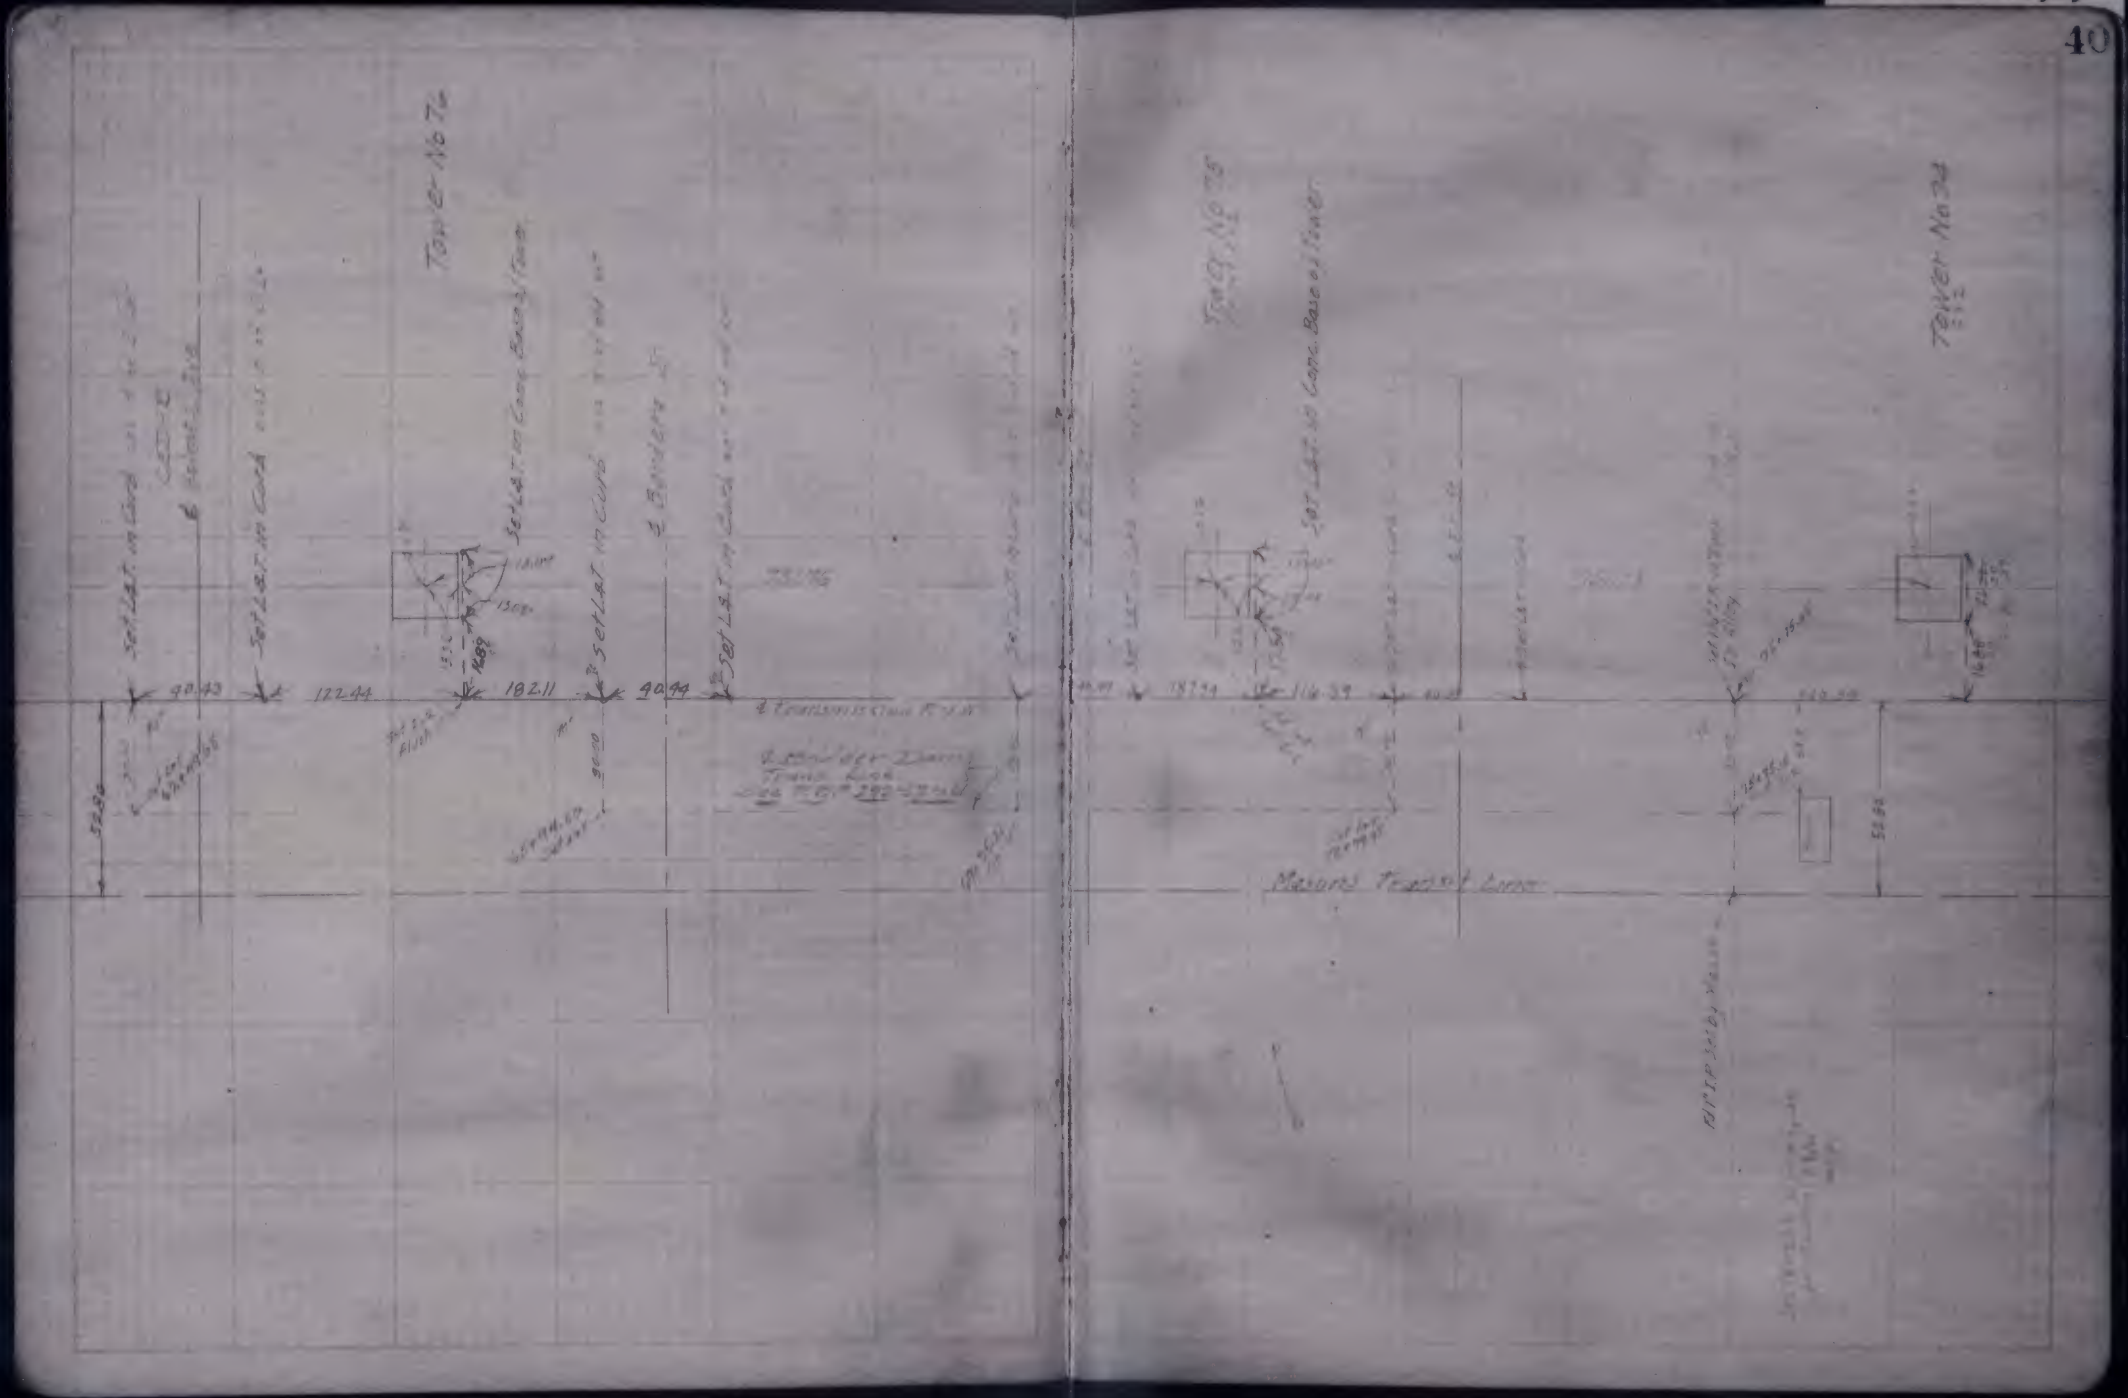

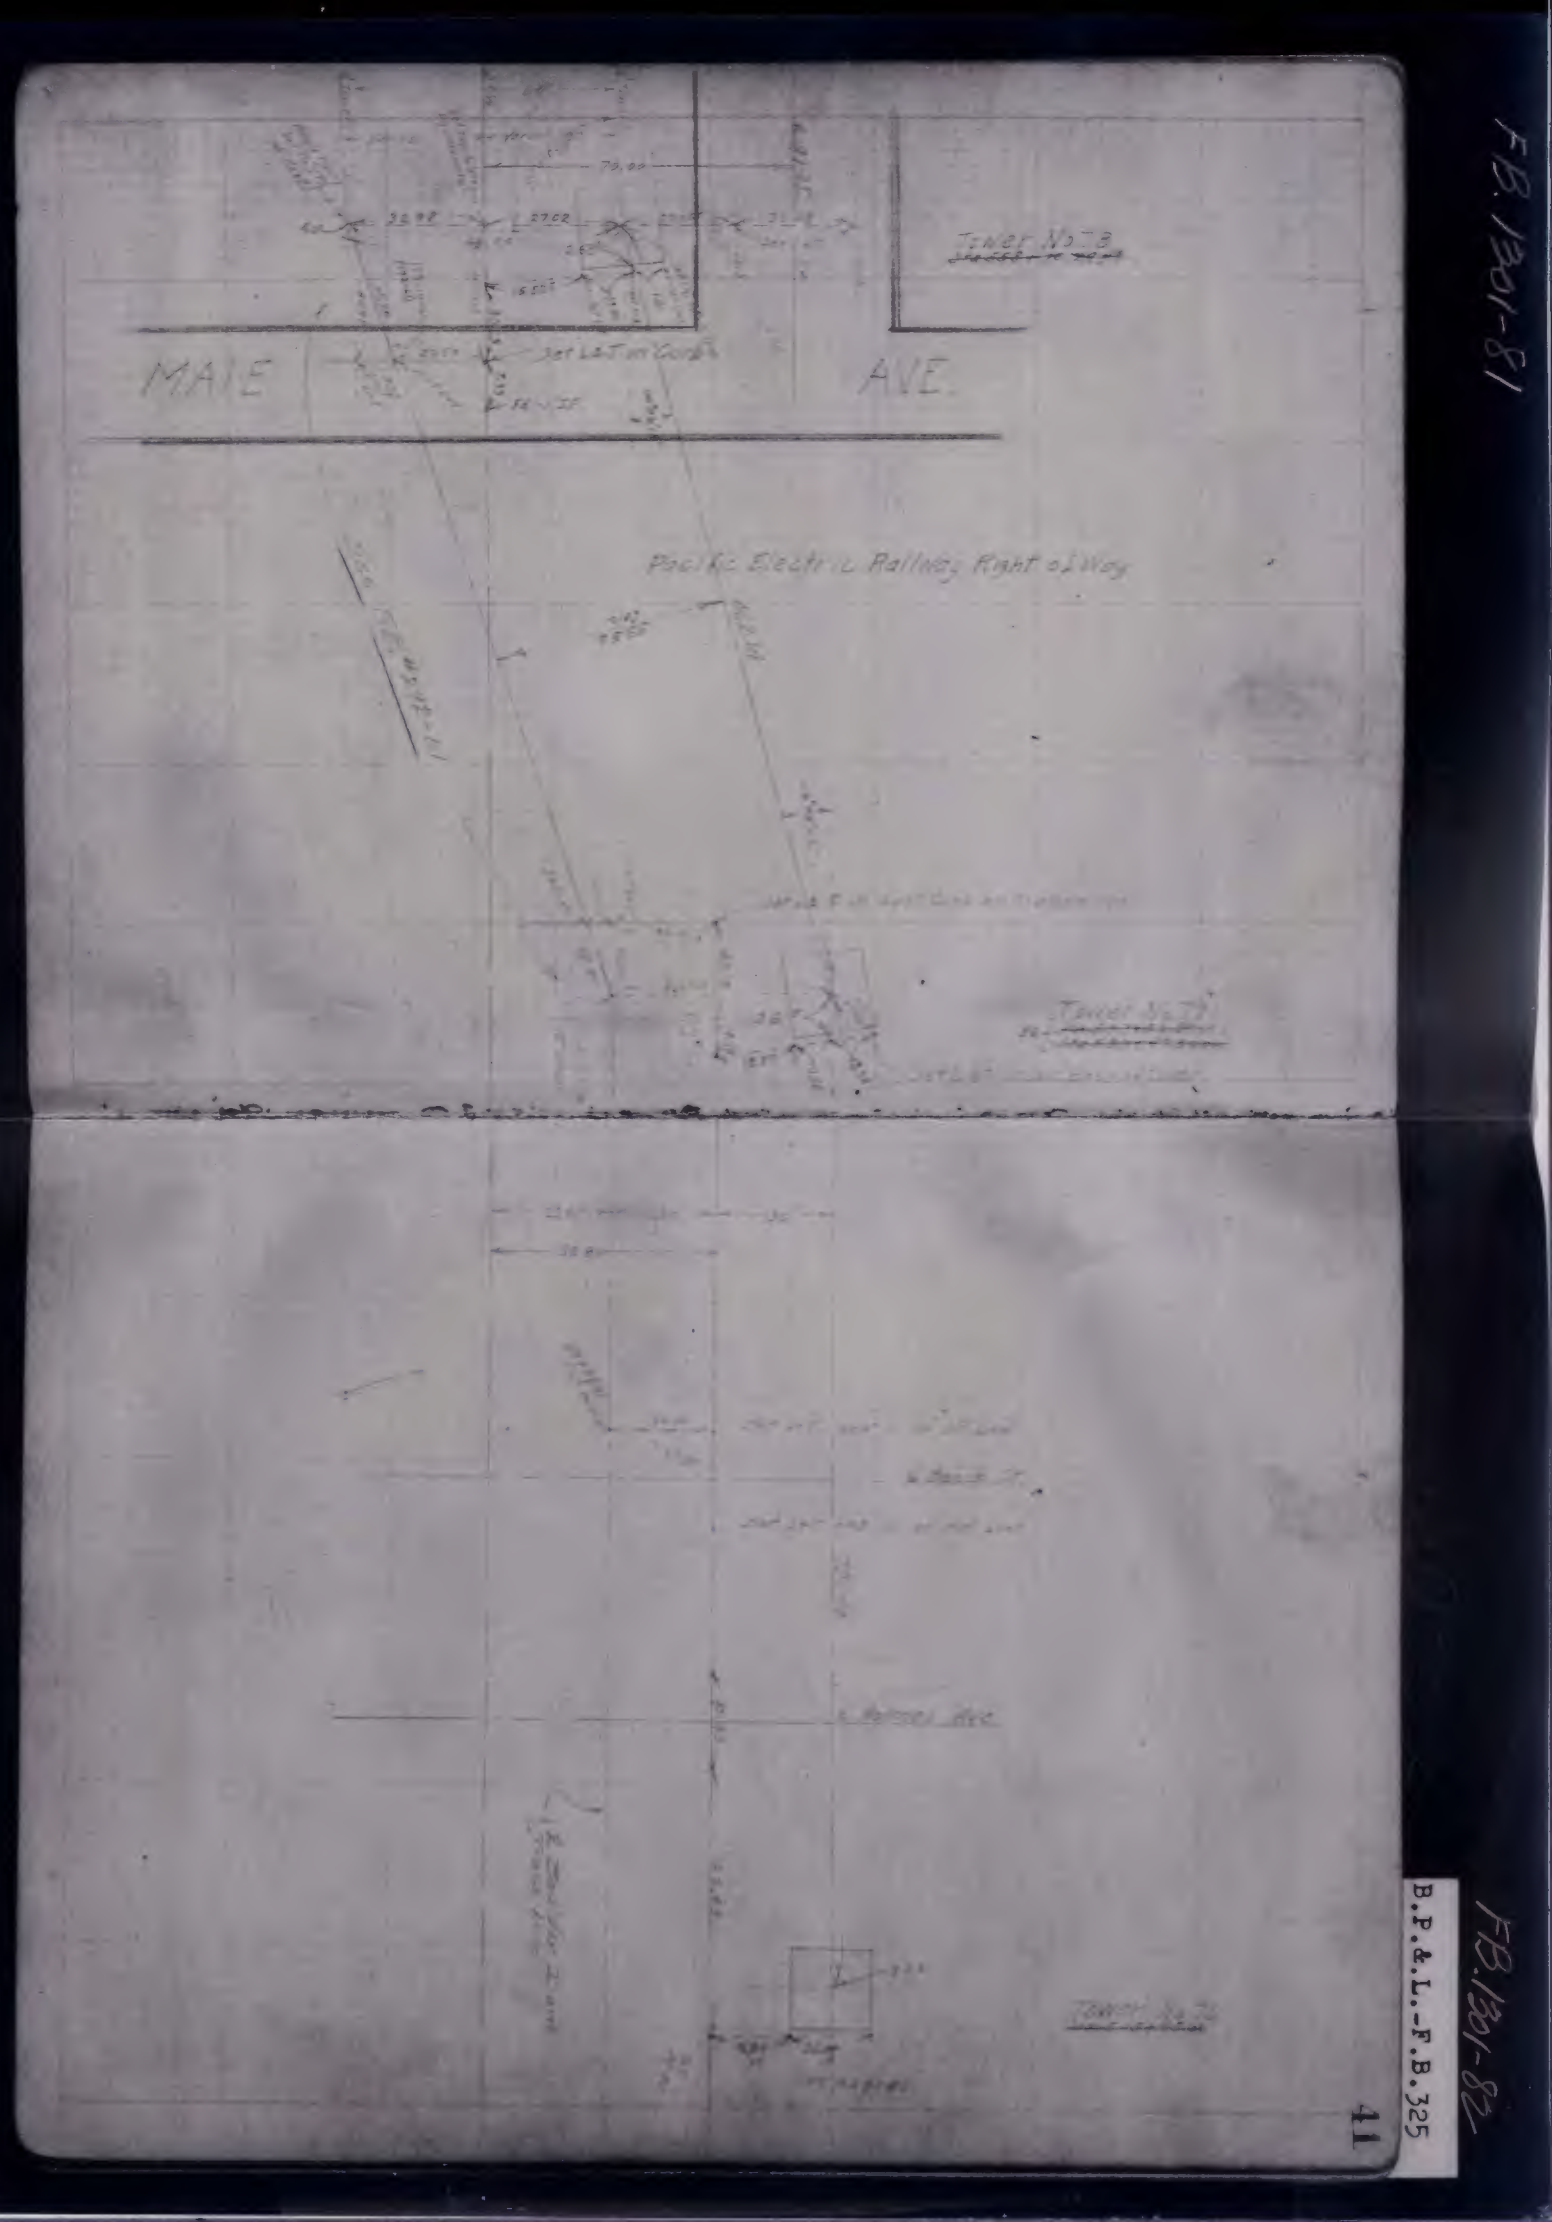

FB. 1301-81

FB. 1301-82

B.P.&L.-F.B.325

41

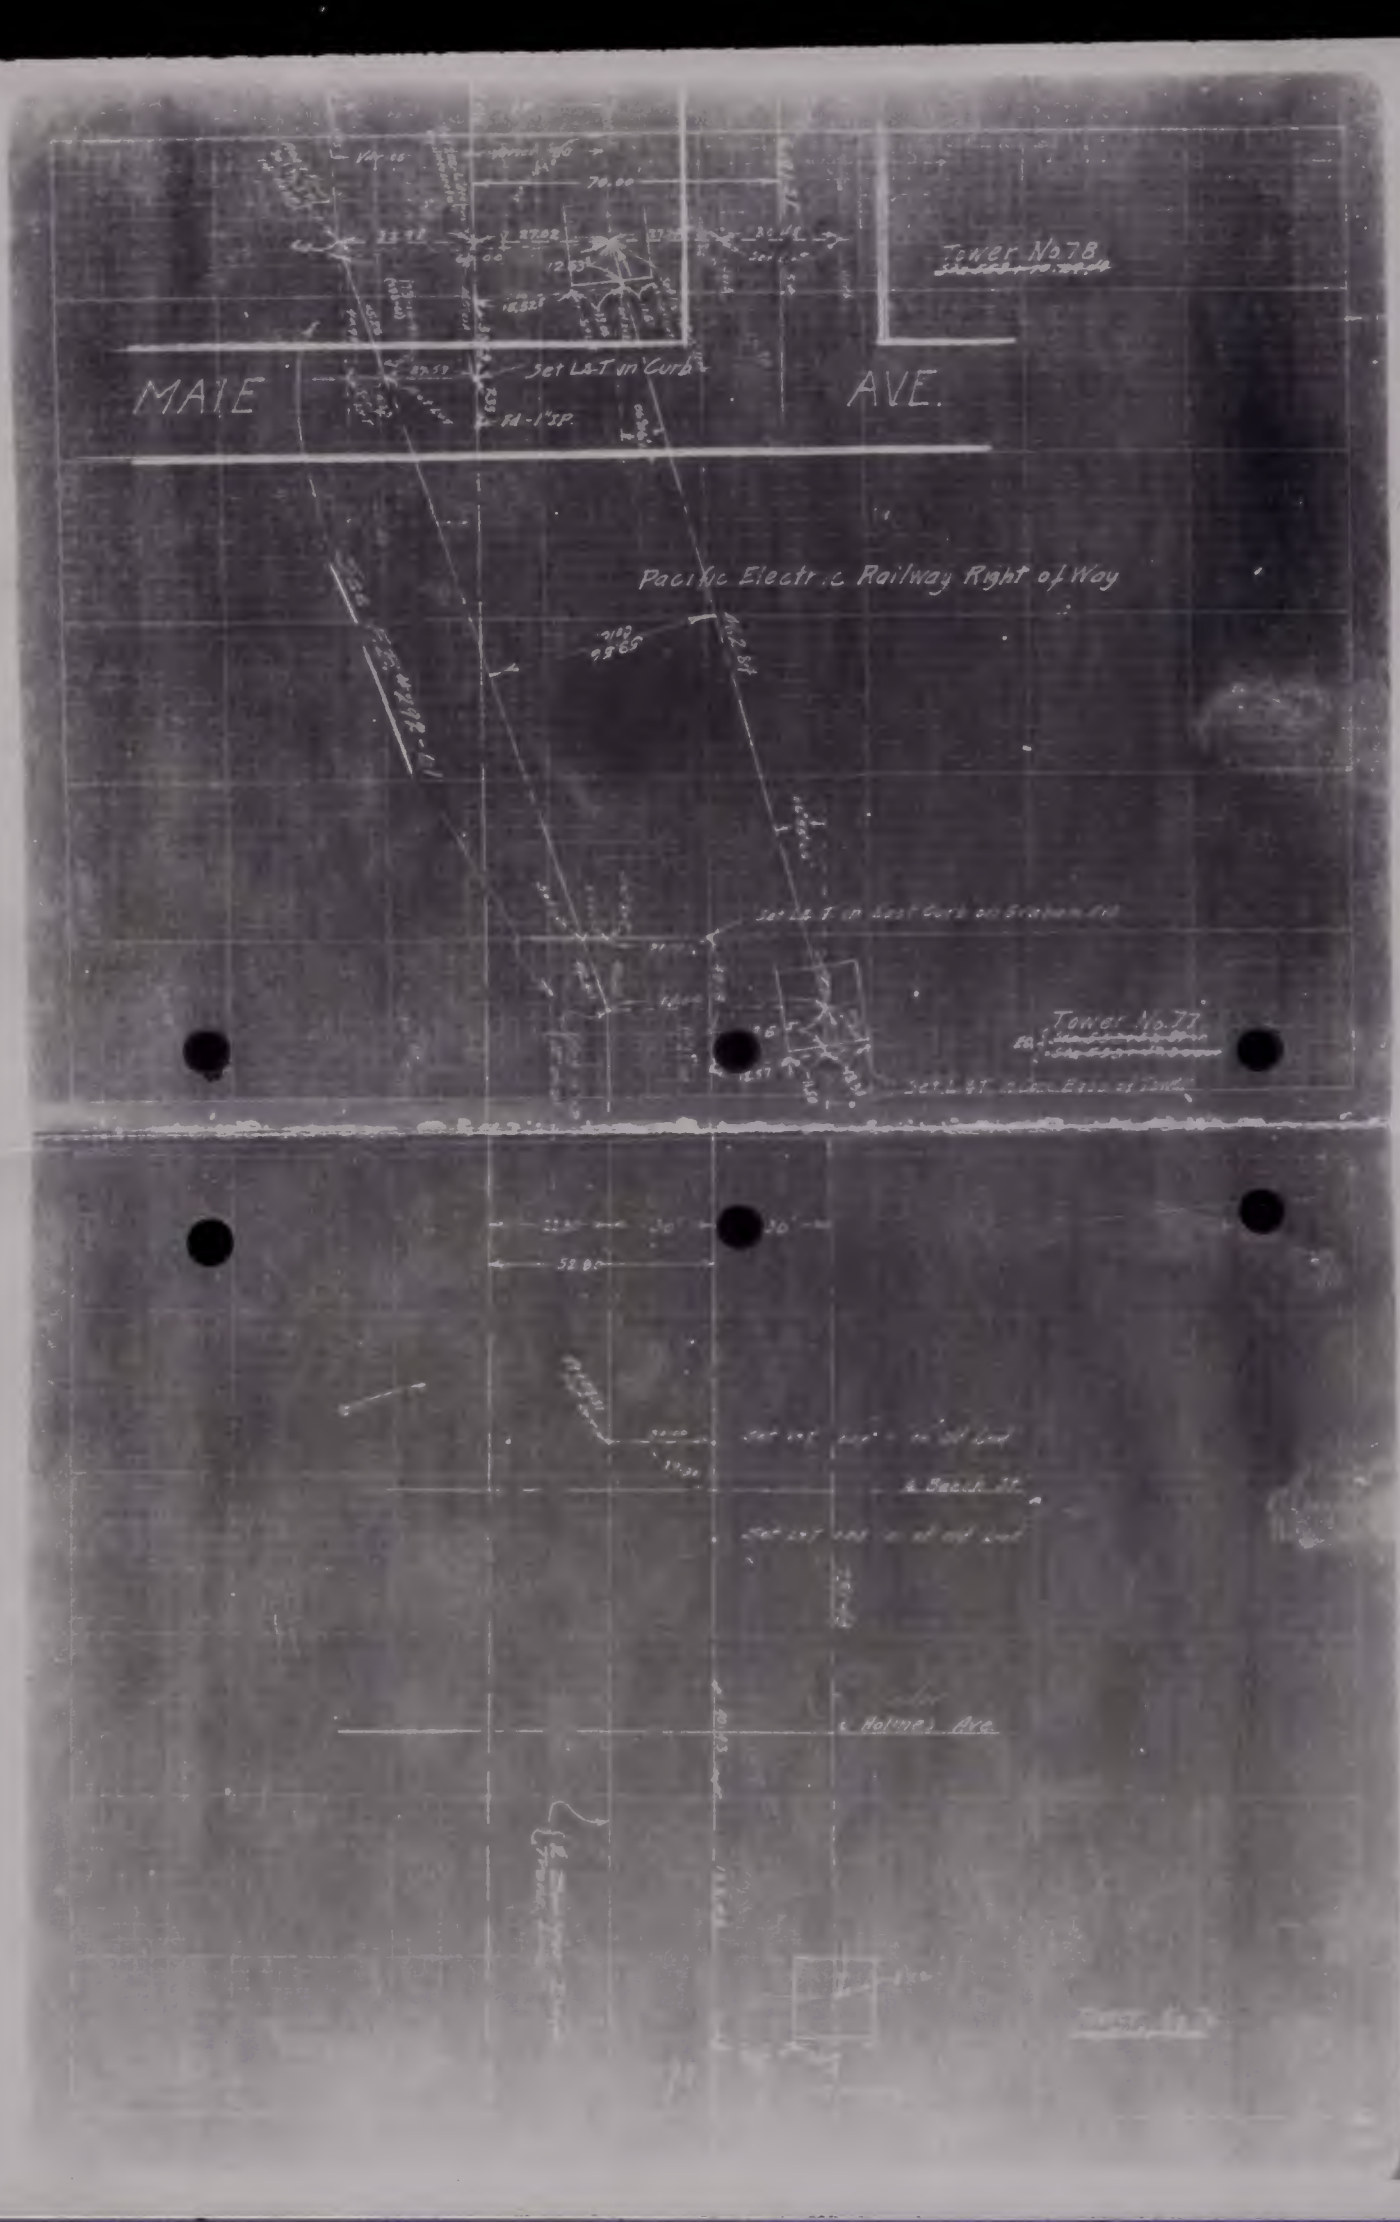
Tower No 78
MAIE
AVE.
Set L & T in Curb
Pacific Electric Railway Right of Way
Tower No 77
Holmes Ave

B.P.&L.-F.B.125

FB.1301-83

FB.1301-84

B.P.&.L.-F.B.325

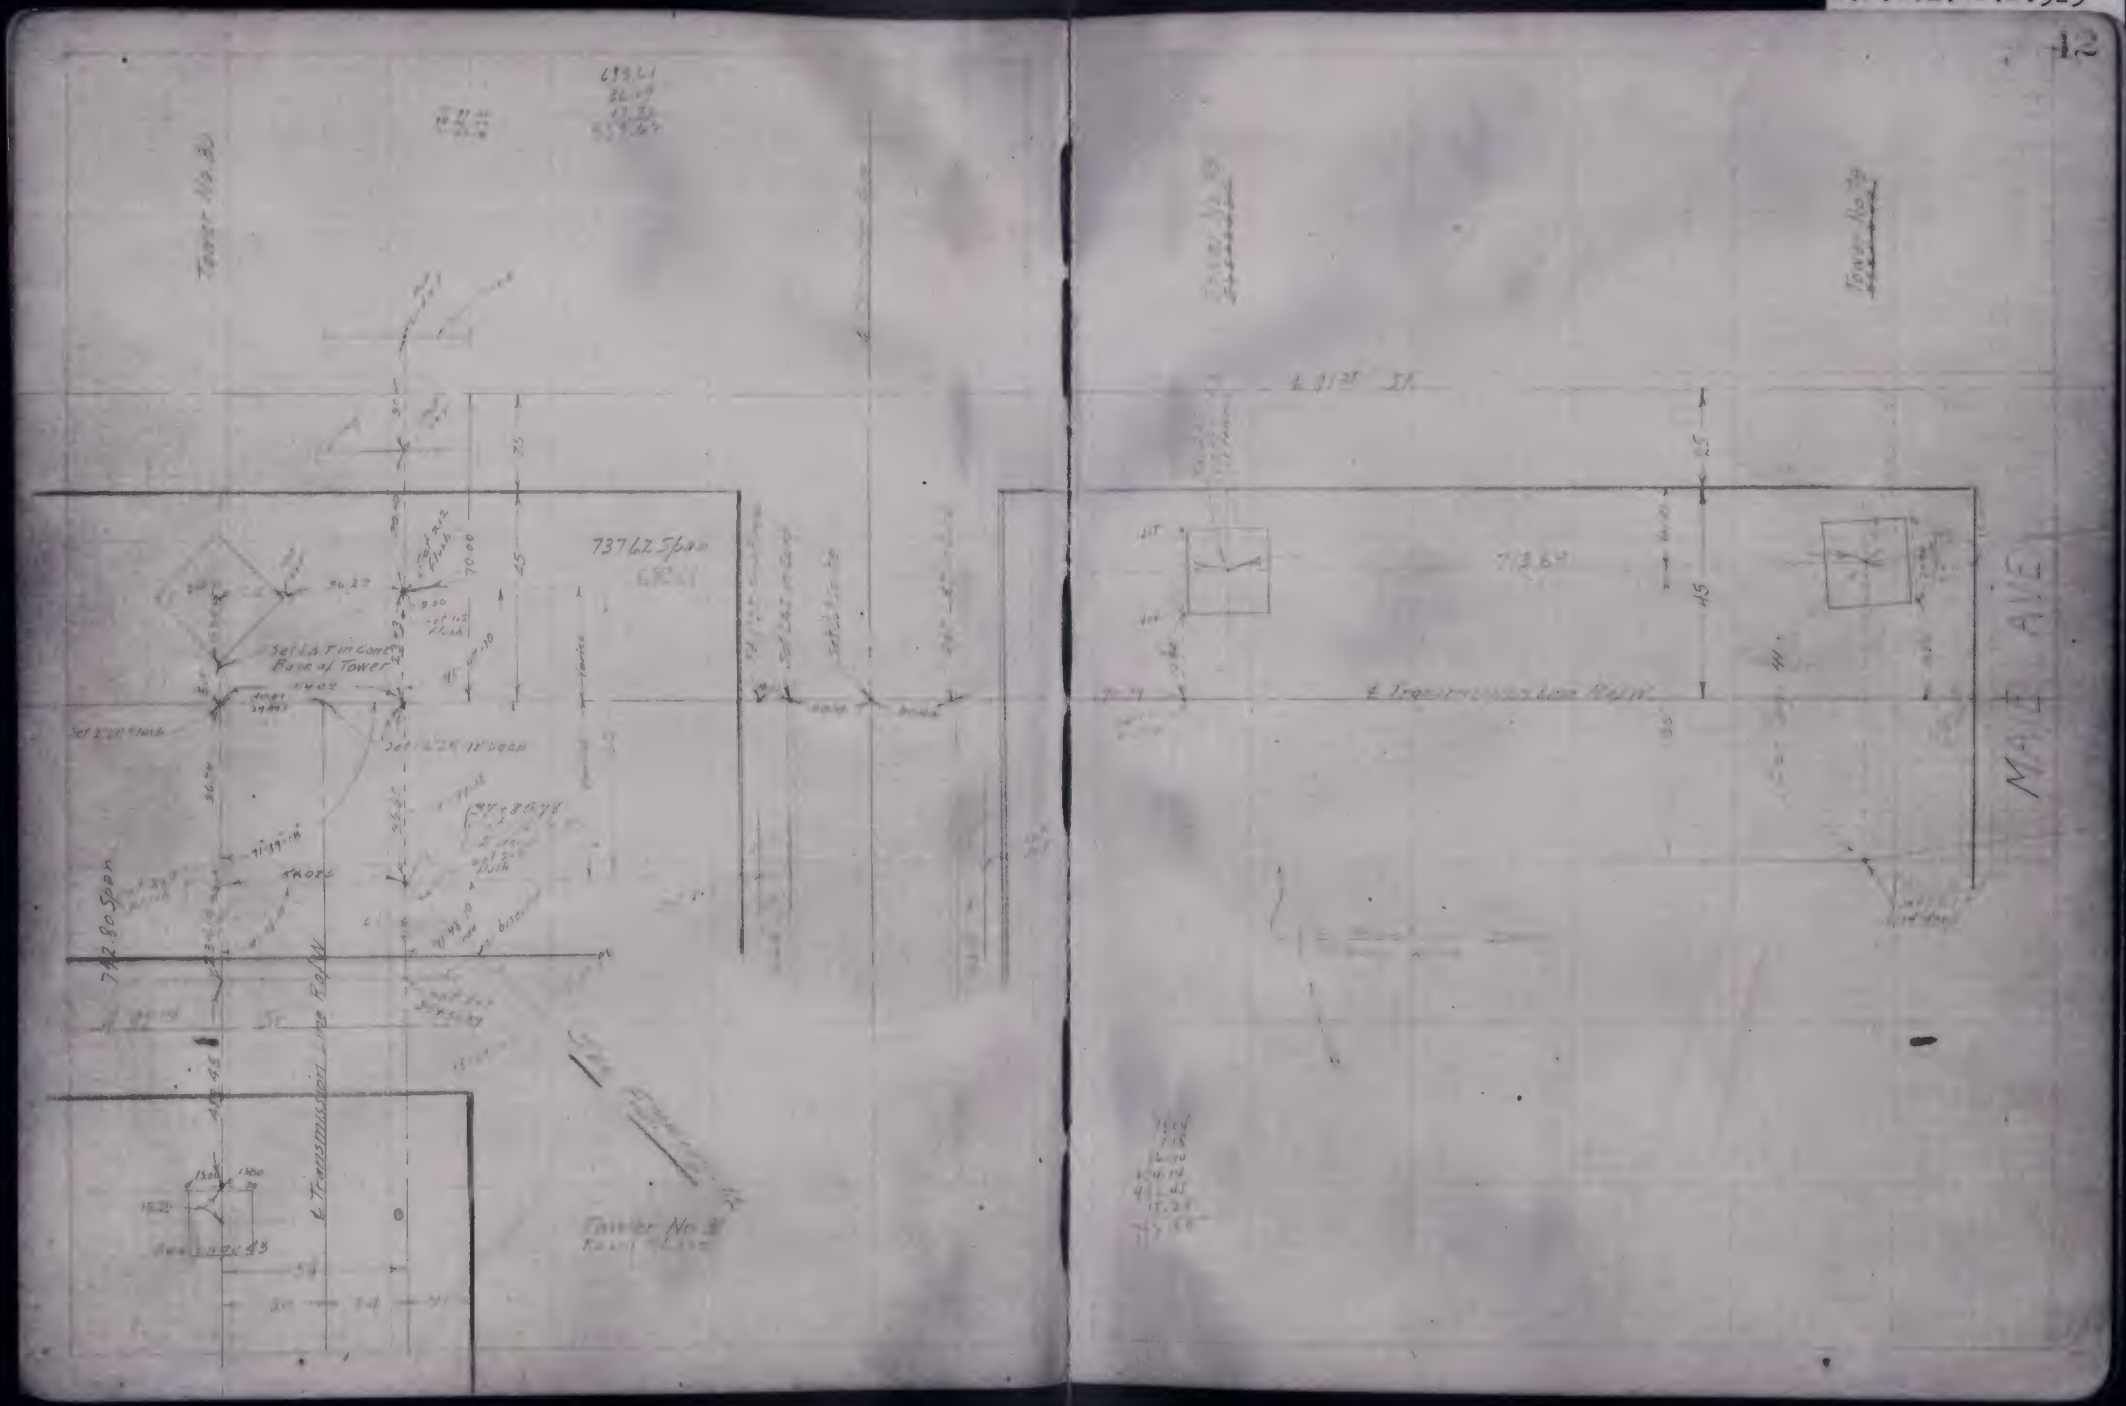
Tower No 2
Tower No 3
Set 4 A Tin cone Base of Tower
Set 2"x2" Stake
Set 1"x2" 12" Hub
Set 1"x2" Hub
Set 1"x2" Stake
Set 1"x2" Hub
Set 1"x2" Hub
Set 1"x2" Hub

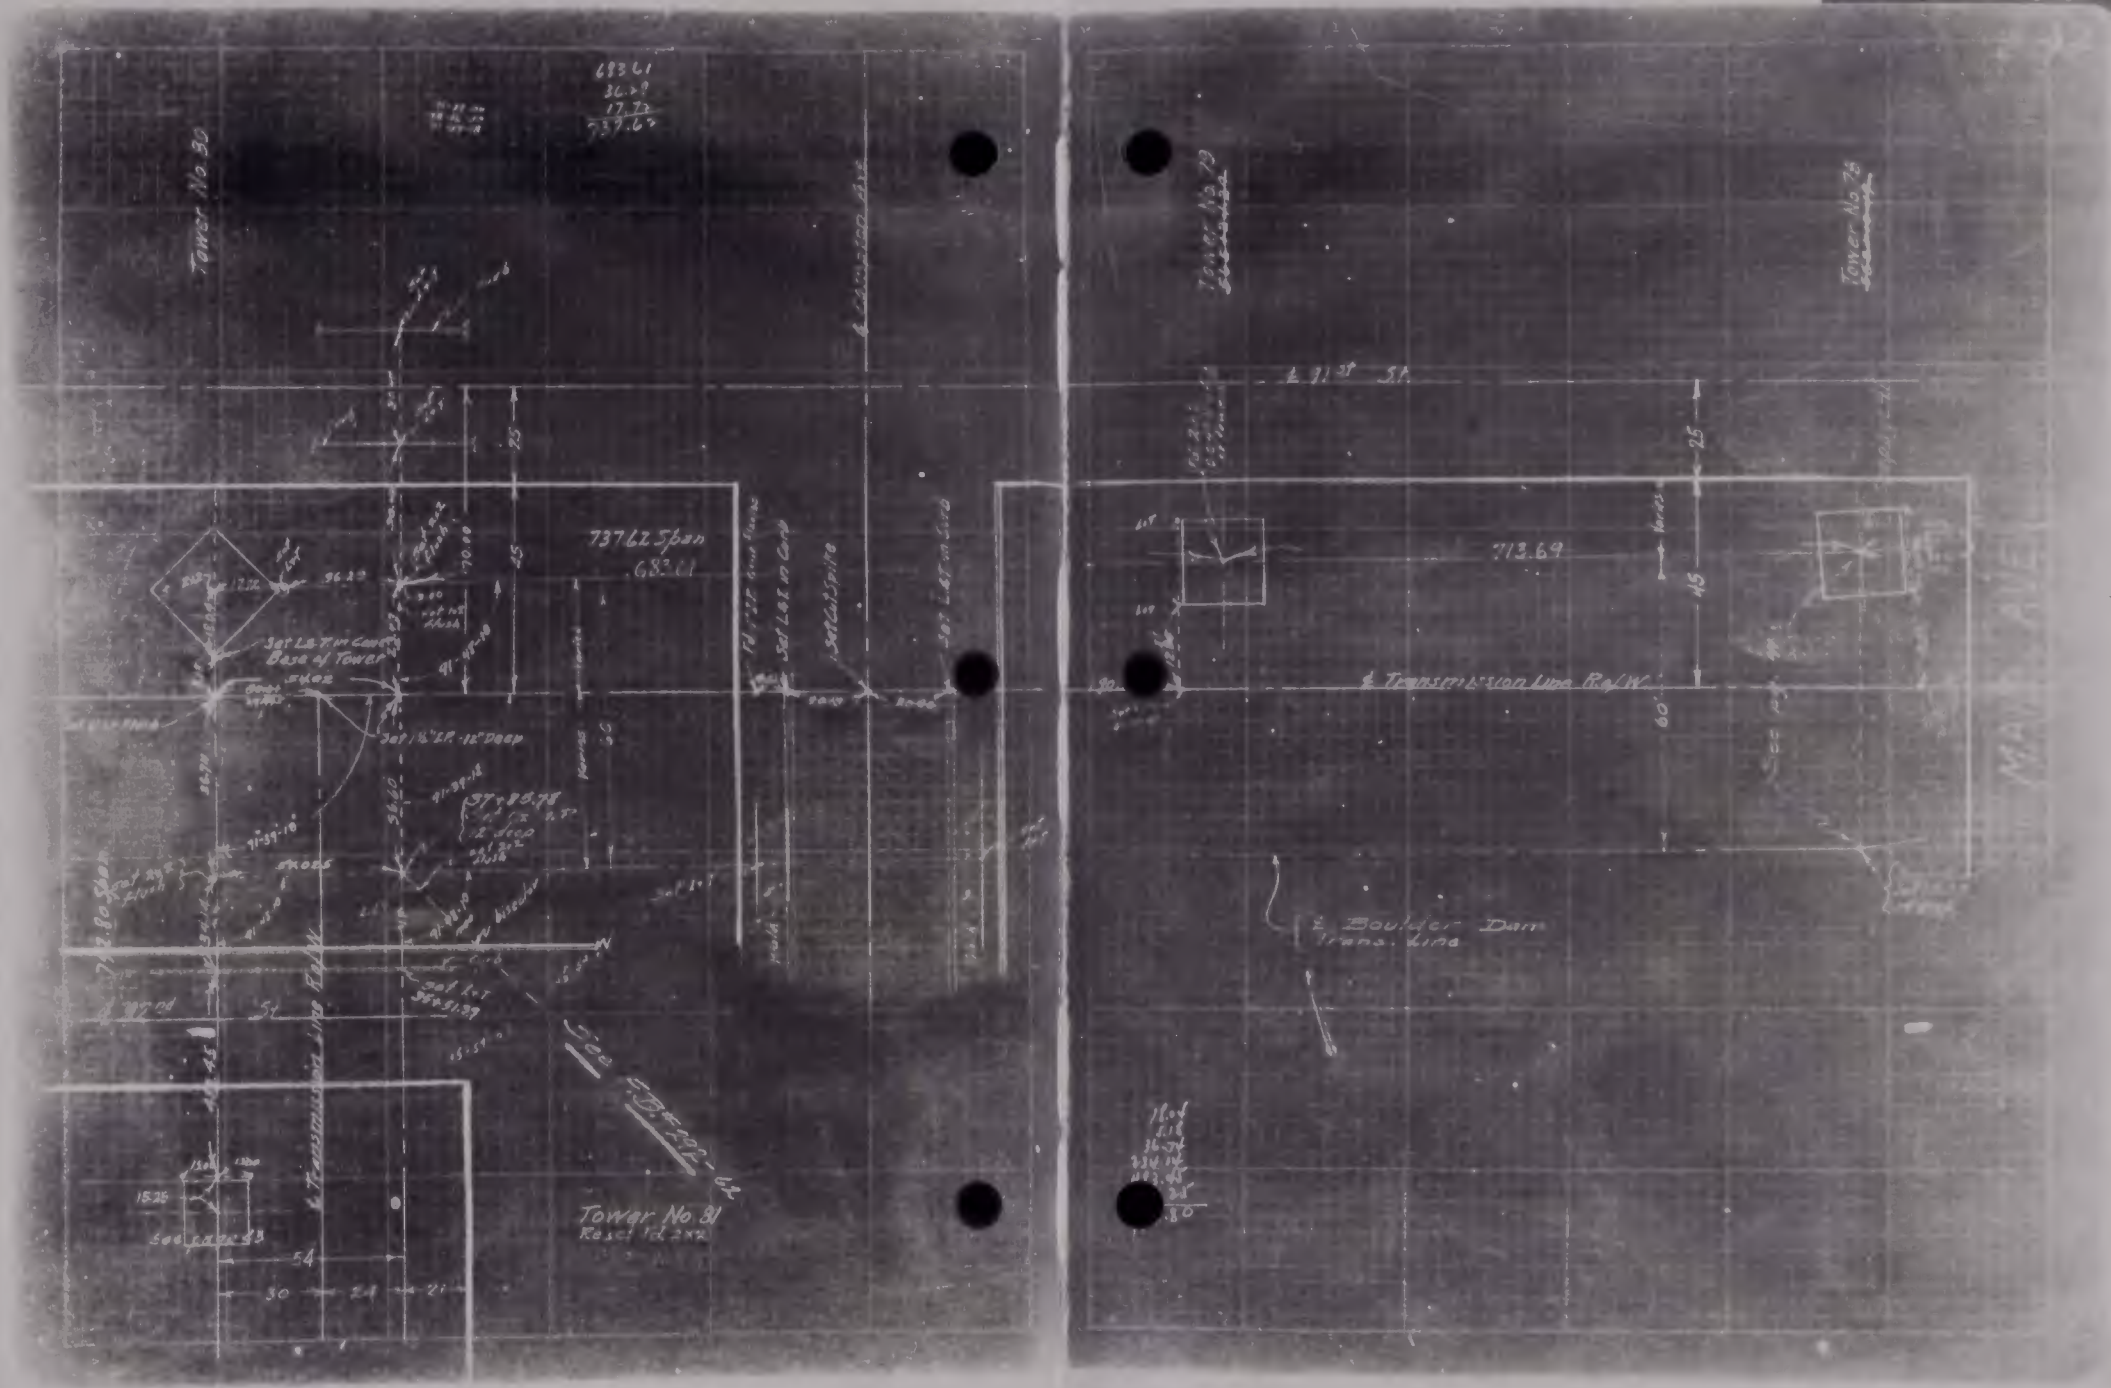
Tower No 80
Tower No 79
Tower No 78
737.62 Span
683.61
713.69
Set L.S. 7" in Conc. Base of Tower
Set 1/2" I.P. - 12" Deep
Set L.S.E. in Conc.
Set L.S.E. in Curb
Set L.S.E. in Curb
E. Transmission Line R/W
E. Boulder Dam Trans. Line
Tower No. 81
Reset 1'd 2 Nov.
E. Transmission Line R/W
S 21° 38' E
N 21° 38' W

FB.1301-85

FB.1301-86

B.P.&L.-F.B.325

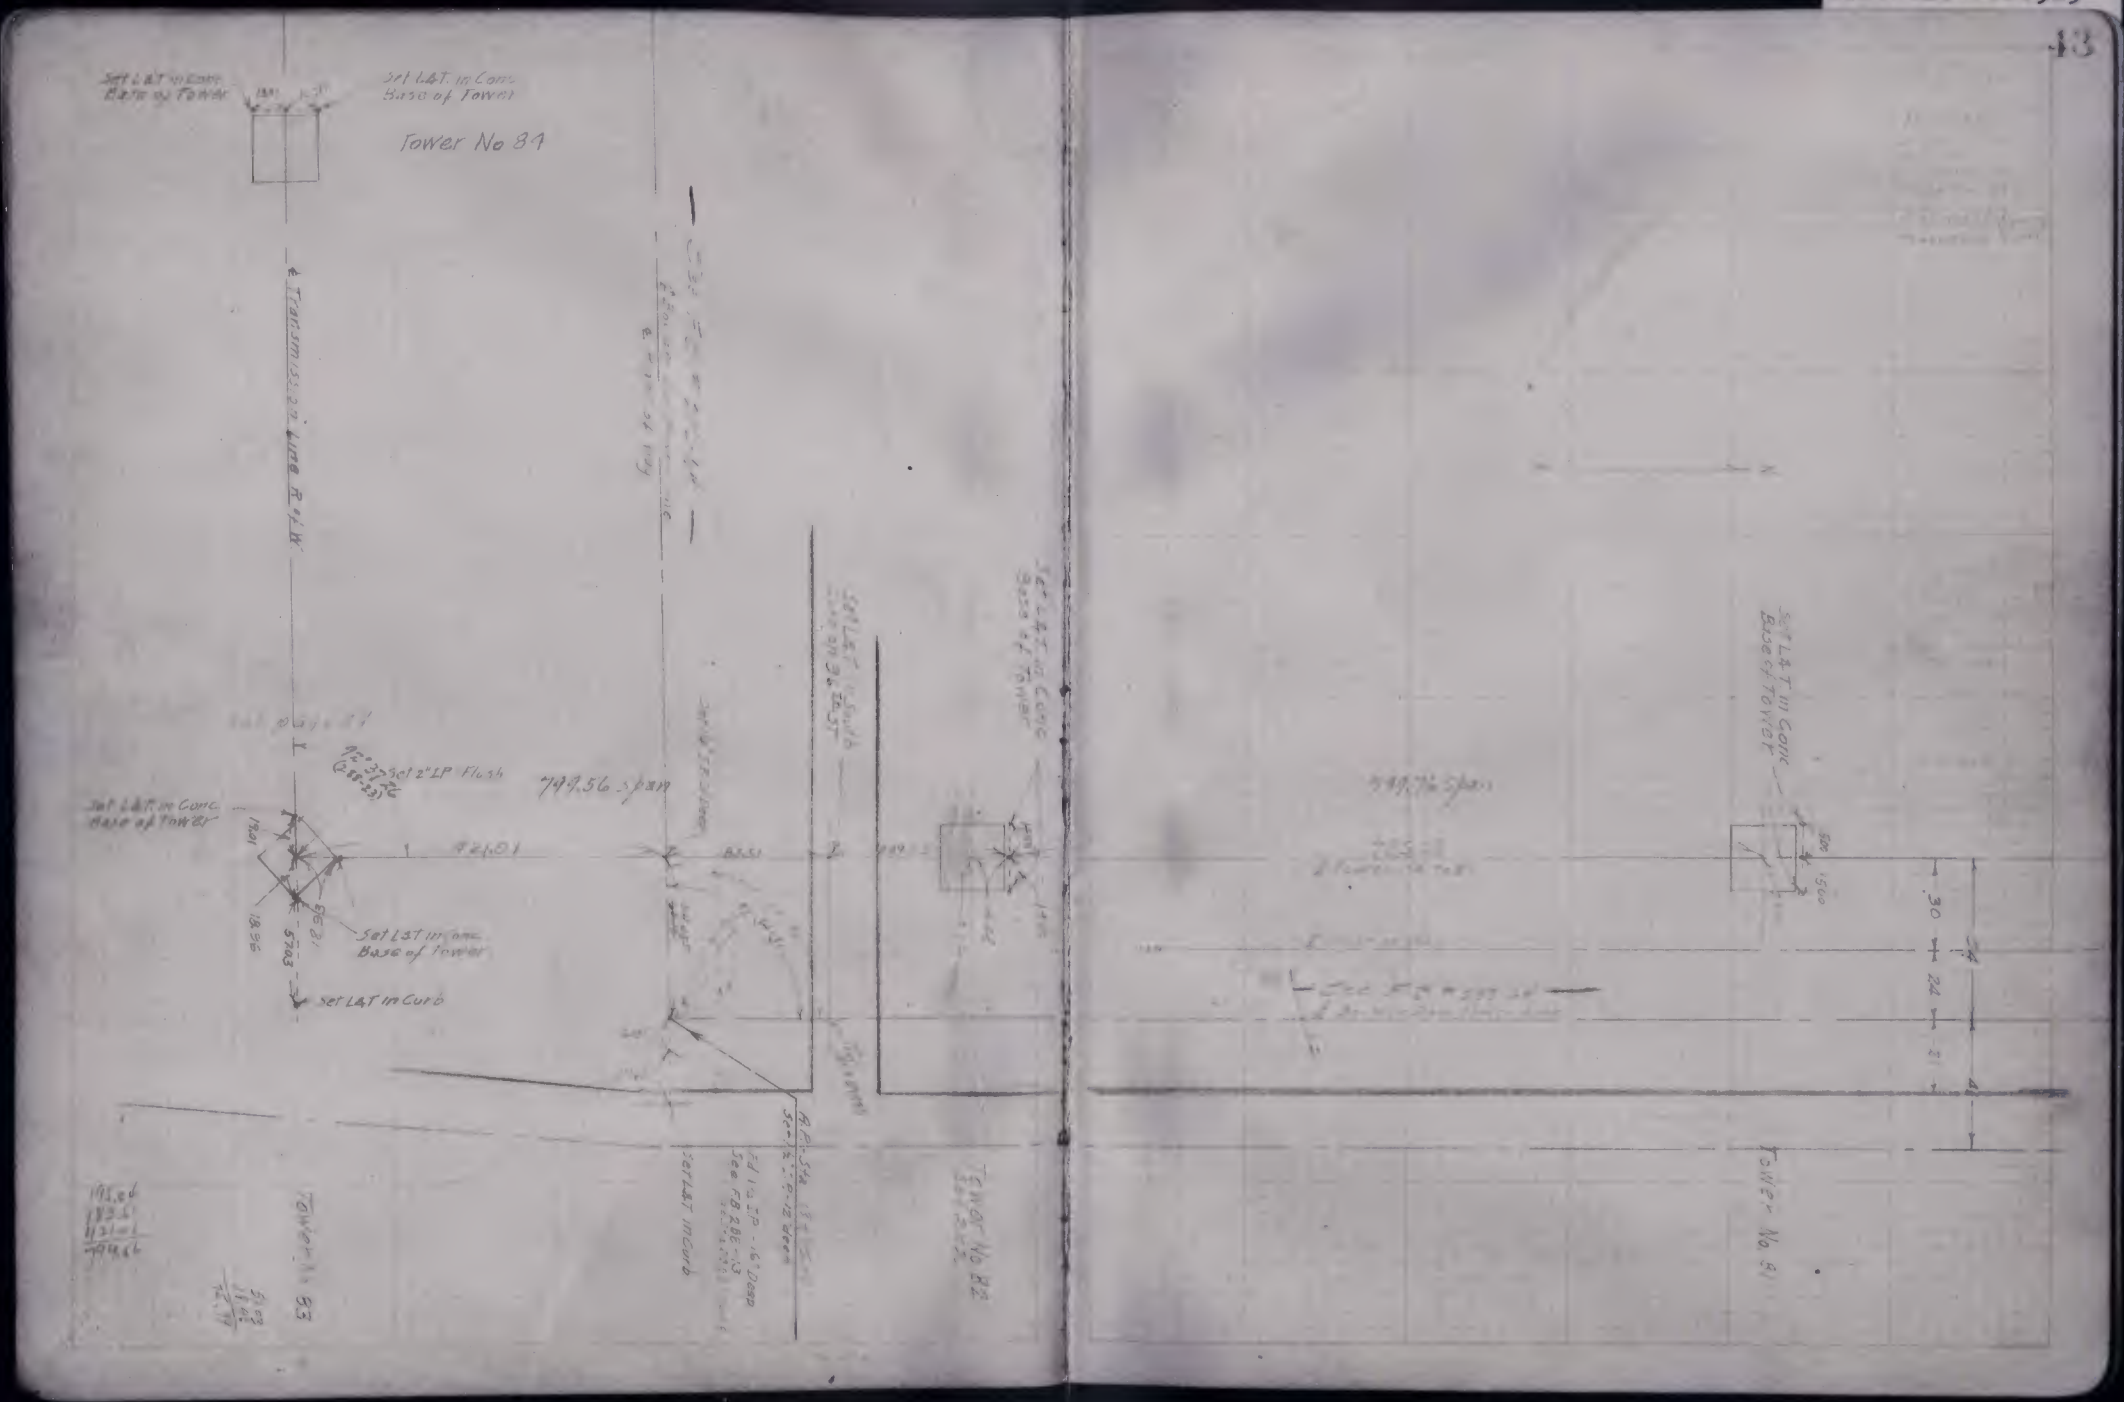

FB.1301-87

FB.1301-88

B.P.&.L.-F.B.325

44

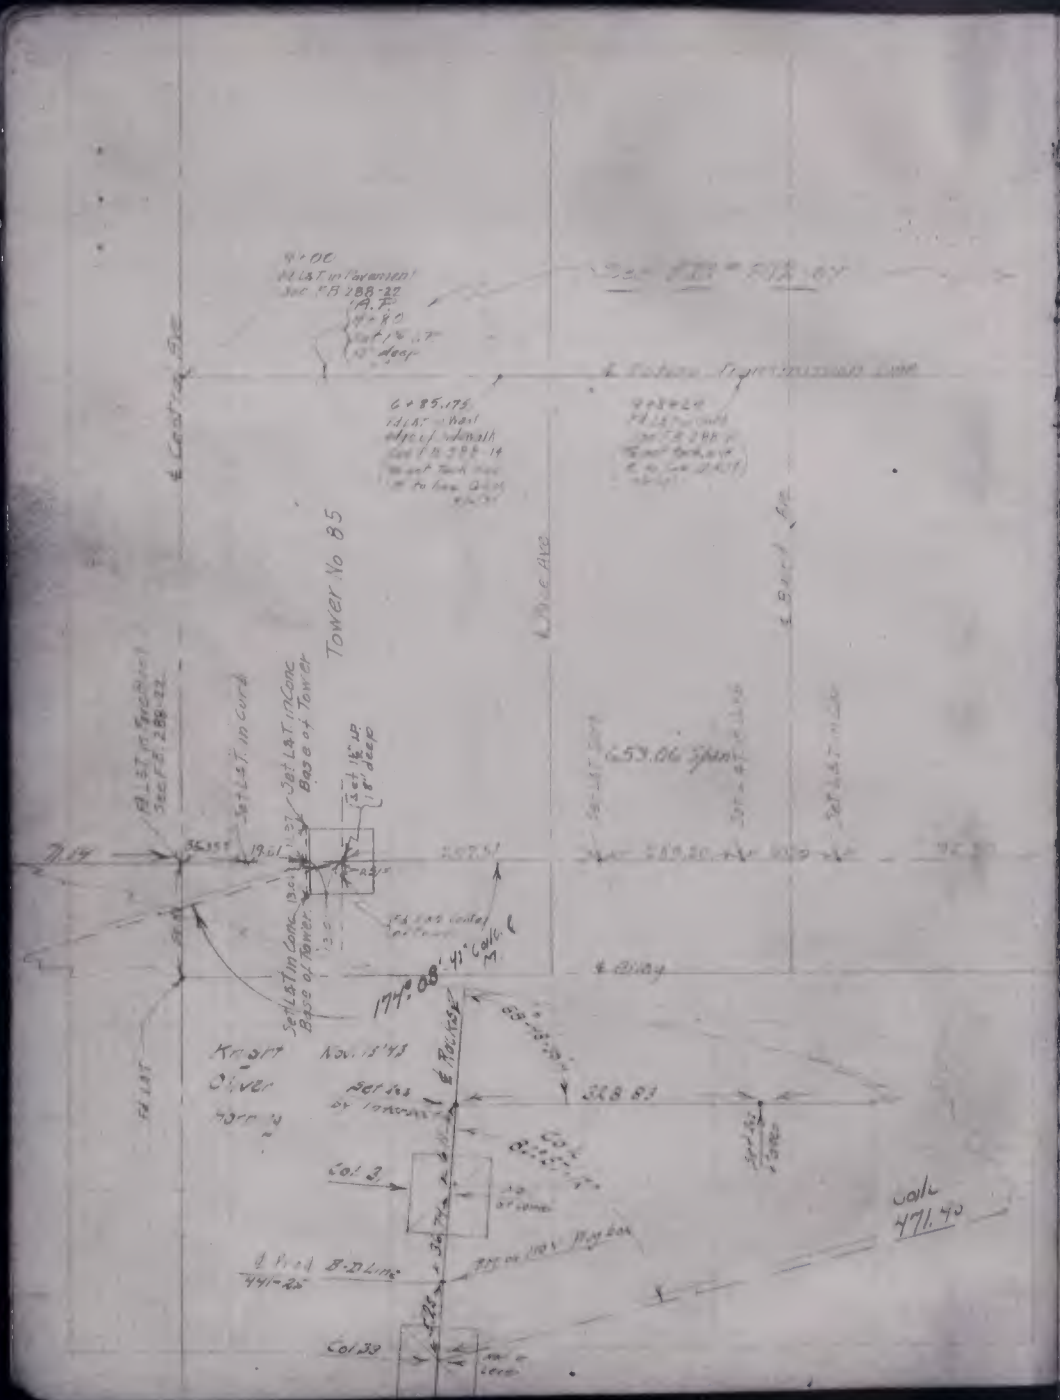

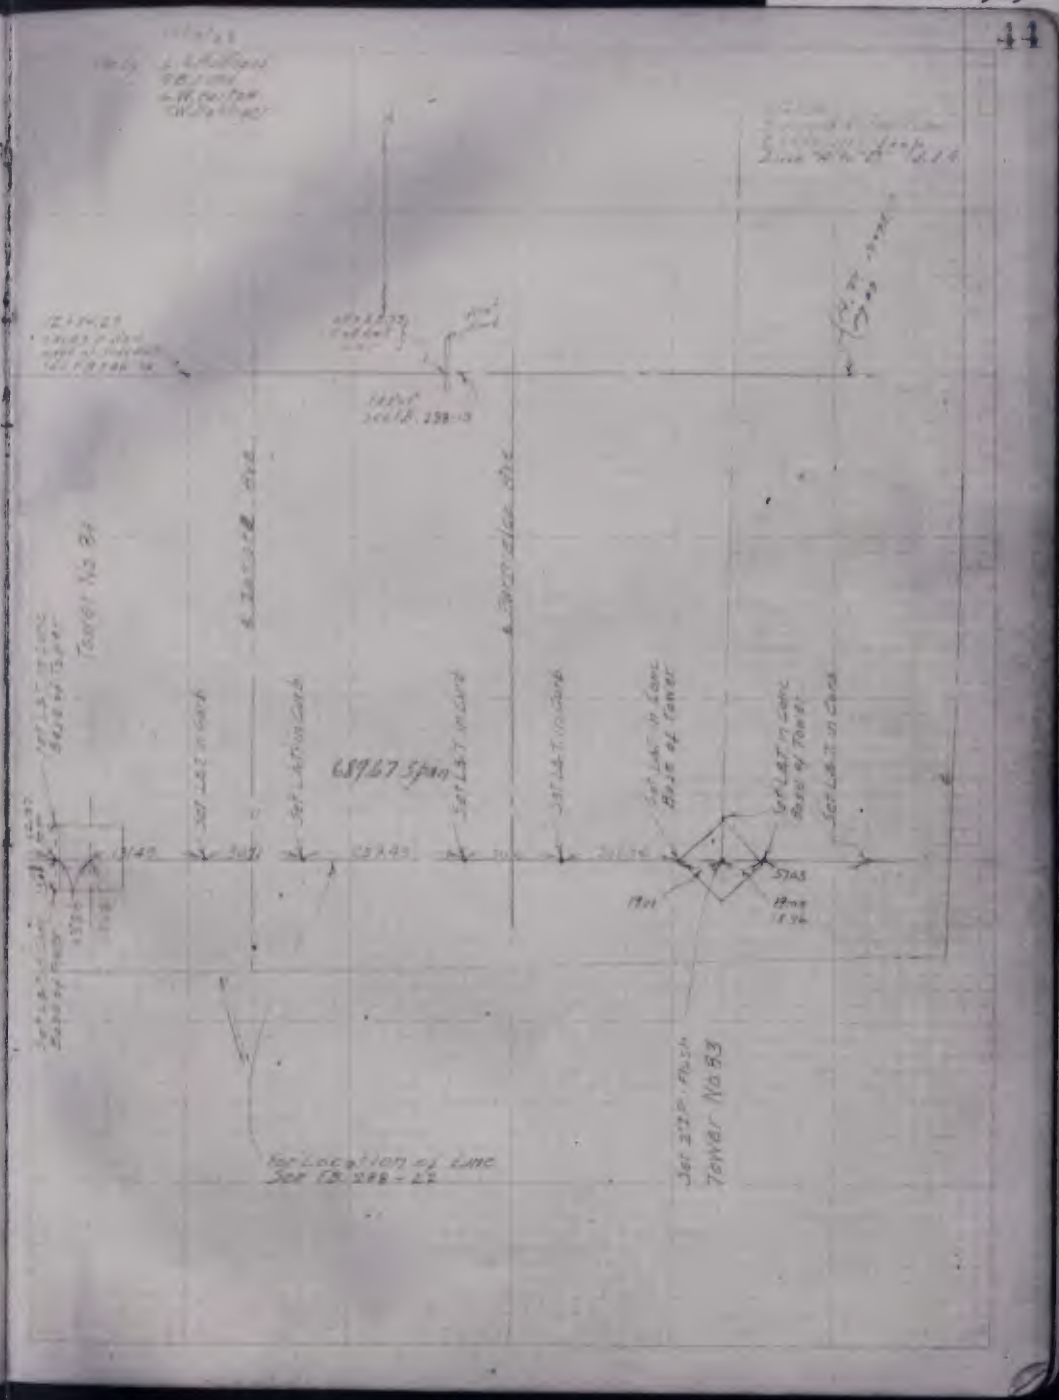

FB.1301-89

FB.1301-90

B.P.&.L.-F.B.325

LOOP LINE
TIES TO ℄ RIGHT-OF-WAY & TOWER CENTERS




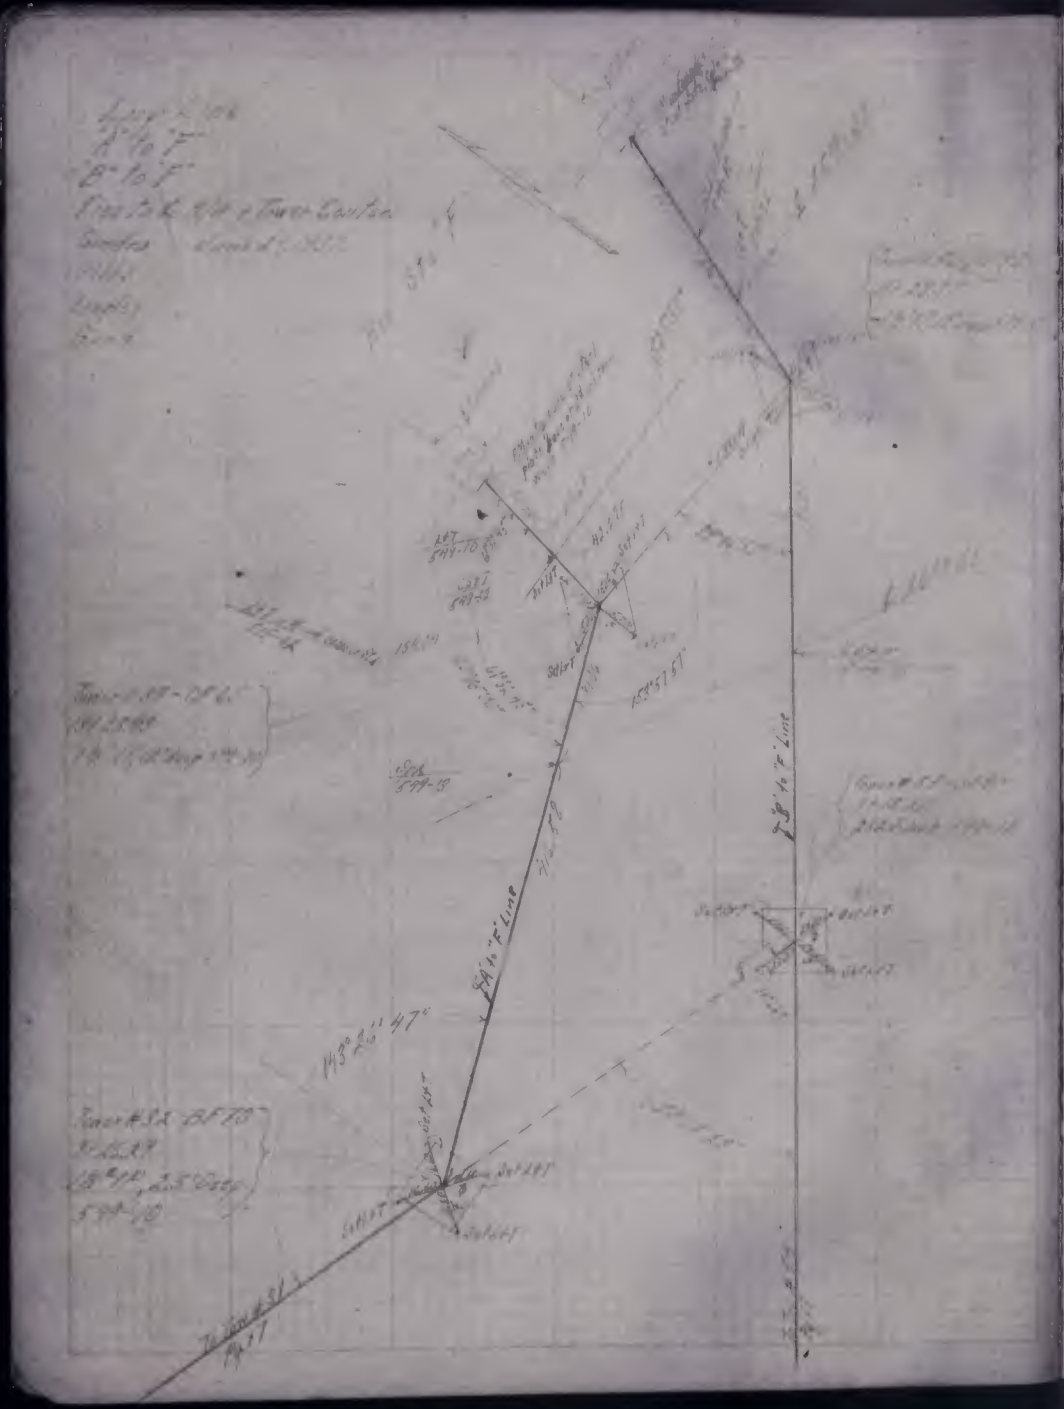

FB.1301-91

FB.1301-92

B.P.&.L.-F.B.325

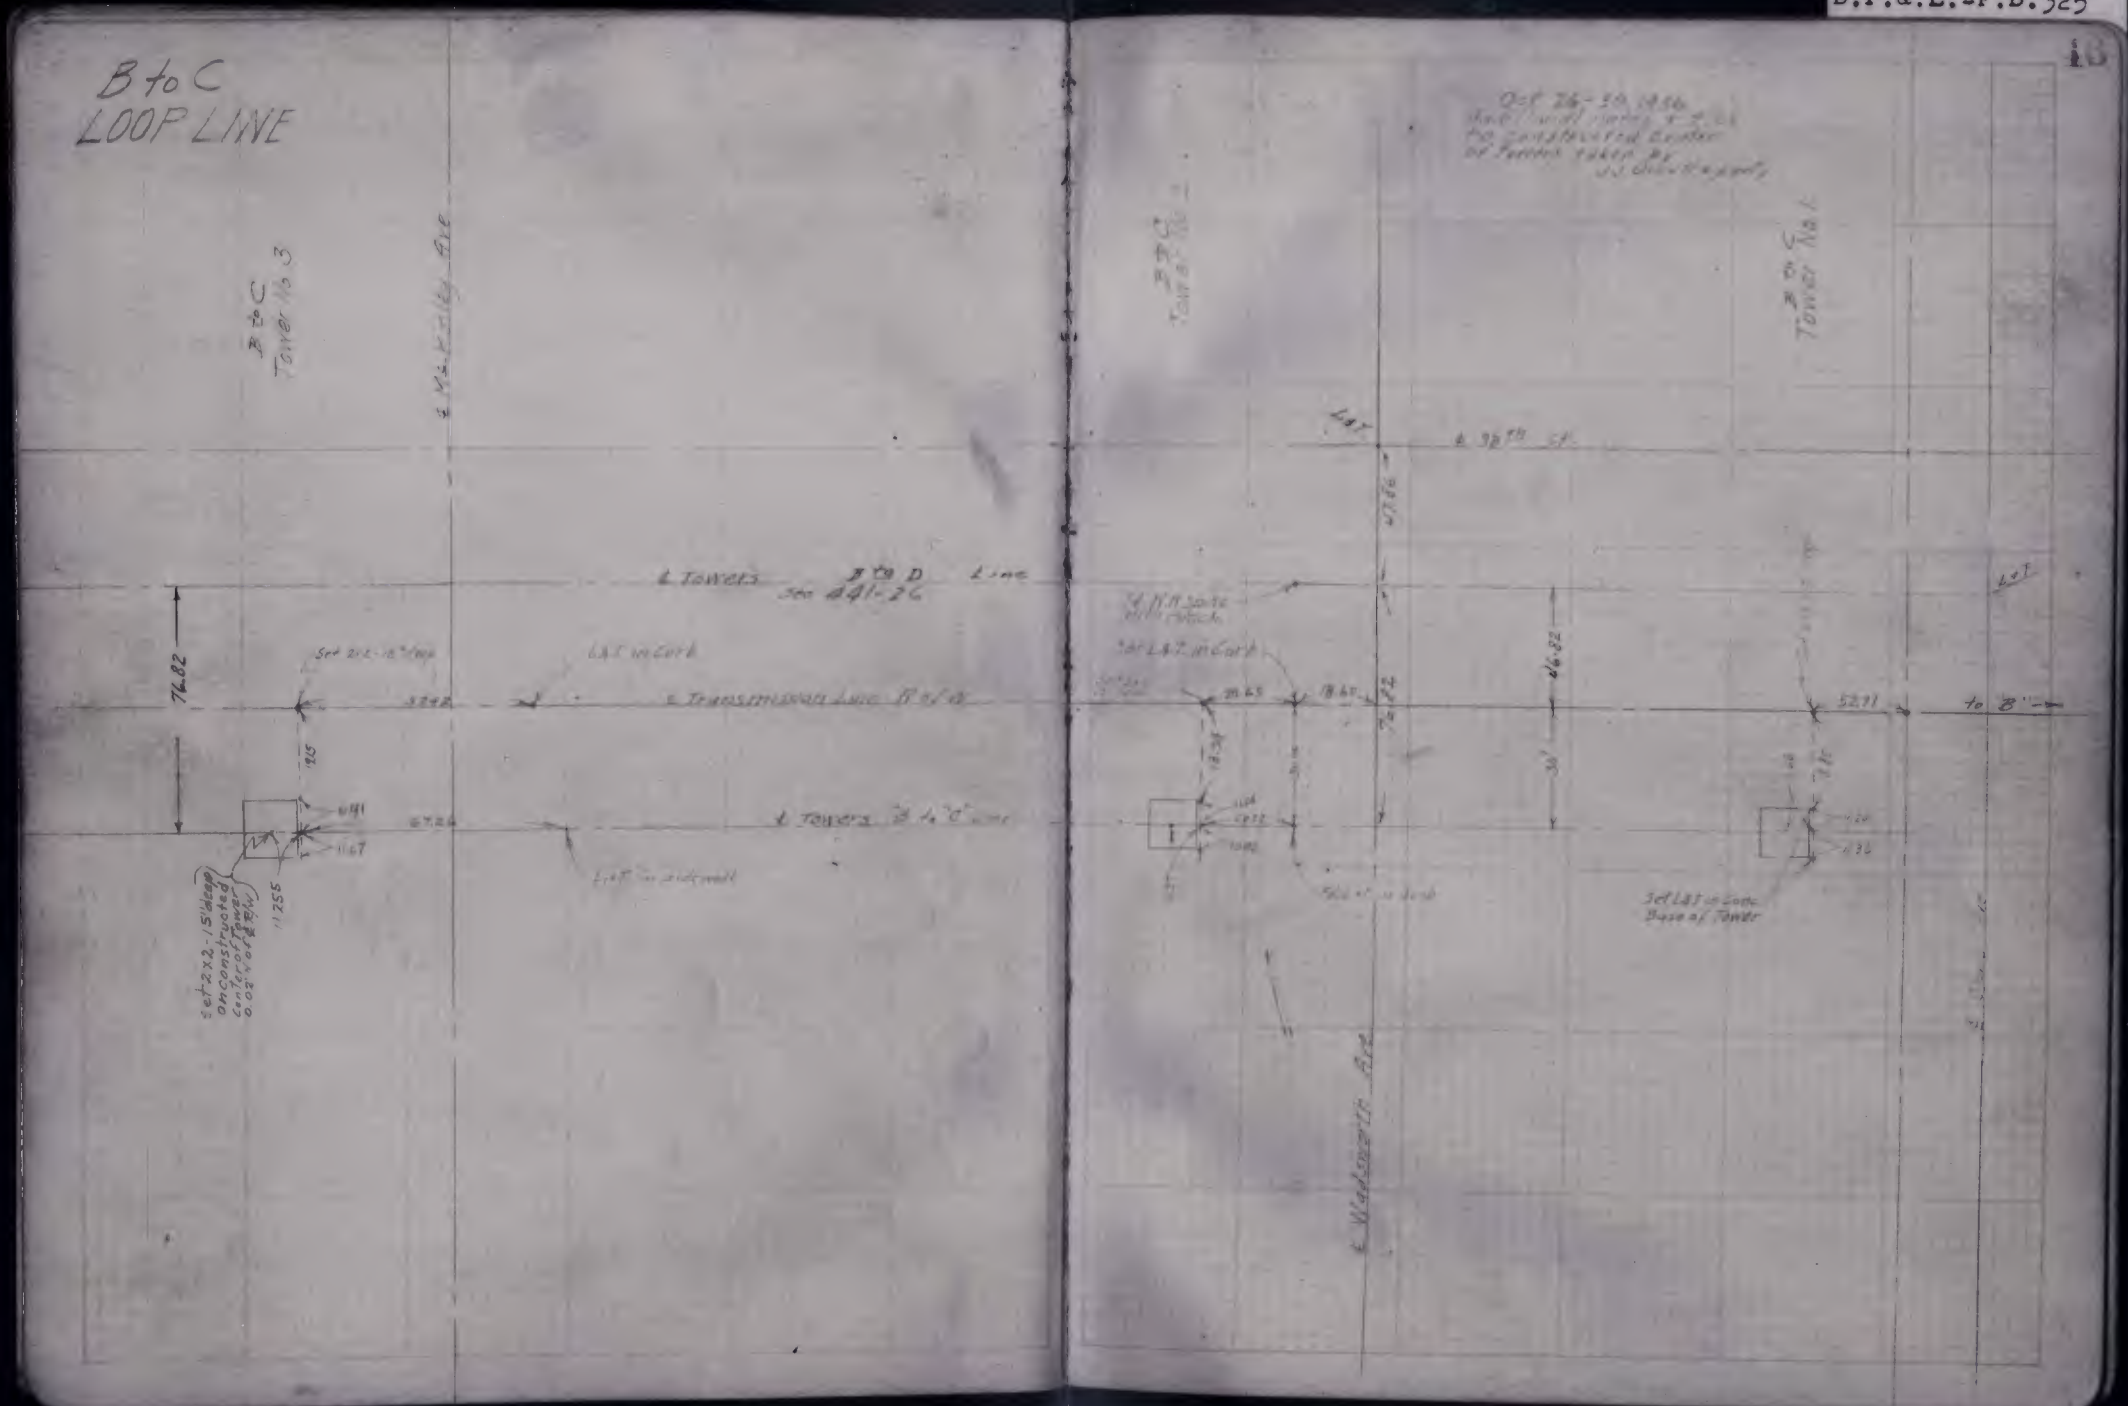

FB.1301-93

FB.1301-94

B.P.&L.-F.B.325

47

Party L.G. Mulhaul
O.B. Field
G.W. Barlow
C.W. Bellinger

Feb 1923

Stanford St

79° 32' 53"

E 98th St

Varies

2°18 per 441.27

per 441.27
90°19'31"

for B to D Line see 441.27 ?

B to D Line ?

46.82

30

Set L&T in Cone Base of Tower

B to C Line

B to C
Tower No 4

90°19'31"

B to C
Tower No 3
See page 46

Set L&T in Conc. Base of Tower

B to C
Tower No 5
See page 48

Set L&T in Conc Base of Tower

FB1301-95

FB.1301-96

B.P.&.L.-F.B.325

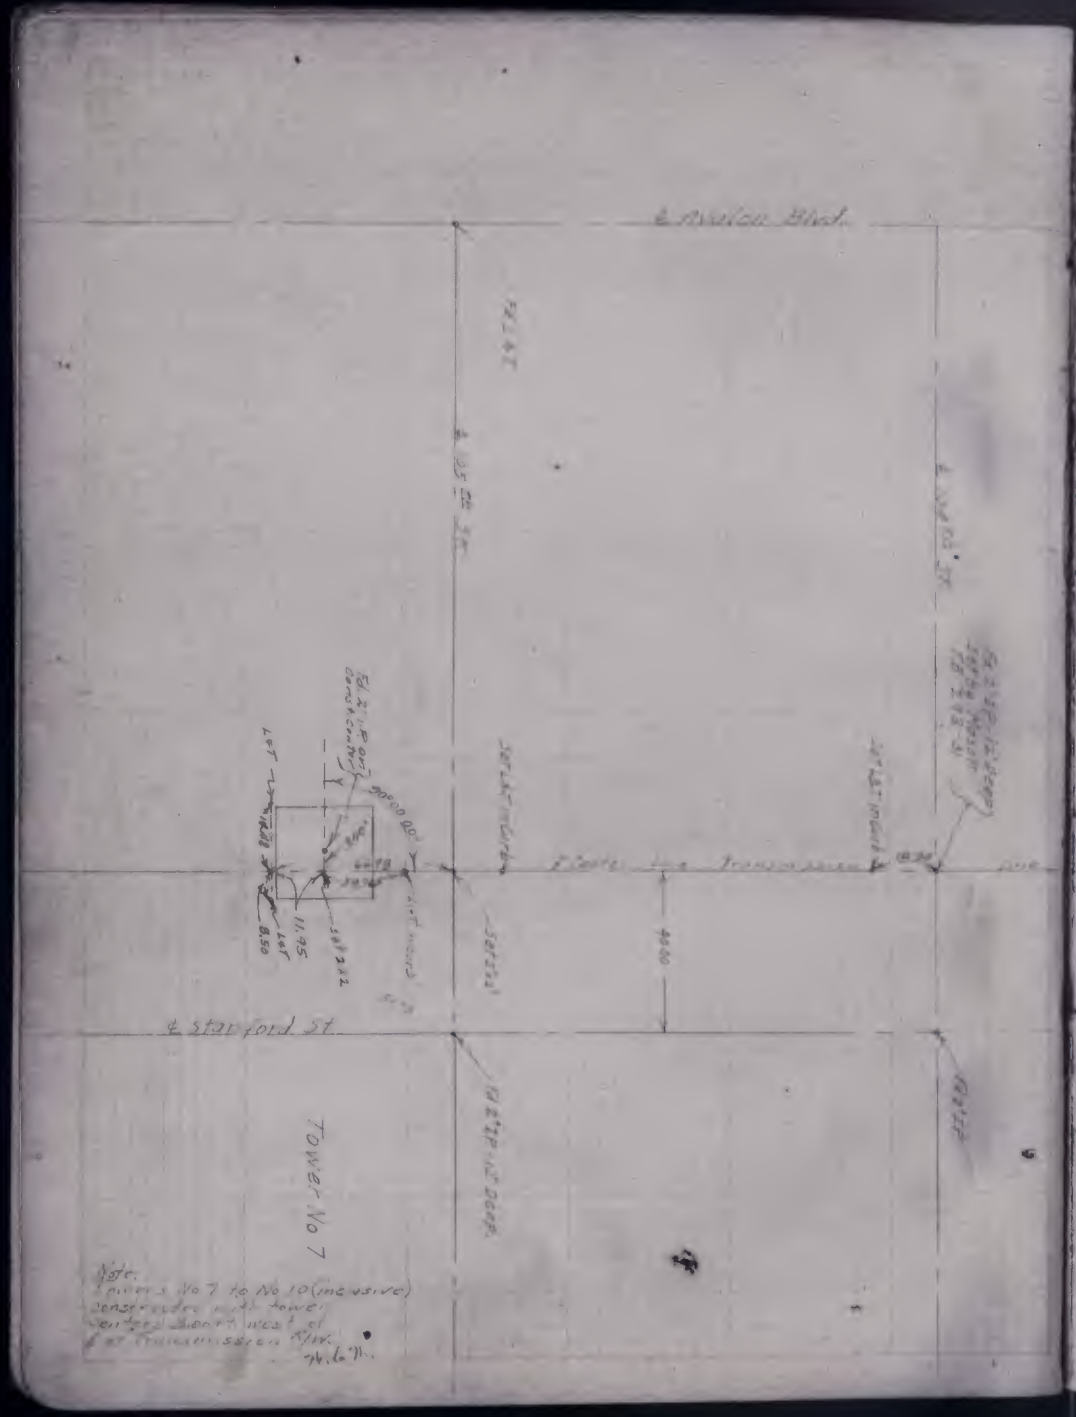

Note.
Towers No 7 to No 10 (inclusive) considered as all towers centered about 8 feet west of E. Transmission Line.
W.L.G.

FB.B01-97

FB.B01-98

B.P.&.L.-F.B.325

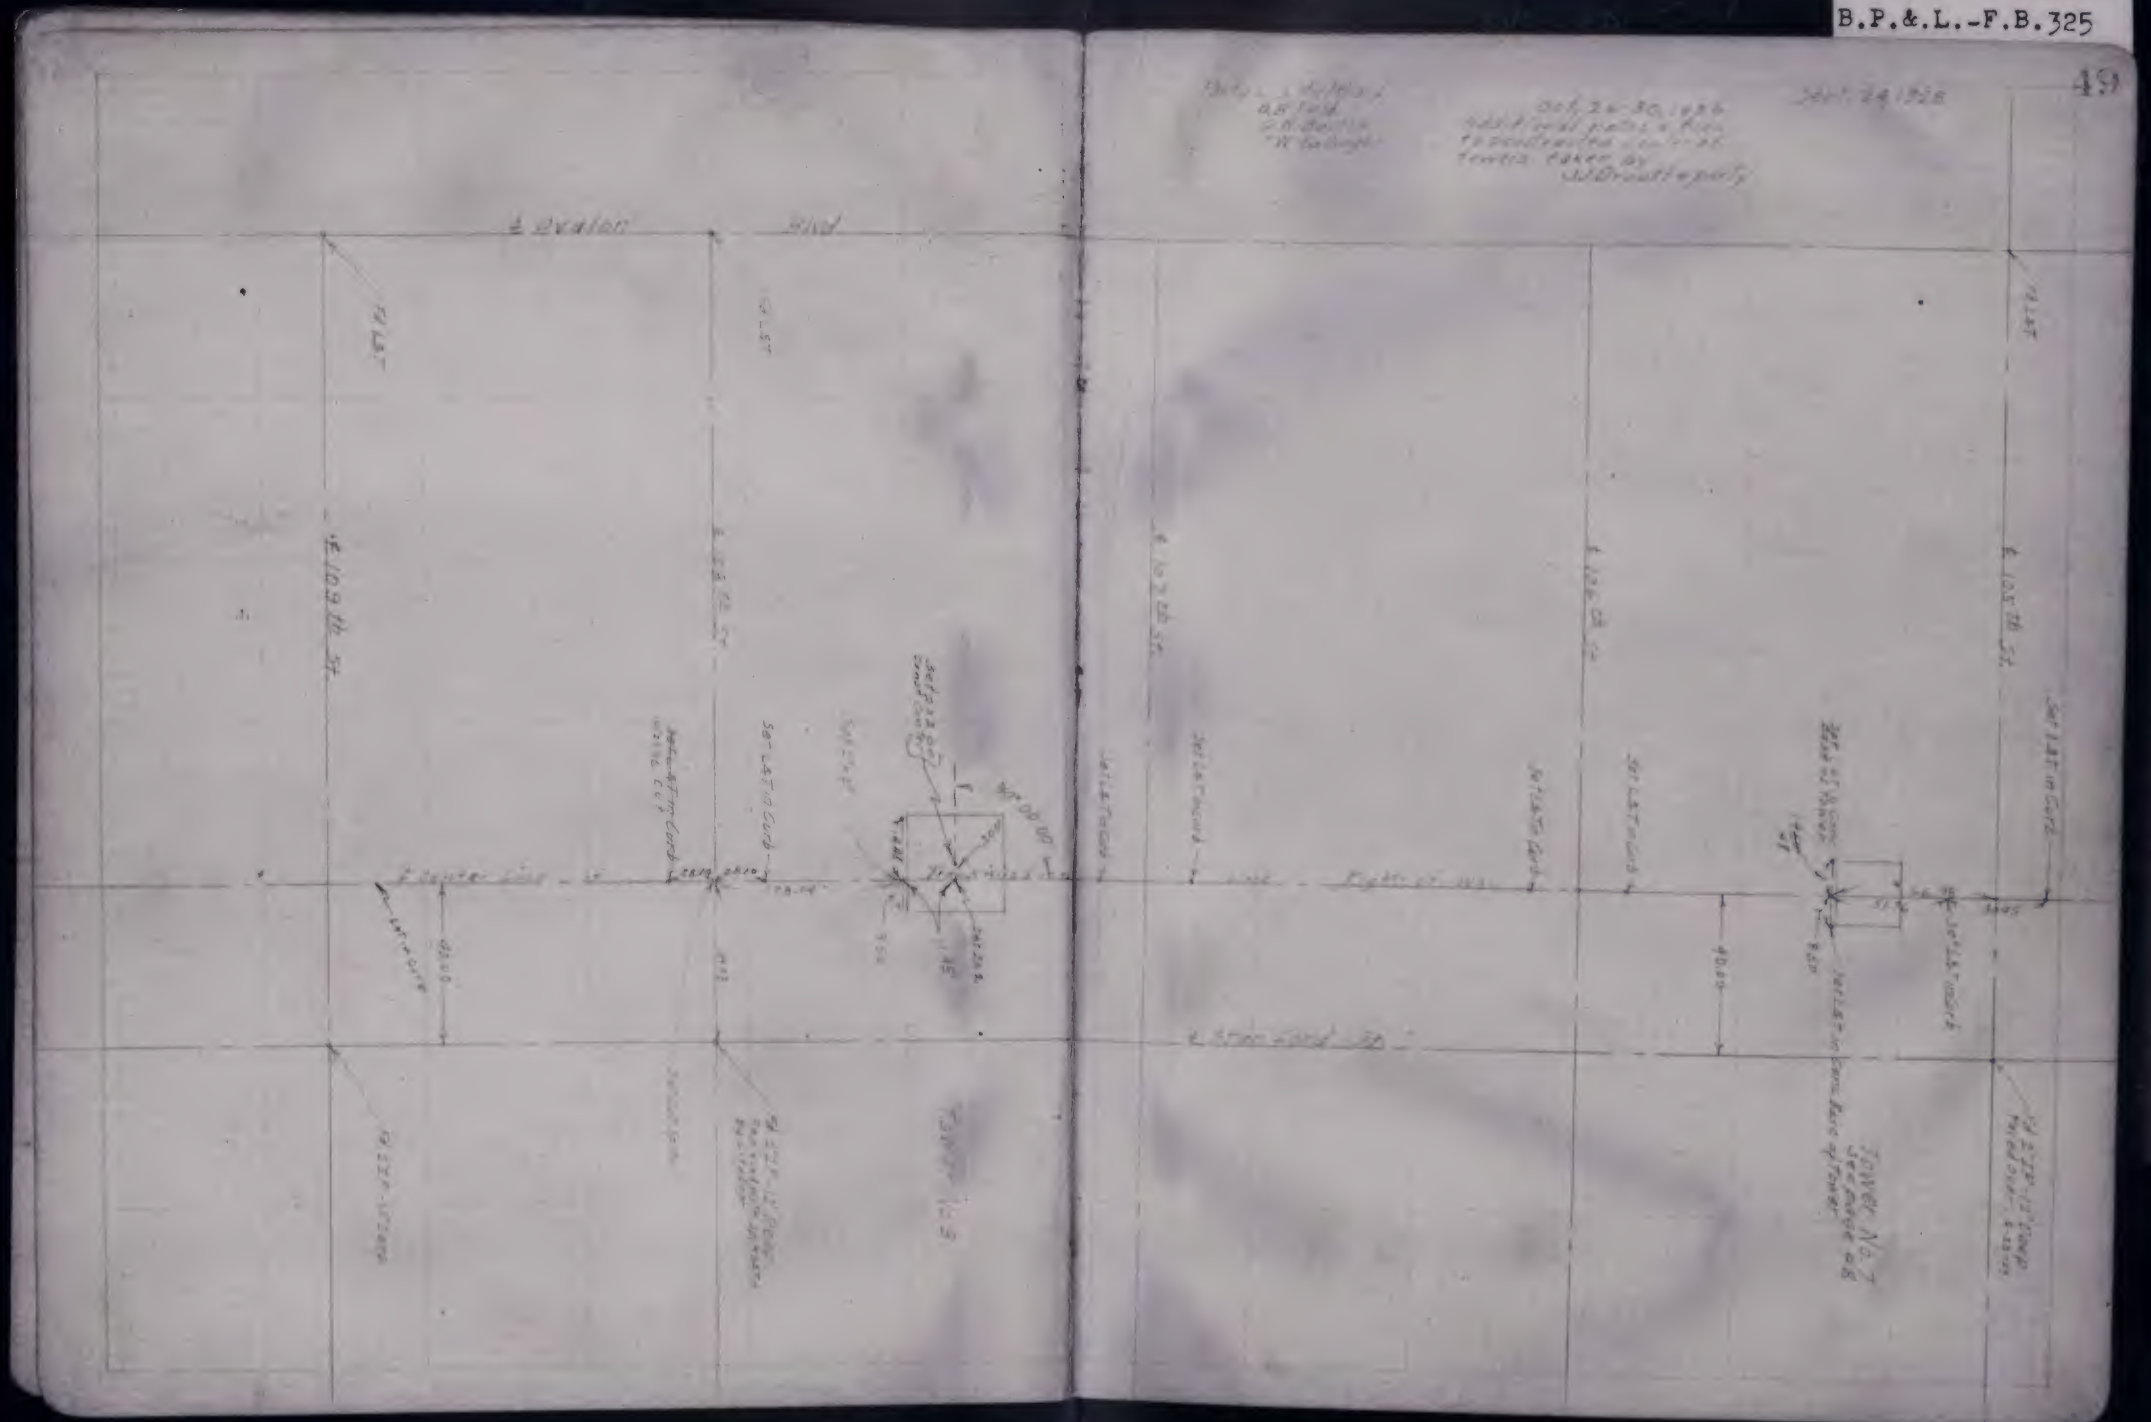

FB.1301-99

FB.1301-100

B.P.&.L.-F.B.325

50

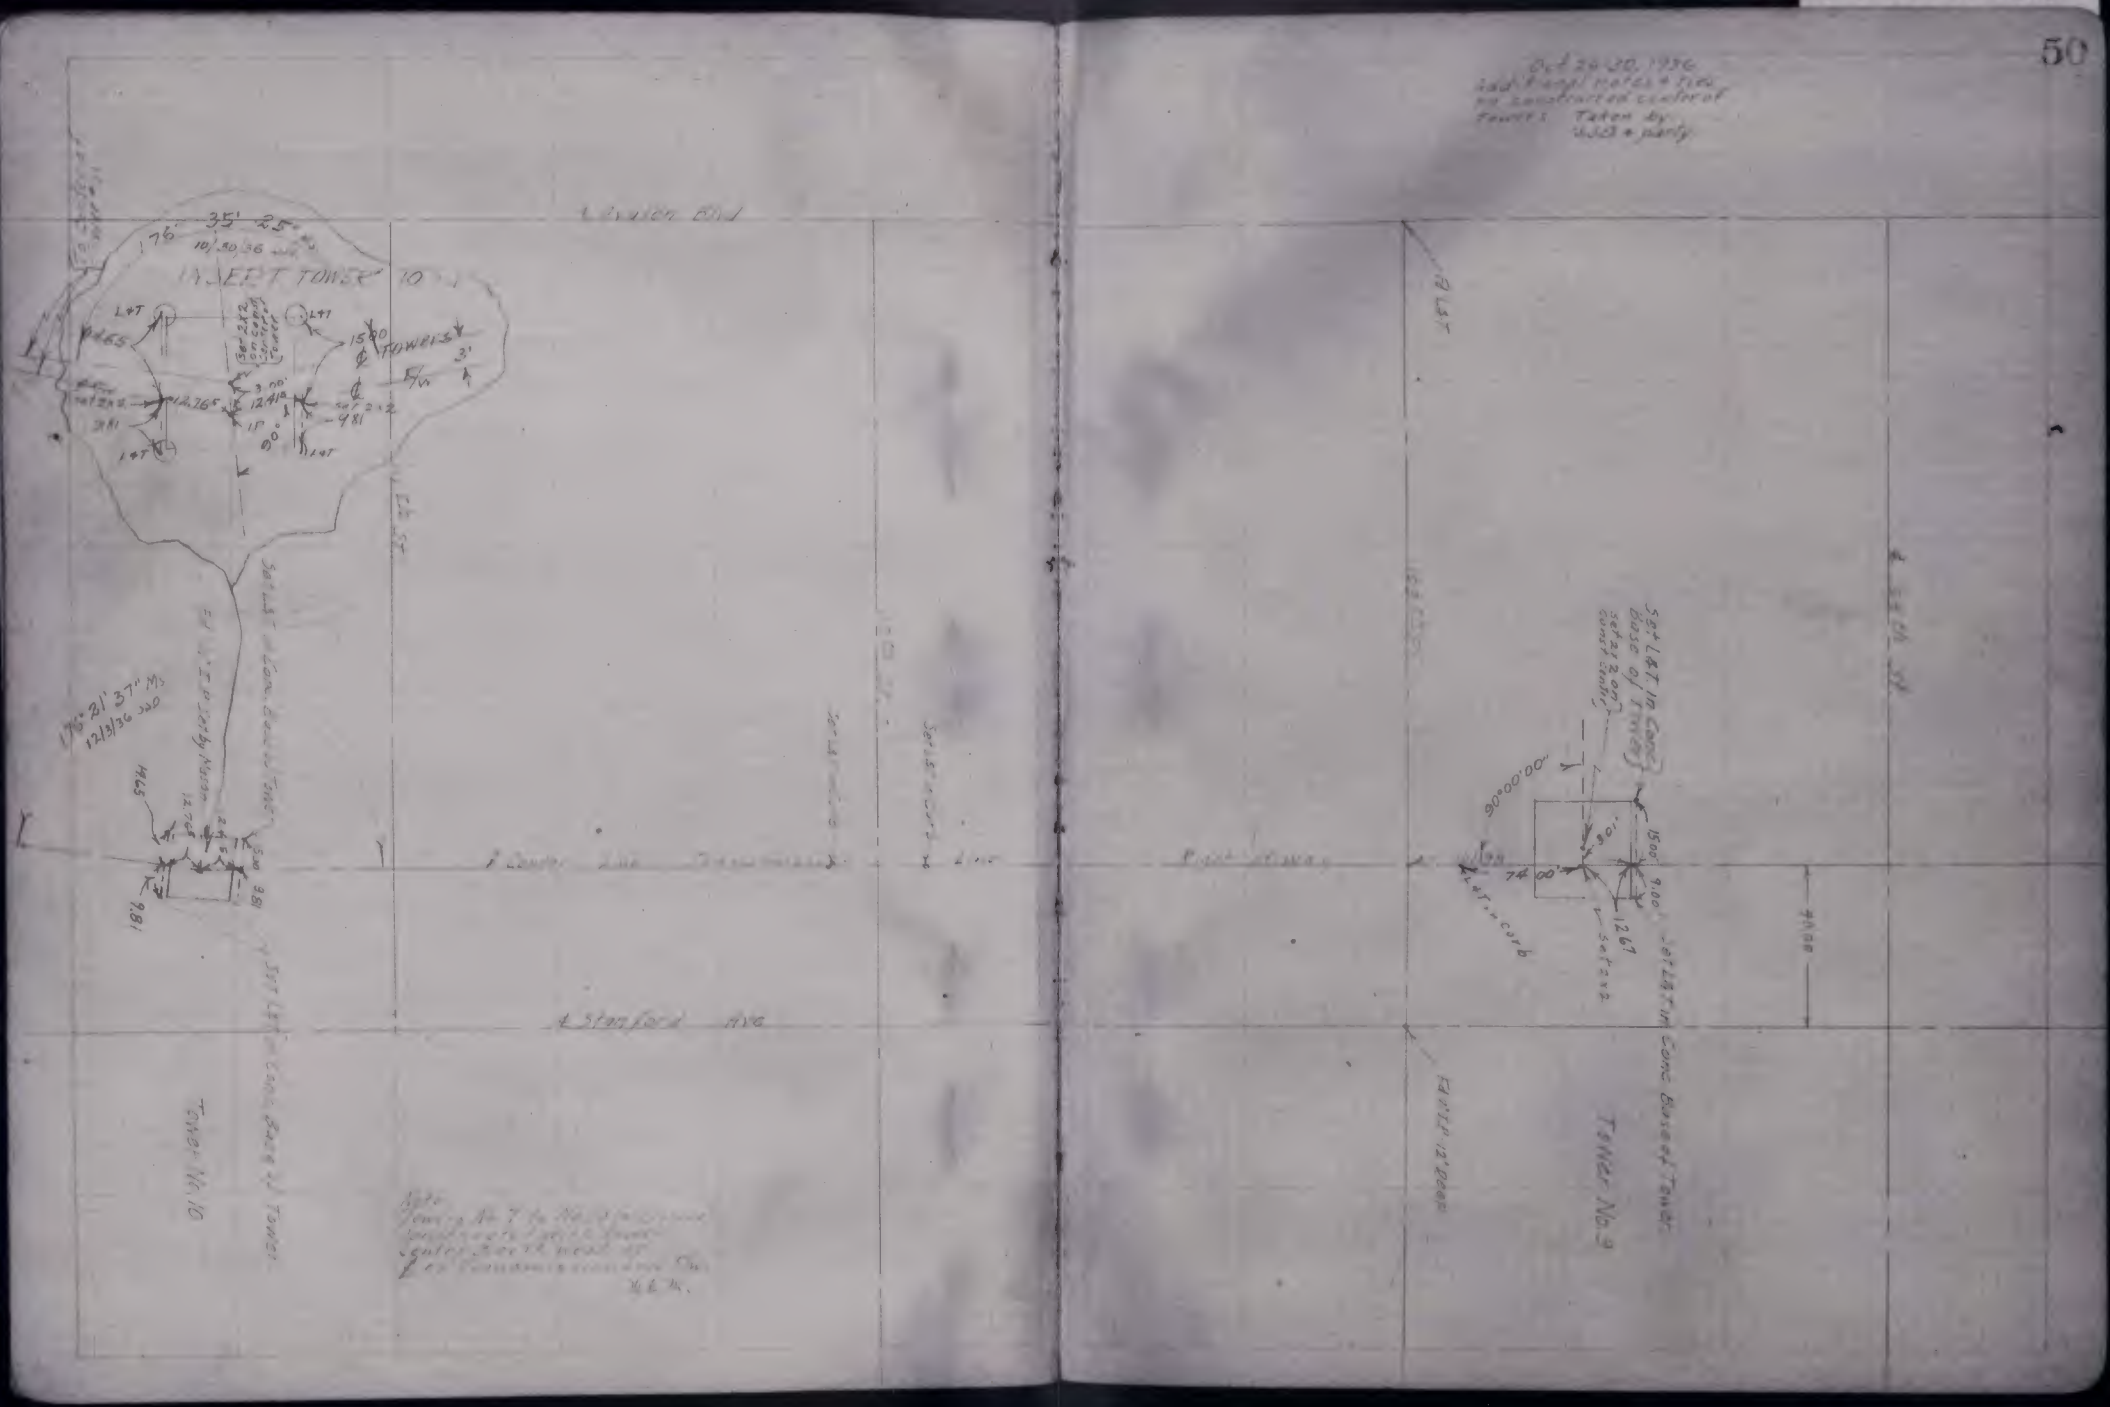

FB.1301-101

FB.1301-102

B.P.&.L.-F.B.325

51

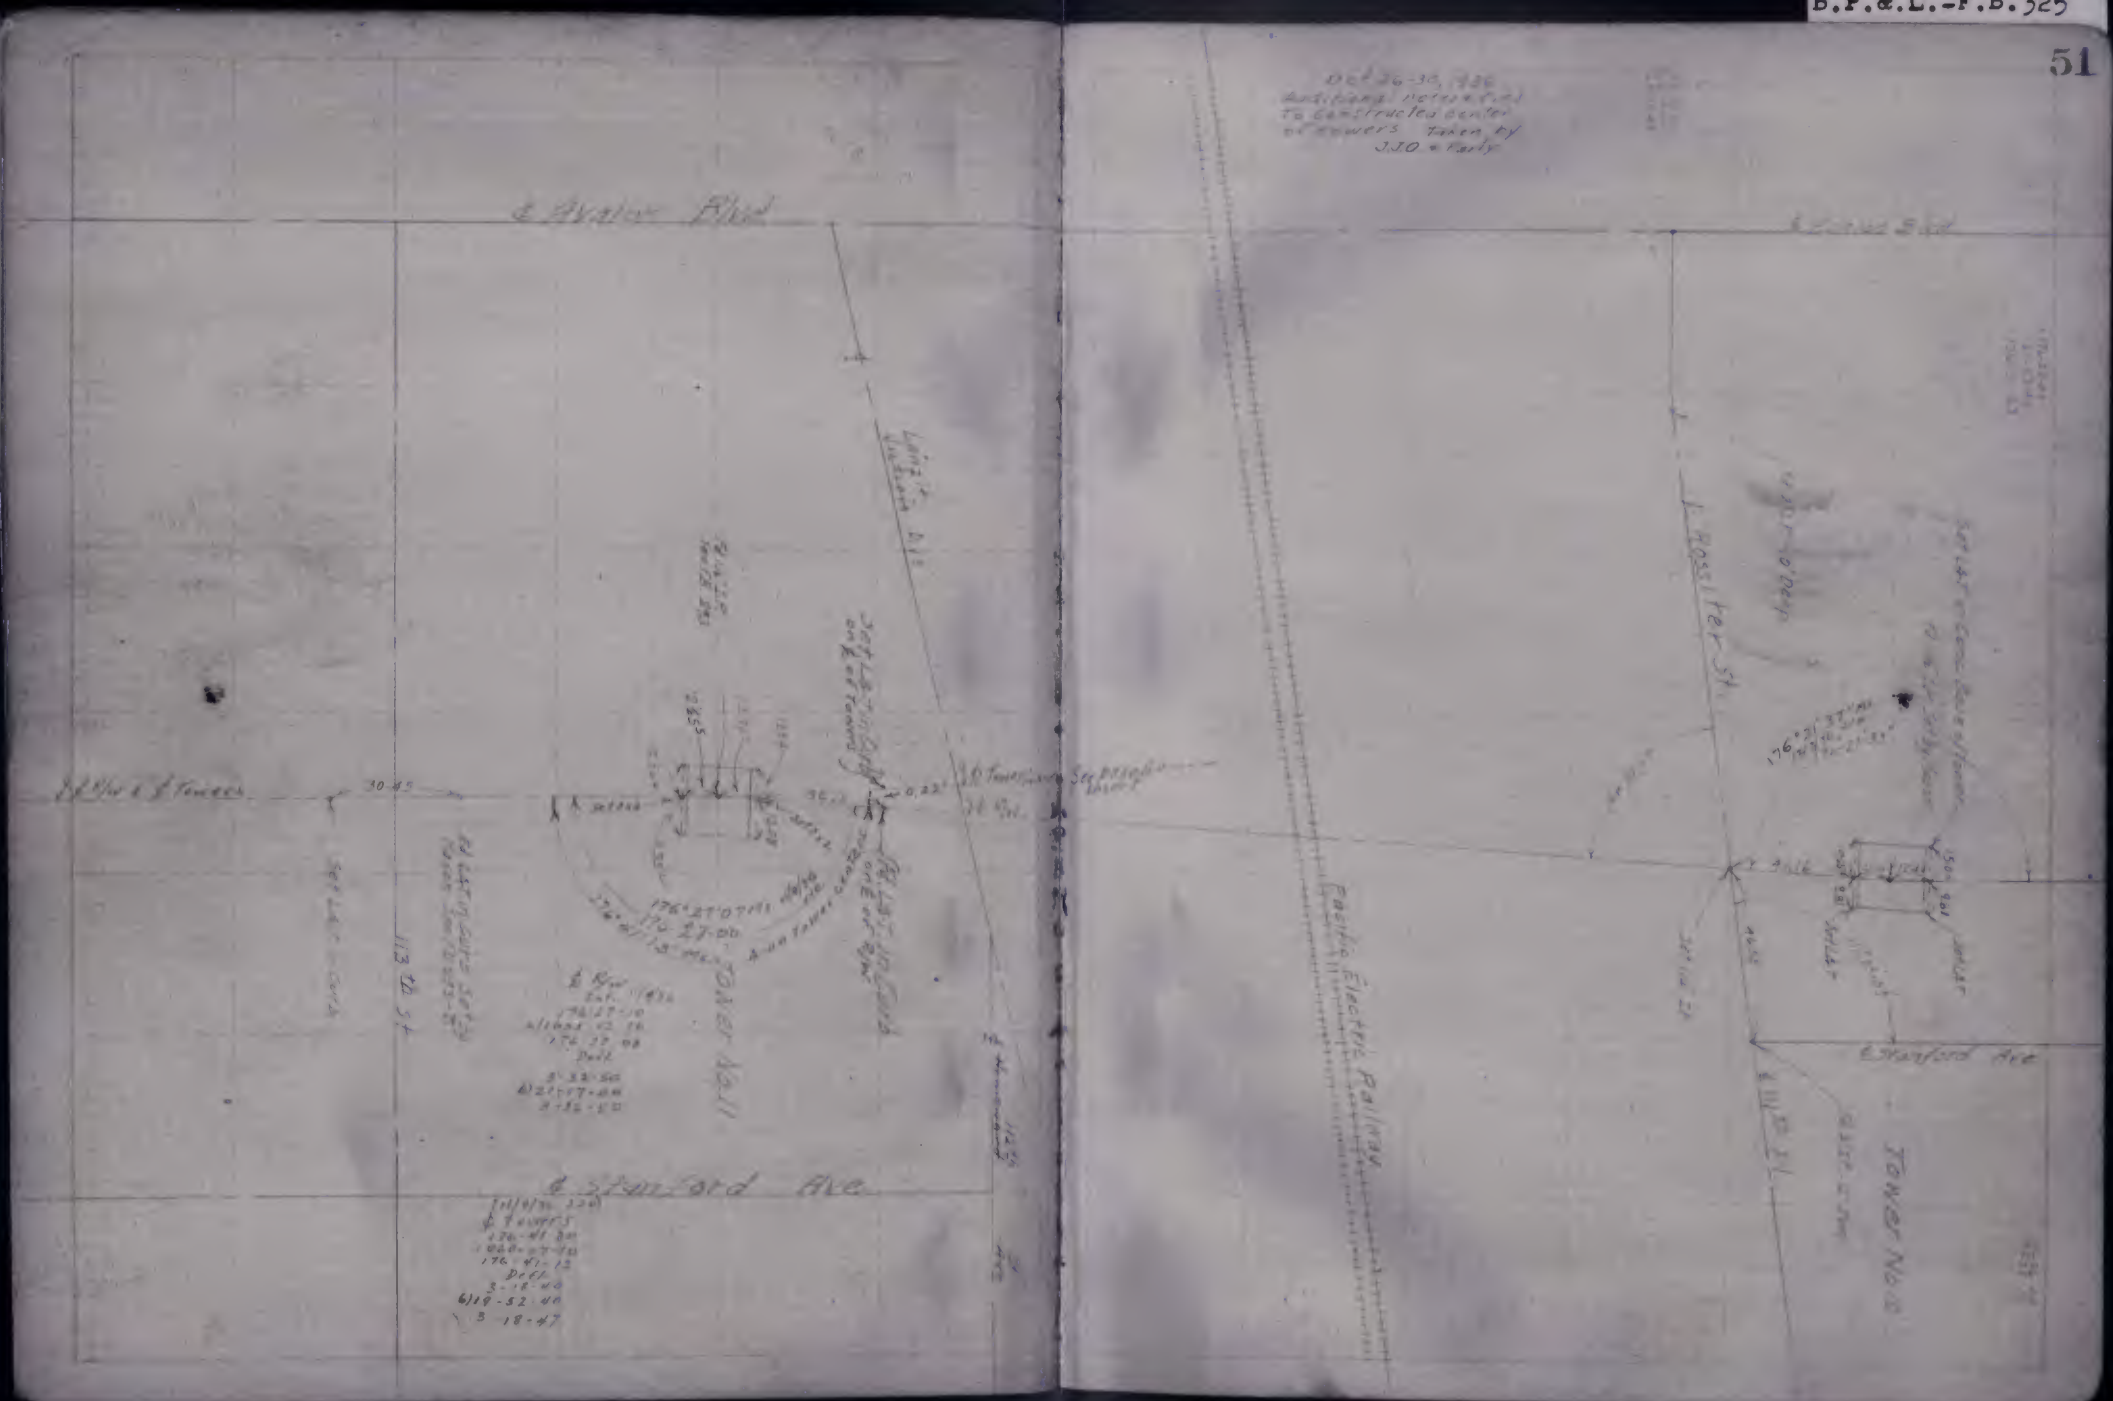

FB 1301-103

FB. 1301-104

B.P.&L.-F.B.325

32

FB.1301-115

FB.1301-116

B.P.&.L.-F.B.325

58

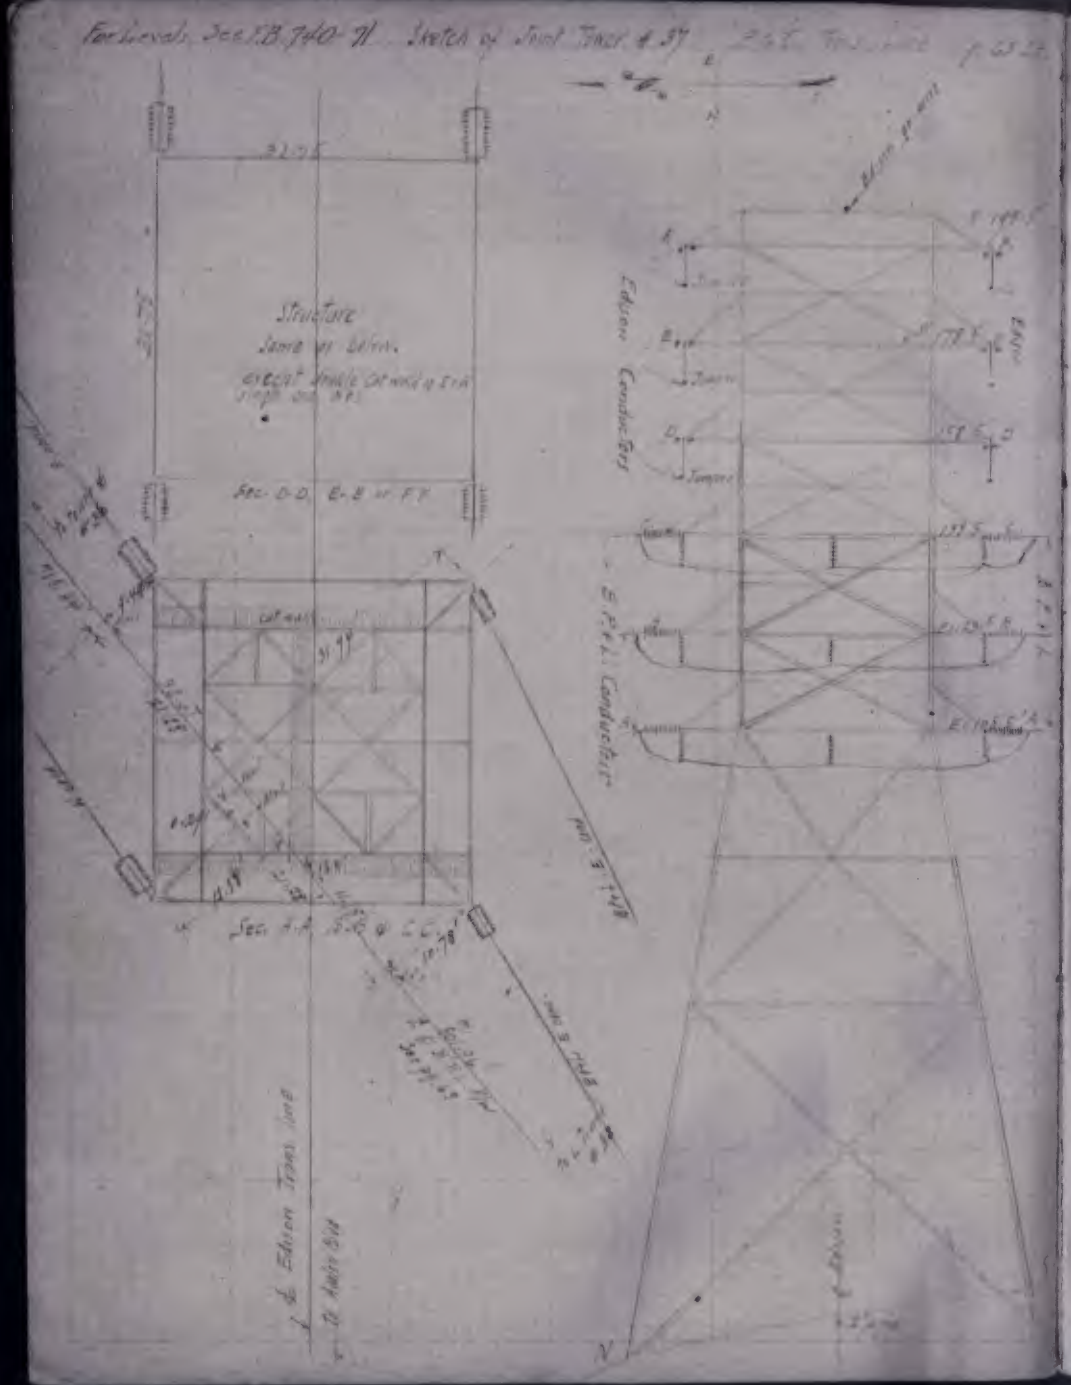

FB.1301-117

FB.1301-118

B.P.&L.-F.B.325

59

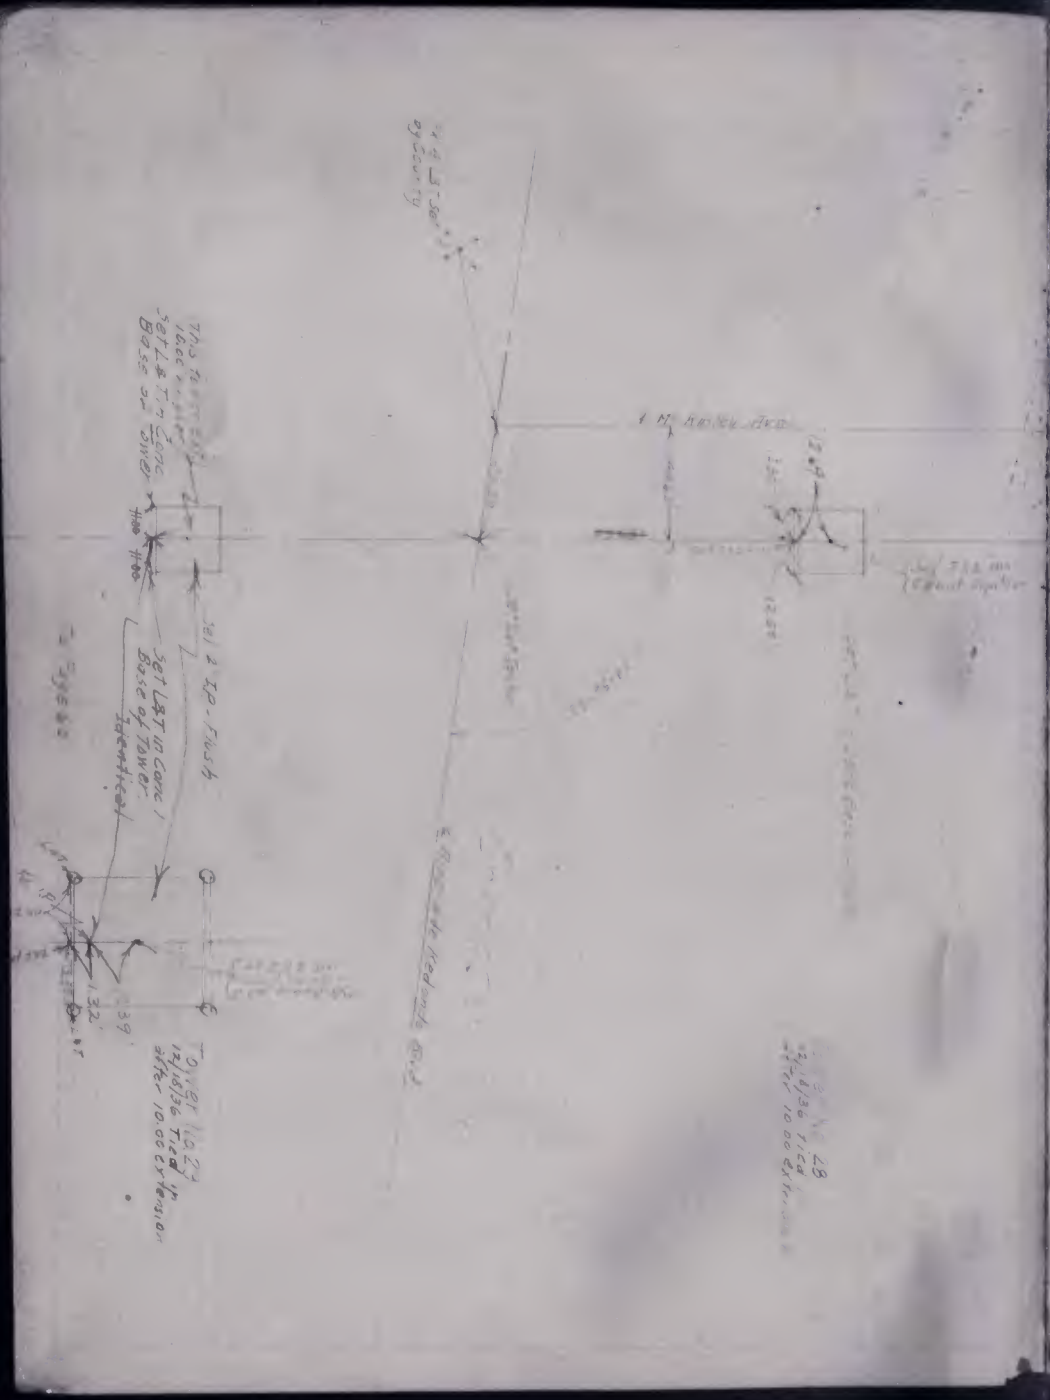

FB.1301-119

FB.1301-120

B.P.&.L.-F.B.325

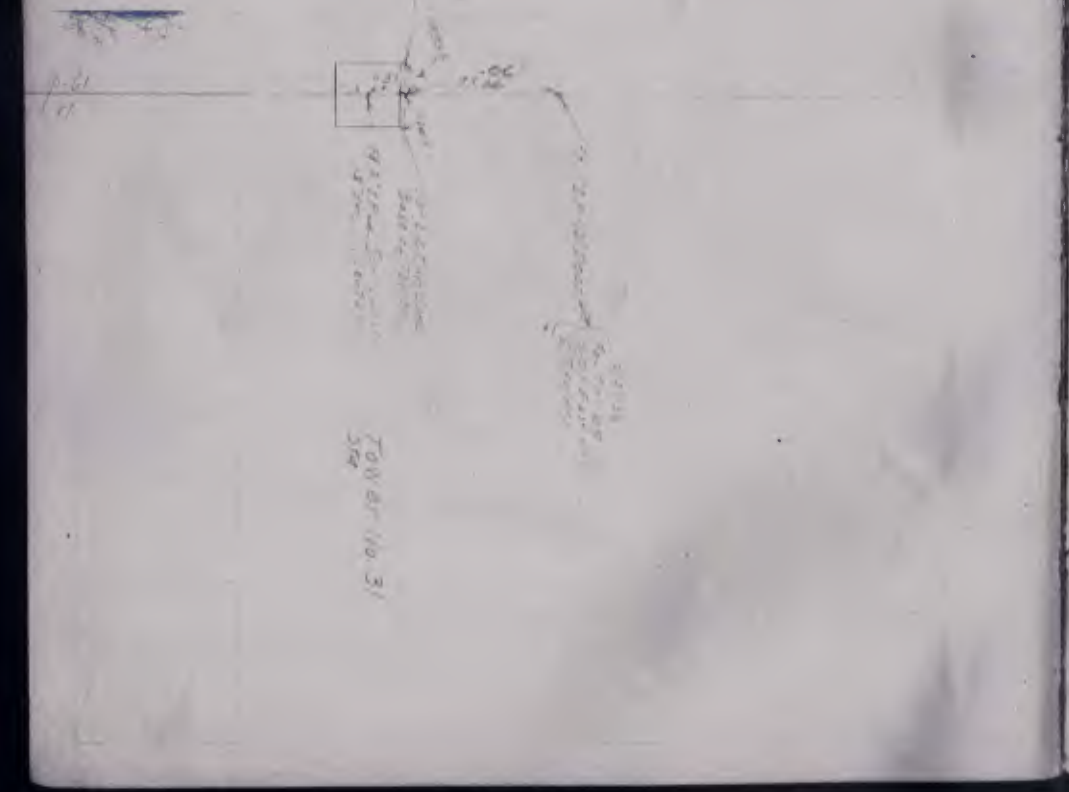

FB.1301-121

FB.1301-122

B.P.&.L.-F.B.325

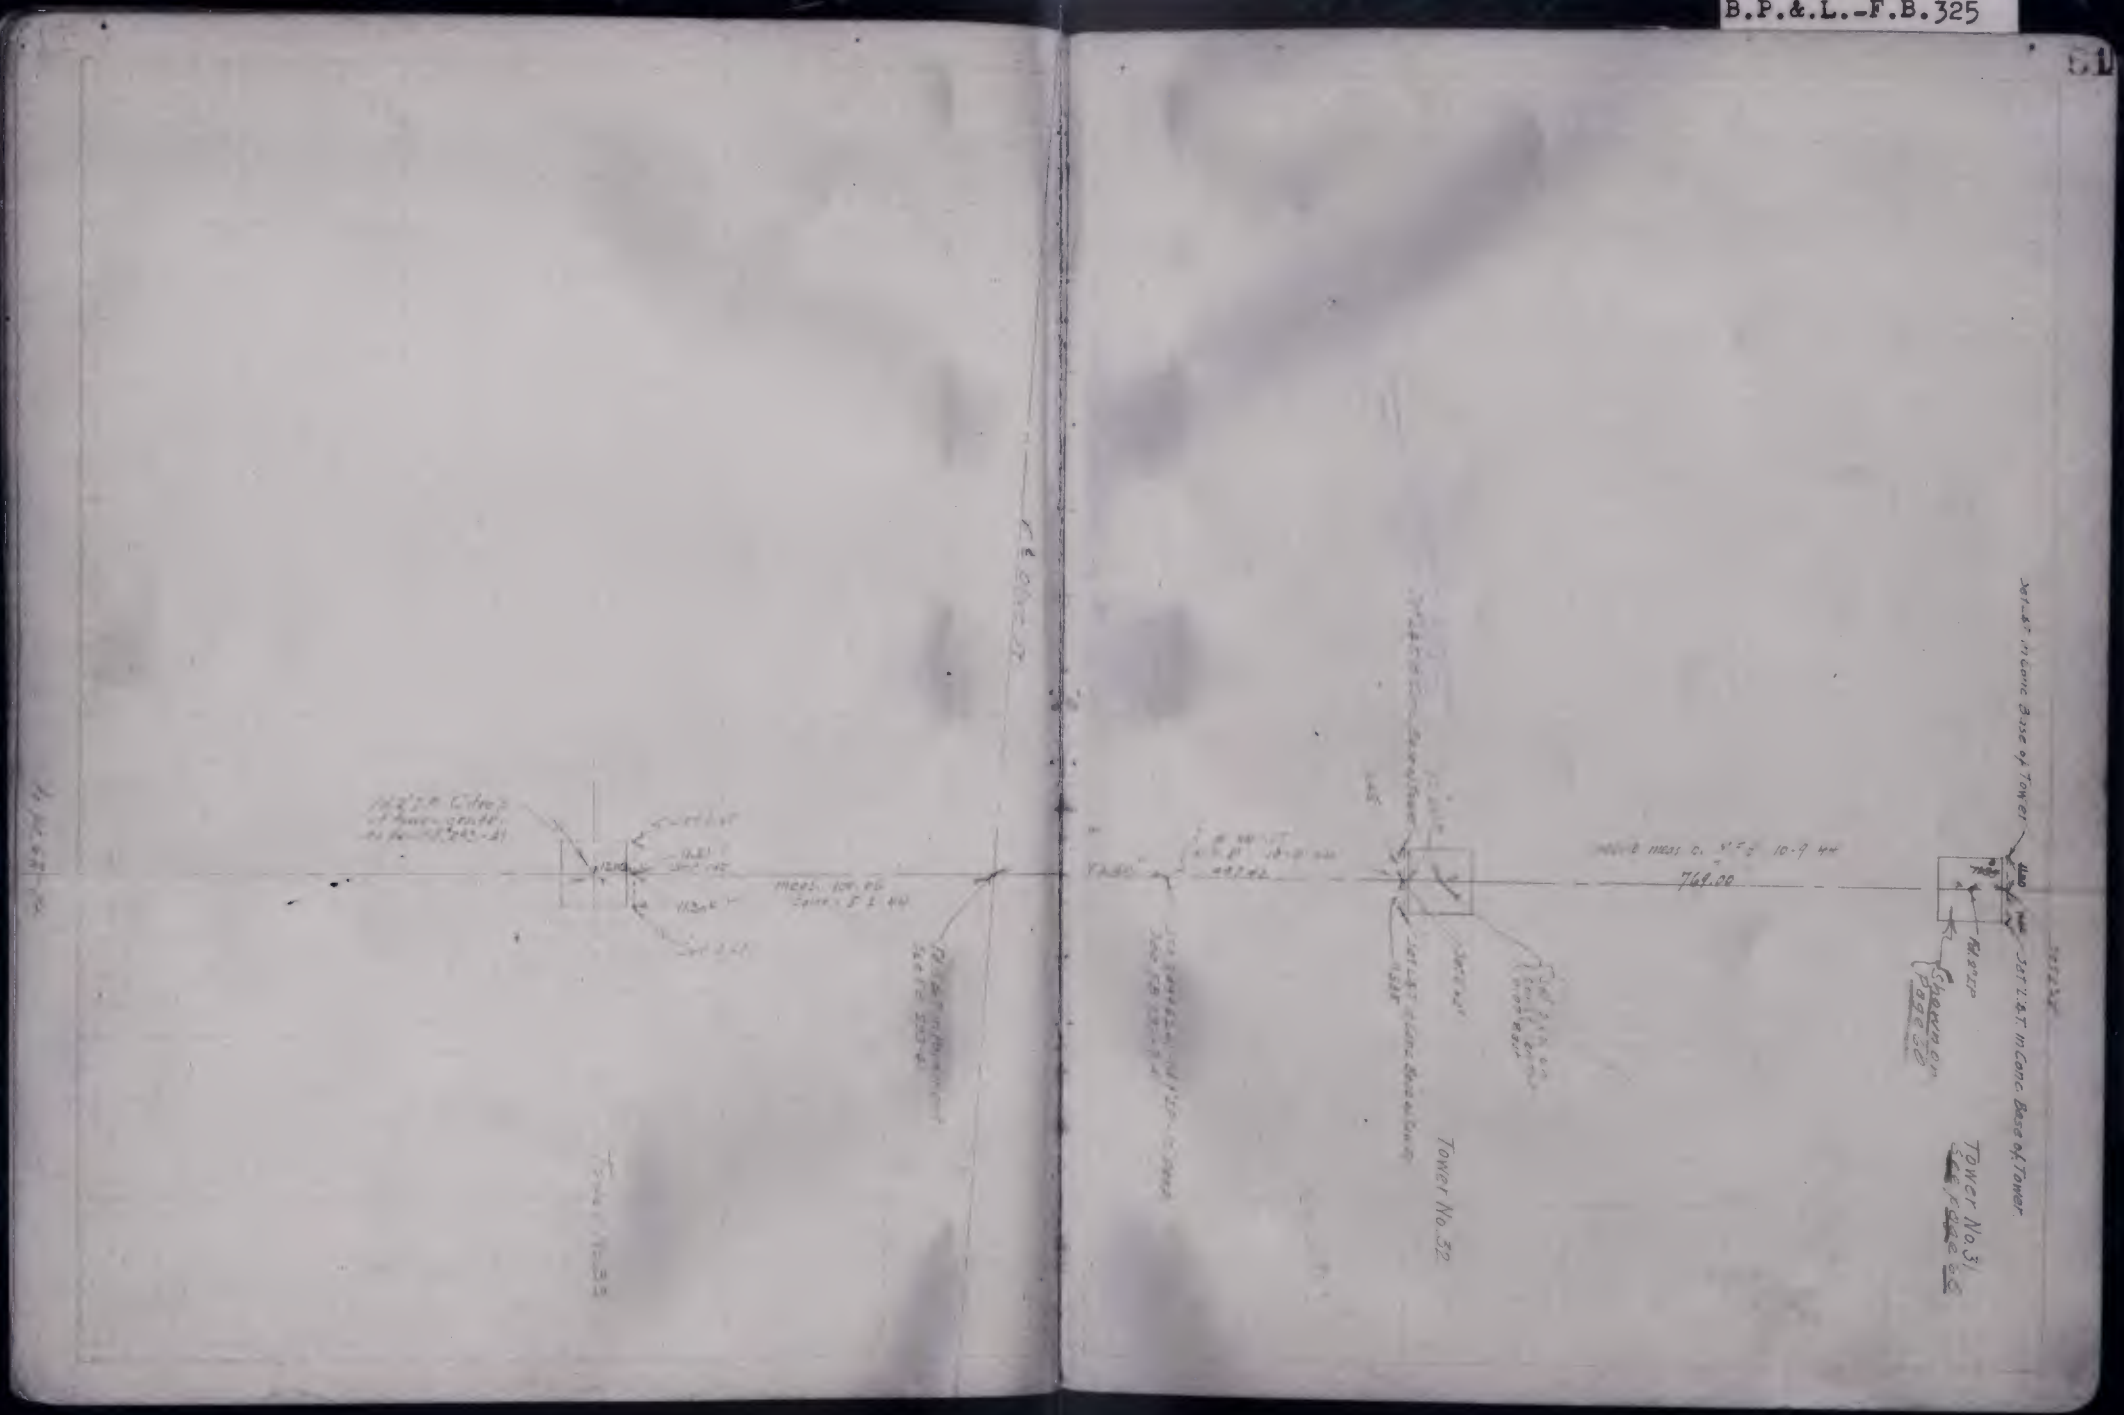

FB.1301-123

FB.1301-124

B.P.&L.-F.B.325

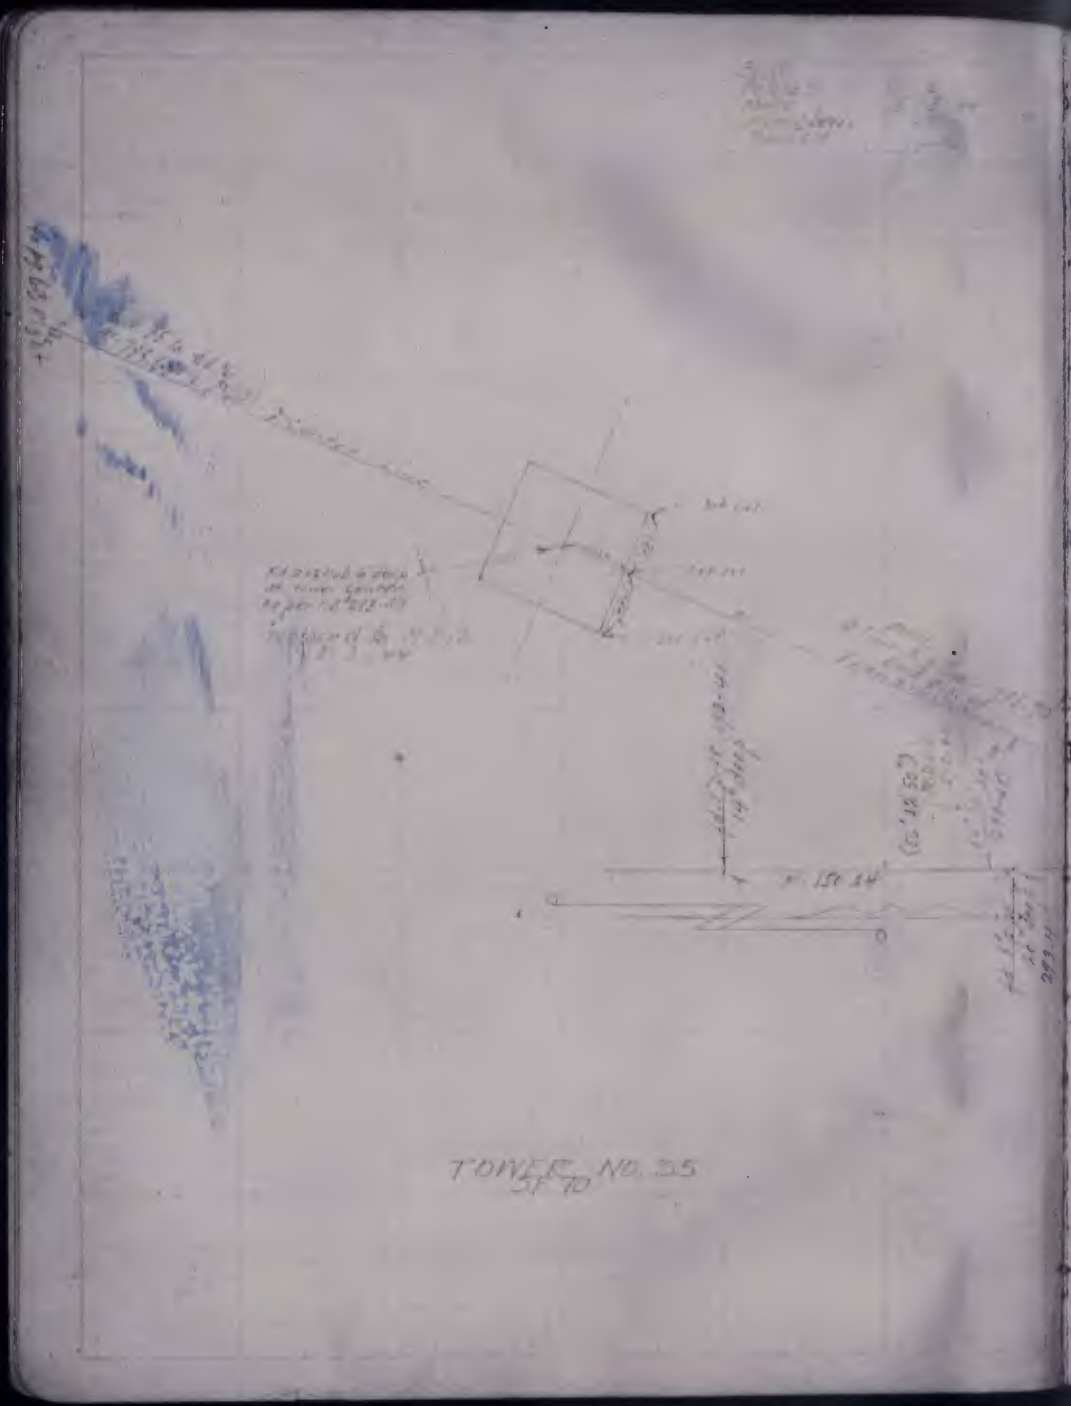

FB.1301-125

FB 1301-126

B.P.&.L.-F.B.325

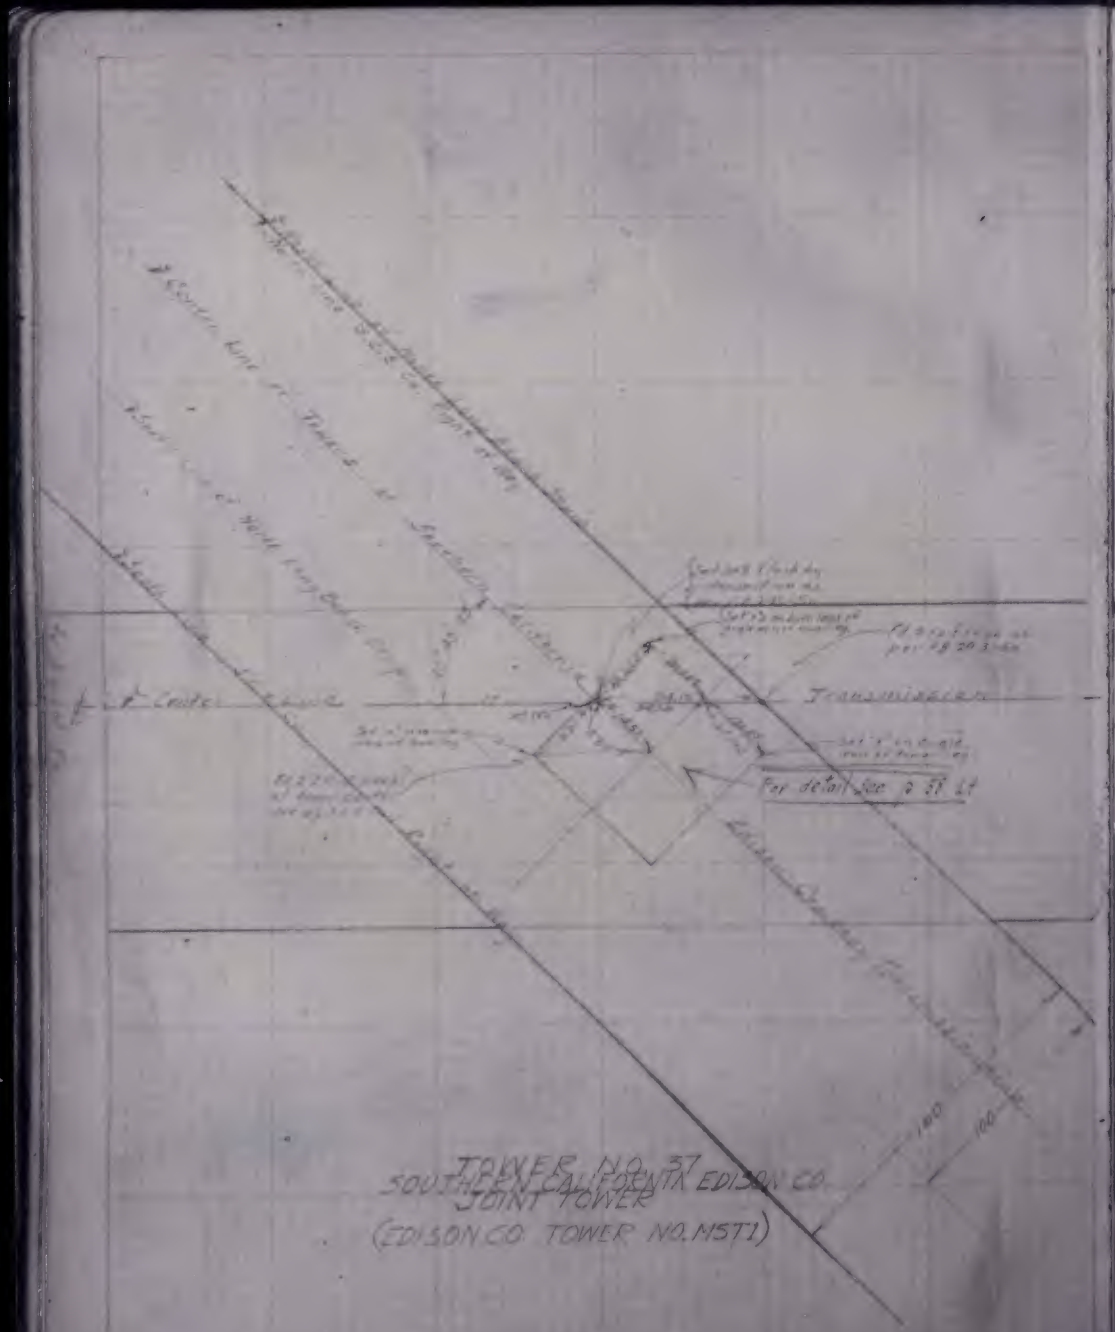

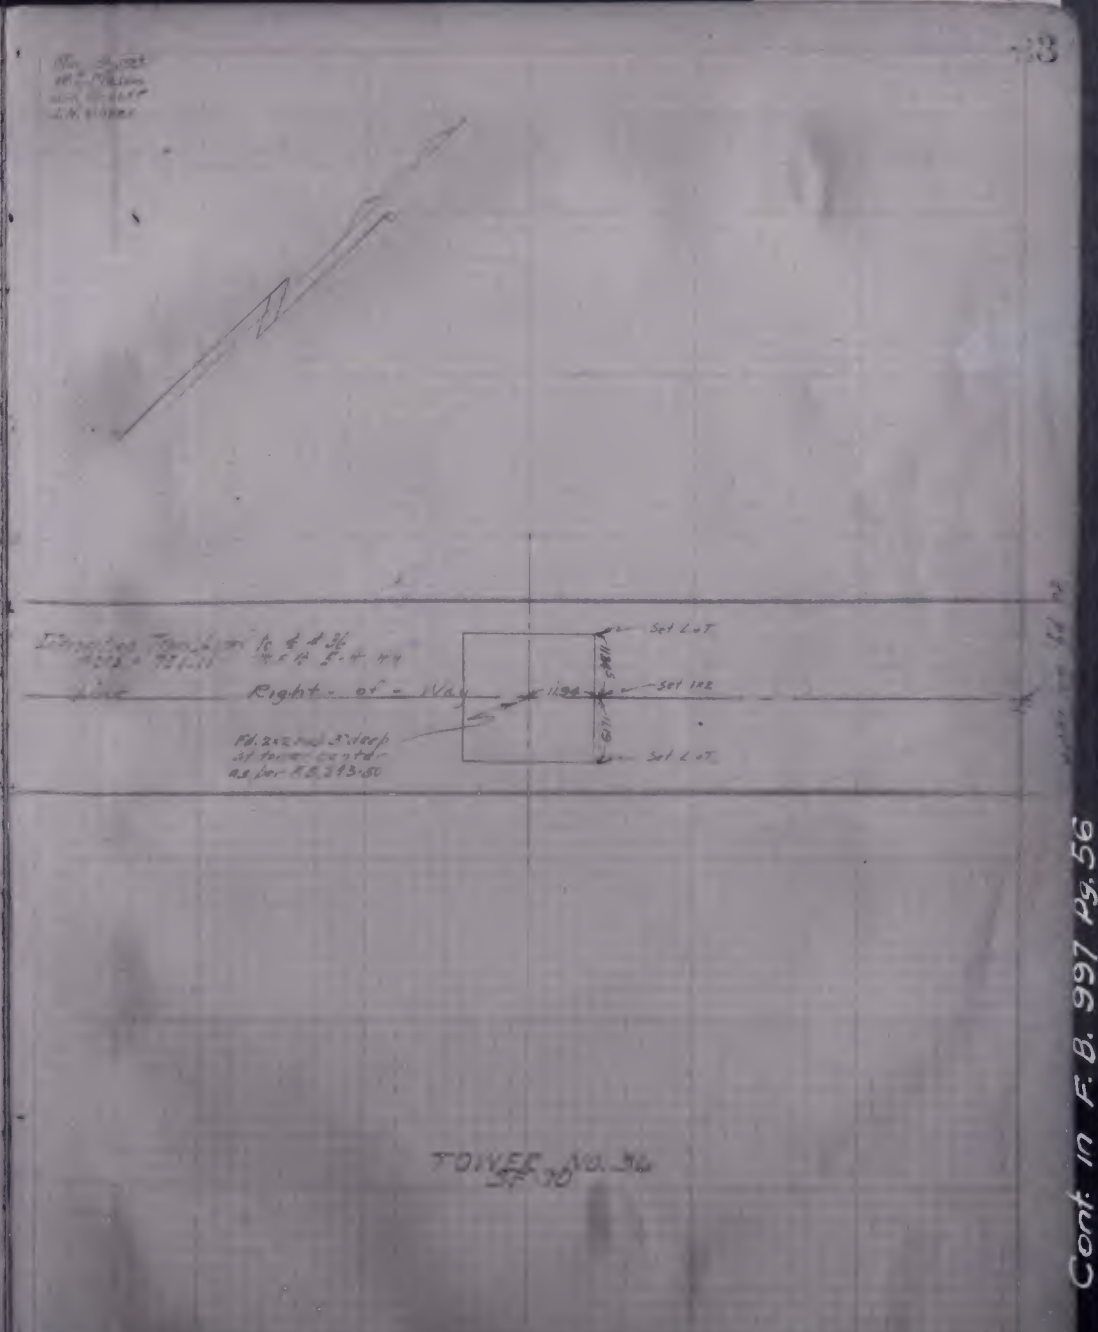

Cont. in F.B. 997 Pg. 56