The original pages of this book are of poor quality. Care has been taken to make the best scans possible. If necessary you can arrange to see the original book at:

Department of Public Works

900 S. Fremont Ave

Survey Public Counter

Alhambra, CA 91803

FB. 1309-1

FB. A 204-74

F.B. 1309-2

STATE OF CALIFORNIA — DIVISION OF HIGHWAYS

B Line

Co. LA. Rt. 168 Sec. B — Date 4-12-37 — Page 15

Station	Align	Deflection Lt	Deflection Rt	
246		7 - 14.93		N 27° 01' 45" E
+75		6 - 53.45		
+50		6 - 31.97		
245		6 - 10.48		
+75.25		5 - 49.00		
+60.25	Ex.	5 - 36.31		
+50		5 - 27.50		
+25		5 - 06.02		
244		4 - 44.53		
+75		4 - 23.05		
+50		4 - 01.56		N 49° 40' 00" E
+25		3 - 40.07		
243		3 - 18.59		
+75		1 - 57.09		
+50		2 - 35.61		
+25		2 - 14.13		
242		1 - 52.64		
+75		1 - 31.16		
+50		1 - 09.67		
+25		0 - 48.18		
241		0 - 26.70		
+75		0 - 05.22		
240 + 68.93	BC.			

Δ = 22° 25' 15"
R = 2000.63
T = 396.39
E = 38.90

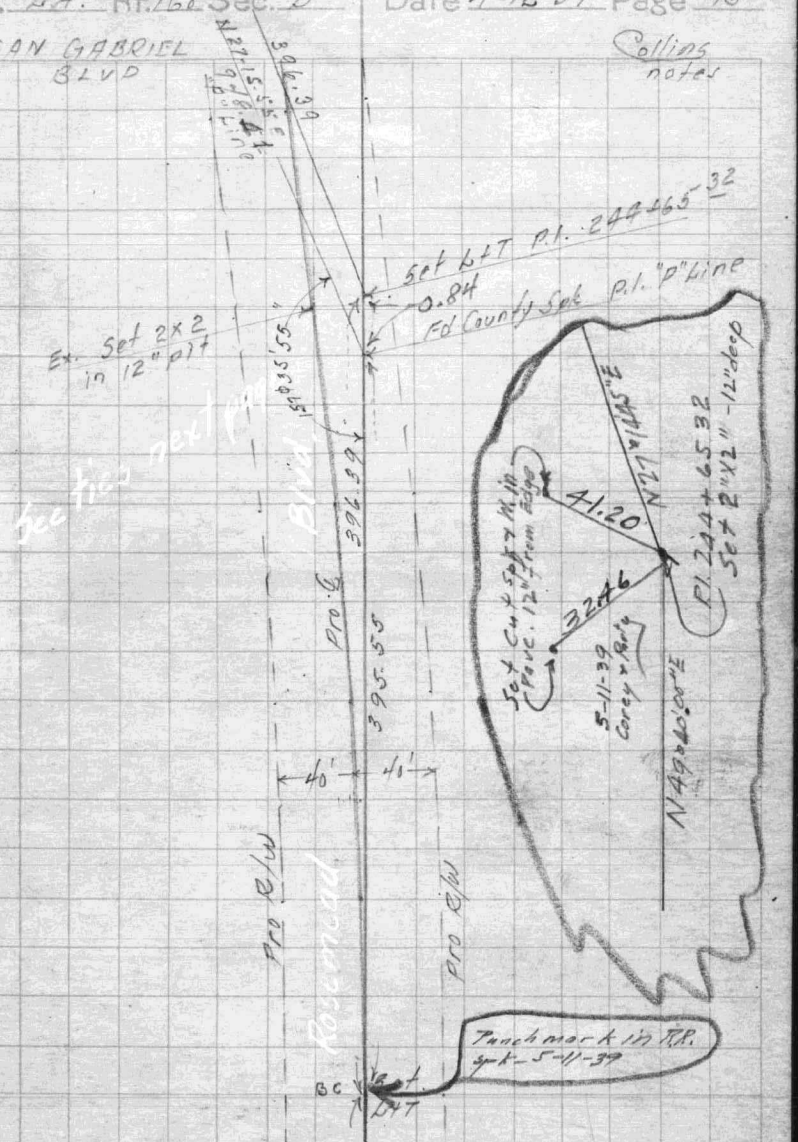

Continued from FB. 1308-120

Dunlap 237+97.82 Crossing Rd.

FB. 1309-3 Back of FB. A 204-74 FB. 1309-4

74

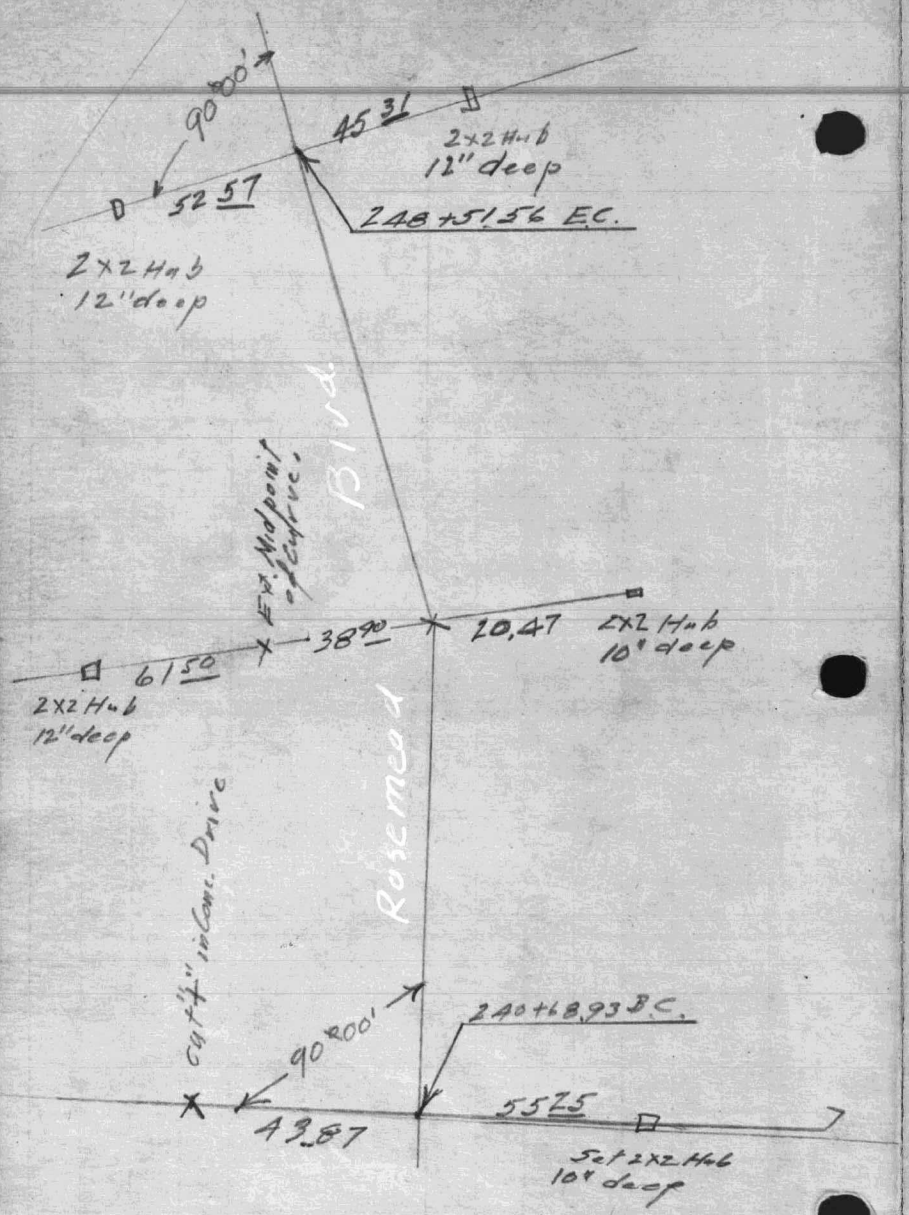

A204

FB.1309-5

FB.A204-75

FB.1309-6

STATE OF CALIFORNIA — DIVISION OF HIGHWAYS

8 Line — Co. LA. Rte. 19 Sec. B — Date 4-12-37 Page 16

Station	Align	Deflection Lt	Deflection Rt
255+91.30	BC.		
+50			
+43.09	End new PCC pave.		
254+02.80	= 254+09.42		
	BP		
+51.56	E.C.	11-12.62	
+50		11-11.28	
+25		10-49.79	
248		10-28.31	
+75		10-06.82	
+50		9-45.34	
+25		9-23.84	
247		9-02.36	
+75		8-40.87	
+50		8-19.39	
+25		7-57.90	
246		7-36.42	

Δ = 22° 25' 15"
R = 2000
T = 792.63
L = 782.39
E = 54.90

N 27° 14' 45" E

SAN GABRIEL BLVD

Fd L+T — BC new ACC pave. — Collins notes

This tangent produced to L+T ℄ Whittier Blvd.

+43.09

Fd L+T — Pl. "B" Line - County ℄

179° 58' 50"
180° 00' 00"
1.50

N 27° 14' 45" E 122.39

551.24

Pro ℄ R/W

Pro ℄ R/W

EC — Set L+T

Tracing by H.R. Spikin
Date 5-11-39

40' — 40'

Retaining Wall

N 27° 14' 45" E 496.39

US 91-D-1.1

(38)

(78)

FB.1309-7

FB.1309-8

FB.A 204-76

STATE OF CALIFORNIA DIVISION OF HIGHWAYS

74

B3 Line

Co. LA Rt 168 Sec. B Date 6-7-37 Page 1

Roy A. Collins - Chief
M.A. Schubert
C.I. Palmer
Don Oberg
M.W. Jackson

Station	Align	Defl. Lt.	Bearing
209		2 - 17.11	
+50		2 - 08.52	
208		1 - 59.92	
+50		1 - 51.33	
207		1 - 42.73	
+50		1 - 34.14	
206		1 - 25.54	
+50		1 - 16.95	
205		1 - 08.35	
+50		0 - 59.76	
204		0 - 51.16	
+50		0 - 42.57	
203		0 - 33.97	
+50		0 - 25.38	
202		0 - 16.78	
+50		0 - 08.20	
201+02.30	BC B3 Line		N 33° 01' 10" E
			N 27° 13' 25" E
			Δ = 54° 47' 45"
			R = 10000.22'
			T = 5501.56'
			L = 10111.56'
			E = 1281'
199+60.23	BC "B" Line		

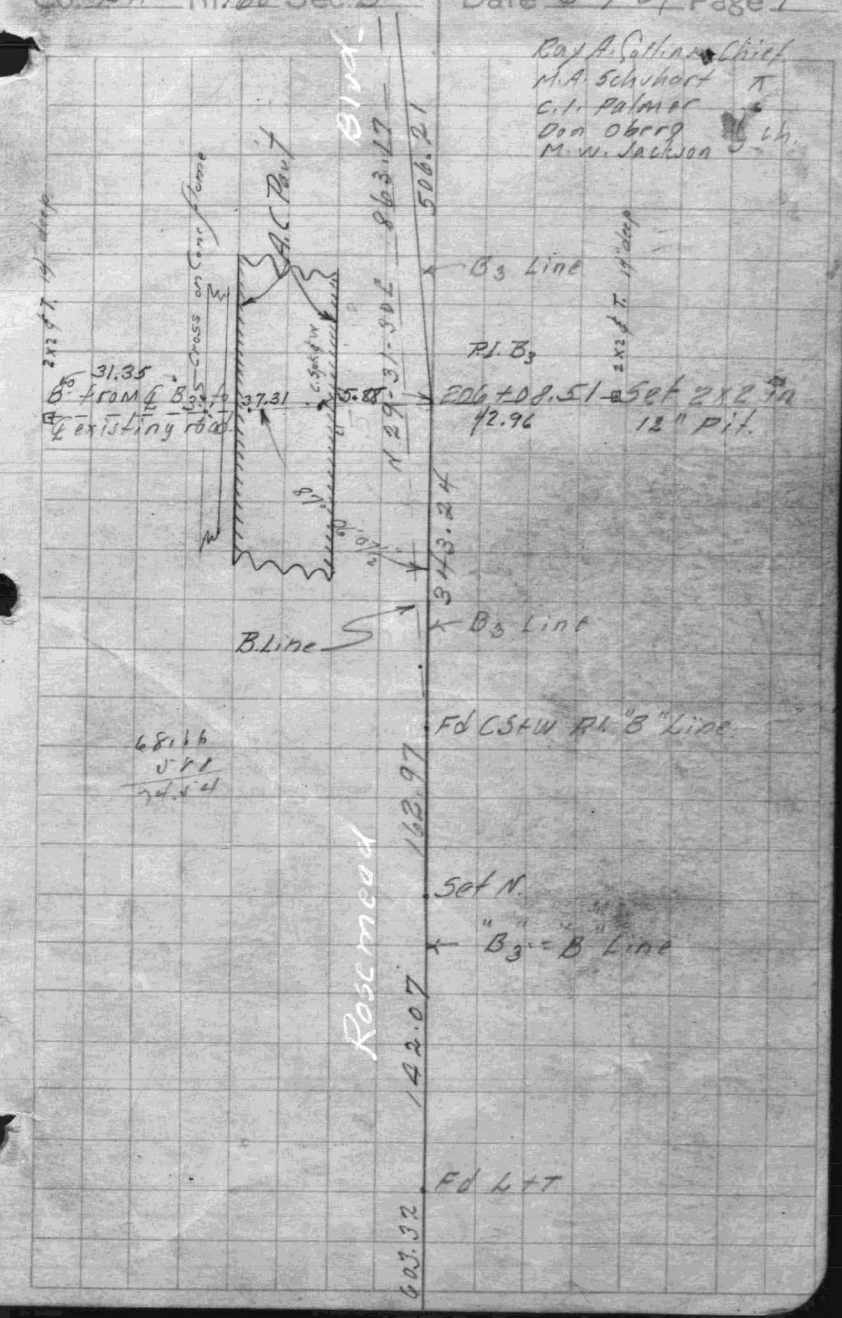

FB: 1309-9

FB. A 204.77

FB. 1309-10

B3 Line

Station

STATE OF CALIFORNIA DIVISION OF HIGHWAYS

Co. LA Rt. 162 Sec. B

77

Date 6-7-37 Page 2

215+01.87 = 215+01.93 "B" Line

211+28.63 = 211+28.39 "B" Line

+13.86	EC	2 - 53.87
211		2 - 51.49
+50		2 - 42.90
210		2 - 34.29
209 +50		2 - 25.70

N 27-13-25 E.

15'

N 27-13-25 E
1014.78
"D" Line

447.36

Set N

Fd CSAW
Pt. "P" Line
POT "B" Line

Rosemead Blvd.

373.24 B Line

373.54

RCC Dr.

5.2

37.13

37.67

2x2 Hub

14.77

Set N

"B" Line
N 29-31-30 E
463.17

N 27-13-25 E
STA 6.21

Hub

FB. 1309-11

FB. A 204-78

FB. 1309-12

STATE OF CALIFORNIA — DIVISION OF HIGHWAYS

Co. 66 Rt. 68 Sec. 5 Date 6-7-77 Page 3

78

B3 Line

Station	Align		Dist Rt	Bearing
224			6 - 27.45	
+50			6 - 10.20	
+70			6 - 00.70	
+50			5 - 44.45	
+40.93	Ex		5 - 36.61 ⊗	
223 +25			5 - 22.97	
			5 - 01.46	
+25			4 - 39.97	
+50			4 - 18.48	
+25 +14			3 - 57.00	
222			3 - 47.52 ⊗	
+25			3 - 35.51	
+50			3 - 14.07	
+25			2 - 52.53	
221			2 - 31.04	
+25			2 - 09.56	
+50			1 - 48.08	
+25			1 - 26.59	
220			1 - 05.11	
+70			0 - 43.62	
219+49.23 BC.			0 - 22.14	

Δ = 22° 26' 35"
R = 2000.00
T = 396.79
L = 783.41
E = 39.98

N 49° 06' 40" E

N 27° 13' 25" E

Rosemead Blvd.

P.I. Sta 65+10 — 38.98 — Set 2x2 12" pit

142.02

139.43

B3 Line

112.00

396.79

447.36

N 27-13-25 E

85.00

90°

4" Curb Return Block & porch 2.00 outside back

Set 2x2 12" pit

Set C.S + W 52.93

90°

42.85

Set 2x2 10" pit

FB. 1309-13

FB. A 204-78 A

FB. 1309-14

STATE OF CALIFORNIA — DIVISION OF HIGHWAYS

B_3 Line

Co. LA Rt 168 Sec. B Date 6-7-37 Page 1

Station	Align	Defl Rt.
229+12.27	EC "B" Line	
229+21.87 =		
	9.6	
+23.74		
+32.04	Ah = EC Bk	11-13.29
+25		11-06.74
227		10-45.25
+25		10-18.77
+50		10-02.28
+25		9-40.79
226		9-19.31
+25		8-57.82
+50		8-36.34
+25		8-14.86
225		7-53.37
+25		7-31.89
+50		7-10.40
+25		6-48.91
224		6-27.43

N 44°10'00" E

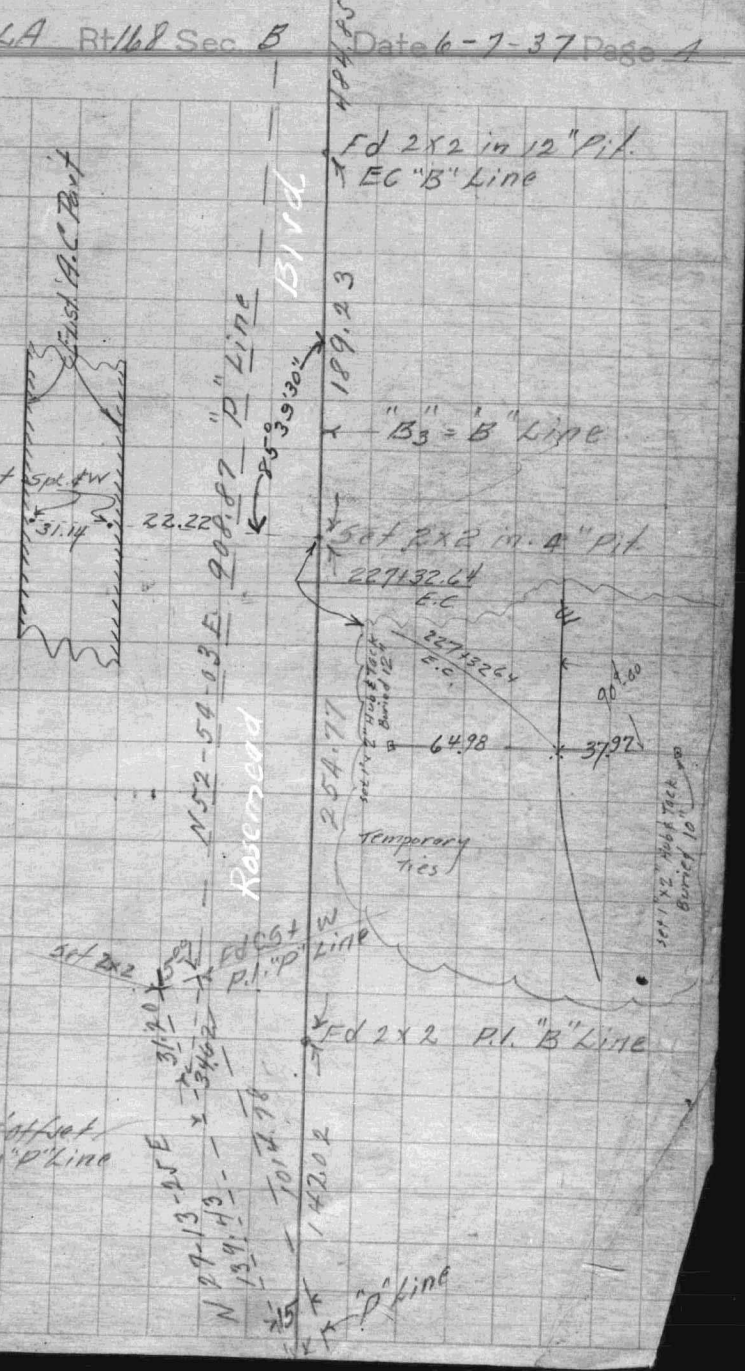

FB. 1309-15

FB. 1309-16

FB. A 204-83

STATE OF CALIFORNIA — DIVISION OF HIGHWAYS

P Line

Station

Co. LA Rt. 168 Sec. B

Date 3-16-37 Page 1

83

Roy A. Collins Chief + noter
M.A. Schubert calc
C.L. Palmer "
Don Oberg } Ch.
H.C. Oegale }
M.W. Jackson } Rod.
Jack Paller }

N 52° 54' 03" E

N 87-19-25 E

N 29-31-30 E

215+01.93 P.I.

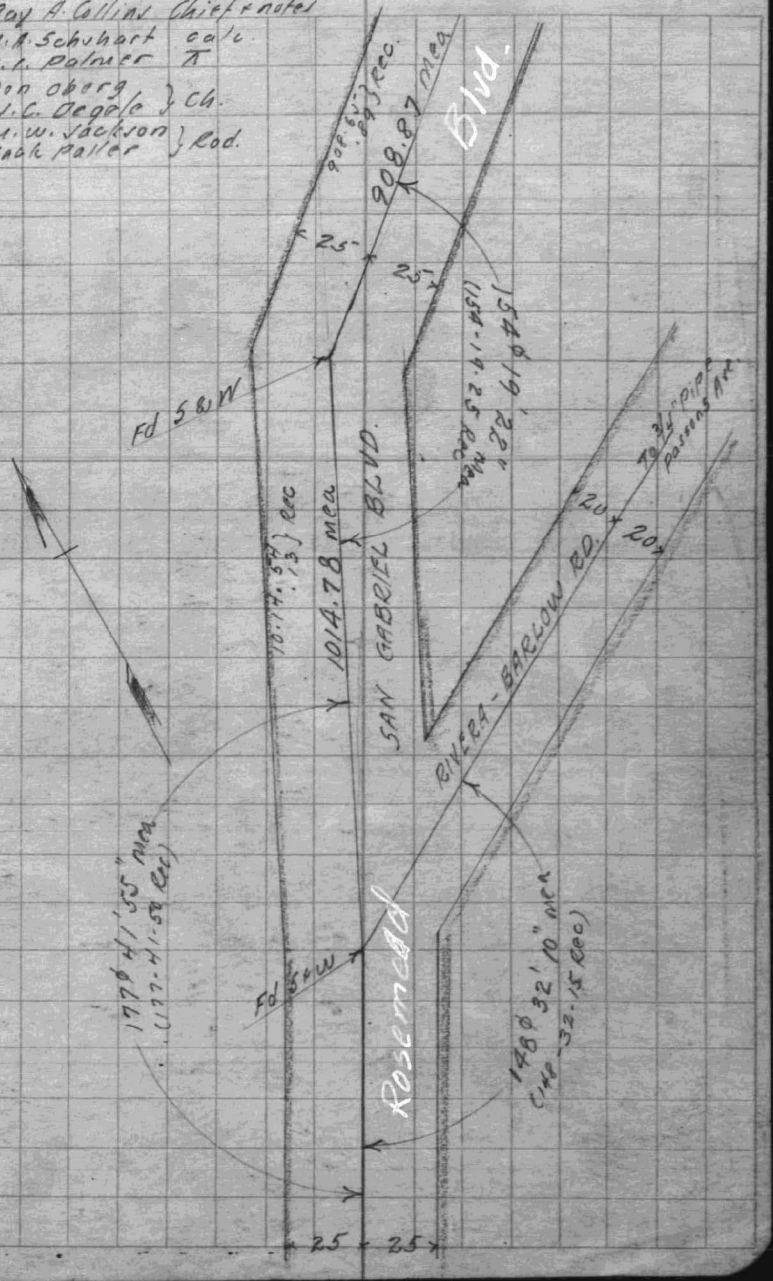

FB.1309-17

FB.A204-84

FB.1309-18

STATE OF CALIFORNIA DIVISION OF HIGHWAYS

Co. LA Rt. 168 Sec. B Date 3-10-97 Page 2

P Line

Station

N 27-15-57 E

N 49-40-00 E

N 52-54-03 E

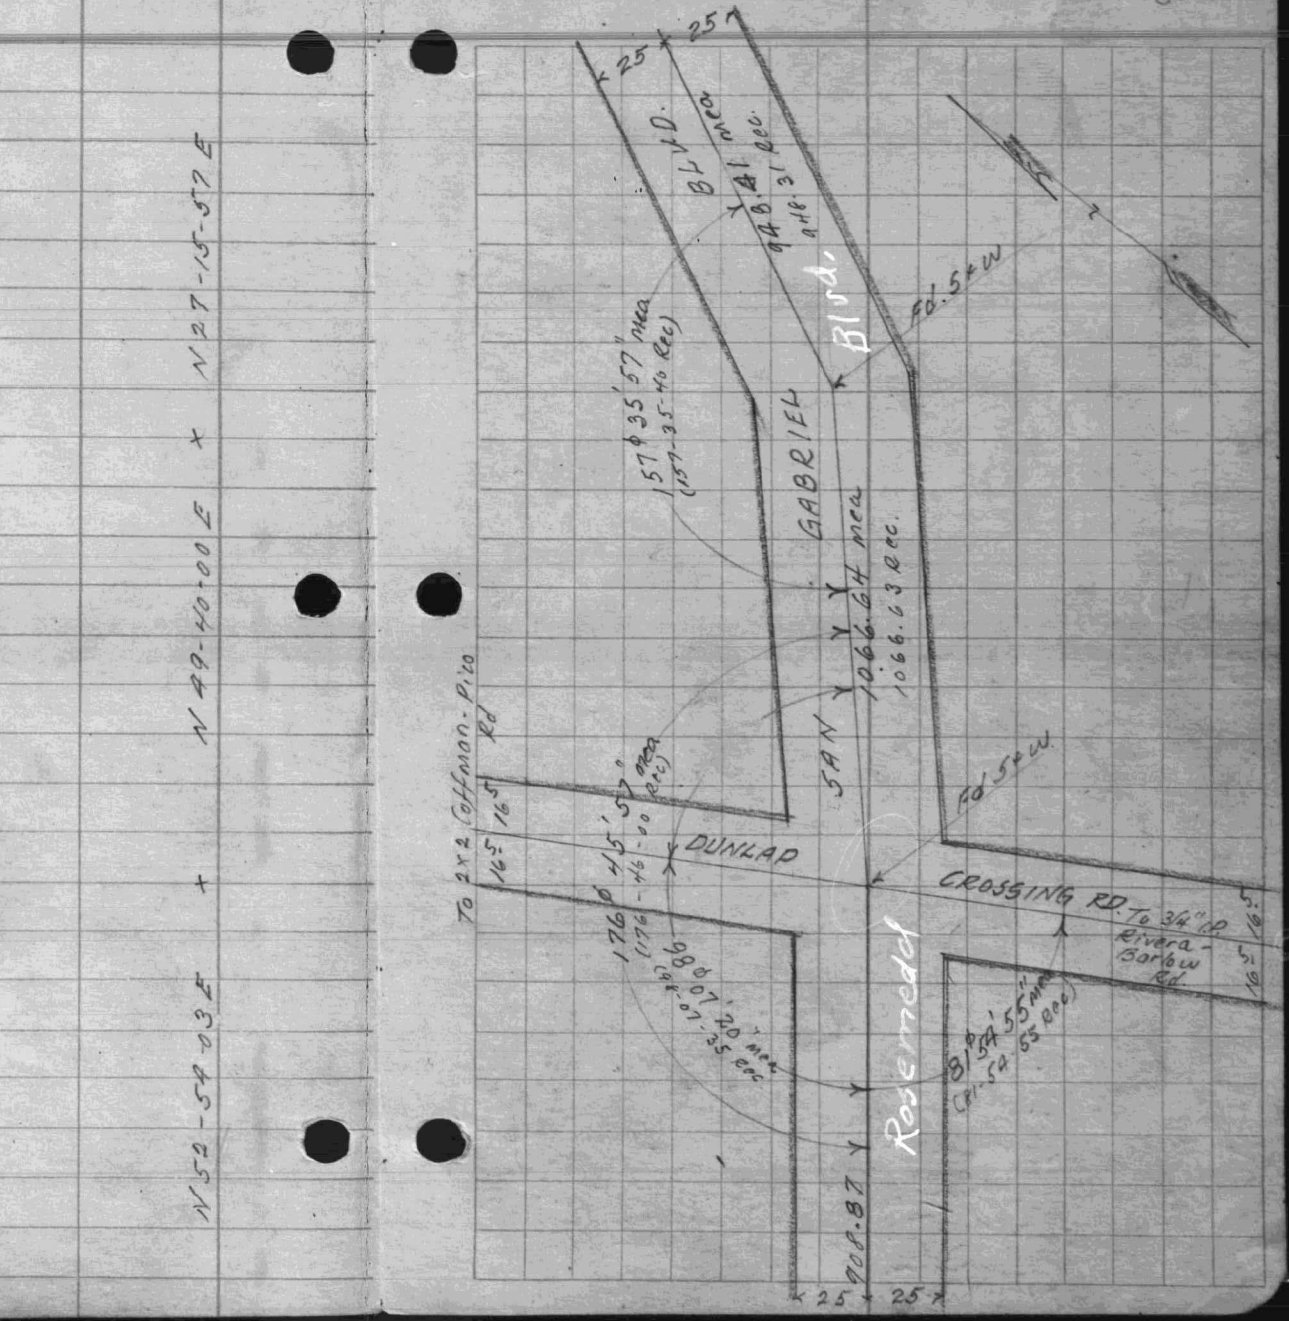

FB.1309-19

FB.1309-20

FB.A204-85

STATE OF CALIFORNIA DIVISION OF HIGHWAYS

85

P Line

Station

Co. LA Rt. 162 Sec. B Date 3-10-37 Page 3

BC of Improvement

N 27-15-57 E

N 27-14-47 E

25A+09.42 (Sta. of Improvement & N)

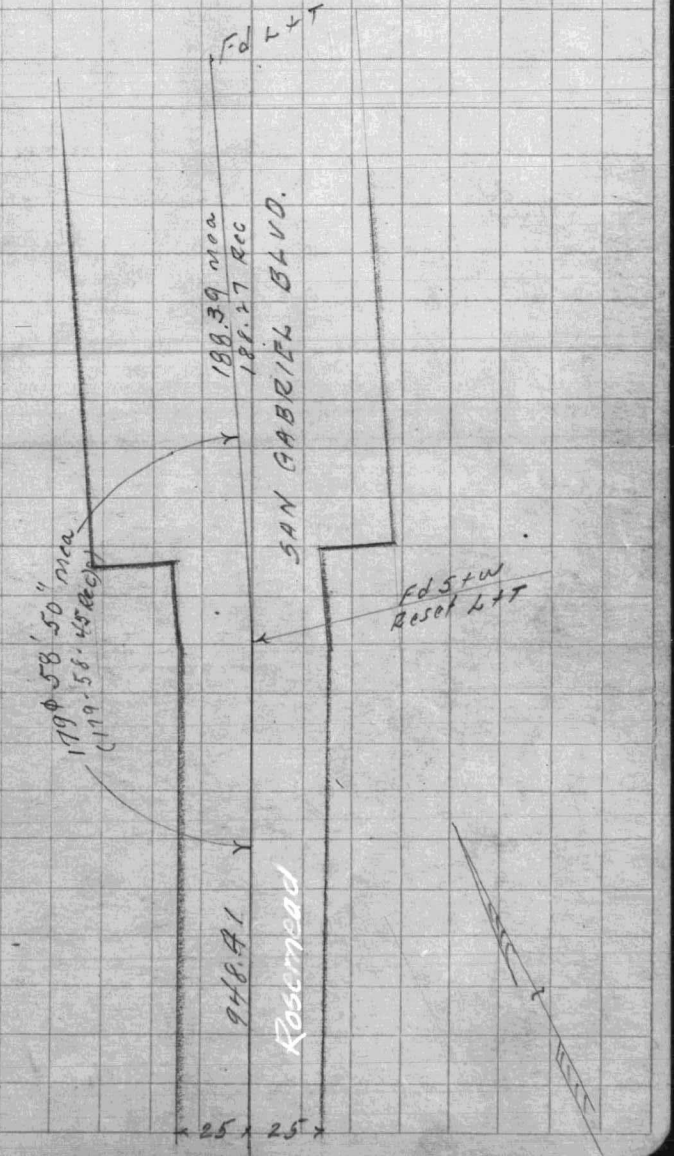

F.B. 1309-21

SURVEY OF LA-168-B (Rosemead Blvd.) INDEX A204-001 PAGE 1 1'

CALIFORNIA DIVISION OF HIGHWAYS DIST. VII

LA-168-B ~~C~~ (See Sec. C Notes)

ALIGNMENT NOTES

ROSEMEAD BLVD.

from

BEVERLY BLVD. to GARVEY AVE.

Sta. "B" 295+85.95 to 364+01.57 = 400+00.14 "B"

Sta. "B" 400+00.14 to "B" 467+47.33 = "C" 0+00.00

Sta. "C" 0+00.00 to "C" 79+74.14

July & August 1946
Wildy
E. Smith - Notes.
Wakefield
Strode
Skinner
Fisher

Ref:- State Highway alignment notes
Book A 204 pages 1-5, 33+34, 56-57, 82
Book R 204 pages 16, 17 + 18
Book A 205 pages 1-15
Book A 205.1 pages 14, 15, 16 + 25.

Record Survey Maps. Nos. 204.3, 204.4, 204.5
Tract Map No. 13463
Los Angeles County Road Dept. field notes F.T.-36 pgs. 579+580; F.T.-37 pages 149, 150 + 156

Note:- In general this survey is a retracement of the original survey as recorded in field books A 204 + A 205. Some difficulty was encountered between Sta. "B" 347+88.29 EC and the end of section "B" the distances recorded not checking within the required limit of error of 1:10000. These discrepancies are all properly shown in the notes.

SURVEY BY Wildy & Party DATE 7-9-46 E.I.S.-Notes

F.B 1309-22

SURVEY OF LA-168-B (Rosemead Blvd.) INDEX A204-001 PAGE (2) 2

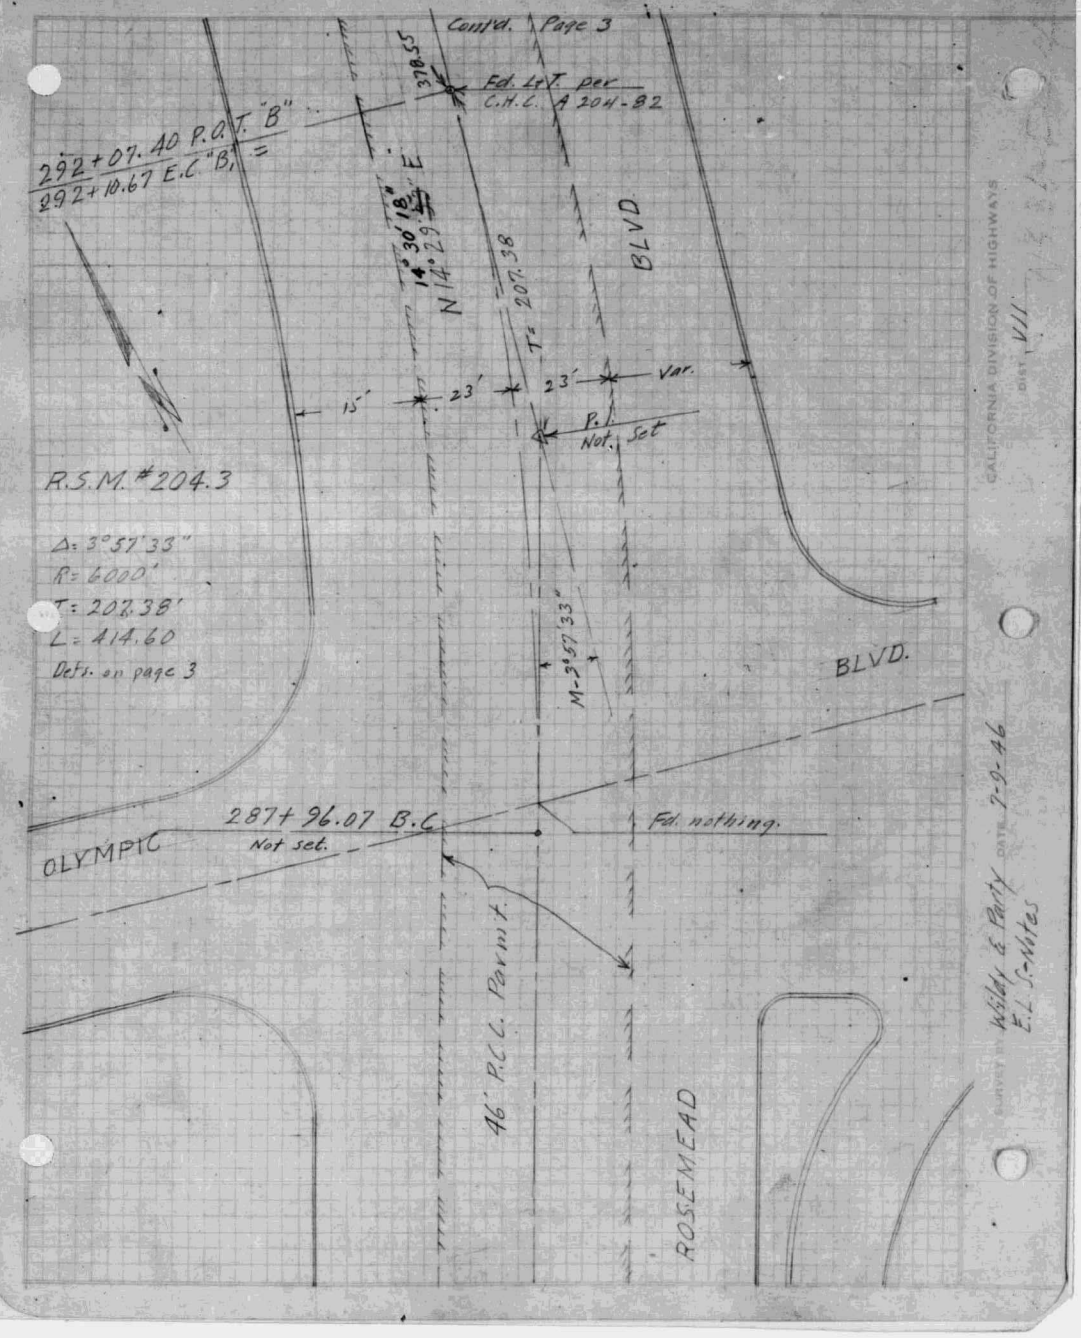

CALIFORNIA DIVISION OF HIGHWAYS DIST. VII

SURVEY BY Wildy & Party DATE 7-9-46 E.I.S.-Notes

F.B 1309-~~24~~ 23

LA-168-B (Rosemead Blvd.) INDEX A204-001 PAGE 3

Cont'd. Page 5

Fd. L&T. in curb.

Not Tan.

P.C.C. Par.

BEVERLY BLVD.

90°08'10" per R.S.M. #204.3

451.67

BLVD.

66.32

29°59'40" per R.S.M. #204.3

Rad. L&T in curb.

To L&T. Straddlers at P.I. per Co. Rd. Dept. FT-36 pg. 579

Meas. 170.88 Rec. = 46.01

To L&T. P.I. Pg. 4 Rec. = 124.90

R=400'

295+85.95 "B" P.O.T.

Reset L&T in expansion joint per C.H.C. A 204-33.

66.65

P.C.C. Par.

Berry Dixon

68.32

P.C.C. Par.

ROSEMEAD

Not Tan

Fd. L&T. in curb.

14°30'18" N 14°29'33" E 378.55 per R.S.M. #204.3

38' 38'

T.E.C.

Cont'd. Page 2

292+07.40	P.O.T.		
292+10.67	E.C.	1°58.77'	
292~		1°55.69'	
+50		1°41.37'	
291~		1°27.05'	
+50		1°12.73'	Δ=3°57'33" Lt.
290~		0°58.41'	R=6000'
+50		0°44.09'	T=207.38'
289~		0°29.79'	L=414.60'
+50		0°15.45'	Sketch page 2
288~		0°01.13'	
287+96.07	B.C.	0°00.00'	

R.S.M. # 204.3

SURVEY BY Willy & Party E.L.S. - Notes DATE 7-9-46

CALIFORNIA DIVISION OF HIGHWAYS DIST. VII

F.B. 1309-~~26~~ 24

SURVEY OF LA-168-B (Beverly Blvd.) INDEX A204-001 PAGE 4

Fd. L&T. P.I. per Co. Rd. Dept. Book FT-36 pg. 580 C.H.C. Book R 204.1-16

Page 25 omitted

BLVD.

545.99 per C.H.C. Bk. R 204.1-16

50'

P.C.C. Pavt.

50'

0.63 Lt. 0.74 Lt.

Meas. 34°40'36"

40'

Fd. L&T. Straddlers per Co. Rd. Dept. book FT-36 Pg. 580 C.H.C. book A 204.1-16

M. 124.92 Rec. = 124.90

11+70.88 Fd. L&T in Pavt. per County Rd. Dept. FT-36 page 580

Δ = 34°40'50" Rec. Δ = 34°40'55" Per Co. Rd. Dept. Book FT 36-580

℄ R=400'

T=124.90

① 34°40'30"
② 138°42'00"
③ 277°24'45"

BEVERLY

Meas. 170.88 Rec. = 124.90

83°59'40"

R=16.01

10+00.00 See Pg. 3

℄ Rosemead Blvd.

SURVEY BY Willy & Party E.L.S. - Notes DATE 7-10-46

CALIFORNIA DIVISION OF HIGHWAYS DIST. VII

F.B 1309-26

F.B. 1309-27

SURVEY OF LA-168-B (Rosemead Blvd.) INDEX A204-001 PAGE 5

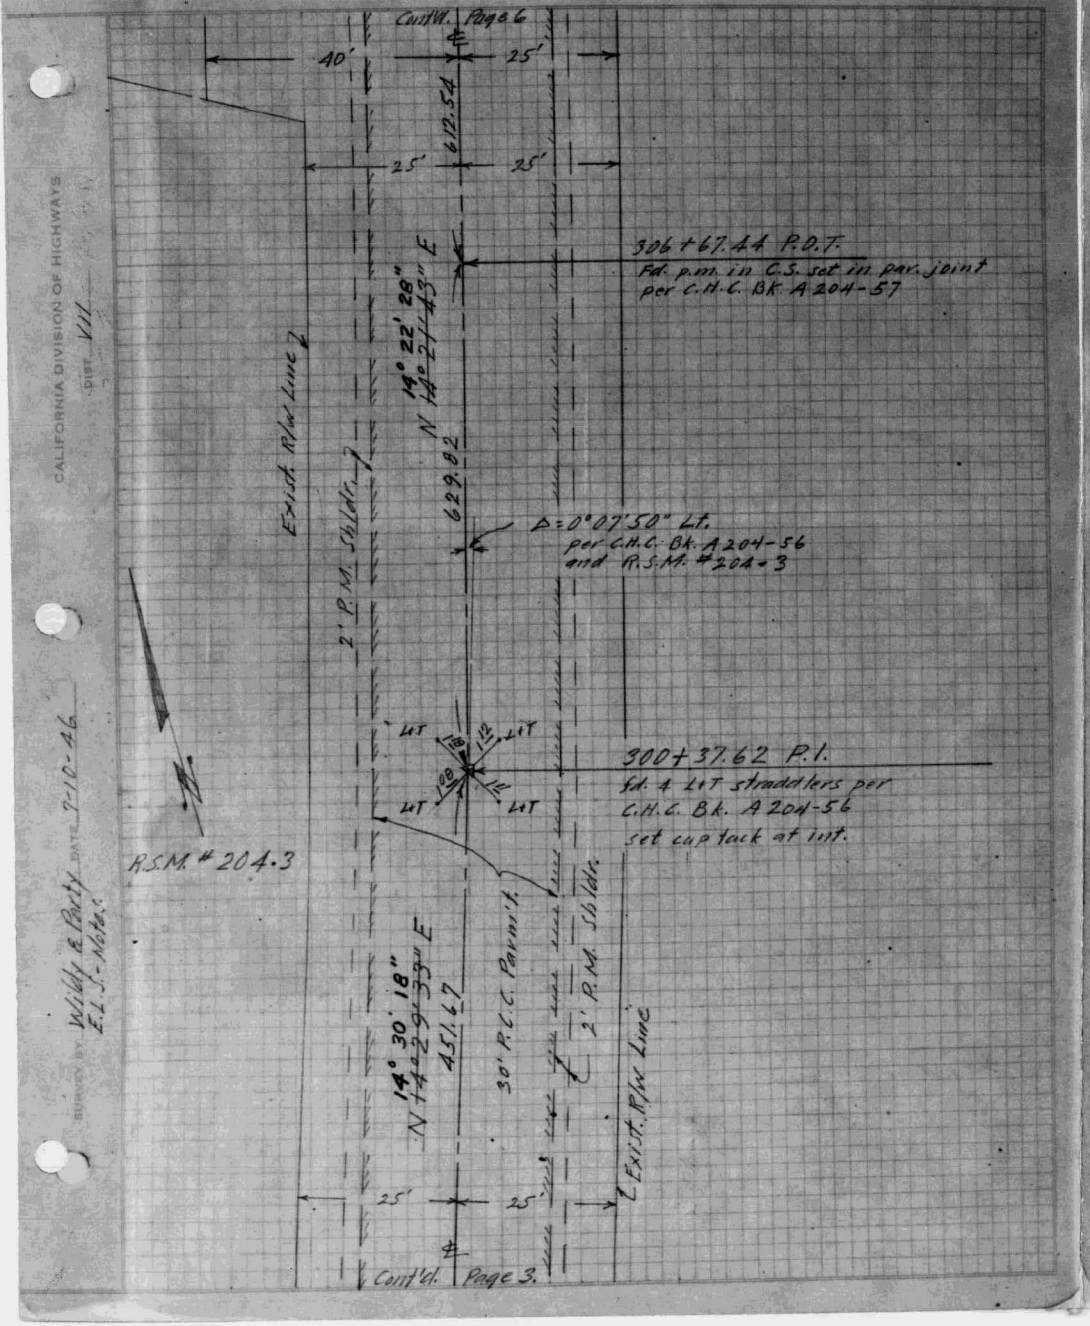

SURVEY BY Willy & Party DATE 7-10-46
E.I.S.-Notes.

CALIFORNIA DIVISION OF HIGHWAYS DIST. VII

SURVEY OF LA-168-B (Rosemead Blvd.) INDEX A204-0^1 PAGE 6

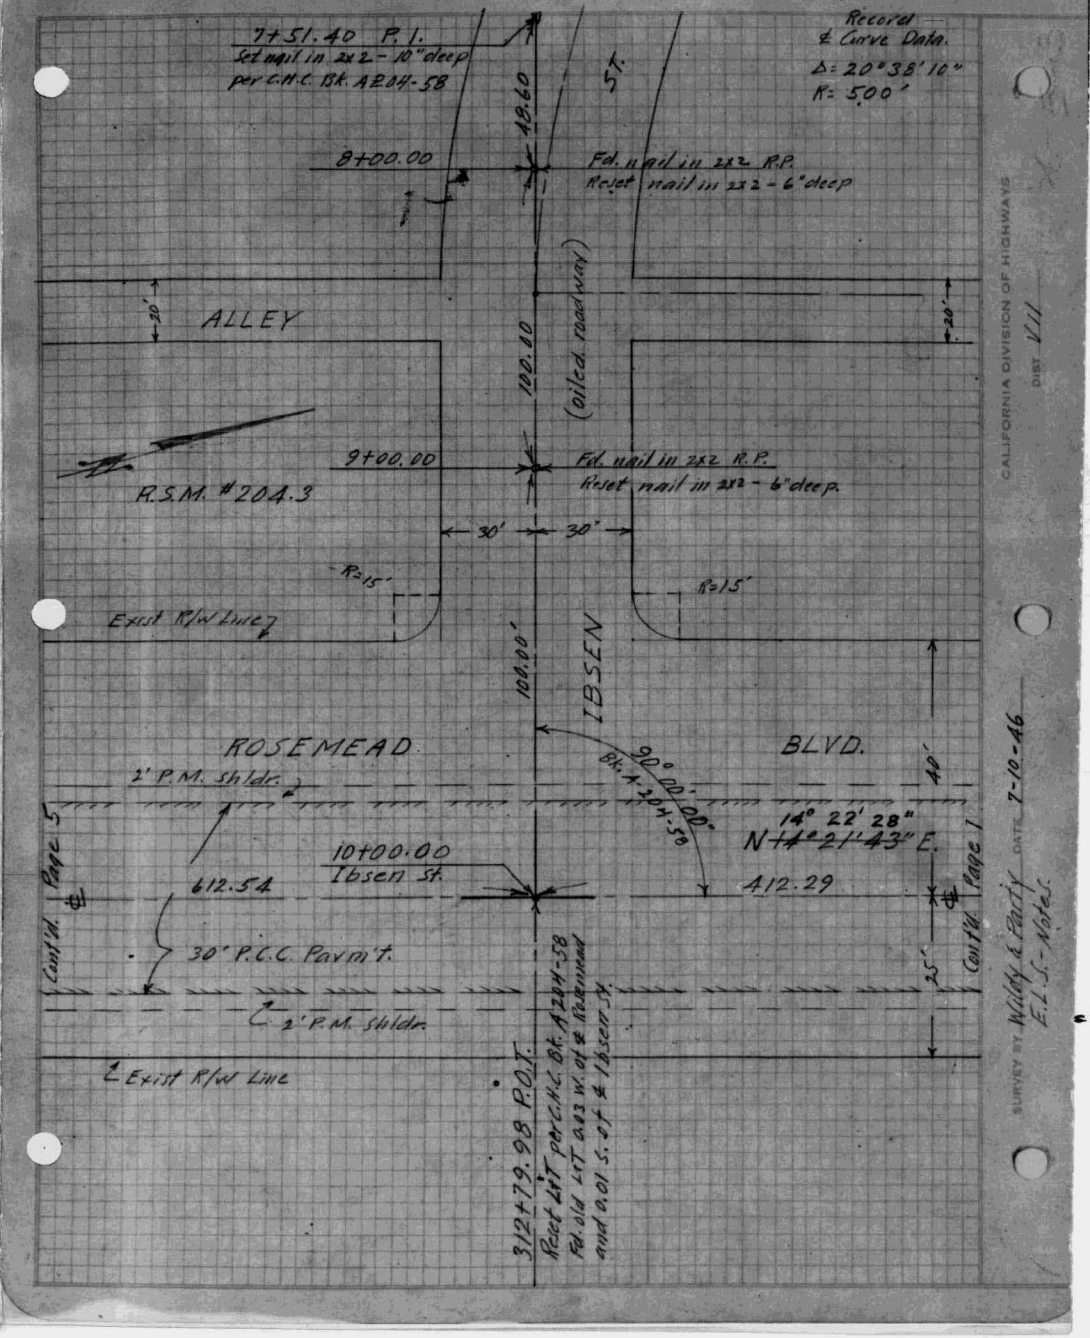

SURVEY BY Willy & Party DATE 7-10-46
E.I.S.-Notes.

CALIFORNIA DIVISION OF HIGHWAYS DIST. VII

F.B. 1309-28

F.B. 1309-29

SURVEY OF LA-168-B (Rosemead Blvd.) INDEX A204-001 PAGE 7

SURVEY OF LA-168-B (Rosemead Blvd.) INDEX A204-001 PAGE 8

CALIFORNIA DIVISION OF HIGHWAYS DIST. VII

SURVEY BY Wildy & Perry DATE 7-12-46 E.L.S. - Notes.

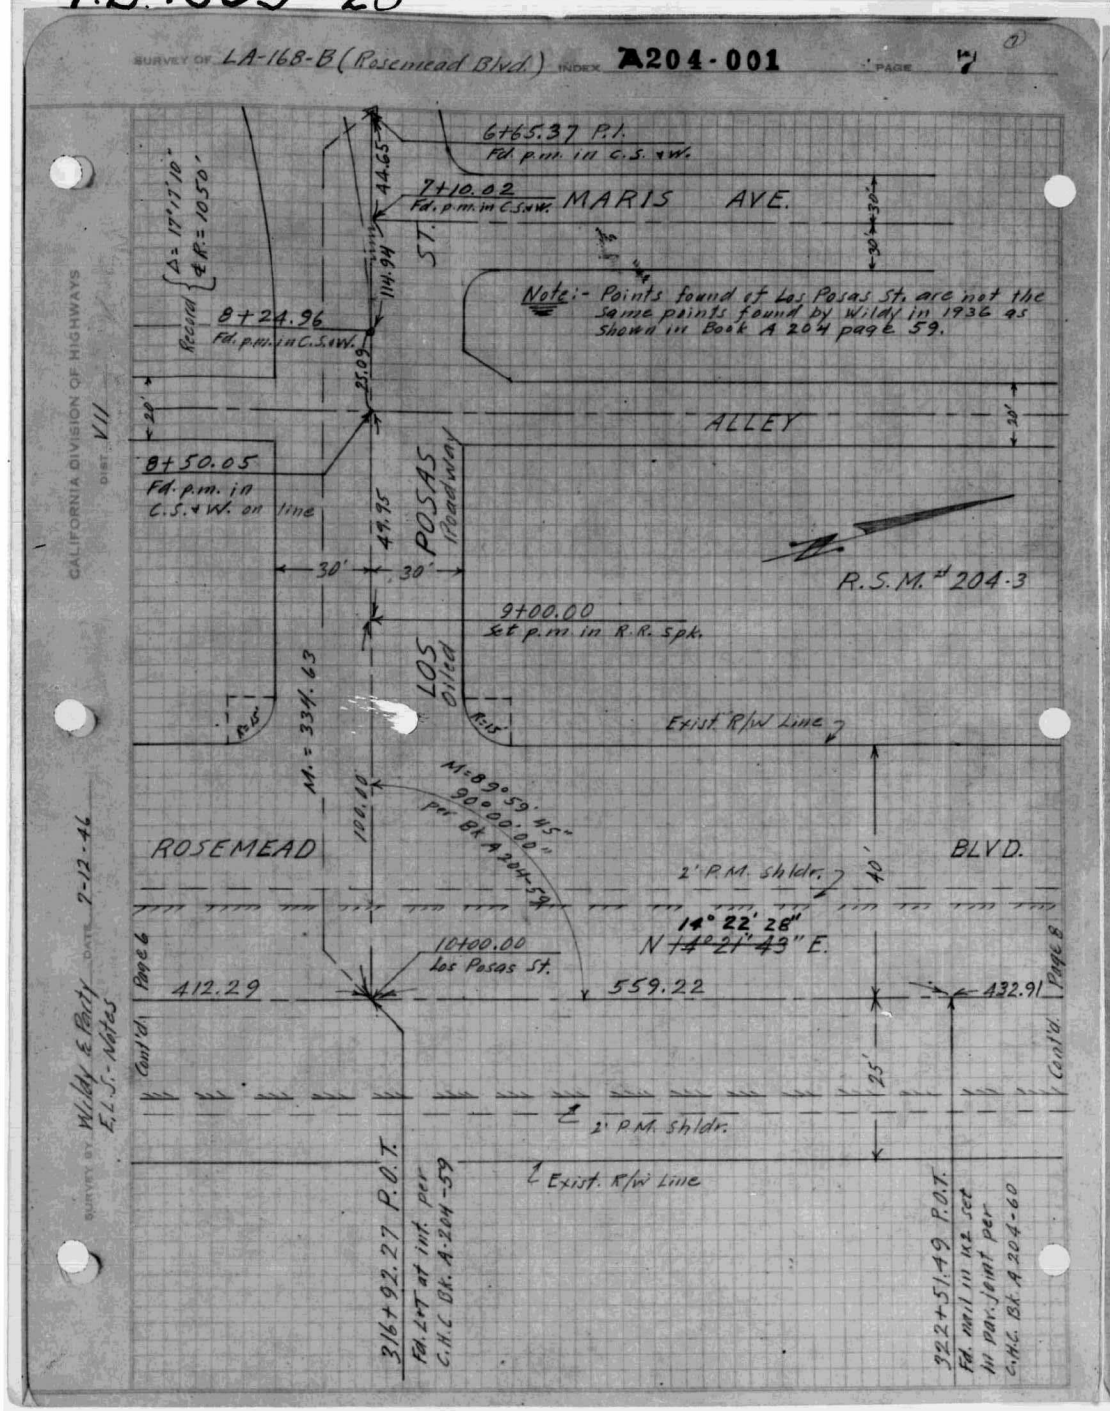

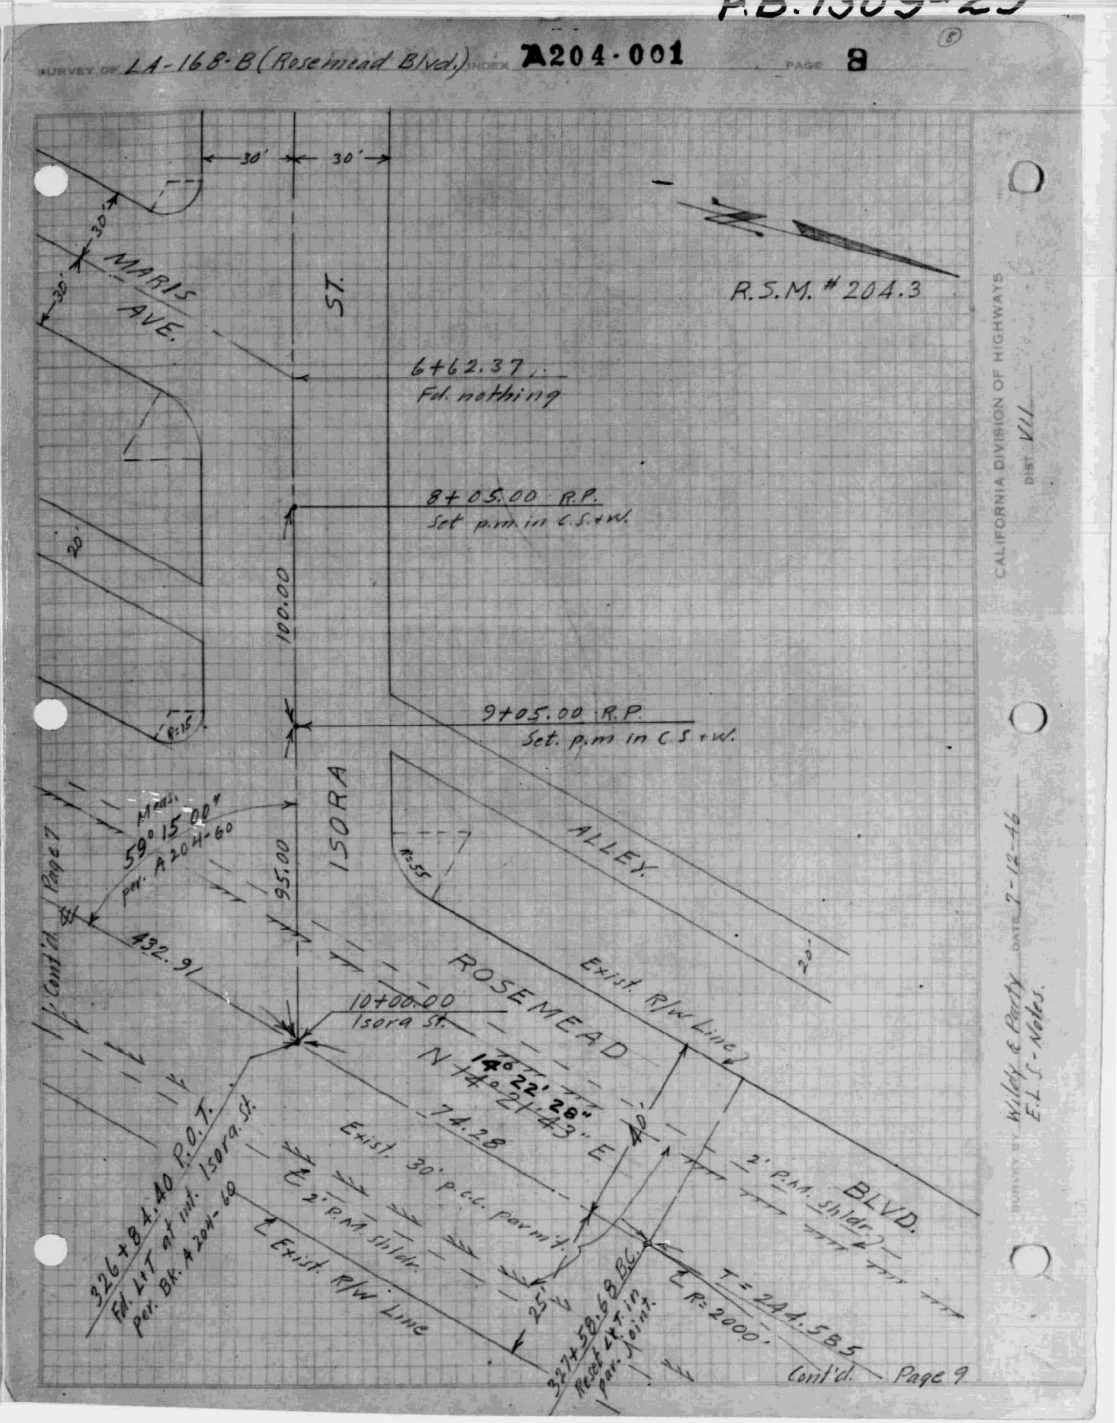

F.B. 1309-30

SURVEY OF LA-168-B (Rosemead Blvd.) INDEX A204-001 PAGE 9

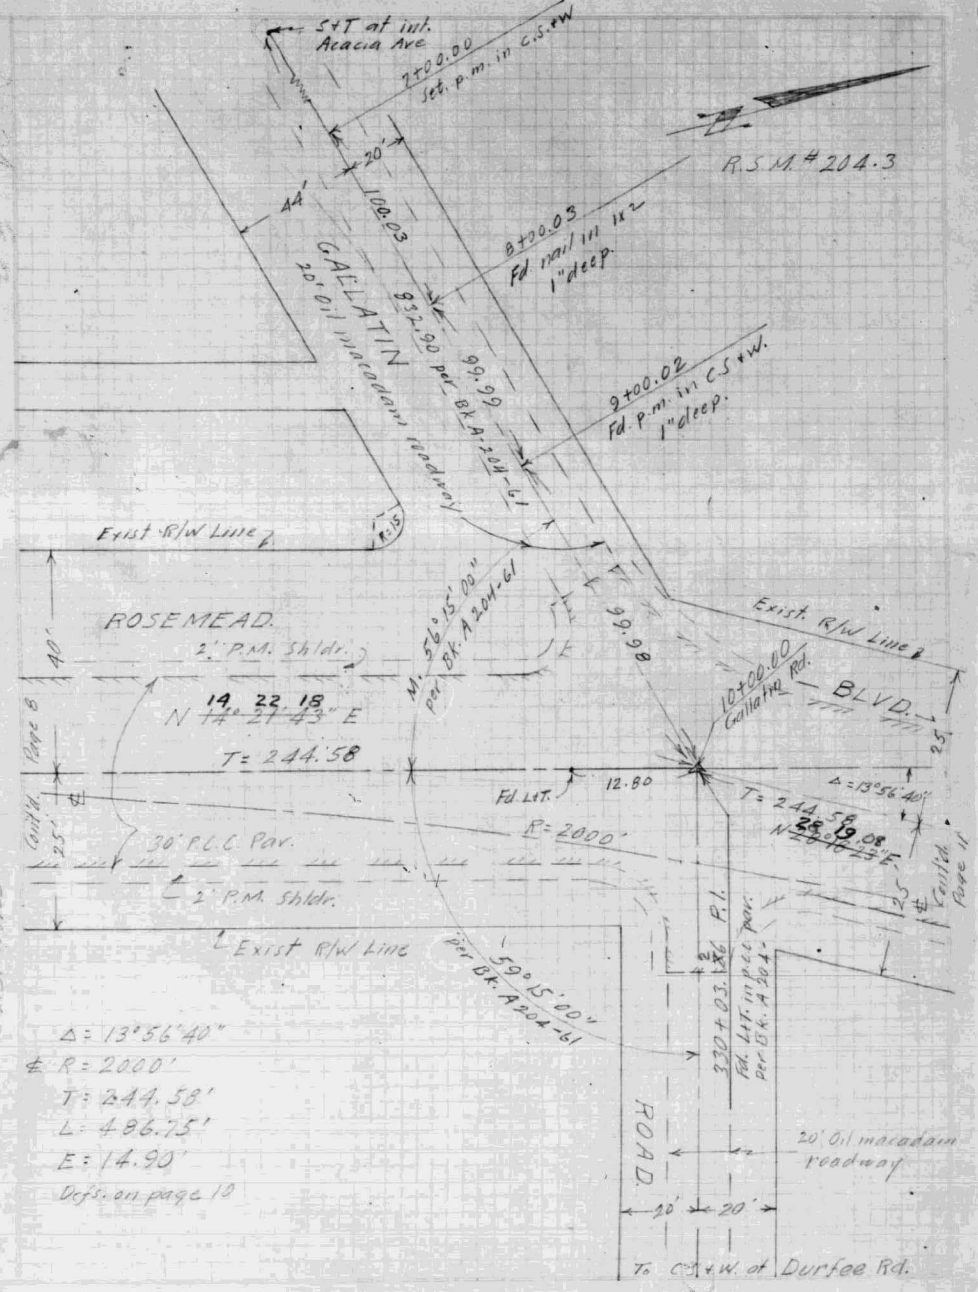

F.B. 1309-31

SURVEY OF LA-168-B (Rosemead Blvd.) INDEX A204-001 PAGE 10

332+45.43	E.C.		6° 58.33'
+25			6° 40.8'
332 ~			6° 19.3'
+75			5° 57.9'
+50			5° 36.4'
+25			5° 14.9'
331 ~			4° 53.4'
+75			4° 31.9'
+50		Δ = 13°56'40" Rt.	4° 10.4'
+25		R = 2000'	3° 48.9'
330 ~		T = 244.58	3° 27.4'
+75		L = 486.75	3° 06.0'
+50		E = 14.90	2° 44.5'
+25		Sketch Pgs. 9-11-	2° 23.0'
329 ~		1' d. = 0.859' Sketch Pgs. 9 & 11	2° 01.5'
+75			1° 40.0'
+50			1° 18.5'
+25			0° 57.0'
328 ~			0° 35.5'
+75			0° 14.0'
327+58.68	B.C.		0° 00.00"

F.B. 1309-32

LA-168-B (Rosemead Blvd.) A204-001 11

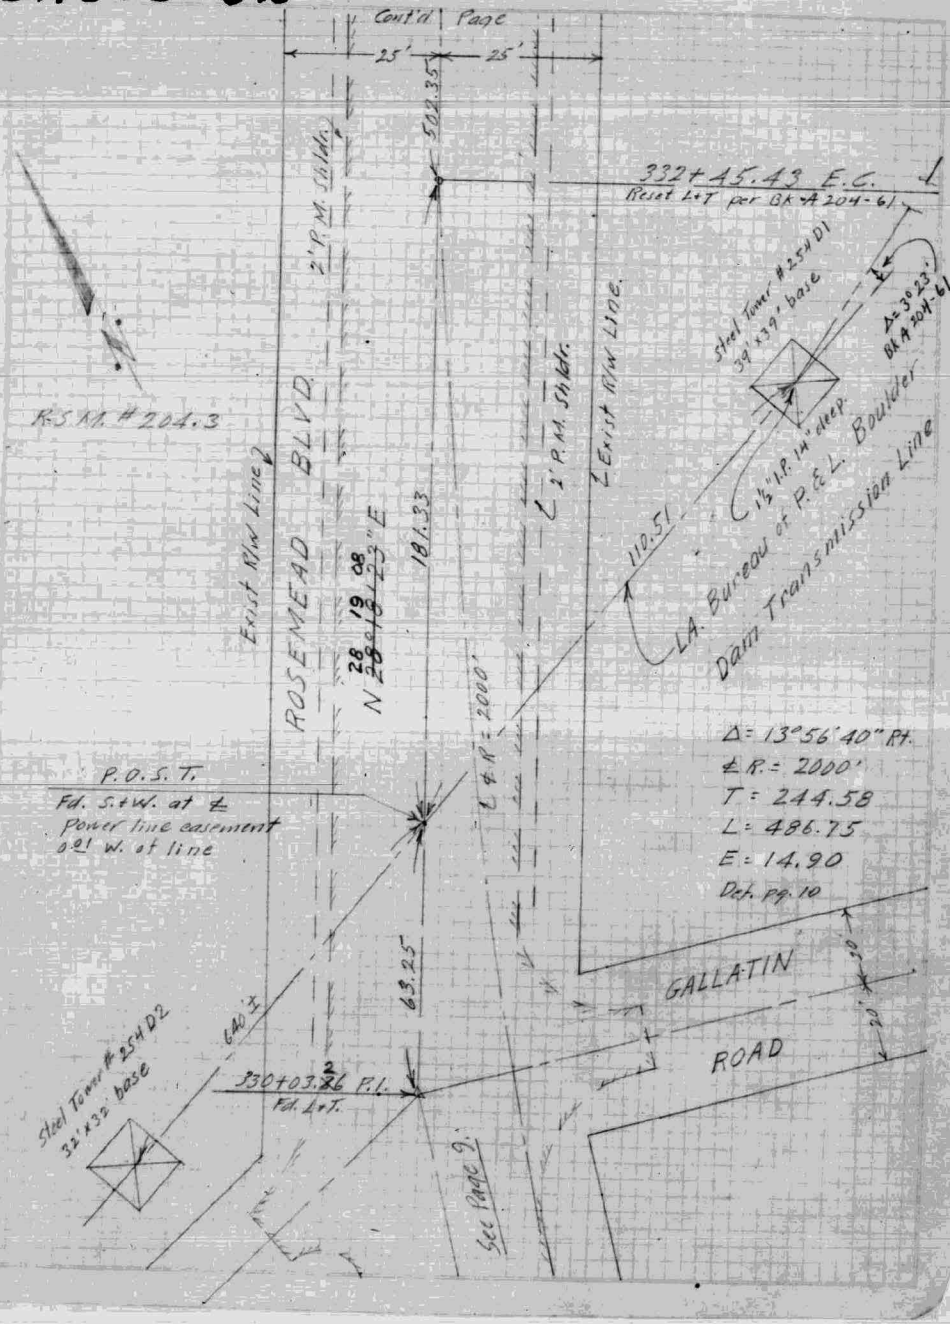

SURVEY OF LA-168-B (Rosemead Blvd.) A204-001 12

F.B. 1309-33

347 ~		8°28.4'
+75		8°06.9'
+50		7°45.4'
+25		7°23.9'
346 ~		7°02.4'
+75		6°41.0'
+50		6°19.5'
+25		5°58.0'
345 ~		5°36.5'
+75		5°15.0'
+50		4°53.5'
+25		4°32.1'
344 ~		4°10.6'
+75		3°49.1'
+50		3°27.6'
+25		3°06.1'
343 ~		2°44.6'
+75		2°23.2'
+50		2°01.7'
+25		1°40.2'
342 ~		1°18.7'
+75		0°57.2'
+50		0°35.7'
+25		0°14.2'
341+08.48	B.C.	0°00.00

Δ = 19°28'30" Rt.
R = 2000'
T = 343.21'
L = 679.81
E = 29.24
1°d = 0°00.859'
Sketch Pages 13 + 14

347+88.29 E.C.	9°44.25'
+75	9°32.9'
+50	9°11.4'
347+25	8°49.9'

Willdy & Karty
E.L.S. - Notes
7-17-46

F.B. 1309-34

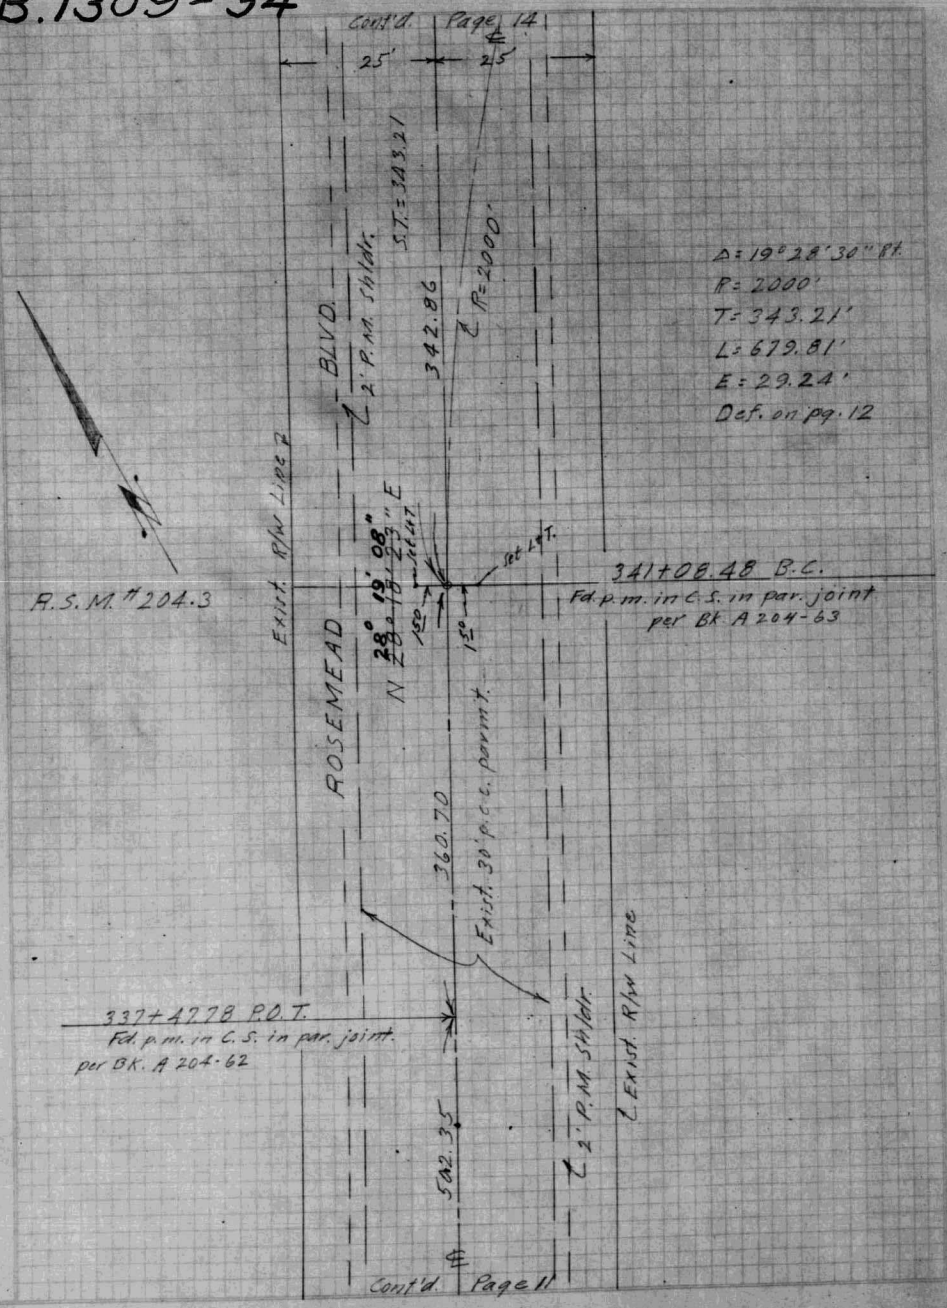

SURVEY BY Wilday & Party DATE 7-16-46
E.L.S. - Notes

CALIFORNIA DIVISION OF HIGHWAYS DIST VII

F.B. 1309-35

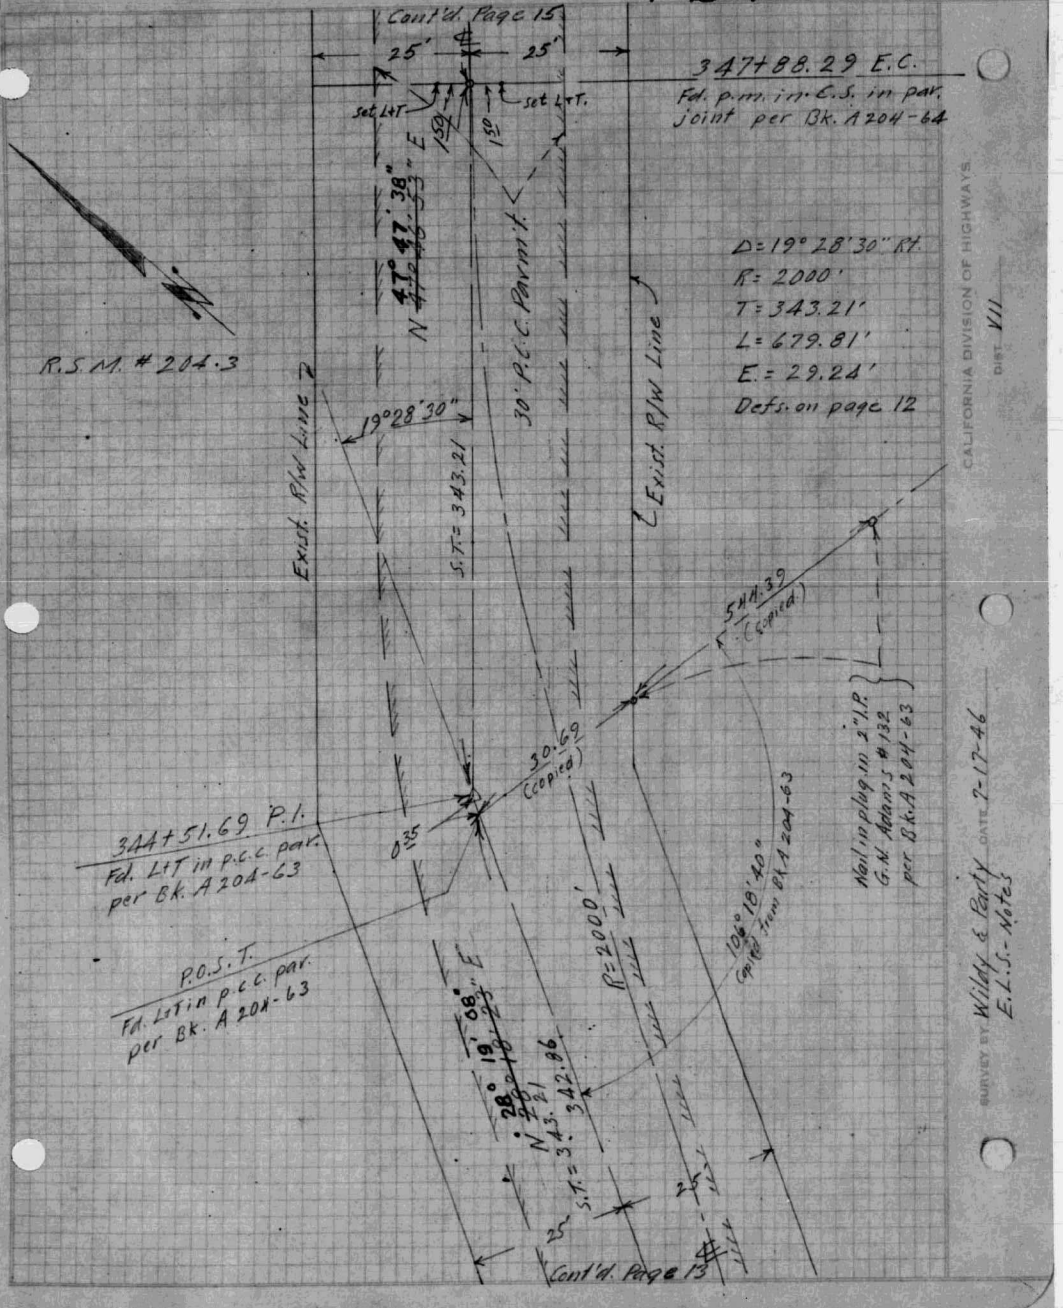

SURVEY BY Wilday & Party DATE 7-17-46
E.L.S. - Notes

CALIFORNIA DIVISION OF HIGHWAYS DIST VII

LA-168-B (Rosemead Blvd.) A204-001 15

F.B. 1309-36

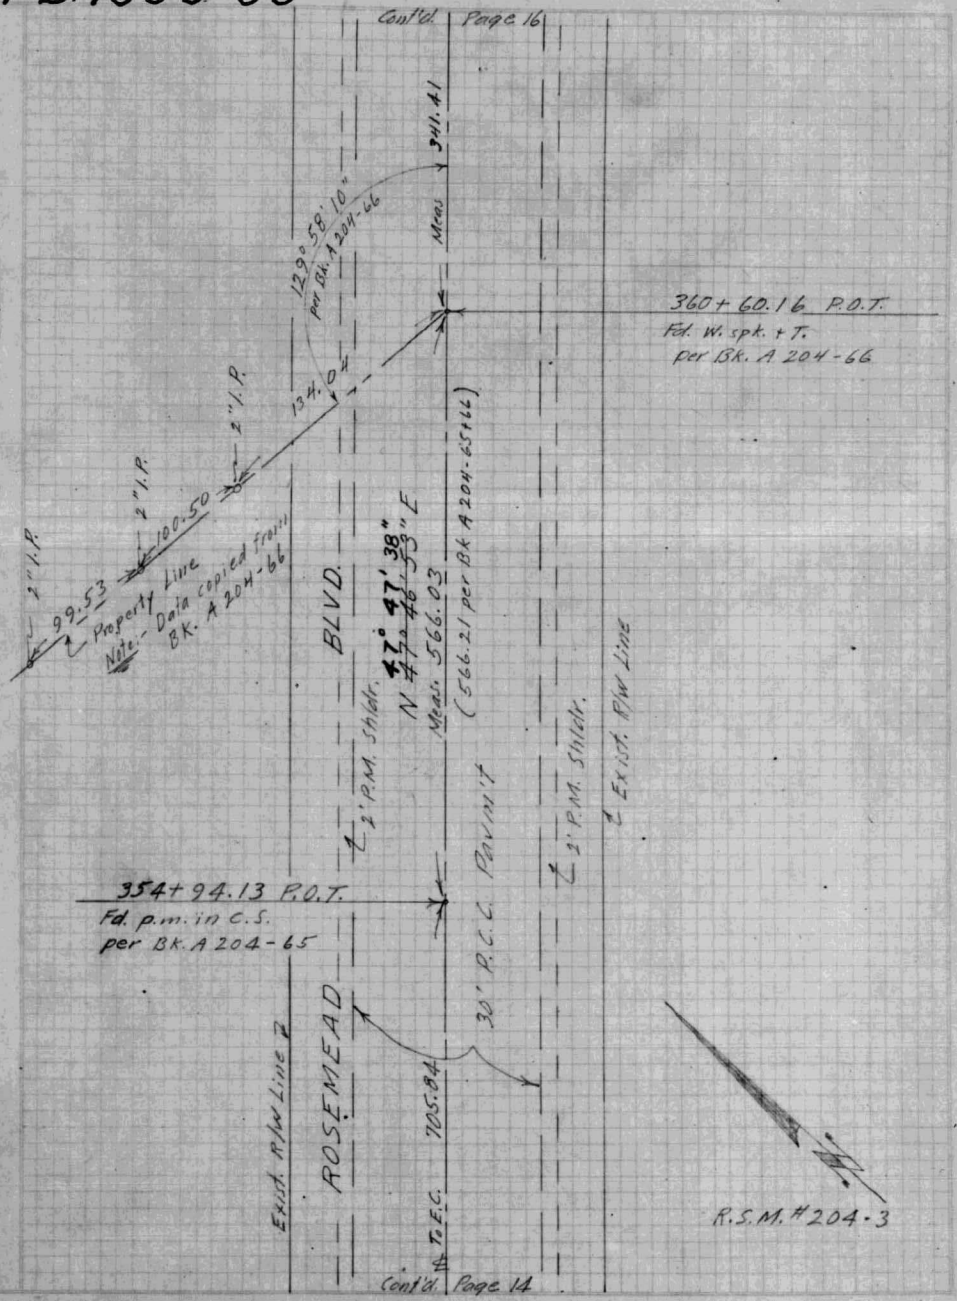

E.L. Smith 7-17-46

LA-168-B (Rosemead Blvd.) A204-001 16

F.B. 1309-37

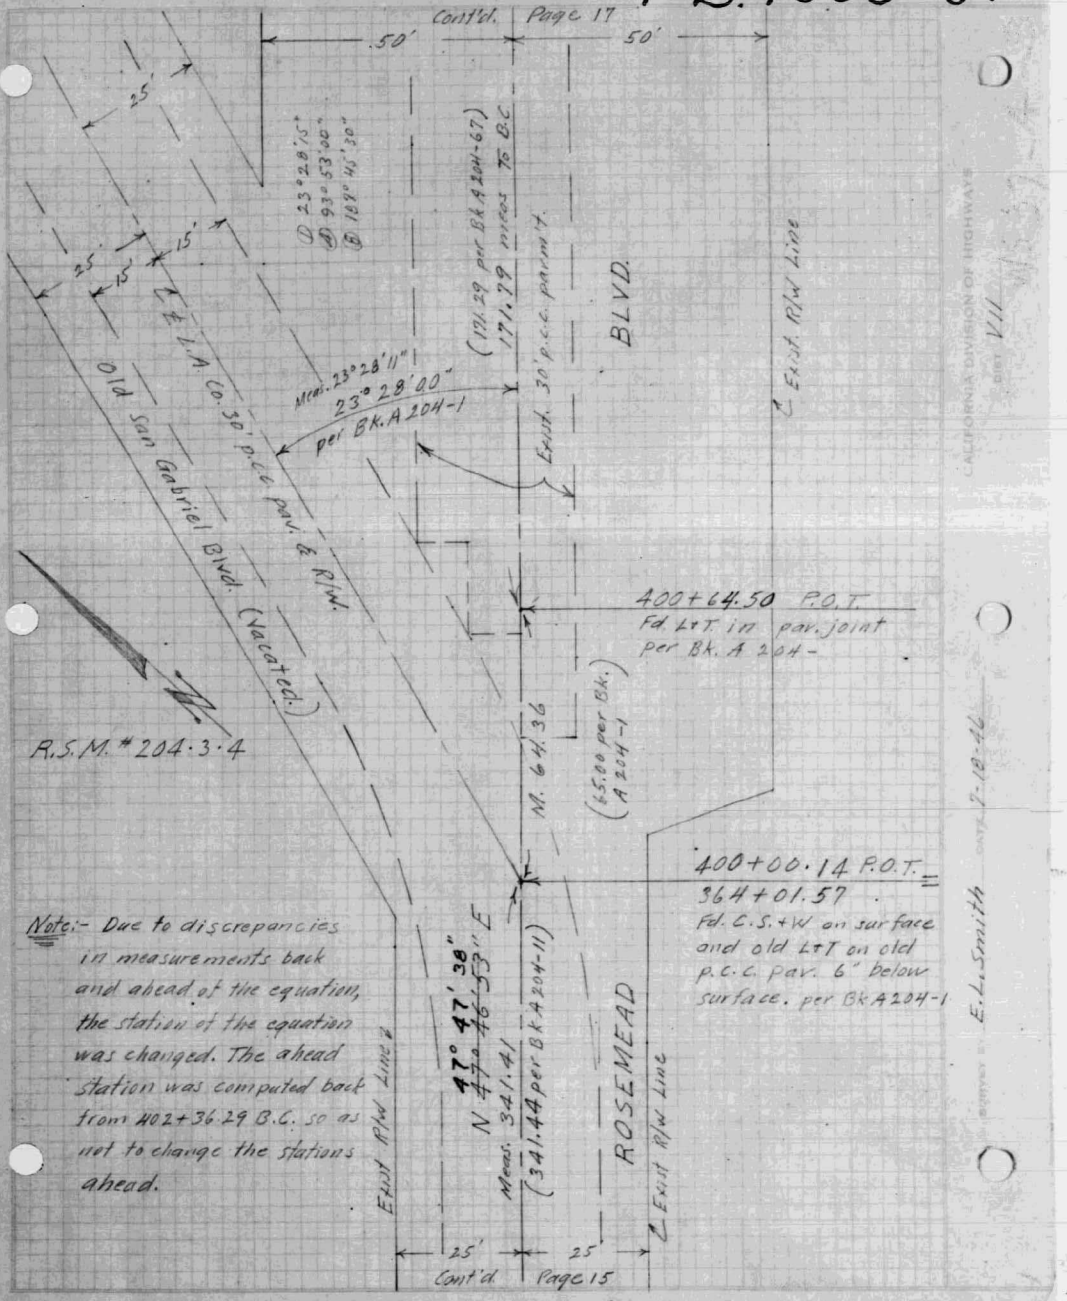

E.L. Smith 7-18-46

F.B. 1309-38

SURVEY OF LA-168-B (Rosemead Blvd) INDEX A204-001 PAGE 18 (18)

+50		5°51.65'	
408 ~		5°23.00'	
+71.24	M.P.O.C.	5°06.50'	Δ = 20°26'00" Lt.
			R = 3000'
			T = 540.69'
+50		4°54.35'	L = 1069.89'
			Ext. = 48.33'
			Sketch pages 17 & 19
407 ~		4°25.70'	
+50		3°57.05'	
406 ~		3°28.40'	
+50		2°59.75'	
405 ~		2°31.10'	
+50		2°02.45'	
404 ~		1°33.80'	
+50		1°05.15'	
403 ~		0°36.50'	
+50		0°07.85'	
402+31.20	P.C.	0°00.00	

413+06.18	E.C.	10°13.00'
413 ~		10°09.50'
+50		9°40.85'
412 ~		9°12.20'
+50		8°43.55'
411 ~		8°14.90'
+50		7°46.25'
410 ~		7°17.60'
+50		6°48.95'
409 ~		6°20.30'

CALIFORNIA DIVISION OF HIGHWAYS DIST VII

SURVEY BY E.L. Smith DATE 7-18-46

Kilday & Party 7-19-46

F.B. 1309-39

SURVEY OF LA-168-B (Rosemead Blvd.) INDEX A204-001 PAGE 17 (17)

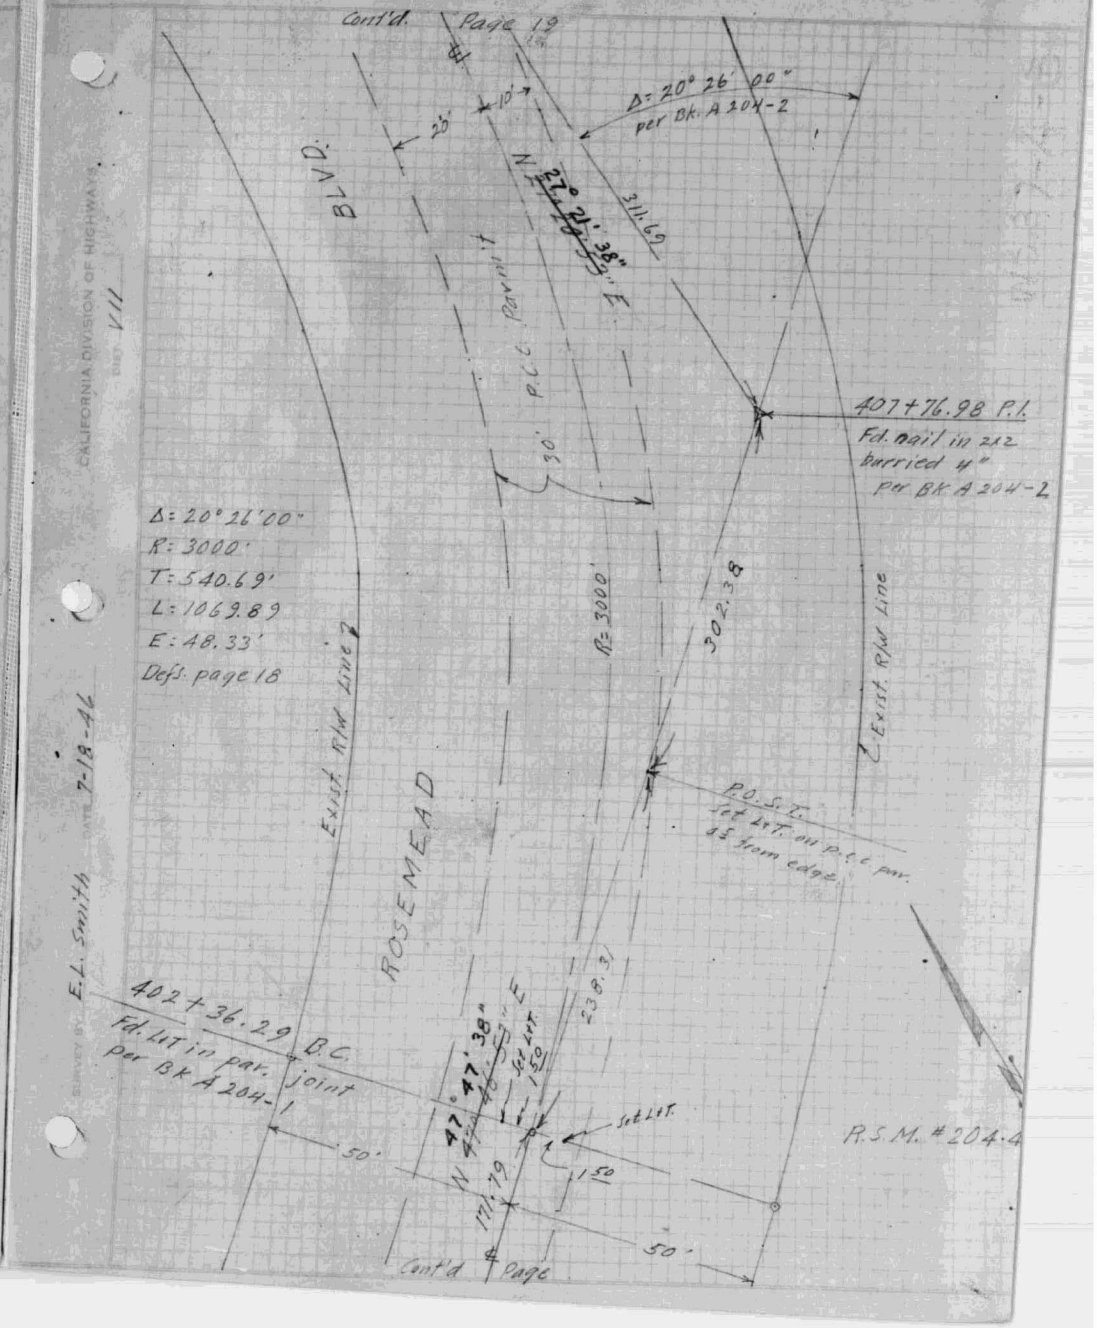

F.B. 1309-41

LA-168-C

A205-001

Note: Distance shown are corrected for Temperature
Angles shown are the Average of eight
For chained distances and record of Angles see P2

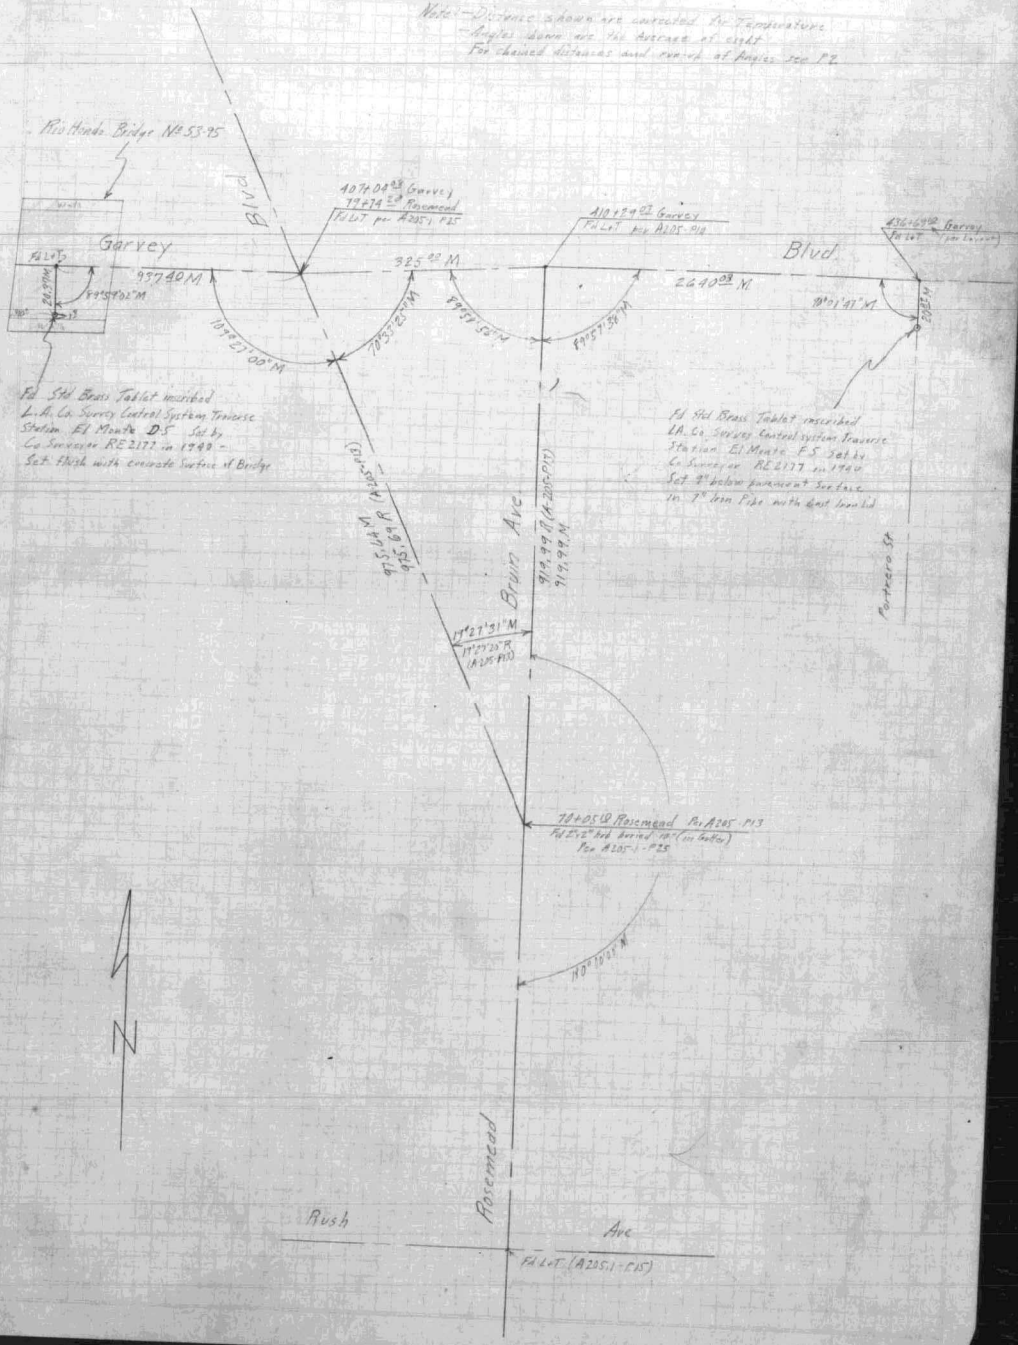

Fullmer Path 6-7-46

F.B. 1309-42

F.B. 1309-43

LA-168-C

A205·001

2

①	109° 26' 45"		T_{pc} = 10.00 @ 6.2'	
②	218° 53' 30"	109° 26' 45"	20.37 @ 85°	= 20.39
④	77° 47' 45"	119° 26' 56"		
⑤	155° 36' 00"	109° 27' 00"	937.32 @ 85°	= 937.40
①	70° 33' 00"			
②	141° 06' 30"	70° 33' 15"	324.95 @ 86°	= 325.00
④	282° 13' 15"	70° 33' 17"		
⑤	209 27 15"	70° 33' 24½"	2639.67 @ 83°	= 2640.03
①	89° 59' 00"			
②	179° 57' 30"	89° 58' 45"	20.82 @ 82°	= 20.82
④	359° 55' 45"	89° 58' 56"		
⑤	359° 51' 30"	89° 58' 56"	975.52 @ 81°	= 975.64
①	89° 58' 00"			
③	179° 55' 30"	89° 57' 45"	919.89 @ 78°	= 919.99
④	359° 50' 30"	89° 57' 37½"		
⑤	359° 41' 00"	89° 57' 37½"		
①	19° 27' 45"			
②	38° 55' 30"	19° 27' 45"		
④	77° 51' 00"	19° 27' 45"		
⑤	155° 40' 45"	19° 27' 33½"		
①	19° 27' 30"	19°27'31" Ave		
②	38° 55' 00"	19° 27' 30"		
④	77° 50' 00"	19° 27' 30"		
⑤	155° 39' 30"	19° 27' 26"		
①	89° 59' 00"			
②	179° 58' 30"	89° 59' 00"		
④	359° 56' 00"	89° 59' 00"		
⑤	359° 52' 15"	89° 59' 02"		
①	90° 02' 30"			
②	180° 03' 45"	90° 01' 52"		
④	90° 07' 30"	90° 01' 52"		
⑤	0° 14' 15"	90° 01' 47"		

Wilday & Perry E.E.'s - Notes

Filkins & Perry

6-7-46

7-25-46

LA-168-B+C (Rosemead Blvd.)

A205·001

3

(25)

TRACT

LINCRIS AVE.

6+25.04
Fd. N.L.T. & N.L.T. Straddlers.

9+30.01
Fd. ⊡ Scr.

N.J. 13463

99° 58' 00" per Bk A 205-1

9+50.00
Fd. L.R.T.

Exist. R/W Line

ROSEMEAD BLVD.

(1310.105 calc. from Bk A 204-5)

N 0° 18' 37" W Meas. 1310.24

0° 17' 52" Sec. "B" = N.0° 17' 52" W Sec. "C"

Fd. L&T. pipe Bk A 205-1

10+00.00
Fawcett Ave.

To E.C.

Set ⊕ L&T straddlers Sec. 1 inset

70' oiled Shldr.

20' P.C.C. Pavmt.

Meas. 1309.99 @ 95°

1310.24

Sec. "B"

Sec. "C"

Fawcett

L&T

Rosemead

Note:- Equation in bearing due to 0°00'45" error in 4000' R. curve back as shown on page 24.

"B" 467+47.33
"C" 0+00.00 P.O.T.

1319.15 (Copied from A 205-1)

90°00'25" Per Bk. A 205-1

89° 59' 35" per Bk A 205-1

R.S.M. # 204-5

15+00
Set C.N.

20' P.A.E. Pav't.

FAWCETT

Fd. Bent spk. in A.C. 20' deep at int.

CHICO AVE.

Note:- Rosemead Blvd. is a straight line from 45+37.09 E.C. Sec. "B" to 66+62.19 B.C. Sec. "C" as per R.S.M. # 204-4-5 and F.B. A 204 & A 205.

SURVEY OF LA-168-C (Rosemead Blvd.) A205-001 PAGE 26

(N.W. cor. Lot 18, Tr. 13463
Fd. cem. filled 2" I.P. with
nail & disc. mkd. RE 617
burried 12"

TRACT NO.

R= 1499.93

LINCRIS AVE.

25'

25'

Meas. 470.01
Rec. = 470.00

Meas. 469.97

R.S.M. # 204.5
Tape #7, std. @ 67°

13463

R= 279.03 Tract

Fd. 2" I.P. filled with cement with nail
and disc. marked RE 617, burried 12"
as per Tr. Map. 13463

Rec. = 79.92
Meas. 79.96

Exist. R/W Line

Meas. 90°01'11"
Rec. = 90°01'15"

9' Oiled Shldr.

50'

N.0°17'52"W.
280.22

Rec = 659.92
Meas. 659.87

Contd. Page 25

Contd. Page 27

20' P.C.C. Pavmt.

9' Oiled Shldr.

50'

ROSEMEAD BLVD.

67.59 R&T
Fd. L+T. in par. joint

Prop. Line Fence

℄ Exist. R/W Line

SURVEY BY Willdy & Party DATE 7-29-46 E.I.S.-Notes

CALIFORNIA DIVISION OF HIGHWAYS DIST. VII

SURVEY OF LA-168-C (Rosemead Blvd.) A205-001 PAGE 6

Contd. Page 28

10 10 10 10

936.50

Exist. R/W Line

9' Oiled Shldr.

N 0°17'52" W.
937.94

BLVD.

R.S.M. # 204.5

18+78.03 P.O.T.
Fd. L+T. in par. joint
per Bk. A 205-4

Set L+T.

100'

100'

50'

50'

9+40.09 P.O.T.
Fd. L+T. in par. joint
per Bk. A 205-2

9' Oiled Shldr.

280.22

20' P.C.C. Pavmt.

ROSEMEAD BLVD.

℄ Exist. R/W Line

Contd. Page 26

SURVEY BY Willdy & Party DATE 7-29-46 E.I.S.-Notes

CALIFORNIA DIVISION OF HIGHWAYS DIST. VII

FB 1309 - 46

LA-168-C (Rosemead Blvd.) A205·001

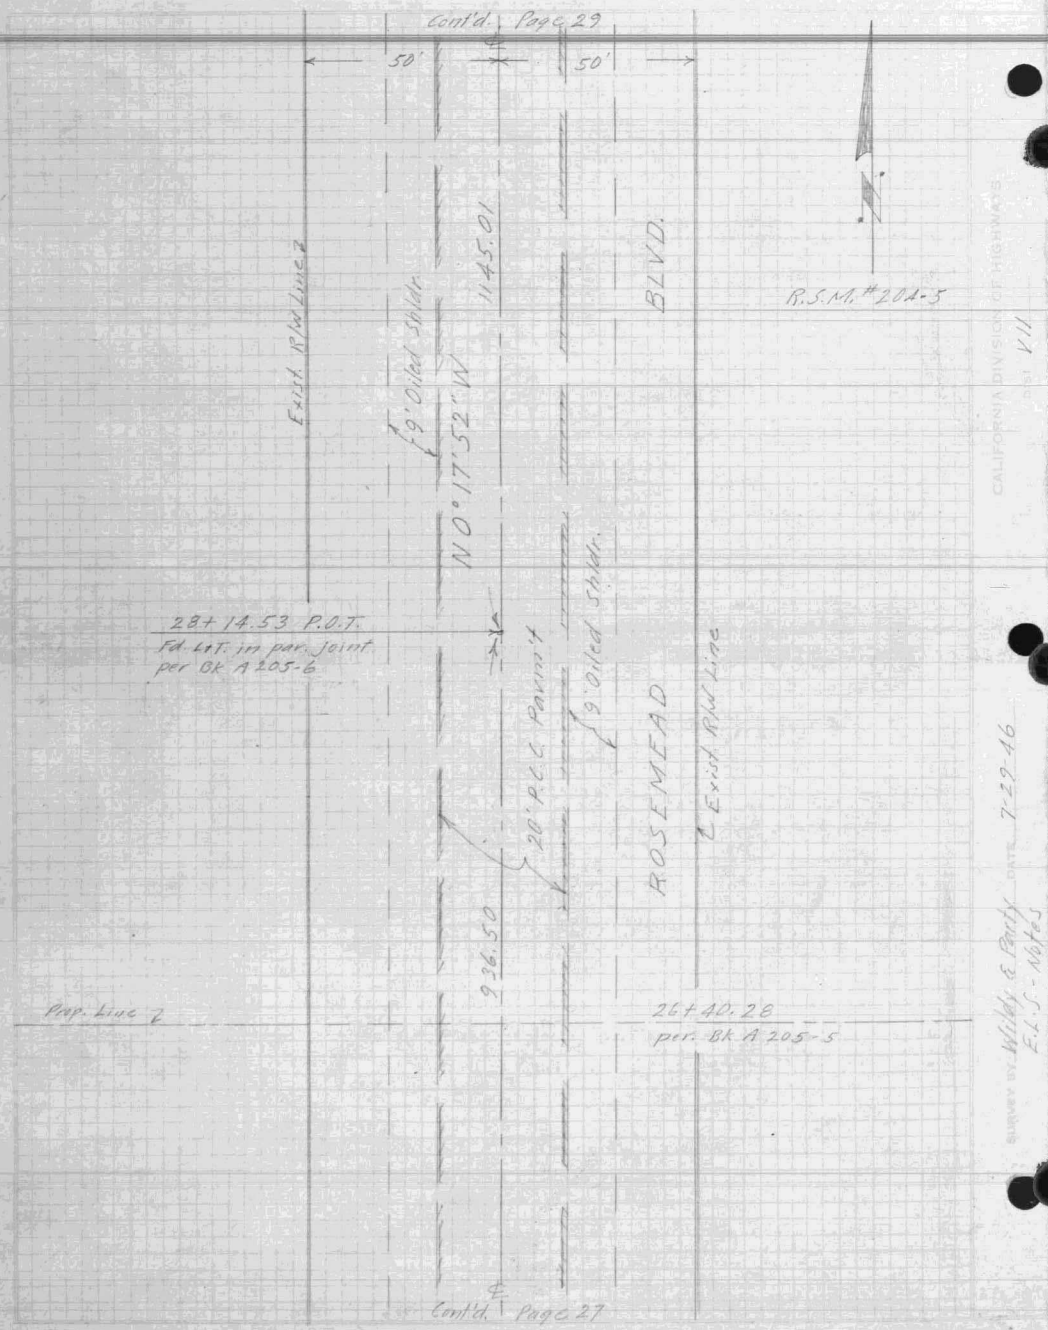

FB 1309 - 47

LA-168-C (Rosemead Blvd.) A205·001 7

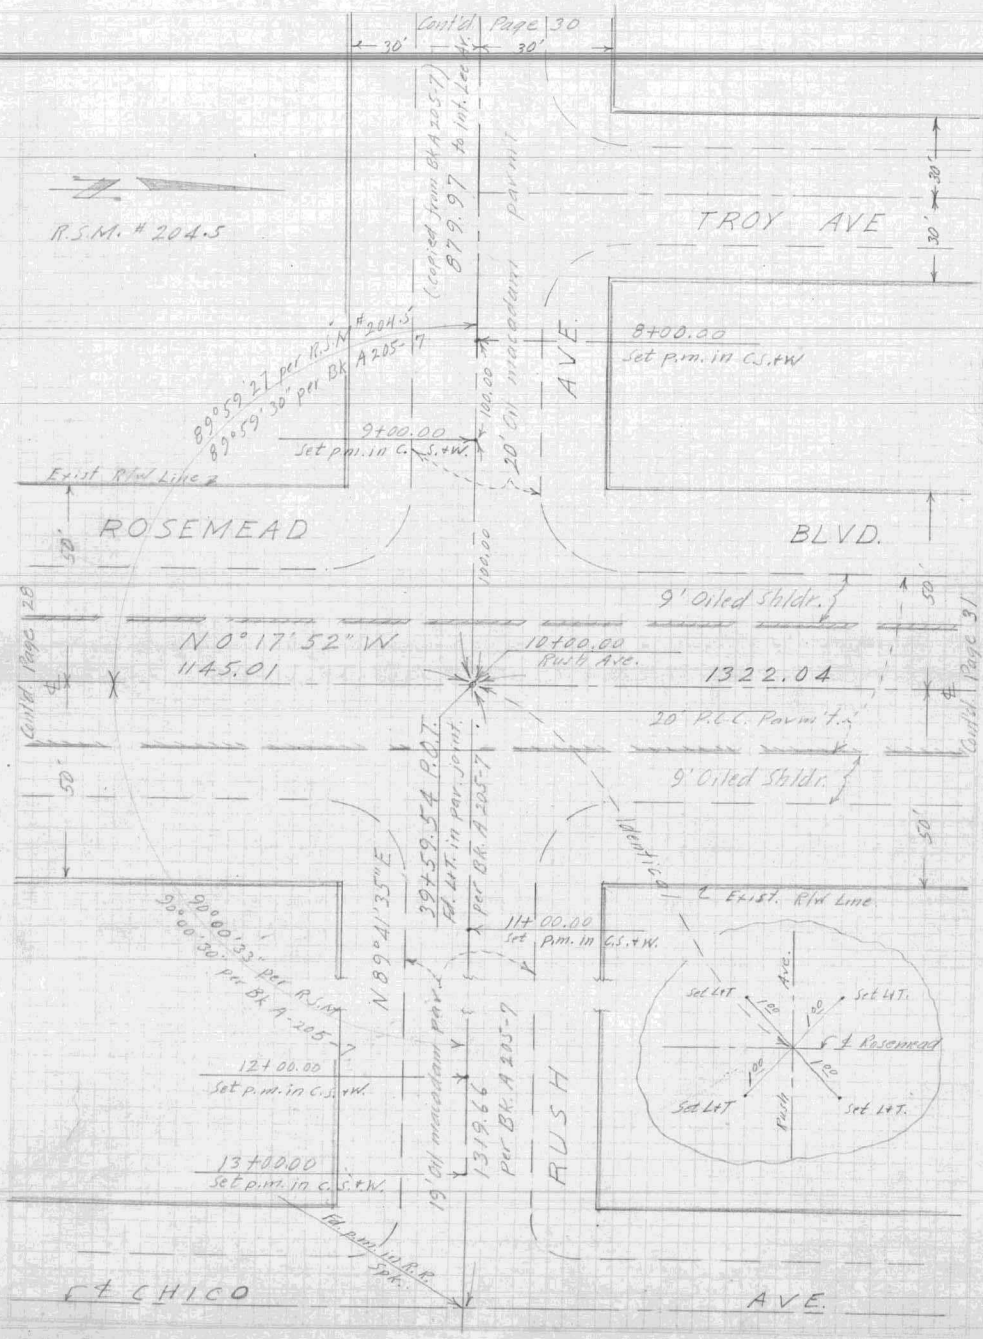

F.B. 1309-48

SURVEY OF LA-168-C (Rush Ave.) A205·001 PAGE 8

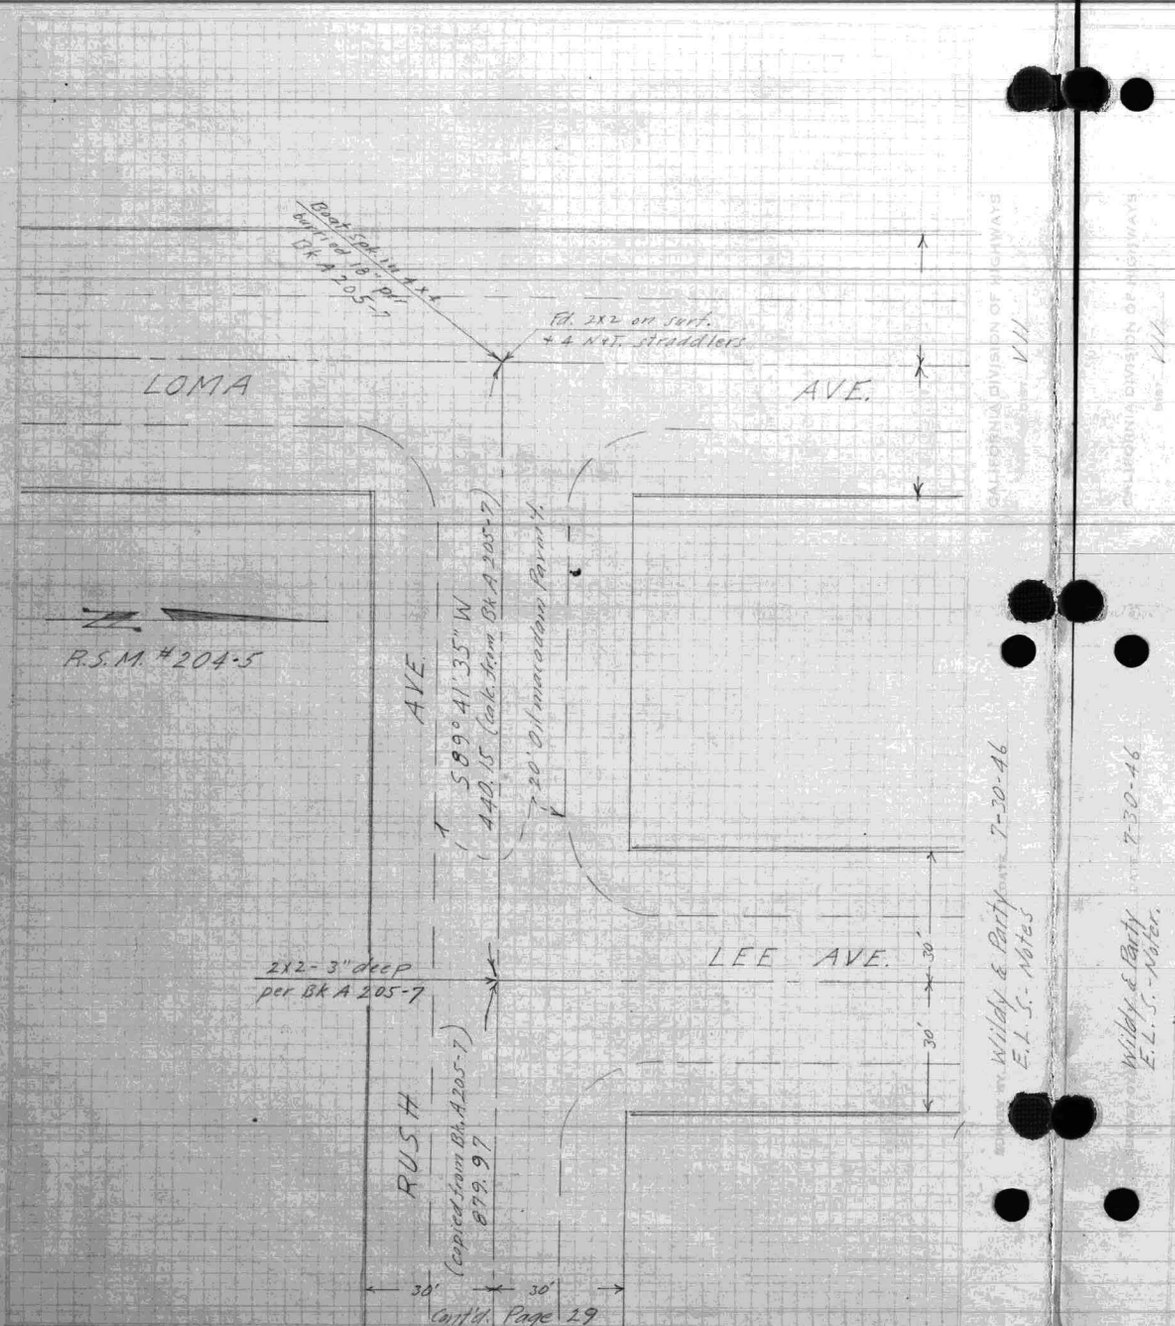

F.B. 1309-49

SURVEY OF LA-168-C (Rosemead Blvd.) A205·001 PAGE 9 (31)

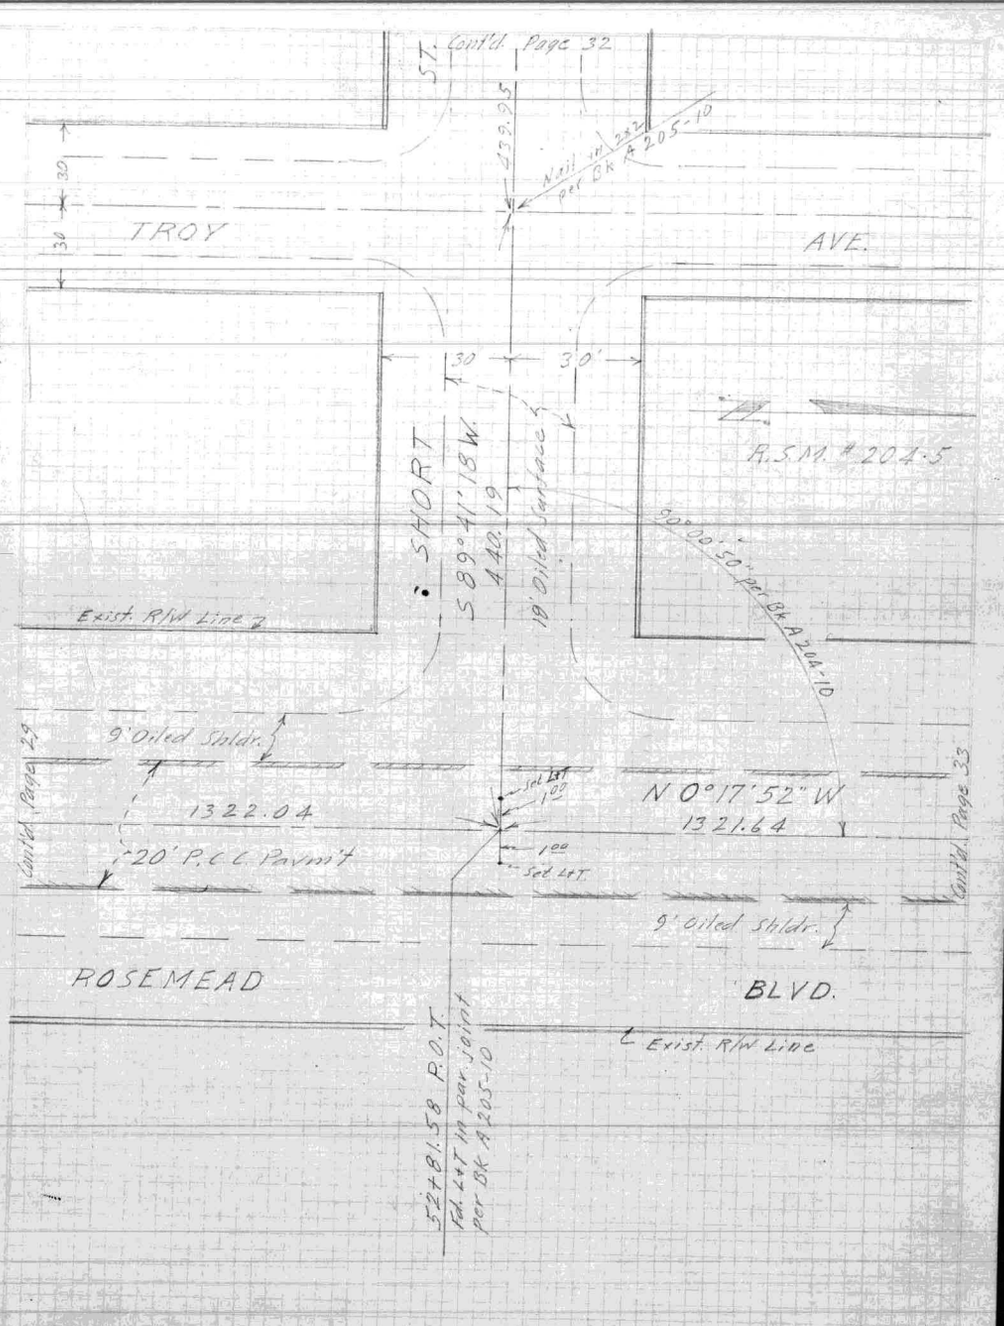

F.B. 1309-50

SURVEY OF LA-168-C (Short St.) A205·001 10

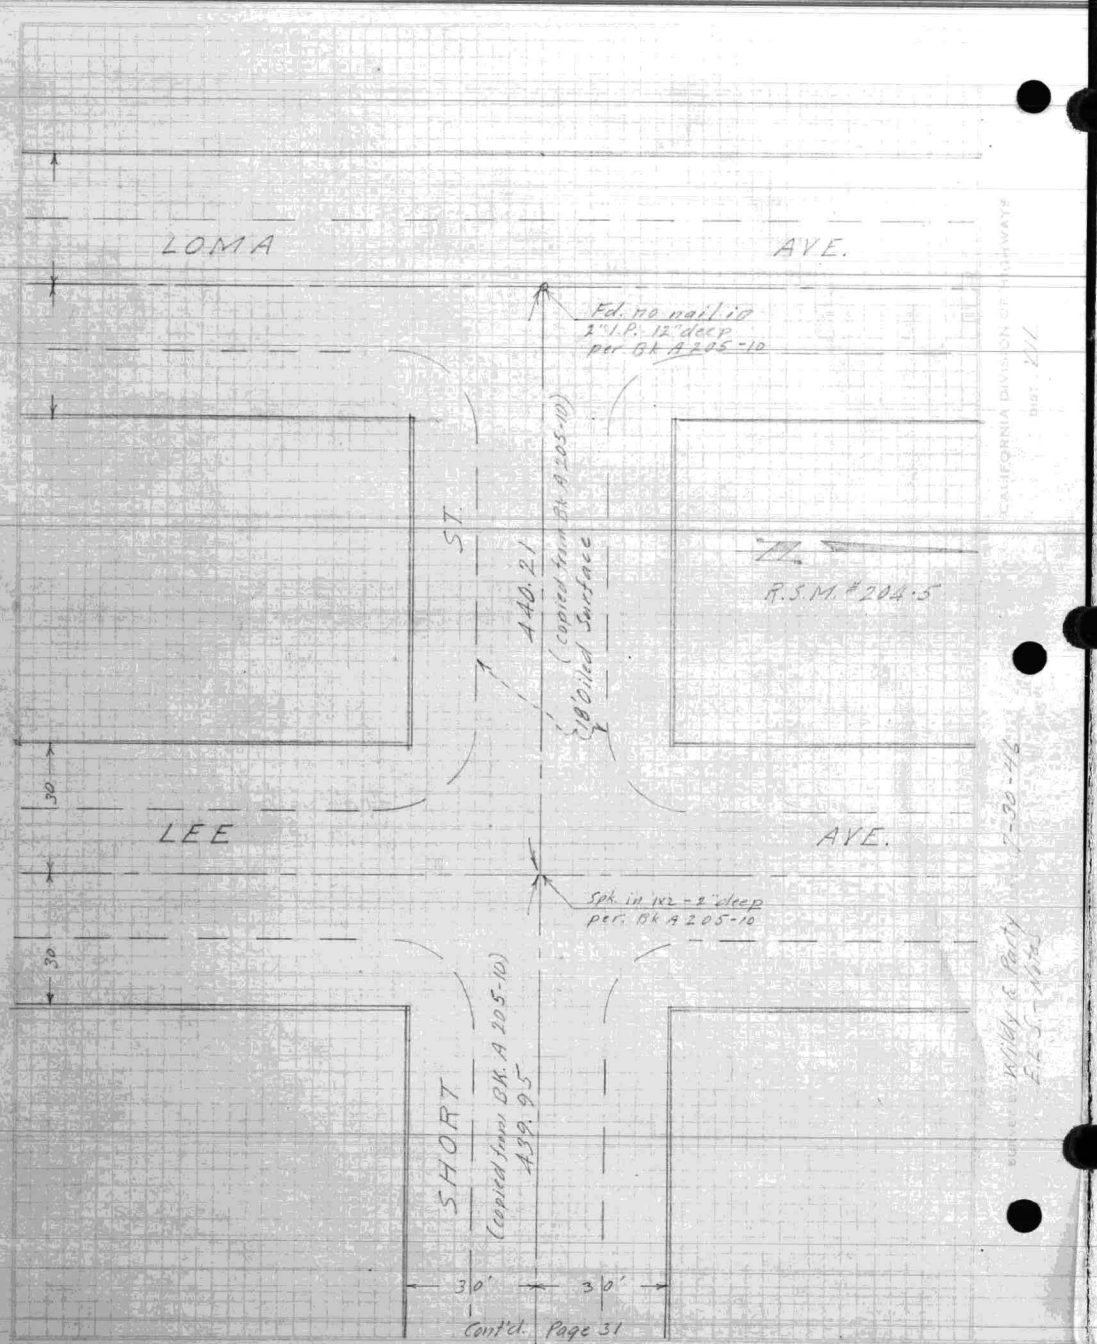

F.B. 1309-51

SURVEY OF LA-168-C (Rosemead Blvd.) A205·001 11

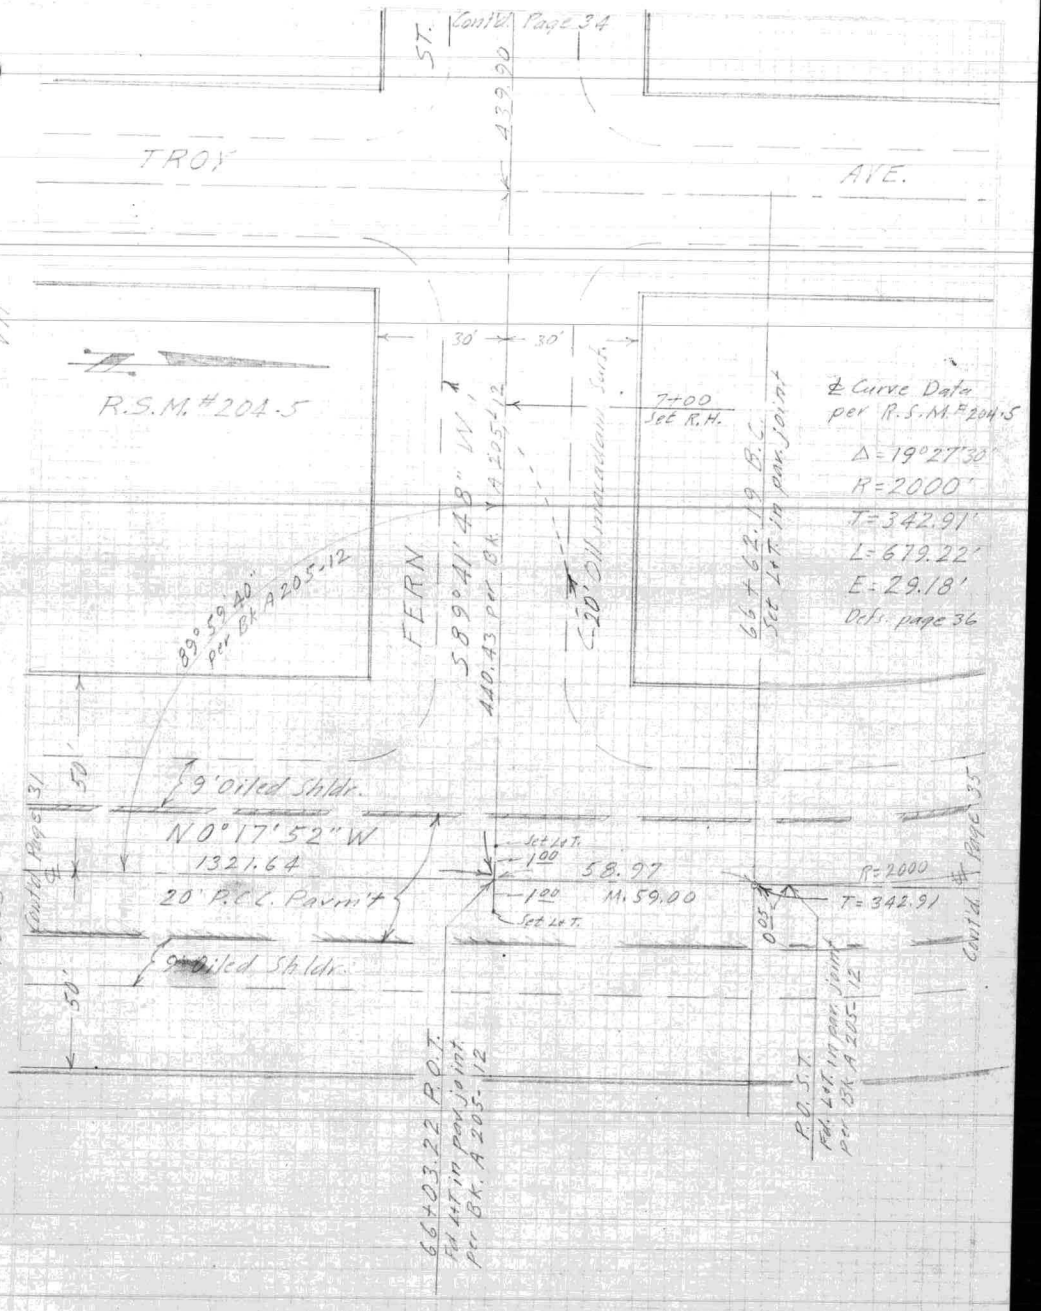

F.B. 1309-52

SURVEY OF LA-168-C (Fern St.) INDEX A205·001 PAGE 12 (34)

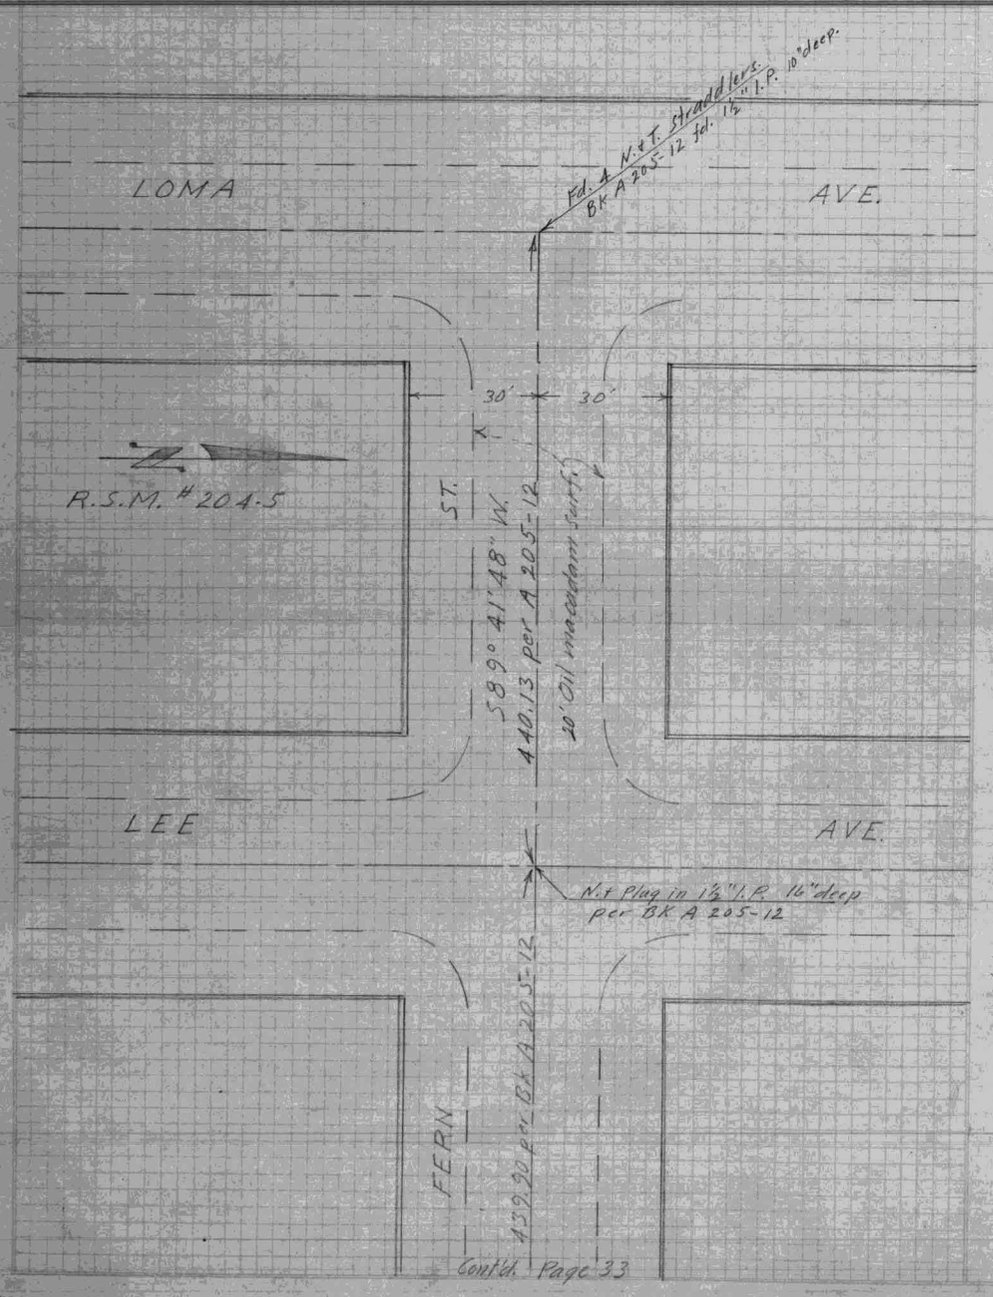

CALIFORNIA DIVISION OF HIGHWAYS DIST. VII

SURVEY BY Wisely & Party DATE 7-31-46 F.B.S. - Notes

CALIFORNIA DIVISION OF HIGHWAYS DIST. VII

SURVEY BY Wisely & Party DATE 7-31-46 F.B.S. - Notes

F.B. 1309-53

SURVEY OF LA-168-C (Rosemead Blvd.) INDEX A205·001 PAGE 12 (35)

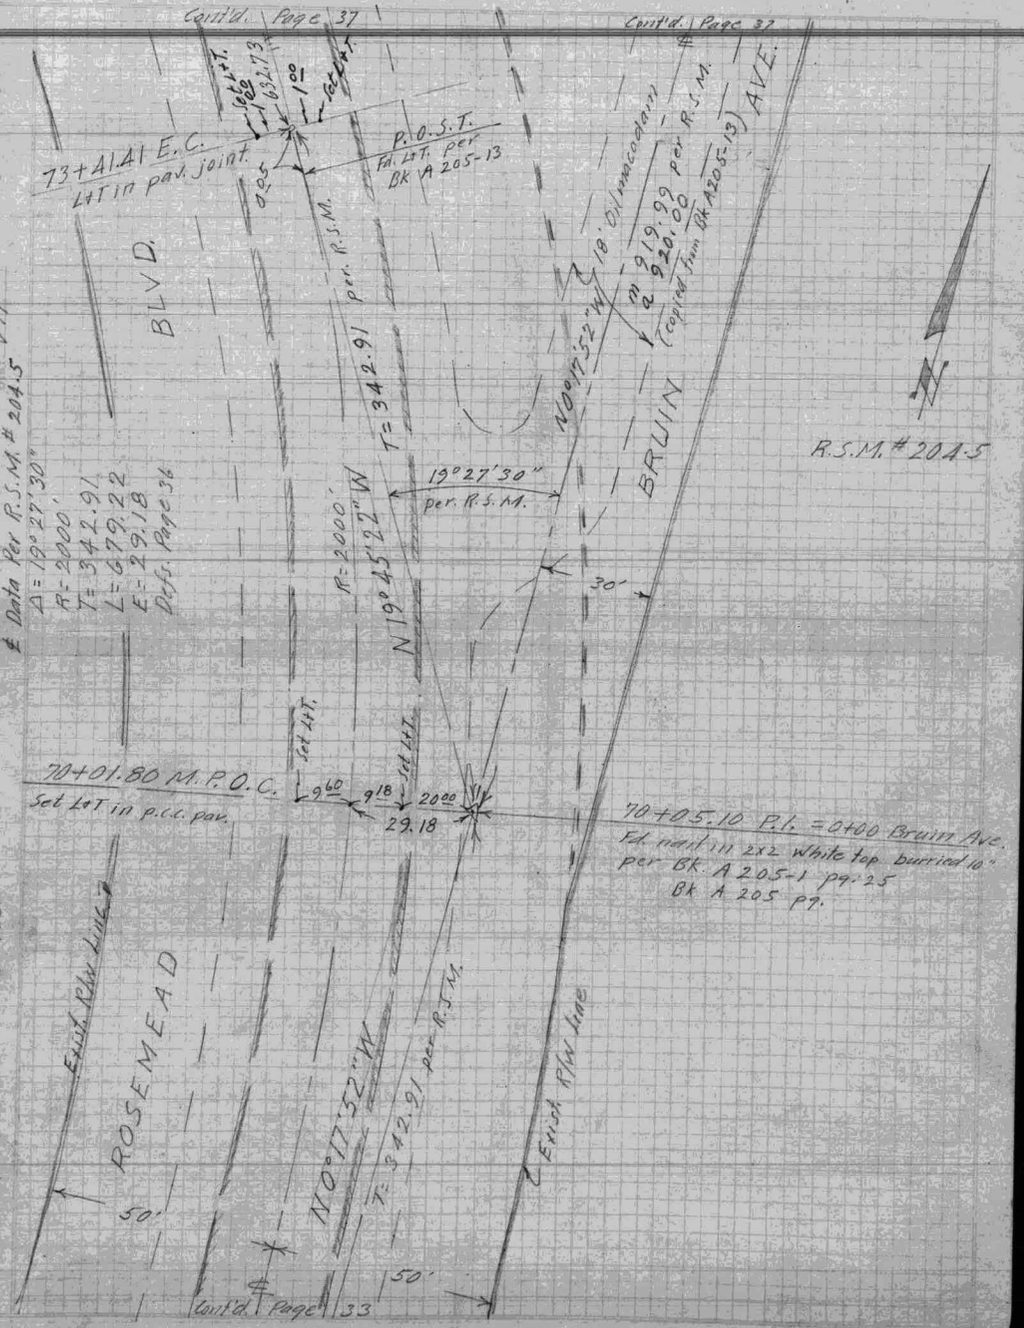

F.B. 1309-54

F.B. 1309-55

SURVEY OF LA-168-C (Rosemead Blvd.) A205-001 PAGE 14 (36)

SURVEY OF LA-168-C (Rosemead Blvd.) A205-001 PAGE 15 (37)

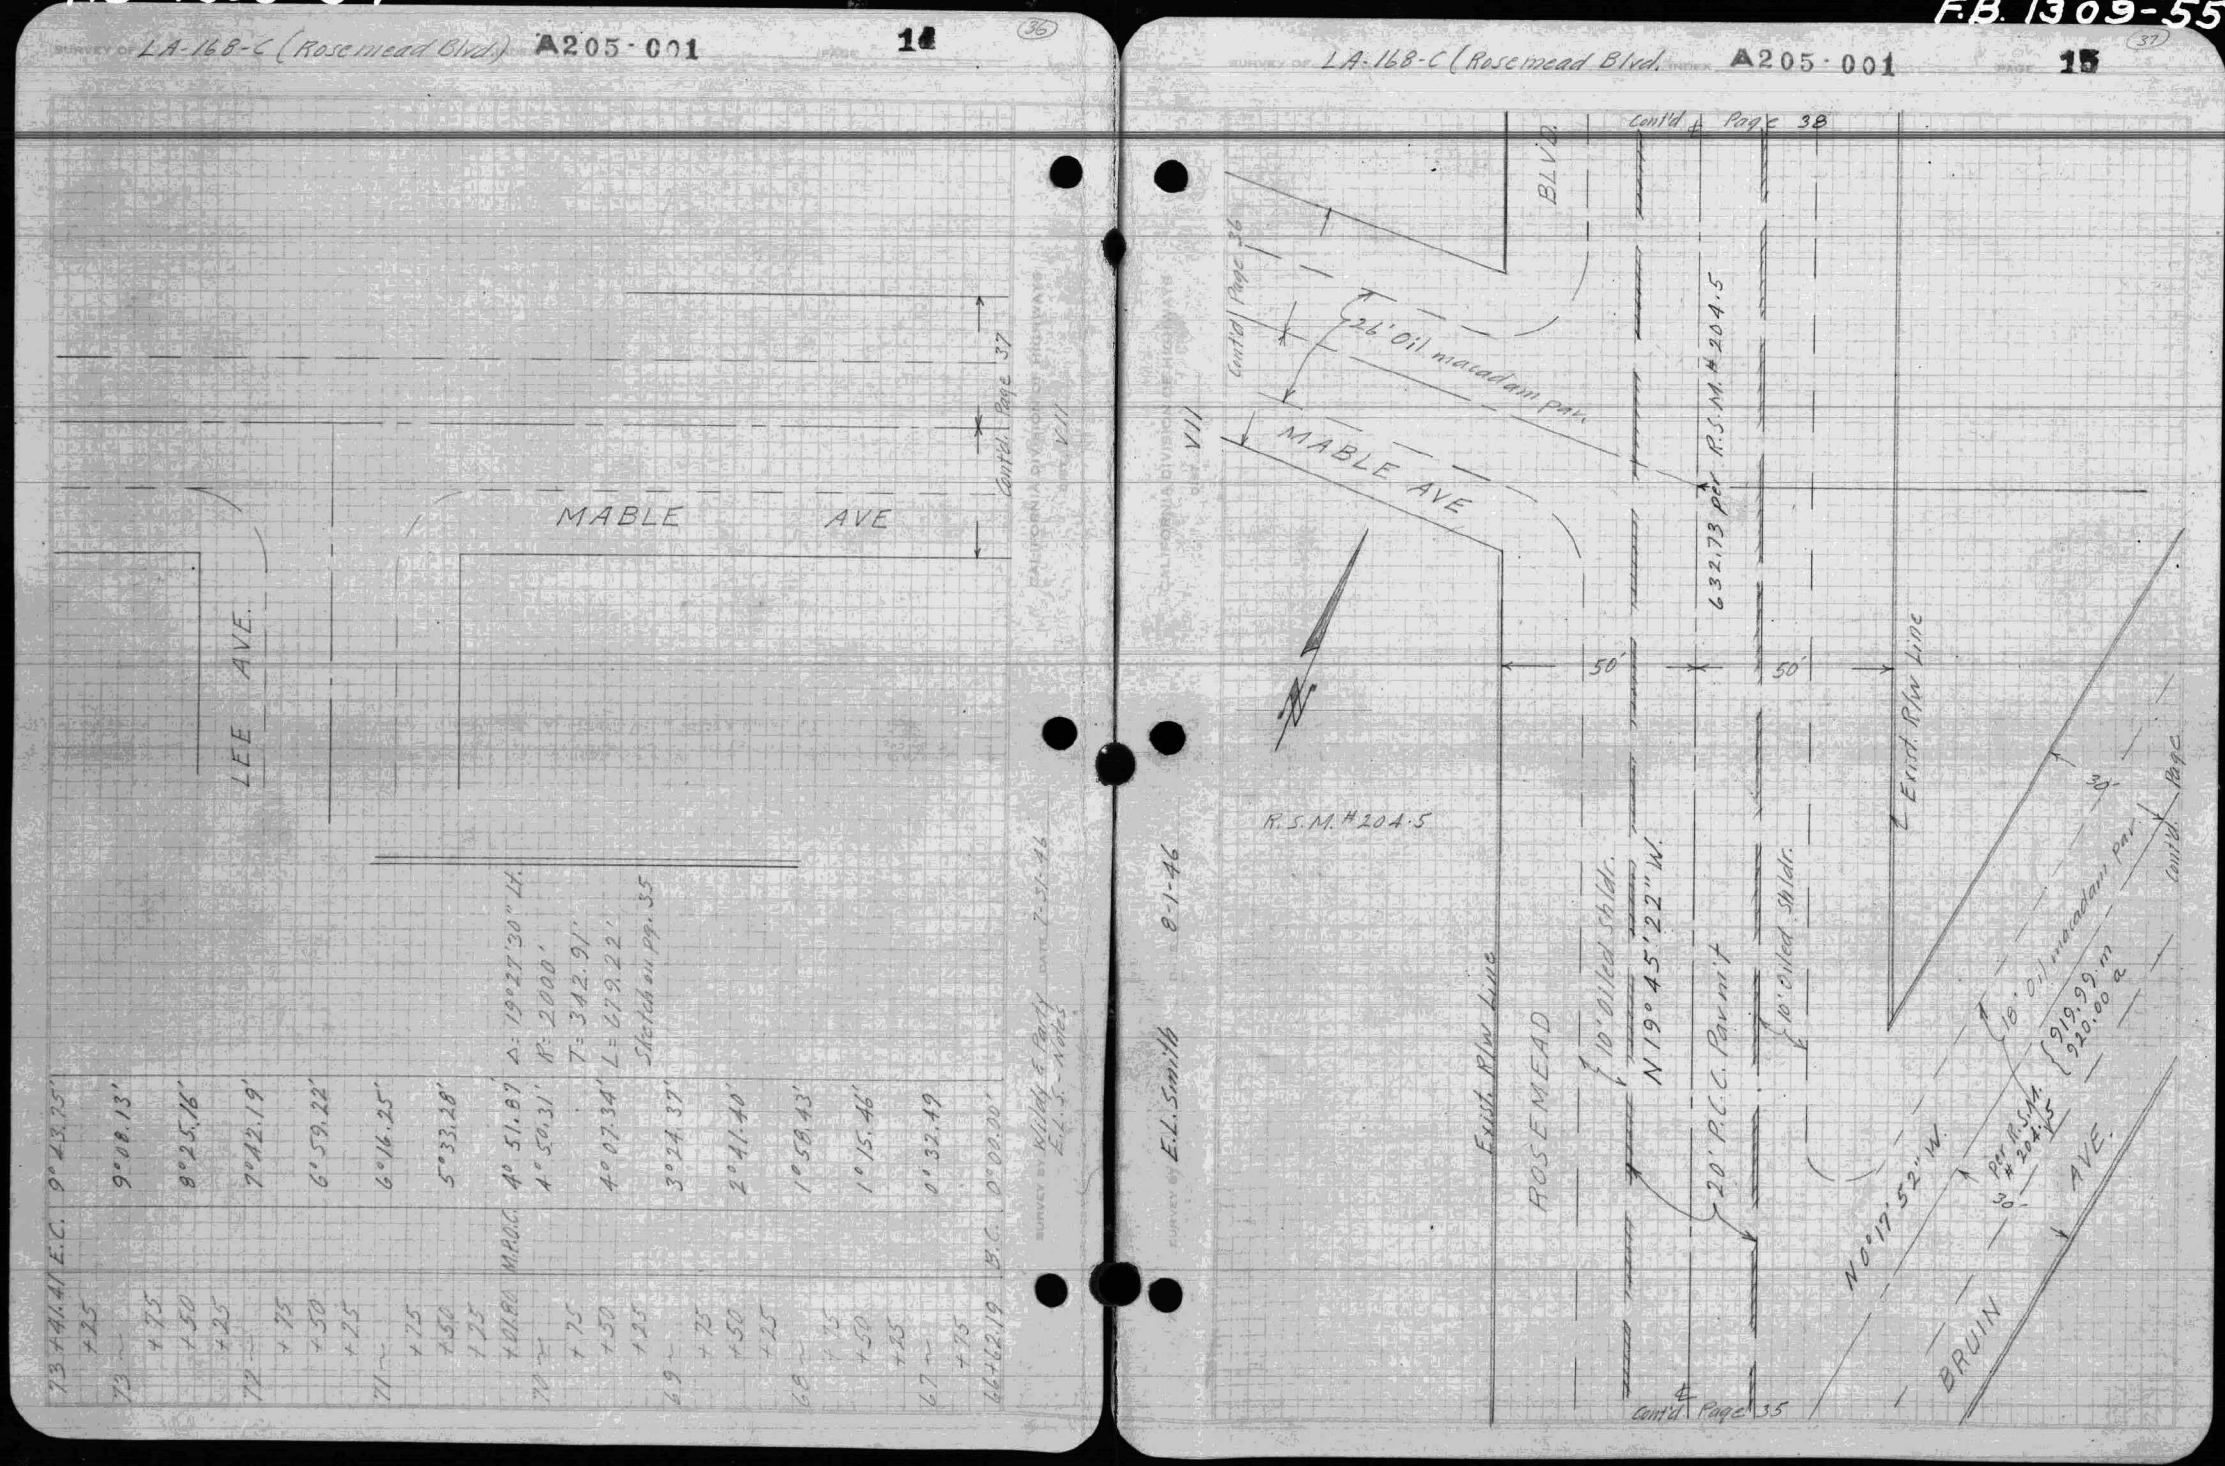

73+41.41	E.C.	9°43.75'		
+25				
73		9°08.13'		
+75				
+50		8°25.16'		
+25				
72		7°42.19'		
+75				
+50		6°59.22'		
+25				
71		6°16.25'		
+75				
+50		5°33.28'		
+25				
+01.61	M.A.C.	4°51.81'	Δ = 19°27'30" Lt.	
70		4°50.31'	R = 2000'	
+75			T = 342.91'	
+50		4°07.34'	L = 679.22'	
69		3°24.37'		
+75				
+50		2°41.40'		
+25				
68		1°58.43'		
+75				
+50		1°15.46'		
+25				
67		0°32.49'		
+75				
66+62.19	P.C.	0°00.00'		

F.B. 1309-56

SURVEY OF LA-168-C (Rosemead Blvd.) A205·001 PAGE 16 (38)

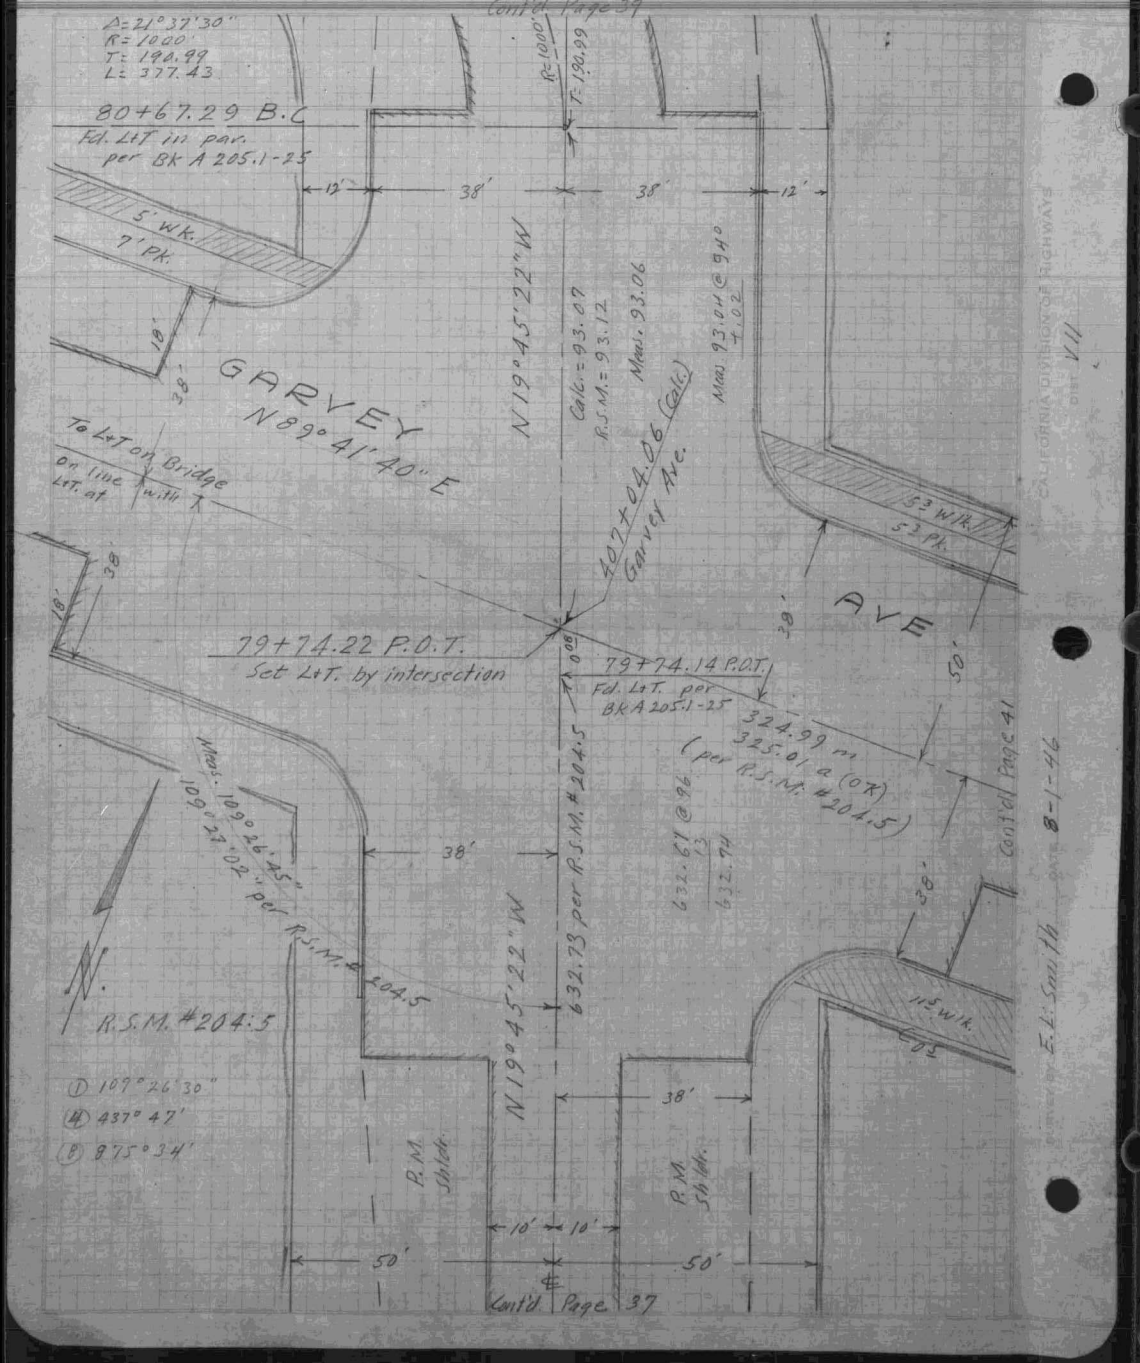

F.B. 1309-57

SURVEY OF LA-168-C (Rosemead Blvd.) A205·001 PAGE 17 (39)

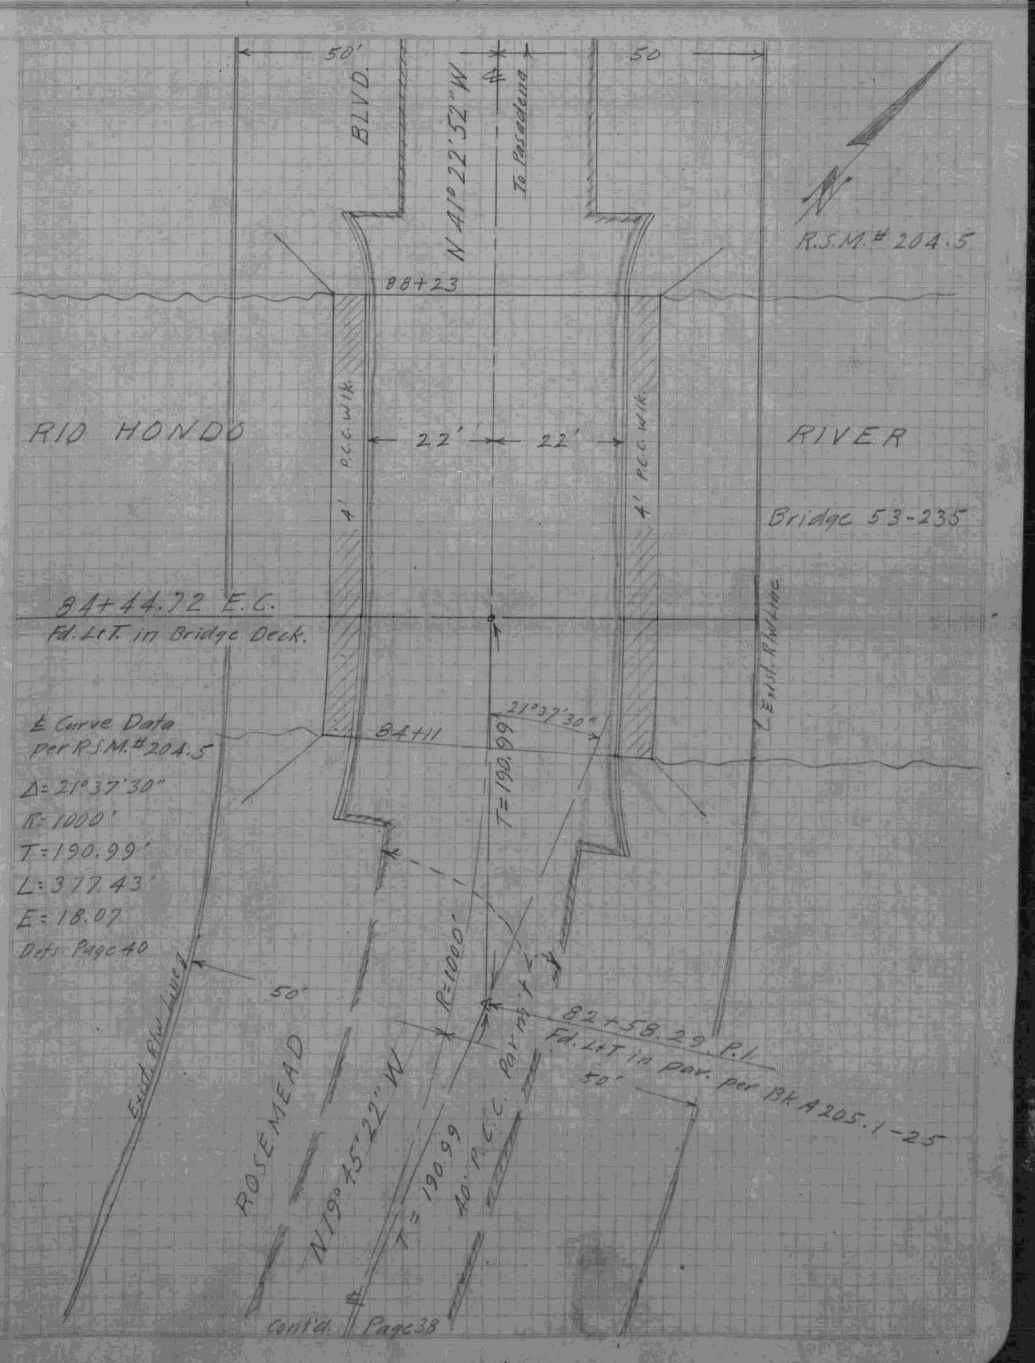

F.B. 1309-58

A205·001 18

84+44.72	E.C.	10°48.75'
+25		
84 ~		
+75		
+50		
+25		
83 ~		
+75		
+50		
+25		
82 ~		
+75		
+50		
+25		
81 ~		
+75		
80+67.29	B.C.	0°00.00'

Δ = 21°37'30"
R = 1000'
T = 190.99'
L = 377.43'
E = 18.07
Sketch page 38-39

CALIFORNIA DIVISION OF HIGHWAYS
DIST. VII
DATE 8-2-46
SURVEY BY E.L. Smith

F.B. 1309-59

LA-168-C (Garvey Ave.) A205·001 19

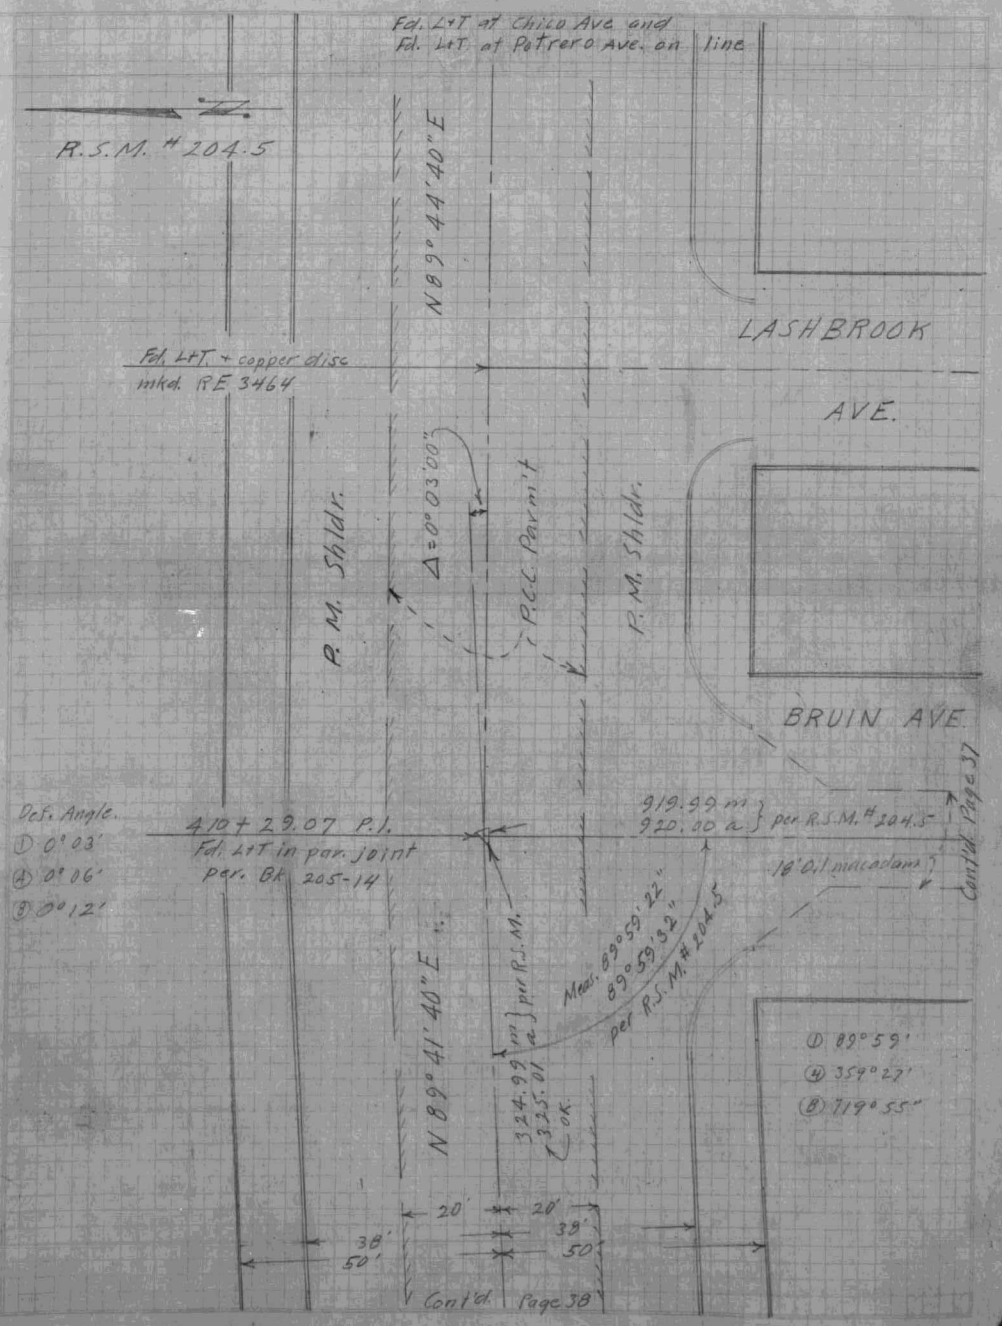

F.B. 1309-60

SURVEY OF LA-168-A&B INDEX A204-001 PAGE 1 25

CALIFORNIA DIVISION OF HIGHWAYS DIST VII

LA-168-A&B

ROSEMEAD BOULEVARD

ALIGNMENT TIES

Sta. 528+00 "A" to Sta 288+45 "B"

AS BUILT

REFERENCES:-

Construction Layout's
R/W Maps

SEPTEMBER 1949

Kurland & Party

Ryley
Fenner
Pelen
Sugden

Kurland & Party SEPT. '49

F.B. 1309-61

SURVEY OF LA-168-A INDEX A204-001 PAGE 2 26

CALIFORNIA DIVISION OF HIGHWAYS DIST VII

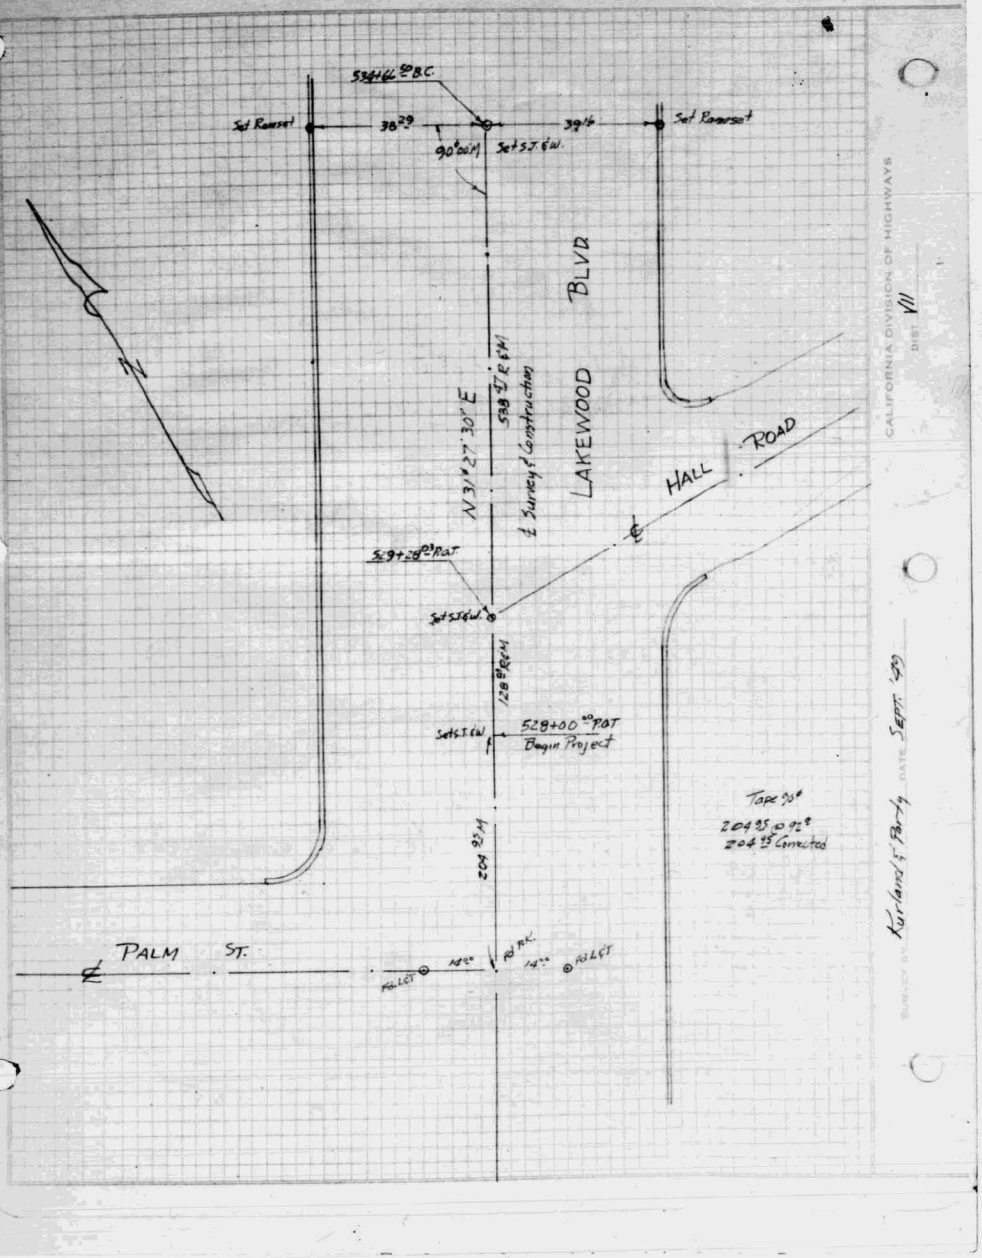

F.B. 1309-62

SURVEY OF LA-168-A A204-001 PAGE 3 27

CALIFORNIA DIVISION OF HIGHWAYS DIST. VII

SURVEY BY Kurland & Bartly DATE Sept. '49

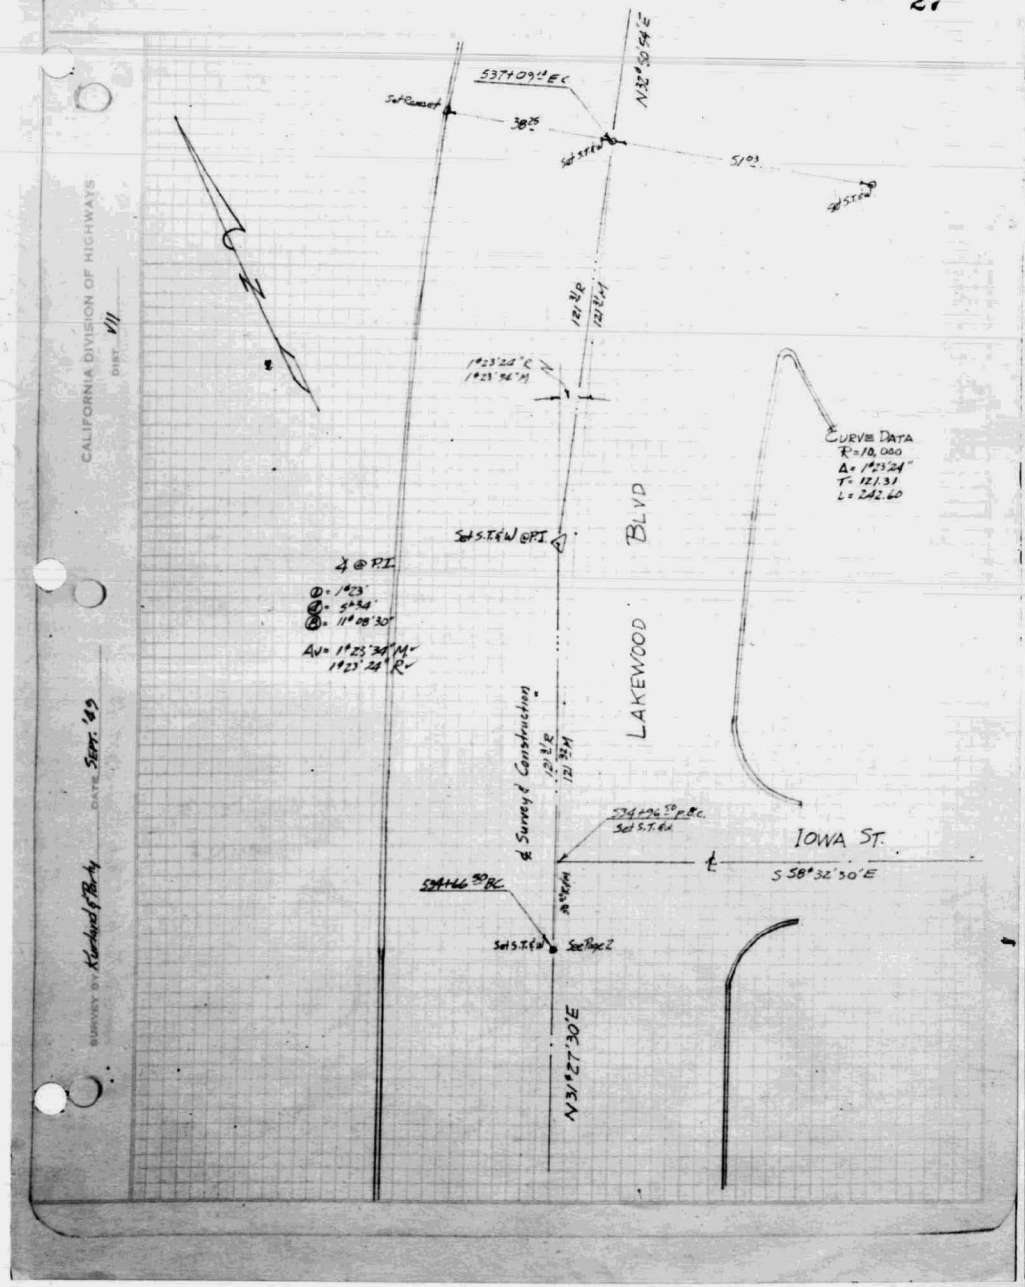

F.B. 1309-63

SURVEY OF LA-168-A INDEX A204-001 PAGE 4 28

CALIFORNIA DIVISION OF HIGHWAYS DIST. VII

SURVEY BY Kurland & Bartly DATE Sept. '49

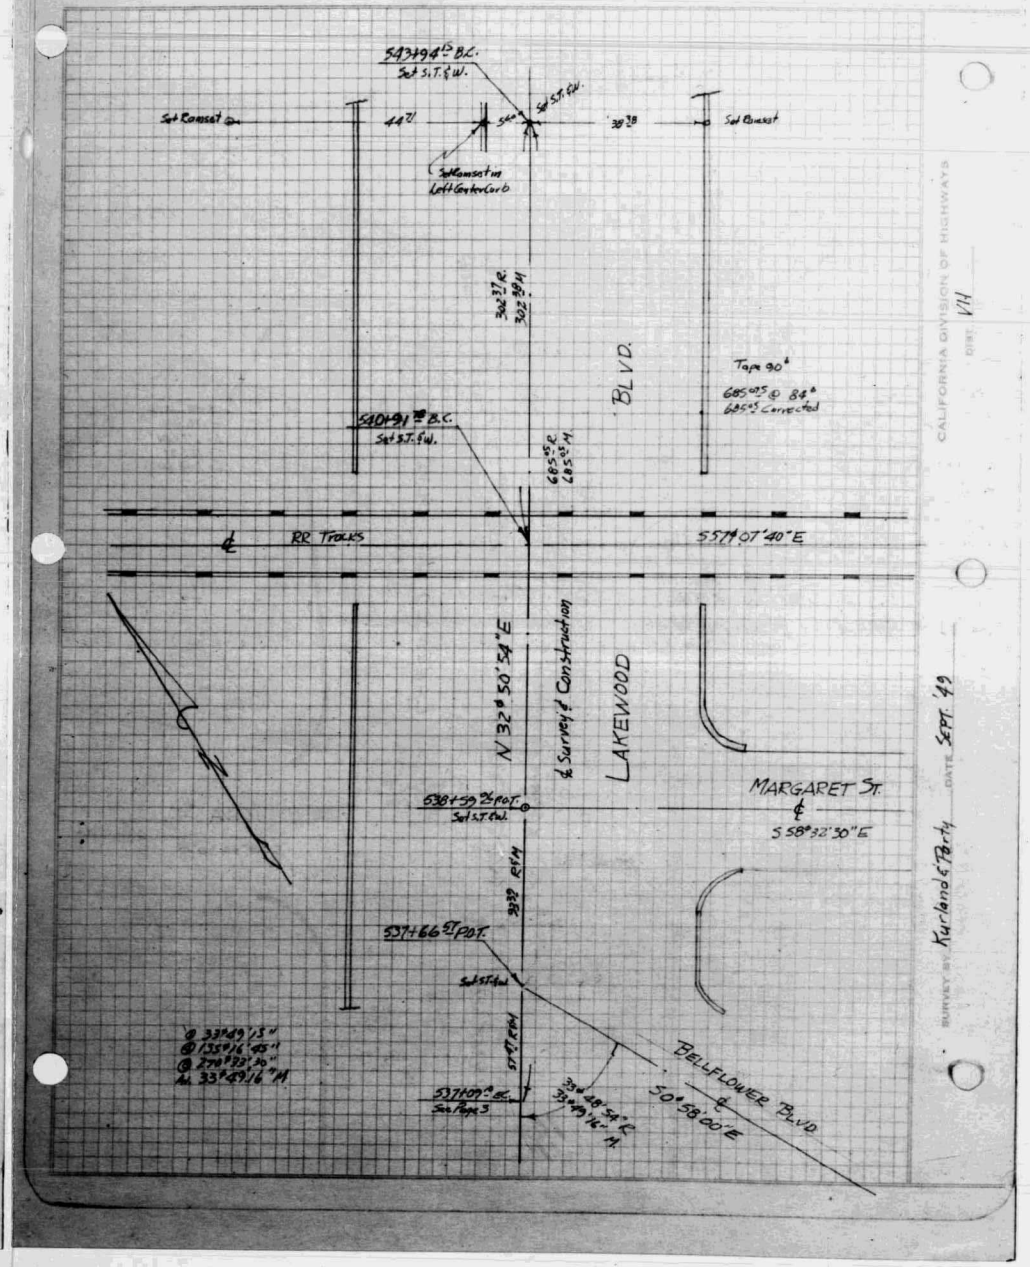

F.B. 1309-64

F.B. 1309-65

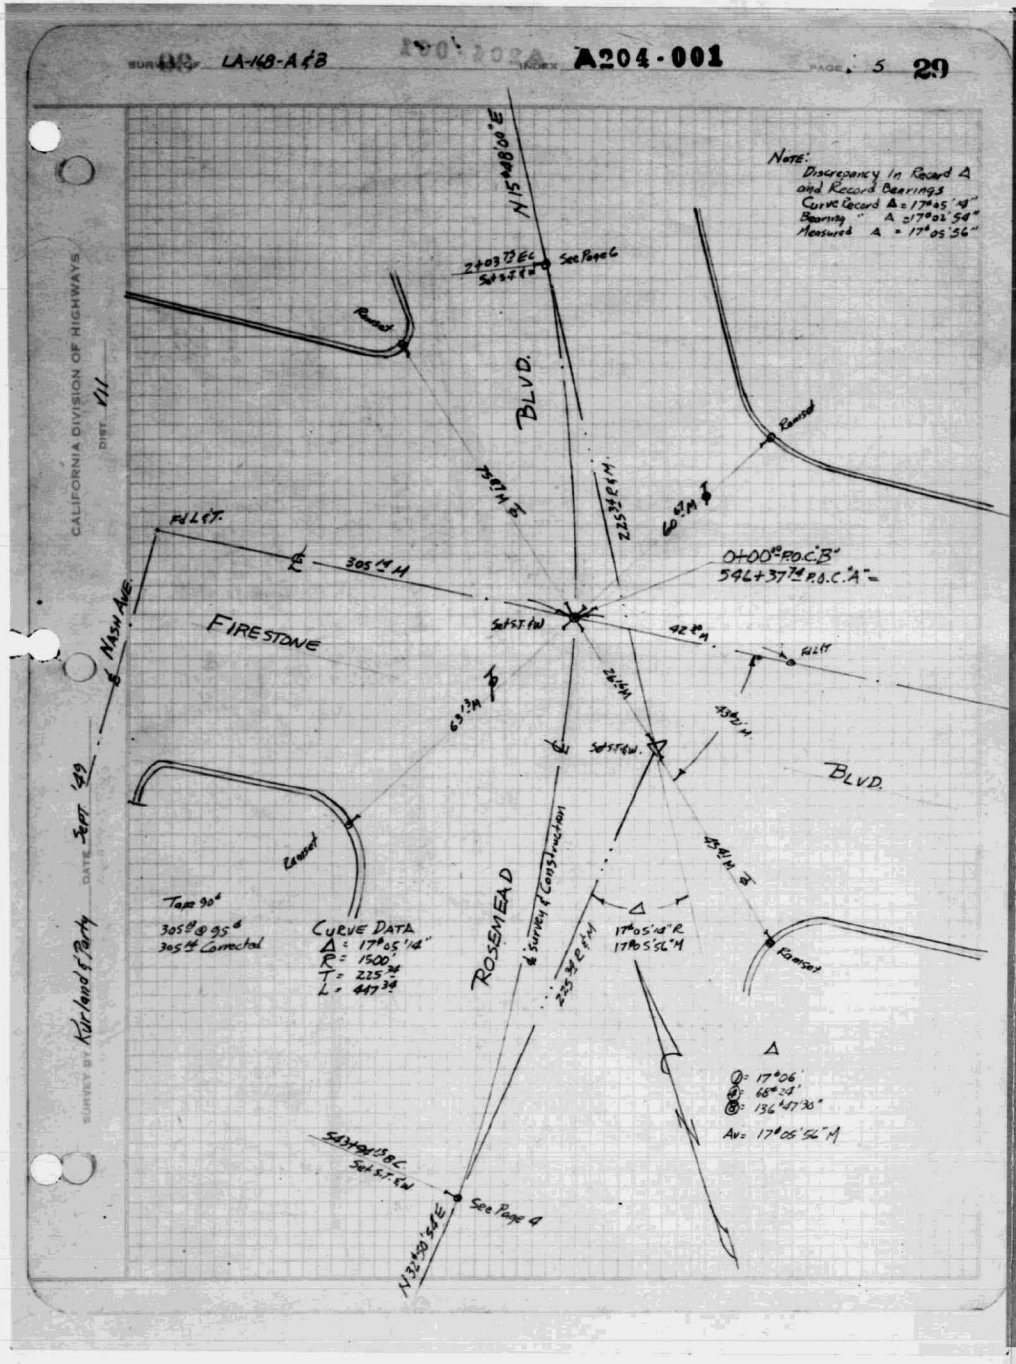

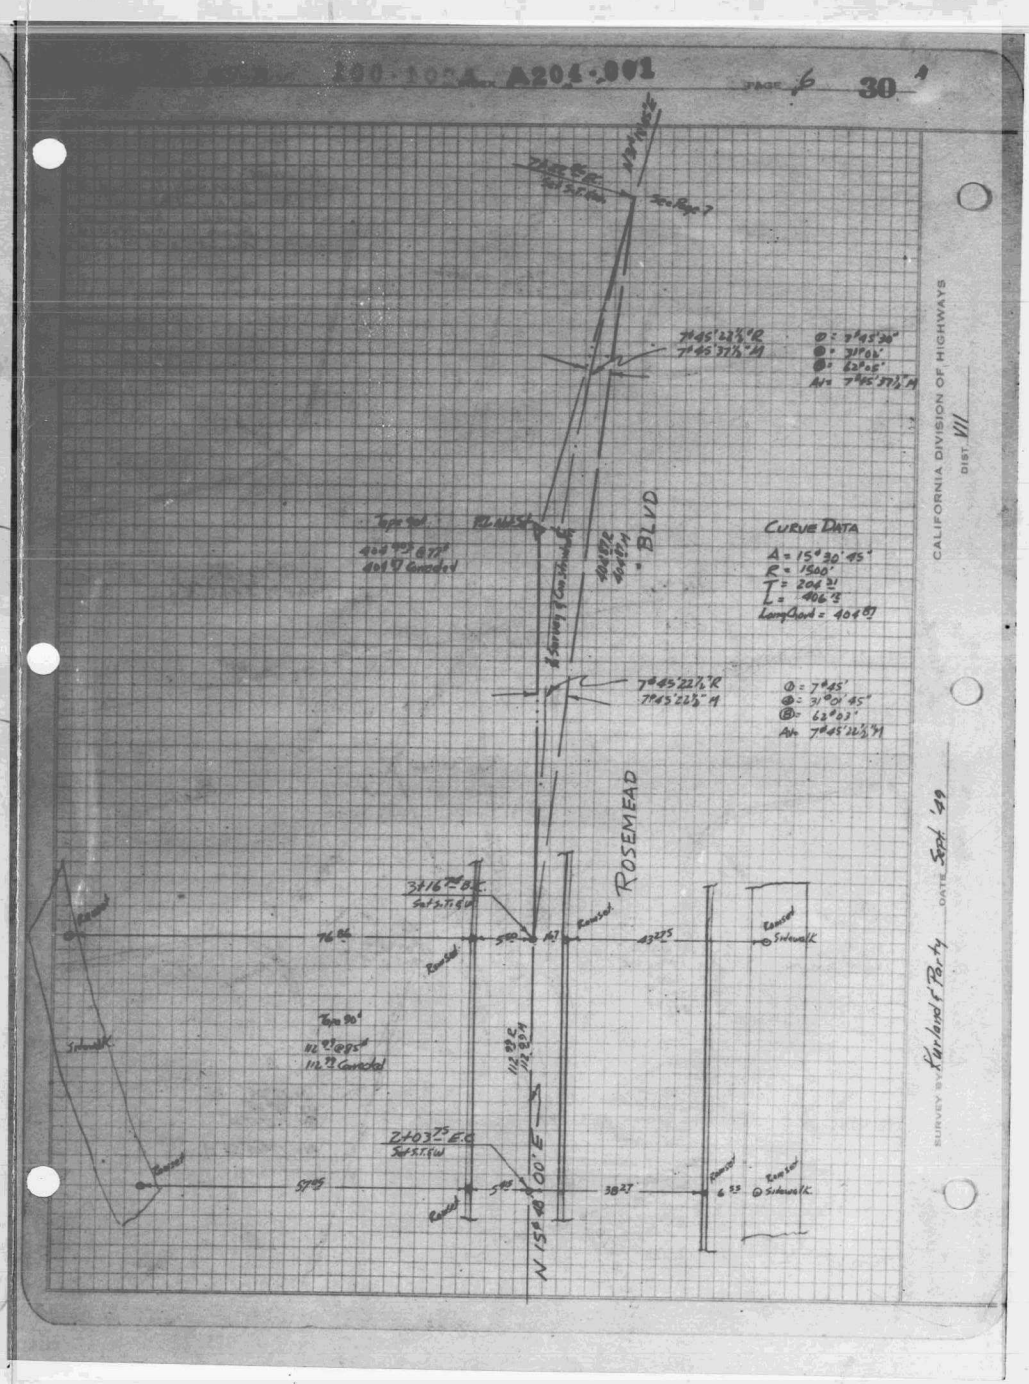

F.B. 1309-66

LA-168-B A204-001 7 31

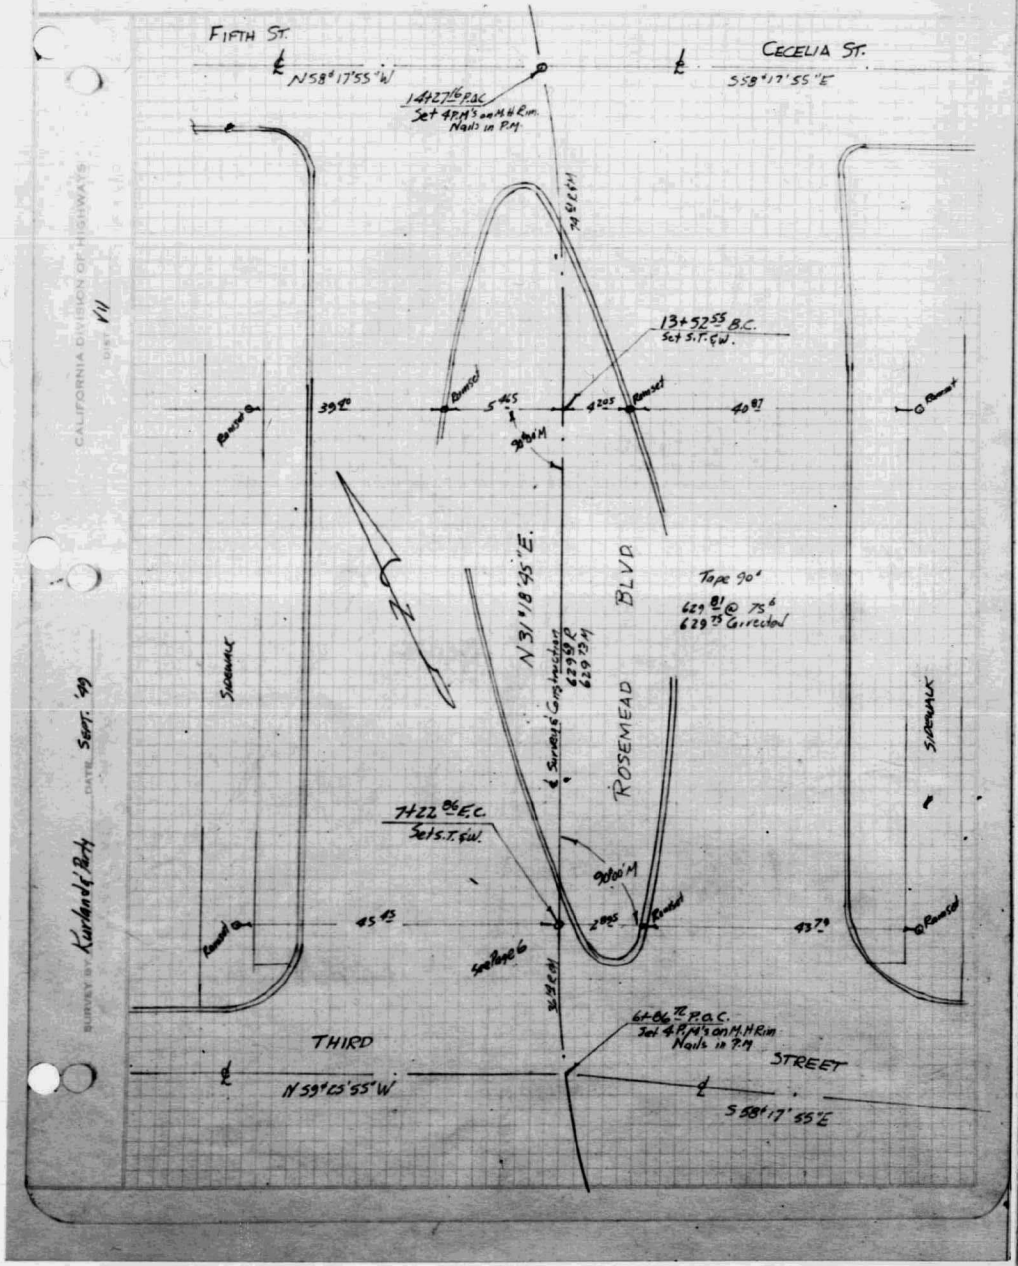

F.B. 1309-67

SURVEY OF LA-168-B INDEX A204-001 PAGE 8 32

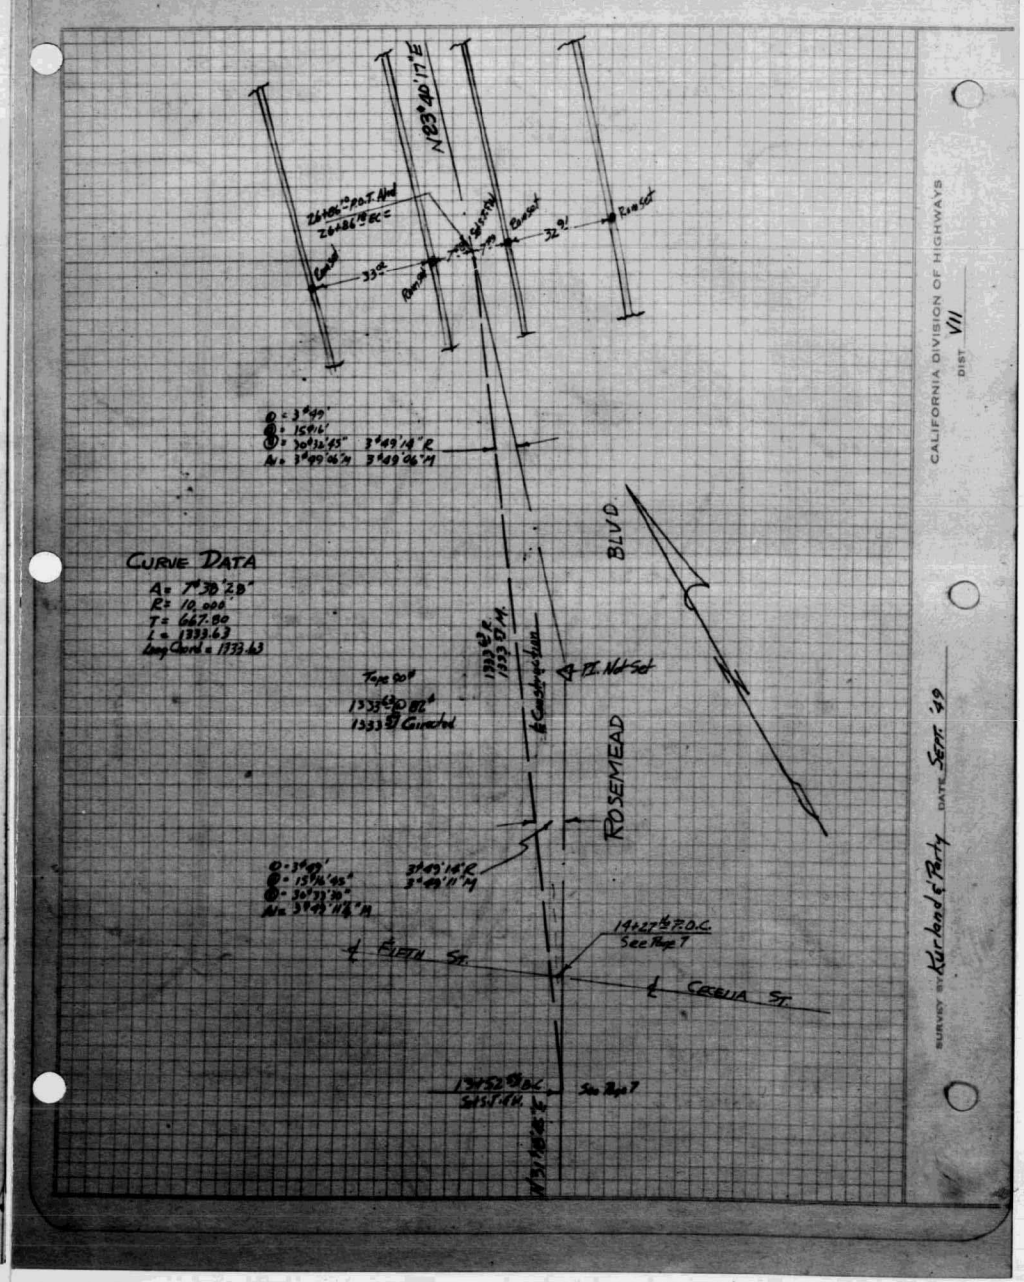

F.B. 1309-68

F.B. 1309-69

SURVEY OF LA-168-B INDEX A204-001 PAGE 9 33

CALIFORNIA DIVISION OF HIGHWAYS DIST. VII


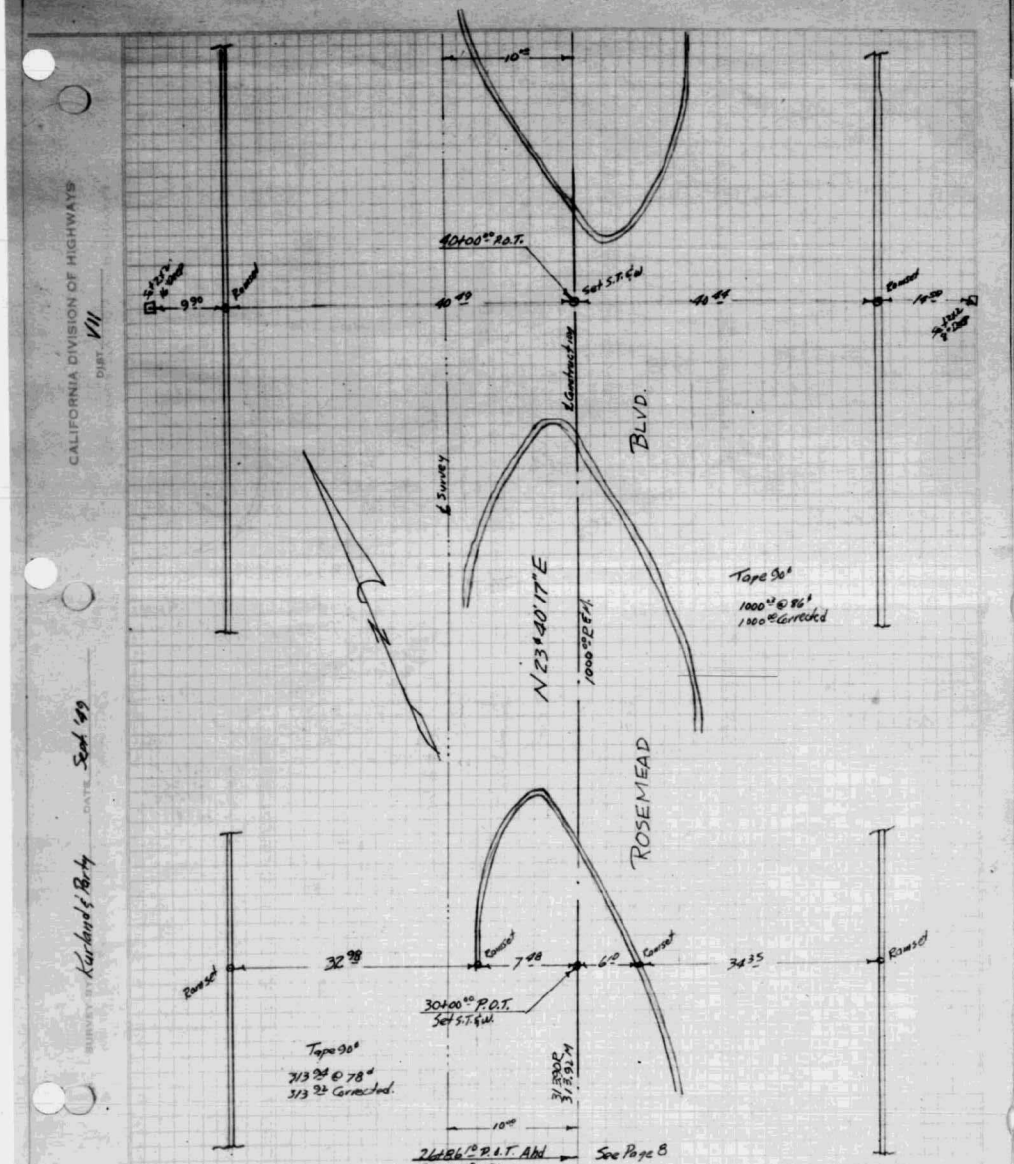

SURVEY OF LA-168-B INDEX A204-001 PAGE 10 34

CALIFORNIA DIVISION OF HIGHWAYS DIST. VII


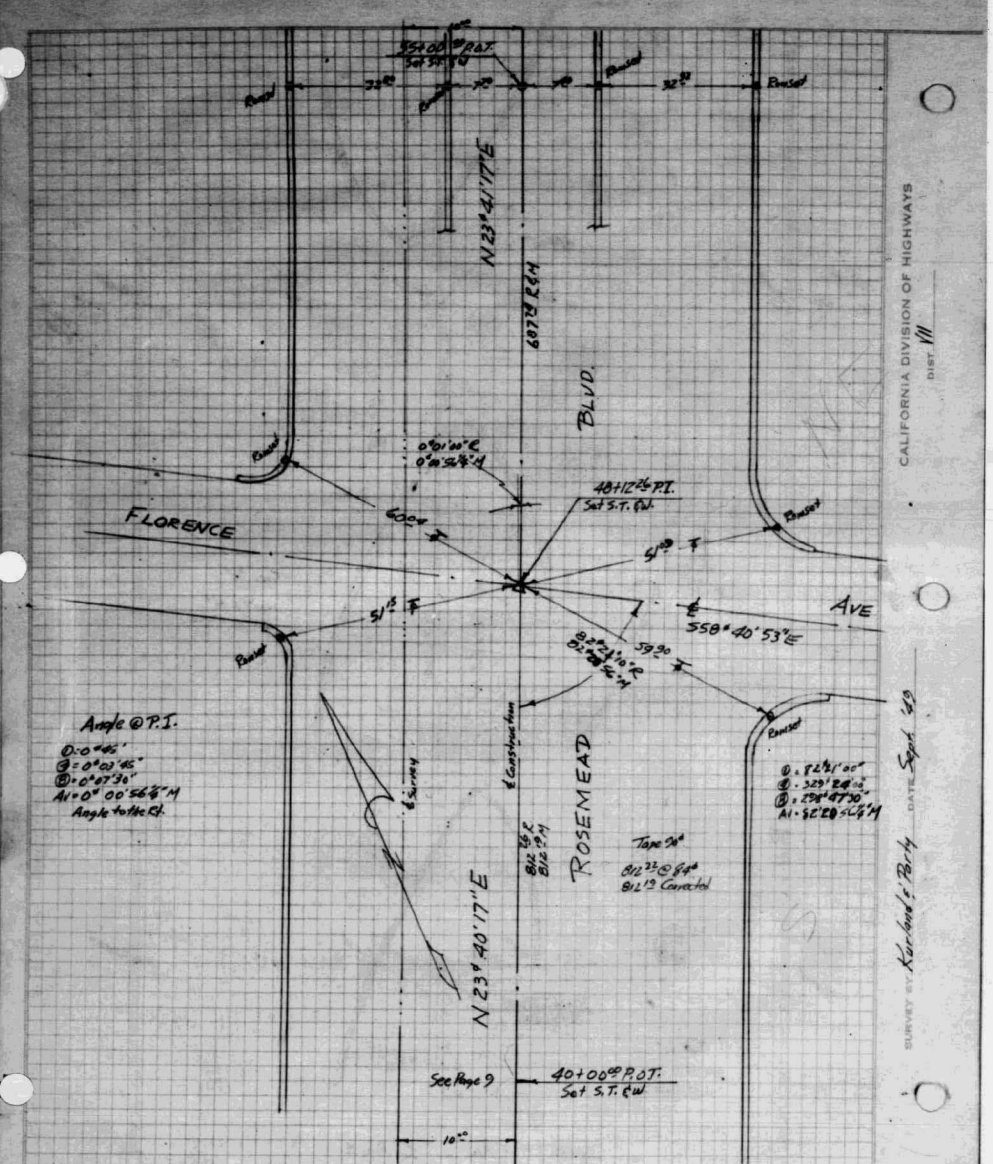

F.B. 1309-70

F.B. 1309-71

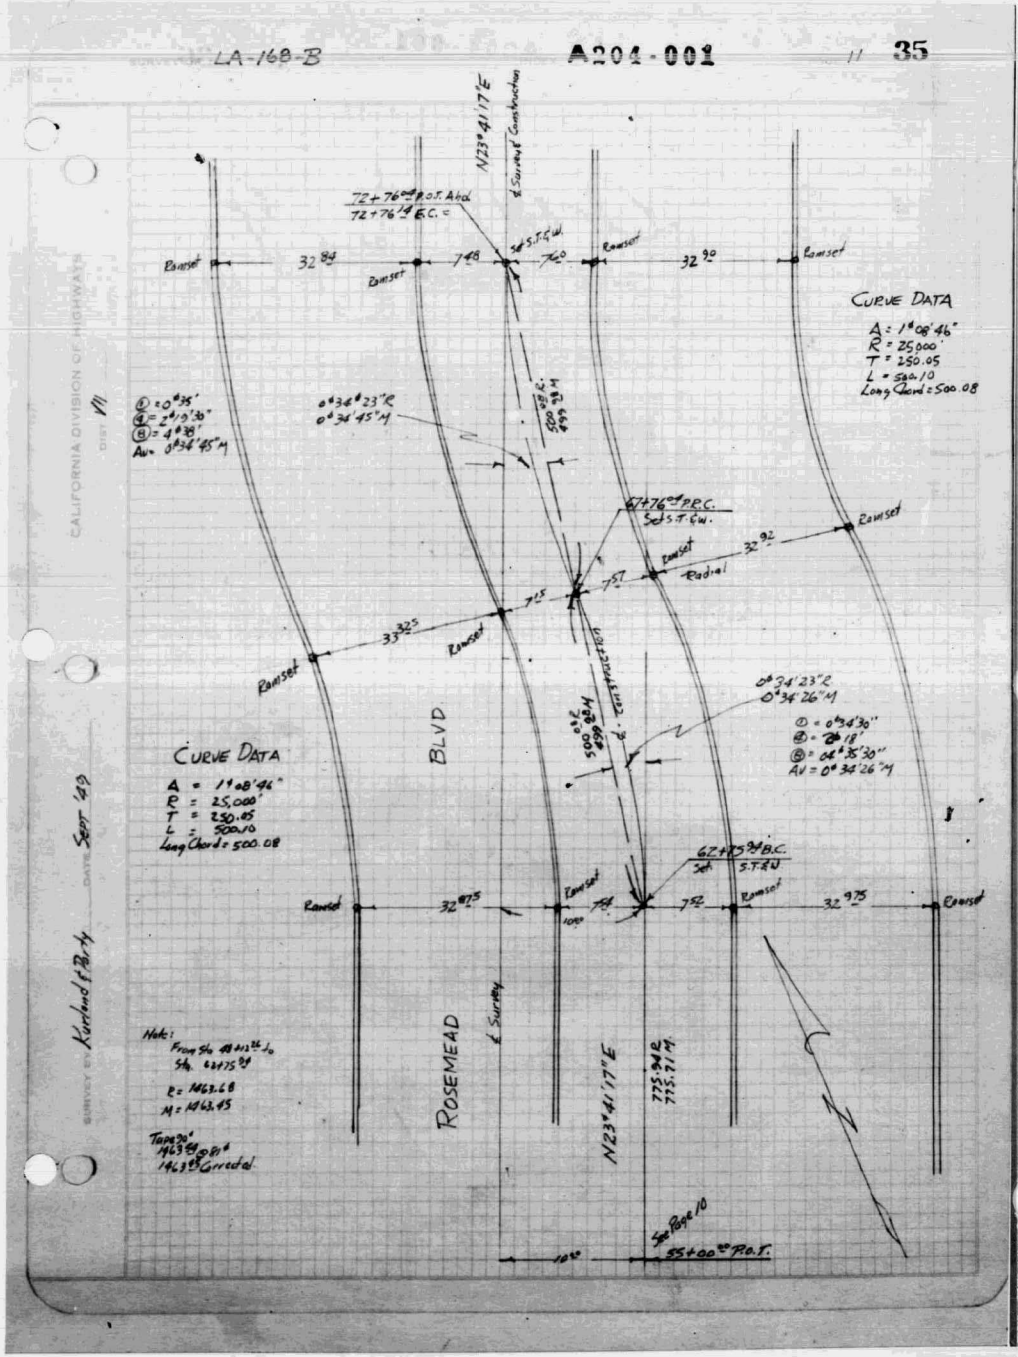

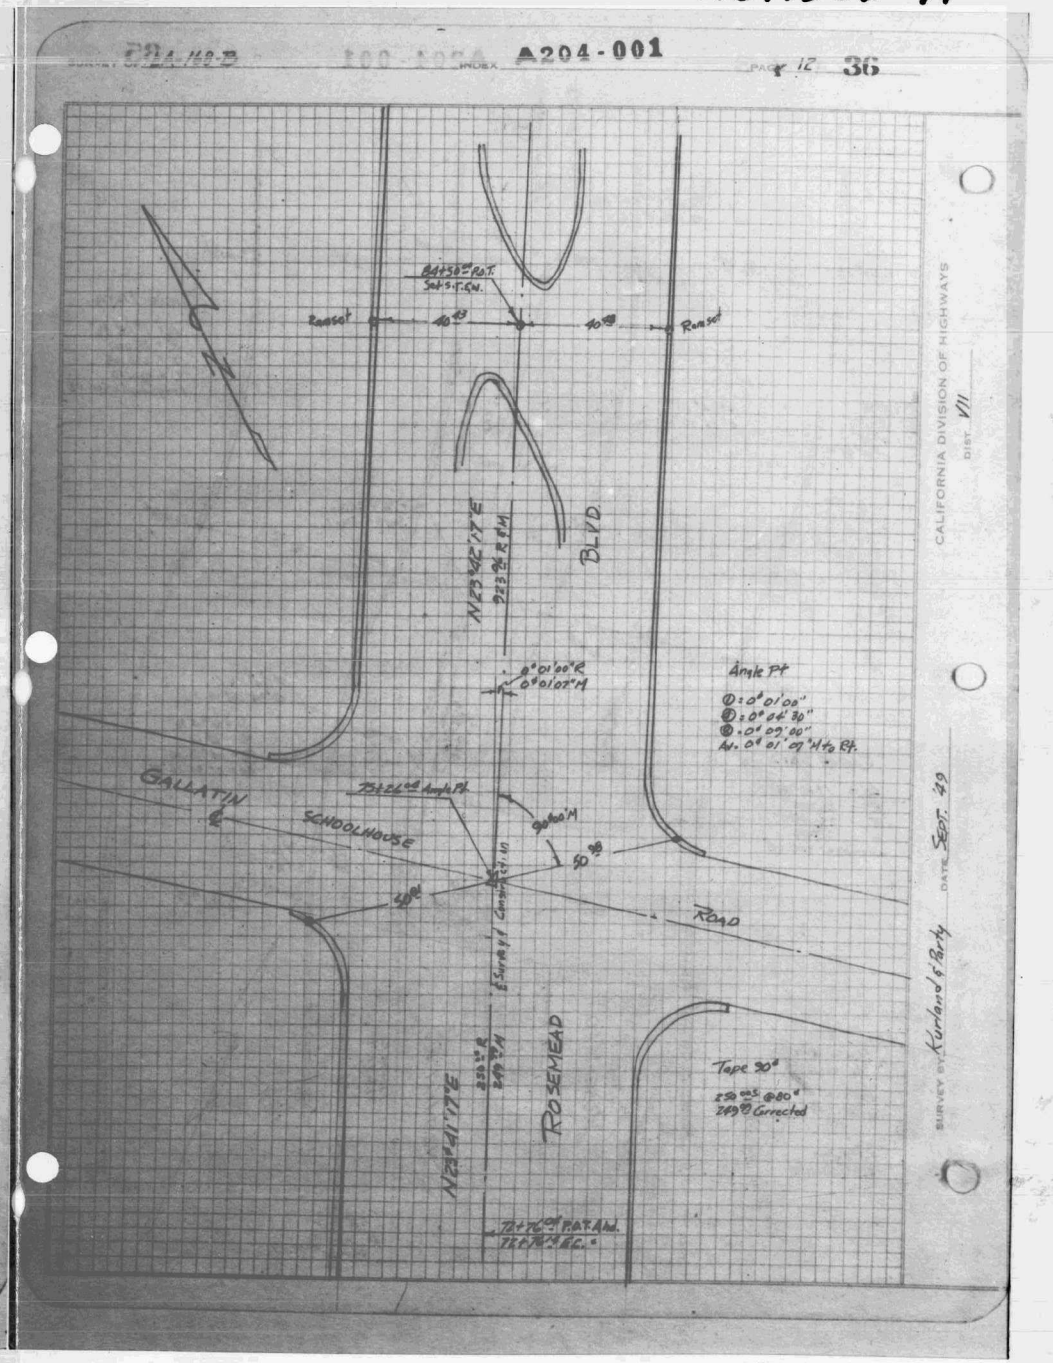

F.B. 1309-72

F.B. 1309-73

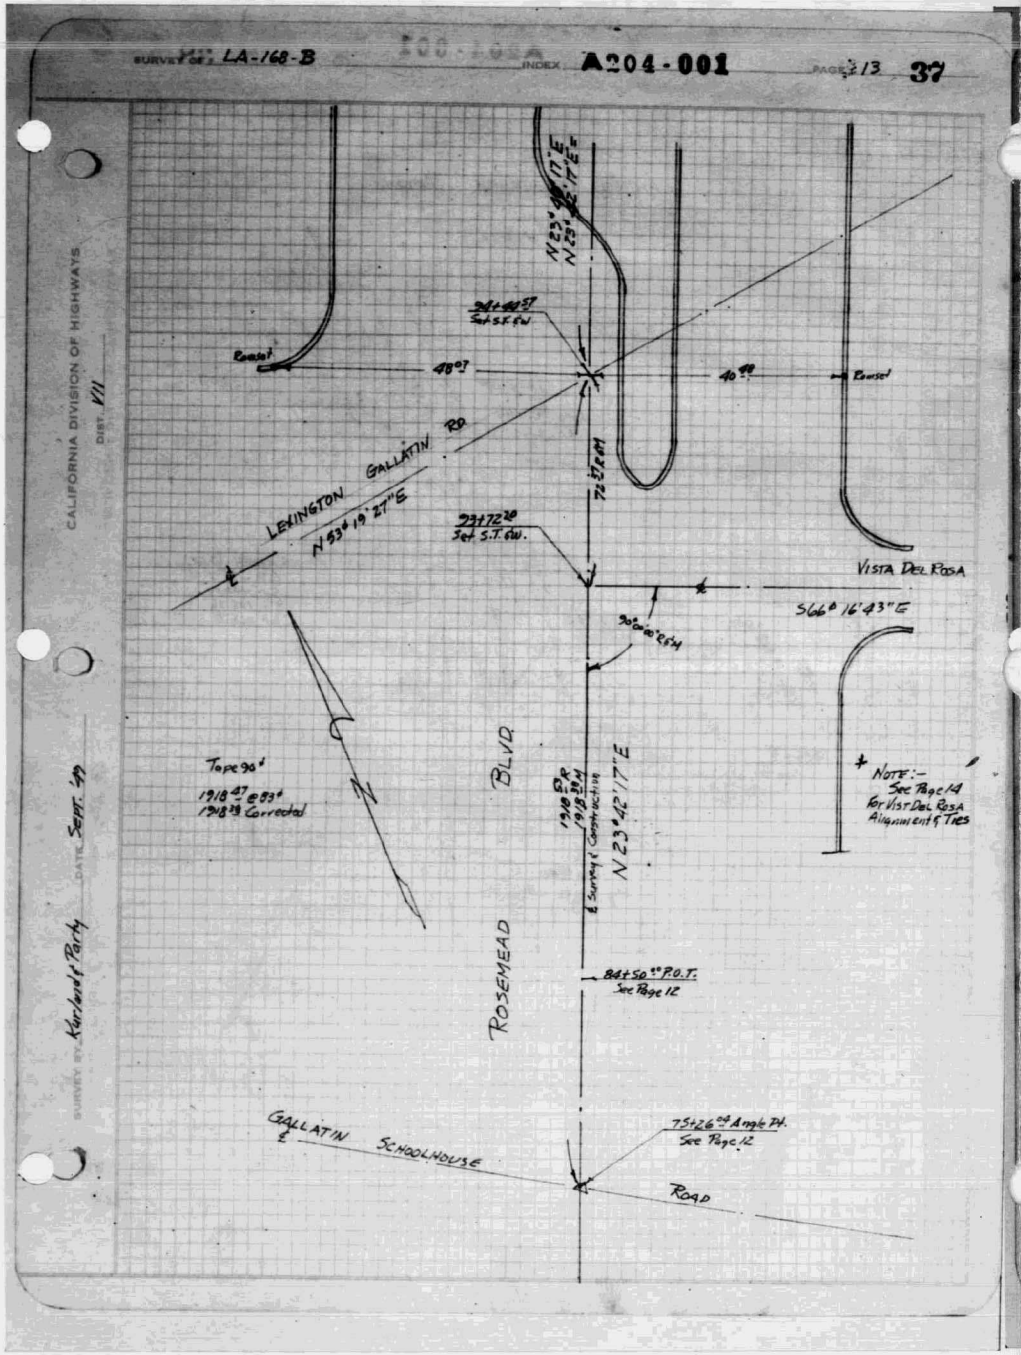

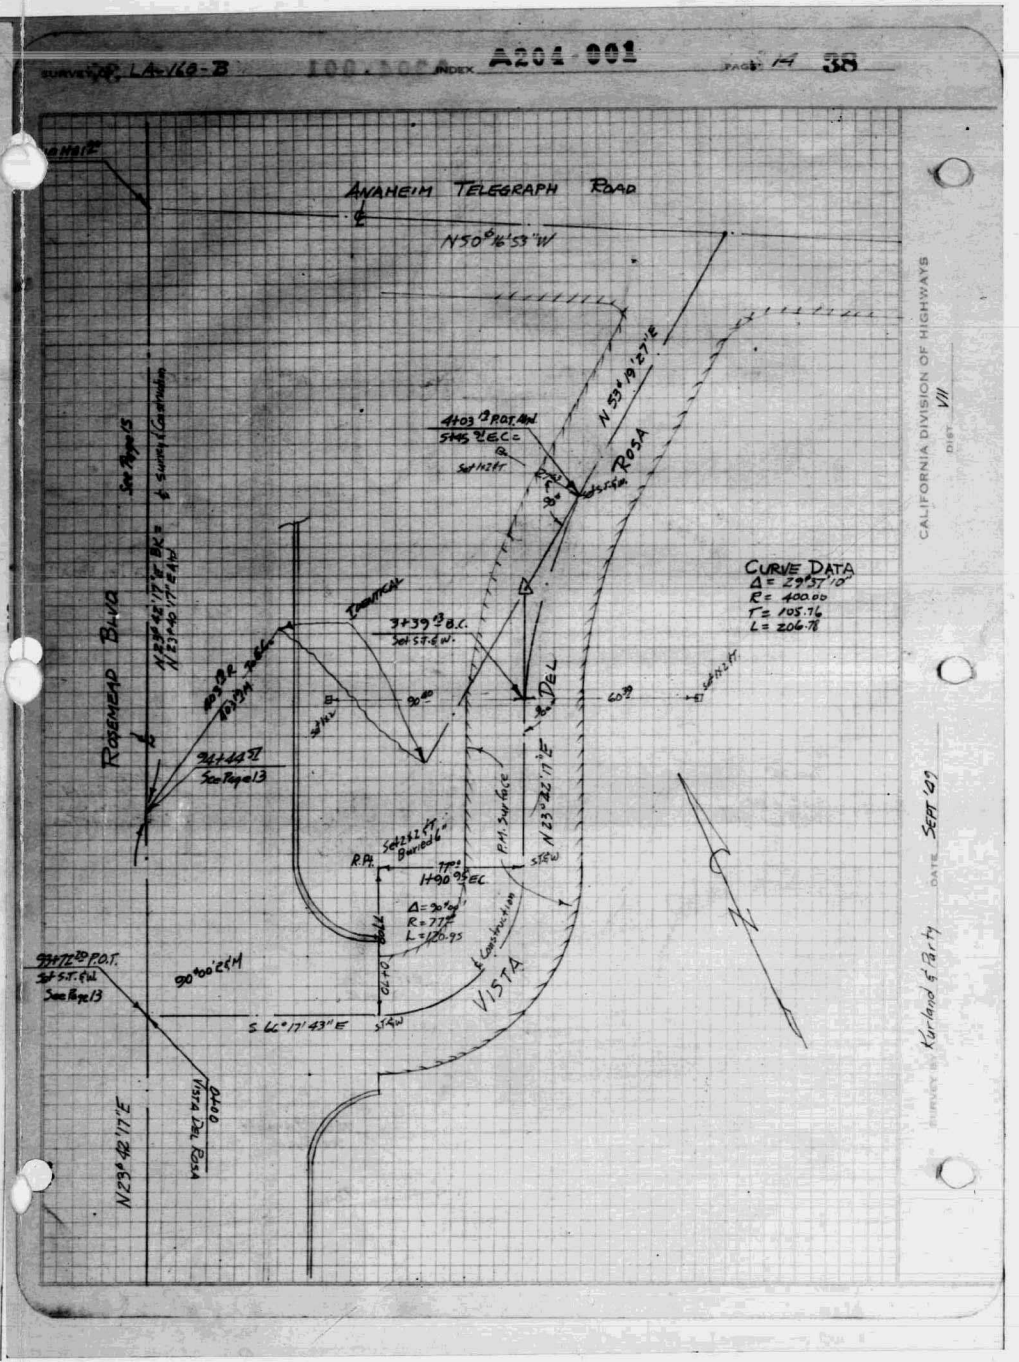

F.B. 1309-74

LA-168-B A204-001 15 39

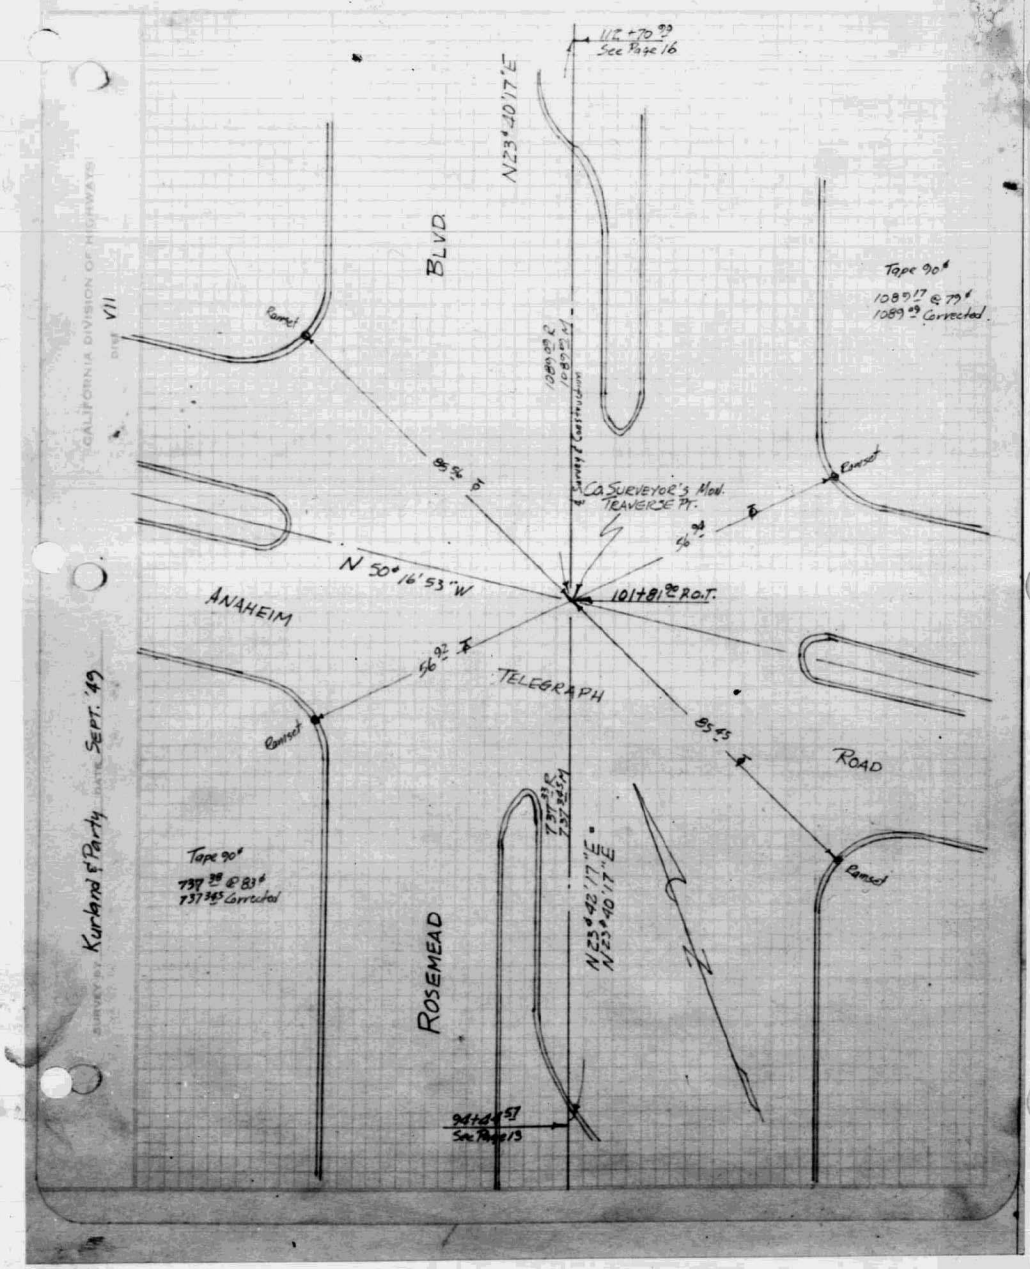

Kurland & Party DATE Sept. '49

CALIFORNIA DIVISION OF HIGHWAYS DIST. VII

F.B. 1309-75

SURVEY OF LA-168-B A204-001 16 40

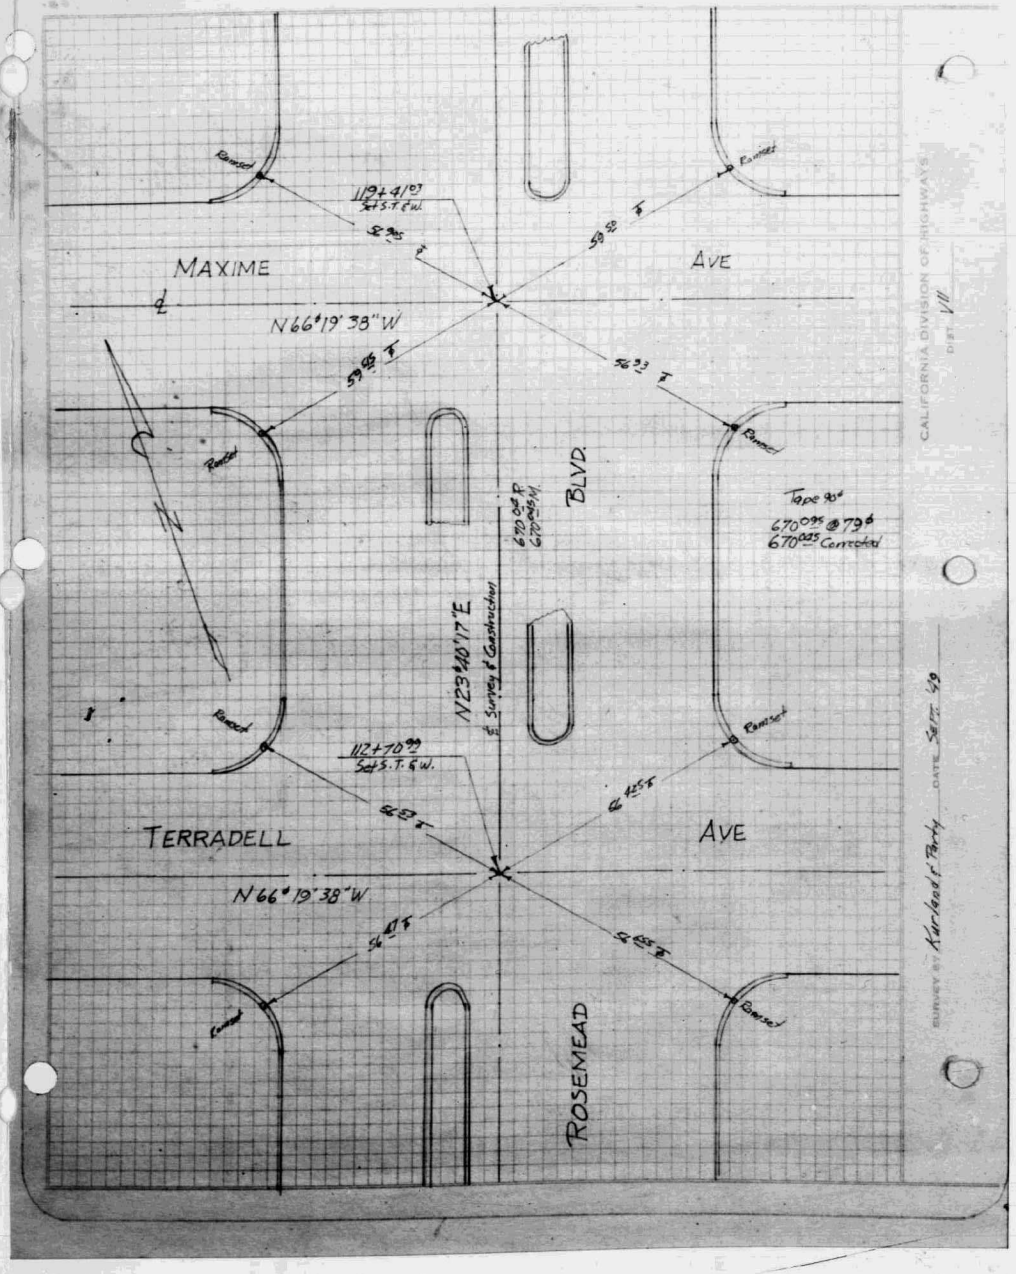

Kurland & Party DATE Sept. '49

CALIFORNIA DIVISION OF HIGHWAYS DIST. VII

F.B. 1309-76

F.B. 1309-77

SURVEY OF LA-168-B INDEX A204-001 PAGE 17 41

CALIFORNIA DIVISION OF HIGHWAYS DIST. VII

SURVEY BY Kurland & Party DATE Sept. '59

1314+47.68 B.C. See Page 18

Tape 90°
201.935 @ 80°
201.92 Corrected

201.92 R
201.92 M

BLVD.

AERO DRIVE

1294+43.78 Set S.T. & w.

N 23° 42' 42" E

S 66° 17' 18" E

363.93 R
363.93 M

0° 02' 25" R
0° 02' 17" M

Angle @ Angle Pt
Δ = 0° 02' 30"
Ⓑ = 0° 09' 00"
Ⓒ = 0° 18' 30"
Av = 0° 02' 17" M

59.34 ft

56.55 ft

1254+81.92 Set S.T. & w

SHADE LANE

N 70° 16' 21" W

Construction

℄ Survey

57.45 ft

53.26 ft

Tape 90°
363.955 @ 80°
363.93 Corrected

640.72 R
640.72 M

N 23° 40' 17" E

ROSEMEAD

Tape @ 90°
640.82 @ 80°
640.78 Corrected

1194+41.93 See Page 16

SURVEY OF LA-168-B INDEX A204-001 PAGE 18 42

CALIFORNIA DIVISION OF HIGHWAYS DIST. VII

SURVEY BY Kurland & Party DATE Sept. '59

N 20° 07' 42" E

1354+22.06 P.O.T. Abd.
1354+22.06 E.C. =

Reset

32.98

Burset

7.68

7.55

Set S.T. & w.

Reset

71.76

147 ft

Ⓐ = 1° 48' 00"
Ⓑ = 7° 10' 30"
Ⓒ = 1° 48' 21" 30"
Av. = 1° 47' 41"

1° 47' 30" R
1° 47' 41" M

CURVE DATA
Δ = 3° 35' 00"
R = 6000
T = 187.68
L = 375.73
L.Ch = 375.18

℄ Survey & Construction

375.19 C
375.54 M

1337.35 Z
Not Set

℄ P.E. R.R. R/W ?

N 69° 20' 33" W

P.E. Not Set

Tape 90°
375.18 @ 80°
375.14 Corrected.

BLVD.

ROSEMEAD

1° 47' 30" R
1° 47' 00" M

Ⓐ = 1° 46' 45"
Ⓑ = 7° 08' 00"
Ⓒ = 1° 46' 22"
Av = 1° 47' 00"

Reset

39.98

Burset

6.51

1314+47.67 B.C.
Set S.T. & w.

7.55

Burset

32.34

Reset

15.70

2 x 2 ft.

N 23° 42' 42" E

F.B. 1309-78

SURVEY OF LA-168-B INDEX A204-001 PAGE 19 43

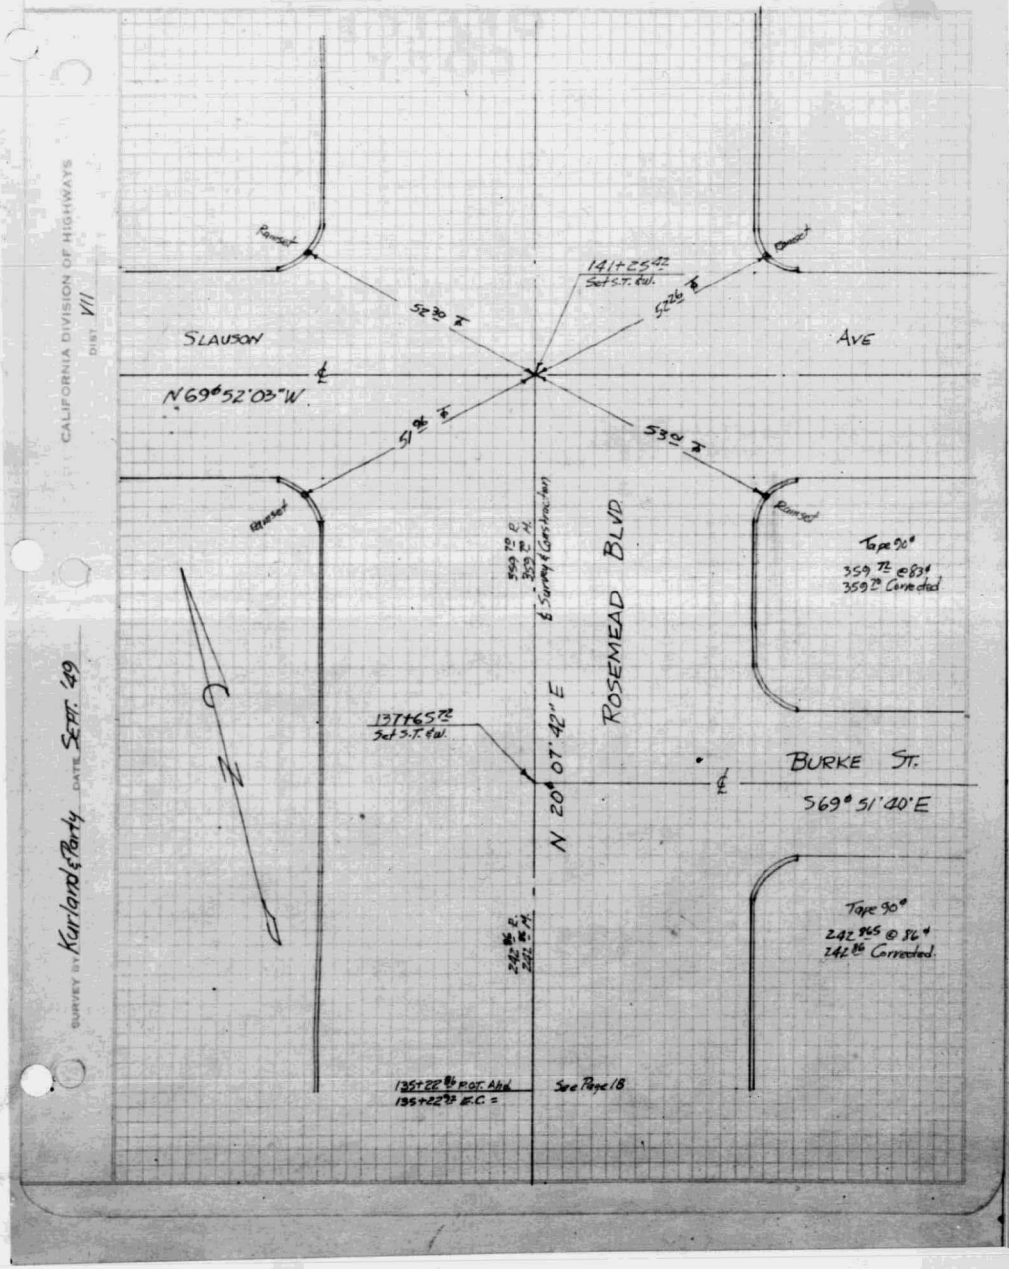

CALIFORNIA DIVISION OF HIGHWAYS DIST. VII

SURVEY BY Kurland & Party DATE SEPT. '49

F.B. 1309-79

SURVEY OF LA-168-B INDEX A204-001 PAGE 20 44

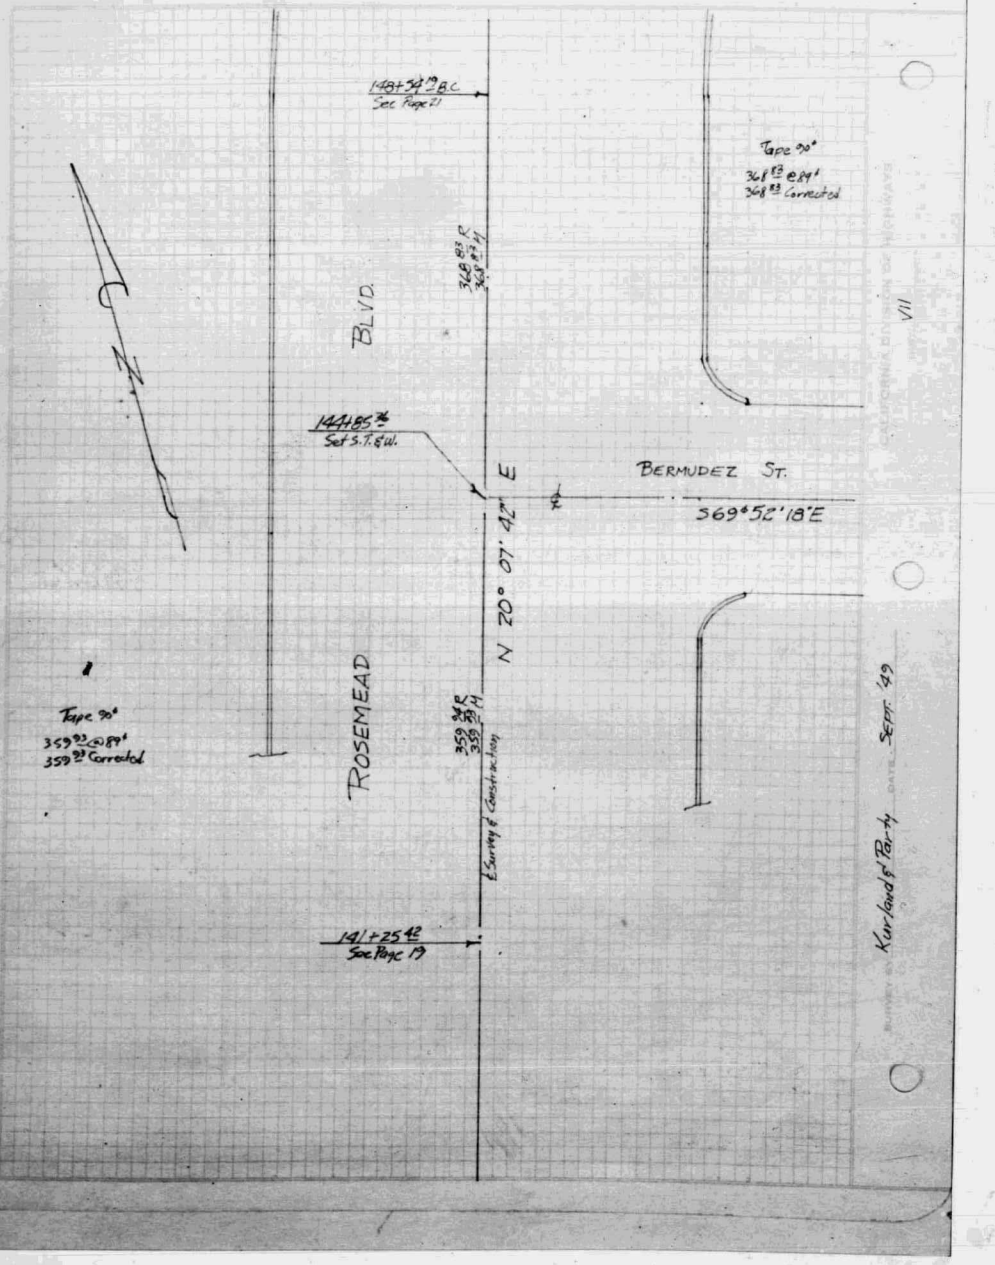

DIST. VII CALIFORNIA DIVISION OF HIGHWAYS

SURVEY BY Kurland & Party DATE SEPT. '49

F.B. 1309-80

F.B. 1309-81

SURVEY OF LA-168-B INDEX A204-001 PAGE 21 45

CALIFORNIA DIVISION OF HIGHWAYS DIST VII

SURVEY BY Kurland's Party DATE Sept. '49

Tape 90'
841.38' @ 68°
841.29' Corrected

Note:-
(168+51.33 By Measure) = (168+51.58 Per R/W Maps)
Same Point

168+51.33 P.O.T.
See Page 22

N 3°10'02" E
Blvd

160+10.18 E.C.
Set S.T.&W.

Rowset

Δ = 5°31'30"
Ⓐ = 22°08'30"
Ⓑ = 66°09'00"
Av = 5°31'08"

3129
3125

B.C. to M.R.O.C.-E.C.
5°31'10" R
5°31'08" M

Δ = 2°45'30"
Ⓐ = 11°02'00"
Ⓑ = 22°04'30"
Av = 2°45'34"

B.C. to M.R.O.C.
2°45'35" R
2°45'34" M

154+32.19 M.R.O.C.
Set S.T.&W.

3128
3115

Main Line A.T.&S.F.
℄
N 50°15'18" W

154+13.29
Not Set

P.I. Not Set

Sidewalk

P.C.C.

E.C. to M.R.O.C.
2°45'35" R
2°45'49" M

Δ = 2°46'00"
Ⓐ = 11°03'30"
Ⓑ = 22°06'30"
Av = 2°45'49"

148+54.19 B.C.
Set S.T.&W.

3124
31685

N 20°07'42" E
℄ Survey & Construction

ROSEMEAD

CURVE DATA
Δ = 11°02'10"
R = 6000'
T = 579.78
L = 1155.99
½ L.C. = 577.77

SURVEY OF LA-168-B INDEX A204-001 PAGE 22 46

CALIFORNIA DIVISION OF HIGHWAYS DIST VII

SURVEY BY Kurland's Party DATE Sept. '49

190+37.67 B.C.
See Page 23

Tape 90'
1347.65 @ 85°
1347.05 Corrected

183+00.22 P.O.T.
Set S.T.&W.

Rowset

3257
7.55
6.47
3493

Tape 90'
613.85 @ 82°
613.71 Corrected

N 3°10'02" E
Blvd

1347.65 R
1347.05 M

176+86.13 P.O.T.
Set S.T.&W.

4" I.P. & Boss
Tag in Conc.

4051
7.79
4252

09°06'19"

834.52 R
834.32 M

Tape 90'
834.855 @ 70°
834.745 Corrected

℄ Survey & Construction

ROSEMEAD

168+51.33 P.O.T.
Set S.T.&W.
See Page 21

3419
5002

INSET

F.B. 1309-82

F.B. 1309-83

LA-168-B A204-001 23 47

LA-168-B A204-001 24 48

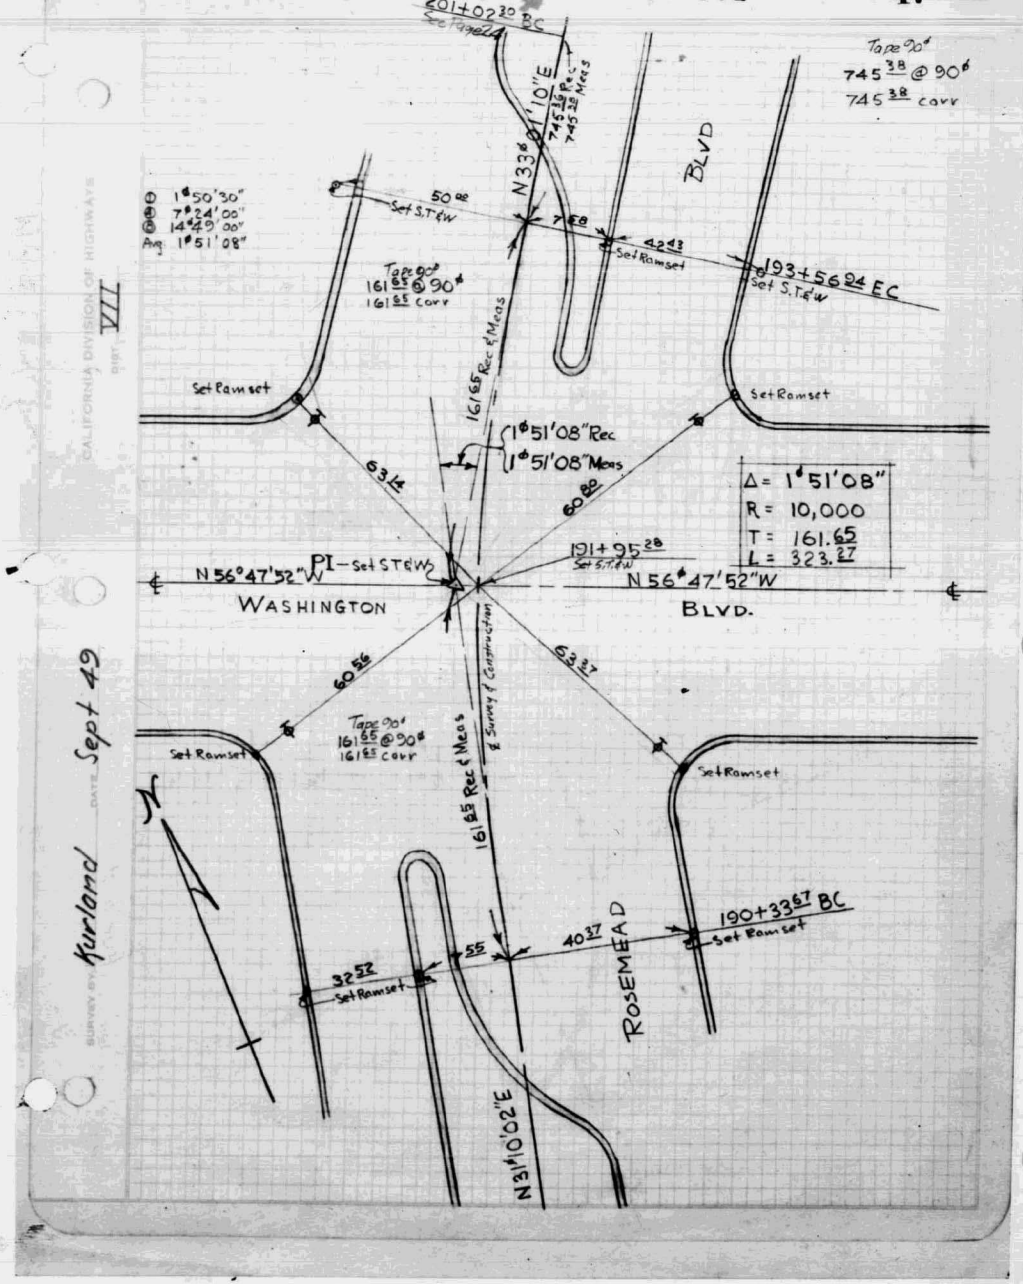

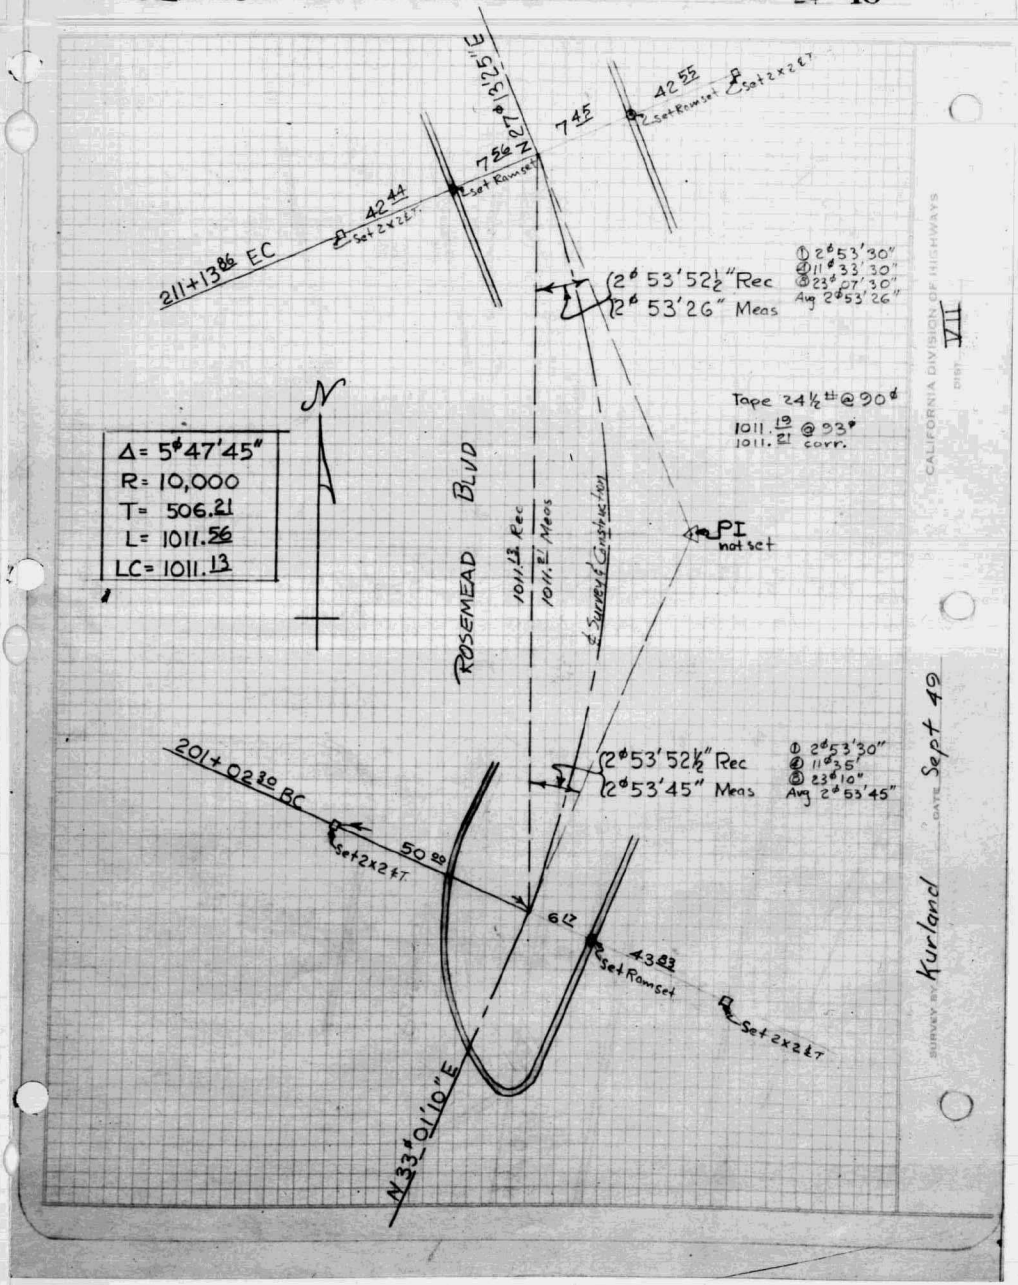

F.B. 1309-84

F.B. 1305-85

SURVEY OF LA-160-B INDEX A204-001 PAGE 25 49

CALIFORNIA DIVISION OF HIGHWAYS DIST. VII

SURVEY BY Kurland DATE Sept '49

219+75.42 B.C.
see page 26

37°

37°

Tape 90°
495.28 @ 90°
495.28 Corrected

BLVD.

N 27° 13' 25" E 7

495.28 @ 90°
495.28 Corrected

495.28 E&M

33'45'55" R.

E. Rivera & Barlow Rd.

N 60° 59' 20" E 7

Chiseled "X"

402.22

214+79.44 P.O.T.

S.T. & W.

30.56

Chiseled "X"

ROSEMEAD

Survey & Construction

365.52 E&M

Tape 90°
356.38 @ 90°
356.38 Corrected

365.52 @ 90°
365.52 Corrected

211+13.86 E.C.
see page 24

37°

37°

SURVEY OF LA-168-B INDEX A204-001 PAGE 26 50

CALIFORNIA DIVISION OF HIGHWAYS DIST. VII

SURVEY BY Kurland DATE Sept. 49

Set 2x2 ET.

S.T. & W.

Ranged 7.85

Ranged 7.49

Ranged 7.60

Ranged 7.49

Ranged 7.33

F.B. 1309-86

F.B. 1309-87

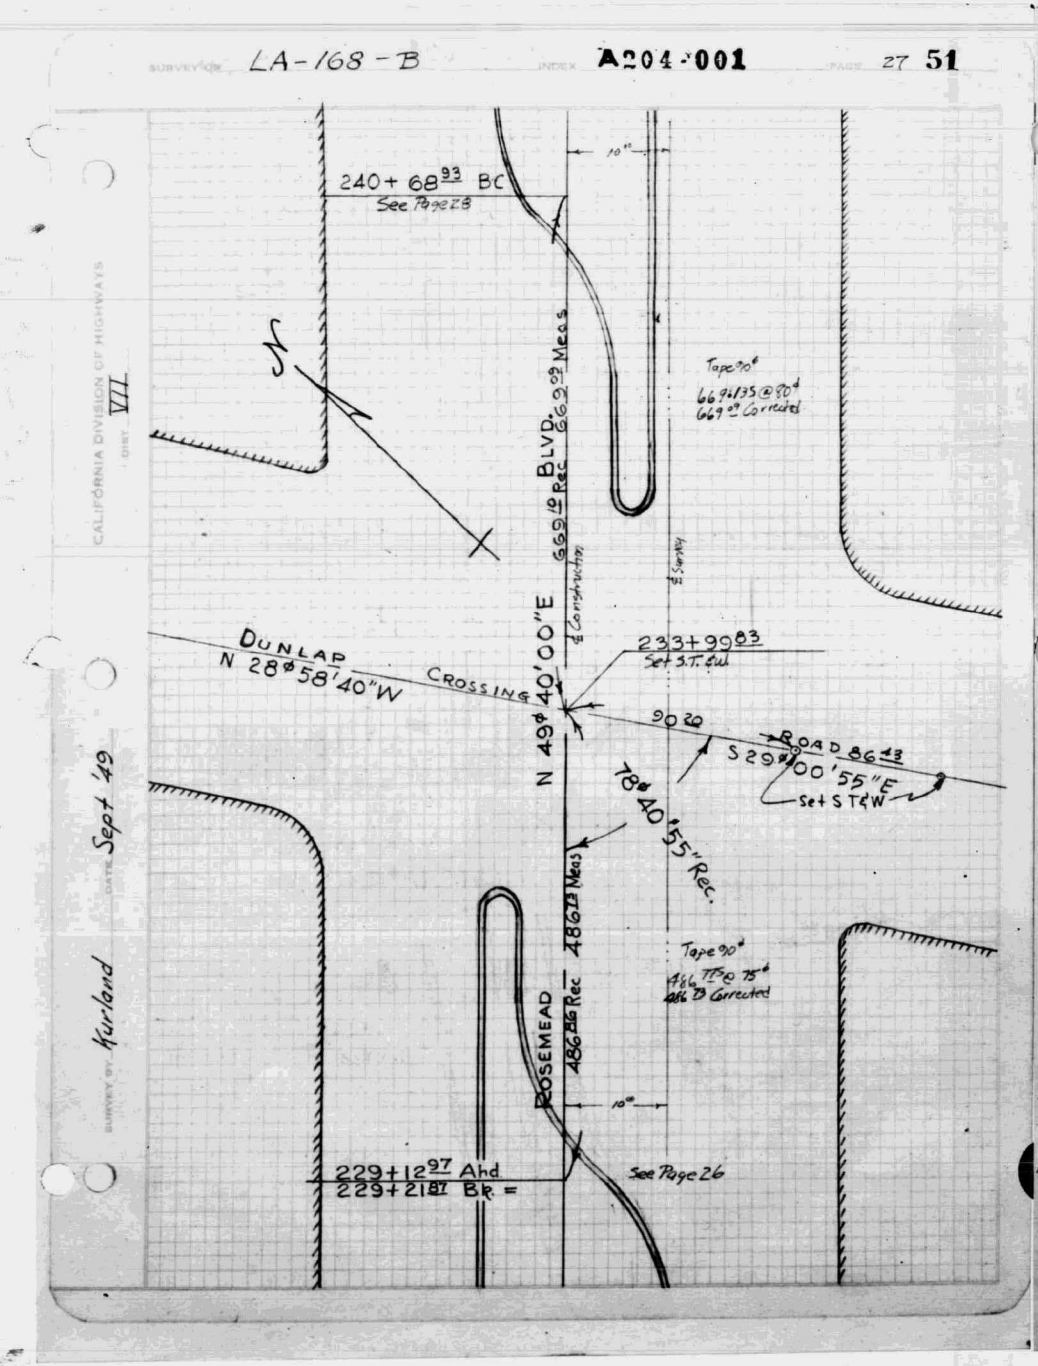

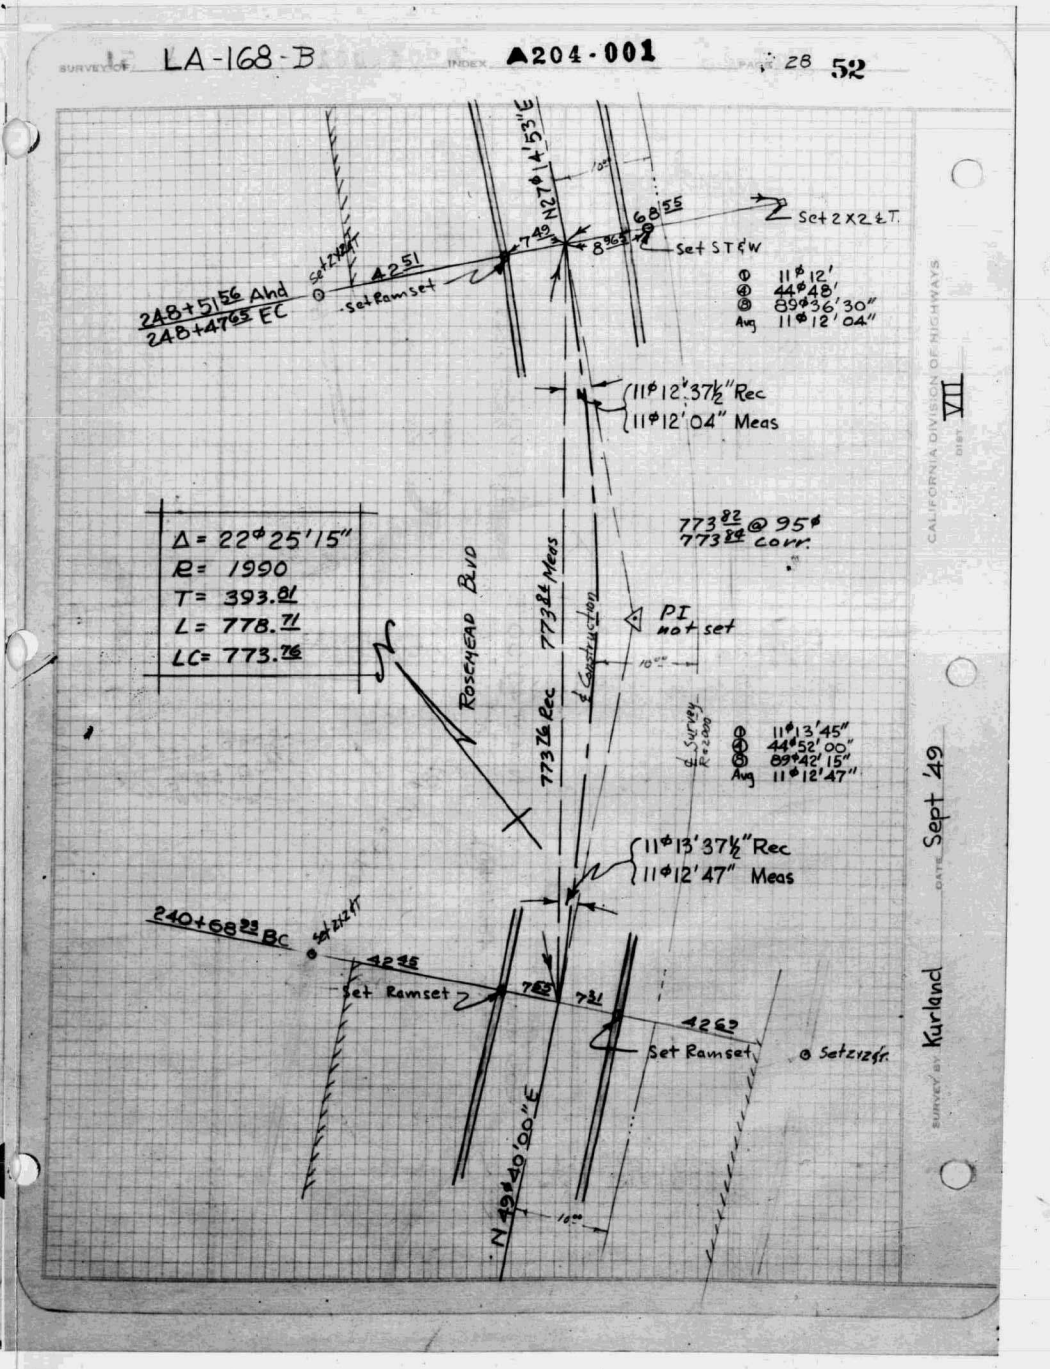

F.B. 1309-88

F.B. 1309-89

SURVEY OF LA-168-B INDEX A204-001 PAGE 29 53

CALIFORNIA DIVISION OF HIGHWAYS DIST. VII

SURVEY BY Kurland DATE Sept. '49

255+97.49 B.C. See Page 30

254+50 Begin Curb

254+50 Begin Curb

BLVD

ROSEMEAD

℄ Construction

℄ Survey

N 27°14'53"E = N 27°51'00"E Ah'd.

168.27 E. & M.

739.31 R.
739.32 M.

Tape 90°
739.31 @ 76°
739.32 Corrected

254+09.42 Ah'd
254+02.82 Bk. =

Ramset

7.485

7.58

Ramset

See Page 28

N 27°14'53"E

551.24 R.
551.08 M.

10%

248+51.36 P.O.T. Ah'd.
248+47.42 E.C. =

See Page 28

SURVEY OF LA-168-B INDEX A204-001 PAGE 30 54

CALIFORNIA DIVISION OF HIGHWAYS DIST. VII

SURVEY BY Kurland DATE Sept. '49




10%

31.82

Ramset

7.49

7.65

Ramset

42.42

Ramset

263+91.75 P.O.T. Ah'd.
263+87.82 E.C. =

Δ = 11°22'
Δ = 45°32'
Δ = 91°04'
Av. = 11°23'00"

11°22'25" R.
11°23'00" M.

BLVD

CURVE DATA
Δ = 22°44'50"
R = 1990'
T = 402.31
L = 794.23
L. Chord = 784.88

784.88 E.
784.19 M.

℄ Construction

P.I. Not Set

785.163 @ 94°
785.12 Corrected

℄ Survey
P-200

ROSEMEAD

11°22'25" R.
11°22'28" M.


Ramset
Recessed Curb

32.92

7.81

Ramset

7.44

Ramset

32.92

Ramset

10%

N 27°51'00"E

Δ = 11°22'
Δ = 45°30'00" = 11°22'30"
Δ = 90°39'45"
Av. = 11°22'28"

F.B. 1309 - 89

A204-001

SURVEY OF LA-168-B INDEX SHEET 30 54

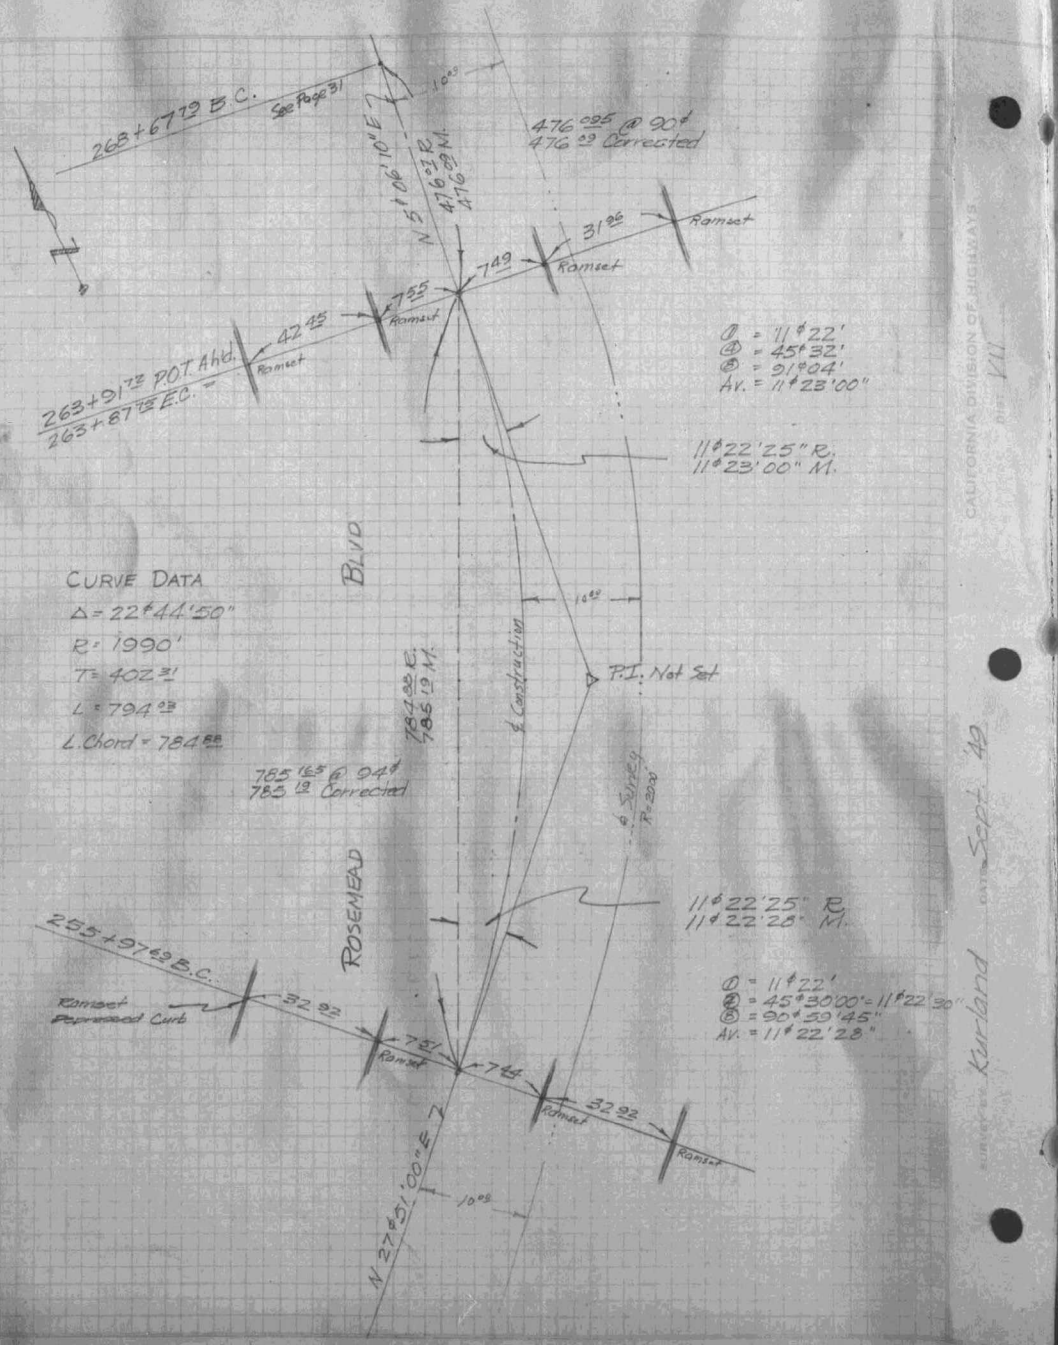

CALIFORNIA DIVISION OF HIGHWAYS DIST. VIII

Surveyed Kurland Date Sept 49

Computed Kurland Date Sept 49

F.B. 1309 - 90

A204-001

LA-168-B 31 55

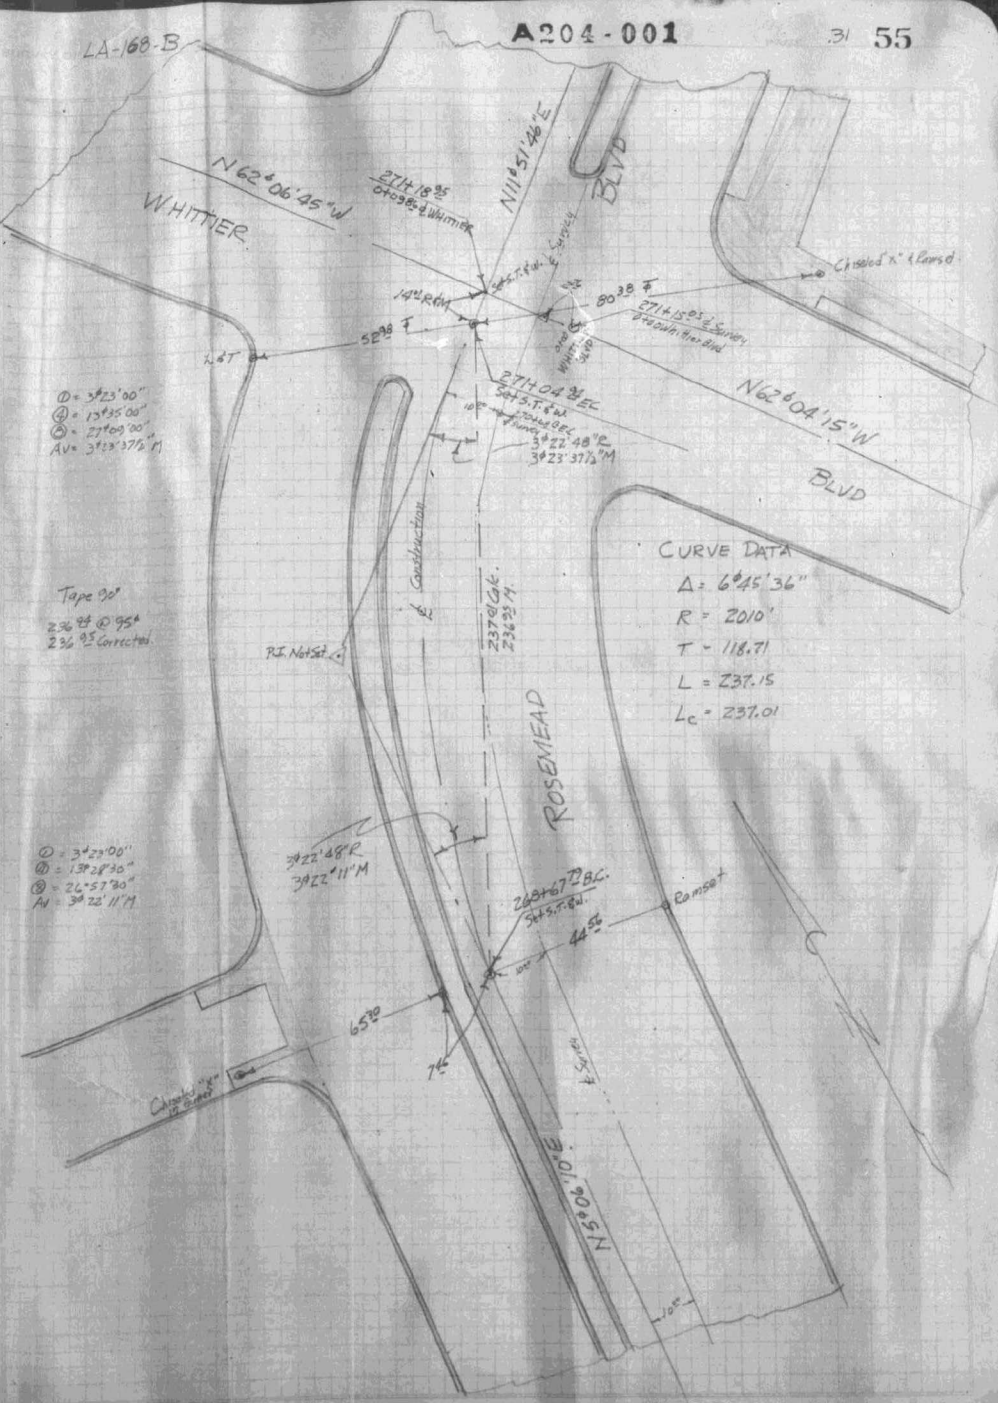

F.B. 1309 - 90

LA-168-B A204-001 31 55

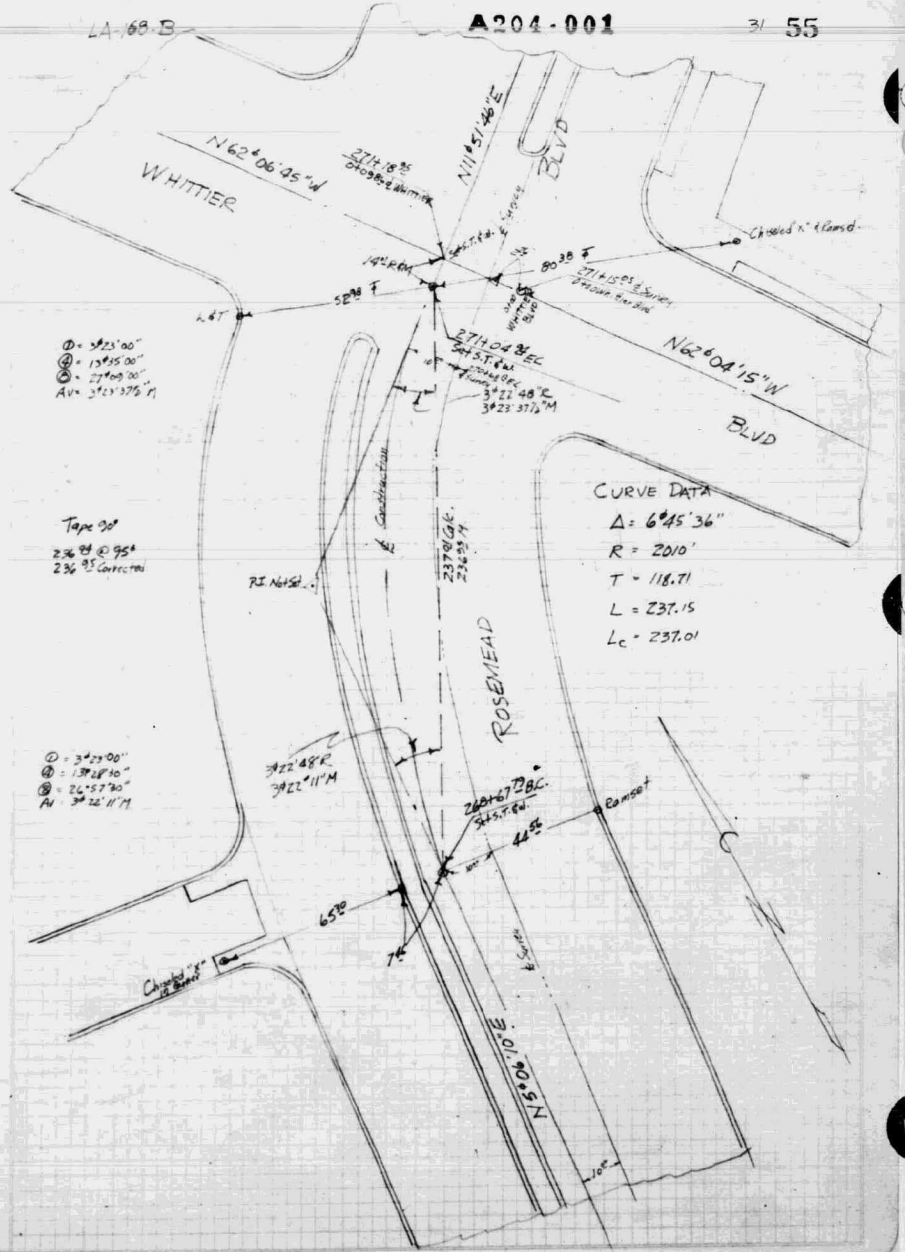

F.B. 1309 - 91

LA-168-B A204-001 32 56

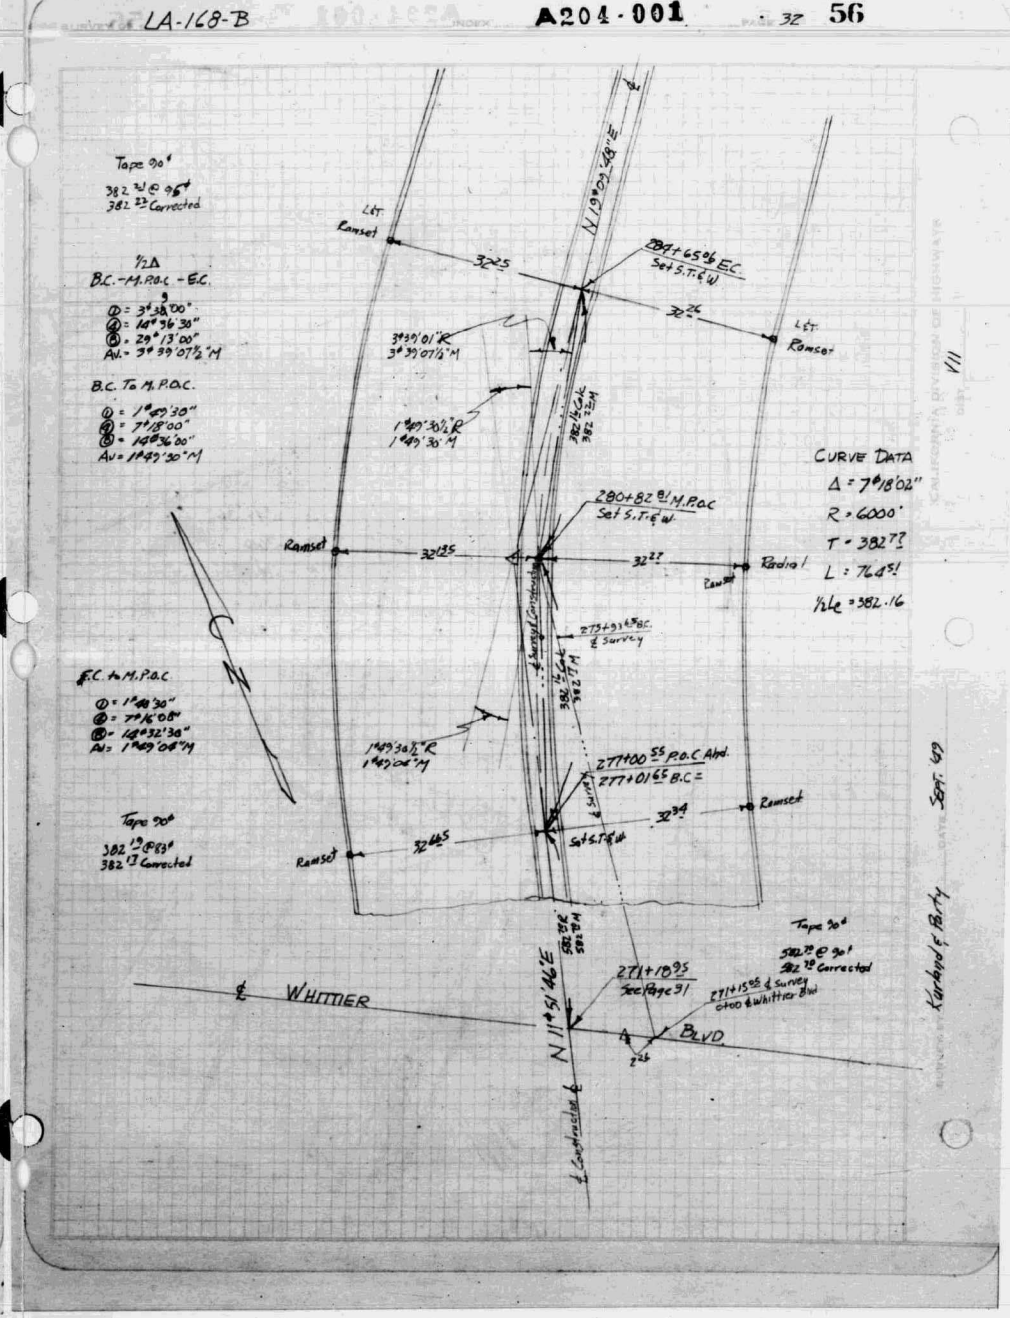

F.B. 1309 - 92

SURVEY OF LA-168-B INDEX A204-001 PAGE 33 57

CALIFORNIA DIVISION OF HIGHWAYS DIST. VII

SURVEY BY Kurland & Berry DATE SEPT. '69

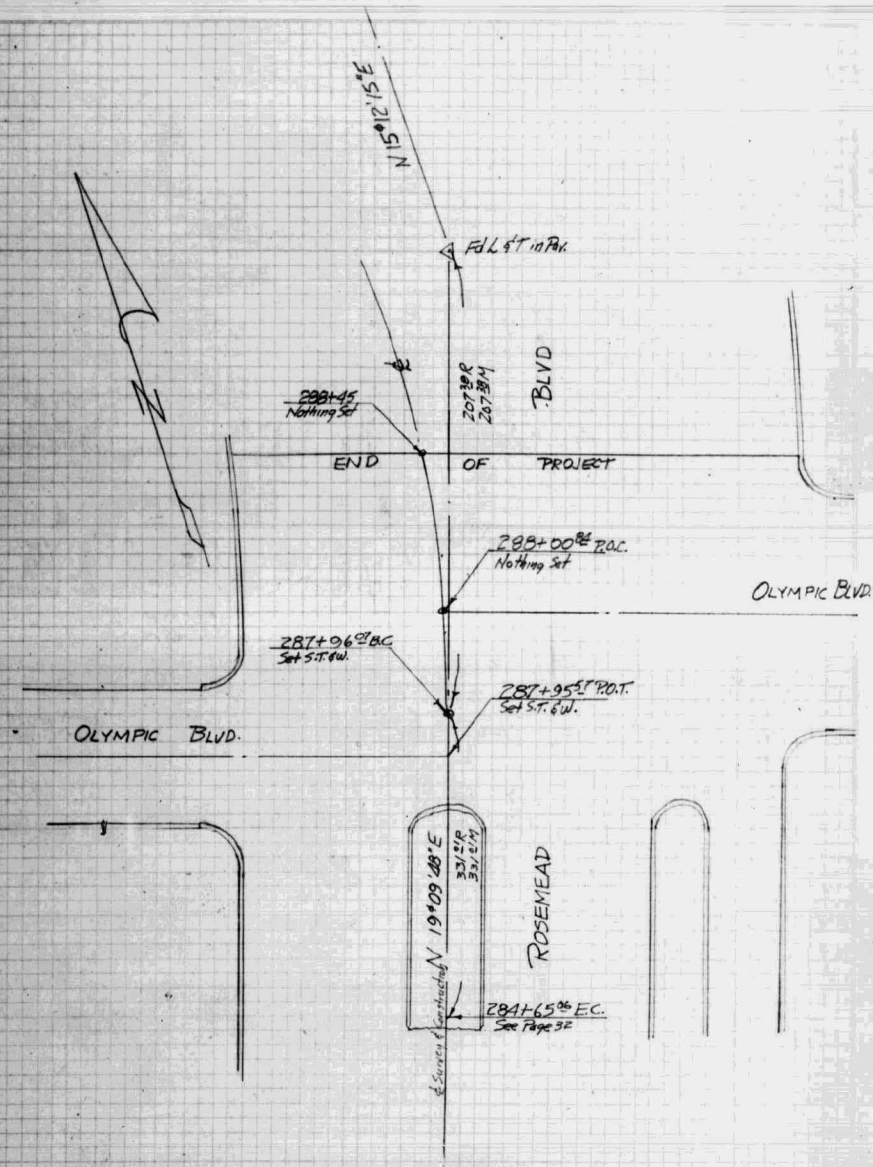

F.B. 1309 - 93

SURVEY OF LA-168-B INDEX A204-001 PAGE 34 58

CALIFORNIA DIVISION OF HIGHWAYS DIST. VII

SURVEY BY Kurland & Berry DATE SEPT. '69

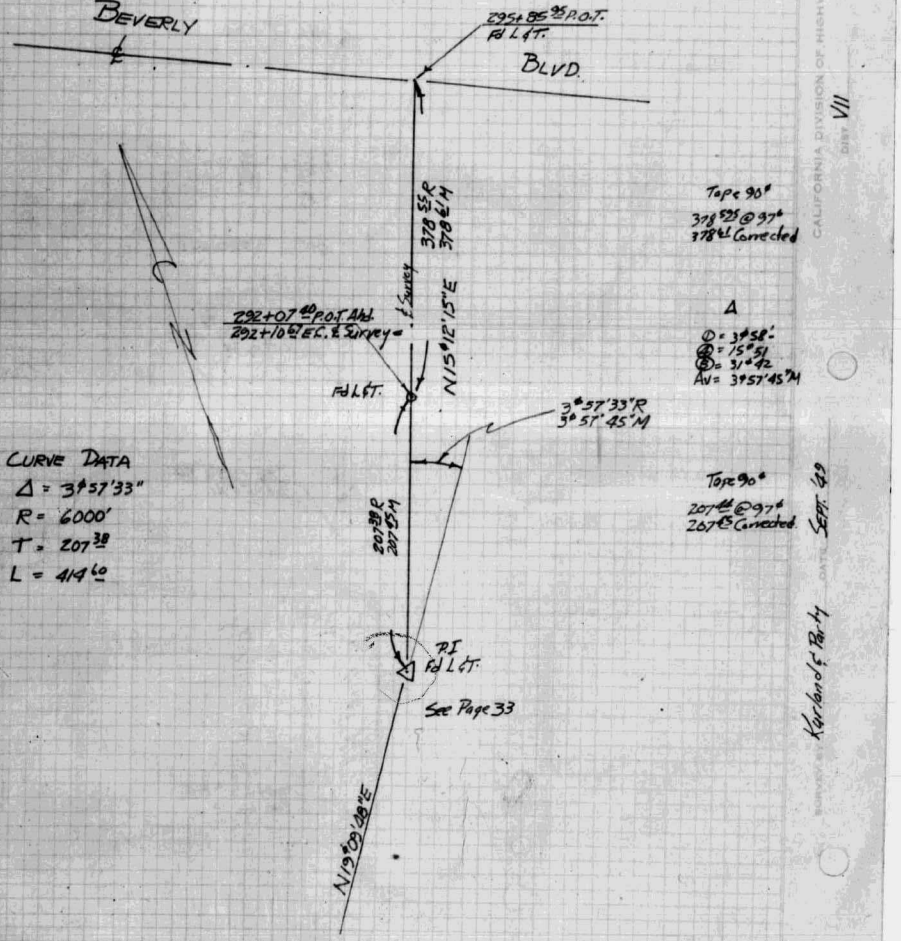

1309-94

F.B. 1309-95

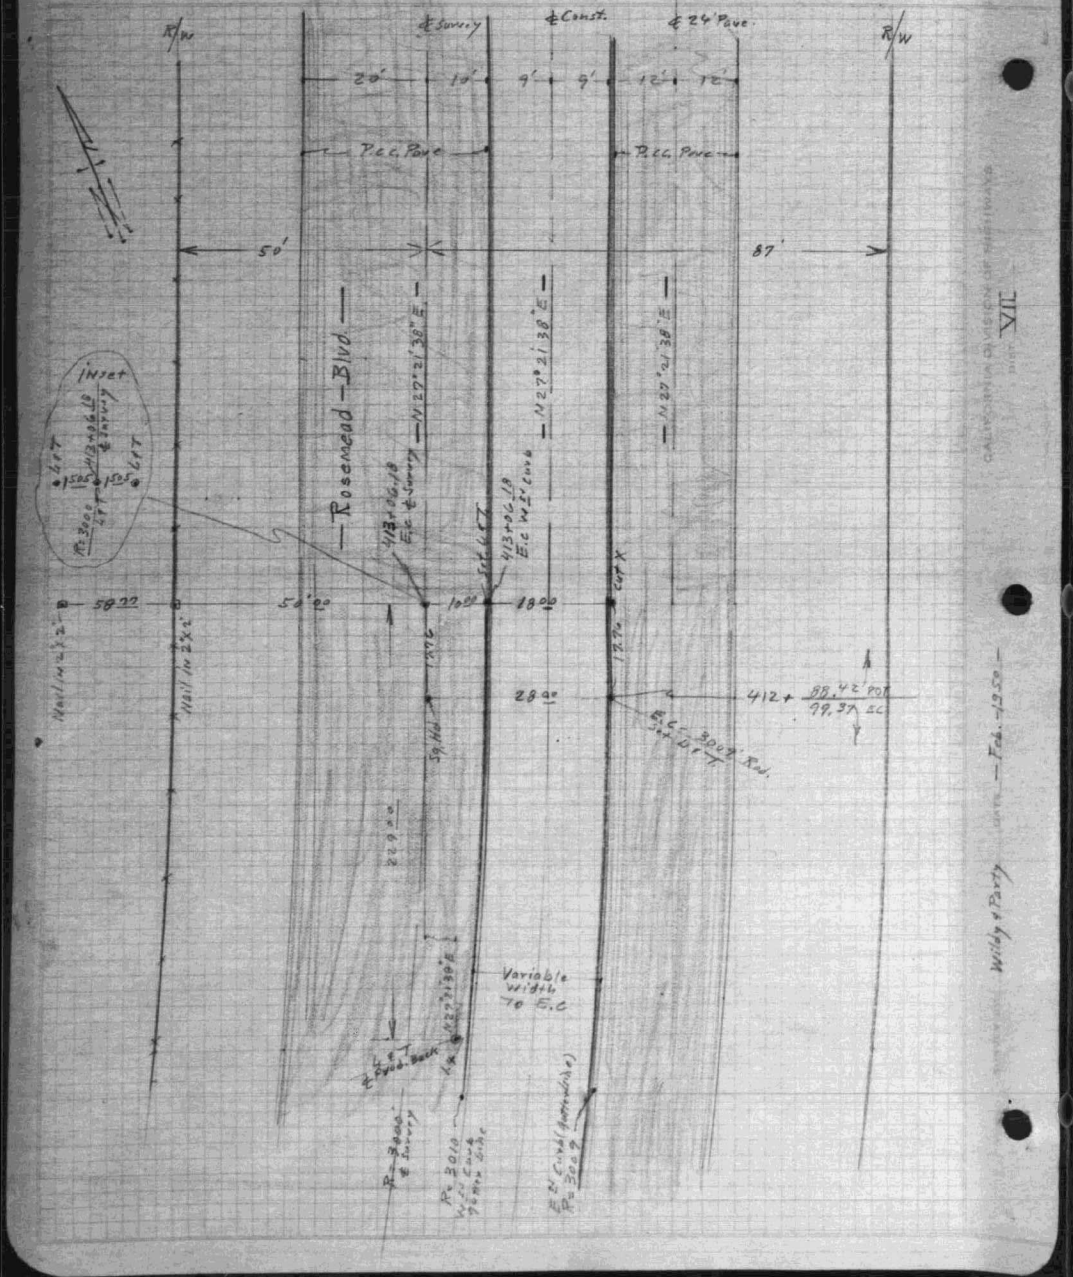

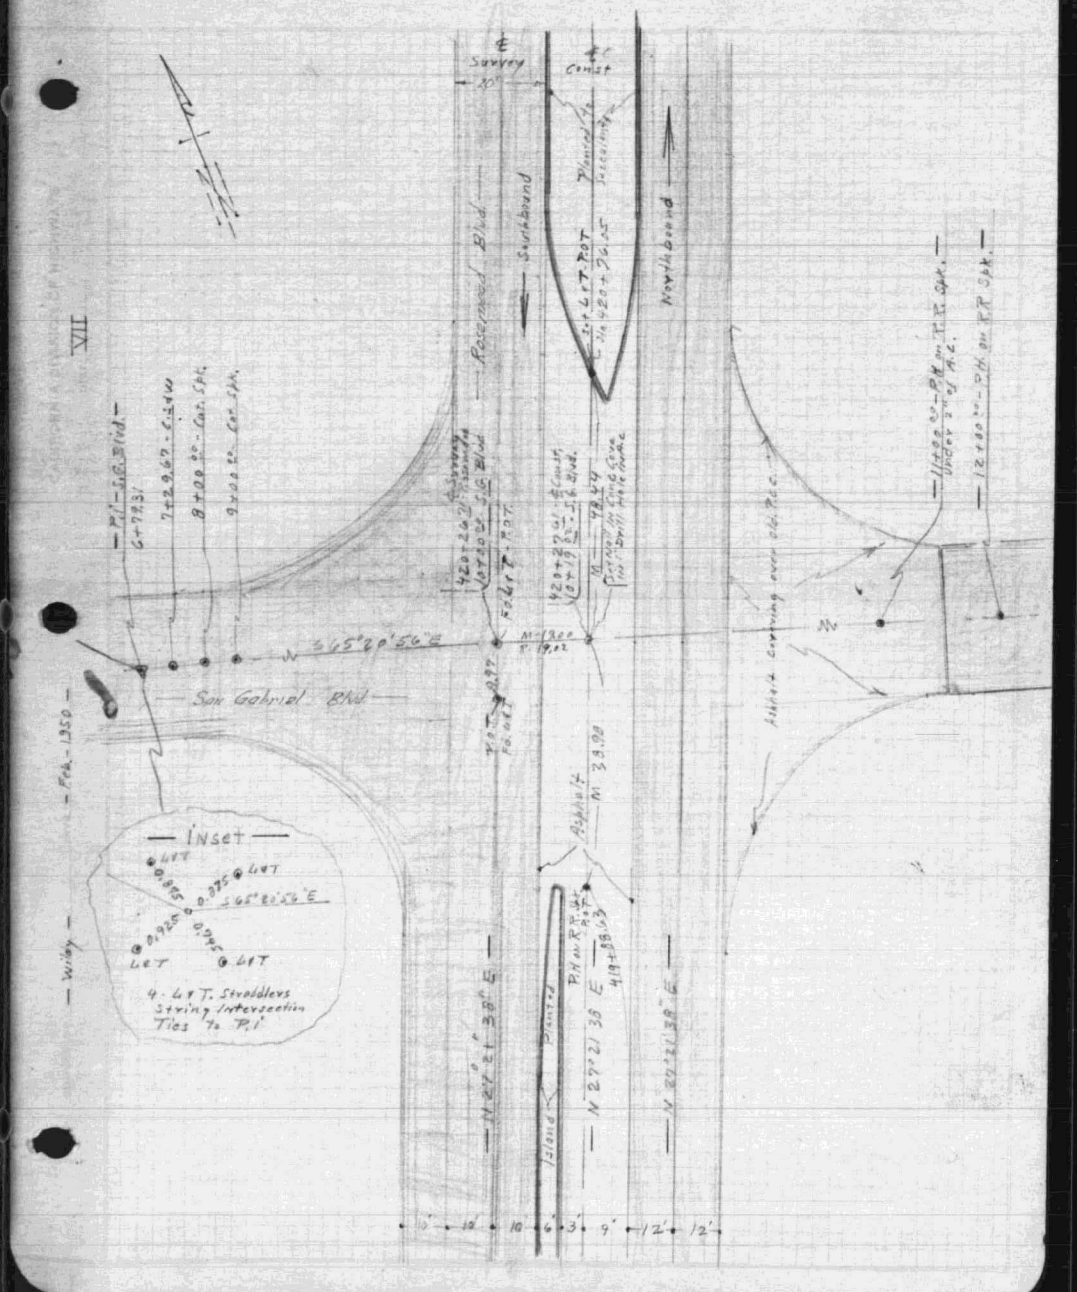

F.B. 1309-96

F.B. 1309-97

SURVEY OF — LA-168-B — A204-001 L.C. 74

℄ Survey
Δ = 27°39'30" Lt.
R = 4000
T = 969.65
L = 1930.92

Southbound — Blvd — Rosemead — Blvd — Northbound
To Lambert Rd. — To Garvey Ave.
℄ Survey — P.C.C. Pave. — ℄ Const. — Curb — P.C.C. Pave. — Curb
R=4000 — R=4019 — M-264-46

— 435+06.19 — B.C. —
— both ℄ Survey & ℄ Const. —
10 — 8 — 8 — 8
Fd. 4 Lt — Set 4 Lt — Set 2 Rt — Set 4 Lt

— Inset —
℄ — 4 Lt Out — R=4000' — 0.46 — 0.20 — 2 — 2 — Rad. to P.O.C.

430+54.06 P.O.T. — 4 Lt
428+86.52 — 4 Lt

— N 27°31'39" E —
— N 27°31'39" E —
— N 27°31'39" E —

50' — 82'
Rt/w
10 + 10 + 9 + 9 + 12 + 12

454	+37.07 P.T.	13°49.75
454	—	13°33.79
	+50 —	13°17.81
453	—	12°59.82
	+50 —	12°42.34
452	—	12°07.85
	+50 —	11°46.37
451	—	11°24.88
	+50 —	11°03.40
450	—	10°41.91
	+50 —	10°20.42
449	—	9°58.94
	+50 —	9°37.45
448	—	9°15.96
	+50 —	8°54.47
447	—	8°32.98
	+50 —	8°11.50
446	—	7°50.02
	+50 —	7°28.53
445	—	7°07.05
	+50 —	6°45.56
444	—	6°24.08
	+50 —	6°02.59
443	—	5°41.11
	+50 —	5°19.62
442	—	4°58.14
	+50 —	4°36.65
441	—	4°15.17
	+50 —	3°53.68
440	—	3°32.20
	+50 —	3°10.71
439	—	2°49.22
	+50 —	2°27.74
438	—	2°06.25
	+50 —	1°44.77
437	—	1°23.28
	+50	1°01.80
436	—	0°40.31
	+50 —	0°18.83
	+06.17 B.C.	0°00'

Rt/w

Reflections of 4000' Rad. Curves
Wiley — Date — Feb. 1953 — Wiley & Party — Feb. 1953 —
CALIFORNIA DIVISION OF HIGHWAYS — DIST. XII

SURVEY OF — LA-168-B — A204-001 L.C. 75

℄ Survey and 2 Pave. — ℄ Const. — 24' Pave.
10' — 10' — 9' — 9' — 12' — 12'
Southbound — Rosemead Blvd. — Northbound

℄ Const.
Δ = 27°39'30"
R = 4019
T = 989.33
L = 1940.09

Set Sq. Rd. ⊡ S+W 11+60
Set P.H. on T.R. Sta 11+60

444+76.215 M-P.O.C. ℄ Const. Set ⊡ Spk. & W.

Radial
444+71.63 M. P.O.C. ℄ Survey - Fd. 4 Lt
M-23-A-204-001

Set P.K. on T.R. Spike
444+46.32 - ℄ Const
10+21.28 Worsham

444+32.39 ℄ Survey
10+00.02 Worsham Rd
From Layout Maps
Set 4 Lt.

4 Lt — 19.00 — 29.895' — #23 — 21.28 — 4 Lt — 4 Lt
GL - 39.33
M - 39.30
10+32.54 Set 4 Lt
10+57.06 Set 4 Lt
24.55 — 42.94 — 60.00 — N 77°17'39" E — Worsham Rd.
Pave. — Asphalt — 123°21'55"

Long Chord — N 20°39'34" E — 70.51 C
R=4000' — R=4019'

F.B. 1309 - 98

—LA-168-B—

A204-001

1 18 76

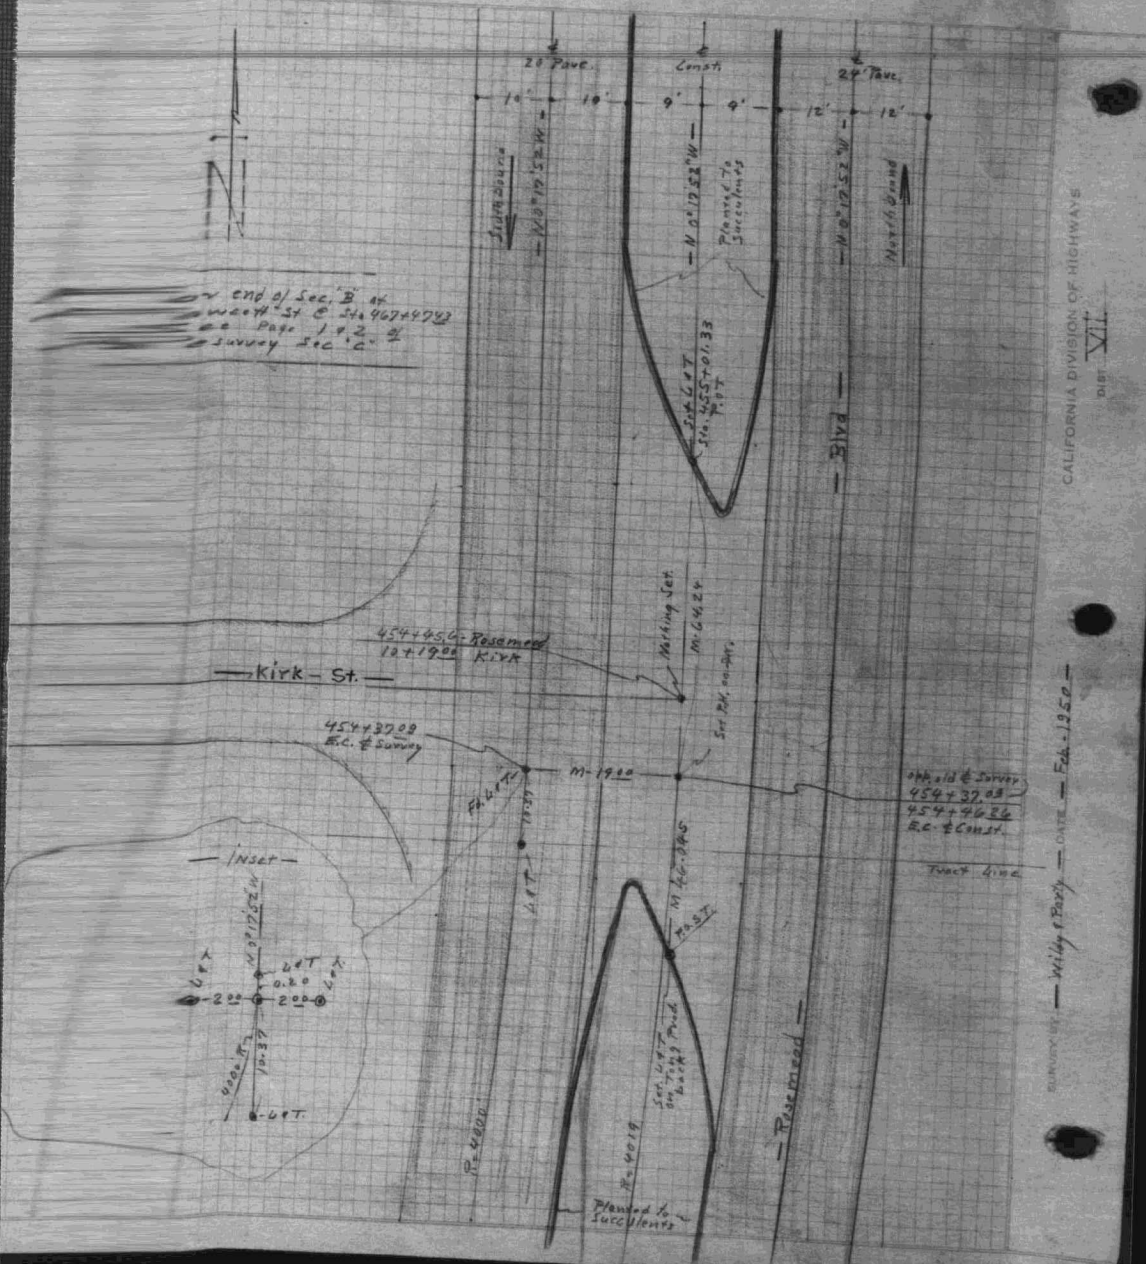

See Page 1 of 2 of Survey Sec 'C' #

CALIFORNIA DIVISION OF HIGHWAYS

DIST XII

SURVEYED — Wildy & Parry — DATE — Feb. 1950

F.B. 1309-99

—LA-168-C— A205-001 41

—L.A.—168—C——

— Resurvey - Rosemead - Blvd. —

— Fawcett - Ave - to - Garvey Ave —

Sta.— 0+00 — to — 85+00

— Pages — 1 - 14

VII

— Wildy & Party — Feb. 1950 —

— February — 1950 —

Wildy — Notes
Kim — ⊼
Lukes — H.C.
Thomas — R.C.
Moor — Assis.

— Reference —

Alignment Notes (State) of July and August 1946 —Pages-1-16 - A205-001—

Layout Maps of Feb.-1949 Used on Cont. #07VC115

Miscellaneous State R/w Maps Rosemead Blvd Fawcett to Garvey Ave —1949— R.S.M # 205.2

F.B. 1309-100

F.B. 1309-101

— LA-168-C — A205-001 L.2 42

— LA-168 C — A205-001 L.3 43

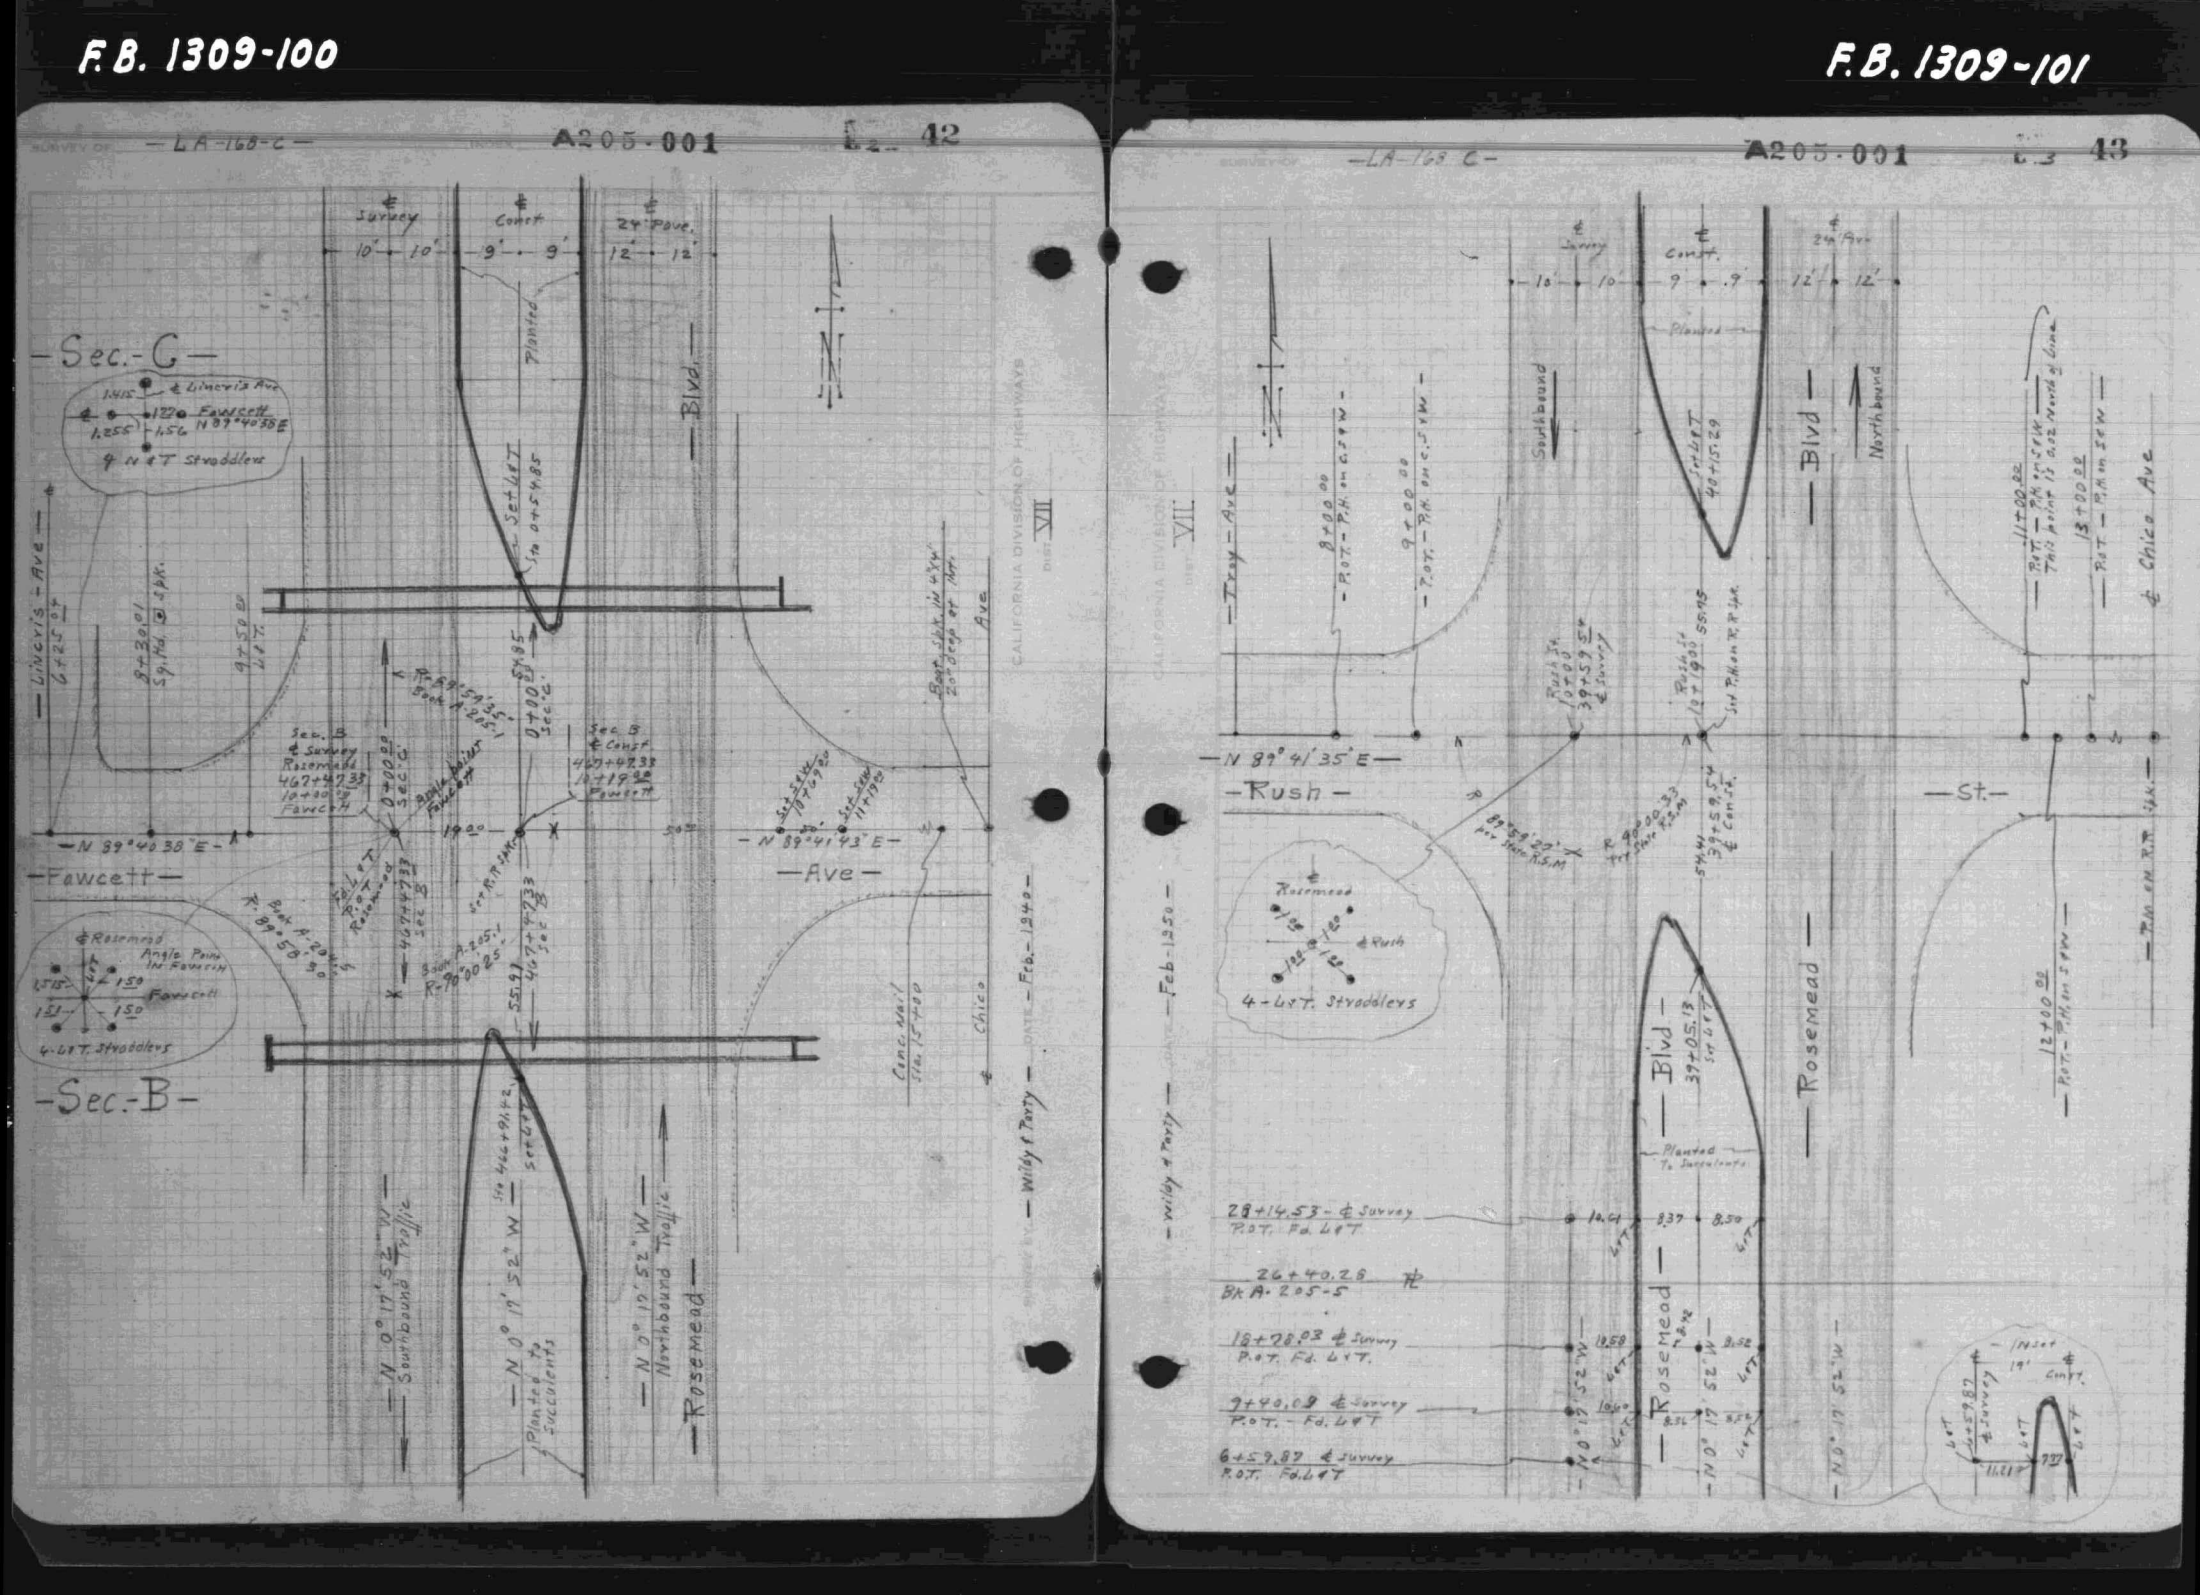

F.B. 1309-102

F.B. 1309-103

— LA 168 C —

A205-001

4 44

LA-168-C

A205-001

5 45

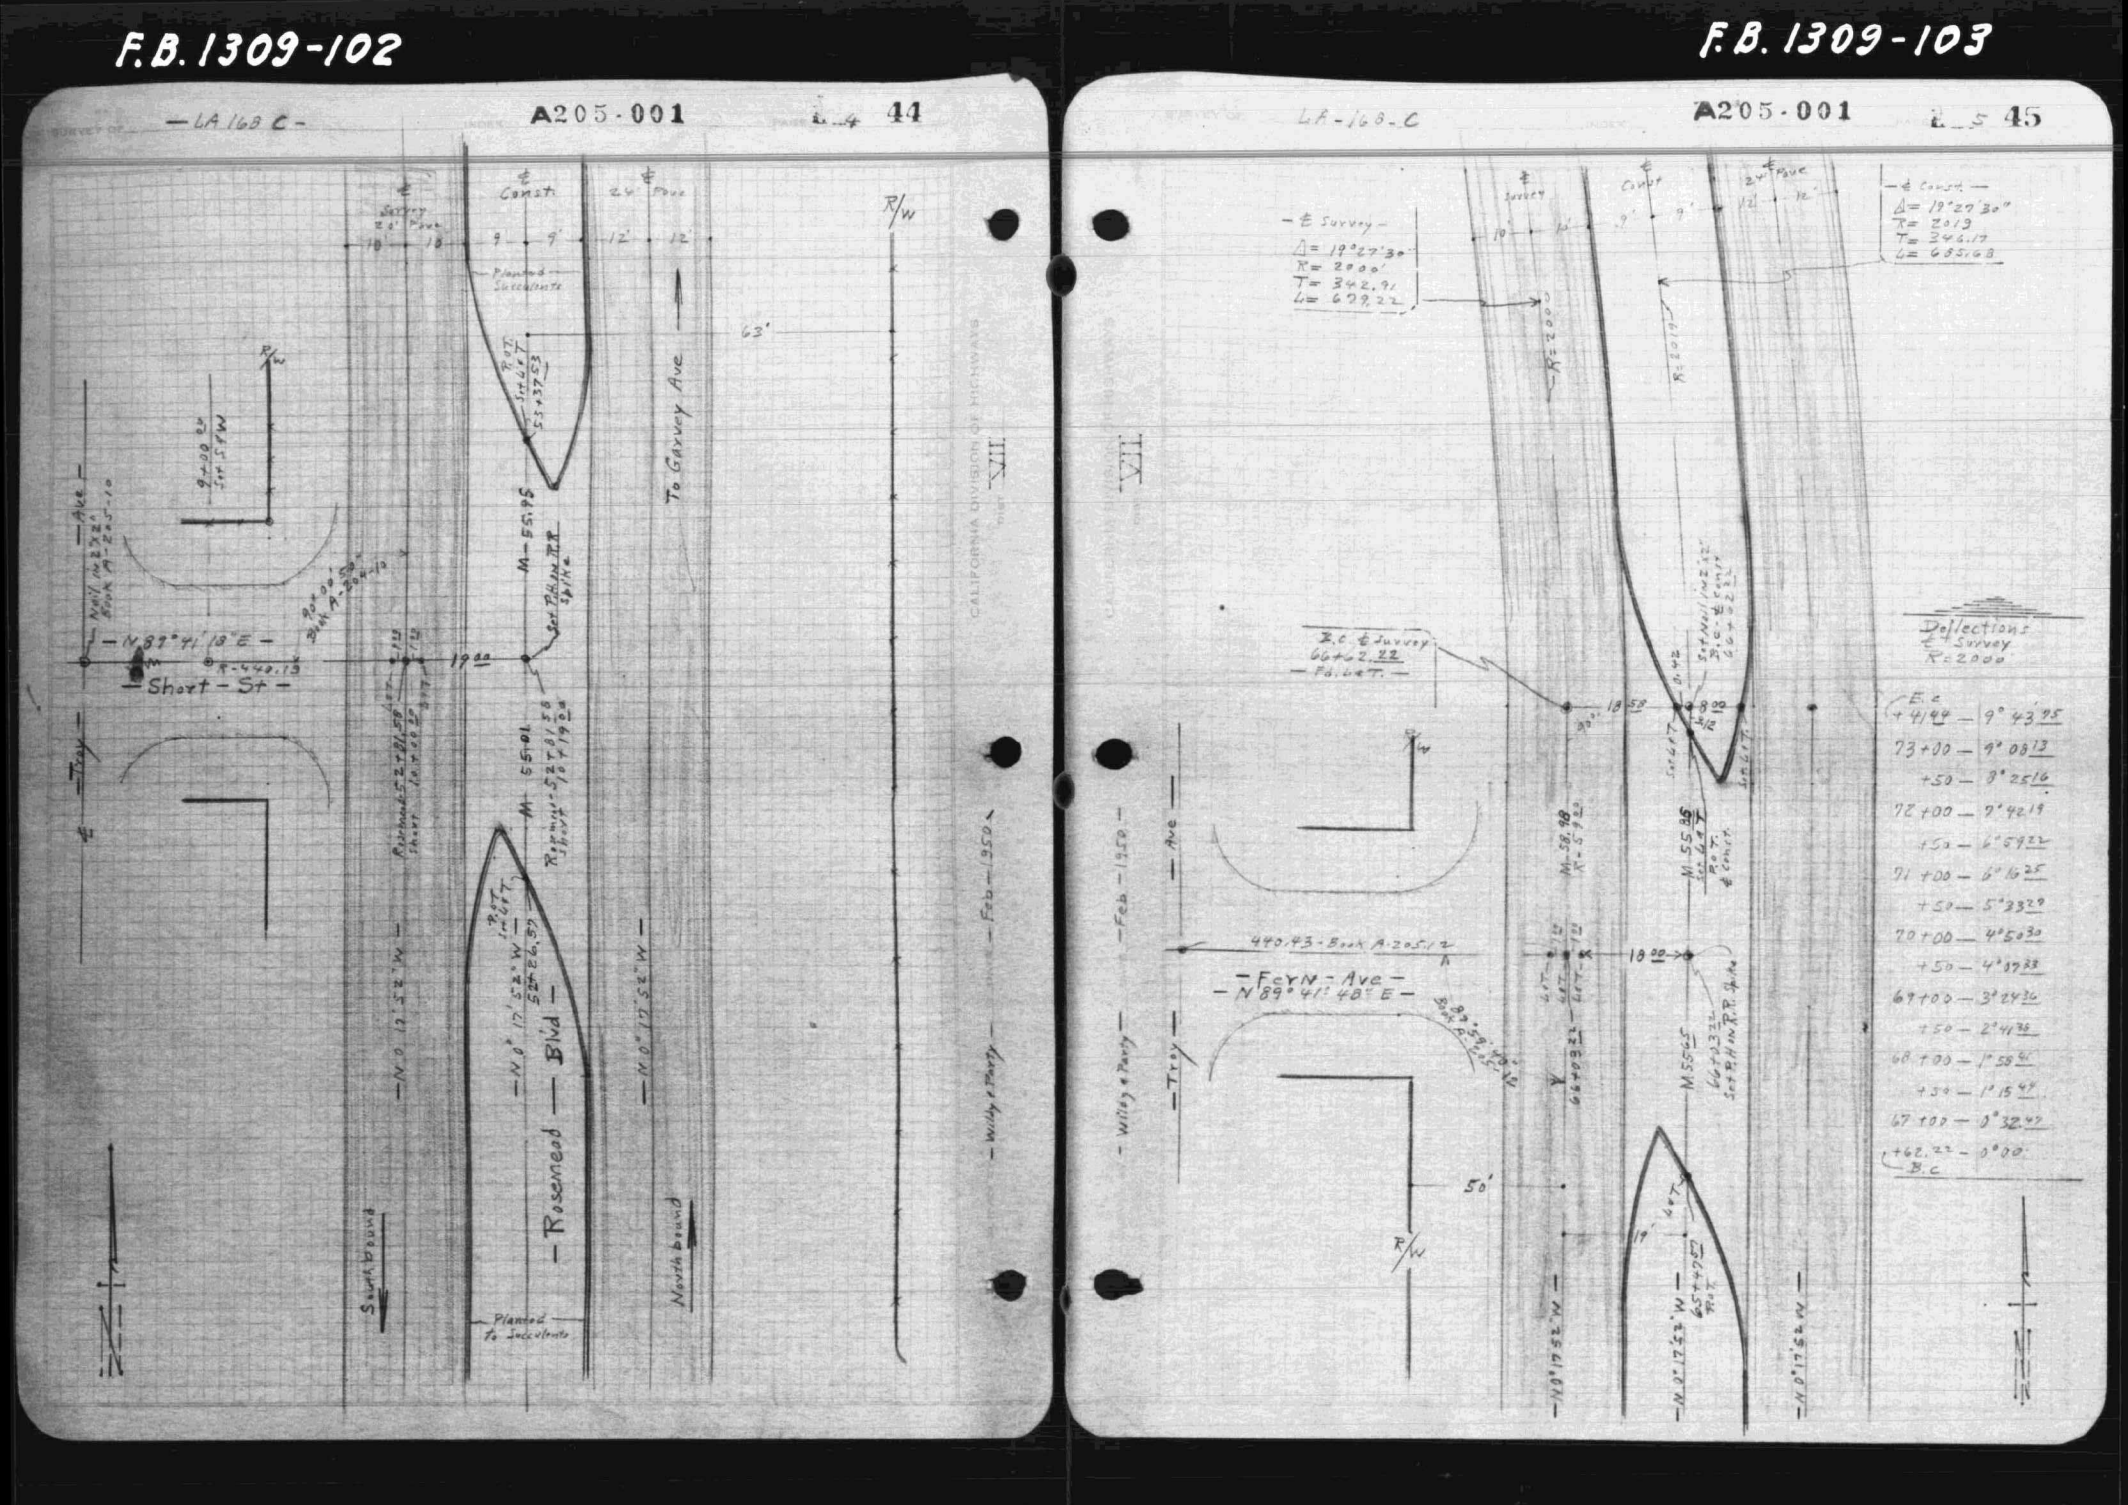
— Short St —
— N 89° 41' 18" E —
— Fern Ave —
— N 89° 41' 48" E —
To Garvey Ave
— Troy —
— Feb — 1950 —
— Wiley's Party —
— N 0° 17' 52" W —
South bound
North bound
R/W
50'
63'
Deflections
℄ Survey
Rc 2000
℄ Survey
Δ = 19°27'30"
R = 2000'
T = 342.91
L = 679.22
℄ Const.
Δ = 19°27'30"
R = 2019
T = 345.17
L = 685.68
P.C. ℄ Survey 66+62.22
P.C. ℄ Const. 66+62.22
— Fd. 64 T. —
M-65.95
M-58.88
M-55.95
M-55.65
Set Thin P.P. Spike
Set Nail in Top of Curb
Set Thin P.P. Spike
Nail in Top of Curb
Book A-205-10
440.43 - Book A-205-12
℄ Const.
℄ Survey
Pave
Curb
Sidewalk
Planted
Succulents
Sta 103 + 31.22
Sta 103 + 41.22

F.B. 1309-104

F.B. 1309-105

LA-168-C A205-001 L 6 46

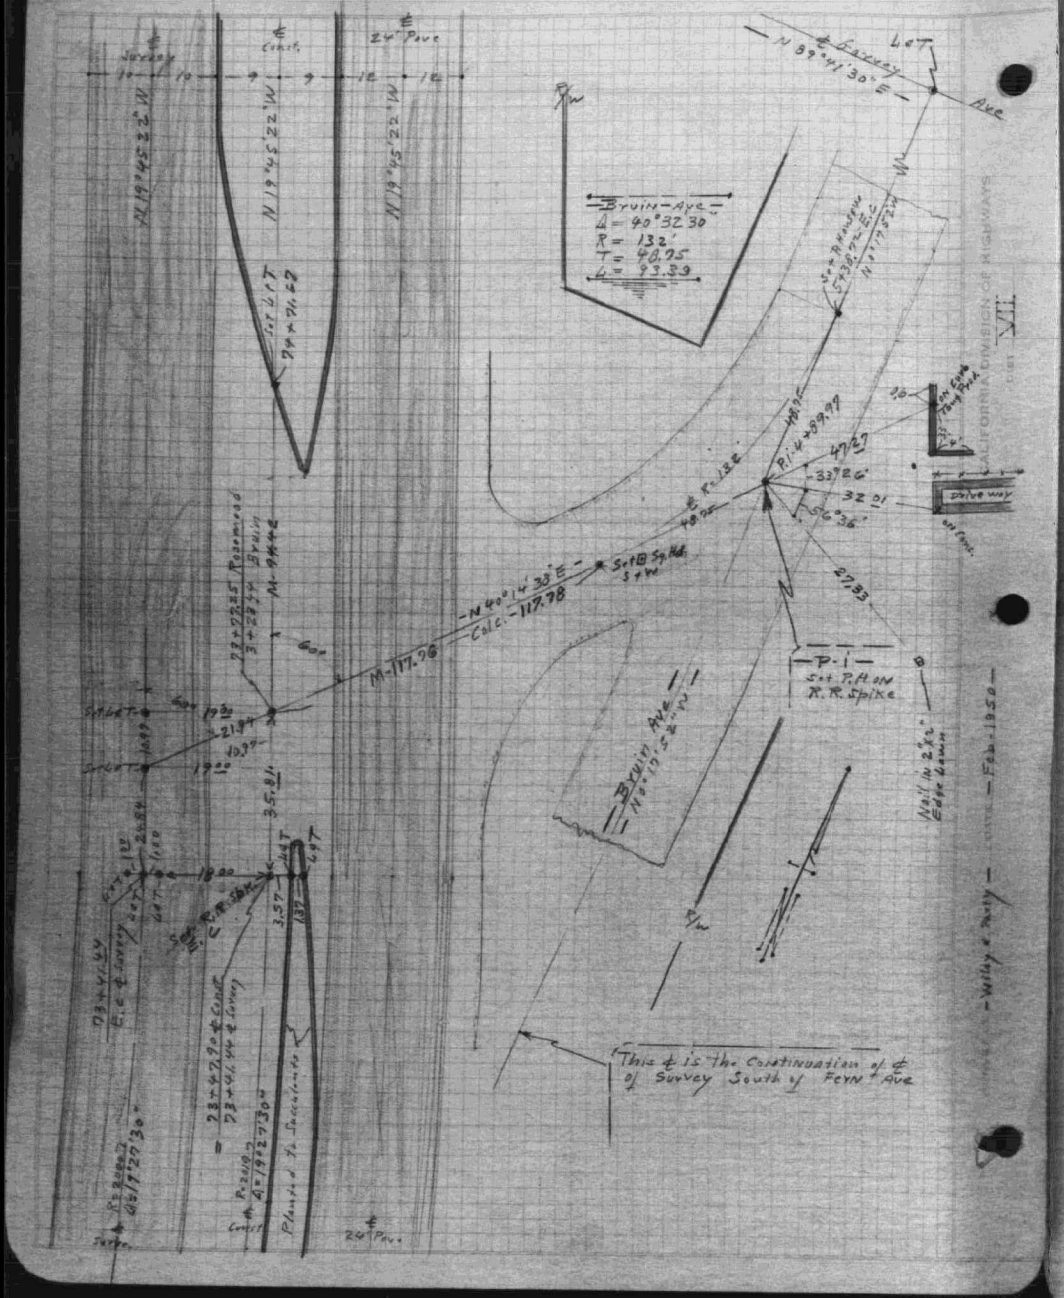

LA-168-C A205-001 L 7 47

F. B. 1309-106

F. B. 1309-107

—LA-168-C— A205-001 L 8 48

—LA-168-C— A205-001 L 8 49

CALIFORNIA DIVISION OF HIGHWAYS
DIST. VII
COUNTY LOS ANGELES
ROUTE 4
SURVEY CO. —Wildy & Party— DATE —Feb 1950—

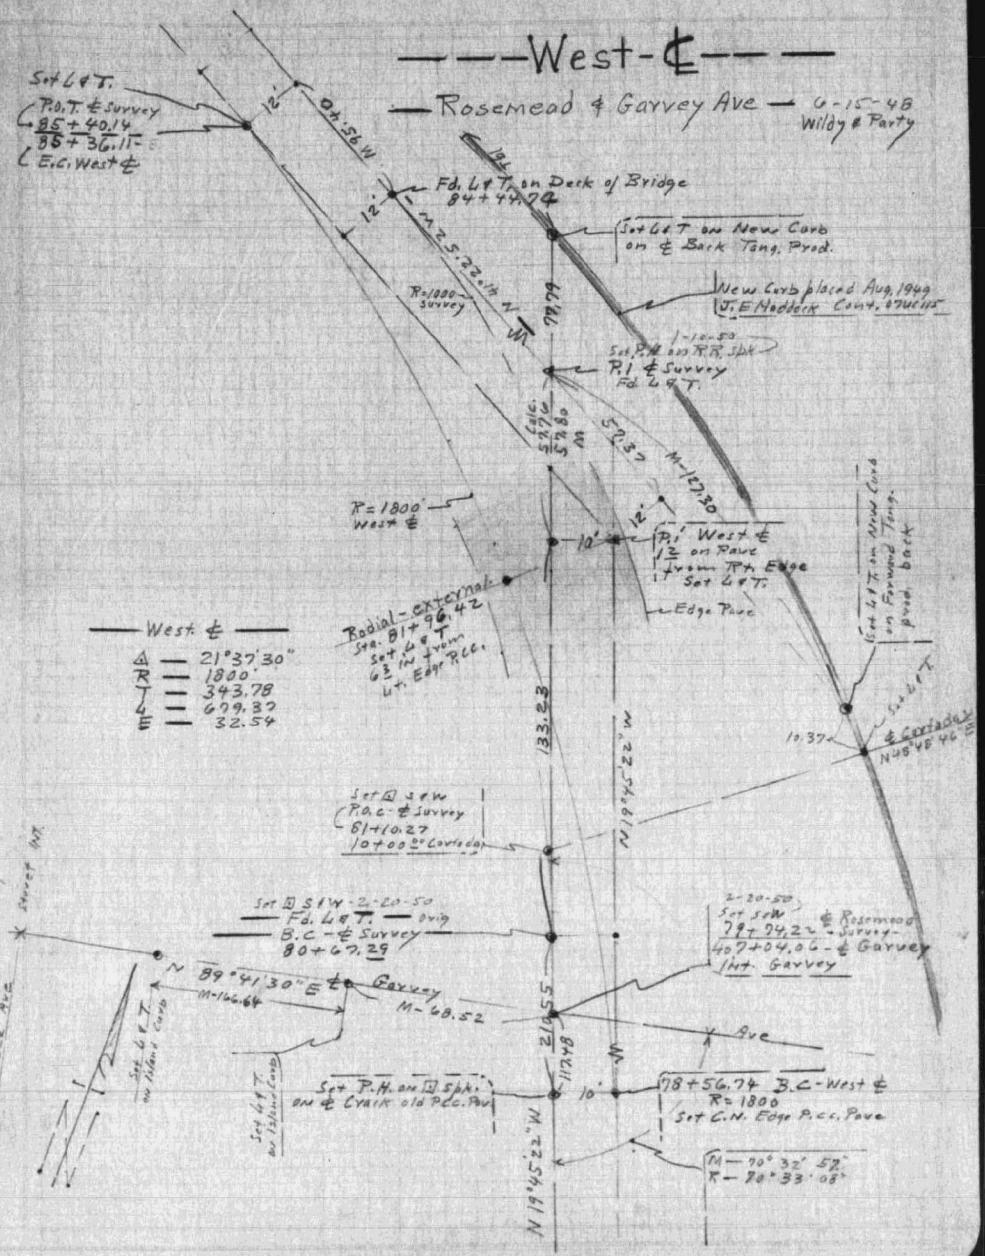

F.B. 1309-108

— LA-168-C — A205-001 L 50

— Deflections —
— West ℄ —
50'd 47.747
1'd = .95493

E.C +	40.14 / 36 11	10° 48 25
85		10 14 27
+ 50		9 26 52
84		8 38 27
+ 50		7 51 03
+ 25		7° 27 15
83		7° 03 28
+ 75		6° 39 54
+ 50		6° 15 54
+ 25		5° 51 05
82		5° 27 99
+ 96.42		5° 24 37
+ 75		5° 03 91
+ 50		4° 40 04
+ 25		4° 16 17
81		3° 52 30
B.C.R - + 80.58		3° 33 60
+ 50		3° 04 55
80		2° 16 80
+ 50		1° 29 06
79		0° 41 31
B.C. 78 + 56 74		0° 00 00

CALIFORNIA DIVISION OF HIGHWAYS DIST. VII
Wildy & Party DATE 6-15-49

F.B. 1309-109

— LA-168-C — A205-001 L 11 51

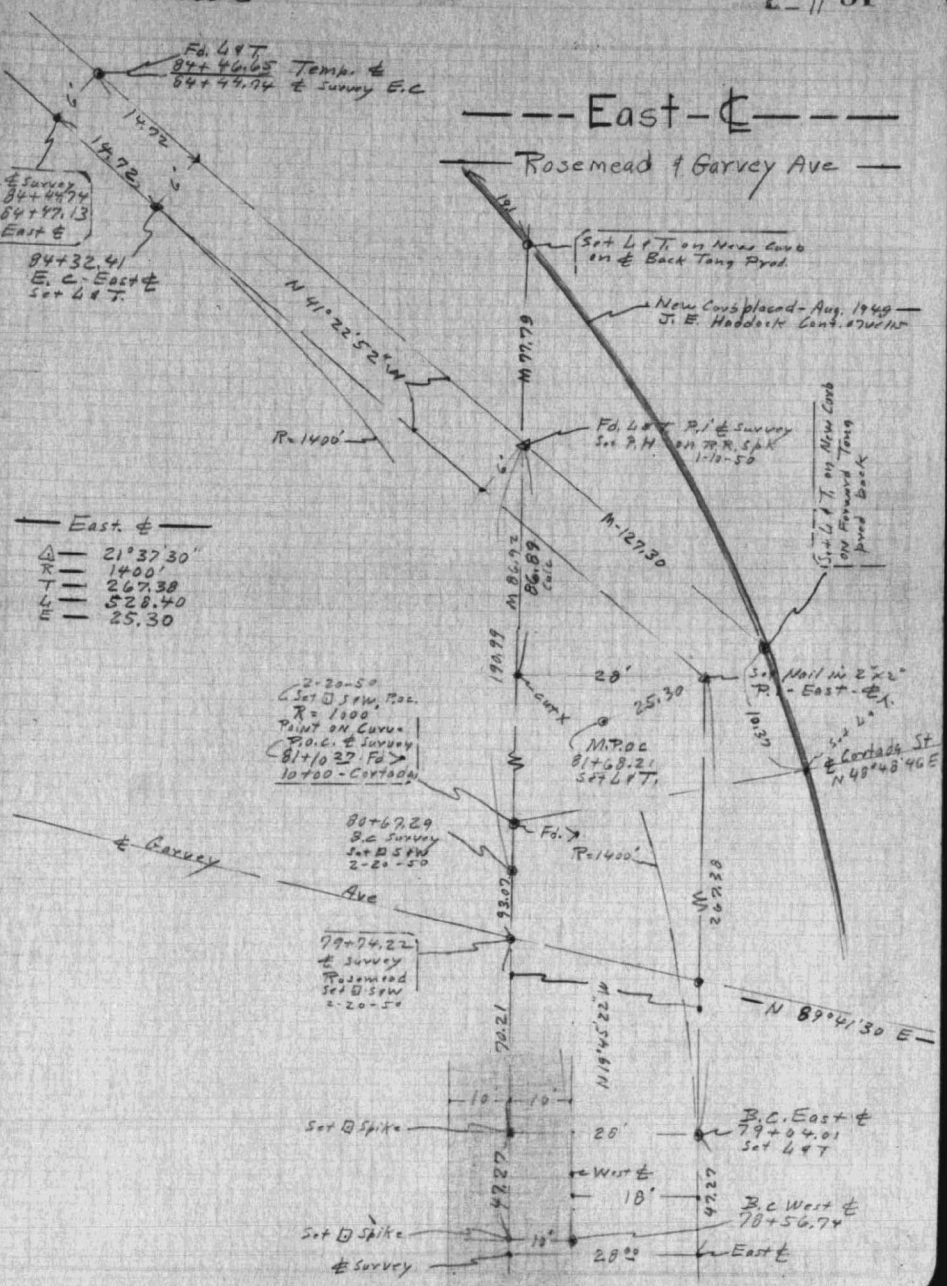

CALIFORNIA DIVISION OF HIGHWAYS DIST. VII
Wildy & Party DATE 6-15-49

F.B. 1309 - 110

SURVEY OF — LA-168-C — INDEX A205-001 PAGE L 72 52

— Deflections —
— East ℄ —

50'd = 1° 01.39
25d = 0° 30.69
1d = 1.228

E.C +32.41 — 10° 48' 75

B4	10° 08 86
+75	9° 38.18
+50	9° 07 48
+25	8° 36.80
B3	8° 06 10
+75	7° 35.42
+50	7° 04 72
+25	6° 34 04
B2	6° 03 34
+75	5° 32.66
Ext. +68 21	5° 24 37
+50	5° 01 96
+25	4° 31.28
B1	4° 00 56
+75	3° 29.89
+50	2° 59 20
B.C.R. +08 94	2° 08 80
B0	1° 57 82
+75	1° 27.13
+50	0° 56 44
+25	0° 25.75
B.C 79+04 01	0° 00

Radius — 1400'

— Wildy & Purdy — Feb. — 1950 —

F.B. 1309 - 111

— LA-168-B — A204-001 H 69

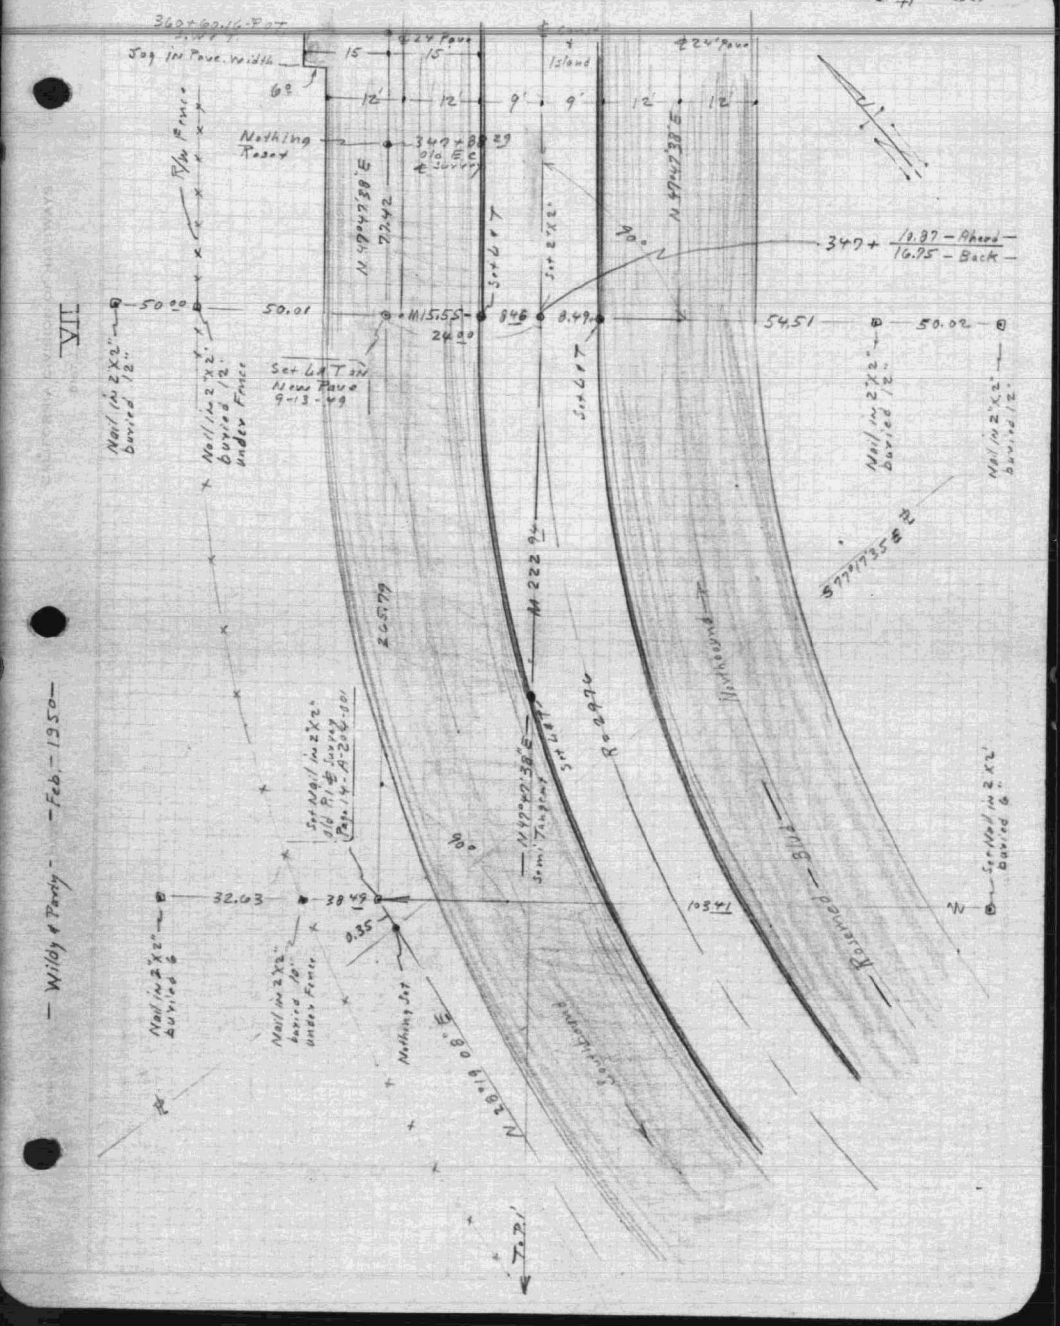
362+92.16 P.O.T.
Sag in Pave. Width
15
24' Pave
Island
12'
9'
Nothing Recov
349+88.29 P.O.C. ℄ Survey
N 19°44'38" E
72.42
N 47°47'38" E
347+ 10.87 — Ahead / 16.95 — Back
50.01
M 15.55
8.46
8.49
54.51
50.02
Set LAT 3N News Pave 9-13-49
Nail in 2"x2" buried 12"
Nail in 2"x2" buried 12" under Fence
Nail in 2"x2" buried 6"
Nail in 2"x2" buried 10" under Fence
Set Nail in Pile Survey Sta. 14+20.6 Offset
Junc. Tangent
N 22° 94' E
S 77° 17' 35" E
Tangent
Radius — 1400'
32.03
38.49
0.35
N 28° 18' 80" E
90°
10341
N
Nothing Set

SURVEY — LA-168-B — INDEX — A204-001 — 12 70

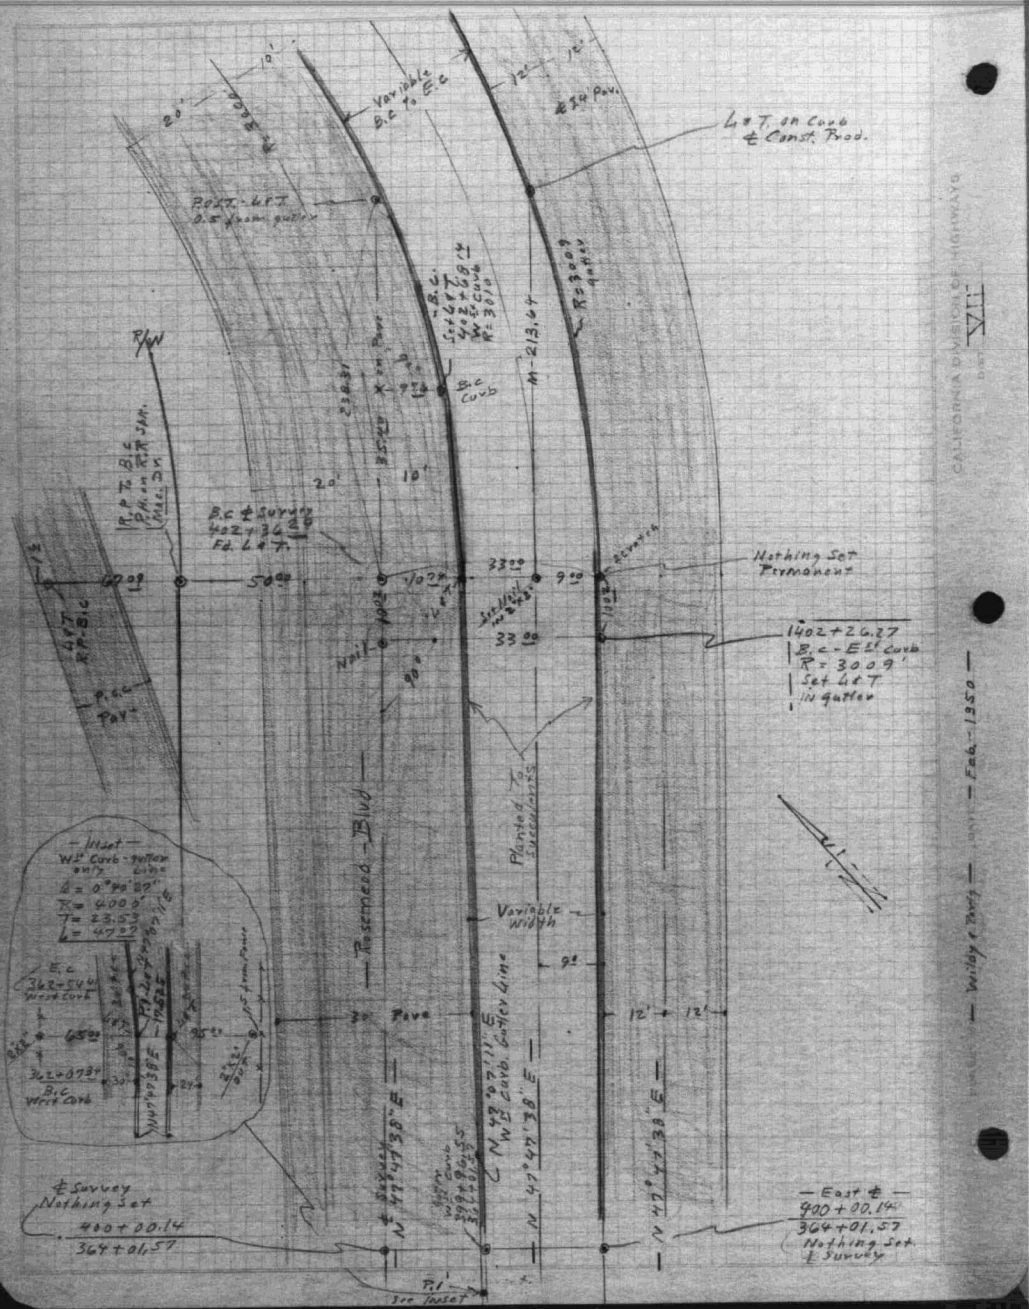

LA-168-B — A204-001 — 71 13

— West-Curb —

Δ = 19°45'33
R = 3010
T = 524.22
L = 1038.04

ld = .571
50'd = 0°28.55

E.C 413+06.18 =	9°52.77
413+00	9°49.24
+50	9°20.68
412	8°52.13
+50	8°23.58
411	7°55.03
+50	7°26.46
410	6°57.91
+50	6°29.36
409	6°00.81
+50	5°32.26
408	5°03.71
+50	4°35.16
407	4°06.61
+50	3°38.07
406	3°09.48
+50	2°40.94
405	2°12.39
+50	1°43.84
404	1°15.29
+50	0°46.74
403	0°18.19
402+68.14 = B.C	0°00.00

— East — Curb —

Δ = 20°26'
R = 3009'
T = 542.31
L = 1073.10

ld = .5712'
50'd = 0°28.56

412 + 88.42 POT / 99.37 FC	10°13.20
+50	9°47.78
412	9°16.22
+50	8°47.66
411	8°19.11
+50	7°50.57
410	7°21.98
+50	6°53.42
409	6°24.86
+50	5°56.29
408	5°27.73
+50	4°59.17
407	4°30.61
+50	4°02.04
406	3°33.48
+50	3°04.92
405	2°36.36
+50	2°07.79
404	1°39.23
+50	1°10.67
403	0°42.11
+50	0°13.55
402 + 26.27 BC	0°00'

Wilby & Parry — Feb. 1950

Contd. on Pg. 95