The original pages of this book are of poor quality. Care has been taken to make the best scans possible. If necessary you can arrange to see the original book at:

Department of Public Works

900 S. Fremont Ave

Survey Public Counter

Alhambra, CA 91803

F.B. 1313 - 3

Property of
EDWARD M. LYNCH

See vellum copy of Tract

Date 6/1/23
Weather 75°
Notes R.C. Sargent
Instrument
Head Chain Blake
Rear Chain Woods.

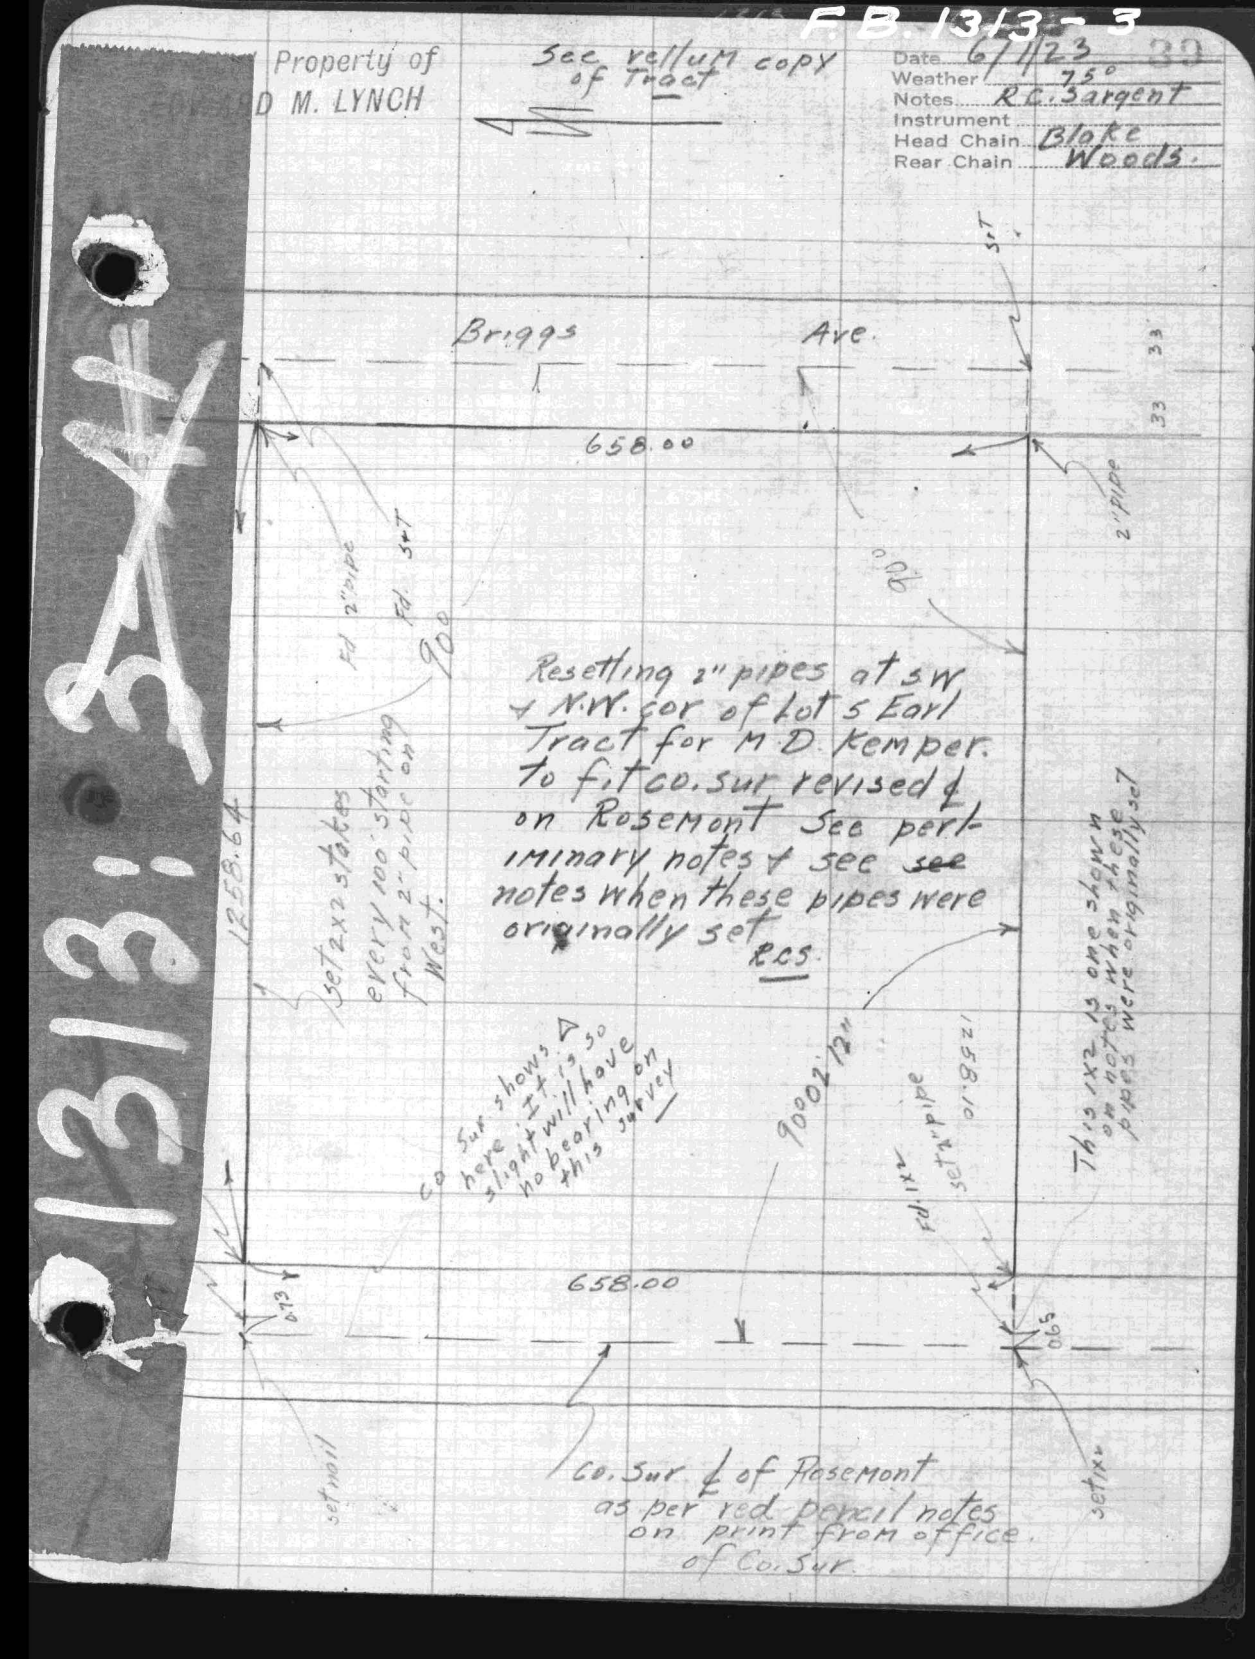

Resetting 2" pipes at S.W. & N.W. cor of Lot 5 Earl Tract for M.D. Kemper. To fit Co. Sur revised & on Rosemont See preliminary notes & see ~~see~~ notes when these pipes were originally set R.C.S.

Co. Sur & of Rosemont as per red pencil notes on print from office of Co. Sur.

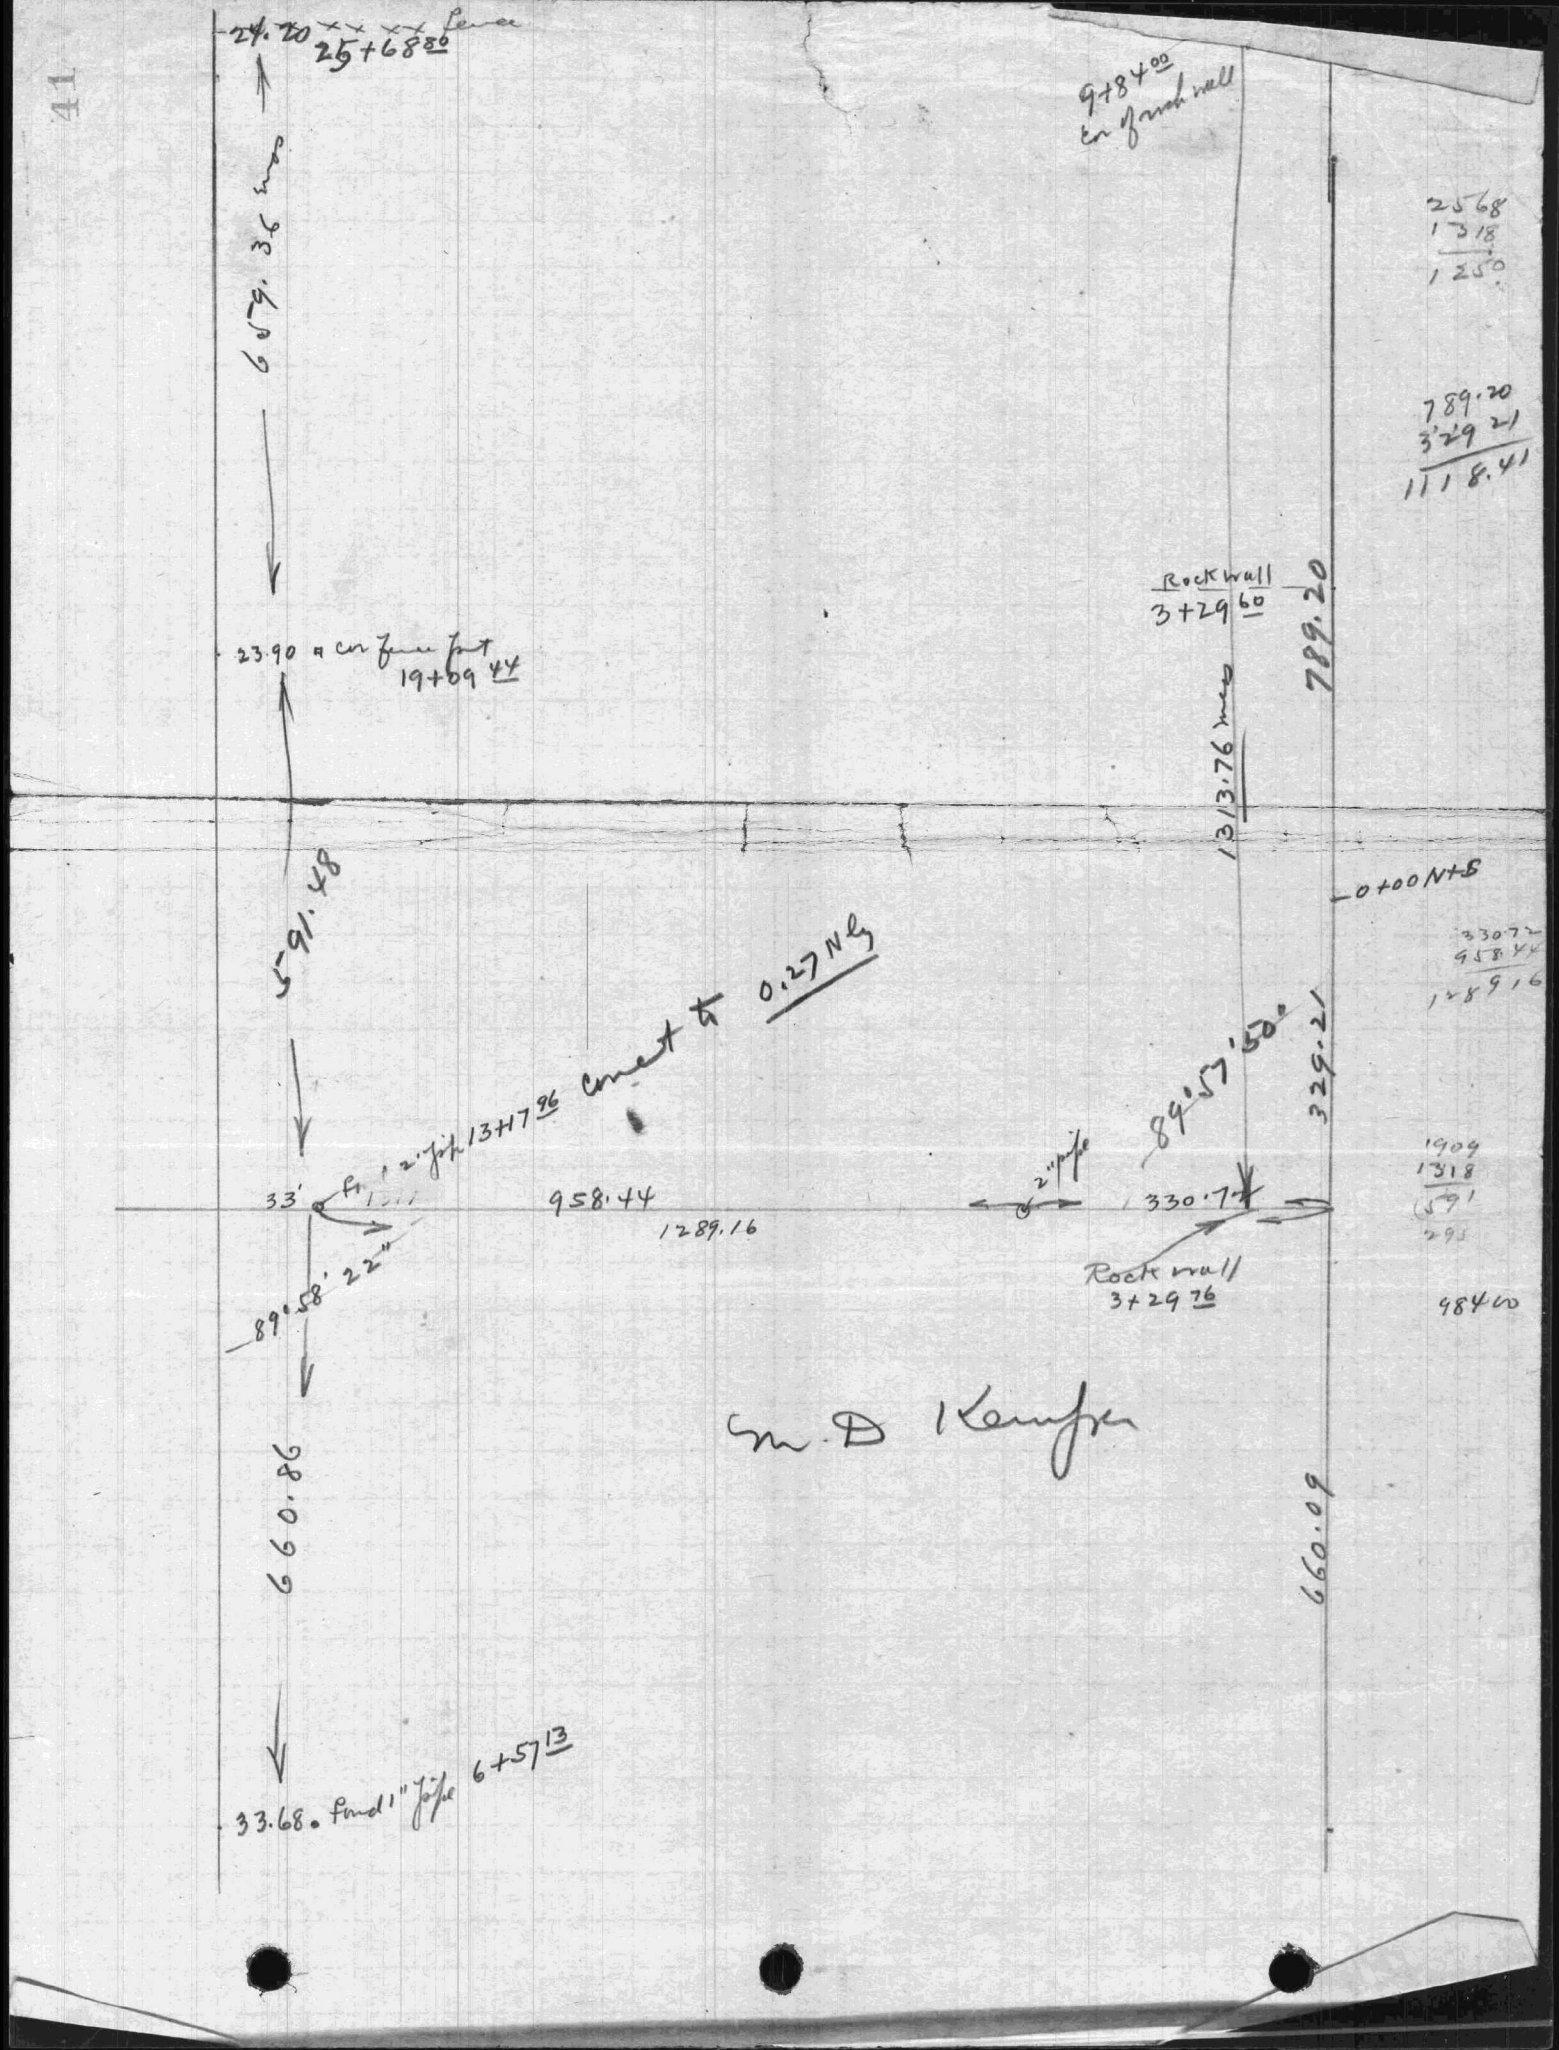
24.20 xx xx Fence
25+68.80
659.36 mes
9+84.00
En Rock wall
2568
1318
1250
789.20
329.21
1118.41
Rock wall
3+29.60
789.20
23.90 a cr fence post
19+09.44
1313.76 mes
0+00 N+S
591.48
330.72
958.44
1289.16
Cement to 0.27 N&W
89°57'50"
325.21
33' fr 1" pipe
13+17.96
958.44
1289.16
2" pipe
330.72
1909
1318
591
295
89°58'22"
Rock wall
3+29.76
484.00
660.86
660.09
33.68. found 1" pipe
6+57.13

F.B. 1313 - 4

40

Personal Property of
EDWARD M. LYNCH

Establishing 4 cor. of Lots Earl Tract for M.D. Kemper see preliminary survey notes

Date 5/22/23
Weather Moderate
Notes R.C. Sargent
Instrument "
Head Chain H.A. Blake
Rear Chain C.L. Woods

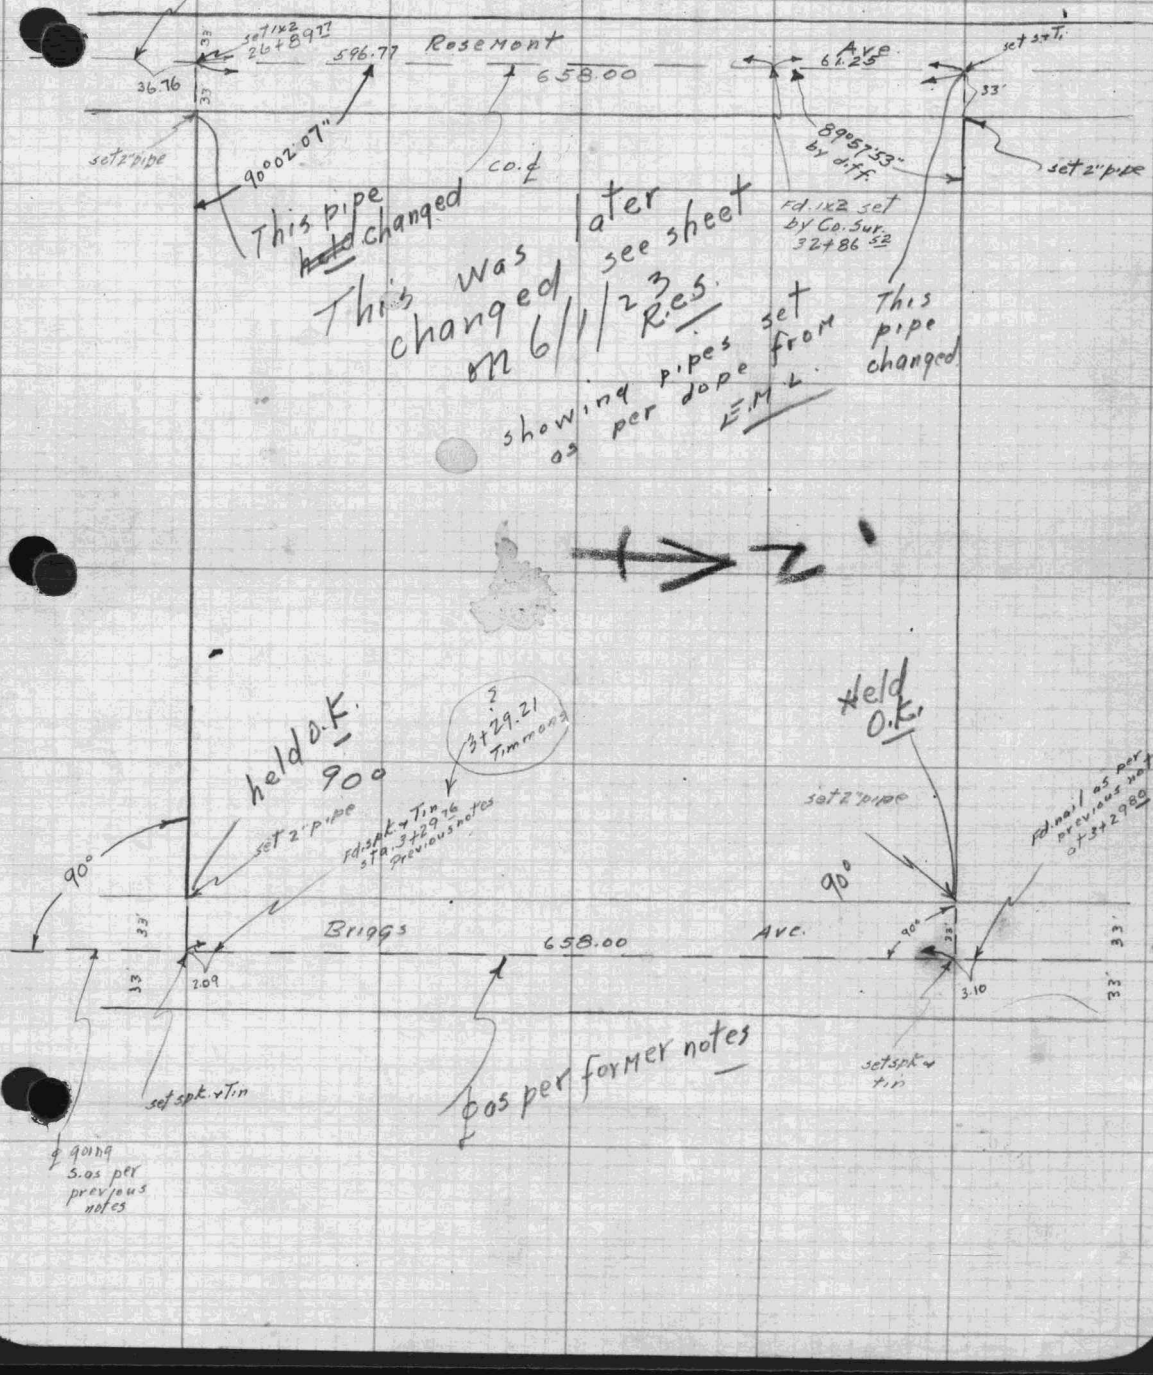

F.B. 1313 - 4546

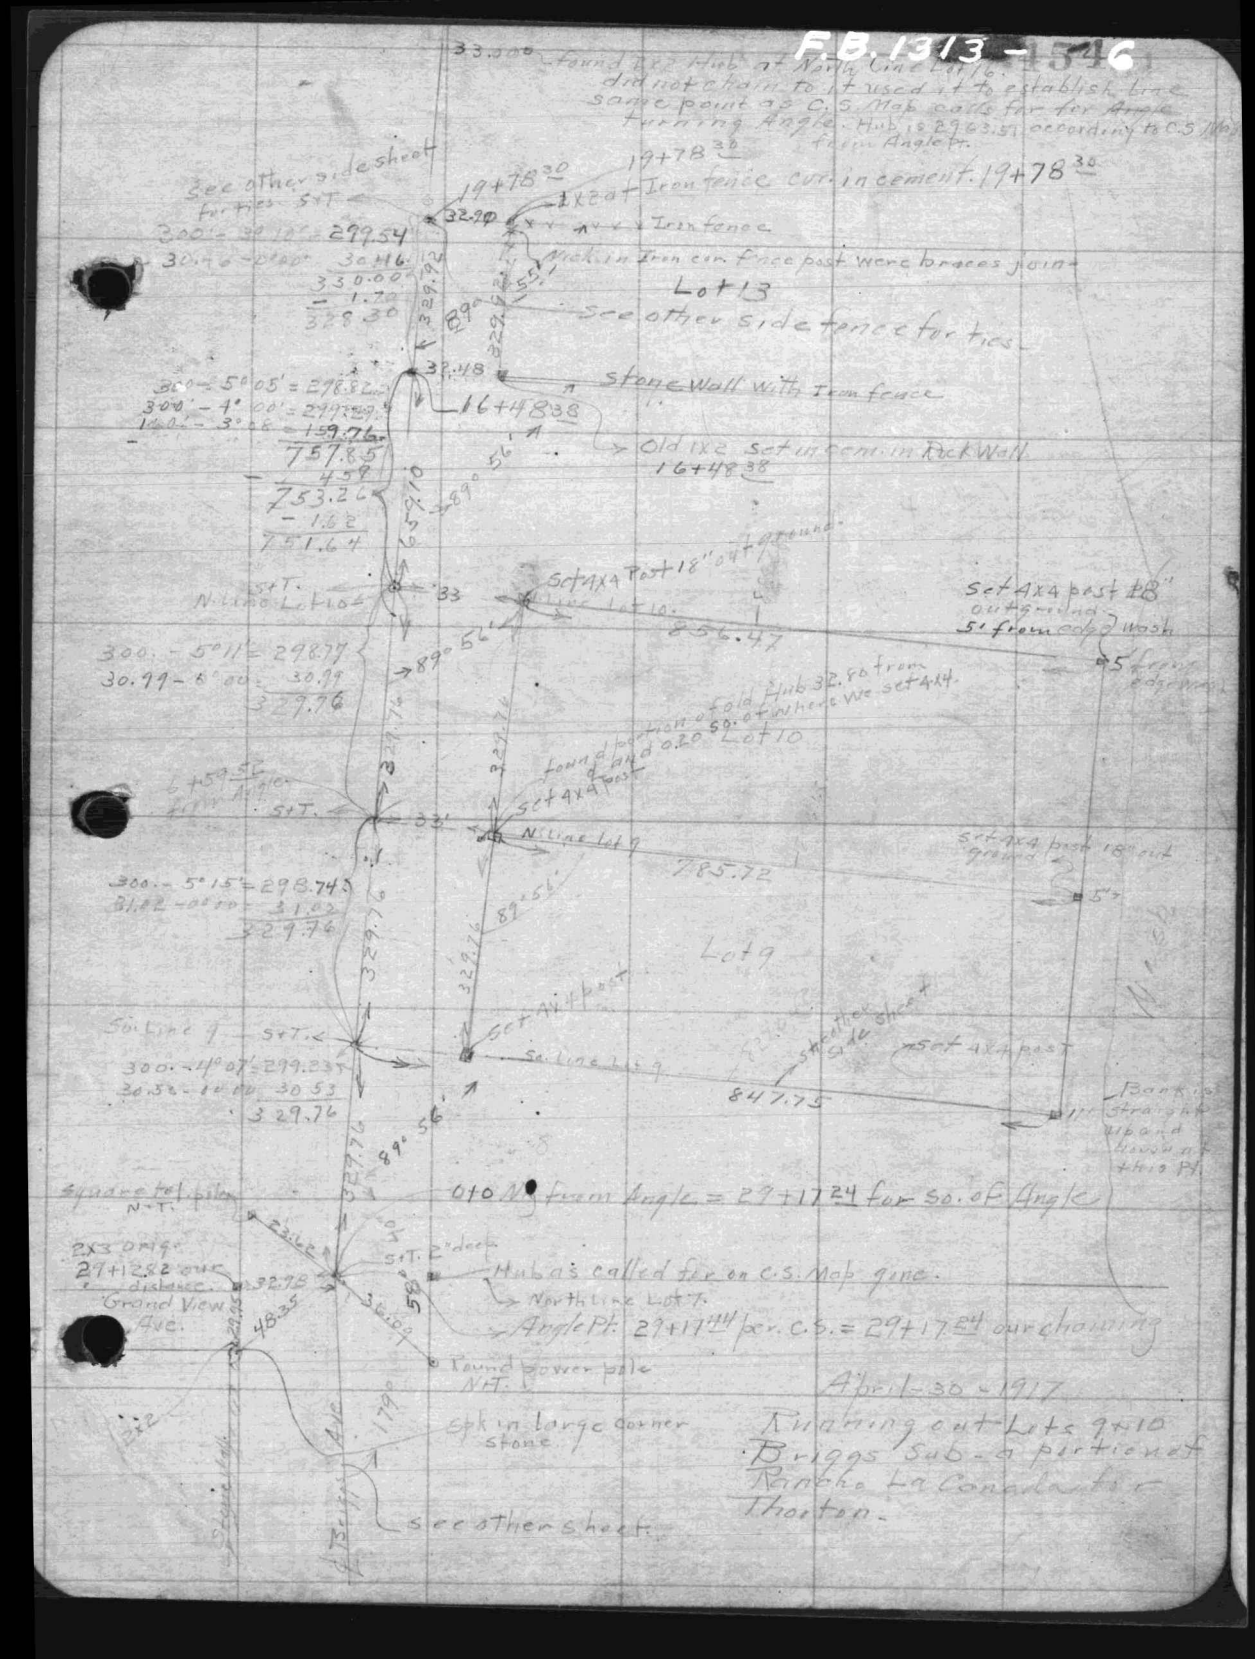
33.00 found 1x2 Hub at North Line Lot 9.
did not chain to it used it to establish line
same point as C.S. Map calls for for Angle
turning Angle. Hub is 2963.5' according to C.S. Map
from Angle Pt.
See other side sheet for ties S+T.
19+78.30
1x2 cut Iron fence cur. in cement. 19+78.30
Iron fence
Mark in Iron cur. fence post were braces join
Lot 13
See other side fence for ties
Stone Wall with Iron fence
16+48.38
Old Ixc set in cem. in Rock Wall
16+48.38
Set 4x4 Post 18" out
Line Lot 10.
856.47
Set 4x4 post 18" out 5' from edge of road
5' from edge of road
found 1x2 Hub 32.80 from
Lot 10
Set 4x4 post
N Line Lot 9
785.72
Set 4x4 post 18" out
Lot 9
Set 4x4 post
847.75
Bank is straight up and down on this PL
Square tel. pile N.T.
0 to M from Angle = 29+17.24 for So. of Angle
2x3 orig. 27+12.82 occ. distance.
Grand View Ave.
S+T. 2" dect
Hub as called for on C.S. Map gine.
North Line Lot 7.
Angle Pt. 29+17.44 per C.S. = 29+17.24 our chaining
Found power pole N.T.
Spk in large corner stone
See other sheet.
April 30 - 1917
Running out Lots 9+10
Briggs Sub - a portion of
Rancho La Canada for
Thorton.

33-70

F.B. 1613 - 7

Oct. 15 1914

H.S. Neel
Reese

F.B. Darcy

Rectcaking Brown Lanvier tract

La Crescenta.

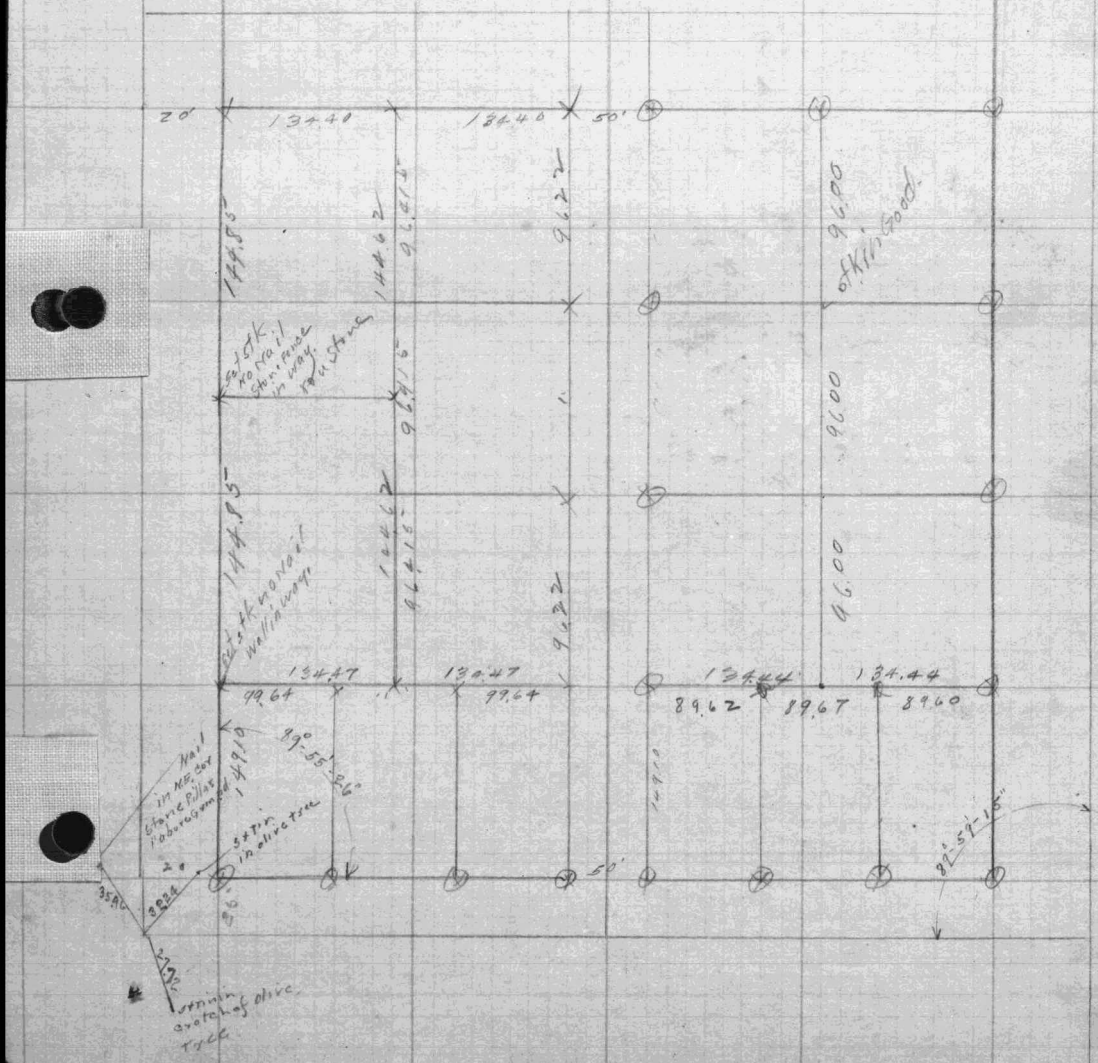

33-71

F.B. 1313-8

For Sur. W. of Briggs Ave & S. of Fairmont

Sec. Pt. 45-122
45-129

Showing 5" Iron Pipe at Cor. of Fairmont & Briggs Ave

Oct. 15, 1914

Inches
Hardy

G.S.P. Briggs Ave

90° 45' 30"

90° 59' 15"

33°

4x4 c.s. 1+24.44

4666.7

4x4 c.s. 15+31.86

2e 33.44'

3.26

28" Elm

2e 39x3

2e 4x3

4666.7

2e 39x3

Hdg's Checked

1" = 40'

33-72

FB. 313-9

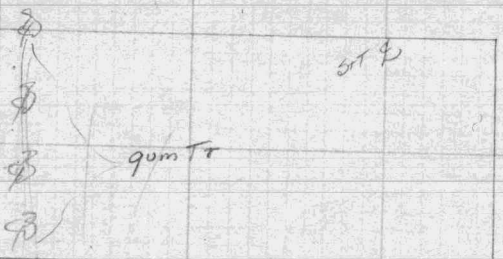

33.44.

C.S = 15+31.86 4x4

℄ of Briggs Ave (C.S.)

4x4

C.S = 1+24.44

4.55

45 -B

F.B. 1313 -10

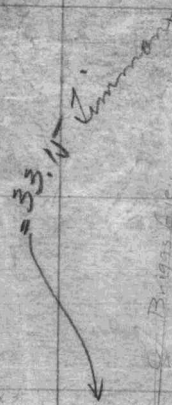

44

See other Sheet for this point

Old orig. - X -
as called for
Mag.

Grand View Ave.

Great Oak Stone Wall just NW edge of walk on north

Ekd

Ave.

3°.1

N

Lucile

230 - 4°15' 225°37'
- 4°11' chec - 46
225°.1

45-B

F.B. 1313 -11

(Same as F.B. ~~1049~~ 1313 -10)

Copied by Sullivan

Briggs Sub. of La Cañada Rancho

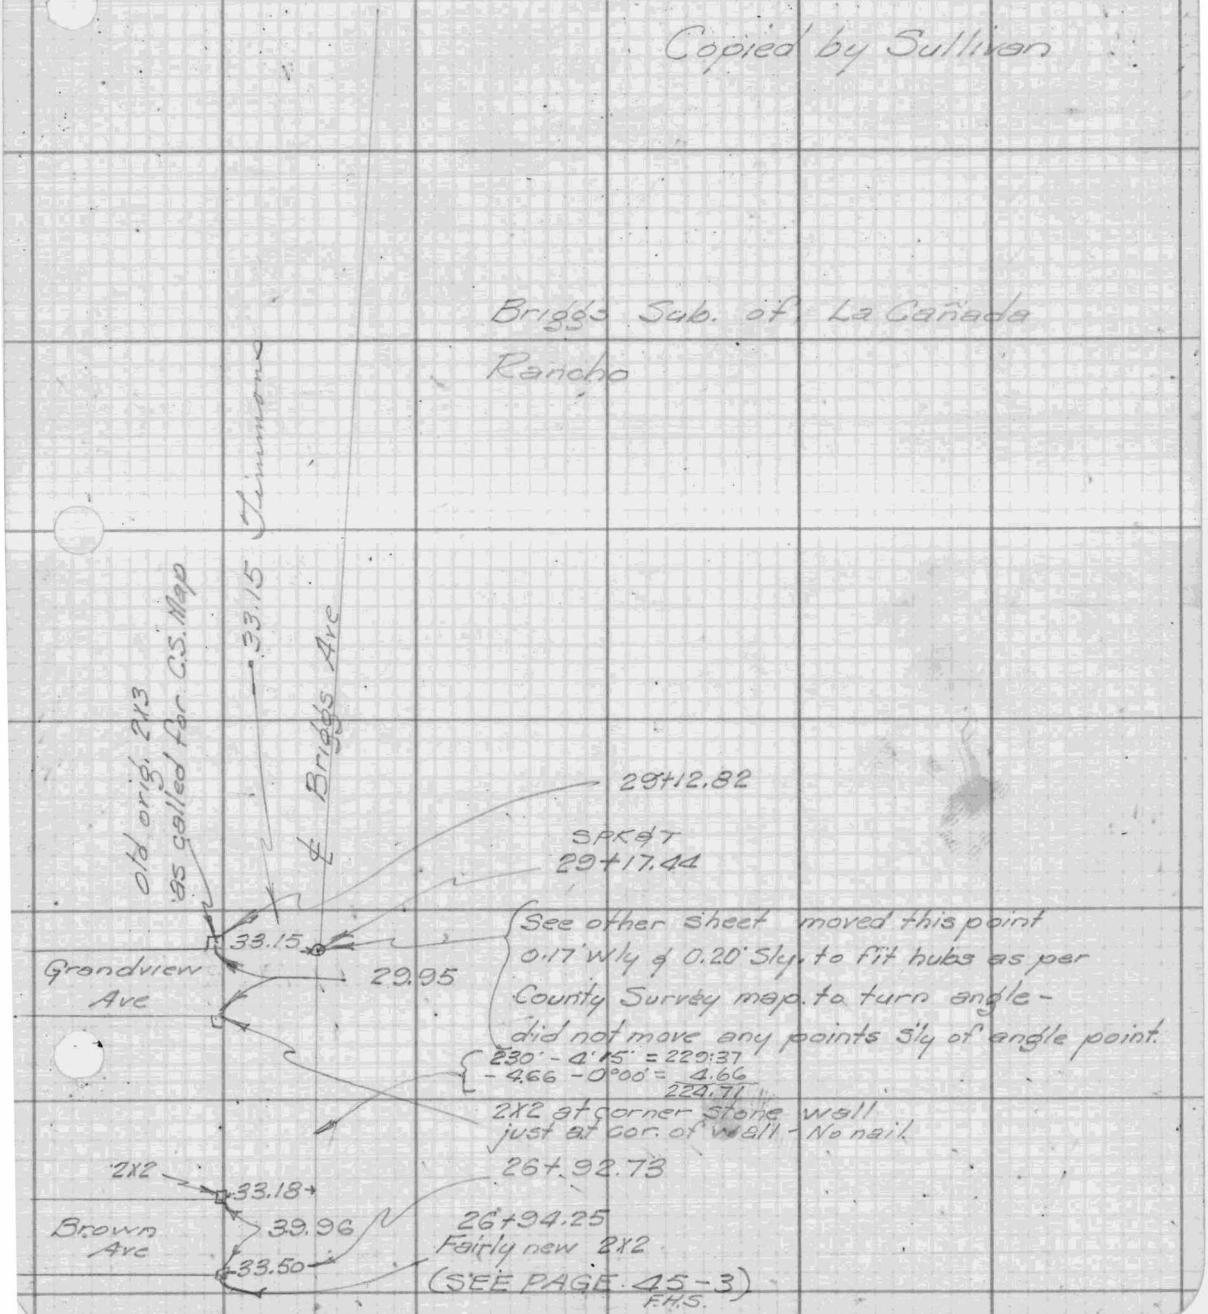

45 3

FB 1313-12

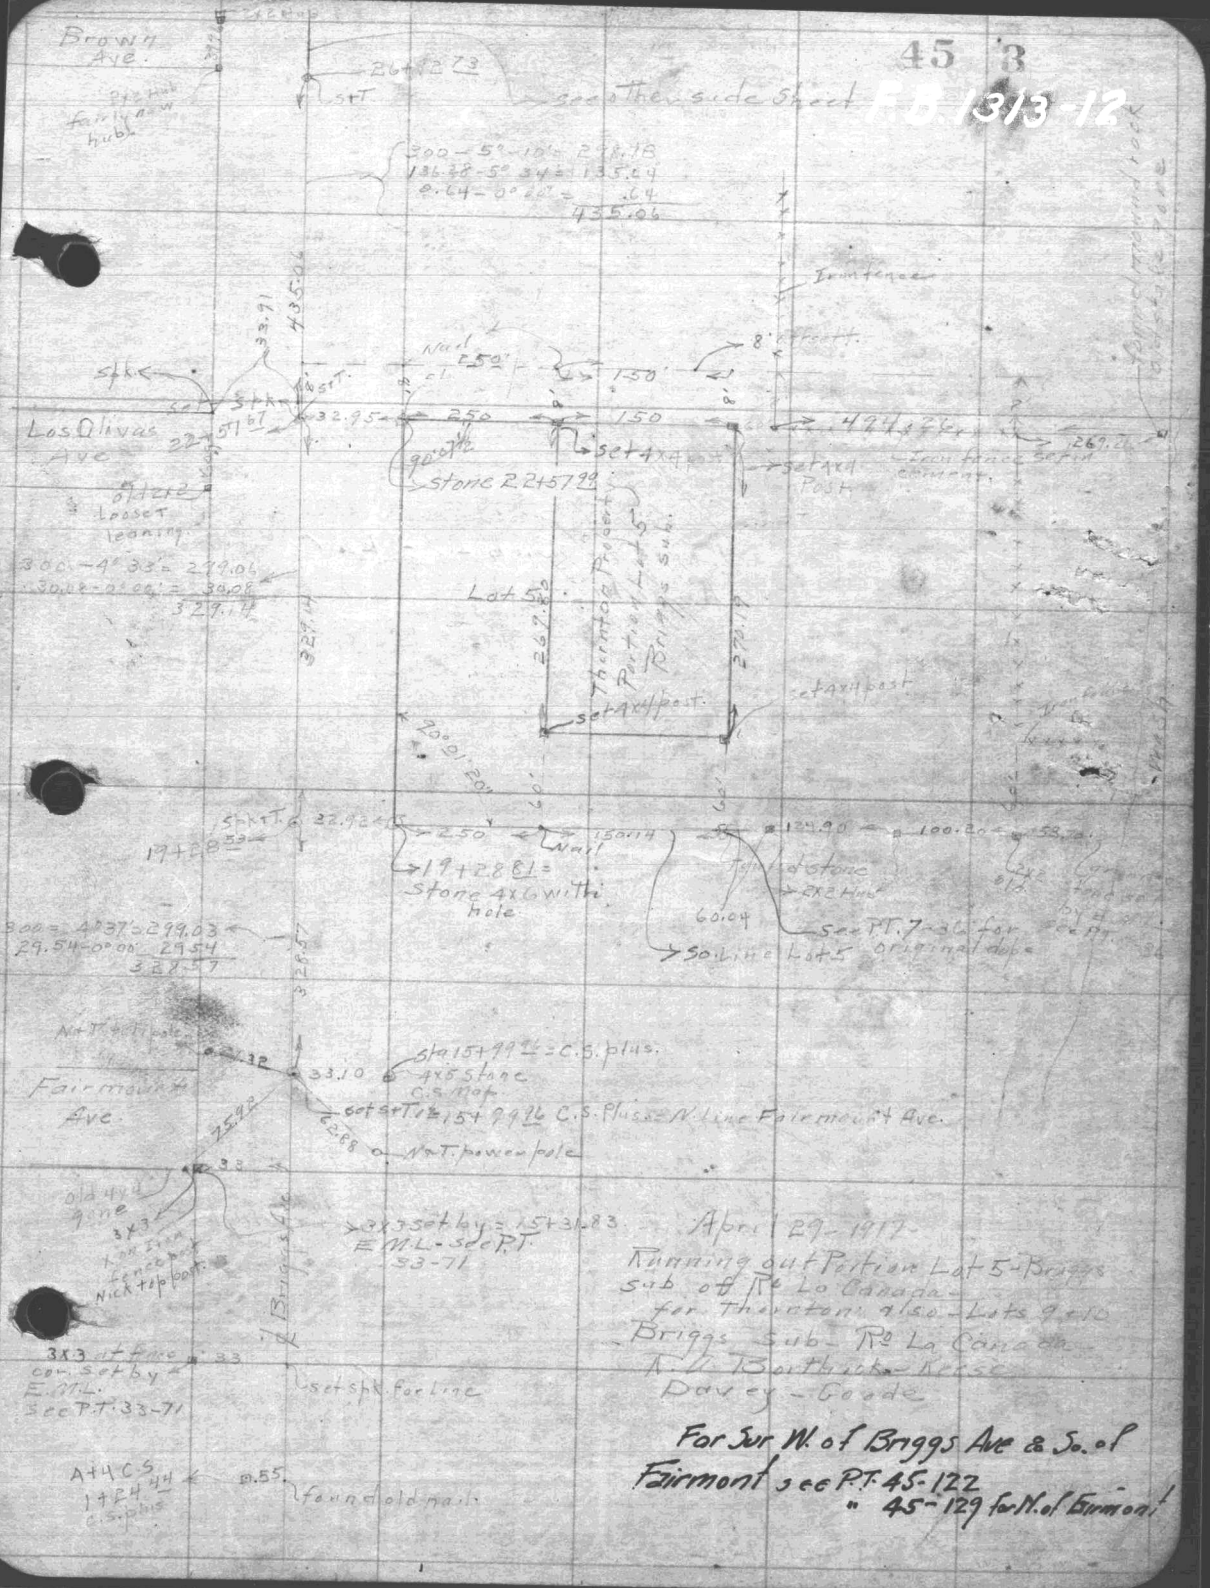
Brown Ave.
Fairmount Ave.
Los Olivas Ave
Lot 5
Thornton Road
Stone 2.2+57.99
set 4x4 post
Stone 4x6 with hole
19+28.81=
Sta 15+99.96=C.S. plus
4x5 Stone
C.S. Mon
set Sta 15+99.96 C.S. Plus = N. line Fairmount Ave.
3x3 set by = 15+31.83
E.M.L. - see P.T. 33-71
Nick top post
3x3 set by E.M.L. see P.T. 33-71
set spk. for line
A+C.S. 1+24.44 C.S. plus
found old nail.
See other side Sheet
Tree fence
Fence
Stone
2x2 Hub
See P.T. 7-36 for original dope
Nail
Spk.
Post
Set 4x4 post
Set 4x4 post
Set 4x4 post
Loose leaning
Old 4x4 pine
Tree
Tree
Tree

So Line Lot [redacted]

194 - 2° 17' = 193.85
300 - 0° 05' = 299.95
244 - 1° 12' = 243.90
110 - 00° 00' = 110.00
847.75

N.E. Line Lot 10 = (92.68)
40' - 0° 48' = 254.12
78' - 1° 18' = 78.11
220.20 - 1° 37' = 220.11
197.0 - 0° 30' = 197.00
134.80 - 1° 32' = 134.80
884.47

N. Line Lot 7 & So. Line 10
176.00 - 1° 40' = 175.93
300.00 - 1° 34' = 299.89
108.10 - 0° 00' = 108.10
219.00 - 0° 00' = 219.00
15.80 - 0° 00' = 15.80
818.72

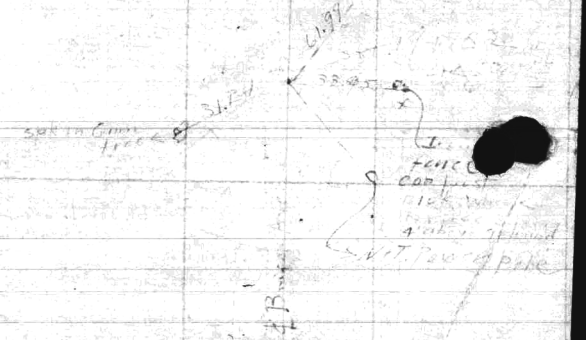

45 + F.B. 1313-14
(Same as pg. 13)

1313 - [illegible]

45-109

Survey in La Cresenta
for. Bentley of Glendale
C.E. Hughes
G. [illegible] Tain
Gossmann
Oct 19, 21, 1918
Streets 66 ft wide

For Sur. on N. side Michigan Ave see P.T. 45-122
P.T. 45-132 For Sur. So end of Rosemont.

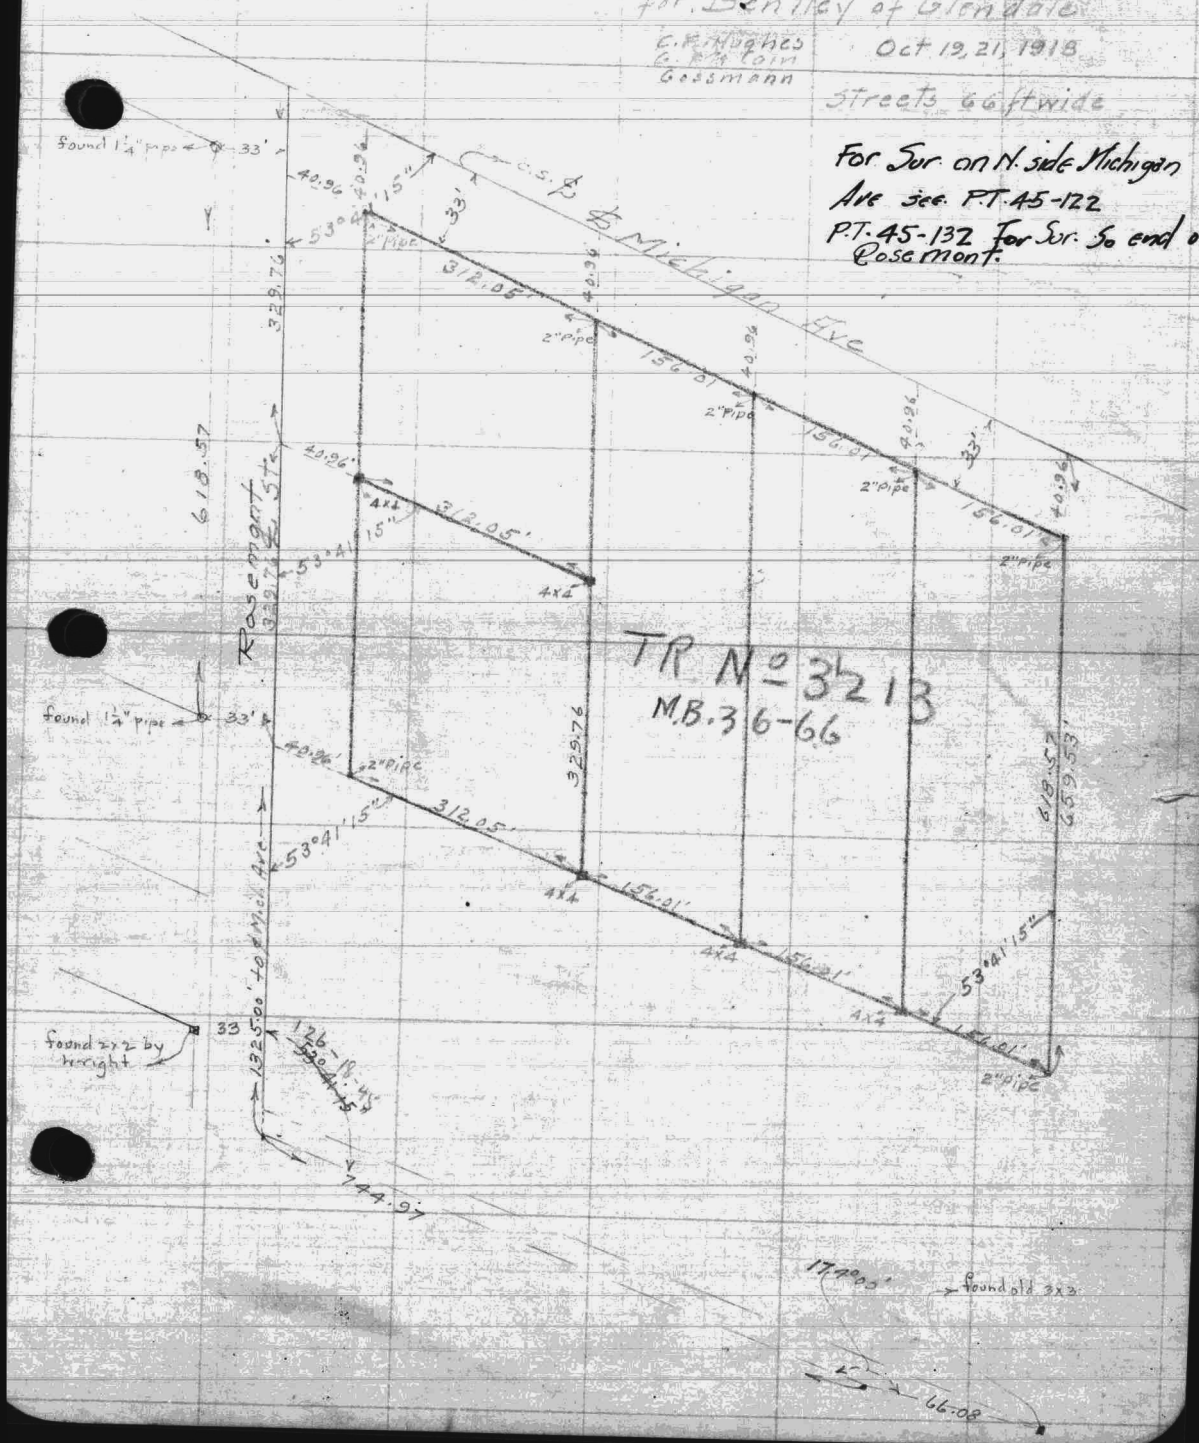

45-122

313

TR 3771

SURVEY OF BROWN & JANVIER TR.
IN THE
EARL TRACT, (LA CANADA).
CRESCENTA CANADA

Surveyed.
4/12. 13/1920

Dean
Sergeant
Coy.

Weather Cool

Note All measurements made with the exception of those on Richmond Ave. were made with 300 Chain using 3 ops distance. Mich. Ave was chained with 100' chain

For Surveys in Vicinity see. P.T. 45-109"
" 334-72-71"
" 45-3-L"
C.S Map of Mich Ave. — 1070 R.
" " " Briggs Ave. 2307 R

see P.T. 45-129 For. Sur. to North (101c)

F.B. 1313-17

122-A

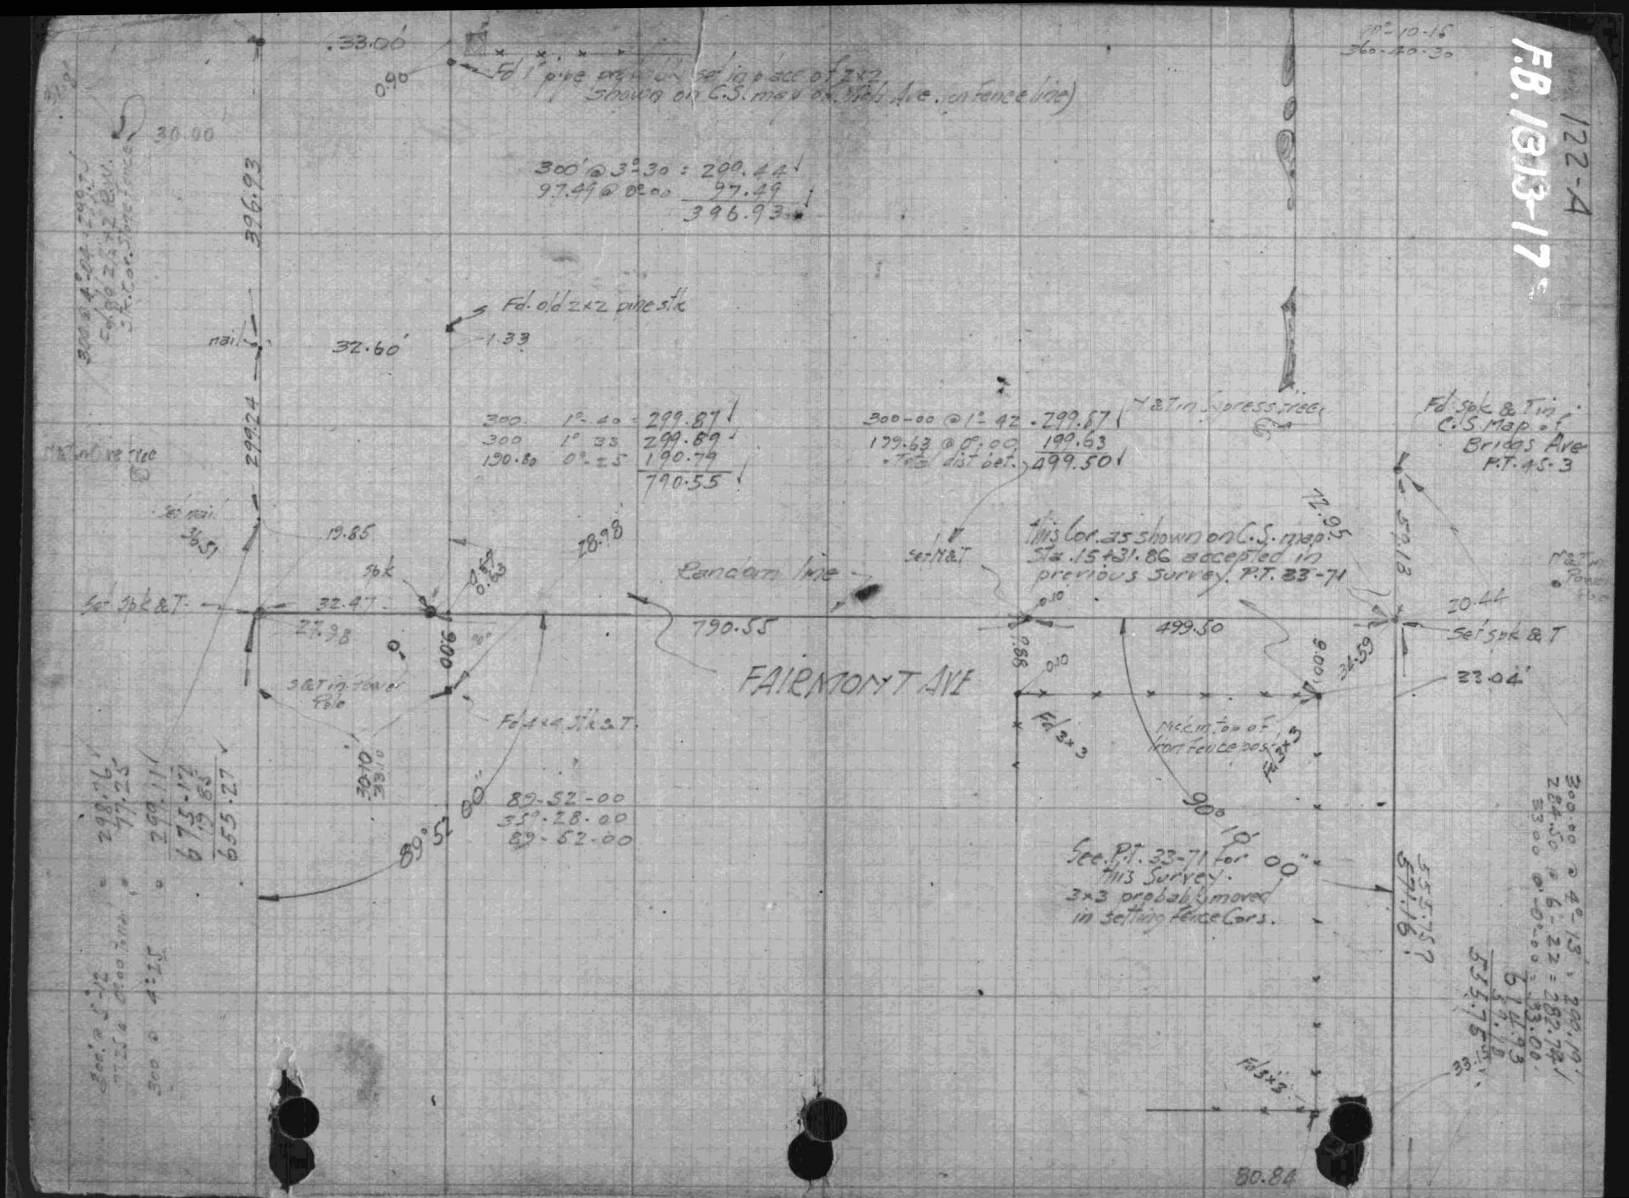

F.B. 1313-19

129-A

45-128

F.B. 1313-20

Fd. old 4x4 ± 2' high on tree line

0.6 fence

said to have been standing ±30 yr.

Old Fence standing ±30 yrs.

±191 ft

Lot 4

20.35 ch.

896.42

set 2" pk on tree line

set 8x8 Con. Mon.

Lot 3

20 Ac. ± E. of Ventura Blvd.

990.00'

Lot 2



set 6x6 Con. Mon.

896.42

956.31

30

30


rec dist. dead

89-32-30

358.10

Fd. o.6' 2x2 at fence Cor. ± 18" under. P.T. 30-86

291.33

0.30'

Fd. new 2x2 pine Stk. & T

Fd. 3x3

330.00

330.62

Fd. 4x6 & T

Fd. 4x6 & T

Fd. Spk. & T 2' under P.T. 45-39

20

660.65

291.35 by diff

Fd. nail .09 west & .04 south of 2x2 1' under P.T. 7-122

90° 28' 00"

261.57

45-129

Survey of 20 Ac ± (Fairmont Tr) North of the Brown & Janvier Tr.

5/12/1920

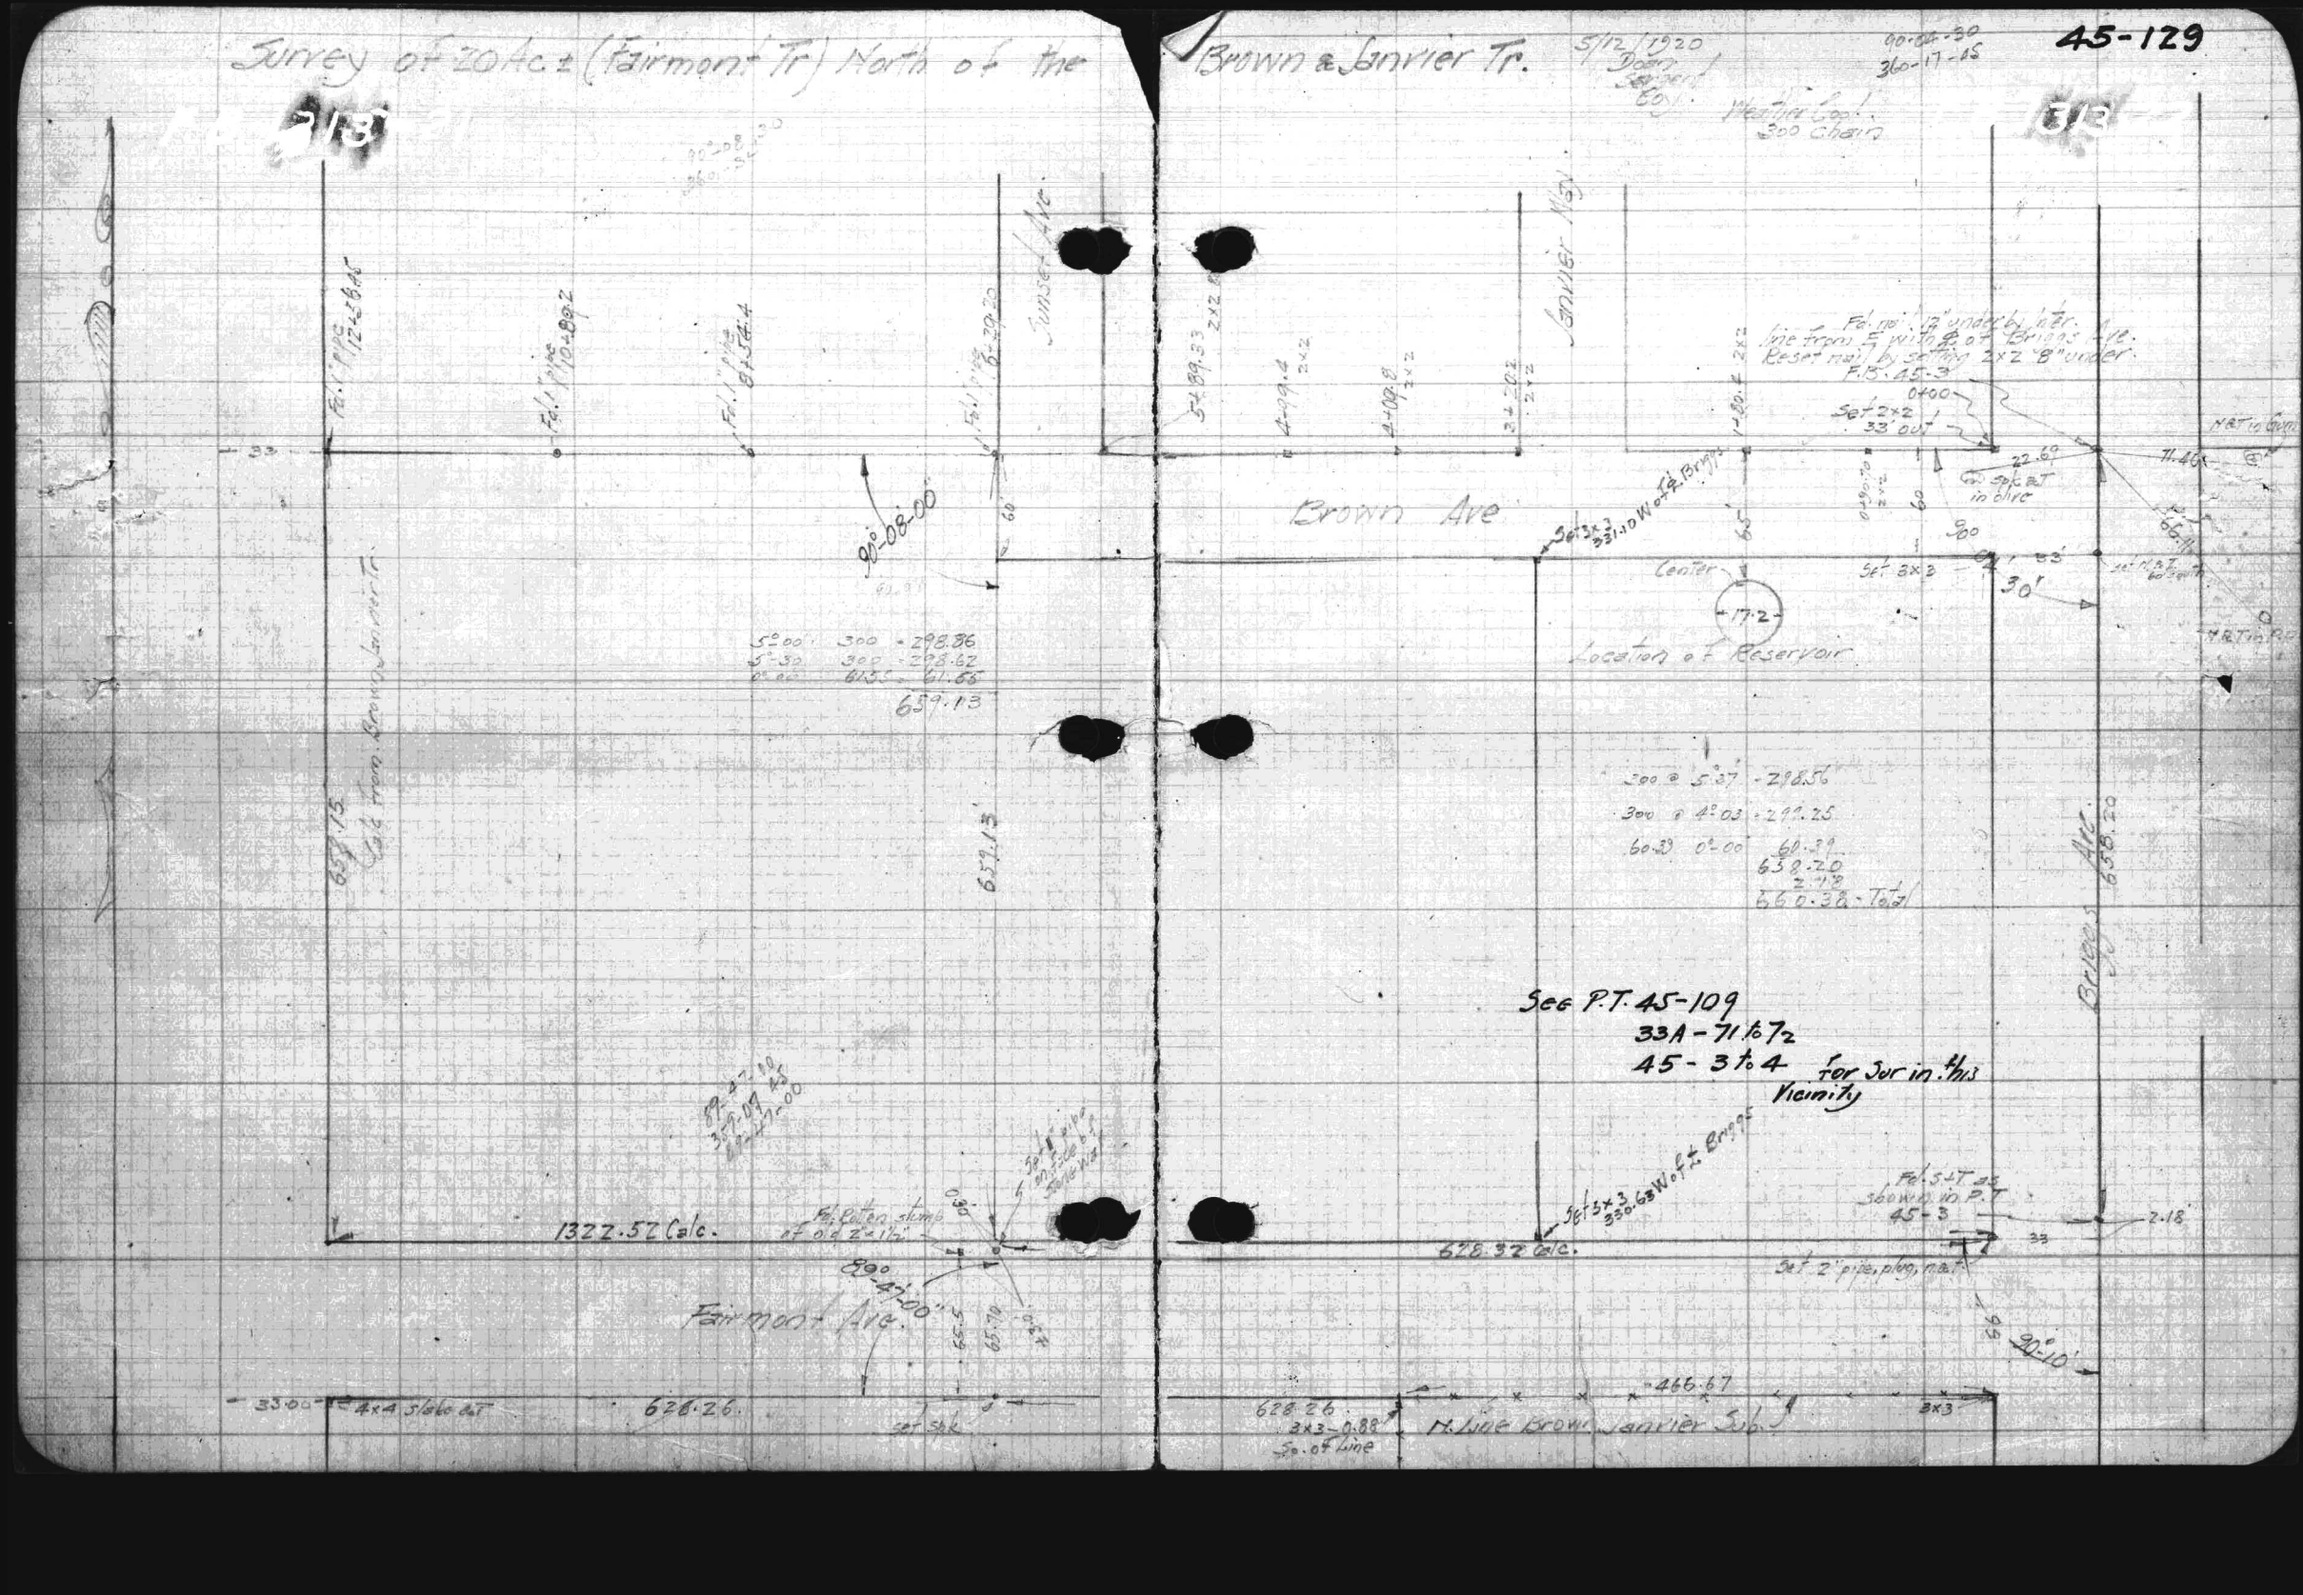
Brown Ave
Janvier Way
Sunset Ave
Fairmont Ave
Location of Reservoir
Center
Set 3x3
Set 2x2
Fd. pipe

Personal Property of EDWARD M. LYNCH

New Tr. # 8218

For Mrs. Louise Joyner
Ordered by H. Reynolds
Job # 585

F 860

Date 2-7-24
Weather 72° F
Notes K. L. Wheeley
Instrument Berger #14325
Head Chain C. W. Barlow
Rear Chain G. M. Thompson
Chain 100.01 @ 60° F

F.B. 13-23

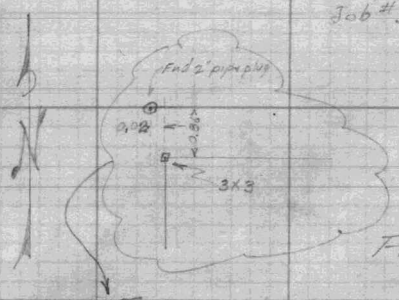

Note

Fairmount Ave.

466.34

Fnd 3X3 in concrete

Fnd 3X3 in concrete
N.E. Cor. Lot 1
M.B. 68-74

316.84

150.00

89°56'20"

00°03'33"

108.84

326.51

108.84

108.83

108.84

466.51

316.66

100.00 100.00 66.66 100.00 150.00 100.00

Briggs Ave.

1 2 3 4 5 6 7 8 9

140.00

90°04'50"

89°56'27"

100.00 100.00 66.58 100.00 100.00

466.58

Fnd 3X3 in concrete
S.E. Cor. Lot 8
M.B. 68-74

Fnd 3X3 in concrete

El Centro Ave

See P.T. 45-3-122-129

(1)

879

F.B. 1313-24

Date 4/23/23
Weather Moderate
Notes R.C. Sargent
Instrument H.A. Blake
Head Chain Chas. Woods
Rear Chain

Personal Property of EDWARD M. LYNCH

Survey of Lot 3 Earl Tract

Lot 4 Seaview Terrace

Tract for N.D. Kemper

Fd. 2" pipe set by self (Dr. Black, Surveyor)

Fd. spk. + Tin c. 14 North

Fd. old orig. 2x2 in Mound of Rock. 25+92.14

cor. of fence sta. 25+68.80

Olive Orchard

set 1x2 sta 25+68.56

set 1x2 sta 22+44.66

set 1x2 with n+T in top sta. 19+12.03

17+12.43 Fd. orig. 2x2 in mound of rock.

N+T sta 19+09.44 on corner fence post

Fd. new 1x2 set by co. 1.81 W. of line + sta 19+11.87

2" pipe at cor wall 12+80.37

set 1x2 13+17.98

cor. rock wall 4+23.20

set nail 6+57.21

cor. of stone pillar 6+31.63

Fd. nail as per P.T. 45-122 also

Fd. 1" pipe sta. 0-0.90

Fd. spk. + Tin as per ties

Rosemont

Random line Fairmount Ave

Tract 5147

Fd. 2" pipe New. 13+17.96

89°58'22"

958.44

see P.T. 45-122-132 45-3 45-4 7-36

Tr. 5147

Fd. 2" pipe

330.72

89°57'50"

End of Rock wall 3+29.76

cor. of old rock wall 3+29.60

new fence cor. 3+25.20

Lot 5 Earl Tr.

Reservoir

30' Grand View Alley

Lot 13

Lot 10

Lot 9

Ave.

159.32

329.80

32.95

3.10 Sq

2.09 Sq

660.09

Fd. 4x4

Fd. 4x4 N.E.

Spk + Tin as per P.T. 45-4

7+89.42 cor. iron fence 2x2 mound of rock 9+89.43

9+84.20 cor. of rock wall

9+89.20

as per 45-4

3+29.80 set 1x2 mound of rock wall 3+29.67

Spk + Tin as per P.T. 45-4

Spk + Tin 0.3 east of E

Res.

also going N. + S

set spk + Tin in position of one last in P.T. 45-4

Spk + Tin P.T. 45-4

31

TR No 6358
TR No 6594

Exterior survey of 10 Acres +- for Dr. Negley v Janvier

Date 3/20/24
Weather cold
Notes R.C. Sargent
Instrument
Head Chain Wm. Feeley
Rear Chain M.C. Avers

See PT 45-3 x 128
F860

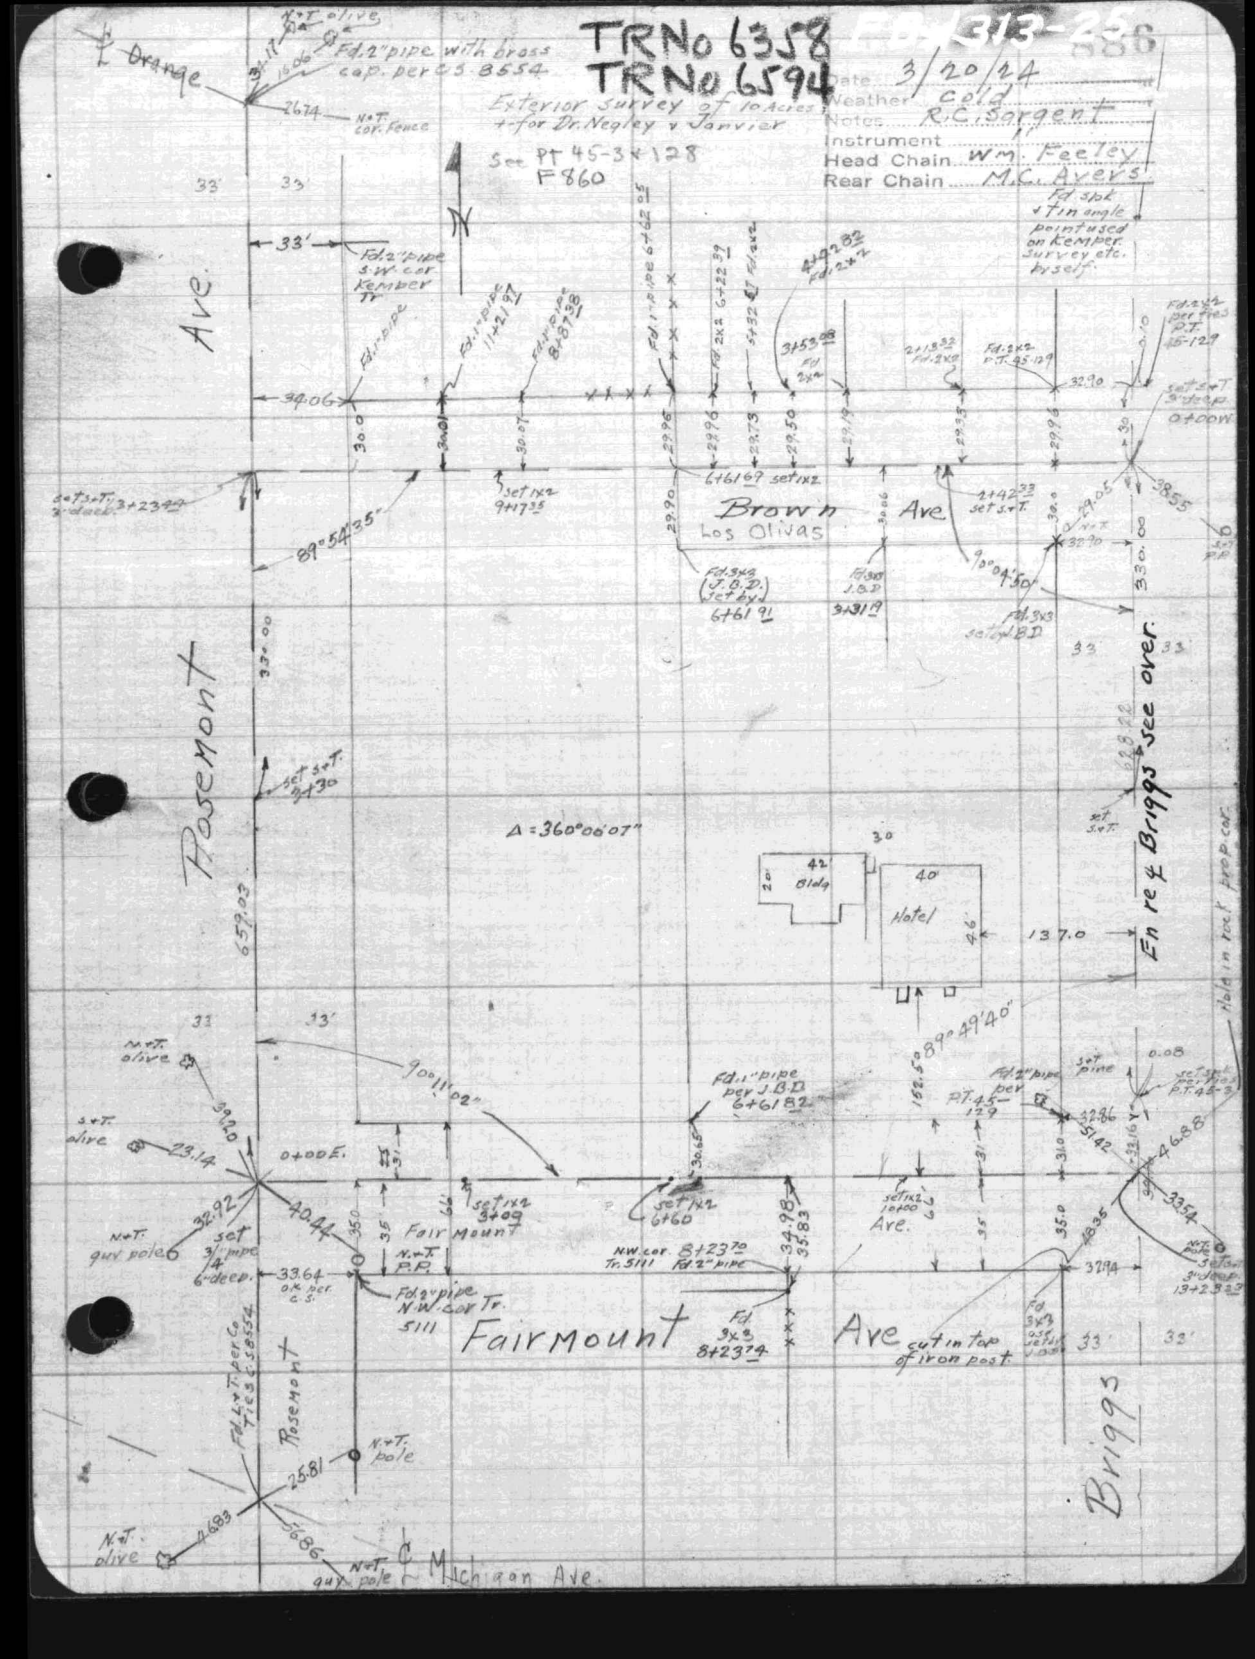

886-A

In re ℄ Briggs Ave.

The ℄ as established by J.B.D. P.T. 45-128-129 etc is evidently erroneous as he held to points found as established in P.T. 45-3

It will be found that these notes (P.T. 45-3 back of page) show that the angle point N. of Brown Ave should be moved 0.17 W. + 0.20 S. to be C.S. ℄ + that points S of this were not corrected. To allow for this 0.17 therefore this survey is based on true C.S. ℄ Briggs Ave as per C.S. 7616 + P.T. 45-3

F.B. 1313-27

C.P. Day F.B. 170

F.B. 1313-28

"Poppyfields"

Job #790 – Tract #6954

Ties to water-valves at Street Intersections

V8

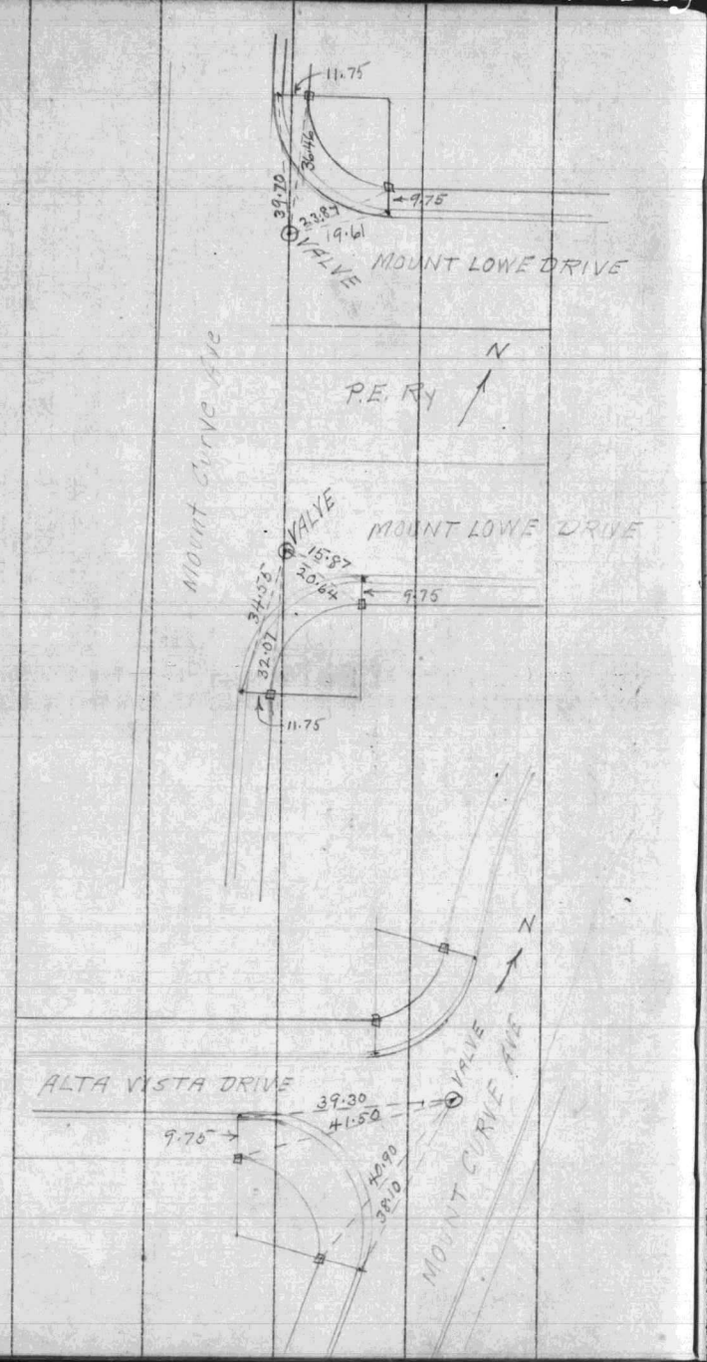

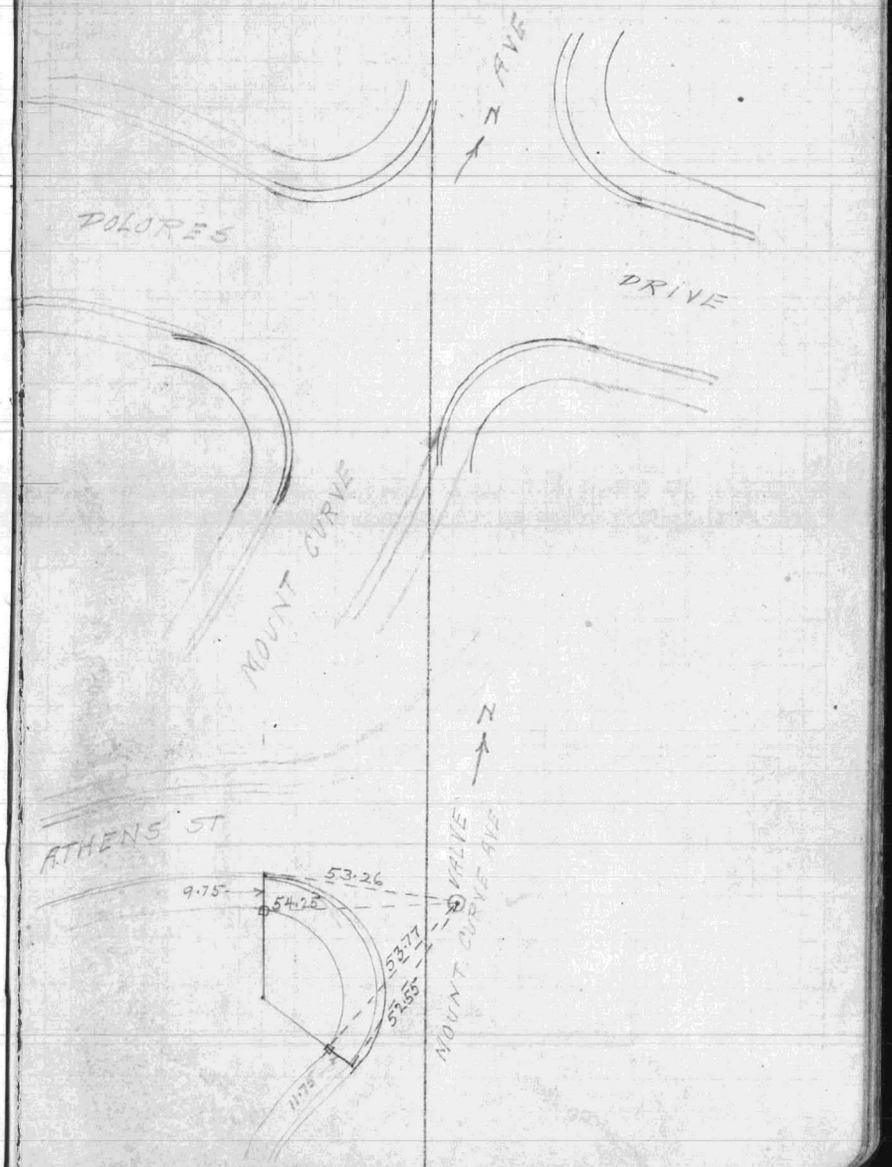

F.B. 1313-29

C. P. Day F.B. 170

F.B. 1313-30

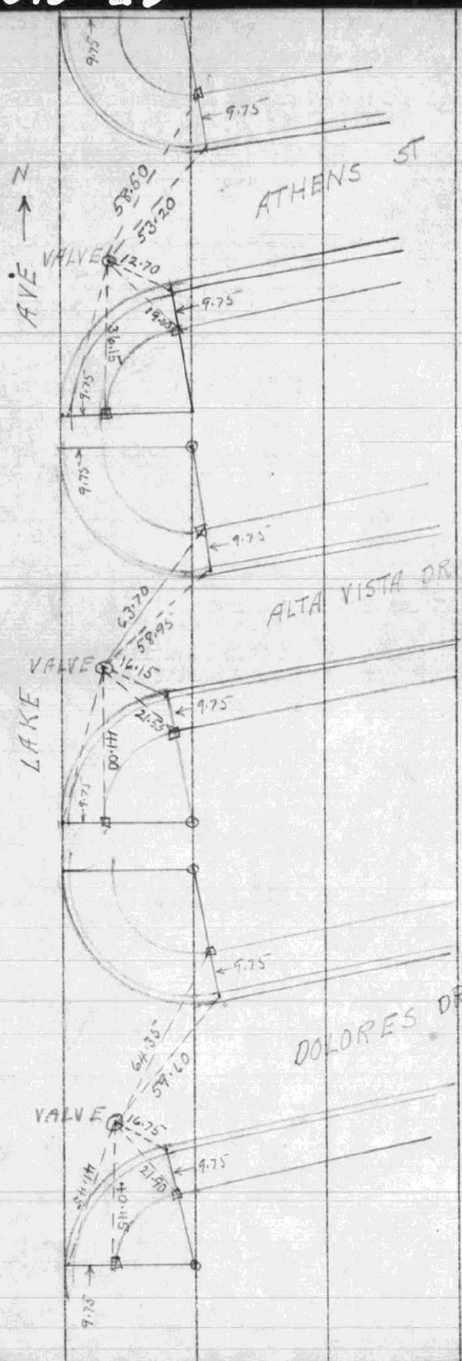

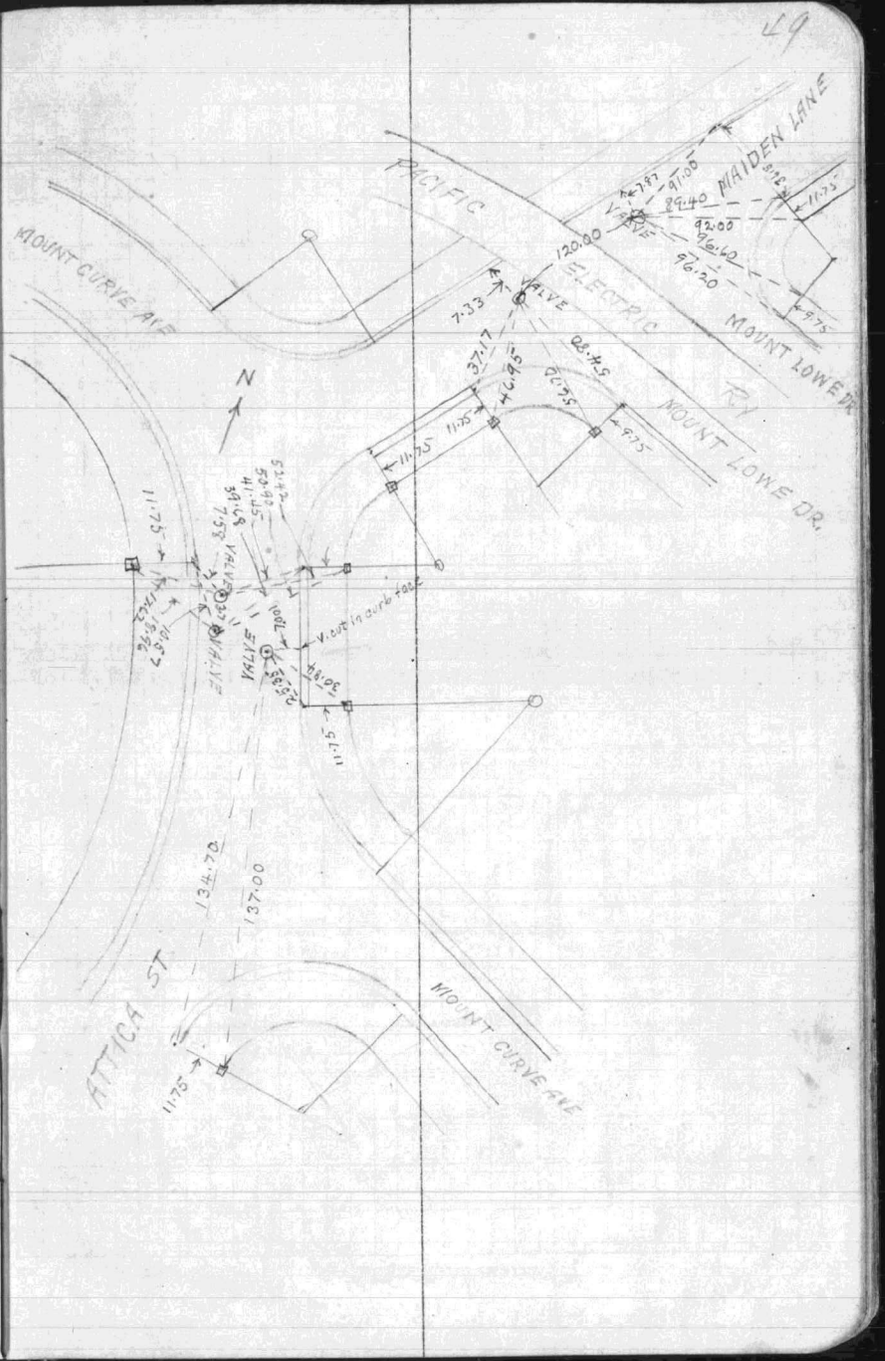

F.B. 1313-31

F.B. 170
C.P. Day Notes.

F.B. 1313-32

50

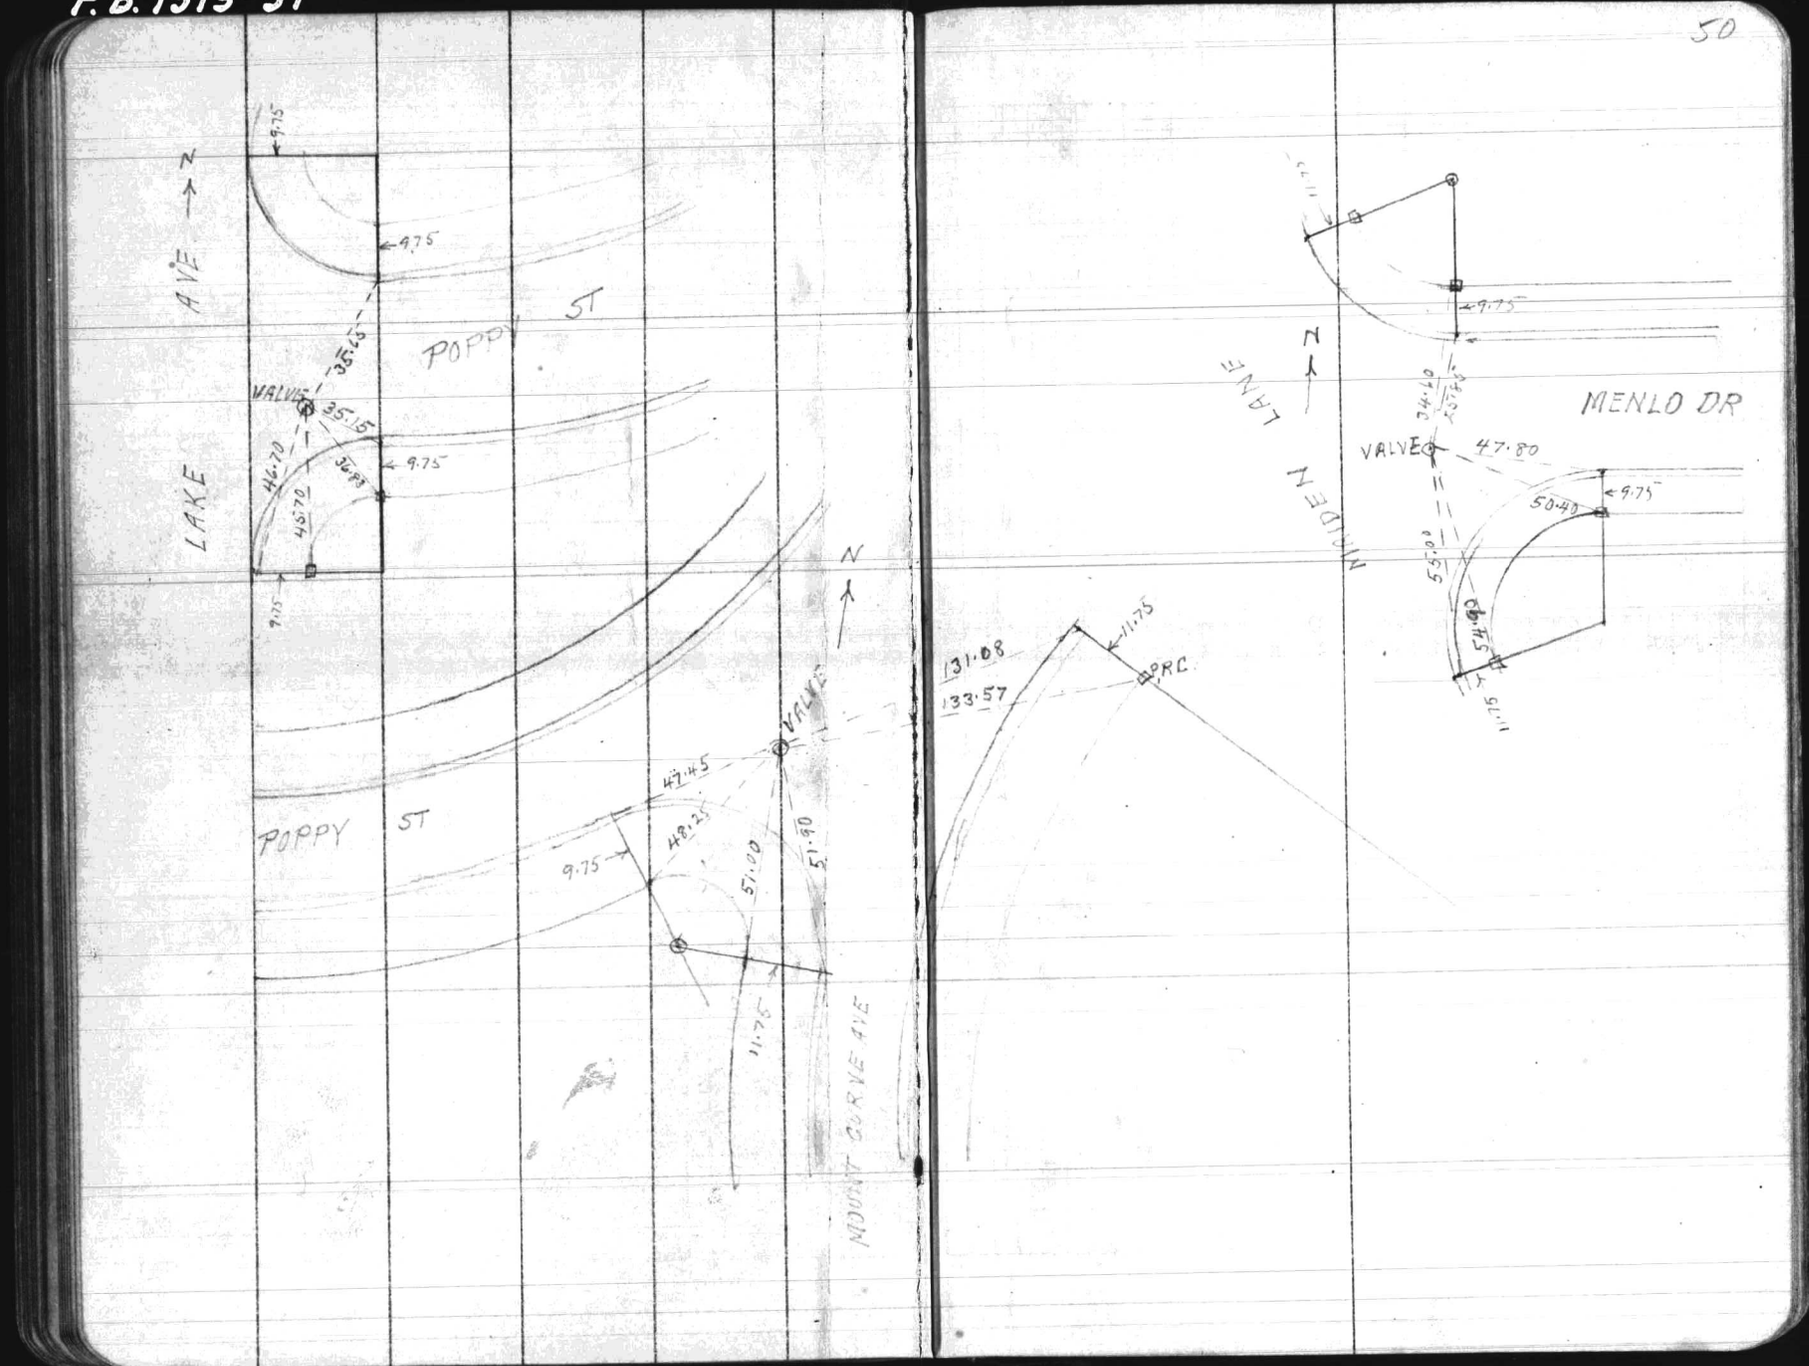

F.B. 1313-33

SHEET 1 OF 5 SHEETS

Job No. 4522 Date 8-26-47
Lot No. 10-16 F. B.
Tract 3546
Client YEAGER

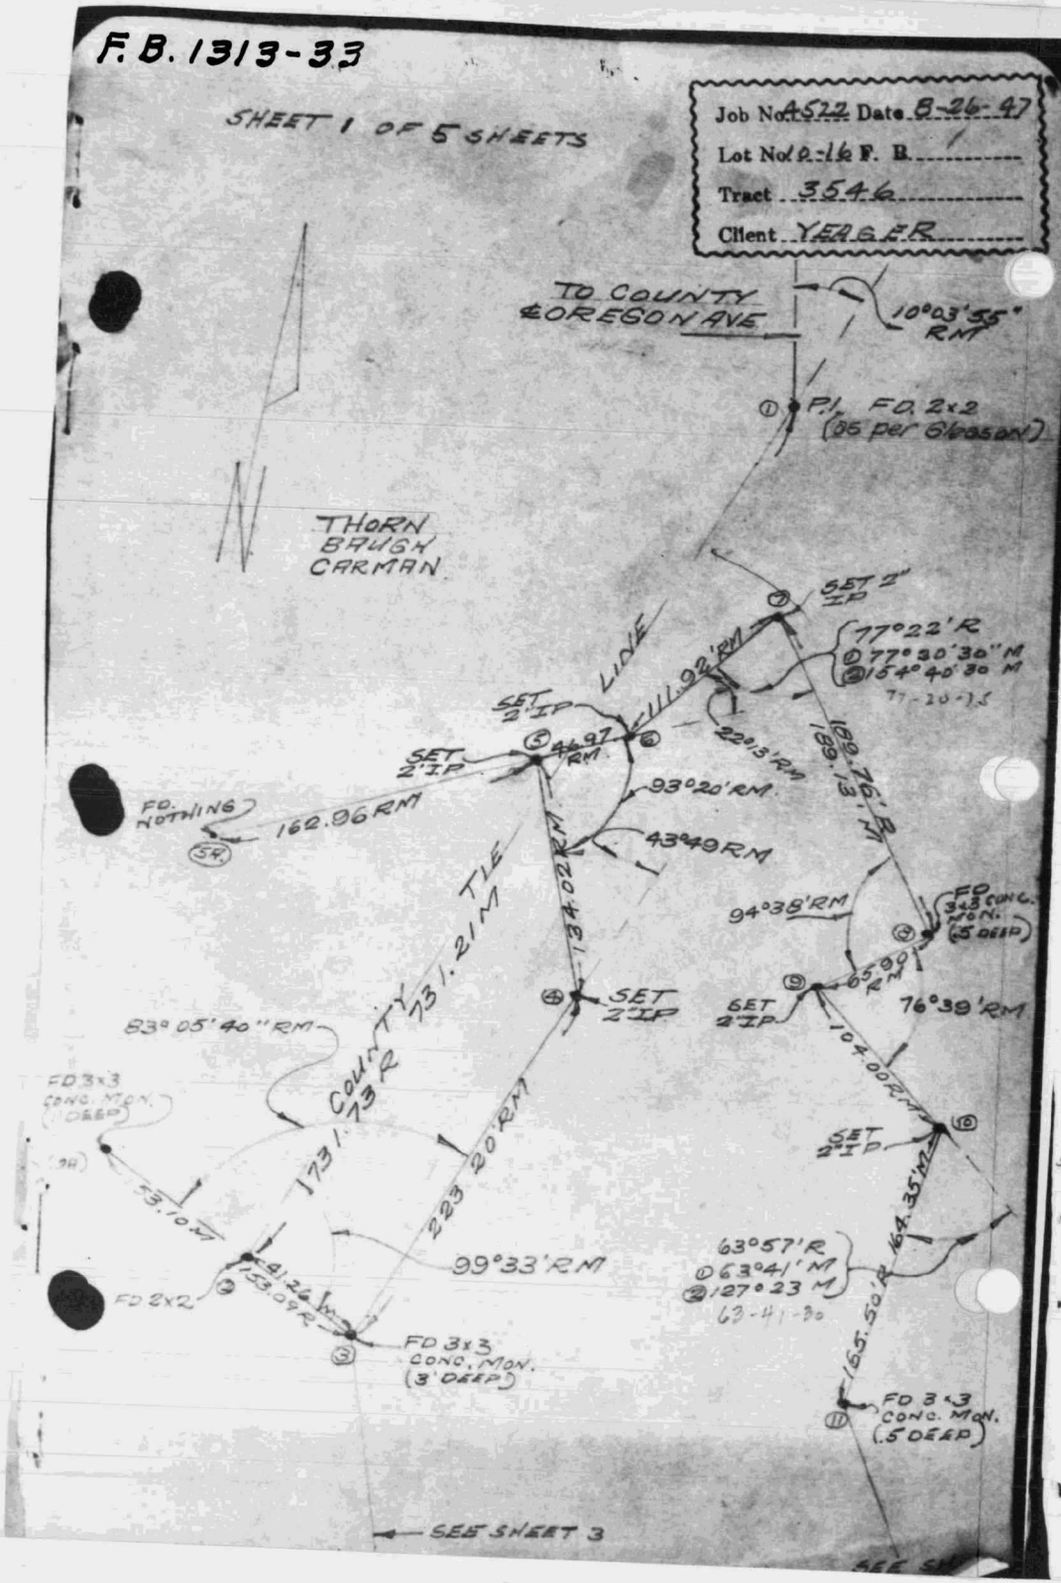

F.B. 1313-34

SHEET 2 OF 5 SHEETS

Job No. 4522 Date
Lot No. 10-16 F. B.
Tract 3546
Client YEAGER

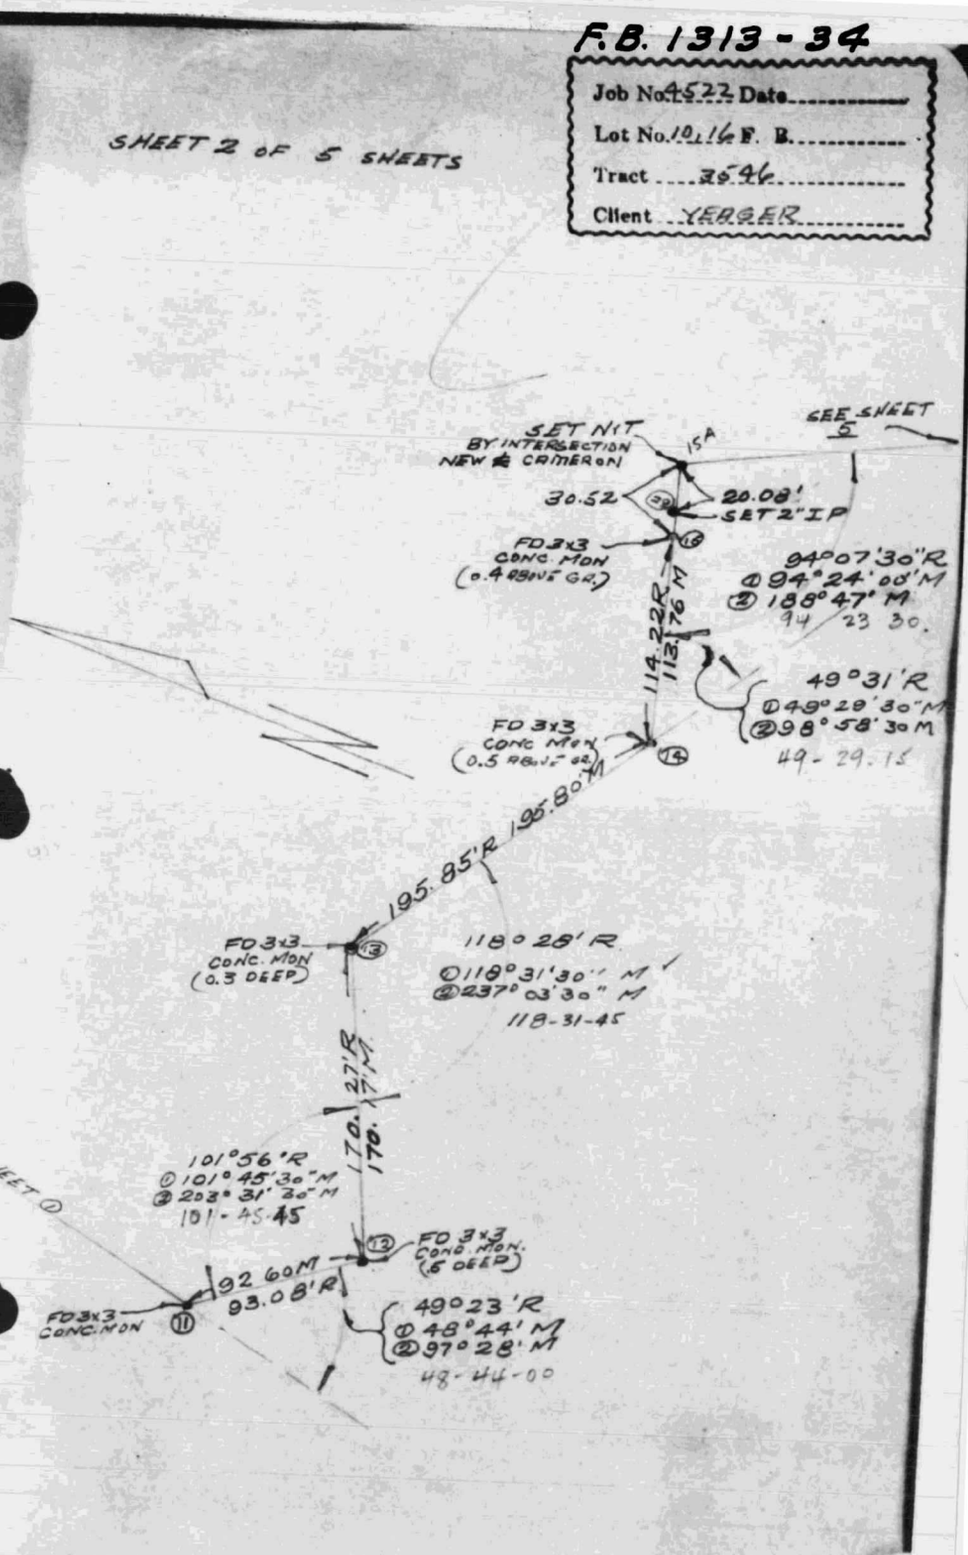

F.B. 1313-35

SEE SHEET 1

SHEET 3 OF 5 SHEETS

Job No. 4522 Date
Lot No. 10, 16 F. B.
Tract 3546
Client YEAGER

37°45' R
① 37°38' M
② 75°16' 30" M
37-38-15

421.01'M
422.79'R

FD 3x3 CONC. MON (0A ABOVE GR.)

137.10 R
136.63 M

42°11' R
① 42°00' M
② 84°00' M

FD 3x3 CONC MON. (1.5 DEEP)

262.00 R
261.40 M

42°14' R
① 41°49' 30" M
② 83°39' 30" M
41 49 45

FD 3x3 CONC. MON. (1.2 DEEP)

SEE SHEET (4)

F.B. 1313-36

SHEET 4 OF 5 SHEETS

Job No. 4522 Date
Lot No. 10, 16 F. B.
Tract 3546
Client YEAGER

SEE SHEET 3

SET NAIL

196.02' R.M. & CAMERON

SET 2" IP

109°52' R.M.

SET NAIL

PI

98.92

101°00' R

SET N.T.

SET NAIL

SET 2" IP

184.76' R.M. & CAMERON

SET NAIL

SET 2" IP

EC

119°05' R

126.38' R (CHORD)

SET 2" IP

224.90' R

57°25' R

SET 2" IP

112°26' R

87.45' R

SEE SHEET 3

F. B. 1313-37

Job No. 4522 Date
Lot No. 10, 16 F. B.
Tract 3546
Client YEAGER

SHEET 5 OF 5 SHEETS

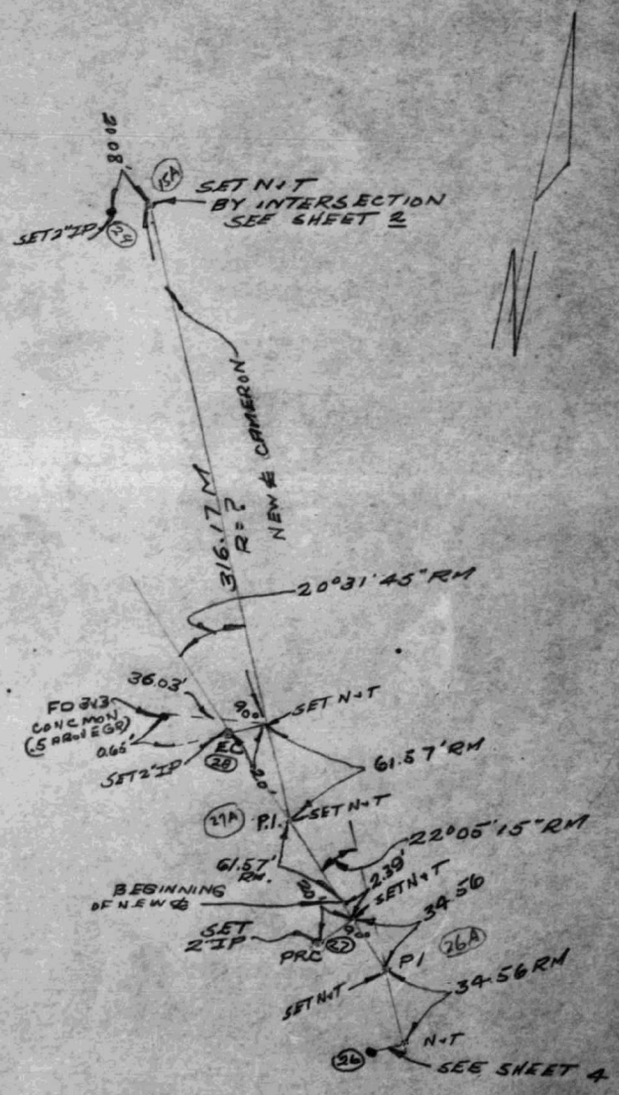

F. B. 1313-38

HAROLD A. BARNETT CIVIL ENGINEER 35 SO. RAYMOND AVE. PASADENA 1, CALIF. R. E. 1216	PARTY D. Smith Doherty Barton	JOB NO. 6423 LOT Por. 10 TRACT 3546 CLIENT W. B. Kail DATE 11-7-50
	SHEET 1 OF 1 SHEETS	

1

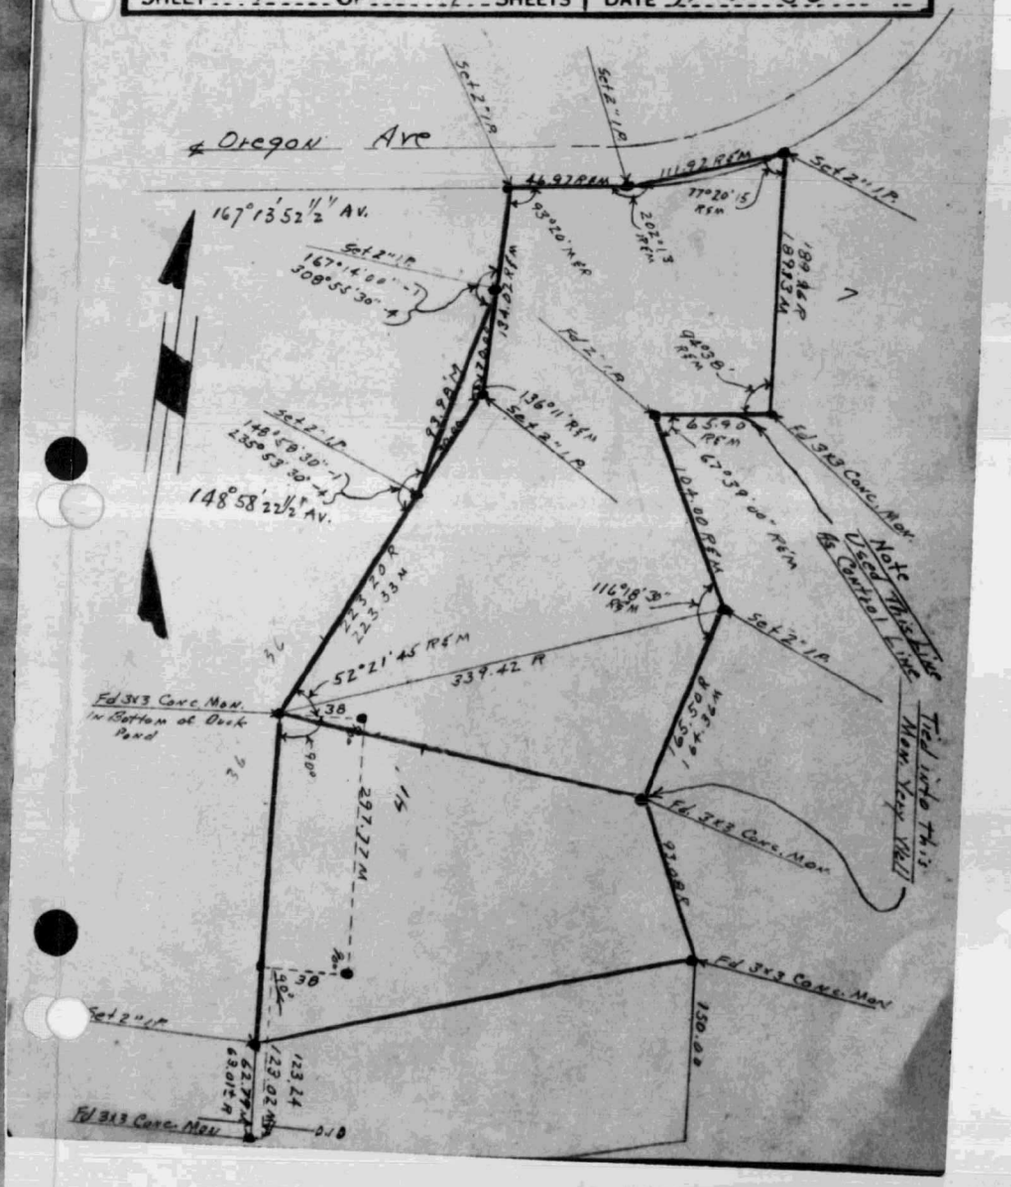

F.B. 1313-39

F.B. 1313-40

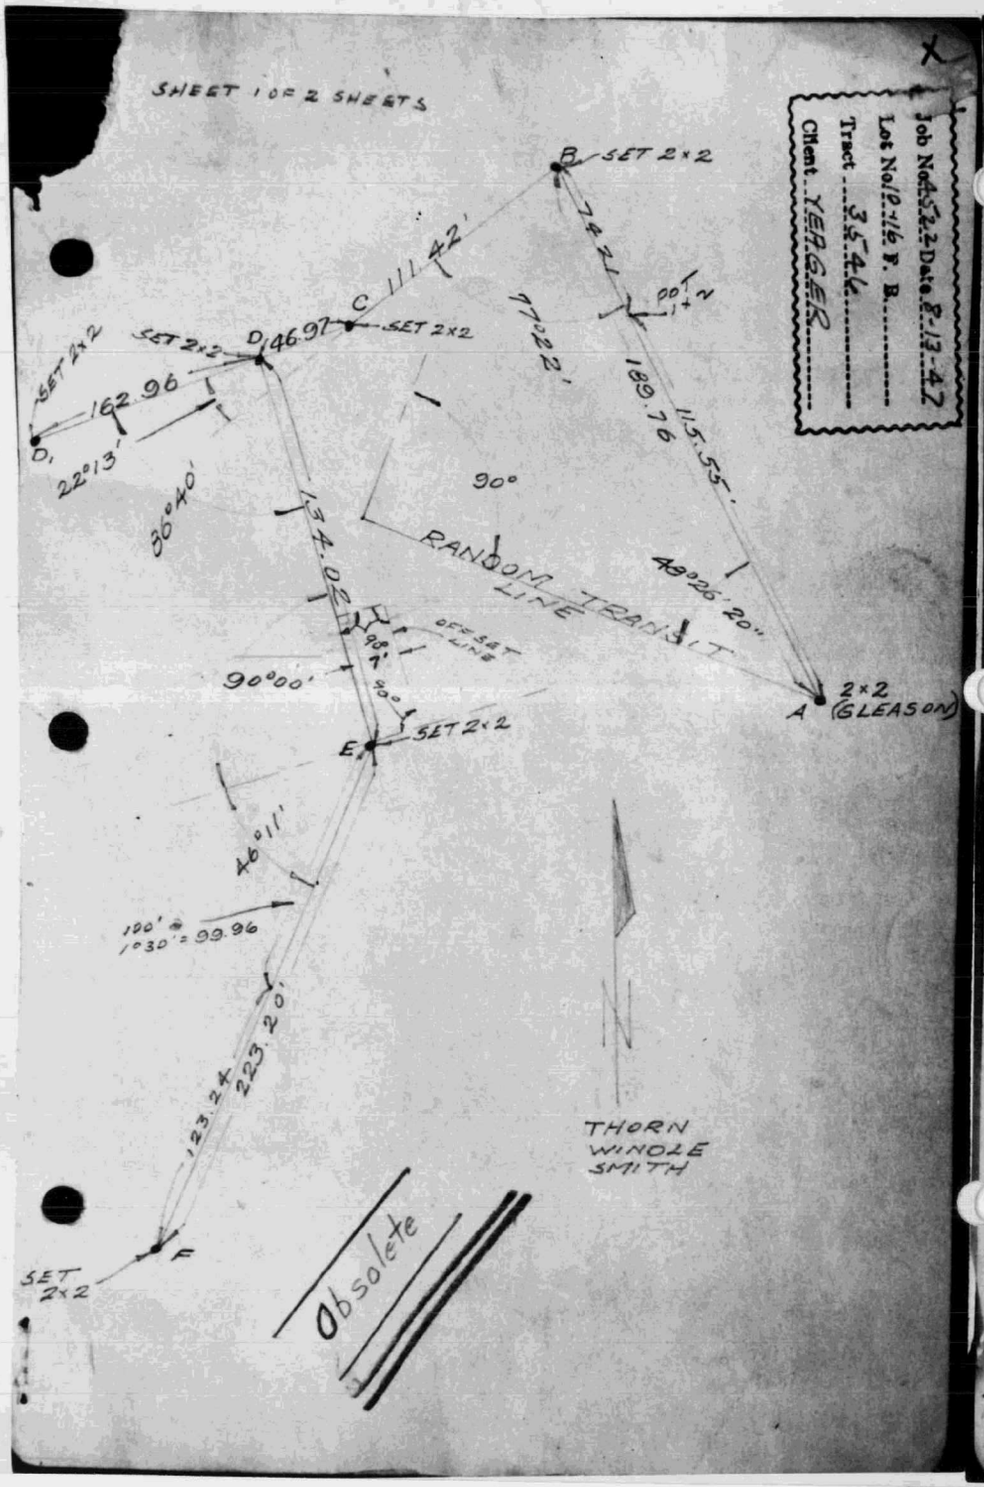

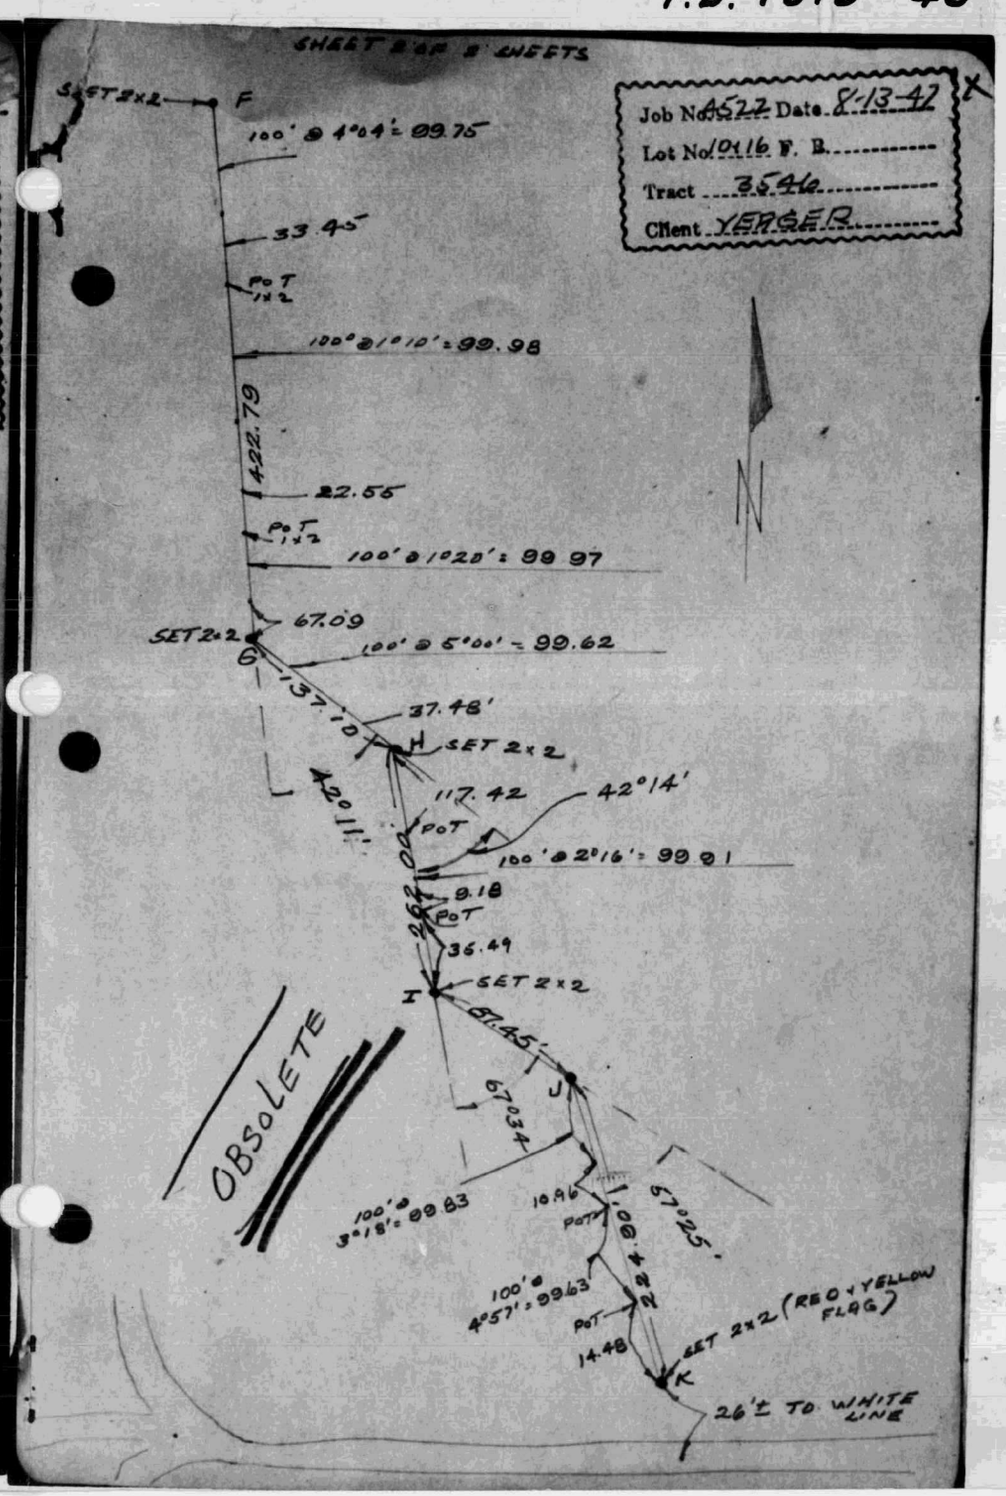

Co. Eng. F.B. 1313:41

SURVEY OF SAN GABRIEL BLVD F B NO. PAGE

SURVEY BY WEACCO INC. TRACT NO. Tie on San Gabriel Blvd. & Marshall St.

DATE 10-18-1967

W.S. 44-B-6

L.S. 2970 T.H. Shima Jr.

MARSHALL ST.

Set Nail & Tie's Pc - C5FB - 1405 Pg - 16

Set 2" I.P. & By. Cap in H.H. & Tie's Per RDFB 505-21

Fd L&T & Prod

Set L&T

Fd L&T

SAN GABRIEL BLVD.

To Nail @ Norwood Place Set & Tie's C5FB 1405-16

1) 89° 58'
2) 179° 56' 00"
4) 359° 58' 20"
= 89° 58' 00"
M & RDFB-505-21

89° 58' 00"

61.40 M

43.37 M

45.97

23.26 M

179° 58' 00" Per RDFB 505-21

45.87

Set L&T

Fd L&T

MARSHALL

SAN

100'

50' 50'

1313:42

Co. Eng. F.B. 1313:42

SURVEY OF SAN GABRIEL BLVD F B NO. PAGE

SURVEY BY WEACCO INC. TRACT NO. Tie on San Gabriel Blvd. & Central Ave.

DATE 10 - 18 - 1967

W.S. 44-B5

L.S. 2970 T.A. Shima Jr.

Fd C.S. Mon. in H.H. Per C.S.F.B. 1421-23 Poured Cover To Surface

50' Fure

Fd L&T

BLVD

Fd L&T

100'

90°

54.09 M

54.61 M

30'

CENTRAL

AVE

30'

60'

30'

30'

54.165 M

54.46 M

Fd L&T

SAN GABRIEL

Fd L&T

50' 50'

100'

To C.S. Mon @ Per C5FB-1421-21

1) 90° 08' 12"
2) 180° 13' 36"
4) 00° 33' 00"
90° 08' 16" Av.

(90° 08' 25" Per C5FB 1421-23

To C.S. Mon @ & Gladys Ave Per C5FB 1421-31

SURVEYORS SERVICE COMPANY - LOS ANGELES - STOCK NO. 411

DO NOT EXTEND NOTES THIS SIDE OF LINE