INDEX TO F.B. 1764

| DATE | J.N. | DESCRIPTION | NOTES | PAGES |
|---|---|---|---|---|
| 10-52 | 8650 | CENTERLINE SURVEY FOR PROPOSED SEWER PROJECTS SOUTH WHITTIER AREA No. 1 | C.L. | 5-140 |
| 6-54 | 0303.00 | CENTERLINE SURVEY INEZ STREET SEWER DISTRICT | C.L. | 141-169 |
| 7-54 | " | " " LUKAY ST. " " | C.L. | 171-178 |
| 6-55 | 1773.14 | " " CREME ST. " " | C.L. | 179-191 |
| 8-58 | 0303.00 | " " ALLEGAN ST. " " | C.L. | 193-217 |

Microfilmed Feb 87

D.W. file o.k. June 87

Notes Ck'd by
Map No.
Office Work
Checked
Date

Survey of
JN Tape Std oF
Surveyed by
Notes Date
Indexed

F.B. PG.

PWFB 0827 2024

F. B. ~~1764~~ Pg. ~~5~~

| | |
|---|---|
| Notes Ck'd by [illegible] | Survey of So. Whittier Area #1 |
| Map No. C.S.P. 2 Pull-1-3 | W. O. 8650 Tape No. [illegible] St'd. 68 °F |
| Office Work R. L. Green | Surveyed by MACK |
| Checked C. J. Galli | Notes [illegible] Date 10-[illegible] |
| Date [illegible] | Indexed [illegible] |

℄ SURVEY FOR PROPOSED SEWER PROJECTS

J.N. 8650

SOUTH WHITTIER AREA #1

PARTY

MACK CHIEF
FRONK A
TAFOYA R.C.
MOODY R.C.

Note: Any Additions or Changes on This Sheet Must be Made or Circled in Red Ink With Date and Name of Person Making Change.

Do not extend notes this side of this line.

RETURN TO
LOS ANGELES COUNTY SURVEYOR
726 LOS ANGELES COUNTY
ENGINEERING BLDG.

76F3095 247 2-51

F. B. 1764 Pg. 6

PWFB 0827

2025

& INDEX TO PAGES

RETURN TO
LOS ANGELES COUNTY SURVEYOR
726 LOS ANGELES COUNTY
ENGINEERING BLDG.

Do not extend notes this side of this line.

Note: Any Additions or Changes on This Sheet Must be Made or Circled in Red Ink With Date and Name of Person Making Change.

PWFB 0828 1168, 1169, 1170, 1171

| | |
|---|---|
| Notes Ck'd by | Survey of |
| Map No. | W. O. Tape No. Std. |
| Office Work | Surveyed by |
| Checked | Notes Date |
| Date | Indexed |

F. B. Pg.

INDEX TO PAGES (CONT.)

Note: Any Additions or Changes on This Sheet Must be Made or Circled in Red Ink With Date and Name of Person Making Change.

Do not extend notes this side of this line.

RETURN TO
LOS ANGELES COUNTY SURVEYOR
726 LOS ANGELES COUNTY
ENGINEERING BLDG.

76F309S 247 2-51

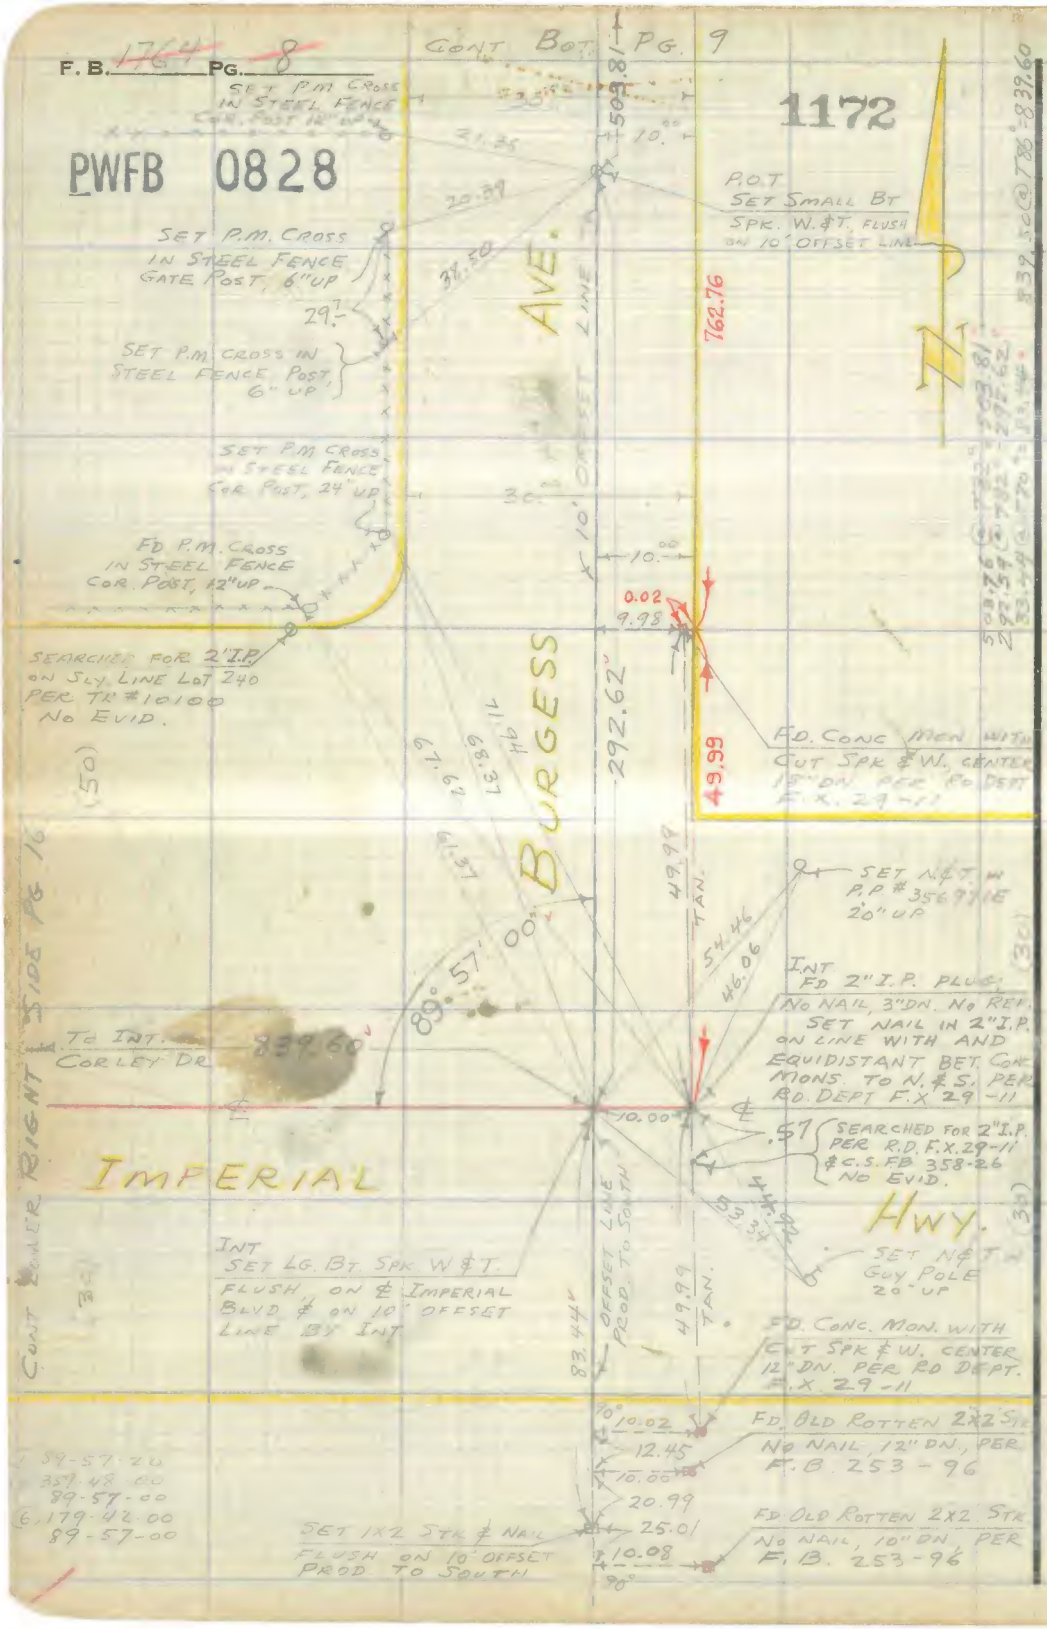


RETURN TO
LOS ANGELES COUNTY SURVEYOR
726 LOS ANGELES COUNTY
ENGINEERING BLDG.

Do not extend notes this side of this line.

Note: Any Additions or Changes on This Sheet Must be Made or Circled in Red Ink With Date and Name of Person Making Change.

PWFB 0828 1173, 1174

F. B. 1764 PG. 9

| | |
|---|---|
| Notes Ck'd by [illegible] | Survey of So. Whittier Ave. |
| Map No. [illegible] | W. O. 8650 Tape No. 0134 St'd. 68 °F |
| Office Work [illegible] | Surveyed by MACK |
| Checked [illegible] | Notes Date [illegible] |
| Date [illegible] | Indexed [illegible] |

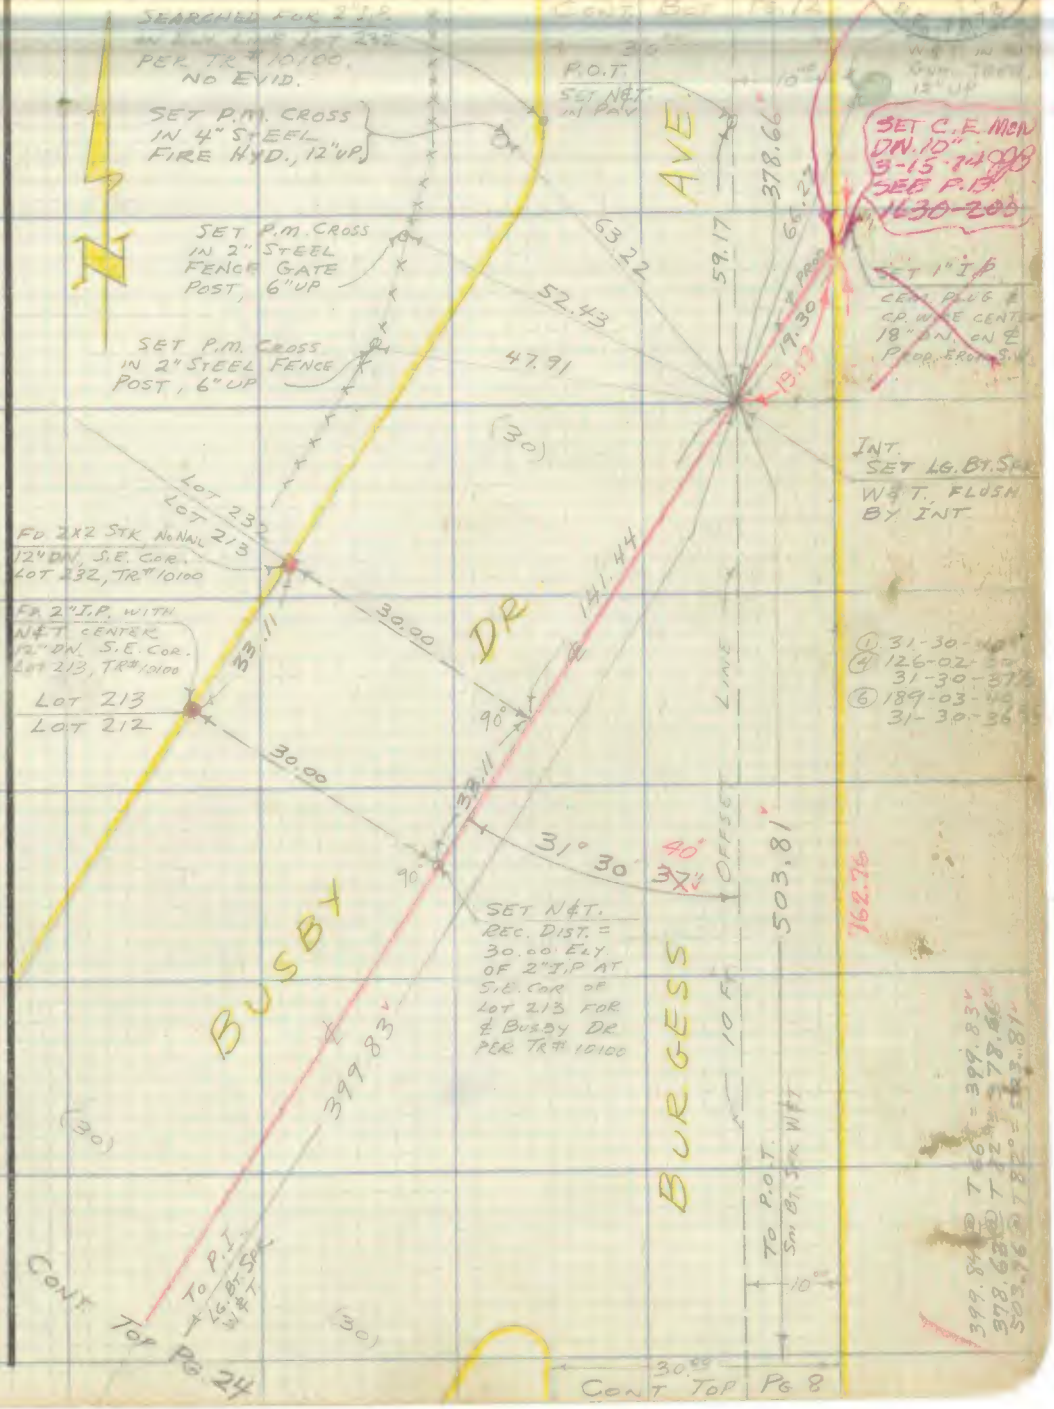


Note: Any Additions or Changes on This Sheet Must be Made or Circled in Red Ink With Date and Name of Person Making Change.

Do not extend notes this side of this line.

RETURN TO
LOS ANGELES COUNTY SURVEYOR
726 LOS ANGELES COUNTY
ENGINEERING BLDG.

76F3095 247 2-51

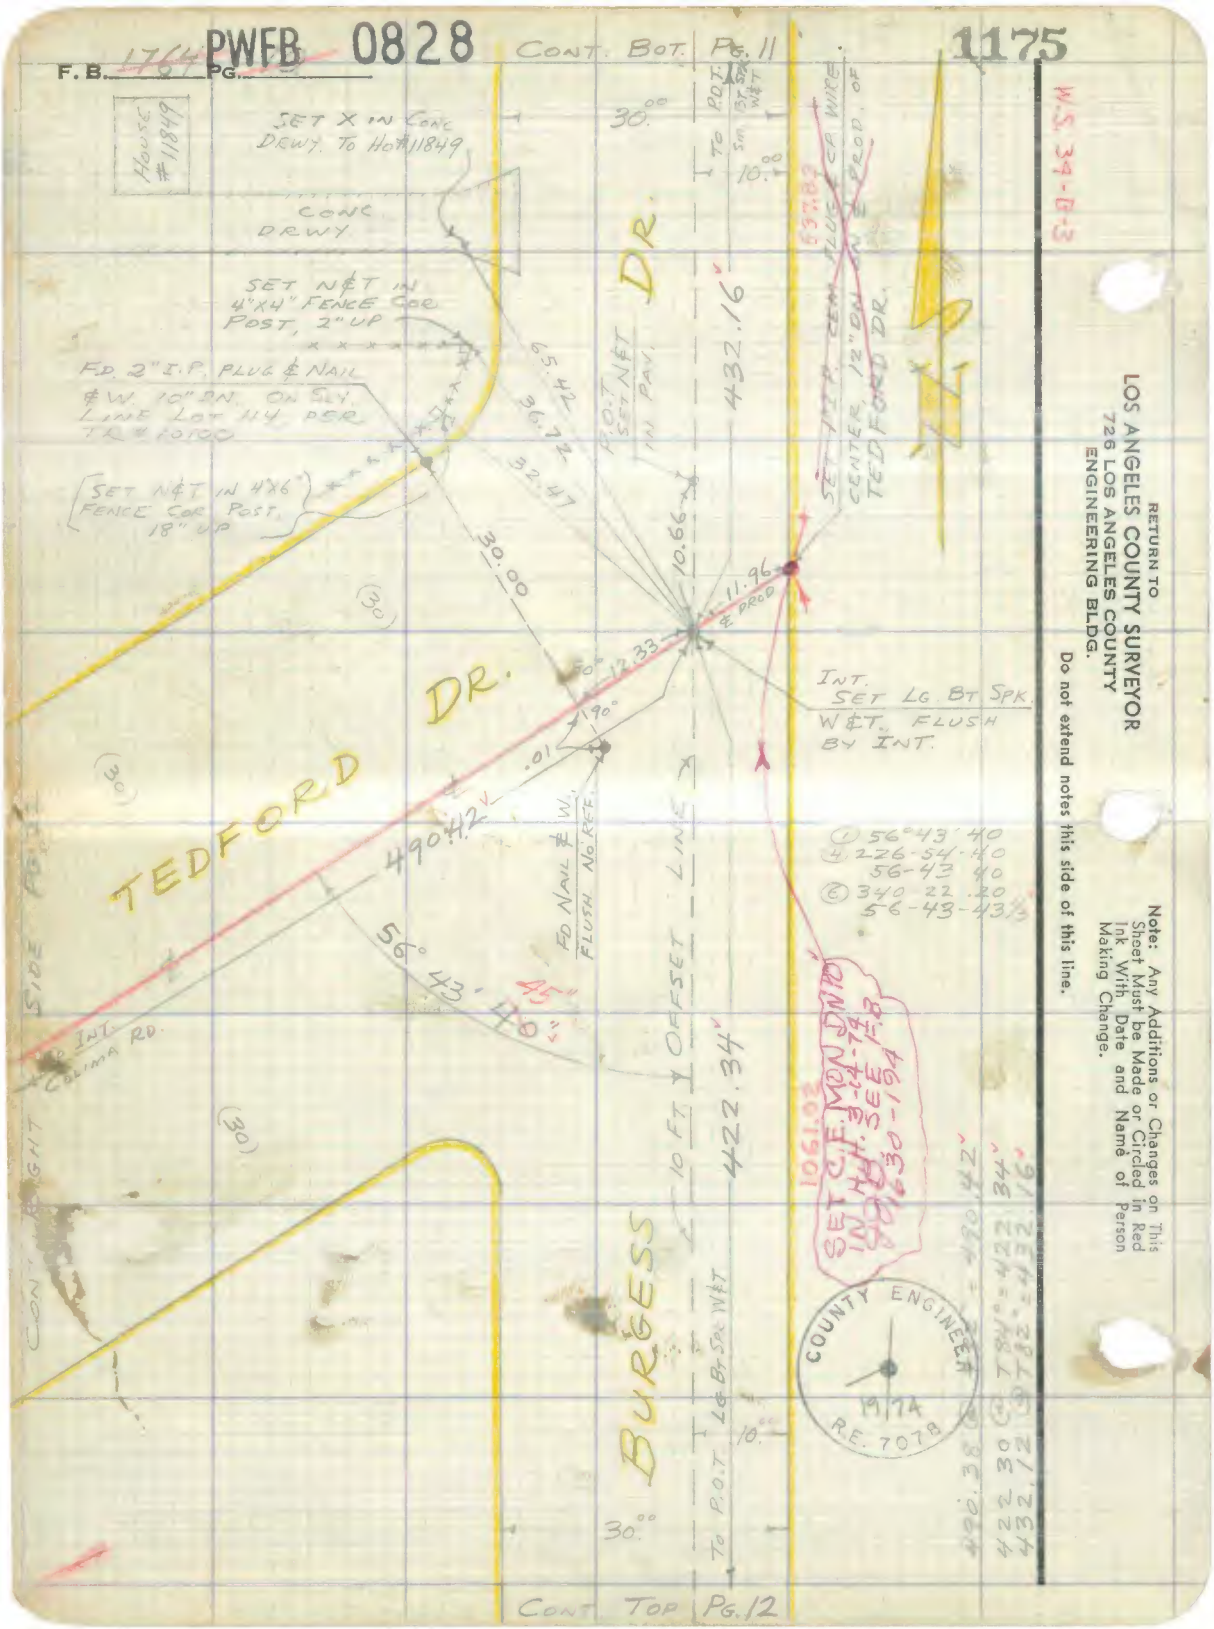


RETURN TO
LOS ANGELES COUNTY SURVEYOR
726 LOS ANGELES COUNTY
ENGINEERING BLDG.

Do not extend notes this side of this line.

Note: Any Additions or Changes on This Sheet Must be Made or Circled in Red Ink With Date and Name of Person Making Change.

PWFB 0828 1176

| | |
|---|---|
| Notes Ck'd by | Survey of |
| Map No. | W. O. Tape No. St'd. °F |
| Office Work | Surveyed by |
| Checked | Notes Date |
| Date | Indexed |

F. B. Pg.

Note: Any Additions or Changes on This Sheet Must be Made or Circled in Red Ink With Date and Name of Person Making Change.

Do not extend notes this side of this line.

RETURN TO
LOS ANGELES COUNTY SURVEYOR
726 LOS ANGELES COUNTY
ENGINEERING BLDG.

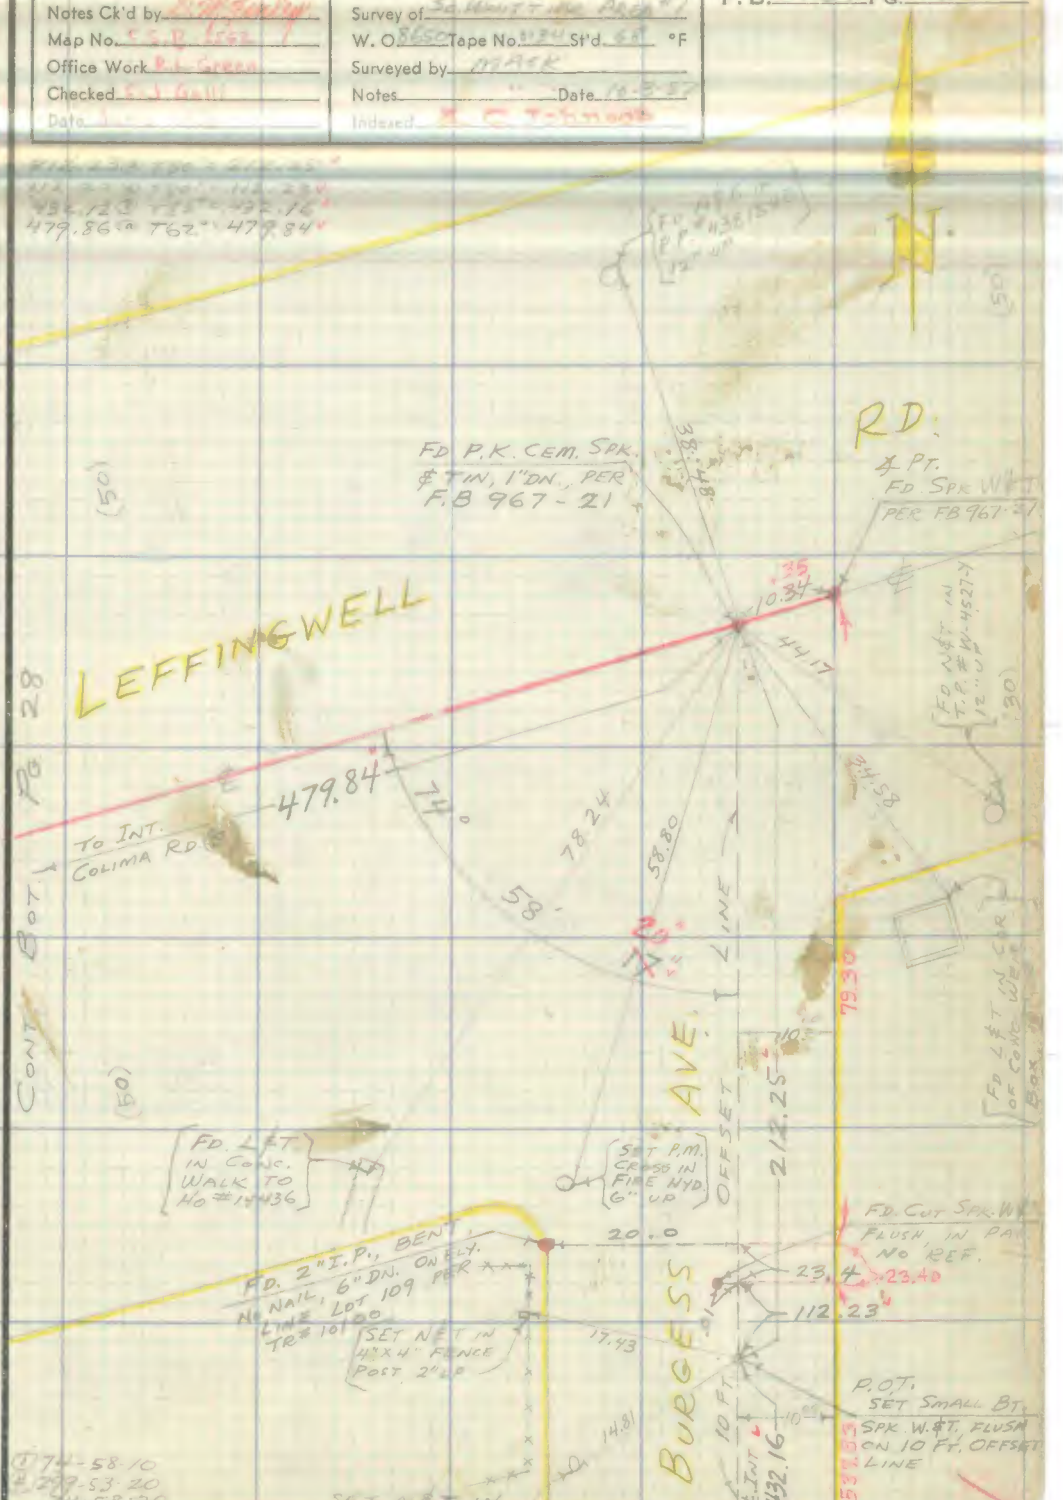


76F309S 247 2-51

F. B. 1764 PG. 12

PWFB 0828

CONT BOT PG 10 1177, 1178

W.S. 39-8-3

RETURN TO
LOS ANGELES COUNTY SURVEYOR
726 LOS ANGELES COUNTY
ENGINEERING BLDG.

Do not extend notes this side of this line.

Note: Any Additions or Changes on This Sheet Must be Made or Circled in Red Ink With Date and Name of Person Making Change.

PWFB 0827 2027

| | |
|---|---|
| Notes Ck'd by | Survey of |
| Map No. | W. O. Tape No. St'd. °F |
| Office Work | Surveyed by |
| Checked | Notes Date |
| Date | Indexed |

F. B. PG.

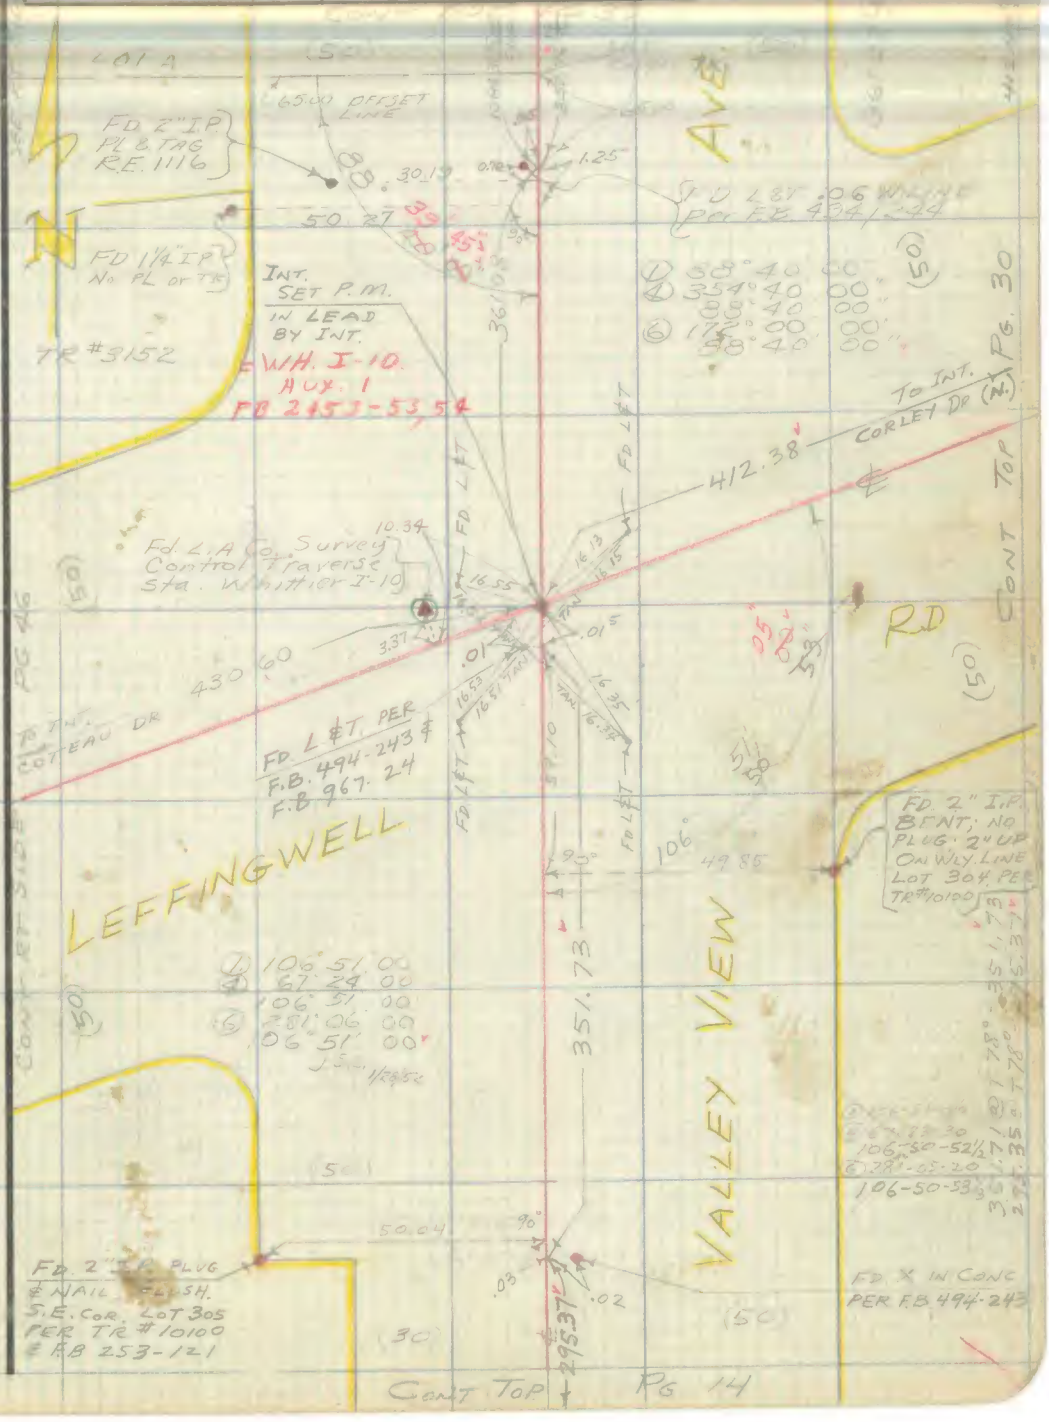


Note: Any Additions or Changes on This Sheet Must be Made or Circled in Red Ink With Date and Name of Person Making Change.

Do not extend notes this side of this line.

RETURN TO
LOS ANGELES COUNTY SURVEYOR
726 LOS ANGELES COUNTY
ENGINEERING BLDG.

76F3095 247 2-51

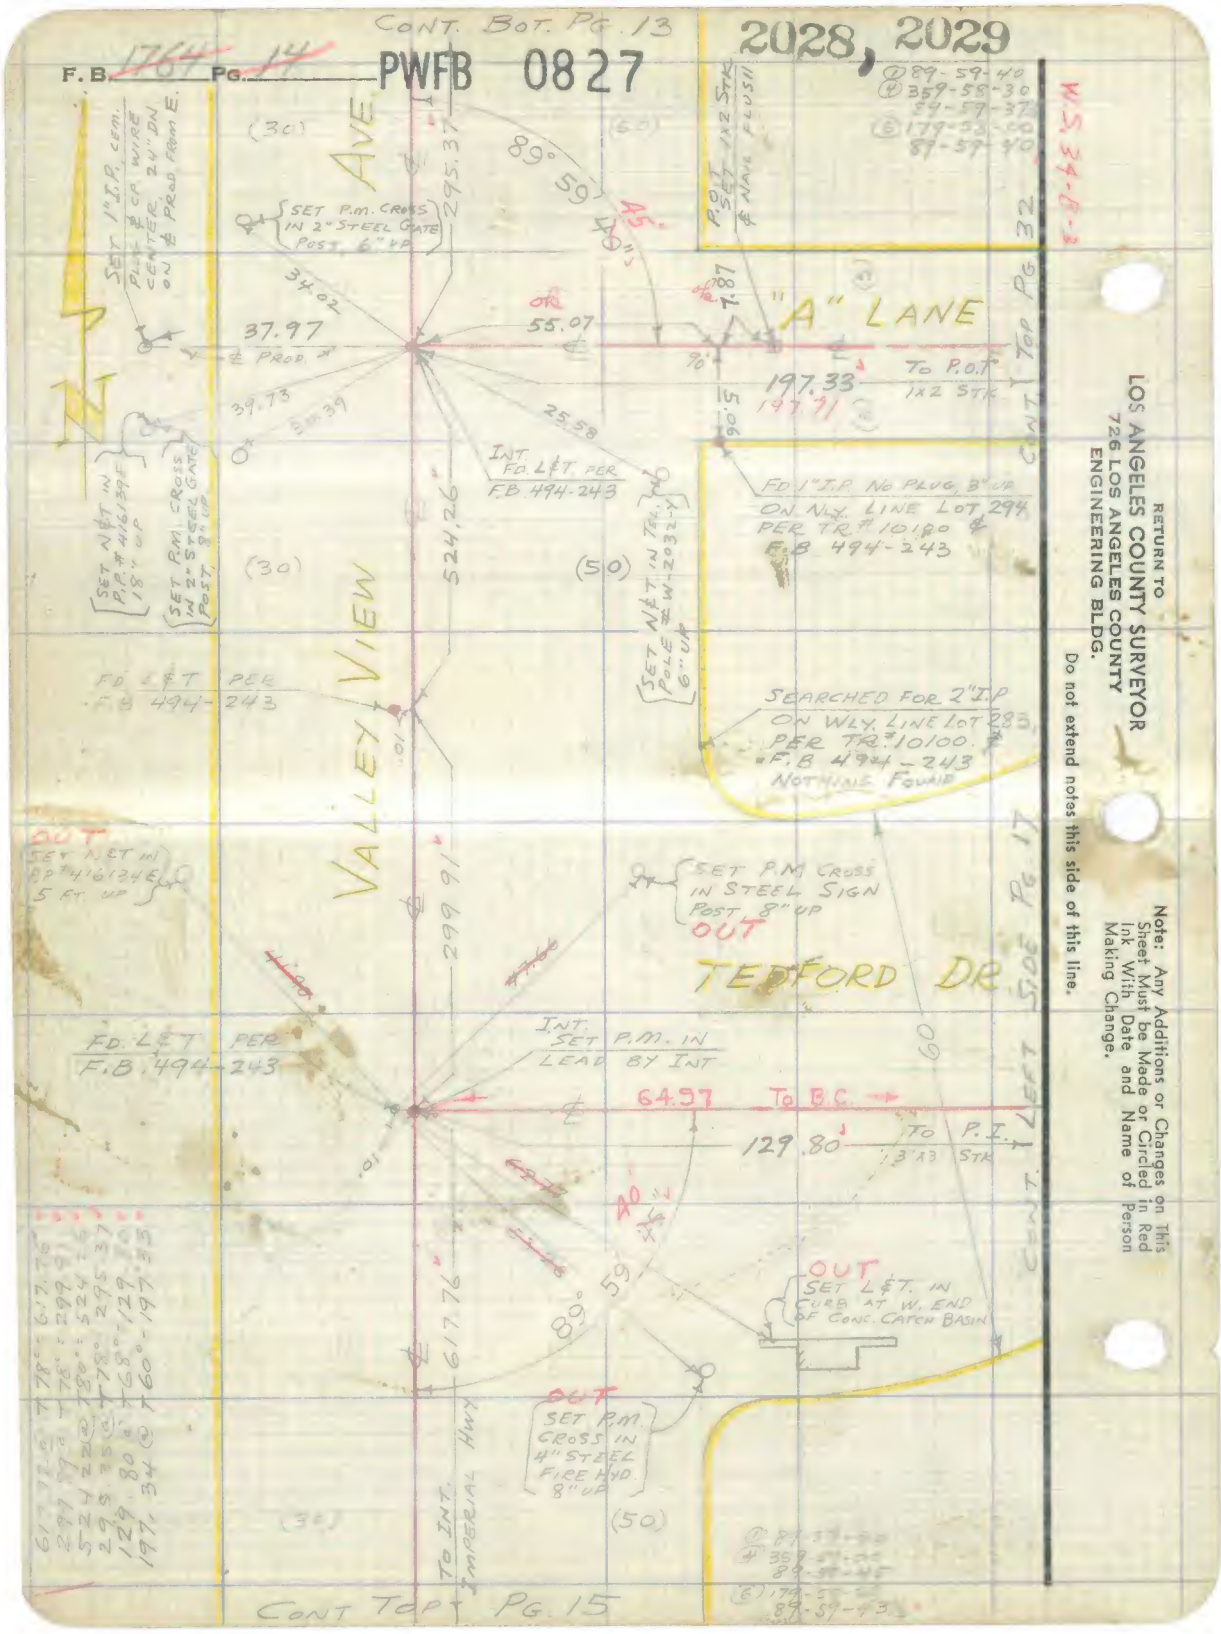
CONT. BOT. PG. 13
2028, 2029
F.B. 1764 PG. 14
PWFB 0827
W.S. 34-B-3
SET 1" I.P. CEM. PLUG & CP. WIRE CENTER, 24" DN ON ℄ PROD FROM E.
SET P.M. CROSS IN 2" STEEL GATE POST, 6" UP
295.37
89° 59'
A5
P.O.T. SET 1x2 STK & NAIL FLUSH
"A" LANE
37.97
℄ PROD.
55.07
197.33
197.91
TO P.O.T. 1x2 STK
INT. FD. L&T. PER F.B. 494-243
FD 1" I.P. NO PLUG, 3" UP ON NLY. LINE LOT 294 PER TR. #10100 & F.B. 494-243
SET N&T IN P.P. #416139E 18" UP
SET P.M. CROSS IN 2" STEEL GATE POST, 8" UP
524.26
SET N&T IN TEL. POLE #W-2032-Y 6" UP
VALLEY VIEW
FD L&T PER F.B. 494-243
SEARCHED FOR 2" I.P. ON WLY. LINE LOT 283, PER TR. #10100 & F.B. 494-243 NOTHING FOUND
OUT
SET N&T IN P.P. #416134E 5 FT. UP
SET P.M. CROSS IN STEEL SIGN POST 8" UP
OUT
TEDFORD DR
299.91
FD. L&T PER F.B. 494-243
INT. SET P.M. IN LEAD BY INT
64.97
TO B.C.
129.80
TO P.I. 3"x3 STK
A0
OUT
SET L&T. IN CURB AT W. END OF CONC. CATCH BASIN
89° 59'
617.76
OUT
SET P.M. CROSS IN 4" STEEL FIRE HYD. 8" UP
TO INT. IMPERIAL HWY
CONT. TOP PG. 32
CONT. LEFT SIDE PG. 17
CONT TOP PG. 15
RETURN TO
LOS ANGELES COUNTY SURVEYOR
726 LOS ANGELES COUNTY
ENGINEERING BLDG.
Do not extend notes this side of this line.
Note: Any Additions or Changes on This Sheet Must be Made or Circled in Red Ink With Date and Name of Person Making Change.

76F309S 247 2-51

RETURN TO
LOS ANGELES COUNTY SURVEYOR
726 LOS ANGELES COUNTY
ENGINEERING BLDG.

**Note:** Any Additions or Changes on This Sheet Must be Made or Circled in Red Ink With Date and Name of Person Making Change.

Do not extend notes this side of this line.

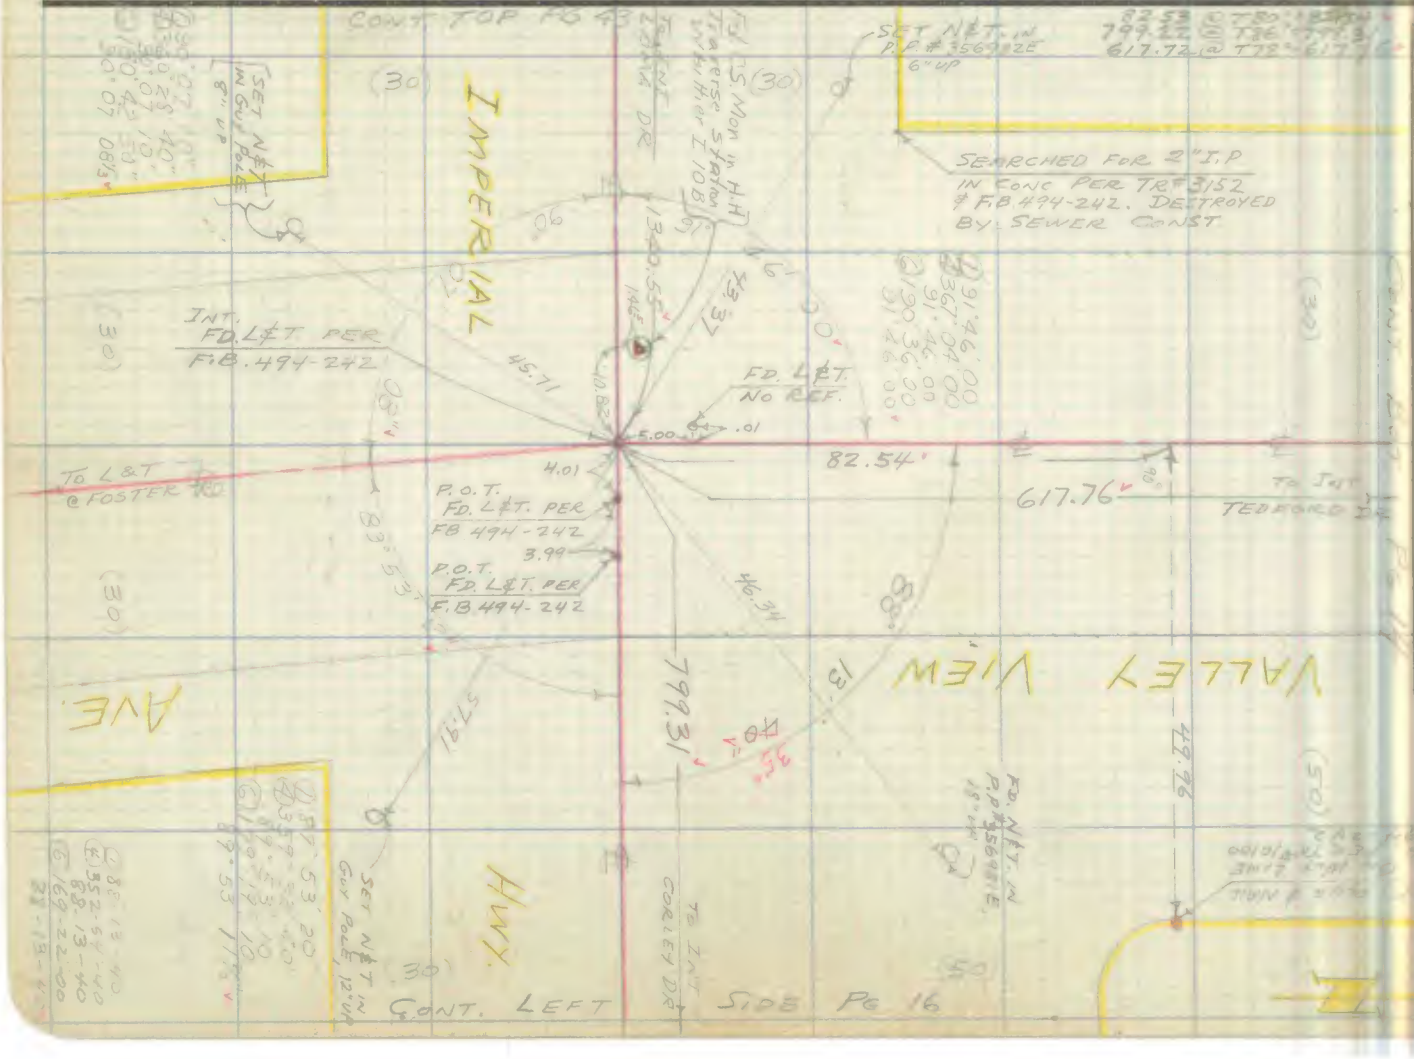


PWFB 0827

2030

Notes Ck'd by
Map No.
Office Work
Checked
Date

Survey of
W. O. Tape No. St'd. °F
Surveyed by
Notes Date
Indexed

F. B. 1744 Pg. 15

F. B. 1764 PG. 16

2031

PWFB 0827

COUNTY ENGINEER R.E. 7078

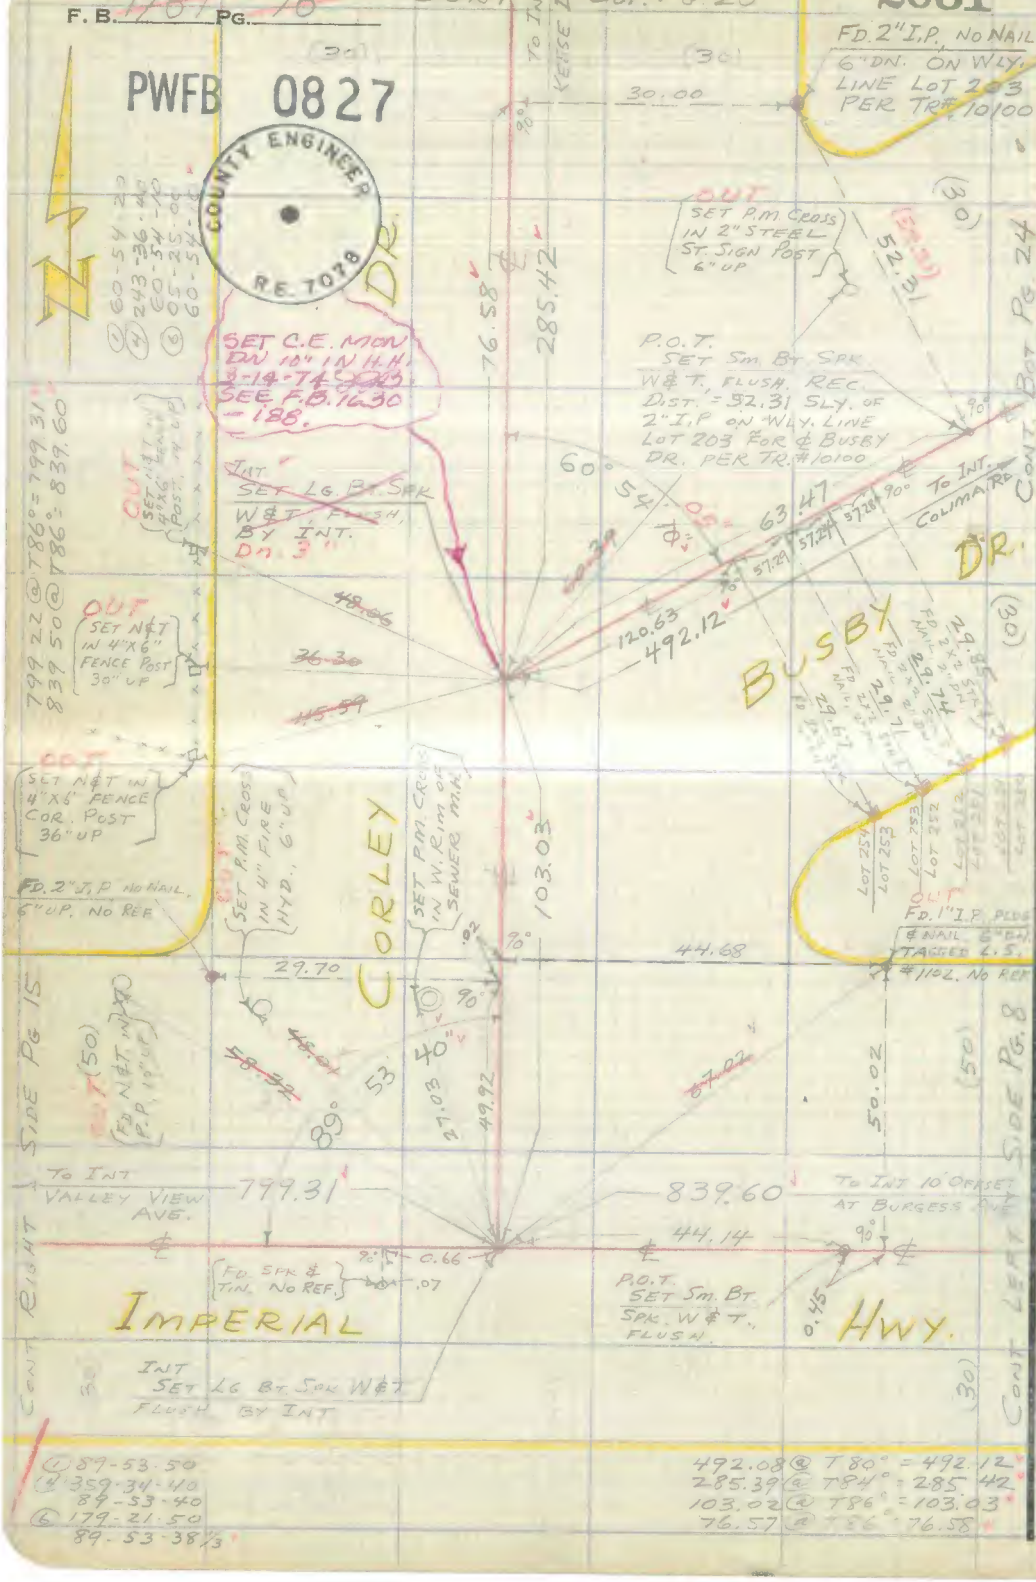


W.S.-34-B-3

RETURN TO
LOS ANGELES COUNTY SURVEYOR
726 LOS ANGELES COUNTY
ENGINEERING BLDG.

Do not extend notes this side of this line.

Note: Any Additions or Changes on This Sheet Must be Made or Circled in Red Ink With Date and Name of Person Making Change.

PWFB 0827 2032, 2033

| | |
|---|---|
| Notes Ck'd by | Survey of |
| Map No. | W. O. Tape No. St'd. °F |
| Office Work | Surveyed by |
| Checked | Notes Date |
| Date | Indexed |

F. B. Pg.

Note: Any Additions or Changes on This Sheet Must be Made or Circled in Red Ink With Date and Name of Person Making Change.

Do not extend notes this side of this line.

RETURN TO
LOS ANGELES COUNTY SURVEYOR
726 LOS ANGELES COUNTY
ENGINEERING BLDG.

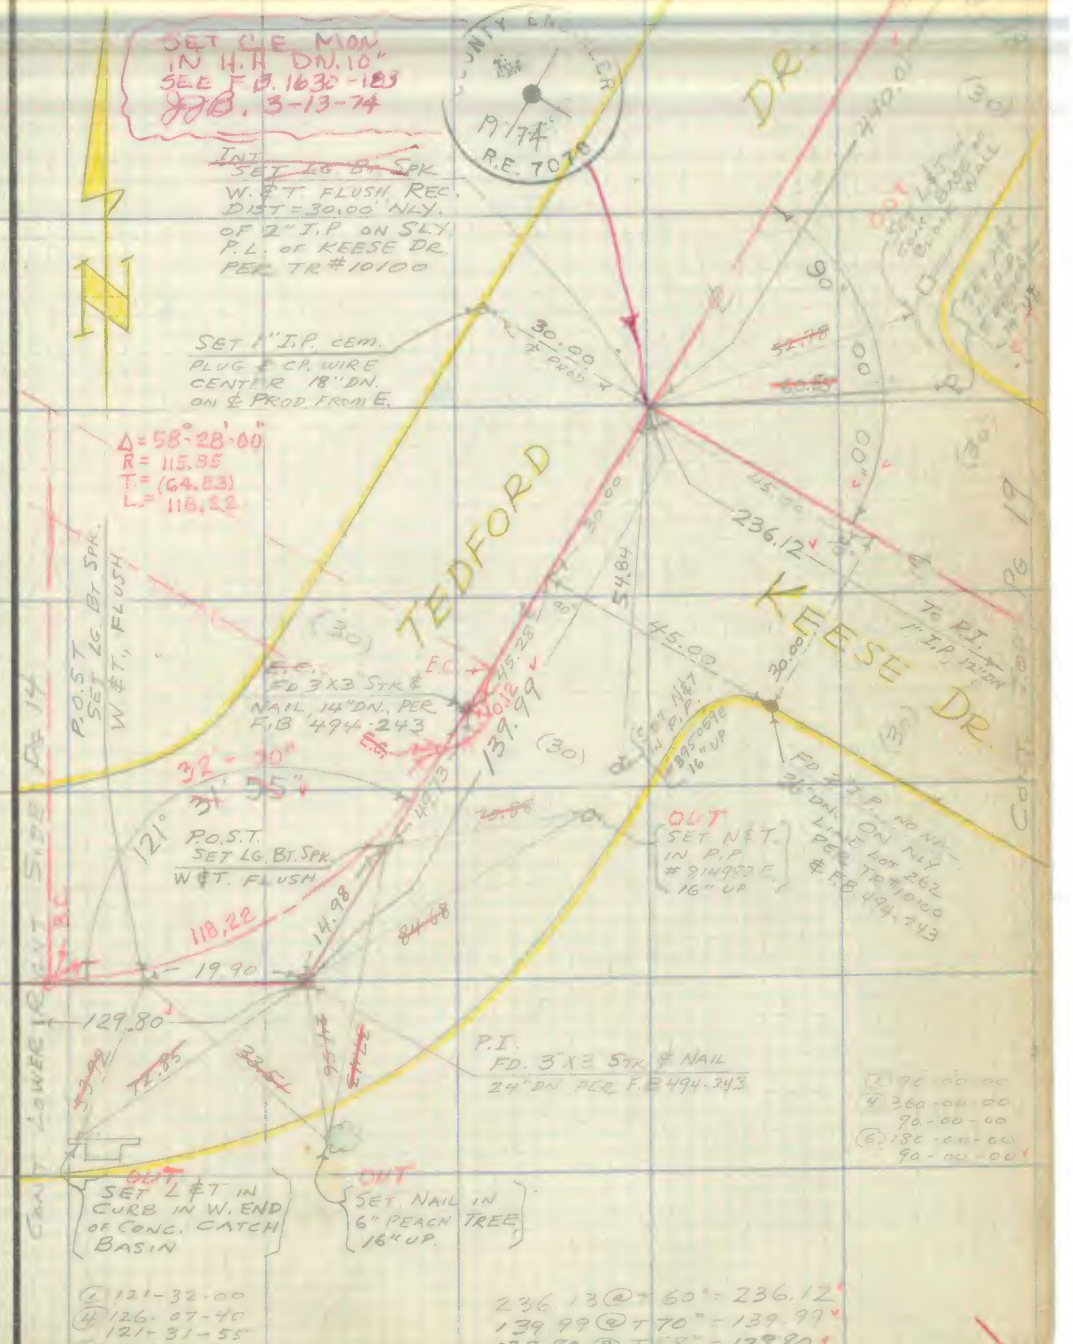


76F309S 247 2-51

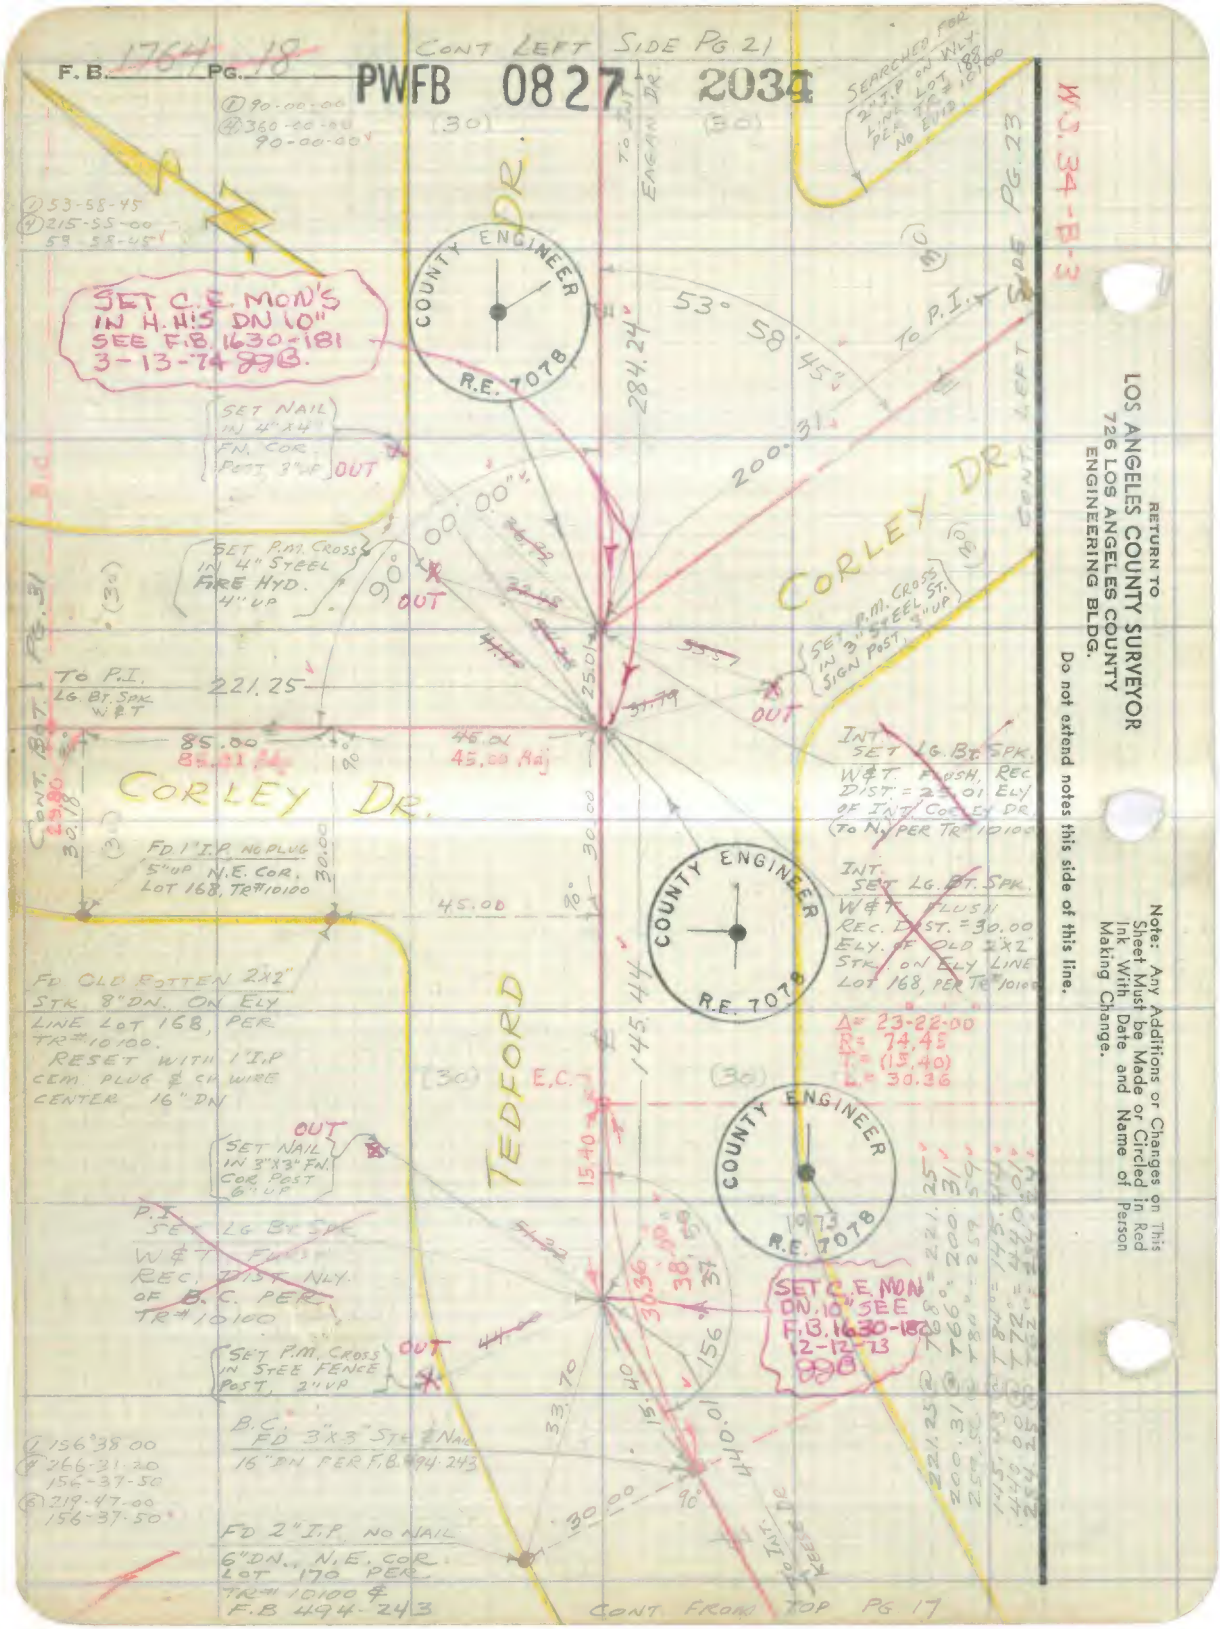
F.B. 1764 PG. 18
PWFB 0827 2034
CONT LEFT SIDE PG 21
W.J. 34-B-3
SEARCHED FOR 2" I.P. ON WLY. LINE LOT 188 PER TR# 10100 NO EVID.
SET C.E. MON'S IN H.H.'S DN 10" SEE F.B. 1630-181 3-13-74 BB
COUNTY ENGINEER R.E. 7078
SET NAIL IN 4"X4" FN. COR. POST 3" UP OUT
SET P.M. CROSS IN 4" STEEL FIRE HYD. 4" UP OUT
SET P.M. CROSS IN 3" STEEL ST. SIGN POST 3" UP OUT
TO P.I. LG. BT. SPK. W&T
CORLEY DR.
TEDFORD DR.
FD 1" I.P. NO PLUG 5" UP N.E. COR. LOT 168, TR# 10100
FD OLD ROTTEN 2X2" STK 8" DN. ON ELY LINE LOT 168, PER TR# 10100. RESET WITH 1" I.P. CEM. PLUG & CH. WIRE CENTER 16" DN
SET NAIL IN 3"X3" FN. COR POST 6" UP OUT
P.I. SET LG BT SPK W&T FLUSH REC. DIST. NLY. OF B.C. PER TR# 10100
SET P.M. CROSS IN STEE FENCE POST, 2" UP OUT
B.C. FD 3"X3" STK & NAIL 16" DN PER F.B. 494-243
FD 2" I.P. NO NAIL 6" DN., N.E. COR. LOT 170 PER TR# 10100 & F.B. 494-243
INT. SET LG. BT. SPK. W&T FLUSH, REC. DIST. = 25.01 ELY OF INT. CORLEY DR. (TO N.) PER TR# 10100
INT. SET LG. BT. SPK. W&T FLUSH REC. DIST. = 30.00 ELY. OF OLD 2"X2" STK. ON ELY LINE LOT 168, PER TR# 10100
Δ = 23-22-00
R = 74.45
T = (15.40)
L = 30.36
SET C.E. MON DN. 10" SEE F.B. 1630-182 12-12-73 BB
CONT. FROM TOP PG 17
RETURN TO LOS ANGELES COUNTY SURVEYOR 726 LOS ANGELES COUNTY ENGINEERING BLDG.
Do not extend notes this side of this line.
Note: Any Additions or Changes on This Sheet Must be Made or Circled in Red Ink With Date and Name of Person Making Change.

PWFB 0827 2035

| | |
|---|---|
| Notes Ck'd by | Survey of |
| Map No. | W. O. Tape No. St'd. °F |
| Office Work | Surveyed by |
| Checked | Notes Date |
| Date | Indexed |

F. B. Pg.

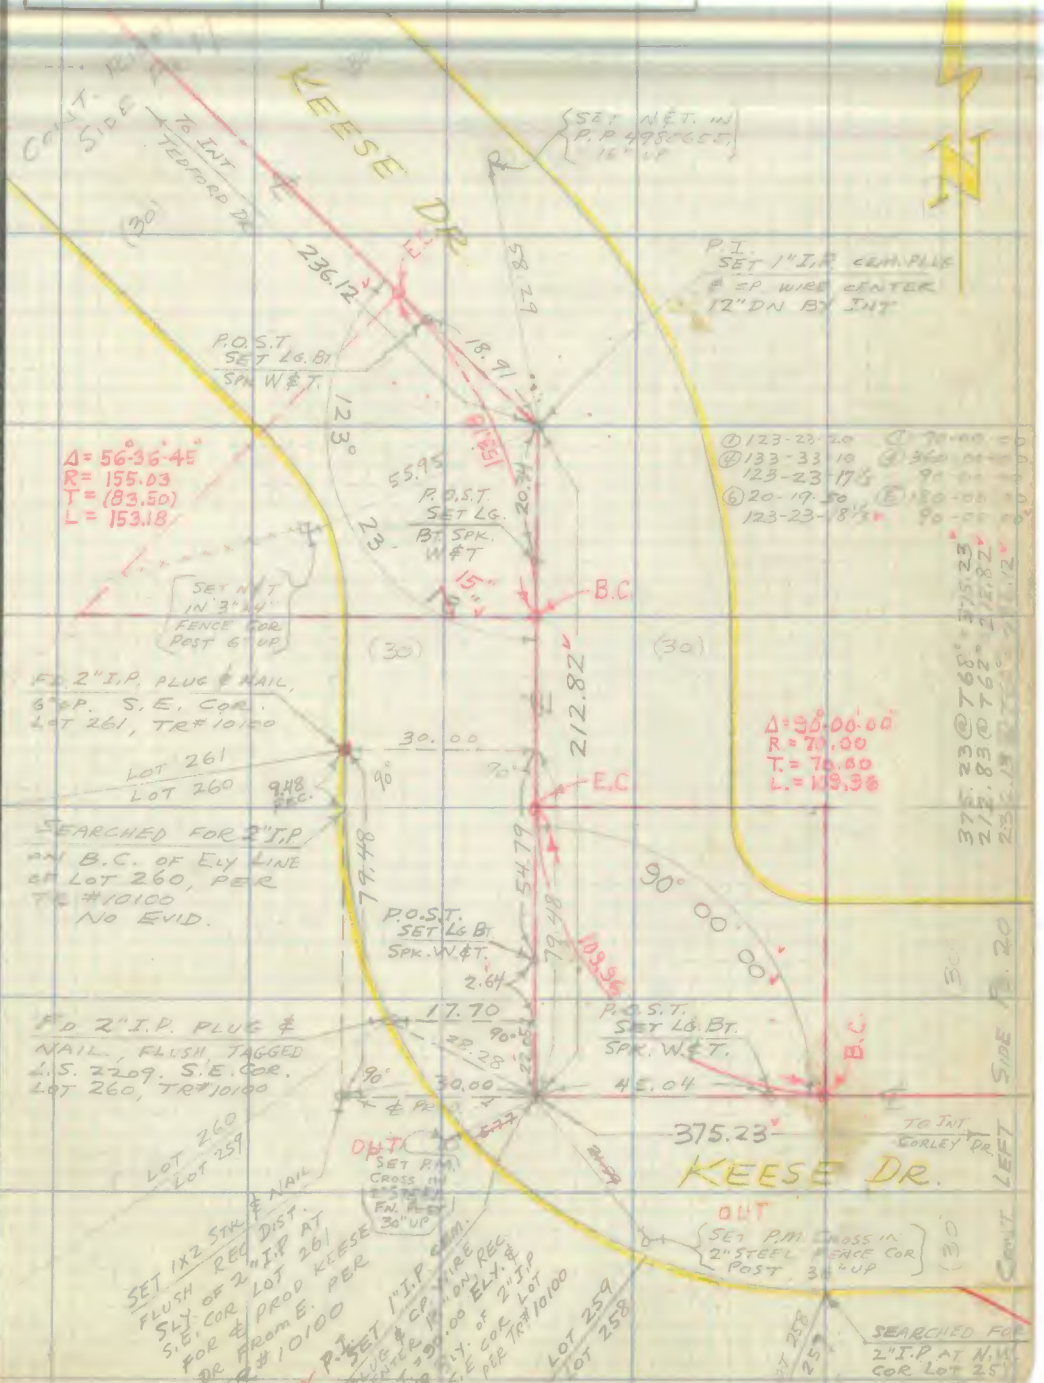


Note: Any Additions or Changes on This Sheet Must be Made or Circled in Red Ink With Date and Name of Person Making Change.

Do not extend notes this side of this line.

RETURN TO
LOS ANGELES COUNTY SURVEYOR
726 LOS ANGELES COUNTY
ENGINEERING BLDG.

76F3095 247 2-51

F.B. ~~1764~~ 20 PG.

PWFB 0827

CONT. BOT. PG 23

2036, 2037

(1) 123-13-15
(4) 132-53-00
123-13-15
(6) 19-19-40
123-13-16 2/3"

SEARCHED FOR 3" I.P. ON WLY LINE LOT 196 PER TR # 10100 NO EVID.

W.S. 34-D-3

DR.

TO P.I. 1" I.P. 1.4" ON

SEARCHED FOR STK. ON B.C. OF P.L. PER TR # 10100 NO EVID.

OUT SET P.M. CROSS IN 2" STEEL ST. SIGN POST, 2" UP

OUT SET P.M. CROSS IN 4" FIRE HYD 2" UP

TO P.I. LG. BT. SPK.

TOP PG 26

OUT SET P.M. CROSS IN 2" STEEL PIPE OF GAS METER GUARD, 2" UP

311.86

335.43'

INT. SET LG. BT. SPK. W&T BY INT. FOR N. & S. BET ~~2" I.P. AT S.W. COR LOT 203 & 2"X2" STK & NAIL AT N.E. COR LOT 185 PER TR # 10100~~ BUSBY DR. AND B.C.

SET C.E. MON DN. 10" IN H.H. 3-14-74 ~~3-18~~ - SEE F.B. 1630-189

COUNTY ENGINEER R.E. 7078

CORLEY

CHERE DR.

CONT.

24.41

30.16

33.04

20°

123° 13' 15"

FD 1" I.P. FLUSH NO NAIL ON B.C. OF N.P.L. OF LOT 197 PER TR # 10100

SET L&T. IN CONC WALK TO HO. # 14304

(1) 89-58-10
(4) 359-52-20
89-58-05
(6) 179-48-40
89-58-06 2/3"

375.23 @ T84° = 285.42
285.42 @ T84° = 420.90
420.90 @ T86° = 311.86
311.86 @ T86° = 335.43
335.43 @ T64° = 375.23

W&T SPK. BT. SPK. W&T
DIST 1-30 ON WLY
5" I.P. ON NLY LINE
LOT 255 PER TR # 10100

(30)

420.90

SET C.E. MON DN 10" IN H.H. 3-14-74 ~~3-18~~ SEE F.B. 1630-187

10"

07"

58

89°

COUNTY ENGINEER R.E. 7078

SET P.M. CROSS IN 4" FIRE HYD., 4" UP

38.04

SET P.M. CROSS IN 4" STEEL ST. SIGN POST, 6" UP

30.30

KEESE DR

TO P.I.

375.23

INT. ~~SET LG. BT. SPK~~ W&T FLUSH BY INT.

SET NAIL IN FENCE END POST, 4" UP

30.0

54.61

44.96

29.97

285.42

81.53

TO INT. BUSBY DR.

FD 2" I.P. NO NAIL 18" DN ON NLY LINE LOT 255 PER TR # 10100

SET P.M. CROSS IN 2" STEEL FENCE COR. POST, 6" UP

CONT. TOP PG. 16

RETURN TO
LOS ANGELES COUNTY SURVEYOR
726 LOS ANGELES COUNTY
ENGINEERING BLDG.

Do not extend notes this side of this line.

Note: Any Additions or Changes on This Sheet Must be Made or Circled in Red Ink With Date and Name of Person Making Change.

PWFB 0828 1182

| | |
|---|---|
| Notes Ck'd by [illegible] | Survey of [illegible] |
| Map No. [illegible] | W. O. [illegible] Tape No. [illegible] St'd. [illegible] °F |
| Office Work [illegible] | Surveyed by [illegible] |
| Checked [illegible] | Notes [illegible] Date [illegible] |
| Date [illegible] | Indexed [illegible] |

F. B. 1761 Pg. 21

W.S. 34-B-3

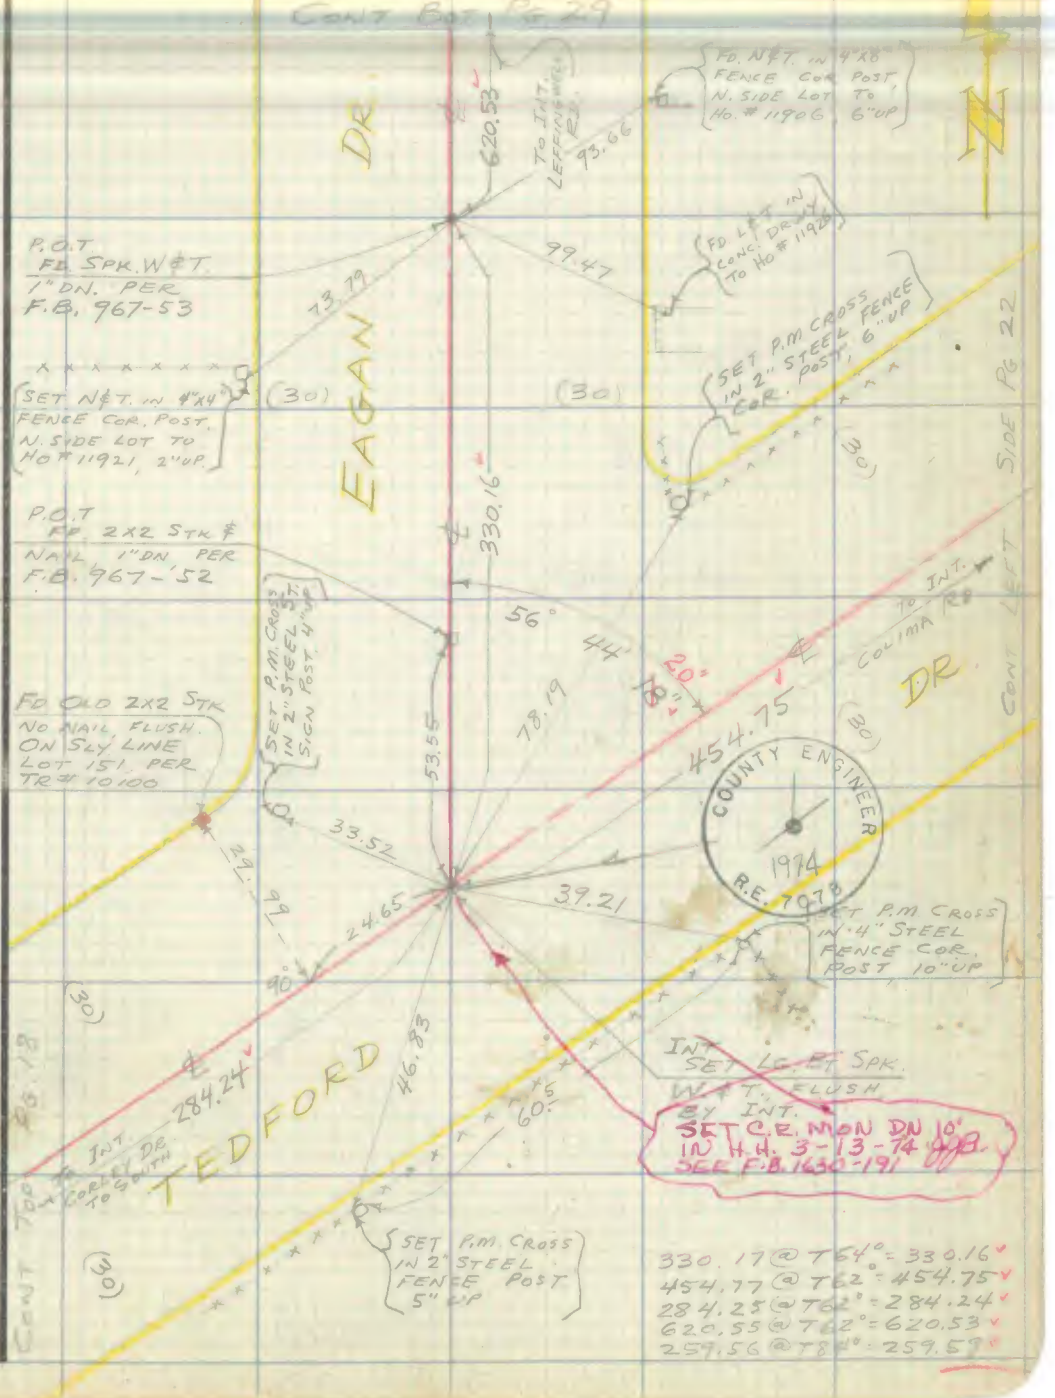


Note: Any Additions or Changes on This Sheet Must be Made or Circled in Red Ink With Date and Name of Person Making Change.

Do not extend notes this side of this line.

RETURN TO
LOS ANGELES COUNTY SURVEYOR
726 LOS ANGELES COUNTY ENGINEERING BLDG.

76F309S 247 2-51

F.B. 1764 PG. 27

PWFB 0828

1183

CONT. BOT. PG 27

W.S. 34-B-3

(1) 123-15-40
(4) 123-02-00
123-15-30
(6) 19-33-00
123-15-30

COUNTY ENGINEER
1974
R.E. 7078

SET C.E. MON IN H.H. DN 10" SEE F.B. 1630-192 JJB. 3-13-74

INT. SET LG. BT. SPK. W&T. FLUSH BY INT.

TO P.O.T. SET BT. SPK W&T

(30) (30)

RD.

415.01

90° 53.24

FD 2" I.P. CENT. PL 0.6' W & NAIL FLUSH. TAGGED L.S. 4102. ON S'LY LINE 115' PER T.R. #10100

29.96

70°

88.54

70.75

30"

15'

33.82

35.23

123°

83.32

490.42

TO INT. AT 10' OFFSET BURGESS DR.

DR.

CONT. LEFT SIDE PG. 10

SET P.M. CROSS IN 2" STEEL FENCE COR. POST, 6" UP

SET P.M. CROSS IN 4" STEEL FIRE HYD., 12" UP

38.83

SET N&T IN 4"x5" FENCE COR. POST 4" UP

88.95

454.75

TO INT. EAGAN DR.

TEDFORD

315.72

CONT. RIGHT SIDE PG 21

SET P.M. CROSS IN 2" STEEL FENCE COR. POST, 6" UP

SET P.M. CROSS IN 2" STEEL FENCE COR. POST 3" UP OPP. US SIDE GARAGE TO HOUSE #12023

71.51

75.81

33.19

SET P.M. CROSS IN 2" STEEL FENCE COR. POST, 8" UP

P.O.T. SET SP. BT. SP. IN W&T. FLUSH

COLINA

SET LG. BT. SPK. W&T IN 18" GUM TREE, 8" UP

454.77 @ 762° = 454.75
490.38 @ 782° = 490.42
315.72 @ 764° = 315.07
315.73 @ 764° = 315.72
288.30 @ 764° = 288.29

45.92

288.29

TO INT. GREENE DR.

(30) (30)

SET P.M. CROSS IN 2" STEEL FENCE COR. POST, 6" UP

CONT. TOP PG 25

RETURN TO
LOS ANGELES COUNTY SURVEYOR
726 LOS ANGELES COUNTY
ENGINEERING BLDG.

Do not extend notes this side of this line.

Note: Any Additions or Changes on This Sheet Must be Made or Circled in Red Ink With Date and Name of Person Making Change.

PWFB 0828

1184

| | |
|---|---|
| Notes Ck'd by: [illegible] | Survey of: So. Whittier Area #1 |
| Map No. [illegible] | W. O. [illegible] Tape No. ____ St'd. ____ °F |
| Office Work [illegible] | Surveyed by: [illegible] |
| Checked [illegible] | Notes ____ Date [illegible] |
| Date [illegible] | Indexed [illegible] |

F. B. 1764 PG. 23

WS 34-B-3

Note: Any Additions or Changes on This Sheet Must be Made or Circled in Red Ink With Date and Name of Person Making Change.

Do not extend notes this side of this line.

RETURN TO
LOS ANGELES COUNTY SURVEYOR
726 LOS ANGELES COUNTY
ENGINEERING BLDG.

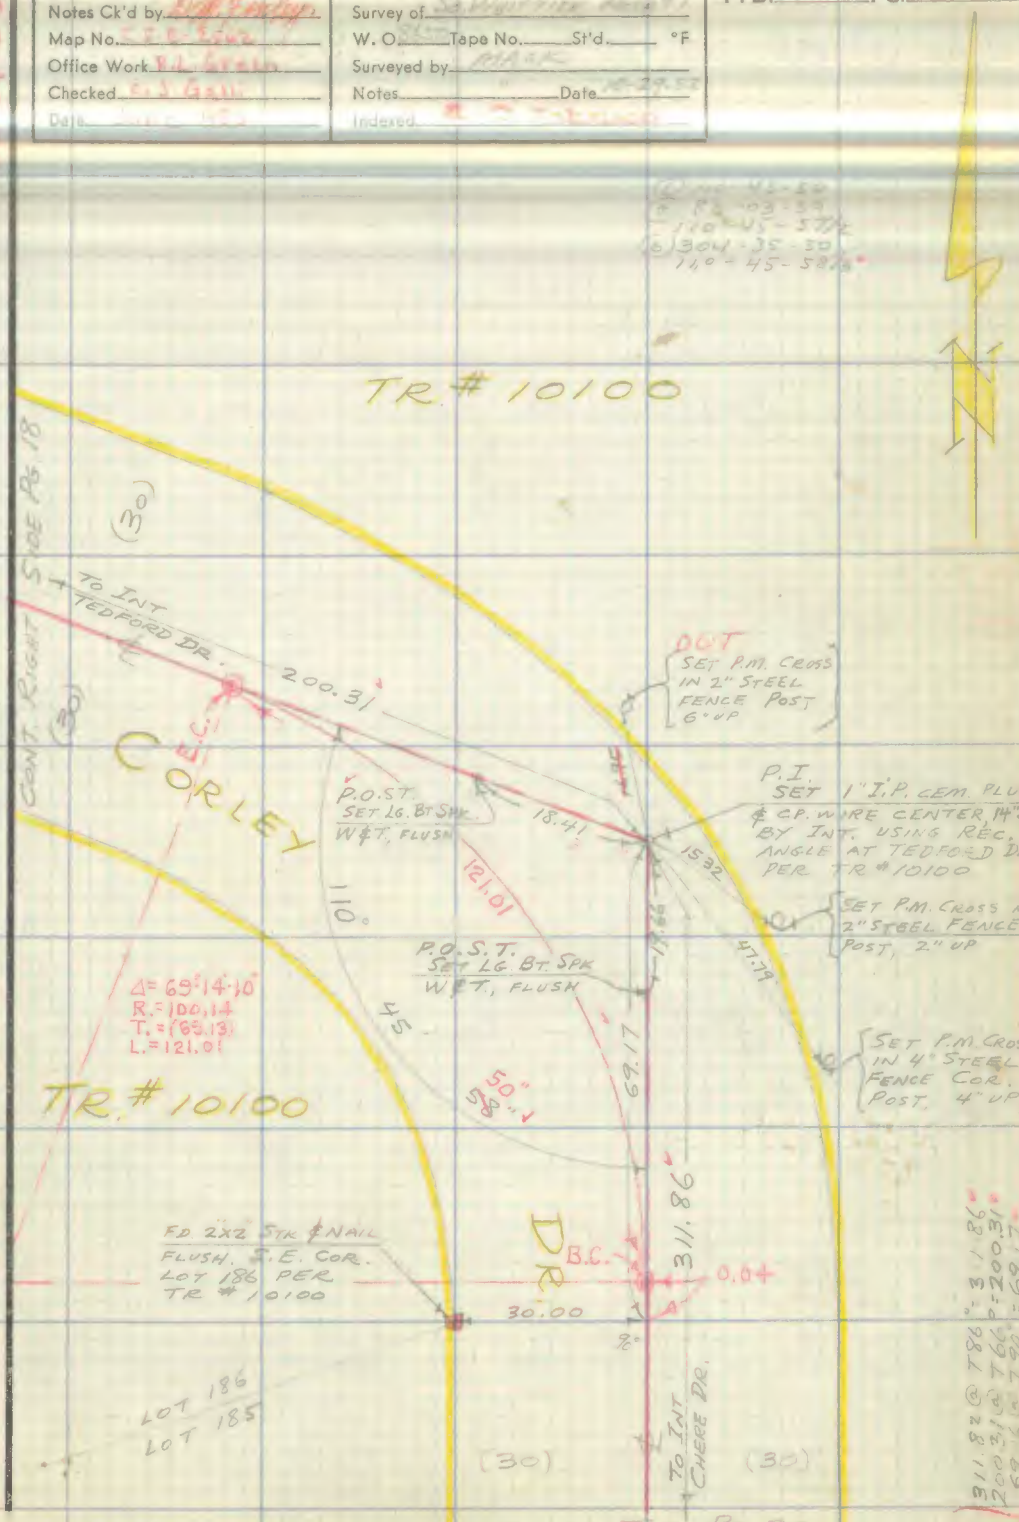


76F309S 247 2-51

F. B. 1764 PG. 24

PWFB 0828

1185

W.S. 34-B-2

CONT LOWER LEFT SIDE PG. 9

SET 5m BT. SPK W&T
REC. DIST. = 30.00 ELY.
OF 2" I.P. ON ELY LINE
LOT 211 FOR & BUSBY
DR. PER TR#10100

399.84 @ T66° = 399.83
230.04 @ T66° = 230.04
492.08 @ T80° = 492.12
411.40 @ T80° = 411.43

Δ = 23°20'05"
R = 275.74
T = (72.17)
L = 141.18

FD. 2" I.P. NO NAIL
18" DN. ON ELY
LINE LOT 211 AT
E.C. OF P.L. PER
TR# 10100

FD. 2" I.P. WITH
NAIL 10" DN.
ON WLY. LINE
LOT 211 PER
TR#10100

FD. OLD 2x2" STKE
NAIL, 2" DN. ON S.Y.
LINE LOT 211 AT
B.C. OF P.L. PER
TR#10100

SET 5m. BT SPK
W&T. REC. DIST.
=30.00 SLY OF
2x2" STK. ON SLY
LINE LOT 211 FOR
& BUSBY DR PER
TR#10100

SET NAIL IN
PERCH TREE 6" DIA.

SET 1x1 STK
# NAIL ON TOP
# 2" ABOVE GROUND

SET NAIL IN
FENCE COR.
POST OF 18"
PICKET FENCE
2" UP

SET NAIL IN
FENCE COR.
POST OF 18"
PICKET FENCE
2" UP

FD. 2x2" STKE & NAIL 1" UP
N.W. COR. LOT 235
PER TR# 10100

SET C.E. MON. ON 10"
3-15-74 SDB
SEE F.B. 1630-195

SET LG. BT SPK
W&T IN 24"
PEPPER TREE
12" UP

SET C.E. MON. DONE
IN H.H. 3-15-74 SDB
SEE F.B. 1630-197

SET BT
SPK. W&T
FLUSH, BY I.T.

P.O.T. NAIL & WASHER
FD.
REC. DIST. = 30.00
WLY. OF 2" I.P. ON
WLY. LINE LOT 211
FOR & COLIMA RD.
PER TR#10100

To P.O.T.
5m. BT SPK W&T

SET N&T
IN 4"x4" FENCE
POST 8" UP

SET P.M. CROSS
IN 2" STEEL ST.
SIGN POST 2" UP

SET P.M. CROSS
IN 4" FIRE HYD.
2" UP

To INT.
CORLEY
DR.

119-08-40
116-34-20
119-08-35
354-51-20
119-08-33 1/3

CONT BOT. PG. 25

CONT UPPER RIGHT SIDE PG. 16

COLIMA RD

BUSBY DR

COUNTY ENGINEER
R.E. 7078
1974

RETURN TO
LOS ANGELES COUNTY SURVEYOR
726 LOS ANGELES COUNTY
ENGINEERING BLDG.

Do not extend notes this side of this line.

Note: Any Additions or Changes on This Sheet Must be Made or Circled in Red Ink With Date and Name of Person Making Change.

PWFB 0828 1186

| | |
|---|---|
| Notes Ck'd by [illegible] | Survey of [illegible] |
| Map No. C.S.B.-[illegible] | W. O. [illegible] Tape No. [illegible] St'd. [illegible] °F |
| Office Work R. L. Green | Surveyed by [illegible] |
| Checked C. J. Galli | Notes [illegible] Date [illegible] |
| Date [illegible] | Indexed [illegible] |

F.B. 1764 Pg. 25

W.S. 34-83

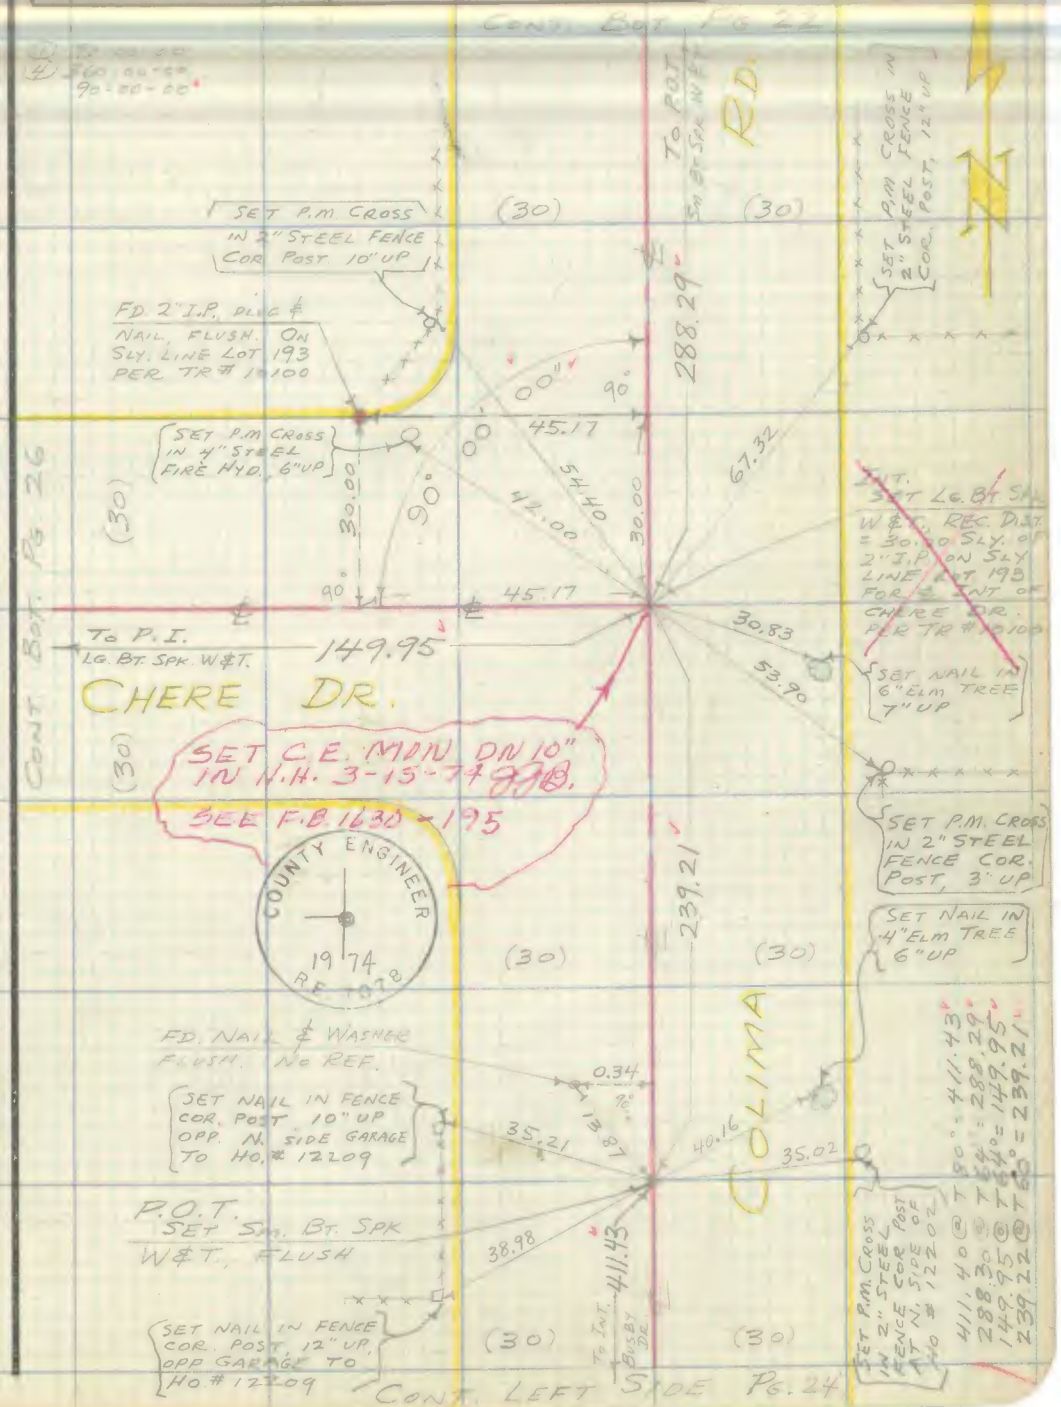


Note: Any Additions or Changes on This Sheet Must be Made or Circled in Red Ink With Date and Name of Person Making Change.

Do not extend notes this side of this line.

RETURN TO
LOS ANGELES COUNTY SURVEYOR
726 LOS ANGELES COUNTY
ENGINEERING BLDG.

76F3095 247 2-51

PWFB 0828 1187

F.B. 1764 PG. 26

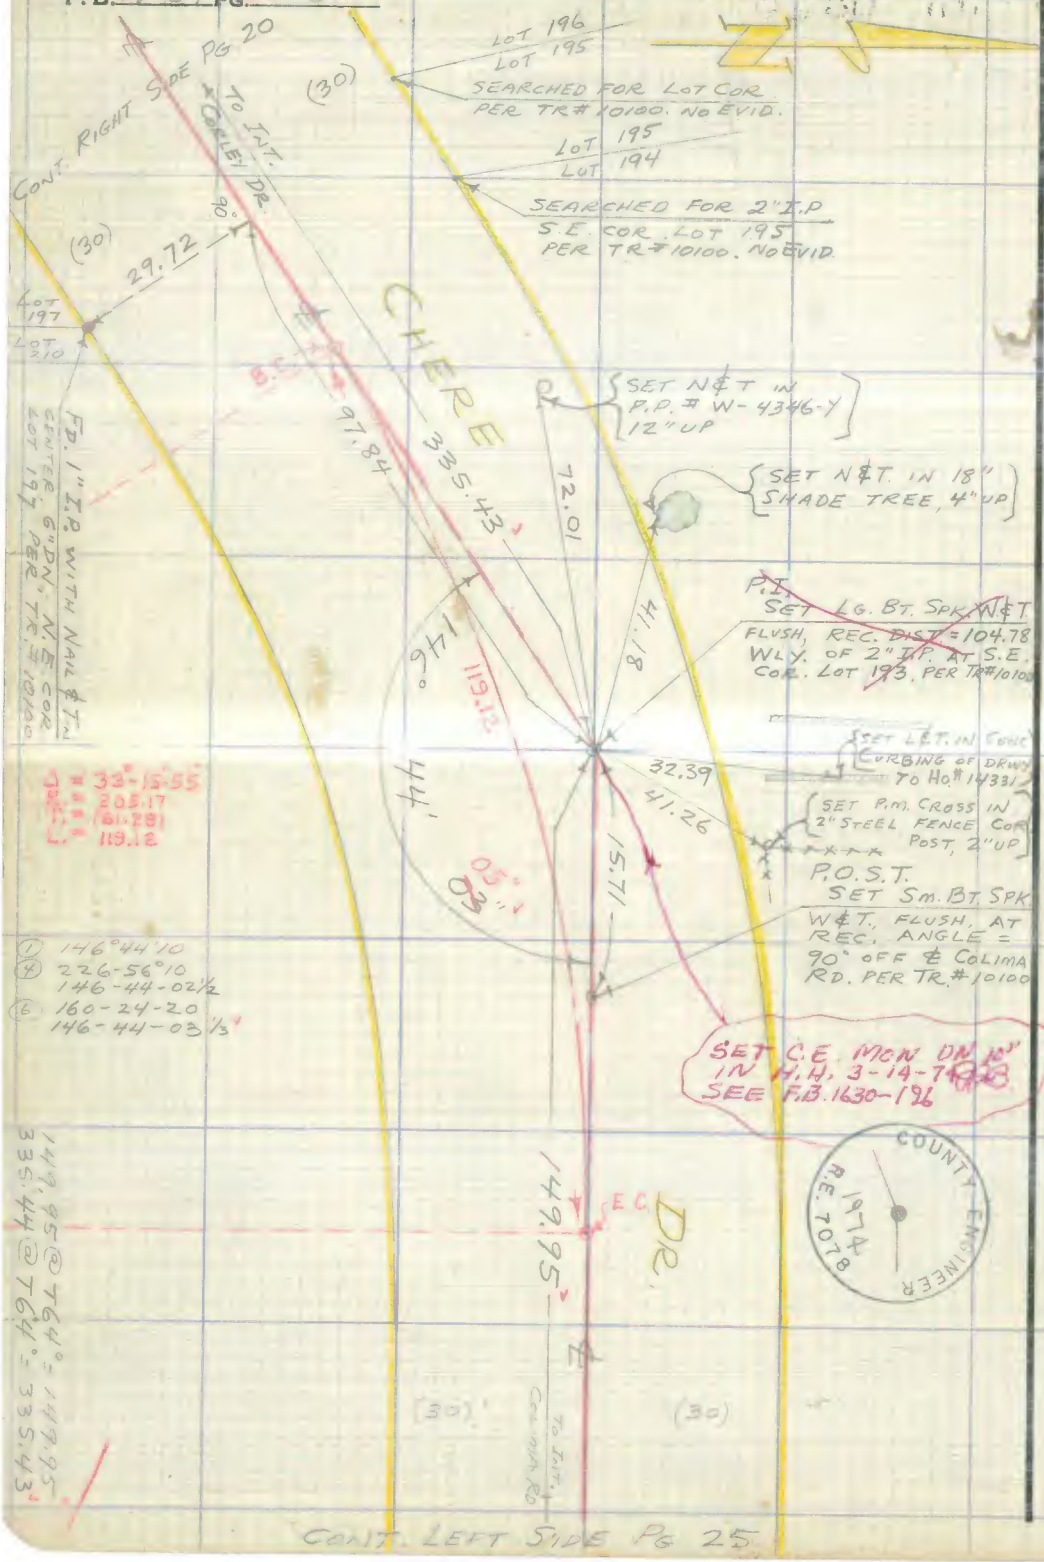


W.S. 34-B-3

RETURN TO
LOS ANGELES COUNTY SURVEYOR
726 LOS ANGELES COUNTY
ENGINEERING BLDG.

Do not extend notes this side of this line.

Note: Any Additions or Changes on This Sheet Must be Made or Circled in Red Ink With Date and Name of Person Making Change.

COUNTY ENGINEER
1974
R.E. 7078

CONT. LEFT SIDE PG 25

PWFB 0828 1188

| | | |
|---|---|---|
| Notes Ck'd by [illegible] | Survey of So. Whittier Area #1 | F.B. 1764 Pg. 27 |
| Map No. C.S.P. [illegible] | W.O. [illegible] Tape No. [illegible] St'd. [illegible] °F | |
| Office Work R.L. Green | Surveyed by MACK | |
| Checked C.J. Gaill | Notes [illegible] Date 11-12-57 | |
| Date [illegible] | Indexed C. Johnson | |

164-59-50
299-59-00
164-59-45

CONT. LEFT SIDE PG. 28

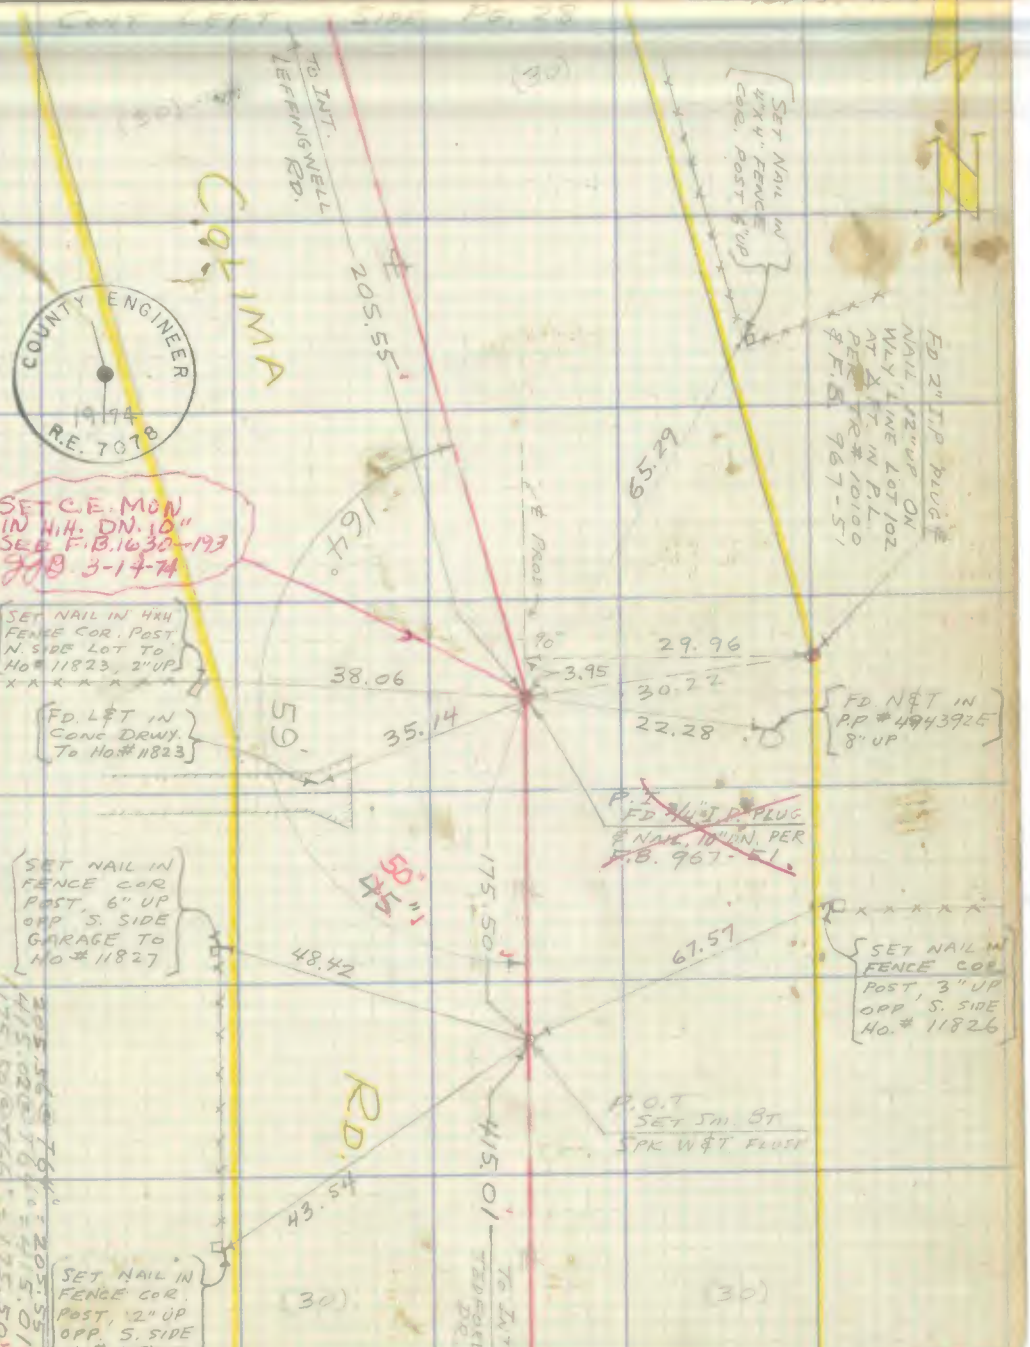


CONT. TOP PG 22

Note: Any Additions or Changes on This Sheet Must be Made or Circled in Red Ink With Date and Name of Person Making Change.

Do not extend notes this side of this line.

RETURN TO
LOS ANGELES COUNTY SURVEYOR
726 LOS ANGELES COUNTY
ENGINEERING BLDG.

76F3095 247 2-51

RETURN TO
LOS ANGELES COUNTY SURVEYOR
726 LOS ANGELES COUNTY
ENGINEERING BLDG.

Note: Any Additions or Changes on This Sheet Must be Made or Circled in Red Ink With Date and Name of Person Making Change.

Do not extend notes this side of this line.

1189

W.S. 34-B-3

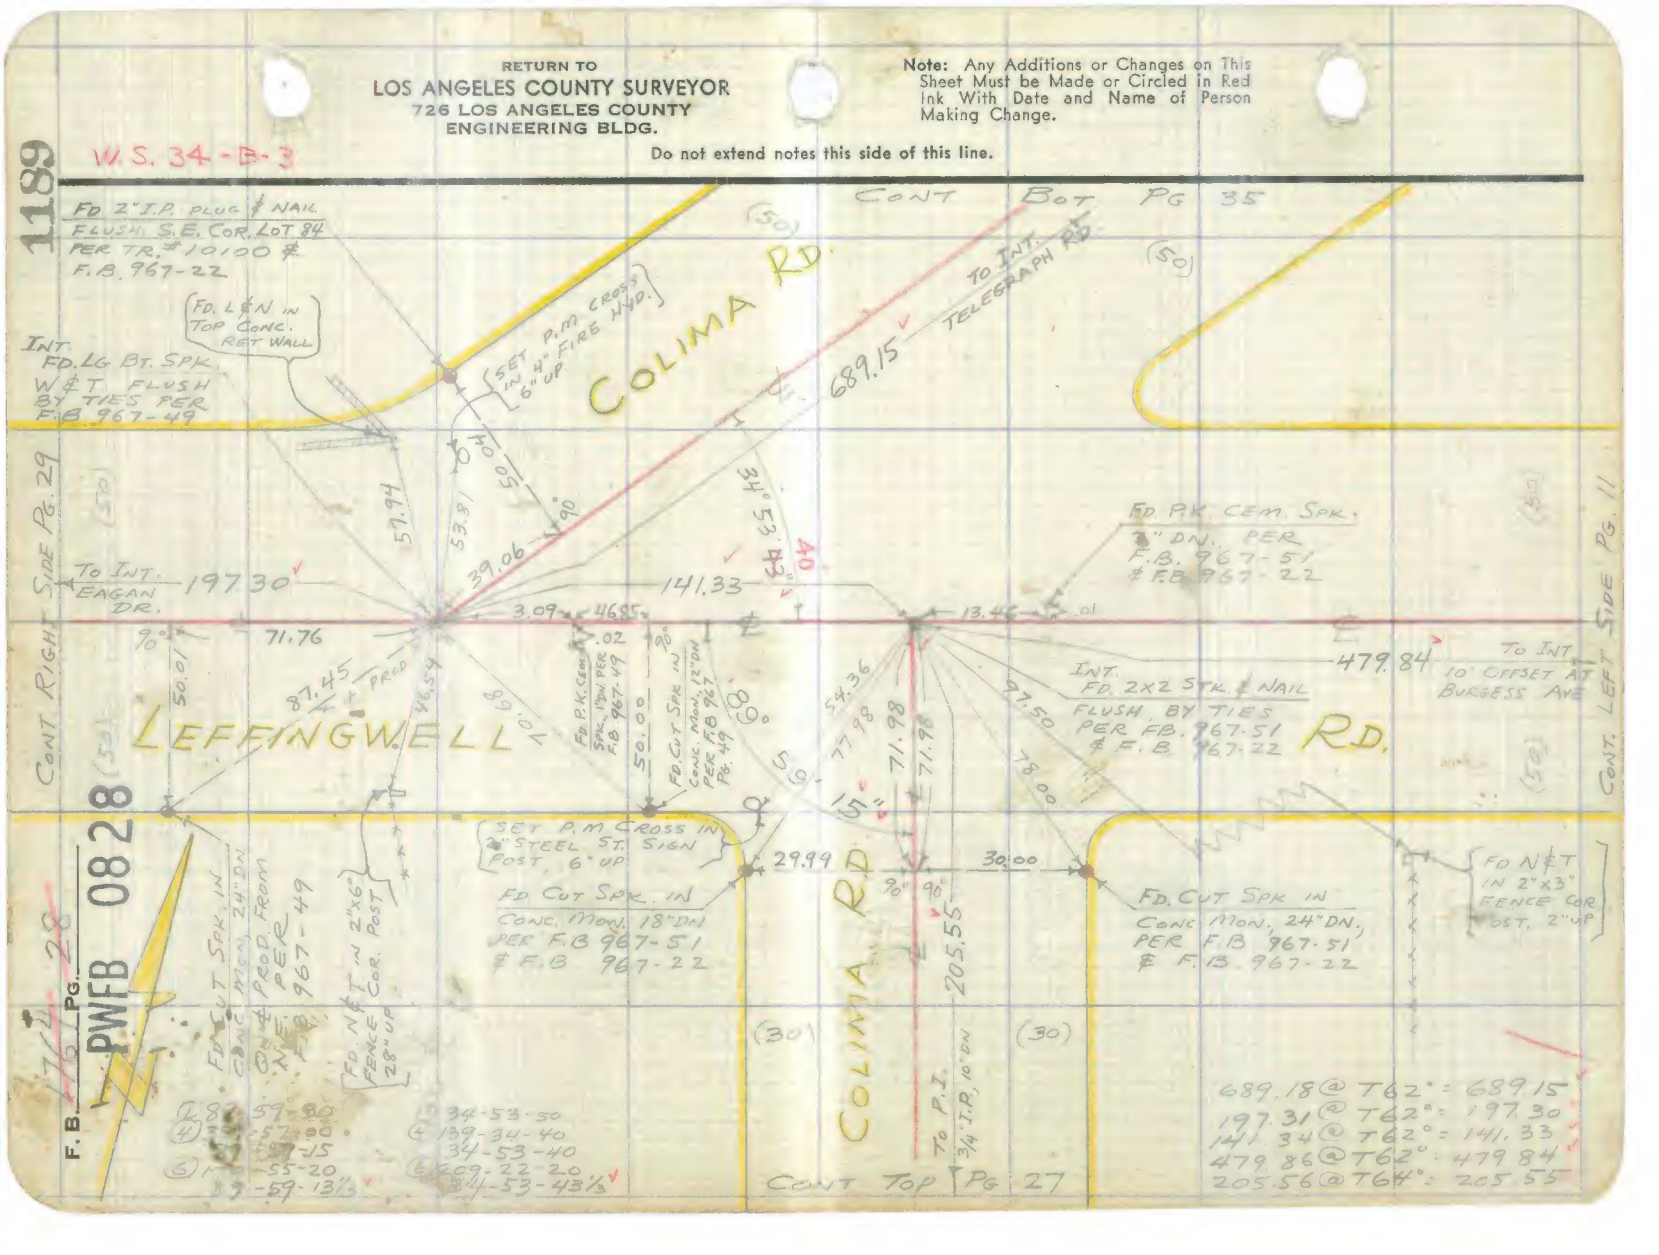


F.B. 174 Pg. 28

PWFB 0828

PWFB 0827 2039

| | |
|---|---|
| Notes Ck'd by | Survey of So. WHITTIER AREA #1 |
| Map No. | W. O. 5650 Tape No. 0130 St'd. 68 °F |
| Office Work R.L. Green | Surveyed by MACK |
| Checked | Notes " Date 11-21-52 |
| Date | Indexed |

F. B. 1751 Pg.

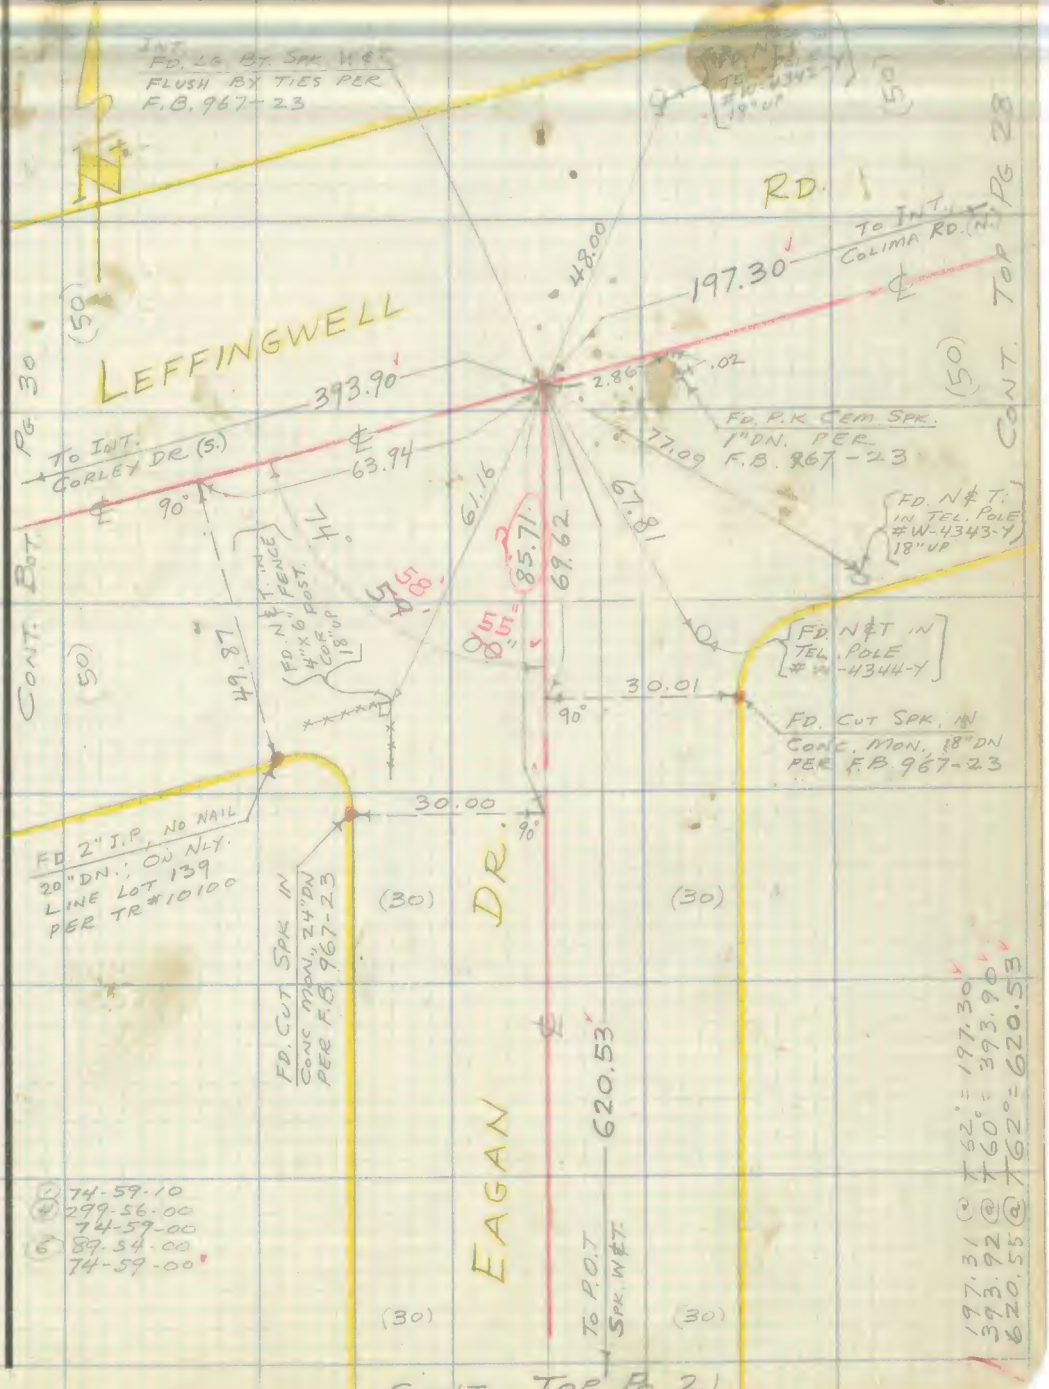


Note: Any Additions or Changes on This Sheet Must be Made or Circled in Red Ink With Date and Name of Person Making Change.

Do not extend notes this side of this line.

RETURN TO
LOS ANGELES COUNTY SURVEYOR
726 LOS ANGELES COUNTY
ENGINEERING BLDG.

76F309S 247 2-51

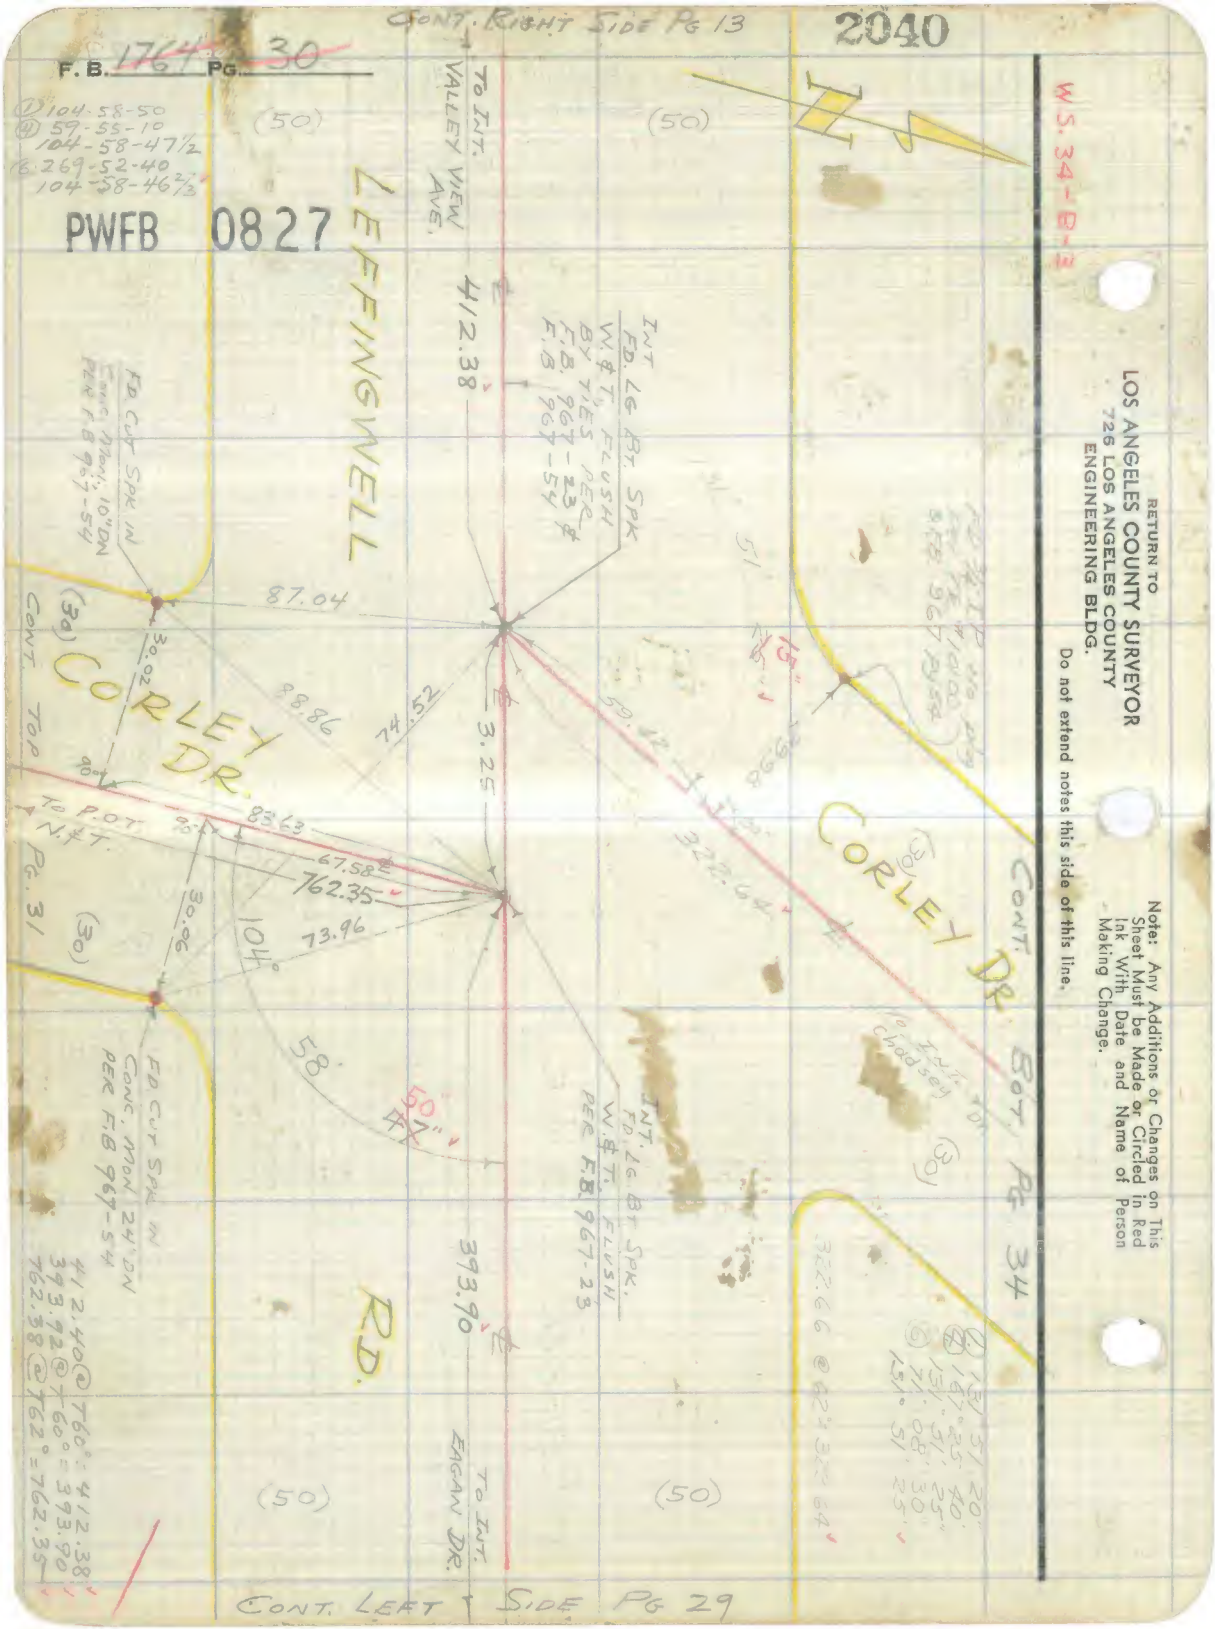

CONT. RIGHT SIDE PG 13
2040
F.B. 1764 PG. 30
PWFB 0827
W.S. 34-B-3
RETURN TO
LOS ANGELES COUNTY SURVEYOR
726 LOS ANGELES COUNTY
ENGINEERING BLDG.
Do not extend notes this side of this line.
Note: Any Additions or Changes on This Sheet Must be Made or Circled in Red Ink With Date and Name of Person Making Change.
LEFFINGWELL
CORLEY DR.
CORLEY DR.
RD.
TO INT. VALLEY VIEW AVE.
TO INT. EAGAN DR.
TO INT. FD. LG. BT. SPK. W.&T. FLUSH BY TIES PER F.B. 967-23 & F.B. 967-54
INT. FD. LG. BT. SPK. W.&T. FLUSH PER F.B. 967-23
FD. CUT SPK. IN CONC. MON. 10" DN PER F.B. 967-54
FD. CUT SPK. IN CONC. MON. 24" DN PER F.B. 967-54
CONT. TOP PG. 31
CONT. BOT. PG. 34
CONT. LEFT SIDE PG 29
(50)
(30)
412.38
87.04
88.86
74.52
3.25
59.42
322.64
83.63
67.58
762.35
73.96
30.02
30.06
104°
58
47"
50"
393.90
15"

PWFB 0827

2041

| | |
|---|---|
| Notes Ck'd by | Survey of |
| Map No. | W. O. Tape No. St'd. |
| Office Work | Surveyed by |
| Checked | Notes Date |
| Date | Indexed |

F. B. 1764 PG. 37

WS 34-B3

4" UP N.E. COR LOT
TIES PER TR #10100
& F.B 967-54

29.07

(30)

FD 2" I.P. PLUG &
NAIL 6" UP. N.E. COR.
LOT 164, PER TR #10100
& F.B. 967-54

29.62

FD. 2" I.P PLUG &
NAIL FLUSH. N.E. COR.
LOT 165, PER TR #10100
& F.B. 967-54

29.73

P.O.T.
FD. N. & T. FLUSH
PER F.B. 967-54

90°

99.67

100.16

90°

90.20

TO INT. LEFFINGWELL RD.

762.35

(30)

CORLEY

FD. LET IN CONC STEP OF WALK TO No. #12000

300' TAPE STAND = 84°F
113.26 @ 87°04' @ T60° = 112.3
113.46 @ 7°57' @ T60° = 112.3

"A" LANE

(5)

INT.
SET LG. BT. SPK
W. & T. FLUSH,
BY INT.

08°00'

5.54

51.38

43.10

FD. LET IN 6" CONC CURBING

CONT. 1 BOT PG 32

TO P.O.T
1x2 STK

112.37

(5)

225.12

33.88
E.C.

SEARCHED FOR 2" I.P.
N.E. COR. LOT 166
PER TR. #10100.
NO EVID.

65.32

61.44

146°

46'

Δ = 33°13'25"
R. = 205.92
T. = 61.44
L = 119.41

SET NAIL IN 4"x6" FENCE COR POST 12" UP

25' DR.

① 88-08-00
② 352-32-00
88-08-00
③ 168-48-00
88-08-00

OUT

SET 1" I.P. CEM. PLUG
& CP. WIRE & CENTER 12" DN
ON & PROD FROM S.E.

26.65
& PROD.

119.41

67.78

① 146-46-20
② 227-05-40
146-46-25
③ 160-38-40
146-46-26 2/3

COUNTY ENGINEER
1973
R.E. 20708

P.O.T. 1x2 STK.
W. & T. FLUSH
BY INT.

25.27
& PROD.

221.25

61.44 TO E.C.

96.74

OUT

SET NAIL IN P.P. 20" UP

TO INT. LEFFINGWELL RD.

SET NAIL IN P.P. #542654 14" UP

SET C.E. MON IN H.H.
DN. 10" SEE F.B. 1630
— 180 9073. 12-12-73

SET 1" I.P. CEM. PLUG
& CP WIRE CENTER,
12" DN. ON & PROD.
FROM NORTH

762.38 @ T62° = 762.35
221.25 @ T68° = 221.25
65.32 @ T68° = 65.32

CONT. LEFT SIDE PG 15

Note: Any Additions or Changes on This Sheet Must be Made or Circled in Red Ink With Date and Name of Person Making Change.

Do not extend notes this side of this line.

RETURN TO
LOS ANGELES COUNTY SURVEYOR
726 LOS ANGELES COUNTY
ENGINEERING BLDG.

76F309S 247 2-51

2042

F. B. 164 PG. 32

PWFB 0827

CONT. UPPER RIGHT SIDE PG. 14

W.S. 34-B-3

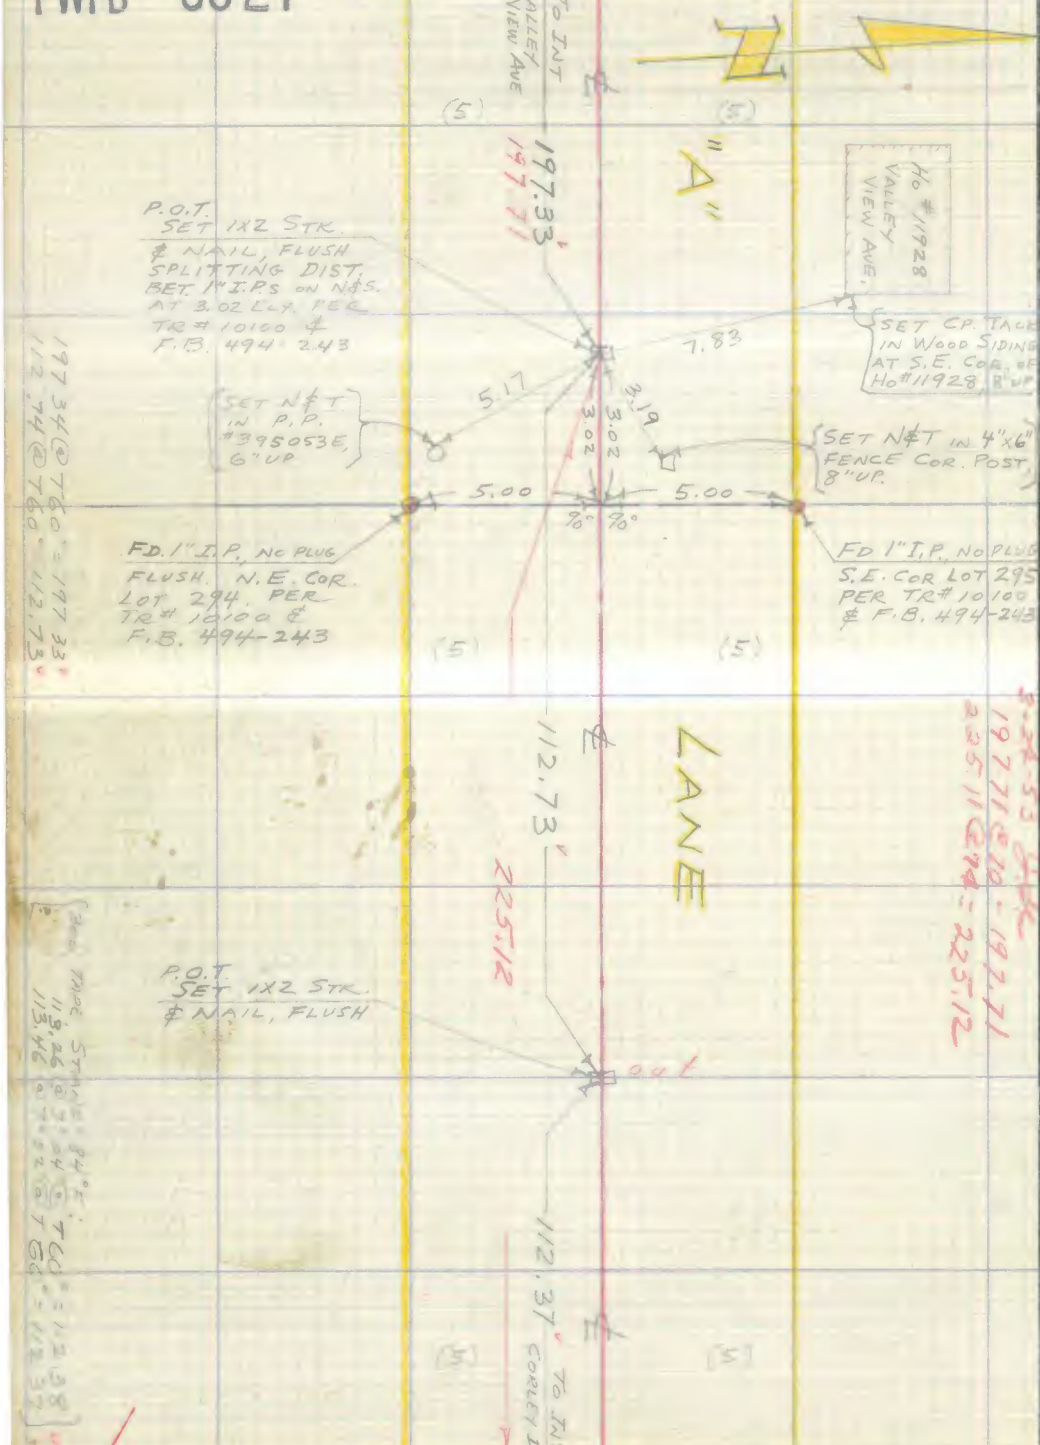


RETURN TO
LOS ANGELES COUNTY SURVEYOR
726 LOS ANGELES COUNTY
ENGINEERING BLDG.

Do not extend notes this side of this line.

Note: Any Additions or Changes on This Sheet Must be Made or Circled in Red Ink With Date and Name of Person Making Change.

CONT. LEFT SIDE PG. 31

PWFB 0827 2043

F.B. ~~1764~~ PG. ~~33~~

| | |
|---|---|
| Notes Ck'd by [illegible] | Survey of So. Whittier Area #1 |
| Map No. C.S.B. 2362 | W. O. 8550 Tape No. 0134 St'd. 68 °F |
| Office Work R. L. Green | Surveyed by MACK |
| Checked C. J. Galli | Notes " Date 12-1-52 |
| Date [illegible] | Indexed [illegible] |

W.S. 34-E-3

Note: Any Additions or Changes on This Sheet Must be Made or Circled in Red Ink With Date and Name of Person Making Change.

Do not extend notes this side of this line.

RETURN TO
LOS ANGELES COUNTY SURVEYOR
726 LOS ANGELES COUNTY
ENGINEERING BLDG.

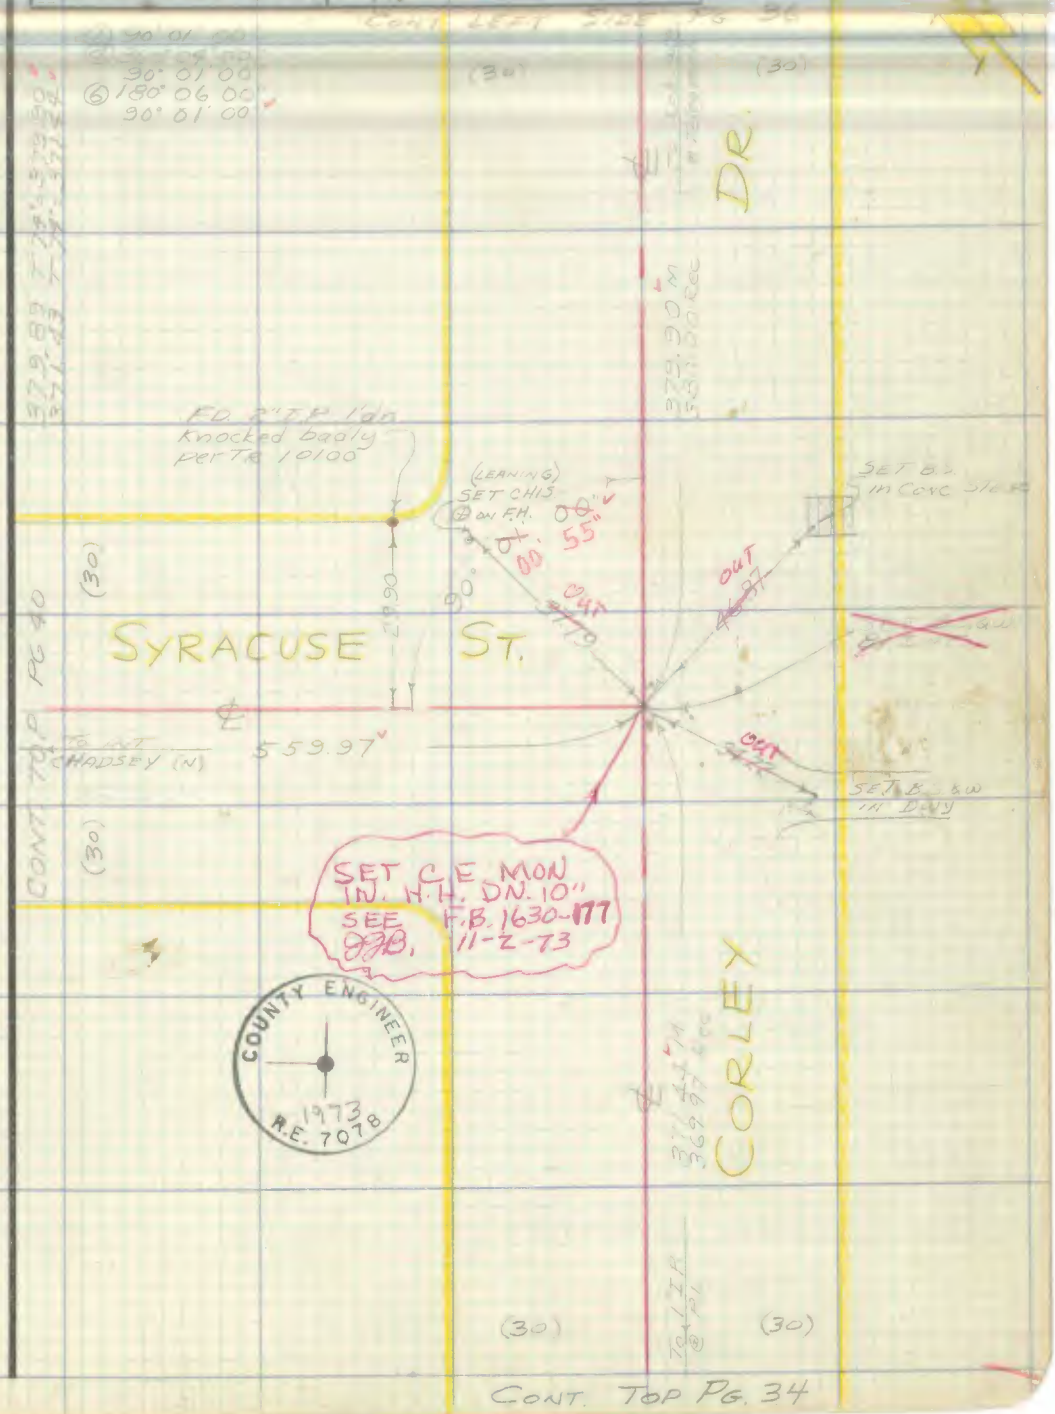


76F309S 247 2-51

F.B. 1764 34 PG.

PWFB 0827

2044

CONT. BOT. PG. 33

P.O.T.
FD N&T 1" DN.
PER F.B 972-137

SEARCHED FOR 2" I.P
S.E. COR LOT 42
PER TR# 10100
NO EVID.

REC & CURVE DATA
Δ = 15° 14' 30"
R = 430.55
T = 49.97 calc.

~~P.O.S.T.~~ P.O.T.
FD N&T 1" DN.
PER F.B 972-137

166° 44' 30"
306° 57' 00"
166° 44' 15"
280° 25' 30"
166° 44' 15"

~~SET 1" I.P. BY I.N.T.~~
16 DR. CONC.
& W. SET B.S. 3' N&E.

214.55 @ 6.00 = 214.55
114.37 @ 6.00 = 114.37

90° 00' 00"
360° 00' 00"
30° 00' 00"
150° 00' 00"

COUNTY ENGINEER 1973 R.E. 7078

SET C.E. MON.
IN H.H. DN. 10"
SEE F.B. 1630-178
O.B. 11-2-73

SEARCHED FOR 2" I.P
PER TR. 10100
NO EVIDENCE

FD. CHIS. IN F.H.

SET CHIS. IN F.H.

CHADSEY DR.

TO 1" I.P. P.L.

214.55 M
214.73 R.C.

FD. ROTTEN 2"x2" PER TR# 10100

FD N&T 1" DN
per F.B 967-125

FD 2"x6" N.H.
LEANING S.E.
BIG ROT

FD 2"x12" N.H.
PER TR 10100
ROT 36

LOT 35

CONT. RIGHT SIDE PG. 30

CONT. RIGHT SIDE PG. 41

(30)

DR.

Δ = 72.42

10.61

37.44

P.C.

SET N&T PR.

58.20

Δ = 13-15-40
R = 430.55
T = 49.97
L = 96.49

62.37

39.49

B.C.

SET B.S. IN CONC. STOP

94.32

114.37 M
114.73 R.C.

64.40

SET C.E. MON. IN H.H. DN. 10" SEE F.B. 1630-178 O.B. 11-2-73

SET C.H.I.S. IN F.H.

90°00'00"

37.05

30.00

55.79

55.46

29.87

FD N&T IN Fn Post

104

CORLEY

29.94

90°

16 x 6 N&T LEANING S.E.

SET B.S.&W. IN Daly

SET 1" I.P. CONC. & W. 1.0' ON ℄ PROD

COUNTY ENGINEER 1973 R.E. 7078

W.S. 34-B-3

RETURN TO
LOS ANGELES COUNTY SURVEYOR
726 LOS ANGELES COUNTY
ENGINEERING BLDG.

Do not extend notes this side of this line.

Note: Any Additions or Changes on This Sheet Must be Made or Circled in Red Ink With Date and Name of Person Making Change.

PWFB 0828 1192

| | |
|---|---|
| Notes Ck'd by | Survey of So. WHITTIER AREA #1 |
| Map No. | W. O. Tape No. Std. 68 °F |
| Office Work | Surveyed by MACK |
| Checked | Notes Date 12-2-52 |
| Date | Indexed |

F. B. 1764 Pg. 35

Note: Any Additions or Changes on This Sheet Must be Made or Circled in Red Ink With Date and Name of Person Making Change.

Do not extend notes this side of this line.

RETURN TO
LOS ANGELES COUNTY SURVEYOR
726 LOS ANGELES COUNTY
ENGINEERING BLDG.

76F3095 247 2-51

RETURN TO
LOS ANGELES COUNTY SURVEYOR
726 LOS ANGELES COUNTY
ENGINEERING BLDG.

Note: Any Additions or Changes on This Sheet Must be Made or Circled in Red Ink. With Date and Name of Person Making Change.

Do not extend notes this side of this line.

W.S. 34-B-3

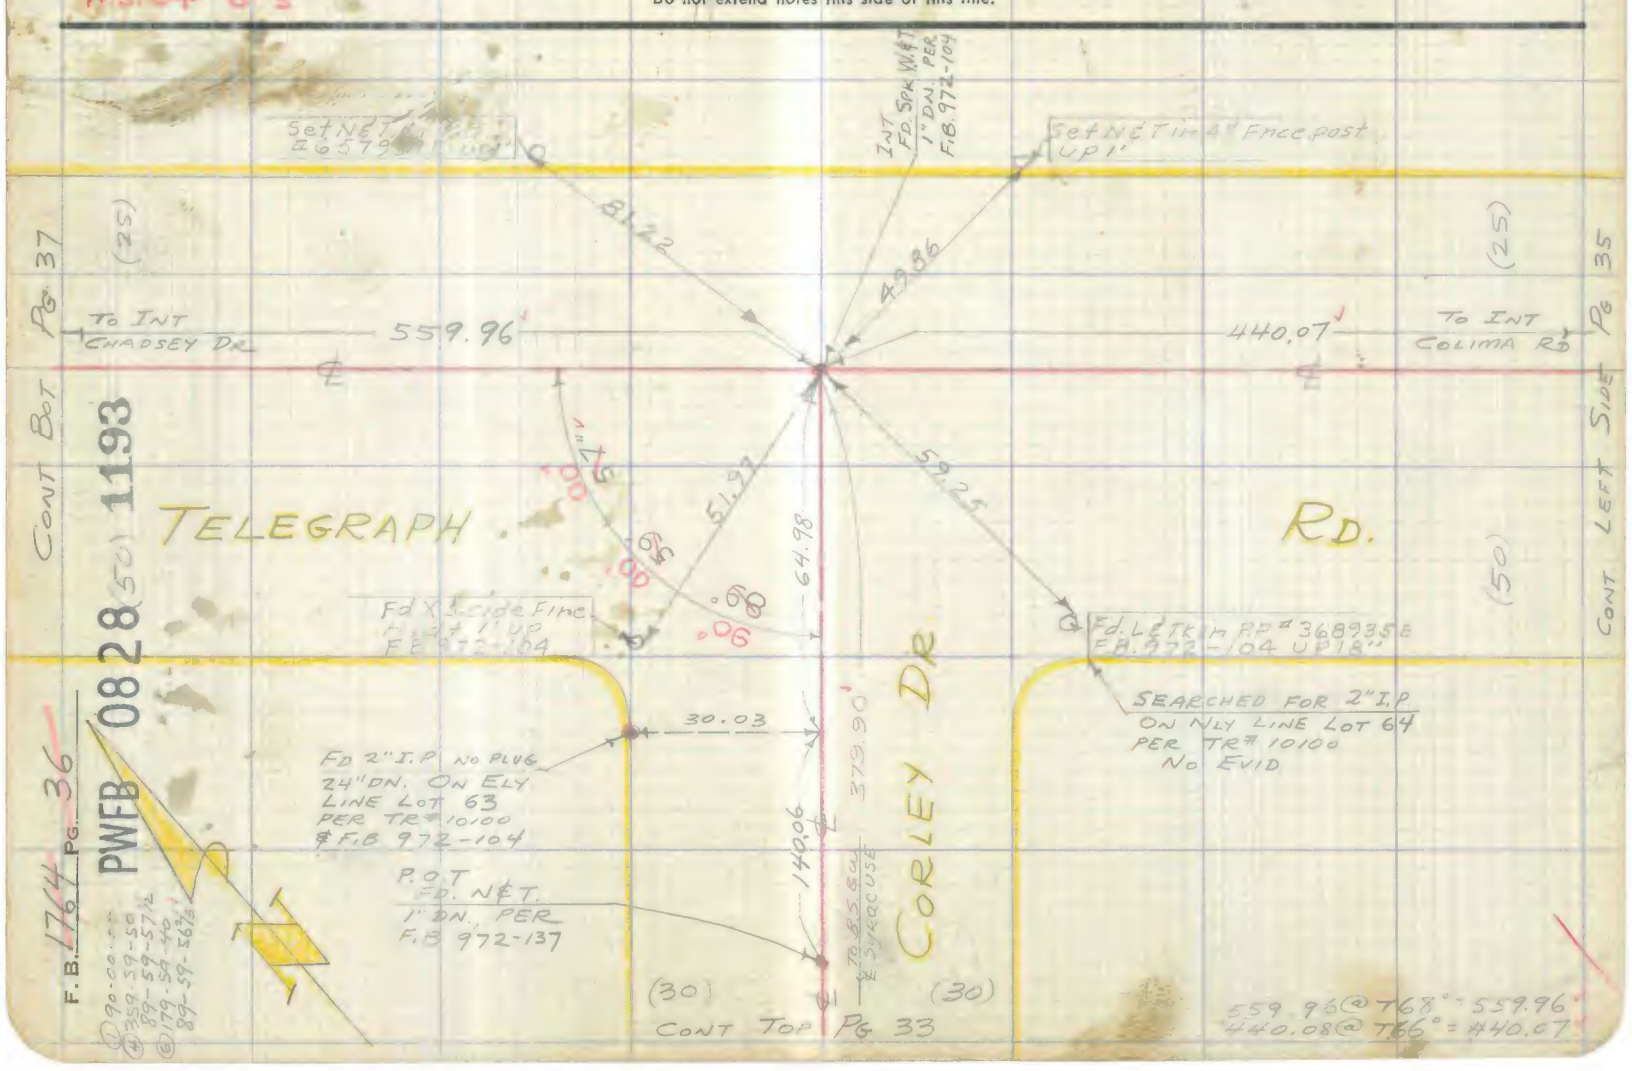


F.B. 1764 PG. 36

PWFB 08 28 (50) 1193

① 90-00-00
② 359-59-50
③ 89-59-57½
④ 179-59-40
⑤ 89-59-56½

PWFB 0827 2045

F. B. 1764 Pg. 37

| | |
|---|---|
| Notes Ck'd by [illegible] | Survey of So. Whittier Area #1 |
| Map No. [illegible] | W. O. 8650 Tape No. 034 St'd. 68 °F |
| Office Work R. L. Green | Surveyed by MACK |
| Checked [illegible] | Notes " Date 12-4-52 |
| Date [illegible] | Indexed [illegible] |

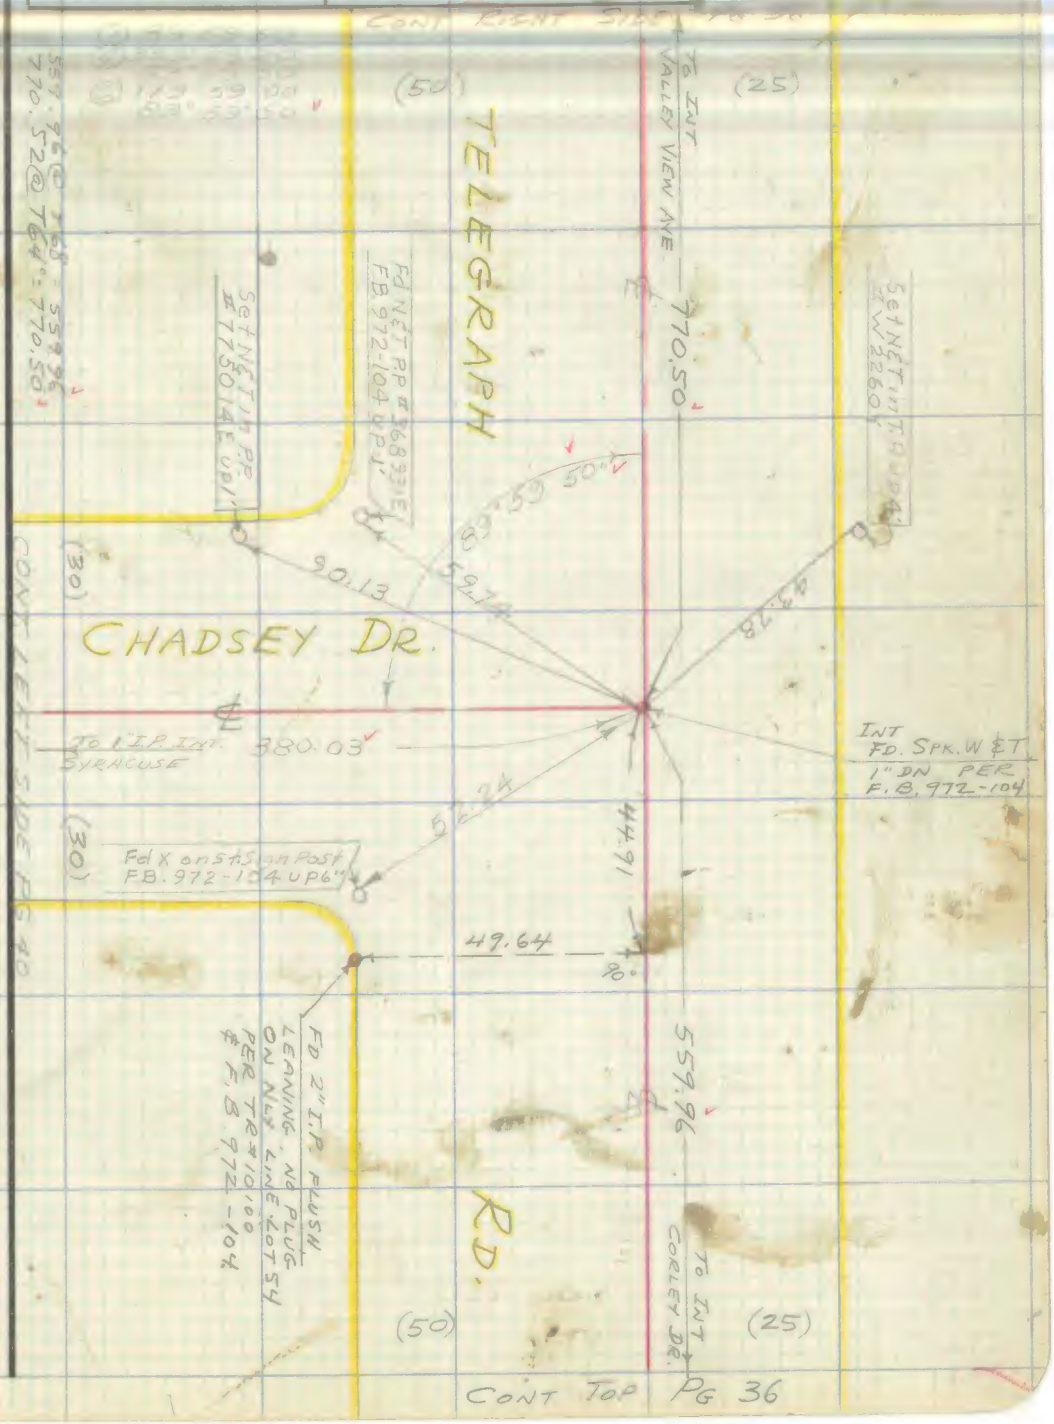


Note: Any Additions or Changes on This Sheet Must be Made or Circled in Red Ink With Date and Name of Person Making Change.

Do not extend notes this side of this line.

RETURN TO
LOS ANGELES COUNTY SURVEYOR
726 LOS ANGELES COUNTY
ENGINEERING BLDG.

76F309S 247 2-51

RETURN TO
LOS ANGELES COUNTY SURVEYOR
726 LOS ANGELES COUNTY
ENGINEERING BLDG.

Note: Any Additions or Changes on This Sheet Must be Made or Circled in Red Ink With Date and Name of Person Making Change.

Do not extend notes this side of this line.

W.S. 4-B-3

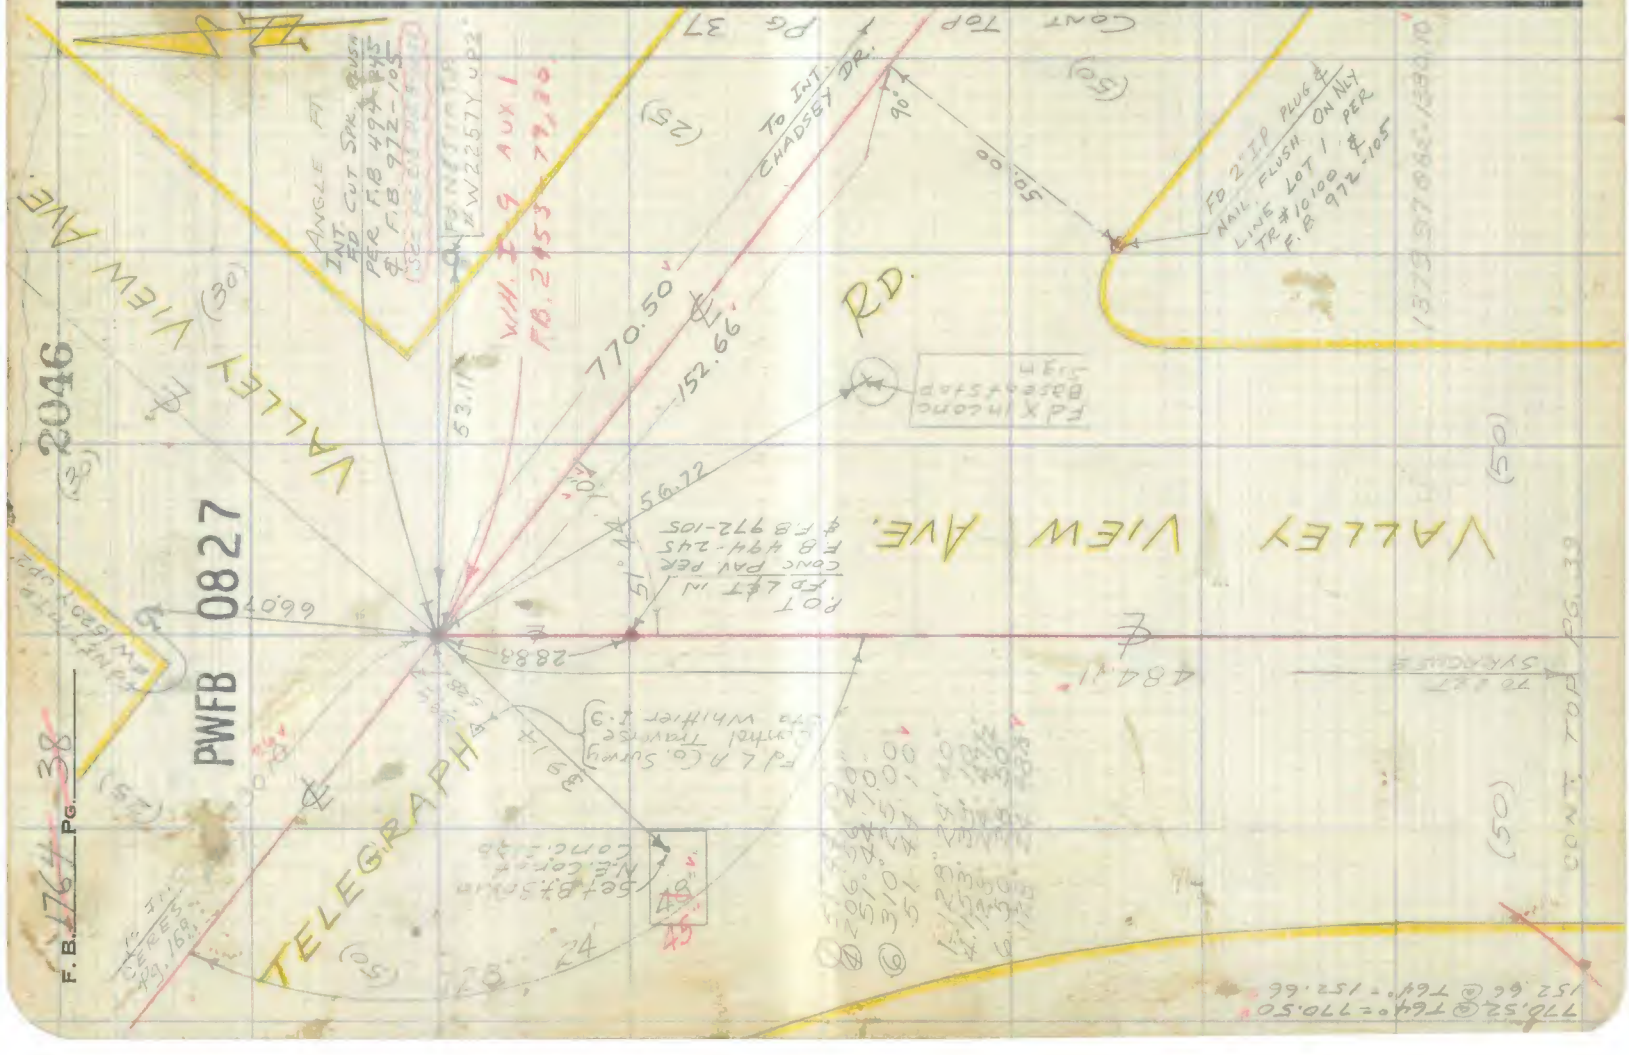

PWEB 0827

2047

F. B. [illegible] PG. 39

| | |
|---|---|
| Notes Ck'd by [illegible] | Survey of SO. WHITTIER AREA |
| Map No. C.S.B. [illegible] | W. O. [illegible] Tape No. ____ St'd. ____ °F |
| Office Work R. J. Green | Surveyed by [illegible] |
| Checked [illegible] | Notes [illegible] Date [illegible] |
| Date June 1952 | Indexed [illegible] |

W 34-B-3

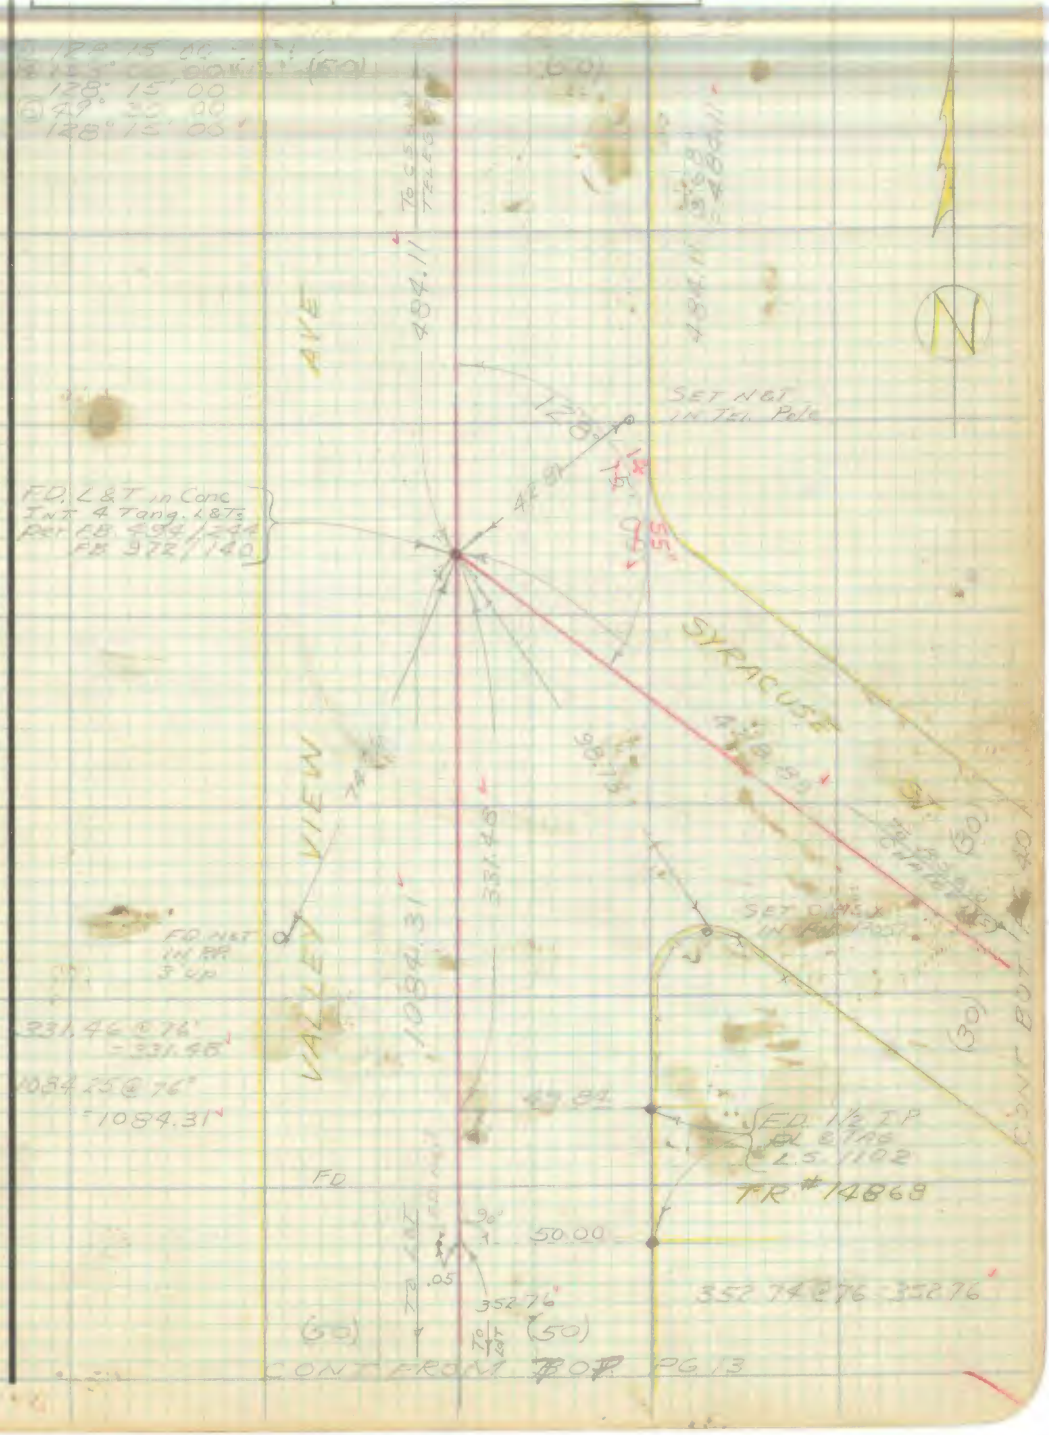


Note: Any Additions or Changes on This Sheet Must be Made or Circled in Red Ink With Date and Name of Person Making Change.

Do not extend notes this side of this line.

RETURN TO
LOS ANGELES COUNTY SURVEYOR
726 LOS ANGELES COUNTY
ENGINEERING BLDG.

76F3095 247 10M 1-49

RETURN TO
LOS ANGELES COUNTY SURVEYOR
726 LOS ANGELES COUNTY
ENGINEERING BLDG.

Note: Any Additions or Changes on This Sheet Must be Made or Circled in Red Ink With Date and Name of Person Making Change.

Do not extend notes this side of this line.

W.S. 34-B-3

2048

PWFB 0827

F. B. 164 PG.

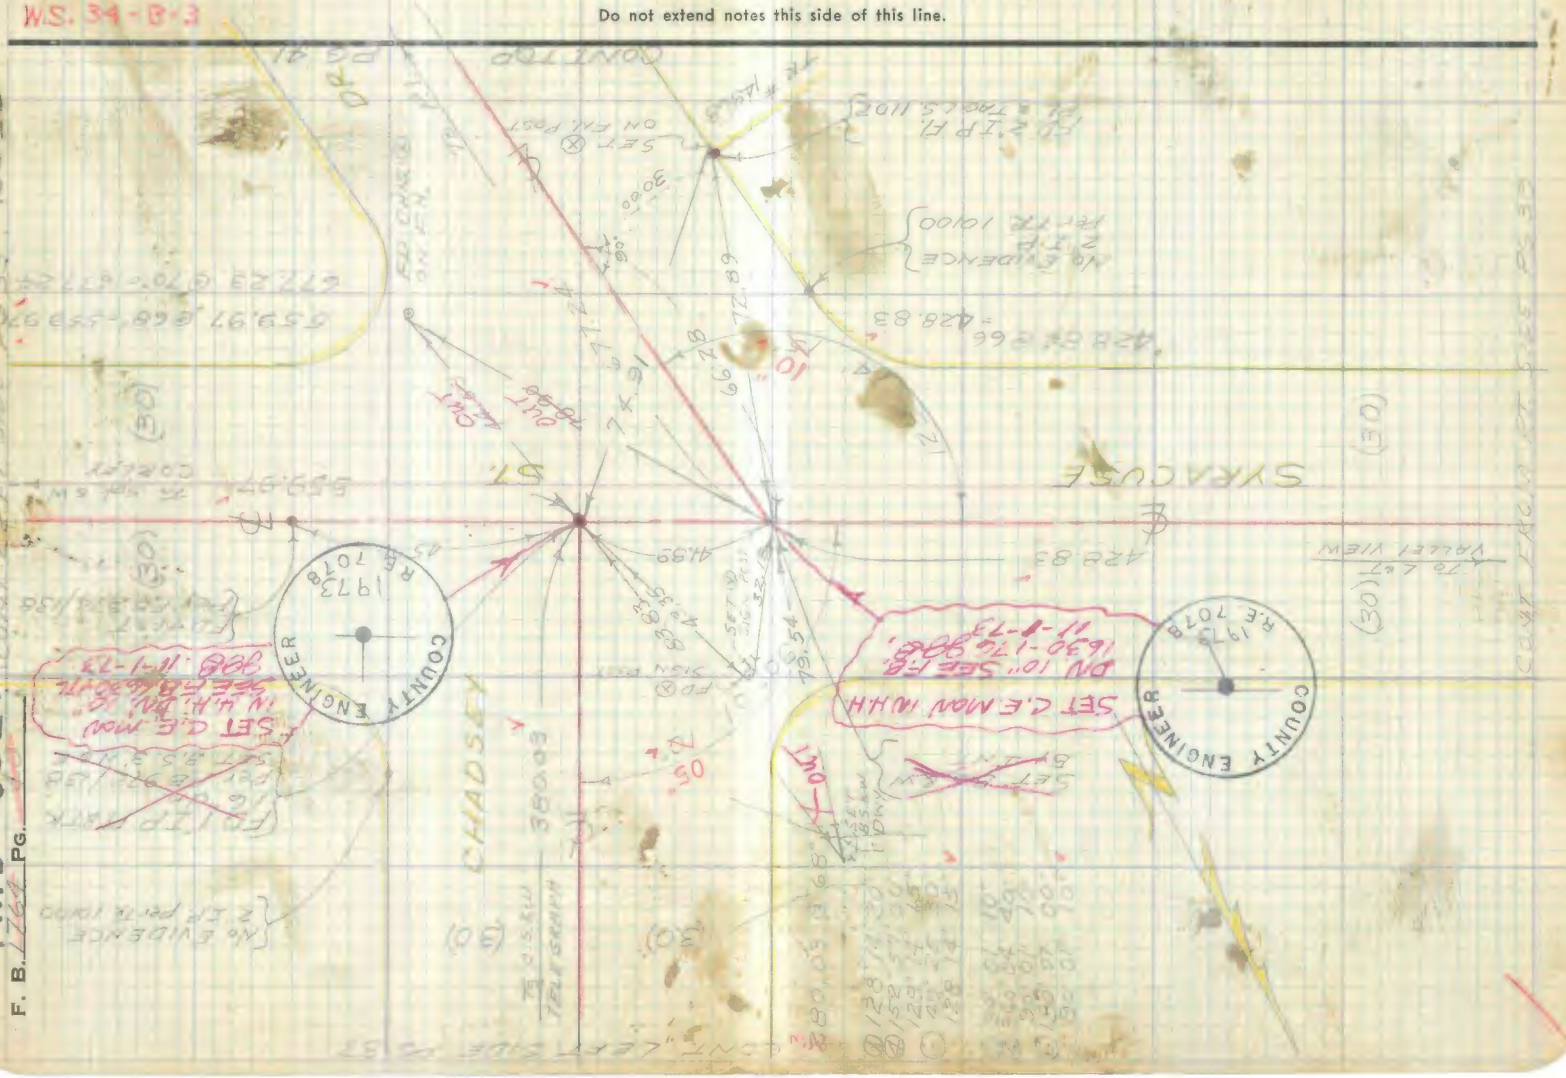

PWFB 0827 2049, 2050

| | |
|---|---|
| Notes Ck'd by [illegible] | Survey of S. WHITTIER AREA |
| Map No. [illegible] | W. O. [illegible] Tape No. [illegible] St'd. [illegible] °F |
| Office Work R. L. Green | Surveyed by J. S. COATES |
| Checked [illegible] | Notes [illegible] Date [illegible] |
| Date JULY 1956 | Indexed [illegible] |

F. B. [illegible] PG. [illegible]

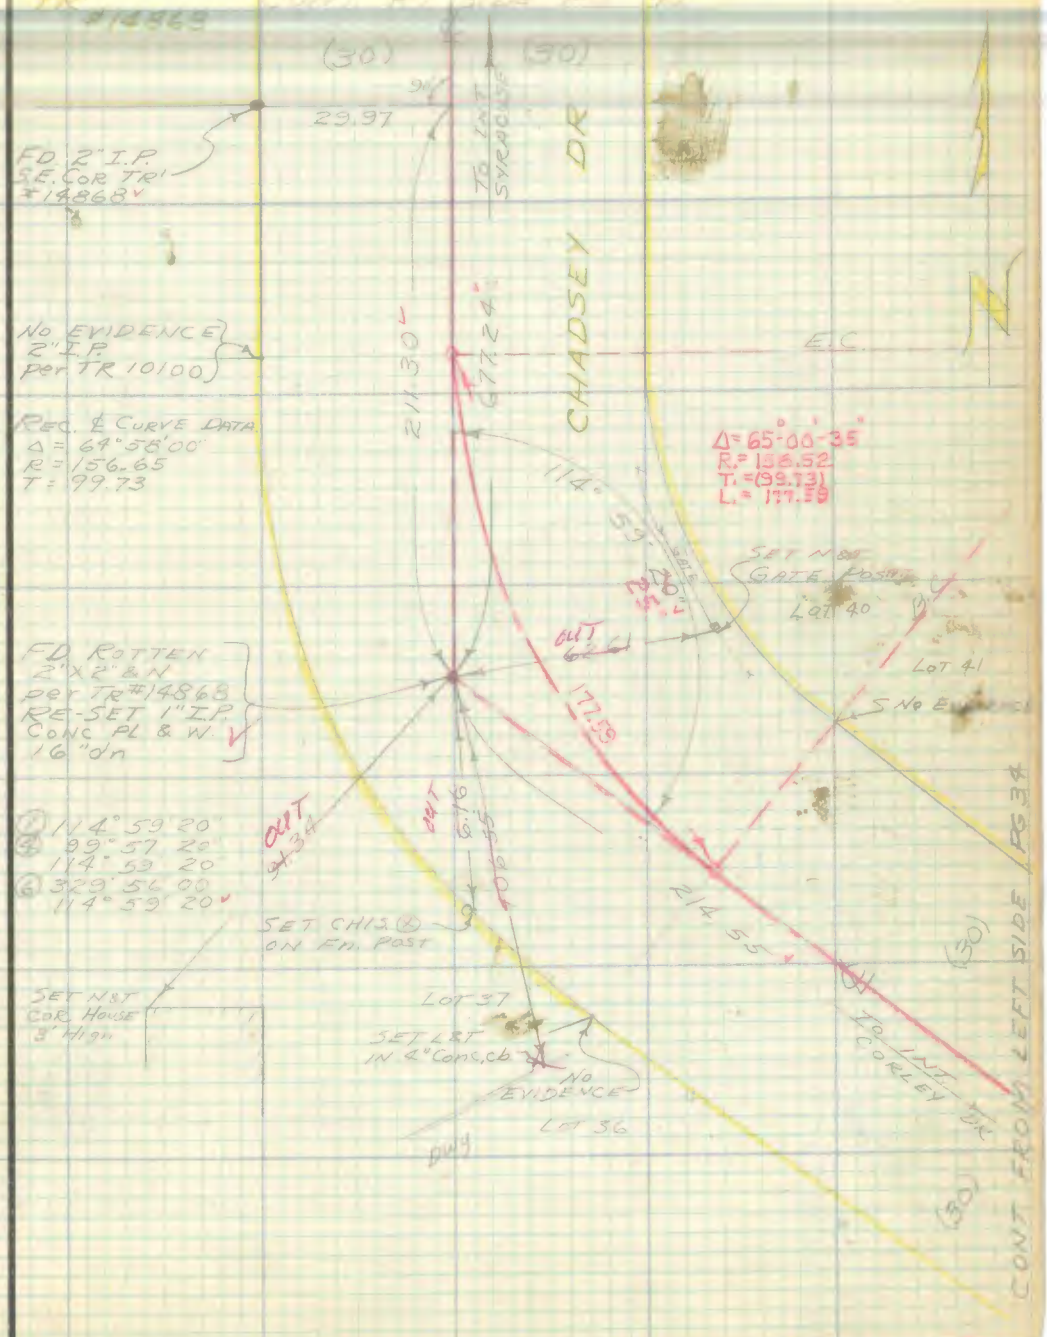


Note: Any Additions or Changes on This Sheet Must be Made or Circled in Red Ink With Date and Name of Person Making Change.

Do not extend notes this side of this line.

RETURN TO
LOS ANGELES COUNTY SURVEYOR
726 LOS ANGELES COUNTY
ENGINEERING BLDG.

76F309S 247 10M 1-49

F. B. 1765 PG. 42

RETURN TO
LOS ANGELES COUNTY SURVEYOR
726 LOS ANGELES COUNTY
ENGINEERING BLDG.

Note: Any Additions or Changes on This Sheet Must be Made or Circled in Red Ink With Date and Name of Person Making Change.

Do not extend notes this side of this line.

PWFB 0827

2051

F. B. ______ PG. ______

Notes Ck'd by D. M. Finley
Map No. C.S.B.-2562-1-2
Office Work E. L. Green
Checked C. J. Galli
Date ______

Survey of ______
W. O. ______ Tape No. ______ St'd. ______ °F
Surveyed by ______
Notes ______ Date ______
Indexed ______

**Note:** Any Additions or Changes on This Sheet Must be Made or Circled in Red Ink With Date and Name of Person Making Change.

Do not extend notes this side of this line.

RETURN TO
LOS ANGELES COUNTY SURVEYOR
726 LOS ANGELES COUNTY
ENGINEERING BLDG.

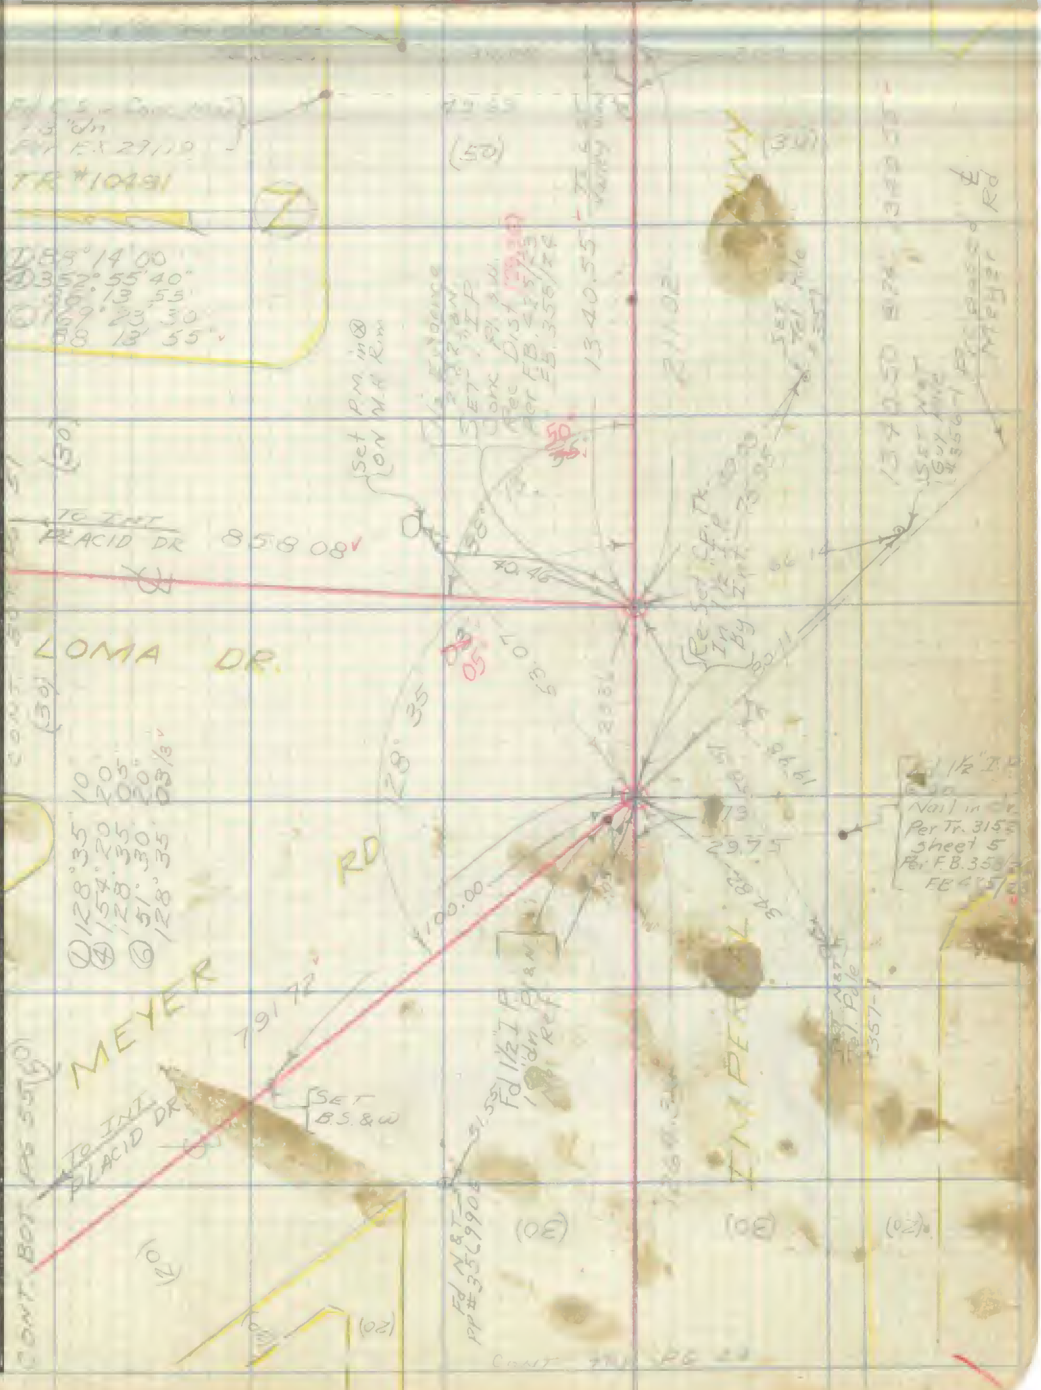


76F309S 247 2-51

PWFB 0827 2052

F.B. 1764 PG. 44

W.S. 34-B-3

RETURN TO
LOS ANGELES COUNTY SURVEYOR
726 LOS ANGELES COUNTY
ENGINEERING BLDG.

Do not extend notes this side of this line.

Note: Any Additions or Changes on This Sheet Must be Made or Circled in Red Ink With Date and Name of Person Making Change.

PWEB 0827

2053, 2054

F. B. _____ PG. 45

| | |
|---|---|
| Notes Ck'd by D. M. Finley | Survey of |
| Map No. | W. O. Tape No. St'd. °F |
| Office Work | Surveyed by |
| Checked | Notes Date |
| Date | Indexed |

Note: Any Additions or Changes on This Sheet Must be Made or Circled in Red Ink With Date and Name of Person Making Change.

Do not extend notes this side of this line.

RETURN TO
LOS ANGELES COUNTY SURVEYOR
726 LOS ANGELES COUNTY
ENGINEERING BLDG.

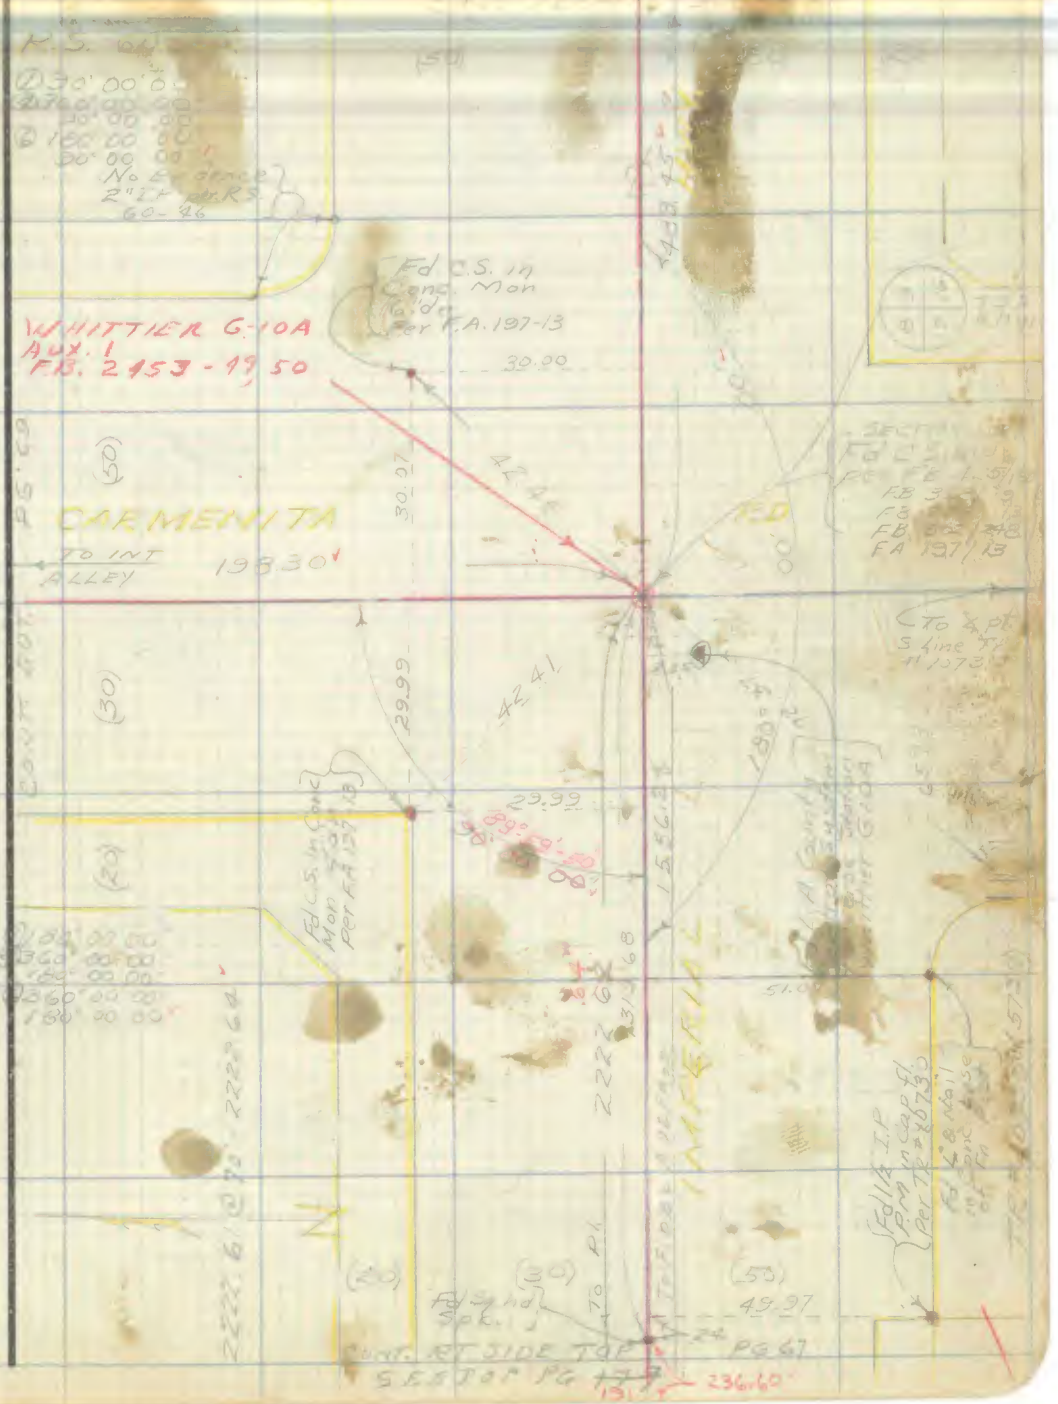


76F3095 247 2-51

PWFB 0827 2055

F.B. 1264 Pg. 46

W.S. 34-B-3

RETURN TO
LOS ANGELES COUNTY SURVEYOR
726 LOS ANGELES COUNTY
ENGINEERING BLDG.

Do not extend notes this side of this line.

Note: Any Additions or Changes on This Sheet Must be Made or Circled in Red Ink With Date and Name of Person Making Change.

76F309S 247 2-51

RETURN TO
LOS ANGELES COUNTY SURVEYOR
726 LOS ANGELES COUNTY
ENGINEERING BLDG.

**Note:** Any Additions or Changes on This Sheet Must be Made or Circled in Red Ink With Date and Name of Person Making Change.

Do not extend notes this side of this line.

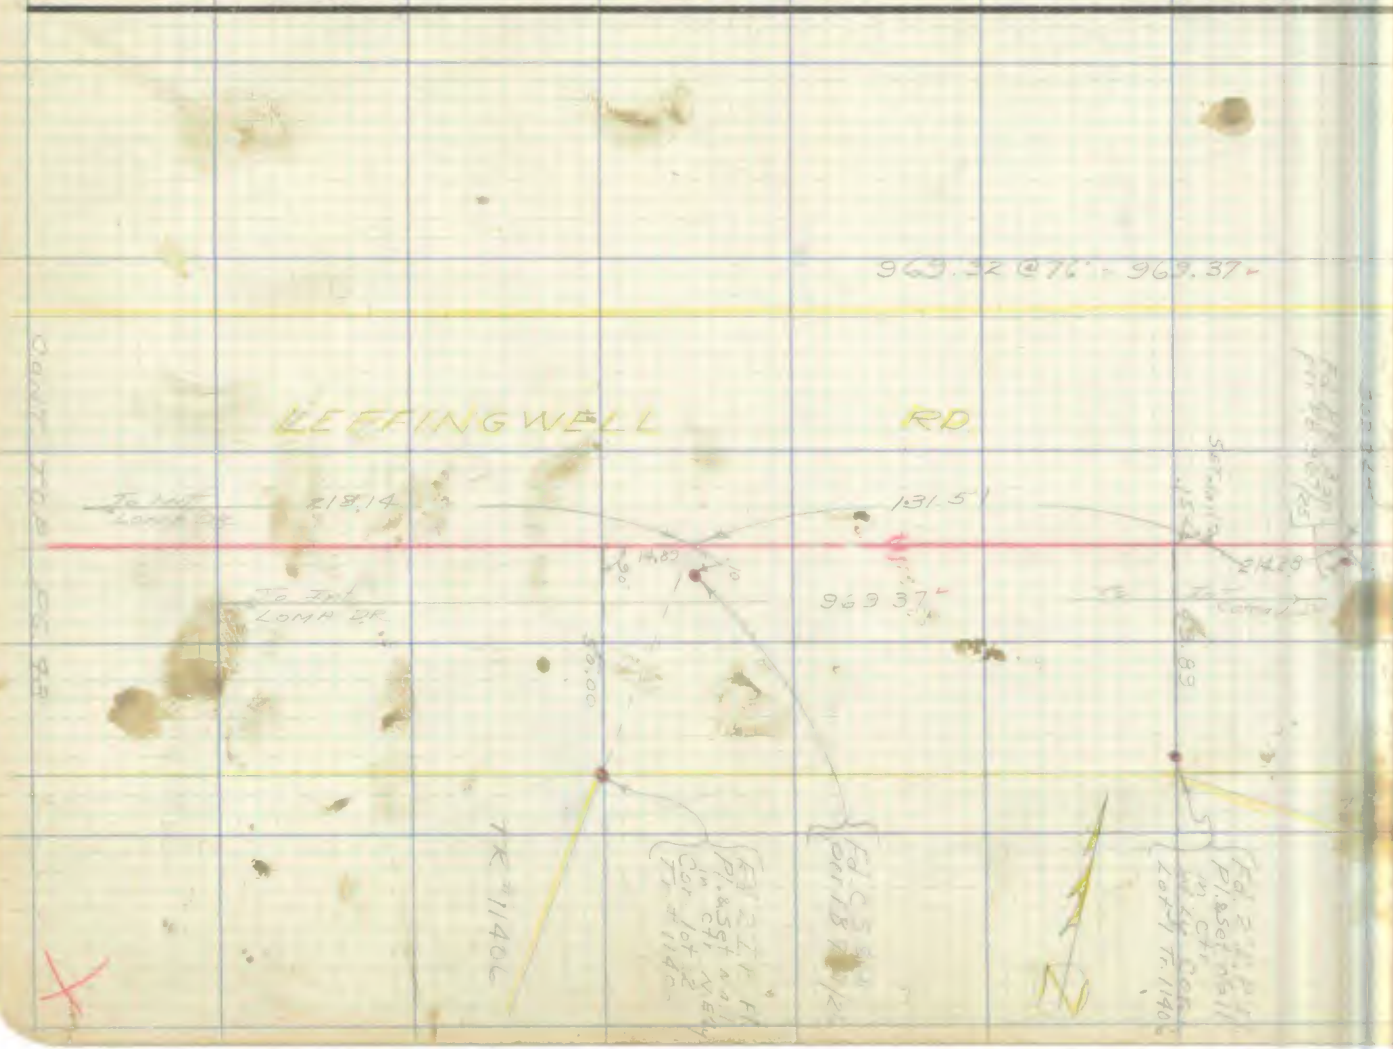


Notes Ck'd by D. M. Fisher
Map No.
Office Work
Checked
Date

Survey of
W. O. Tape No. St'd. °F
Surveyed by
Notes Date
Indexed

PWFB 0827

2056

F. B. Pg.

F. B. 1764 Pg. 48

PWFB 0827

2057 , 2058

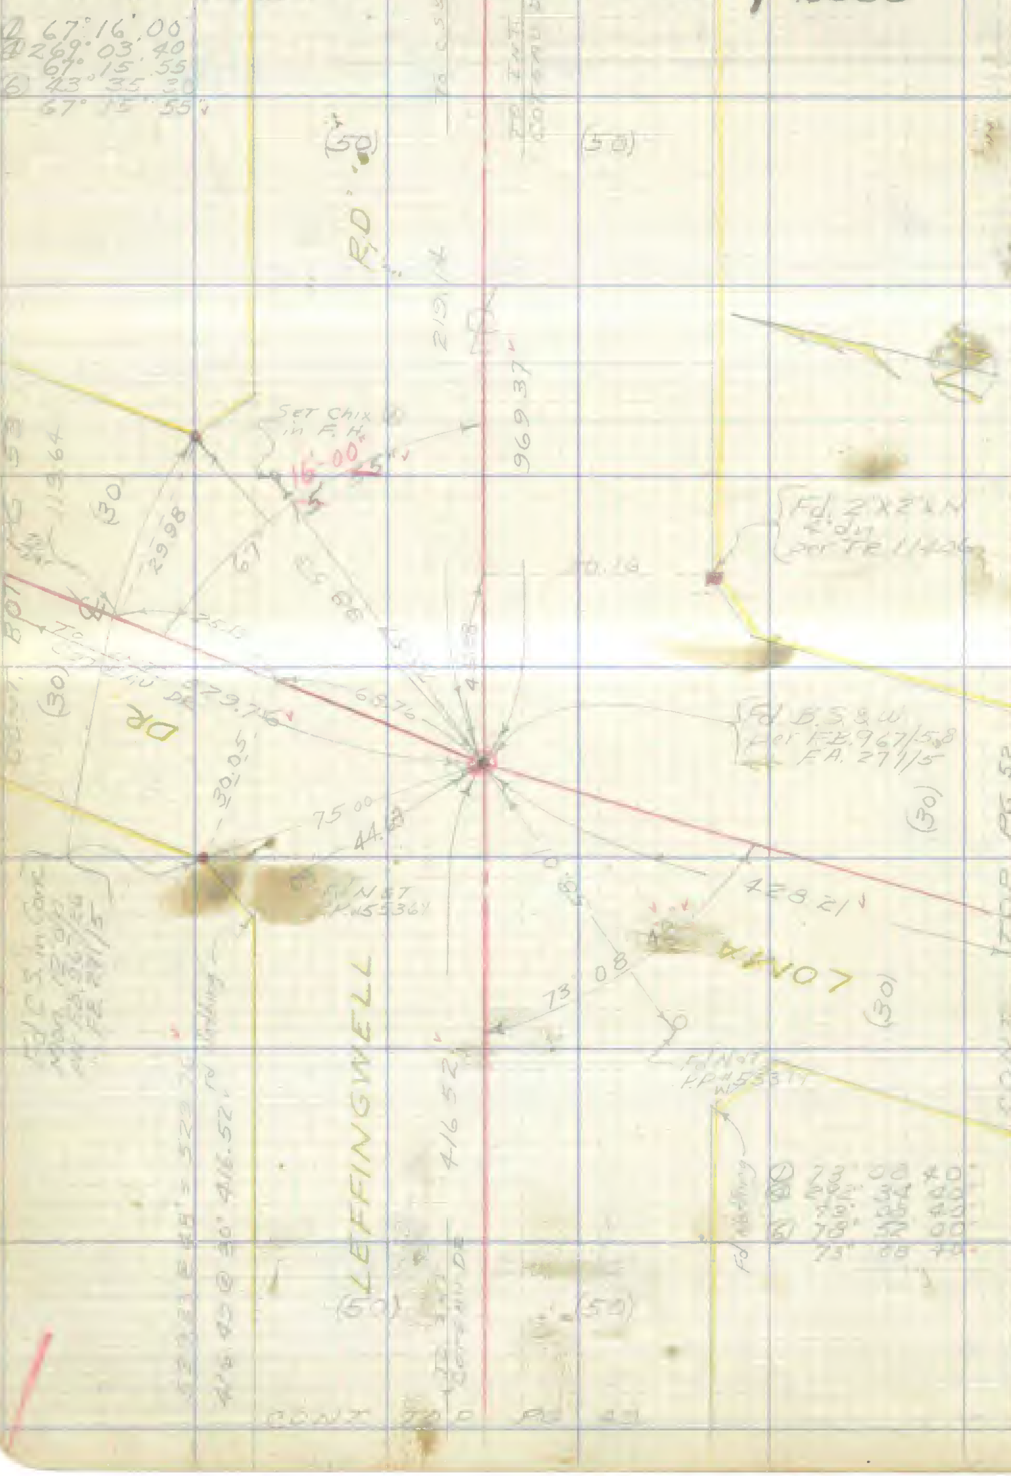


RETURN TO
LOS ANGELES COUNTY SURVEYOR
726 LOS ANGELES COUNTY
ENGINEERING BLDG.

Note: Any Additions or Changes on This Sheet Must be Made or Circled in Red Ink With Date and Name of Person Making Change.

Do not extend notes this side of this line.

PWFB 0827

2059

F. B. ___ Pg. ___

| | |
|---|---|
| Notes Ck'd by D. M. Finley | Survey of ___ |
| Map No. C.S.B.-2562 | W. O. ___ Tape No. ___ St'd. ___ °F |
| Office Work R.L. Green | Surveyed by ___ |
| Checked C. J. Gauss | Notes ___ Date ___ |
| Date ___ | Indexed ___ |

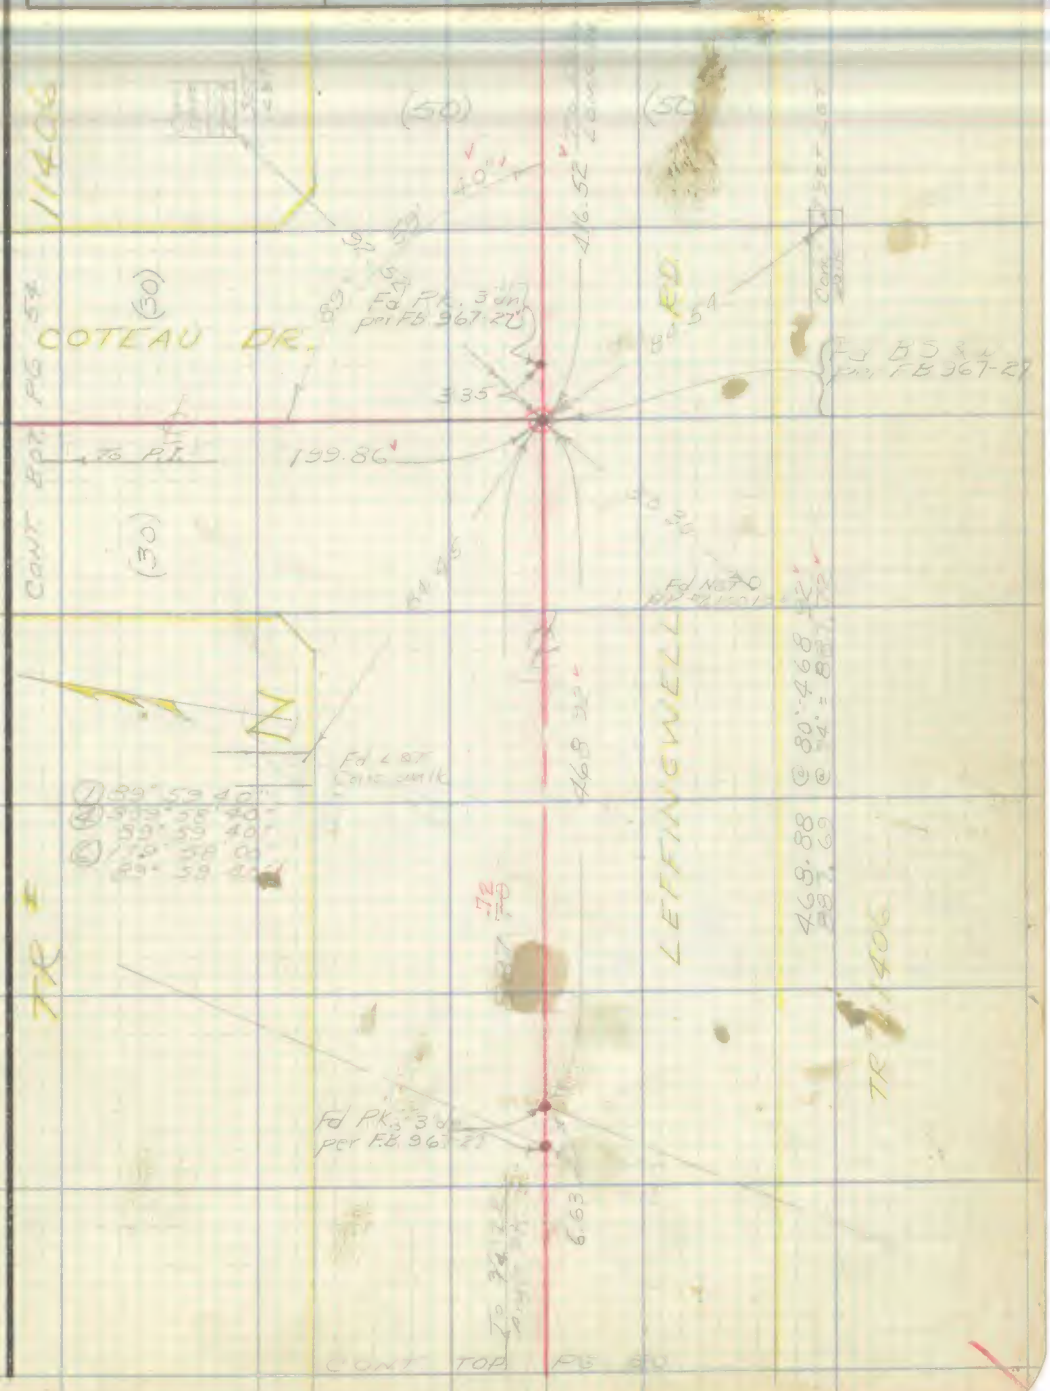


Note: Any Additions or Changes on This Sheet Must be Made or Circled in Red Ink With Date and Name of Person Making Change.

Do not extend notes this side of this line.

RETURN TO
LOS ANGELES COUNTY SURVEYOR
726 LOS ANGELES COUNTY
ENGINEERING BLDG.

76F3095 247 2-51

RETURN TO
LOS ANGELES COUNTY SURVEYOR
726 LOS ANGELES COUNTY
ENGINEERING BLDG.

Note: Any Additions or Changes on This Sheet Must be Made or Circled in Red Ink With Date and Name of Person Making Change.

W.S. 34-B-2

Do not extend notes this side of this line.

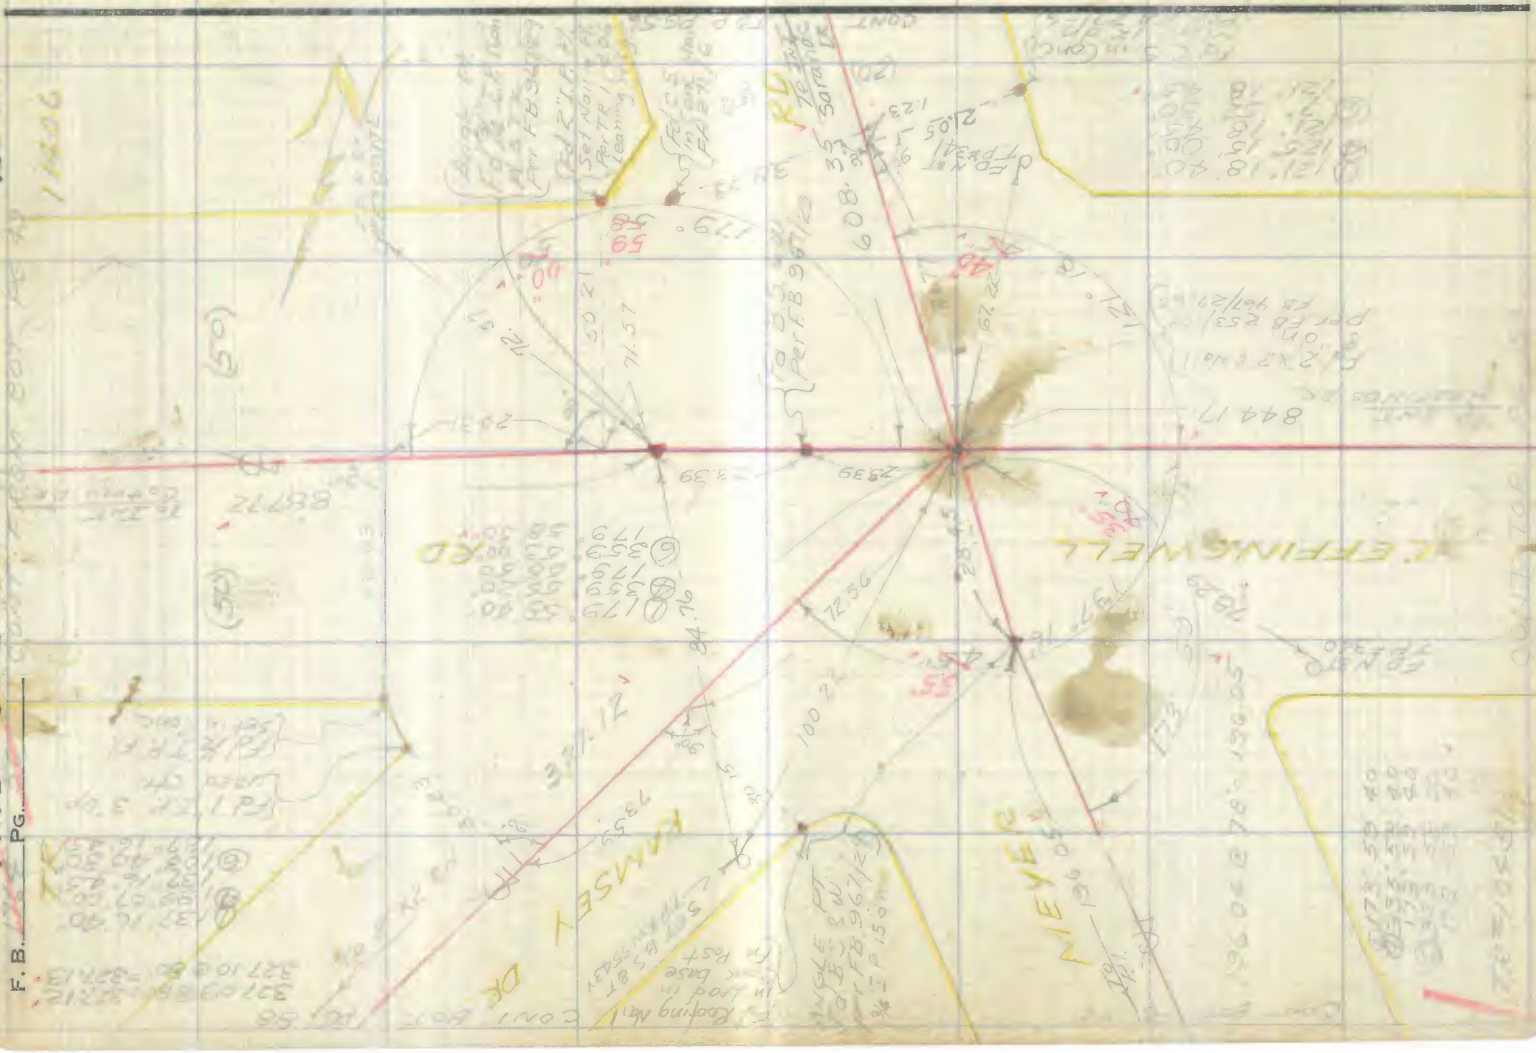


2060

PWFB 0827

F. B. Pg.

PWFB 0827 2061

| | |
|---|---|
| Notes Ck'd by C. M. Finley | Survey of |
| Map No. | W. O. Tape No. St'd. °F |
| Office Work R. L. Green | Surveyed by |
| Checked C. J. Gall | Notes Date |
| Date | Indexed |

F. B. Pg.

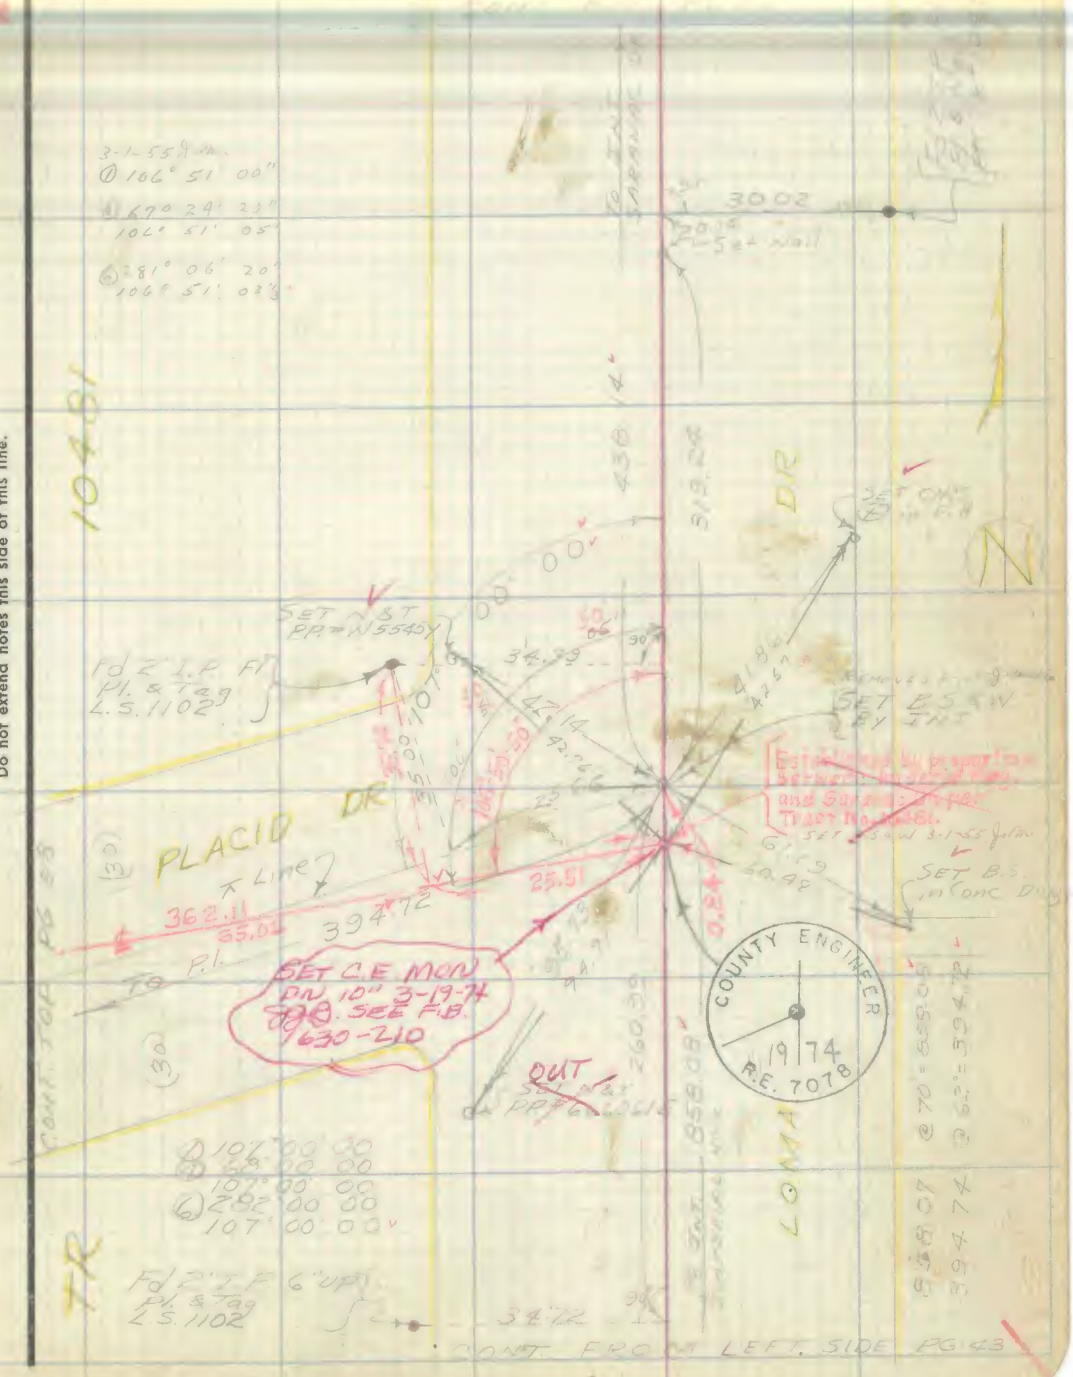


Note: Any Additions or Changes on This Sheet Must be Made or Circled in Red Ink With Date and Name of Person Making Change.

Do not extend notes this side of this line.

RETURN TO
LOS ANGELES COUNTY SURVEYOR
726 LOS ANGELES COUNTY
ENGINEERING BLDG.

76F309S 247 2-51

F. B. 1564 PG. 52

PWFB 0827

2062

W.S. 34-B-3

RETURN TO
LOS ANGELES COUNTY SURVEYOR
726 LOS ANGELES COUNTY
ENGINEERING BLDG.

Do not extend notes this side of this line.

Note: Any Additions or Changes on This Sheet Must be Made or Circled in Red Ink With Date and Name of Person Making Change.

PWFB 0827 2063, 2064

| | |
|---|---|
| Notes Ck'd by D. M. Finley | Survey of [illegible] |
| Map No. [illegible] | W. O. [illegible] Tape No. [illegible] St'd. [illegible] °F |
| Office Work R. L. Green | Surveyed by J. S. Coates |
| Checked [illegible] | Notes [illegible] Date [illegible] |
| Date [illegible] | Indexed [illegible] |

F. B. [illegible] PG. [illegible]

W.S. 34-B-3

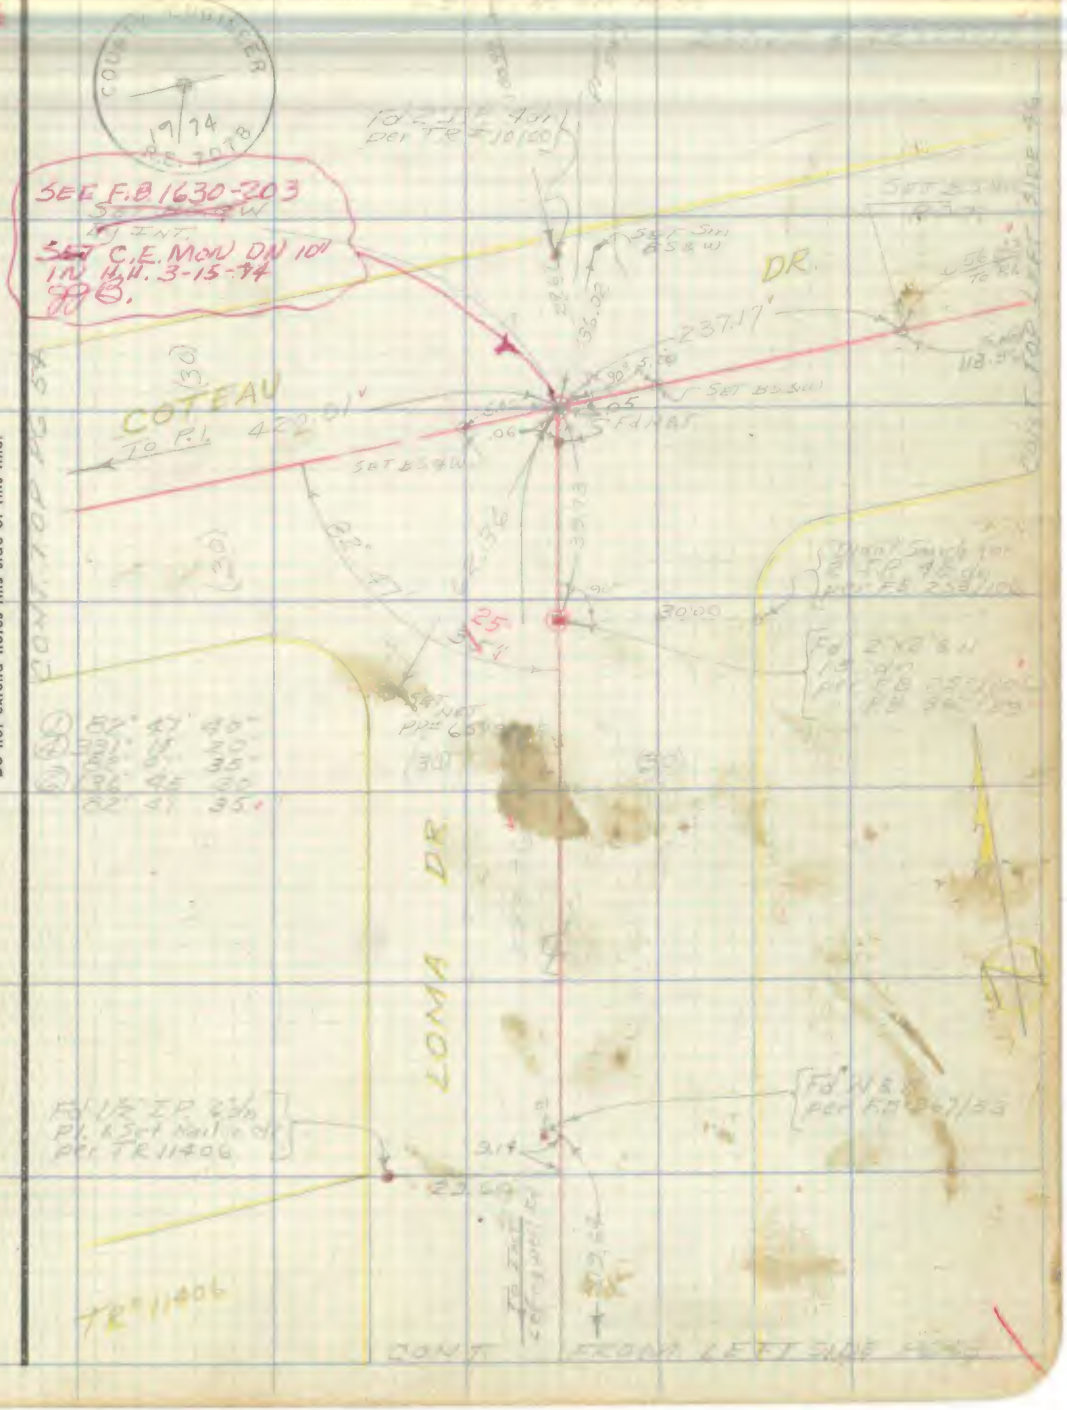


Note: Any Additions or Changes on This Sheet Must be Made or Circled in Red Ink With Date and Name of Person Making Change.

Do not extend notes this side of this line.

RETURN TO
LOS ANGELES COUNTY SURVEYOR
726 LOS ANGELES COUNTY
ENGINEERING BLDG.

76F3095 247 2-51

2065

F. B. ____ PG. ____

PWFB 0827

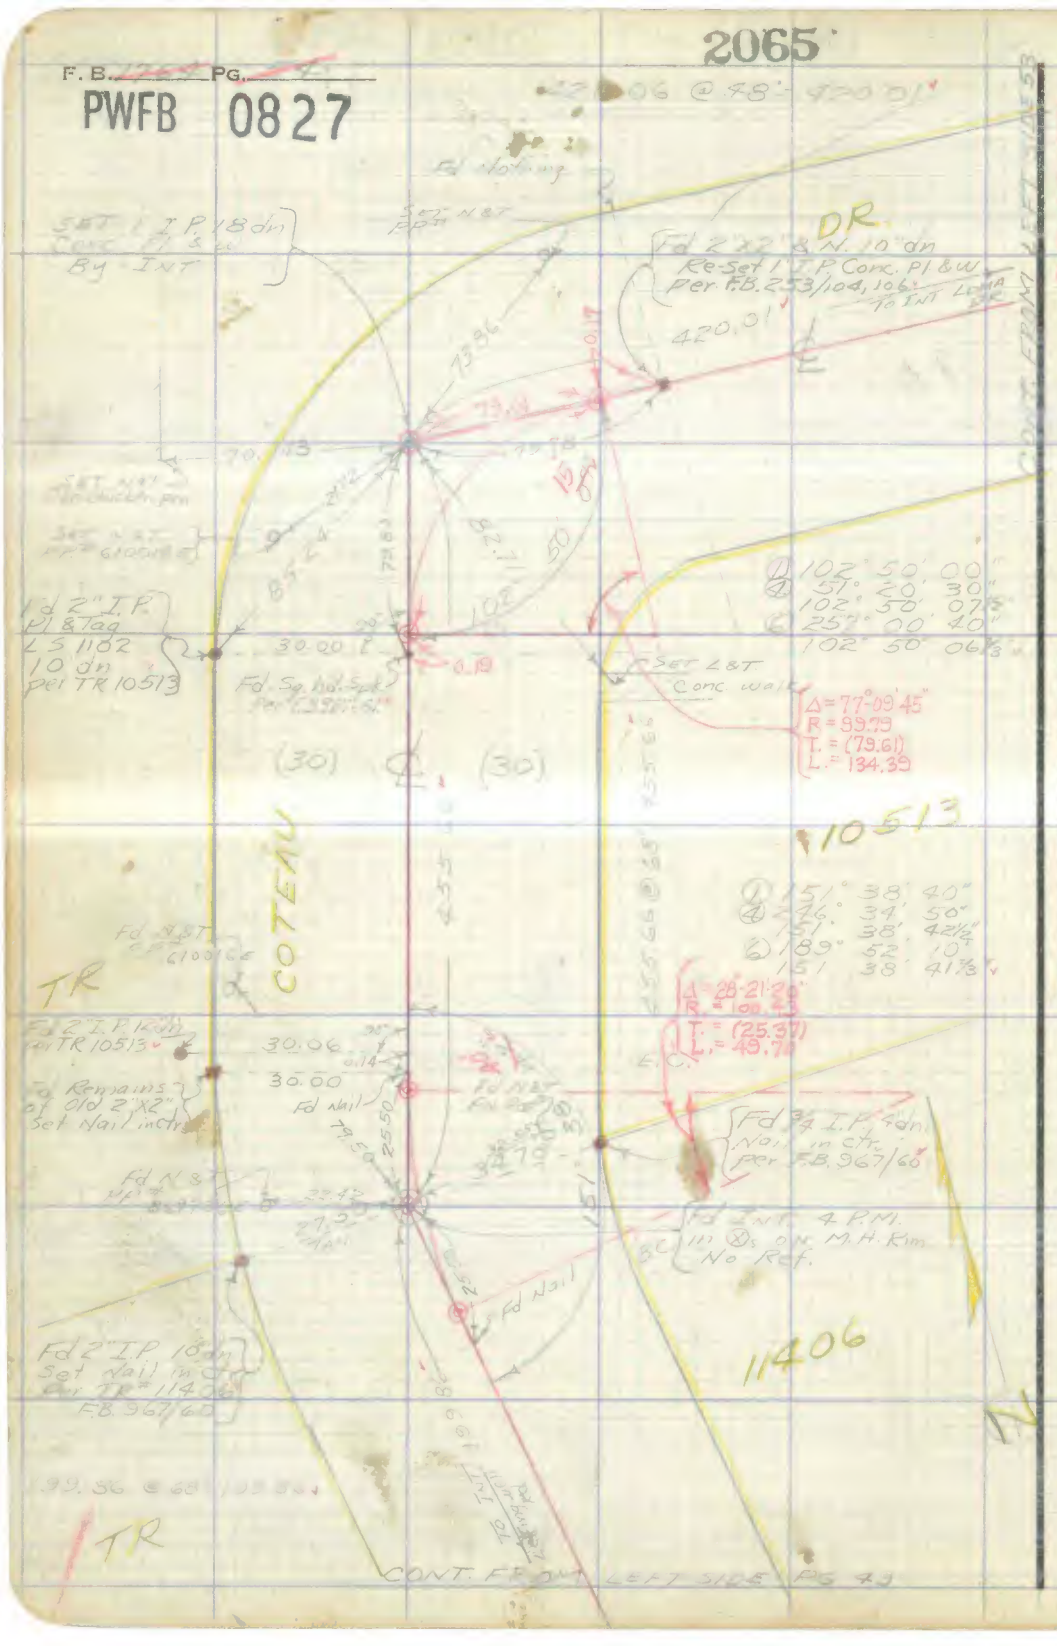


W.S. 24-B-2

RETURN TO
LOS ANGELES COUNTY SURVEYOR
726 LOS ANGELES COUNTY
ENGINEERING BLDG.

Do not extend notes this side of this line.

Note: Any Additions or Changes on This Sheet Must be Made or Circled in Red Ink With Date and Name of Person Making Change.

PWFB 0827 2066, 2067

| | |
|---|---|
| Notes Ck'd by D. M. Finley | Survey of |
| Map No. C.S.B-2563 | W. O. Tape No. St'd. °F |
| Office Work R. L. Green | Surveyed by |
| Checked C. J. Galli | Notes Date |
| Date June 1966 | Indexed II - Total cost |

F. B. PG.

W.S. 34-B-3

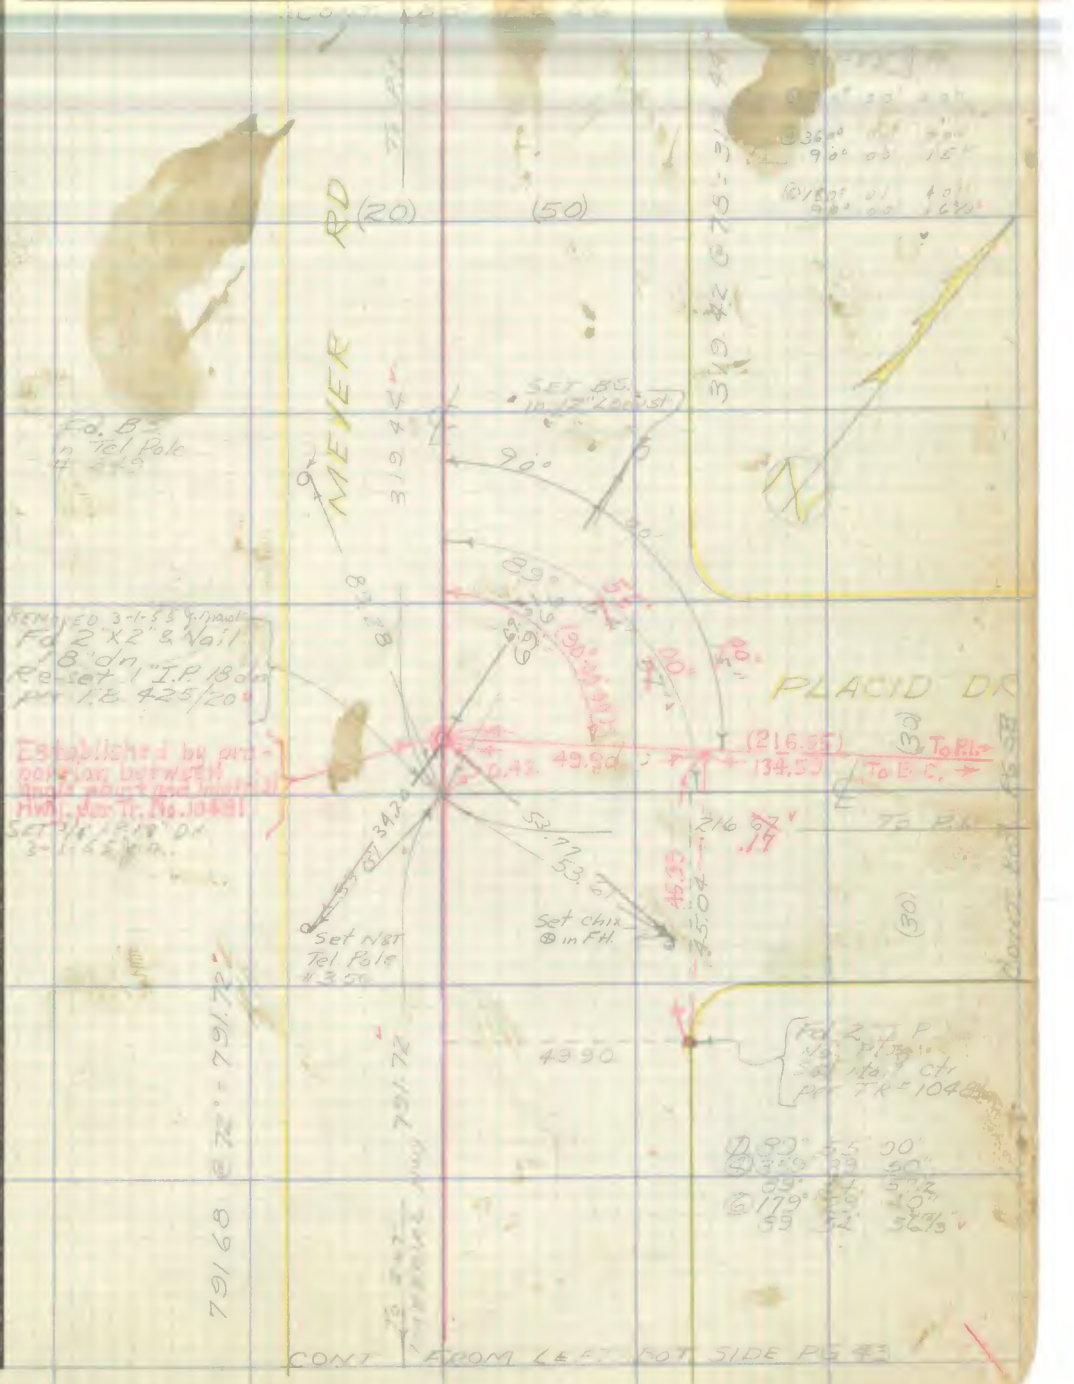


Note: Any Additions or Changes on This Sheet Must be Made or Circled in Red Ink With Date and Name of Person Making Change.

Do not extend notes this side of this line.

RETURN TO
LOS ANGELES COUNTY SURVEYOR
726 LOS ANGELES COUNTY
ENGINEERING BLDG.

76F309S 247 2-51

F. B. 1761 Pg. 56 CONT FROM RT SIDE PG 20

PWFB 0827

W.S. 34-B-3

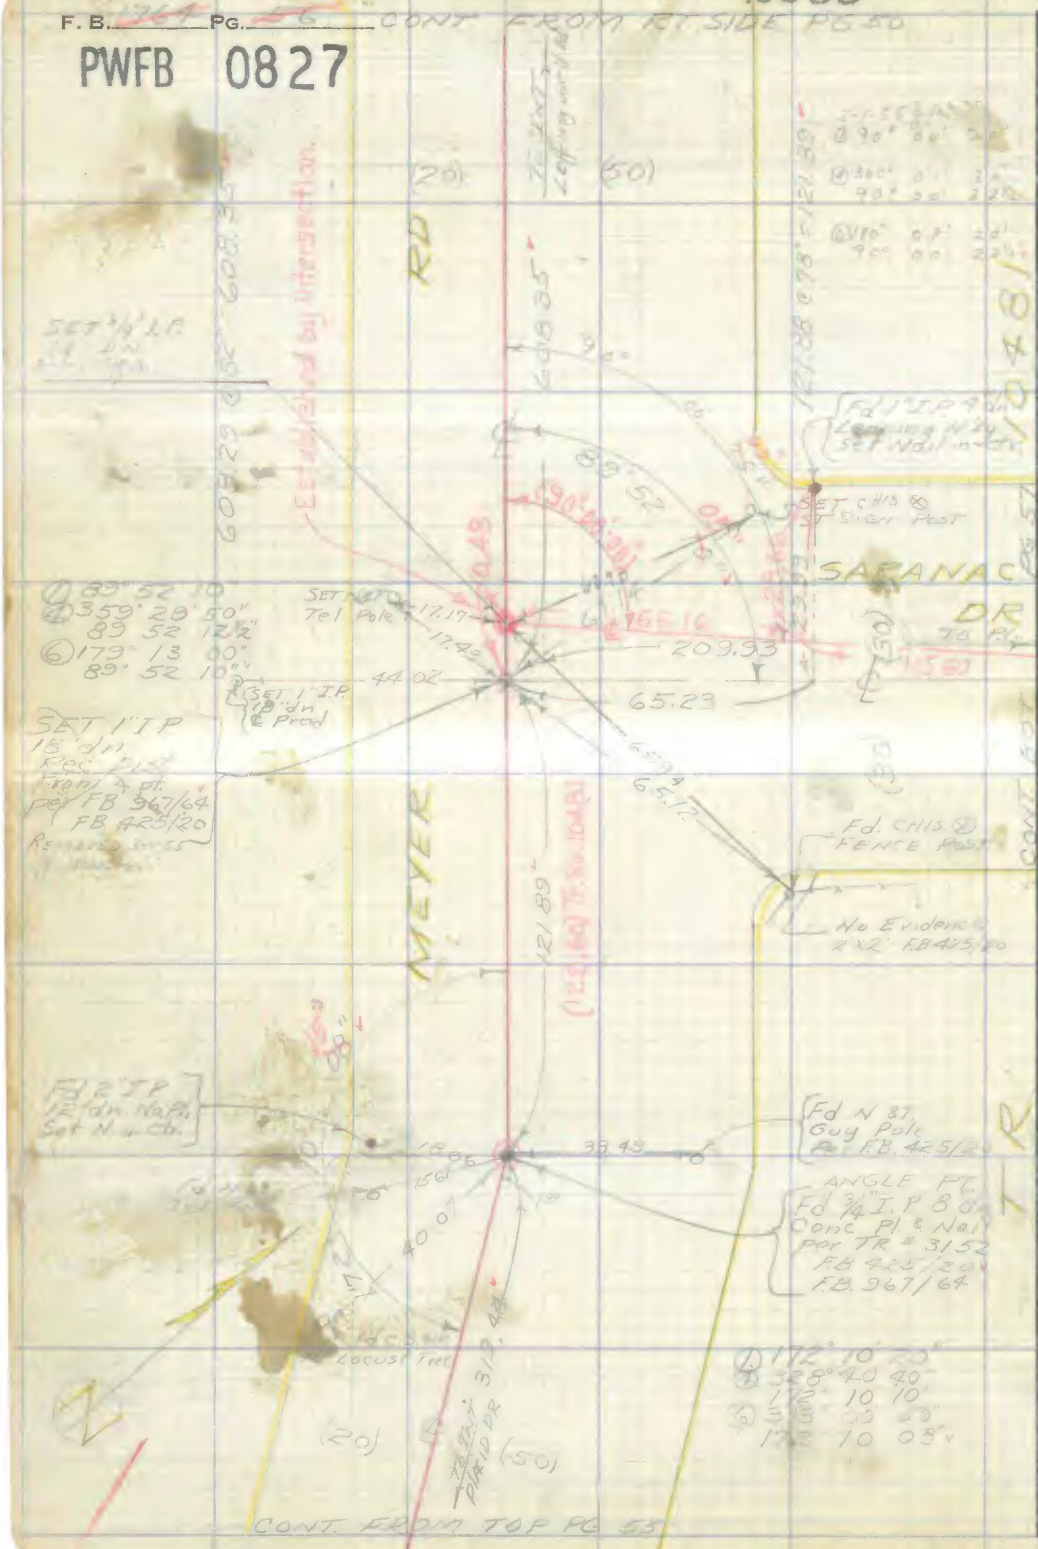


RETURN TO
LOS ANGELES COUNTY SURVEYOR
726 LOS ANGELES COUNTY
ENGINEERING BLDG.

Do not extend notes this side of this line.

Note: Any Additions or Changes on This Sheet Must be Made or Circled in Red Ink With Date and Name of Person Making Change.

PWFB 0827 2069

F. B. [illegible] PG. [illegible]

| | |
|---|---|
| Notes Ck'd by D. M. Fitler | Survey of [illegible] |
| Map No. [illegible] | W. O. [illegible] Tape No. [illegible] St'd. [illegible] °F |
| Office Work [illegible] | Surveyed by [illegible] |
| Checked [illegible] | Notes [illegible] Date [illegible] |
| Date [illegible] | Indexed [illegible] |

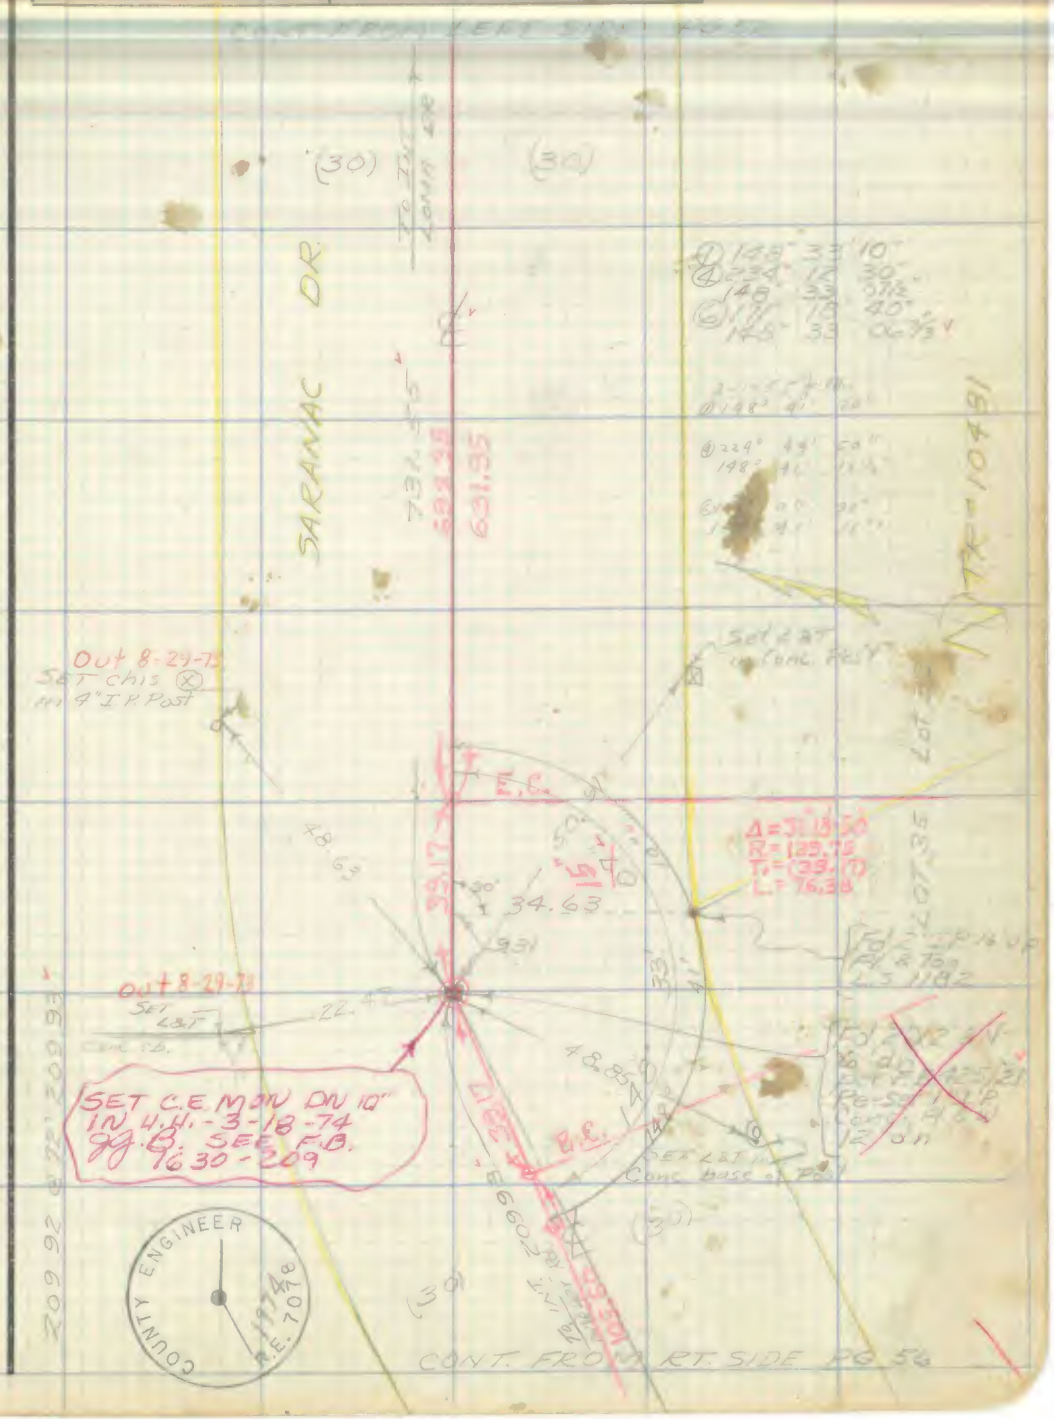


Note: Any Additions or Changes on This Sheet Must be Made or Circled in Red Ink With Date and Name of Person Making Change.

Do not extend notes this side of this line.

RETURN TO
LOS ANGELES COUNTY SURVEYOR
726 LOS ANGELES COUNTY
ENGINEERING BLDG.

76F309S 247 2-51

F. B. 1764 PG. 58

PWFB 0827

2070

W.S. 34-B-3

RETURN TO
LOS ANGELES COUNTY SURVEYOR
726 LOS ANGELES COUNTY
ENGINEERING BLDG.

Do not extend notes this side of this line.

Note: Any Additions or Changes on This Sheet Must be Made or Circled in Red Ink With Date and Name of Person Making Change.

PWFB 0827 2071

| | |
|---|---|
| Notes Ck'd by D. M. Finley | Survey of |
| Map No. C.S.B.-3561 | W. O. Tape No. St'd. °F |
| Office Work R. L. Grant | Surveyed by |
| Checked C. J. Galli | Notes Date |
| Date | Indexed |

F. B. PG.

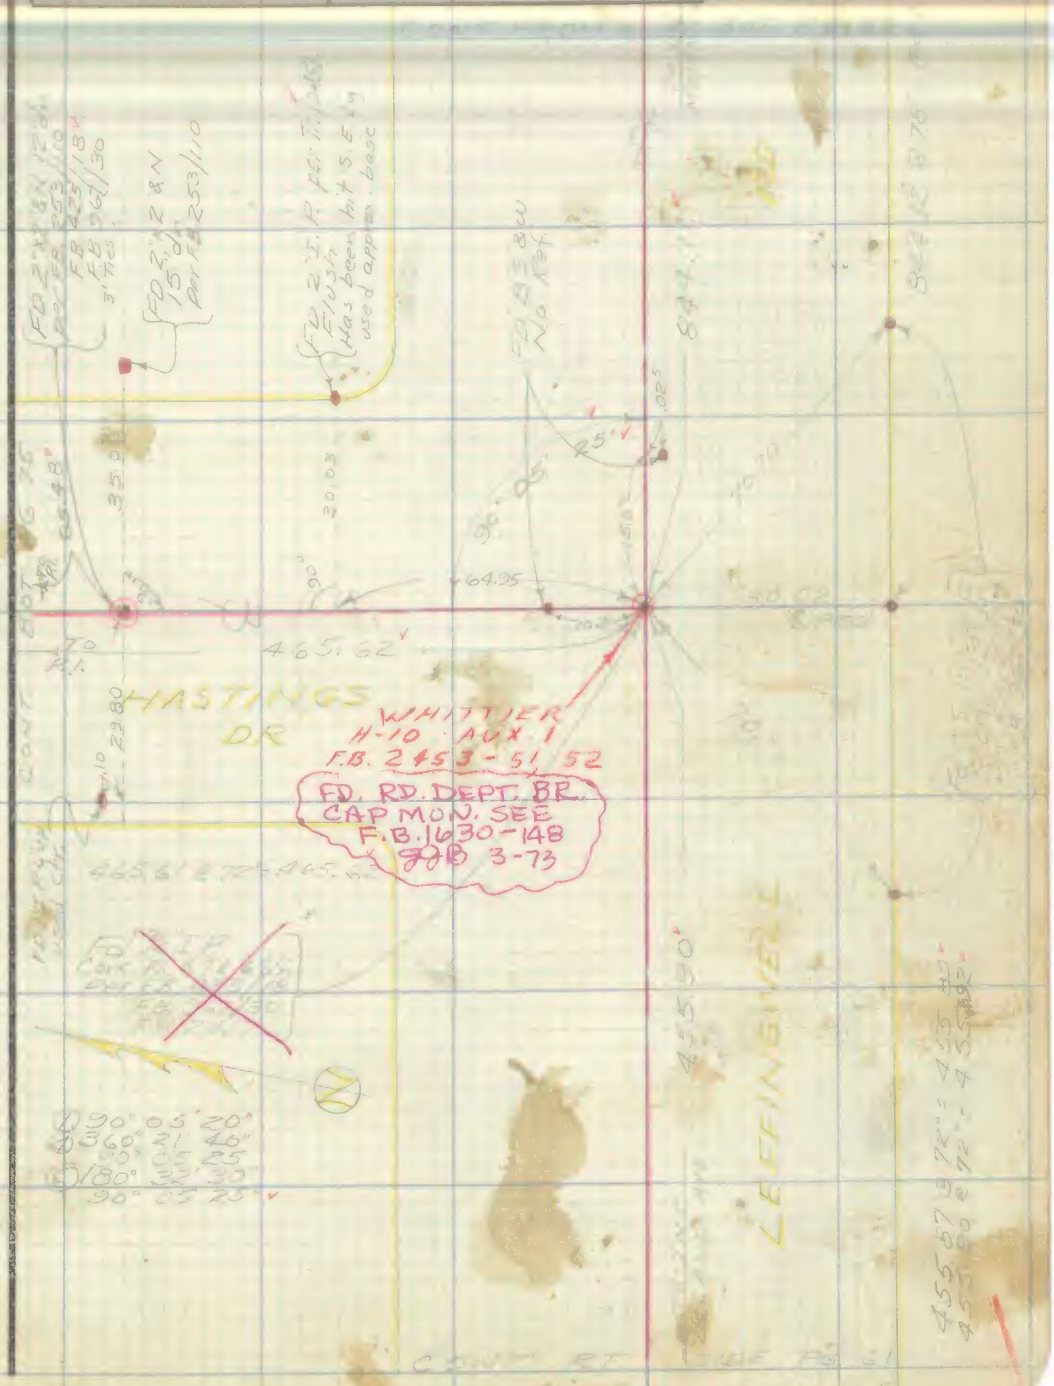


Note: Any Additions or Changes on This Sheet Must be Made or Circled in Red Ink With Date and Name of Person Making Change.

Do not extend notes this side of this line.

RETURN TO
LOS ANGELES COUNTY SURVEYOR
726 LOS ANGELES COUNTY
ENGINEERING BLDG.

76F3095 247 2-51

F. B. ____ PG. ____

PWFB 0827

2072

W.S. 34-A-3

RETURN TO
LOS ANGELES COUNTY SURVEYOR
726 LOS ANGELES COUNTY
ENGINEERING BLDG.

Do not extend notes this side of this line.

Note: Any Additions or Changes on This Sheet Must be Made or Circled in Red Ink With Date and Name of Person Making Change.

PWFB 0827

2073

F. B. _____ PG. _____

| | |
|---|---|
| Notes Ck'd by D. M. Pinter | Survey of |
| Map No. | W. O. Tape No. St'd. °F |
| Office Work | Surveyed by |
| Checked | Notes Date |
| Date | Indexed |

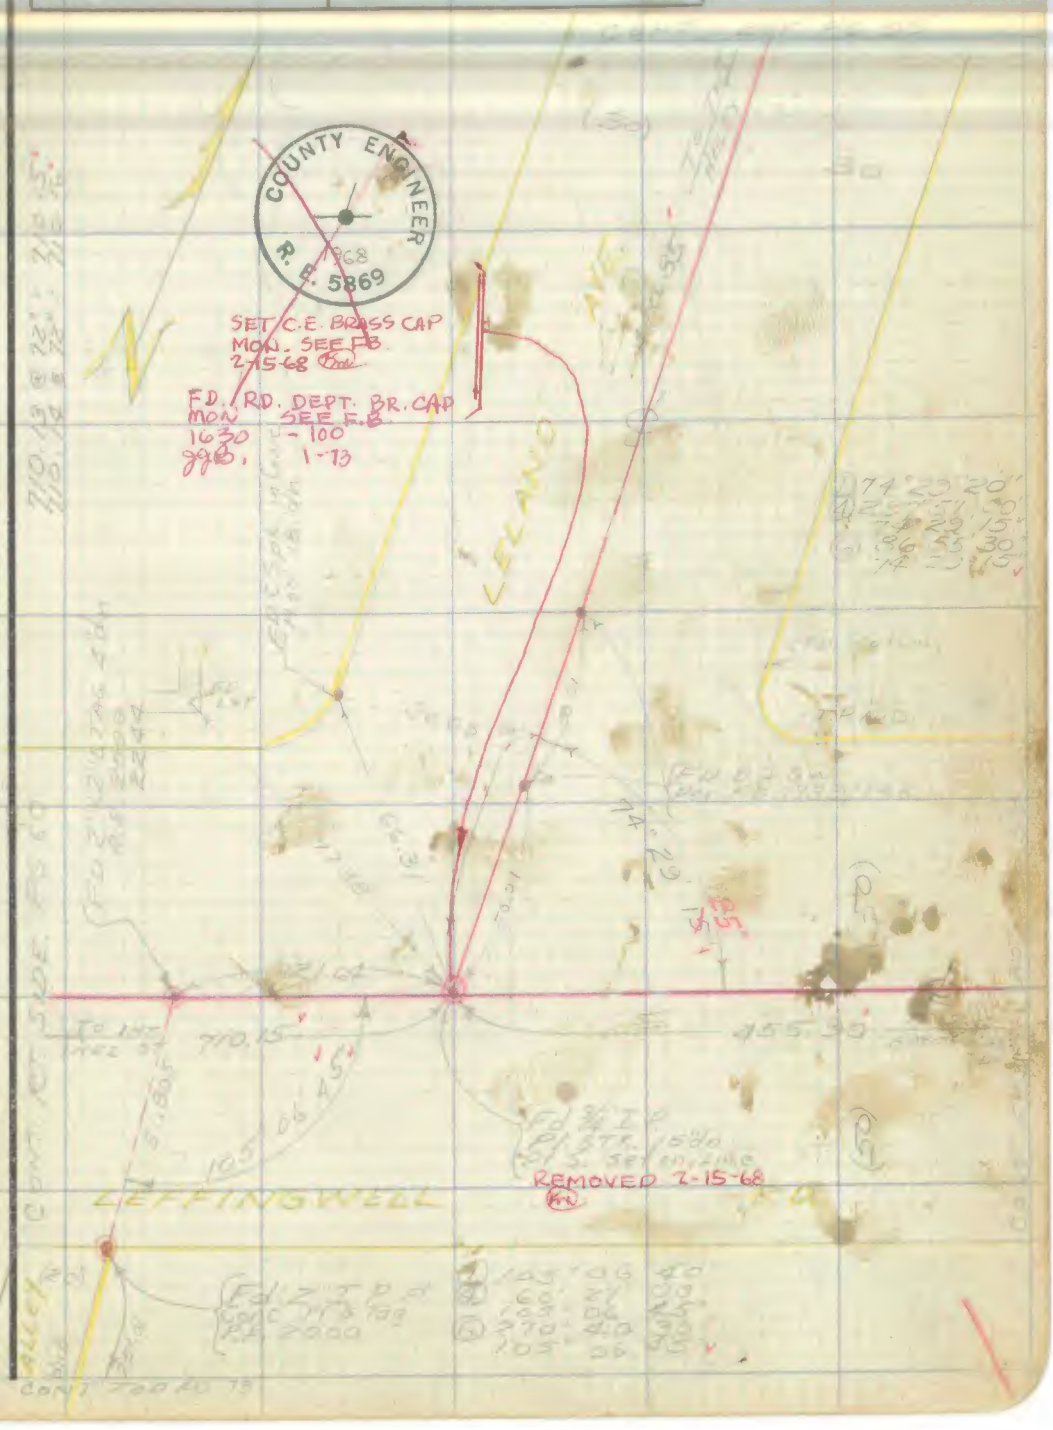


Note: Any Additions or Changes on This Sheet Must be Made or Circled in Red Ink With Date and Name of Person Making Change.

Do not extend notes this side of this line.

RETURN TO
LOS ANGELES COUNTY SURVEYOR
726 LOS ANGELES COUNTY
ENGINEERING BLDG.

76F309S 247 2-51

F. B. _____ PG. _____

PWFB 0827

2074

W.S. 34-A-3

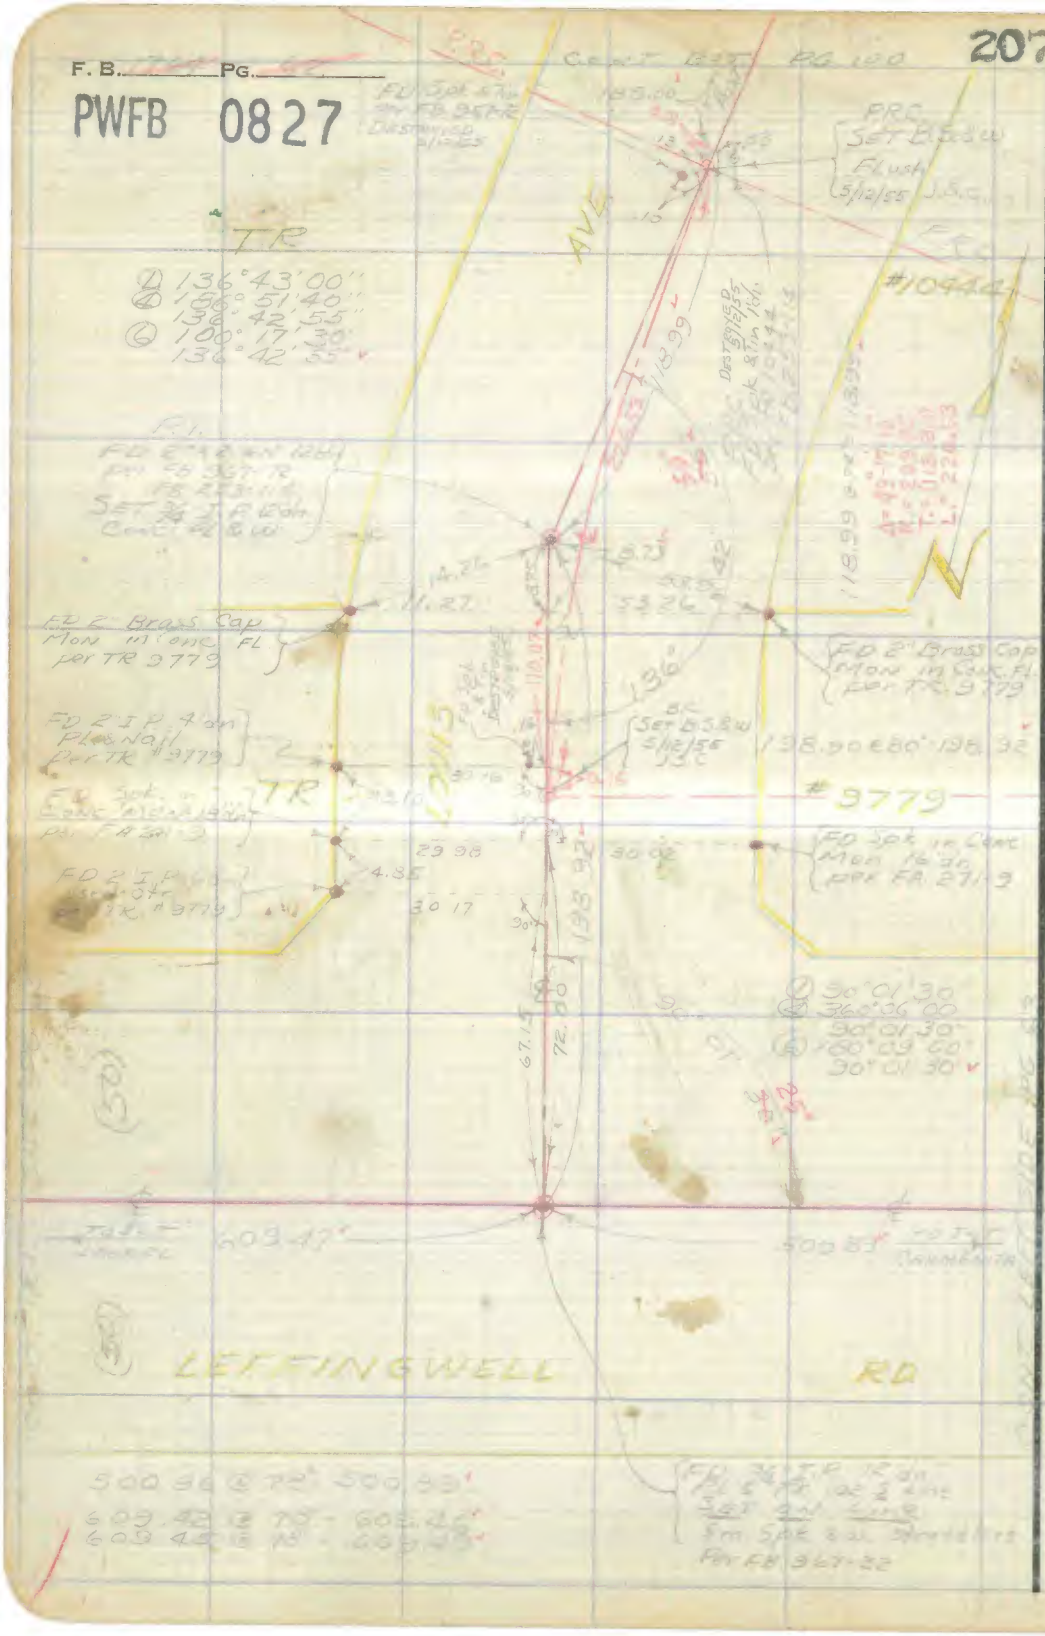


RETURN TO
LOS ANGELES COUNTY SURVEYOR
726 LOS ANGELES COUNTY
ENGINEERING BLDG.

Do not extend notes this side of this line.

Note: Any Additions or Changes on This Sheet Must be Made or Circled in Red Ink With Date and Name of Person Making Change.

PWFB 0827 2075, 2076

| | |
|---|---|
| Notes Ck'd by D. M. Finley | Survey of |
| Map No. C.I.E. 2562 | W. O. Tape No. St'd. °F |
| Office Work R. L. Green | Surveyed by |
| Checked C. J. Gant | Notes Date |
| Date June 1952 | Indexed M. C. Johnson |

F. B. Pg.

WC 34-A-3

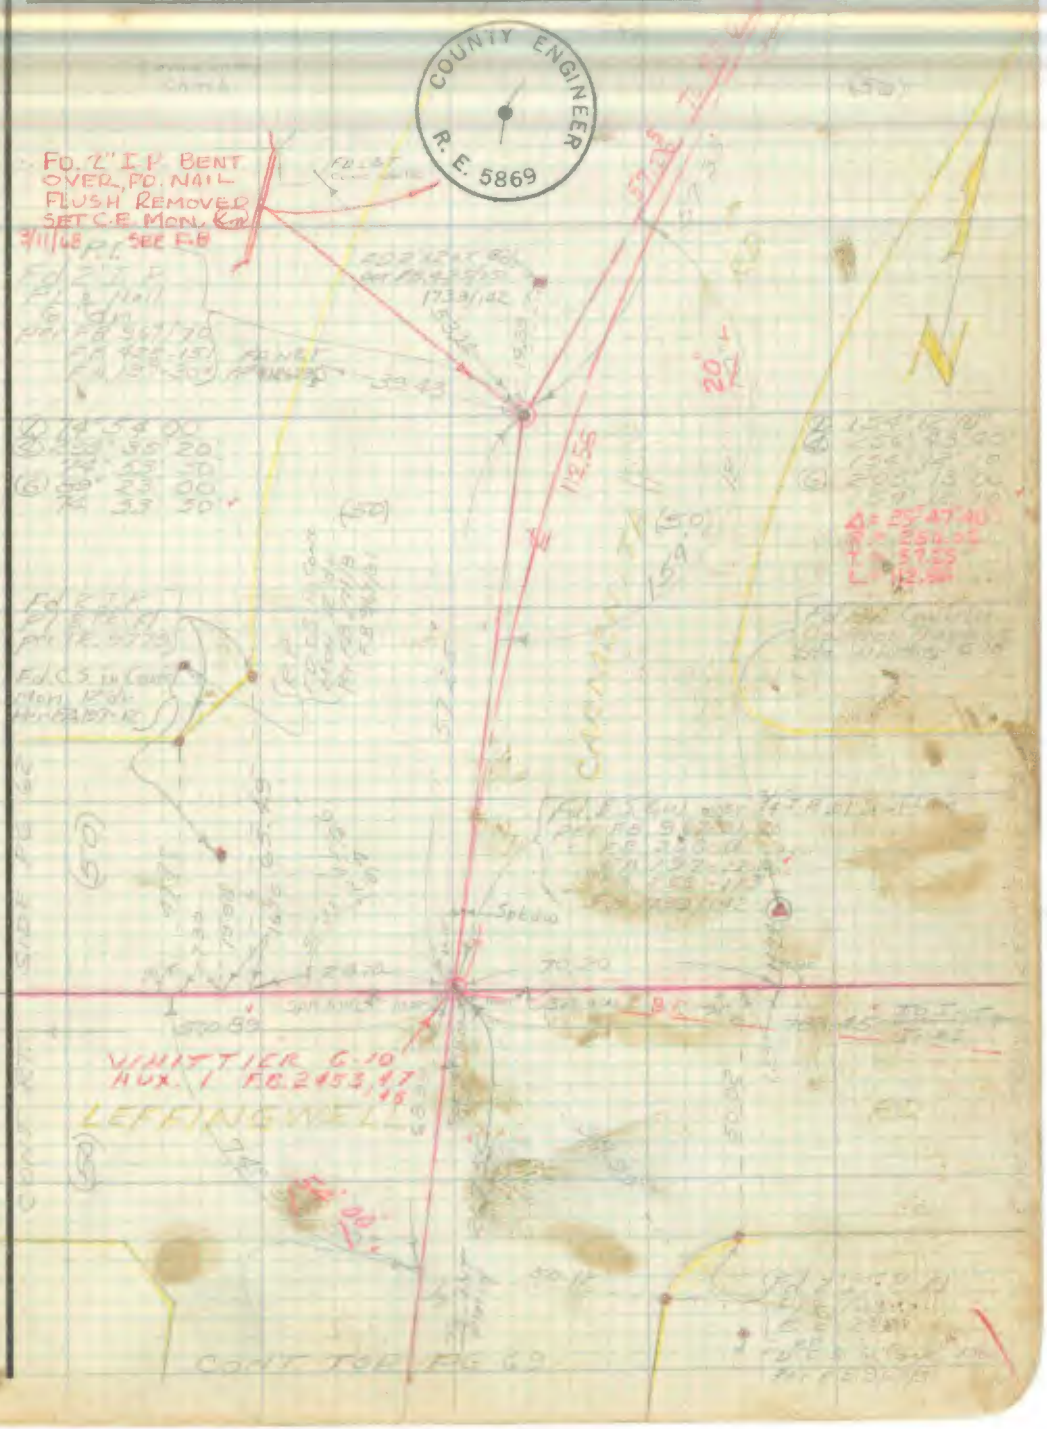


Note: Any Additions or Changes on This Sheet Must be Made or Circled in Red Ink With Date and Name of Person Making Change.

Do not extend notes this side of this line.

RETURN TO
LOS ANGELES COUNTY SURVEYOR
726 LOS ANGELES COUNTY
ENGINEERING BLDG.

76F309S 247 10M 1-49

F. B. 1764 PG.

PWFB 0827

2077

W.S. 34-A-3

RETURN TO
LOS ANGELES COUNTY SURVEYOR
726 LOS ANGELES COUNTY
ENGINEERING BLDG.

Do not extend notes this side of this line.

Note: Any Additions or Changes on This Sheet Must be Made or Circled in Red Ink With Date and Name of Person Making Change.

PWFB 0827 2078, 2079

| | |
|---|---|
| Notes Ck'd by D. M. Finley | Survey of |
| Map No. | W. O. Tape No. St'd. °F |
| Office Work K. L. Green | Surveyed by |
| Checked | Notes Date |
| Date June 1956 | Indexed R. C. Johnson |

F. B. PG. 65

SET C.E. MON. 6-15-72 SEE F.B. 1630-44

COUNTY ENGINEER R.E. 2078

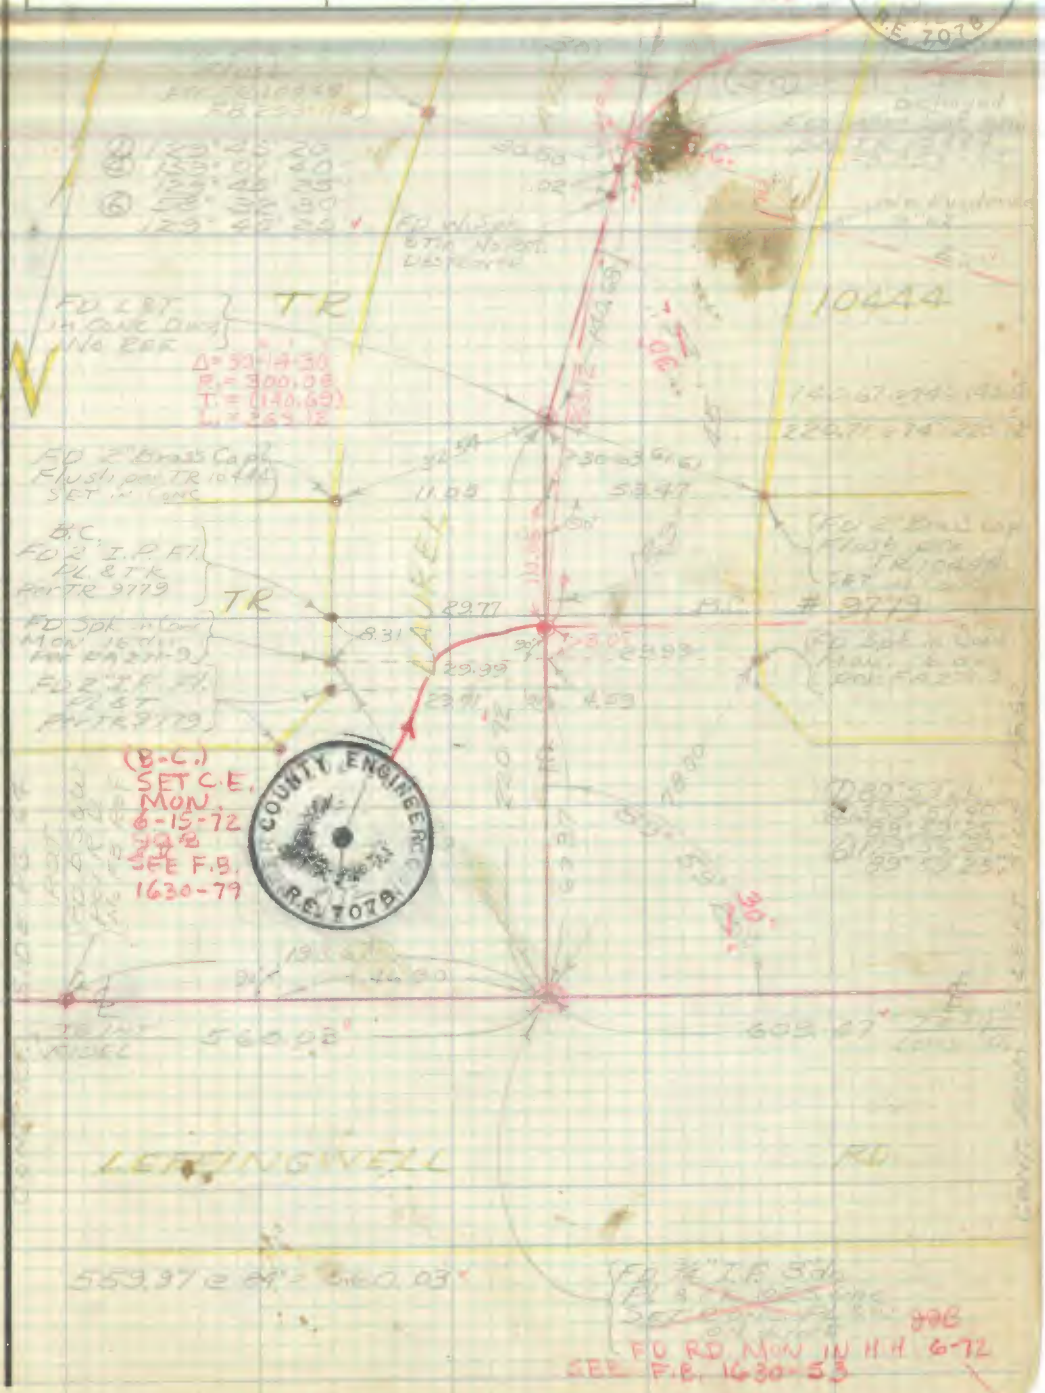


Note: Any Additions or Changes on This Sheet Must be Made or Circled in Red Ink With Date and Name of Person Making Change.

Do not extend notes this side of this line.

RETURN TO
LOS ANGELES COUNTY SURVEYOR
726 LOS ANGELES COUNTY
ENGINEERING BLDG.

76F309S 247 10M 1-49

F. B. 1744 PG. 66

PWFB 0827

W.S. 34-A-3

RETURN TO
LOS ANGELES COUNTY SURVEYOR
726 LOS ANGELES COUNTY
ENGINEERING BLDG.

Do not extend notes this side of this line.

Note: Any Additions or Changes on This Sheet Must be Made or Circled in Red Ink With Date and Name of Person Making Change.

PWEB 0827 2081

| | |
|---|---|
| Notes Ck'd by D. M. Fuller | Survey of [illegible] |
| Map No. C.S.B.-2562 | W. O. ____ Tape No. ____ St'd. ____ °F |
| Office Work R. L. Green | Surveyed by [illegible] |
| Checked C. J. Gatti | Notes ____ Date ____ |
| Date [illegible] | Indexed H. C. Johnson |

F. B. ____ PG. 67

WS 34-A-3

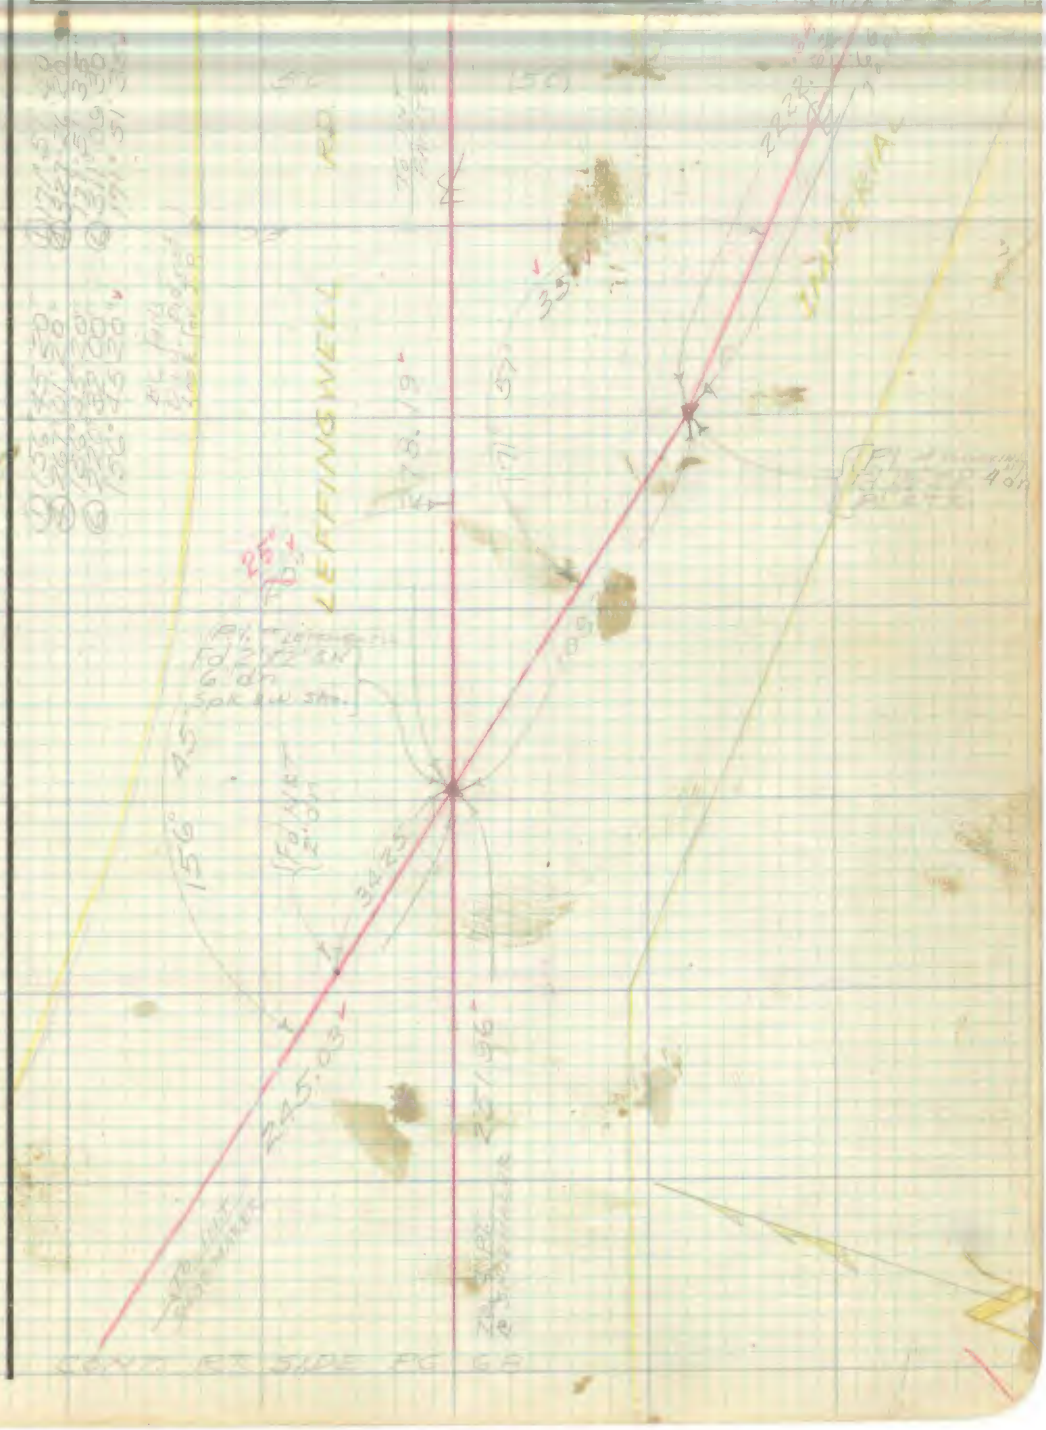


Note: Any Additions or Changes on This Sheet Must be Made or Circled in Red Ink With Date and Name of Person Making Change.

Do not extend notes this side of this line.

RETURN TO
LOS ANGELES COUNTY SURVEYOR
726 LOS ANGELES COUNTY
ENGINEERING BLDG.

76F309S 247 10M 1-49

F. B. 1764 PG. 68

2082

PWFB 0827

RETURN TO
LOS ANGELES COUNTY SURVEYOR
726 LOS ANGELES COUNTY
ENGINEERING BLDG.

Do not extend notes this side of this line.

Note: Any Additions or Changes on This Sheet Must be Made or Circled in Red Ink With Date and Name of Person Making Change.

PWFB 0827 2083, 2084

F. B. ____ PG. 69

| | |
|---|---|
| Notes Ck'd by D. M. Finley | Survey of S. Whittier Arm 1 |
| Map No. C.S.B. 2562 | W. O. ____ Tape No. ____ St'd. ____ °F |
| Office Work R. L. Green | Surveyed by J. S. Carter |
| Checked C. J. Gall | Notes J. S. C. Date 2-10-59 |
| Date June 1956 | Indexed A. C. Johnson |

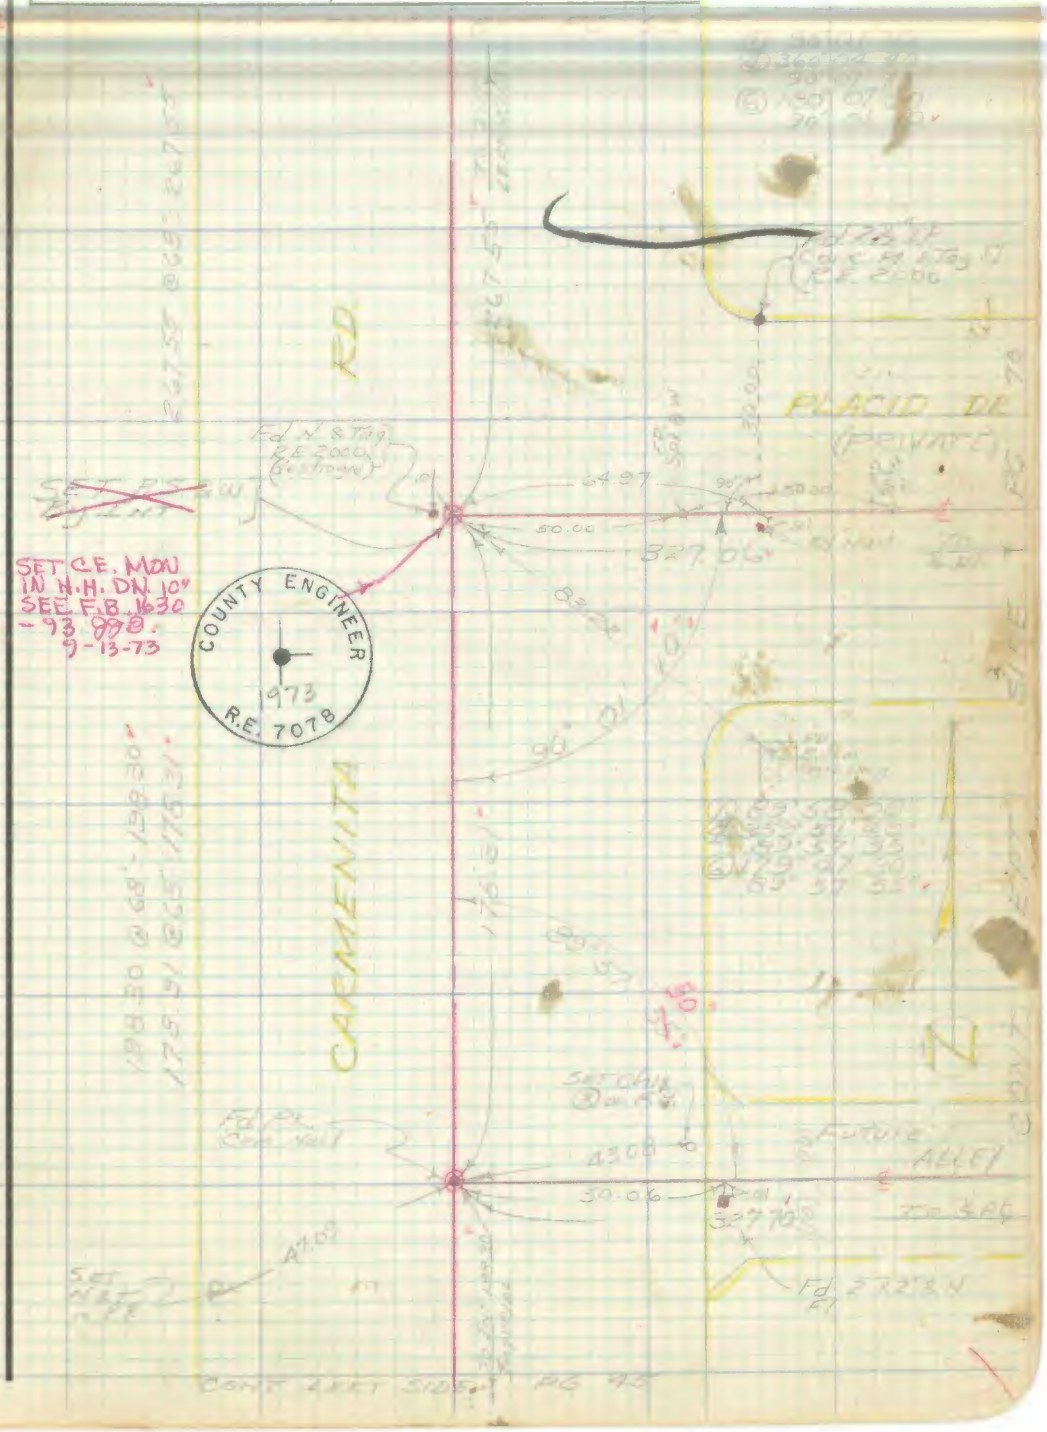


Note: Any Additions or Changes on This Sheet Must be Made or Circled in Red Ink With Date and Name of Person Making Change.

Do not extend notes this side of this line.

RETURN TO
LOS ANGELES COUNTY SURVEYOR
726 LOS ANGELES COUNTY
ENGINEERING BLDG.

76F309S 247 10M 1-49

F. B. 1764 PG. 70

2085

PWFB 0827

W.S. 34-A-3

RETURN TO
LOS ANGELES COUNTY SURVEYOR
726 LOS ANGELES COUNTY
ENGINEERING BLDG.

Do not extend notes this side of this line.

Note: Any Additions or Changes on This Sheet Must be Made or Circled in Red Ink With Date and Name of Person Making Change.

PWFB 0827

2086

F. B. _____ PG. _____

| | |
|---|---|
| Notes Ck'd by D. M. Finley | Survey of |
| Map No. C.S.B. 2502 | W. O. _____ Tape No. _____ St'd. _____ °F |
| Office Work R. L. Green | Surveyed by |
| Checked C. J. Gall | Notes _____ Date _____ |
| Date June 1960 | Indexed |

Note: Any Additions or Changes on This Sheet Must be Made or Circled in Red Ink With Date and Name of Person Making Change.

Do not extend notes this side of this line.

RETURN TO
LOS ANGELES COUNTY SURVEYOR
726 LOS ANGELES COUNTY
ENGINEERING BLDG.

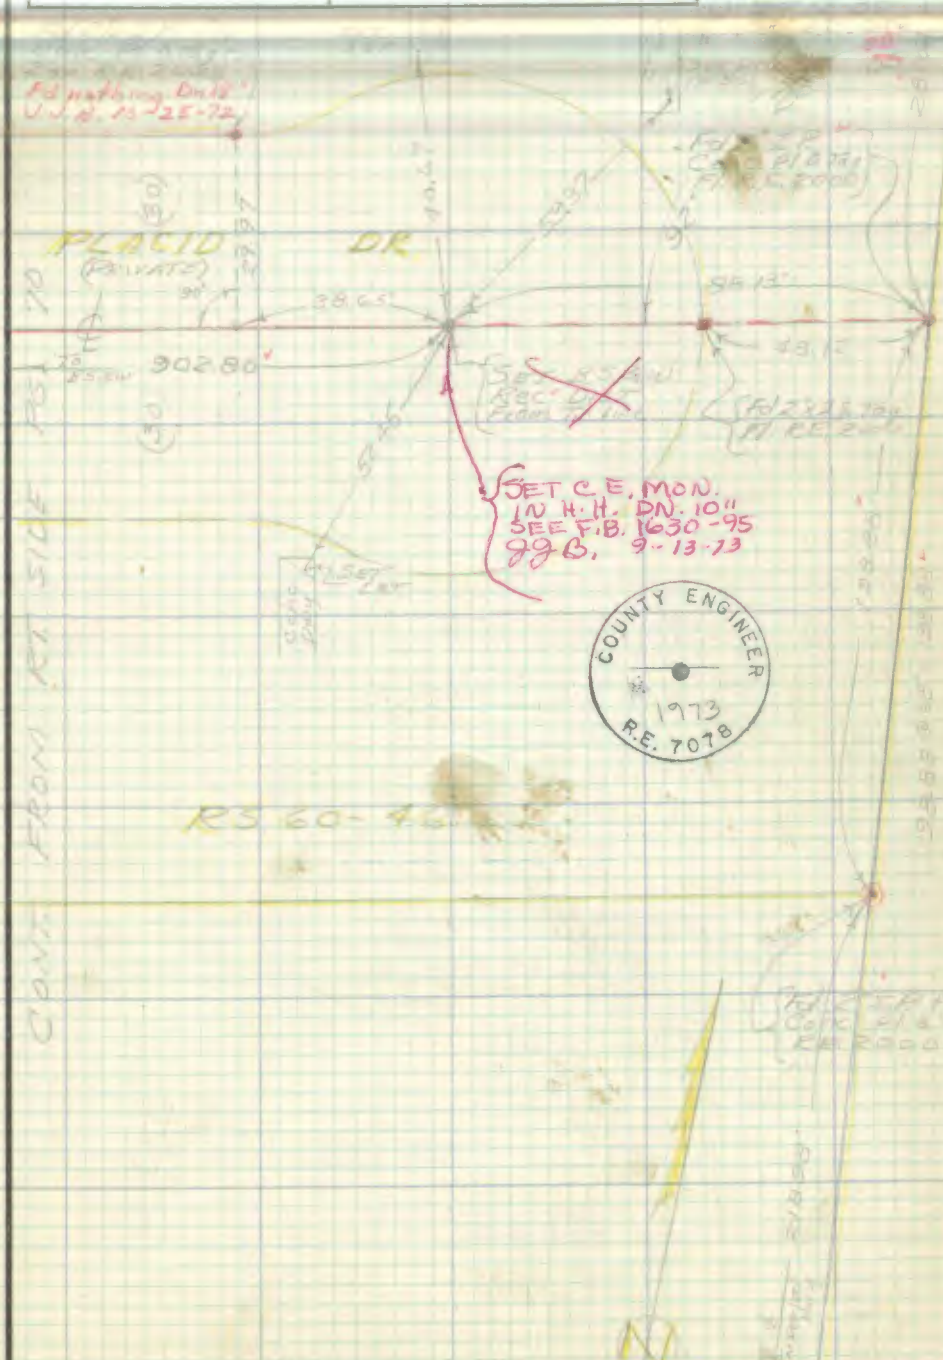


76F309S 247 10M 1-49

F. B. [illegible] PG. 72

PWFB 0827

2087

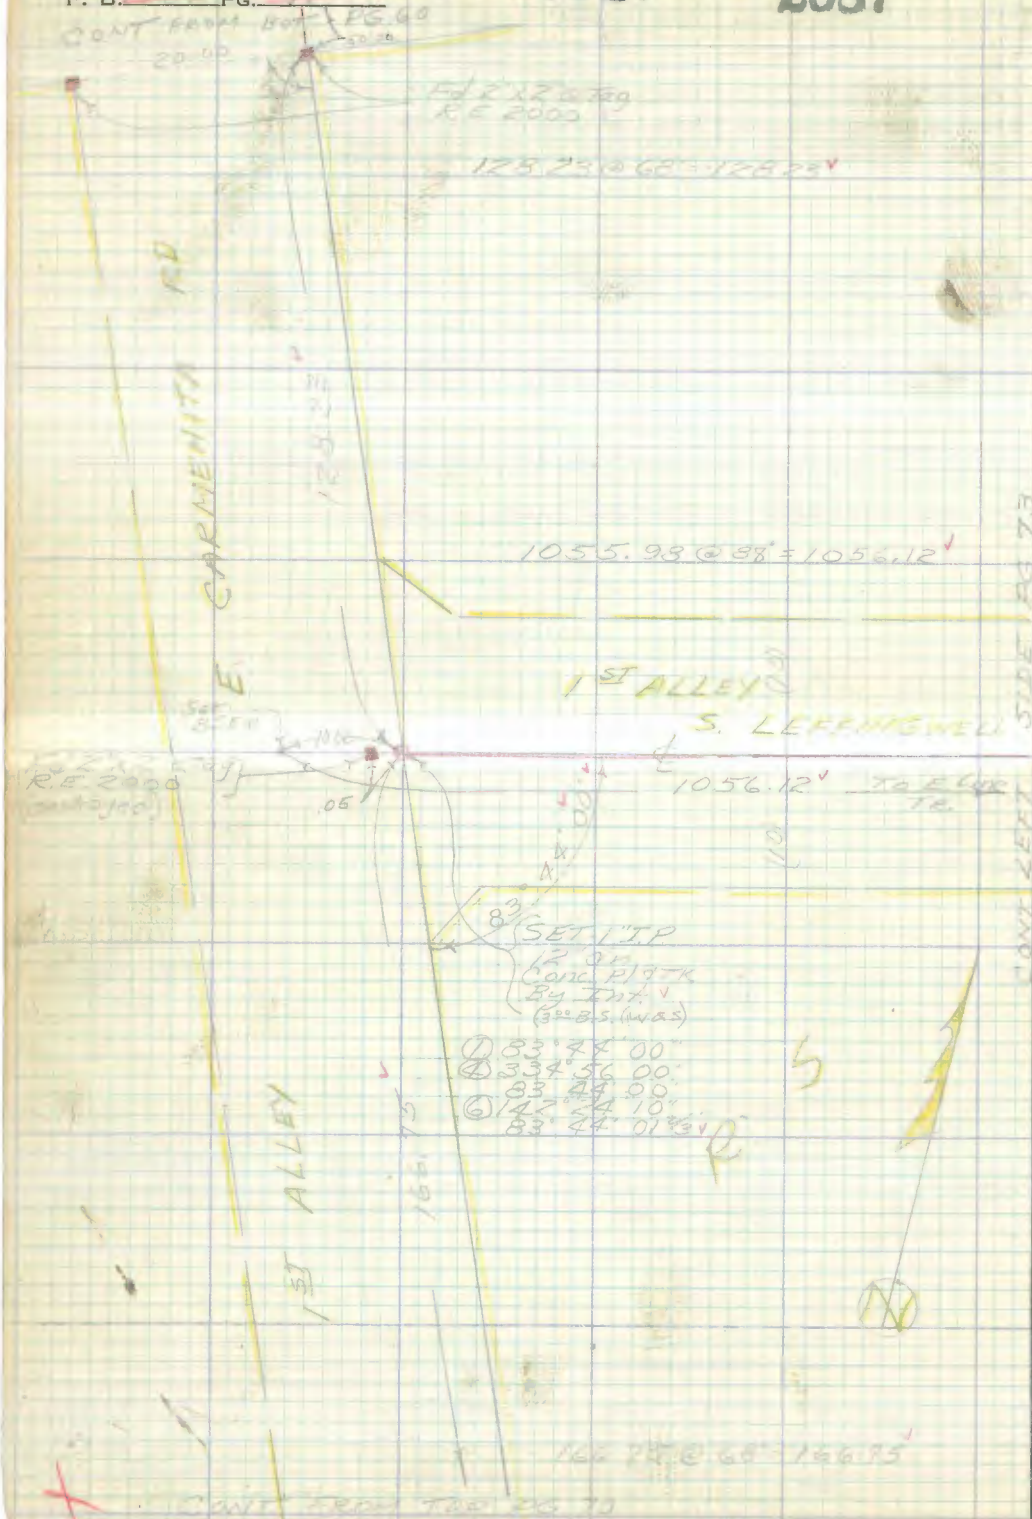


RETURN TO
LOS ANGELES COUNTY SURVEYOR
726 LOS ANGELES COUNTY
ENGINEERING BLDG.

Do not extend notes this side of this line.

Note: Any Additions or Changes on This Sheet Must be Made or Circled in Red Ink With Date and Name of Person Making Change.

PWFB 0827 2088

| | |
|---|---|
| Notes Ck'd by D. M. Pinker | Survey of [illegible] |
| Map No. C.S.B. [illegible] | W. O. [illegible] Tape No. [illegible] St'd. [illegible] °F |
| Office Work R. L. Green | Surveyed by J. S. [illegible] |
| Checked S. J. Galli | Notes [illegible] Date [illegible] |
| Date June 1976 | Indexed [illegible] |

F. B. [illegible] PG. [illegible]

W.S. 3-9-A-3

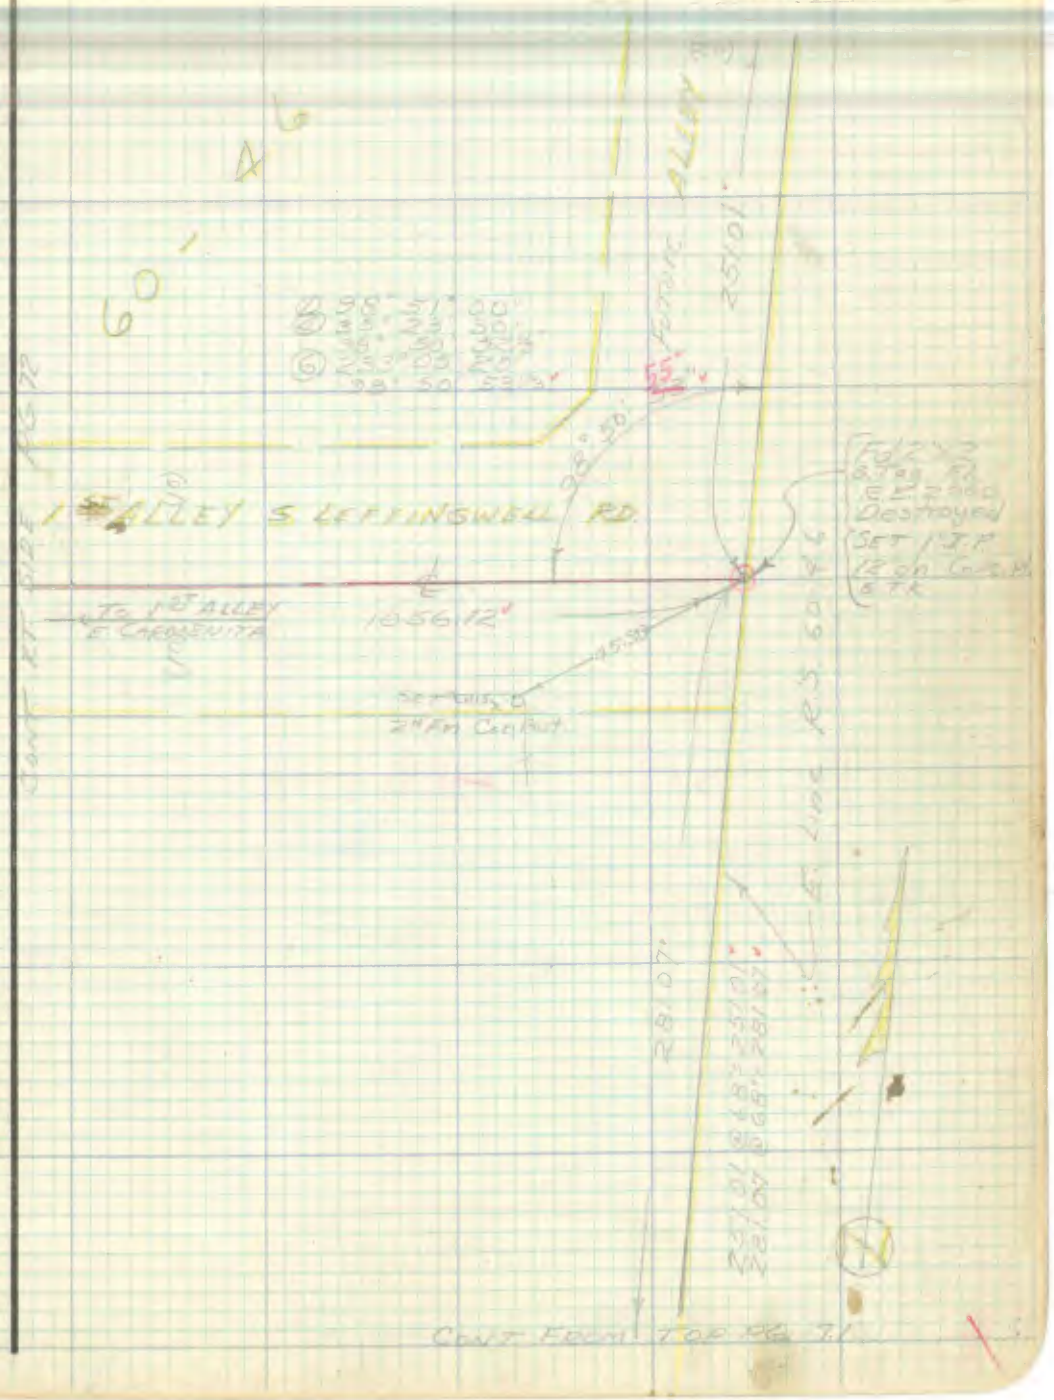


Note: Any Additions or Changes on This Sheet Must be Made or Circled in Red Ink With Date and Name of Person Making Change.

Do not extend notes this side of this line.

RETURN TO
LOS ANGELES COUNTY SURVEYOR
726 LOS ANGELES COUNTY
ENGINEERING BLDG.

76F309S 247 10M 1-49

F. B. 1764 PG. 74

PWFB 0827

2089

W.S. 34-B-3


RETURN TO
LOS ANGELES COUNTY SURVEYOR
726 LOS ANGELES COUNTY
ENGINEERING BLDG.

Do not extend notes this side of this line.

Note: Any Additions or Changes on This Sheet Must be Made or Circled in Red Ink With Date and Name of Person Making Change.

PWFB 0827 2090, 2091

| | |
|---|---|
| Notes Ck'd by D. M. Finley | Survey of [illegible] |
| Map No. [illegible] | W. O. [illegible] Tape No. [illegible] St'd. [illegible] °F |
| Office Work R. L. Green | Surveyed by J. S. Coates |
| Checked C. J. Gall | Notes [illegible] Date [illegible] |
| Date [illegible] | Indexed [illegible] |

F. B. [illegible] PG. [illegible]

M.S. 34-B-3

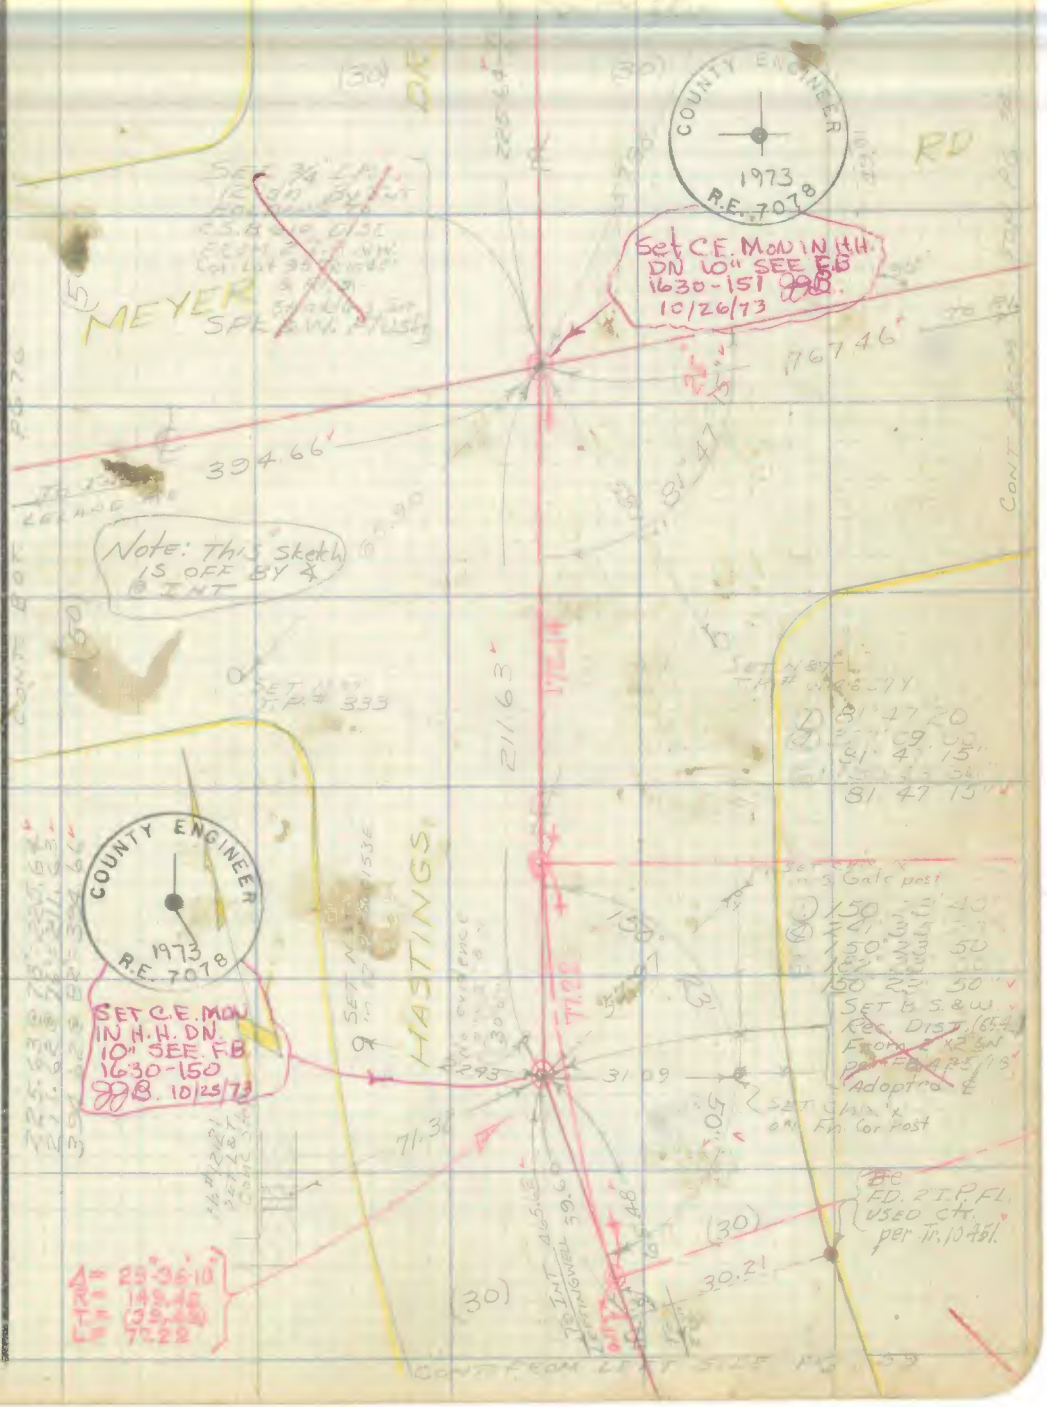


Note: Any Additions or Changes on This Sheet Must be Made or Circled in Red Ink With Date and Name of Person Making Change.

Do not extend notes this side of this line.

RETURN TO
LOS ANGELES COUNTY SURVEYOR
726 LOS ANGELES COUNTY
ENGINEERING BLDG.

76F3095 247 2-51

F. B. _____ Pg. _____

PWFB 0827

2092

W.S. 34-F-3

RETURN TO
LOS ANGELES COUNTY SURVEYOR
726 LOS ANGELES COUNTY
ENGINEERING BLDG.

Do not extend notes this side of this line.

Note: Any Additions or Changes on This Sheet Must be Made or Circled in Red Ink With Date and Name of Person Making Change.

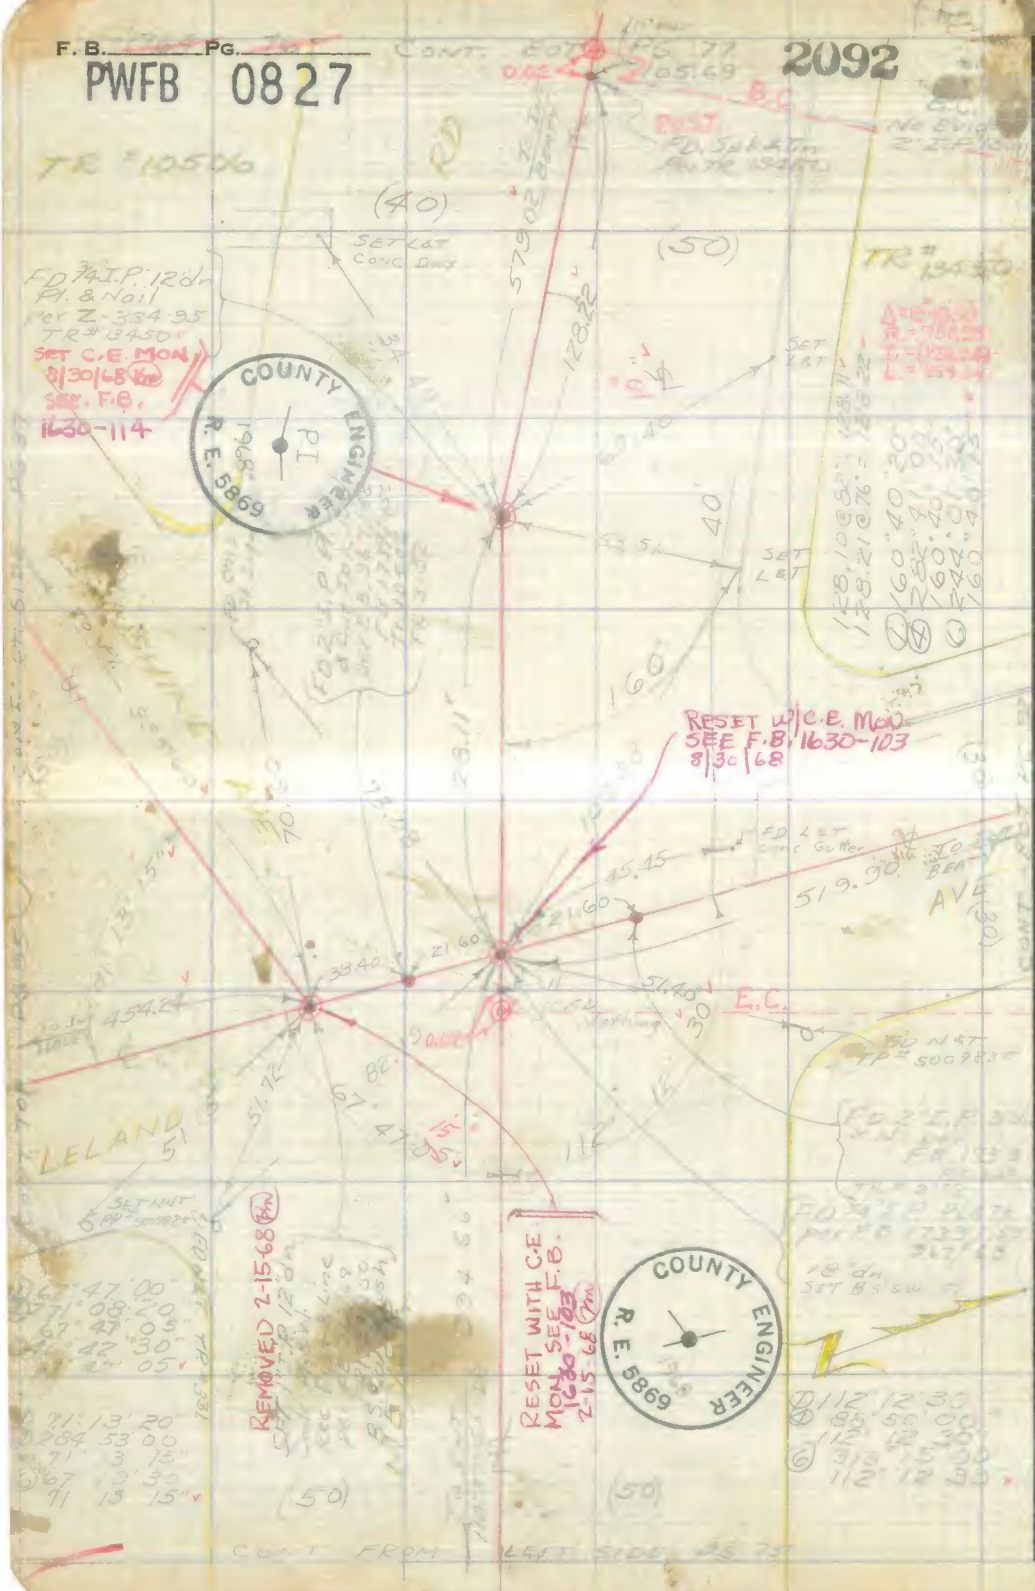

PWFB 0827 2093

F. B. [illegible] PG. [illegible]

| | |
|---|---|
| Notes Ck'd by D. M. Finley | Survey of S. Whittier [illegible] |
| Map No. C.S.B. 2562 | W. O. [illegible] Tape No. [illegible] St'd. [illegible] °F |
| Office Work R. I. Green | Surveyed by [illegible] |
| Checked C. J. Gaill | Notes [illegible] Date [illegible] |
| Date June 1965 | Indexed A. C. Johnson |

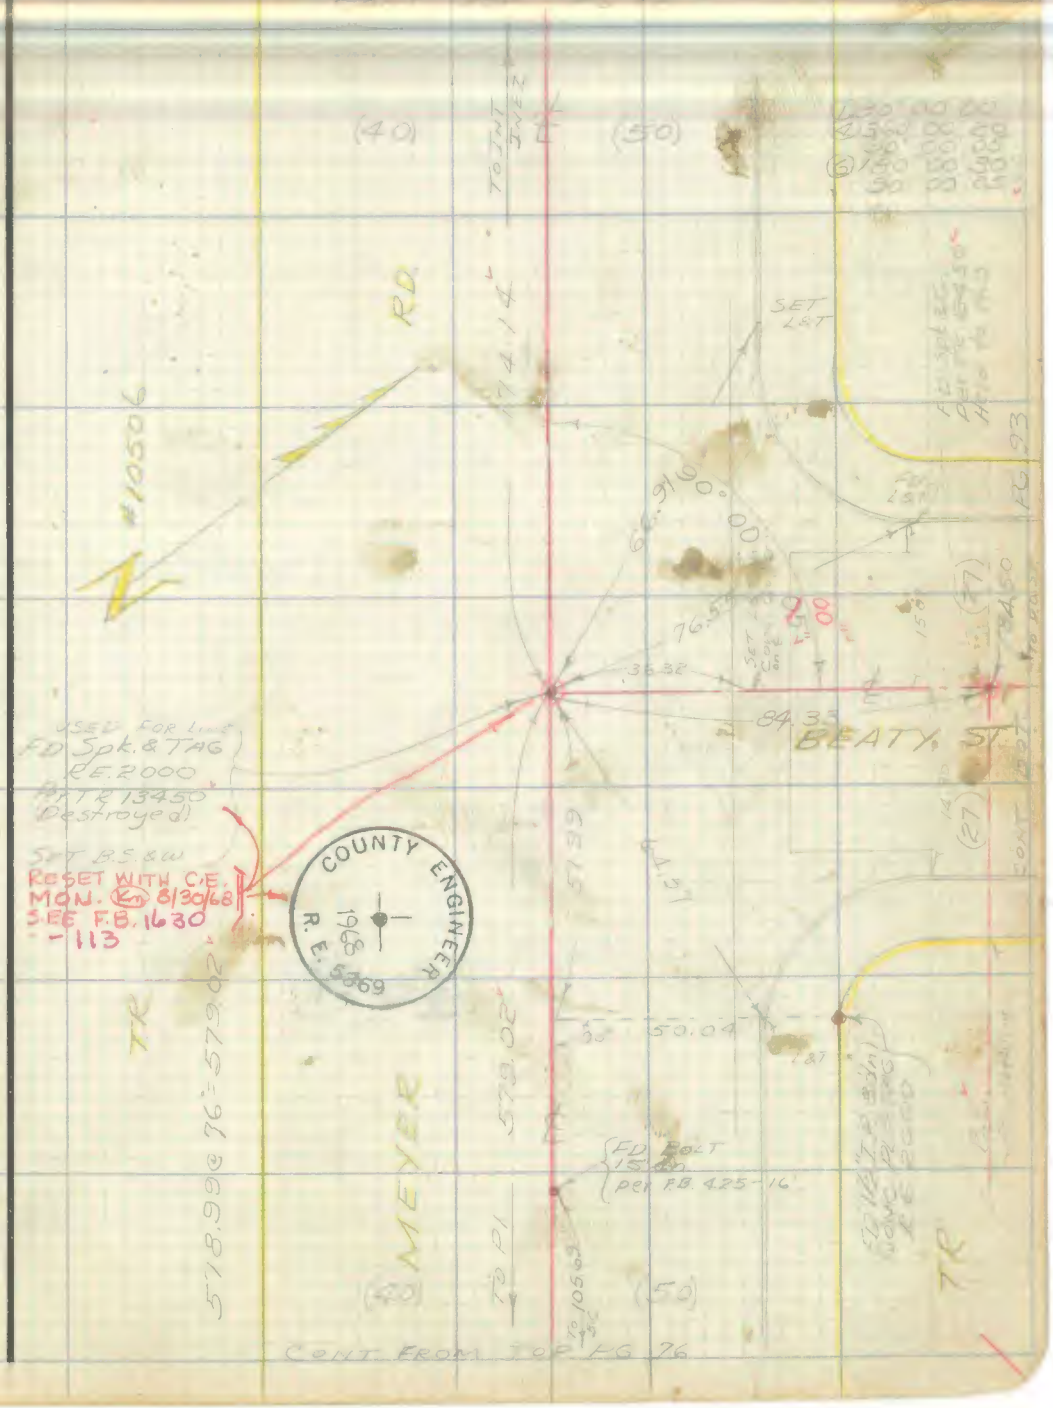


Note: Any Additions or Changes on This Sheet Must be Made or Circled in Red Ink With Date and Name of Person Making Change.

Do not extend notes this side of this line.

RETURN TO
LOS ANGELES COUNTY SURVEYOR
726 LOS ANGELES COUNTY
ENGINEERING BLDG.

76F309S 247 2-51

F. B. 1764 PG. 78

PWFB 0827

2094

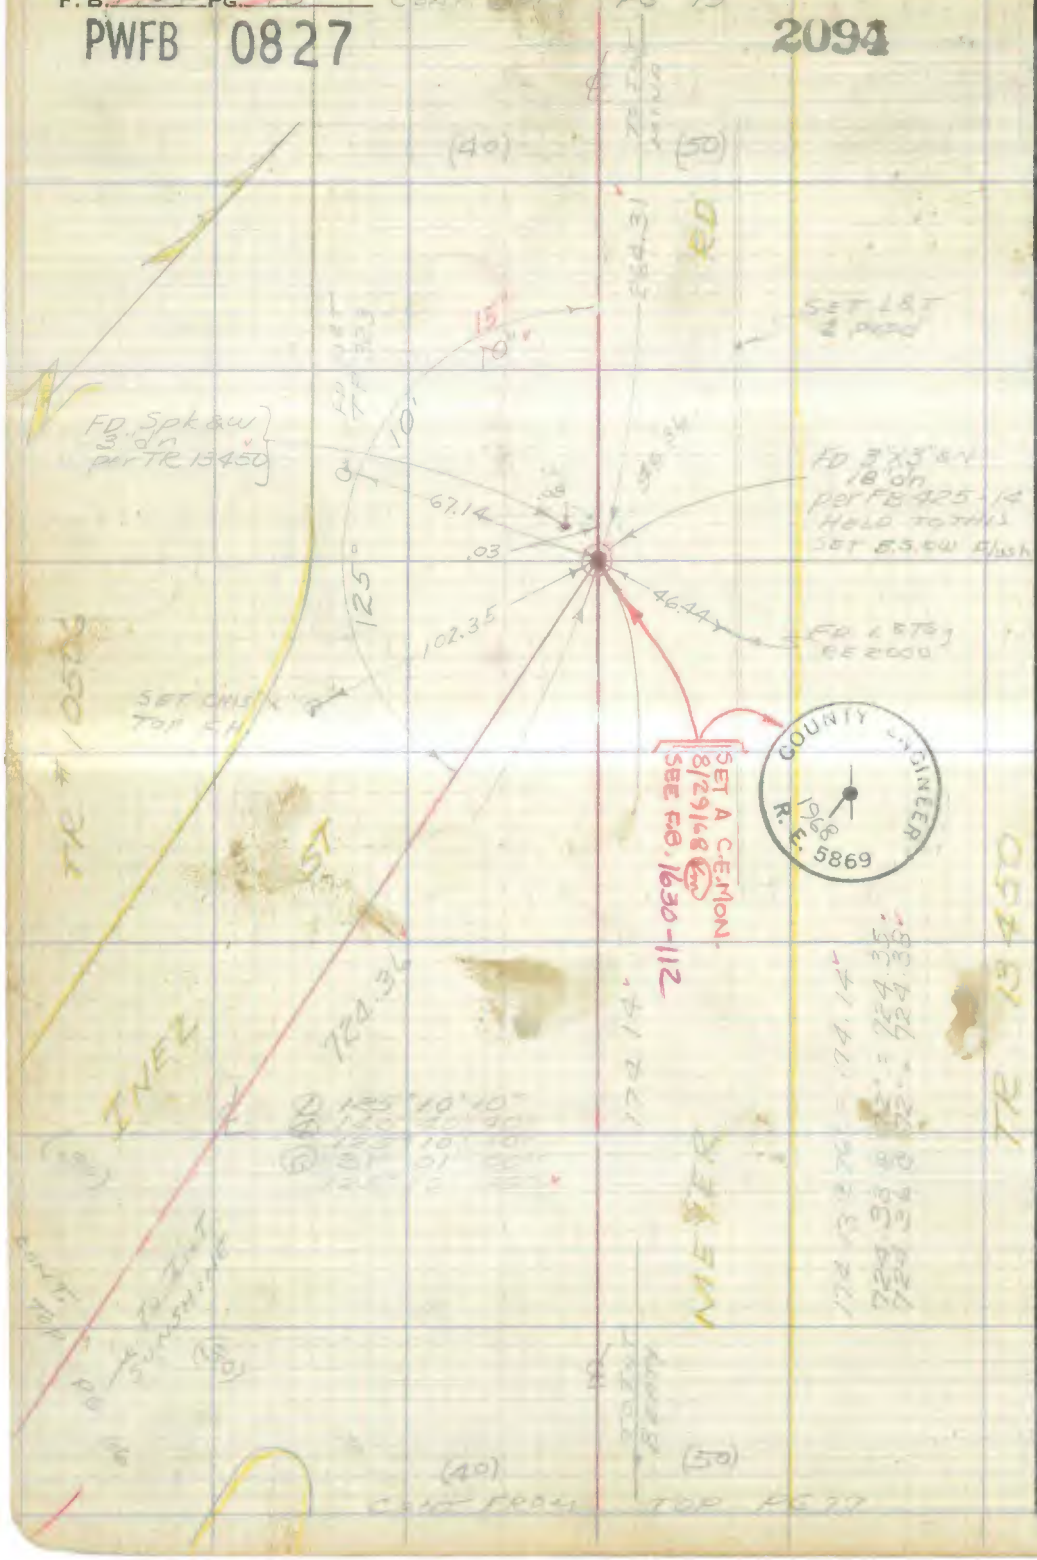


W.S. 34-A-3

RETURN TO
LOS ANGELES COUNTY SURVEYOR
726 LOS ANGELES COUNTY
ENGINEERING BLDG.

Do not extend notes this side of this line.

Note: Any Additions or Changes on This Sheet Must be Made or Circled in Red Ink With Date and Name of Person Making Change.

PWFB 0827 2095

| | |
|---|---|
| Notes Ck'd by D. M. Finley | Survey of [illegible] |
| Map No. [illegible] | W. O. [illegible] Tape No. ____ St'd. ____ °F |
| Office Work [illegible] | Surveyed by [illegible] |
| Checked [illegible] | Notes [illegible] Date ____ |
| Date [illegible] | Indexed [illegible] |

F. B. [illegible] PG. [illegible]

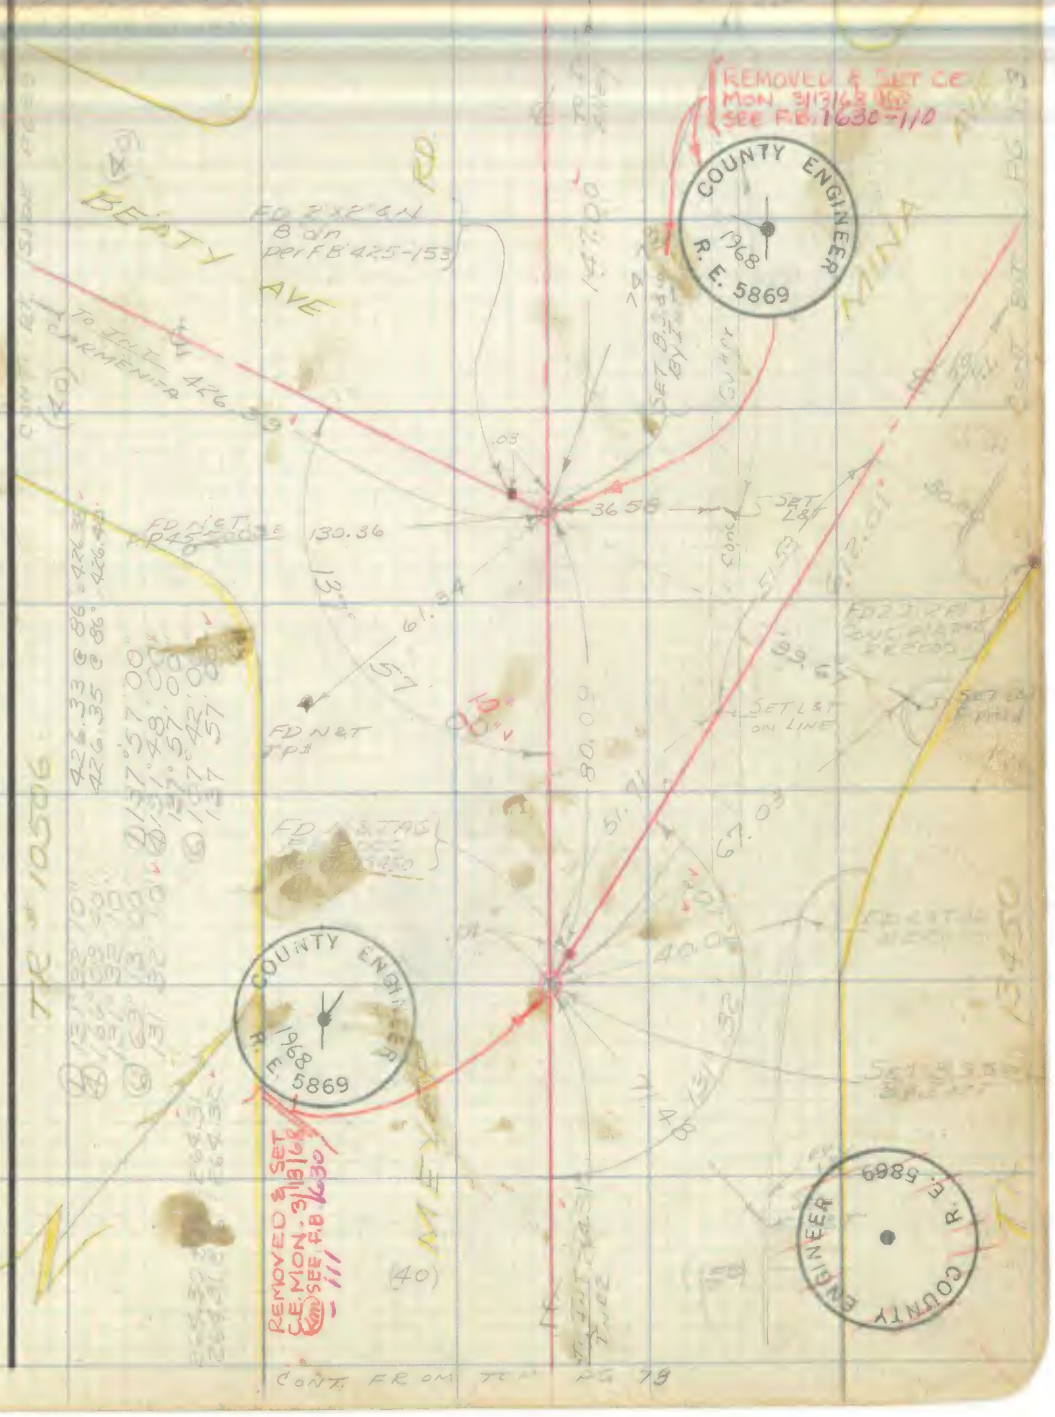


Note: Any Additions or Changes on This Sheet Must be Made or Circled in Red Ink With Date and Name of Person Making Change.

Do not extend notes this side of this line.

RETURN TO
LOS ANGELES COUNTY SURVEYOR
726 LOS ANGELES COUNTY
ENGINEERING BLDG.

76F309S 247 2-51

2096 2097

F. B. 1764 PG. 80

PWFB 0827

RETURN TO
LOS ANGELES COUNTY SURVEYOR
726 LOS ANGELES COUNTY
ENGINEERING BLDG.

Do not extend notes this side of this line.

Note: Any Additions or Changes on This Sheet Must be Made or Circled in Red Ink With Date and Name of Person Making Change.

PWFB 0827

2098

| | |
|---|---|
| Notes Ck'd by D. M. Fuller | Survey of S. Whittier Ave. |
| Map No. | W. O. Tape No. St'd. °F |
| Office Work R. L. Green | Surveyed by J.S. Conrad |
| Checked | Notes Date |
| Date | Indexed M. C. Johnson |

F. B. Pg.

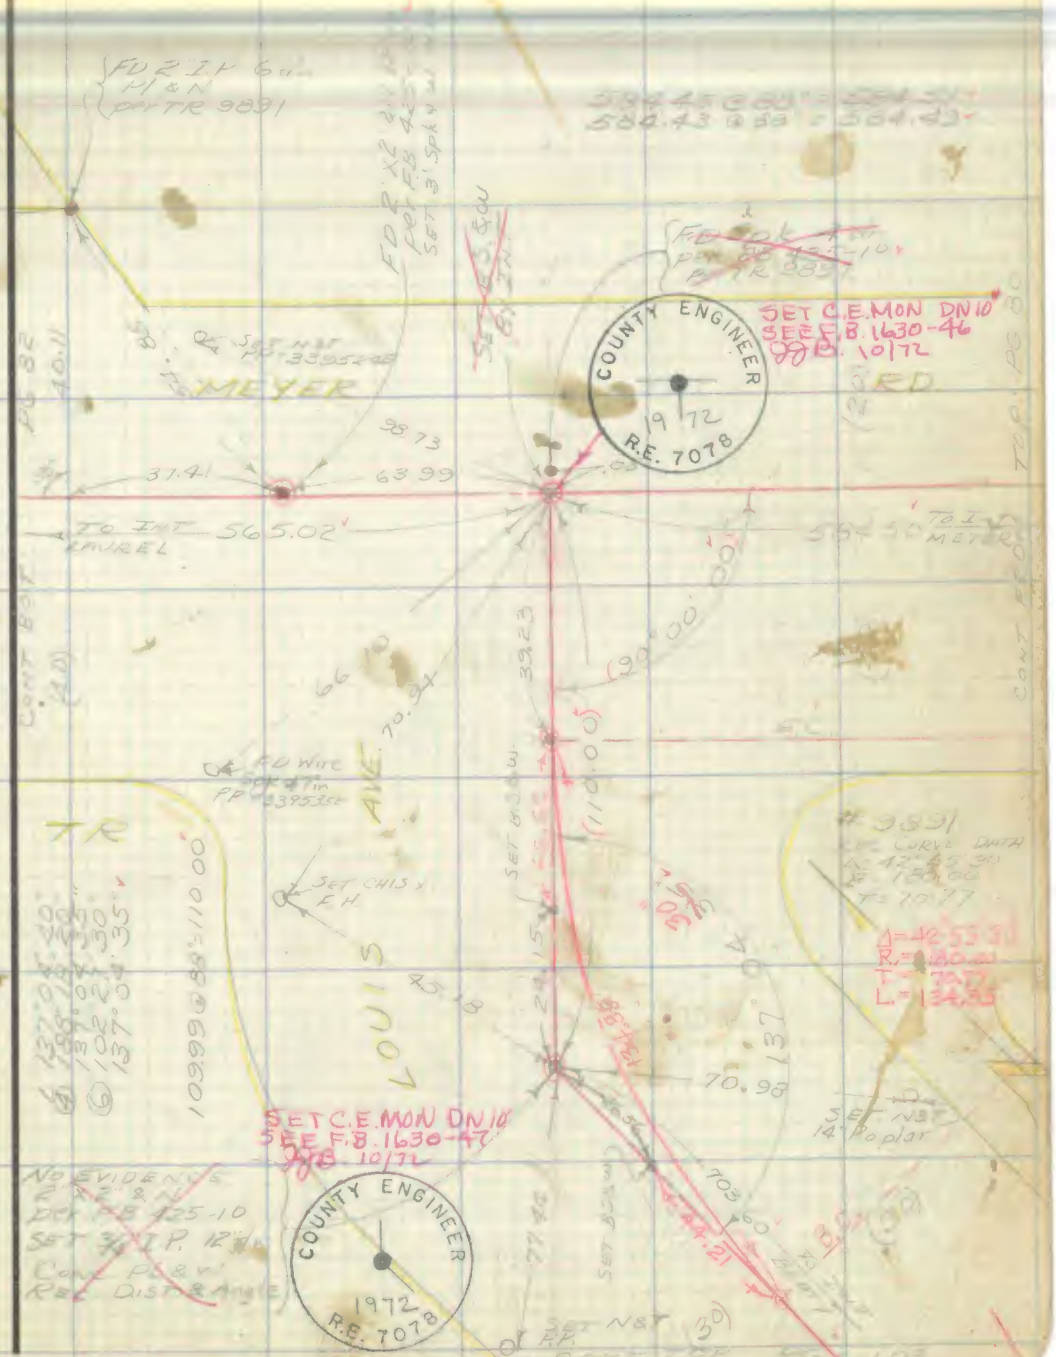


Note: Any Additions or Changes on This Sheet Must be Made or Circled in Red Ink With Date and Name of Person Making Change.

Do not extend notes this side of this line.

RETURN TO
LOS ANGELES COUNTY SURVEYOR
726 LOS ANGELES COUNTY
ENGINEERING BLDG.

76F309S 247 2-51

PWFB 0827 2099

F. B. _____ PG 82

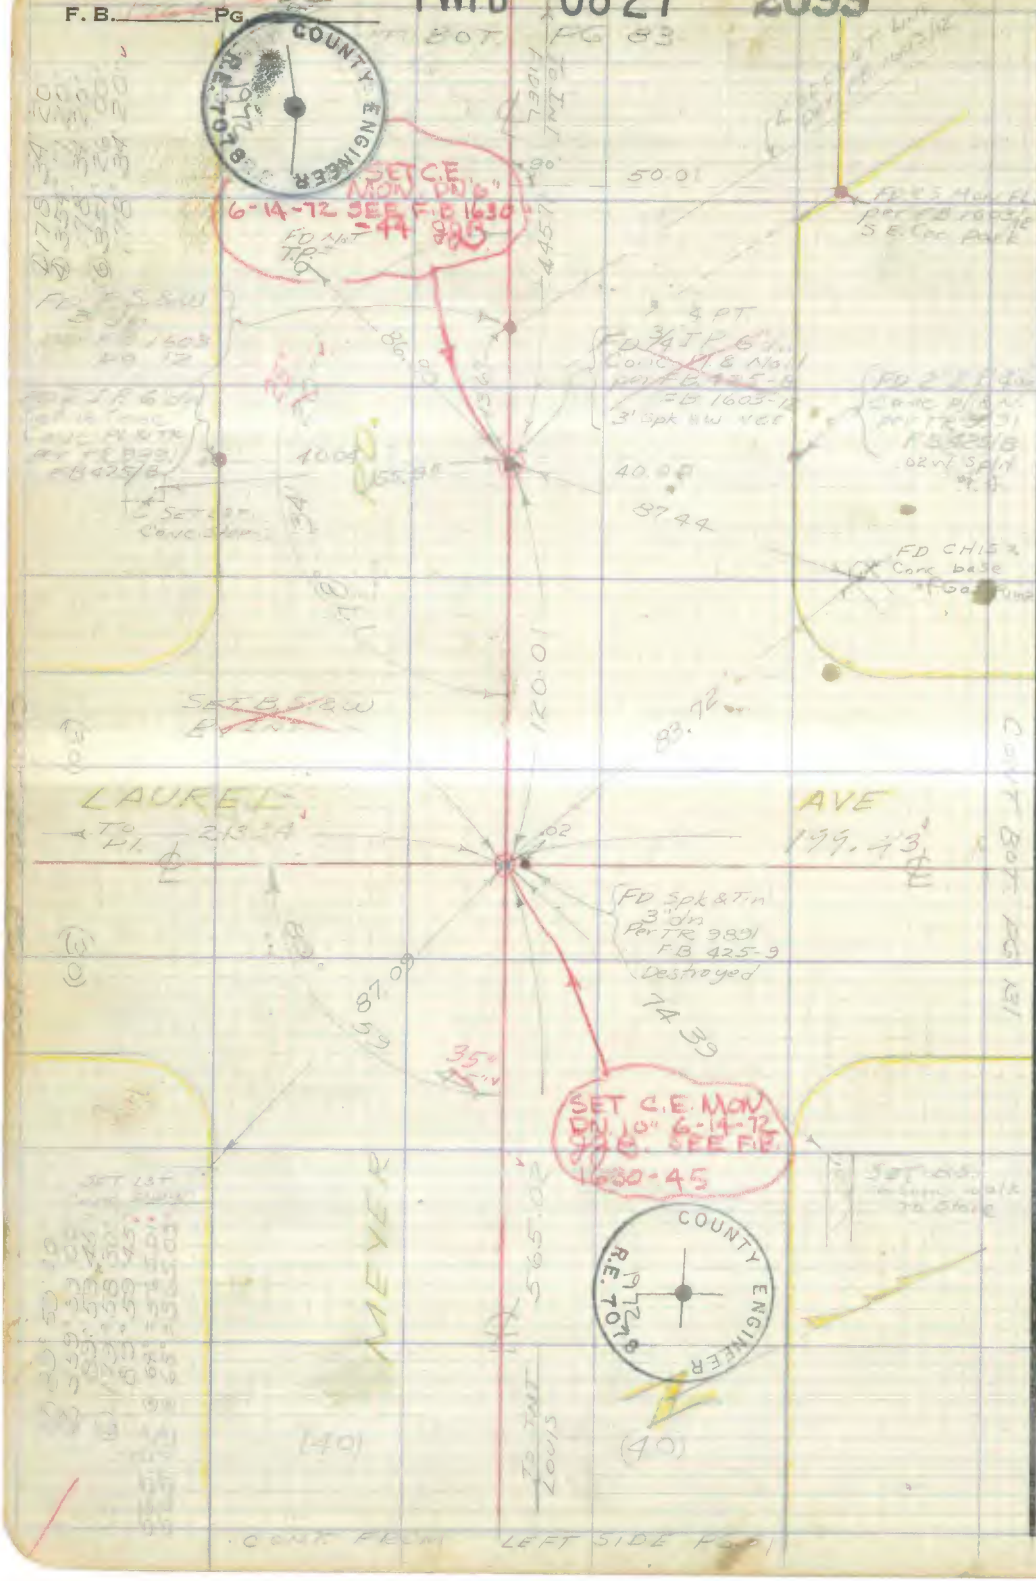


RETURN TO
LOS ANGELES COUNTY SURVEYOR
726 LOS ANGELES COUNTY
ENGINEERING BLDG.

Do not extend notes this side of this line.

Note: Any Additions or Changes on This Sheet Must be Made or Circled in Red Ink With Date and Name of Person Making Change.

PWFB 0827

2100

F.B. ____ PG. ____

| | |
|---|---|
| Notes Ck'd by D. M. Finley | Survey of |
| Map No. | W. O. ____ Tape No. ____ St'd. ____ °F |
| Office Work R. L. Green | Surveyed by |
| Checked | Notes ____ Date |
| Date | Indexed J. C. Johnson |

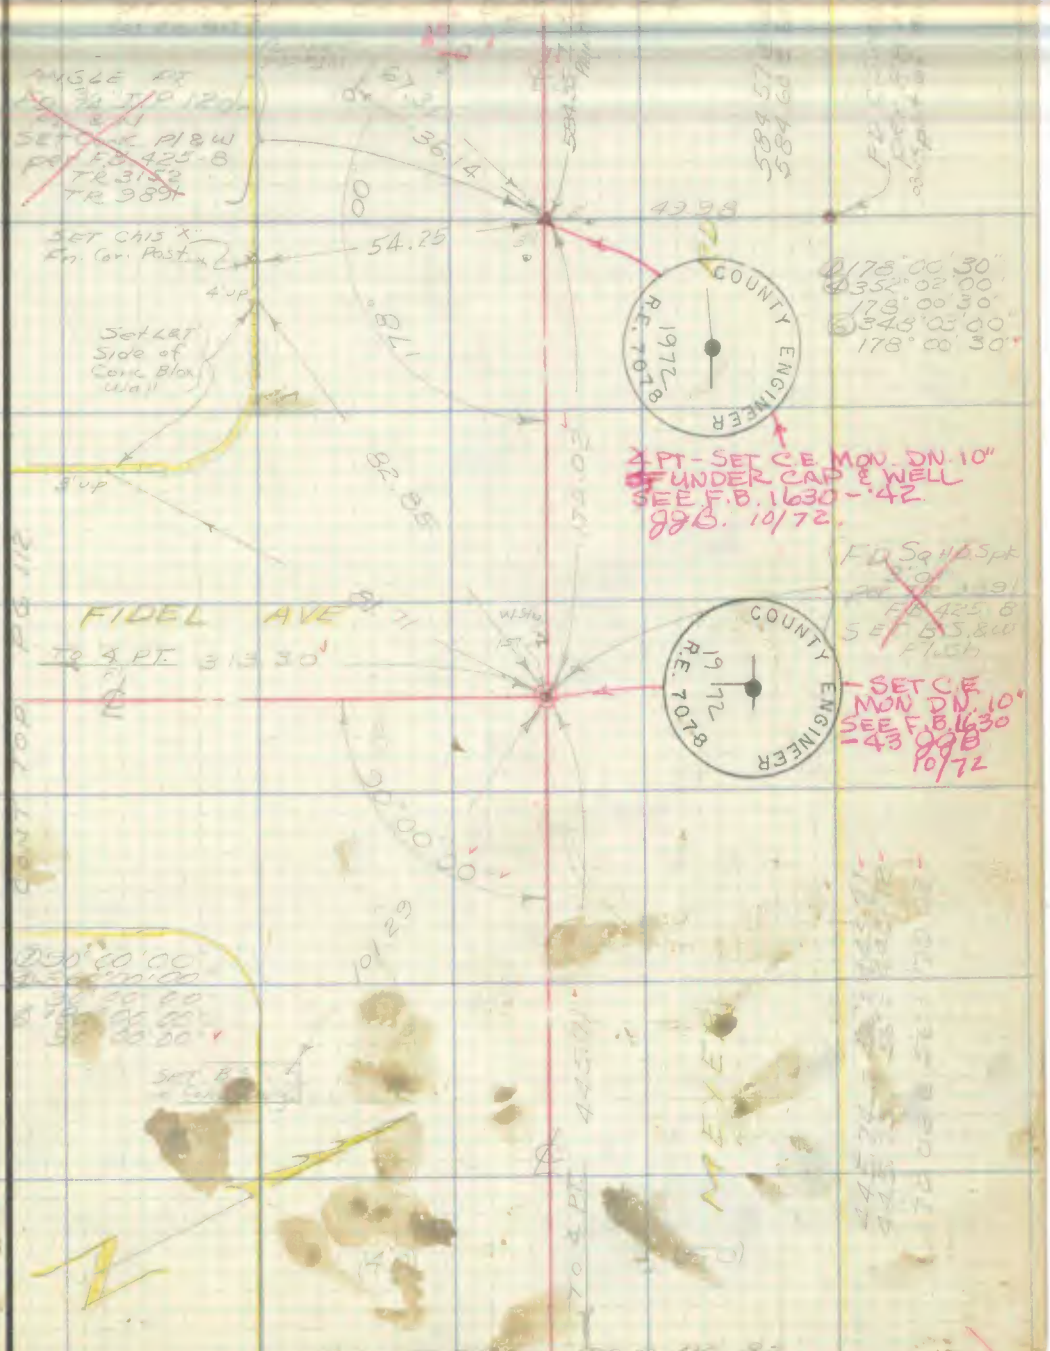


Note: Any Additions or Changes on This Sheet Must be Made or Circled in Red Ink With Date and Name of Person Making Change.

Do not extend notes this side of this line.

RETURN TO
LOS ANGELES COUNTY SURVEYOR
726 LOS ANGELES COUNTY
ENGINEERING BLDG.

76F309S 247 2-51

F. B. _____ PG. _____

PWFB 0827

2101 , 2102

CONT BOT PG 85

W.S. 34-A-2

RETURN TO
LOS ANGELES COUNTY SURVEYOR
726 LOS ANGELES COUNTY
ENGINEERING BLDG.

Do not extend notes this side of this line.

Note: Any Additions or Changes on This Sheet Must be Made or Circled in Red Ink With Date and Name of Person Making Change.

PWFB 0827

2103

| | |
|---|---|
| Notes Ck'd by D. M. Finley | Survey of S. Weather [illegible] |
| Map No. [illegible] | W. O. [illegible] Tape No. ____ St'd. ____ °F |
| Office Work [illegible] | Surveyed by J. S. Coates |
| Checked [illegible] | Notes [illegible] Date ____ |
| Date [illegible] | Indexed M. C. Johnson |

F. B. ____ PG. ____

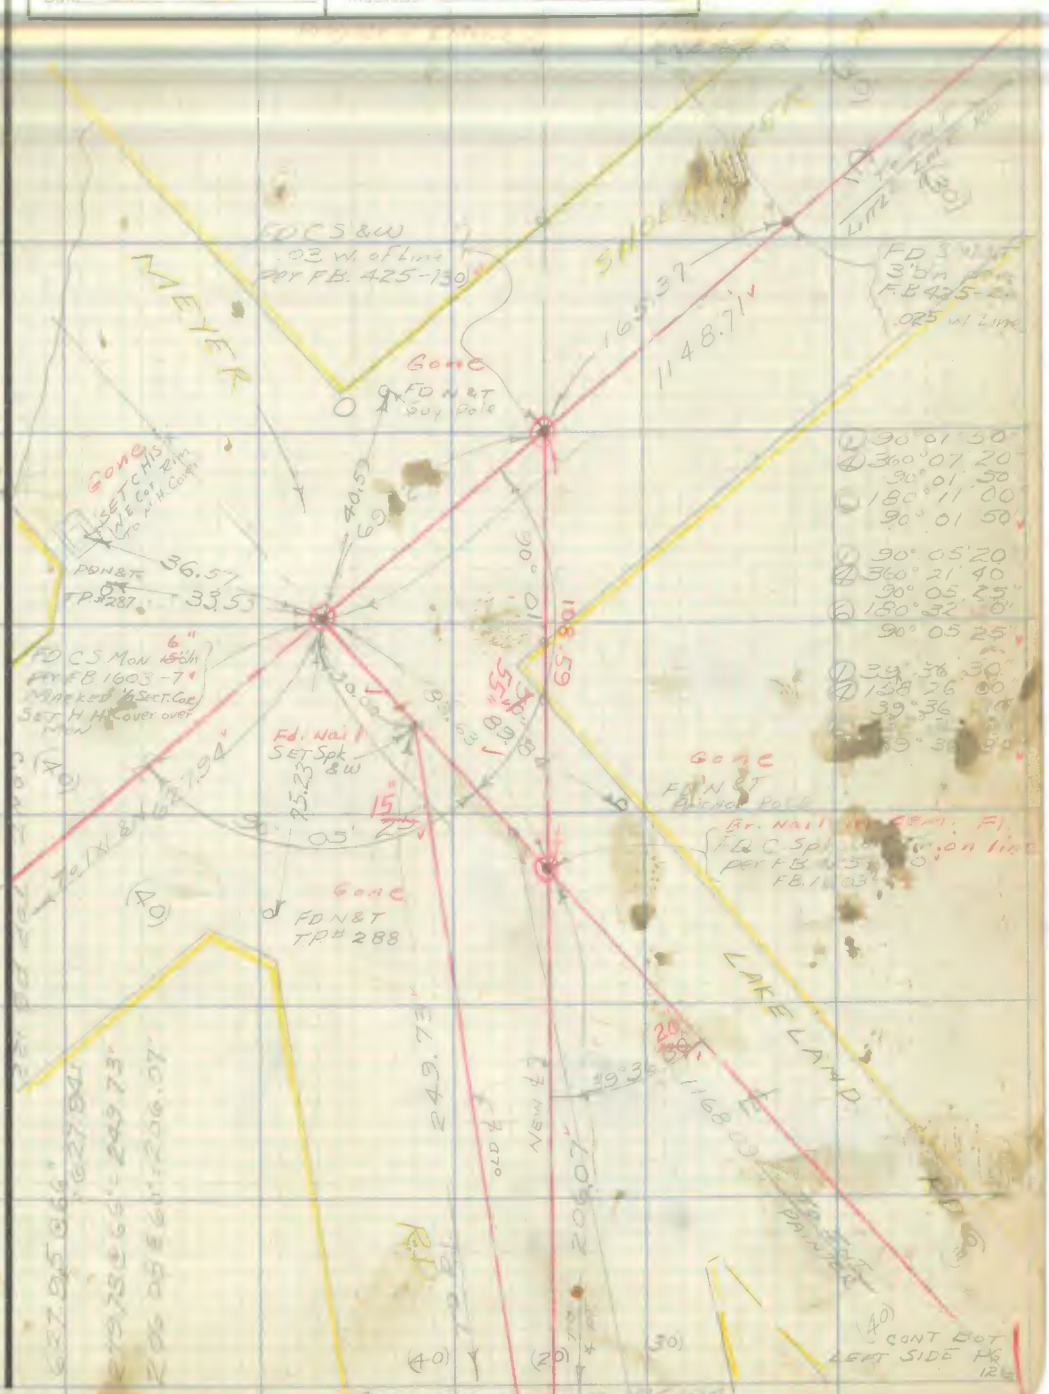


Note: Any Additions or Changes on This Sheet Must be Made or Circled in Red Ink With Date and Name of Person Making Change.

Do not extend notes this side of this line.

RETURN TO
LOS ANGELES COUNTY SURVEYOR
726 LOS ANGELES COUNTY
ENGINEERING BLDG.

76F3095 247 2-51

2104

F. B. ____ PG. ____

PWFB 0827

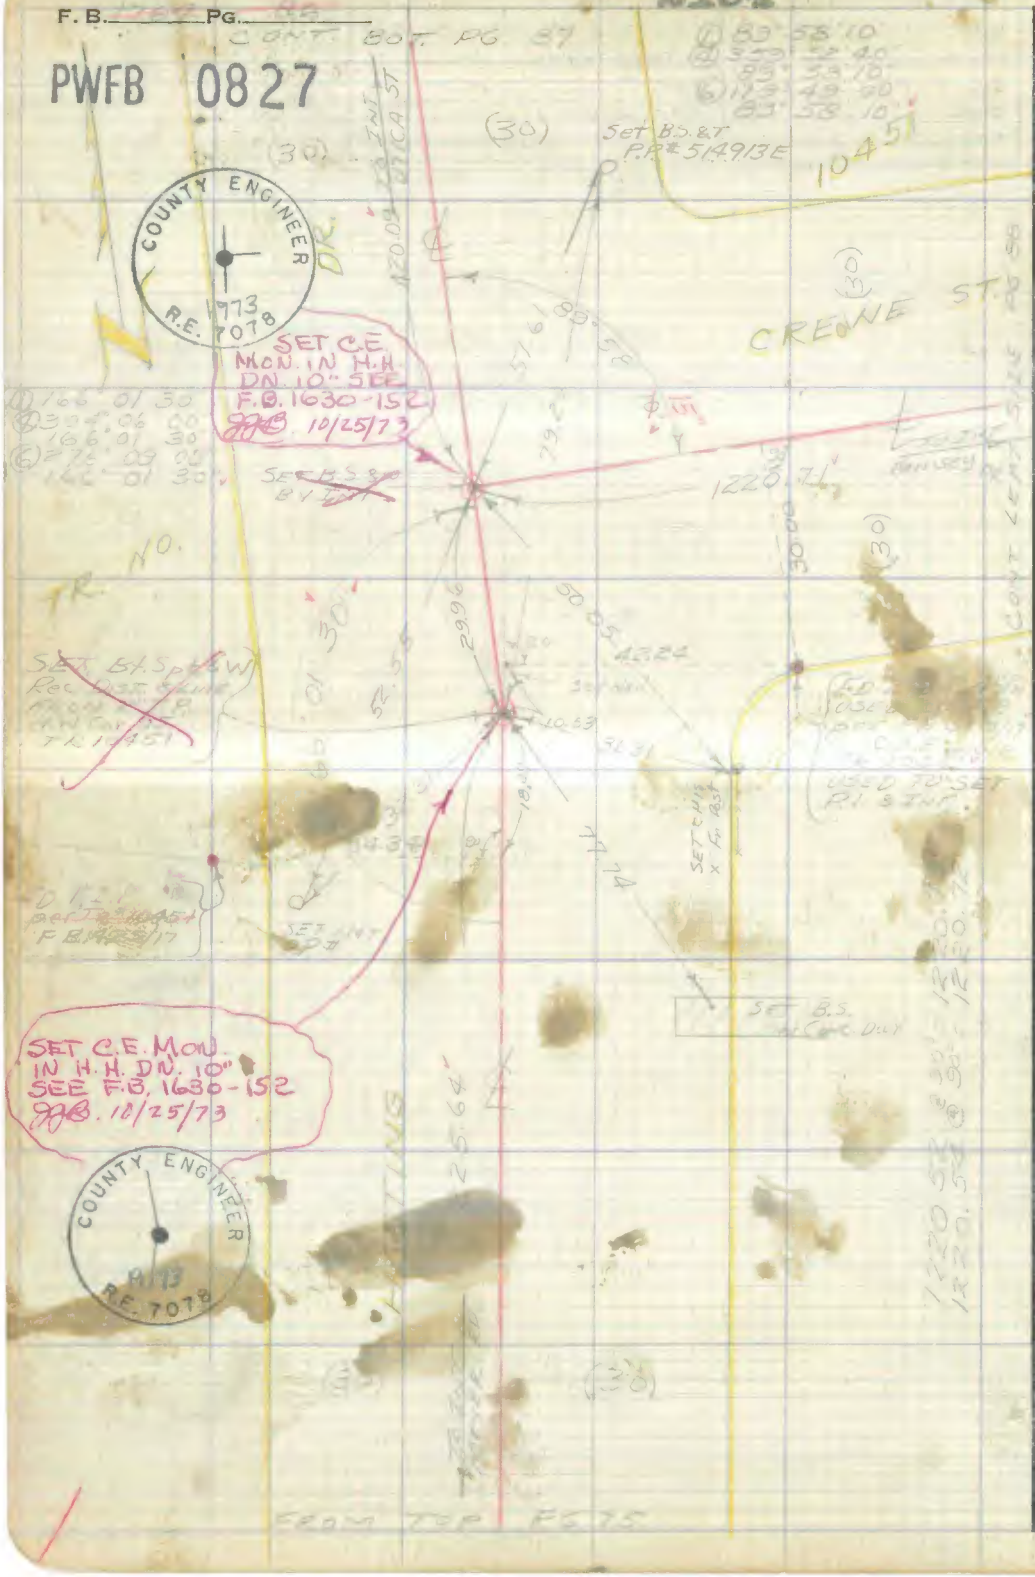


W.S. 34-B-3

RETURN TO
LOS ANGELES COUNTY SURVEYOR
726 LOS ANGELES COUNTY
ENGINEERING BLDG.

Do not extend notes this side of this line.

Note: Any Additions or Changes on This Sheet Must be Made or Circled in Red Ink With Date and Name of Person Making Change.

PWFB 0827 2105

| | |
|---|---|
| Notes Ck'd by D. M. Finler | Survey of |
| Map No. C.S.B.-2502 | W. O. Tape No. St'd. °F |
| Office Work R. L. Green | Surveyed by |
| Checked C. J. Gam | Notes Date |
| Date 1-2-1981 | Indexed |

F. B. Pg.

WB 34-B-3

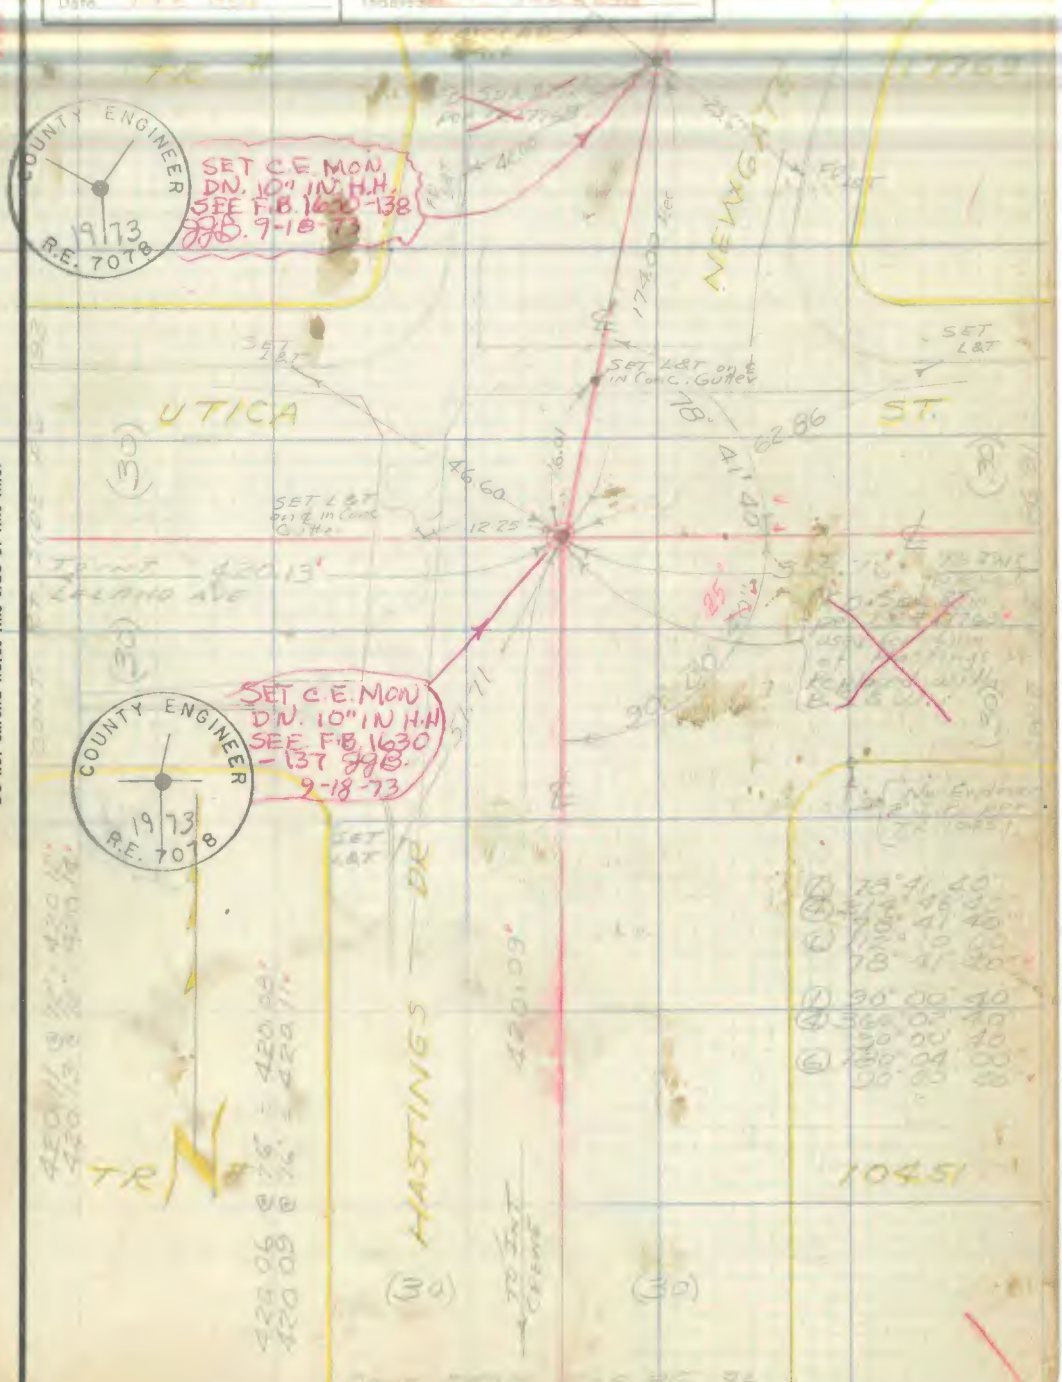


Note: Any Additions or Changes on This Sheet Must be Made or Circled in Red Ink With Date and Name of Person Making Change.

Do not extend notes this side of this line.

RETURN TO
LOS ANGELES COUNTY SURVEYOR
726 LOS ANGELES COUNTY
ENGINEERING BLDG.

76F309S 247 2-51

PWFB 0827 2106, 2107

F. B. 1764 PG. 88

W.S. 34-B-3

RETURN TO
LOS ANGELES COUNTY SURVEYOR
726 LOS ANGELES COUNTY
ENGINEERING BLDG.

Do not extend notes this side of this line.

Note: Any Additions or Changes on This Sheet Must be Made or Circled in Red Ink With Date and Name of Person Making Change.

PWFB 0827 2108, 2109

| | |
|---|---|
| Notes Ck'd by D. M. Finley | Survey of |
| Map No. C.S.B. 2567 | W. O. Tape No. St'd. °F |
| Office Work R. L. Green | Surveyed by J. S. Coates |
| Checked C. J. Gatti | Notes Date |
| Date | Indexed A. C. Johnson |

F. B. PG.

W.S. 34-B-3

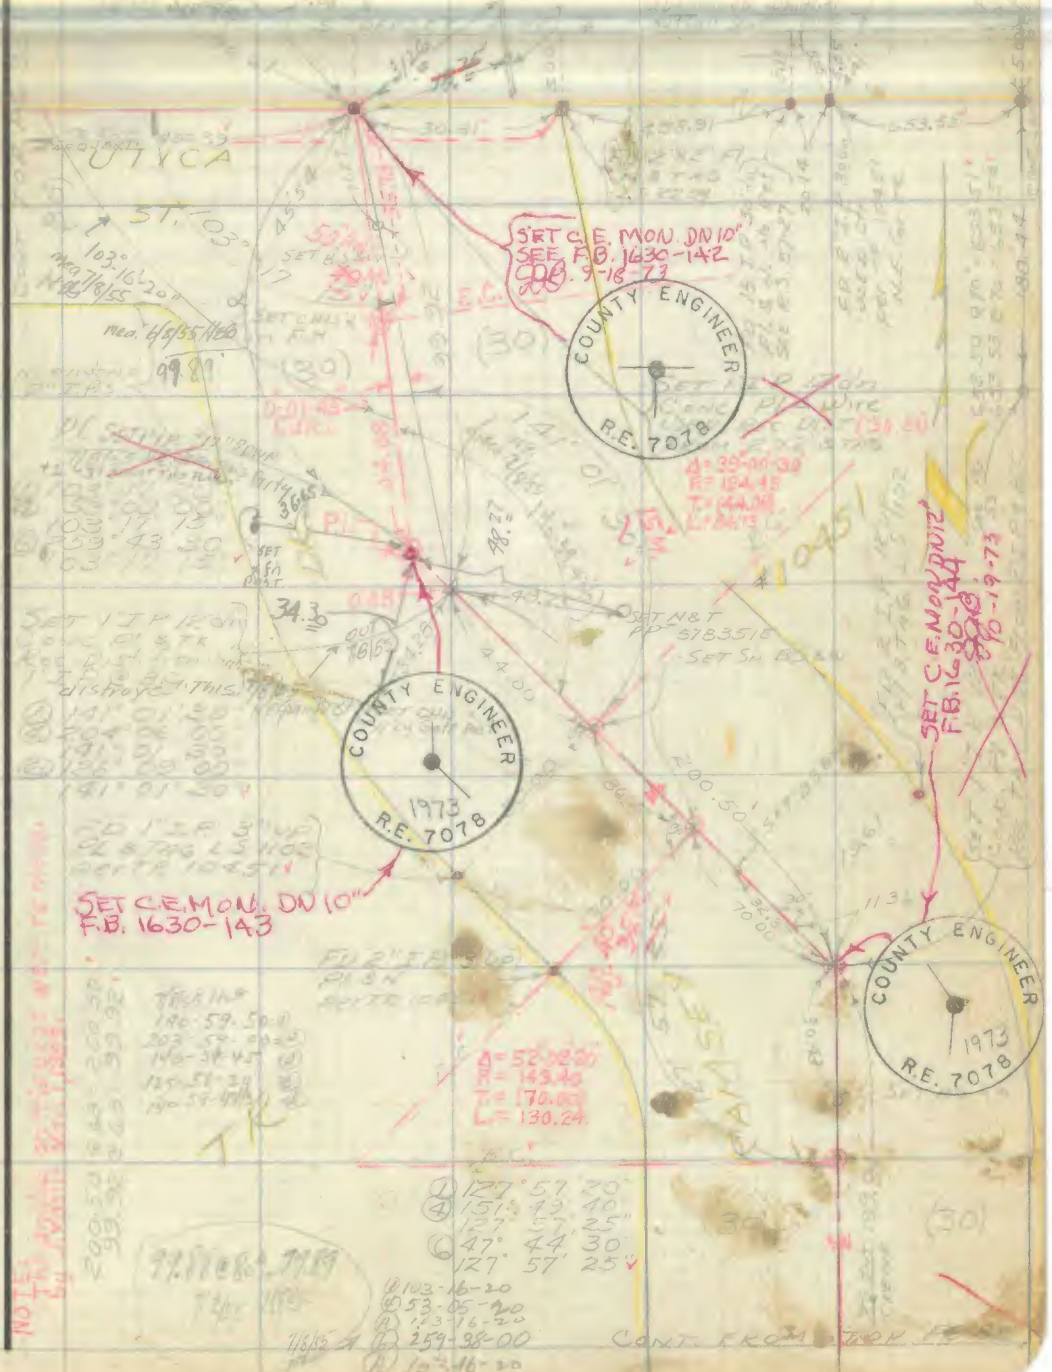


Note: Any Additions or Changes on This Sheet Must be Made or Circled in Red Ink With Date and Name of Person Making Change.

Do not extend notes this side of this line.

RETURN TO
LOS ANGELES COUNTY SURVEYOR
726 LOS ANGELES COUNTY
ENGINEERING BLDG.

76F309S 247 2-51

F. B. 1764 PG. 90

PWFB 0827

CONT FROM LEFT SIDE PG 89

2110

W.S. 34-B-3

RETURN TO
LOS ANGELES COUNTY SURVEYOR
726 LOS ANGELES COUNTY
ENGINEERING BLDG.

Do not extend notes this side of this line.

Note: Any Additions or Changes on This Sheet Must be Made or Circled in Red Ink With Date and Name of Person Making Change.

PWFB 0827

2111

F. B. [illegible] PG [illegible]

| | |
|---|---|
| Notes Ck'd by D. M. Finley | Survey of S. WHITTIER [illegible] |
| Map No. C.S.B.-2562 | W. O. [illegible] Tape No. [illegible] St'd. [illegible] °F |
| Office Work R. L. Green | Surveyed by U.S. COATES |
| Checked C. J. Galli | Notes [illegible] Date [illegible] |
| Date [illegible] | Indexed [illegible] |

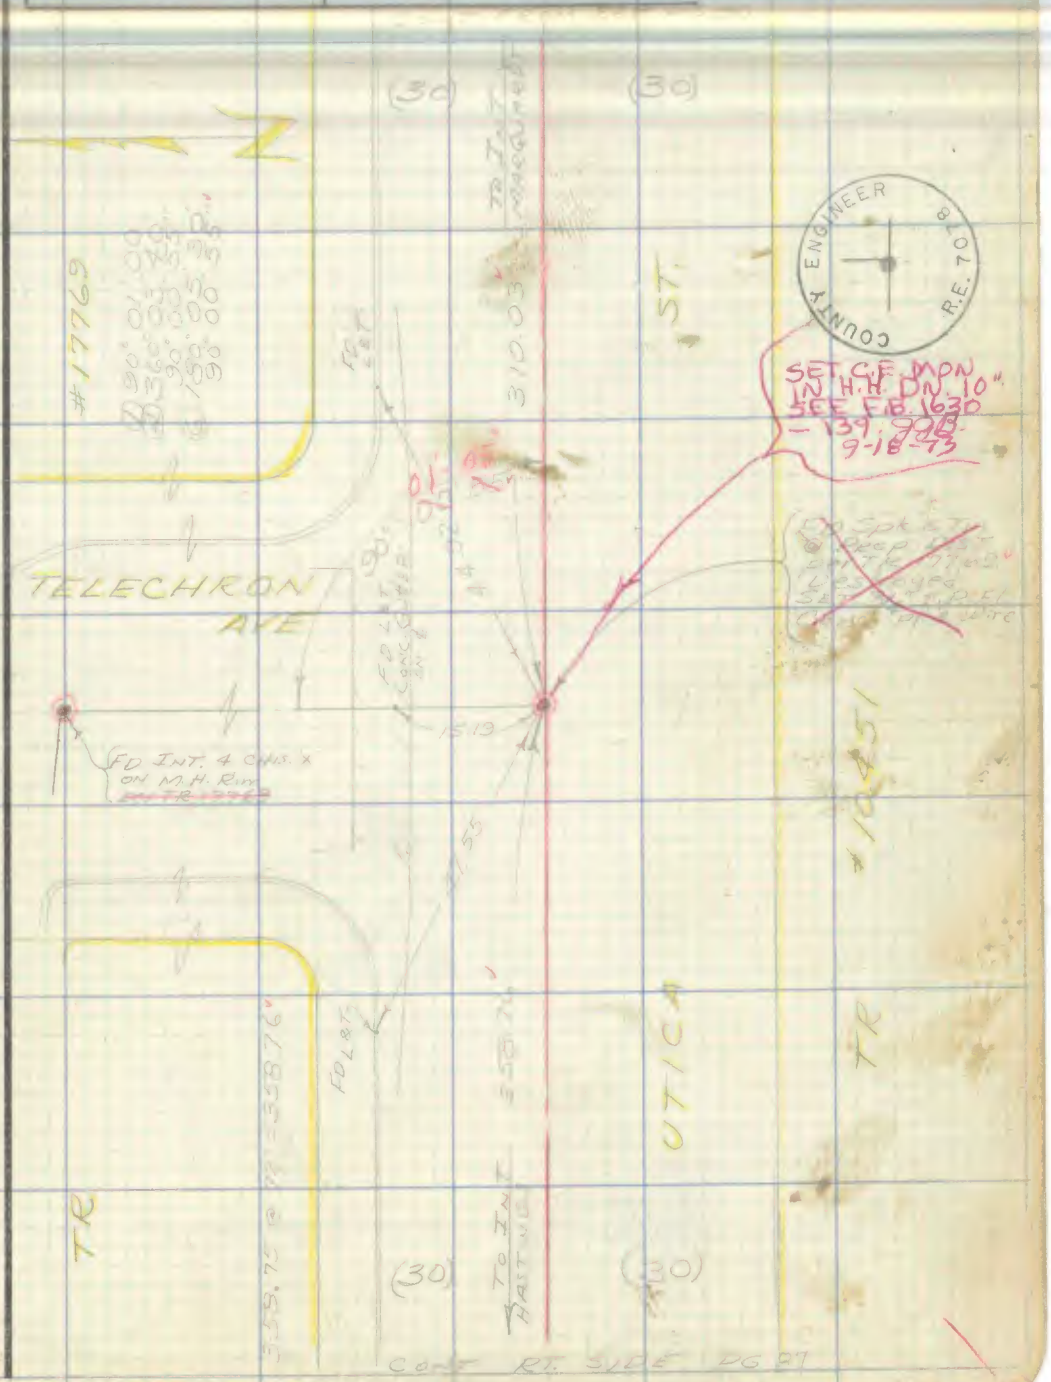


Note: Any Additions or Changes on This Sheet Must be Made or Circled in Red Ink With Date and Name of Person Making Change.

Do not extend notes this side of this line.

RETURN TO
LOS ANGELES COUNTY SURVEYOR
726 LOS ANGELES COUNTY
ENGINEERING BLDG.

76F309S 247 2-51

F. B. 1764 PG. 92

2112

PWFB 0827

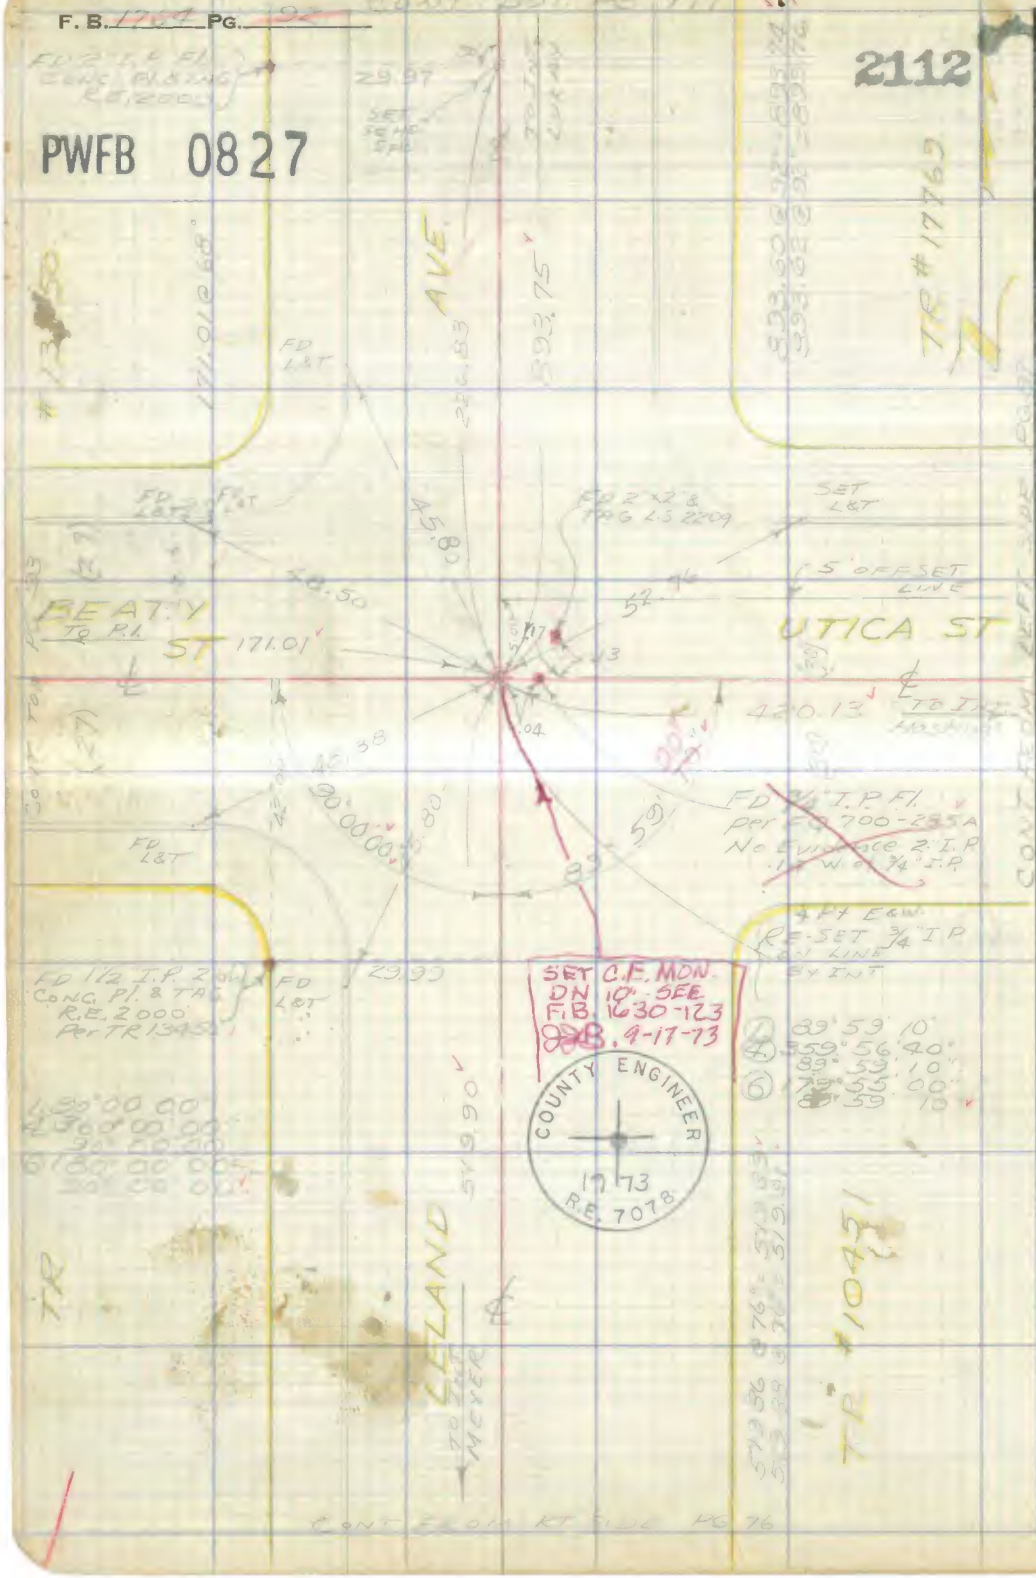


W.S. 34-B-3

RETURN TO
LOS ANGELES COUNTY SURVEYOR
726 LOS ANGELES COUNTY
ENGINEERING BLDG.

Do not extend notes this side of this line.

Note: Any Additions or Changes on This Sheet Must be Made or Circled in Red Ink With Date and Name of Person Making Change.

PWFB 0827 2113, 2114

F. B. 1764 Pg. [illegible]

| | |
|---|---|
| Notes Ck'd by D. M. Finlet | Survey of [illegible] |
| Map No. C.S.B. 7562 | W. O. [illegible] Tape No. [illegible] St'd. [illegible] °F |
| Office Work R. L. Green | Surveyed by J. S. Coates |
| Checked C. J. Gaill | Notes [illegible] Date [illegible] |
| Date [illegible] | Indexed [illegible] |

WS 34-A-3

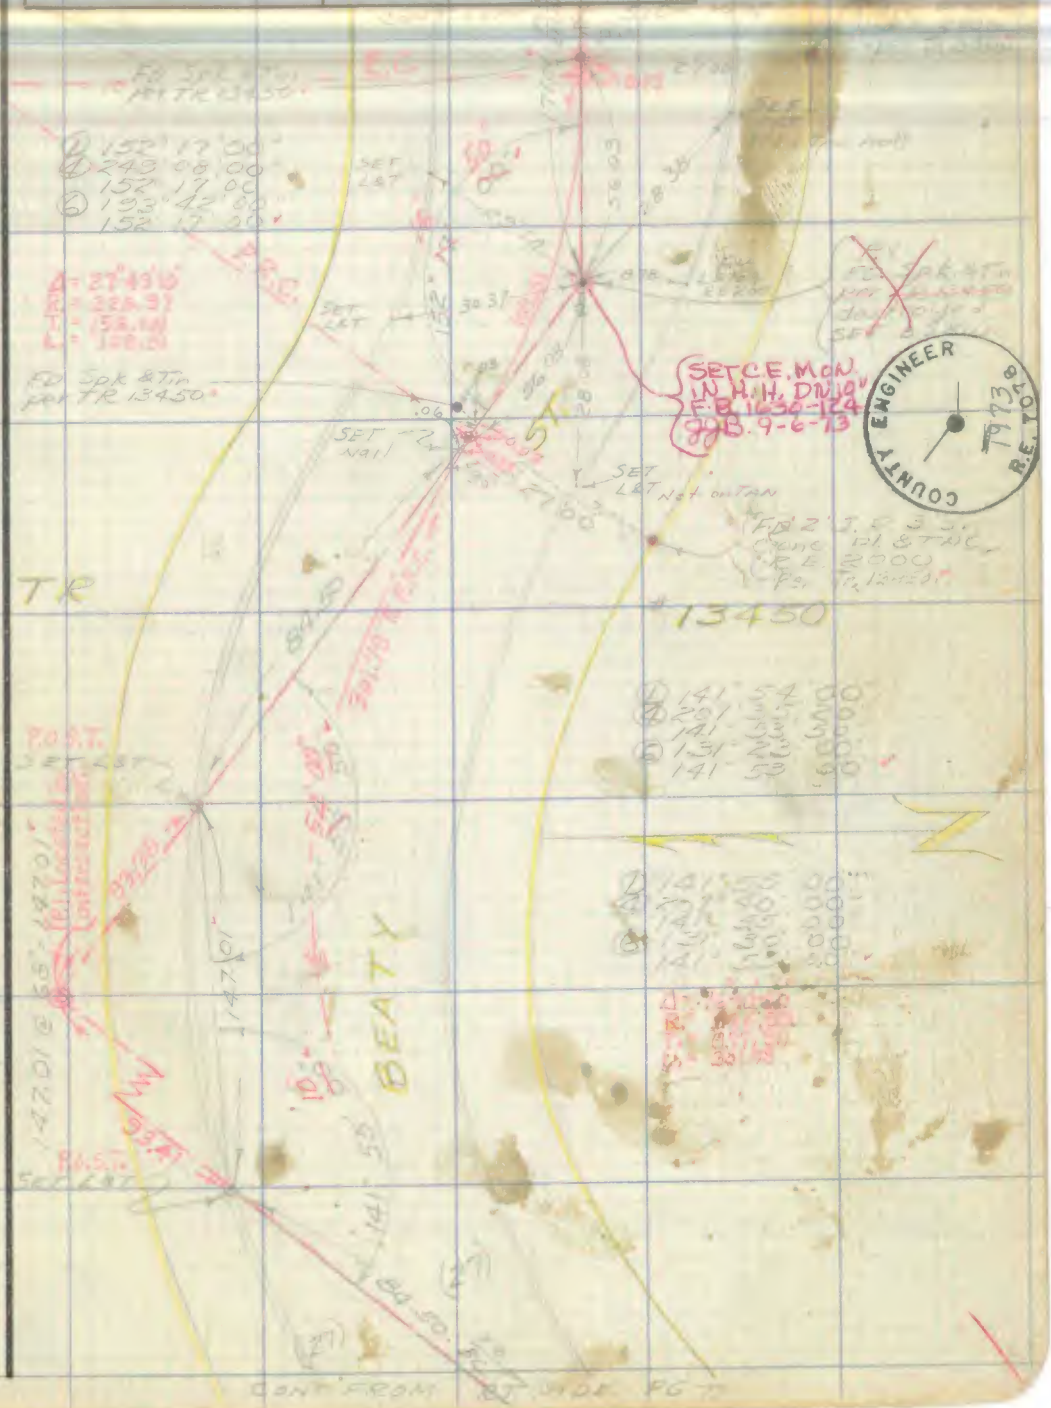


Note: Any Additions or Changes on This Sheet Must be Made or Circled in Red Ink With Date and Name of Person Making Change.

Do not extend notes this side of this line.

RETURN TO
LOS ANGELES COUNTY SURVEYOR
726 LOS ANGELES COUNTY
ENGINEERING BLDG.

76F309S 247 2-51

PWFB 0827 2115

F. B. 1764 PG. 94

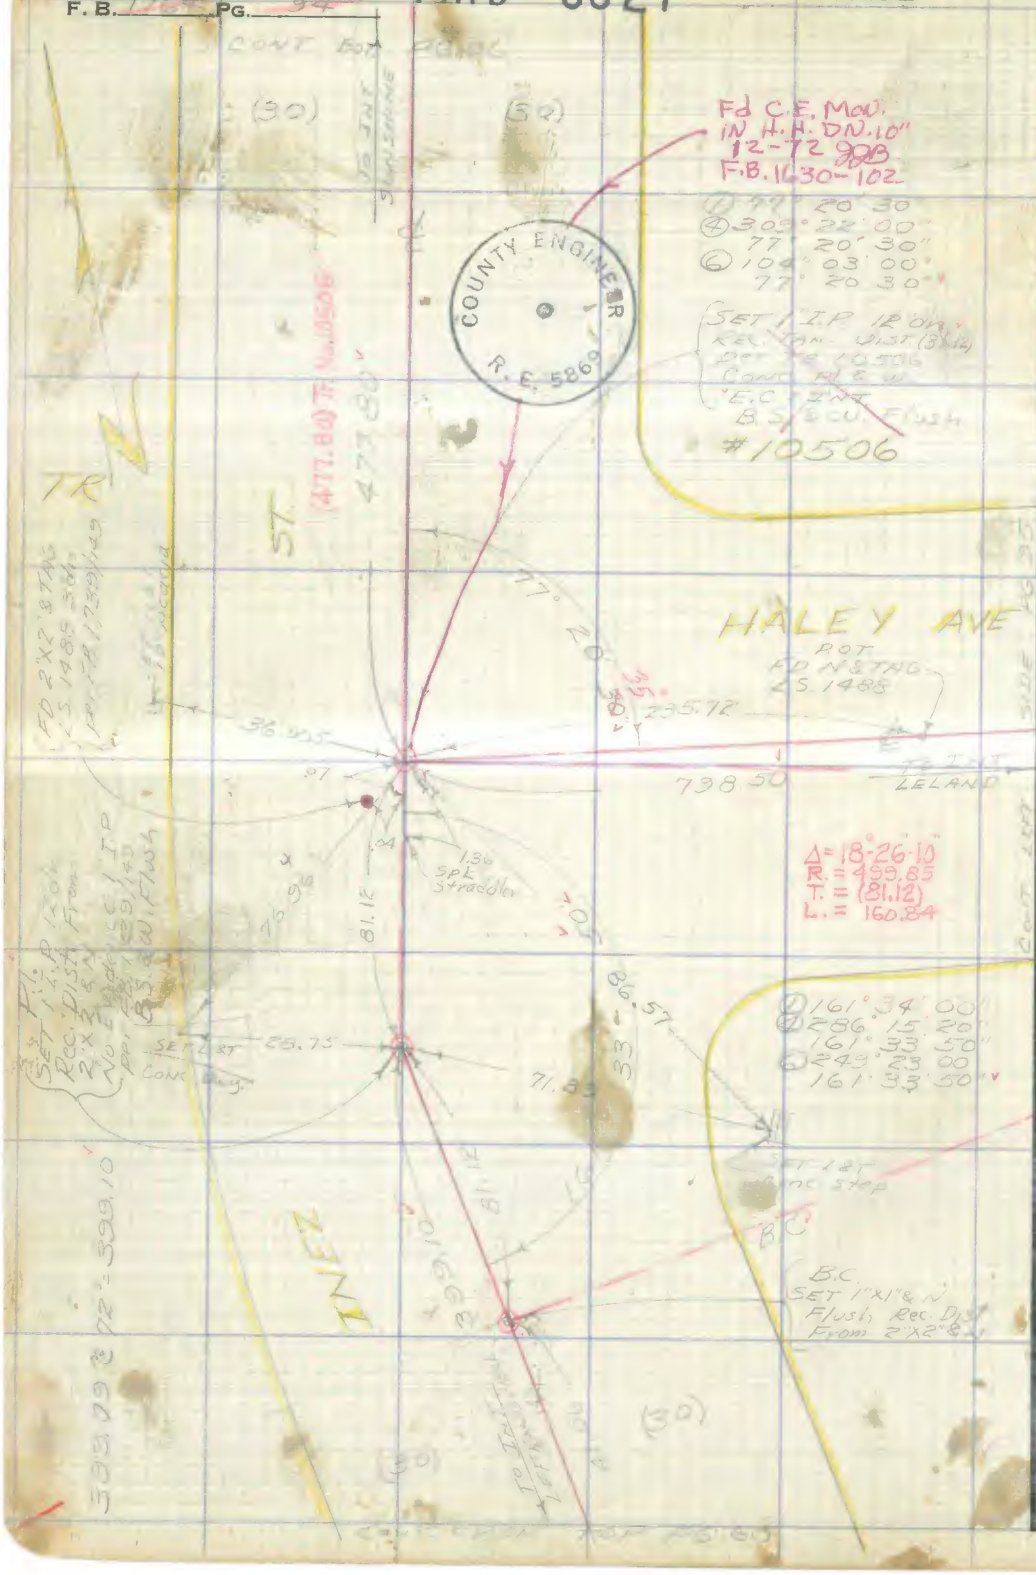


RETURN TO
LOS ANGELES COUNTY SURVEYOR
726 LOS ANGELES COUNTY
ENGINEERING BLDG.

Do not extend notes this side of this line.

Note: Any Additions or Changes on This Sheet Must be Made or Circled in Red Ink With Date and Name of Person Making Change.

PWFB 0827

2116

| | |
|---|---|
| Notes Ck'd by D. M. Fisher | Survey of S. Whittier Area 21 |
| Map No. C-8-1 | W. O. 5 Tape No. 0154 St'd. 68 °F |
| Office Work R. C. Green | Surveyed by J. S. Cowan |
| Checked C. J. Galli | Notes J.S.C. Date 10/53 |
| Date | Indexed |

F. B. 1064 Pg. 85

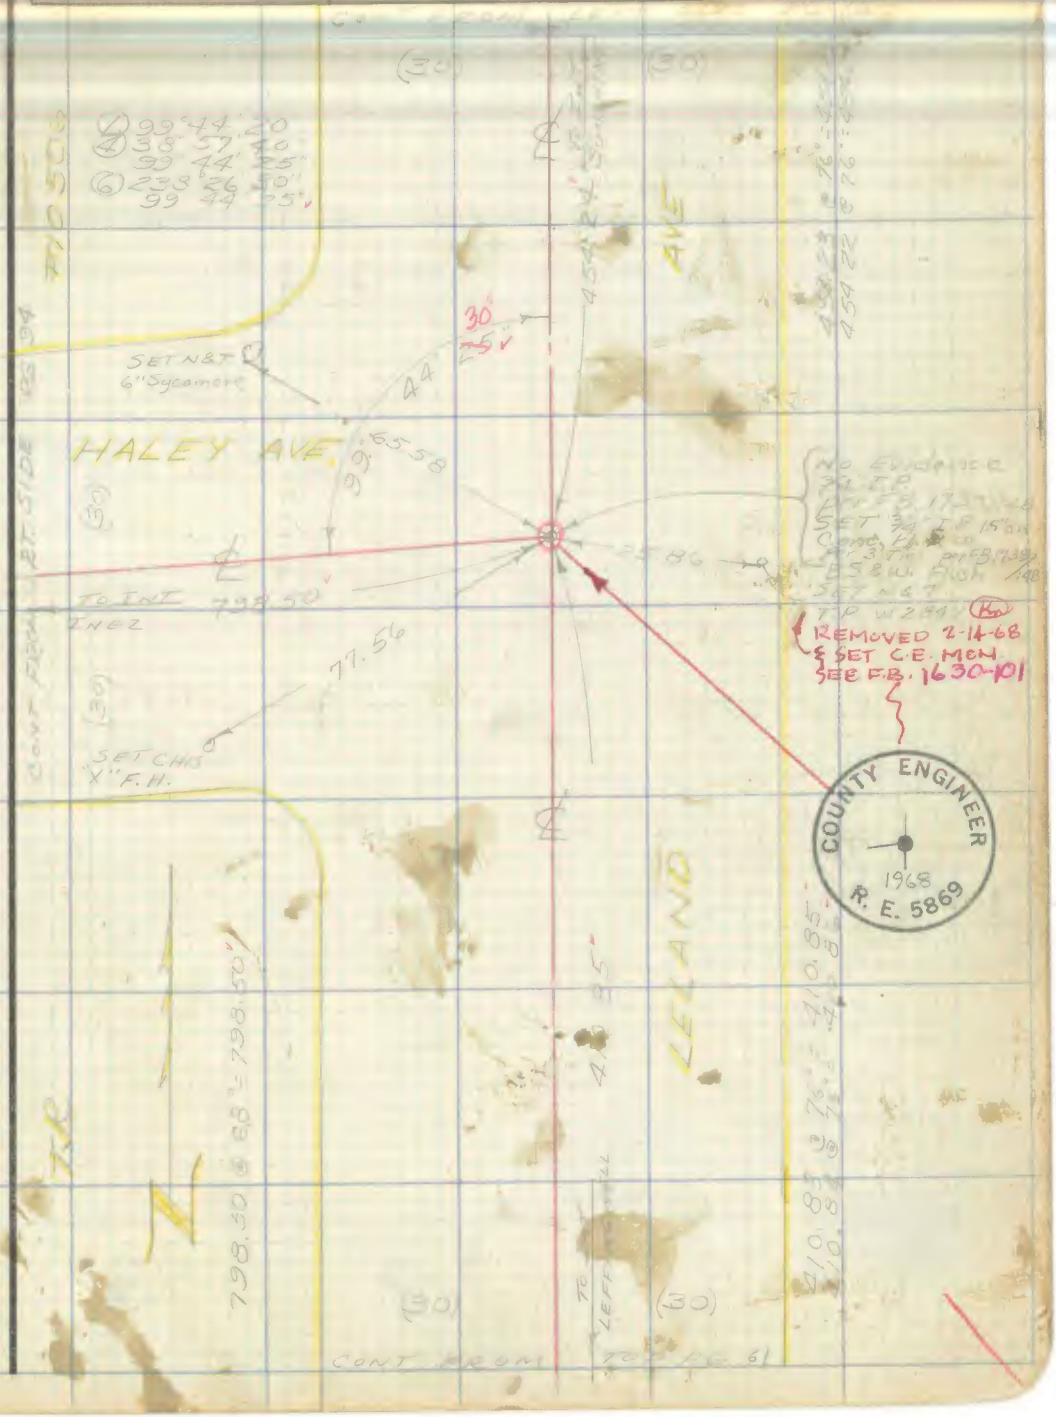


Note: Any Additions or Changes on This Sheet Must be Made or Circled in Red Ink With Date and Name of Person Making Change.

Do not extend notes this side of this line.

RETURN TO
LOS ANGELES COUNTY SURVEYOR
726 LOS ANGELES COUNTY
ENGINEERING BLDG.

76F3095 247 2-51

F. B. 164 PG. 96

PWFB 0827

2117

CONT FROM BOT. LEFT SIDE PG 78

W.S. 34-A-3

RETURN TO
LOS ANGELES COUNTY SURVEYOR
726 LOS ANGELES COUNTY
ENGINEERING BLDG.

Do not extend notes this side of this line.

Note: Any Additions or Changes on This Sheet Must be Made or Circled in Red Ink With Date and Name of Person Making Change.

PWFB 0827 2118, 2119

F. B. [illegible] PG. [illegible]

| | |
|---|---|
| Notes Ck'd by D. M. Finley | Survey of [illegible] |
| Map No. C.S.B. 2562 | W. O. [illegible] Tape No. [illegible] St'd. 68 °F |
| Office Work K. L. Green | Surveyed by [illegible] |
| Checked C. J. Gaill | Notes J.S.C. Date [illegible] |
| Date [illegible] | Indexed [illegible] |

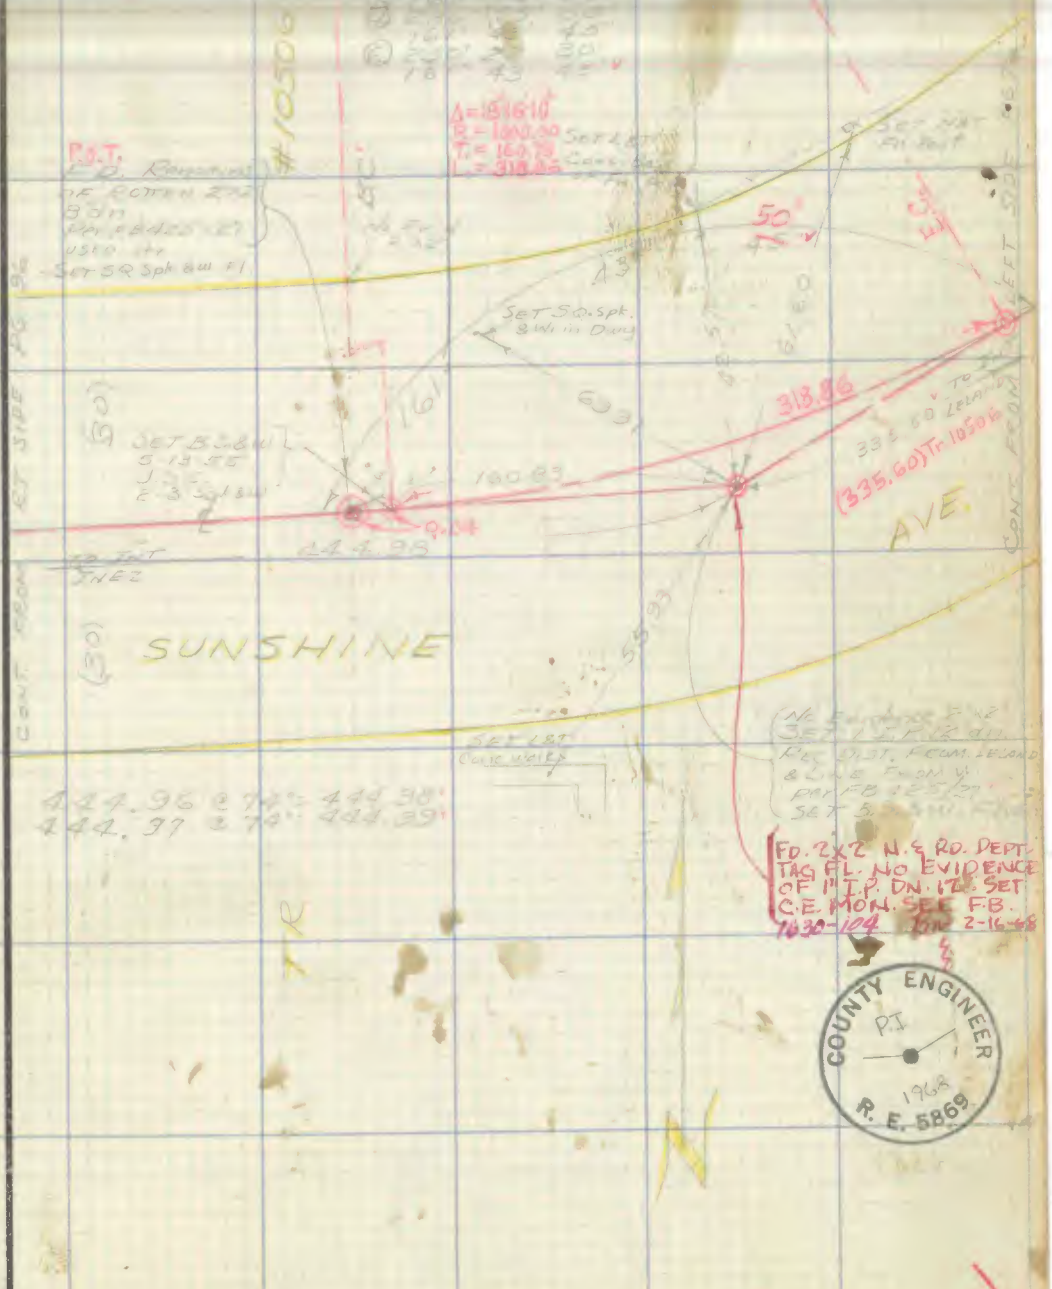


Note: Any Additions or Changes on This Sheet Must be Made or Circled in Red Ink With Date and Name of Person Making Change.

Do not extend notes this side of this line.

RETURN TO
LOS ANGELES COUNTY SURVEYOR
726 LOS ANGELES COUNTY
ENGINEERING BLDG.

76F3095 247 2-51

PWFB 0827 2120, 2121

F. B. _____ Pg. _____

W.S. 34-A-2

RETURN TO
LOS ANGELES COUNTY SURVEYOR
726 LOS ANGELES COUNTY
ENGINEERING BLDG.

Do not extend notes this side of this line.

Note: Any Additions or Changes on This Sheet Must be Made or Circled In Red Ink With Date and Name of Person Making Change.

COUNTY ENGINEER
R. E. 5869

REMOVED & SET C.E. MON.
7-16-68
SEE F.B. 1650-106

SUNSHINE AVE

CARMENITA

E.C.

REMOVED & SET
C.E. MON. 3/11/68
SEE F.B.
SEE Rd. Dept. F.B.
75-0827-18
FOR NEW P.E.

COUNTY ENGINEER
R. E. 5869

CONT. FROM TOP PG. 3

PWFB 0827

2122, 2123

F. B. [illegible] PG. [illegible]

| | |
|---|---|
| Notes Ck'd by D. M. Pimes | Survey of [illegible] |
| Map No. C 98-2562 | W. O. [illegible] Tape No. [illegible] St'd. 68 °F |
| Office Work R. L. Green | Surveyed by [illegible] |
| Checked C. J. [illegible] | Notes [illegible] Date [illegible] |
| Date [illegible] | Indexed [illegible] |

COUNTY ENGINEER 1918 R. E. 5869

W.C. 34-A-3

Note: Any Additions or Changes on This Sheet Must be Made or Circled in Red Ink With Date and Name of Person Making Change.

Do not extend notes this side of this line.

RETURN TO
LOS ANGELES COUNTY SURVEYOR
726 LOS ANGELES COUNTY
ENGINEERING BLDG.

76F309S 247 2-51

F. B. 1764 PG. 100

2124

PWFB 0827

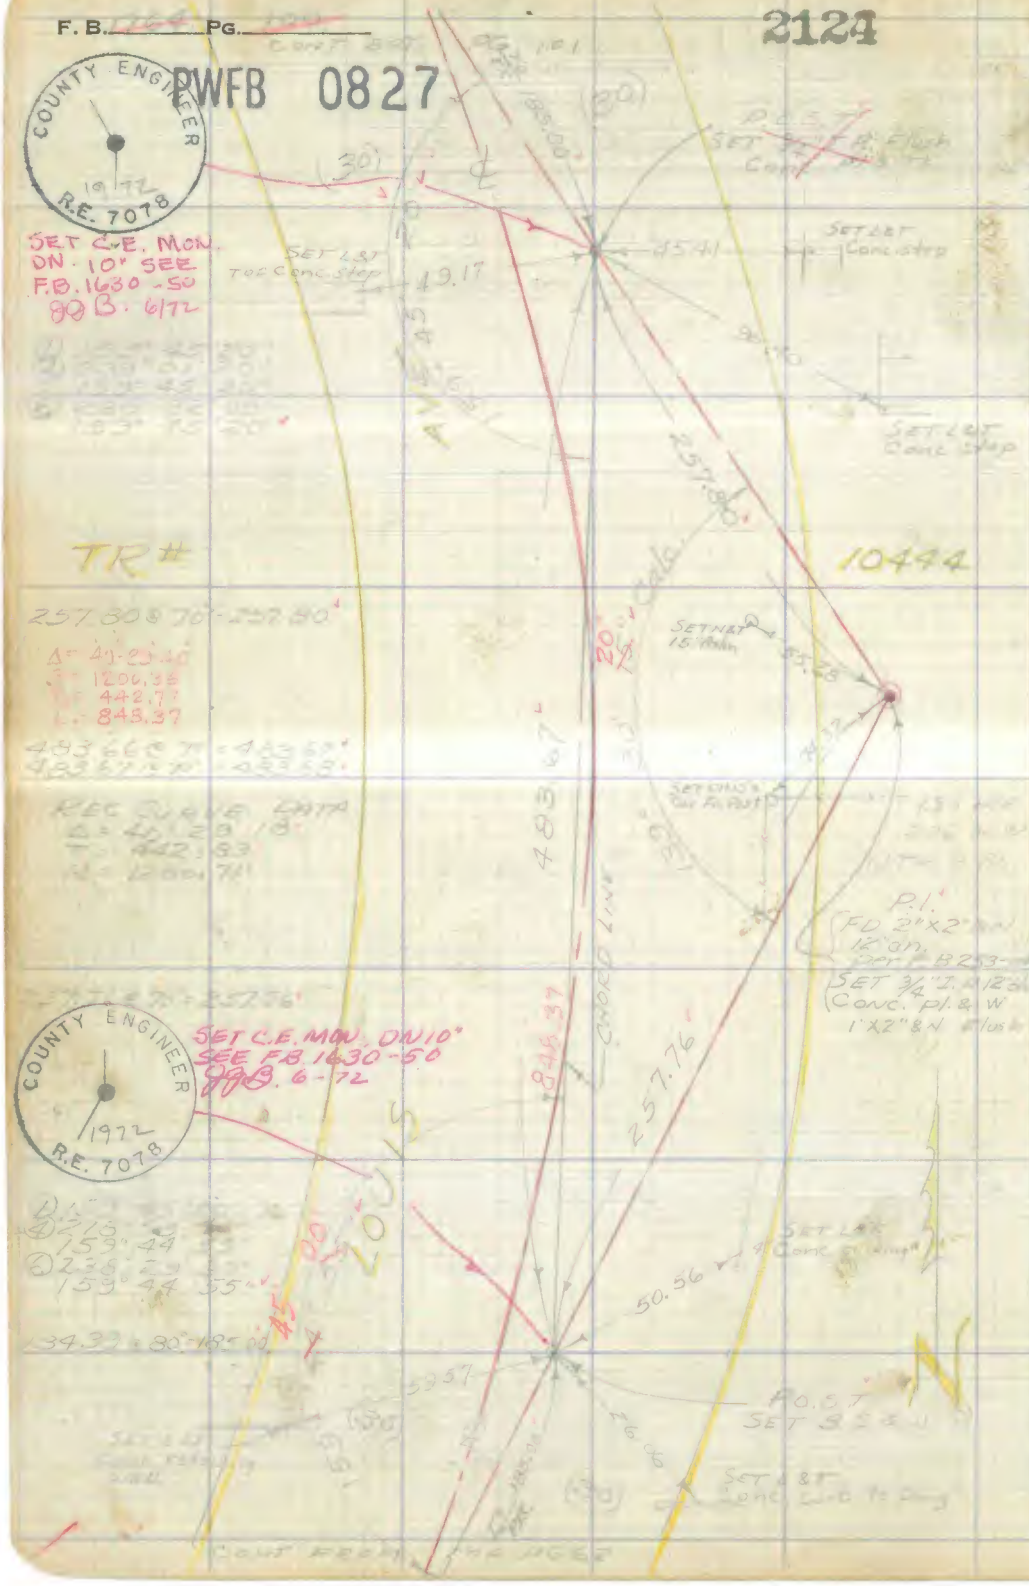


W.S. 34-A-3

RETURN TO
LOS ANGELES COUNTY SURVEYOR
726 LOS ANGELES COUNTY
ENGINEERING BLDG.

Do not extend notes this side of this line.

Note: Any Additions or Changes on This Sheet Must be Made or Circled in Red Ink With Date and Name of Person Making Change.

PWFB 0827 2125

| | |
|---|---|
| Notes Ck'd by D. M. Pinley | Survey of [illegible] |
| Map No. [illegible] | W. O. [illegible] Tape No. [illegible] St'd. [illegible] °F |
| Office Work [illegible] | Surveyed by J. S. Conrad |
| Checked [illegible] | Notes J.S.C. Date [illegible] |
| Date [illegible] | Indexed [illegible] |

F. B. [illegible] PG. [illegible]

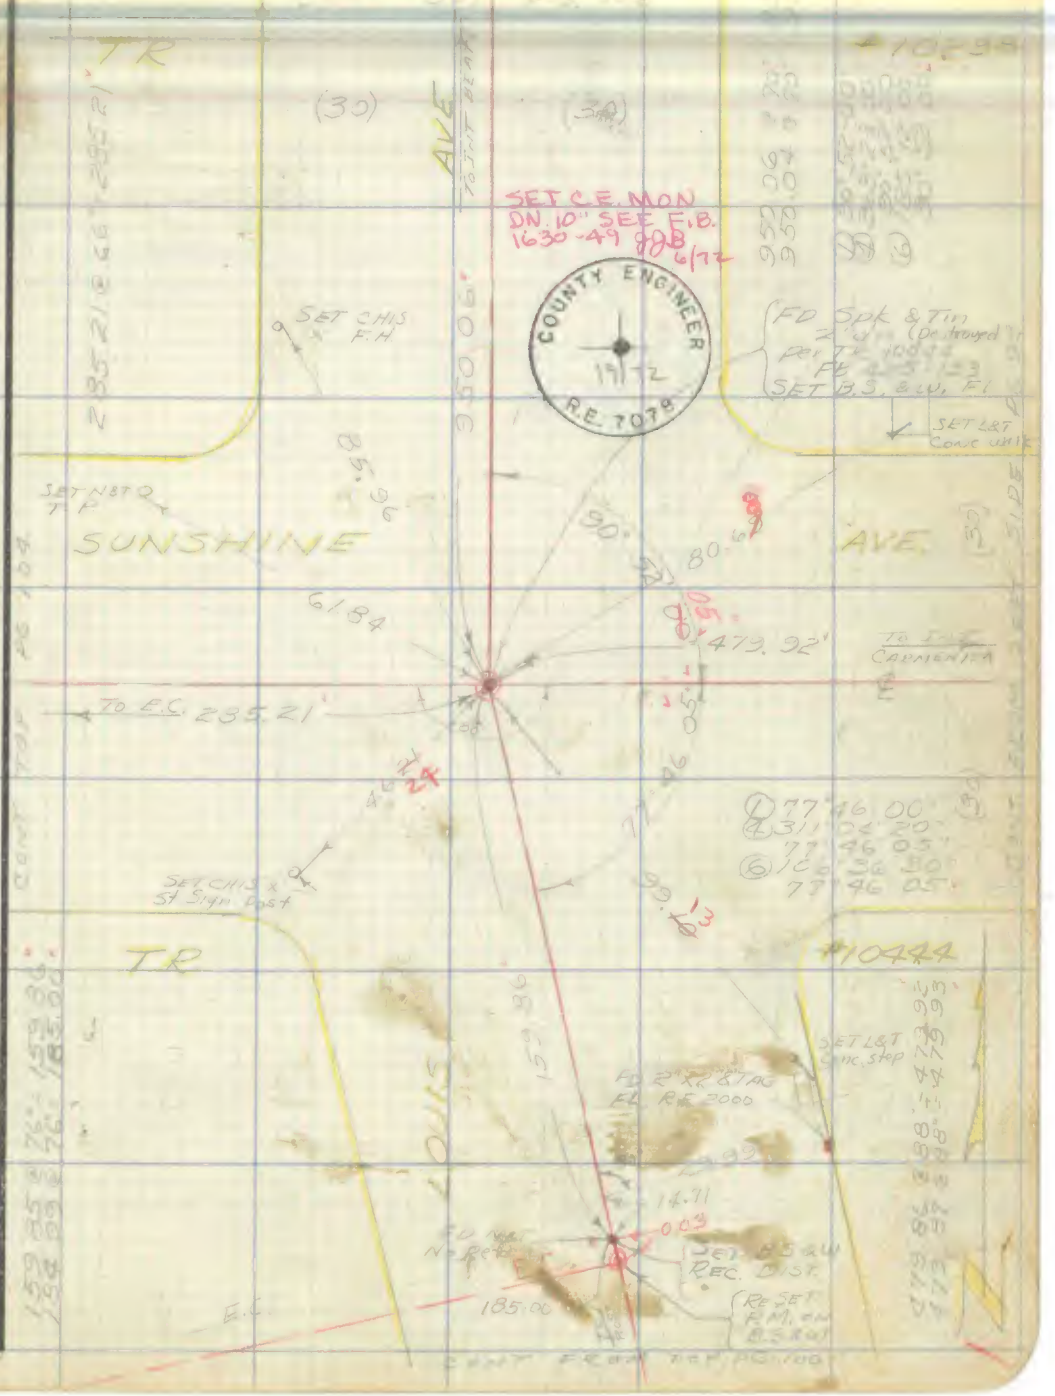


Note: Any Additions or Changes on This Sheet Must be Made or Circled in Red Ink With Date and Name of Person Making Change.

Do not extend notes this side of this line.

RETURN TO
LOS ANGELES COUNTY SURVEYOR
726 LOS ANGELES COUNTY
ENGINEERING BLDG.

76F309S 247 2-51

F. B. 1764 PG. 102

PWFB 0827

2126

W.S. 34-A-3

RETURN TO
LOS ANGELES COUNTY SURVEYOR
726 LOS ANGELES COUNTY
ENGINEERING BLDG.

Do not extend notes this side of this line.

Note: Any Additions or Changes on This Sheet Must be Made or Circled in Red Ink With Date and Name of Person Making Change.

PWFB 0827 2127

| | |
|---|---|
| Notes Ck'd by D. M. Finley | Survey of [illegible] |
| Map No. C.S.B-2562 | W. O. [illegible] Tape No. [illegible] St'd. [illegible] °F |
| Office Work R. L. Green | Surveyed by [illegible] |
| Checked C. J. Gulli | Notes [illegible] Date [illegible] |
| Date [illegible] | Indexed [illegible] |

F. B. [illegible] PG. [illegible]

W.S. 34-A-3

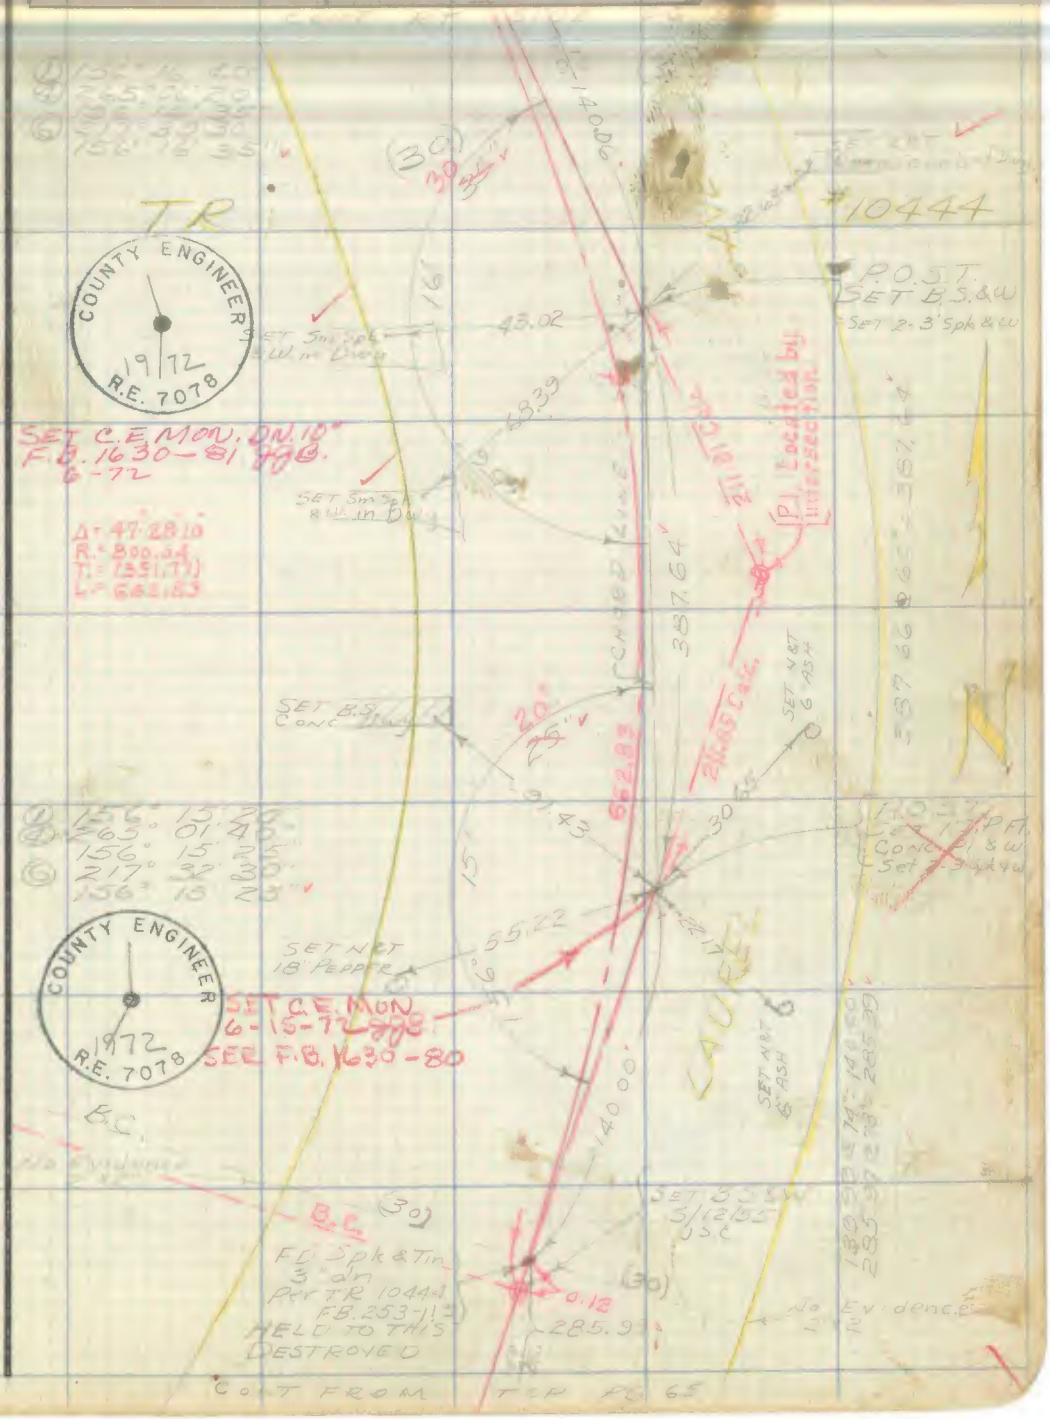


Note: Any Additions or Changes on This Sheet Must be Made or Circled in Red Ink With Date and Name of Person Making Change.

Do not extend notes this side of this line.

RETURN TO
LOS ANGELES COUNTY SURVEYOR
726 LOS ANGELES COUNTY
ENGINEERING BLDG.

76F309S 247 2-51

F. B. 1724 PG. 104

PWFB 0827

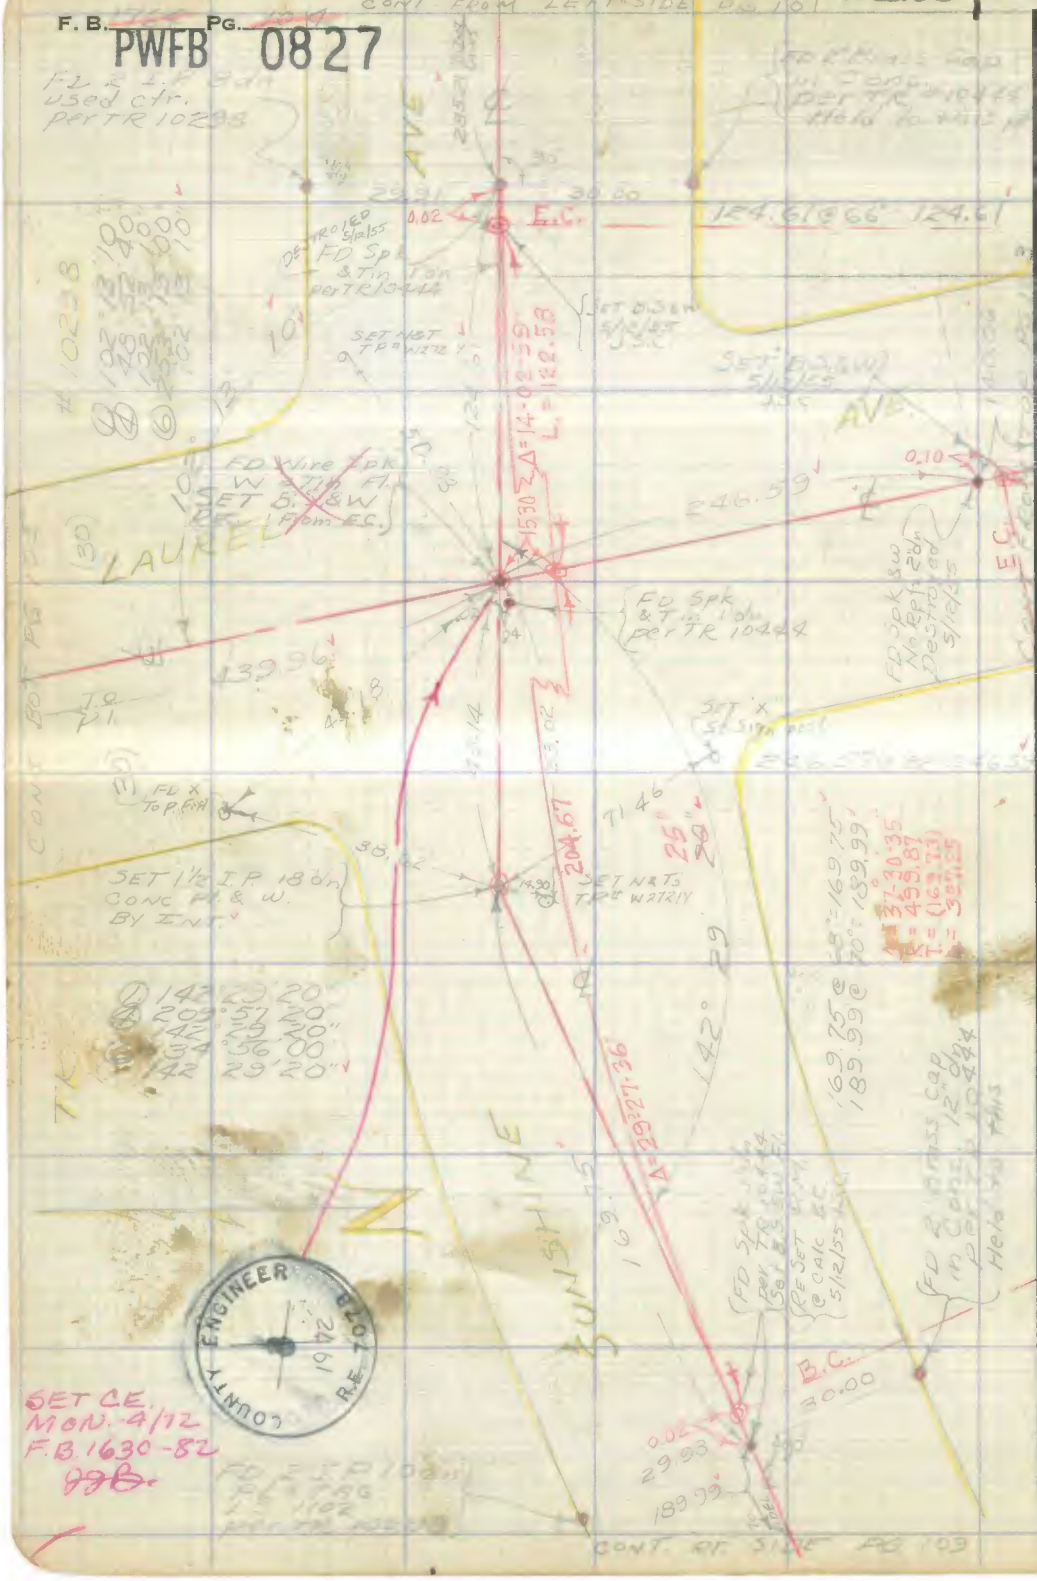


RETURN TO
LOS ANGELES COUNTY SURVEYOR
726 LOS ANGELES COUNTY
ENGINEERING BLDG.

Do not extend notes this side of this line.

Note: Any Additions or Changes on This Sheet must be Made or Circled in Red Ink With Date and Name of Person Making Change.

PWFB 0827 2130, 2131

| | |
|---|---|
| Notes Ck'd by D. M. Finley | Survey of |
| Map No. | W. O. Tape No. St'd. °F |
| Office Work | Surveyed by |
| Checked | Notes Date |
| Date | Indexed |

F. B. Pg.

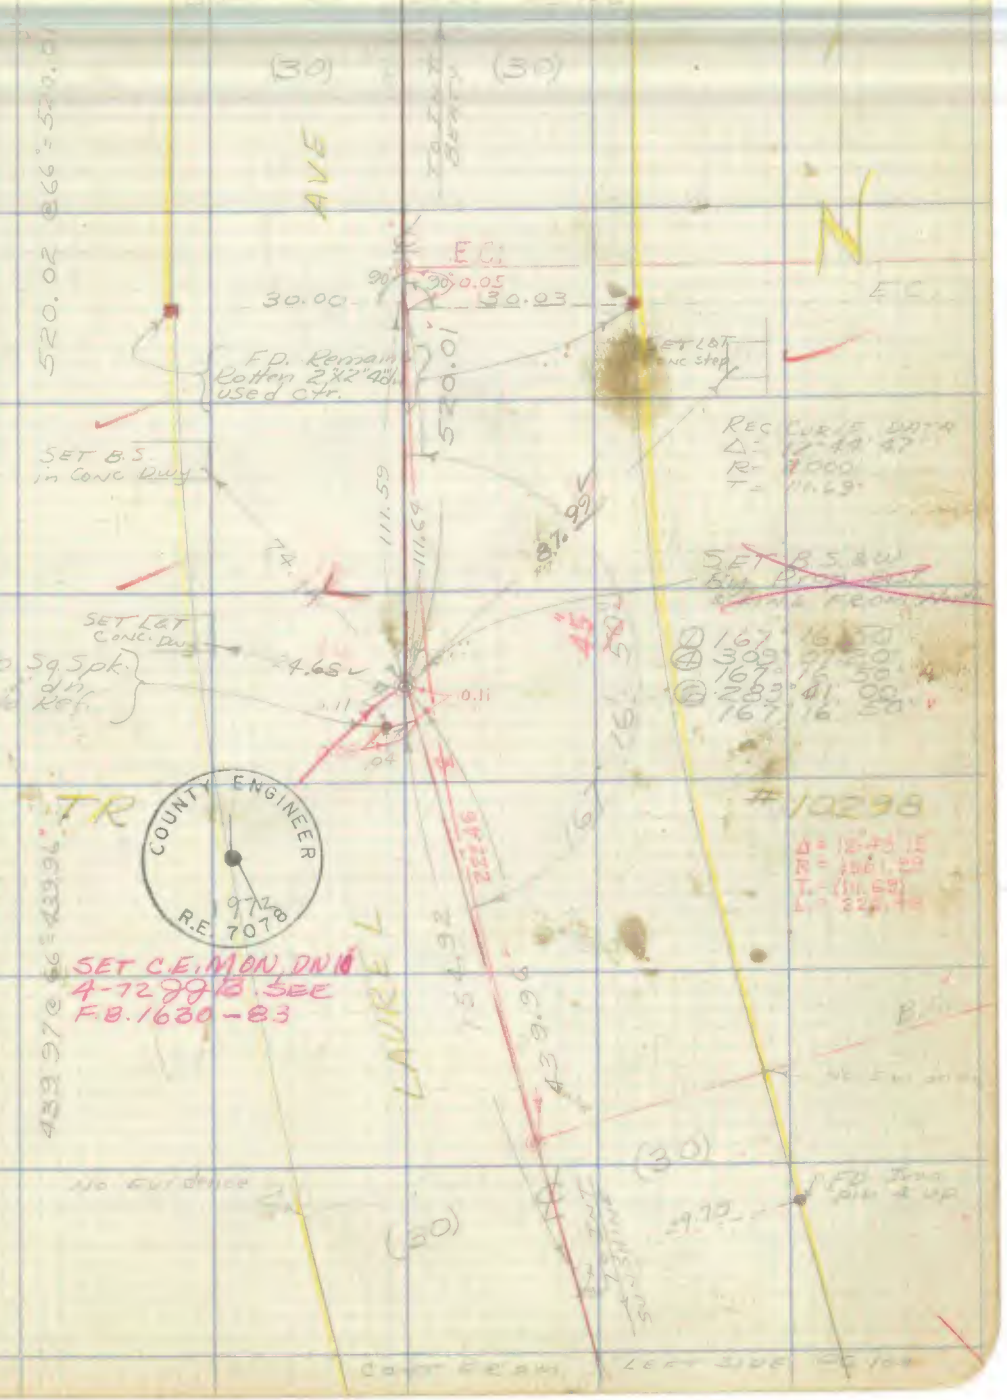


Note: Any Additions or Changes on This Sheet Must be Made or Circled in Red Ink With Date and Name of Person Making Change.

Do not extend notes this side of this line.

RETURN TO
LOS ANGELES COUNTY SURVEYOR
726 LOS ANGELES COUNTY
ENGINEERING BLDG.

76F3095 247 2-51

2132 2133

F.B. 1764 PG. 106 CONT FROM LEFT SIDE PG 102

PWFB 0827

W.S. 34-A-3

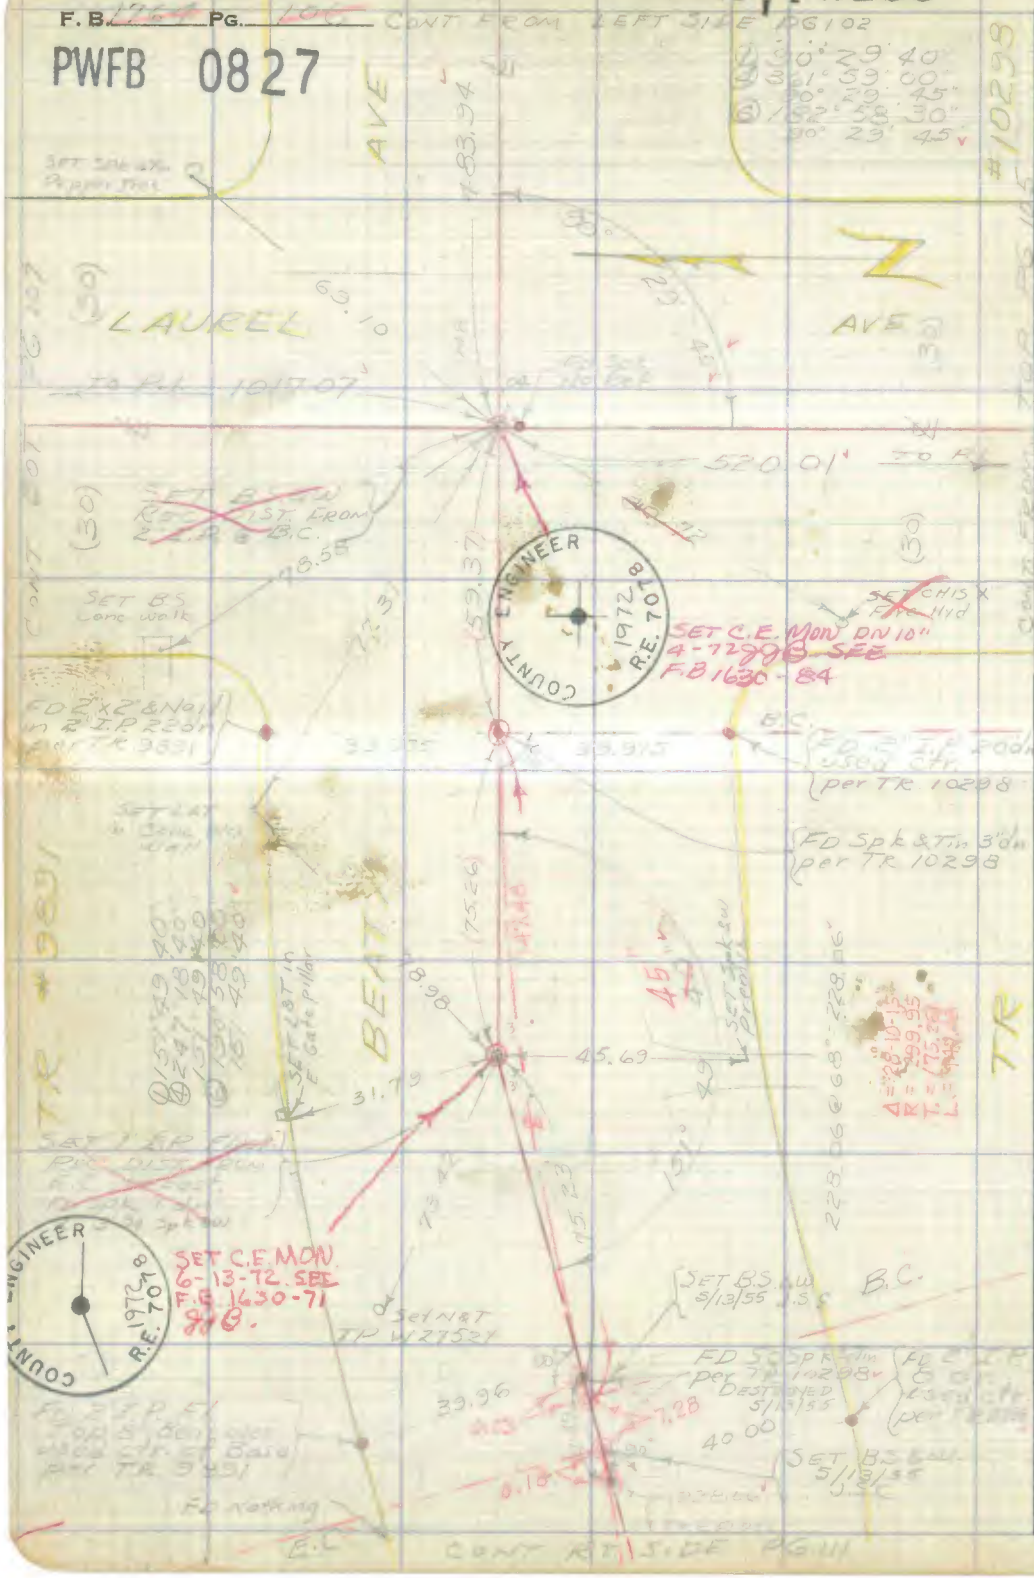


RETURN TO
LOS ANGELES COUNTY SURVEYOR
726 LOS ANGELES COUNTY
ENGINEERING BLDG.

Do not extend notes this side of this line.

Note: Any Additions or Changes on This Sheet Must be Made or Circled in Red Ink With Date and Name of Person Making Change.

PWFB 0827 2134

| | |
|---|---|
| Notes Ck'd by D. M. Finley | Survey of [illegible] |
| Map No. C.S.B. 2542 | W. O. [illegible] Tape No. [illegible] St'd. [illegible] °F |
| Office Work R. L. Green | Surveyed by [illegible] |
| Checked C. J. Gall | Notes [illegible] Date [illegible] |
| Date [illegible] | Indexed [illegible] |

F. B. [illegible] PG. [illegible]

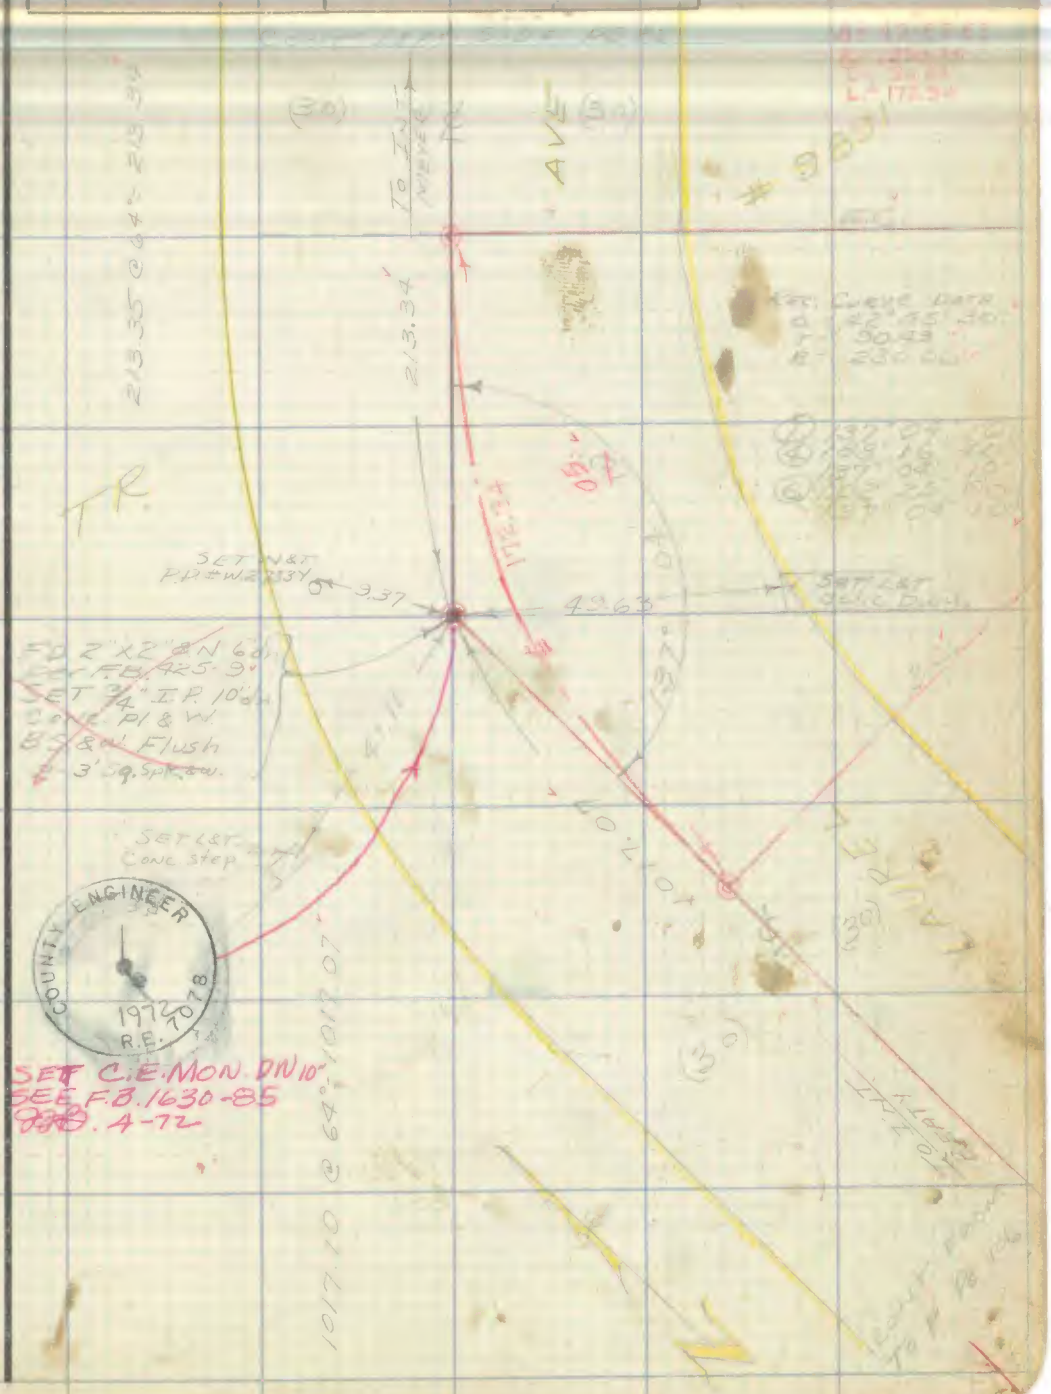


Note: Any Additions or Changes on This Sheet Must be Made or Circled in Red Ink With Date and Name of Person Making Change.

Do not extend notes this side of this line.

RETURN TO
LOS ANGELES COUNTY SURVEYOR
726 LOS ANGELES COUNTY
ENGINEERING BLDG.

76F309S 247 2-51

F. B. 176 PG.

PWFB 0827

W.S. 34 A-3

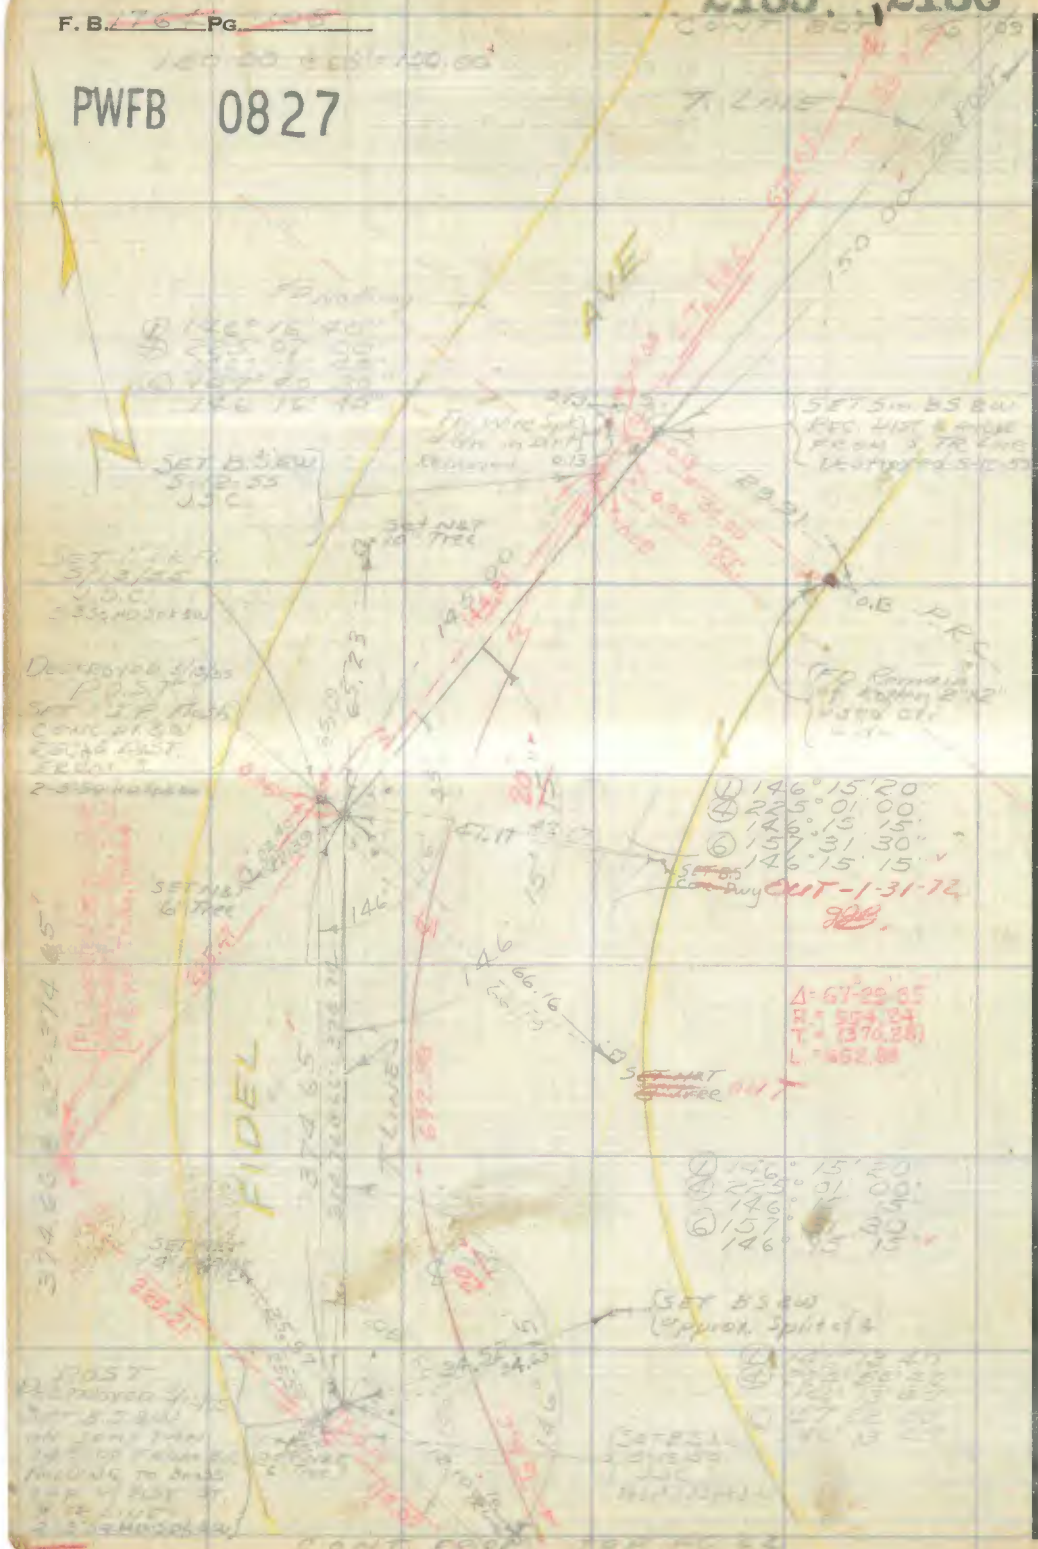


RETURN TO
LOS ANGELES COUNTY SURVEYOR
726 LOS ANGELES COUNTY
ENGINEERING BLDG.
Do not extend notes this side of this line.

Note: Any Additions or Changes on This Sheet Must be Made or Circled in Red Ink With Date and Name of Person Making Change.

PWFB 0827

2137

| | |
|---|---|
| Notes Ck'd by D. M. Fisher | Survey of |
| Map No. | W. O. Tape No. St'd. °F |
| Office Work | Surveyed by |
| Checked | Notes Date |
| Date | Indexed |

F. B. Pg.

#10298

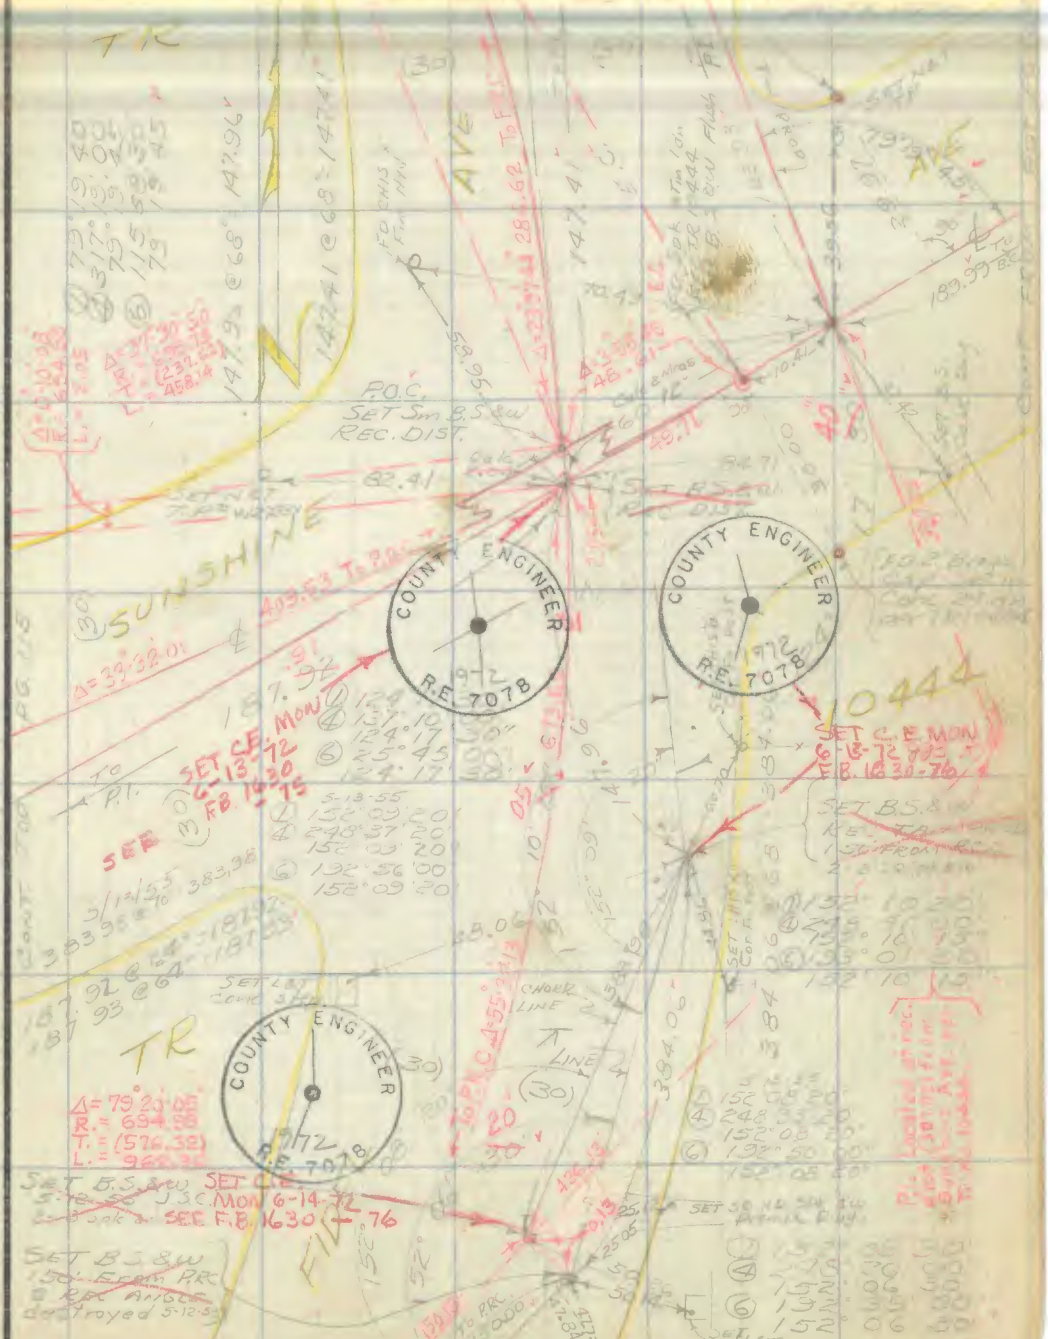


Note: Any Additions or Changes on This Sheet Must be Made or Circled in Red Ink With Date and Name of Person Making Change.

Do not extend notes this side of this line.

RETURN TO
LOS ANGELES COUNTY SURVEYOR
726 LOS ANGELES COUNTY
ENGINEERING BLDG.

76F309S 247 2-51

F. B. 1764 PG. 110

PWFB 0827

2138

W.S. 34-A-3

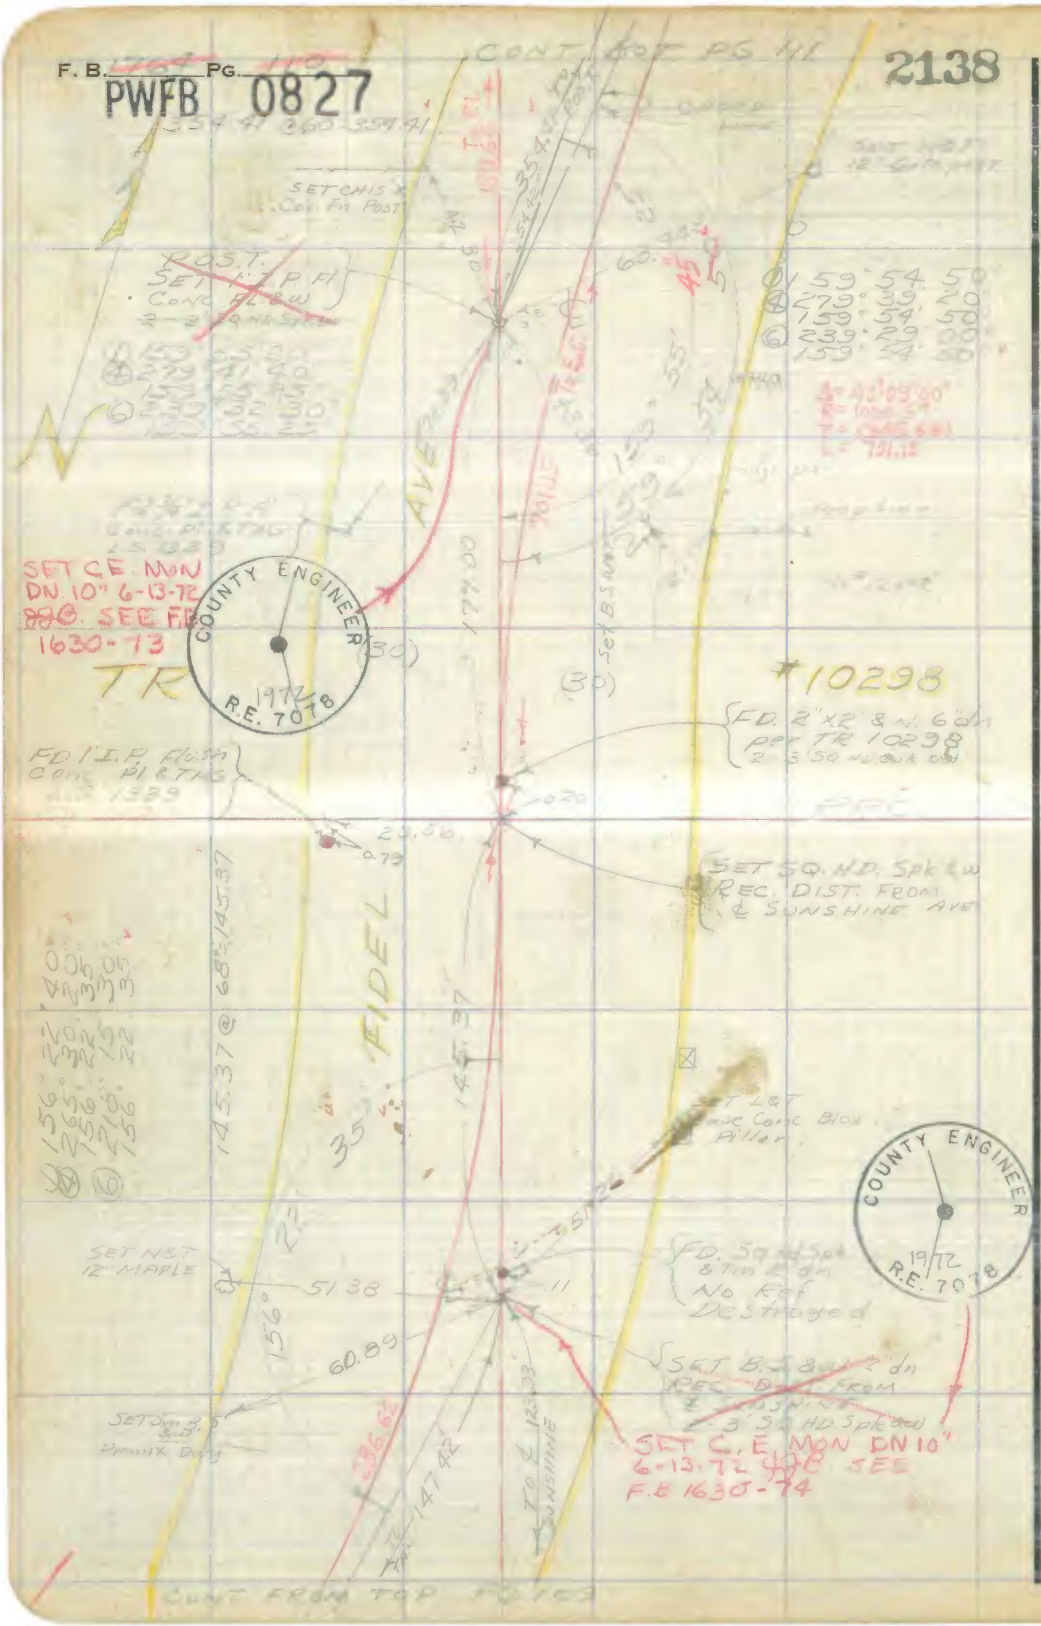


RETURN TO
LOS ANGELES COUNTY SURVEYOR
726 LOS ANGELES COUNTY
ENGINEERING BLDG.

Do not extend notes this side of this line.

Note: Any Additions or Changes on This Sheet Must be Made or Circled in Red Ink With Date and Name of Person Making Change.

PWFB 0827 2139, 2140

| | |
|---|---|
| Notes Ck'd by D. M. Finley | Survey of [illegible] |
| Map No. [illegible] | W. O. [illegible] Tape No. [illegible] St'd. [illegible] °F |
| Office Work [illegible] | Surveyed by J. S. [illegible] |
| Checked [illegible] | Notes [illegible] Date [illegible] |
| Date [illegible] | Indexed [illegible] Johnson |

F. B. [illegible] PG. [illegible]

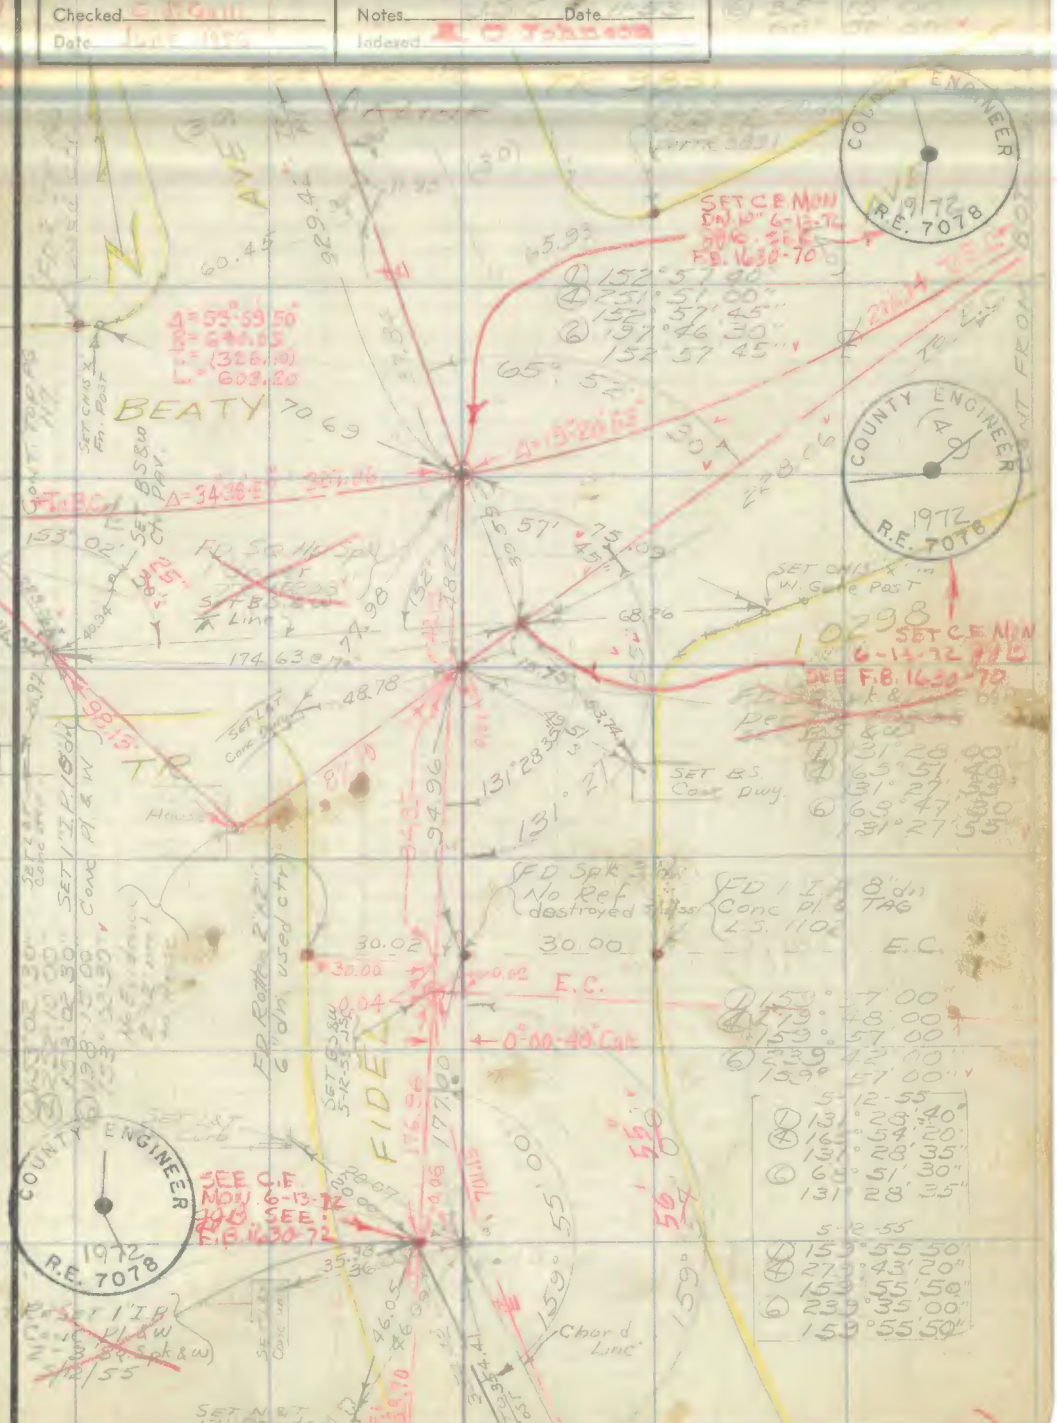


Note: Any Additions or Changes on This Sheet Must be Made or Circled in Red Ink With Date and Name of Person Making Change.

Do not extend notes this side of this line.

RETURN TO
LOS ANGELES COUNTY SURVEYOR
726 LOS ANGELES COUNTY
ENGINEERING BLDG.

76F309S 247 2-51

PWFB 0827 2141, 2142

F. B. ~~[illegible]~~ PG. ~~[illegible]~~

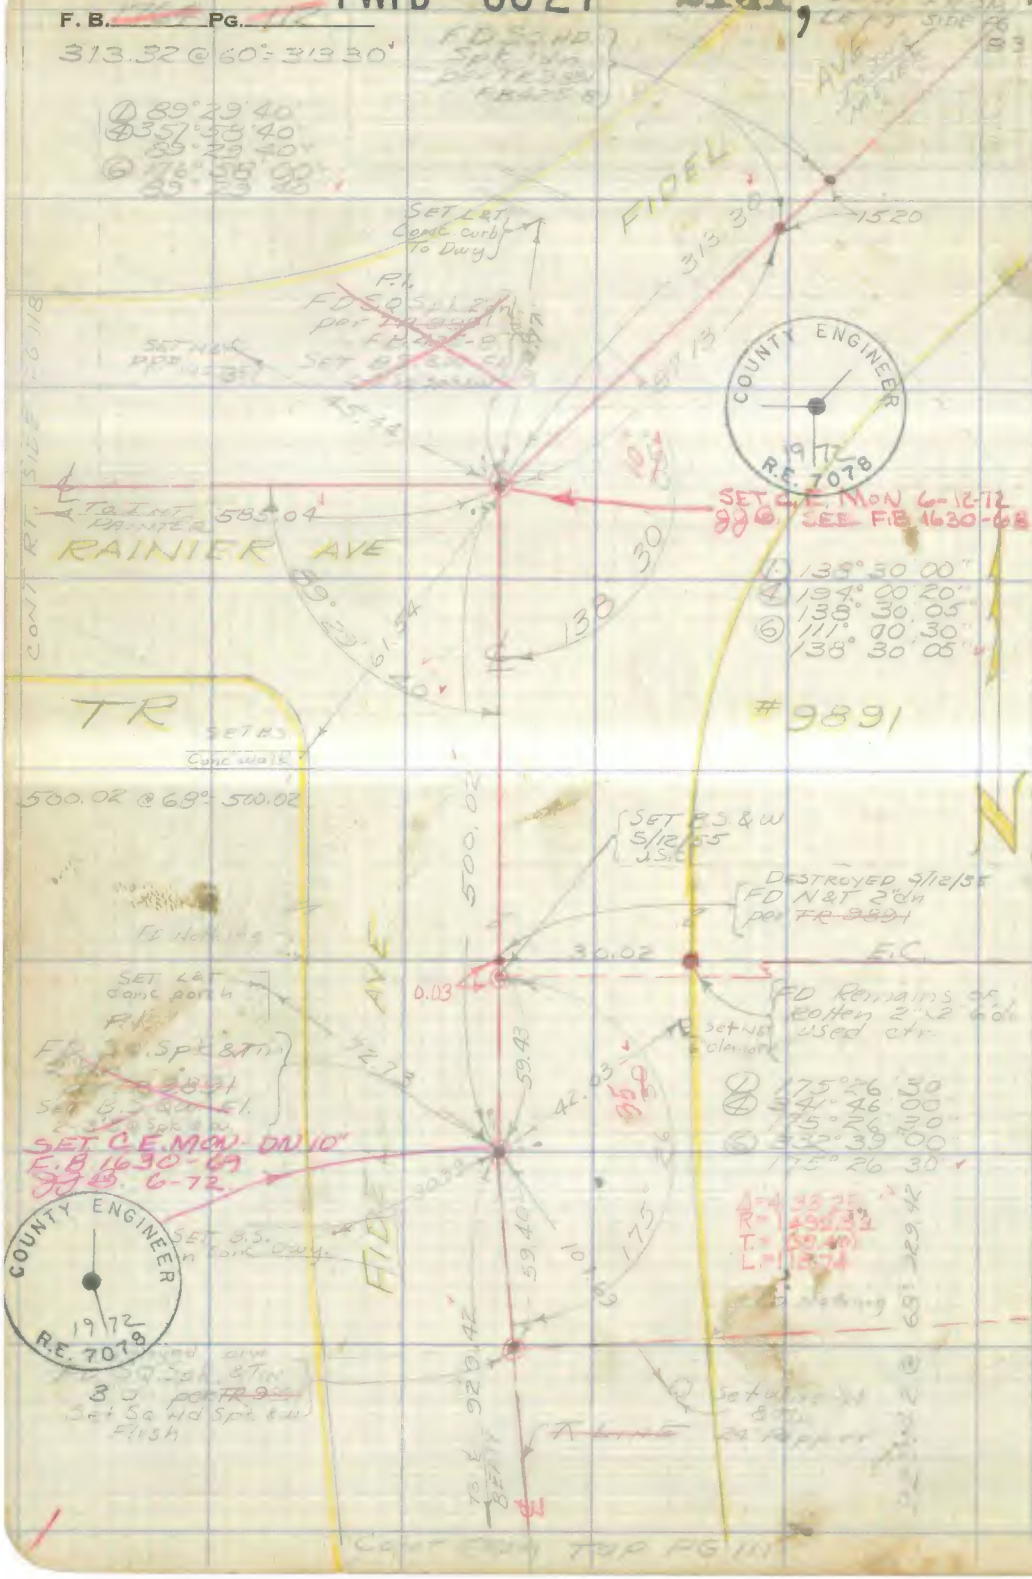


W.S. 34-A-3

RETURN TO
LOS ANGELES COUNTY SURVEYOR
726 LOS ANGELES COUNTY
ENGINEERING BLDG.

Do not extend notes this side of this line.

Note: Any Additions or Changes on This Sheet Must be Made or Circled in Red Ink With Date and Name of Person Making Change.

PWFB 0827 2143, 2144

| | |
|---|---|
| Notes Ck'd by D. M. Finley | Survey of [illegible] |
| Map No. C.S.B. 3562 | W. O. [illegible] Tape No. [illegible] St'd. [illegible] °F |
| Office Work R. L. Green | Surveyed by [illegible] |
| Checked C. J. Gill | Notes [illegible] Date [illegible] |
| Date [illegible] | Indexed [illegible] |

F. B. [illegible] Pg. [illegible]

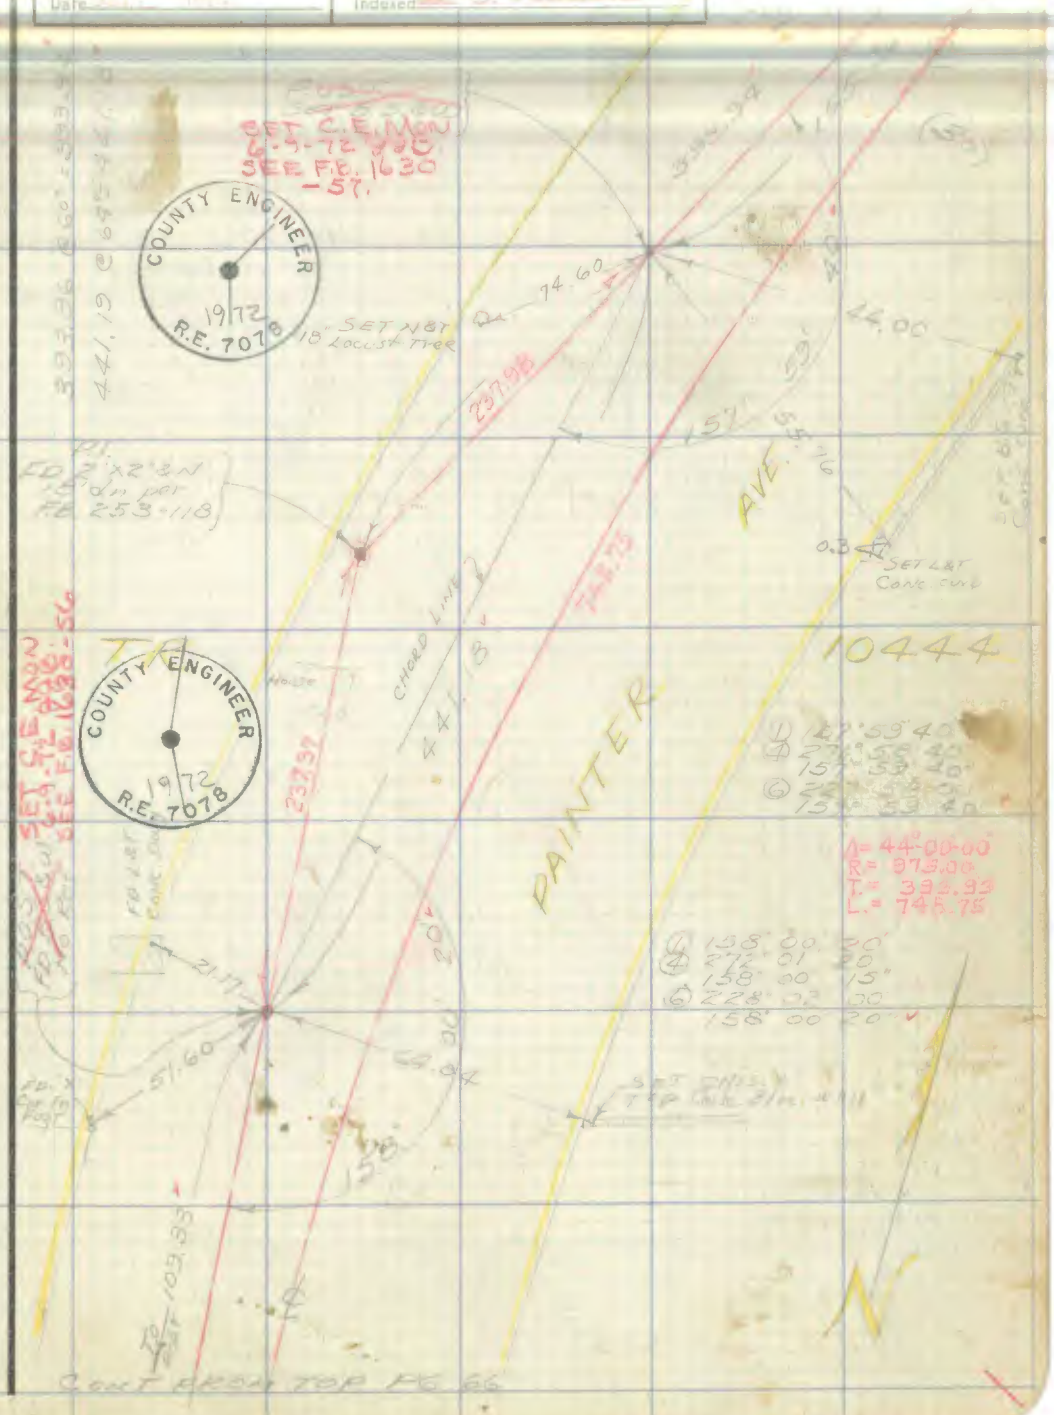


Note: Any Additions or Changes on This Sheet Must be Made or Circled in Red Ink With Date and Name of Person Making Change.

Do not extend notes this side of this line.

RETURN TO
LOS ANGELES COUNTY SURVEYOR
726 LOS ANGELES COUNTY
ENGINEERING BLDG.

76F3095 247 2-51

PWFB 0827 2145, 2146

F. B. _____ Pg. _____

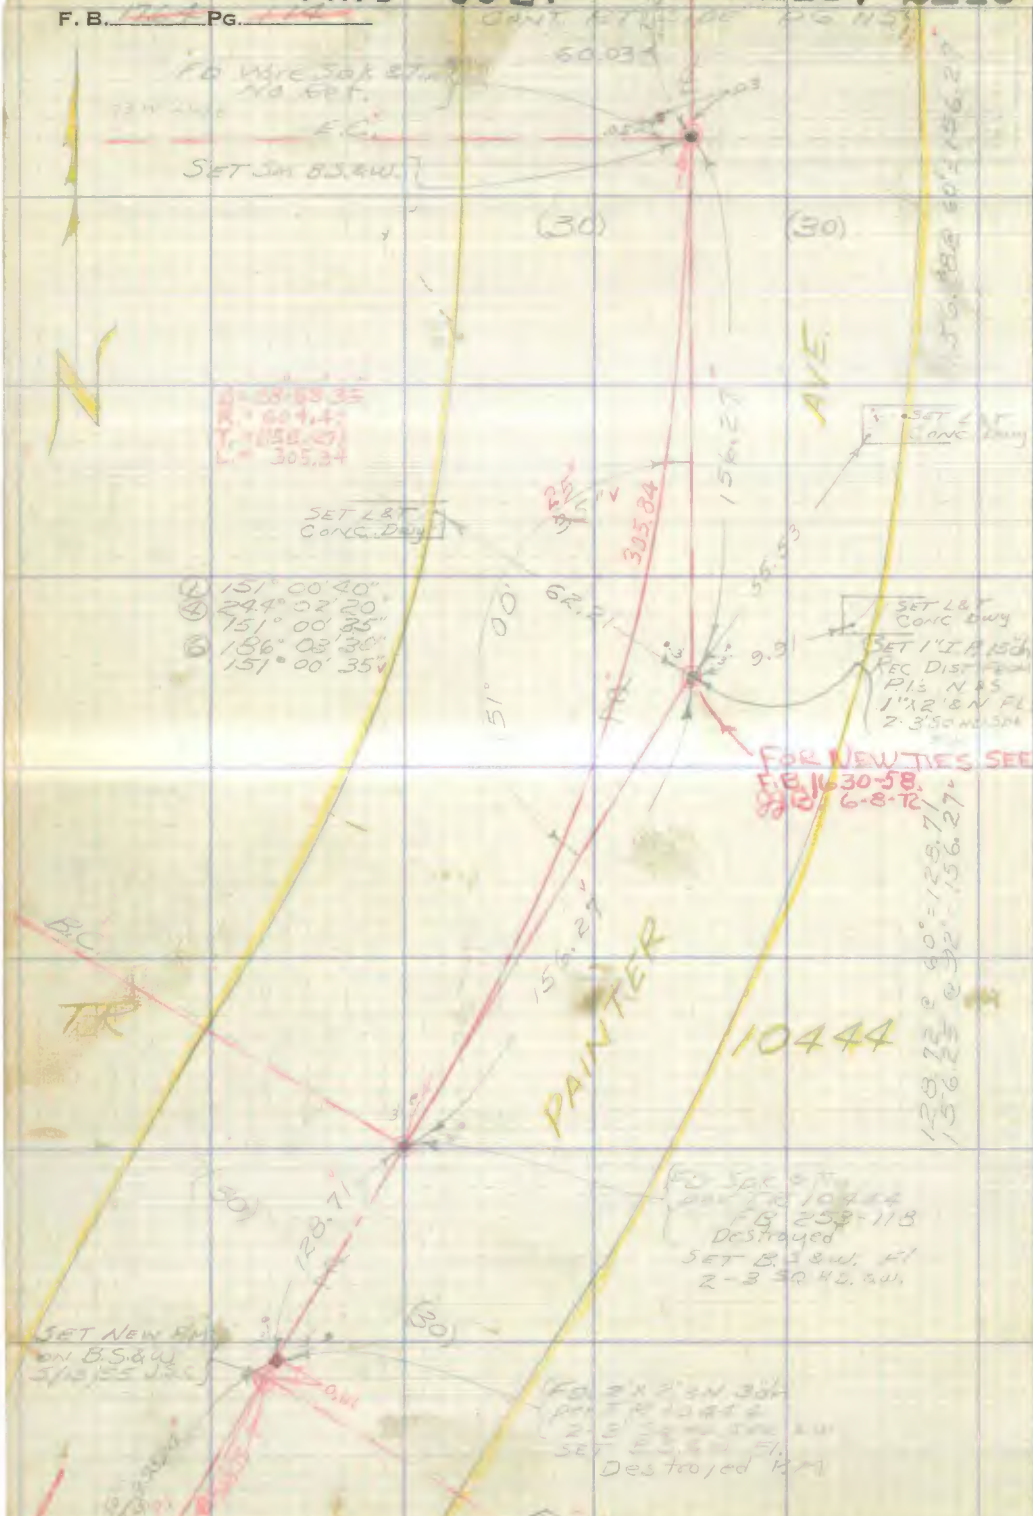


RETURN TO
LOS ANGELES COUNTY SURVEYOR
726 LOS ANGELES COUNTY
ENGINEERING BLDG.

Do not extend notes this side of this line.

Note: Any Additions or Changes on This Sheet Must be Made or Circled in Red Ink With Date and Name of Person Making Change.

PWFB 0827 2147, 2148

F. B. ____ PG. ____

| | |
|---|---|
| Notes Ck'd by D. M. Finley | Survey of [illegible] |
| Map No. C.S.B.-2563 | W. O. ____ Tape No. ____ St'd. ____ °F |
| Office Work R.L. Green | Surveyed by [illegible] |
| Checked C. J. Gain | Notes J.S.C. Date [illegible] |
| Date [illegible] | Indexed [illegible] |

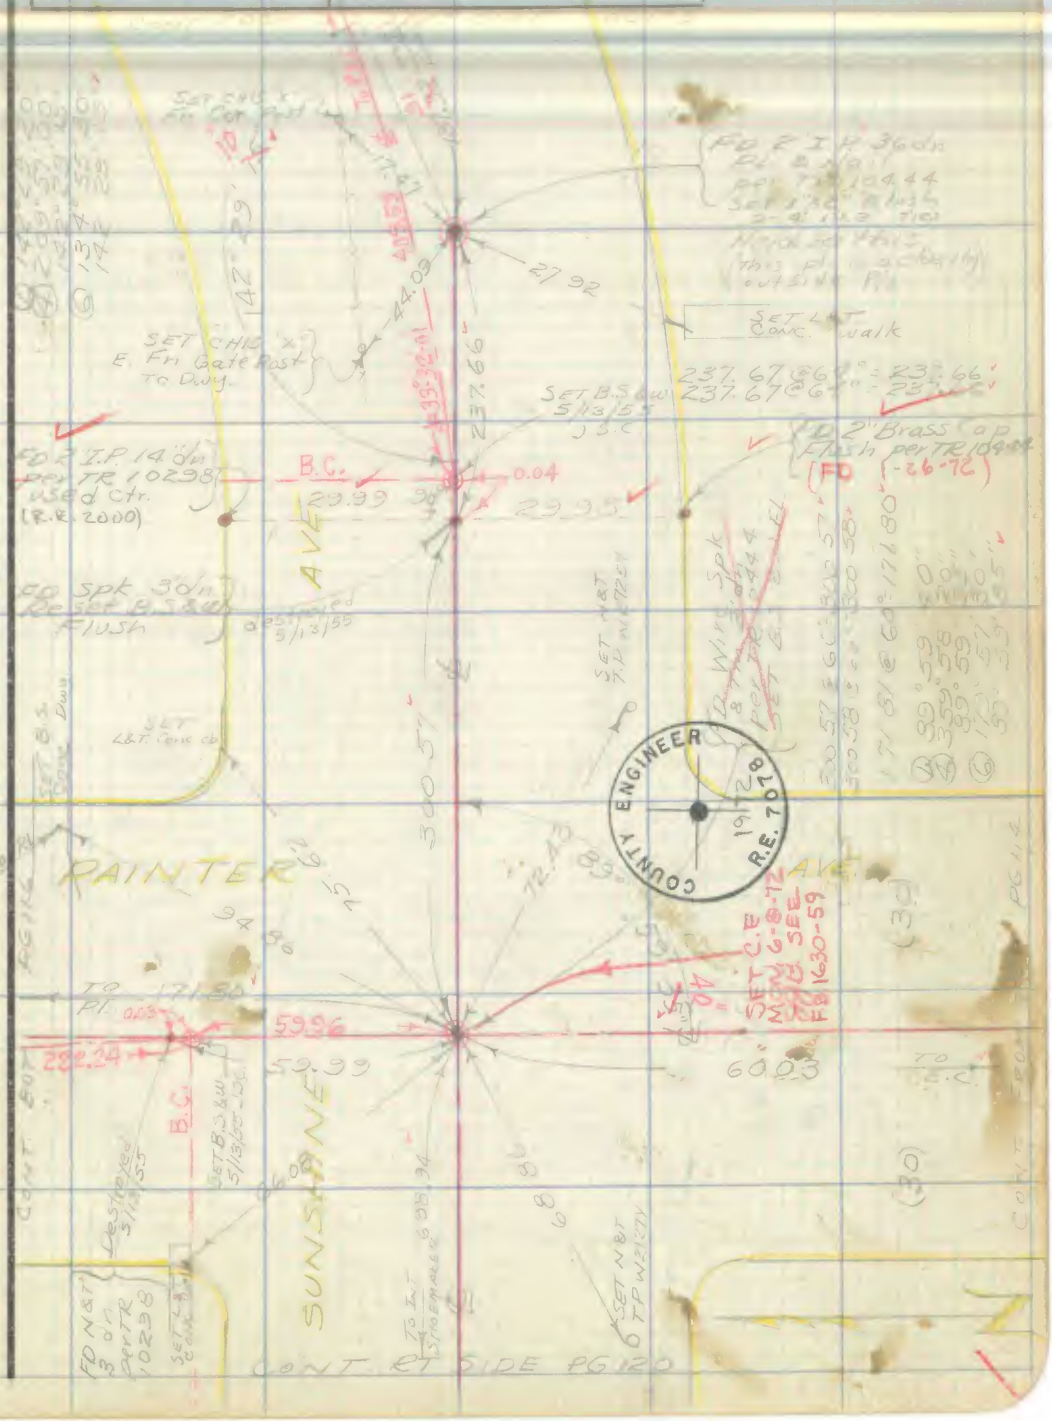


Note: Any Additions or Changes on This Sheet Must be Made or Circled in Red Ink With Date and Name of Person Making Change.

Do not extend notes this side of this line.

RETURN TO
LOS ANGELES COUNTY SURVEYOR
726 LOS ANGELES COUNTY
ENGINEERING BLDG.

76F309S 247 2-51

PWFB 0827 2149, 2150, 2151, 2152

F. B. PG.

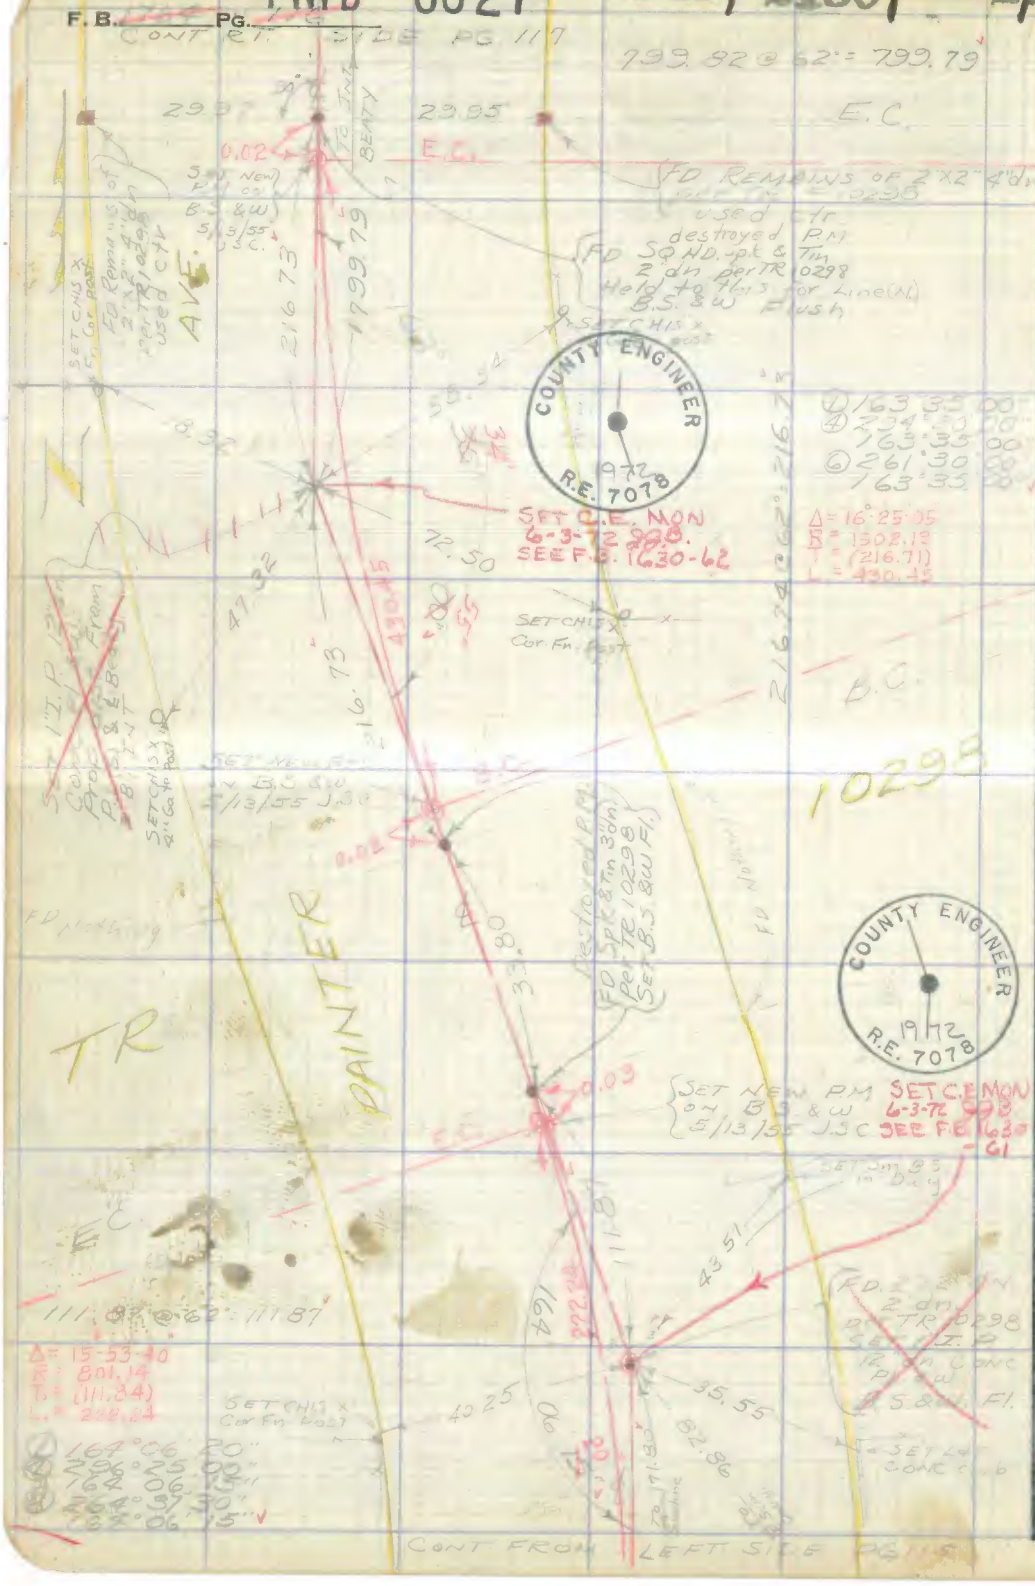


W.S. 34-A-3

RETURN TO
LOS ANGELES COUNTY SURVEYOR
726 LOS ANGELES COUNTY
ENGINEERING BLDG.

Do not extend notes this side of this line.

Note: Any Additions or Changes on This Sheet Must be Made or Circled in Red Ink With Date and Name of Person Making Change.

PWFB 0827 2153, 2154, 2155

| | |
|---|---|
| Notes Ck'd by D. M. Finley | Survey of |
| Map No. | W. O. Tape No. St'd °F |
| Office Work R. L. Green | Surveyed by |
| Checked | Notes Date |
| Date | Indexed |

F. B. Pg.

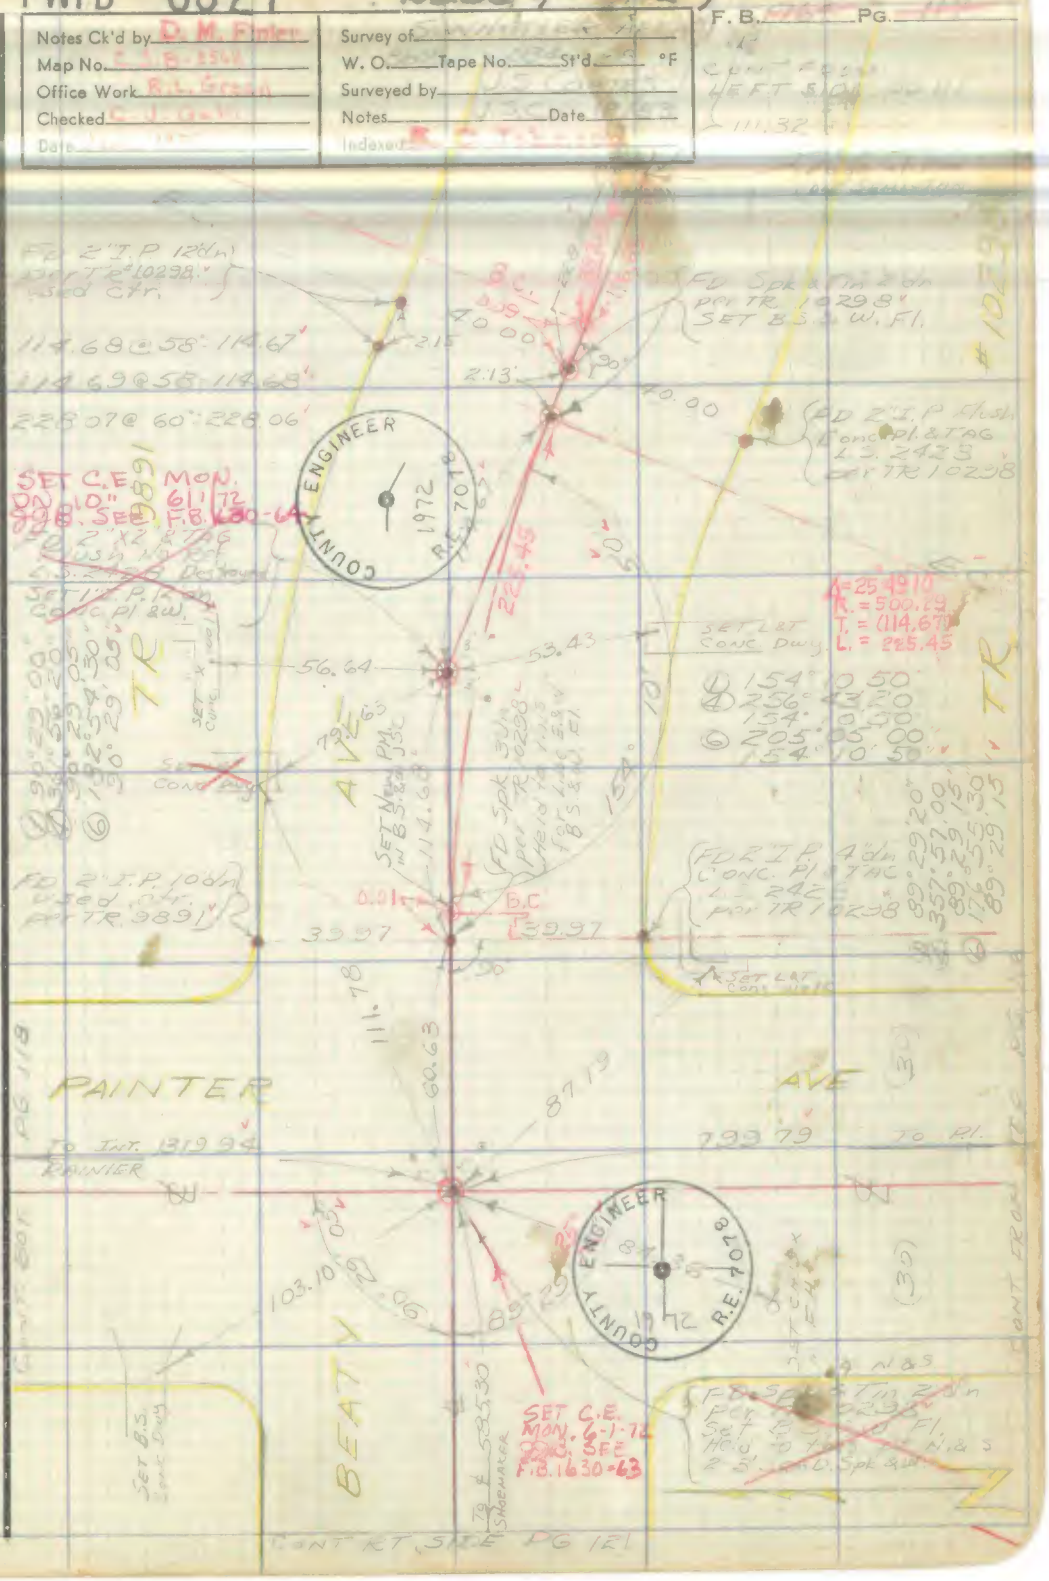


Note: Any Additions or Changes on This Sheet Must be Made or Circled in Red Ink With Date and Name of Person Making Change.

Do not extend notes this side of this line.

RETURN TO
LOS ANGELES COUNTY SURVEYOR
726 LOS ANGELES COUNTY
ENGINEERING BLDG.

76F309S 247 2-51

2156

F. B. 1762 PG. 118 CONT. BOTH PG 119

PWFB 0827

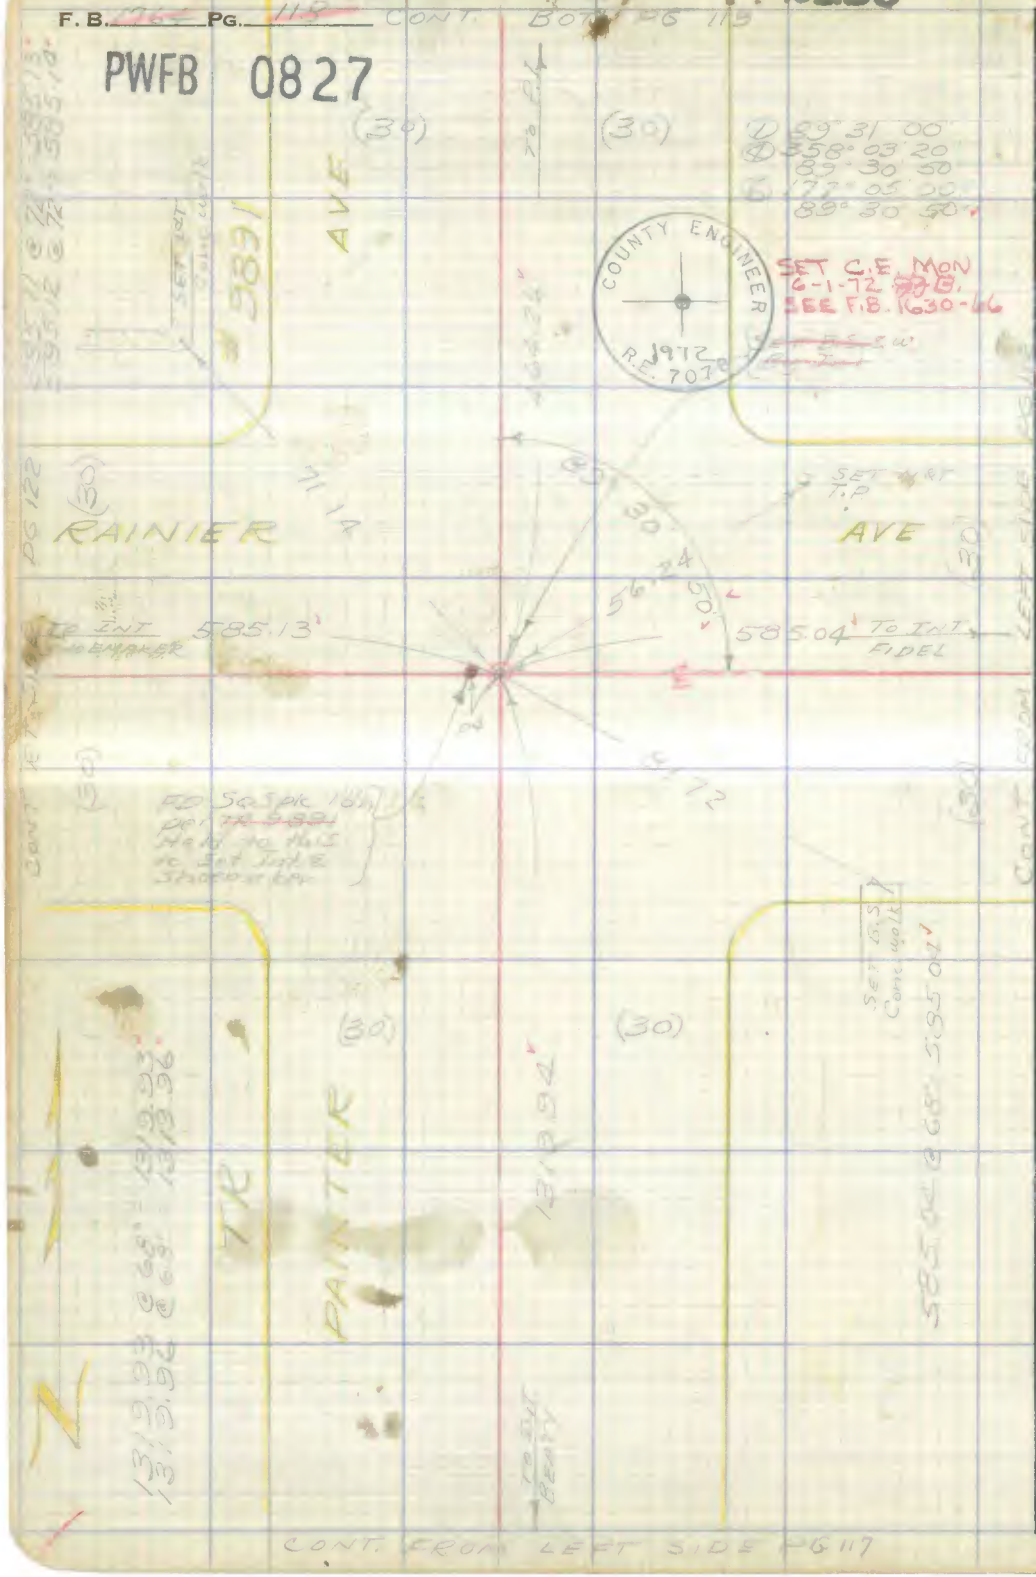


W.S. 34-A-3

RETURN TO
LOS ANGELES COUNTY SURVEYOR
726 LOS ANGELES COUNTY
ENGINEERING BLDG.

Do not extend notes this side of this line.

Note: Any Additions or Changes on This Sheet Must be Made or Circled in Red Ink With Date and Name of Person Making Change.

PWFB 0827 2157, 2158

F.B. [illegible] PG. [illegible]

| | |
|---|---|
| Notes Ck'd by D. M. Finler | Survey of [illegible] |
| Map No. [illegible] | W. O. [illegible] Tape No. [illegible] St'd. [illegible] °F |
| Office Work R. L. Green | Surveyed by [illegible] |
| Checked [illegible] | Notes [illegible] Date [illegible] |
| Date [illegible] | Indexed [illegible] |

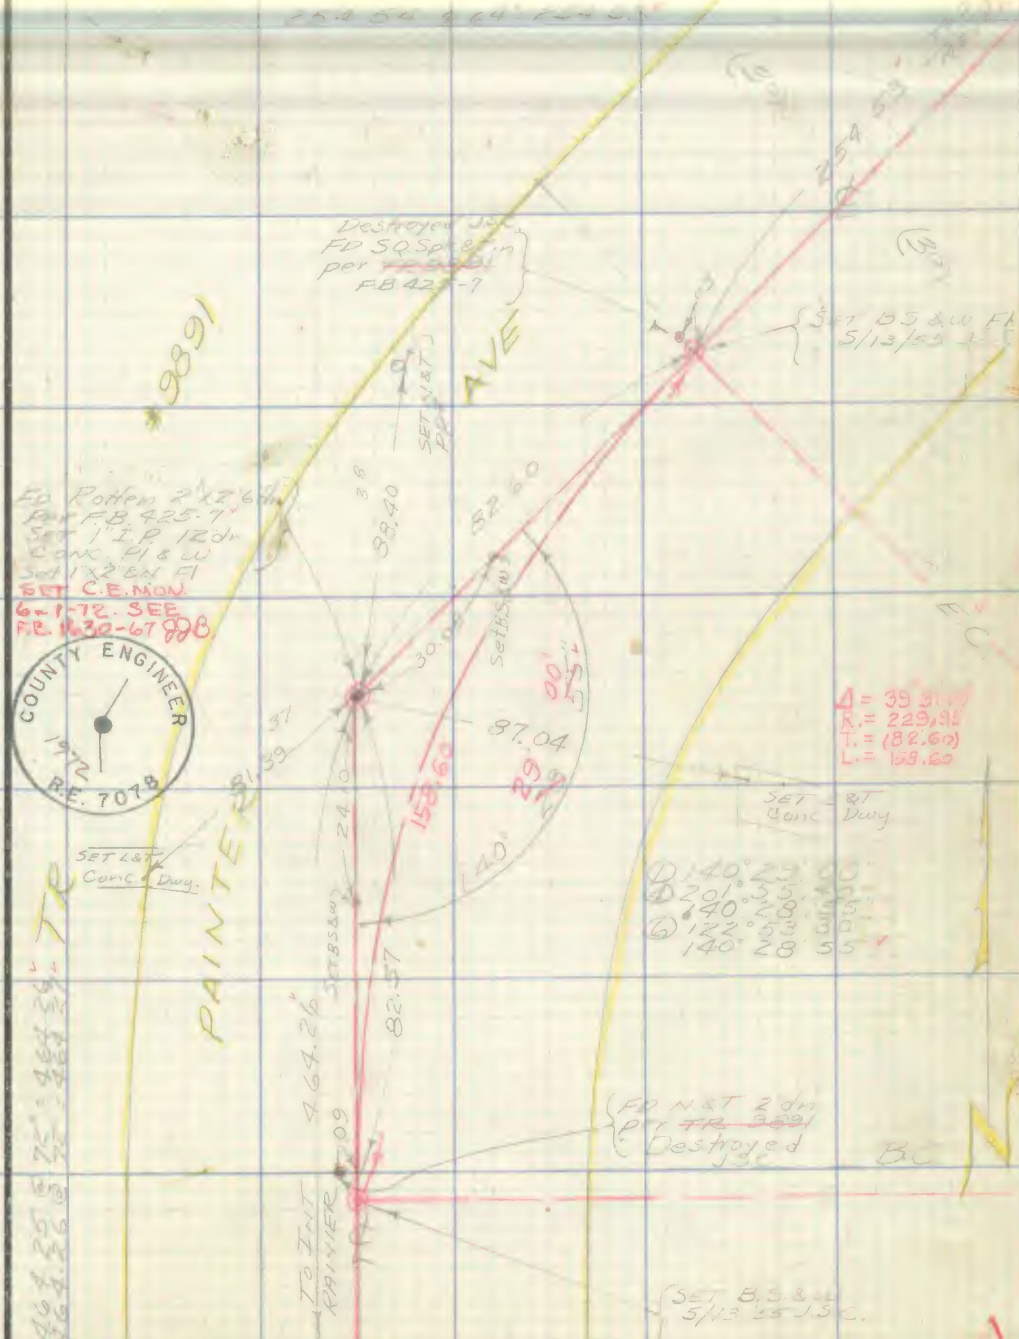


Note: Any Additions or Changes on This Sheet Must be Made or Circled in Red Ink With Date and Name of Person Making Change.

Do not extend notes this side of this line.

RETURN TO
LOS ANGELES COUNTY SURVEYOR
726 LOS ANGELES COUNTY
ENGINEERING BLDG.

76F309S 247 2-51

PWFB 0827 2159

F. B. 1764 PG. 120 CONT BOT PG 121

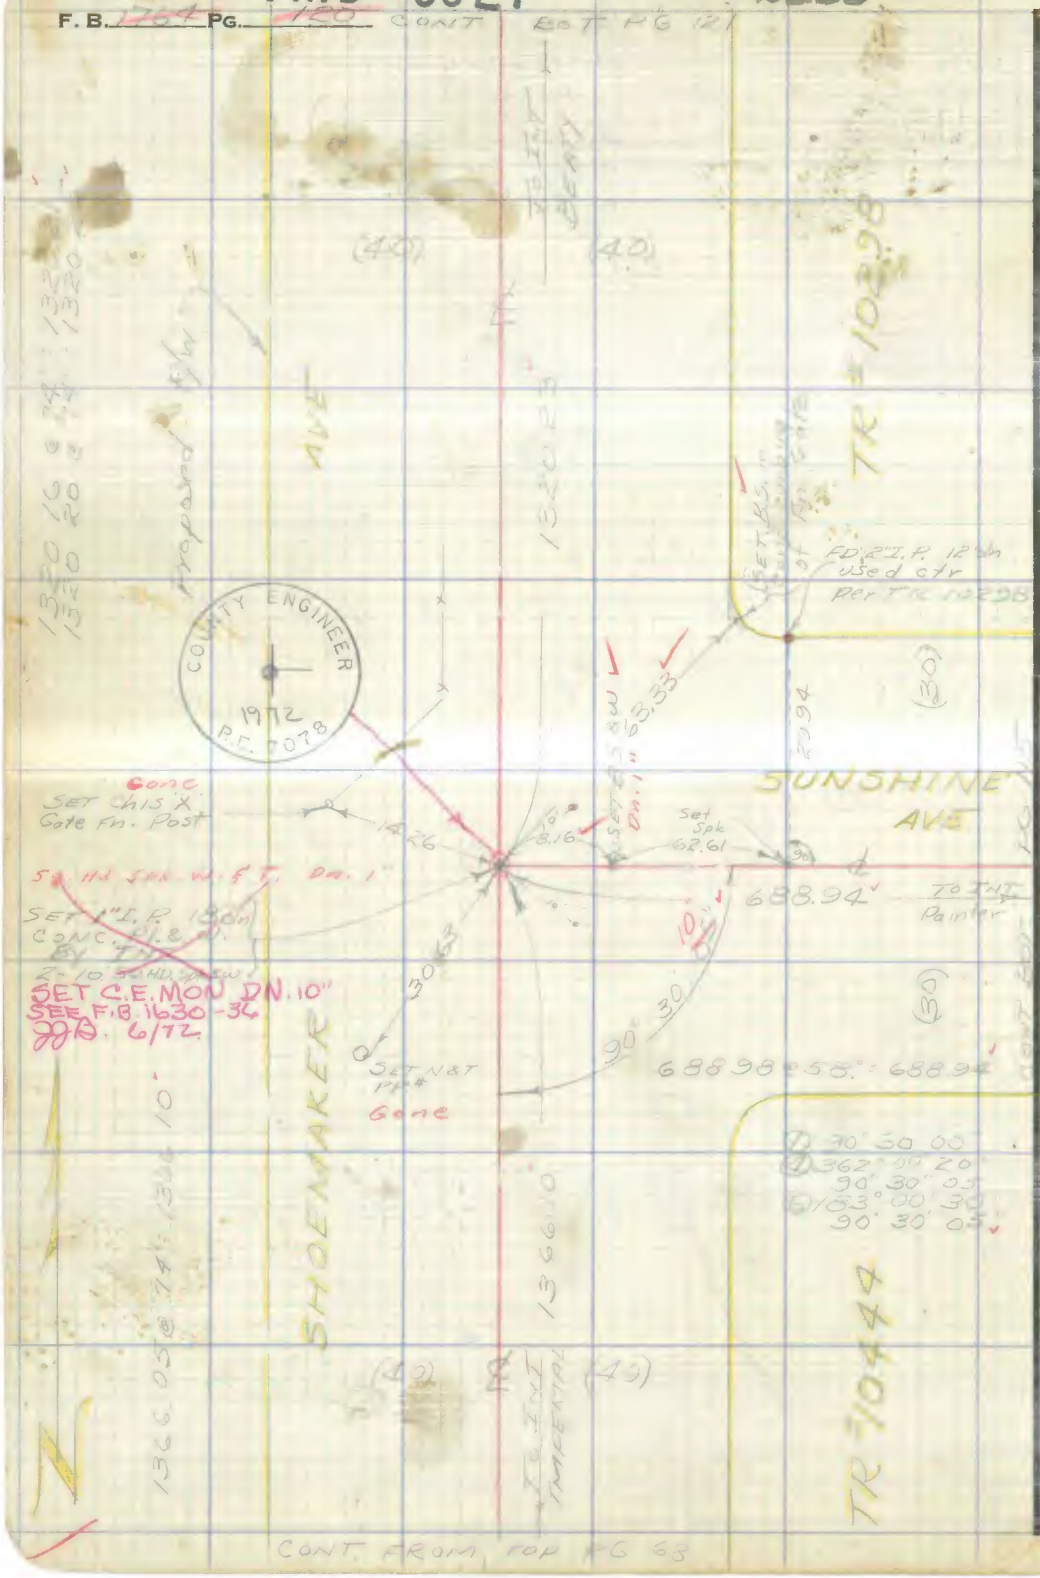


RETURN TO
LOS ANGELES COUNTY SURVEYOR
726 LOS ANGELES COUNTY
ENGINEERING BLDG.

Do not extend notes this side of this line.

Note: Any Additions or Changes on This Sheet Must be Made or Circled in Red Ink With Date and Name of Person Making Change.

CONT. FROM TOP PG 68

PWFB 0827

2160

F. B. ____ PG. ____

| | |
|---|---|
| Notes Ck'd by D. M. Finley | Survey of |
| Map No. | W. O. Tape No. St'd. °F |
| Office Work R. L. Green | Surveyed by |
| Checked | Notes Date |
| Date | Indexed |

MS 34-A-3

Note: Any Additions or Changes on This Sheet Must be Made or Circled in Red Ink With Date and Name of Person Making Change.

Do not extend notes this side of this line.

RETURN TO
LOS ANGELES COUNTY SURVEYOR
726 LOS ANGELES COUNTY
ENGINEERING BLDG.

76F309S 247 2-51

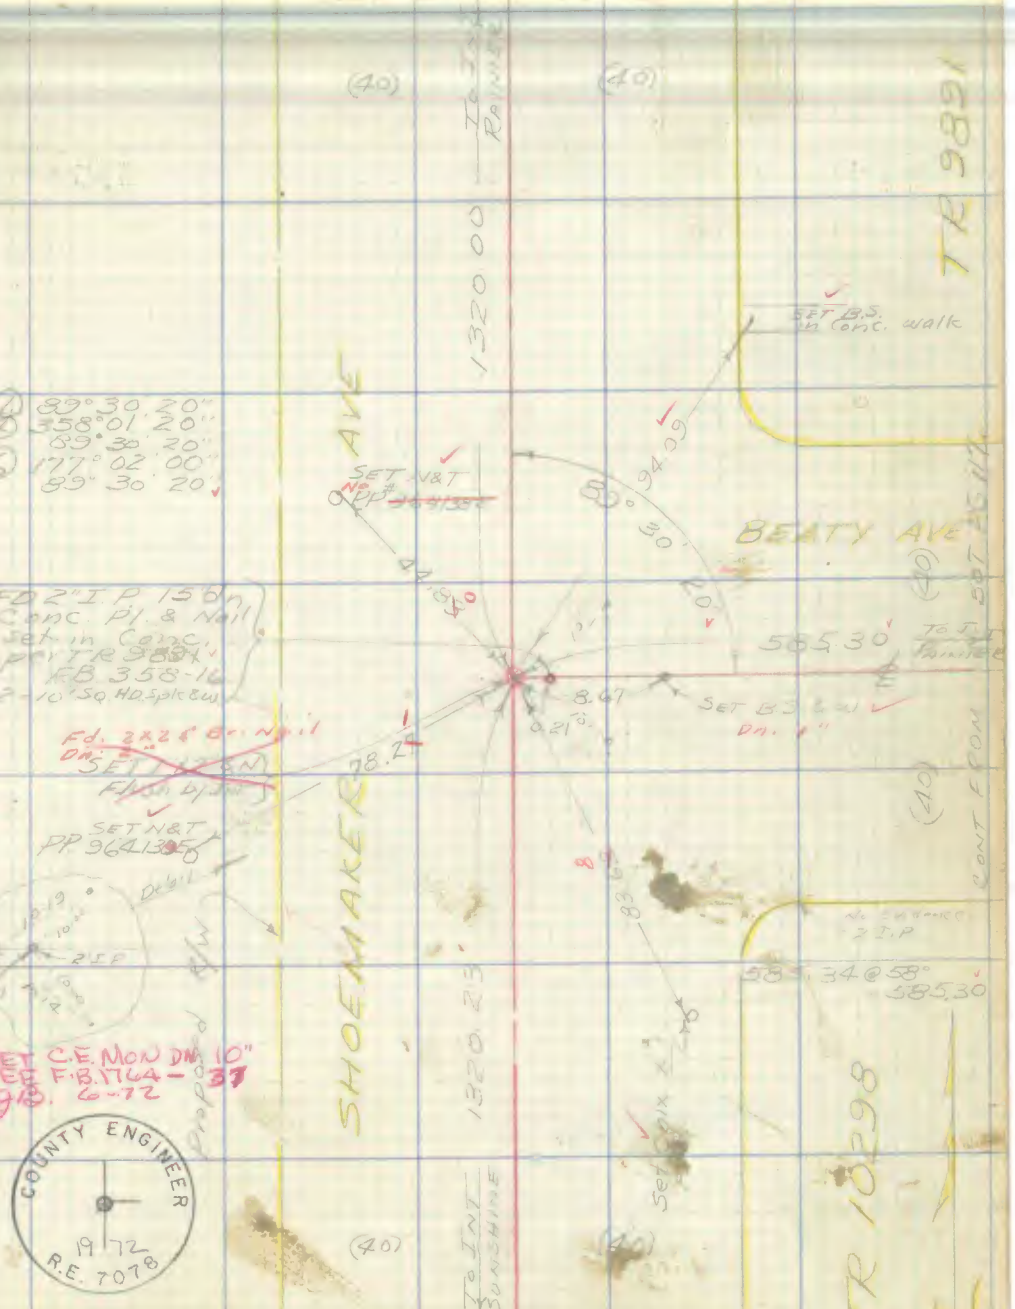

F. B. 1764 PG. 122

PWFB 0827

2161

W.S. 34-A-3

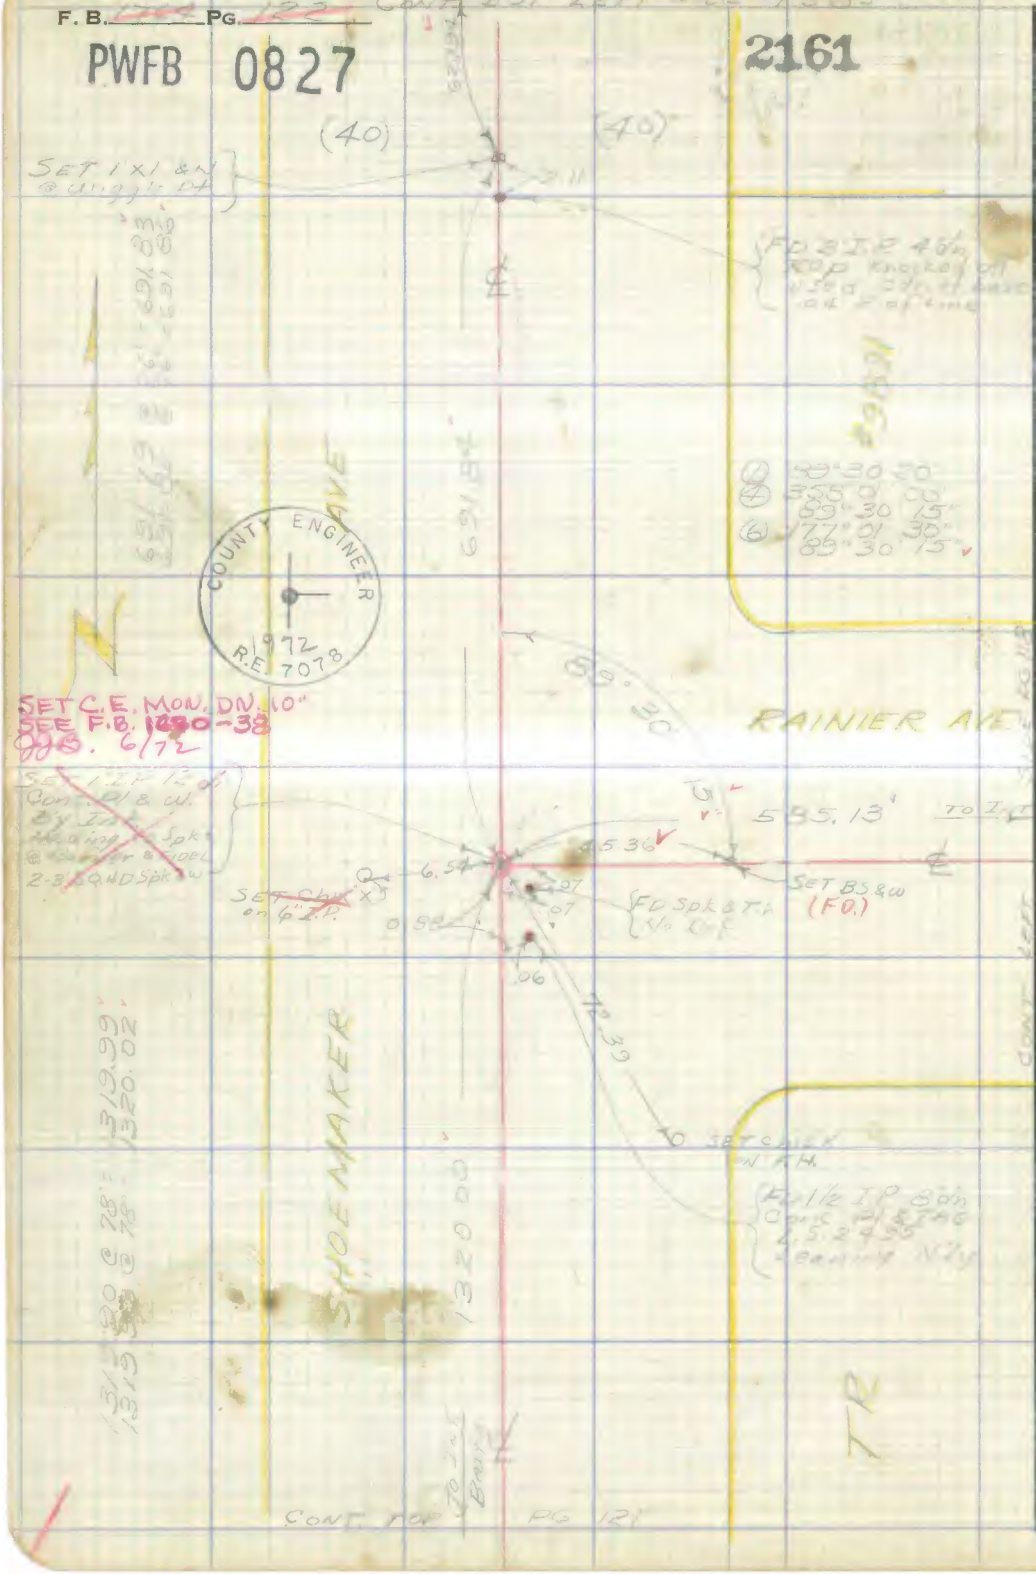


RETURN TO
LOS ANGELES COUNTY SURVEYOR
726 LOS ANGELES COUNTY
ENGINEERING BLDG.

Do not extend notes this side of this line.

Note: Any Additions or Changes on This Sheet Must be Made or Circled in Red Ink With Date and Name of Person Making Change.

PWFB 0827

2162

F. B. [illegible] PG. [illegible]

| | |
|---|---|
| Notes Ck'd by D. M. Finley | Survey of S. Whittier Area 51 |
| Map No. [illegible] | W. O. [illegible] Tape No. [illegible] St'd. [illegible] °F |
| Office Work K. L. Green | Surveyed by [illegible] |
| Checked C. J. Gaili | Notes [illegible] Date [illegible] |
| Date [illegible] | Indexed [illegible] |

W.O. 34-A-2

Note: Any Additions or Changes on This Sheet Must be Made or Circled in Red Ink With Date and Name of Person Making Change.

Do not extend notes this side of this line.

RETURN TO
LOS ANGELES COUNTY SURVEYOR
726 LOS ANGELES COUNTY
ENGINEERING BLDG.

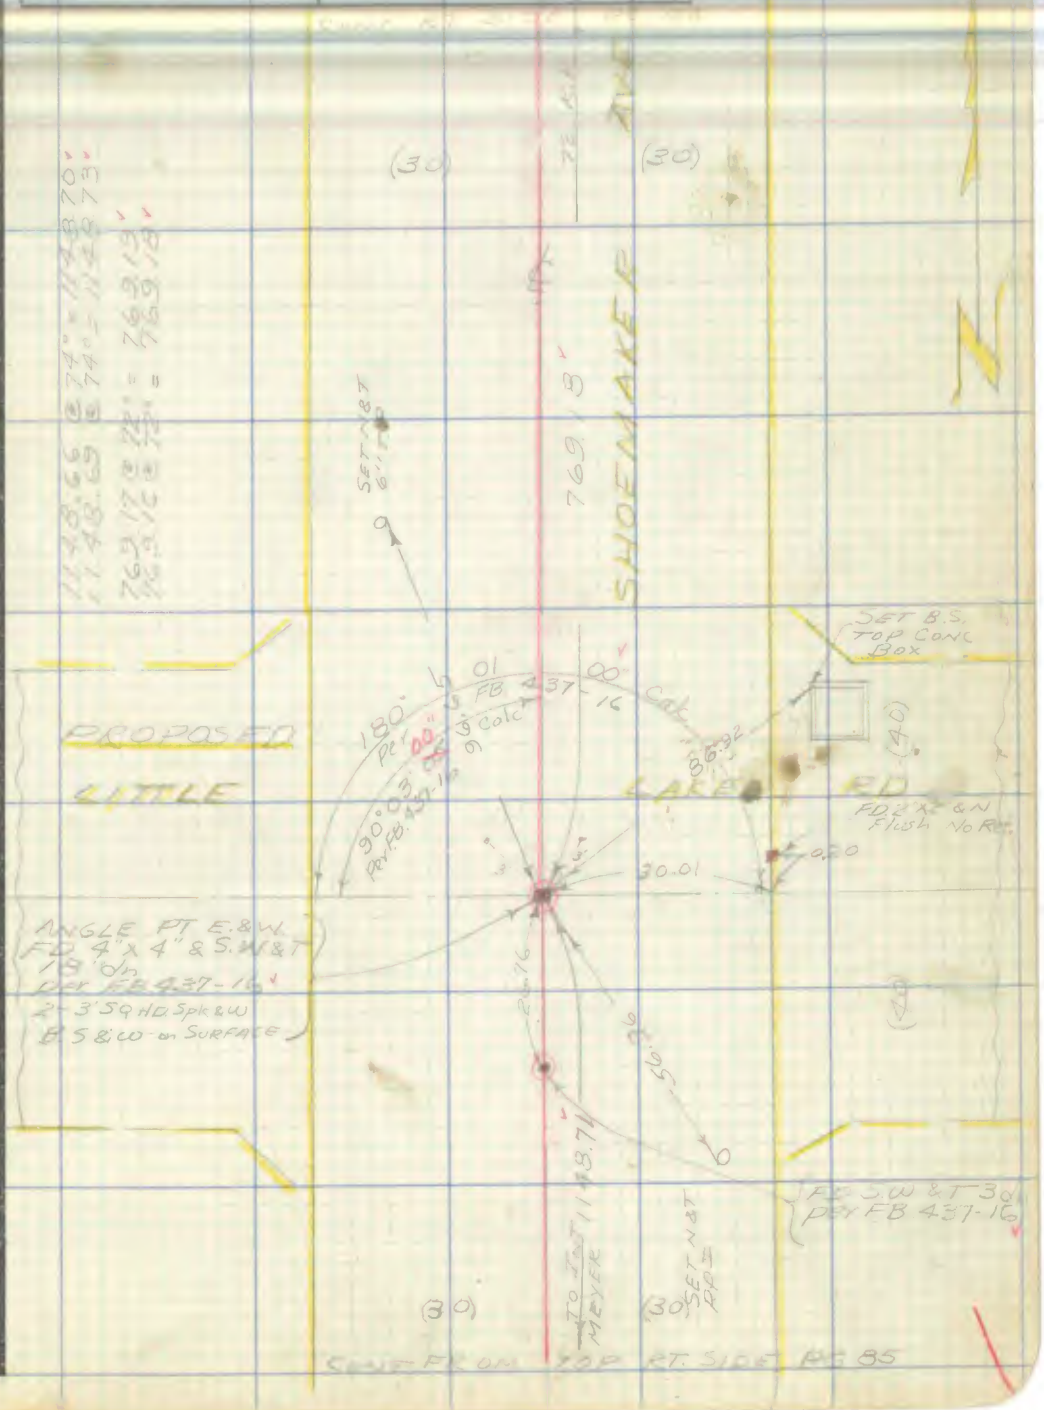


76F309S 247 2-51

F. B. 1165 Pg. 124 CONT LEFT SIDE PG 127

PWFB 0827 2163

W.S. 34-A-2

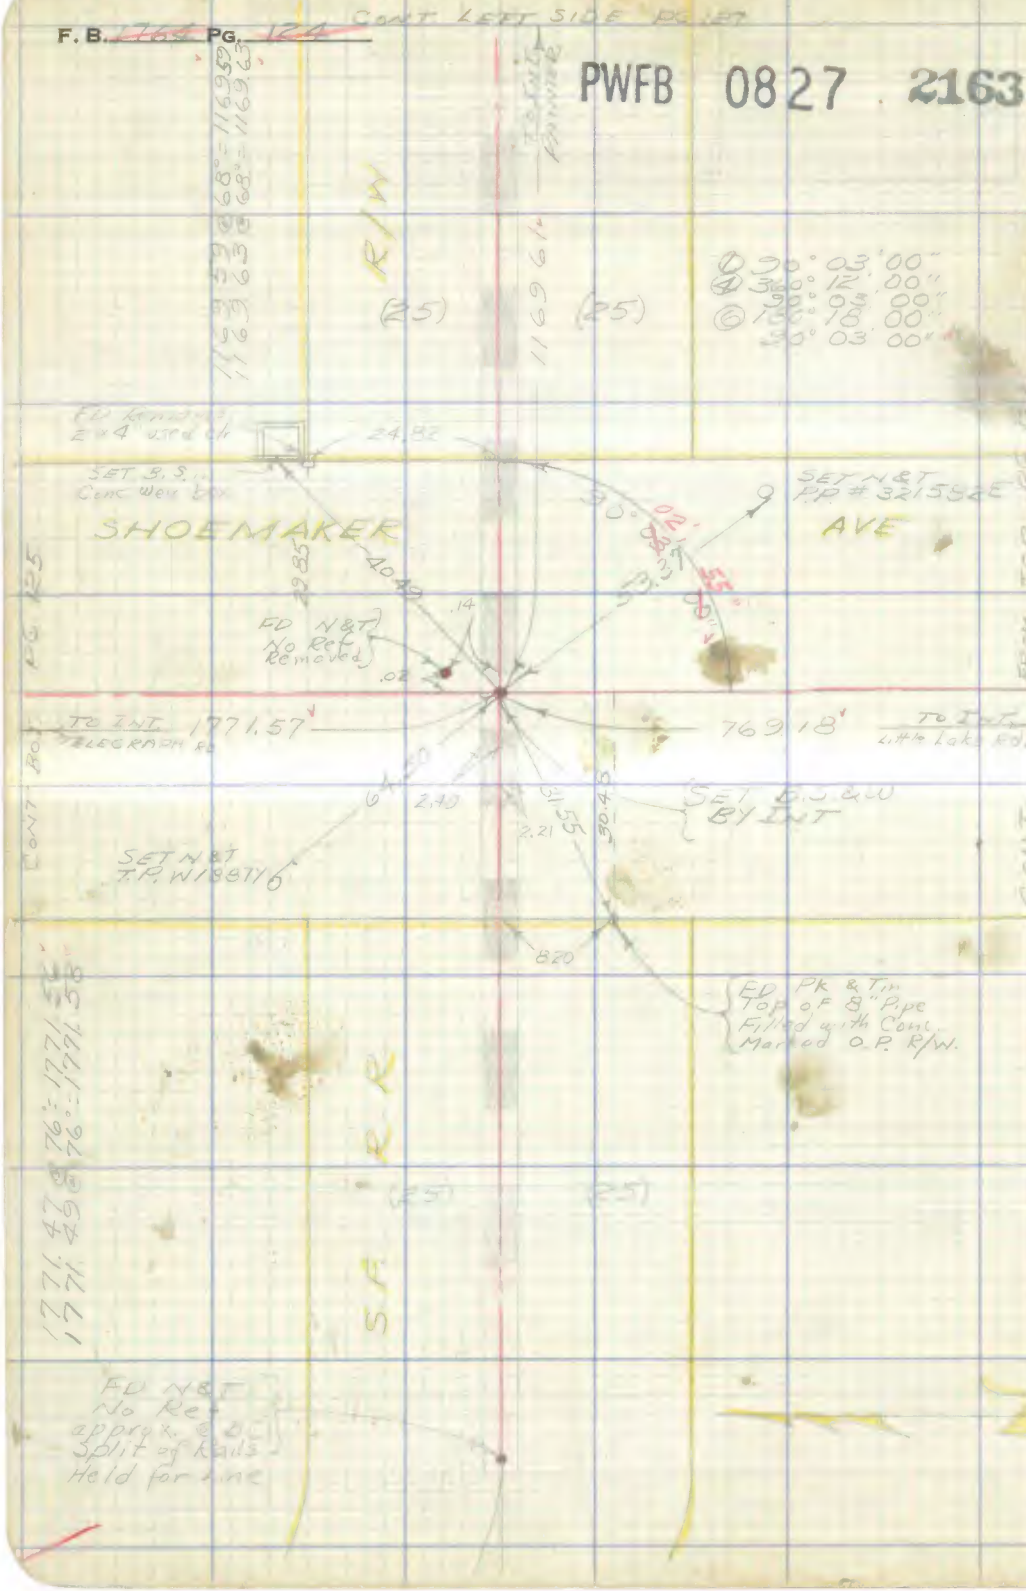


RETURN TO
LOS ANGELES COUNTY SURVEYOR
726 LOS ANGELES COUNTY
ENGINEERING BLDG.

Do not extend notes this side of this line.

Note: Any Additions or Changes on This Sheet Must be Made or Circled in Red Ink, With Date and Name of Person Making Change.

PWFB 0927

1017

F. B. 1764 PG. 128

| | |
|---|---|
| Notes Ck'd by D. M. Finley | Survey of S. Whittier Ave #1 |
| Map No. C.S.B.-2562 | W. O. 8659 Tape No. 0134 St'd. 68 °F |
| Office Work R. L. Green | Surveyed by J. S. Coates |
| Checked C. J. Galli | Notes J.S.C. Date 12-63 |
| Date [illegible] | Indexed [illegible] |

W.I. 34-A-2

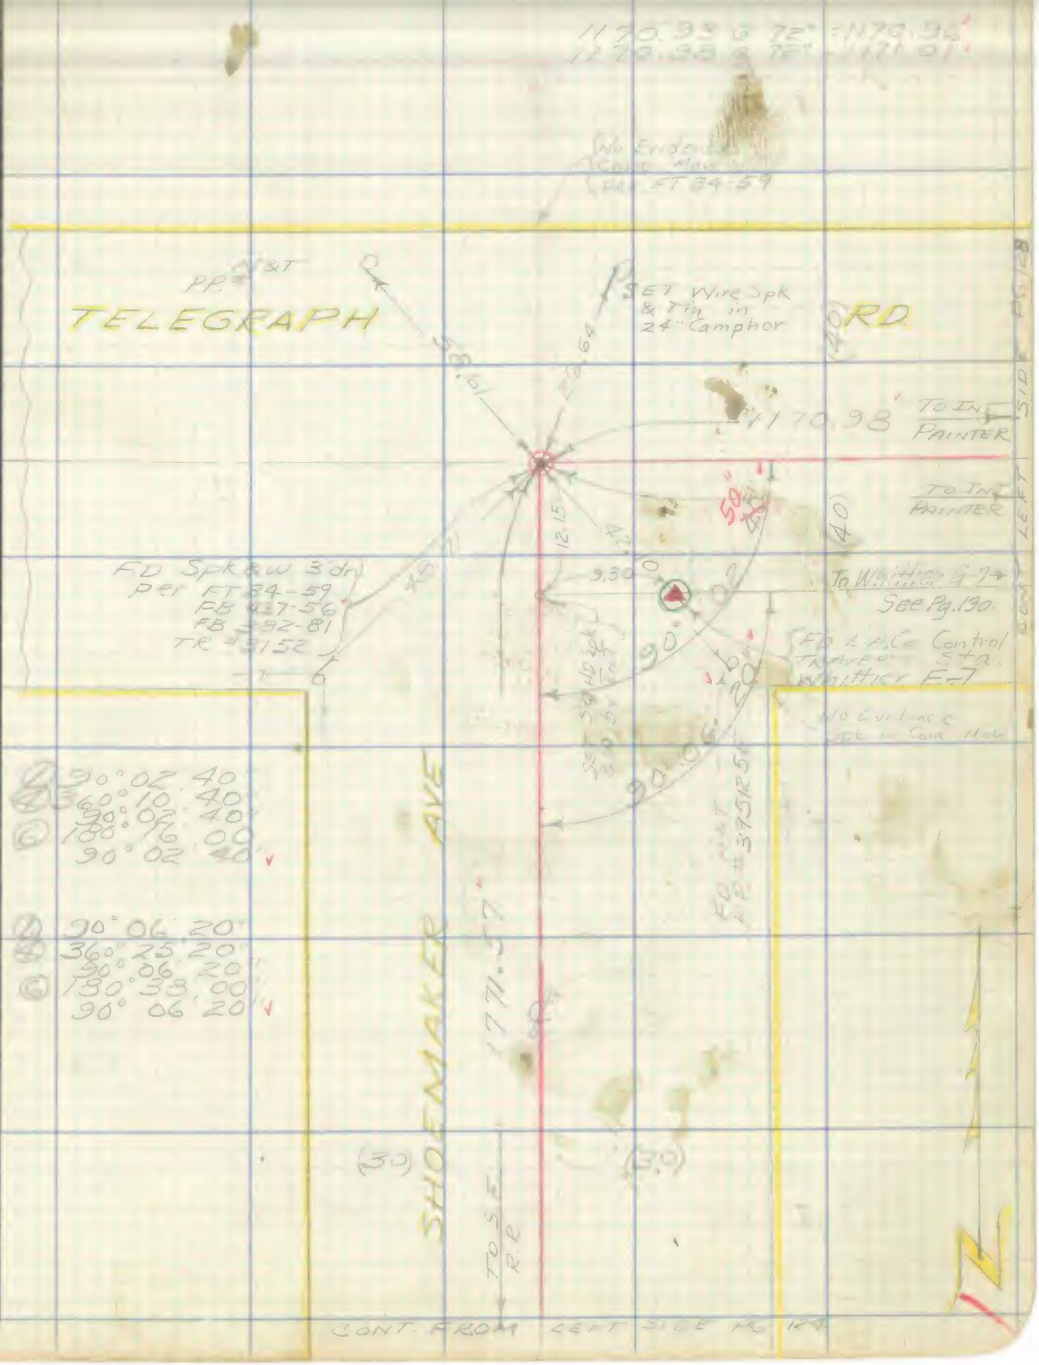


Note: Any Additions or Changes on This Sheet Must be Made or Circled in Red Ink With Date and Name of Person Making Change.

Do not extend notes this side of this line.

RETURN TO
LOS ANGELES COUNTY SURVEYOR
726 LOS ANGELES COUNTY
ENGINEERING BLDG.

76F3095 247 2-51

F. B. 764 PG. 126

W.S. 34-A-2

RETURN TO
LOS ANGELES COUNTY SURVEYOR
726 LOS ANGELES COUNTY
ENGINEERING BLDG.
Do not extend notes this side of this line.

Note: Any Additions or Changes on This Sheet Must be Made or Circled in Red Ink With Date and Name of Person Making Change.

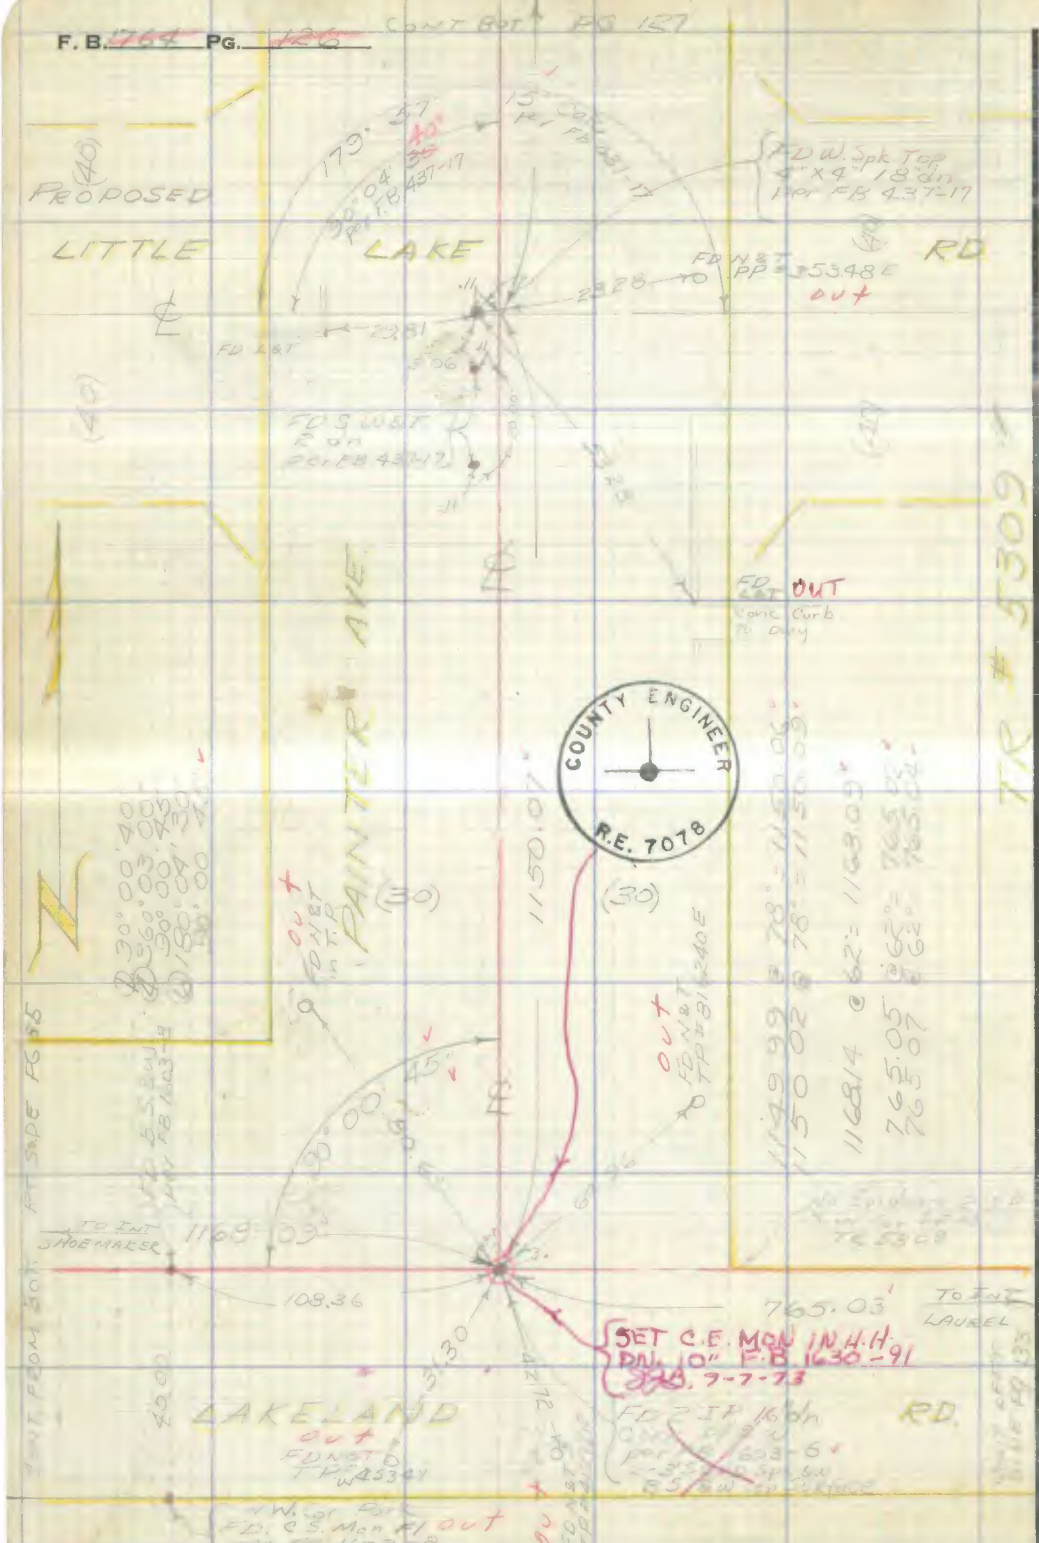

PWFB 0827

2165

F. B. [illegible] PG. [illegible]

| | |
|---|---|
| Notes Ck'd by D. M. Pinter | Survey of [illegible] |
| Map No. C.S.B. 2566 | W. O. [illegible] Tape No. [illegible] St'd. [illegible] °F |
| Office Work [illegible] | Surveyed by [illegible] |
| Checked [illegible] | Notes [illegible] Date [illegible] |
| Date [illegible] | Indexed [illegible] |

W.S. 34-A-2

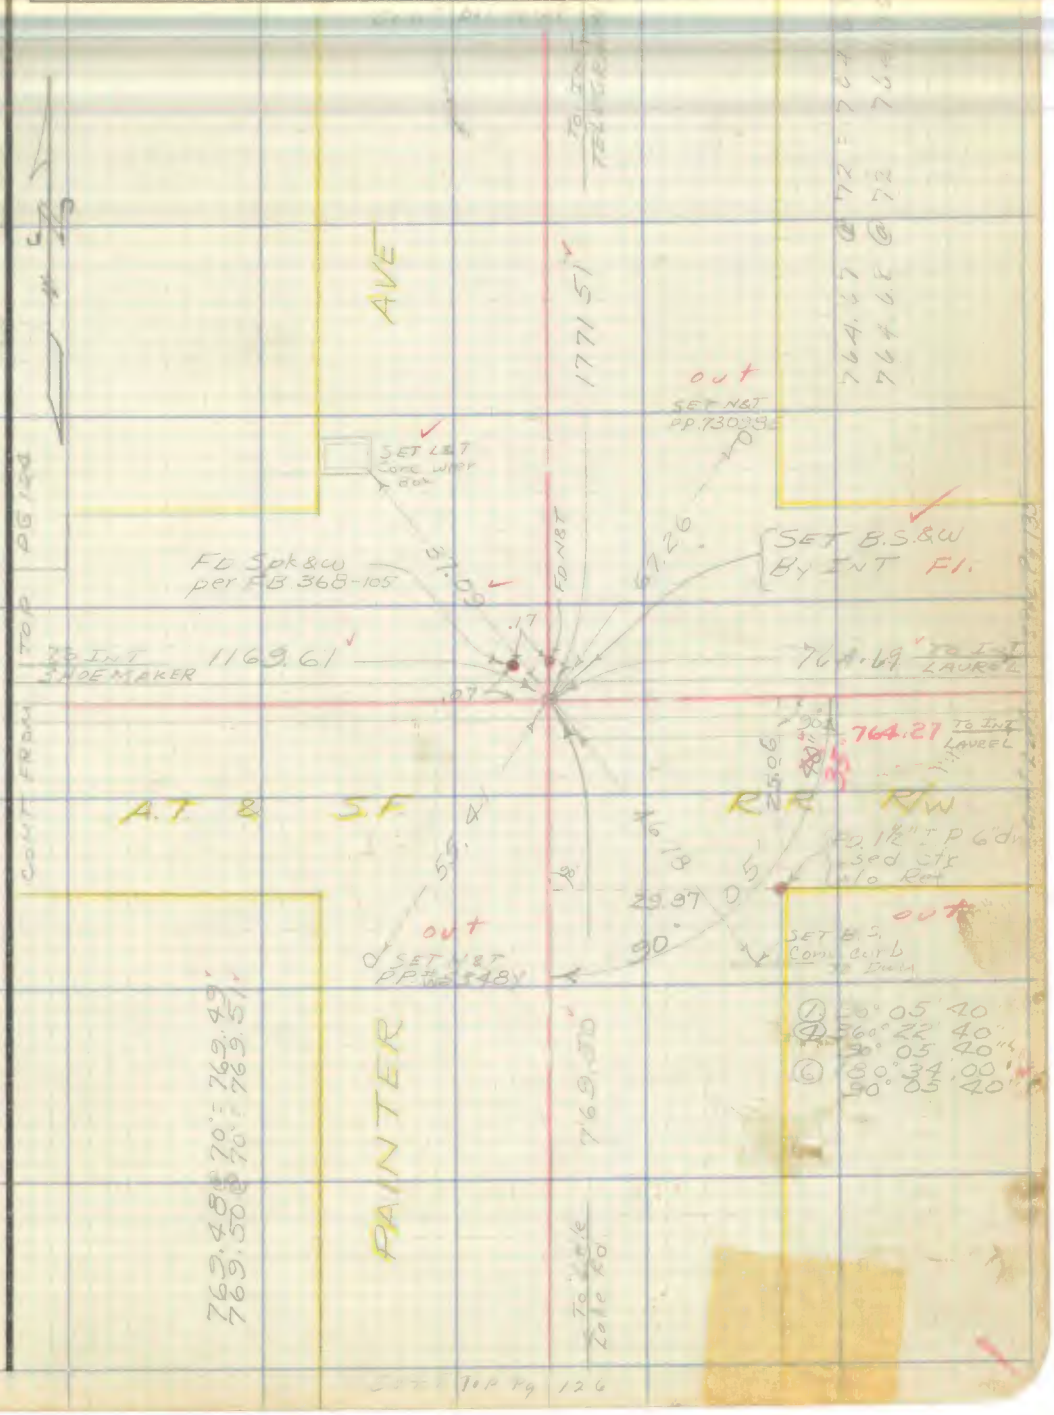


Note: Any Additions or Changes on This Sheet Must be Made or Circled in Red Ink With Date and Name of Person Making Change.

Do not extend notes this side of this line.

RETURN TO
LOS ANGELES COUNTY SURVEYOR
726 LOS ANGELES COUNTY
ENGINEERING BLDG.

76F309S 247 2-51

RETURN TO
LOS ANGELES COUNTY SURVEYOR
726 LOS ANGELES COUNTY
ENGINEERING BLDG.

Note: Any Additions or Changes on This Sheet Must be Made or Circled in Red Ink With Date and Name of Person Making Change.

W.S. 34-A-2

Do not extend notes this side of this line.

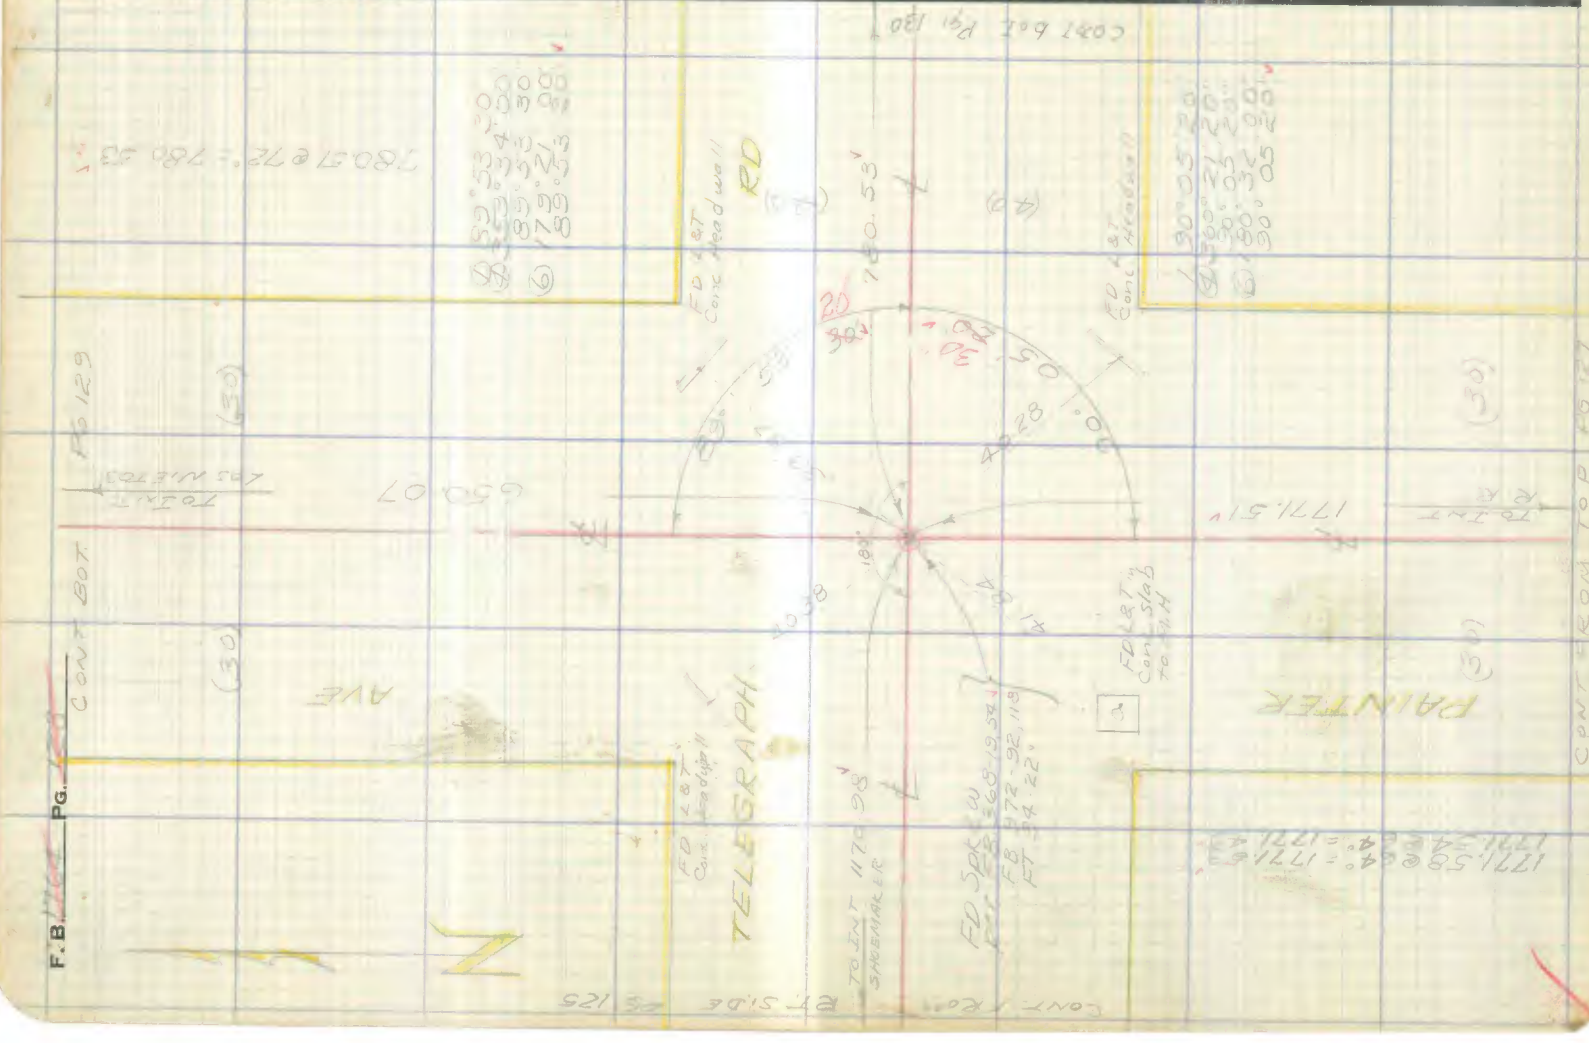

PWFB 0927 1019, 1020

F. B. 1284 PG. 129

| | |
|---|---|
| Notes Ck'd by D. M. Finley | Survey of S. Whittier Area |
| Map No. C.S. B-2562 | W. O. 5633 Tape No. 0134 St'd. 68 °F |
| Office Work R. L. Green | Surveyed by J. S. Coate |
| Checked C. J. Galli | Notes J. S. C. Date 1-8-54 |
| Date [illegible] | Indexed R. T. Johnson |

W.S. 34-A-2

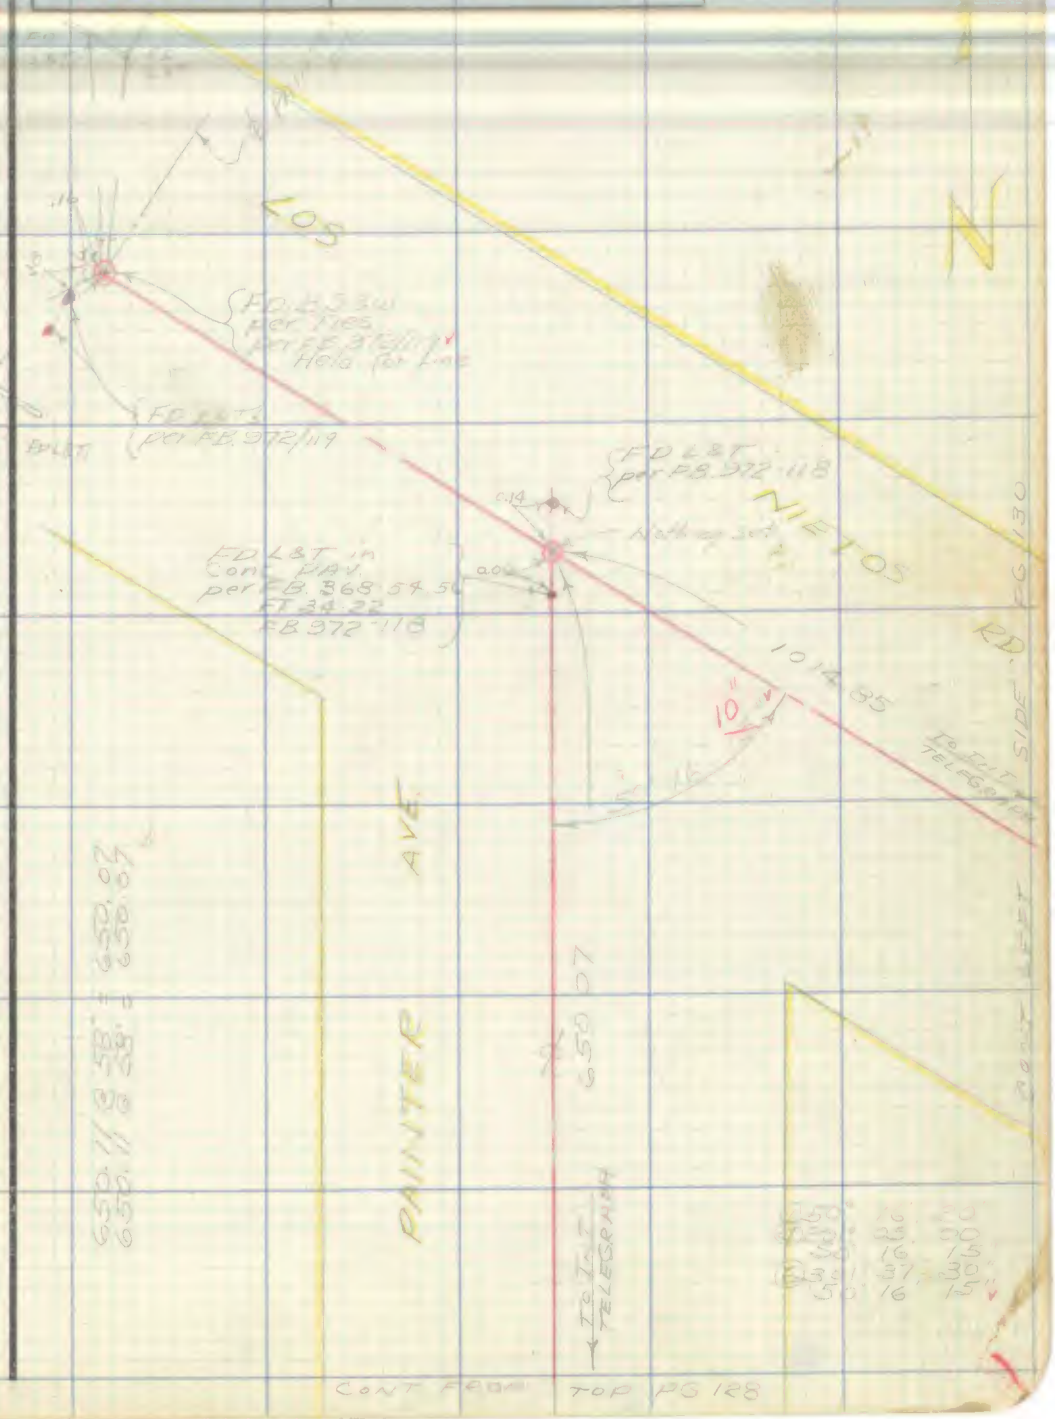


Note: Any Additions or Changes on This Sheet Must be Made or Circled in Red Ink With Date and Name of Person Making Change.

Do not extend notes this side of this line.

RETURN TO
LOS ANGELES COUNTY SURVEYOR
726 LOS ANGELES COUNTY
ENGINEERING BLDG.

76F309S 247 2-51

F. B. 1764 PG. 130

PWFB 0927

1021

W.S. 34-A-2

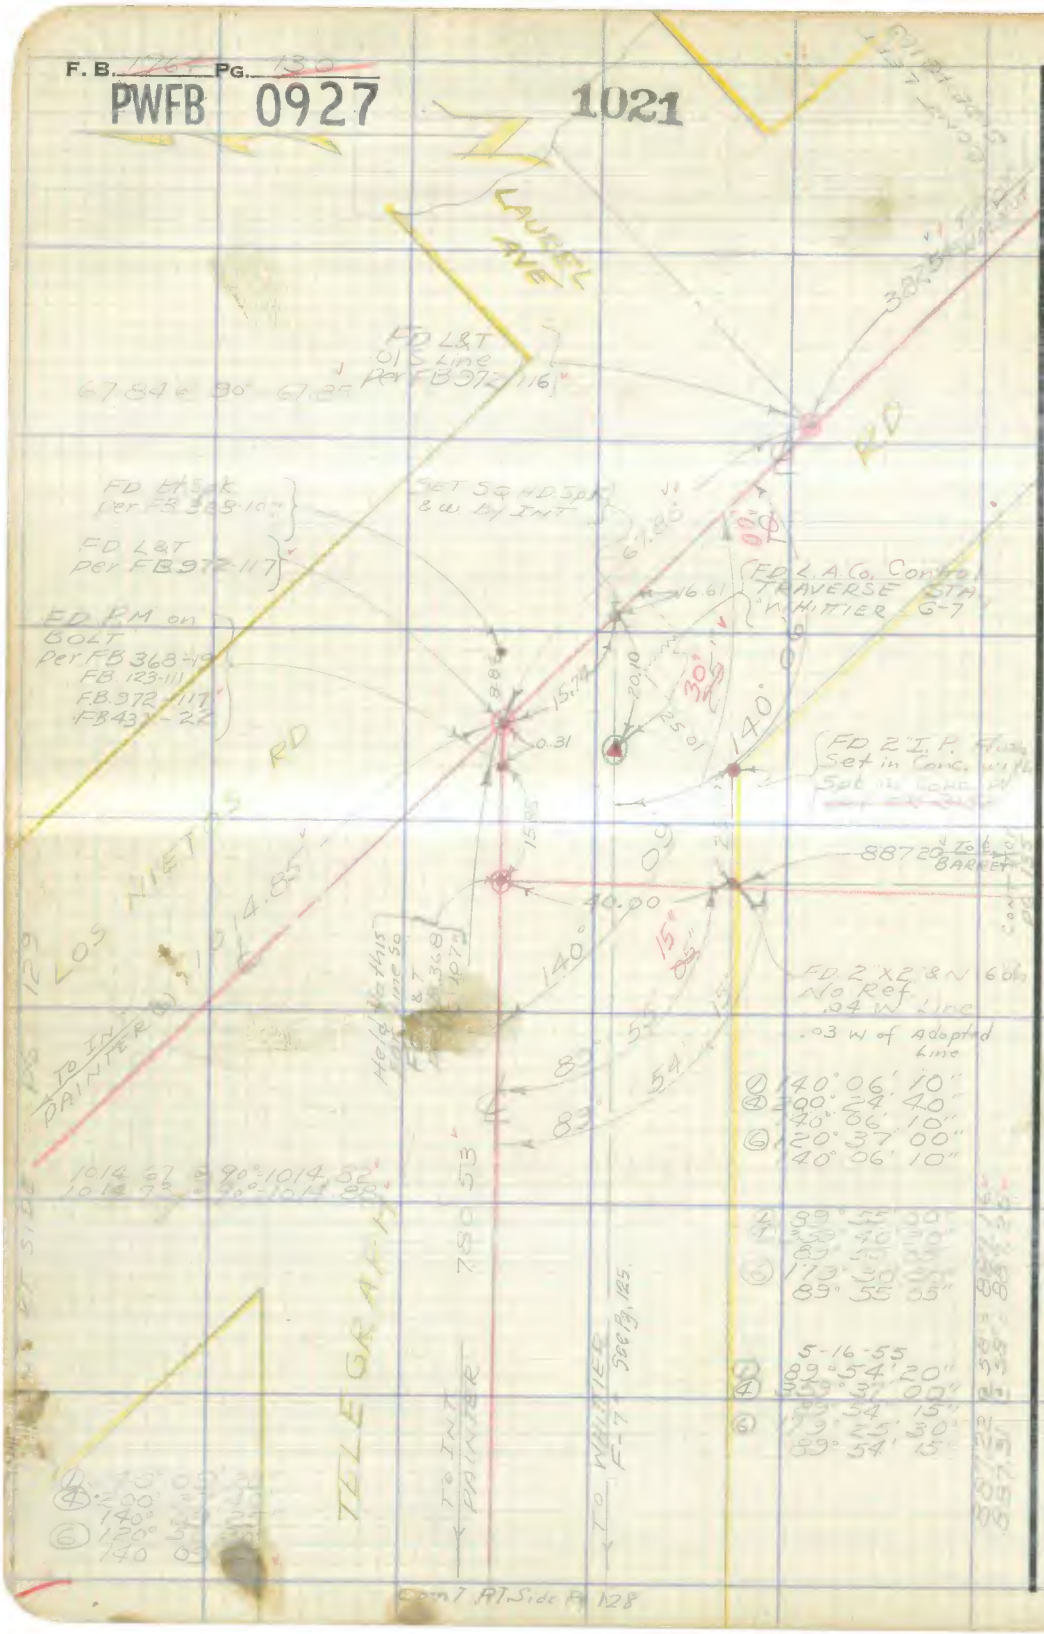


RETURN TO
LOS ANGELES COUNTY SURVEYOR
726 LOS ANGELES COUNTY
ENGINEERING BLDG.

Do not extend notes this side of this line.

Note: Any Additions or Changes on This Sheet Must be Made or Circled in Red Ink With Date and Name of Person Making Change.

PWFB 0827 2166

| | |
|---|---|
| Notes Ck'd by D. M. Finley | Survey of [illegible] |
| Map No. [illegible] | W. O. [illegible] Tape No. [illegible] St'd. [illegible] °F |
| Office Work [illegible] | Surveyed by [illegible] |
| Checked [illegible] | Notes [illegible] Date [illegible] |
| Date [illegible] | Indexed [illegible] |

F. B. [illegible] Pg. [illegible]

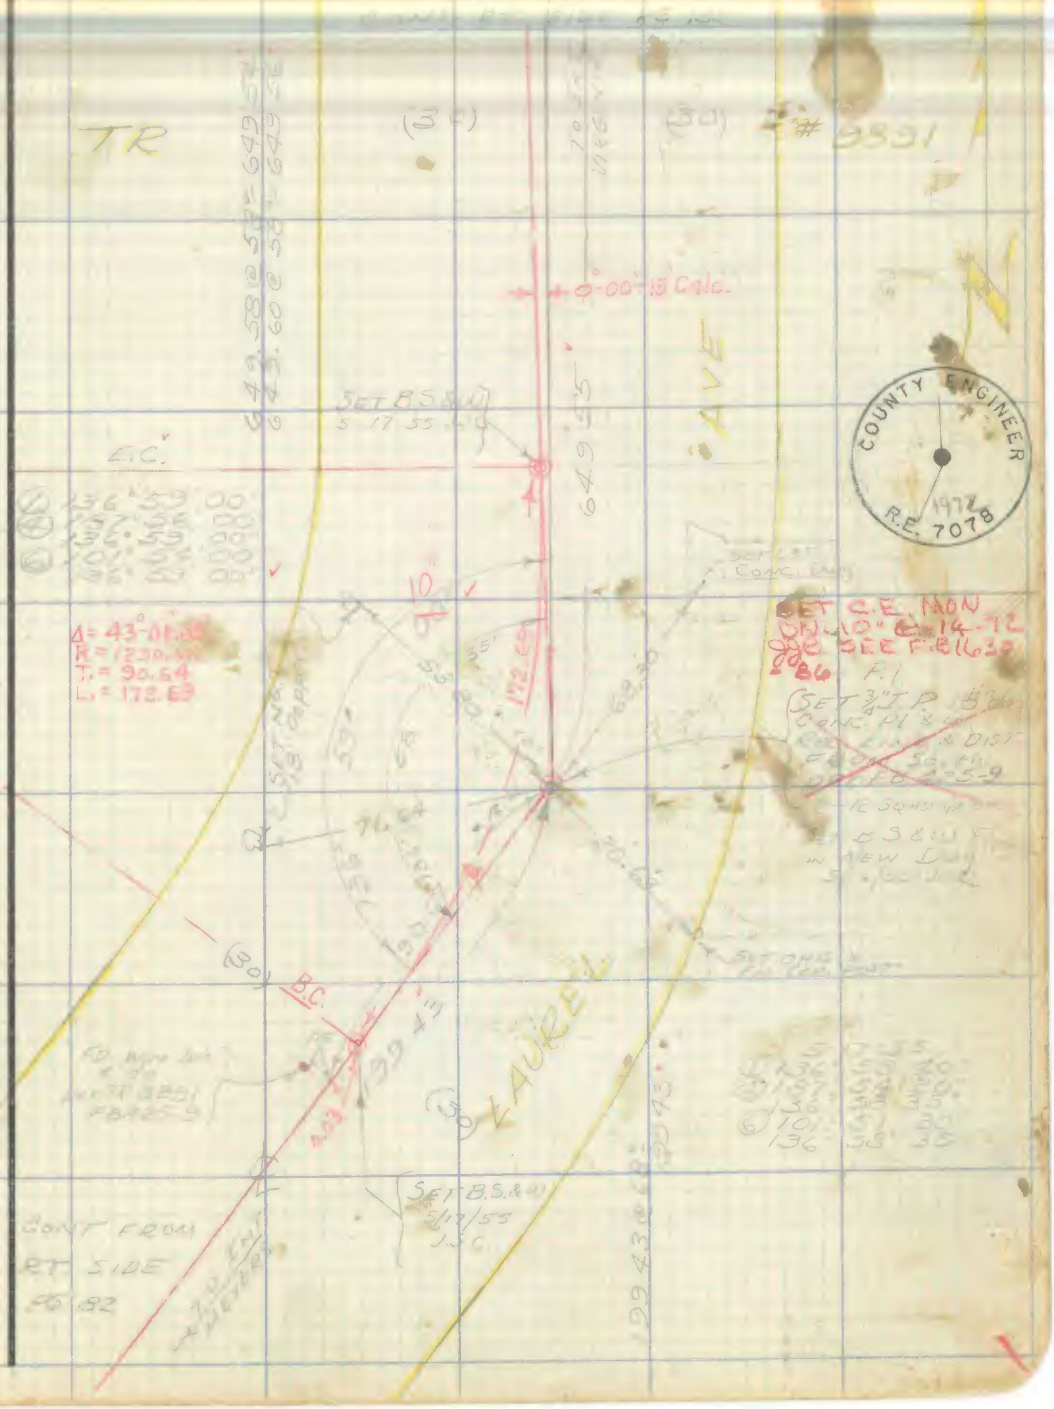


Note: Any Additions or Changes on This Sheet Must be Made or Circled in Red Ink With Date and Name of Person Making Change.

Do not extend notes this side of this line.

RETURN TO
LOS ANGELES COUNTY SURVEYOR
726 LOS ANGELES COUNTY
ENGINEERING BLDG.

76F3095 247 2-51

RETURN TO
LOS ANGELES COUNTY SURVEYOR
726 LOS ANGELES COUNTY
ENGINEERING BLDG.

**Note:** Any Additions or Changes on This Sheet Must be Made or Circled in Red Ink With Date and Name of Person Making Change.

W.S. 34-A-2

Do not extend notes this side of this line.

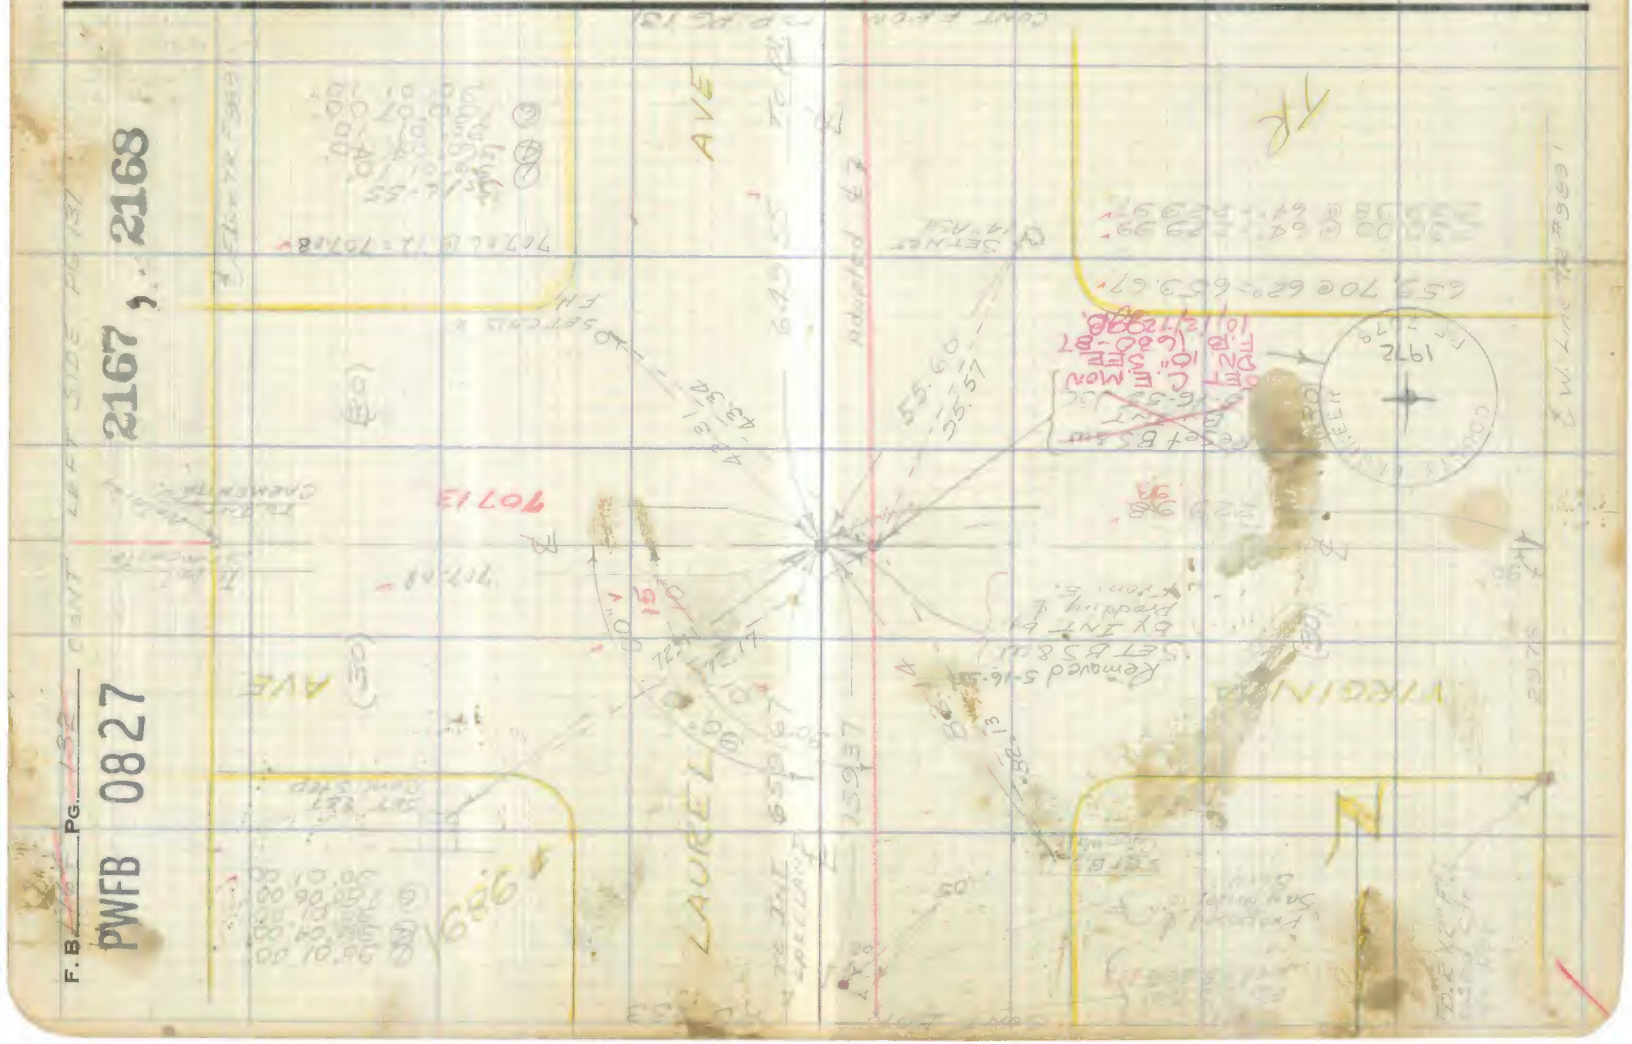


F.B. 2167, 2168 Pg. 132

PWFB 0827

PWFB 0827

2169

F. B. _____ Pg. _____

| | |
|---|---|
| Notes Ck'd by D. M. Finley | Survey of |
| Map No. C.S.P. 2562 | W. O. _____ Tape No. _____ St'd. _____ °F |
| Office Work R. L. Green | Surveyed by |
| Checked | Notes _____ Date _____ |
| Date | Indexed |

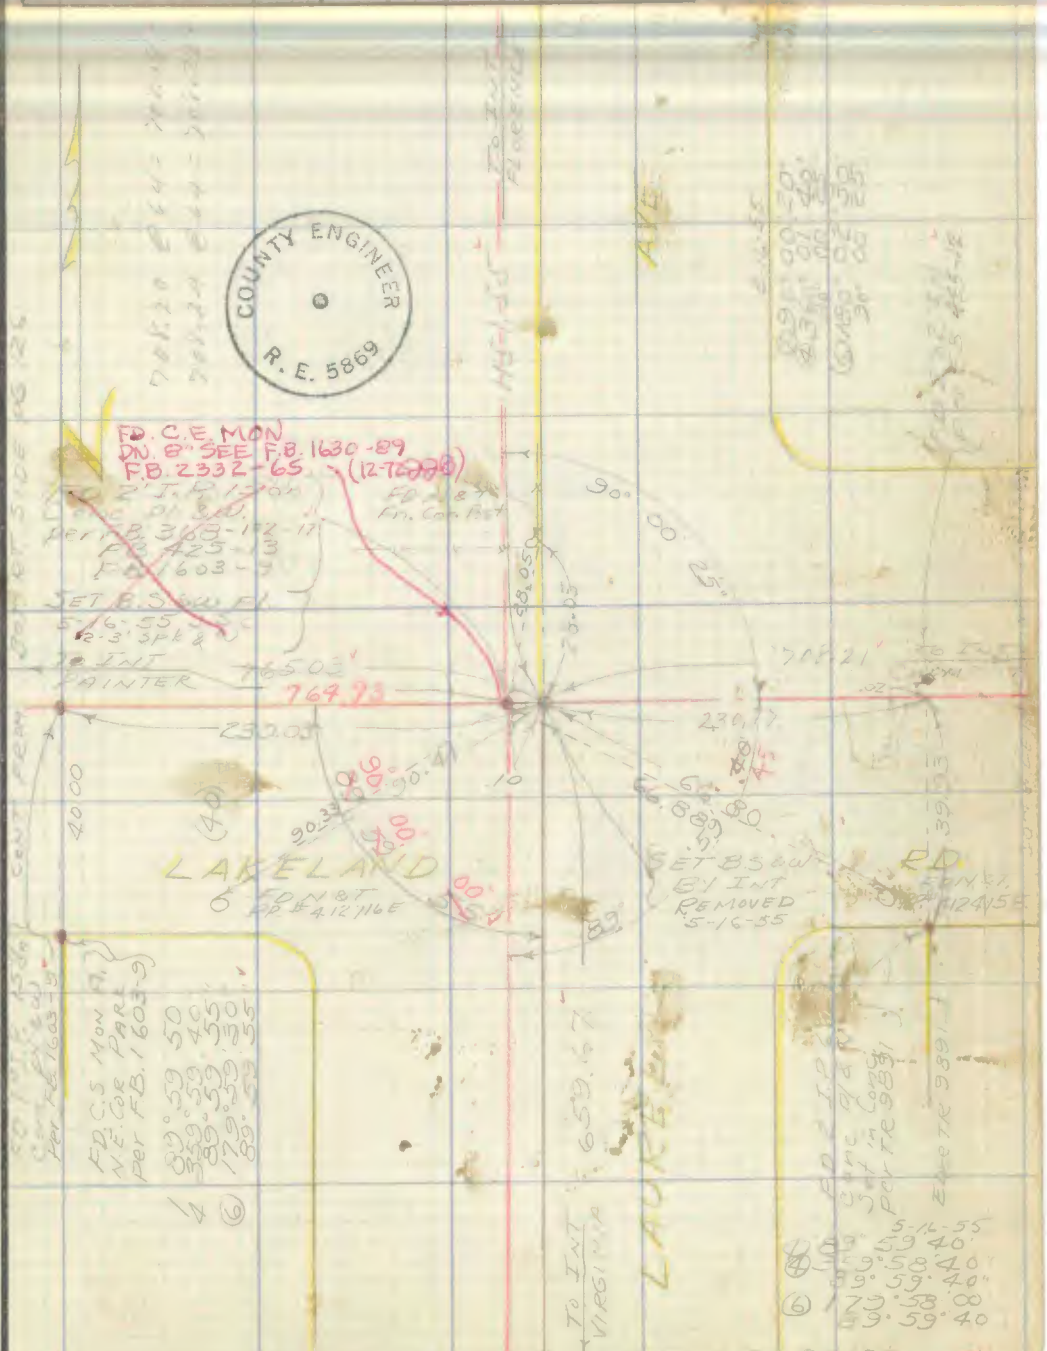


Note: Any Additions or Changes on This Sheet Must be Made or Circled in Red Ink With Date and Name of Person Making Change.

Do not extend notes this side of this line.

RETURN TO
LOS ANGELES COUNTY SURVEYOR
726 LOS ANGELES COUNTY
ENGINEERING BLDG.

76F309S 247 2-51

PWFB 0827 2170

F. B. 1764 PG. 134

WS 34-A-2

RETURN TO
LOS ANGELES COUNTY SURVEYOR
726 LOS ANGELES COUNTY
ENGINEERING BLDG.

Do not extend notes this side of this line.

Note: Any Additions or Changes on This Sheet Must be Made or Circled in Red Ink With Date and Name of Person Making Change.

PWFB 0827

2171

| | |
|---|---|

F. B. 1264 Pg. 125

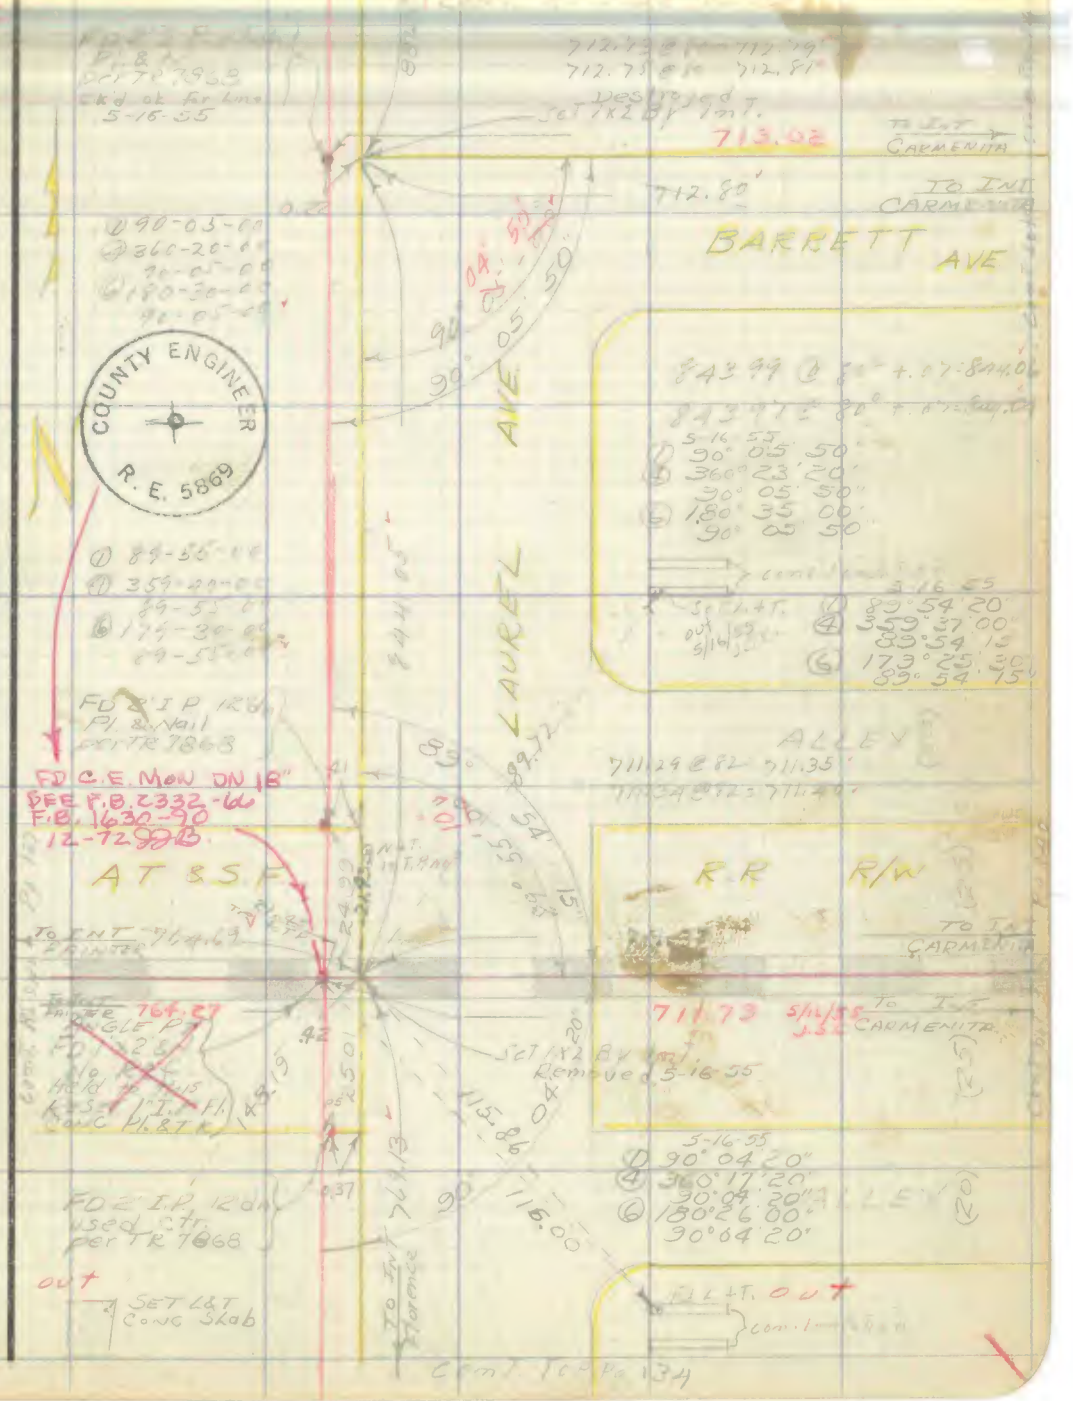


Note: Any Additions or Changes on This Sheet Must be Made or Circled in Red Ink With Date and Name of Person Making Change.

Do not extend notes this side of this line.

RETURN TO
LOS ANGELES COUNTY SURVEYOR
726 LOS ANGELES COUNTY
ENGINEERING BLDG.

76F309S 247 2-51

PWFB 0827 2172, 2173

F. B. 705 PG. 130

WS 34-A-3

RETURN TO
LOS ANGELES COUNTY SURVEYOR
726 LOS ANGELES COUNTY
ENGINEERING BLDG.

Do not extend notes this side of this line.

Note: Any Additions or Changes on This Sheet Must be Made or Circled in Red Ink With Date and Name of Person Making Change.

PWFB 0827 2174, 2175, 2176, 2177

| | | |
|---|---|---|
| Notes Ck'd by D. M. Finley | Survey of | F. B. ____ Pg. ____ |
| Map No. C.S.B. 3568 | W. O. ____ Tape No. ____ St'd. ____ °F | |
| Office Work R. L. Green | Surveyed by | |
| Checked C. J. Gaill | Notes ____ Date ____ | |
| Date 1-12-1955 | Indexed M. C. Johnson | |

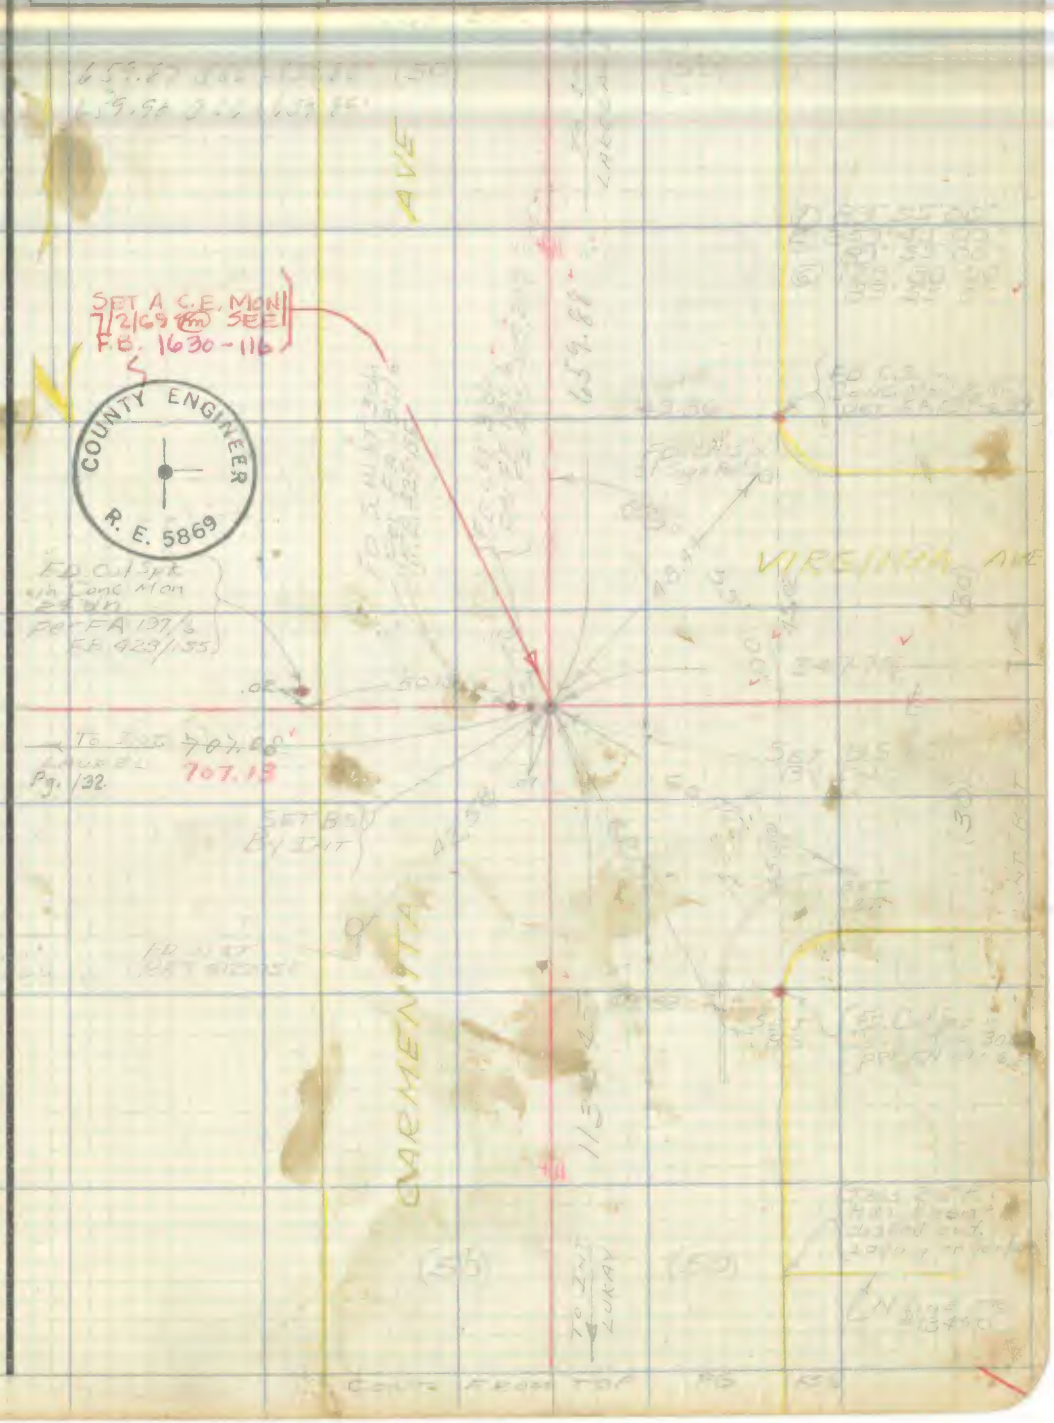


Note: Any Additions or Changes on This Sheet Must be Made or Circled in Red Ink With Date and Name of Person Making Change.

Do not extend notes this side of this line.

RETURN TO
LOS ANGELES COUNTY SURVEYOR
726 LOS ANGELES COUNTY
ENGINEERING BLDG.

76F309S 247 2-51

2178, 2179

F. B. 264 PG. 138

PWFB 0827

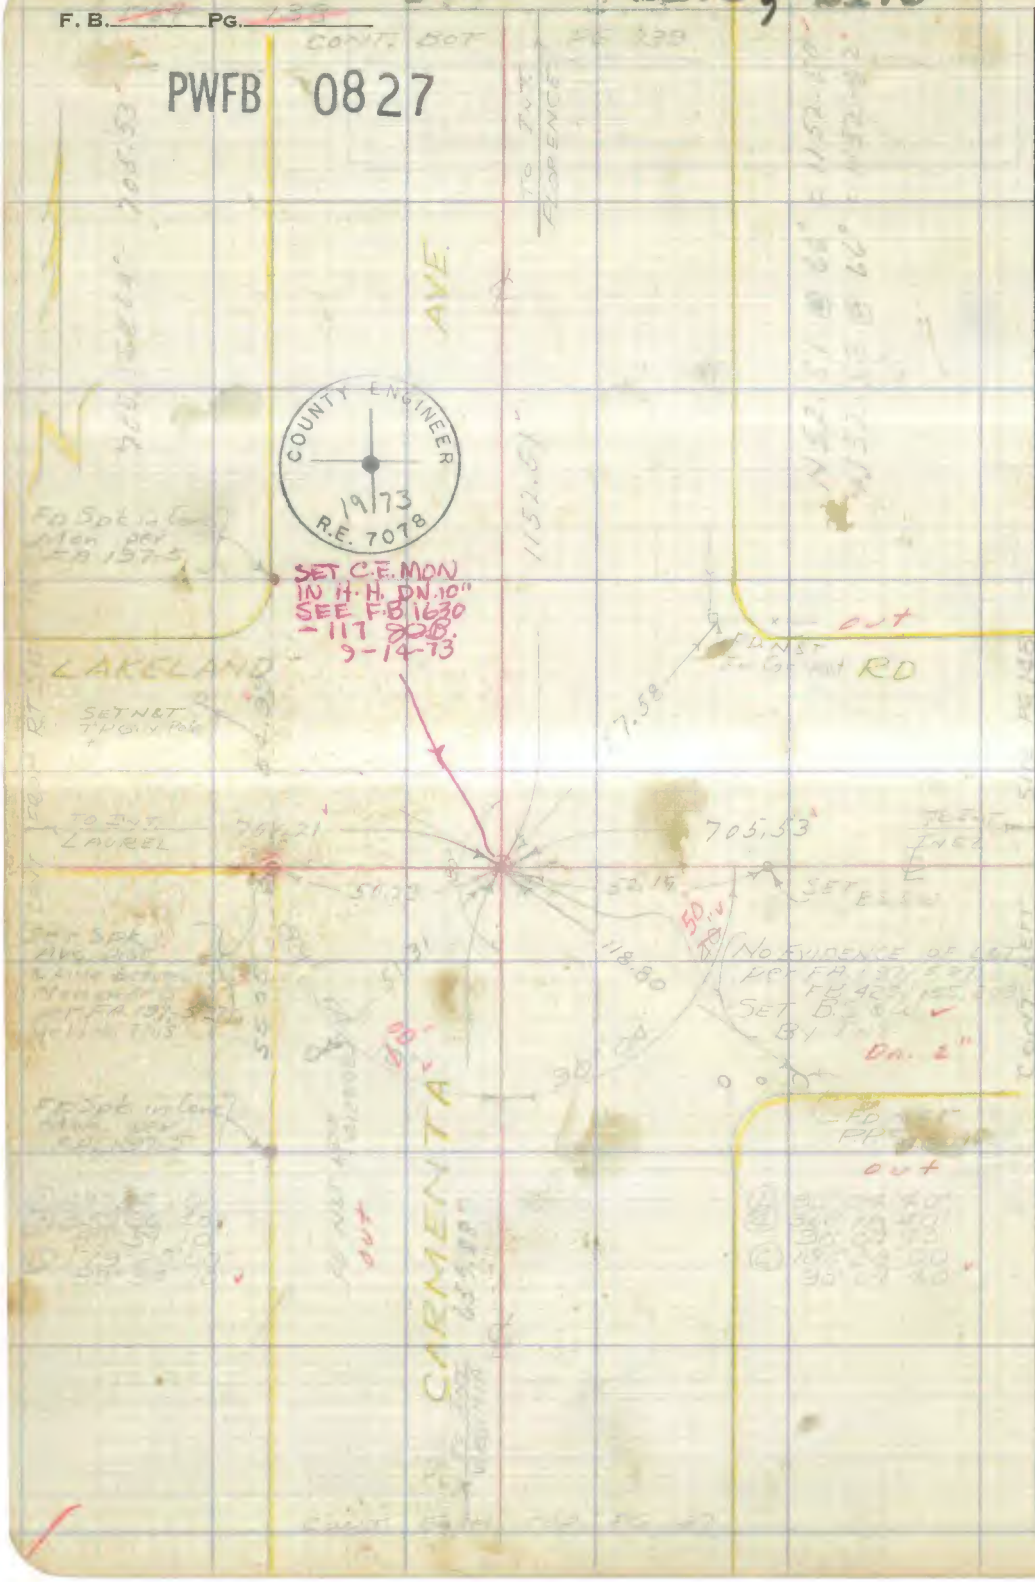


W.S. 34-A-2

RETURN TO
LOS ANGELES COUNTY SURVEYOR
726 LOS ANGELES COUNTY
ENGINEERING BLDG.

Do not extend notes this side of this line.

Note: Any Additions or Changes on This Sheet Must be Made or Circled in Red Ink With Date and Name of Person Making Change.

PWFB 0827 2180

| | |
|---|---|
| Notes Ck'd by D. M. Finley | Survey of |
| Map No. C.S.B. 2962 | W. O. Tape No. St'd. °F |
| Office Work R. U. Gracia | Surveyed by |
| Checked C. J. Gill | Notes Date |
| Date | Indexed |

F. B. PG.

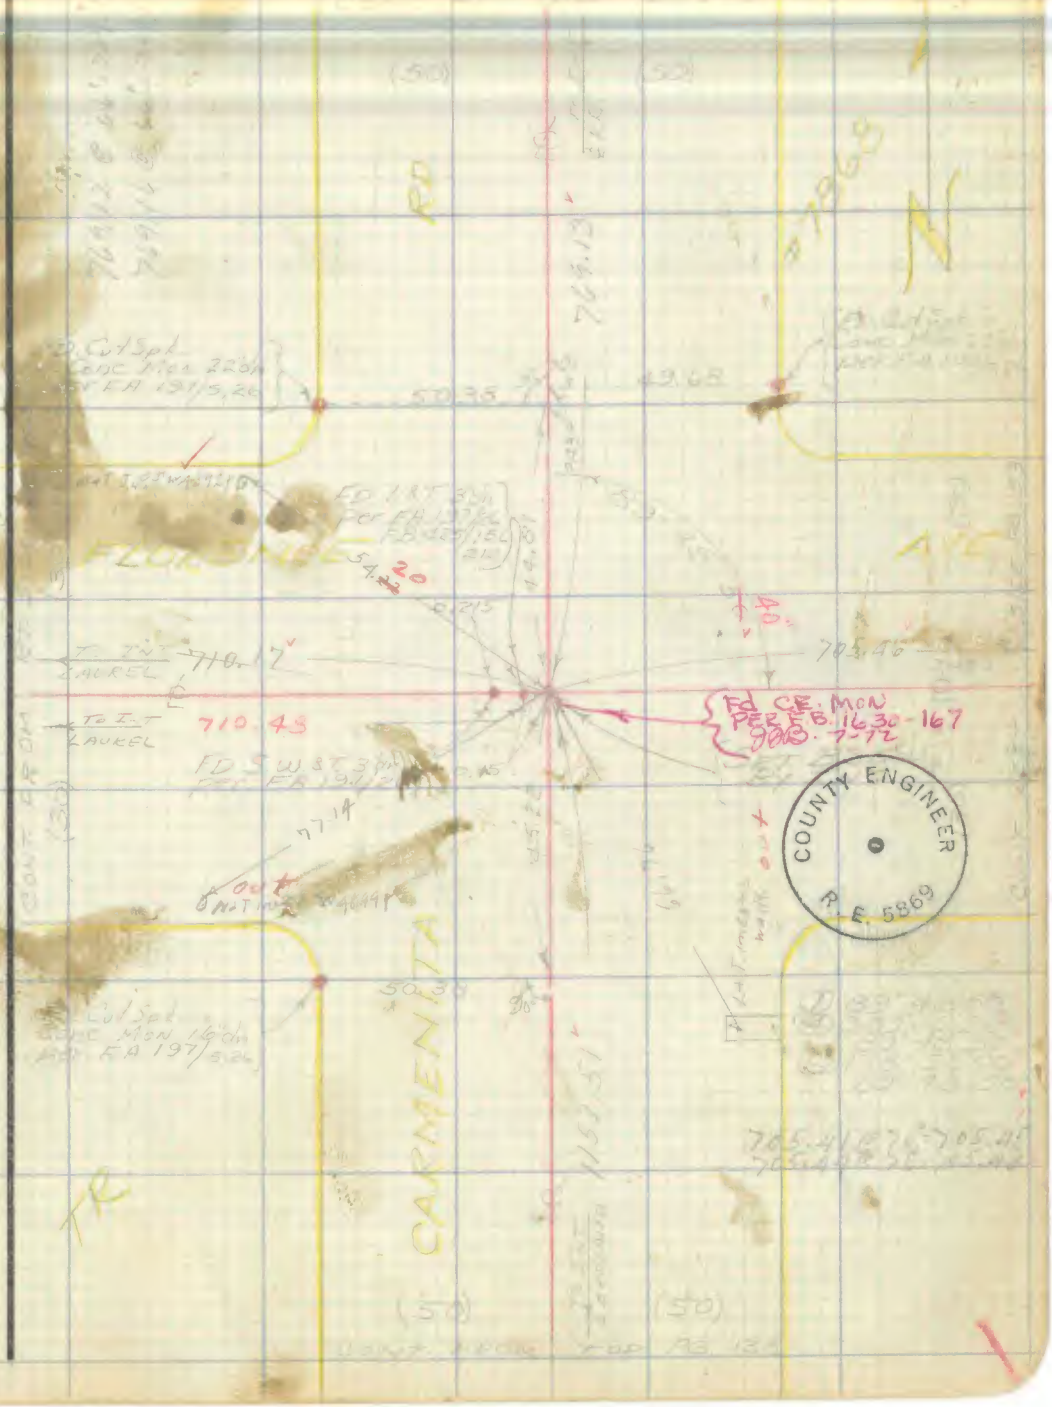


Note: Any Additions or Changes on This Sheet Must be Made or Circled in Red Ink With Date and Name of Person Making Change.

Do not extend notes this side of this line.

RETURN TO
LOS ANGELES COUNTY SURVEYOR
726 LOS ANGELES COUNTY
ENGINEERING BLDG.

76F309S 247 2-51

RETURN TO
LOS ANGELES COUNTY SURVEYOR
726 LOS ANGELES COUNTY
ENGINEERING BLDG.

Note: Any Additions or Changes on This Sheet Must be Made or Circled in Red Ink With Date and Name of Person Making Change.

W.S. 34-A-2

Do not extend notes this side of this line.

2181

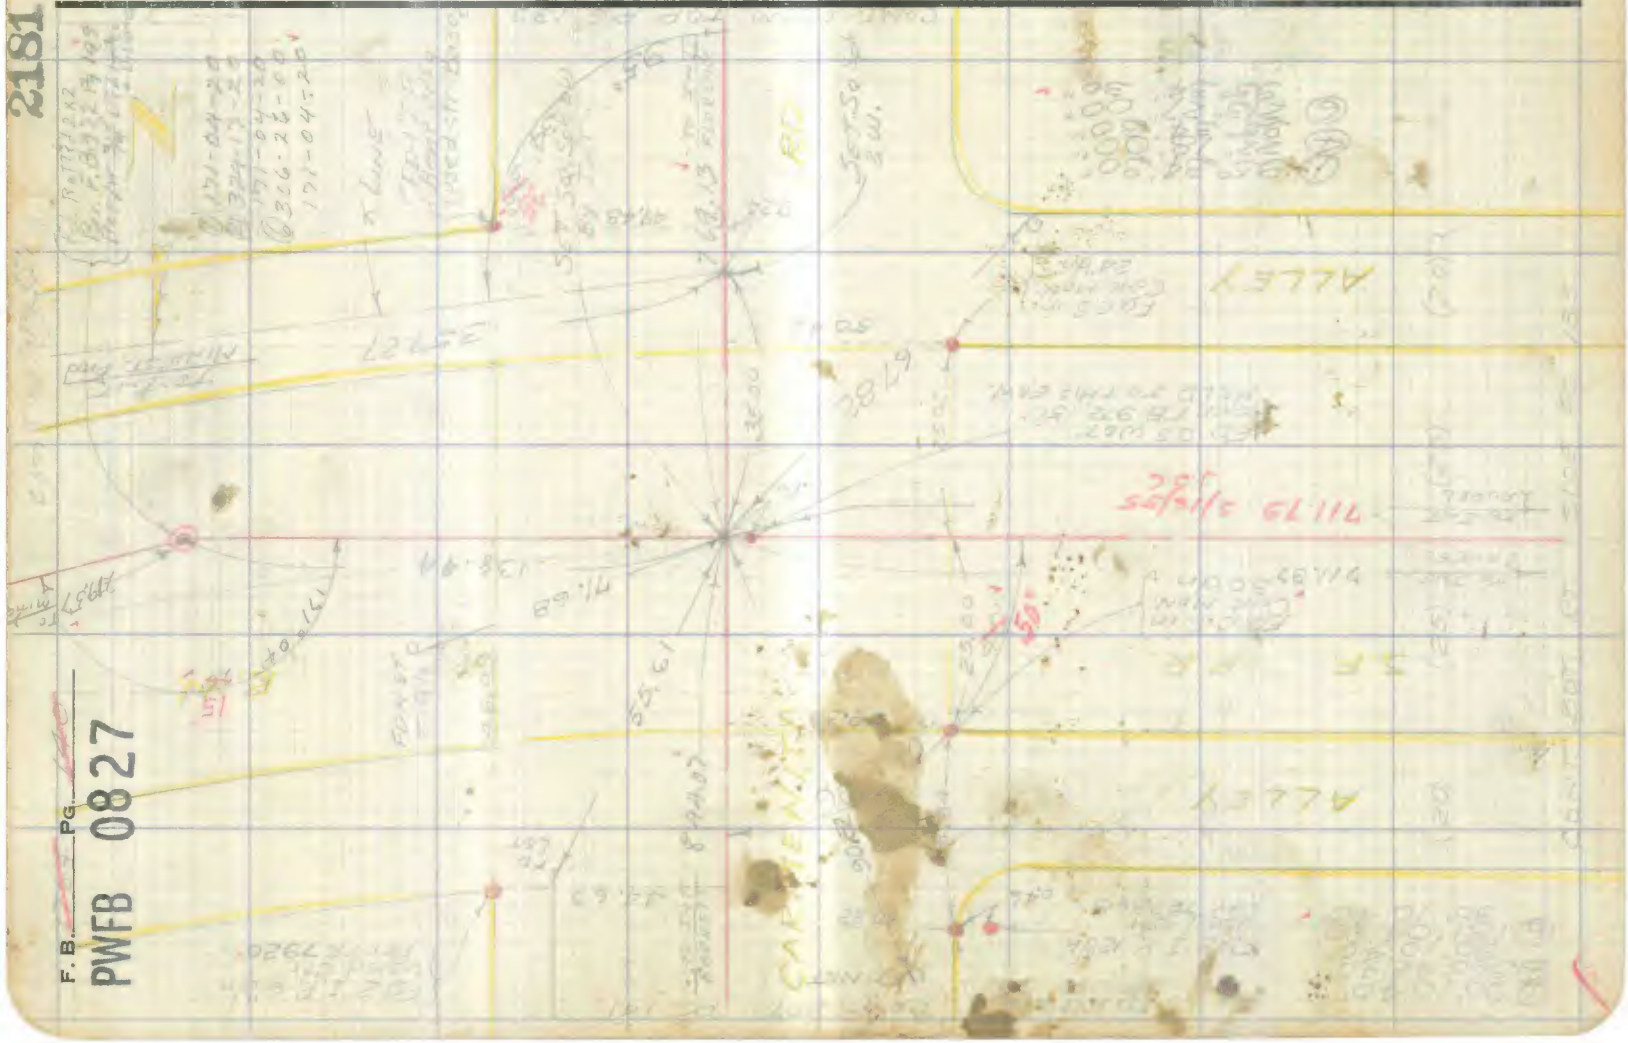

F. B. ____ PG. ____

PWFB 0827

PWFB 0927 1023, 1024

F. B. _____ PG. _____

| | |
|---|---|
| Notes Ck'd by D. M. Finley | Survey of |
| Map No. C.S.B.-2562 | W. O. _____ Tape No. _____ St'd. _____ °F |
| Office Work R. L. Green | Surveyed by |
| Checked C. J. Gall | Notes _____ Date _____ |
| Date June 1960 | Indexed A. C. Johnson |

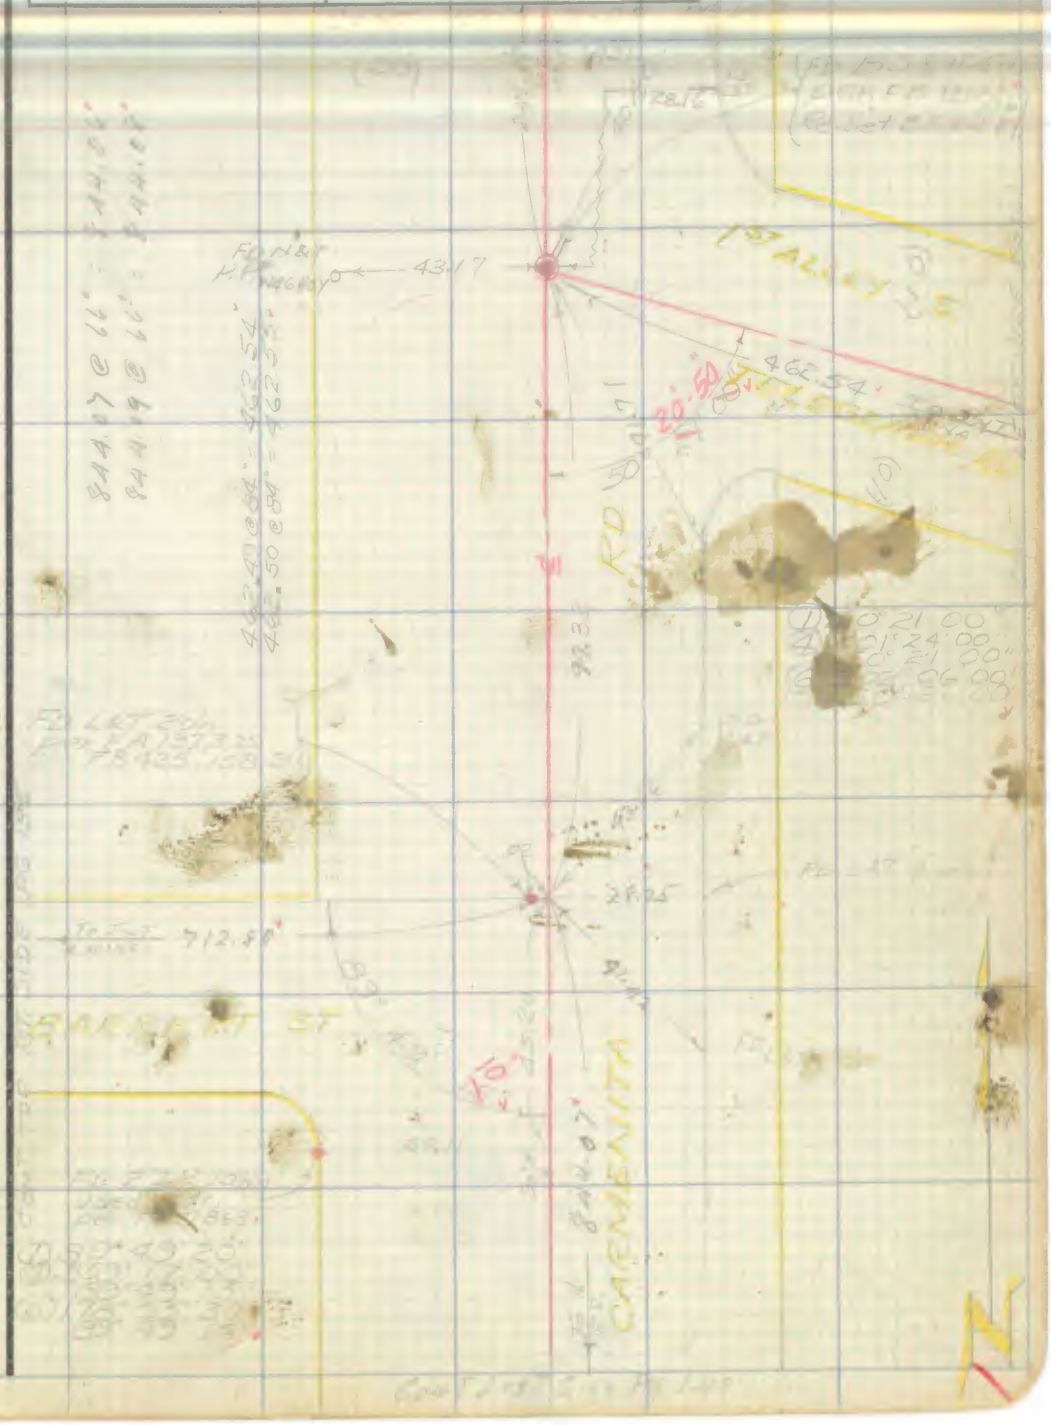


Note: Any Additions or Changes on This Sheet Must be Made or Circled in Red Ink With Date and Name of Person Making Change.

Do not extend notes this side of this line.

RETURN TO
LOS ANGELES COUNTY SURVEYOR
726 LOS ANGELES COUNTY
ENGINEERING BLDG.

76F3095 247 2-51

PWFB 0927 1025, 1026

F. B. 1264 PG. 142

WS 34-A-2

RETURN TO
LOS ANGELES COUNTY SURVEYOR
726 LOS ANGELES COUNTY
ENGINEERING BLDG.

Do not extend notes this side of this line.

Note: Any Additions or Changes on This Sheet Must be Made or Circled in Red Ink With Date and Name of Person Making Change.

PWFB 0827 2182, 2183

F. B. ____ PG. ____

| | |
|---|---|
| Notes Ck'd by D. M. Finley | Survey of ____ |
| Map No. C-S-B-2562 | W. O. ____ Tape No. ____ St'd. ____ °F |
| Office Work R. L. Green | Surveyed by ____ |
| Checked C. J. Galli | Notes ____ Date ____ |
| Date June 1974 | Indexed ____ |

W.S. 34-A-2

Note: Any Additions or Changes on This Sheet Must be Made or Circled in Red Ink With Date and Name of Person Making Change.

Do not extend notes this side of this line.

RETURN TO
LOS ANGELES COUNTY SURVEYOR
726 LOS ANGELES COUNTY
ENGINEERING BLDG.

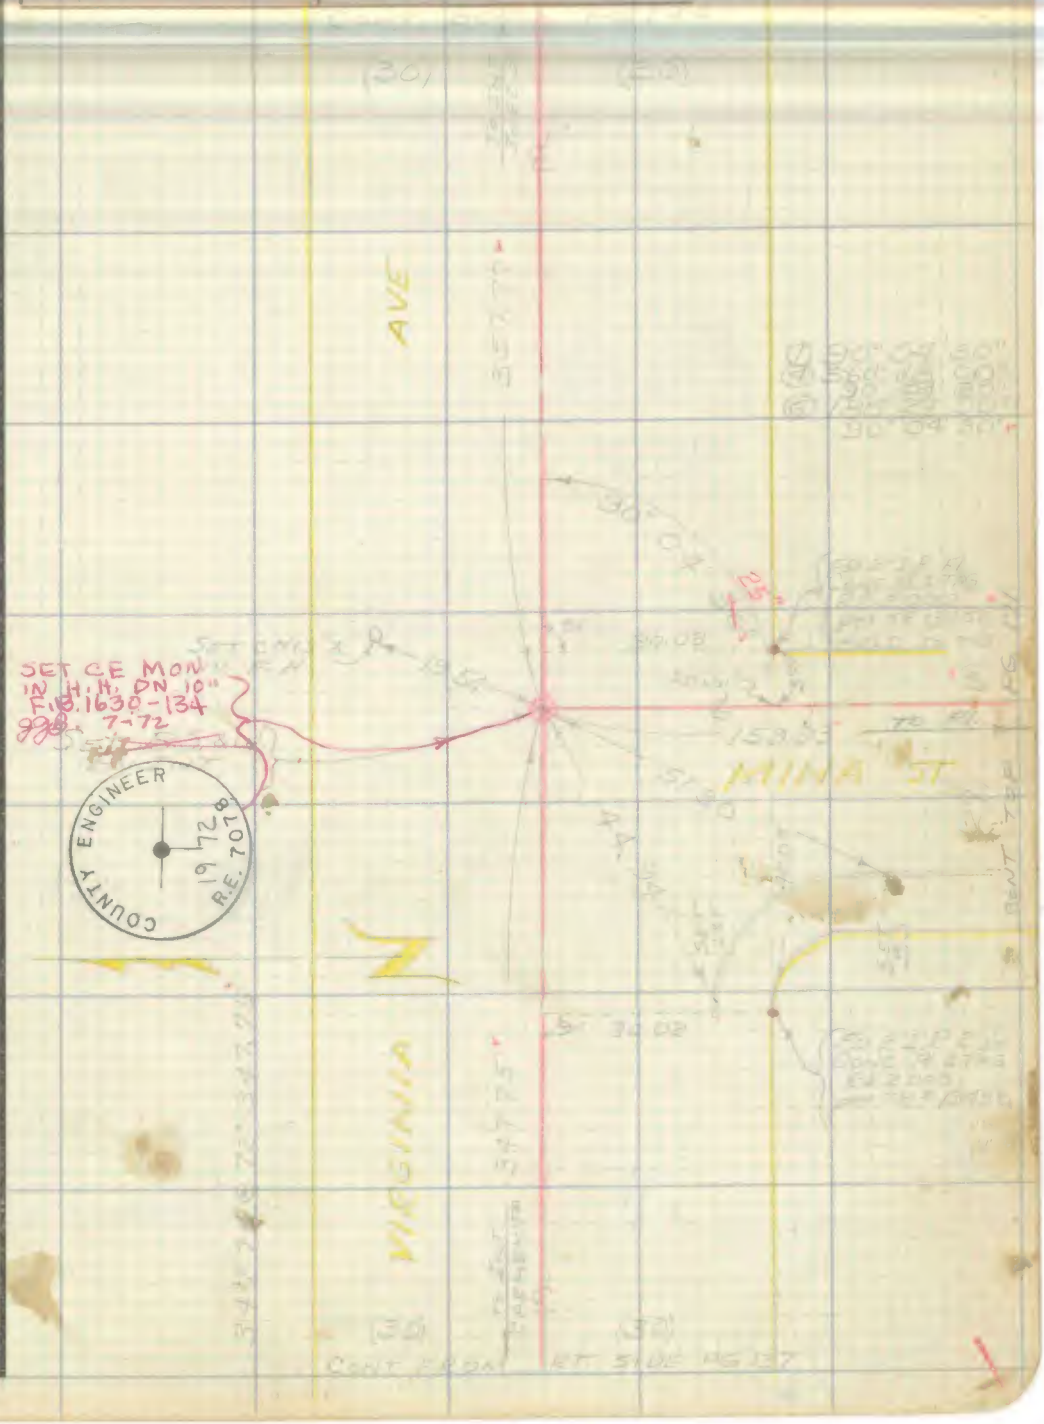


76F3095 247 2-51

F. B. _____ PG. _____ CONT LEFT SIDE PG 145

PWFB 0827

2184 , 2185

W.S. 34-A-2

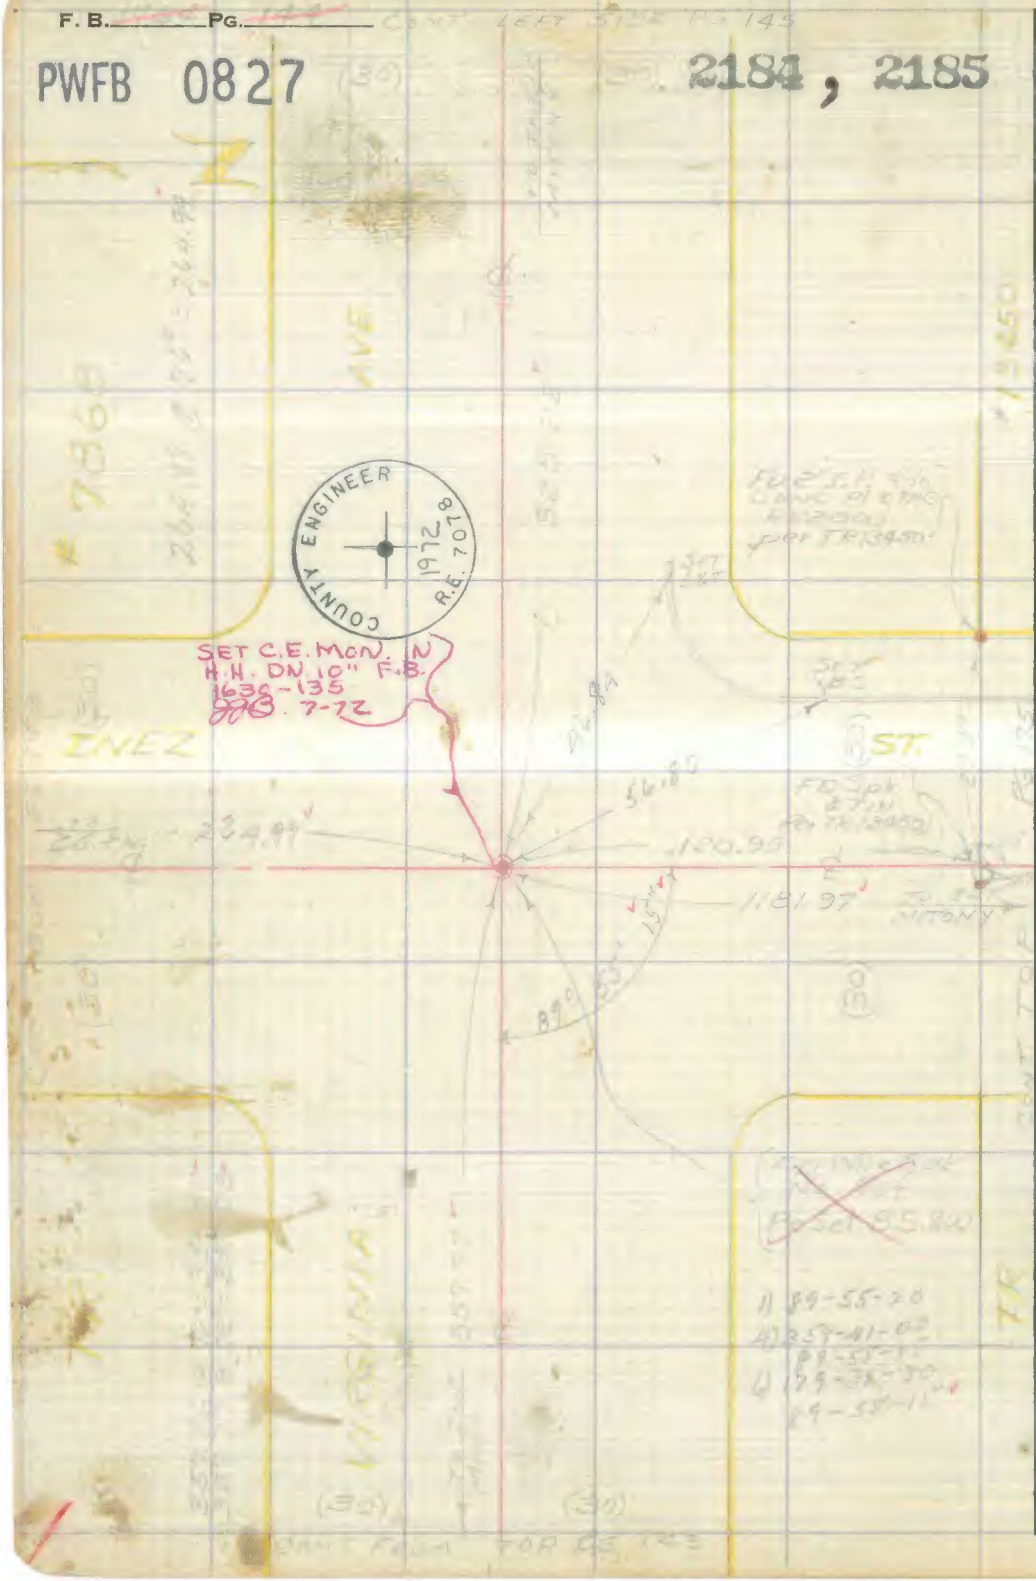


RETURN TO
LOS ANGELES COUNTY SURVEYOR
726 LOS ANGELES COUNTY
ENGINEERING BLDG.

Do not extend notes this side of this line.

Note: Any Additions or Changes on This Sheet Must be Made or Circled in Red Ink With Date and Name of Person Making Change.

PWFB 0827 2186, 2187, 2188, 2189

F. B. ____ PG. ____

| | |
|---|---|
| Notes Ck'd by D. M. Finley | Survey of ____ |
| Map No. C.S.B.-2561 | W. O. ____ Tape No. ____ St'd. ____ °F |
| Office Work R.L. Green | Surveyed by ____ |
| Checked C. J. Gau | Notes ____ Date ____ |
| Date ____ | Indexed ____ |

W.S. 34-A-2

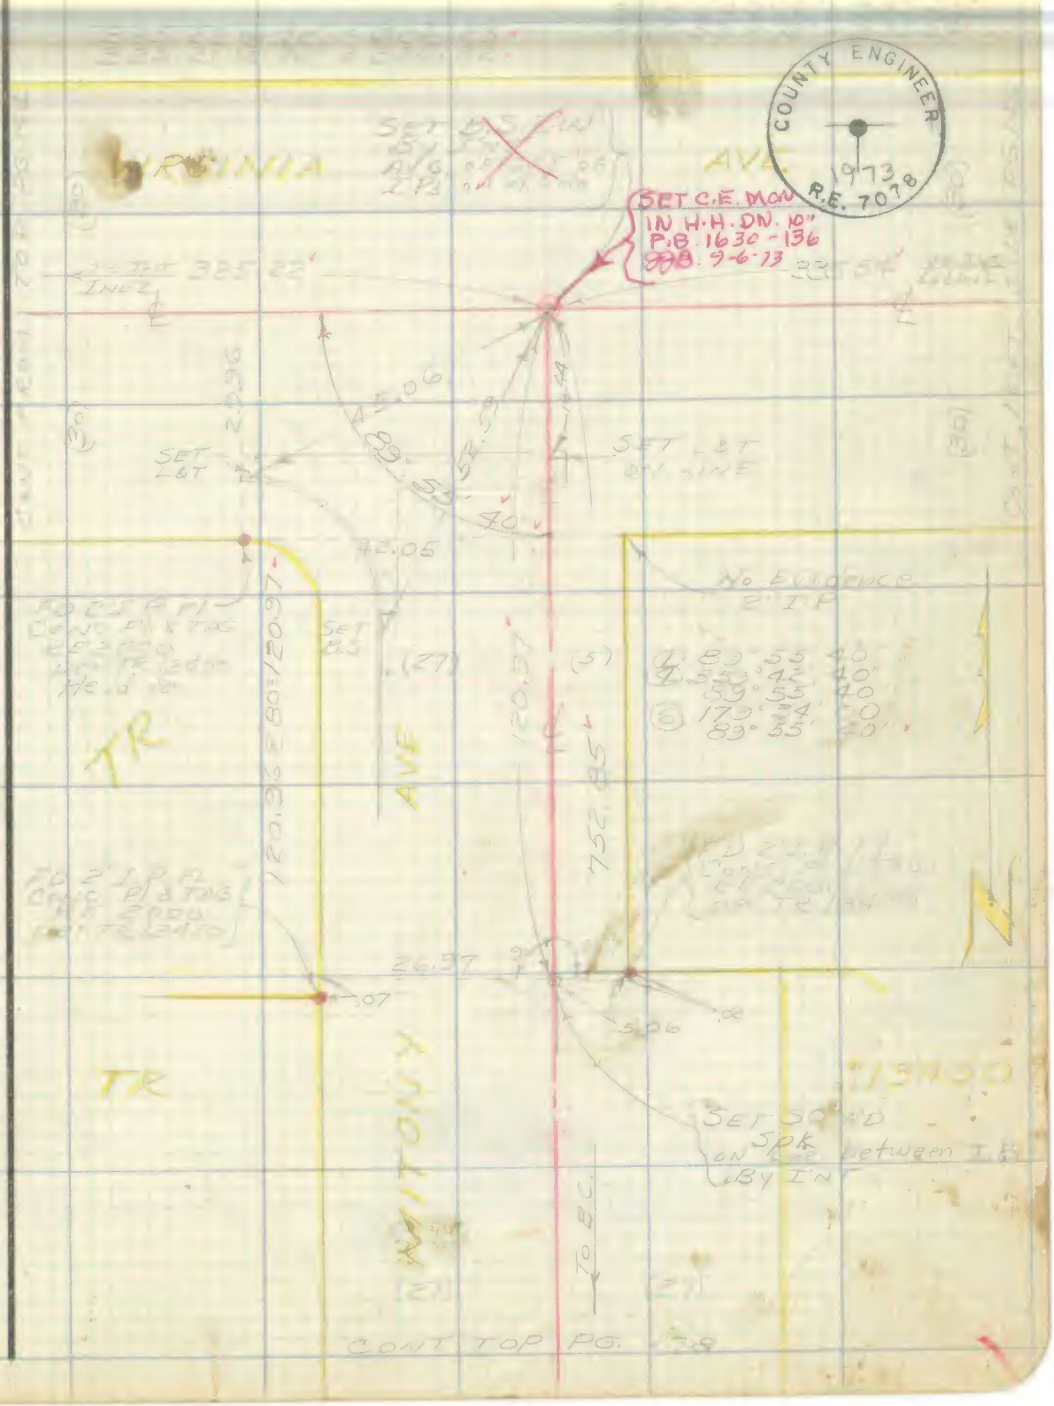


Note: Any Additions or Changes on This Sheet Must be Made or Circled in Red Ink With Date and Name of Person Making Change.

Do not extend notes this side of this line.

RETURN TO
LOS ANGELES COUNTY SURVEYOR
726 LOS ANGELES COUNTY
ENGINEERING BLDG.

76F309S 247 2-51

PWFB 0827 2190 , 2191

F. B. _____ PG. _____

COUNTY ENGINEER
19 73
R.E. 7078

SET C.E. MON. IN H.H. DN. 10" F.B. 1630-120 9-6-73

W.S. 34-B-2

HERMES ST.

LELAND AVE

COUNTY ENGINEER
R.E. 7078

SET C.E. MON IN H.H. DN. 10" SEE F.B. 1630-121 9-14-73

40'

VIRGINIA

FENDALE ST.

RETURN TO
LOS ANGELES COUNTY SURVEYOR
726 LOS ANGELES COUNTY
ENGINEERING BLDG.

Do not extend notes this side of this line.

Note: Any Additions or Changes on This Sheet Must be Made or Circled in Red Ink With Date and Name of Person Making Change.

PWFB 0827 2192, 2193

| | |
|---|---|
| Notes Ck'd by D. M. Finley | Survey of |
| Map No. C.S. P.I. 25K2 | W. O. Tape No. St'd. °F |
| Office Work R. L. Grace | Surveyed by |
| Checked C. J. Galli | Notes Date |
| Date June | Indexed R. C. Johnson |

F. B. Pg.

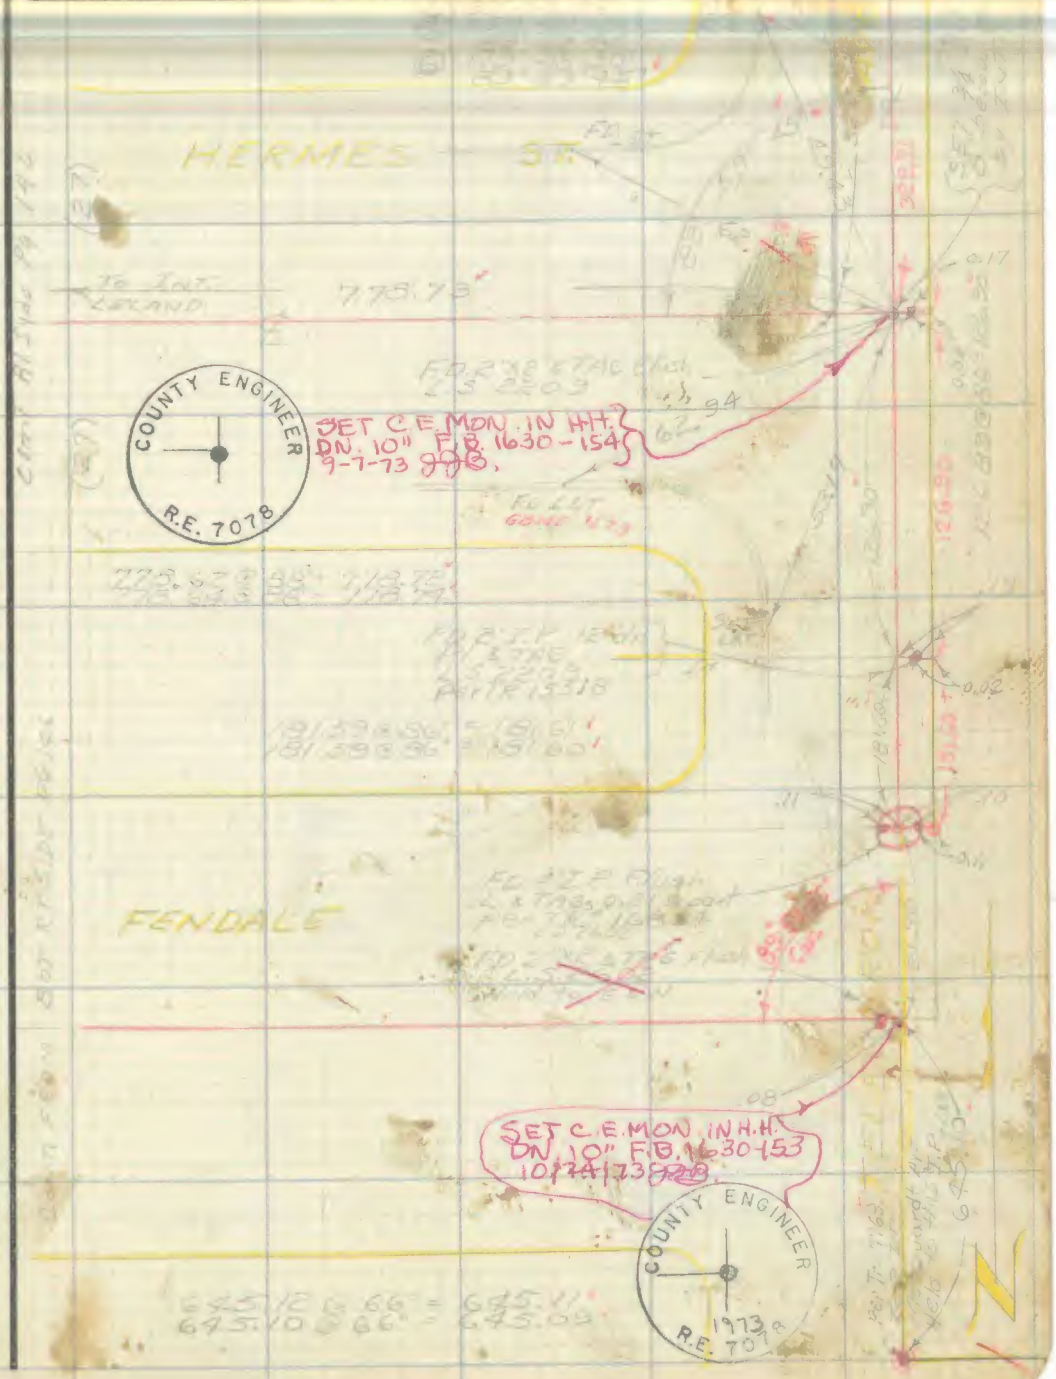


Note: Any Additions or Changes on This Sheet Must be Made or Circled in Red Ink With Date and Name of Person Making Change.

Do not extend notes this side of this line.

RETURN TO
LOS ANGELES COUNTY SURVEYOR
726 LOS ANGELES COUNTY
ENGINEERING BLDG.

76F3095 247 2-51

F. B. _____ PG. _____

PWFB 0827

2194

W.S. 34-A-2

RETURN TO
LOS ANGELES COUNTY SURVEYOR
726 LOS ANGELES COUNTY
ENGINEERING BLDG.

Do not extend notes this side of this line.

Note: Any Additions or Changes on This Sheet Must be Made or Circled in Red Ink With Date and Name of Person Making Change.

PWFB 0827

2195

| | |
|---|---|
| Notes Ck'd by D. M. Finley | Survey of |
| Map No. C.S.R-2562 | W. O. Tape No. St'd. °F |
| Office Work R. L. Green | Surveyed by |
| Checked C. J. Gaul | Notes Date |
| Date | Indexed |

F. B. PG.

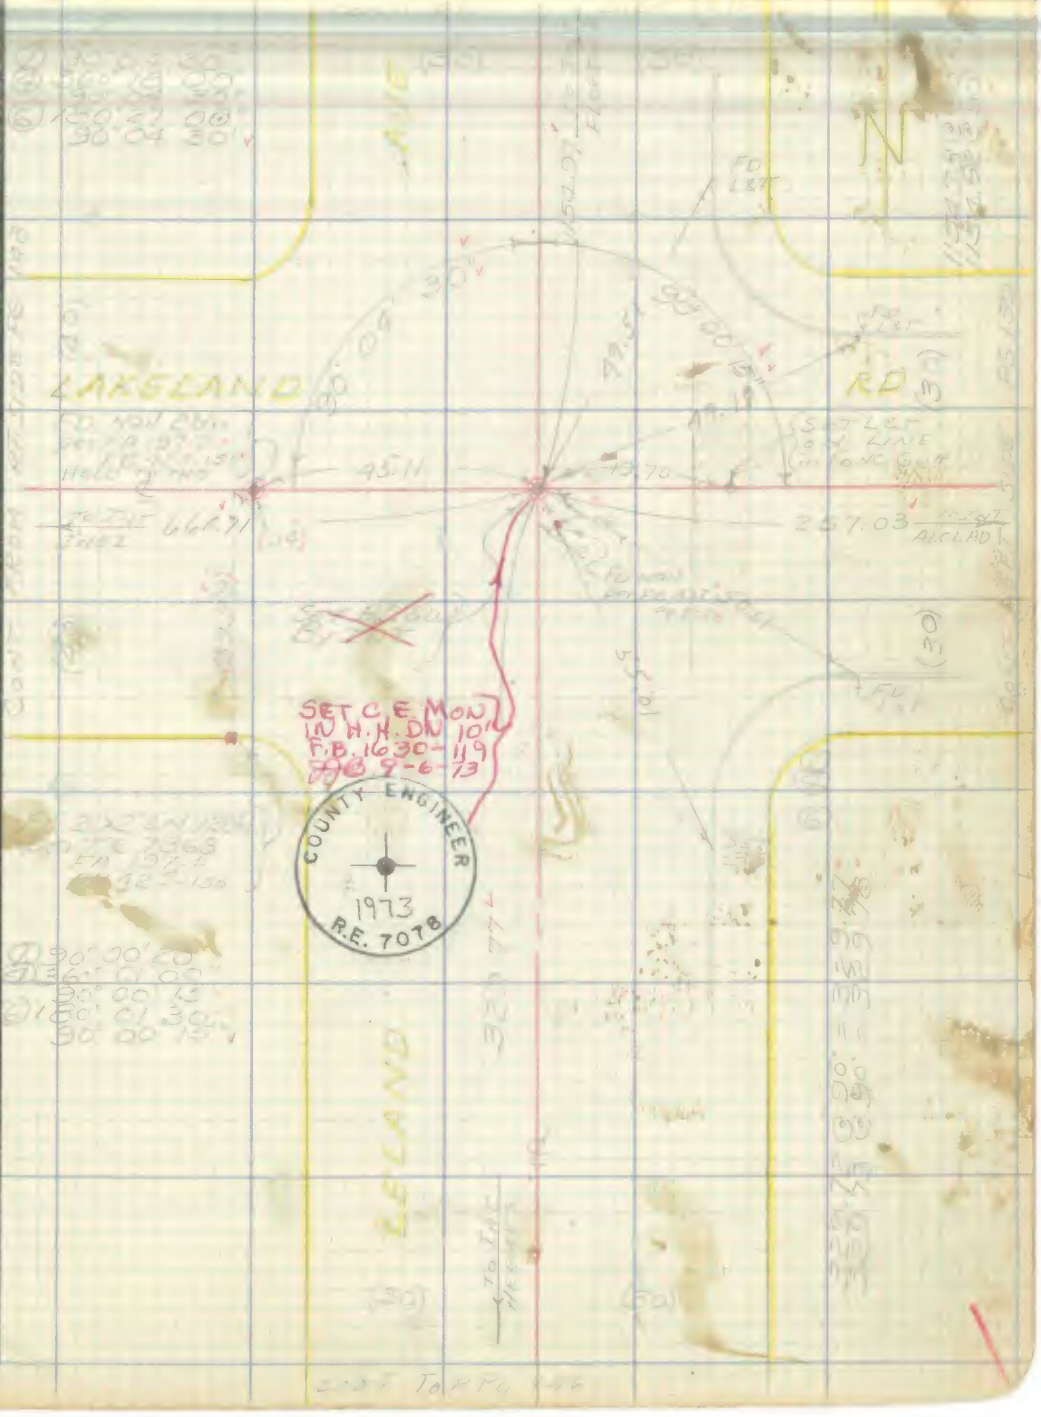


Note: Any Additions or Changes on This Sheet Must be Made or Circled in Red Ink With Date and Name of Person Making Change.

Do not extend notes this side of this line.

RETURN TO
LOS ANGELES COUNTY SURVEYOR
726 LOS ANGELES COUNTY
ENGINEERING BLDG.

76F3095 247 2-51

F. B. _____ PG. _____

PWFB 0827

2196

W.S. 34-B-2

RETURN TO
LOS ANGELES COUNTY SURVEYOR
726 LOS ANGELES COUNTY
ENGINEERING BLDG.

Do not extend notes this side of this line.

Note: Any Additions or Changes on This Sheet Must be Made or Circled in Red Ink With Date and Name of Person Making Change.

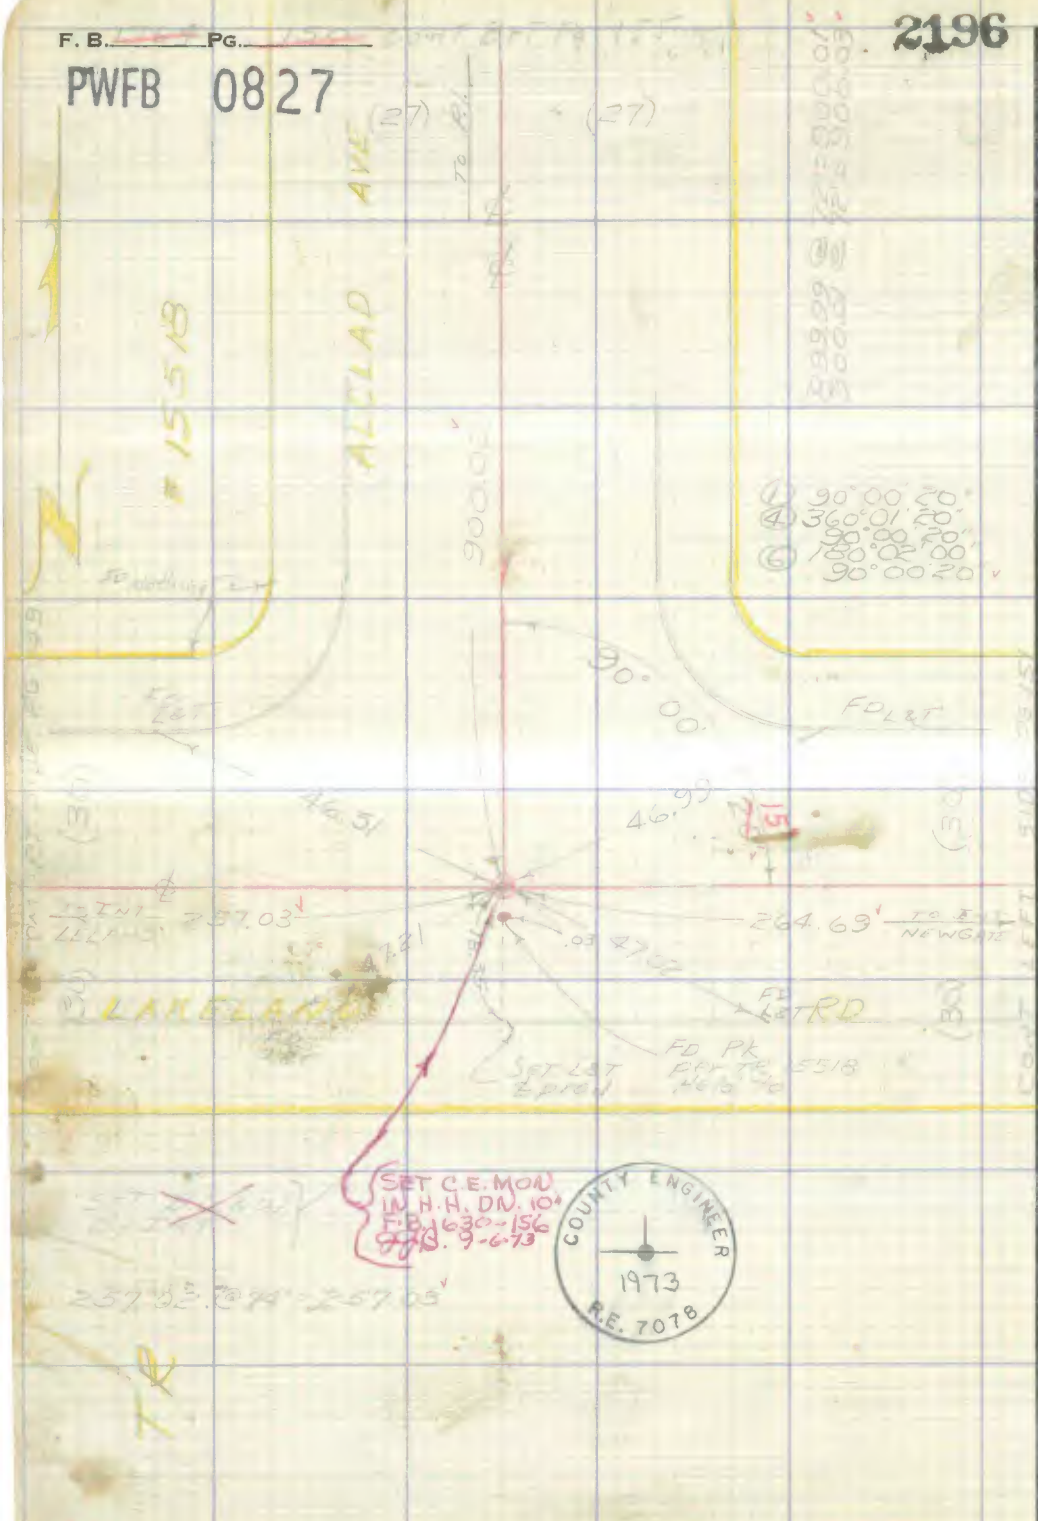

PWFB 0827

2197

| | |
|---|---|
| Notes Ck'd by D. M. Finley | Survey of |
| Map No. C.S.B.-2562 | W. O. Tape No. St'd. °F |
| Office Work R. L. Green | Surveyed by |
| Checked C. J. Gall | Notes Date |
| Date | Indexed |

F. B. PG.

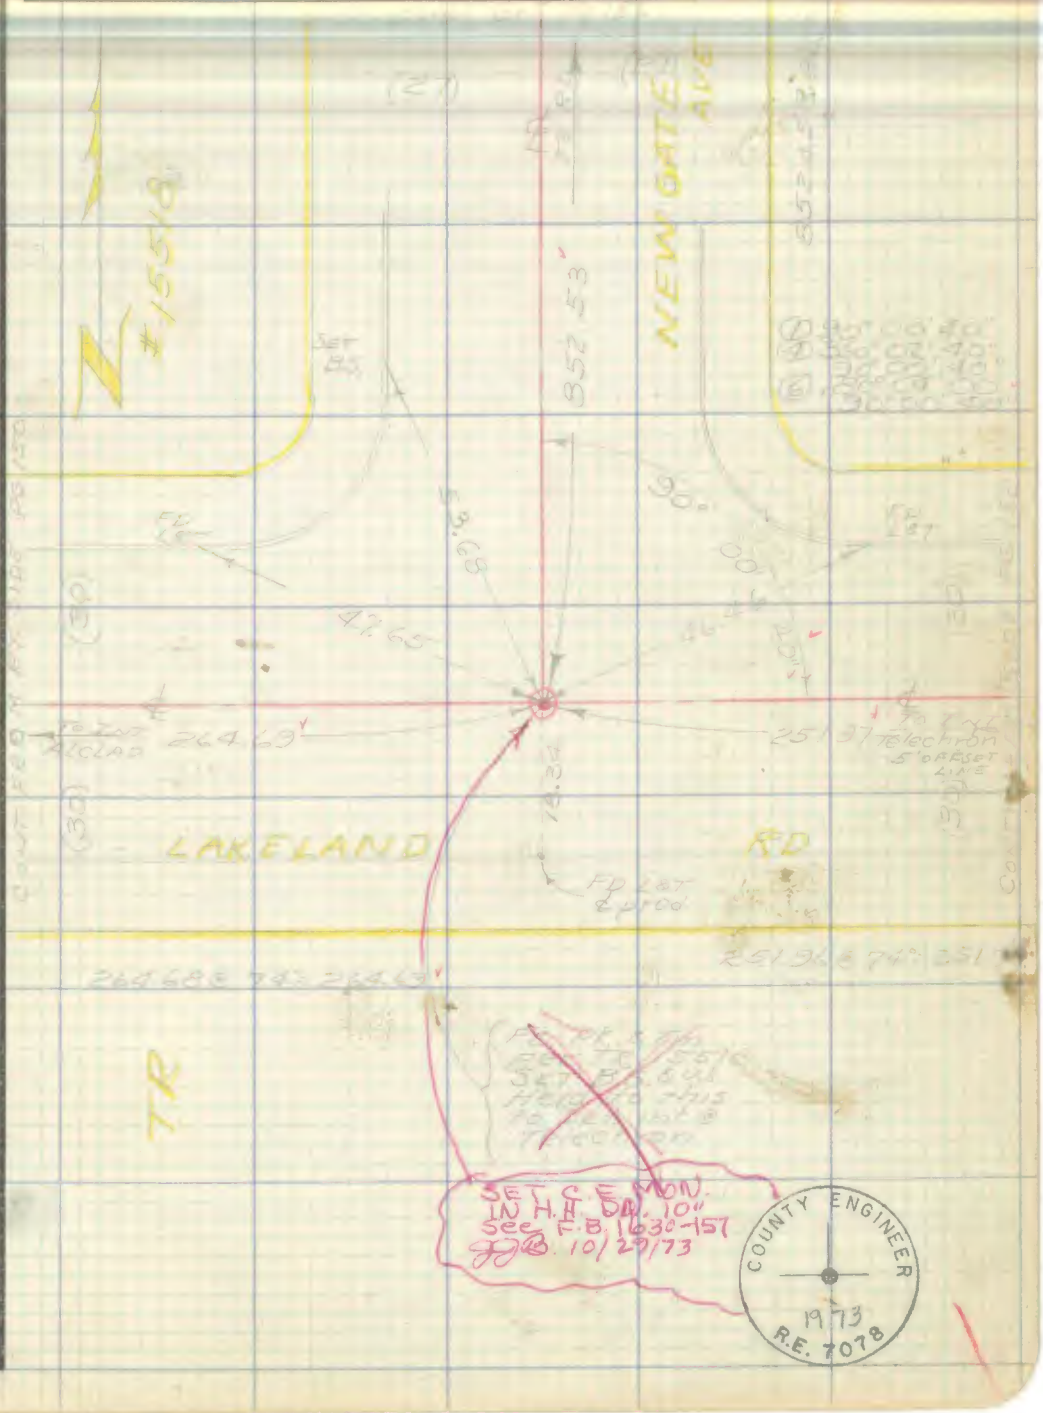


Note: Any Additions or Changes on This Sheet Must be Made or Circled in Red Ink With Date and Name of Person Making Change.

Do not extend notes this side of this line.

RETURN TO
LOS ANGELES COUNTY SURVEYOR
726 LOS ANGELES COUNTY
ENGINEERING BLDG.

76F3095 247 2-51

F. B. ____ PG. 152

PWFB 0827

2198

W.S. 34-B-2

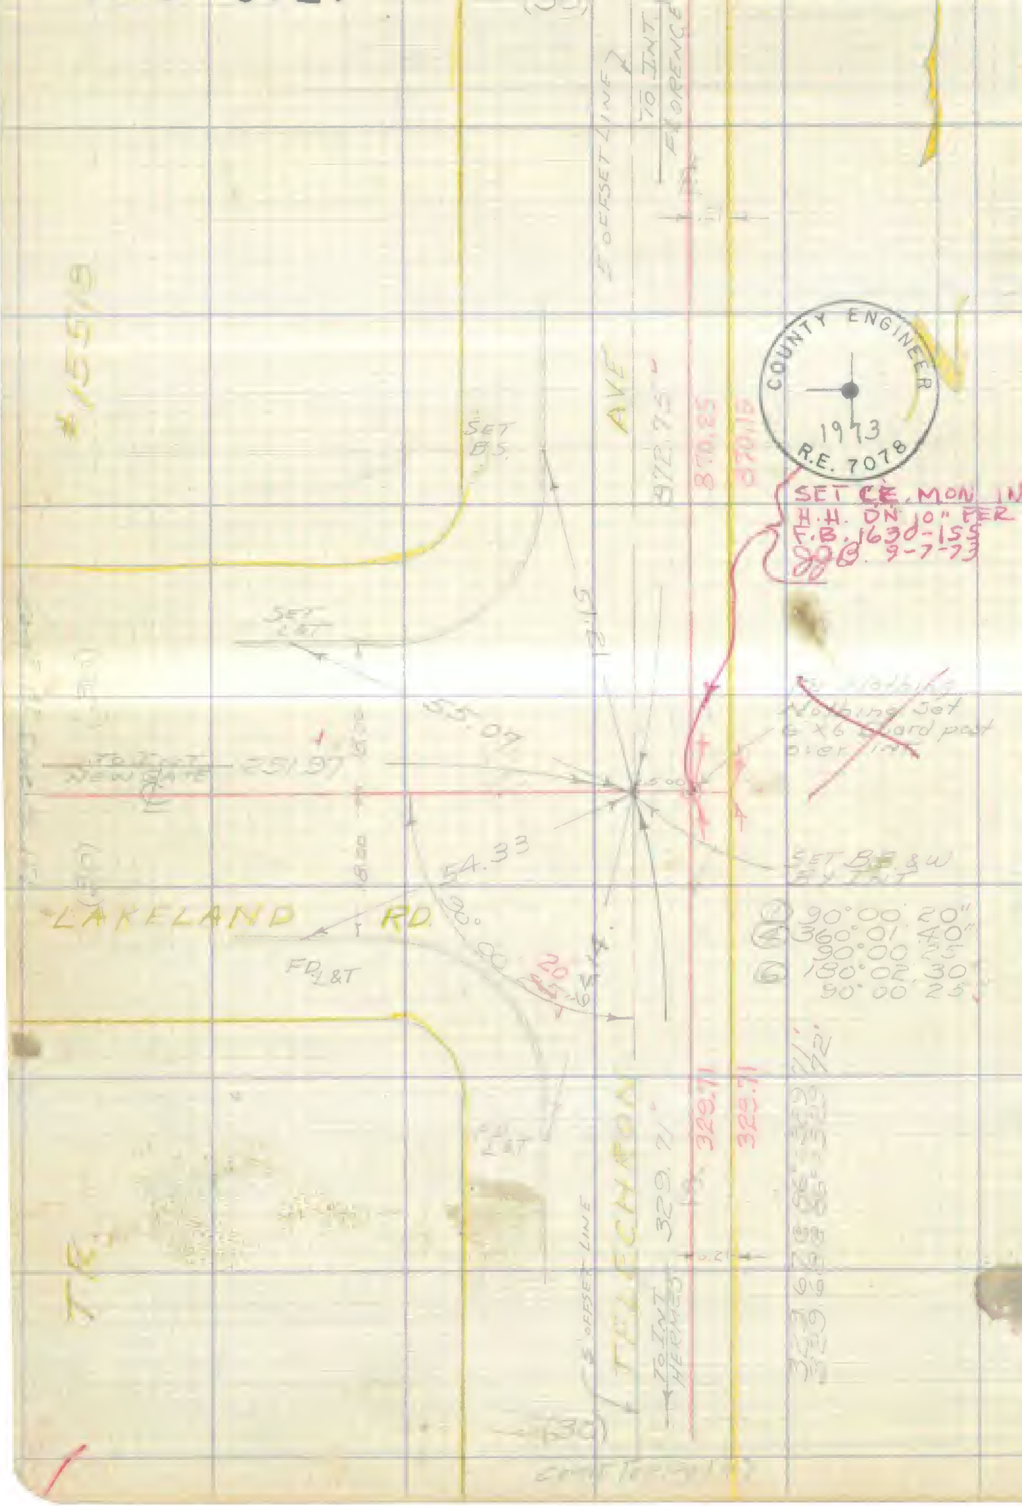


RETURN TO
LOS ANGELES COUNTY SURVEYOR
726 LOS ANGELES COUNTY
ENGINEERING BLDG.

Do not extend notes this side of this line.

Note: Any Additions or Changes on This Sheet Must be Made or Circled in Red Ink With Date and Name of Person Making Change.

PWFB 0827

2199

F. B. _____ PG. _____

Notes Ck'd by D. M. Foley
Map No. C.S.B. 2542
Office Work R.L. Green
Checked C.J. Gatti
Date June 1955

Survey of _____
W. O. _____ Tape No. _____ St'd. _____ °F
Surveyed by _____
Notes _____ Date _____
Indexed _____

W.S. 34-A-2

Note: Any Additions or Changes on This Sheet Must be Made or Circled in Red Ink With Date and Name of Person Making Change.

Do not extend notes this side of this line.

RETURN TO
LOS ANGELES COUNTY SURVEYOR
726 LOS ANGELES COUNTY
ENGINEERING BLDG.

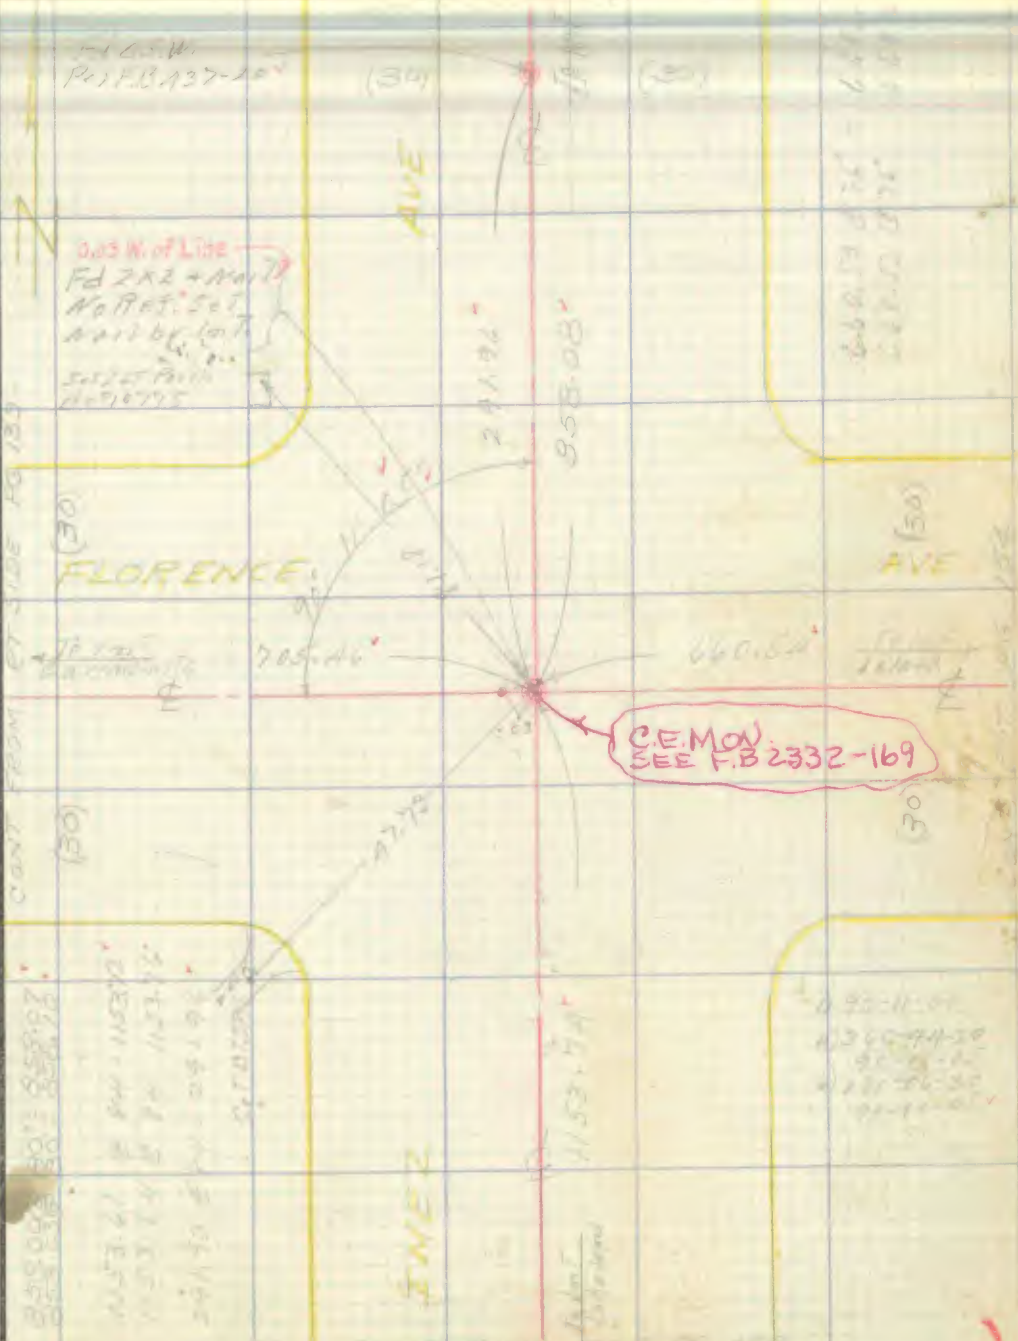


76F3095 247 2-51

F. B. _____ PG. _____

PWFB 0827

2200

W.S. 34-B-2

RETURN TO
LOS ANGELES COUNTY SURVEYOR
726 LOS ANGELES COUNTY
ENGINEERING BLDG.

Do not extend notes this side of this line.

Note: Any Additions or Changes on This Sheet Must be Made or Circled in Red Ink With Date and Name of Person Making Change.

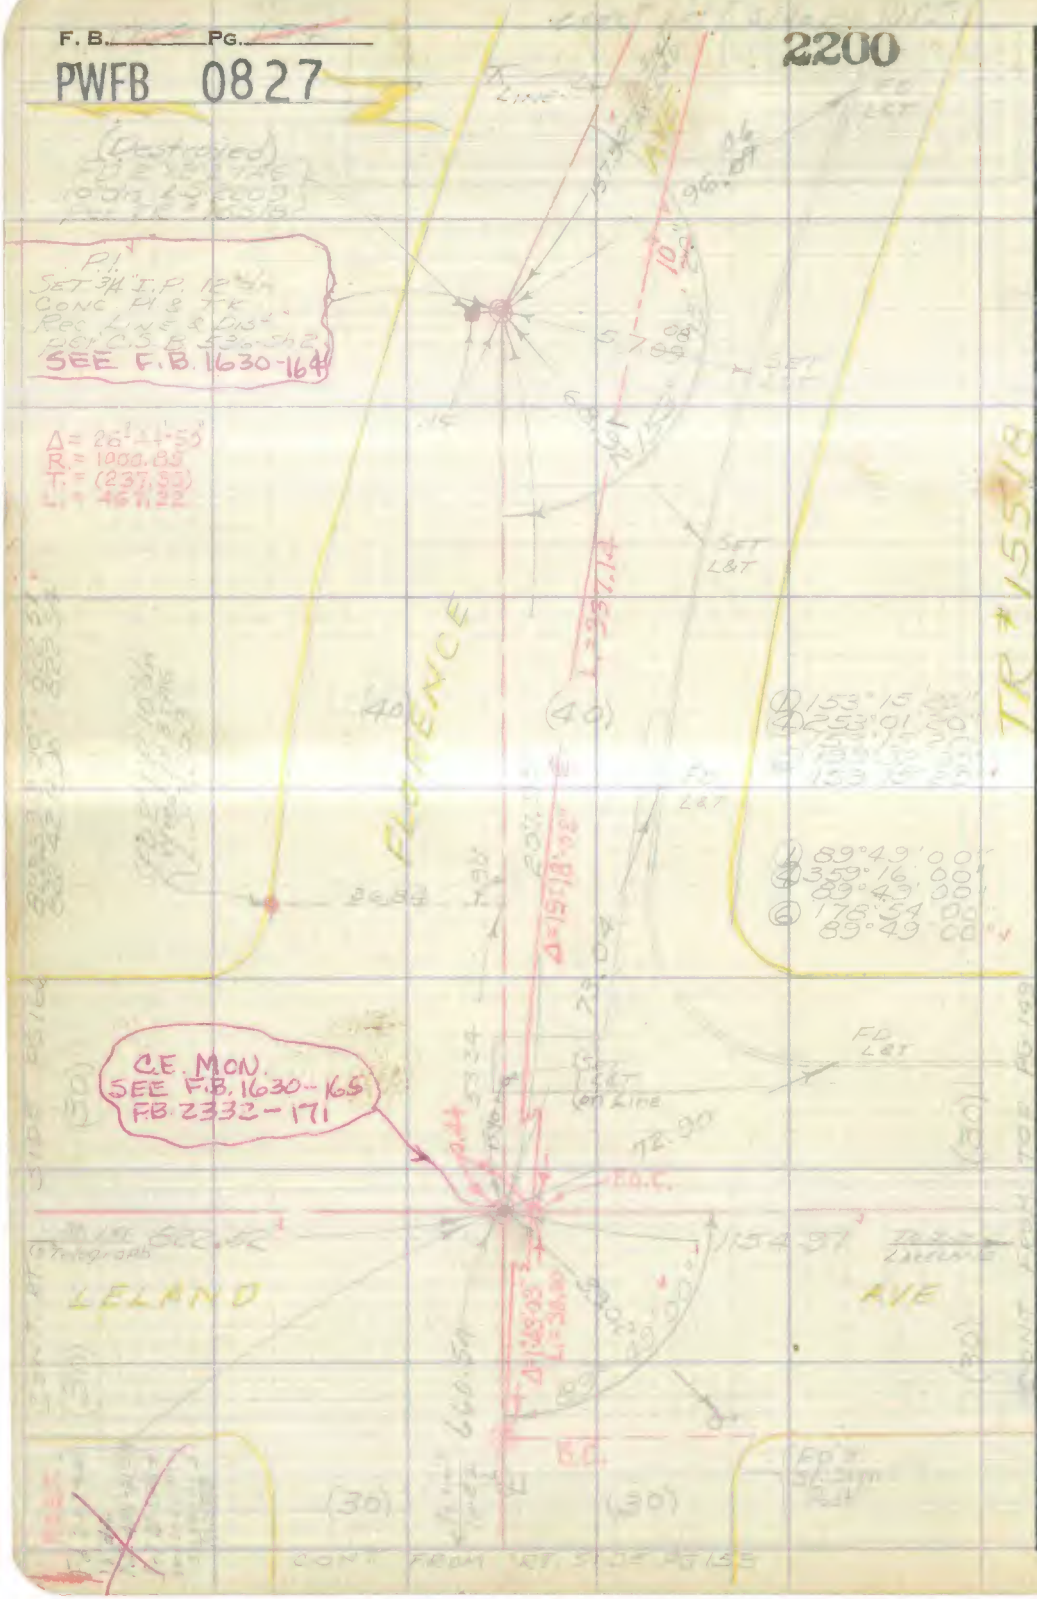

PWFB 0827

2201

F. B. 1764 PG. 155

| | |
|---|---|
| Notes Ck'd by D. M. Finley | Survey of |
| Map No. C.S.T. - 7562 | W. O. Tape No. St'd. °F |
| Office Work R. L. Green | Surveyed by |
| Checked E. J. Gaill | Notes Date |
| Date | Indexed |

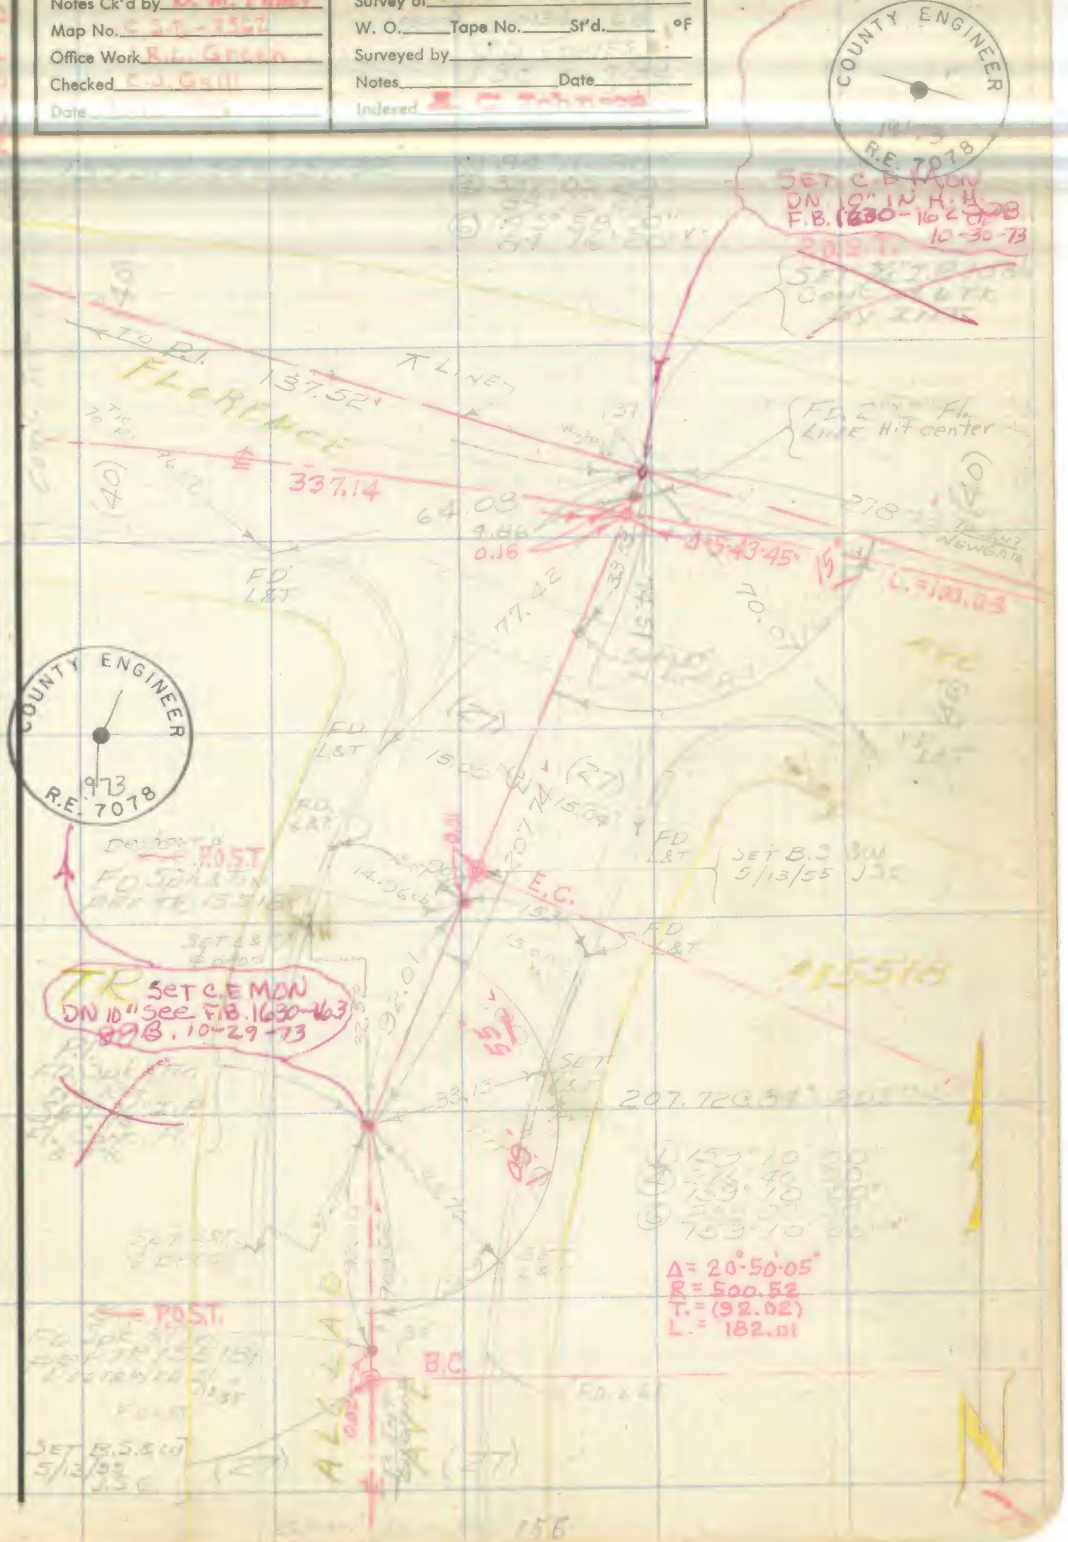


Note: Any Additions or Changes on This Sheet Must be Made or Circled in Red Ink With Date and Name of Person Making Change.

Do not extend notes this side of this line.

RETURN TO
LOS ANGELES COUNTY SURVEYOR
726 LOS ANGELES COUNTY
ENGINEERING BLDG.

76F3095 247 4-53

F.B. 1764 PG. 156 PWFB 0827 2202

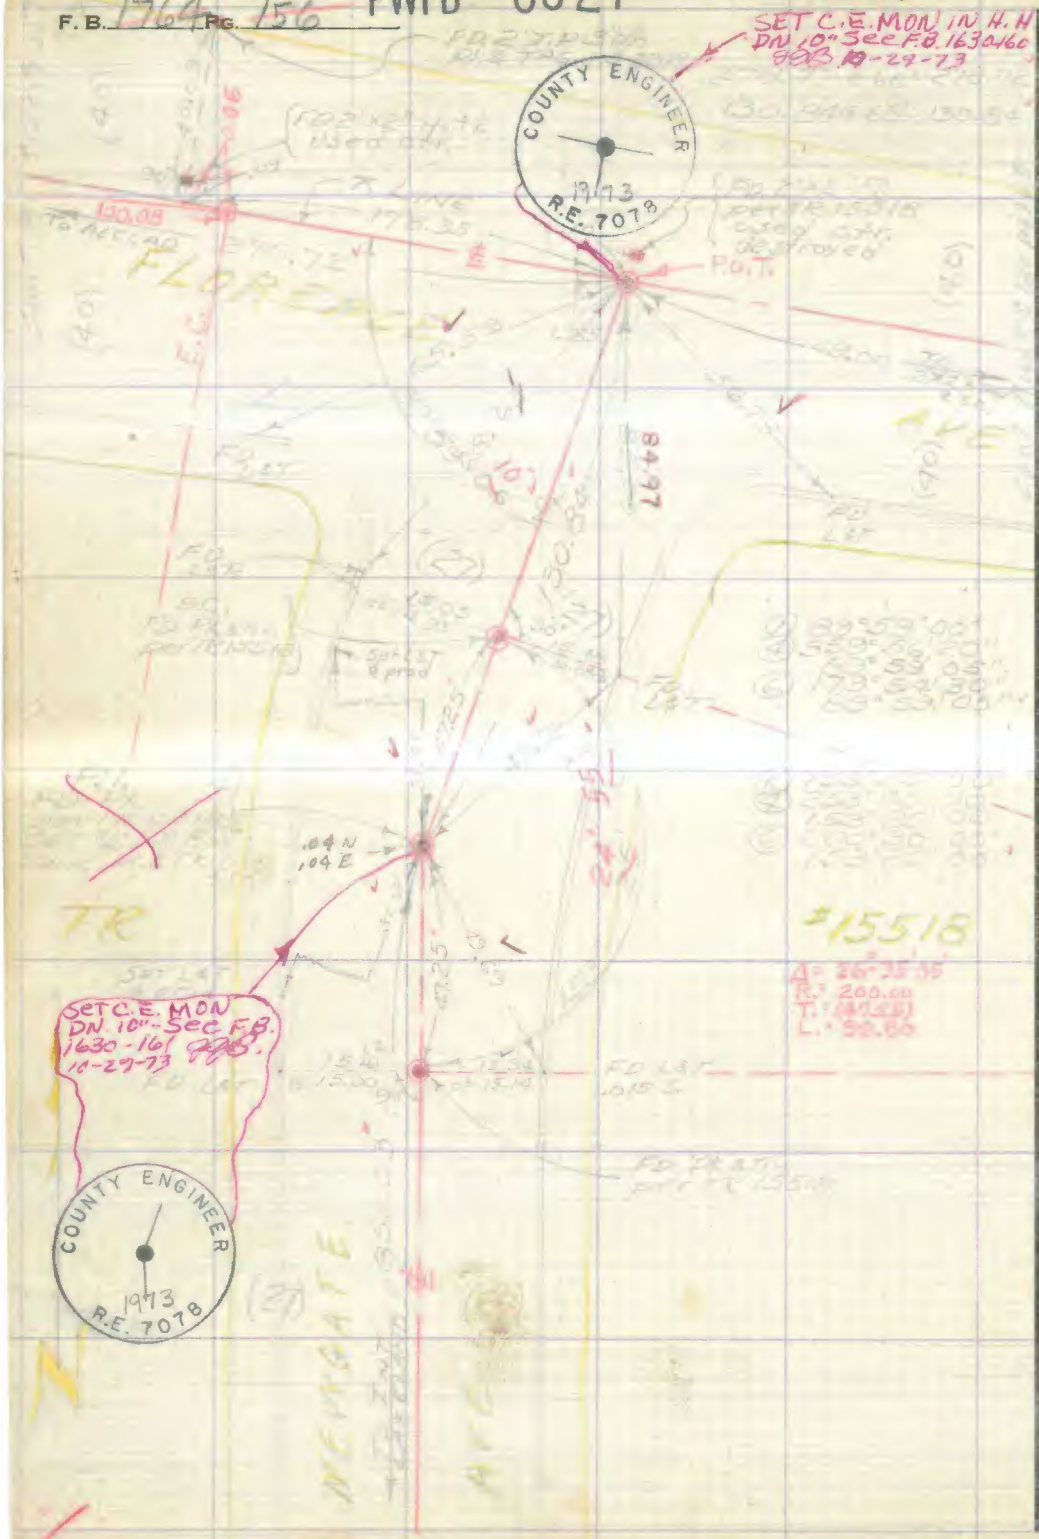


W.S. 34-B-2

RETURN TO
LOS ANGELES COUNTY SURVEYOR
726 LOS ANGELES COUNTY
ENGINEERING BLDG.

Do not extend notes this side of this line.

Note: Any Additions or Changes on This Sheet Must be Made or Circled in Red Ink With Date and Name of Person Making Change.

PWFB 0827 2203

F. B. _____ PG. 157

| | |
|---|---|
| Notes Ck'd by D. M. Finley | Survey of [illegible] |
| Map No. C.S.B. 2562 | W. O. _____ Tape No. _____ St'd. _____ °F |
| Office Work R. L. Green | Surveyed by [illegible] |
| Checked C. J. Galli | Notes _____ Date [illegible] |
| Date [illegible] | Indexed [illegible] |

W.S. 34-A-2

Note: Any Additions or Changes on This Sheet Must be Made or Circled in Red Ink With Date and Name of Person Making Change.

Do not extend notes this side of this line.

RETURN TO
LOS ANGELES COUNTY SURVEYOR
726 LOS ANGELES COUNTY
ENGINEERING BLDG.

76F309S 247 2-51

F. B. _____ Pg. 153

PWFB 0827

2204

W.S. 34-A-2

RETURN TO
LOS ANGELES COUNTY SURVEYOR
726 LOS ANGELES COUNTY
ENGINEERING BLDG.

Do not extend notes this side of this line.

Note: Any Additions or Changes on This Sheet Must be Made or Circled in Red Ink With Date and Name of Person Making Change.

PWFB 0827 2205

| | |
|---|---|
| Notes Ck'd by D. M. Finley | Survey of |
| Map No. C.S.B. | W. O. Tape No. St'd. °F |
| Office Work R.L. Green | Surveyed by |
| Checked C. J. Gall | Notes Date |
| Date | Indexed R. C. Johnson |

F. B. Pg. 159

WS 34-A-2

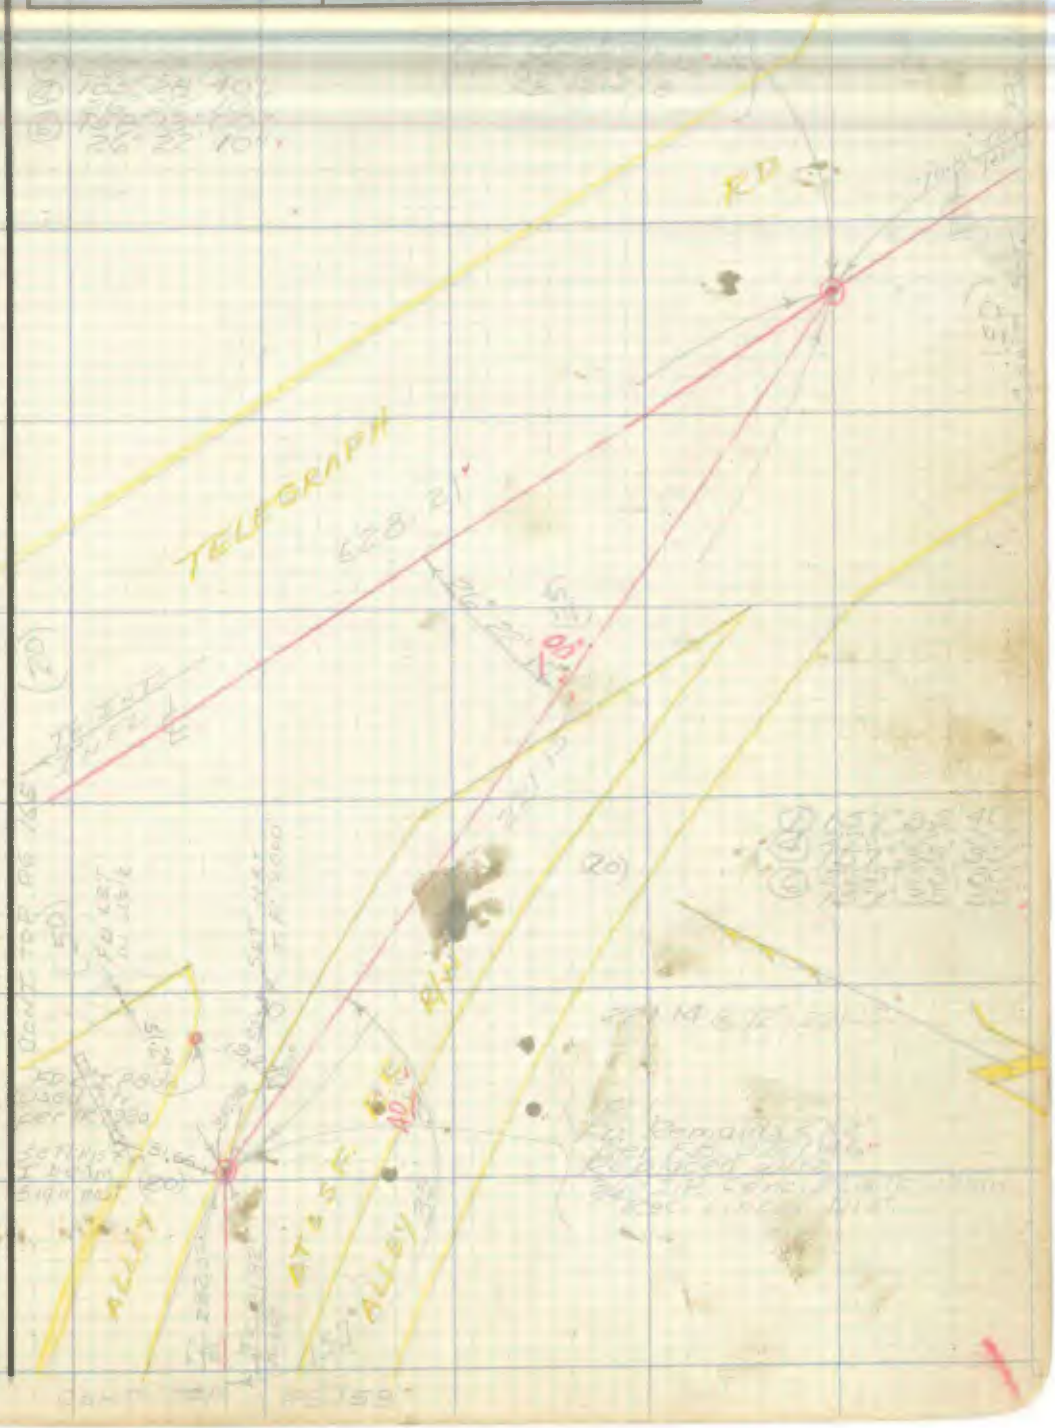


Note: Any Additions or Changes on This Sheet Must be Made or Circled in Red Ink With Date and Name of Person Making Change.

Do not extend notes this side of this line.

RETURN TO
LOS ANGELES COUNTY SURVEYOR
726 LOS ANGELES COUNTY
ENGINEERING BLDG.

76F3098 247 4-53

PWFB 0827

2206

F. B. _____ Pg. _____

W.S. 34-B-2

RETURN TO
LOS ANGELES COUNTY SURVEYOR
726 LOS ANGELES COUNTY
ENGINEERING BLDG.
Do not extend notes this side of this line.

Note: Any Additions or Changes on This Sheet Must be Made or Circled in Red Ink With Date and Name of Person Making Change.

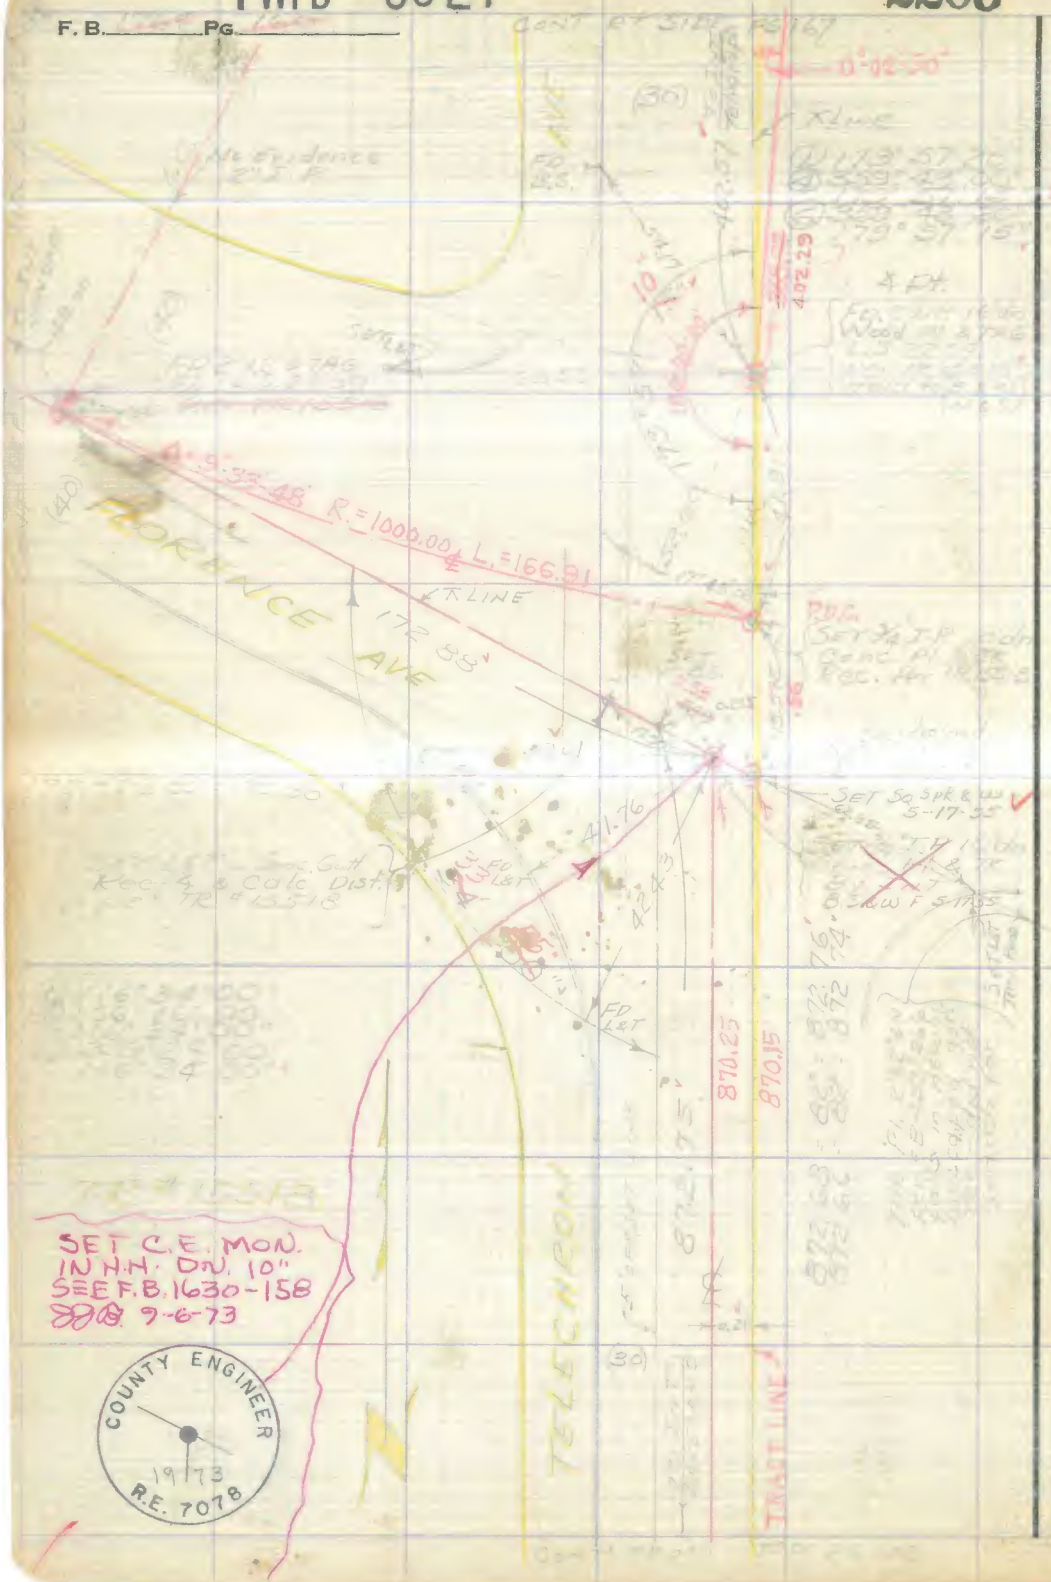


SET C.E. MON.
IN H.H. DN. 10"
SEE F.B. 1630-158
9-6-73

COUNTY ENGINEER
1973
R.E. 7078

76F3095 247 4-53

RETURN TO
LOS ANGELES COUNTY SURVEYOR
726 LOS ANGELES COUNTY
ENGINEERING BLDG.

**Note:** Any Additions or Changes on This Sheet Must be Made or Circled in Red Ink With Date and Name of Person Making Change.

**Do not extend notes this side of this line.**

W.S. 34-A-2

PWFB 0927 1027

Notes Ck'd by D. M. Finley
Map No.
Office Work R. L. Green
Checked
Date

Survey of
W. O. Tape No. St'd. °F
Surveyed by
Notes Date
Indexed

F. B. PG.

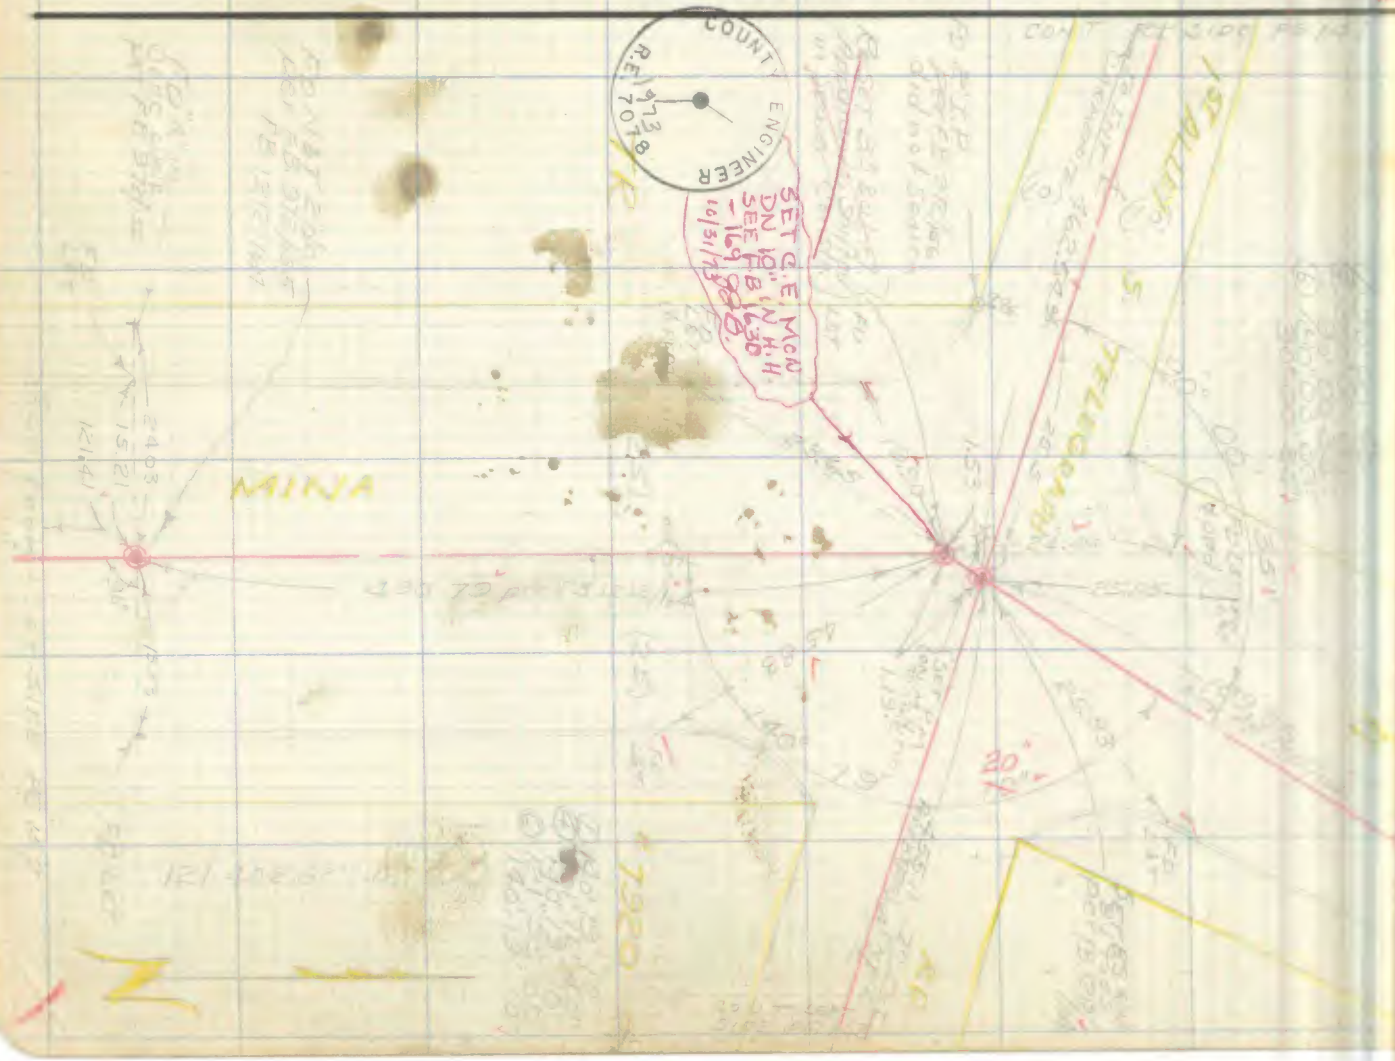

PWFB 0927 1028

F. B. ____ PG. ____

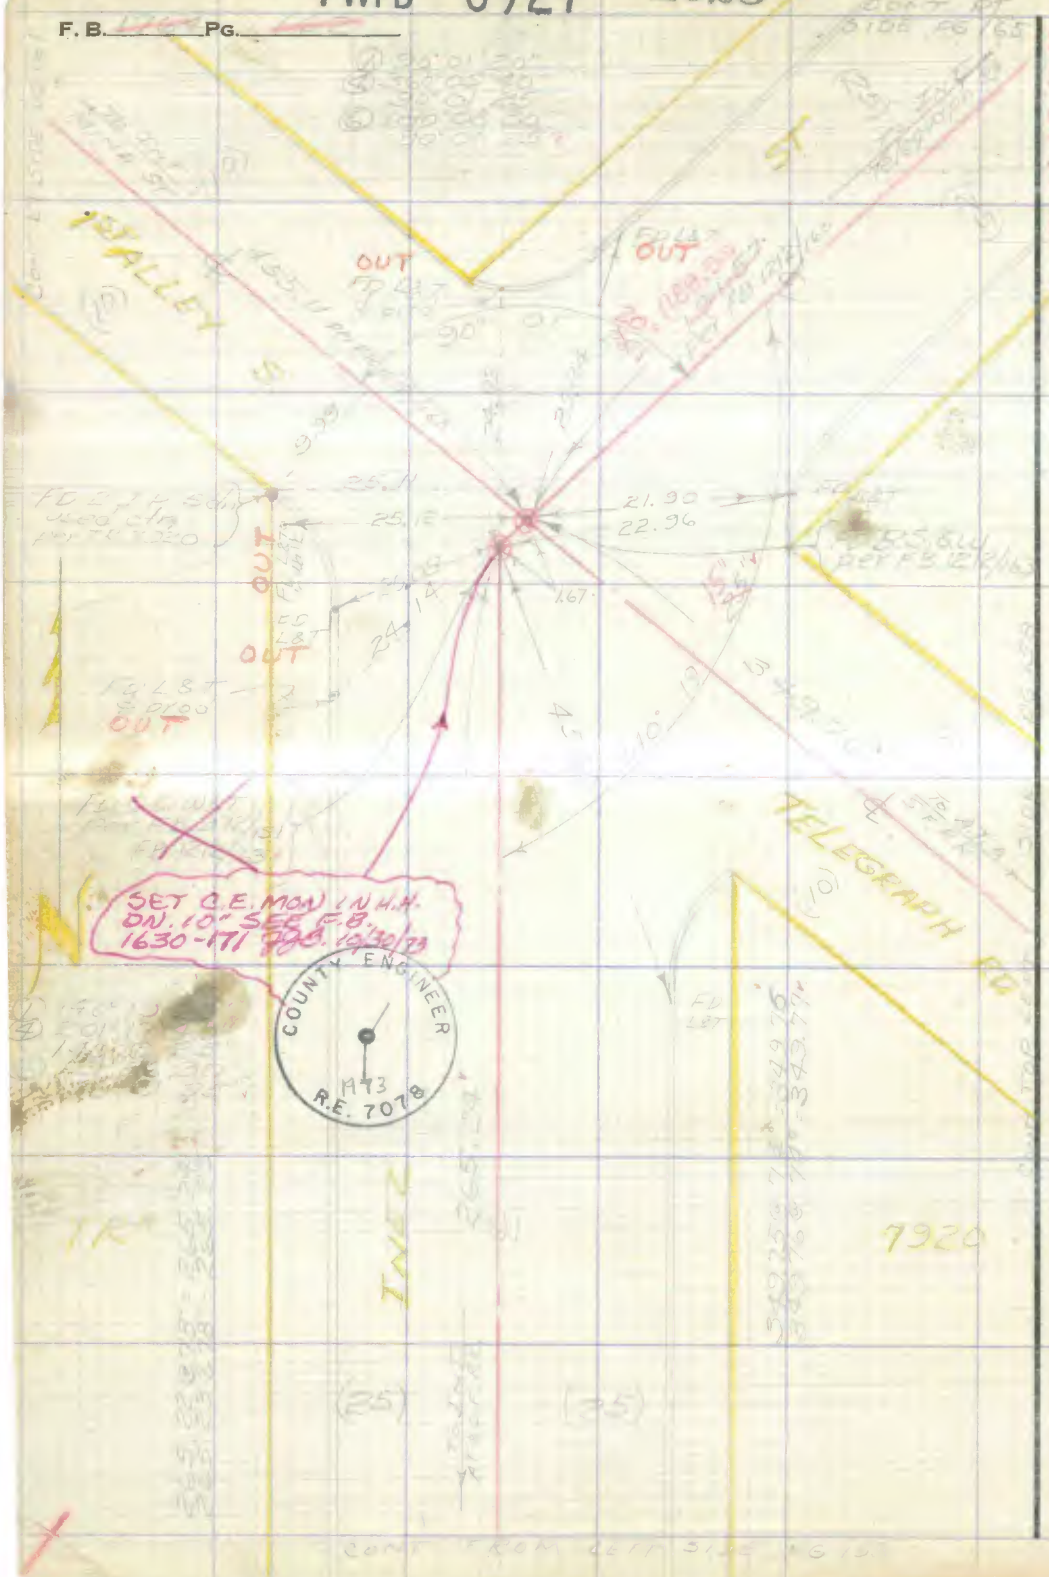


RETURN TO
LOS ANGELES COUNTY SURVEYOR
726 LOS ANGELES COUNTY
ENGINEERING BLDG.

Do not extend notes this side of this line.

Note: Any Additions or Changes on This Sheet Must be Made or Circled in Red Ink With Date and Name of Person Making Change.

PWFB 0927 1029

WS 34-A-2

| | |
|---|---|
| Notes Ck'd by D. McFinley | Survey of [illegible] |
| Map No. C.S.B-2562 | W. O. ____ Tape No. ____ St'd. ____ °F |
| Office Work R.L. Green | Surveyed by [illegible] |
| Checked C.J. Gohl | Notes ____ Date ____ |
| Date [illegible] | Indexed [illegible] |

F. B. ____ PG. ____

Note: Any Additions or Changes on This Sheet Must be Made or Circled In Red Ink With Date and Name of Person Making Change.

Do not extend notes this side of this line.

RETURN TO
LOS ANGELES COUNTY SURVEYOR
726 LOS ANGELES COUNTY
ENGINEERING BLDG.

76F3095 247 4-53

PWFB 0927 1030

F. B. [illegible] PG. [illegible]

W.S. 34-A-2.

RETURN TO
LOS ANGELES COUNTY SURVEYOR
726 LOS ANGELES COUNTY
ENGINEERING BLDG.

Do not extend notes this side of this line.

Note: Any Additions or Changes on This Sheet Must be Made or Circled in Red Ink With Date and Name of Person Making Change.

PWFB 0927

1031

F. B. ____ PG. ____

| | |
|---|---|
| Notes Ck'd by D. M. Finley | Survey of ____ |
| Map No. C.S.W. 2562 | W. O. ____ Tape No. ____ St'd. ____ °F |
| Office Work R. L. Green | Surveyed by ____ |
| Checked C. J. Galli | Notes ____ Date ____ |
| Date ____ | Indexed R. C. Johnson |

W 34-A-2

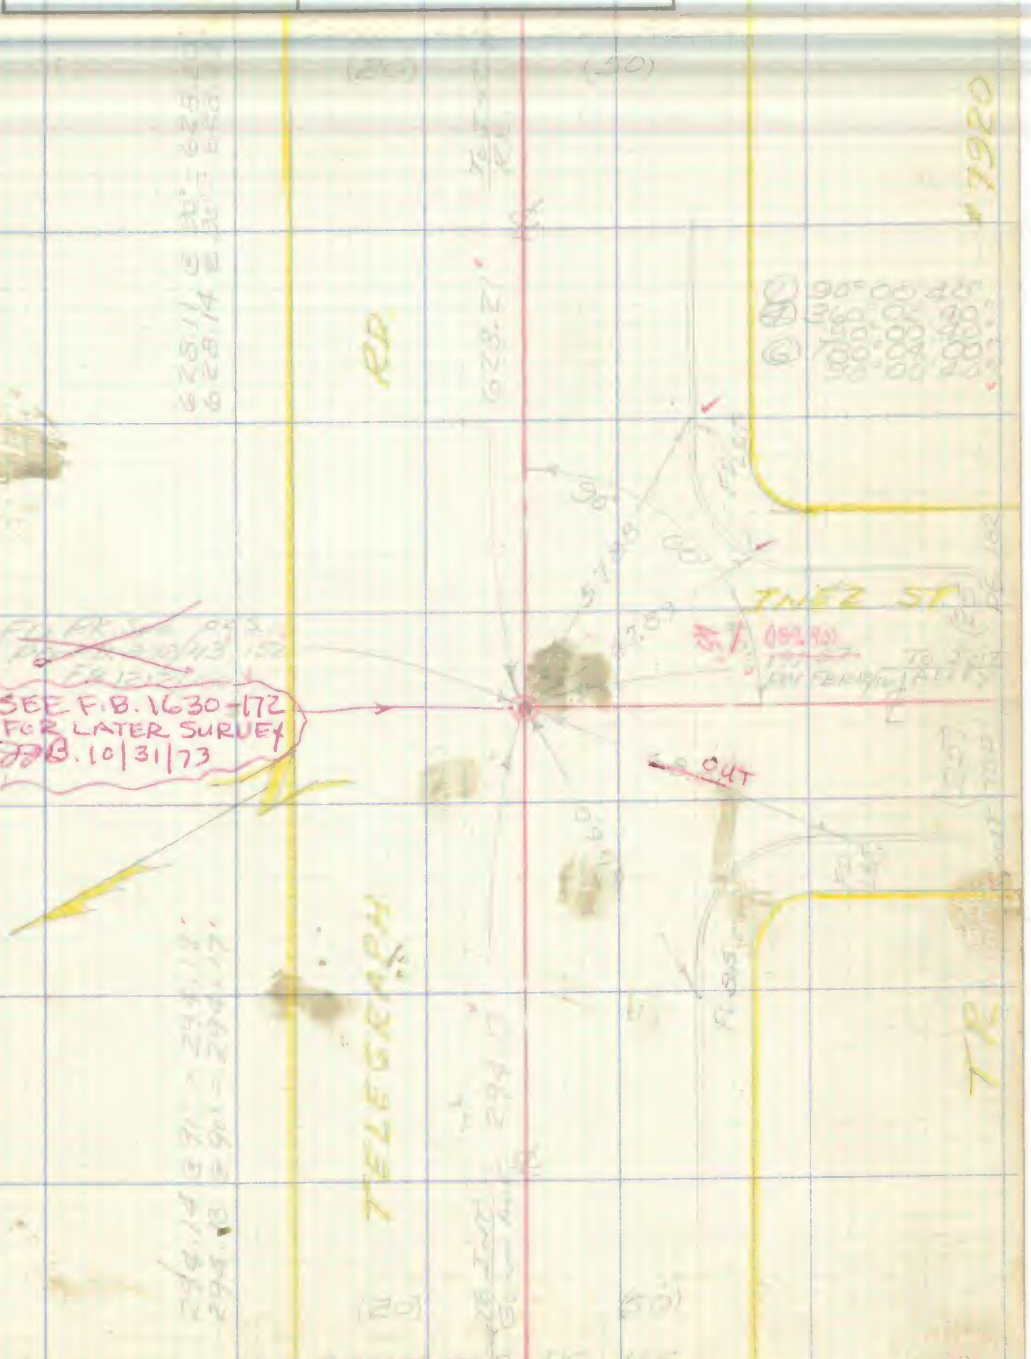


Note: Any Additions or Changes on This Sheet Must be Made or Circled in Red Ink With Date and Name of Person Making Change.

Do not extend notes this side of this line.

RETURN TO
LOS ANGELES COUNTY SURVEYOR
726 LOS ANGELES COUNTY
ENGINEERING BLDG.

76F3098 247 4-53

F. B. _____ Pg. _____

PWFB 0827

2208

W.S. 34-B-2

RETURN TO
LOS ANGELES COUNTY SURVEYOR
726 LOS ANGELES COUNTY
ENGINEERING BLDG.

Do not extend notes this side of this line.

Note: Any Additions or Changes on This Sheet Must be Made or Circled in Red Ink With Date and Name of Person Making Change.

PWFB 0827 2209

| | |
|---|---|
| Notes Ck'd by D. M. Finley | Survey of |
| Map No. C.S. B-2562 | W. O. Tape No. St'd. °F |
| Office Work R. L. Green | Surveyed by |
| Checked S. J. Gall | Notes Date |
| Date | Indexed R. C. Tabrand |

F. B. Pg.

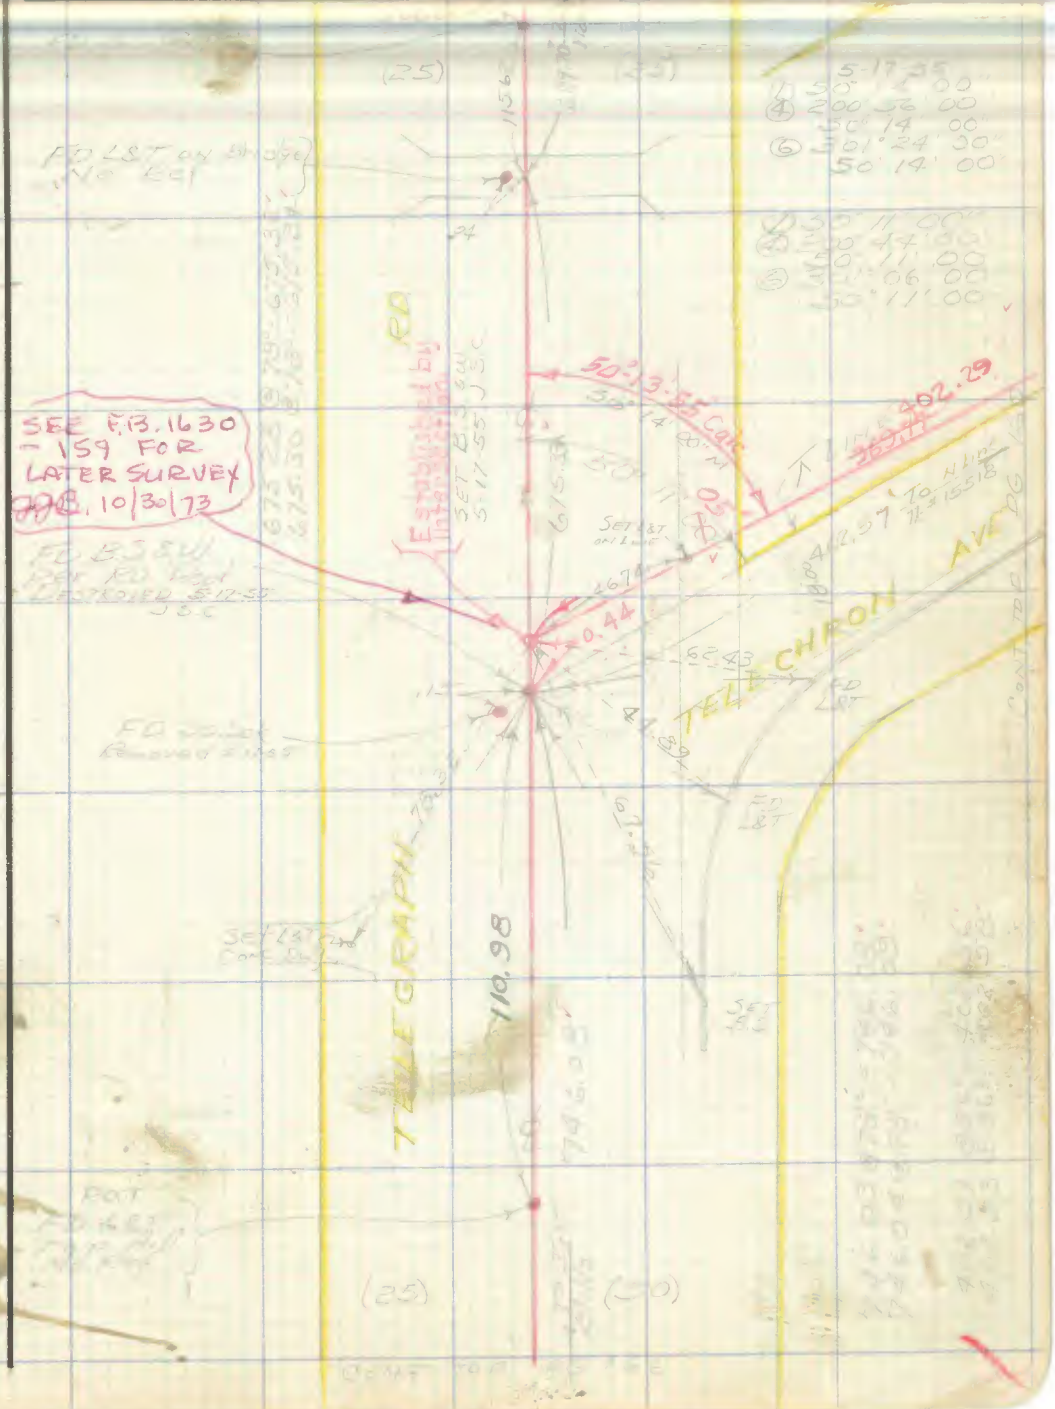


Note: Any Additions or Changes on This Sheet Must be Made or Circled in Red Ink With Date and Name of Person Making Change.

Do not extend notes this side of this line.

RETURN TO
LOS ANGELES COUNTY SURVEYOR
726 LOS ANGELES COUNTY
ENGINEERING BLDG.

76F3098 247 4-53

PWFB 0827 2210

F. B. 1764 Pg. 168

W.S. 34-B-2

RETURN TO
LOS ANGELES COUNTY SURVEYOR
726 LOS ANGELES COUNTY
ENGINEERING BLDG.

Do not extend notes this side of this line.

Note: Any Additions or Changes on This Sheet Must be Made or Circled in Red Ink With Date and Name of Person Making Change.

PWFB 0827 2211, 2212

W.C. 34-B-2

| | |
|---|---|
| Notes Ck'd by D. M. Finley | Survey of |
| Map No. C.S.B. 2562 | W. O. ___ Tape No. ___ St'd. ___ °F |
| Office Work R. L. Green | Surveyed by |
| Checked C. J. Galli | Notes ___ Date |
| Date | Indexed |

F. B. ___ Pg. ___

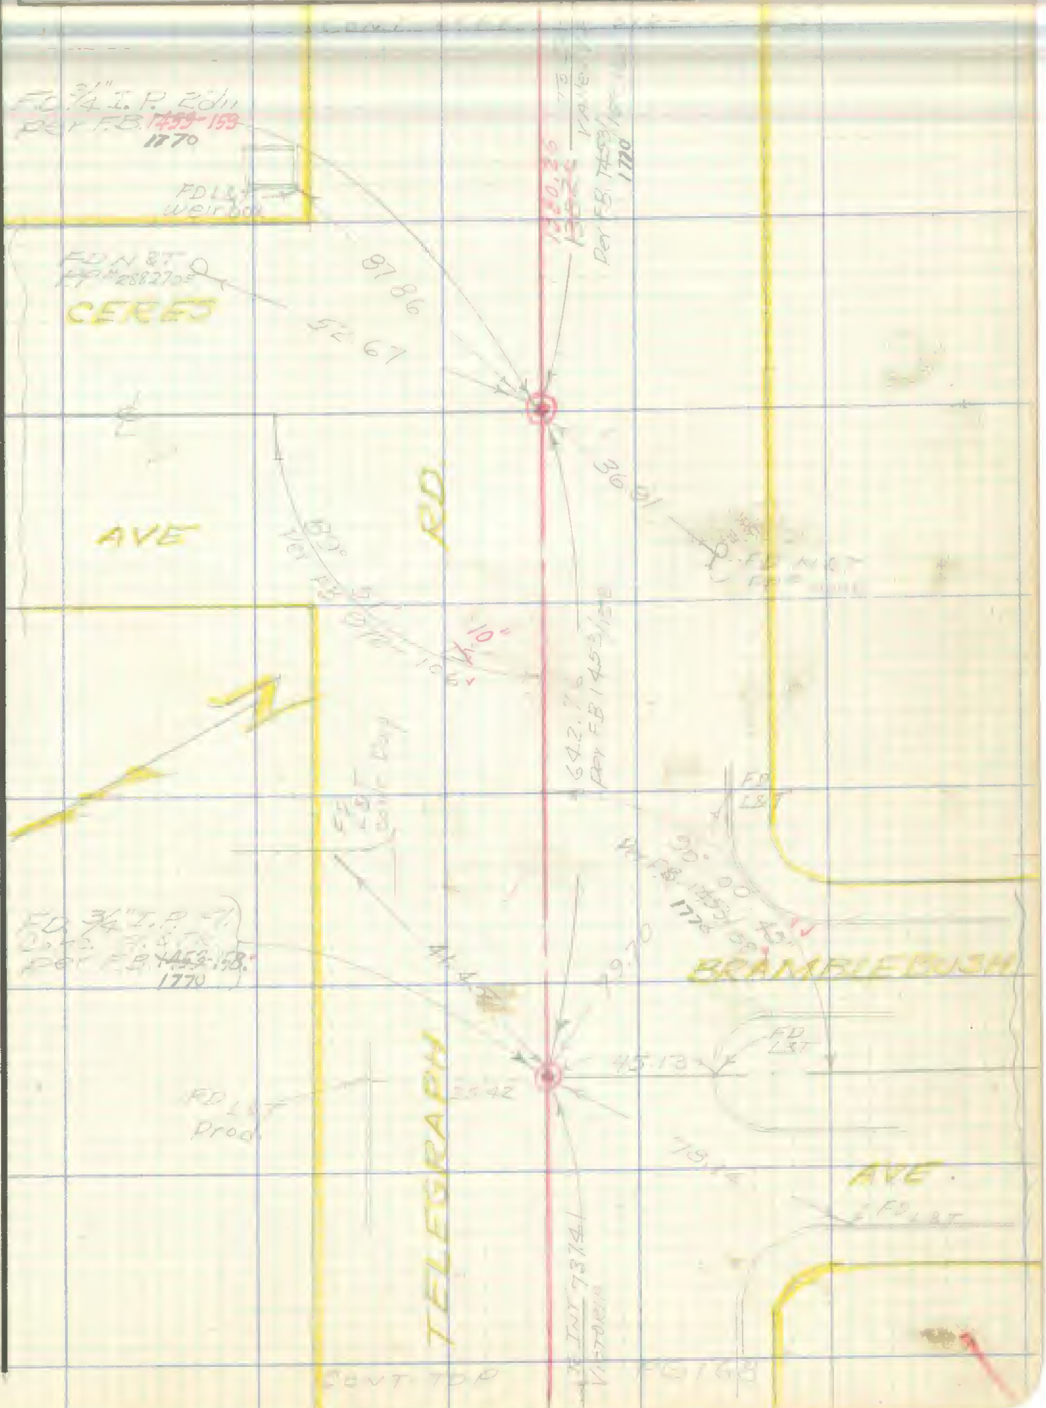


**Note:** Any Additions or Changes on This Sheet Must be Made or Circled in Red Ink With Date and Name of Person Making Change.

**Do not extend notes this side of this line.**

RETURN TO
LOS ANGELES COUNTY SURVEYOR
726 LOS ANGELES COUNTY
ENGINEERING BLDG.

76F3005 247 4-53

RETURN TO
LOS ANGELES COUNTY SURVEYOR
726 LOS ANGELES COUNTY
ENGINEERING BLDG.

Note: Any Additions or Changes on This Sheet Must be Made or Circled In Red Ink With Date and Name of Person Making Change.

Do not extend notes this side of this line.

F. B. 1754 PG. 170

PWFB 0827

2213

| | |
|---|---|
| Notes Ck'd by D. M. Finley | Survey of [illegible] |
| Map No. C.S.B. 3562 | W. O. ____ Tape No. 134 St'd. ____ °F |
| Office Work R. L. Green | Surveyed by [illegible] |
| Checked C. J. Galli | Notes ____ Date 8/54 |
| Date [illegible] | Indexed [illegible] |

F. B. ____ PG. 177

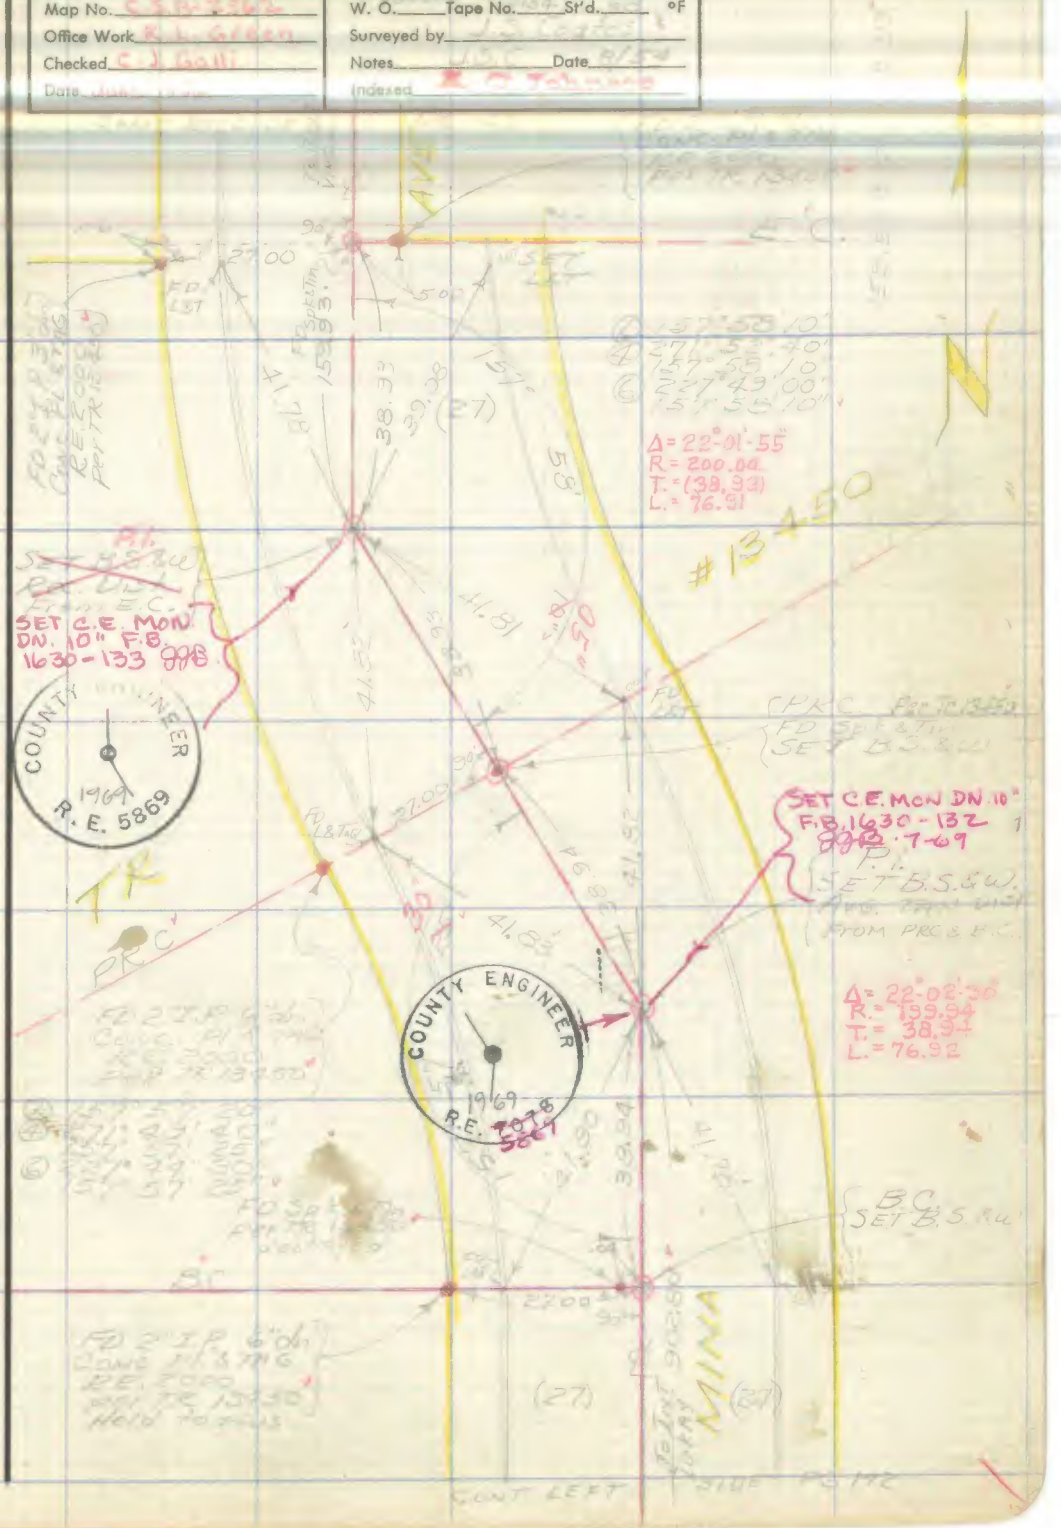


Note: Any Additions or Changes on This Sheet Must be Made or Circled in Red Ink With Date and Name of Person Making Change.

Do not extend notes this side of this line.

RETURN TO
LOS ANGELES COUNTY SURVEYOR
726 LOS ANGELES COUNTY
ENGINEERING BLDG.

76F3095 247 4-53

PWFB 0827 2214

F. B. 1764 PG. 172

W.S. 34-A3

RETURN TO
LOS ANGELES COUNTY SURVEYOR
726 LOS ANGELES COUNTY
ENGINEERING BLDG.
Do not extend notes this side of this line.

Note: Any Additions or Changes on This Sheet Must be Made or Circled in Red Ink With Date and Name of Person Making Change.

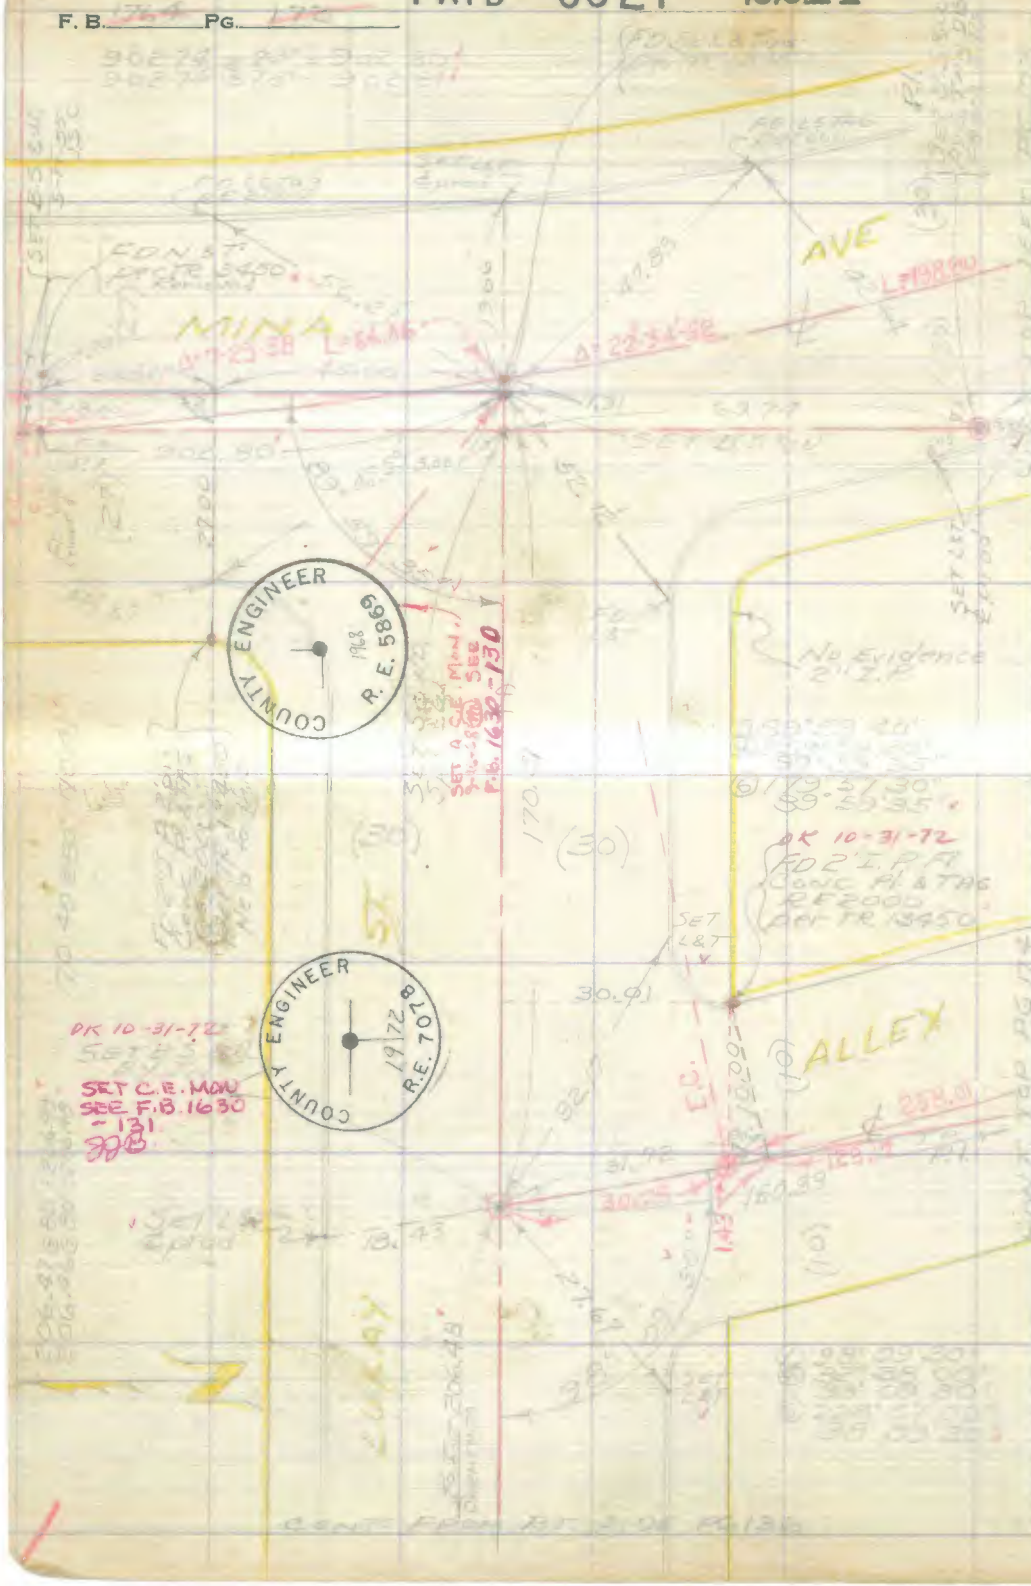

PWFB 0827

2215

| | |
|---|---|
| Notes Ck'd by D. M. Finley | Survey of |
| Map No. | W. O. Tape No. St'd. °F |
| Office Work R. L. Green | Surveyed by |
| Checked C. J. Gaill | Notes Date |
| Date | Indexed R. O. Johnson |

F. B. Pg.

WS 34-A-3

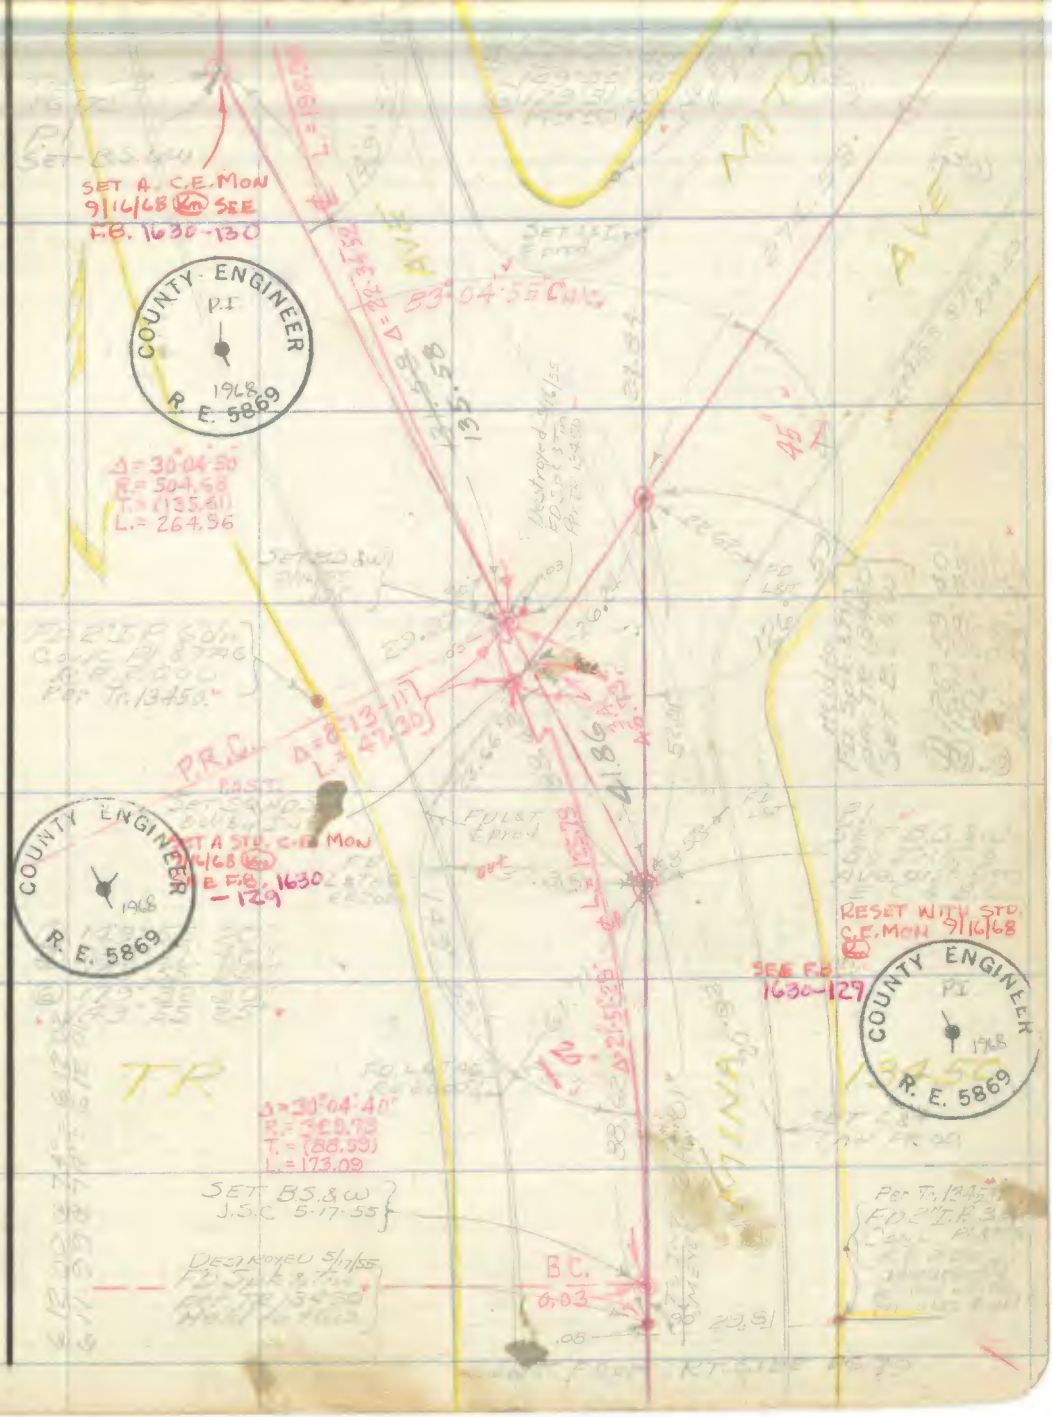


Note: Any Additions or Changes on This Sheet Must be Made or Circled in Red Ink With Date and Name of Person Making Change.

Do not extend notes this side of this line.

RETURN TO
LOS ANGELES COUNTY SURVEYOR
726 LOS ANGELES COUNTY
ENGINEERING BLDG.

76F3098 247 4-53

PWFD 0827 2216

F. B. _____ PG. _____

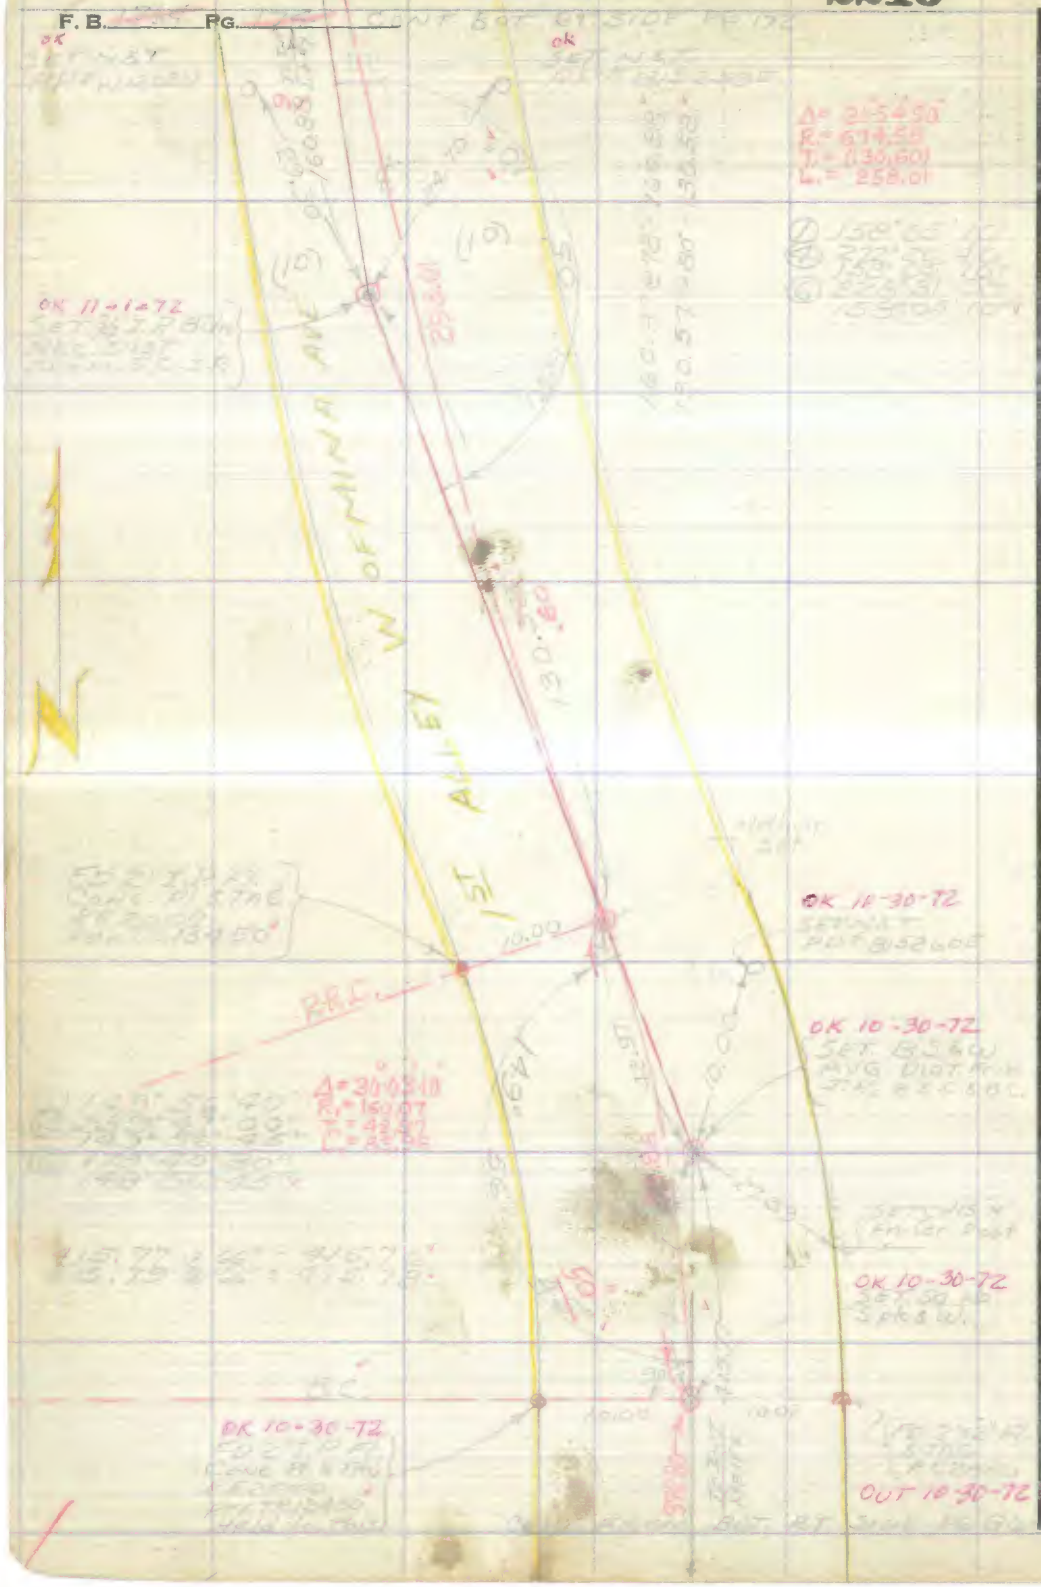


W.S. 34-A-3

RETURN TO:
LOS ANGELES COUNTY SURVEYOR
726 LOS ANGELES COUNTY
ENGINEERING BLDG.

Do not extend notes this side of this line.

Note: Any Additions or Changes on This Sheet Must be Made or Circled in Red Ink With Date and Name of Person Making Change.

PWFB 0827 2217

| | |
|---|---|
| Notes Ck'd by D. M. Finley | Survey of |
| Map No. | W. O. Tape No. St'd. °F |
| Office Work R. L. Green | Surveyed by |
| Checked C. J. Gall | Notes Date |
| Date | Indexed |

F. B. PG.

W.S. 34-A-3

Note: Any Additions or Changes on This Sheet Must be Made or Circled in Red Ink With Date and Name of Person Making Change.

Do not extend notes this side of this line.

RETURN TO
LOS ANGELES COUNTY SURVEYOR
726 LOS ANGELES COUNTY
ENGINEERING BLDG.

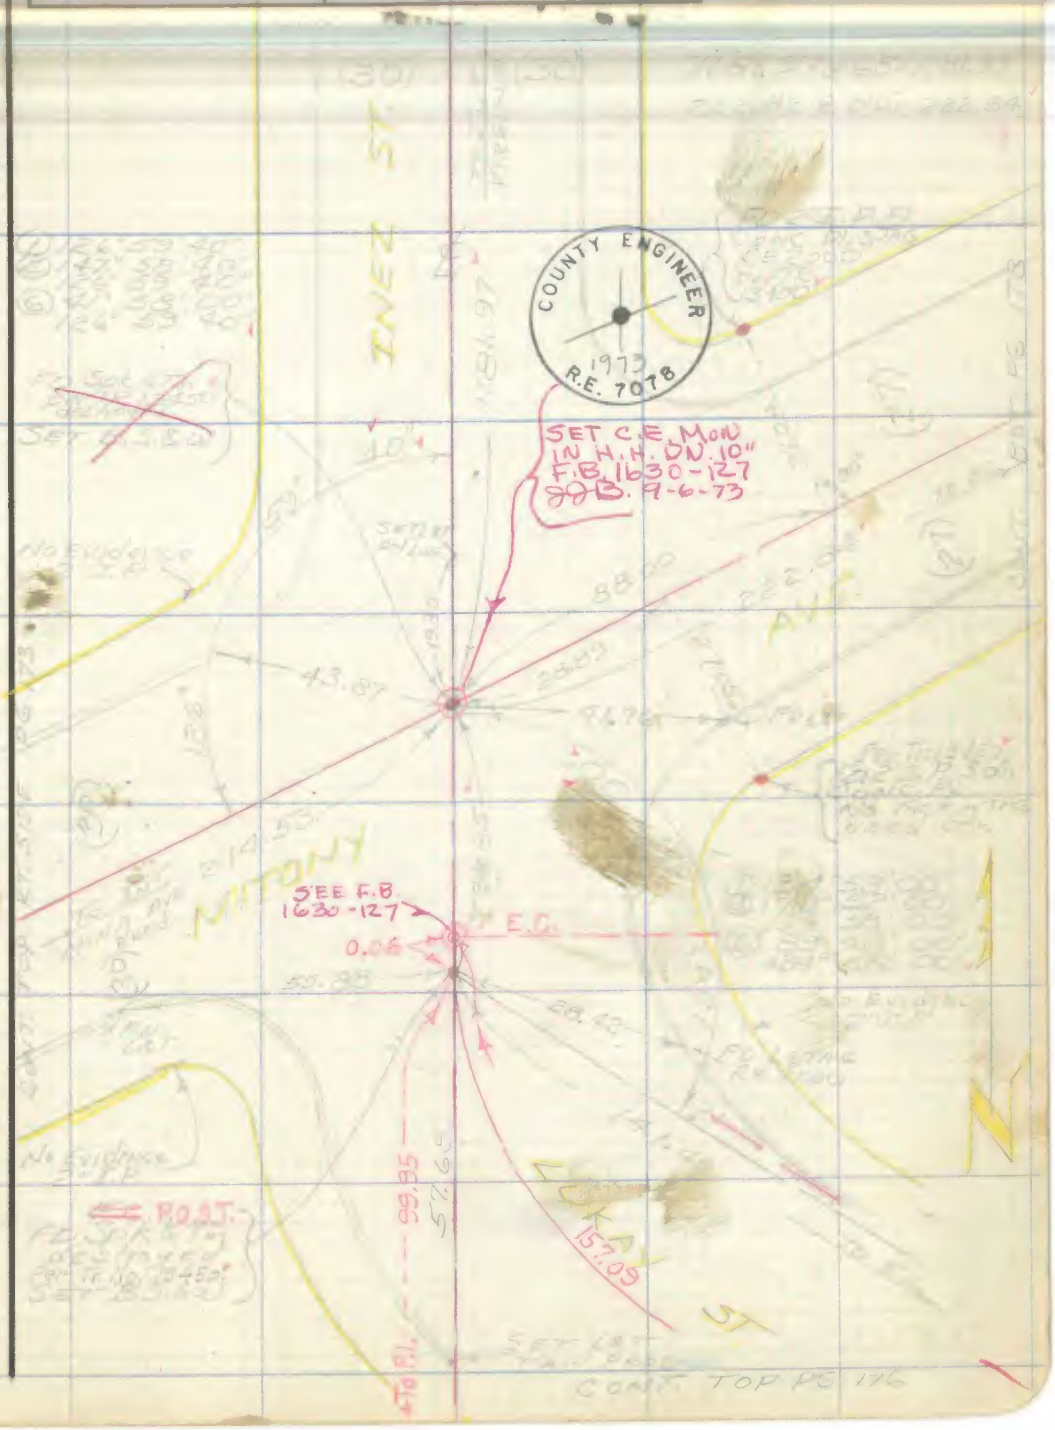


76F3098 247 4-53

PWFB 0827

2218

F. B. ____ Pg. 176

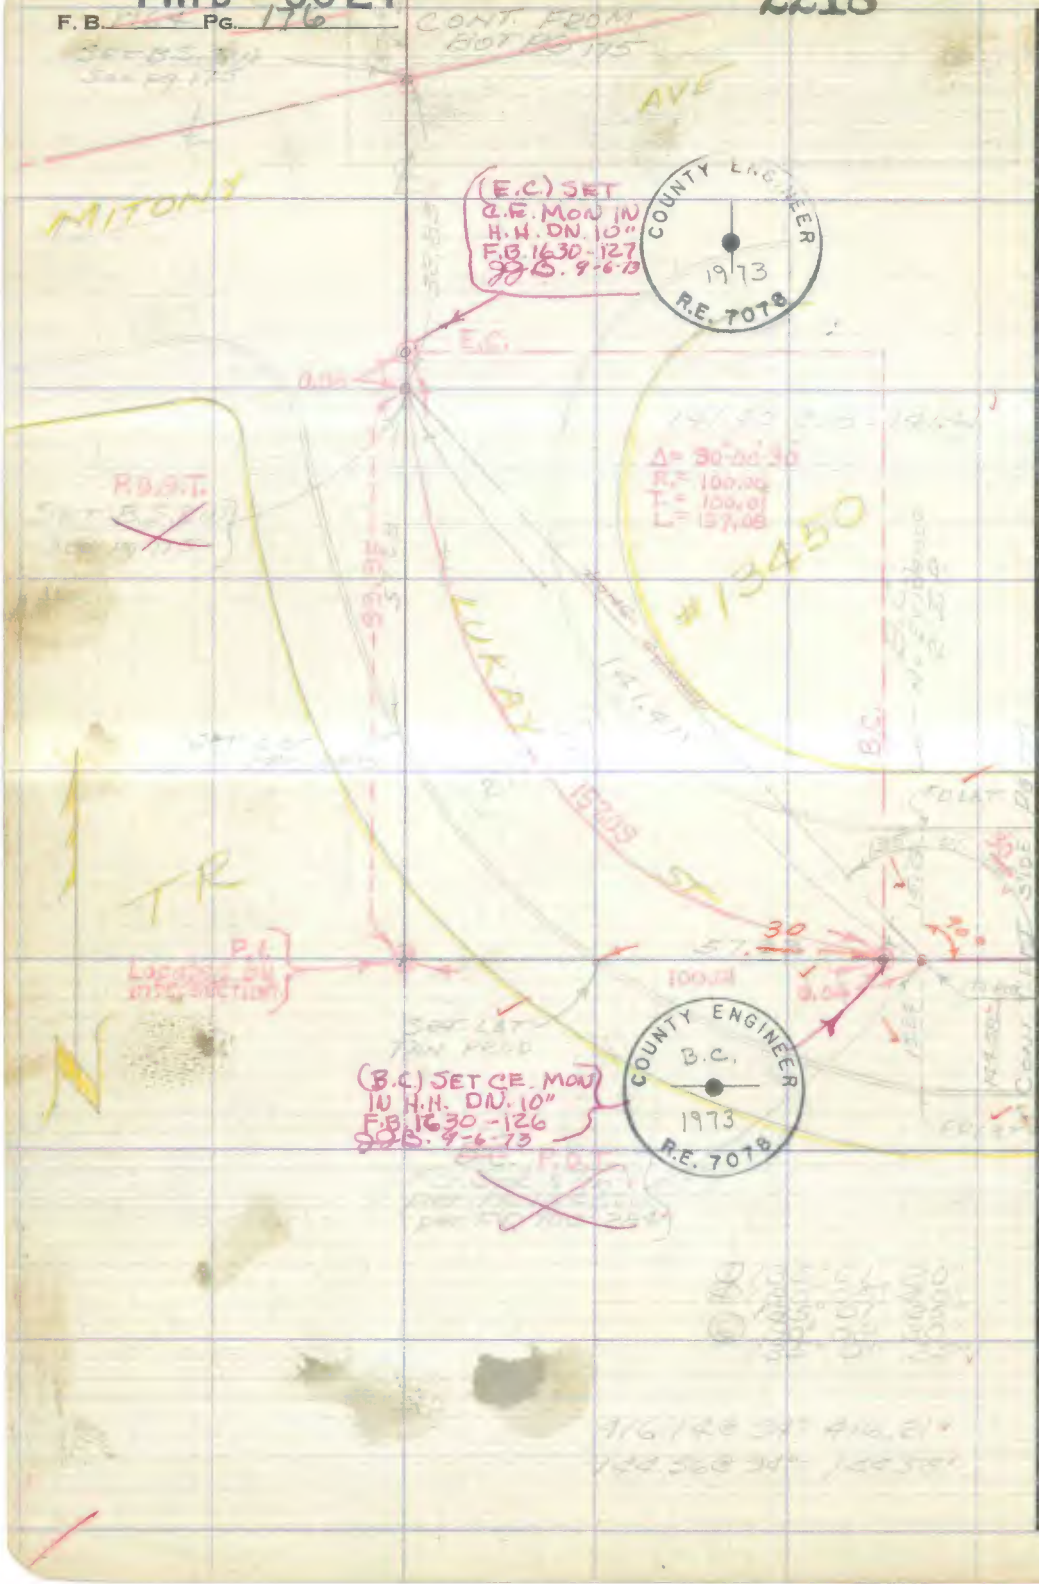


W.S. 34-B-3

RETURN TO
LOS ANGELES COUNTY SURVEYOR
726 LOS ANGELES COUNTY
ENGINEERING BLDG.

Do not extend notes this side of this line.

Note: Any Additions or Changes on This Sheet Must be Made or Circled in Red Ink With Date and Name of Person Making Change.

PWFB 0827

2219

| | |
|---|---|
| Notes Ck'd by D. M. Finley | Survey of |
| Map No. CSA-2562 | W. O. Tape No. St'd. °F |
| Office Work R. L. Green | Surveyed by |
| Checked C. J. Gall | Notes Date |
| Date | Indexed |

F. B. Pg.

Note: Any Additions or Changes on This Sheet Must be Made or Circled in Red Ink With Date and Name of Person Making Change.

Do not extend notes this side of this line.

RETURN TO
LOS ANGELES COUNTY SURVEYOR
726 LOS ANGELES COUNTY
ENGINEERING BLDG.

76FS085 247 4-53

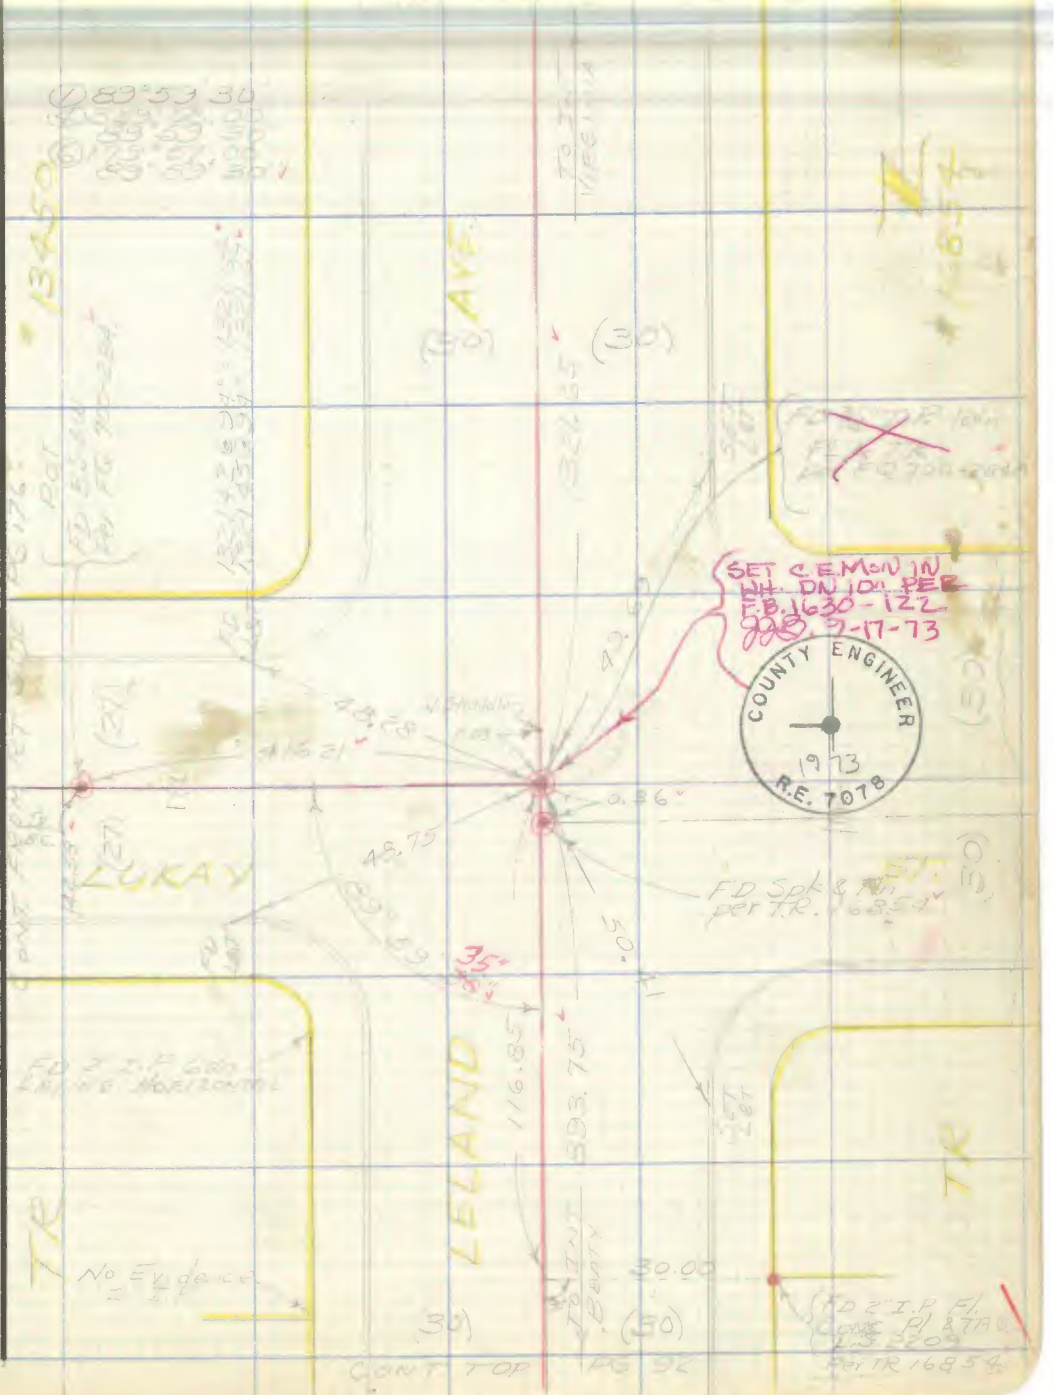

2220, 2221, 2222

F. B. PG.

PWFB 0827

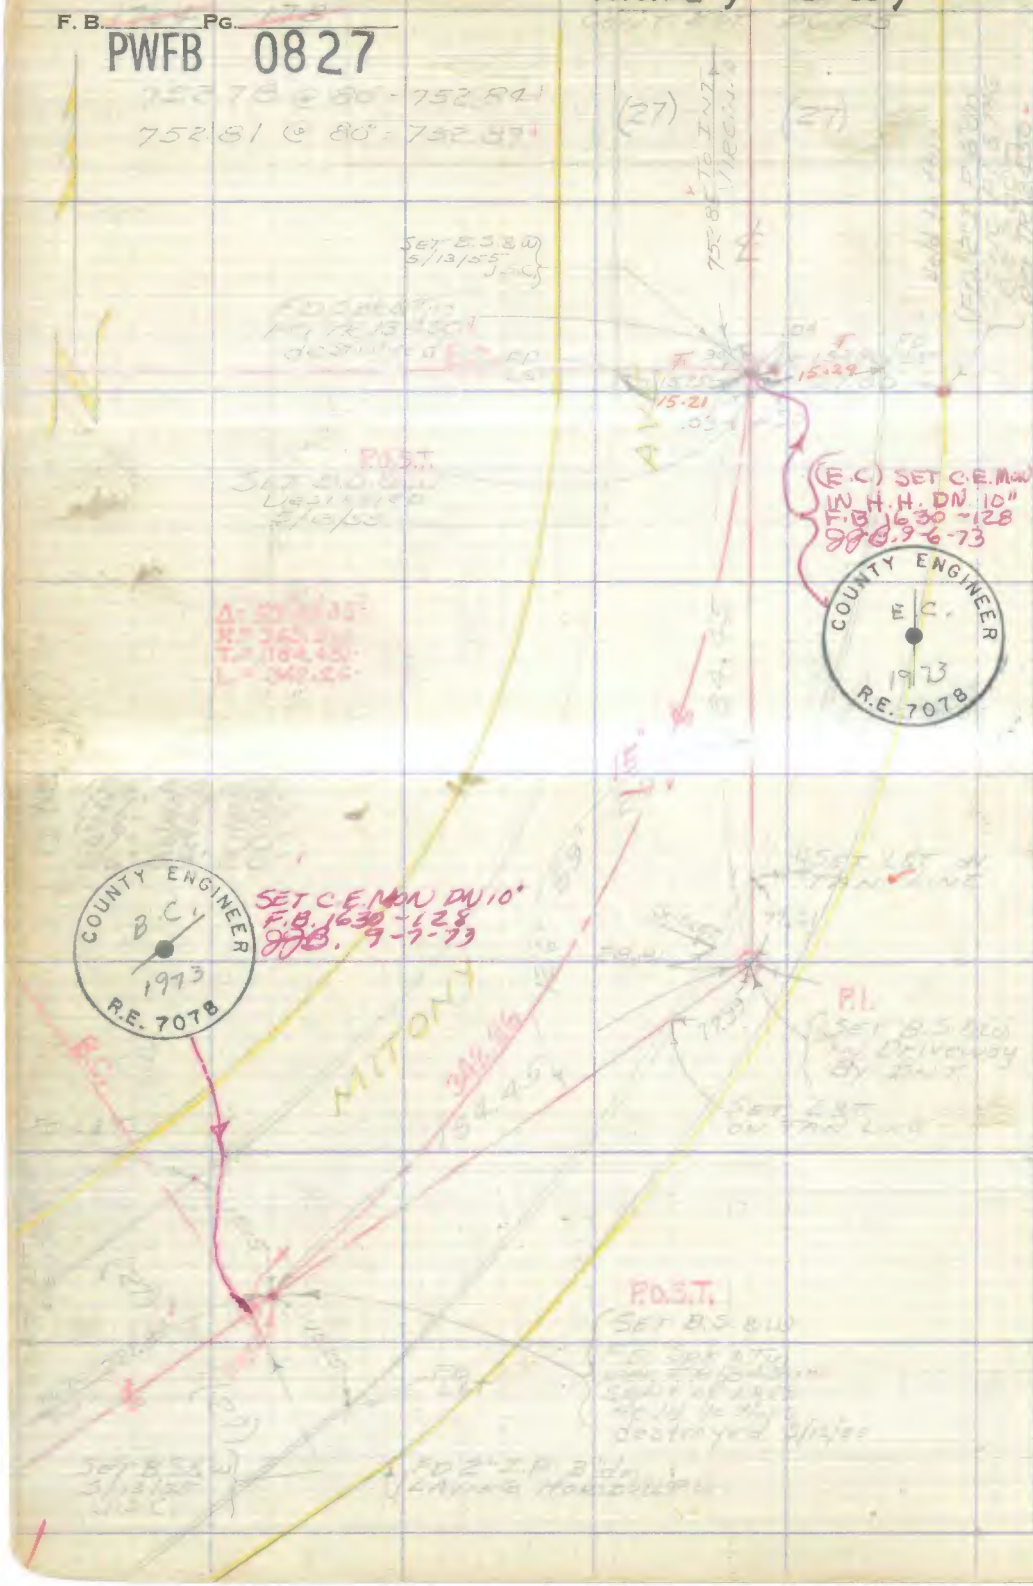


WS 34-A-3

RETURN TO
LOS ANGELES COUNTY SURVEYOR
726 LOS ANGELES COUNTY
ENGINEERING BLDG.

Do not extend notes this side of this line.

Note: Any Additions or Changes on This Sheet Must be Made or Circled in Red Ink With Date and Name of Person Making Change.

PWFB 0827 2223

| | |
|---|---|
| Notes Ck'd by | Survey of CREWE ST (CI) |
| Map No. | W. O. Tape No. 6 St'd. 68 °F |
| Office Work | Surveyed by H E Granquist |
| Checked | Notes P E G Date 6-27-55 |
| Date | Indexed S. C. Tobrocco 9-13-55 |

F. B. 1764 Pg. 179

CREWE ST.
C.I. No. 1773.14

CENTER LINE & PROPERTY LINE NOTES
FOR
5 FT EASEMENT & 6 FT. EASEMENT.
BACK LOTS OF 48 to 50, ALSO 50 & 52
TRACT No. 10451 M.B. 155 P 45.

F.B. 1764 Pg 179 to Pg 190

H E Granquist Chief
F.E. Brooks Tech.
G.L. Martinsen Head Chain
G.P. Alwine Rear

Note: Any Additions or Changes on This Sheet Must be Made or Circled in Red Ink With Date and Name of Person Making Change.

Do not extend notes this side of this line.

RETURN TO
LOS ANGELES COUNTY SURVEYOR
726 LOS ANGELES COUNTY
ENGINEERING BLDG.

76F309S S&E #247, 8-54

F. B. 1764 Pg. 180

PWFB 0827

2224, 2225

Index P.L.

RETURN TO
LOS ANGELES COUNTY SURVEYOR
726 LOS ANGELES COUNTY
ENGINEERING BLDG.

Do not extend notes this side of this line.

Note: Any Additions or Changes on This Sheet Must be Made or Circled In Red Ink With Date and Name of Person Making Change.

PWFB 0827 2226, 2227

| | |
|---|---|
| Notes Ck'd by | Survey of |
| Map No. | W. O. Tape No. St'd. °F |
| Office Work | Surveyed by |
| Checked | Notes Date |
| Date | Indexed |

F. B. Pg.

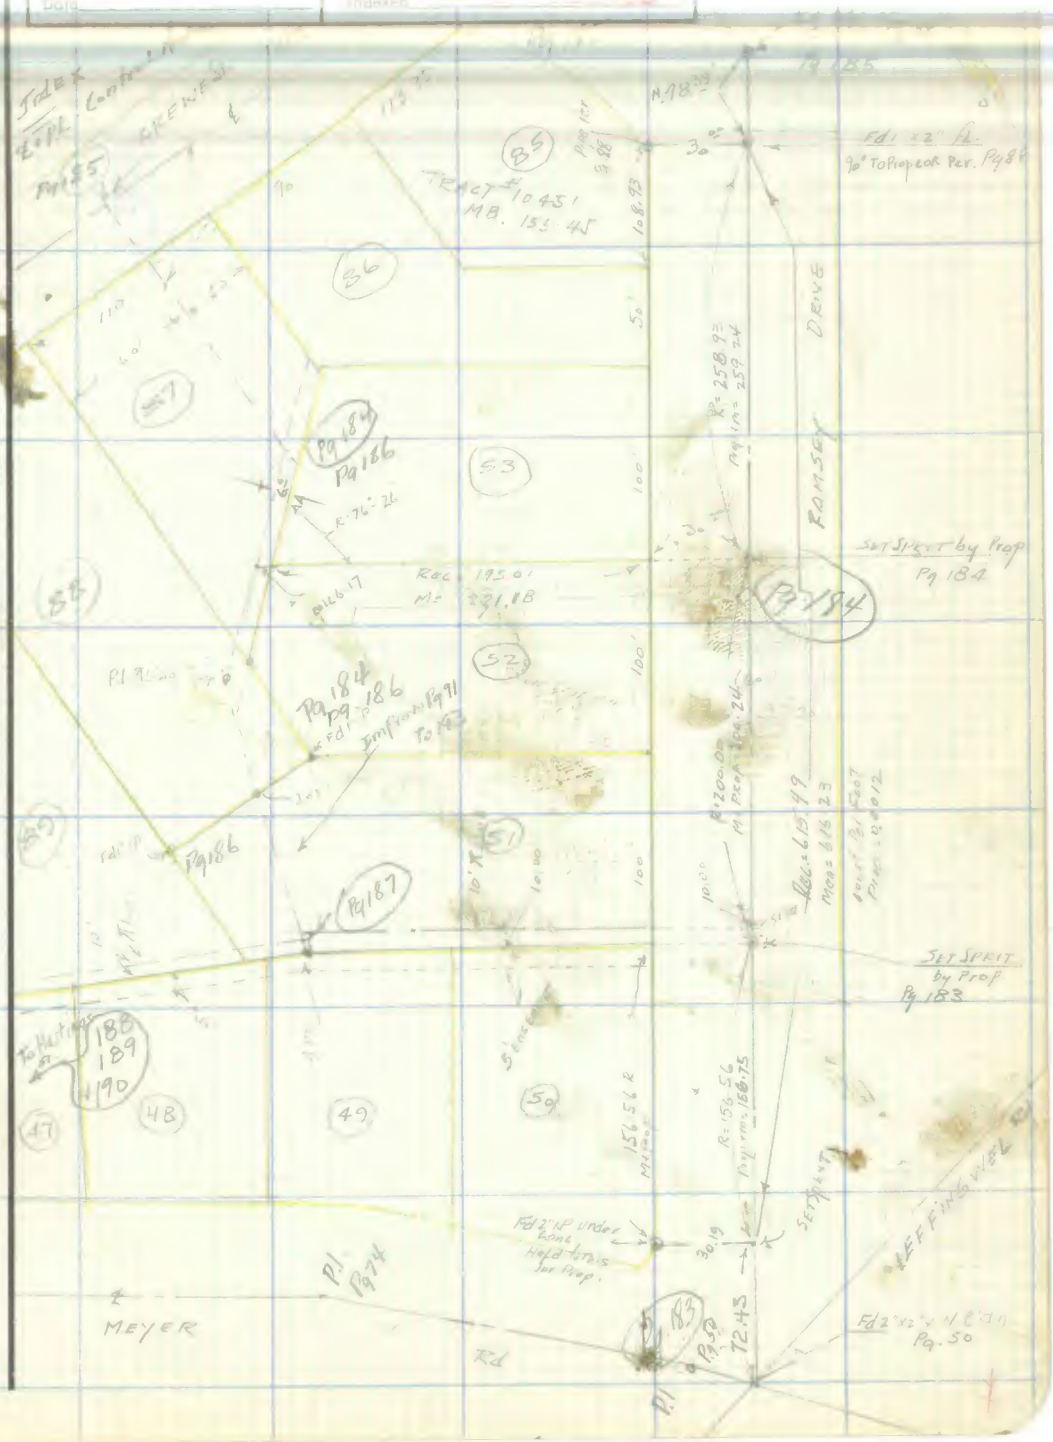


Note: Any Additions or Changes on This Sheet Must be Made or Circled in Red Ink With Date and Name of Person Making Change.

Do not extend notes this side of this line.

RETURN TO
LOS ANGELES COUNTY SURVEYOR
726 LOS ANGELES COUNTY
ENGINEERING BLDG.

76F309S S&E #247. 8-54

F. B. 1764 PG. 122

PWFB 0827

[redacted], 2228, 2229

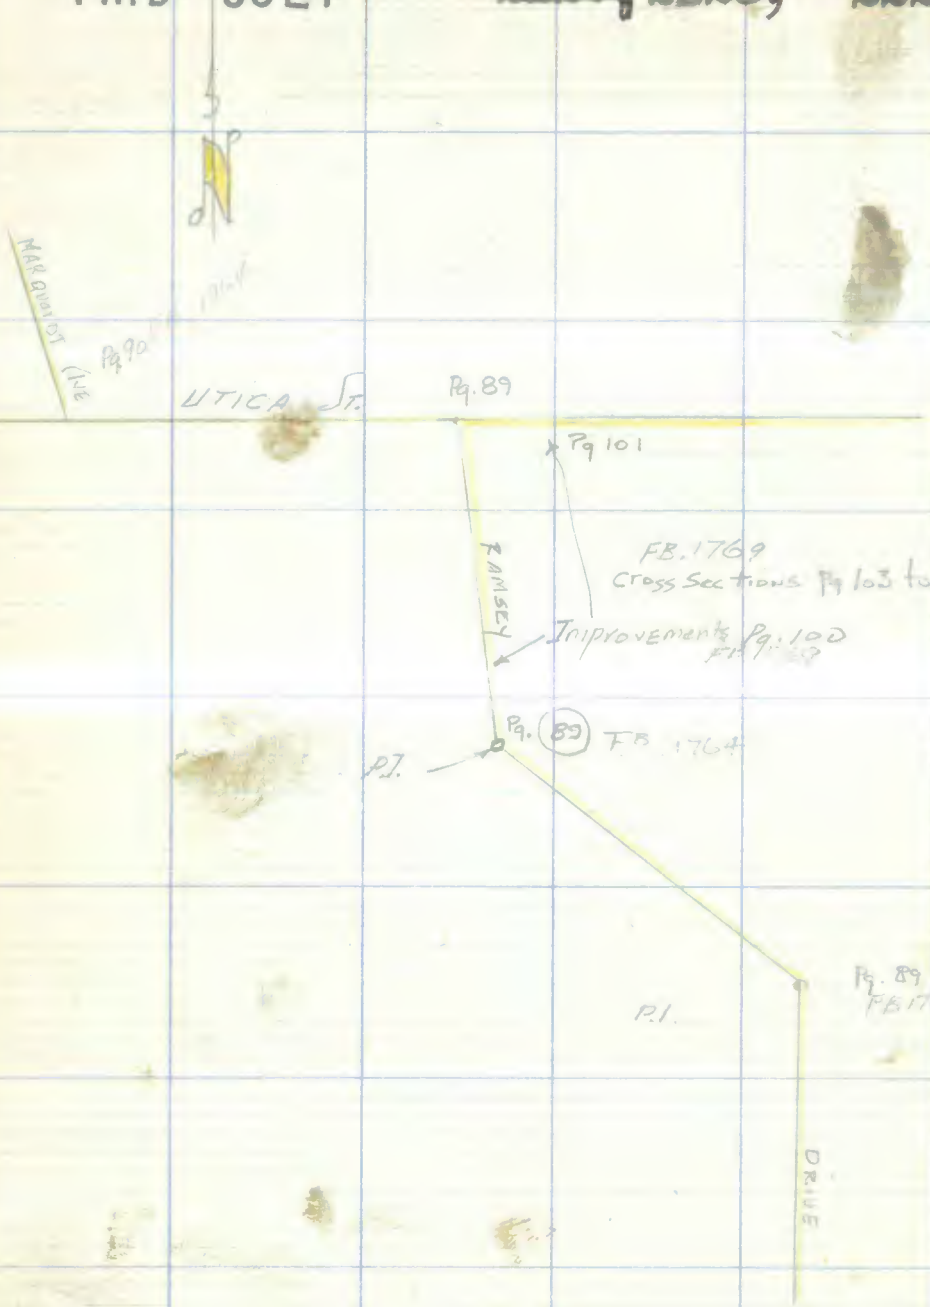


RETURN TO
LOS ANGELES COUNTY SURVEYOR
726 LOS ANGELES COUNTY
ENGINEERING BLDG.
Do not extend notes this side of this line.

Note: Any Additions or Changes on This Sheet Must be Made or Circled in Red Ink With Date and Name of Person Making Change.

PWFB 0827 [redacted] 2230

| | |
|---|---|
| Notes Ck'd by [illegible] | Survey of [illegible] |
| Map No. | W. O. Tape No. St'd. °F |
| Office Work | Surveyed by [illegible] |
| Checked | Notes [illegible] Date [illegible] |
| Date | Indexed [illegible] |

F. B. Pg.

WS 34-B-3

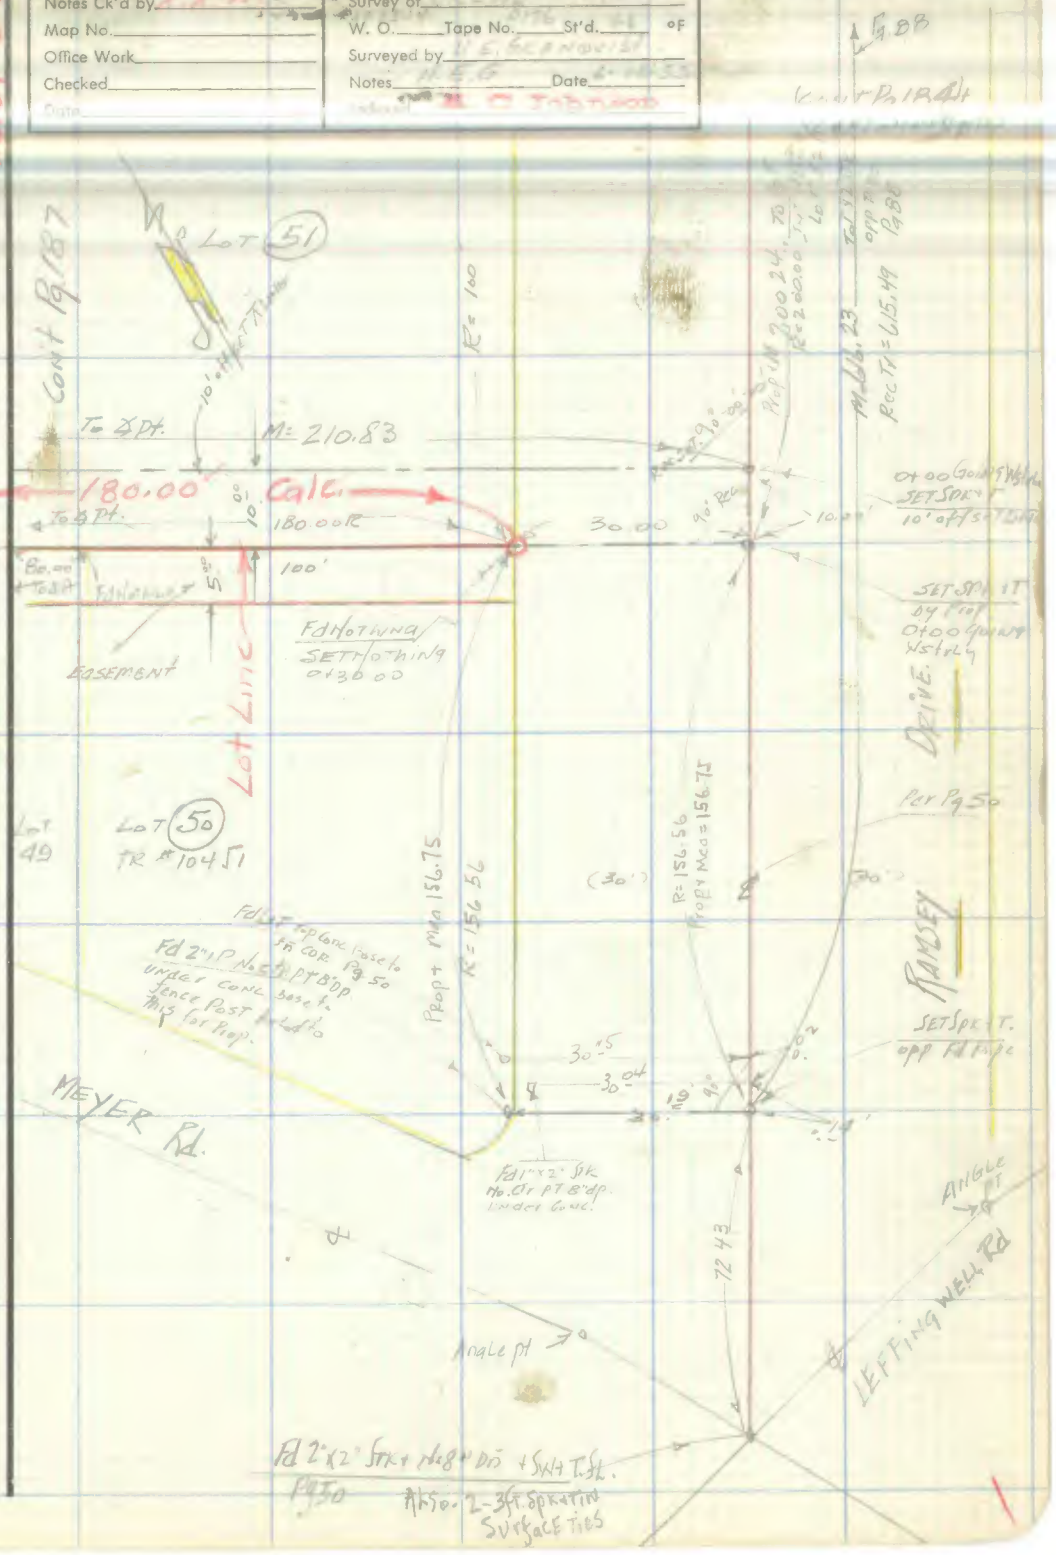


Note: Any Additions or Changes on This Sheet Must be Made or Circled in Red Ink With Date and Name of Person Making Change.

Do not extend notes this side of this line.

RETURN TO
LOS ANGELES COUNTY SURVEYOR
726 LOS ANGELES COUNTY
ENGINEERING BLDG.

76F309S S&E #247. 8-54

PWFB 0827

F. B. _____ PG. _____

2231

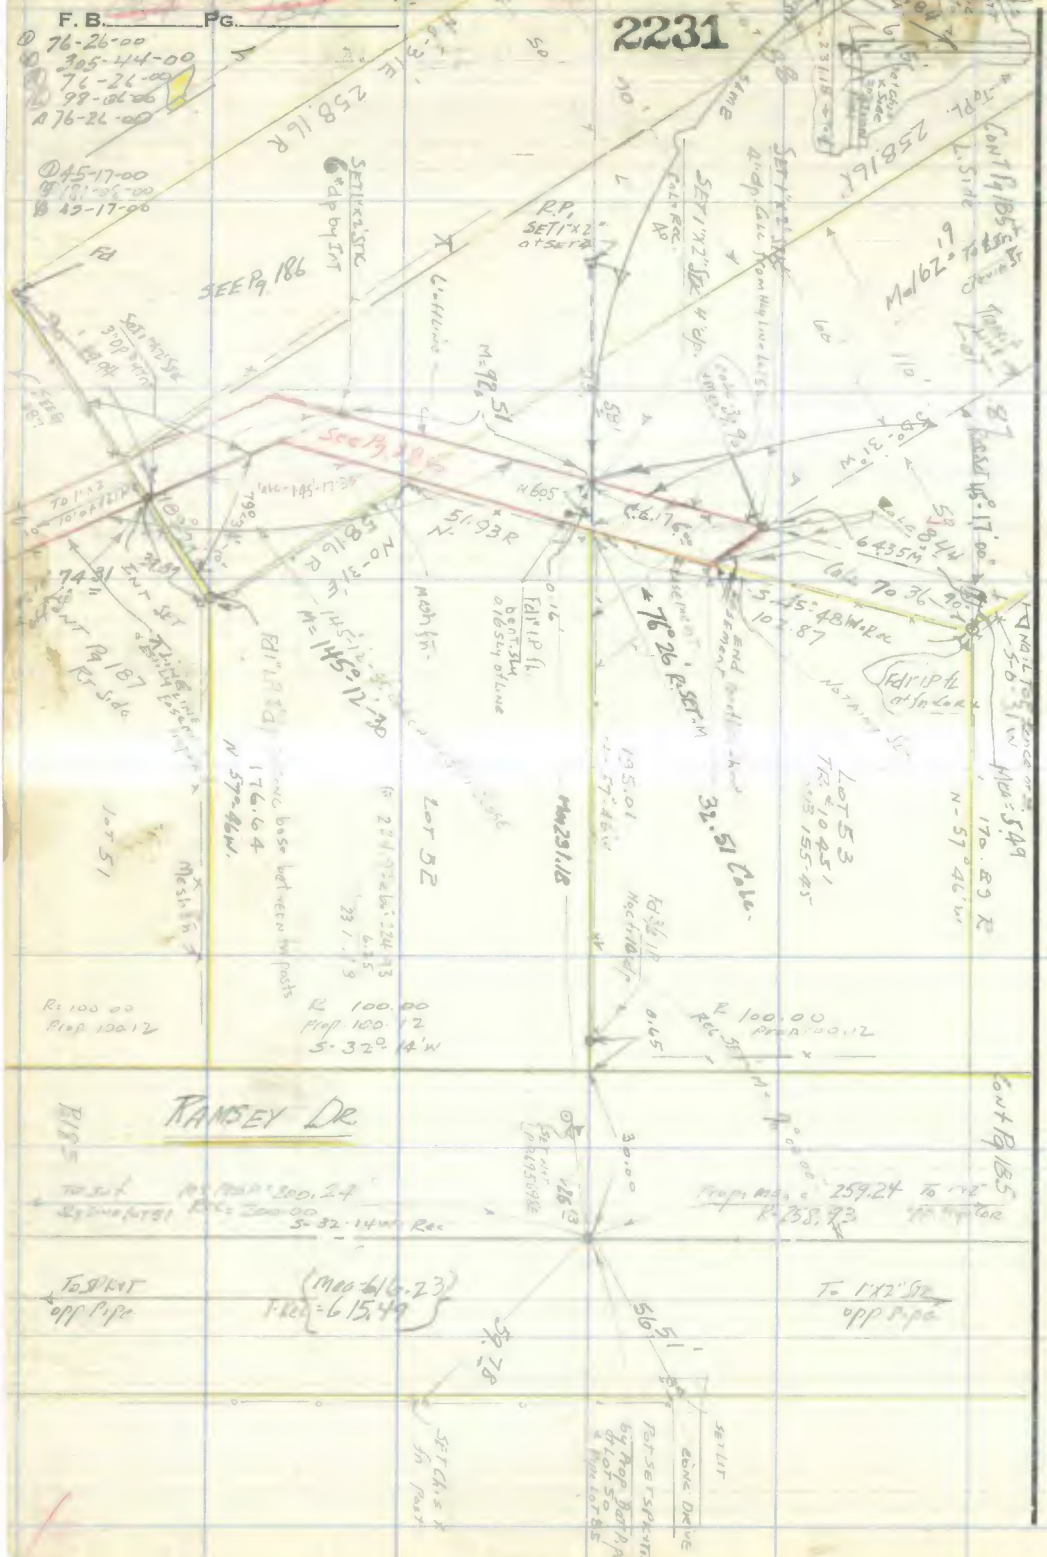


RETURN TO
LOS ANGELES COUNTY SURVEYOR
726 LOS ANGELES COUNTY
ENGINEERING BLDG.

Do not extend notes this side of this line.

Note: Any Additions or Changes on This Sheet Must be Made or Circled in Red Ink With Date and Name of Person Making Change.

PWFB 0827 2232, 2233

| | |
|---|---|
| Notes Ck'd by | Survey of |
| Map No. | W. O. Tape No. St'd. °F |
| Office Work | Surveyed by |
| Checked | Notes Date |
| Date | Indexed |

F. B. Pg.

Note: Any Additions or Changes on This Sheet Must be Made or Circled in Red Ink With Date and Name of Person Making Change.

Do not extend notes this side of this line.

RETURN TO
LOS ANGELES COUNTY SURVEYOR
726 LOS ANGELES COUNTY
ENGINEERING BLDG.

76F309S S&E #247. 8-54

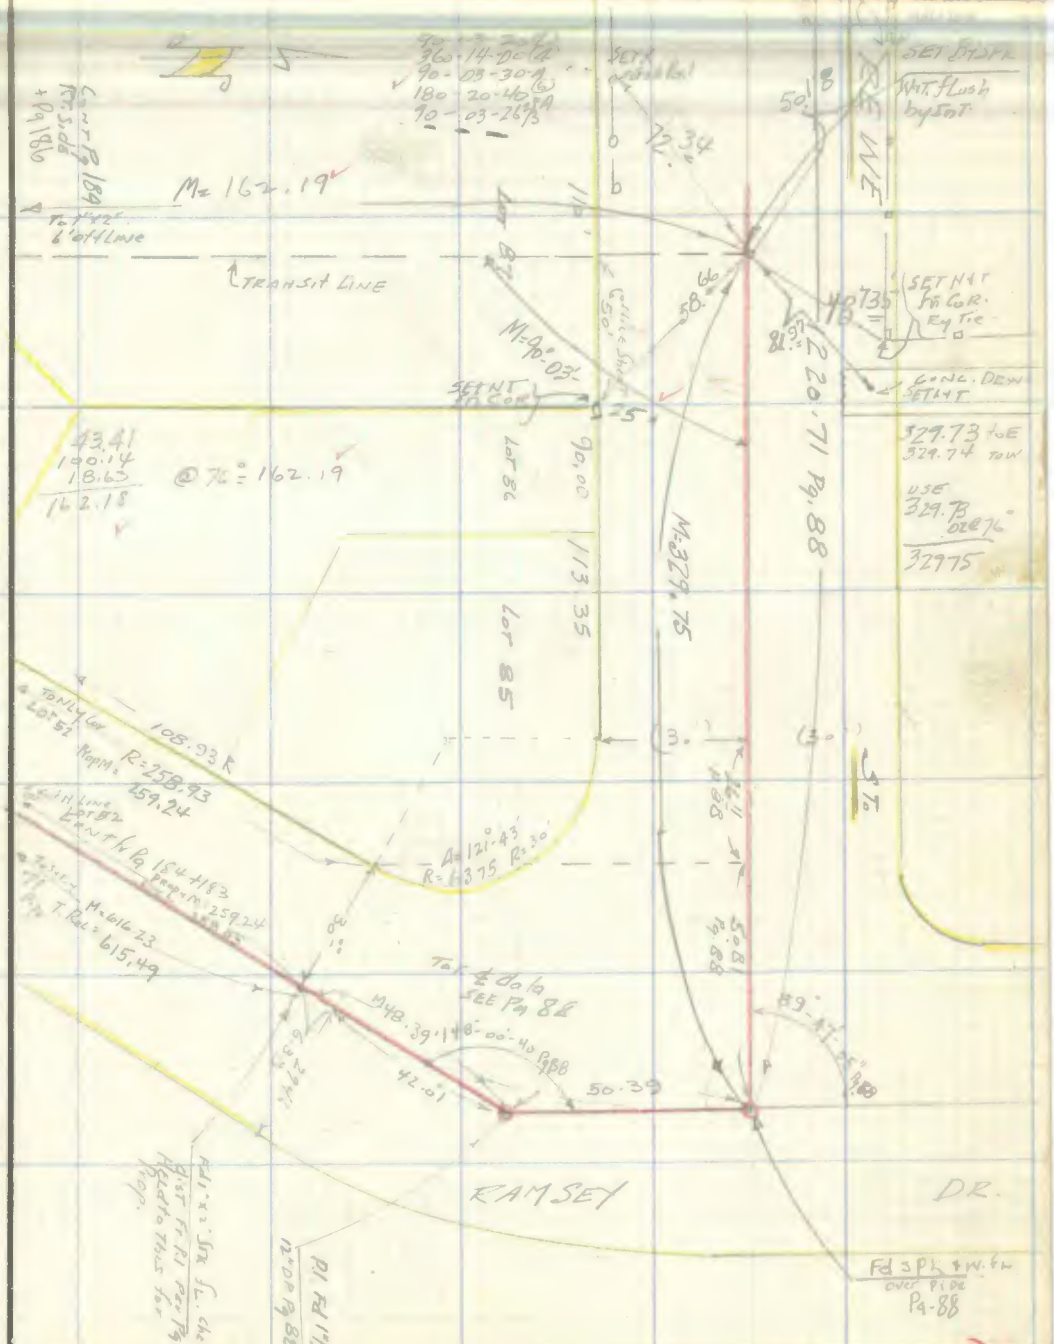

F. B. 764 Pg. 186

2234

PWFB 0827

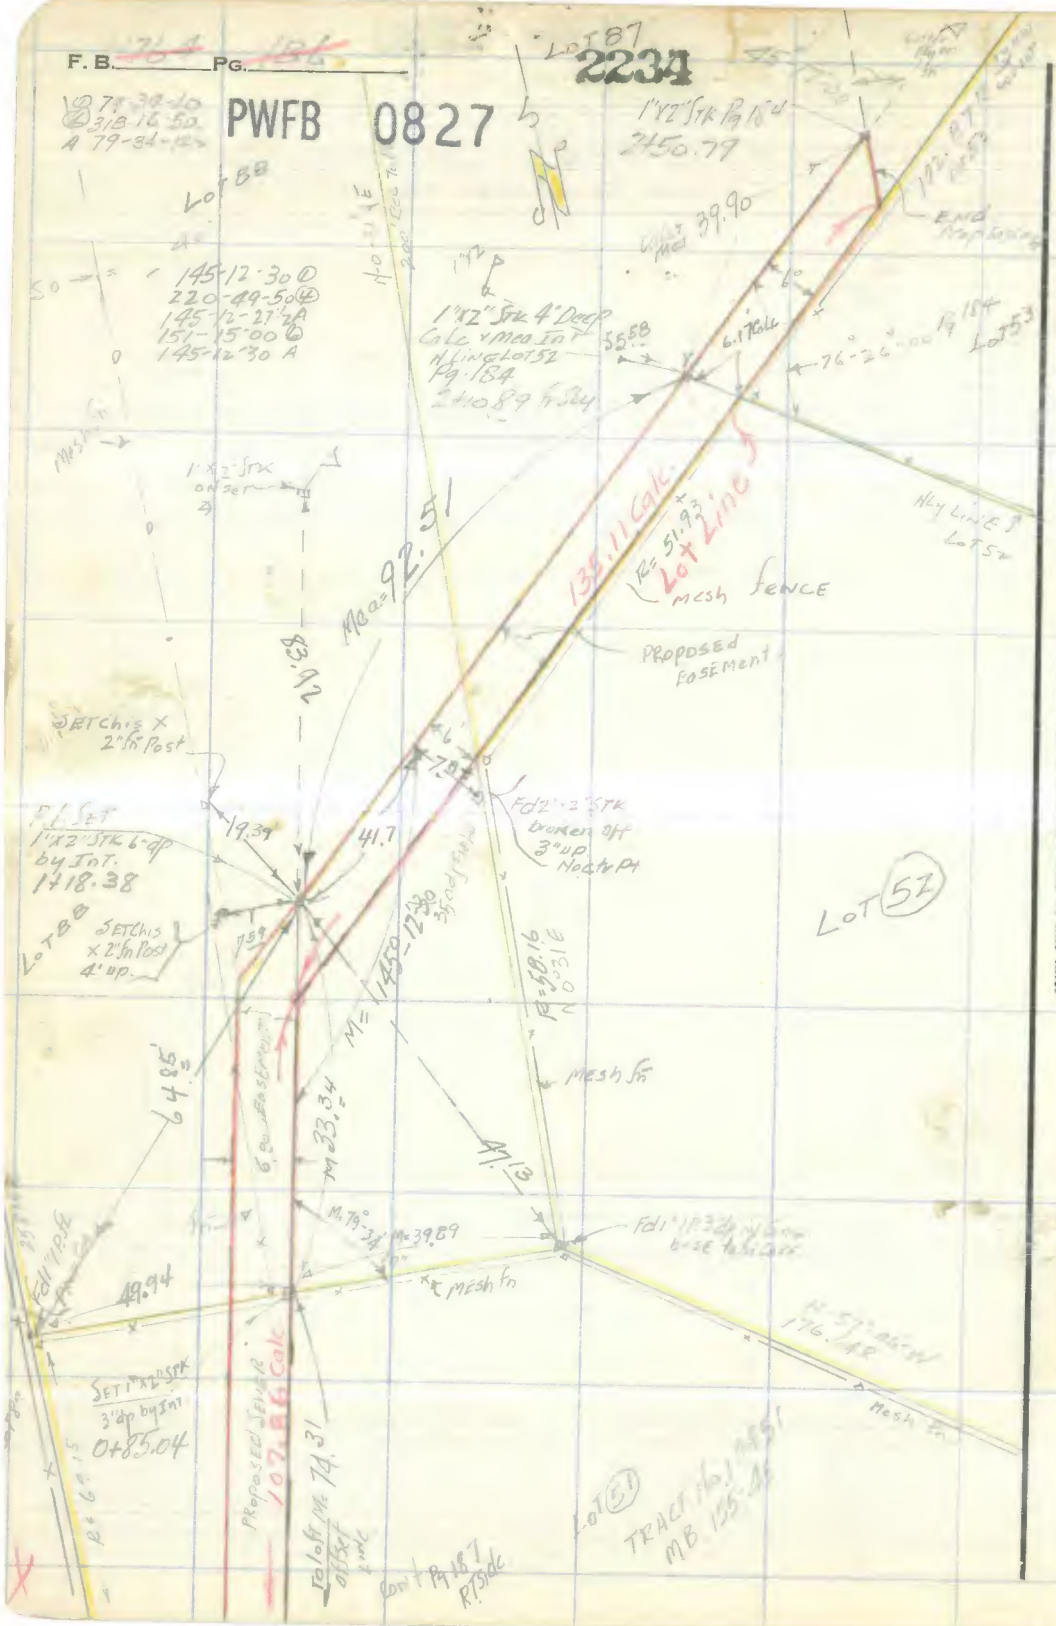


RETURN TO
LOS ANGELES COUNTY SURVEYOR
726 LOS ANGELES COUNTY
ENGINEERING BLDG.

Do not extend notes this side of this line.

Note: Any Additions or Changes on This Sheet Must be Made or Circled in Red Ink With Date and Name of Person Making Change.

PWFB 0827

2235

| | |
|---|---|
| Notes Ck'd by | Survey of |
| Map No. | W. O. Tape No. St'd. °F |
| Office Work | Surveyed by |
| Checked | Notes Date |
| Date | Indexed |

F. B. Pg.

Note: Any Additions or Changes on This Sheet Must be Made or Circled in Red Ink With Date and Name of Person Making Change.

Do not extend notes this side of this line.

RETURN TO
LOS ANGELES COUNTY SURVEYOR
726 LOS ANGELES COUNTY
ENGINEERING BLDG.

76F309S S&E #247, 8-54

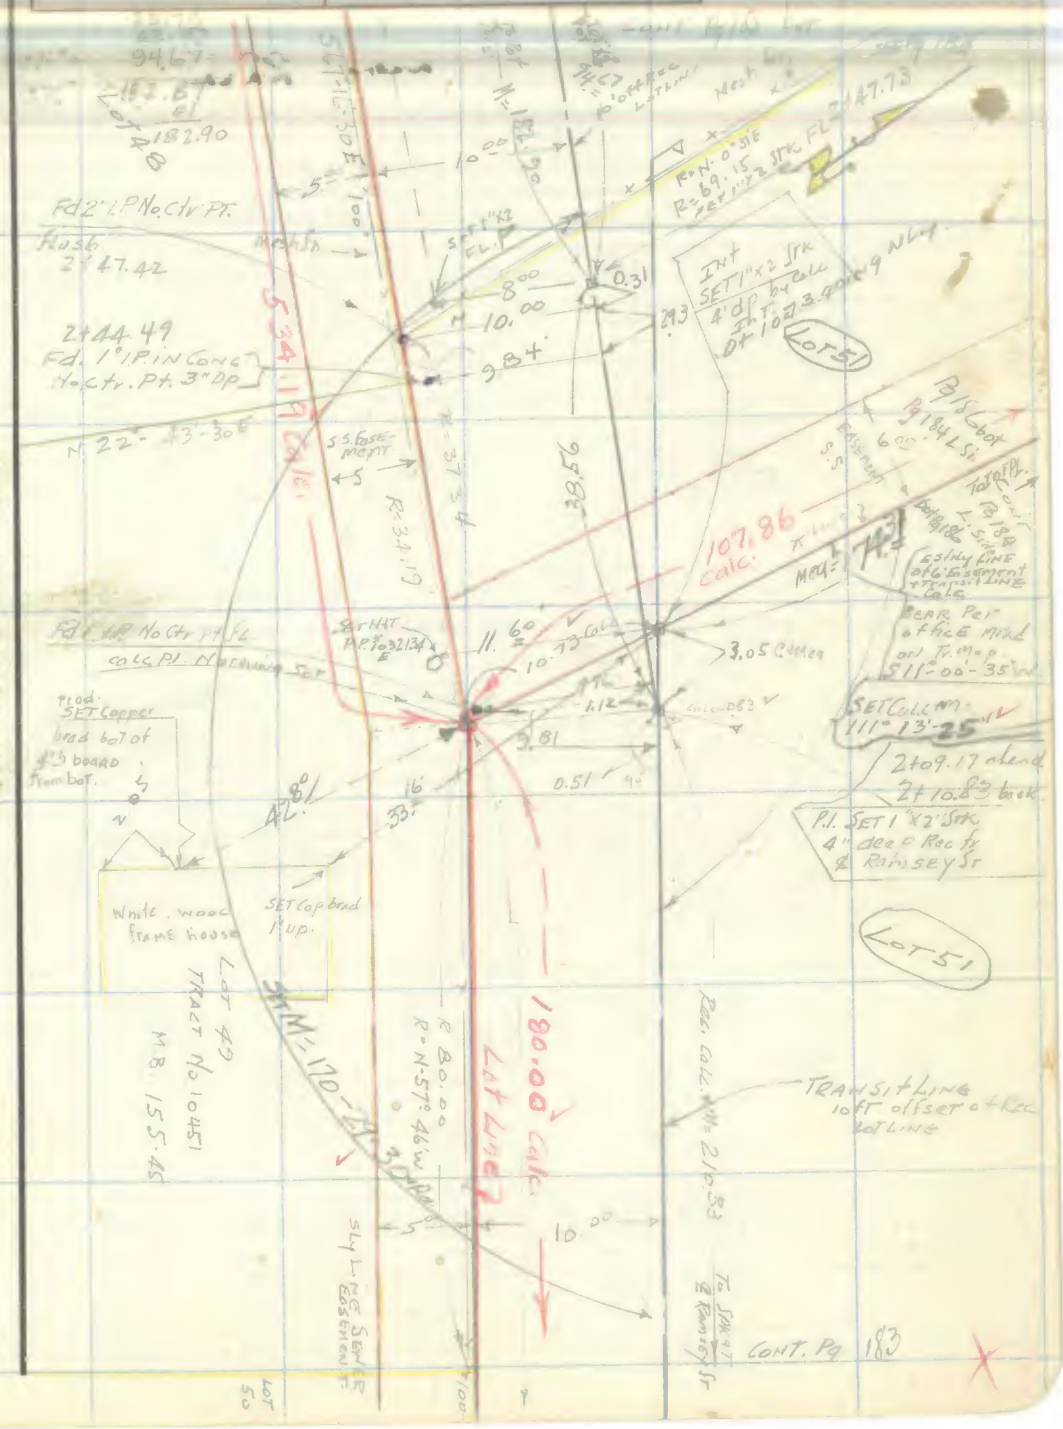

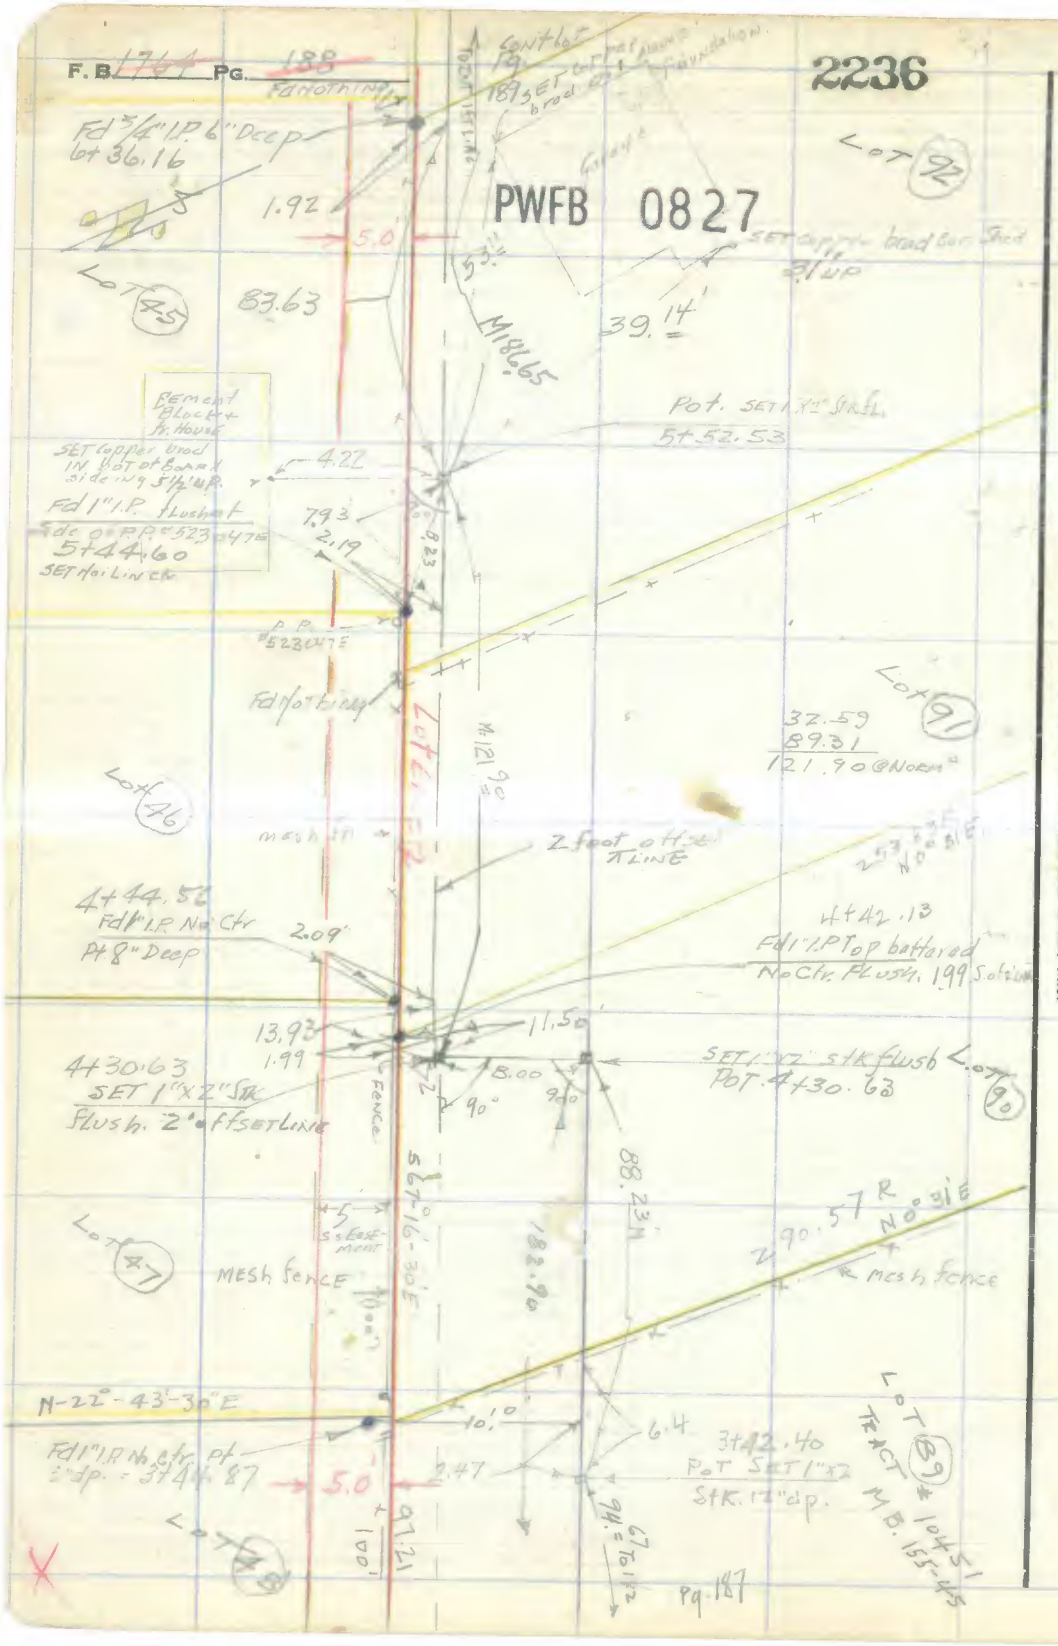


RETURN TO
LOS ANGELES COUNTY SURVEYOR
726 LOS ANGELES COUNTY
ENGINEERING BLDG.

Do not extend notes this side of this line.

Note: Any Additions or Changes on This Sheet Must be Made or Circled in Red Ink With Date and Name of Person Making Change.

PWFB 0827 2237

| | |
|---|---|
| Notes Ck'd by | Survey of |
| Map No. | W. O. 14 Tape No. St'd. °F |
| Office Work | Surveyed by |
| Checked | Notes Date |

F. B. Pg.

168 - 42 - 30 = A
314 - 50 - 00 = G
168 - 42 - 30 = A
292 - 15 - 00 = G
168 - 42 - 30 = A

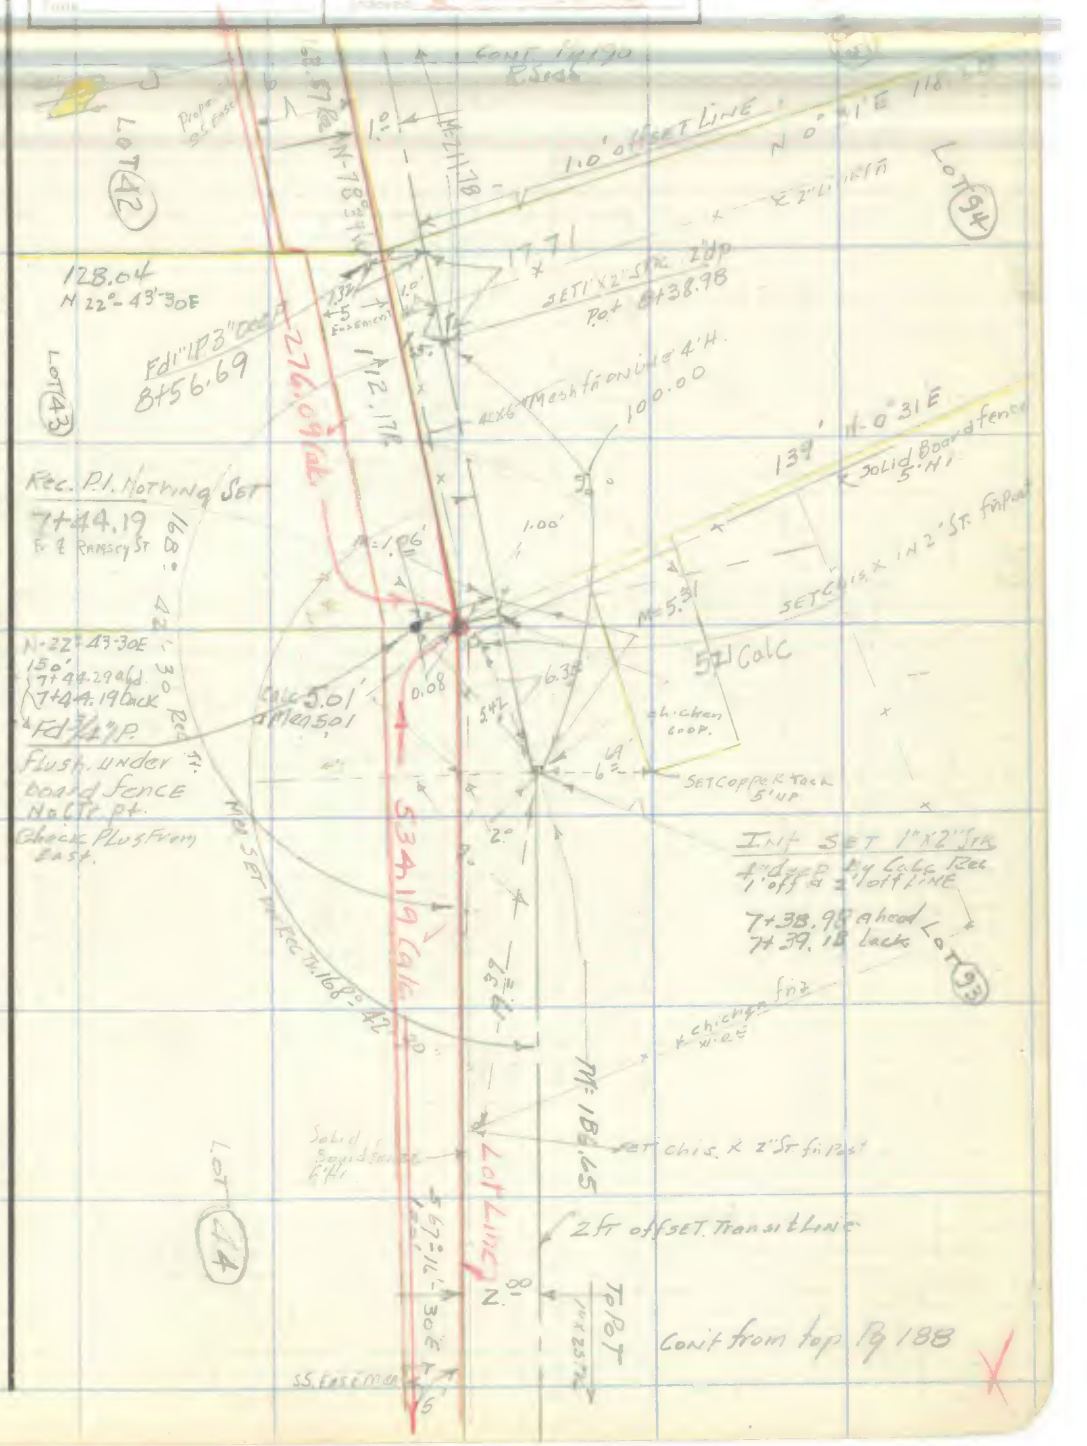


Note: Any Additions or Changes on This Sheet Must be Made or Circled in Red Ink With Date and Name of Person Making Change.

Do not extend notes this side of this line.

RETURN TO
LOS ANGELES COUNTY SURVEYOR
726 LOS ANGELES COUNTY
ENGINEERING BLDG.

76F309S S&E #247. 8-54

F. B. ~~1764~~ PG. ~~190~~

PWFB 0827

2238

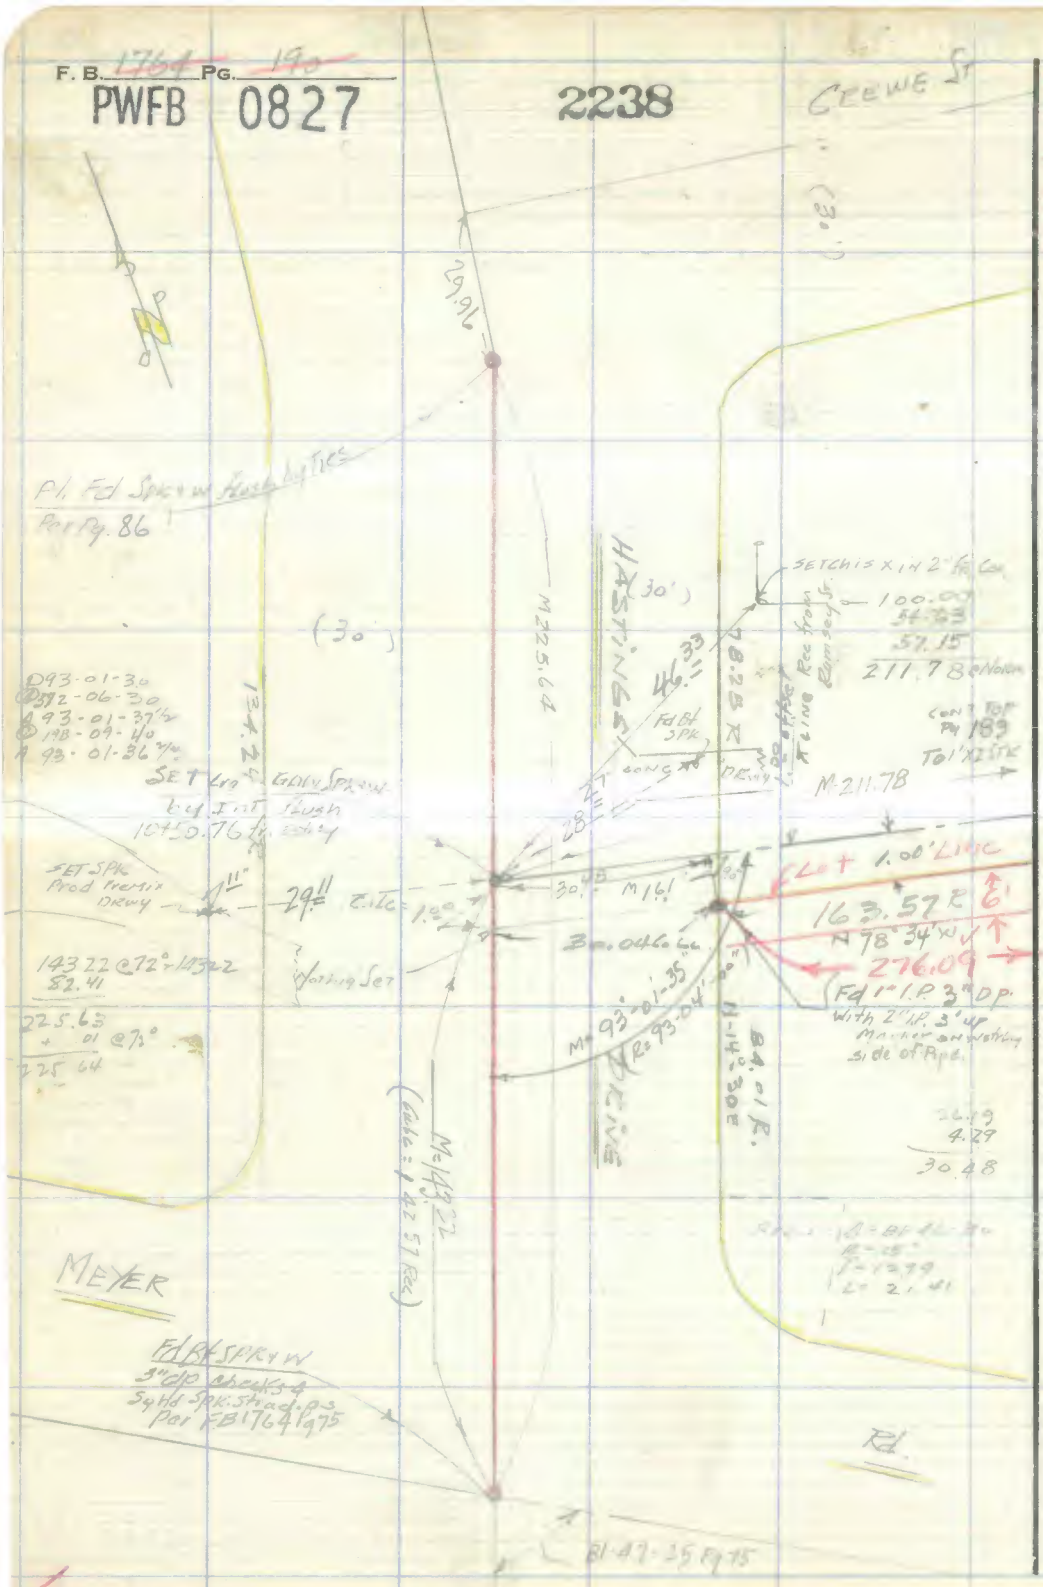


RETURN TO
LOS ANGELES COUNTY SURVEYOR
726 LOS ANGELES COUNTY
ENGINEERING BLDG.

Do not extend notes this side of this line.

**Note:** Any Additions or Changes on This Sheet Must be Made or Circled in Red Ink With Date and Name of Person Making Change.

PWFB 0827 2239 191

| | |
|---|---|
| Notes Ck'd by [illegible] | Survey of SUNSHINE AVE |
| Map No. CSB-2562 | W. O. [illegible] Tape No. [illegible] St'd. [illegible] °F |
| Office Work [illegible] | Surveyed by [illegible] |
| Checked [illegible] | Notes [illegible] Date [illegible] |
| Date June 1966 | Indexed [illegible] |

F. B. [illegible] Pg. [illegible]

Note: Any Additions or Changes on This Sheet Must be Made or Circled in Red Ink With Date and Name of Person Making Change.

Do not extend notes this side of this line.

RETURN TO
LOS ANGELES COUNTY SURVEYOR
726 LOS ANGELES COUNTY
ENGINEERING BLDG.

76F3095 247 4-53

F. B. 192 PG. 192

RETURN TO
LOS ANGELES COUNTY SURVEYOR
726 LOS ANGELES COUNTY
ENGINEERING BLDG.

Do not extend notes this side of this line.

**Note:** Any Additions or Changes on This Sheet Must be Made or Circled in Red Ink With Date and Name of Person Making Change.

PWFB 0827

2240

| | | |
|---|---|---|
| Notes Ck'd by [illegible] | Survey of [illegible] | F. B. [illegible] PG. 195 |
| Map No. | JN 0863.00 Tape [illegible] Std. 69 °F | |
| Office Work | Surveyed by [illegible] | |
| Checked | Notes [illegible] Date [illegible] | |
| Date | Indexed 2-15-59 | |

JN 0863.00

ALLEGAN ST - S.S.D

CENTER LINE SURVEY

see Index pg 154

C.I. 2051.14

Party: Sapper
Shoemaker
Carr
Lieber

Note: Any Additions or Changes on This Sheet Must be Made or Circled in Red Ink With Date and Name of Person Making Change.

Do not extend notes this side of this line.

RETURN TO
LOS ANGELES COUNTY ENGINEER
700 LOS ANGELES COUNTY ENGINEERING BLDG.

76F309S CE #247—3-57

F. B. ~~[illegible]~~ PG. 194

PWFB 0827

2241, 2242, 2243, 2244

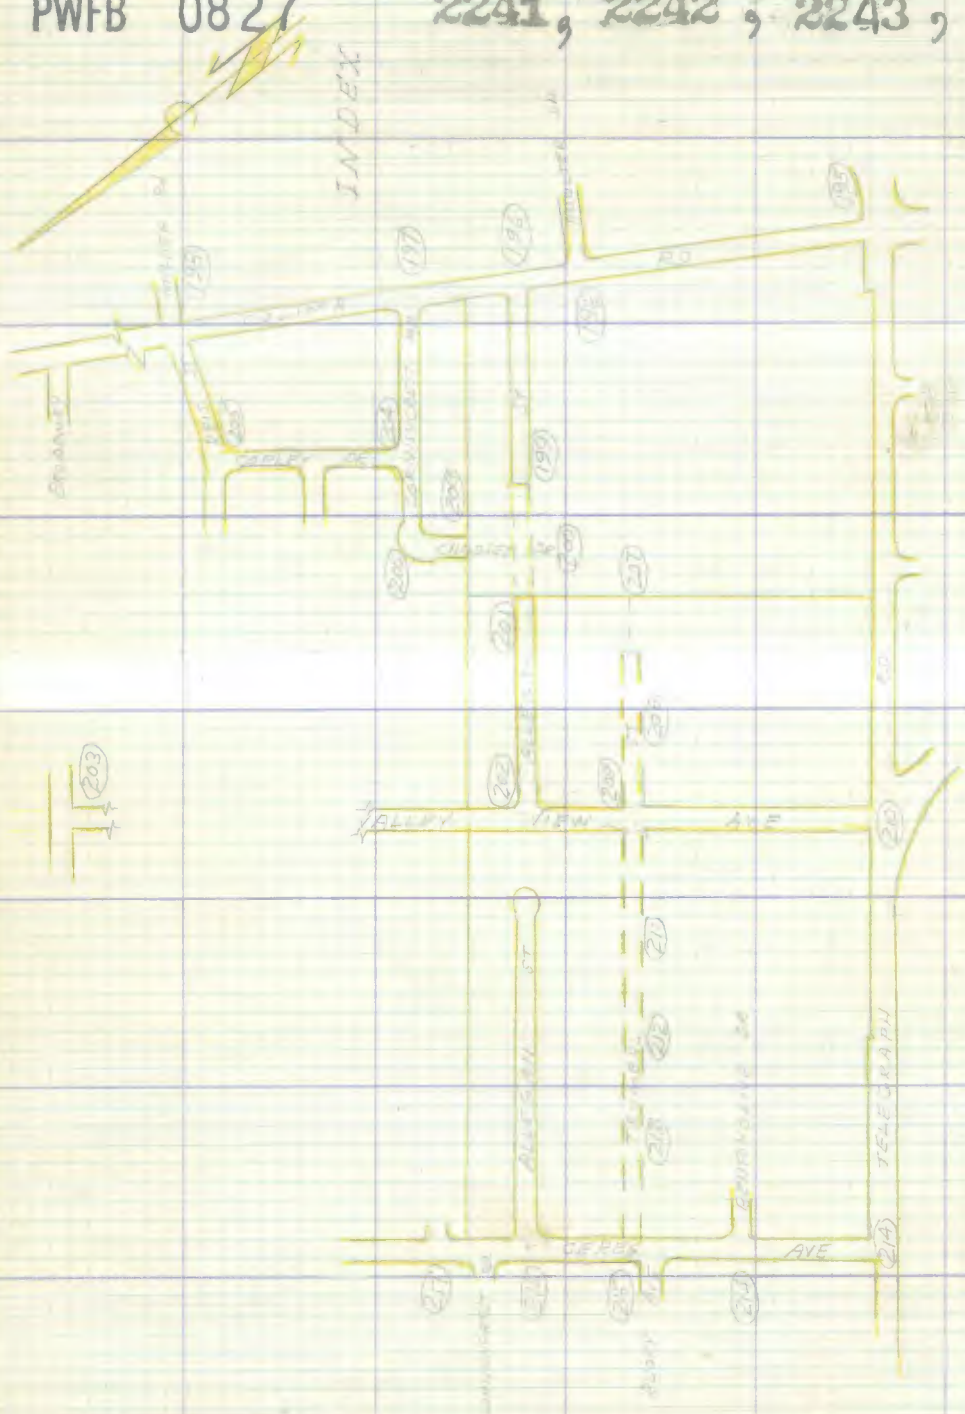


RETURN TO
LOS ANGELES COUNTY ENGINEER
700 LOS ANGELES COUNTY ENGINEERING BLDG.

Do not extend notes this side of this line.

Note: Any Additions or Changes on This Sheet Must be Made or Circled in Red Ink With Date and Name of Person Making Change.

76F309S CE #247—3-57

RETURN TO
LOS ANGELES COUNTY ENGINEER
700 LOS ANGELES COUNTY ENGINEERING BLDG.

Note: Any Additions or Changes on This Sheet Must be Made or Circled in Red Ink With Date and Name of Person Making Change.

Do not extend notes this side of this line.

W.S. 34-B-3

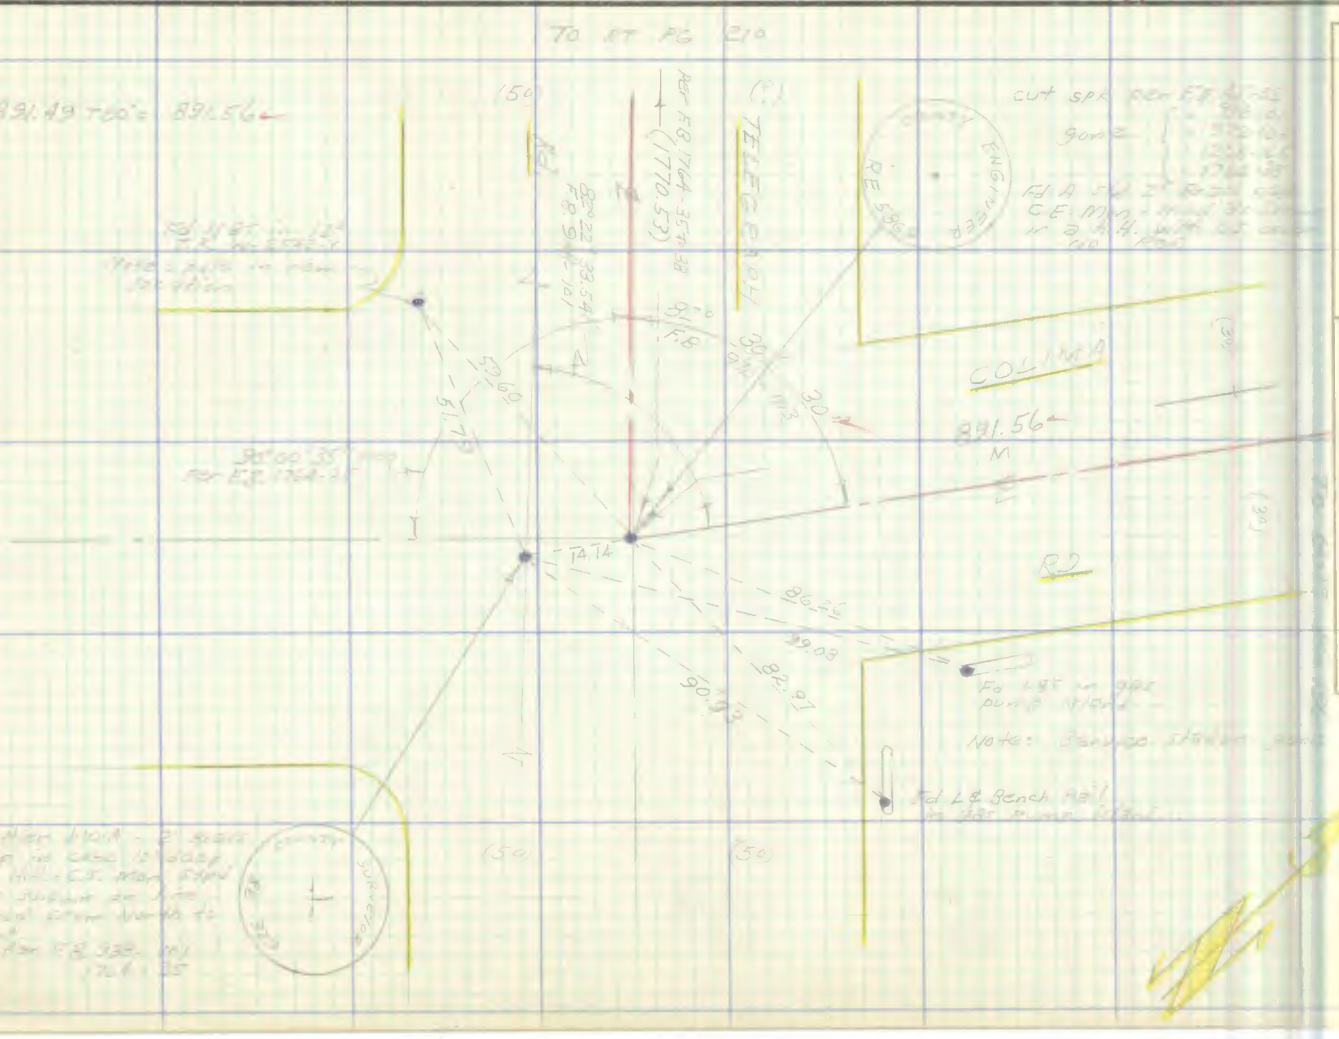


Notes Ck'd by
Map No.
Office Work
Checked
Date

Survey of
JN Tape Std. °F
Surveyed by
Notes
Indexed Date

PWFB 0828

1195

F.B. PG. 195

F. B. 174 PG. 196

PWFB 0828

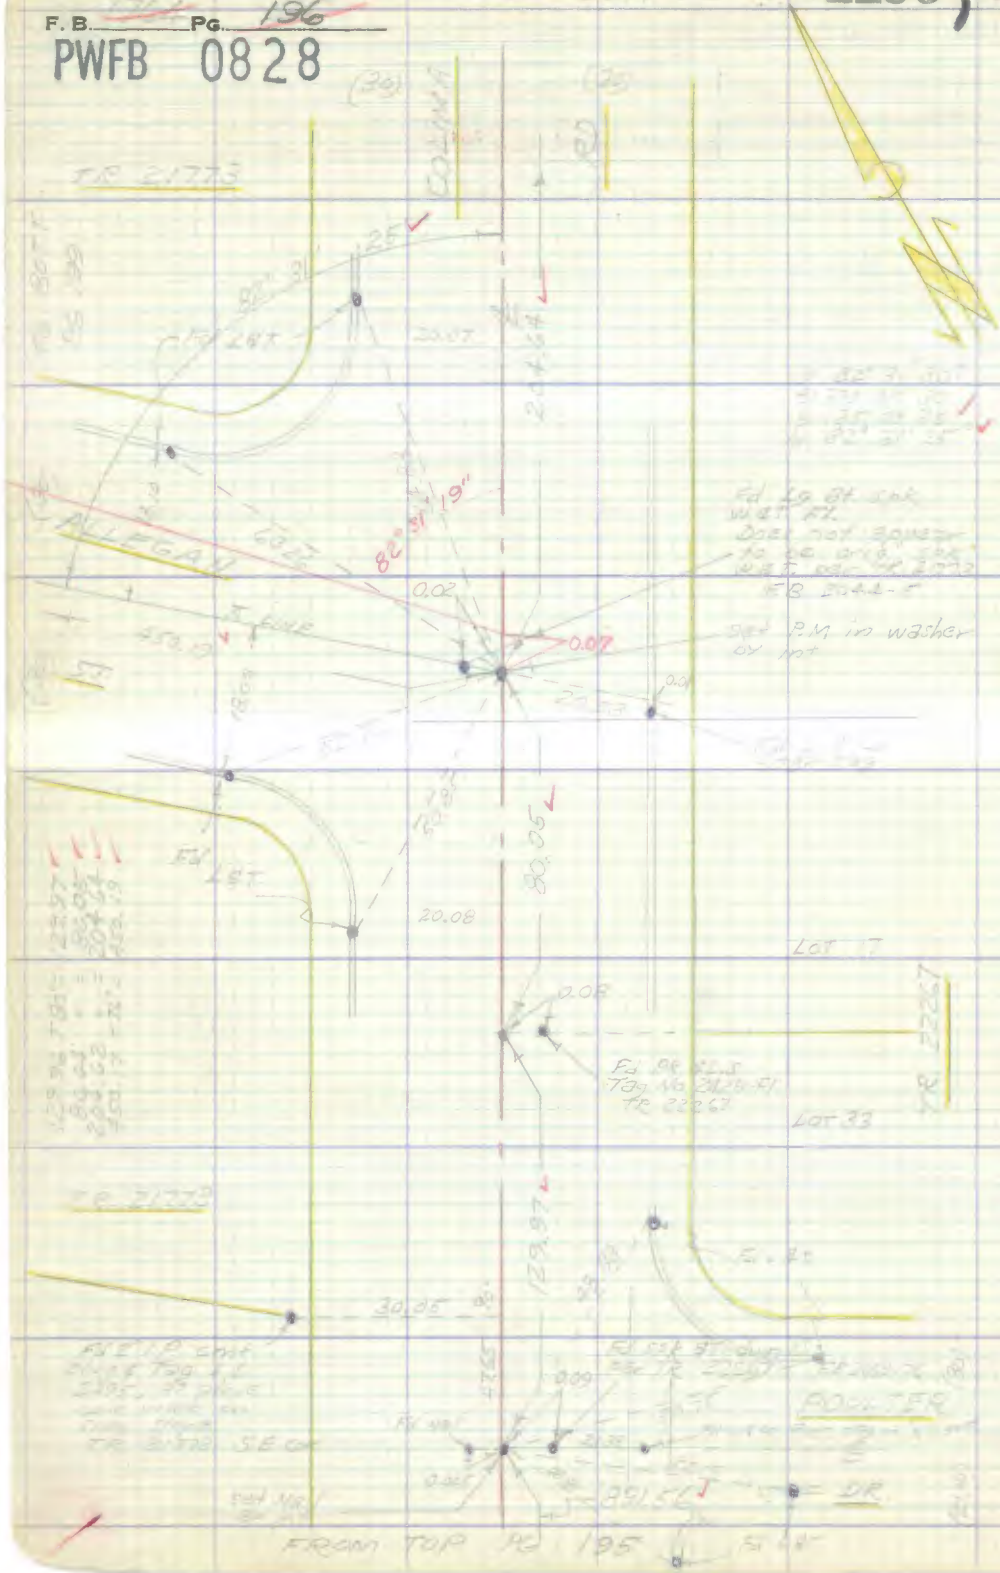


RETURN TO
LOS ANGELES COUNTY ENGINEER
700 LOS ANGELES COUNTY ENGINEERING BLDG.

Do not extend notes this side of this line.

Note: Any Additions or Changes on This Sheet Must be Made or Circled in Red Ink With Date and Name of Person Making Change.

PWFB 0828

1198

| | | |
|---|---|---|
| Notes Ck'd by | Survey of | F. B. ____ Pg. 197 |
| Map No. | JN ____ Tape ____ Std ____ °F | |
| Office Work | Surveyed by | |
| Checked | Notes ____ Date ____ | |
| Date | Indexed | |

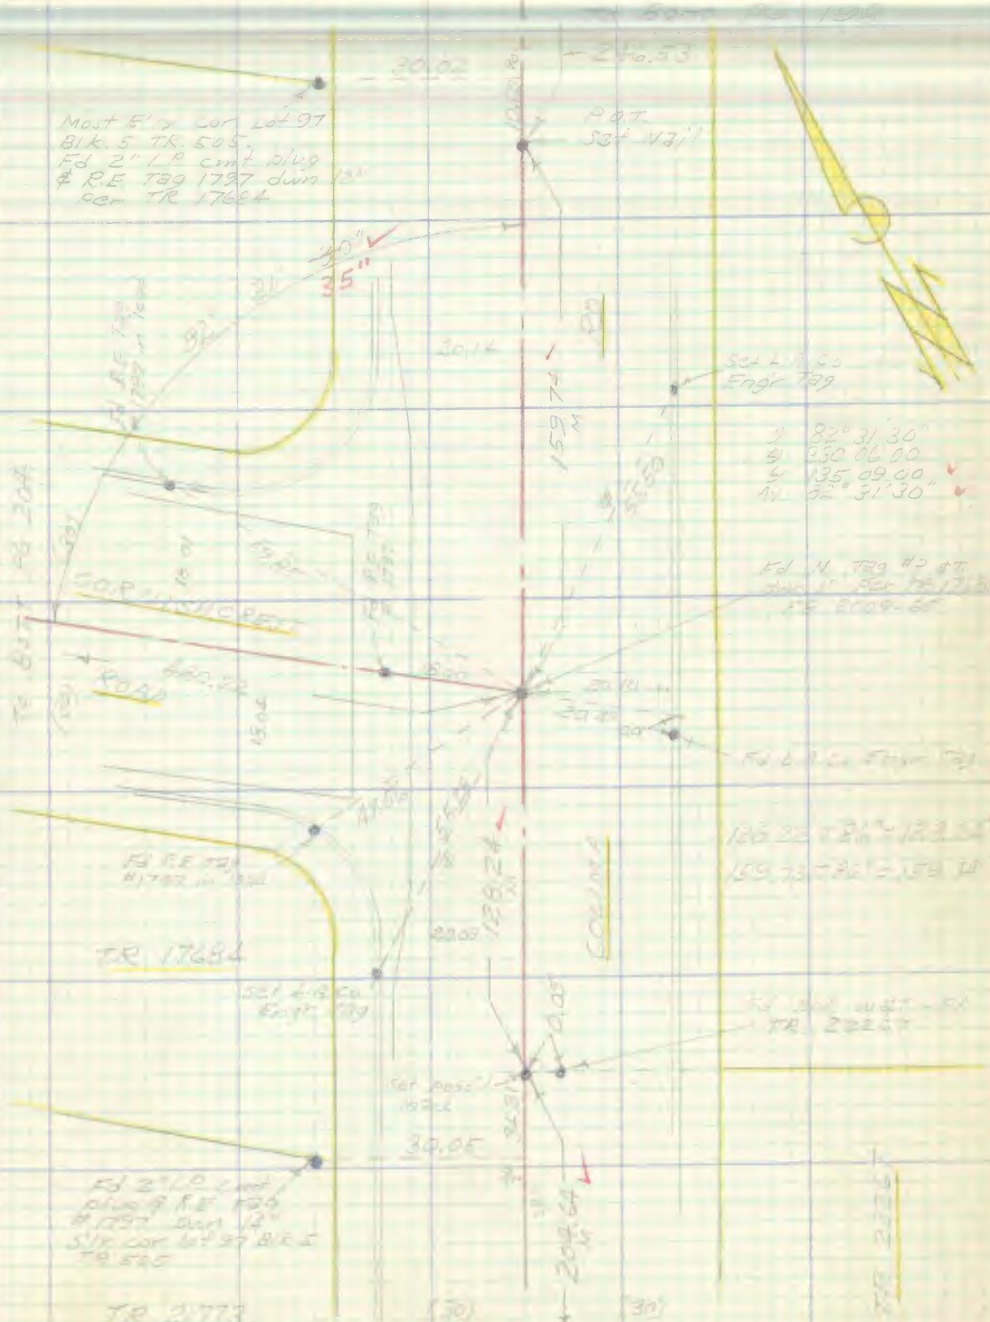


Note: Any Additions or Changes on This Sheet Must be Made or Circled in Red Ink With Date and Name of Person Making Change.

Do not extend notes this side of this line.

RETURN TO
LOS ANGELES COUNTY ENGINEER
700 LOS ANGELES COUNTY ENGINEERING BLDG.

76F3095 CE #247—3-5"

F. B. 1199 Pg. 198

PWFB 0828

1199 , 1200

W.S. 34 - B-2

RETURN TO
LOS ANGELES COUNTY ENGINEER
700 LOS ANGELES COUNTY ENGINEERING BLDG.

Do not extend notes this side of this line.

Note: Any Additions or Changes on This Sheet Must be Made or Circled in Red Ink With Date and Name of Person Making Change.

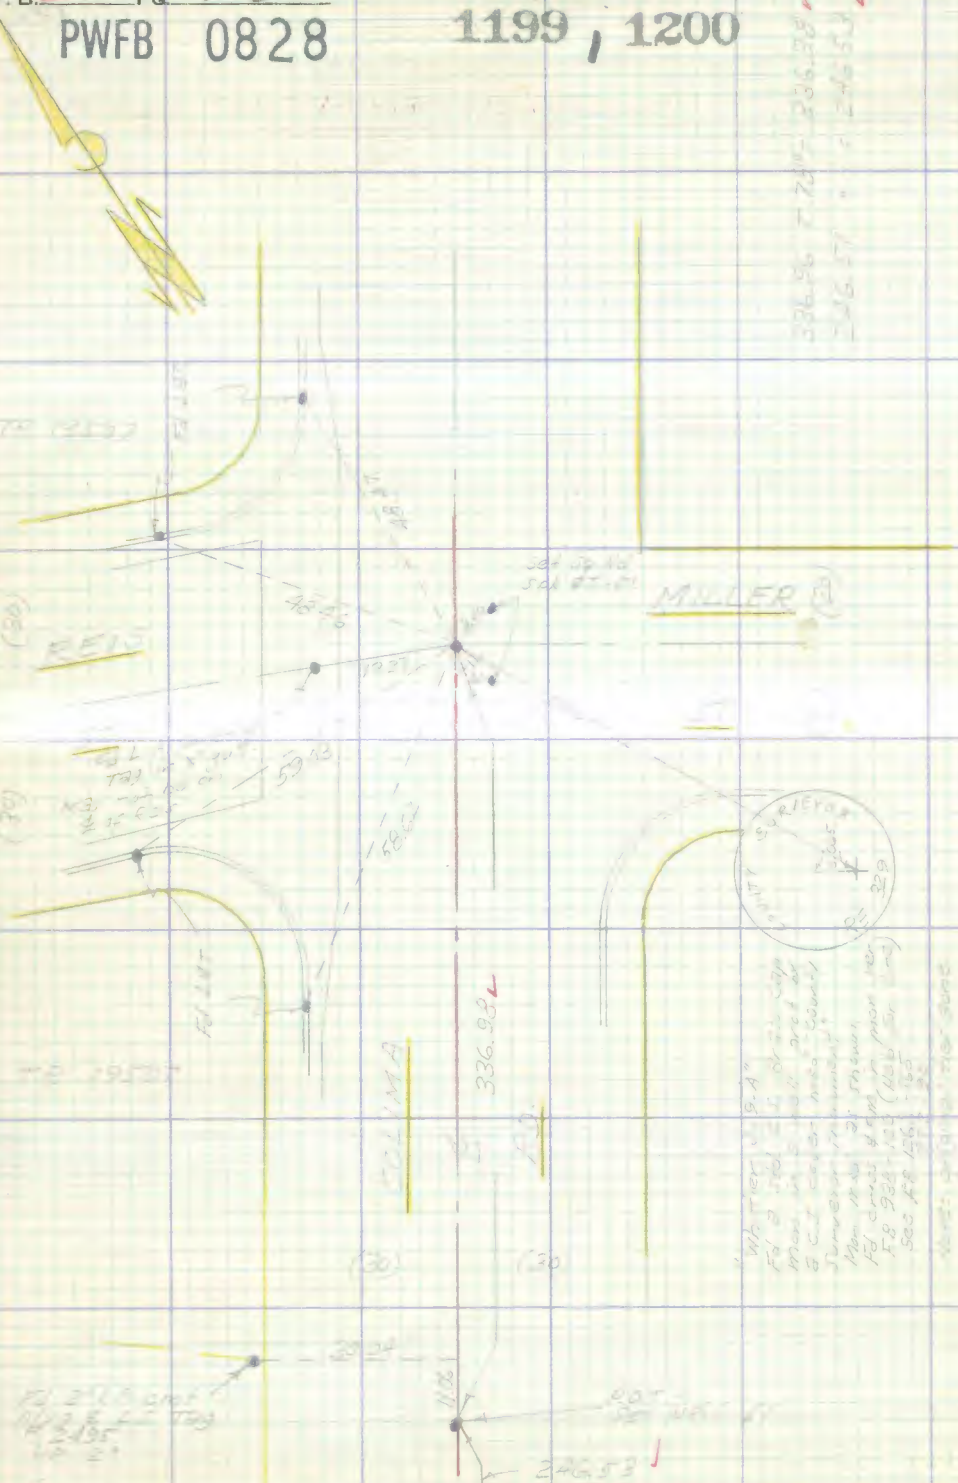


FROM TOP PG 197

76F309S CE #247—3-57

RETURN TO
LOS ANGELES COUNTY ENGINEER
700 LOS ANGELES COUNTY ENGINEERING BLDG.

**Note:** Any Additions or Changes on This Sheet Must be Made or Circled in Red Ink With Date and Name of Person Making Change.

**Do not extend notes this side of this line.**

W.S. 34-B-3

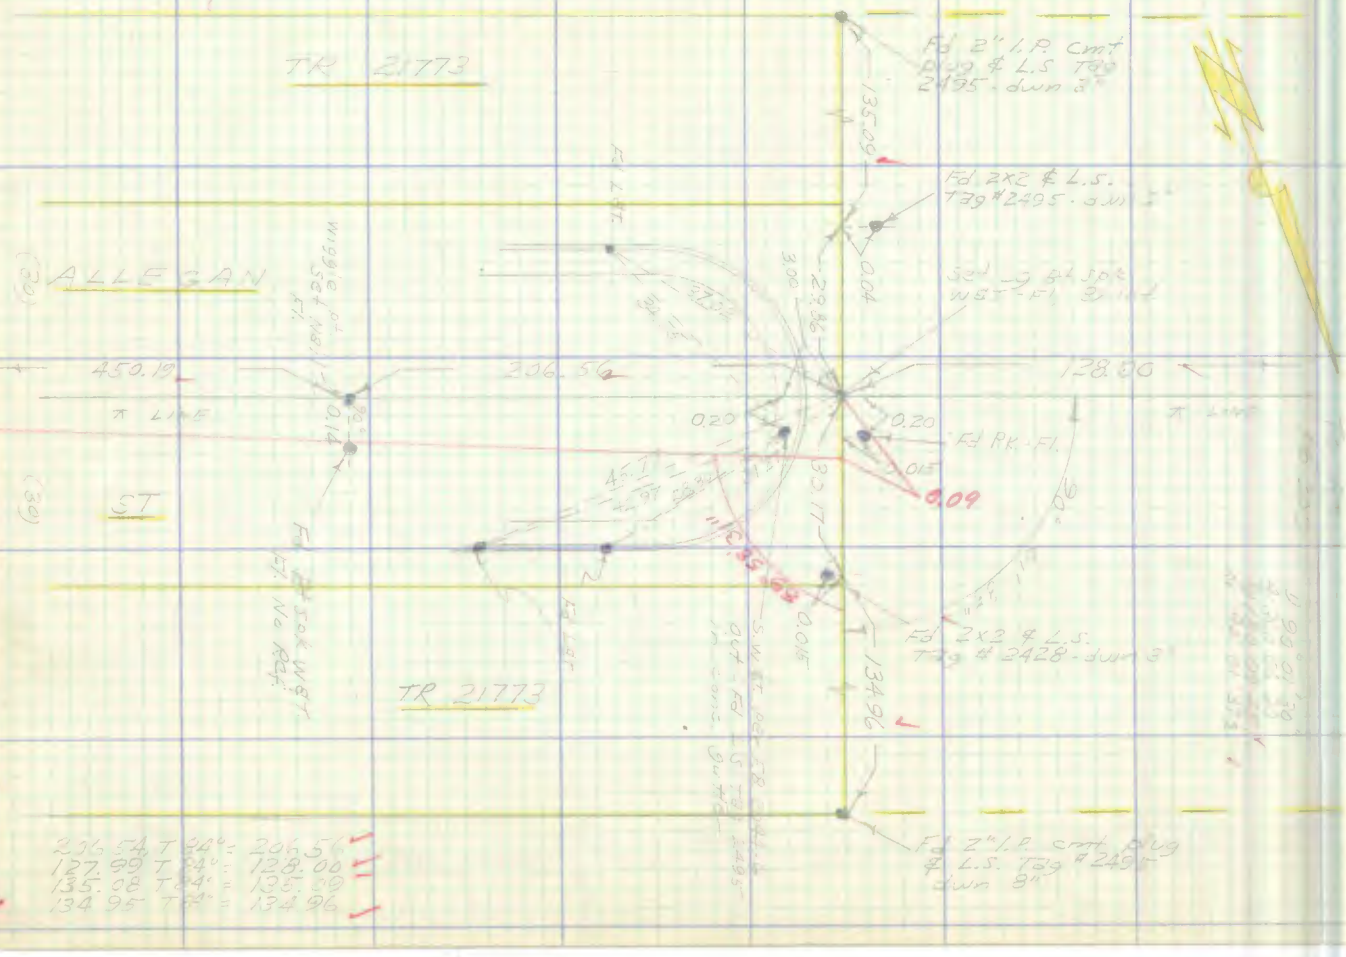


Notes Ck'd by
Map No.
Office Work
Checked
Date

Survey of
JN Tape Std of
Surveyed by
Notes Date
Indexed

F. B. PG.

PWFB 0828

1201

F. B. 176 Pg. 200

1202

PWFB 0828

W.S. 34-B-3

RETURN TO
LOS ANGELES COUNTY ENGINEER
700 LOS ANGELES COUNTY ENGINEERING BLDG.

Do not extend notes this side of this line.

Note: Any Additions or Changes on This Sheet Must be Made or Circled in Red Ink With Date and Name of Person Making Change.

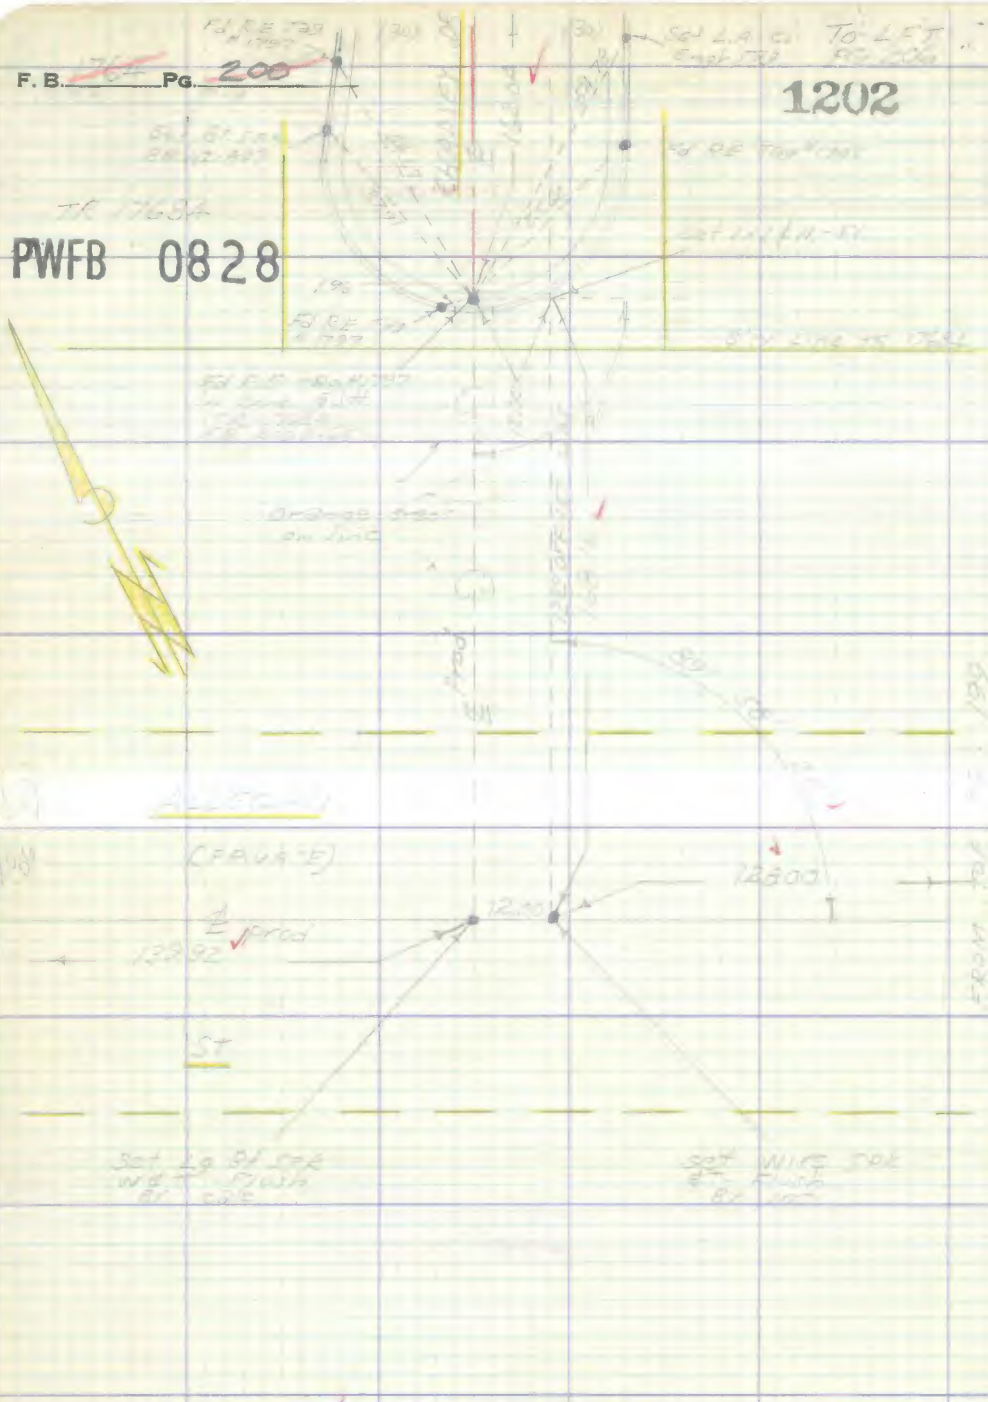

PWFB 0828

1203

| | |
|---|---|
| Notes Ck'd by | Survey of |
| Map No. | JN Tape Std °F |
| Office Work | Surveyed by |
| Checked | Notes Date |
| Date | Indexed |

F. B. PG. 201

W.S. 34-B

Note: Any Additions or Changes on This Sheet Must be Made or Circled in Red Ink With Date and Name of Person Making Change.

Do not extend notes this side of this line.

RETURN TO
LOS ANGELES COUNTY ENGINEER
700 LOS ANGELES COUNTY ENGINEERING BLDG.

76F309S CE #247—3-57

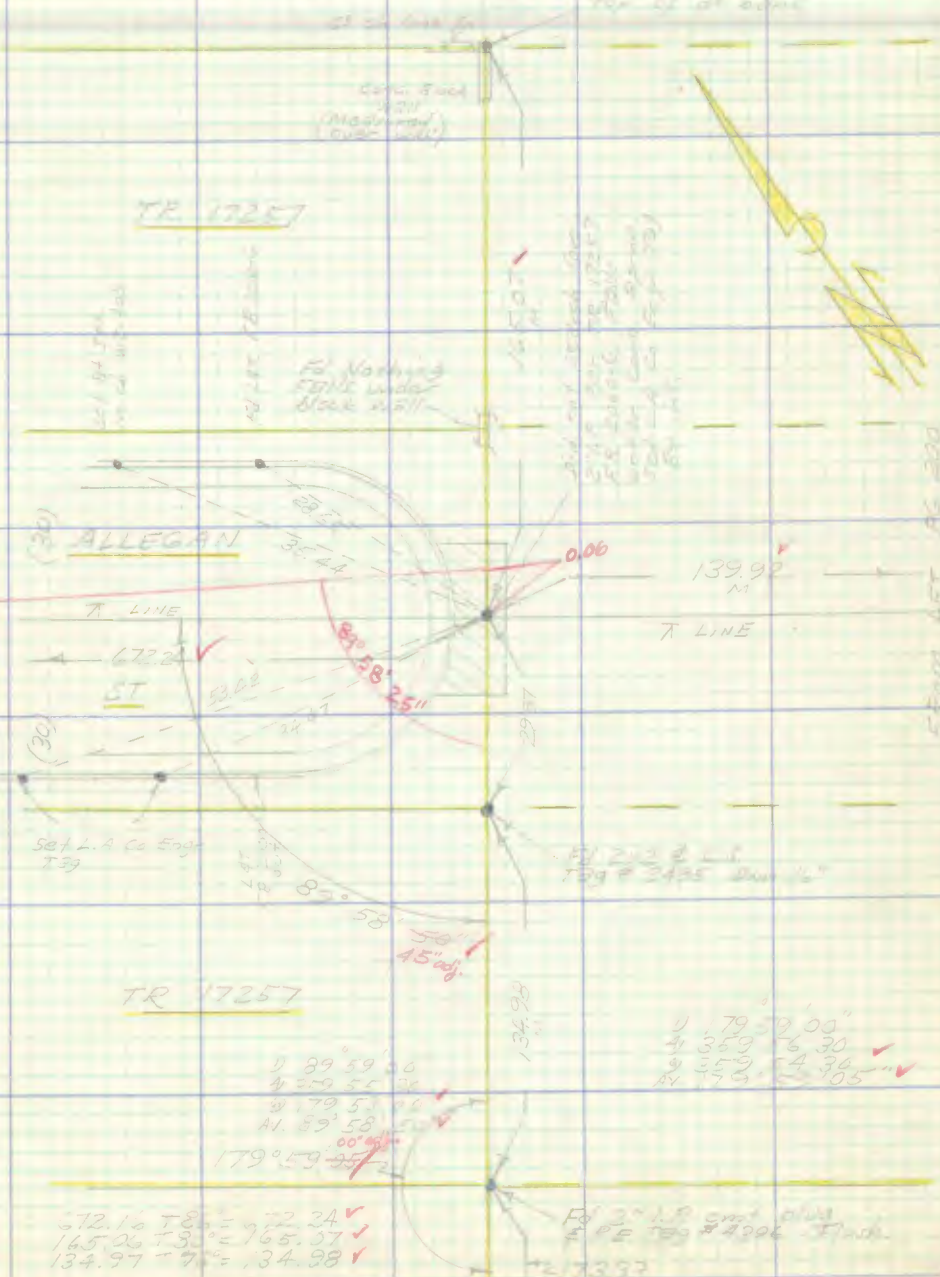

F. B. ~~[illegible]~~ Pg. 202

PWFB 0828

1204

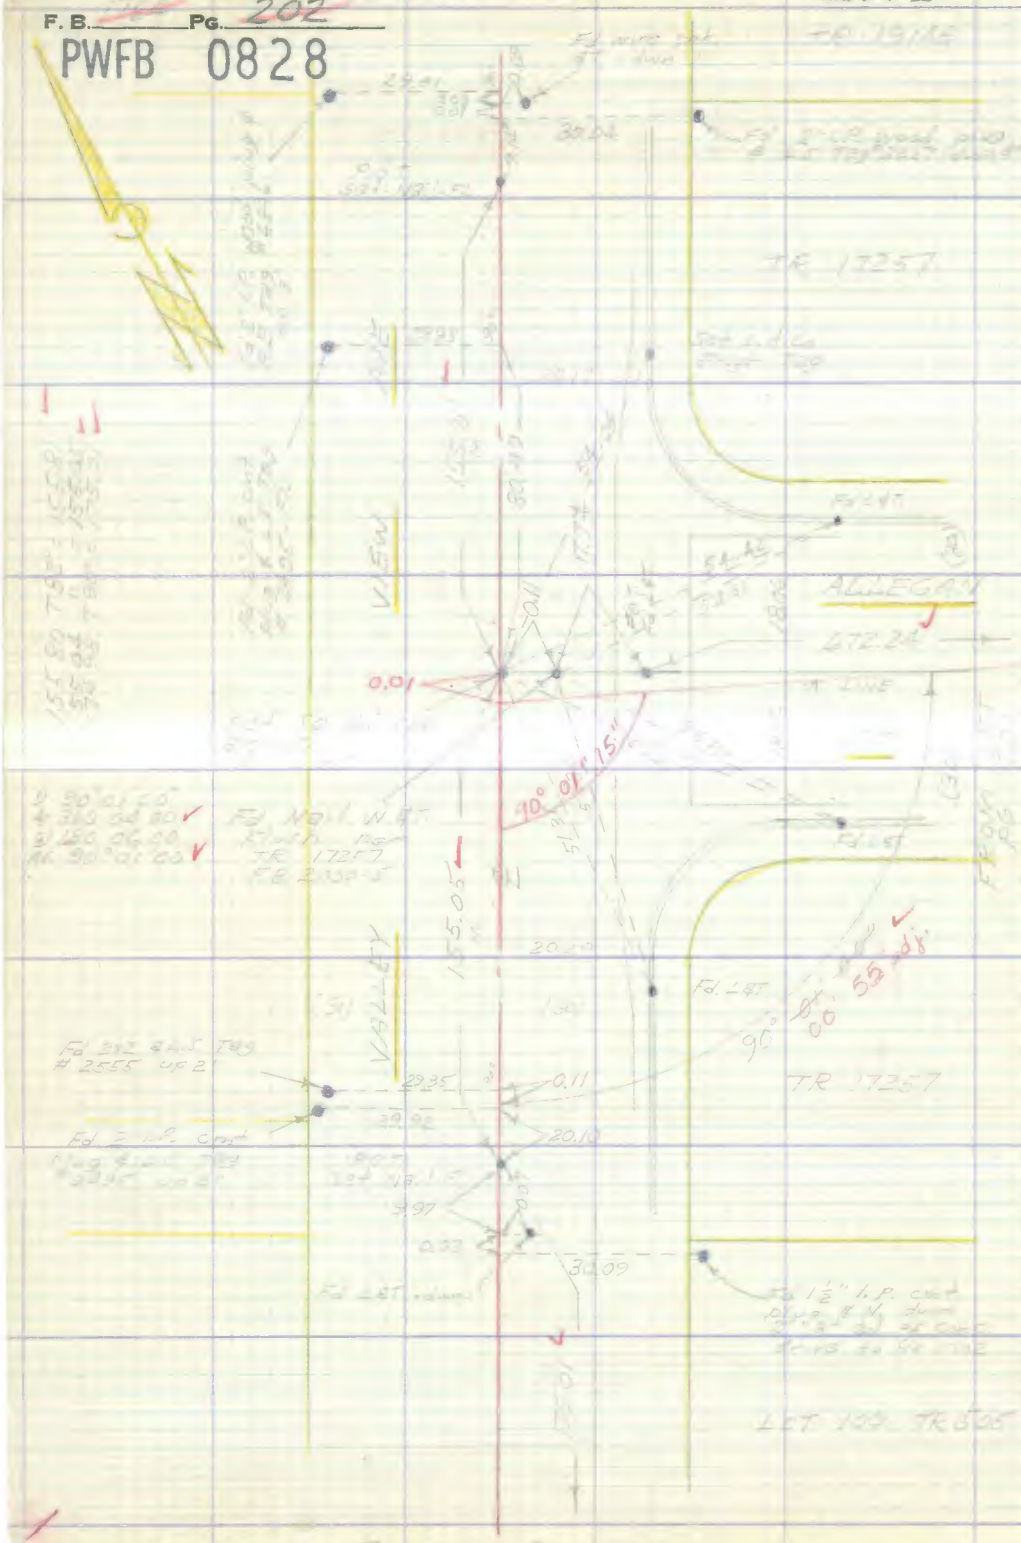


W.S. 34-B-2

RETURN TO
LOS ANGELES COUNTY ENGINEER
700 LOS ANGELES COUNTY ENGINEERING BLDG.

Do not extend notes this side of this line.

Note: Any Additions or Changes on This Sheet Must be Made or Circled in Red Ink With Date and Name of Person Making Change.

PWFB 0828

1205, 1206

| | |
|---|---|
| Notes Ck'd by [illegible] | Survey of [illegible] |
| Map No. | JN [illegible] Tape [illegible] Std [illegible] °F |
| Office Work | Surveyed by [illegible] |
| Checked | Notes [illegible] Date [illegible] |
| Date | Indexed [illegible] |

F. B. [illegible] PG. 203

Note: Any Additions or Changes on This Sheet Must be Made or Circled in Red Ink With Date and Name of Person Making Change.

Do not extend notes this side of this line.

RETURN TO
LOS ANGELES COUNTY ENGINEER
700 LOS ANGELES COUNTY ENGINEERING BLDG.

76F309S CE #247—9-57

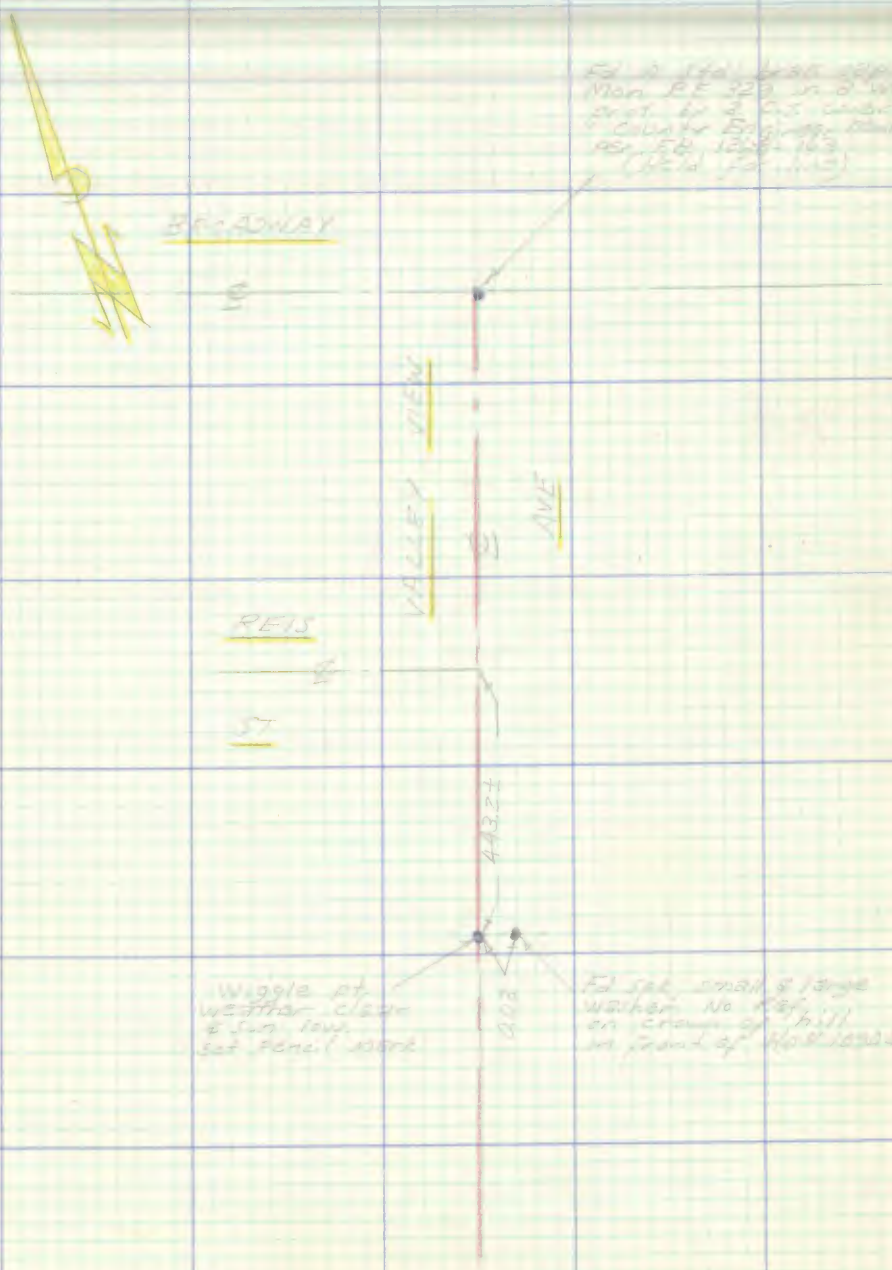


FROM TOP PG 202

F. B. ____ Pg. 204

PWFB 0828

1207

W.S. 34-B-3

RETURN TO
LOS ANGELES COUNTY ENGINEER
700 LOS ANGELES COUNTY ENGINEERING BLDG.

Do not extend notes this side of this line.

Note: Any Additions or Changes on This Sheet Must be Made or Circled in Red Ink With Date and Name of Person Making Change.

FROM LFT PG 197

PWFB 0828

1208

| | |
|---|---|
| Notes Ck'd by [illegible] | Survey of [illegible] |
| Map No. | JN [illegible] Tape [illegible] Std [illegible] °F |
| Office Work | Surveyed by [illegible] |
| Checked | Notes [illegible] Date [illegible] |
| Date | Indexed A. C. Johnson |

F. B. [illegible] PG. 205

W.S. 34-B-2

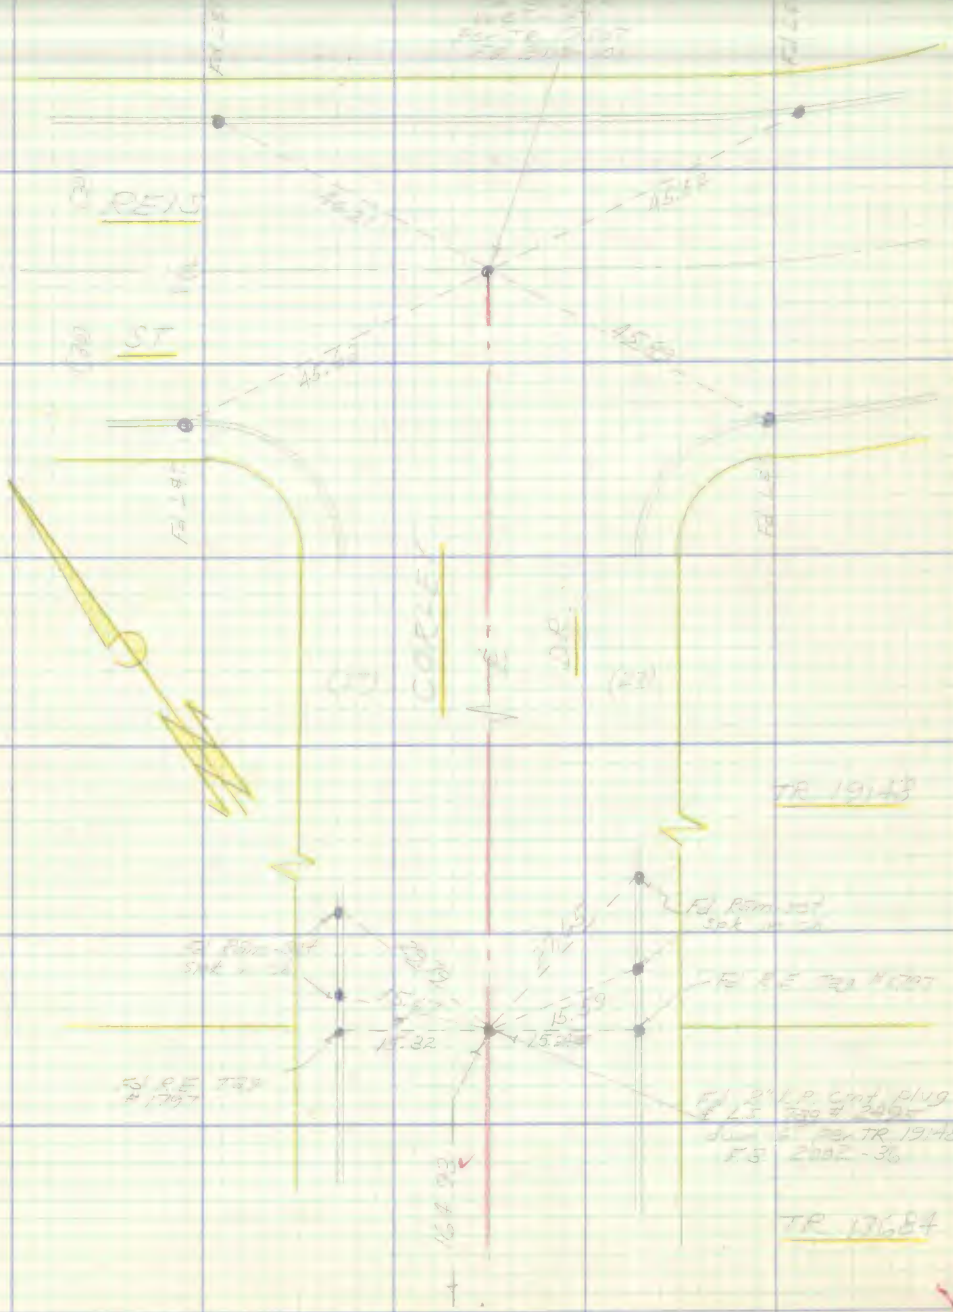


Note: Any Additions or Changes on This Sheet Must be Made or Circled in Red Ink With Date and Name of Person Making Change.

Do not extend notes this side of this line.

RETURN TO
LOS ANGELES COUNTY ENGINEER
700 LOS ANGELES COUNTY ENGINEERING BLDG.

76F309S CE #247—3-57

PWFB 0828 1209

F. B. 176 Pg. 206

W.S. 34-B-2

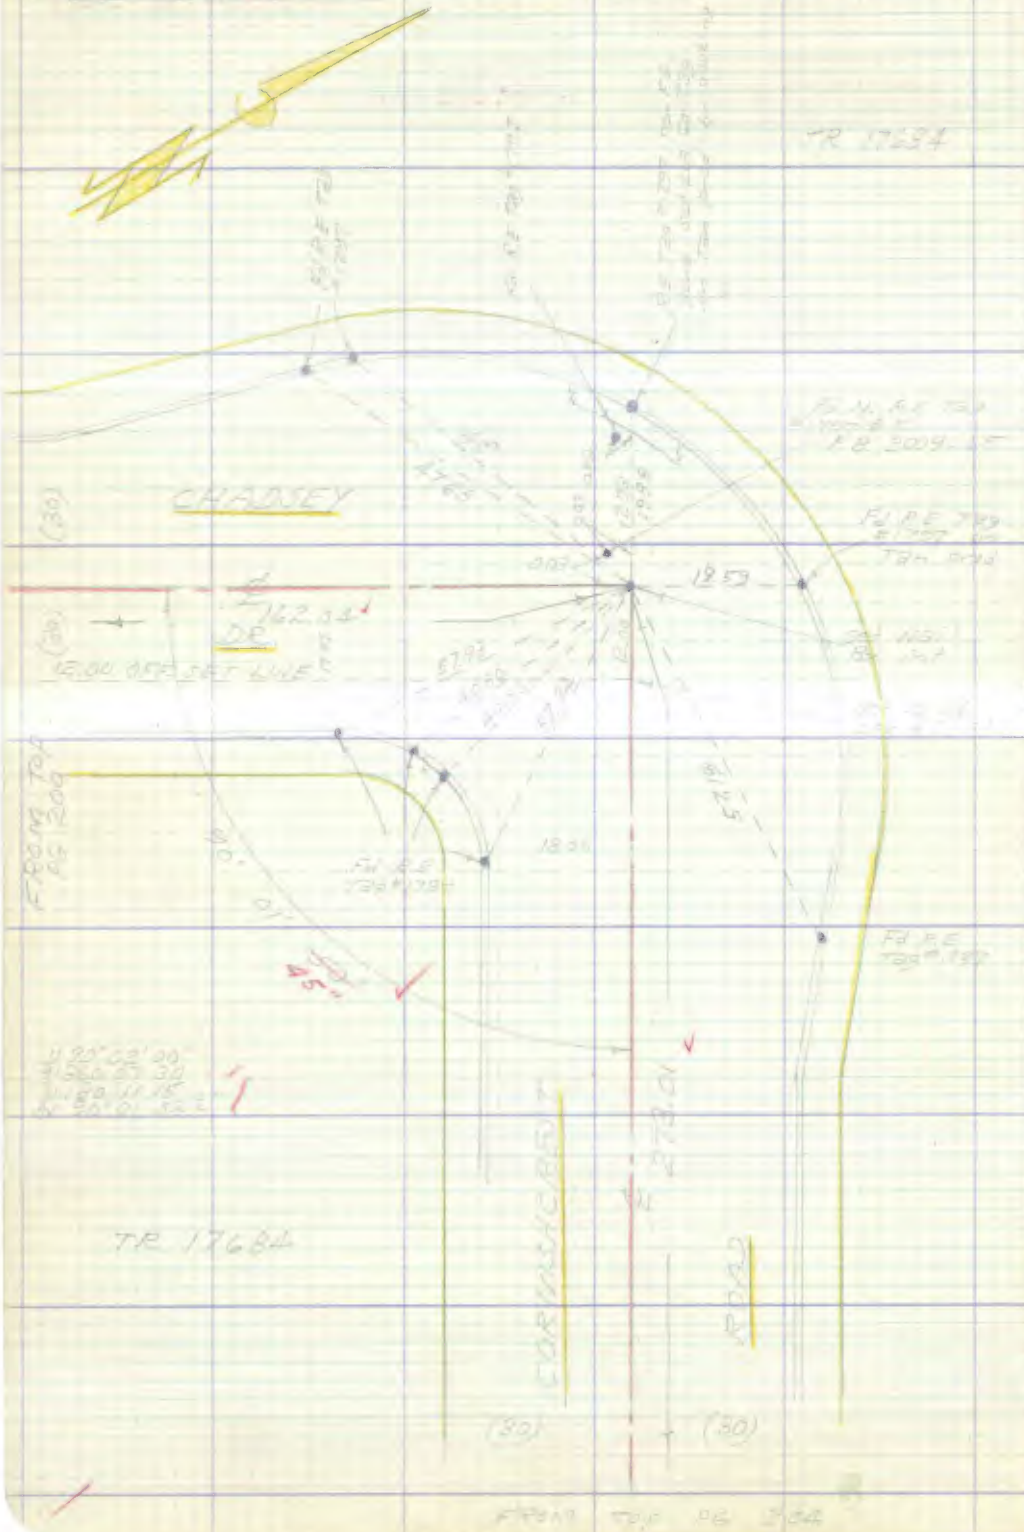


RETURN TO
LOS ANGELES COUNTY ENGINEER
700 LOS ANGELES COUNTY ENGINEERING BLDG.

Note: Any Additions or Changes on This Sheet Must be Made or Circled in Red Ink With Date and Name of Person Making Change.

Do not extend notes this side of this line.

PWFB 0827

2246

| | |
|---|---|
| Notes Ck'd by [illegible] | Survey of [illegible] |
| Map No. | JN [illegible] Tape [illegible] Std [illegible] °F |
| Office Work | Surveyed by [illegible] |
| Checked | Notes [illegible] Date [illegible] |
| Date | Indexed [illegible] |

F. B. [illegible] PG. 207

W.S. 34-B-3

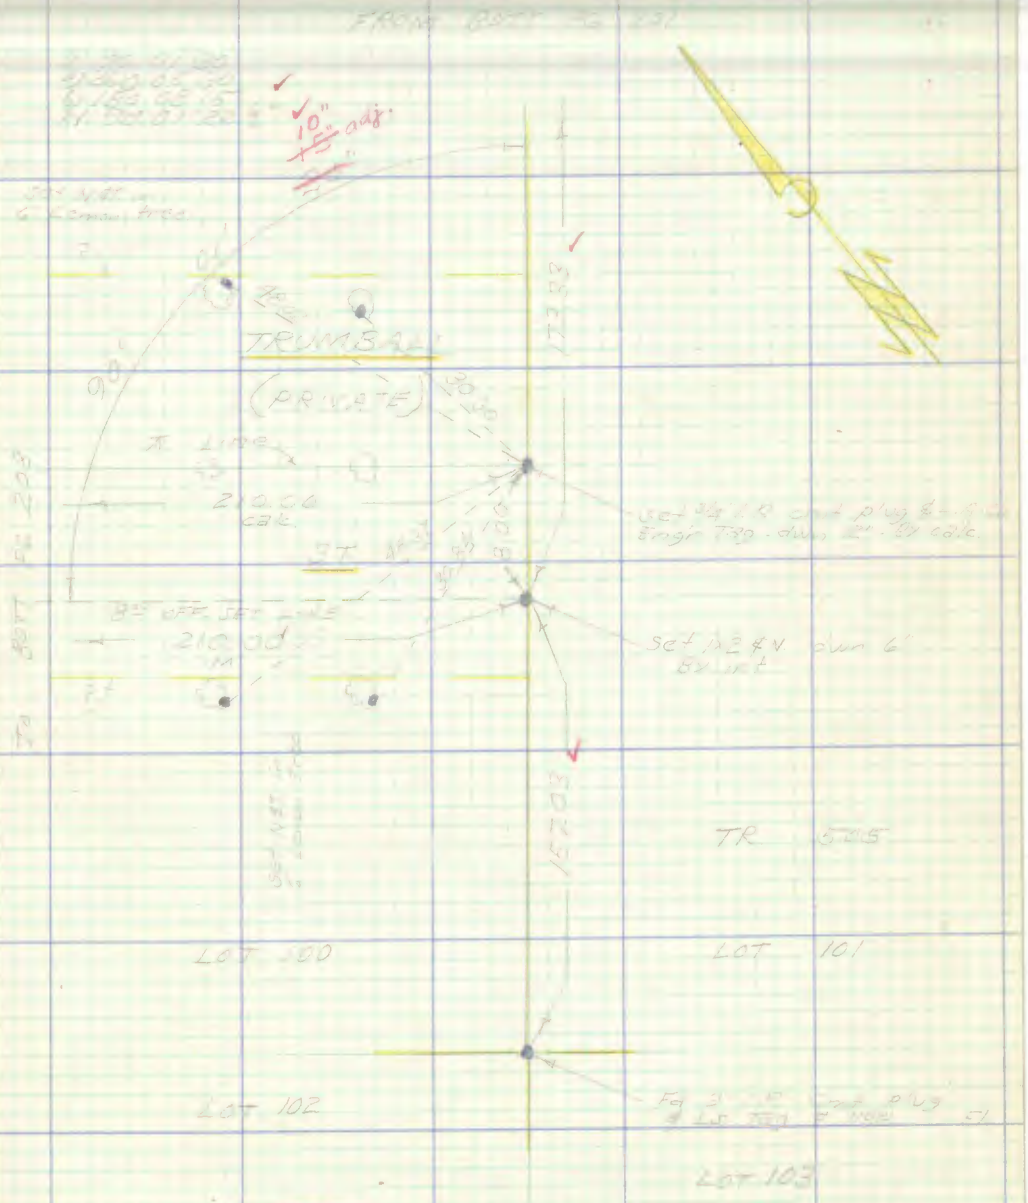


173.31 T 84° = 173.33
157.01 T 82° = 157.03
209.93 T 90° = 210.00

Note: Any Additions or Changes on This Sheet Must be Made or Circled in Red Ink With Date and Name of Person Making Change.

Do not extend notes this side of this line.

RETURN TO
LOS ANGELES COUNTY ENGINEER
700 LOS ANGELES COUNTY ENGINEERING BLDG.

76F309S CE #247—3-57

RETURN TO
LOS ANGELES COUNTY ENGINEER
700 LOS ANGELES COUNTY ENGINEERING BLDG.

Note: Any Additions or Changes on This Sheet Must be Made or Circled in Red Ink With Date and Name of Person Making Change.

Do not extend notes this side of this line.

2247

F. B. ____ PG. ____

PWFB 0827

PWFB 0827

2248

| | | |
|---|---|---|
| Notes Ck'd by [illegible] | Survey of [illegible] | F. B. [illegible] Pg. 209 |
| Map No. | JN [illegible] Tape [illegible] Std. [illegible] °F | |
| Office Work | Surveyed by [illegible] | |
| Checked | Notes [illegible] Date [illegible] | |
| Date | Indexed [illegible] | |

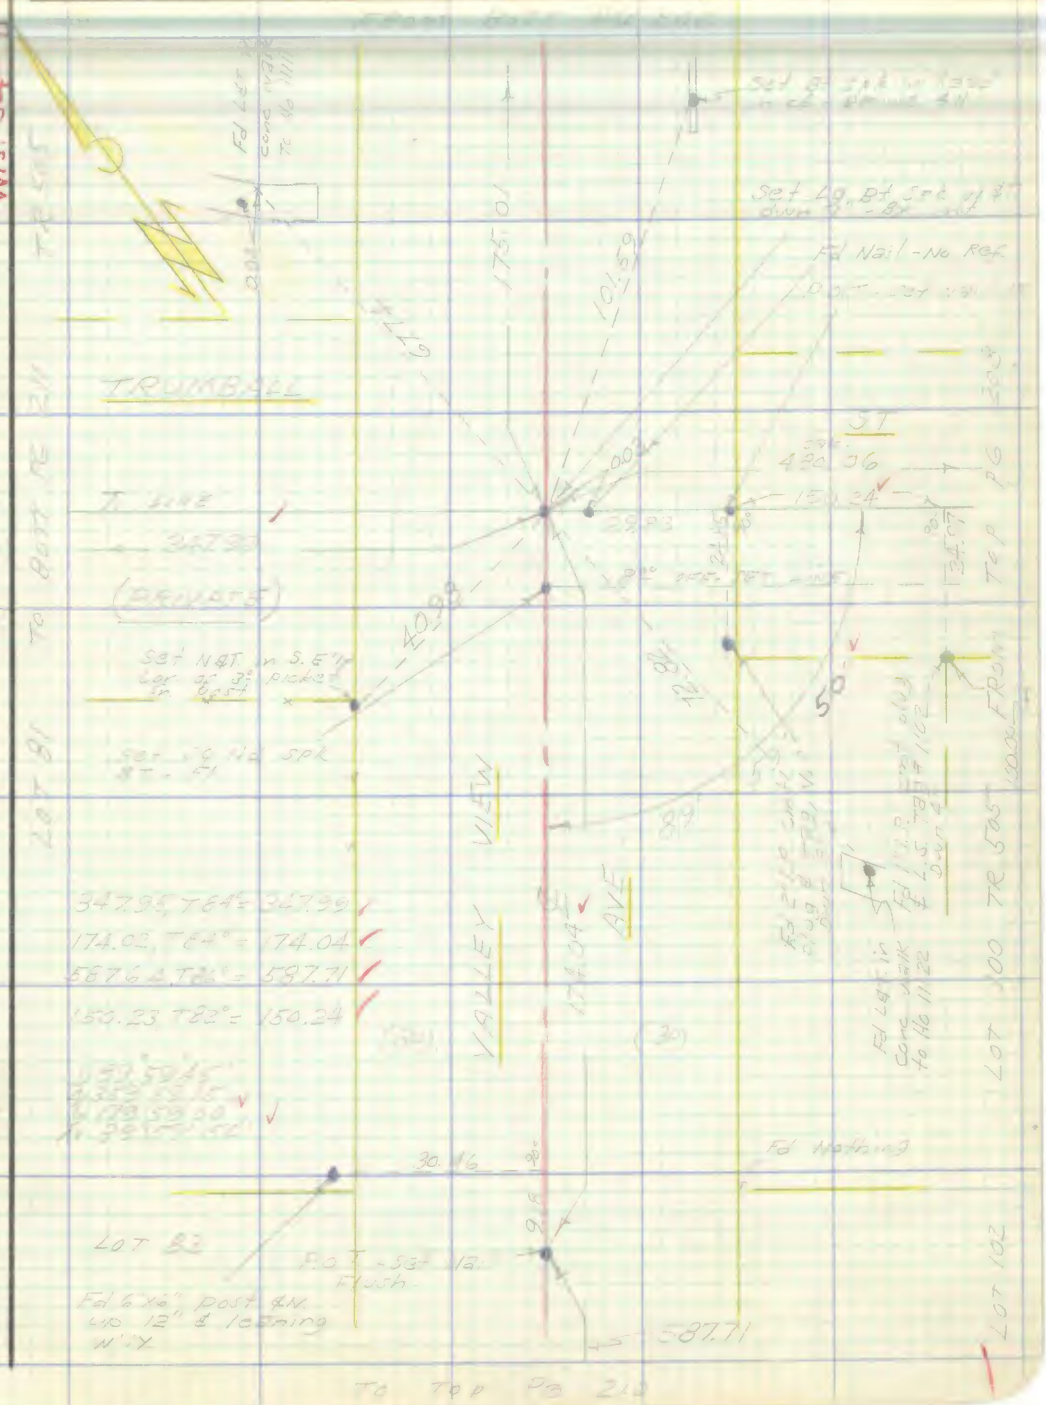


Note: Any Additions or Changes on This Sheet Must be Made or Circled in Red Ink With Date and Name of Person Making Change.

Do not extend notes this side of this line.

RETURN TO
LOS ANGELES COUNTY ENGINEER
700 LOS ANGELES COUNTY ENGINEERING BLDG.

76F309S CE #247—3-57

F. B. ~~764~~ Pg. ~~210~~

PWFB 0827

2249

FROM BOTT PG 209

W.S 34-B-3

RETURN TO
LOS ANGELES COUNTY ENGINEER
700 LOS ANGELES COUNTY ENGINEERING BLDG.

Do not extend notes this side of this line.

Note: Any Additions or Changes on This Sheet Must be Made or Circled in Red Ink With Date and Name of Person Making Change.

PWFB 0827 2250

| | |
|---|---|
| Notes Ck'd by [illegible] | Survey of [illegible] |
| Map No. | JN [illegible] Tape [illegible] Std. [illegible] °F |
| Office Work | Surveyed by [illegible] |
| Checked | Notes [illegible] Date [illegible] |
| Date | Indexed [illegible] |

F. B. [illegible] PG. 211

W.S. 34 - B

Note: Any Additions or Changes on This Sheet Must be Made or Circled in Red Ink With Date and Name of Person Making Change.

Do not extend notes this side of this line.

RETURN TO
LOS ANGELES COUNTY ENGINEER
700 LOS ANGELES COUNTY ENGINEERING BLDG.

76F3095 CE #247—3-57

F. B. ~~174~~ Pg. ~~212~~

PWFB 0827

2251

W.S. 34-B-2

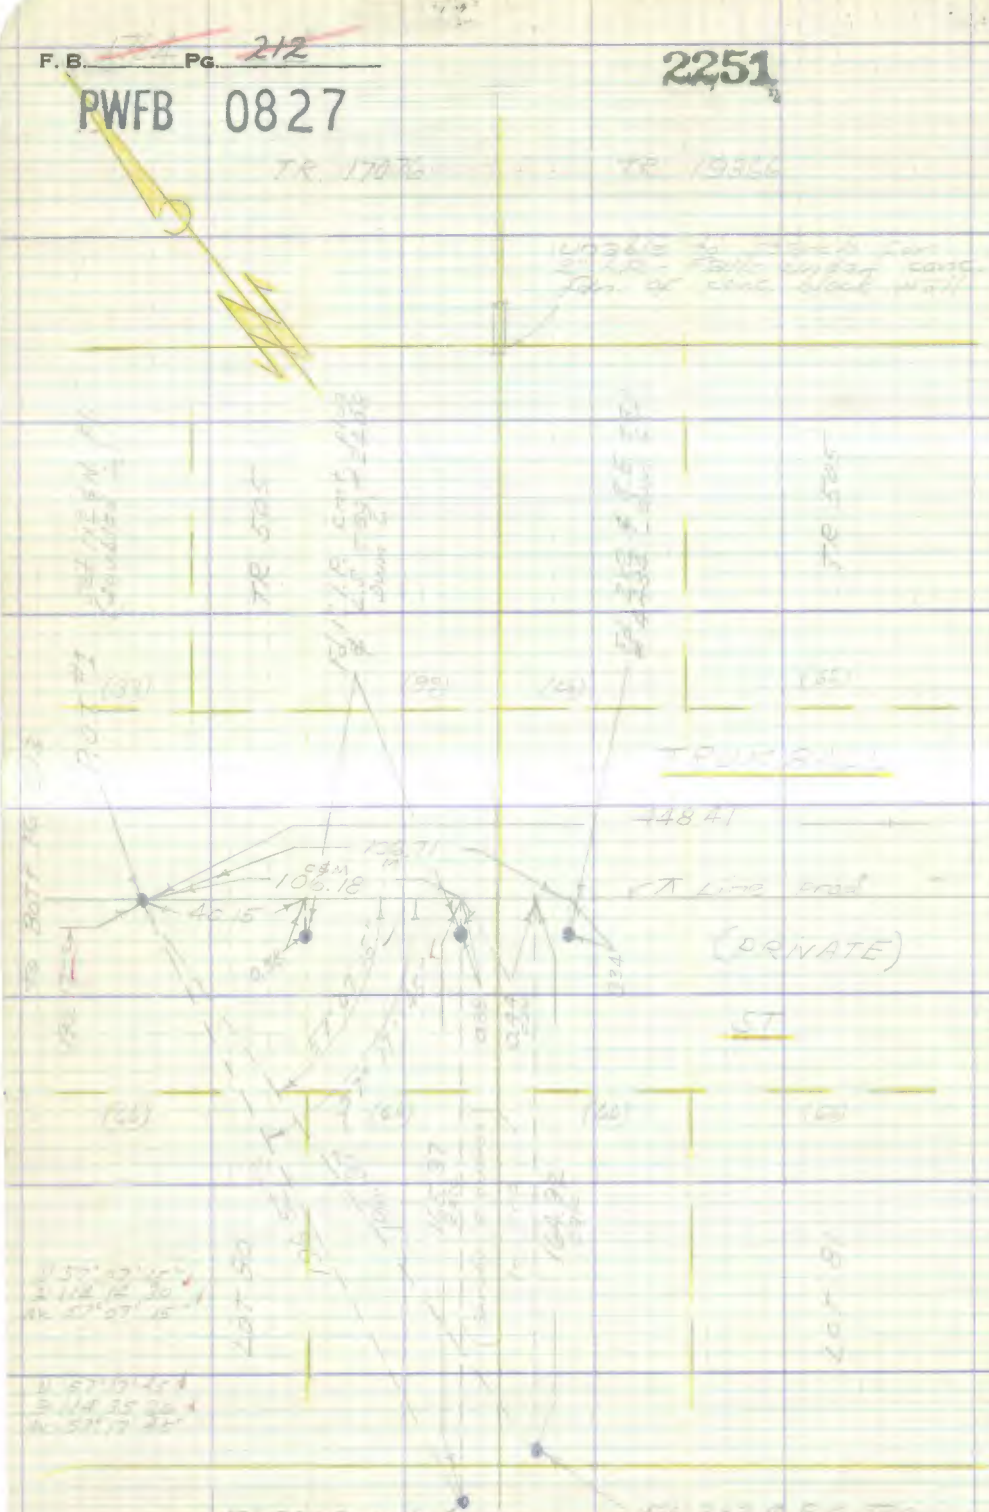


RETURN TO
LOS ANGELES COUNTY ENGINEER
700 LOS ANGELES COUNTY ENGINEERING BLDG.

Do not extend notes this side of this line.

Note: Any Additions or Changes on This Sheet Must be Made or Circled in Red Ink With Date and Name of Person Making Change.

PWFB 0827

2252

| | |
|---|---|
| Notes Ck'd by | Survey of |
| Map No. | JN Tape Std °F |
| Office Work | Surveyed by |
| Checked | Notes Date |
| Date | Indexed |

F. B. Pg. 213

Note: Any Additions or Changes on This Sheet Must be Made or Circled in Red Ink With Date and Name of Person Making Change.

Do not extend notes this side of this line.

RETURN TO
LOS ANGELES COUNTY ENGINEER
700 LOS ANGELES COUNTY ENGINEERING BLDG.

76F309S CE #247—3-57

FROM LAST PG 212

F. B. ~~174~~ PG. ~~214~~

PWFB 0827

FROM BOTT PG 215

2253

W.S. 34 - B - 2

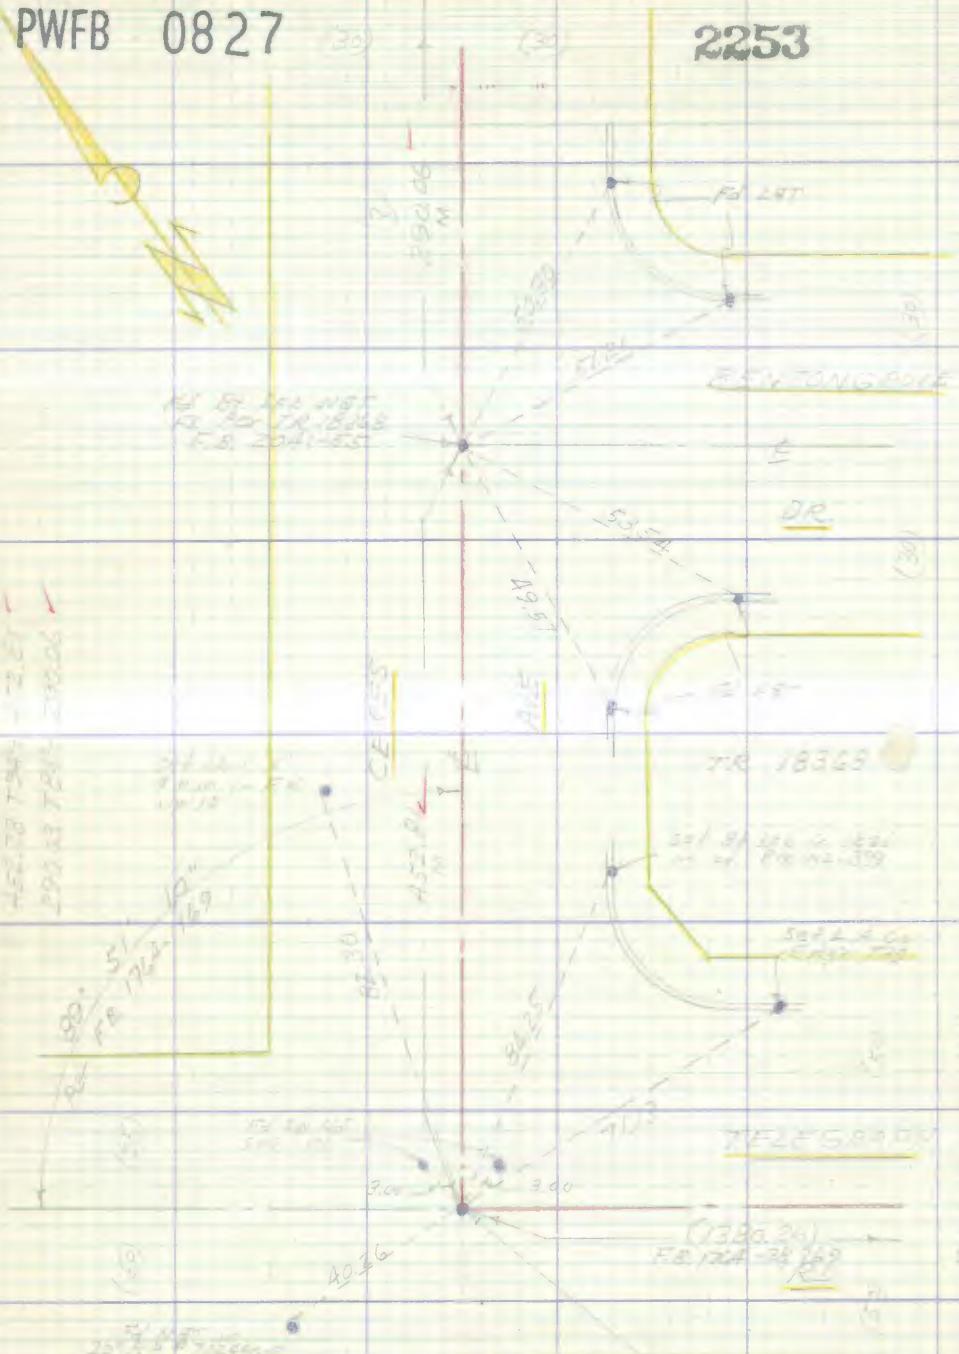


RETURN TO
LOS ANGELES COUNTY ENGINEER
700 LOS ANGELES COUNTY ENGINEERING BLDG.

Do not extend notes this side of this line.

Note: Any Additions or Changes on This Sheet Must be Made or Circled in Red Ink With Date and Name of Person Making Change.

76F309S CE #247—3-57

RETURN TO
LOS ANGELES COUNTY ENGINEER
700 LOS ANGELES COUNTY ENGINEERING BLDG.

Note: Any Additions or Changes on This Sheet Must be Made or Circled in Red Ink With Date and Name of Person Making Change.

Do not extend notes this side of this line.

W.S. 34-B-

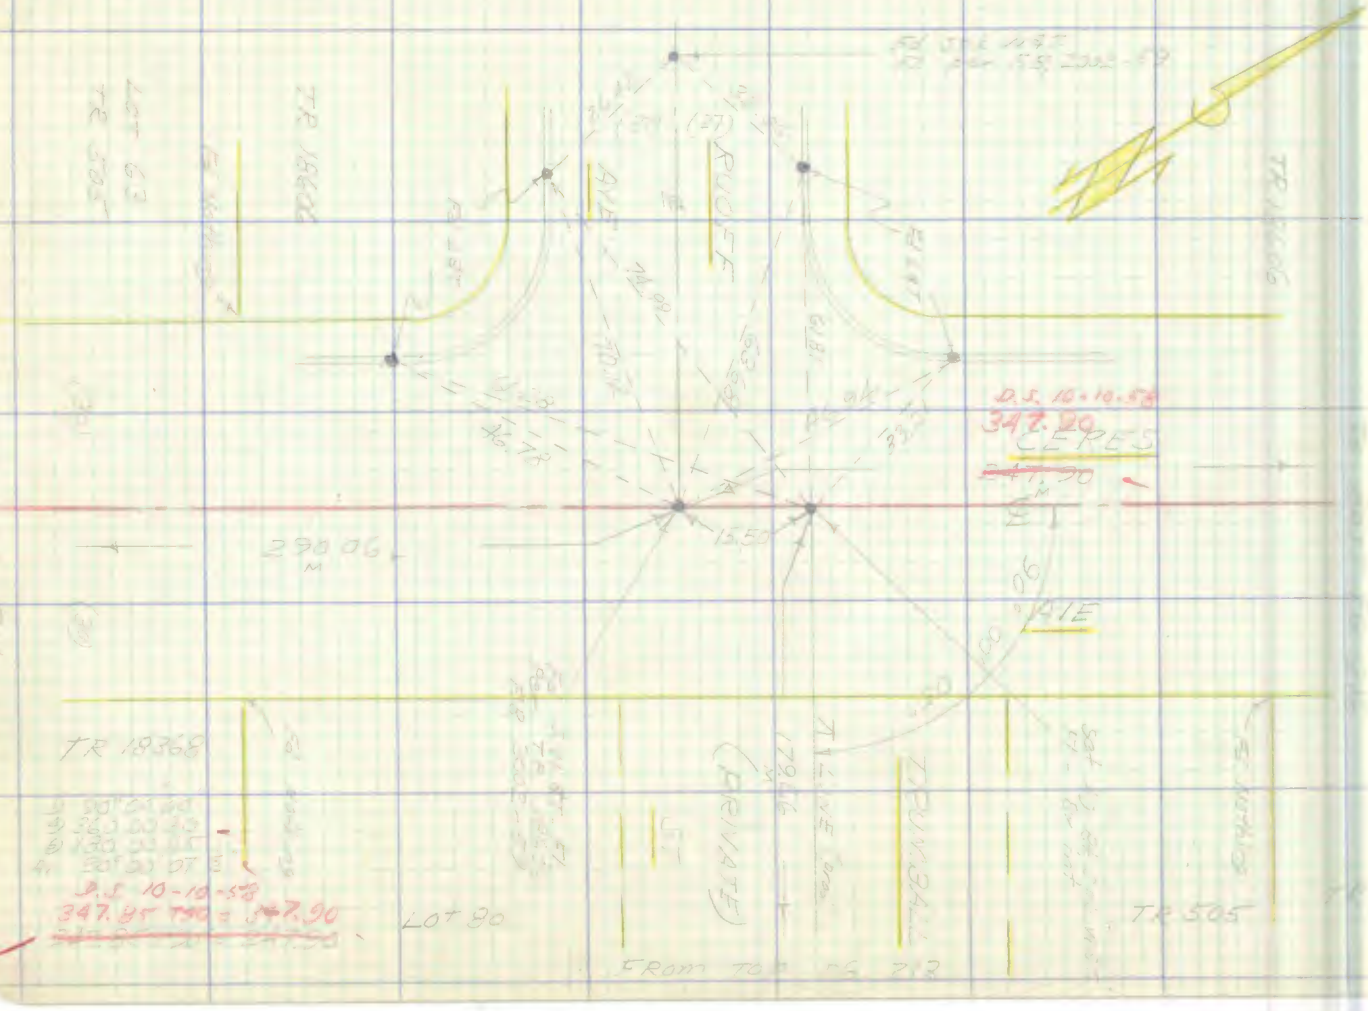


Notes Ck'd by
Map No.
Office Work
Checked
Date

Survey of
JN
Tape
Std
oF
Surveyed by
Notes
Date

PWFB 0827

2254

F B
PG. 215

RETURN TO
LOS ANGELES COUNTY ENGINEER
700 LOS ANGELES COUNTY ENGINEERING BLDG.

Note: Any Additions or Changes on This Sheet Must be Made or Circled in Red Ink With Date and Name of Person Making Change.

W.S. 34 - B-2

Do not extend notes this side of this line.

2255, 2256

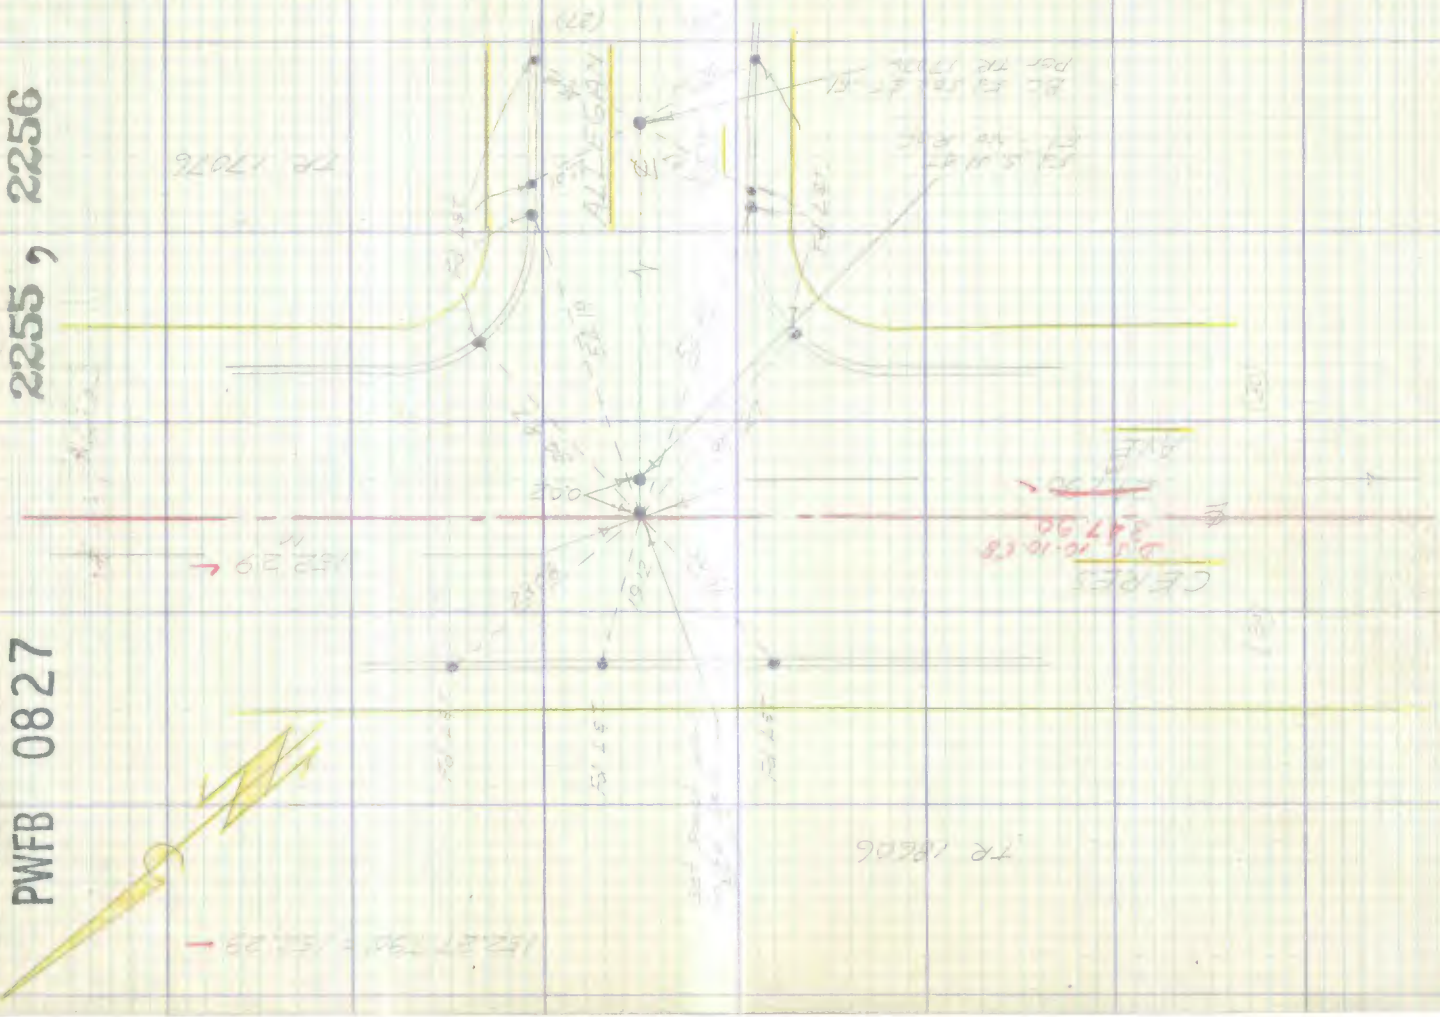

F.B. PWFB 0827 PG. 216

WFB 0827

2257

| | |
|---|---|
| Notes Ck'd by | Survey of |
| Map No. | JN Tape Std °F |
| Office Work | Surveyed by |
| Checked | Notes Date |
| Date | Indexed L. C. Johnson |

F. B. Pg. 217

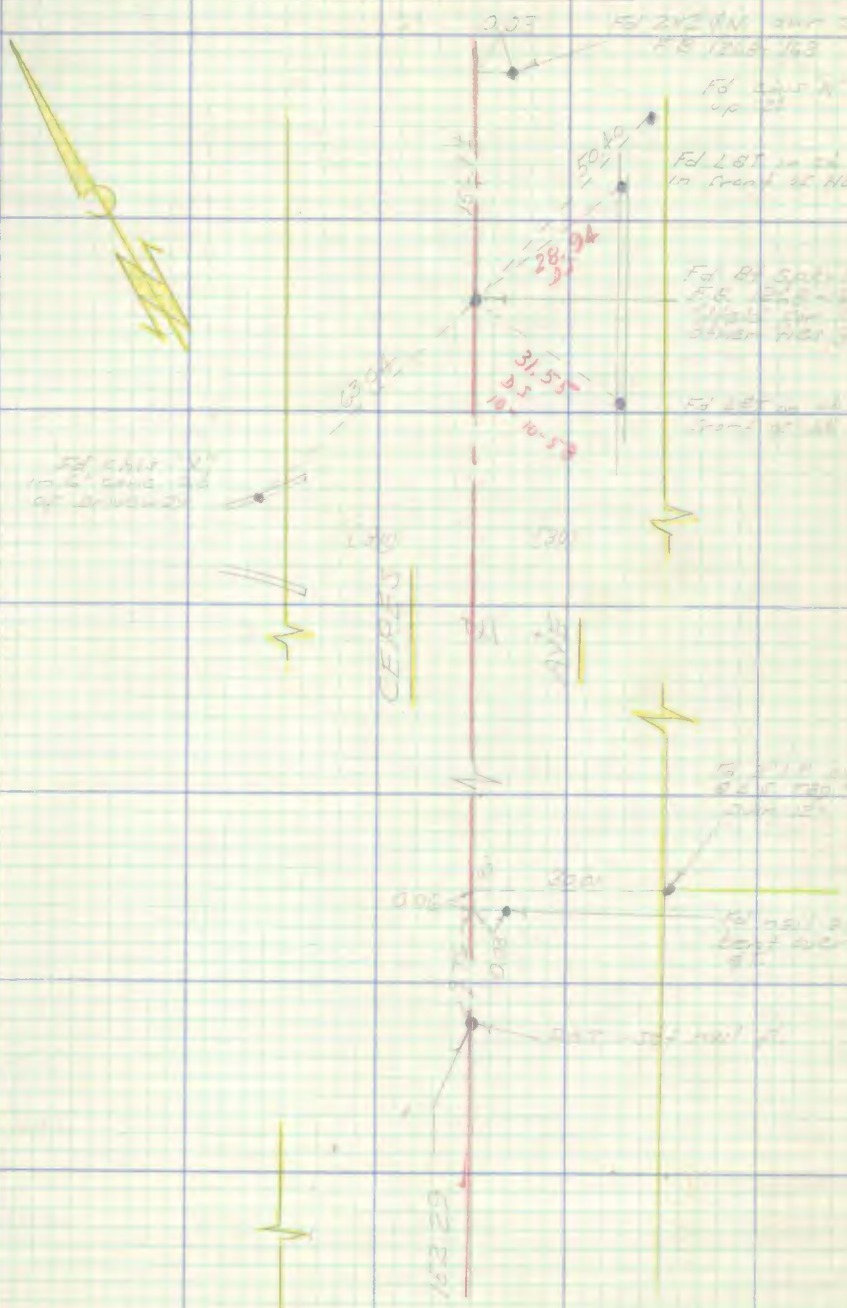

From Top Pg 216