INDEX TO F.B. 1799

DATE	J.N.	DESCRIPTION		NOTES	PAGES
1953	6951	ARTESIA-NORWALK STORM DRAIN PROJECT NO. 21, DIV. NO. 1, LINES A&B			
"	"	CENTERLINE SURVEY		C.L.	5-65
"	"	" "		"	66-110
"	"	" "		"	205-248
"	"	P.E.R.R. R/W	Del Amo Blvd. to Norwalk Blvd.	Topog	113-126
"	"	NORWALK BLVD.	P.E.R.R. to Sheridan St.	"	126-174
"	"	SHERIDAN ST.	Norwalk Blvd. to 420 ft. Easterly	"	174-176
"	"	TRANSIT LINE	Sheridan St. to Firestone Blvd.	"	176-179
"	"	SILVER BOW AVE.	Firestone Blvd. to Leffingwell Road	"	179-192
"	"	TRANSIT LINE	Leffingwell Road to Imperial Hwy.	"	192-196
"	"	CENTER LINE SURVEY 2- LINE "A".		C.L.	205-248

Microfilmed March '87
P.W. file o.k. Aug '87

Notes Ck'd by
Map No.
Office Work
Checked
Date

Survey of
JN Tape Std °F
Surveyed by
Notes Date
Indexed

F.B. 1799

RETURN TO
LOS ANGELES COUNTY ENGINEER
LOS ANGELES COUNTY ENGINEERING BLDG.

Note: Any Additions or Changes on This Sheet Must be Made or Circled in Red Ink With Date and Name of Person Making Change.

Do not extend notes this side of this line.

DATE	J.B.	DESCRIPTION	NOTES	PAGES

INDEX TO F.B. _____ (CONT'D)

F.B. 1799 PG. 4

PWFB 0526

1013

Notes Ck'd by Galli
Map No.
Office Work
Checked
Date

Survey of Artesia-Norwalk
W. O. 6951 Tape No. St'd. °F
Surveyed by English
Notes " Date 5-53
Indexed C. Johnson
1-15-54

F. B. Pg.

ARTESIA-NORWALK
J.N. 6951

CENTERLINE SURVEY
OF STREET ALONG
PROPOSED ROUTE
OF

STORM DRAIN
PROJECT No 21
DIVISION No 1
LINES A & B

June 1953
English
Sappell
Peterson
Oben
Lind

Note: Any Additions or Changes on This Sheet Must be Made or Circled in Red Ink With Date and Name of Person Making Change.

Do not extend notes this side of this line.

RETURN TO
LOS ANGELES COUNTY SURVEYOR
726 LOS ANGELES COUNTY
ENGINEERING BLDG.

76F309S 247 2-51

PWFB 0526

1014

F. B. 1789 PG. 6

ALONDRA BLVD.

HERMOSURA ST.
160 TH. ST.
ALGARDI. ST.
161 ST. ST.
162 ND. ST.
163 RD. ST.
CHESTERTON ST.
164 TH. ST.
CEDARVALE ST.
165 TH. ST.
166 TH. ST.

27 39 38 37 36 26 35 34 33 32 31 25

INDEX MAP

24

ARTESIA BLVD.

23

NORWALK BLVD

ASHWORTH ST.
179 TH. ST.
180 TH. ST.
ALLEY
183 RD. ST.
ALLEY
ALLEY
186 TH. ST.

22 21 20 19 19 18

Note:
For Addition to this Index Map See pg. 66 & 67

17

ORANGETHORPE BLVD.

HIBBING ST.
191 ST. ST.
192 ND. ST.
193 RD. ST.
194 TH. ST.
BINGHAM ST.
195 TH. ST.

16 15 14 13 12

P.E.R.R.

FLORA VISTA ST.

11

BLOOMFIELD AVE

10

P.E.R.R.

DEL AMO BLVD.

8 9

RETURN TO
LOS ANGELES COUNTY SURVEYOR
72B LOS ANGELES COUNTY
ENGINEERING BLDG.

Do not extend notes this side of this line.

Note: Any Additions or Changes on This Sheet Must be Made or Circled in Red Ink With Date and Name of Person Making Change.

371

PWFB 0726

Notes Ck'd by	Survey of	F. B. Pg.
Map No.	W. O. 6851 Tape No. St'd. °F	
Office Work	Surveyed by English	
Checked	Notes 1" Date 5-53	
Date	Indexed	

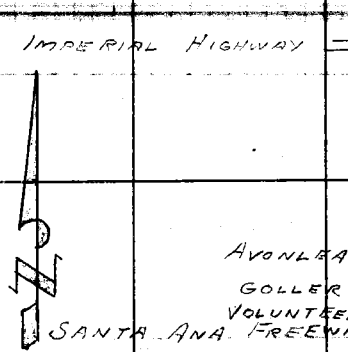

Note: Any Additions or Changes on This Sheet Must be Made or Circled in Red Ink With Date and Name of Person Making Change.

Do not extend notes this side of this line.

RETURN TO
LOS ANGELES COUNTY SURVEYOR
726 LOS ANGELES COUNTY
ENGINEERING BLDG.

F.B. 1799 PG. 8

W.S. 31-E-1

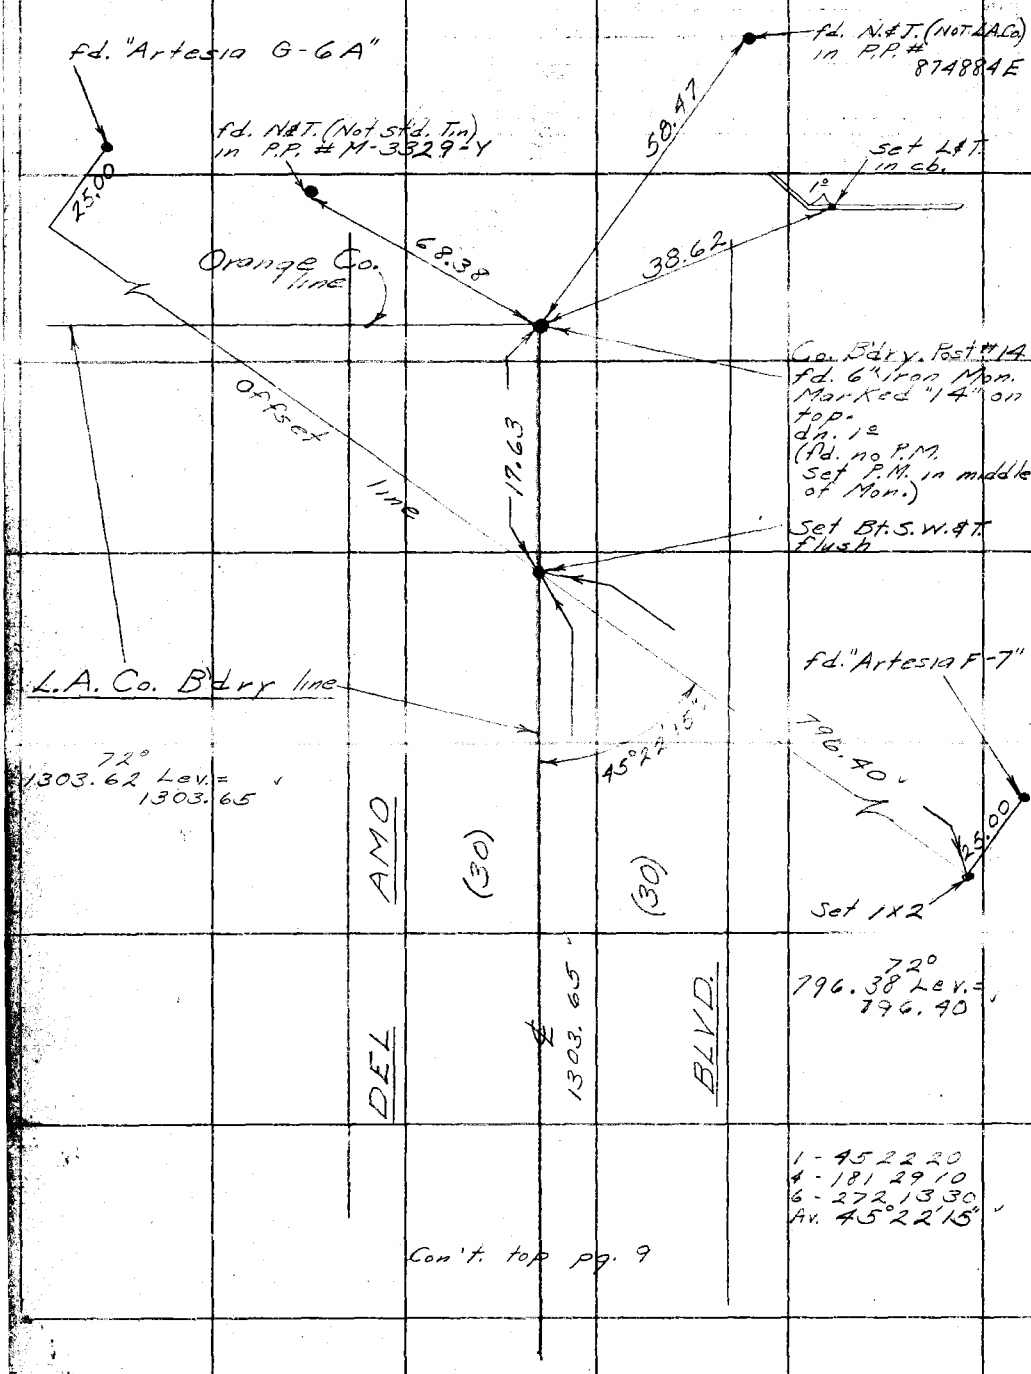

Con't. top pg. 9

RETURN TO
LOS ANGELES COUNTY SURVEYOR
726 LOS ANGELES COUNTY
ENGINEERING BLDG.
Do not extend notes this side of this line.

Note: Any Additions or Changes on This Sheet Must be Made or Circled in Red Ink With Date and Name of Person Making Change.

76F309S 247 2-51

RETURN TO
LOS ANGELES COUNTY SURVEYOR
726 LOS ANGELES COUNTY ENGINEERING BLDG.

Note: Any Additions or Changes on This Sheet Must be Made or Circled in Red Ink With Date and Name of Person Making Change.

Do not extend notes this side of this line.

W.S. 1 7-1

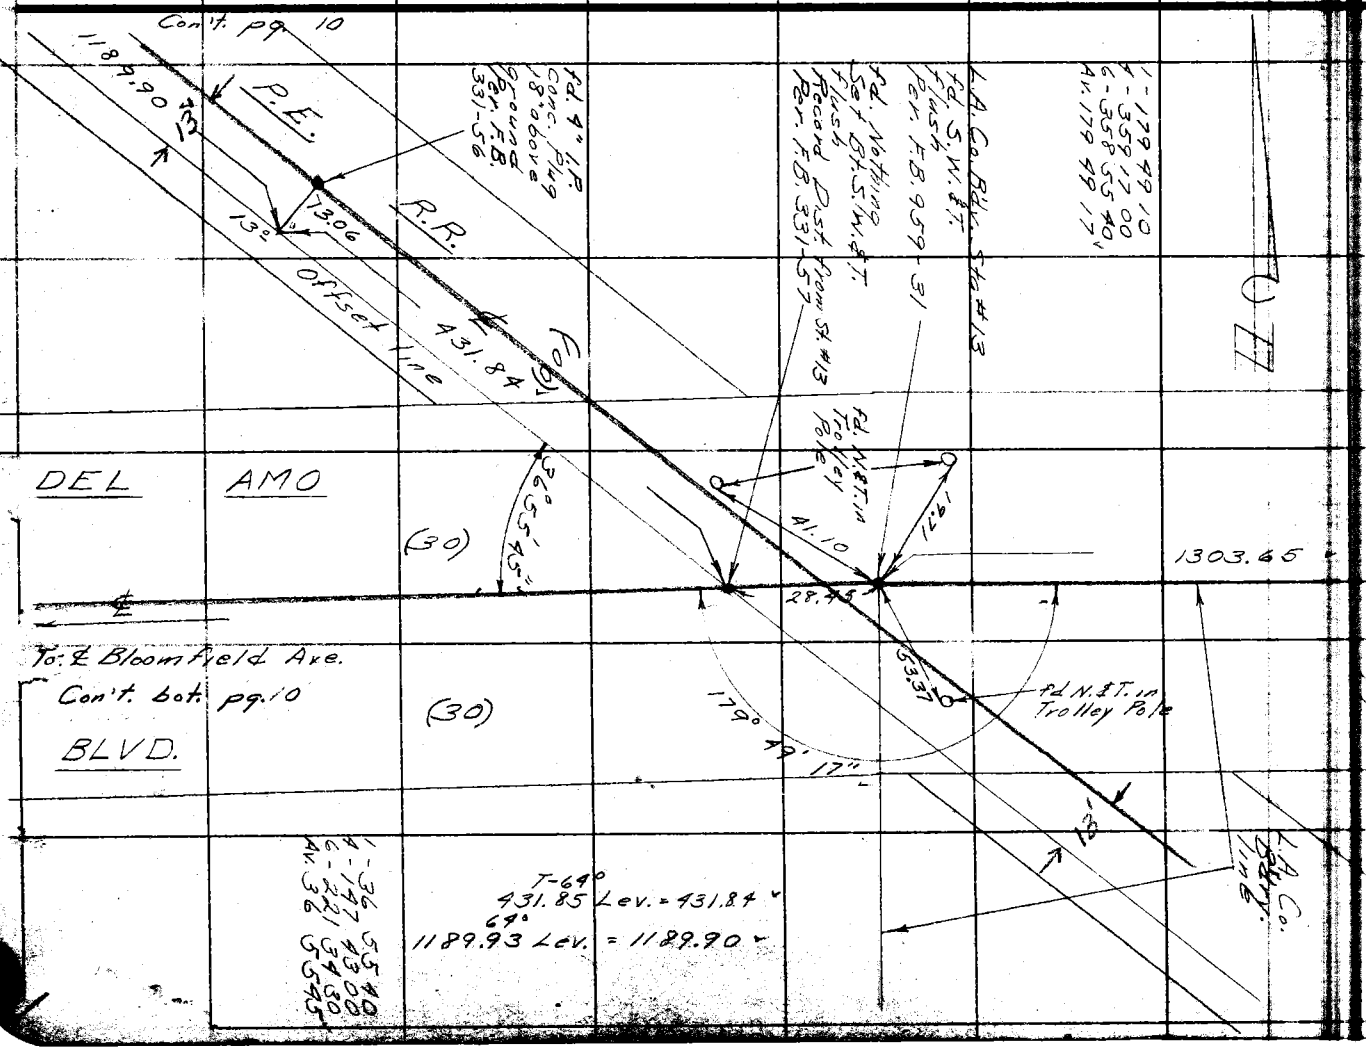

Notes Ck'd by Galli
Map No.
Office Work
Checked
Date

Survey of
W. O. 6957 Tape No. St'd. °F
Surveyed by
Notes
Indexed Date 5-53

PWFB 0527

F. B. PG. 66

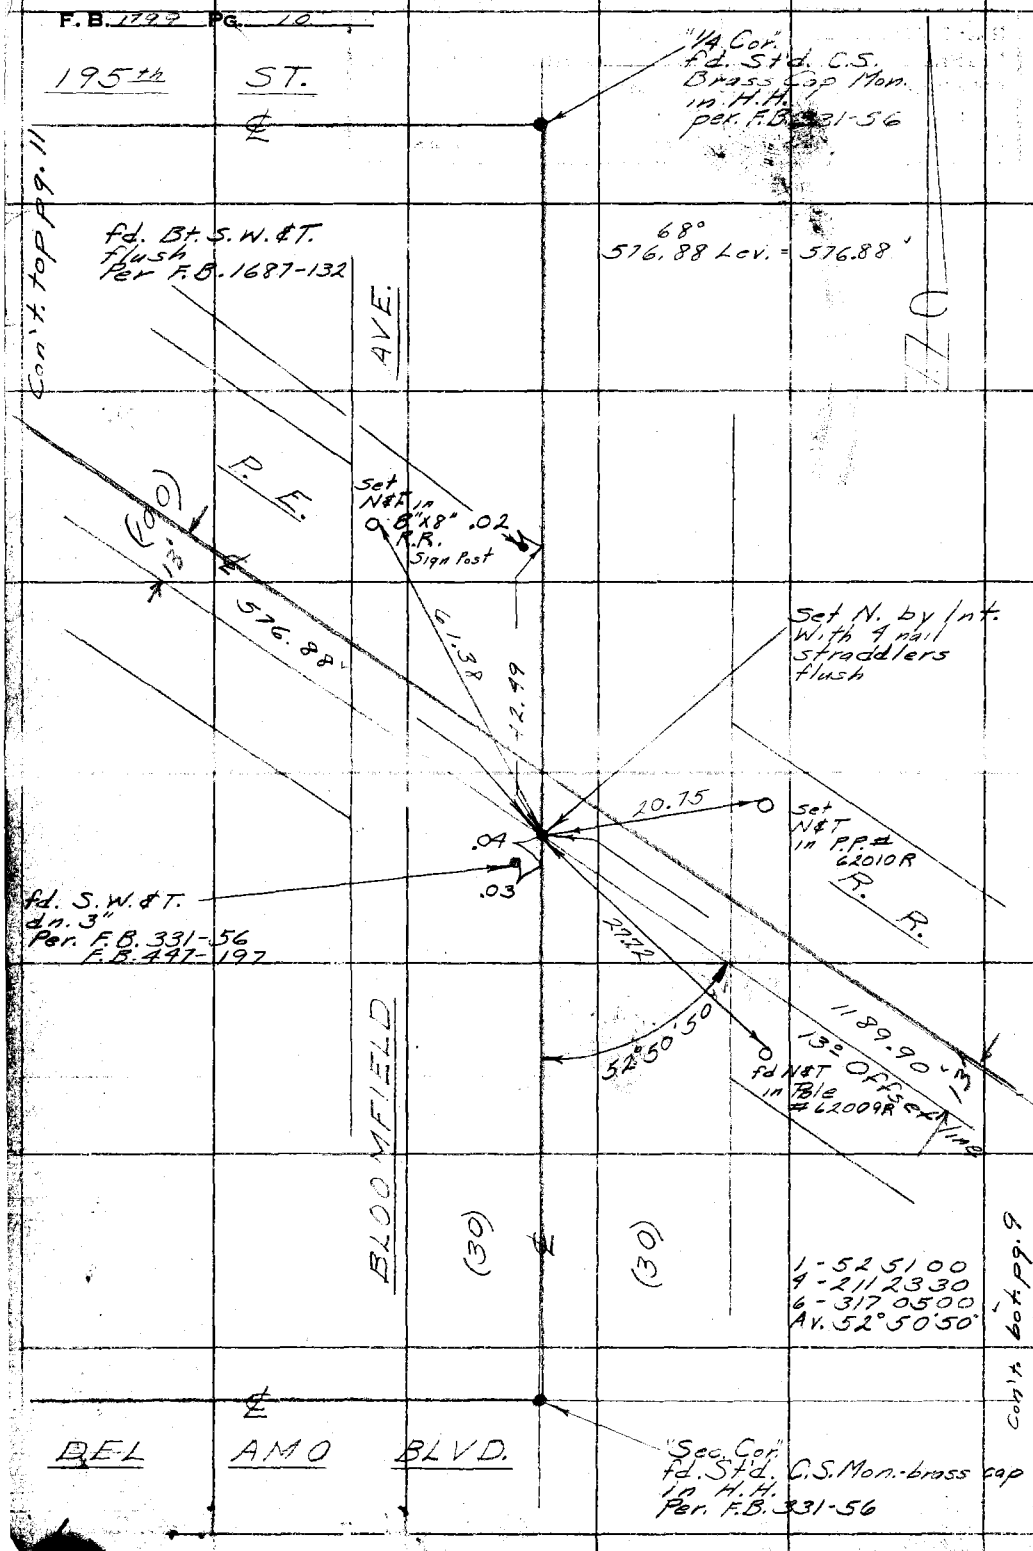

W.S. 31-D-1

RETURN TO
LOS ANGELES COUNTY SURVEYOR
725 LOS ANGELES COUNTY
ENGINEERING BLDG.

Do not extend notes this side of this line.

Note: Any Additions or Changes on This Sheet Must be Made or Circled in Red Ink With Date and Name of Person Making Change.

PWFB 0526 1017, 1018

Notes Ck'd by Galli	Survey of Artesia Norwalk
Map No.	W. O. 6951 Tape No. St'd. °F
Office Work	Surveyed by English
Checked	Notes " Date 6-53
Date	Indexed [illegible]

F. B. 1797 PG. 11

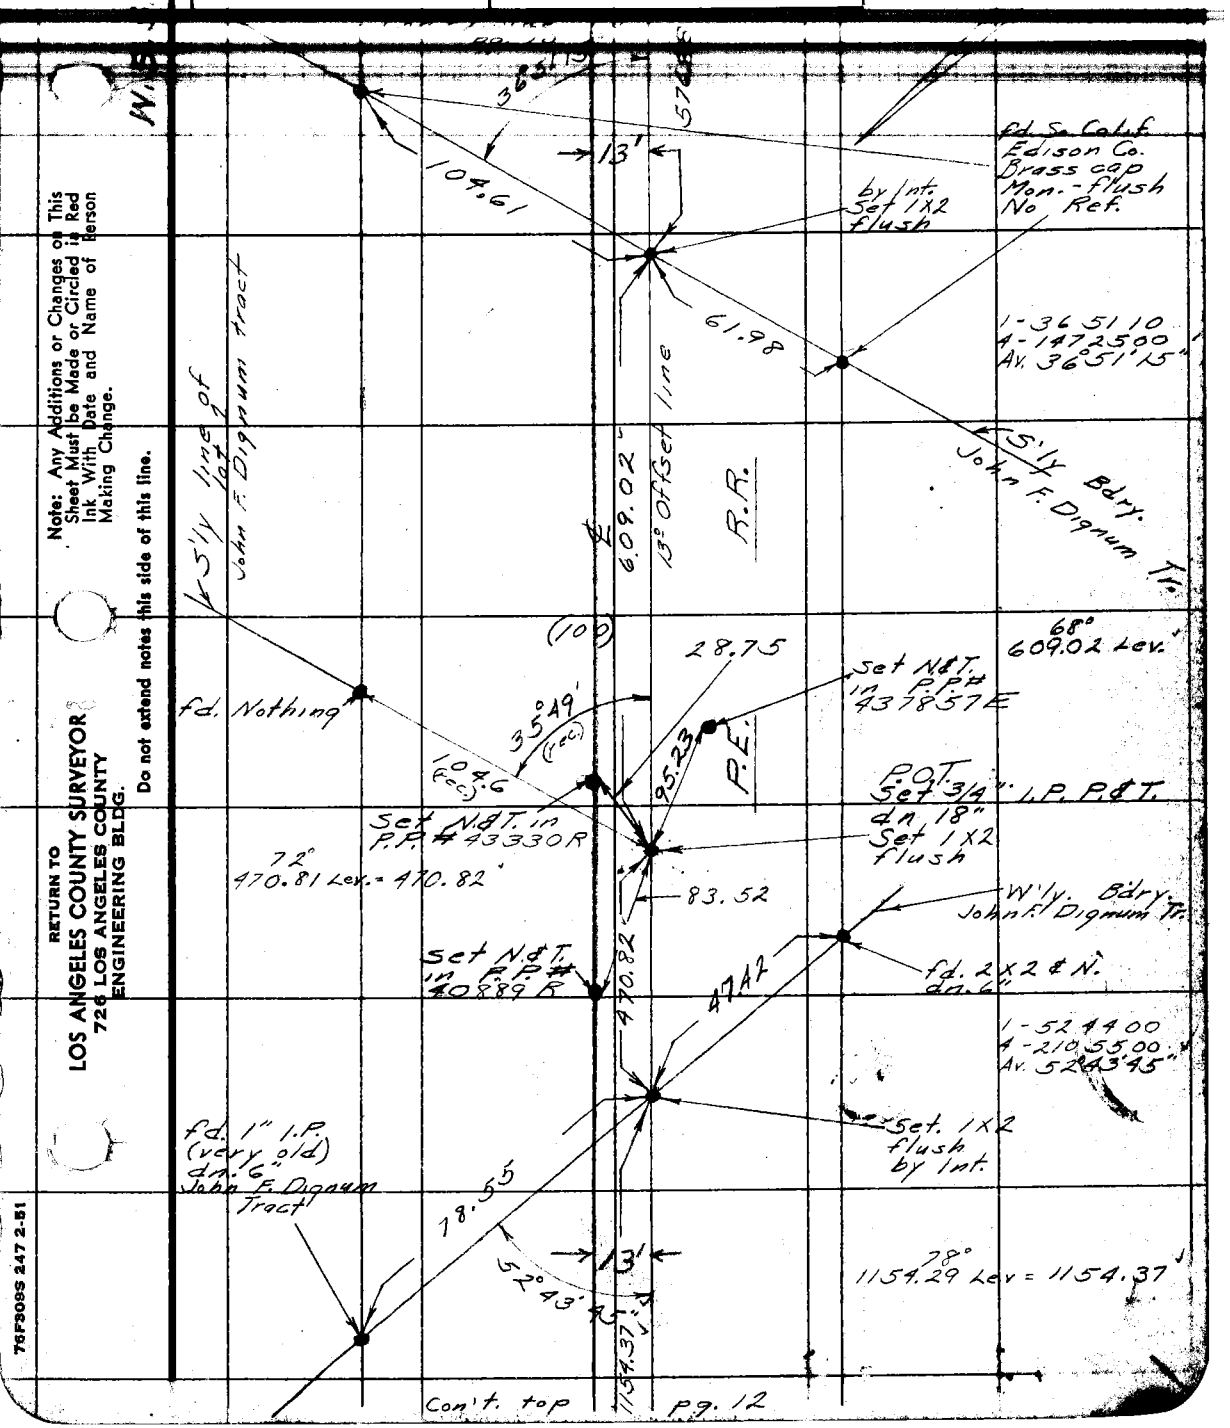

pg. 12

Note: Any Additions or Changes on This Sheet Must be Made or Circled in Red Ink With Date and Name of Person Making Change.

Do not extend notes this side of this line.

RETURN TO
LOS ANGELES COUNTY SURVEYOR
726 LOS ANGELES COUNTY
ENGINEERING BLDG.

76F309S 247 2-51

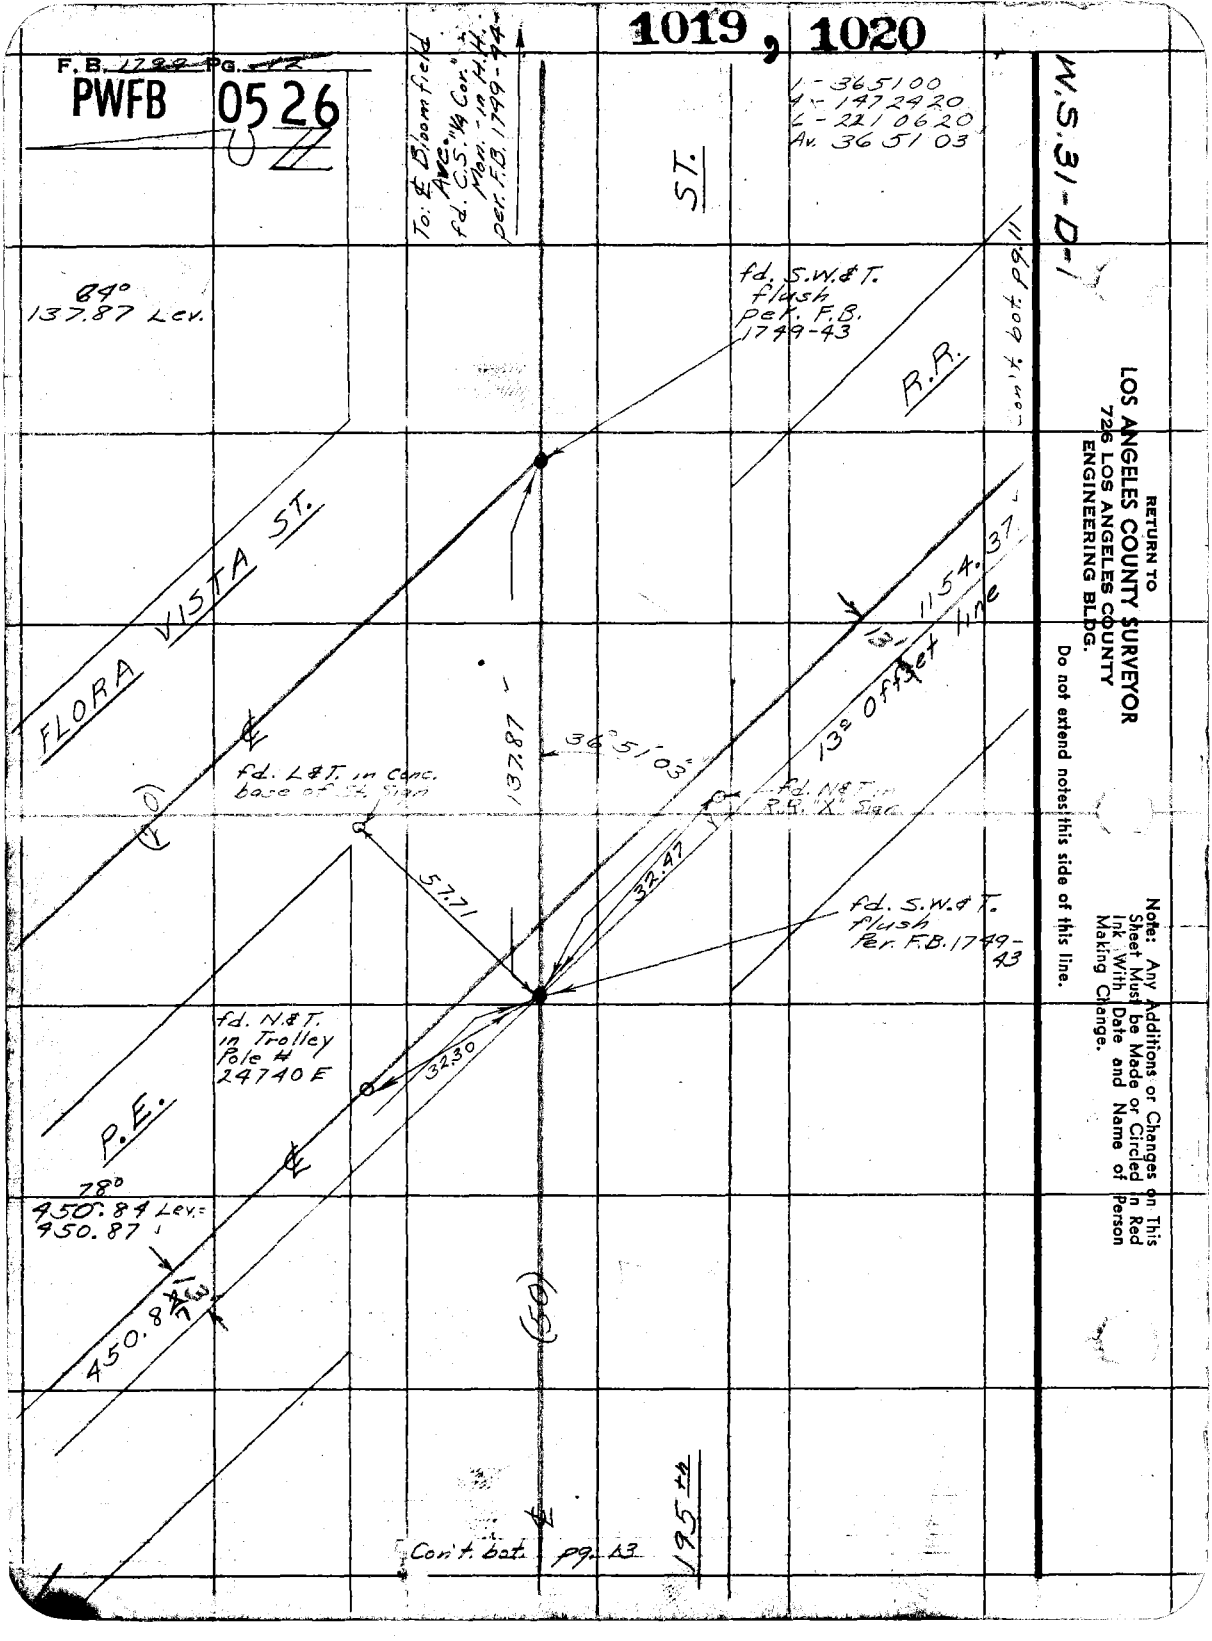
1019, 1020
F.B. 1799 Pg. 12
PWFB 0526
To: ℄ Bloomfield Ave. fd. C.S. "Va Cor." Mon. in H.H. per. F.B. 1749-94
1 - 365100
4 - 1472420
6 - 2210620
Av. 365103
W.S. 31-D-1
ST.
64°
137.87 Lev.
fd. S.W.&T. flush per. F.B. 1749-43
R.R.
Con't. bot. pg. 11
FLORA VISTA ST.
1154.37
13° Offset line
137.87
36°51'03"
fd. L&T. in Conc. base of St. Sign
fd. N&T in R.R. "X" Sign
57.71
32.47
fd. S.W.&T. flush Per. F.B. 1749-43
fd. N.&T. in Trolley Pole # 24740 E
32.30
P.E.
78°
450.84 Lev.=
450.87
450.87
(50)
195th
Con't. bot. pg. 13
RETURN TO
LOS ANGELES COUNTY SURVEYOR
726 LOS ANGELES COUNTY
ENGINEERING BLDG.
Do not extend notes this side of this line.
Note: Any Additions or Changes on This Sheet Must be Made or Circled in Red Ink With Date and Name of Person Making Change.

PWFB 0526

1021

Notes Ck'd by Galli	Survey of Artesia-Norwalk	F. B. 1749 Pg. 13
Map No.	W. O. 6951 Tape No. St'd. °F	
Office Work	Surveyed by English	
Checked	Notes " Date 6-53	
Date	Indexed	

W.S. D-1

Note: Any Additions or Changes on This Sheet Must be Made or Circled in Red Ink With Date and Name of Person Making Change.

Do not extend notes this side of this line.

RETURN TO
LOS ANGELES COUNTY SURVEYOR
726 LOS ANGELES COUNTY
ENGINEERING BLDG.

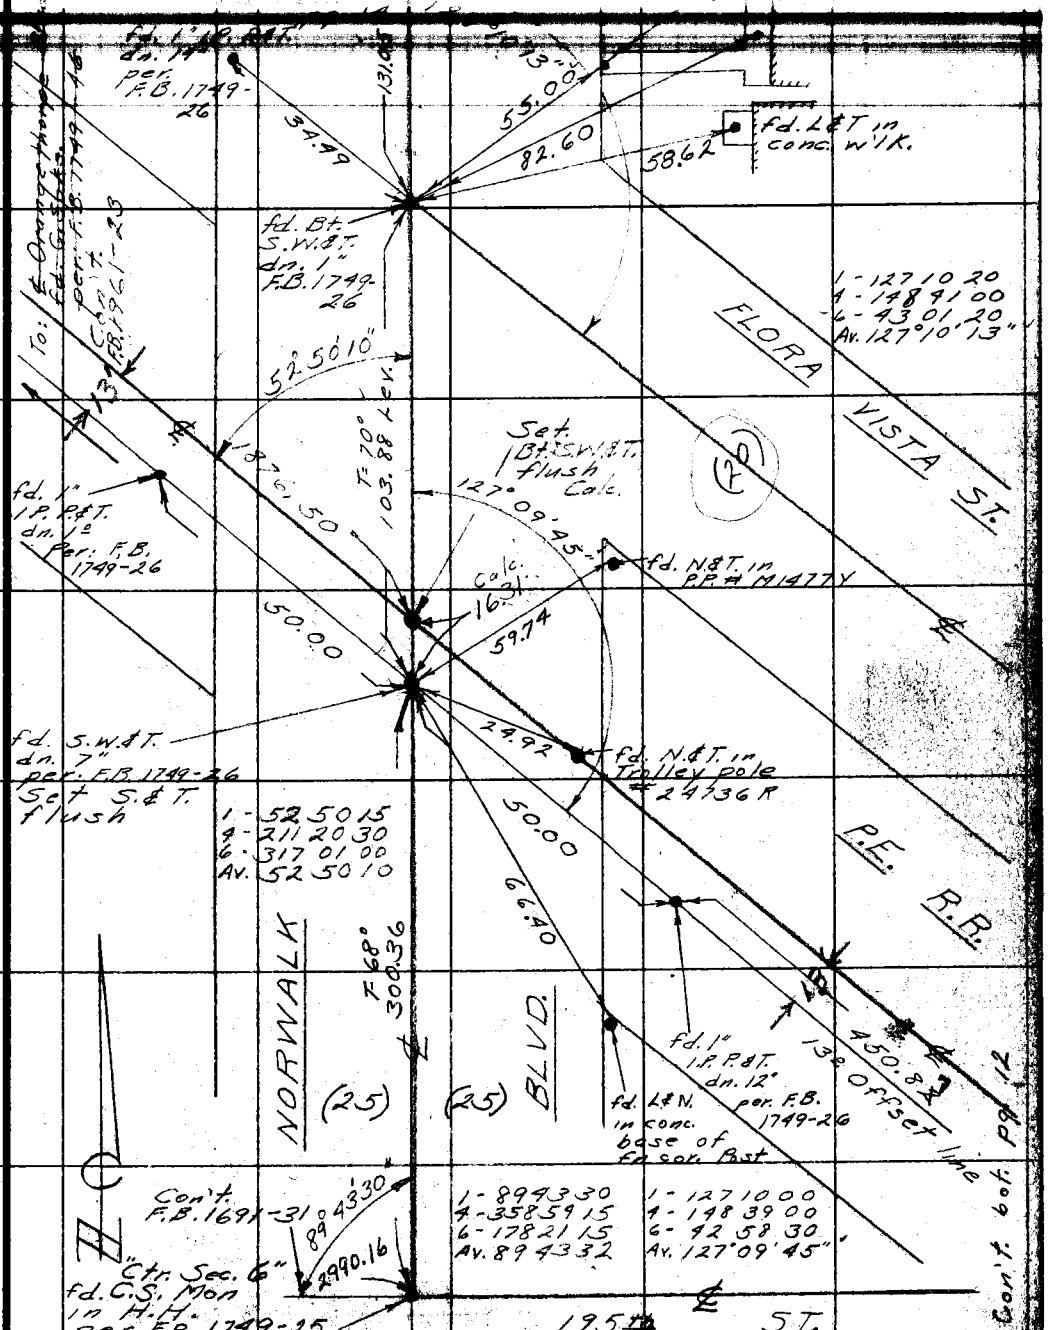

76F3095 247 2-51

F. B. ~~1799~~ PG. ~~14~~

PWFB 0526

1022

W.S. 31-D-1

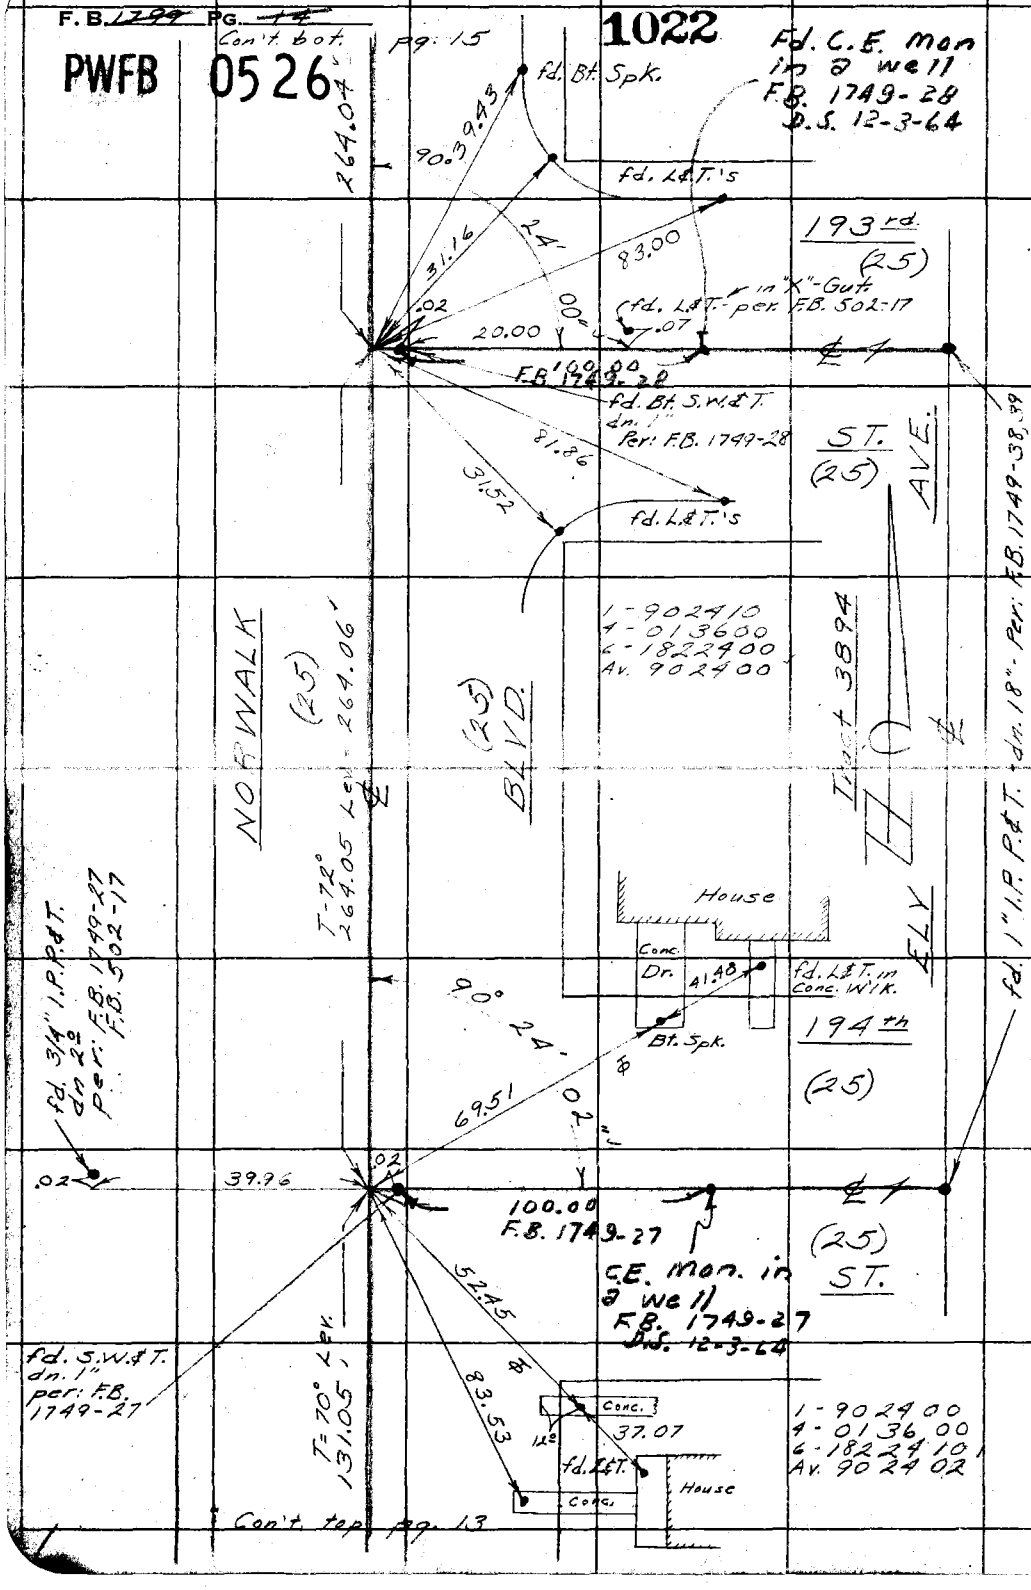

RETURN TO
LOS ANGELES COUNTY SURVEYOR
726 LOS ANGELES COUNTY
ENGINEERING BLDG.

Do not extend notes this side of this line.

Note: Any Additions or Changes on This Sheet Must be Made or Circled in Red Ink With Date and Name of Person Making Change.

PWFB 0626

1138

Map No.	W. O. 6951 Tape No. St'd. °F	F. B. 1749 Pg. 15
Office Work	Surveyed by English	
Checked	Notes Date 6-53	
Date	Indexed	

Con't. bot. pg. 16

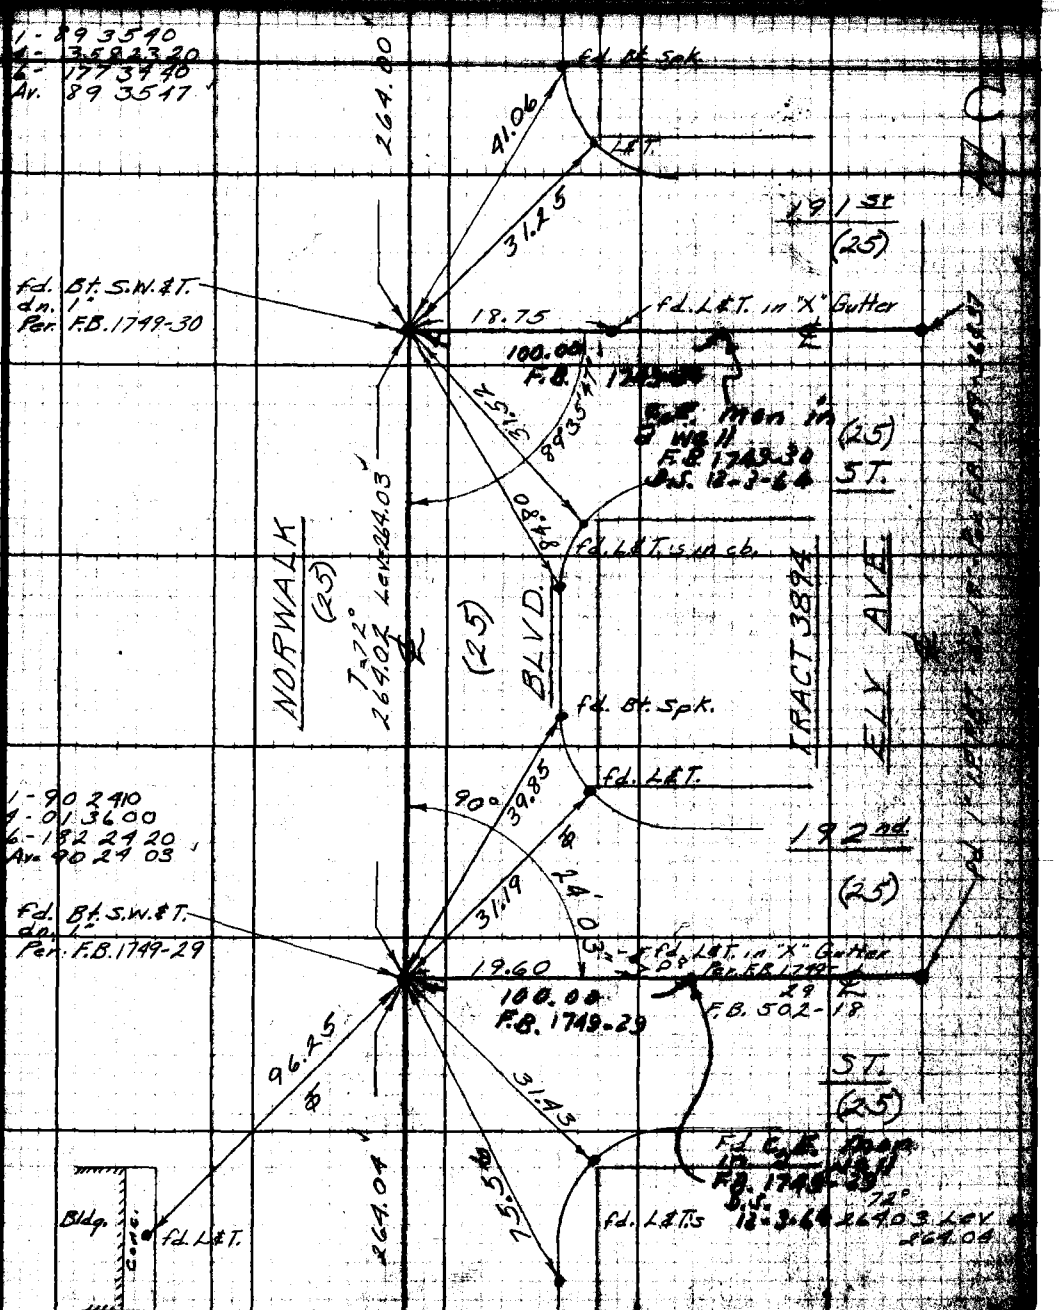

Con't. top pg. 14

Note: Any Additions or Changes on This Sheet Must Be Made or Circled in Red Ink With Date and Name of Person Making Change.

Do not extend notes this side of this line.

RETURN TO
LOS ANGELES COUNTY SURVEYOR
726 LOS ANGELES COUNTY
ENGINEERING BLDG.

75F3098 247 2-61

F.B. 1749 PG. 16

PWFB 0626

1139

Con't. bot pg. 17

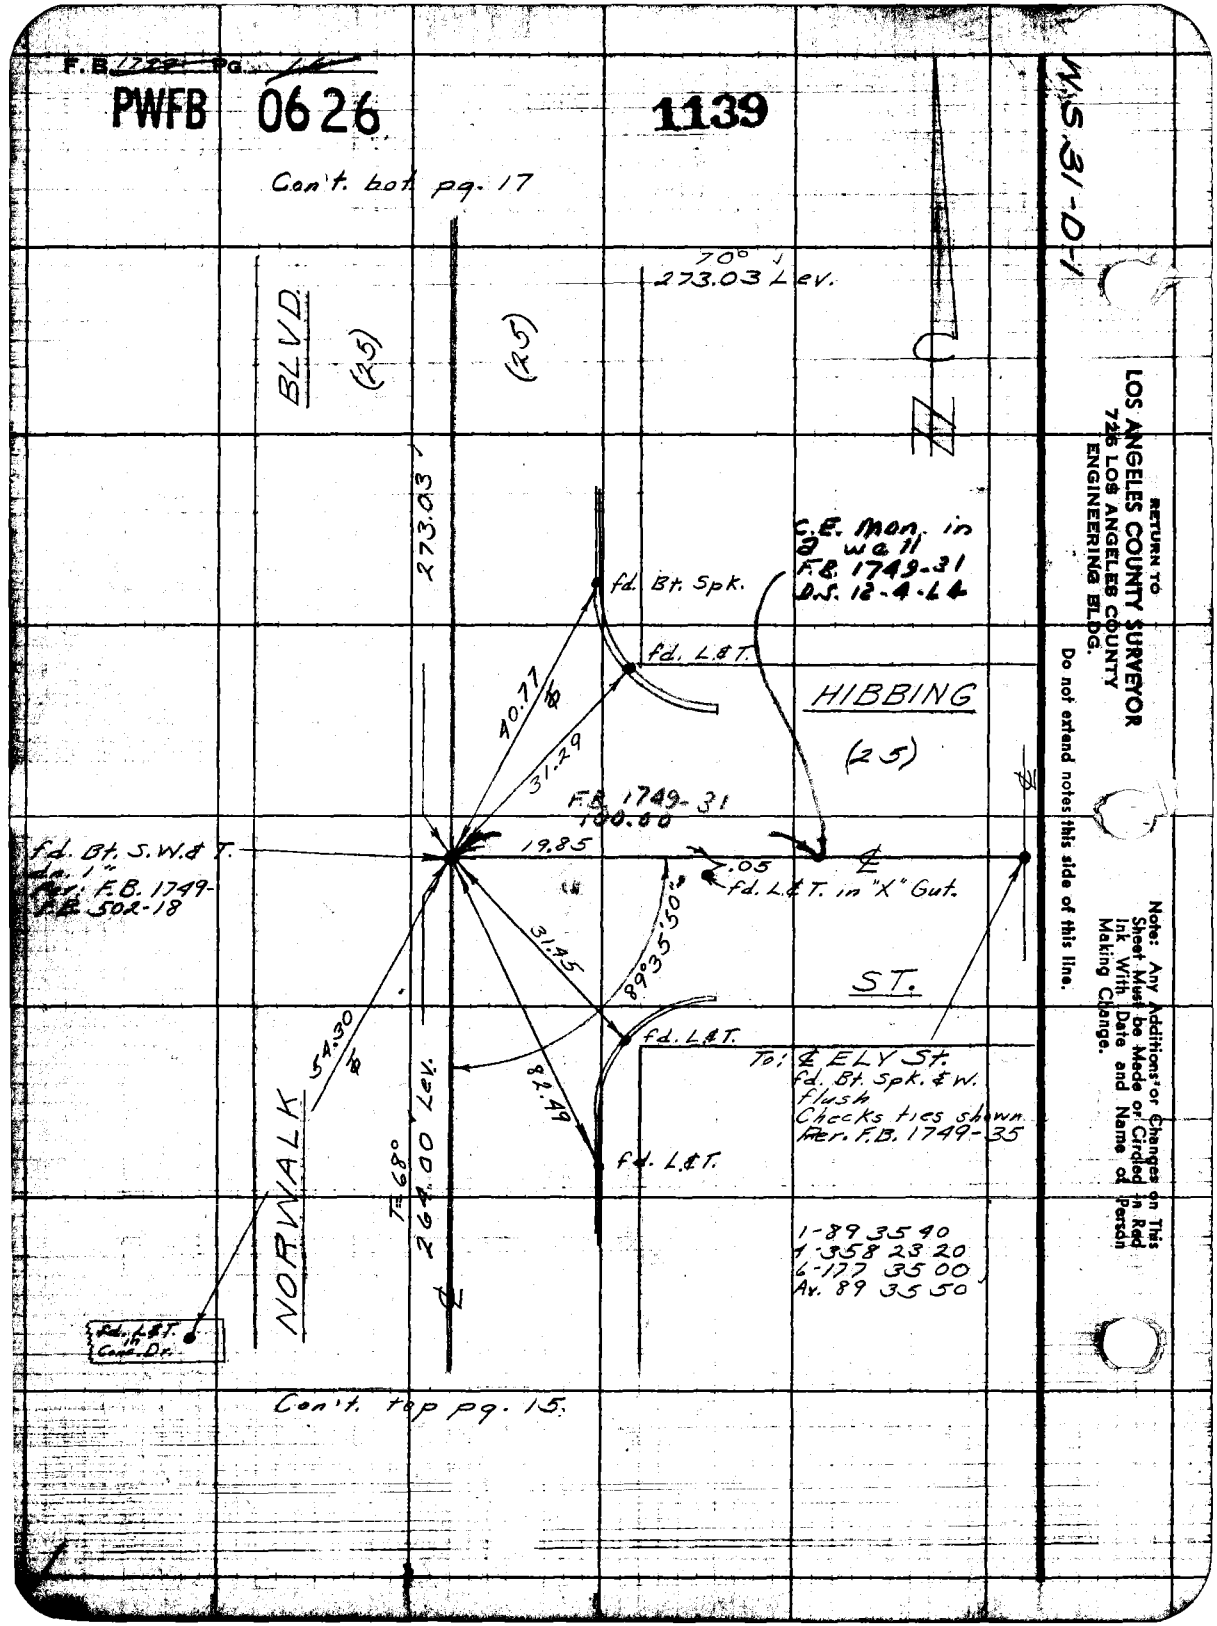

Con't. top pg. 15.

WS-31-D-1

RETURN TO
LOS ANGELES COUNTY SURVEYOR
7225 LOS ANGELES COUNTY
ENGINEERING BLDG.

Do not extend notes this side of this line.

Note: Any Additions or Changes on This Sheet Must be Made or Circled in Red Ink With Date and Name of Person Making Change.

PWFB 0626 1140, 1141

Map No.
Office Work
Checked
Date

Survey of Artesia-Norwalk
W. O. 6931 Tape No. St'd °F
Surveyed by English
Notes Date 6-53
Indexed E. C. Johnson

F. B. 1789 Pg. 47

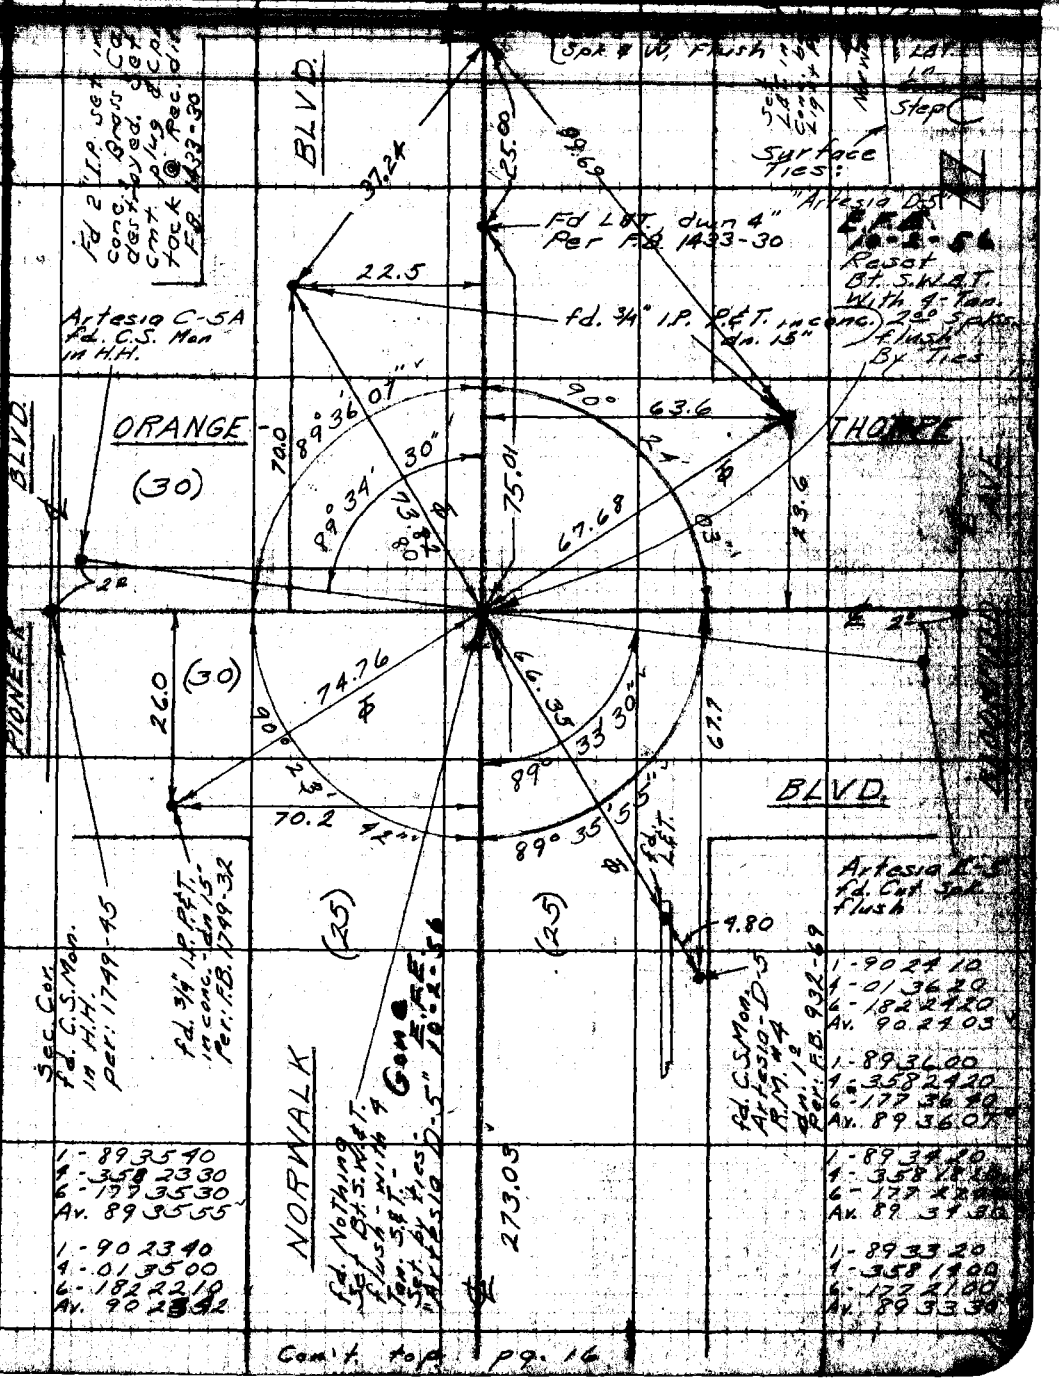

Note: Any Additions or Changes on This Sheet Must Be Made or Circled in Red Ink With Date and Name of Person Making Change.

Do not enter notes on this side of this line.

RETURN TO
LOS ANGELES COUNTY SURVEYOR
726 LOS ANGELES COUNTY
ENGINEERING BLDG.

PWFB 0626

F.B. 1799 PG. 18

Con't. bot. pg. 19

1142

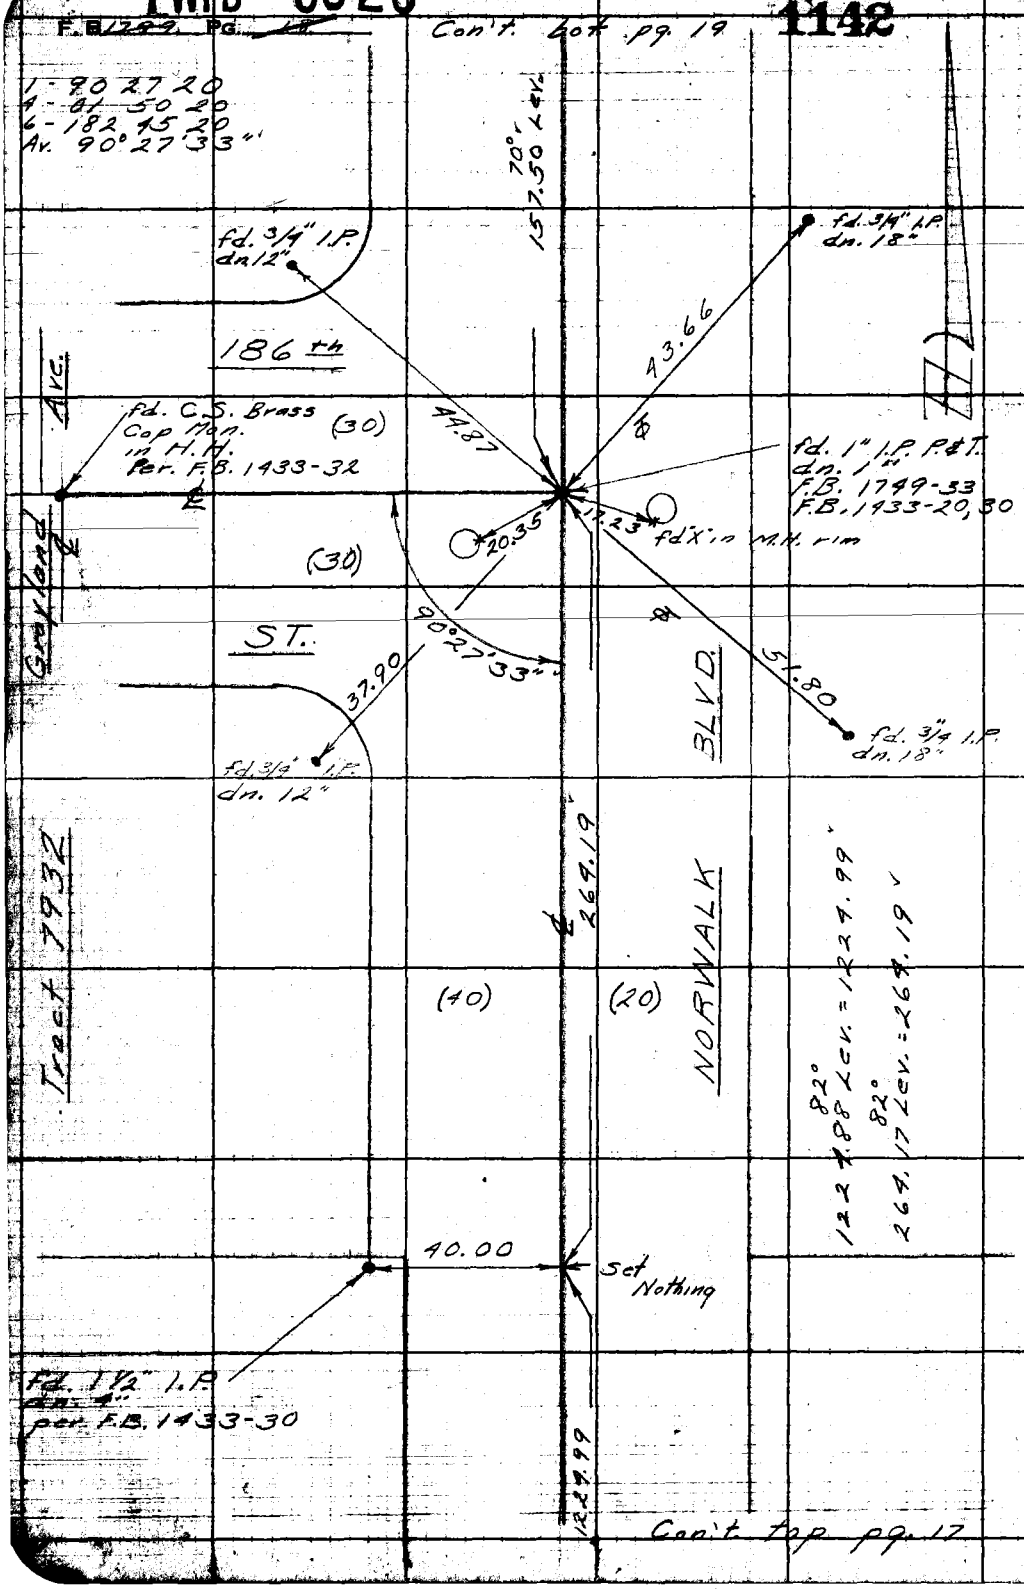

Con't. top pg. 17

W.S. 33-D-6

RETURN TO
LOS ANGELES COUNTY SURVEYOR
726 LOS ANGELES COUNTY
ENGINEERING BLDG.

Do not extend notes this side of this line.

Note: Any Additions or Changes on This Sheet Must be Made or Circled in Red Ink With Date and Name of Person Making Change.

PWFB 0626 1143, 1144

Notes Ck'd by Galli	Survey of Artesia-Norwalk	F.B. 1799 Pg. 19
Map No.	W.O. 2931 Tape No. Std. °F	
Office Work	Surveyed by English	
Checked	Notes " Date 6-38	
Date	Indexed	

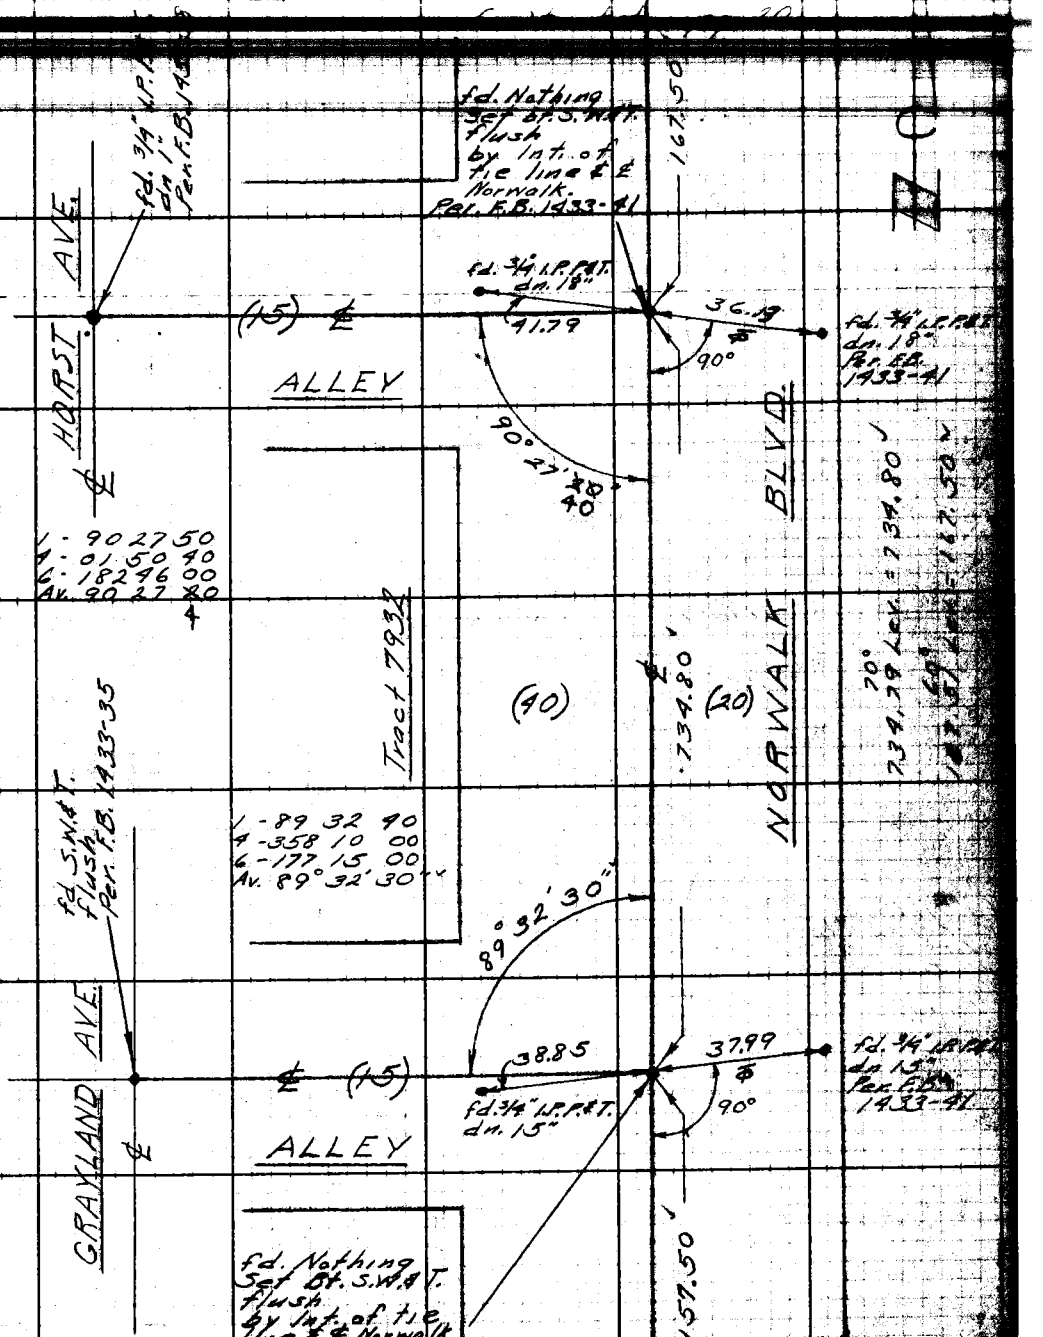

Con't. top pg. 18

Note: Any Additions or Changes on This Sheet Must be Made or Circled in Red Ink With Date and Name of Person Making Change.

Do not extend notes this side of this line.

RETURN TO
LOS ANGELES COUNTY SURVEYOR
726 LOS ANGELES COUNTY
ENGINEERING BLDG.

76F3095 247 2-51

F.B. 1799 PG. 20 Con't. bot. pg. 21.

PWFB 0626

1145

1 - 90 23 30
4 - 01 33 20
6 - 182 20 00
Av. 90 23 20

1 - 89 35 20
4 - 358 21 40
6 - 177 32 30
Av. 89 35 25

1 - 90 27 20
4 - 01 49 20
6 - 182 43 40
Av. 90 27 17

1 - 89 33 50
4 - 358 16 00
6 - 177 24 00
Av. 89 34 00

W.S. 33-D-5

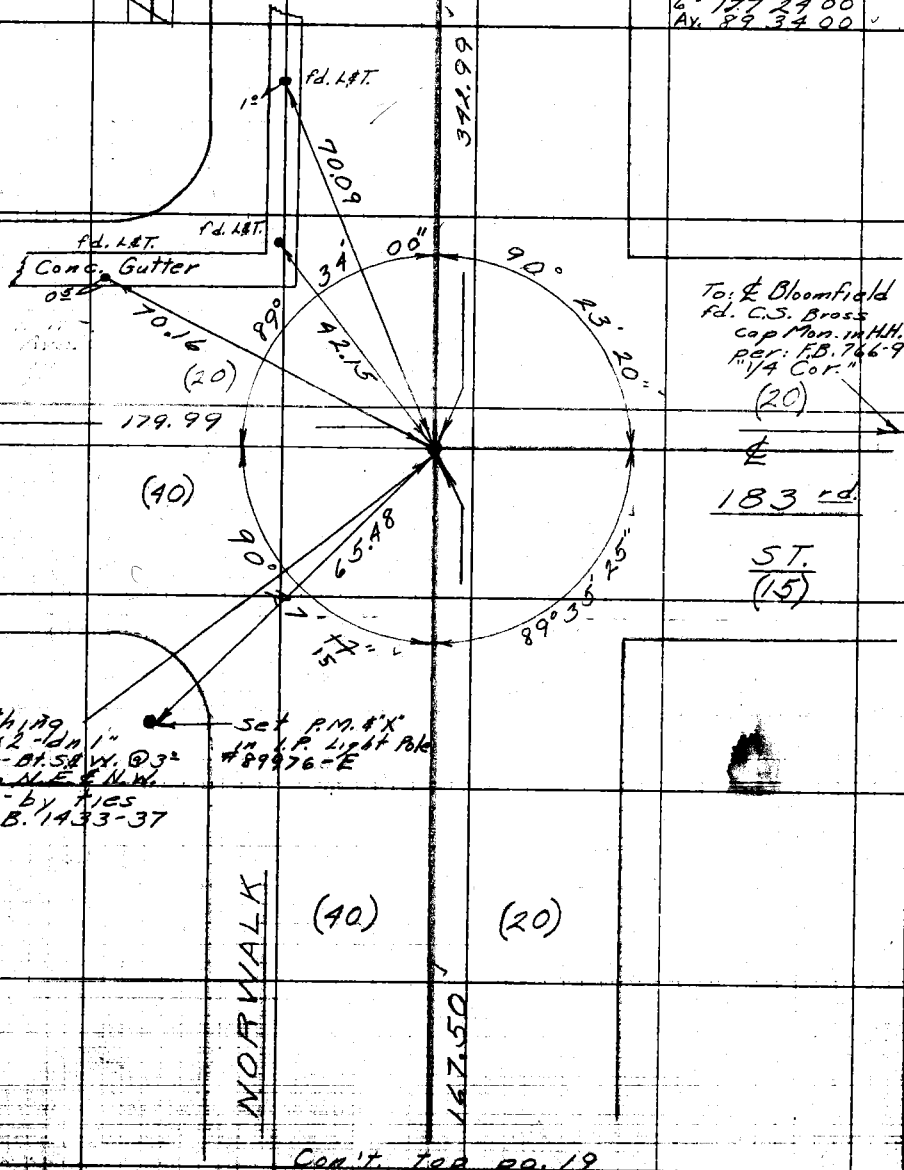

Con't. top pg. 19

RETURN TO
LOS ANGELES COUNTY SURVEYOR
726 LOS ANGELES COUNTY
ENGINEERING BLDG.

Do not extend notes this side of this line.

Note: Any Additions or Changes on This Sheet Must be Made or Circled in Red Ink. With Date and Name of Person Making Change.

PWFB 0626 1146

Notes Ck'd by Gall	Survey of Artesia-Norwalk	F. B. 1722 Pg. [illegible]
Map No.	W. O. 6951 Tape No. St'd °F	
Office Work	Surveyed by English	
Checked	Notes " Date 6-33	
Date	Indexed [illegible]	

Cont. Bot. pg. 22

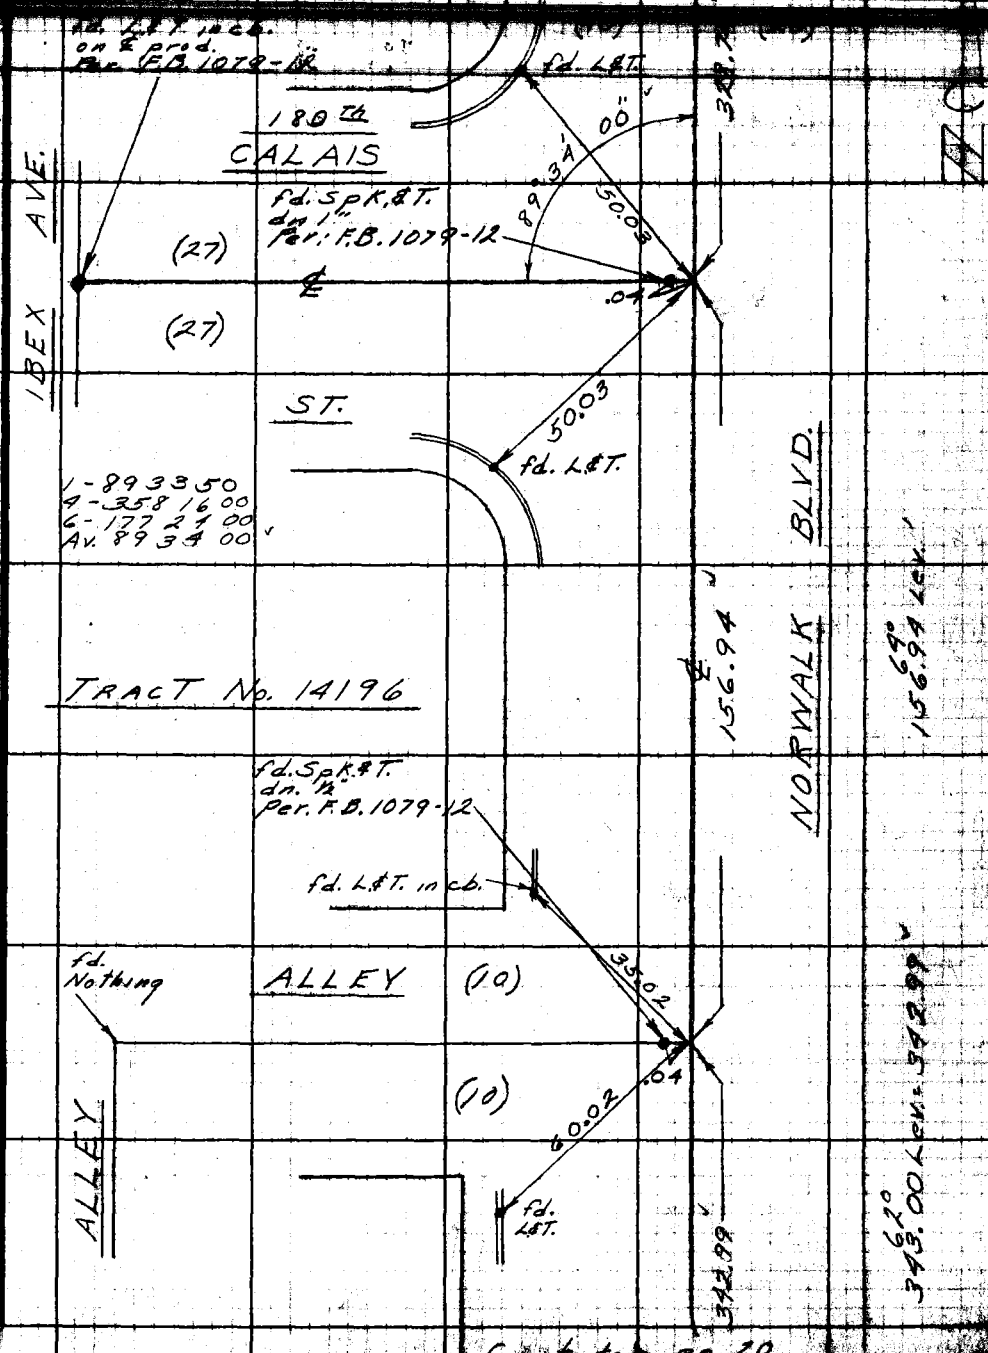

Cont. to pg. 20

Note: Any Additions or Changes on This Sheet Must be Made or Circled in Red Ink With Date and Name of Person Making Change.

Do not extend notes this side of this line.

RETURN TO
LOS ANGELES COUNTY SURVEYOR
726 LOS ANGELES COUNTY
ENGINEERING BLDG.

76F3095 247 2-51

PWFB 0626 1147

F.B. ~~1799~~ PG. ~~22~~

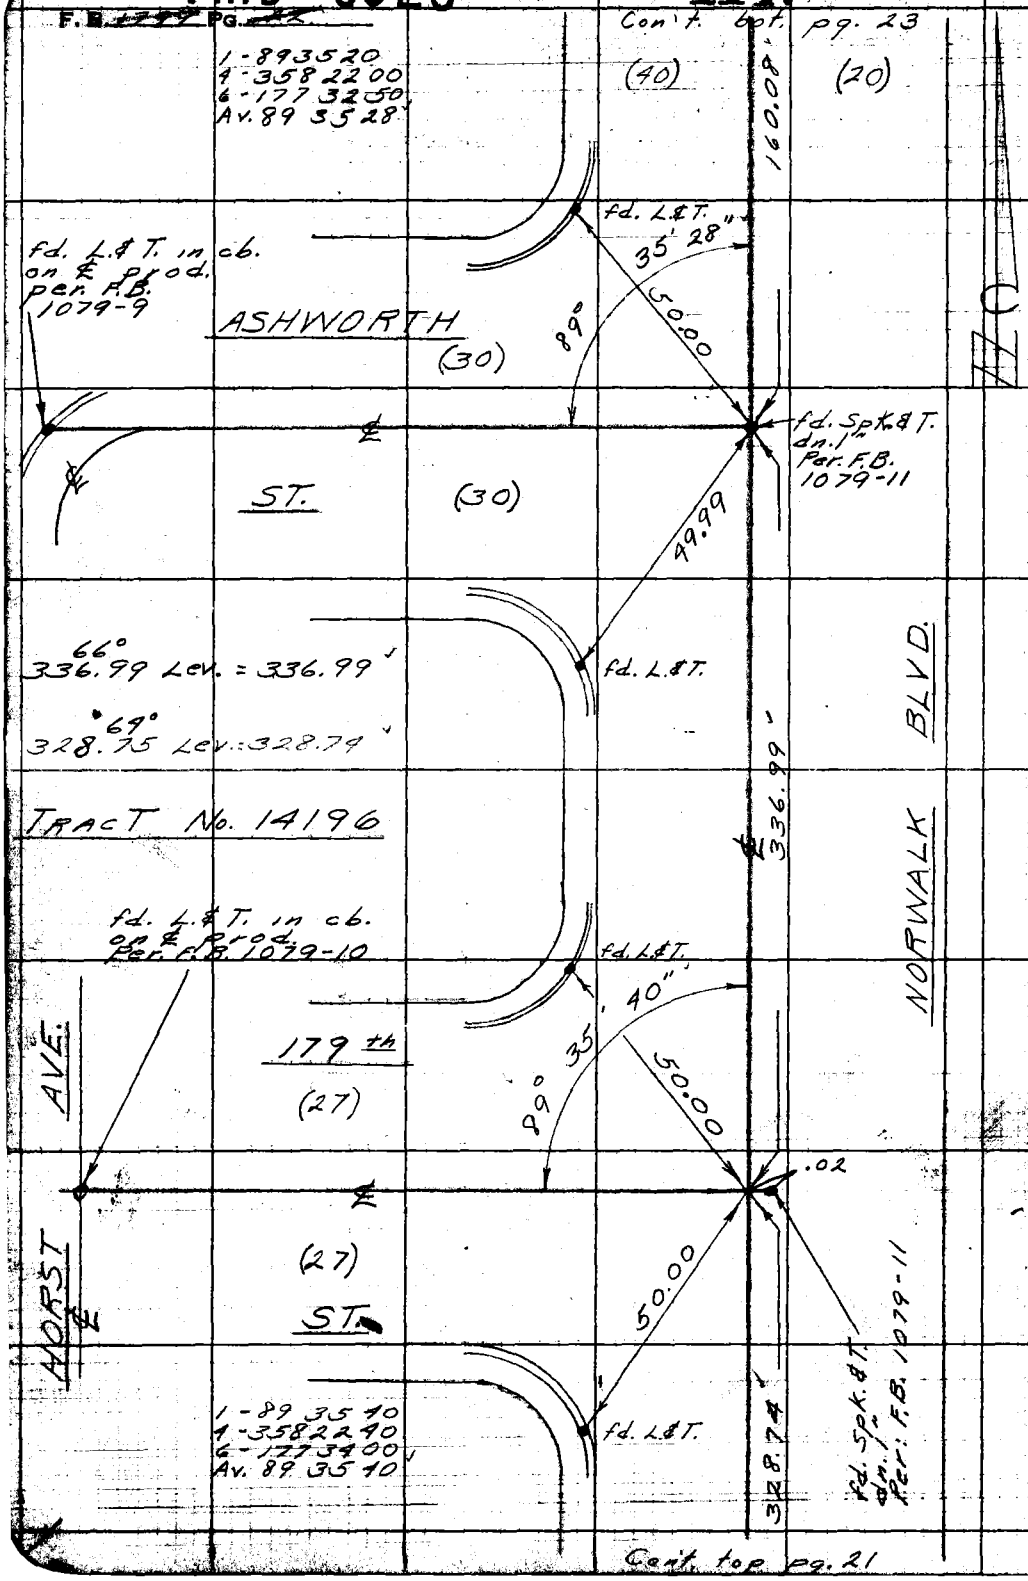

W.S. 33-D-5

RETURN TO
LOS ANGELES COUNTY SURVEYOR
726 LOS ANGELES COUNTY
ENGINEERING BLDG.

Do not extend notes this side of this line.

Note: Any Additions or Changes on This Sheet Must be Made or Circled in Red Ink With Date and Name of Person Making Change.

PWFB 0626 1148

Notes Ch'd by Galli	Survey of Artesia - Norwalk	F.B. 1799 Pg. 40
Map No.	W. O. 6951 Tape No. St'd. °F	
Office Work	Surveyed by English	
Checked	Notes " Date 6-53	
Date	Indexed	

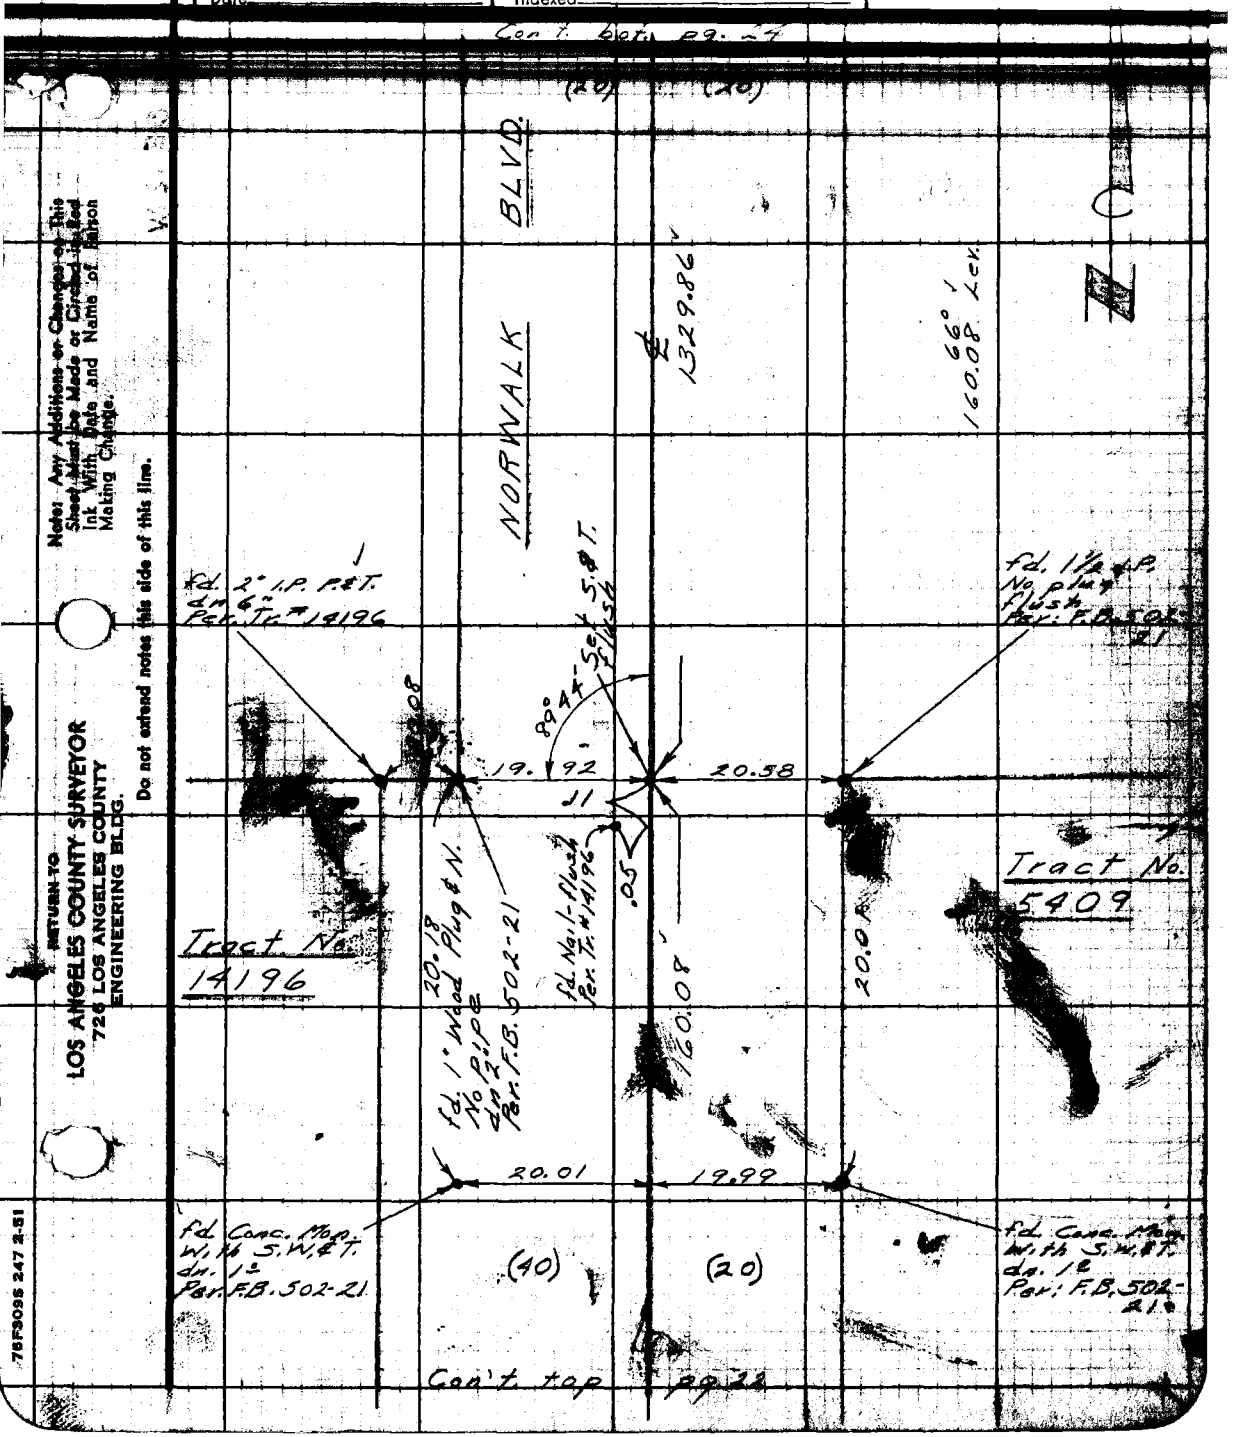

Note: Any Additions or Changes on This Sheet Must be Made or Circled in Red Ink With Date and Name of Person Making Change.

Do not extend notes this side of this line.

RETURN TO
LOS ANGELES COUNTY SURVEYOR
726 LOS ANGELES COUNTY
ENGINEERING BLDG.

76F3095 247 2-51

F.B. ~~1299~~ PG. ~~24~~ Con't. R. Side pg. 25

PWFB 0626

1149

W.S. 33-D-5

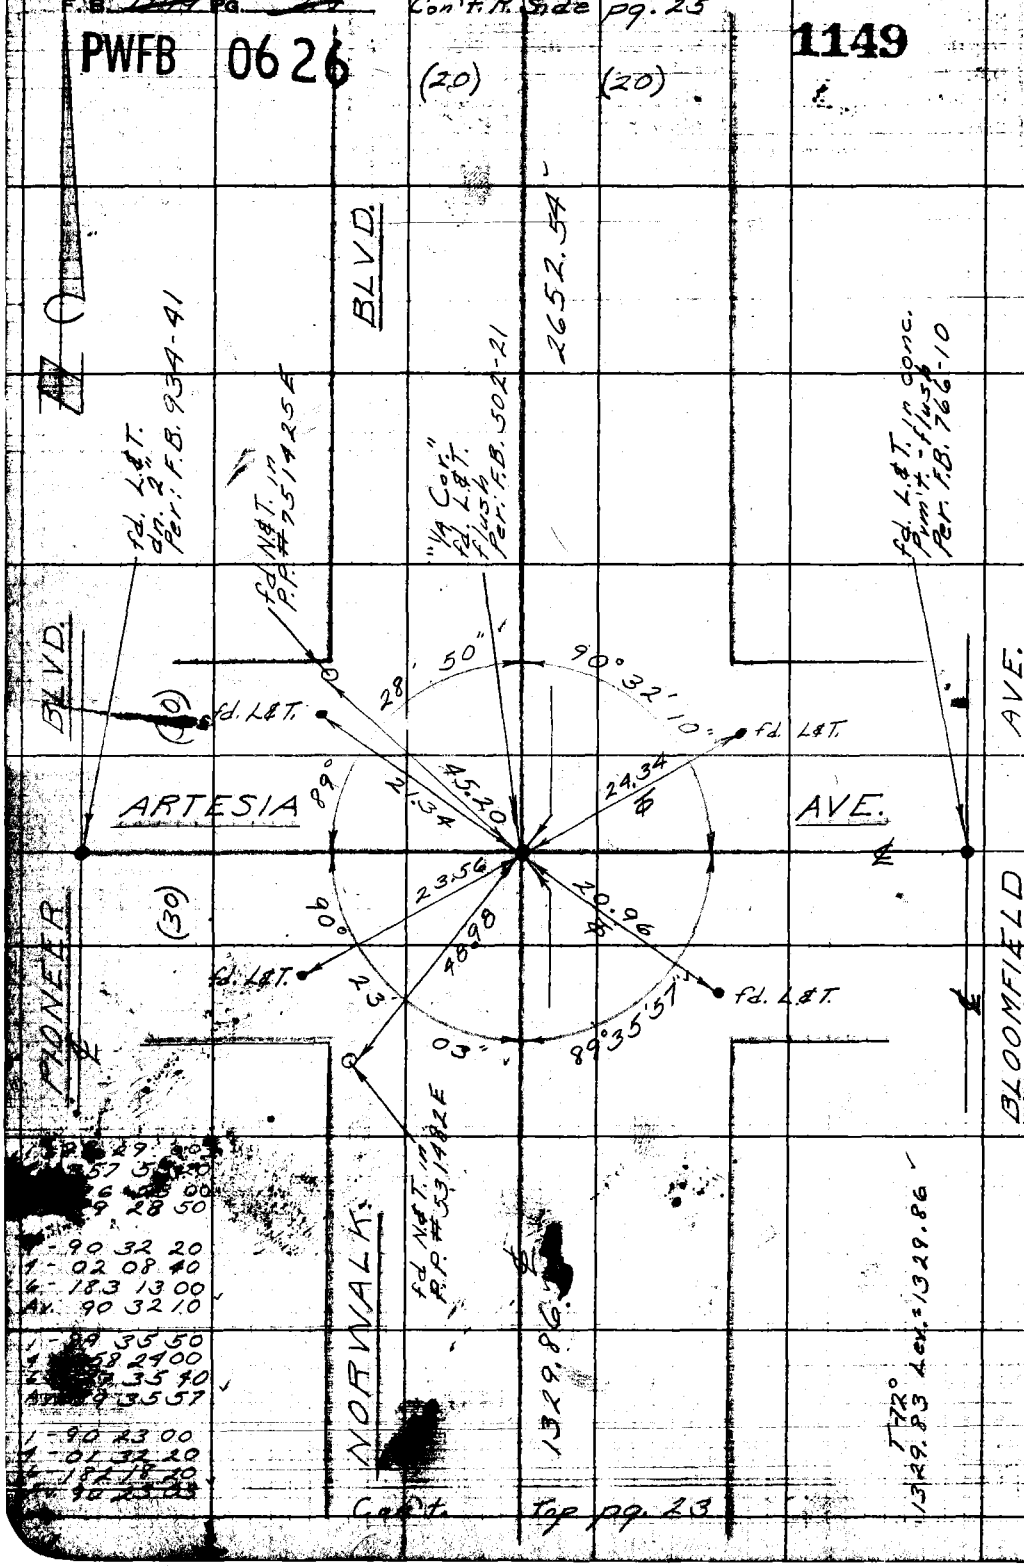

1 - 90 32 20
4 - 02 08 40
6 - 183 13 00
Av. 90 32 10

1 - 89 35 50
4 - 58 24 00
6 - 35 40
Av. 89 35 57

1 - 90 23 00
4 - 01 32 20
6 - 182 18 20
Av. 90 23 03

Con't. top pg. 23

RETURN TO
LOS ANGELES COUNTY SURVEYOR
726 LOS ANGELES COUNTY
ENGINEERING BLDG.

Do not extend notes this side of this line.

Note: Any Additions or Changes on This Sheet Must be Made or Circled in Red Ink With Date and Name of Person Making Change.

PWFB 0626

1150

F. B. [illegible] Pg. [illegible]

Notes [illegible] by Galli
Map [illegible]
Office [illegible]
Checked [illegible]
Date

Survey of Artesia - Norwalk
W. O. [illegible] Tape No. [illegible] Wd.
Surveyed by English
Notes [illegible] Date [illegible]
Indexed [illegible] C. John[illegible]

1-89 05 40
4-356 23 00
6-[illegible]
Av. 89 05 43

Av. 90 50 13

1-89 13 00
4-356 52 30
6-175 18 30
Av. 89 13 05

1-90 51 00
4-03 23 20
6-185 05 00
Av. 90 50 50

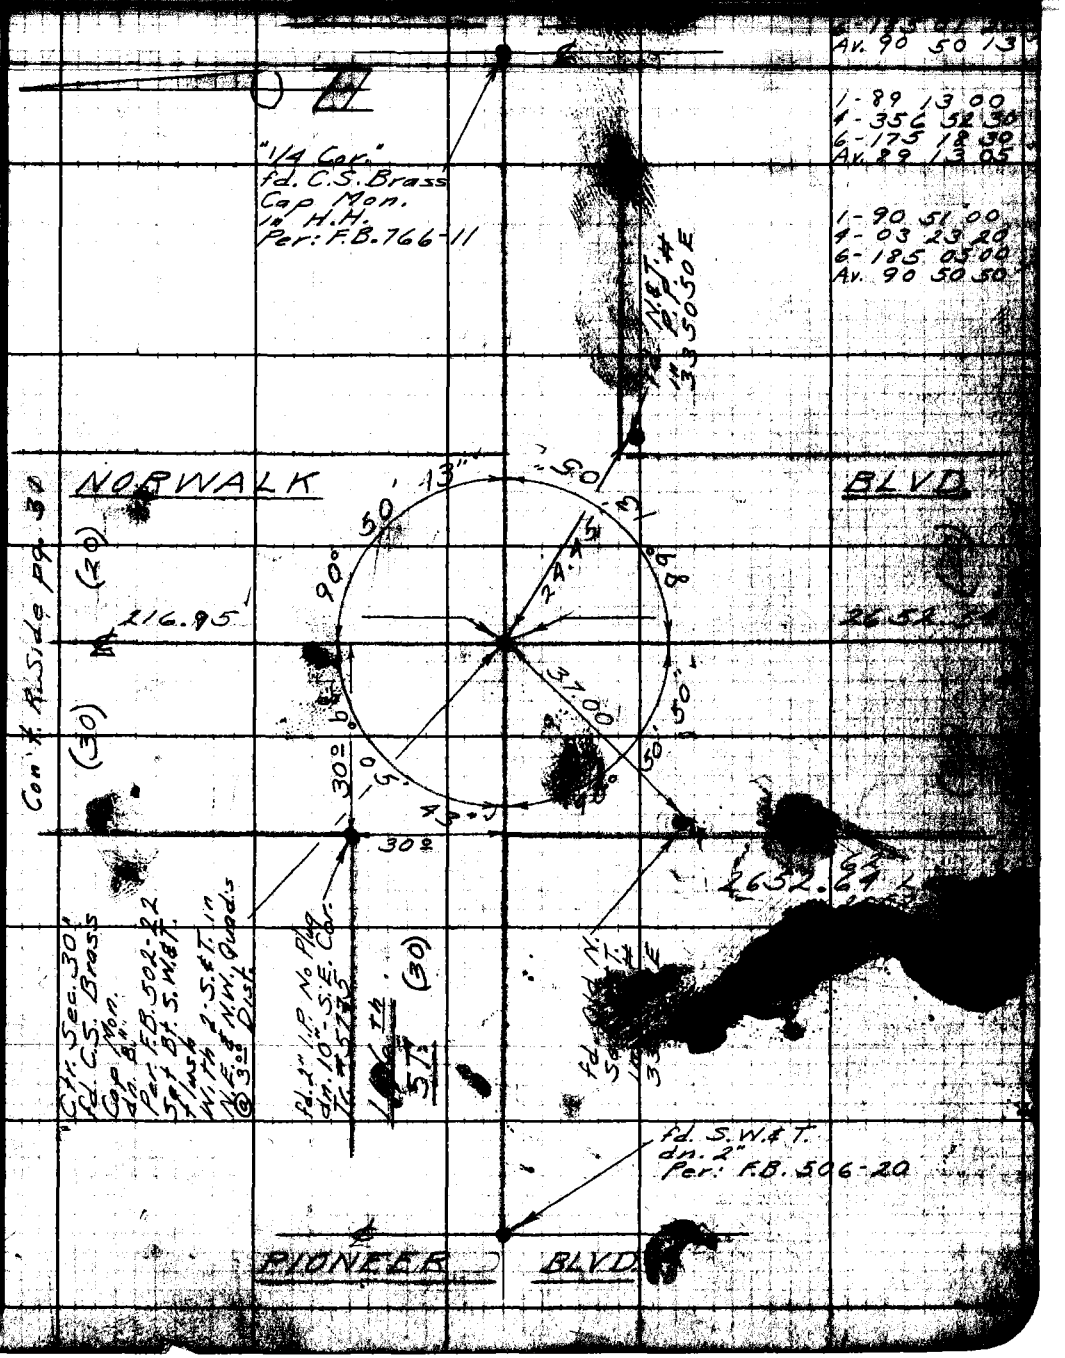

Note: Any Additions or Changes on This Sheet Must be Made or Circled in Red Ink With Date and Name of Person Making Change.

Do not extend [illegible] side of this line.

RETURN TO
LOS ANGELES COUNTY SURVEYOR
726 LOS ANGELES COUNTY
ENGINEERING BLDG.

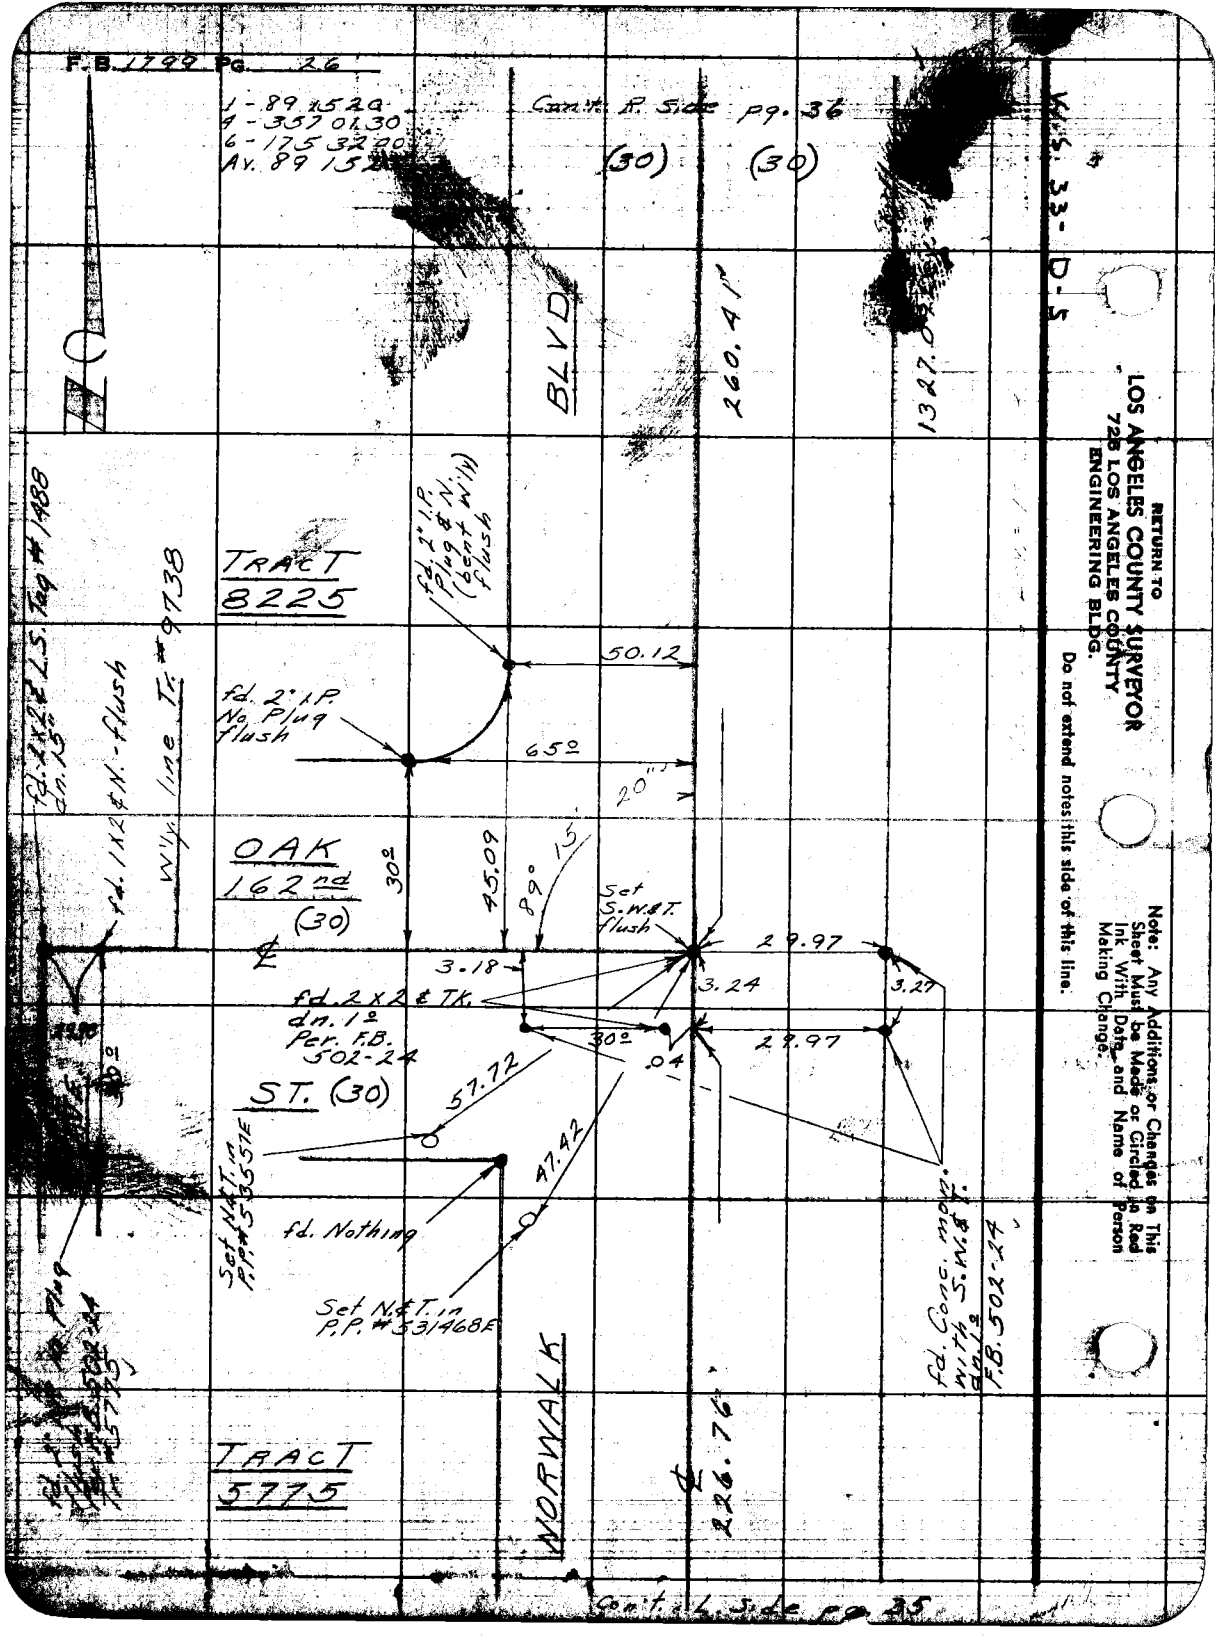
F.B. 1799 Pg. 26
1 - 89 15 20
4 - 357 01 30
6 - 175 32 00
Av. 89 15
Con't. R. Side pg. 36
(30)
(30)
BLVD
260.41'
1327.0
TRACT 8225
fd. 2" I.P. Plug & N. (bent W'ly) flush
50.12
fd. 2" I.P. No Plug flush
65°
20"
OAK 162nd (30)
30°
45.09
89°
15
Set S.W.&T. flush
29.97
3.18
3.24
3.27
fd. 2x2 & TK. dn. 1° Per. F.B. 502-24
30°
.04
29.97
ST. (30)
57.72
47.42
Set N&T. in P.P. #53557E
fd. Nothing
Set N&T. in P.P. #531468E
fd. Conc. mon. with S.W.&T. dn. 1° F.B. 502-24
NORWALK
226.76'
TRACT 5775
fd. 2x2 & L.S. Tag #1488 dn. 15"
fd. 1x2 & N. - flush
W'ly line Tr. #9738
Con't. L. Side pg. 35
K.S. 33-D-5
RETURN TO
LOS ANGELES COUNTY SURVEYOR
728 LOS ANGELES COUNTY
ENGINEERING BLDG.
Do not extend notes this side of this line.
Note: Any Additions or Changes on This Sheet Must be Made or Circled in Red Ink With Date and Name of Person Making Change.

PWFB 0726 373

Map No.	W. O. 6951 Tape No. St'd. °F	Artesia-Norwalk F.B. 1299 Pg. 21
Office Work	Surveyed by English	
Checked	Notes Date 2-33	
Date	Indexed	

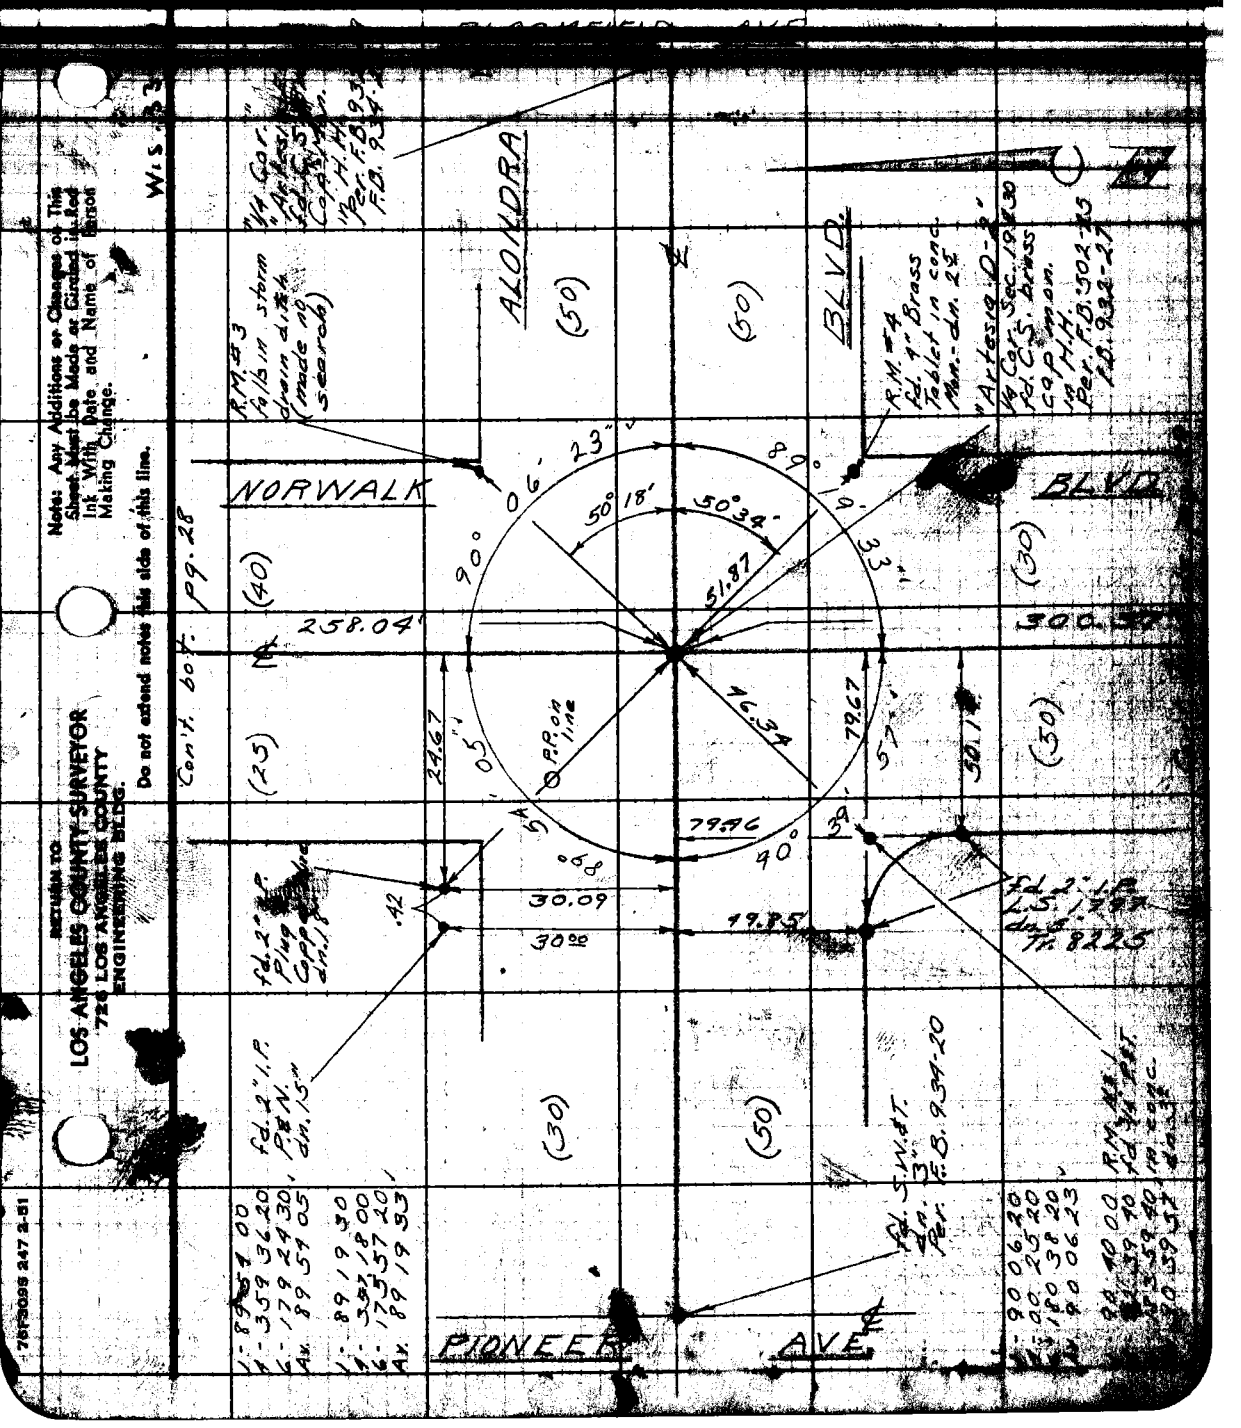

Note: Any Additions or Changes on This Sheet Must be Made or Circled in Red Ink With Date and Name of Person Making Change.

Do not extend notes this side of this line.

RETURN TO
LOS ANGELES COUNTY SURVEYOR
726 LOS ANGELES COUNTY
ENGINEERING BLDG.

76F3095 247 2-51

PWFB 0726 374, 375






































RETURN TO
LOS ANGELES COUNTY SURVEYOR
726 LOS ANGELES COUNTY
ENGINEERING BLDG.

Do not extend notes this side of this line.

Note: Any Additions or Changes on This Sheet Must be Made or Circled in Red Ink With Date and Name of Person Making Change.

PWFB 0726

376

Notes Ck'd by Gatti	Survey of Artesia-Norwalk	F.B. 1799 Pg. 27
Map No.	W. O. 1951 Tape No. St'd. °F	
Office Work	Surveyed by English	
Checked	Notes Date 6-33	
Date	Indexed	

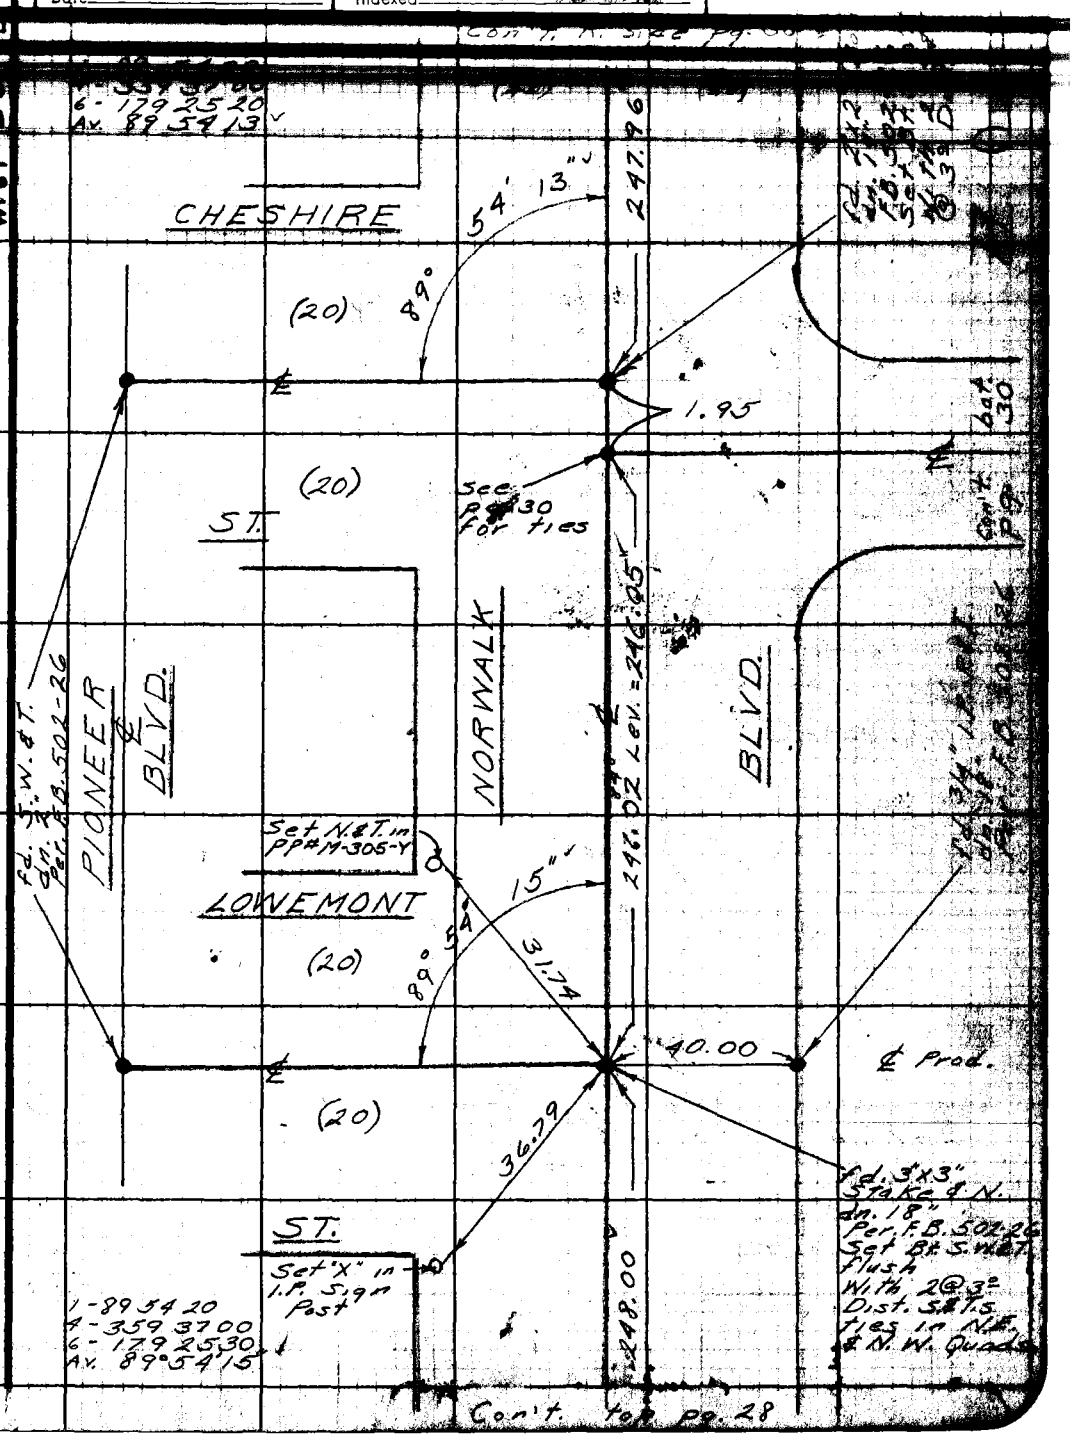

Note: Any Additions or Changes on This Sheet Must be Made or Circled in Red Ink With Date and Name of Person Making Change.

Do not extend notes this side of this line.

RETURN TO
LOS ANGELES COUNTY SURVEYOR
726 LOS ANGELES COUNTY
ENGINEERING BLDG.

76F3095 247 2-51

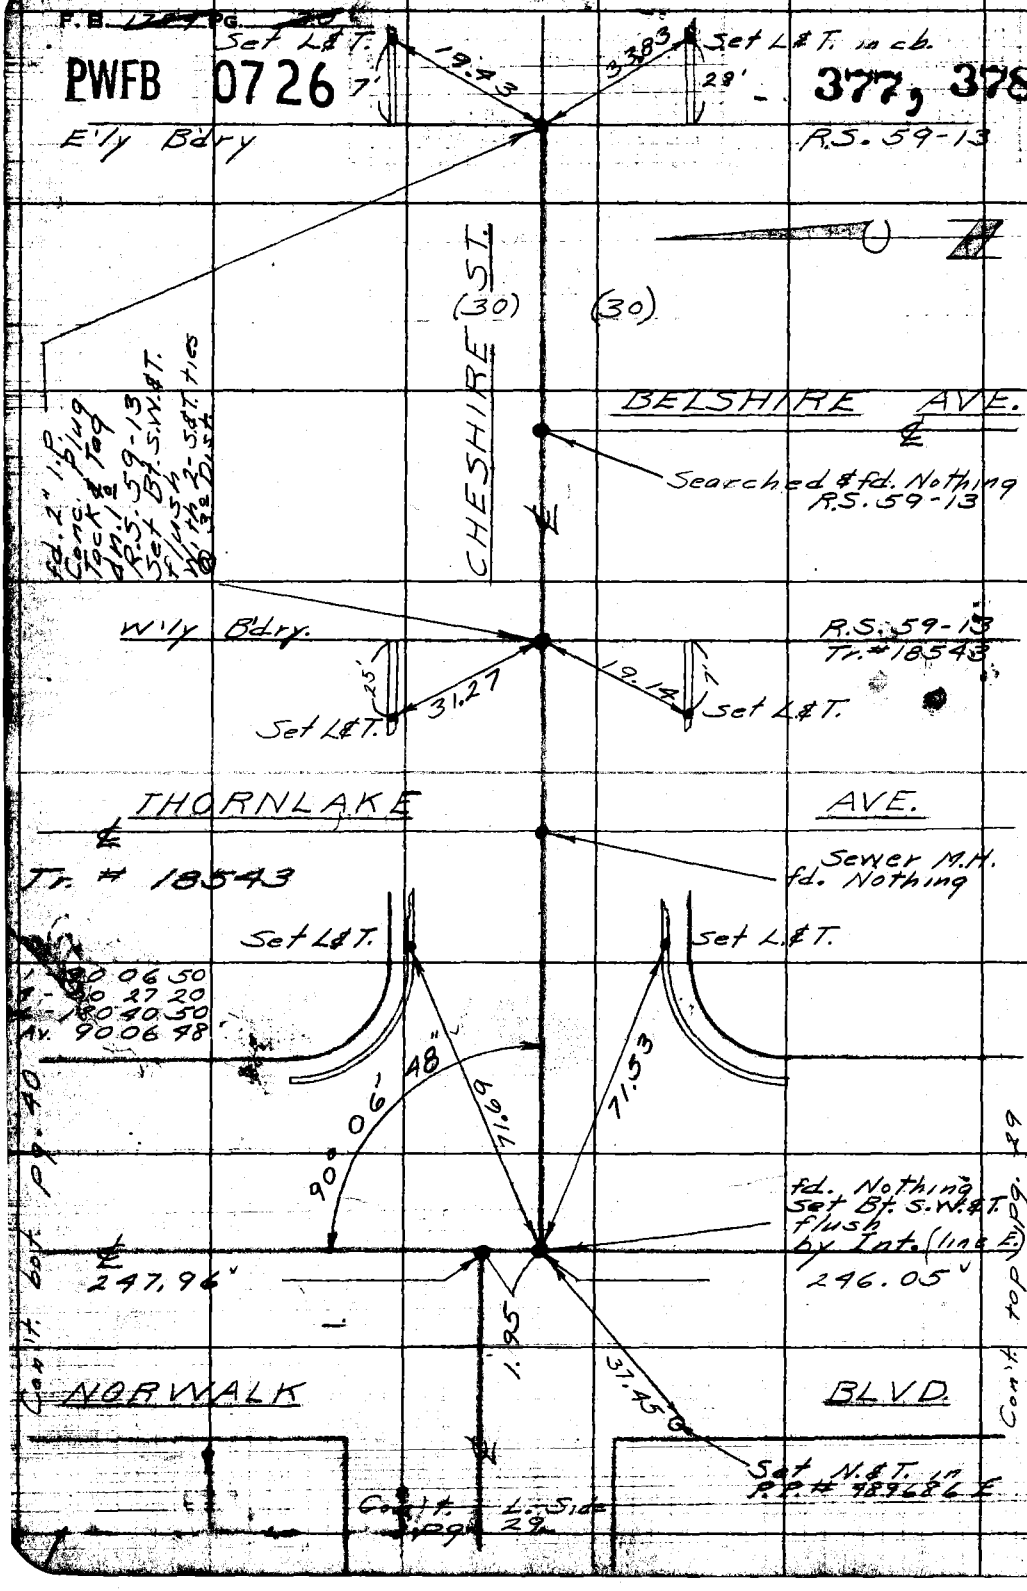

RETURN TO
LOS ANGELES COUNTY SURVEYOR
725 LOS ANGELES COUNTY
ENGINEERING BLDG.

Do not extend notes this side of this line.

Note: Any Additions or Changes on This Sheet Must be Made or Circled in Red Ink With Date and Name of Person Making Change.


Artesia-Norwalk F.B. 1799 PG. 31

Map No.
Office Work
Checked
Date

W.O. 6731 Tape No. St'd. °F
Surveyed by English
Notes " Date 6-53
Indexed

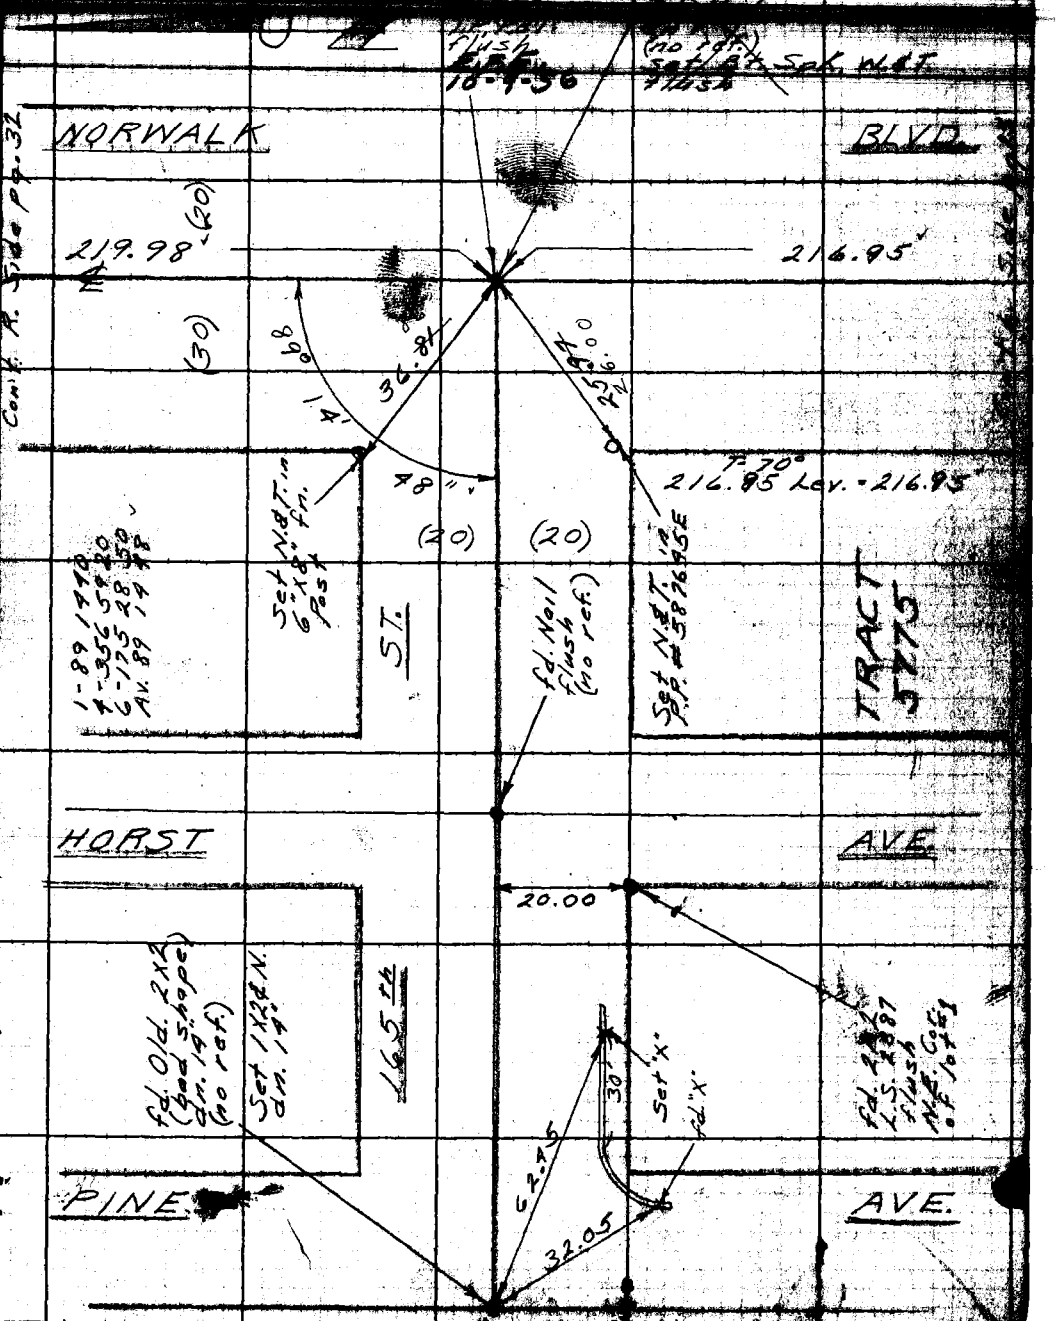

Do not extend [illegible] side of this line.

Note: Any Additions or Changes on this Map must be Made on Circled in Red Ink, Note Date and Name of Person Making Change.

SUBMIT TO LOS ANGELES COUNTY SURVEYOR 7th LOS ANGELES COUNTY ENGINEERING BLDG.

76F3095 247 8 SR

PWFB 0626 1154, 1155

F.B. 179 PG. 22

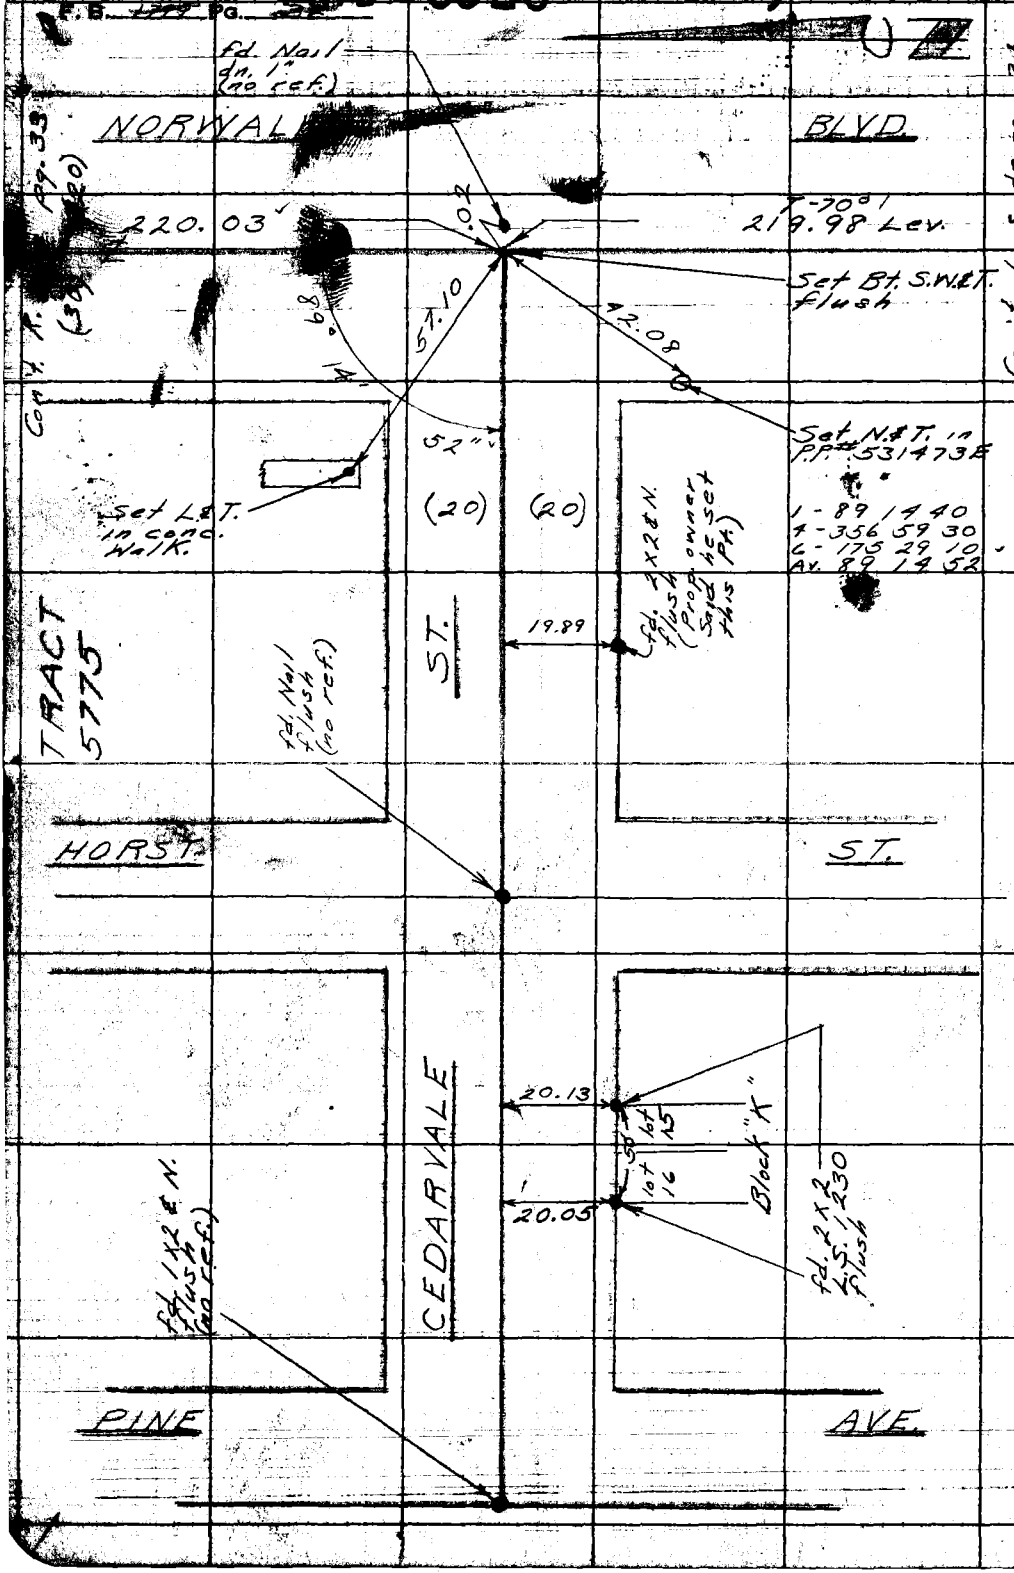

W.S. 33-D5

RETURN TO
LOS ANGELES COUNTY SURVEYOR
725 LOS ANGELES COUNTY
ENGINEERING BLDG.

Do not extend notes this side of this line.

Note: Any Additions or Changes on This Sheet Must be Made or Circled in Red Ink With Date and Name of Person Making Change.

PWFB - O[illegible]

1156 , 1157

F. B. ~~1799~~ Pg. ~~33~~

Map No.
Office Work
Checked
Date

Survey of Artesia-Norwalk
W. O. 6951 Tape No. Std. °F
Surveyed by English
Notes Date 6-33
Indexed R. C. Johnson

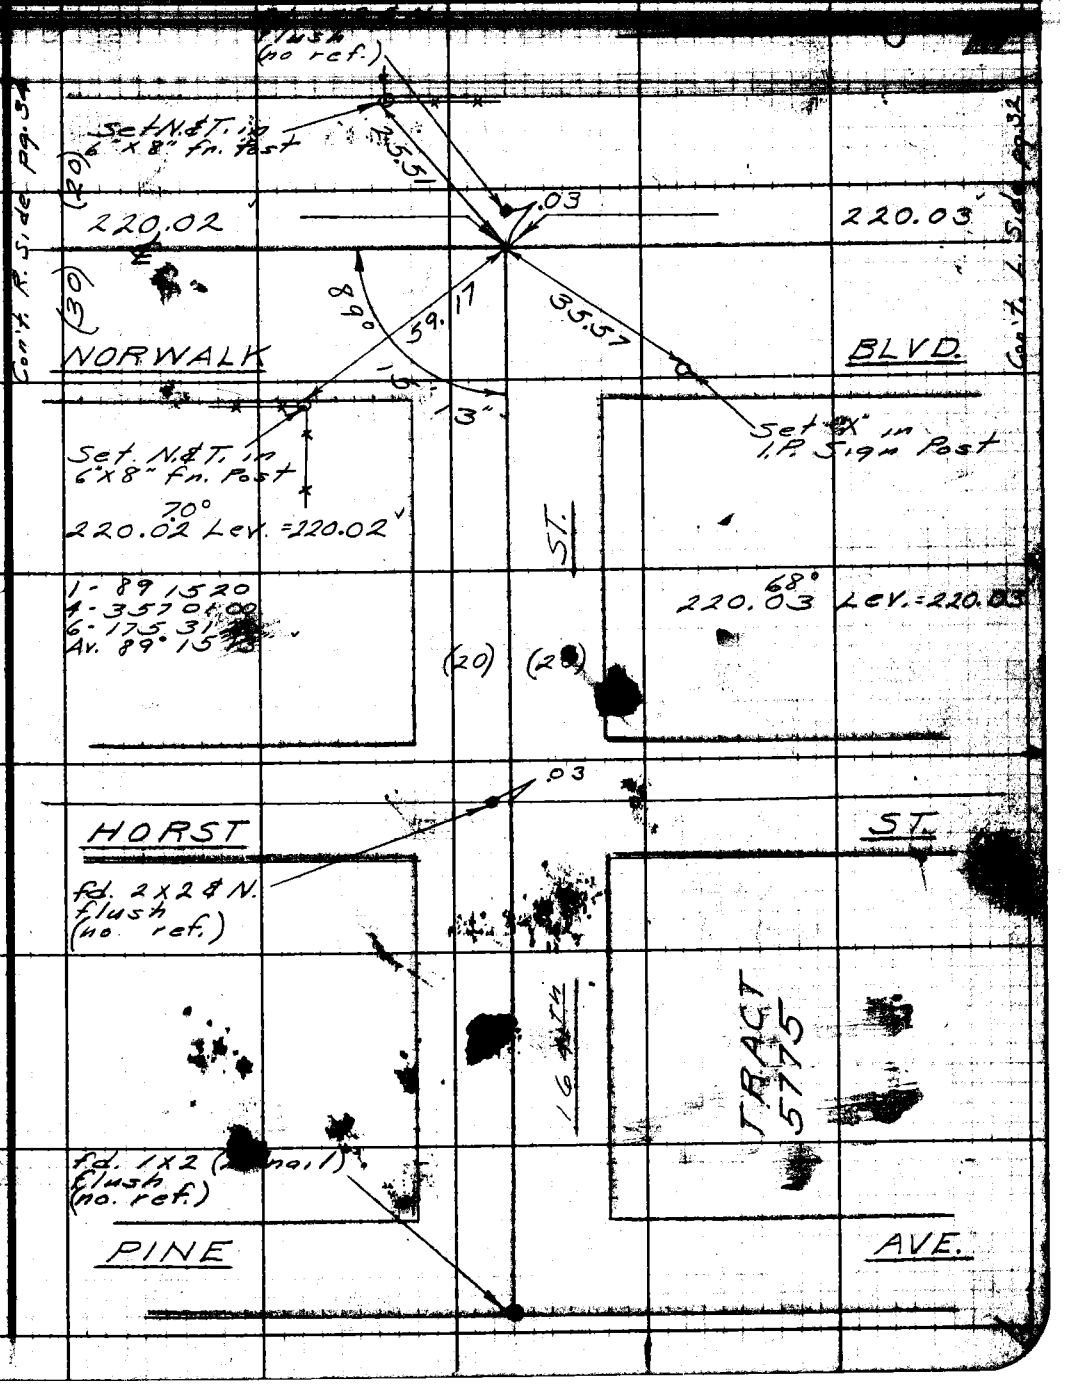

Note: Any Additions or Changes on This Sheet Must be Made or Circled in Red Ink With Date and Name of Person Making Change.

Do not extend notes this side of this line.

RETURN TO
LOS ANGELES COUNTY SURVEYOR
726 LOS ANGELES COUNTY
ENGINEERING BLDG.

75F3096 247 2-51

1158, 1159

PWFB 0626

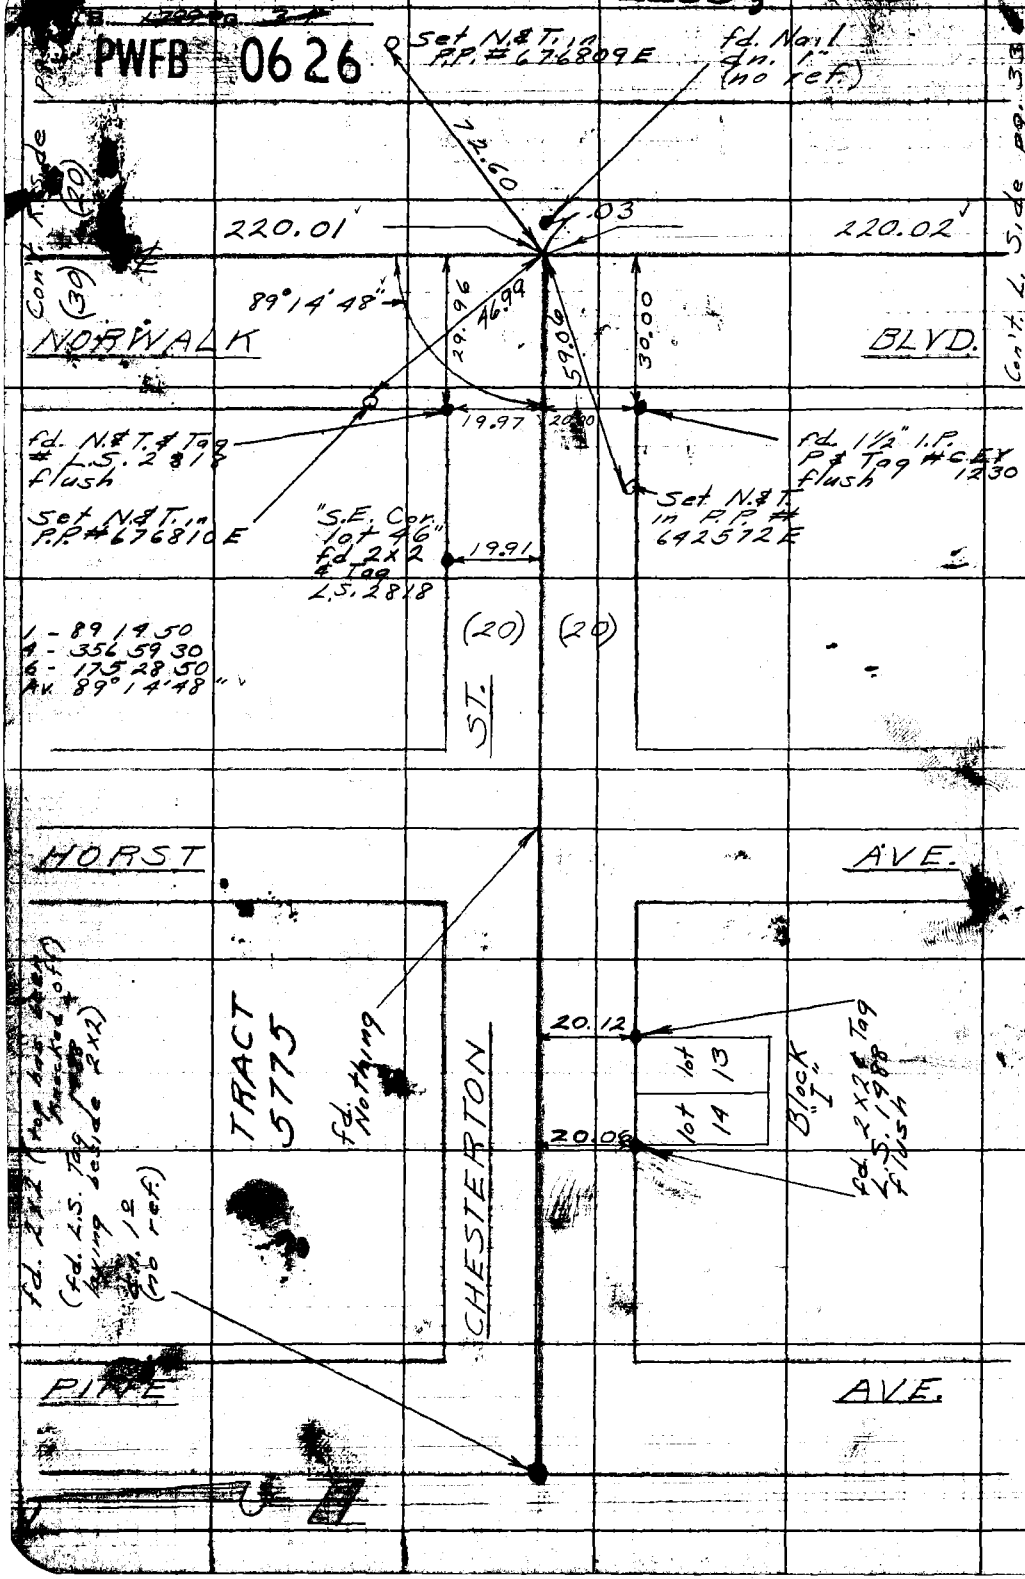

W.S. 33-D-5

RETURN TO
LOS ANGELES COUNTY SURVEYOR
726 LOS ANGELES COUNTY
ENGINEERING BLDG.

Do not extend notes this side of this line.

Note: Any Additions or Changes on This Sheet Must be Made or Circled in Red Ink With Date and Name of Person Making Change.

PWFB 0626 1160, 1161

Notes Ck'd by Galli	Survey of Artesia-Norwalk	F. B. 1299 Pg.
Map No.	W. O. 6931 Tape No. St'd.	
Office Work	Surveyed by English	
Checked	Notes Date 6-55	
Date	Indexed R C Johnson	

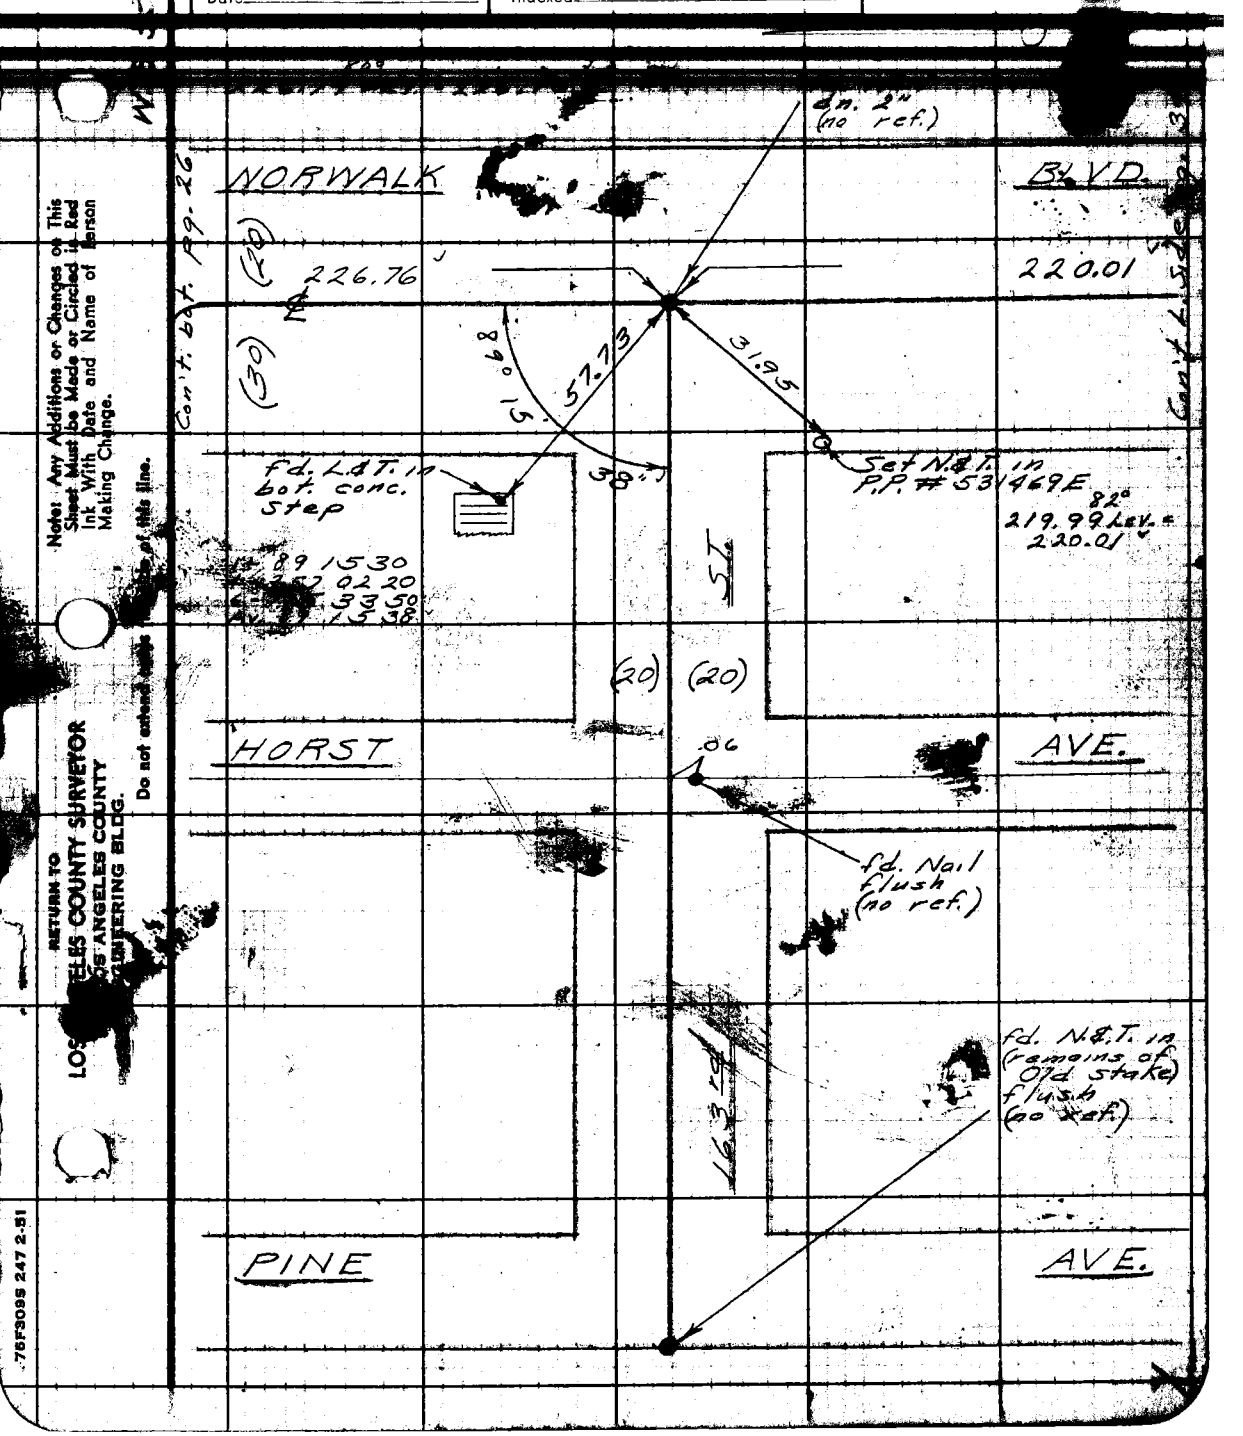

Note: Any Additions or Changes on This Sheet Must be Made or Circled in Red Ink With Date and Name of Person Making Change.

Do not extend notes [illegible] of this line.

RETURN TO LOS ANGELES COUNTY SURVEYOR LOS ANGELES COUNTY ENGINEERING BLDG.

76F3095 247 2-51

PWFB 0626

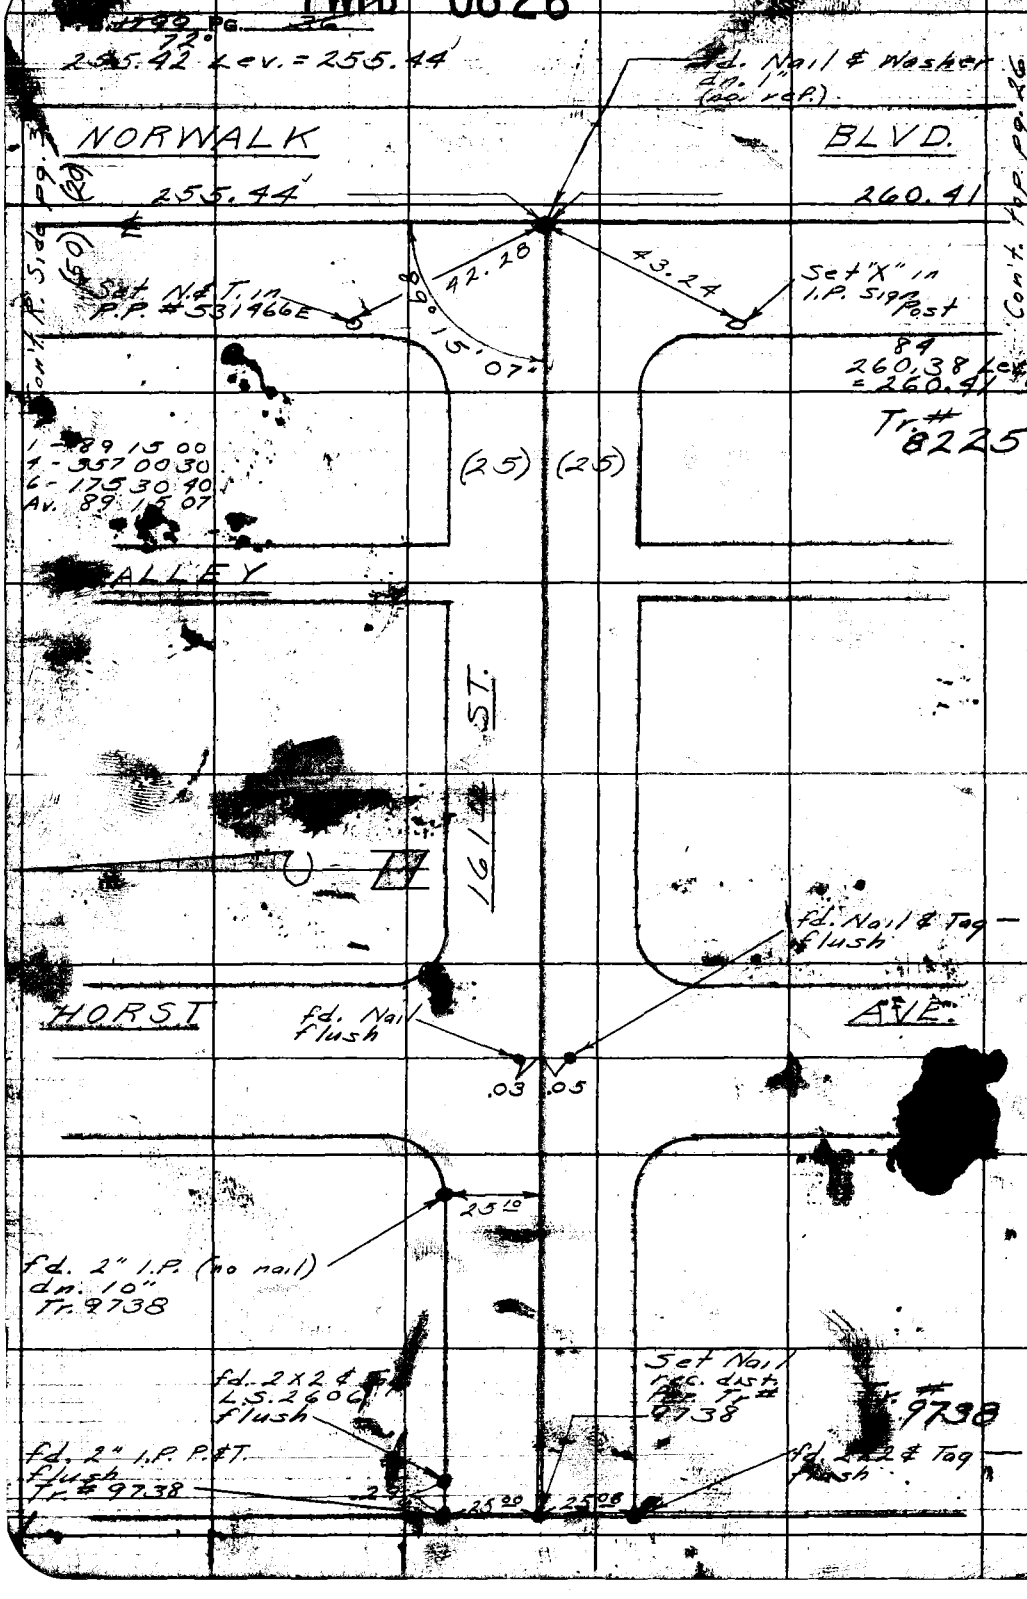

W.S. 33-D-5

RETURN TO
LOS ANGELES COUNTY SURVEYOR
726 LOS ANGELES COUNTY
ENGINEERING BLDG.

Do not extend notes this side of this line.

Any Additions or Changes on This
Must be Made or Circled in Red
With Date and Name of Person
ing Change.

PWFB 0726 381, 382

Notes Ck'd by Gall	Survey of Artesia-Norwalk	F.B. 1289 Pg.
Map No.	W. O. 69.51 Tape No. St'd. °F	
Office Work	Surveyed by English	
Checked	Notes " Date 6-53	
Date	Indexed	

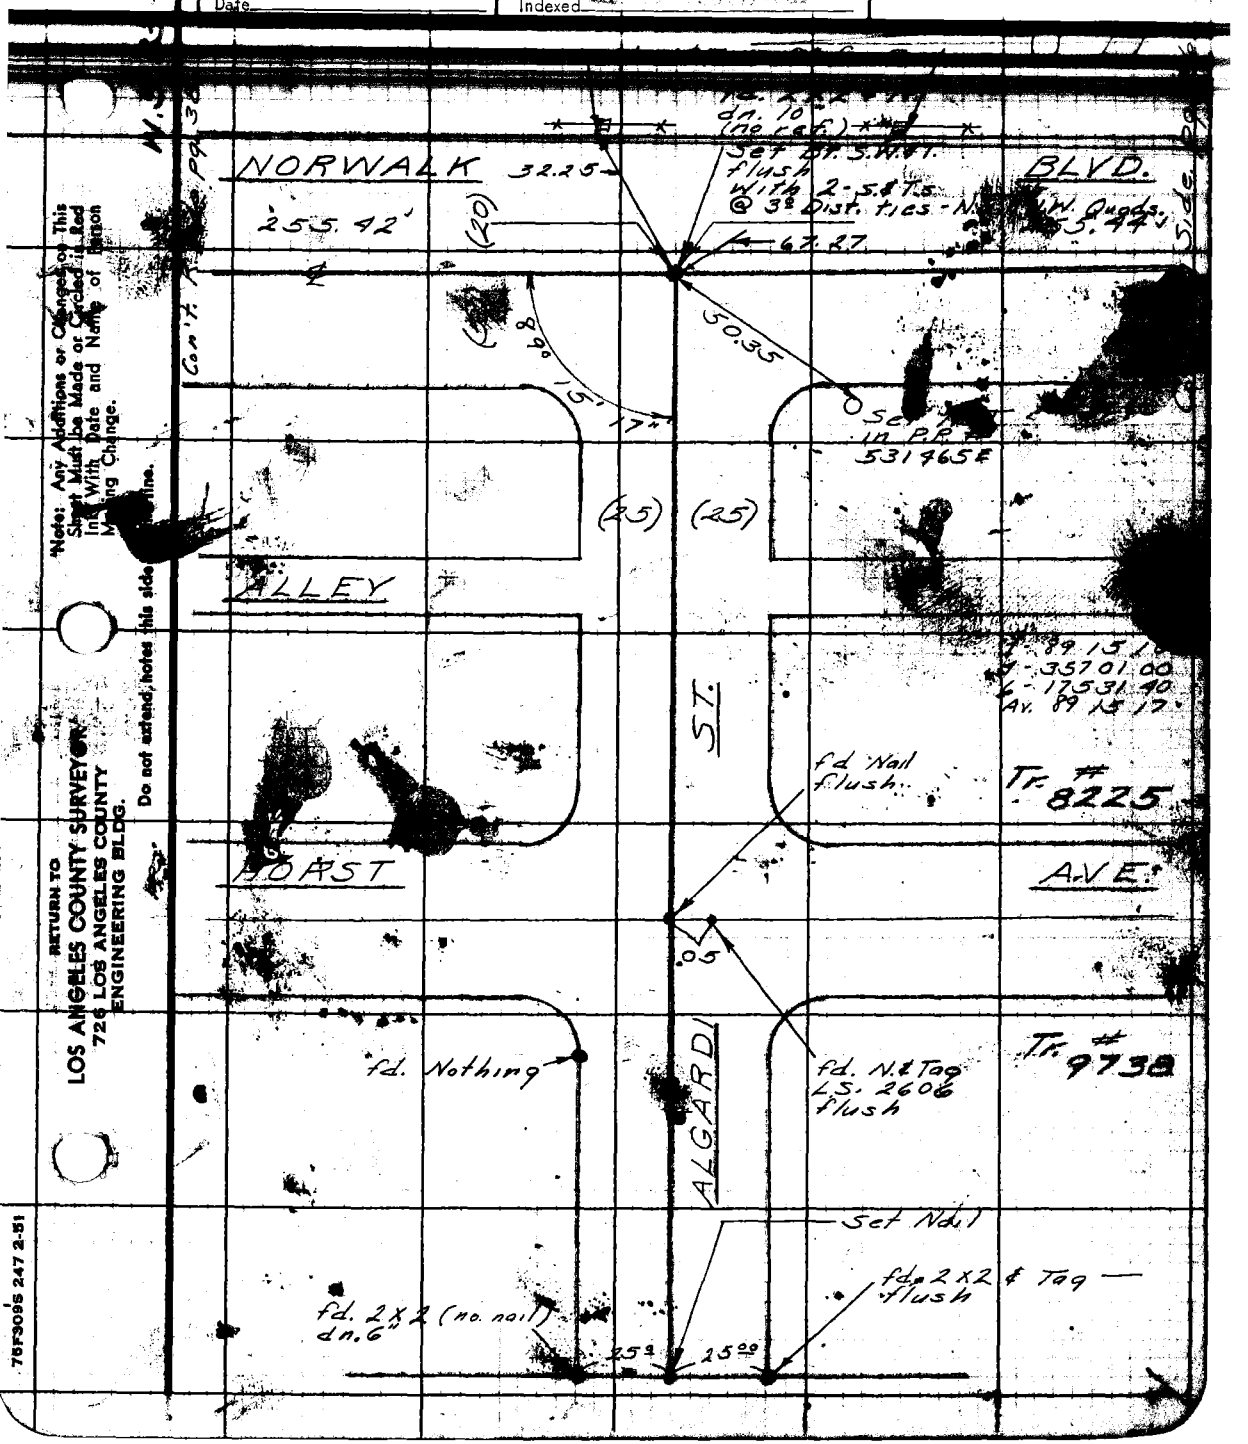

Note: Any Additions or Changes on This Sheet Must be Made or Circled in Red Ink With Date and Name of Person Making Change.

Do not extend notes this side of line.

RETURN TO
LOS ANGELES COUNTY SURVEYOR
726 LOS ANGELES COUNTY
ENGINEERING BLDG.

75F309S 247 2-51

PWFB 0726 383, 384

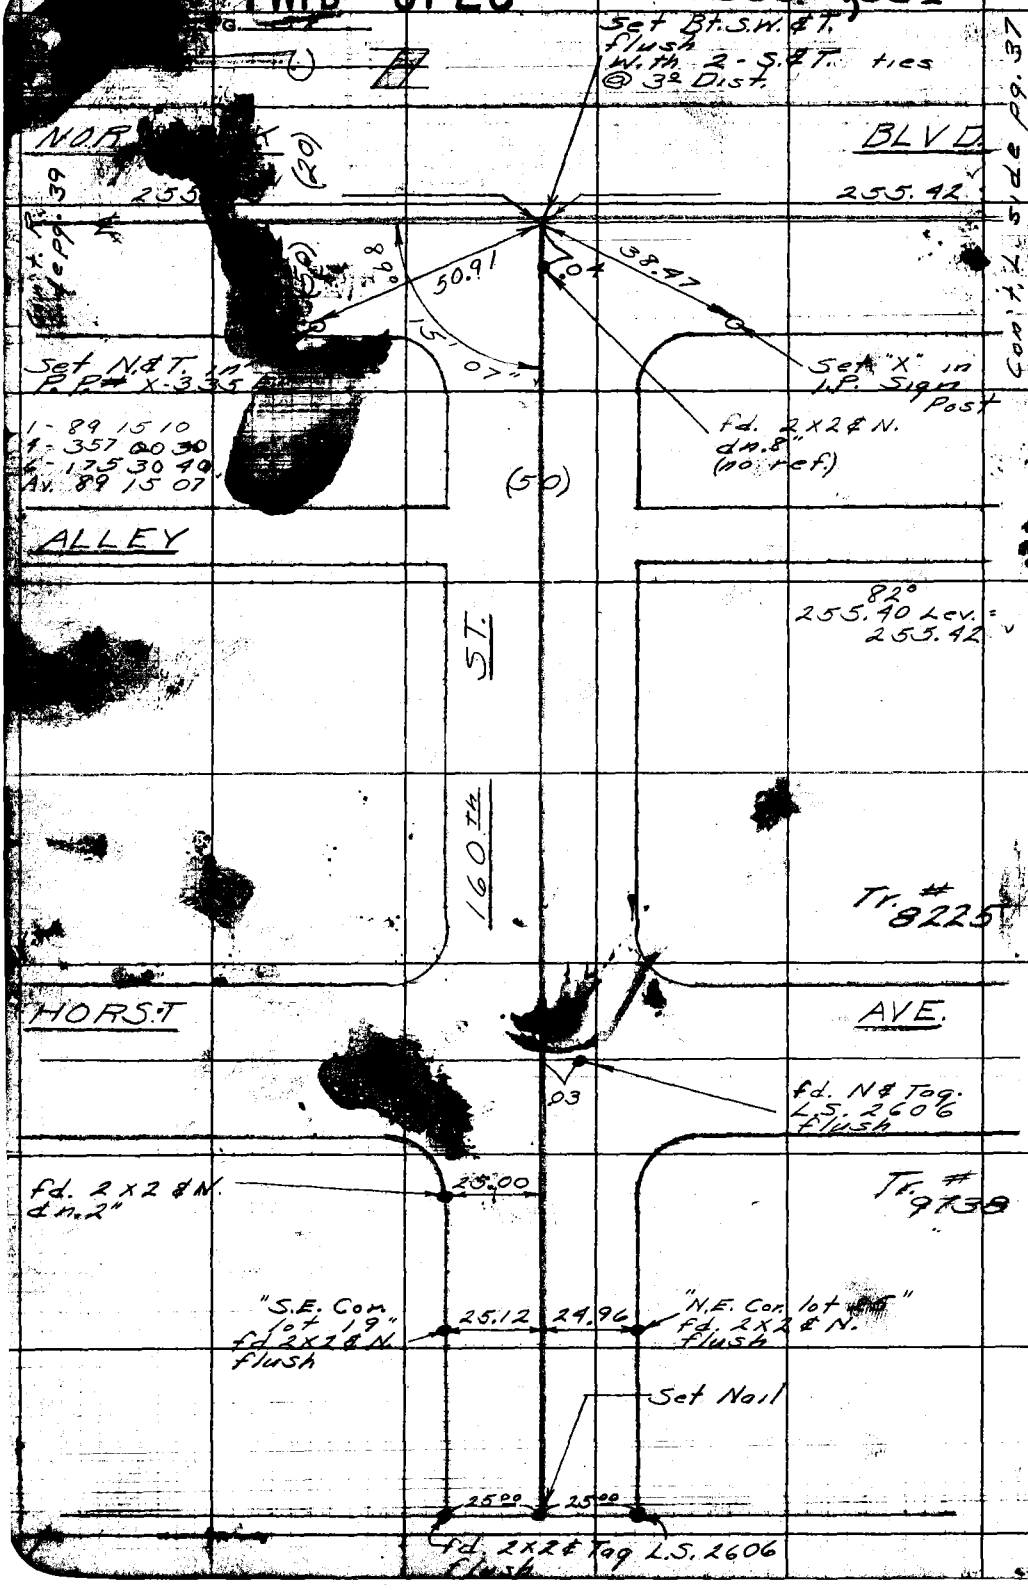

W.S. 33-D-4

Cont'd. side pg. 37

RETURN TO
LOS ANGELES COUNTY SURVEYOR
726 LOS ANGELES COUNTY
ENGINEERING BLDG.

Do not extend notes this side of this line.

Note: Any Additions or Changes on This Sheet Must be Made or Circled in Red Ink With Date and Name of Person Making Change.

PWFB 0726 385, 386

Notes Ck'd by Galli	Survey of Artesia - Norwalk	F.B. 1789 Pg. 39
Map No.	W.O. 6951 Tape No. Std. °F	
Office Work	Surveyed by English	
Checked	Notes " Date 6-53	
Date	Indexed Johnson	

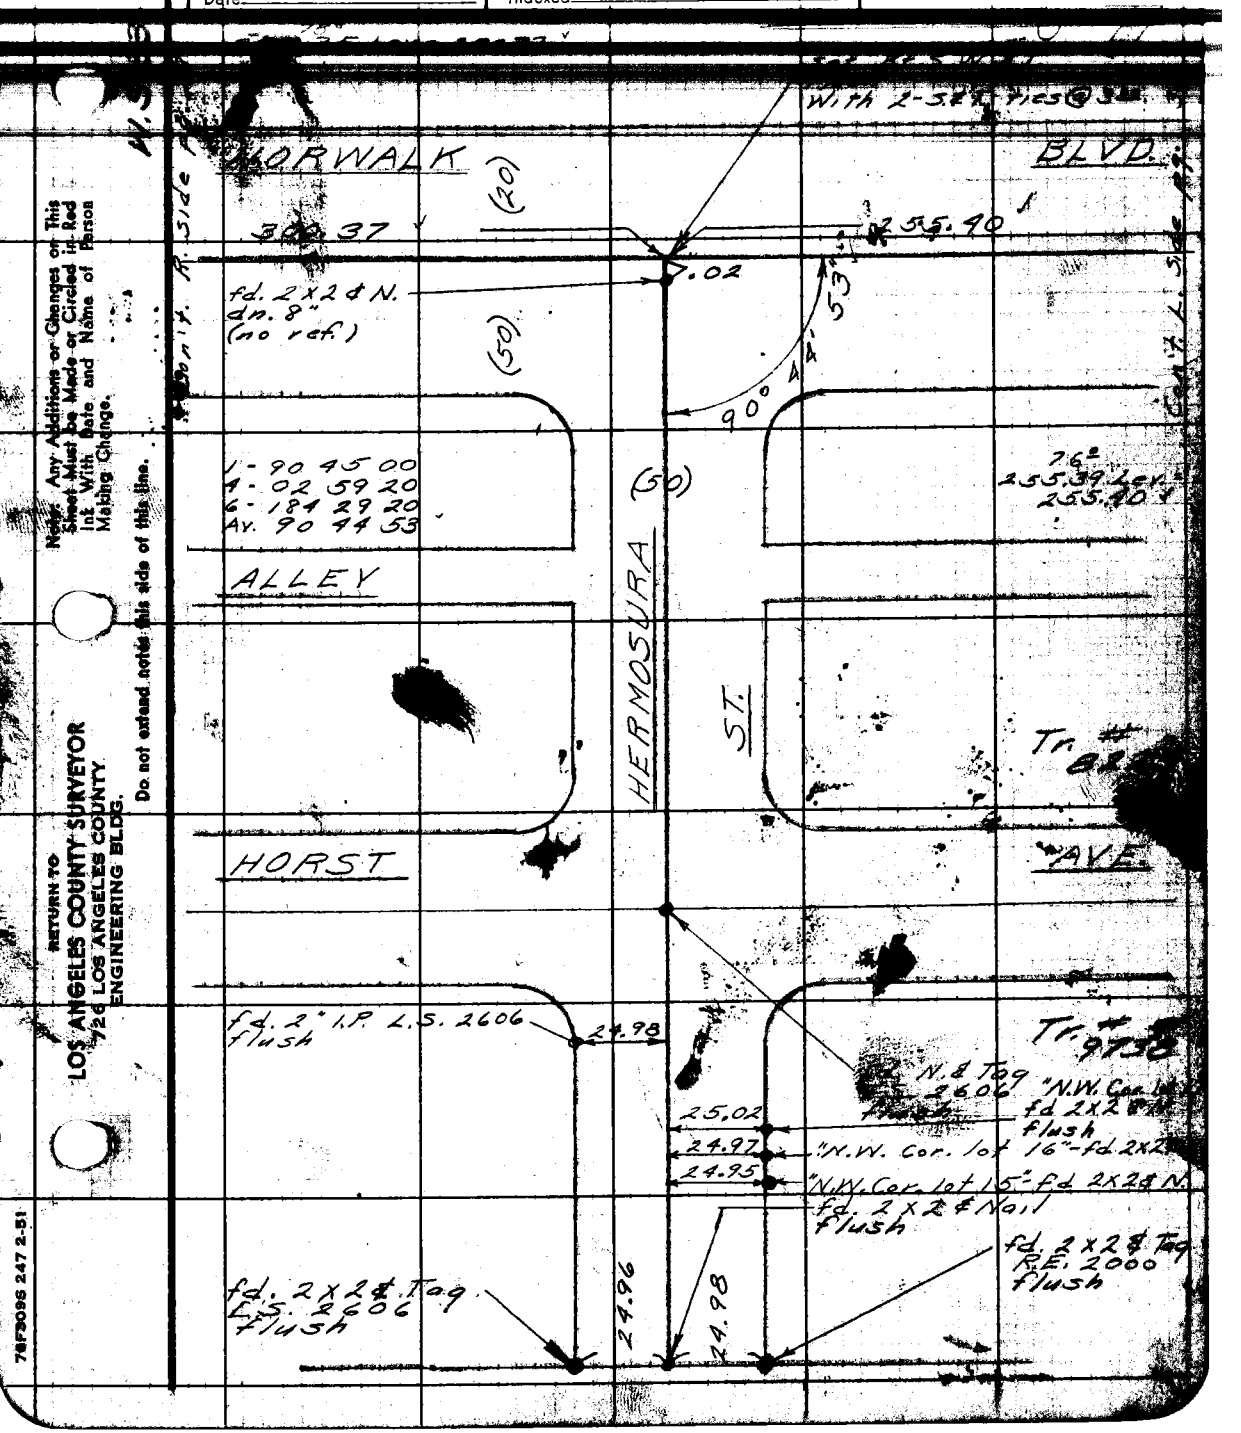

Note: Any Additions or Changes on This Sheet Must Be Made or Circled in Red Ink With Date and Name of Person Making Change.

Do not extend notes this side of this line.

RETURN TO
LOS ANGELES COUNTY SURVEYOR
726 LOS ANGELES COUNTY
ENGINEERING BLDG.

76F3096 247 2-51

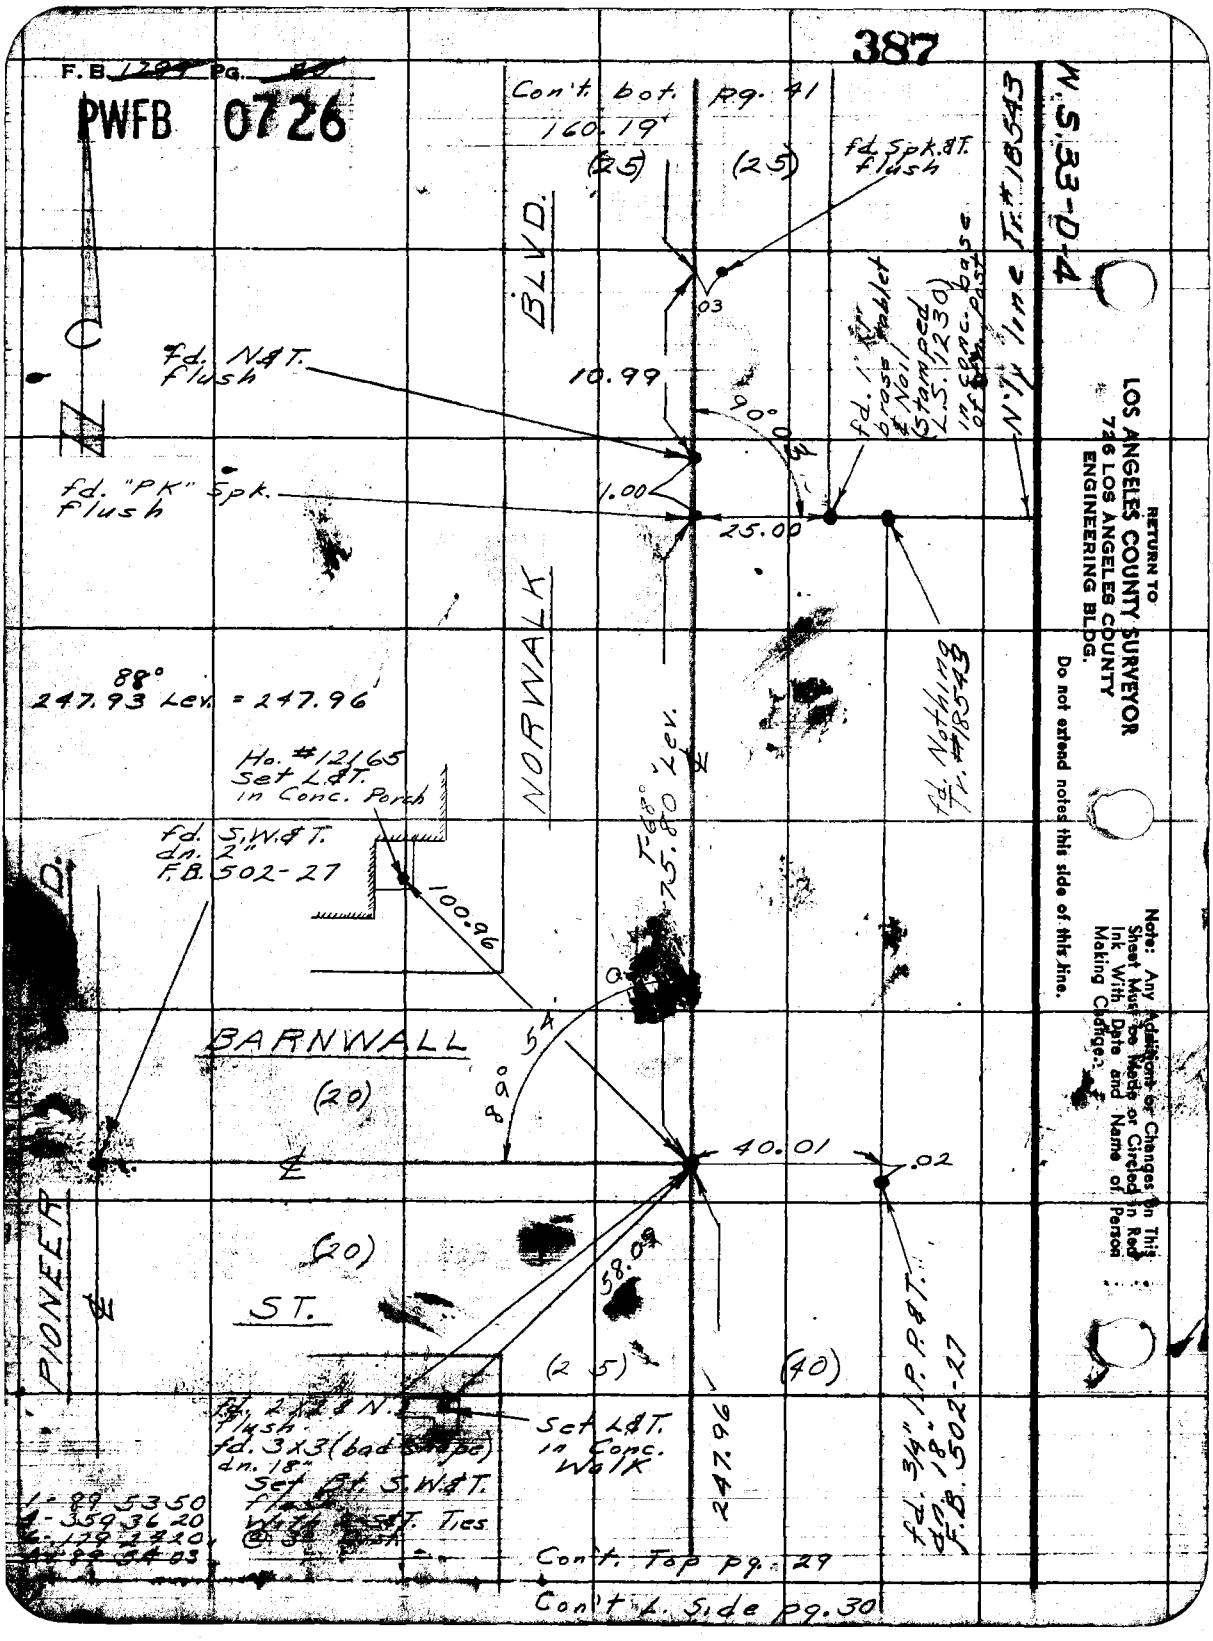
387
F.B. 1294 Pg. 40
PWFB 0726
Con't. bot. pg. 41
160.19'
(25)
(25)
fd. Spk. & T. flush
BLVD.
.03
fd. N&T. flush
10.99
90°
fd. 1" brass tablet & Nail (Stamped L.S. 1230) in conc. base of ... post
N'ly line Tr. #18543
W.S. 33-D-4
fd. "PK" Spk. flush
1.00
25.00
NORWALK
88°
247.93 Lev. = 247.96
Ho. #12165 Set L&T. in Conc. Porch
fd. S.W.&T. dn. 2" F.B. 502-27
100.96
T-68°
75.80 Lev.
fd. Nothing Tr. #18543
BARNWALL
(20)
89°
54
40.01
.02
(20)
58.09
ST.
PIONEER
(25)
(40)
fd. 2x2 & N. flush
fd. 3x3 (bad shape) dn. 18"
Set Bt. S.W.&T. flush
Set L&T. in Conc. Walk
247.96
fd. 3/4" I.P. P.&T. dn. 18" F.B. 502-27
1-89 53 50
4-359 36 20
6-179 24 20
Con't. Top pg. 29
Con't L. Side pg. 30
RETURN TO
LOS ANGELES COUNTY SURVEYOR
726 LOS ANGELES COUNTY
ENGINEERING BLDG.
Do not extend notes this side of this line.
Note: Any Additions or Changes on This Sheet Must be Made or Circled in Red Ink With Date and Name of Person Making Change.

PWFB 0726 388

Map No.	W. O. 6851 Tape No.	St'd. °F
Office Work	Surveyed by English	
Checked	Notes "	Date 7-53
Date	Indexed	

F. B. 1799 Pg. 41

Artesia-Norwalk

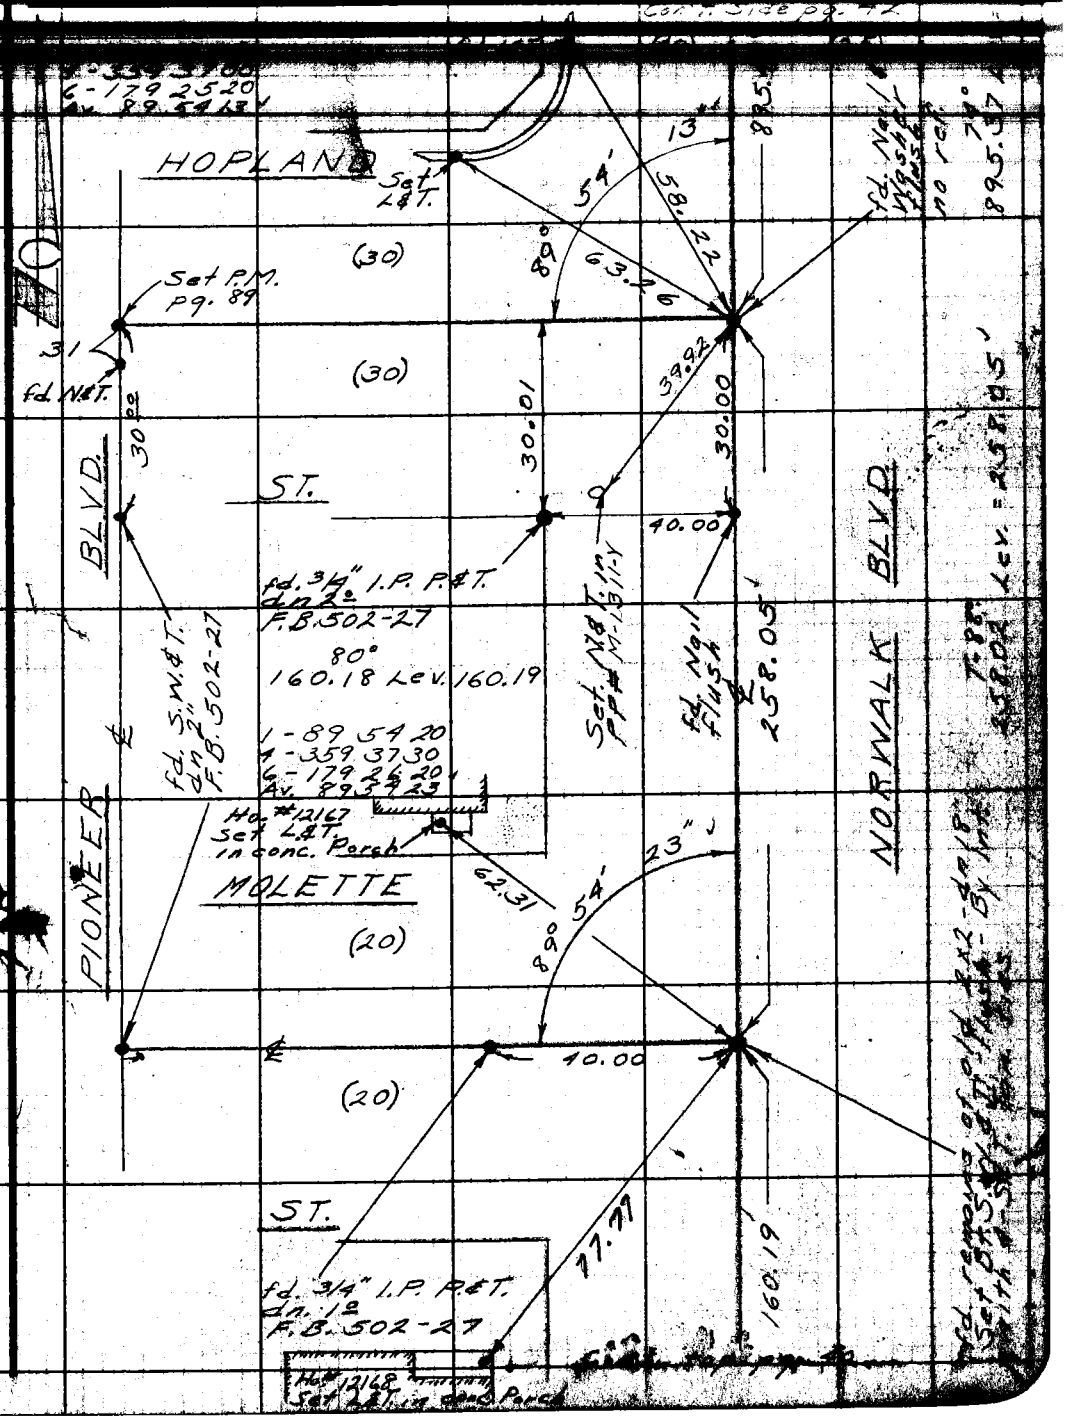

Note: Any Additions or Changes on This Sheet Must be Made or Circled in Red Ink With Date and Name of Person Making Change.

Do not extend notes this side of this line.

RETURN TO
LOS ANGELES COUNTY SURVEYOR
726 LOS ANGELES COUNTY
ENGINEERING BLDG.

PWFB 0726 389

F.B. 1799 PG. 42

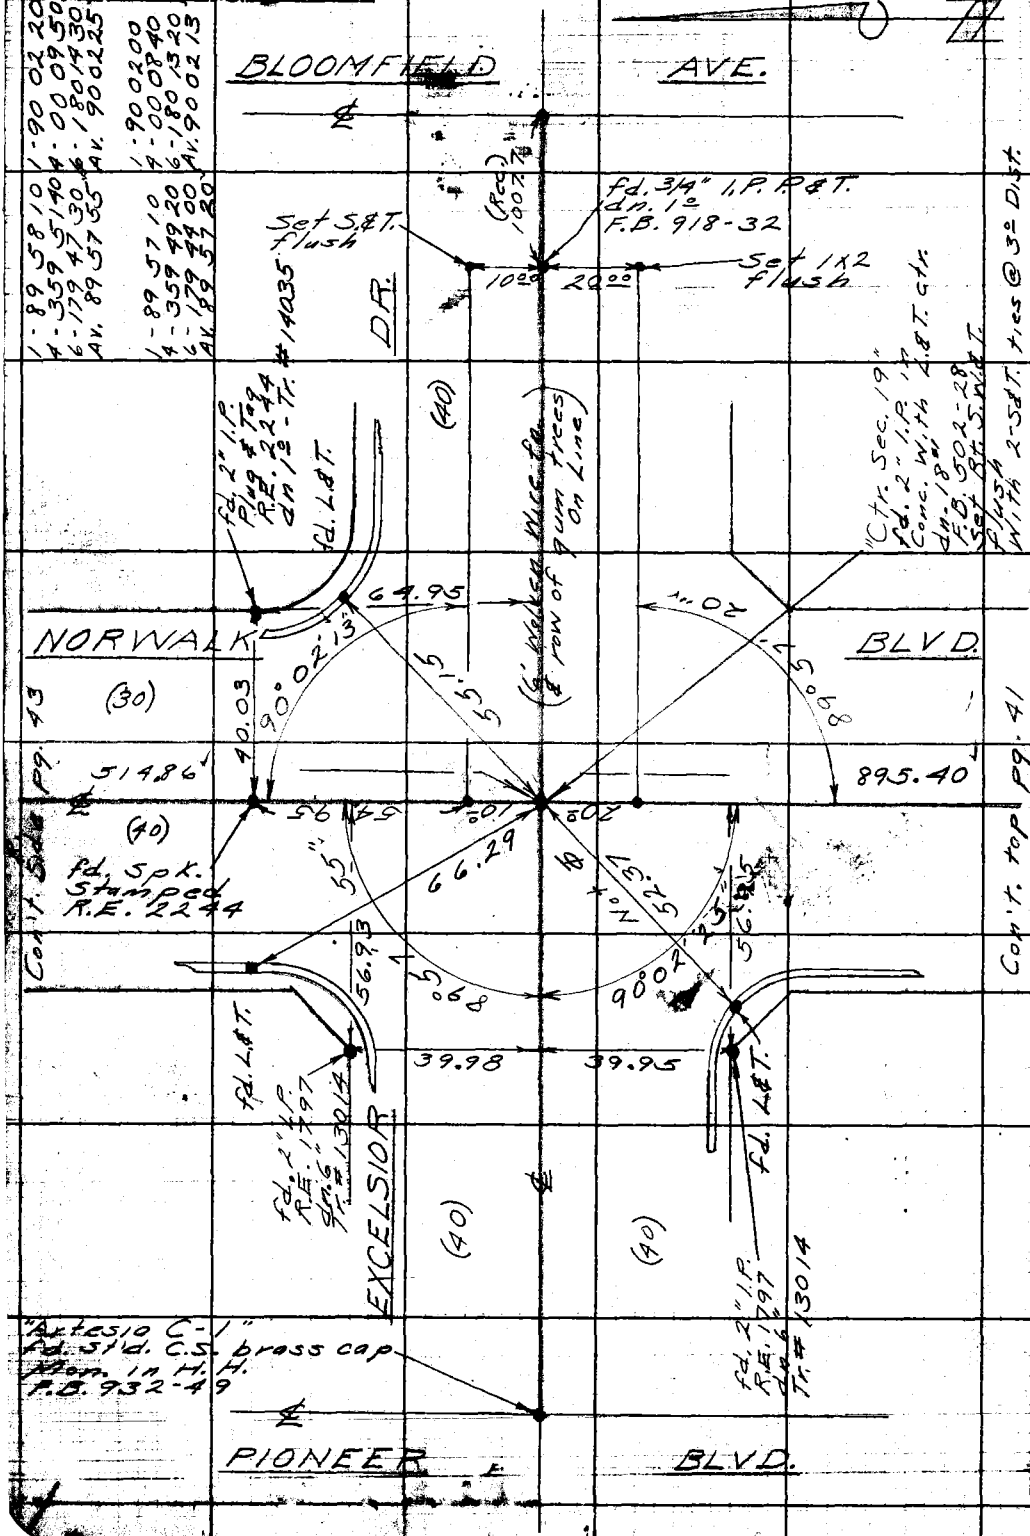

1-89 58 10 1-90 02 20
4-359 51 40 4-00 09 50
6-179 47 30 6-180 14 30
Av. 89 57 55 Av. 90 02 25

1-89 57 10 1-90 02 00
4-359 49 20 4-00 08 40
6-179 44 00 6-180 13 20
Av. 89 57 20 Av. 90 02 13

W.S. 33-D-4

RETURN TO
LOS ANGELES COUNTY SURVEYOR
726 LOS ANGELES COUNTY
ENGINEERING BLDG.

Do not extend notes this side of this line.

Note: Any Additions or Changes on This Sheet Must be Made or Circled in Red Ink With Date and Name of Person Making Change.

PWFB 0726 390

Notes Ckd by Gall	Survey of Artesia-Norwalk F.B. 1747 PG. 43
Map No.	W. O. 6951 Tape No. St'd. °F
Office Work	Surveyed by English
Checked	Notes " Date 7-53
Date	Indexed

W-38-D-4

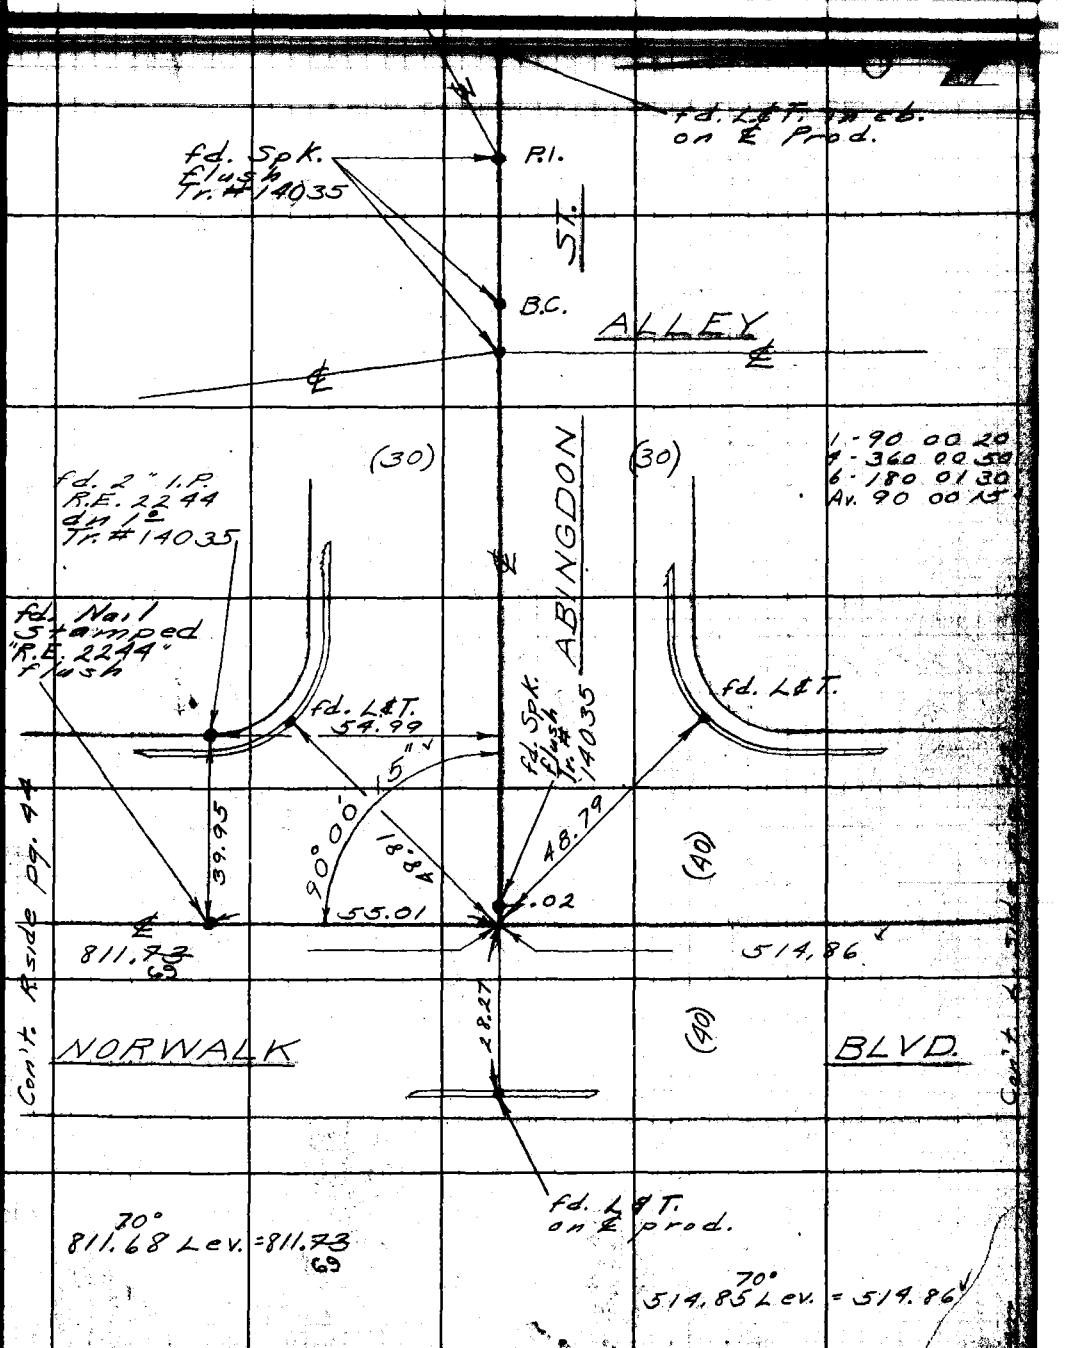

Note: Any Additions or Changes on This Sheet Must be Made or Circled in Red Ink With Date and Name of Person Making Change.

Do not extend notes this side of this line.

RETURN TO
LOS ANGELES COUNTY SURVEYOR
726 LOS ANGELES COUNTY
ENGINEERING BLDG.

76F309S 247 2-51

PWFB 0726 391

F.B. 1709 Pg. 14

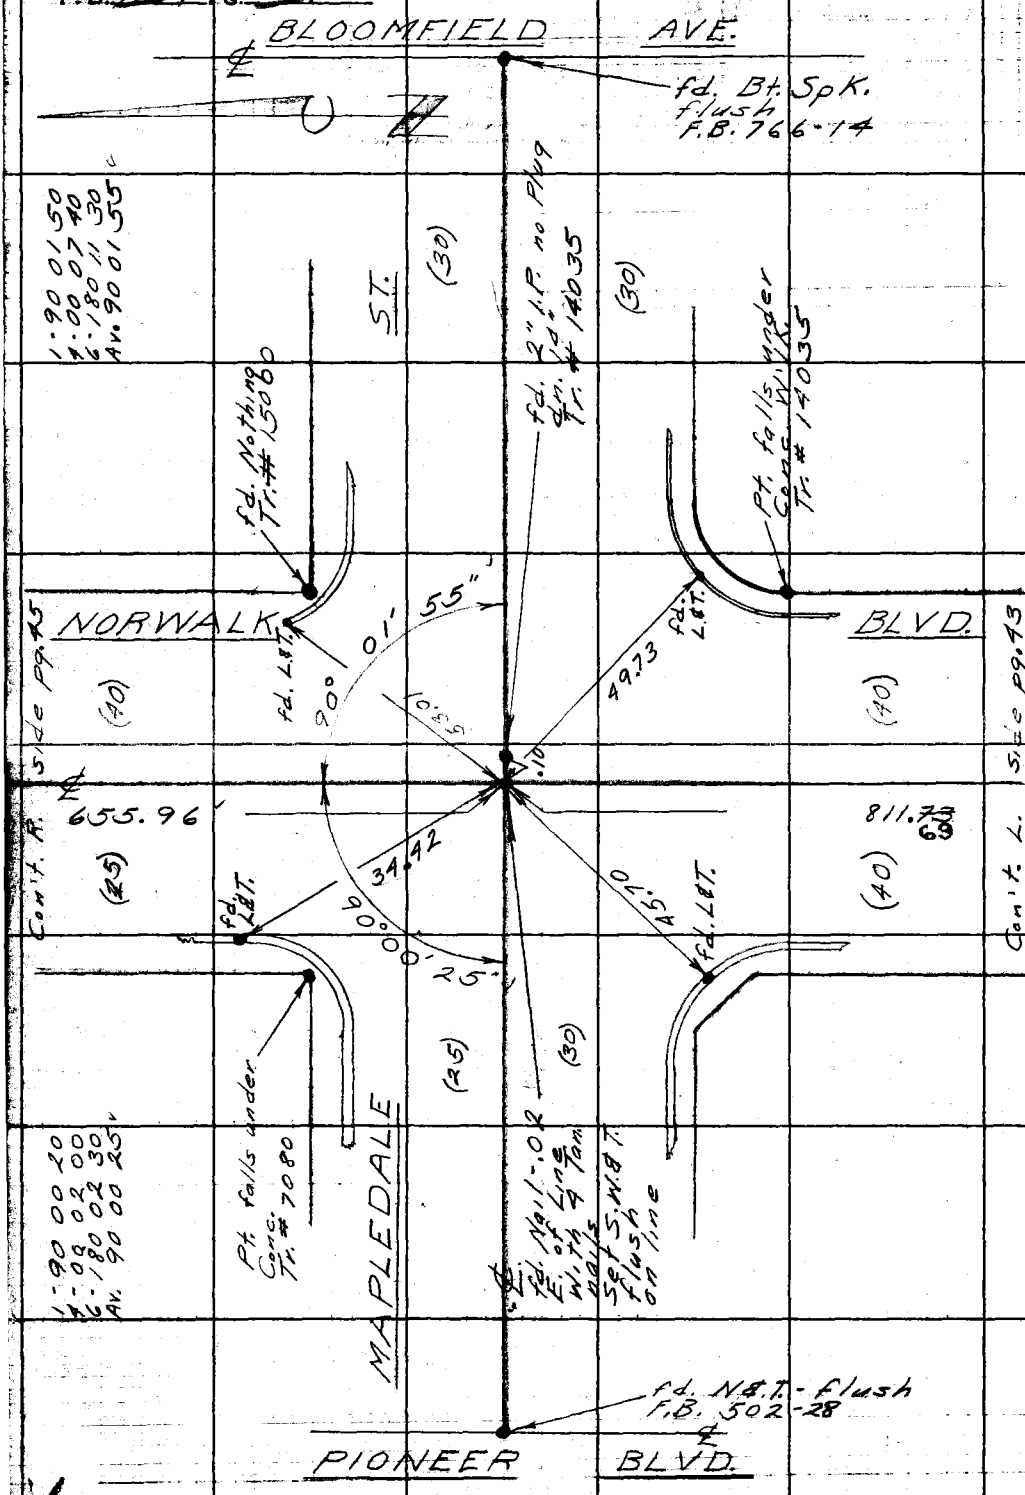

W.S. 38-D-4

RETURN TO
LOS ANGELES COUNTY SURVEYOR
726 LOS ANGELES COUNTY
ENGINEERING BLDG.

Do not extend notes this side of this line.

Note: Any Additions or Changes on This Sheet Must be Made or Circled in Red Ink With Date and Name of Person Making Change.

PWFB 0726

392

Notes Ck'd by Galli	Survey of Artesia-Norwalk	F. B. 1799 Pg. 45
Map No.	W. O. 6951 Tape No. St'd. °F	
Office Work	Surveyed by English	
Checked	Notes " Date 7-53	
Date	Indexed [illegible]	

W. [illegible]-D-4

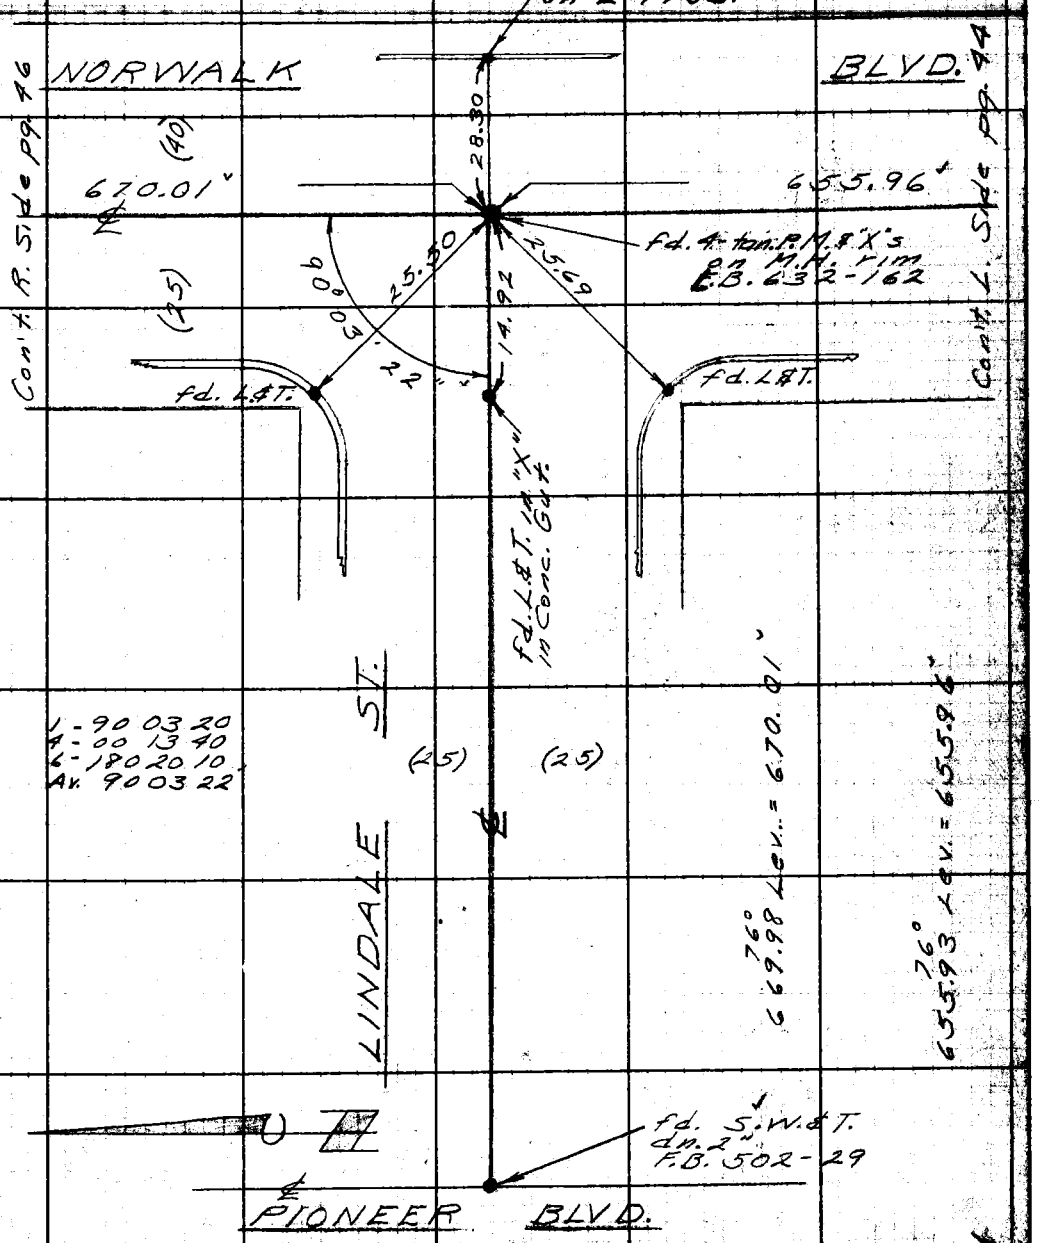

Note: Any Additions or Changes on This Sheet Must be Made or Circled in Red Ink With Date and Name of Person Making Change.

Do not extend notes this side of this line.

RETURN TO
LOS ANGELES COUNTY SURVEYOR
726 LOS ANGELES COUNTY
ENGINEERING BLDG.

76F309S 247 2-51

PWFB 0726 393

F.B. 1299 PG. 36

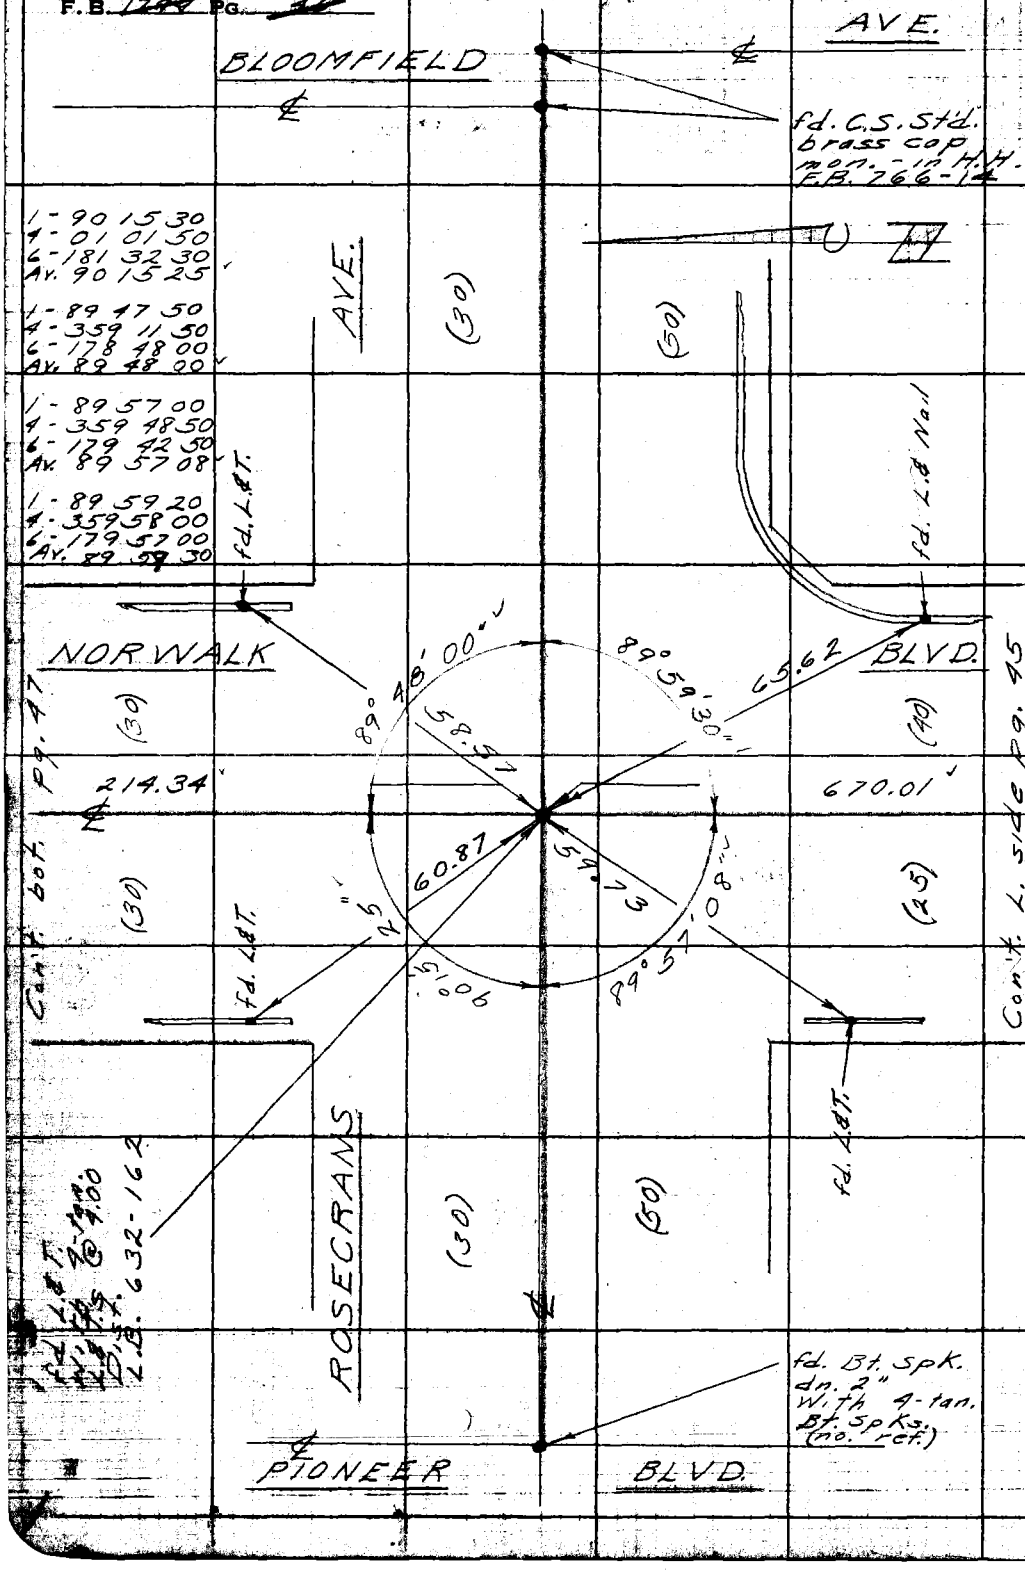

W.S. 33-D-4

RETURN TO
LOS ANGELES COUNTY SURVEYOR
726 LOS ANGELES COUNTY
ENGINEERING BLDG.

Do not extend notes this side of this line.

Note: Any Additions or Changes on This Sheet Must be Made or Circled in Red Ink With Date and Name of Person Making Change.

PWFB 0726 394

Notes Ch'd by Gall	Survey of Artesia-Norwalk	F.B. 1789 PG. 47
Map No.	W. O. 6951 Tape No. St'd. °F	
Office Work	Surveyed by English	
Checked	Notes 7" Date 7-53	
Date	Indexed H. C. Johnson	

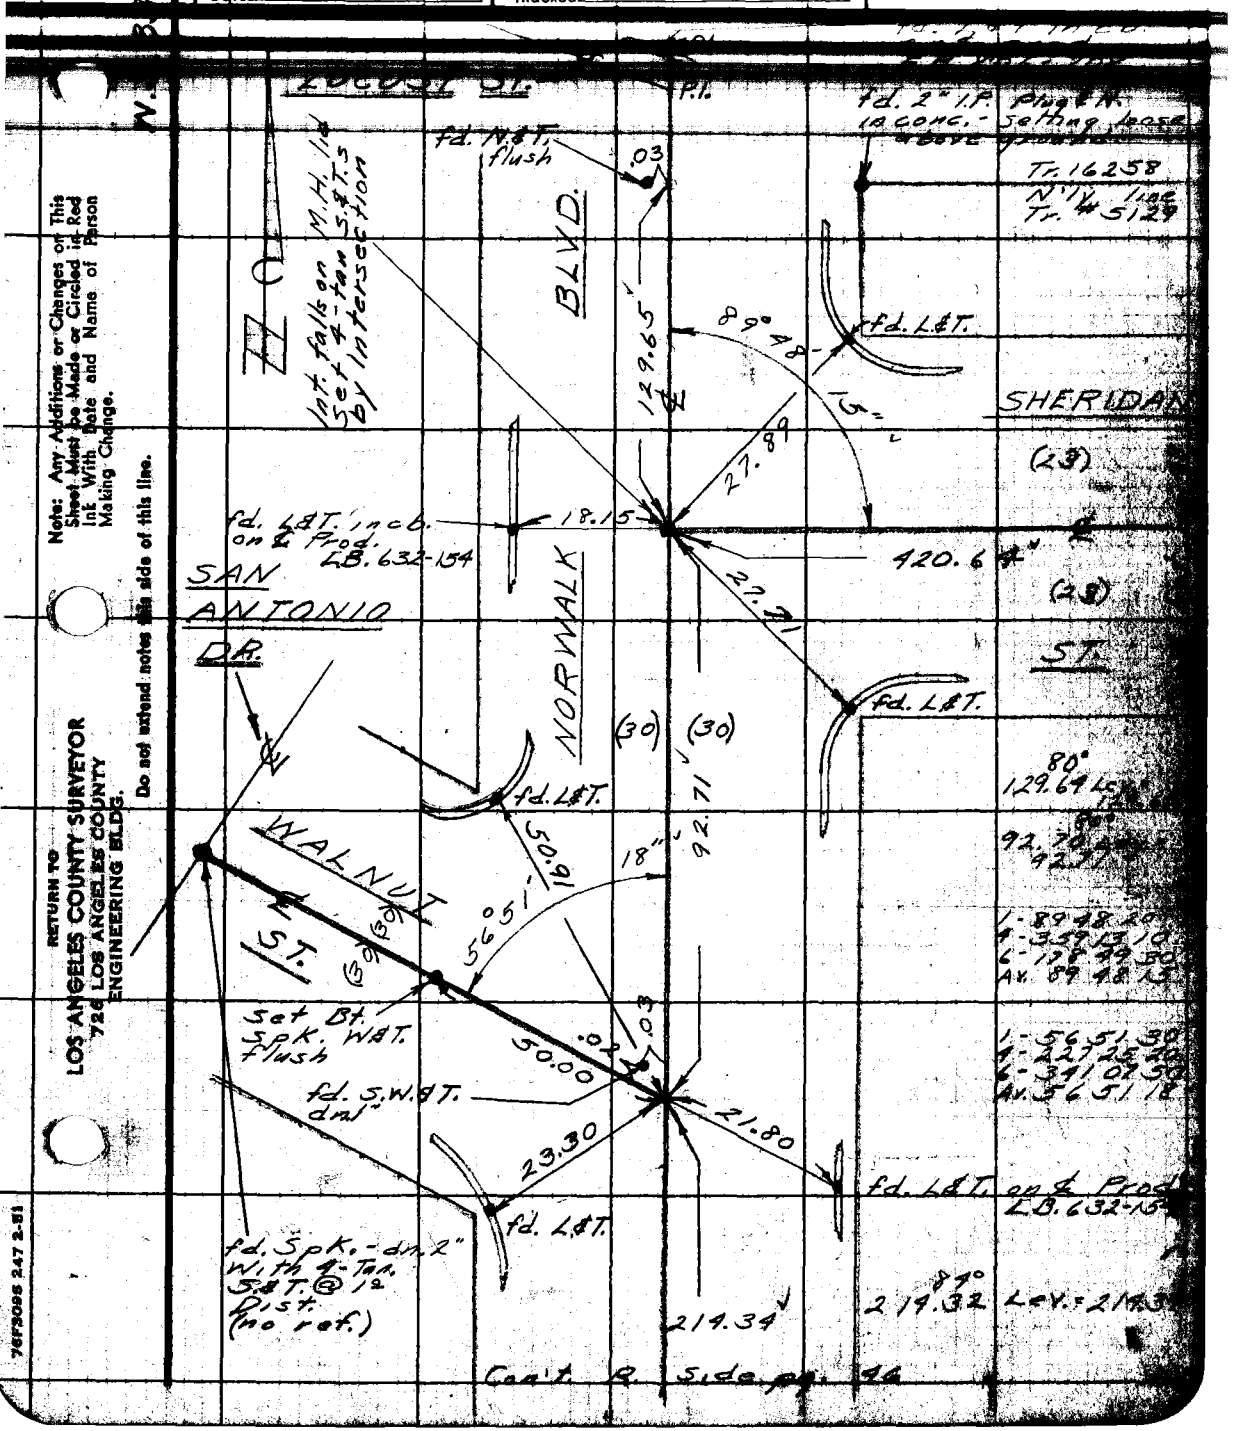

Con't. R. Side pg. 46

Note: Any Additions or Changes on This Sheet Must be Made or Circled in Red Ink With Date and Name of Person Making Change.

Do not extend notes this side of this line.

RETURN TO
LOS ANGELES COUNTY SURVEYOR
726 LOS ANGELES COUNTY ENGINEERING BLDG.

76F3095 247 2-51

F.B. 1299 PG. 18

PWFB 0726

395

W.S. 33-D-4

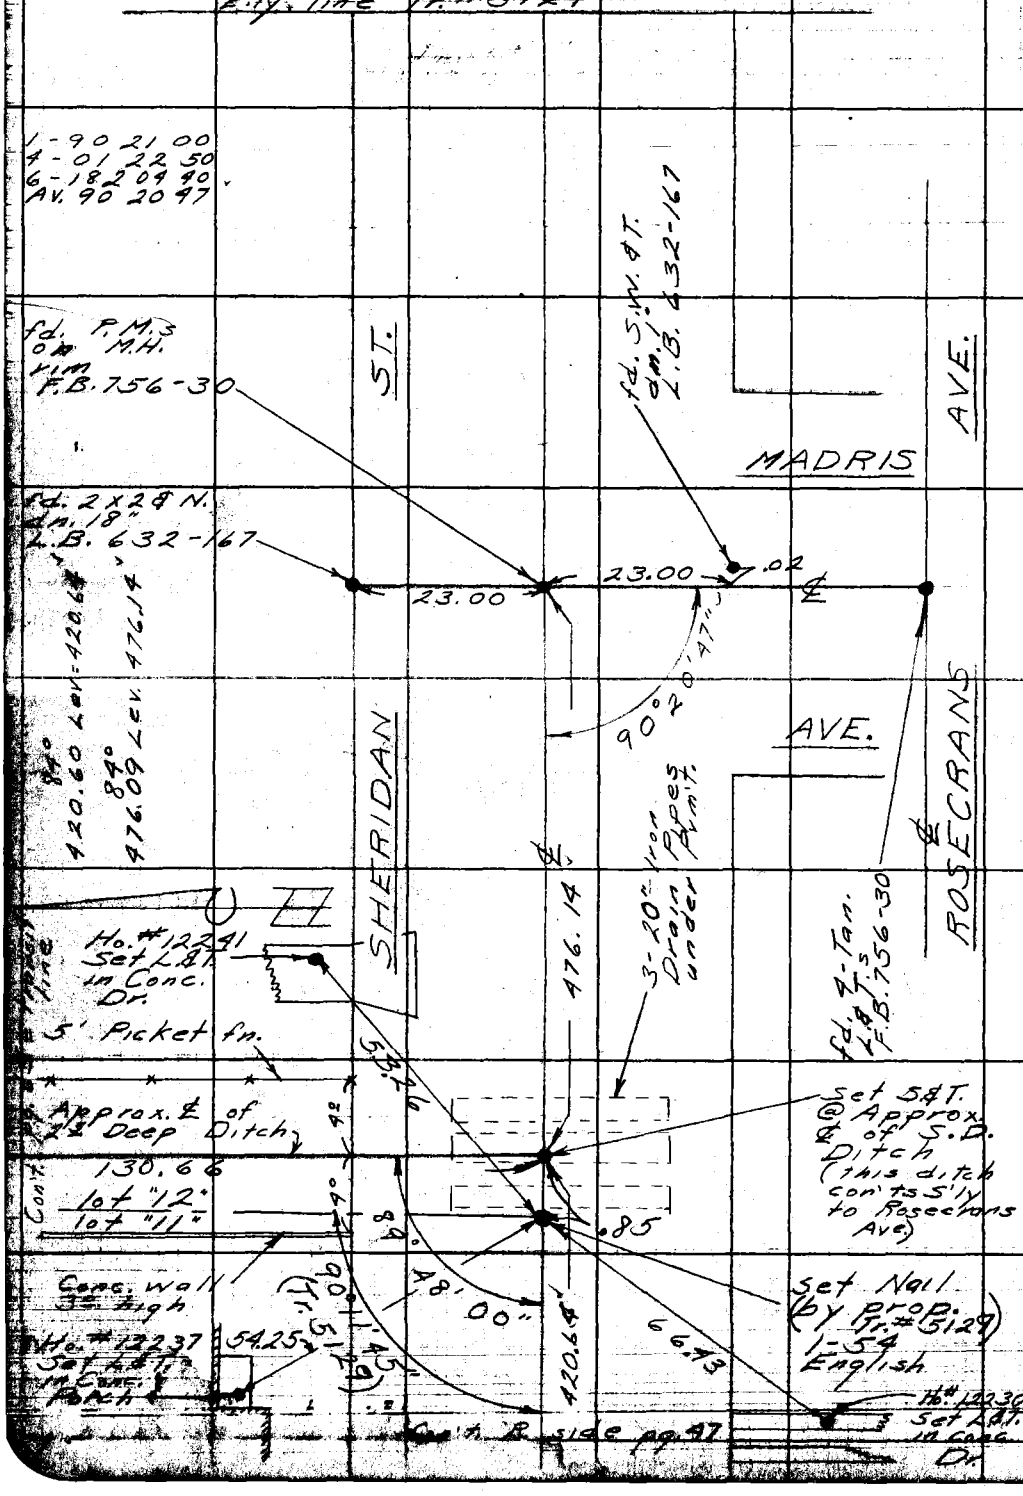

RETURN TO
LOS ANGELES COUNTY SURVEYOR
726 LOS ANGELES COUNTY
ENGINEERING BLDG.

Do not extend notes this side of this line.

Note: Any Additions or Changes on This Sheet Must be Made or Circled in Red Ink With Date and Name of Person Making Change.

PWFB 0726 396, 397

Artesia-Norwalk F.B. 1297 Pg. 49

Map No.
Office Work
Checked
Date

W. O. 69.5A Tape No. St'd. °F
Surveyed by English
Notes " Date 7-33
Indexed

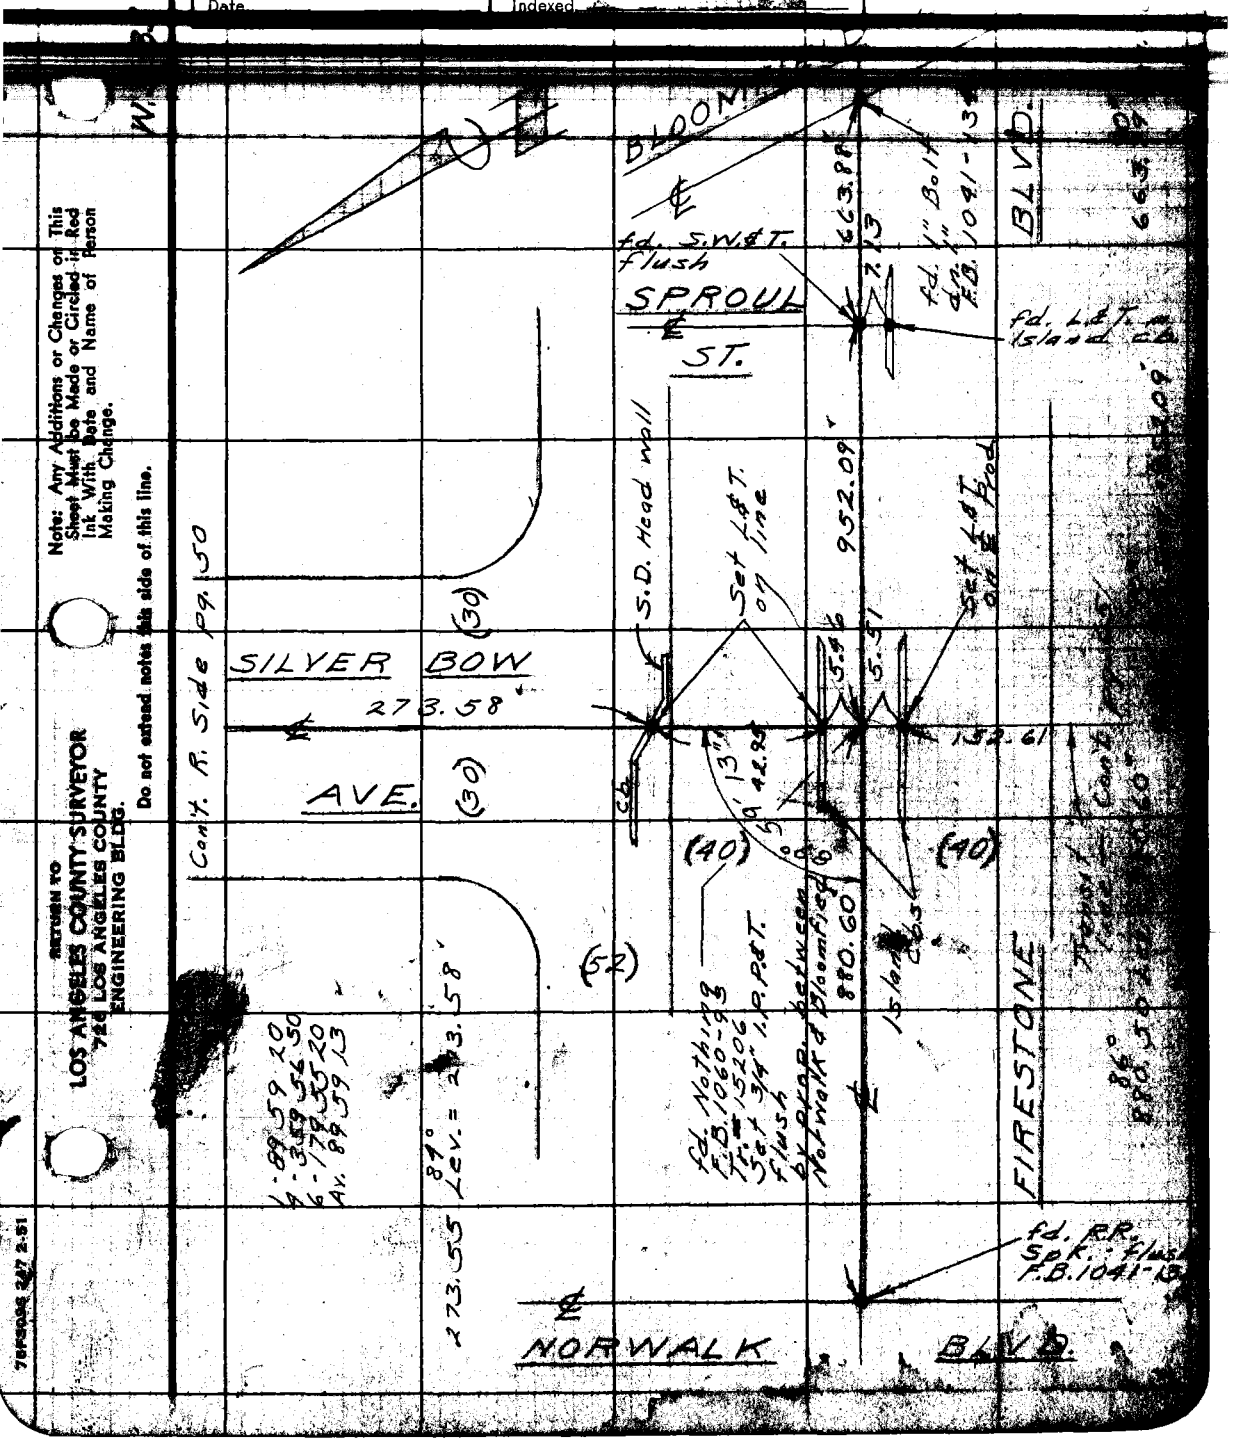

Note: Any Additions or Changes on This Sheet Must be Made or Circled in Red Ink With Date and Name of Person Making Change.

Do not extend notes this side of this line.

RETURN TO
LOS ANGELES COUNTY SURVEYOR
726 LOS ANGELES COUNTY
ENGINEERING BLDG.

76F3036 2/7 2-51

RETURN TO
LOS ANGELES COUNTY SURVEYOR
726 LOS ANGELES COUNTY
ENGINEERING BLDG.

Note: Any Additions or Changes on This Sheet Must be Made or Circled in Red Ink With Date and Name of Person Making Change.

Do not extend notes this side of this line.

W.S. 33-D-3

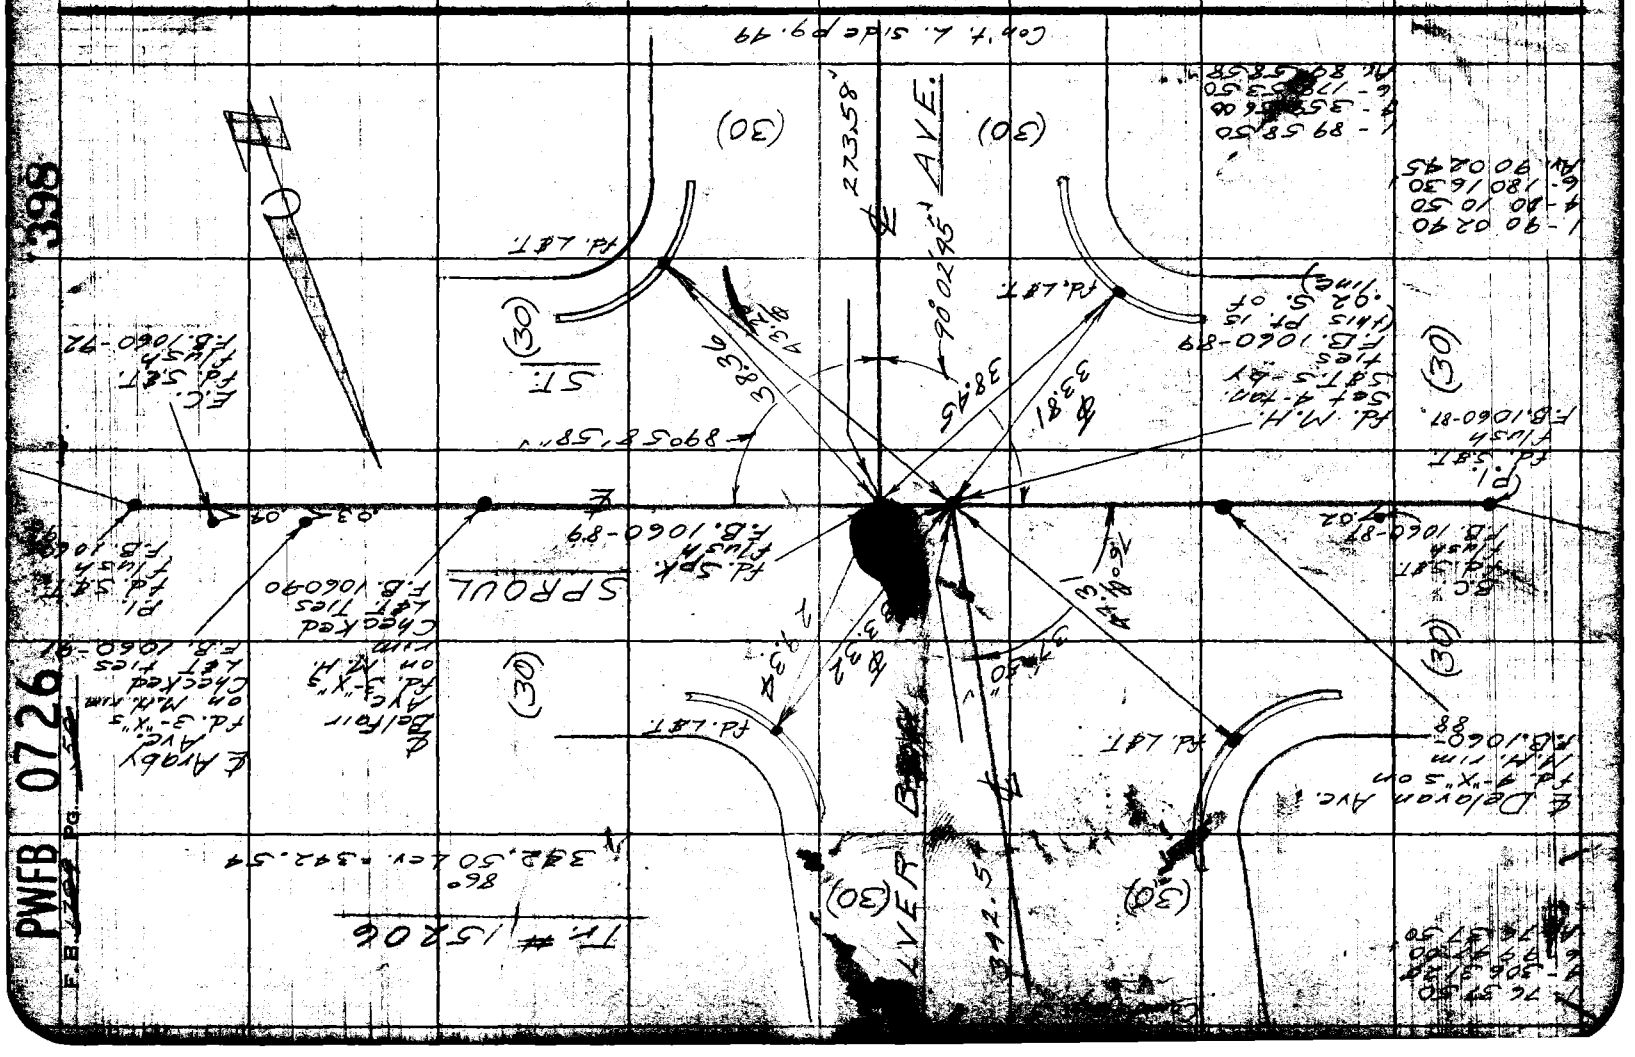

PWFB 0726

398

79F3095 247 2-51

RETURN TO
LOS ANGELES COUNTY SURVEYOR
726 LOS ANGELES COUNTY
ENGINEERING BLDG.

Note: Any Additions or Changes on This Sheet Must be Made or Circled in Red Ink With Date and Name of Person Making Change.

Do not extend notes this side of this line.

W. 35 D-3

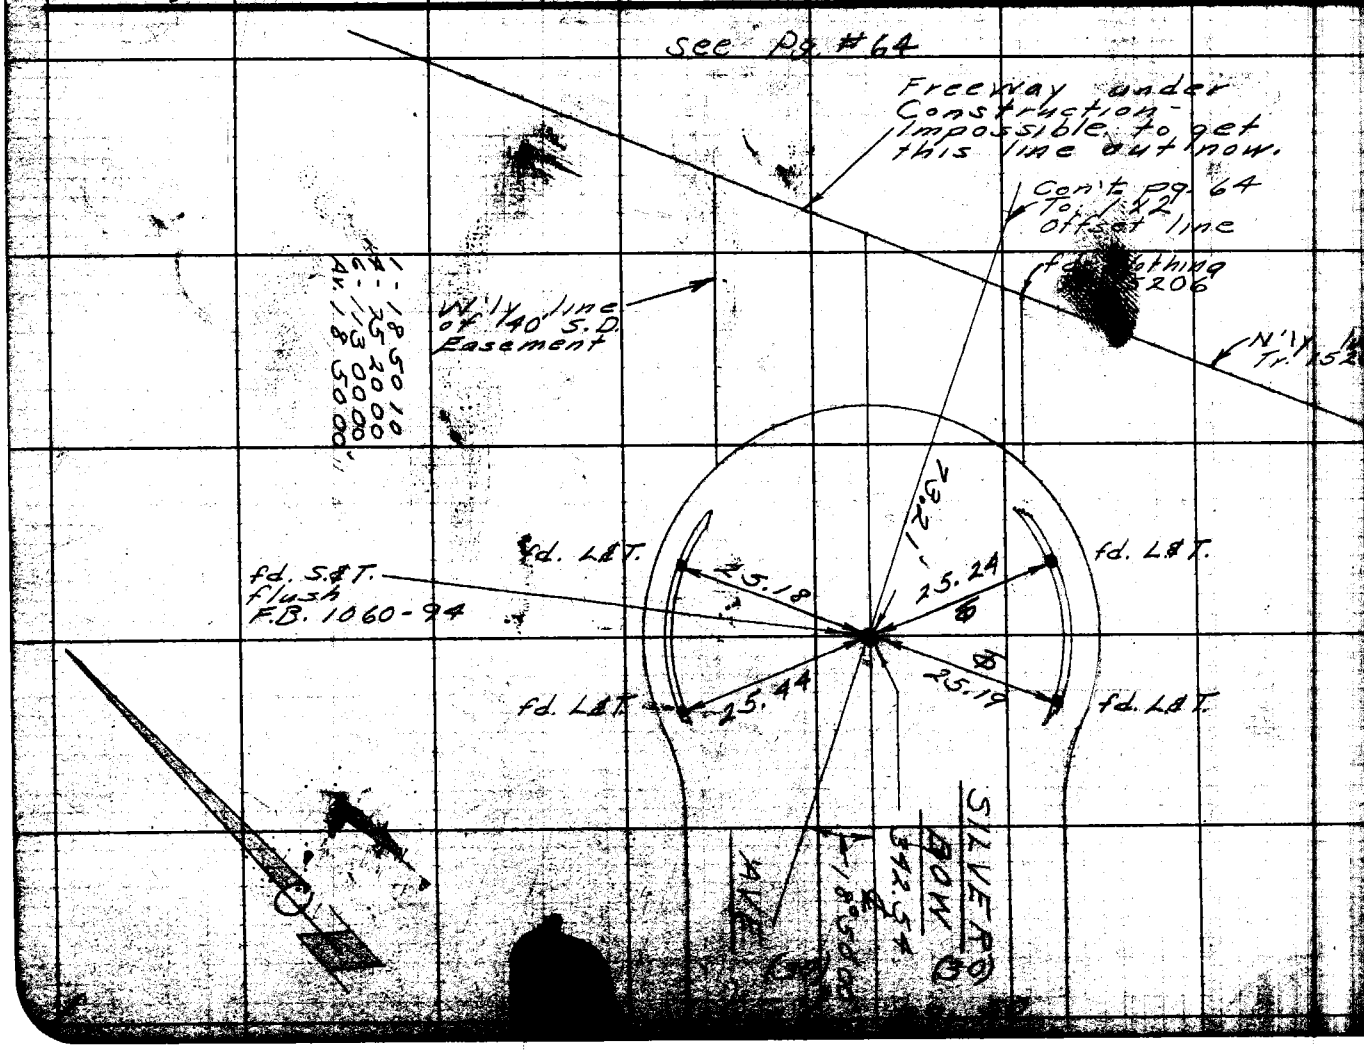

PWFB 0726

399

Map No.
Office Work
Checked

W.O. 6251 Tape No. Sf'd. °F
Surveyed by Employee
Notes " Date 7-53

PWFB 0726 400, 401

F.B. [illegible] PG. [illegible]

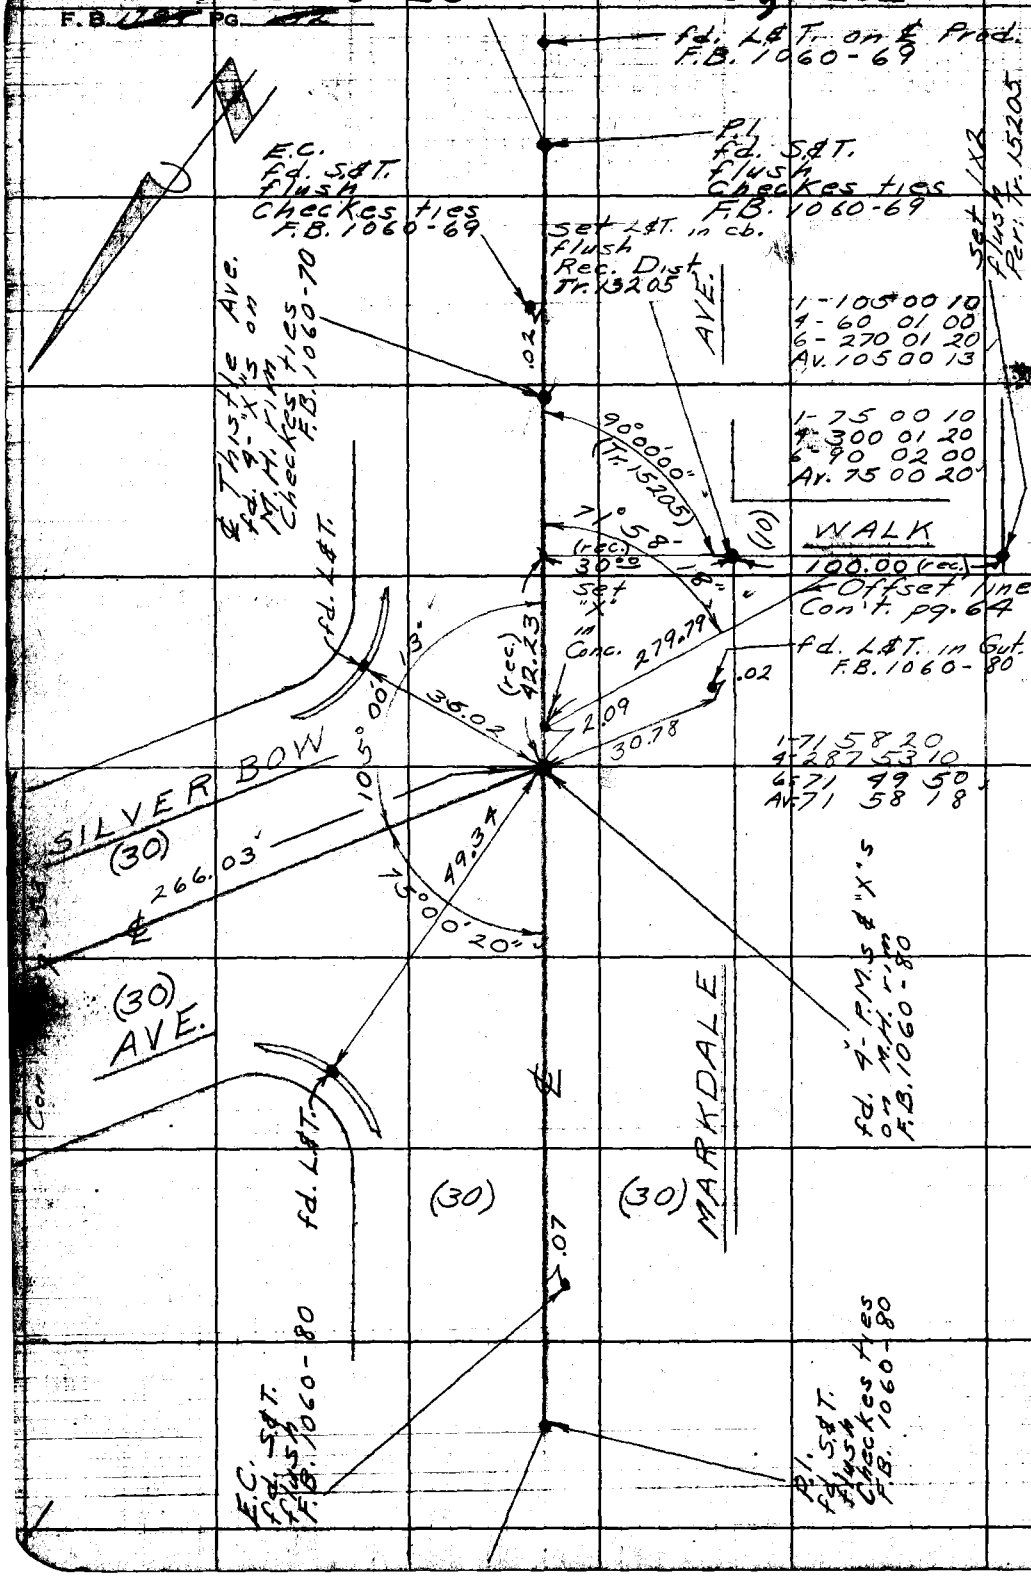

W.S. 33-D-3

RETURN TO
LOS ANGELES COUNTY SURVEYOR
726 LOS ANGELES COUNTY
ENGINEERING BLDG.

Do not extend notes this side of this line.

Note: Any Additions or Changes on This Sheet Must be Made or Circled in Red Ink With Date and Name of Person Making Change.

PWFB 0726 402

Map No.	W. O. 6951 Tape No. St'd. °F	Artesia-Norwalk F. B. 1799 PG. 93
Office Work	Surveyed by English	
Checked	Notes Date 7-53	
Date	Indexed E. C. Johnson	

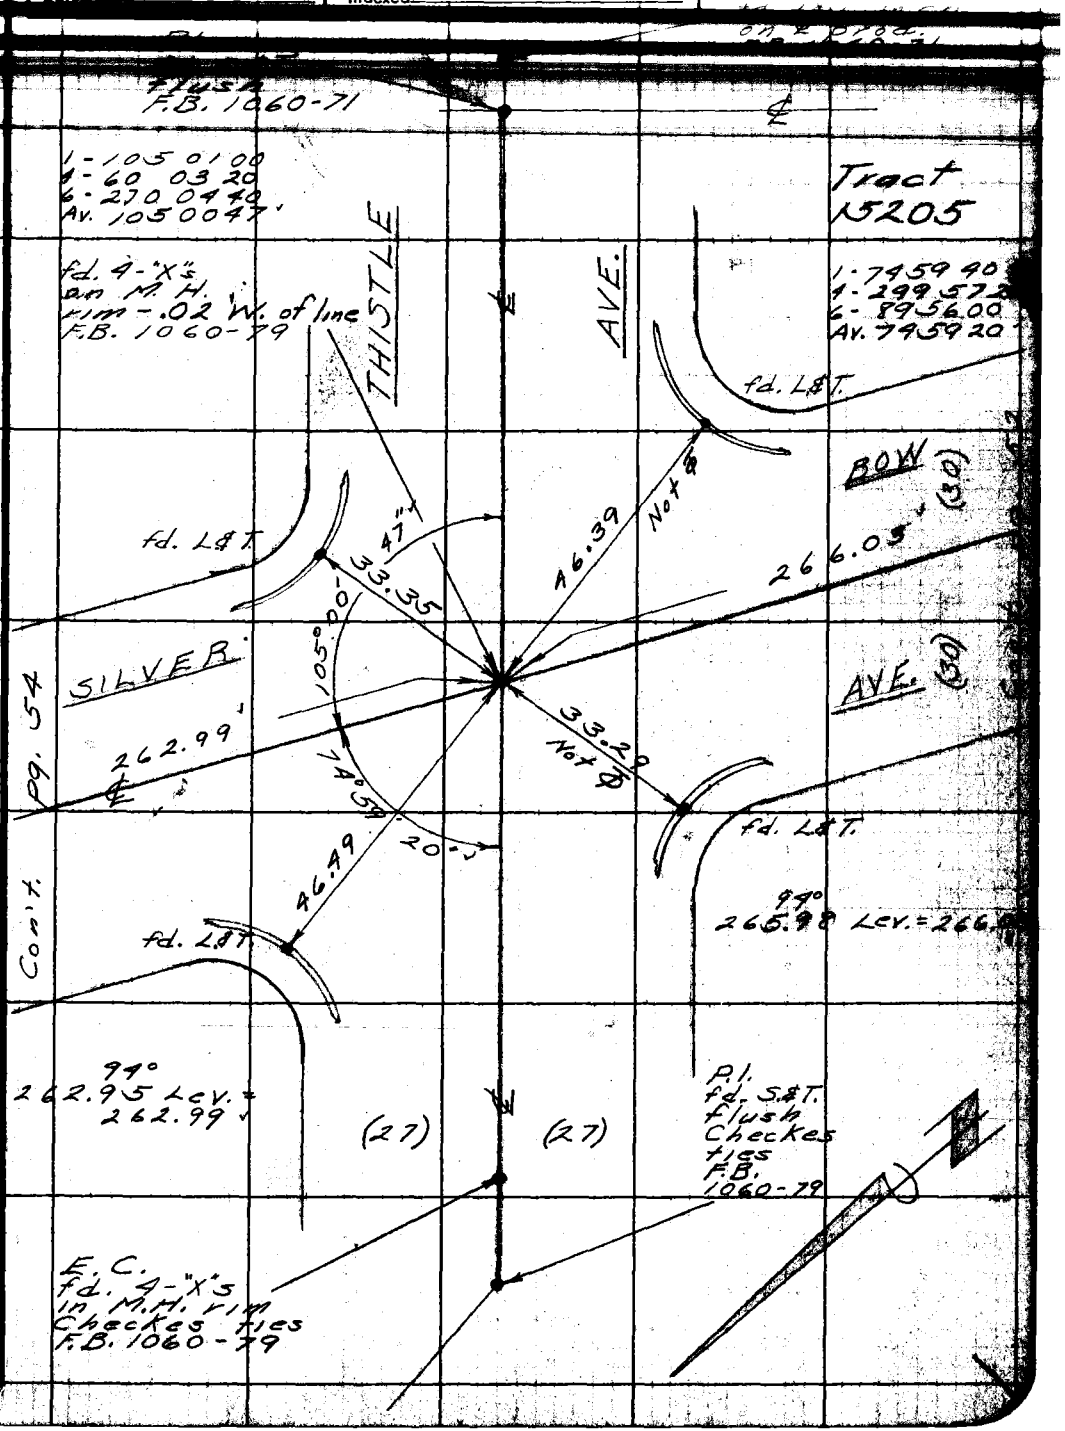

Note: Any Additions or Changes on This Sheet Must be Made or Circled in Red Ink With Date and Name of Person Making Change.

Do not extend notes this side of this line.

RETURN TO
LOS ANGELES COUNTY SURVEYOR
726 LOS ANGELES COUNTY
ENGINEERING BLDG.

76F3095 247 2-51

F.B. 1797 PG. 54

PWFB 0726

Con't. pg. 55

403

W.S. 33-D-3

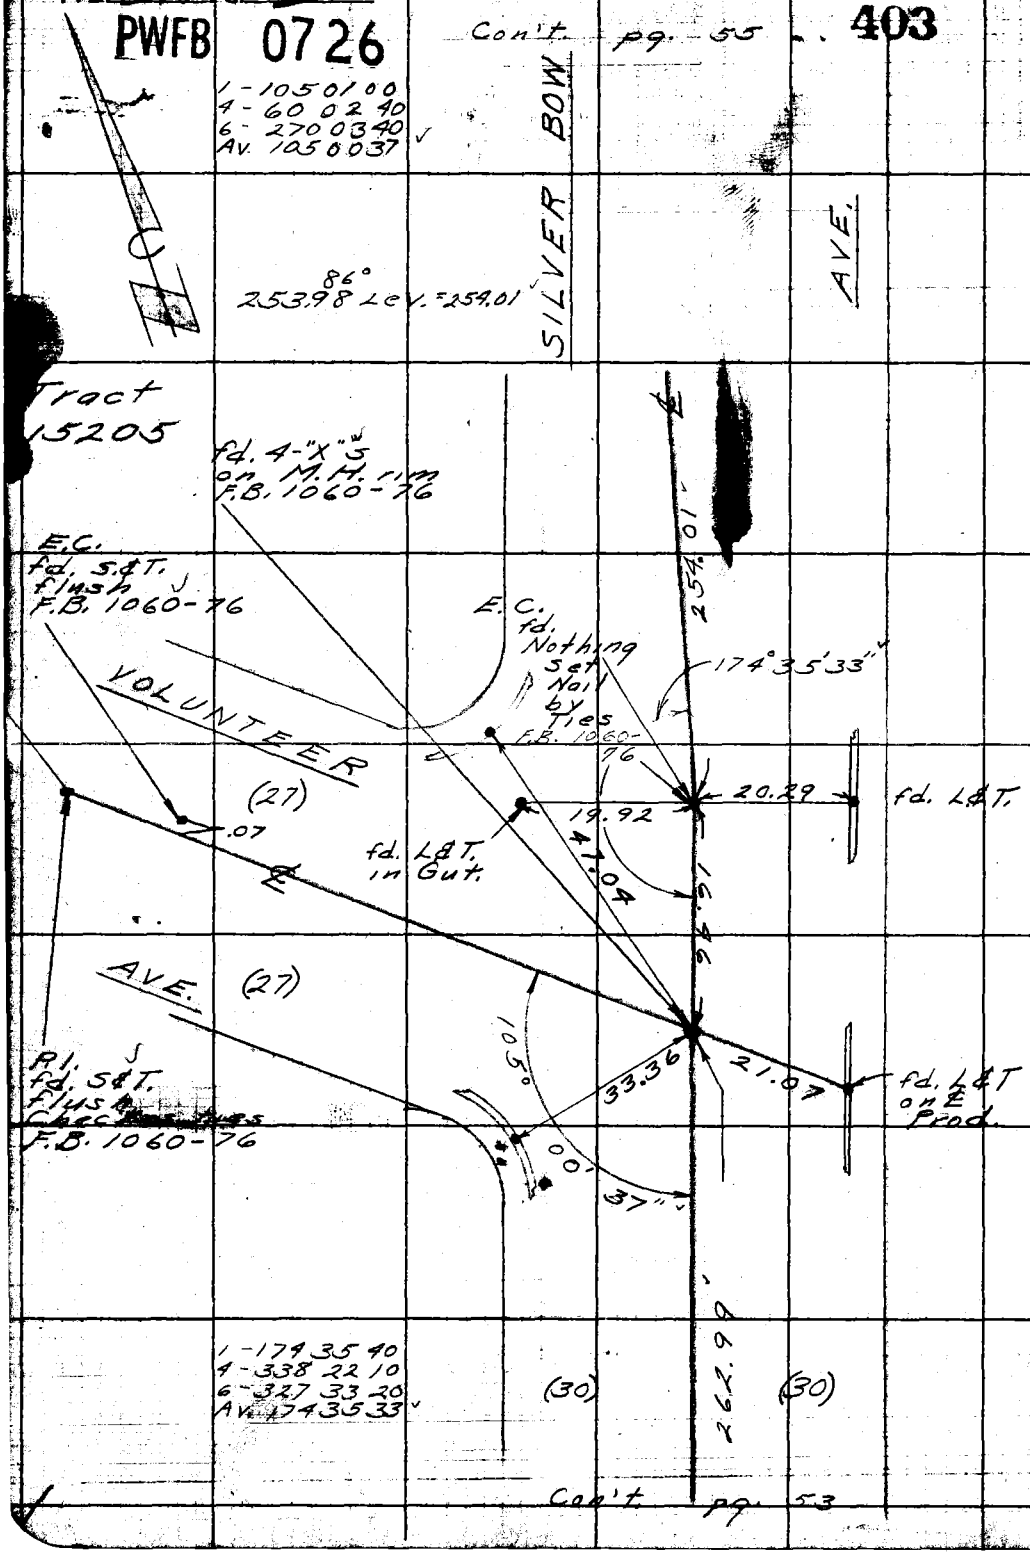

Con't. pg. 53

RETURN TO
LOS ANGELES COUNTY SURVEYOR
726 LOS ANGELES COUNTY
ENGINEERING BLDG.

Do not extend notes this side of this line.

Note: Any Additions or Changes on This Sheet Must be Made or Circled in Red Ink With Date and Name of Person Making Change.

PWFB 0726 404

Map No.	W. O. 6951	Tape No. ___ St'd. ___ °F
Checked	Surveyed by English	
Date	Notes "	Date 7-53
	Indexed	

Artesia-Norwalk F.B. 1790 Pg. 95

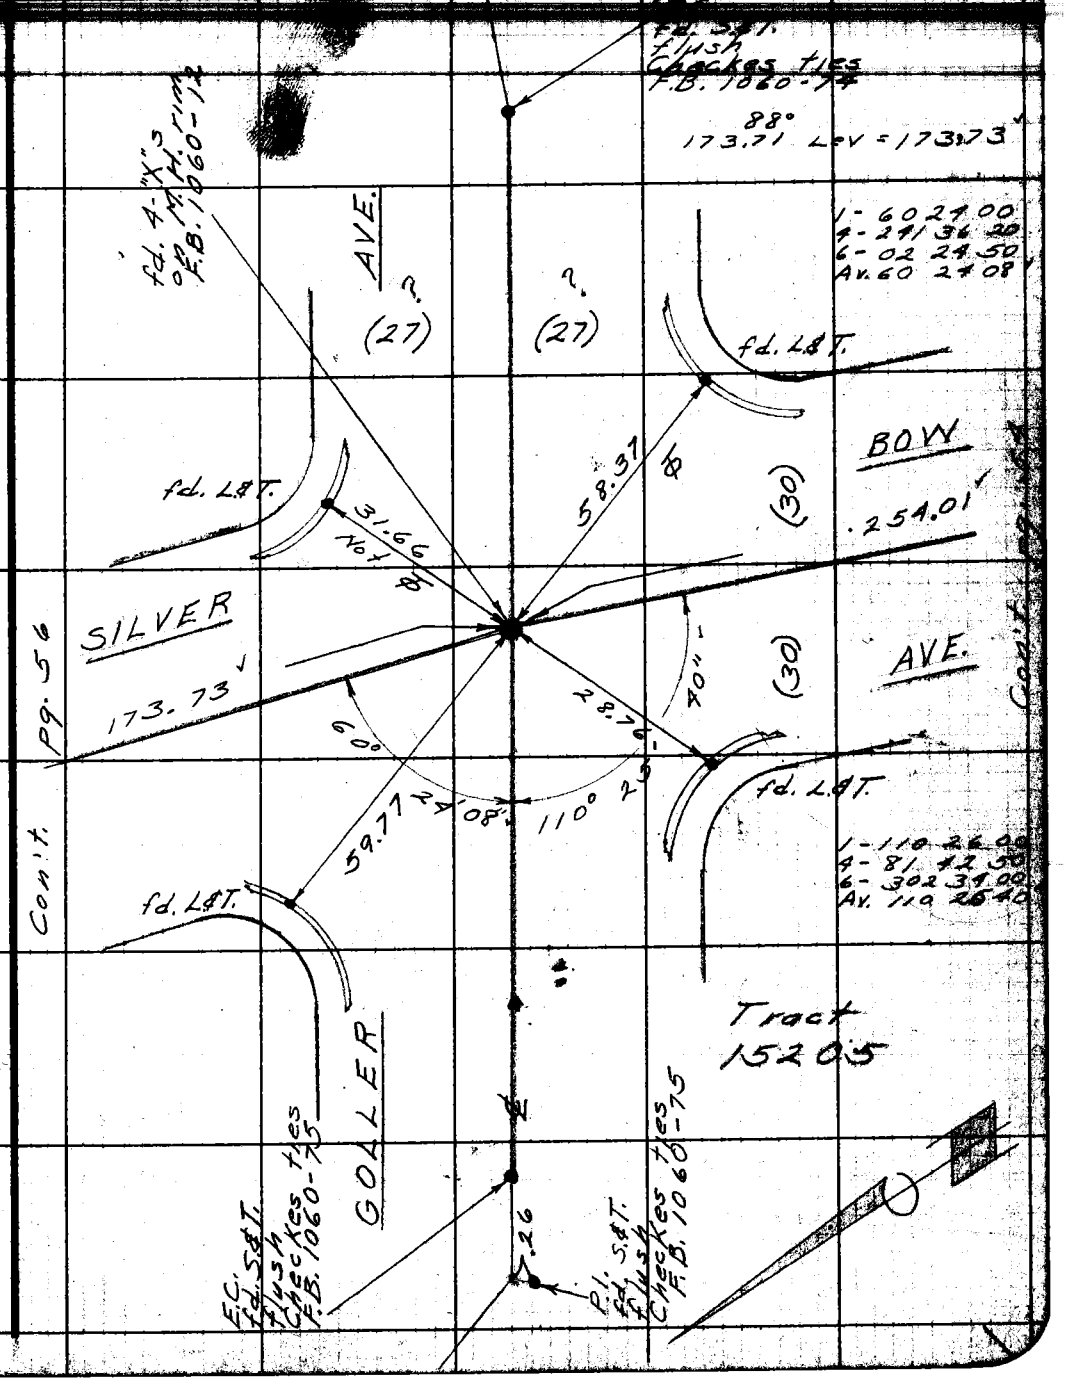

Note: Any Additions or Changes on This Sheet Must be Made or Circled in Red Ink With Date and Name of Person Making Change.

Do not extend notes this side of this line.

RETURN TO
LOS ANGELES COUNTY SURVEYOR
726 LOS ANGELES COUNTY
ENGINEERING BLDG.

76F3095 247 2-51

PWFB 0726 405

F.B. 1299 Pg. 56

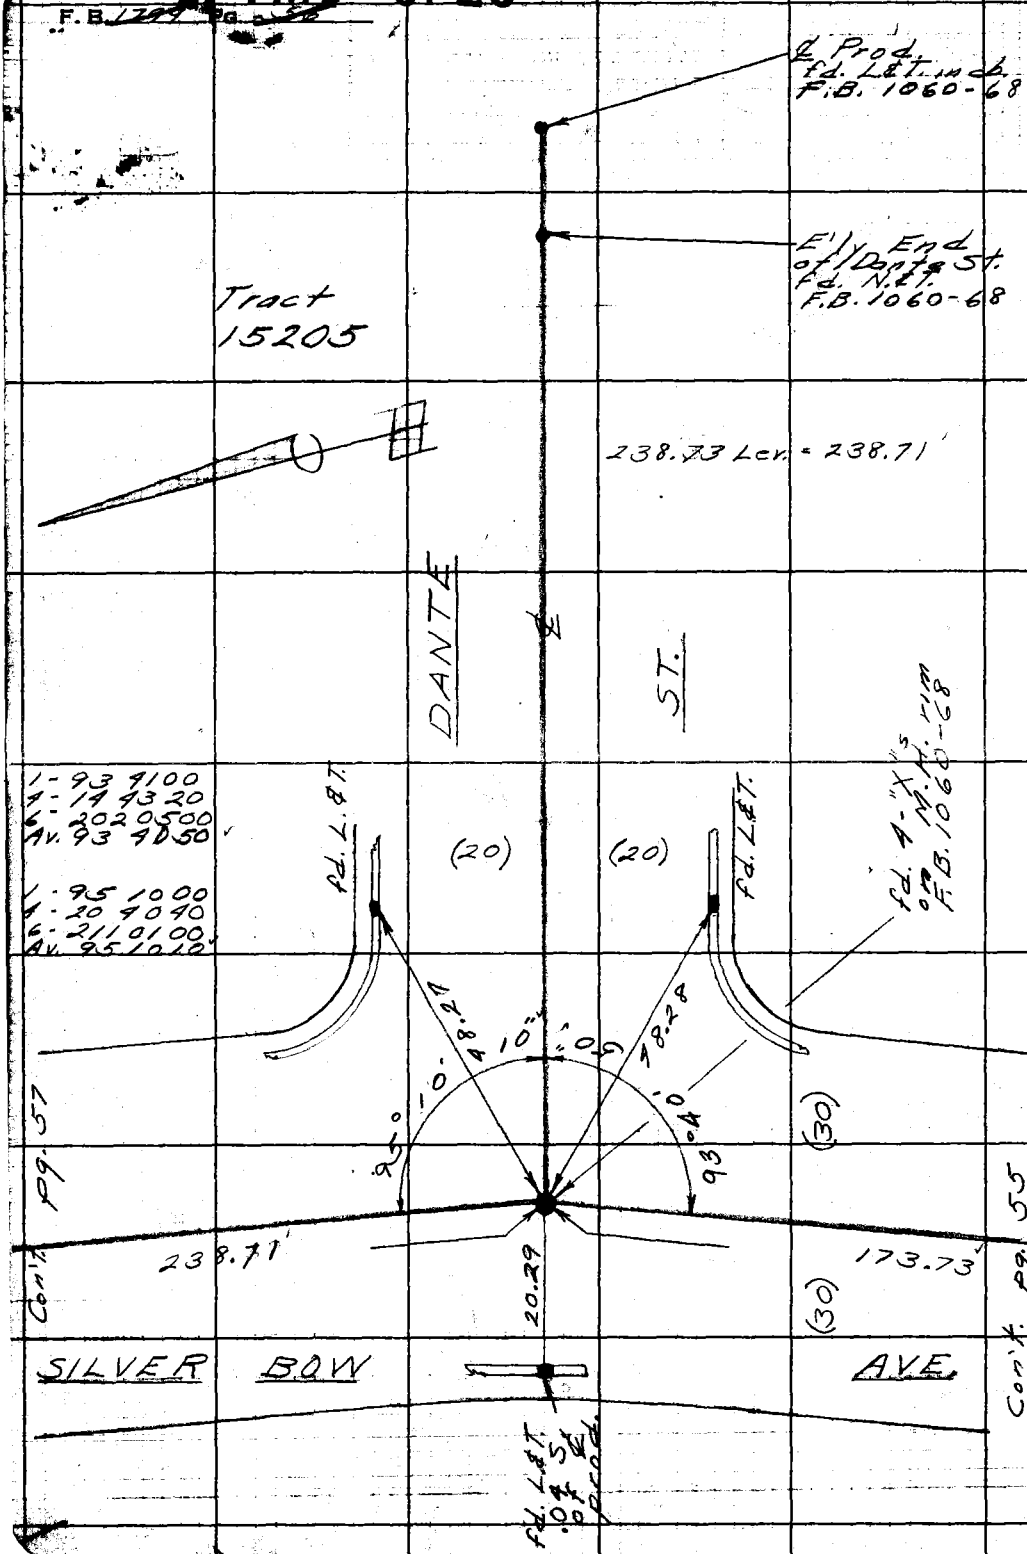

W.S. 33-D-3

RETURN TO
LOS ANGELES COUNTY SURVEYOR
726 LOS ANGELES COUNTY
ENGINEERING BLDG.

Do not extend notes this side of this line.

Note: Any Additions or Changes on This Sheet Must be Made or Circled in Red Ink With Date and Name of Person Making Change.

PWFB 0826 377

F. B. 1797 PG. 57

Notes Ck'd by: [illegible]
Map No.
Office Work
Checked
Date

Survey: Artesia-Norwalk
W. O. 6951 Tape No. St'd. °F
Surveyed by: English
Notes: " Date 7-53
Indexed: [illegible]

W.S. 33 D 3

1-95 06 00
4-20 24 00
6-210 36 00
Av. 95 06 00

1-95 06 20
4-20 26 40
6-210 40 00
Av. 95 06 40

1-84 56 30
4-339 45 30
6-149 38 20
Av. 84 56 23

1-84 50 40
4-339 23 40
6-149 05 20
Av. 84 50 53

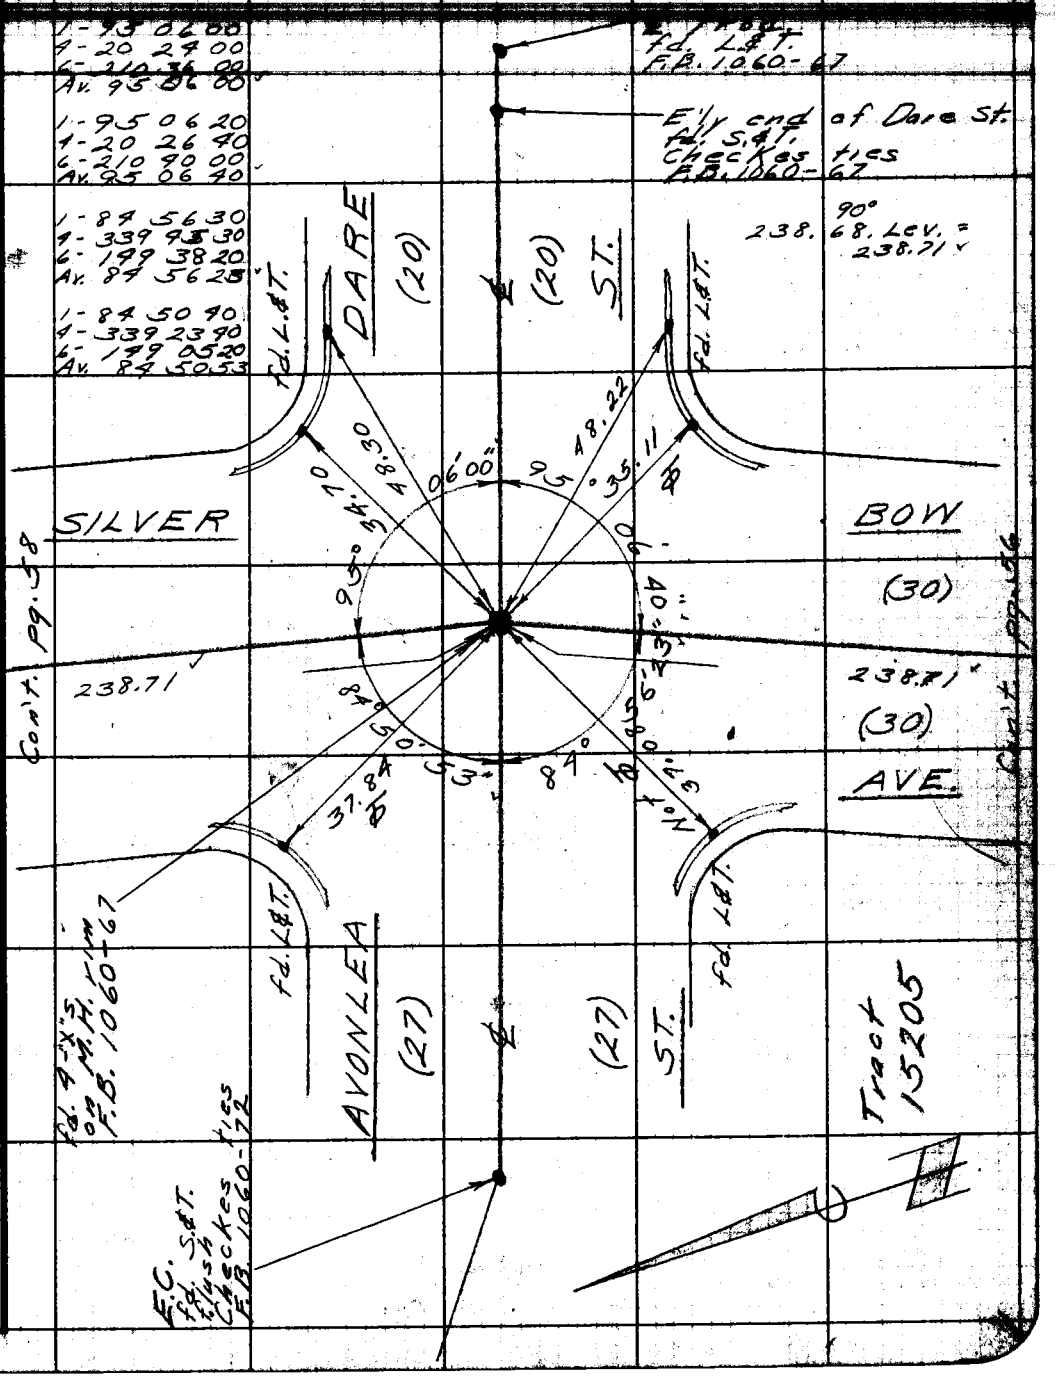

Note: Any Additions or Changes on This Sheet Must be Made or Circled in Red Ink With Date and Name of Person Making Change.

Do not extend notes this side of this line.

RETURN TO
LOS ANGELES COUNTY SURVEYOR
726 LOS ANGELES COUNTY
ENGINEERING BLDG.

76F309S 247 2-51

PWFB 0826 378

F.B. ~~1799~~ PG. ~~58~~

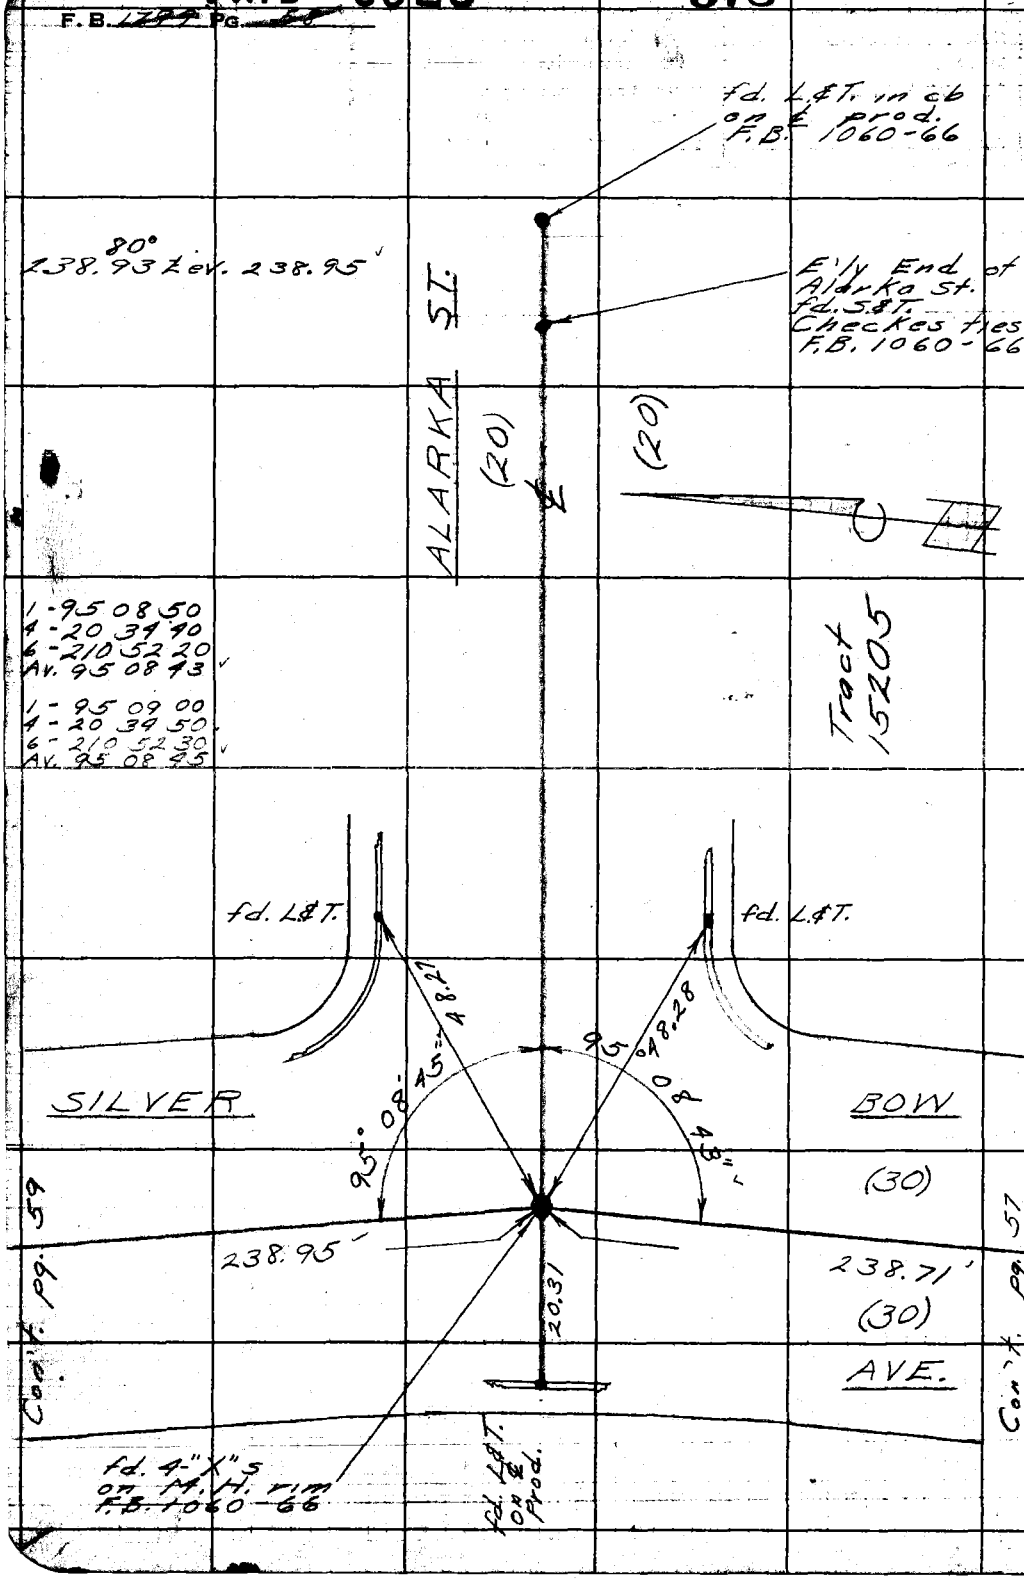

W.S. 33-D-3

RETURN TO
LOS ANGELES COUNTY SURVEYOR
726 LOS ANGELES COUNTY
ENGINEERING BLDG.

Do not extend notes this side of this line.

Note: Any Additions or Changes on This Sheet Must be Made or Circled in Red Ink With Date and Name of Person Making Change.

PWFB 0826

379

Notes Ck'd by Galli	Survey of Artesia - Norwalk	F. B. 1299 Pg. 59
Map No.	W. O. 6951 Tape No. St'd. °F	
Office Work	Surveyed by English	
Checked	Notes Date 7-53	
Date	Indexed F. C. Johnson	

W.S. 33 C 3

4 - 355 44 30
6 - 173 37 00
Av. 88 56 10

1 - 96 41 20
4 - 26 46 50
6 - 220 10 00
Av. 96 41 40

1 - 178 55 50
4 - 355 42 50
6 - 353 34 00
Av. 178 55 40

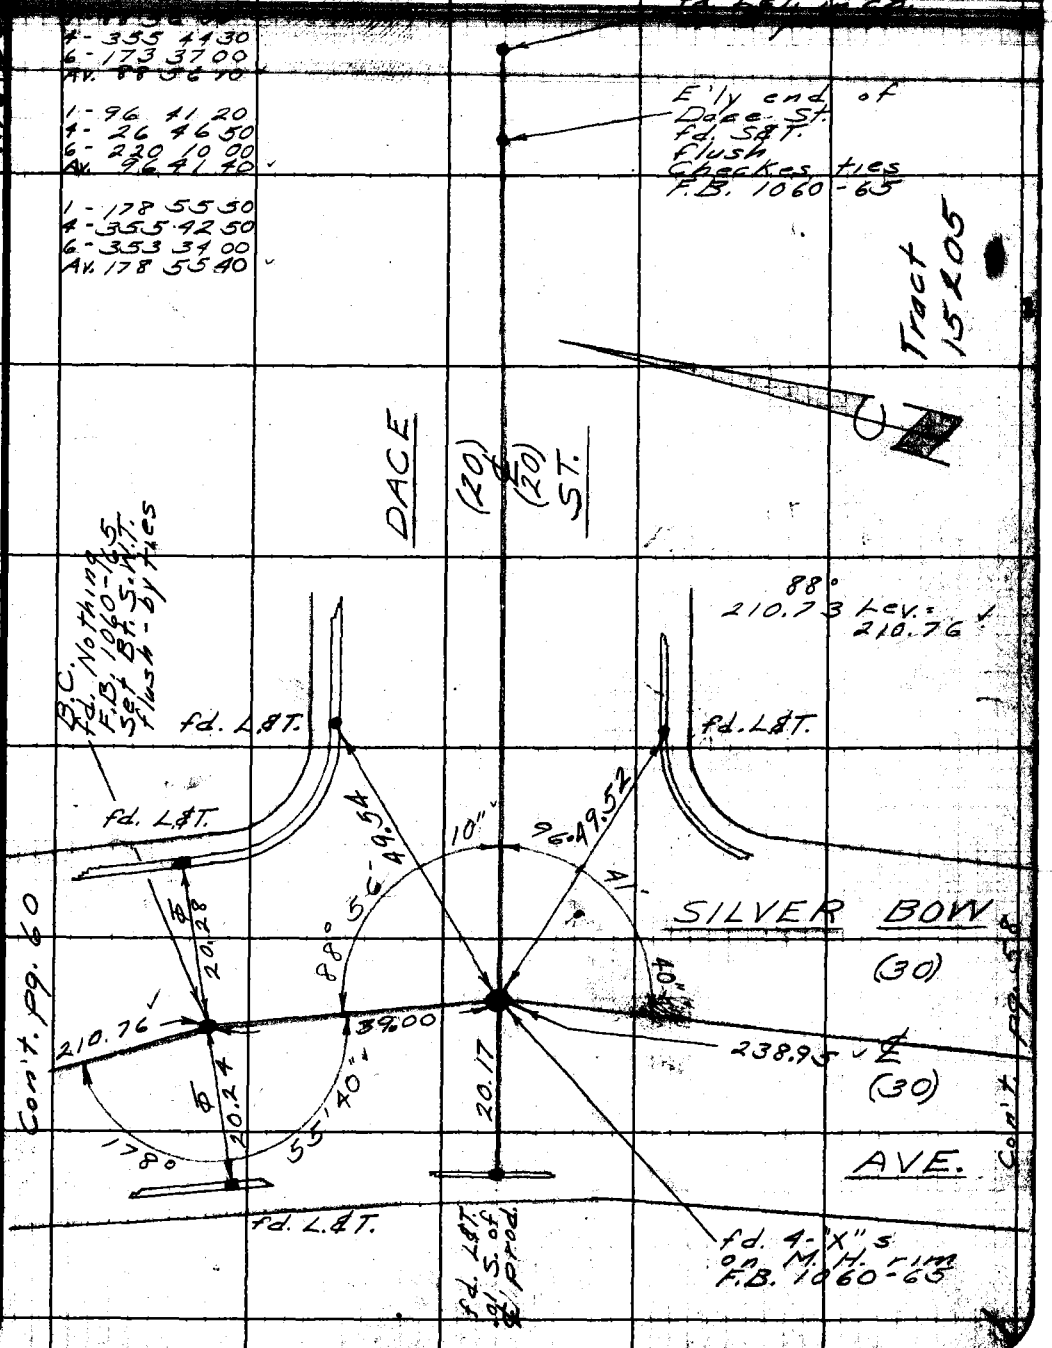

Note: Any Additions or Changes on This Sheet Must be Made or Circled in Red Ink With Date and Name of Person Making Change.

Do not extend notes this side of this line.

RETURN TO
LOS ANGELES COUNTY SURVEYOR
726 LOS ANGELES COUNTY
ENGINEERING BLDG.

76F3095 247 2-51

PWFB 0826

380

F.B. ~~1799~~ PG. ~~60~~

W.S. 33-D-3

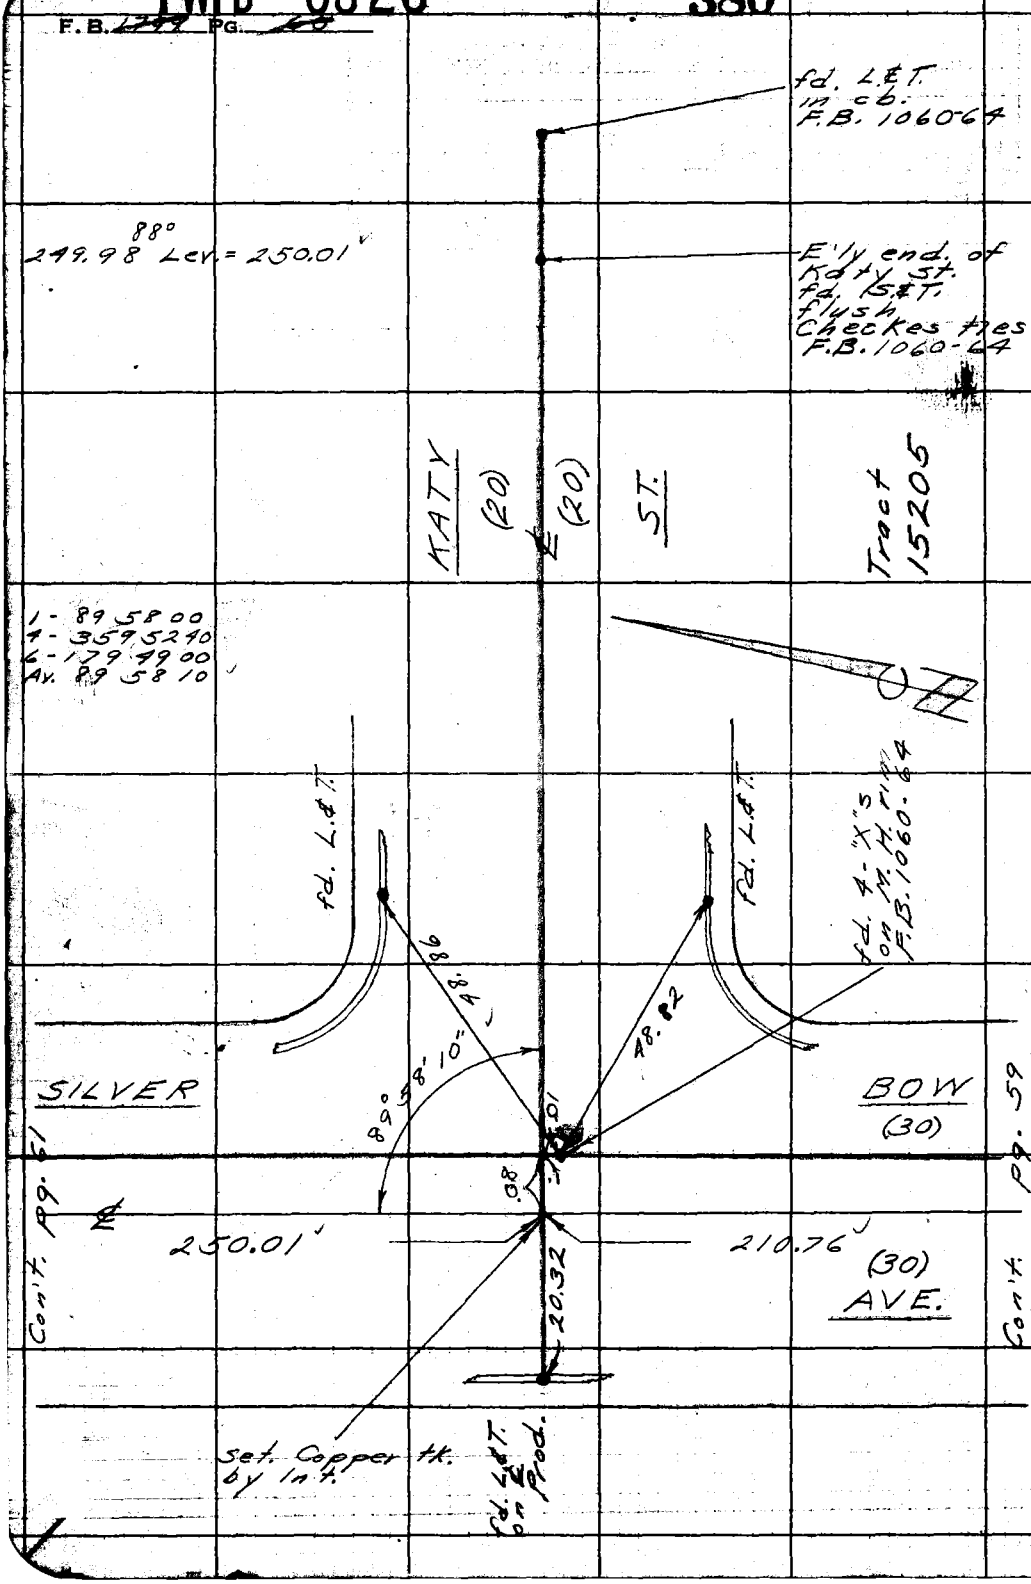

RETURN TO
LOS ANGELES COUNTY SURVEYOR
726 LOS ANGELES COUNTY
ENGINEERING BLDG.

Do not extend notes this side of this line.

Note: Any Additions or Changes on This Sheet Must be Made or Circled in Red Ink With Date and Name of Person Making Change.

PWFB 0826

381

Notes Ck'd by Galli	Survey of Artesia - Norwalk	F.B. 1799 Pg. 61
Map No.	W.O. 6931 Tape No. St'd. °F	
Office Work	Surveyed by English	
Checked	Notes Date 7-53	
Date	Indexed A. C. Johnson	

fd L&T. in cb.

W.S. 3[illegible]-3

Note: Any Additions or Changes on This Sheet Must be Made or Circled in Red Ink With Date and Name of Person Making Change.

Do not extend notes this side of this line.

RETURN TO
LOS ANGELES COUNTY SURVEYOR
726 LOS ANGELES COUNTY
ENGINEERING BLDG.

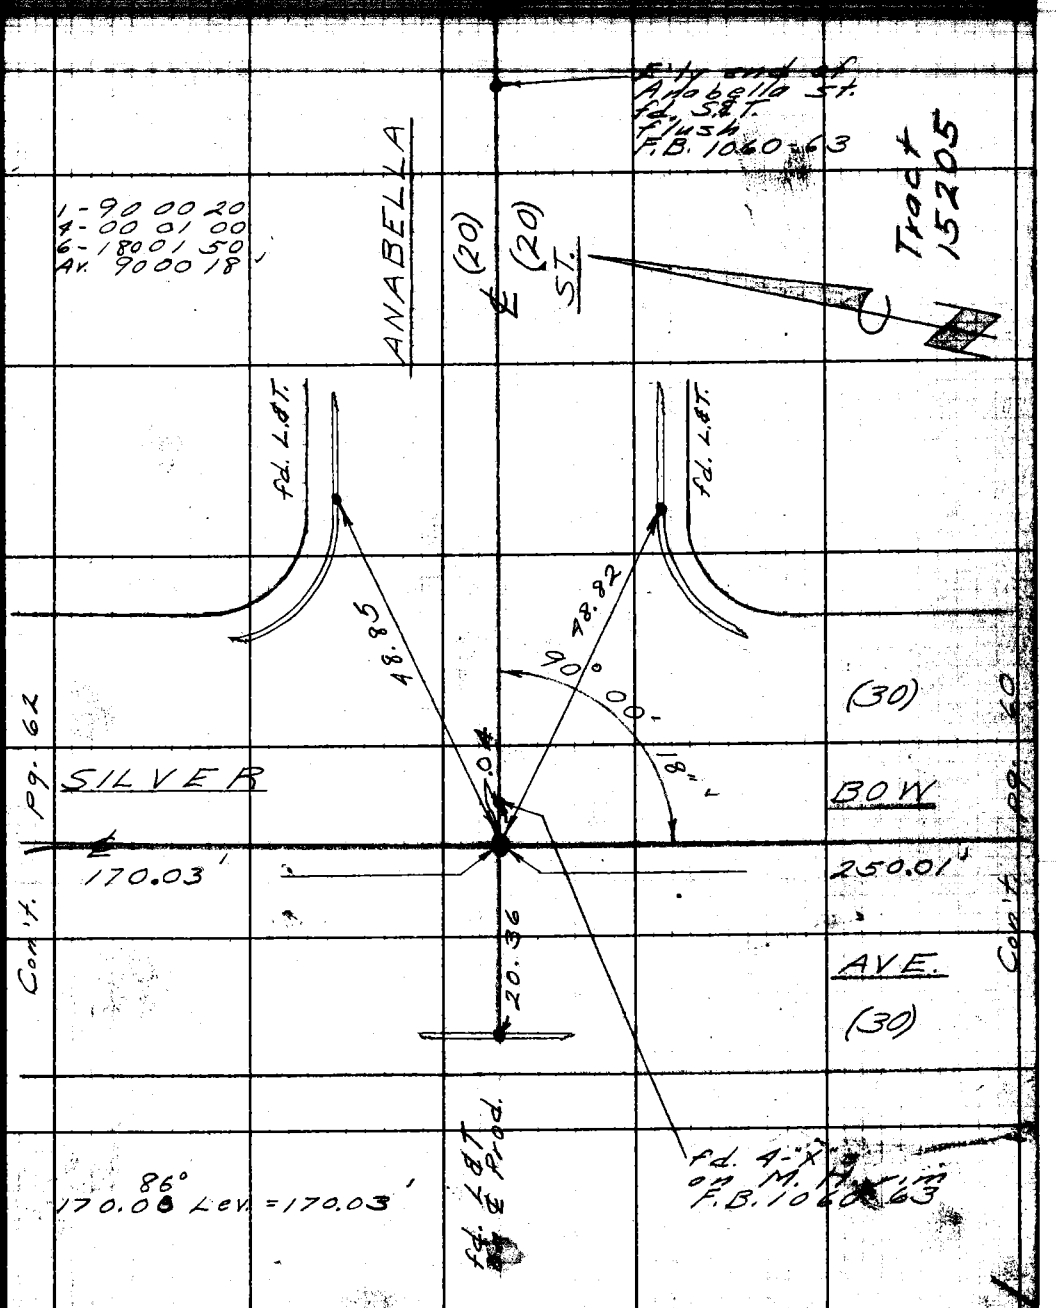

76F309S 247 2-51

PWFB 0826 382

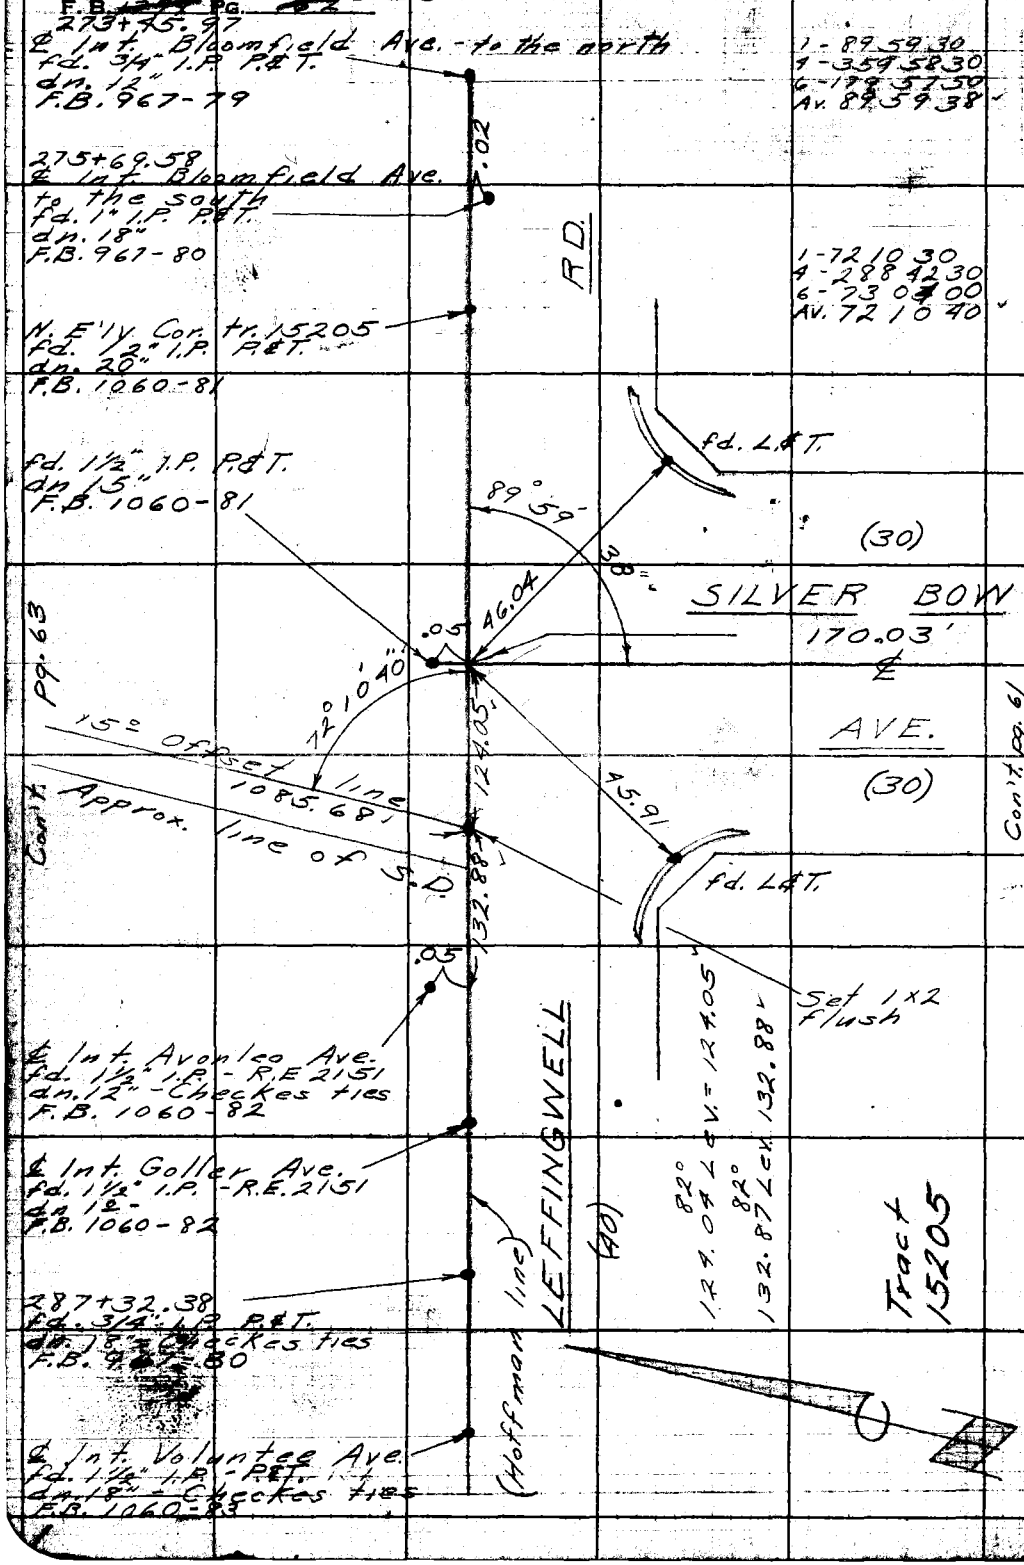

W.S. 33-D-3

RETURN TO
LOS ANGELES COUNTY SURVEYOR
726 LOS ANGELES COUNTY
ENGINEERING BLDG.

Do not extend notes this side of this line.

Note: Any Additions or Changes on This Sheet Must be Made or Circled in Red Ink With Date and Name of Person Making Change.

PWFB 0826

383

Notes Ck'd by Galli	Survey of Artesia-Norwalk	F.B. [illegible] Pg. [illegible]
Map No.	W.O. 6951 Tape No. St'd. °F	
Office Work	Surveyed by English	
Checked	Notes " Date 7-53	
Date	Indexed [illegible]	

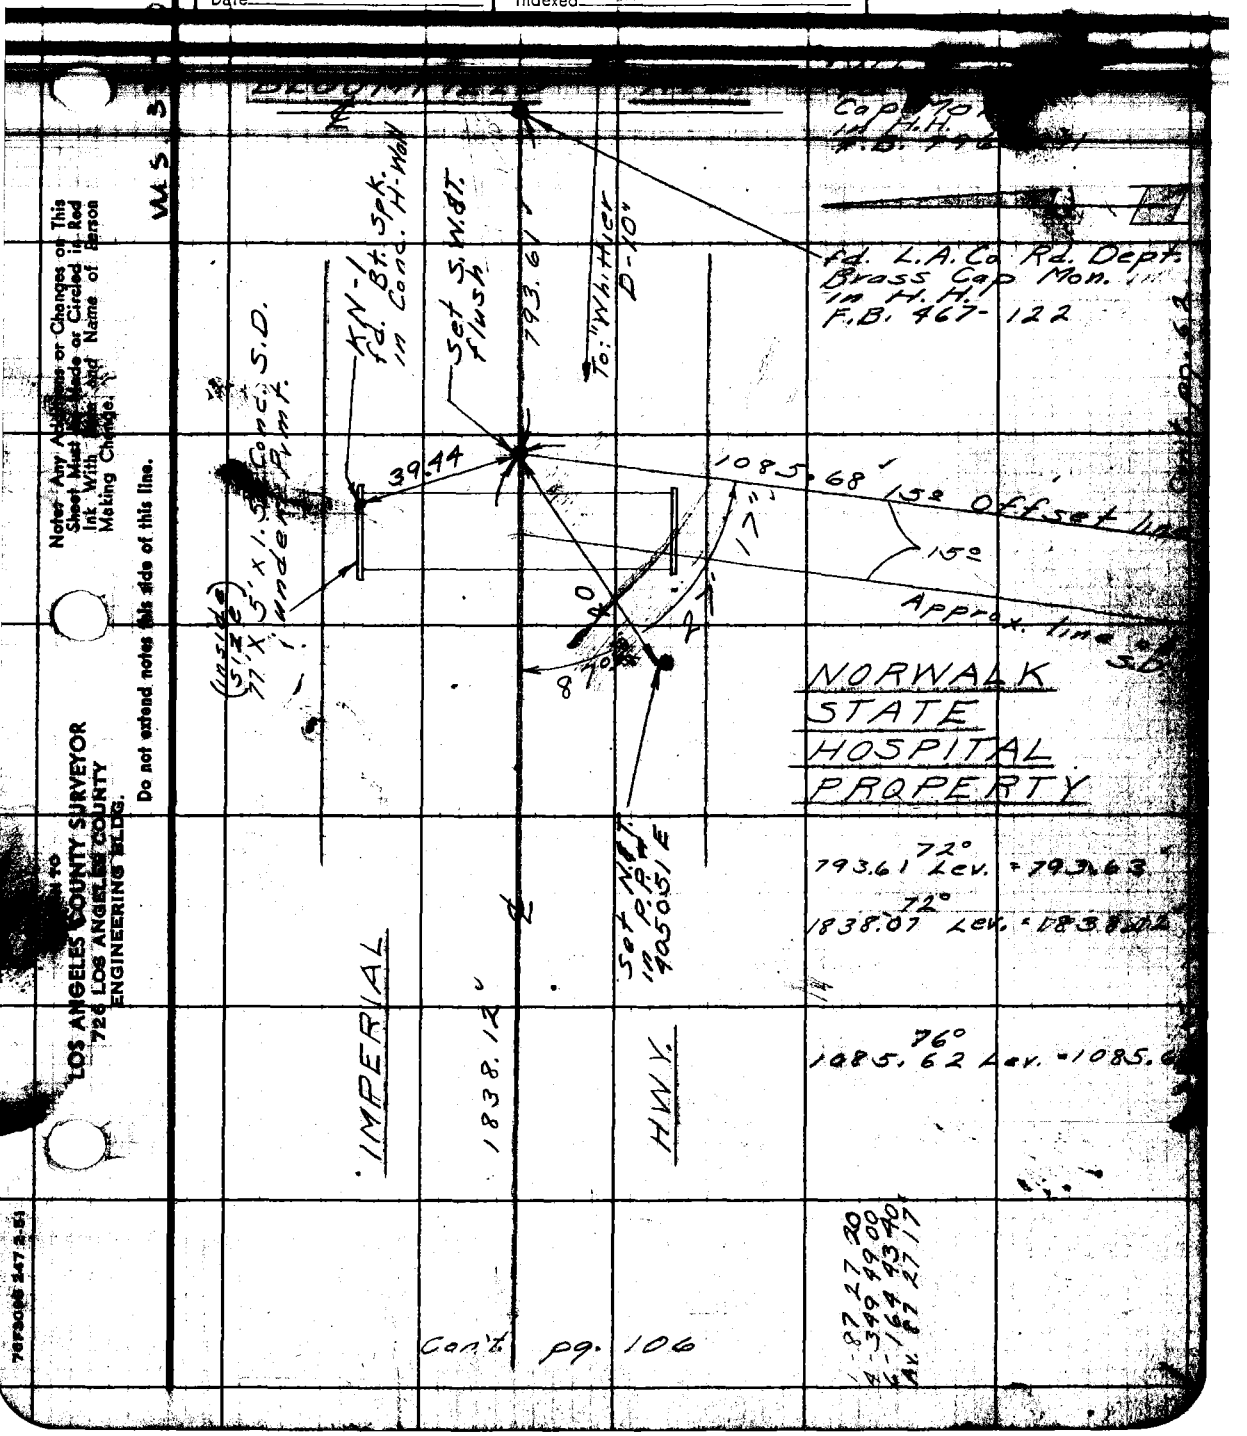

Notes: Any Additions or Changes on This Sheet Must Be Made or Circled in Red Ink With Date and Name of Person Making Change.

Do not extend notes this side of this line.

LOS ANGELES COUNTY SURVEYOR
726 LOS ANGELES COUNTY
ENGINEERING BLDG.

76F3006 247 2-51

F.B. 1799 PG. 64

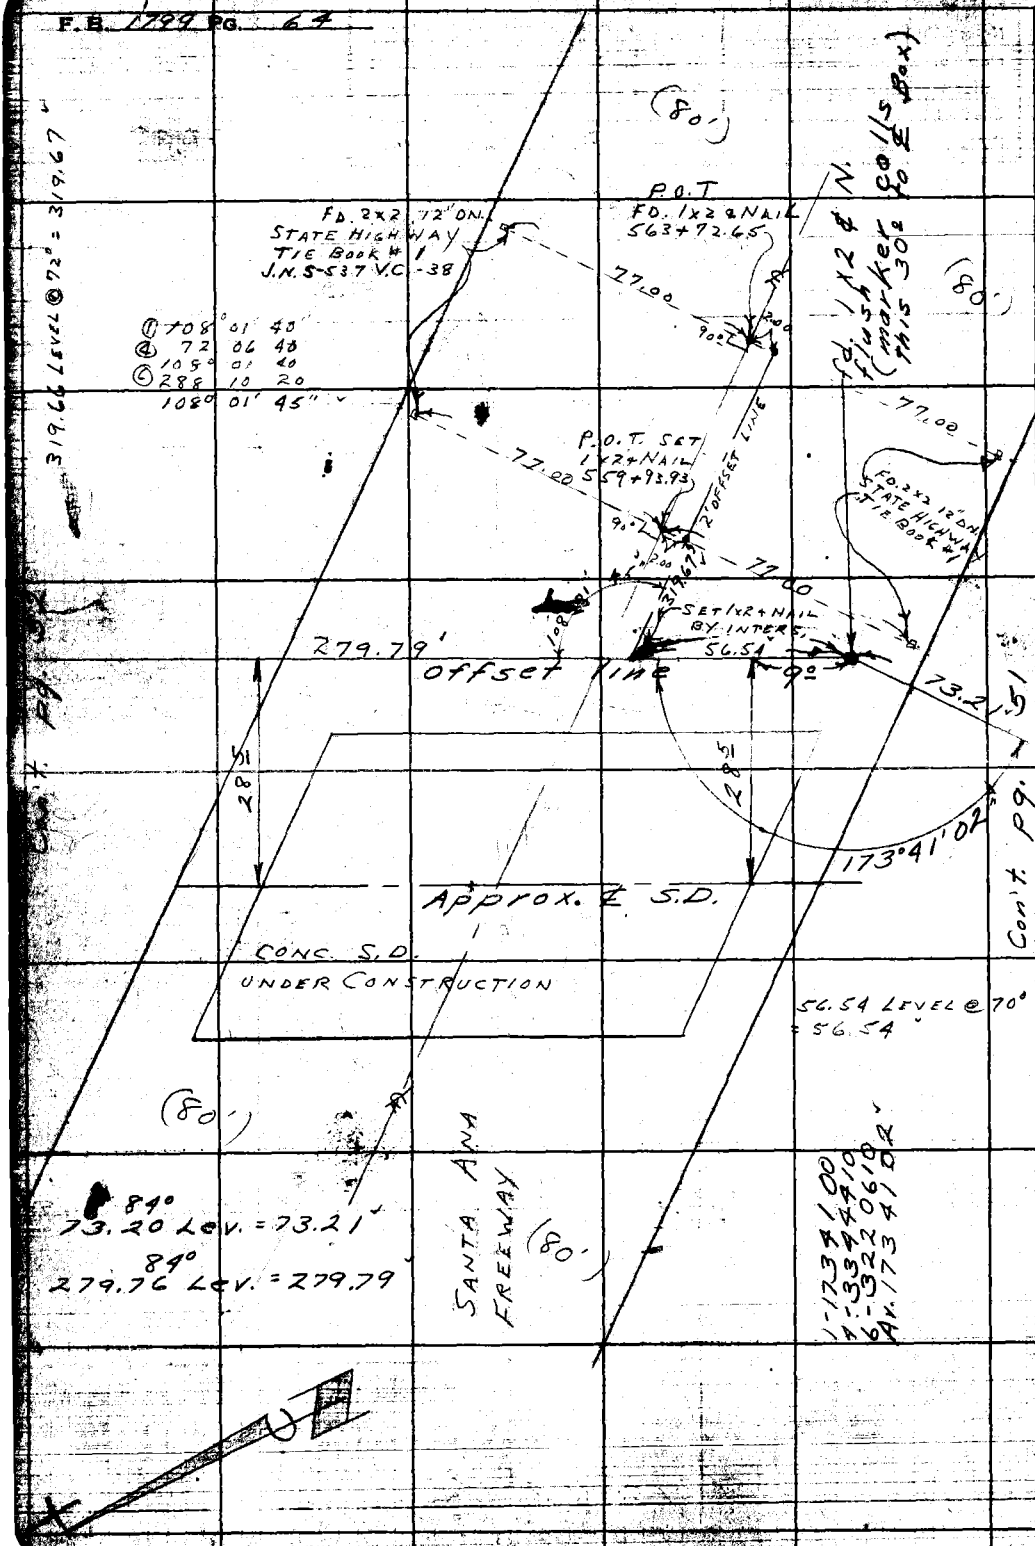

RETURN TO
LOS ANGELES COUNTY SURVEYOR
726 LOS ANGELES COUNTY
ENGINEERING BLDG.

Do not extend notes this side of this line.

Note: Any Additions on This Sheet Must be in Red Ink With Date and Reason of Making Change.

PWFB 0726 407

F.B. 1287 Pg. 68

W.O. 6901 Tape No. Wd. °F

Checked

Date

Notes Date 7-53

Indexed

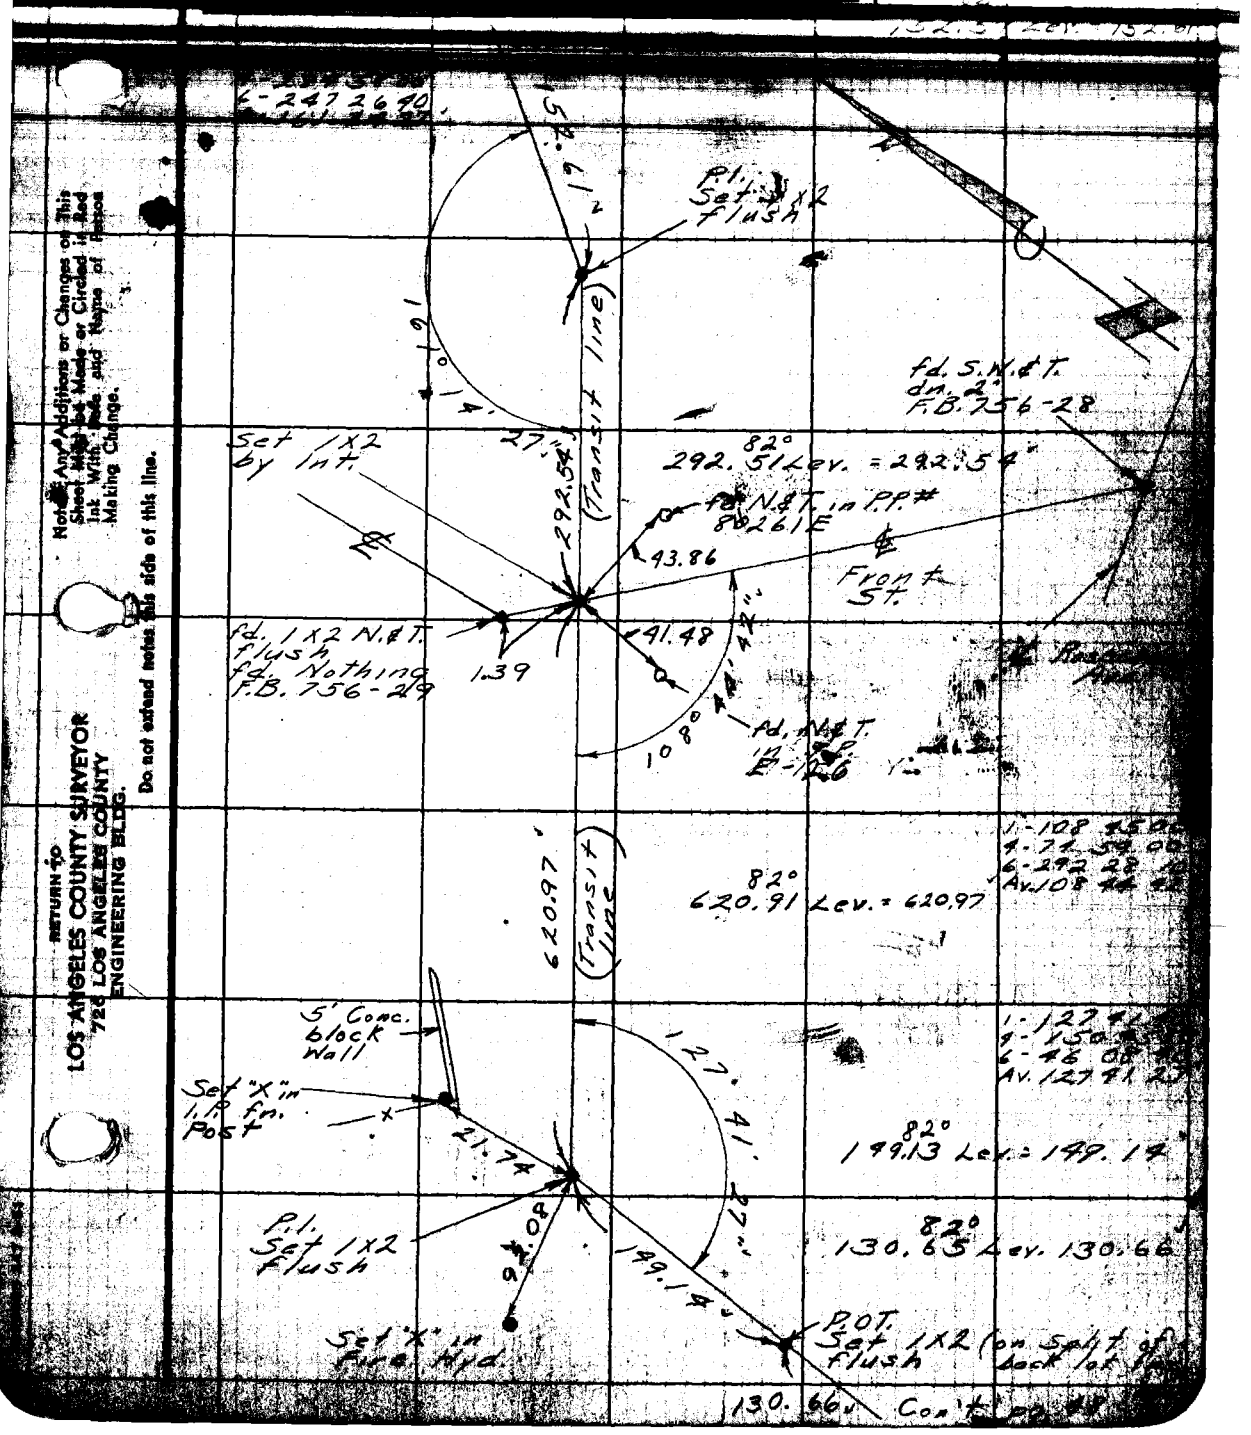

RETURN TO
LOS ANGELES COUNTY SURVEYOR
726 LOS ANGELES COUNTY
ENGINEERING BLDG.

Note: Any Additions or Changes on This Sheet Must be Made or Circled in Red Ink With Date and Name of Person Making Change.

Do not extend notes this side of this line.

F.B. 1799 PG. 66

Cont bott pg #67

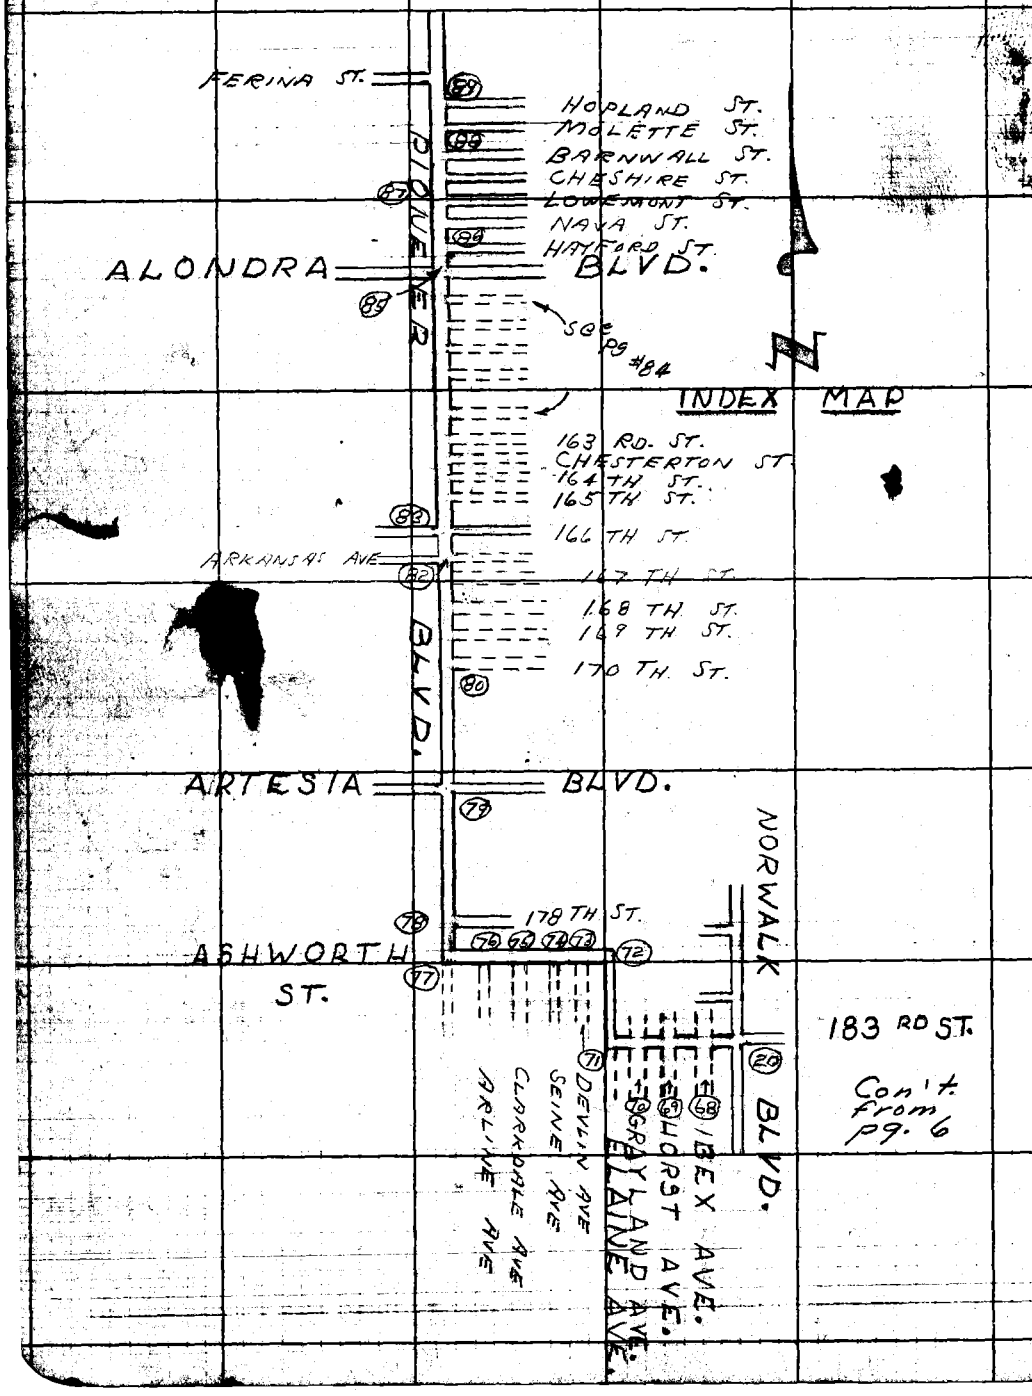

RETURN TO
LOS ANGELES COUNTY SURVEYOR
726 LOS ANGELES COUNTY
ENGINEERING BLDG.

Do not extend notes this side of this line.

Note: Any Additions or Changes on This Sheet Must be Made or Circled in Red Ink With Date and Name of Person Making Change.

PWFB 0726 412

Notes Ck'd by Galli	Survey of ARTESIA NORWALK	F.B. 1299 Pg. [illegible]
Map No.	W. O. [illegible] Type No. Std.	
Office Work	Surveyed by ENGLISH	
Checked	Notes [illegible] 7-53	
Date	Indexed E. C. Johnson 2-2-54	

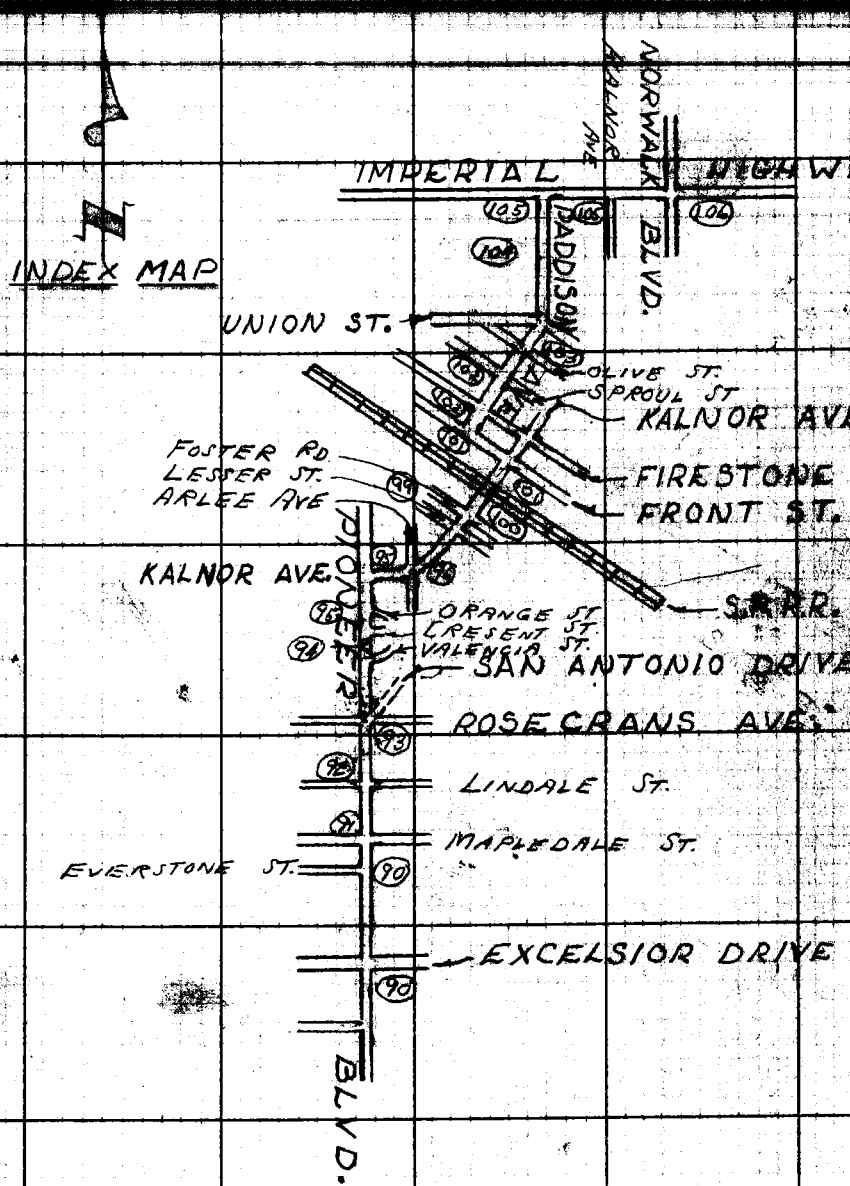

Note: Any Additions or Changes on This Sheet Must be Made or Circled in Red Ink With Date and Name of Person Making Change.

Do not extend notes this side of this line.

RETURN TO
LOS ANGELES COUNTY SURVEYOR
726 LOS ANGELES COUNTY
ENGINEERING BLDG.

76F3095 247 2-51

Cont from top pg #66

RETURN TO
LOS ANGELES COUNTY SURVEYOR
726 LOS ANGELES COUNTY
ENGINEERING BLDG.

Note: Any Additions or Changes on This Sheet Must be Made or Circled in Red Ink With Date and Name of Person Making Change.

Do not extend notes this side of this line.

W.S. 33-D-5

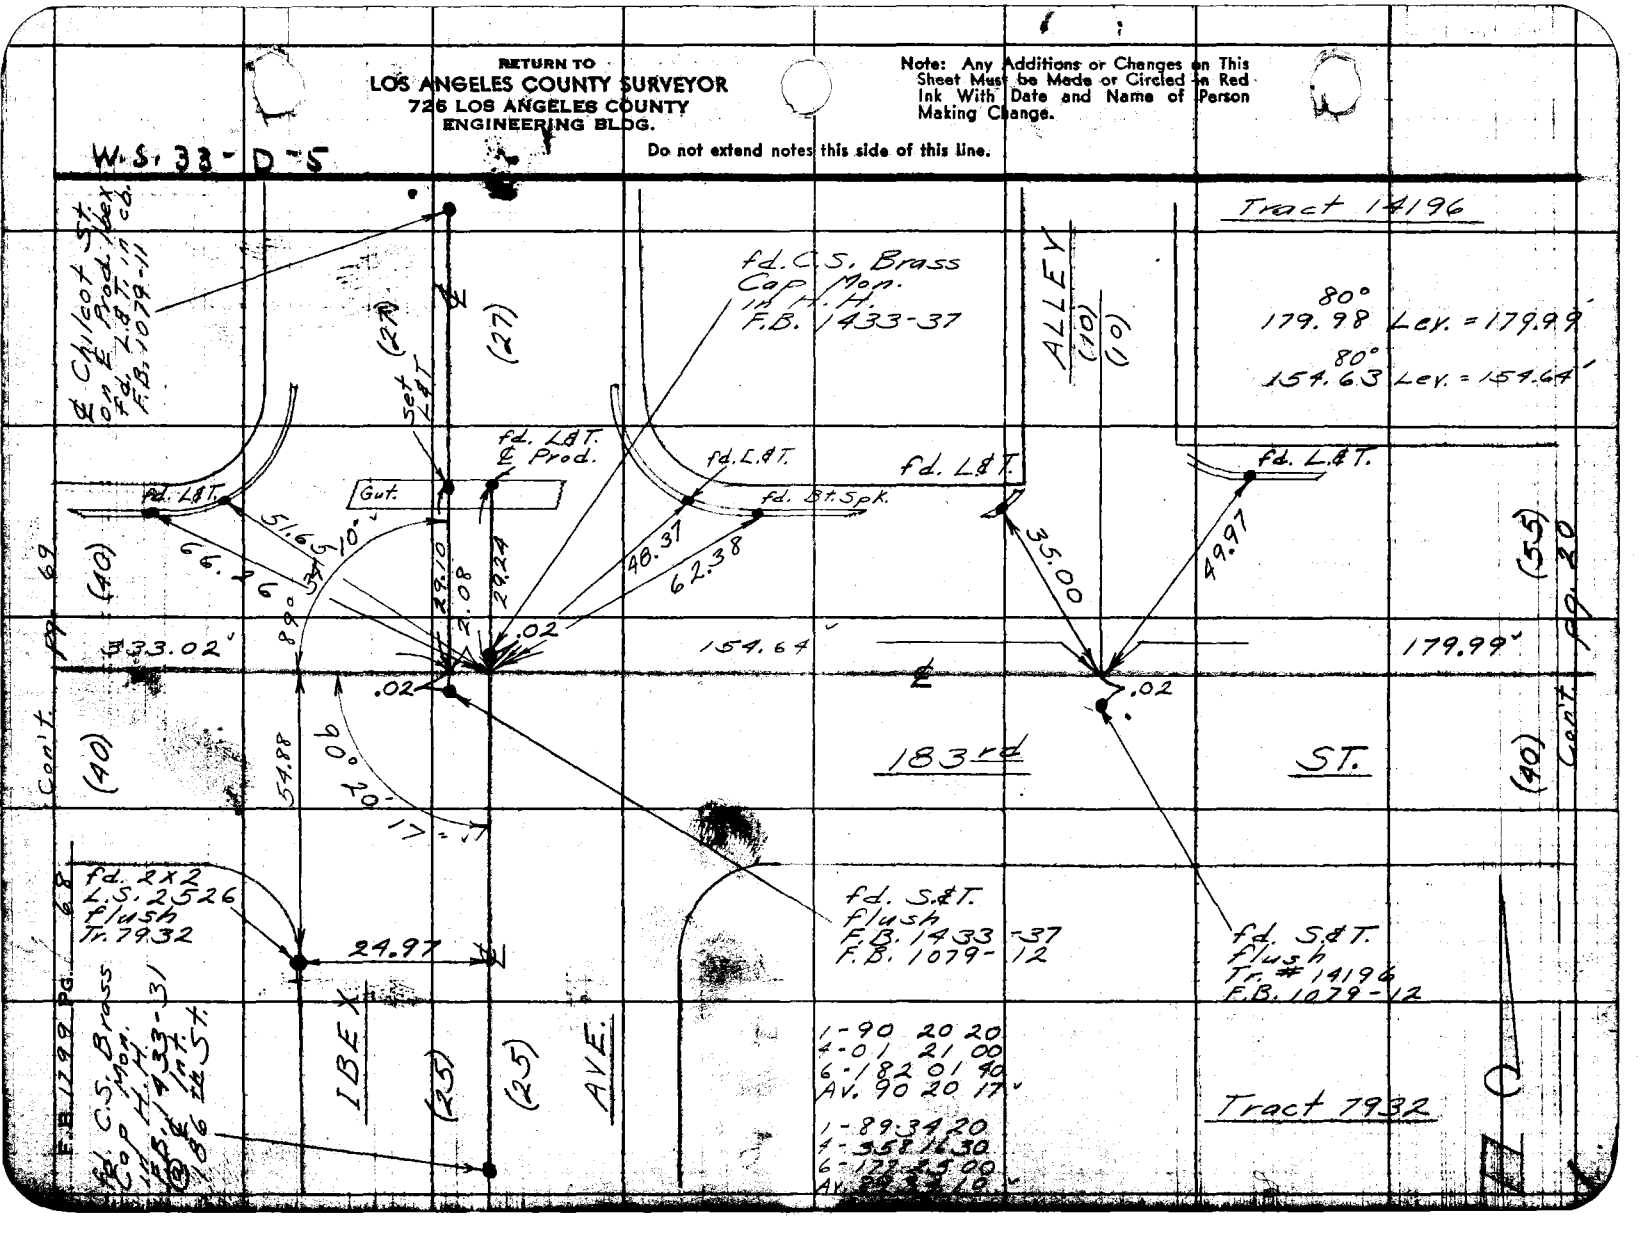

PWFB 0626 1164

Notes Ck'd by: [illegible]	Survey of: Artesia-Norwalk F.B. 1299 Pg. 69
Map No.	W. O. 6931 Tape No. St'd. °F
Office Work	Surveyed by: English
Checked	Notes " Date 7-53
Date	Indexed

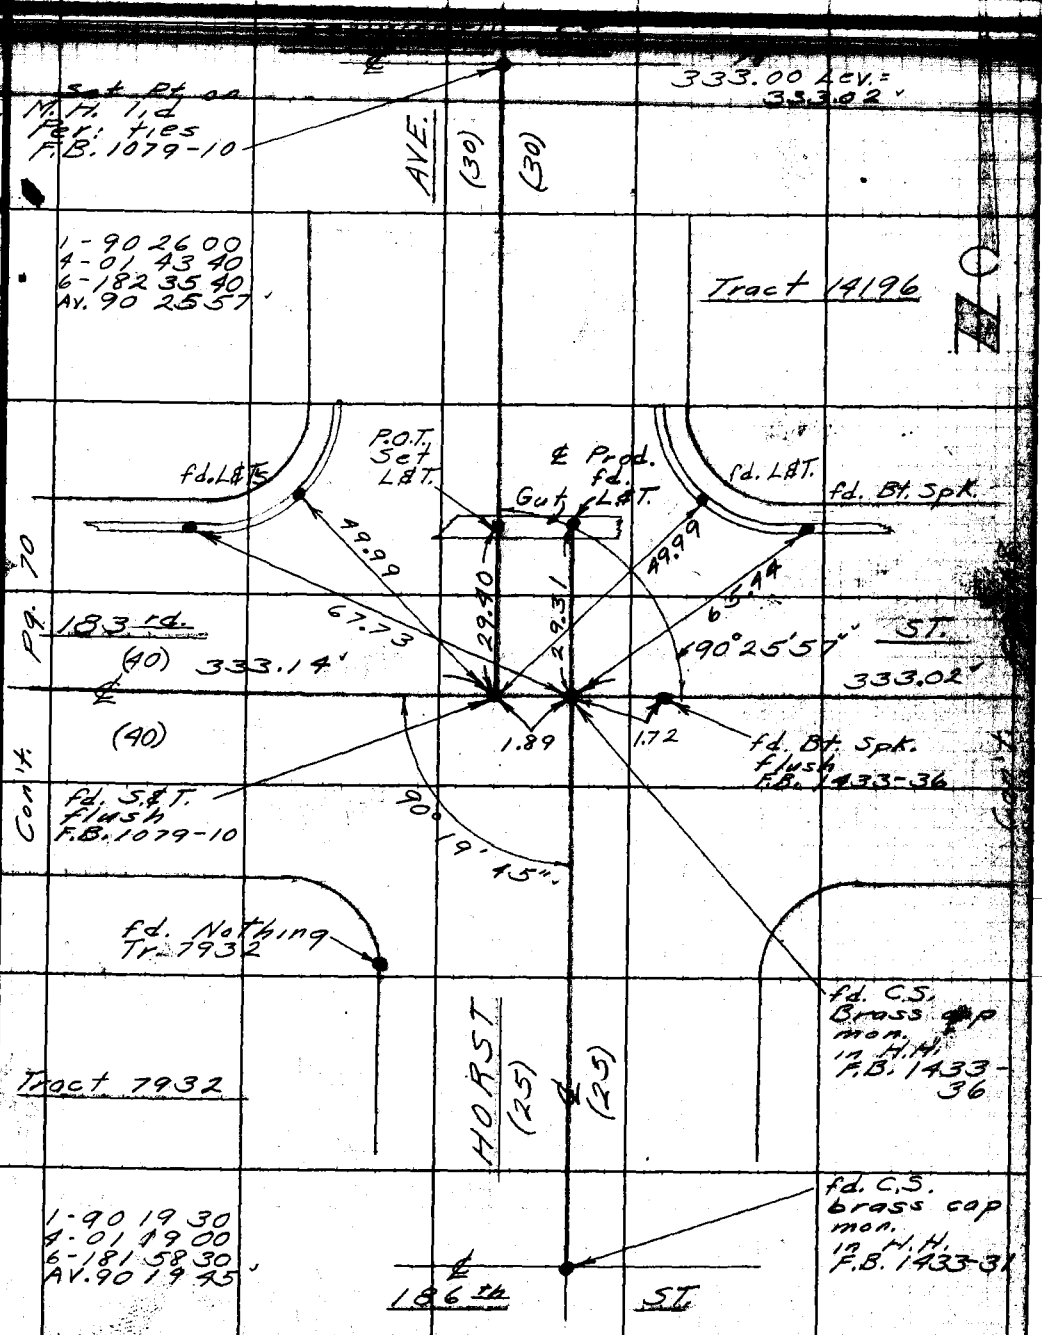

Note: Any Additions or Changes on This Sheet Must be Made or Circled in Red Ink With Date and Name of Person Making Change.

Do not extend notes this side of this line.

RETURN TO
LOS ANGELES COUNTY SURVEYOR
726 LOS ANGELES COUNTY
ENGINEERING BLDG.

76F3095 247 2-51

PWFB 0626 1165

F.B. 1299 PG. 70

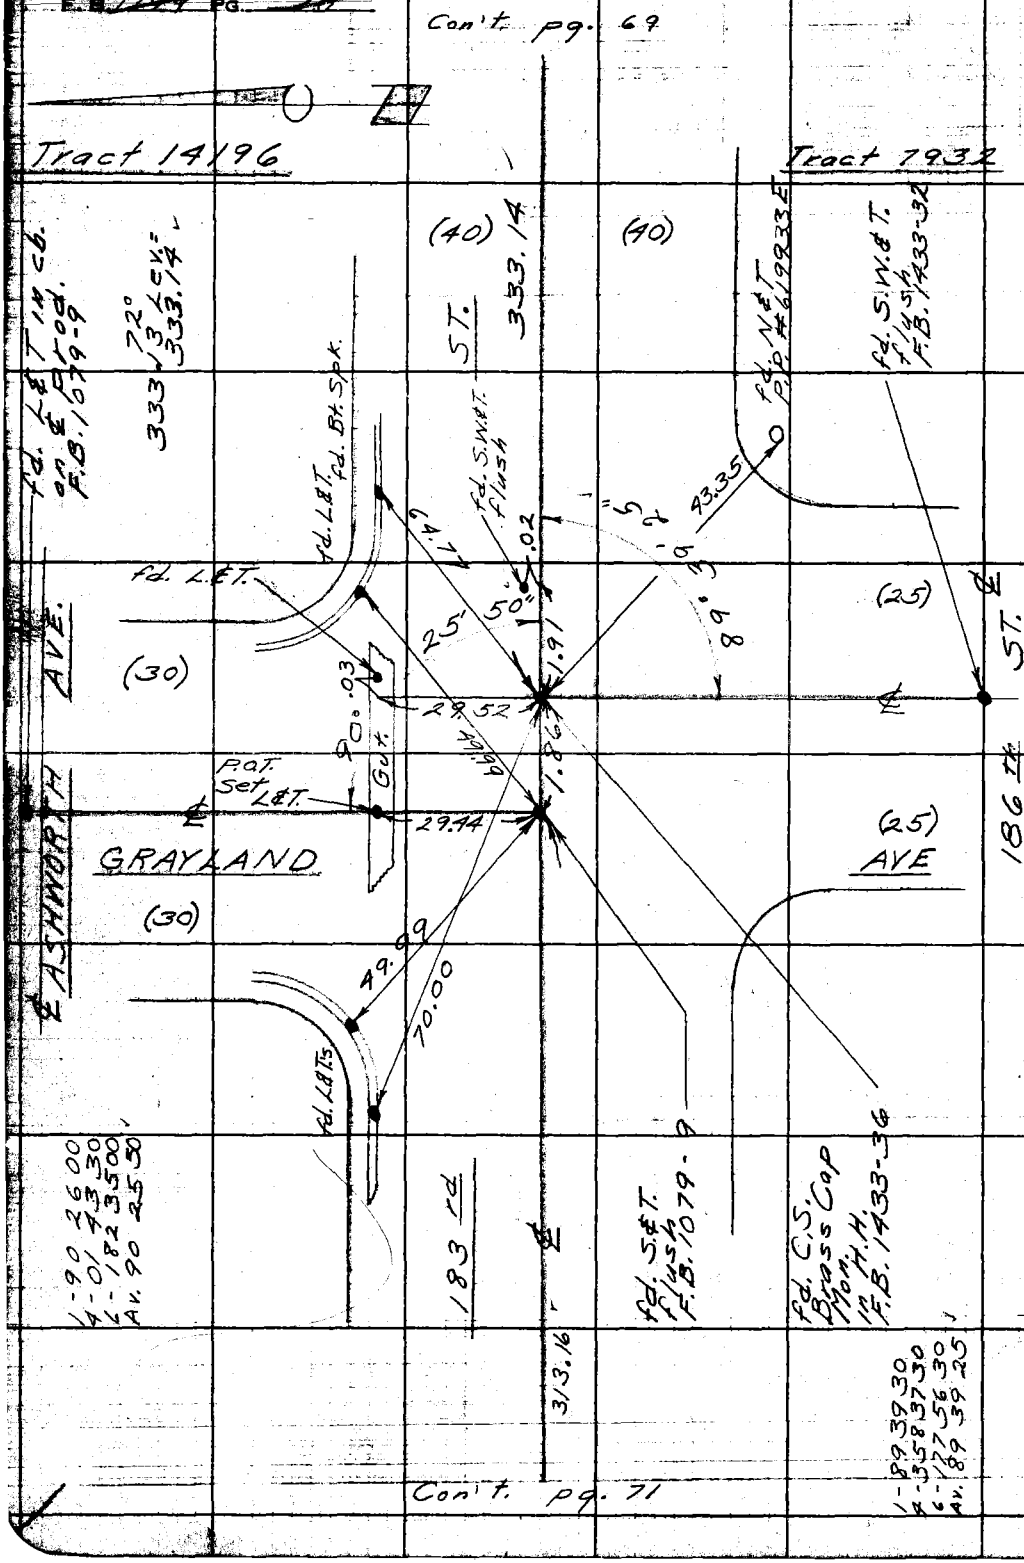

W.S. 33-D-5

RETURN TO
LOS ANGELES COUNTY SURVEYOR
726 LOS ANGELES COUNTY
ENGINEERING BLDG.

Do not extend notes this side of this line.

Note: Any Additions or Changes on This Sheet Must be Made or Circled in Red Ink With Date and Name of Person Making Change.

PWFB 0626 1166

Map No.	W.O.	Tape No. Std. °F
Office Work	Surveyed by	English
Checked	Notes	Date 7-33
Date	Indexed	

Artesia - Norwalk F.B. 1299 Pg. 37

74°
661.55 @ Lev.
661.38

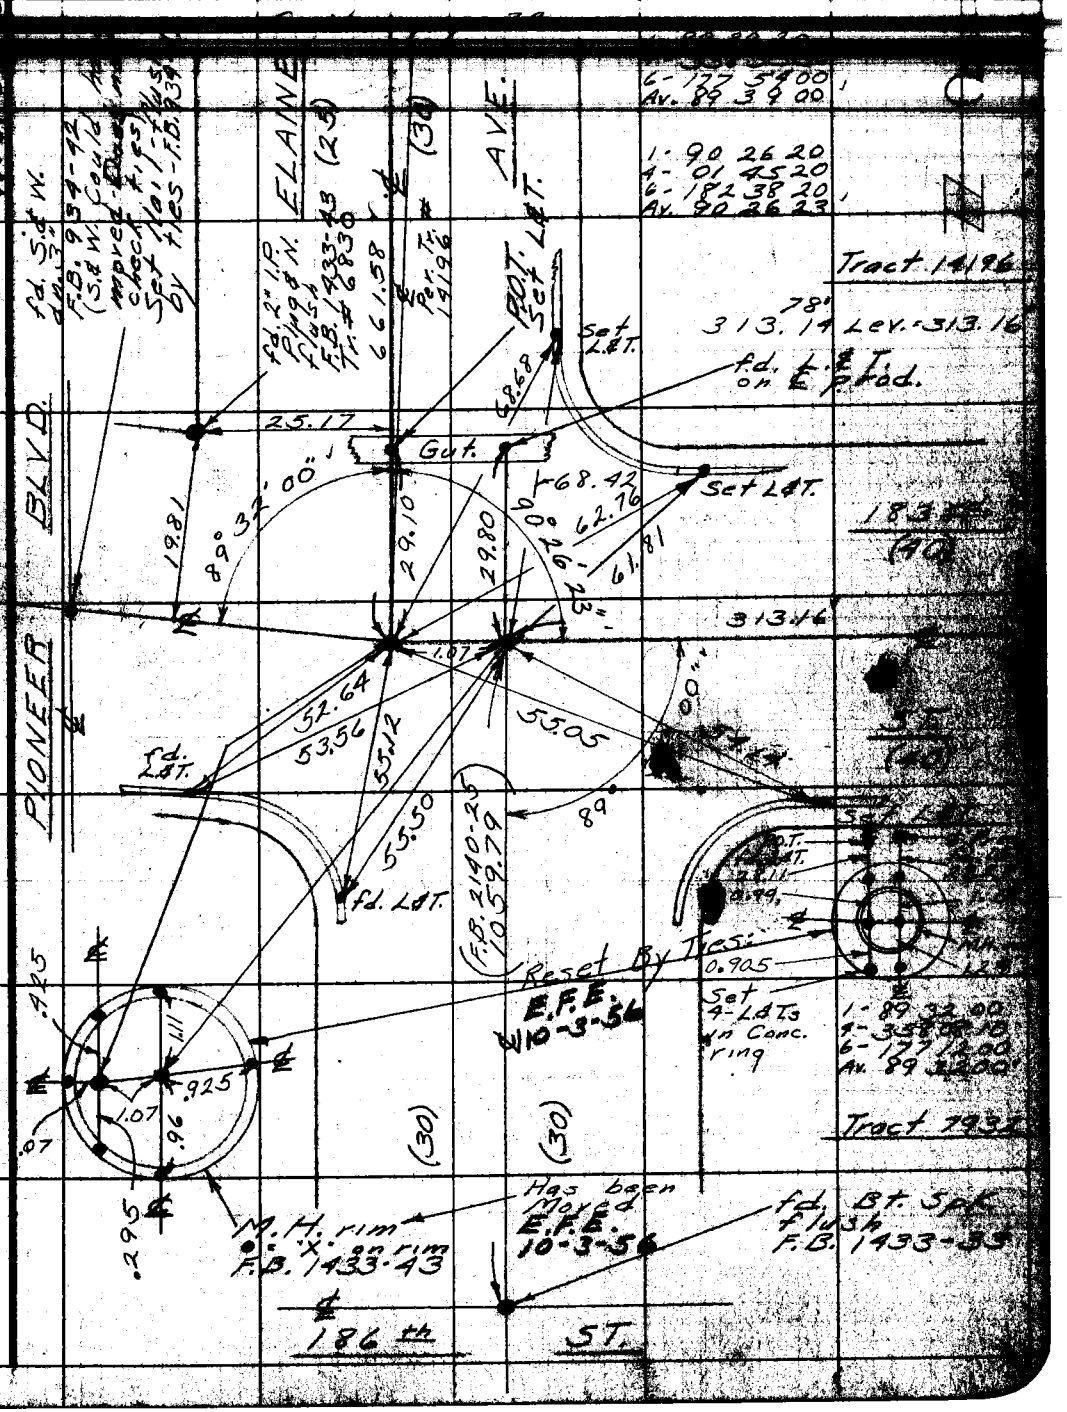

Note: Any Additions or Changes on This Sheet Must be Made or Circled in Red Ink With Date and Name of Person Making Change.

Do not extend notes on side of this line.

RETURN TO
LOS ANGELES COUNTY SURVEYOR
726 LOS ANGELES COUNTY
ENGINEERING BLDG.

76F5098 247 8-51

PWFB 0626 Con't. F.B. 2140-26 1167

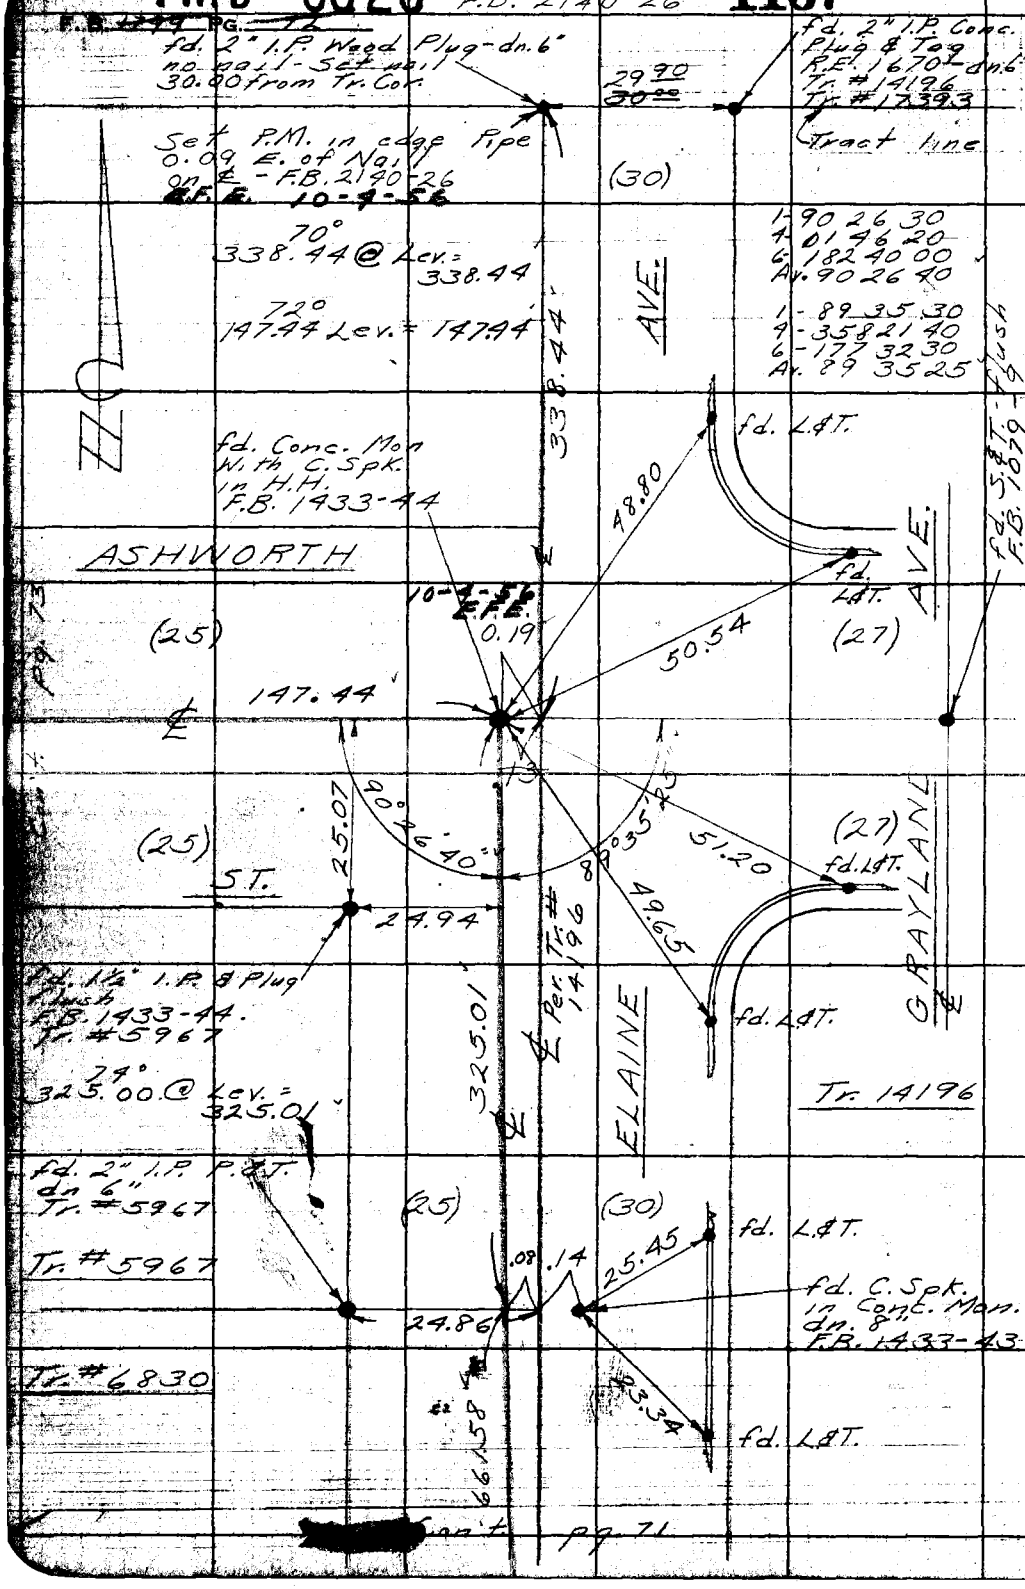

Con't. pg. 71

RETURN TO
LOS ANGELES COUNTY SURVEYOR
725 LOS ANGELES COUNTY
ENGINEERING BLDG.
Do not extend notes this side of this line.
Note: Any Additions or Changes on This Sheet Must be Made or Circled in Red Ink With Date and Name of Person Making Change.

PWFB 0626

1168

Notes Ck'd by Galli	Survey of Artesia Norwalk	F.B. [illegible] Pg. [illegible]
Map No.	W. O. 6951 Tape No. Std. °F	
Office Work	Surveyed by English	
Checked	Notes " Date 10-53	
Date	Indexed [illegible]	

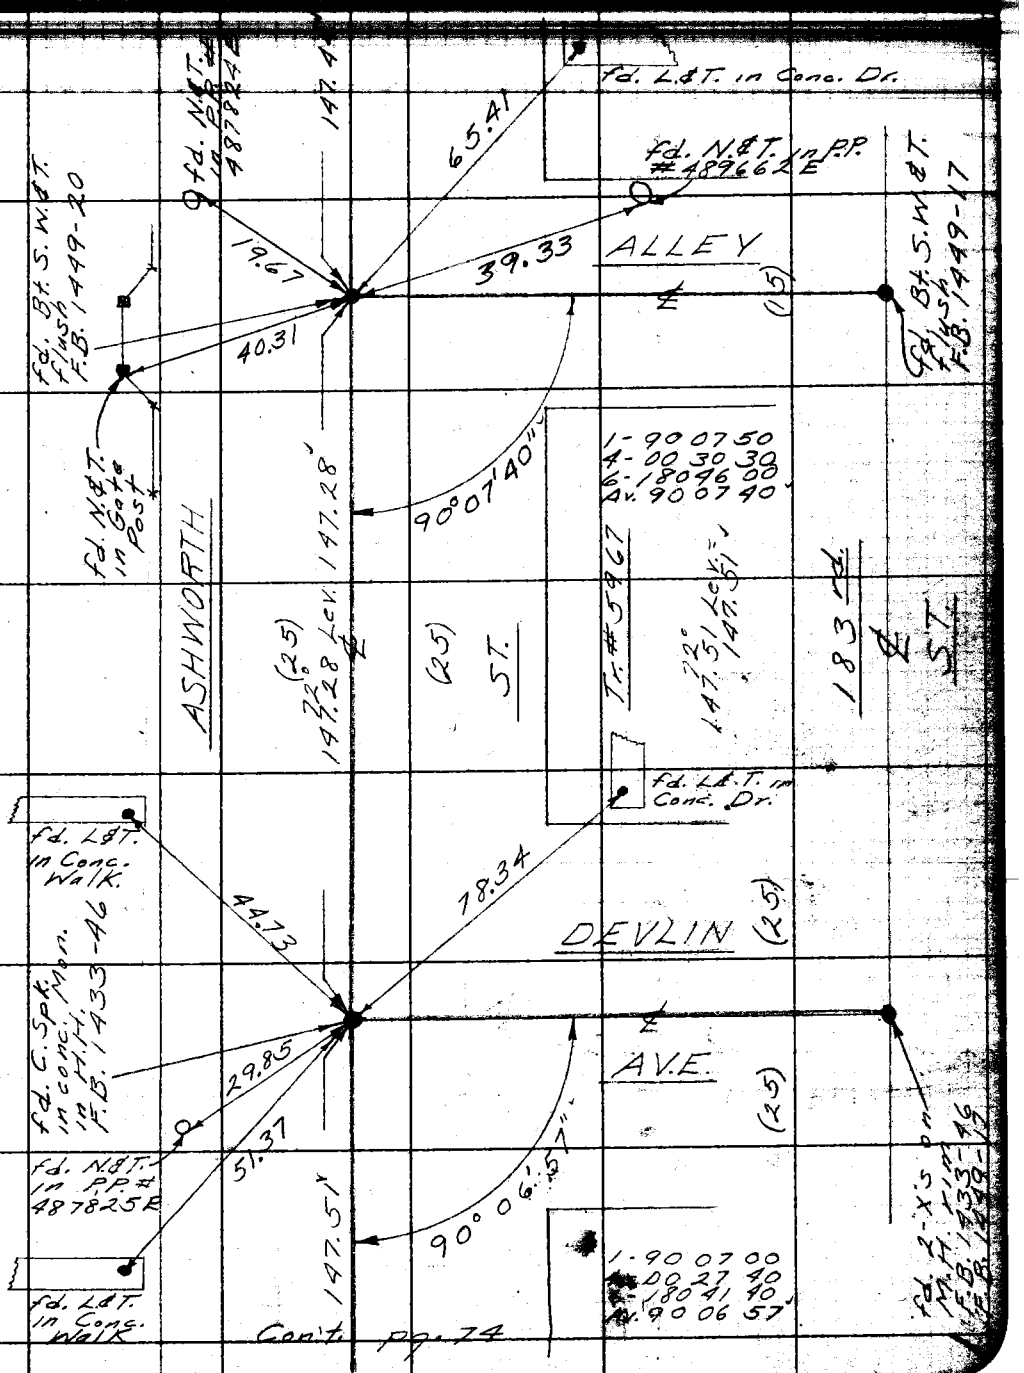

Con't. pg. 74

W.S. 33

Note: Any Additions or Changes on This Sheet Must be Made or Circled in Red Ink With Date and Name of Person Making Change.

Do not extend notes this side of this line.

RETURN TO
LOS ANGELES COUNTY SURVEYOR
726 LOS ANGELES COUNTY
ENGINEERING BLDG.

76F3098 247 4-53

F.B. 1299 Pg. 74

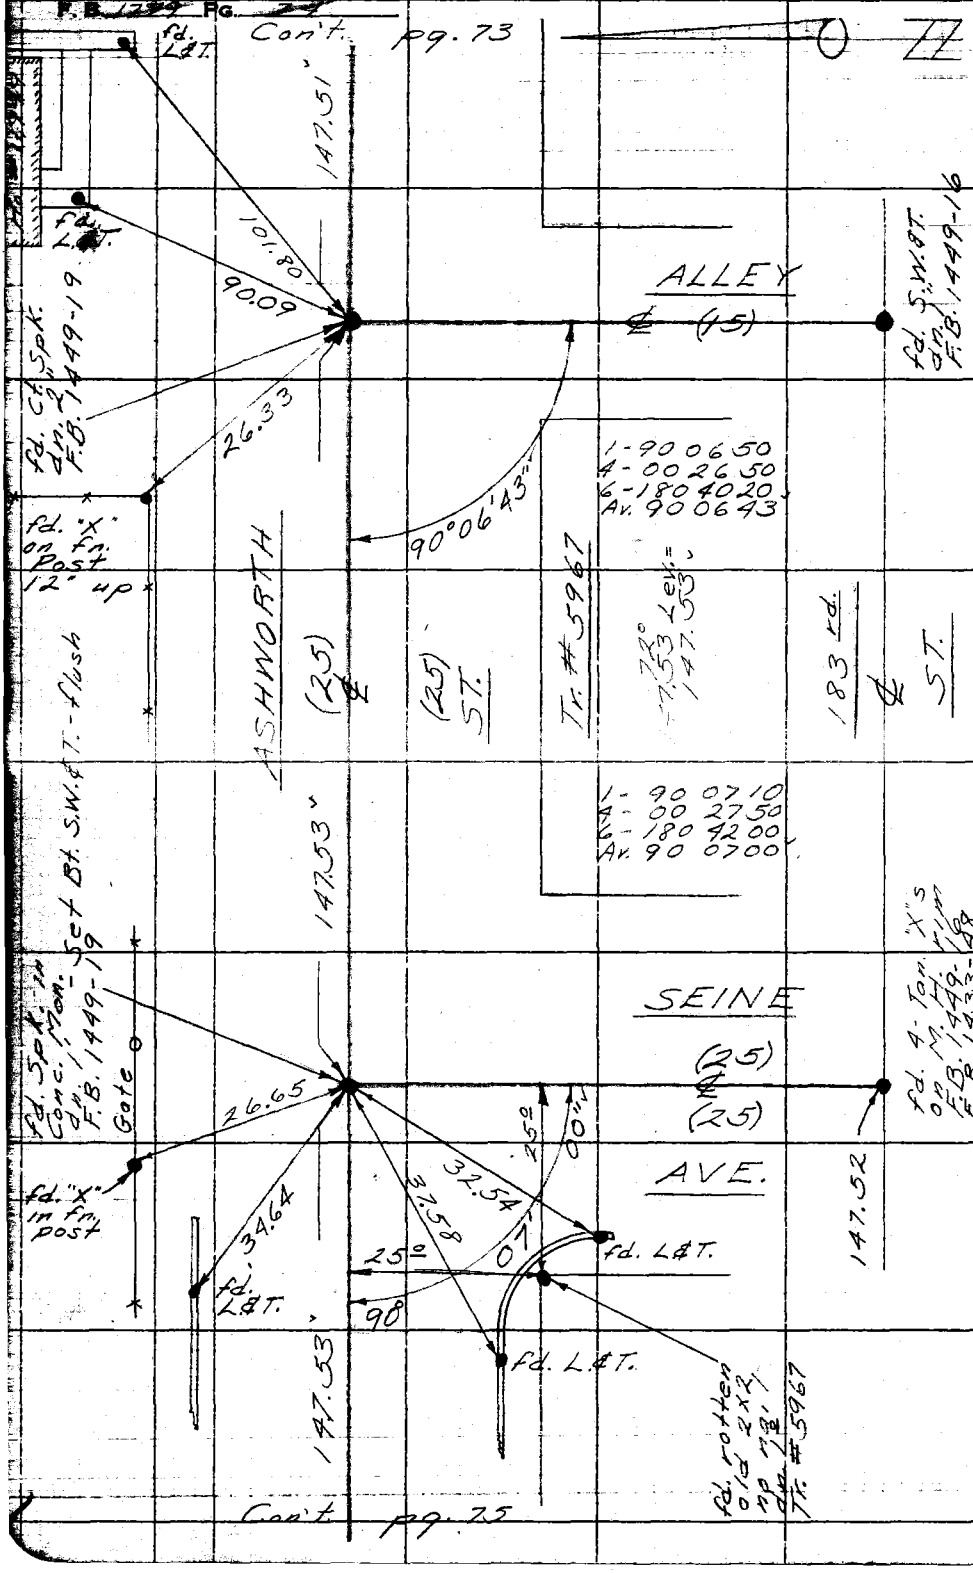

W.S. 33-C-5

RETURN TO
LOS ANGELES COUNTY SURVEYOR
726 LOS ANGELES COUNTY
ENGINEERING BLDG.
Do not extend notes this side of this line.

Note: Any Additions or Changes on This Sheet Must be Made or Circled in Red Ink With Date and Name of Person Making Change.

PWEB 0626

1170, 1171

Notes Ck'd by Gatti
Map No.
Office Work
Checked
Date

Survey of Artesia-Norwalk
W. O. 6757 Tape No. 0150 St'd. 68° °F
Surveyed by English
Notes " Date 10-53
Indexed A. C. Johnson

F. B. 1229 Pg. 75

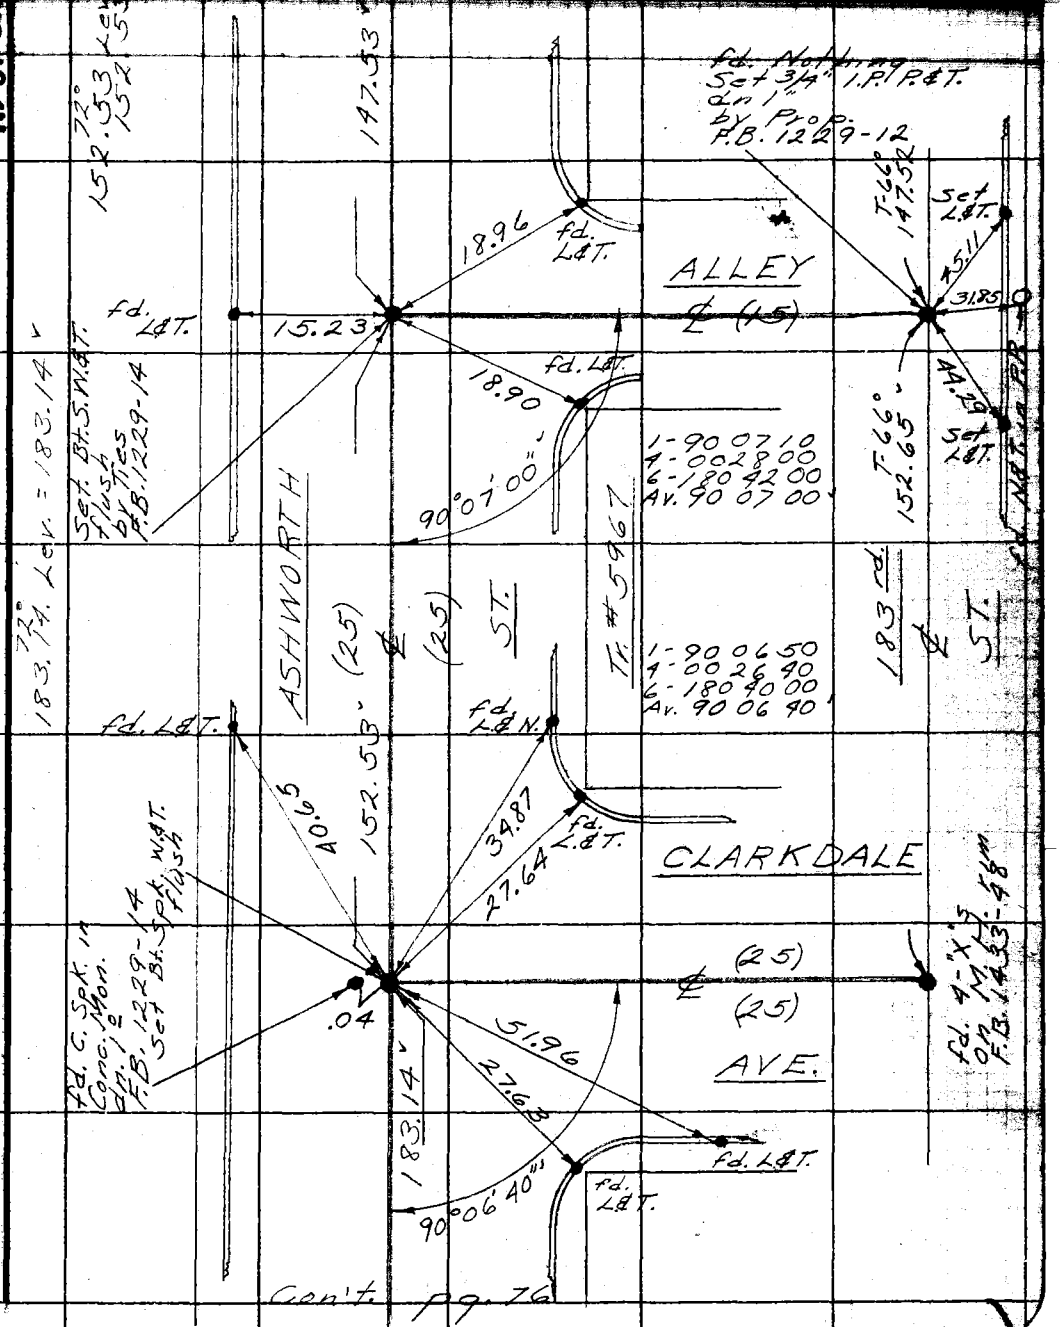

Con't. pg. 76

Note: Any Additions or Changes on This Sheet Must be Made or Circled in Red Ink With Date and Name of Person Making Change.

Do not extend notes this side of this line.

RETURN TO
LOS ANGELES COUNTY SURVEYOR
726 LOS ANGELES COUNTY
ENGINEERING BLDG.

76F3095 247 4-53

PWFB 0626 1172

F.B. ~~1249~~ PG. ~~26~~

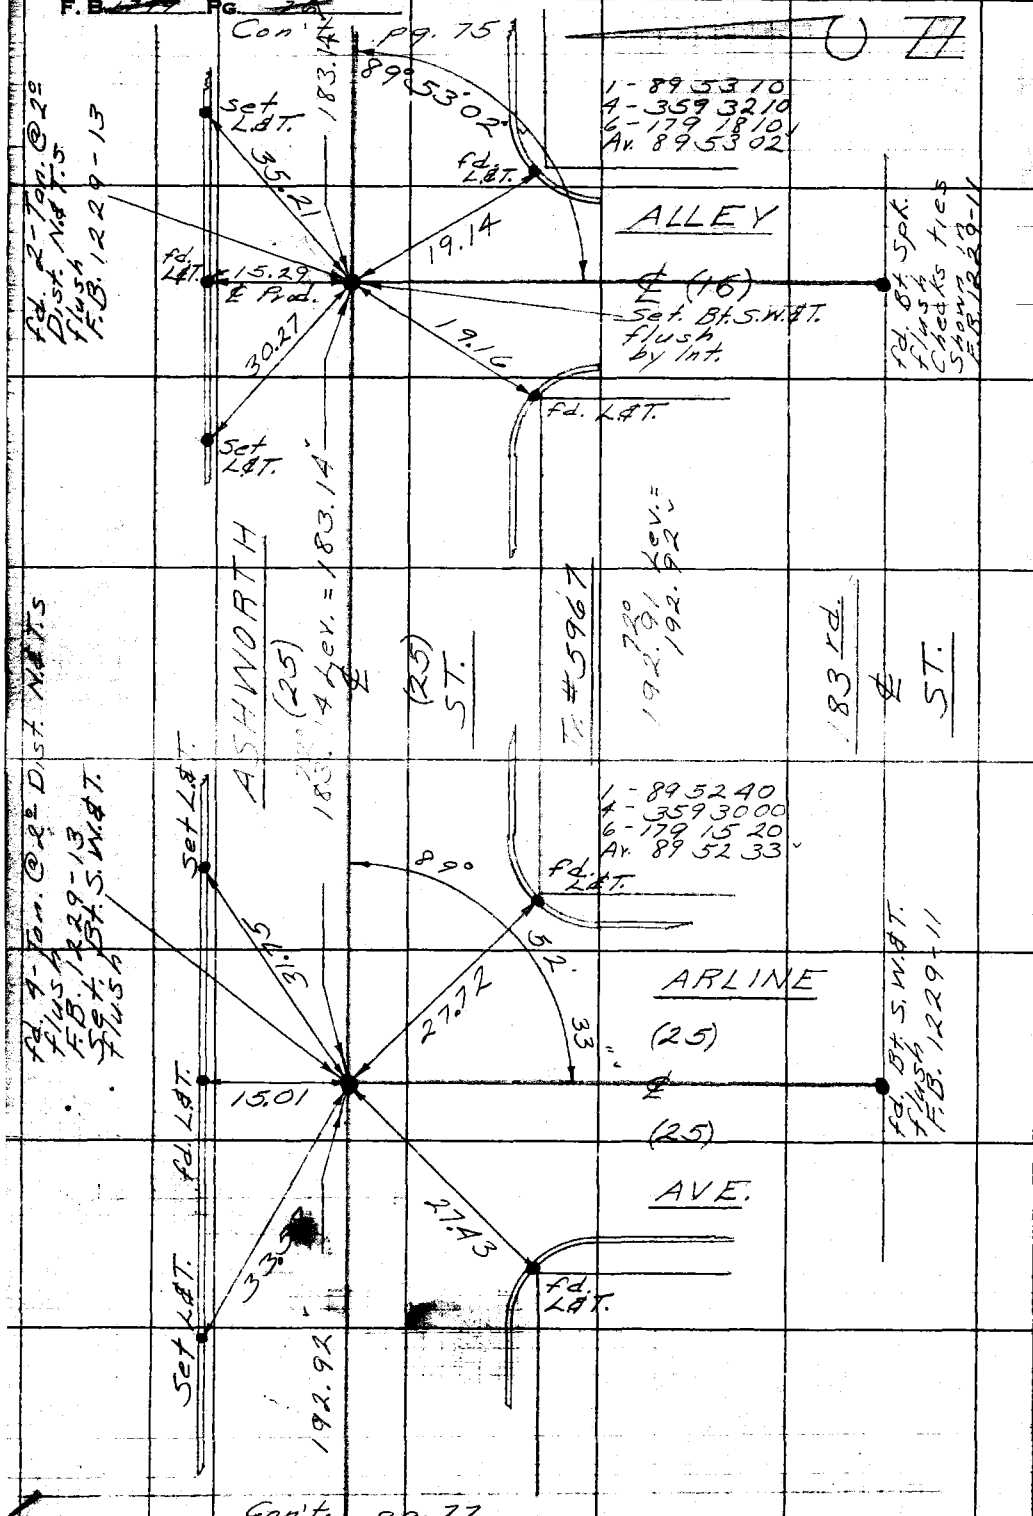

W.S. 33-C-5

RETURN TO
LOS ANGELES COUNTY SURVEYOR
726 LOS ANGELES COUNTY
ENGINEERING BLDG.

Do not extend notes this side of this line.

Note: Any Additions or Changes on This Sheet Must be Made or Circled in Red Ink With Date and Name of Person Making Change.

PWFB 0626

1173

Notes Ck'd by Galli
Map No.
Office Work
Checked
Date

Survey of Artesia - Norwalk
W. O. Tape No. St'd. °F
Surveyed by English
Notes Date 10-53
Indexed A. C. Johnson

F. B. PG.

Note: Any Additions or Changes on This Sheet Must be Made or Circled in Red Ink With Date and Name of Person Making Change.

Do not extend notes this side of this line.

RETURN TO
LOS ANGELES COUNTY SURVEYOR
726 LOS ANGELES COUNTY
ENGINEERING BLDG.

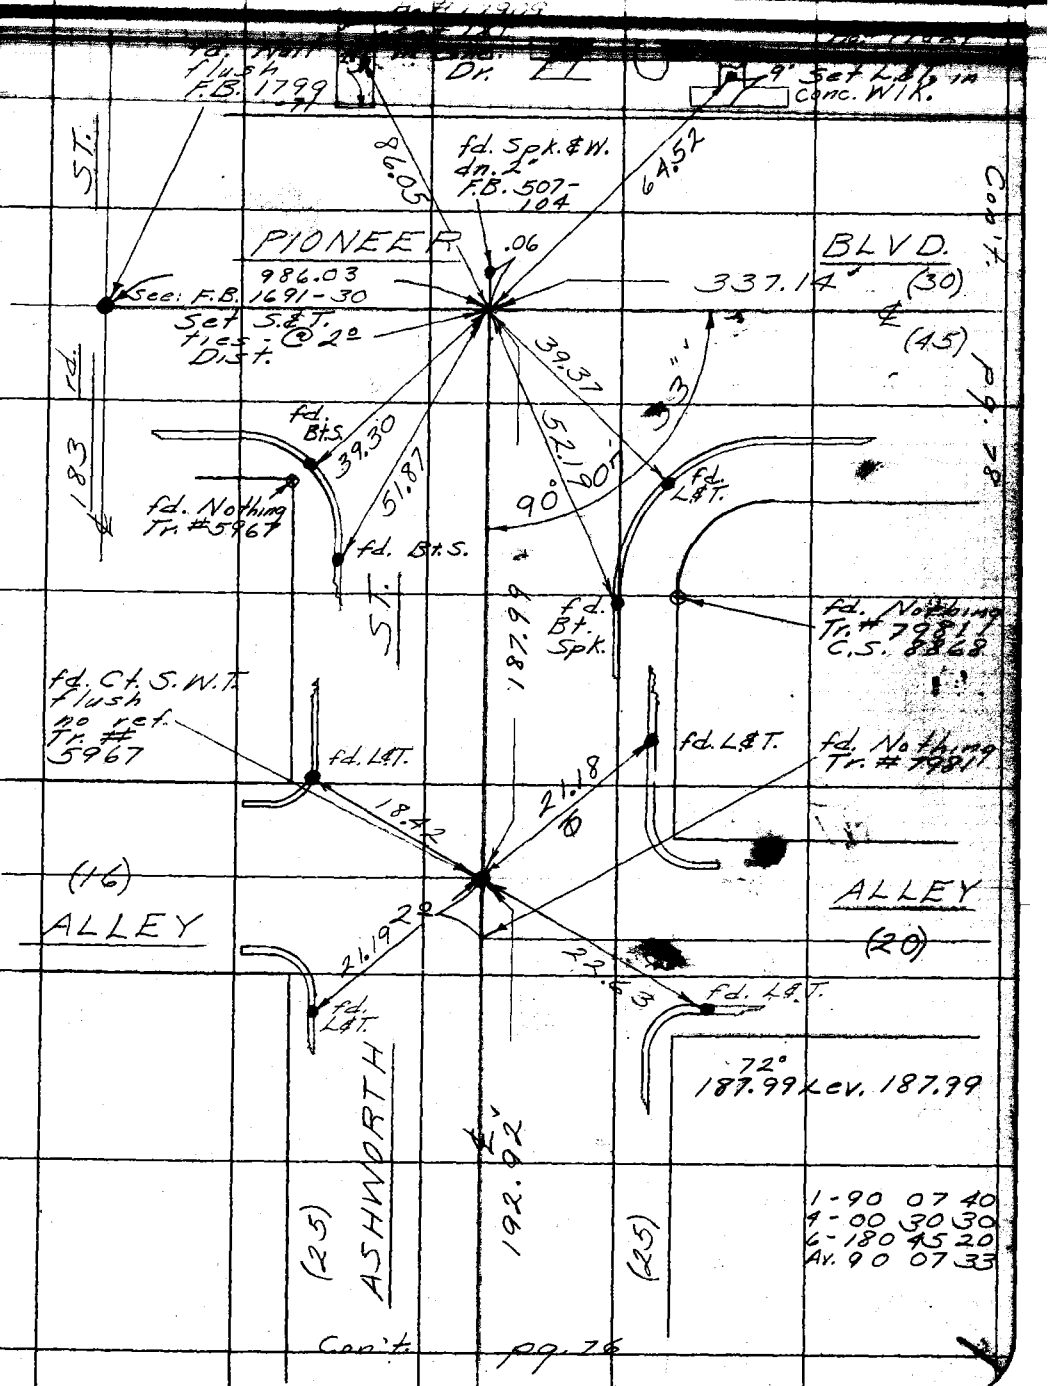

76F3095 247 4-53

RETURN TO
LOS ANGELES COUNTY SURVEYOR
726 LOS ANGELES COUNTY
ENGINEERING BLDG.

Note: Any Additions or Changes on This Sheet Must be Made or Circled in Red Ink With Date and Name of Person Making Change.

Do not extend notes this side of this line.

W.S. 33-C-5

1171

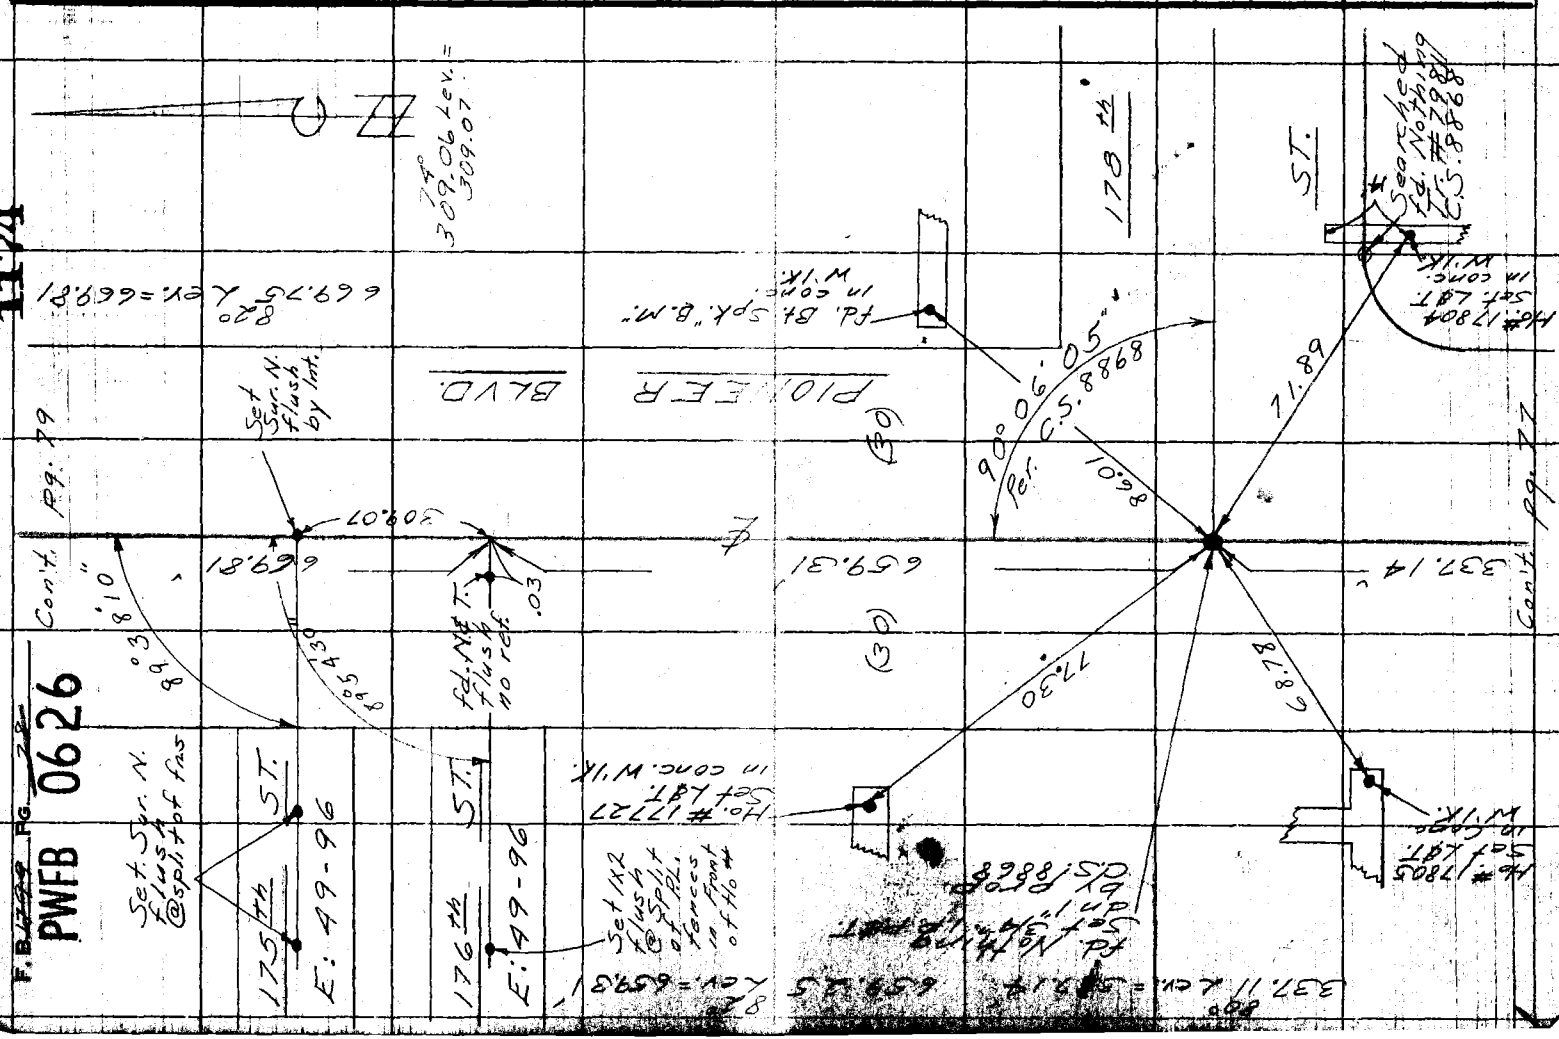

PWFB 0626 1175 79

Notes Ck'd by Gatti	Survey of Artesia Promenade
Map No.	W. O. 6951 Tape No. St'd. °F
Office Work	Surveyed by English
Checked	Notes Date 10-53
Date	Indexed A. C. Johnson

F. B. Pg. 79.

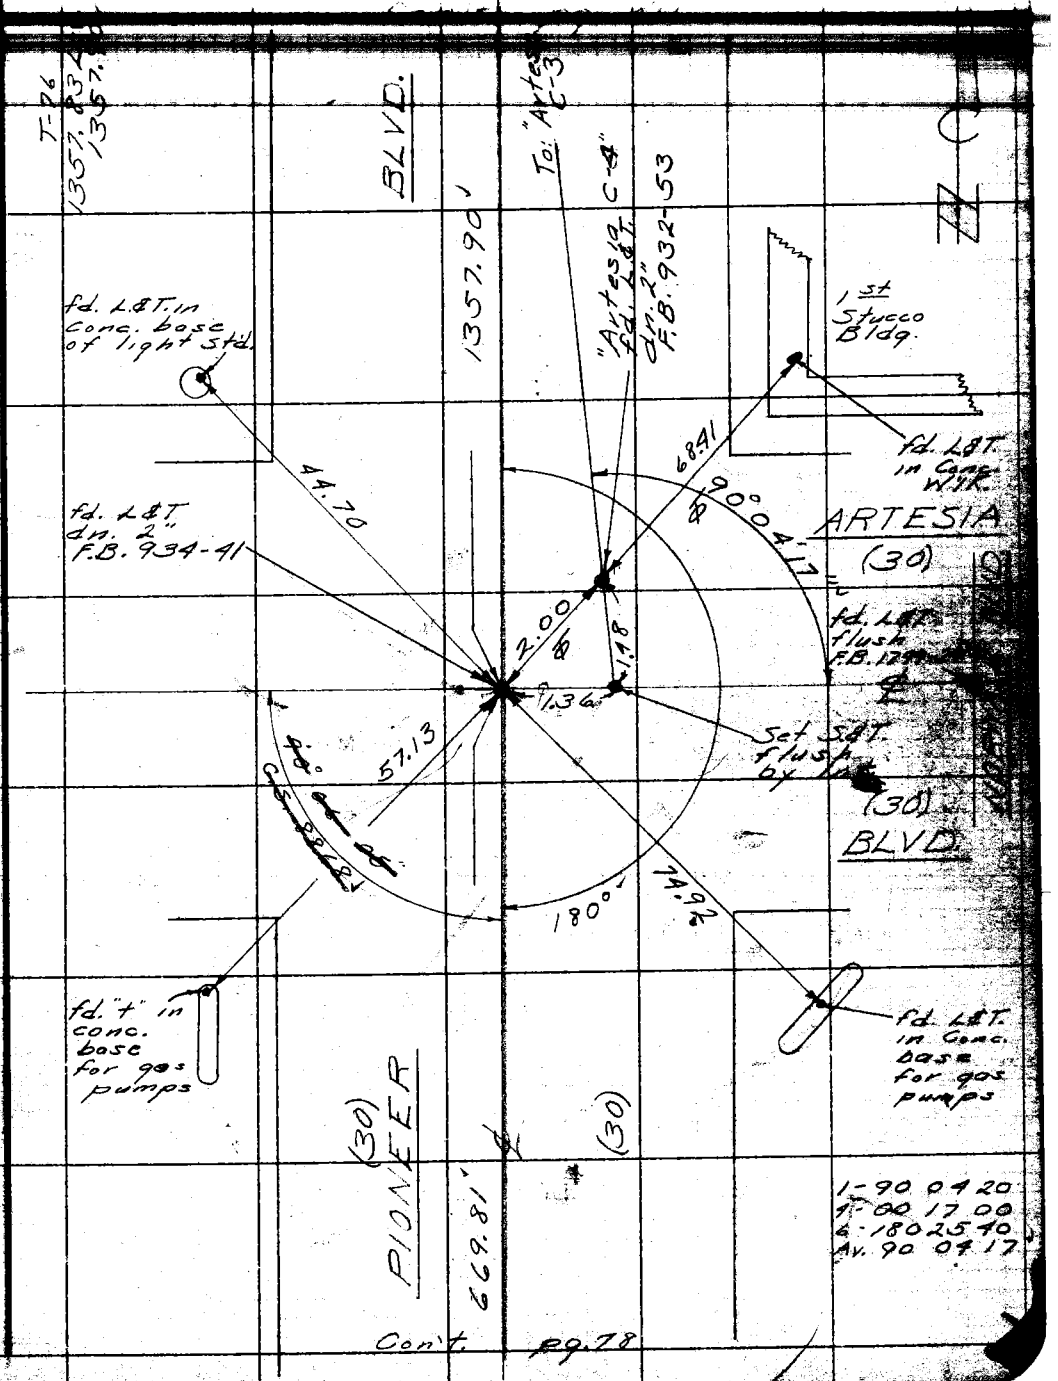

Note: Any Additions or Changes on This Sheet Must be Made or Circled in Red Ink With Date and Name of Person Making Change.

Do not extend notes this side of this line.

RETURN TO
LOS ANGELES COUNTY SURVEYOR
726 LOS ANGELES COUNTY
ENGINEERING BLDG.

76F3098 247 4-53

PWFB 0626 1176

F.B. ~~1799~~ Pg. ~~80~~

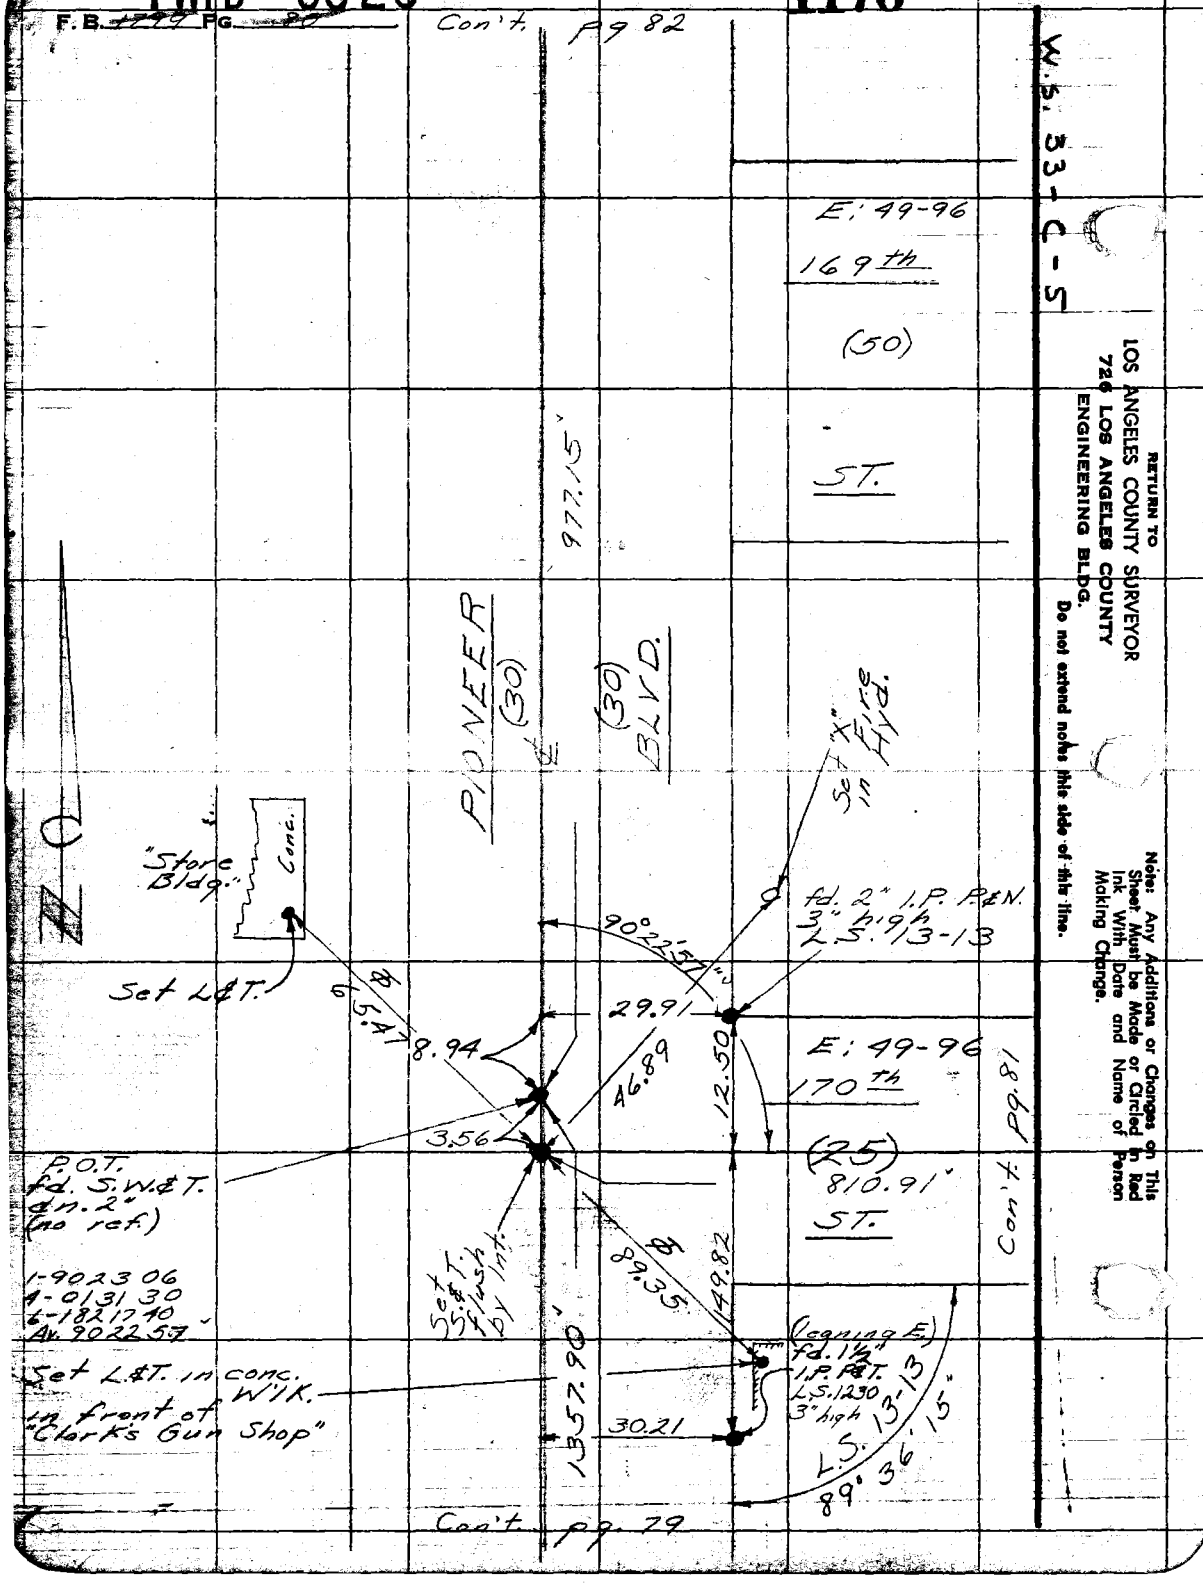

RETURN TO
LOS ANGELES COUNTY SURVEYOR
726 LOS ANGELES COUNTY
ENGINEERING BLDG.
Do not extend notes this side of this line.

Note: Any Additions or Changes on This Sheet Must be Made or Circled in Red Ink With Date and Name of Person Making Change.

PWFB 0626

1177

Notes Ck'd by Galli
Map No.
Office Work
Checked
Date

Survey of Artesia-Norwalk
W. O. 6951 Tape No. St'd. °F
Surveyed by English
Notes Date 10-53
Indexed S. C. Johnson

F. B. ~~1799~~ Pg. ~~81~~

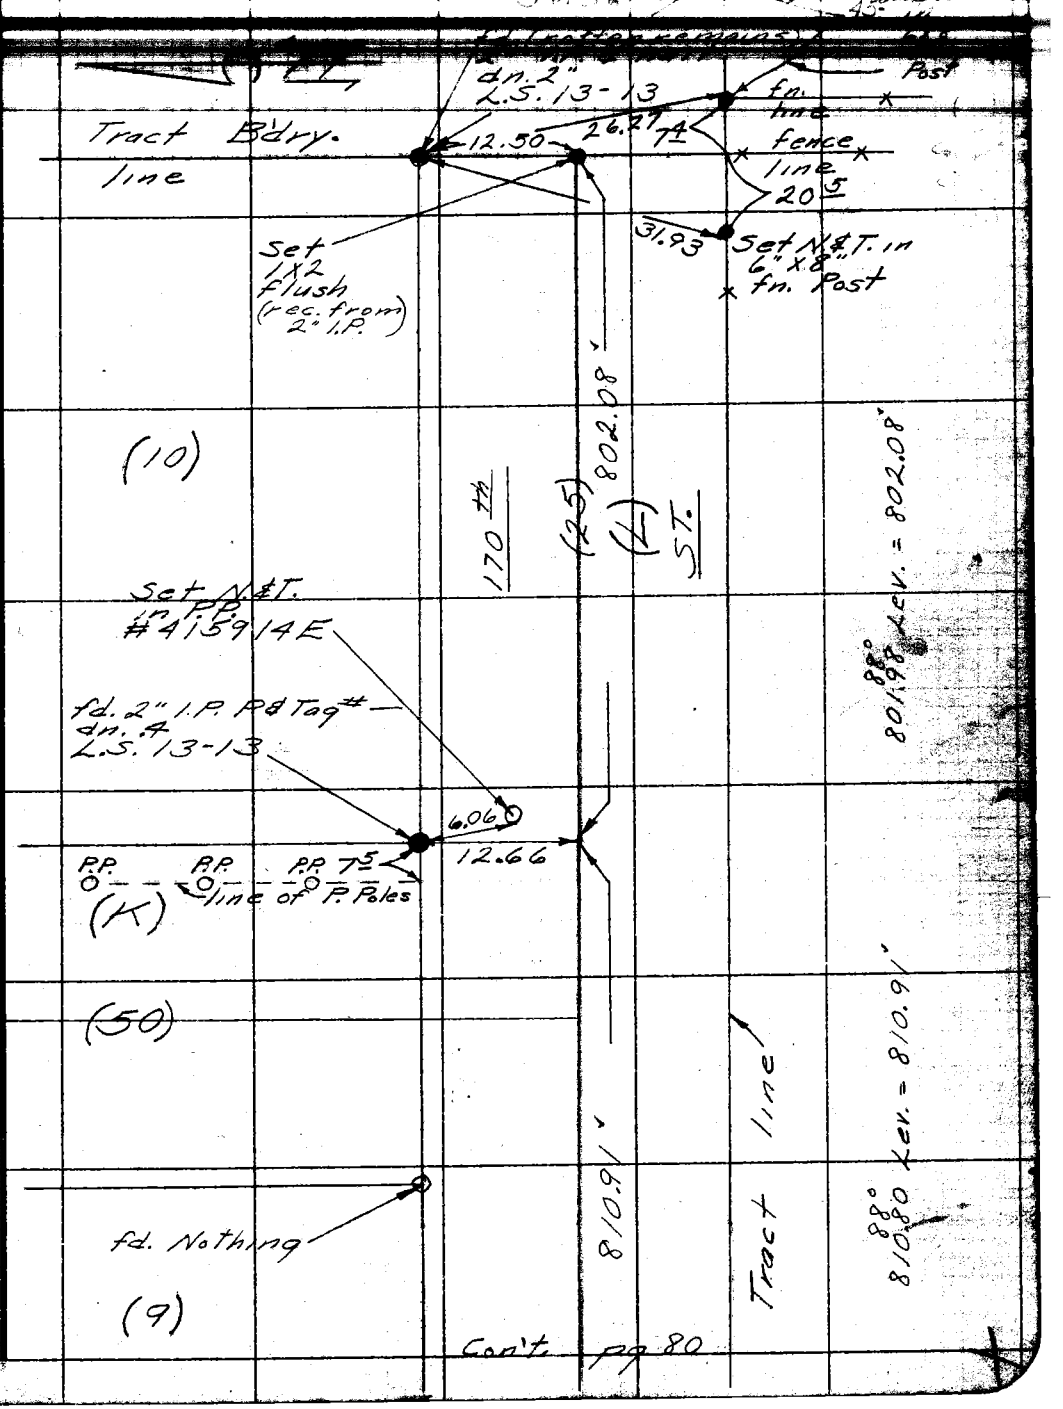

Con't. pg 80

Note: Any Additions or Changes on This Sheet Must be Made or Circled in Red Ink With Date and Name of Person Making Change.

Do not extend notes this side of this line.

RETURN TO
LOS ANGELES COUNTY SURVEYOR
726 LOS ANGELES COUNTY
ENGINEERING BLDG.

76F3098 247 4-53

F.B. ~~1299~~ PG. ~~82~~

PWFB 0626 Con't. pg. 83

1178

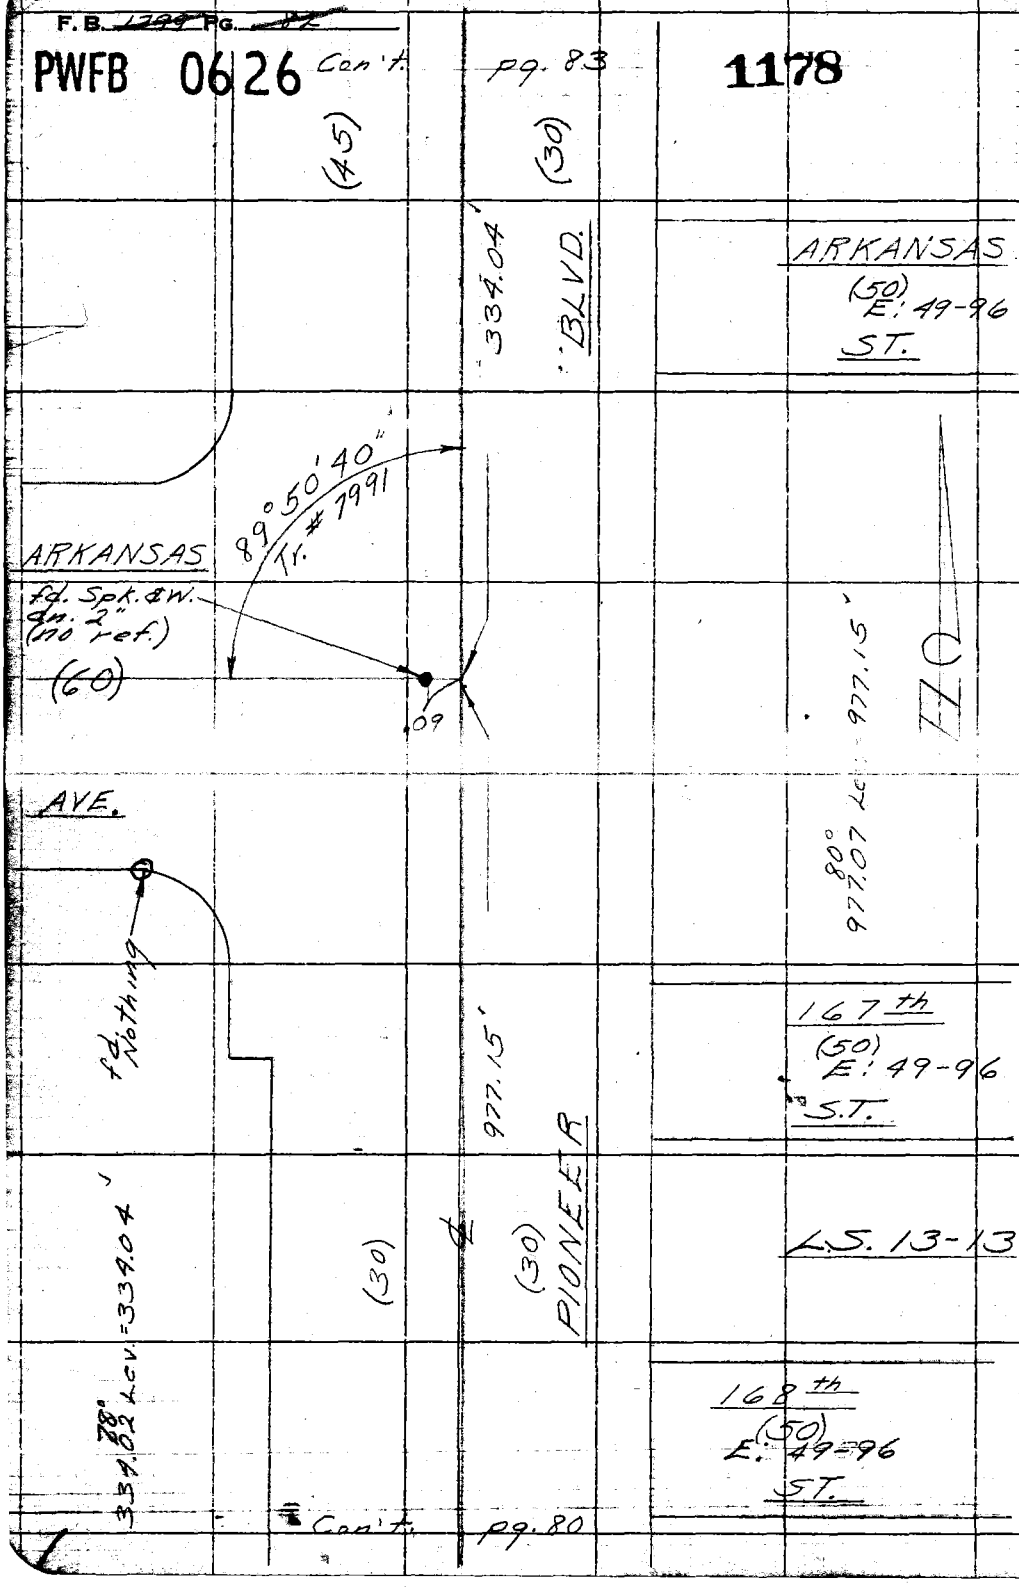

W.S. 3.3 - C-5

RETURN TO
LOS ANGELES COUNTY SURVEYOR
726 LOS ANGELES COUNTY
ENGINEERING BLDG.

Do not extend notes this side of this line.

Note: Any Additions or Changes on This Sheet Must be Made or Circled in Red Ink With Date and Name of Person Making Change.

PWFB 0626

1179

Notes Ck'd by Galli	Survey of Artesia-Norwalk
Map No.	W. O. 6951 Tape No. Std. °F
Office Work	Surveyed by English
Checked	Notes " Date 10-53
Date	Indexed A. C. Johnson

F. B. 1199 PG. 83

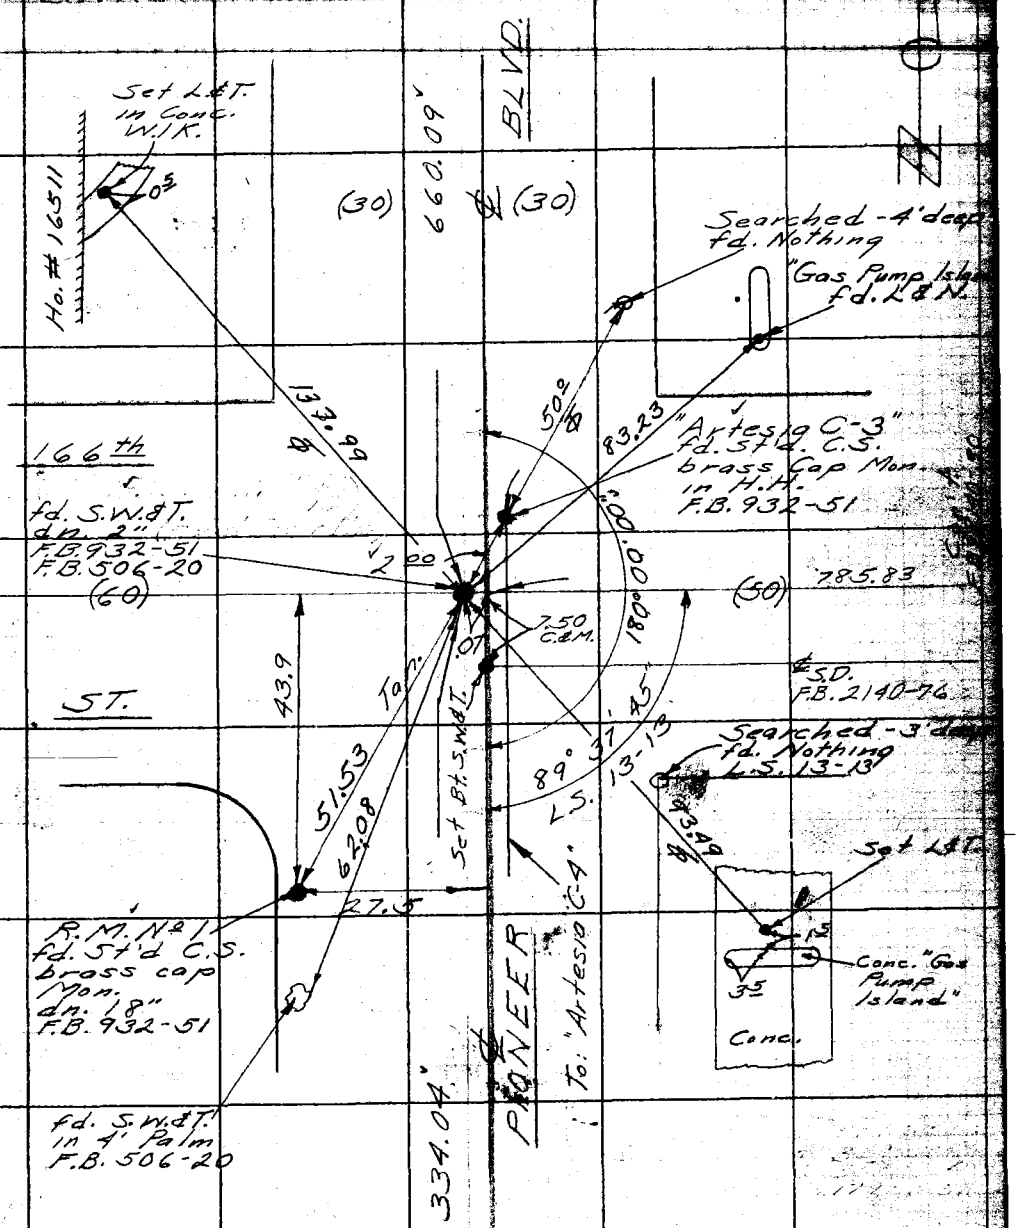

Con't. pg. 82

W. S. 3

Note: Any Additions or Changes on This Sheet Must be Made or Circled in Red Ink With Date and Name of Person Making Change.

Do not extend notes this side of this line.

RETURN TO
LOS ANGELES COUNTY SURVEYOR
726 LOS ANGELES COUNTY
ENGINEERING BLDG.

76F3098 247 4-53

F.B. ~~1299~~ PG. ~~84~~ Con't. pg. 85 **1180, 1181**

PWFB 0626

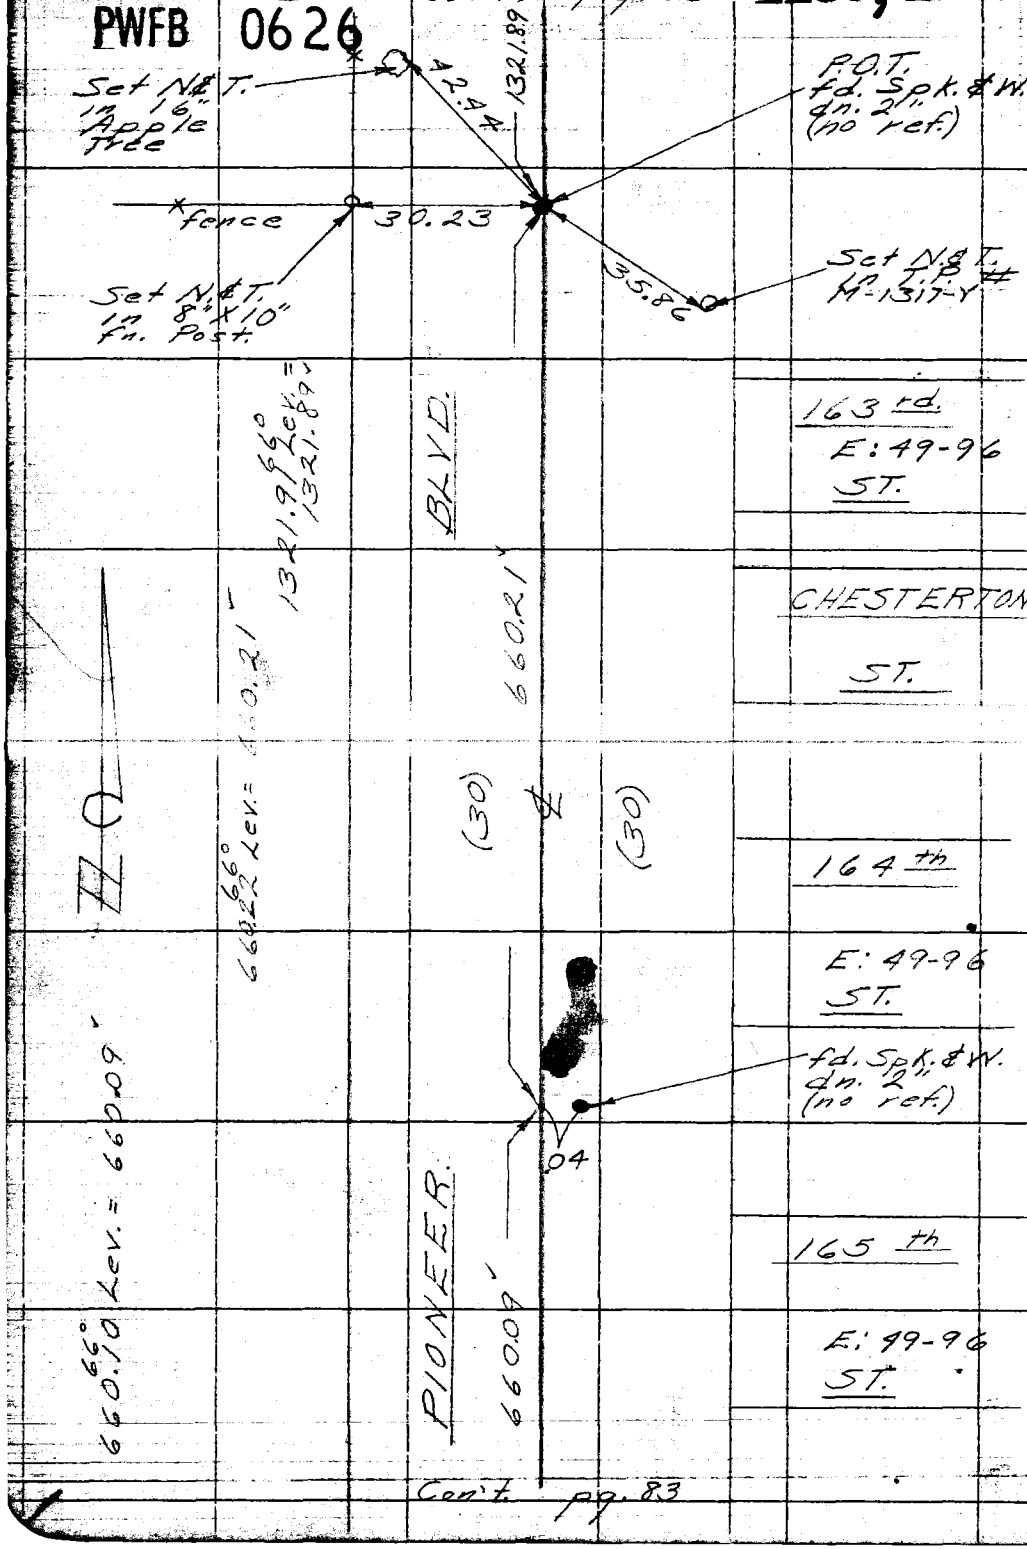

Con't. pg. 83

W.S. 33-C-S

RETURN TO
LOS ANGELES COUNTY SURVEYOR
726 LOS ANGELES COUNTY
ENGINEERING BLDG.
Do not extend notes this side of this line.

Note: Any Additions or Changes on This Sheet Must be Made or Circled in Red Ink With Date and Name of Person Making Change.

PWFB 0726

413

Notes Ck'd by Galli	Survey of Artesia-Norwalk
Map No.	W. O. 6951 Tape No. St'd. °F
Office Work	Surveyed by English
Checked	Notes Date 10
Date	Indexed A C Johnson

F. B. [illegible] Pg. [illegible]

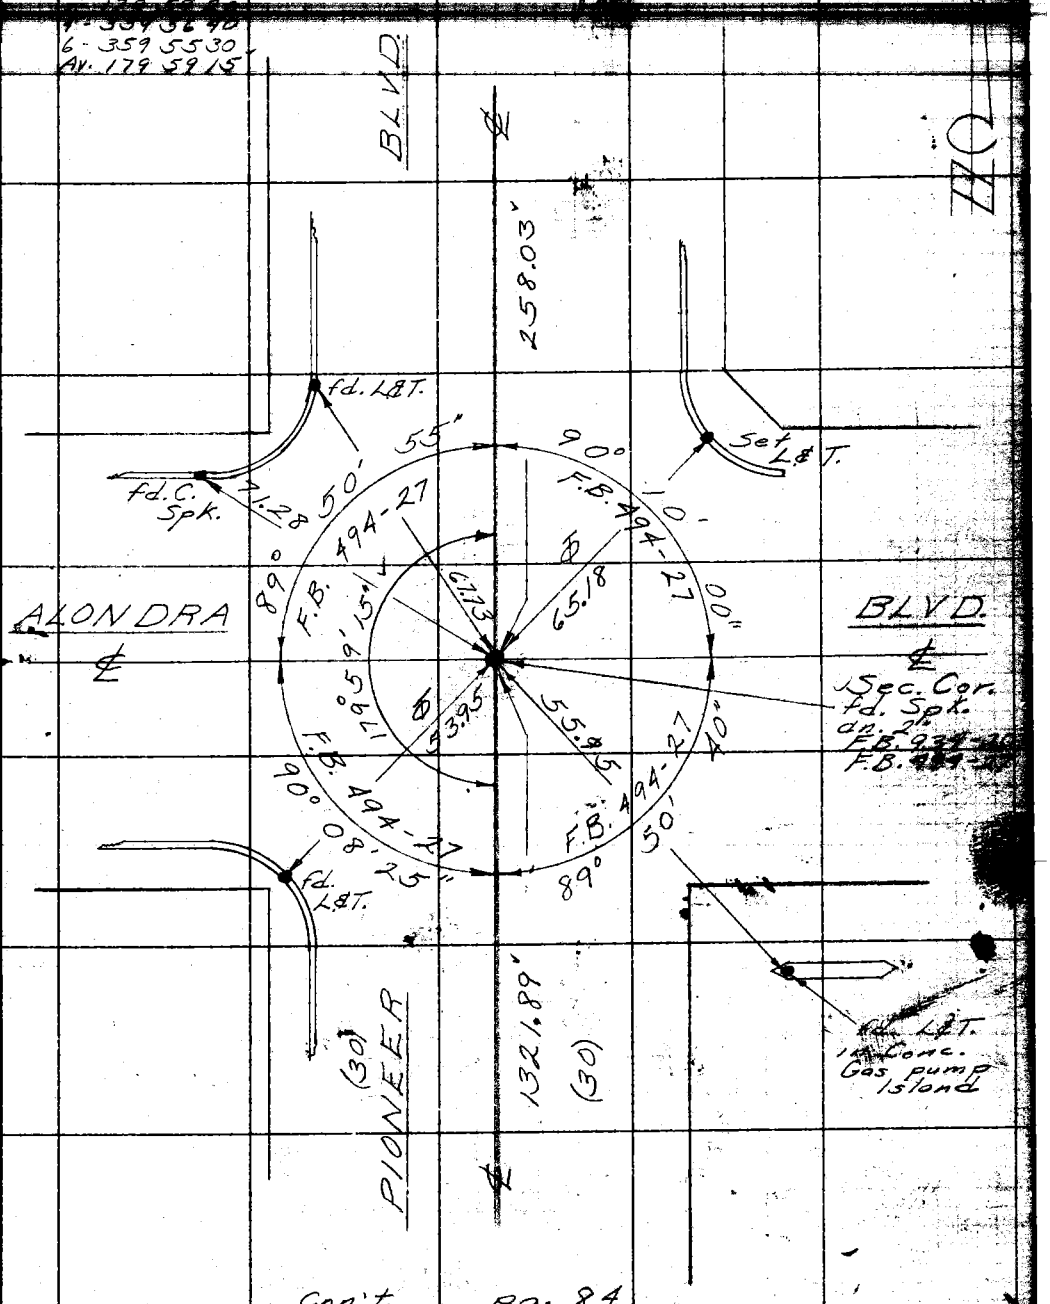

Con't. pg. 84

Any Additions or Changes on This Sheet Must be Made or Circled in Red Ink With Date and Name of Person Making Change.

Do not extend notes this side of this line.

RETURN TO
LOS ANGELES COUNTY SURVEYOR
726 LOS ANGELES COUNTY
ENGINEERING BLDG.

76F3095 247 4-53

PWFB 0726

414, 415

F.B. 1799 PG. 86

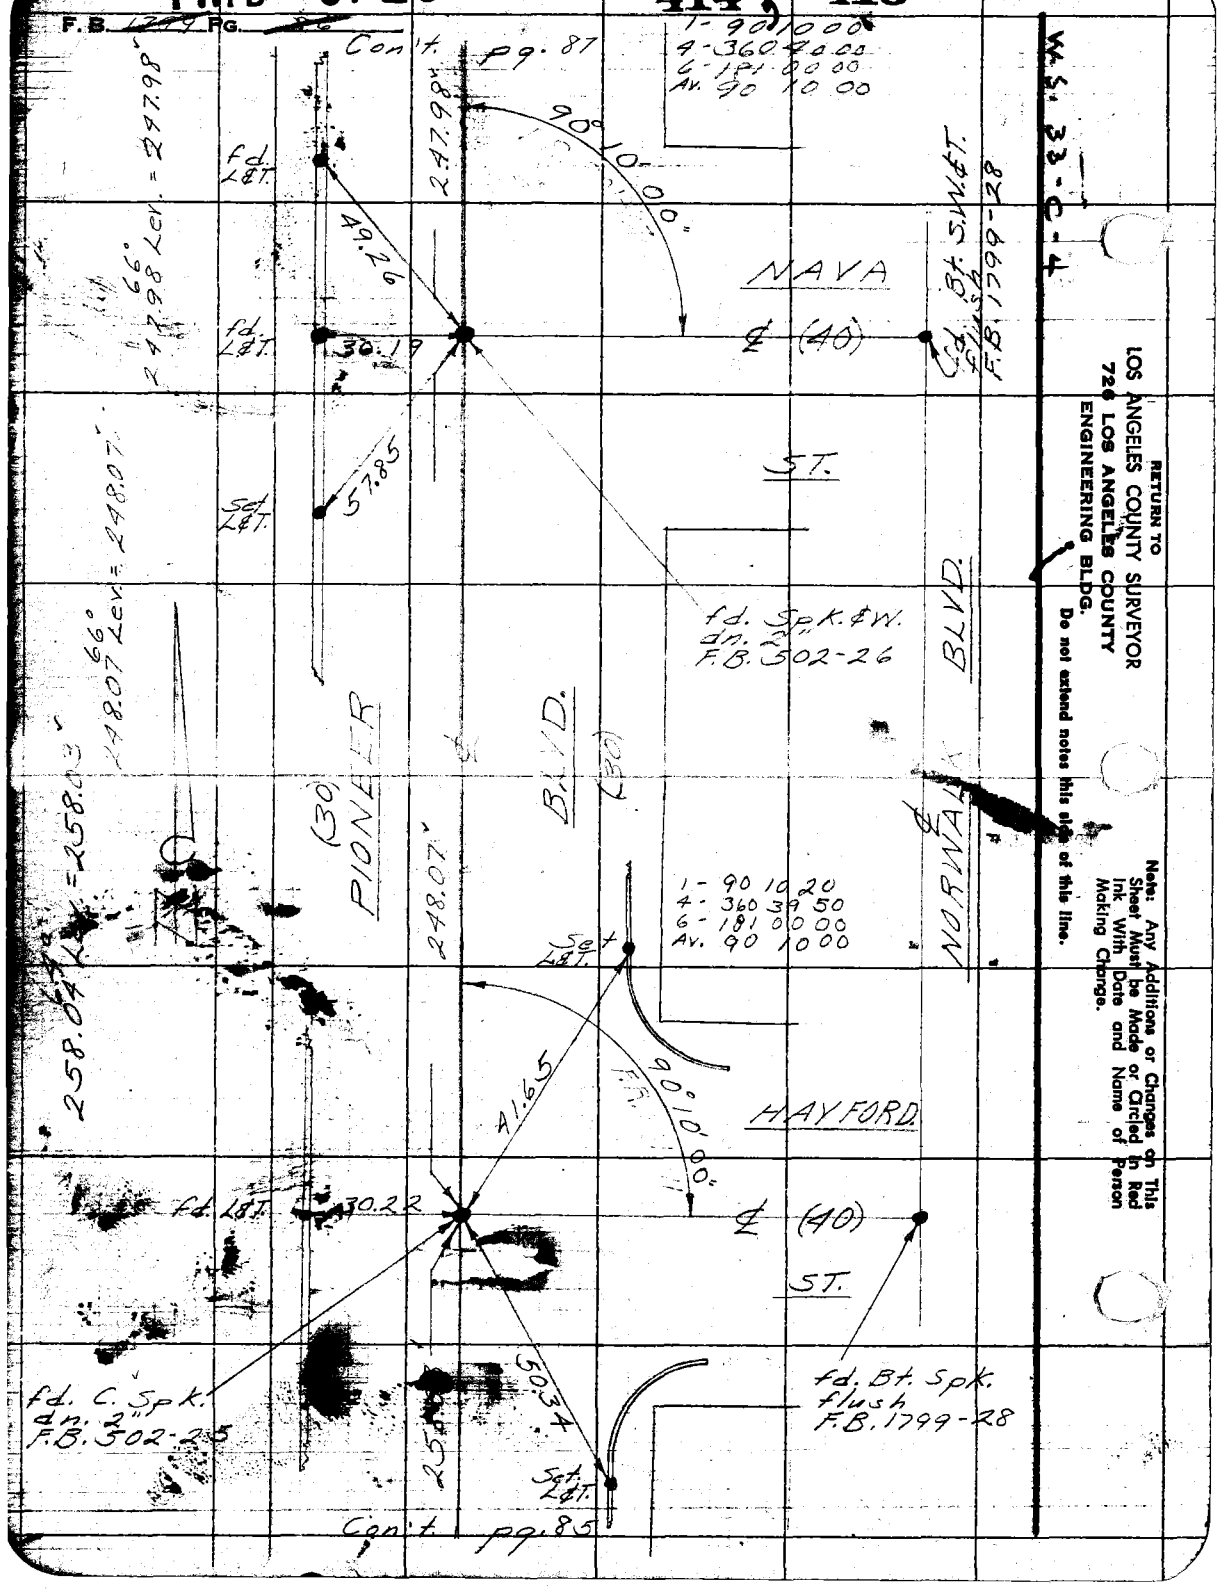

RETURN TO
LOS ANGELES COUNTY SURVEYOR
726 LOS ANGELES COUNTY
ENGINEERING BLDG.

Do not extend notes this side of this line.

Note: Any Additions or Changes on This Sheet Must be Made or Circled in Red Ink With Date and Name of Person Making Change.

PWFB 0726 416

Notes Ck'd by Galli	Survey of [illegible]	F.B. [illegible] Pg. [illegible]
Map No.	W. O. 6951 Tape No. St'd. °F	
Office Work	Surveyed by English	
Checked	Notes " Date 11-53	
Date	Indexed R. C. Johnson	

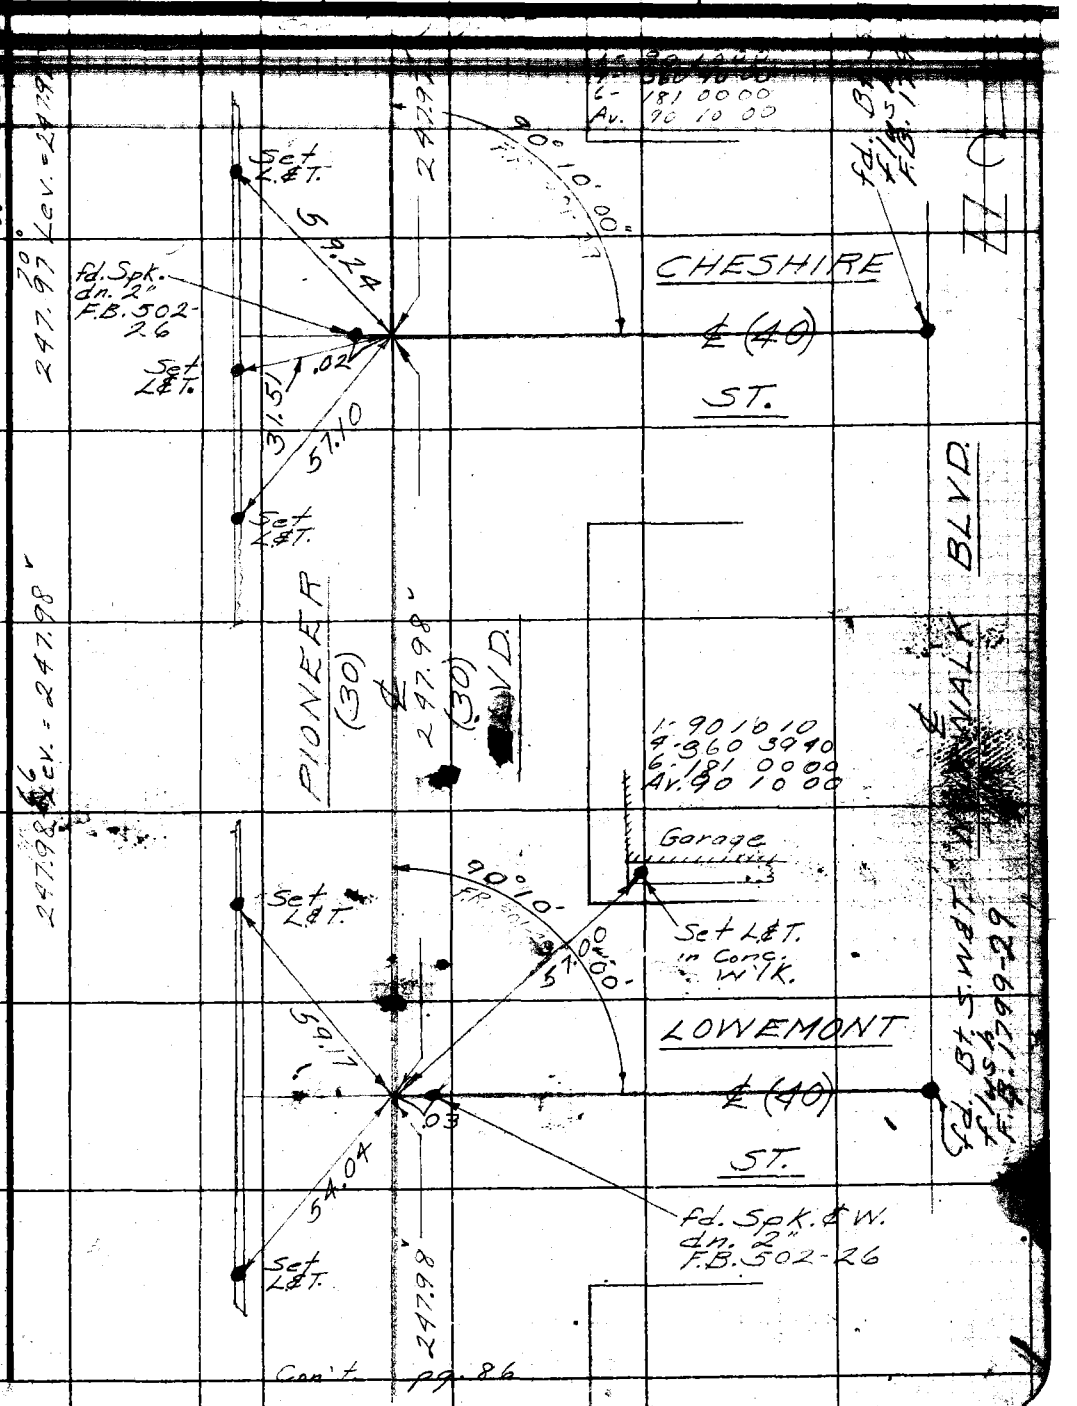

Con't pg. 86

Note: Any Additions or Changes on This Sheet Must be Made or Circled in Red Ink With Date and Name of Person Making Change.

Do not extend notes this side of this line.

RETURN TO
LOS ANGELES COUNTY SURVEYOR
726 LOS ANGELES COUNTY
ENGINEERING BLDG.

76F3098 247 4-53

PWFB 0726 417, 418

F.B. 1799 Pg. 88

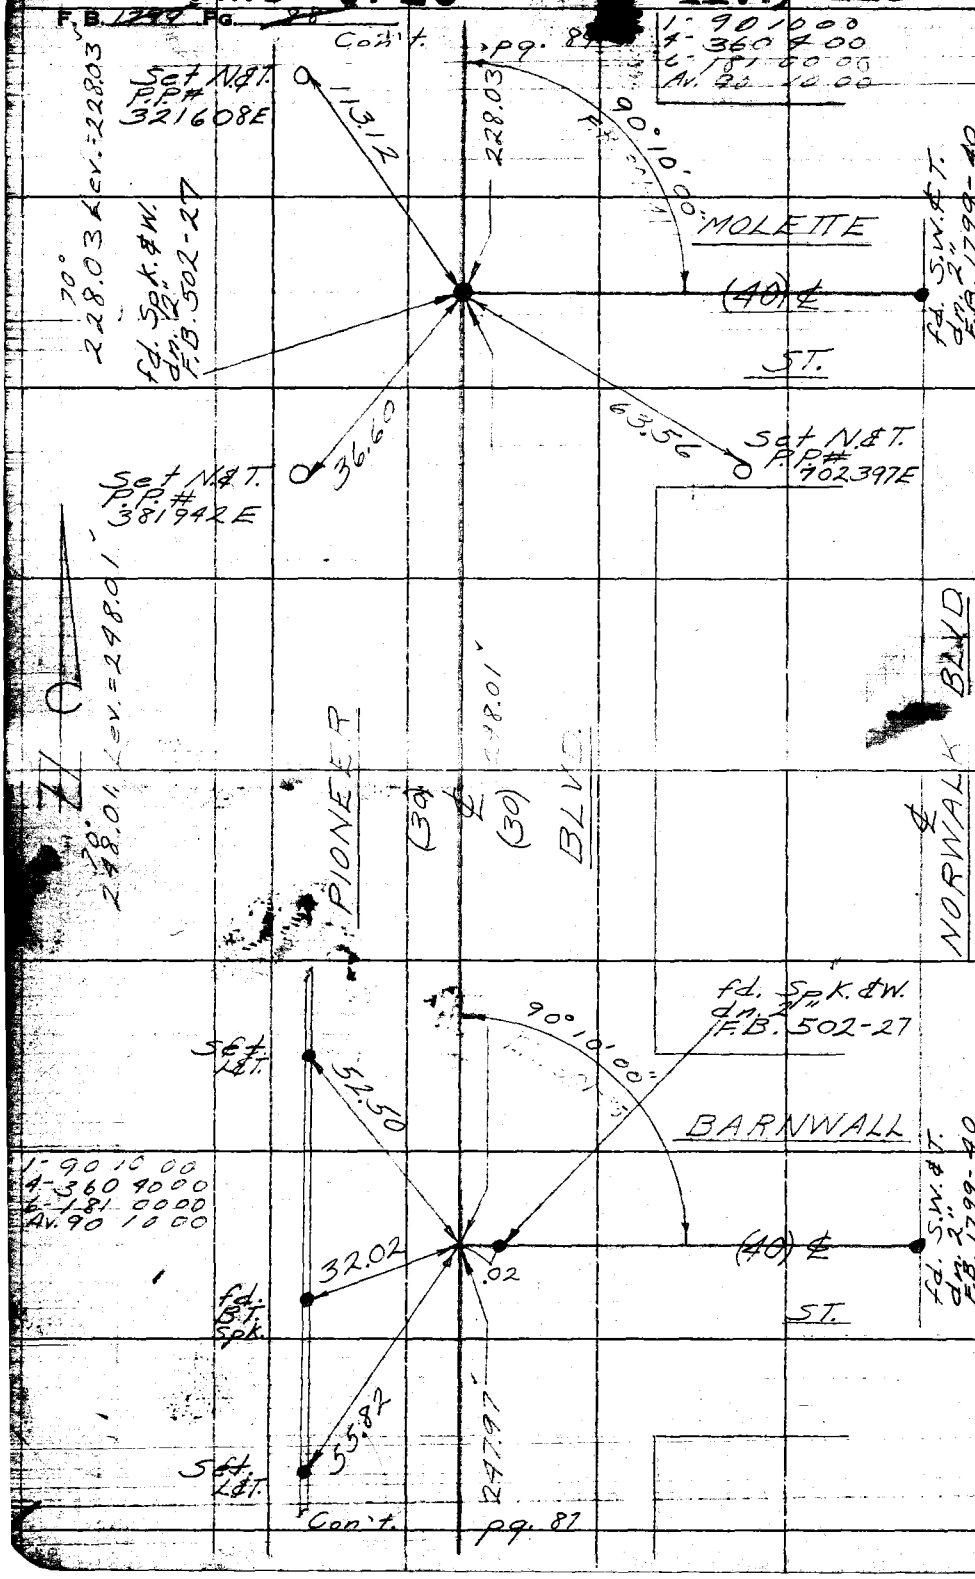

W.S. 33-C-4

RETURN TO
LOS ANGELES COUNTY SURVEYOR
726 LOS ANGELES COUNTY
ENGINEERING BLDG.

Do not extend notes this side of this line.

Note: Any Additions or Changes on This Sheet Must be Made or Circled in Red Ink With Date and Name of Person Making Change.

PWFB 0726

419

Notes Ck'd by Galli
Map No.
Office Work
Checked
Date

Survey of [illegible]
W. O. [illegible] Tape No. St'd.
Surveyed by English
Notes " Date 11-53
Indexed A. C. Johnson

F. B. [illegible] PG. [illegible]

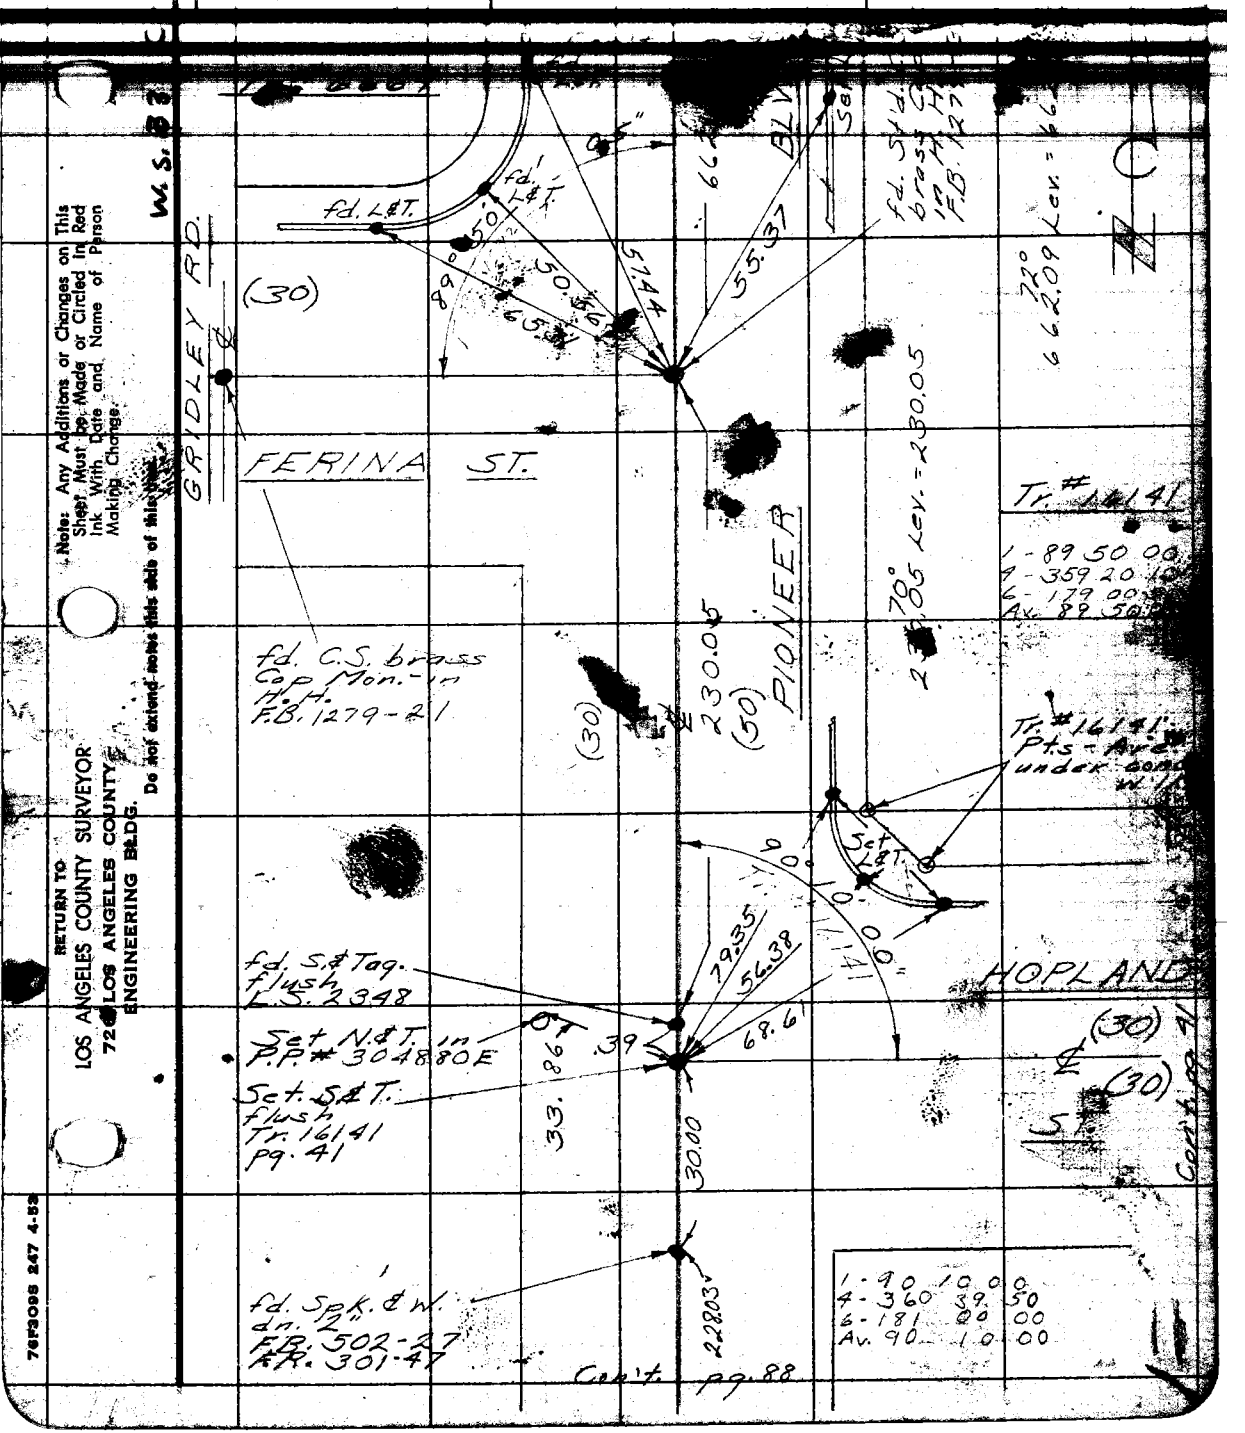

Note: Any Additions or Changes on This Sheet Must be Made or Circled in Red Ink With Date and Name of Person Making Change.

Do not extend notes this side of this line.

RETURN TO
LOS ANGELES COUNTY SURVEYOR
72 LOS ANGELES COUNTY
ENGINEERING BLDG.

76F3098 247 4-53

PWFB 0726 420, 421

F.B. 1799 Fg. 90

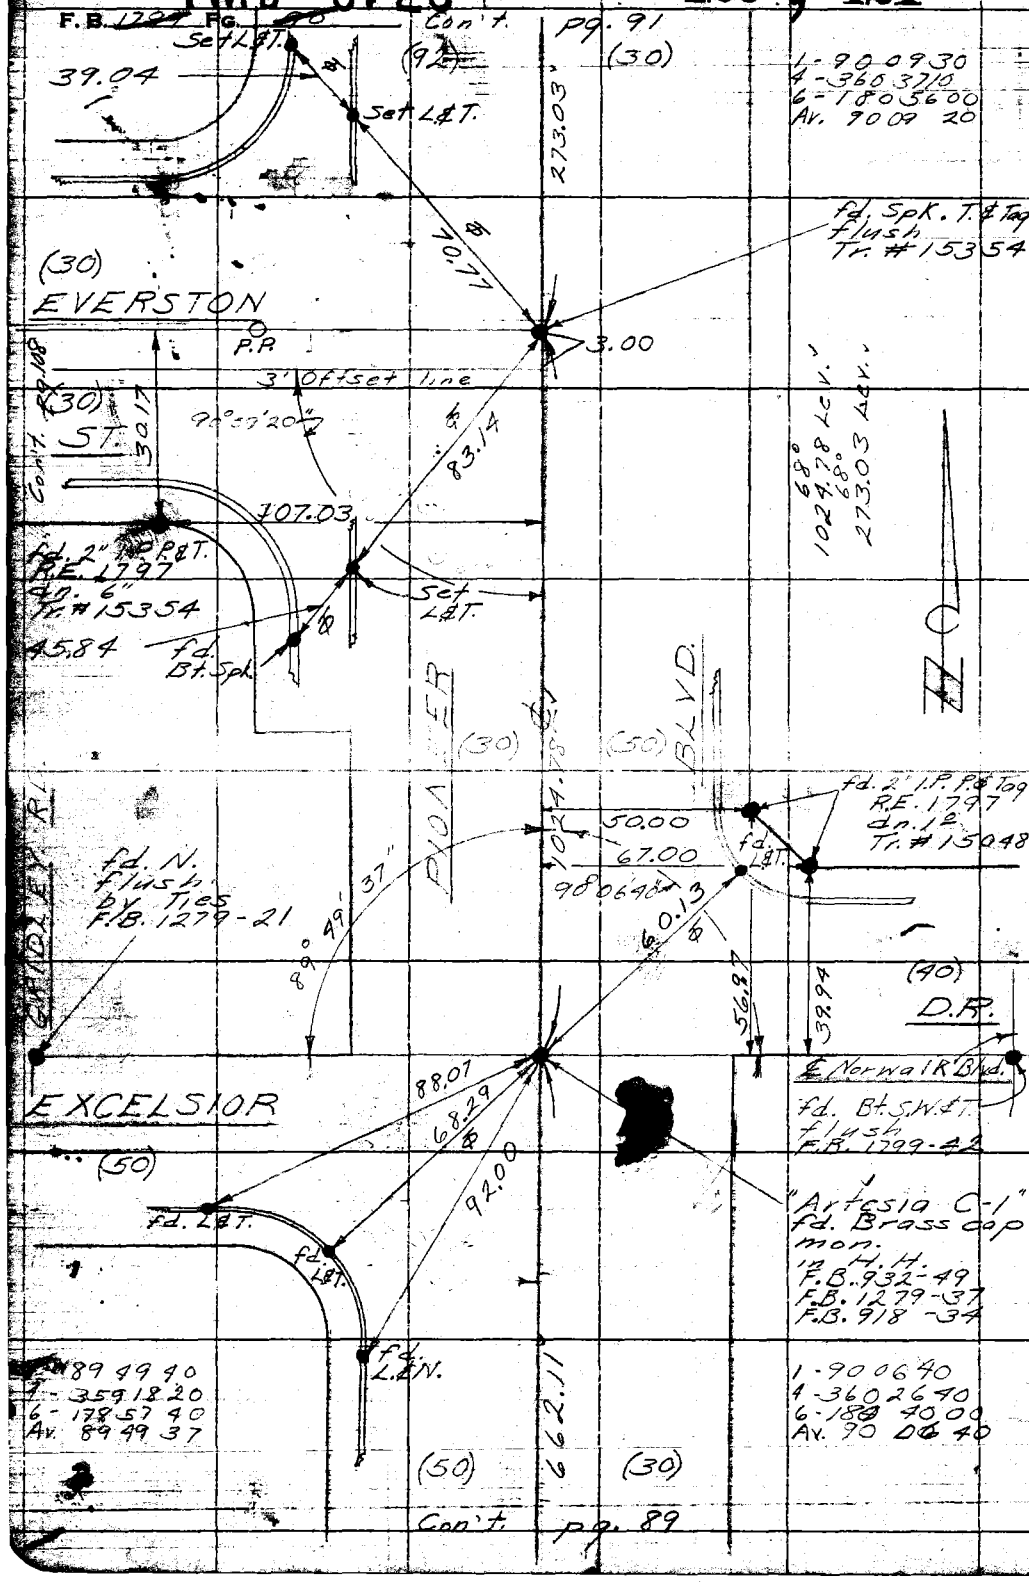

W.S. 33-4-4

RETURN TO
LOS ANGELES COUNTY SURVEYOR
726 LOS ANGELES COUNTY
ENGINEERING BLDG.

Do not extend notes this side of this line.

Note: Any Additions or Changes on This Sheet Must be Made or Circled in Red Ink With Date and Name of Person Making Change.

PWEB 0726 422

Notes Ck'd by Galli	Survey of
Map No.	W. O. 6751 Tape No. Std. of
Office Work	Surveyed by English
Checked	Notes 1" Date 11-53
Date	Indexed A. C. Johnson

F. B. 1792 PG. 41

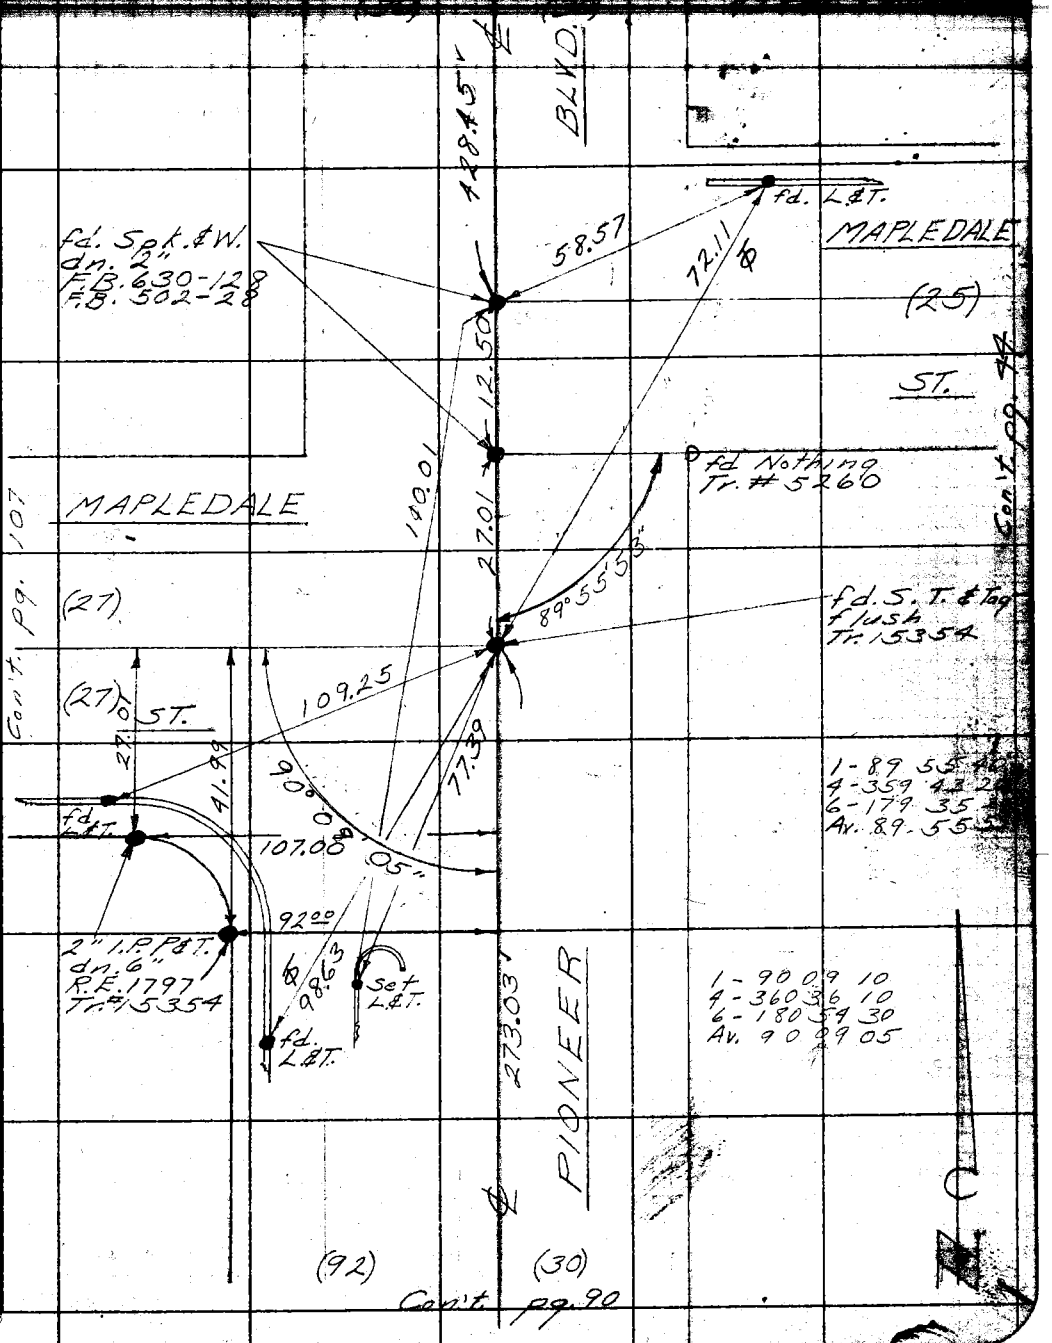

Note: Any Additions or Changes on This Sheet Must be Made or Circled in Red Ink With Date and Name of Person Making Change.

Do not extend notes this side of this line.

RETURN TO
LOS ANGELES COUNTY SURVEYOR
726 LOS ANGELES COUNTY
ENGINEERING BLDG.

W.S. 33-

76F3095 247 4-53

PWFB 0726

423

F.B. 1789 PG. 92

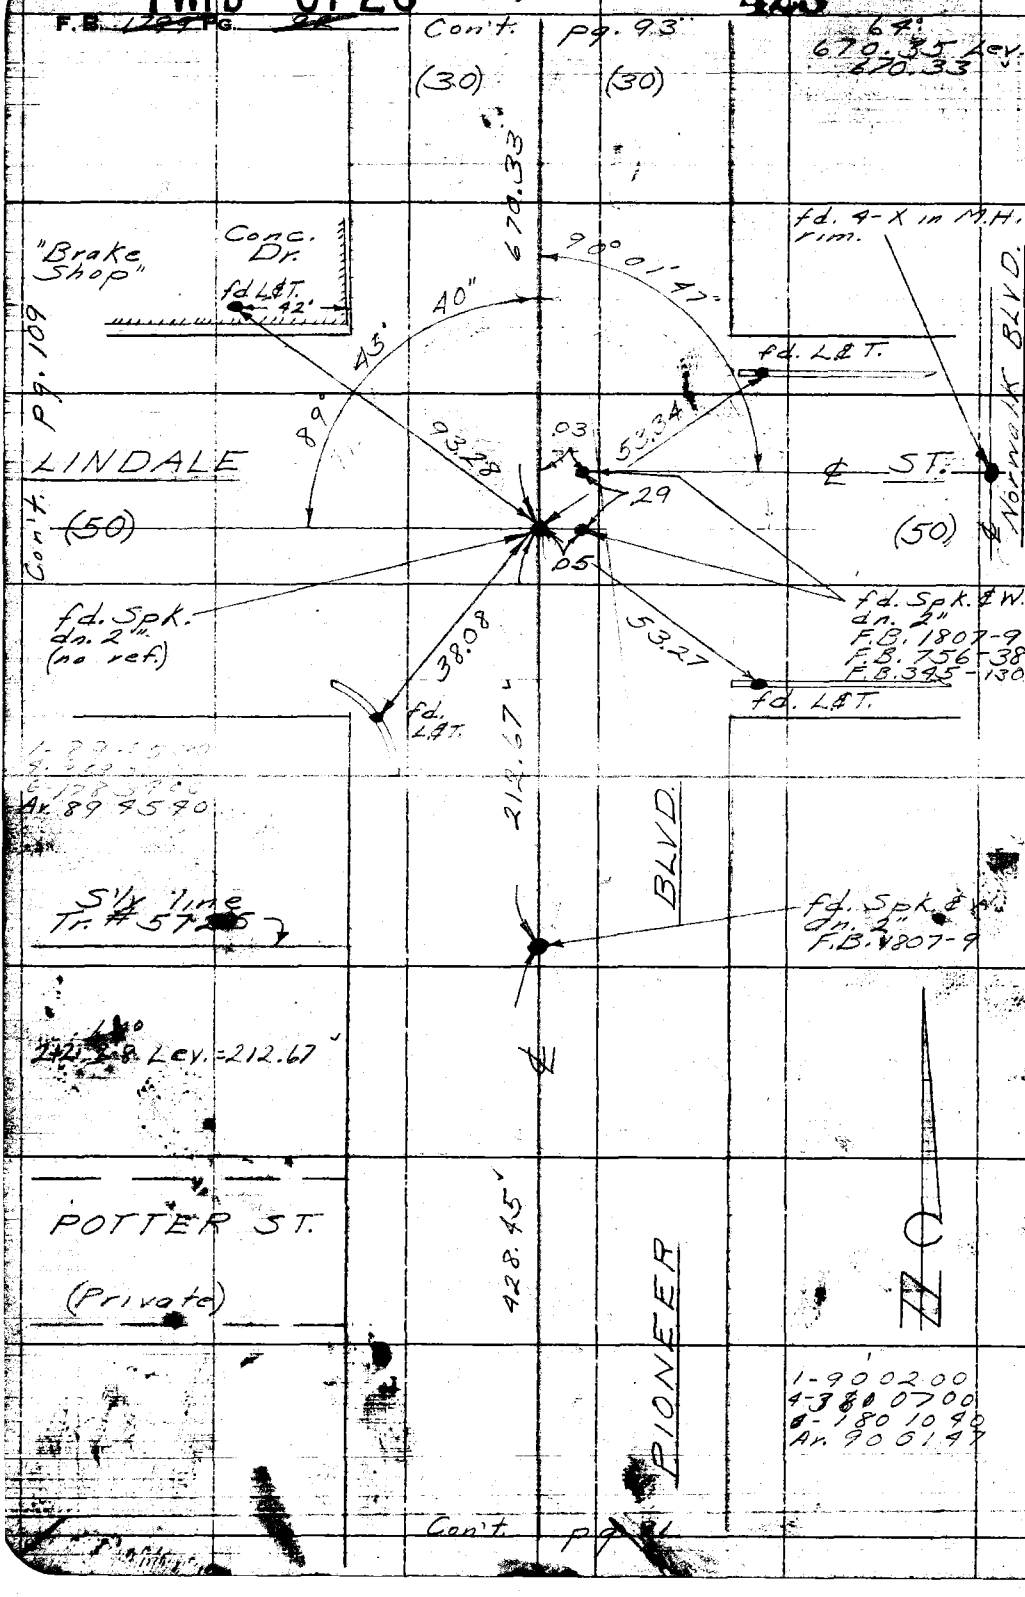

RETURN TO
LOS ANGELES COUNTY SURVEYOR
726 LOS ANGELES COUNTY
ENGINEERING BLDG.

Do not extend notes this side of this line.

Note: Any Additions or Changes on This Sheet Must be Made or Circled in Red Ink With Date and Name of Person Making Change.

PWFB 0726

424

Notes Ck'd by Galli	Survey of Artesia-Norwalk	F. B. [illegible] PG. [illegible]
Map No.	W. O. 6951 Tape No. Std. °F	fd. S.W.L.T.
Office Work	Surveyed by English	fn. 2" @ ℄ Int.
Checked	Notes " Date 11-53	℄ Pt. Locust &
Date	Indexed A. C. Johnson	fd. S.W.L.T.

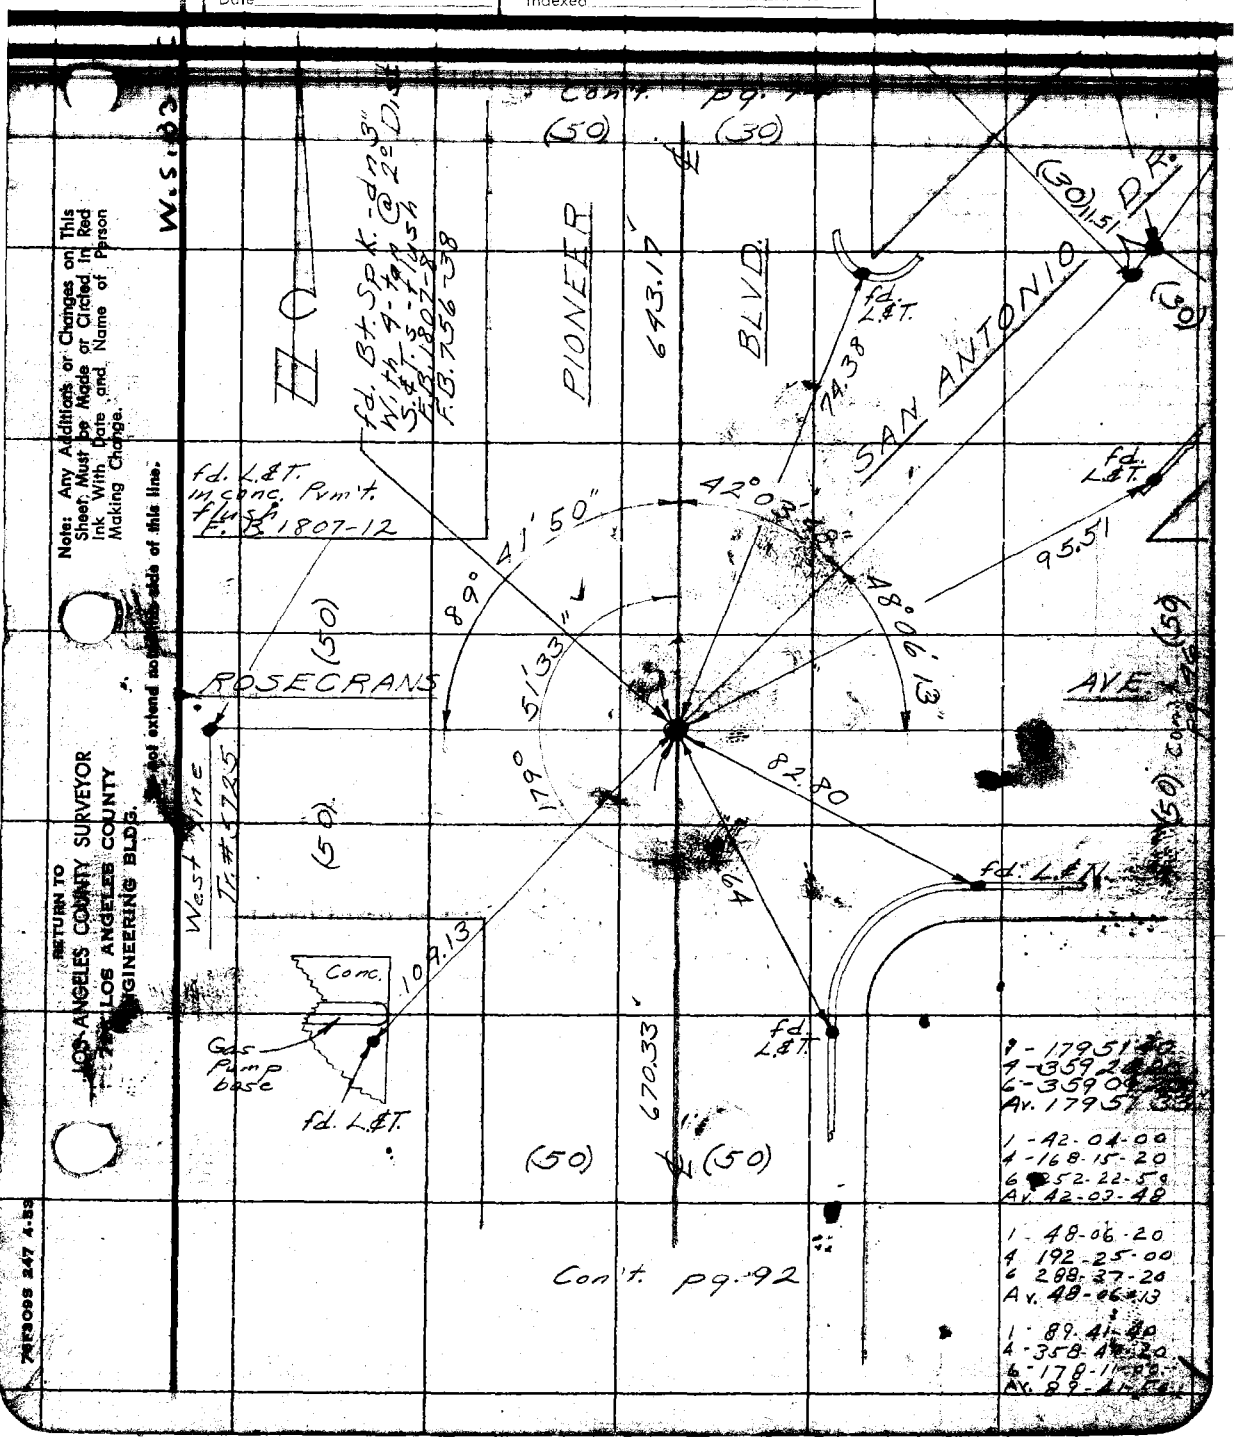

9 - 179 51 [illegible]
4 - 359 2[illegible]
6 - 359 0[illegible]
Av. 179 51 [illegible]

1 - 42-04-00
4 - 168-15-20
6 - 252-22-50
Av. 42-03-48

1 - 48-06-20
4 - 192-25-00
6 - 288-37-20
Av. 48-06-13

1 - 89-41-40
4 - 358-4[illegible]-20
6 - 178-11-00
Av. 89-41-[illegible]

Note: Any Additions or Changes on This Sheet Must be Made or Circled in Red Ink With Date and Name of Person Making Change.

Do not extend notes into side of this line.

RETURN TO
LOS ANGELES COUNTY SURVEYOR
[illegible] LOS ANGELES COUNTY
ENGINEERING BLDG.

76F3093 247 4-53

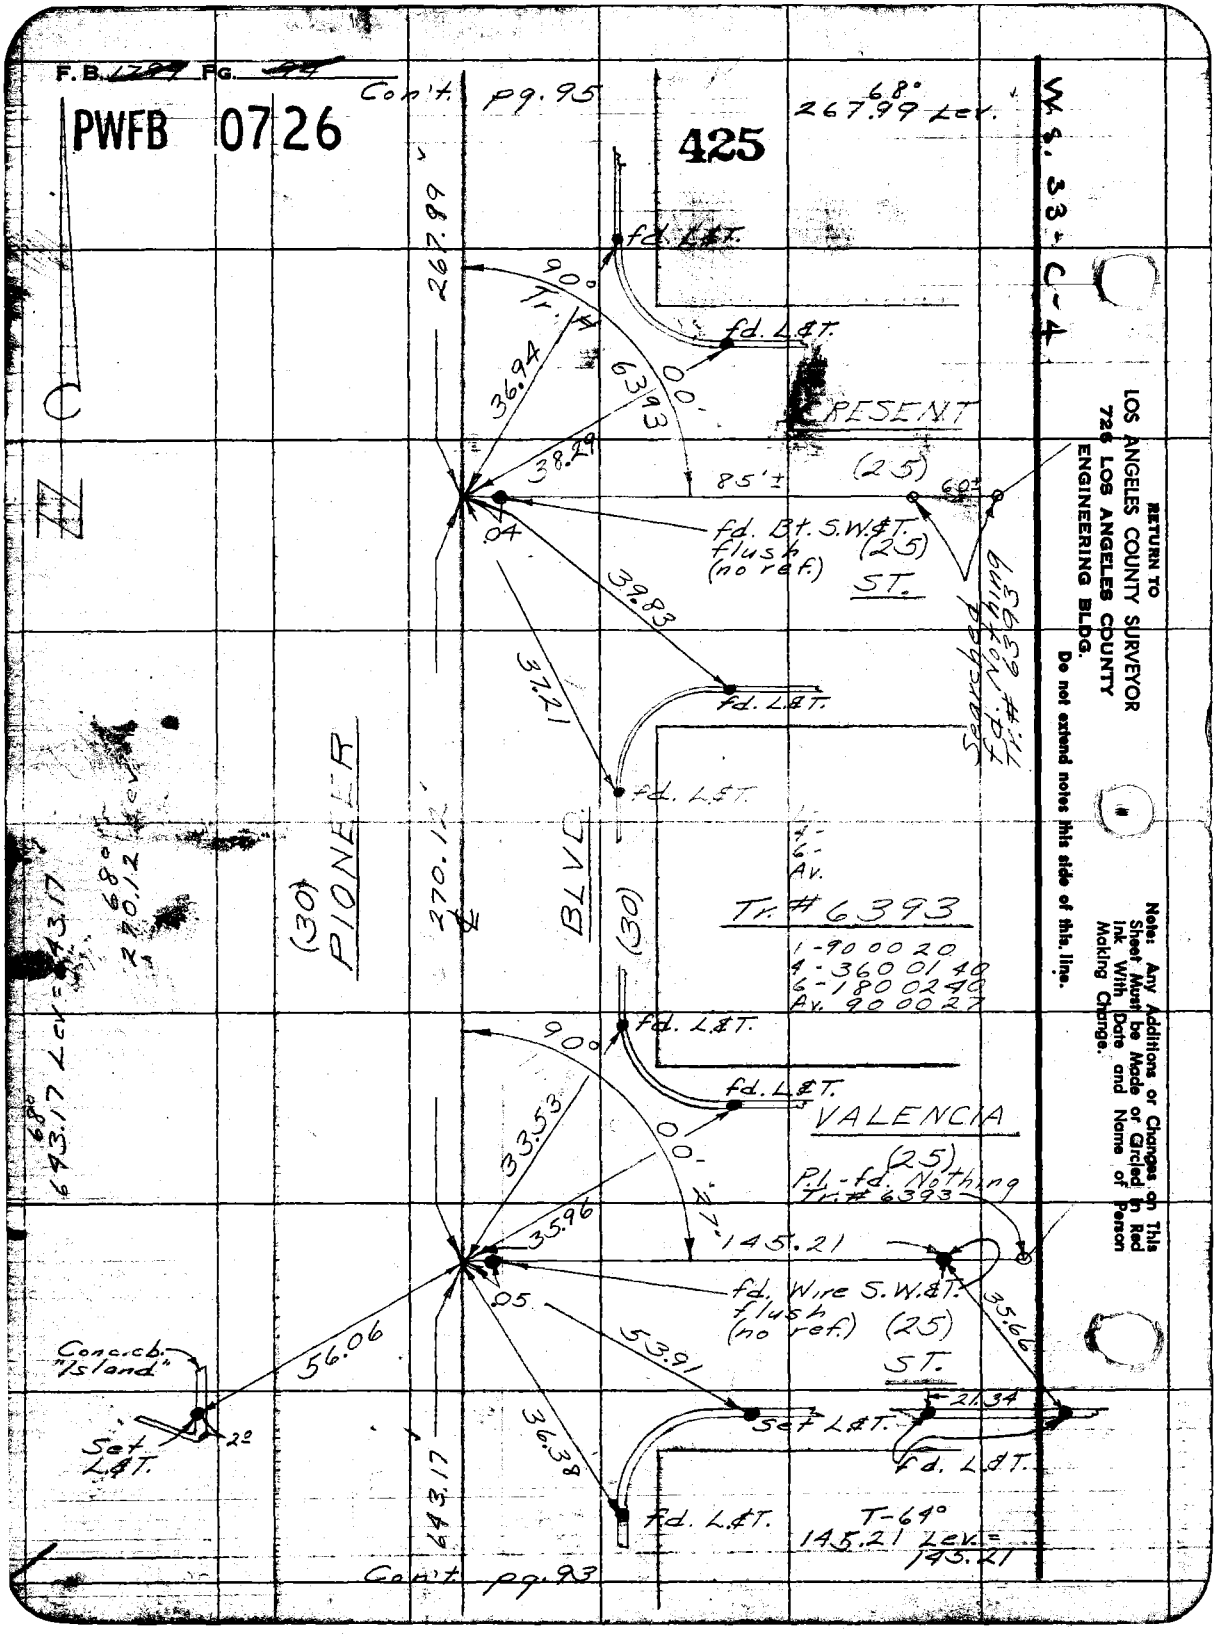
F.B. 1799 Pg. 94
PWFB 0726
Con't. pg. 95
425
68° 267.99 Lev.
W.S. 33-C-4
267.99
fd. L&T.
90°
Tr. # 6393
00'
36.94
38.29
CRESENT
(25)
85'±
60±
fd. Bt. S.W.&T. flush (no ref.)
(25)
ST.
.04
39.83
37.21
Searched fd. Nothing Tr. # 6393
fd. L&T.
fd. L&T.
PIONEER
(30)
270.12
BLVD.
(30)
1-
4-
6-
Av.
Tr. # 6393
1-90 00 20
4-360 01 40
6-180 02 40
Av. 90 00 27
68° 270.12 Lev.
643.17 Lev = 643.17
68°
fd. L&T.
90°
fd. L&T.
VALENCIA
(25)
P.L.-fd. Nothing Tr. # 6393
33.53
00'
27'
145.21
35.96
fd. Wire S.W.&T. flush (no ref.)
(25)
ST.
.05
35.66
53.91
56.06
Concrete "Island"
Set L&T.
2°
21.34
Set L&T.
fd. L&T.
36.38
643.17
fd. L&T.
T-64°
145.21 Lev. = 145.21
Con't. pg. 93
RETURN TO
LOS ANGELES COUNTY SURVEYOR
726 LOS ANGELES COUNTY
ENGINEERING BLDG.
Do not extend notes this side of this line.
Note: Any Additions or Changes on This Sheet Must be Made or Circled in Red Ink With Date and Name of Person Making Change.

PWFB 0726 426, 427

Notes Ck'd by Galli	Survey of Antonio-Norwalk	F.B. 1204 Pg. 23
Map No.	W. O. 6951 Tape No. Sr'd. °F	
Office Work	Surveyed by English	
Checked	Notes " Date 11-53	
Date	Indexed A. C. Johnson	

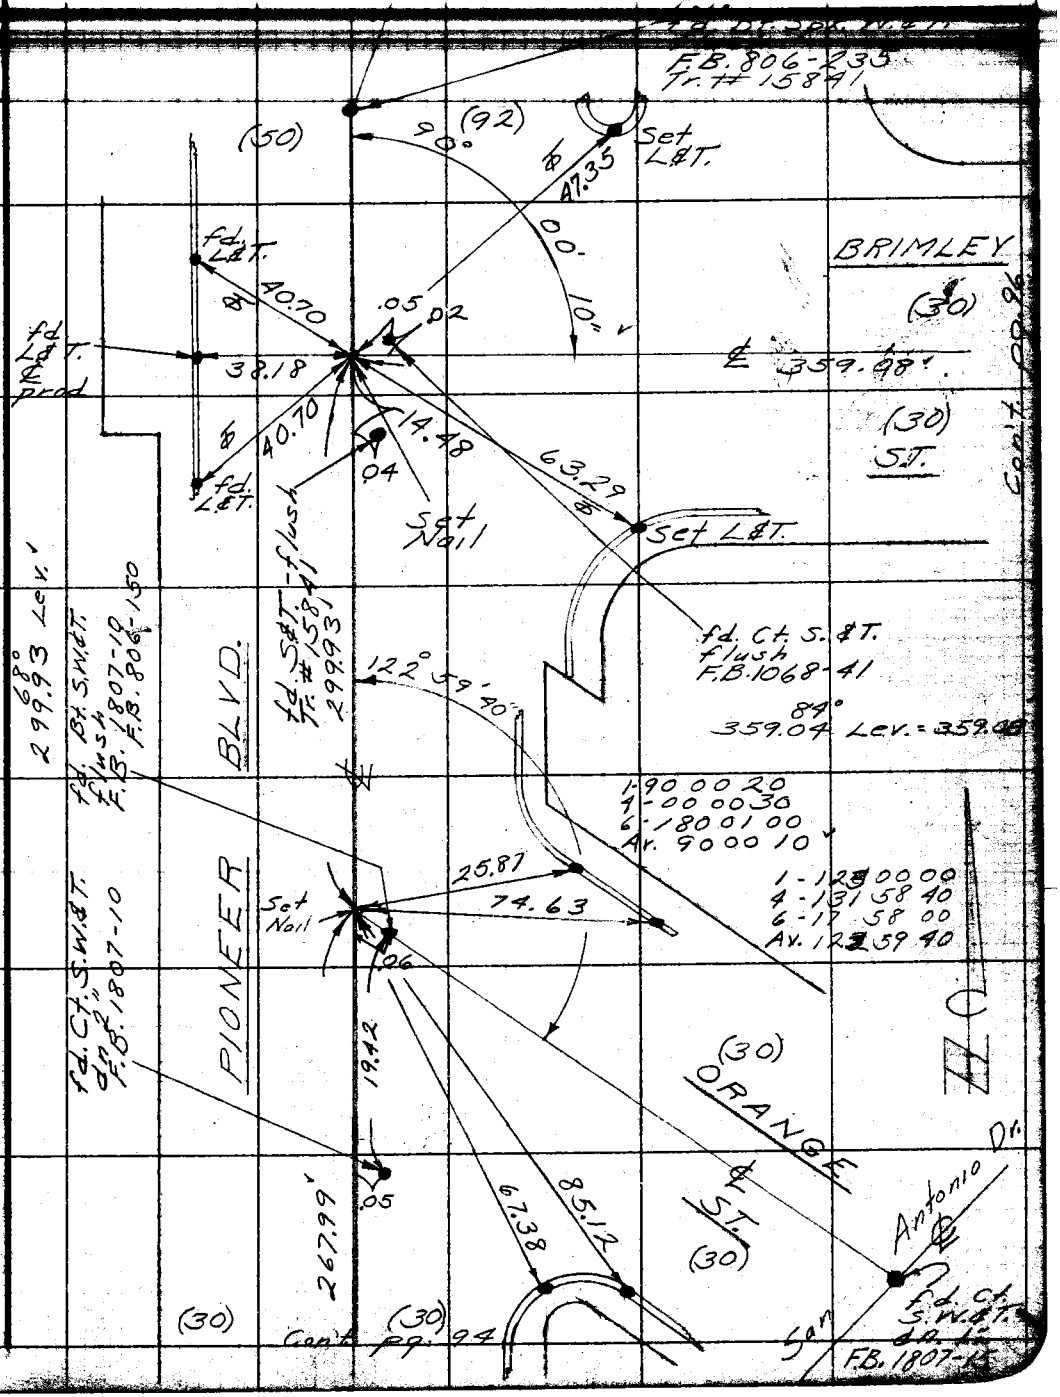

Note: Any Additions or Changes on This Sheet Must be Made or Circled in Red Ink With Date and Name of Person Making Change.

Do not extend notes this side of this line.

RETURN TO
LOS ANGELES COUNTY SURVEYOR
726 LOS ANGELES COUNTY
ENGINEERING BLDG.

78F3095.247 4-53


Con't. pg. 97

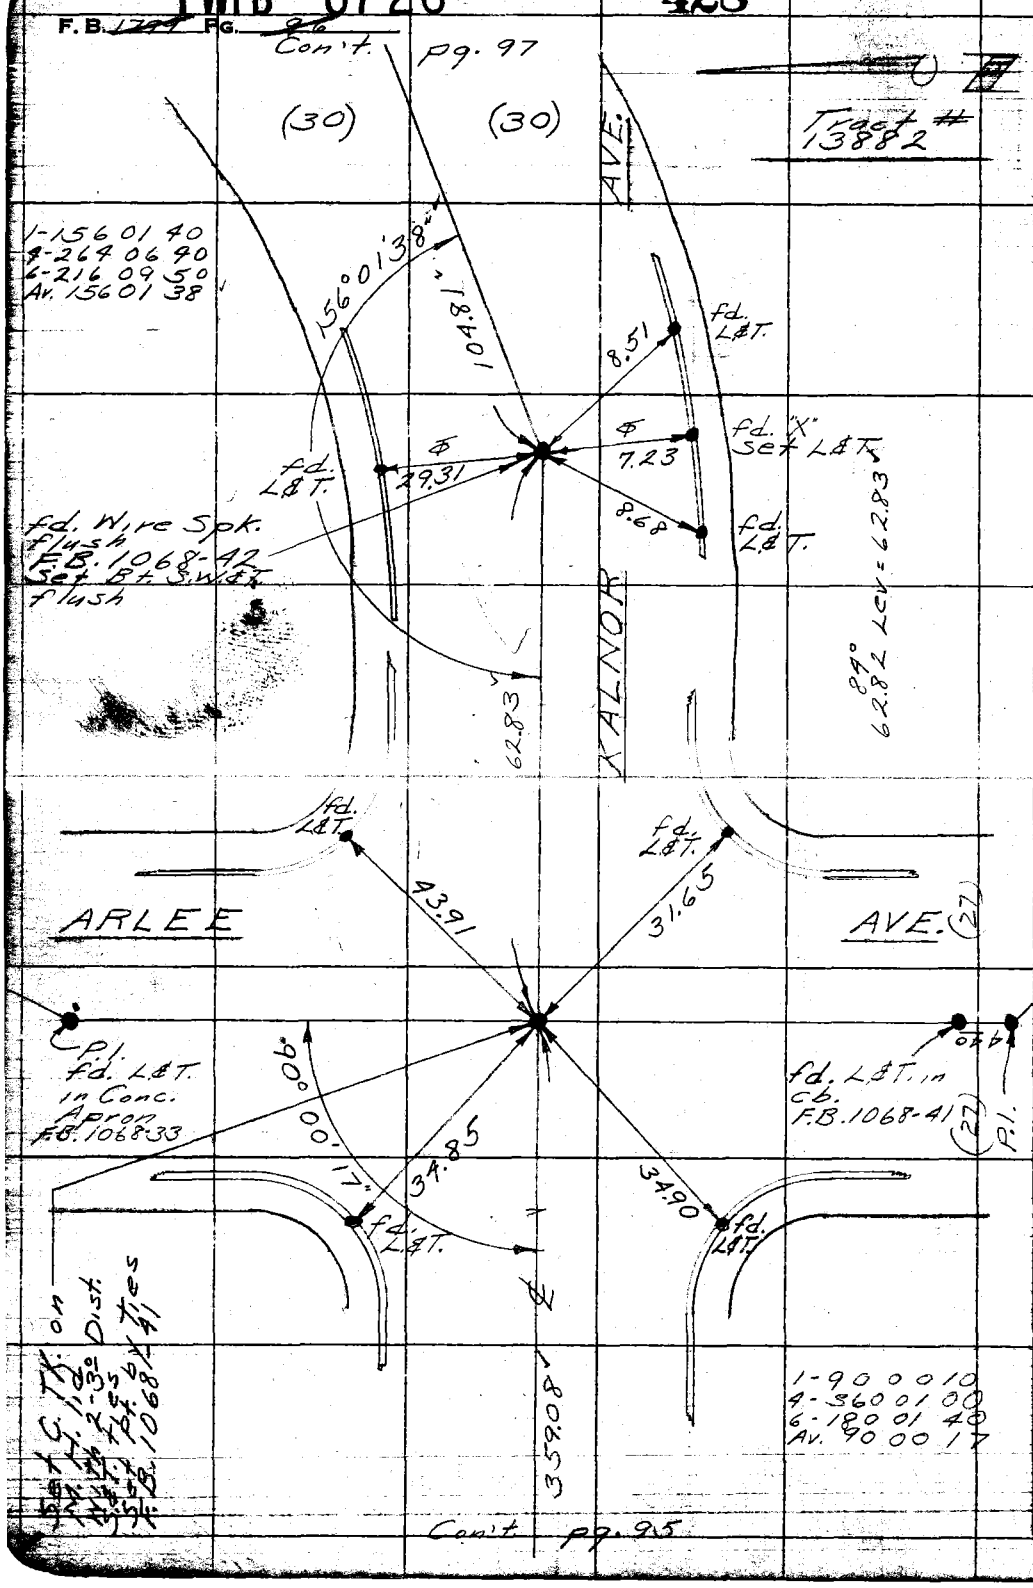

Con't pg. 95

RETURN TO
LOS ANGELES COUNTY SURVEYOR
726 LOS ANGELES COUNTY
ENGINEERING BLDG.
Do not extend notes this side of this line.

Note: Any Additions or Changes on This Sheet Must be Made or Circled in Red Ink With Date and Name of Person Making Change.

PWFB 0726

429

Notes Ck'd by Gatti	Survey of Artesia-Norwalk
Map No.	W. O. 6951 Tape No. St'd. °F
Office Work	Surveyed by English
Checked	Notes Date 11-53
Date	Indexed [illegible] Johnson

F. B. [illegible] Pg. [illegible]

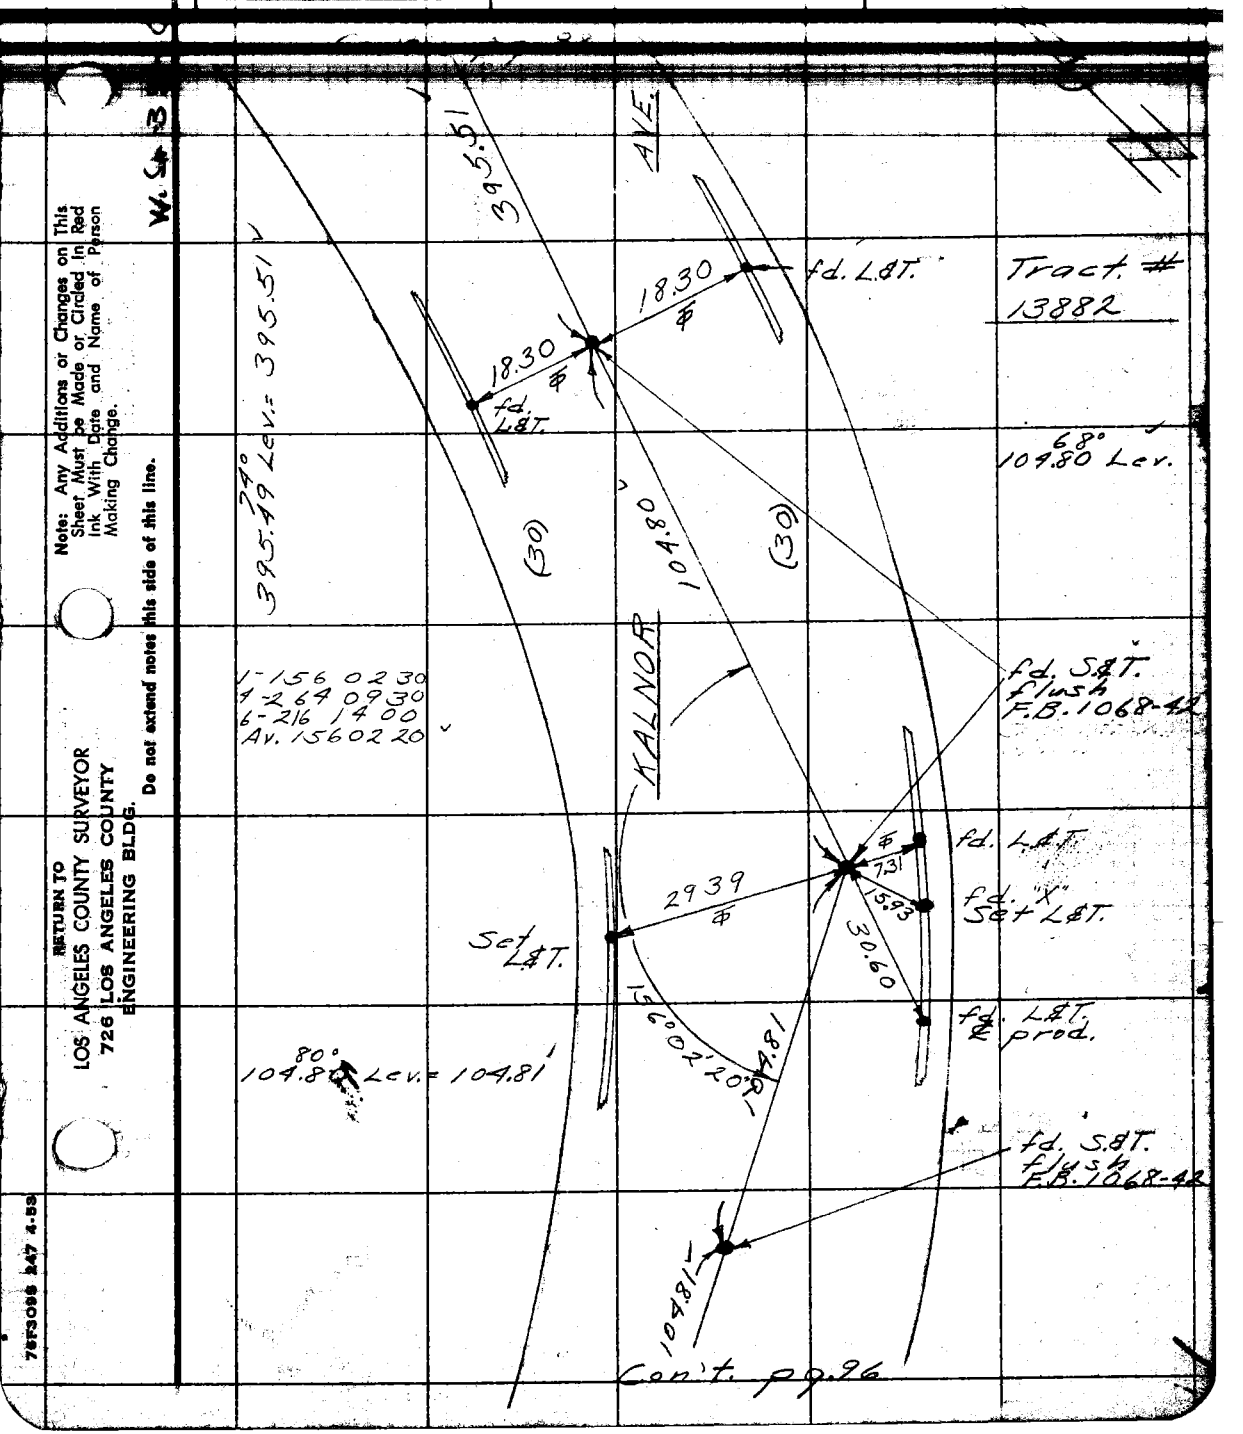

Note: Any Additions or Changes on This Sheet Must be Made or Circled in Red Ink With Date and Name of Person Making Change.

Do not extend notes this side of this line.

RETURN TO
LOS ANGELES COUNTY SURVEYOR
726 LOS ANGELES COUNTY
ENGINEERING BLDG.

76F3098 247 4-53

F. B. 1739 PG. 98

Con't. pg. 97

W.S. 33-C-3

fd. 4"X" on M.H. rim F.B. 1068-37

Tract # 13882

(30)

395.51' (30)

fd. L&T.

18.26

18.24

fd. L&T.

fd. Wire S.&T. flush F.B. 1068-37

41.93

37.75'

41.92

74° 37.75 Lev.

171°30'25"

1- 171 30 30
4- 326 02 00
6- 309 02 30
Av. 171 30 25

74° 37.76 Lev.

KALNOR

37.76'

AVE.

Con't. pg. 99

RETURN TO
LOS ANGELES COUNTY SURVEYOR
726 LOS ANGELES COUNTY
ENGINEERING BLDG.
Do not extend notes this side of this line.

Note: Any Additions or Changes on This Sheet Must be Made or Circled in Red Ink With Date and Name of Person Making Change.

PWEB 0726 431, 432, 433

Notes Ck'd by Galli	Survey of Artesia-Norwalk	F.B. 1299 Pg. 99
Map No.	W. O. 6951 Tape No. 0130 Std.	74° 371.18 Lev. = 371.19
Office Work	Surveyed by English	
Checked	Notes Date 4-53	1-94 44 30
Date	Indexed A. C. Johnson	4-18 58 00

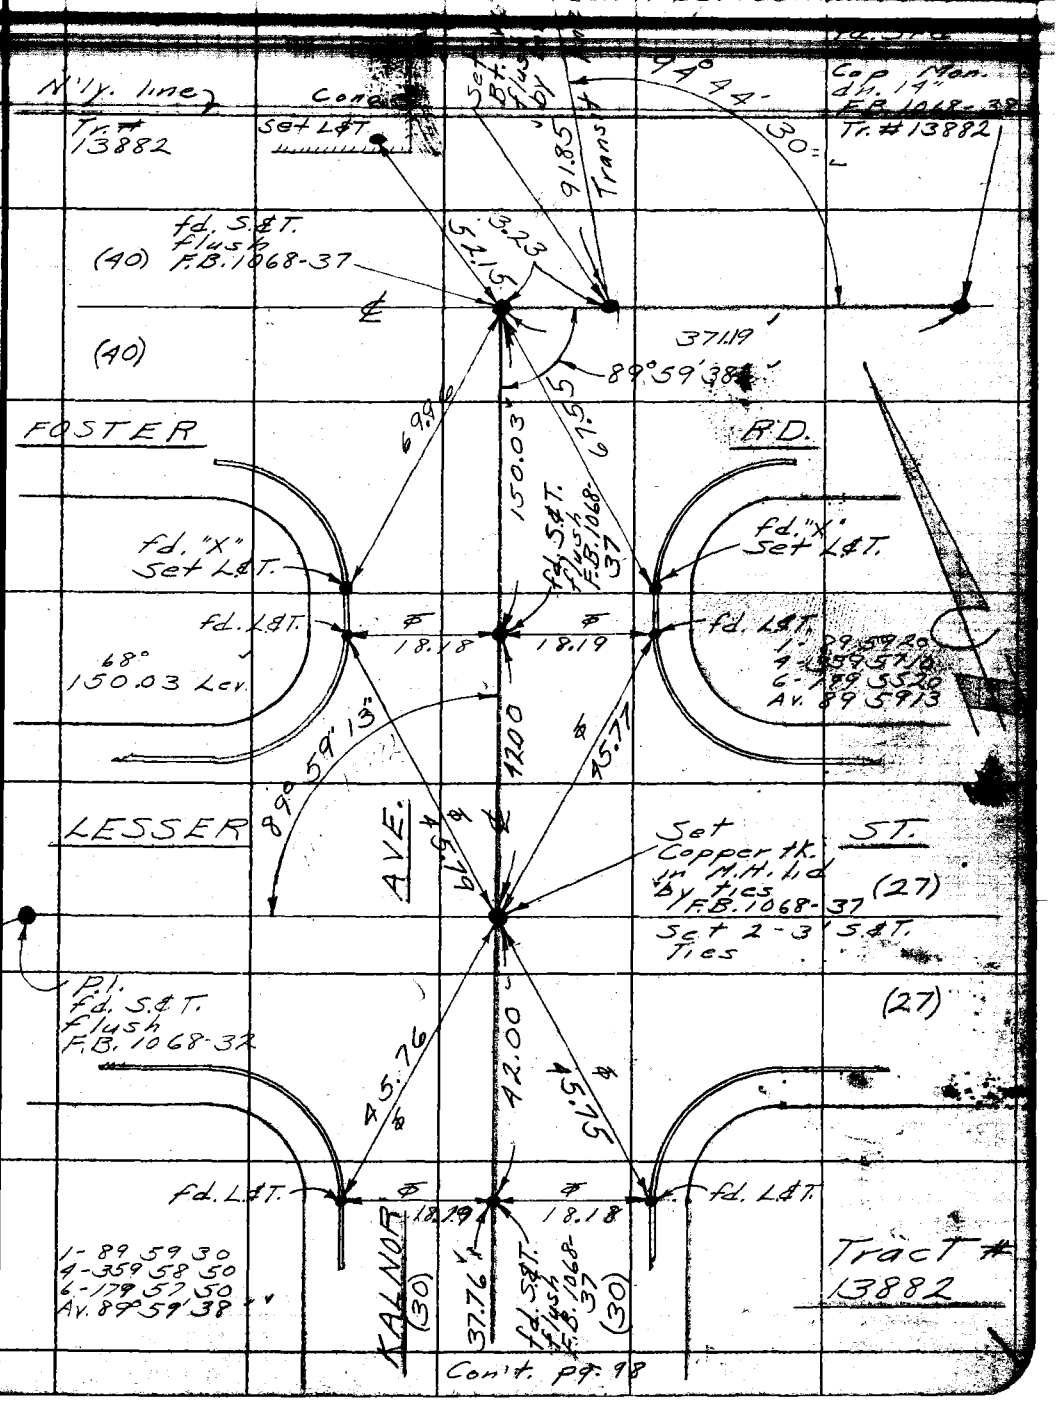

Con't. pg. 98

Note: Any Additions or Changes on This Sheet Must be Made or Circled in Red Ink With Date and Name of Person Making Change.

Do not extend notes this side of this line.

RETURN TO
LOS ANGELES COUNTY SURVEYOR
726 LOS ANGELES COUNTY
ENGINEERING BLDG.

76F3095 247 4-53

F. B. 1799 PG. 100 Con't. pg. 101

PWFB 0726

434

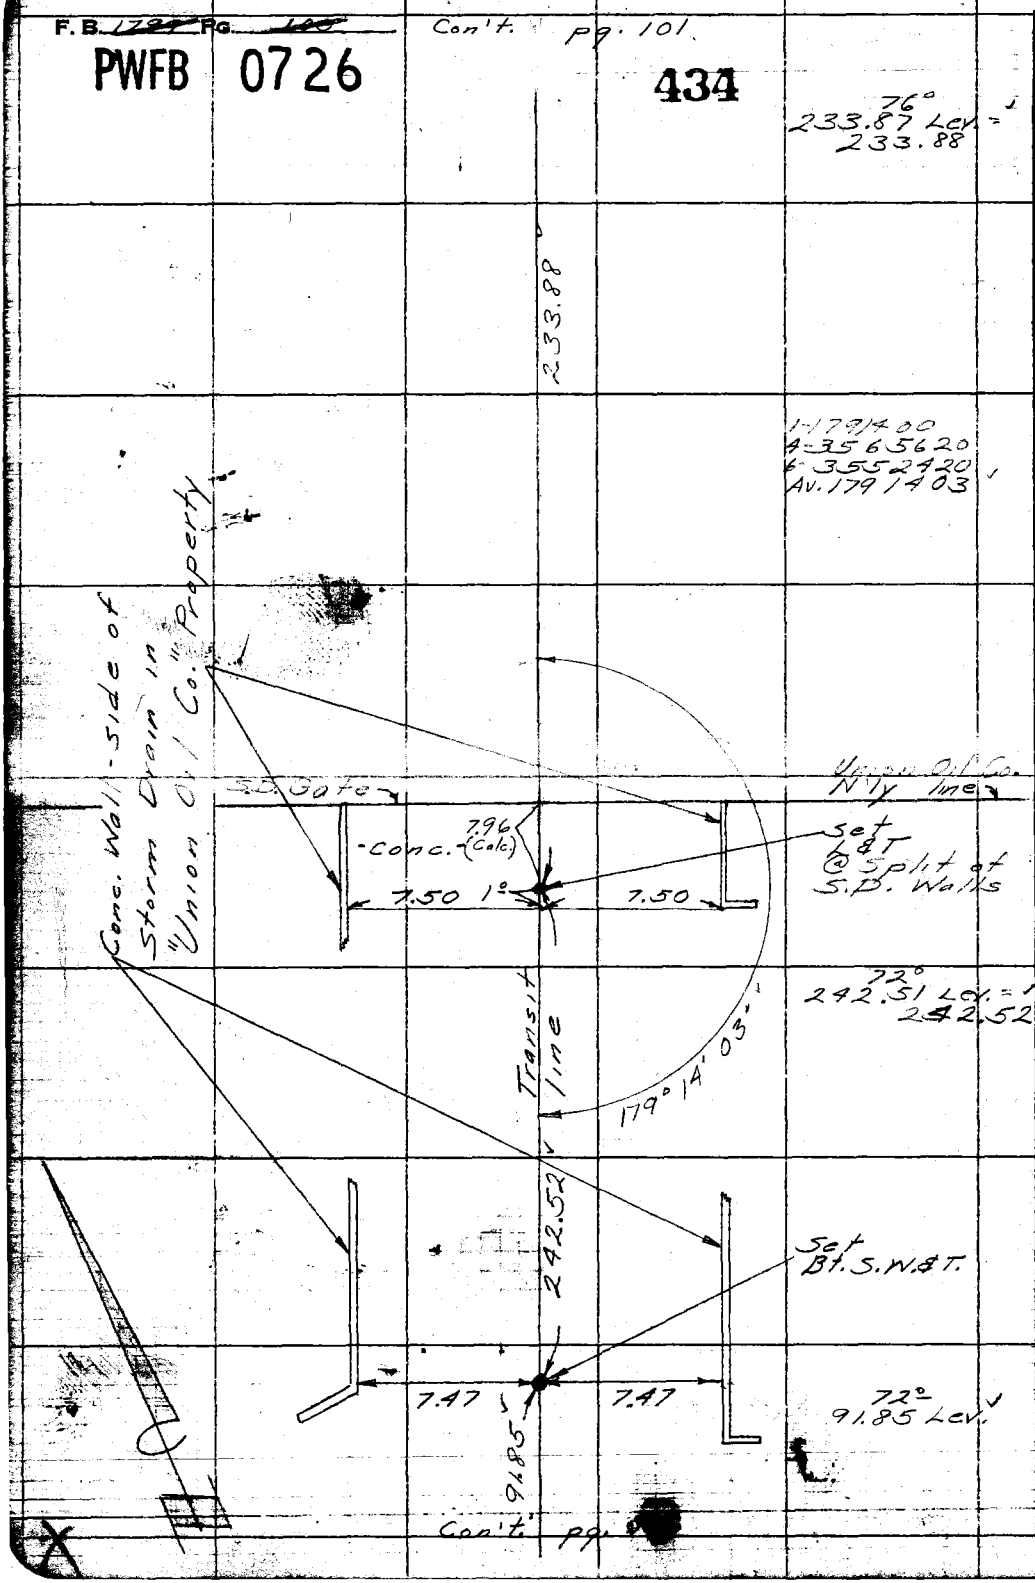

Con't. pg.

RETURN TO
LOS ANGELES COUNTY SURVEYOR
726 LOS ANGELES COUNTY
ENGINEERING BLDG.
Do not extend notes this side of this line.

Note: Any Additions or Changes on This Sheet Must be Made or Circled in Red Ink With Date and Name of Person Making Change.

PWFB 0726

435, 436

F.B. [illegible] Pg. [illegible]

Notes Ck'd by Galli
Map No.
Office Work
Checked
Date

Survey of Artesia-Norwalk
W. O. 6957 Tape No. St'd. °F
Surveyed by English
Notes " Date 11-53
Indexed K. C. Johnson

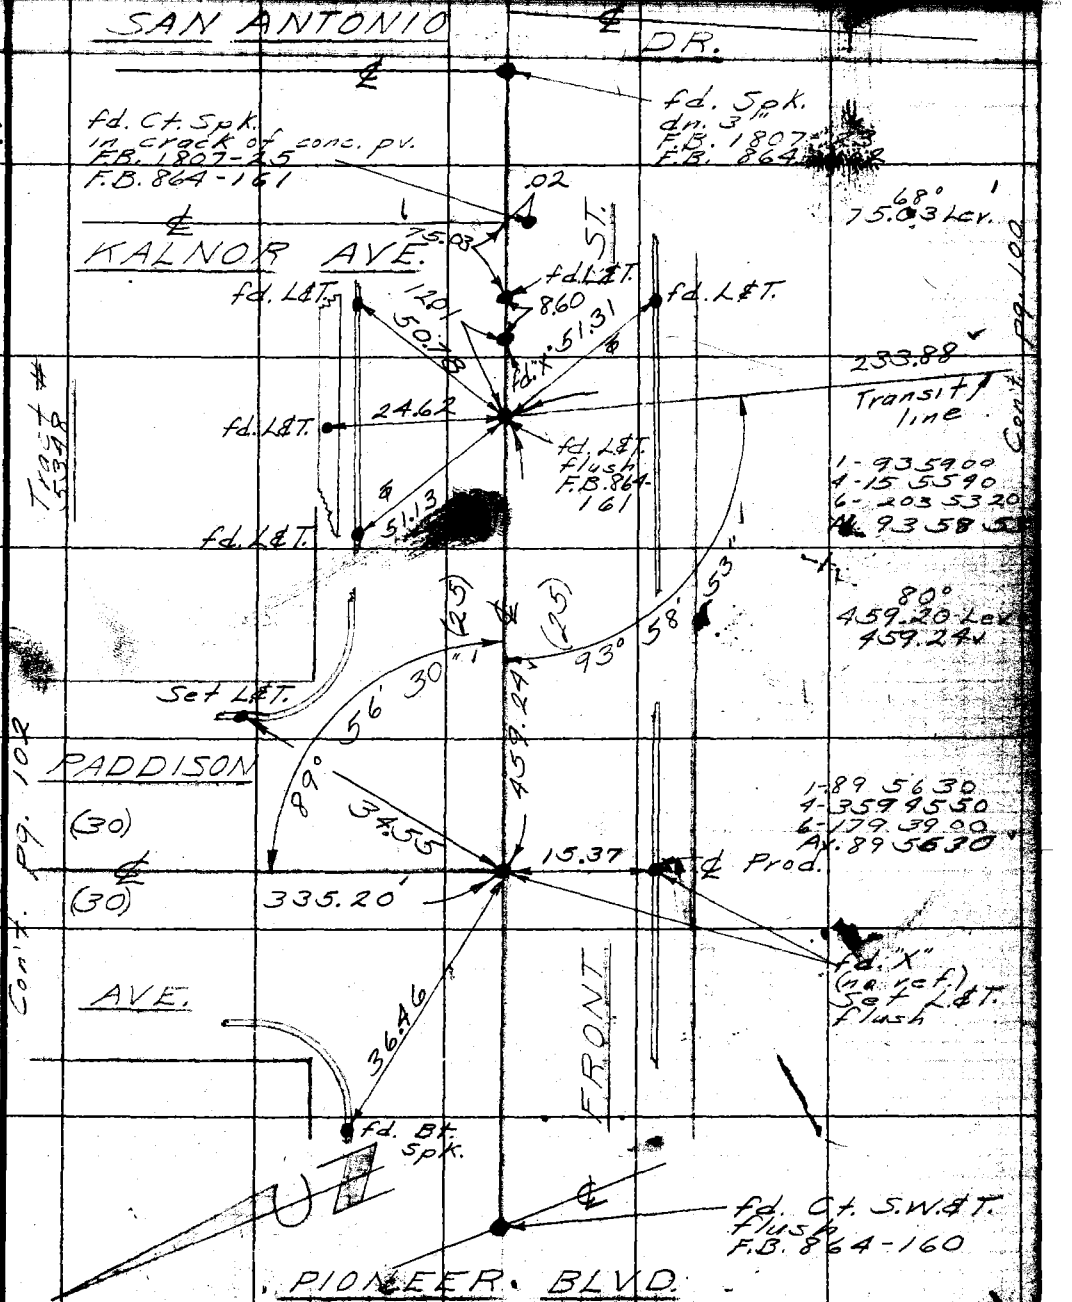

Note: Any Additions or Changes on This Sheet Must be Made or Circled in Red Ink With Date and Name of Person Making Change.

Do not extend notes this side of this line.

RETURN TO
LOS ANGELES COUNTY SURVEYOR
726 LOS ANGELES COUNTY
ENGINEERING BLDG.

76F3095 247 4-53

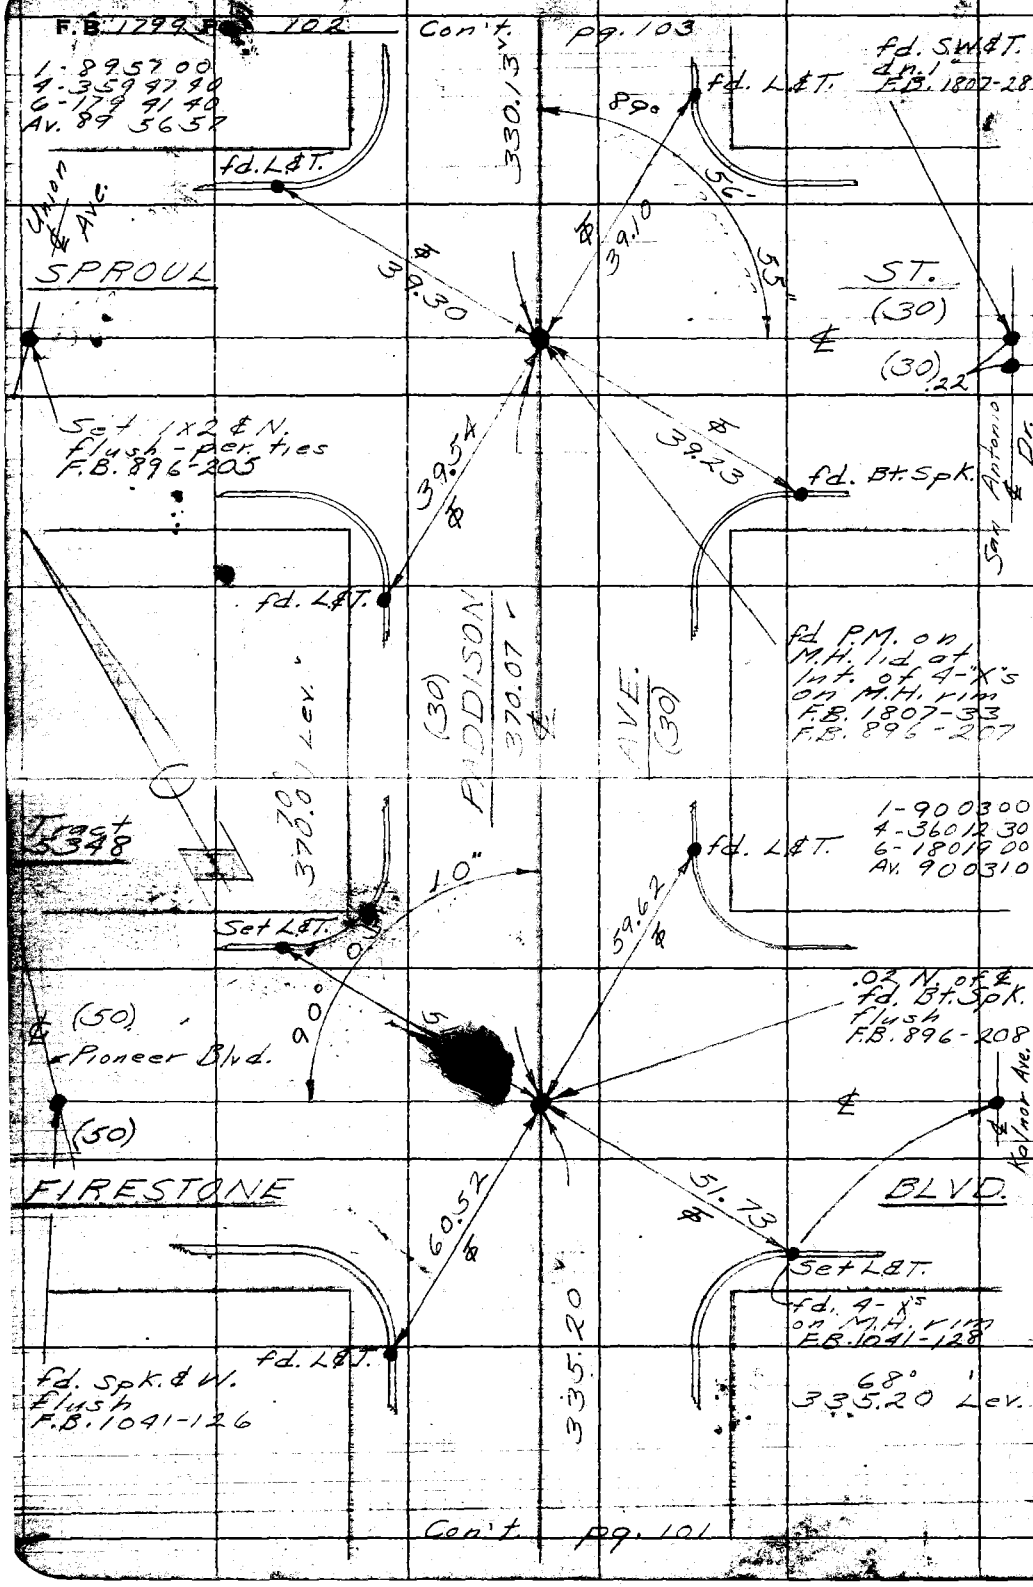

W.S. 33-C-3, D-3

RETURN TO
LOS ANGELES COUNTY SURVEYOR
726 LOS ANGELES COUNTY
ENGINEERING BLDG.

Do not extend notes this side of this line.

Note: Any Additions or Changes on This Sheet Must be Made or Circled in Red Ink With Date and Name of Person Making Change.

PWFB 0826 389, 390

Notes Ck'd by Galli	Survey of Artesia-Norwalk	F.B. [illegible] PG. [illegible]
Map No.	W. O. 6951 Tape No. St'd. °F	1-90 03 00
Office Work	Surveyed by English	4-00 12 40
Checked	Notes " Date 11-53	6-180 18 40
Date	Indexed A. C. Johnson	Av. 90 03 07

W.S. 33

Note: Any Additions or Changes on This Sheet Must be Made or Circled in Red Ink With Date and Name of Person Making Change.

Do not extend notes this side of this line.

RETURN TO
LOS ANGELES COUNTY SURVEYOR
726 LOS ANGELES COUNTY
ENGINEERING BLDG.

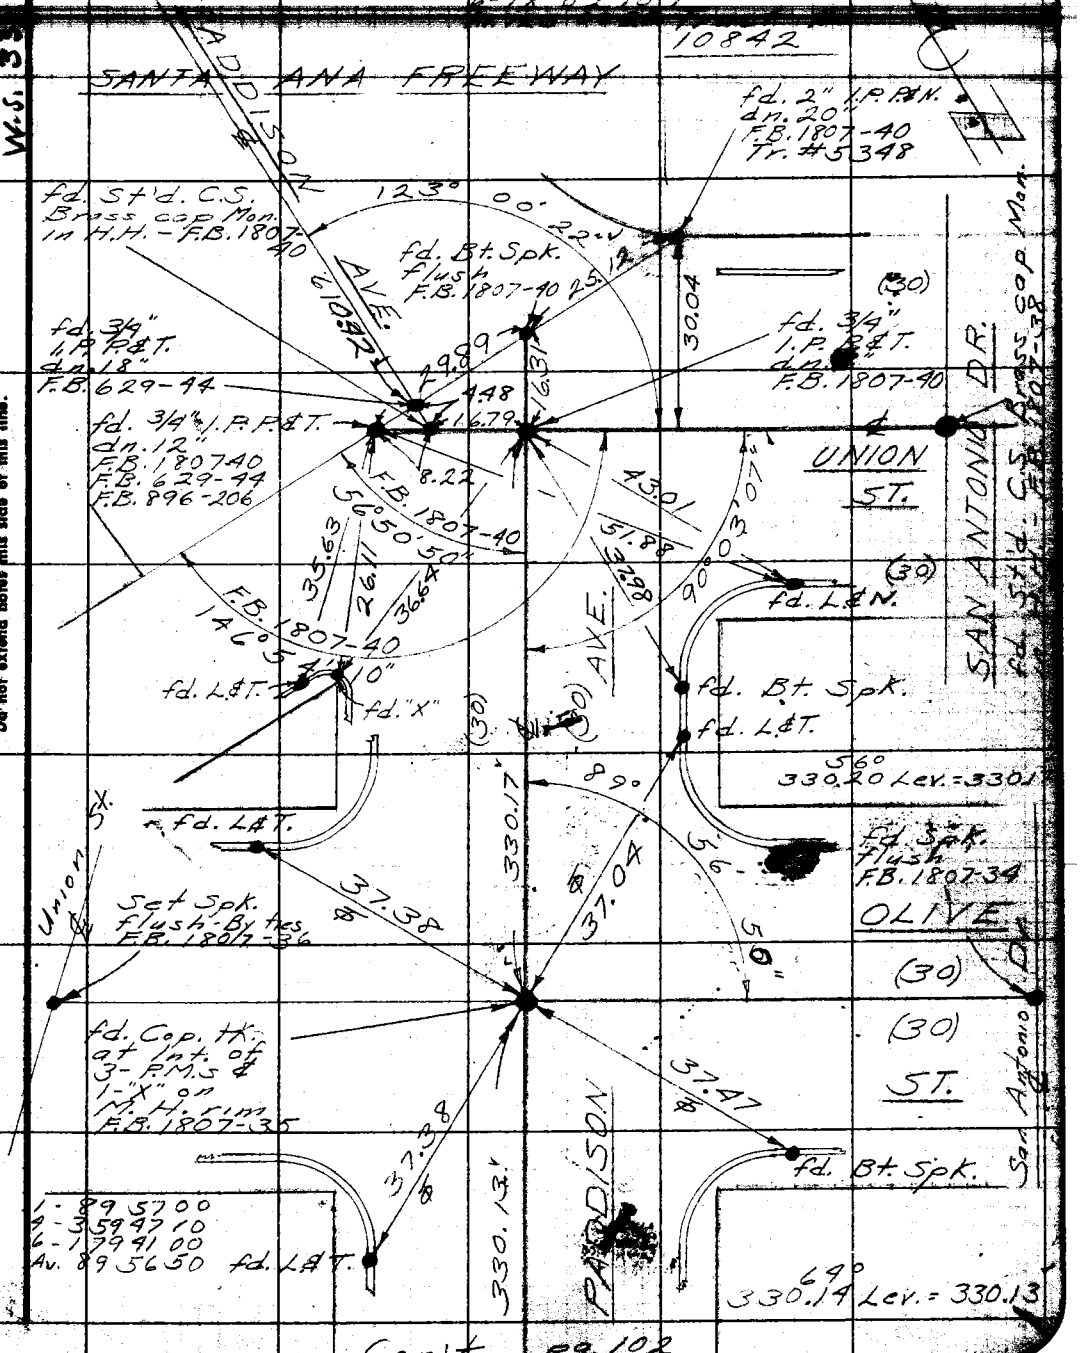

Con't. pg. 102

76F3098 247 4-53

PWFB 0826 391, 392

F.B. 1799 PG. 104

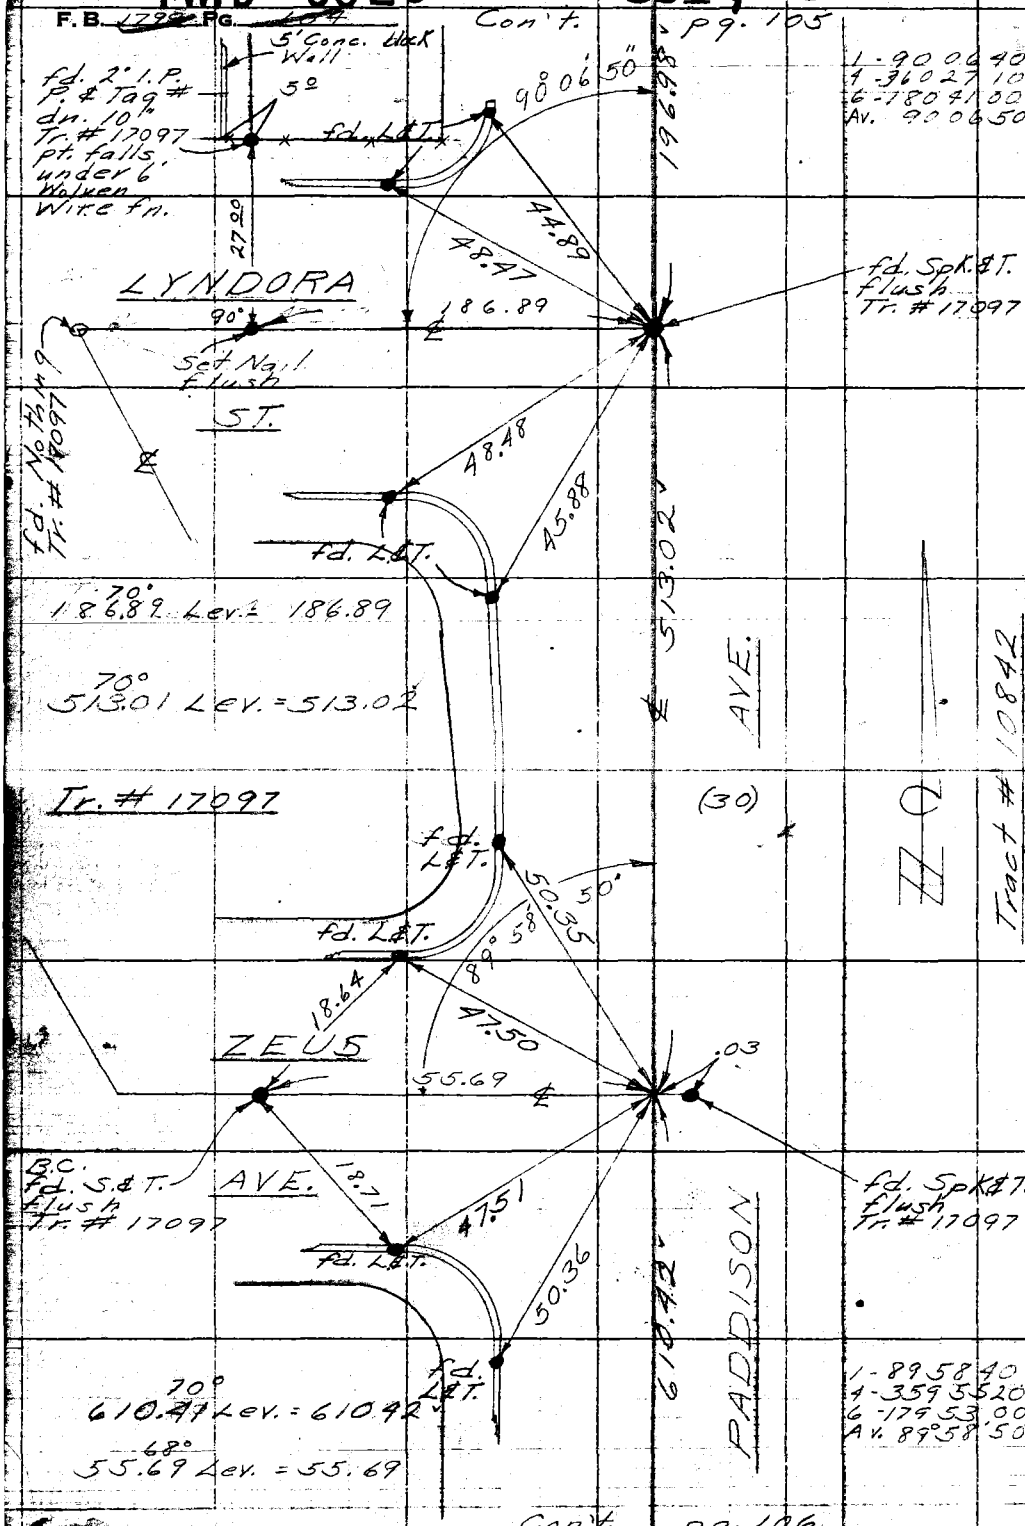

W.S. 33-D-3

RETURN TO
LOS ANGELES COUNTY SURVEYOR
726 LOS ANGELES COUNTY
ENGINEERING BLDG.

Do not extend notes this side of this line.

Note: Any Additions or Changes on This Sheet Must be Made or Circled in Red Ink With Date and Name of Person Making Change.

PWFB 0826

393

Notes Ck'd by Galli
Map No.
Office Work
Checked
Date

Survey of Artesia - Norwalk
W.O. 6451 Tape No. Sr'd. °F
Surveyed by English
Notes Date 11-53
Indexed Johnson

F.B. PG.

W.S. B3-

Note: Any Additions or Changes on This Sheet Must be Made or Circled in Red Ink With Date and Name of Person Making Change.

Do not extend notes this side of this line.

RETURN TO
LOS ANGELES COUNTY SURVEYOR
726 LOS ANGELES COUNTY
ENGINEERING BLDG.

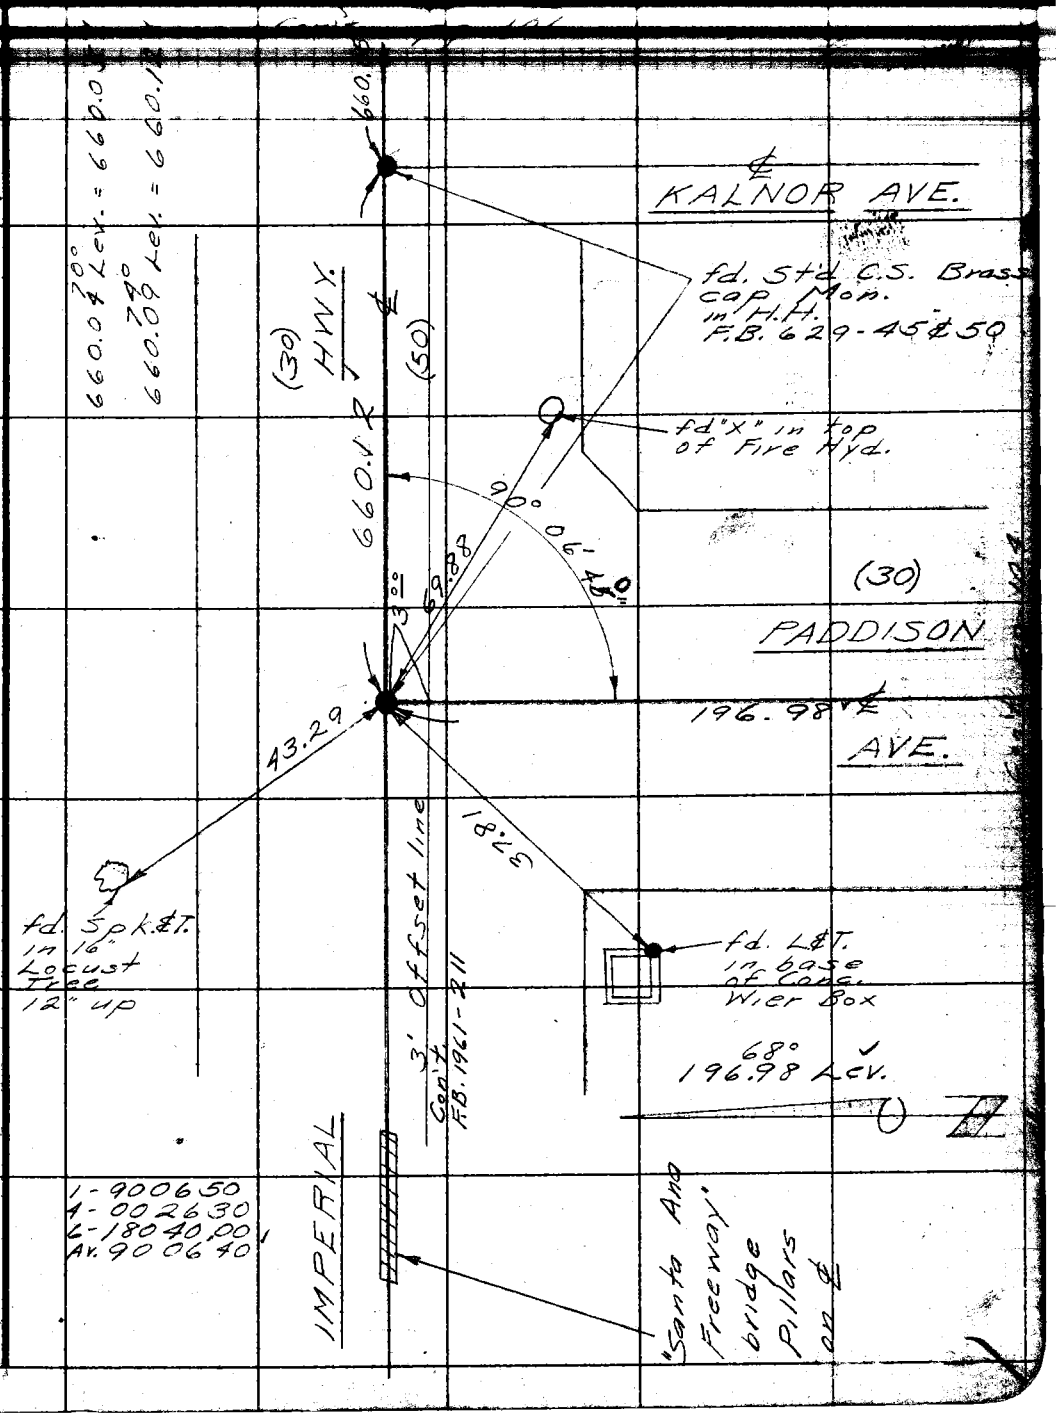

76F3095 247 4-53

F.B. 1797 Pg. 206

PWFB 0826

394, 395

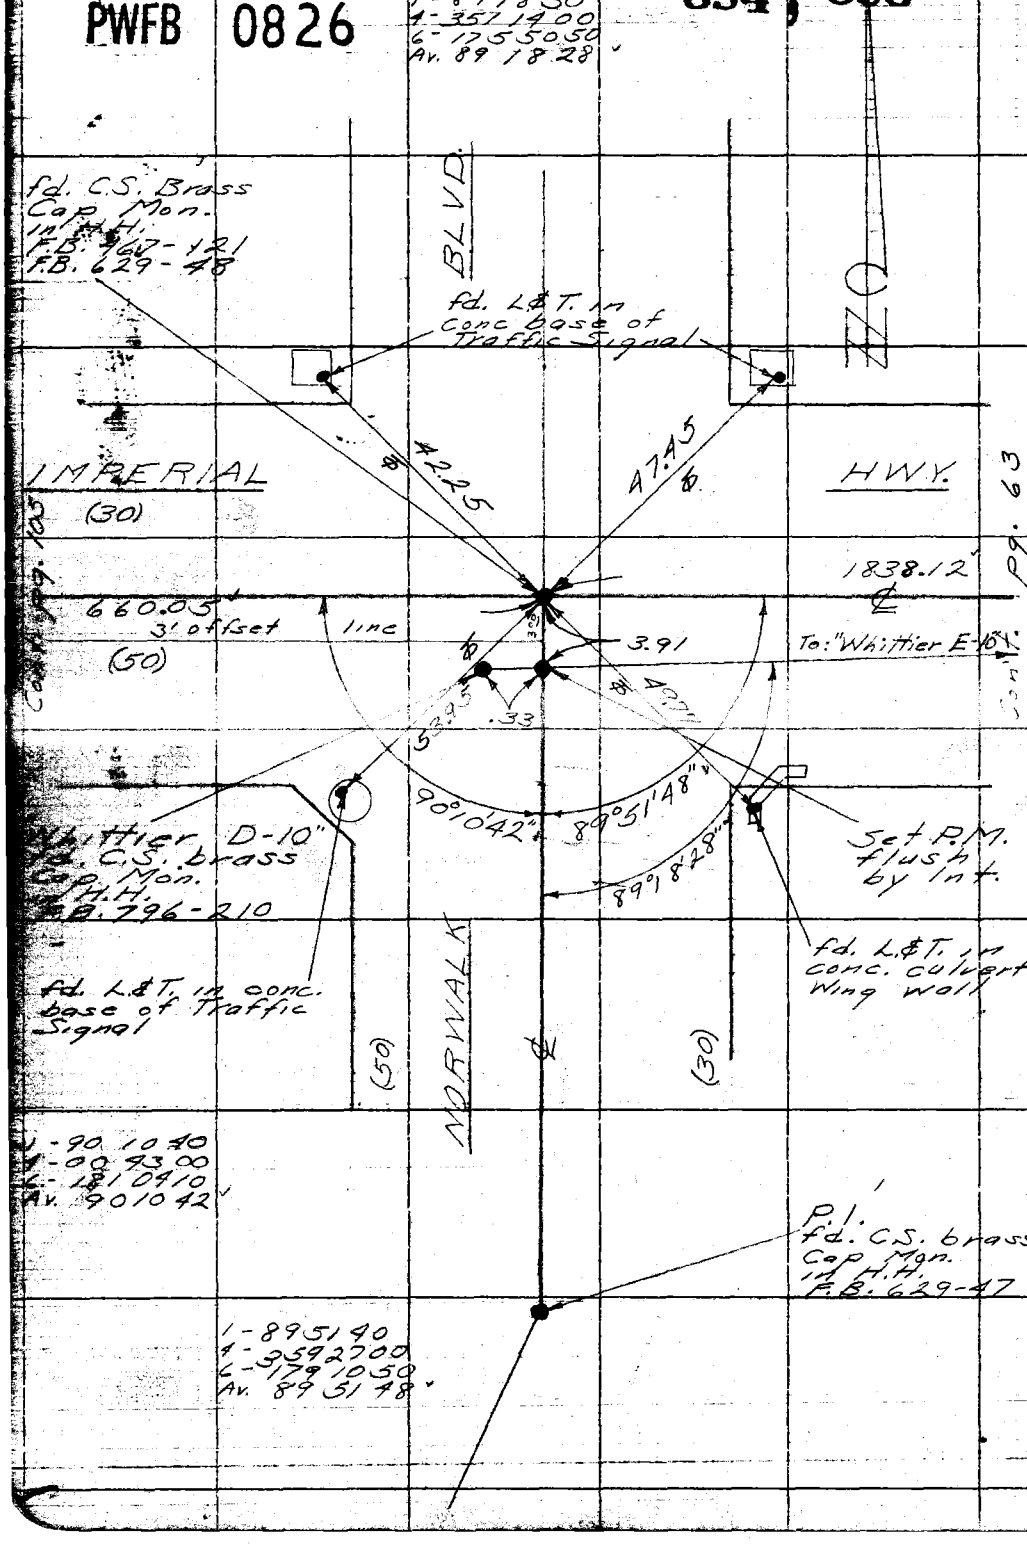

W.S. 33-D-3

RETURN TO
LOS ANGELES COUNTY SURVEYOR
726 LOS ANGELES COUNTY
ENGINEERING BLDG.

Do not extend notes this side of this line.

Note: Any Additions or Changes on This Sheet Must be Made or Circled in Red Ink With Date and Name of Person Making Change.

PWFB 0726

437

Notes Ck'd by
Map No.
Office Work
Checked
Date

Survey of Artesia-Norwalk
W. O. 6202.00 Tape No. Str'd. °F
Surveyed by English
Notes 1" Date 4-54
Indexed

F. B. Pg.

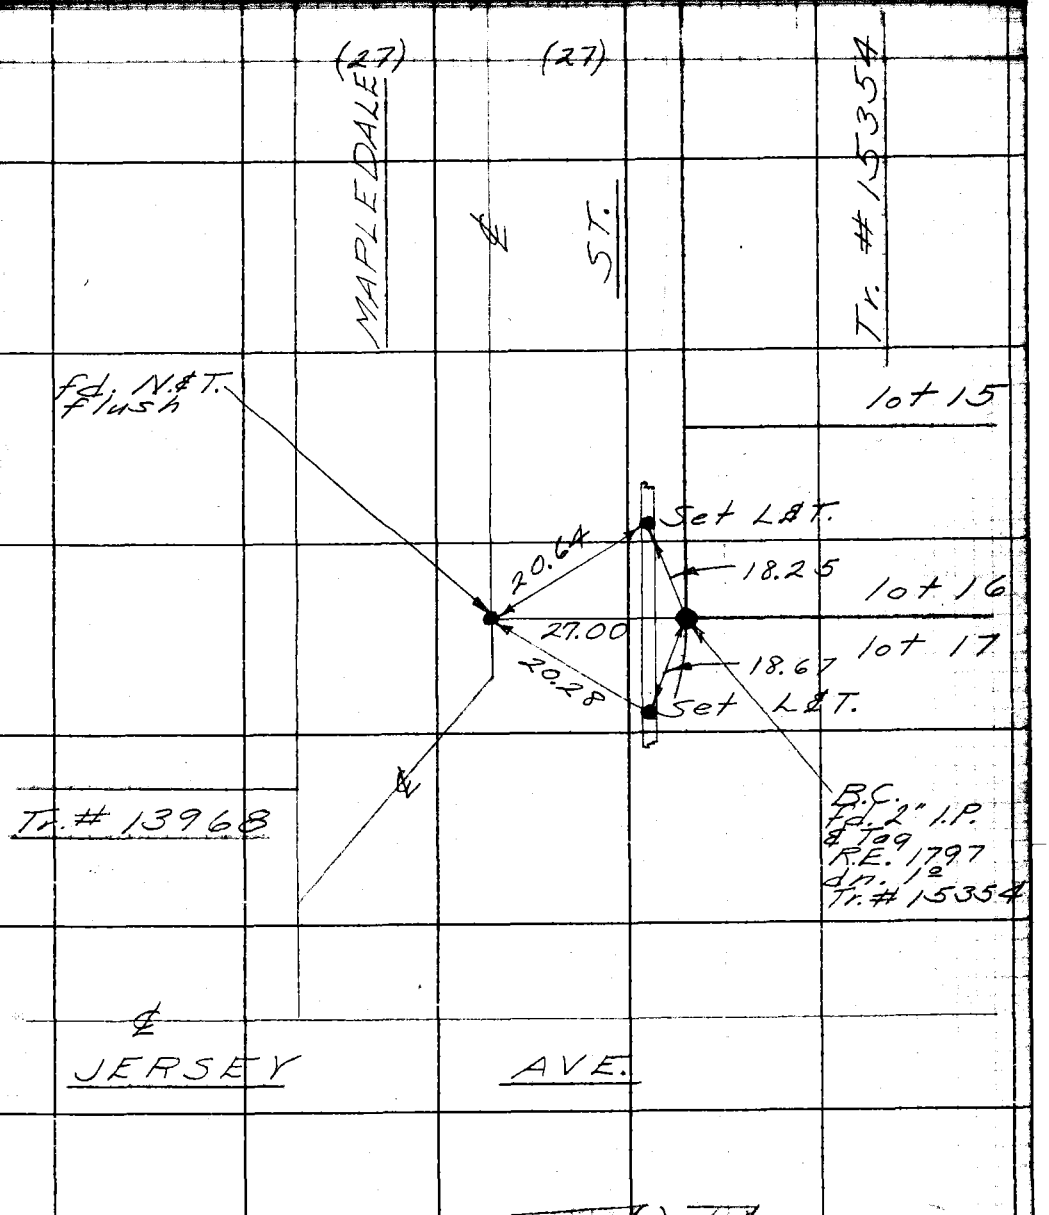

Note: Any Additions or Changes on This Sheet Must be Made or Circled in Red Ink With Date and Name of Person Making Change.

Do not extend notes this side of this line.

RETURN TO
LOS ANGELES COUNTY SURVEYOR
726 LOS ANGELES COUNTY
ENGINEERING BLDG.

76FS093 247 4-53

F.B. ~~1789~~ PG. ~~108~~

PWFB 0726

438

W.S. 33-C-4

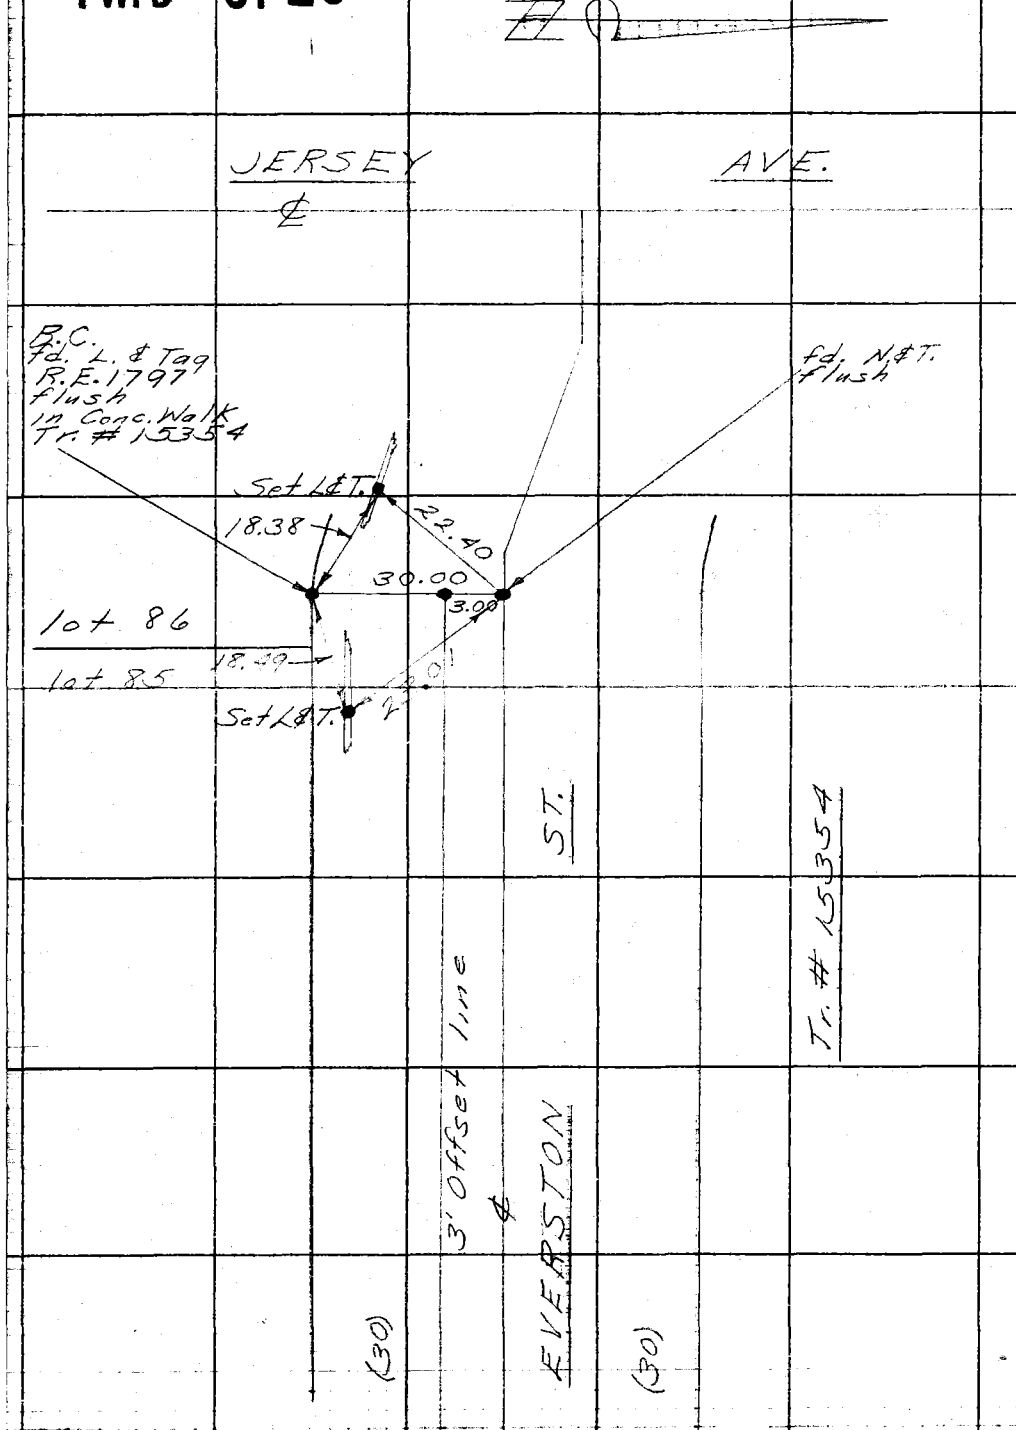

Con't. pg. 90

RETURN TO
LOS ANGELES COUNTY SURVEYOR
723 LOS ANGELES COUNTY
ENGINEERING BLDG.

Do not extend notes this side of this line.

Note: Any Additions or Changes on This Sheet Must be Made or Circled in Red Ink With Date and Name of Person Making Change.

PWFB 0726

439

Notes Ck'd by ____	Survey of Artesia-Norwalk	F.B. 128 Pg. 109
Map No. ____	W. O. ____ Tape No. ____ Std. ____ °F	
Office Work ____	Surveyed by English	
Checked ____	Notes ____ Date 4-54	
Date ____	Indexed ____	

W.S. 3 4

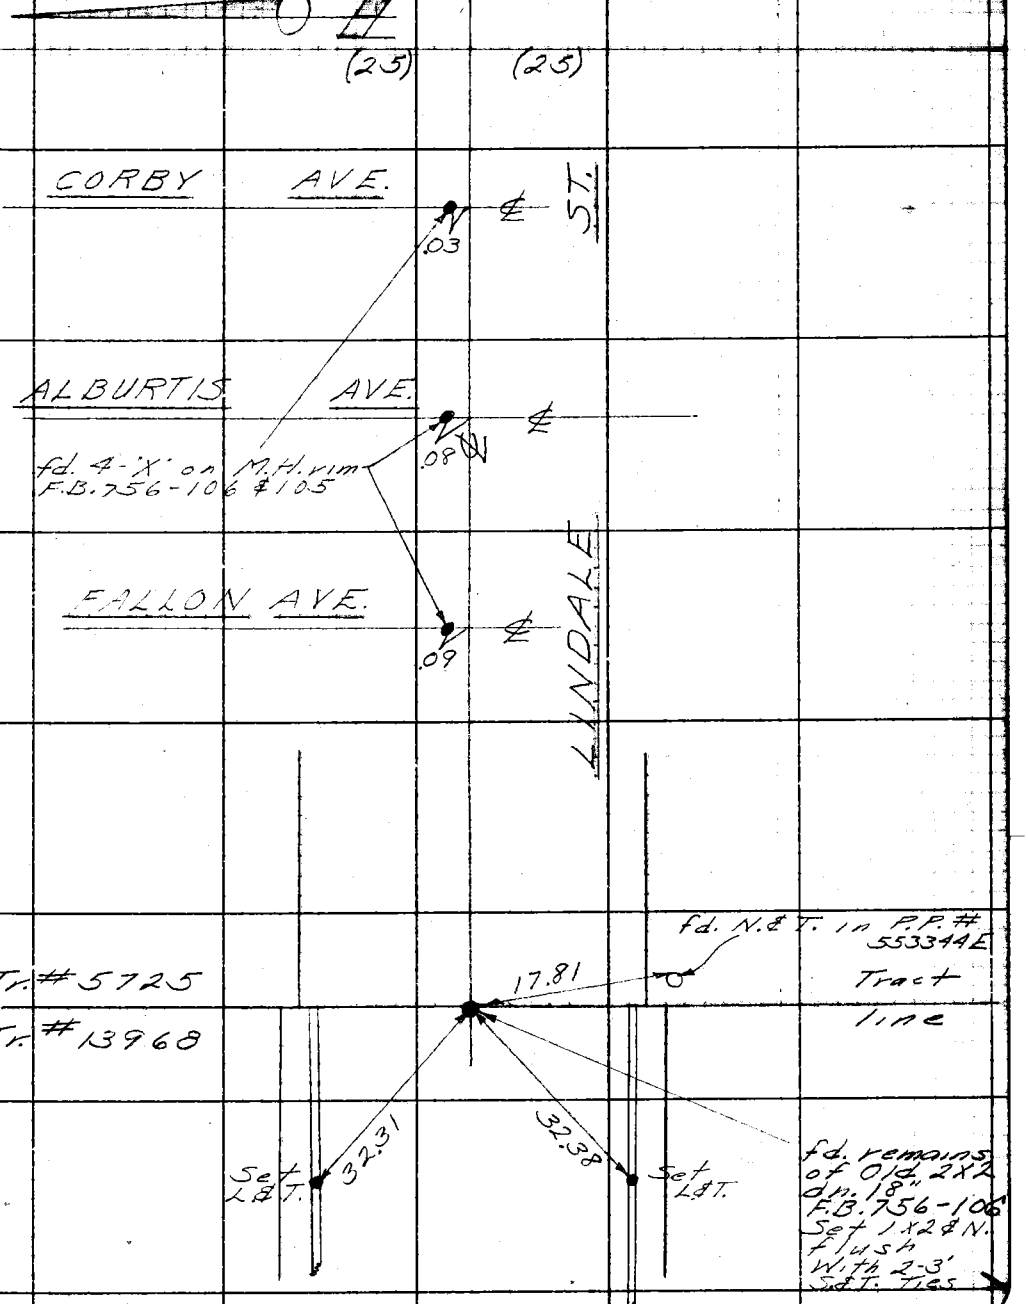

Note: Any Additions or Changes on This Sheet Must be Made or Circled in Red Ink With Date and Name of Person Making Change.

Do not extend notes this side of this line.

RETURN TO
LOS ANGELES COUNTY SURVEYOR
726 LOS ANGELES COUNTY
ENGINEERING BLDG.

76F3008 247 4-53

RETURN TO
LOS ANGELES COUNTY SURVEYOR
726 LOS ANGELES COUNTY
ENGINEERING BLDG.

Note: Any Additions or Changes on This Sheet Must be Made or Circled in Red Ink With Date and Name of Person Making Change.

Do not extend notes this side of this line.

F. B. 1799 PG. 110

Notes Ck'd by	Survey of Artesia-Norwalk	F.B. 132 Pg. 113
Map No.	W. O. 6951 Tape No. Sr'd. °F	
Office Work	Surveyed by English	
Checked	Notes Date 11-53	
Date	Indexed A. C. Johnson 12-28-53	

ARTESIA-NORWALK
J.N. 6951

TOPOGRAPHY
ALONG
PROPOSED ROUTE
OF

STORM DRAIN
PROJECT No. 21
DIVISION No. 1
LINE A

Nov. 1953
English
Sappell
Peterson
Lund

Note: Any Additions or Changes on This Sheet Must be Made or Circled In Red Ink With Date and Name of Person Making Change.

Do not extend notes this side of this line.

RETURN TO
LOS ANGELES COUNTY SURVEYOR
726 LOS ANGELES COUNTY
ENGINEERING BLDG.

7628095 247 4-53

F.B. 1799 PG. 114

RETURN TO
LOS ANGELES COUNTY SURVEYOR
726 LOS ANGELES COUNTY
ENGINEERING BLDG.

Do not extend notes this side of this line.

Note: Any Additions or Changes on This Sheet Must be Made or Circled in Red Ink With Date and Name of Person Making Change.

Notes Ck'd by	Survey of Artesia - Norwalk	F. B. 1799 Pg. 115
Map No.	W. O. 6951 Tape No. Std. °F	
Office Work	Surveyed by English	
Checked	Notes Sappell Date 12-53	
Date	Indexed	

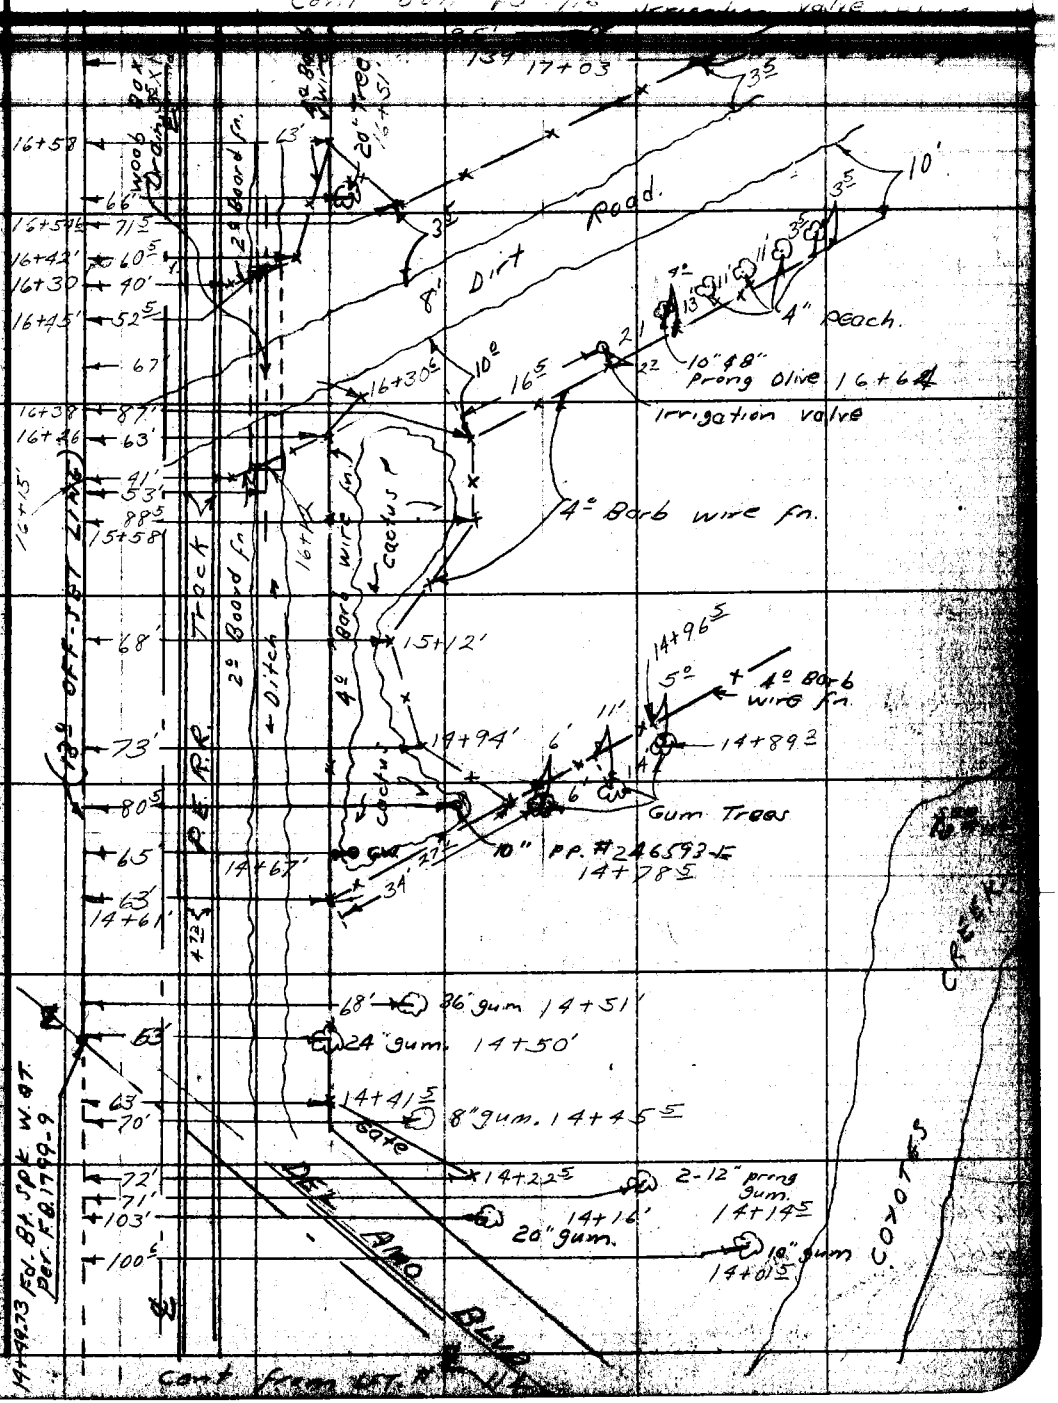

Note: Any Additions or Changes on This Sheet Must be Made or Circled in Red Ink With Date and Name of Person Making Change.

Do not extend notes this side of this line.

RETURN TO
LOS ANGELES COUNTY SURVEYOR
726 LOS ANGELES COUNTY
ENGINEERING BLDG.

14+50

F.B. 1799 Pg. 116

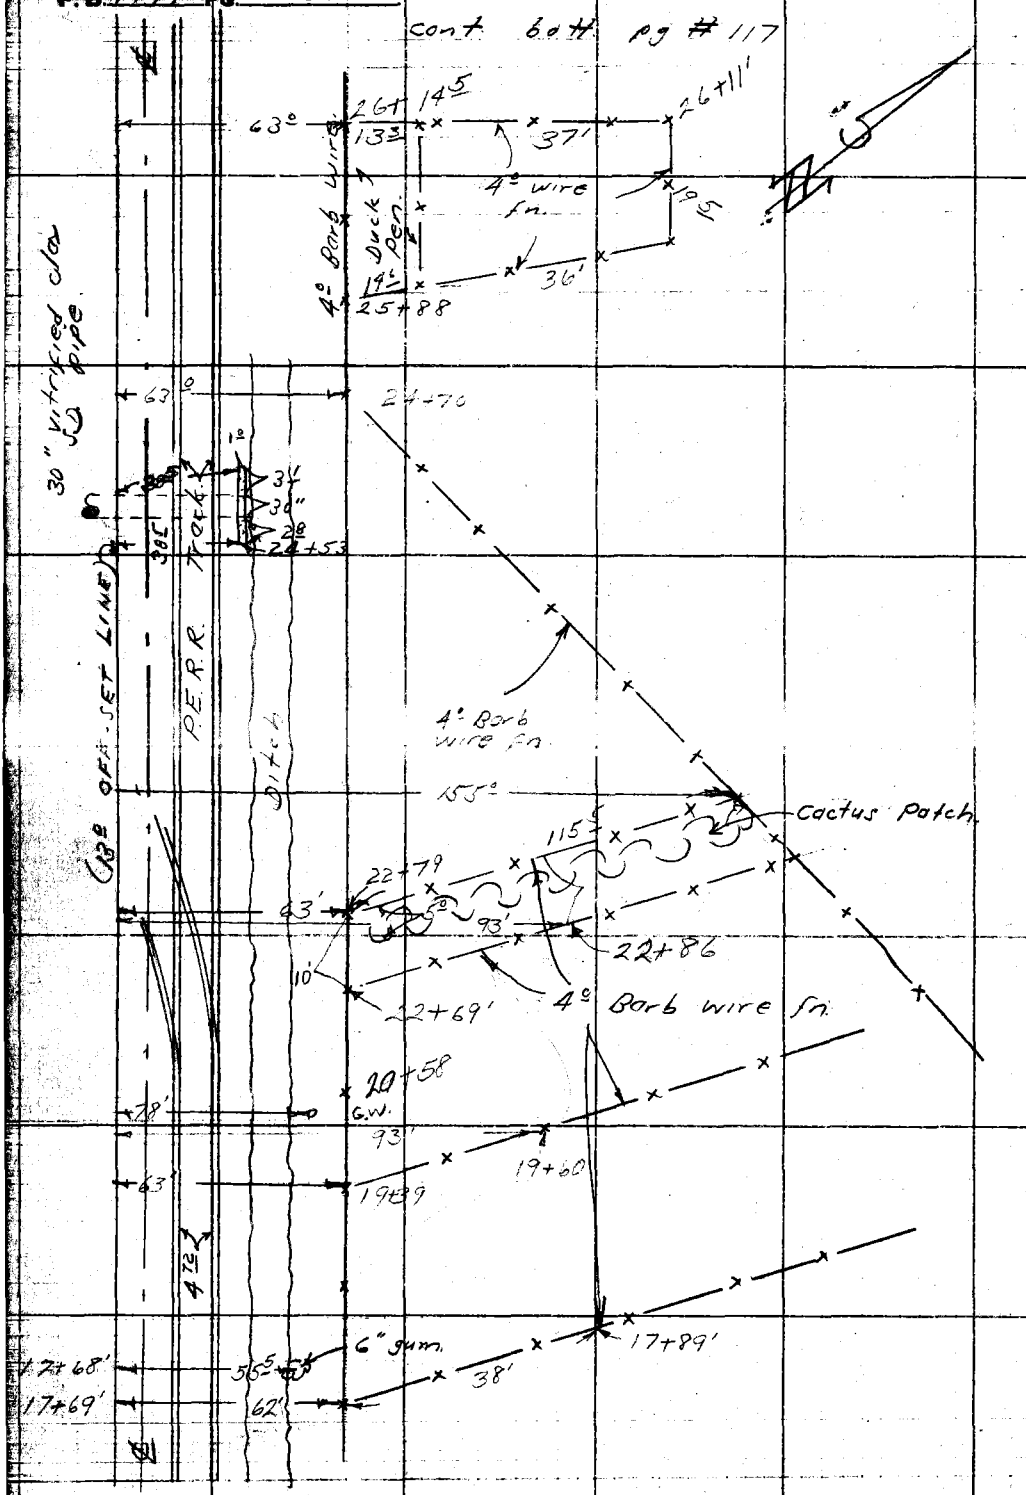

18+00
19+00
20+00
21+00
22+00
50'

26+31.9
25

cont. from top pg # 115

RETURN TO
LOS ANGELES COUNTY SURVEYOR
726 LOS ANGELES COUNTY
ENGINEERING BLDG.

Do not extend notes this side of this line.

Note: Any Additions or Changes on This Sheet Must be Made or Circled in Red Ink With Date and Name of Person Making Change.

Notes Ck'd by	Survey of Artesia-Norwalk	F.B. 1799 Pg. 117
Map No.	W. O. 1951 Tape No. Sta'd. °F	
Office Work	Surveyed by English	
Checked	Notes Sappell Date 12-53	
Date	Indexed	

93
50

27+80

Note: Any Additions or Changes on This Sheet Must be Made or Circled in Red Ink With Date and Name of Person Making Change.

Do not extend notes this side of this line.

RETURN TO
LOS ANGELES COUNTY SURVEYOR
726 LOS ANGELES COUNTY
ENGINEERING BLDG.

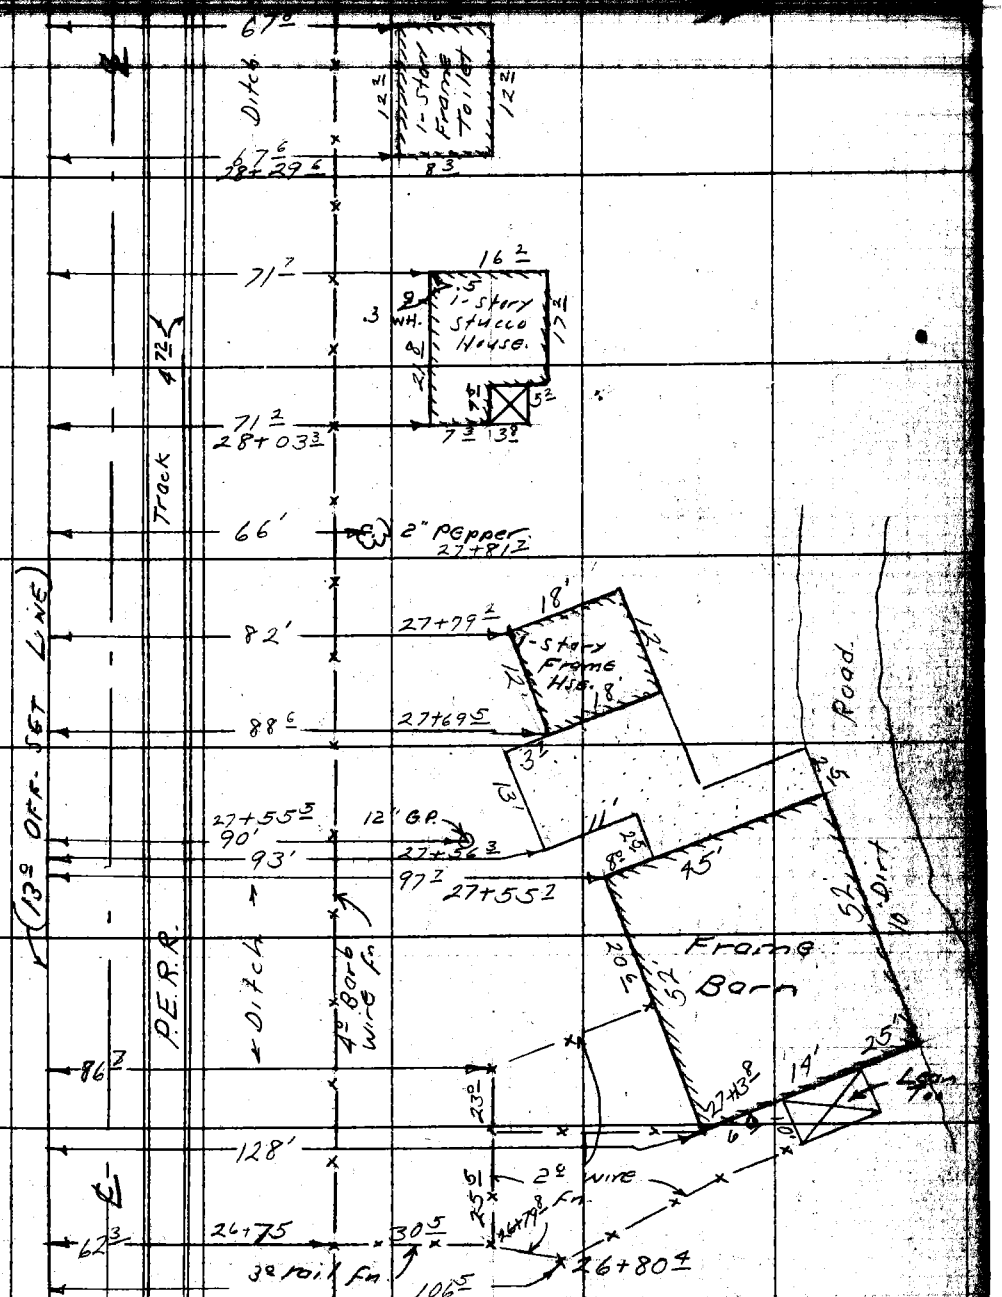

93
3 06 7/128

1x2
26+30.40

79F3098 247 4-53

Cont. from top pg # 116

F.B. 1799 Pg. 118

Cont. both. pg #119

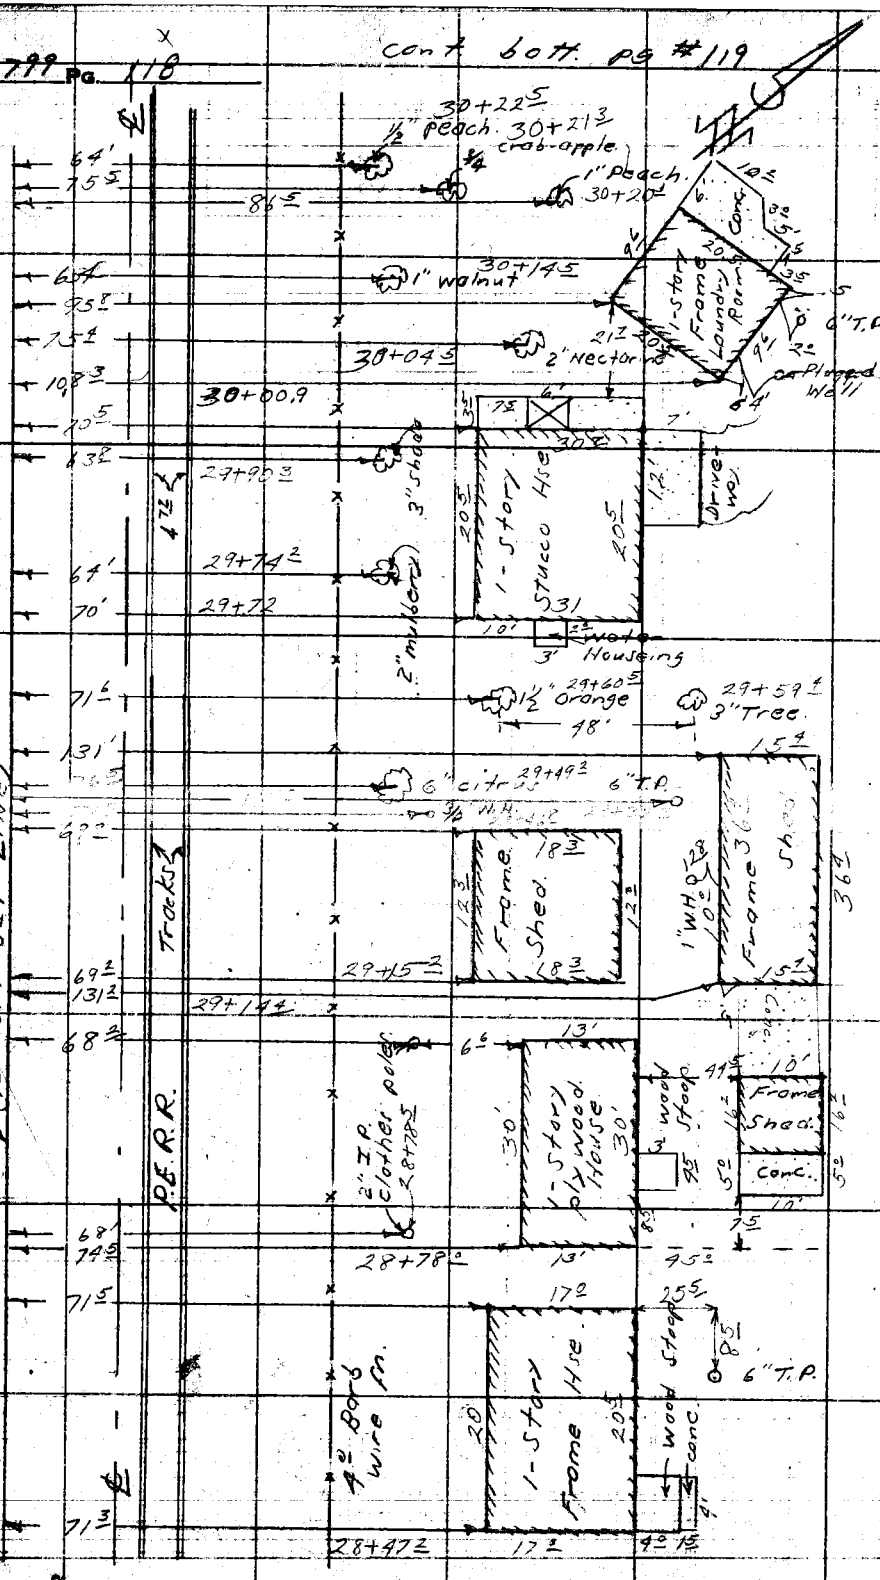

Cont. from top pg # 117

RETURN TO
LOS ANGELES COUNTY SURVEYOR
720 LOS ANGELES COUNTY
ENGINEERING BLDG.

Do not extend notes this side of this line.

Note: Any Additions or Changes on This Sheet Must be Made or Circled in Red Ink With Date and Name of Person Making Change.

S.E.
32.50 50
3 3 8 5
3 7 9 5

Notes Ck'd by	Survey of Artesia - Norwalk	F.B. 1799 PG. 119
Map No.	W. O. 6957 Tape No. Std. of	
Office Work	Surveyed by English	
Checked	Notes Sappell Date 12-53	
Date	Indexed R. C. Johnson	

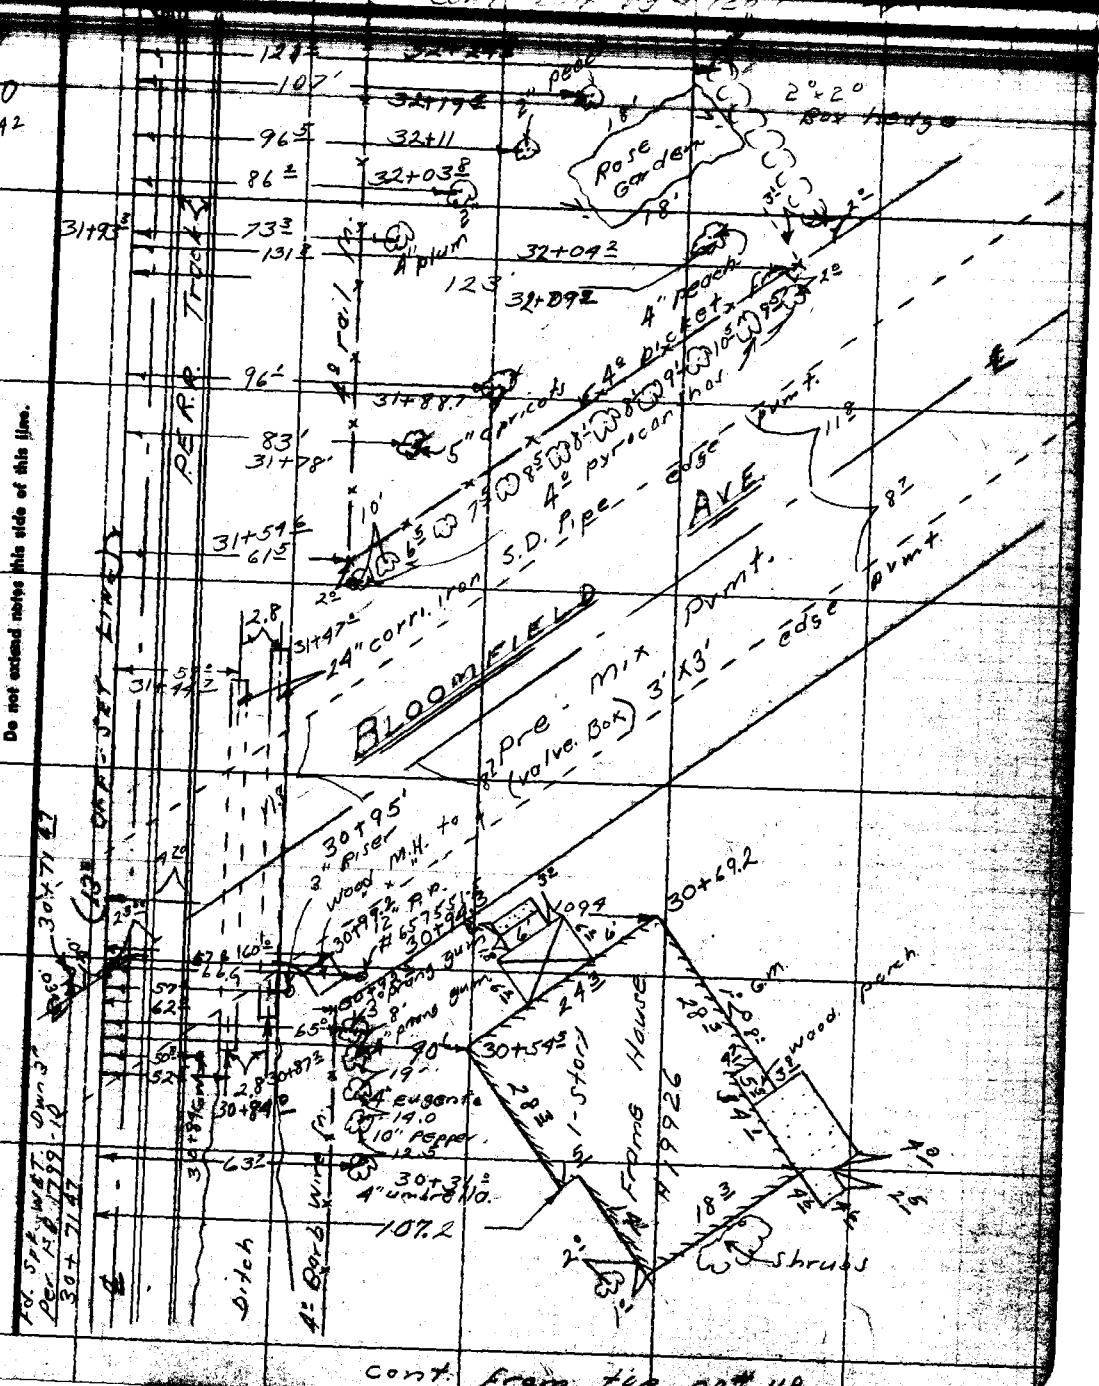

Note: Any Additions or Changes on This Sheet Must be Made or Circled in Red Ink With Date and Name of Person Making Change.

Do not extend notes this side of this line.

RETURN TO
LOS ANGELES COUNTY SURVEYOR
726 LOS ANGELES COUNTY
ENGINEERING BLDG.

cont. from top pg# 118

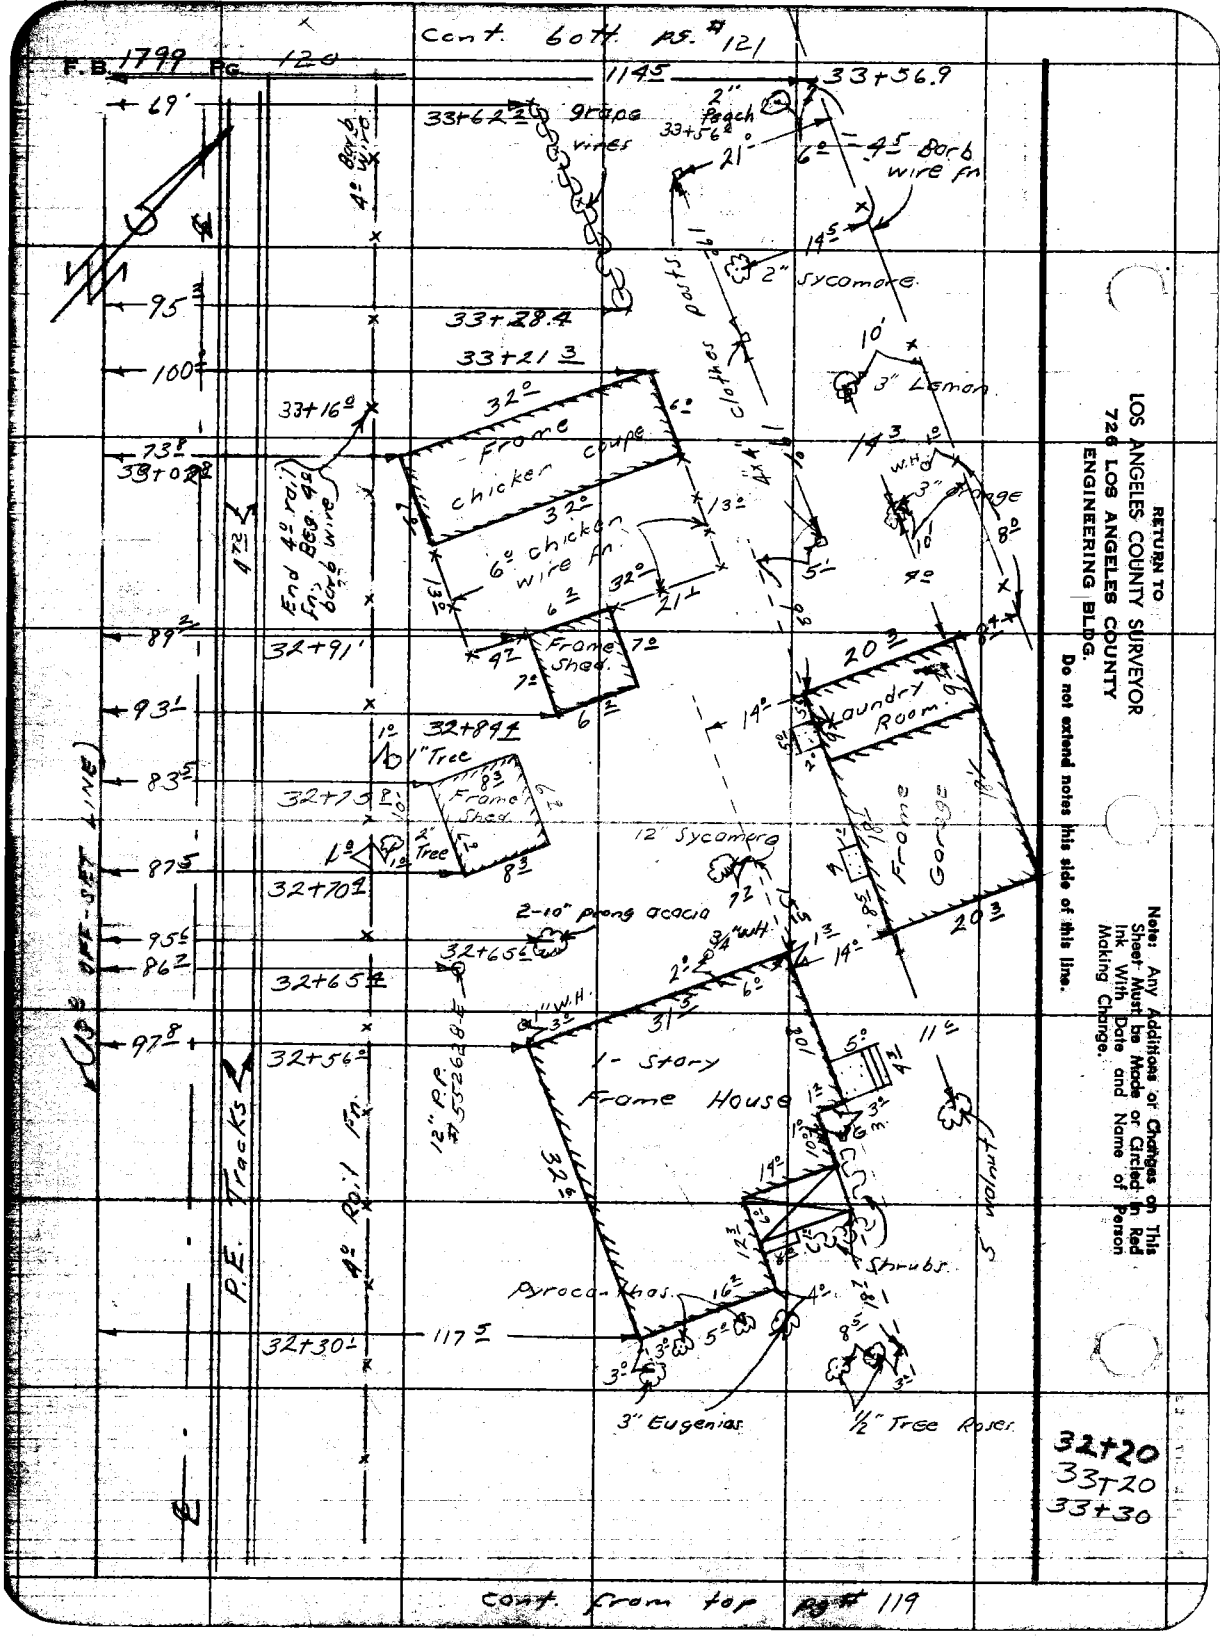

RETURN TO
LOS ANGELES COUNTY SURVEYOR
726 LOS ANGELES COUNTY
ENGINEERING BLDG.
Do not extend notes this side of this line.

Note: Any Additions or Changes on This Sheet Must be Made or Circled in Red Ink With Date and Name of Person Making Change.

21 01
2899

Notes Ck'd by
Map No.
Office Work
Checked
Date

Survey of Artesia - Norwalk
W. O. 6951 Tape No. St'd. °F
Surveyed by English
Notes Sappell Date 12-53
Indexed A. C. Johnson

F. B. 1799 Pg. 121

cont Lott pg#

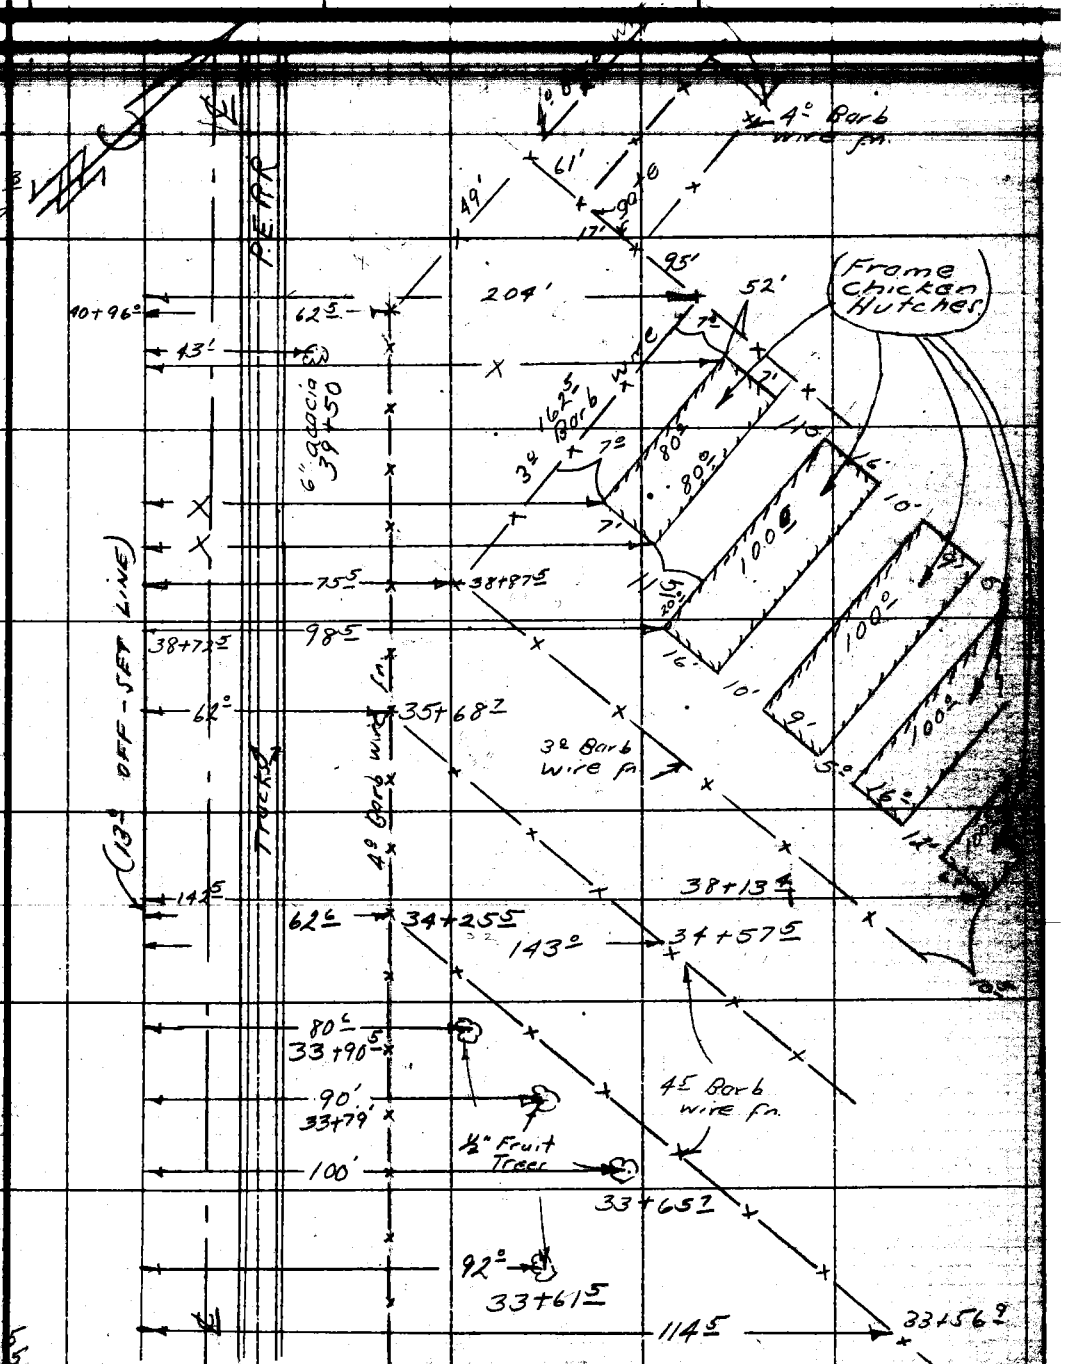

cont from top pg #120

Note: Any Additions or Changes on This Sheet Must be Made or Circled in Red Ink With Date and Name of Person Making Change.

Do not extend notes this side of this line.

RETURN TO
LOS ANGELES COUNTY SURVEYOR
726 LOS ANGELES COUNTY
ENGINEERING BLDG.

38+00
2 31.3
687
29

62.5
36
98
141.5
125.4

80
63
143
33+30
2 68.65
1 01.35
37+00.00

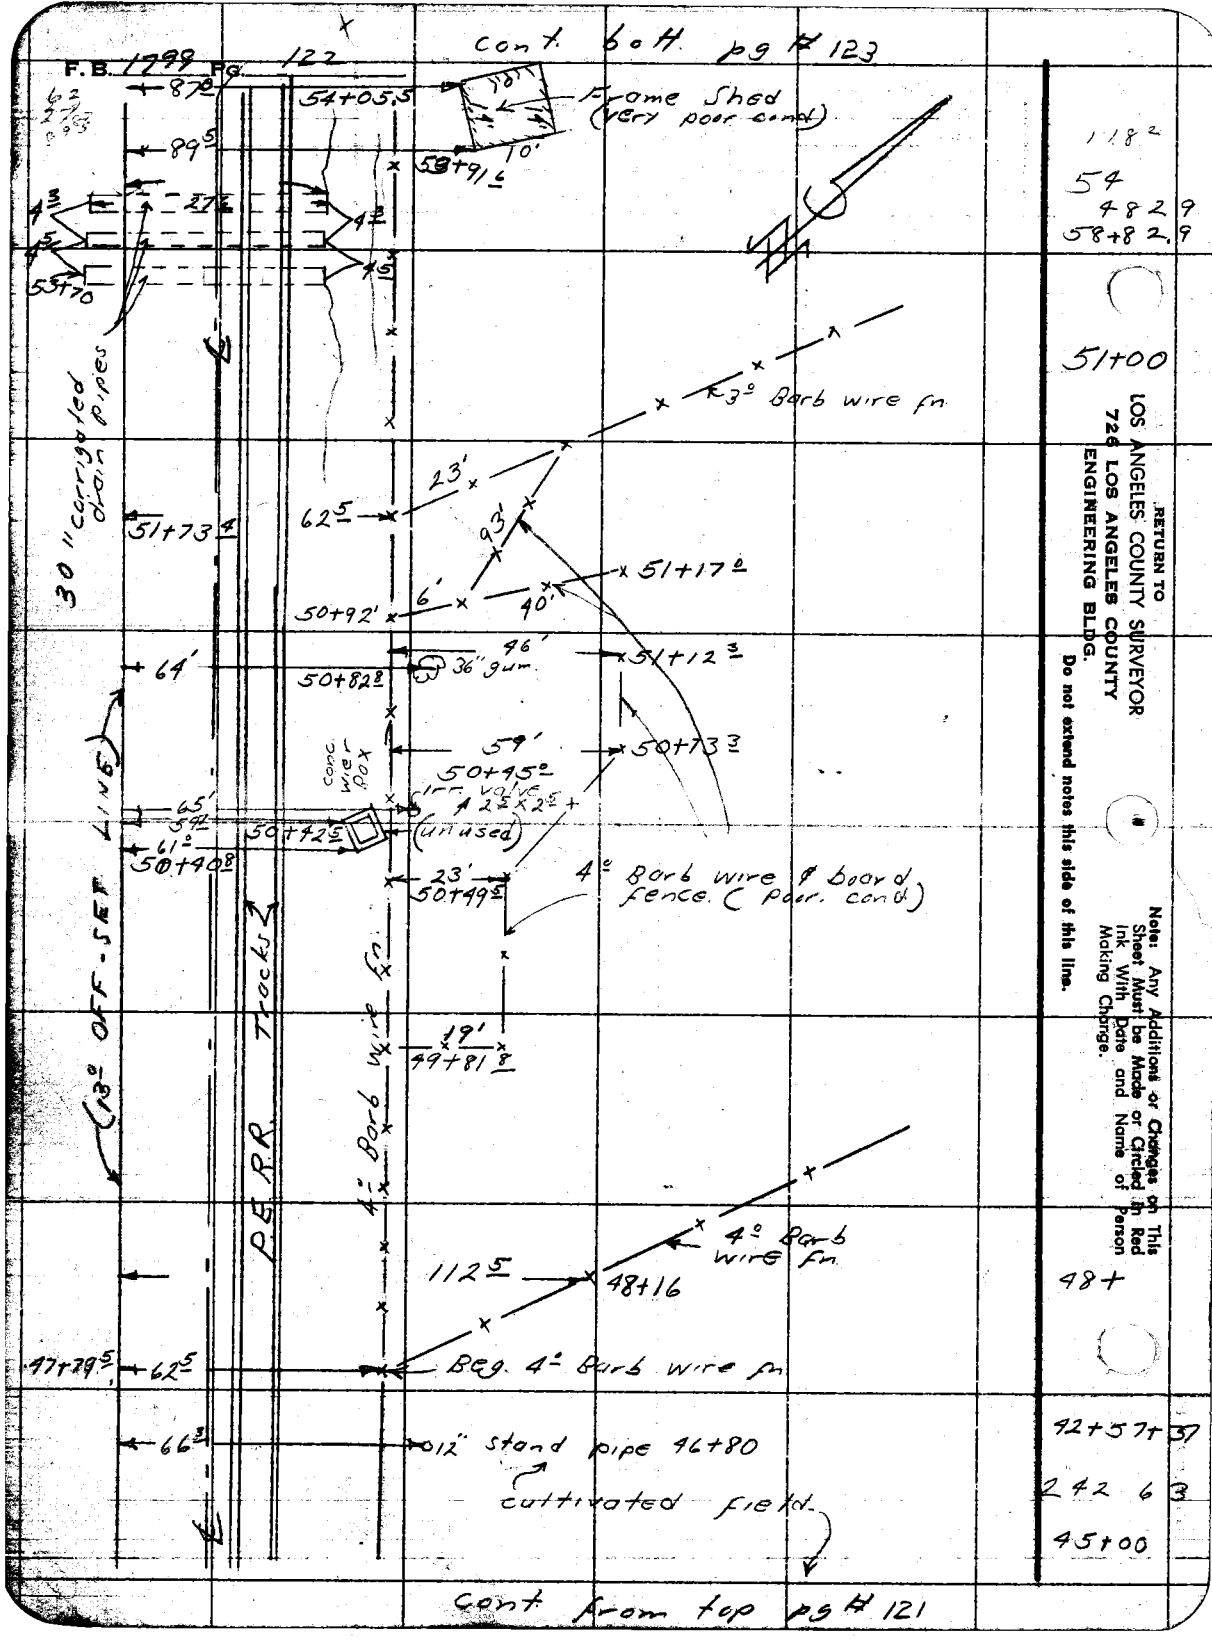

RETURN TO
LOS ANGELES COUNTY SURVEYOR
726 LOS ANGELES COUNTY
ENGINEERING BLDG.
Do not extend notes this side of this line.

Note: Any Additions or Changes on This Sheet Must be Made or Circled in Red Ink With Date and Name of Person Making Change.

20247
28050
48297

Notes Ck'd by	Survey of Artesia - Norwalk
Map No.	W. O. 6757 Tape No. St'd. °F
Office Work	Surveyed by English
Checked	Notes Sappell Date 12-53
Date	Indexed A. C. Johnson

F. B. 1799 PG. 123

cont. bott. pg # 124

63
73
136

43+
45+
48+

Note: Any Additions or Changes on This Sheet Must be Made or Circled in Red Ink With Date and Name of Person Making Change.

RETURN TO
LOS ANGELES COUNTY SURVEYOR
726 LOS ANGELES COUNTY
ENGINEERING BLDG.

Do not extend notes this side of this line.

62 5
42 3
104 8

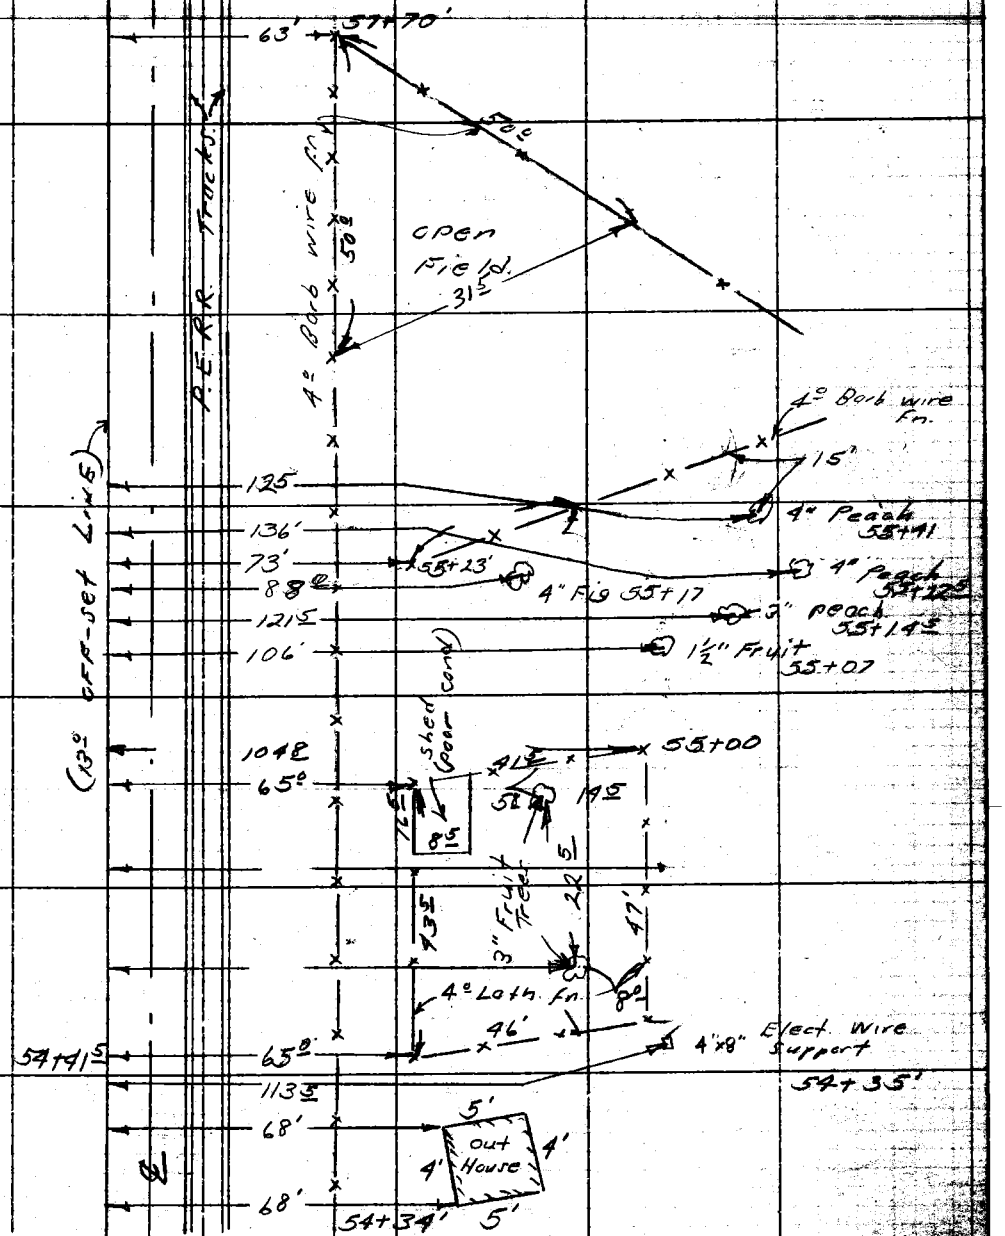

51+00
42+57.37

cont. from top pg # 122

F. B. 1799 PG. 124

cont bott. pg # 125

RETURN TO
LOS ANGELES COUNTY SURVEYOR
726 LOS ANGELES COUNTY
ENGINEERING BLDG.
Do not extend notes this side of this line.

Note: Any Additions or Changes on This Sheet Must be Made or Circled in Red Ink With Date and Name of Person Making Change.

183 4

Notes Ck'd by	Survey of Artesia - Norwalk
Map No.	W. O. 6851 Tape No. St'd. °F
Office Work	Surveyed by English
Checked	Notes Sappell Date 11-53
Date	Indexed [illegible]

F. B. 1798 PG. 125

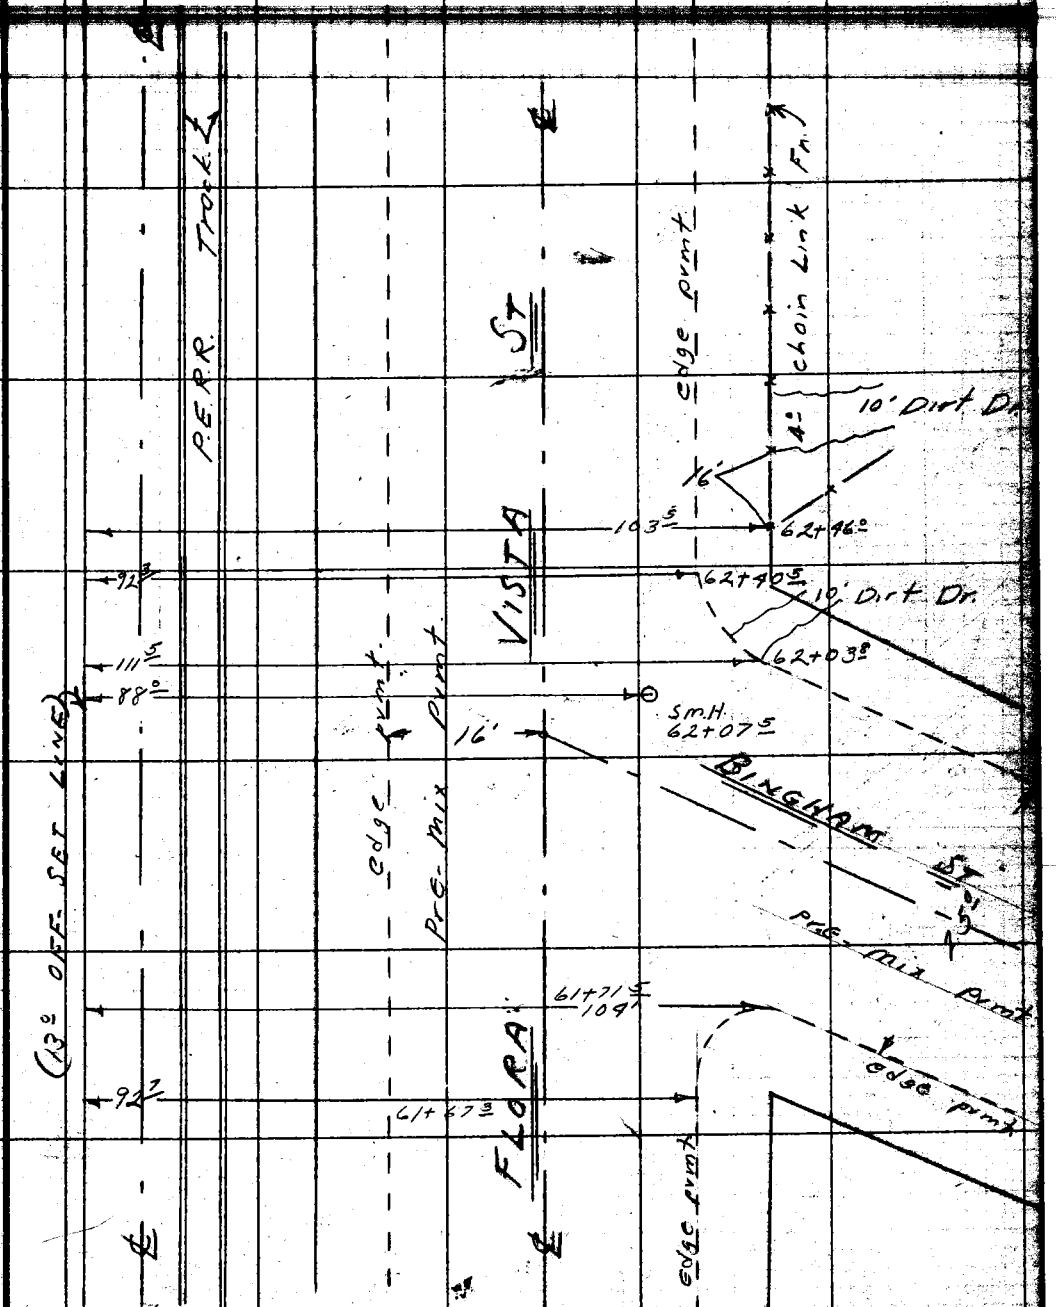

Note: Any Additions or Changes on This Sheet Must be Made or Circled in Red Ink With Date and Name of Person Making Change.

Do not extend notes this side of this line.

RETURN TO
LOS ANGELES COUNTY SURVEYOR
726 LOS ANGELES COUNTY
ENGINEERING BLDG.

Cont. from top pg# 124

76F3095 247 4-53

F.B. 1799 PG. 126

Cont. both pg # 127

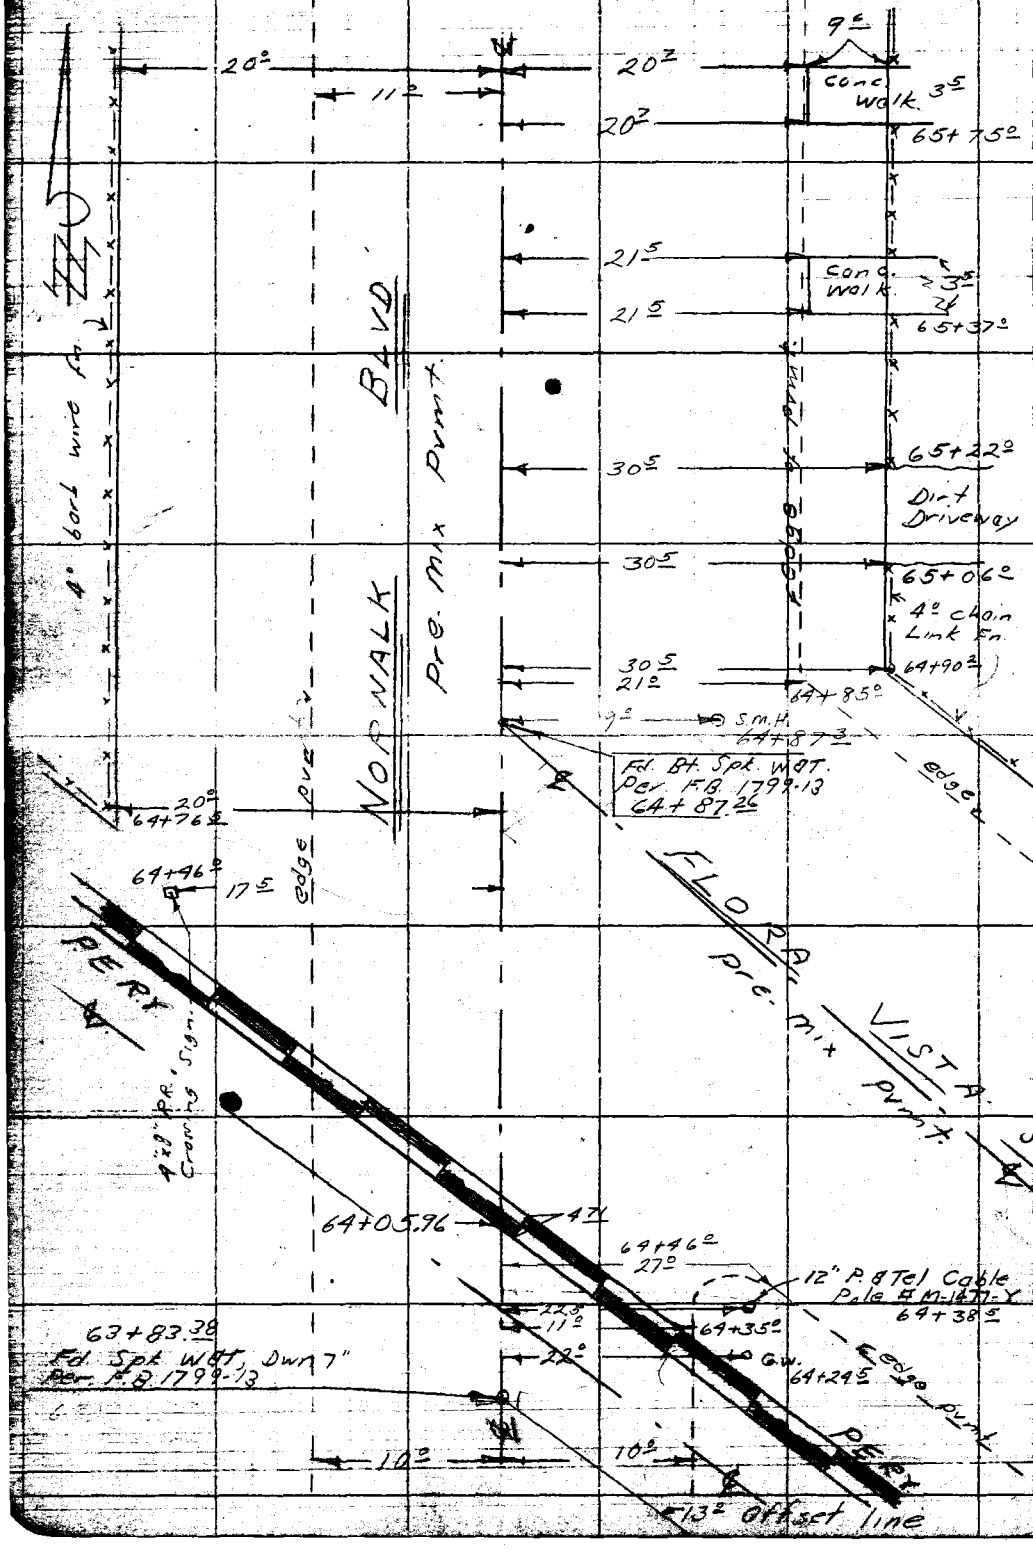

RETURN TO
LOS ANGELES COUNTY SURVEYOR
726 LOS ANGELES COUNTY
ENGINEERING BLDG.
Do not extend notes this side of this line.

Note: Any Additions or Changes on This Sheet Must be Made or Circled in Red Ink With Date and Name of Person Making Change.

Notes Ck'd by	Survey of Artesia - Norwalk	F.B. 1799 Pg. 127
Map No.	W. O. 6951 Tape No. St'd. °F	Cont. bott pg #128
Office Work	Surveyed by English	
Checked	Notes Sappell Date 11-53	
Date	Indexed R. C. Johnson	

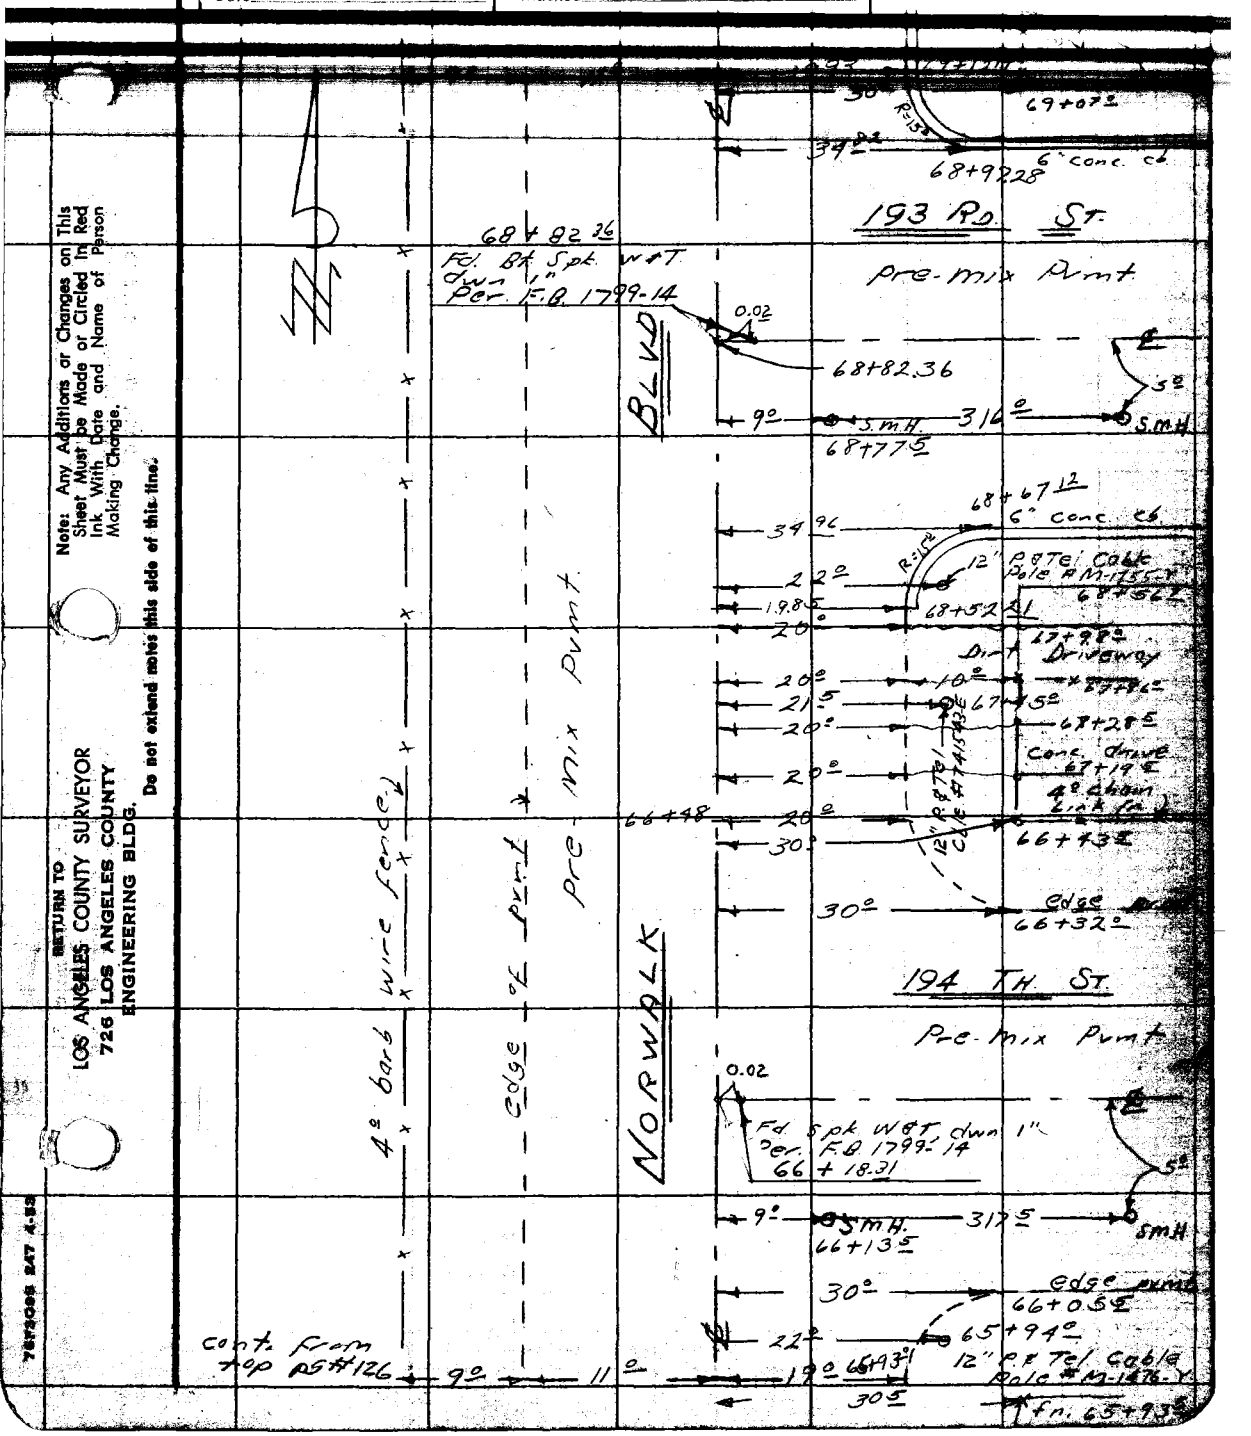

Note: Any Additions or Changes on This Sheet Must be Made or Circled In Red Ink With Date and Name of Person Making Change.

Do not extend notes this side of this line.

RETURN TO
LOS ANGELES COUNTY SURVEYOR
726 LOS ANGELES COUNTY
ENGINEERING BLDG.

76F3098 247 4-53

F.B. 1799 Pg. 128

Cont. bott pg # 129

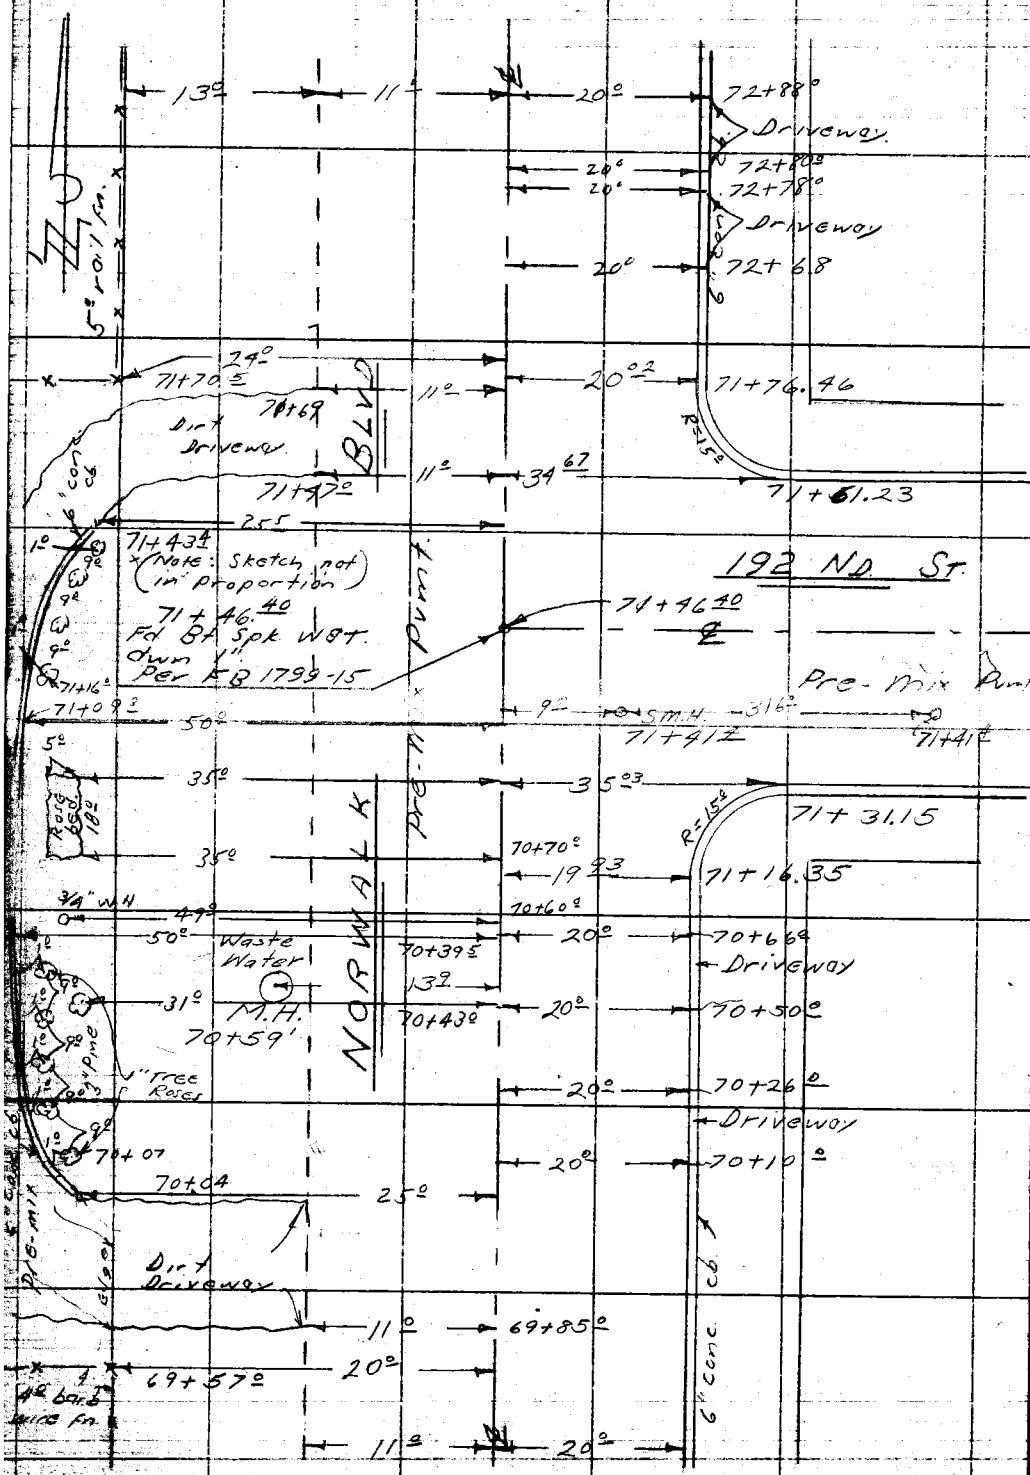

Cont from top pg # 127

RETURN TO
LOS ANGELES COUNTY SURVEYOR
726 LOS ANGELES COUNTY
ENGINEERING BLDG.

Do not extend notes this side of this line.

Note: Any Additions or Changes on This Sheet Must be Made or Circled in Red Ink With Date and Name of Person Making Change.

69

Notes Ck'd by
Map No.
Office Work
Checked
Date

Survey of Artesia - Norwalk
W. O. 247 Tape No. Std. °F
Surveyed by English
Notes Page 11 Date 11-53
Indexed R. C. Johnson

F. B. 1799 Pg. 129
Cont 6077 pg # 130

Note: Any Additions or Changes on This Sheet Must be Made or Circled in Red Ink With Date and Name of Person Making Change.

Do not extend notes this side of this line.

RETURN TO
LOS ANGELES COUNTY SURVEYOR
726 LOS ANGELES COUNTY
ENGINEERING BLDG.

78FS098 247 4-53

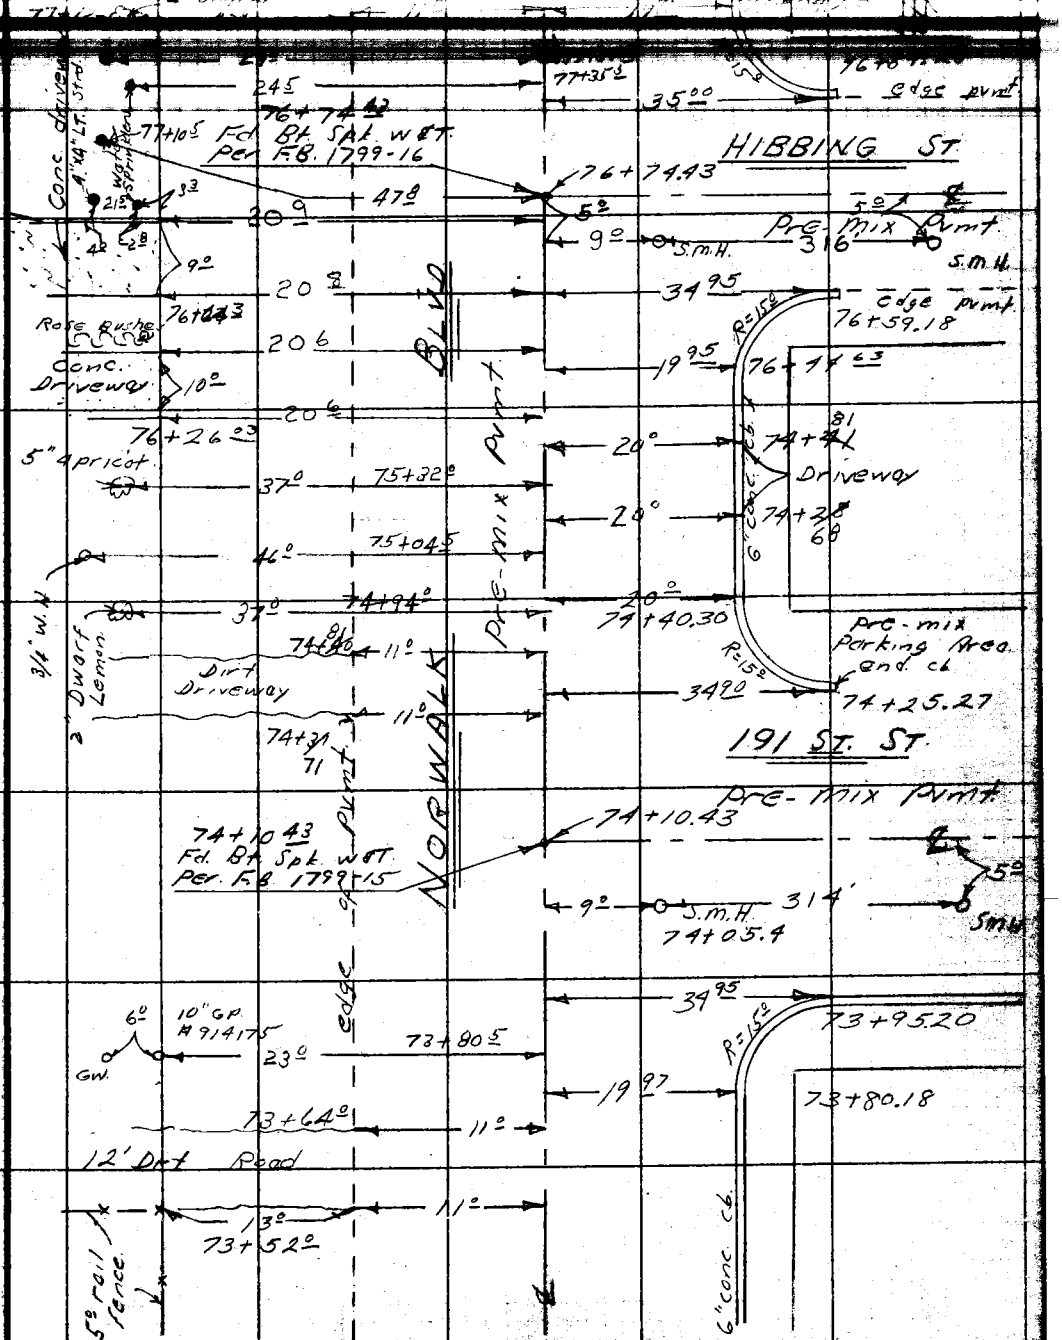

cont from top pg # 128

Cont. both pg. # 131

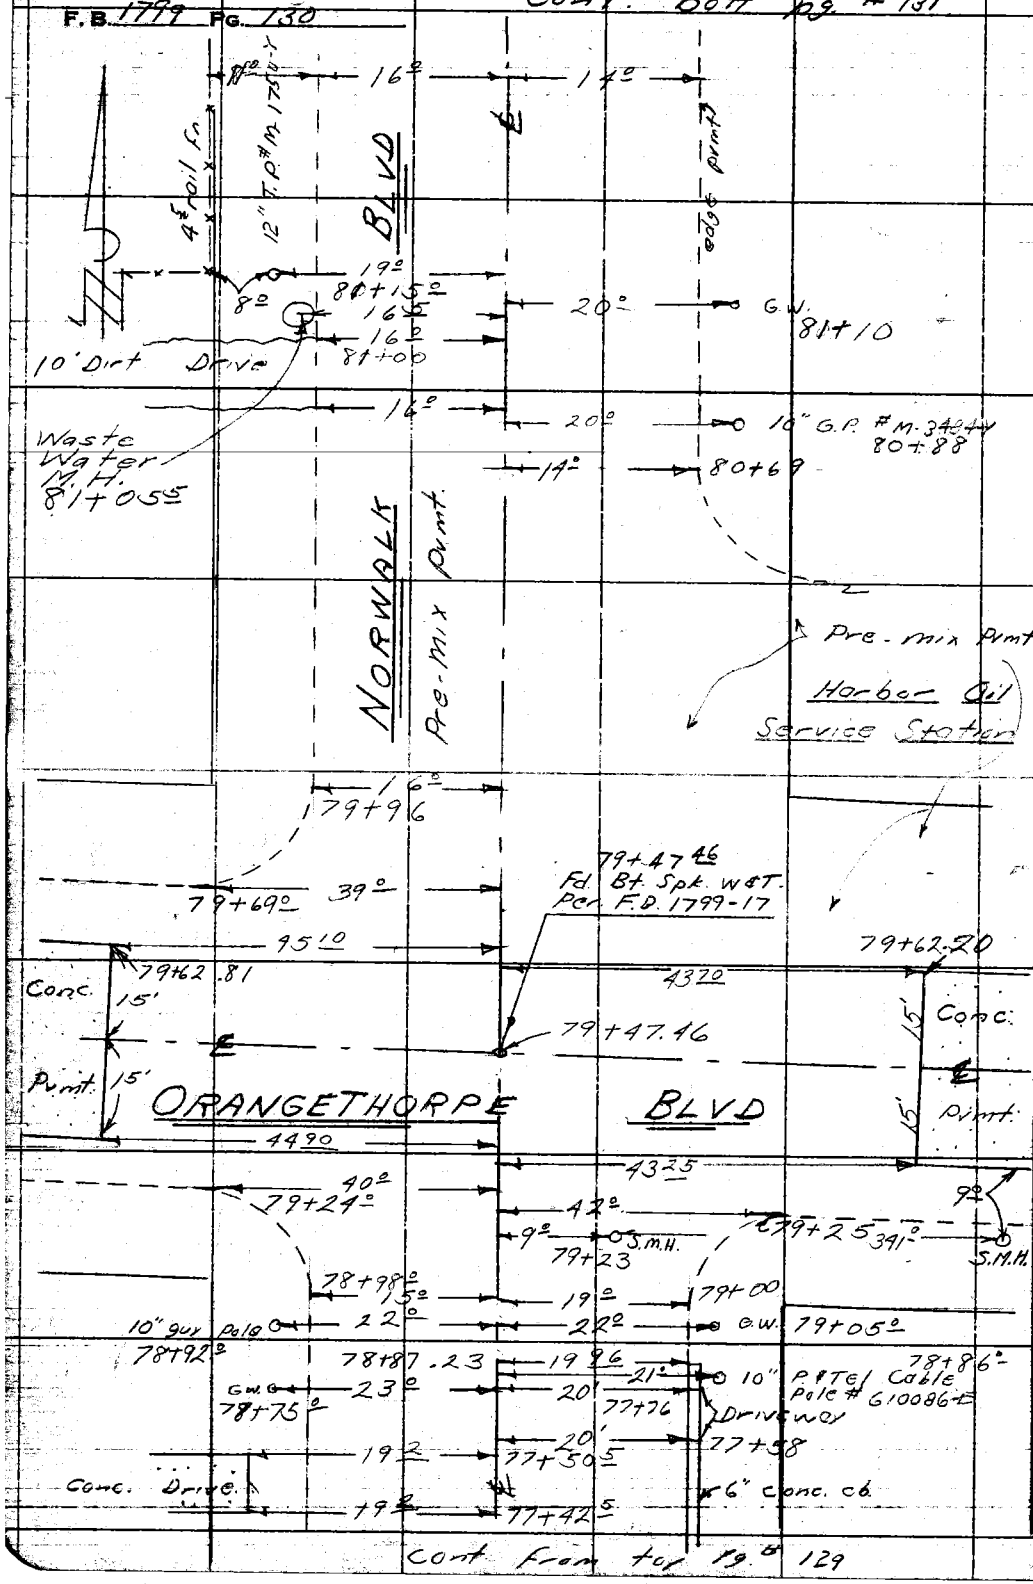

Cont from top pg. # 129

RETURN TO
LOS ANGELES COUNTY SURVEYOR
726 LOS ANGELES COUNTY
ENGINEERING BLDG.
Do not extend notes this side of this line.

Note: Any Additions or Changes on This Sheet Must be Made or Circled in Red Ink With Date and Name of Person Making Change.

Notes Ck'd by	Survey of Artesia - Norwalk	F. B. 1799 PG. 131
Map No.	W. O. 695' Tape No. St'd. °F	Cont both pg # 132
Office Work	Surveyed by English	
Checked	Notes Sopell Date 11-53	
Date	Indexed	

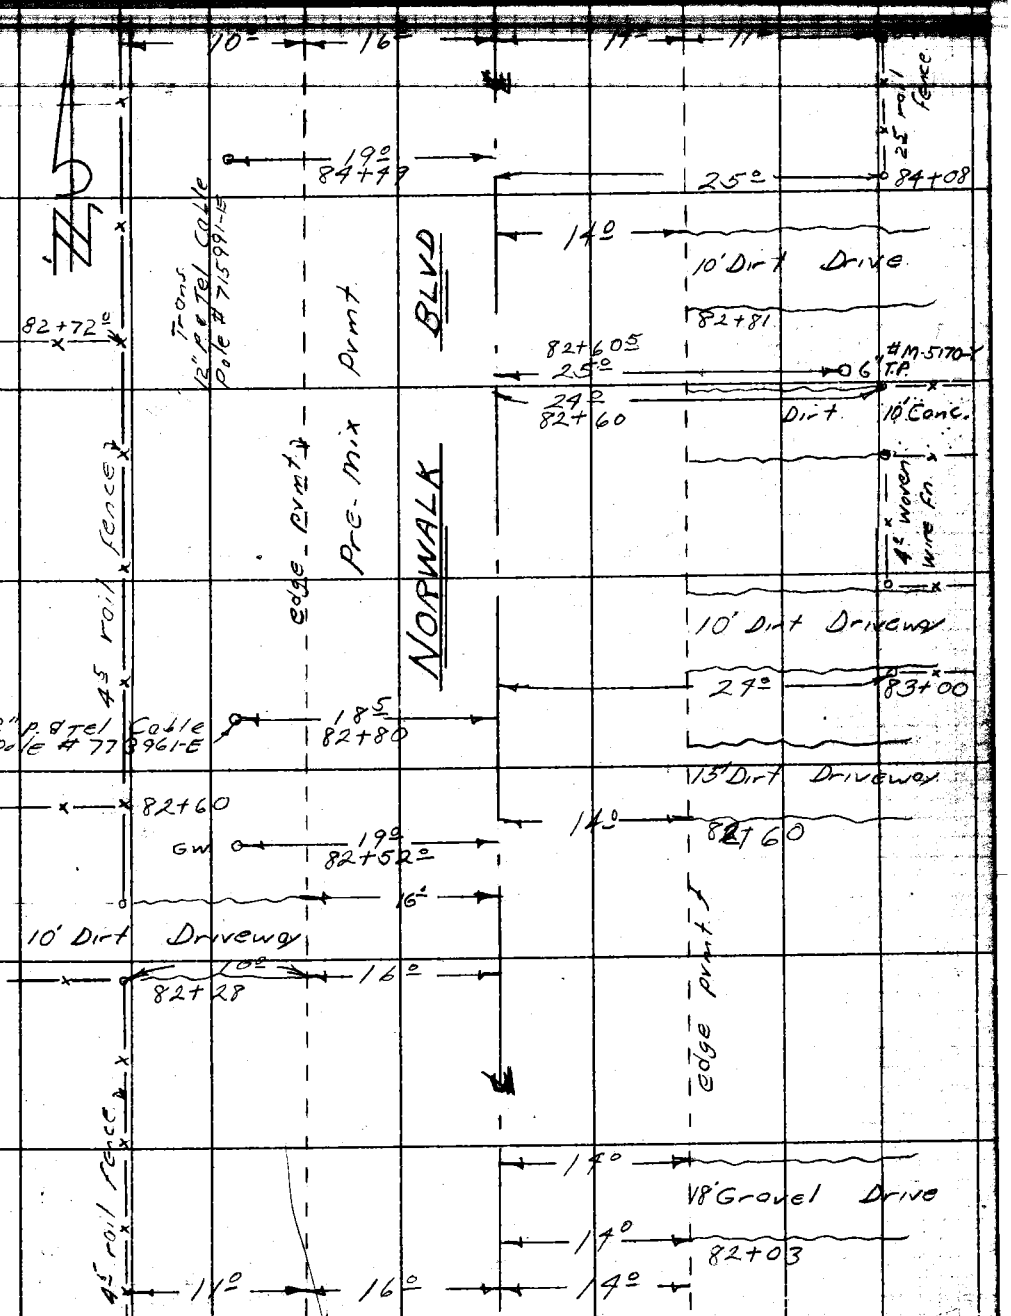

Cont from top pg # 130

Note: Any Additions or Changes on This Sheet Must be Made or Circled in Red Ink With Date and Name of Person Making Change.

Do not extend notes this side of this line.

RETURN TO
LOS ANGELES COUNTY SURVEYOR
726 LOS ANGELES COUNTY
ENGINEERING BLDG.

78FS09S 247 4-53

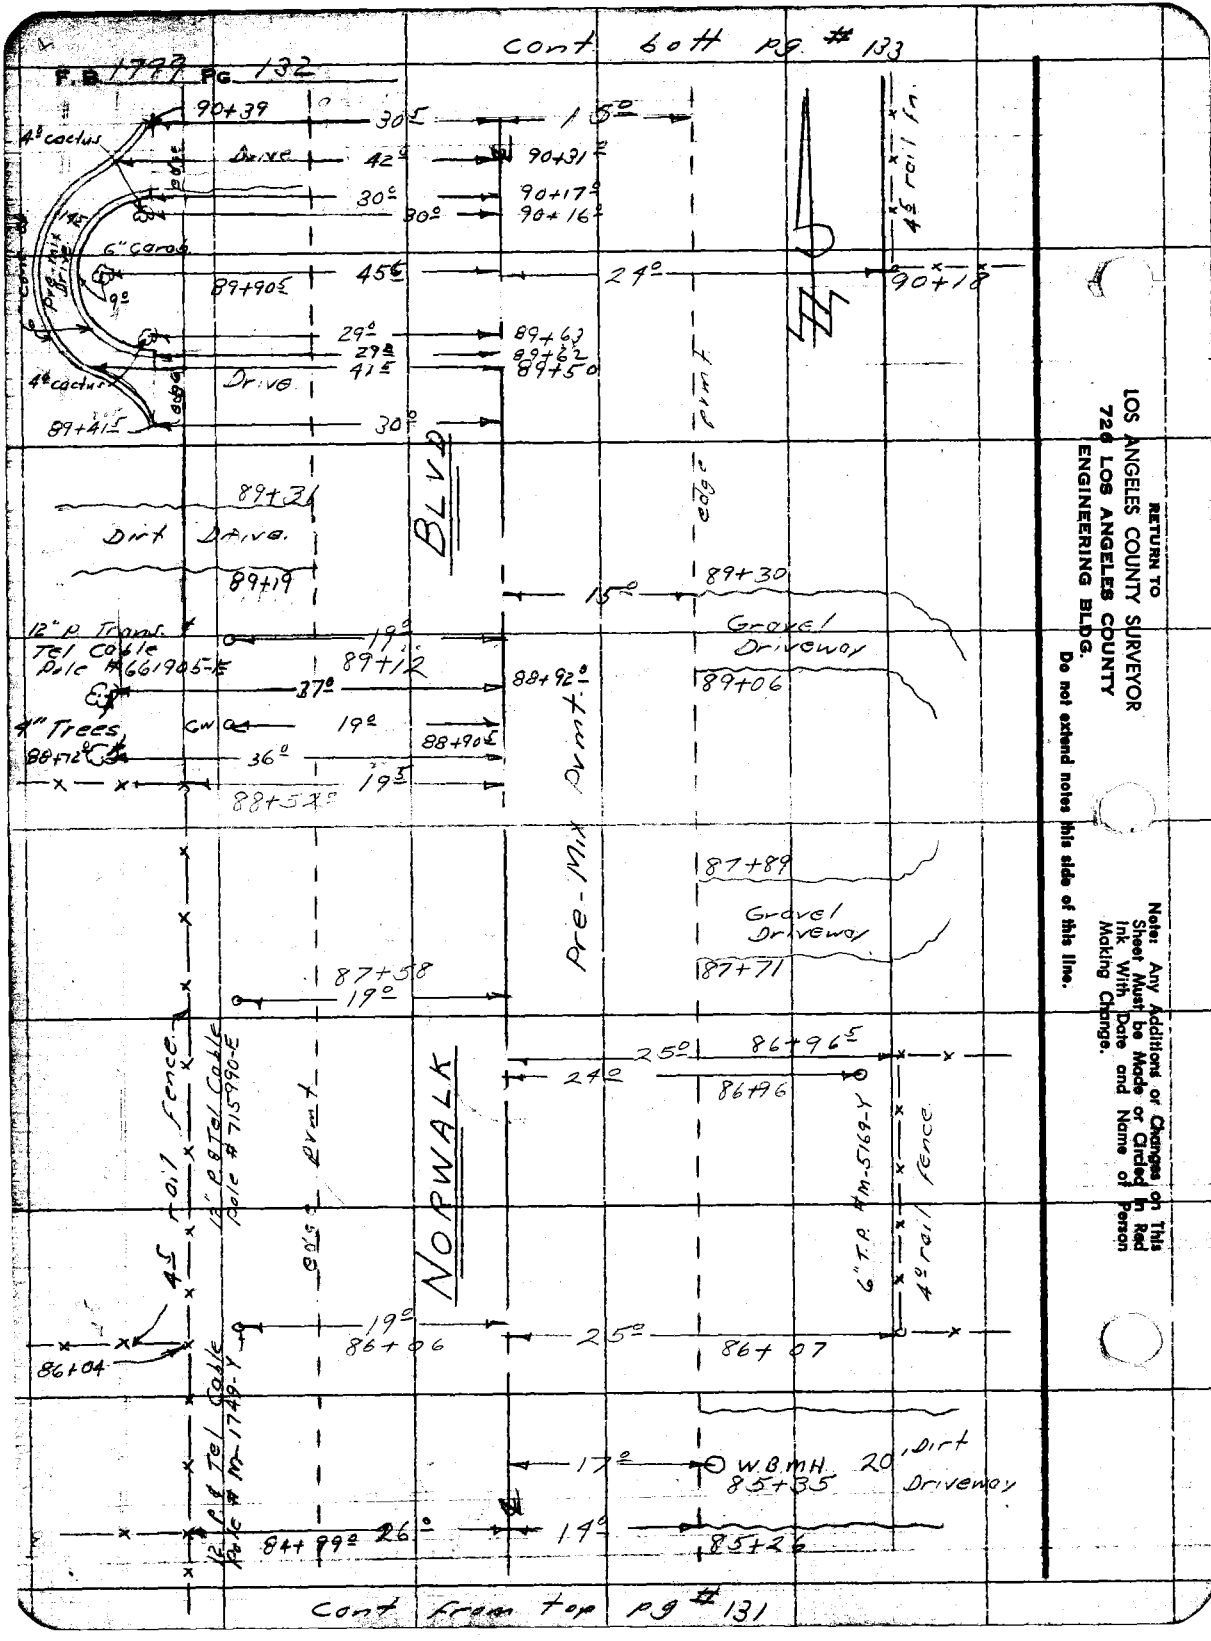

RETURN TO
LOS ANGELES COUNTY SURVEYOR
726 LOS ANGELES COUNTY
ENGINEERING BLDG.
Do not extend notes this side of this line.

Note: Any Additions or Changes on This Sheet Must be Made or Circled in Red Ink With Date and Name of Person Making Change.

Notes Ck'd by
Map No.
Office Work
Checked
Date

Survey of Artesia - Norwalk
W. O. 6951 Tape No. Sr'd. °F
Surveyed by English
Notes Sappell Date 11-53
Indexed A C Johnson

F. B. 1799 Pg. 133

cont. batt pg #134

25

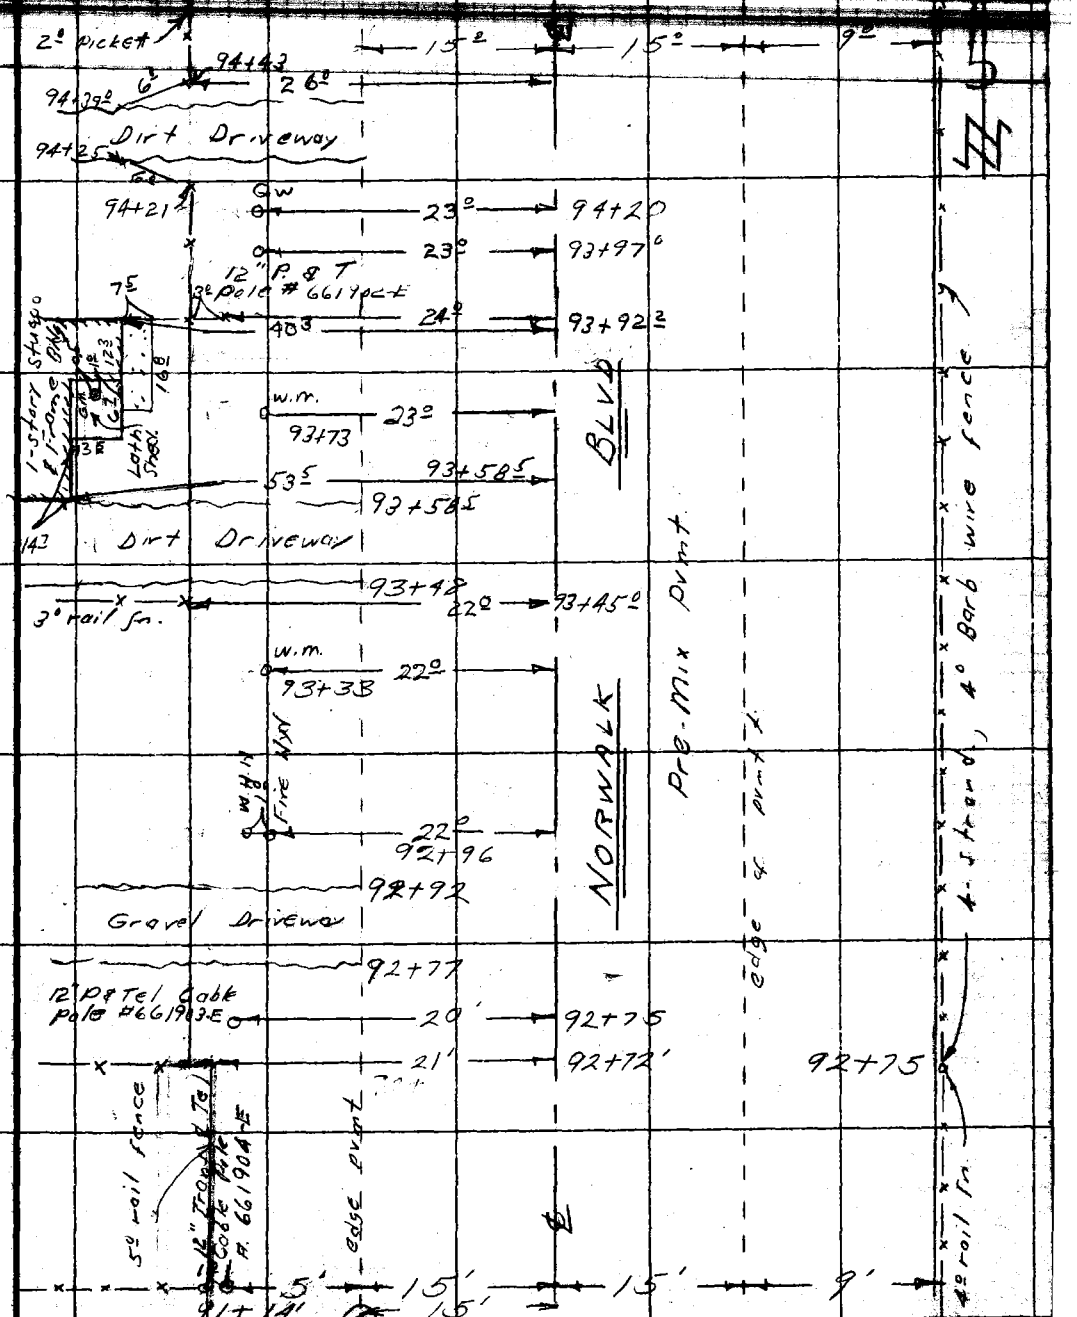

91+06.5 Waste Water M.H.

cont. from top pg #132

Note: Any Additions or Changes on This Sheet Must be Made or Circled in Red Ink With Date and Name of Person Making Change.

Do not extend notes this side of this line.

RETURN TO
LOS ANGELES COUNTY SURVEYOR
726 LOS ANGELES COUNTY
ENGINEERING BLDG.

76F3095 247 4-53

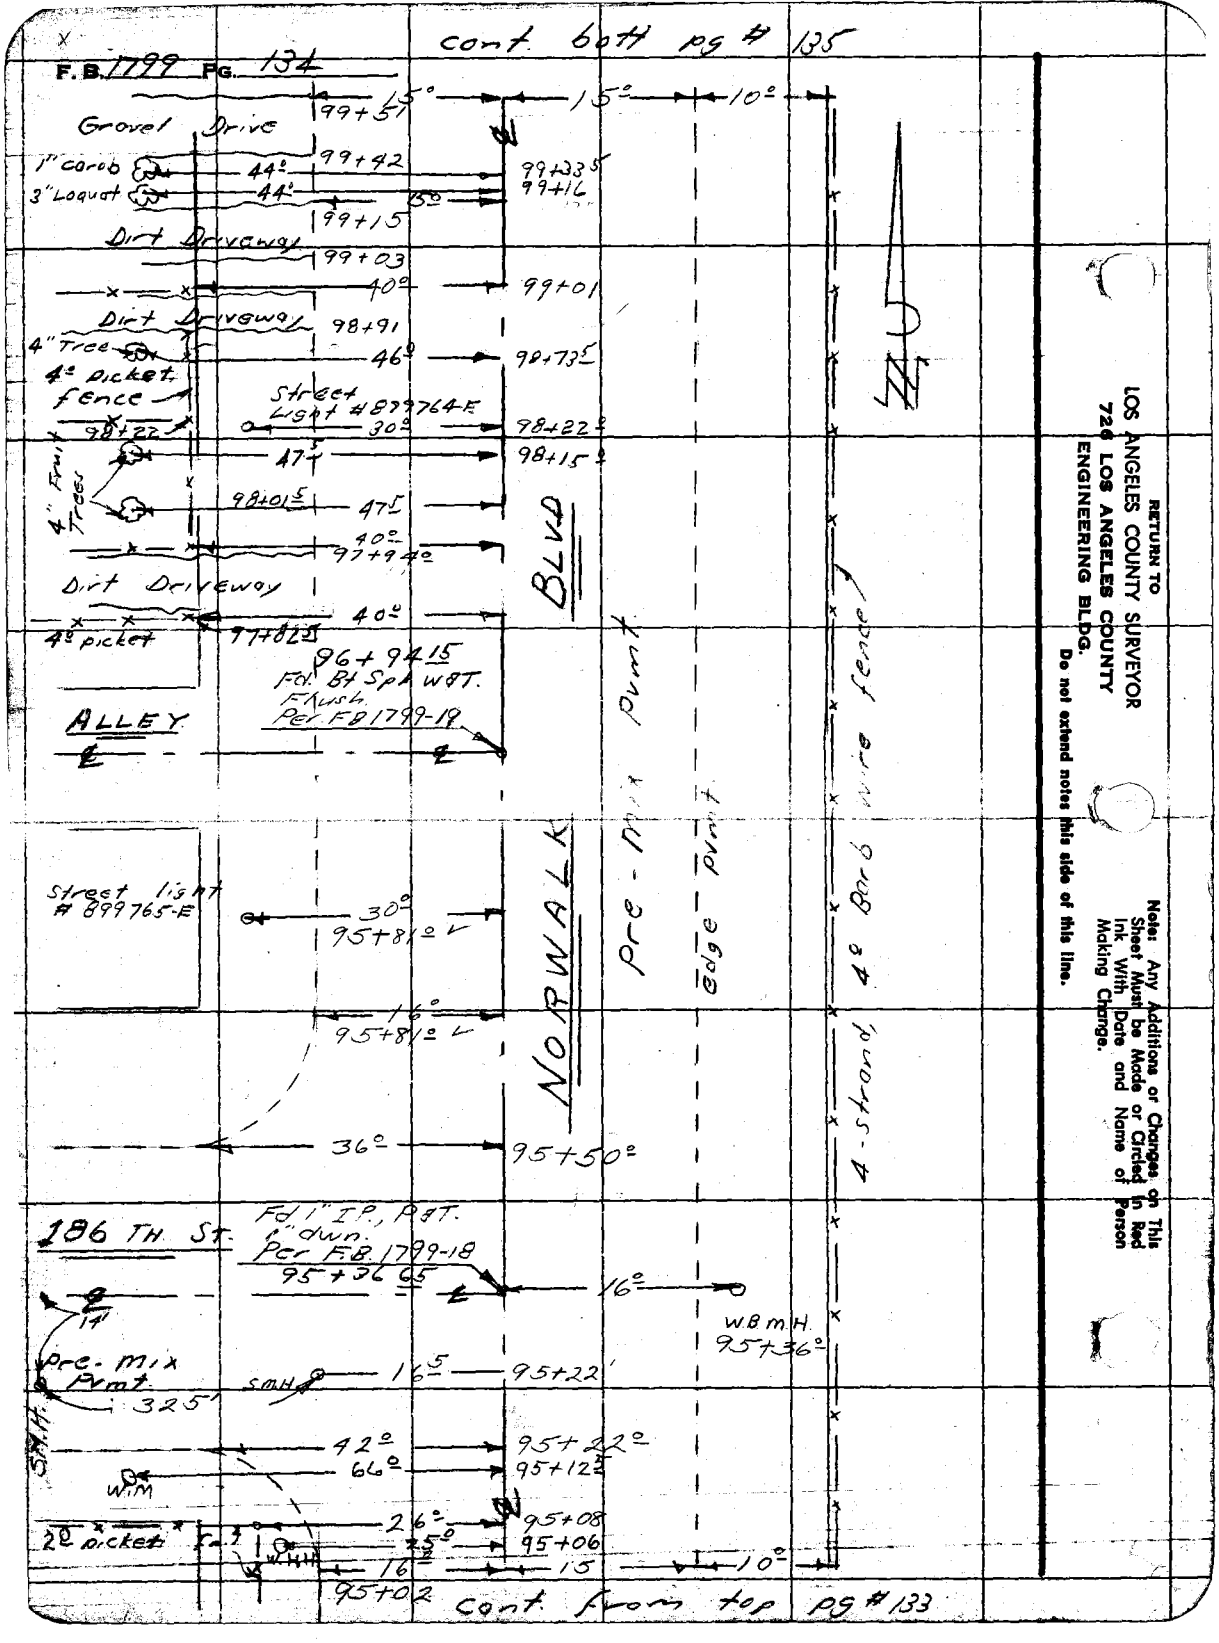
cont. bott pg # 135
F.B. 1799 Pg. 134
15°
15°
10°
99+51
Gravel Drive
1" carob
3" Loquat
44°
44°
99+42
99+33.5
99+16
15°
99+15
Dirt Driveway
99+03
40°
99+01
Dirt Driveway
98+91
4" Tree
46°
98+73.5
4° picket fence
Street Light #899764-E
98+22
30°
98+22.5
47.5
98+15.5
4" Fruit Trees
98+01.5
47.5
40°
97+94.5
Dirt Driveway
40°
4° picket
97+82.5
96+94.15
Fd. Bt Spk W&T.
Flush.
Per FB 1799-19
ALLEY
BLVD
NORWALK
Pre-Mix Pvmt
Edge Pvmt
4-strand, 4° Barb wire fence
Street light # 899765-E
30°
95+81.0
16°
95+81.0
36°
95+50.0
186 TH. ST.
Fd 1" I.P., P&T.
1" dwn.
Per F.B. 1799-18
95+36.65
16°
14'
W.B.M.H.
95+36.0
Pre-Mix Pvmt.
325'
S.M.H.
16.5
95+22'
42°
95+22.0
66°
95+12.5
W.M.
26°
95+08
2° picket
25°
95+06
16°
15
10°
95+02
cont. from top pg # 133
RETURN TO
LOS ANGELES COUNTY SURVEYOR
726 LOS ANGELES COUNTY
ENGINEERING BLDG.
Do not extend notes this side of this line.
Note: Any Additions or Changes on This Sheet Must be Made or Circled in Red Ink With Date and Name of Person Making Change.

Notes Ck'd by
Map No.
Office Work
Checked
Date

Survey of Artesia - Norwalk
W. O. 695 Tape No. St'd. °F
Surveyed by English
Notes Sappell Date 11-53
Indexed R C Johnson

F. B. 1799 Pg. 135

Note: Any Additions or Changes on This Sheet Must be Made or Circled In Red Ink With Date and Name of Person Making Change.

Do not extend notes this side of this line.

RETURN TO
LOS ANGELES COUNTY SURVEYOR
726 LOS ANGELES COUNTY
ENGINEERING BLDG.

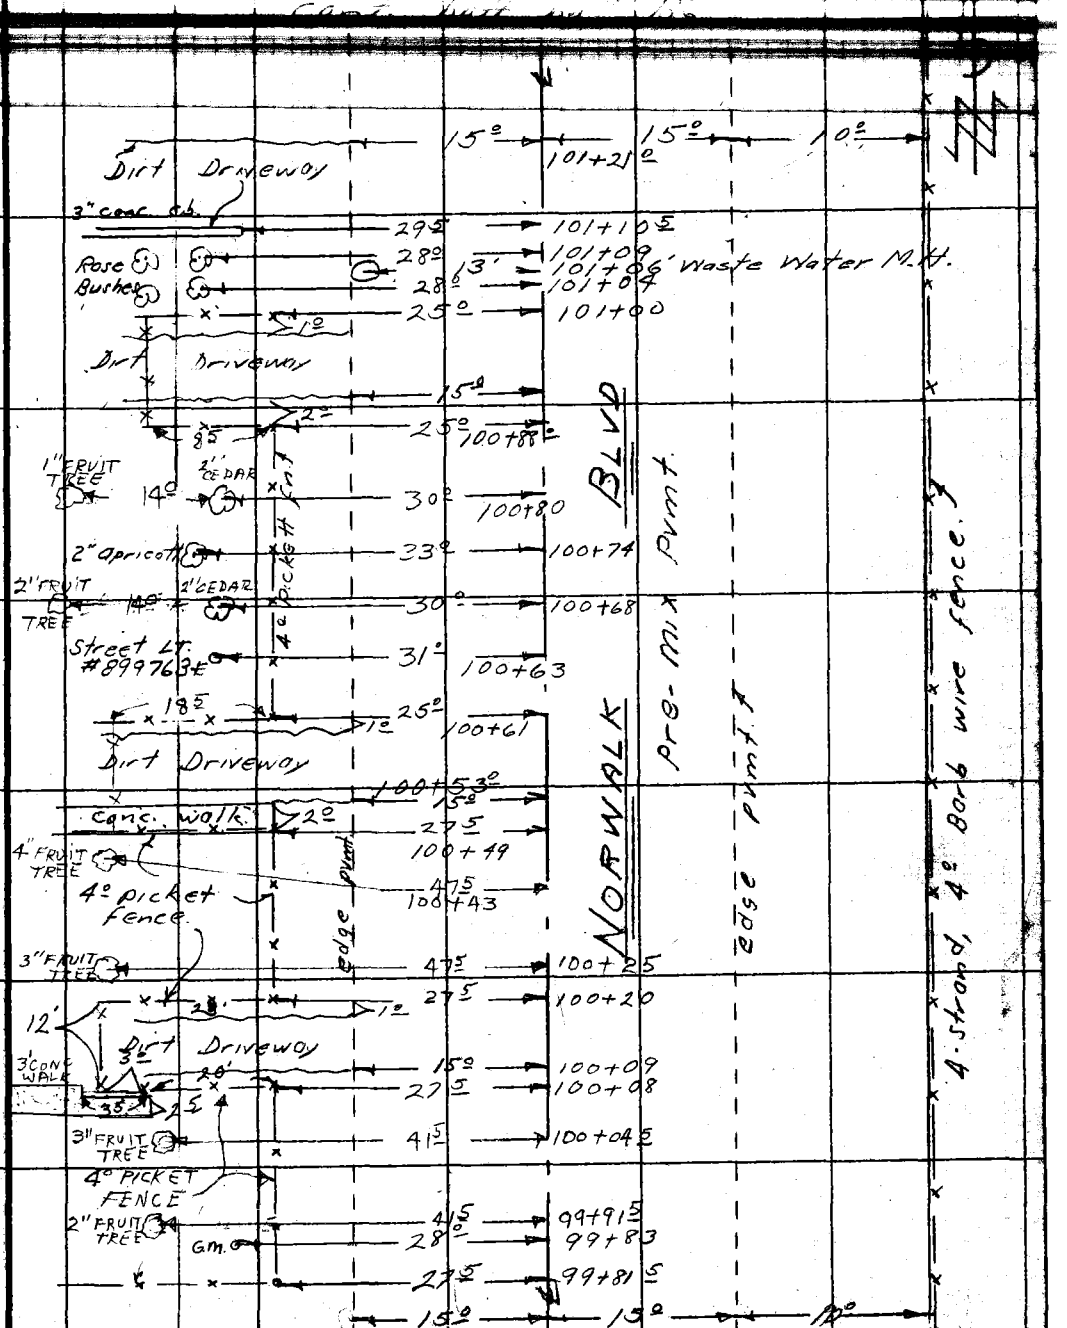

cont from top pg # 134

78F3098 247 4-55

X

cont. both pg. # 137

F.B. 1799 PG. 136

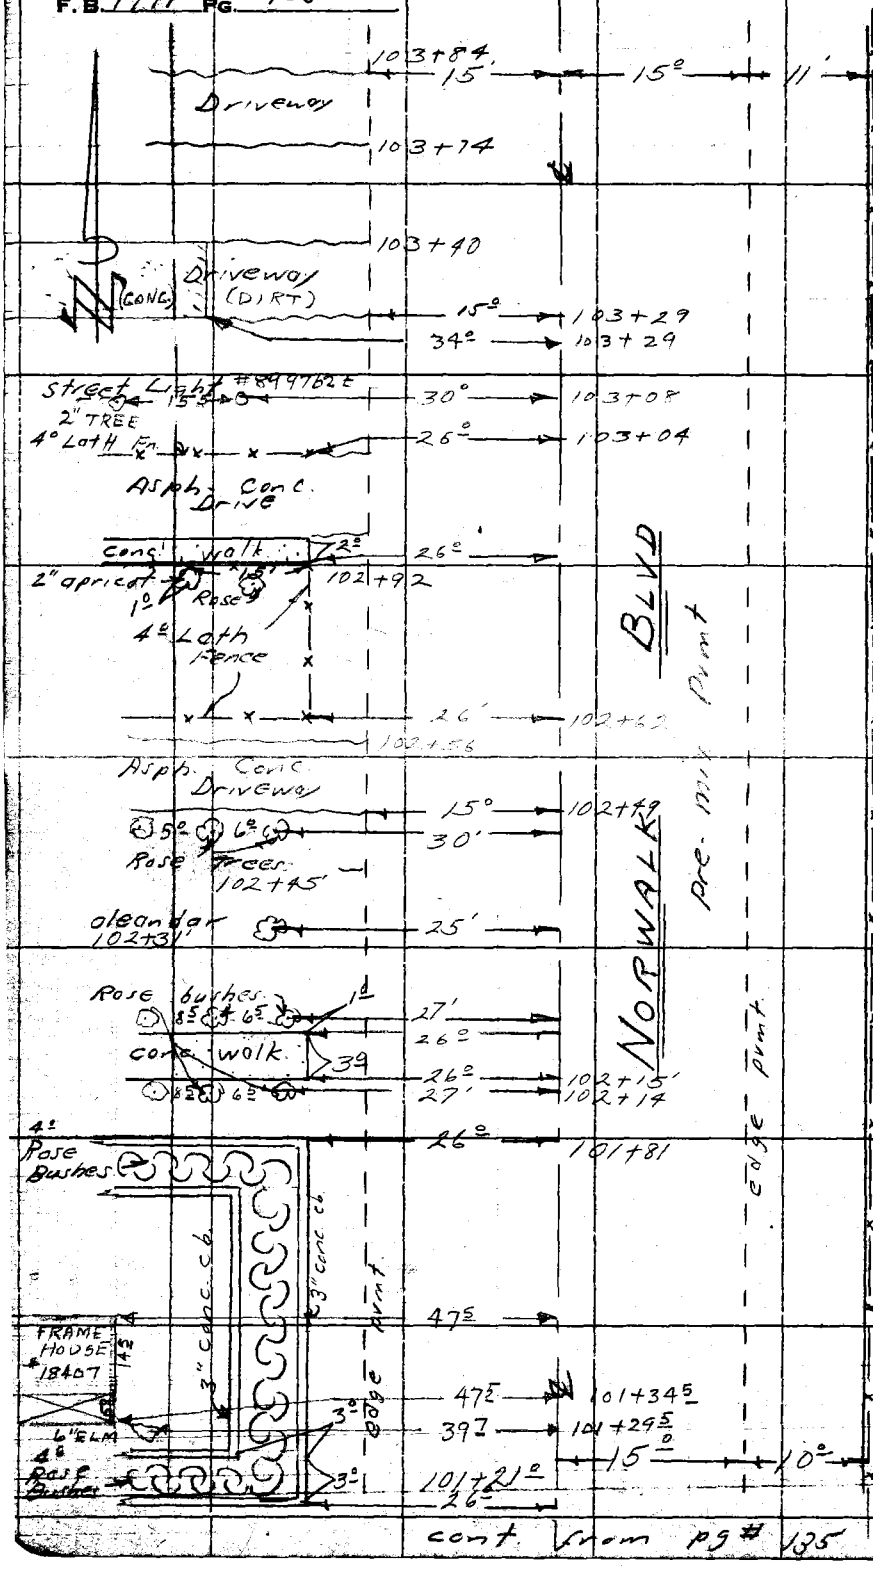

cont. from pg # 135

RETURN TO
LOS ANGELES COUNTY SURVEYOR
726 LOS ANGELES COUNTY
ENGINEERING BLDG.
Do not extend notes this side of this line.

Note: Any Additions or Changes on This Sheet Must be Made or Circled in Red Ink With Date and Name of Person Making Change.

Notes Ck'd by	Survey of Artesia. Norwalk.	F. B. 1799 Pg. 137
Map No.	W. O. 6951 Tape No. St'd. °F	cont. bott pg # 138
Office Work	Surveyed by English	
Checked	Notes Sappell Date 11-53	
Date	Indexed B. C. Johnson	

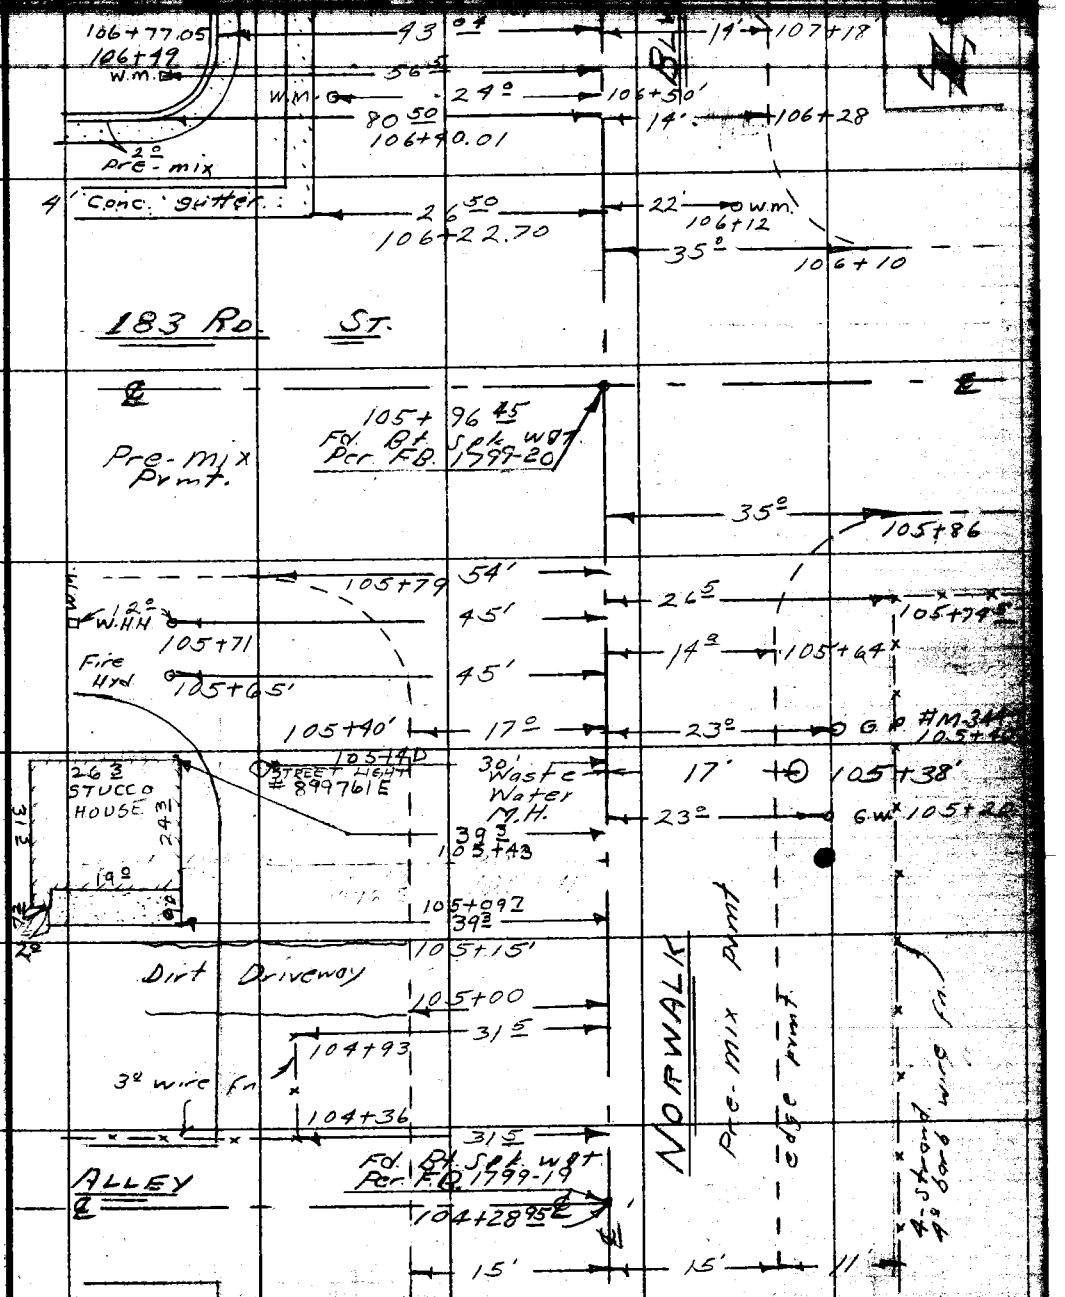

cont from top pg # 136

Note: Any Additions or Changes on This Sheet Must be Made or Circled in Red Ink With Date and Name of Person Making Change.

Do not extend notes this side of this line.

RETURN TO
LOS ANGELES COUNTY SURVEYOR
726 LOS ANGELES COUNTY
ENGINEERING BLDG.

76F3095 247 4-53

cont. bott pg # 139

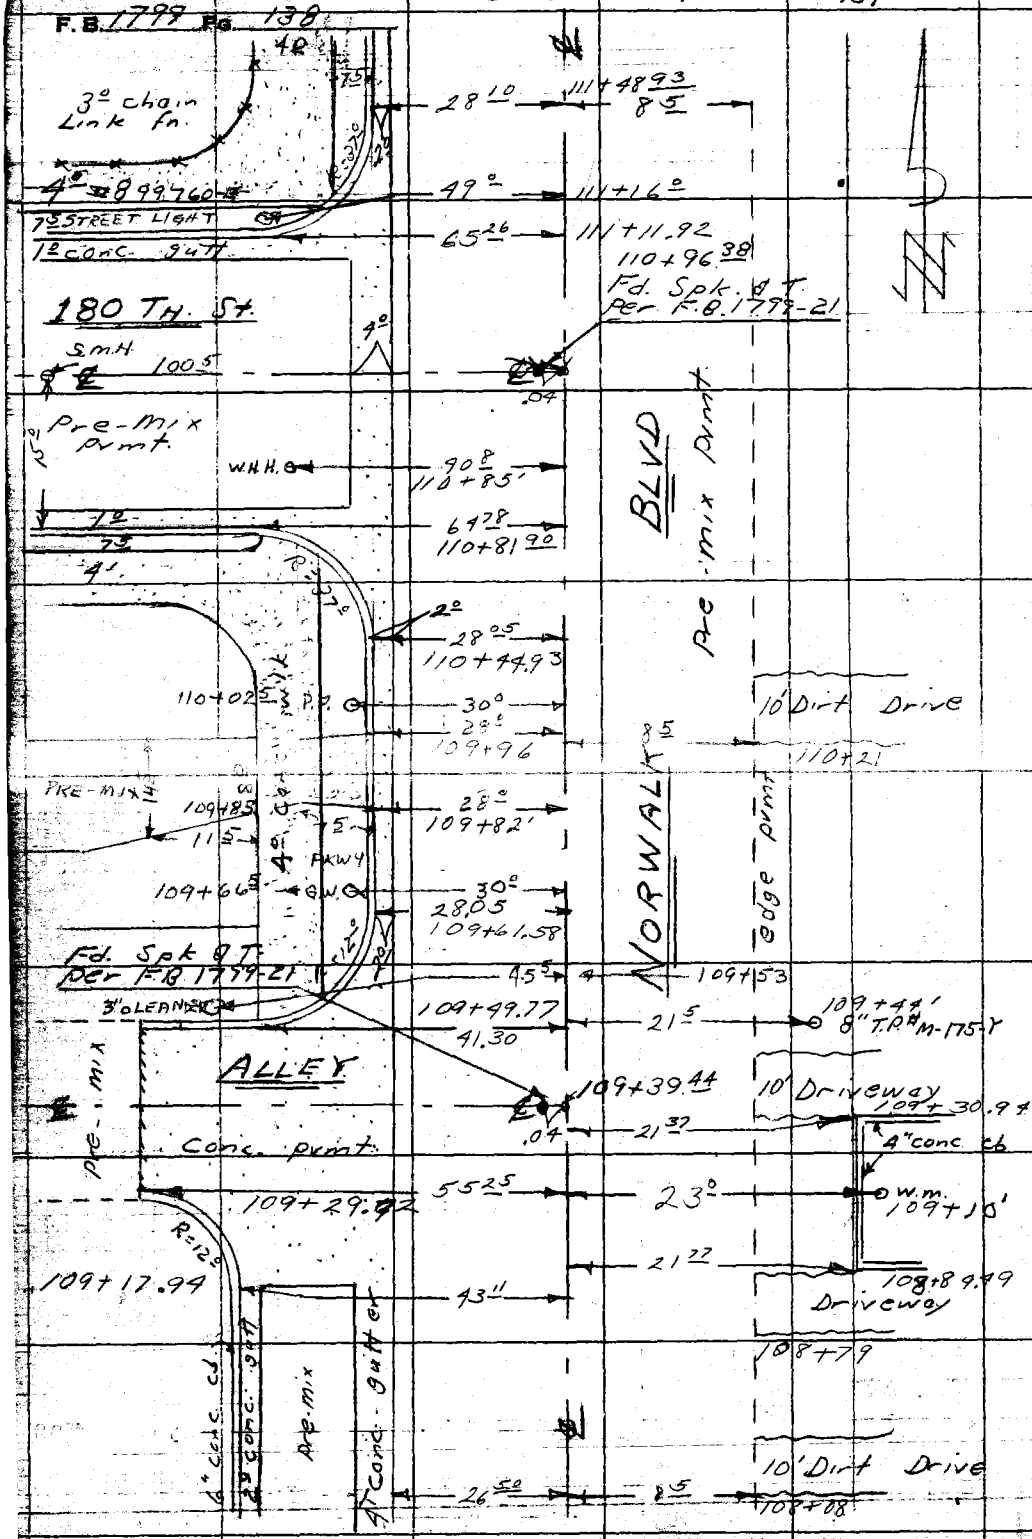

cont. from top pg # 137

RETURN TO
LOS ANGELES COUNTY SURVEYOR
726 LOS ANGELES COUNTY
ENGINEERING BLDG.
Do not extend notes this side of this line.

Note: Any Additions or Changes on This Sheet Must be Made or Checked in Red Ink With Date and Name of Person Making Change.

Notes Ck'd by	Survey of Artesia - Norwalk	F.B. 1799 Pg. 139
Map No.	W. O. 6951 Tape No. Sr'd. °F	Cont bott pg # 140
Office Work	Surveyed by English	
Checked	Notes Sappell Date 11-53	
Date	Indexed A. C. Johnson	

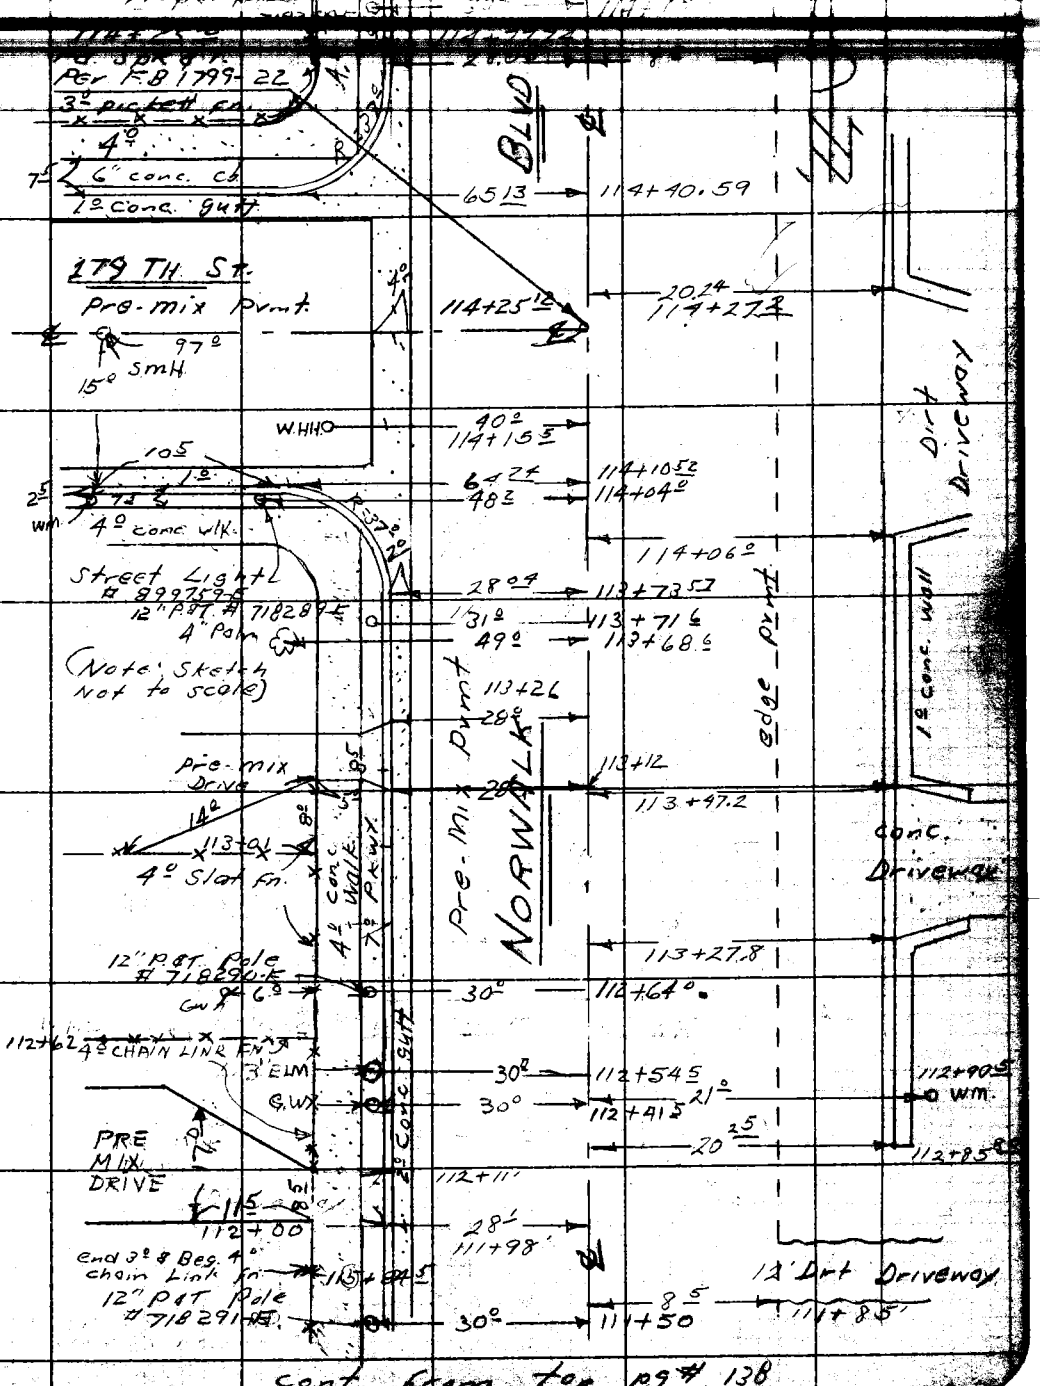

cont from top pg # 138

Note: Any Additions or Changes on This Sheet Must be Made or Circled in Red Ink With Date and Name of Person Making Change.

Do not extend notes this side of this line.

RETURN TO
LOS ANGELES COUNTY SURVEYOR
726 LOS ANGELES COUNTY
ENGINEERING BLDG.

76F3095 247 4-53

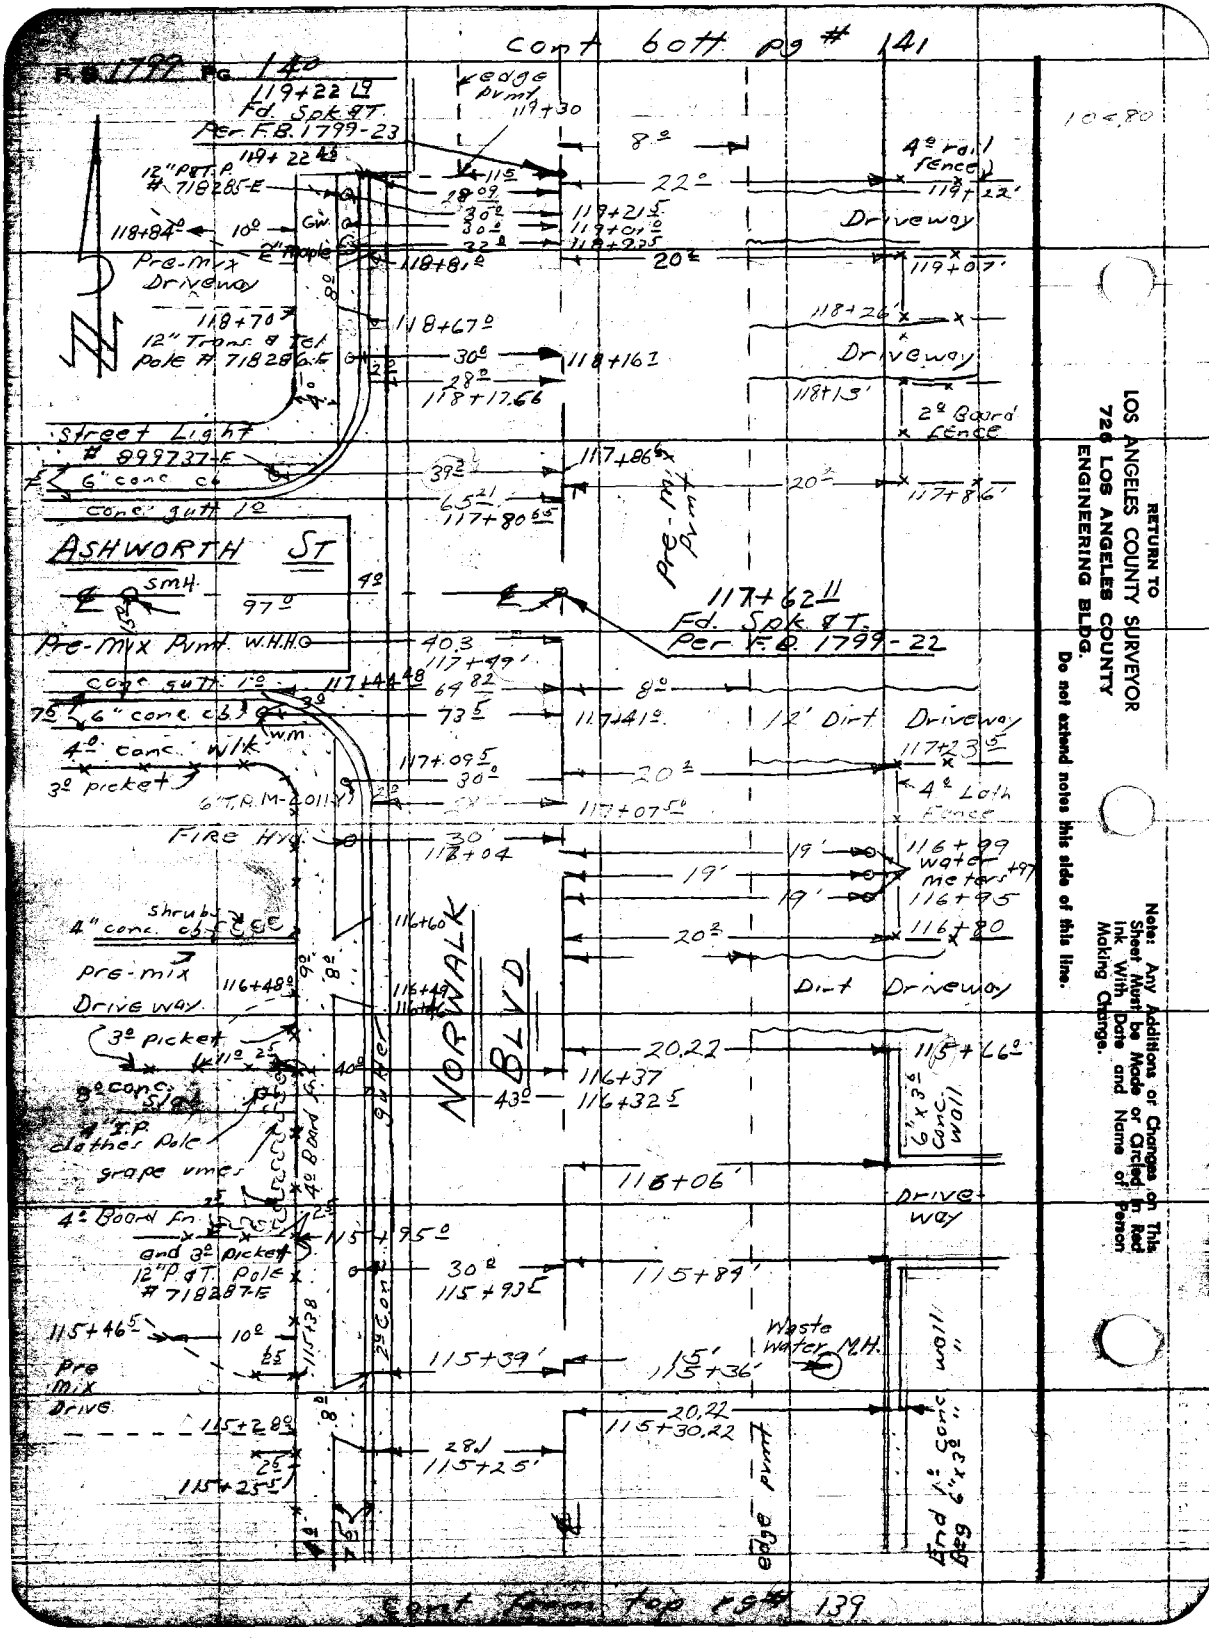

RETURN TO
LOS ANGELES COUNTY SURVEYOR
726 LOS ANGELES COUNTY
ENGINEERING BLDG.
Do not extend notes this side of this line.

Note: Any Additions or Changes on This Sheet Must be Made or Circled in Red Ink With Date and Name of Person Making Change.

Cont from top pg # 139

Notes Ck'd by	Survey of Artesia - Norwalk	F.B. 1792 Pg. 141
Map No.	W. O. 685 Tape No. St'd. °F	
Office Work	Surveyed by English	cont. both pg # 142
Checked	Notes Scopell Date 11-53	
Date	Indexed	

Note: Any Additions or Changes on This Sheet Must be Made or Circled In Red Ink With Date and Name of Person Making Change.

Do not extend notes this side of this line.

RETURN TO
LOS ANGELES COUNTY SURVEYOR
726 LOS ANGELES COUNTY
ENGINEERING BLDG.

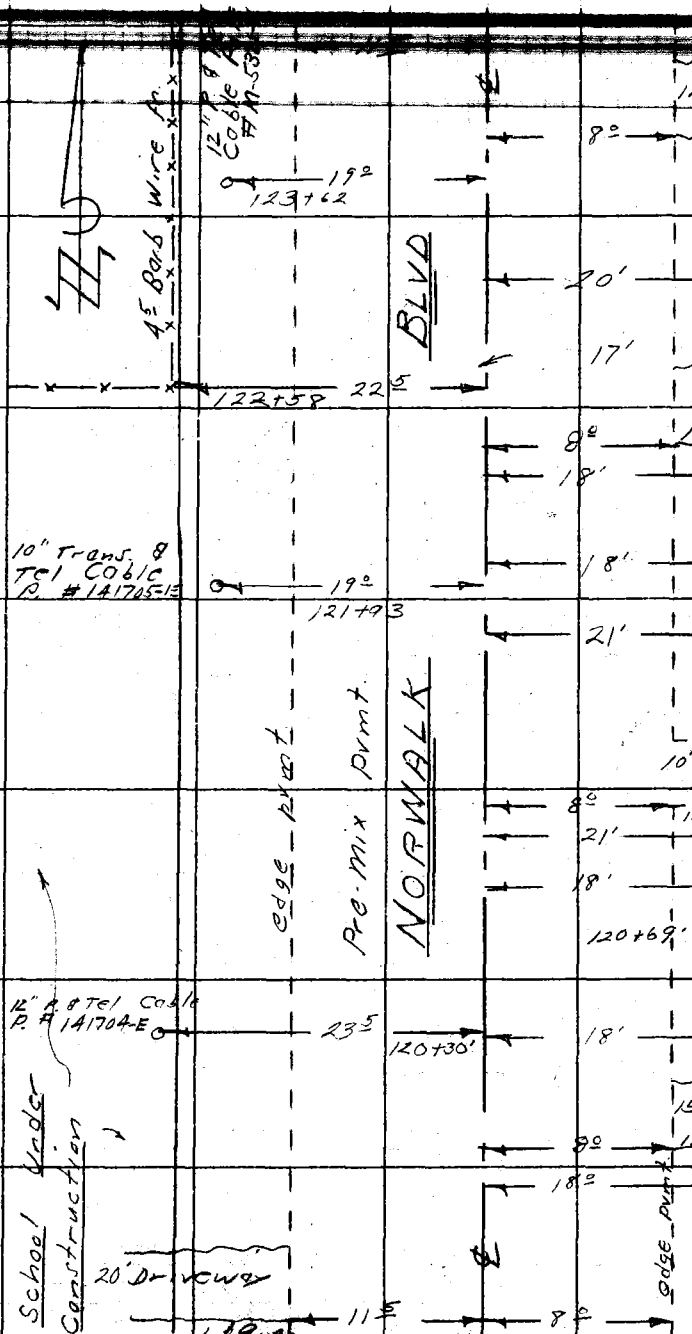

cont from top pg # 140

78F5095 247 4-53

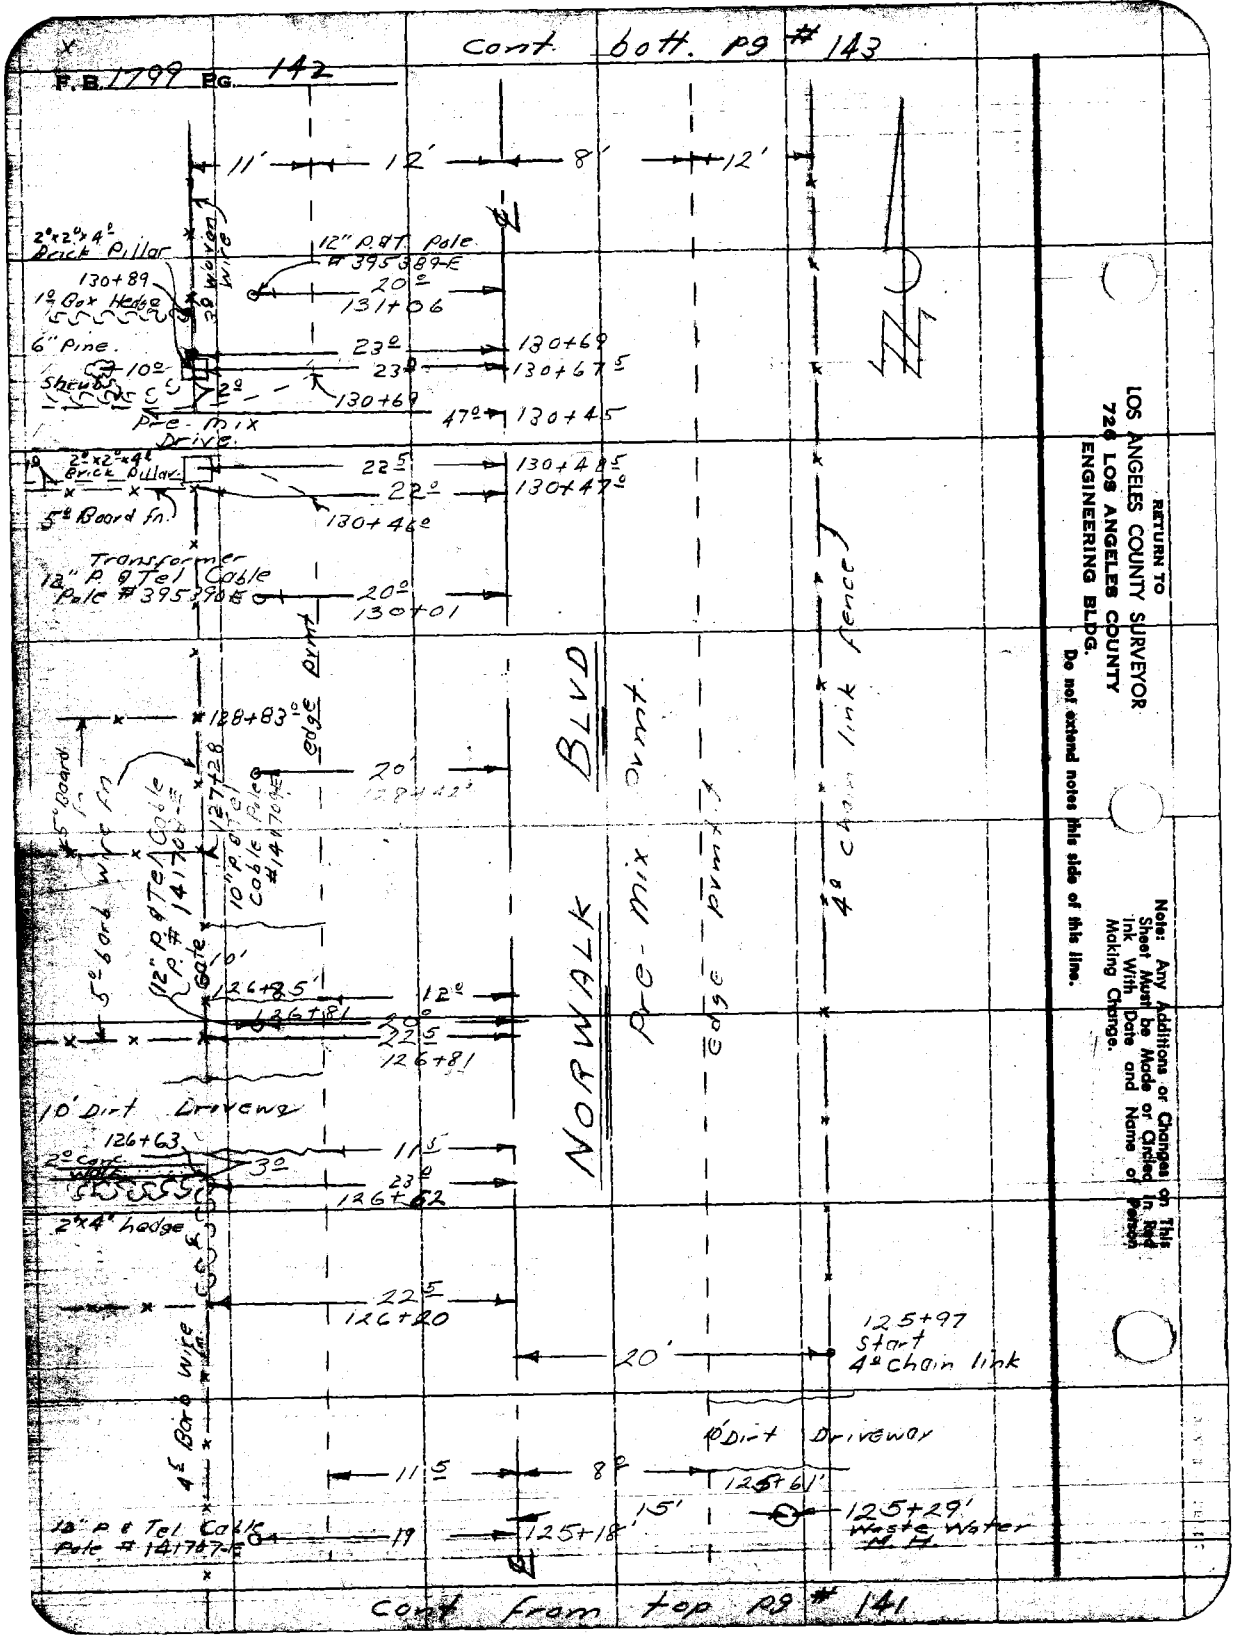

RETURN TO
LOS ANGELES COUNTY SURVEYOR
726 LOS ANGELES COUNTY
ENGINEERING BLDG.
Do not extend notes this side of this line.

Note: Any Additions or Changes on This Sheet Must be Made or Circled in Red Ink With Date and Name of Person Making Change.

Notes Ck'd by	Survey of Artesia - Norwalk	F.B. 1797 Pg. 143
Map No.	W. O. 6951 Tape No. St'd. °F	cont bott. pg #144
Office Work	Surveyed by English	
Checked	Notes Sappell Date 11-53	
Date	Indexed	

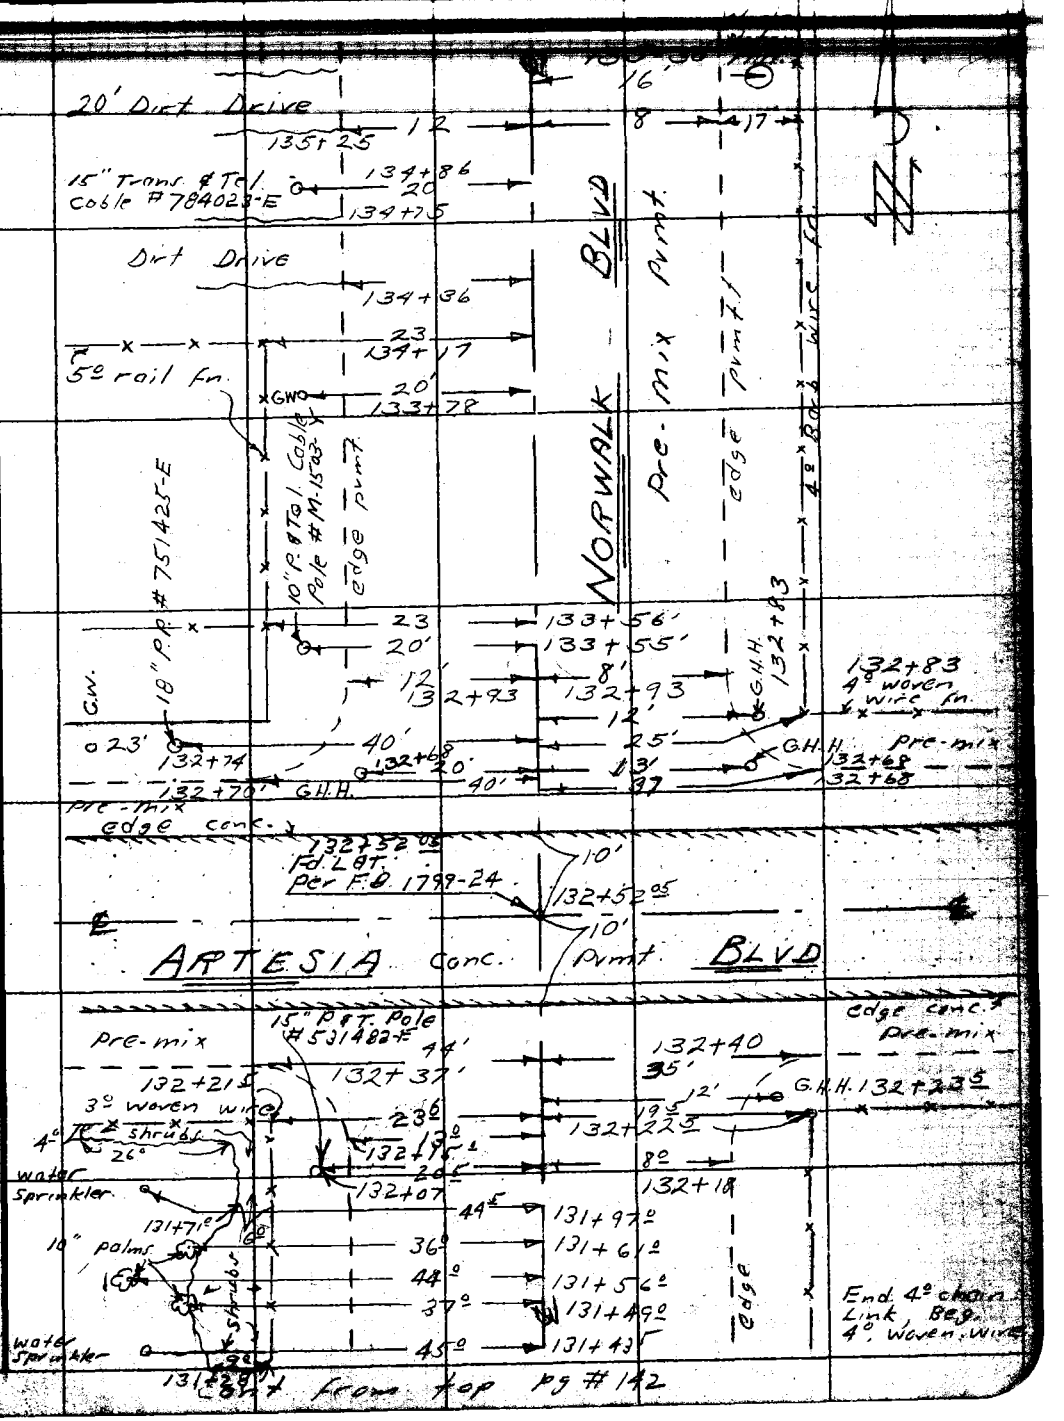

Note: Any Additions or Changes on This Sheet Must be Made or Circled in Red Ink With Date and Name of Person Making Change.

Do not extend notes this side of this line.

RETURN TO
LOS ANGELES COUNTY SURVEYOR
726 LOS ANGELES COUNTY
ENGINEERING BLDG.

78F3098 247 4-53

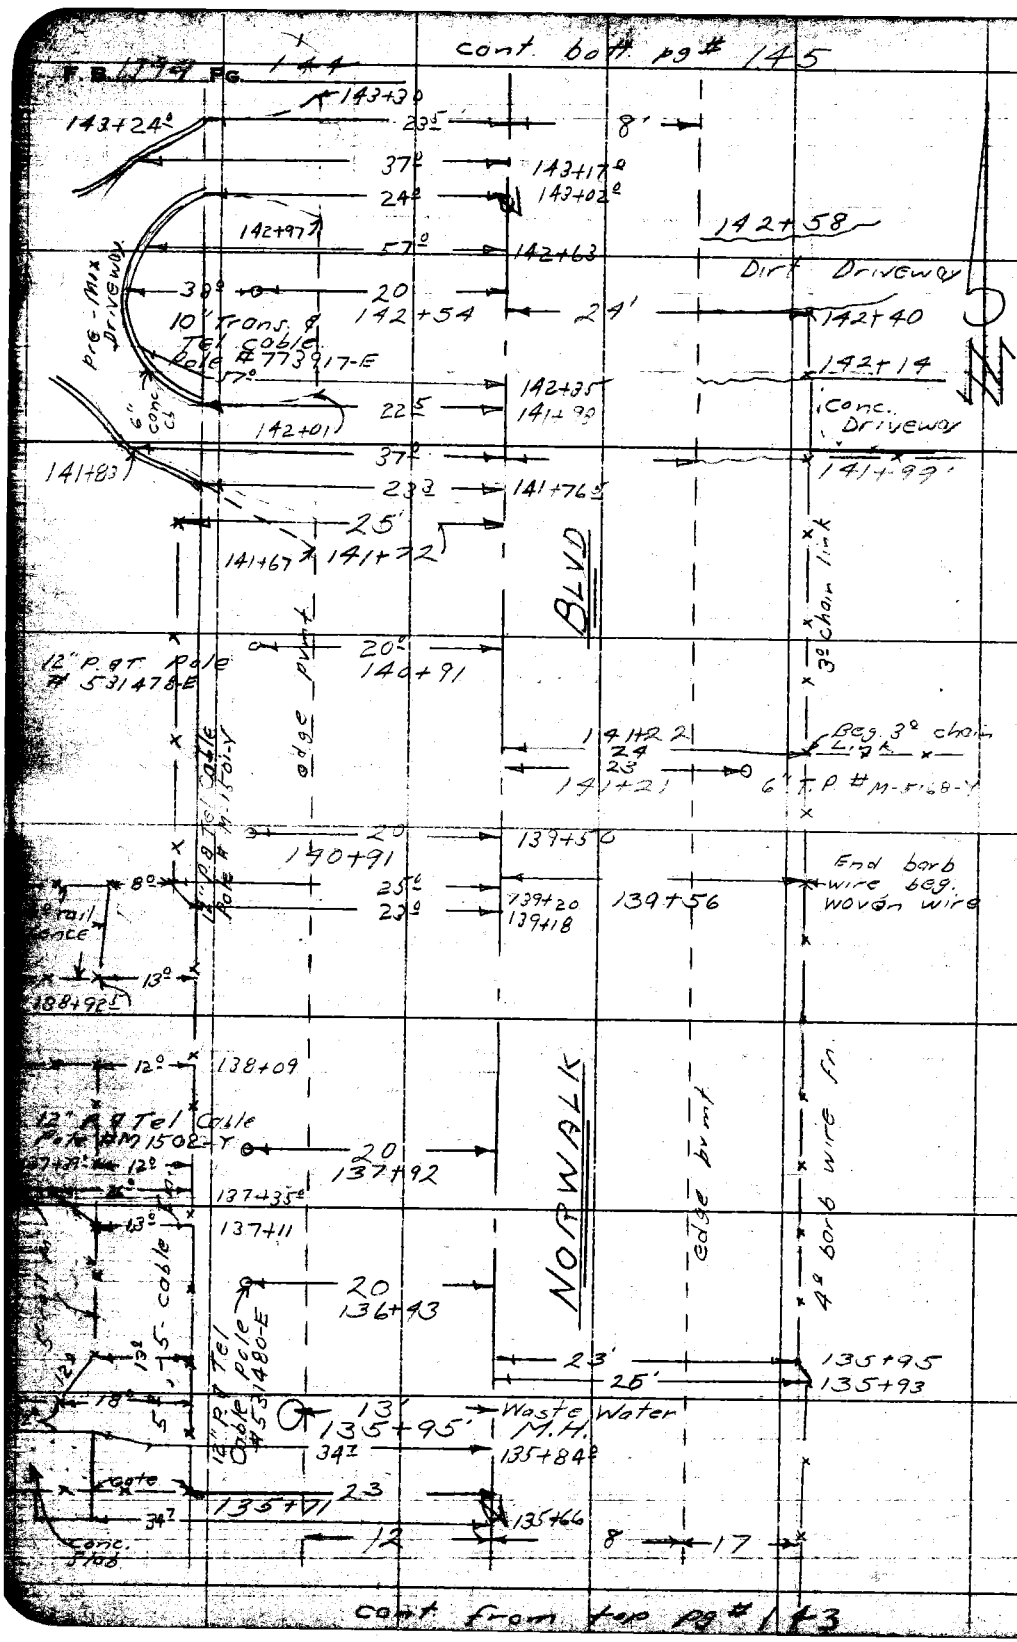

RETURN TO
LOS ANGELES COUNTY SURVEYOR
726 LOS ANGELES COUNTY
ENGINEERING BLDG.

Do not extend notes this side of this line.

Note: Any Additions or Changes on This Sheet Must be Made or Circled in Red Ink With Date and Name of Person Making Change.

Notes Ck'd by	Survey of Artesia-Norwalk	F. B. [illegible] Pg. 145
Map No.	W. O. 6957 Tape No. Str'd. °F	
Office Work	Surveyed by English	
Checked	Notes Sappell Date 11-53	
Date	Indexed [illegible]	

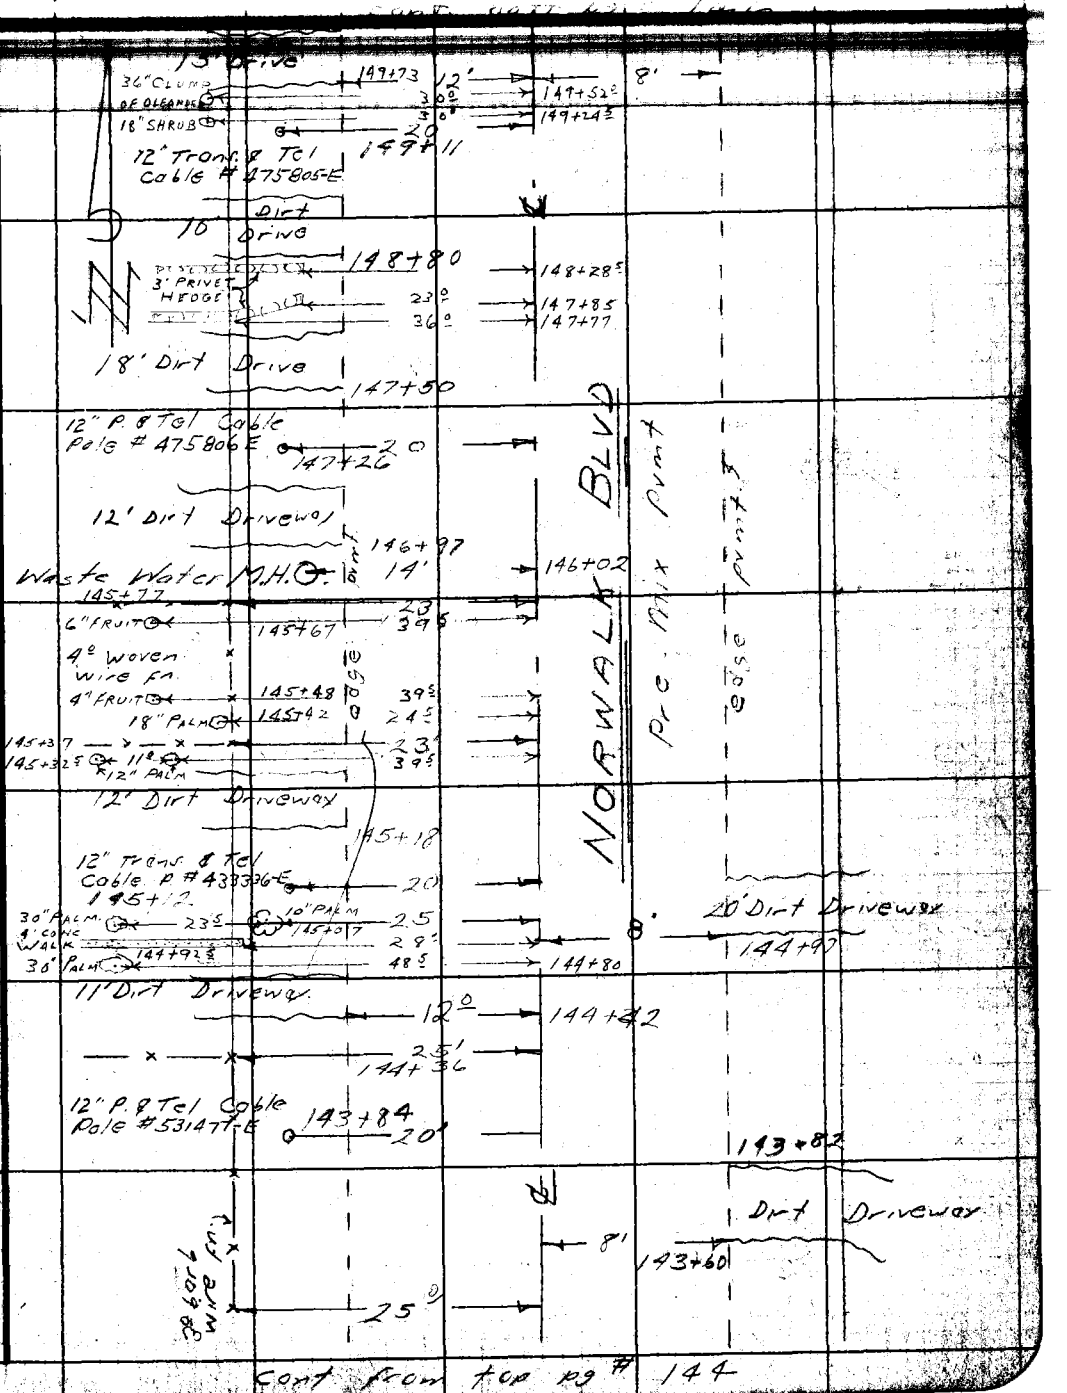

Cont from top pg # 144

Note: Any Additions or Changes on This Sheet Must be Made or Circled in Red Ink With Date and Name of Person Making Change.

Do not extend notes this side of this line.

RETURN TO
LOS ANGELES COUNTY SURVEYOR
726 LOS ANGELES COUNTY
ENGINEERING BLDG.

7873G98 247 4-53

cont. bott pg. 147

F.B. 1799 Pg. 146

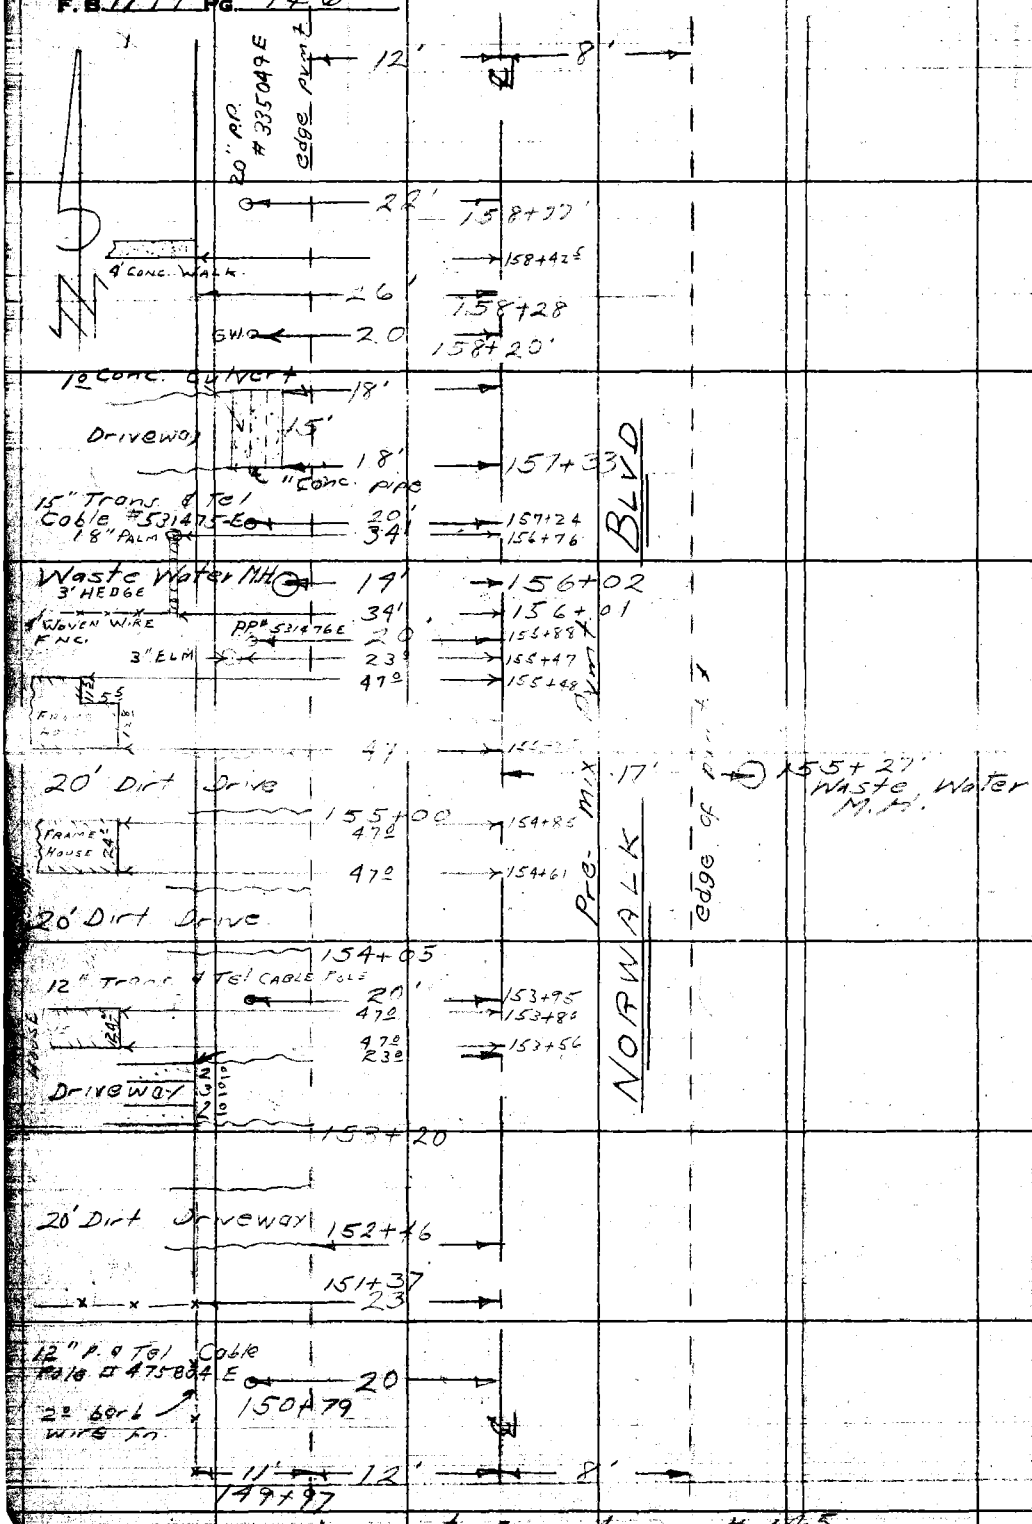

cont from top pg # 145

RETURN TO
LOS ANGELES COUNTY SURVEYOR
726 LOS ANGELES COUNTY
ENGINEERING BLDG.

Do not extend notes this side of this line.

Note: Any Additions or Changes on This Sheet Must be Made or Circled in Red Ink With Date and Name of Person Making Change.

Notes Ck'd by	Survey of Artesia - Norwalk	F. B. 1799 Pg. 147
Map No.	W. O. 6857 Tape No. Std. °F	cont. bott. Pg #148
Office Work	Surveyed by English	
Checked	Notes Sappell Date 11-53	
Date	Indexed A. C. Johnson	

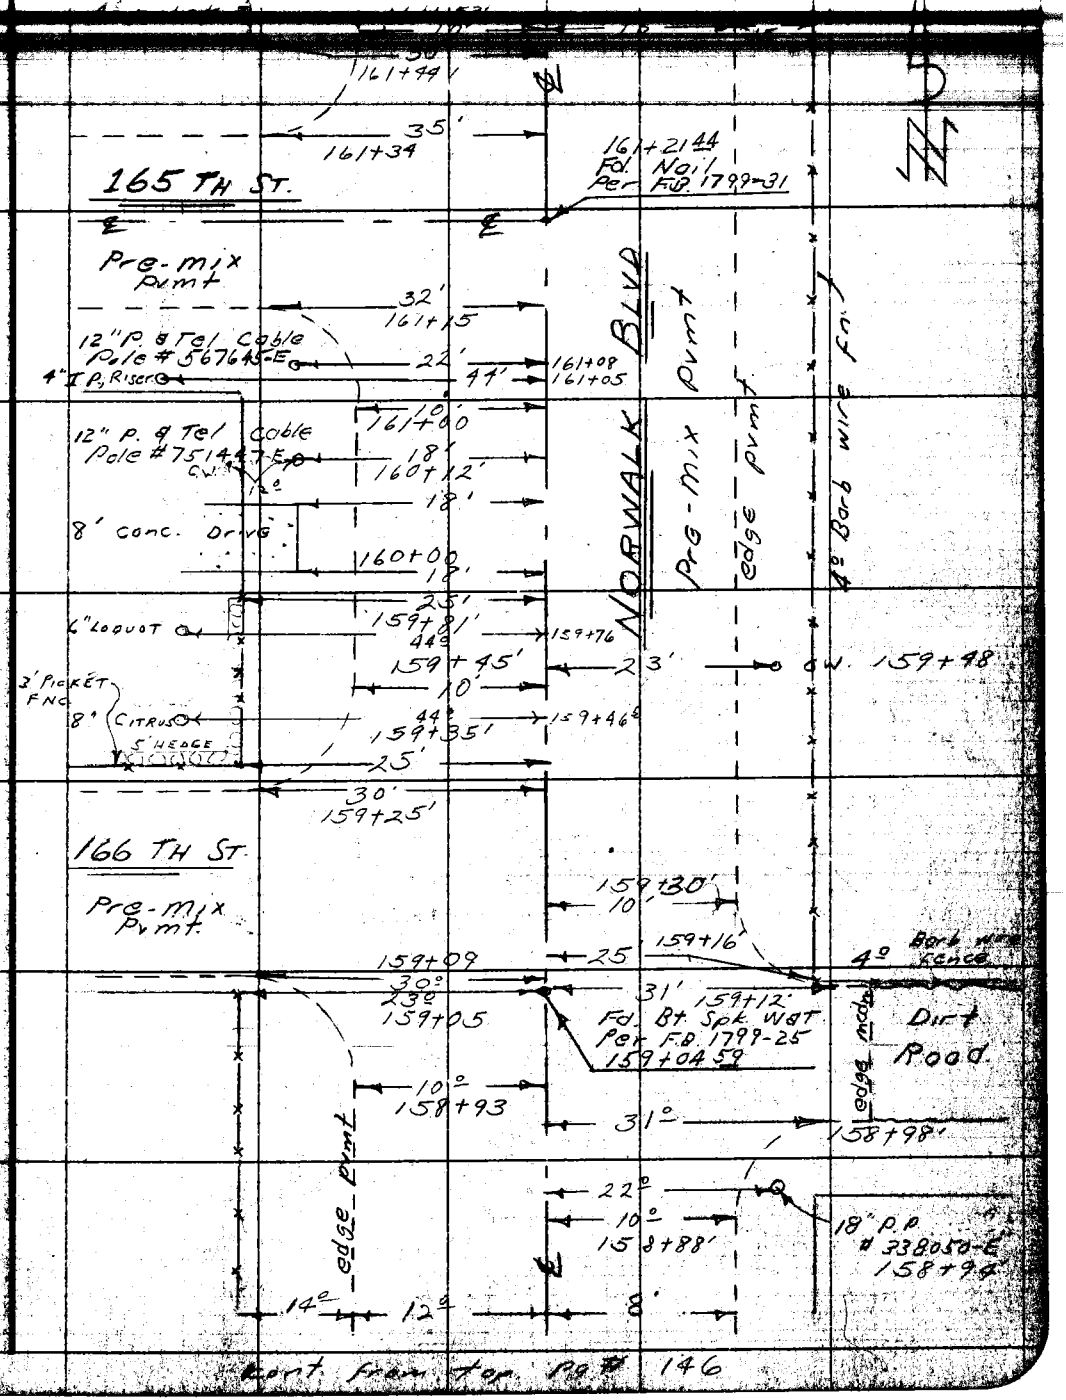

cont. from top Pg # 146

Note: Any Additions or Changes on This Sheet Must be Made or Circled in Red Ink With Date and Name of Person Making Change.

Do not extend notes this side of this line.

RETURN TO
LOS ANGELES COUNTY SURVEYOR
726 LOS ANGELES COUNTY
ENGINEERING BLDG.

761-2005 247 4-53

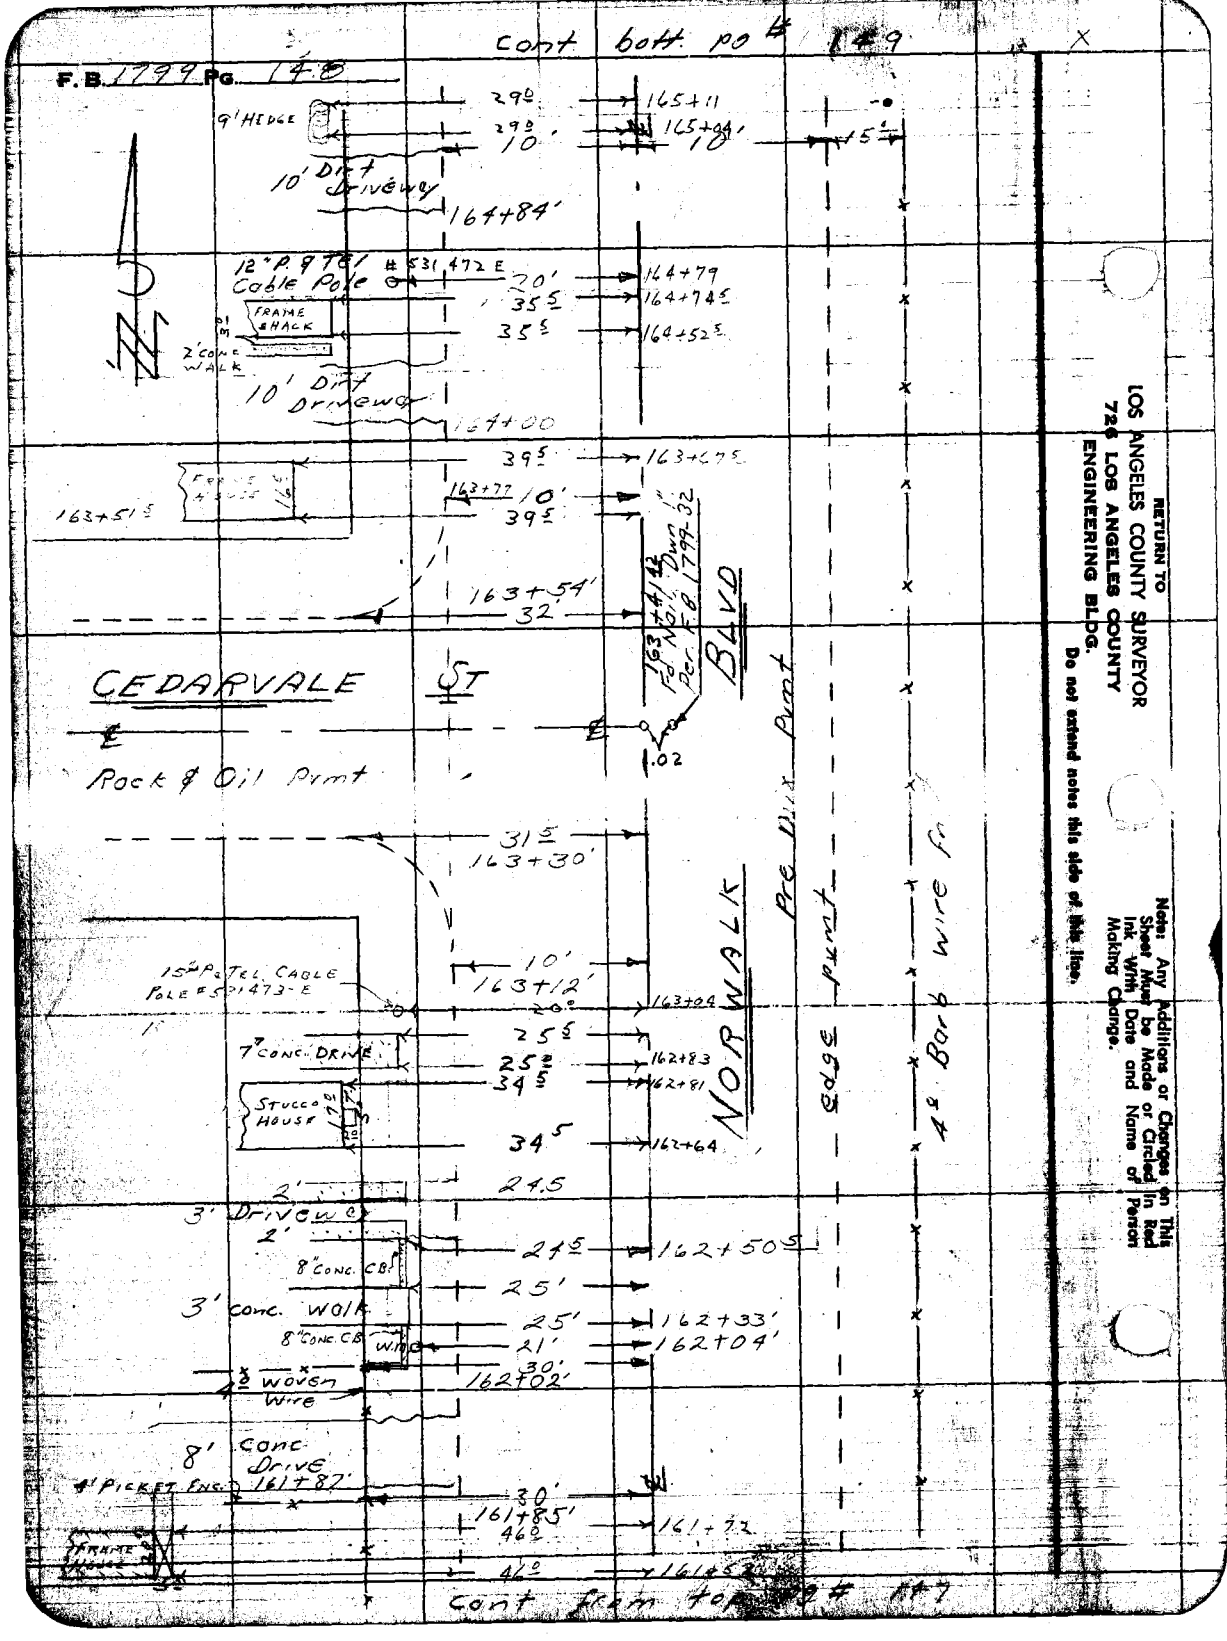
cont bott pg # 149
F.B. 1799 Pg. 148
9' HEDGE
29.0
165+11
29.0
165+04
10'
10'
15'
10' Dirt Driveway
164+84'
12" P. & Tel Cable Pole
531,472 E
20'
164+79
35.5
164+74.5
FRAME SHACK
35.5
164+52.5
2' CONC WALK
10' Dirt Driveway
164+00
39.5
163+67.5
163+77
10'
39.5
163+51.5
163+54'
32'
163+41.42 Fd Nail Dwn 1" Per F.B. 1799-32
BLVD
CEDARVALE ST
Rock & Oil Pvmt
.02
31.5
163+30'
Pre Dix Pvmt
NORWALK
Edge pvmt
4" Barb wire fn
15" P. & Tel. Cable Pole # 531473-E
10'
163+12'
20.0
163+04
25.5
7" CONC. DRIVE
25.0
162+83
34.5
162+81
STUCCO HOUSE
34.5
162+64
2'
24.5
3' Driveway
2'
24.5
162+50.5
8" CONC. CB
25'
3' conc. walk
25'
162+33'
8" CONC. CB
21'
162+04'
30'
162+02'
4" woven wire
8' Conc Drive
161+87'
4' PICKET FNC.
30'
161+85'
46.0
161+72
FRAME HOUSE
46.0
161+52
cont from top pg # 147
RETURN TO
LOS ANGELES COUNTY SURVEYOR
726 LOS ANGELES COUNTY
ENGINEERING BLDG.
Do not extend notes this side of this line.
Note: Any Additions or Changes on This Sheet Must be Made or Circled in Red Ink With Date and Name of Person Making Change.

Notes Ch'd by	Survey of Artesia - Norwalk	F.B. 1.7 Pg. 149
Map No.	W. O. 6951 Tape No. St'd. °F	
Office Work	Surveyed by English	
Checked	Notes Sappell Date 11-53	cont. bott pg #150
Date	Indexed	

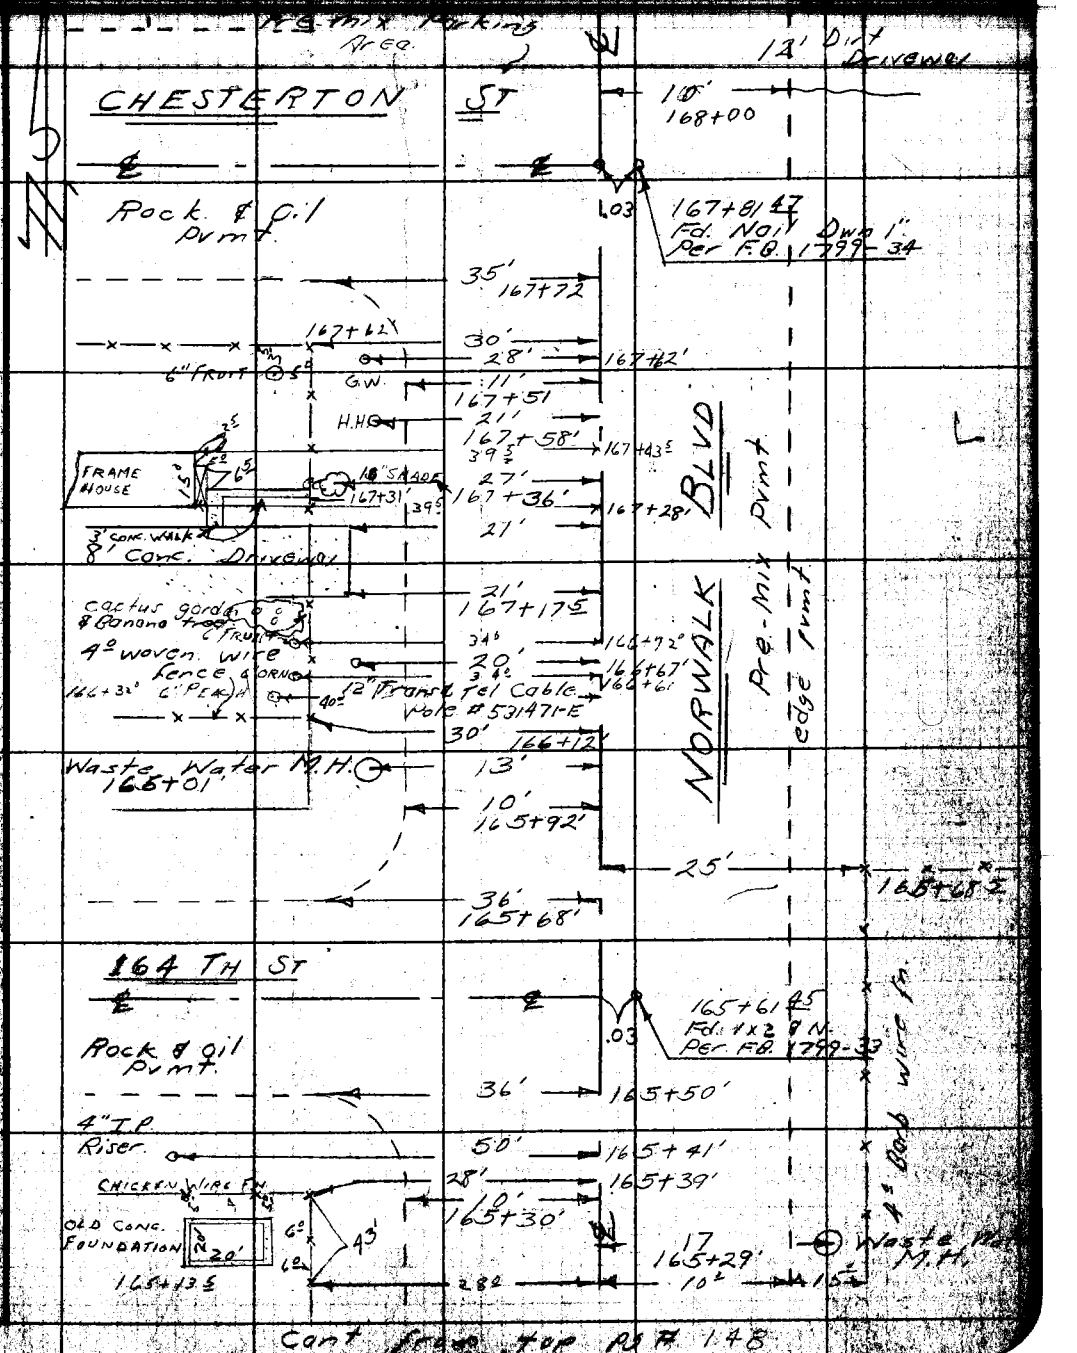

Cont from top pg # 148

Note: Any Additions or Changes on This Sheet Must be Made or Circled in Red Ink With Date and Name of Person Making Change.

Do not extend notes this side of this line.

RETURN TO
LOS ANGELES COUNTY SURVEYOR
726 LOS ANGELES COUNTY
ENGINEERING BLDG.

76F2095 247 4-53

cont. bott pg # 151

F.B. 1799 Pg. 150

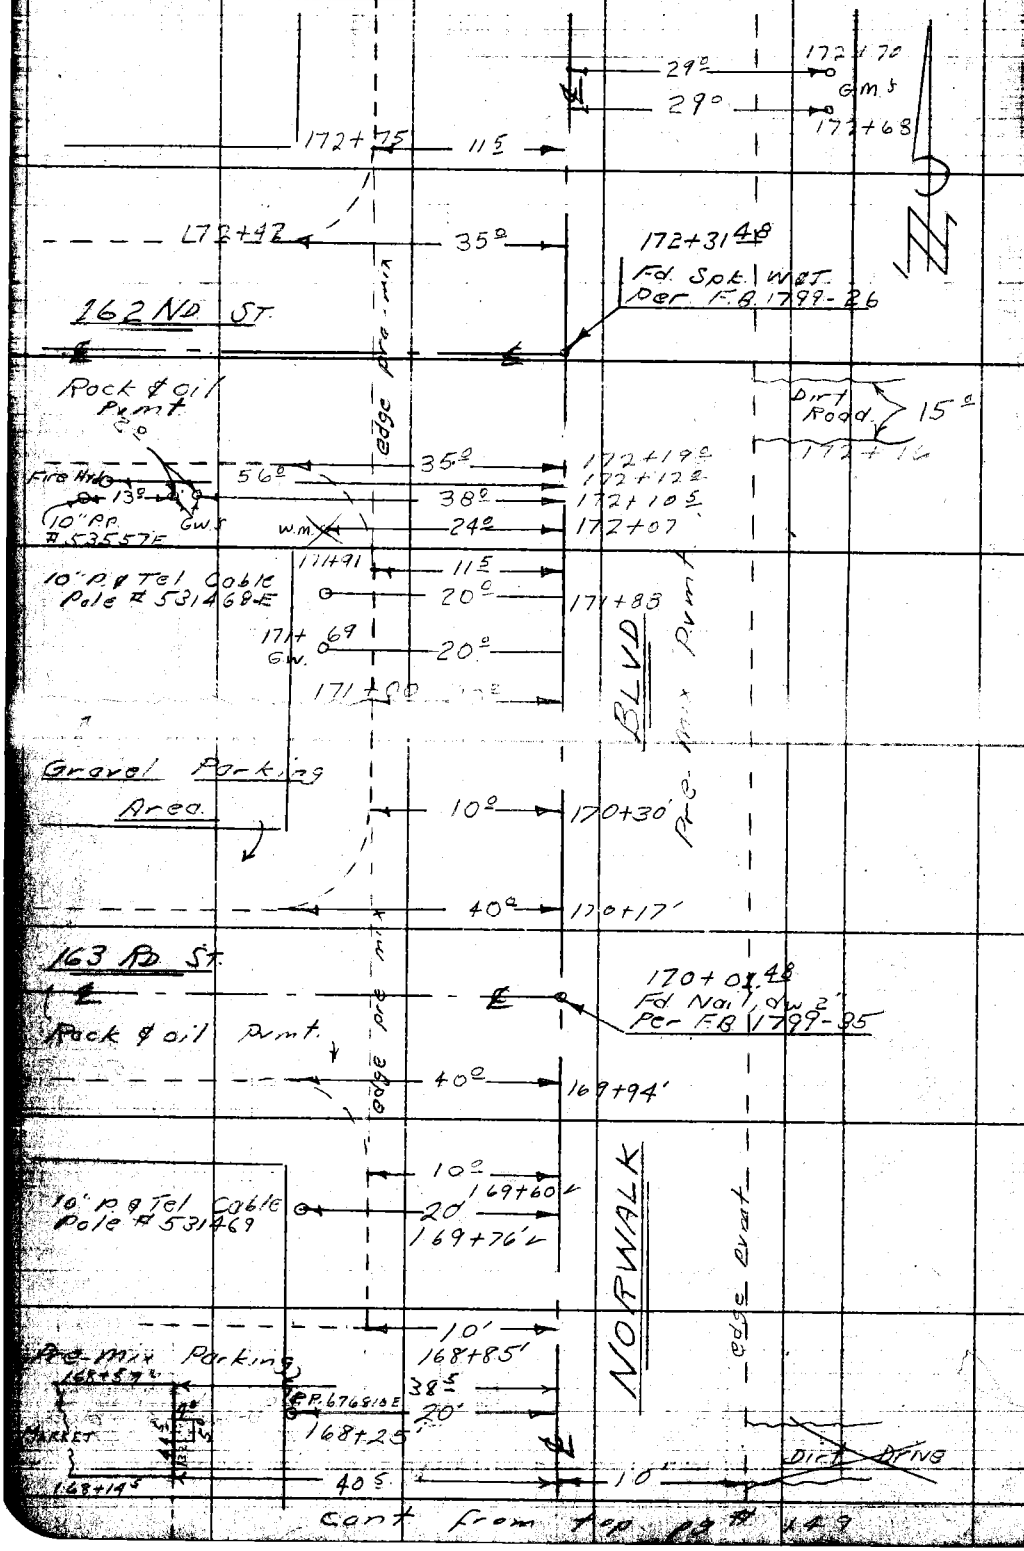

cont from top pg # 149

RETURN TO
LOS ANGELES COUNTY SURVEYOR
726 LOS ANGELES COUNTY
ENGINEERING BLDG.

Do not extend notes this side of this line.

Note: Any Additions or Changes on This Sheet Must be Made or Circled in Red Ink With Date and Name of Person Making Change.

Notes Ck'd by
Map No.
Office Work
Checked
Date

Survey of [illegible]
W. O. 6951 Tape No. St'd. °F
Surveyed by English
Notes Sappell Date 11-53
Indexed

F. B. Pg.

cont. both pg # 152

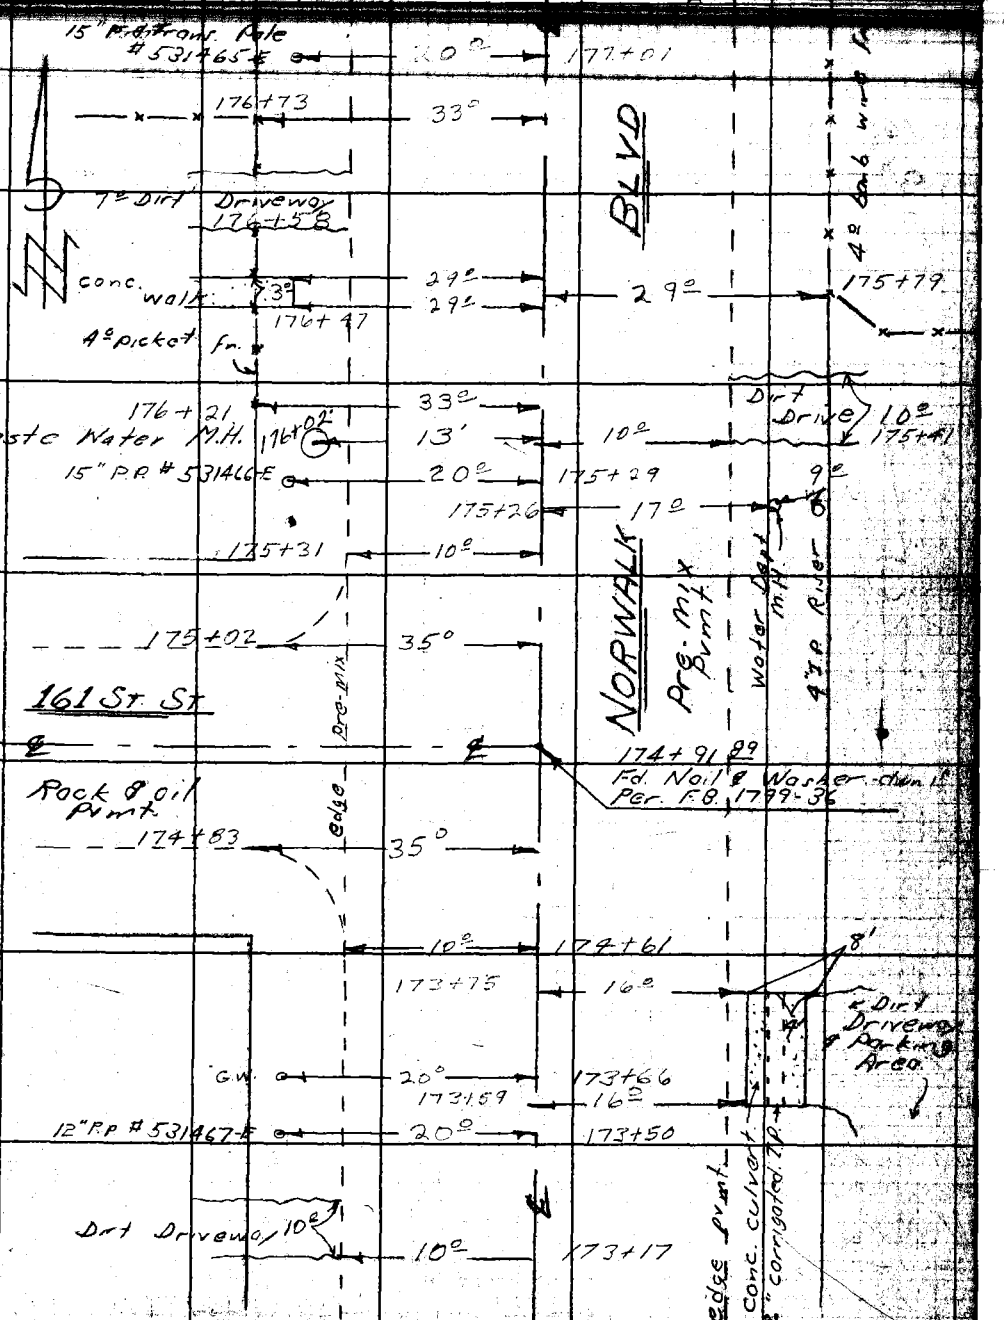

cont from top pg 4

Note: Any Additions or Changes on This Sheet Must be Made or Circled in Red Ink With Date and Name of Person Making Change.

Do not extend notes this side of this line.

RETURN TO
LOS ANGELES COUNTY SURVEYOR
726 LOS ANGELES COUNTY
ENGINEERING BLDG.

7673095 247 4-53

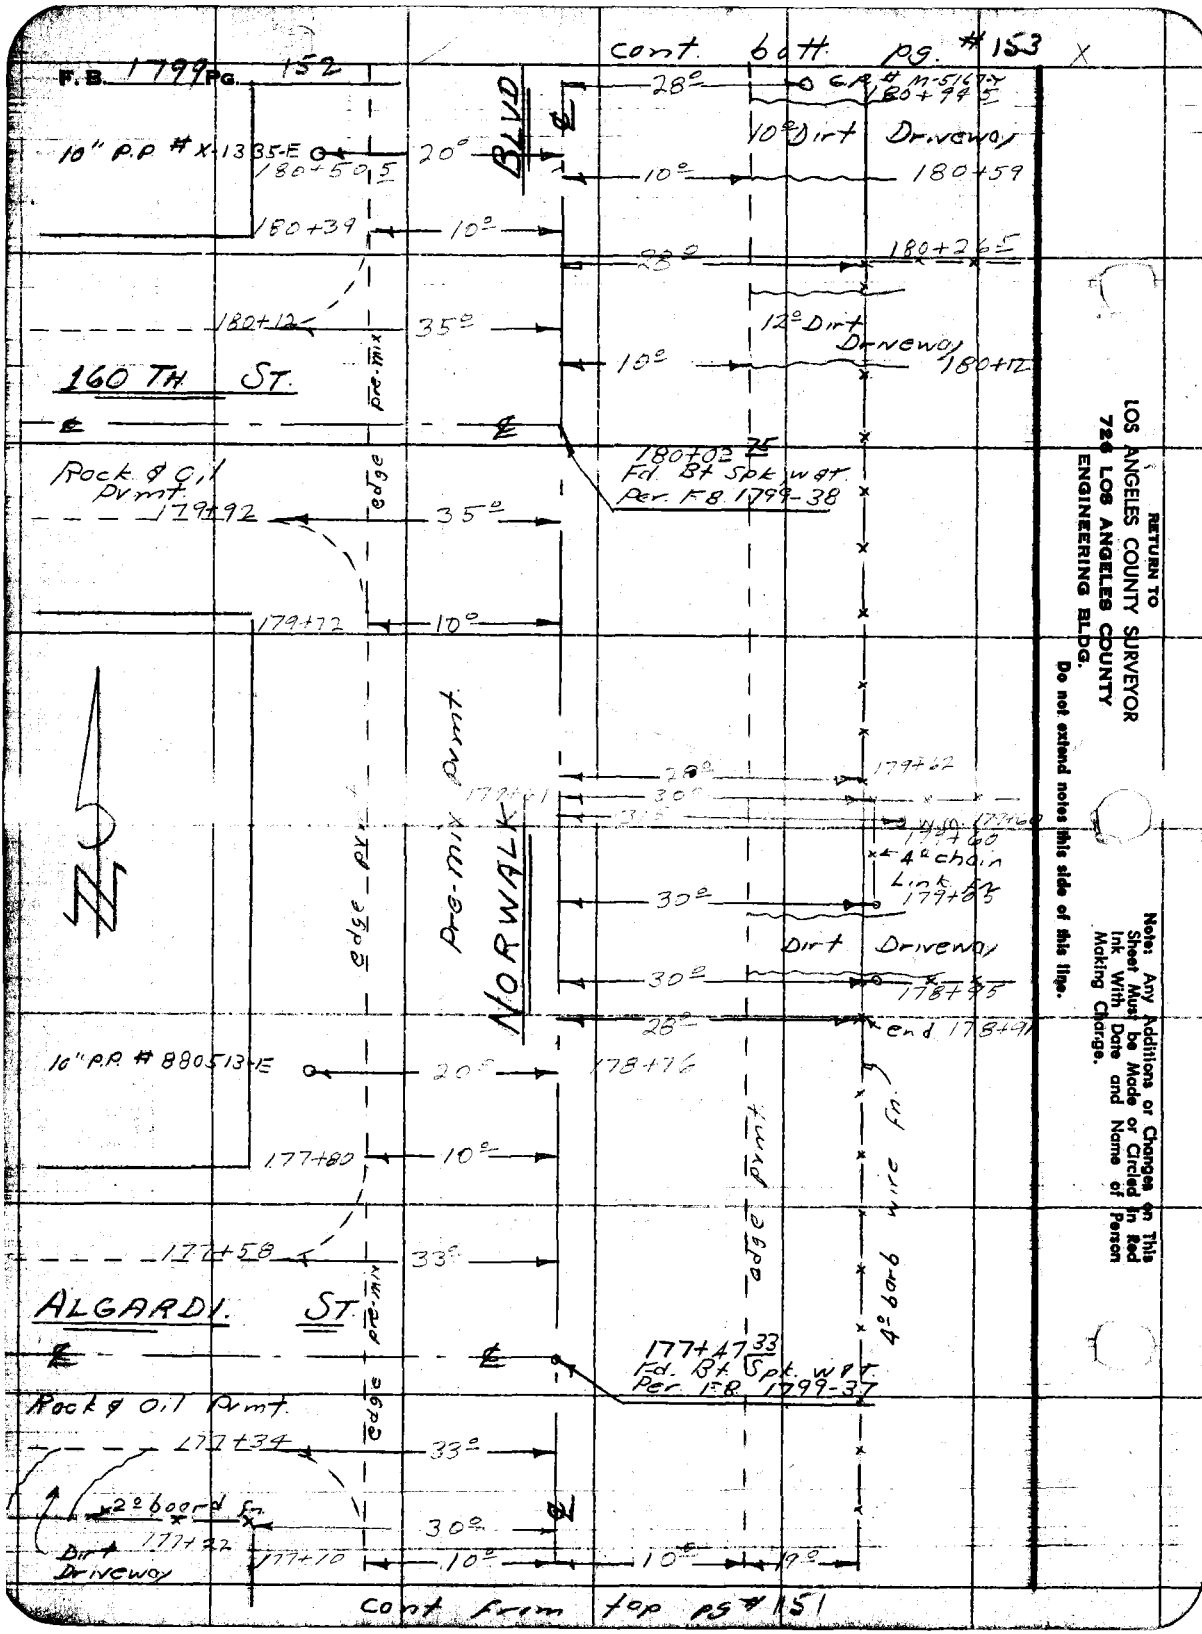

RETURN TO
LOS ANGELES COUNTY SURVEYOR
726 LOS ANGELES COUNTY
ENGINEERING BLDG.
Do not extend notes this side of this line.

Note: Any Additions or Changes on This Sheet Must be Made or Circled in Red Ink With Date and Name of Person Making Change.

Notes Ch'd by	Survey of Artesia - Norwalk	F.B. 1799 Pg. 153
Map No.	W. O. 6957 Tape No. St'd. °F	
Office Work	Surveyed by English	
Checked	Notes Peterson Date 11-53	
Date	Indexed	

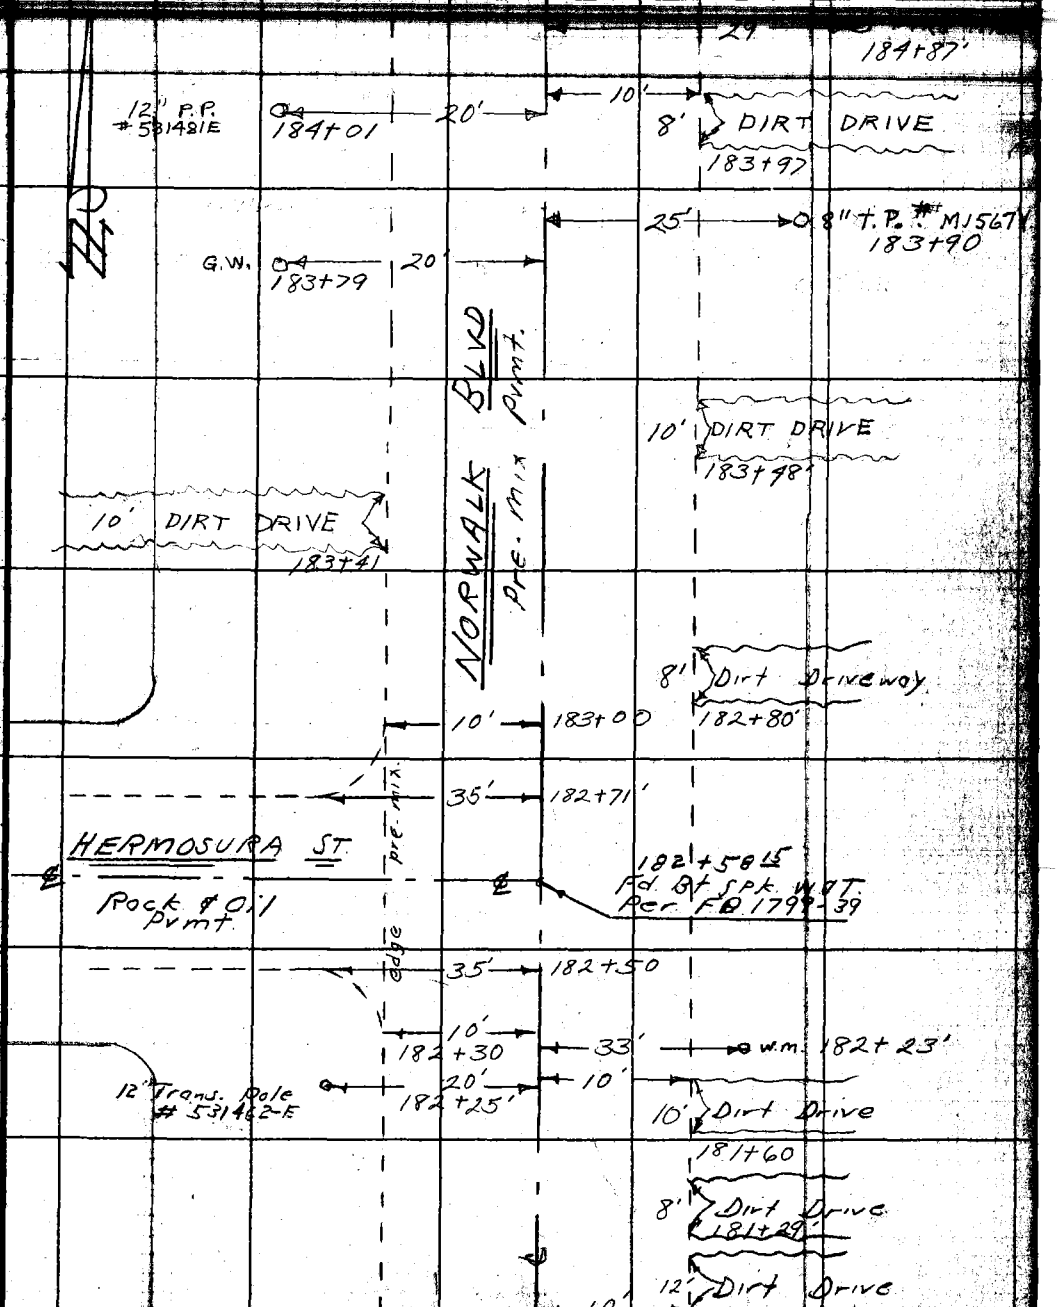

Note: Any Additions or Changes on This Sheet Must be Made or Circled in Red Ink With Date and Name of Person Making Change.

Do not extend notes this side of this line.

RETURN TO
LOS ANGELES COUNTY SURVEYOR
726 LOS ANGELES COUNTY
ENGINEERING BLDG.

76F2098 247 4-53

cont. from top pg # 152

F.B. 1799 PG. 154

CONT BOTT PG 153

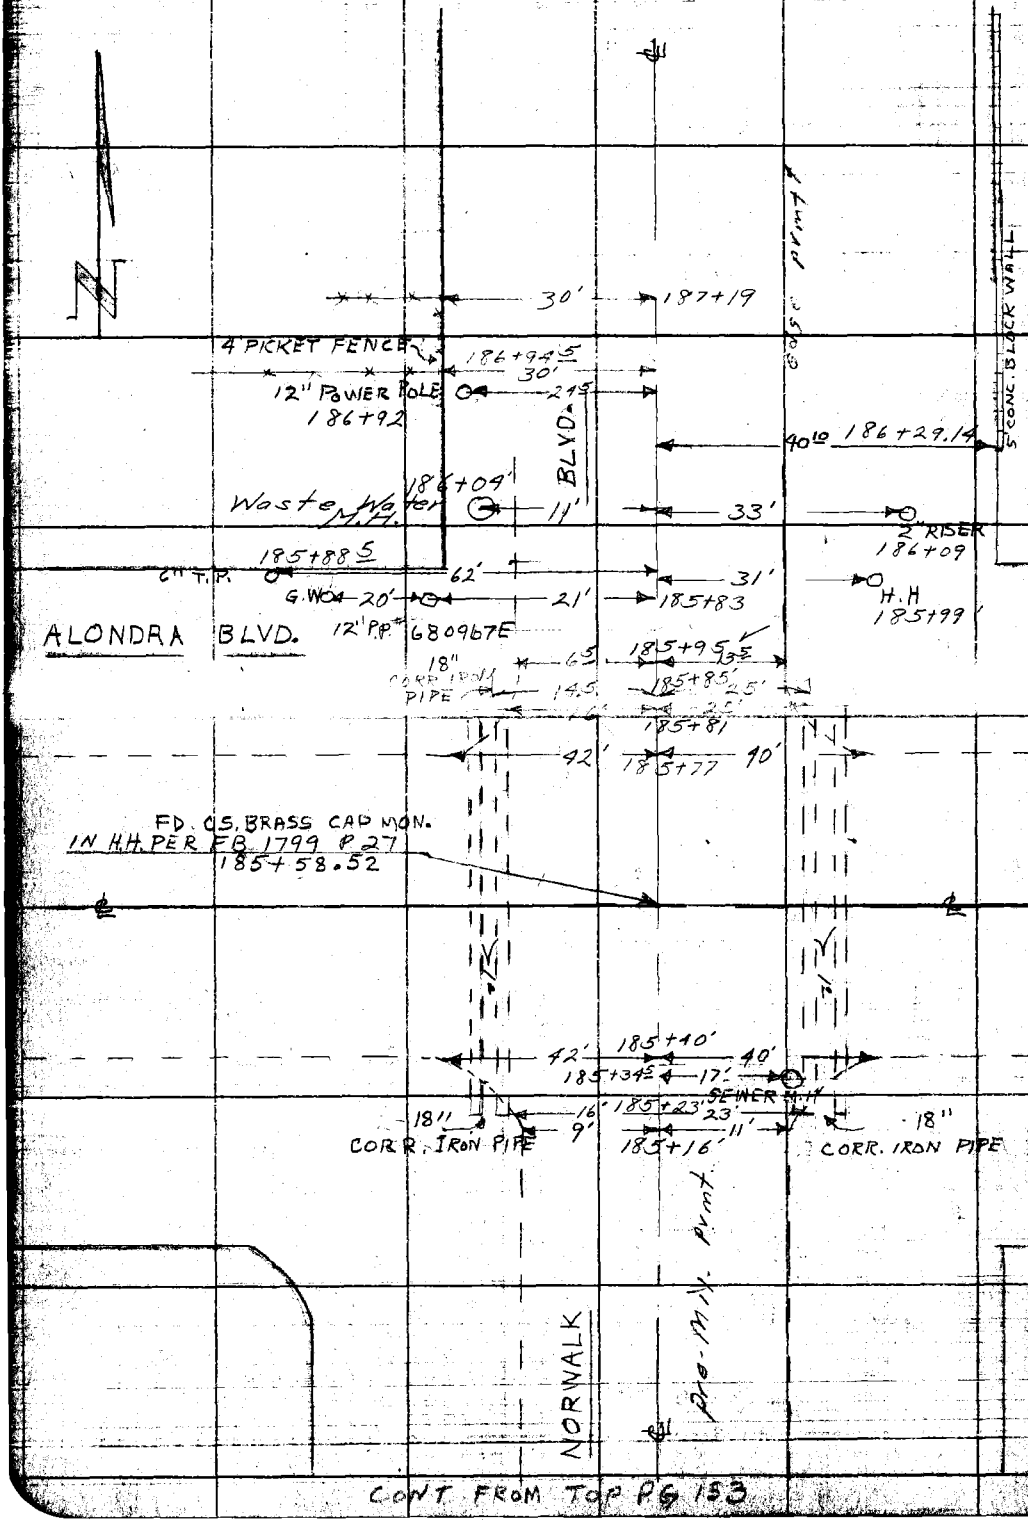

RETURN TO
LOS ANGELES COUNTY SURVEYOR
724 LOS ANGELES COUNTY
ENGINEERING BLDG.
Do not extend notes this side of this line.

Note: Any Additions or Changes on This Sheet Must be Made or Circled in Red Ink With Date and Name of Person Making Change.

CONT FROM TOP PG 153

Notes Ck'd by
Map No.
Office Work
Checked
Date

Survey of ARTESIA - NORWALK
W. O. Tape No. St'd. °F
Surveyed by ENGLISH
Notes PETERSON Date 11-53
Indexed

F.B. Pg. 155

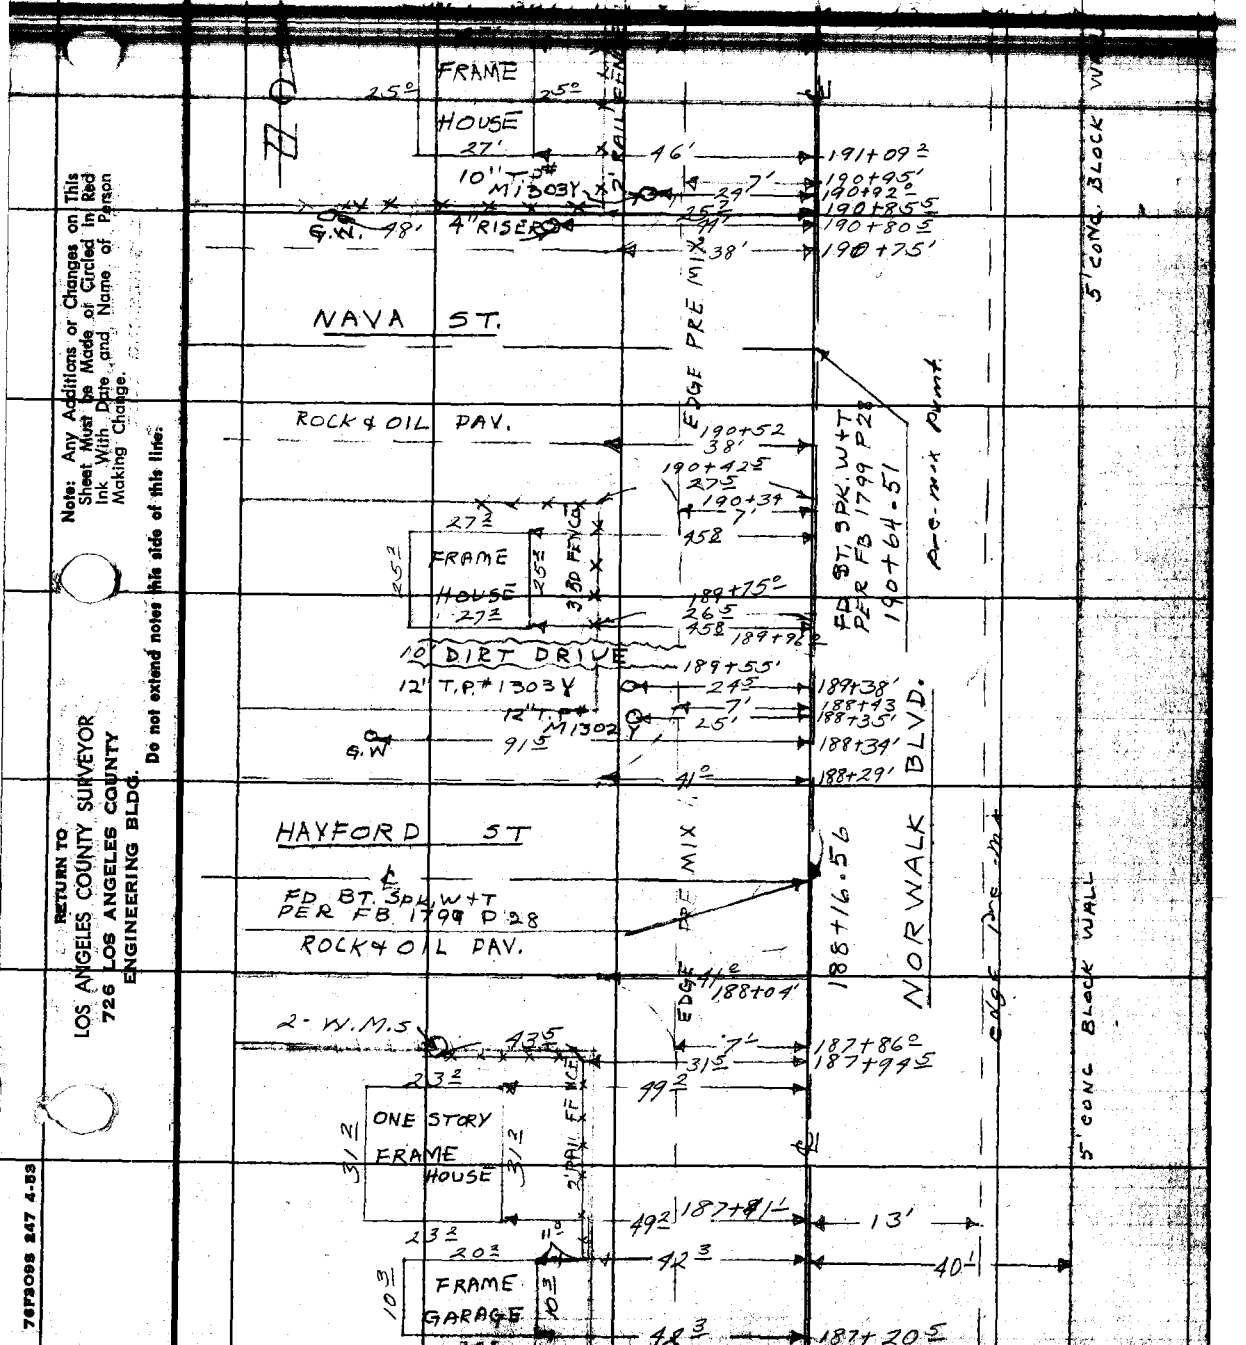

CONT. FROM TOP PG 154

Notes: Any Additions or Changes on This Sheet Must be Made of Circled in Red Ink With Date and Name of Person Making Change.

Do not extend notes this side of this line.

RETURN TO
LOS ANGELES COUNTY SURVEYOR
726 LOS ANGELES COUNTY
ENGINEERING BLDG.

7673098 247 4-53

F.B. 1799 PG. 156

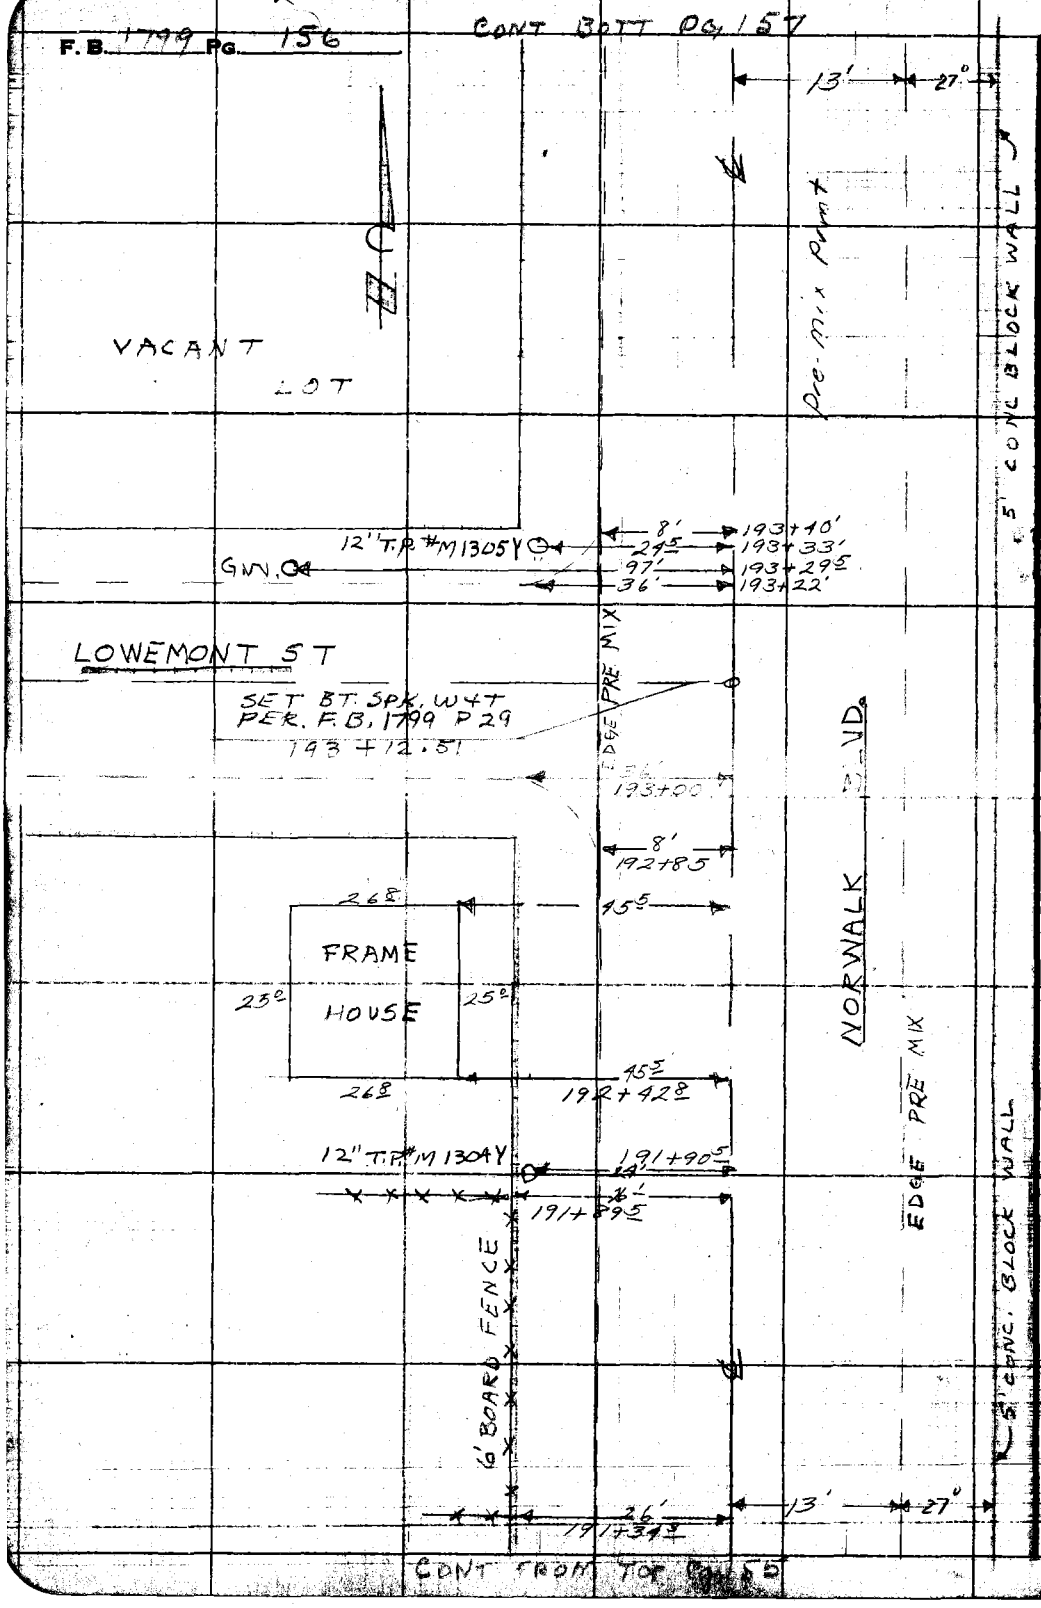

RETURN TO
LOS ANGELES COUNTY SURVEYOR
726 LOS ANGELES COUNTY
ENGINEERING BLDG.

Do not extend notes this side of this line.

Note: Any Additions or Changes on This Sheet Must be Made or Circled in Red Ink With Date and Name of Person Making Change.

Notes Ck'd by	Survey of ARTESIA - NORWALK	F. B. PG. 157
Map No.	W. O. Tape No. St'd. °F	
Office Work	Surveyed by ENGLISH	
Checked	Notes PETERSON Date 11-53	
Date	Indexed	

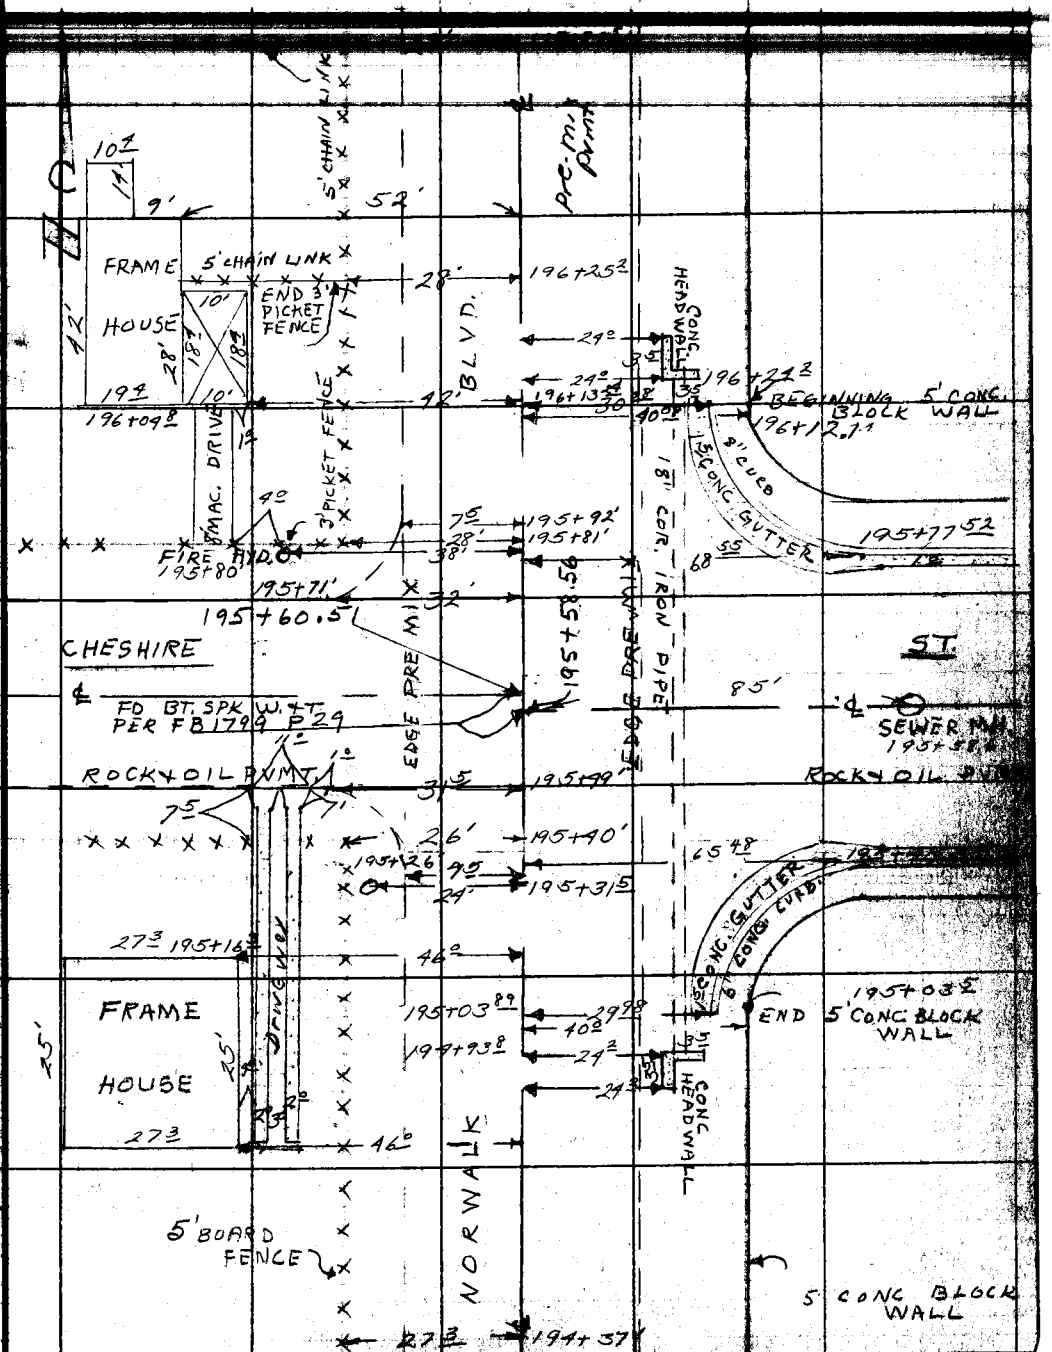

CONT FROM TOP PG 156

Note: Any Additions or Changes on This Sheet Must be Made or Circled in Red Ink With Date and Name of Person Making Change.

Do not extend notes this side of this line.

RETURN TO
LOS ANGELES COUNTY SURVEYOR
726 LOS ANGELES COUNTY
ENGINEERING BLDG.

76F3095 847 4-53

F.B. 1799 Pg. 158

CONT BOTT PG 159

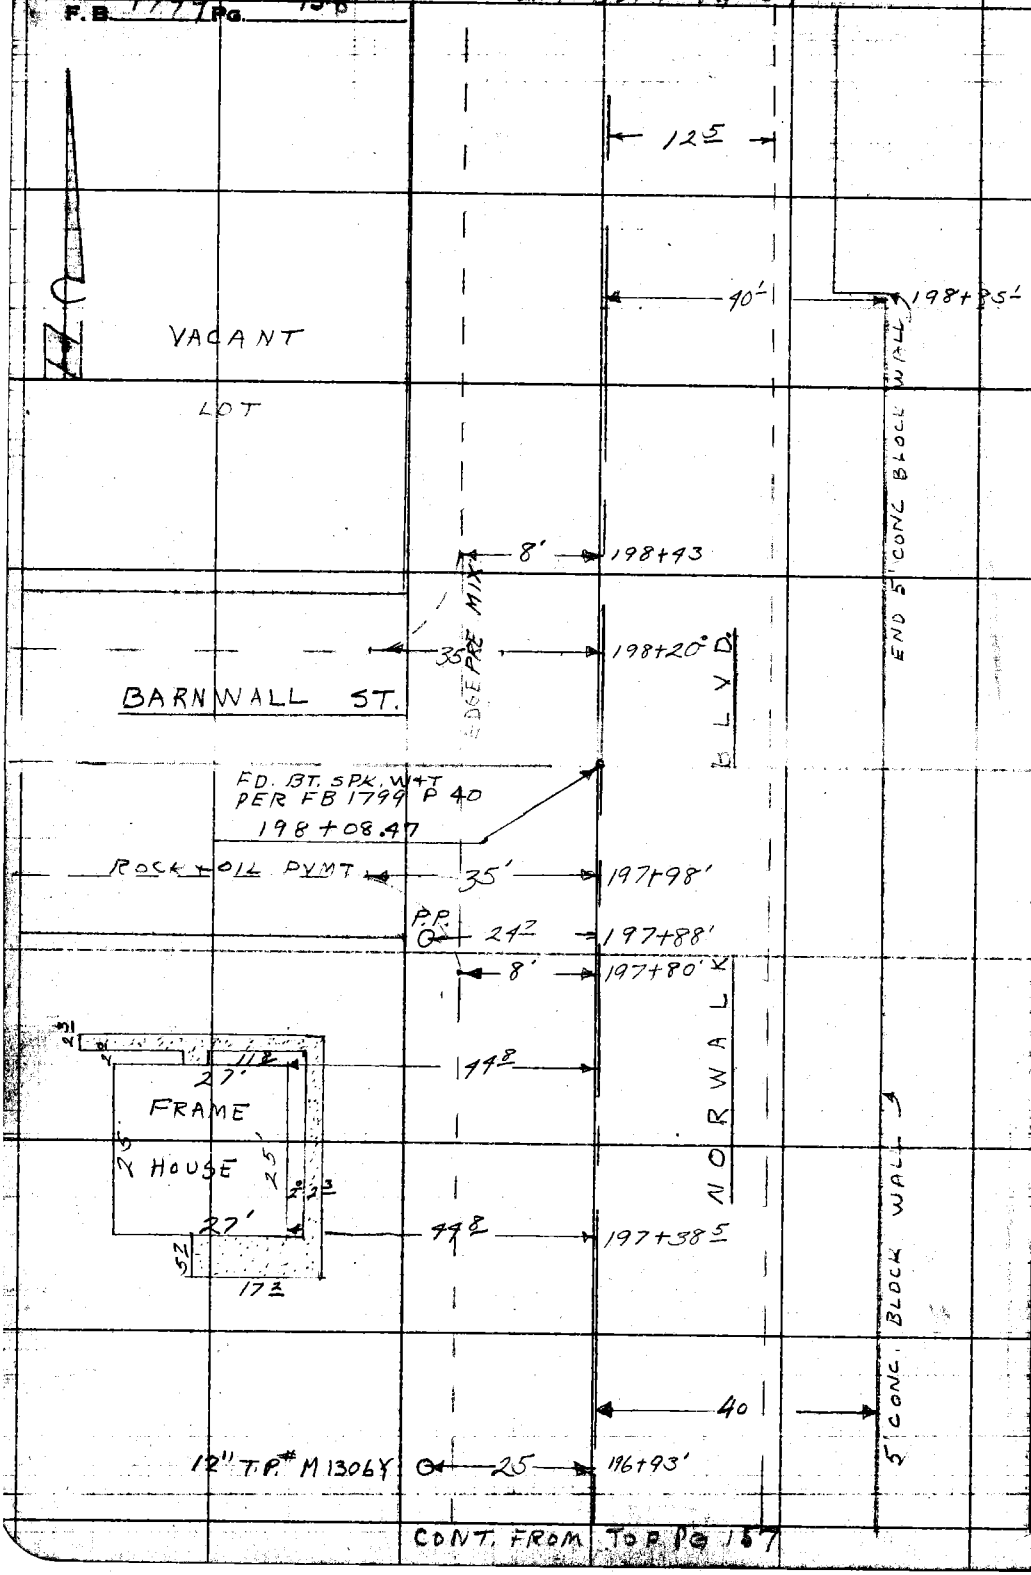

CONT. FROM TOP PG 157

RETURN TO
LOS ANGELES COUNTY SURVEYOR
726 LOS ANGELES COUNTY
ENGINEERING BLDG.
Do not extend notes this side of this line.

Note: Any Additions or Changes on This Sheet Must be Made or Circled in Red Ink With Date and Name of Person Making Change.

Notes Ck'd by
Map No.
Office Work
Checked
Date

Survey of Artesia - Norwalk
W. O. 6957 Tape No. Sr'd. °F
Surveyed by English
Notes Sappell Date 11-53
Indexed

F. B. 1700 Pg. 159

Cont. bott Pg # 160

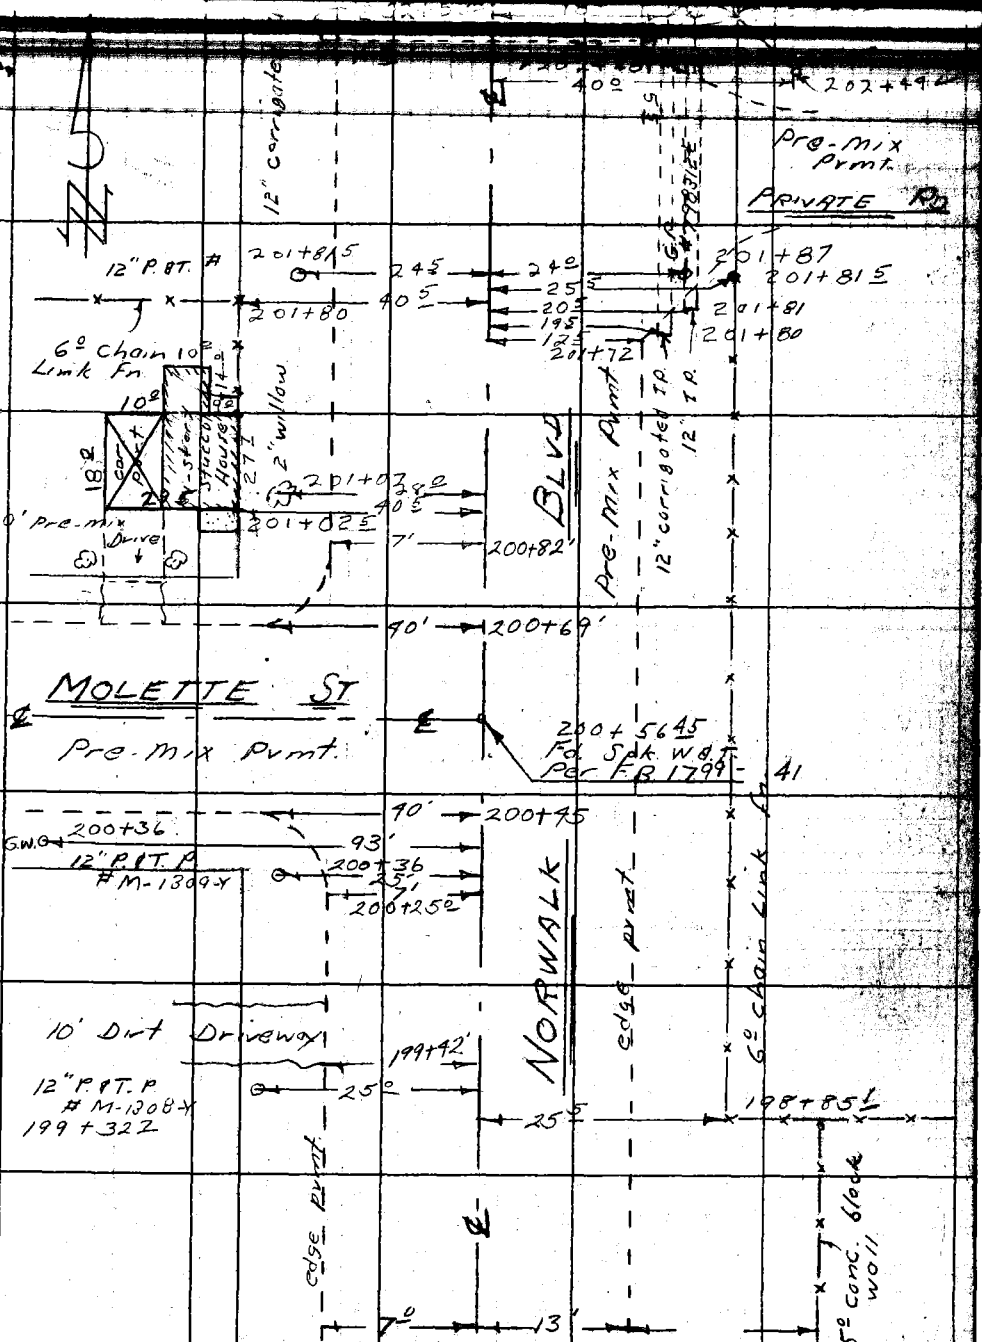

Cont. from Top Pg 158

Note: Any Additions or Changes on This Sheet Must be Made or Circled in Red Ink With Date and Name of Person Making Change.

Do not extend notes this side of this line.

RETURN TO
LOS ANGELES COUNTY SURVEYOR
726 LOS ANGELES COUNTY
ENGINEERING BLDG.

75F3096 247 4-53

cont both pg #161

F.B. 1799 Pg. 160

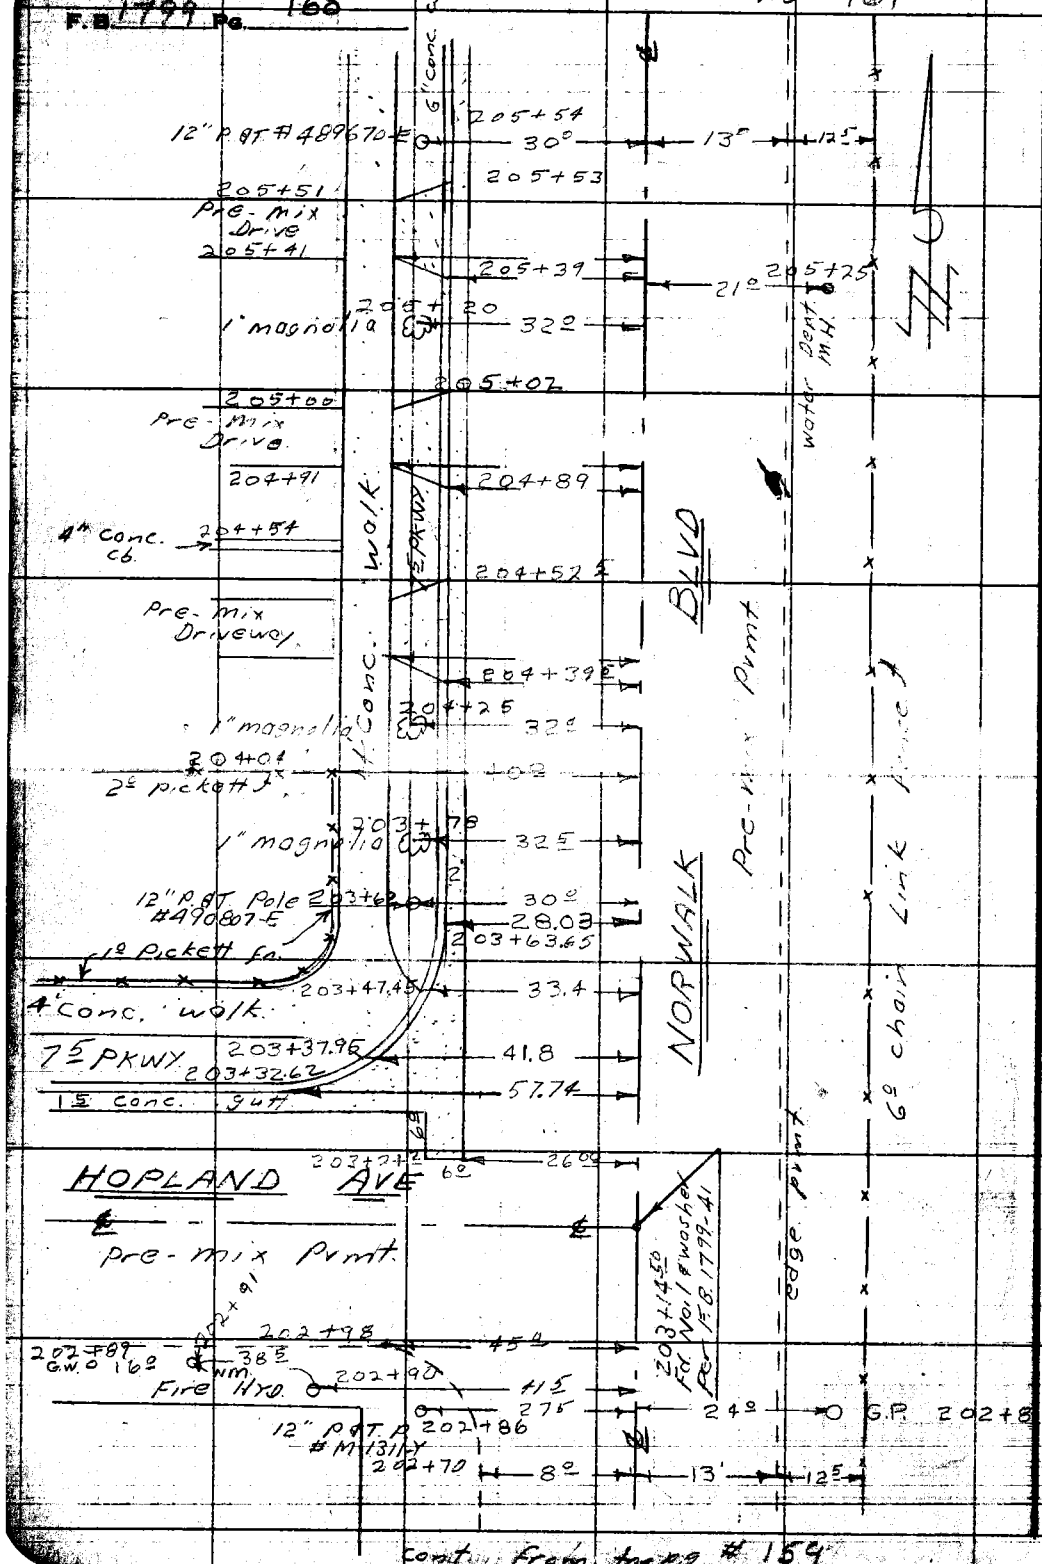

RETURN TO
LOS ANGELES COUNTY SURVEYOR
726 LOS ANGELES COUNTY
ENGINEERING BLDG.
Do not extend notes this side of this line.

Note: Any Additions or Changes on This Sheet Must be Made or Circled in Red Ink With Date and Name of Person Making Change.

cont. from top pg #159

Notes Ck'd by	Survey of Artesia - Norwalk	F.B. 1709 Pg. 161
Map No.	W. O. 6951 Tape No. St'd. °F	Cont. bott pg 162
Office Work	Surveyed by English	
Checked	Notes Sappell Date 11-53	
Date	Indexed C. Johnson	

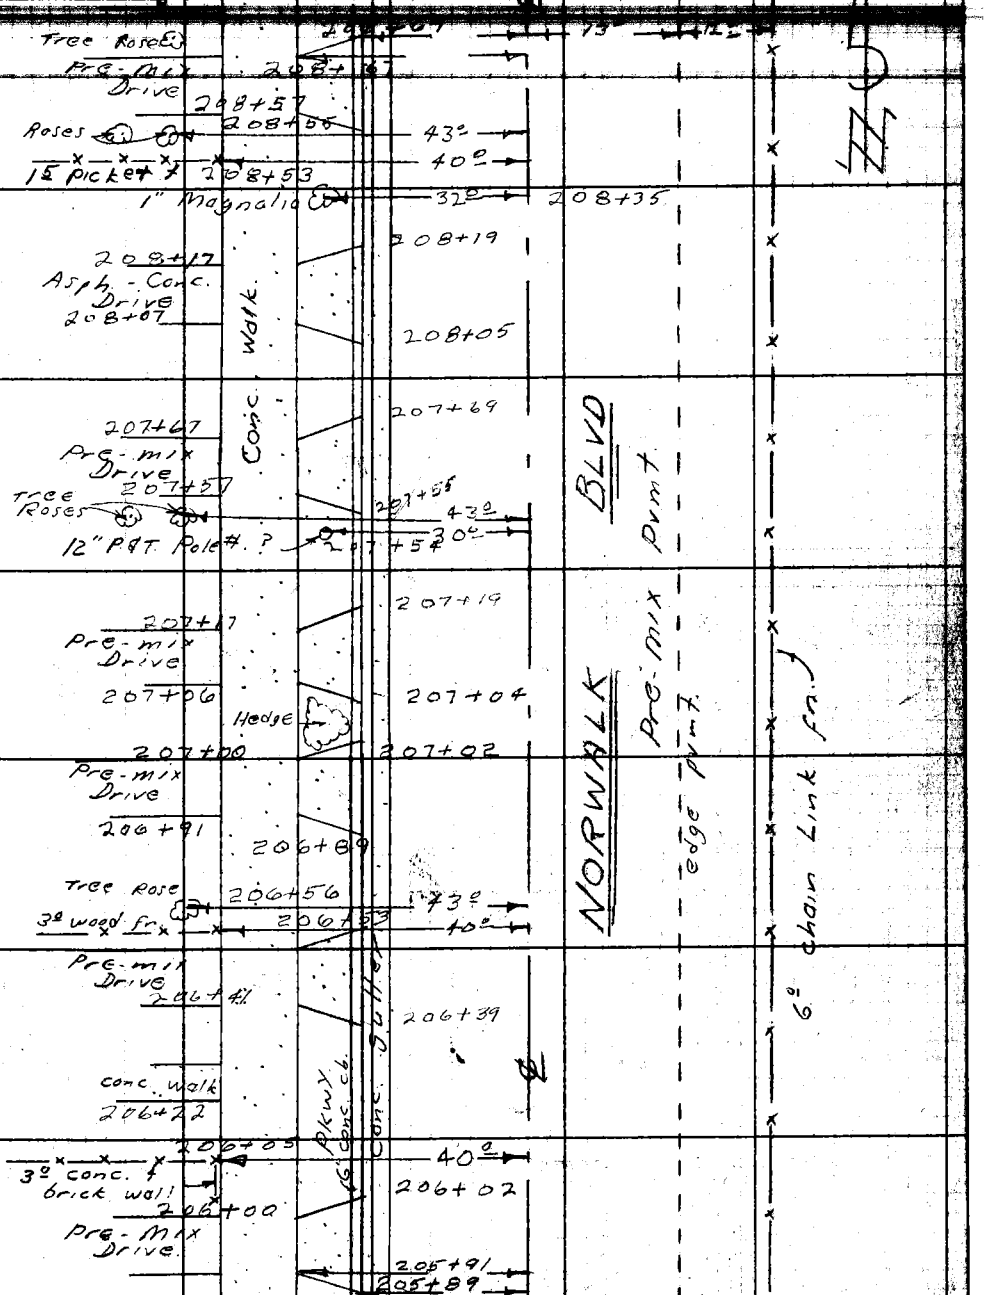

cont. from top pg # 160

Note: Any Additions or Changes on This Sheet Must be Made or Circled in Red Ink With Date and Name of Person Making Change.

Do not extend notes this side of this line.

RETURN TO
LOS ANGELES COUNTY SURVEYOR
726 LOS ANGELES COUNTY
ENGINEERING BLDG.

76F3095 247 4-53

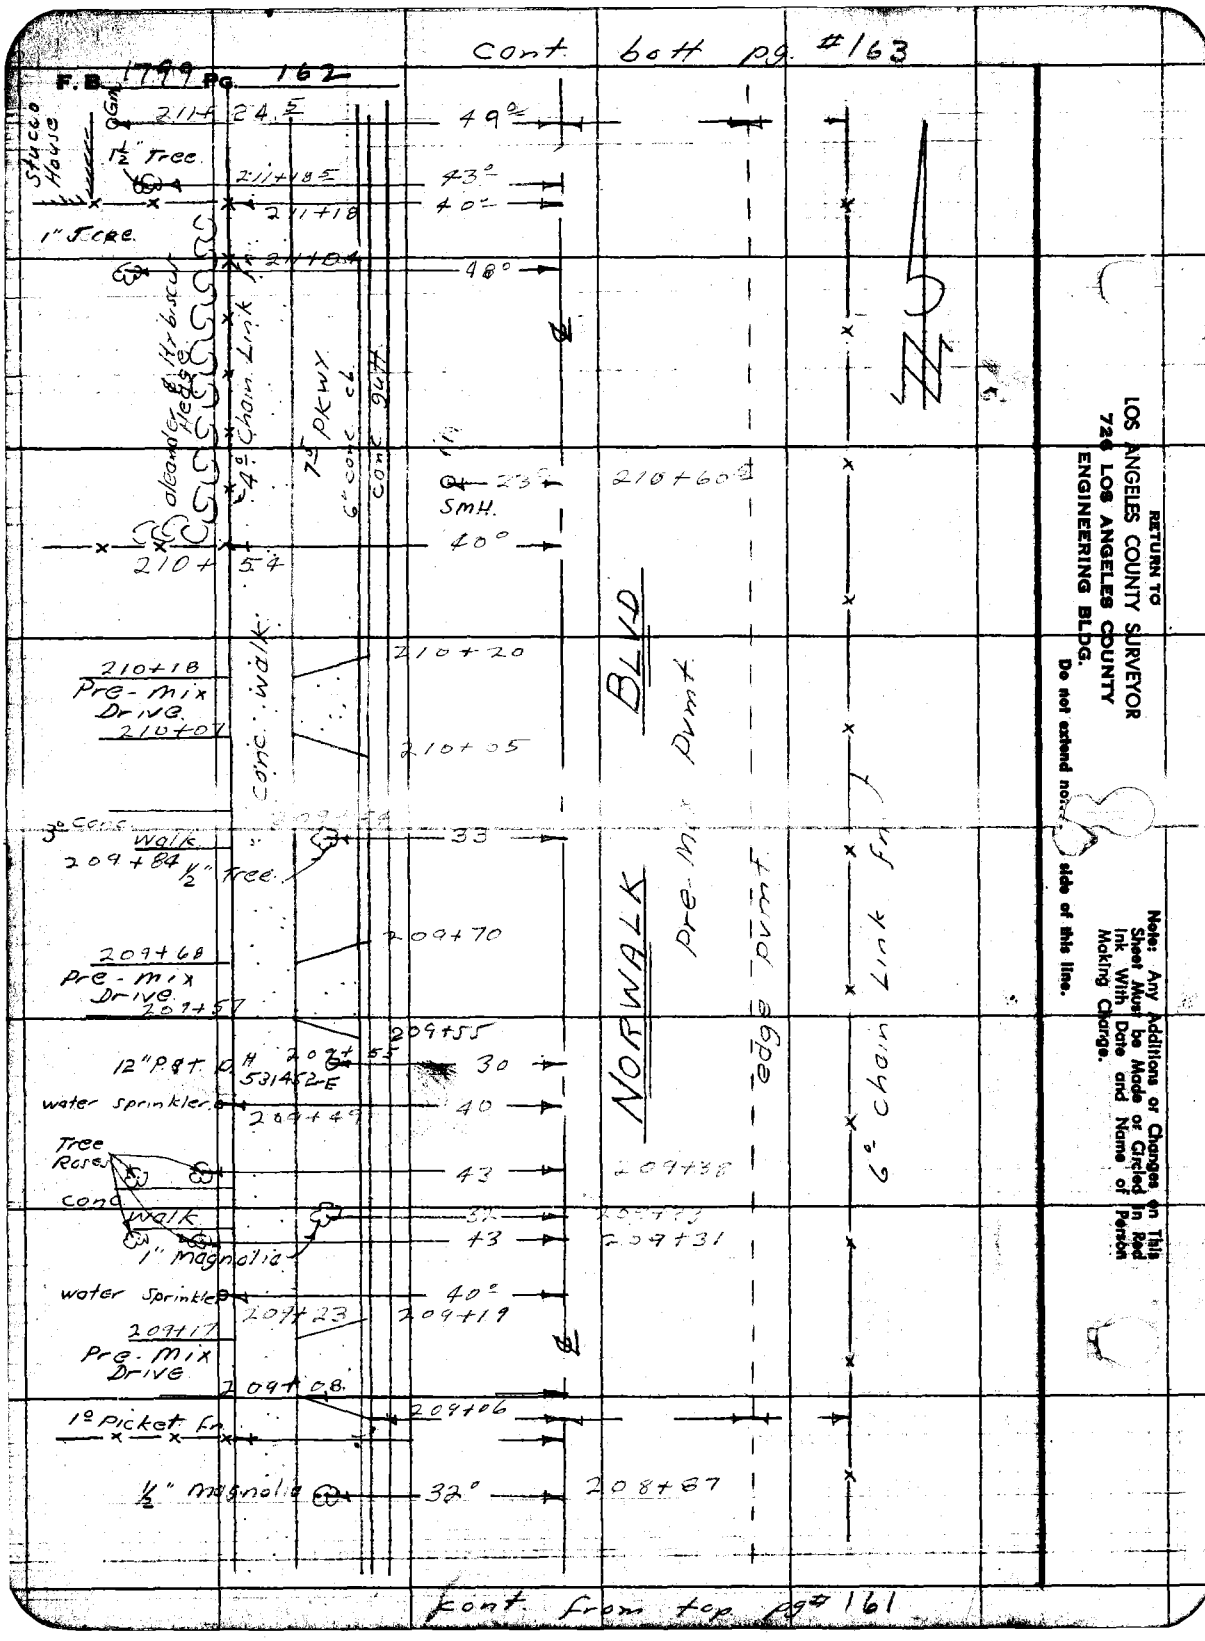

Cont. bott pg. #163
F.B. 1799 Pg. 162
Stucco House
Gm
211+24.5
49°
1½" Tree
211+18.5
43°
211+18
40°
1" Tree
211+04
48°
oleander & Hybiscus Hedge
4° Chain Link
7.5 PKWY
6" conc. cb
conc. gutt
23°
SMH.
210+60
40°
210+54
210+18
Pre-mix Drive
210+07
conc. walk
210+20
210+05
BLVD
Pre-mix Pvmt
3° conc. walk
209+84
½" Tree
33
209+70
209+68
Pre-mix Drive
209+57
209+55
12" P&T O.H.
531452-E
30
water sprinkler
209+49
40
NORWALK
edge pvmt
6° Chain Link Fn
Tree Roses
43
209+38
conc walk
43
209+31
1" Magnolia
water Sprinkler
40°
209+23
209+19
209+17
Pre-mix Drive
209+08
209+06
1° Picket Fn
½" Magnolia
32°
208+87
RETURN TO
LOS ANGELES COUNTY SURVEYOR
726 LOS ANGELES COUNTY
ENGINEERING BLDG.
Do not extend note side of this line.
Note: Any Additions or Changes on This Sheet Must be Made or Circled in Red Ink With Date and Name of Person Making Change.
Cont. from top pg# 161

1799 163

Notes Ck'd by	Survey of Artesia - Norwalk	F. B. Pg.
Map No.	W. O. 6951 Tape No. St'd. °F	
Office Work	Surveyed by English	
Checked	Notes Sappell Date 11-53	
Date	Indexed	

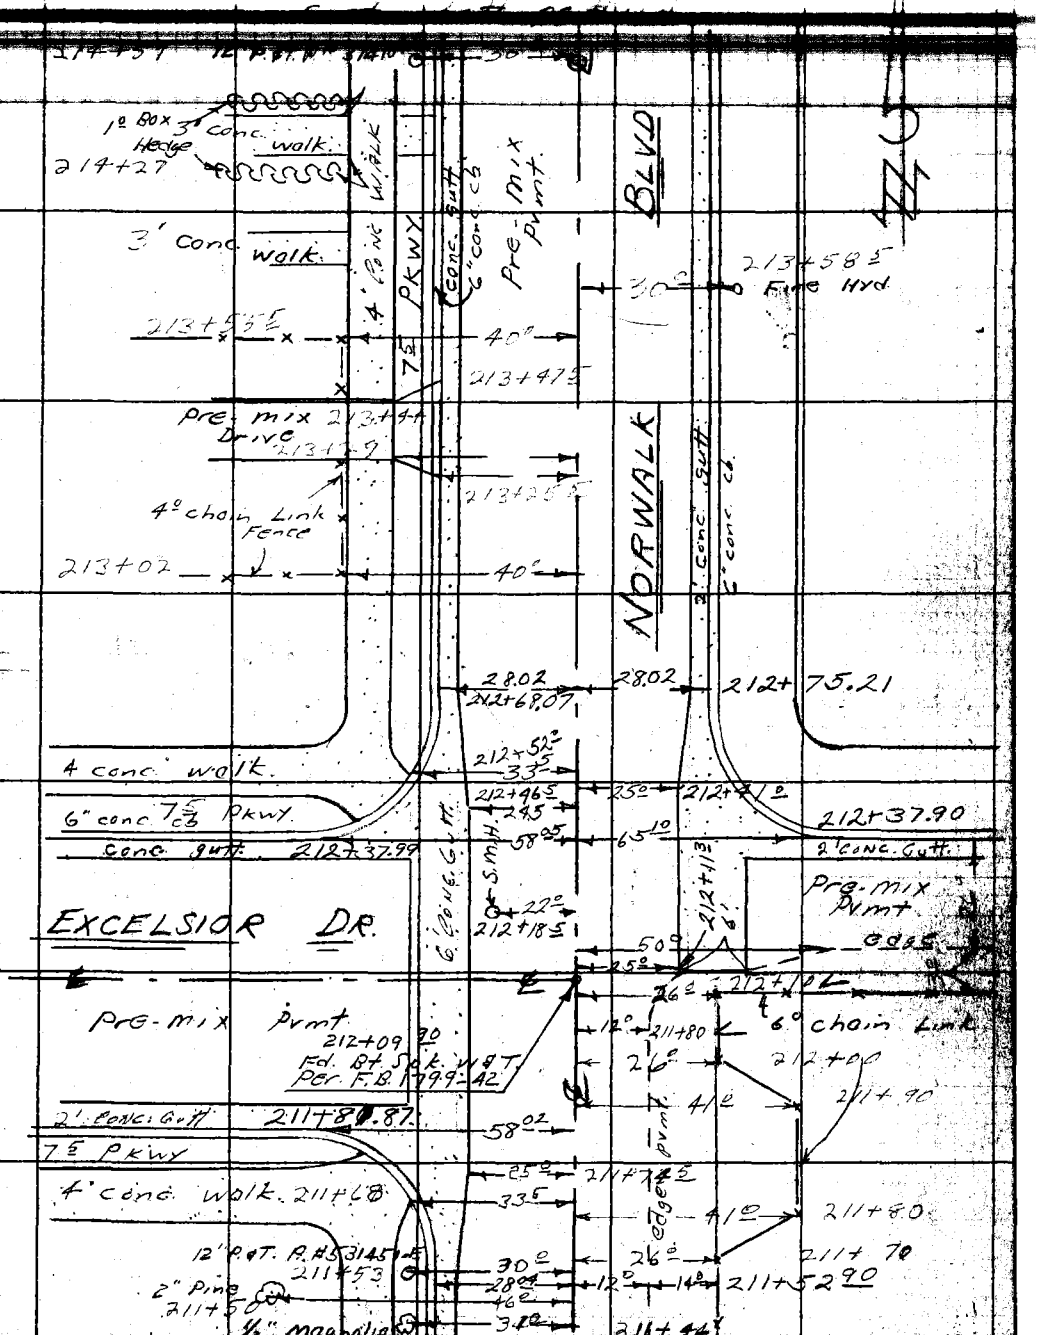

cont from top pg # 162

Note: Any Additions or Changes on This Sheet Must be Made or Circled in Red Ink With Date and Name of Person Making Change.

Do not extend notes this side of this line.

RETURN TO
LOS ANGELES COUNTY SURVEYOR
726 LOS ANGELES COUNTY
ENGINEERING BLDG.

TEMPORS 247 4-53

Cont. both pg # 165

F.B. 1799 Pg. 164

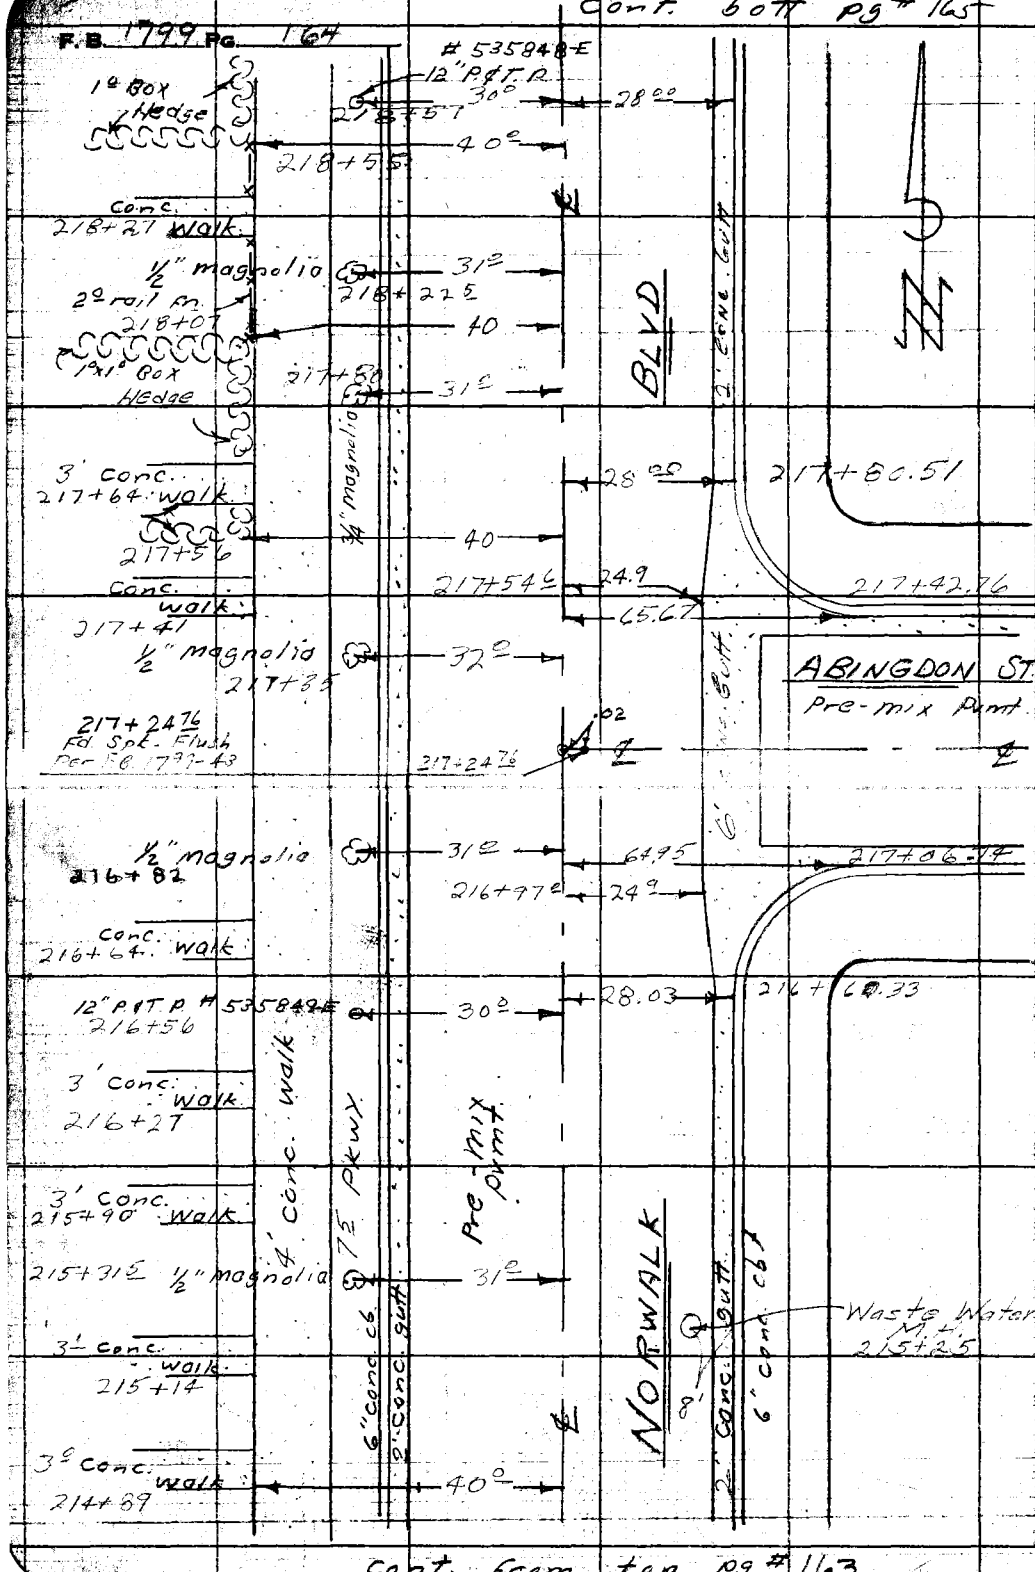

RETURN TO
LOS ANGELES COUNTY SURVEYOR
720 LOS ANGELES COUNTY
ENGINEERING BLDG.

Do not extend notes this side of this line.

Note: Any Additions or Changes in This Sheet Must be Made or Circled In Red Ink With Date and Name of Person Making Change.

Cont. from top pg # 163

Notes Ck'd by	Survey of Artesia - Norwalk	F. B. 1000 Pg. 165
Map No.	W. O. 6951 Tape No. Sr'd. °F	X
Office Work	Surveyed by English	
Checked	Notes Sappell Date 11-53	
Date	Indexed C. Johnson	

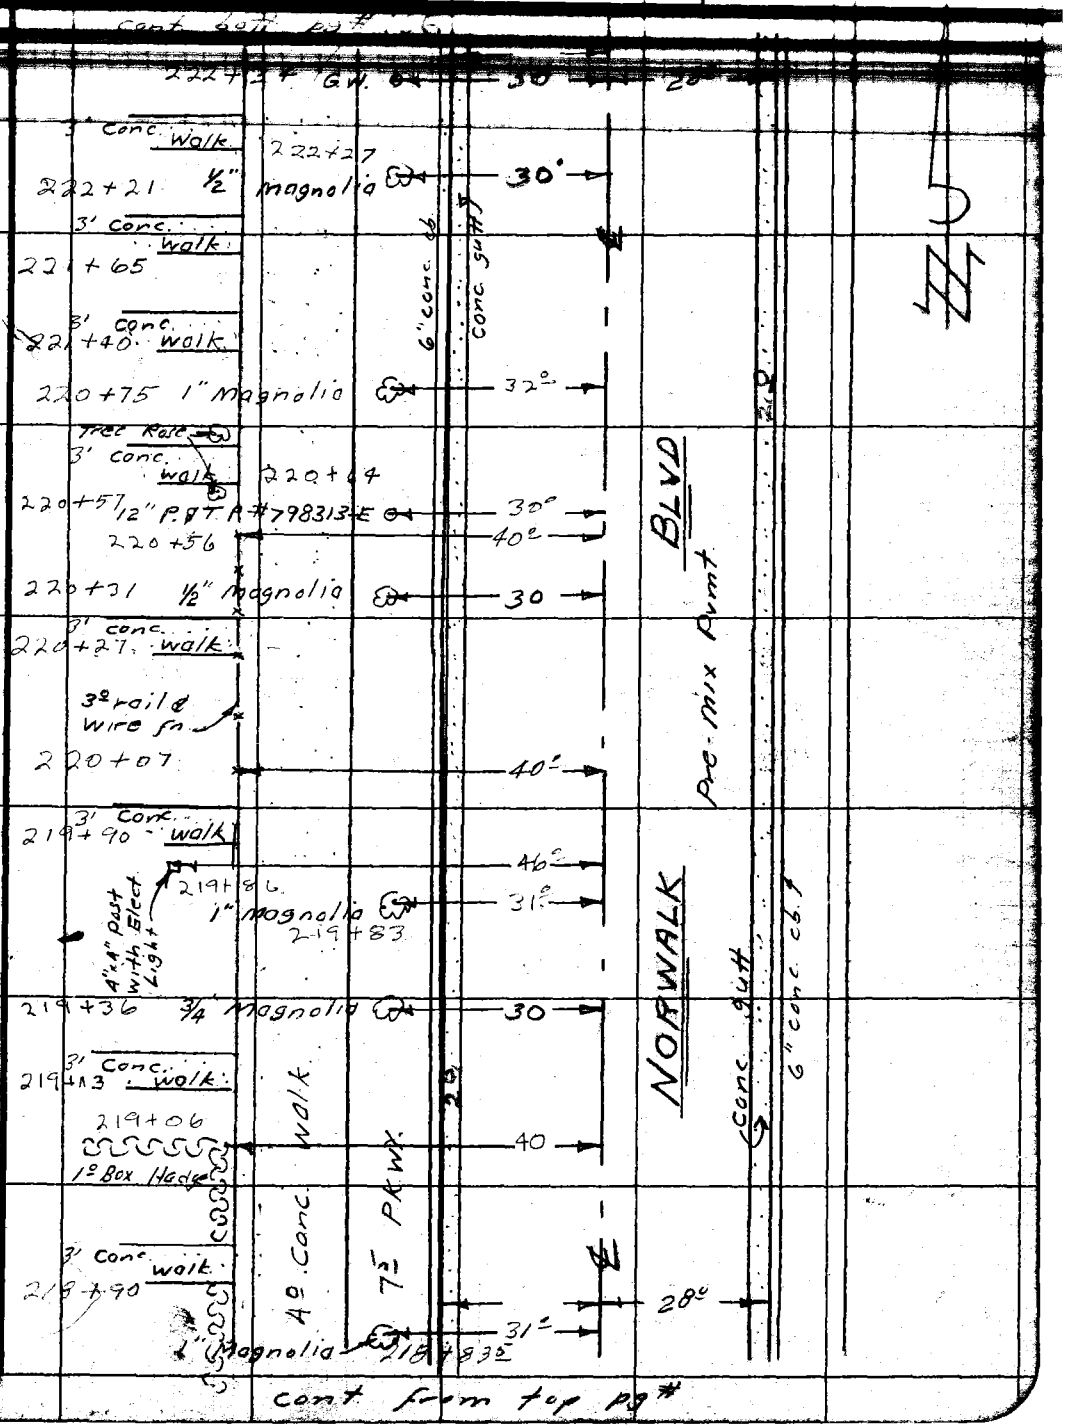

Note: Any Additions or Changes on This Sheet Must be Made or Circled in Red Ink With Date and Name of Person Making Change.

Do not extend notes this side of this line.

RETURN TO
LOS ANGELES COUNTY SURVEYOR
726 LOS ANGELES COUNTY
ENGINEERING BLDG.

76F3095 247 4-53

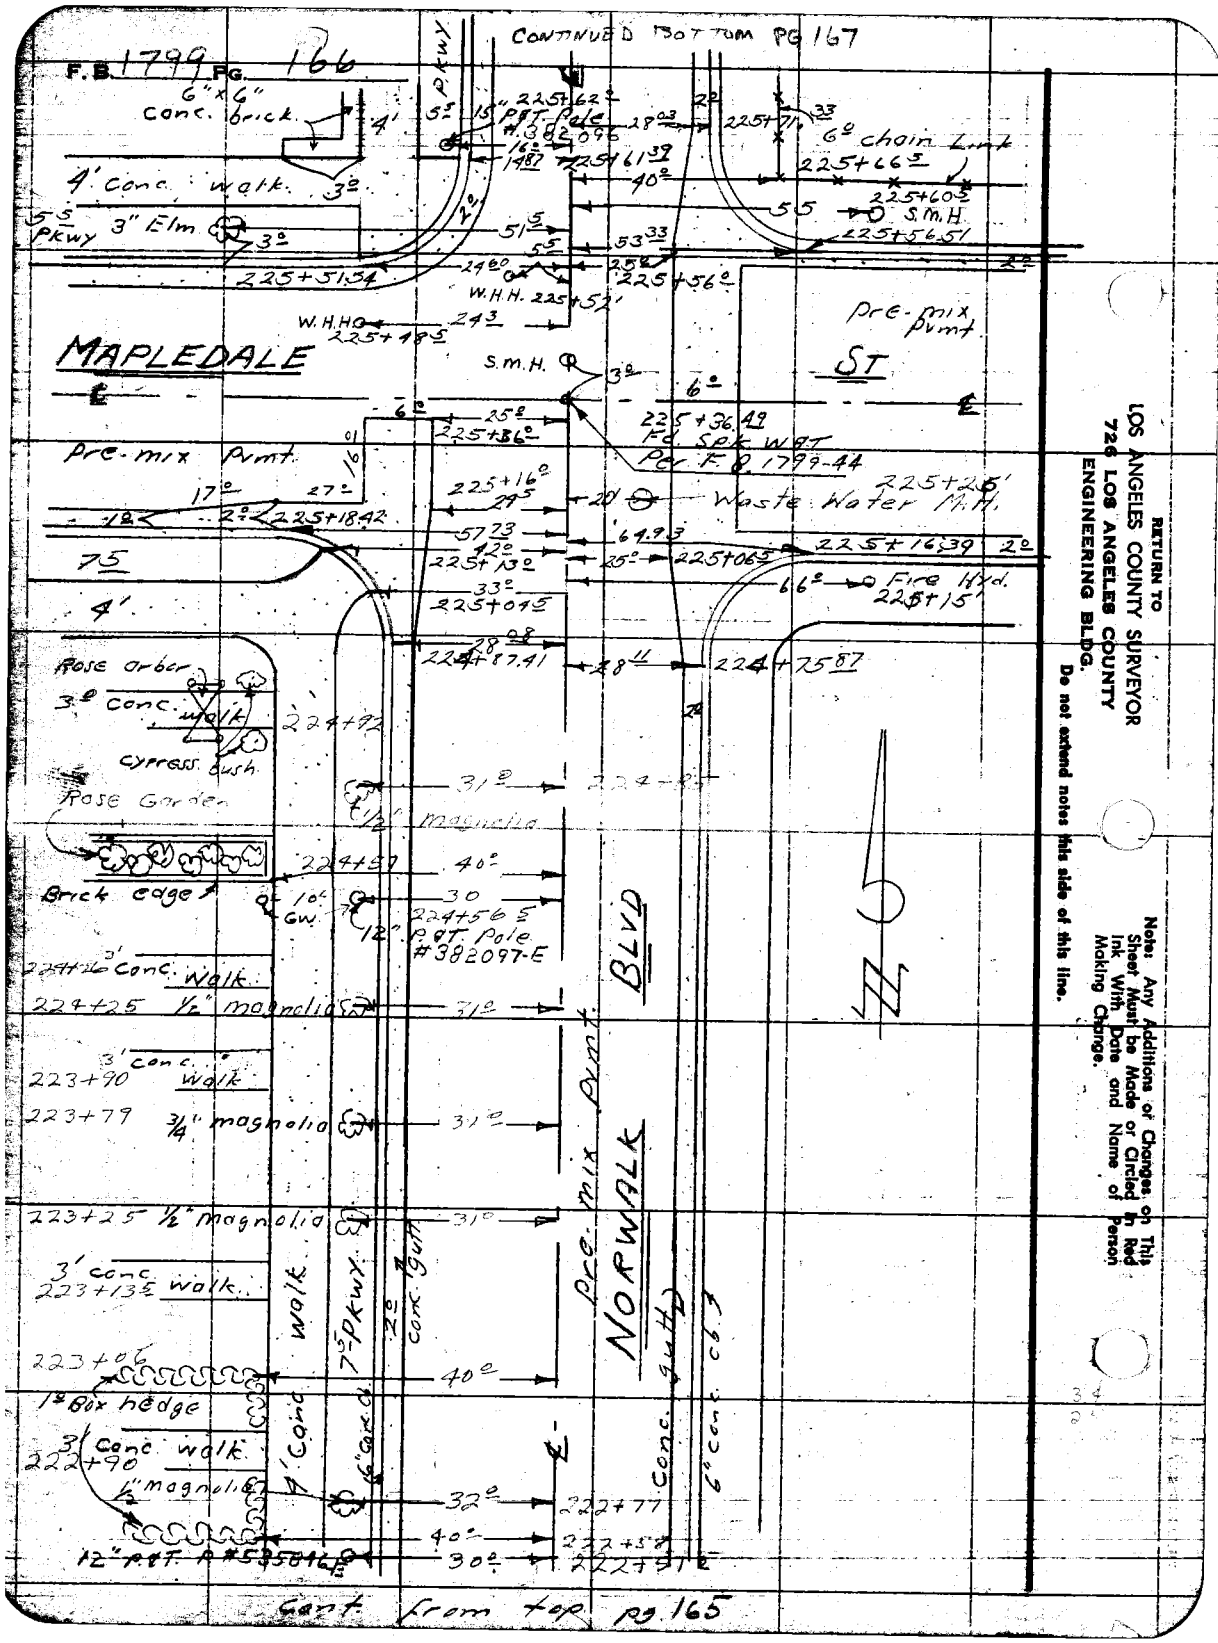

RETURN TO
LOS ANGELES COUNTY SURVEYOR
726 LOS ANGELES COUNTY
ENGINEERING BLDG.

Do not extend notes this side of this line.

Note: Any Additions or Changes on This Sheet Must be Made or Circled in Red Ink With Date and Name of Person Making Change.

Notes Ck'd by
Map No.
Office Work
Checked
Date

Survey of Artesia - Norwalk
W. O. 6257 Tape No. Sr'd. °F
Surveyed by English
Notes Sept 11 Date 11-53
Indexed

F. B. Pg.

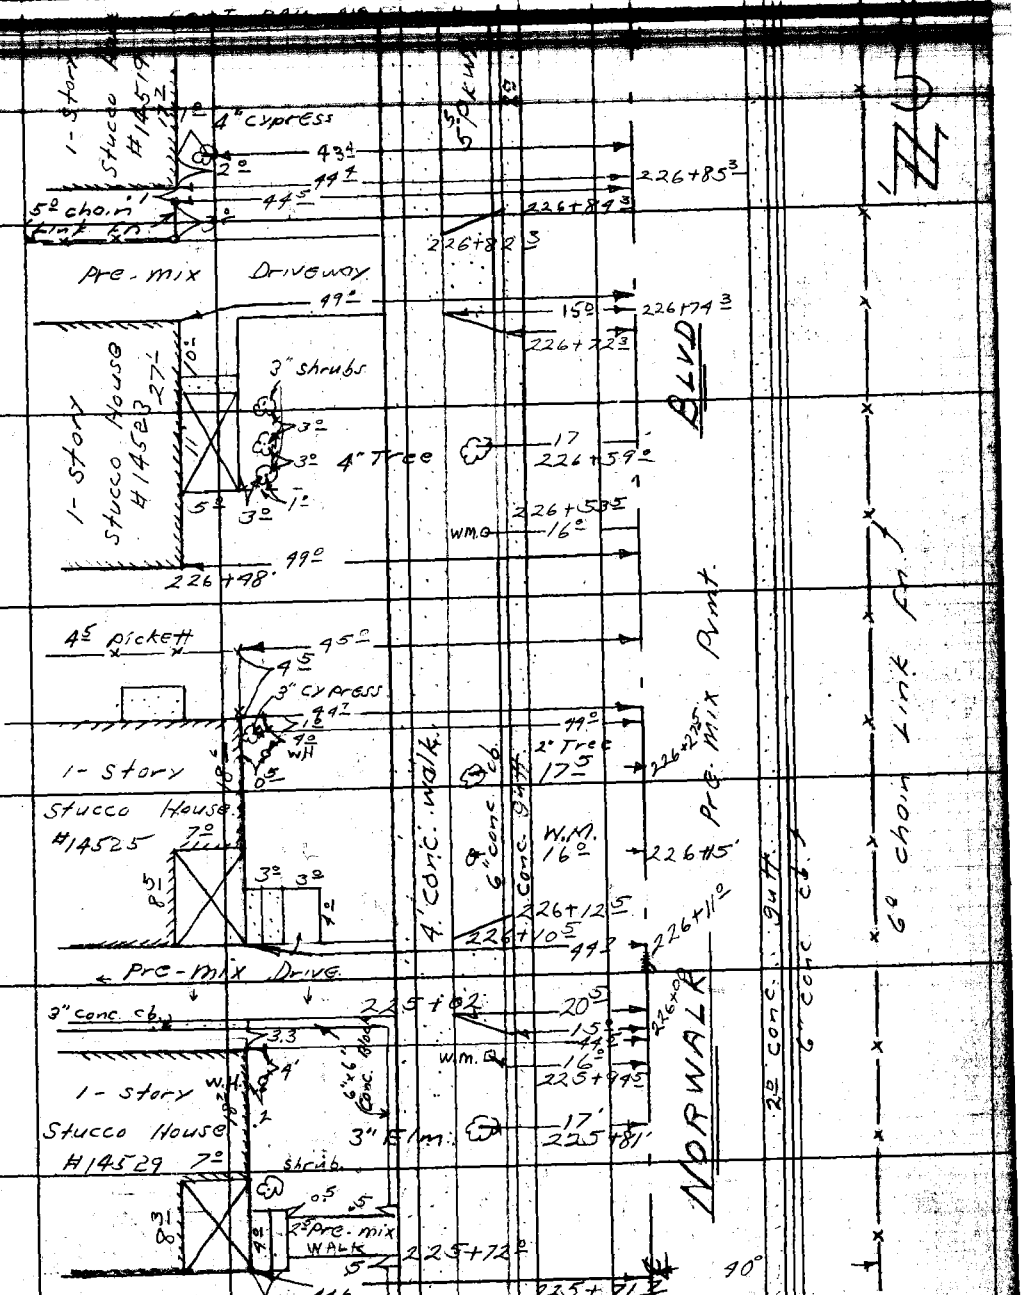

Note: Any Additions or Changes on This Sheet Must be Made or Circled in Red Ink With Date and Name of Person Making Change.

Do not extend notes this side of this line.

RETURN TO
LOS ANGELES COUNTY SURVEYOR
726 LOS ANGELES COUNTY
ENGINEERING BLDG.

76FBOOS 247 4-53

cont from top pg# 166

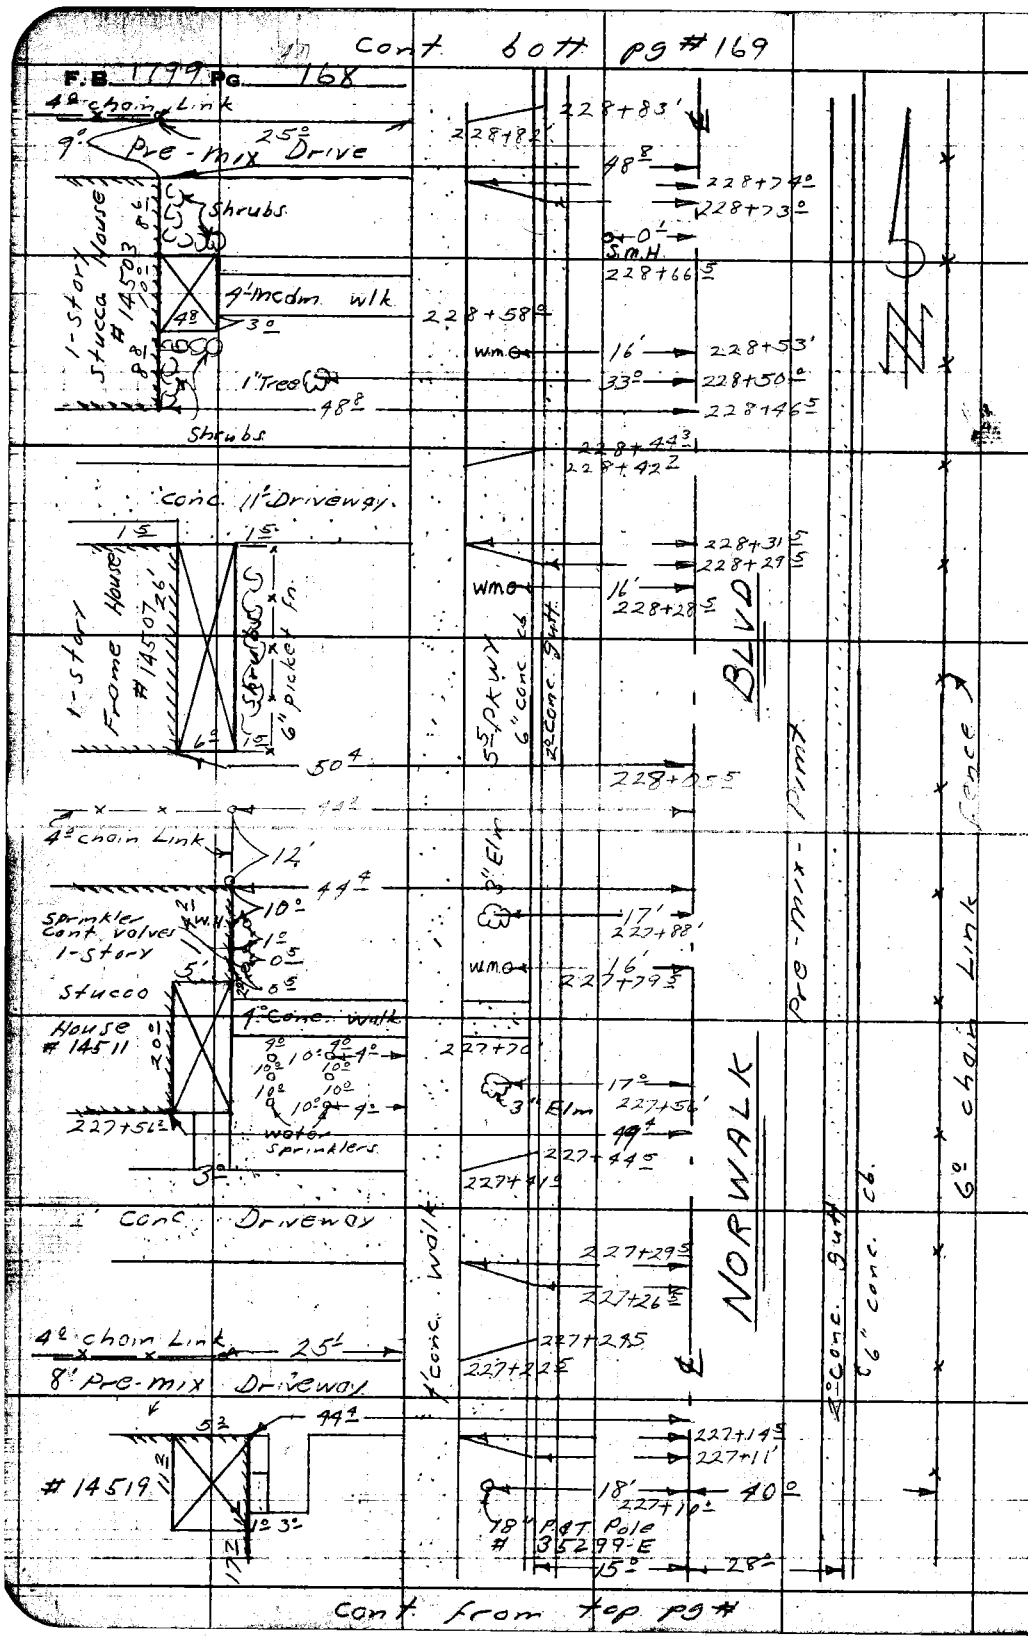

RETURN TO
LOS ANGELES COUNTY SURVEYOR
726 LOS ANGELES COUNTY
ENGINEERING BLDG.
Do not extend notes this side of this line.

Note: Any Additions or Changes on This Sheet Must be Made or Circled in Red Ink With Date and Name of Person Making Change.

Notes Ck'd by	Survey of Artesia - Norwalk	F. B. ____ PG. 162
Map No.	W. O. 6951 Tape No. ____ St'd. ____ °F	cont. bott pg # 170
Office Work	Surveyed by English	
Checked	Notes Sappell Date 11-53	
Date	Indexed	

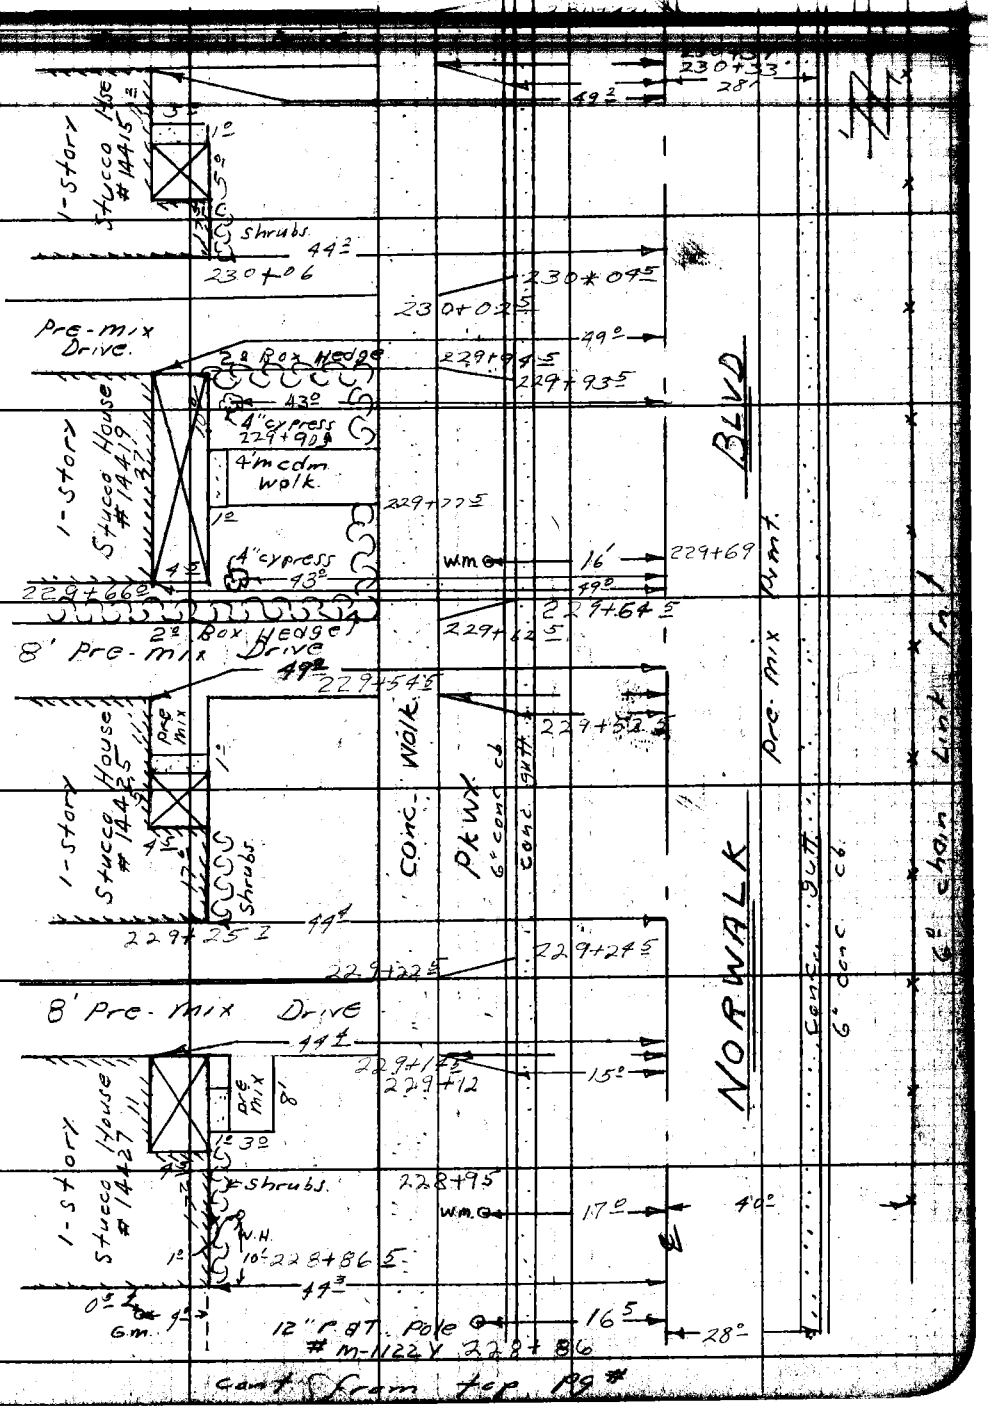

cont from top pg #

Note: Any Additions or Changes on This Sheet Must be Made or Circled in Red Ink With Date and Name of Person Making Change.

Do not extend notes this side of this line.

RETURN TO
LOS ANGELES COUNTY SURVEYOR
726 LOS ANGELES COUNTY
ENGINEERING BLDG.

76F3095 247 4-53

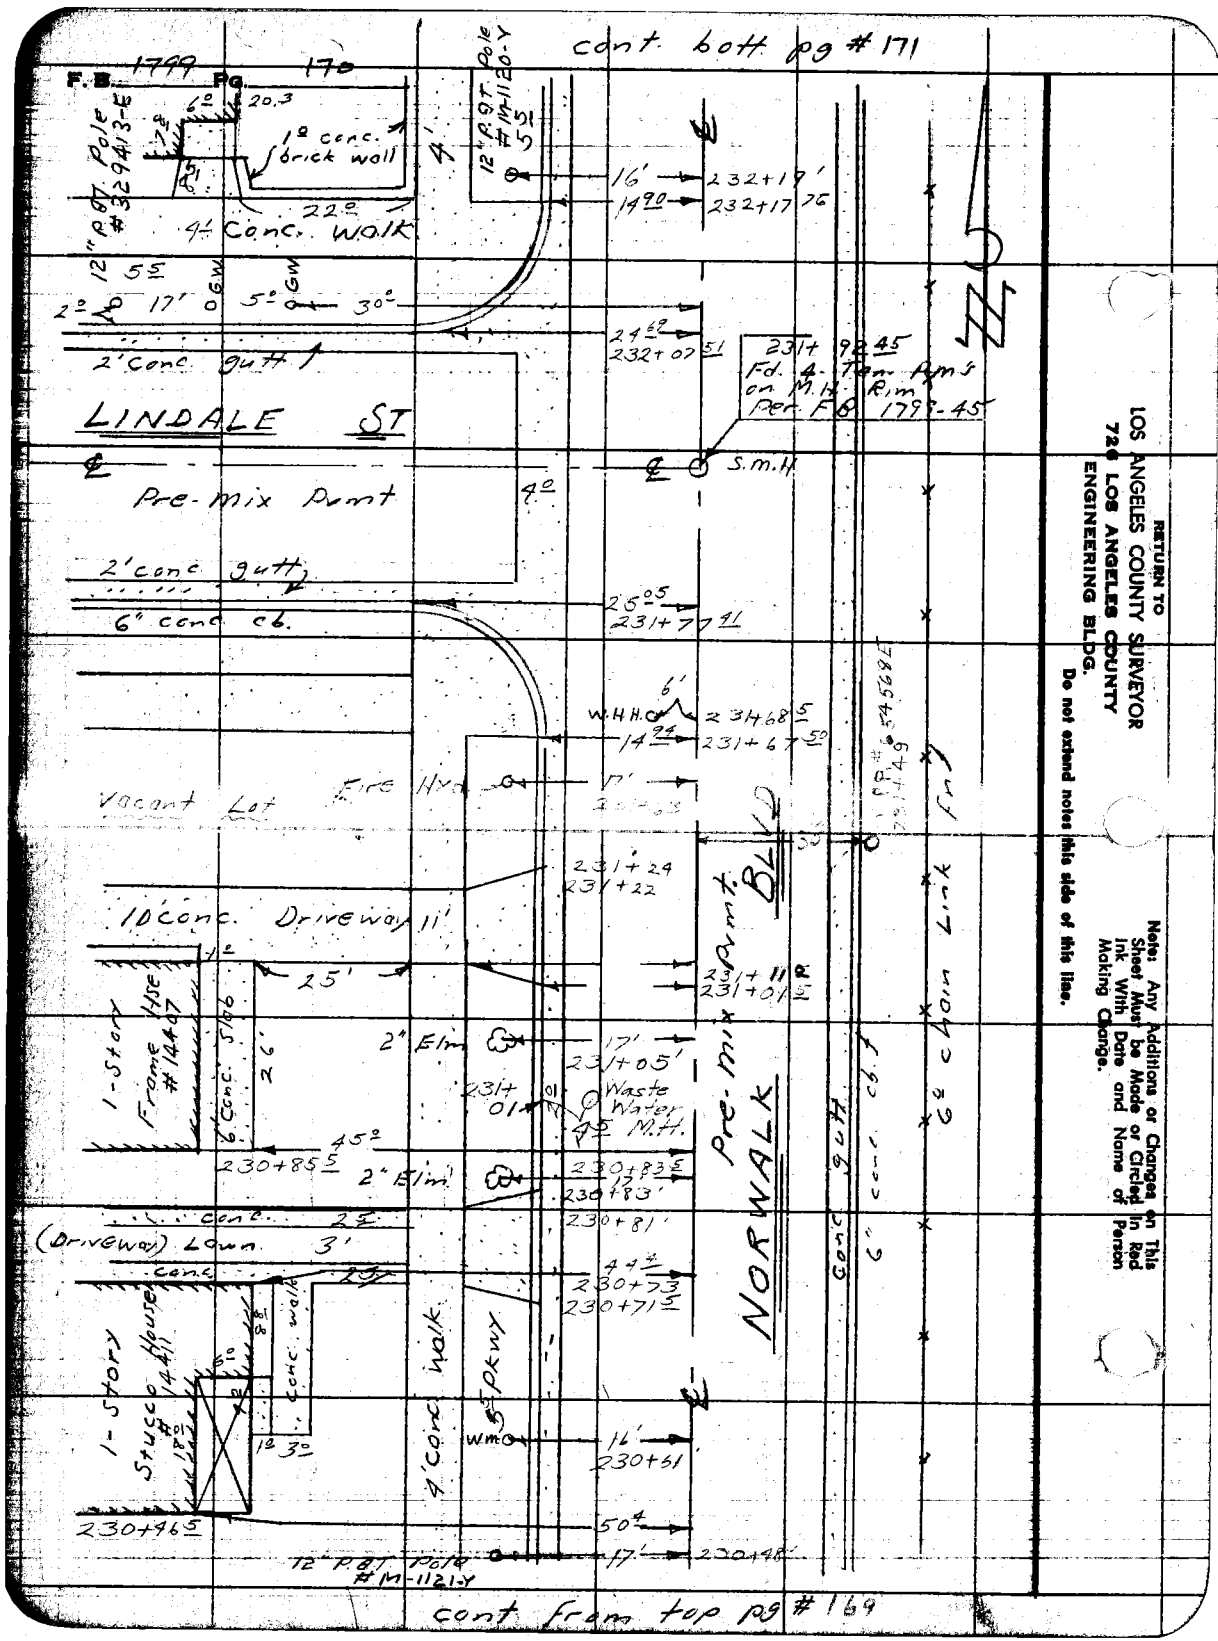

RETURN TO
LOS ANGELES COUNTY SURVEYOR
720 LOS ANGELES COUNTY
ENGINEERING BLDG.
Do not extend notes this side of this line.

Note: Any Additions or Changes on This Sheet Must be Made or Circled in Red Ink With Date and Name of Person Making Change.

Notes Ck'd by	Survey of Artesia - Norwalk	F.B. 1700 Pg. 171
Map No.	W. O. 6951 Tape No. St'd. °F	
Office Work	Surveyed by English	
Checked	Notes Sappell Date 11-53	
Date	Indexed	

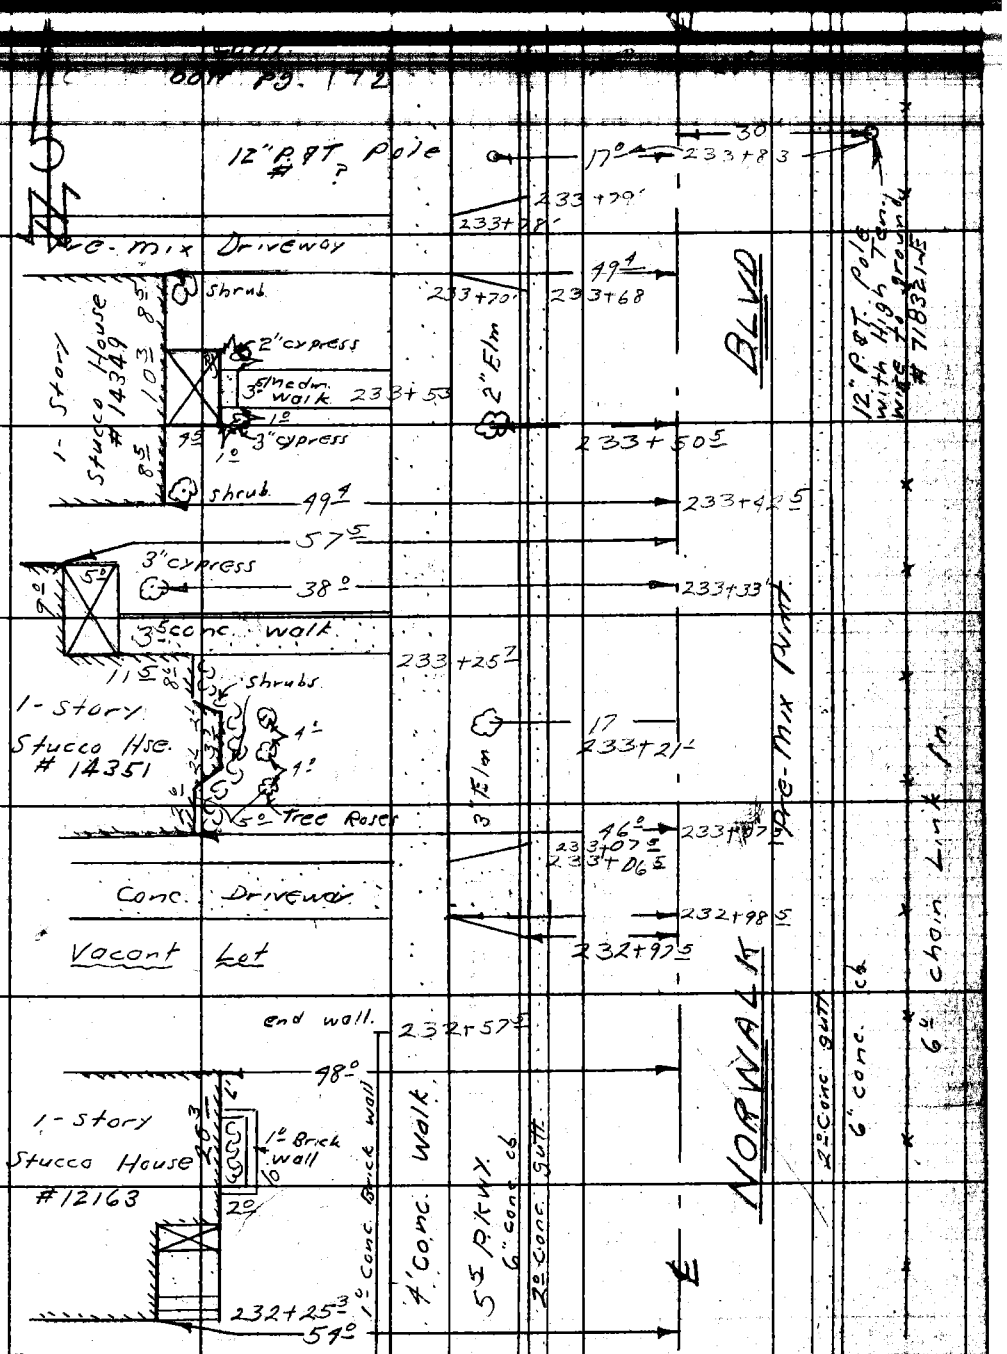

Cont. from top Pg # 170

Note: Any Additions or Changes on This Sheet Must be Made or Circled in Red Ink With Date and Name of Person Making Change.

Do not extend notes this side of this line.

RETURN TO
LOS ANGELES COUNTY SURVEYOR
726 LOS ANGELES COUNTY
ENGINEERING BLDG.

76F8095 247 4-53

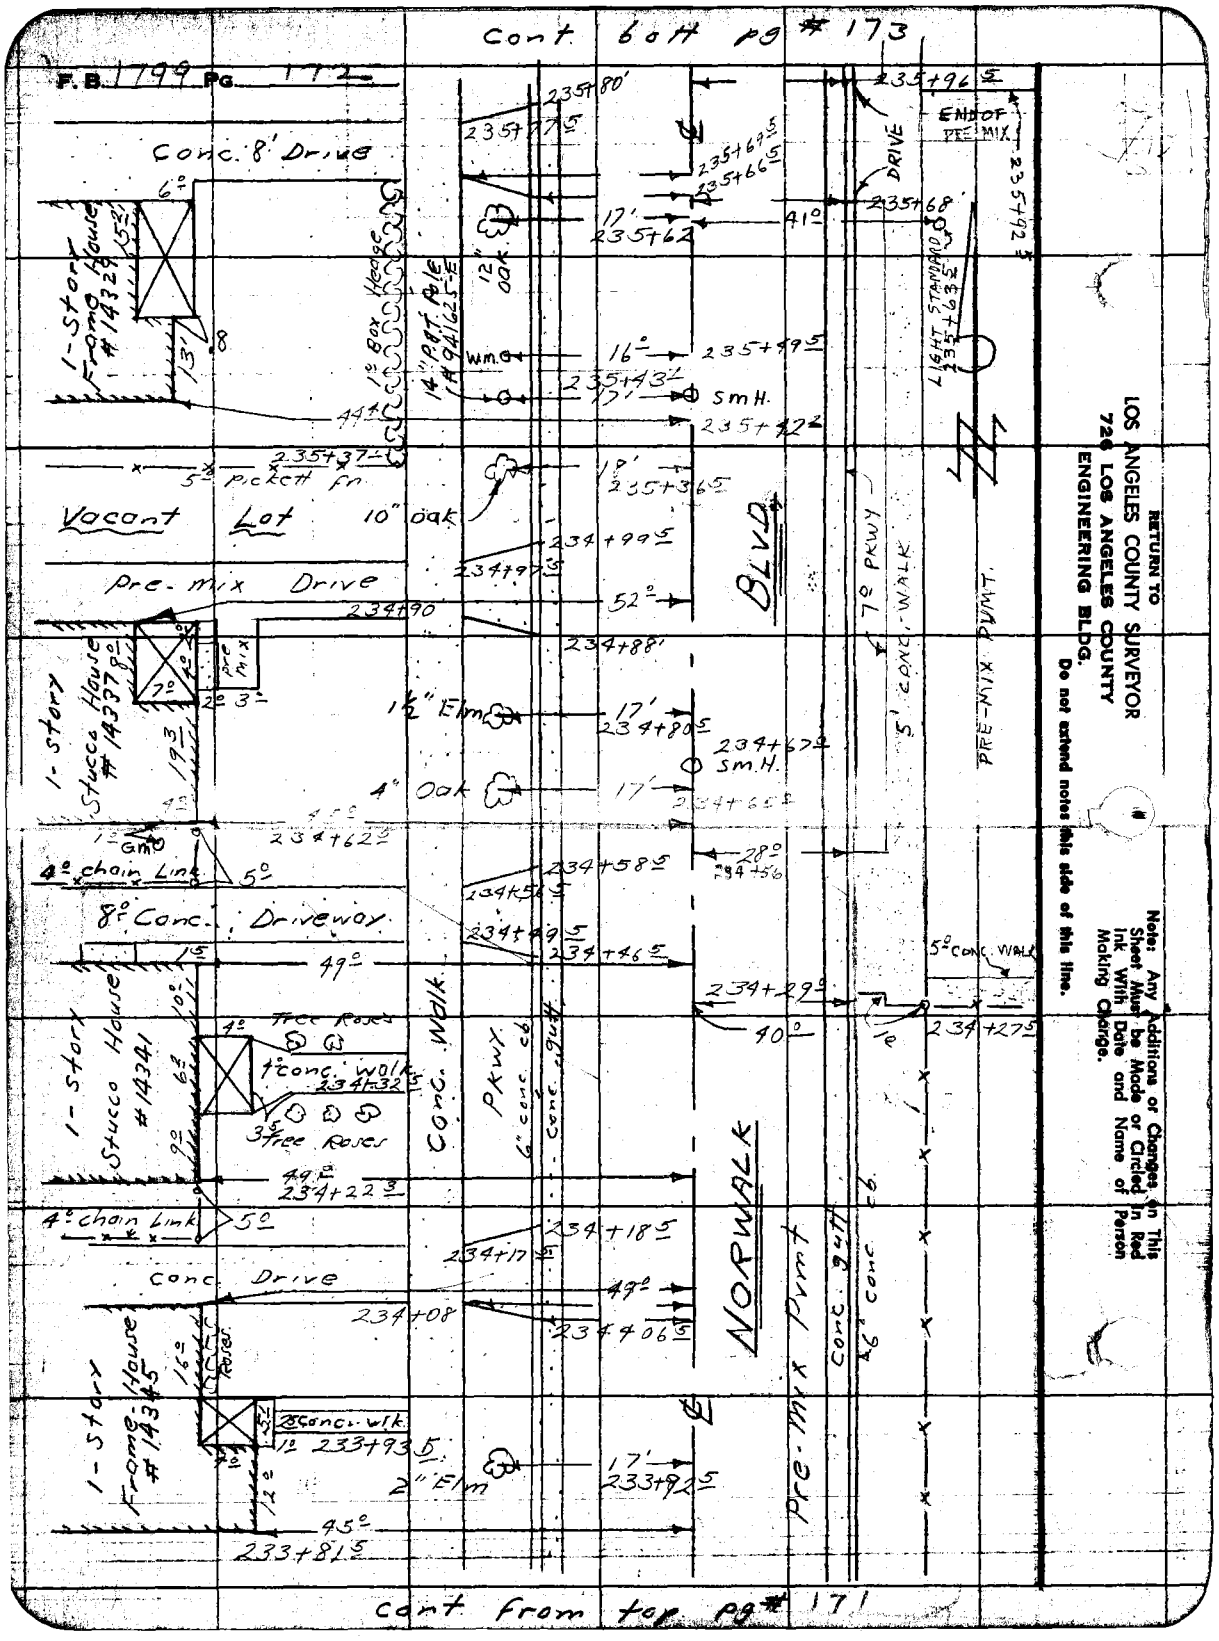

RETURN TO
LOS ANGELES COUNTY SURVEYOR
726 LOS ANGELES COUNTY
ENGINEERING BLDG.
Do not extend notes this side of this line.

Note: Any Additions or Changes on This Sheet Must be Made or Circled in Red Ink With Date and Name of Person Making Change.

Notes Ck'd by
Map No.
Office Work
Checked
Date

Survey of Artesia - Norwalk
W. O. 6951 Tape No. St'd. °F
Surveyed by English
Notes Sappell Date 11-53
Indexed

F. B. 1799 Pg. 172

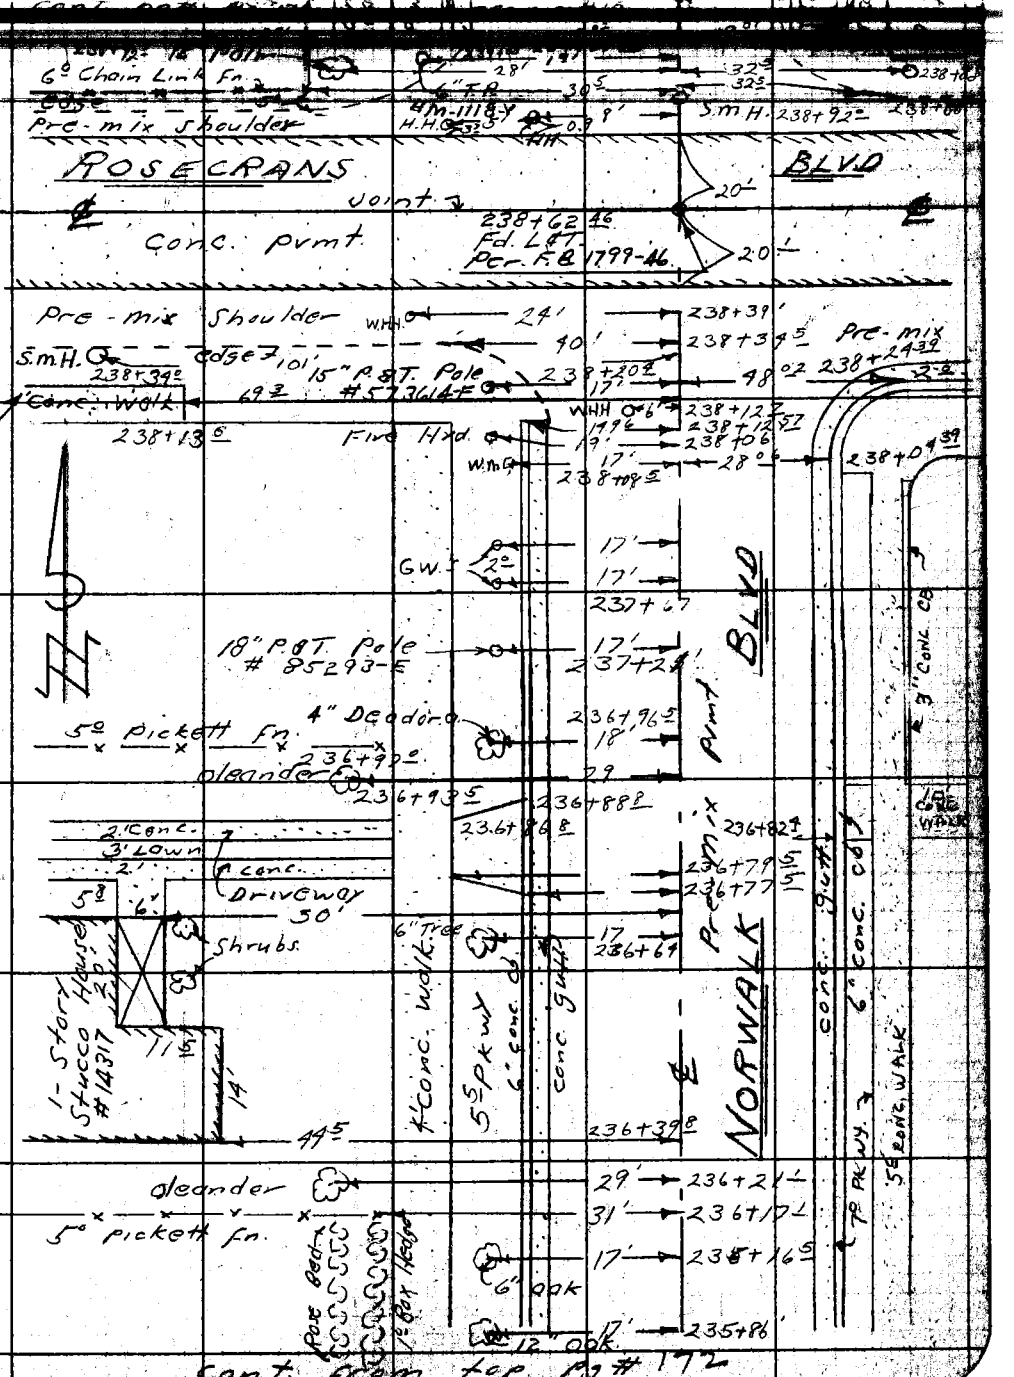

Cont. from top Pg # 172

Note: Any Additions or Changes on This Sheet Must be Made or Circled in Red Ink With Date and Name of Person Making Change.

Do not extend notes this side of this line.

RETURN TO
LOS ANGELES COUNTY SURVEYOR
726 LOS ANGELES COUNTY
ENGINEERING BLDG.

76F3095 247 4-53

F.B. 1799 PG. 174

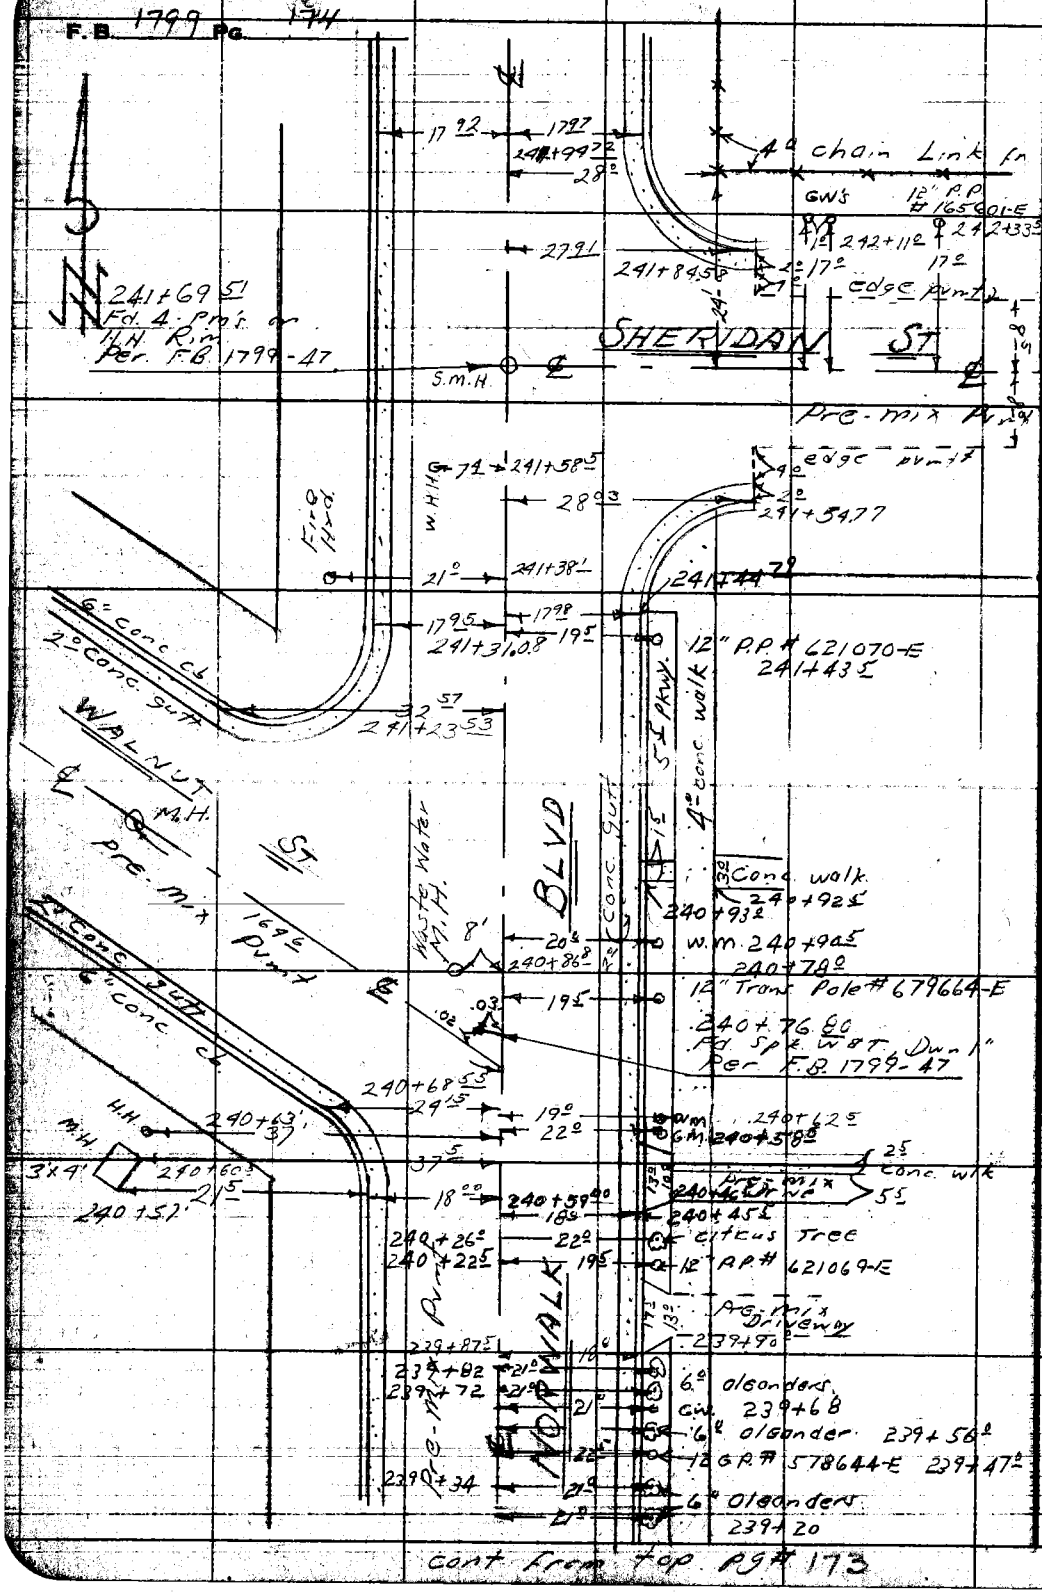

RETURN TO
LOS ANGELES COUNTY SURVEYOR
726 LOS ANGELES COUNTY
ENGINEERING BLDG.

Do not extend notes this side of this line.

Note: Any Additions or Changes on This Sheet Must be Made in Red Ink With Date and Name of Person Making Change.

Notes Ck'd by	Survey of Artesia - Norwalk	F. B. ___ Pg. 175
Map No.	W. O. 6857 Tape No. ___ St'd. ___ °F	
Office Work	Surveyed by English	
Checked	Notes Sappell Date 11-53	
Date	Indexed	

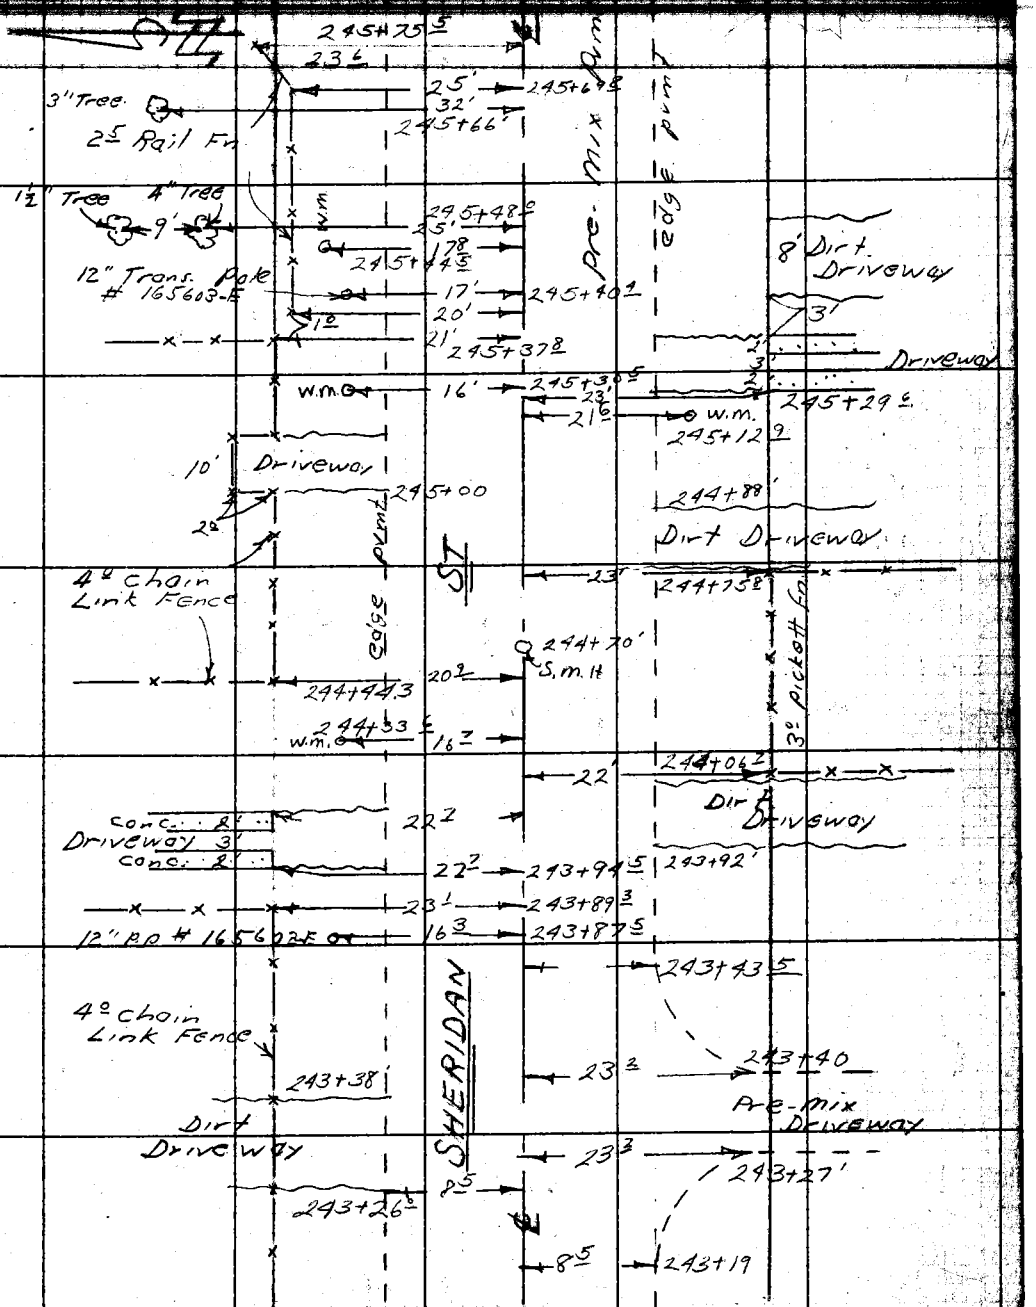

Cont from RT Pg # 174

Note: Any Additions or Changes on This Sheet Must be Made or Circled in Red Ink With Date and Name of Person Making Change.

Do not extend notes this side of this line.

RETURN TO
LOS ANGELES COUNTY SURVEYOR
726 LOS ANGELES COUNTY
ENGINEERING BLDG.

78F8095 247 4-53

F.B. 1799 PG. 176

cont. 60# pg # 177

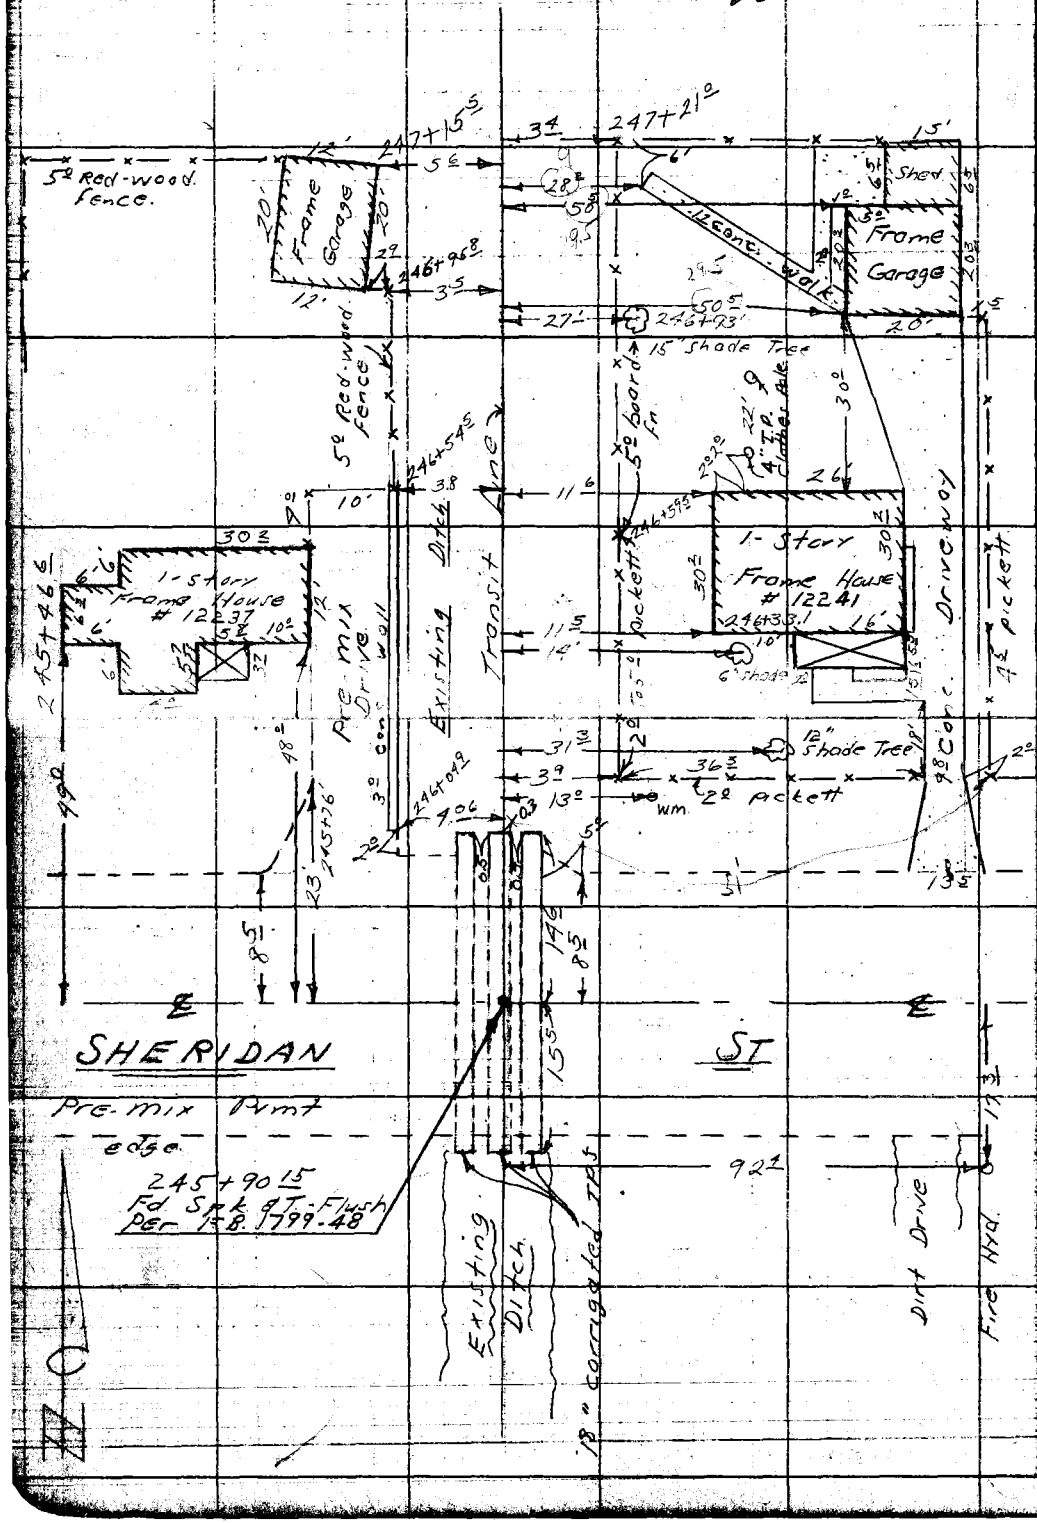

RETURN TO
LOS ANGELES COUNTY SURVEYOR
726 LOS ANGELES COUNTY
ENGINEERING BLDG.

Do not extend holes this side of this line.

Note: Any Additions or Changes on This Sheet Must be Made or Circled in Red Ink With Date and Name of Person Making Change.

Notes Ck'd by	Survey of Artesia - Norwalk
Map No.	W. O. 6951 Tape No. Sr'd. °F
Office Work	Surveyed by English
Checked	Notes Sippell Date 12-53
Date	Indexed

F.B. 1799 Pg. 177

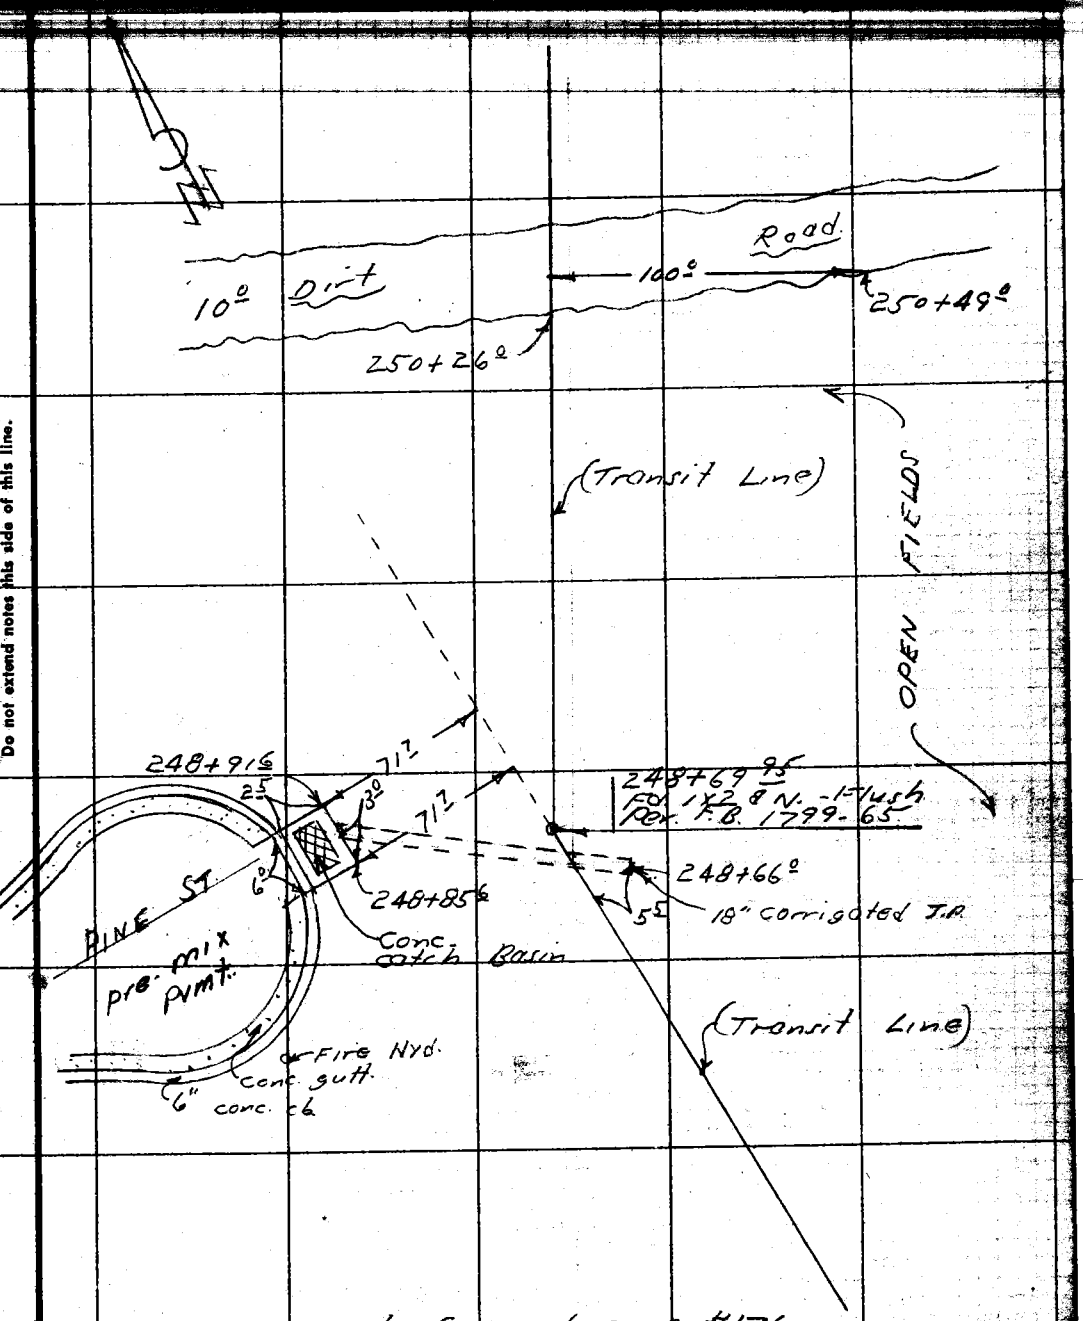

cont from top pg #176

Note: Any Additions or Changes on This Sheet Must be Made or Circled in Red Ink With Date and Name of Person Making Change.

Do not extend notes this side of this line.

RETURN TO
LOS ANGELES COUNTY SURVEYOR
726 LOS ANGELES COUNTY
ENGINEERING BLDG.

76F3095 247 4-53

F.B. 1799 PG. 178

Cont. bott. pg #179

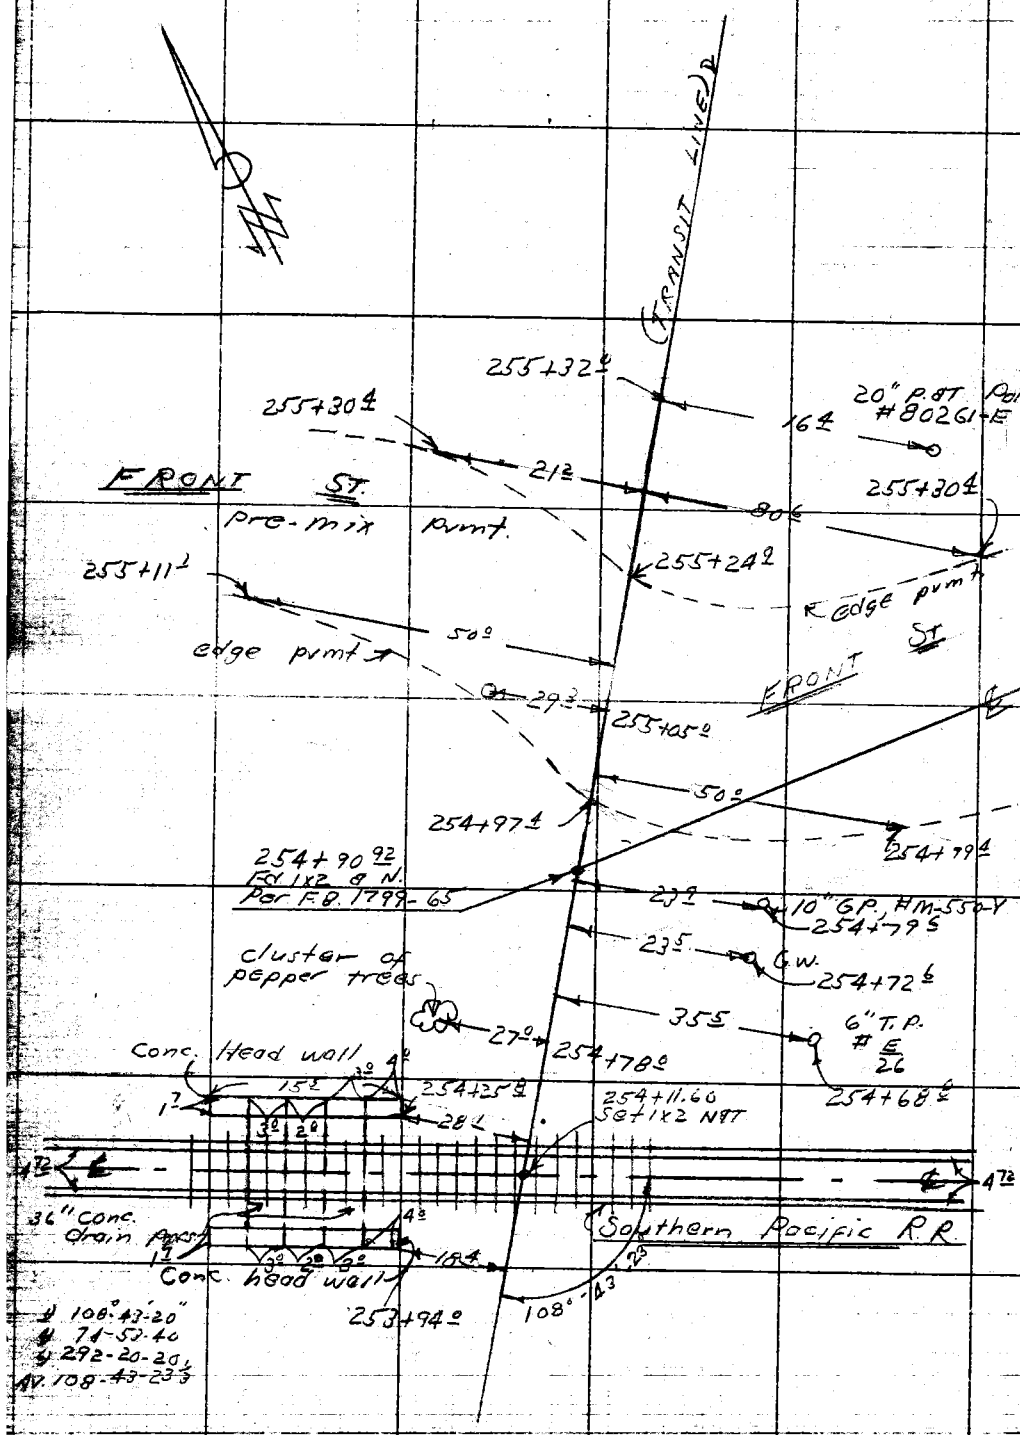

Cont from F.B. pg #177

RETURN TO
LOS ANGELES COUNTY SURVEYOR
720 LOS ANGELES COUNTY
ENGINEERING BLDG.
Do not extend notes this side of this line.

Note: Any Additions or Changes on This Sheet Must be Made or Circled in Red Ink With Date and Name of Person Making Change.

1799 179

F. B. _____ Pg. _____

Notes Ck'd by _____
Map No. _____
Office Work _____
Checked _____
Date _____

Survey of Artesia - Norwalk
W. O. 6851 Tape No. _____ St'd. _____ °F
Surveyed by English
Notes Sacrell Date 11-53
Indexed C. Johnson

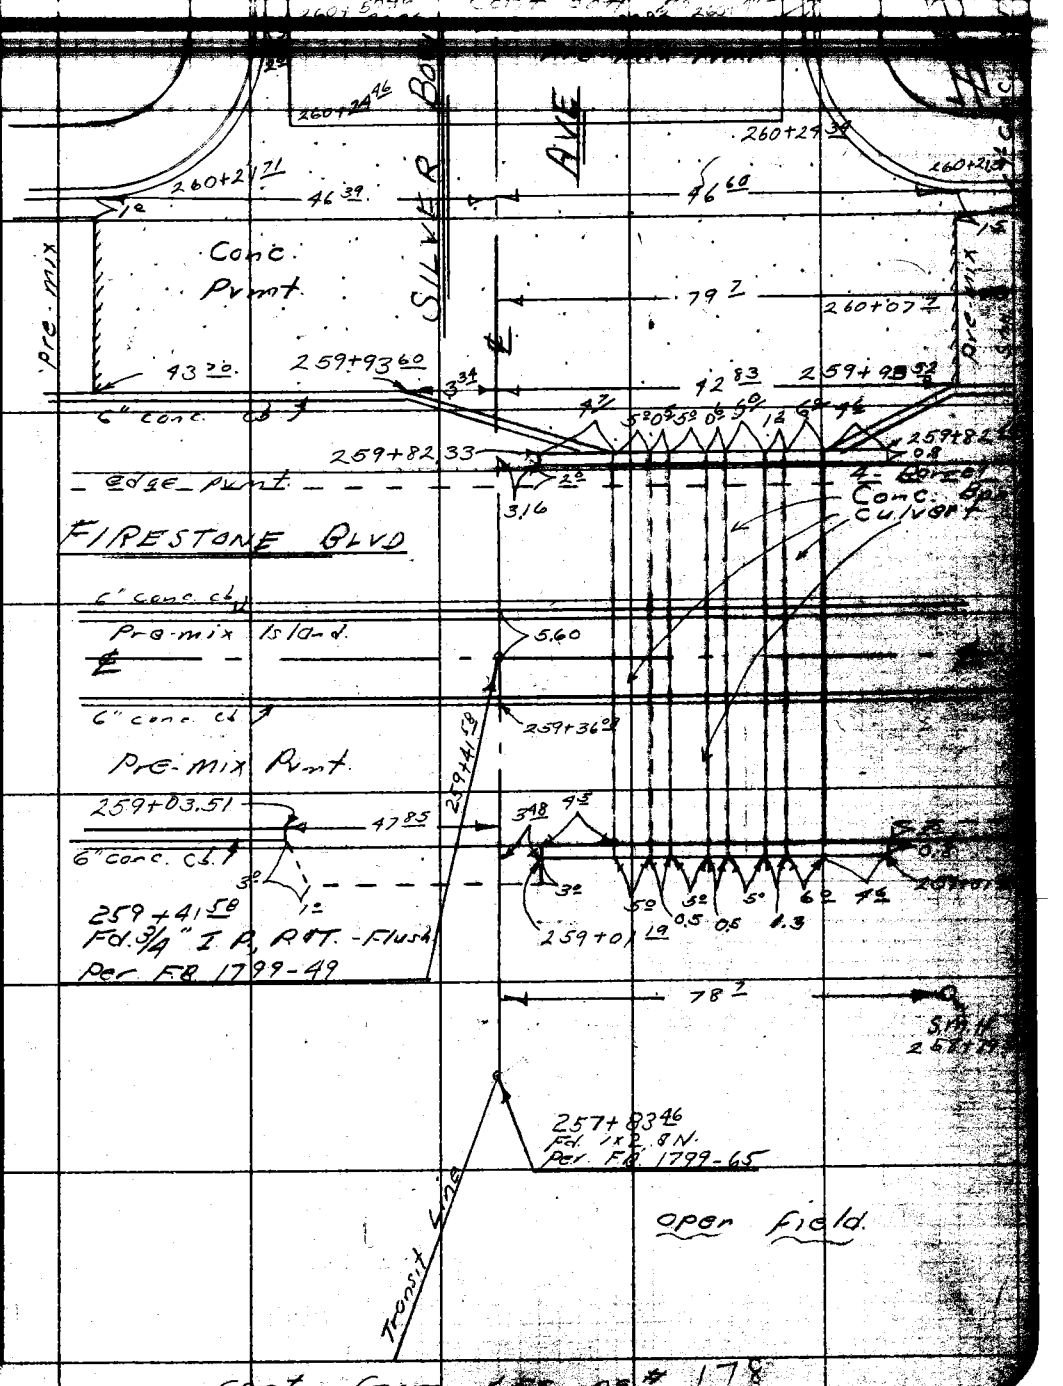

cont from LFT pg # 178

Note: Any Additions or Changes on This Sheet Must be Made or Circled in Red Ink With Date and Name of Person Making Change.

Do not extend notes this side of this line.

RETURN TO
LOS ANGELES COUNTY SURVEYOR
726 LOS ANGELES COUNTY
ENGINEERING BLDG.

78F3098 247 4-53

cont. bott. pg #181

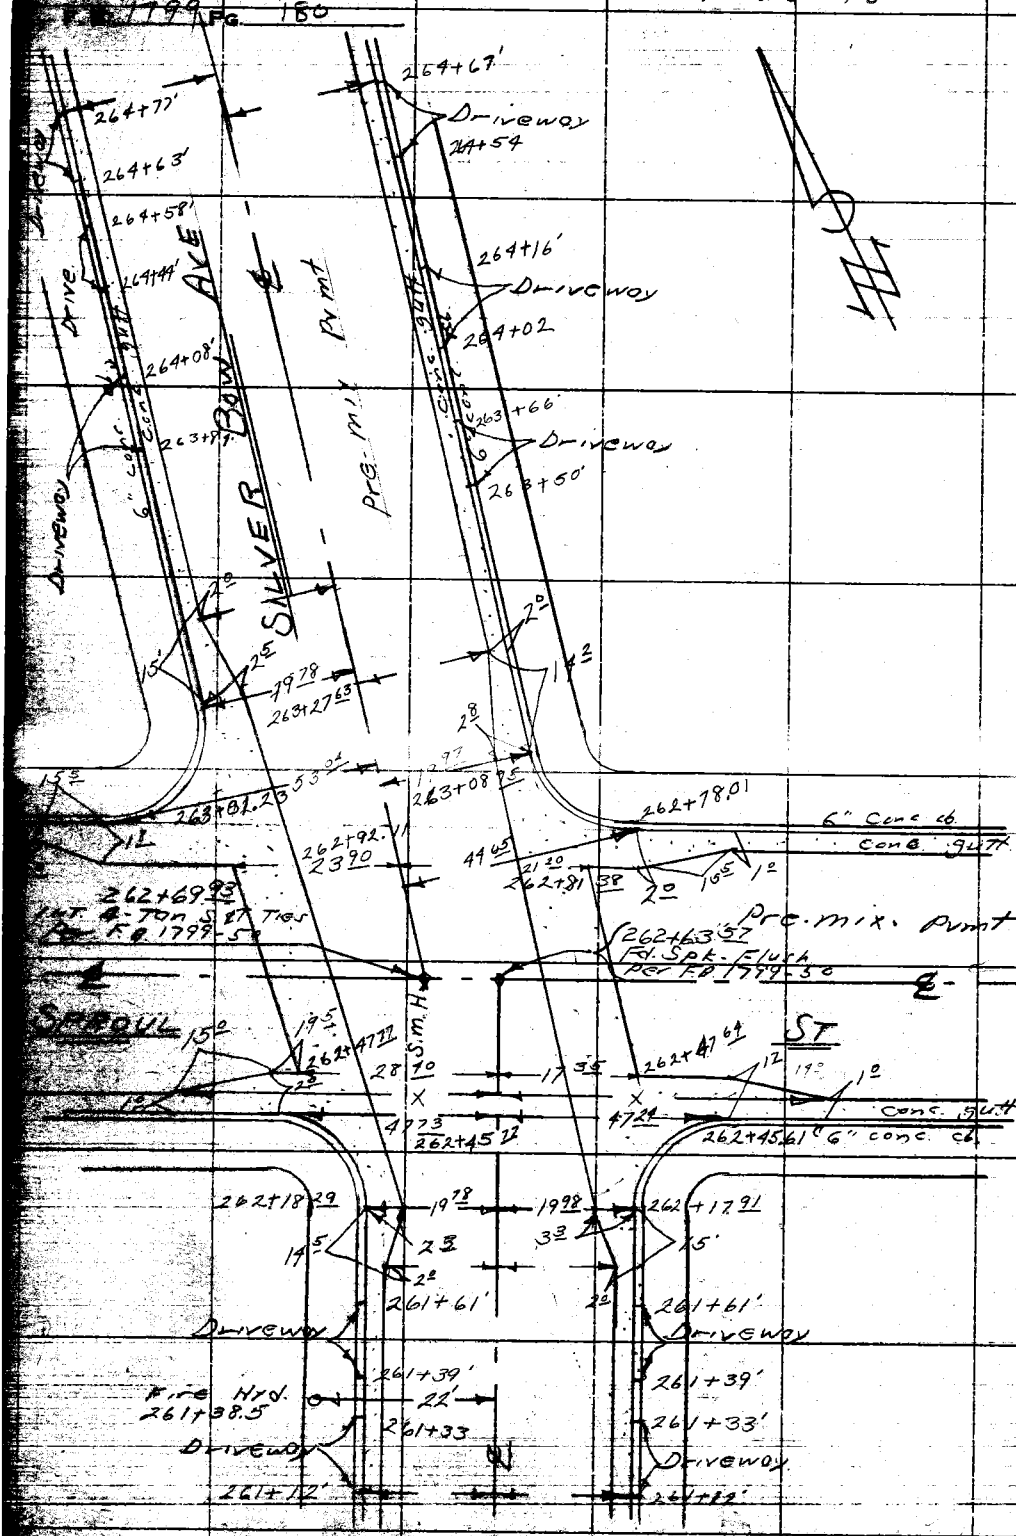

cont. from top pg #179

RETURN TO
LOS ANGELES COUNTY SURVEYOR
726 LOS ANGELES COUNTY
ENGINEERING BLDG.
Do not extend notes this side of this line.

Note: Any Additions or Changes on This Sheet Must be Made or Circled in Red Ink With Date and Name of Person Making Change.

3904

Notes Ch'd by
Map No.
Office Work
Checked
Date

Survey of Artesia - Norwalk
W. O. 6951 Tape No. St'd. °F
Surveyed by English
Notes Sappell Date 11-53
Indexed A. C. Johnson

F.B. 1799 Pg. 181

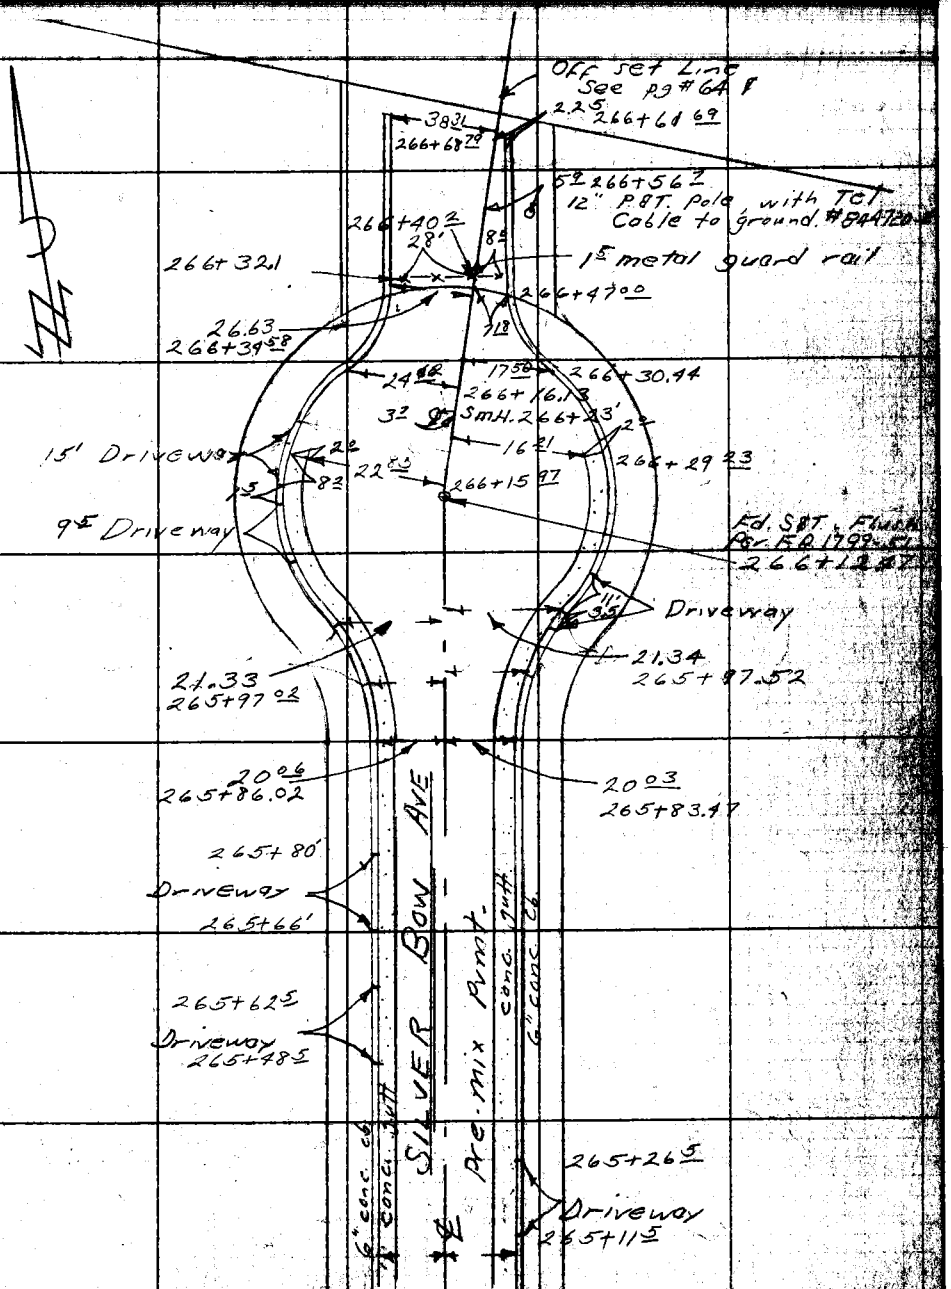

Note: Any Additions or Changes on This Sheet Must be Made or Circled in Red Ink With Date and Name of Person Making Change.

Do not extend notes this side of this line.

RETURN TO
LOS ANGELES COUNTY SURVEYOR
726 LOS ANGELES COUNTY
ENGINEERING BLDG.

76F3095 247 4-53

Cont. from top pg # 180

F.B. 1799 Pg. 182

cont. RT Pg # 183

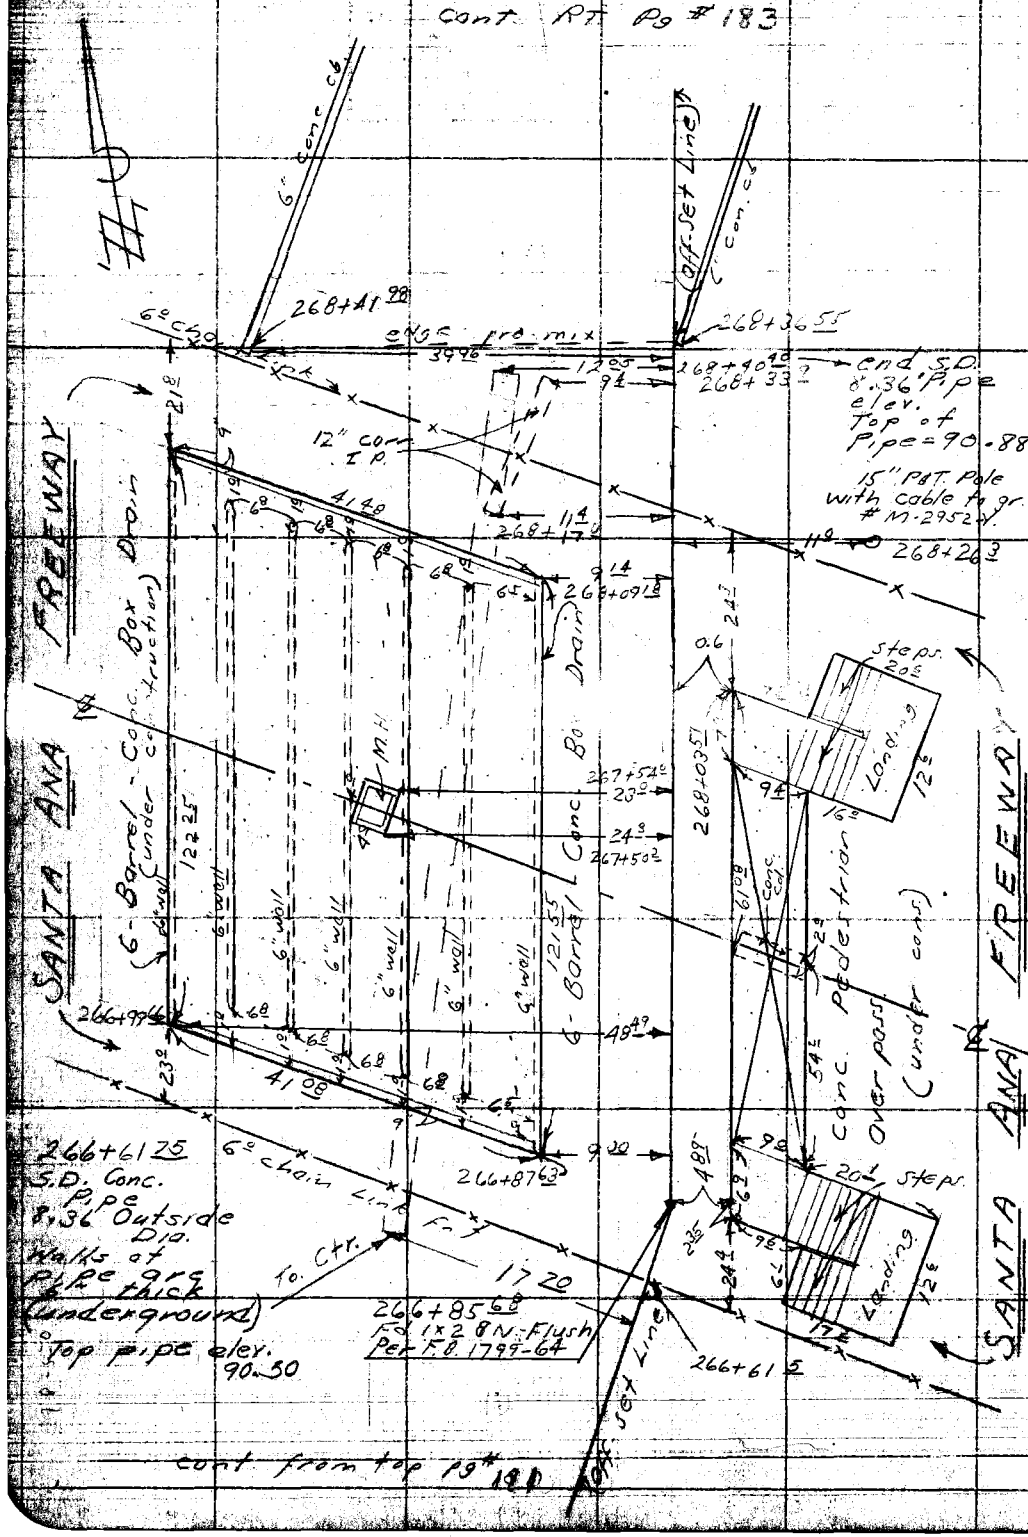

RETURN TO
LOS ANGELES COUNTY SURVEYOR
726 LOS ANGELES COUNTY
ENGINEERING BLDG.

Do not extend notes this side of this line.

Note: Any Additions or Changes on This Sheet Must be Made or Circled in Red Ink With Date and Name of Person Making Change.

76F3096 247 4-53

RETURN TO
LOS ANGELES COUNTY SURVEYOR
726 LOS ANGELES COUNTY
ENGINEERING BLDG.

Note: Any Additions or Changes on This Sheet Must be Made or Circled in Red Ink With Date and Name of Person Making Change.

Do not extend notes this side of this line.

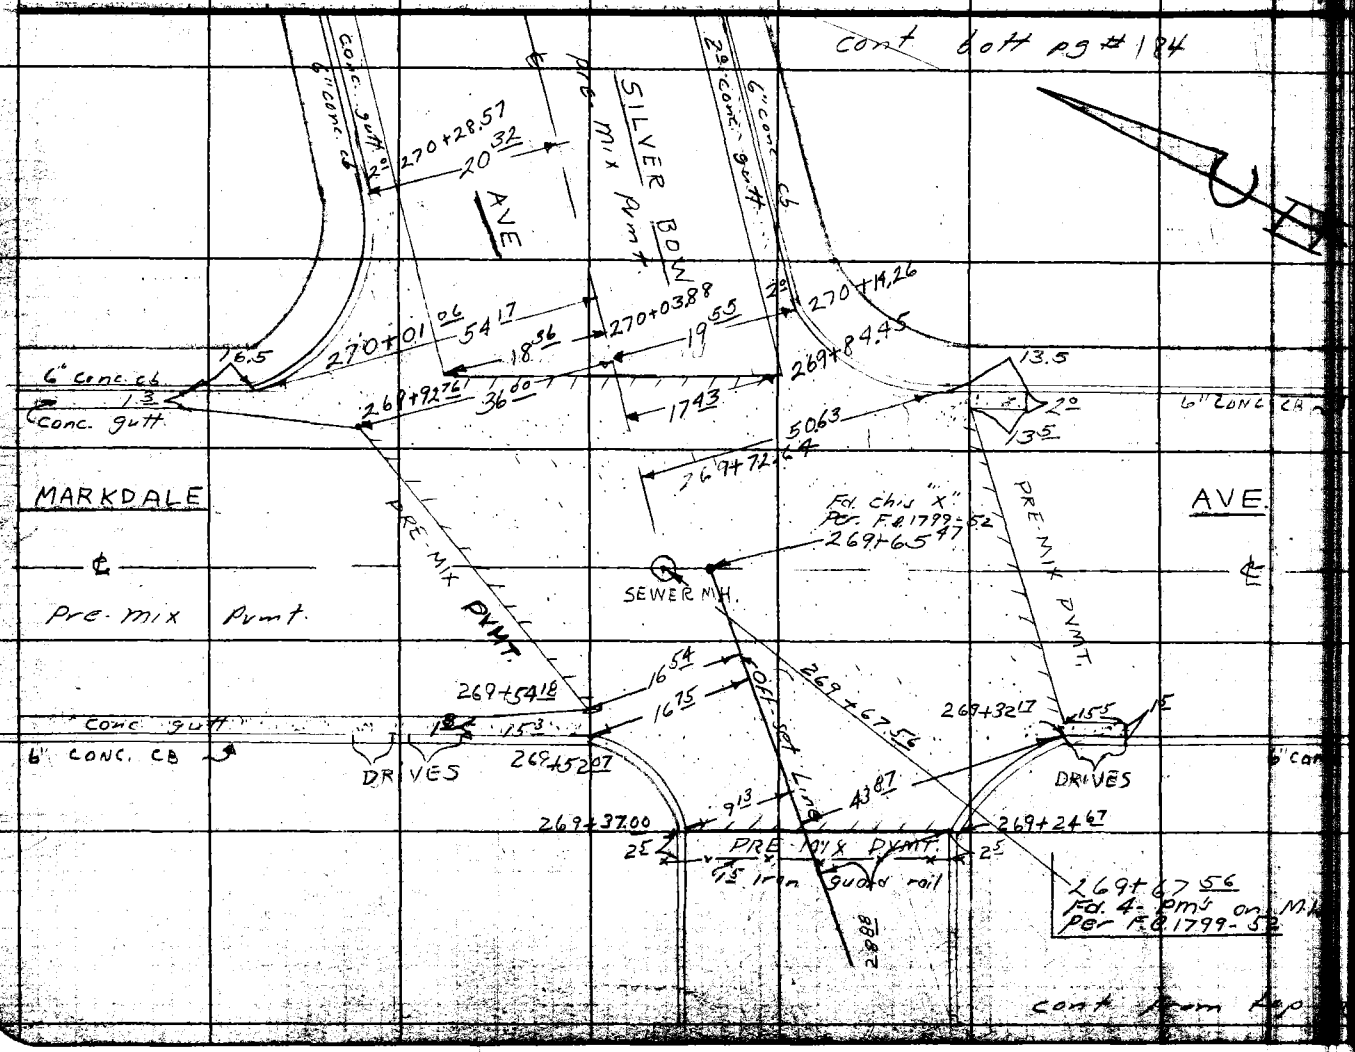

Map No.
Office Work
Checked
Date

W. O. Tape No. Sr'd. of
Surveyed by ENGLISH
Notes Date
Indexed

F.B. 1799 PG. 182

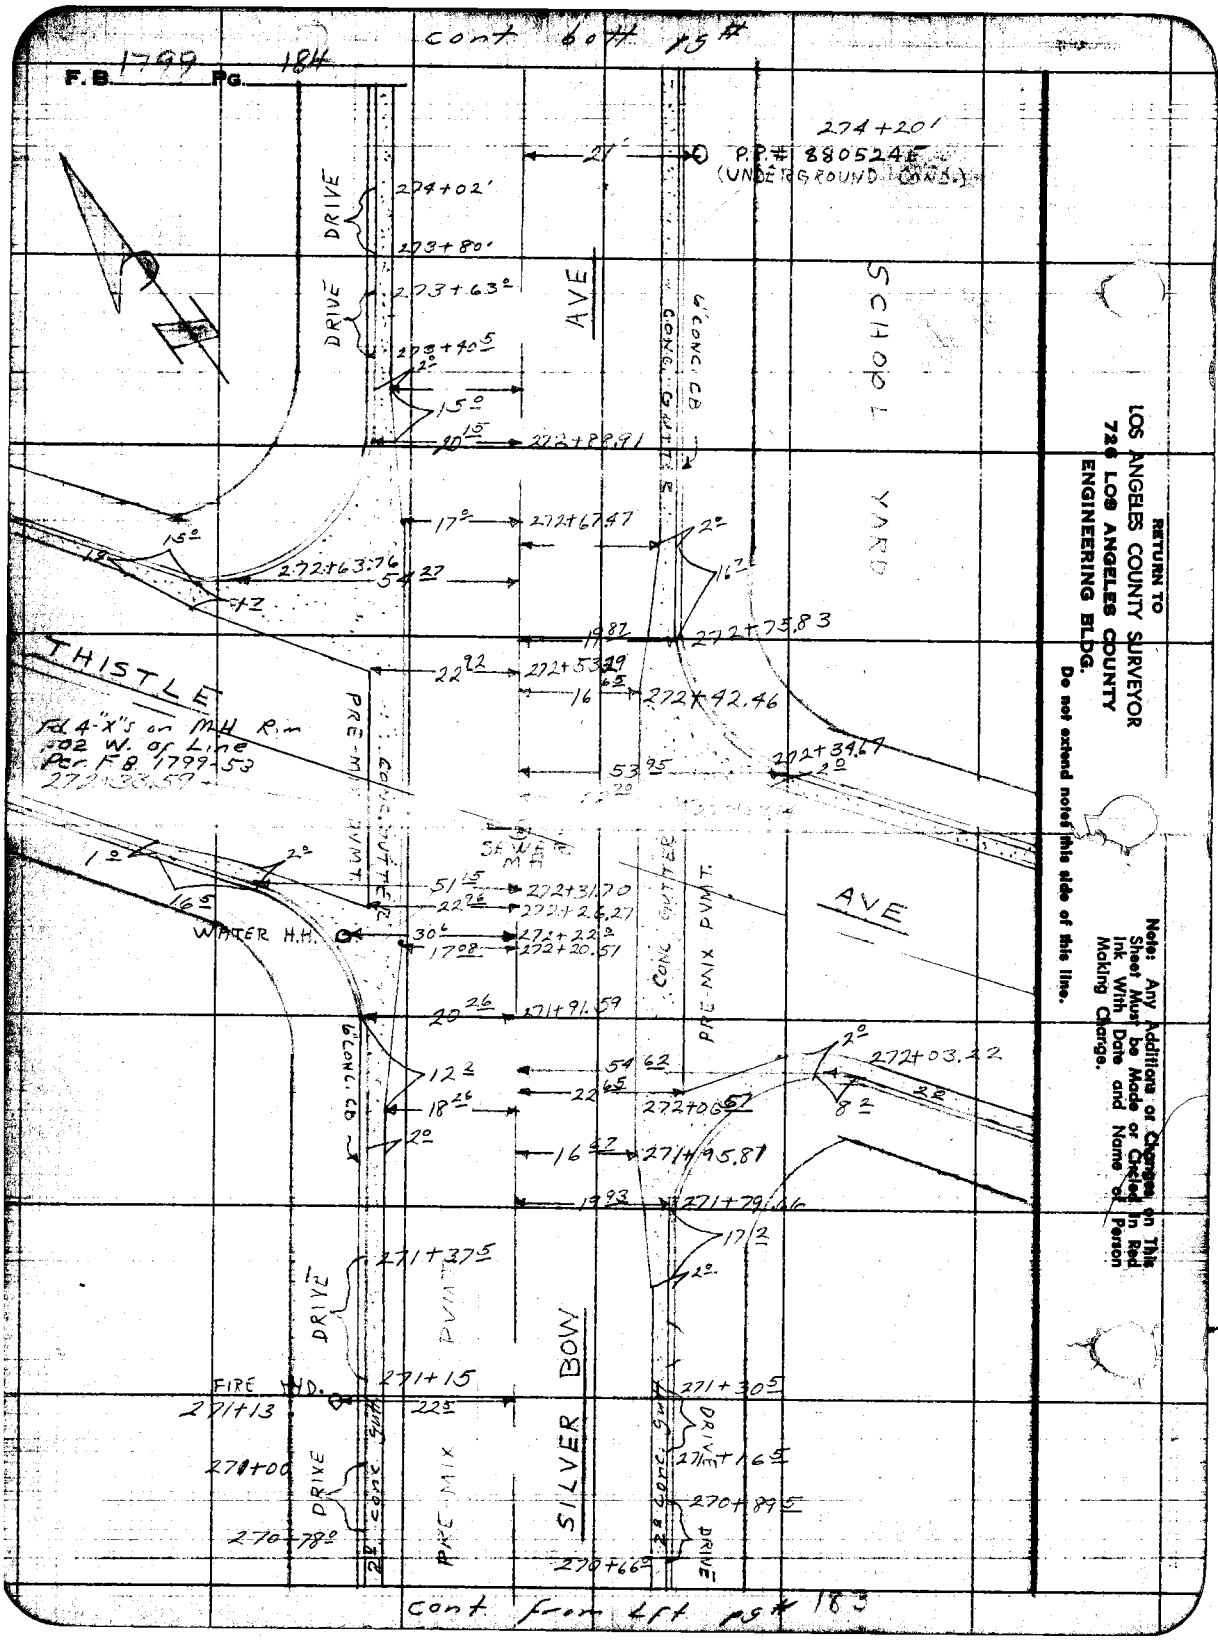

RETURN TO
LOS ANGELES COUNTY SURVEYOR
726 LOS ANGELES COUNTY
ENGINEERING BLDG.
Do not extend notes this side of this line.

Note: Any Additions or Changes on This Sheet Must be Made or Circled in Red Ink With Date and Name of Person Making Change.

Notes Ck'd by	Survey of ARTESIA-NORWALK	F.B. 1799 PG. 185
Map No.	W. O. Tape No. St'd. °F	cont Bott pg 186
Office Work	Surveyed by ENGLISH	
Checked	Notes PETERSON Date 12-53	
Date	Indexed [illegible]	

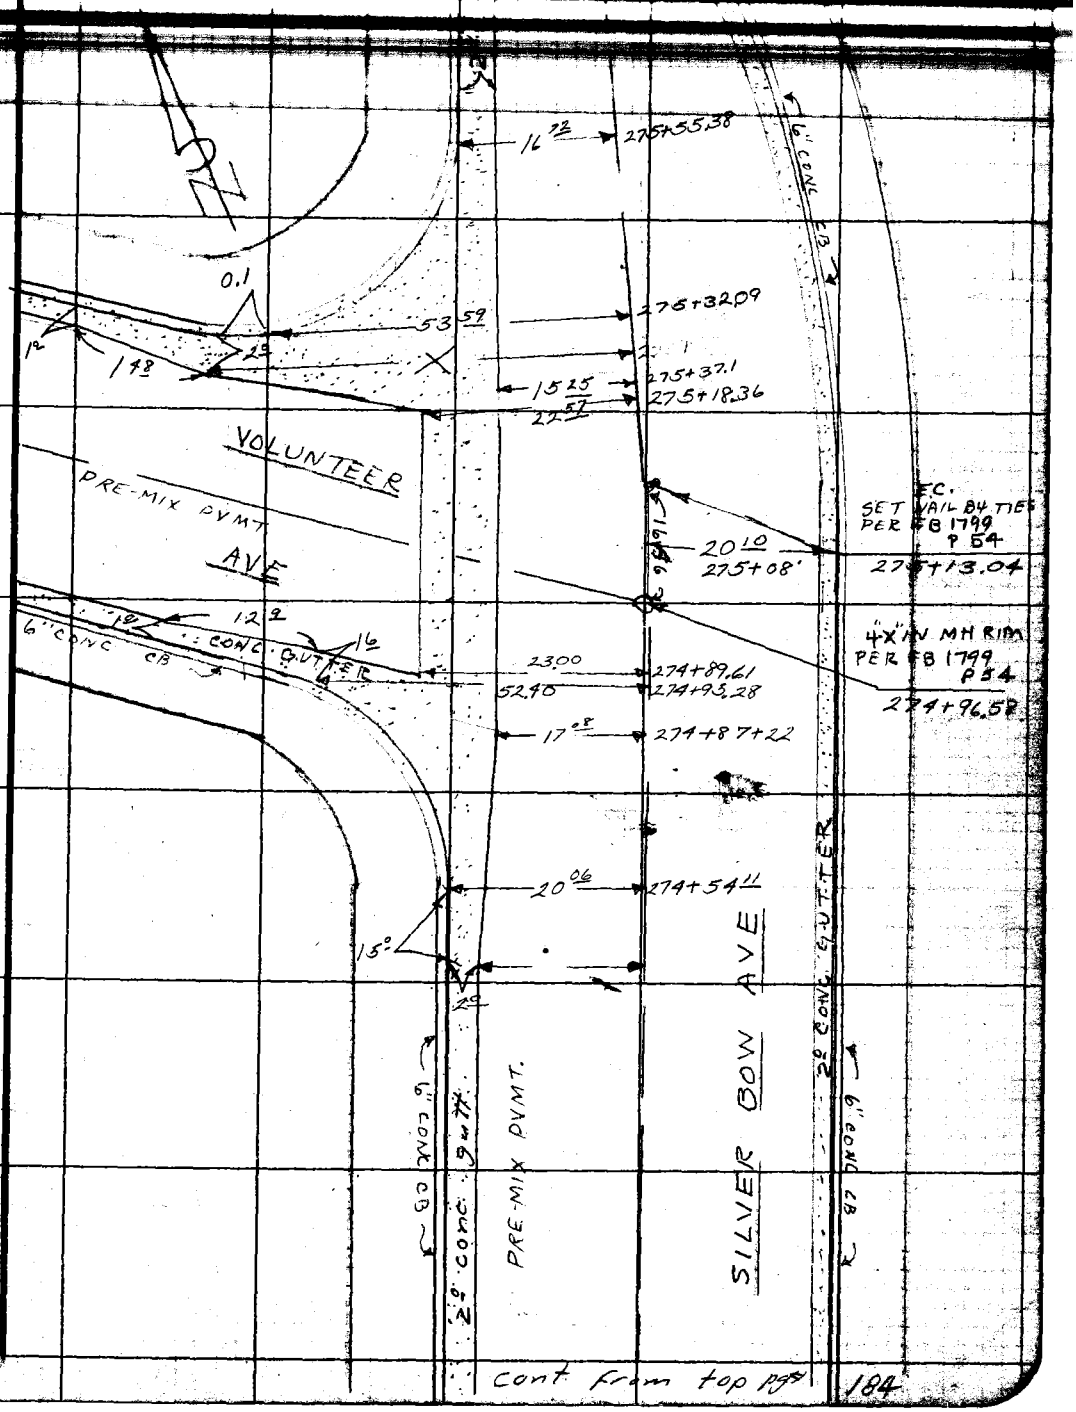

Note: Any Additions or Changes on This Sheet Must be Made or Circled in Red Ink With Date and Name of Person Making Change.

Do not extend notes this side of this line.

RETURN TO
LOS ANGELES COUNTY SURVEYOR
726 LOS ANGELES COUNTY
ENGINEERING BLDG.

76F3098 247 4-53

cont from top pg 184

F.B. 1799 PG. 186

Cont RT pg # 187

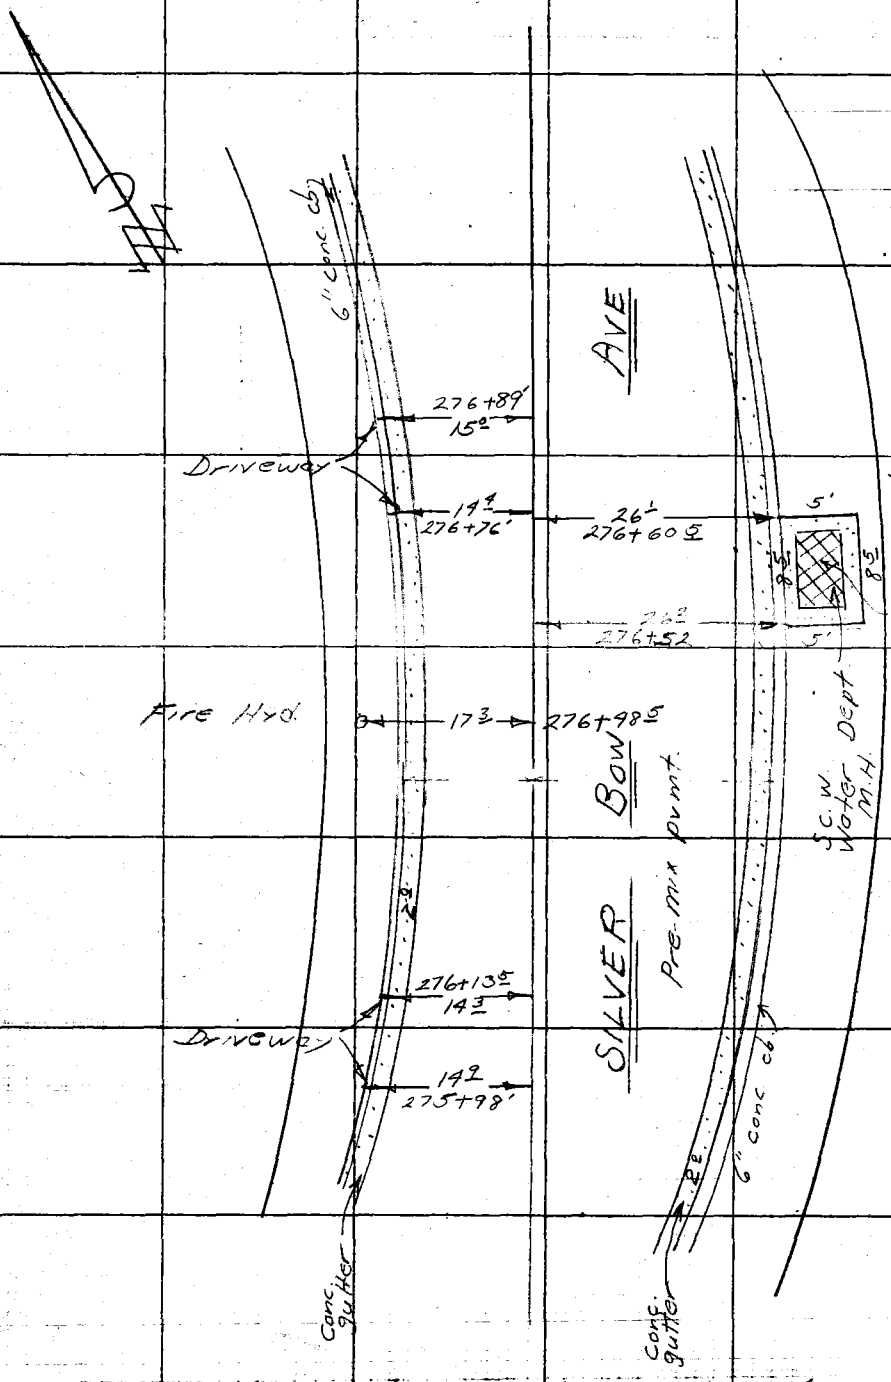

Cont from top. pg # 185

RETURN TO
LOS ANGELES COUNTY SURVEYOR
726 LOS ANGELES COUNTY
ENGINEERING BLDG.
Do not extend notes this side of this line.

Notes: Any Additions or Changes on This Sheet Must be Made or Circled in Red Ink With Date and Name of Person Making Change.

76F9095 247 4-53

RETURN TO
LOS ANGELES COUNTY SURVEYOR
726 LOS ANGELES COUNTY
ENGINEERING BLDG.

Note: Any Additions or Changes on This Sheet Must be Made or Circled In Red Ink With Date and Name of Person Making Change.

Do not extend notes this side of this line.

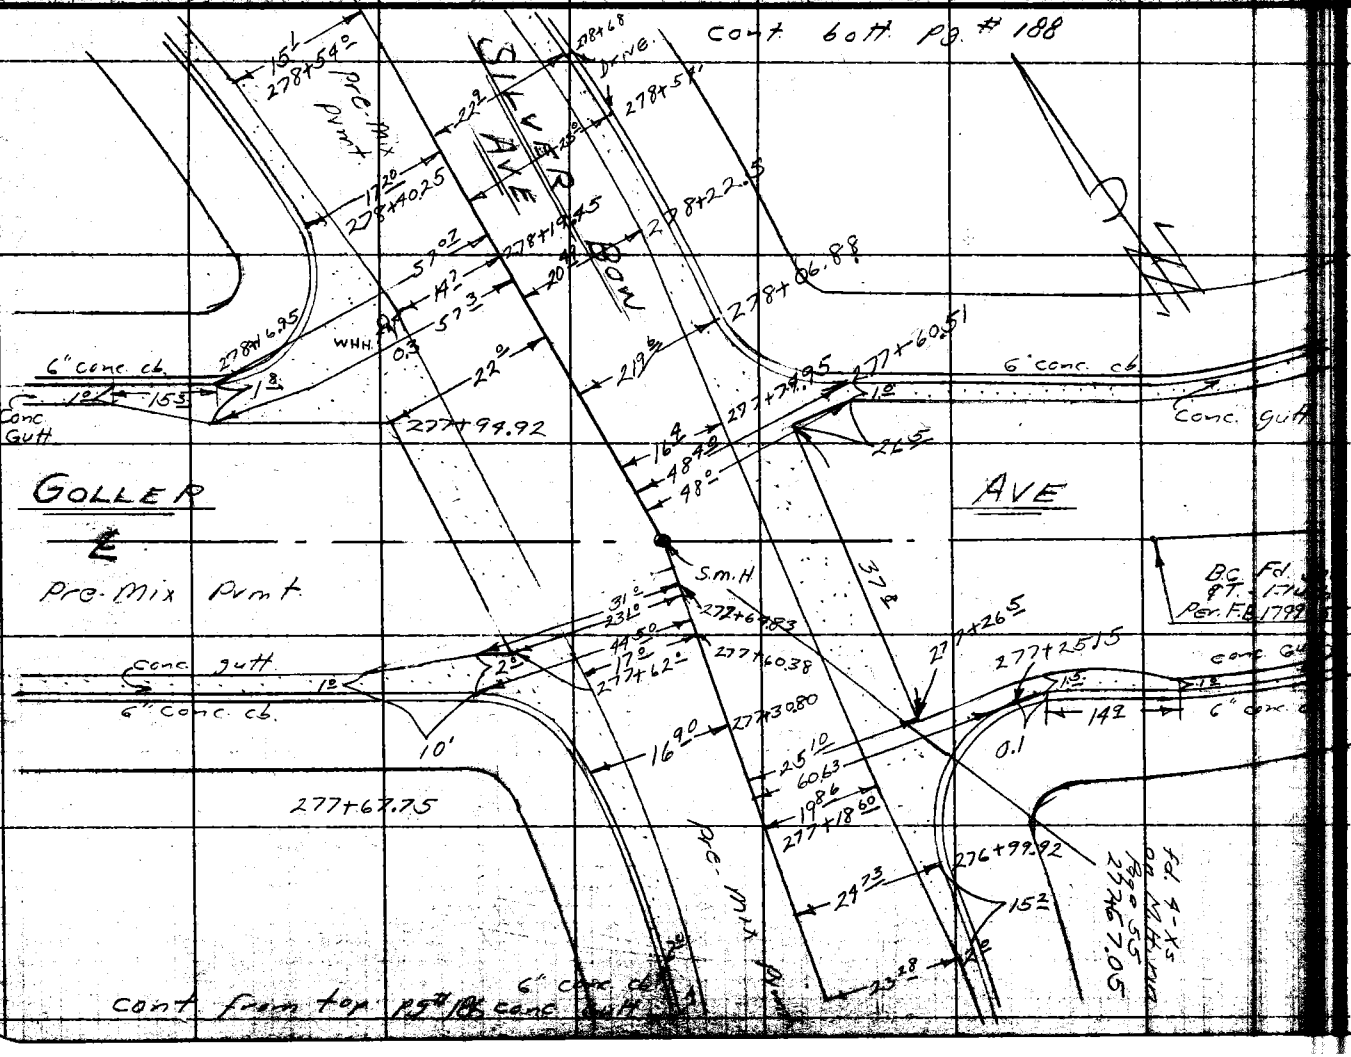

Notes Ck'd by
Map No.
Office Work
Checked
Date

Survey of Pr. Terr. - Nocturne
W. O. 6957 Tape No. Std. °F
Surveyed by English
Notes Sappell Date 11-5-53
Indexed

F.B. 1799 Pg. 187

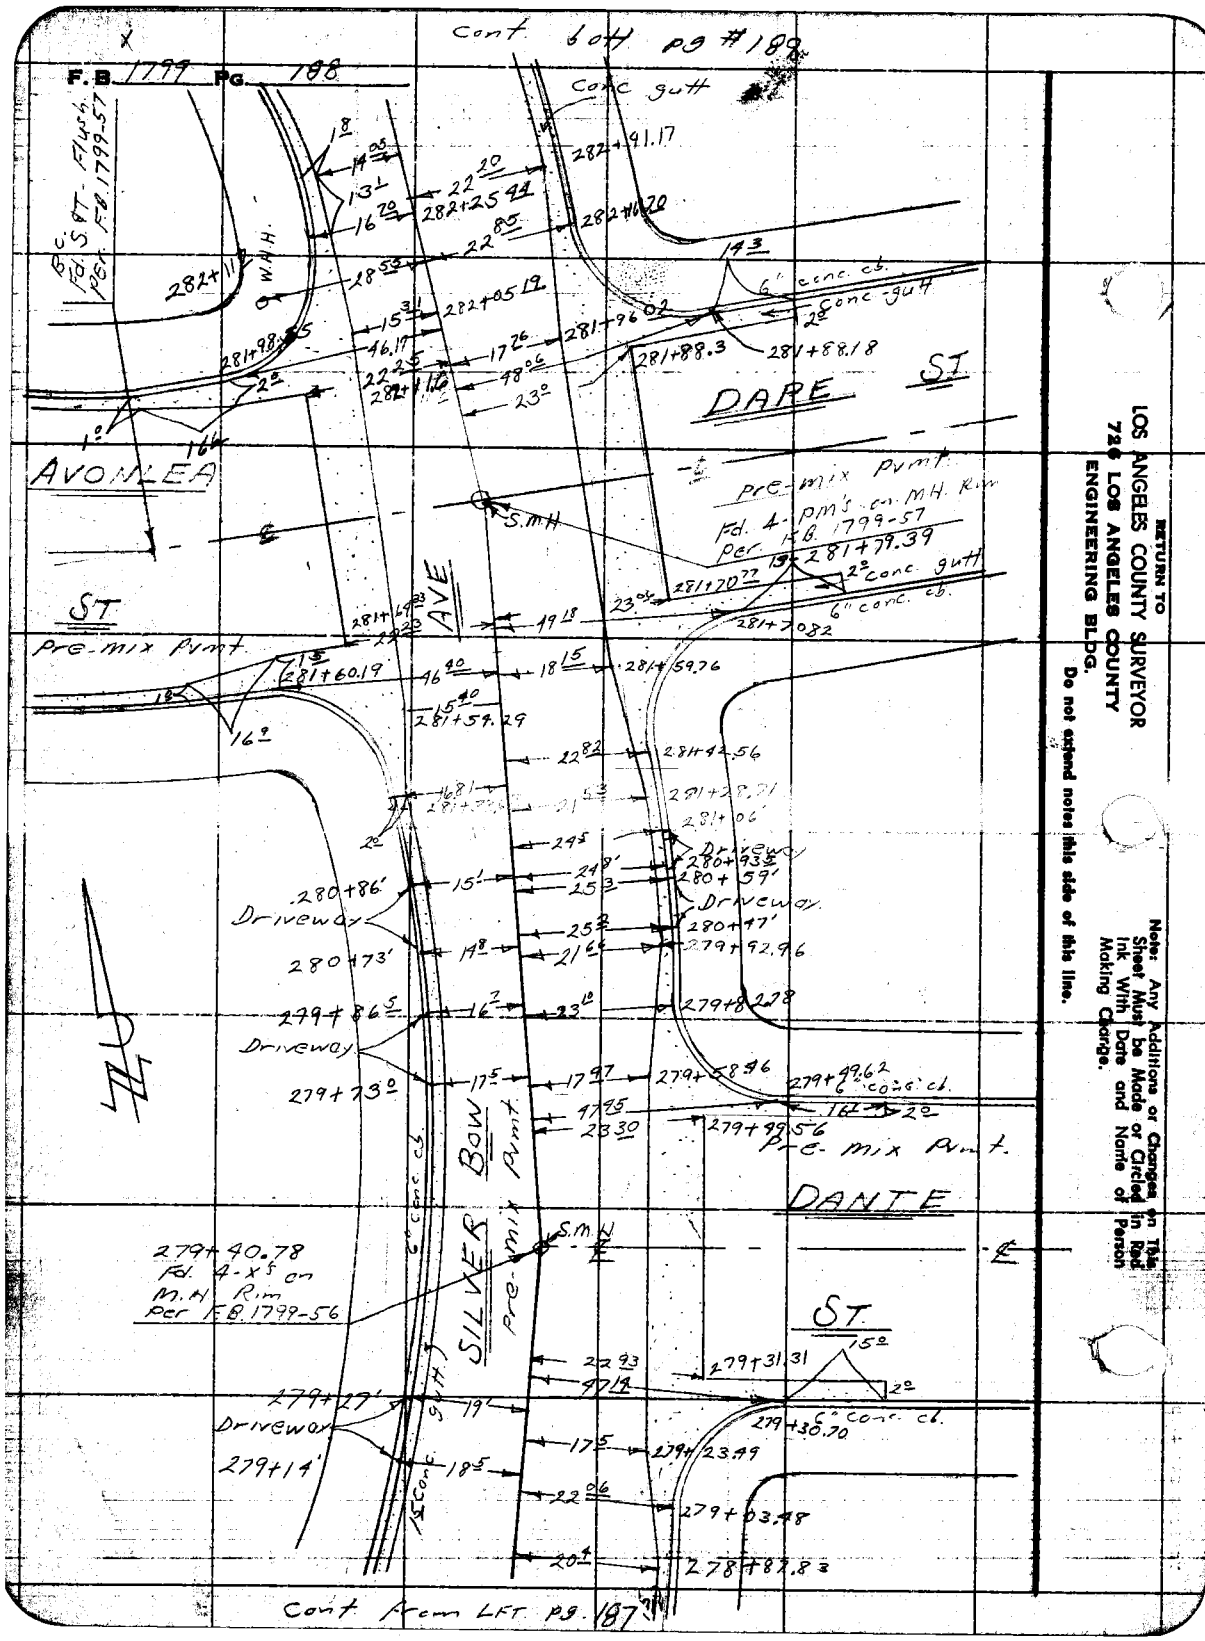

RETURN TO
LOS ANGELES COUNTY SURVEYOR
726 LOS ANGELES COUNTY
ENGINEERING BLDG.

Do not extend notes this side of this line.

Note: Any Additions or Changes on This Sheet Must be Made or Circled in Red Ink With Date and Name of Person Making Change.

Notes Ck'd by	Survey of Artesia - Norwalk	F.B. 1799 Pg. 189
Map No.	W. O. 2851 Tape No. St'd. °F	
Office Work	Surveyed by English	
Checked	Notes Sappell Date 12-53	
Date	Indexed	

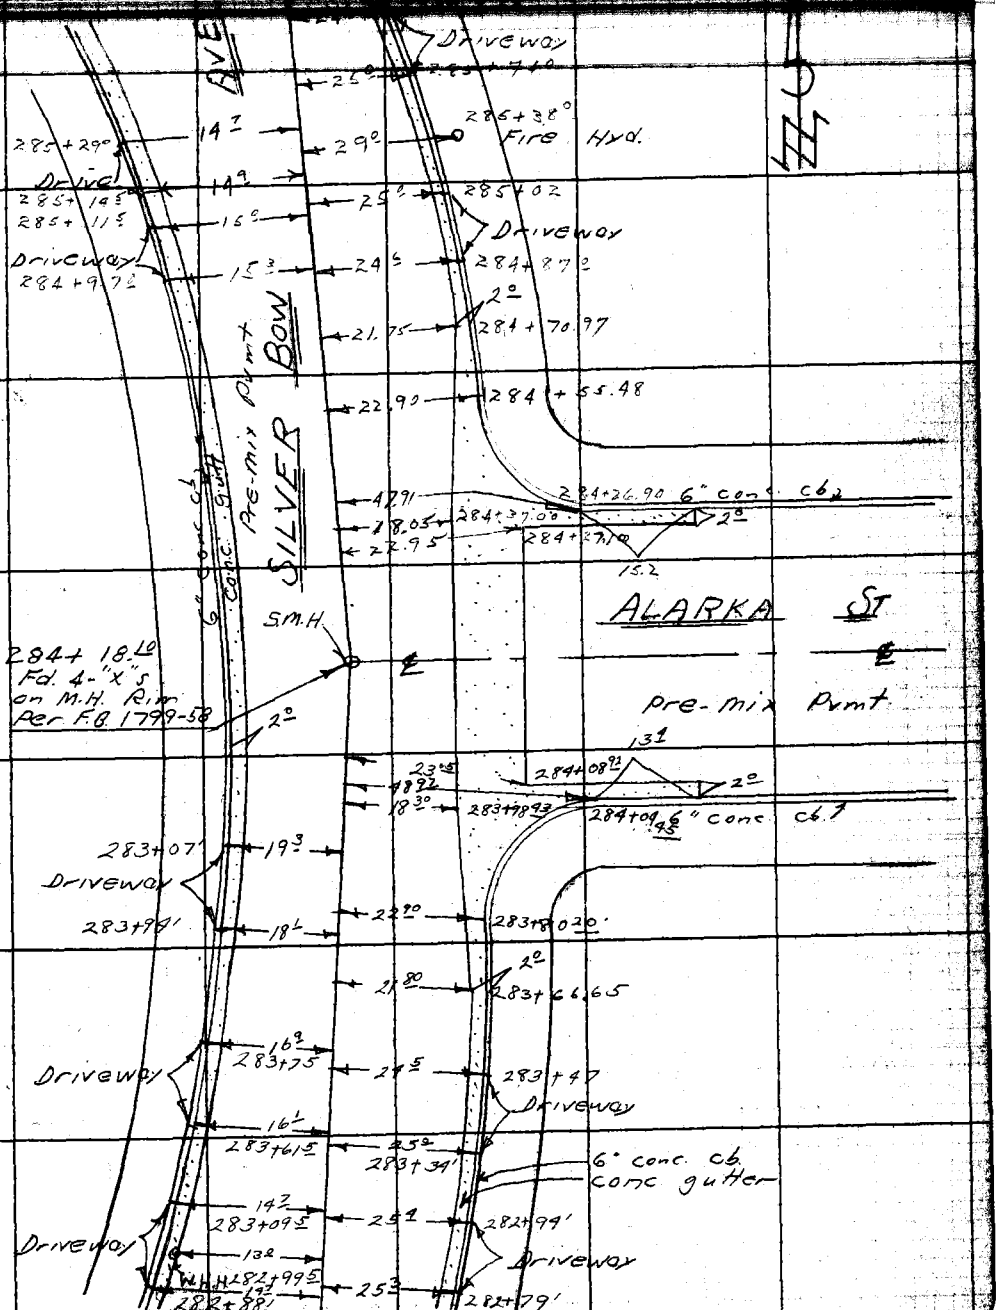

cont. from top pg# 188

Note: Any Additions or Changes on This Sheet Must be Made or Circled in Red Ink With Date and Name of Person Making Change.

Do not extend notes this side of this line.

RETURN TO
LOS ANGELES COUNTY SURVEYOR
726 LOS ANGELES COUNTY
ENGINEERING BLDG.

76F3098 247 4-53

F.B. 1799 PG. 190

Cont. both pg # 191

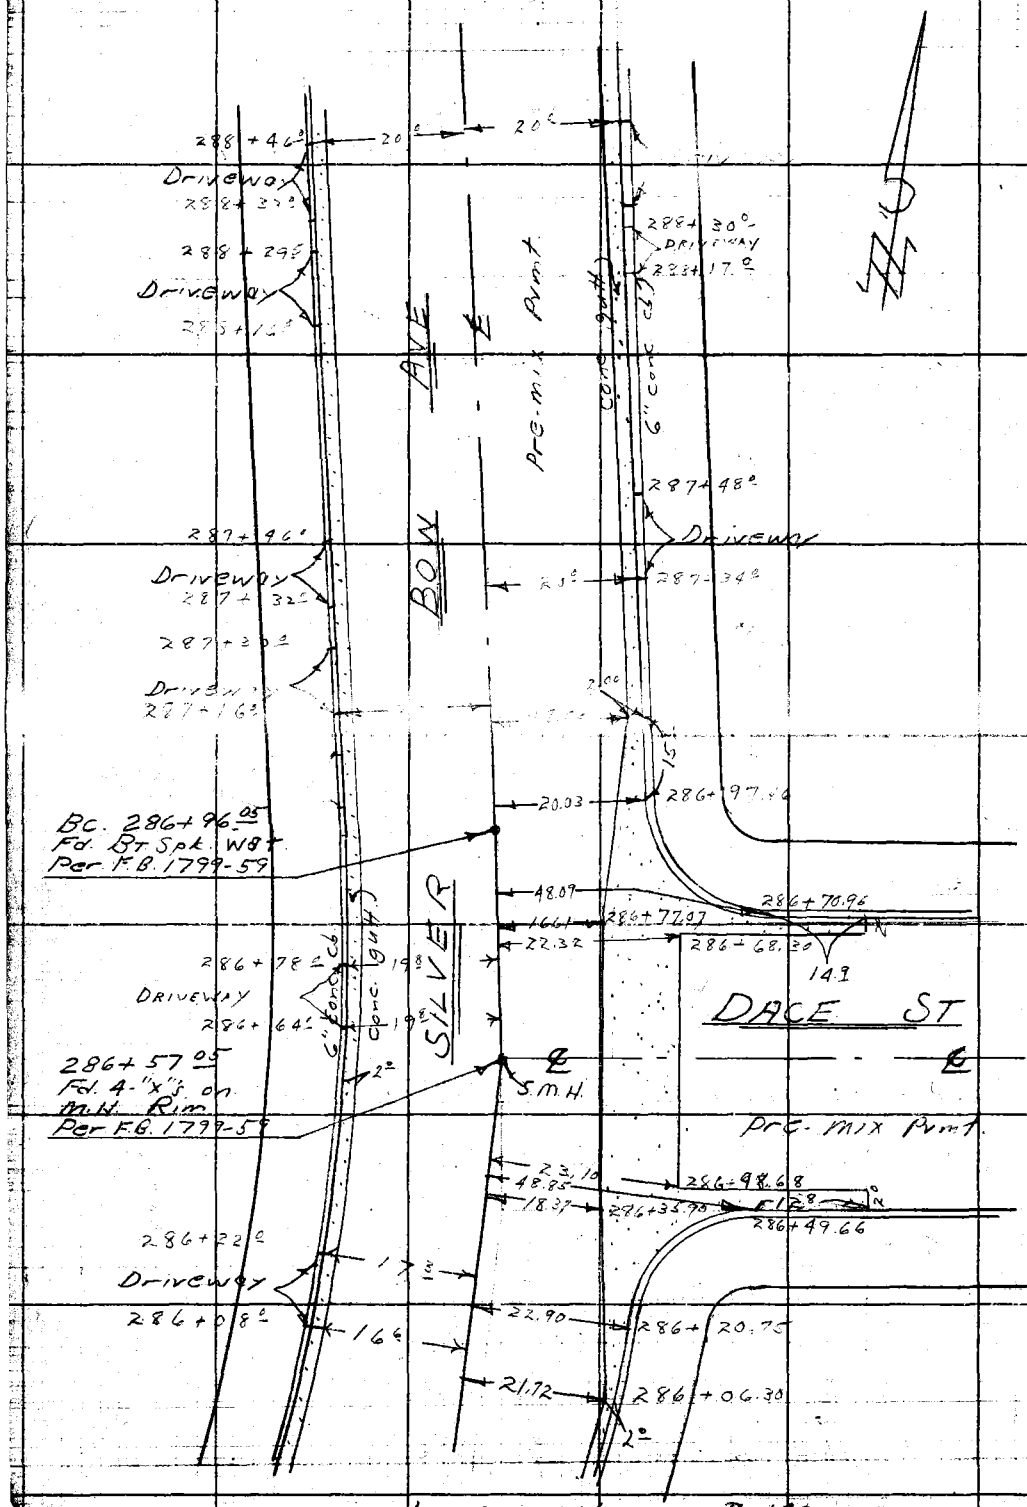

RETURN TO
LOS ANGELES COUNTY SURVEYOR
726 LOS ANGELES COUNTY
ENGINEERING BLDG.
Do not extend notes this side of this line.

Note: Any Additions or Changes on This Sheet Must be Made or Circled in Red Ink With Date and Name of Person Making Change.

Cont. from top pg # 189

Notes Ck'd by
Map No.
Office Work
Checked
Date

Survey of Artesia - Norwalk
W. O. 6951 Tape No. St'd. °F
Surveyed by English
Notes Sappell Date 12-53
Indexed

F. B. 1799 Pg. 191

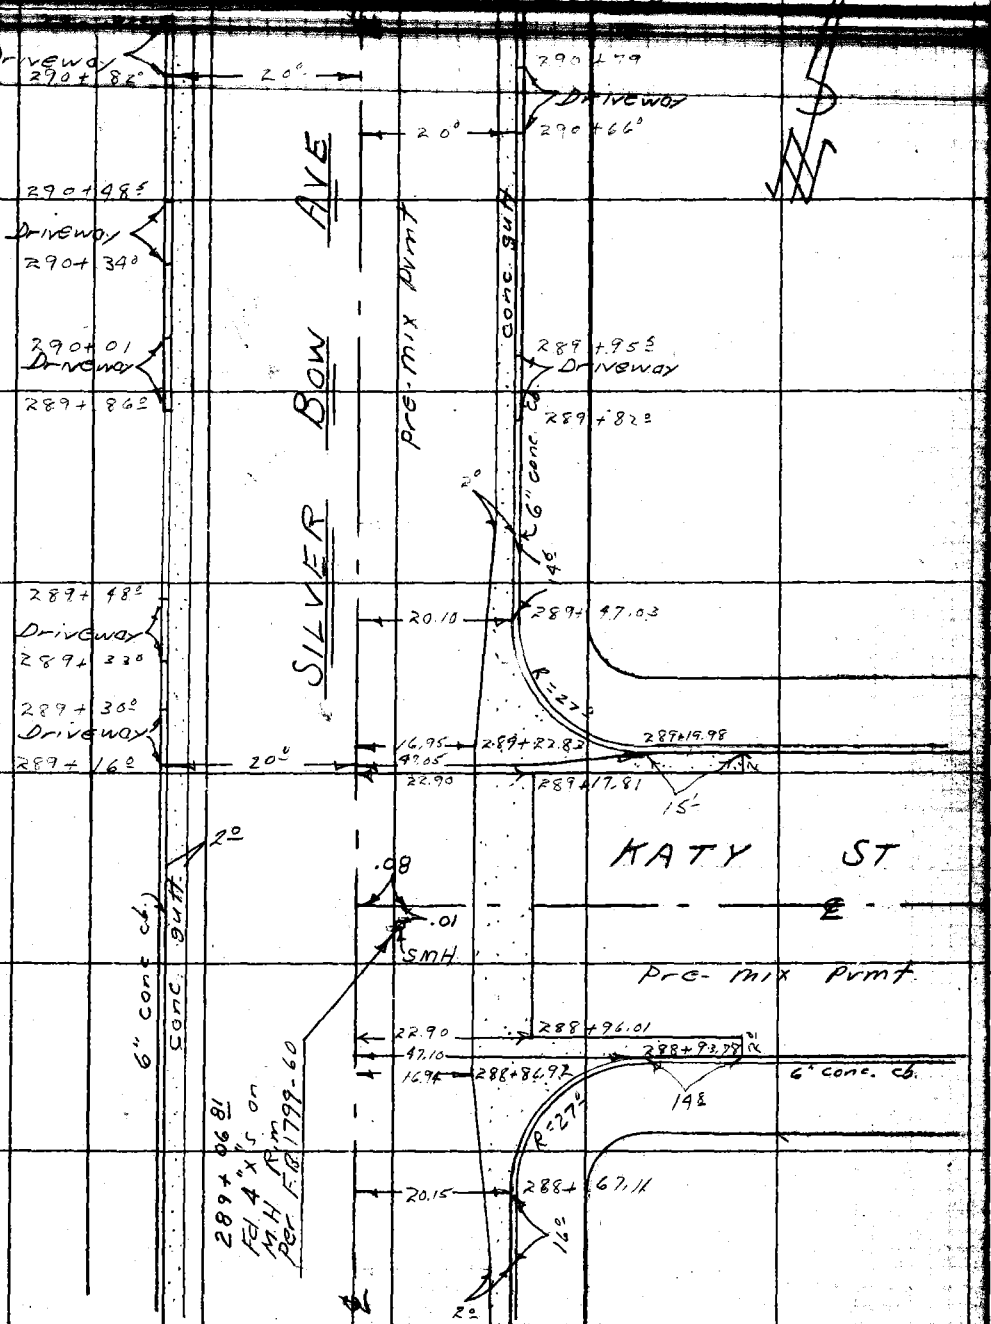

Notes: Any Additions or Changes on This Sheet Must be Made or Circled in Red Ink With Date and Name of Person Making Change.

Do not extend notes this side of this line.

RETURN TO
LOS ANGELES COUNTY SURVEYOR
726 LOS ANGELES COUNTY
ENGINEERING BLDG.

76F3098 247 4-53

cont from top pg # 190

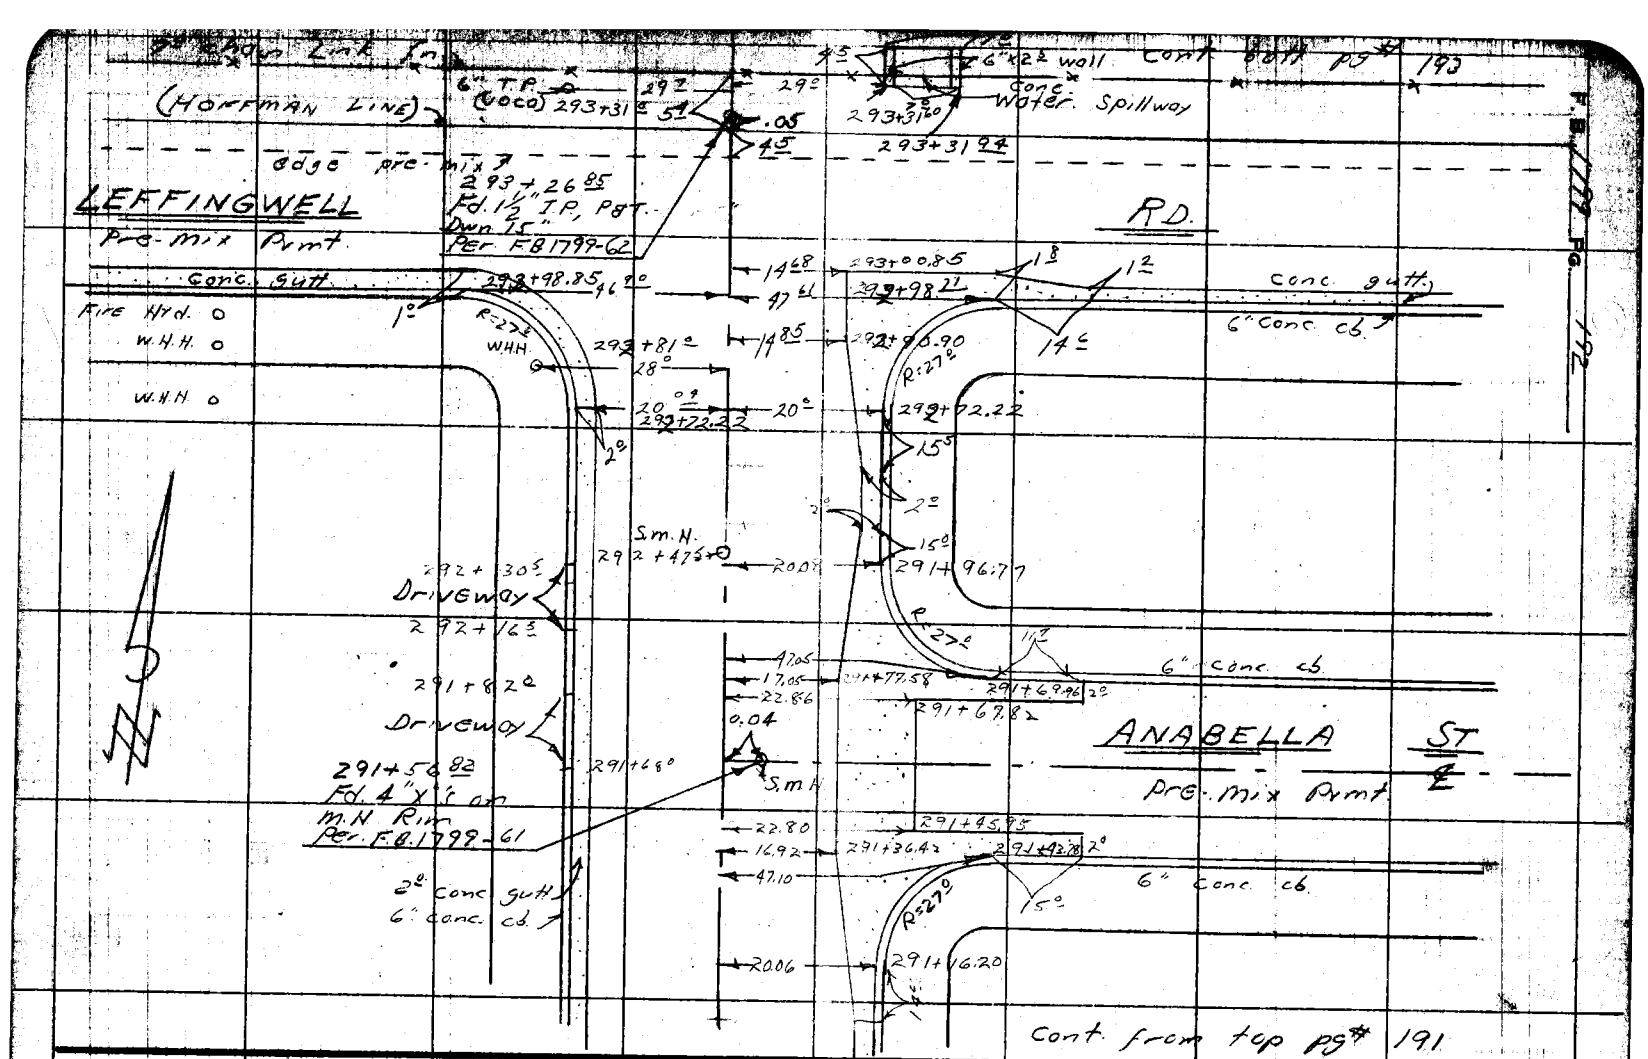

RETURN TO
LOS ANGELES COUNTY SURVEYOR
726 LOS ANGELES COUNTY
ENGINEERING BLDG.

Note: Any Additions or Changes on This Sheet Must be Made or Circled in Red Ink With Date and Name of Person Making Change.

Do not extend notes this side of this line.

Notes Ck'd by	Survey of Artesia - Norwalk	F. B. 1799 Pg. 193
Map No.	W. O. 6951 Tape No. St'd. °F	
Office Work	Surveyed by English	
Checked	Notes Sanvell Date 12-53	
Date	Indexed	

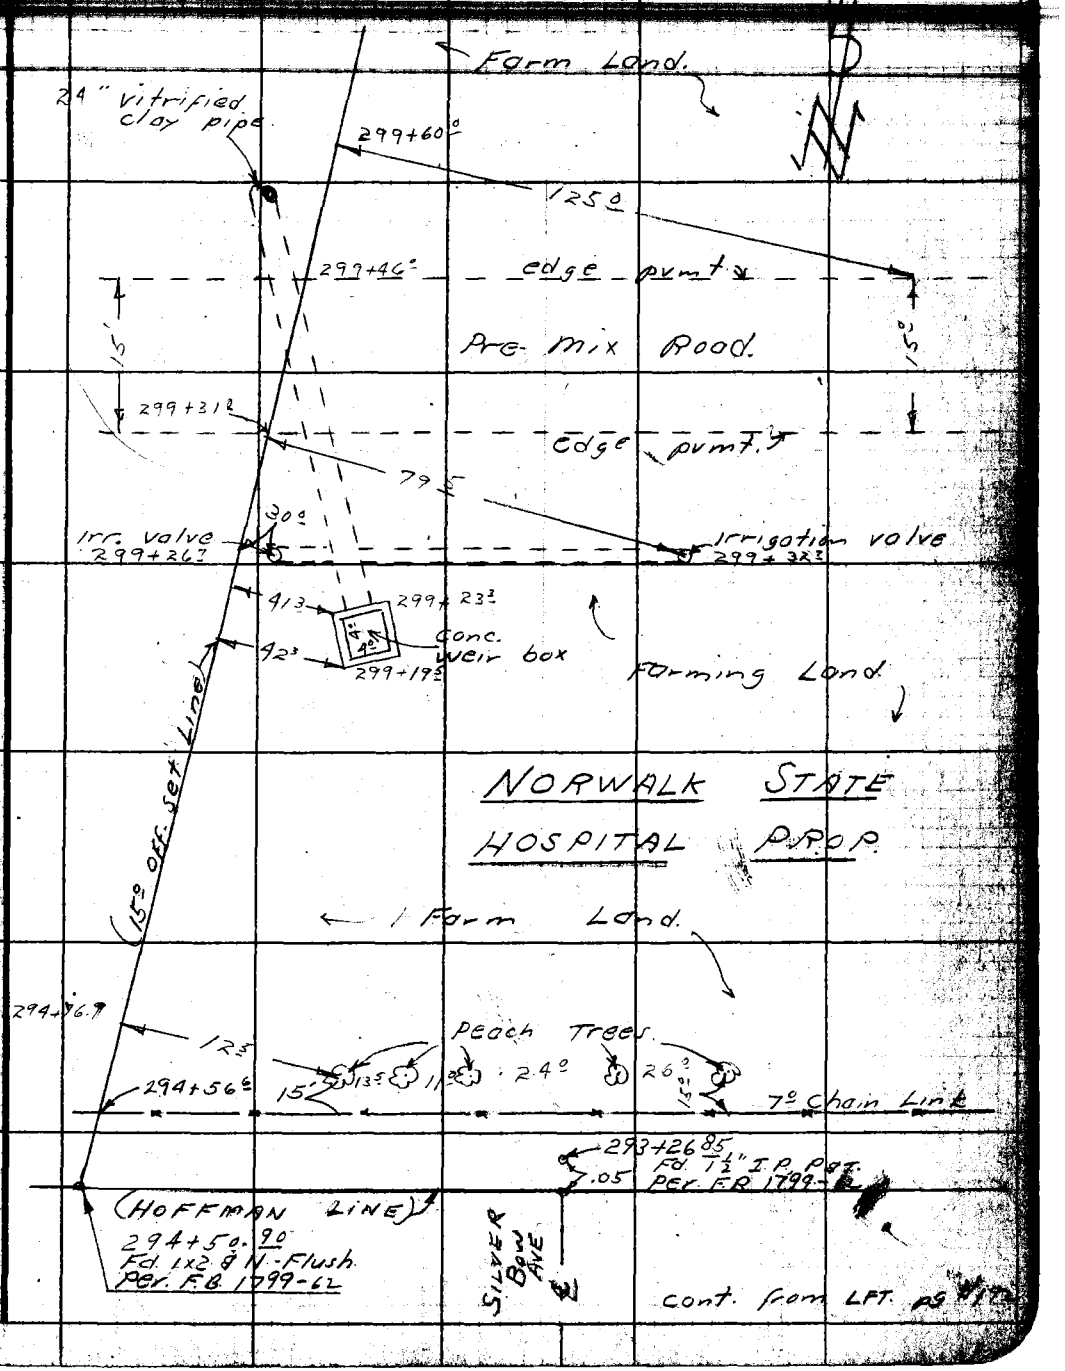

Note: Any Additions or Changes on This Sheet Must be Made or Circled in Red Ink With Date and Name of Person Making Change.

Do not extend notes this side of this line.

RETURN TO
LOS ANGELES COUNTY SURVEYOR
726 LOS ANGELES COUNTY
ENGINEERING BLDG.

76F3098 247 4-53

F.B. 1799 PG. 194

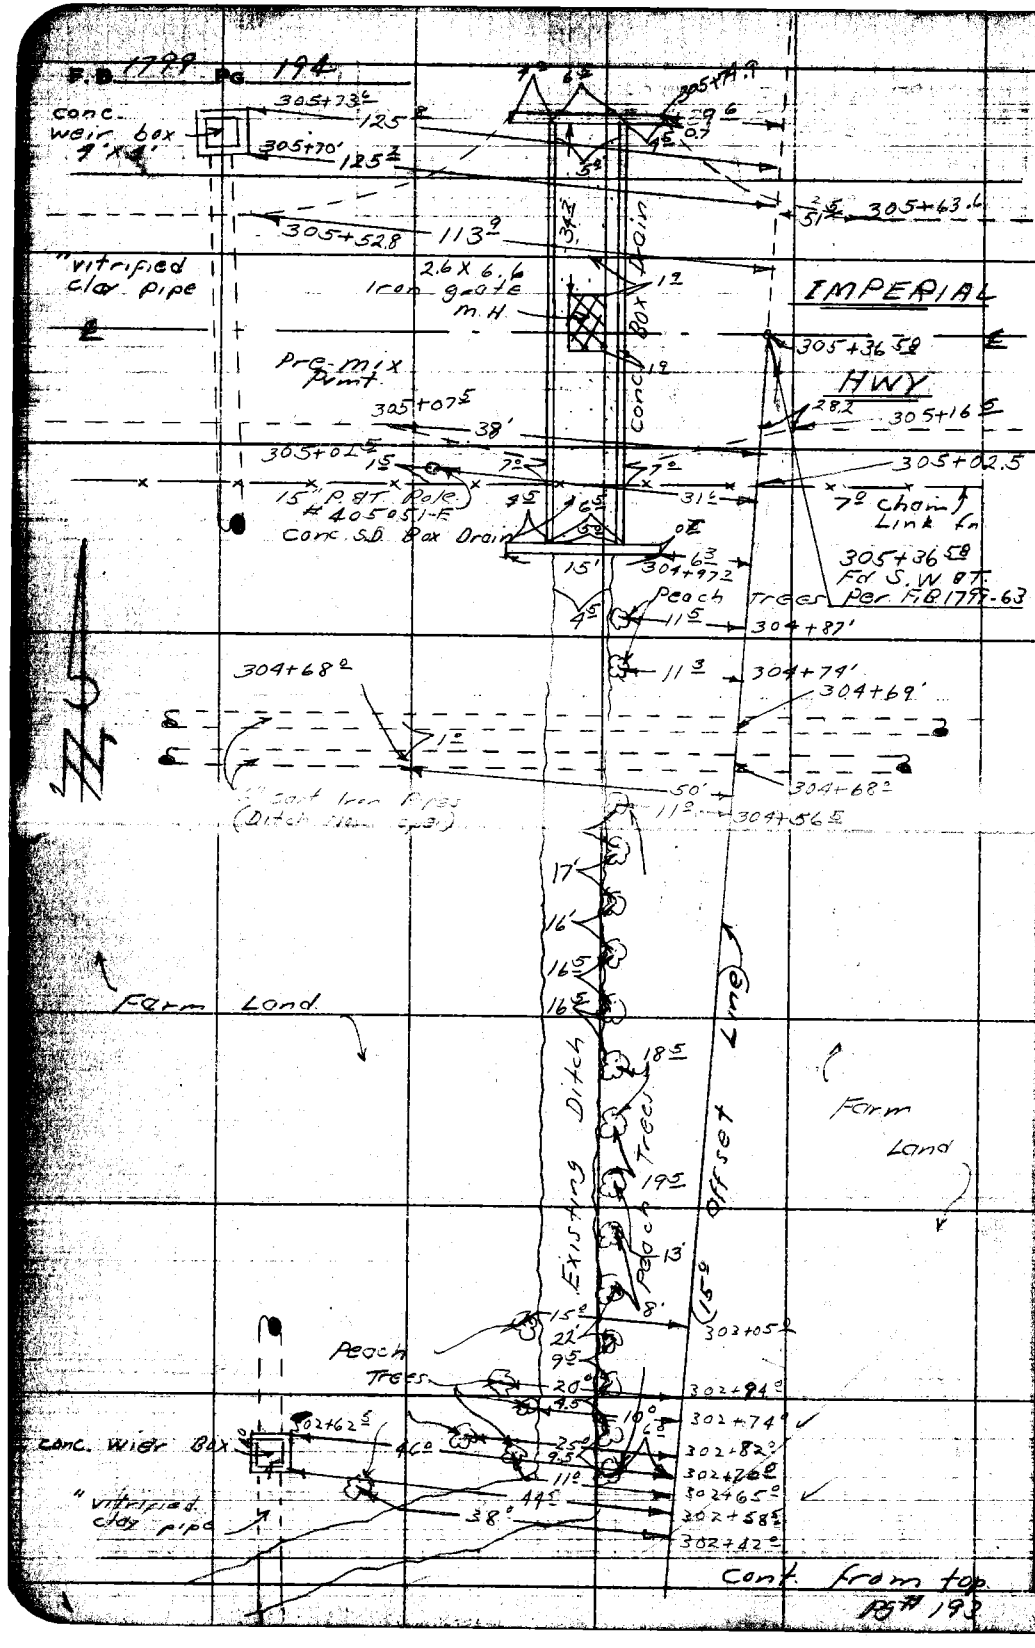

RETURN TO
LOS ANGELES COUNTY SURVEYOR
726 LOS ANGELES COUNTY
ENGINEERING BLDG.

Do not extend notes this side of this line.

Note: Any Additions or Changes on This Sheet Must be Made or Credit in Red Ink With Date and Name of Person Making Change.

76F3095 S&E #247 1-56

PLEASE RETURN TO
LOS ANGELES COUNTY ENGINEER
700 LOS ANGELES COUNTY ENGINEERING BLDG.

Note: Any Additions or Changes on This Sheet Must be Made or Circled in Red Ink With Date and Name of Person Making Change.

Do not extend this side of this line.

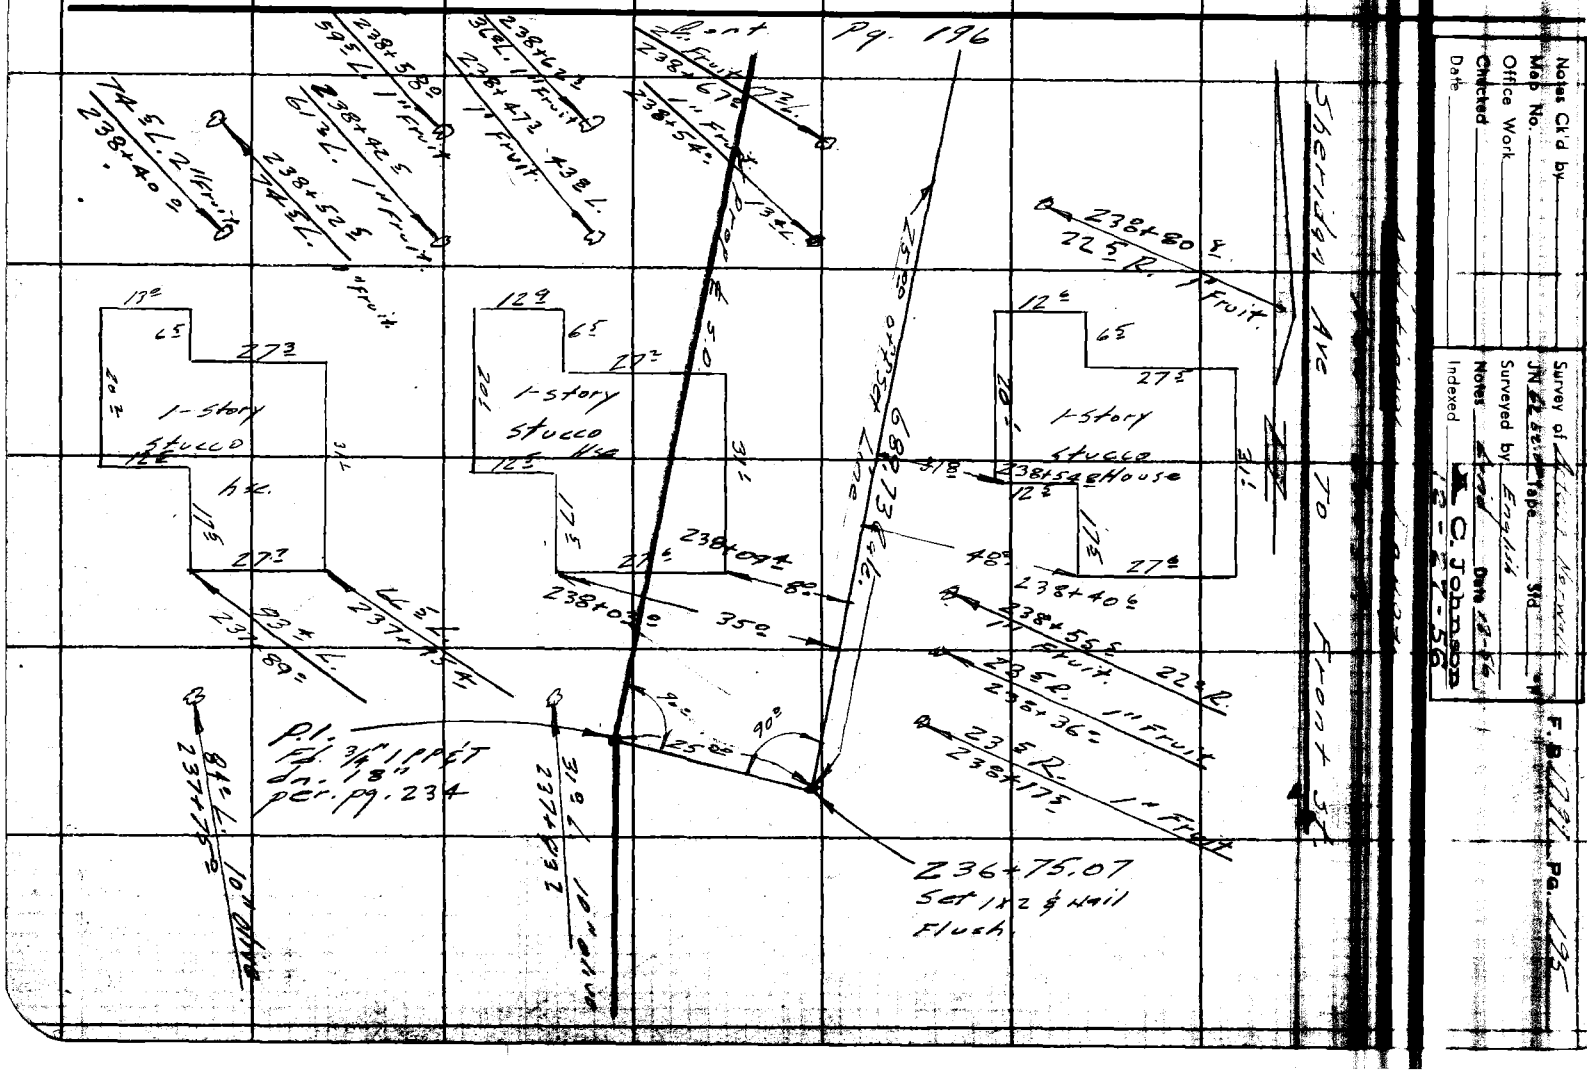

F. B. 2799 PG. 196

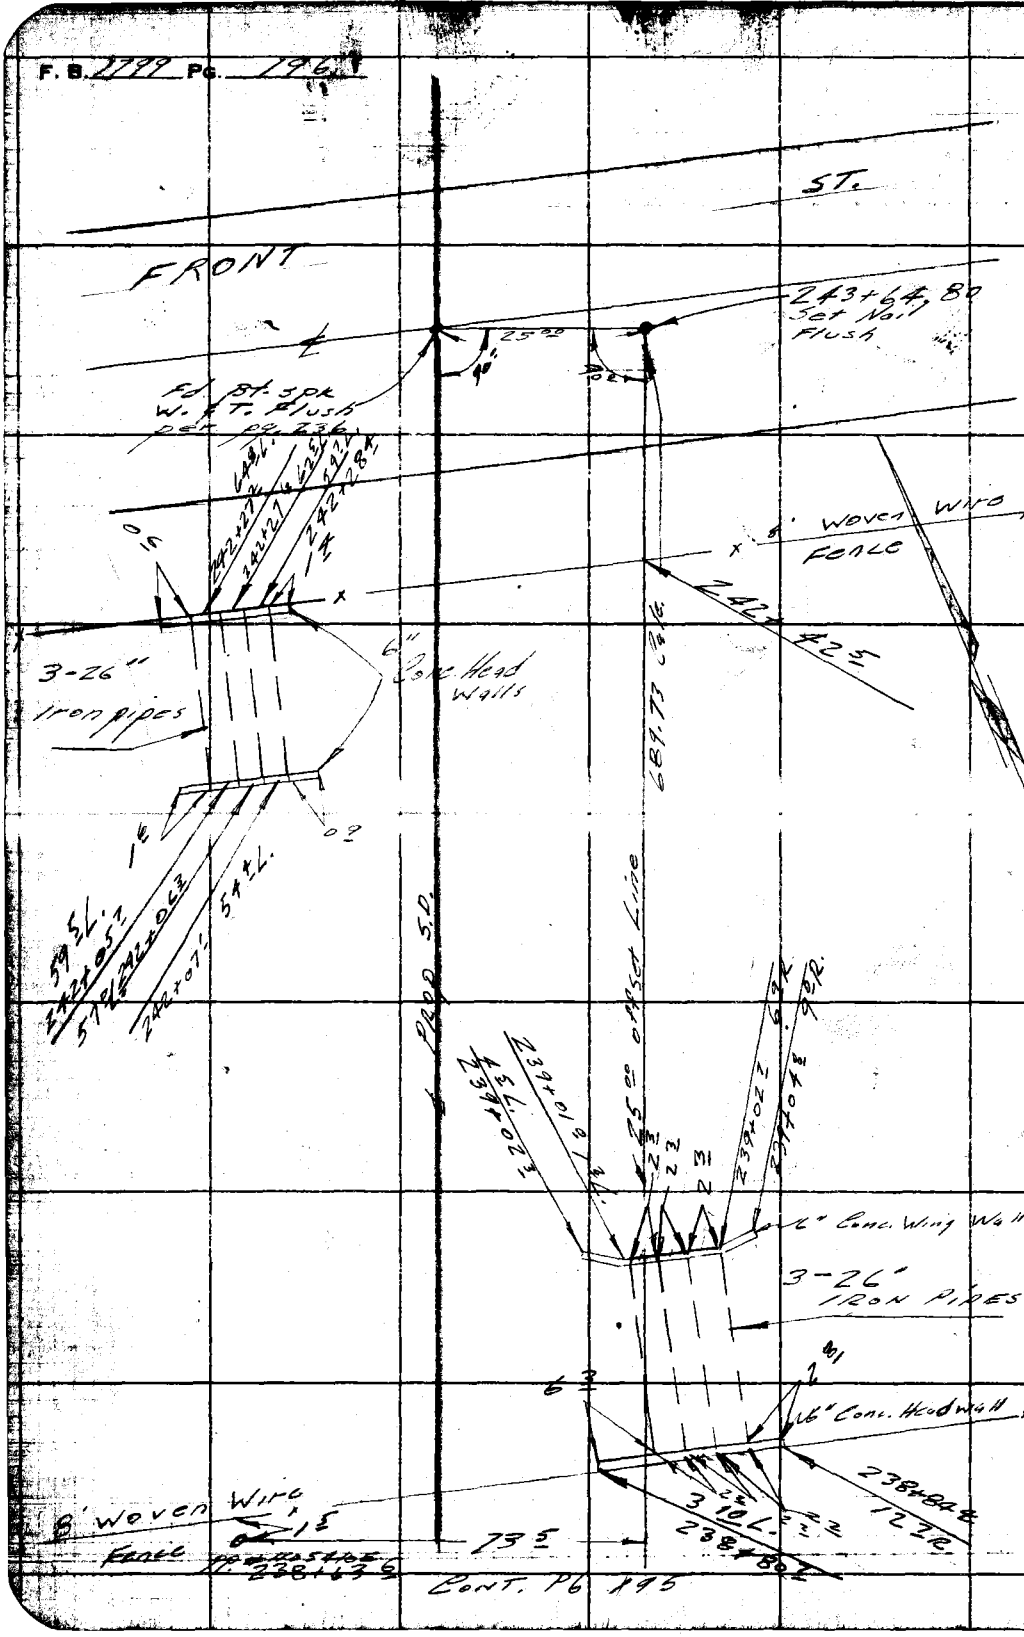

PLEASE RETURN TO
LOS ANGELES COUNTY ENGINEER
700 Los Angeles County Engineering Bldg.
Do not extend this side of this line.

Note: Any Additions or Changes on this Sheet Must be Made or Circled in Red Ink With Date and Name of Person Making Change.

PWFB 0527 67

Notes Ck'd by Ajo	Survey of Artesia-Norwalk
Map No.	W. O. 6951 Tape No. St'd. °F
Office Work	Surveyed by English
Checked	Notes " Date 12-53
Date	Indexed R. C. Johnson

F. B. 1799 Pg. 200

ARTESIA-NORWALK

J.N. 6951
6202.00

CENTERLINE OF
PROPOSED STORM
DRAIN

PROJECT No. 21.
DIVISION No. 1
LINE A

See pg 67 for index map.

December 1953
English
Sappe[illegible]
Peters
Lind

LINE CHANGE
JUNE '58
See F.B. 2143/75

Note: Any Additions or Changes on This Sheet Must be Made or Circled in Red Ink With Date and Name of Person Making Change.

Do not extend notes this side of this line.

RETURN TO
LOS ANGELES COUNTY SURVEYOR
726 LOS ANGELES COUNTY
ENGINEERING BLDG.

76F3098 247 4-53

Con't. pg. 207

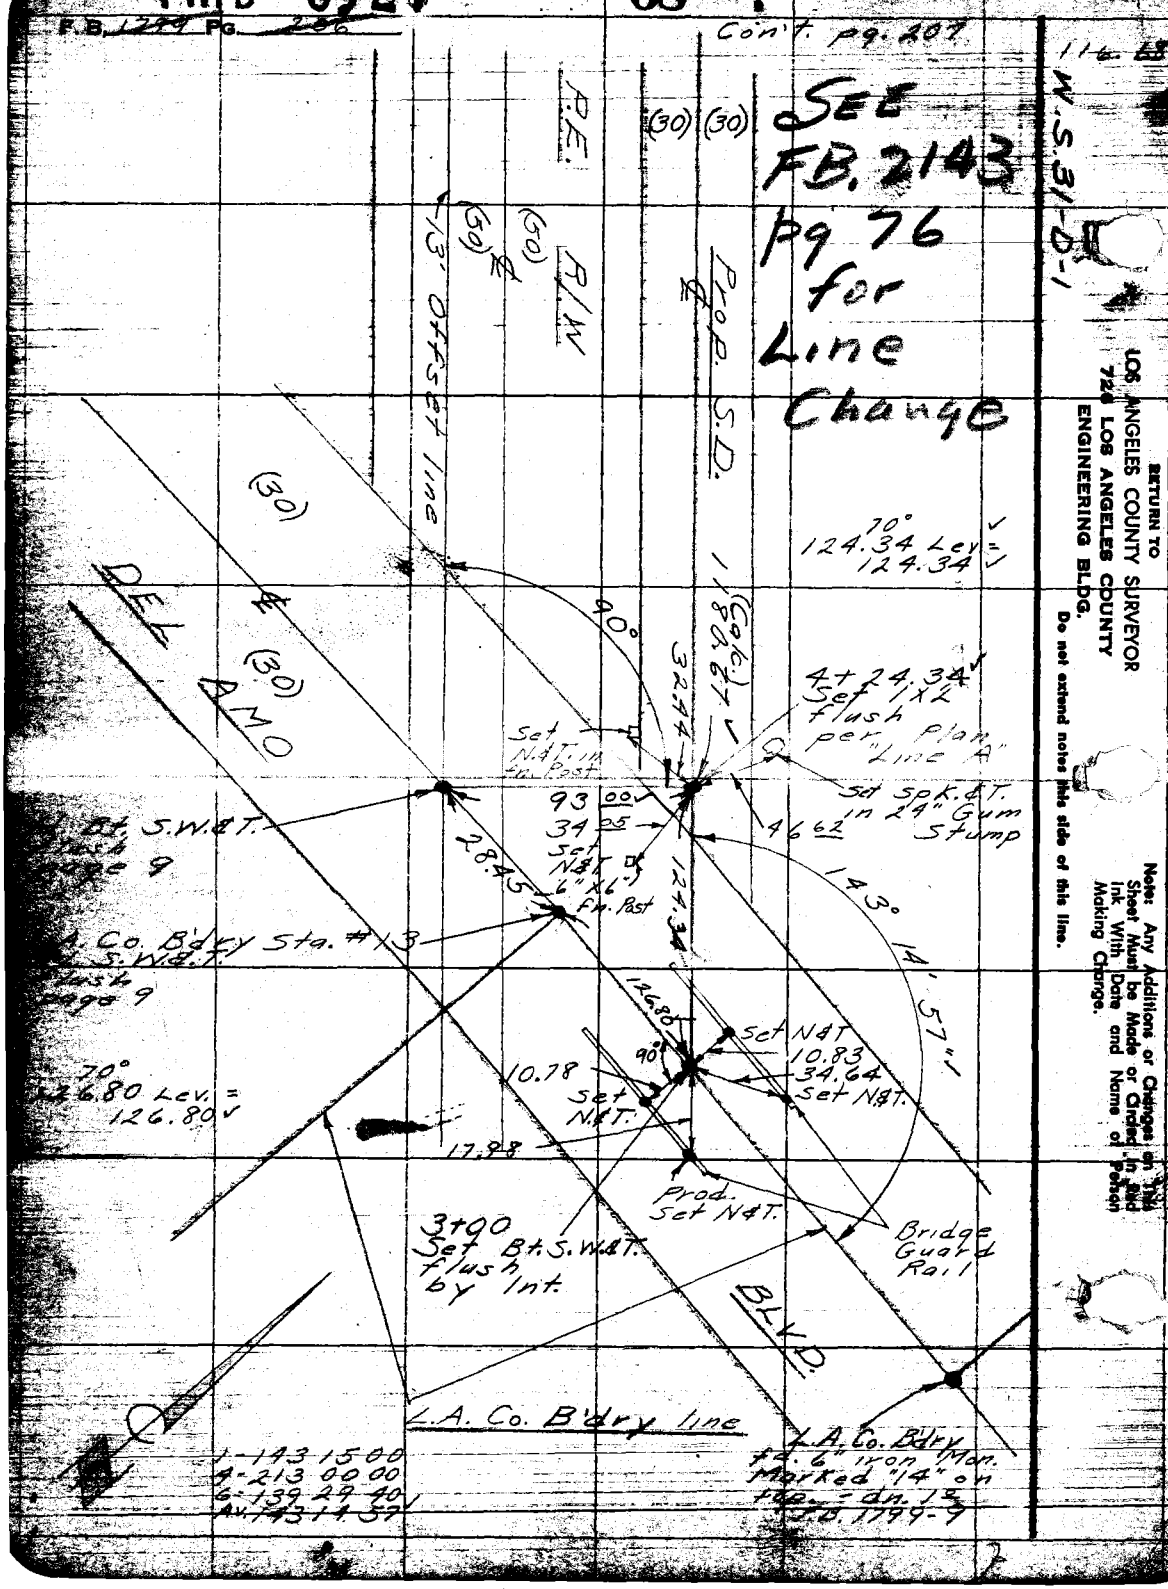

RETURN TO
LOS ANGELES COUNTY SURVEYOR
724 LOS ANGELES COUNTY
ENGINEERING BLDG.
Do not extend notes this side of this line.

Note: Any Additions or Changes on This Sheet Must be Made or Checked in Red Ink. With Date and Name of Person Making Change.

PWFB 0526 1023, 1024

Notes Ck'd by Ap	Survey of Artesia-Norwalk	F.B. 1249 Pg. 207
Map No.	W. O. 6951 Tape No. Sr'd.	
Office Work	Surveyed by English	
Checked	Notes " Date 12-33	
Date	Indexed A. C. Johnson	

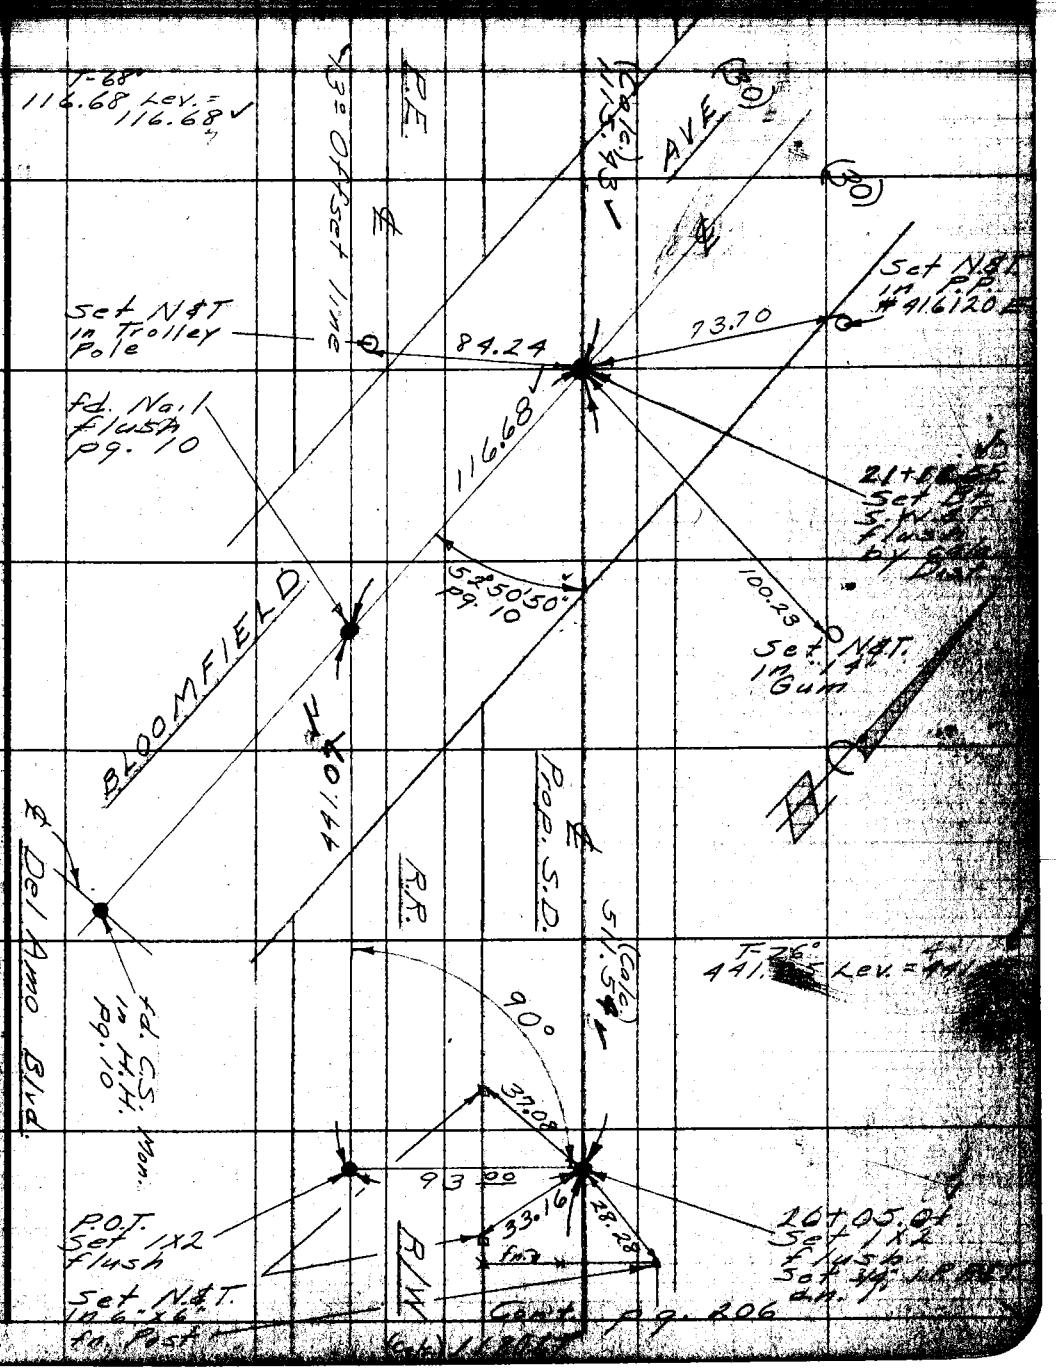

Note: Any Additions or Changes on This Sheet Must be Made or Circled in Red Ink With Date and Name of Person Making Change.

Do not extend notes this side of this line.

RETURN TO
LOS ANGELES COUNTY SURVEYOR
726 LOS ANGELES COUNTY
ENGINEERING BLDG.

RETURN TO
LOS ANGELES COUNTY SURVEYOR
726 LOS ANGELES COUNTY
ENGINEERING BLDG.

Note: Any Additions or Changes on This Sheet Must be Made or Circled in Red Ink With Date and Name of Person Making Change.

Do not extend notes this side of this line.

W.S. 31-D-1

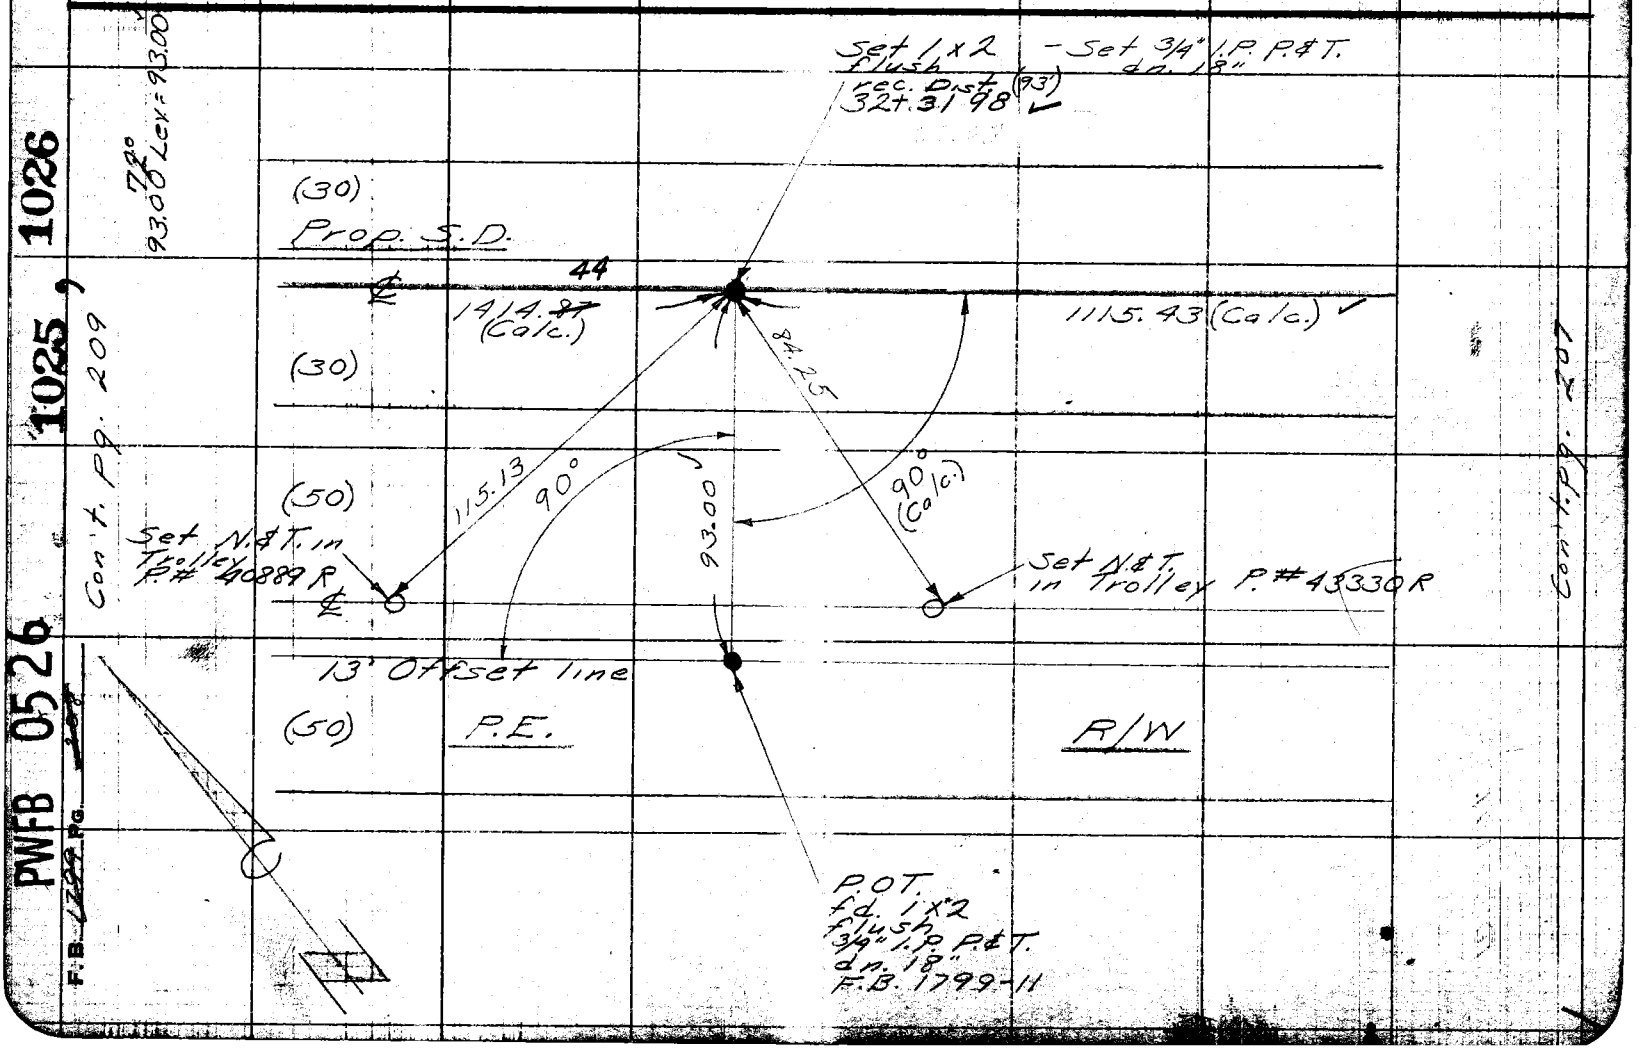

PWFB 0526 1025, 1026

F.B. 1799 PG. 209

PWFB 0526 1027, 1028

Notes Ck'd by Aja	Survey of Artesia-Norwalk	F.B. 1799 Pg. 209
Map No.	W. O. 6931 Tape No. St'd.	
Office Work	Surveyed by English	
Checked	Notes " Date 12-53	Con't. pg. 208
Date	Indexed A. C. Johnson	

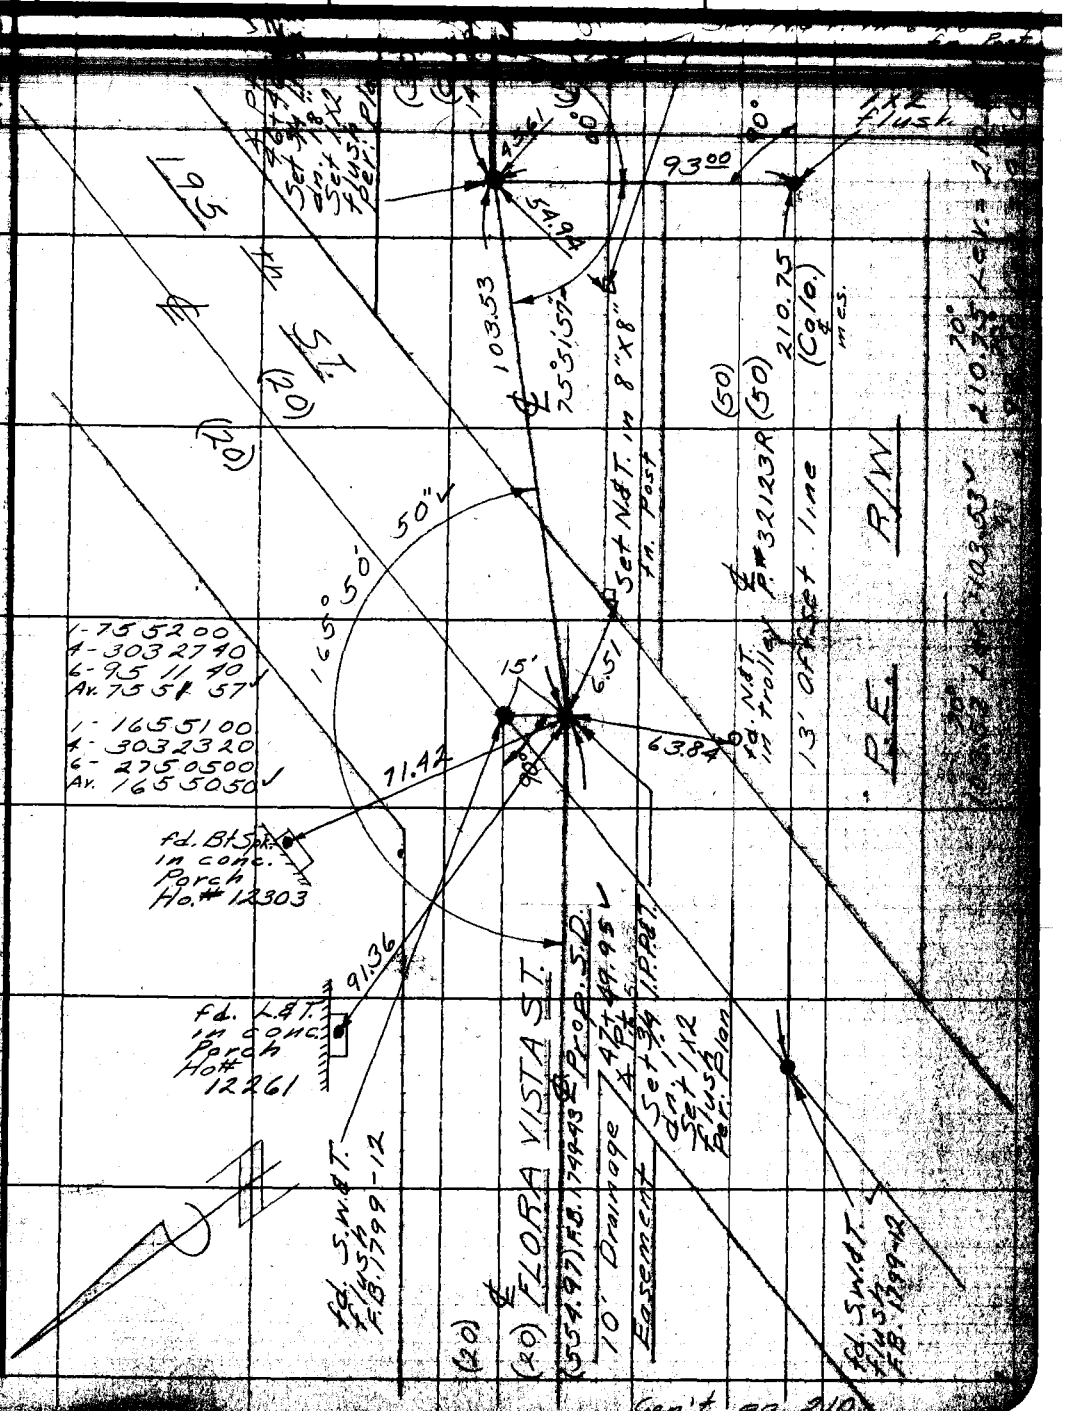

Note: Any Additions or Changes on This Sheet Must be Made or Circled in Red Ink With Date and Name of Person Making Change.

Do not extend notes this side of this line.

RETURN TO
LOS ANGELES COUNTY SURVEYOR
726 LOS ANGELES COUNTY
ENGINEERING BLDG.

Con't. pg. 210

PWFB 0526

F.B. 1799 Pg. 210

1029

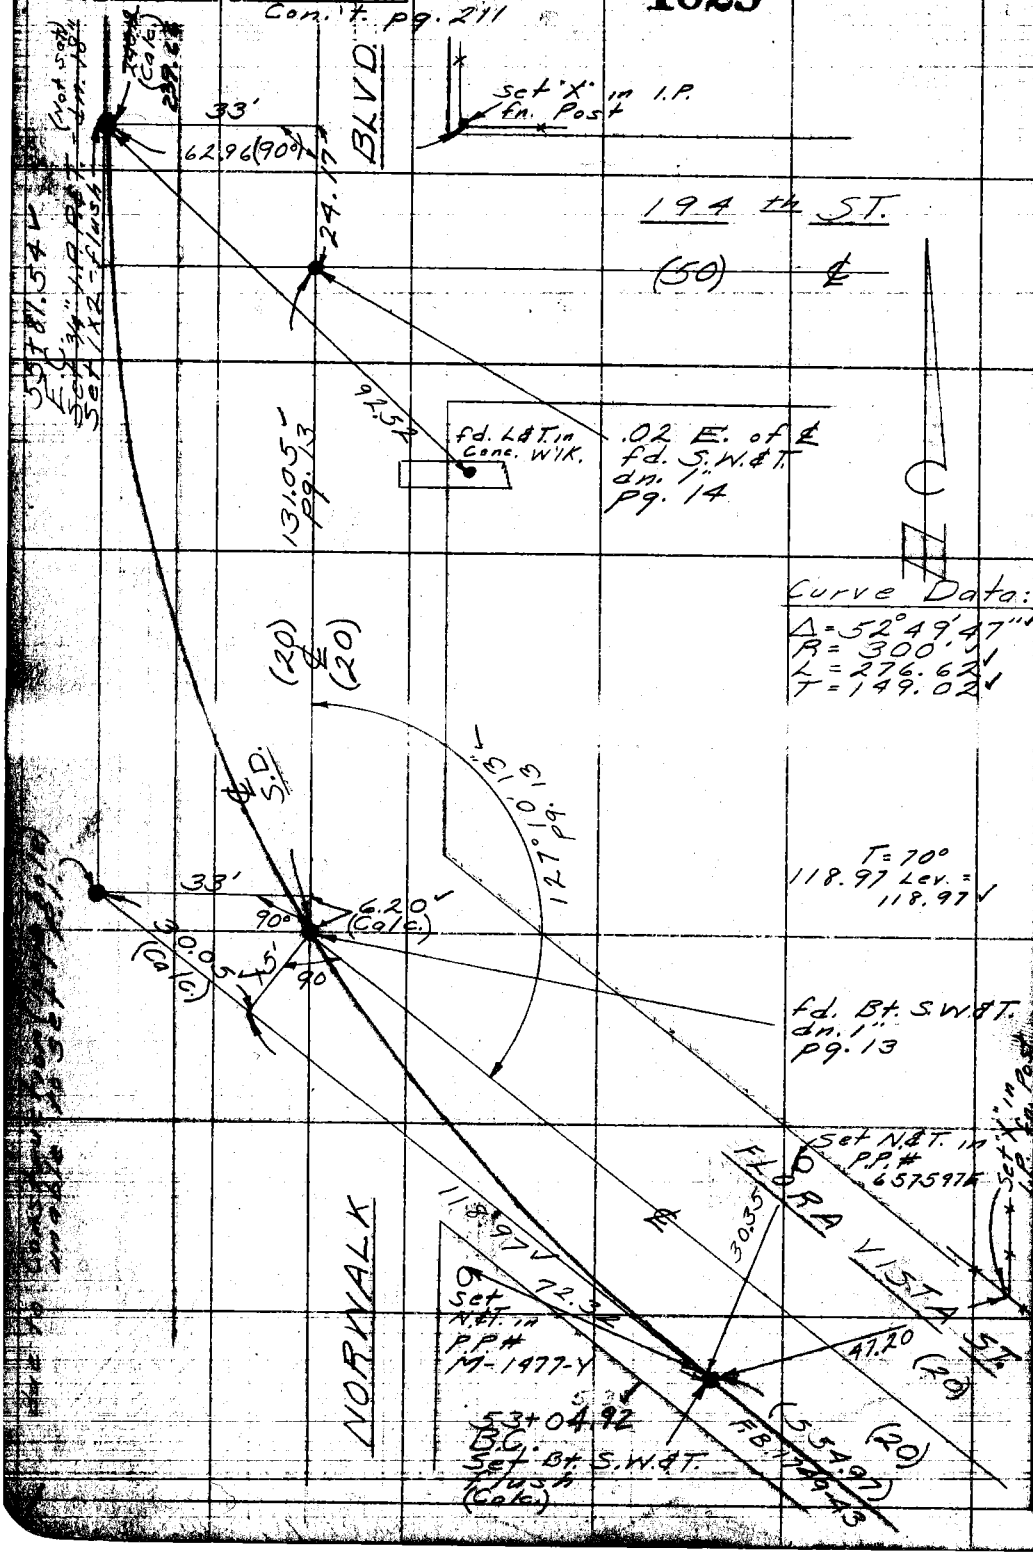

W.S. 31-D-1

52

RETURN TO
LOS ANGELES COUNTY SURVEYOR
726 LOS ANGELES COUNTY
ENGINEERING BLDG.

Do not extend notes this side of this line.

Note: Any Additions or Changes on this Sheet Must be Made or Circled in Red Ink With Date and Name of Person Making Change.

PWFB 0626

1182

Notes Ck'd by Aja	Survey of Artesia-Norwalk	F. B. [illegible] Pg. [illegible]
Map No.	W. O. 6951 Tape No. St'd. °F	
Office Work	Surveyed by English	
Checked	Notes " Date 12-53	
Date	Indexed A. C. Johnson	

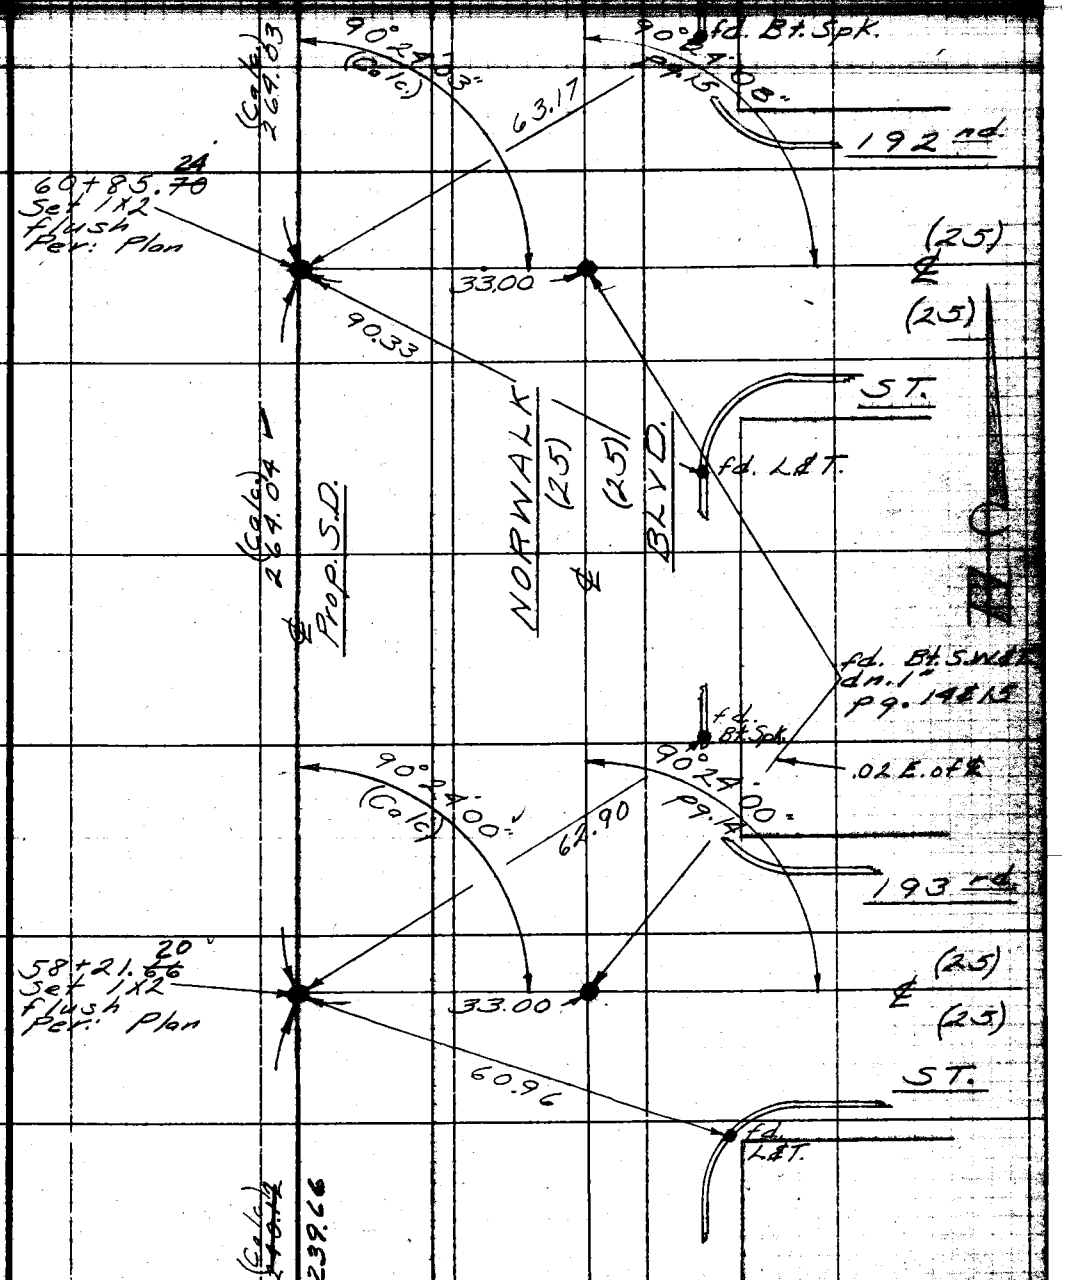

Con't. pg. 210

Note: Any Additions or Changes on This Sheet Must be Made or Circled in Red Ink With Date and Name of Person Making Change.

Do not extend notes this side of this line.

RETURN TO
LOS ANGELES COUNTY SURVEYOR
726 LOS ANGELES COUNTY
ENGINEERING BLDG.

75F3098 247 4-53

PWFB 0626

F.B. ~~1799~~ PG. ~~212~~

Con't. pg. 213

1183

W.S. 31-D-1

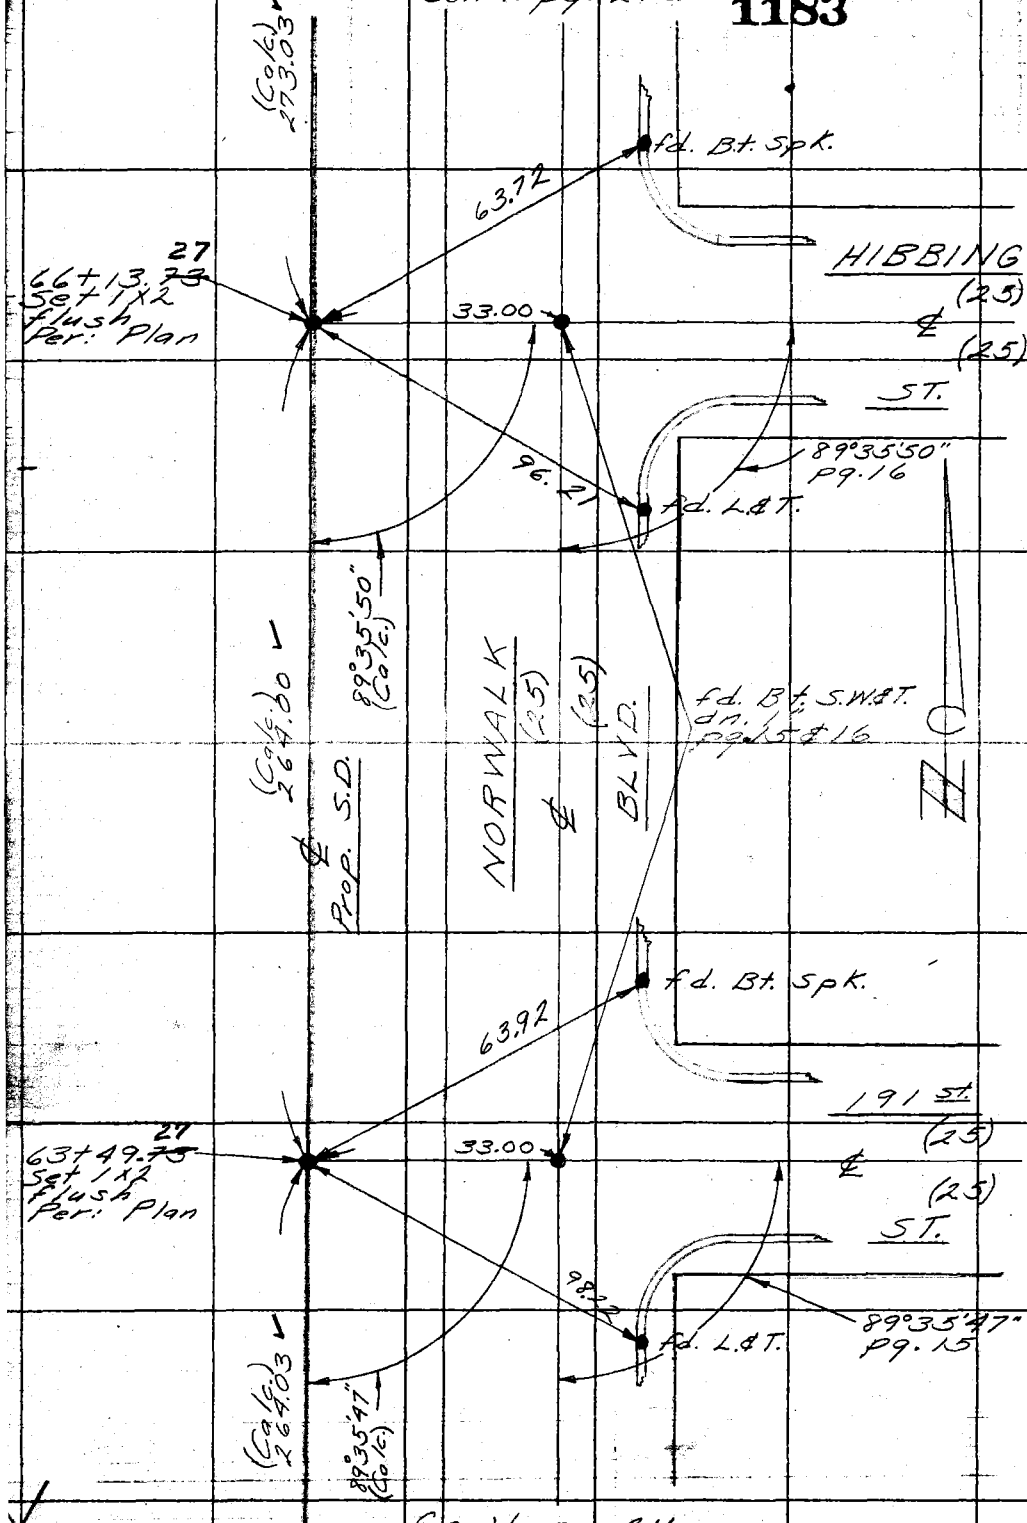

RETURN TO
LOS ANGELES COUNTY SURVEYOR
726 LOS ANGELES COUNTY
ENGINEERING BLDG.

Do not extend notes this side of this line.

Note: Any Additions or Changes on This Sheet Must be Made or Circled in Red Ink With Date and Name of Person Making Change.

Con't. pg. 211

PWFB 0626 1184

Notes Ck'd by Ajo	Survey of Artesia-Norwalk
Map No.	W. O. 6951 Tape No. St'd. °F
Office Work	Surveyed by English
Checked	Notes " Date 12-53
Date	Indexed

F. B. [illegible] PG. [illegible]

W. [illegible] D-1

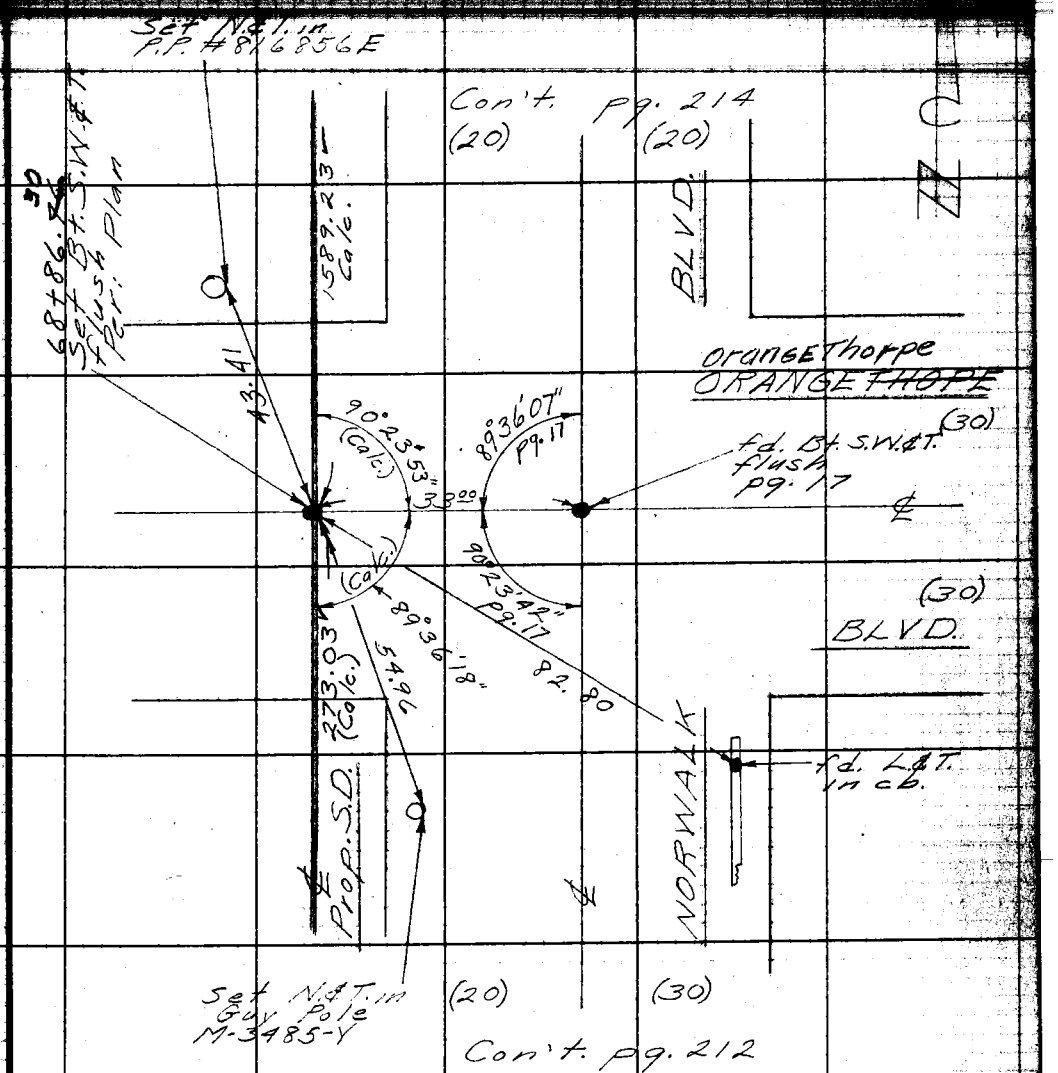

Note: Any Additions or Changes on This Sheet Must be Made or Circled in Red Ink With Date and Name of Person Making Change.

Do not extend notes this side of this line.

RETURN TO
LOS ANGELES COUNTY SURVEYOR
726 LOS ANGELES COUNTY
ENGINEERING BLDG.

76FB095 247 4-53

PWFB 0626 1185

F.B. ~~1799~~ PG. ~~214~~

W.S. 33-D-6

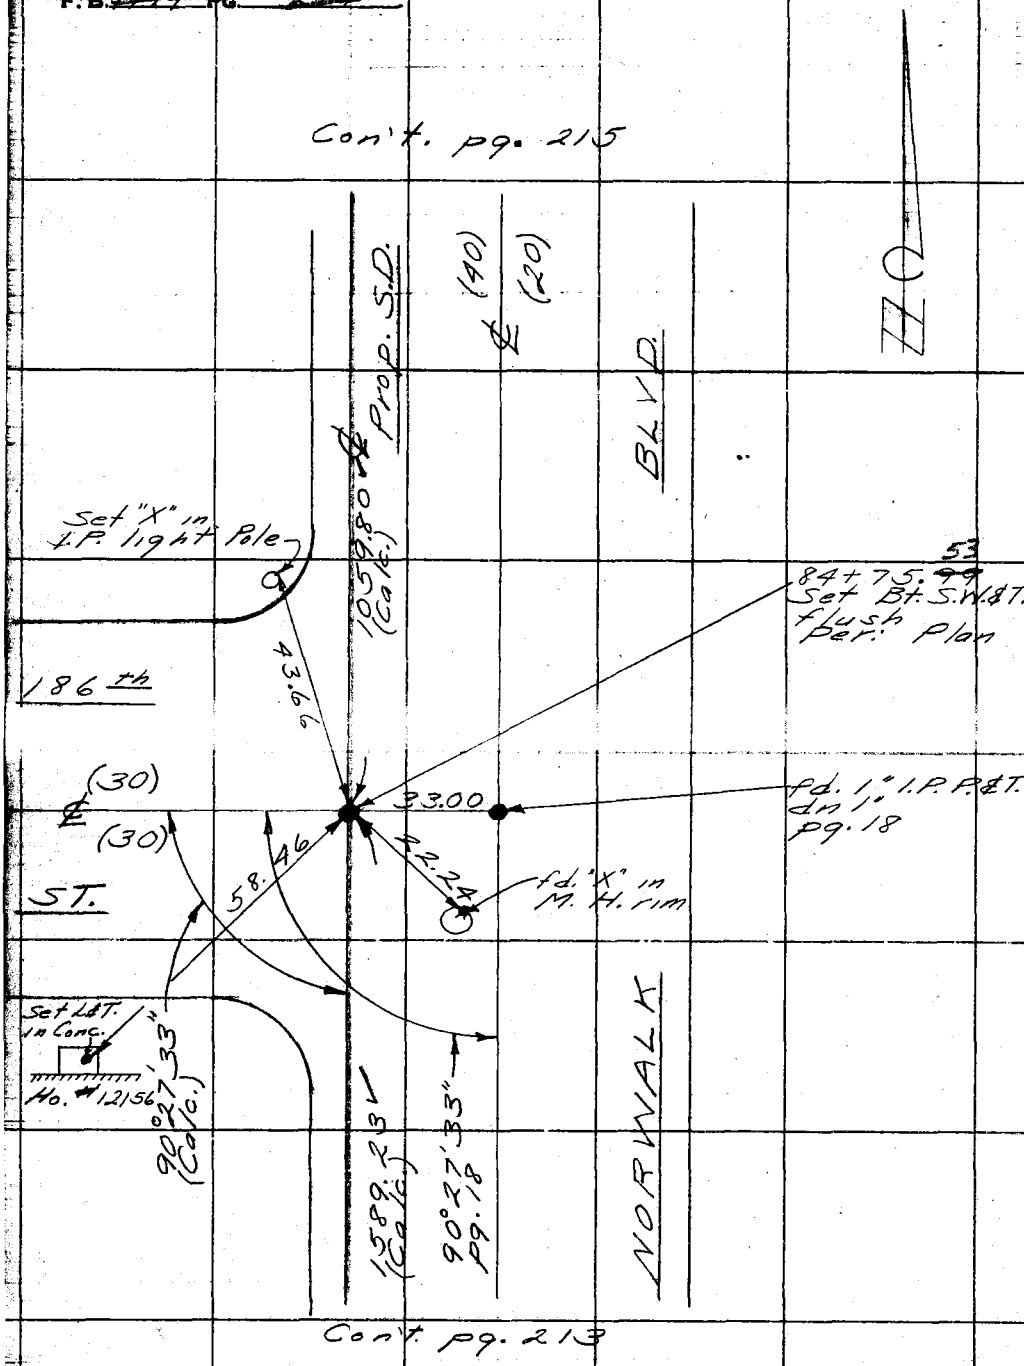

RETURN TO
LOS ANGELES COUNTY SURVEYOR
726 LOS ANGELES COUNTY
ENGINEERING BLDG.

Do not extend notes this side of this line.

Note: Any Additions or Changes on This Sheet Must be Made or Circled in Red Ink With Date and Name of Person Making Change.

PWFB 0626 1186

Notes Ck'd by Ajo	Survey of Artesia-Norwalk	F.B. 1799 Pg. 215
Map No.	W. O. 6951 Tape No. St'd. °F	
Office Work	Surveyed by English	
Checked	Notes " Date 12-53	
Date	Indexed A. C. Johnson	

W. 53-D-5

Con't. pg. 216

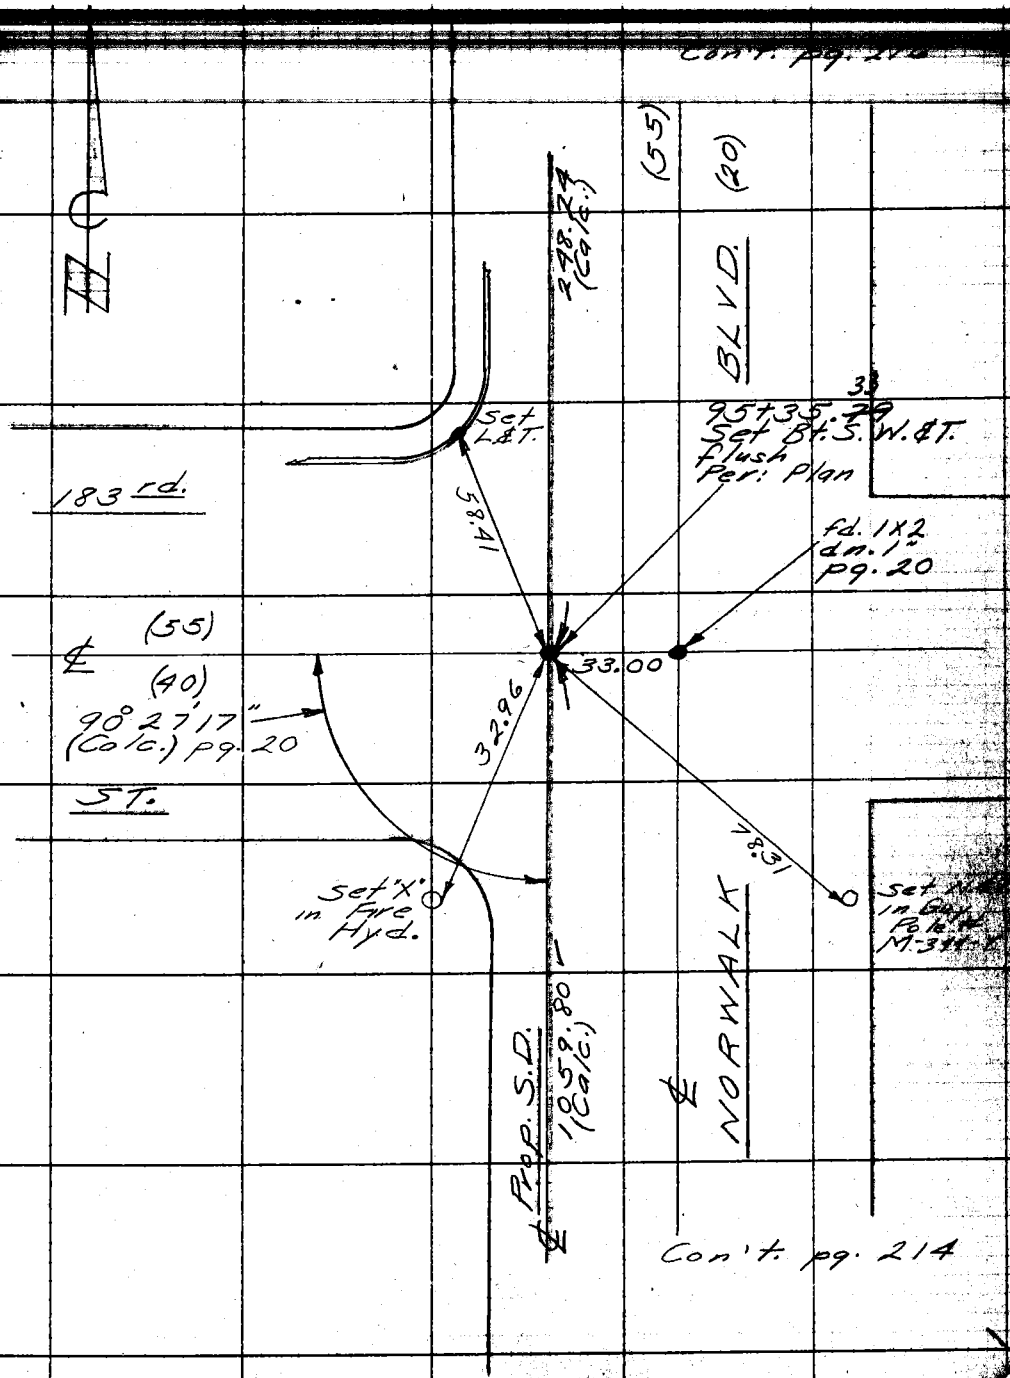

Con't. pg. 214

Note: Any Additions or Changes on This Sheet Must be Made or Circled in Red Ink With Date and Name of Person Making Change.

Do not extend notes this side of this line.

RETURN TO
LOS ANGELES COUNTY SURVEYOR
726 LOS ANGELES COUNTY
ENGINEERING BLDG.

76F3095 247 4-53

PWFB 0626

1187

F.B. ~~1799~~ Pg. ~~216~~

Con't. pg. 217

W.S. 33-0-5

Data for both Curves:

$\Delta = 5°42'38"$
$R = 90.$
$T = 4.49$
$L = 8.97$

E.C. 03
98+93.~~49~~
Set Bt. S.W.&T.
flush
by Calc.

P.I.
Set Bt. S.W.&T.
flush

B.C. 84.06
98+~~84.52~~
Set Bt. S.W.&T.
flush
by calc.

ALLEY

(20)℄

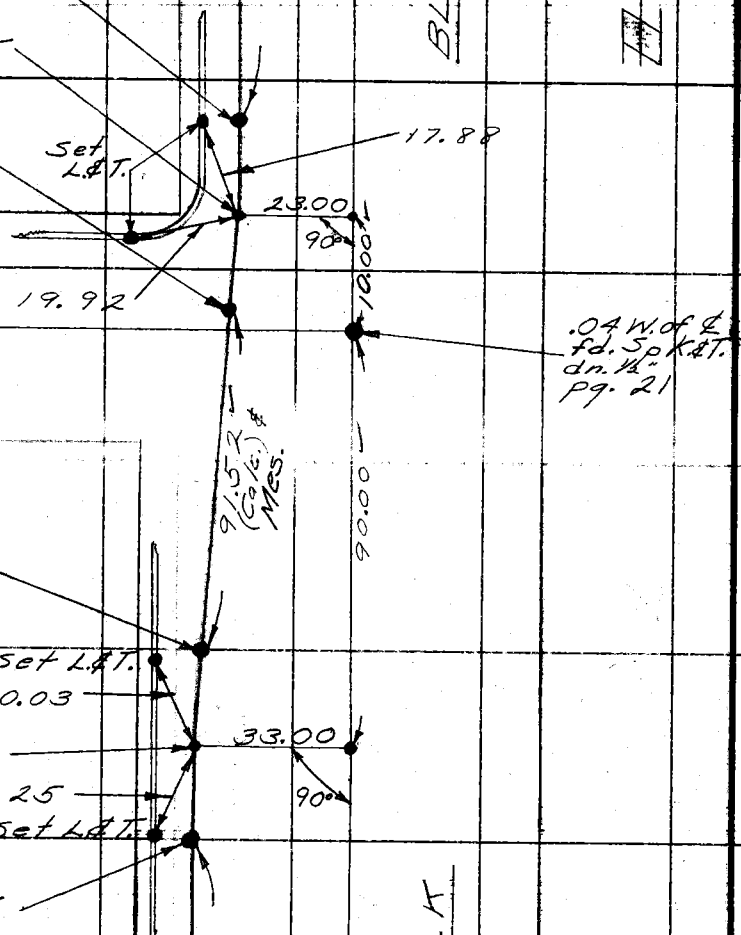

E.C. ~~92.54~~
97+~~92.00~~
Set Bt. S.W.&T.
flush
by Calc.

P.I.
Set Bt. S.W.&T.
flush

B.C. 83.57
97+~~84.03~~
Set Bt. S.W.&T.
flush
by calc.

Con't. pg. 215

RETURN TO
LOS ANGELES COUNTY SURVEYOR
726 LOS ANGELES COUNTY
ENGINEERING BLDG.

Do not extend notes this side of this line.

Note: Any Additions or Changes on This Sheet Must be Made or Circled in Red Ink With Date and Name of Person Making Change.

PWFB 0626

1188

Notes Ck'd by Aja	Survey of Artesia-Norwalk
Map No.	W. O. 6951 Tape No. Std. °F
Office Work	Surveyed by English
Checked	Notes " Date 12-53
Date	Indexed A. C. Johnson

F. B. 1299 Pg. 217

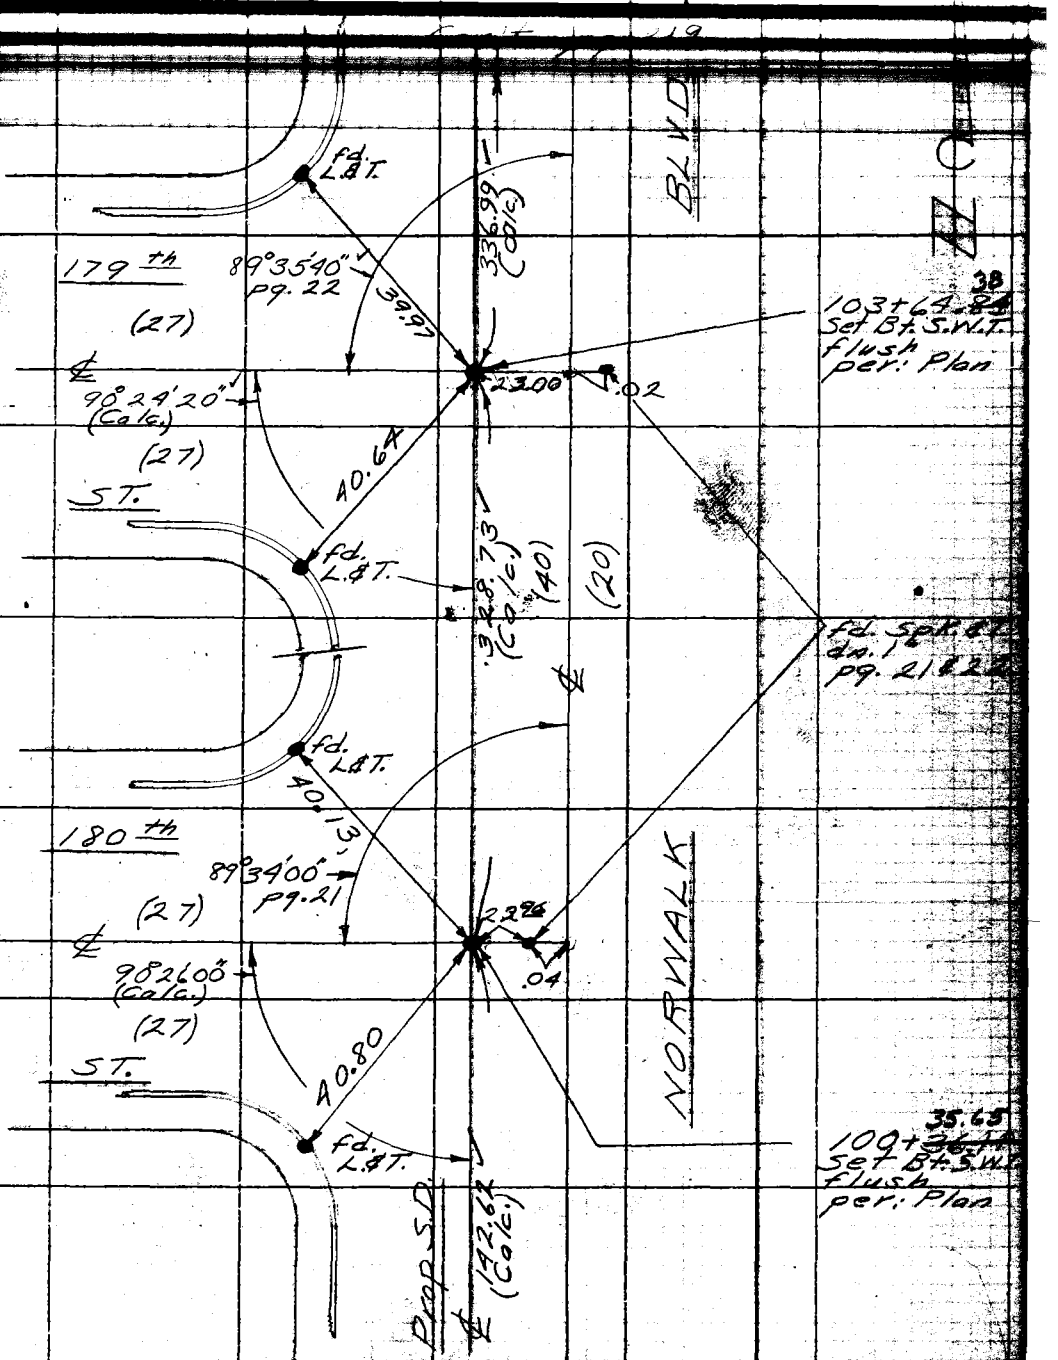

Con't. pg. 216

142.62

Note: Any Additions or Changes on This Sheet Must be Made or Circled in Red Ink With Date and Name of Person Making Change.

Do not extend notes this side of this line.

RETURN TO
LOS ANGELES COUNTY SURVEYOR
726 LOS ANGELES COUNTY
ENGINEERING BLDG.

76F2098 247 4-53

F.B. 1799 Pg. 218

PWFB 0626

Con't. pg # 220

1189

W.S. 33-0-5

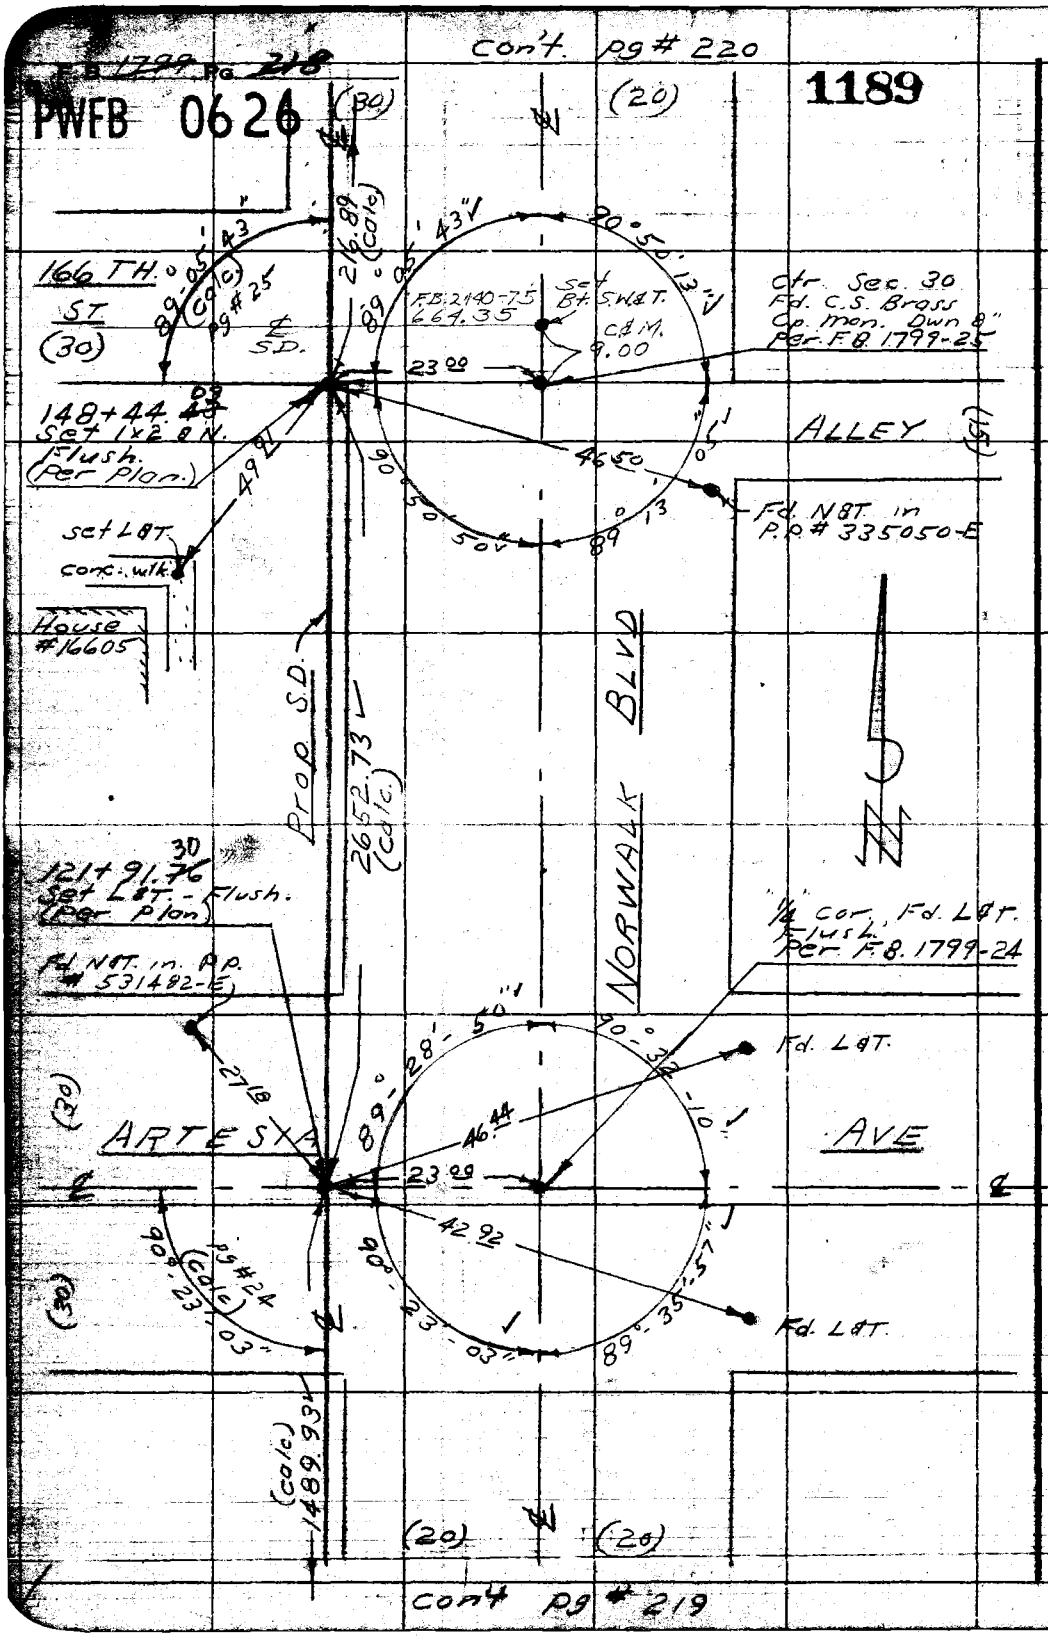

Cont pg # 219

RETURN TO
LOS ANGELES COUNTY SURVEYOR
726 LOS ANGELES COUNTY
ENGINEERING BLDG.

Do not extend notes this side of this line.

Note: Any Additions or Changes on This Sheet Must be Made or Circled in Red Ink With Date and Name of Person Making Change.

PWFB 0626 1190

F. B. ~~1799~~ Pg. ~~219~~

Notes Ck'd by Aja
Map No.
Office Work
Checked
Date

Survey of Artesia - Norwalk
W. O. 6951 Tape No. Sr'd. °F
Surveyed by English
Notes Sappell Date 12-53
Indexed

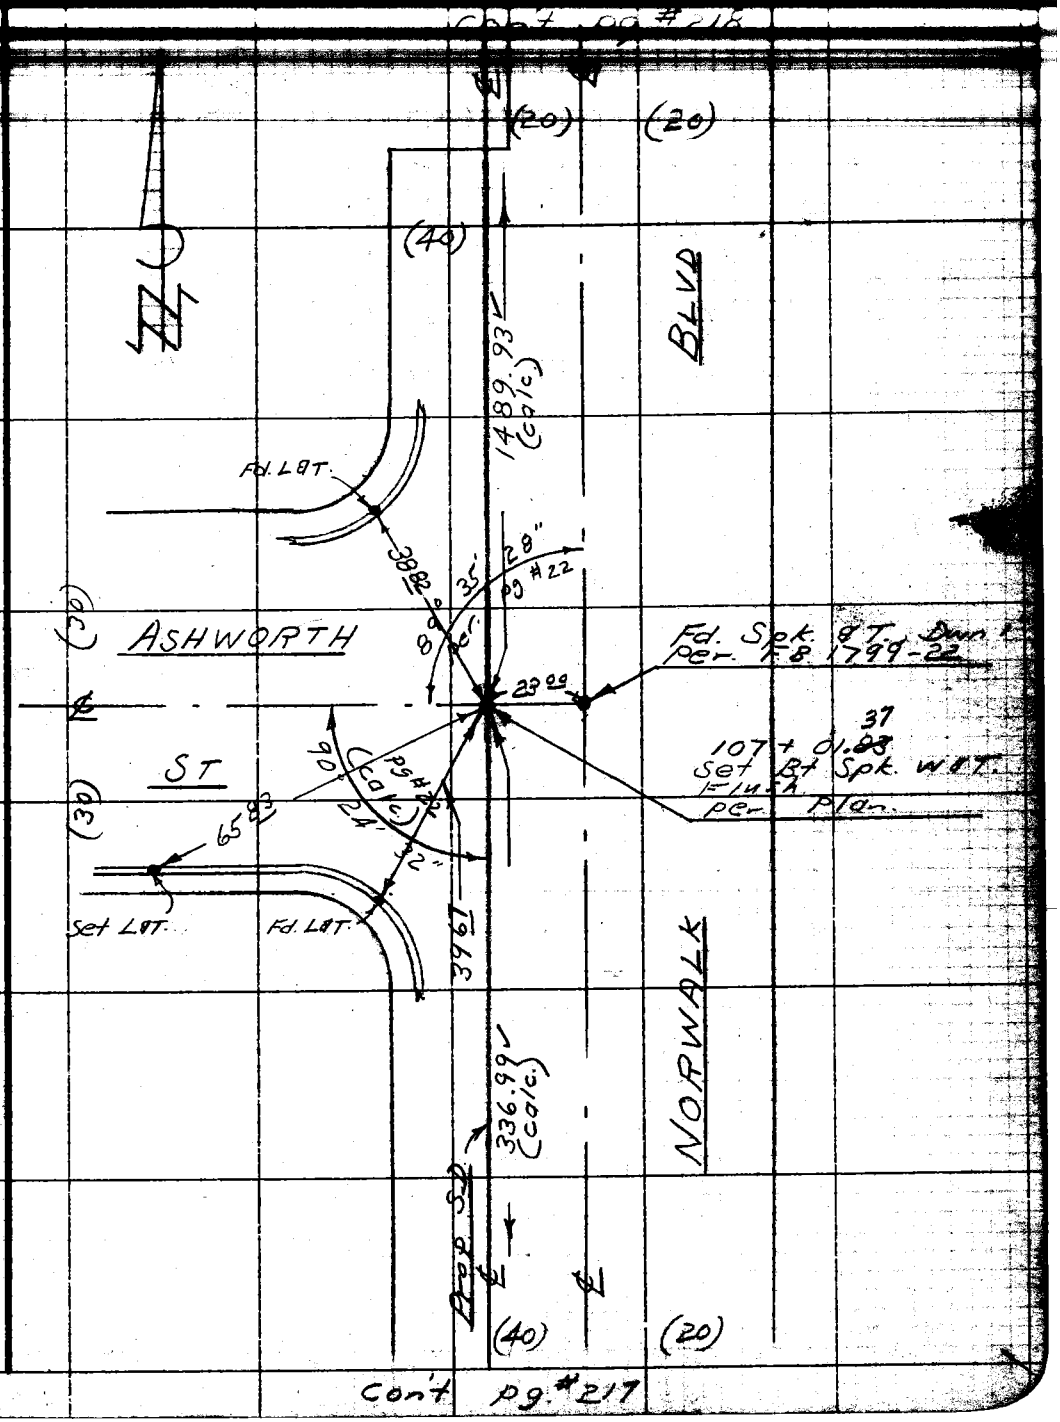

Note: Any Additions or Changes on This Sheet Must be Made or Circled in Red Ink With Date and Name of Person Making Change.

Do not extend notes this side of this line.

RETURN TO
LOS ANGELES COUNTY SURVEYOR
726 LOS ANGELES COUNTY
ENGINEERING BLDG.

76F3098 247 4-53

PWFB 0626

F.B. ~~1799~~ PG. ~~22~~

con't pg # 221

1191, 1192

W.S. 33-0-5

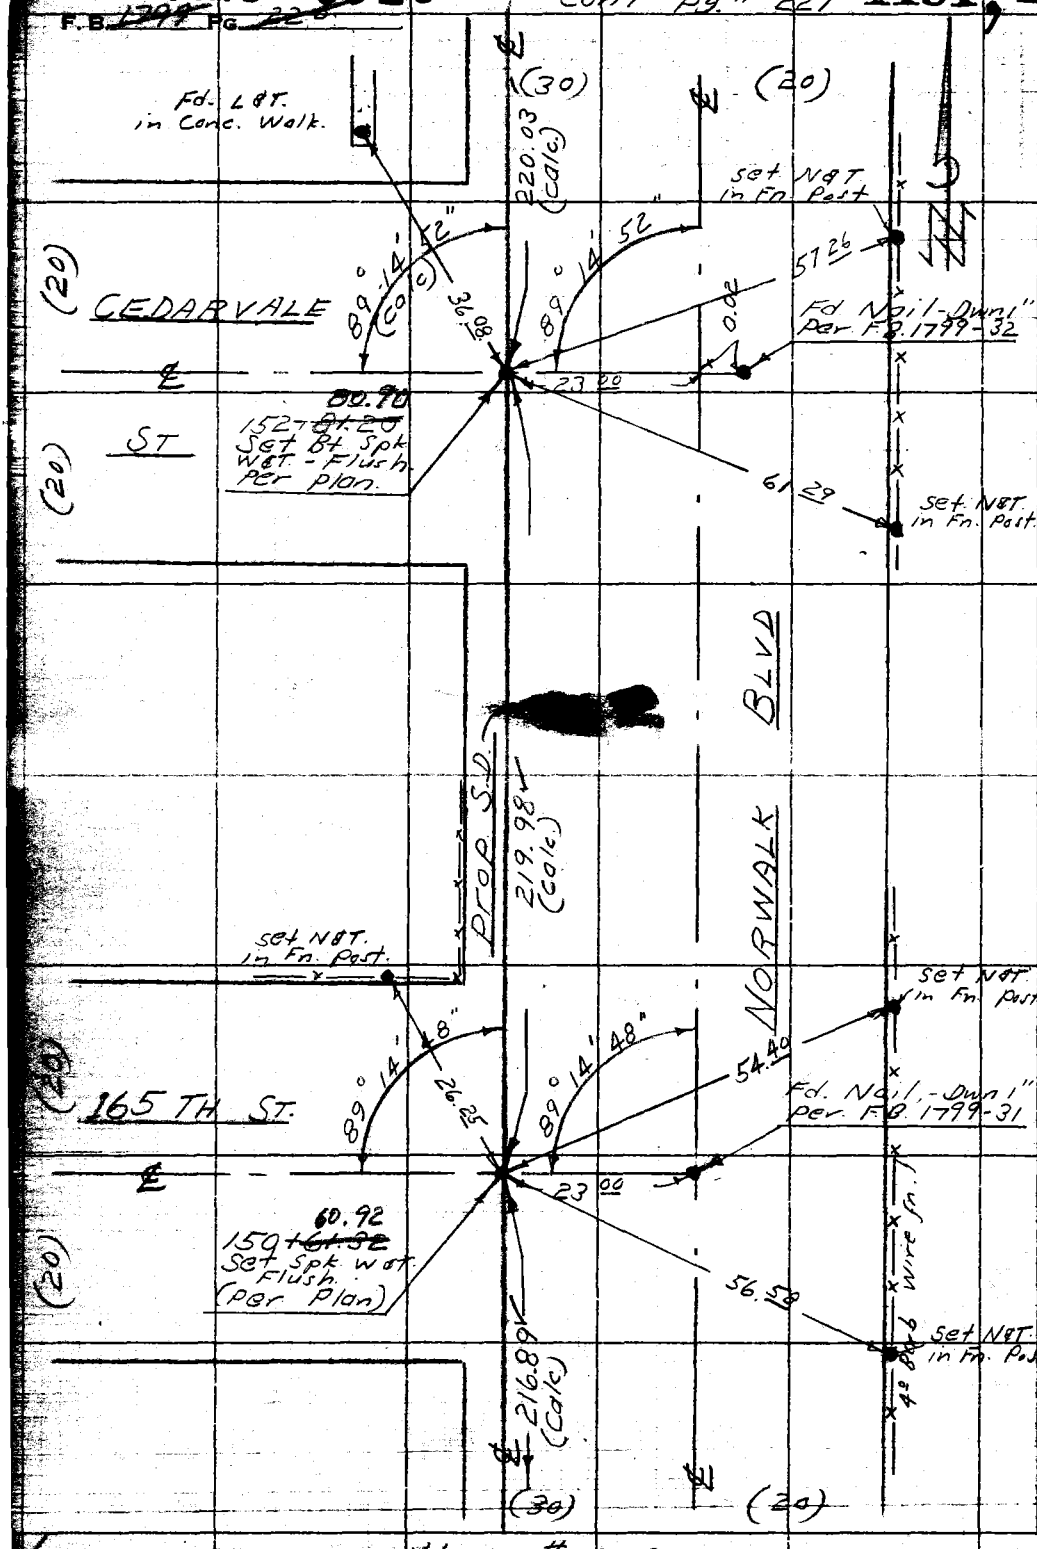

RETURN TO
LOS ANGELES COUNTY SURVEYOR
726 LOS ANGELES COUNTY
ENGINEERING BLDG.
Do not extend notes this side of this line.

Note: Any Additions or Changes on This Sheet Must be Made or Circled in Red Ink With Date and Name of Person Making Change.

con't pg # 218

PWFB 0626

1193, 1194

F.B. 1799 Pg. 221

Notes Ck'd by Aja
Map No.
Office Work
Checked
Date

Survey of Artesia - Norwalk
W. O. 6951 Tape No. Std. °F
Surveyed by English
Notes Sappell Date 12-53
Indexed A C Johnson

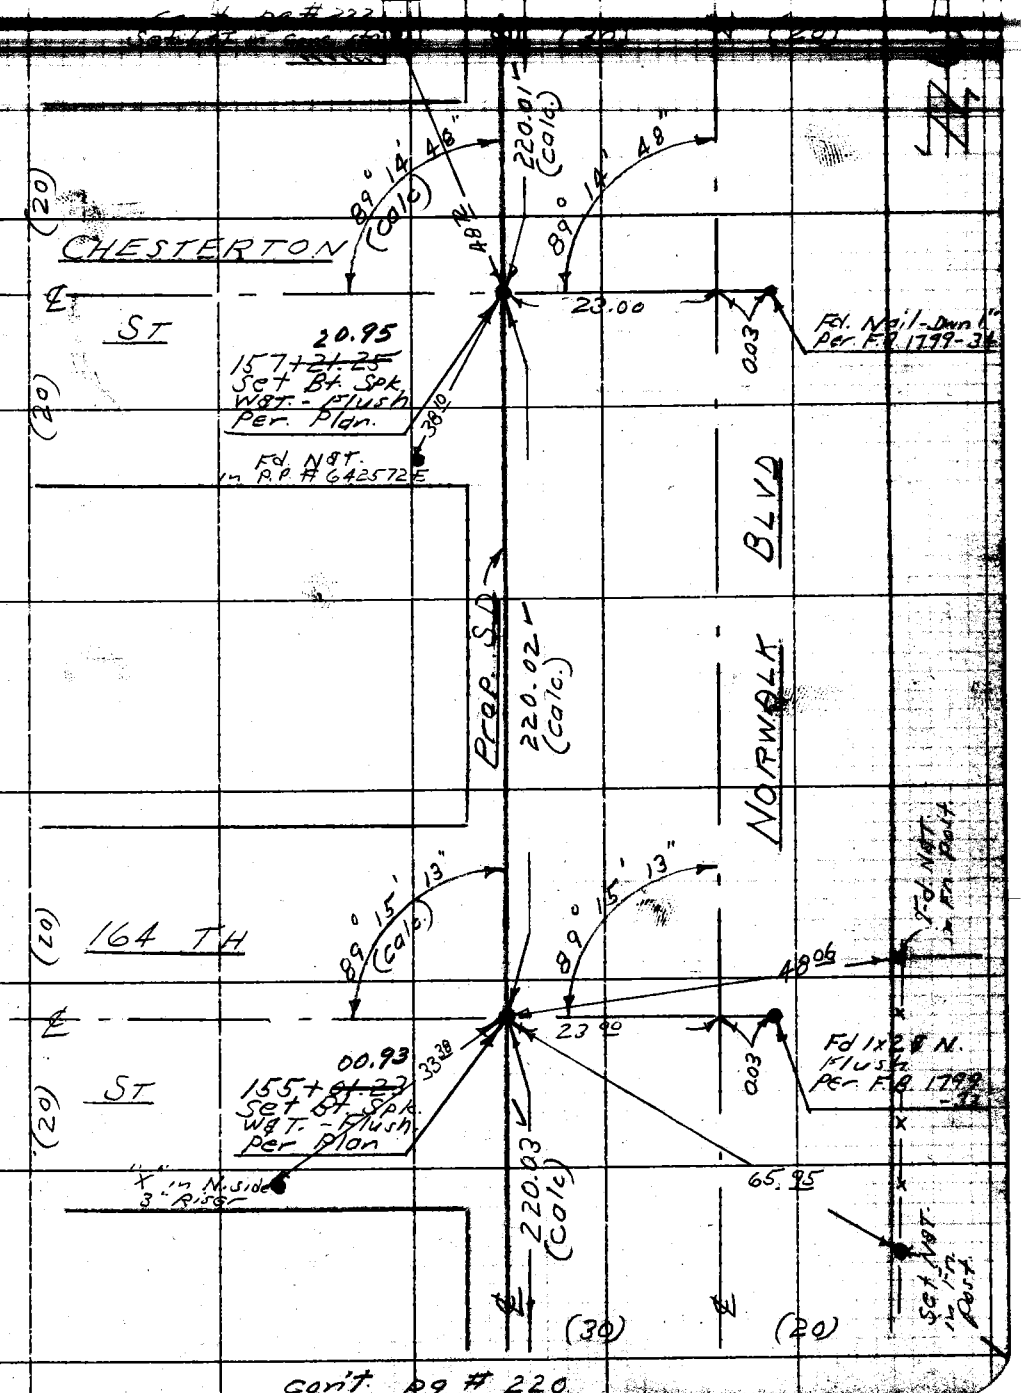

con't pg # 220

Note: Any Additions or Changes on This Sheet Must be Made or Circled in Red Ink With Date and Name of Person Making Change.

Do not extend notes this side of this line.

RETURN TO
LOS ANGELES COUNTY SURVEYOR
726 LOS ANGELES COUNTY
ENGINEERING BLDG.

78F0098 247 4-53

PWFB 0626 con't pg. # 223 1195, 1196

F.B. ~~1799~~ PG. ~~222~~

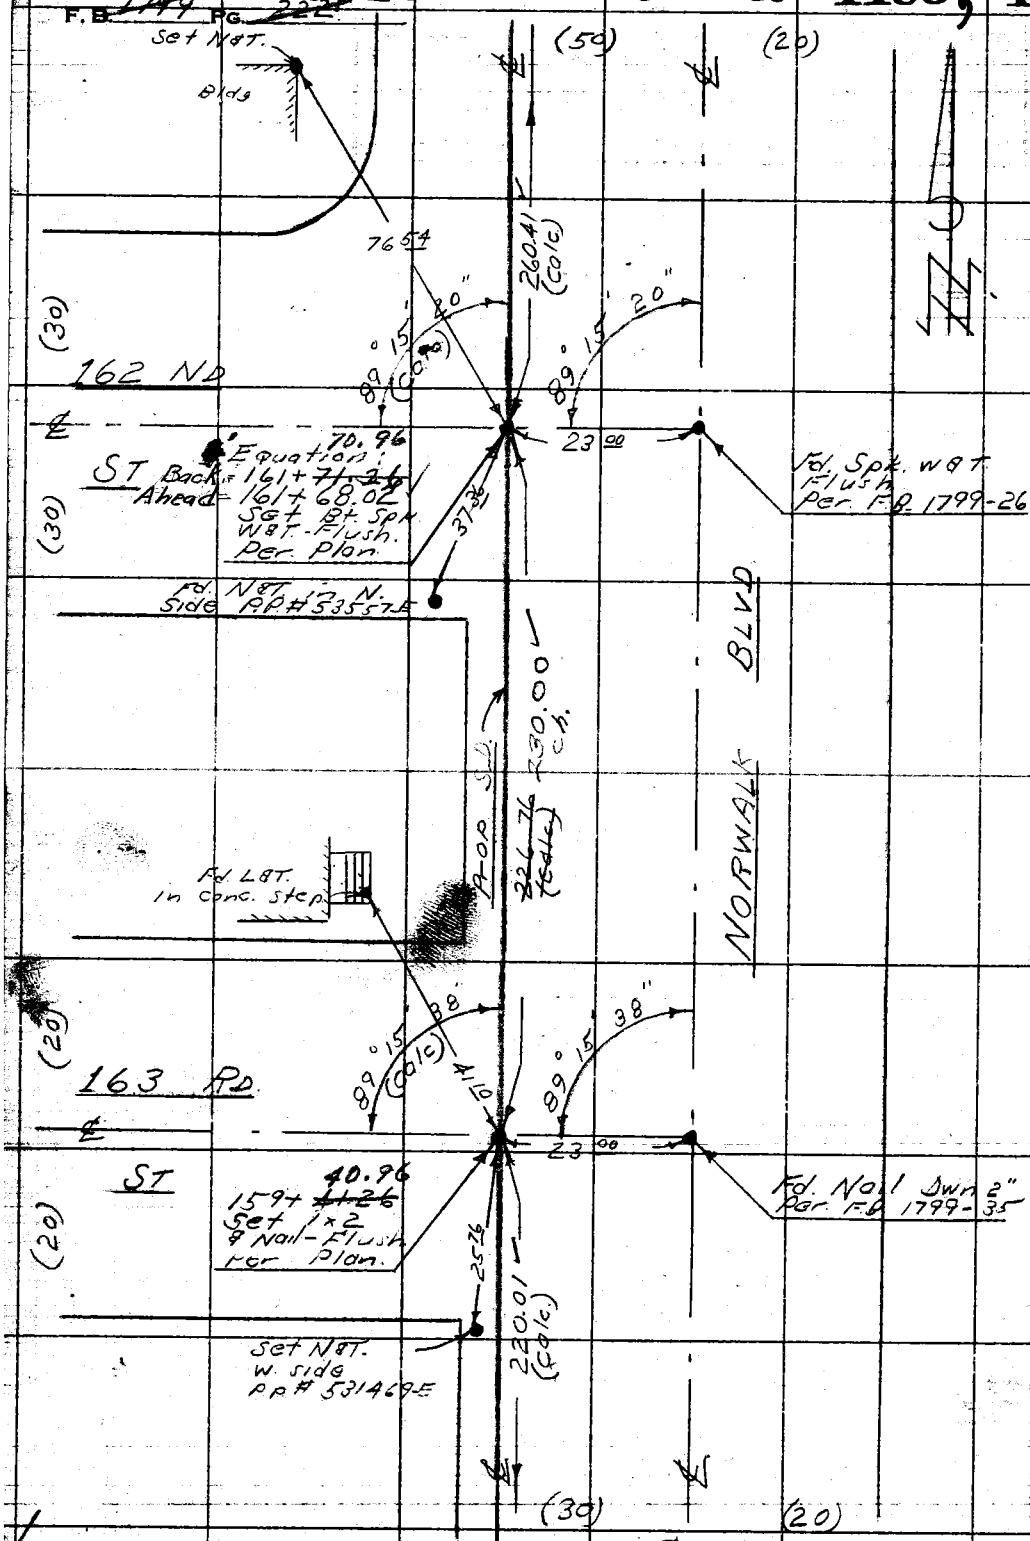

W.S. 33-D-5

RETURN TO
LOS ANGELES COUNTY SURVEYOR
726 LOS ANGELES COUNTY
ENGINEERING BLDG.

Do not extend notes this side of this line.

Note: Any Additions or Changes on This Sheet Must be Made or Circled in Red Ink With Date and Name of Person Making Change.

con't pg #221

PWFB 0726

441

F. B. 1799 Pg. 223

Notes Ck'd by Aja
Map No.
Office Work
Checked
Date

Survey of Artesia - Norwalk
W. O. 6957 Tape No. St'd. °F
Surveyed by English
Notes Sappell Date 12-53
Indexed A. C. Johnson

D-4, D-5

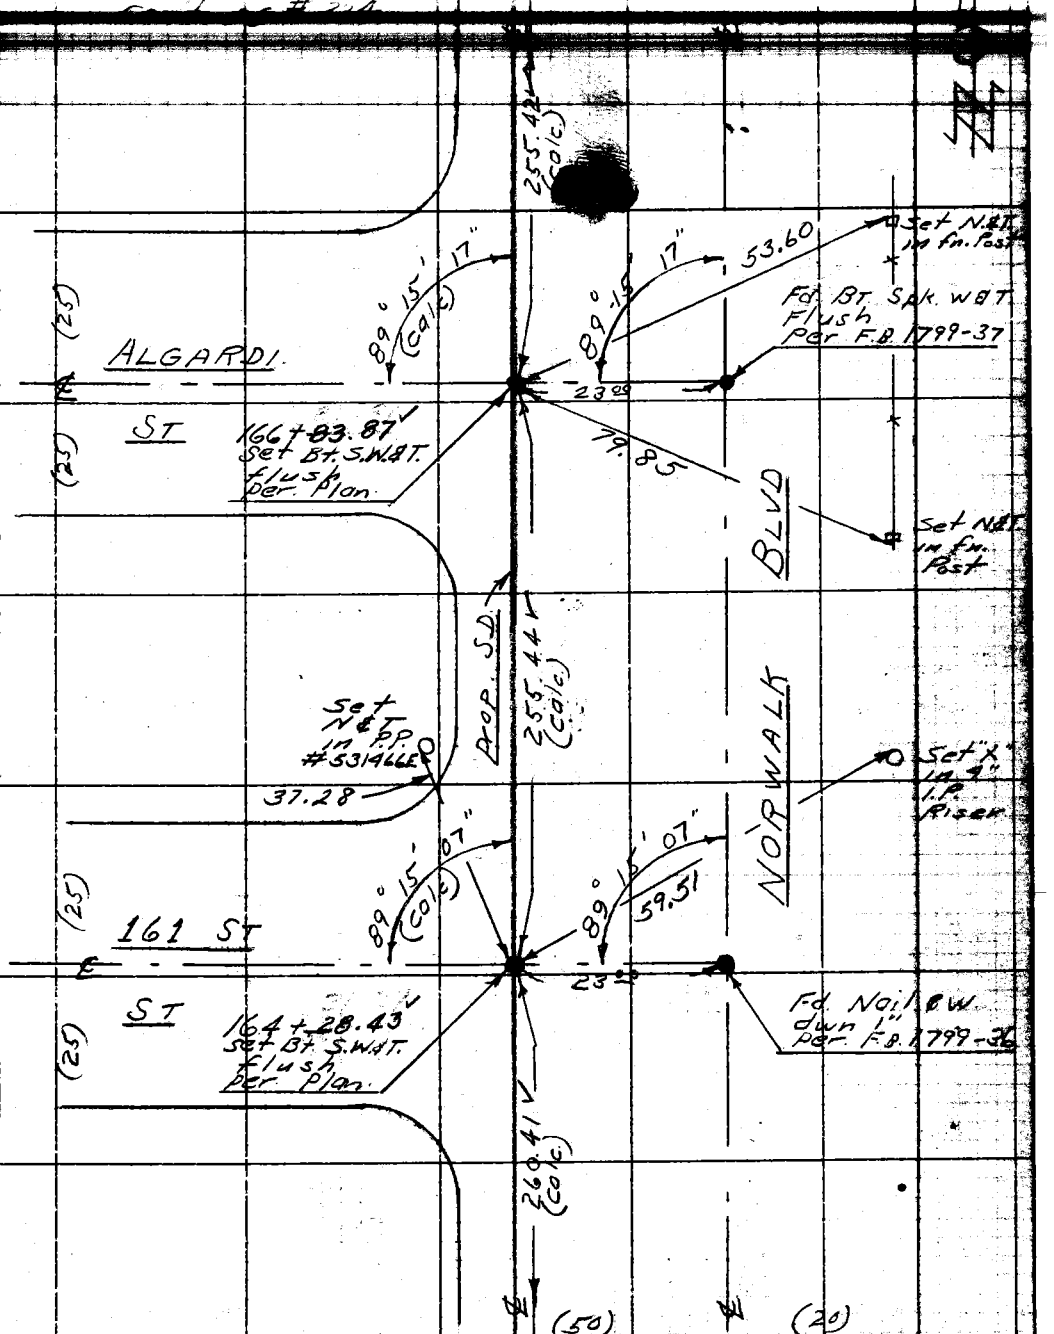

cont pg # 222

Note: Any Additions or Changes on This Sheet Must be Made or Circled in Red Ink With Date and Name of Person Making Change.

Do not extend notes this side of this line.

RETURN TO
LOS ANGELES COUNTY SURVEYOR
726 LOS ANGELES COUNTY
ENGINEERING BLDG.

76F3005 247 4-53

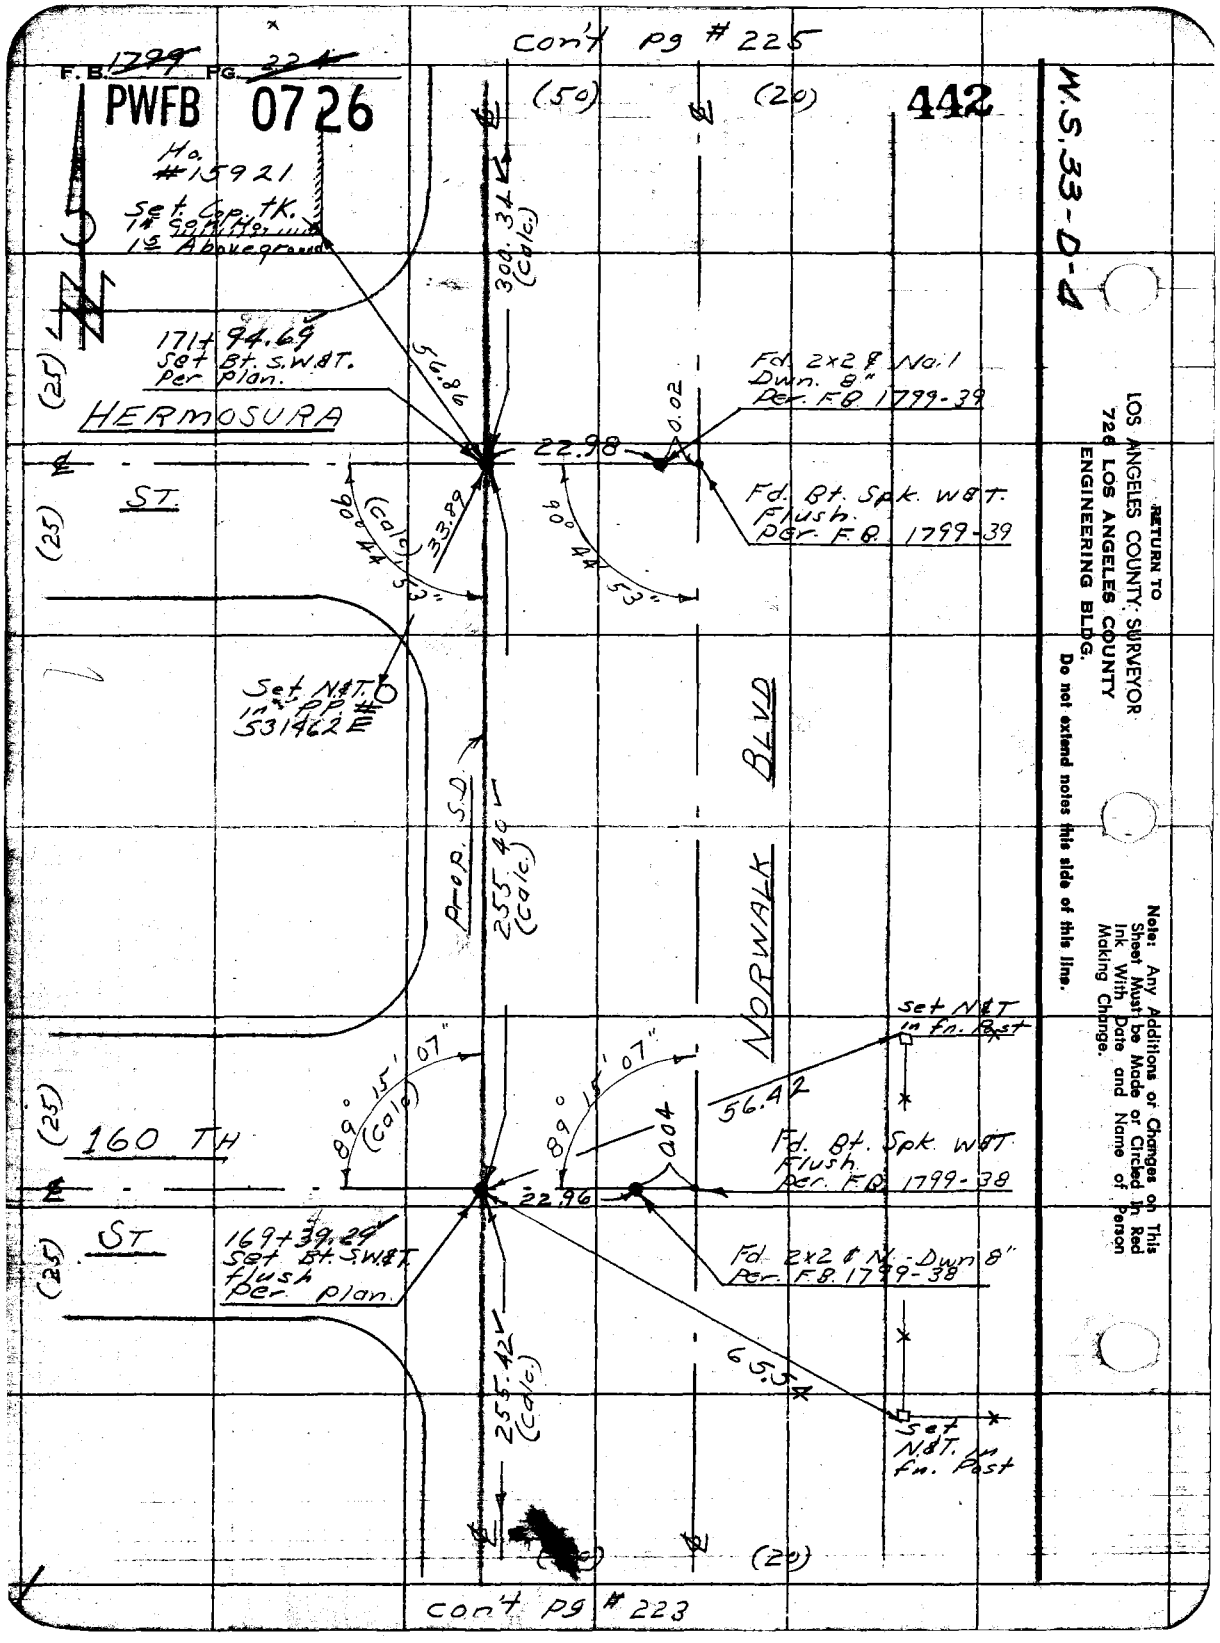

RETURN TO
LOS ANGELES COUNTY SURVEYOR
726 LOS ANGELES COUNTY
ENGINEERING BLDG.

Do not extend notes this side of this line.

Note: Any Additions or Changes on This Sheet Must be Made or Circled in Red Ink With Date and Name of Person Making Change.

PWFB 0726

443

F. B. 1799 Pg. 228

Notes Ck'd by [illegible]
Map No.
Office Work
Checked
Date

Survey of Artesia-Norwalk
W. O. 6951 Tape No. St'd. °F
Surveyed by English
Notes Sappell Date 1-54
Indexed A C Johnson

Con't pg # 226

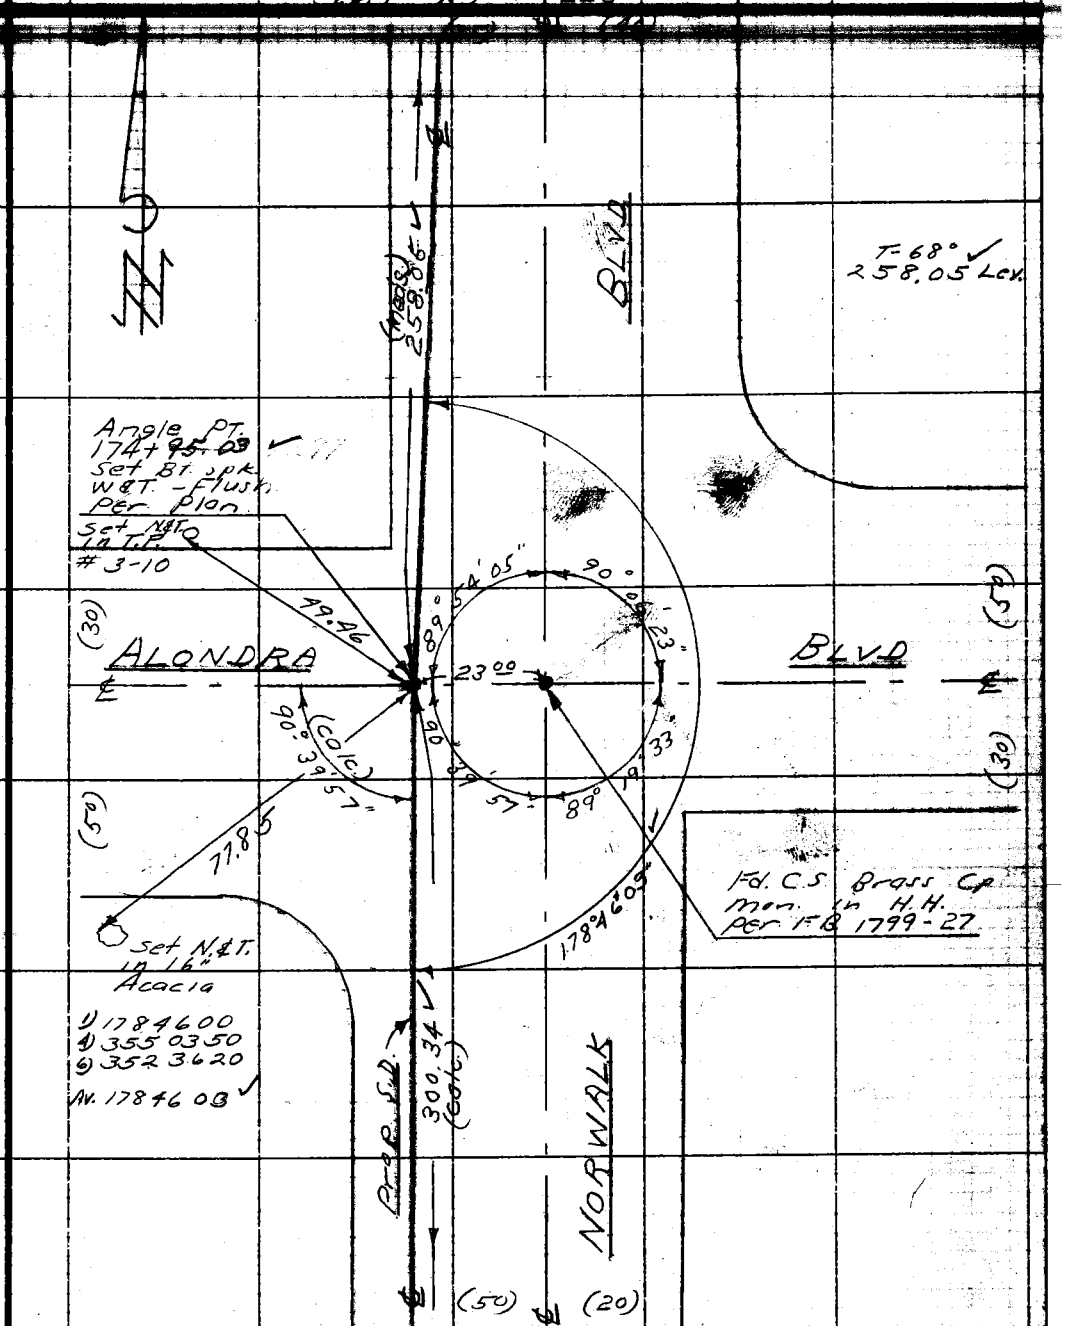

Con't pg # 224

Note: Any Additions or Changes on This Sheet Must be Made or Circled in Red Ink With Date and Name of Person Making Change.

Do not extend notes this side of this line.

RETURN TO
LOS ANGELES COUNTY SURVEYOR
726 LOS ANGELES COUNTY
ENGINEERING BLDG.

76F3098 247 4-58

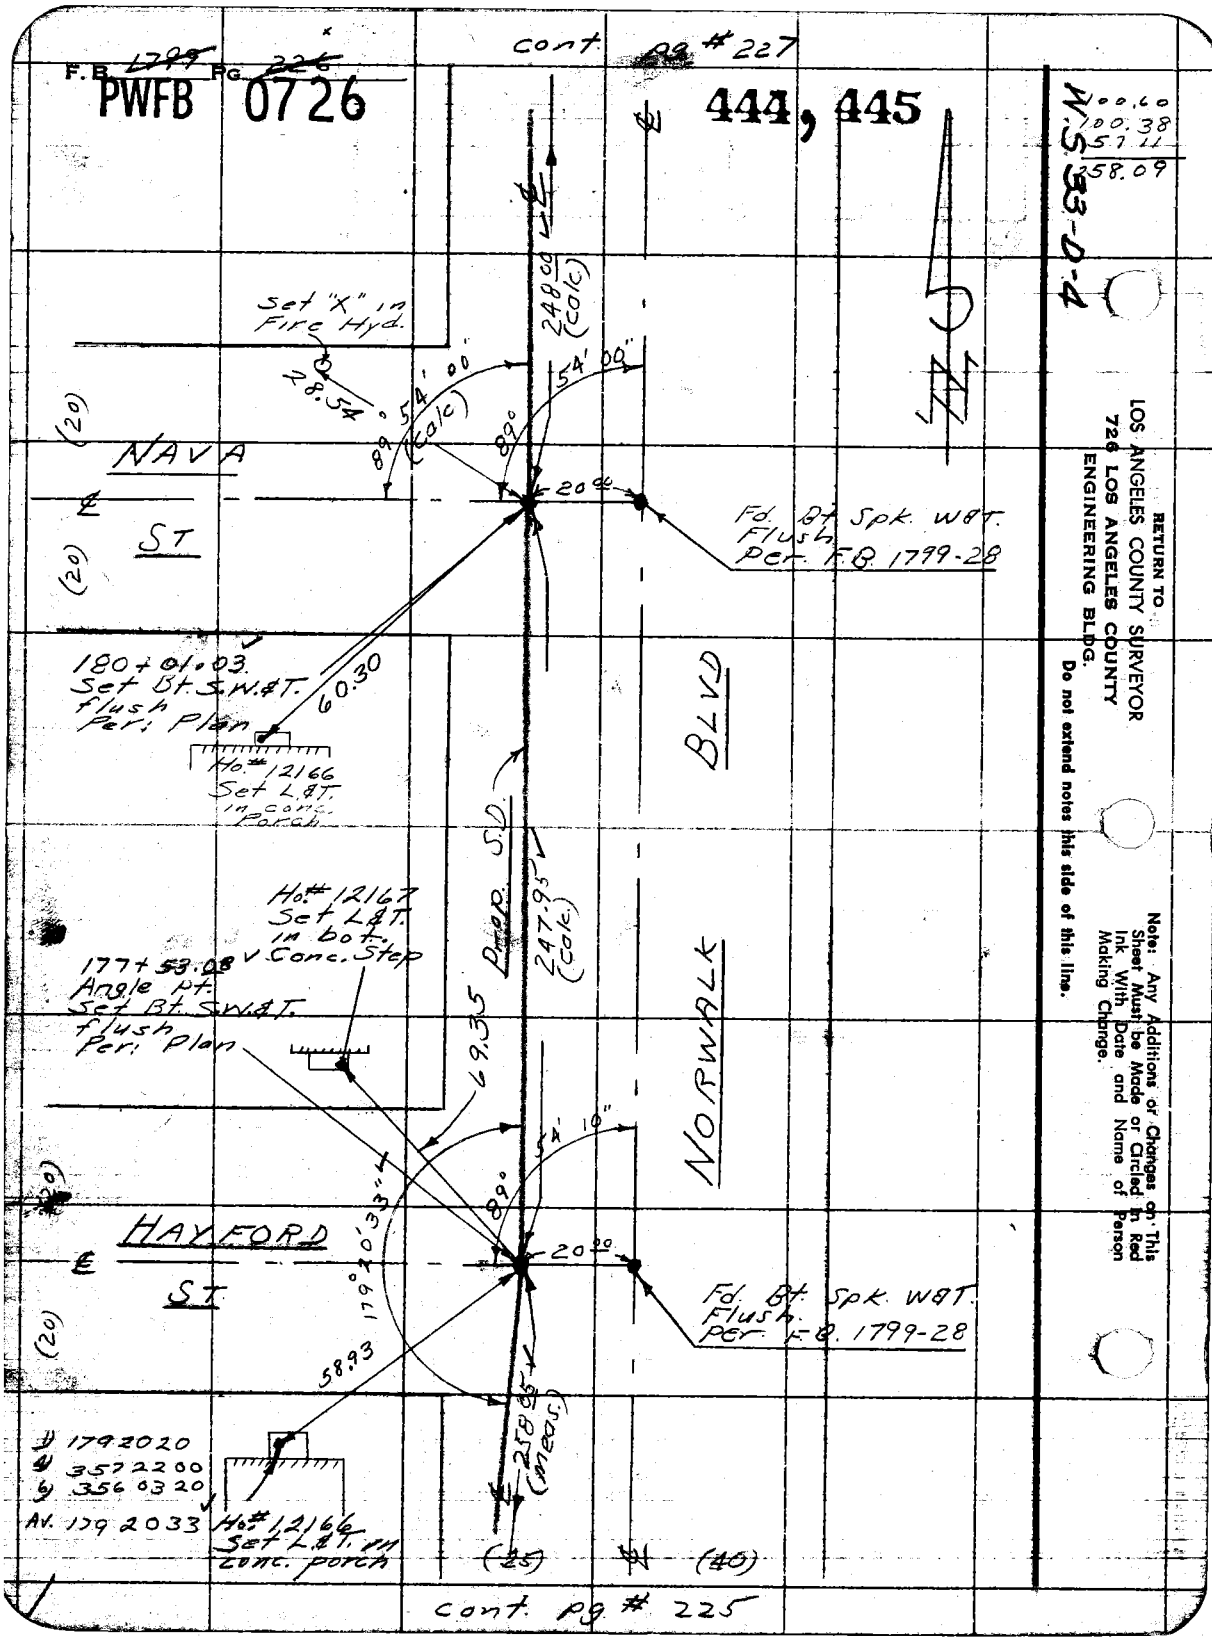

cont. pg # 227
F.B. 1799 Pg. 226
PWFB 0726
444, 445
W.S. 33-D-4
100.60
100.38
57.11
258.09
Set "X" in Fire Hyd.
28.54
89° 54' 00" (calc)
248.00 (calc)
54' 00"
89°
20.00
NAVA ST
(20)
Fd. Bt. Spk. W&T. Flush Per. F.B. 1799-28
180+01.03 Set Bt. S.W.&T. flush Per. Plan
60.30
Ho. # 12166 Set L&T. in conc. Porch
BLVD
Prop. S.D.
247.95 (calc)
Ho. # 12167 Set L&T. in bot. Conc. Step
177+53.08 Angle Pt. Set Bt. S.W.&T. flush Per. Plan
69.35
NORWALK
54' 10"
179° 20' 33"
HAYFORD ST
58.93
258.05 (meas.)
1) 1792020
4) 3572200
6) 3560320
AV. 1792033
Ho. # 12166 Set L&T. in conc. porch
(25)
(40)
cont. pg # 225
RETURN TO
LOS ANGELES COUNTY SURVEYOR
726 LOS ANGELES COUNTY
ENGINEERING BLDG.
Do not extend notes this side of this line.
Note: Any Additions or Changes on This Sheet Must be Made or Circled in Red Ink With Date and Name of Person Making Change.

PWFB 0726

446

Notes Ck'd by Aja	Survey of Artesia - Norwalk
Map No.	W. O. 6951 Tape No. Sr'd. °F
Office Work	Surveyed by English
Checked	Notes Sappell Date 12-54
Date	Indexed A. C. Johnson

F. B. 1799 Pg. 227

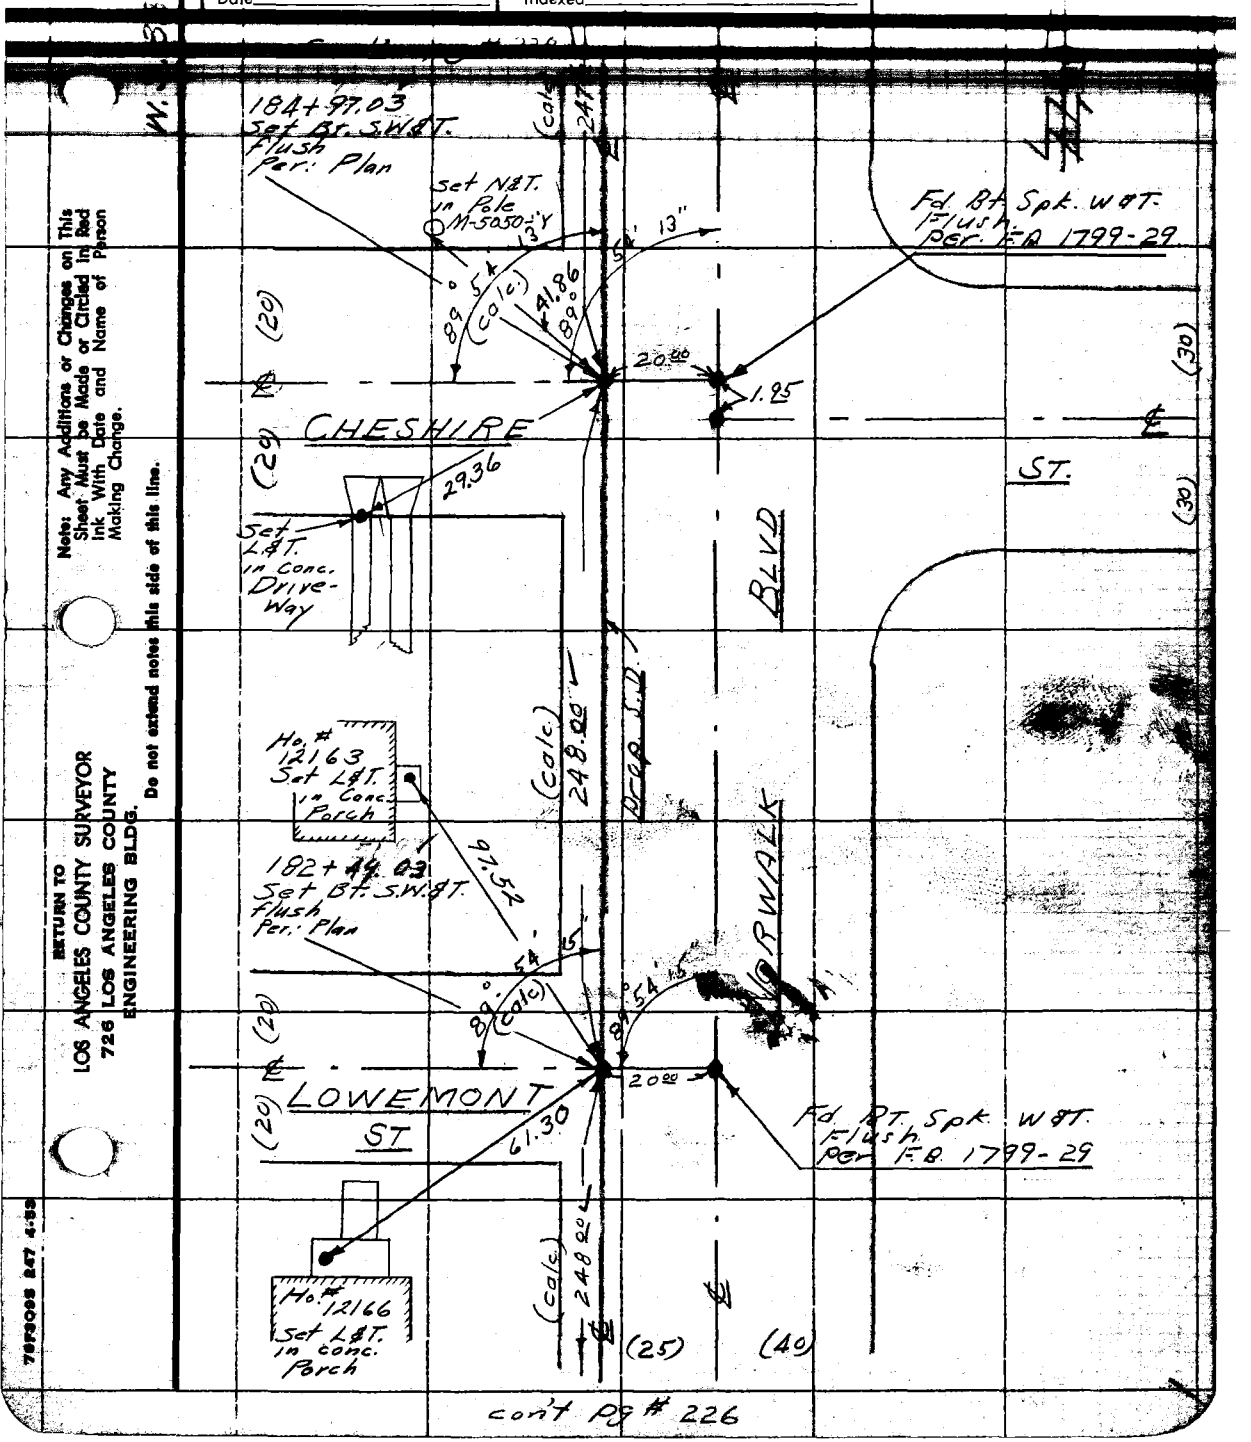

con't Pg # 226

Note: Any Additions or Changes on This Sheet Must be Made or Circled in Red Ink With Date and Name of Person Making Change.

Do not extend notes this side of this line.

RETURN TO
LOS ANGELES COUNTY SURVEYOR
726 LOS ANGELES COUNTY
ENGINEERING BLDG.

76F3095 247 4-53

PWFB 0726 Con't pg # 229. 447, 448

F.B. 1799 PG. 228

W.S. 33-D-4

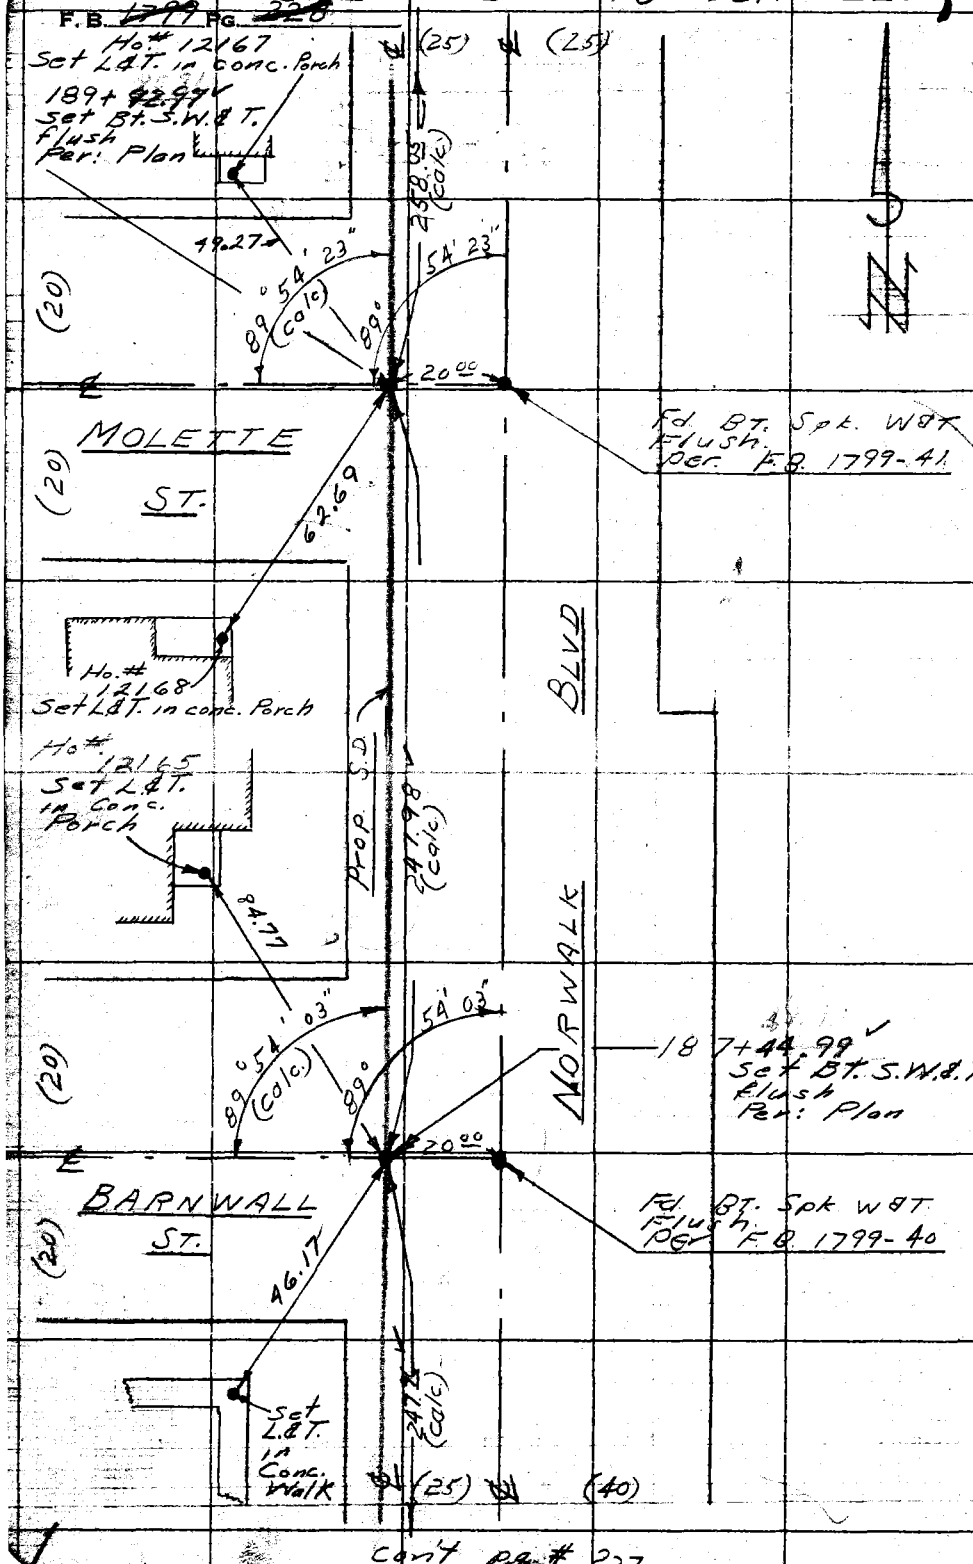

RETURN TO
LOS ANGELES COUNTY SURVEYOR
726 LOS ANGELES COUNTY
ENGINEERING BLDG.
Do not extend notes this side of this line.

Note: Any Additions or Changes on This Sheet Must be Made or Circled in Red Ink With Date and Name of Person Making Change.

Con't pg # 227

PWFB 0726

449, 450

F.B. 1799 PG. 229

Notes Ck'd by Aja
Map No.
Office Work
Checked
Date

Survey of Artesia - Norwalk
W. O. 6951 Tape No. St'd. °F
Surveyed by English
Notes Sappell Date 1-54
Indexed E. C. Johnson

Con't pg #230

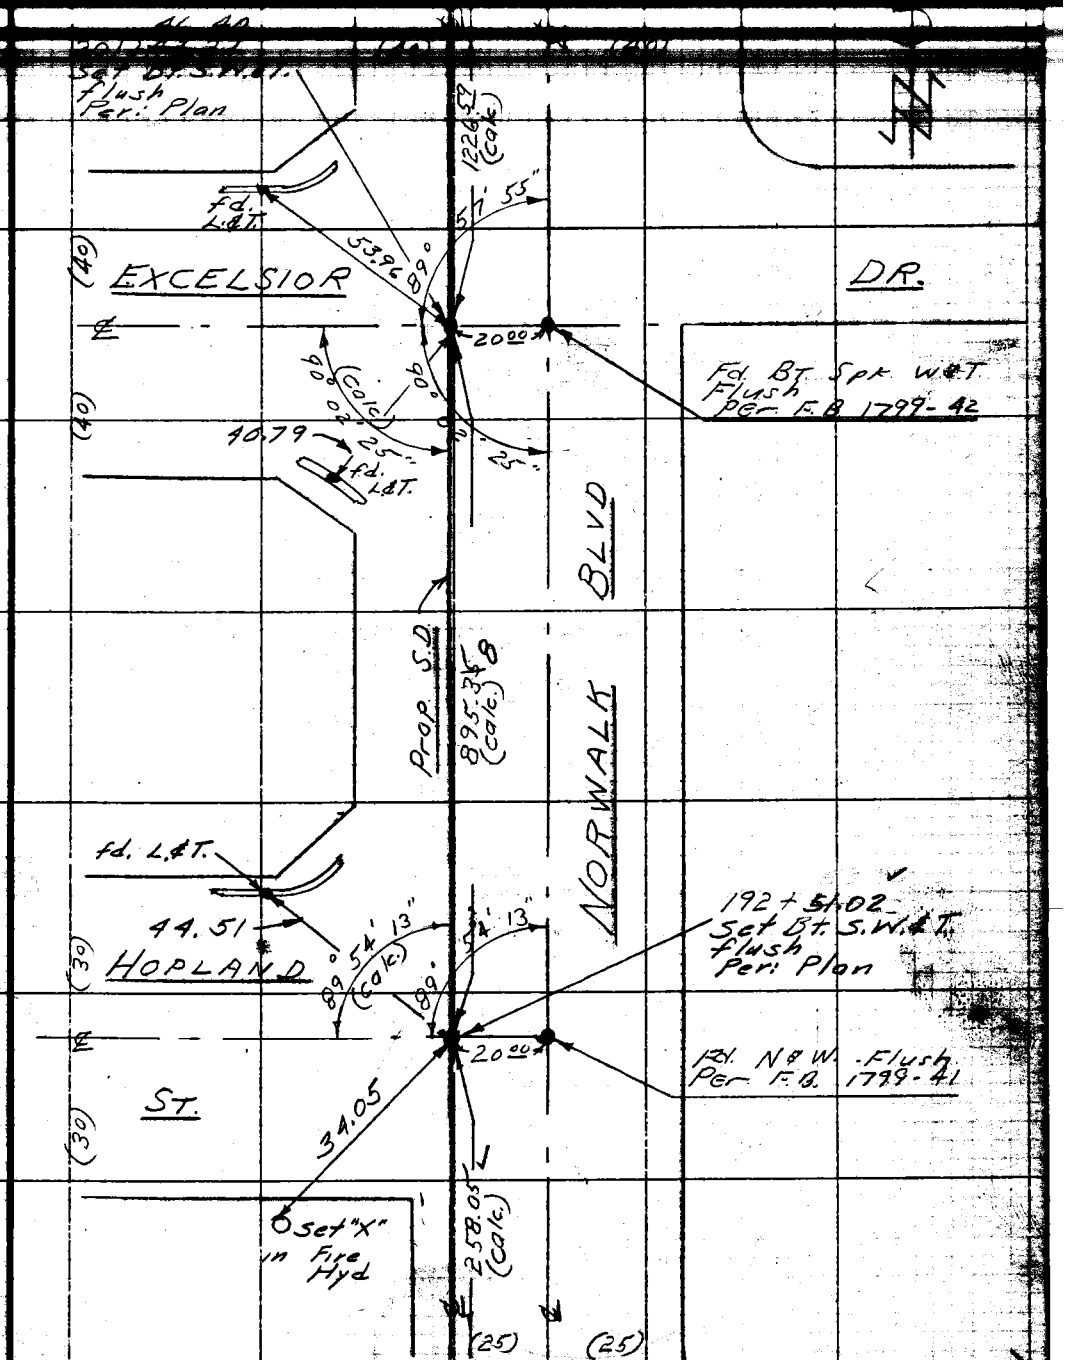

Note: Any Additions or Changes on This Sheet Must be Made or Circled in Red Ink With Date and Name of Person Making Change.

Do not extend notes this side of this line.

RETURN TO
LOS ANGELES COUNTY SURVEYOR
725 LOS ANGELES COUNTY
ENGINEERING BLDG.

76F3098 247 4-53

con't pg # 228

con't pg # 231

F.B. ~~1799~~ PG. ~~224~~

PWFB 0726

W.S. 33-D-4

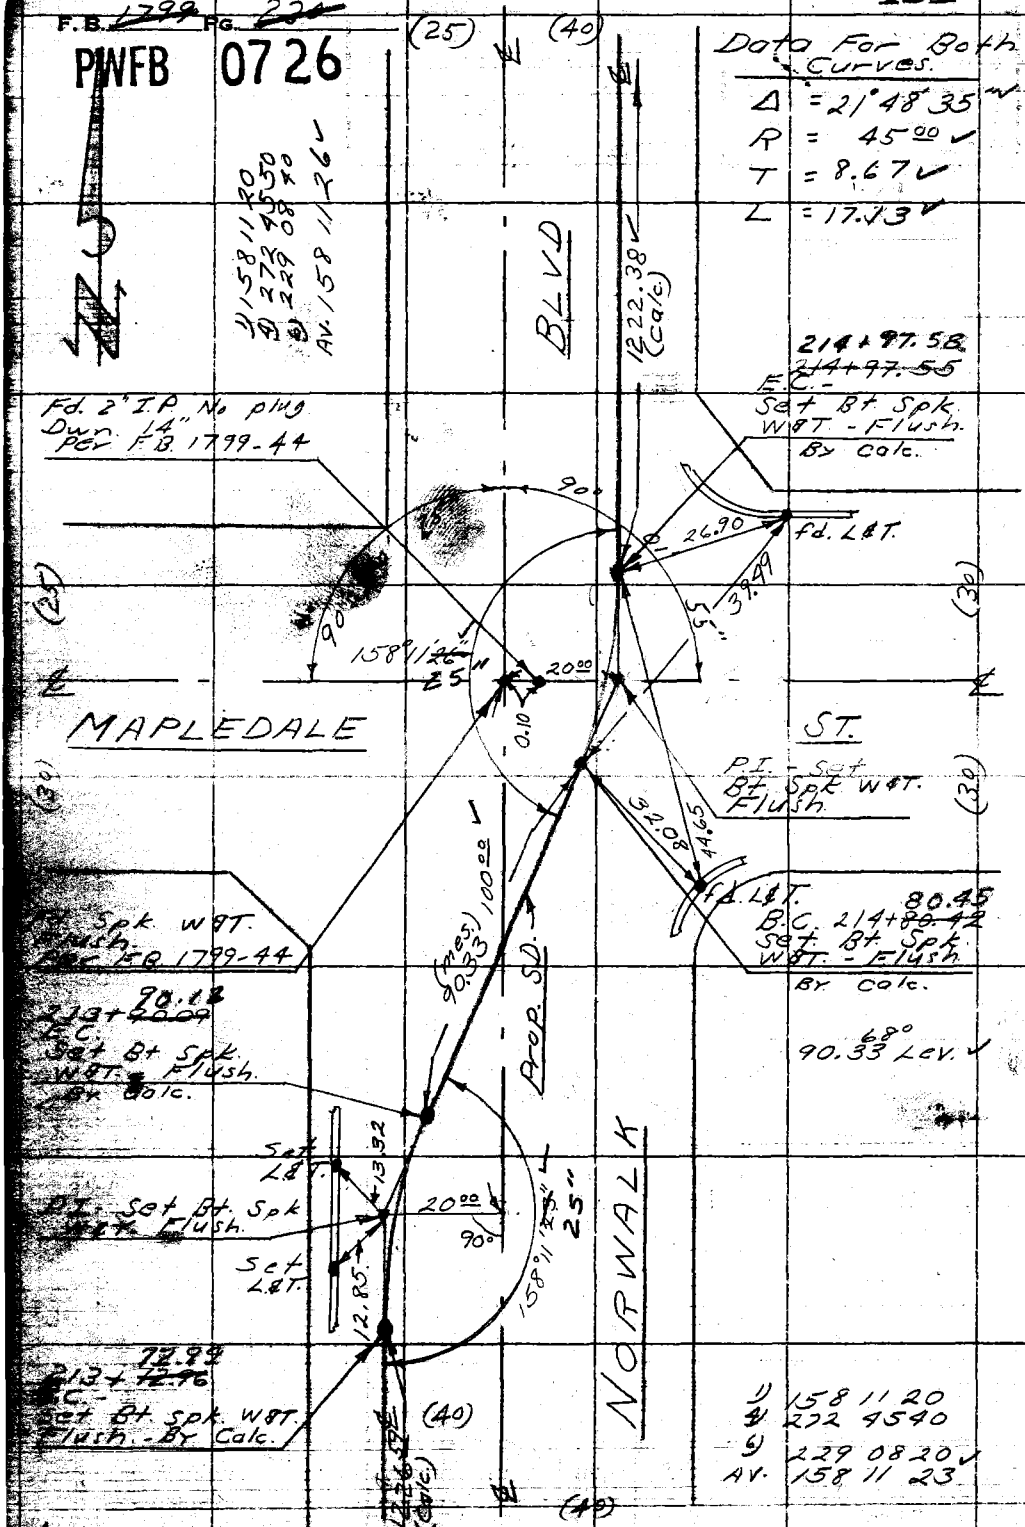

Data For Both Curves.

Δ = 21°48'35"

R = 45.00

T = 8.67

L = 17.13

1) 158 11 20
4) 272 45 50
6) 229 08 40
AV. 158 11 26

1) 158 11 20
4) 272 45 40
6) 229 08 20
AV. 158 11 23

179 59 60
158 11 25
21 48 35

RETURN TO
LOS ANGELES COUNTY SURVEYOR
726 LOS ANGELES COUNTY
ENGINEERING BLDG.
Do not extend notes this side of this line.

Note: Any Additions or Changes on This Sheet Must be Made or Circled in Red Ink With Date and Name of Person Making Change.

con't pg #229

PWFB 0726 452

Notes Ck'd by	Survey of Artesia - Norwalk	F.B. ~~1799~~ Pg. ~~231~~
Map No.	W. O. 695 Tape No. Std. °F	Con't pg #232
Office Work	Surveyed by English	
Checked	Notes Sappell Date 1-54	
Date	Indexed E. C. Johnson	

W. 3 D-4

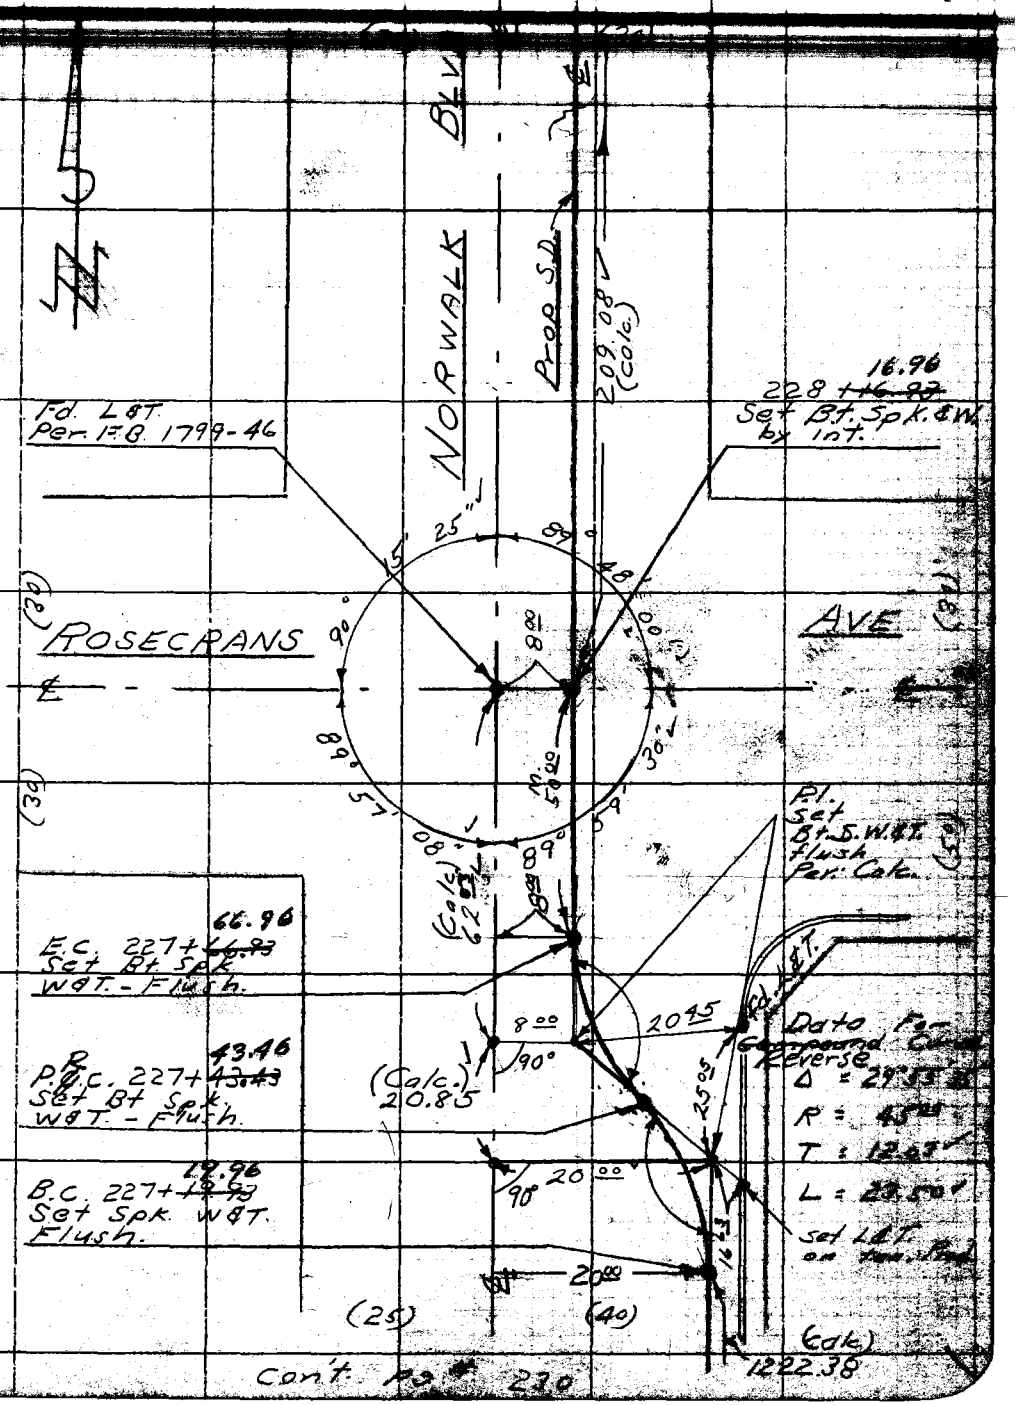

Con't pg # 230

Note: Any Additions or Changes on This Sheet Must be Made or Circled in Red Ink With Date and Name of Person Making Change.

Do not extend notes this side of this line.

RETURN TO LOS ANGELES COUNTY SURVEYOR 726 LOS ANGELES COUNTY ENGINEERING BLDG.

TERMOSA 247 4-58

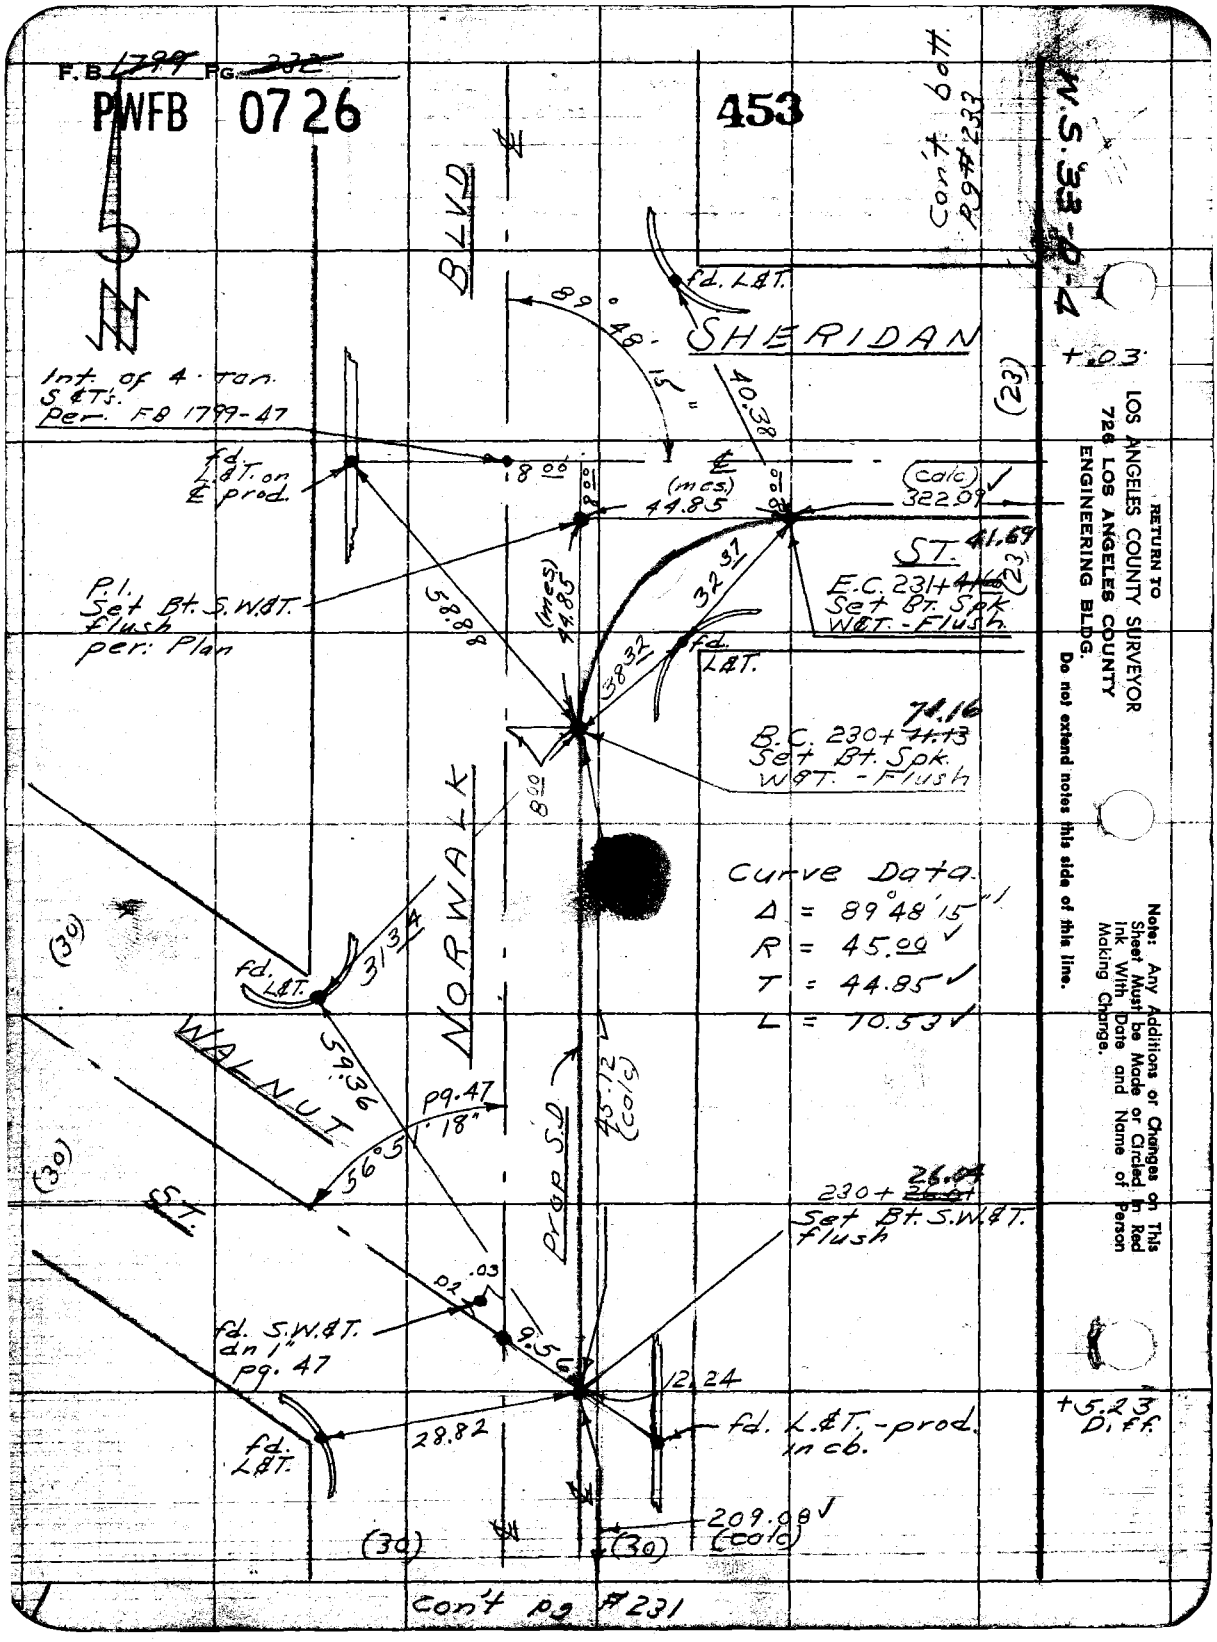
F.B. 1799 Pg. 232
PWFB 0726
453
W.S. 33-D-4
Con't bott. pg #233
BLVD
SHERIDAN
fd. L&T.
89° 48' 15"
40.38
Int. of 4 Ton. S&T's. Per. FB 1799-47
fd. L&T. on ℄ prod.
8.00
(mes.) 44.85
(calc) 322.09
ST. 41.69
E.C. 231+ 41.69
Set Bt. Spk. W&T. - Flush
P.I. Set Bt. S.W.&T. flush per: Plan
58.88
(mes.) 44.85
32.37
38.32
fd. L&T.
B.C. 230+ 71.16
Set Bt. Spk. W&T. - Flush
NORWALK
Curve Data
Δ = 89° 48' 15"
R = 45.00
T = 44.85
L = 70.53
(30)
fd. L&T.
31.34
WALNUT
59.36
pg. 47
56° 51' 18"
45.12 (calc)
Prop S.D.
ST.
230+ 26.04
Set Bt. S.W.&T. flush
.03
fd. S.W.&T. dn 1" pg. 47
9.56
12.24
fd. L&T.
28.82
fd. L.&T. - prod. in cb.
209.08 (calc)
+.03
+5.23 Diff.
Con't pg #231
RETURN TO
LOS ANGELES COUNTY SURVEYOR
726 LOS ANGELES COUNTY
ENGINEERING BLDG.
Do not extend notes this side of this line.
Note: Any Additions or Changes on This Sheet Must be Made or Circled in Red Ink With Date and Name of Person Making Change.

PWFB 0726

454

Notes Ck'd by Aja	Survey of Artesia - Norwalk	F.B. ~~1799~~ Pg. ~~233~~
Map No.	W. O. 6951 Tape No. St'd. °F	
Office Work	Surveyed by English	
Checked	Notes Sappell Date 1-54	
Date	Indexed A. C. Johnson	

D-4

Note: Any Additions or Changes on This Sheet Must be Made or Circled in Red Ink With Date and Name of Person Making Change.

Do not extend notes this side of this line.

RETURN TO
LOS ANGELES COUNTY SURVEYOR
726 LOS ANGELES COUNTY
ENGINEERING BLDG.

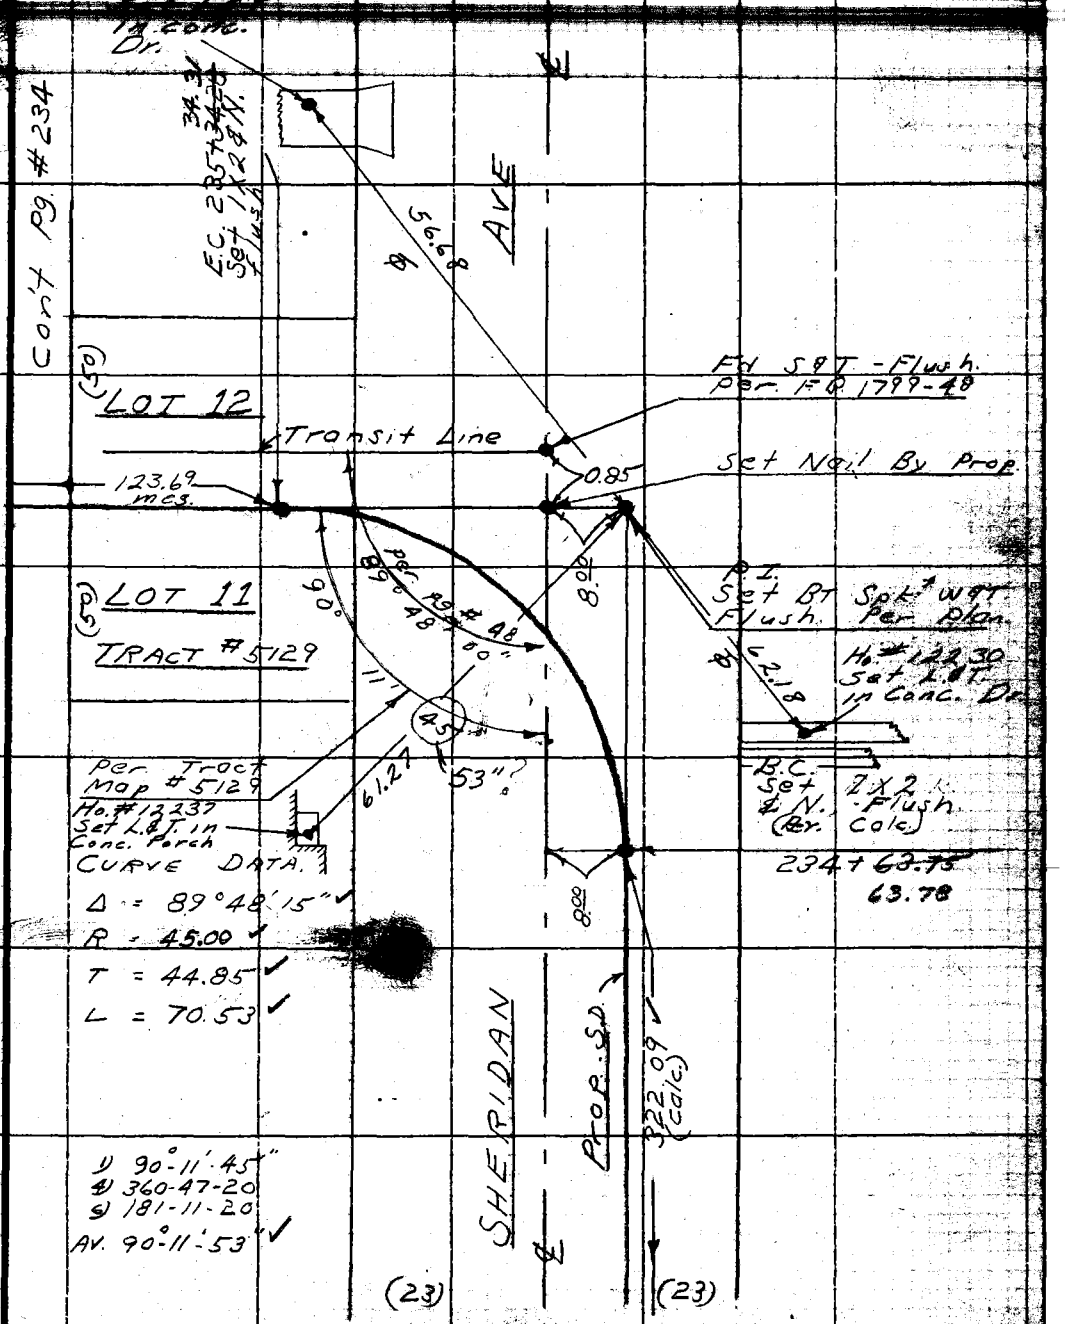

76F3098 247 4-53

F. B. ~~1799~~ PG. ~~221~~

PWFB 0726

455

1 - 133 52 20
4 - 125 30 00
6 - 83 15 00
Av. 133°52'30"

W.S. 33-D-4

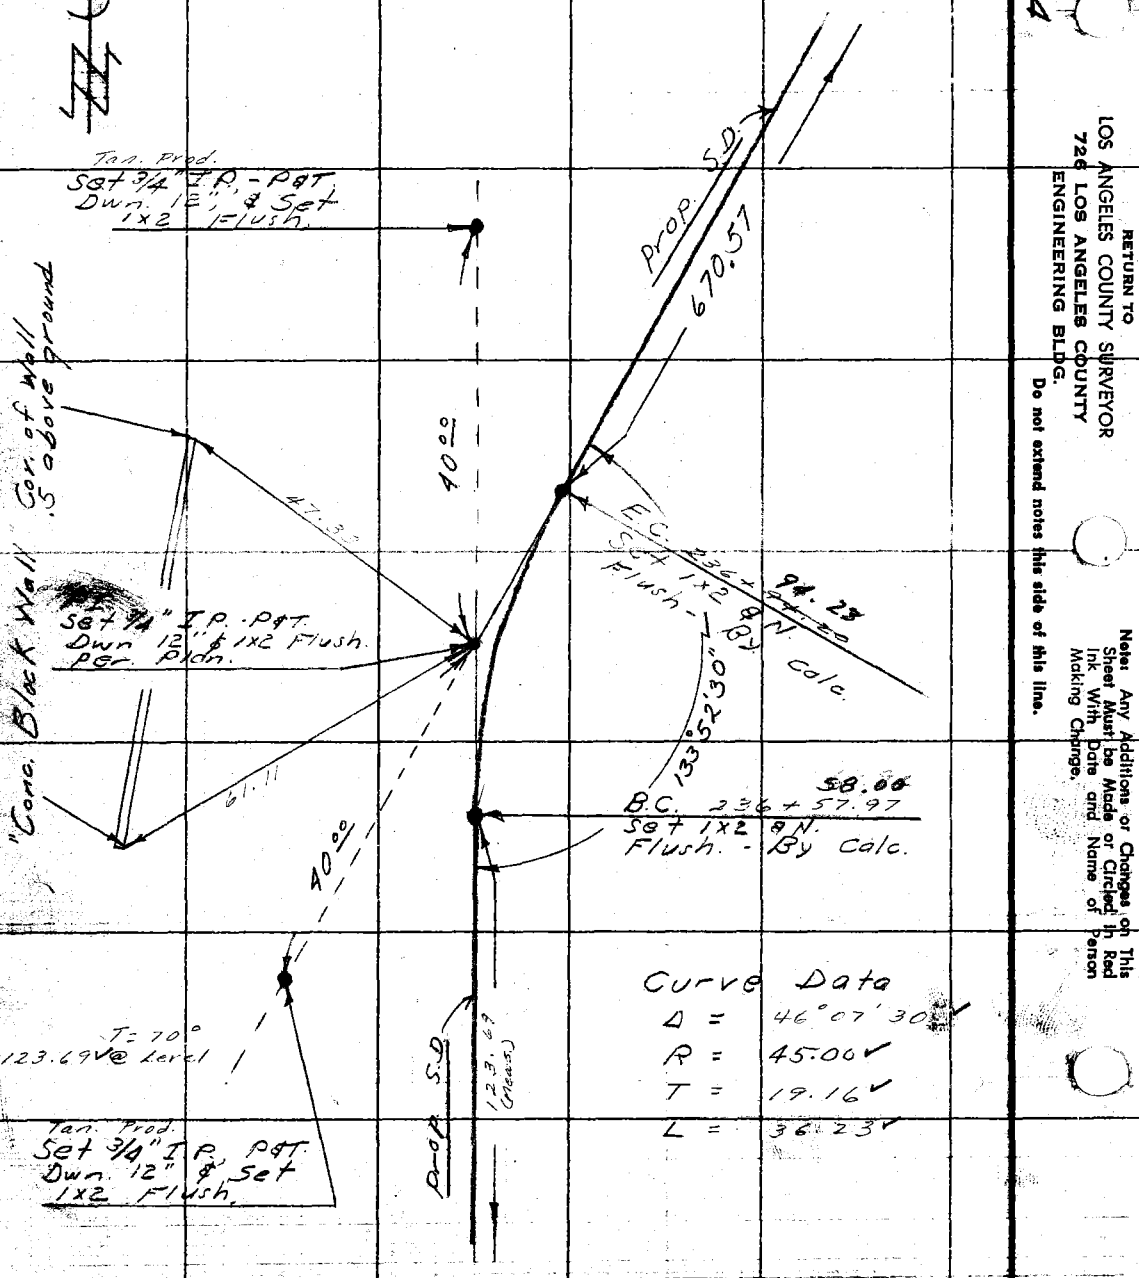

Curve Data

Δ = 46°07'30"
R = 45.00
T = 19.16
L = 36.23

RETURN TO
LOS ANGELES COUNTY SURVEYOR
726 LOS ANGELES COUNTY
ENGINEERING BLDG.
Do not extend notes this side of this line.

Note: Any Additions or Changes on This Sheet Must be Made or Circled in Red Ink With Date and Name of Person Making Change.

Notes Ck'd by
Map No.
Office Work
Checked
Date

Survey of Artesia - Norwalk
W. O. 6957 Tape No. Sr'd. °F
Surveyed by English
Notes Sappell Date 1-54
Indexed

F. B. 1799 Pg. 235

Blank

Note: Any Additions or Changes on This Sheet Must be Made or Circled in Red Ink With Date and Name of Person Making Change.

Do not extend notes this side of this line.

RETURN TO
LOS ANGELES COUNTY SURVEYOR
726 LOS ANGELES COUNTY
ENGINEERING BLDG.

76F3098 247 4-53

RETURN TO
LOS ANGELES COUNTY SURVEYOR
726 LOS ANGELES COUNTY
ENGINEERING BLDG.

Note: Any Additions or Changes on This Sheet Must be Made or Circled in Red Ink With Date and Name of Person Making Change.

Do not extend notes this side of this line.

W.S. 33-D-4

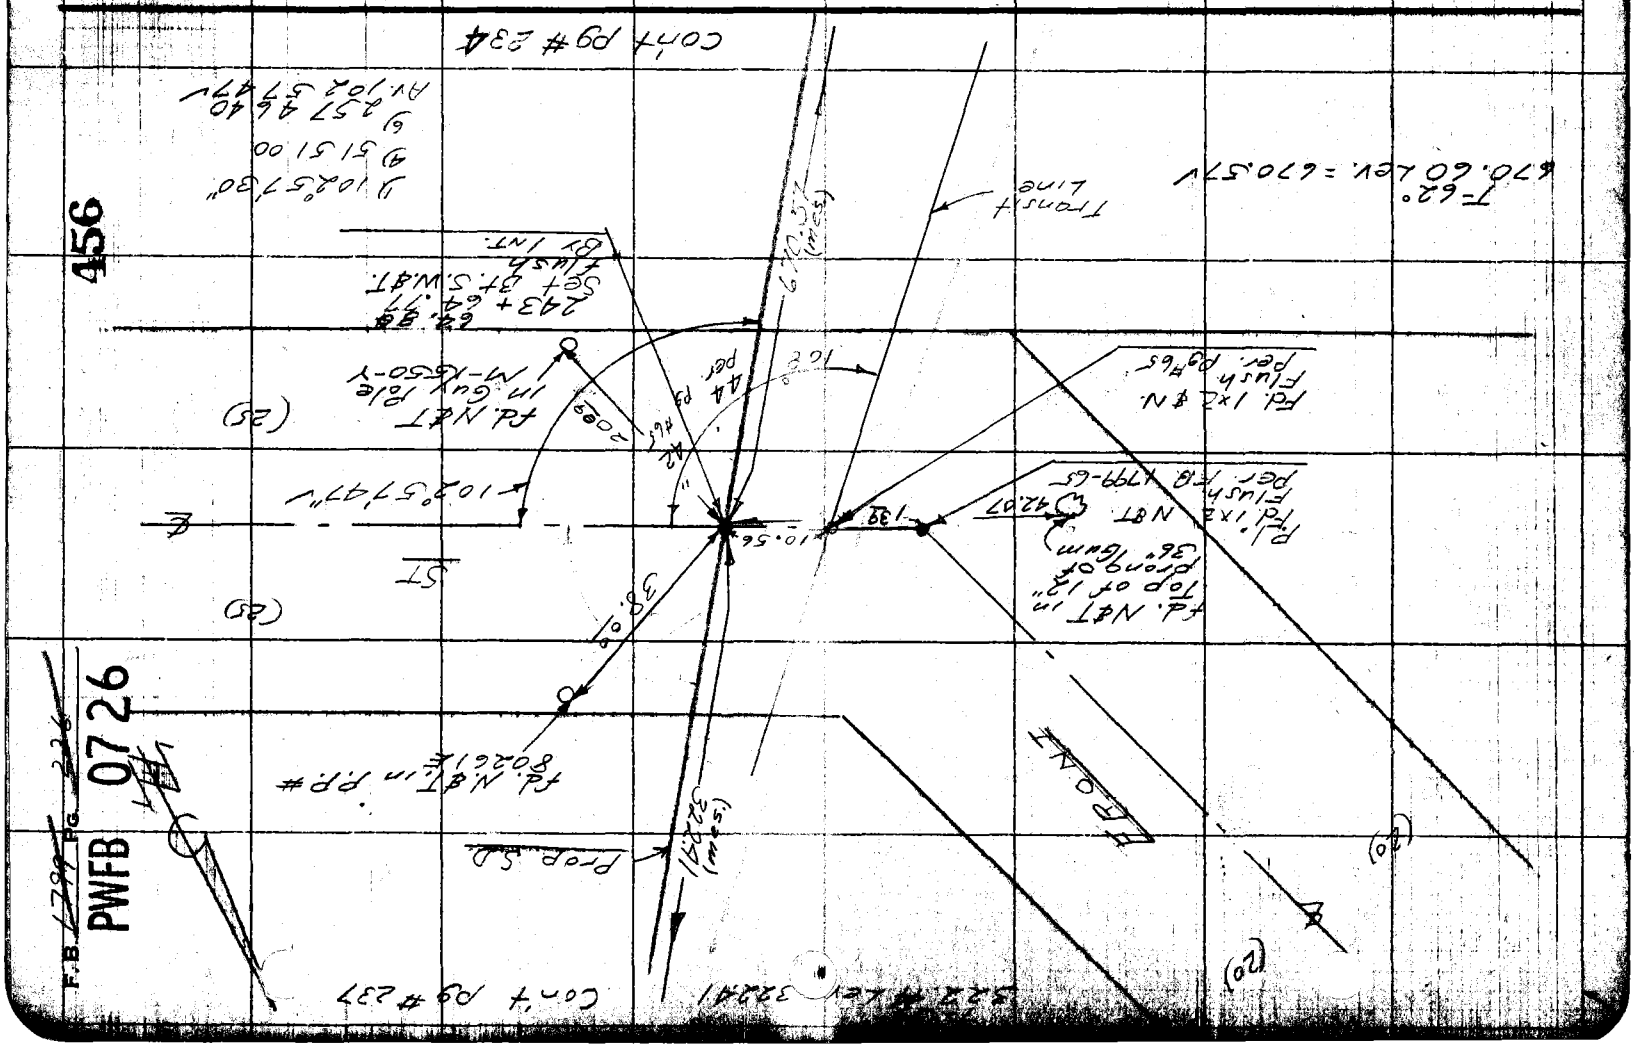

456

F.B. 1799 PG. 226

PWFB 0726

PWFB 0726 457

F. B. 1799 PG. 237

Notes Cr'd by Aja	Survey of Artesia - Norwalk
Map No.	W. O. 6957 Tape No. Sr'd. °F
Office Work	Surveyed by English
Checked	Notes Sappell Date 1-54
Date	Indexed A C Johnson

Cont. pg # 238

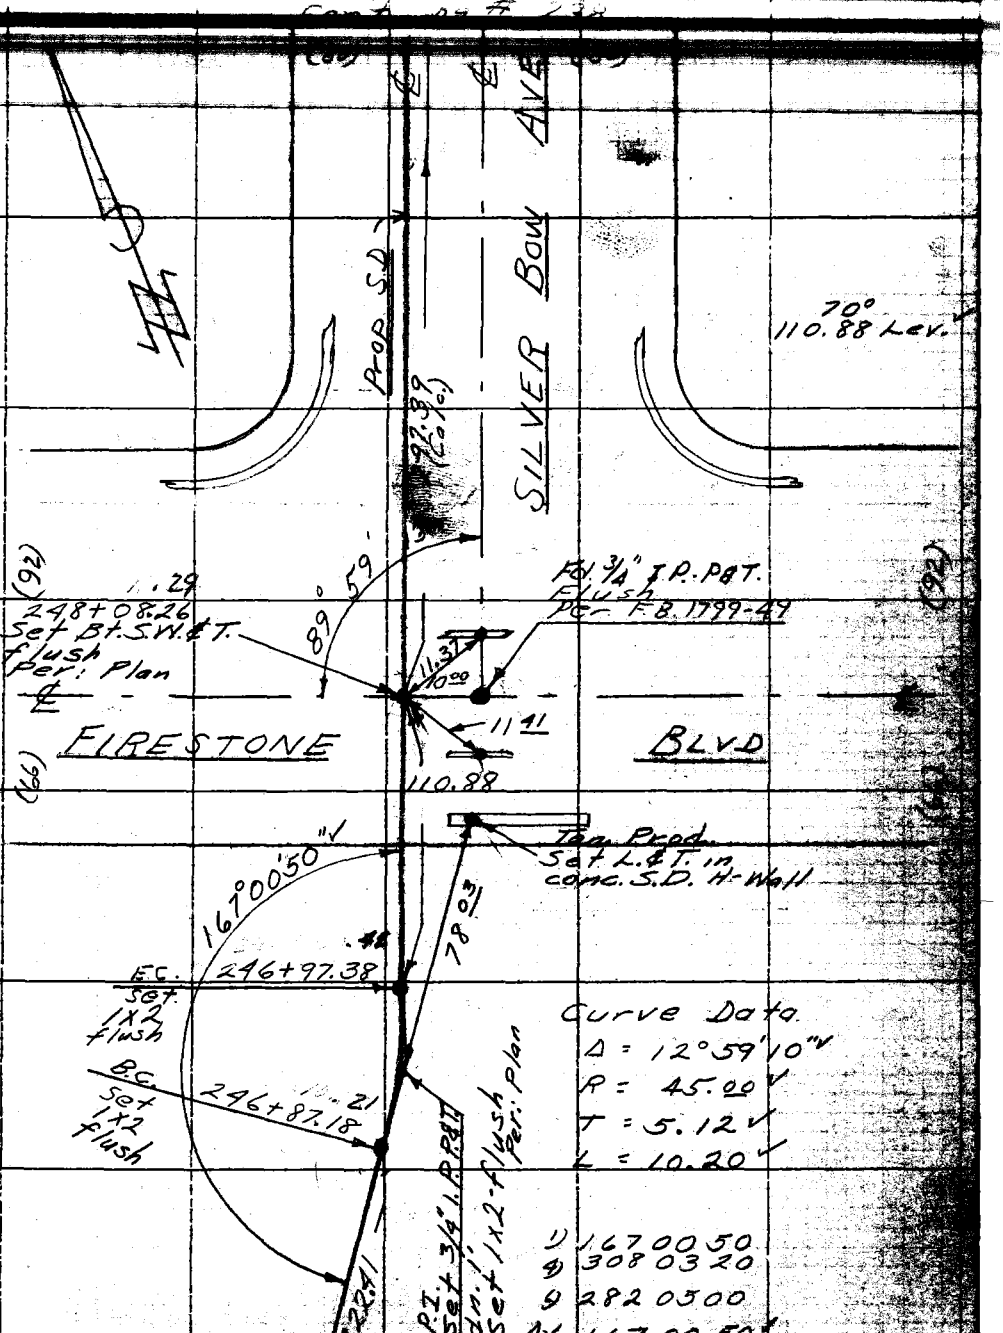

Cont. Pg # 236

Note: Any Additions or Changes on This Sheet Must be Made or Circled in Red Ink With Date and Name of Person Making Change.

Do not extend notes this side of this line.

RETURN TO
LOS ANGELES COUNTY SURVEYOR
726 LOS ANGELES COUNTY
ENGINEERING BLDG.

F.B. 1799 PG. 238

RWFB 0726

W.S. 33-D-3

251+06
250 57 25
48 75

RETURN TO
LOS ANGELES COUNTY SURVEYOR
726 LOS ANGELES COUNTY
ENGINEERING BLDG.
Do not extend notes this side of this line.

Note: Any Additions or Changes on This Sheet Must be Made or Circled in Red Ink With Date and Name of Person Making Change.

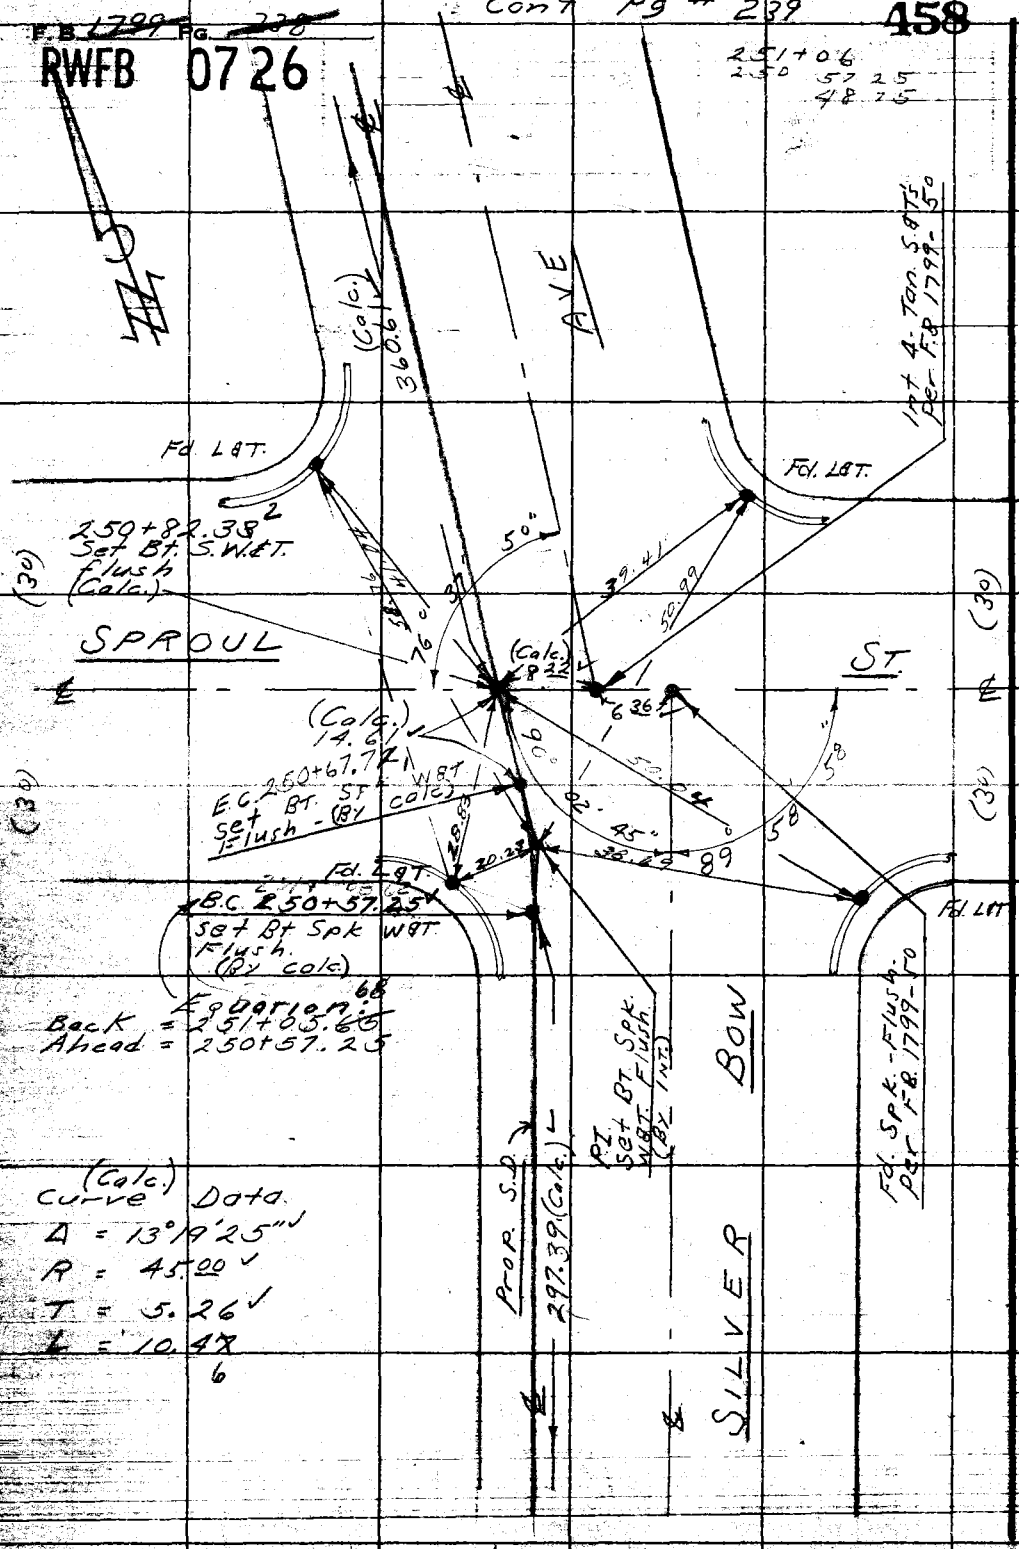

PWFB 0726

459

Notes Ck'd by	Survey of Artesia - Norwalk
Map No.	W. O. 6951 Tape No. Sr'd. °F
Office Work	Surveyed by English
Checked	Notes Sappell Date 1-54
Date	Indexed R C Johnson

F. B. 1799 Pg. 239

Con't pg # 240

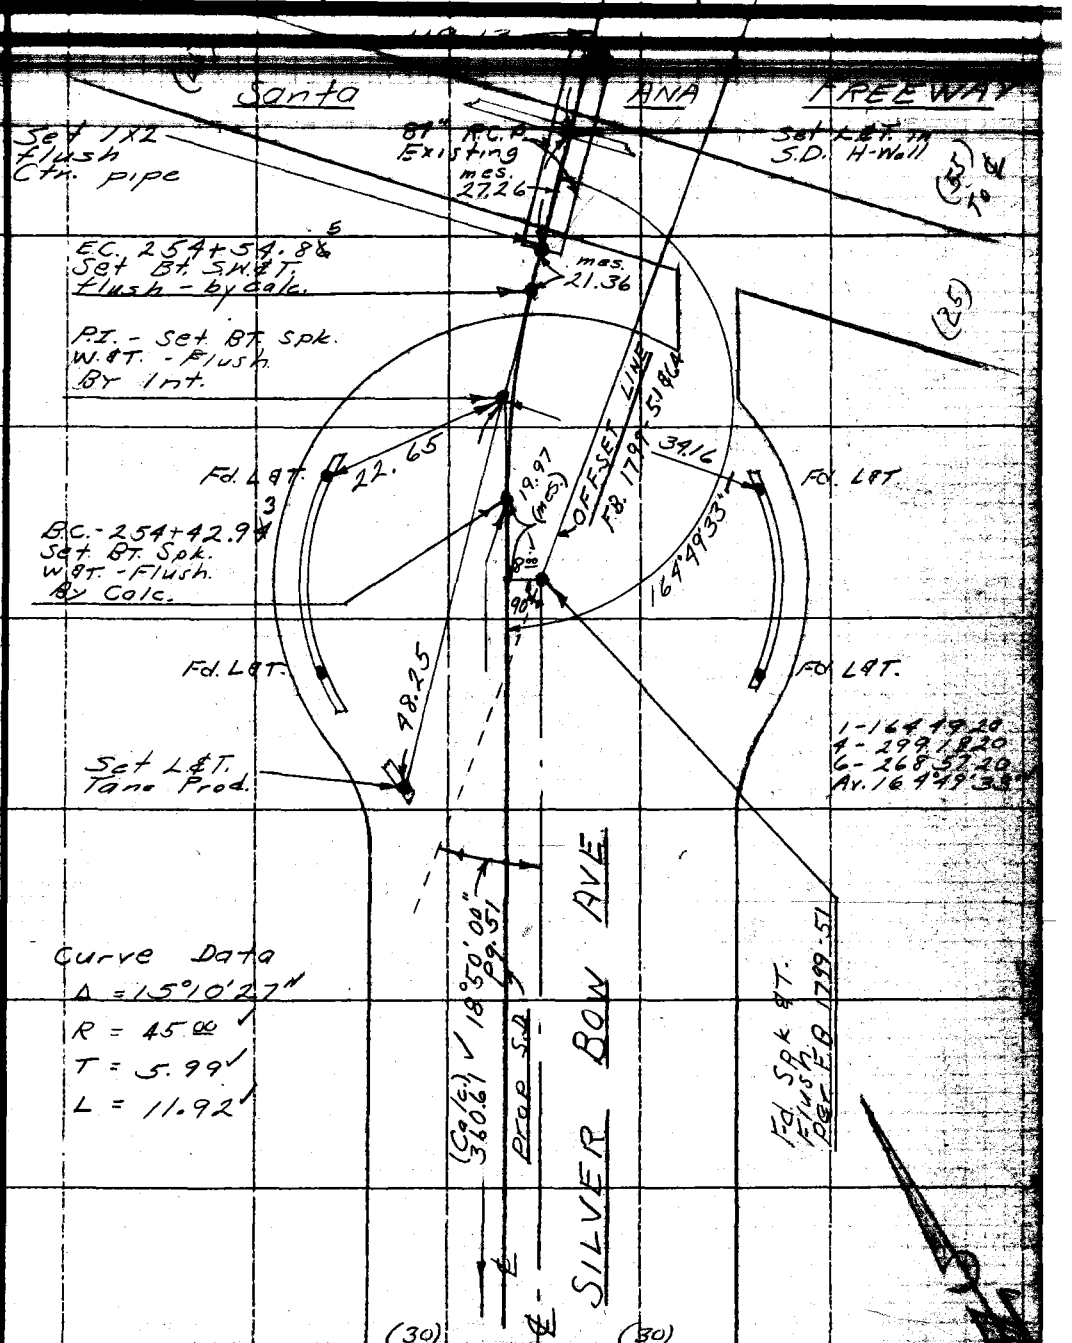

Note: Any Additions or Changes on This Sheet Must be Made or Circled in Red Ink With Date and Name of Person Making Change.

Do not extend notes this side of this line.

RETURN TO
LOS ANGELES COUNTY SURVEYOR
726 LOS ANGELES COUNTY
ENGINEERING BLDG.

149.48
3035
11913

Con't pg # 238

F.B. ~~1799~~ PG. ~~246~~

PWFB 0726

Con't pg # 241

1 - 164 59 20
4 - 299 58 20
6 - 269 57 20
Av. 164°59'33"

Calc.
Curve Data.
Δ = 15°00'27"
R = 45.00
T = 5.93
L = 11.79

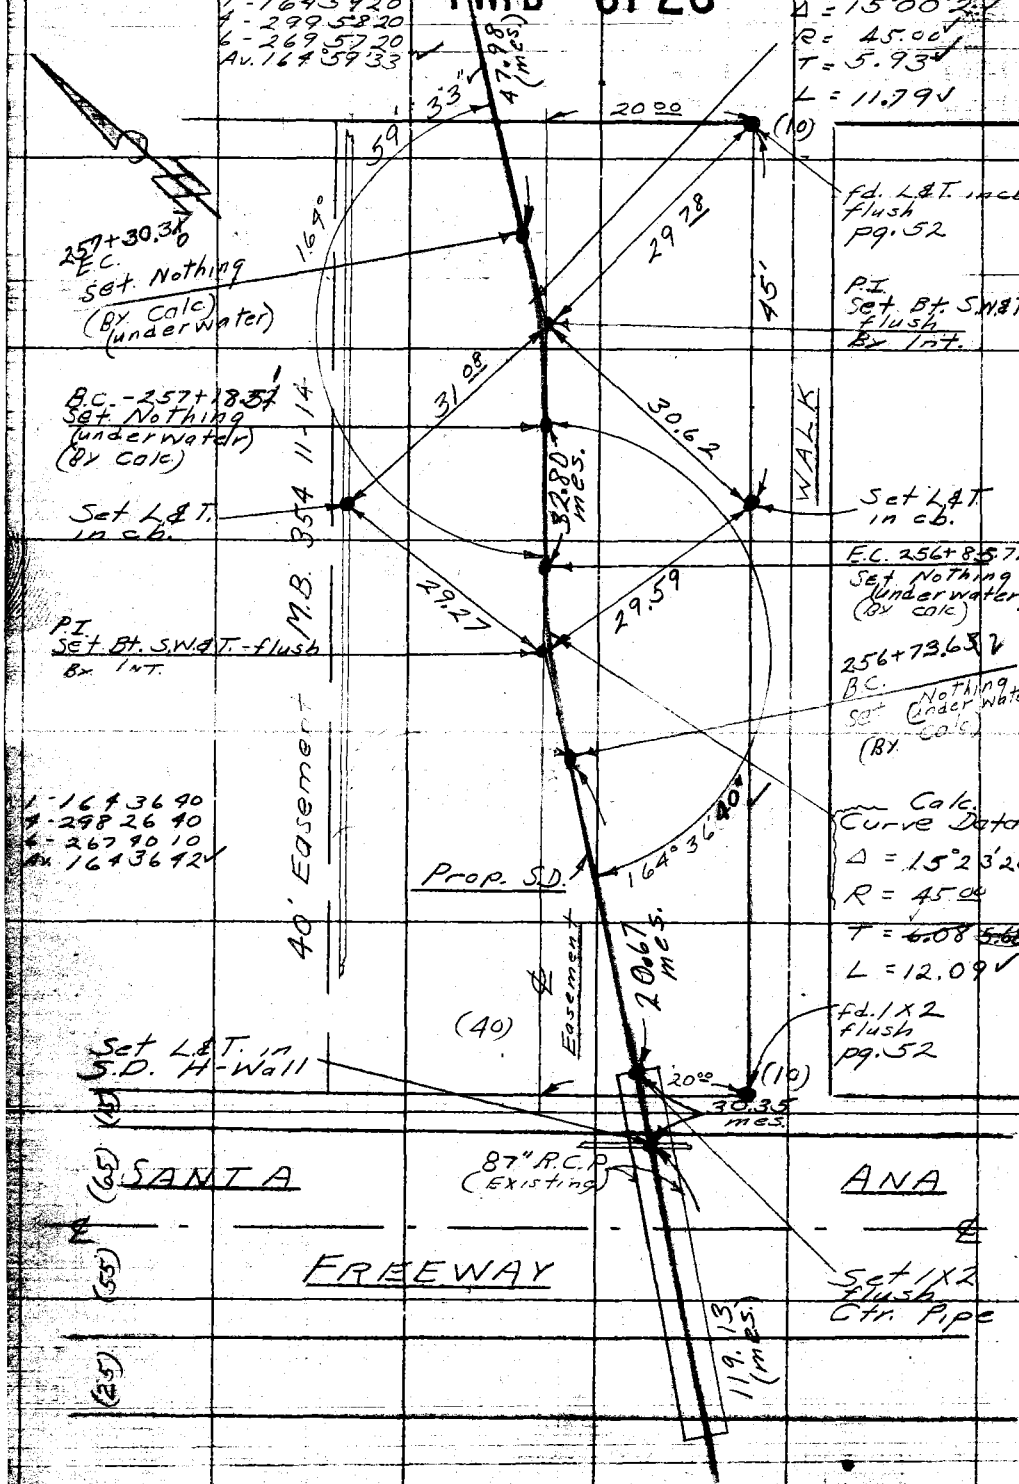

1 - 164 36 40
4 - 298 26 40
6 - 267 40 10
Av. 164 36 42

Calc.
Curve Data.
Δ = 15°23'20"
R = 45.00
T = ~~6.08~~ ~~5.68~~
L = 12.09

W.S. 33-D-3

3.91
5.93
7.98
3.91

26.75
6.08

RETURN TO
LOS ANGELES COUNTY SURVEYOR
726 LOS ANGELES COUNTY
ENGINEERING BLDG.

Do not extend notes this side of this line.

Note: Any Additions or Changes on This Sheet Must be Made or Circled in Red Ink With Date and Name of Person Making Change.

6.08
5.93
12.01

19.67

44.81
12.01
32.80

con't pg # 239

PWFB 0726 461, 462

Notes Ck'd by Ajo	Survey of Artesia - Norwalk	F. B. [illegible] PG. [illegible]
Map No.	W. O. 6951 Tape No. St'd. °F	
Office Work	Surveyed by English	
Checked	Notes " Date 1-54	
Date	Indexed C. Johnson	

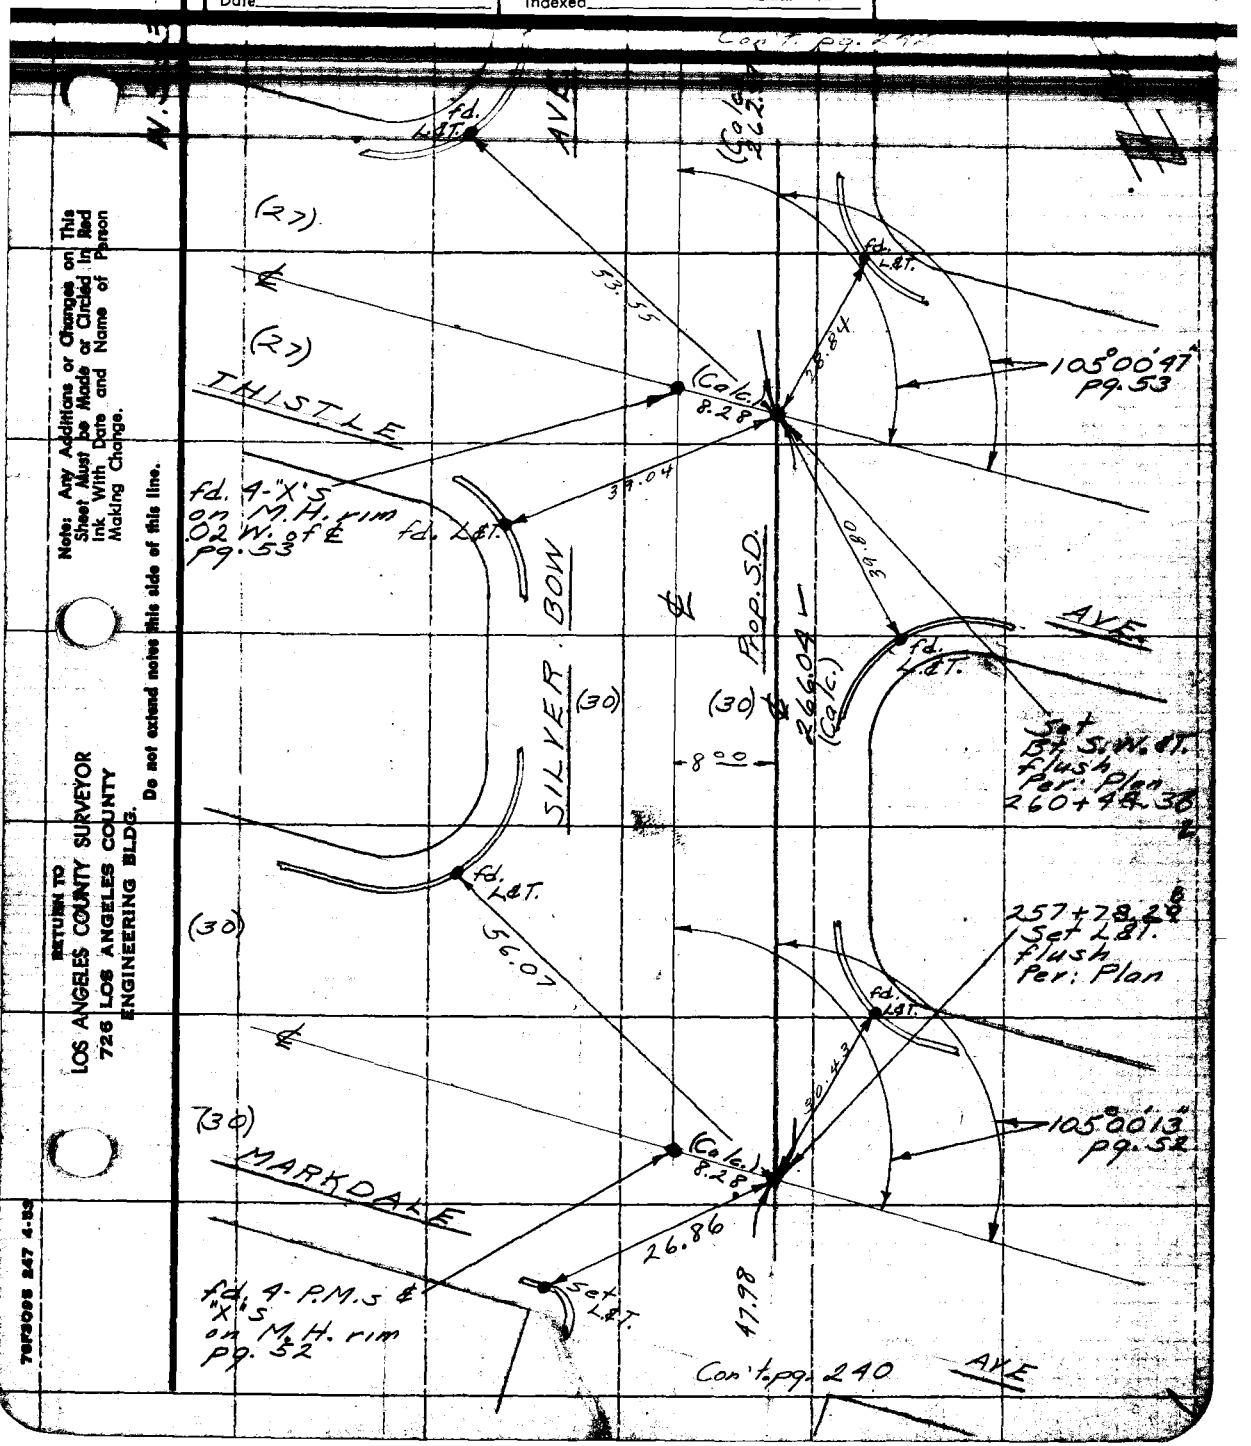

Note: Any Additions or Changes on This Sheet Must be Made or Circled in Red Ink With Date and Name of Person Making Change.

Do not extend notes this side of this line.

RETURN TO
LOS ANGELES COUNTY SURVEYOR
726 LOS ANGELES COUNTY
ENGINEERING BLDG.

76F3095 247 4-53

F.B. 1729 PG. 24

PWFB 0726

463

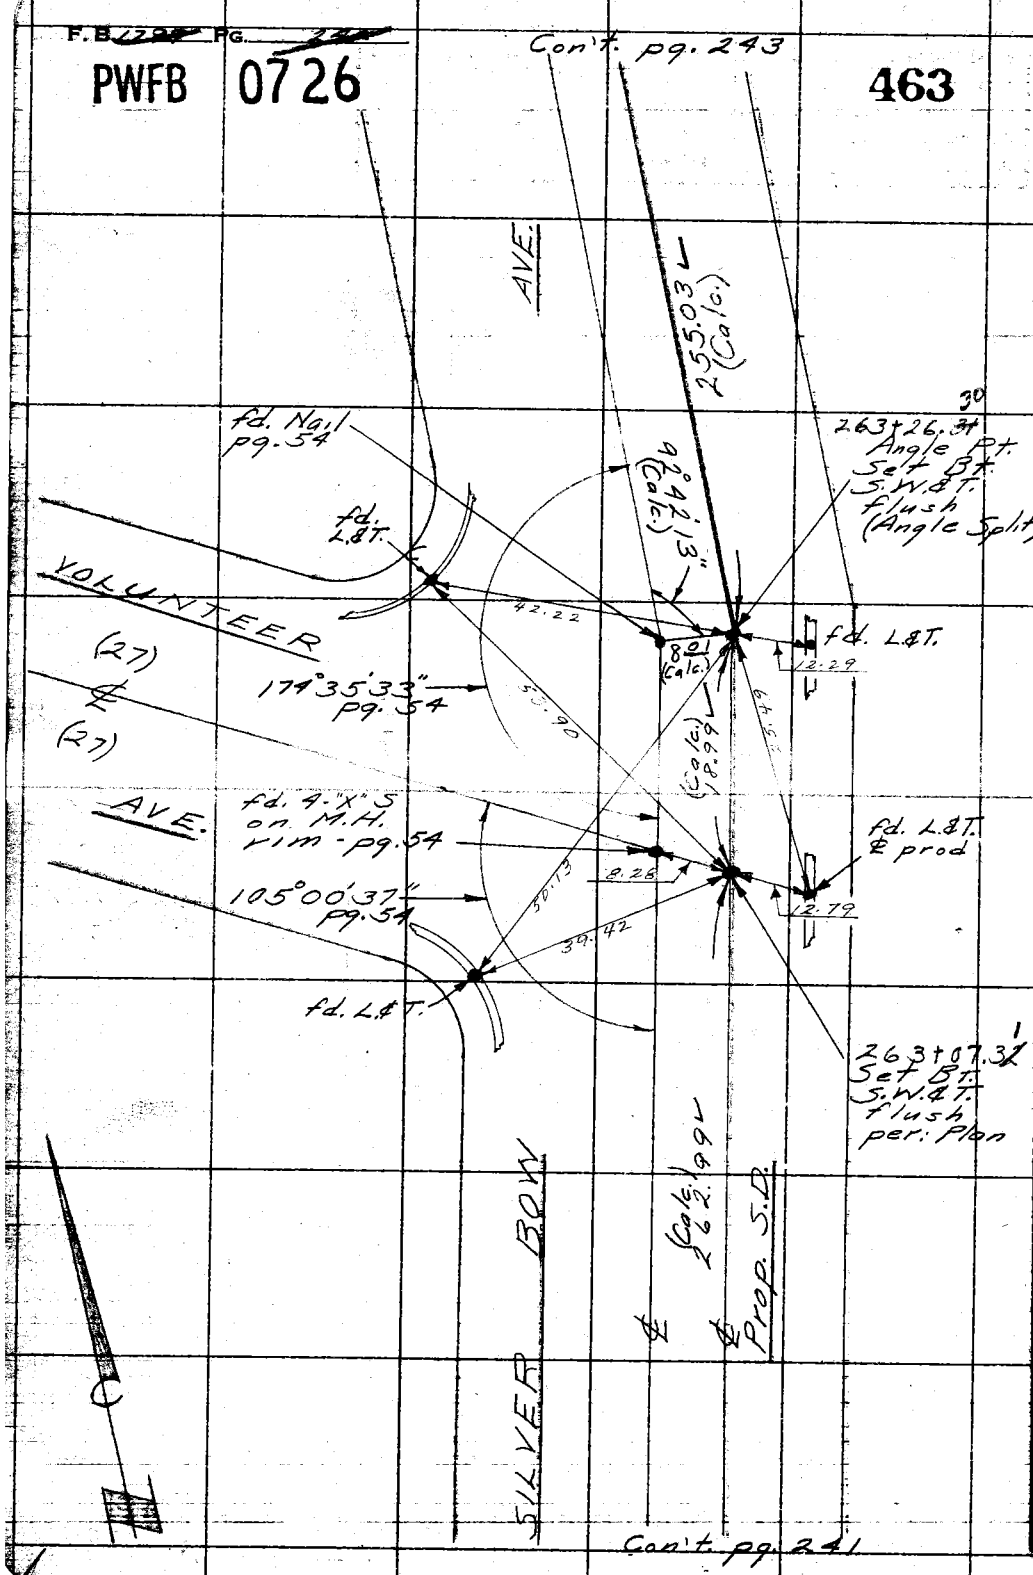

W.S. 33-D-3

RETURN TO
LOS ANGELES COUNTY SURVEYOR
726 LOS ANGELES COUNTY
ENGINEERING BLDG.

Do not extend notes this side of this line.

Note: Any Additions or Changes on This Sheet Must be Made or Circled in Red Ink With Date and Name of Person Making Change.

PWFB 0726

464

Notes Ck'd by Aju	Survey of Artesia-Norwalk	F. B. [illegible] Pg. [illegible]
Map No.	W. O. 6951 Tape No. St'd. °F	
Office Work	Surveyed by English	
Checked	Notes Date 1-54	
Date	Indexed E. C. Johnson	

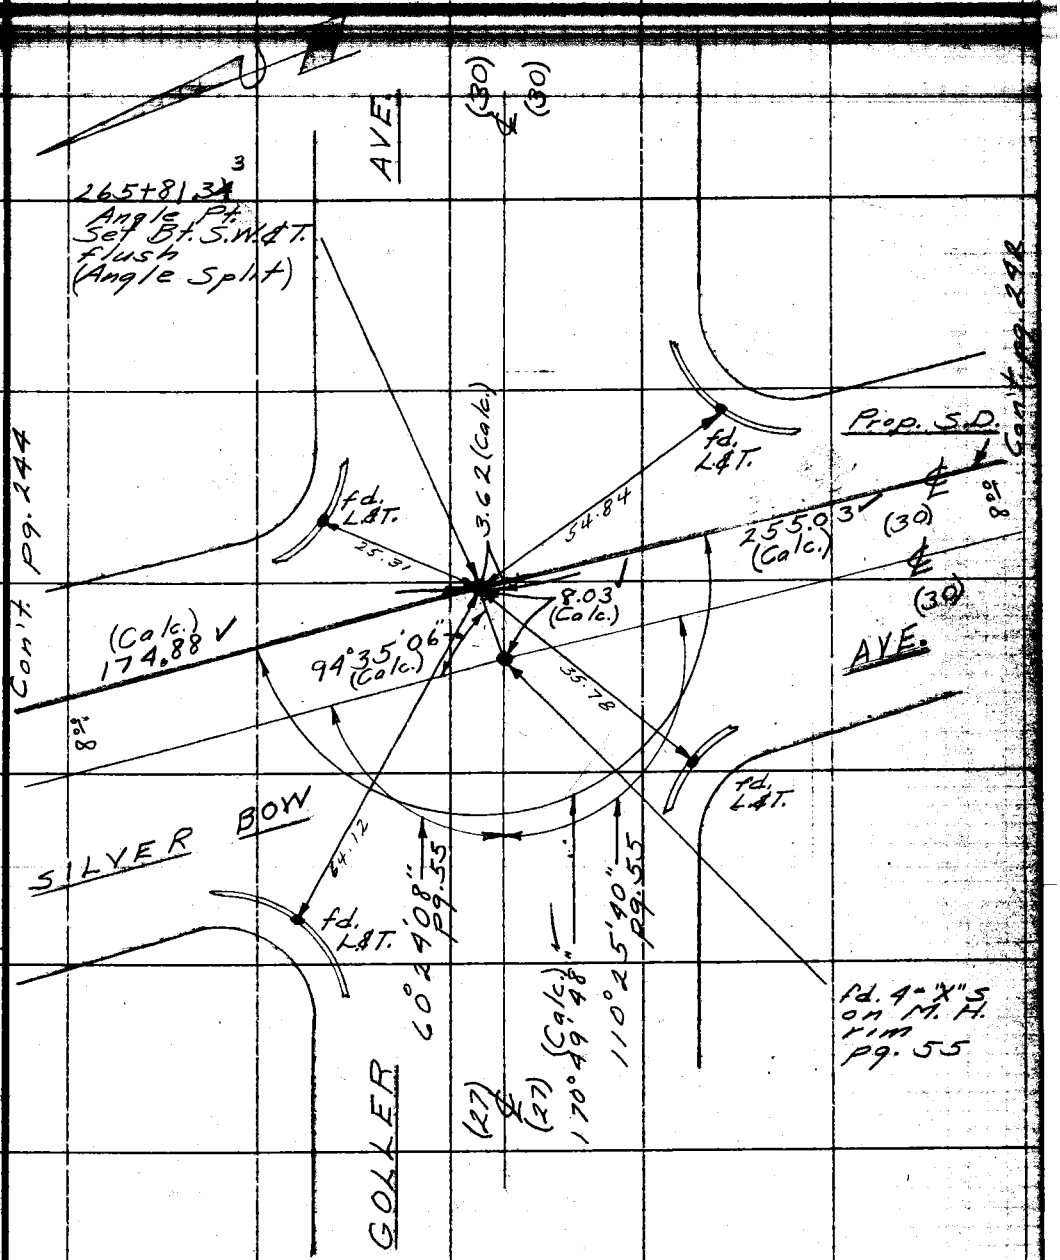

Note: Any Additions or Changes on This Sheet Must be Made or Circled in Red Ink With Date and Name of Person Making Change.

Do not extend notes this side of this line.

RETURN TO
LOS ANGELES COUNTY SURVEYOR
726 LOS ANGELES COUNTY
ENGINEERING BLDG.

76F3098 247 4-53

PWFB 0726

465

F.B. [illegible] PG. [illegible]

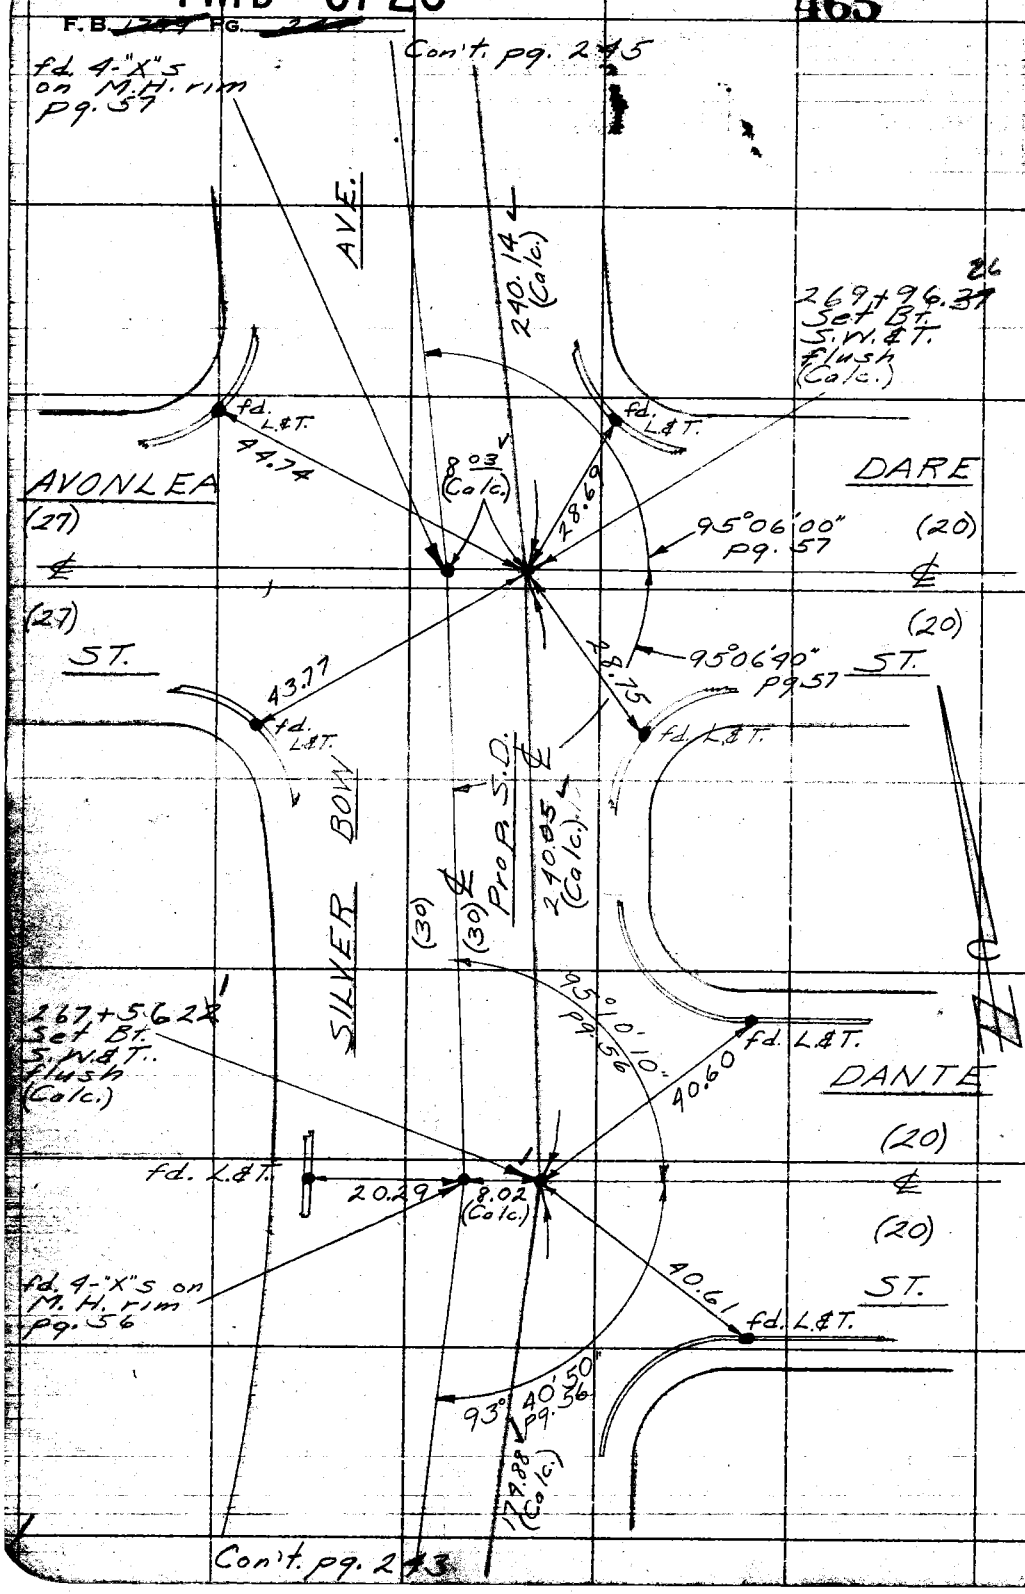

W.S. 33-D-3

RETURN TO
LOS ANGELES COUNTY SURVEYOR
726 LOS ANGELES COUNTY
ENGINEERING BLDG.

Do not extend notes this side of this line.

Note: Any Additions or Changes on This Sheet Must be Made or Circled in Red Ink With Date and Name of Person Making Change.

PWFB 0826

397

Notes Ck'd by Aja	Survey of Artesia - Norwalk	F. B. ~~1797~~ Pg. ~~245~~ 15.92
Map No.	W. O. 695 Tape No. Std. °F	275+ ~~[illegible]~~
Office Work	Surveyed by English	∡ P.T. - B.C.
Checked	Notes " Date 1-54	Set Bt. S.W.&T.
Date	Indexed A. C. Johnson	flush @ Split of Angle

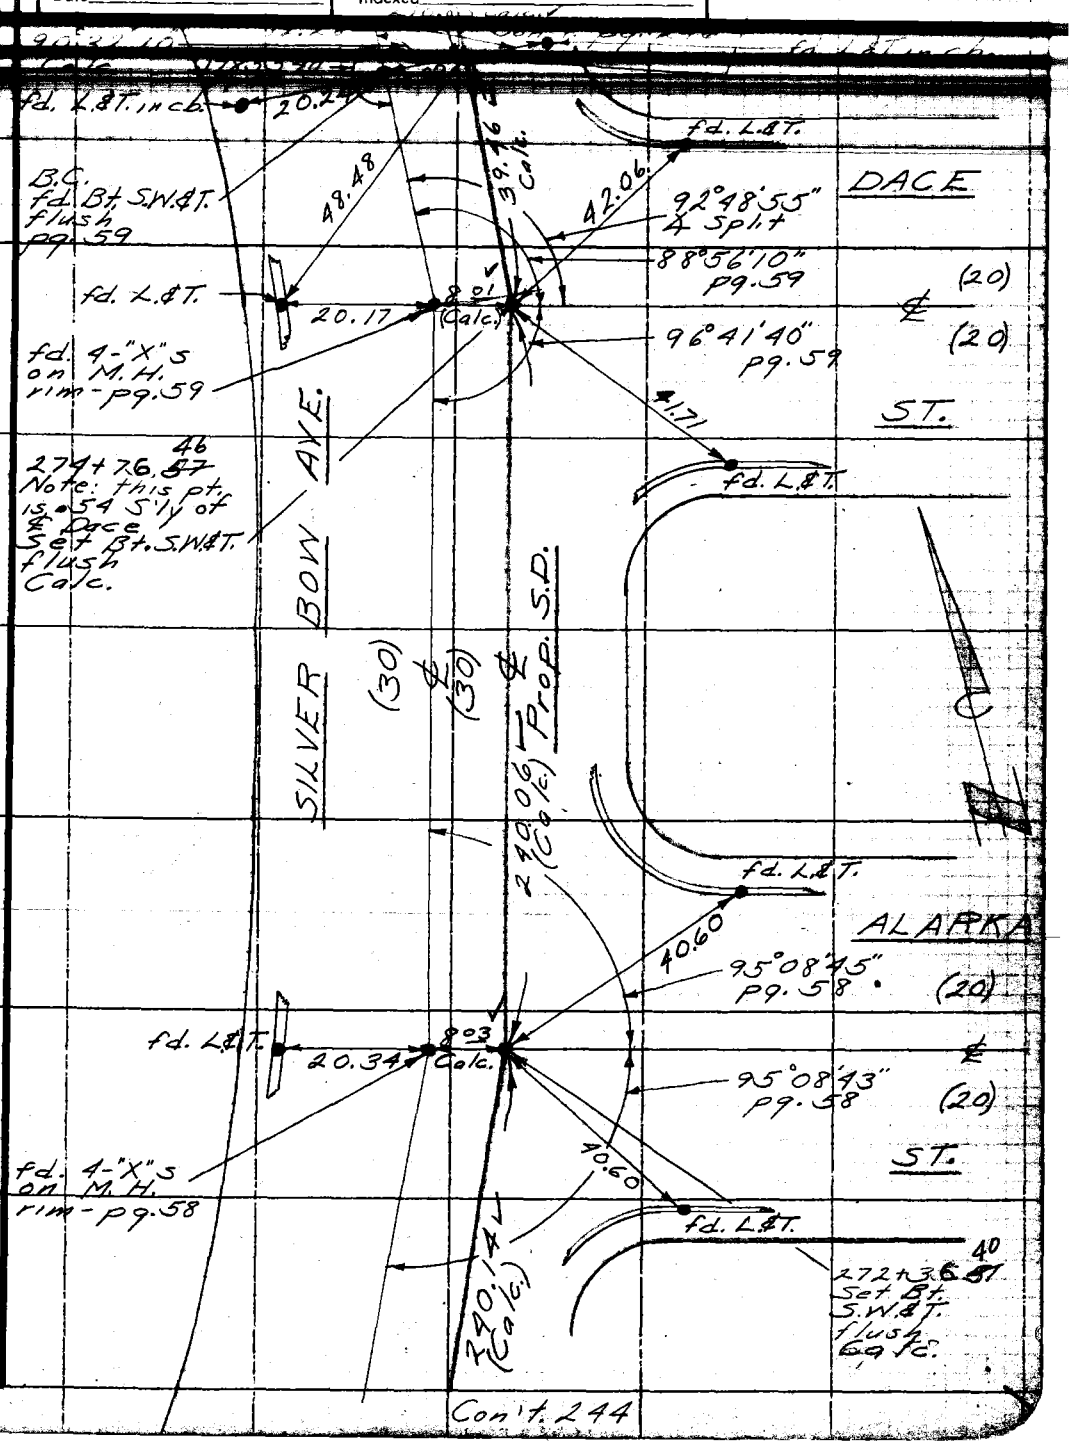

Note: Any Additions or Changes on This Sheet Must be Made or Circled in Red Ink With Date and Name of Person Making Change.

Do not extend notes this side of this line.

RETURN TO
LOS ANGELES COUNTY SURVEYOR
726 LOS ANGELES COUNTY
ENGINEERING BLDG.

76FS098 247 4-58

F.B. ~~1798~~ PG. ~~246~~ Con't. pg. 247

PWFB 0826

398, 399

W.S. 33-D-3

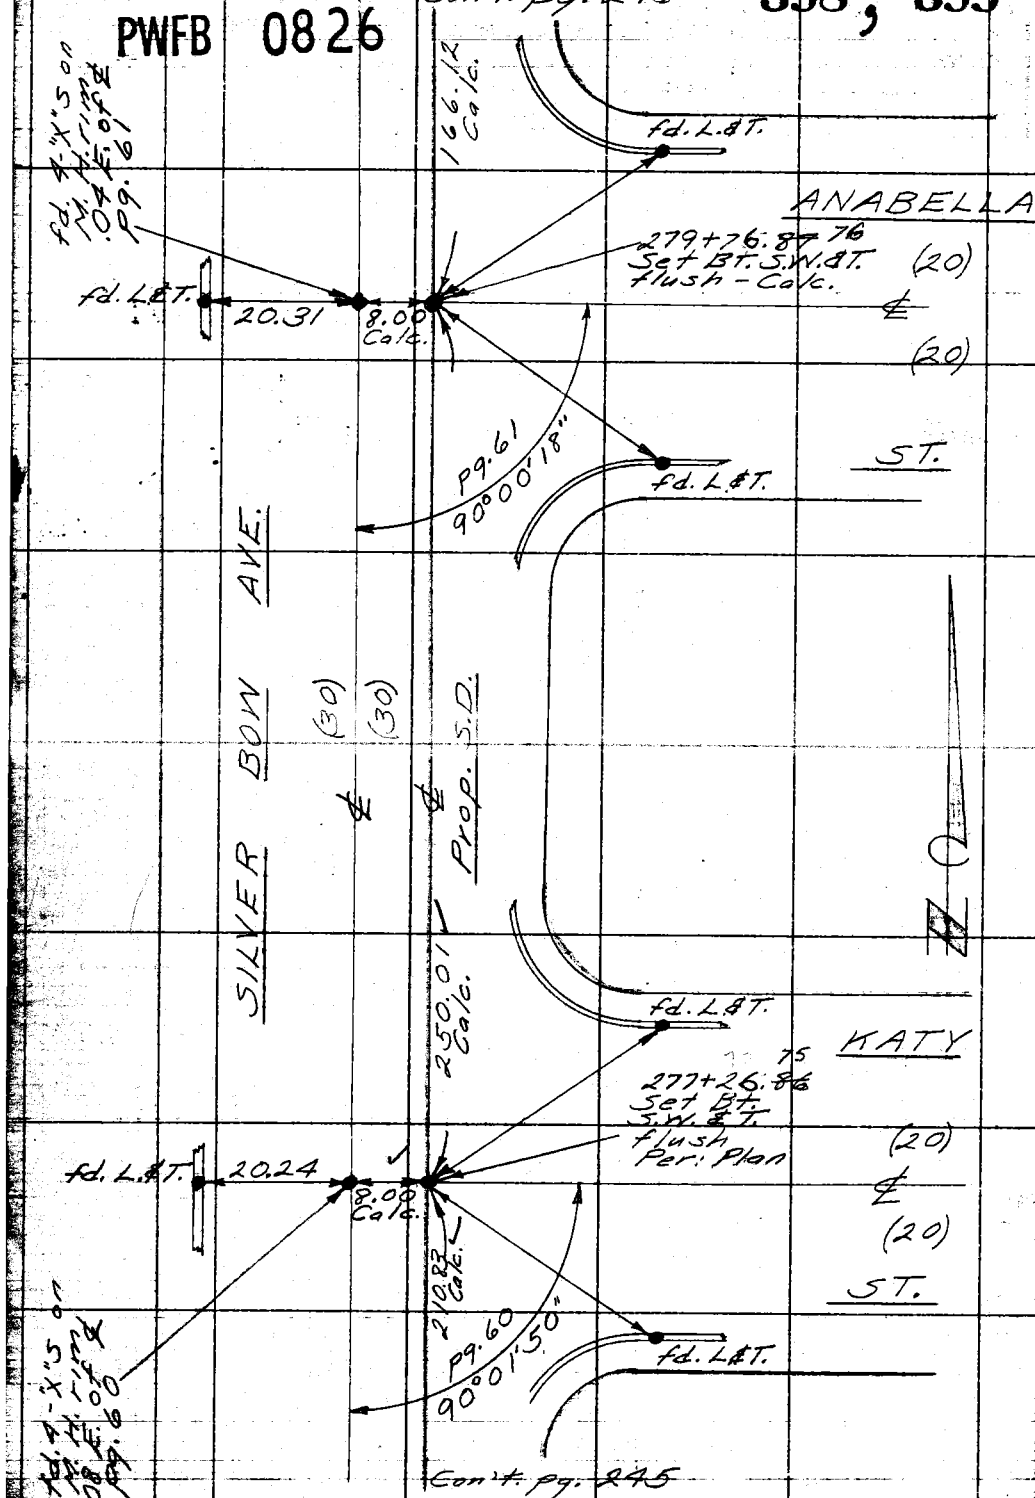

Con't. pg. 245

RETURN TO
LOS ANGELES COUNTY SURVEYOR
726 LOS ANGELES COUNTY
ENGINEERING BLDG.

Do not extend notes this side of this line.

Note: Any Additions or Changes on This Sheet Must be Made or Circled in Red Ink With Date and Name of Person Making Charge.

PWFB 0826

Notes Ck'd by Aja	Survey of Artesia - Norwalk	F. B. [illegible] Pg. [illegible]
Map No.	W. O. [illegible] Tape No. Std.	400
Office Work	Surveyed by English	
Checked	Notes Date [illegible]	
Date	Indexed E. C. Johnson	

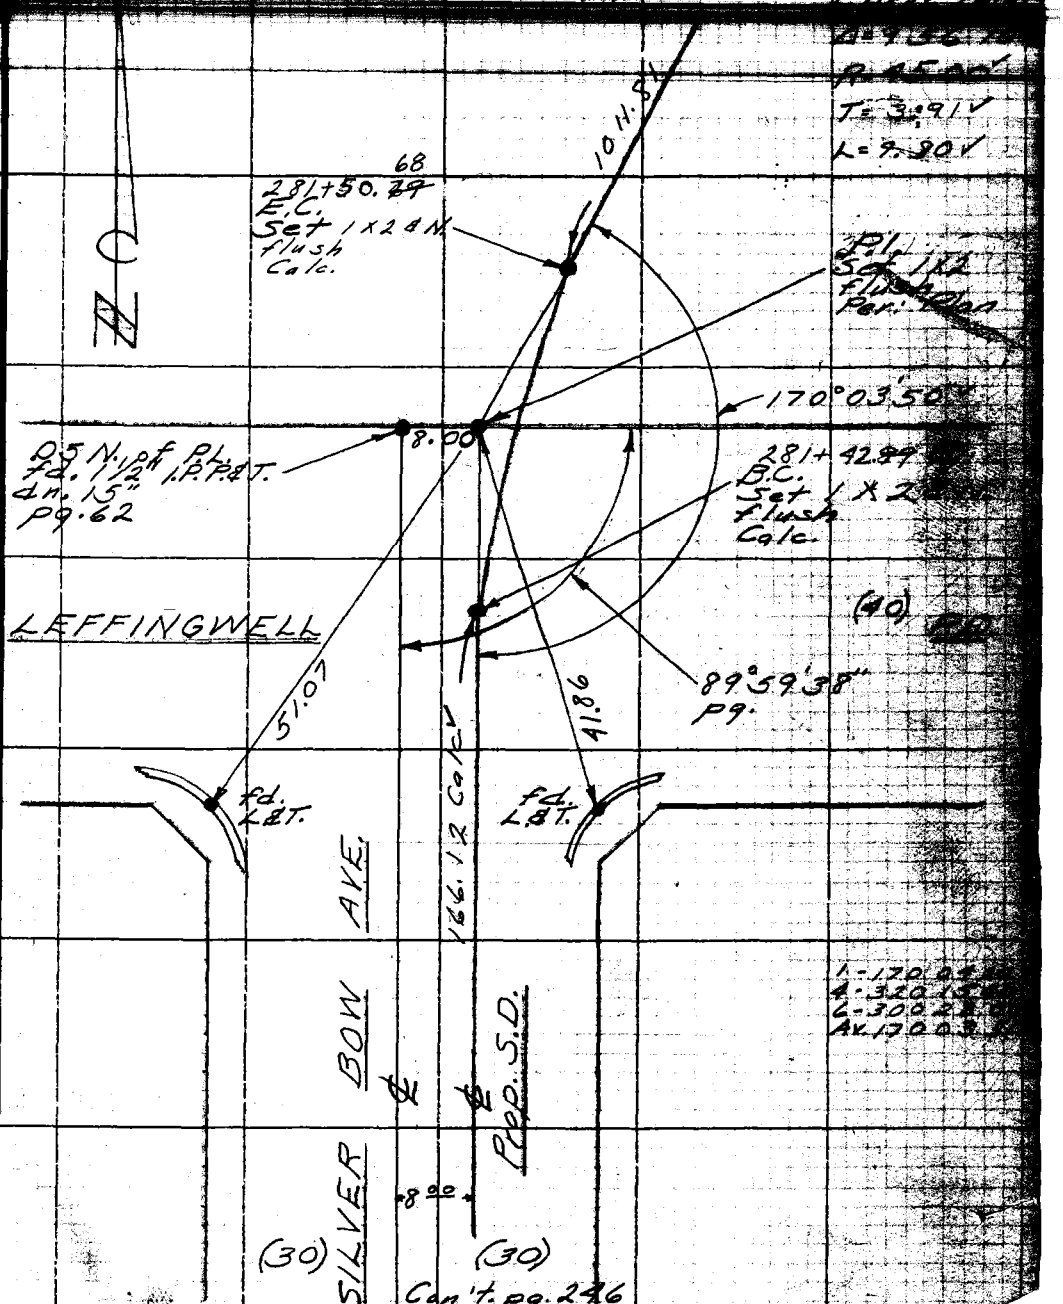

Note: Any Additions or Changes on This Sheet Must be Made or Circled in Red Ink With Date and Name of Person Making Change.

Do not extend notes this side of this line.

RETURN TO
LOS ANGELES COUNTY SURVEYOR
725 LOS ANGELES COUNTY
ENGINEERING BLDG.

75F8095 247

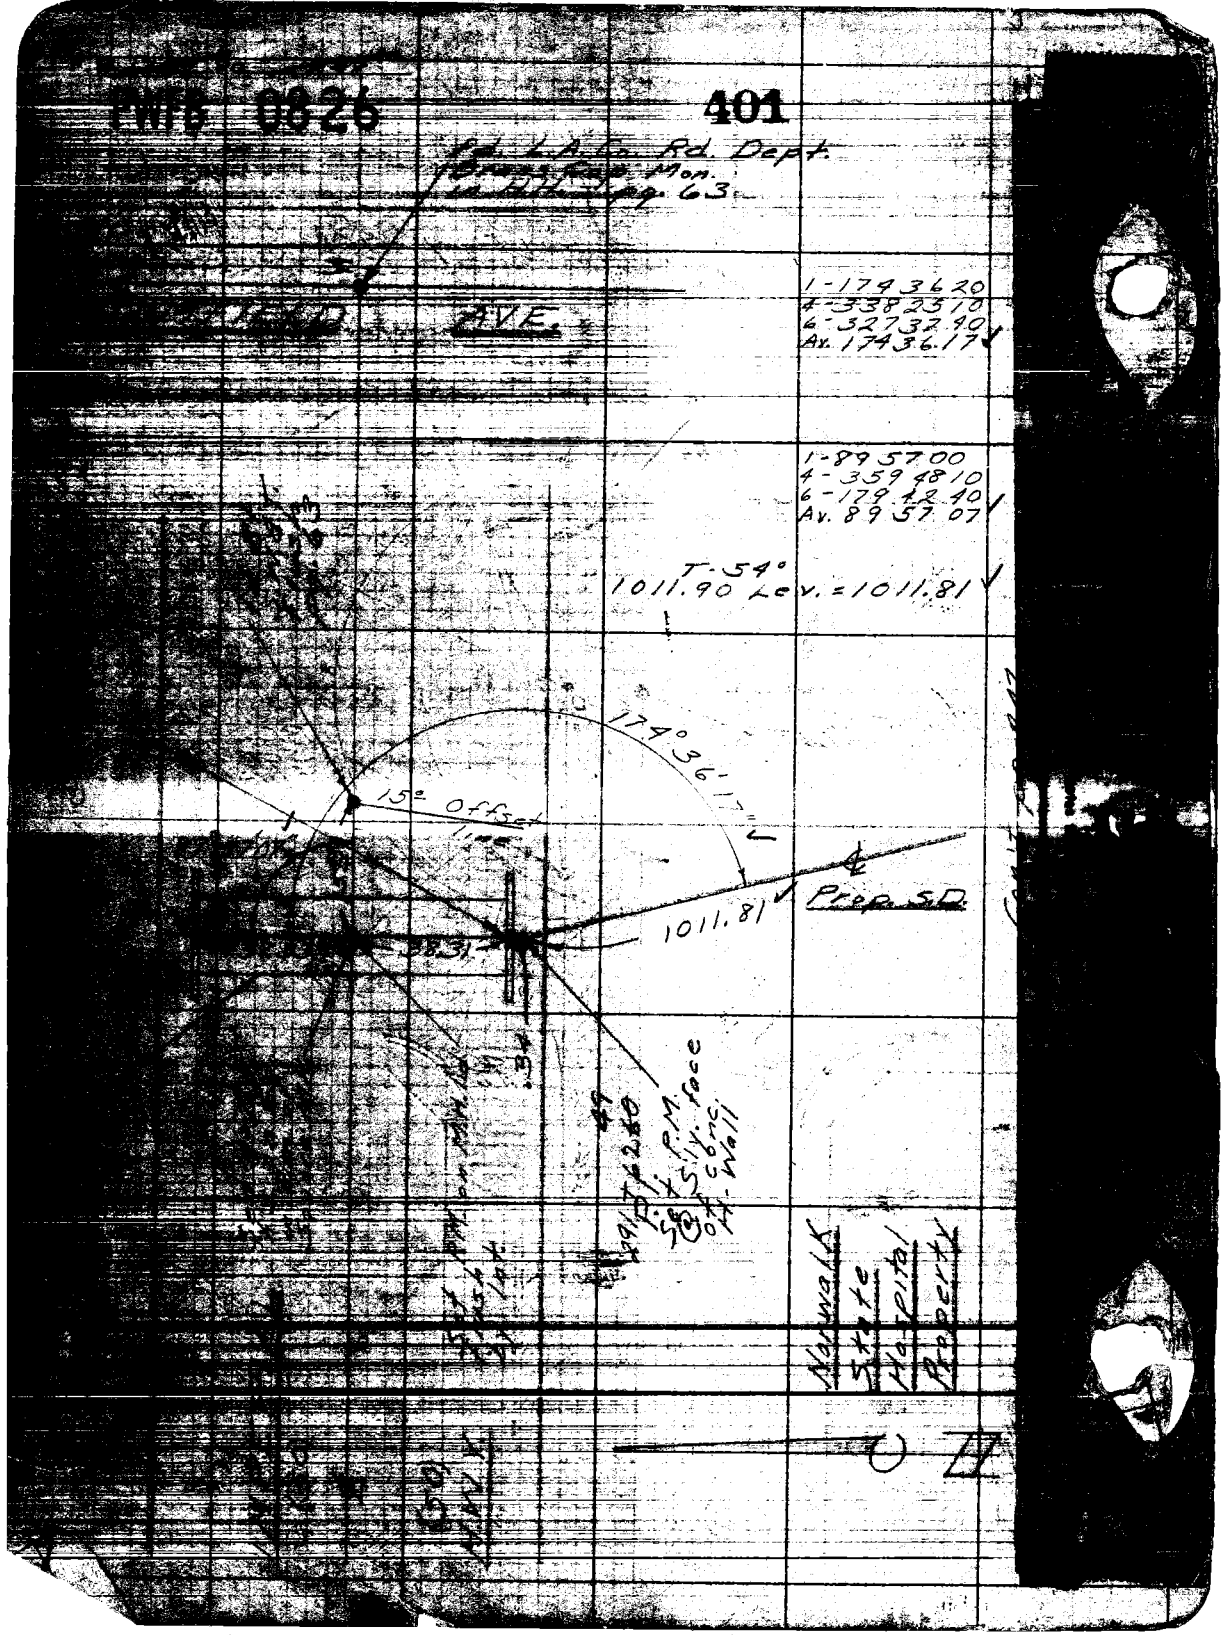
Rd. L.A.Co. Rd. Dept.
Brass Cap Mon.
pg. 63
AVE.
1-1743620
4-3382510
6-3273240
Av. 1743617
1-8957 00
4-3594810
6-1794240
Av. 8957 07
T-54°
1011.90 Lev. = 1011.81
174°36'17"
15° Offset line
1011.81
Prop. S.D.
38.31
.34
49
Set P.M. @ Sly. face of conc. H-Wall
Norwalk State Hospital Property