Notes Ck'd by
Map No.
Office Work
Checked
Date

Survey of
JN Tape Std °F
Surveyed by
Notes Date
Indexed

F.B. 1818 Pg.

Page	Title	Description
		BALDWIN PARK BLVD. J.N. 8641
5-7	Index	
8-74	C.L.	Align. & Int. sts. from Valley Blvd. to West Ramona Blvd.
81-153	Topo.	From Valley Blvd. to West Ramona Blvd.
155-182	C.L.	New align. from Valley Blvd. to Torch St.
185-197	Topo.	From Valley Blvd. to Torch St. & Baldwin Park.
199-200	Mon.	Monument at intersection of Bess Ave. and Baldwin Park Blvd. Reference Puente B-5.
		BALDWIN PARK J.N. 0054.15
205-217	Bdry.	Survey of Prop. lines.
219-226	B.M.	Bench Levels Baldwin Park.

LOS ANGELES
403 Los Angeles

Microfilmed Jan 86

PLEASE RETURN TO
LOS ANGELES COUNTY ENGINEER
403 LOS ANGELES COUNTY ENGINEERING BLDG.

Note: Any Additions or Changes on this Sheet Must be Made or Circled in Red Ink With Date and Name of Person Making Change

Do not extend this side of this line.

F.B. _____ PG. _____

Notes Ck'd by C. J. GALLI	Survey of	F. B. Pg.
Map No. C.S.B- 2497-1-3	W. O. Tape No. St'd. °F	
Office Work Burns	Surveyed by	
Checked C.J.G.	Notes Date	
Date	Indexed	

Note: Any Additions or Changes on This Sheet Must be Made or Circled In Red Ink With Date and Name of Person Making Change.

Do not extend notes this side of this line.

RETURN TO
LOS ANGELES COUNTY SURVEYOR
726 LOS ANGELES COUNTY
ENGINEERING BLDG.

CENTER LINE AND TOPOGRAPHIC SURVEY OF BALDWIN PARK BLVD

FROM

VALLEY BLVD

TO

WEST RAMONA BLVD

AS ORDERED BY THE COUNTY REGIONAL PLANNING COMMISSION

J.N. 8691 Old No.

J.N. 0074.03 New No.

J.N. Lanigan

R.J. Mitchell
L.C. Smiley
J.A. Visolovich
R.C. Clifford

Jan. & Feb. 1953

TRANSIT:

Sept., Oct., Nov. 1953

TRANSIT: Brunson #

76F3098 247 4-53

F. B. 1818 Pg. 6

JN 8641 — INDEX

Page Numbers shown in **Red** Refer to Center Line Survey

Page Numbers shown in **Green** Refer to Location of Improvements

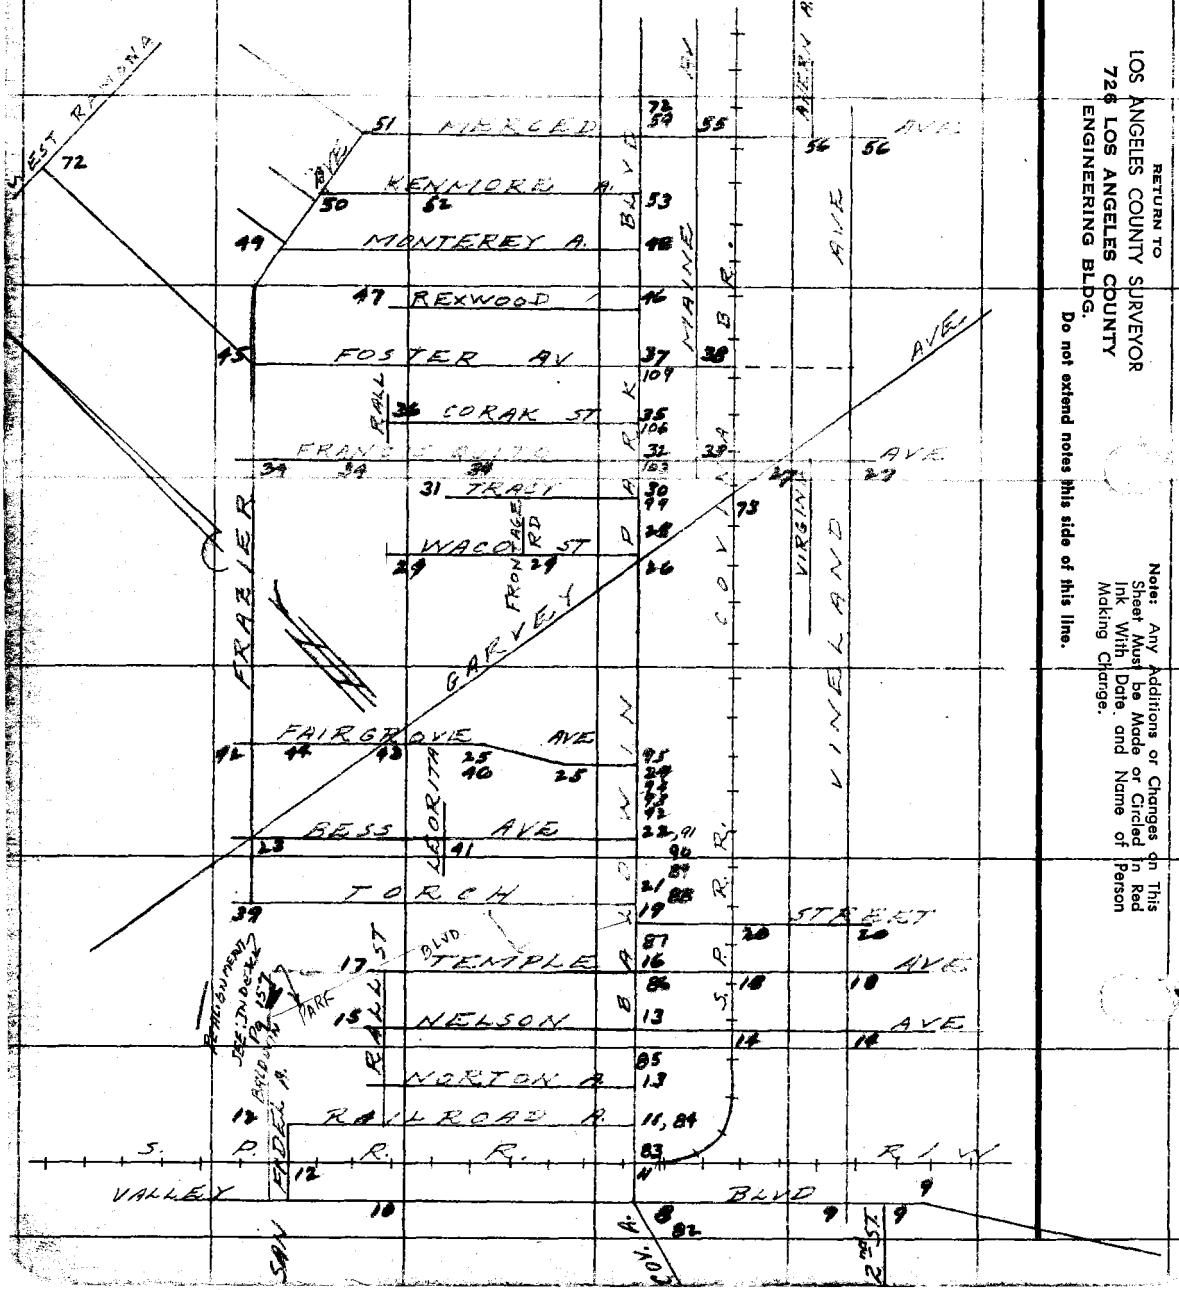

RETURN TO
LOS ANGELES COUNTY SURVEYOR
726 LOS ANGELES COUNTY
ENGINEERING BLDG.

Do not extend notes this side of this line.

Note: Any Additions or Changes on This Sheet Must be Made or Circled in Red Ink With Date and Name of Person Making Change.

Notes Ck'd by C. J. GALLI
Map No. C. S. B. - 2497 - 1, 2, 3
Office Work Burns
Checked C. J. G.
Date Feb. 1955

Survey of BALDWIN PARK BLVD
W. O. 8641 Tape No. 0131 St'd. 68 °F
Surveyed by C. J. Long
Notes J. J. ERTM Date 1-31-53
Indexed

F. B. 1818 Pg. 1

R. J. MITCHELL

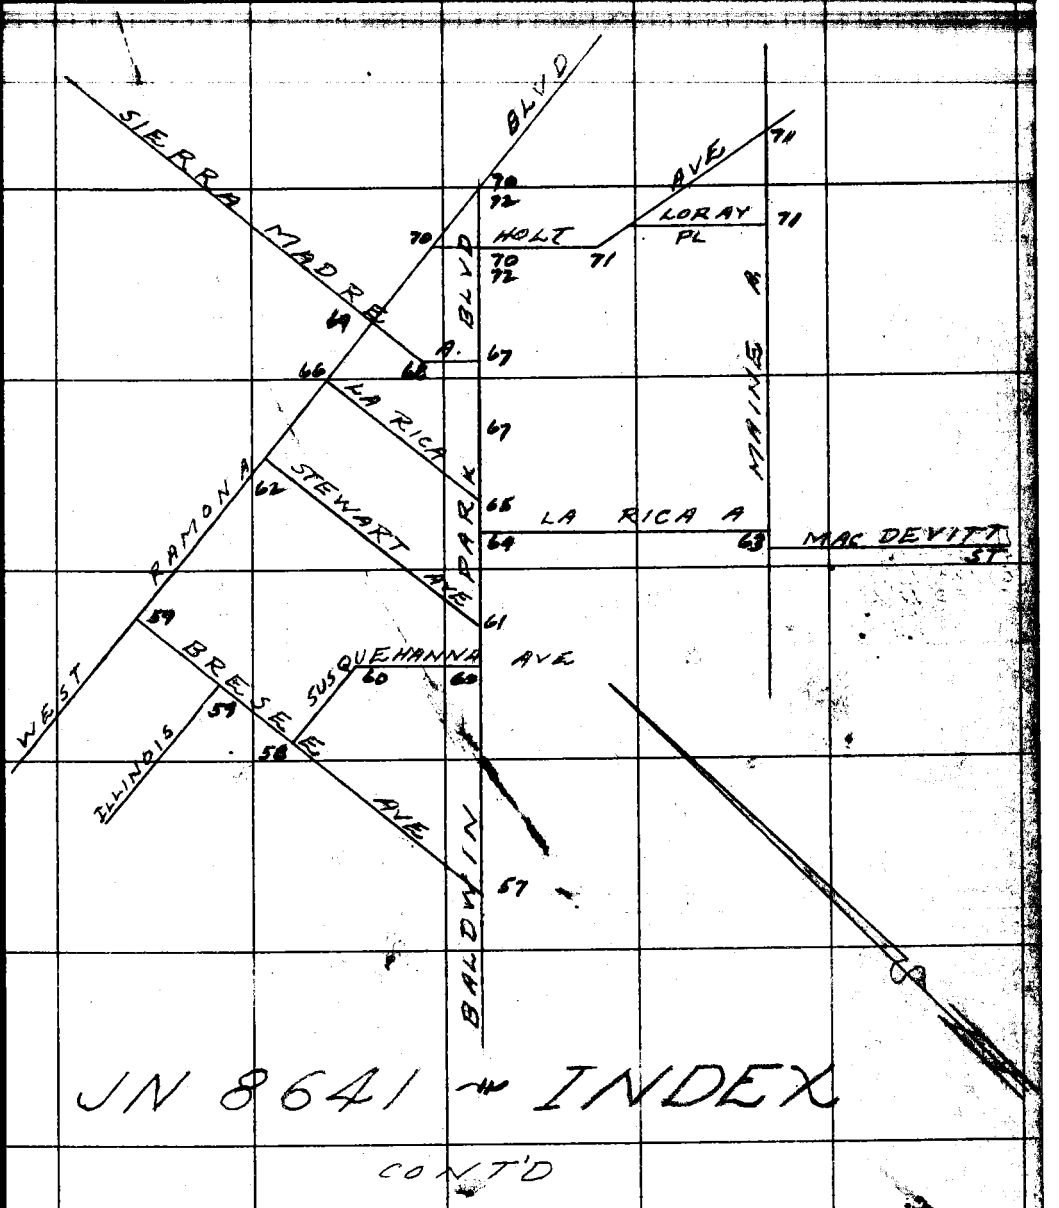

JN 8641 — INDEX

CONT'D

Note: Any Additions or Changes on This Sheet Must be Made or Circled in Red Ink With Date and Name of Person Making Change.

Do not extend notes this side of this line.

RETURN TO
LOS ANGELES COUNTY SURVEYOR
726 LOS ANGELES COUNTY
ENGINEERING BLDG.

76F309S 247 2-51

RETURN TO
LOS ANGELES COUNTY SURVEYOR
725 LOS ANGELES COUNTY
ENGINEERING BLDG.

Note: Any Additions or Changes on This Sheet Must be Made or Circled in Red Ink With Date and Name of Person Making Change.

Do not extend notes this side of this line.

W.S. 46 = E.6

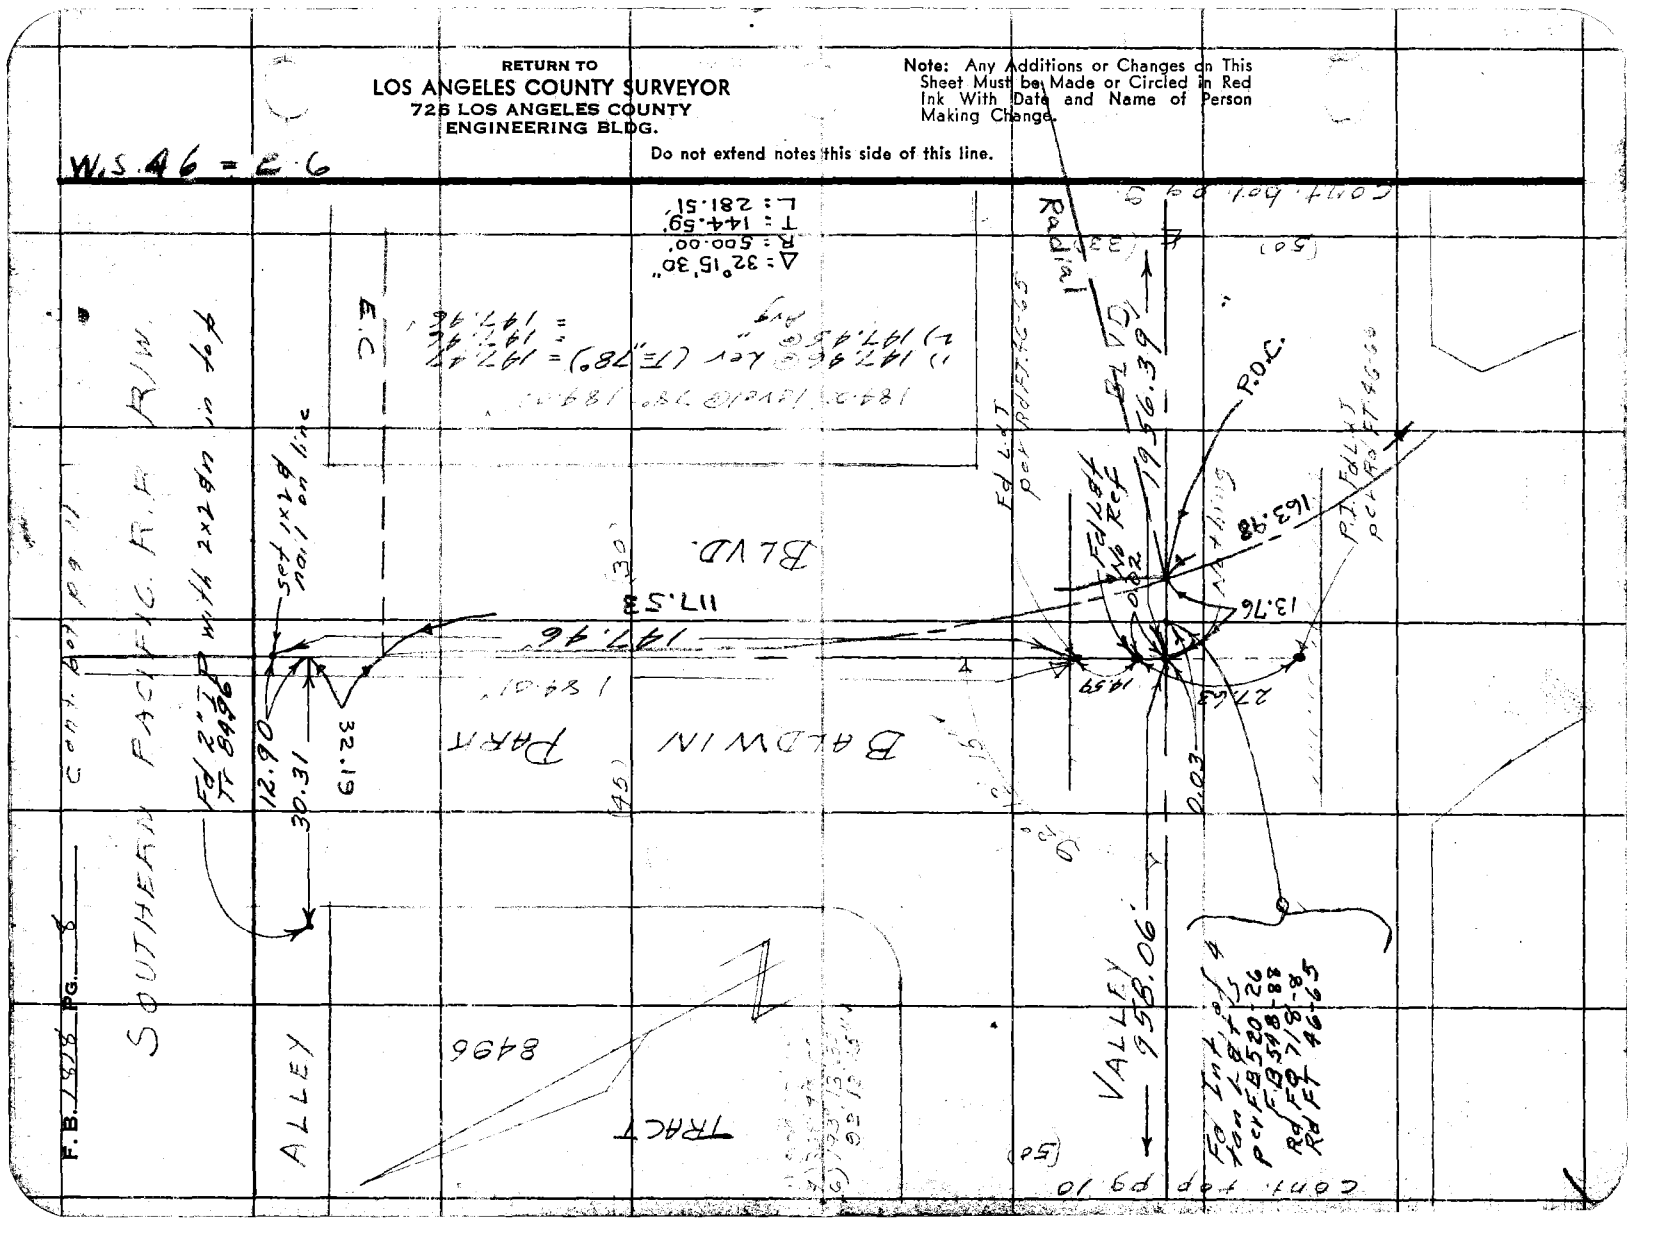

Notes Ck'd C. J. GALLI
Map No. C-5 B-2497-1
Office Work Burns
Checked C.J.G.
Date Feb 1955

Survey of Field Work for Control
W. O. 8108 Tape No. 9135 St'd. 62 °F
Surveyed by J. L. Lawrence & Party
Notes L. L. & T. Date 10-50
Indexed 1-19-51

F. B. 718 Pg. 9

R. J. MITCHELL

Note: Any Additions or Changes on This Sheet Must be Made or Circled in Red Ink With Date and Name of Person Making Change.

Do not extend notes this side of this line.

RETURN TO
LOS ANGELES COUNTY SURVEYOR
726 LOS ANGELES COUNTY
ENGINEERING BLDG.

76F3095 247 2-51

West 8th St

Angle Point
Fd chis'd with
4" long L.I.P.s
F.B. 520-25
See F.B. 542-9
F.B. 744-206

33.01
13.16

No tie for
2" I.P. F.B. 744-206

Fd Std. C.S. Bl. Cap
Mon. up 1" &
mkd as shown
per F.B. 744-206

Fd L&T
F.B. 744-206

~~Fd L&T @ Int~~
~~1 Int L&T. Rd~~
~~F.B. 718-10~~

Fd: L&T @
Int. of L&T. lies
F.B. 718-10

94.40

2.00'

COUNTY SURVEYOR
ANGLE PT.
R/W
RE 21.77

BLVD

SECOND

AVE

Fd Std. w/ L&T
F.B. 744-206
Rd. F.B. 718-10

New Pt.
Fd Std. w/ L&T
F.B. 744-206

Cor. Std. Fd.
Surv. Mon. in Well
Mon. 12.0 in Height
Rec. F.B. 926-301
F.B. 520

37.84
Fd Std. Pt.
Surv. Mon.
Mon. 12.0 in Height
Rec. F.B. 926-301
F.B. 520

0.04
Mon. lies
0.04
N'ly from
Line

91.67

VINELAND
set chis'd "+" tie

0.96

0.04

AVE
Fd. L&T. tie

VALLEY

1956.39

94.39 @ Rec (T=78) = 94.40'
37.84 @ Rec (T=78) = 37.84'
91.66 @ Rec (T=78) = 91.67'
1) 1956.21 @ Rec (T=82.°) = 1956.39'
2) 1956.21 @ R = 1956.39'

CONT RIGHT PG 8

F.B. 1918 PG. 10

cont. last pg. 8

(50') ℄ (50')

BLVD

958.06'

8227

RALL ST.
(VAC.)

TRACT

VALLEY

RETURN TO
LOS ANGELES COUNTY SURVEYOR
725 LOS ANGELES COUNTY
ENGINEERING BLDG.

Do not extend notes this side of this line.

Note: Any Additions or Changes on This Sheet Must be Made or Circled in Red Ink With Date and Name of Person Making Change.

Notes Ck'd by C. J. GALLI
Map No. C.S.B-2497-1
Office Work Burns
Checked C.J.G.
Date F-1 1955

Survey of
W. O. 8691 Tape No. 3134 St'd. 68 °F
Surveyed by
Notes
Indexed

F. B. PG.

R. J. Mitchell

Note: Any Additions or Changes on This Sheet Must be Made or Circled in Red Ink With Date and Name of Person Making Change.

Do not extend notes this side of this line.

RETURN TO
LOS ANGELES COUNTY SURVEYOR
726 LOS ANGELES COUNTY
ENGINEERING BLDG.

West, 46.7

Set tag Bl. stk. w. ⊕ on line

BALDWIN PARK

89° 10' 45"

955.27

207.13

SUB.

Set nail & tag in guard rail

1556.79'

RAILROAD AVE.

Fd remains of 2" - 6" pc

Fd pcs FB 520-26

Scc FB 598-99-100

Fd pcs as shown

by scc dist. from Valley Blvd

pcs FB 598-99.

40.53

31.72

47.15

90°

35.70

Fd chis. & tag on top of R.R. rail each R/W mon't.

Fd nail & tag

Nothing set

05

S. P.

R. R.

R/W.

1) 89° 10' 30"
2) 356° 40' 30"
3) 175° 00' 45"
89° 10' 06"

Set nail & tag on top of curb

1) 207.12 @ Ler (FB2) = 207.14
2) 207.11 @ Ler " = 207.13
3) = 207.13

TRACT

cont. top pg 9

8227

RETURN TO
LOS ANGELES COUNTY SURVEYOR
725 LOS ANGELES COUNTY
ENGINEERING BLDG.

Note: Any Additions or Changes on This Sheet Must be Made or Circled in Red Ink With Date and Name of Person Making Change.

Do not extend notes this side of this line.

W.S. 46 - C - 6

1) 1556.68 (Meas. (Fee)) = 1556.80'
2) 1556.63 " = 1552.19 "

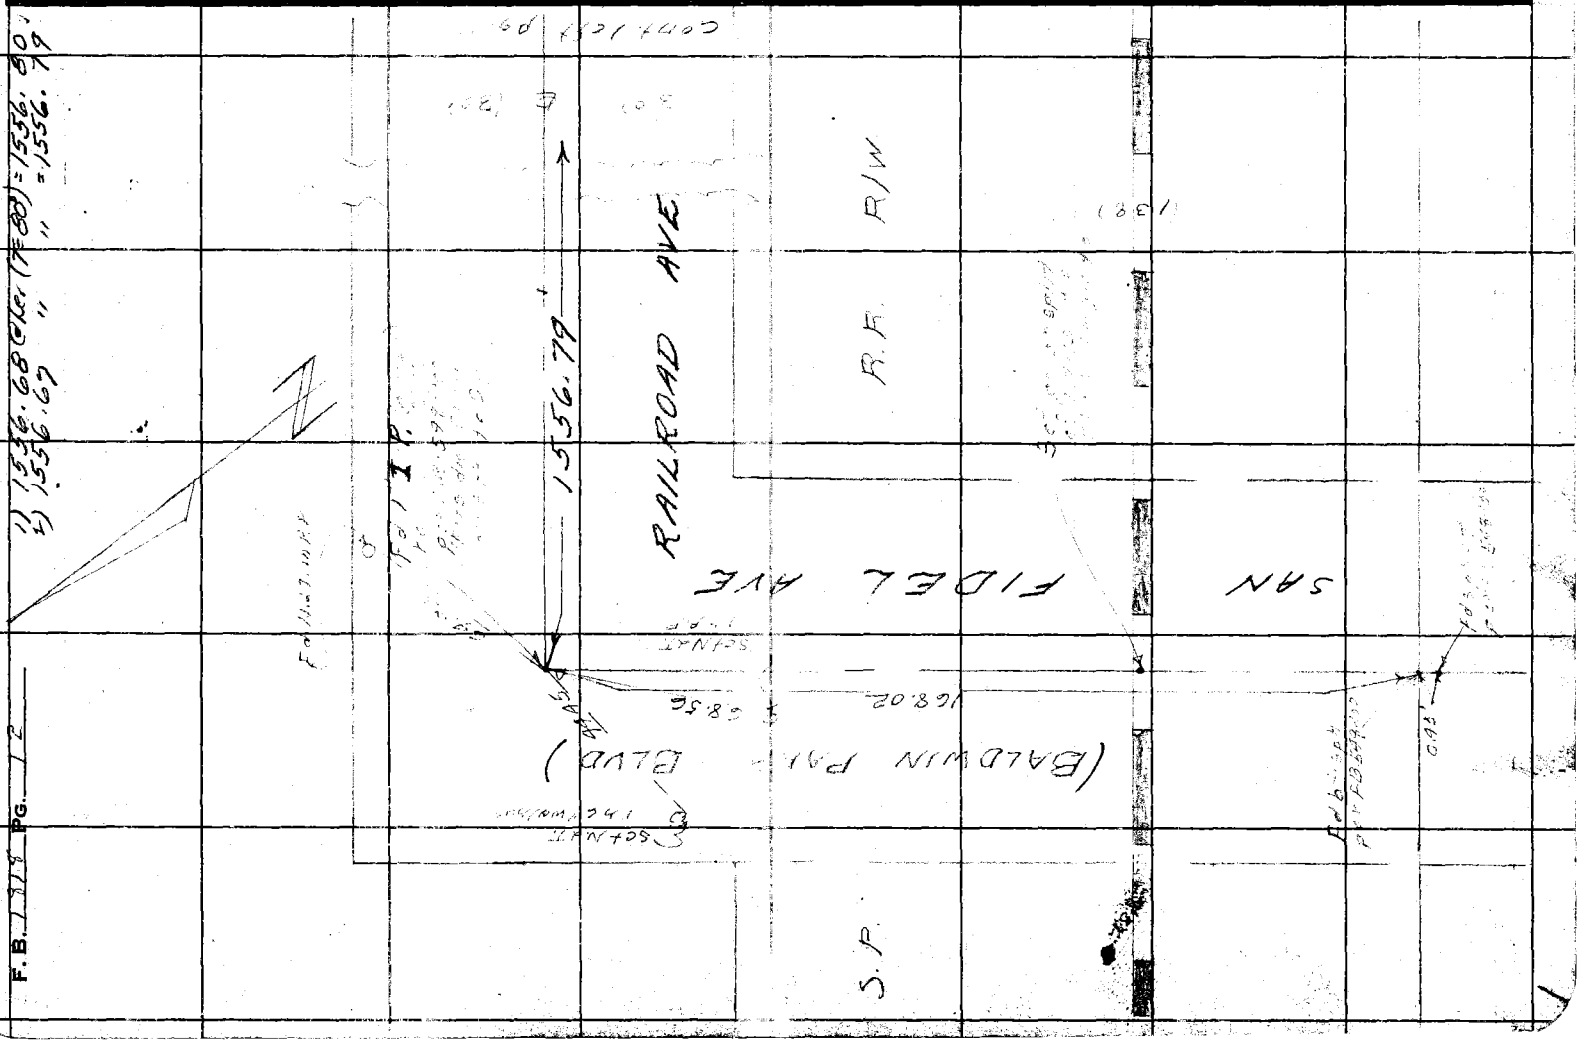

F.B. 1114 PG. 12

Notes Ck'd by C. J. GALLI
Map No. C.S.B - 2497 - 1
Office Work Burns
Checked C.J.G.
Date Jul 1955

Survey of Byron Jackson Co.
W. O. 8641 Tape No. 8144 St'd. 68 °F
Surveyed by [illegible] Date [illegible]
Notes [illegible]

F. B. _____ Pg. _____
R. L. MITCHELL

Note: Any Additions or Changes on This Sheet Must be Made or Circled in Red Ink With Date and Name of Person Making Change.

Do not extend notes this side of this line.

RETURN TO
LOS ANGELES COUNTY SURVEYOR
726 LOS ANGELES COUNTY
ENGINEERING BLDG.

W. 5.44 - 8

DE BASSETT

89°

182.73

Fd C.S. Mon
dn. 2.3'
PC PB 520-10
Fd. 4 Iron S&W
tics out
5.00 — No Ref.
Mon. is mkd as
shown below &
Falls 0.02SE &
0.02 Nef lines
shown.

957.53

33.00

977.46

47.34

Set nothing by int.

Set L.dT. in
cone. at end pipe

NELSON AVE

Fd NAIL
1.0.0

Cont. top pg. 13

Cont. bot pg. 14

COUNTY SURVEYOR MONUMENT

1) 977.46 @ E78 = 977.46
2) 977.46 @ " = 977.46
Avg " = 977.46

1) 957.46 @ Lor (T=82°) = 957.55
2) 957.46 @ " = 957.53
Avg " = 957.53

Made No Search from any
Office in Establishing
Dist. Sta. Nelson Ave (N&E 59-5)
O.T. Basset Tract 508. (N&E 59-5)
Note that this is on record "Ass't."

93.27

560.00

S. 1 AVE.

MORTON

BALDWIN PARK

955.89 / Lor (T=84°) = 547.07
547.00 @ " = 547.06
Avg " = 547.06

12.94 @ Lor (T=70°) = 560.00
To Lot (T=70°) = 560.00

AVE

Not contig.

30 & 30'

cont. top pg. 11

76F3095 247 2-51

RETURN TO
LOS ANGELES COUNTY SURVEYOR
725 LOS ANGELES COUNTY
ENGINEERING BLDG.

Note: Any Additions or Changes on This Sheet Must be Made or Circled in Red Ink With Date and Name of Person Making Change.

Do not extend notes this side of this line.

W.S. 46-C-6

AVE

R.R.

BRANCH

NELSON

COMM. Right of Way

VINELAND

AVE

VAC.

COVINA

P.O.

S.

(20)

(20)

F.B. 1518 PG. 11

76F309S 247 2-51

RETURN TO
LOS ANGELES COUNTY SURVEYOR
726 LOS ANGELES COUNTY
ENGINEERING BLDG.

Note: Any Additions or Changes on This Sheet Must be Made or Circled in Red Ink With Date and Name of Person Making Change.

Do not extend notes this side of this line.

W. S. 4

-5

Notes Ck'd by C. J. GALLI
Map No. C.S.B. - 2497-1
Office Work Burns
Checked C. J. G.
Date Feb 1955

Survey of
W. O.
Surveyed by
Notes

Tape No. 8733 Std. @ °F
R. J. MITCHELL

F. B. PG.

60' RALL

NELSON (Not connected)

AVE.

957.53'

COUNTY SURVEYOR MONUMENT

Fd C.S. Mon
Pol 2-3
N 520-11
Mon. is
shown
Mkd
Pol
W.

RETURN TO
LOS ANGELES COUNTY SURVEYOR
726 LOS ANGELES COUNTY
ENGINEERING BLDG.

Note: Any Additions or Changes on This Sheet Must be Made or Circled in Red Ink With Date and Name of Person Making Change.

Do not extend notes this side of this line.

W.S 46 -C-5

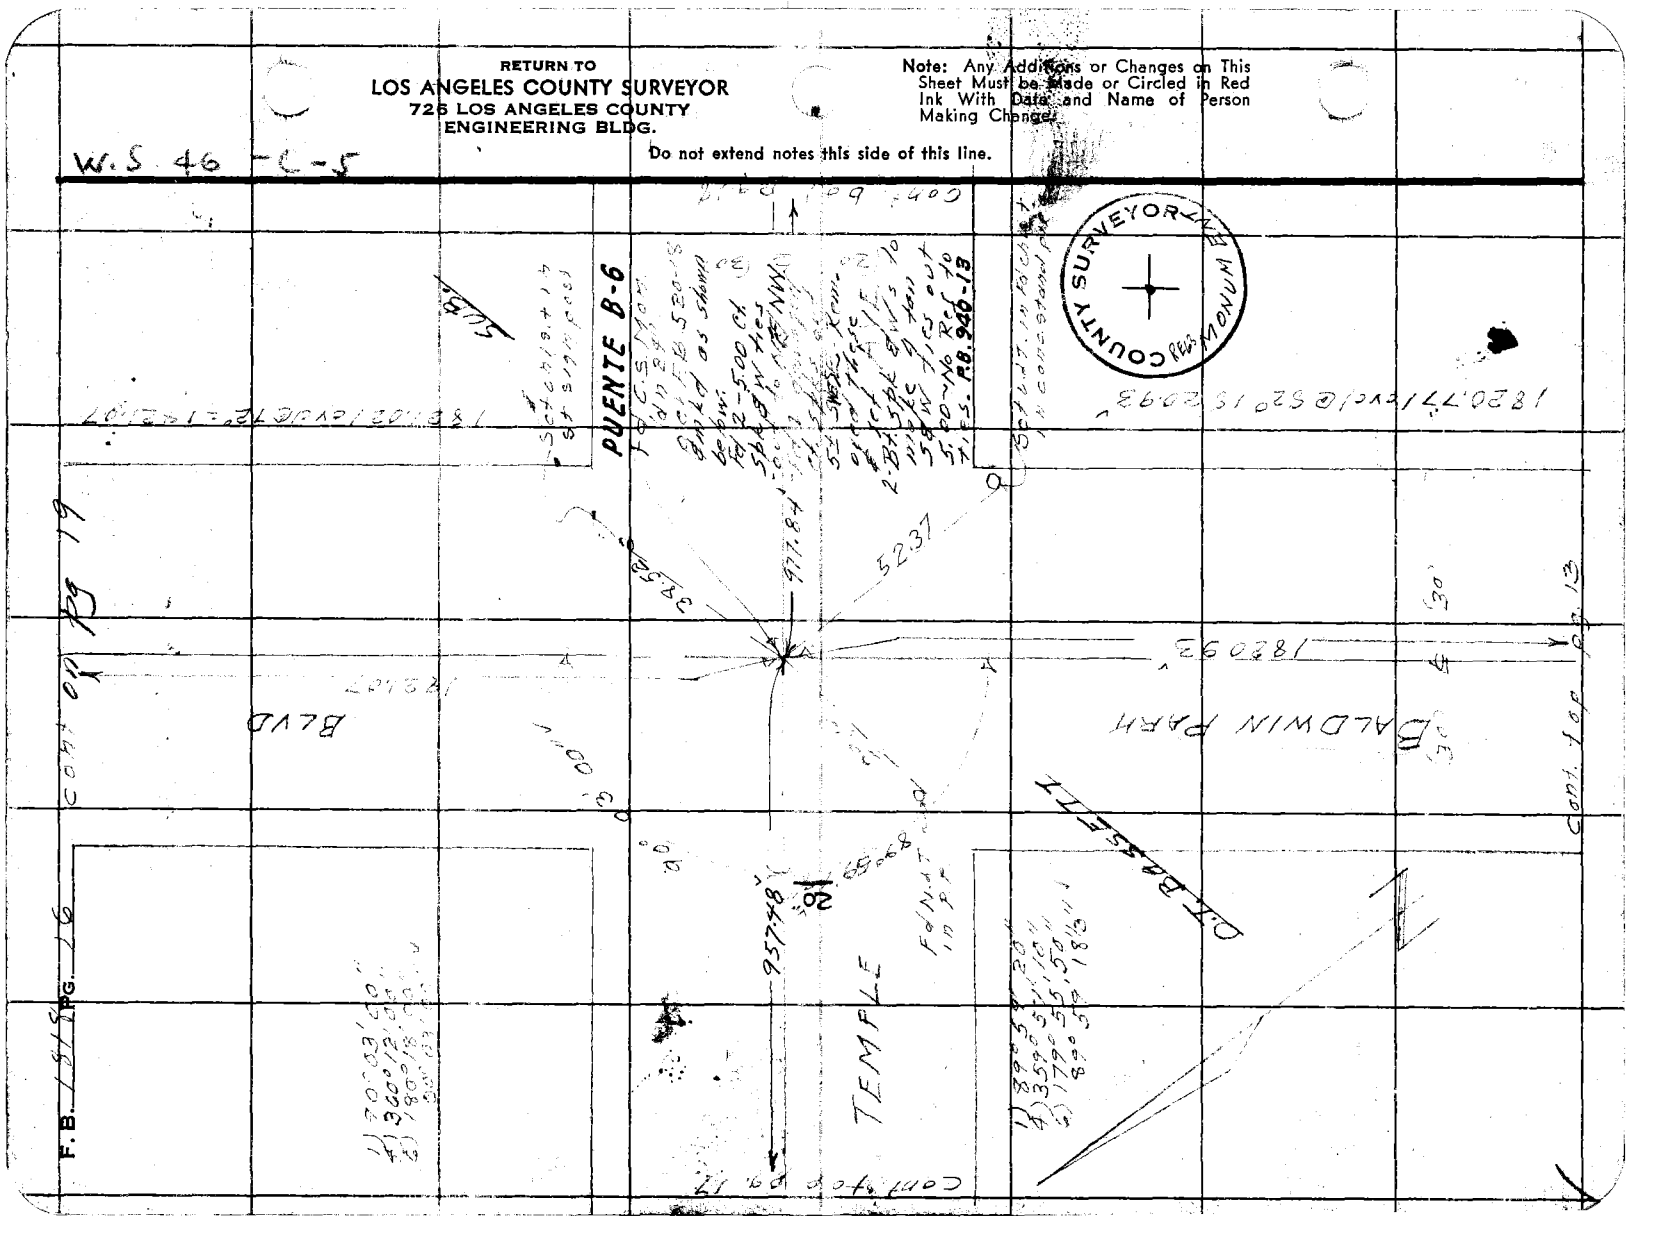

Notes Ck'd by C. J. GALLI
Map No. C.S.B-2497-1
Office Work Burns
Checked C.J.G.
Date Feb. 1955

Survey of [illegible]
W. O. 864 Tape No. 9131 St'd. 68 °F
Surveyed by [illegible]
Notes [illegible] Date 2-7-53
Indexed C. Johnson

F. B. 1846 PG. 77

R. J. MITCHELL

W.S. 4

Note: Any Additions or Changes on This Sheet Must be Made or Circled in Red Ink With Date and Name of Person Making Change.

Do not extend notes this side of this line.

RETURN TO
LOS ANGELES COUNTY SURVEYOR
726 LOS ANGELES COUNTY
ENGINEERING BLDG.

AVE

TEMPLE

957.48

957.42 @ 1'
957.40 "

El T = 80° = 957.49
" = 957.47
Avg. = 957.48'

Set chiseled X in E. side of conc. retaining wall

54.00'

HALL ST.

43.62

Set chiseled X in top of metal top of valve box

Fd C.S. Mon
in 36
Ecl. B.B. 53 E 19
& mkd 95 Shown
C.E.O.B. - TRAV. STA. 7

COUNTY SURVEYOR
RECD

76F30S 247 2-51

RETURN TO
LOS ANGELES COUNTY SURVEYOR
725 LOS ANGELES COUNTY
ENGINEERING BLDG.

Note: Any Additions or Changes on This Sheet Must be Made or Circled in Red Ink With Date and Name of Person Making Change.

Do not extend notes this side of this line.

W.S. 46-C-5

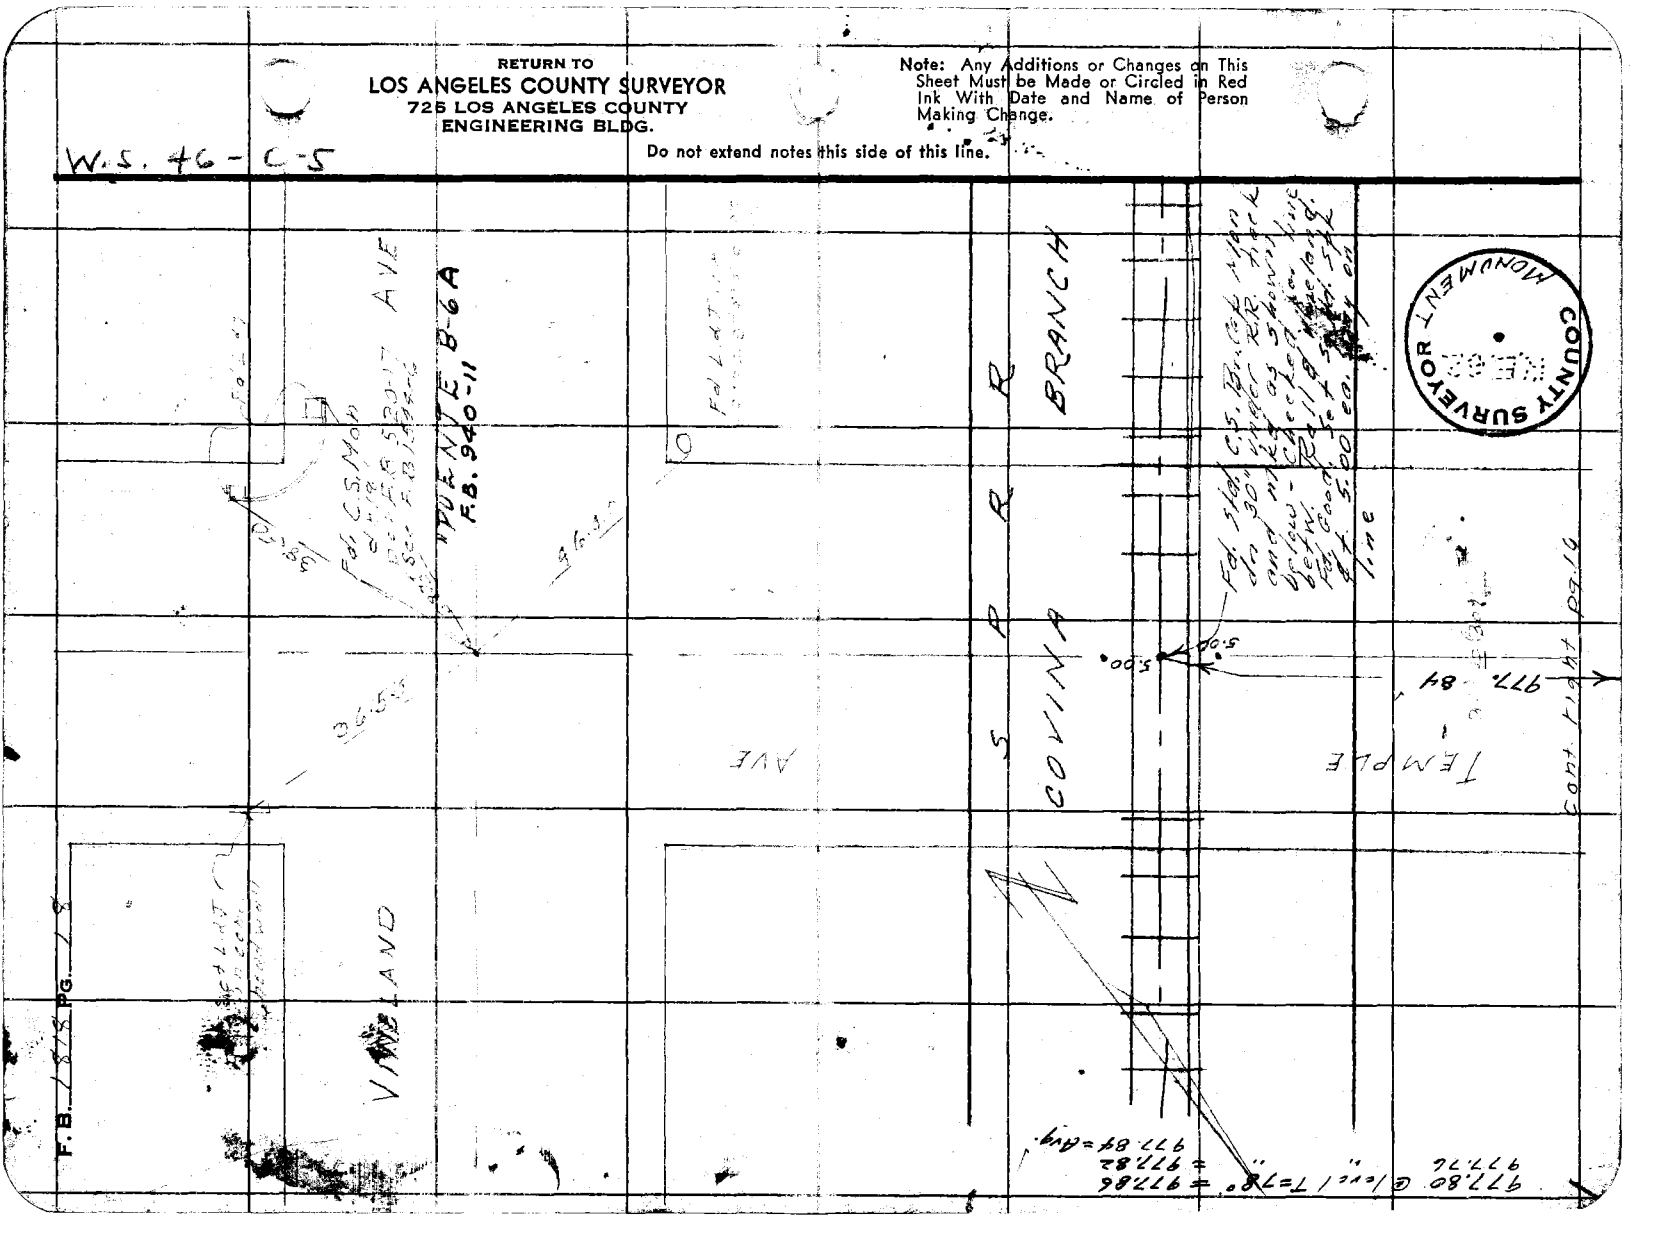

COUNTY SURVEYOR MONUMENT

76F309S 247 2-51

RETURN TO
LOS ANGELES COUNTY SURVEYOR
726 LOS ANGELES COUNTY
ENGINEERING BLDG.

Note: Any Additions or Changes on This Sheet Must be Made or Circled in Red Ink With Date and Name of Person Making Change.

Do not extend notes this side of this line.

W. S. 46

Notes Ck'd by C. J. BALL
Map No. C.S.B-24971
Office Work Burns
Checked C. J. G.
Date Feb. 1955

Survey of W. 08 C4 Tape No 2137 Std. 66 °F
Surveyed by J. MITCHELL
Notes
Indexed Date 2-5-53

F. B. PG.

cont bot pg 21

1) 957.31 @ Ler (T=63°) = 957.27 Contd on
2) 957.34 @ " " = 957.30 page
Av. = 957.28 71 (Left)

957.28

BALDWIN PARK

TORCH ST.
ELLIOT AVE

PRO. ELLIOT AVE.

O.T. BASSETT

AVE.

1) 300.03 @ Ler (T=82°) = 300.06
2) 300.02 @ " " = 300.05
Avg = 300.05

1) 677.10 @ Ler (T=82°) = 677.16
2) 677.09 @ " " = 677.15
Avg = 677.15

cont for 2016

RETURN TO
LOS ANGELES COUNTY SURVEYOR
726 LOS ANGELES COUNTY
ENGINEERING BLDG.

Note: Any Additions or Changes on This Sheet Must be Made or Circled in Red Ink With Date and Name of Person Making Change.

W.S. 46 - C-5

Do not extend notes this side of this line.

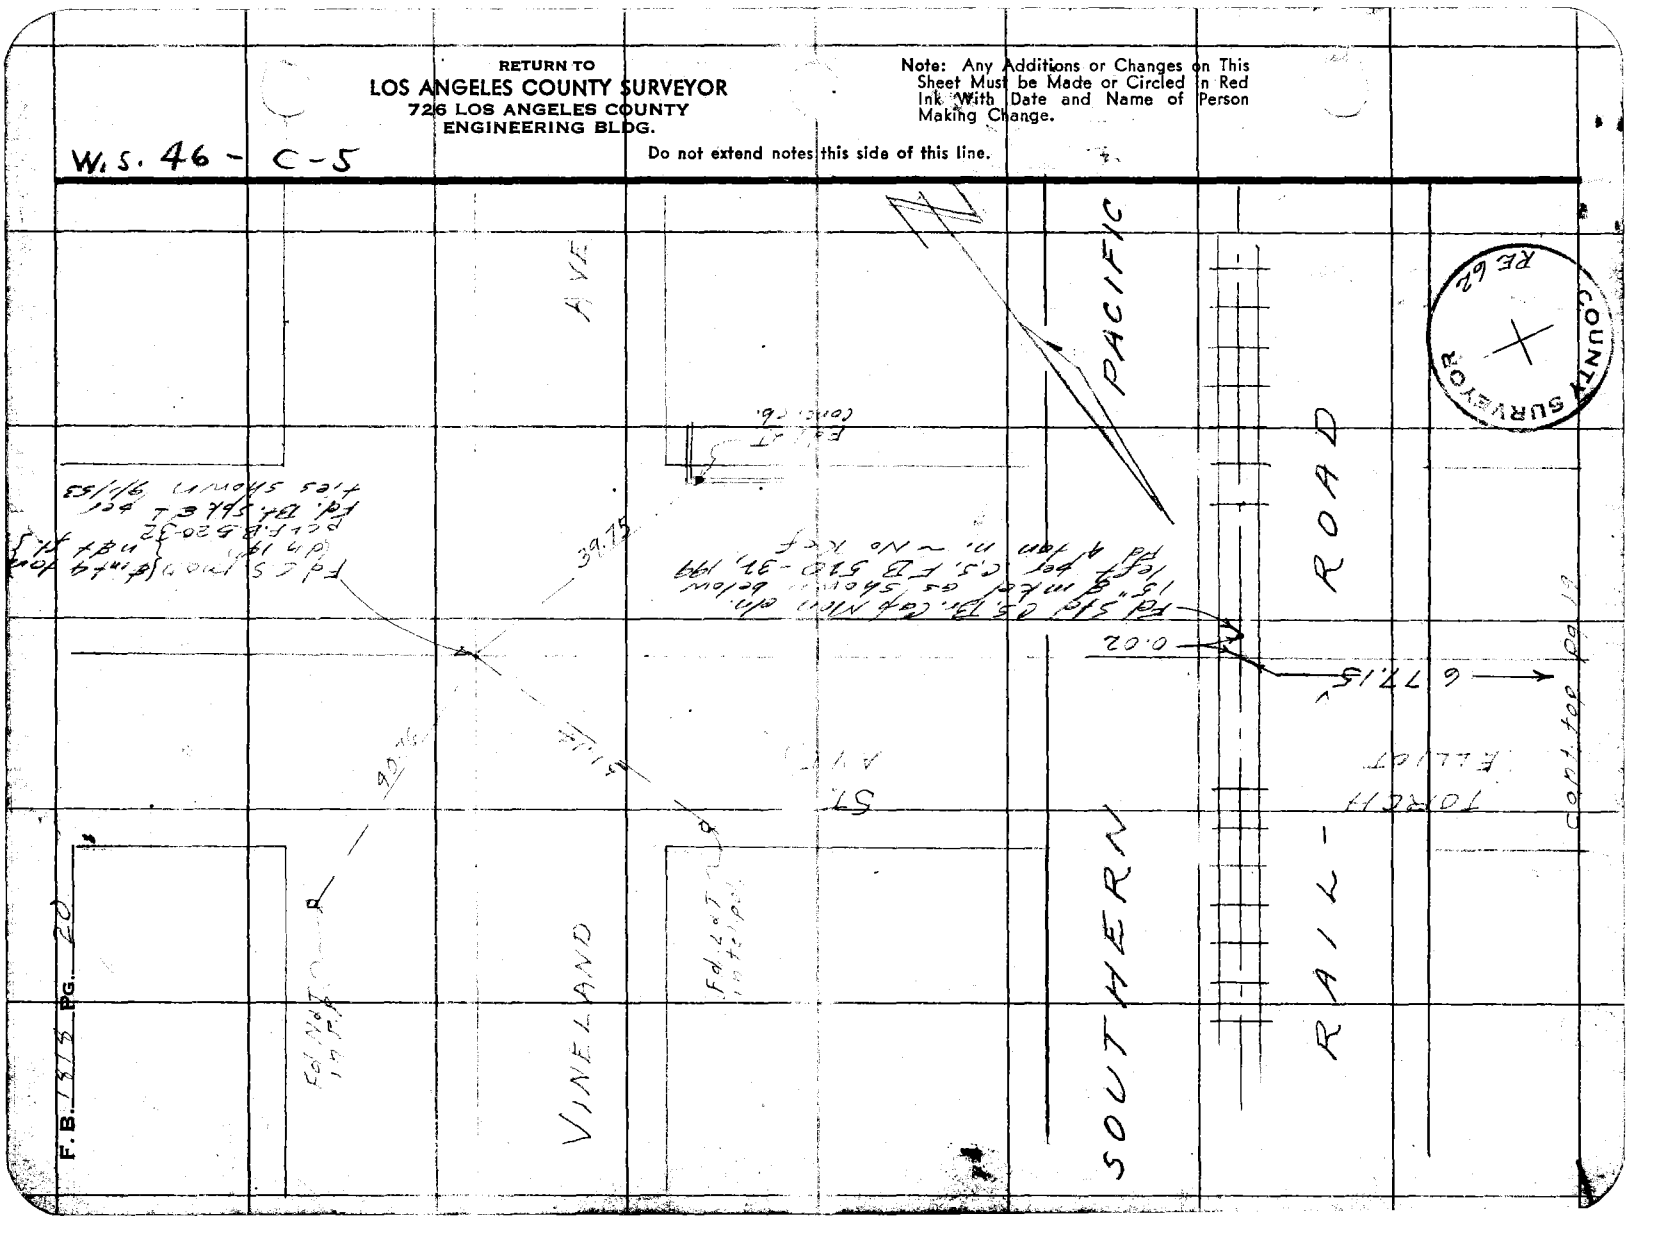

Notes Ck'd by C. J. GALLI
Map No. C.S.B - 2457-1
Office Work Burns
Checked C.J.G.
Date Feb. 1955

Survey of B[illegible]
W. O. 876 Tape No. 8131 St'd. 68 °F
Surveyed by J. J. Langan & R. J. MITCHELL
Notes J. J. Langan Date 2-5-53
Indexed A. G. Tabrnacle 2/13

F. B. [illegible] PG. [illegible]

W. 53 4

Notes: Any Additions or Changes on This Sheet Must be Made or Circled in Red Ink With Date and Name of Person Making Change.

Do not extend notes this side of this line.

RETURN TO
LOS ANGELES COUNTY SURVEYOR
726 LOS ANGELES COUNTY
ENGINEERING BLDG.

BLVD

791.50'

Sct chiseled in cal. face post.

Sct N. & T. in 12" walnut

Sct N. & T. in 14" double

8.24

8.30

44.57

Sct N. & T. in 18" double

P.C.S. Mon. P.C.I. F.B. 520-33

SUB.

45.03

S 79°

Sct N. & T. in 28" pepper

110.83'

110.89 (Rec. S 79° 110.83')

1) 179° 57' 50"
4) 359° 57' 30"
6) 359° 57' 20"
179° 57' 53½" (Rec.)

BASSETT

O.T.

cont. on pg. 19

Fd. S. W. & T. 10.0 (N.W.)

E. 951.28 (Rec. S 89° 41' 00" E. 951.28)

BALD WIN PARK

89° 41' 00"

791.45'

1) 89° 40' 50"
4) 358° 43' 50"
6) 178° 06' 00"
89° 41' 00"

cont. left on pg. 19

76F309S 247 2-51

RETURN TO
LOS ANGELES COUNTY SURVEYOR
726 LOS ANGELES COUNTY
ENGINEERING BLDG.

Note: Any Additions or Changes on This Sheet Must be Made or Circled in Red Ink With Date and Name of Person Making Change.

Do not extend notes this side of this line.

W.S. 46-E-5

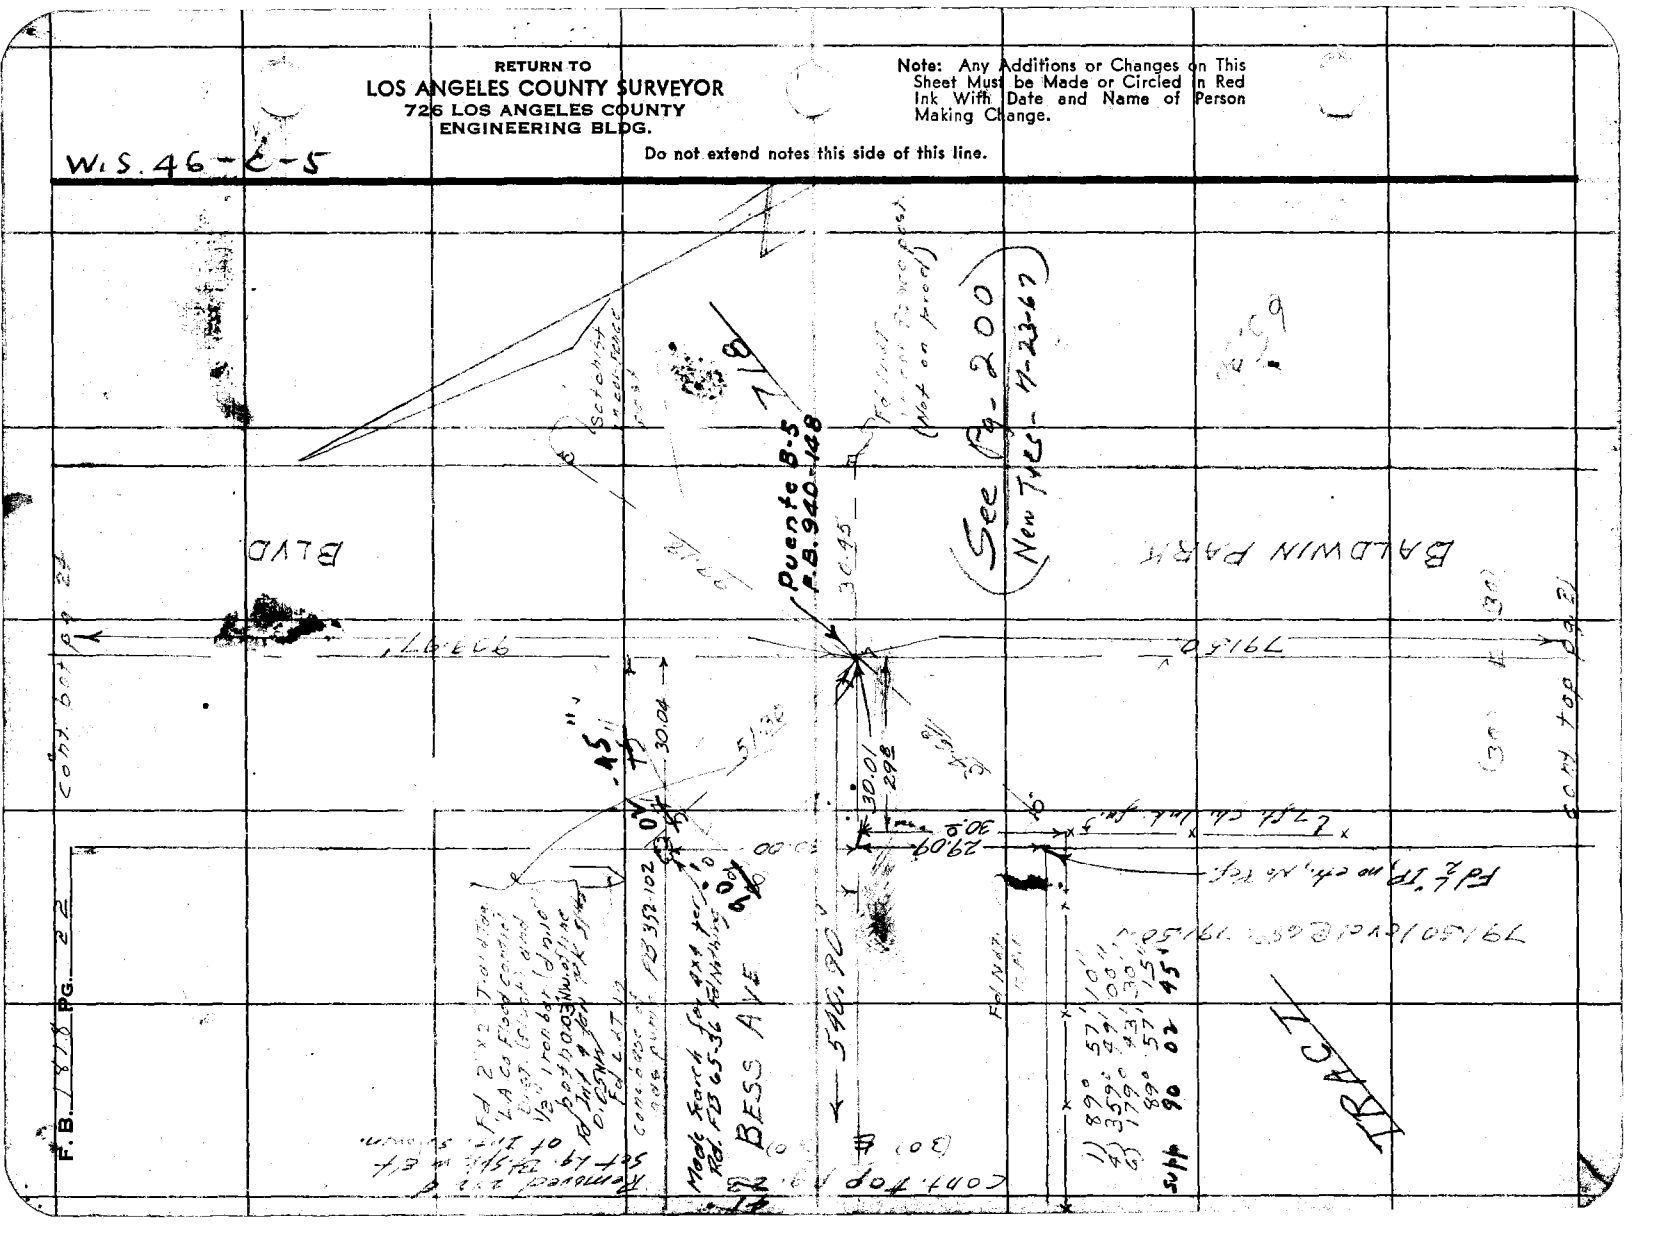

76F309S 247 2-51

RETURN TO
LOS ANGELES COUNTY SURVEYOR
726 LOS ANGELES COUNTY
ENGINEERING BLDG.

Note: Any Additions or Changes on This Sheet Must be Made or Circled in Red Ink With Date and Name of Person Making Change.

Do not extend notes this side of this line.

W.S. 40

1) 670.74 @ Ler (T=68°) = 670.74
2) 670.73 @ " " = 670.73
Av = 670.73

1) 1848.33 @ Ler (T=84°) = 1848.51
4) 1848.31 @ " " = 1848.50
Avg = 1848.51

Compton Blvd.

FRAZIER

Angle Pt. Garvey Ave.
Fd L.A.T.
3 main L.T.'s
per F.B. 520-12
See F.B. 520-198

Accepted This Pt. for E. Garvey Ave to East, (See pgs. 41, 26, 27, 73)

670.73
Not Chained

1848.51

Compton Blvd.

43

ALVE.

N 7°-37'-00" W

670.73

AVE.

BESS

GARVEY ST.

1) 47 37 00
2) 130 38 10
3) 265 42 10
Av) 47 37 01 2/3

Ndtes Ck'd by C. J. GALLI
Map No. C.S.B.- 2497-2
Office Work BURNS
Ctecked C.J.G.
Date Feb 1955

Survey of Compton Blvd.
W. O. 2497 Tape No. 0139 Std. 68 °F
Surveyed by [illegible] Date 2-11-53
Notes Indexed

F. B. [illegible] PG. [illegible]

R. MITCHELL

RETURN TO
LOS ANGELES COUNTY SURVEYOR
726 LOS ANGELES COUNTY
ENGINEERING BLDG.

Note: Any Additions or Changes on This Sheet Must be Made or Circled in Red Ink With Date and Name of Person Making Change.

Do not extend notes this side of this line.

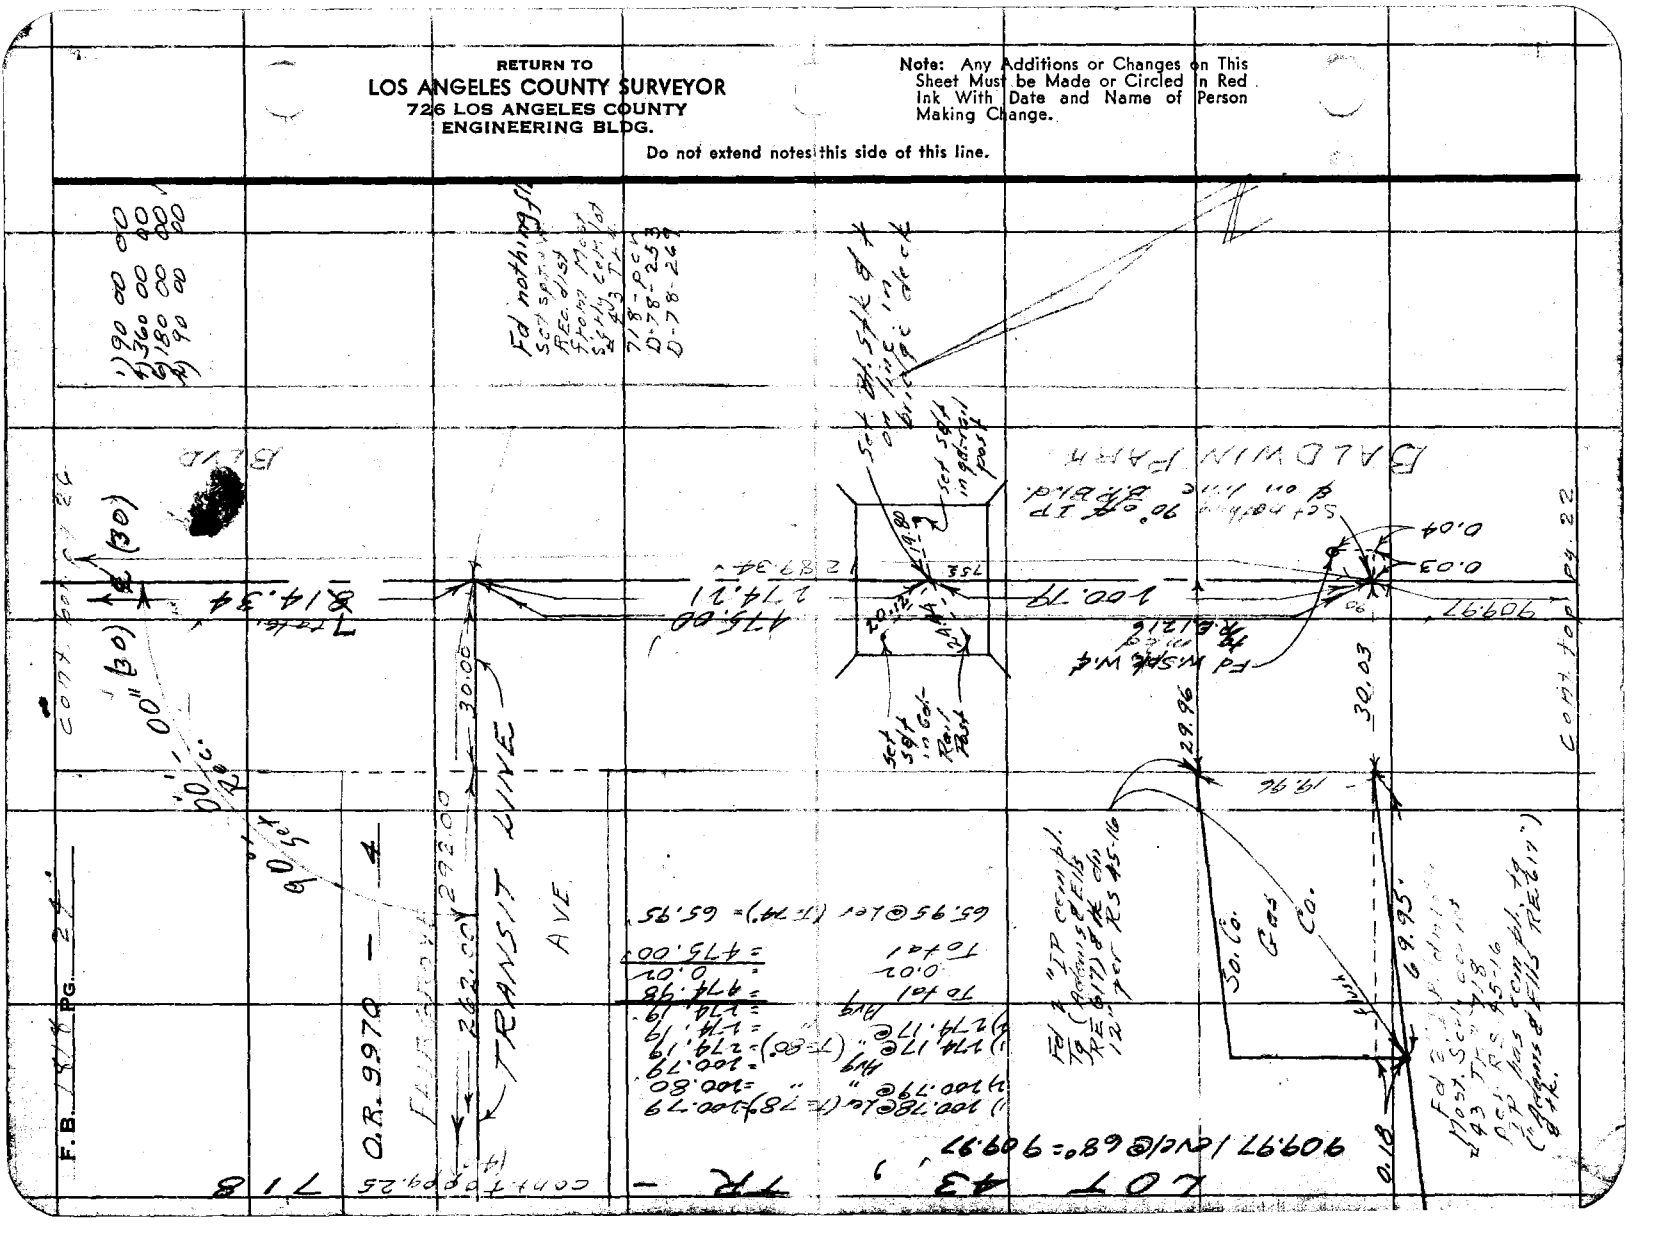
TRANSIT LINE
AVE
LOT 43
TR
O.R. 9970
F.B. 184 PG. 24
TIE
30.00
30.03
29.96
100.79
475.00
814.34
909.97
909.97 / CNCL @ 68' = 909.97
65.95 @ Lot (R 74') = 65.95
474.78
0.01
475.00
100.79 @ Lot (R 78') = 100.79
100.80
174.19 @ Lot (R 60') = 174.19
174.19
Fd nothing found
Set spike in top of curb
Fd 1" IP corner
Fd 3/4" IP
Set 3/4" IP
Fd Nail & Tag

76F309S 247 2-51

RETURN TO
LOS ANGELES COUNTY SURVEYOR
726 LOS ANGELES COUNTY
ENGINEERING BLDG.

Note: Any Additions or Changes on This Sheet Must be Made or Circled in Red Ink With Date and Name of Person Making Change.

Do not extend notes this side of this line.

Notes Ck'd by C. J. GALLI
Map No. C.S.B. 2497-2
Office Work Burns
Checked C. J. G.
Date Feb 1958

Survey of W. O. 86 Tape No. 8737 Std. 69 °F
Surveyed by J. J. L. & M. Date 2-18-53
Notes Indexed ~ Traversed

F. B. Book PG.
R. J. MITCHELL

1) 176.72 @ ker (I = 89°) = 176.
2) 176.74 @ " " = 176.
Av = 176.

Cont'd from Pg. 39

set n & t see pg. 40

173° 30' 33"-85' 10" adj.

FAIRGROVE

Fd 2" IP dn 6" No ctr - No Ref.

1.16

292.00

292.00

AVE

194.74

6.78

201.53

176.75

1.17

Fd 2" IP no ctr dn 6" - No Ref.

(dn 2")

Fd 1x2-dmgd. & notchd-No

set 1" IP cem pl. & tk. dn 12"
Rec Dist & Angle fr.
Spk & W in Baldwin
Pk Blvd per D-78-269
OR 9970 4 Std. Apr. 15, 1930

Set n & 2-3.00 sgt ties
Rec. dist. fr. Lot in
Garvey Ave per C.S.B
1786-1 and on line shown.

See also detail on pg. 40

1)	173	33	20
4)	334	13	20
6)	321	00	00
Av)	173	33	20

1)	173	31	00
4)	334	04	20
6)	321	06	30
Av)	173	31	05

(No. Garvey)

1)	173	33	00
4)	334	12	30
6)	321	18	30
Av)	173	33	05

1)	173	30	30
4)	334	02	20
6)	321	03	20
Av)	173	30	33 1/3

(No. Baldwin Pk. Blvd.)

RETURN TO
LOS ANGELES COUNTY SURVEYOR
725 LOS ANGELES COUNTY
ENGINEERING BLDG.

Note: Any Additions or Changes on This Sheet Must be Made or Circled in Red Ink With Date and Name of Person Making Change.

Do not extend notes this side of this line.

W.S. 46 - C - 5

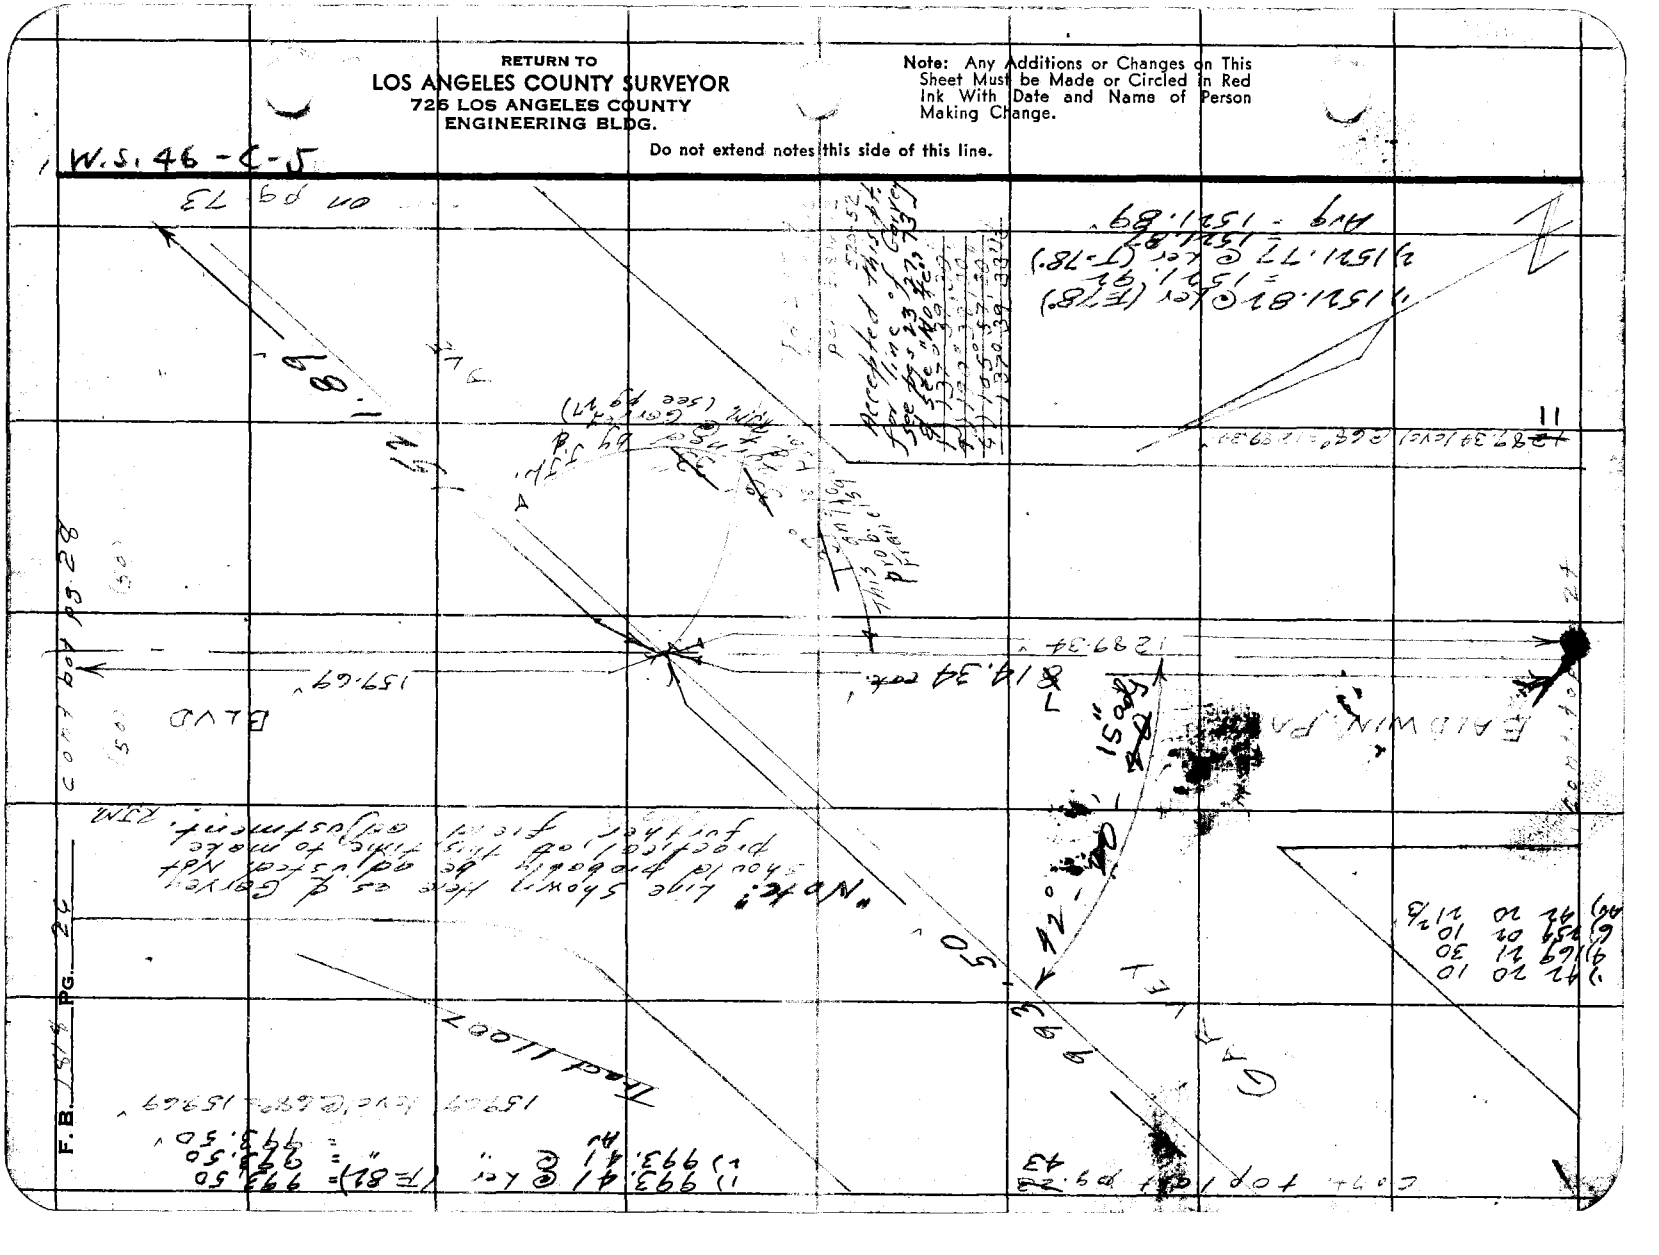

76F3095 247 2-51

RETURN TO
LOS ANGELES COUNTY SURVEYOR
726 LOS ANGELES COUNTY
ENGINEERING BLDG.

Note: Any Additions or Changes on This Sheet Must be Made or Circled in Red Ink With Date and Name of Person Making Change.

Do not extend notes this side of this line.

W.S. 46 [illegible] -5

Contd Bkm Pg. 33

RANCHO SAN PEDRO

455.41'

0-02-15"

715.34'

Fd L.&T. P.C.C. F.B. 814-18 Sec. F.B. 520-46 4 stamped L.&T.'s in M.C.S.

0.13

0.10

Set Pencil M by Int. (See pg 26)

28.54

28.43

GARVEY AVE

Rec. M.C.S.

AVE

VIRGINIA AVE

493.85'

Fd. Std. C.S.B.M. Cap. N.on. dm. 1/8" in H.H. per C.S. F.B. 520-46

1) 493.79 L or (T=88) = 493.85
2) 493.80 " = 493.86
D-g = 493.85

1) 455.34 @ L or (T=90) = 455.34
2) 455.34 @ " " = 455.34
Avg

1)	50	26	10
4)	201	25	20
6)	302	37	40
Av)	50	26	16 1/3

Contr. right top Pg. 73

50 ft

Ck'd by C. J. GALLI
Map No. C.S.B. - 2497-2
Office Work BURNS
Checked C.J.G.
Date Feb. 1955

Survey of W. Ore. & Pac. Ry. Co. "F" Std. E.R.
Surveyed by J. J. [illegible]
Notes J.J.L. & T.
Indexed [illegible]
Date 10-5-53

F. B. [illegible] Pg. [illegible]

MITCHELL
1 lon
2 + to
lon. 520-46

RETURN TO
LOS ANGELES COUNTY SURVEYOR
726 LOS ANGELES COUNTY
ENGINEERING BLDG.

Note: Any Additions or Changes on This Sheet Must be Made or Circled in Red Ink With Date and Name of Person Making Change.

Do not extend notes this side of this line.

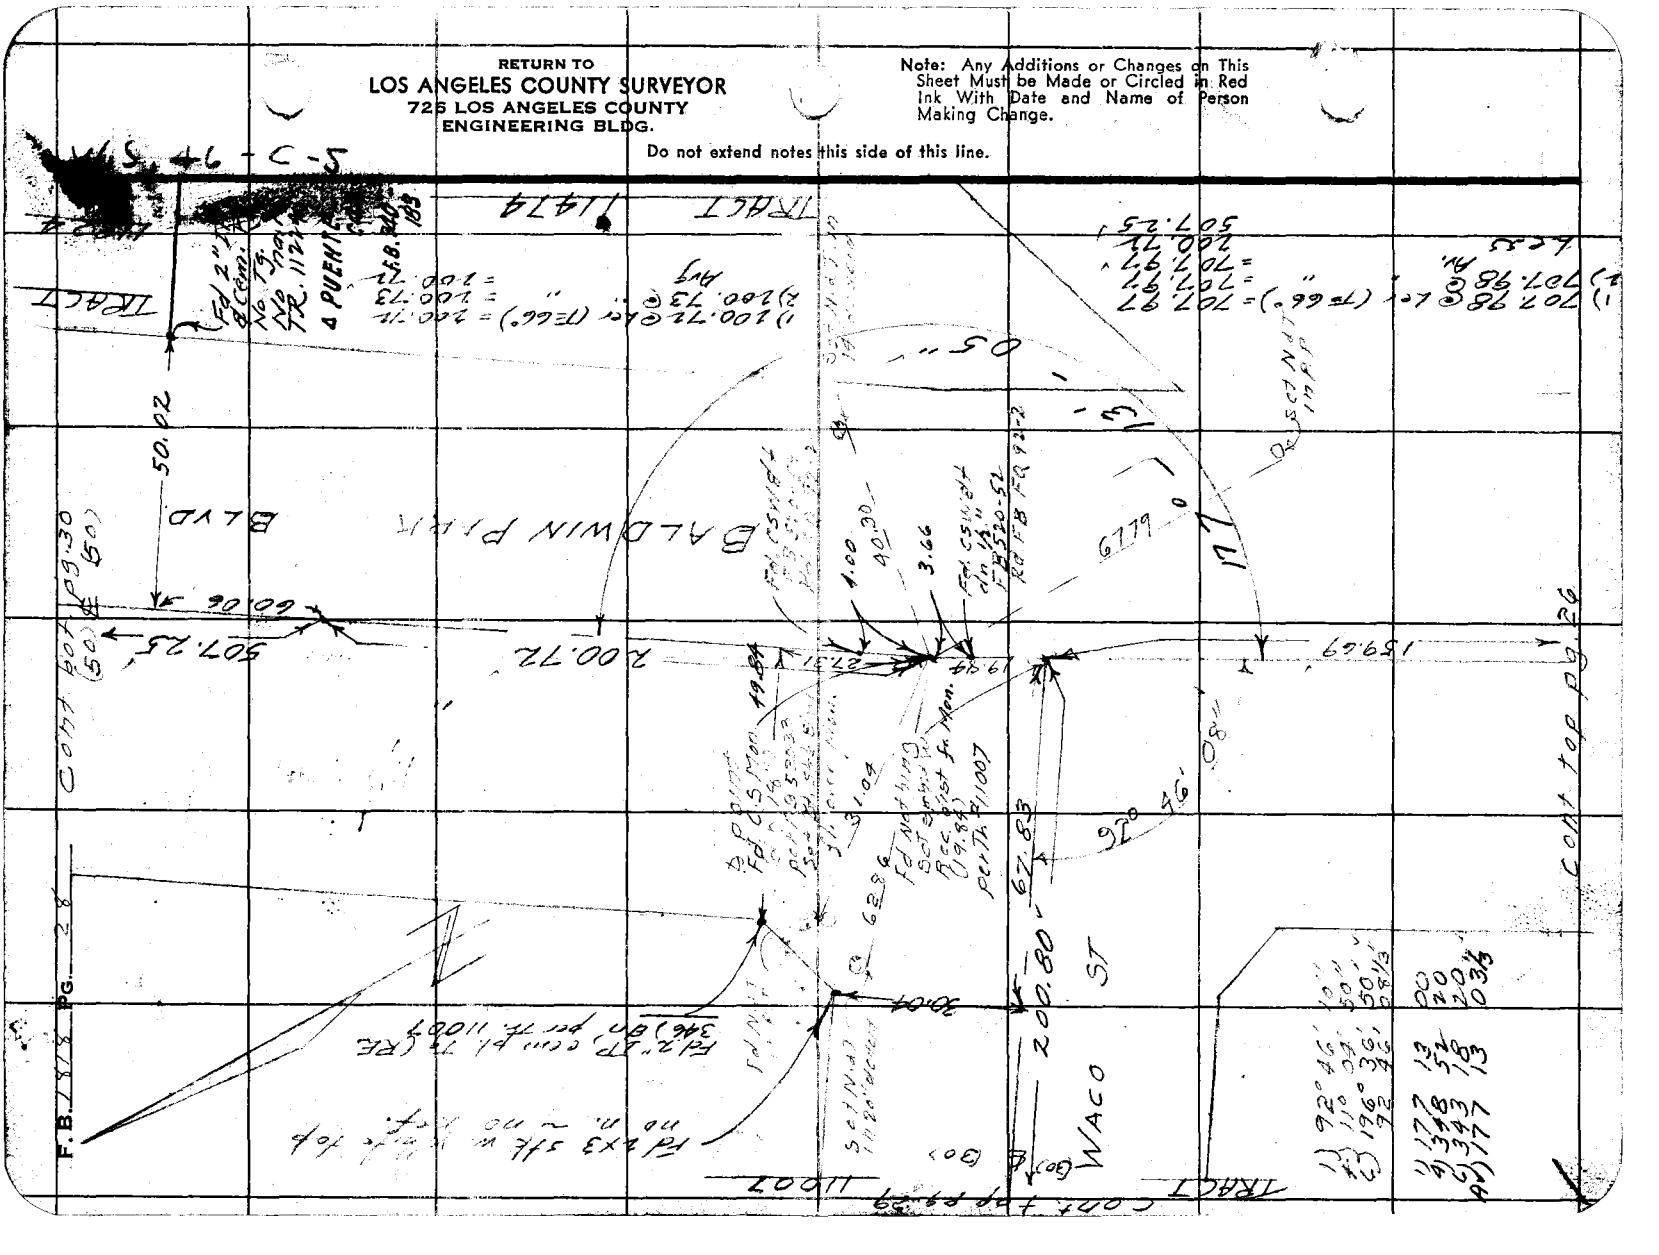
BALDWIN PARK BLVD
WACO ST
TRACT 11974
TRACT 11007
F.B. 878 PG. 28
200.72
200.80
50.02
60.06
507.25
159.69
67.83
92° 46'
Cont top pg. 26
Cont top pg. 29
Fd 2" IP Cor. & Cond. No Tag

Notes Ck'd by C. J. GALLI
Map No. C.S.B. - 2497 - 2
Office Work Burns
Checked C.J.G.
Date Feb. 1955

Survey of Burns
W. O. 8691 Tape No. 8131 St'd. 68 °F
Surveyed by J. J. Langan & R. J. MITCHELL
Notes J.J.L. 8/M Date 2-11-53
Indexed A. O. Johnson

F. B. 1148 PG. 27

Note: Any Additions or Changes or This Sheet Must be Made or Circled in Red Ink With Date and Name of Person Making Change.

Do not extend notes this side of this line.

RETURN TO
LOS ANGELES COUNTY SURVEYOR
726 LOS ANGELES COUNTY
ENGINEERING BLDG.

(30) (30)

Set Sm. Bt. Spk & t on line

Fd. Sq. Hd Spk & W - No Ref.

0.11

(10) "FRONTAGE RD" (State Highway)

PROP.

Fd. 4" Spk & W - No Ref Prop St. (Maby)

(50') STREET

0.11

WACO

Set Sm. Bt. Spk. & t on line

Fd 2x2 Spk No Ref.

29.87

10.97

Set Sm. Bt. Spk & t on line

TRACT 11007

Rec. Brng = N 41°-26-42"E

80°

3.44' Set

Set Nail (R.C.L. 0.15' (3.44') pct TR 11007 (Set angle Replaced w. with 1" IP Cem'd L. & Co. Tk dig 18" Rec. angle & dist. fr. 2" IP.

Ang. Pt in Tr. Line Fd 1" I.P. coupling & N. (dg 30')

pct TR 11007 I.P. has Tg RE 346 Fd 4 tan Spk & t. ties on surface & Fd 2x2 & tn on surface at int of ties & over I.P.

TR. 11216

1) 154.87 @ 1cr (E 61°) = 154.87
2) 154.81 @ " = 154.81
Avg = 154.81

1) 306.57 @ 1cr (E 82°) = 306.67
2) 306.58 @ " = 306.61
Avg. = 306.61

1) 200.85 @ 1cr (E 82°) = 200.87
2) 200.84 @ " = 200.86
Avg = 200.86

" = 30.00

" = 64.20

1) 200.79 @
2) 200.82 @

(82°) = 200.
200.
200.

76F3095 247 2-51

RETURN TO
LOS ANGELES COUNTY SURVEYOR
726 LOS ANGELES COUNTY
ENGINEERING BLDG.

Note: Any Additions or Changes on This Sheet Must be Made or Circled in Red Ink With Date and Name of Person Making Change.

Do not extend notes this side of this line.

W.S. 46-C-5

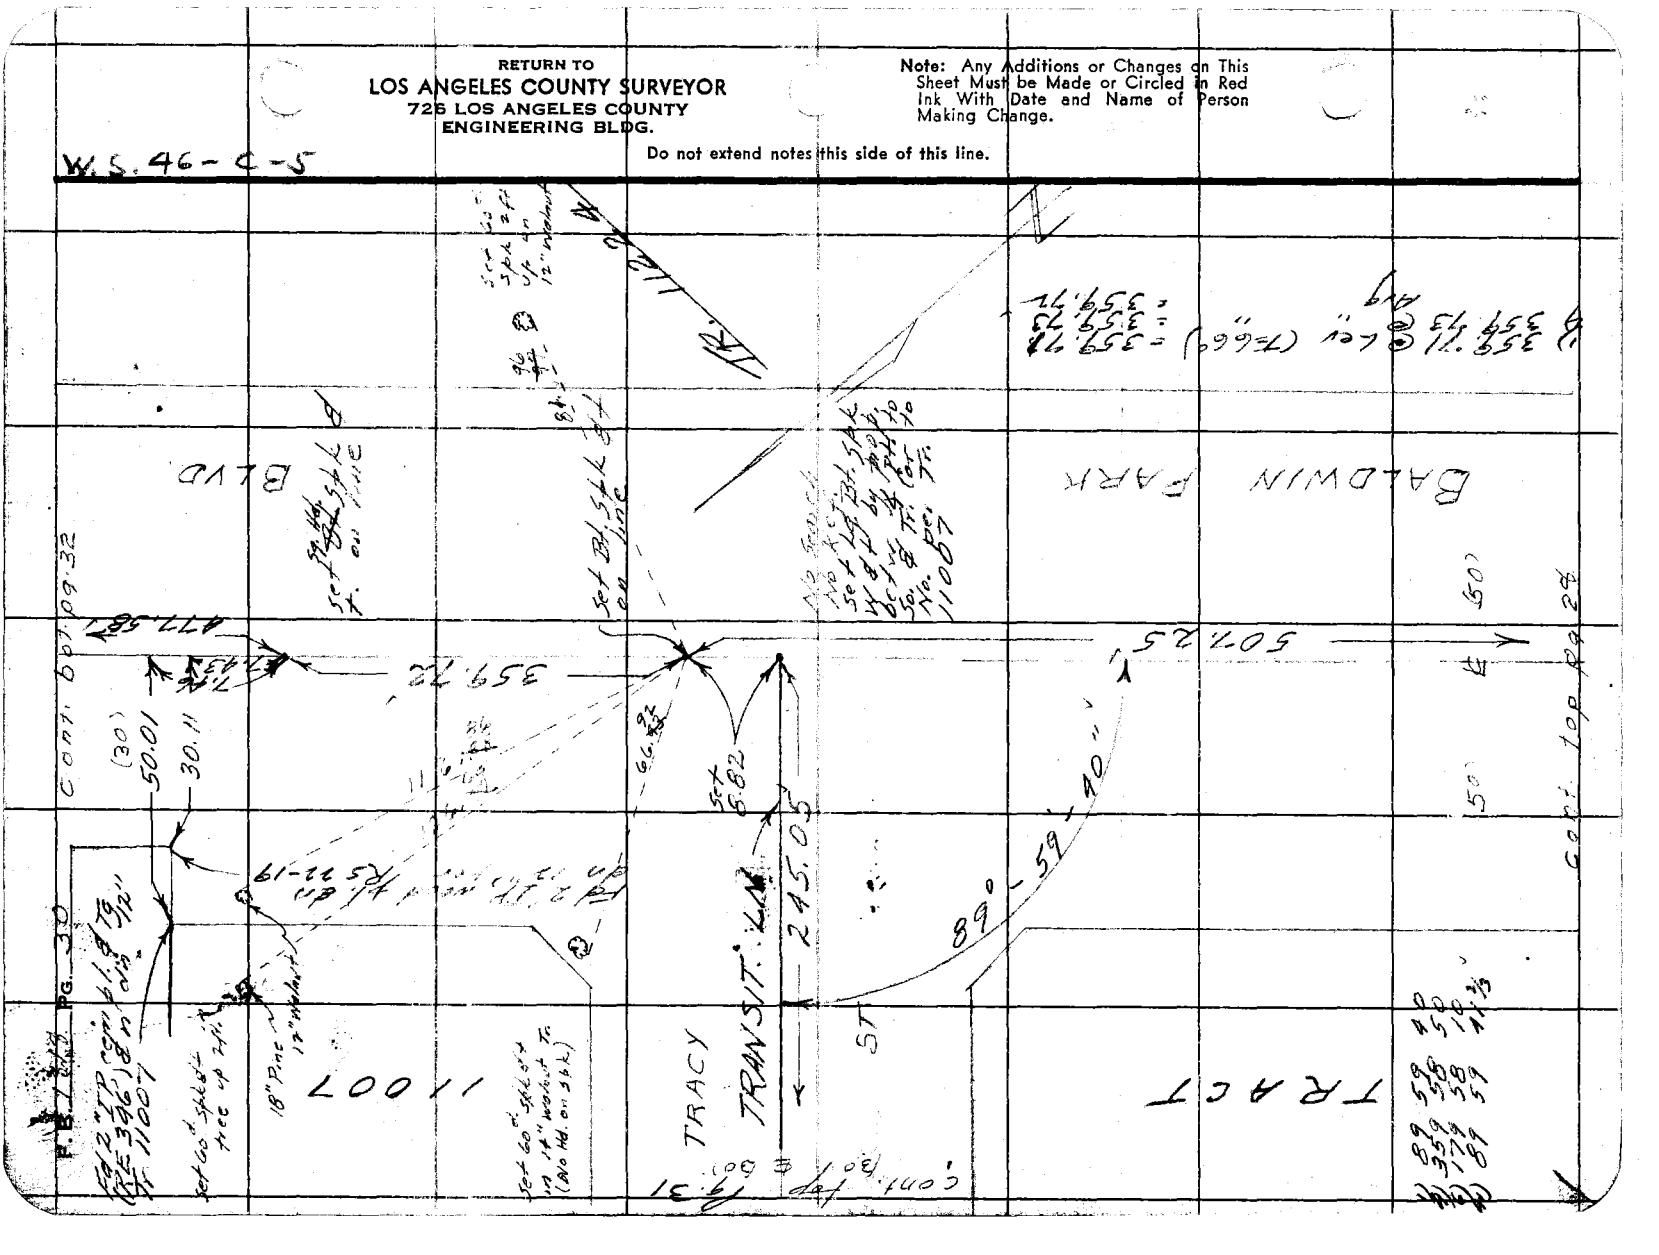

76F309S.247 2-51

RETURN TO
LOS ANGELES COUNTY SURVEYOR
726 LOS ANGELES COUNTY
ENGINEERING BLDG.

Note: Any Additions or Changes on This Sheet Must be Made or Circled in Red Ink With Date and Name of Person Making Change.

Do not extend notes this side of this line.

1.50

1) 235.87 @ Ler (T=68°) = 235.87
2) 235.85 @ Ler " = 235.85
Avg = 235.86

1) 321.09 @ " " = 321.09
2) 321.10 @ " " = 321.10
Avg = 321.09

LOT 5 LOT 6
BLOCK A

Fd 2x2 & bent nail
No Ref.

TRACT
TRACY

Set 30.00

Set n&t

235.86 321.09 245.05

TRANSIT LINE

1.84

Set 0.30 in

2880
29.67

STREET

Fd 1/2" Pipe
No Tag
No Ref

1) 245.04 @ Ler (T=66°) = 245.04
2) 245.06 @ " " = 245.06
Avg = 245.05

0.06

Fd. 3/4" Pipe
No Tag
No Ref.

LOT 8 LOT 17
BLOCK B

Notes Ck'd by K. J. Hall
Map No. C.S.B - 24971-2
Office Work Burns
Checked C.J.G.
Date Feb. 1955

Survey of Los Angeles County
W. O. 5267 Sheet No. 3 of 6 Sheets
Surveyed by J. J. Mitchell Date 2-17-53
Notes Indirect

F. B. 8 PG. 27

J. MITCHELL

RETURN TO
LOS ANGELES COUNTY SURVEYOR
725 LOS ANGELES COUNTY
ENGINEERING BLDG.

Note: Any Additions or Changes on This Sheet Must be Made or Circled in Red Ink With Date and Name of Person Making Change.

Do not extend notes this side of this line.

W.S. 46 - C-5

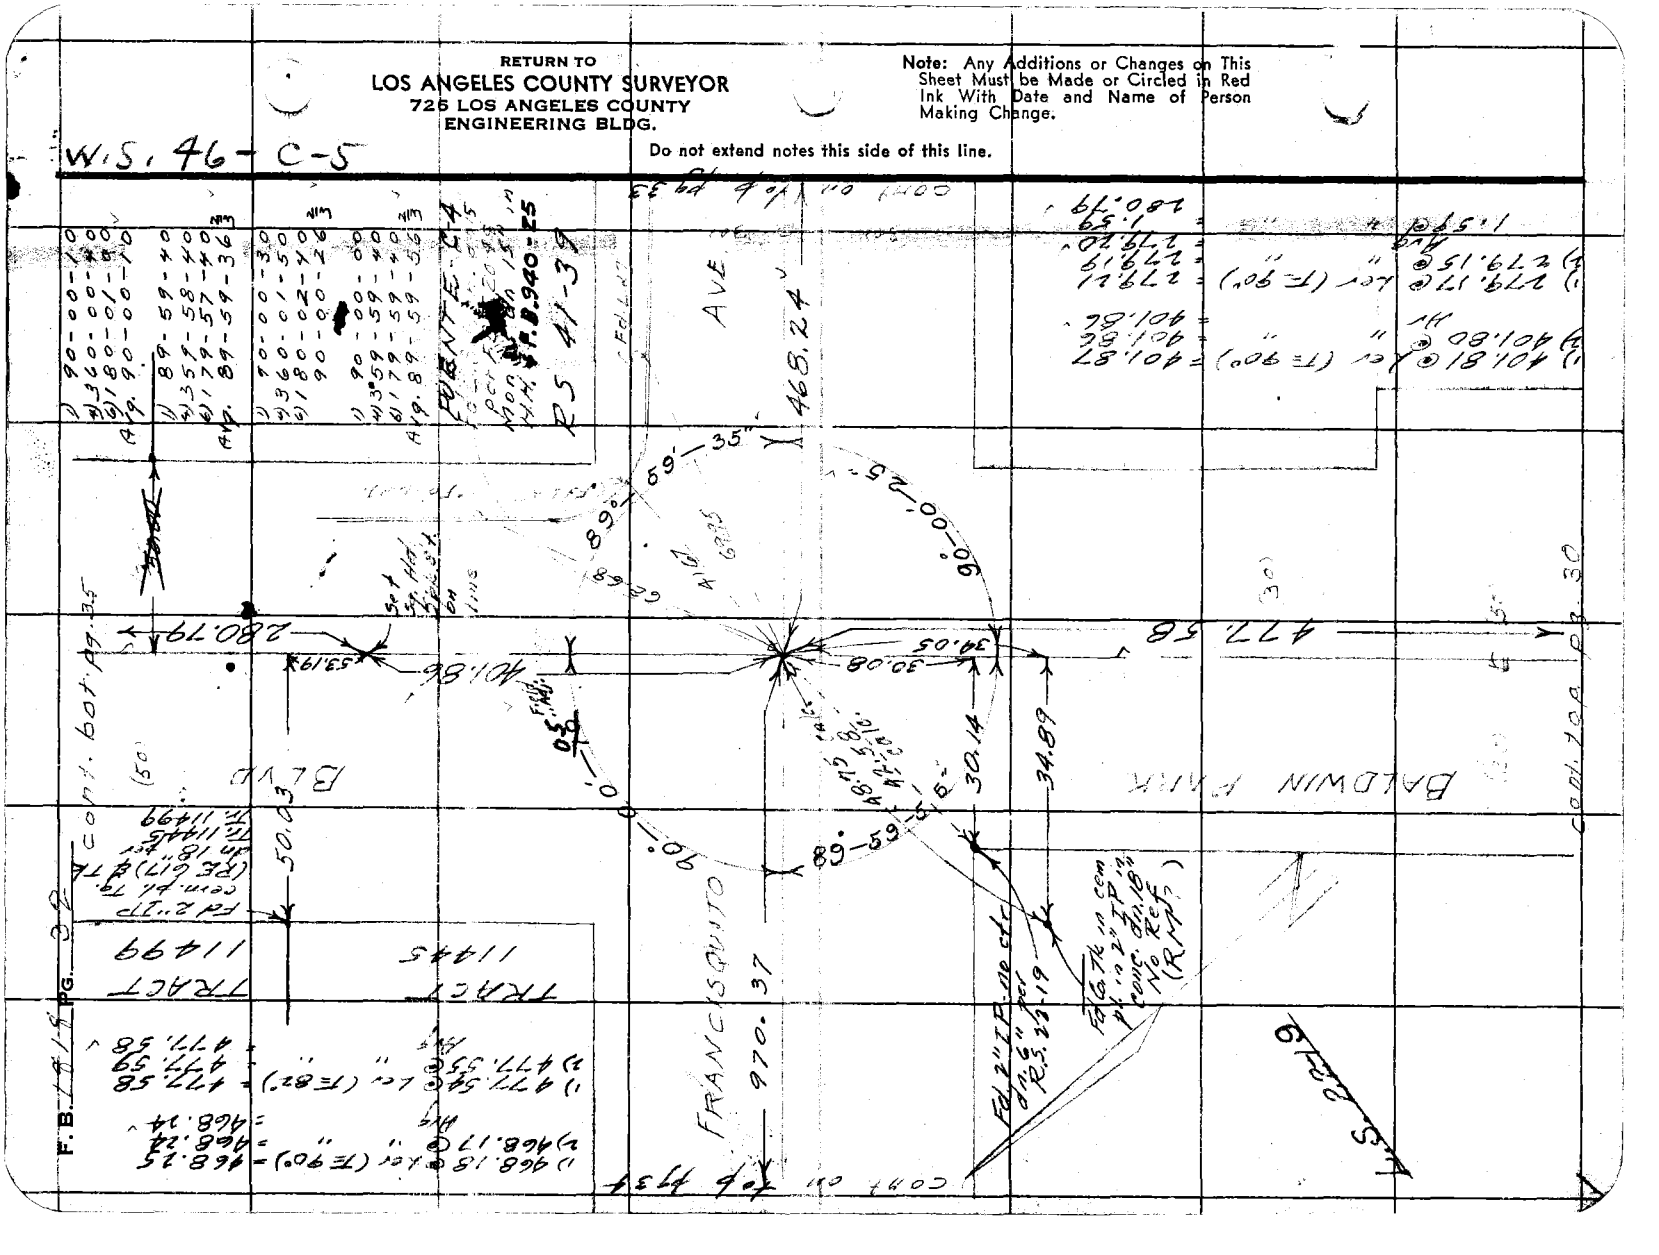
AVE
BLVD
FRANCISQUITO
BALDWIN PARK
FUENTE
P.S. 41-39
M.M. F.B. 940-25
280.79
401.86
471.58
468.14
970.37
30.14
34.89
50.03
89-59
90-00-25
89-59-35
R=460.24'
Fd 2" I.P. no tag
Fd 2" I.P. no tag
P.S. 25-19
Fd 2" I.P. in conc.
N 2.2' ± to P.L.
Conc. Bnd.
No Ref.
(R.M.P.)
Fd 2" I.P. in conc.
N 2.2' ± to P.L.
Conc. Bnd.
No Ref.
(R.M.P.)
Conc. Bnd.
Conc. Bnd.
Conc. Bnd.

Notes Ck'd by C. J. GALLS
Map No. C.S.B. 2497-2
Office Work Burns
Checked C.J.G.
Date Feb. 1955

Survey of [illegible]
W. O. [illegible] Tape No. 01 [illegible] Std. 68 °F
Surveyed by R. J. MITCHELL
Notes [illegible] Date 9-53
Indexed O Johnson

F. B. [illegible] Pg. 33

W.S. 4

1122

AVE

1683'

edge of pvmt

Fd. CS w/ ⊄ FB 520-47

MAINE

AVE.

30.00 meas.

5.00 5.00 5.00 5.00

Fd ⊙ & sm. t. No Ref. at Int. of tan CS w/ ⊄ tics out 5.00 on ⊄ ea. way. No Ref. (Prob. set by RBE in 1935 - FB 520-47) Made no attempt to recover Mon.

edge of pvmt

TRACT

FRANCISQUITO

1) 509.56 @ rad (T=90°) = 509.62
2) 509.56 " " = 509.62
Avg = 509.62

509.62

COUNTY SURVEYOR RE 2177

Fd. CS w/ ⊄ (No Ref. Prob. set by R.B.E. - FB 520-47)

Fd std C.S. Br. Cap Mon dn 18" mkd as shown above (FB 529-97) under m. (no Ref.) ⊄ Int ⊄ tan 59. Nail spks & w. - Tics to 2 Hub walls fall 0.03 NEly 0.02 NW - See ref.

5.00 5.00

S. P. R. R. see also Tr. 11224 R/W

1555.41

cont'd on Pg. 27

Note: Any Additions or Changes on This Sheet Must be Made or Circled in Red Ink With Date and Name of Person Making Change.

Do not extend notes this side of this line.

RETURN TO
LOS ANGELES COUNTY SURVEYOR
726 LOS ANGELES COUNTY
ENGINEERING BLDG.

76F309S 247 2-51

RETURN TO
LOS ANGELES COUNTY SURVEYOR
725 LOS ANGELES COUNTY
ENGINEERING BLDG.

NOTE: Any Additions or Changes on This Sheet Must be Made or Circled in Red Ink With Date and Name of Person Making Change.

Do not extend notes this side of this line.

W.S. 46-C-4

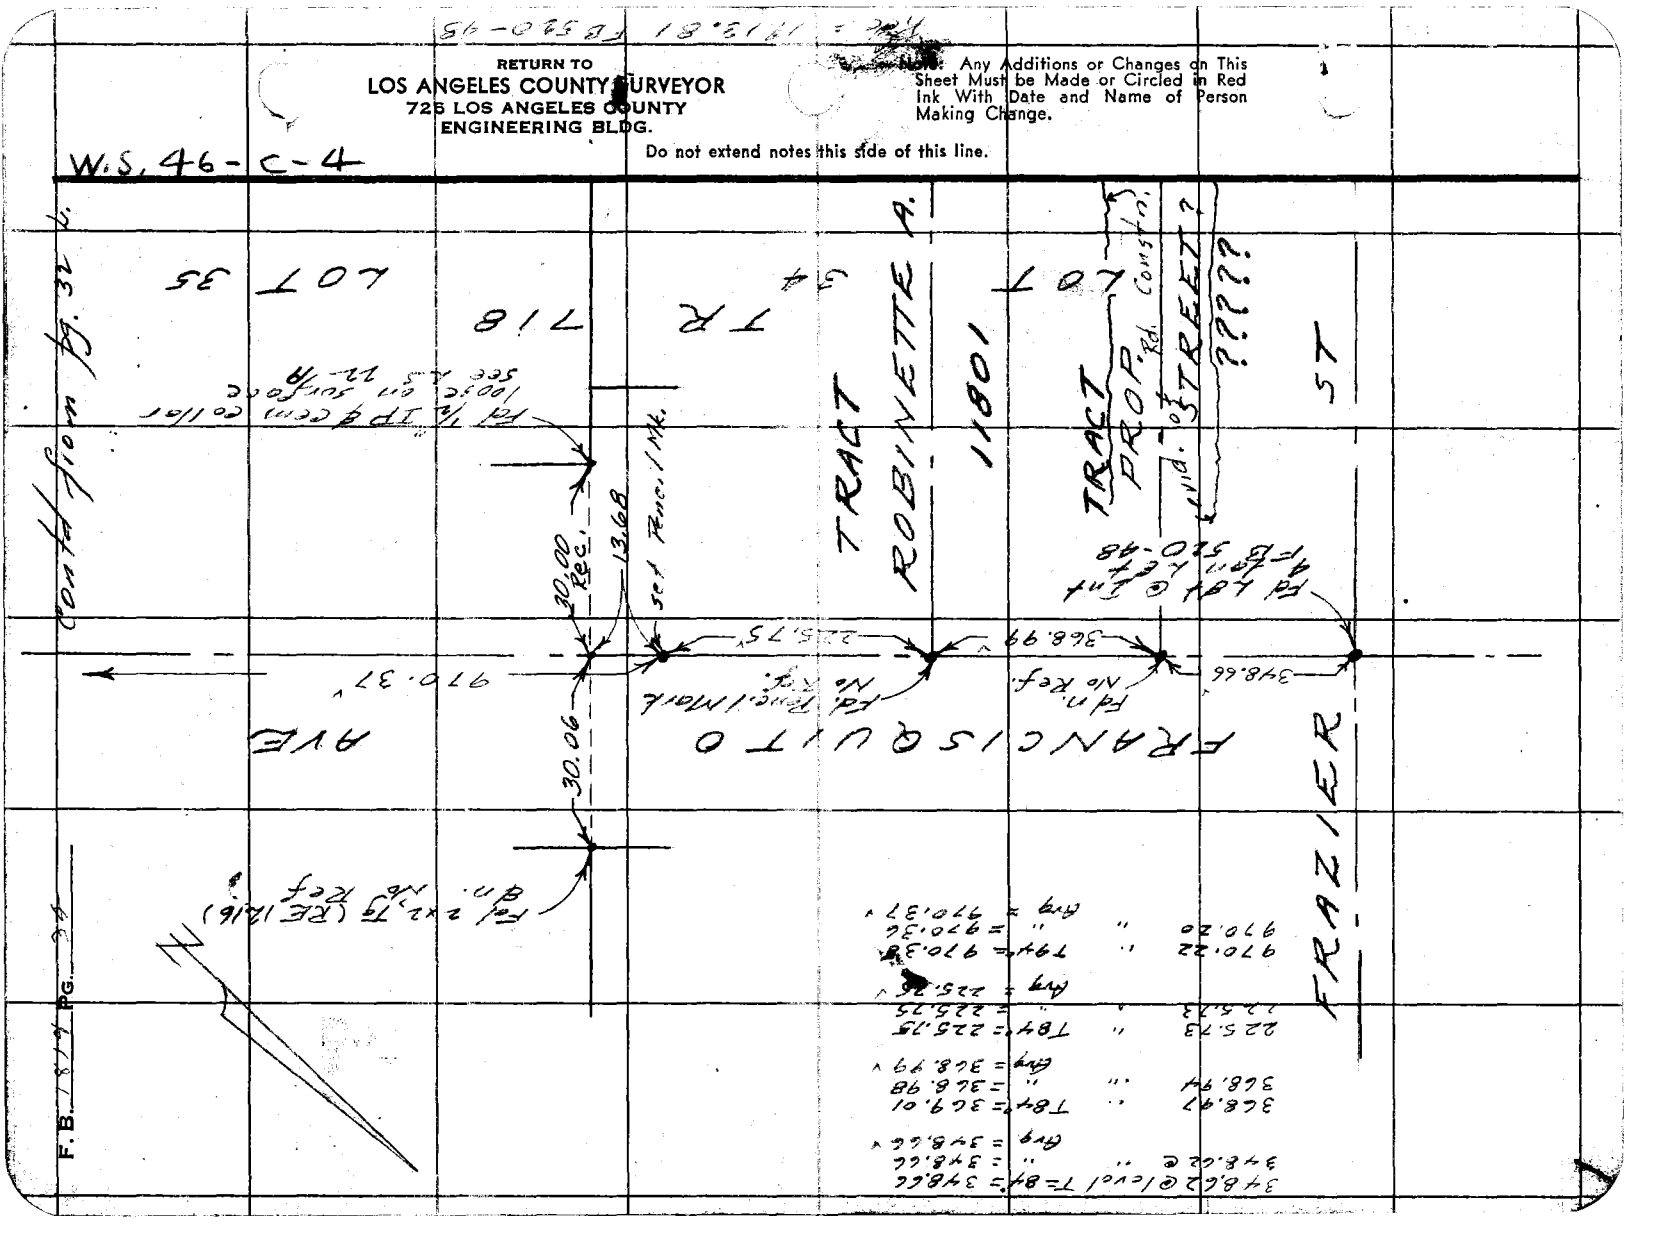

Notes Ck'd by C. J. GALLI
Map No. C.S.B. - 2497-2
Office Work Burns
Checked C.J.G.
Date Feb. 1955

Survey of BALDWIN PARK TRACT
W. O. 6414 Tape No. 913 St'd. 62 °F
Surveyed by J. J. LORIMER (R. J. MITCHELL)
Notes J. J. LORIMER Date 2-17-53
Indexed A. O. Johnson

F. B. [illegible] PG. 38

Cont'd on Pg 37

Note: Any Additions or Changes on This Sheet Must be Made or Circled in Red Ink With Date and Name of Person Making Change.

Do not extend notes this side of this line.

RETURN TO
LOS ANGELES COUNTY SURVEYOR
726 LOS ANGELES COUNTY
ENGINEERING BLDG.

76F3095 247 2-51

RETURN TO
LOS ANGELES COUNTY SURVEYOR
725 LOS ANGELES COUNTY
ENGINEERING BLDG.

Note: Any Additions or Changes on This Sheet Must be Made or Circled in Red Ink With Date and Name of Person Making Change.

Do not extend notes this side of this line.

W.S. 46 - C-4

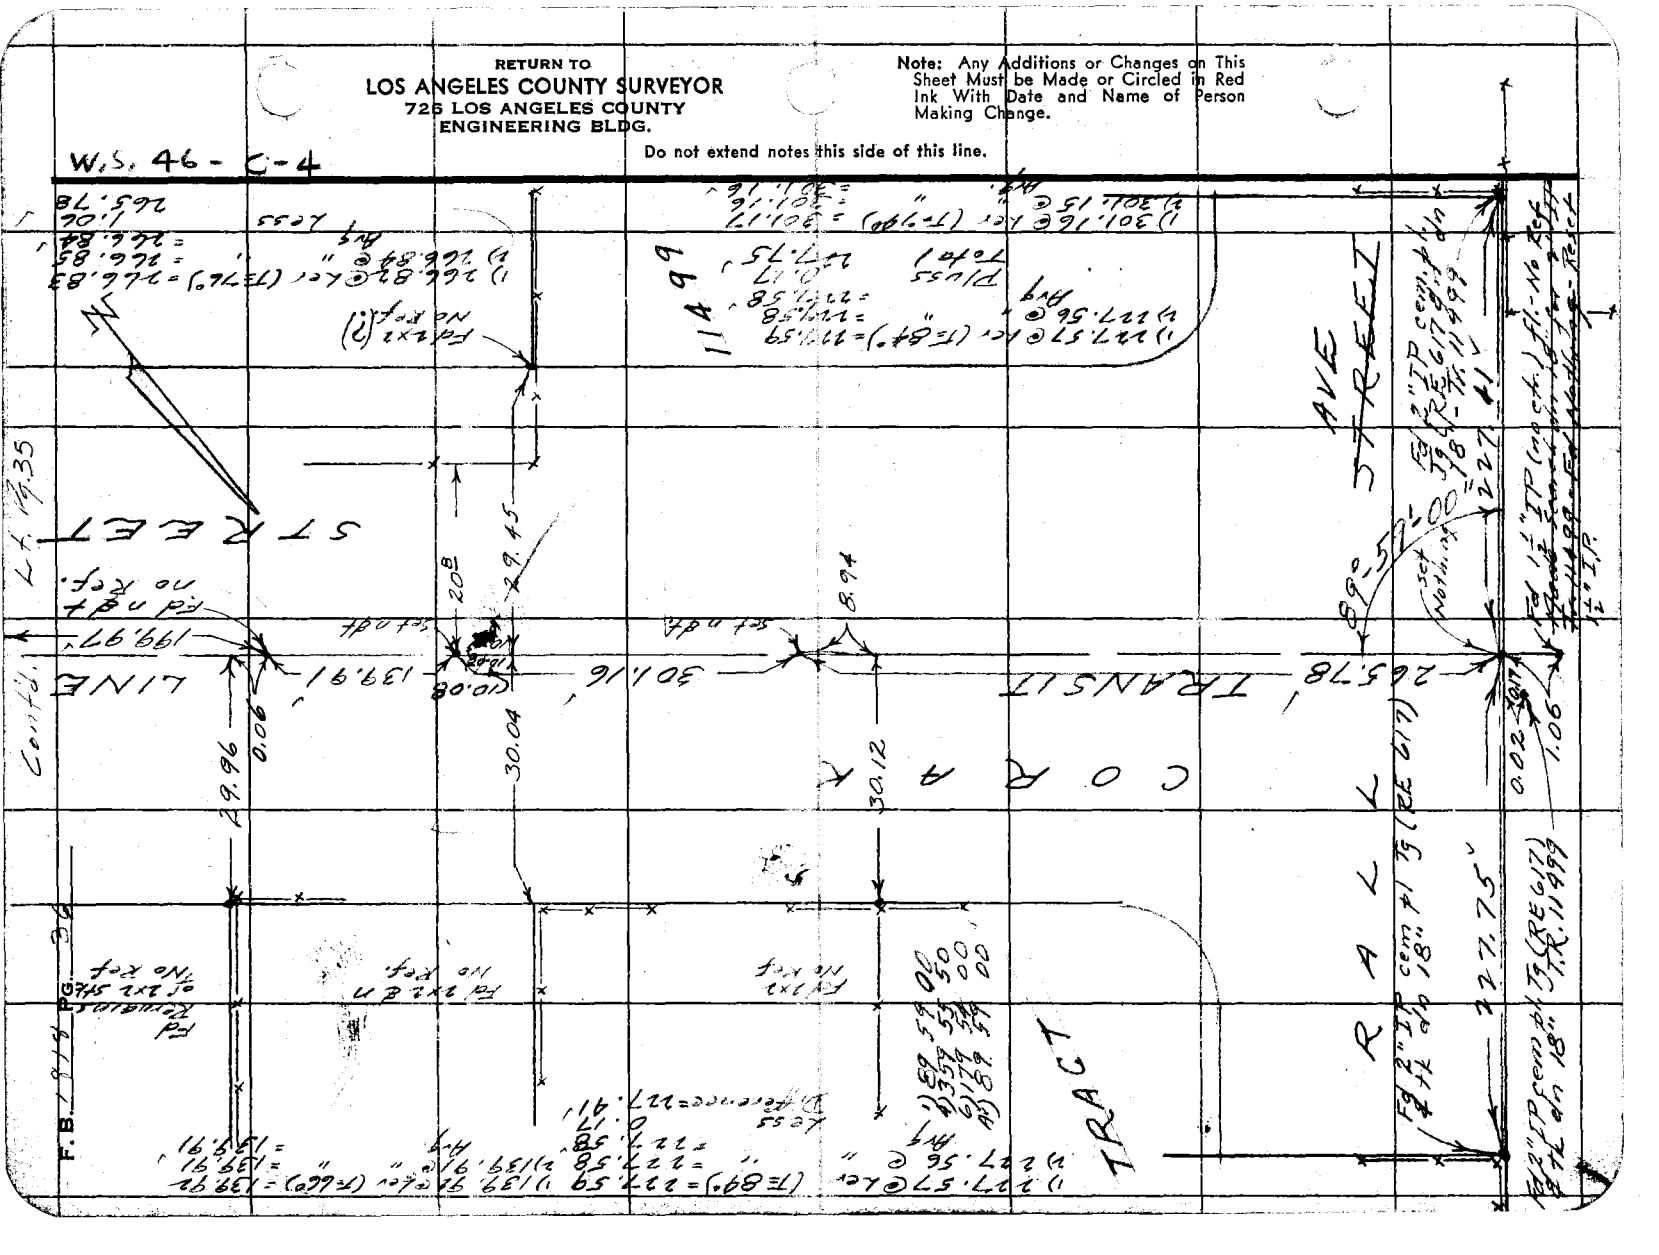

Notes Ck'd by C. J. GALLI
Map No. C.S.B-2497-2,3
Office Work Burns
Checked C.J.G.
Date FEB 1955

Survey of BALDWIN PARK BLVD.
W. O. 8641 Tape No. 0/3 St'd. 68 °F
Surveyed by J. J. L. [illegible]
Notes J. J. L. [illegible] Date 2-19-53
Indexed [illegible]

F. B. 1515 PG. 37

Note: Any Additions or Changes on This Sheet Must be Made or Circled in Red Ink With Date and Name of Person Making Change.

Do not extend notes this side of this line.

RETURN TO
LOS ANGELES COUNTY SURVEYOR
726 LOS ANGELES COUNTY
ENGINEERING BLDG.

W.S.46

Cont'd on pg 45

90°00'-20"

BLVD

30.03

Fd 2x2, Tg (L.S. 2544) dn no Ref

30.11

FOSTER

Fd. PK spk. No Ref.

1913.74

0.09

29.92

0.08

0.13

Fd. C/L spk. w/ dt FB 511-44

Fd 2x2 spk dn. 6" psc. FB 511-44 Set spk @ 3.00 NE @ 3.00 NW - Fd. nail 0.98 NW @ 0.98 SW - Removed 2x2 @ Set 1" IP 6 cm Flush @ C.O. Tk @ 16" by Int.

468.32

AVE

Cont'd on pg 45

1) 90 00 20
2) 360 01 30
3) 180 02 10
4) 90 00 21 1/3

BALDWIN PARK

229.74

0.03

Fd Sq. Hd spk @ t No Ref.

50.00

0.03

Fd Sq. Hd spk @ t No Ref. Set by local resident

175.01

Cont'd from pg 35

1) 278.75 (T=78°)
2) 279.72 @ " " (T=78°)
3) 279.00 " " "
4) 279.74 " " "
Less (See above)

1) 111.95 @ " " (T=8°)
2) 111.86 @ " " (T=8°)
3) 111.84 @ " " (T=8°)
4) 111.84 @ " " (T=8°)

1) 468.28 @ " " (T=8°)
2) 468.28 @ " " (T=8°)

Cont'd on pg 35

76F309S 247 2-51

F. B. 1818 PG. 38

1) 488.79 @ 1er (T=82') = 488.83
2) 488.77 @ " " = 488.81
R.S. = 488.82'
20.75 @ " = 20.75
Total = 509.57

W.S. 46-D-4

S. P. R. R. R/W

Set 1½" IP on split of R.S. 8' on line of prod.

Fd ¾" IP in conc. top of pipe is bent, used pt. where pipe enters conc.

Mag. Search for ¾" IP in conc. No Evid. - Rd Z 85-8

20.05

20.75

30.04

AVE

Set B.S. 8' Left of P.C. Grand Ave.

50.57'

Fd ¾" IP in conc. dn 6" per Rd Z 85-5

Fd ¾" IP in conc. dn 6" Rd Z 85-8

30.12

29.86

Fd Spk. & W dn 3" Rd. Z 85-8

30.02

30.03

MAIN AVE

No Search for ¾" I.P.

No Search for ¾" IP

FOSTER

165.32'

cont'd from pg 37

RETURN TO
LOS ANGELES COUNTY SURVEYOR
725 LOS ANGELES COUNTY
ENGINEERING BLDG.

Do not extend notes this side of this line.

Note: Any Additions or Changes on This Sheet Must be Made or Circled in Red Ink With Date and Name of Person Making Change.

Notes Ck'd by C. J. GALLI
Map No. C.S.B - 2457-1
Office Work Burns
Checked C.J.G.
Date Feb. 1955

Survey of
W. O. 9641 Tape No. 0114 Std. 66 °F
Surveyed by R. J. MITCHELL
Notes R. J. MITCHELL Date 9/1/53
Indexed

F. B. 1818 Pg. 39

W.S. 46

Note: Any Additions or Changes on This Sheet Must be Made or Circled in Red Ink With Date and Name of Person Making Change.

Do not extend notes this side of this line.

RETURN TO
LOS ANGELES COUNTY SURVEYOR
726 LOS ANGELES COUNTY
ENGINEERING BLDG.

(100)

FRAZIER

(30)

STREET

(30)

TORRANCE AVE.
(ELLIOT)

30.16

50.00

S.T.

(50?)

EXISTING R/W

TRACT
14056

(50?)

(50)

(50)

ELLIOT
(TORRANCE)
&
CSB1209

AVENUE
(STREET)

continued from page 19

247 4-53

RETURN TO
LOS ANGELES COUNTY SURVEYOR
726 LOS ANGELES COUNTY
ENGINEERING BLDG.

Note: Any Additions or Changes on This Sheet Must be Made or Circled in Red Ink With Date and Name of Person Making Change.

Do not extend notes this side of this line.

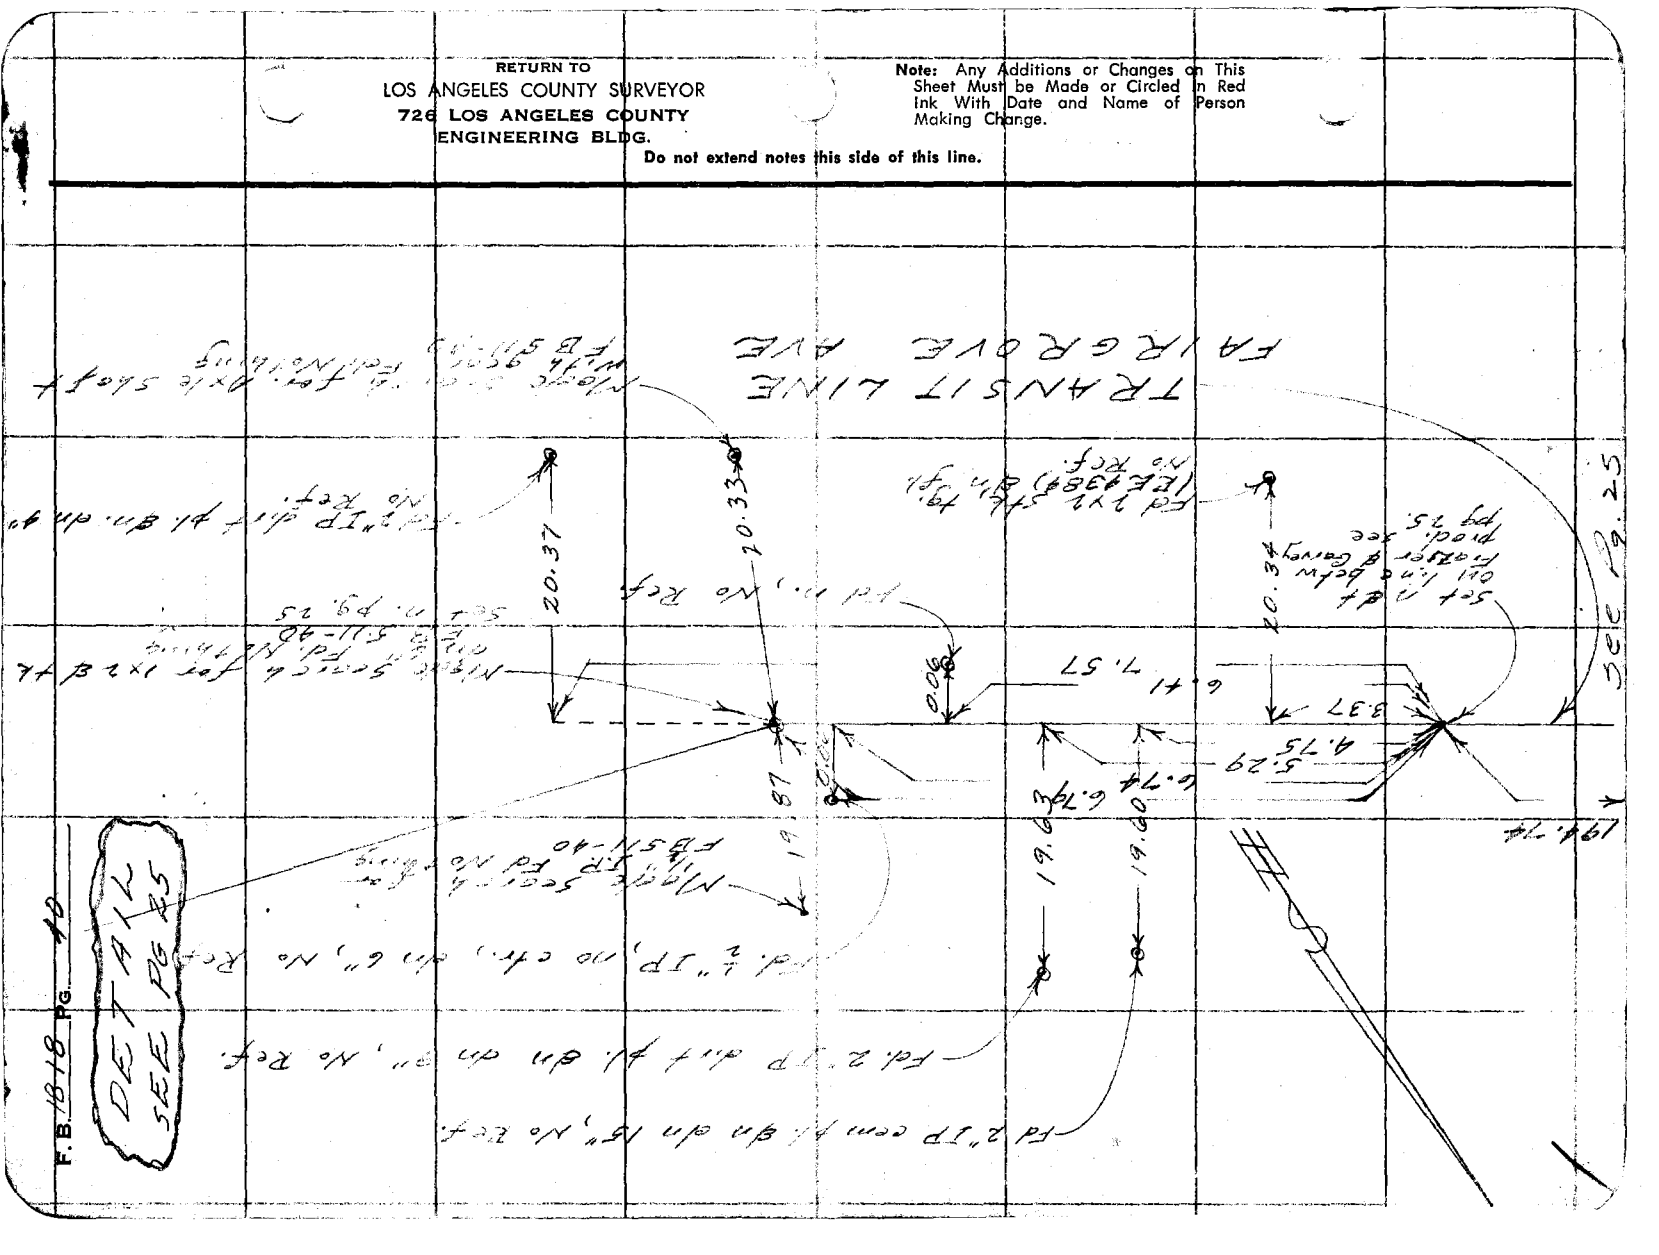

76F3095 247 4-53

RETURN TO
LOS ANGELES COUNTY SURVEYOR
726 LOS ANGELES COUNTY
ENGINEERING BLDG.

Note: Any Additions or Changes on This Sheet Must be Made or Circled in Red Ink With Date and Name of Person Making Change.

Do not extend notes this side of this line.

Notes Ck'd by G. J. GALLI
Map No. CSB-2497-1,2
Office Work Burns
Checked C. J. G.
Date Feb 1955

Survey of Pendleton Park Estates
W. O. 6611 Tape No. 9/45 Sr'd. 6.8 °F
Surveyed by
Notes
Indexed C. J. GALLI Date OCT 1953

F.B. 1816 Pg. 41

TR

LEORITA

BESS

AVENUE

STREET

Fd L (M&C RE 12/16) & Tr
No Ref
1) 702.51 @ Ler (T=70°) = 702.
2) 702.52 @ " " = 702.
Avg = 702.

Set n&t

670.73

6.30

18.55

Assume L&Ts to be on fies and fd. int to fall 0.61 S of line

Set n&t

540.83

540.90

Fd n & (Prob. St. No Ref. & see de below

30±

14±

13211

Fd L (M&C RE 12/16) & Tr
No Ref.

1) 540.90 @ Ler (T=72°) = 540.91
2) 540.88 @ " = 540.89
Avg = 540.90

Fd "
No Ref
0.05

Fd
No Ref

L

RETURN TO
LOS ANGELES COUNTY SURV
726 LOS ANGELES COUNTY
ENGINEERING BLDG.

Note: Any Additions or Changes on This Sheet Must be Made or Circled in Red Ink With Date and Name of Person Making Change.

Do not extend notes this side of this line.

IW.S. 46-C-5

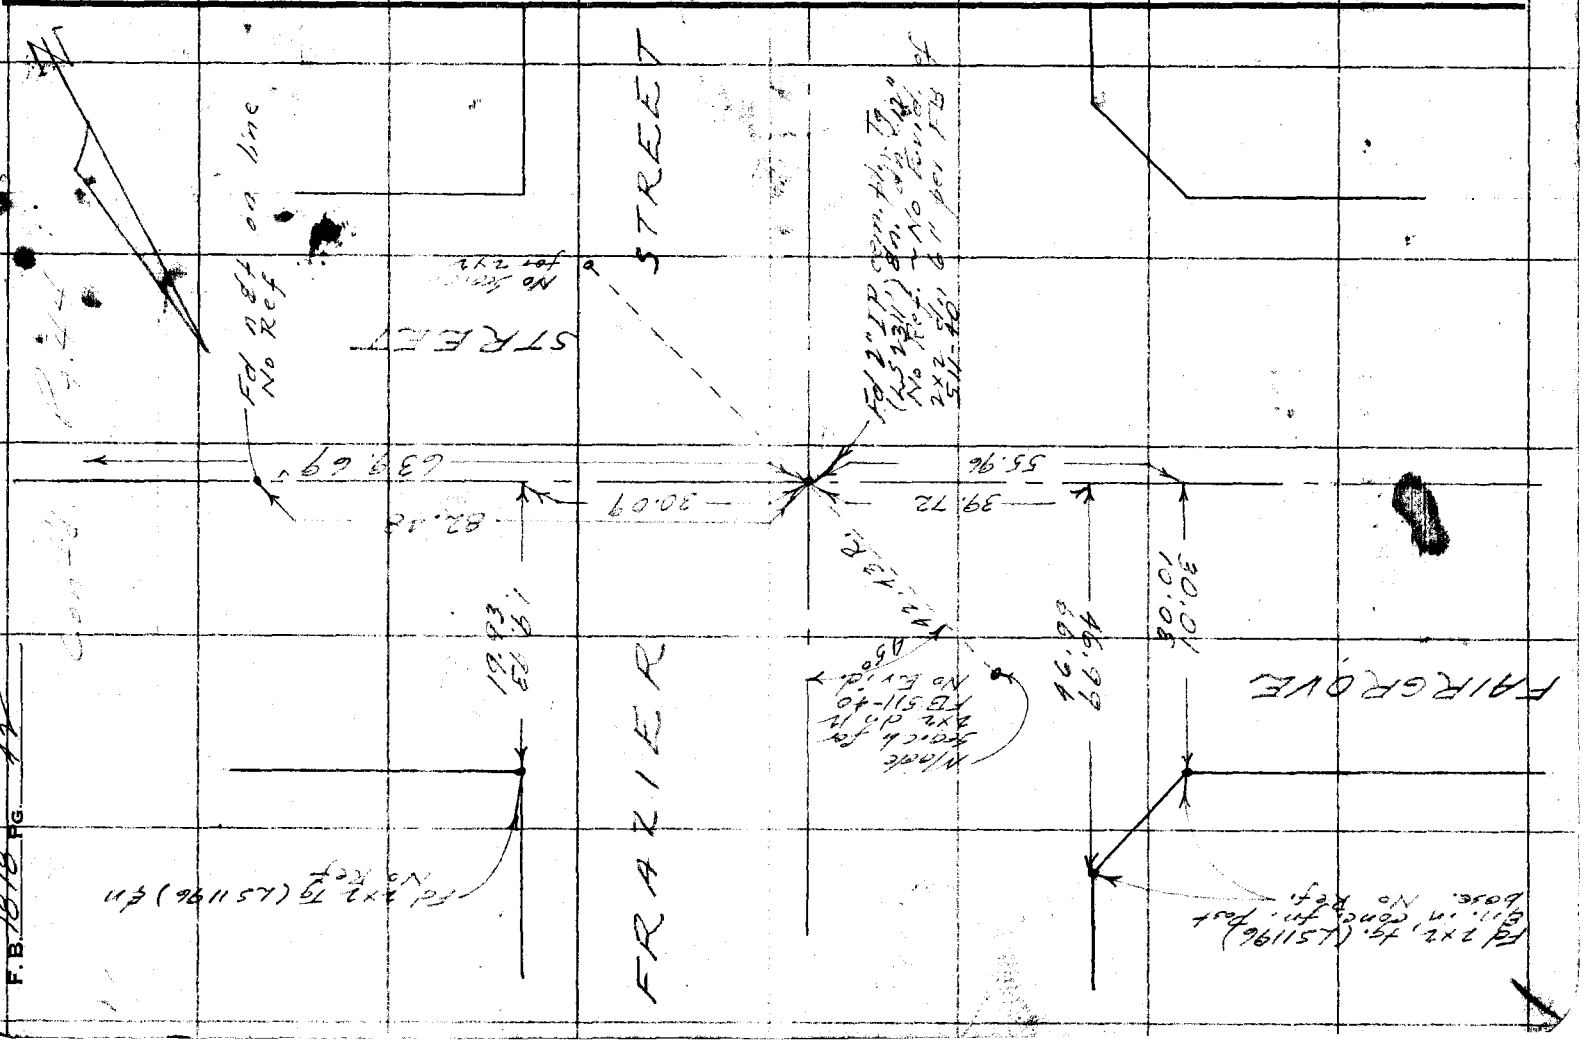

76FS095 247 4-53

RETURN TO
LOS ANGELES COUNTY SURVEYOR
726 LOS ANGELES COUNTY
ENGINEERING BLDG.

Note: Any Additions or Changes on This Sheet Must be Made or Circled in Red Ink With Date and Name of Person Making Change.

Do not extend notes this side of this line.

W. S. 46

1) 375.70 @ L.o. (T=70°) = 375.75
2) 375.68 @ " " = 375.73
Avg = 375.74

55"

cont'd on / pg. 26

1) 132 22 50
2) 168 31 20
3) 74 11 20
Av) 132 22 53 1/3

132 22'

993.50

FAIRGROVE

VOID

SEE DETAIL

Fd. L&T for 51 Hwy
C.S. FB 814-146
C.S. FB 814-8

375.74

194.74

201.53

TRANSIT LINE

AVENUE

Cont'd on pg.

1848.51

DETAIL

0.04

0.05

Set Pencil Mk on line shown by L&T.

194.74

375.74

201.53

L&T

1848.51

Cont'd from page 43

Notes Ck'd by K. J. Hall
Mdp No. C.S.B. - 2497-2
Office Work C.J.G.
Checked
Date Feb 1955

Survey of Fairgrove Park Est.
W. O. 6641 Tape No. 2445 Yd. 64 of F
Surveyed by R. J. [illegible]
Notes F. J. [illegible]
C. Johnson
Indexed

F.B. 1818 PG. 43

RETURN TO
LOS ANGELES COUNTY SURVEYOR
726 LOS ANGELES COUNTY
ENGINEERING BLDG.

Note: Any Additions or Changes on This Sheet Must be Made or Circled in Red Ink With Date and Name of Person Making Change.

Do not extend notes this side of this line.

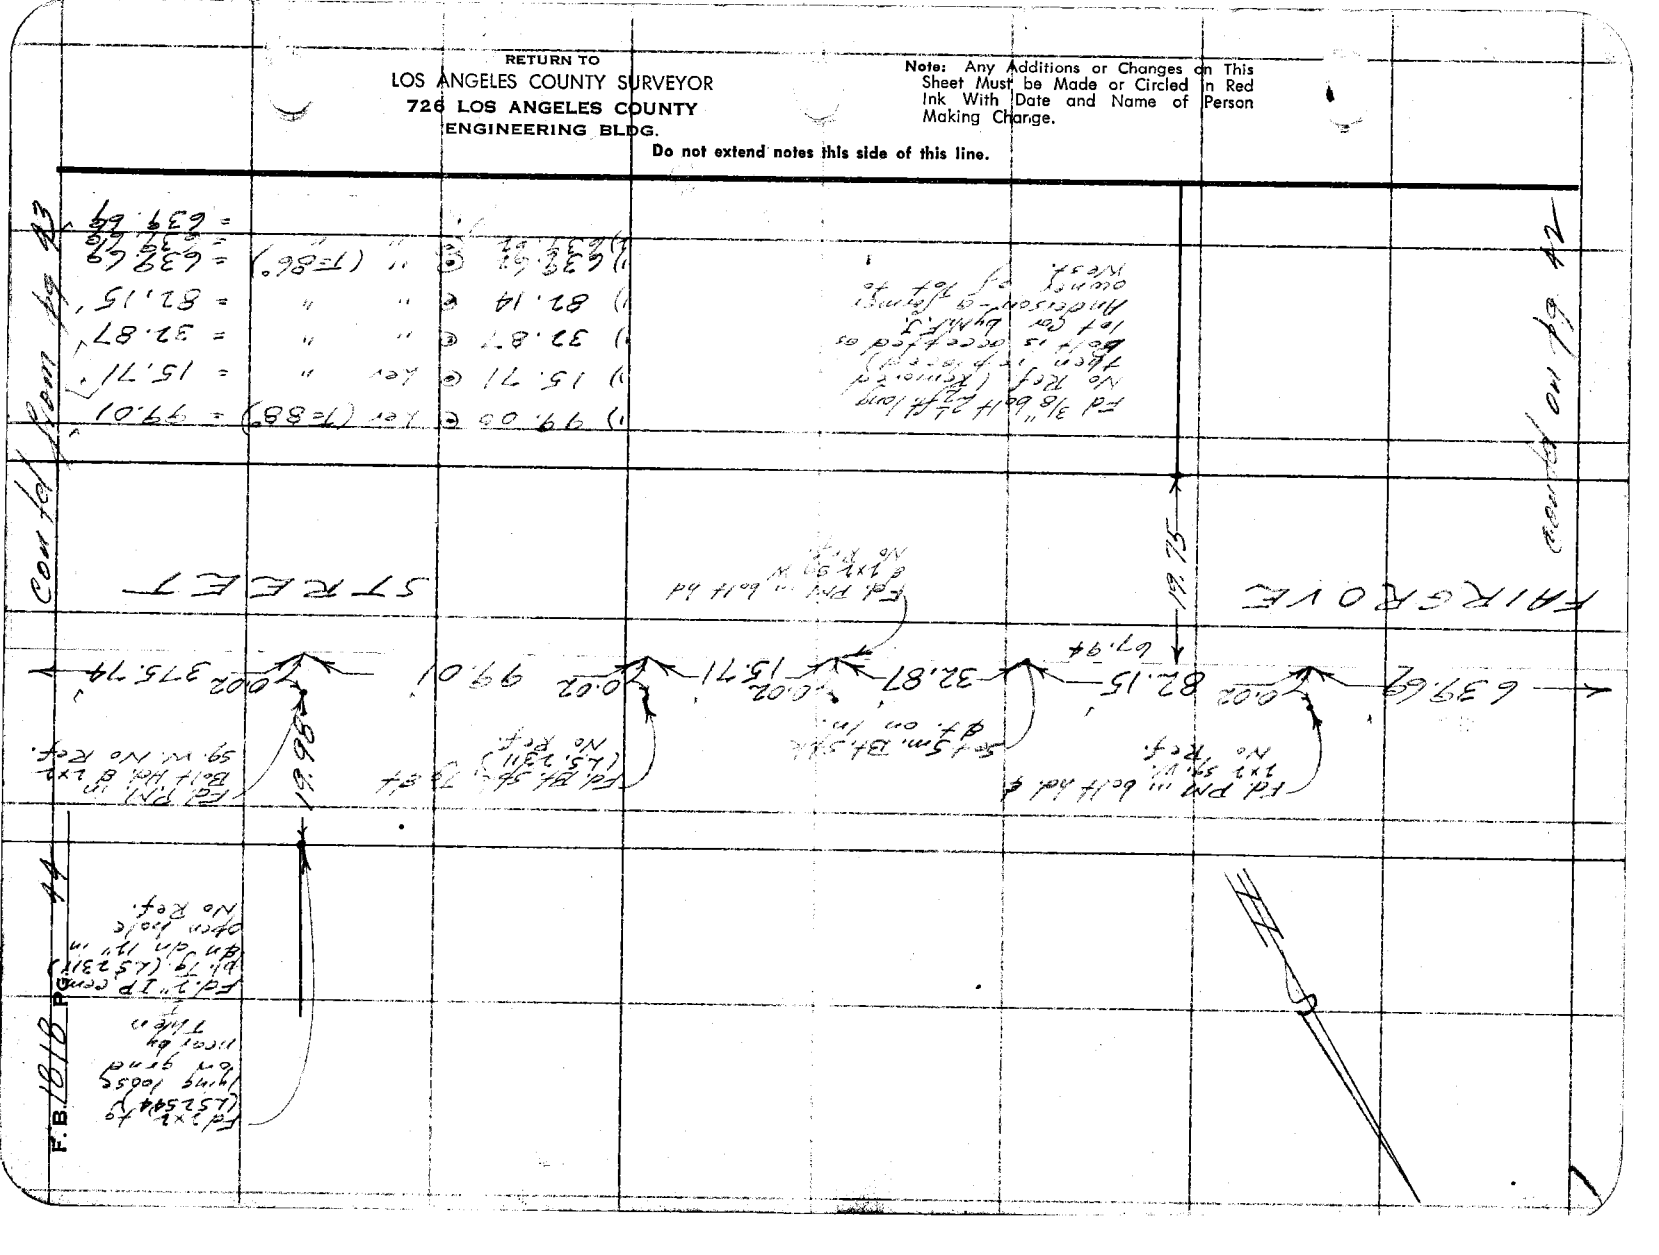

F.B. 1818 PG. 44

76F3095 247 4-53

RETURN TO
LOS ANGELES COUNTY SURVEYOR
726 LOS ANGELES COUNTY
ENGINEERING BLDG.

Note: Any Additions or Changes on This Sheet Must be Made or Circled in Red Ink With Date and Name of Person Making Change.

Do not extend notes this side of this line.

W.S. 146 - C 1

Notes Ck'd by E. J. GALLI
Map No. C.S.B. 24-97-2,3
Office Work Burns
Checked C.J.G.
Date Feb. 1955

Survey of Baldwin Park Blvd.
W. O. 8641 Tape No. 2445' rd. 68 oF
Surveyed by
Notes
Indexed Date

F.B. 1213 PG. 45

TR 8805

Centerline Survey

TRAVIER

1913.74

TRACT

Fd 2½" d in dm 10" in excellent condition - FB 511-42, Set Spk & tin tag out 3.00 NW & NE

65.76 Rec. & Meas

Fd Spk & w, 3ft FB (511-42 (on line as shown))

FOSTER AVE.

STREET

TR 9805

1) 1913.66 @ 1cr (T=16°) =1913.
2) 1913.62 @ " (T=16°) =1913.
Avg

T10

RETURN TO
LOS ANGELES COUNTY SURVEYOR
726 LOS ANGELES COUNTY
ENGINEERING BLDG.

Note: Any Additions or Changes on This Sheet Must be Made or Circled in Red Ink With Date and Name of Person Making Change.

Do not extend notes this side of this line.

W.S. 46 - D - 4

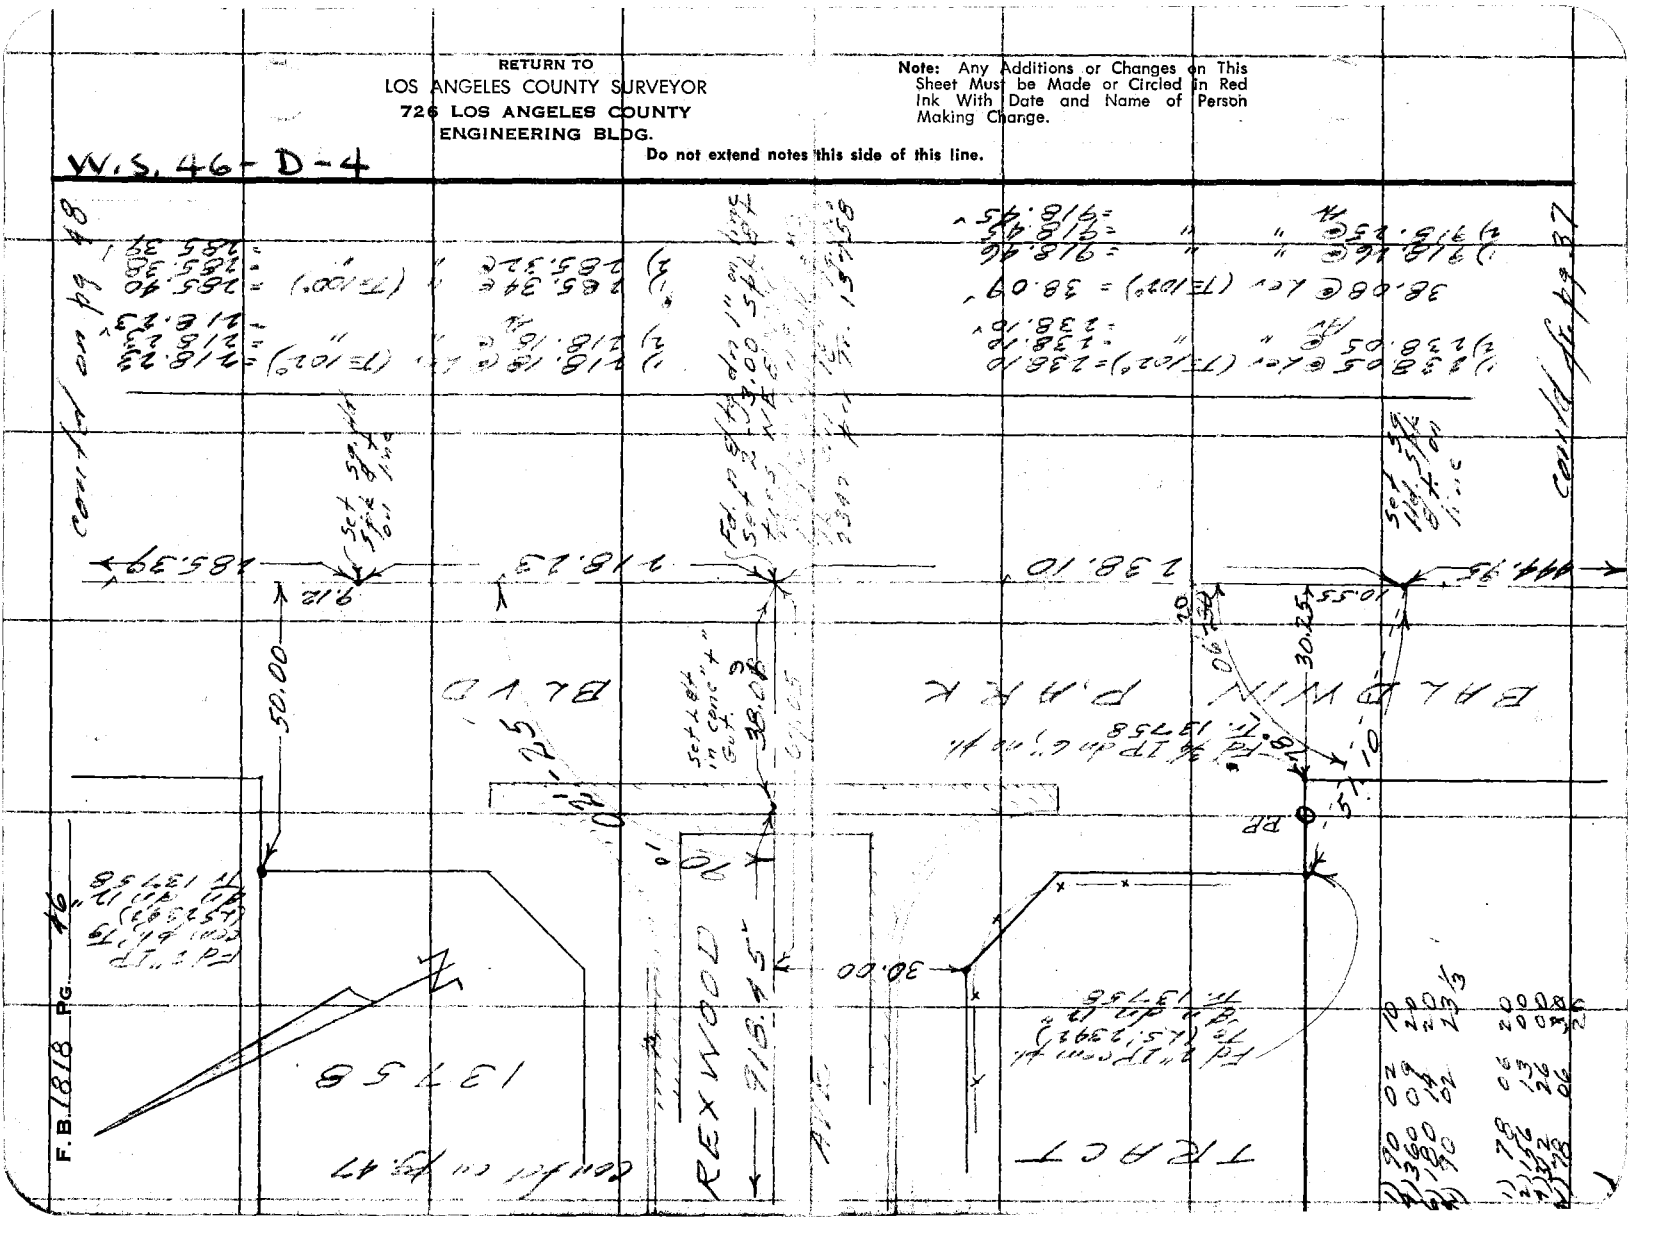

76F3098 247 4-53

RETURN TO
LOS ANGELES COUNTY SURVEYOR
726 LOS ANGELES COUNTY
ENGINEERING BLDG.

Note: Any Additions or Changes on This Sheet Must be Made or Circled in Red Ink With Date and Name of Person Making Change.

Do not extend notes this side of this line.

W.S. 46 - 4

Notes Ck'd by K. J. Hall
Map No. C.S.B. - 24973
Office Work Burns
Checked C.J.G.
Date Feb. 1955

Survey of Los Angeles City Bdy.
W. O. 8647 Tape No. 01145'd. 6-6 of
Surveyed by R. J. Mitchell
Notes R. J. Mitchell Date Oct
Indexed C. Johnson

F.B. 12178 PG. 47

Move Seal ck for 2" IP on 12" Fd Nail & Tag Tr. 13758

REXWOOD

Fd n & sm. t. No Ref

0.02

Fd n & sm. t. No Ref

0.02

Set pencil mk.

Set this "T" in cross gutter on line prod.

17.03

918.45'

90°

See F.B. 1950-57 for continuation of Rexwood Ave

Fd n & sm. t. No Ref

AVENUE

0.05

Fd 2" IP corn 0.1 (L 52342) & mon 12" per Tr. 13758

1) 85 54 10
2) 174 48 40
3) 345 37 00
4) 85 54 15

Fd 3/4" IP d/n 12" No Conc. collar - May be I.P. per Tr. 13758 or Tr. 13758

FUTURE

FUTURE

FUTURE

AVE.

ST.

1421

N

RETURN TO
LOS ANGELES COUNTY SURVEYOR
726 LOS ANGELES COUNTY
ENGINEERING BLDG.

Note: Any Additions or Changes on This Sheet Must be Made or Circled in Red Ink With Date and Name of Person Making Change.

Do not extend notes this side of this line.

WS. 46 - D - 4

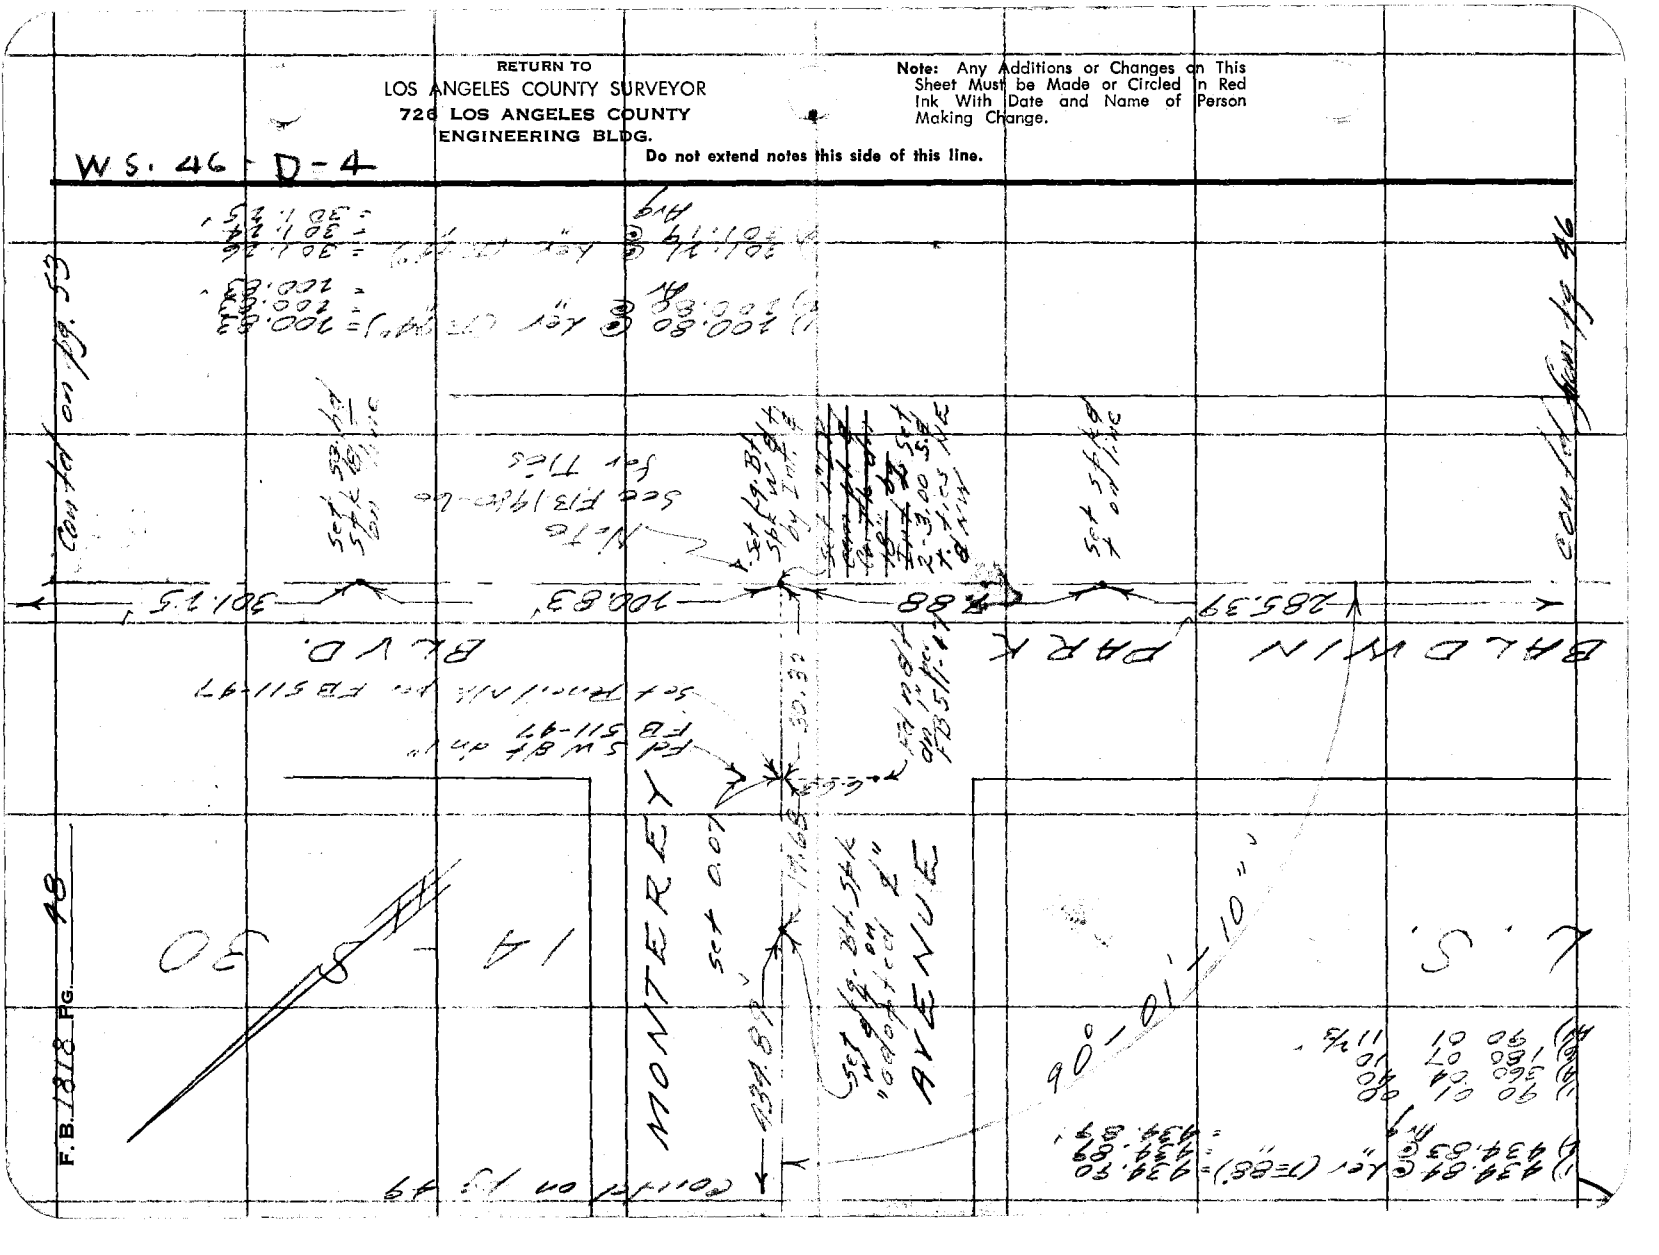

76FS095 247 4-53

RETURN TO
LOS ANGELES COUNTY SURVEYOR
726 LOS ANGELES COUNTY
ENGINEERING BLDG.

Note: Any Additions or Changes on This Sheet Must be Made or Circled in Red Ink With Date and Name of Person Making Change.

Do not extend notes this side of this line.

W.S. 46 - 4

Notes Ck'd by C.J. GALLI
Map No. C.S.B - 2497-3
Office Work Burns
Checked C.J.G.
Date Feb. 1955

Survey of Monterey Park Blvd.
W. O. 8641 Tape No. 0/14 Sy'd. 68 of
Surveyed by R. I. [illegible]
Notes [illegible]
Indexed [illegible] Date OCT 1955
C. Johnson

F.B. 7813 Pg. 44

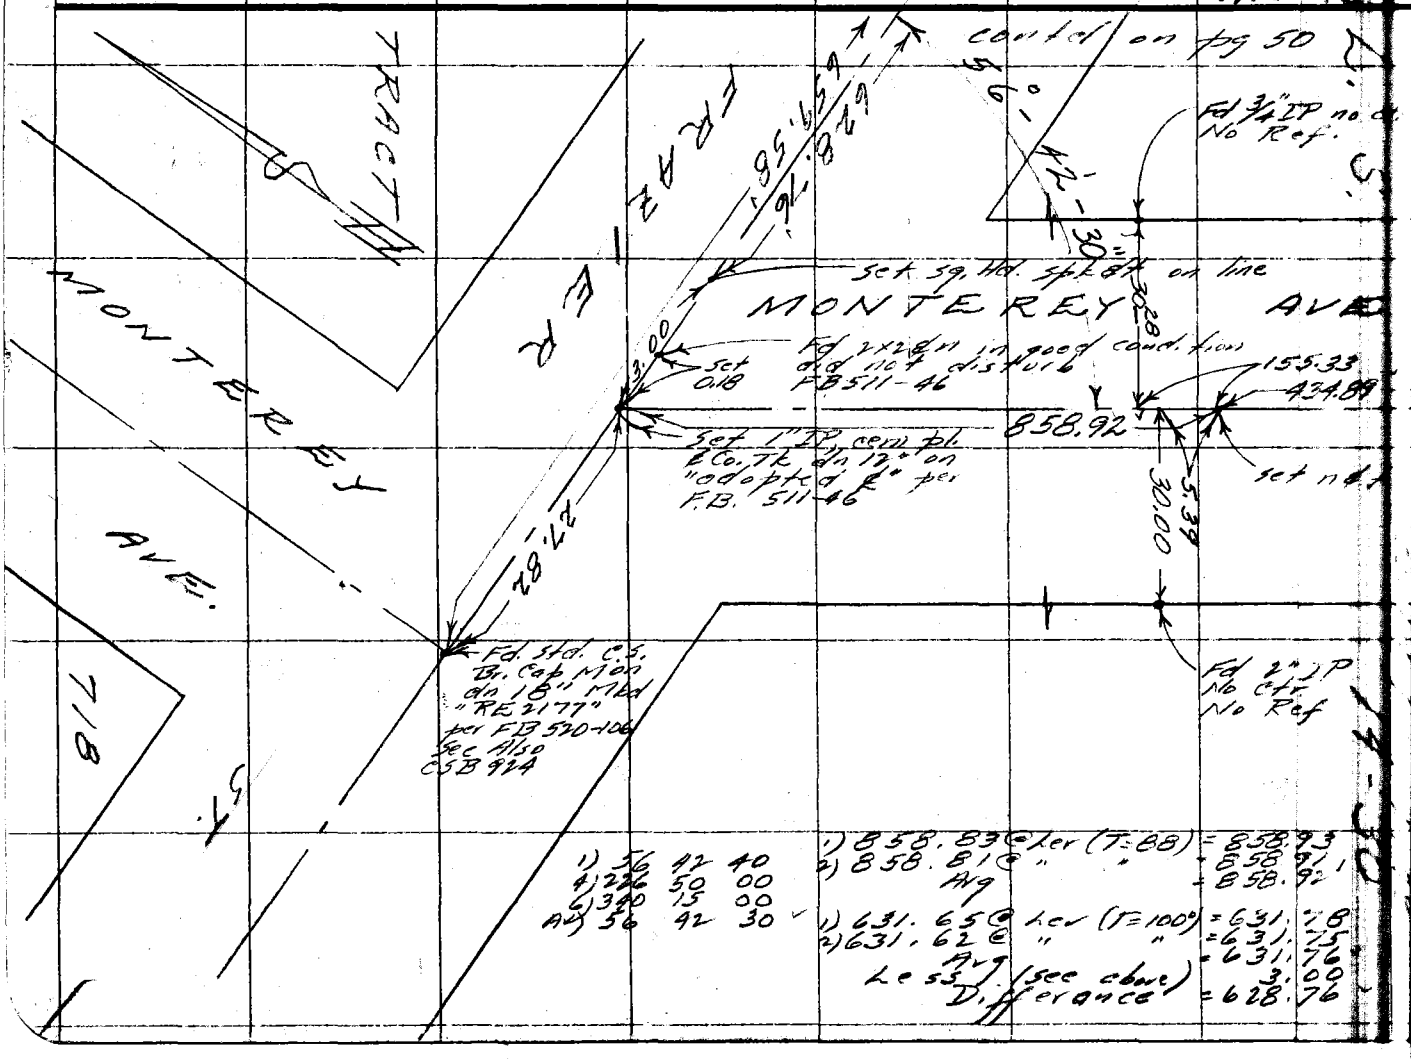

RETURN TO
LOS ANGELES COUNTY SURVEYOR
726 LOS ANGELES COUNTY
ENGINEERING BLDG.

Note: Any Additions or Changes on This Sheet Must be Made or Circled in Red Ink With Date and Name of Person Making Change.

Do not extend notes this side of this line.

W.S. 46 - D - 4

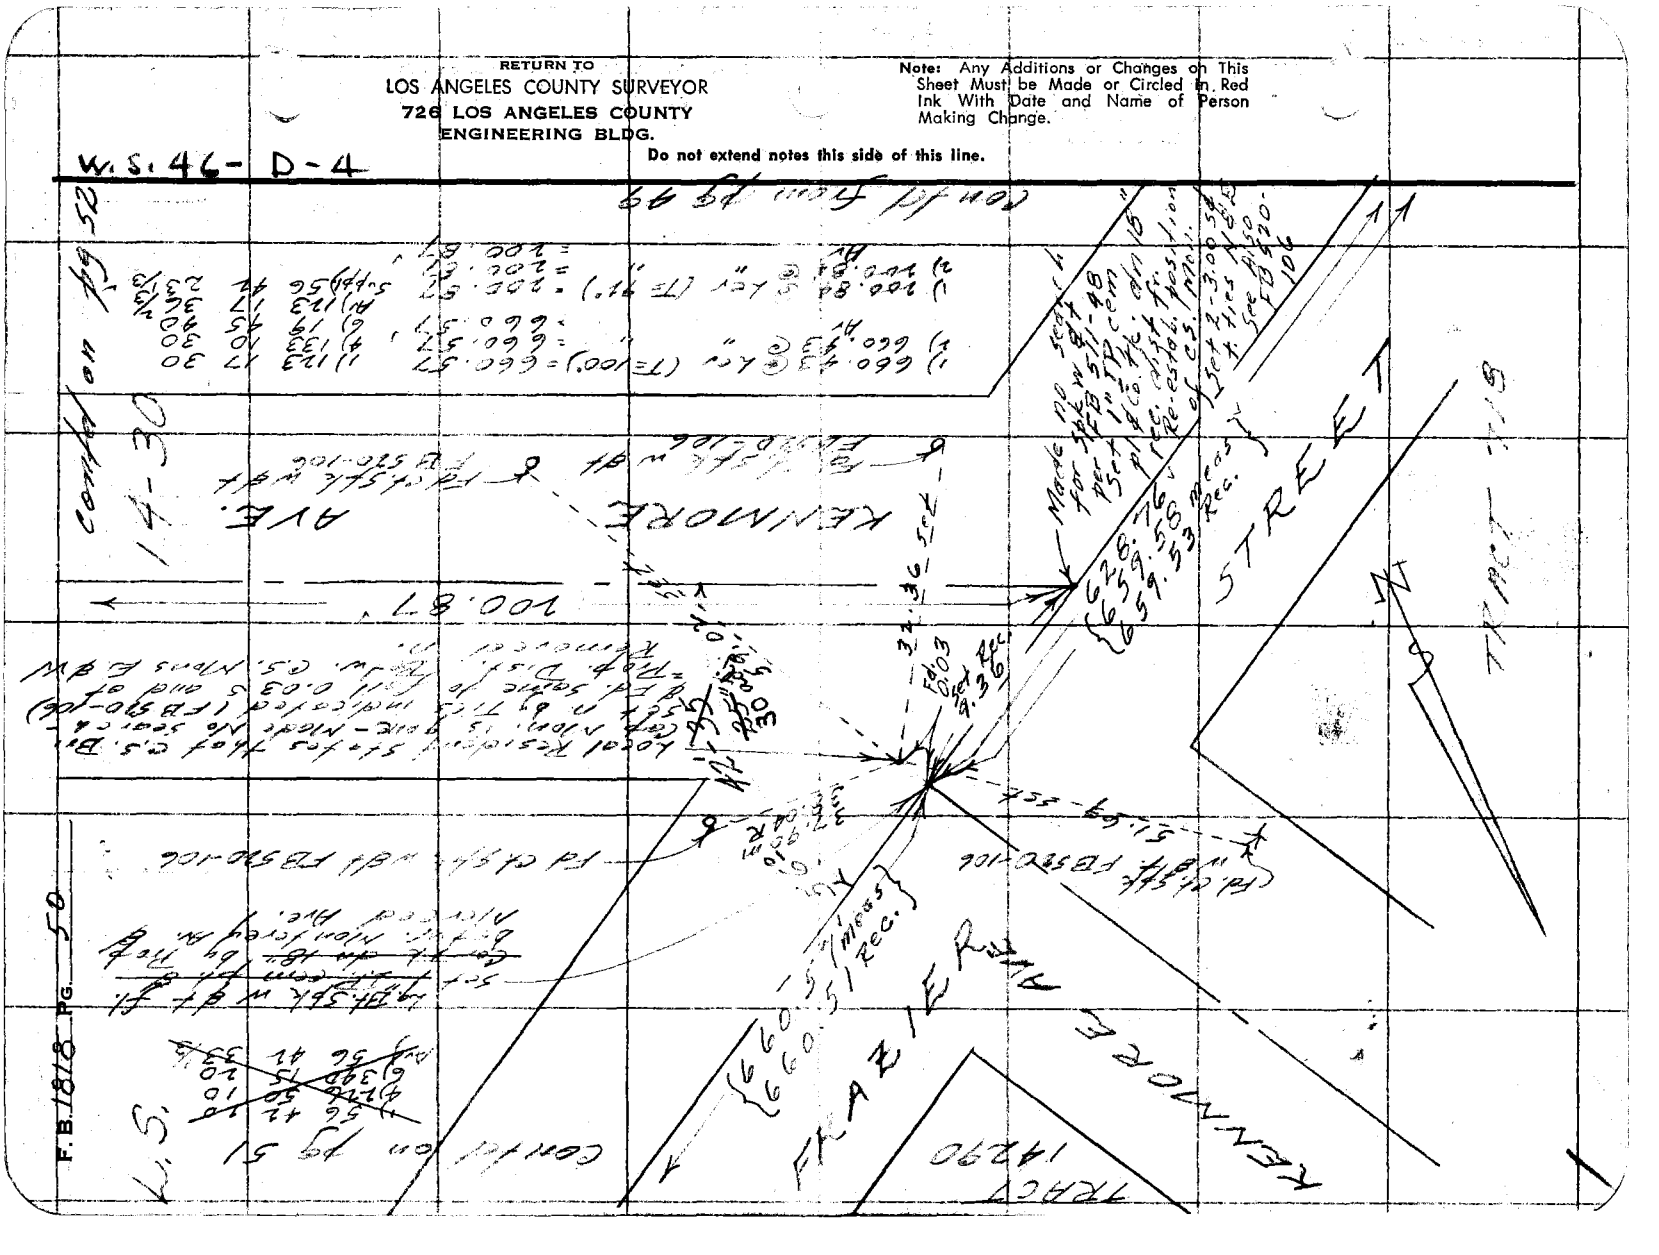

76F3098 247 4-53

RETURN TO
LOS ANGELES COUNTY SURVEYOR
726 LOS ANGELES COUNTY
ENGINEERING BLDG.

Note: Any Additions or Changes on This Sheet Must be Made or Circled in Red Ink With Date and Name of Person Making Change.

Do not extend notes this side of this line.

W.S. 46 -4

Notes Ck'd by C. J. GALLI
Mdp No. C.S.B. 247-3
Office Work BURNS
Checked C.J.G.
Date Feb 1955

Survey of Baldwin Park Blvd
W. O. 864 Tape No. 9145'd. 64 °F
Surveyed by R. L.
Notes
Indexed A. C. Johnson Date 6/6/

F.B. 1016 PG. 51

TR 6285

MERCED AVENUE

FB 520
FB 511

TRACT

1) 123 19 40
4) 133 18 38
6) 19 57 20
AV) 123 19 33 1/3

14290

Fd. Std. C.S. Bn Cap. Mon. dn. 1B", I.O. Hitt W. Corr. mkd "LA Co. Road" per FB 520-62

N 57° 19' E 299.04

299.04 — 335.17

Fd. Std. C.S. Bn Cap. Mon. dn. 1B", I.O. Hitt W. Corr. mkd "LA Co. Road" per FB 520-62

15.00 — 5.00 — 20.00

Ent. (1½" IP) FB 514-18 CSB 424

Fd. C.S. Spk W. 0.5' Ref. No. Ref.

N 57° 19' E 1292.21

S 57° 19' W 1292.21

L.S. 14290

30" adj.

123° - 19' - 30"

1) 299.04 @ Cor (T=68°)
2) 299.04 @ " "
Avg.

1) 335.18 @ Cor (T=68°)
2) 335.16 @ " "
Avg

299.04
299.04
299.04

335.18
335.16
335.17

Contd from pg. 50

RETURN TO
LOS ANGELES COUNTY SURVEYOR
726 LOS ANGELES COUNTY
ENGINEERING BLDG.

Note: Any Additions or Changes on This Sheet Must be Made or Circled in Red Ink With Date and Name of Person Making Change.

Do not extend notes this side of this line.

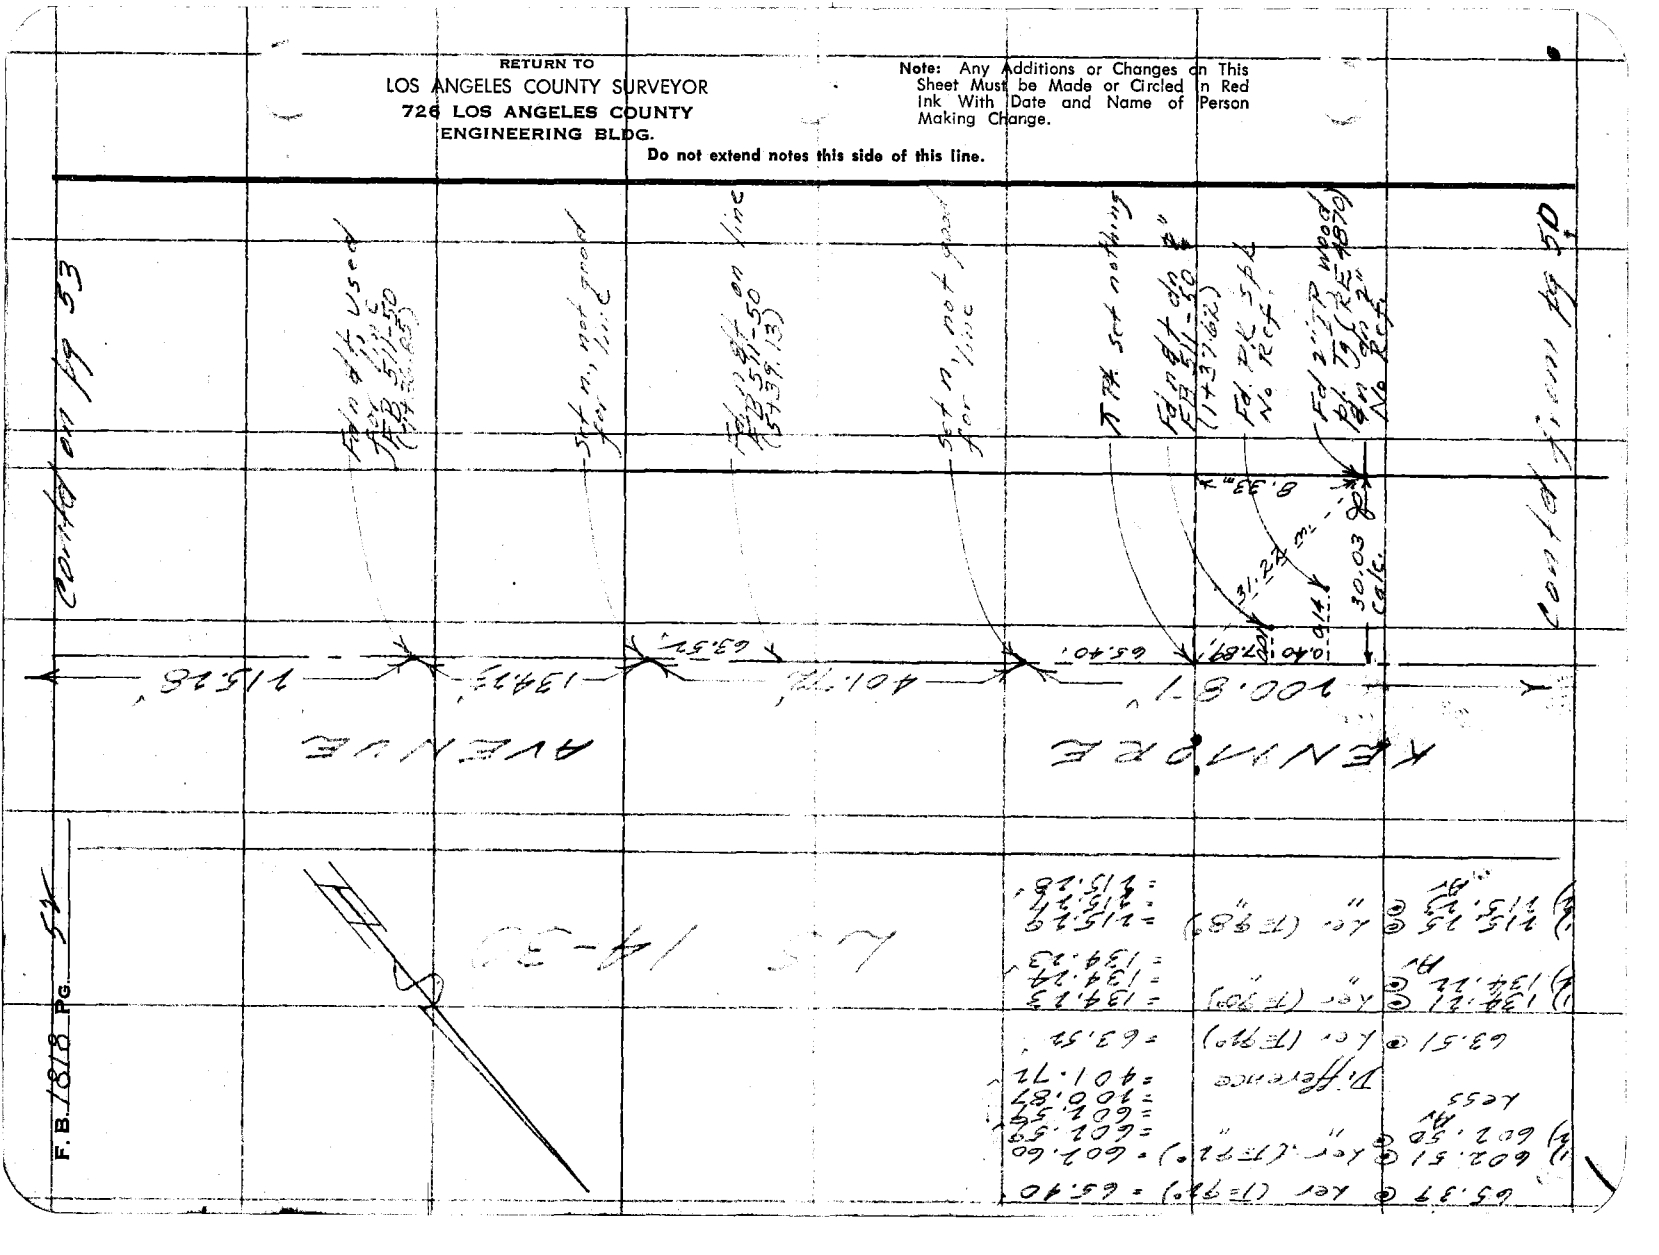
F.B. 1818 PG. 54
AVENUE
AVENUE
100.87'
401.72'
65.40'
30.03 Calc.
8.33"
31.23'
10.40

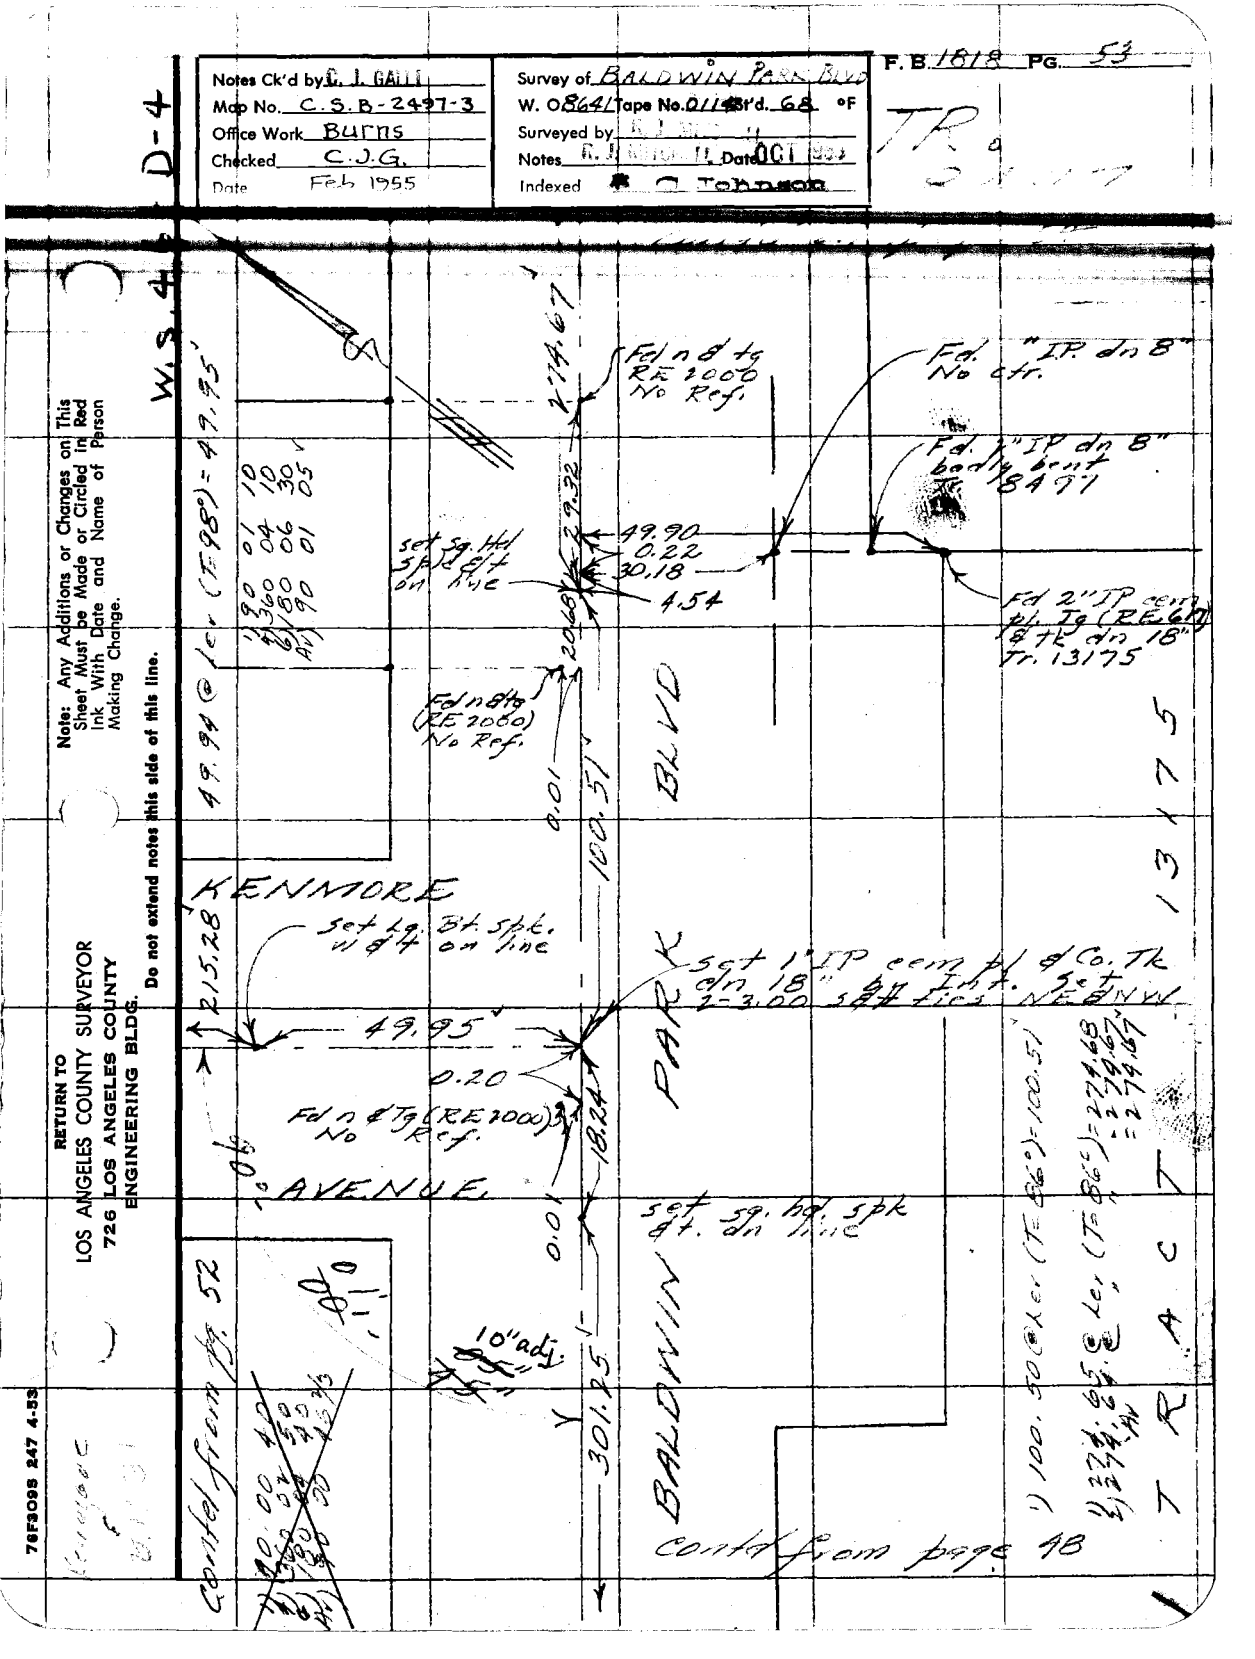
Notes Ck'd by C. J. GALLI
Map No. C.S.B-2497-3
Office Work BURNS
Checked C.J.G.
Date Feb 1955
Survey of BALDWIN PARK BLVD
W. O. 8641 Tape No. 011 St'd. 68 °F
Surveyed by
Notes Date OCT
Indexed
F. B. 1818 PG. 53
D-4
W. S. 4
Note: Any Additions or Changes on This Sheet Must be Made or Circled in Red Ink With Date and Name of Person Making Change.
Do not extend notes this side of this line.
RETURN TO
LOS ANGELES COUNTY SURVEYOR
726 LOS ANGELES COUNTY
ENGINEERING BLDG.
78FSOSB 247 4-53
49.94 @ Ly. (TE 98°) = 49.95'
Fd n & tg RE 2000 No Ref.
Fd. "IP dn 8" No Ctr.
Fd. 1" IP dn 8" badly bent
set Sq. Hd Spk flt on line
49.90
0.22
30.18
4.54
Fd 2" IP cem w/ Tg (RE 6.1') 18" Tk dn 18" Tr. 13175
Fd n & tg (RE 2000) No Ref.
KENMORE
set Lg. Bt. Spk. w/ tg on line
215.28'
49.95'
0.20
Fd n & Tg (RE 2000) No Ref.
10' AVENUE
set 1" IP cem w/ Co. Tk dn 18" Inf. Set 2-3.00 Spk Ties NE & NW
BALDWIN PARK BLVD
set Lg. Bt. Spk on line
301.25'
10" adj.
Contd from pg. 52
Contd from page 48
13175

F.B. 1818 PG. 54

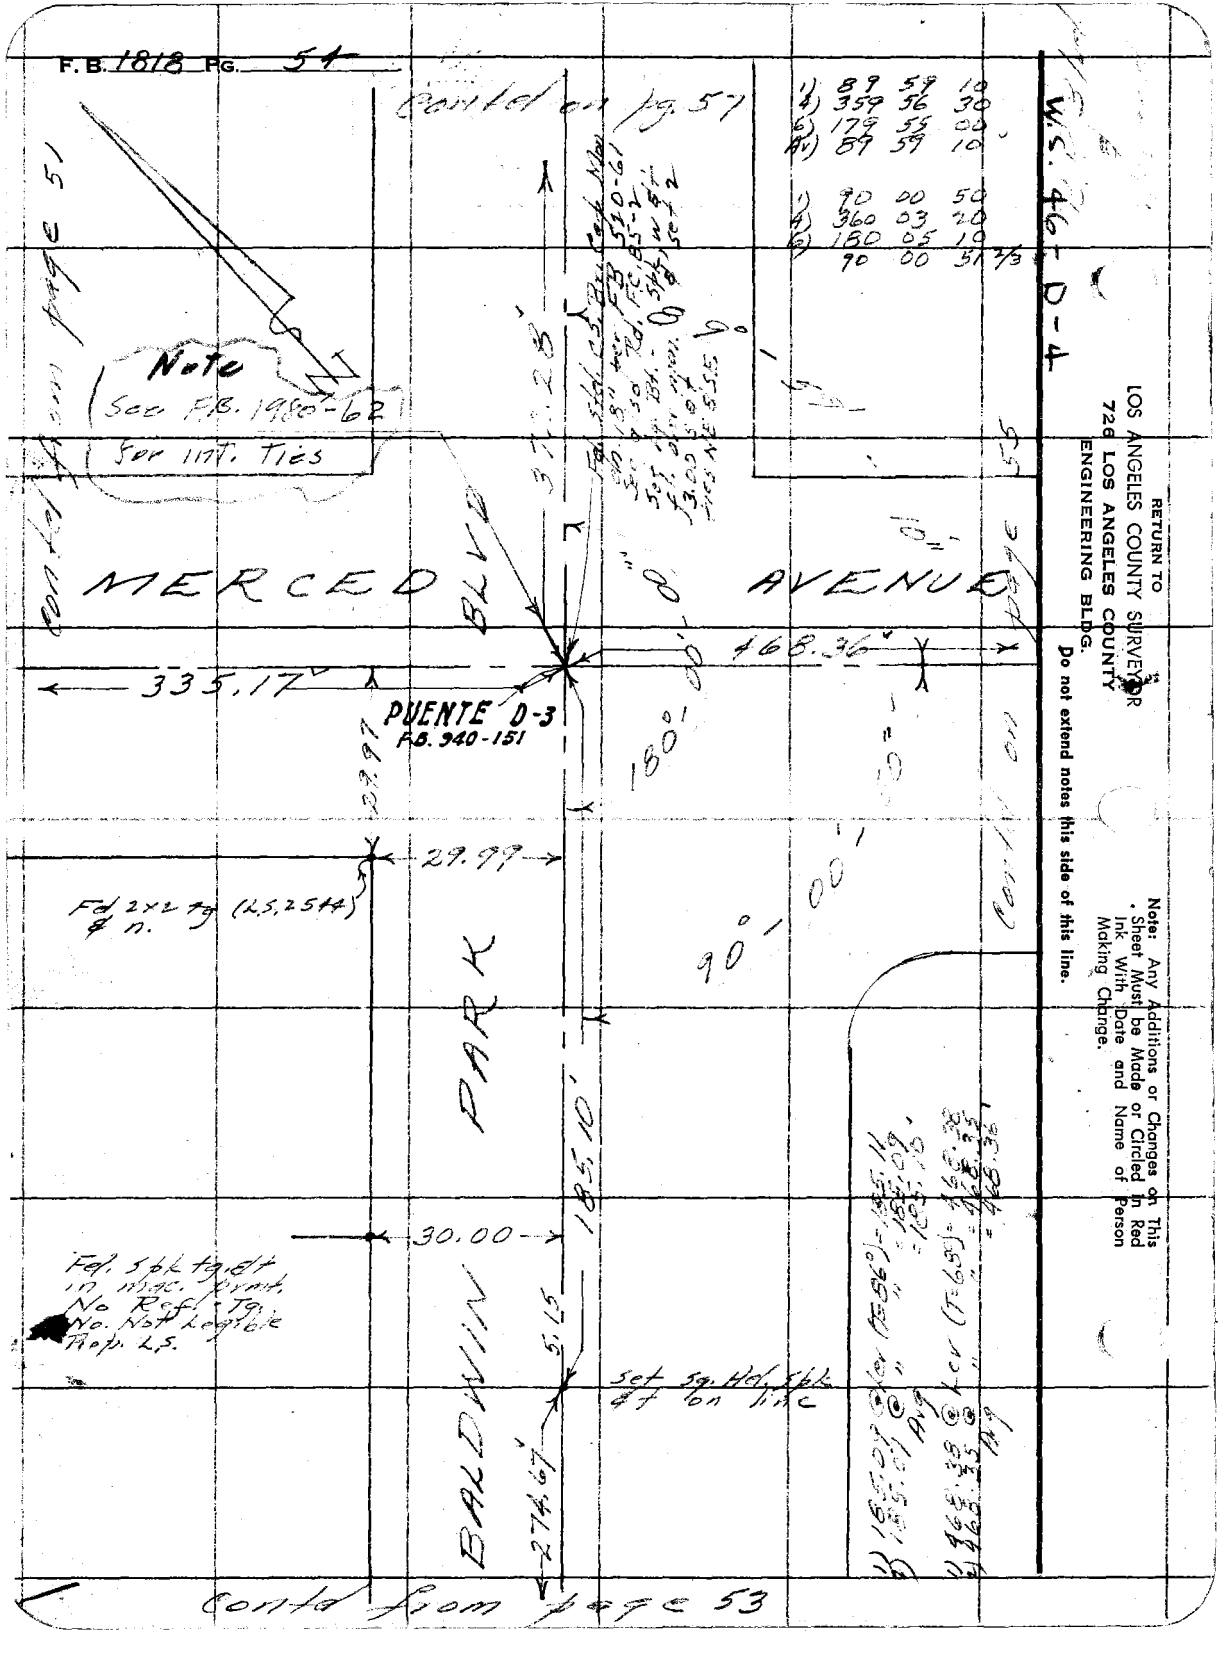

RETURN TO
LOS ANGELES COUNTY SURVEYOR
726 LOS ANGELES COUNTY
ENGINEERING BLDG.

Do not extend notes this side of this line.

Note: Any Additions or Changes on This Sheet Must be Made or Circled in Red Ink With Date and Name of Person Making Change.

Notes Ck'd by C. J. GALLI
Map No. C.S.B-2497-3
Office Work Burns
Checked C.J.G.
Date Feb 1955

Survey of 5462 MAIN PARK SUBD
W. O. 8641 Tape No. 01145 Std. 68 °F
Surveyed by R. J.
Notes R.J. Date OCT 1950
Indexed C. Johnson

F. B. 1818 Pg. 55

W.S. 46 D 4

Note: Any Additions or Changes on This Sheet Must be Made or Circled in Red Ink With Date and Name of Person Making Change.

Do not extend notes this side of this line.

RETURN TO
LOS ANGELES COUNTY SURVEYOR
726 LOS ANGELES COUNTY
ENGINEERING BLDG.

SOUTHERN PACIFIC R/W

RR

AVENUE

MAIN AVENUE

Fd 1" I.P. 0.02 S 0.00 E 597.90 Fd 2" I.P. on line Ref. 5.00 S 0.00 E Brs. N 0° 24' E 6.00 Ref. 2.00 S 3.00 W Ref. 5.00 N 0.00 W

Fd 1" I.P. 0.02 N 0.00 E Ref. 1.16 E

6.89

Fd 1" I.P. 0.02 N 0.00 E

6.00

0.02

50°.35'

Fd L&T FB 520-61

1) 509.36 @ Lee (TE 681) - 509.36
2) 507.35 @ Lee (TE 681) - 507.35
Avg - 508.35

Fd L&T FB 520-61

41.10'

48°.43'

Fd PK spk on surface of C.L. NE & Opp NW of Int. - Removed - Searched all 36" - Fd no evid. of C.S. Mon shown on F.B. 520-61 - Set mail by ties & checked some per line. Set 2 Sq. Wt. Spk & ties out 3.00 NE & NW

Fd L&T FB 520-61

63.69

Fd L&T FB 520-61 ← 1840.15

48°.31'

Fd L&T FB 520-61

1) 90 00 00
4) 360 01 10
6) 180 02 00
Avg 90 00 20

10" adj

Contd on pg 63

Contd from pg 54

78F309S 247 4-53

RETURN TO
LOS ANGELES COUNTY SURVEYOR
726 LOS ANGELES COUNTY
ENGINEERING BLDG.

Note: Any Additions or Changes on This Sheet Must be Made or Circled in Red Ink With Date and Name of Person Making Change.

Do not extend notes this side of this line.

W.S. 46-D-4

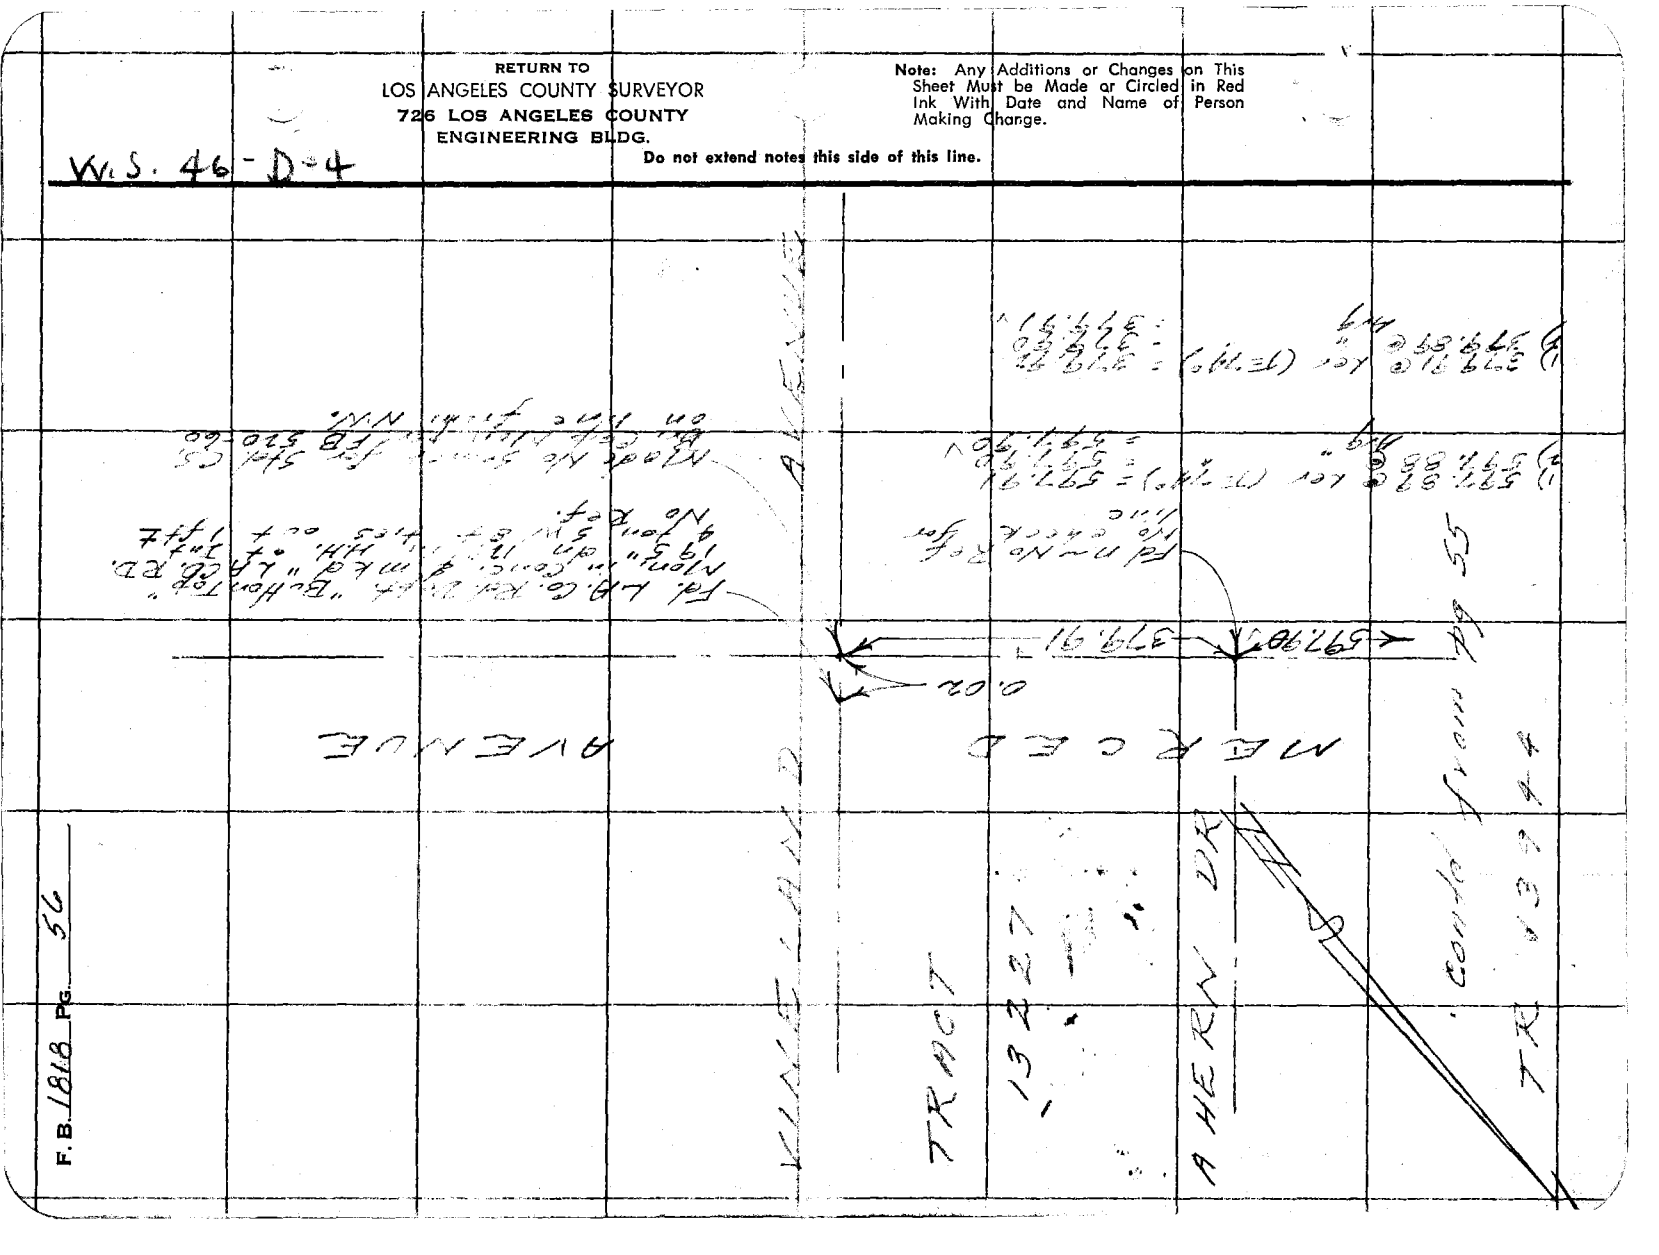

F.B. 1818 Pg. 56

Notes Ck'd by C. J. GALLI
Map No. C.S.B-2497-3
Office Work Burns
Checked C.J.G.
Date Feb. 1955

Survey of
W. O. 2641 Tape No. 0114 St'd. 68 °F
Surveyed by
Notes Date
Indexed A. C. Johnson

F. B. Pg. 57

cont'd on pg 60

Note: Any Additions or Changes on This Sheet Must be Made or Circled in Red Ink With Date and Name of Person Making Change.

Do not extend notes this side of this line.

RETURN TO
LOS ANGELES COUNTY SURVEYOR
726 LOS ANGELES COUNTY
ENGINEERING BLDG.

78F3098 247 4-53

W. S. 46

TR-5159

Fd. L&T in C6 FB 690-9

set L.T. on line

Center line 10' WIDE ALLEY

Fd. L&T in Ch. Rd. FC. 85-21, C.S. FB. 690-14

Ch. broken out L&T some FB 690-14

Fd. L&T in Ch FB 690-14

TRACT 6285

BALDWIN PARK

Contd from pg 54

RETURN TO
LOS ANGELES COUNTY SURVEYOR
726 LOS ANGELES COUNTY
ENGINEERING BLDG.

Note: Any Additions or Changes on This Sheet Must be Made or Circled in Red Ink With Date and Name of Person Making Change.

Do not extend notes this side of this line.

W.S. 46-D-4

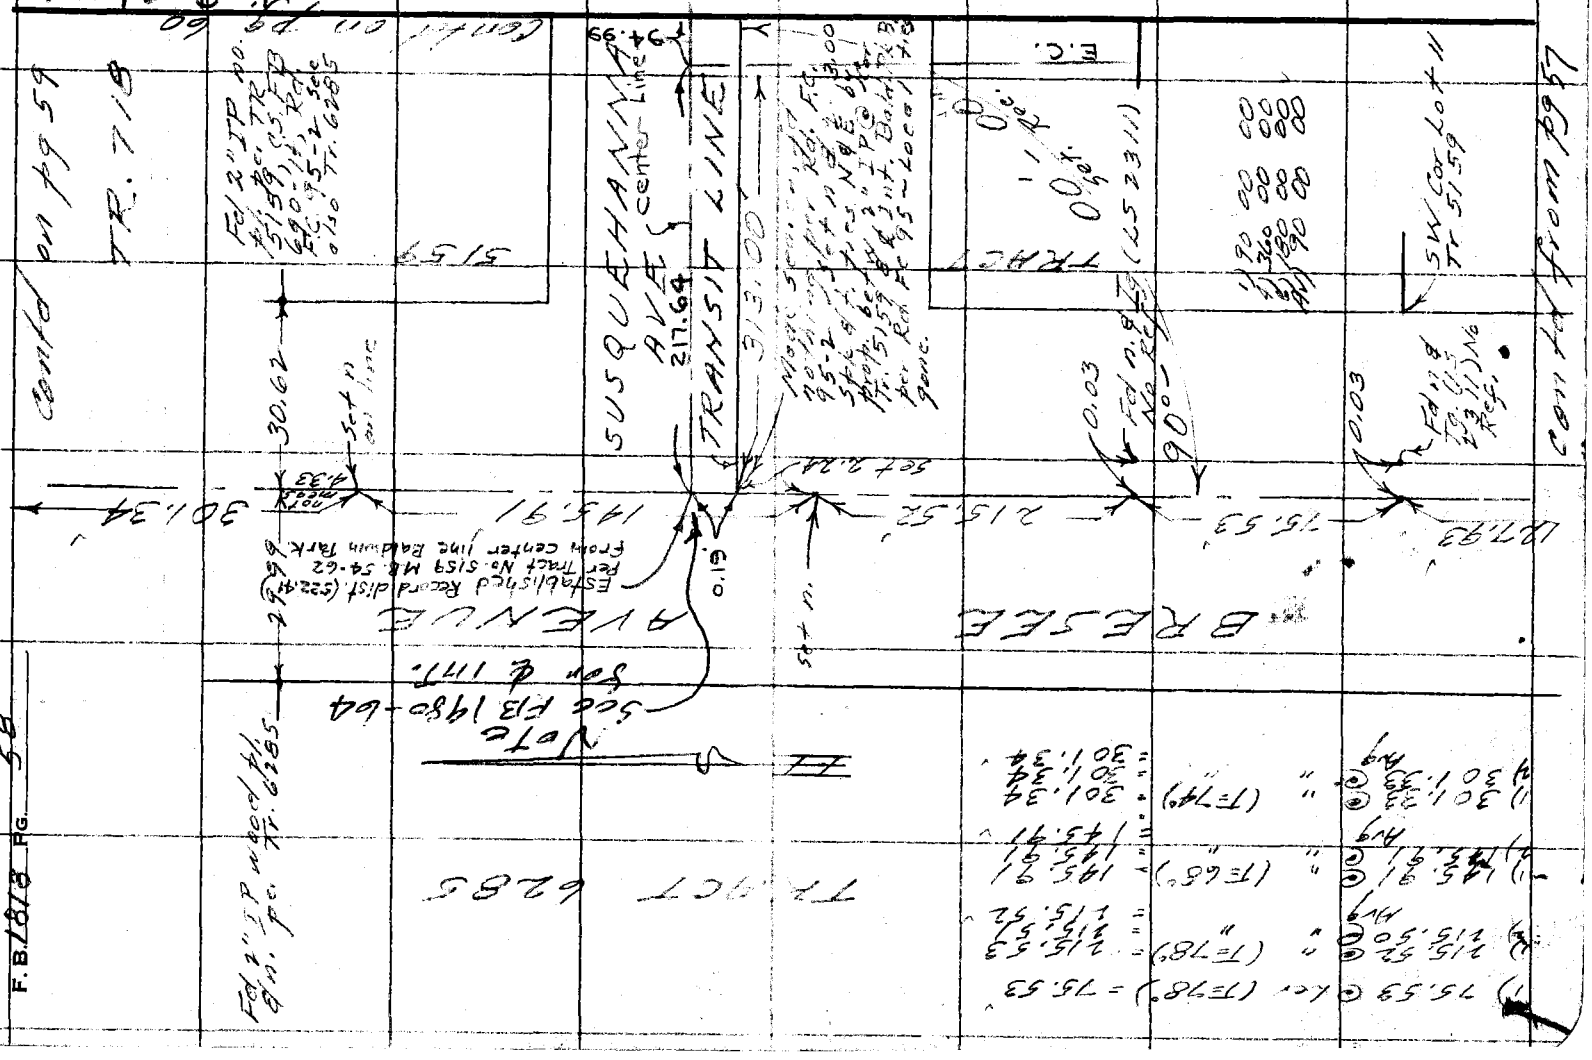
SUSQUEHANNA AVE (Center Line)
TRANSIT LINE
BRESEE AVENUE

Notes Ck'd by C. J. GALLI
Map No. C.S.B-2497-3
Office Work Burns
Checked C.J.G.
Date Feb. 1955

Survey of BALDWIN PARK BLVD
W. O. 8641 Tape No. 0114 St'd. 68 °F
Surveyed by [illegible]
Notes [illegible] Date NOV 1955
Indexed C. Johnson

F.B. 1812 PG. 59

W. S. 4

Note: Any Additions or Changes on This Sheet Must be Made or Circled in Red Ink With Date and Name of Person Making Change.

Do not extend notes this side of this line.

RETURN TO
LOS ANGELES COUNTY SURVEYOR
726 LOS ANGELES COUNTY
ENGINEERING BLDG.

edge print

0.02 — Fd L&T No Ref
12.99 — Fd n on Lead FB690-14
RAMONA
0.03 — Fd Int. & tan L&T FB520-110
0.01 — Fd L&T FB520-110
4.96 — Fd L&T in ch.s "□" FB690-91
8.06 — BLVD
edge print 25.83 — Fd L&T No Ref.
Fd L&T in "T" Gut FB690-14

Cont'd on Pg 63

Gut. T

#1 89 58 40
#1 359 54 50
#1 179 54 50
#1 89 58 40 1/3

ILLINOIS STREET

STREET

AVENUE

89°

643.85'

643.89 (T=76°)
643.89
643.89
643.86 Ker.
643.86 Ave.

58'

45° Deflection

16'

1"

Fn. Cor.

30.2
17.6

Set n on line

30.34'

Cont'd from page 58

76F3095 247 4-55

3867

RETURN TO
LOS ANGELES COUNTY SURVEYOR
726 LOS ANGELES COUNTY
ENGINEERING BLDG.

Note: Any Additions or Changes on This Sheet Must be Made or Circled in Red Ink With Date and Name of Person Making Change.

Do not extend notes this side of this line.

W.S. 46-D-4

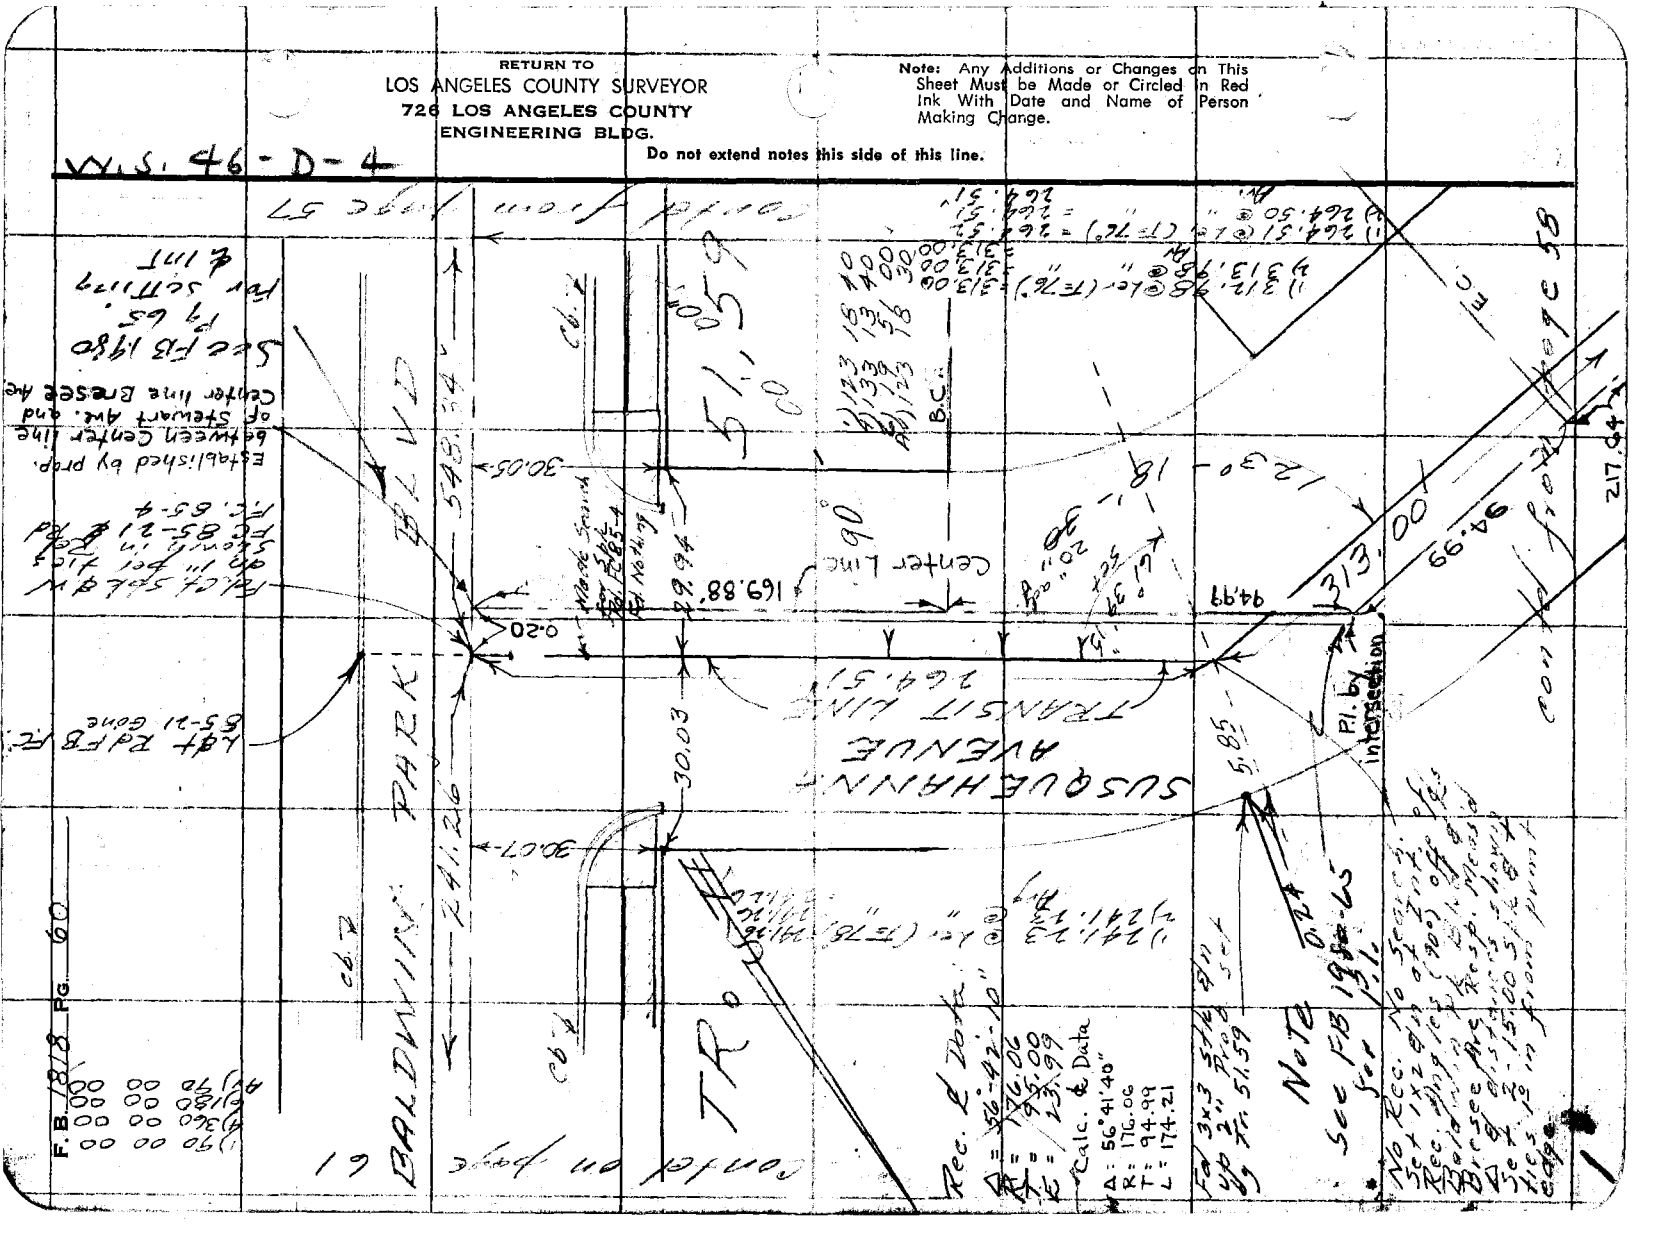

Notes Ck'd by C. J. CALL
Map No. C.S.B- 2497-3
Office Work Burns
Checked C.J.G.
Date Feb. 1955

Survey of
W. O. 8641 Tape No. 01146 rd. 68 °F
Surveyed by
Notes
Indexed

Date
C. Johnson

F. B. 2 2 Pg. 61

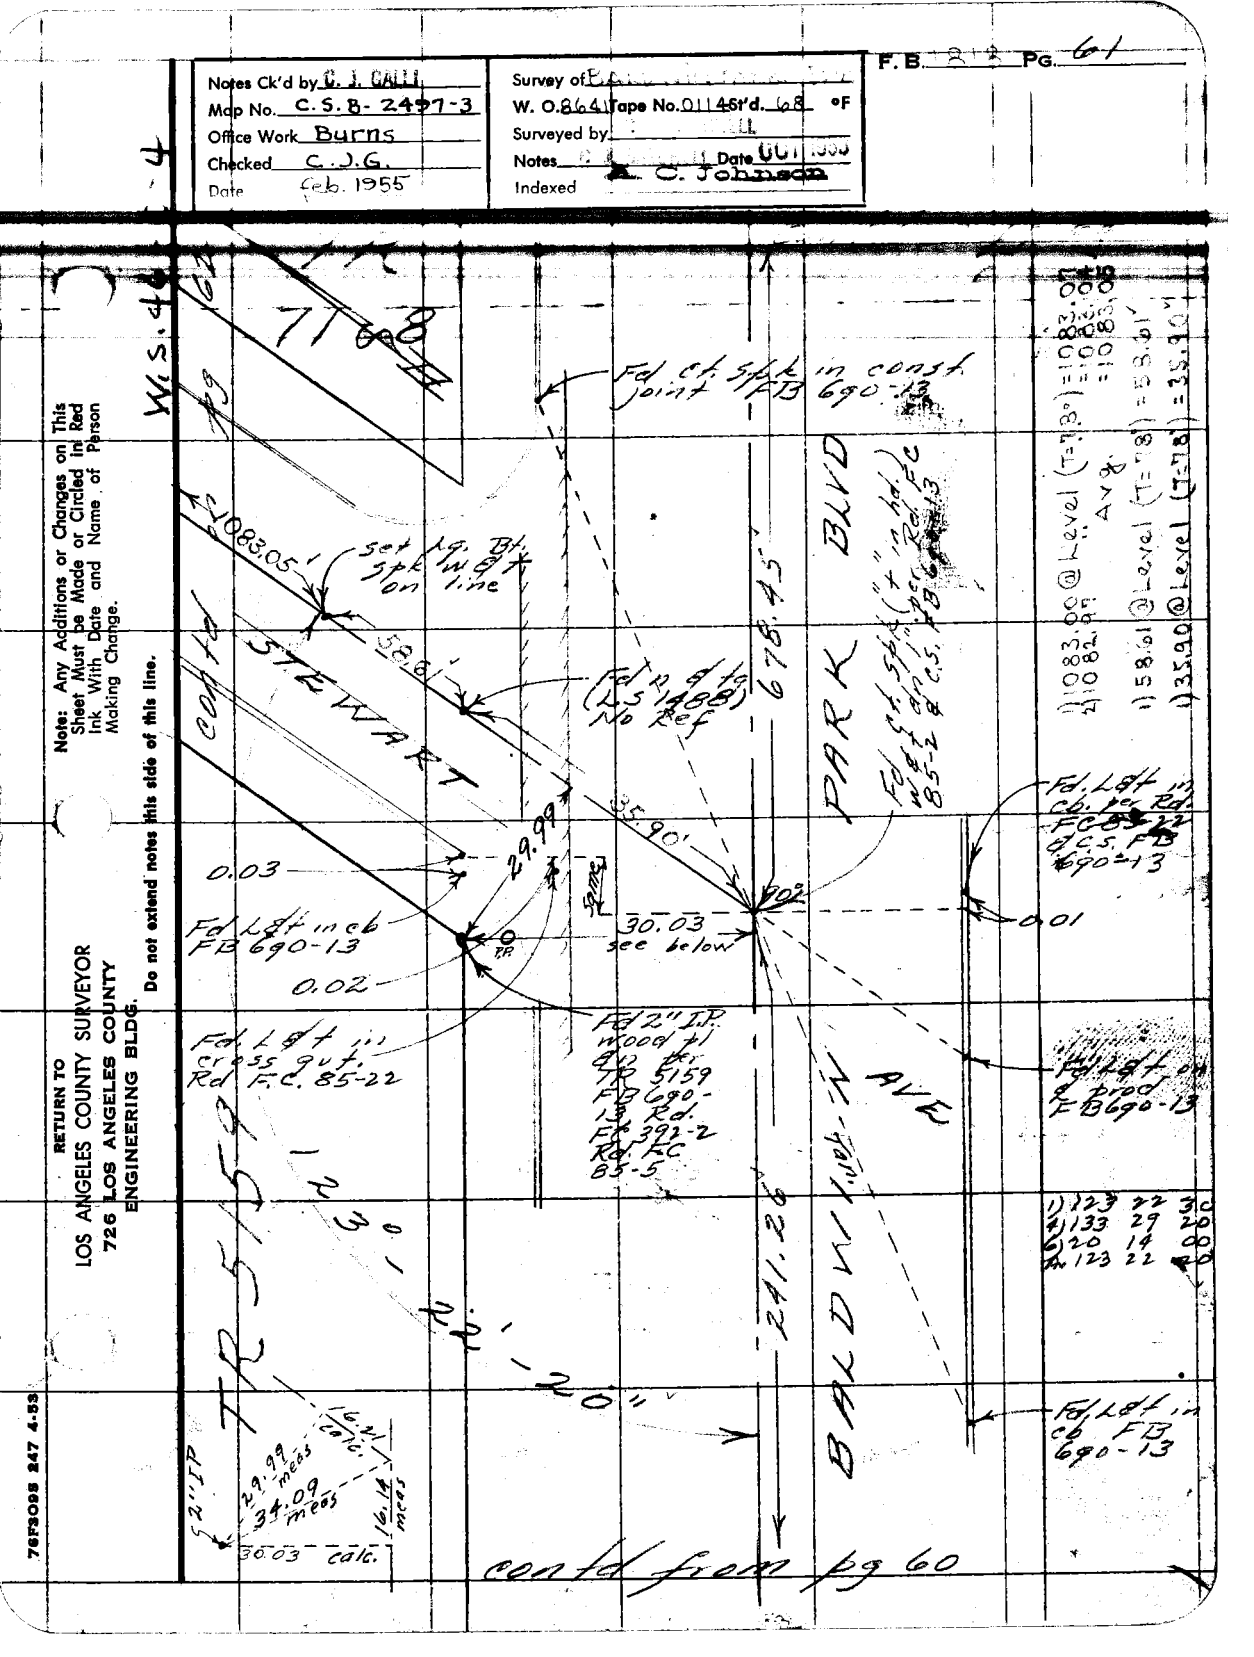

Note: Any Additions or Changes on This Sheet Must be Made or Circled in Red Ink With Date and Name of Person Making Change.

Do not extend notes this side of this line.

RETURN TO
LOS ANGELES COUNTY SURVEYOR
726 LOS ANGELES COUNTY
ENGINEERING BLDG.

76F308 247 4.53

F. B. 1818 Pg. 62

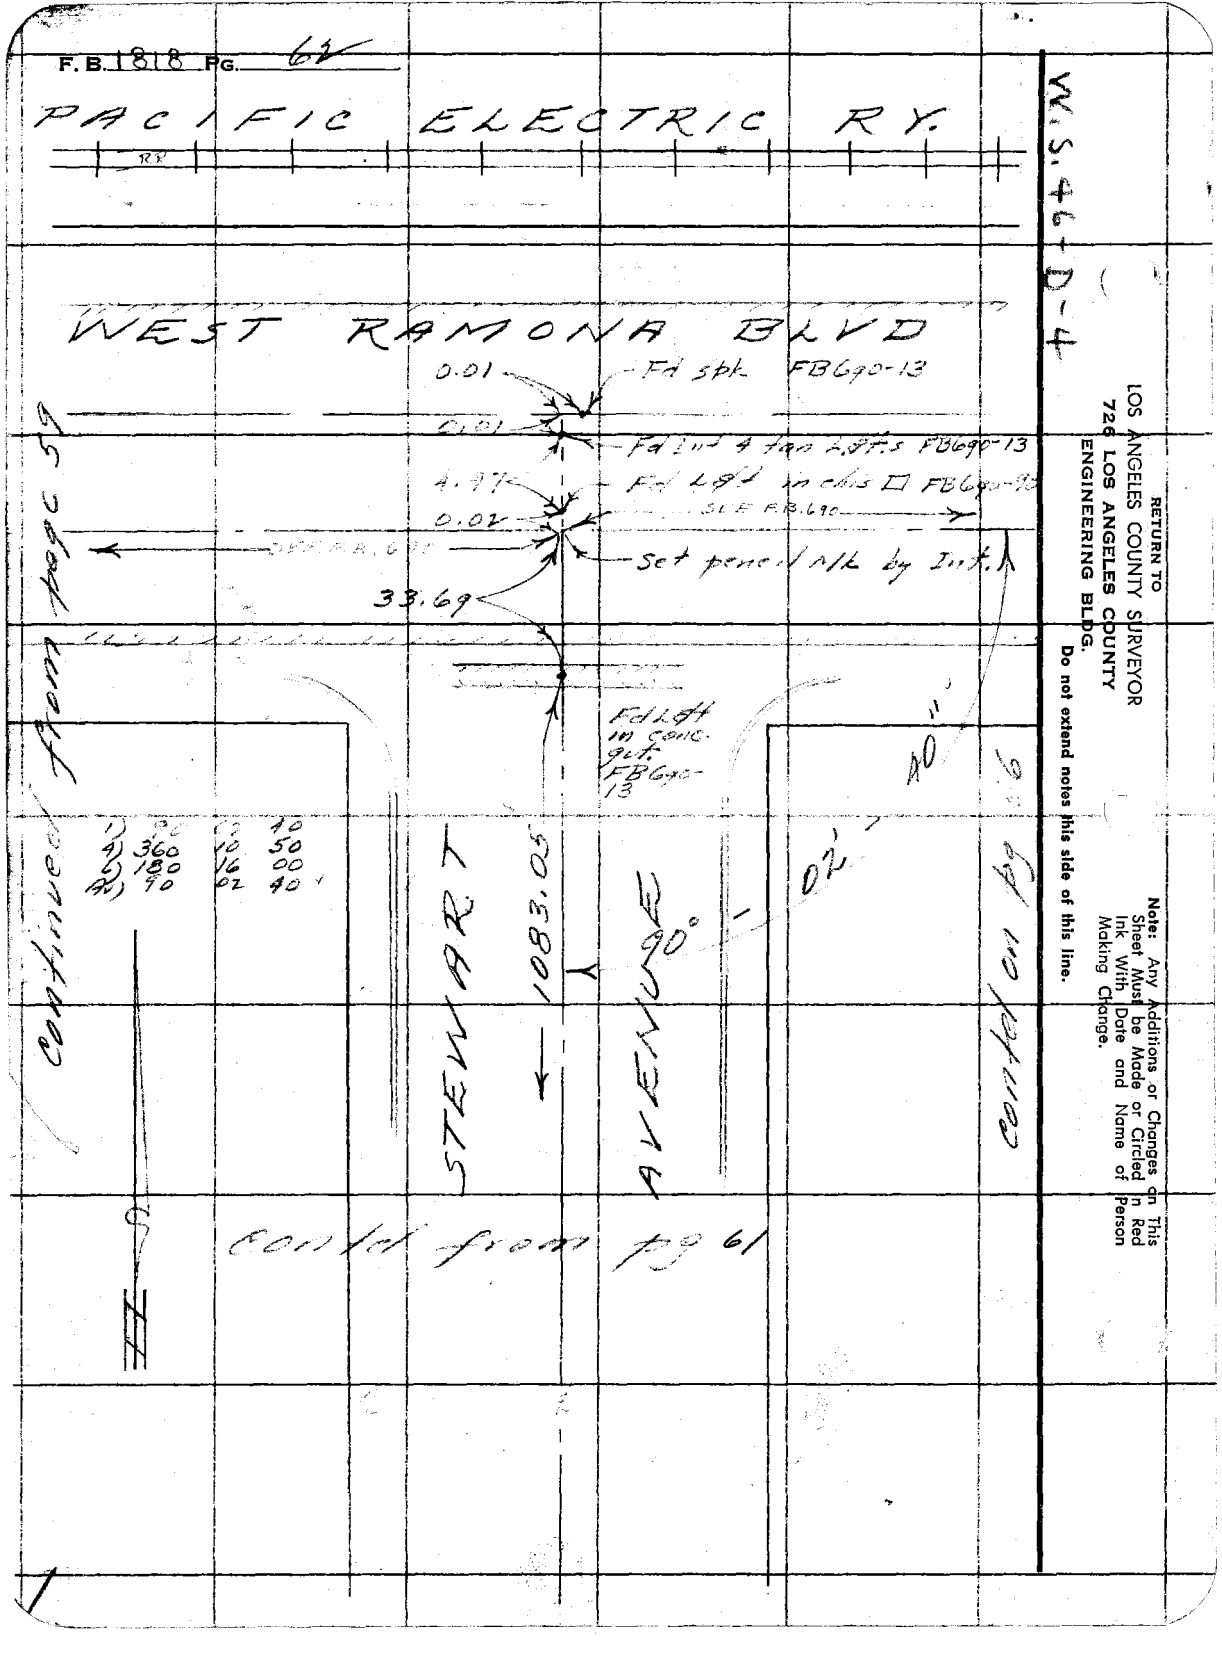

RETURN TO
LOS ANGELES COUNTY SURVEYOR
726 LOS ANGELES COUNTY
ENGINEERING BLDG.

Do not extend notes this side of this line.

Note: Any Additions or Changes on This Sheet Must be Made or Circled In Red Ink With Date and Name of Person Making Change.

W.S. 46-D-4

76F3095 247 4-53

RETURN TO
LOS ANGELES COUNTY SURVEYOR
726 LOS ANGELES COUNTY
ENGINEERING BLDG.

Note: Any Additions or Changes on This Sheet Must be Made or Circled in Red Ink With Date and Name of Person Making Change.

Do not extend notes this side of this line.

D-4

Notes Ck'd by C. J. GALLI
Map No. C.S.B-24-77-3
Office Work Burns
Checked C.J.G.
Date Feb 1955

Survey of W.O. 5641 Tape No. 2145rd. 64 of
Surveyed by R. J. [illegible]
Notes
Indexed C. J. Johnson Date

F.B. 1813 PG. 63

W.C. (4) 3559 59 50
3559 58 20
3559 57 35
3559 56 35

TRACT 3889 — cont'd from pg 64

Fd 2" IP (no ctr) Tr 3889 - Rd. FC 85-7 Rd FC 82-7

1) 1459.15 @ Lee (T=86°) = 1459.32
2) 1459.12 @ " " = 1459.29
Avg = 1459.30'

1) 1839.89 @ Lee (T=86°) = 1840.16
2) 1839.93 @ " " = 1840.15
Avg = 1840.15'

Cont'd from pg 55

MAINE

RICA AVE

Fd 1/2" IP (See Detail) 46.80'

Fd 1/2" IP FD 5/20 61

20.74
0.02
29.68

0.18
2.02
1.03
0.18

0.04

Fd nail & sm. dia. Ref.

Nail & Tack Ref. FD 80-45

Fd 1/2" IP Ref. sm. dia.

0.05

24.75
18.17

Fd nail & tack No Ref.

Fd 1/2" IP Ref. sm. dia.

Fd 1/2" IP FD 5/20 61

Fd 1/2" IP Ref. sm. dia.

RETURN TO
LOS ANGELES COUNTY SURVEYOR
726 LOS ANGELES COUNTY
ENGINEERING BLDG.

Note: Any Additions or Changes on This Sheet Must be Made or Circled in Red Ink With Date and Name of Person Making Change.

Do not extend notes this side of this line.

W.S. 46 - D-4

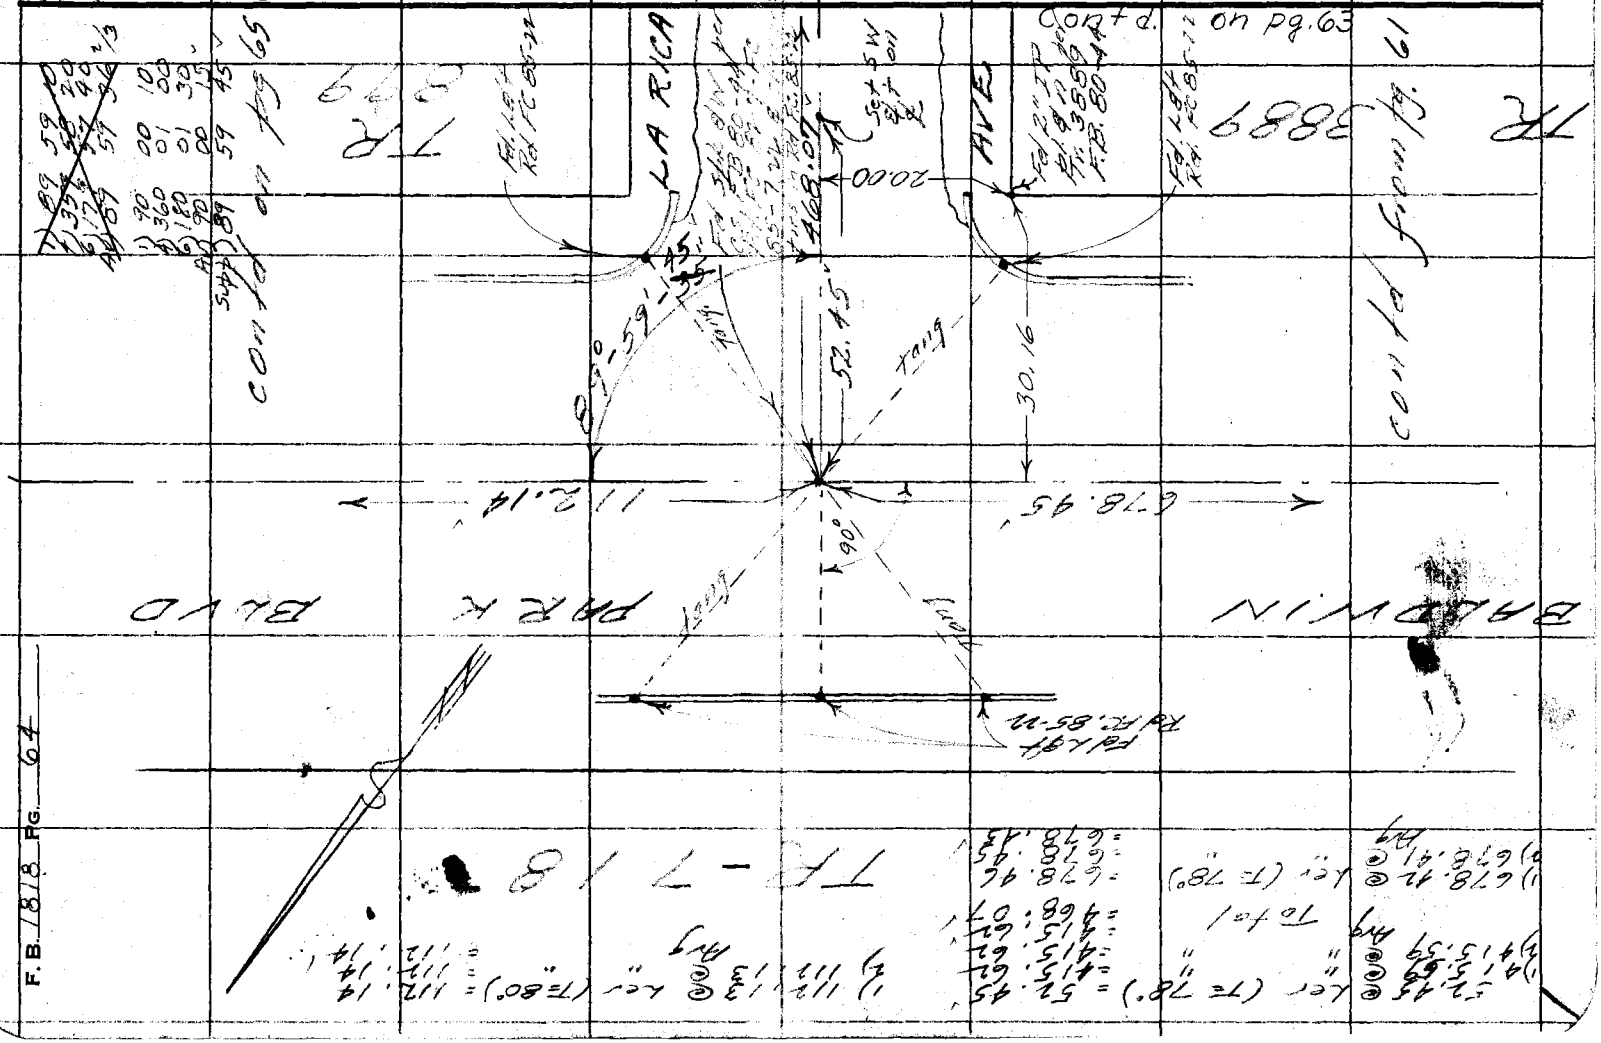

F.B. 1818 PG. 64

Notes Ck'd by C. J. GALLI
Map No. C.S.B-2477-3
Office Work Burns
Checked C.J.G.
Date Feb. 1955

Survey of BALDWIN PARK
W. O. 864 Tape No. 2145 Rd. 68 °F
Surveyed by R. J. MITCHELL
Notes R. J. MITCHELL Date 10/1/1953
Indexed C. Johnson

F. B. 1818 PG. 65

RETURN TO
LOS ANGELES COUNTY SURVEYOR
726 LOS ANGELES COUNTY
ENGINEERING BLDG.

Note: Any Additions or Changes on This Sheet Must be Made or Circled in Red Ink With Date and Name of Person Making Change.

Do not extend notes this side of this line.

Cont'd on pg. 67

RICA TRACT

BLVD

PARICA AVE

BALDWIN PARK

Cont'd from page 67

Fd L&T inch FB690-11

Set Lg Bk. Tk w/ Bkt on line

57.59'

S 1° 59' E 390.11'

Fd L&T Rd FC 85-7

Fd L&T in No. Rd FC 85-7

0.07 Nothing

Tang 32.12

23.17 Tang.

20.30

Fd chis + RA. FC 85-7

24.27

59.84 c.o.

Fd L&T FB690-11

50.00 checked

112.14'

Set 1" IP rem PL & Co Tk dn 18" on ℄ Prod.

Fd L&T Rd. FC 85-7

78.03 ℄ CT (TE 68') = 78.03'

T 1 S R 10

78F3098 247 4-53

RETURN TO
LOS ANGELES COUNTY SURVEYOR
726 LOS ANGELES COUNTY
ENGINEERING BLDG.

Note: Any Additions or Changes on This Sheet Must be Made or Circled In Red Ink With Date and Name of Person Making Change.

Do not extend notes this side of this line.

W.S. 46-D-4

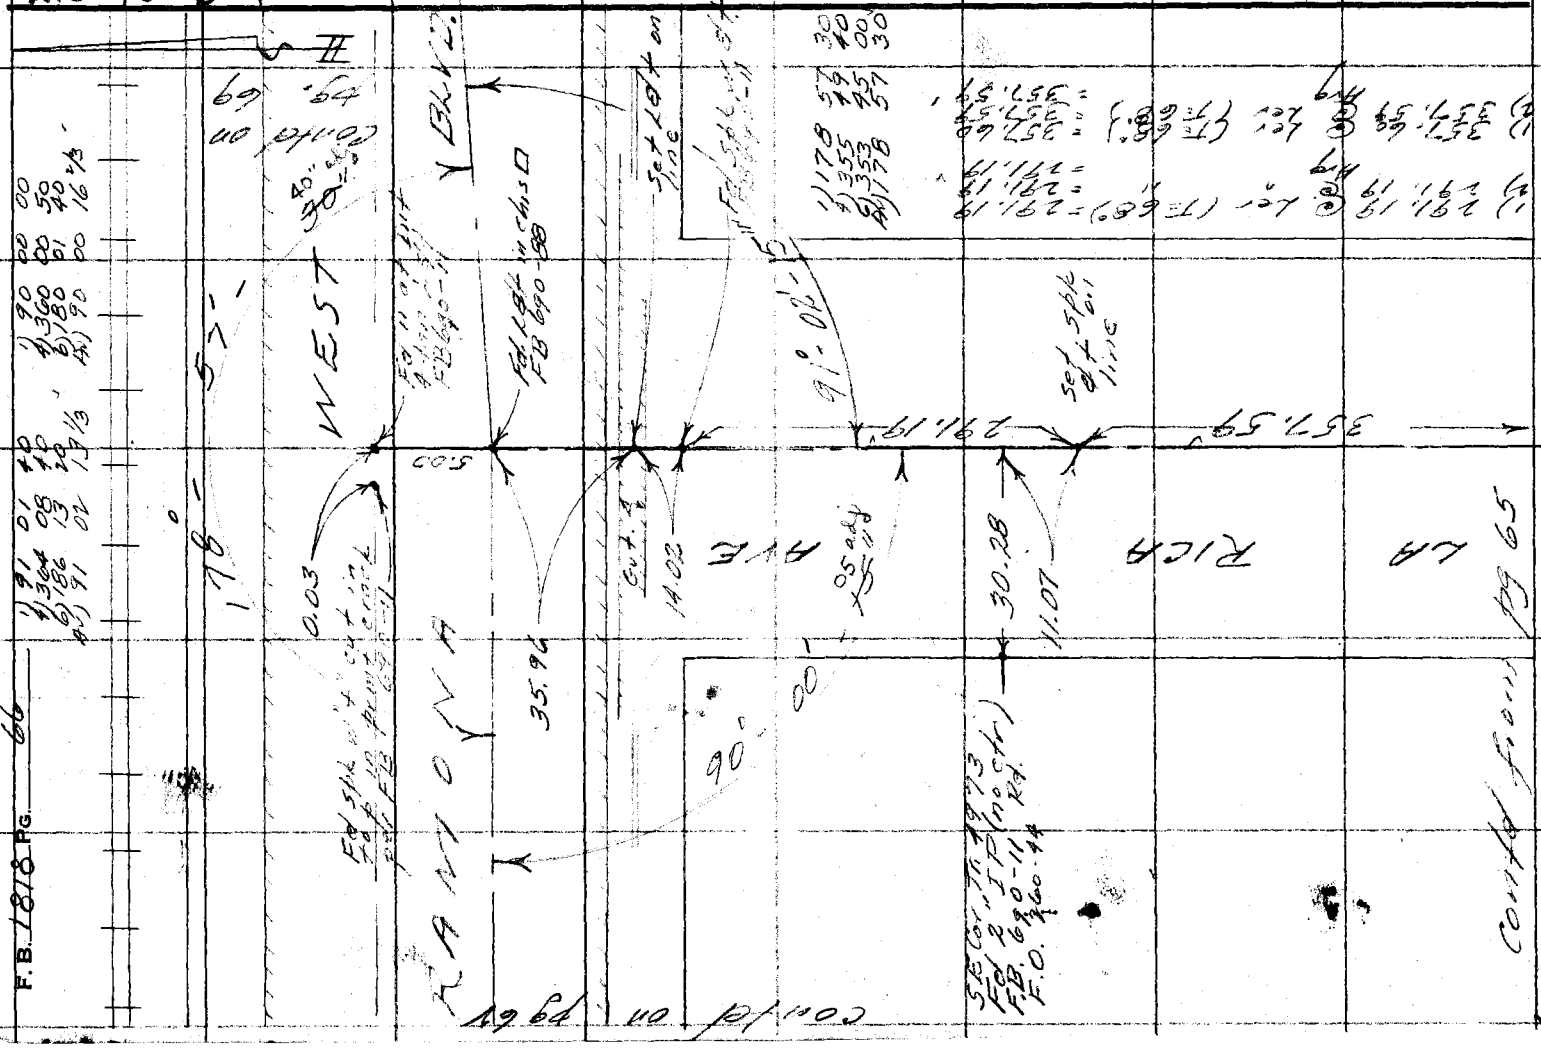

76F3095 247 4-53

RETURN TO
LOS ANGELES COUNTY SURVEYOR
726 LOS ANGELES COUNTY
ENGINEERING BLDG.

Note: Any Additions or Changes on This Sheet Must be Made or Circled in Red Ink With Date and Name of Person Making Change.

Do not extend notes this side of this line.

W.S. 46 -

Notes Ck'd by F. J. GALLI
Map No. C.S.B. - 2497-3
Office Work BURNS
Checked C.J.G.
Date Feb. 1955

Survey of BALDWIN PARK BLVD
W. O. 864 Tape No. 2145 yd. 68 of
Surveyed by R. J. MITCHELL Date 10-11-54
Notes R. J. MITCHELL
Indexed C. Johnson

F.B. 1212 PG. 67

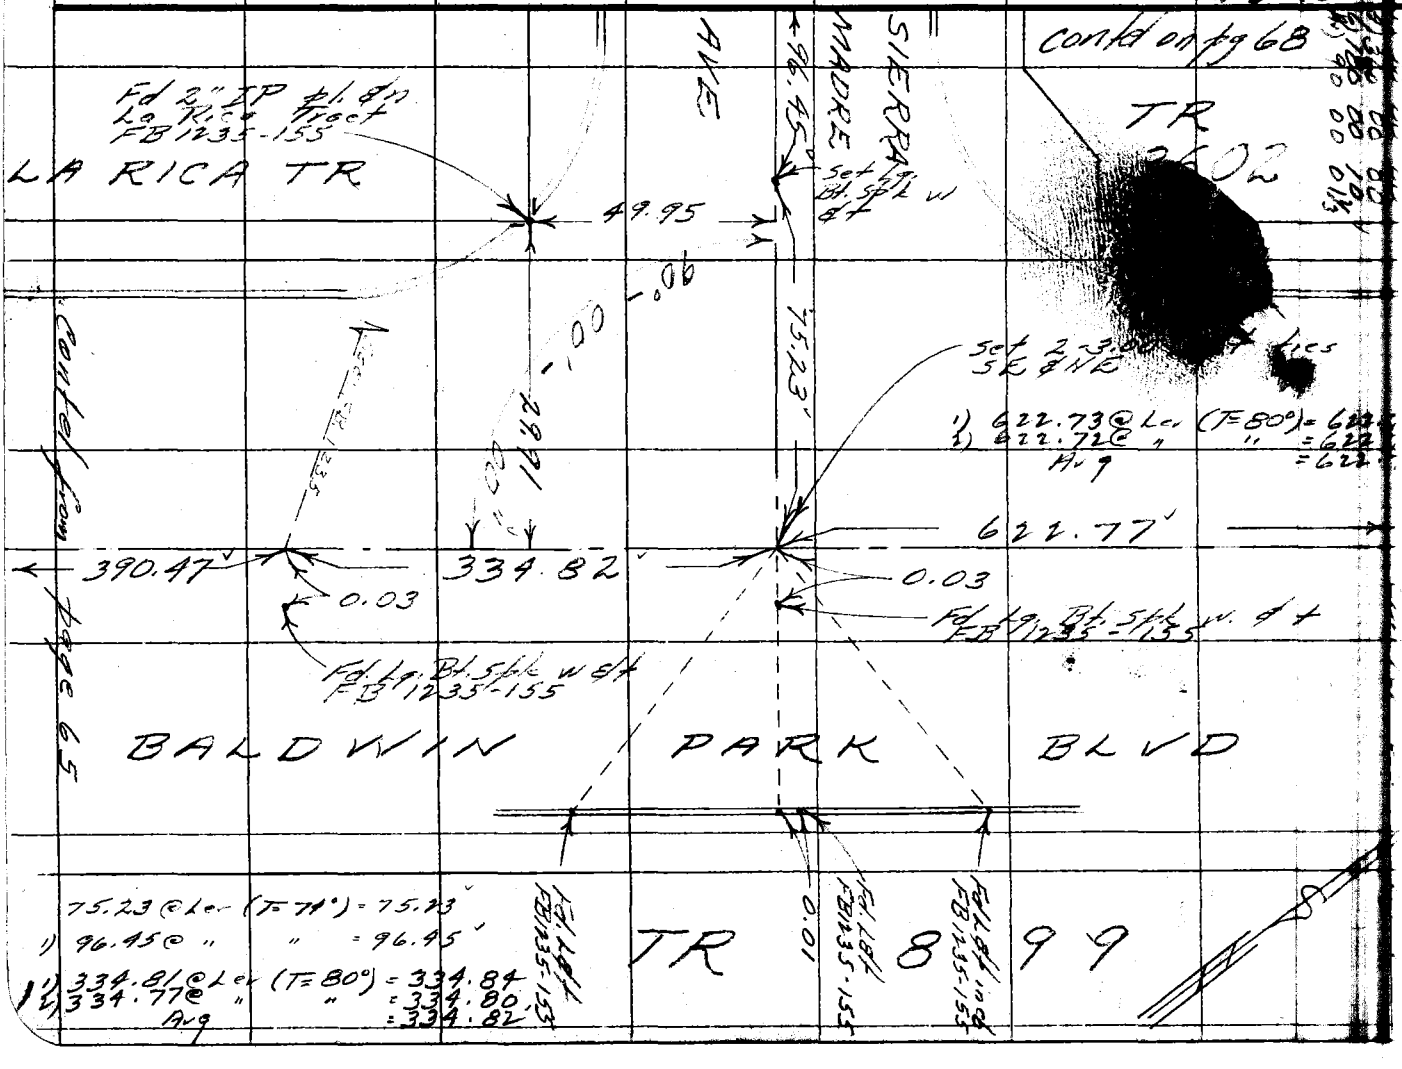

RETURN TO
LOS ANGELES COUNTY SURVEYOR
726 LOS ANGELES COUNTY
ENGINEERING BLDG.

Note: Any Additions or Changes on This Sheet Must be Made or Circled in Red Ink With Date and Name of Person Making Change.

Do not extend notes this side of this line.

W.S. 46 - D - 4

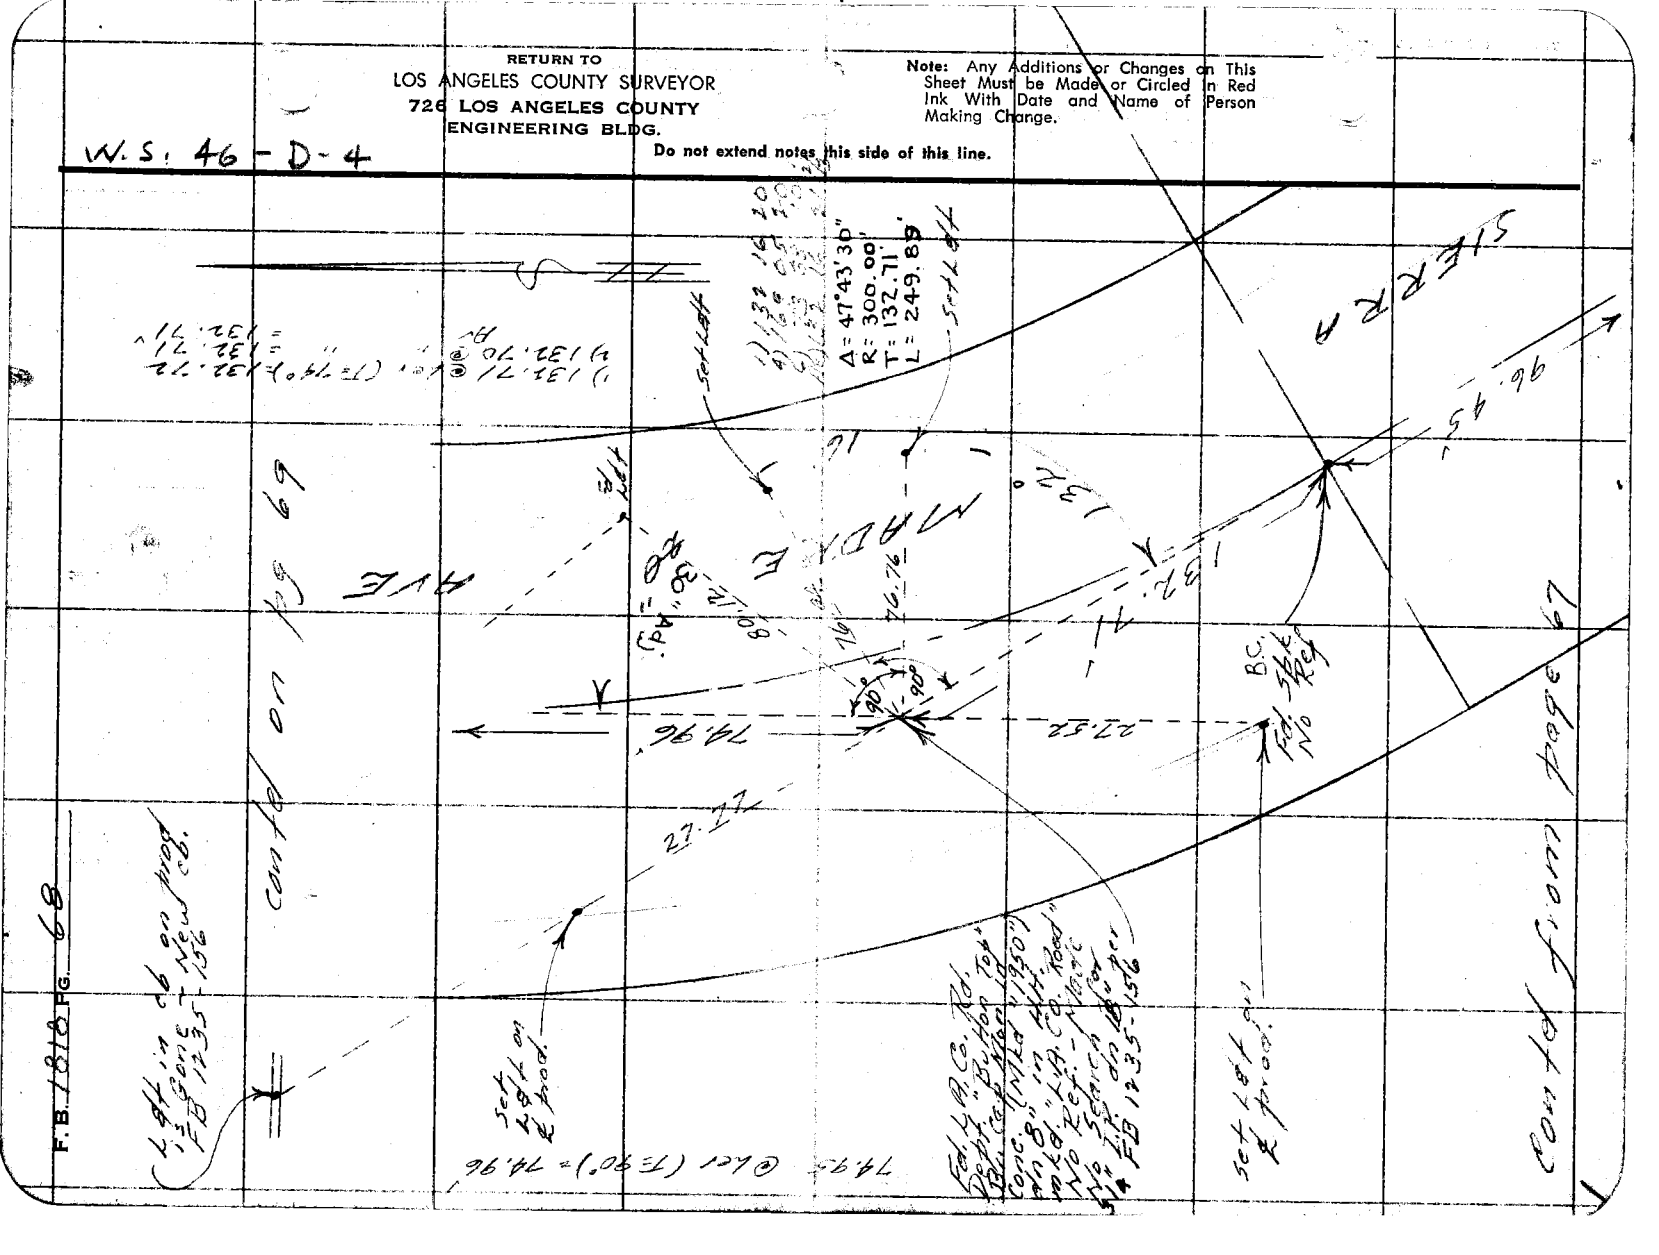

Notes Ck'd by C. J. GALLI
Map No. C.S.B- 2497-3
Office Work Burns
Checked C.J.G.
Date Feb. 1955

Survey of BALDWIN PARK BLVD
W. O. 864 Tape No. 01148 St'd. 62 °F
Surveyed by R.J. Mitchell
Notes Mitchell Date 10-53
Indexed O. Johnson

F. B. 1818 Pg. 69

W. S. 46

PACIFIC ELECTRIC RY

AVE

0.06

WEST

Fd PM in conc & paint "+" FB 1235-105

Fd L&T in chis "B" FB 1235-105

3.71

Fd chis "+" No Ref

Fd PM in W. FB 1235-105

ROMONA

0.02

0.07

5.00

Fd 3pk w&t FB 1235-105

21.64

4.16'

0.07 E.C. Nothing Set

BLVD

Fd L&T - No Ref

Fd. Std. LA Co. Surv. Cont. Sys. Br. Cap Mon. dn 12" N NH & in Rd "Traverse Station PUENTE E 2 A - 1952" No Ref.

0.32

MADRE

10' Adj

80

105° 26'

Co. Rd. No. 74

SIERRA

set Lg. Bt. 5pk w&t on semi-tangent

1) 105 26 20
2) 61 44 10
3) 272 36 00
4) 105 26 00

61.91'

61.90 Rec (TE90) = 61.91'

74.96'

N

cont'd from page 68

RETURN TO
LOS ANGELES COUNTY SURVEYOR
726 LOS ANGELES COUNTY
ENGINEERING BLDG.

Note: Any Additions or Changes on This Sheet Must be Made or Circled in Red Ink With Date and Name of Person Making Change.

Do not extend notes this side of this line.

76F3098 247 4-53

RETURN TO
LOS ANGELES COUNTY SURVEYOR
726 LOS ANGELES COUNTY
ENGINEERING BLDG.

Note: Any Additions or Changes on This Sheet Must be Made or Circled in Red Ink With Date and Name of Person Making Change.

Do not extend notes this side of this line.

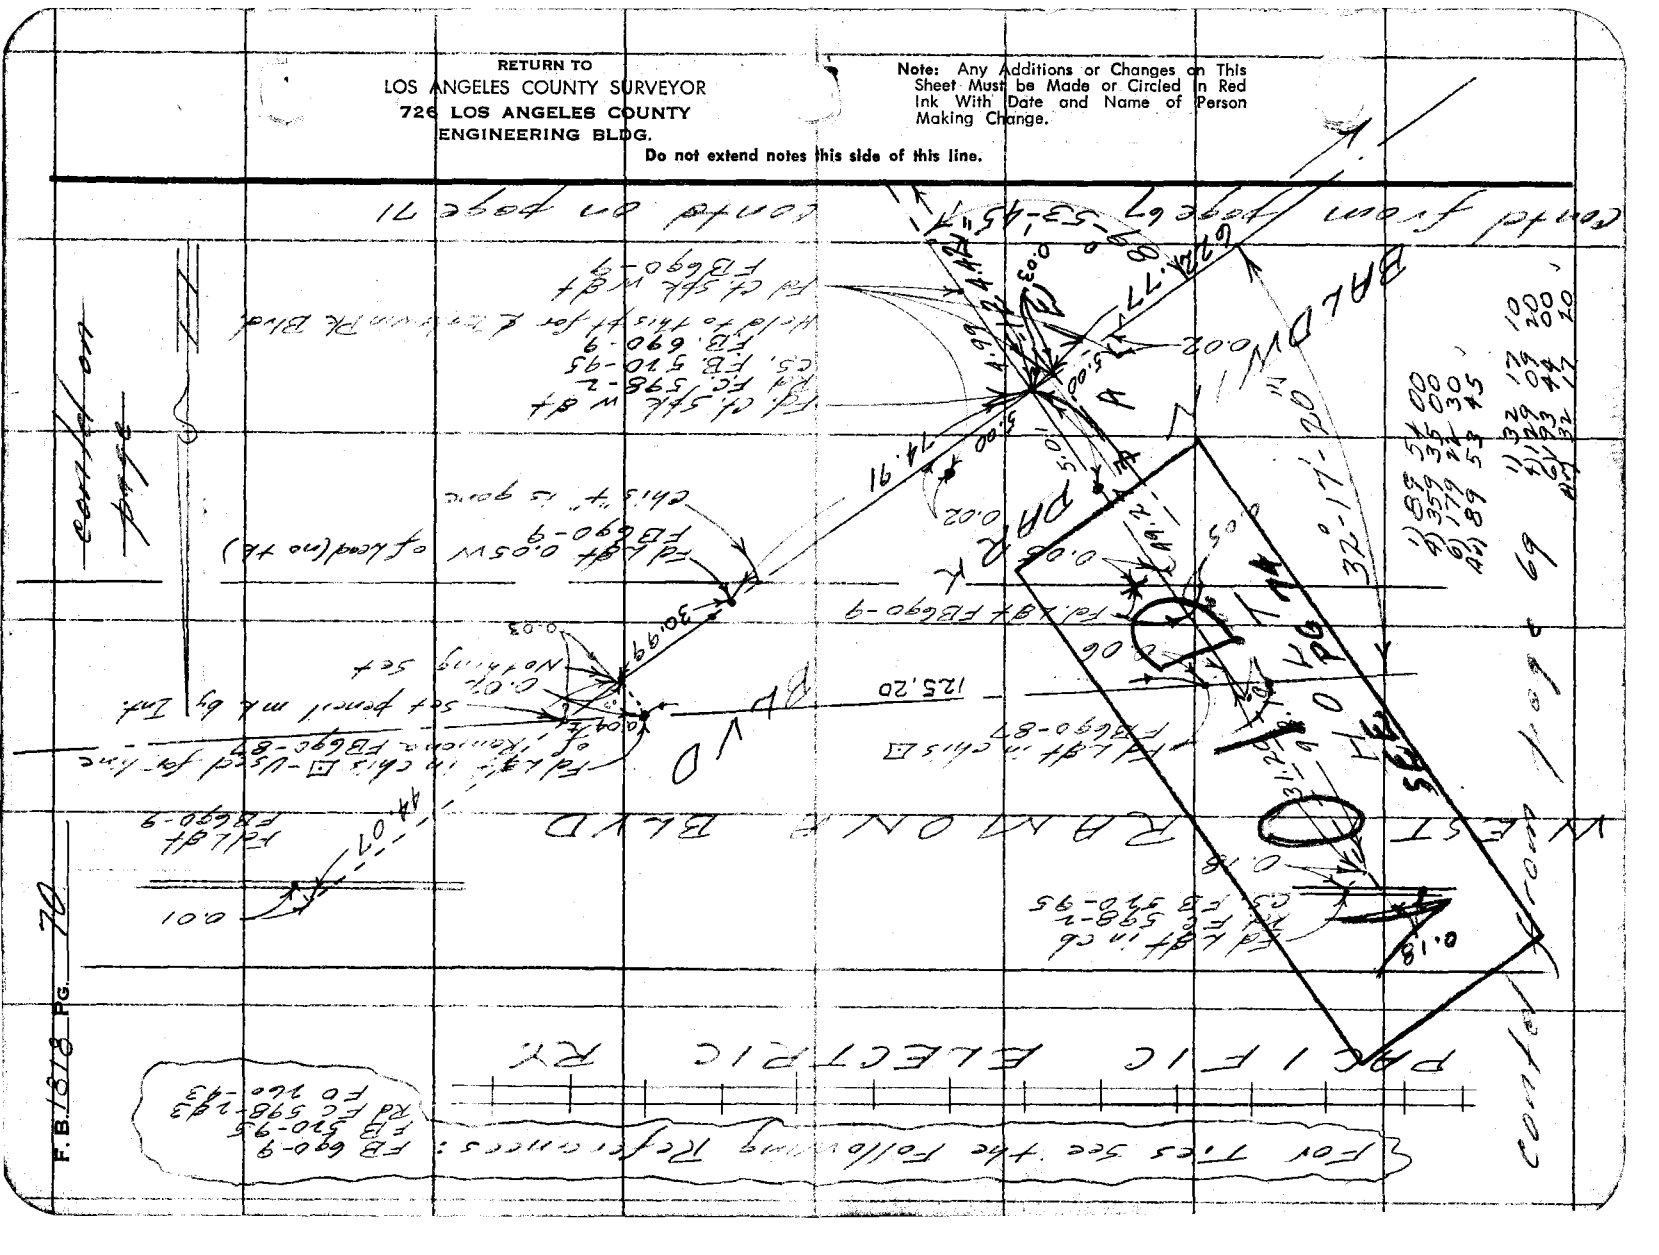

Notes Ck'd by C. J. GALLI
Map No. C-S.B-2497-3
Office Work Burns
Checked C.J.G.
Date Feb. 1955

Survey of BALDWIN PARK BLVD
W. O. 8641 Tape No. 0114 Std. 68 °F
Surveyed by R. J. MITCHELL
Notes R. J. MITCHELL Date
Indexed C. Tabares

F. B. 1818 PG. 71

Note: Any Additions or Changes on This Sheet Must be Made or Circled in Red Ink With Date and Name of Person Making Change.

Do not extend notes this side of this line.

RETURN TO
LOS ANGELES COUNTY SURVEYOR
726 LOS ANGELES COUNTY
ENGINEERING BLDG.

MAINE AVE

Fd. CASH nail dn 5" w. of P.O.T. patch See Rd. Fd. 598

1459.30

CS 8784 (Ref's are not in field)

Same

217.99

Same

35° Calc

45° 49' Same

47' Same

LORAT

AREA 18.00

0.61

Set Pencil Mk by Int

55' Adj

45° Calc

30° 01'

90° 07' 06"

Note that CASH nail @ PT of curve NOT on line in N. Co. Blvd. as shown on Baldwin Park Blvd. Line w. Ct. shown @ Maine. Angles measured are those of adjacent Rd Fd

Set Pencil Mk by Int

HOLT

P.O.S.T. Fd Lead Rd. Fd. 598-3

40° 13' 10"

269.58

269.73

See F.B. 1980-30 for New ℄

0.17

0.07

E.C.

Δ = 40° 13' 10"
R = 200.00
T = 73.64
L = 140.39

0.34

0.15

0.25

P.I. by intersection

Fd Lead @ Int of Holt & Maine checked & fixed per Rd. F.C. 5983

B.C.

0.56

0.15

Fd Lead Rd. F.C. 598-3 (PI is on line shown)

+124.47

All dist. Level @ T-80°

1) 269.73 + 269.73 = 539.46
2) 269.73 + 217.88 = 487.61
3) 217.88 + 353.19 = 571.07
4) 353.19 + 353.17 = 706.36
Avg = 353.18
5) 353.17 + 124.42 = 477.59
6) 124.42 + 124.42 = 248.84
Avg = 124.42

cont'd from pg 70

76F3098 247 4-53

353.17
73.64
179.53

F. B. 1818 PG. 72

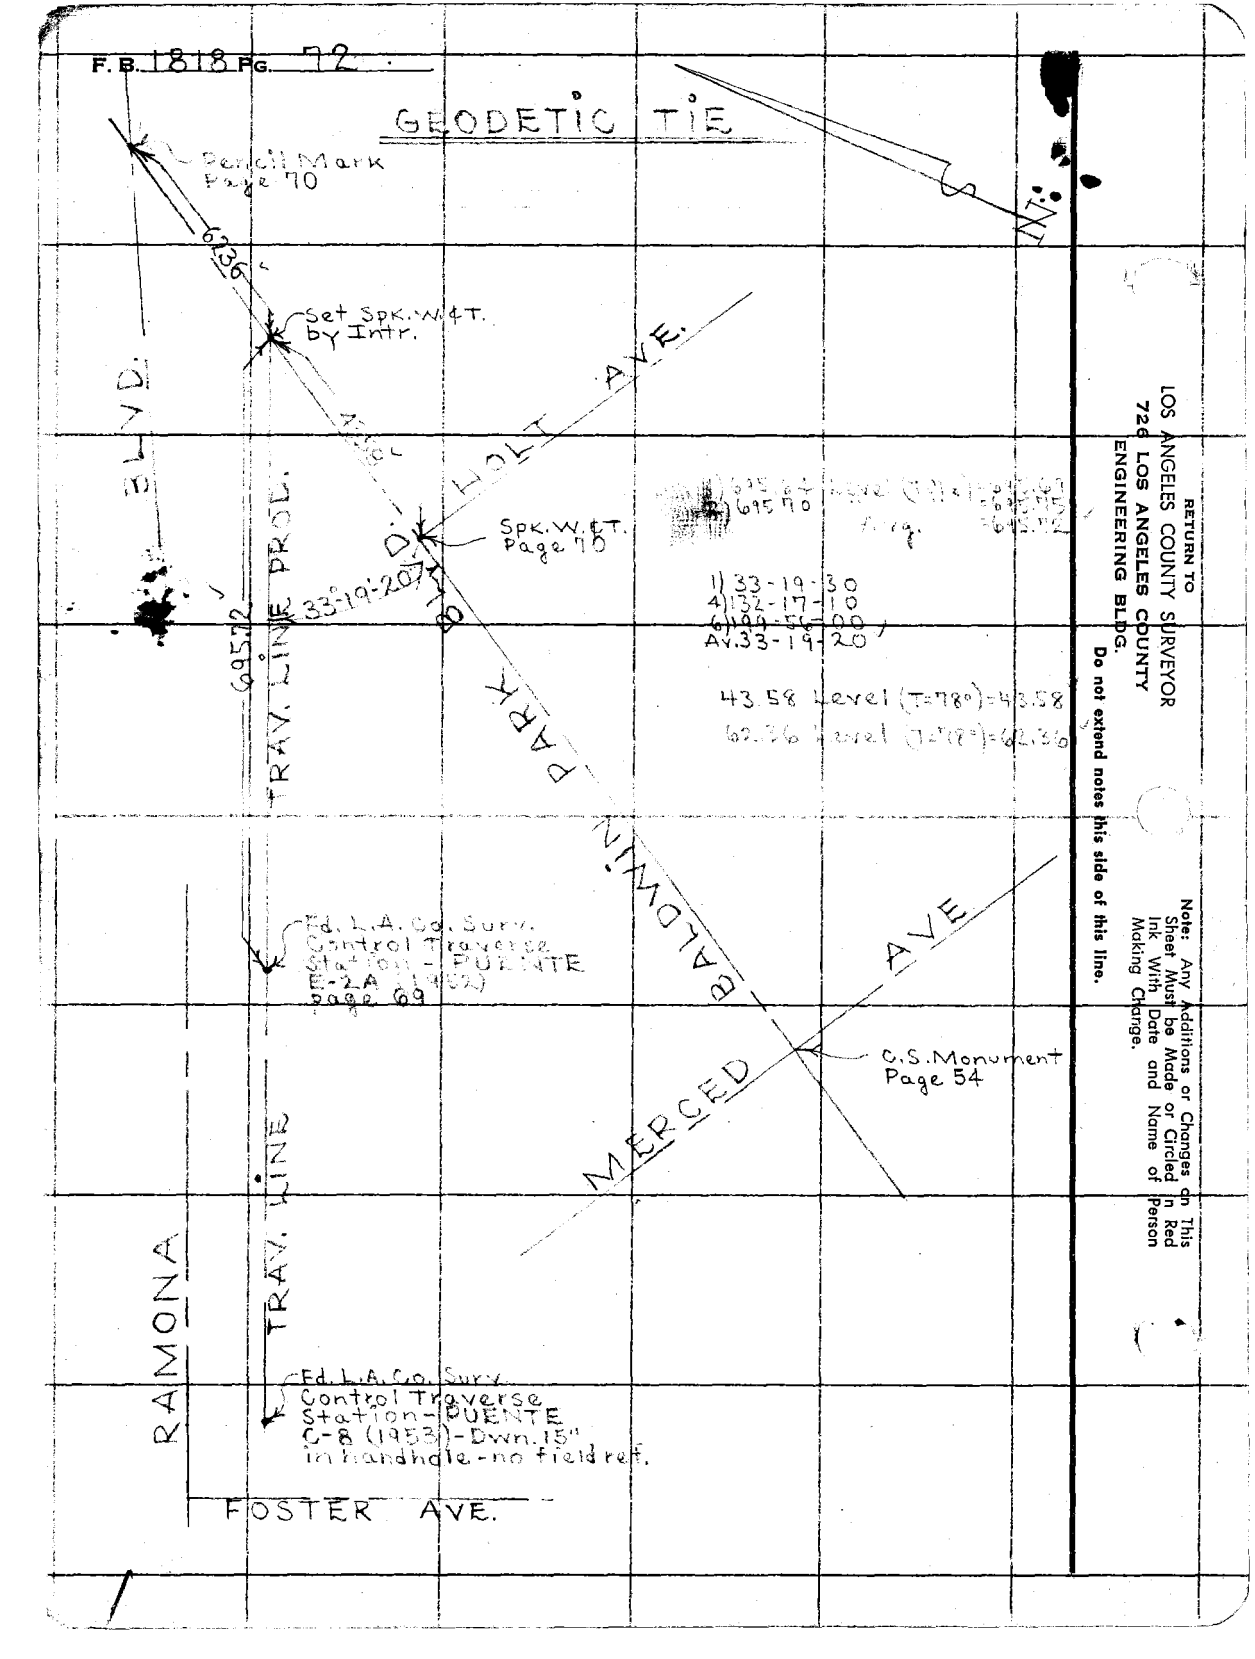

RETURN TO
LOS ANGELES COUNTY SURVEYOR
726 LOS ANGELES COUNTY
ENGINEERING BLDG.

Do not extend notes this side of this line.

Notes: Any Additions or Changes on This Sheet Must be Made or Circled in Red Ink With Date and Name of Person Making Change.

76F3098 247 4-53

RETURN TO
LOS ANGELES COUNTY SURVEYOR
726 LOS ANGELES COUNTY
ENGINEERING BLDG.

Note: Any Additions or Changes on This Sheet Must be Made or Circled in Red Ink With Date and Name of Person Making Change.

Do not extend notes this side of this line.

W.S. 46

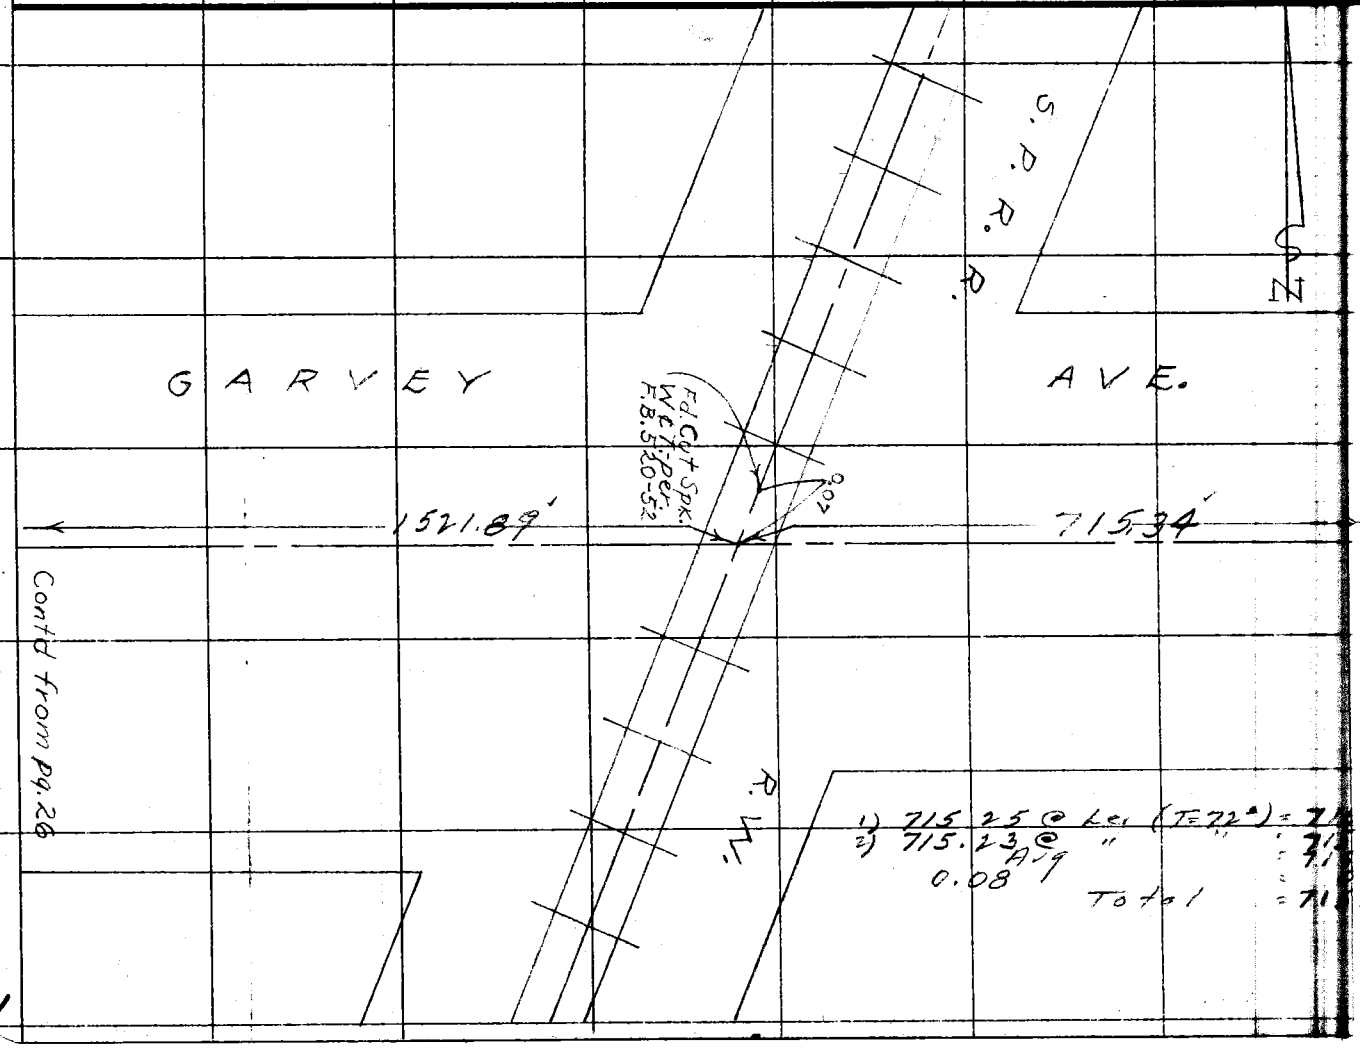

Contd from Pg. 26

1) 715.25 @ Lt (I=72°) = 71
2) 715.23 @ " = 71
Adj 0.08
Total = 71

Notes Ck'd by C. J. GALL
Map No. C.S.B. 2497-2
Office Work Burns
Checked C.J.G.
Date Feb. 1955

Survey of
W. O. 8641 Tape No. 0/145 rd. 68 ft
Surveyed by R. J. MITCHELL Date 10-53
Notes R. J. MITCHELL
Indexed C. C. Johnson

F. B. 818 PG. 53

RETURN TO
LOS ANGELES COUNTY SURVEYOR
726 LOS ANGELES COUNTY
ENGINEERING BLDG.

Note: Any Additions or Changes on This Sheet Must be Made or Circled in Red Ink With Date and Name of Person Making Change.

Do not extend notes this side of this line.

W. S. 46 D - 4

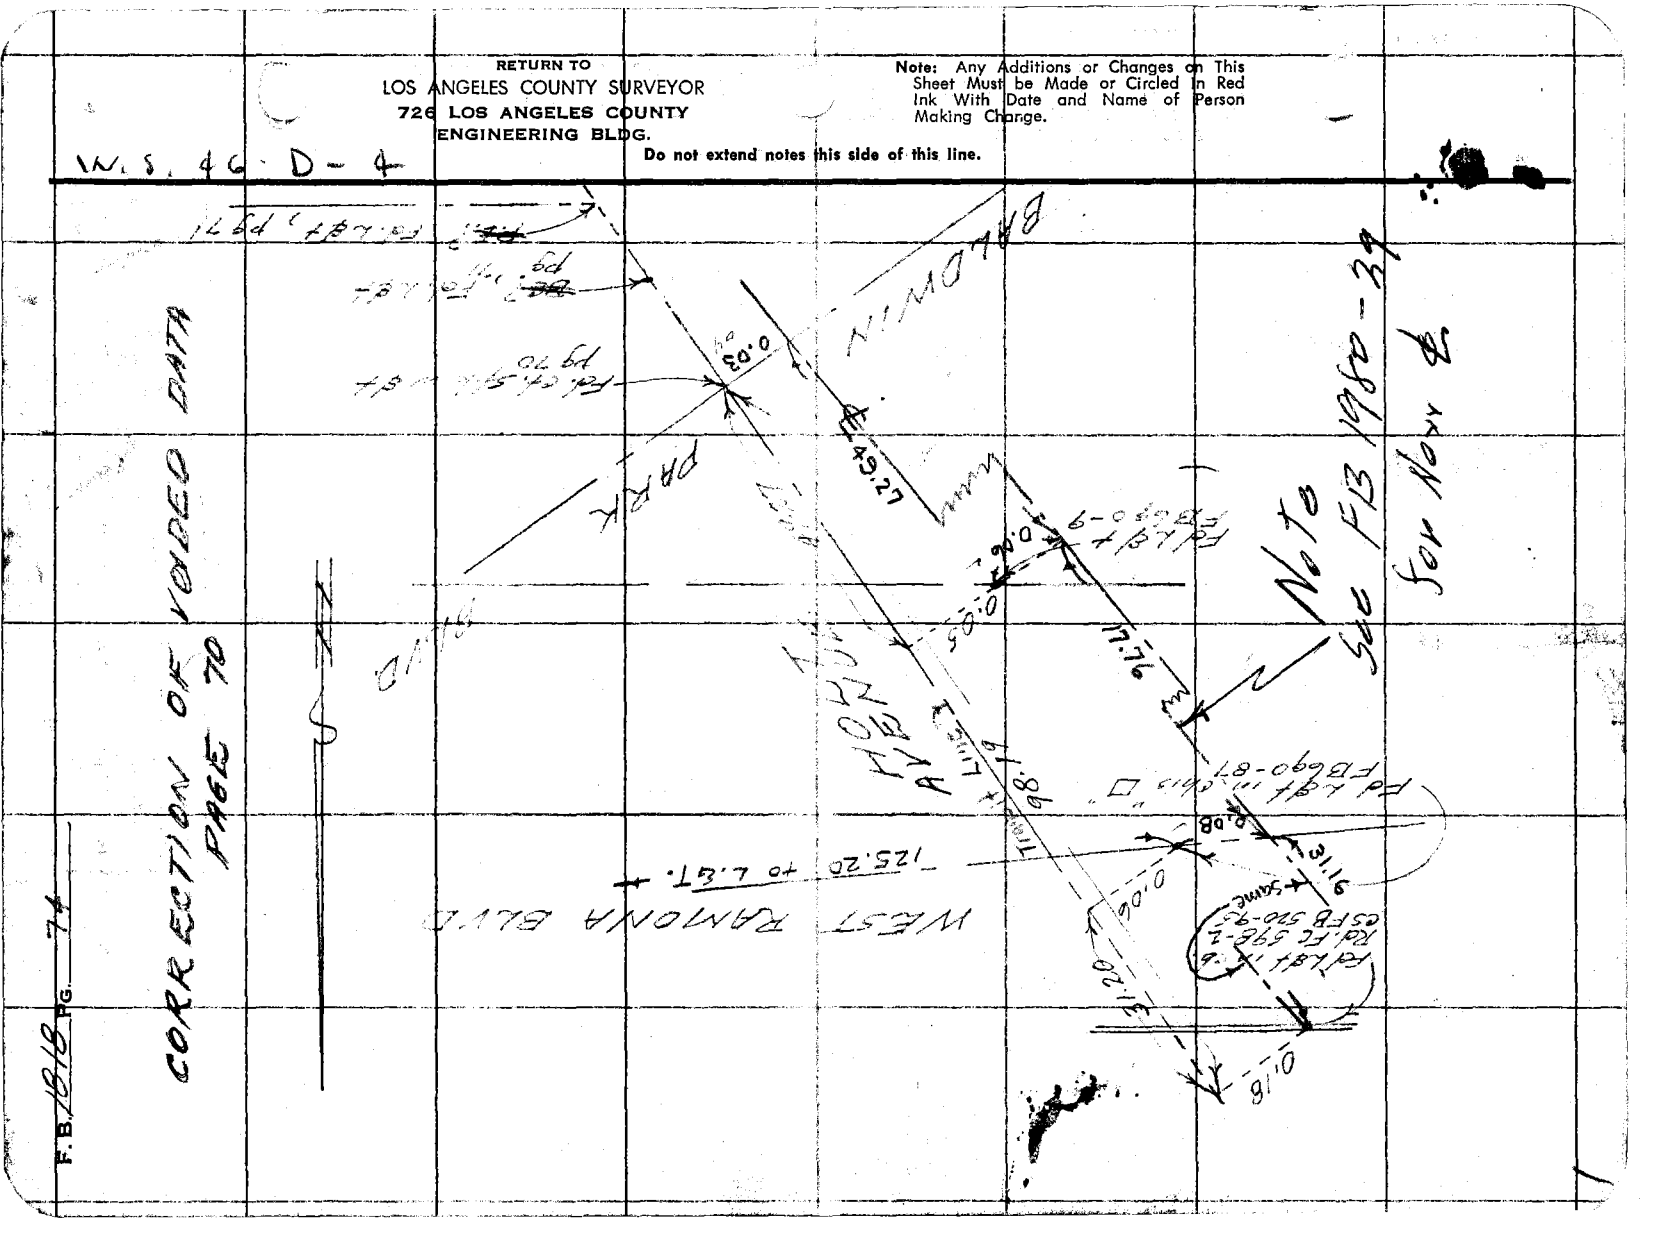

F.B. 1818 PG. 81

Notes Ck'd by
Map No. C.S.B-2497-1
Office Work Burns
Checked Galli
Date Feb. 1955

Survey of
W. O. 8641 Tape No. 014 Std'd. 68° °F
Surveyed by Mitchell
Notes Mitchell Date 11-10-53
C. Johnson
Indexed 12-53

Note: Any Additions or Changes on This Sheet Must be Made or Circled in Red Ink With Date and Name of Person Making Change.

Do not extend notes this side of this line.

RETURN TO
LOS ANGELES COUNTY SURVEYOR
726 LOS ANGELES COUNTY
ENGINEERING BLDG.

SURVEY SHOWING IMPROVEMENT
ALONG THE ROUTE
OF
BALDWIN PARK BLVD.
FROM
VALLEY BLVD.
TO
WEST RAMONA BLVD.
AS REQUESTED BY THE
COUNTY REIGONAL PLANNING
COMMISSION

JN 8641

R.J. Mitchell — T — Nov. 1953
K.C. Stanley — HC
J.A. Kosalovich — HC
R.C. Clifford — RC

For center line survey see
Pages 5 to 60 of F.B. 1818

76F3098 247 4-53

F. B. 1818 PG. 82

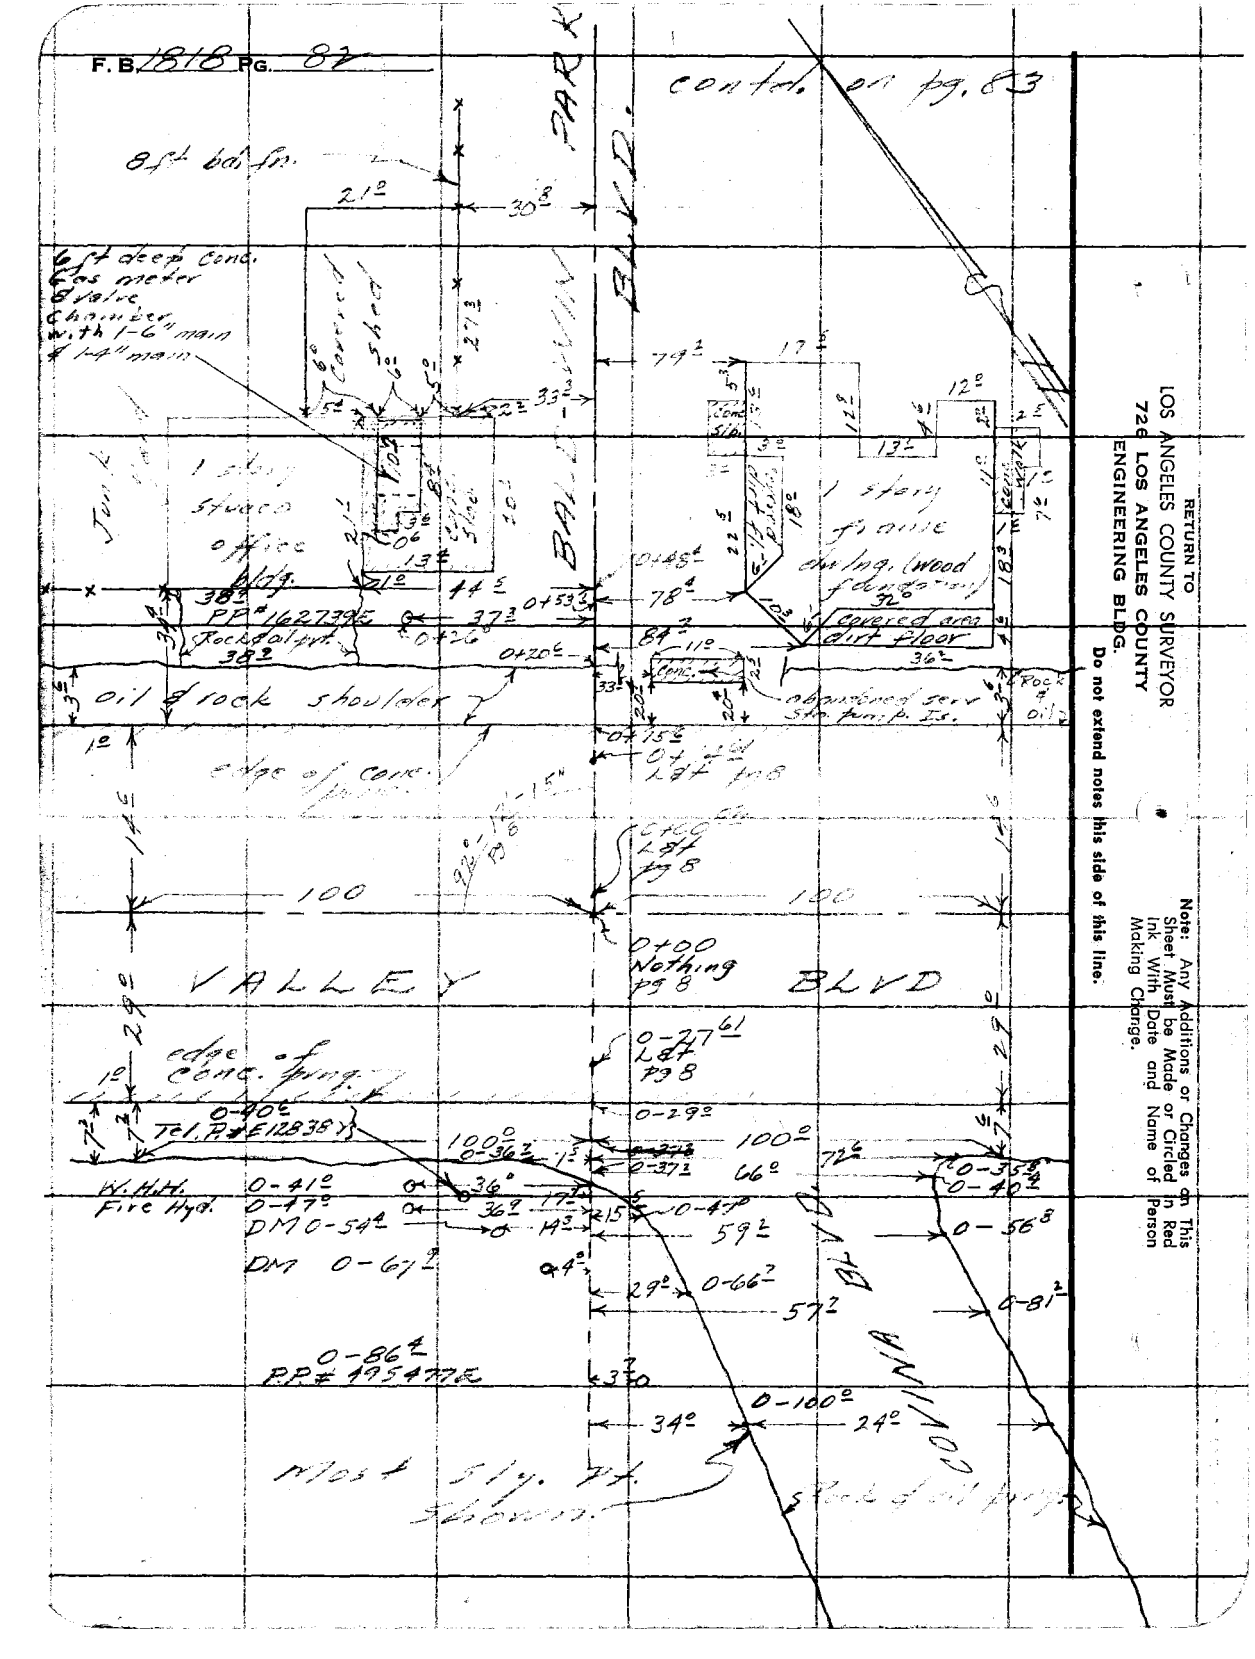

RETURN TO
LOS ANGELES COUNTY SURVEYOR
726 LOS ANGELES COUNTY
ENGINEERING BLDG.

Do not extend notes this side of this line.

Note: Any Additions or Changes on This Sheet Must be Made or Circled in Red Ink With Date and Name of Person Making Change.

Notes Ck'd by
Map No. C.S.B - 2497-1
Office Work Burns
Checked Galli
Date Feb 1955

Survey of Baldwin Park Area
W. O. 8641 Tape No. 0114 Std. 68 °F
Surveyed by Mitchell
Notes Smiley Date 11-10-53
Indexed [redacted] Johnson

F. B. 1845 Pg. 83

Note: Any Additions or Changes on This Sheet Must be Made or Circled in Red Ink With Date and Name of Person Making Change.

Do not extend notes this side of this line.

RETURN TO
LOS ANGELES COUNTY SURVEYOR
726 LOS ANGELES COUNTY
ENGINEERING BLDG.

76F3OSS 247 4-53

BLVD.

16" R.R. #383246E — 22 — 2+83.3

14" Tel. Pole — 7 — 2+52.2

R.R. 100 — ℄ Std. Gauge Rails

Switch Std. — 22 — 2+21.6 — 54.9 — E.C. 2+15.5

2+12.1 — 24 — Sec 2+13.2

℄ Std. Gauge — 23.2 — 2+11.5 — Rails

1+98.2 (Pg. 11) (Main line)

℄ Std. Gauge — Rails

℄ Std. Gauge — 1+81.5 (Main line) — Rails

South Pacific

PARK

30.3 — 8" Tel. Pole 1+66.1

1"x2" N. (1+62.07) (Pg. 8)

1+49.0 — 1+48.6 — 21.7 — 1+46.5 — 33.7 — 12" Grey Pole 1+48.0 — 80.2

Frame Parts-Storage Shed 34.5

18" R.R. #383247E

8 ft. Iron Fence

49.5 — 18.2 — 13th Frame Shed, Chatham Camp — 10.0 — 10.0

1+34.8 — 49.3

1+29.4 — 28.6 — 18" Acacia

50.2 — 11.5 — 10.0

D.M.

22.1 — 1+32.8

1+ — 28.8 — 16" Acacia — 15.5

Garage — Frame Bldg.

30.4 — 50.2 — Storage 20.0

1+03.5 — 50.3 — Conc. Slab — 11.5 — 12.3

1+02.4

BALDWIN

10" Peach

8" Peach

14.5

Cont'd on Pg. 82

Cont'd. Pg. 85

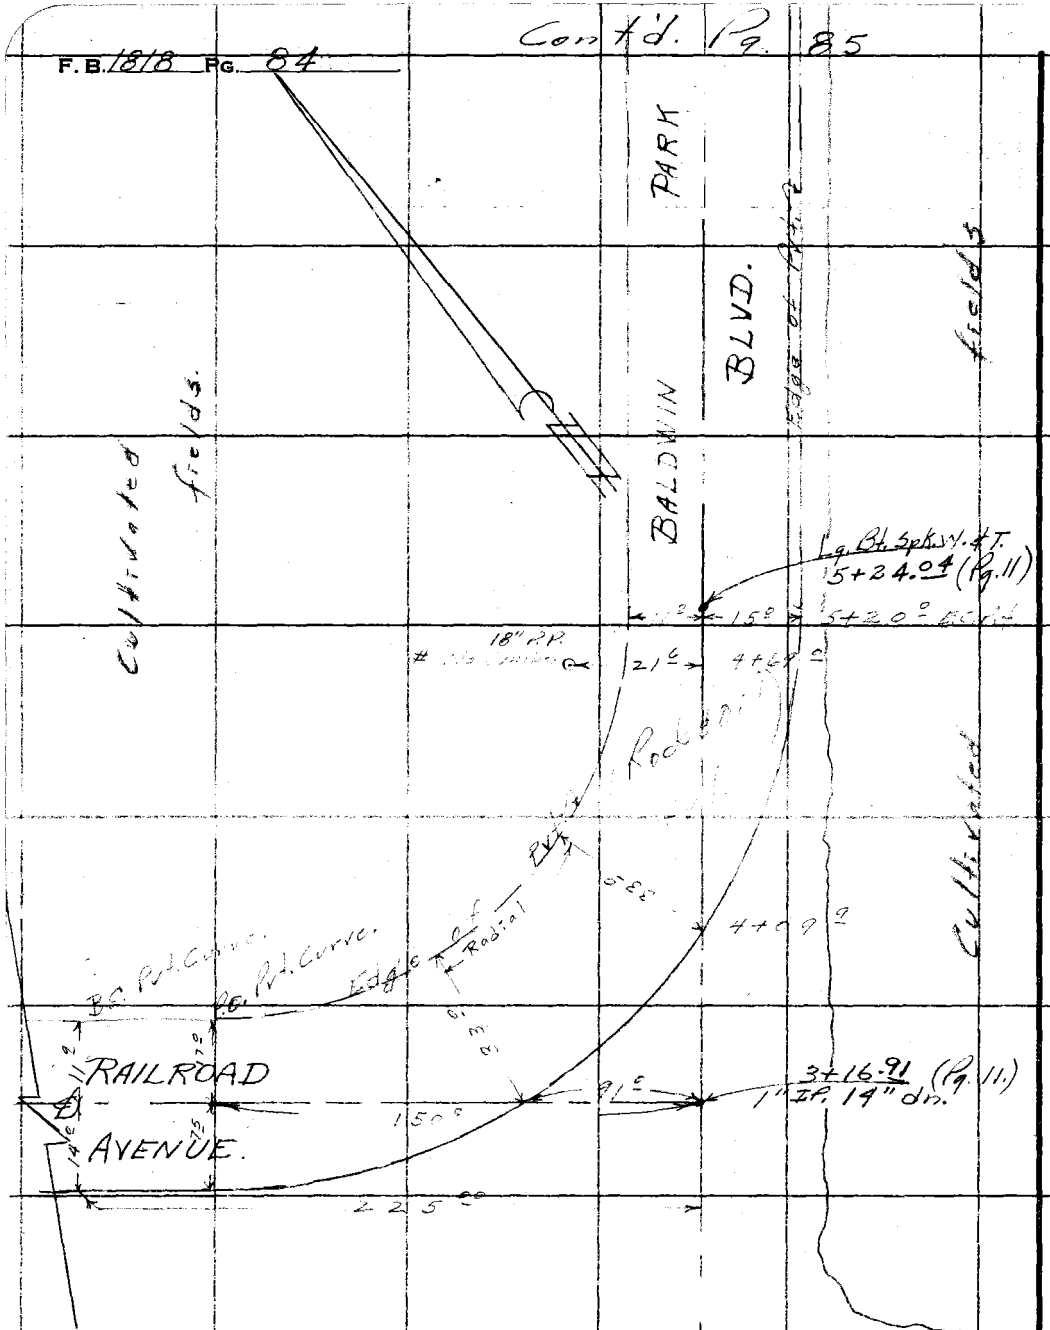

RETURN TO
LOS ANGELES COUNTY SURVEYOR
726 LOS ANGELES COUNTY
ENGINEERING BLDG.
Do not extend notes this side of this line.

Note: Any Additions or Changes on This Sheet Must be Made or Circled in Red Ink With Date and Name of Person Making Change.

Cont'd fr. Pg. 83

Notes Ck'd by
Map No. C.S.B-2497-1
Office Work Burns
Checked Galli
Date Feb. 1955

Survey of Baldwin Park
W. O. 3641 Tape No. 9114 St'd. 68 °F
Surveyed by E.T. Mitchell
Notes J.A. Vrsalovich Date 11-'53
Indexed C. Johnson

F.B. 141-E Pg. 85
Cont'd on Pg. 190

Note: Any Additions or Changes on This Sheet Must be Made or Circled in Red Ink With Date and Name of Person Making Change.

Do not extend notes this side of this line.

RETURN TO
LOS ANGELES COUNTY SURVEYOR
726 LOS ANGELES COUNTY
ENGINEERING BLDG.

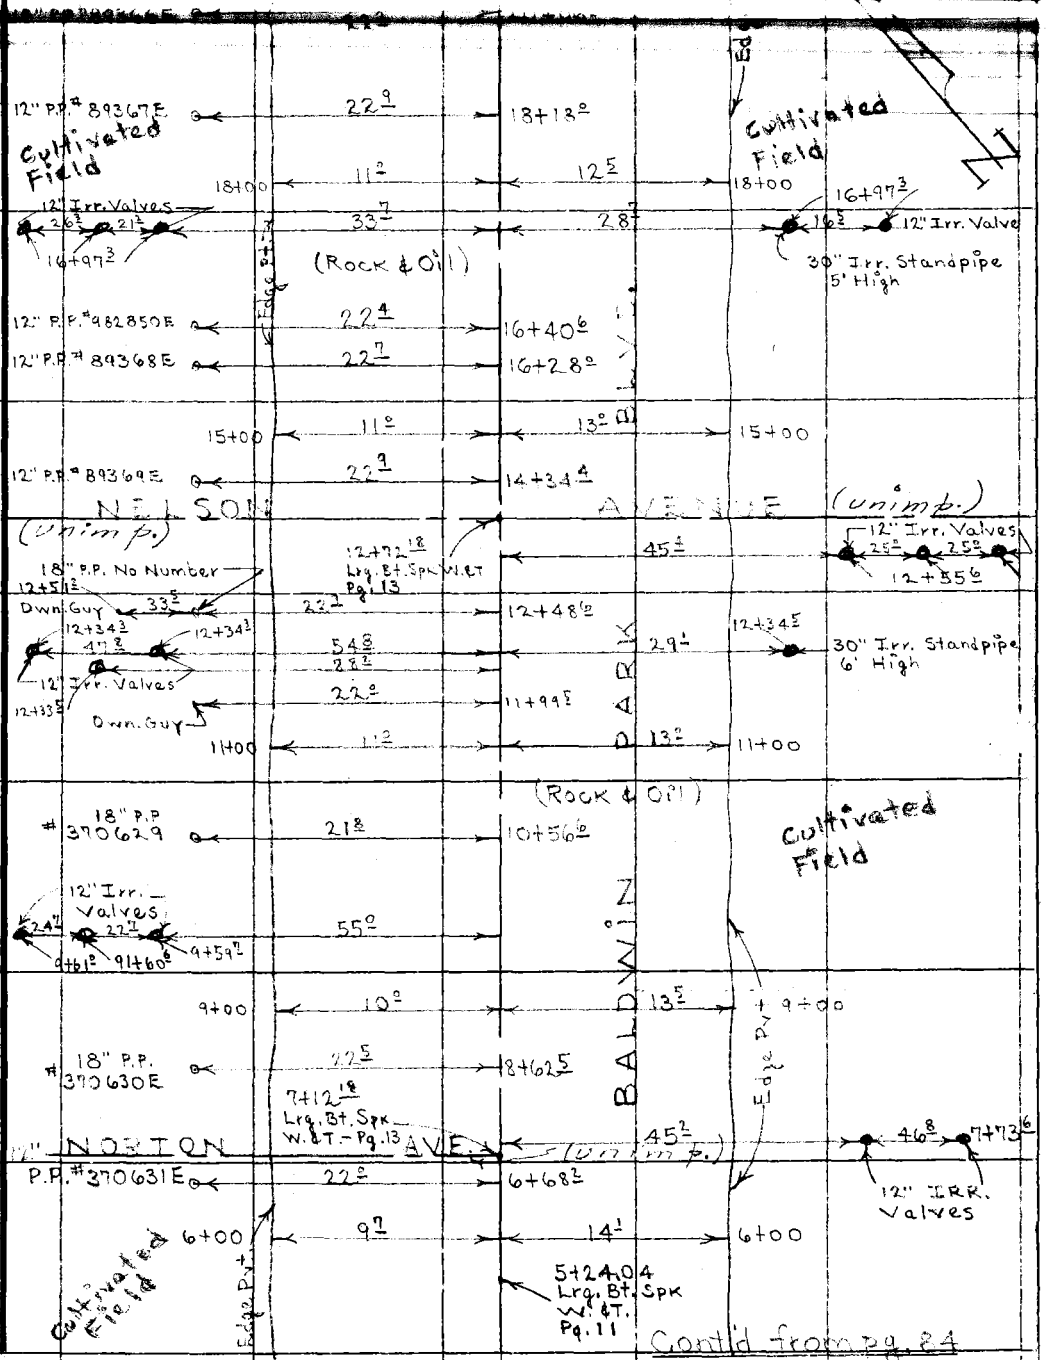

76FS095 247 4-53

F.B. 1818 Pg. 86

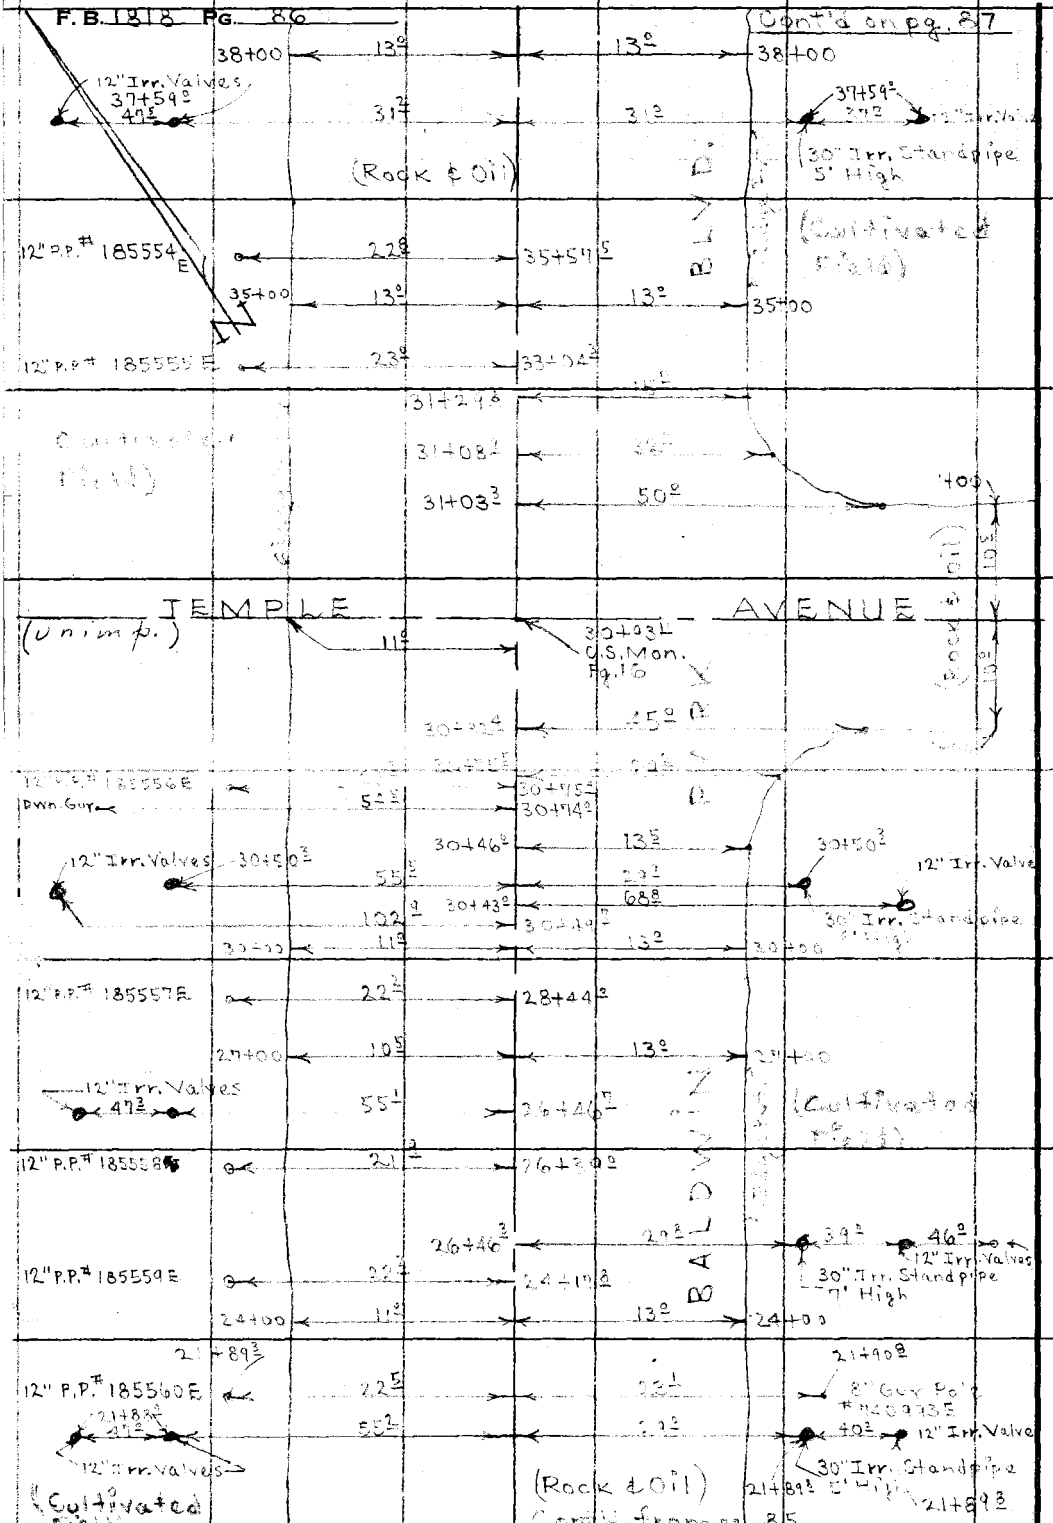

RETURN TO
LOS ANGELES COUNTY SURVEYOR
726 LOS ANGELES COUNTY
ENGINEERING BLDG.

Do not extend notes this side of this line.

Note: Any Additions or Changes on This Sheet Must be Made or Circled In Red Ink With Date and Name of Person Making Change.

Notes Ck'd by
Map No. C.S.B-2497-1
Office Work Burns
Checked Galli
Date Feb 1955

Survey of
W. O. 841 Tape No. 0114 St'd. 68 °F
Surveyed by
Notes F.J.M. Date 11-13-53
Indexed A. C. Johnson

F.B. PG. 87

Note: Any Additions or Changes on This Sheet Must be Made or Circled in Red Ink With Date and Name of Person Making Change.

Do not extend notes this side of this line.

RETURN TO
LOS ANGELES COUNTY SURVEYOR
726 LOS ANGELES COUNTY
ENGINEERING BLDG.

76F3088 247 4-53

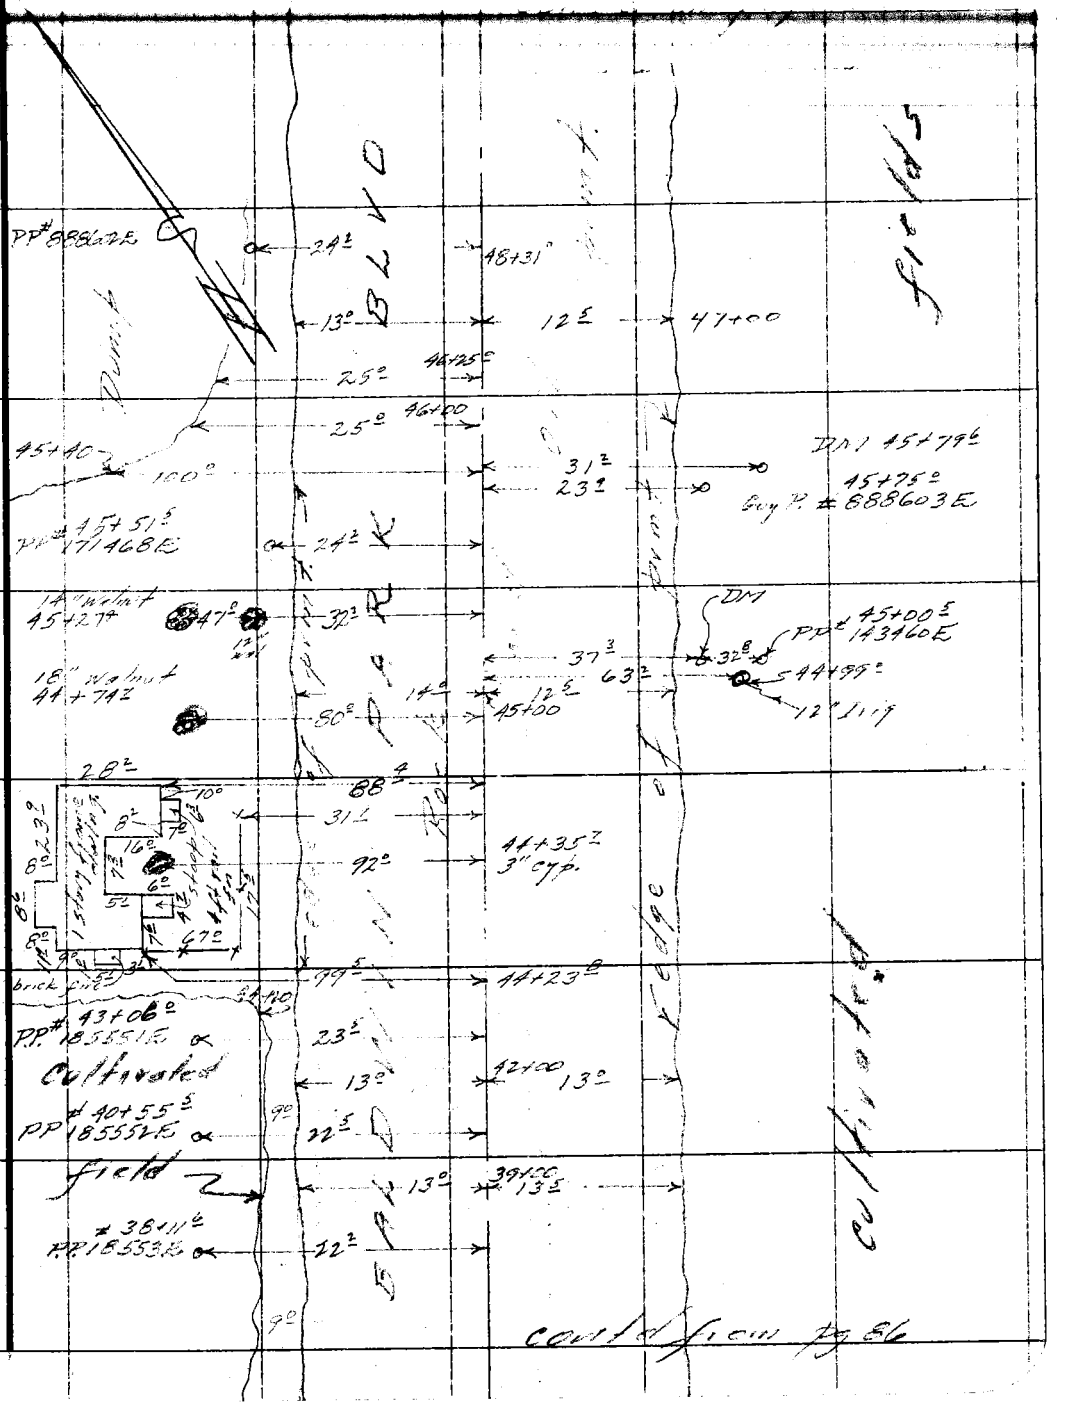

F. B. 1818 PG. 88

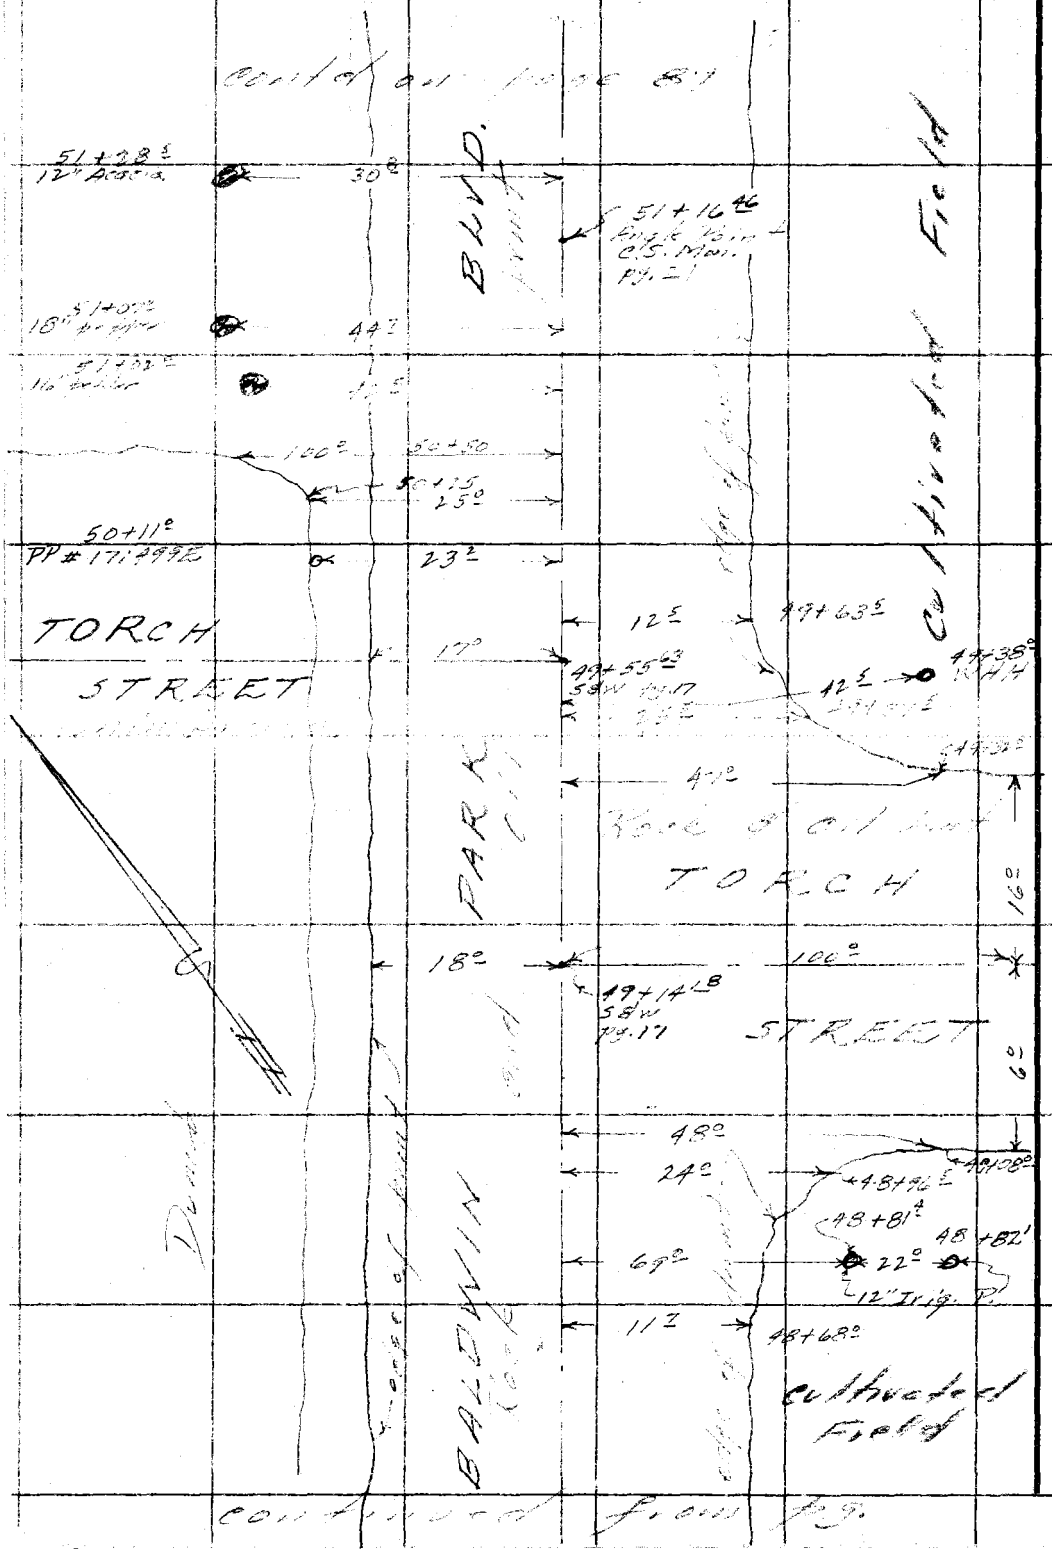

RETURN TO
LOS ANGELES COUNTY SURVEYOR
726 LOS ANGELES COUNTY
ENGINEERING BLDG.

Do not extend notes this side of this line.

Note: Any Additions or Changes on This Sheet Must be Made or Circled in Red Ink With Date and Name of Person Making Change.

Notes Ck'd by	Survey of Eastern Park Est.	F. B. 1510 Pg. 89
Map No. C.S.B-2497-1	W. O. 8641 Tape No. 0114 St'd. 68 oF	Cont'd on Pg. 90
Office Work Burns	Surveyed by E. J. Mitchell	
Checked Galli	Notes J. A. Yrsolovich Date 11-5-53	
Date Feb. 1955	Indexed K. C. Johnson	

Note: Any Additions or Changes on This Sheet Must be Made or Circled In Red Ink With Date and Name of Person Making Change.

Do not extend notes this side of this line.

RETURN TO
LOS ANGELES COUNTY SURVEYOR
726 LOS ANGELES COUNTY
ENGINEERING BLDG.

6' Wire Fence
8' Wire Fence
Head Wall & 18" Culvert
P.P. # 383603E
(Turkey Farm)
6" Shade Tree
8' Wire Fence
P.P. # 711498E
Drive Gate
8' Wire Fence
10' Wire Fence
Edge of Pvmt.
Edge of Pvmt.
Edge of Pvmt.
Edge of Pvmt.
Front Drive
6" Conc. Curbing
(No other evid.)
6" Walnut Tree
18" Acacia
4' Wire Fence
12" Walnut Tree
14" Walnut Tree
12" Walnut Tree
14" Walnut trees
14" Walnut Trees
BLYD.
PARK
BALDWIN
Cont'd from Pg. 88

55+27.5 — 34.2 — 55+21.5 — 59.5 — 55+116.5 — 35.7 — 55+00 — 29.5 — 54+98.2 — 26.2 — 54+87.2 — 23.8 — 54+62.2 — 26.0 — 54+31.5 — 61.3 — 54+20.5 — 21.5 — 54+00 — 30.3 — 53+73.5 — 60.0 — 53+93.5 — 96.0 — 53+56.5 — 29.5 — 53+34.5 — 60.5 — 53+22.5 — 29.4 — 52+29.2 — 24.0 — 52+34.5 — 30.3 — 52+21.2 — 40.0 — 52+26.0 — 108.2 — 52+05.0 — 60.5 — 52+00 — 13.7 — 11.3 — 52+00 — 51+94.3 — 29.6 — 51+80.7 — 106.5 — 51+82.4 — 90.0 — 51+75.3 — 10.5 — 51+50.0 — 30.5 — 51+16.46 — 59+ on 9

7EF3098 247 4-53

F.B. 1818 Pg. 90

Cont'd on Pg. 91

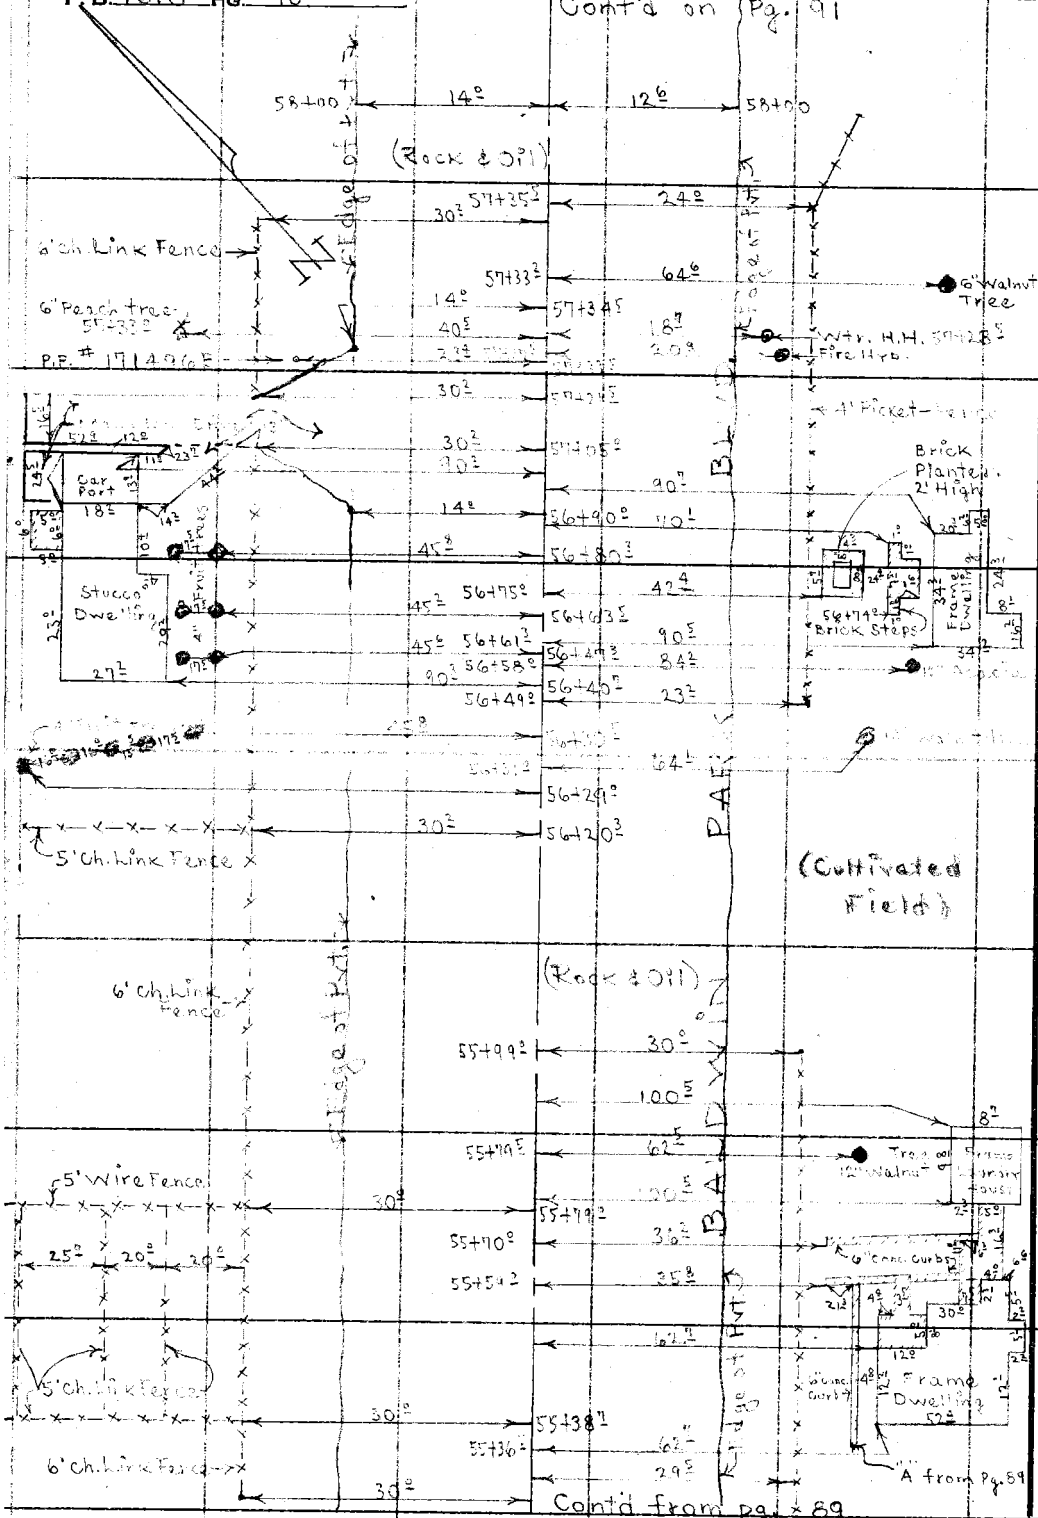

RETURN TO
LOS ANGELES COUNTY SURVEYOR
720 LOS ANGELES COUNTY
ENGINEERING BLDG.

Do not extend notes this side of this line.

Note: Any Additions or Changes on This Sheet Must be Made or Circled in Red Ink With Date and Name of Person Making Change.

Notes Ck'd by
Map No. C.S.B-2497-1,2
Office Work Burns
Checked Galli
Date Feb 1955

Survey of BALDWIN PARK BLVD.
W. O. 8641 Tape No. 0114 St'd. 68 °F
Surveyed by Mitchell
Notes Smiley Date 11-17-53
Indexed A. O. Tahnos

F. B. 181 B PG. 41

Note: Any Additions or Changes on This Sheet Must be Made or Circled in Red Ink With Date and Name of Person Making Change.

Do not extend notes this side of this line.

RETURN TO
LOS ANGELES COUNTY SURVEYOR
726 LOS ANGELES COUNTY
ENGINEERING BLDG.

78F3098 247 4-55

BESS AVE.

BALDWIN PARK BLVD.

Edge of Pvt.

Edge of Pvt.

Chain Link Fnc.

Wooden Fnc.

5 ft. Woven Wire Fnc.

5 ft. Picket Fn.

Gasoline tank & fillers

Pump Island

Conc.

Asphalt

Concrete

Gravel

Driveway

Water H. H.

flowers

6" Concrete Curbs

Poultry House

one story frame (w/conc. floor.) 120 N

22" Shade Tree

32" Acacia

14" Acacia

8" Acacia

16ft Hedge

6" Peach

6" Plum

6" Quince

3" Plum

8" Quince

8" Plum

12" Walnut

20" Acacia

10" Walnut

59+07 96 (Pg. 22)

RETURN TO
LOS ANGELES COUNTY SURVEYOR
726 LOS ANGELES COUNTY
ENGINEERING BLDG.

Note: Any Additions or Changes on This Sheet Must be Made or Circled In Red Ink With Date and Name of Person Making Change.

Do not extend notes this side of this line.

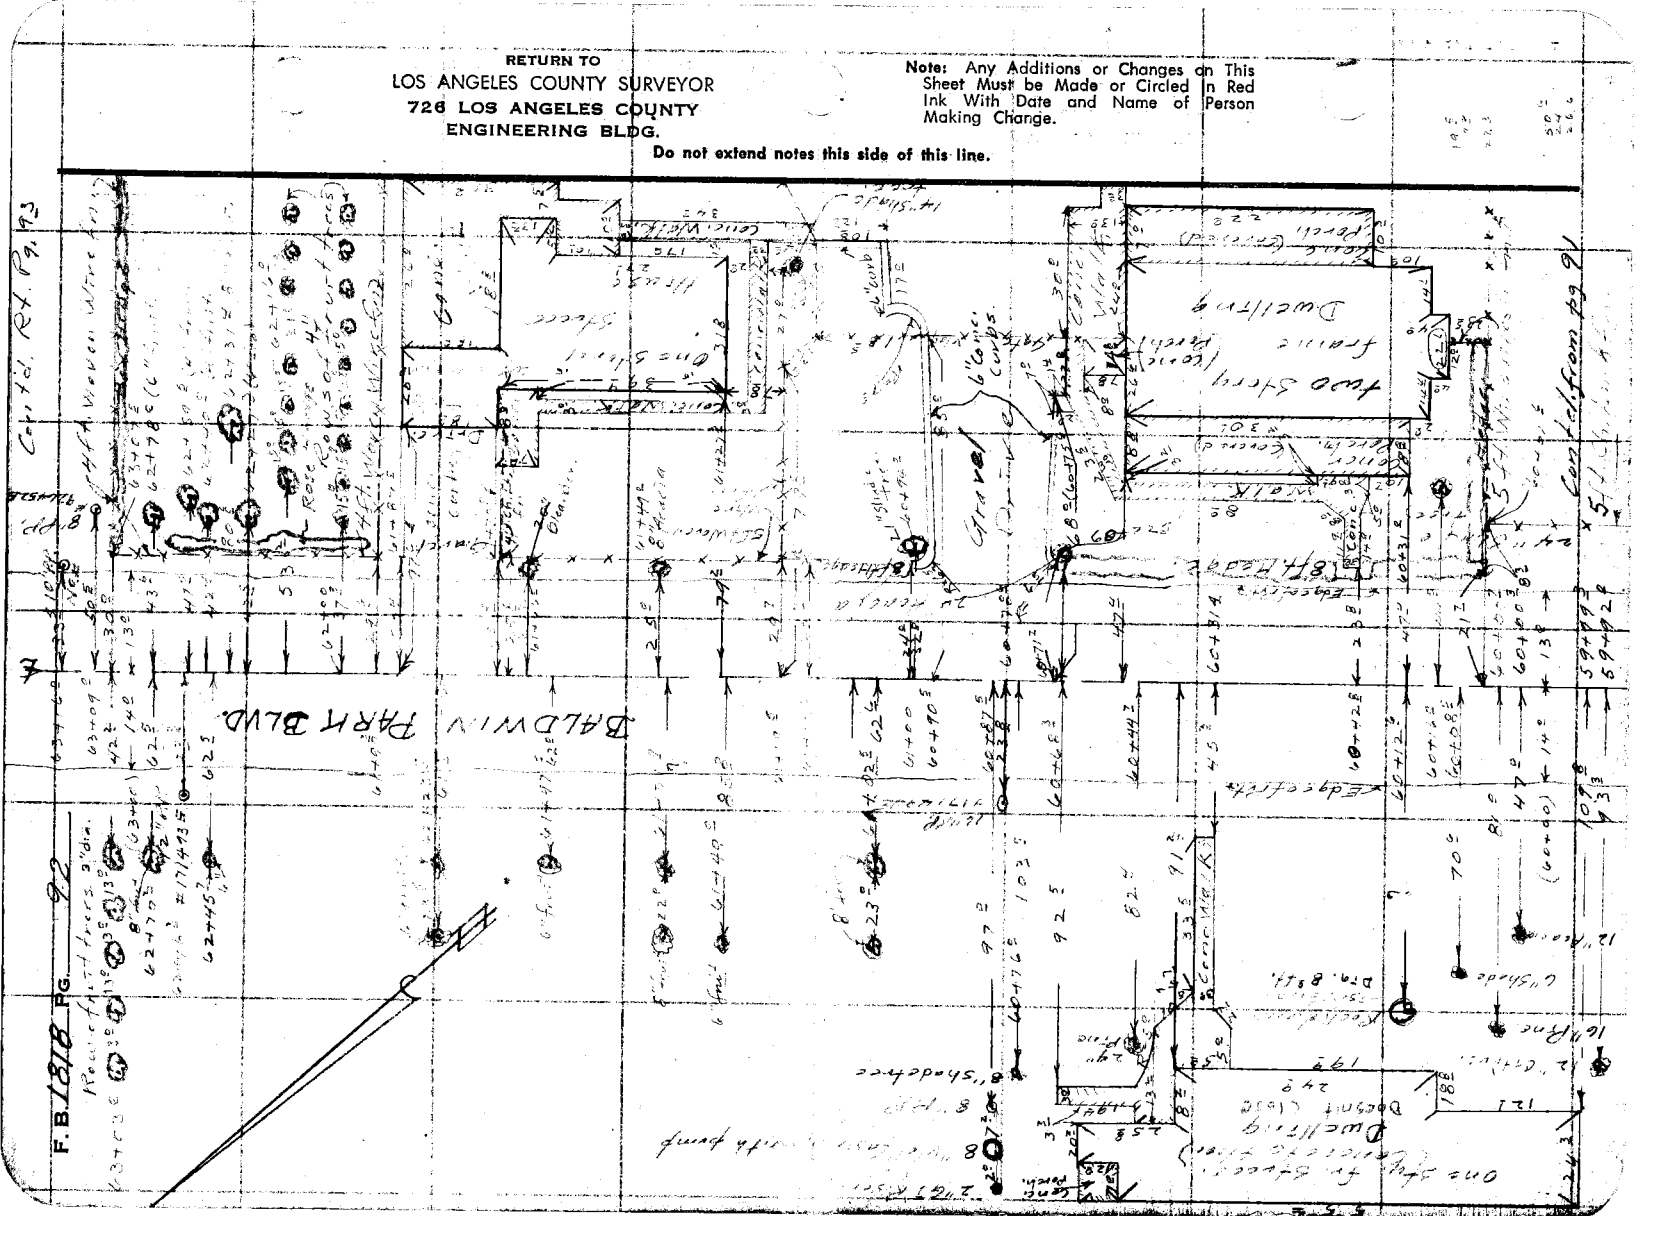

76F3098 247 4-53

RETURN TO
LOS ANGELES COUNTY SURVEYOR
726 LOS ANGELES COUNTY
ENGINEERING BLDG.

Note: Any Additions or Changes on This Sheet Must be Made or Circled in Red Ink With Date and Name of Person Making Change.

Do not extend notes this side of this line.

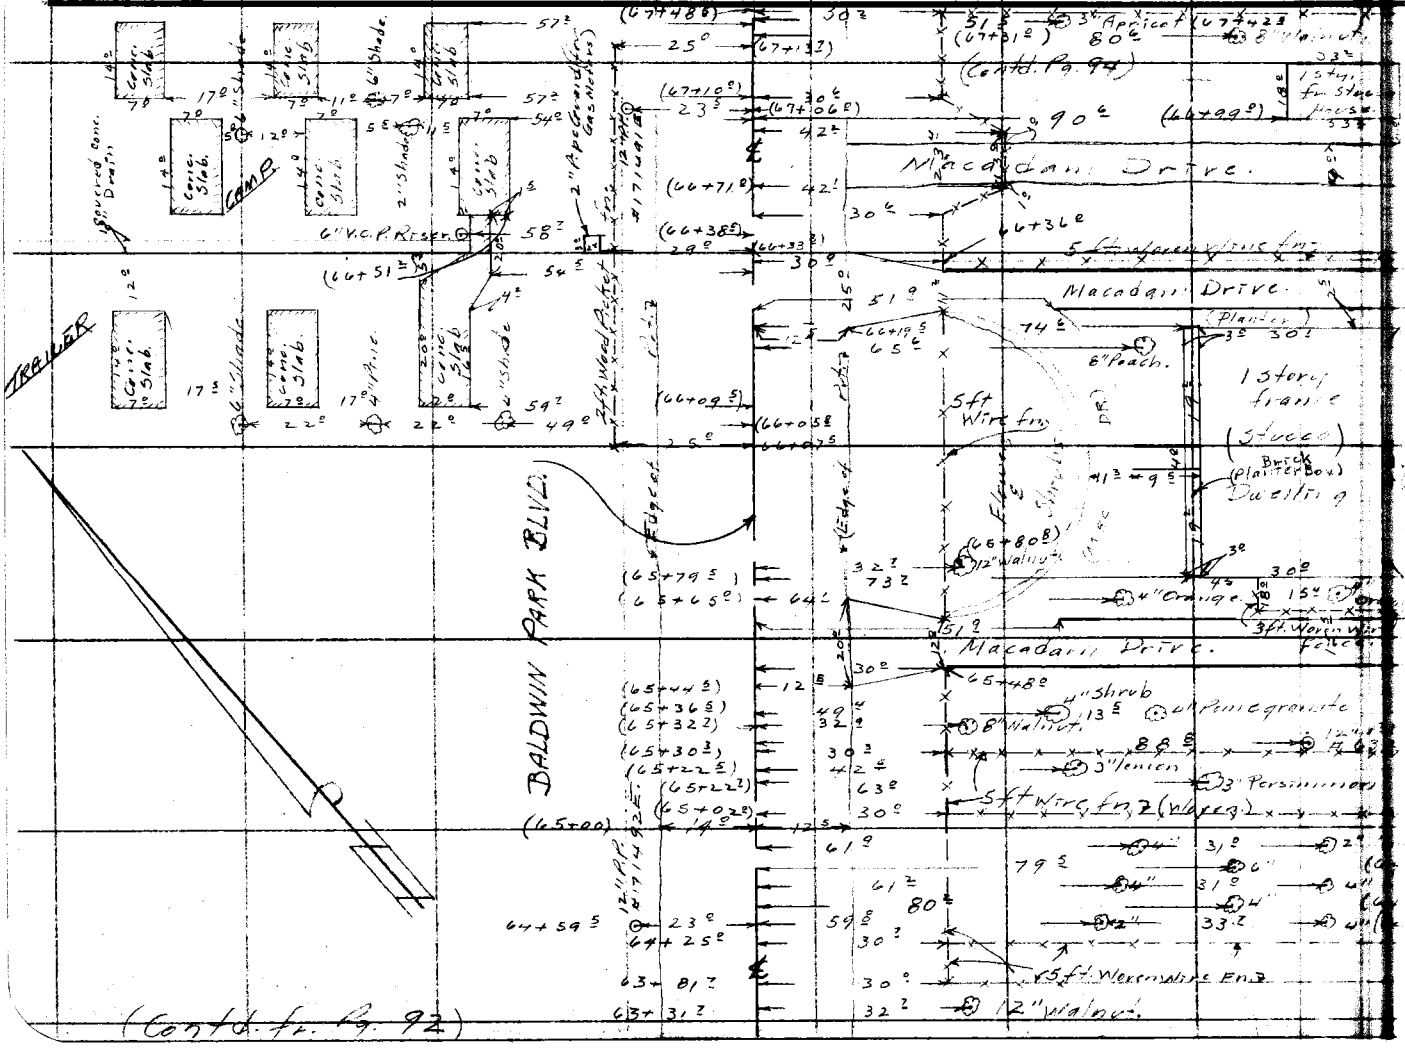
BALDWIN PARK BLVD.
Macadam Drive.
Macadam Drive.
Macadam Drive.
(Contd. Fr. Pg. 92)
(Contd. Pg. 94)
TRAILER CAMP
1 Story frame (Stucco) Dwelling
Brick (planter Box)
Planter
8" Peach.
5ft Wire fnc.
5ft Wire fnc. (where exist.)
5ft Wire fnc. (where exist.) Ends
3ft. Wire Wire Fence
4" Orange
8" Walnut
12" Walnut
3" Lemon
3" Persimmon
4" Shrub
Pepper
Apricot
Gas Meters
Gas Valve
Fire Hydrant
Water Valve
Edge of Pvmt.
Edge of Pvmt.
Edge of Pvmt.
Overhead Conc. Drain
6" V.C.P. Riser
2" Pipe Riser
2" Shade
6" Shade
12" Shade
Fence Post
Fence Post
Fence Post

RETURN TO
LOS ANGELES COUNTY SURVEYOR
726 LOS ANGELES COUNTY
ENGINEERING BLDG.

Note: Any Additions or Changes on This Sheet Must be Made or Circled In Red Ink With Date and Name of Person Making Change.

Do not extend notes this side of this line.

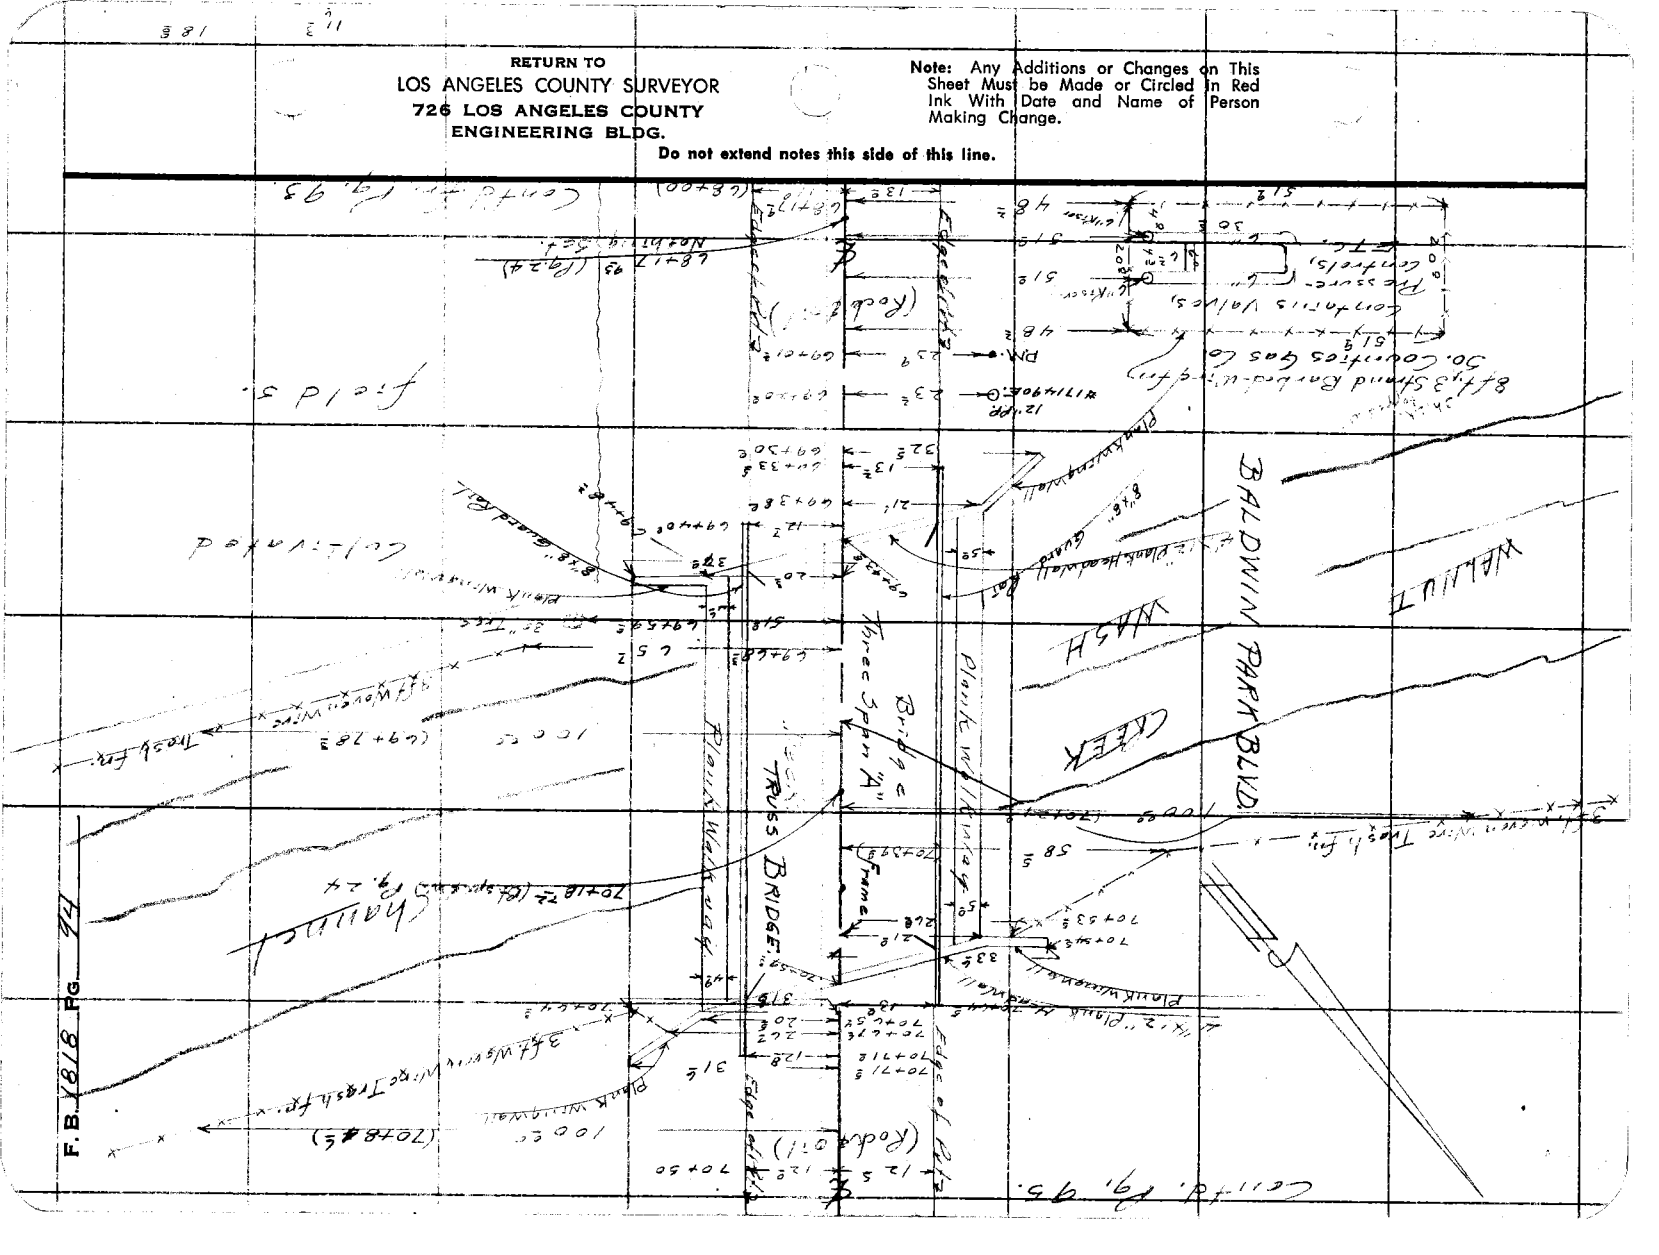
BALDWIN PARK BLVD.
WASH
CREEK
WALNUT
Three Span "A" Bridge
Truss Bridge
Frame
Plank Walk
Plank Handrail
Plank Headwall
Guard Rail
Field Sta.

Notes Ck'd by	Survey of Baldwin Park Blvd.	F. B. 1812 Pg. 25
Map No. C.S.B. - 2497-2	W. O. 8641 Tape No. Chain St'd. 68 °F	
Office Work Burns	Surveyed by R.T. Whitnell	
Checked Galli	Notes T.S.V. plotted Date 11-5-68	
Date 11-7-68	Indexed	

To prepare the contract between Sta. 71+20 and Sta. 87+85.25 pertaining to Removal of Fences for details in this area see State Hwy. map "LA-26-B-Baldwin Park-50 Sht. 7"

(cont'd on pg 99)

FAIRGROVE AVE.

72+92.93 Bt. Spk. & W.-Pg. 24

BALDWIN PARK BLVD.

Edge Pvt.

1 Story frame house-will be moved for firm contract

72+60° 13.5 12.5 72+60°

72+52° 21.8

(Rock & Oil)

72+37° 23.5

70.3

72+20° 37°

36" Gum tree 32.5 72+32° 70.5

24" Gum trees 28.5 11.5 10.3

72+03.8 36°

72+01.5 36.8

22.3

(Note-No Surface Indication of Valve) Fire Hyd 22.8 71+94.2

71+84.2 34.3

(Field) 71+59° 22.8

22.3

71+36.5 44.8

71+35° 24.5

71+21° 51.2

23° 71+09.5

71+02° 36.3

71+08.5 88.6

70+93° 81.4

(Rock & Oil)

70+84° 43°

70+50° 12.5 12.5 70+50°

Edge of Pvt.

Edge Pvt.

4' Wood Picket Fence

6" Conc. Curbing 43.5

(Rock Drive.)

4' Wood Picket Fence

4' Wood Picket Fence

36" Palm Trees

Frame & Stucco Dwelling

4' Wood Picket Fence

6" Lemon Tree

6" Citrus Trees 19.5 14.5 12.5 22.5

4' Wood Picket Fence

6" Orange Tree

8" Avocado Tree 39°

6" Peach Tree 25°

4" Peach Tree 49°

12" Pepper Tree

4' Wire Fence

8' Board Fence

Cont'd from pg. 94

Note: Any Additions or Changes on This Sheet Must be Made or Circled In Red Ink With Date and Name of Person Making Change.

Do not extend notes this side of this line.

RETURN TO
LOS ANGELES COUNTY SURVEYOR
726 LOS ANGELES COUNTY
ENGINEERING BLDG.

76FSOS 247 4-68

RETURN TO
LOS ANGELES COUNTY SURVEYOR
726 LOS ANGELES COUNTY
ENGINEERING BLDG.

Note: Any Additions or Changes on This Sheet Must be Made or Circled in Red Ink With Date and Name of Person Making Change.

Do not extend notes this side of this line.

F. B. 1818 PG. 96

76F3098 247 4-53

RETURN TO
LOS ANGELES COUNTY SURVEYOR
726 LOS ANGELES COUNTY
ENGINEERING BLDG.

Note: Any Additions or Changes on This Sheet Must be Made or Circled in Red Ink With Date and Name of Person Making Change.

Do not extend notes this side of this line.

Notes Ck'd by
Map No.
Office Work
Checked
Date

Survey of
W. O.
Surveyed by
Notes
Date
Indexed

F. B.
PG.

RETURN TO
LOS ANGELES COUNTY SURVEYOR
726 LOS ANGELES COUNTY
ENGINEERING BLDG.

Note: Any Additions or Changes on This Sheet Must be Made or Circled In Red Ink With Date and Name of Person Making Change.

Do not extend notes this side of this line.

F. B. 1818 PG. 98

Notes Ck'd by	Survey of Baldwin Park Blvd.
Map No. C.S.B - 2497-2	W. O. 2611 Tape No. 2114 Std. 68 °F
Office Work Burns	Surveyed by K.D. Pittenger
Checked Galli	Notes [illegible] Date 11-19-53
[illegible]	Indexed

F. B. 1819 Pg. 77

RETURN TO
LOS ANGELES COUNTY SURVEYOR
726 LOS ANGELES COUNTY
ENGINEERING BLDG.

Note: Any Additions or Changes on This Sheet Must be Made or Circled in Red Ink With Date and Name of Person Making Change.

Do not extend notes this side of this line.

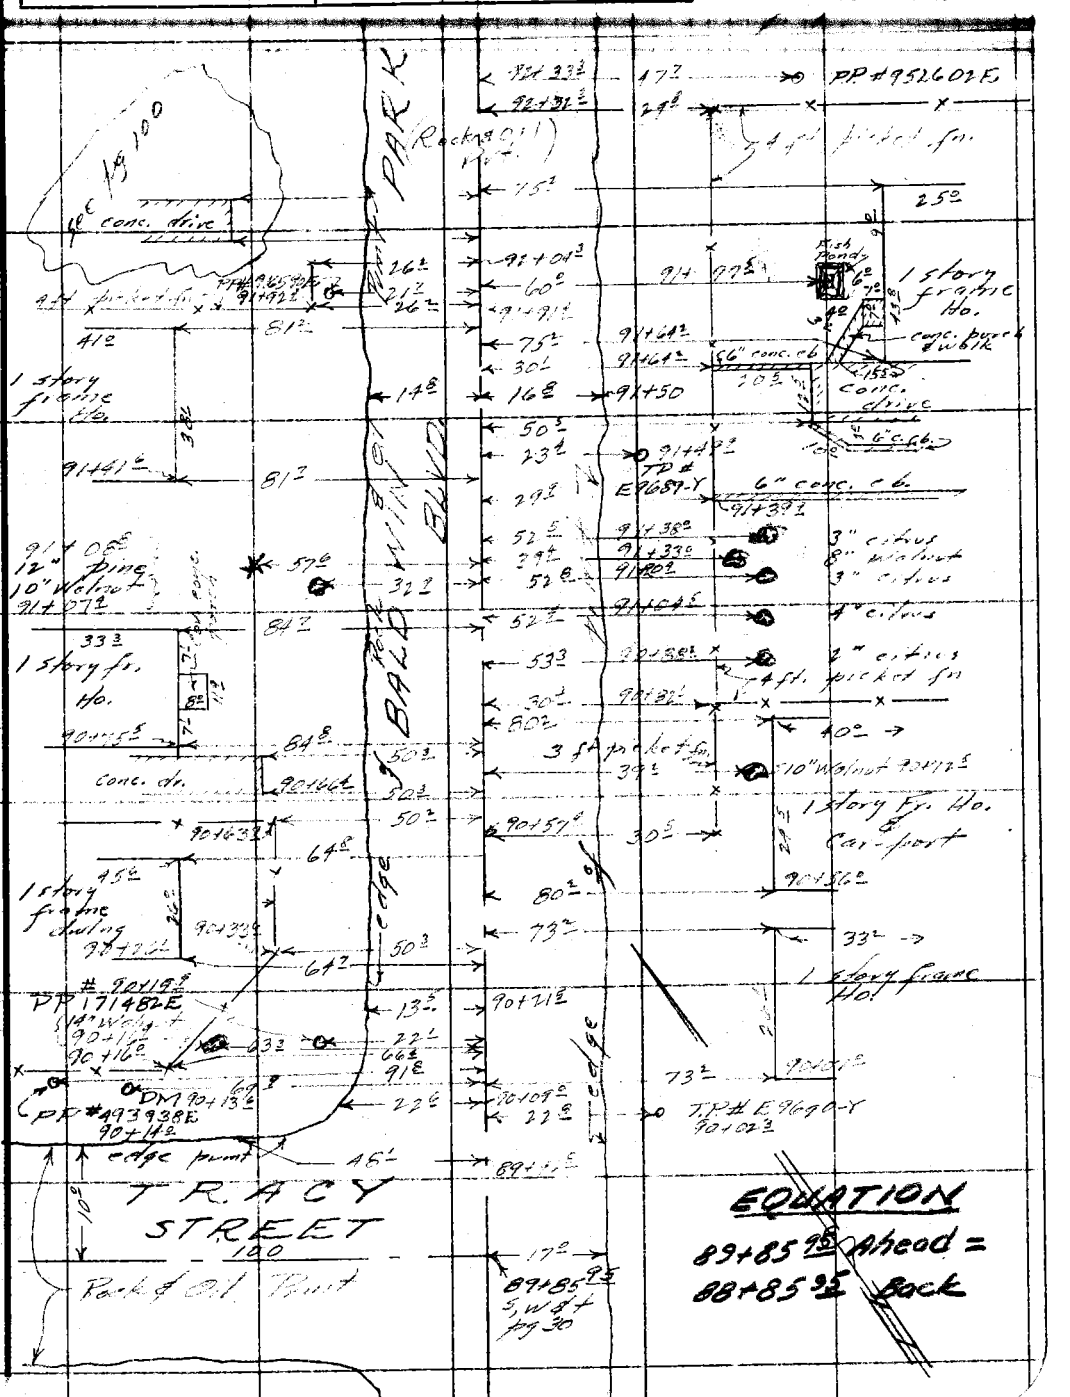
BALDWIN PARK BLVD.
TRACY STREET
100
1 story frame Ho.
1 story frame Ho.
1 story frame dwling
1 story Fr. Ho. & Car-port
1 story frame Ho.
conc. drive
conc. drive
conc. drive

F. B. 1818 Pg. 100

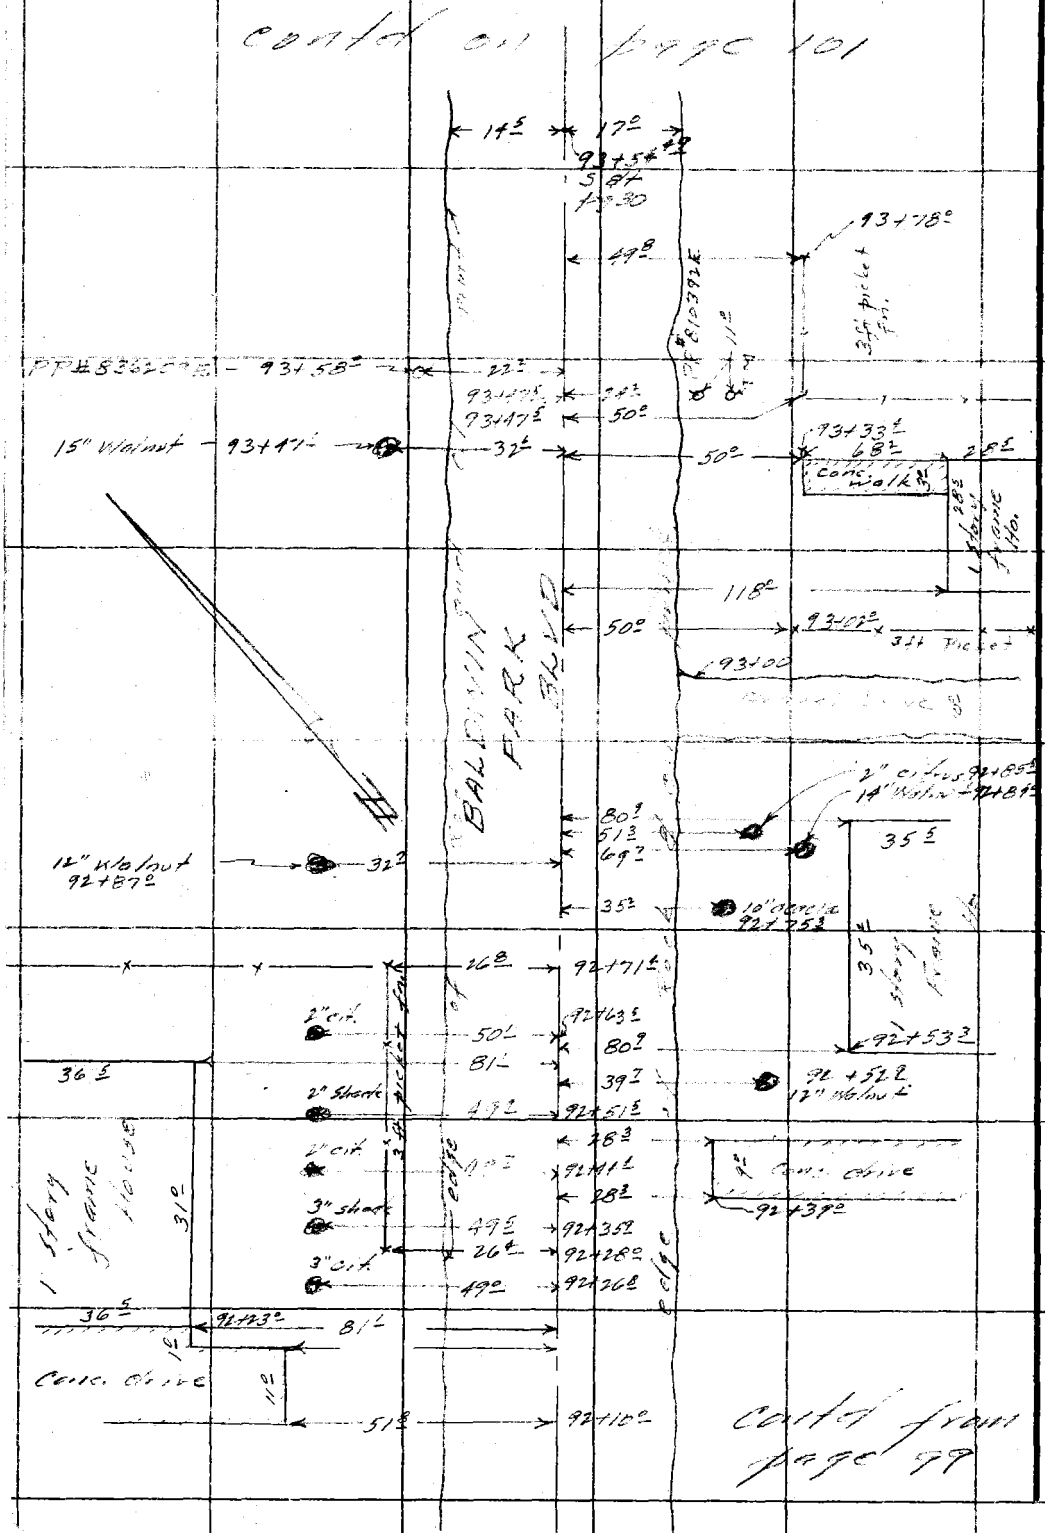

RETURN TO
LOS ANGELES COUNTY SURVEYOR
726 LOS ANGELES COUNTY
ENGINEERING BLDG.

Do not extend notes this side of this line.

Note: Any Additions or Changes on This Sheet Must be Made or Circled in Red Ink With Date and Name of Person Making Change.

Notes Ck'd by		Survey of BALDWIN PARK BLVD	F. B. 1816 Pg. 101
Map No. C.S.B-2497-2		W. O. 8641 Tape No. 2114 St'd. 68 °F	Contd from 102
Office Work Burns		Surveyed by MITCHELL	
Checked Galli		Notes [illegible] Date 11-19-53	
Date [illegible]		Indexed	

RETURN TO
LOS ANGELES COUNTY SURVEYOR
726 LOS ANGELES COUNTY
ENGINEERING BLDG.

Note: Any Additions or Changes on This Sheet Must be Made or Circled in Red Ink With Date and Name of Person Making Change.

Do not extend notes this side of this line.

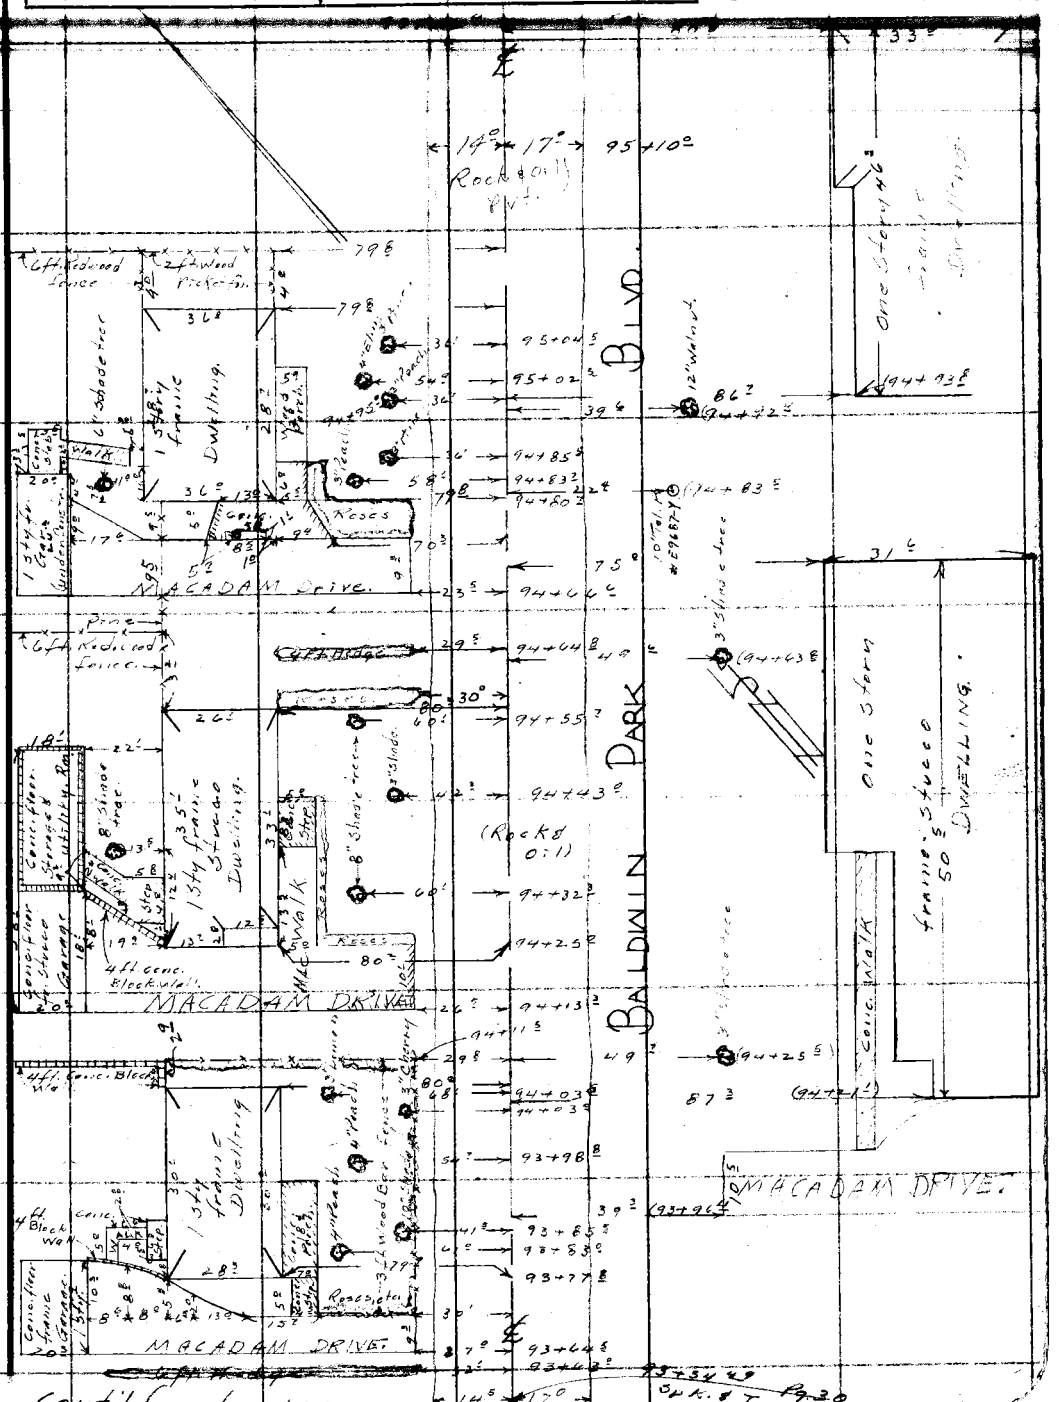
BALDWIN PARK BLVD.
MACADAM DRIVE
MACADAM DRIVE.
MACADAM DRIVE.
1 Sty frame Dwelling
1 Sty frame Stucco Dwelling
1 Sty frame Stucco Dwelling
Garage
Conc. Walk

F. B. 1818 Pg. 102

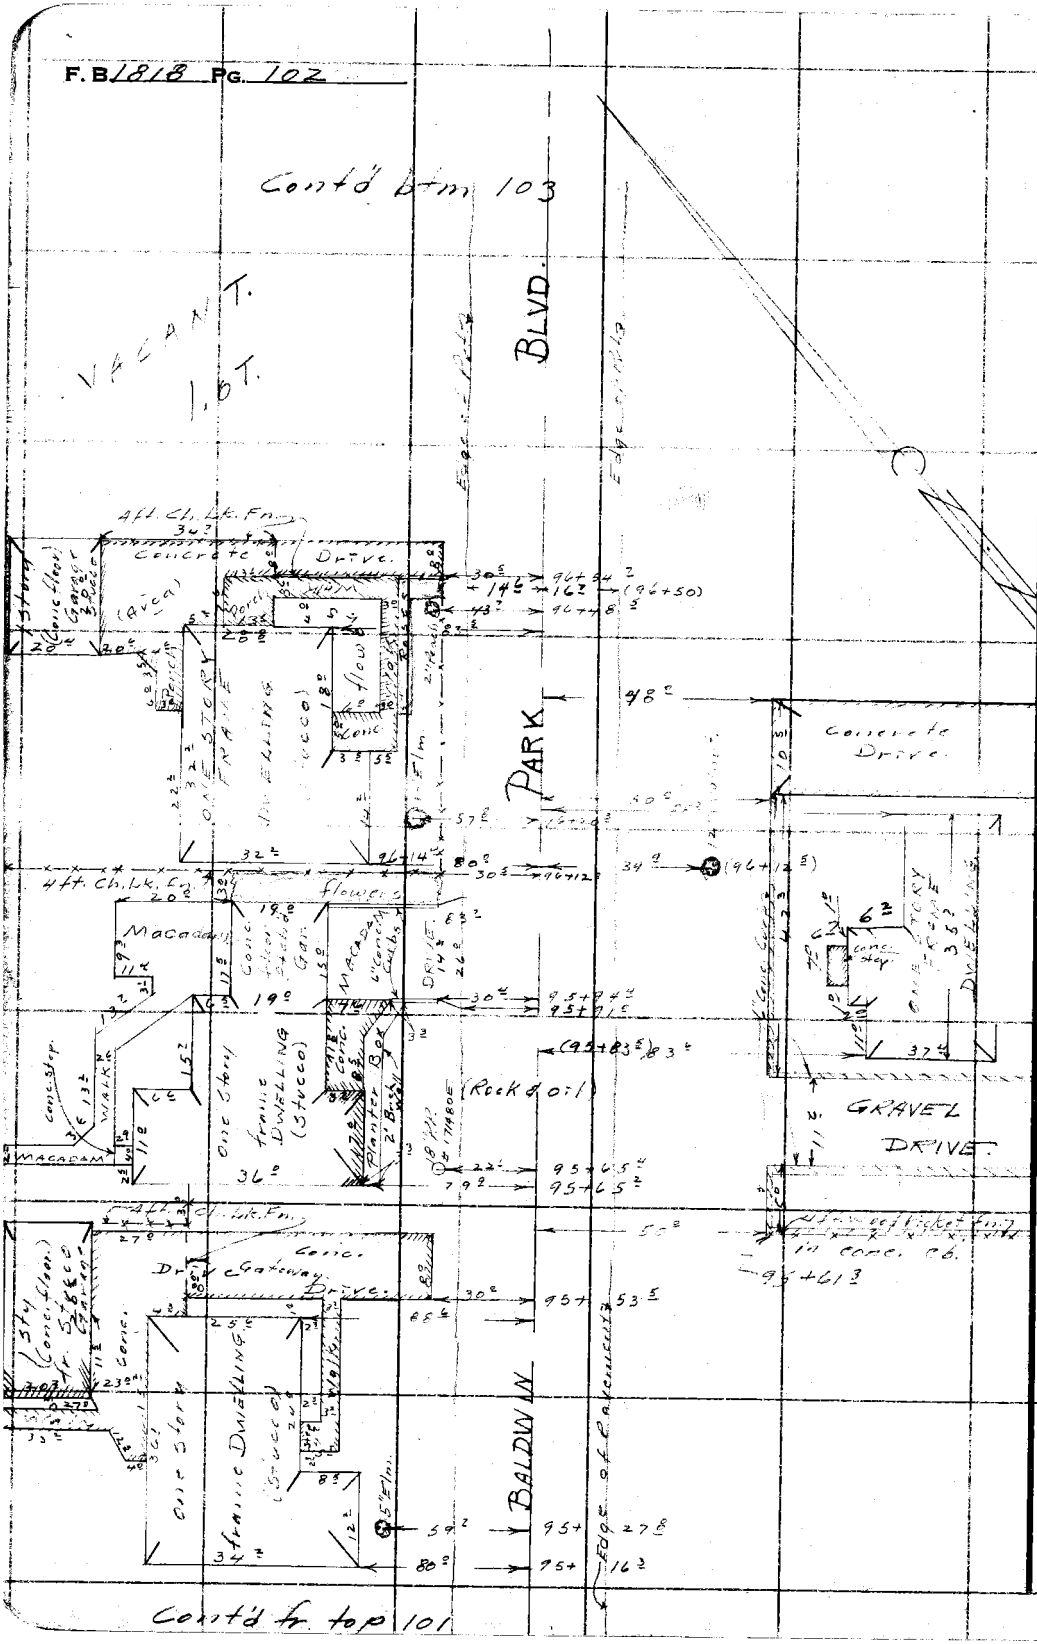

RETURN TO
LOS ANGELES COUNTY SURVEYOR
726 LOS ANGELES COUNTY
ENGINEERING BLDG.

Do not extend notes this side of this line.

Note: Any Additions or Changes on This Sheet Must be Made or Circled in Red Ink With Date and Name of Person Making Change.

Notes Ck'd by
Mdp No. C.S.B - 2497 - 2
Office Work Burns
Checked Galli

Survey of BALDWIN PARK BLVD.
W. O. 8641 Tape No. 211 St'd. 83 °F
Surveyed by R. J. Mitchell L.C.S.
Notes J. A. [illegible] Date
Indexed


Note: Any Additions or Changes on This Sheet Must be Made or Circled in Red Ink With Date and Name of Person Making Change.

Do not extend notes this side of this line.

RETURN TO
LOS ANGELES COUNTY SURVEYOR
726 LOS ANGELES COUNTY
ENGINEERING BLDG.

75F3008 247 4-53

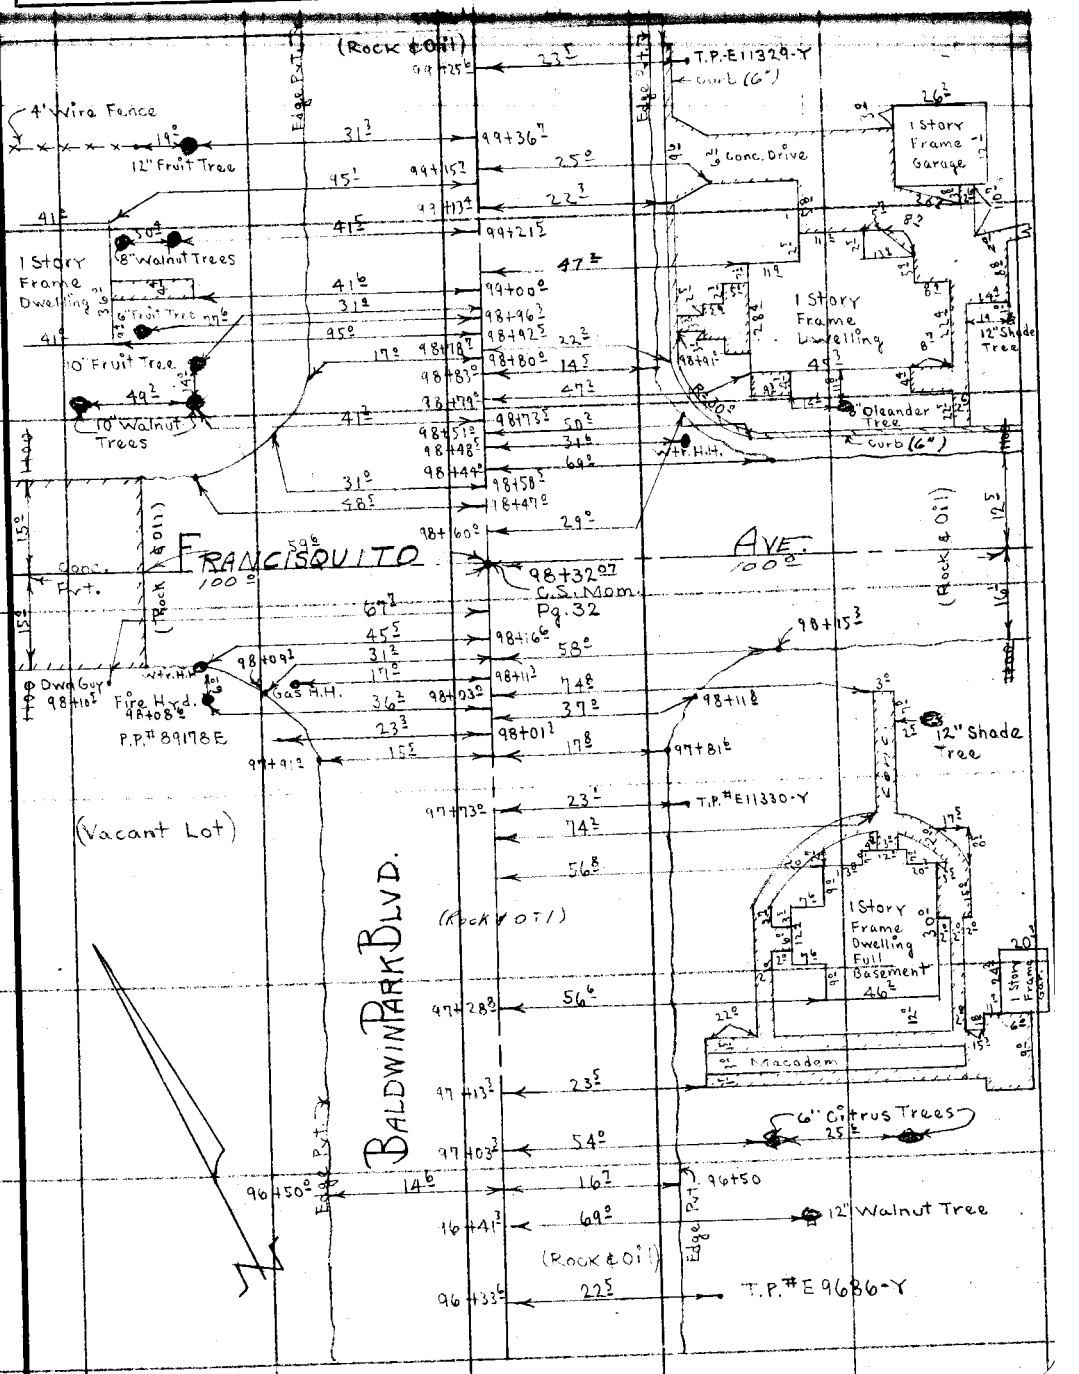

Cont'd from top 102

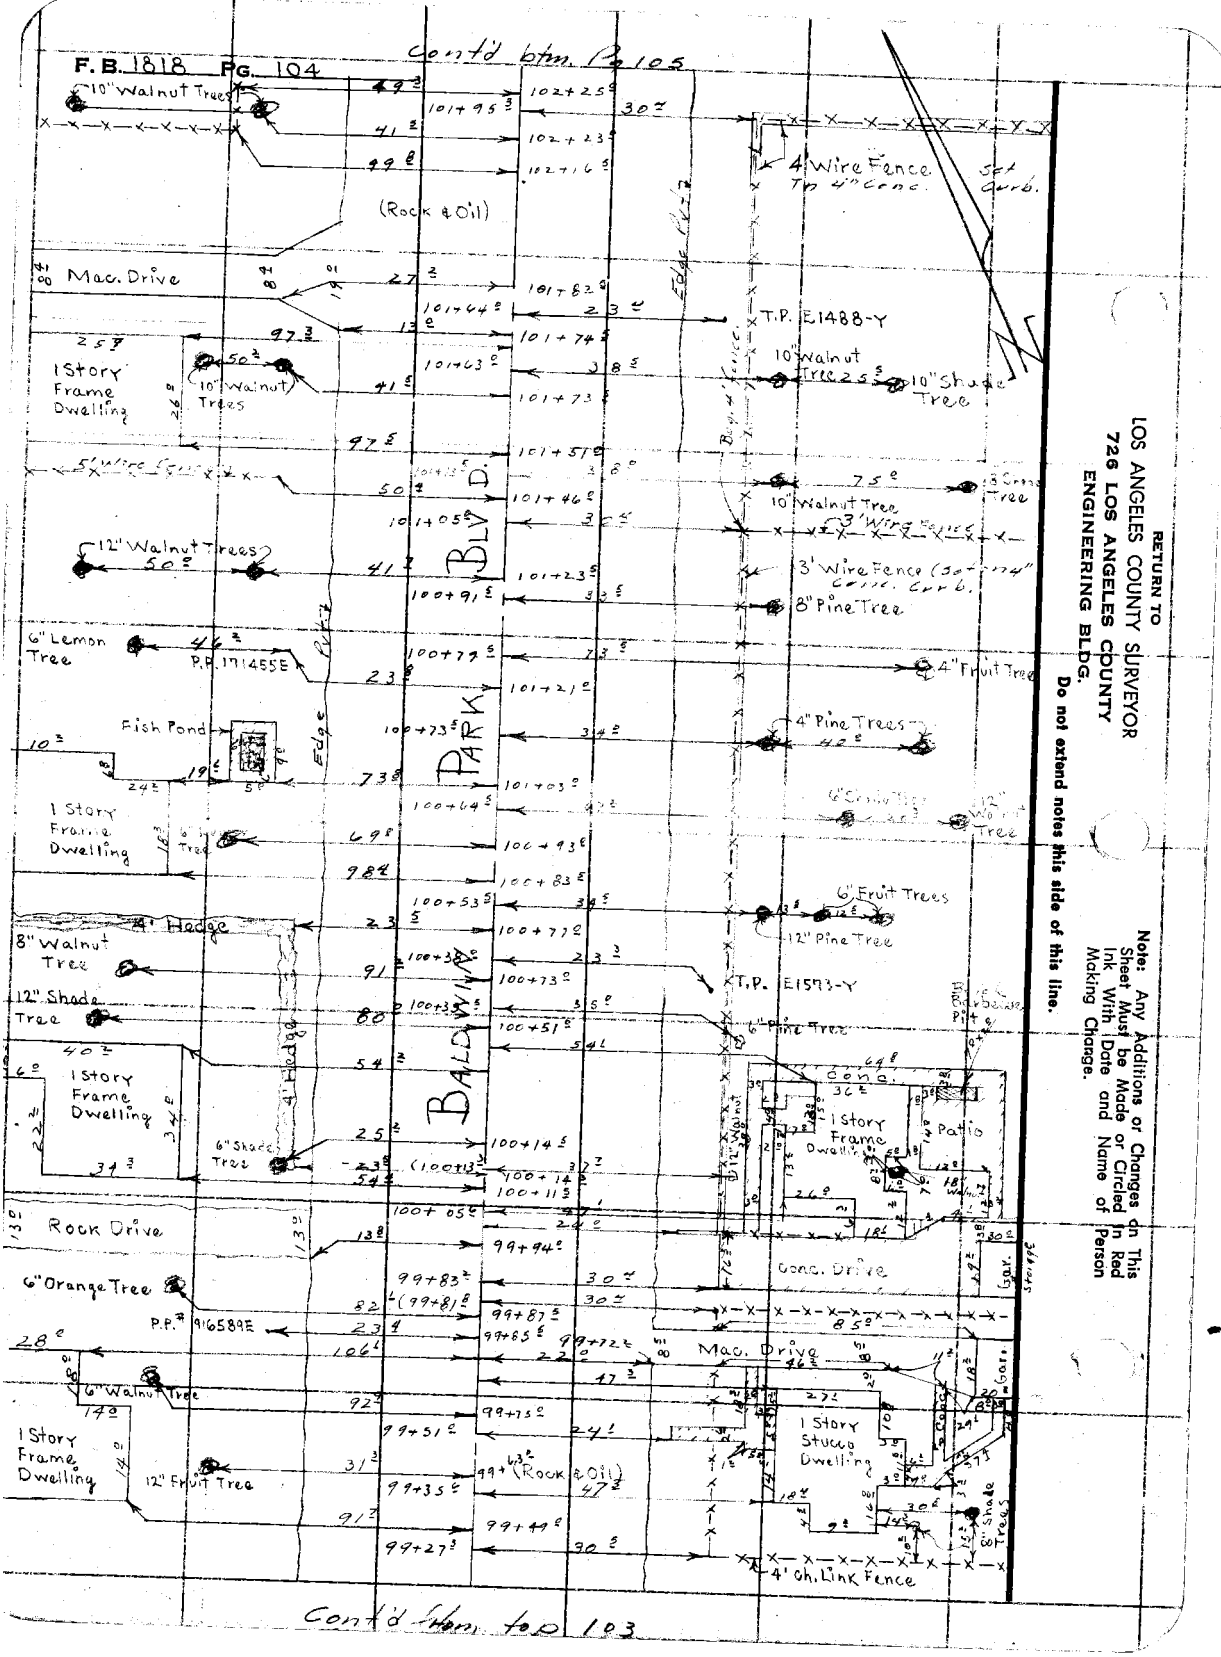
F. B. 1818 Pg. 104
Cont'd btm. Pg 105
10" Walnut Trees
(Rock & Oil)
Mac. Drive
1 Story Frame Dwelling
10" Walnut Trees
12" Walnut Trees
6" Lemon Tree
P.P. 171455E
Fish Pond
1 Story Frame Dwelling
4' Hedge
8" Walnut Tree
12" Shade Tree
1 Story Frame Dwelling
6" Shade Tree
Rock Drive
6" Orange Tree
P.P. 916589E
6" Walnut Tree
1 Story Frame Dwelling
12" Fruit Tree
PARK BLVD.
4' Wire Fence Top 4" Conc.
Set Curb.
T.P. E1488-Y
10" Walnut Tree
10" Shade Tree
3' Wire Fence
8" Pine Tree
4" Fruit Tree
4" Pine Trees
6" Fruit Trees
12" Pine Tree
T.P. E1593-Y
6" Pine Tree
1 Story Frame Dwelling
Patio
Conc. Drive
Mac. Drive
1 Story Stucco Dwelling
4' Ch. Link Fence
Cont'd from 102 103
RETURN TO
LOS ANGELES COUNTY SURVEYOR
726 LOS ANGELES COUNTY
ENGINEERING BLDG.
Do not extend notes this side of this line.
Note: Any Additions or Changes on This Sheet Must be Made or Circled in Red Ink With Date and Name of Person Making Change.

Notes Ck'd by
Map No. C.S.B. - 2497-2
Office Work Burns
Checked Galli

Survey of Baldwin Park Blvd.
W. O. [illegible] Tape No. 0114 Std. 65° °F
Surveyed by K.J. Mitchell
Notes [illegible] Date 20/56

F. B. [illegible] PG. 105

Note: Any Additions or Changes on This Sheet Must be Made or Circled In Red Ink With Date and Name of Person Making Change.

Do not extend notes this side of this line.

RETURN TO
LOS ANGELES COUNTY SURVEYOR
726 LOS ANGELES COUNTY
ENGINEERING BLDG.

7875098 247 4-53

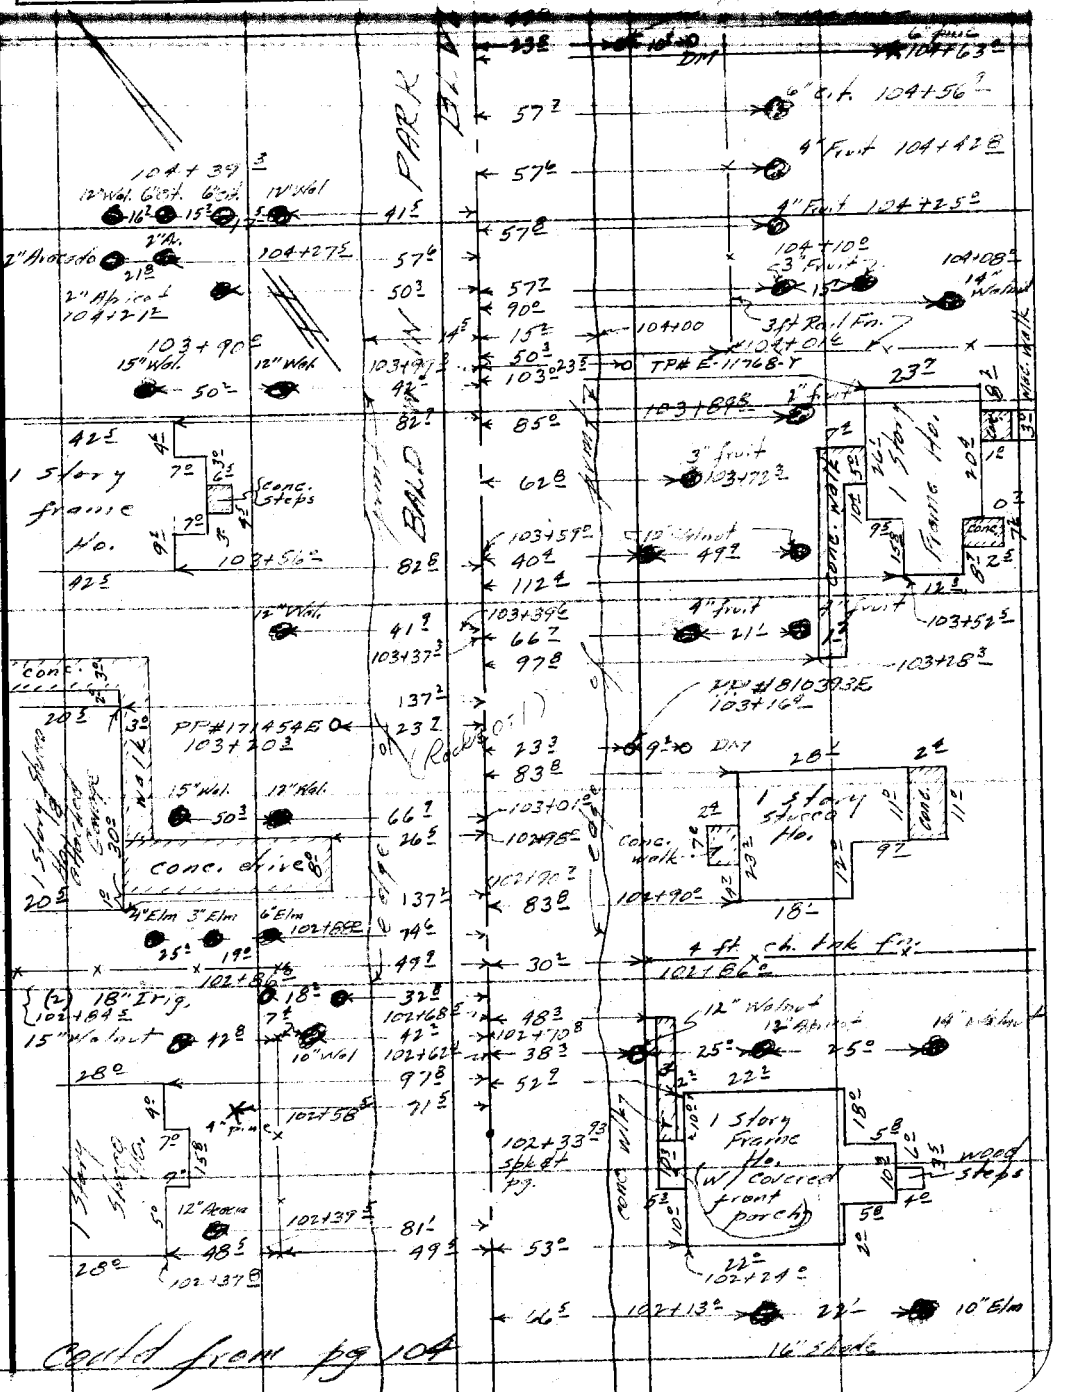
PARK
BALDWIN
Conc. Walk
1 Story Frame No.
1 Story Frame No. w/ Covered front porch
Conc. Steps
Conc. Office
Conc. Walk
Conc. Walk
Conc. Walk

F. B. 1818 Pg. 106

cont'd on page 107

cont'd from page 105

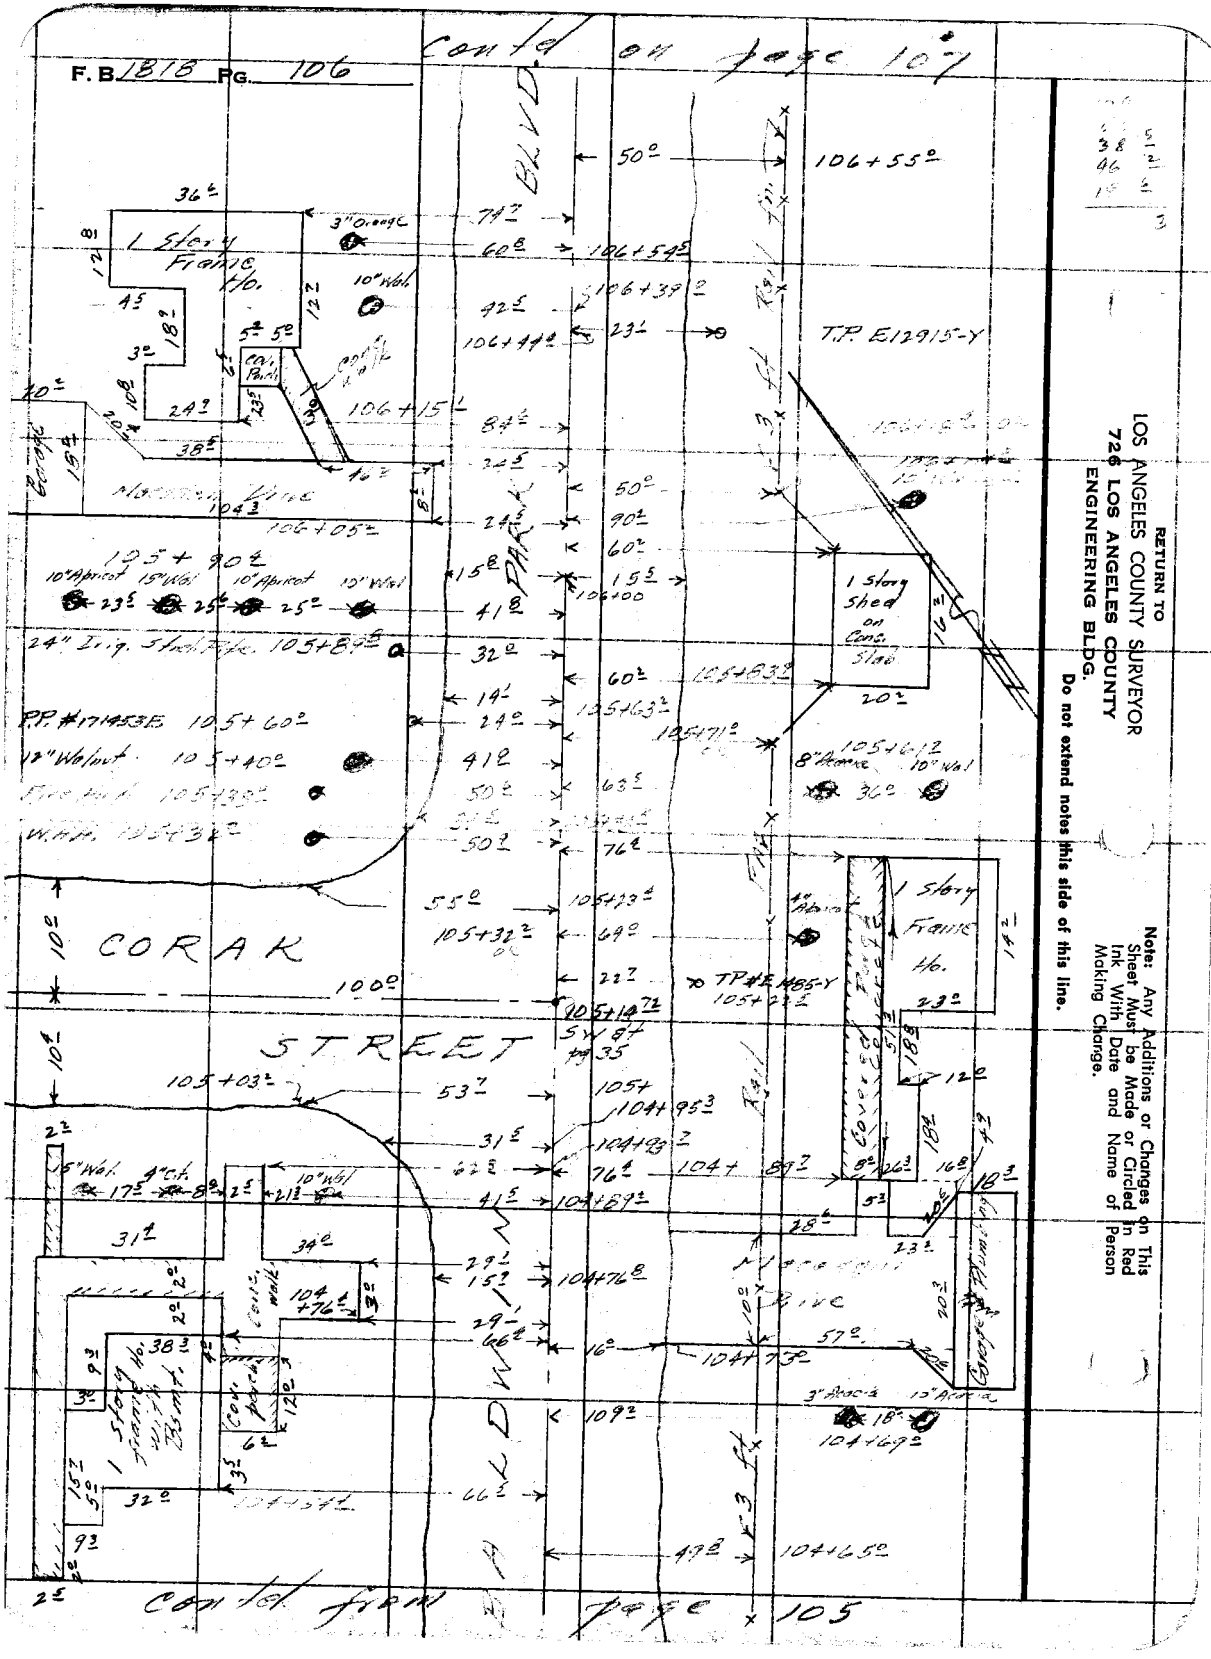
1 Story Frame No.
T.P. E12915-Y
1 Story Shed on Conc. Slab
PP #171453E
CORAK
STREET
1 Story Frame No.
TP#E4185-Y
Fence
Conc. Walk

Notes Ck'd by
Map No. C.S.B. 2497-2
Office Work Burns
Checked Galli

Survey of Baldwin Park Blvd.
W. O. 8641 Tape No. 2114 St'd. 68 °F
Surveyed by Mitchell
Notes Sur. Co. Date 4-23-53
Indexed

F.B. 1818 Pg. 107

Note: Any Additions or Changes on This Sheet Must be Made or Circled In Red Ink With Date and Name of Person Making Change.

Do not extend notes this side of this line.

RETURN TO
LOS ANGELES COUNTY SURVEYOR
726 LOS ANGELES COUNTY
ENGINEERING BLDG.

7-57 2C 2S 247 4-53

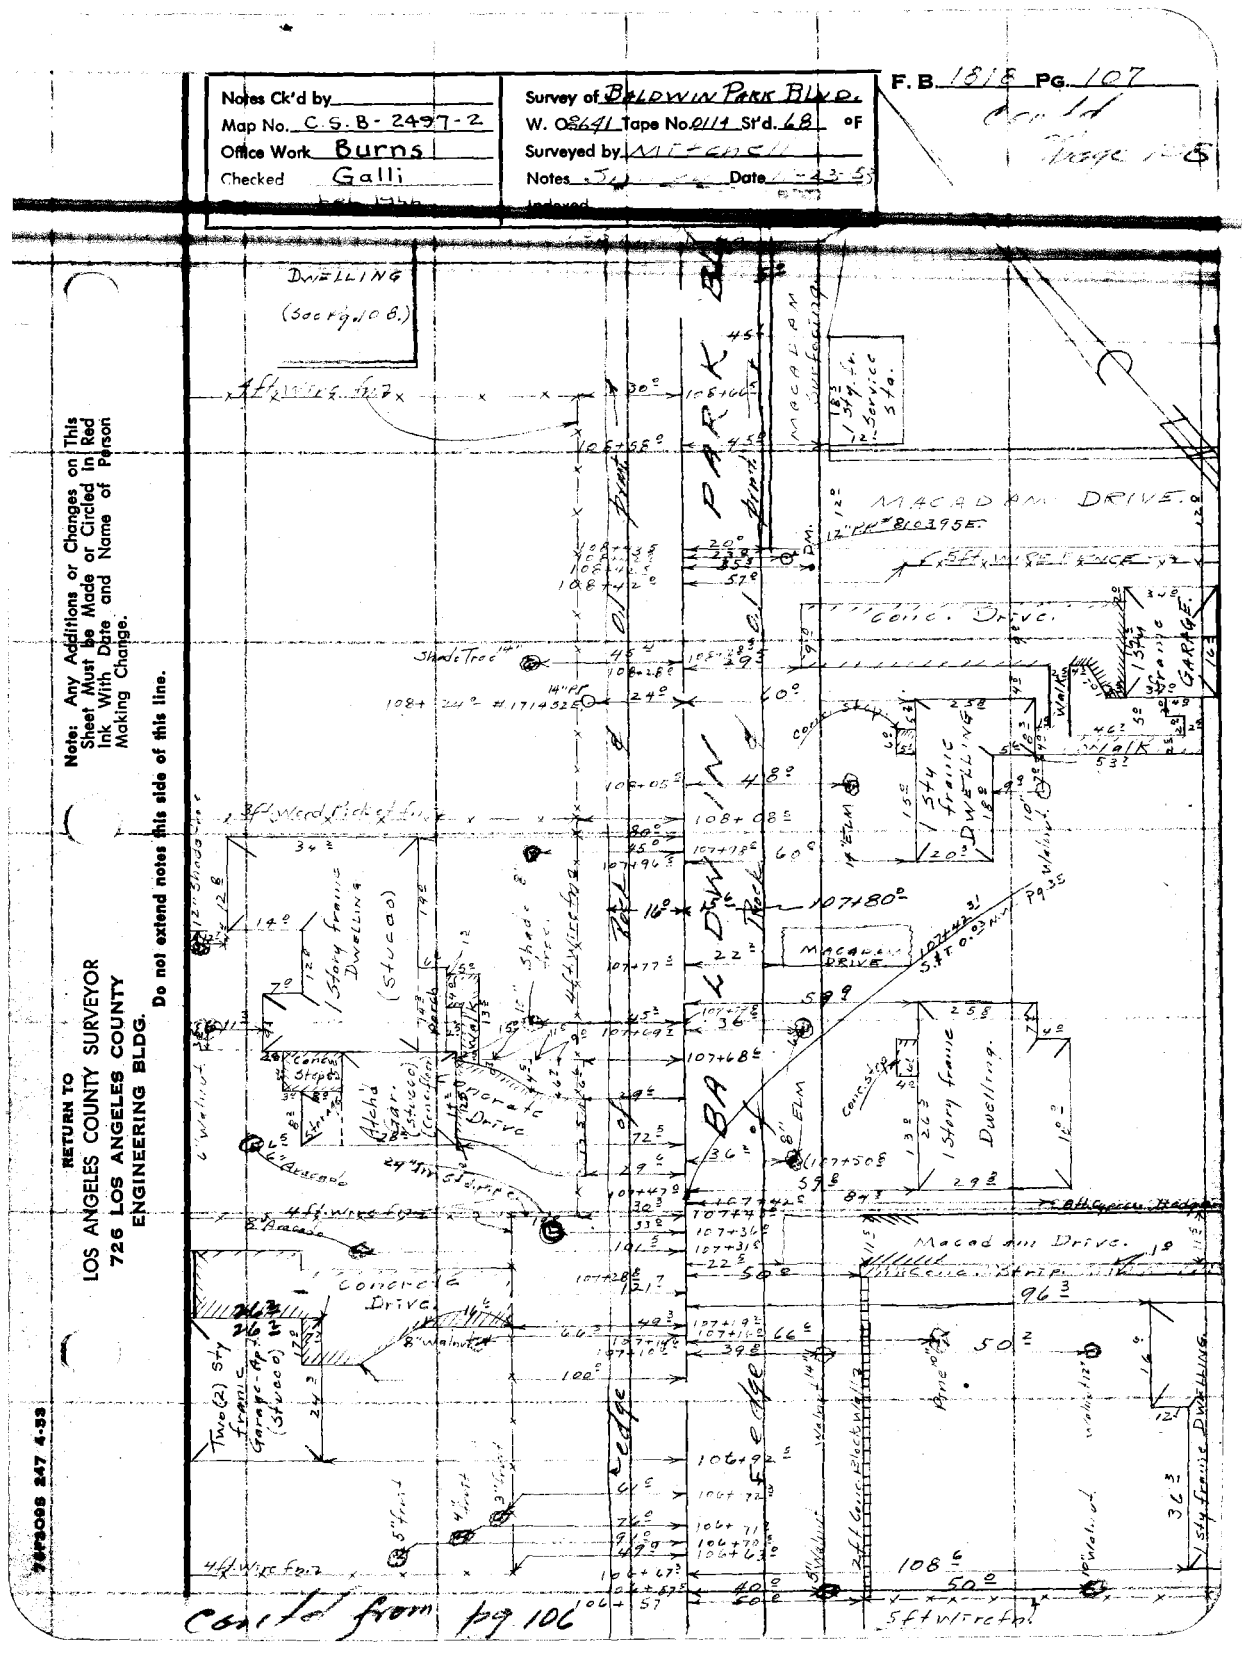

RETURN TO
LOS ANGELES COUNTY SURVEYOR
726 LOS ANGELES COUNTY
ENGINEERING BLDG.

Note: Any Additions or Changes on This Sheet Must be Made or Circled In Red Ink With Date and Name of Person Making Change.

Do not extend notes this side of this line.

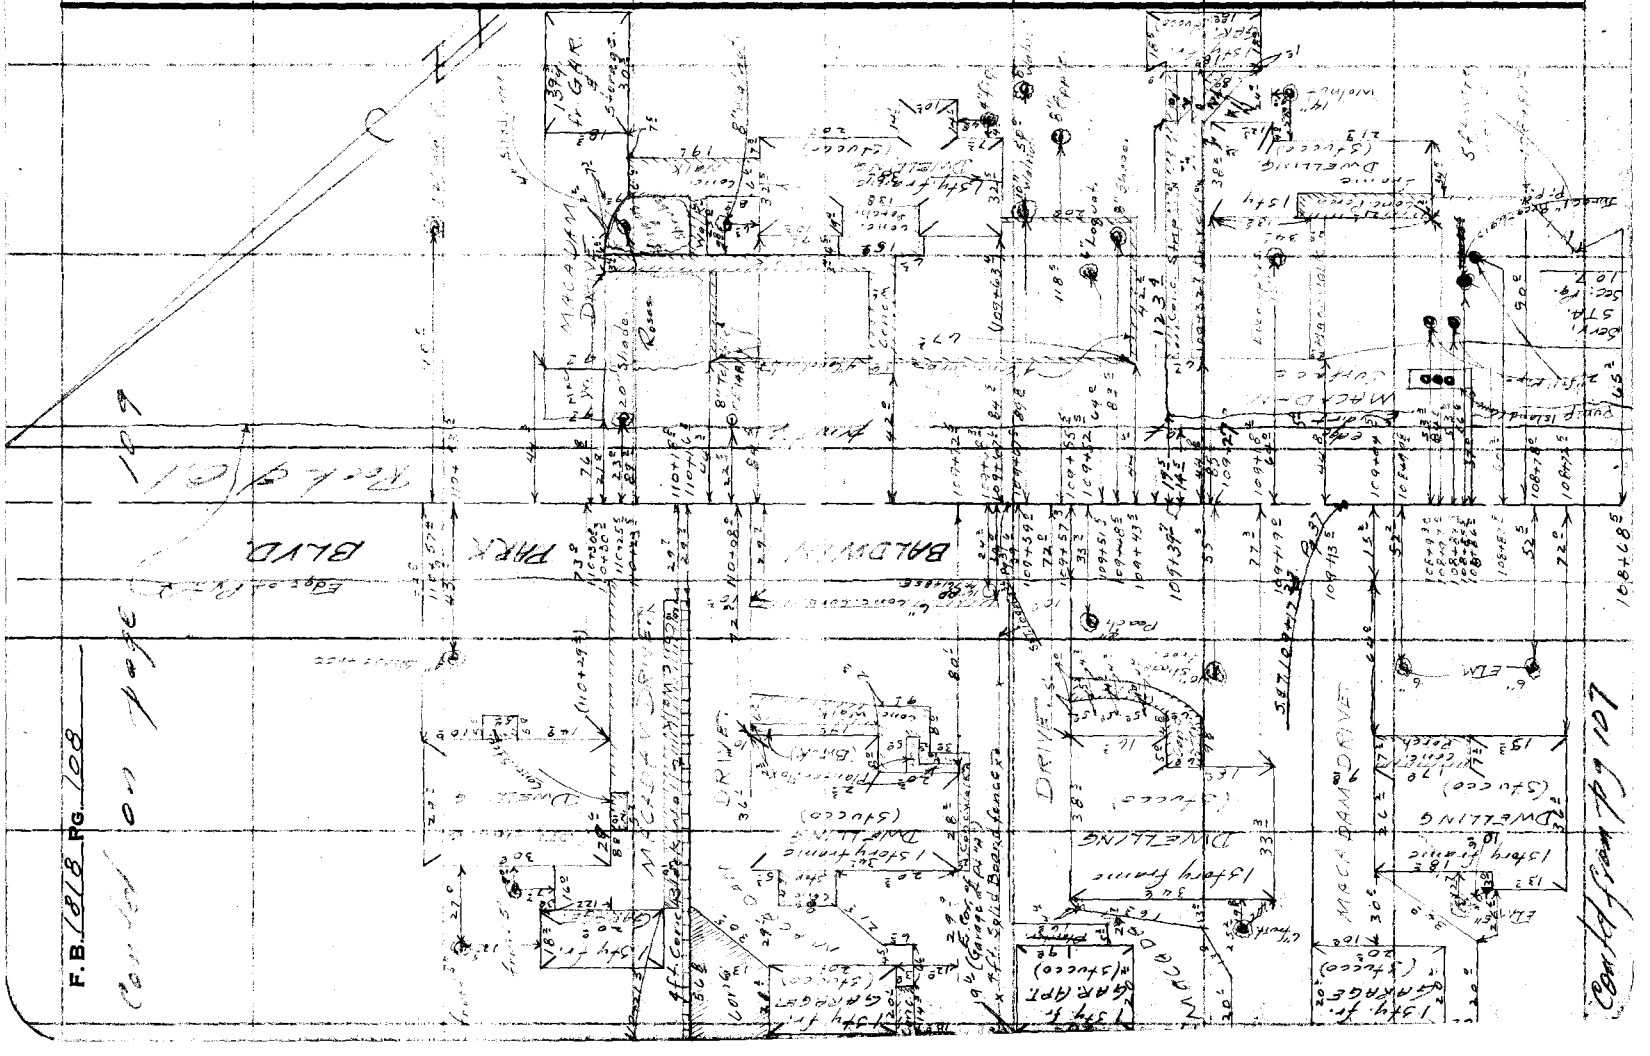

Notes Ck'd by _____
Map No. C.J.B - 2497 - 2,3
Office Work Burns
Checked Galli

Survey of Baldwin Park Blvd
W. O. 824 Tape No. 614 St'd. 62.56 °F
Surveyed by [illegible]
Notes [illegible] Date [illegible]
Indexed [illegible]

F. B. 1615 Pg. 109

Note: Any Additions or Changes on This Sheet Must be Made or Circled in Red Ink With Date and Name of Person Making Change.

RETURN TO
LOS ANGELES COUNTY SURVEYOR
726 LOS ANGELES COUNTY
ENGINEERING BLDG.
Do not extend notes this side of this line.

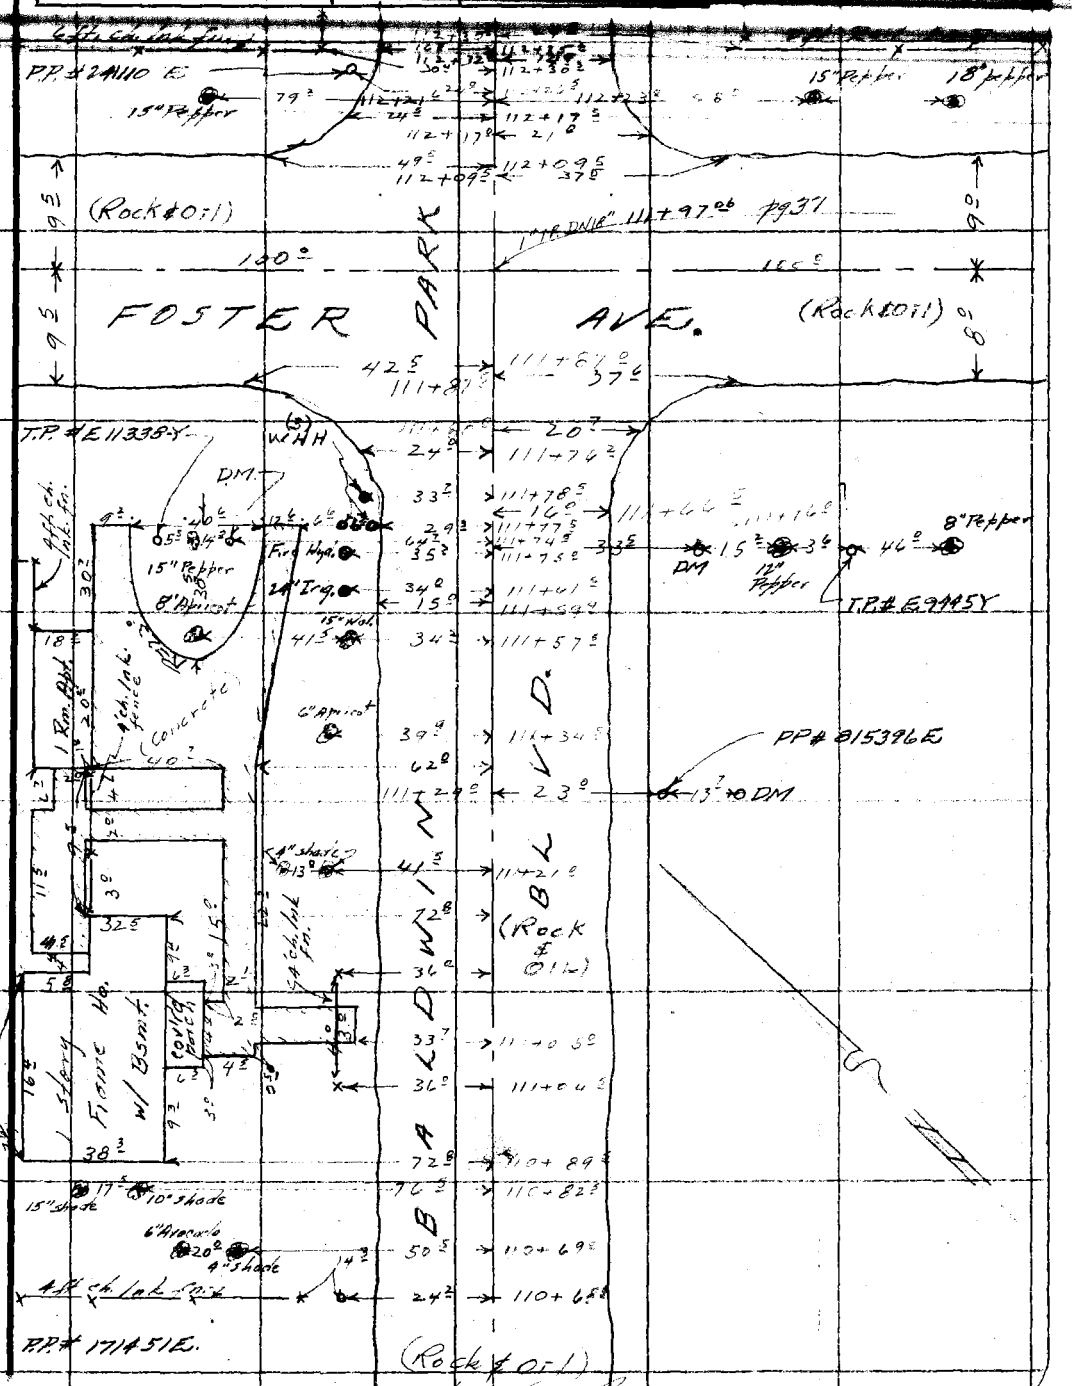

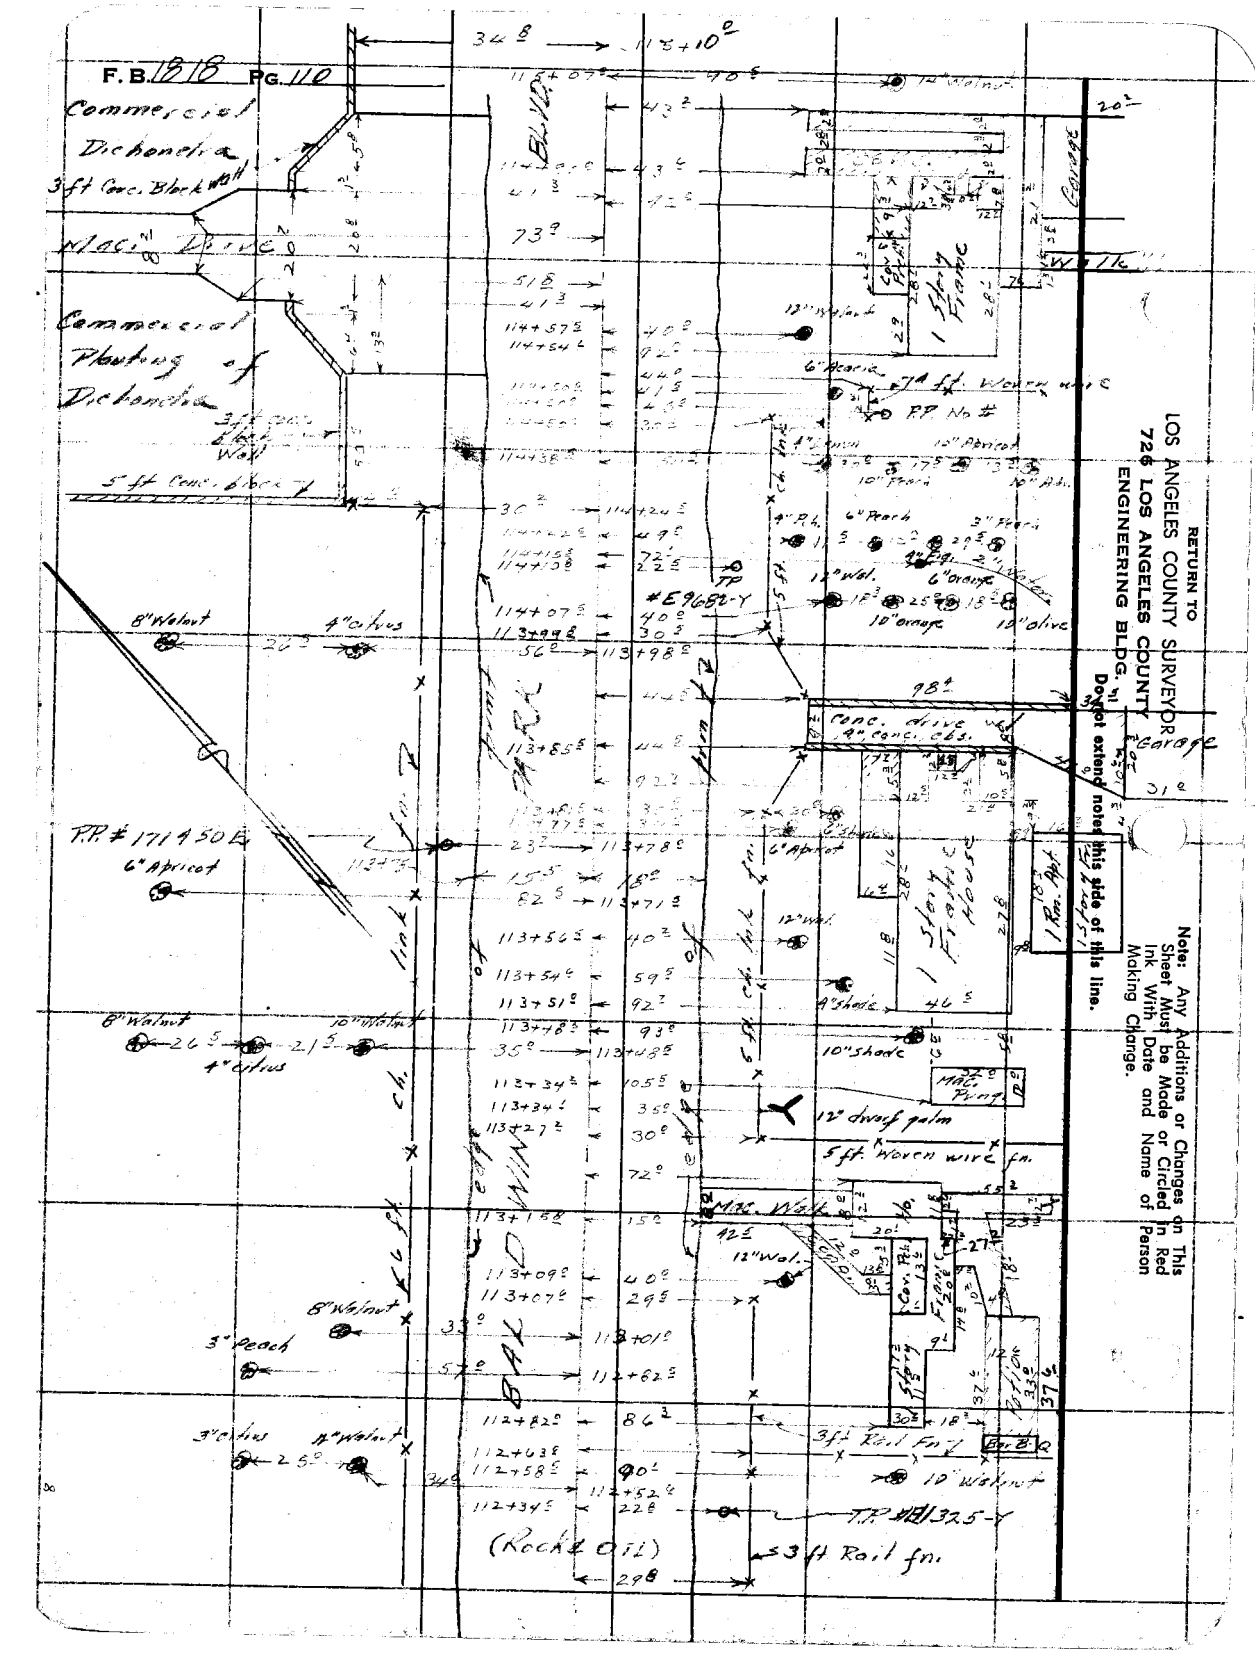
F. B. 1818 Pg. 110
Commercial
Dichondra
3 ft Conc. Block Wall
Mac. Drive
Commercial Planting of Dichondra
3 ft Conc. Block Wall
5 ft Conc. Block Wall
8" Walnut
4" citrus
RR # 171+50 E
6" Apricot
8" Walnut
10" Walnut
4" citrus
3" Peach
3" citrus
12" Walnut
(Rock & Oil)
#E9682-Y
TP
1 Story Frame
Garage
Conc. drive, 4" conc. cbs.
1 Story Frame House
Mac. Walk
Mac. Patio
12" dwarf palm
5 ft. Woven wire fn.
Conc. Walk
Conc. Patio
3 ft Rail fn.
12" Walnut
T.P. #H1325-Y
3 ft Rail fn.
RETURN TO
LOS ANGELES COUNTY SURVEYOR
726 LOS ANGELES COUNTY
ENGINEERING BLDG.
Do not extend notes this side of this line.
Note: Any Additions or Changes on This Sheet Must be Made or Circled in Red Ink With Date and Name of Person Making Change.

Notes Ck'd by
Map No. C.S.B-2497-3
Office Work Burns
Checked Galli
Date

Survey of BALDWIN PARK BLVD
W. O. 8647 Tape No. 214 St'd. 68 °F
Surveyed by MITCHELL, R.J.
Notes Date
Indexed

F. B. 15 18 PG. 117

Note: Any Additions or Changes on This Sheet Must be Made or Circled In Red Ink With Date and Name of Person Making Change.

Do not extend notes this side of this line.

RETURN TO
LOS ANGELES COUNTY SURVEYOR
726 LOS ANGELES COUNTY
ENGINEERING BLDG.

76FS098 247 4-53

RETURN TO
LOS ANGELES COUNTY SURVEYOR
726 LOS ANGELES COUNTY
ENGINEERING BLDG.

Note: Any Additions or Changes on This Sheet Must be Made or Circled In Red Ink With Date and Name of Person Making Change.

Do not extend notes this side of this line.

F.B. 1818 PG. 112

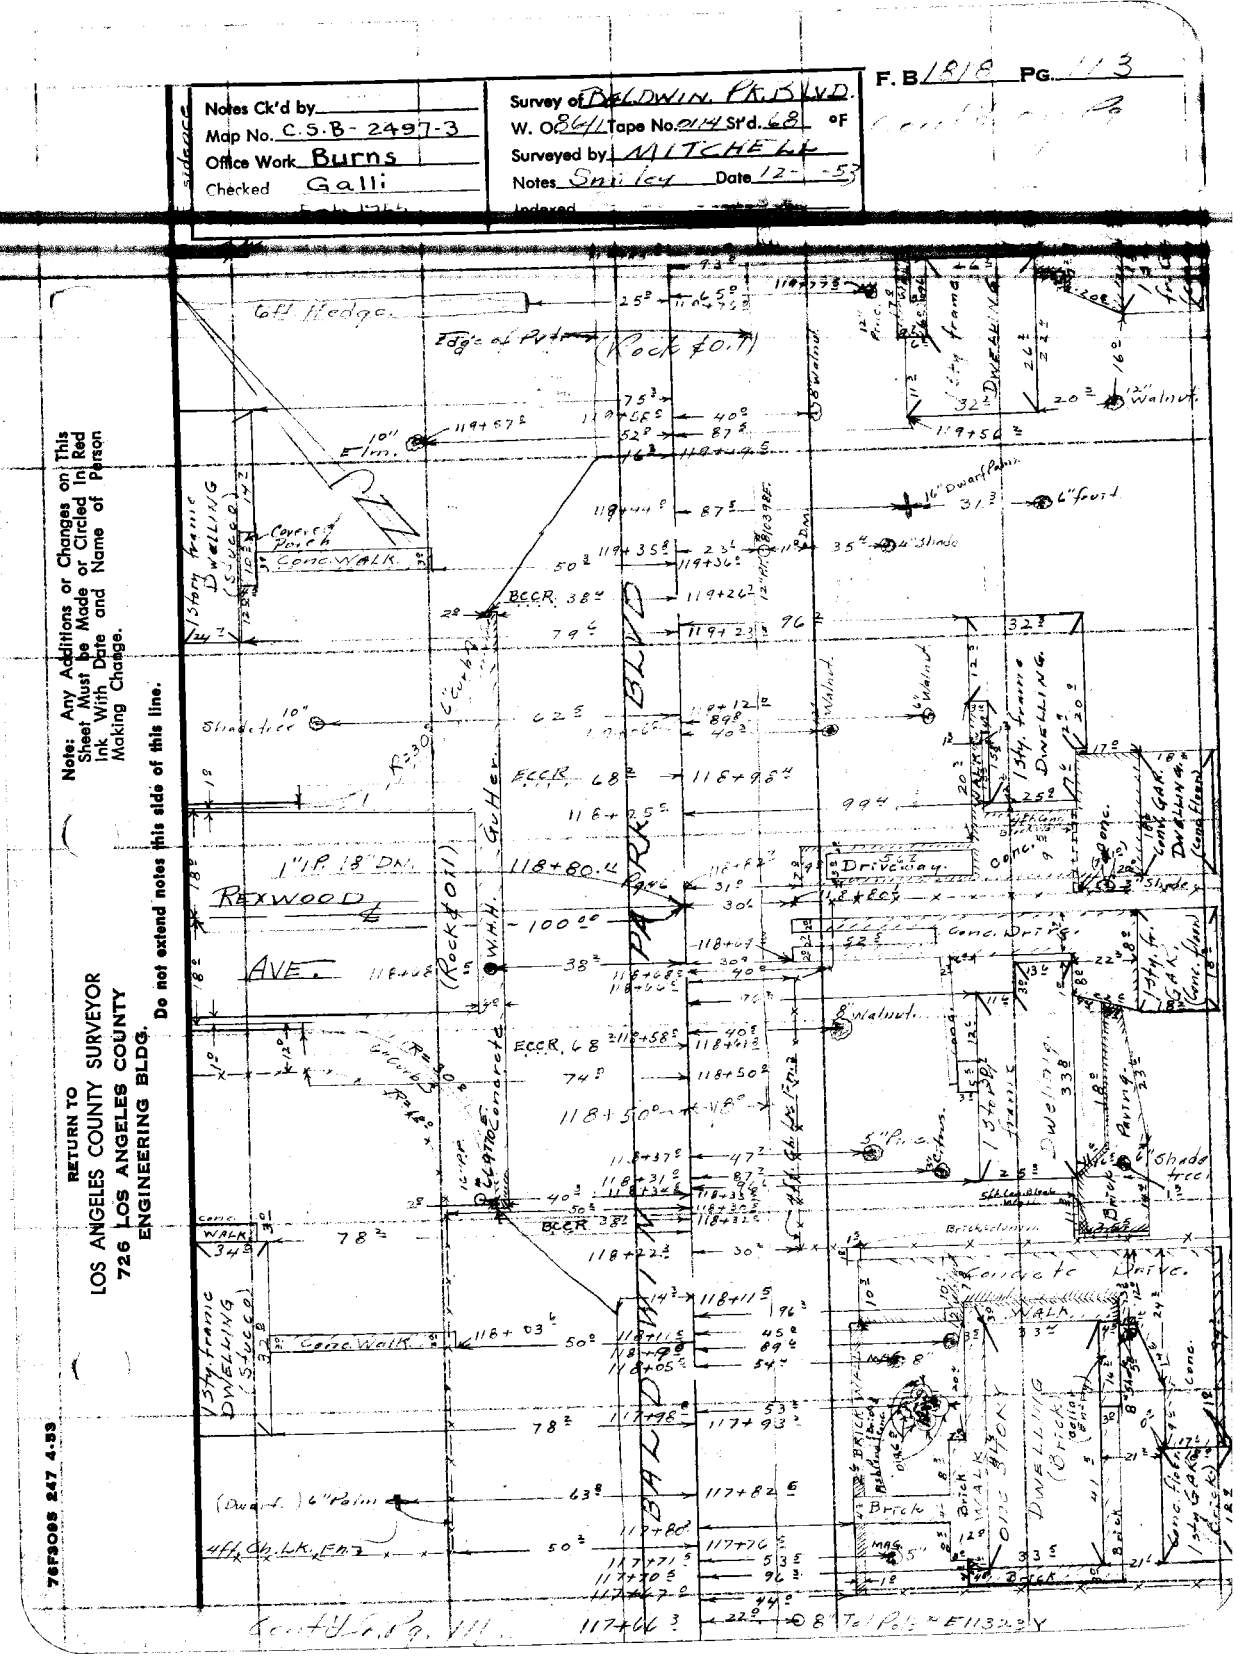
Notes Ck'd by
Map No. C.S.B. 2497-3
Office Work Burns
Checked Galli
Survey of BALDWIN PK. BLVD.
W. O. 8611 Tape No. 214 St'd. 68 °F
Surveyed by MITCHELL
Notes Smiley Date 12-53
Indexed
F. B. 818 Pg. 113
Note: Any Additions or Changes on This Sheet Must be Made or Circled In Red Ink With Date and Name of Person Making Change.
Do not extend notes this side of this line.
RETURN TO
LOS ANGELES COUNTY SURVEYOR
726 LOS ANGELES COUNTY
ENGINEERING BLDG.
76F3005 247 4.33
BALDWIN PARK BLVD
REXWOOD AVE.
Gutter
Curb & Gutter
Concrete Drive
Driveway
Conc. Walk
Covered Porch
Shade tree
Elm.
Walnut
Dwarf Palm
Fruit
Shade
Brick
Garage
Dwelling
Frame
Stucco
Concrete

RETURN TO
LOS ANGELES COUNTY SURVEYOR
726 LOS ANGELES COUNTY
ENGINEERING BLDG.

Note: Any Additions or Changes on This Sheet Must be Made or Circled in Red Ink With Date and Name of Person Making Change.

Do not extend notes this side of this line.

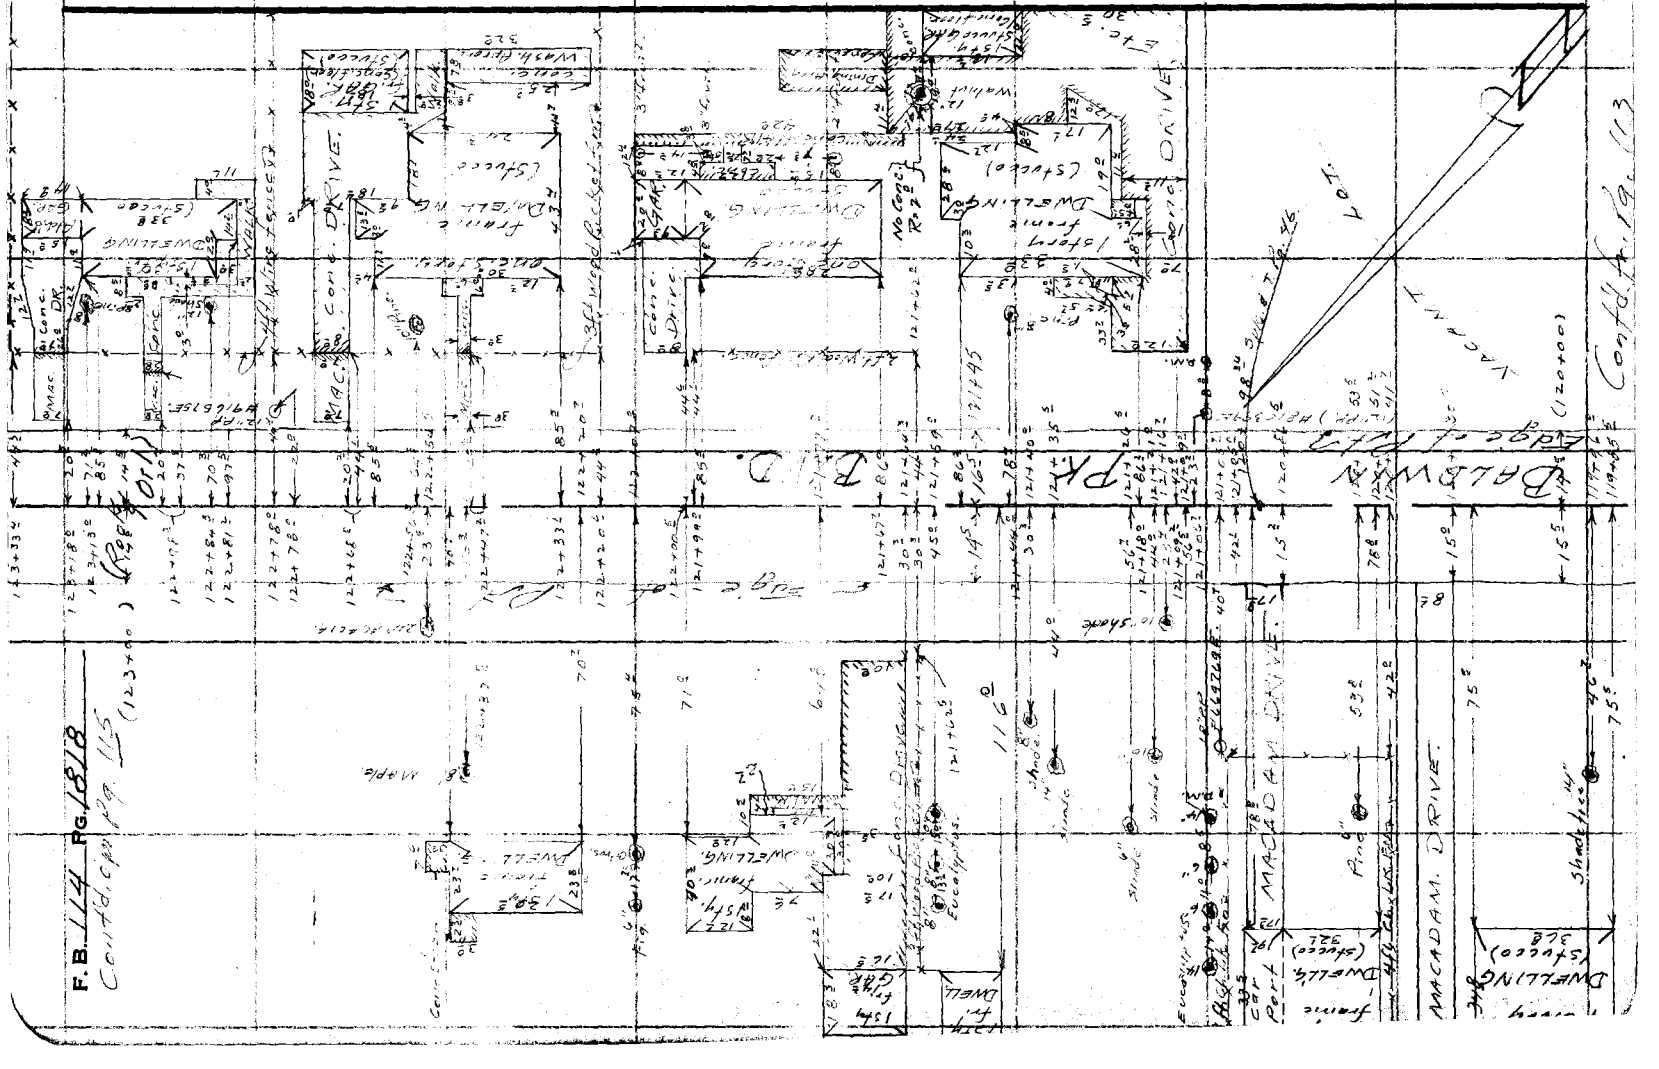


Notes Ck'd by		Survey of Baldwin Park Blvd	F. B. PG. 115
Map No. C.S.B - 2497 - 3		W. O. 814 Tape No. 814 St'd. 68 °F	
Office Work Burns		Surveyed by Mitchell N.J.	
Checked Galli		Notes Mainline Date 12-	
Date Feb. 1955		Indexed	

Note: Any Additions or Changes on This Sheet Must be Made or Circled in Red Ink With Date and Name of Person Making Change.

Do not extend notes this side of this line.

RETURN TO
LOS ANGELES COUNTY SURVEYOR
726 LOS ANGELES COUNTY
ENGINEERING BLDG.

76F3095 247 4-53

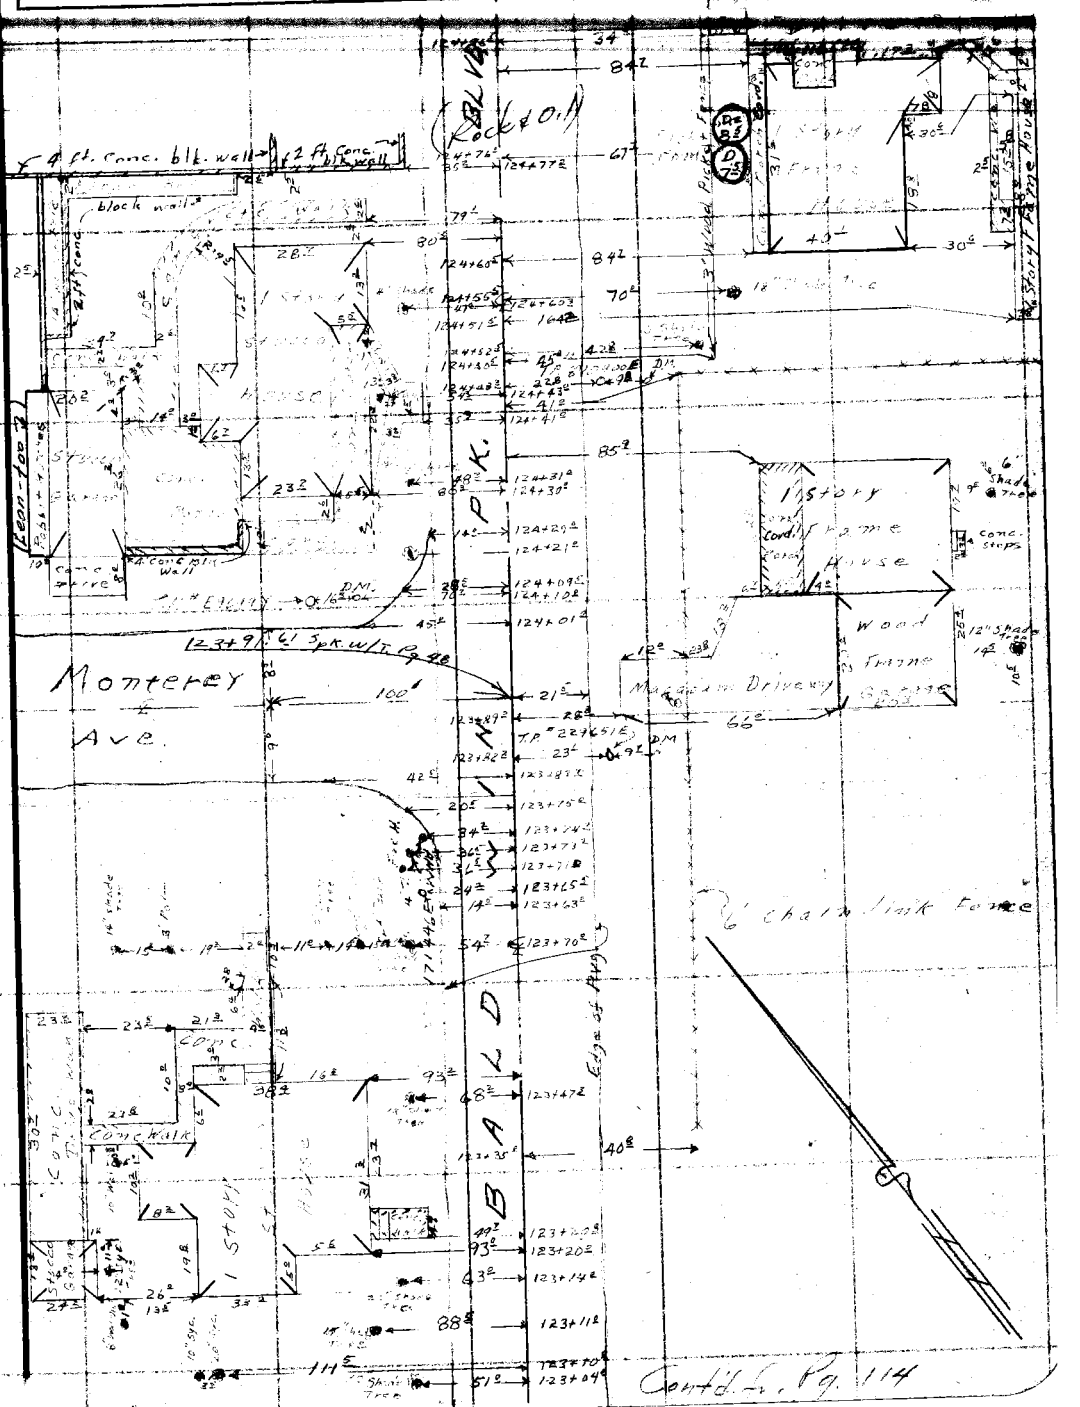

F. B. 1818 Pg. 116

Cont'd. Pg. 117

RETURN TO
LOS ANGELES COUNTY SURVEYOR
726 LOS ANGELES COUNTY
ENGINEERING BLDG.
Do not extend notes this side of this line.

Note: Any Additions or Changes on This Sheet Must be Made or Circled in Red Ink With Date and Name of Person Making Change.

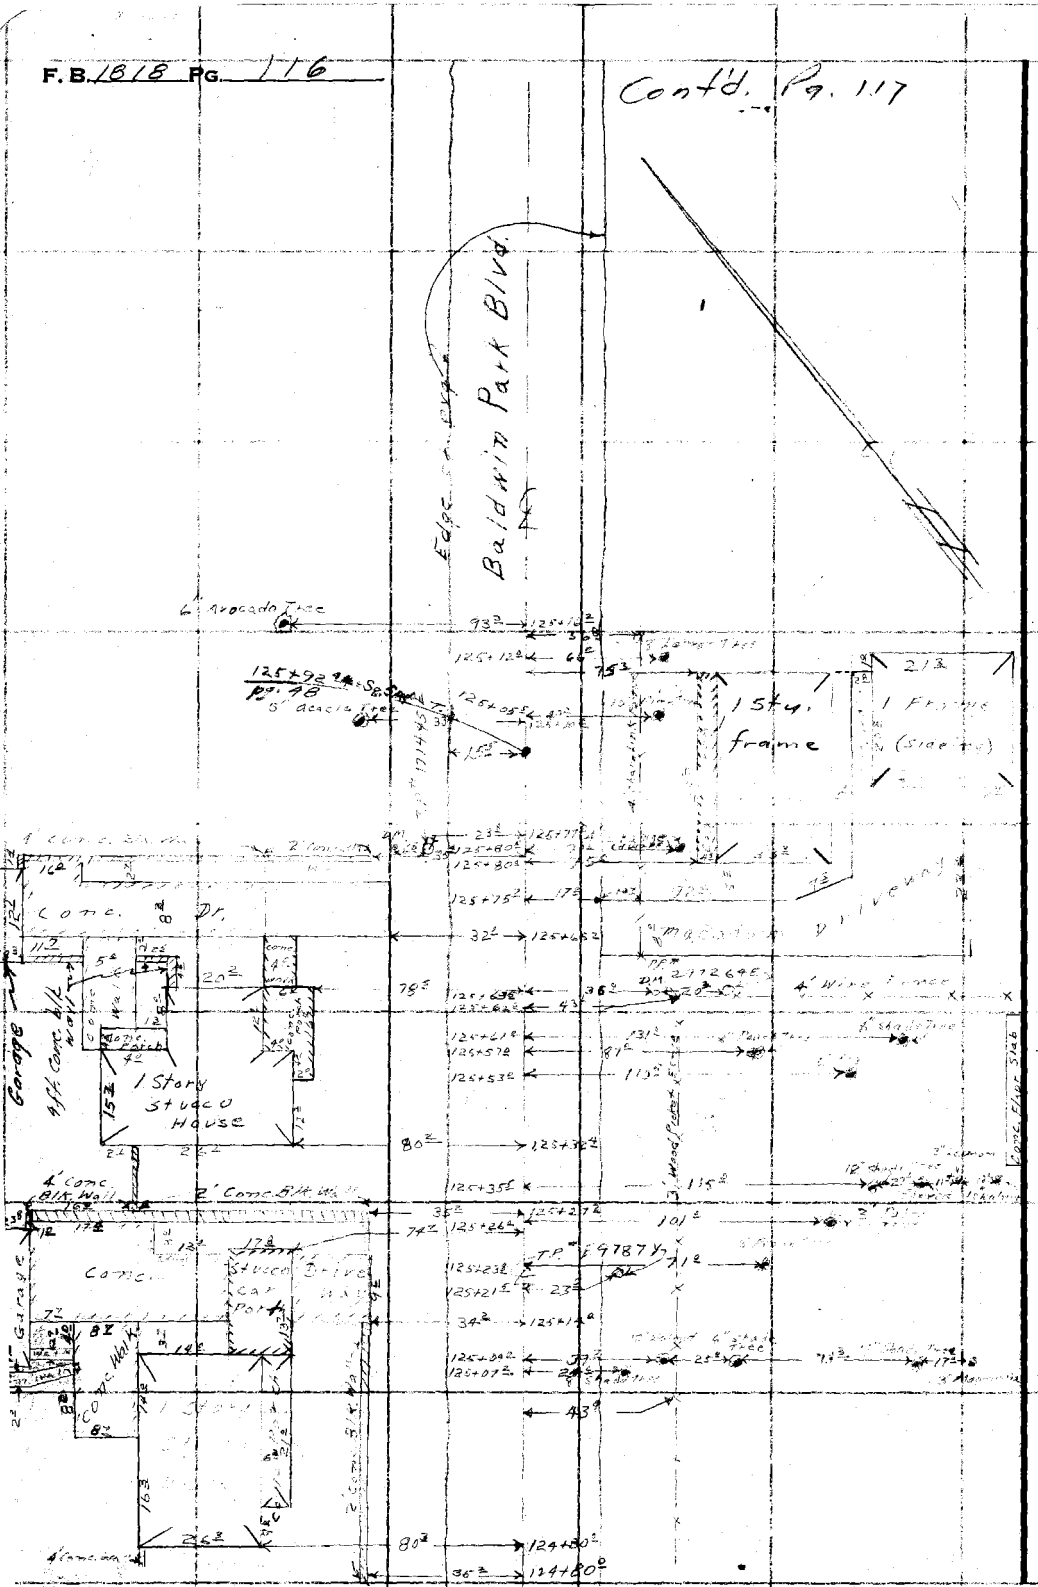

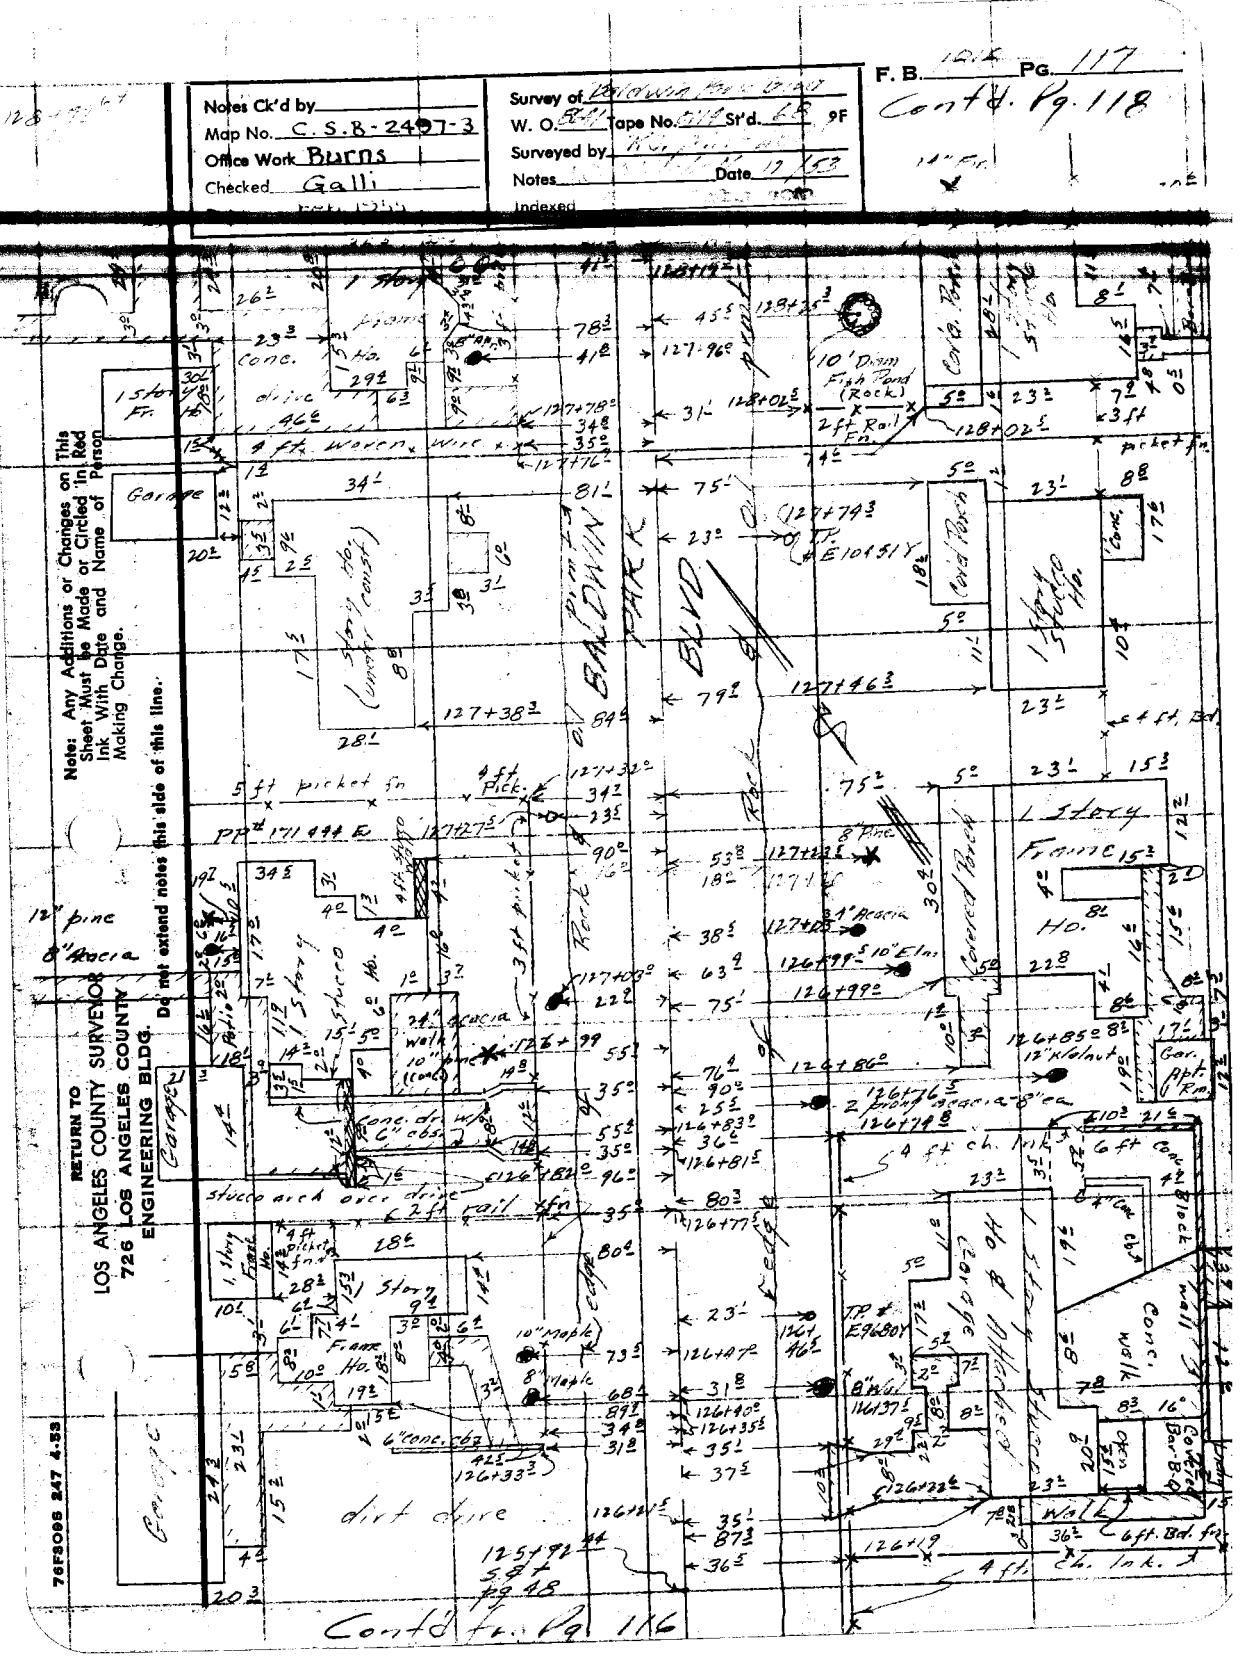
Notes Ck'd by
Map No. C.S.B-2497-3
Office Work Burns
Checked Galli
Survey of
W. O. Tape No. Sr'd.
Surveyed by
Notes
Date
Indexed
F. B. PG. 117
Cont'd. Pg. 118
Note: Any Additions or Changes on This Sheet Must be Made or Circled in Red Ink With Date and Name of Person Making Change.
Do not extend notes this side of this line.
RETURN TO
LOS ANGELES COUNTY SURVEYOR
726 LOS ANGELES COUNTY
ENGINEERING BLDG.
76FSOS 247 4-53
BALDWIN PARK BLVD
Cont'd fr. Pg. 116

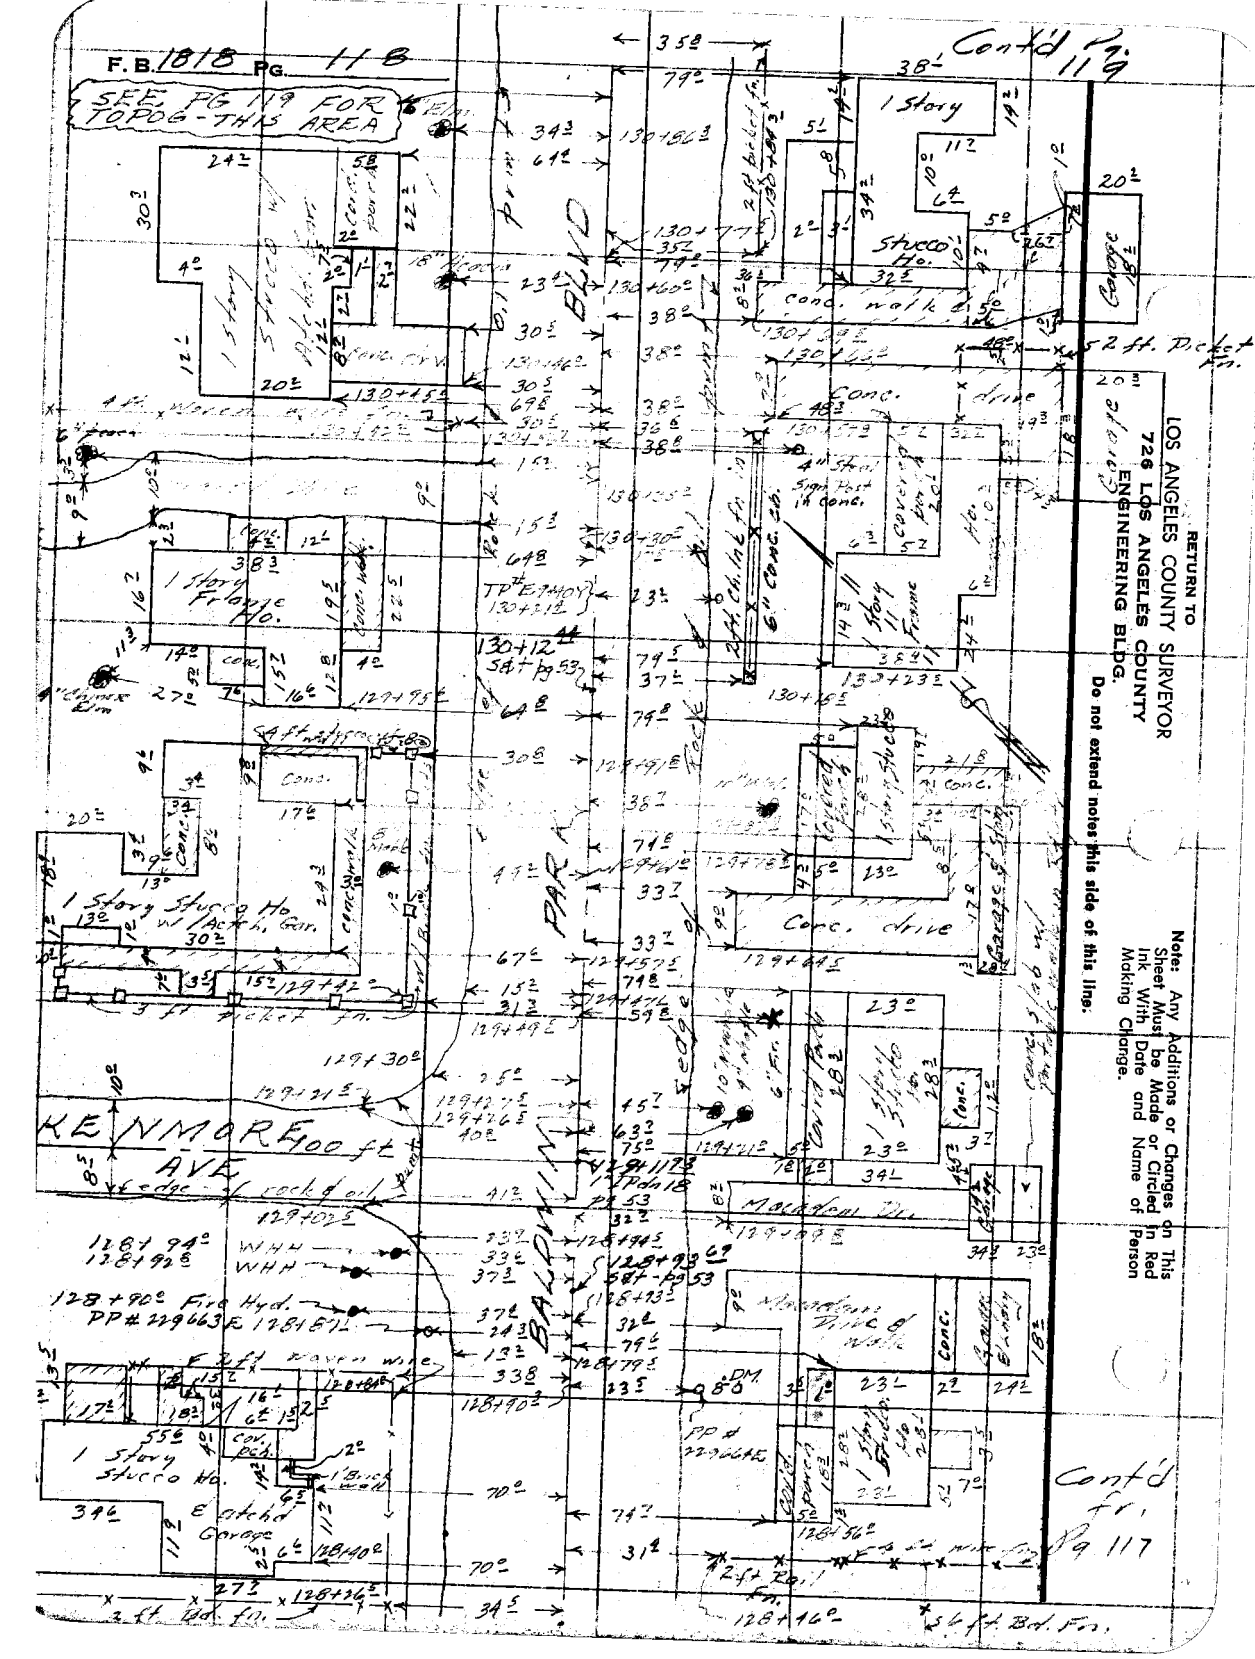
F.B. 1818 PG. 118
SEE PG 119 FOR TOPOG - THIS AREA
Contd Fr 119
1 Story
Stucco Ho.
Garage
Conc. walk
Conc. drive
52 ft. Pk. Fn.
RETURN TO
LOS ANGELES COUNTY SURVEYOR
726 LOS ANGELES COUNTY
ENGINEERING BLDG.
Do not extend notes this side of this line.
Note: Any Additions or Changes on This Sheet Must be Made or Circled in Red Ink With Date and Name of Person Making Change.
1 Story Frame Ho.
1 Story Stucco Ho w/ Att'd. Gar.
Conc.
Conc. drive
KENMORE 400 ft. AVE
BALDWIN
PARK
Contd Fr. Pg 117

Notes Ck'd by
Map No. C.S.B. - 2497 - 3
Office Work Burns
Checked Galli

Survey of Baldwin Park Blvd
W. O. 8641 Tape No. 2114 St'd. 60 °F
Surveyed by K.D. Du Tee
Notes [illegible] Date 12-53
Indexed

F. B. 1818 Pg. 119

132+87 ℄
SBT
pg 54

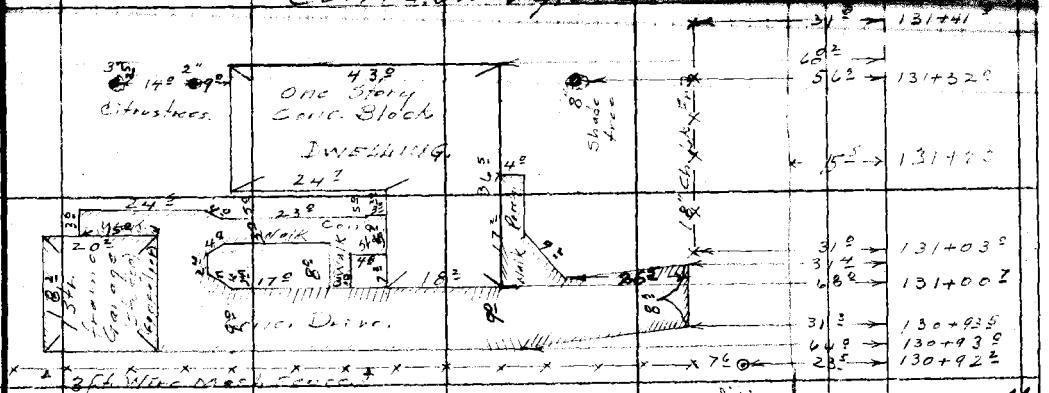

130+12 ℄
SBT
pg 53

Rock Pl.

Baldwin Park Blvd

132+82 ℄
SBT
pg 54

RETURN TO
LOS ANGELES COUNTY SURVEYOR
726 LOS ANGELES COUNTY
ENGINEERING BLDG.

Note: Any Additions or Changes on This Sheet Must be Made or Circled in Red Ink With Date and Name of Person Making Change.

Do not extend notes this side of this line.

76F3098 247 4-53

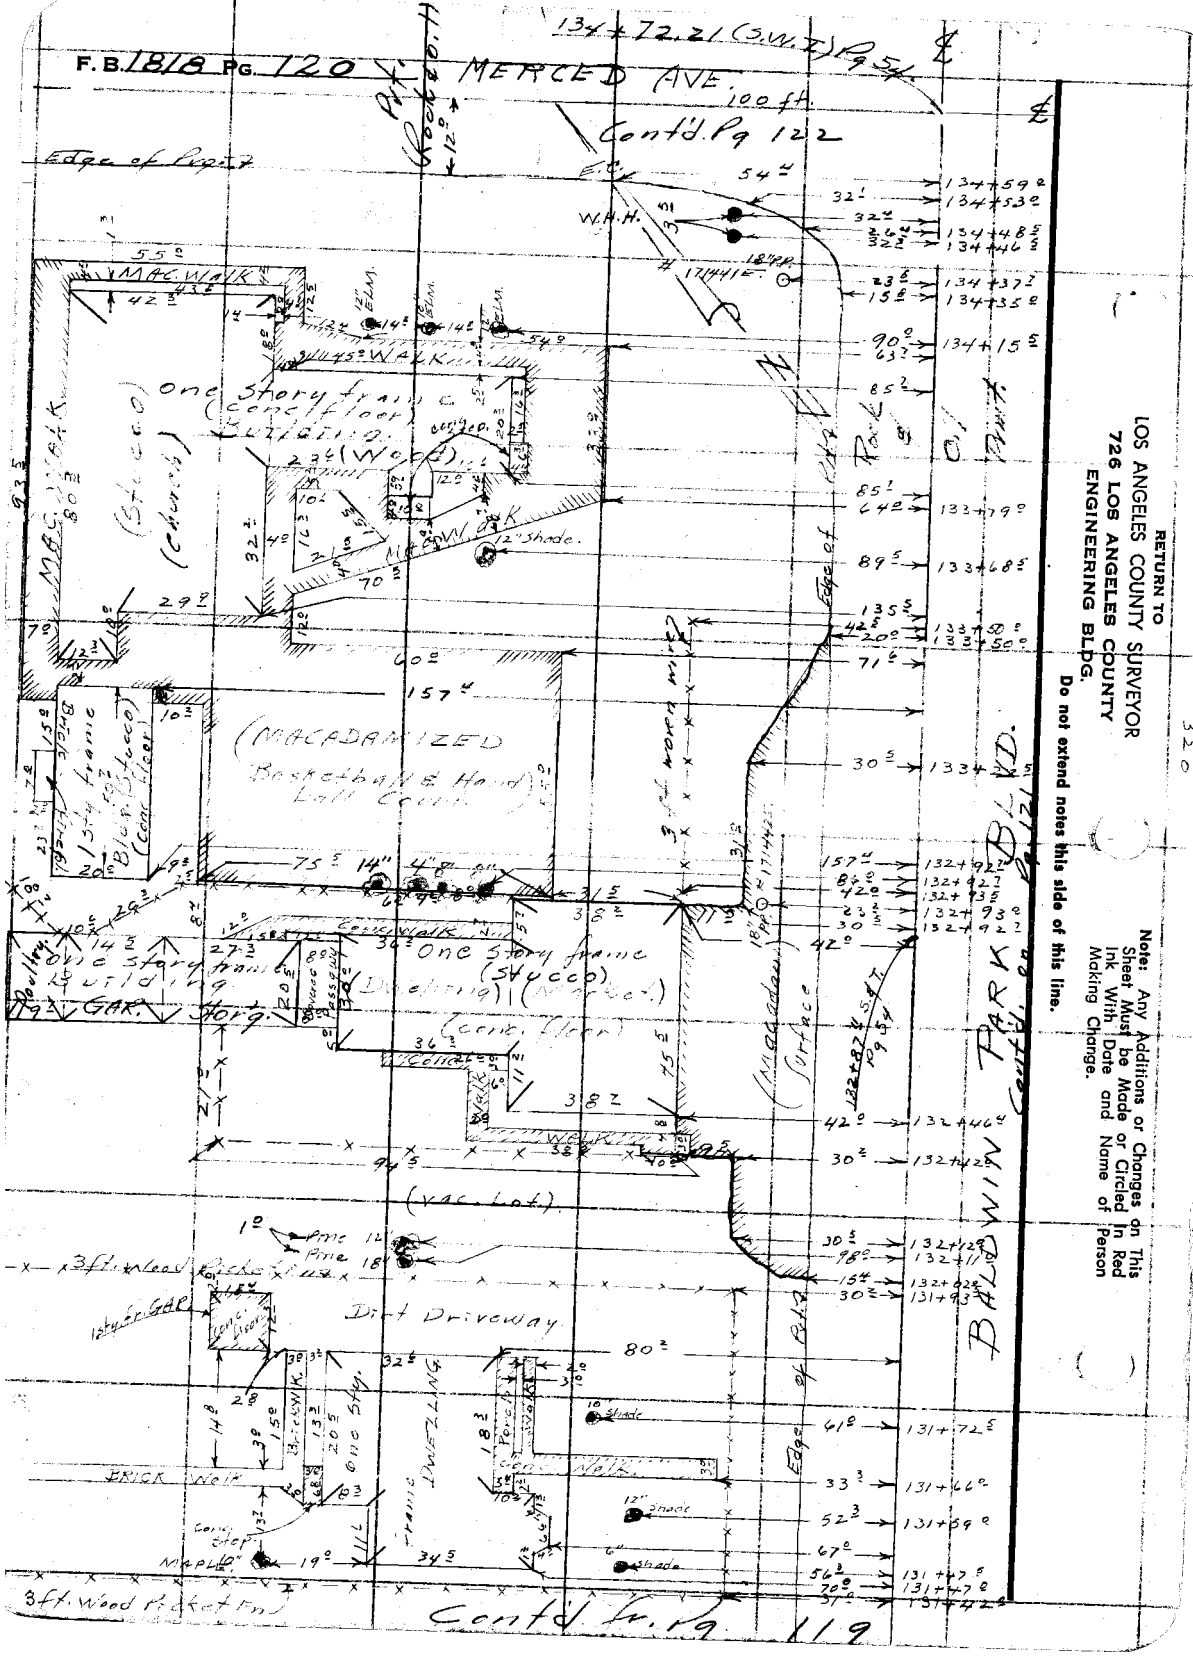
F. B. 1818 PG. 120
MERCED AVE. 100 ft.
Cont'd. Pg 122
Edge of Ripp-rap
W.H.H.
MAC. Walk
(Stucco)
(Conc.)
Edge of Park
Edge of Walk
(MACADAMIZED Basketball & Hand Ball Court)
Edge of Macadam Surface
BALDWIN PARK BLVD.
Center Line
One Story frame (Stucco) Dwelling
Conc. Walk
Conc. Floor
Conc. Steps
Dirt Driveway
Cont'd fr. Pg. 119
RETURN TO
LOS ANGELES COUNTY SURVEYOR
726 LOS ANGELES COUNTY
ENGINEERING BLDG.
Do not extend notes this side of this line.
Note: Any Additions or Changes on This Sheet Must be Made or Circled In Red Ink With Date and Name of Person Making Change.

Notes Ck'd by
Map No. C.S.B - 2497-3
Office Work Burns
Checked Galli
Date Feb 1955

Survey of Baldwin Park Blvd.
W. O. 8641 Tape No. 0114 St'd. 68 °F
Surveyed by R.T. Mitchell
Notes I. Y. [illegible] ado Date 12-14-53
Indexed

F. B. 1818 Pg. 121
Cont'd Pg. 123

Notes: Any Additions or Changes on This Sheet Must be Made or Circled in Red Ink With Date and Name of Person Making Change.

Do not extend notes this side of this line.

RETURN TO
LOS ANGELES COUNTY SURVEYOR
726 LOS ANGELES COUNTY
ENGINEERING BLDG.

76FROBS 247 4-53

Baldwin Park Blvd.

Cont'd on Rgt.

(Rock to Pt.)

Pumps

Pump Is.

Serv. Sta.

Repair Garage

Cafe

Pavement Hoist

Macadam Hwy.

1 Storey Frame House

Brick Patio

Conc. Drive

3' Picket Fence (wood)

F. B. 1848 PG. 122

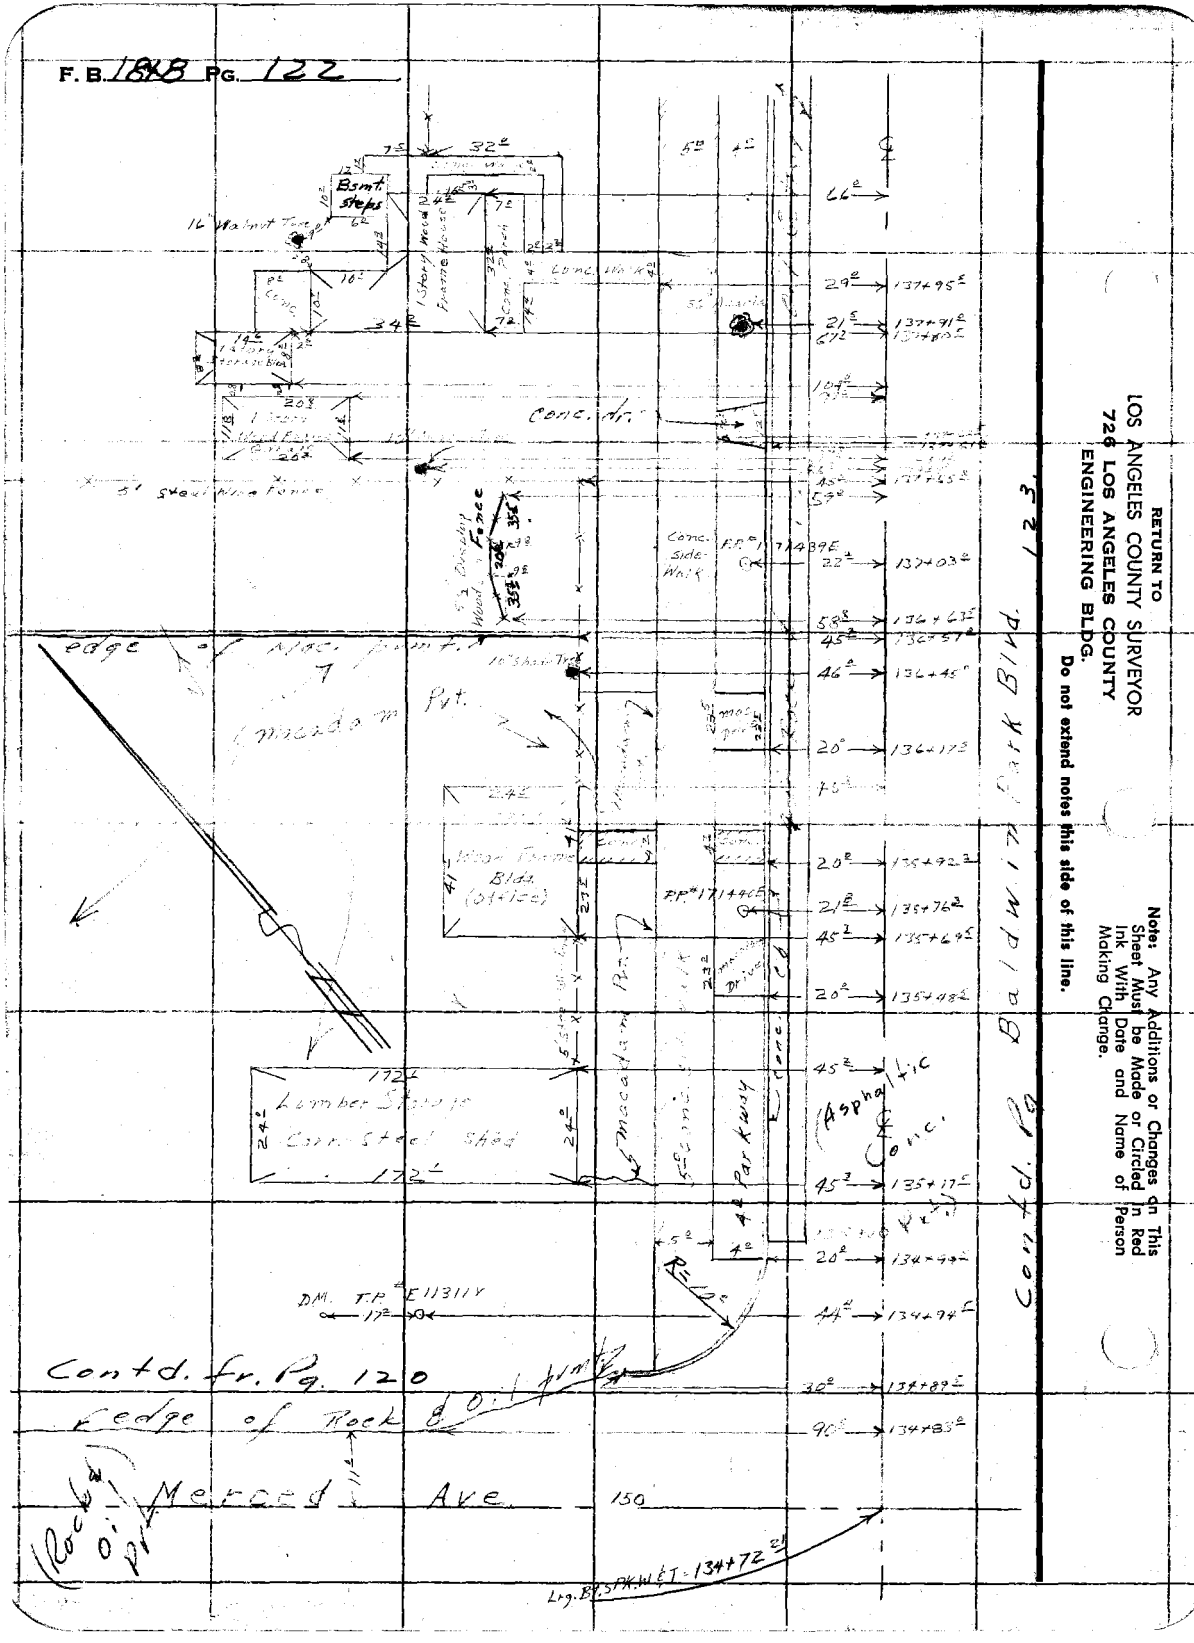
Bsmt. steps
1 Story Wood Frame House
Conc. Walk
Conc. Walk
Conc. Walk
5' Steel Mesh Fence
Conc. Side Walk
Conc. Driveway
Fence
Edge of Asphalt Pvt.
Macadam Pvt.
Bldg. (Office)
Lumber Storage
Corr. Steel Shed
Macadam Pvt.
Asphaltic Conc.
Pvt. Curb
Pvt. Curb
Pvt. Curb

Notes Ck'd by:
Map No. C.S.B - 2497 - 3
Office Work Burns
Checked Galli
Date Feb. 1955

Survey of BALDWIN PARK BLVD
W. O. 8641 Tape No. 0114 St'd. 68 °F
Surveyed by Mitchell
Notes Smiley Date 12-53
Indexed

F. B. 818 Pg. 12.3
Cont'd Pg. 125

Note: Any Additions or Changes on This Sheet Must be Made or Circled in Red Ink With Date and Name of Person Making Change.

Do not extend notes this side of this line.

RETURN TO
LOS ANGELES COUNTY SURVEYOR
726 LOS ANGELES COUNTY
ENGINEERING BLDG.

76F3098 847 4-53

BALDWIN PK. BLVD.

Cont'd Pg. 122

3 ft. ch link fn.

Gate

DWELLING (Stucco)

Conc. Dr.

Drvt. Drive 6 ft. deep Conc. Stair Well

ONE STORY FRAME BLDG. W/Full Basement.

(Class Room) School & CHURCH

4 ft. H. Stair (Flight over 6 ft deep stair well (Conc.)

Play Area

6 ft. CHAIN LINK FN.

Conc. Walk

Brick Wall

Asph. Mastic

Conc. Pk.

Head of Trees

Edge of Pvt. Parking

MERCED AVE

100'

134+72.21 S.W.&I. Pg. 54

RETURN TO
LOS ANGELES COUNTY SURVEYOR
726 LOS ANGELES COUNTY
ENGINEERING BLDG.

Note: Any Additions or Changes on This Sheet Must be Made or Circled In Red Ink With Date and Name of Person Making Change.

Do not extend notes this side of this line.

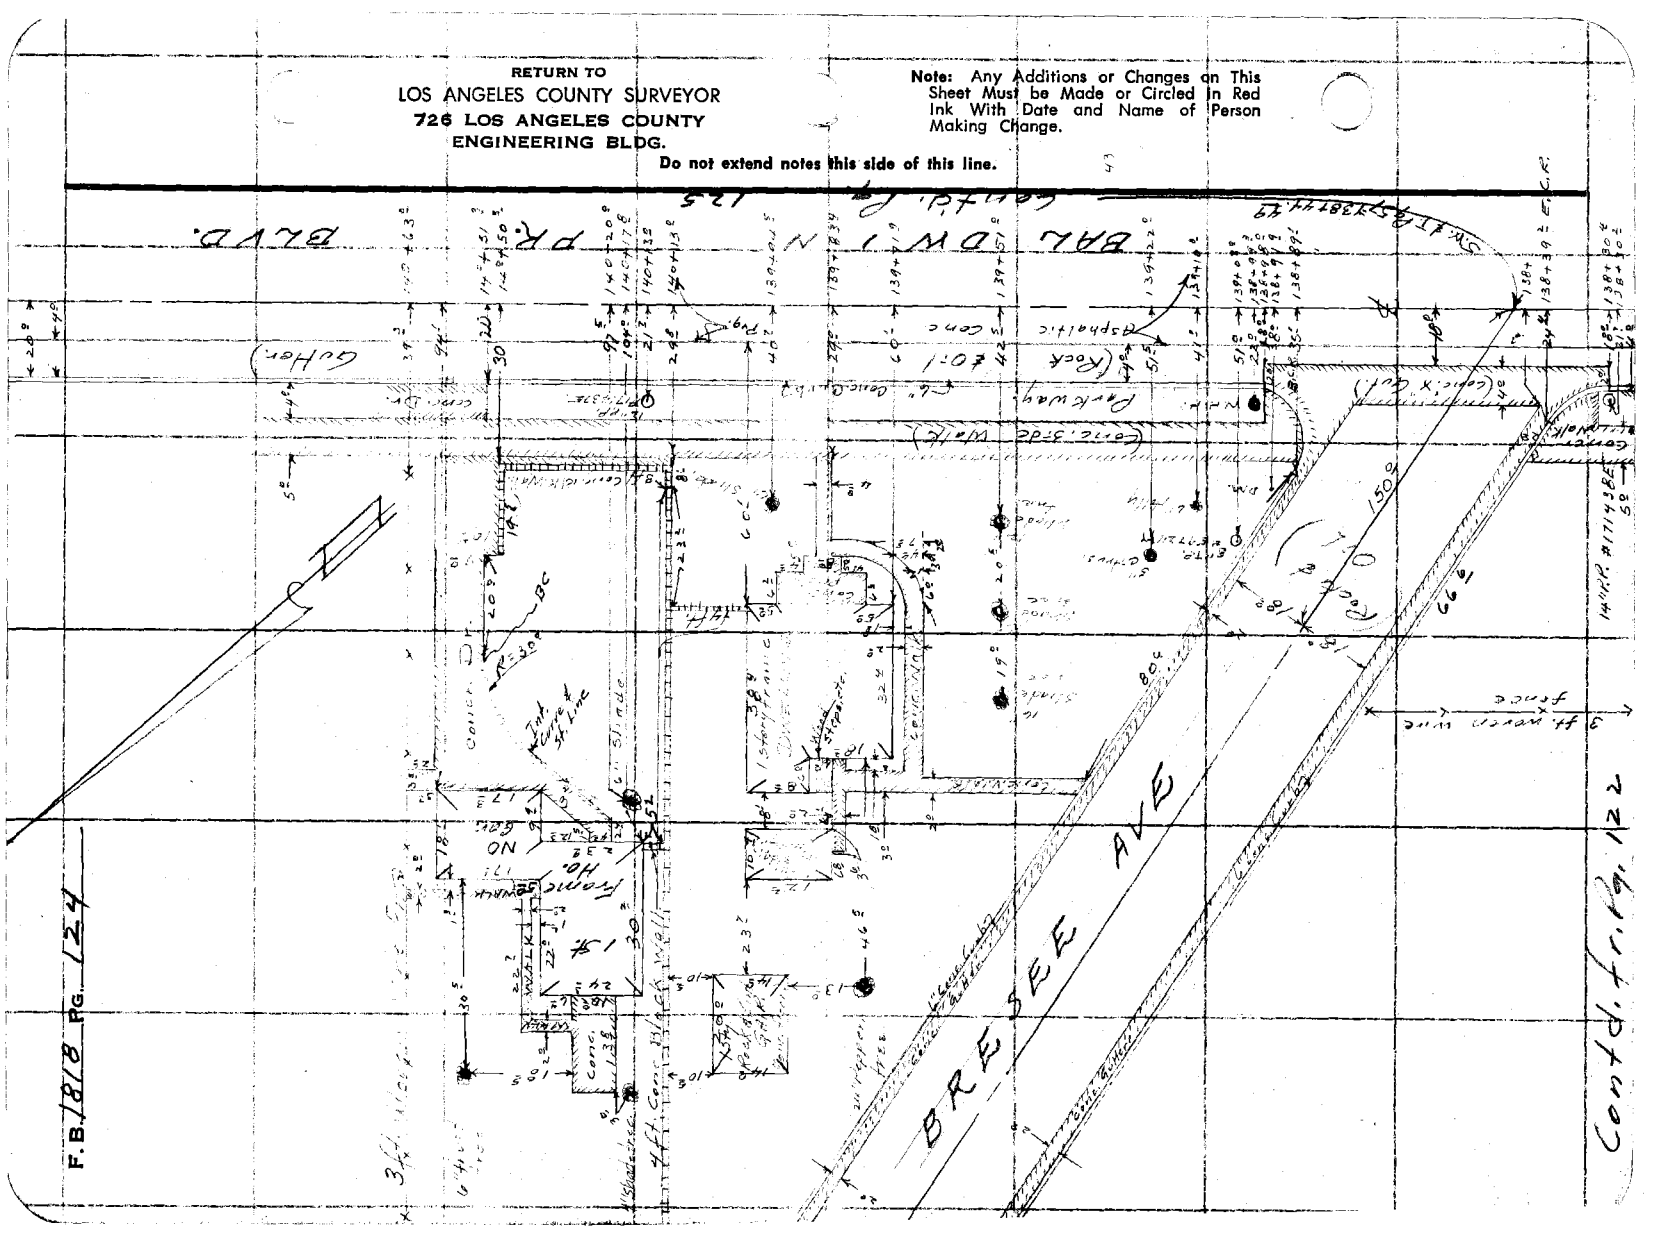

Notes Ck'd by
Map No. C.S.B. - 2497-3
Office Work Burns
Checked Galli

Survey of Baldwin Park Blvd
W. O. 8641 Tape No. 2119 St'd. 68° F
Surveyed by Bell Mc Neely
Notes Watch Date 12-[illegible]
Indexed

F. B. 12-5 PG. 25

Cont'd Pg. 127

Note: Any Additions or Changes on This Sheet Must be Made or Circled in Red Ink With Date and Name of Person Making Change.

Do not extend notes this side of this line.

RETURN TO
LOS ANGELES COUNTY SURVEYOR
726 LOS ANGELES COUNTY
ENGINEERING BLDG.

76F3008 247 4-53

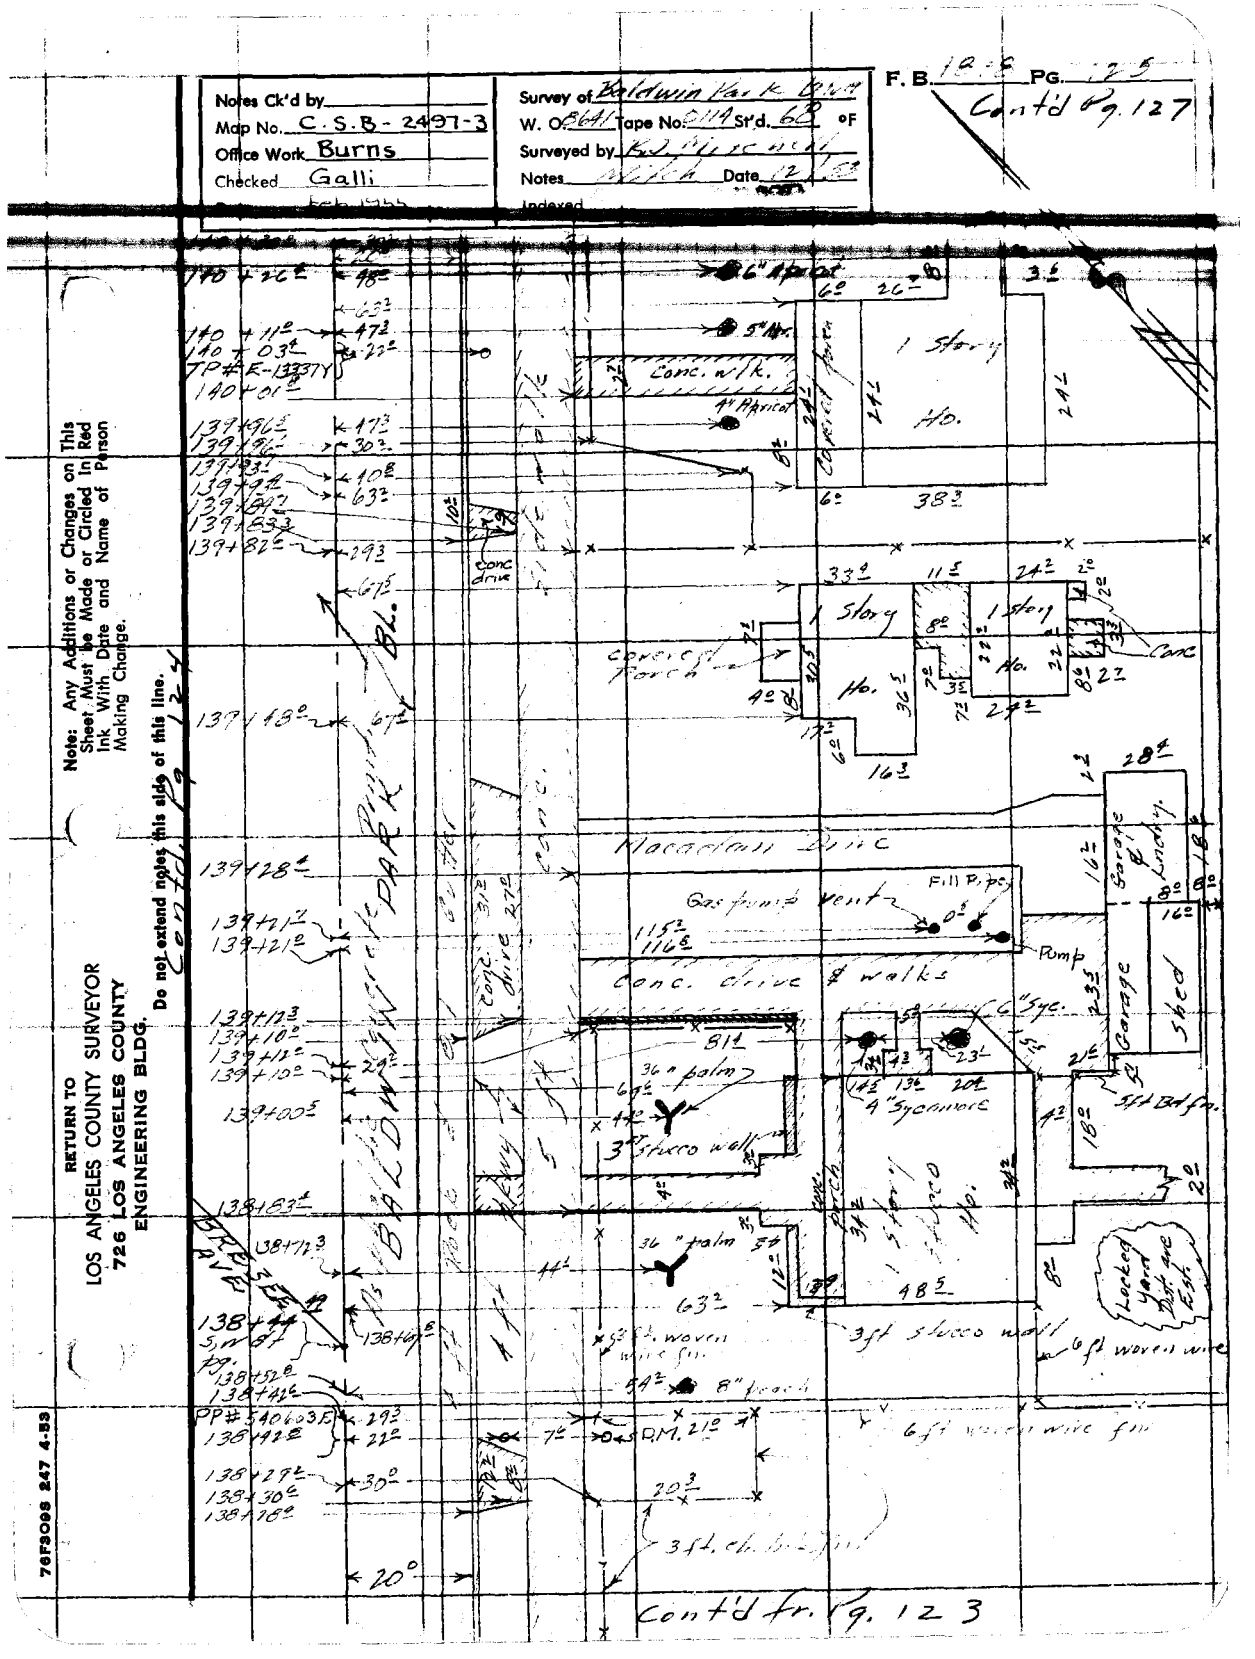

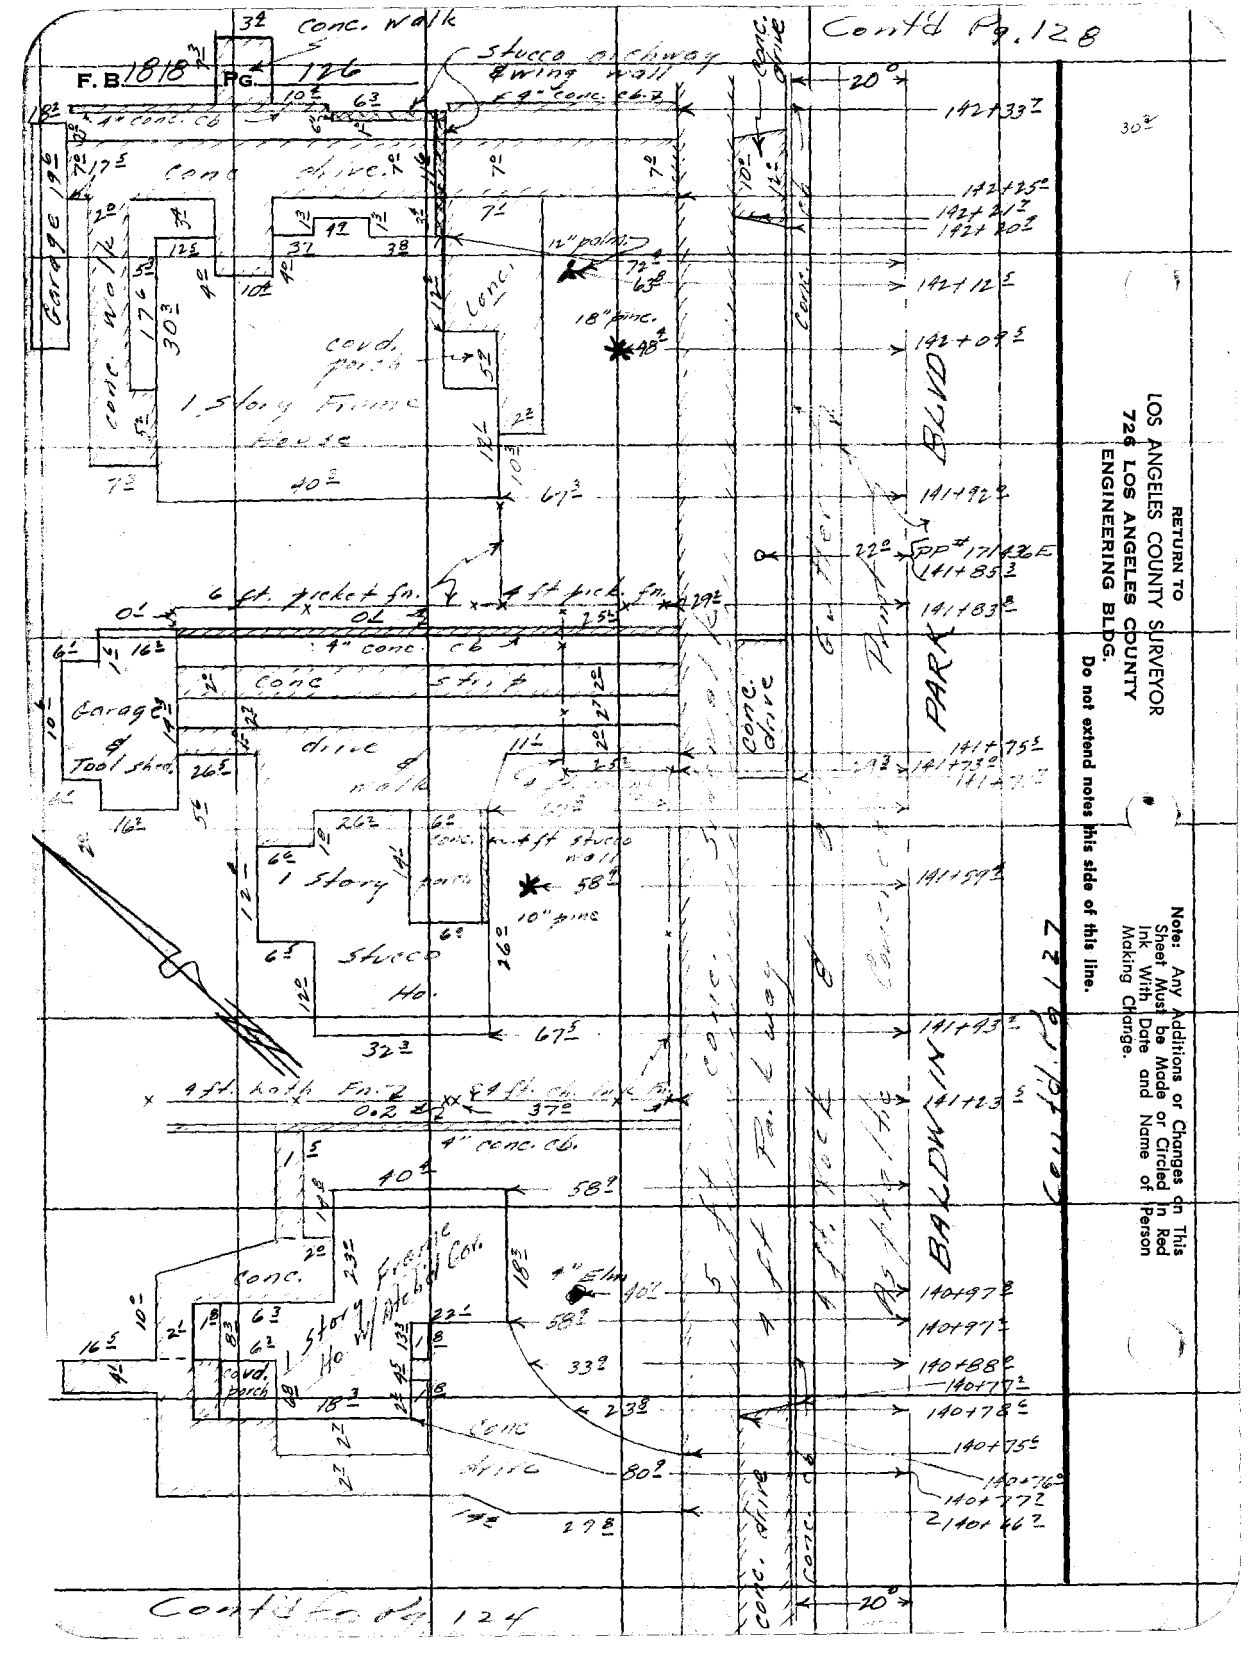
Contd Pg. 128
F. B. 1818 Pg. 176
Conc. Walk
Stucco chimney & wing wall
4" conc. cb
Conc. Drive
20'
Garage
Conc. Walk
Conc. drive
1 Story Frame House
Covd. porch
4" conc. cb
Conc. stairs
Garage & Tool shed
Conc. drive & walk
1 Story Frame
Stucco
Conc. Drive
4" conc. cb.
Conc. Walk
Frame & Stucco House
Covd. Porch
Conc. drive
Conc. Drive
BLVD
PARK
BALDWIN
Contd Pg. 124
RETURN TO
LOS ANGELES COUNTY SURVEYOR
726 LOS ANGELES COUNTY
ENGINEERING BLDG.
Do not extend notes this side of this line.
Note: Any Additions or Changes on This Sheet Must be Made or Circled in Red Ink With Date and Name of Person Making Change.

Notes Ck'd by
Map No. C.S.B-2497-3
Office Work Burns
Checked Galli
Date

Survey of BALDWIN PARK BLVD.
W. O. 5264 Tape No. 21 Std. 68 °F
Surveyed by Mitchell
Notes Date

F. B. 1812 Pg. 127

Cont'd Pg. 129

Note: Any Additions or Changes on This Sheet Must be Made or Circled in Red Ink With Date and Name of Person Making Change.

Do not extend notes this side of this line.

RETURN TO
LOS ANGELES COUNTY SURVEYOR
726 LOS ANGELES COUNTY
ENGINEERING BLDG.

76F3095 247 4-53

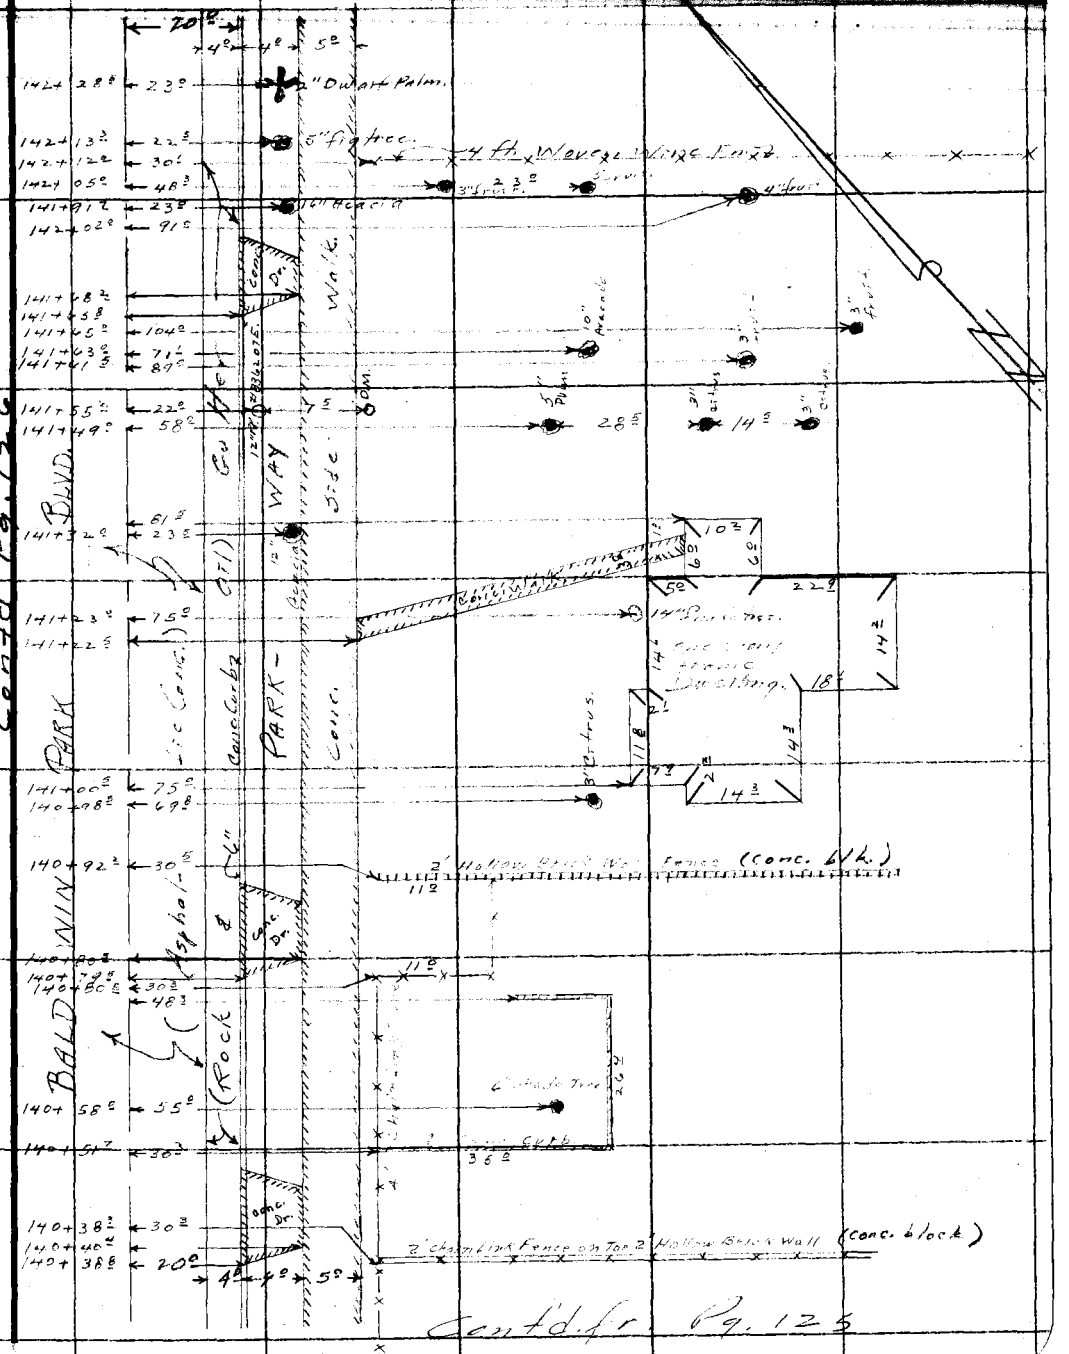

RETURN TO
LOS ANGELES COUNTY SURVEYOR
726 LOS ANGELES COUNTY
ENGINEERING BLDG.

Note: Any Additions or Changes on This Sheet Must be Made or Circled in Red Ink With Date and Name of Person Making Change.

Do not extend notes this side of this line.

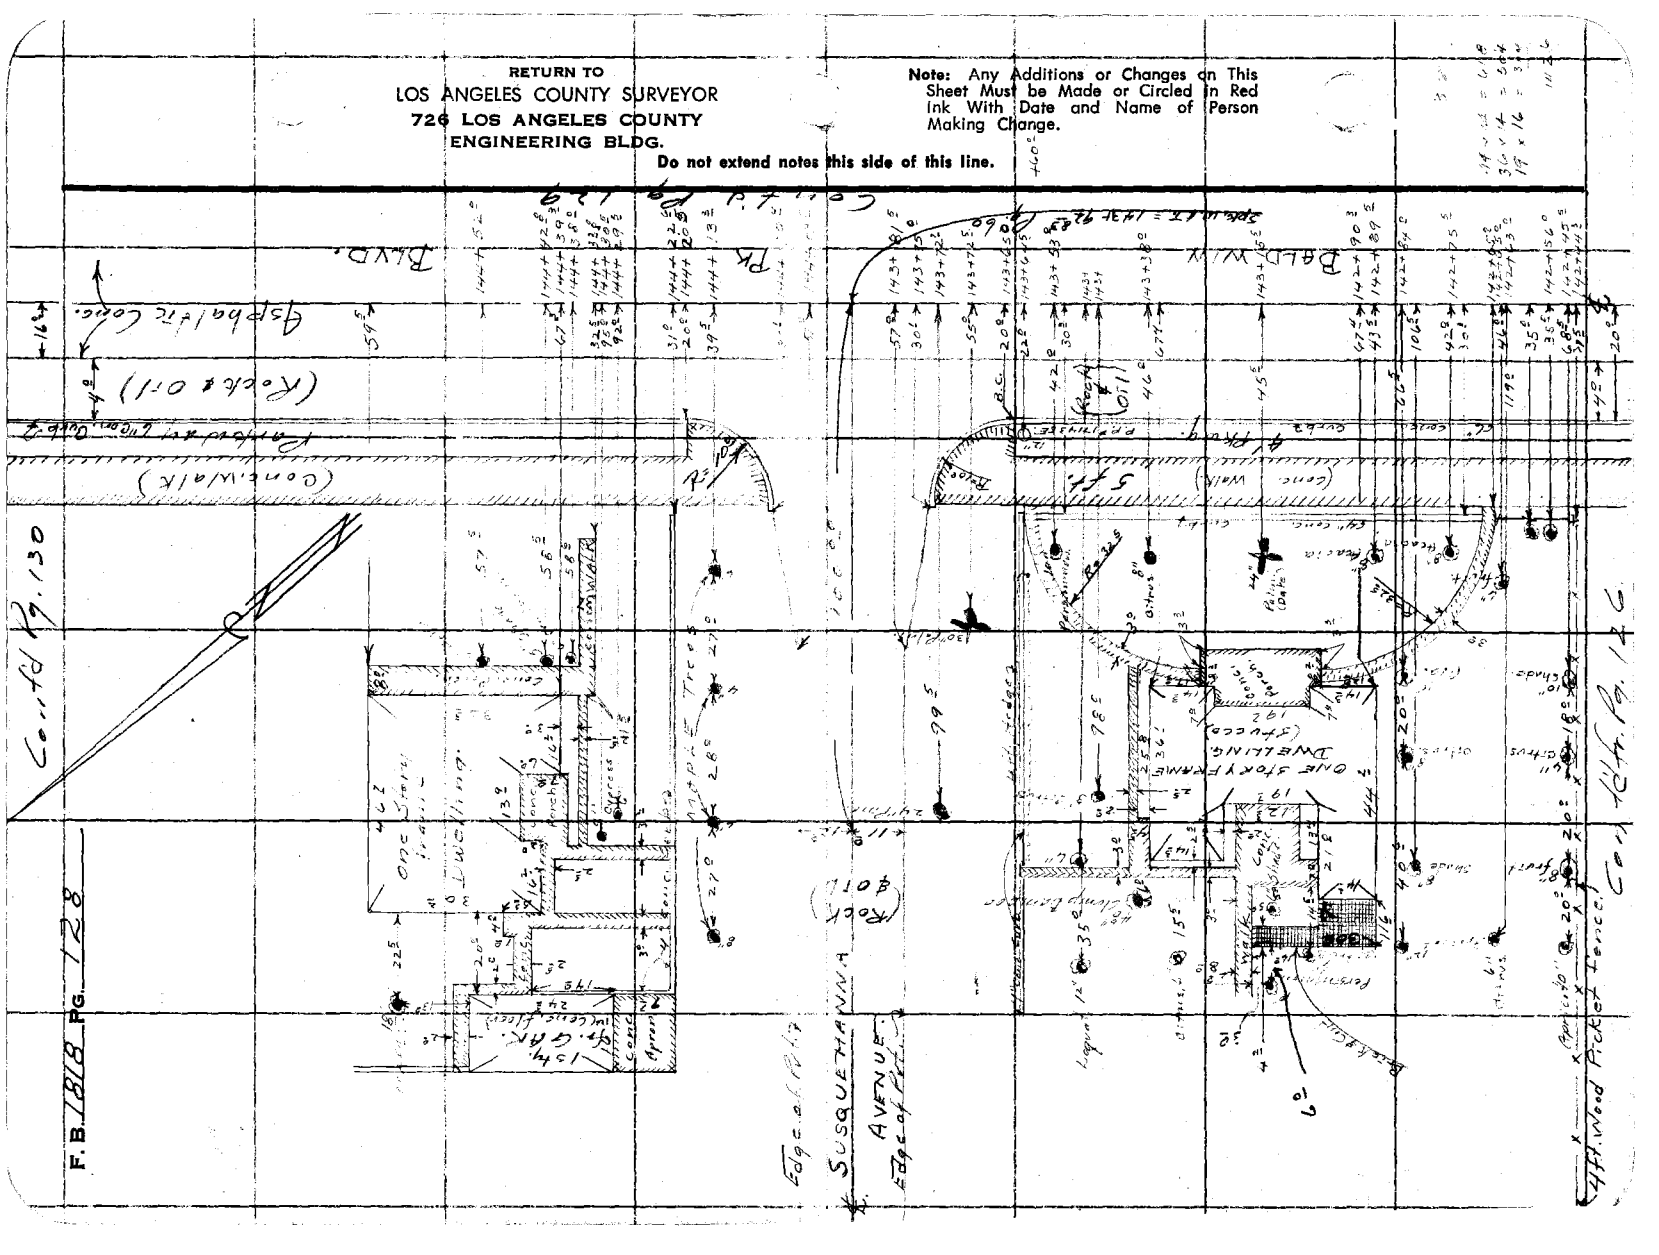
F.B. 1818 PG. 128
Susquehanna Avenue
Edge of Pvmt.
Edge of Pvmt.
Asphaltic Concr.
Curb & Gutter
Concr. Walk
Concr. Walk
Curb & Gutter
Asphaltic Concr.
Blvd.
Pk.
Baldwin
Pk.
Blvd.
Cont. Pg. 130
Cont. Pg. 147
Cont. Pg. 129
Cont. Pg. 129
Cont. Pg. 129

Contd. Pg. 131

Notes Ck'd by
Map No. C.S.B-2497-3
Office Work Burns
Checked Galli

Survey of Baldwin Park Blvd.
W. O. [illegible] Tape No. [illegible] St'd. 68 °F
Surveyed by [illegible]
Notes [illegible] Date 12/15
Indexed

F. B. [illegible] Pg. [illegible]

Note: Any Additions or Changes on This Sheet Must be Made or Circled in Red Ink With Date and Name of Person Making Change.

Do not extend note this side of this line.

RETURN TO
LOS ANGELES COUNTY SURVEYOR
726 LOS ANGELES COUNTY
ENGINEERING BLDG.

76FSOOS 247 4-53

144+65±
144+44±
144+43±
PP #5406
144+41±
144+36±
144+11±
143+92±
PP 60
SUSQUINA AVE
TRANSIT LINE
143+85±
143+84±
143+82±
143+71±
143+69±
143+65±
143+53±
143+47±
143+40±
8" Acacia
143+12±
142+99±
142+86±
6" Acacia
142+82±
TPHE 9433
142+64±
142+46±

BALDWIN PARK BL.
PARK AVE.
E. Alley
W. Alley
Poplar
Cor.
Conc. drive
Conc. drive
Conc.
Conc.
Conc.

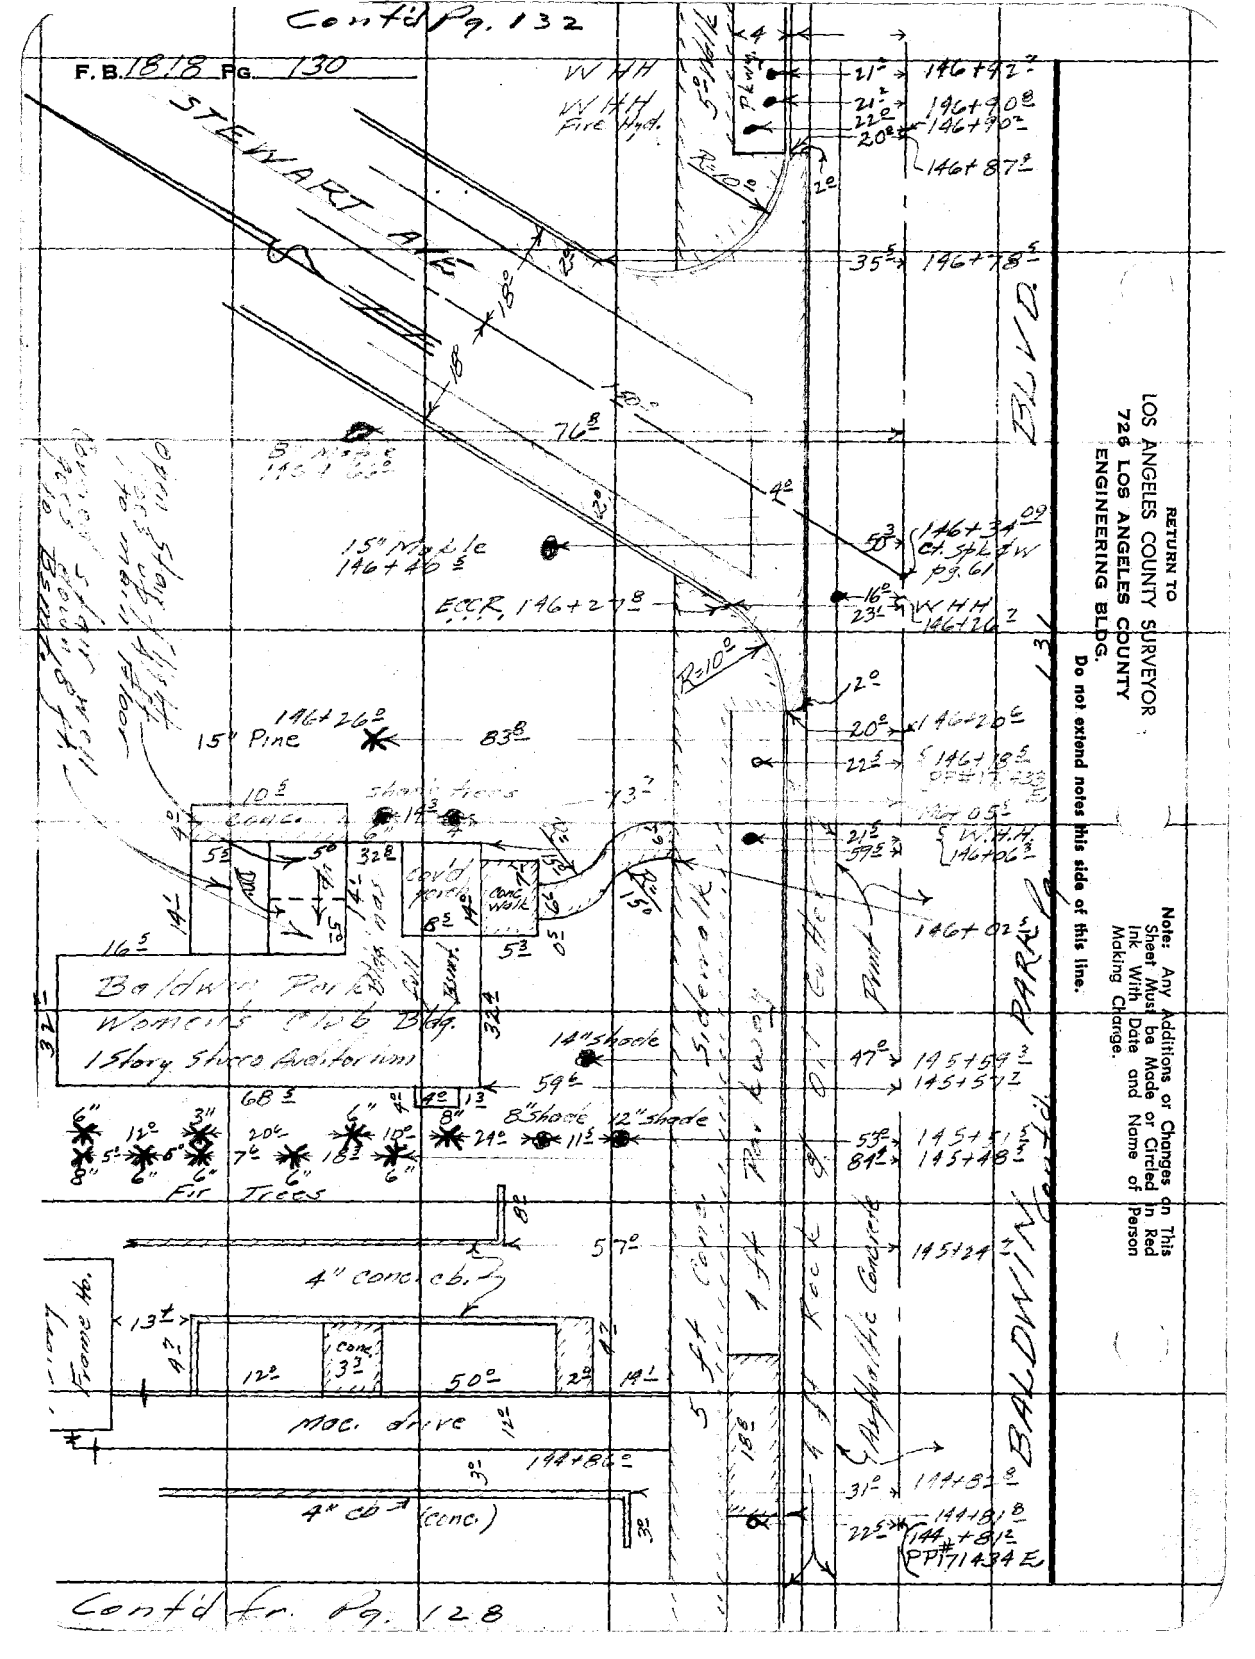
Contd Pg. 132
F. B. 1818 Pg. 130
STEWART AVE.
W H H
W H H Fire Hyd.
R=10'
2°
4°
21°
21½°
22°
20°
146+92±
196+90±
146+90±
146+87±
35±
196+78±
18'
18°
40°
76±
2°
4°
15" Maple
146+40±
58±
146+34.09
Ch. St. & W pg. 61
E.C.C.R. 146+27±
16°
23°
W H H
146+26±
BLVD.
R=10°
2°
20°
146+20±
22°
146+15±
146+26°
15" Pine
83±
10±
Conc.
Shade Trees
43±
21½°
59±
W.H.H.
146+06±
146+02±
Baldwin Park Womens Club Bldg.
1 Story Stucco Auditorium
14" Shade
47°
145+59±
145+57±
59±
68±
8" Shade
12" Shade
6" Fir Trees
53°
84±
145+51±
145+48±
57°
145+24±
4" conc. cb.
Frame Ho.
Conc.
12°
50°
Mac. drive
144+86±
4" cb (conc.)
31°
144+81±
22½°
144+81±
PP# 71434 E.
BALDWIN PARK
Contd fr. Pg. 128
RETURN TO
LOS ANGELES COUNTY SURVEYOR
726 LOS ANGELES COUNTY
ENGINEERING BLDG.
Do not extend notes this side of this line.
Note: Any Additions or Changes on This Sheet Must be Made or Circled in Red Ink With Date and Name of Person Making Change.

Notes Ck'd by
Map No. C.S.B-2497-3
Office Work Burns
Checked Galli

Survey of Baldwin Park Blvd
W. O. 8641 Tape No. 0114 St'd. 68 °F
Surveyed by Mitchell
Notes [illegible] Date 12-53

F. B. 516 Pg. 131

Contd. Pg. 135

Note: Any Additions or Changes on This Sheet Must be Made or Circled In Red Ink With Date and Name of Person Making Change.

Do not extend notes this side of this line.

RETURN TO
LOS ANGELES COUNTY SURVEYOR
726 LOS ANGELES COUNTY
ENGINEERING BLDG.

76FSOSB 247 4-53

Contd. fr. Pg. 129

RETURN TO
LOS ANGELES COUNTY SURVEYOR
726 LOS ANGELES COUNTY
ENGINEERING BLDG.

Note: Any Additions or Changes on This Sheet Must be Made or Circled in Red Ink With Date and Name of Person Making Change.

Do not extend notes this side of this line.

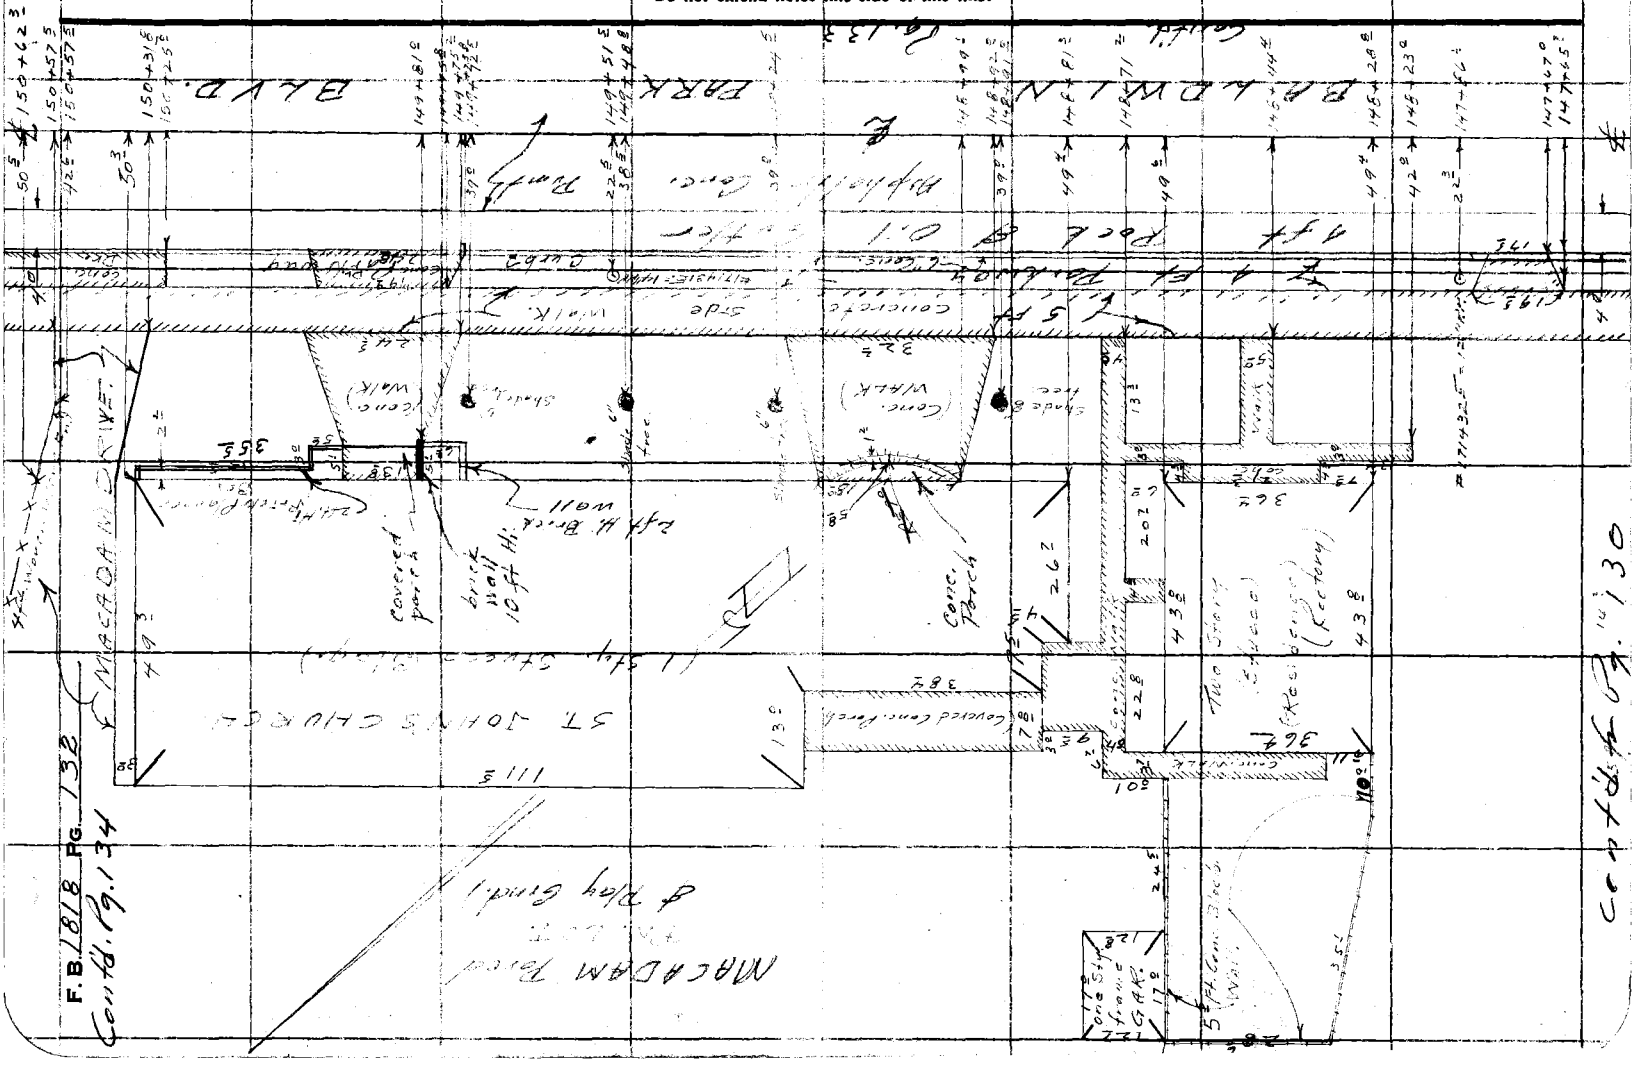

Notes Ck'd by
Map No. C.S.B.-2497-3
Office Work Burns
Checked Galli

Survey of Baldwin Pk. Blvd
W. O. 864A Tape No. 2114 St'd. 68° °F
Surveyed by K. J. [illegible]
Notes [illegible] Date 12-53

F. B. 1814 Pg. 32

Cont'd. Fg. 135

Note: Any Additions or Changes on This Sheet Must be Made or Circled in Red Ink With Date and Name of Person Making Change.

Do not extend notes this side of this line.

RETURN TO
LOS ANGELES COUNTY SURVEYOR
726 LOS ANGELES COUNTY
ENGINEERING BLDG.

76FSOBS 247 4-55

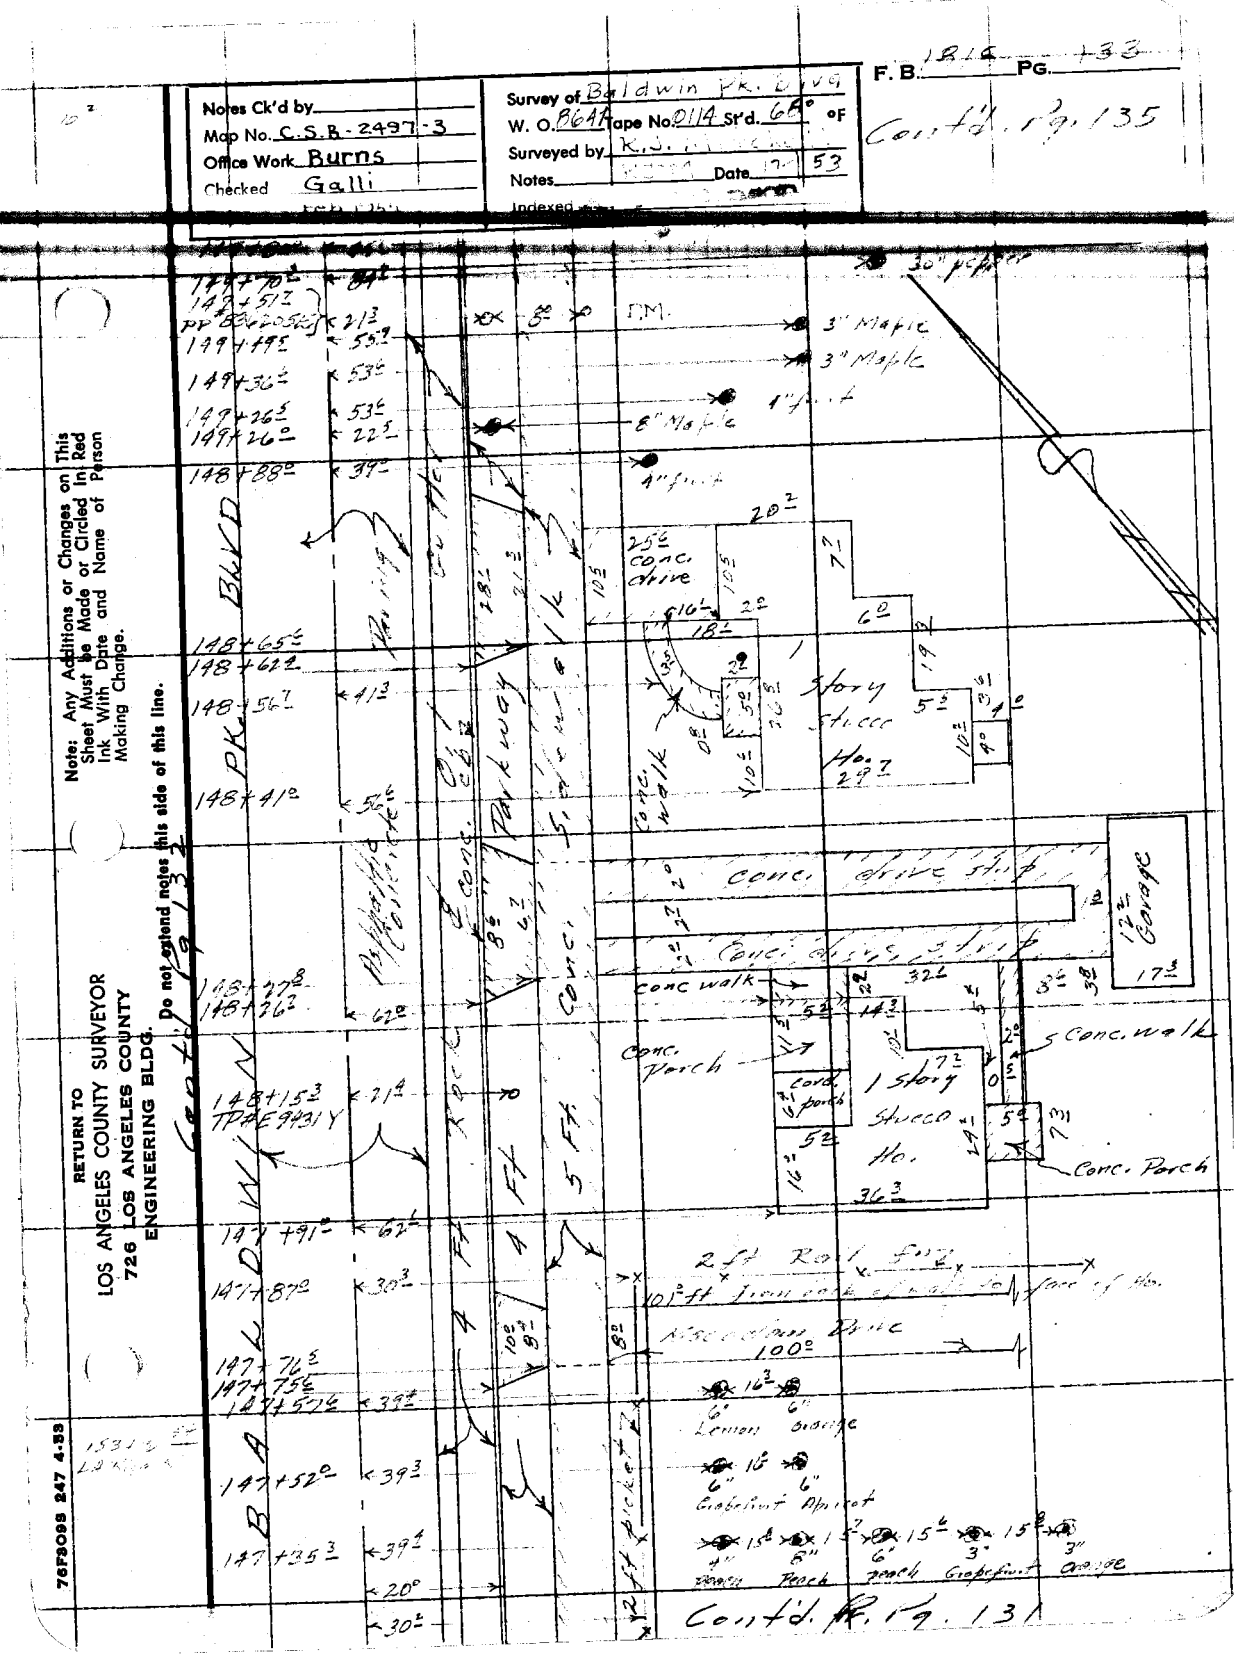

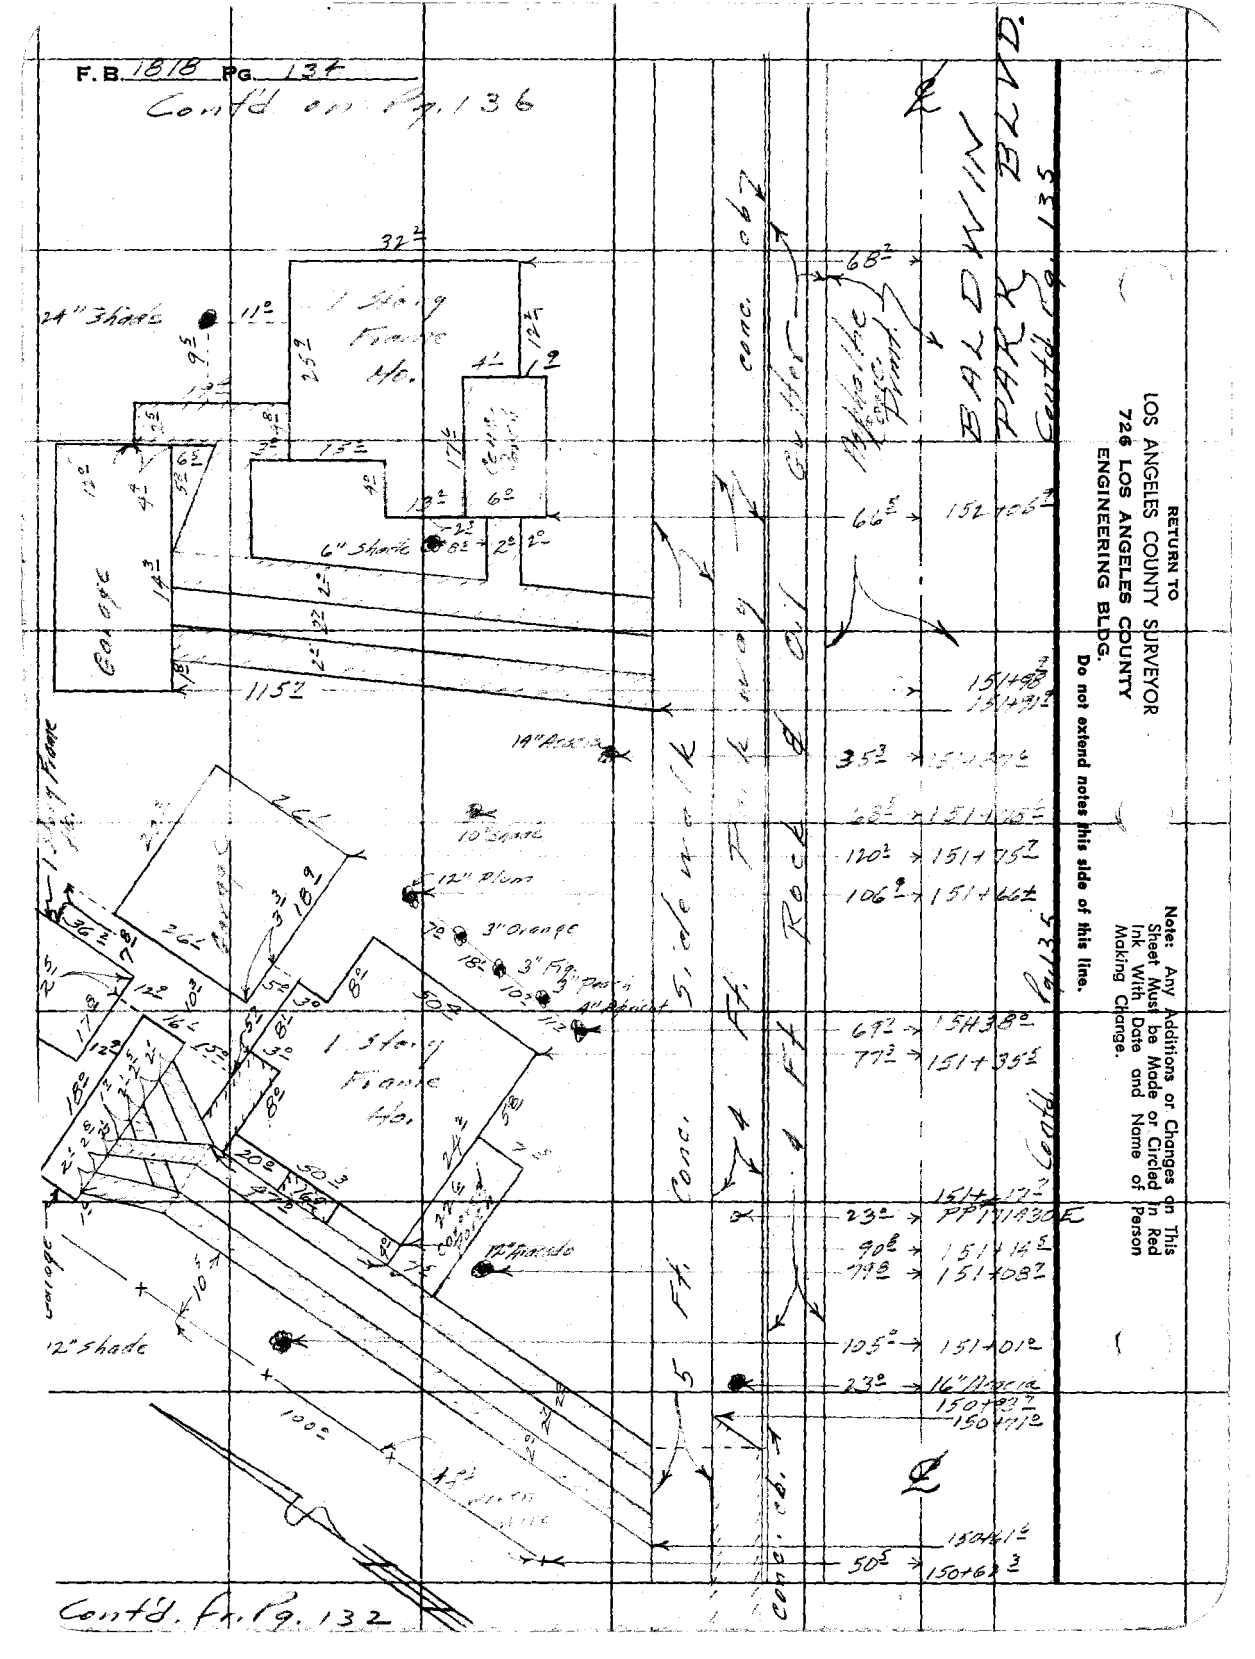
F.B. 1818 Pg. 134
Cont'd on Pg. 136
RETURN TO
LOS ANGELES COUNTY SURVEYOR
726 LOS ANGELES COUNTY
ENGINEERING BLDG.
Do not extend notes this side of this line.
Note: Any Additions or Changes on This Sheet Must be Made or Circled in Red Ink With Date and Name of Person Making Change.
BALDWIN PARK BLVD.
Cont'd Pg. 135
1 Story Frame H/C.
24" Shade
12" Shade
6" Shade
10" Shade
3" Orange
3" Fig
4" Apricot
16" Avocado
Cont'd. Pg. 132

Notes Ck'd by
Map No. C.S.B. 2497-3
Office Work Burns
Checked Galli

Survey of Baldwin Park Blvd
W. O. 964 Tape No. 1114 Std. 68 °F
Surveyed by R.J. Pilgrim
Notes [illegible] Date [illegible]

F. B. 1217 Pg. 134
Cont'd. Pg 137

RETURN TO
LOS ANGELES COUNTY SURVEYOR
726 LOS ANGELES COUNTY
ENGINEERING BLDG.

Note: Any Additions or Changes on This Sheet Must be Made or Circled In Red Ink With Date and Name of Person Making Change.

Do not extend notes this side of this line.

Cont'd. Pg. 134

BALDWIN PARK BLVD.

Cont'd. fr. Pg. 132

Cont'd. fr. Pg. 131

76F3088 247 4-53

RETURN TO
LOS ANGELES COUNTY SURVEYOR
726 LOS ANGELES COUNTY
ENGINEERING BLDG.

Note: Any Additions or Changes on This Sheet Must be Made or Circled in Red Ink With Date and Name of Person Making Change.

Do not extend notes this side of this line.

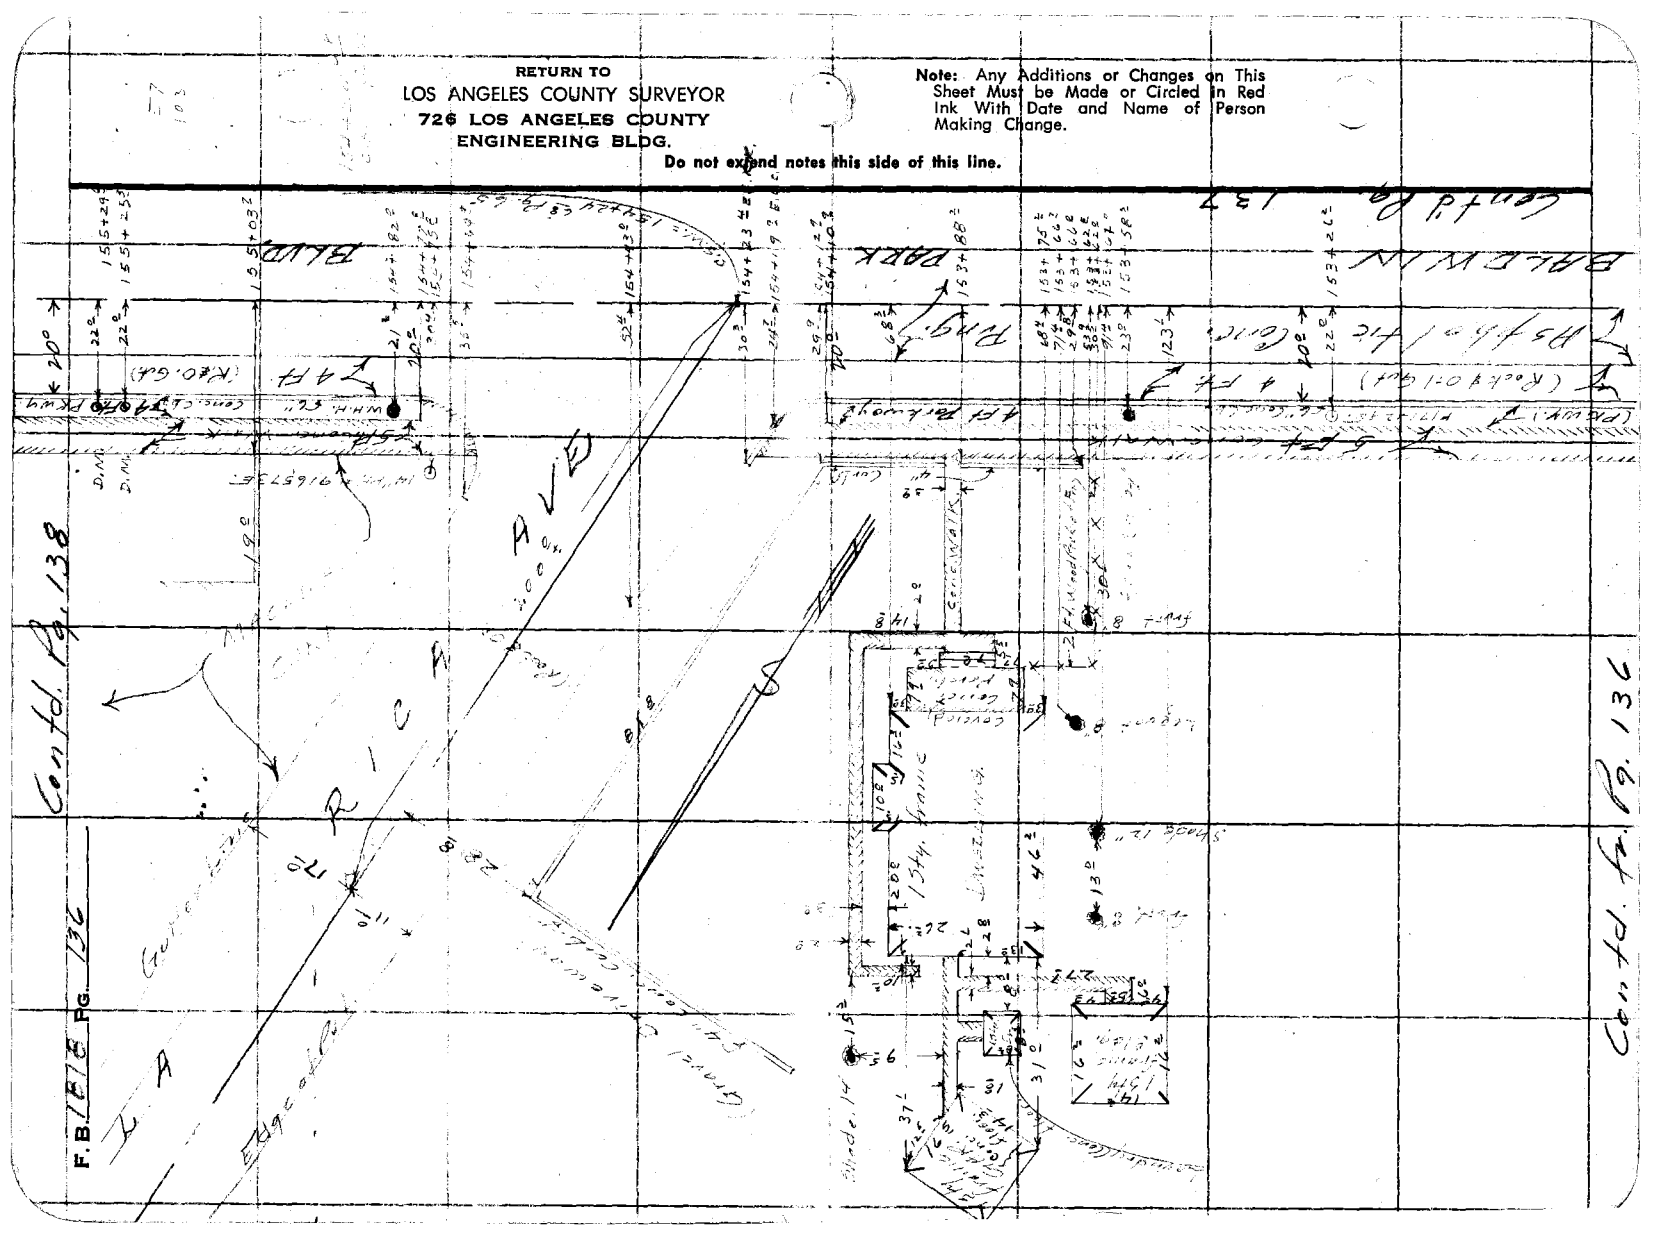
Contd. Pg. 138
Contd. Pg. 136
F.B. 181 Pg. 136
Contd. Pg. 137
BLVD.
PARK
PARKWAY
ALICE
AVE.
4 Ft Parkway

Notes Ck'd by	Survey of Baldwin Park Blvd
Map No. C.S.B-2497-3	W. O.	Tape No.	St'd.	°F
Office Work Burns	Surveyed by K.J. Mitchell
Checked Galli	Notes J.M.M.	Date
	Indexed

F. B. 1018 PG. 137

Cont'd. on Pg. 139

Note: Any Additions or Changes on This Sheet Must be Made or Circled in Red Ink With Date and Name of Person Making Change.

RETURN TO
LOS ANGELES COUNTY SURVEYOR
726 LOS ANGELES COUNTY
ENGINEERING BLDG.

Do not extend notes this side of this line.

Cont'd. fr. Pg. 135

78FSOBS 247 4.83

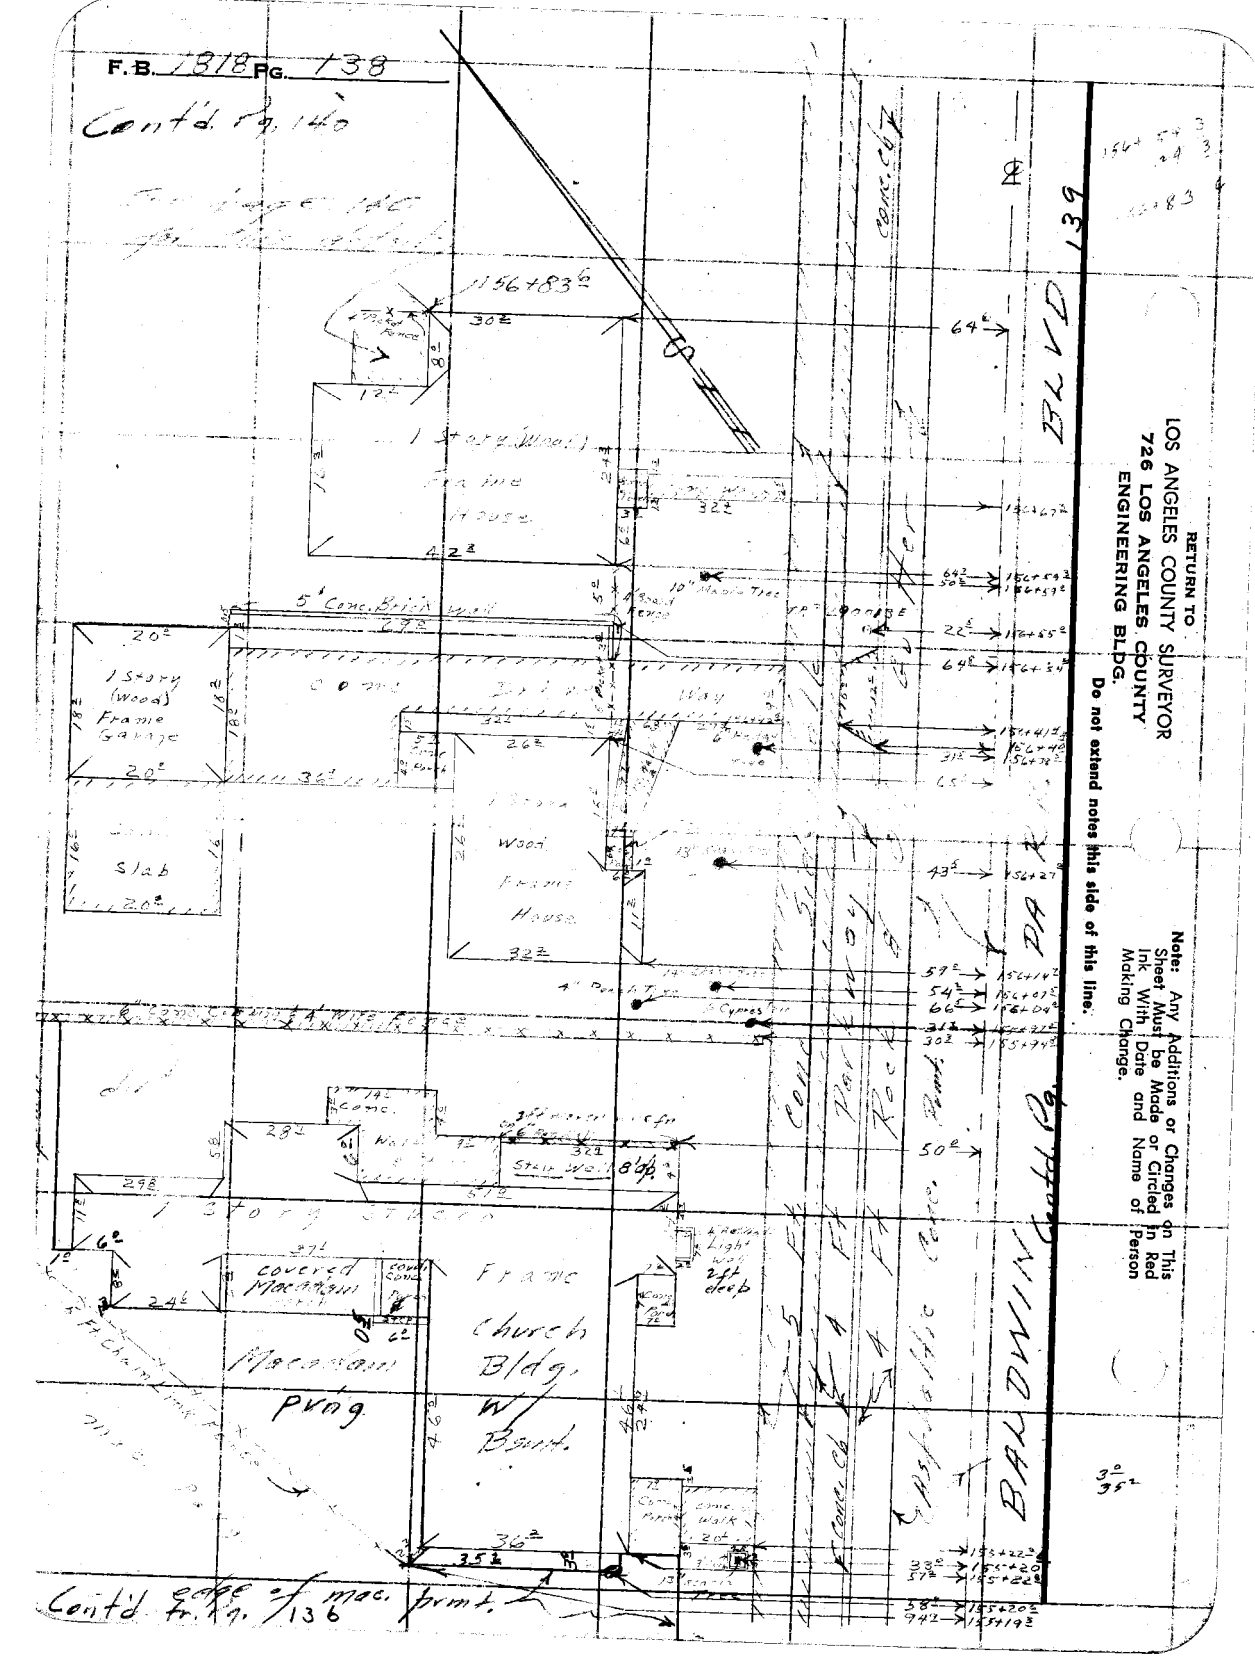
F.B. 1318 Pg. 138
RETURN TO
LOS ANGELES COUNTY SURVEYOR
726 LOS ANGELES COUNTY
ENGINEERING BLDG.
Do not extend notes this side of this line.
Note: Any Additions or Changes on This Sheet Must be Made or Circled in Red Ink With Date and Name of Person Making Change.
BALDWIN
1 Story (Wood) Frame Garage
Slab
1 Story Frame House
Frame Church Bldg. W/ Bsmt.
Covered Macadam
Macadam Pvmg.
5' Conc. Brick Wall
Cover. Cd.
Cont'd. edge of mac. pvmt. fr. pg. 136

Notes Ck'd by
Map No. C.S.B - 2497-3
Office Work Burns
Checked Galli

Survey of Valentia Ma. K 13 Lot 9
W. O. 3641 Tape No. 014 St'd. 68 °F
Surveyed by R. J. [illegible]
Notes R. J. [illegible] Date [illegible]
Indexed

F. B. 12.4 Pg. 129

Cont'd Pg. 141

Note: Any Additions or Changes on This Sheet Must be Made or Circled In Red Ink With Date and Name of Person Making Change.

Do not extend notes this side of this line.

RETURN TO
LOS ANGELES COUNTY SURVEYOR
726 LOS ANGELES COUNTY
ENGINEERING BLDG.

76F3098 247 4-53

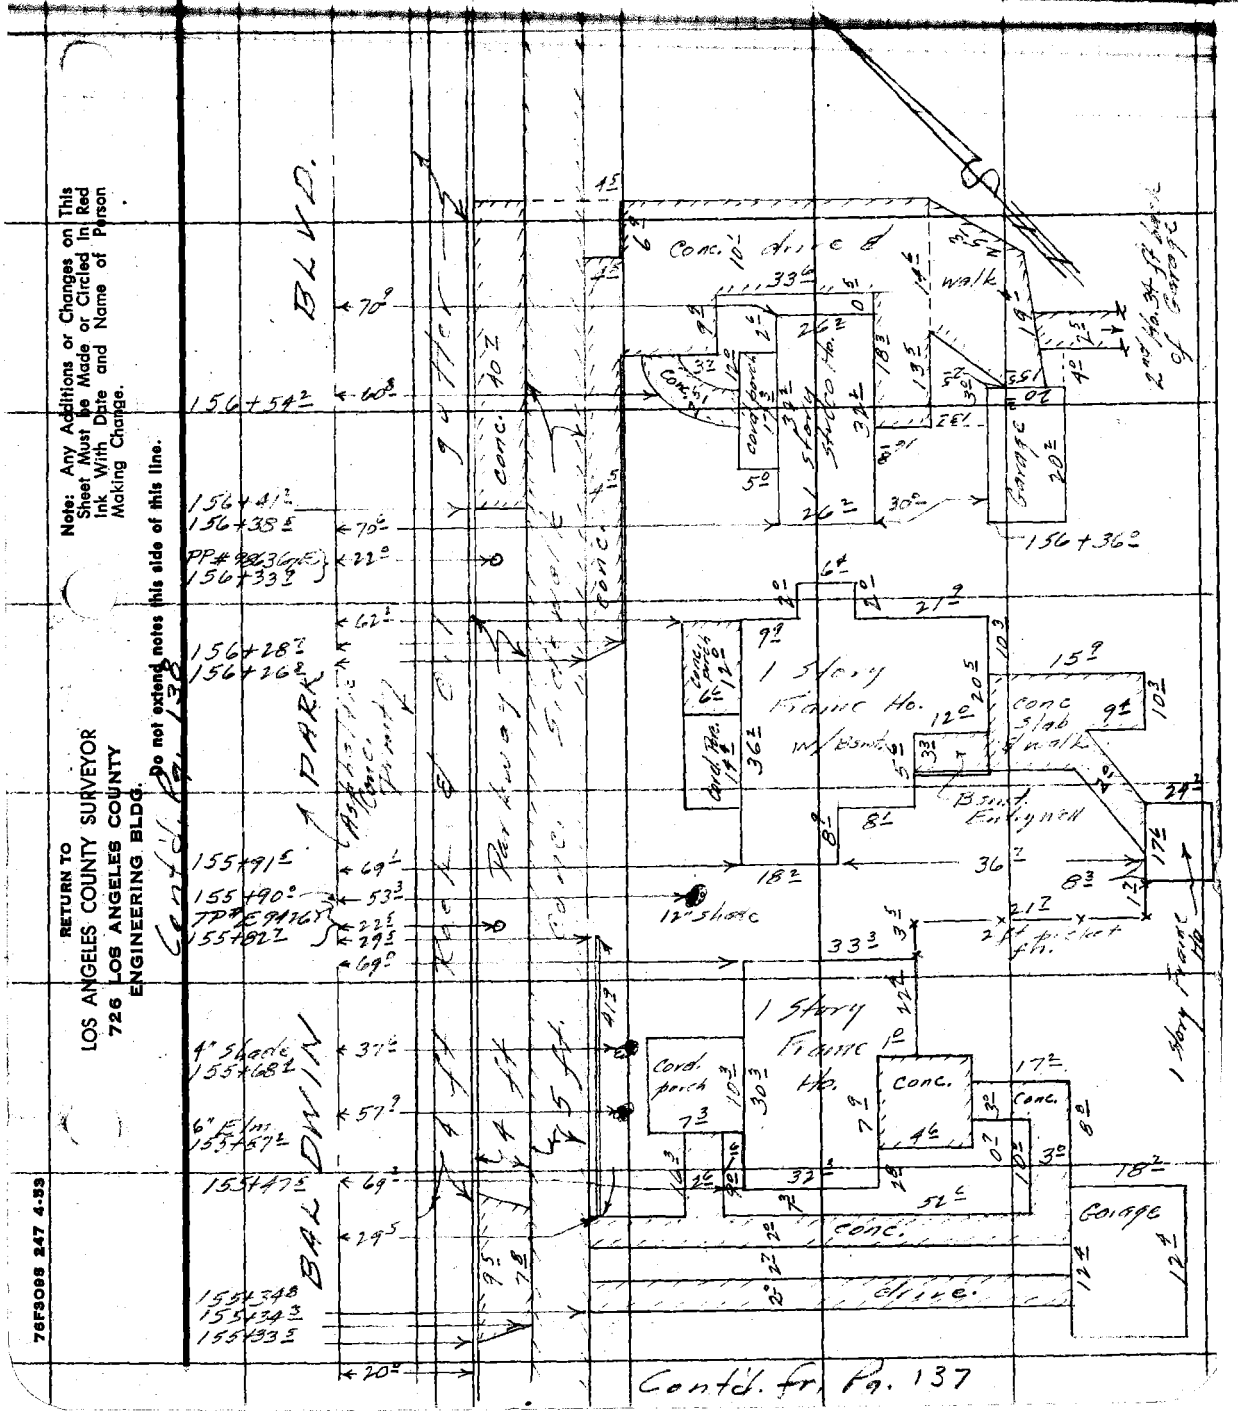

F. B. 1818 PG. 140

Cont'd. Pg. 142

Macadam drive

12" cocoa. palms

4" pepper

12" cocoa palms

Macadam drive w/ 4" conc. curb

conc. drive

Garage & Laundry

1 Story Frame Ho.

Add'n 6th Story well to basement

10" peach 14" 9" peach 16" 10" Apricot peach 12" 6" peach 15" 12" peach

4 ft. steel rod fence

Covd. Carport

Garage

conc. apron

4 ft. brick fence

Ho.

Corner of Ho. see pg. 138

Cont'd. fr. Pg. 138

Conc. curb

Conc. walk

Conc.

Rock wall

Asphalt & Conc. of Public Park

Fr. Thwy

Conc. curb

Conc. curb & gutter

BALDWIN BLVD

RETURN TO
LOS ANGELES COUNTY SURVEYOR
726 LOS ANGELES COUNTY
ENGINEERING BLDG.

Do not extend notes this side of this line.

Note: Any Additions or Changes on This Sheet Must be Made or Circled in Red Ink With Date and Name of Person Making Change.

Notes Ck'd by
Map No. C.S.B-2497-3
Office Work Burns
Checked Galli

Survey of Baldwin Park Blvd.
W. O. 8641 Tape No. 0114 St'd. 66 °F
Surveyed by Mitchell
Notes Sur. - 1911 Date 12-5?

F. B. 1615 Pg. 141
Cont'd. Fr. Pg. 73

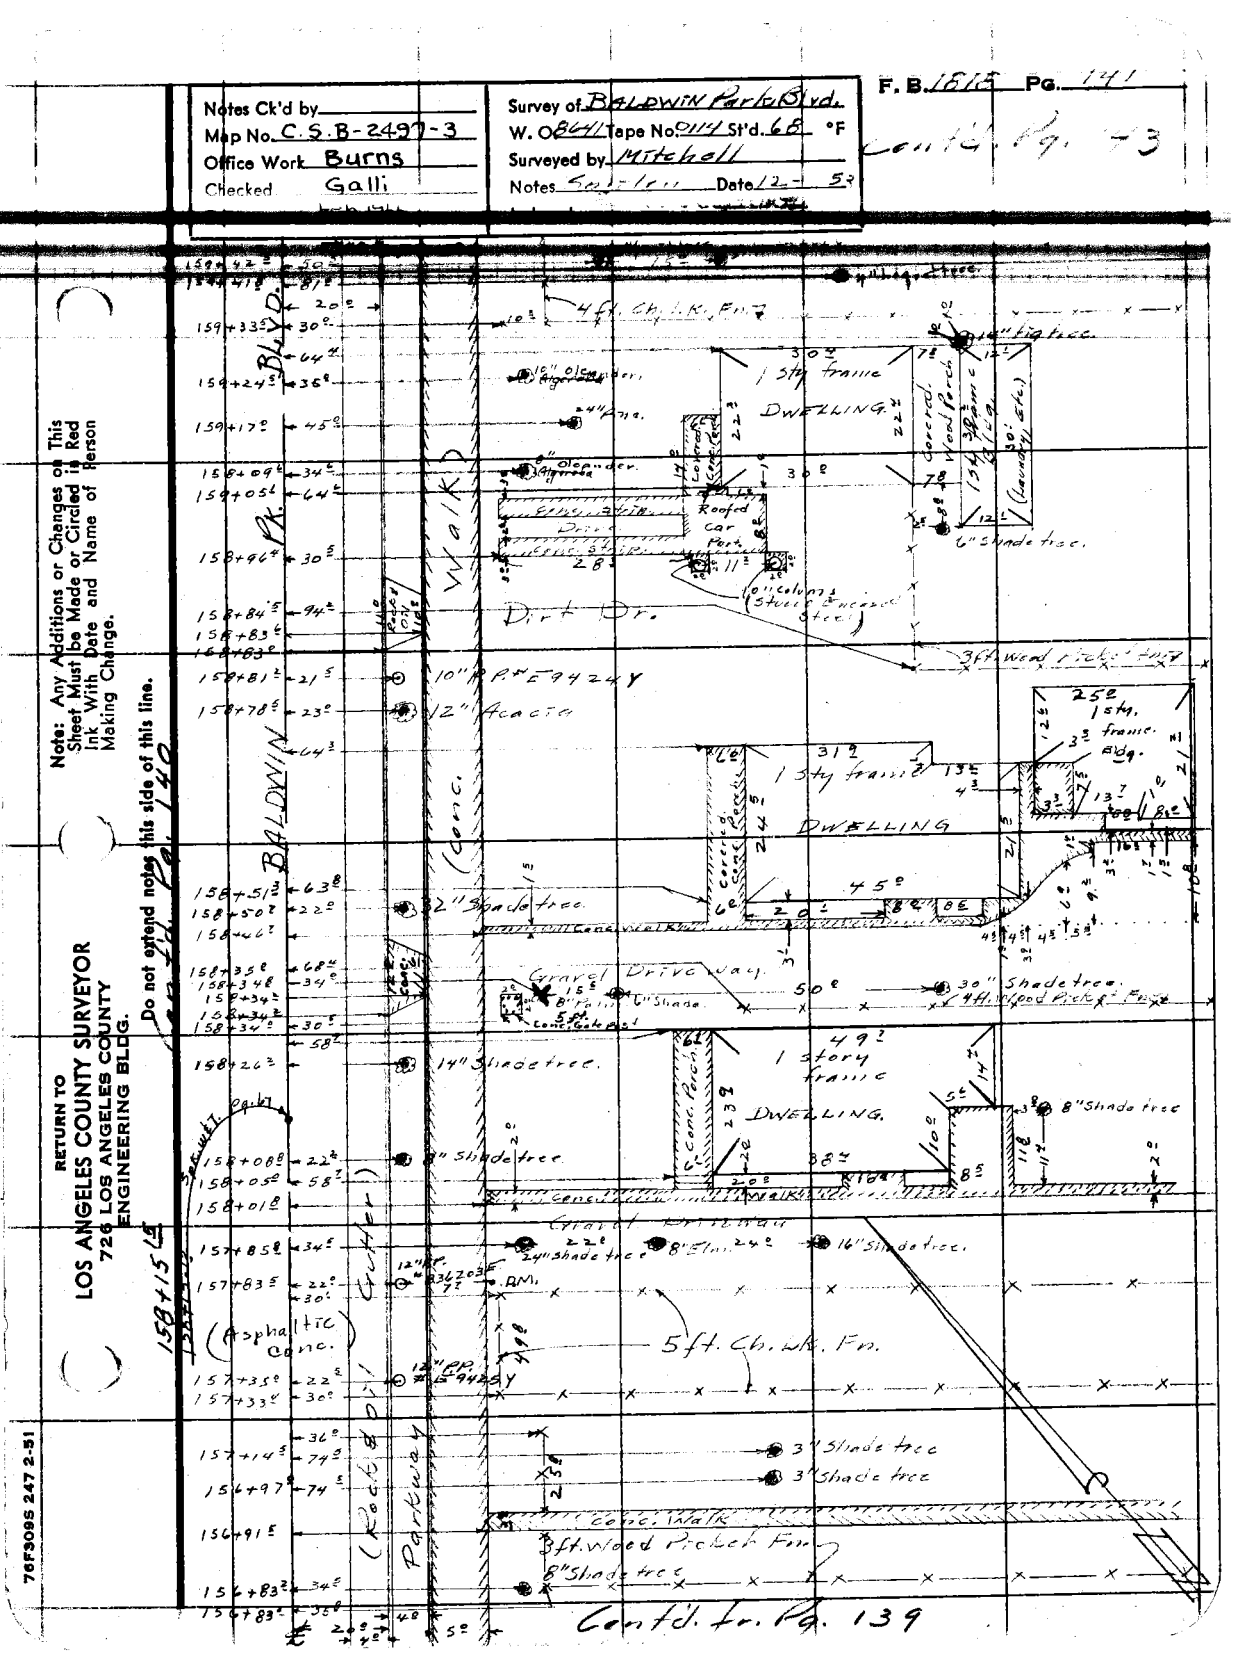
Baldwin Park Blvd.
Walk
Conc.
Dirt Dr.
Gravel Drive way
Gutter
Asphaltic conc.
Parkway
1 Sty frame DWELLING
1 story frame DWELLING
Roofed car Port
Concrete Porch
Concrete Walk
Gravel Driveway
4 ft. Ch. Lk. Fn.
5 ft. Ch. Lk. Fn.
8 ft. Wood Picket Fn.
6" Shade tree.
8" Shade tree.
14" Shade tree.
16" Fig tree.
24" Shade tree.
3 Shade tree
10" Pine
12" Acacia

F. B. 1818 PG. 142

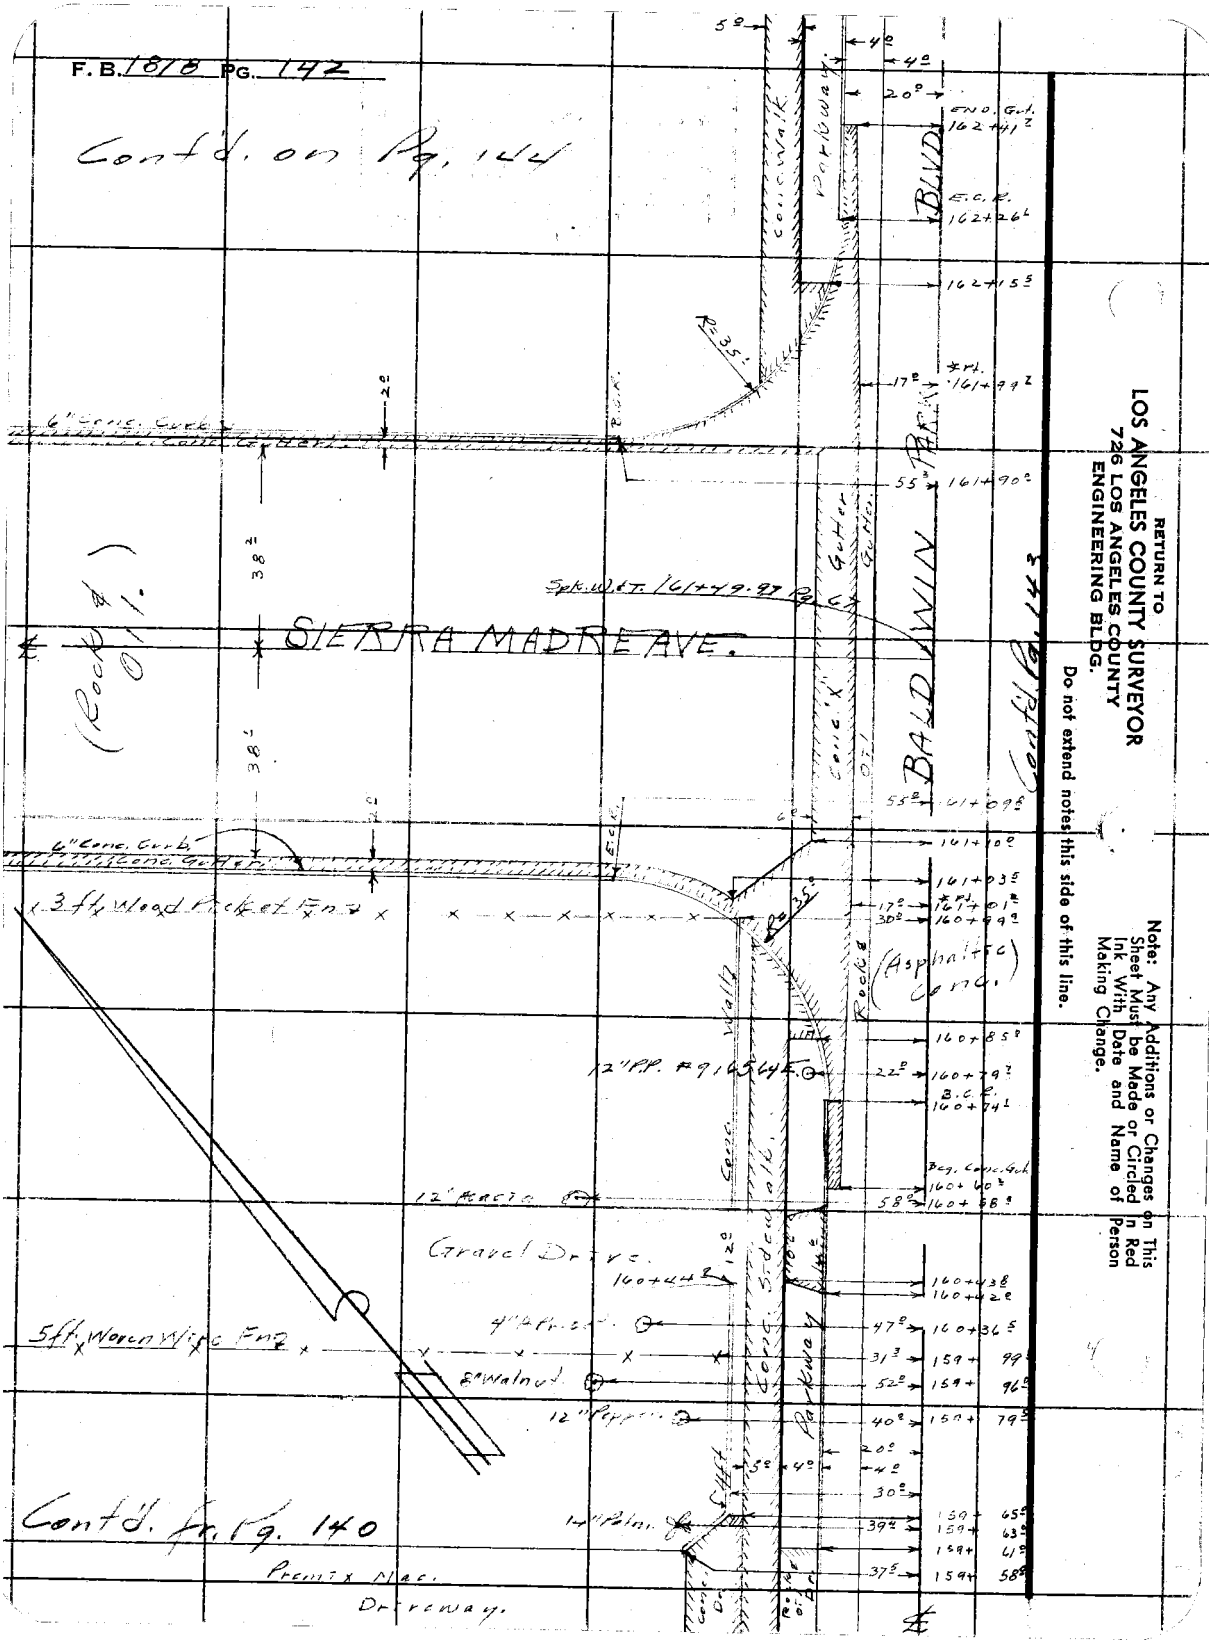

RETURN TO
LOS ANGELES COUNTY SURVEYOR
726 LOS ANGELES COUNTY
ENGINEERING BLDG.

Do not extend notes this side of this line.

Note: Any Additions or Changes on This Sheet Must be Made or Circled In Red Ink With Date and Name of Person Making Change.

F.B. 1212 PG. 143

Cont'd Pg. 145

Notes Ck'd by
Map No. C.S.B-2437-3
Office Work Burns
Checked Galli

Survey of Baldwin Park Blvd
W. O. 2641 Tape No. 0114 St'd. 68 °F
Surveyed by K.J.A. / C.C.H.
Notes K.J.A. Date Jan 59

Note: Any Additions or Changes on This Sheet Must be Made or Circled in Red Ink With Date and Name of Person Making Change.

Do not extend notes this side of this line.

RETURN TO
LOS ANGELES COUNTY SURVEYOR
726 LOS ANGELES COUNTY
ENGINEERING BLDG.

Cont'd Fr. 142

BALDWIN PARK BLVD

1 Story Frame Ho. 7.8

Conc. porch

Conc. walk

Macadam Drive

Gas Station

1 Story Frame Ho.

Conc. walk

Conc. drive

1 Story Frame Ho.

Conc. porch

Conc.

Conc. walk

1 Story Frame Ho.

Conc.

wood porch

Conc. drive

vacant lot

dirt drive

1 Story Stucco Ho. 80 ft fr. P/L

4 ft. ch. link fm.

3 ft. lath fm.

Conc. drive to Ho. back 118 ft fr. St. L

29" Cafe palms

Fire Hyd.

S. M. AVE

SW Cor 0.03 SE

PG 67

WHIT

6" Shade

8" Shade

4" Apricot

DM

TP# K 9423 Y

TP# K 9423 Y

TP# K 9423 Y

Cont'd Fr. 141

76FSOSS 247 4-53

17.00

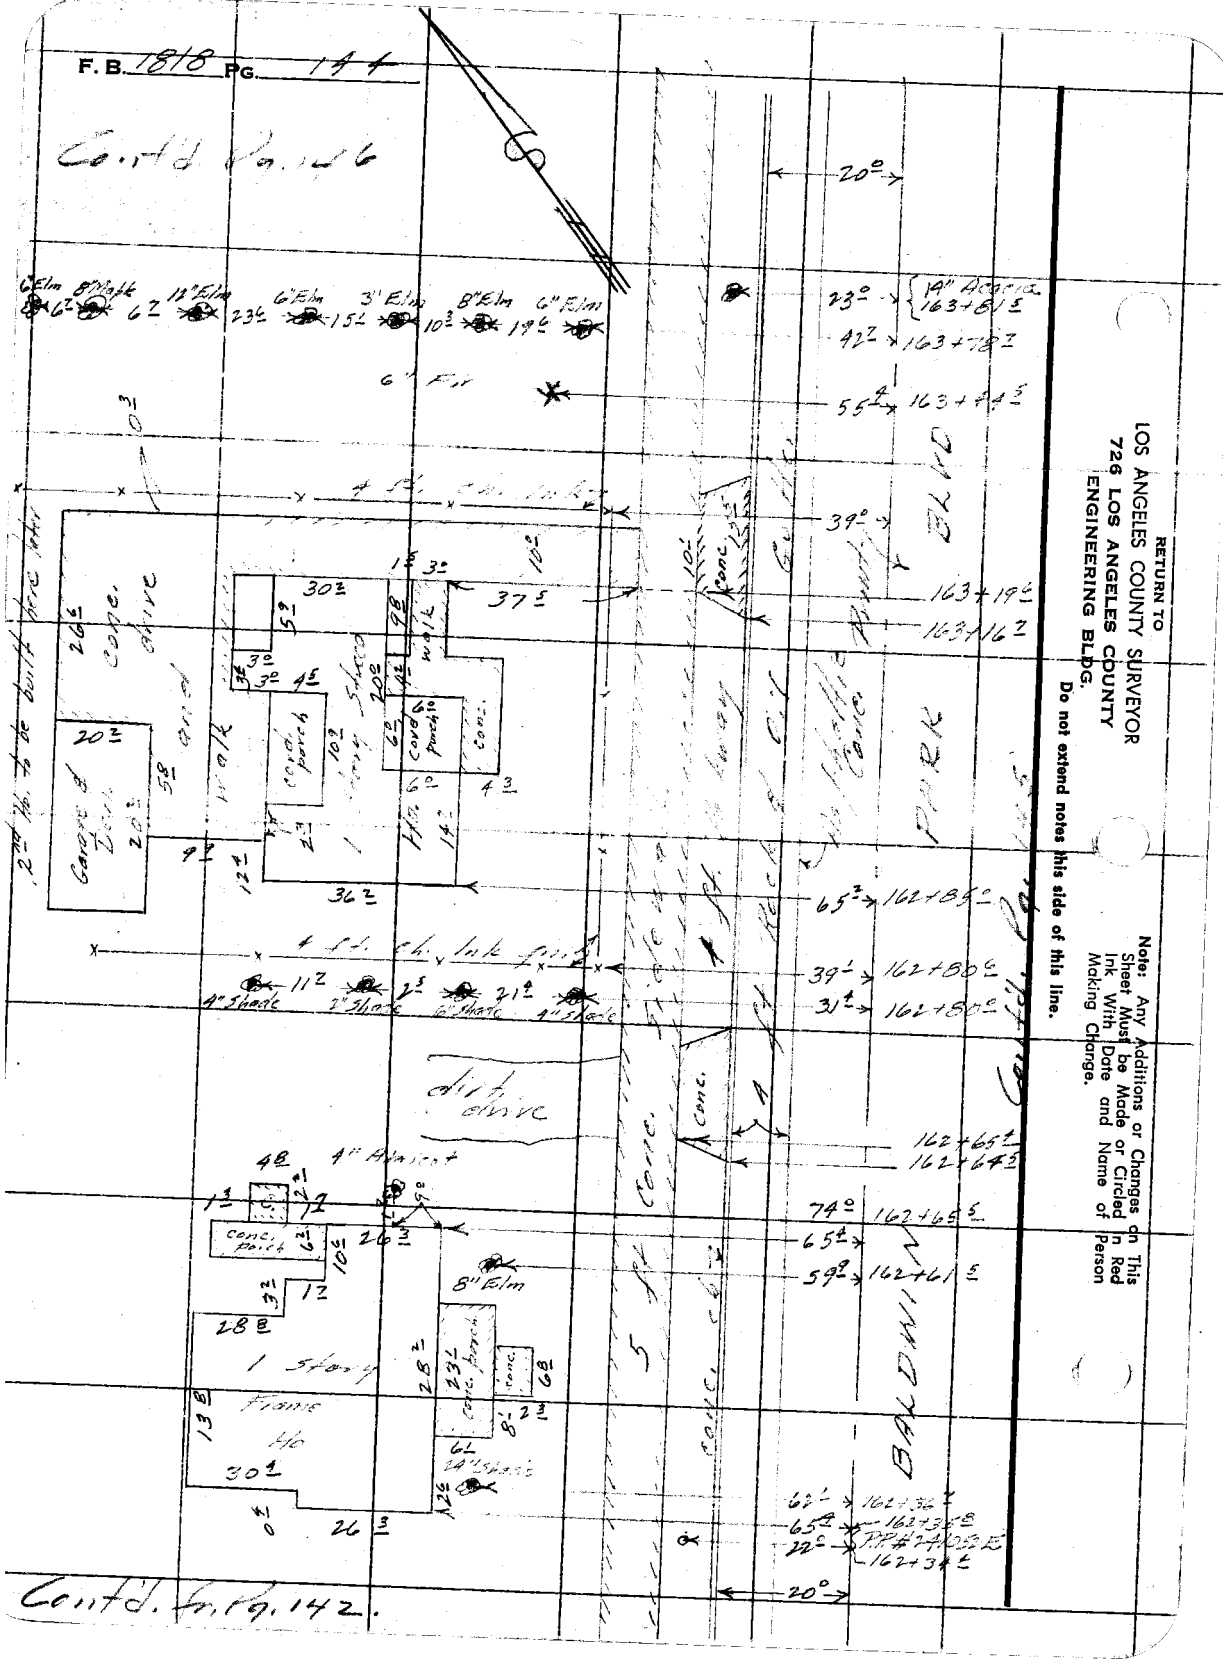
F. B. 1818 PG. 144
Cont'd from p. 146
RETURN TO
LOS ANGELES COUNTY SURVEYOR
726 LOS ANGELES COUNTY
ENGINEERING BLDG.
Do not extend notes this side of this line.
Note: Any Additions or Changes on This Sheet Must be Made or Circled in Red Ink With Date and Name of Person Making Change.
BALDWIN
Cont'd. from p. 142.

Notes Ck'd by
Map No. C.S.B-2497-3
Office Work Burns
Checked Galli

Survey of Baldwin Park Blvd
W. O. 8641 Tape No. 0114 Sr'd. 68 °F
Surveyed by R.T. Mitsuda
Notes Map Date 6-5-59
Indexed

F.B. 1470 Pg. 145

Cont'd. Pg. 147

Note: Any Additions or Changes on This Sheet Must be Made or Circled in Red Ink With Date and Name of Person Making Change.

Do not extend notes this side of this line.

RETURN TO
LOS ANGELES COUNTY SURVEYOR
726 LOS ANGELES COUNTY
ENGINEERING BLDG.

76F3088 247 4-33

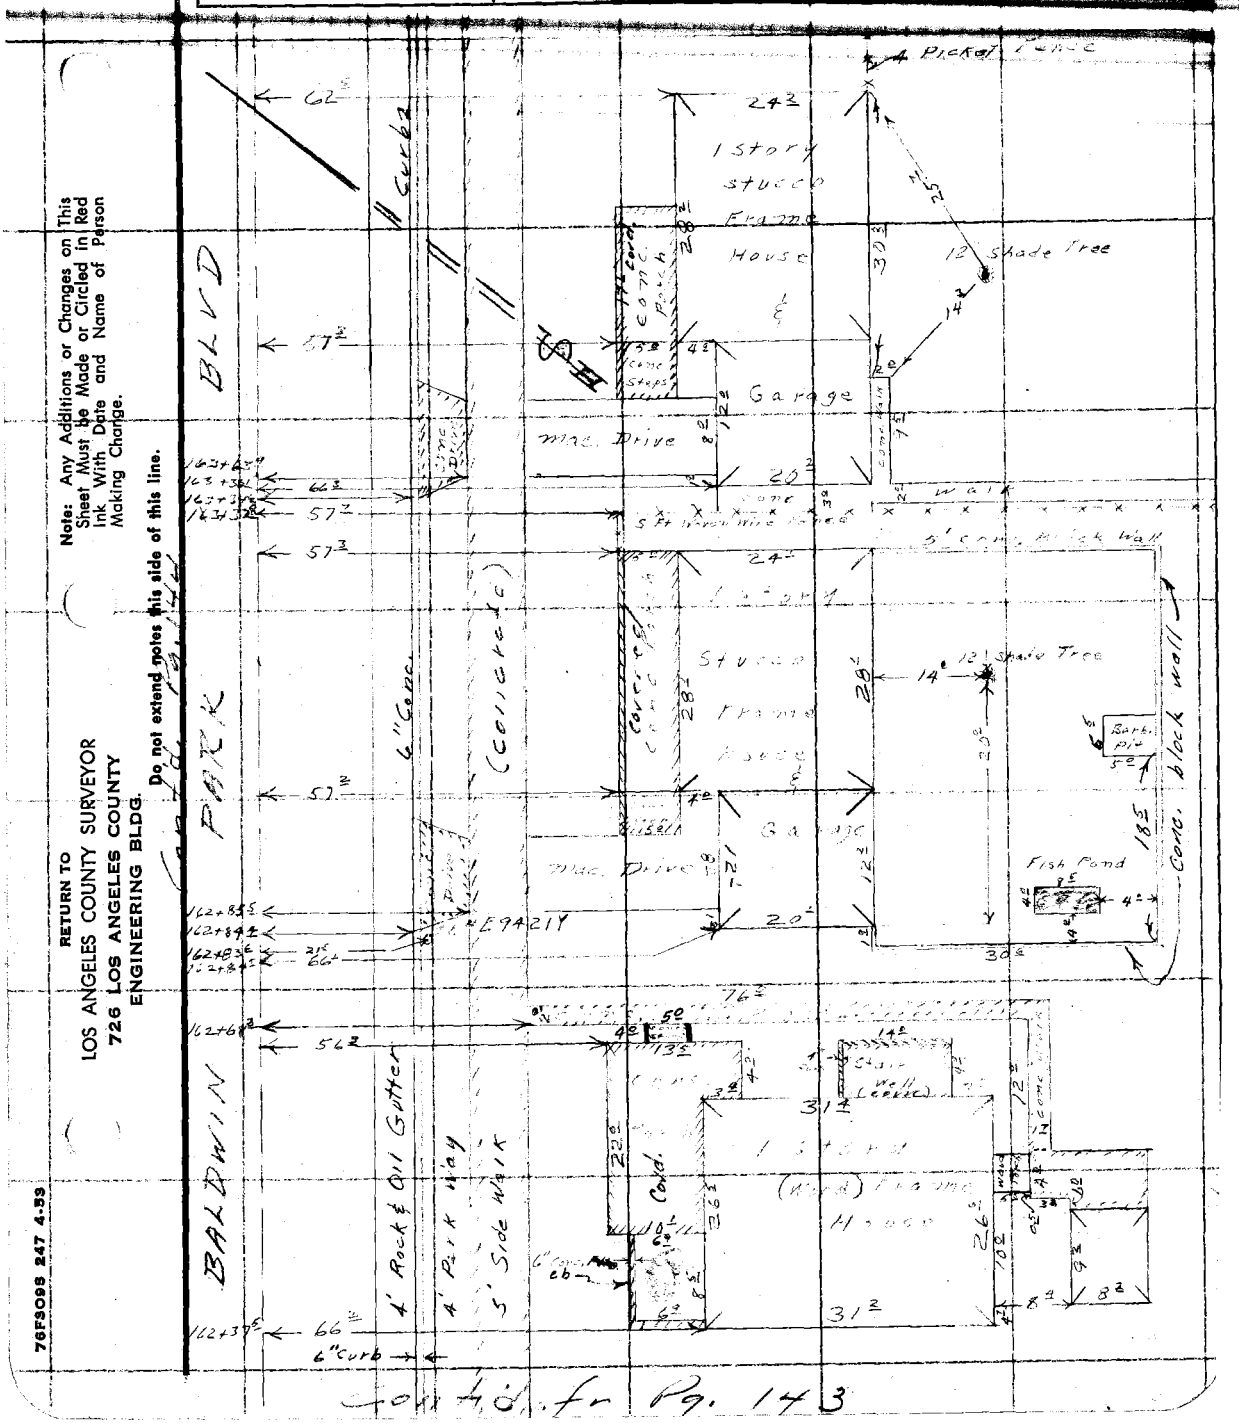

Cont'd. for Pg. 143

RETURN TO
LOS ANGELES COUNTY SURVEYOR
726 LOS ANGELES COUNTY
ENGINEERING BLDG.

Note: Any Additions or Changes on This Sheet Must be Made or Circled in Red Ink With Date and Name of Person Making Change.

Do not extend notes this side of this line.

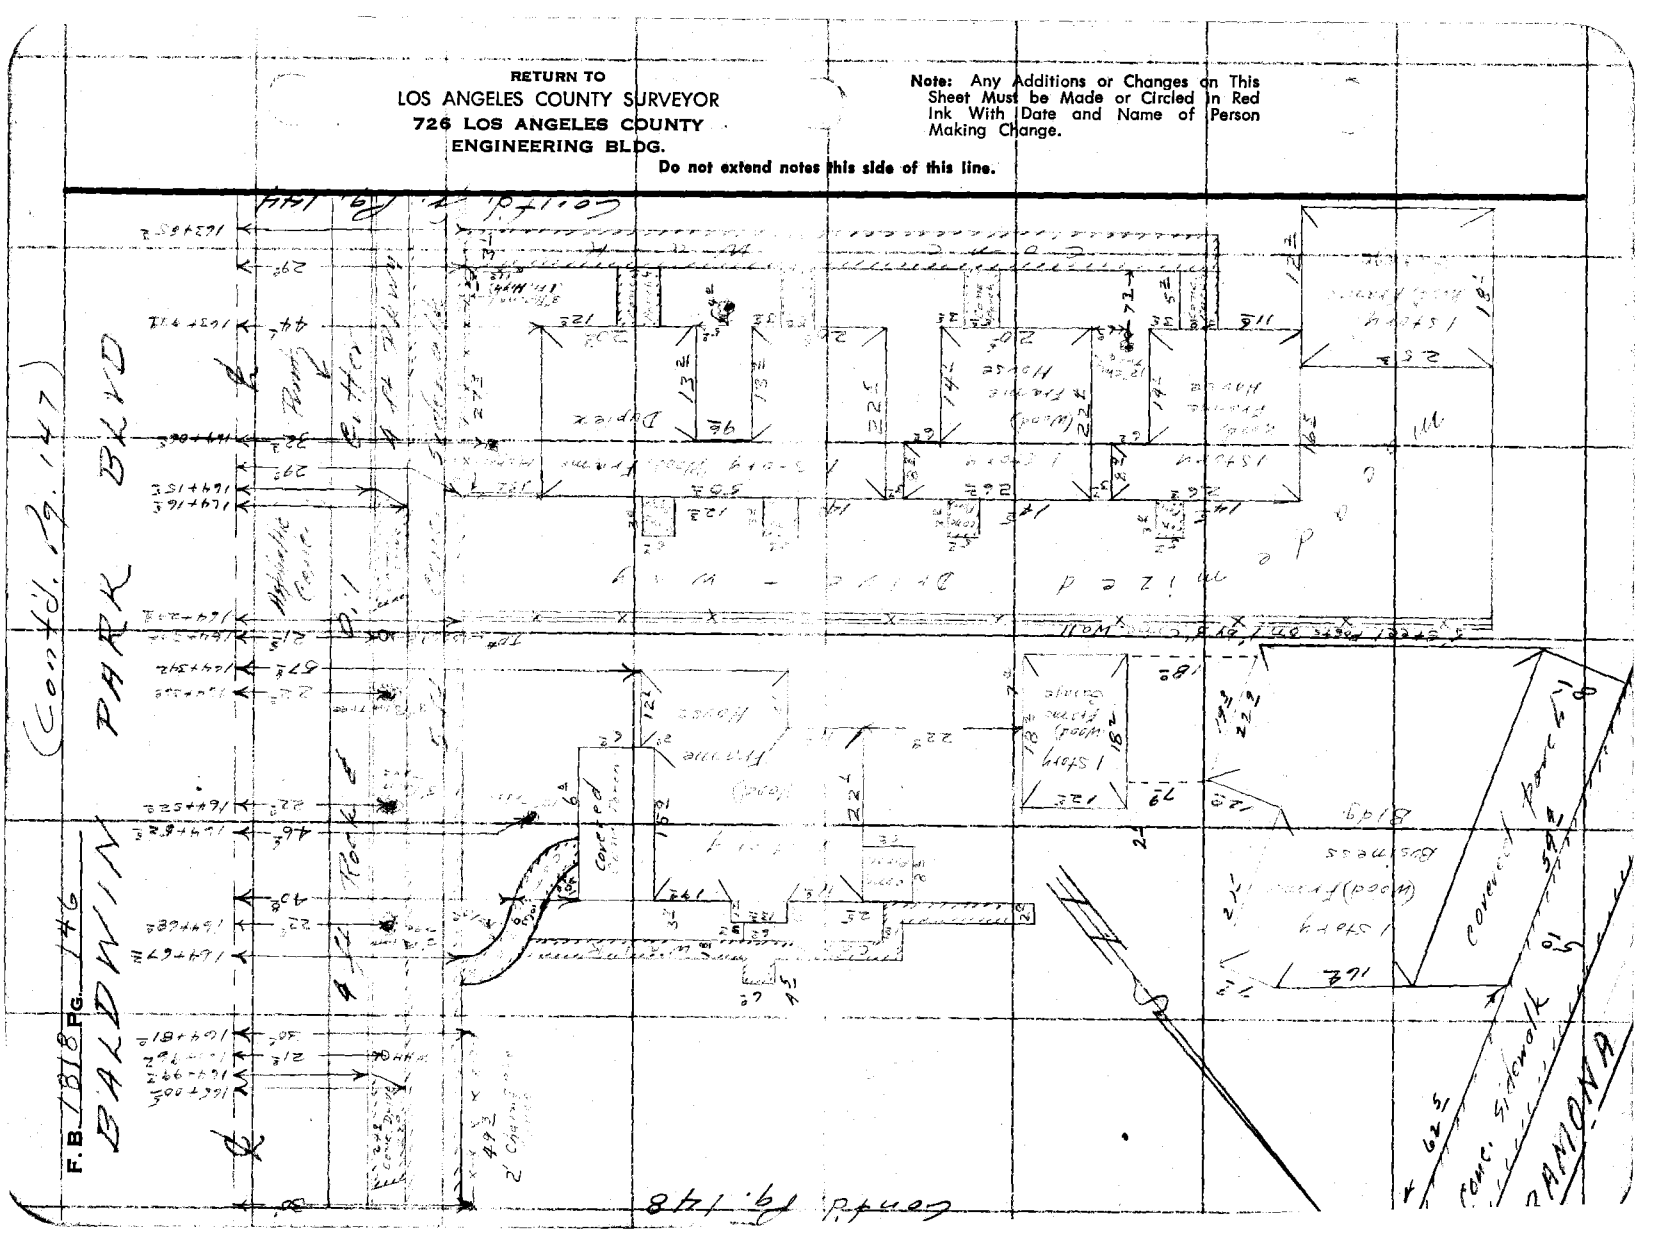

76F3095 247 4-53

RETURN TO
LOS ANGELES COUNTY SURVEYOR
726 LOS ANGELES COUNTY
ENGINEERING BLDG.

Note: Any Additions or Changes on This Sheet Must be Made or Circled In Red Ink With Date and Name of Person Making Change.

Do not extend notes this side of this line.

Notes Ck'd by _____
Map No. C.S.B-2497-3
Office Work Burns
Checked Galli

W. O. 6611 Tape No. 2117 Std. 68 of
Surveyed by Whitehall
Notes Date 1-8-54

F. B. PG.

Cont'd. Pg. 148

Cont'd. Pg. 149

































Cont'd. to Pg. 145

RETURN TO
LOS ANGELES COUNTY SURVEYOR
726 LOS ANGELES COUNTY
ENGINEERING BLDG.

Note: Any Additions or Changes on This Sheet Must be Made or Circled in Red Ink With Date and Name of Person Making Change.

Do not extend notes this side of this line.

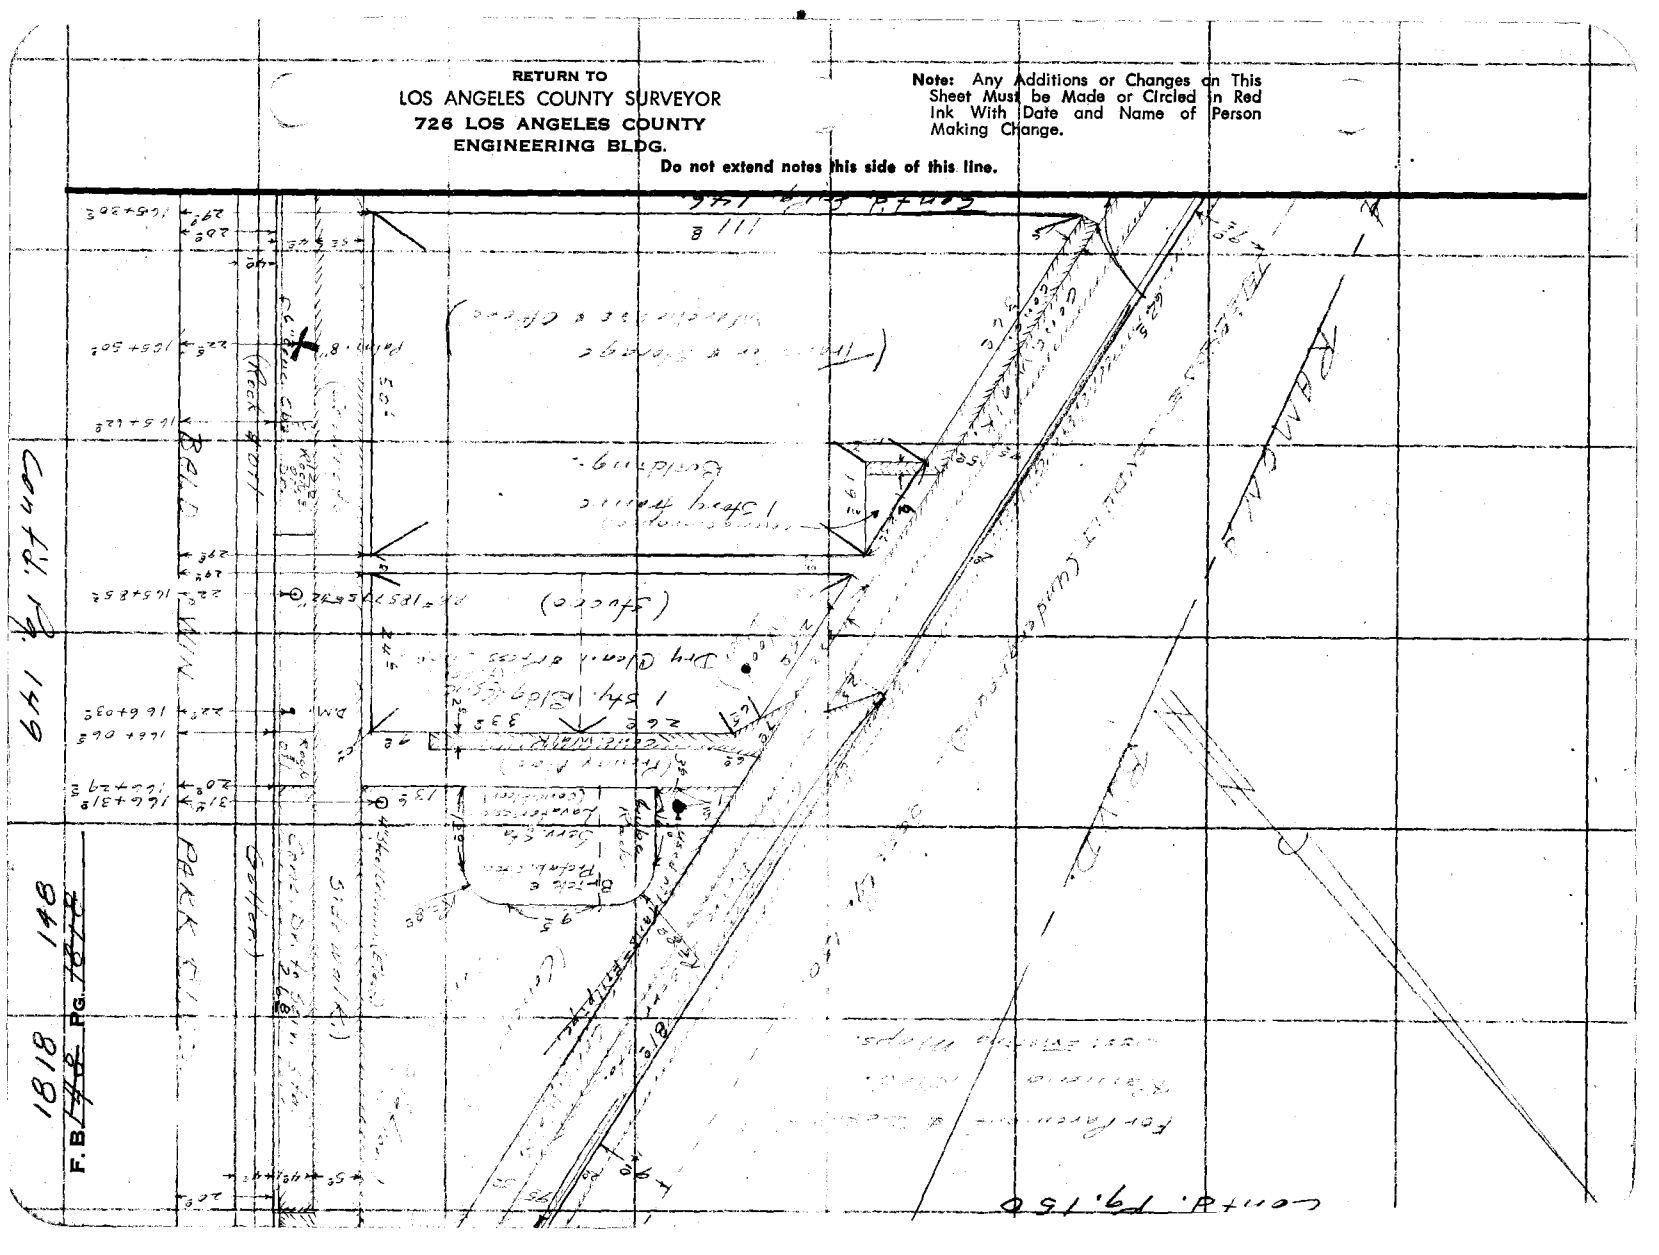
F.B. 1818 Pg. 148
BALD
Gutter
Curb
Sidewalk
Pavement
Bldg.
Dry Cleaning

Notes Ck'd by
Map No. C.S.B-2497-3
Office Work Burns
Checked Galli

Survey of BALDWIN PARK BLVD.
W. O. Tape No. St'd. °F
Surveyed by
Notes Date

F. B. Pg. 149

RETURN TO
LOS ANGELES COUNTY SURVEYOR
726 LOS ANGELES COUNTY
ENGINEERING BLDG.

Note: Any Additions or Changes on This Sheet Must be Made or Circled In Red Ink With Date and Name of Person Making Change.

Do not extend notes this side of this line.

76F3098 247 4-53

RETURN TO
LOS ANGELES COUNTY SURVEYOR
726 LOS ANGELES COUNTY
ENGINEERING BLDG.

Note: Any Additions or Changes on This Sheet Must be Made or Circled in Red Ink With Date and Name of Person Making Change.

Do not extend notes this side of this line.

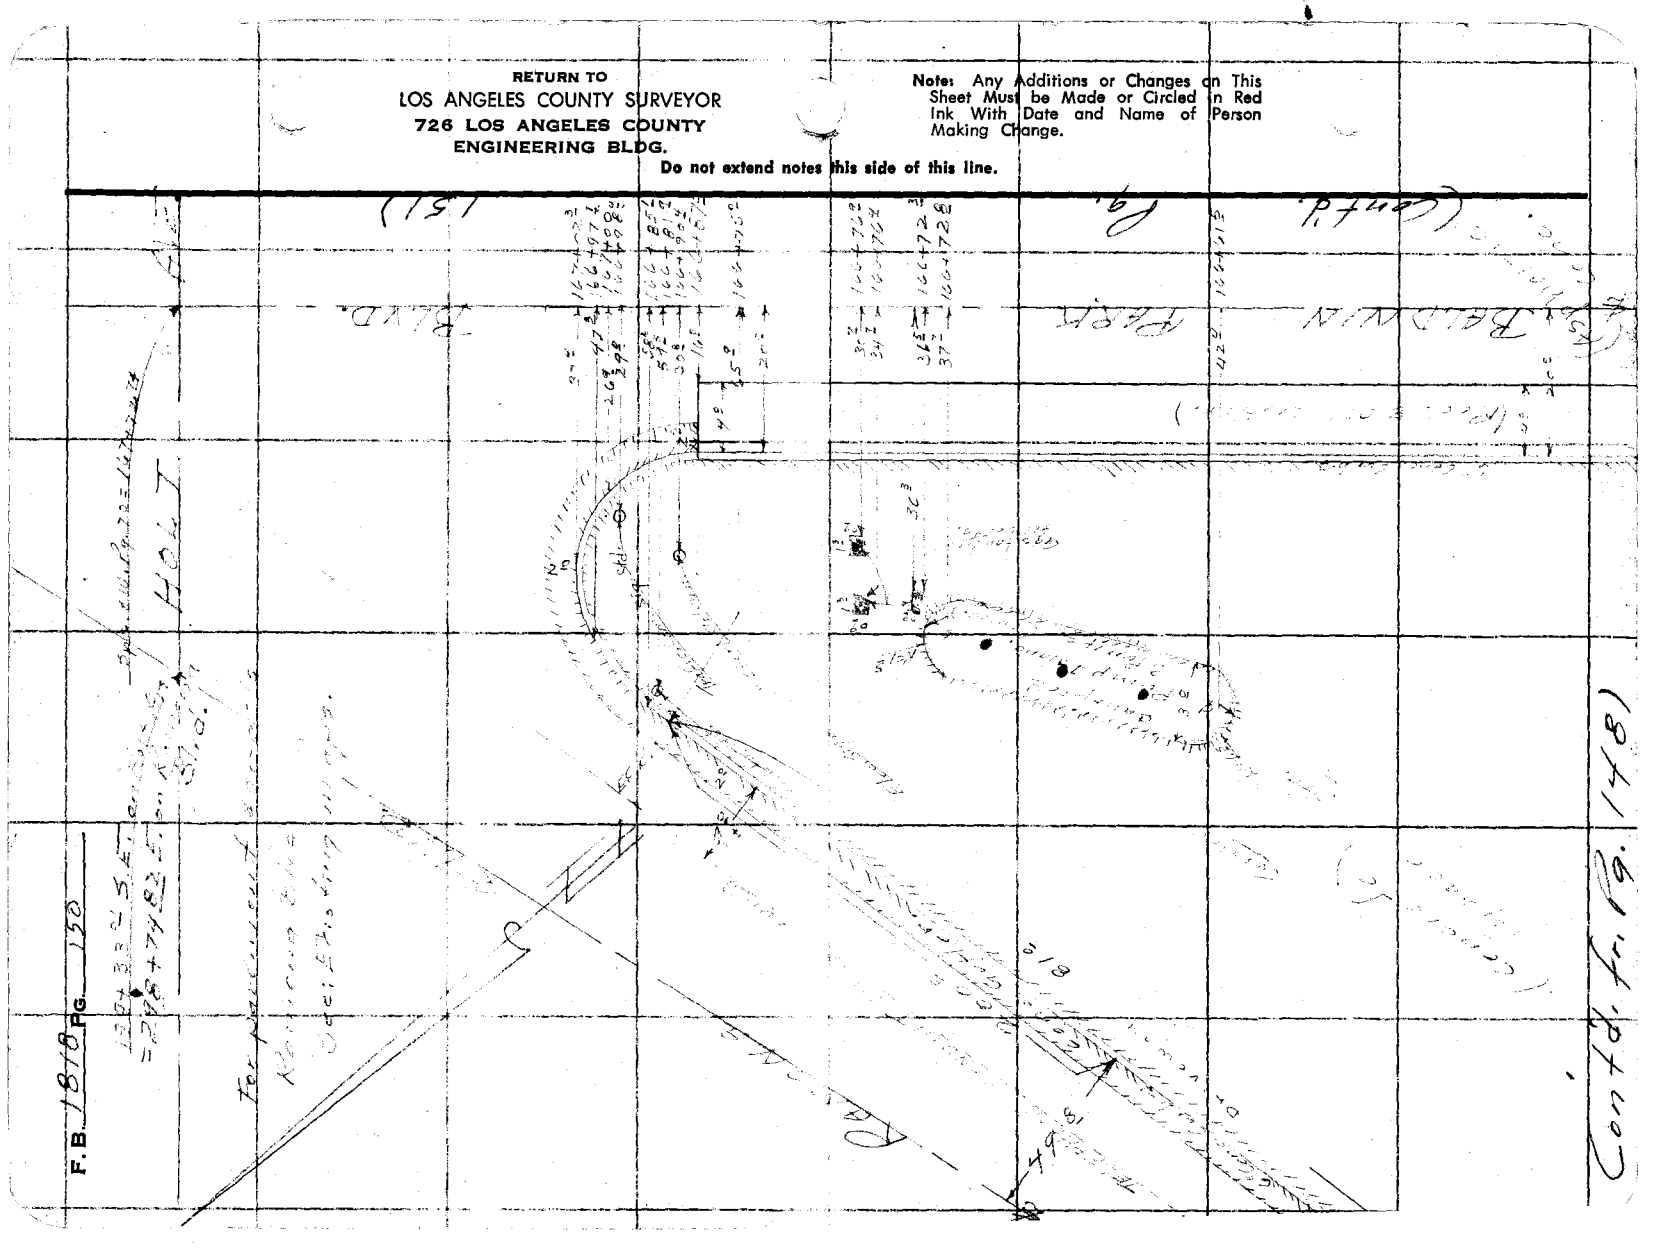

F.B. 1818 PG. 150

76F3098 247 4-53

RETURN TO
LOS ANGELES COUNTY SURVEYOR
726 LOS ANGELES COUNTY
ENGINEERING BLDG.

Note: Any Additions or Changes on This Sheet Must be Made or Circled in Red Ink With Date and Name of Person Making Change.

Do not extend notes this side of this line.

Cont'd from Pg. 152

Notes Ck'd by _____
Map No. C.S.B. 2497-3
Office Work Barns
Checked Galli

Survey of _____
W. O. _____ Tape No. _____ Sh'd _____ oF
Surveyed by _____
Notes _____ Date _____

F. B. _____ PG. _____

167+72.2 ℄ Const. Ctr. Line
= 200+00 Going Sth. on ℄ HOLT
Hollingsworth & Vk.
Pg. 70

Holt Ave.

Const. ℄

Const. ℄

Const. ℄

150) BLVD.

Const. ℄

Ornm. Sth. Lt. Std.

Conc. Walk

Trf. Sig. 167+31.6 ← 32.6

Trof. Sig. 167+23.3 ← 25.9

Pole Co. 167+21.1 ← 21.9

Bldg. Cor. 167+20.5 ← 45.2

End Cb. Ret. 167+12.0 ← 40.2

Conc. Walk 167+10.2 ← 34.2

EH. & DM. 167+10.1 ← 21.5

Trf. Sig.

Conc. Walk

12 x 12

1 Story Brick Store Bldg. (Setback Mkd.)

WHH. 167+10.0 ← 17.2

WHH. 167+08.5 ← 16.3

Cont'd. fr. Pg. 149

BALDWIN PARK

16+100.0

21

24 ft. Conc. Walk

(Cont'd fr. Pg. 149)

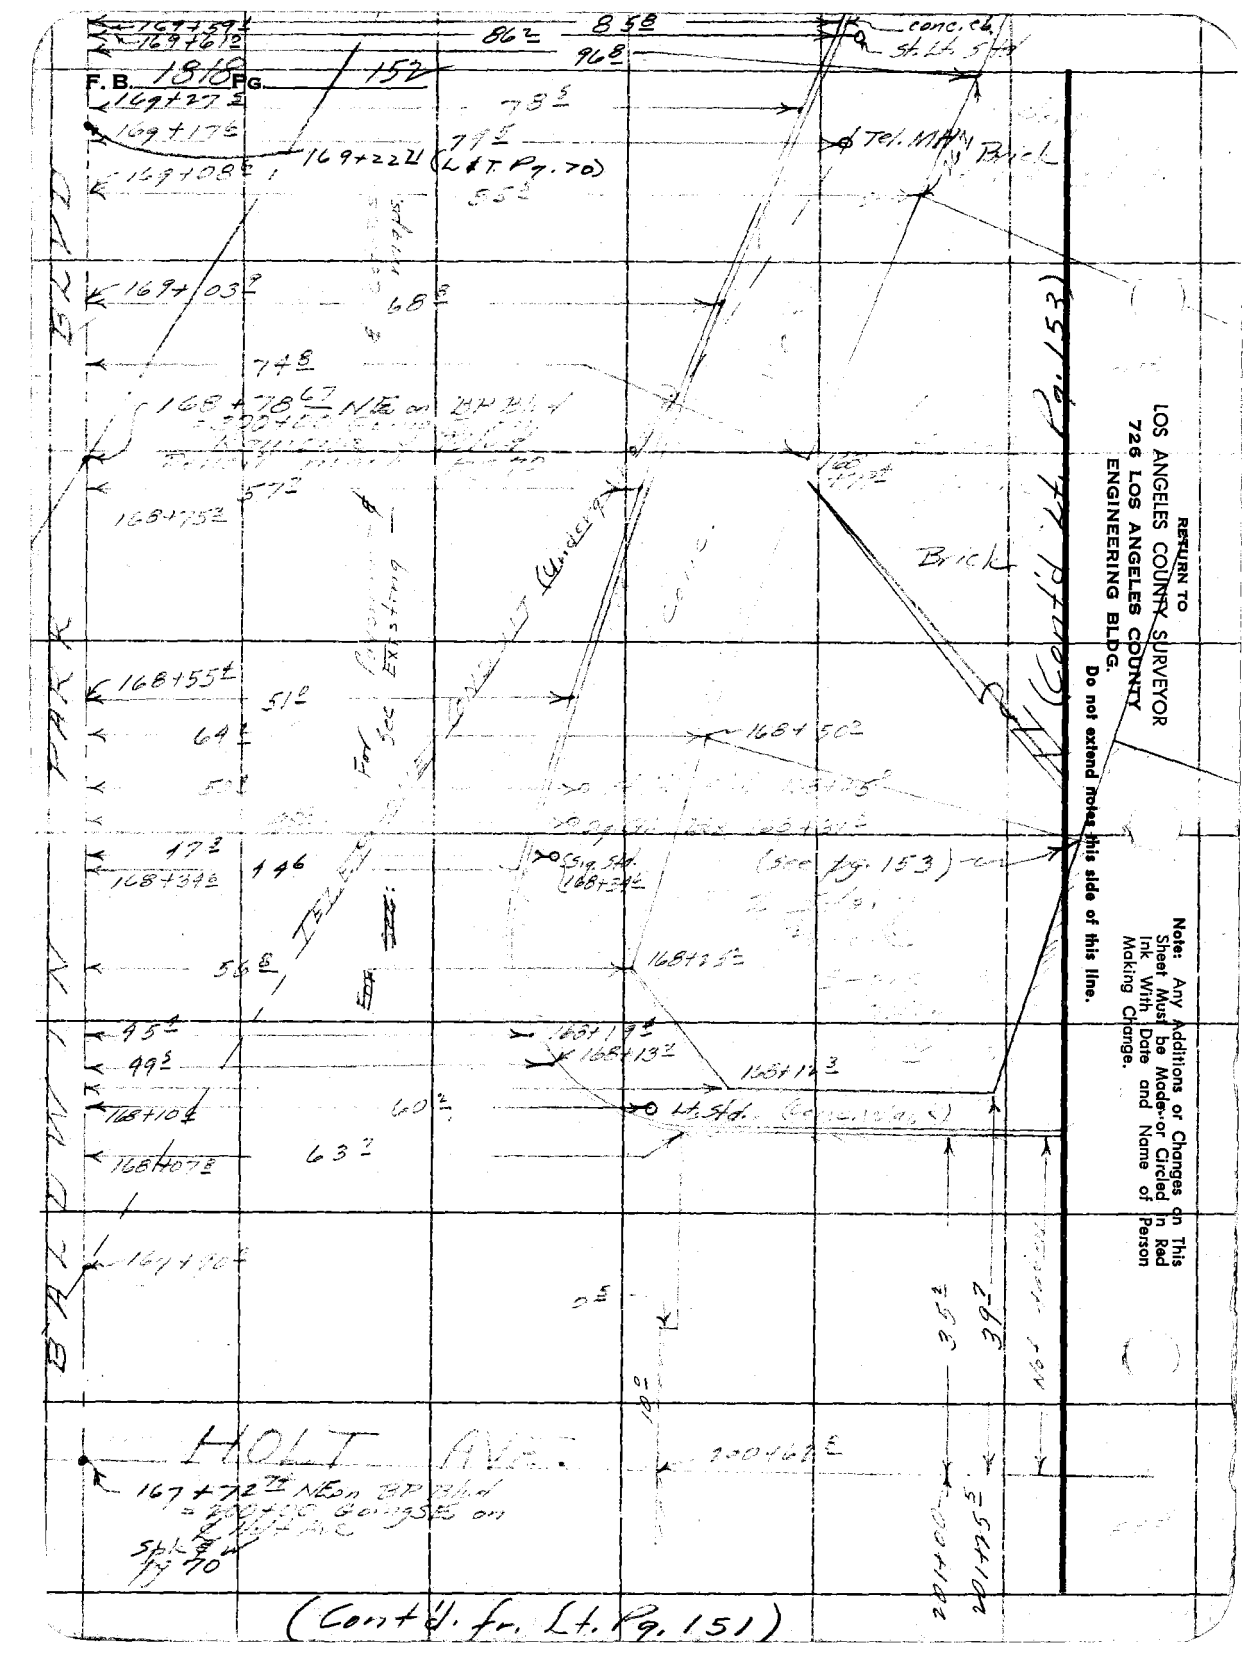
F.B. 1816 Pg. 152
169+27 ±
169+17.5
169+08.5 ±
169+22.4 (L&T Pg. 70)
169+03 ±
168+78.67 NE on 24" Bk.
168+75 ±
168+55 ±
64 ±
168+50 ±
168+34 ±
168+13 ±
168+10 ±
168+07 ±
167+72.72 NE on 30" Bk.
HOLT AVE.
SPK in Lt. Pg. 70
Conc. Ch. St. Lt. S'ly
Tel. M'H'
Brick
Brick
Fnce
Ex. String
Ex. Fnce
Ex. Fnce
Ex. Fnce

Notes Ck'd by
Map No. C.S.B-2497-3
Office Work Burns
Checked Galli

Survey of Baldwin Pk. Blvd
W. O. 8[illegible] Tape No. [illegible] St'd. [illegible] °F
Surveyed by K.J. McKeehen
Notes [illegible] Date [illegible]

F.B. [illegible] Pg. 153

Bldg

Note: Any Additions or Changes on This Sheet Must be Made or Circled in Red Ink With Date and Name of Person Making Change.

Do not extend notes this side of this line.

RETURN TO
LOS ANGELES COUNTY SURVEYOR
726 LOS ANGELES COUNTY
ENGINEERING BLDG.

(Cont'd fr. Rd. Bk. 152)

1 Story Brick

1½ Story Stucco Dwlg.

2 Story Brick

Sidewalk

Pvd.

50 Ft Conc

Conc. Curb

Conc. Pvmt

HOLT AVE

Nothing Pg. 71

76FS098 247 4-53

RETURN TO
LOS ANGELES COUNTY SURVEYOR
726 LOS ANGELES COUNTY
ENGINEERING BLDG.

Note: Any Additions or Changes on This Sheet Must be Made or Circled in Red Ink With Date and Name of Person Making Change.

Do not extend notes this side of this line.

F.B. 1215 PG. 154

Notes Ck'd by W. Brenner	Survey of BALDWIN PARK BLVD.
Map No. C.S.B-2497-1	JN 0074.02 Tape 124 Std 68 °F
Office Work Burns	Surveyed by H.E.G. RANDOLPH
Checked W. Brenner	Notes S. Cl. Date 4/19/55
Date	Indexed

F. B. 1818 PG. 155 REALIGNMENT

J.N. 0074.02

BALDWIN PARK BLVD.
(REALIGNMENT)

CENTERLINE NOTES.

FROM VALLEY BLVD.
NLY TO TORCH ST.

INDEX PG. 156 + PG.
P/L NOTES & NOTES PG. 157 to 184
℄ NOTES ONLY PG. 177, T o. 182.
TRAV. NOTES PG. 185 TO PG. 197

Note: Any Additions or Changes on This Sheet Must be Made or Circled in Red Ink With Date and Name of Person Making Change.

Do not extend this side of this line.

PLEASE RETURN TO
LOS ANGELES COUNTY ENGINEER
700 LOS ANGELES COUNTY ENGINEERING BLDG.

76F309S S&E #247 1-56

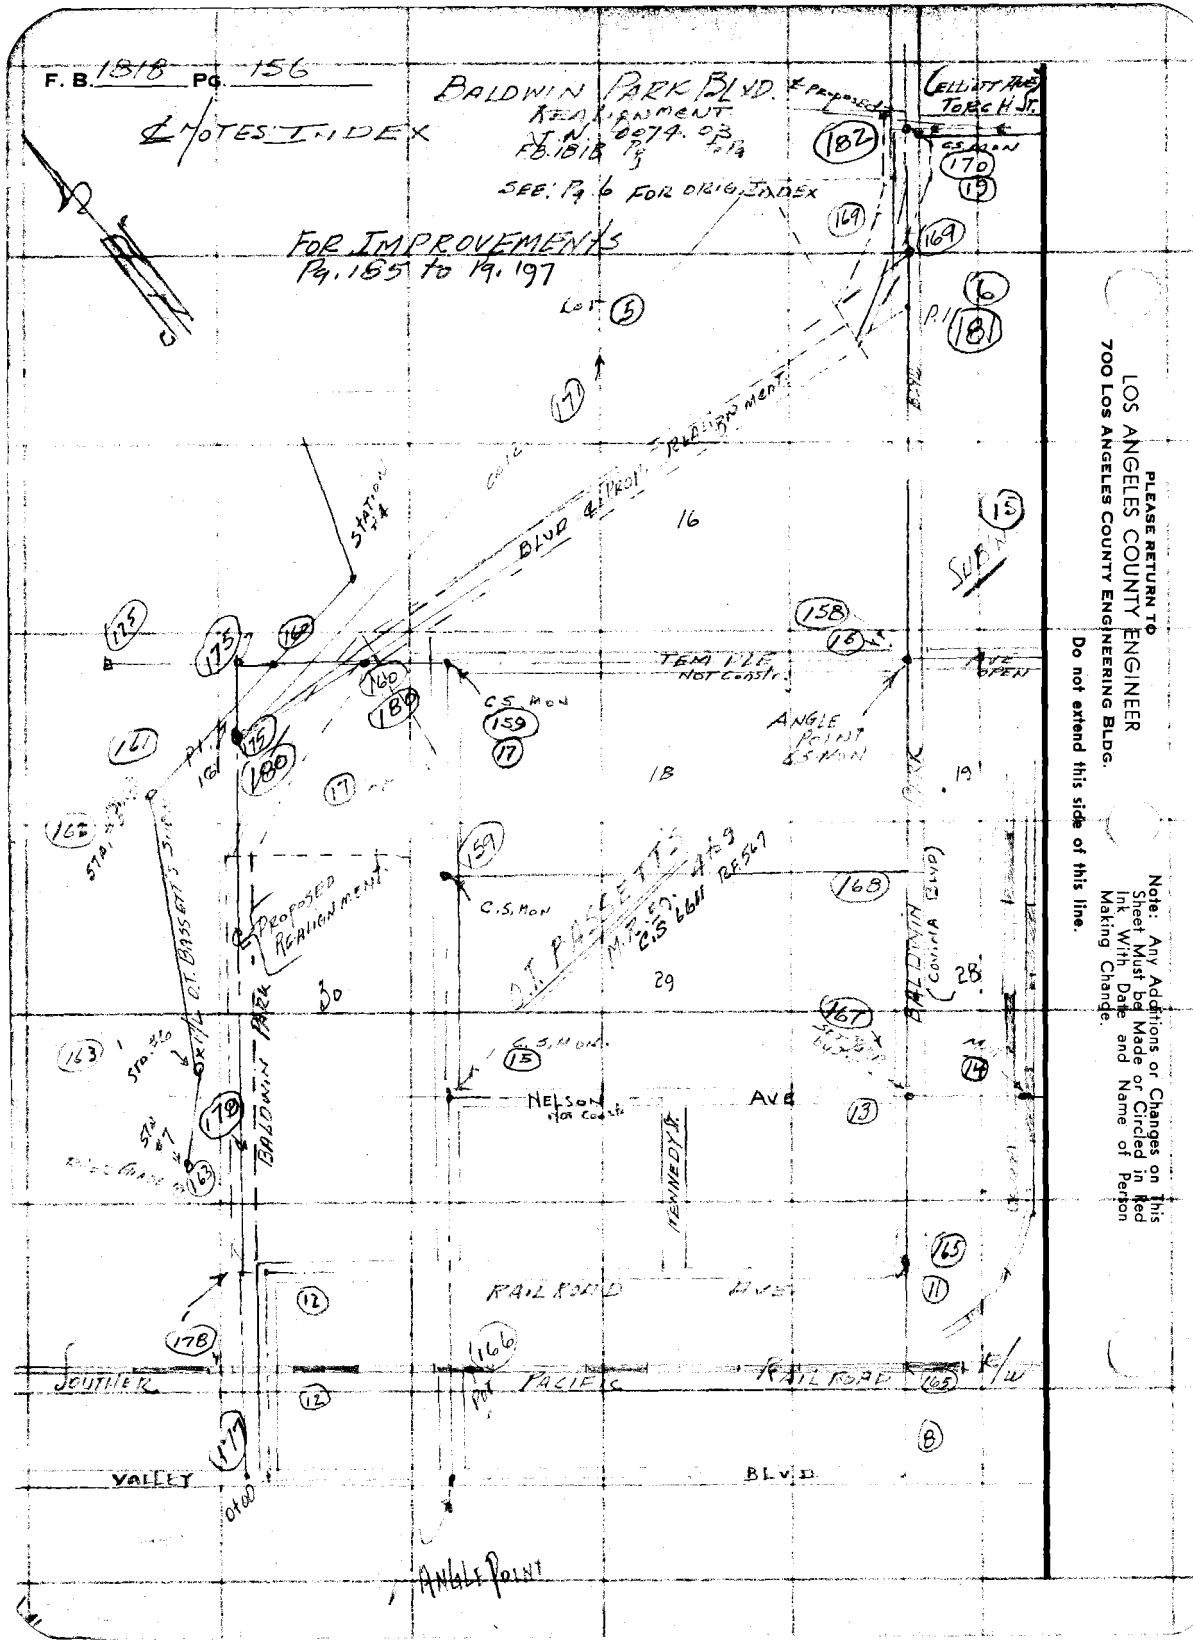

PLEASE RETURN TO
LOS ANGELES COUNTY ENGINEER
700 LOS ANGELES COUNTY ENGINEERING BLDG.

Do not extend this side of this line.

Note: Any Additions or Changes on This Sheet Must be Made or Circled in Red Ink With Date and Name of Person Making Change.

Notes Ck'd by W. Brenner
Map No. C.S.B - 2497-1
Office Work Burns
Checked W. Brenner
Date

Survey of BALDWIN PARK BLVD
JN 00714.03 Tape 0124 Std 68 °F
Surveyed by H. E. GRANQUIST
Notes Date

Indexed

F. B. 1818 Pg. 157
RELIGHTMENT

Note: Any Additions or Changes on This Sheet Must be Made or Circled in Red Ink With Date and Name of Person Making Change.

Do not extend this side of this line.

PLEASE RETURN TO
LOS ANGELES COUNTY ENGINEER
700 LOS ANGELES COUNTY ENGINEERING BLDG.

76F3095 S&E #247 1-56

PLEASE RETURN TO
LOS ANGELES COUNTY ENGINEER
700 LOS ANGELES COUNTY ENGINEERING BLDG.

Note: Any Additions or Changes on This Sheet Must be Made or Circled in Red Ink With Date and Name of Person Making Change.

Do not extend this side of this line.

WS 96 C-5

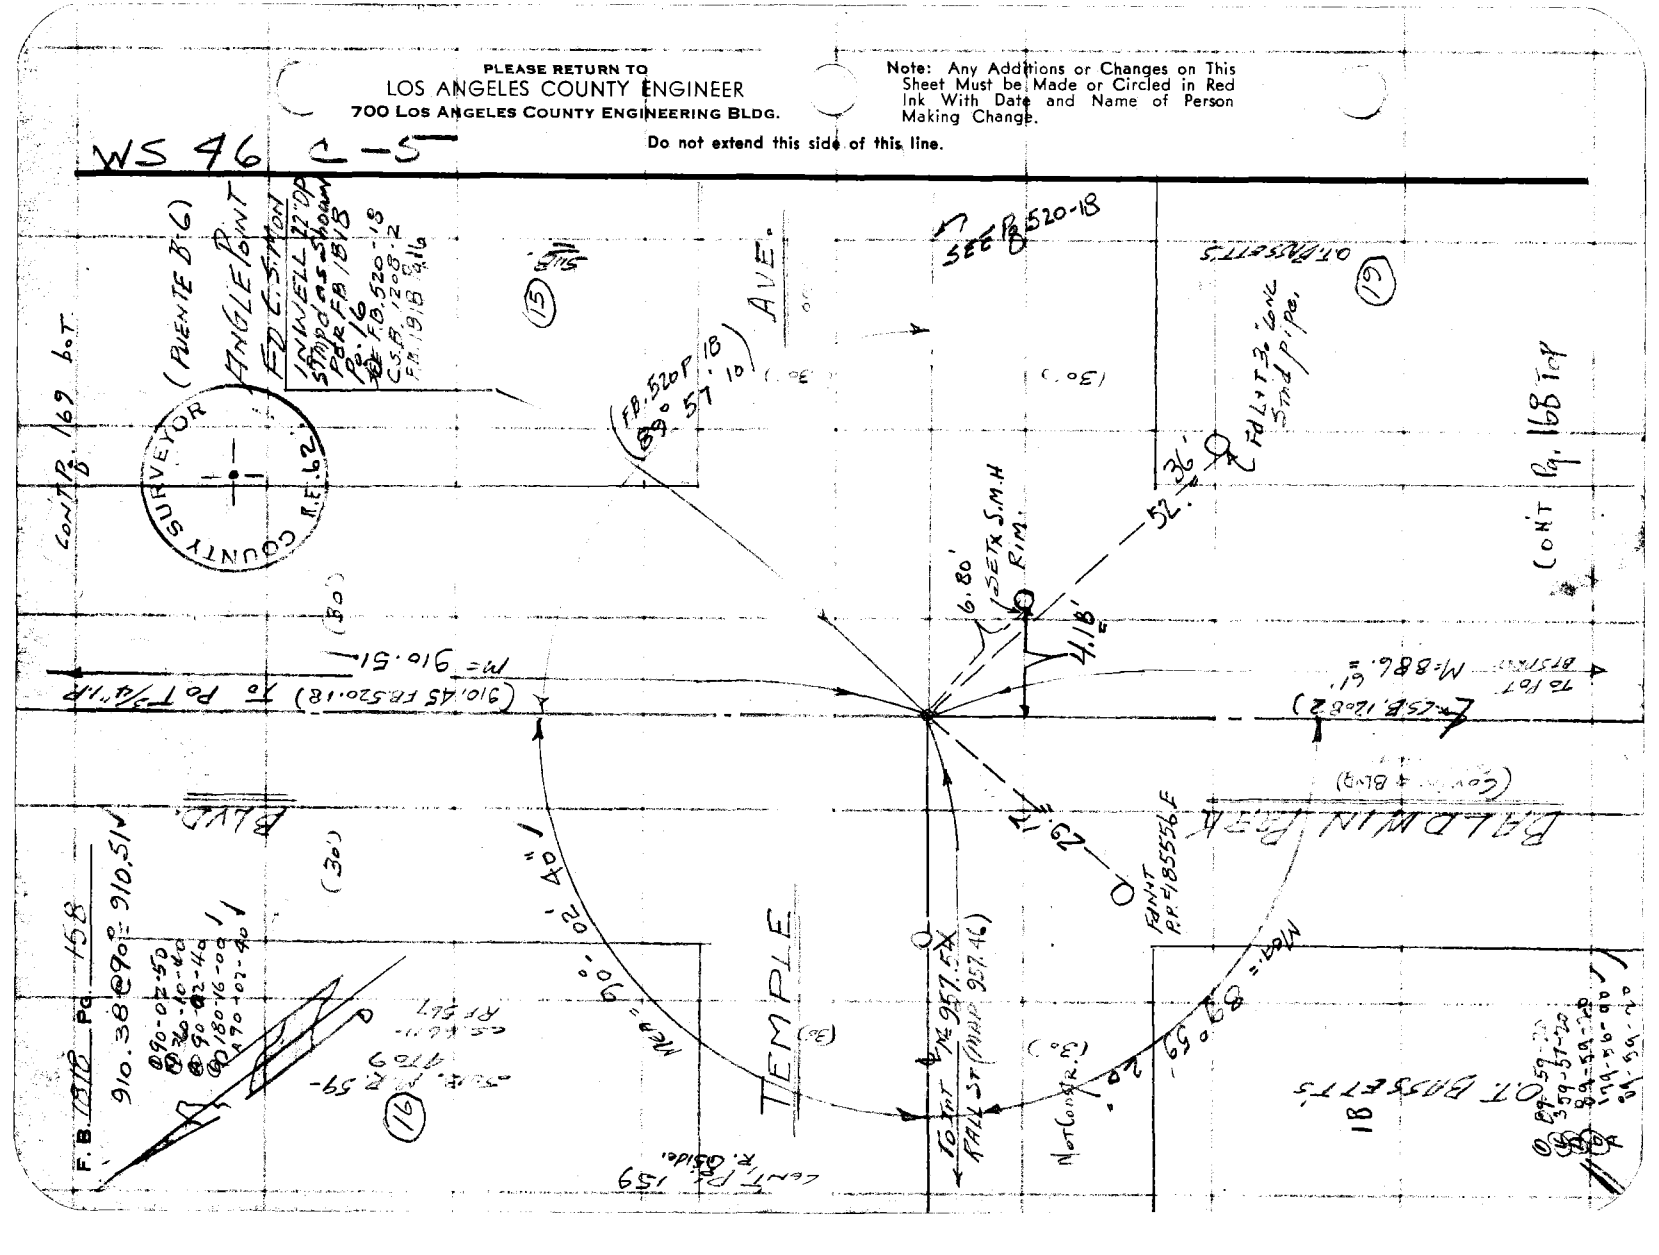

Notes Ck'd by W. Brenner
Map No. C.S.B-2497-1
Office Work Burns
Checked W. Brenner
Date

Survey of Baldwin Park Blvd.
JN 0014.03 Tape 0124 Std 68 °F
Surveyed by H.E. Gibson
Notes H.E.A. Date 4/14/61
Indexed

F.B. 1818 Pg. 159
RE ALIGNMENT
(1) 360-00-30
(2) 90-00-37½

WS 46

Note: Any Additions or Changes on This Sheet Must be Made or Circled in Red Ink With Date and Name of Person Making Change.

Do not extend this side of this line.

PLEASE RETURN TO
LOS ANGELES COUNTY ENGINEER
700 Los Angeles County Engineering Bldg.

76F309S S&E #247 1-56

CONT 1.60 FR

483.12 @ 04°48'

TEMPLE AVE.
NOT CONSTR

CONT 2.15

To Post Pg. 180 198.44'

(CALC FM C.S.B. 1208: 483.23)

To C.S. Mon' Pg 160 M = 483.24

UPPER C.S.B 1208-2

M = 957.52 To Mon.

(MAP 957.46 BALDWIN PARK BLVD.)

68.84'

43.63'

60.00

54.08'

(30')

M = 90° 00'

(MAP 90° 00')

Fd X IN Side 18" UP. OF 18" LONG IRRIG. STND PIPE.

SET LEAD IN TOP OF 12" LONG IRRIG. PIPE.

Fd Chis X IN TOP OF STEEL Pin FOR "V"

COUNTY SURVEYOR R.E. 62

STREET (NOT OPEN) (30')

(910.34 F.B. 520 Pg. 19) (CAL. C.S.B. 1208-2)

POST K.P. SET 3/4" I.P. WITH L.A.C.O. ENGR. TAG. 24" DEEP.

957.52 @ 72° 957.52

957.49 + 88 = 957.64

INT FOUND C.S. MON. 24 STMPS AS SHOWN PER F.B. 1818 Pg. 17 SEE C.S.B. 1208 & F.B. 520-19

(30') (30')

WALL

(1820.68 C.S.B. 1208-2)

TO C.S. MON NELSON AVE

M.P. 59-4+09 L.S. 6611 R.E. 562

17

18

CONT. Pg 520 CONT Pg 15

D.T. BASSETT'S

PLEASE RETURN TO
LOS ANGELES COUNTY ENGINEER
700 LOS ANGELES COUNTY ENGINEERING BLDG.

Note: Any Additions or Changes on This Sheet Must be Made or Circled in Red Ink With Date and Name of Person Making Change.

Do not extend this side of this line.

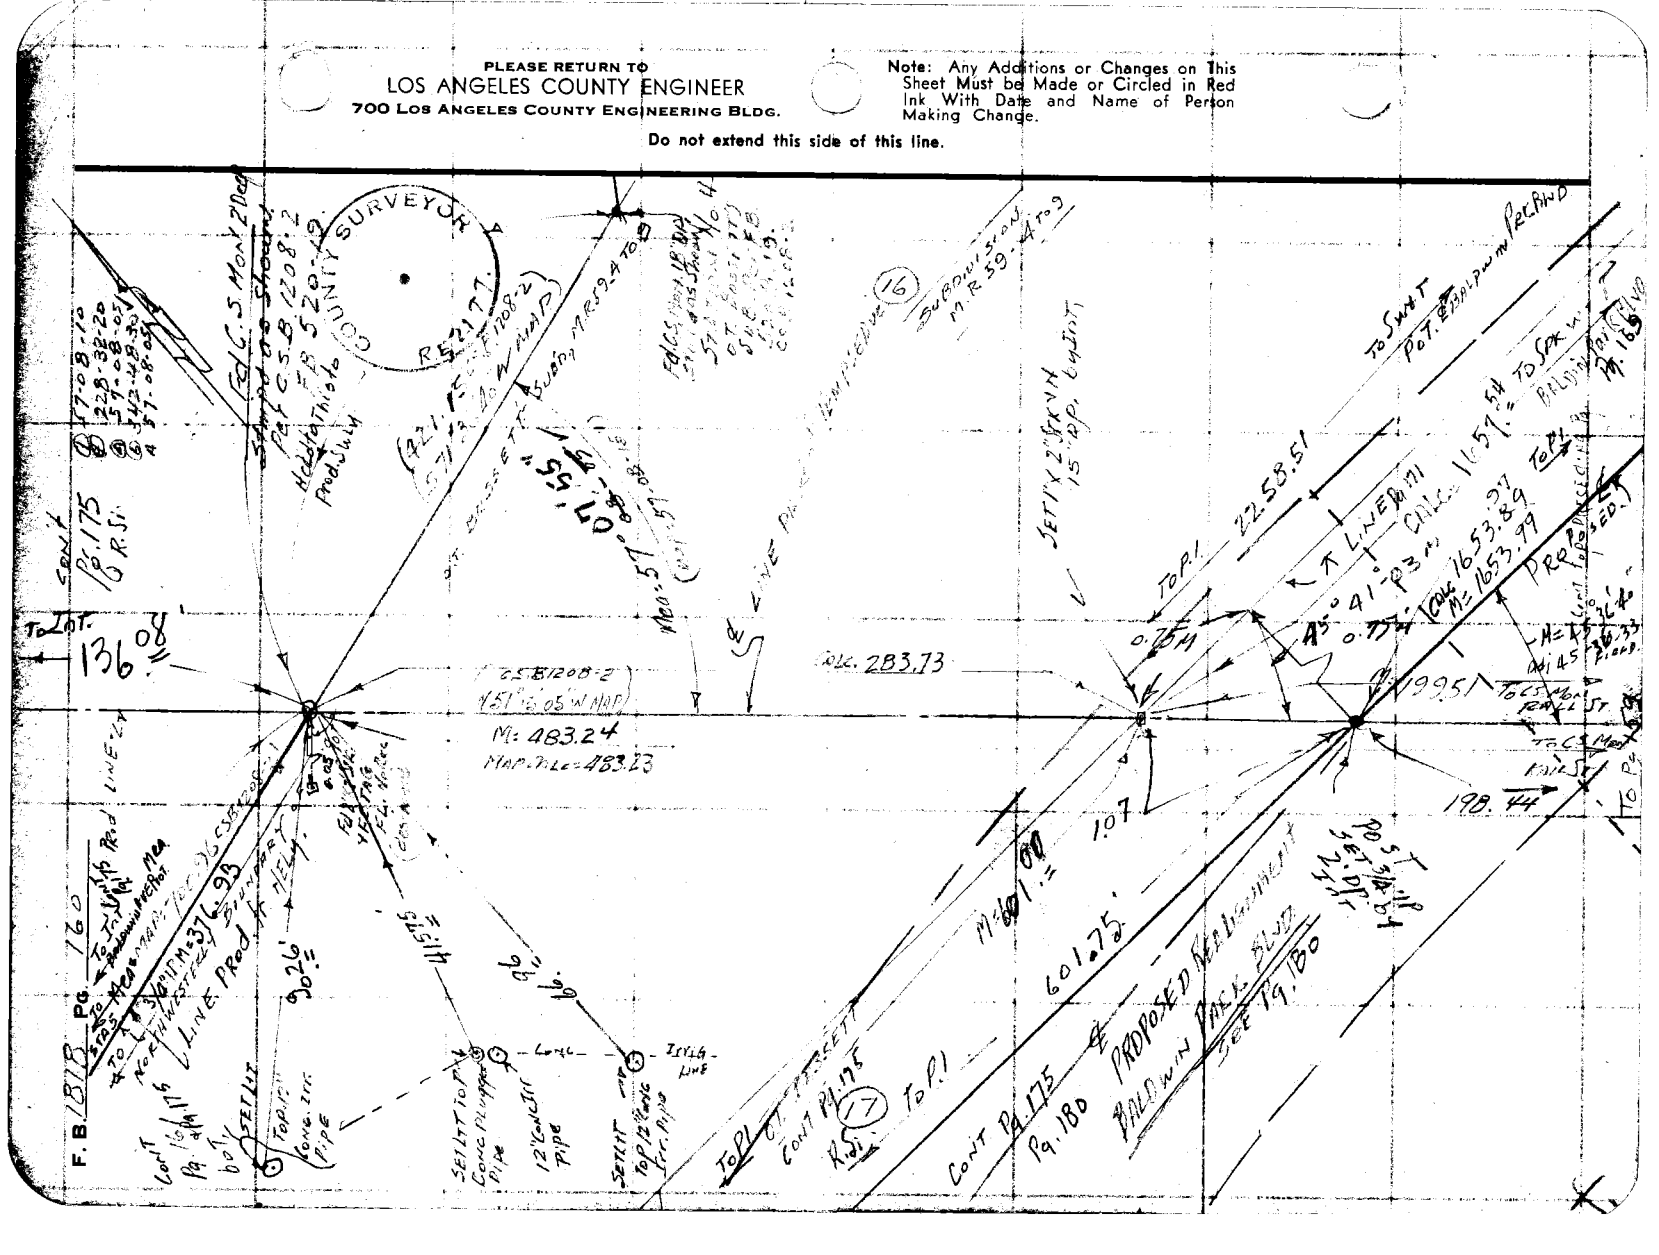

Notes Ck'd by W. Brenner | Survey of BALDWIN PARK BLVD | F. B 1818 Pg. 161
Map No. C.S.B-2497-1 | JN 0074.03 Tape 124 Std 68 °F | REALIGNMENT.
Office Work Burns | Surveyed by H.L. BRAHQUIST
Checked W. Brenner | Notes F.A.S. Date 4/67
Date | Indexed

Note: Any Additions or Changes on This Sheet Must be Made or Circled in Red Ink With Date and Name of Person Making Change.

PLEASE RETURN TO
LOS ANGELES COUNTY ENGINEER
700 LOS ANGELES COUNTY ENGINEERING BLDG.

Do not extend this side of this line.

76F3095 S&E #247 1-56

(A) 168-13-25
(B) 312-53-40
(C) 168-13-25
(D) 289-20-30
(E) 168-13-25

460.41 @ 94° = 460.49
460.40 @ 92° = 460.47

STATION No. 5
O.T. BASSETTS
SET CONC PLUG
W. FR L.A. CO. ENGR
TAG. IN FOUND
2" I.P. CORP
by PROLONGATION
of LINE FROM
HLy. CO. MON '78
AND MEA. REC.
DISTANCE OF
700.96 Ft. C.S. MON
LINE Prod. at
TEMPLE AVE
Pg. 169
PER C.S.B 1208-2
& R.B. 520 Pg. 19

SET 1"x2" STK FL
ON PRODED LINE

5.88

FD NAIL & LIN 2" IP
6" DEEP NO
REC. CALLS
FOR C.S. MON
AUG 3' DEEP
C.S. MON. GONE
OR OUT.
destroyed
NAIL

SET MON 168 13 25 E
(REC. MON PER C.S.B 1208-2)

N 89° 42' 07" W 2216.87 (M)

107.51 @ 90° = 107.51
107.51 @ 98° = 107.51
300' TAPE

P.I. Pg 175
Pg 180

L1 S 89° 42' 07" E 1099.53 (M)
1099.5 (R)

(L1)

(300' TAPE 115 ONES 84°)
USED
216.82 @ 3°01 = 216.52 @ 98 = 216.54
216.75 @ 2°38 = 216.58
216.87 @ 3°13 = 216.53

107.51
324.05

376.93
324.05
700.98 TOTAL NAIL
- 0.02
700.96

126.14

POT SET 3/4" I.P. & TAG
12" DEEP, LIKE plod
FROM N.E.Ly.

700.96 = 96' TO MON
P.I. Pg 175
Pg 180

INT JEEP Pg 175
Pg 180
L.A. Co. Engr
INT. TOP
Conc Jct Line

L.T.K.
Top
Conc
Jct
Line

300' TAPE
376.88 @ 104° = 376.98
376.88 @ 106° = 376.93

MEA 376.93

MEA 700.96

S 89° 42' 07" E 2216.82 (M)

PLEASE RETURN TO
LOS ANGELES COUNTY ENGINEER
700 LOS ANGELES COUNTY ENGINEERING BLDG.

Note: Any Additions or Changes on This Sheet Must be Made or Circled in Red Ink With Date and Name of Person Making Change.

Do not extend this side of this line.

WS. 46 C-5

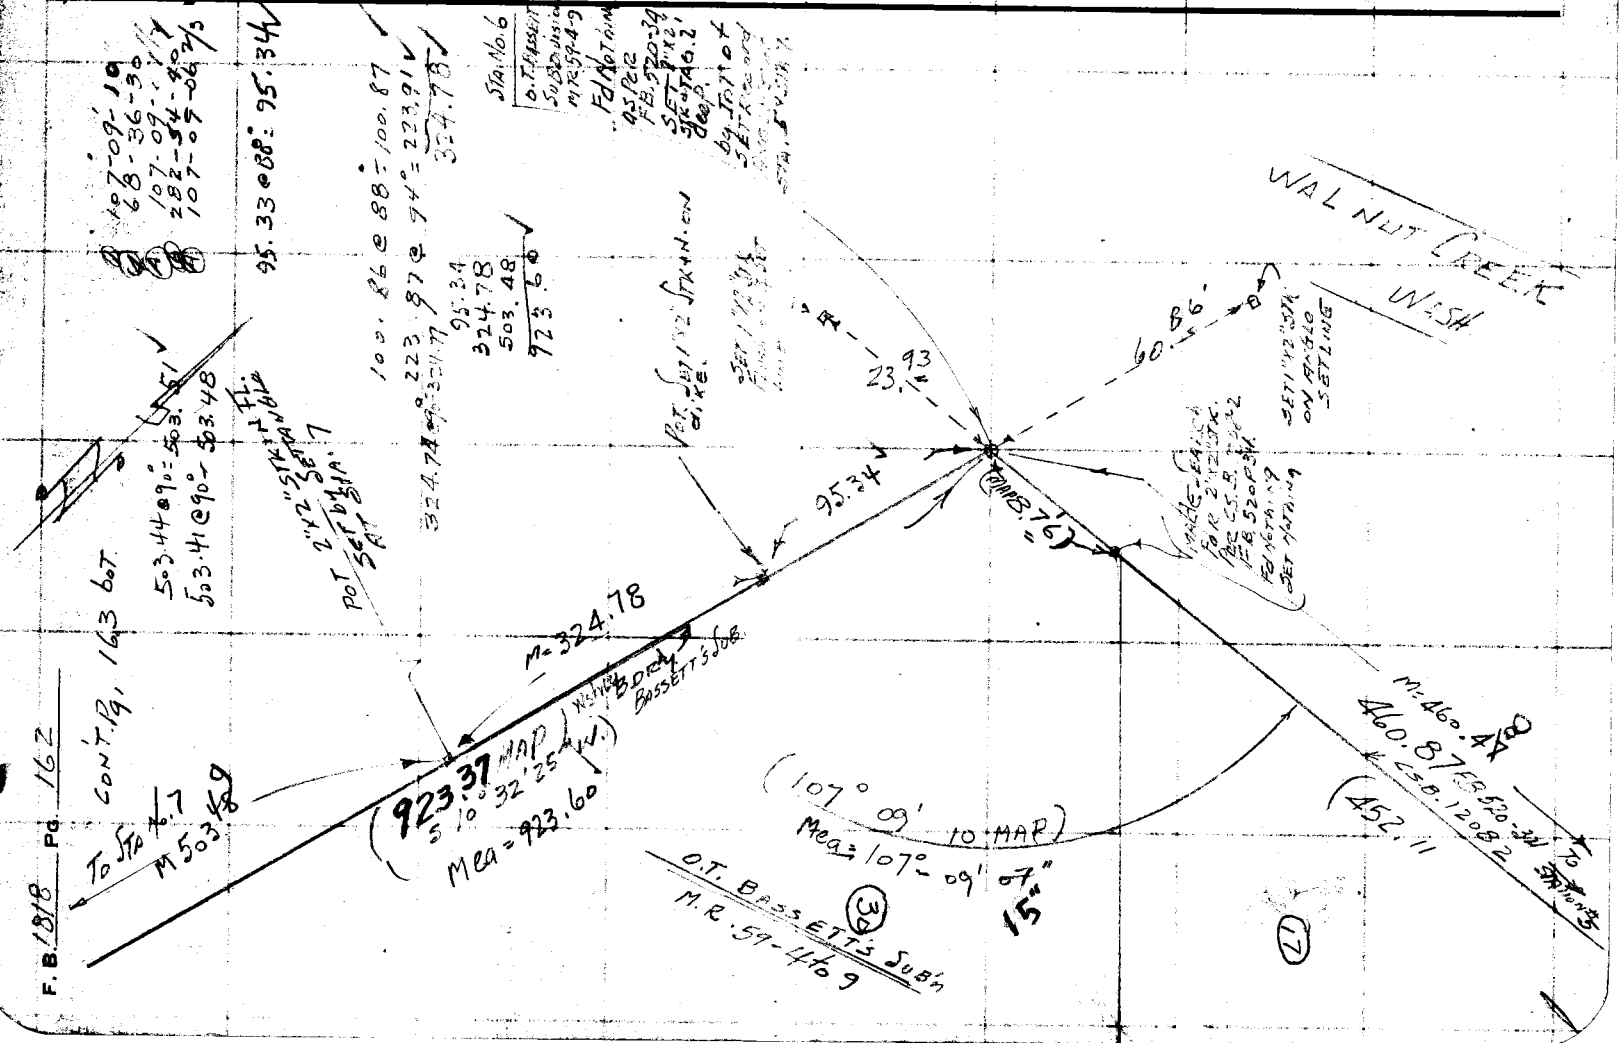

Notes Ck'd by W. Brenner
Map No. C.S.B-2497-1
Office Work Burns
Checked W. Brenner
Date

Survey of BALDWIN PARK BLVD.
JN 0074.01 Tape 0124 Std. 60 °F
Surveyed by H.E. GRANDY
Notes H E G Date 6/21/57
Indexed

F.B. 1010 Pg. 163
REALIGNMENT
208.57 @ 76° = 208.58 T

Note: Any Additions or Changes on this Sheet Must be Made or Circled in Red Ink With Date and Name of Person Making Change.

PLEASE RETURN TO
LOS ANGELES COUNTY ENGINEER
700 LOS ANGELES COUNTY ENGINEERING BLDG.

Do not extend this side of this line.

76F309S 8&E #247 1-56

CONT FR 162

8274'S7

Pot. 1"x2" Stk 15 Deep.

Station No. 8 Fd C.S. Mon Stmpd as shown 2' Deep per C.S. 1208-2 & F.B. 520 Pg. 34

161° 37' 40" F.B. 320-P34

0.565'

COUNTY SURVEY

PROPOSED REALIGNMENT BALDWIN PARK BLVD.

Pot. 3/4" I.P. TAG 20" Deep. Pg. 179

SET N. T.P.P. No. #

501.49 @ 88° = 501.56
91.69
573.25

(573.25 MEASURED) (573.25 MEAS. 573.25)

LANE

Fd 2"x2" Stk N 30" deep. (poor condition) F.B. 520 Pg. 34 = C.S.B. 1208-2 Replaced with 2"x2" Stk. 24" deep.

R.P. 1 STORY CONC. BLDG. FACTORY # 263 COVINA LANE

SET NAIL & TAG

SET NAIL & TAG

SET NAIL & TAG

SET PK IN PVMT FL

STA. No. 7

O.T. BASSETT'S SUBD'N M.B. 59-4 to 9 Fd 2" I.P. Wood Plug set FL. ouerg'd Mon. Stmpd as shown. Per F.B. 520 Pg. 34 & C.S.B. 1208-2 RESET

Mon 30" deep.

COUNTY SURVEY

ANGLE SET = 158° 22' 30" PER C.S.B. 1208-2 F.B. 520 P. 34

① 158-22-30"
② 273-30-00
③ 158-22-30
④ 230-15-00
⑤ 158-22-30

CONT FR 162 TO P

PLEASE RETURN TO
LOS ANGELES COUNTY ENGINEER
700 LOS ANGELES COUNTY ENGINEERING BLDG.

Note: Any Additions or Changes on This Sheet Must be Made or Circled in Red Ink With Date and Name of Person Making Change.

Do not extend this side of this line.

F. B. 1818 Pg. 164

Notes Ck'd by W. Brenner
Map No. C.S.B-2497-1
Office Work Burns
Checked W. Brenner
Date

Survey of BALDWIN PARK VIC
JN 00 74.03 Tape 0°24' Std LB °F
Surveyed by N.E. GRUNDIN & ASSOC
Notes Date 1/56

F. B. 1818 Pg. 165
REALIGNMENT
Cont Pg. 167

Note: Any Additions or Changes on This Sheet Must be Made or Circled in Red Ink With Date and Name of Person Making Change.

Do not extend this side of this line.

PLEASE RETURN TO
LOS ANGELES COUNTY ENGINEER
700 LOS ANGELES COUNTY ENGINEERING BLDG.

76F3095 SAE #247 1-56

M 5546

175-03-33/3 E
89-10-33/3 E

792.99 @86° 793.08'
793.02 @86° 793.11'

MEA = 89° 10'

33 1/3

M 4955

BALDWIN PARK
(COVINA BLVD)

4.415

RAILROAD AVE.

TO P.O.T. 893.08

PER FB 1818-11
FB 548-100

POT. R.P.'S SET SWITT 2" DEEP

SET X SEWER MH.

15.44'

100.00

TO BT SPK W.T. POT. 793.08

TO BT SPK IN Dist. 1556.83

INT OLD COVINA R/W (1556.83 FB 548-100)

SET BT SPK + TIN 3 UP P.P. # 383246E

INT FOUND
3/4" I.P. 20" DEEP
PER FB 1818 P. 11
FB 520-26
C.S.B. 1808-2
C.S.B. 1216-2
SEE FB 548 P. 100

S.P. R/W

S P R.R. | MAIN LINE | TRACKS

NOT OPEN

FD 1" I.P. VIC
VAN CITT MAIN LINE TRACKS
PER PB 11

15' ALLEY

PARKER PL. (45')

SEE PB

(75')

F. B. 1818 PG. 166

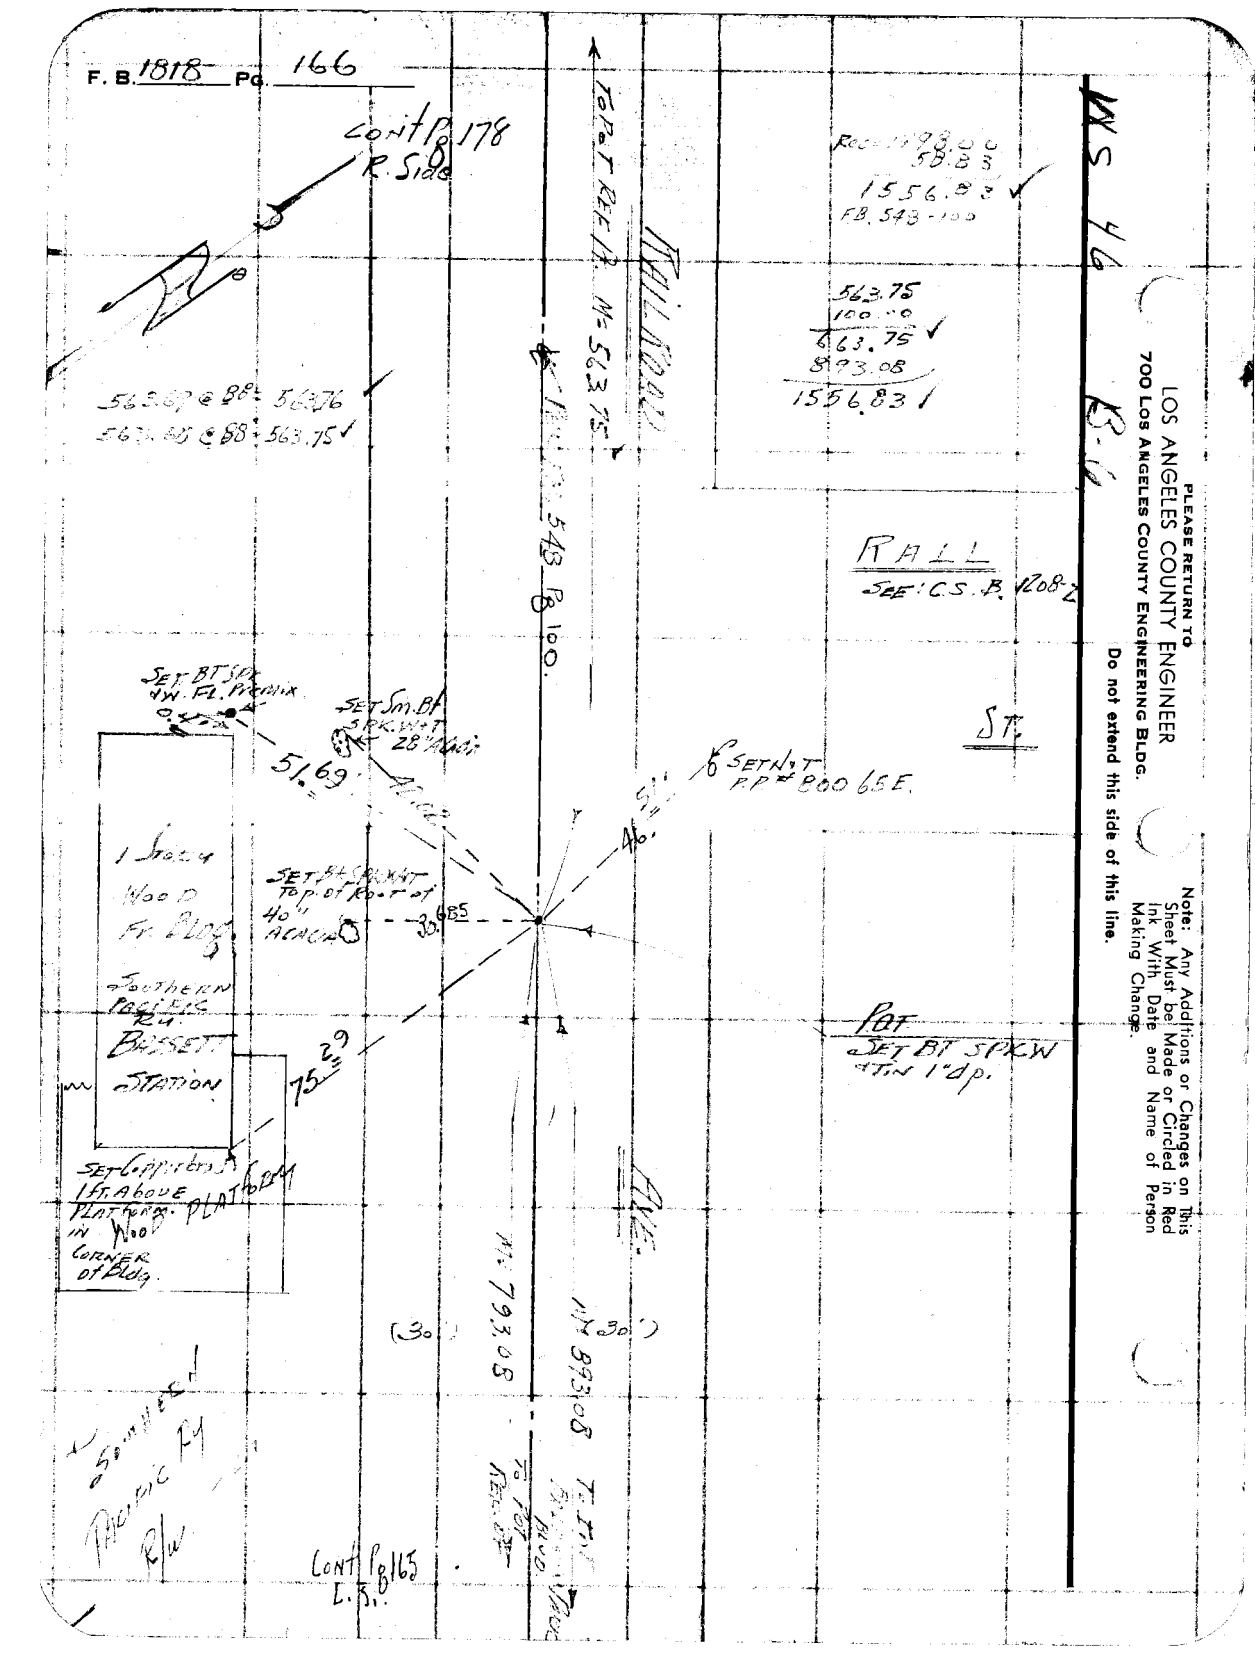

Notes Ck'd by W. Brenner | Survey of BALDWIN PARK BLVD. | P. B. 1818 | Pg. 467
Map No. C.S.B-2497-1 | JN 0074.03 Tape 0124 Std 6B °F | REALIGNMENT.
Office Work Burns | Surveyed by H. E. GRANQUIST
Checked W. Brenner | Notes H.E.G. Date 6/18/57
Indexed

2B

MS 46

Note: Any Additions or Changes on This Sheet Must be Made or Circled in Red Ink With Date and Name of Person Making Change.

Do not extend this side of this line.

PLEASE RETURN TO
LOS ANGELES COUNTY ENGINEER
700 LOS ANGELES COUNTY ENGINEERING BLDG.

76F3095 S&E #247 1-56

29

D.T. BASSETT'S
M.R. 59-4709
CS 6611 REF 567

(30')

BALDWIN PARK BLVD.

(30')

SET 3/4" IP PLG. 3" BELOW TOP THAT BY INTS. MADE SEARCH 4' DEEP FOR U.S. MON PER FD. 1818 Pg. 13 & FB. 520 Pg. 10 FD. NOTHING. MON. POSSIBLY LOST DUE TO SEWER LINE CONST.

T (910.85 FB 520-10) TO FB
M: 910.82
SWLY

FB 15 & FB 520 Pg. 11

(30')

TO C.S. MON RAILR'D ST.

(957.50 MAP)

180°

(977.49 MAP) TO MON Pg Pg. 146 OF

PER FB 520 Pg. 10 & C.S.B 1208-2

NELSON

NOT OPEN

(30')

97

14.38

41.20

47.34

SET X T.M.H. Rim

POT SET Scribd. SPK IT FL WIGGLE PT.

AVE.

NOT OPEN

SET X Side of 8" FIRE PLUG 1 FT. UP.. FD LIT 30 Std'd Pipe. 2' UP.

FD NAIL & P.P. 344 7 AE

N 89° 59' 45" E

B.C. @ 6 89° 59' 40"
359° 59' 00"
89° 59' 45" ✓
179° 59' 30" ✓
89° 59' 45" ✓

955.00 @ 106° = 955.23 ✓
955.02 @ 106° = 955.25 ✓

BALDWIN PARK BLVD. (FORMERLY LONG)
AREA = 955.23
952.1 PB 11/13
PER CSB 1208-2

TO E.I.T. RAILROAD CUE

Cont PB 165 Top

F. B. 1818 PG. 168

Co. F. B. 158

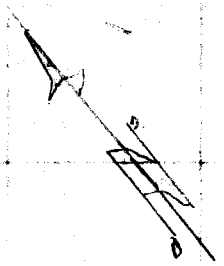

(30')

(30')

816.94'
69.57
886.51 @ 86° = 886.61
886.51 @ 86° = 886.61

M= 886.61' To C.S. Mon. in Mon. Well

BLVD.

(18)

(19)

POT Set Spk. in Tack Point

Set Hit Top of 10" Rd Post

Cable Co.

36.72

M=23.48

Subdivision M.R. 59-4 Tog C 546 11 Rf. 567

#7407.93E

Set Hit D.P. #1855.60E

23.46

R=40.57

M=10.61

9°

24.19 O'

29.795

Fd Lit in Sl. of 30' Conc. Stnd Pipe

FB LT Spk Wit Ref. Pt. Per FB 520 P 10

POT. Fd Nothing Spk Conc. Set Bt Spk Wit 1" DCCP Opp. Ref. Pt. as Per. FB 520 P 10 = 9+09.85 Sta Back

Road Kiln Fa. Rk. (Chained Going E.)

M= C.S. B 426-2

M= 910.84

(29)

O.T. Bassett's

910.67 @ 94° = 910.82
910.71 @ 94° = 910.86

16 Tait Reservoir

28

Cont Pg 167

PLEASE RETURN TO
LOS ANGELES COUNTY ENGINEER
700 Los Angeles County Engineering Bldg.

Do not extend this side of this line.

Note: Any Additions or Changes on This Sheet Must be Made or Circled in Red Ink With Date and Name of Person Making Change.

Notes Ck'd by W. Brenner
Map No. C.S.B-2497-1
Office Work Burns
Checked W. Brenner
Date

Survey of BALDWIN PARK LINE
JN 00794.03 Tape 0127 Std 68 °F
Surveyed by H.E. GRANQUIST
Notes H.E.G. Date 6/19/57
Indexed

F.B. 1818 Pg. 169
→ REALIGNMENT SURVEY

623.27 @ 90° 623.27

5

WS 46

Note: Any Additions or Changes on This Sheet Must be Made or Circled in Red Ink With Date and Name of Person Making Change.

Do not extend this side of this line.

PLEASE RETURN TO
LOS ANGELES COUNTY ENGINEER
700 LOS ANGELES COUNTY ENGINEERING BLDG.

76F309S S&E #247 1-56

2" I.P. Conc. PLUG in Hd. in Co. Engrs. Tab. Ctr. Pt. 24" Deep

See Pg.

Void This P/L

Line Change to Clde Baldwin Park Blvd. See Pg.

Baldwin Park Blvd. Proposed Realignment

N 25° 59' 10" E

Δ = 44° 00' 30"
R = 1200.00'
T = 485.00
L =
EXT =

Void This Control Changed to Orig. & See Pg.

N 635.00 To CC

Set Spkt.

D 1 35-59-10
B 183-56-40
A 135-59-10
C 95-55-00
135-59-10

OK

11.61'

Pot. Set Spkw/T. ½" Deep. 635.00 From Torch Mk. As for Staking Sheet

20.00

4.01 Mea + Calc.

27.01 @ 88-
27.05

P.I. Set 3/4" I.P. & Tag 3" DP Pg. 181. For Ties

6 Subs

Pot Set N. Spk. +T. FL.

Set X Tr. Curb

44'

Park Blvd.

16'-17" M.

Top P/L

Transit Line For Calc.

To "X" Stk. For Transit Line R.P. & Fd. C. Spk. w/T. 1' Deep F.B. 520 Pg. 18

Mea = 1653.99 PPD 1855.82'

5.41'

57.12

97.4

FB 520 P. 18 Calc. Spk. & Tag 10" DP. Ground Search for Tie Pt. See 3818 B

RFB 520-2

RFB 520-18

M = 12.0
R = 12.0
90°

117.28

Set X

Fd Cotten 2" x 2" Stk. No Tag 1.6' Deep. Set 3/4" I.P. & L.A. Co. Engrs. Tag 6" Deep. Replaced not 2" x 2" Stk. as Shown Plans as Ref. Pt. Witness FB 520 Pg 18

Contd Pg 158

To Map

O.T. Bassett's M.R. 59-4 To 9

Baldwin Park Blvd. (County Road) 80'

910.45 FB 520-18 (Mea = 910.51)

F. B. 1818 PG. 170

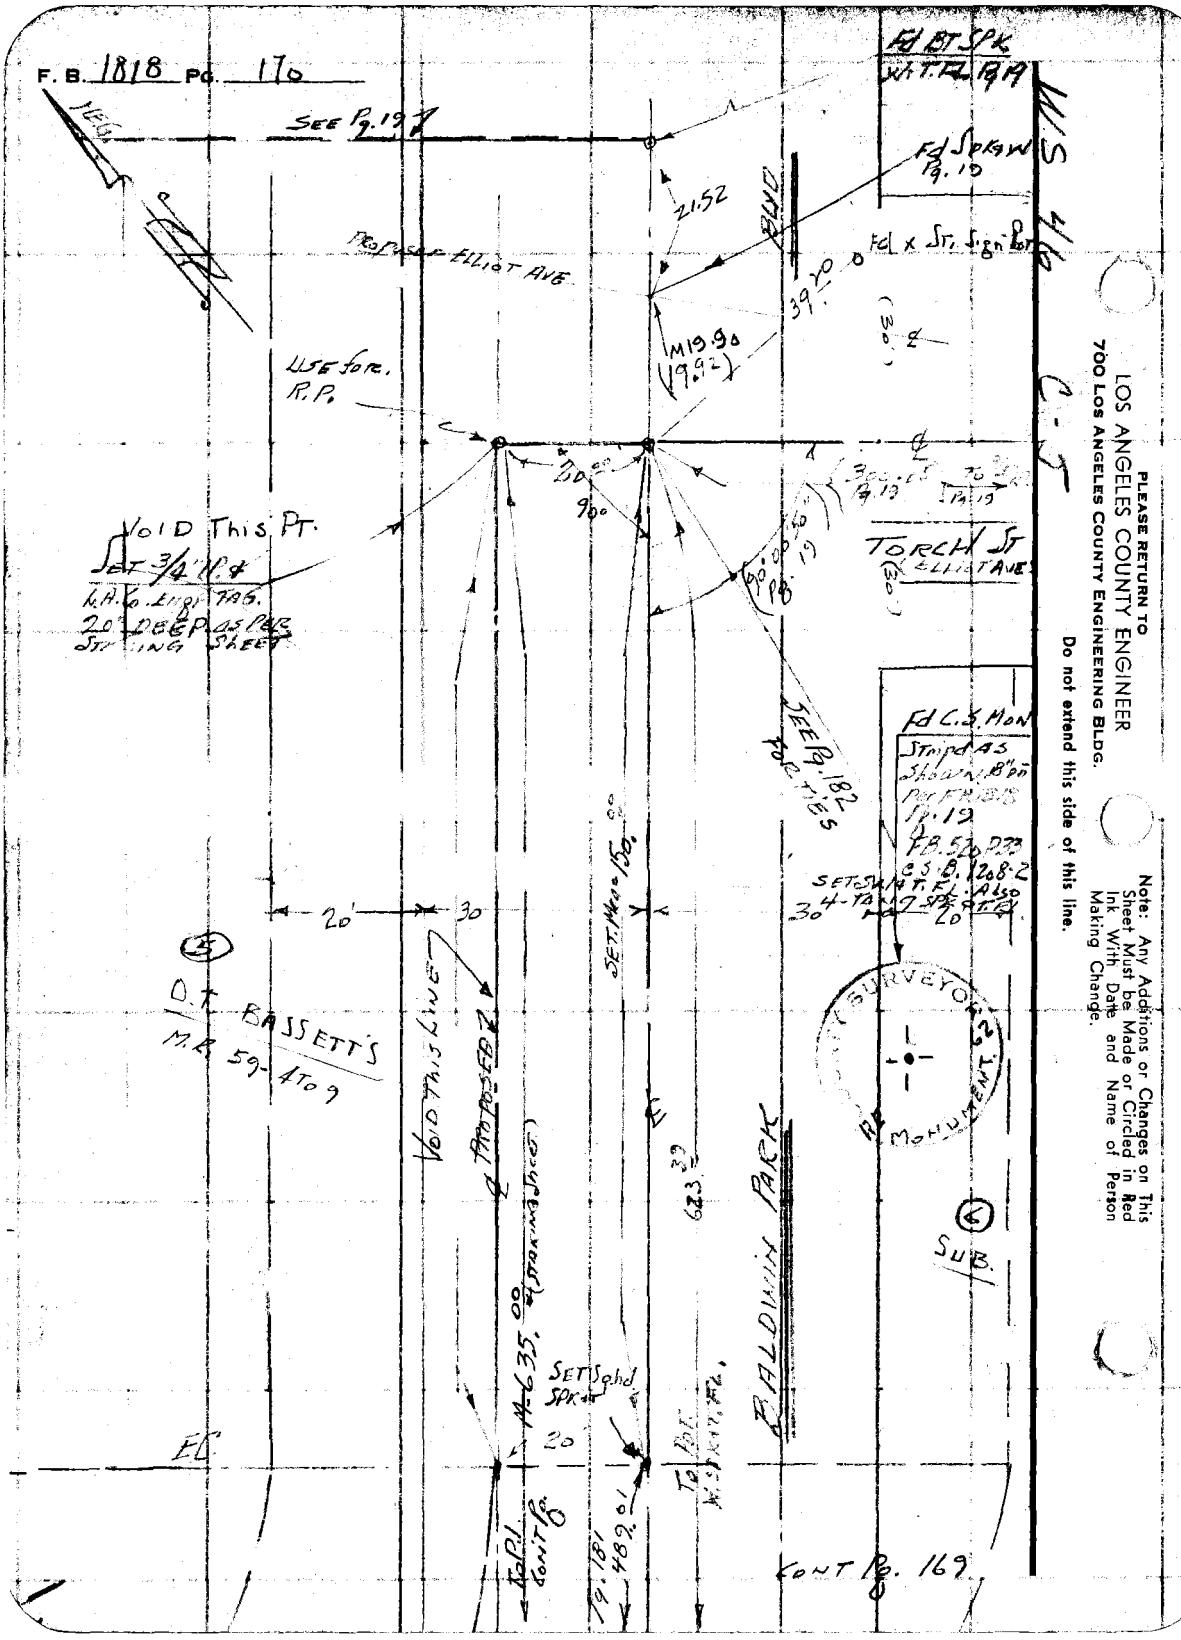

PLEASE RETURN TO
LOS ANGELES COUNTY ENGINEER
700 LOS ANGELES COUNTY ENGINEERING BLDG.

Do not extend this side of this line.

Note: Any Additions or Changes on This Sheet Must be Made or Circled in Red Ink With Date and Name of Person Making Change.

Notes Ck'd by W. Brenner
Map No. C.S.B. 2497-1
Office Work Queens
Checked W. Brenner
Date

Survey of BALDWIN PARK BLVD
JN 0074.3 Tape 0124 Std 69 °F
Surveyed by H.E. GRAHAM 1957
Notes
Date
Indexed

F.B. 1819 Pg. 17
REALIGNMENT

Note: Any Additions or Changes on this Sheet Must be Made or Circled in Red Ink With Date and Name of Person Making Change.

Do not extend this side of this line.

PLEASE RETURN TO
LOS ANGELES COUNTY ENGINEER
700 Los Angeles County Engineering Bldg.

76F3095 S&E #247 1-56

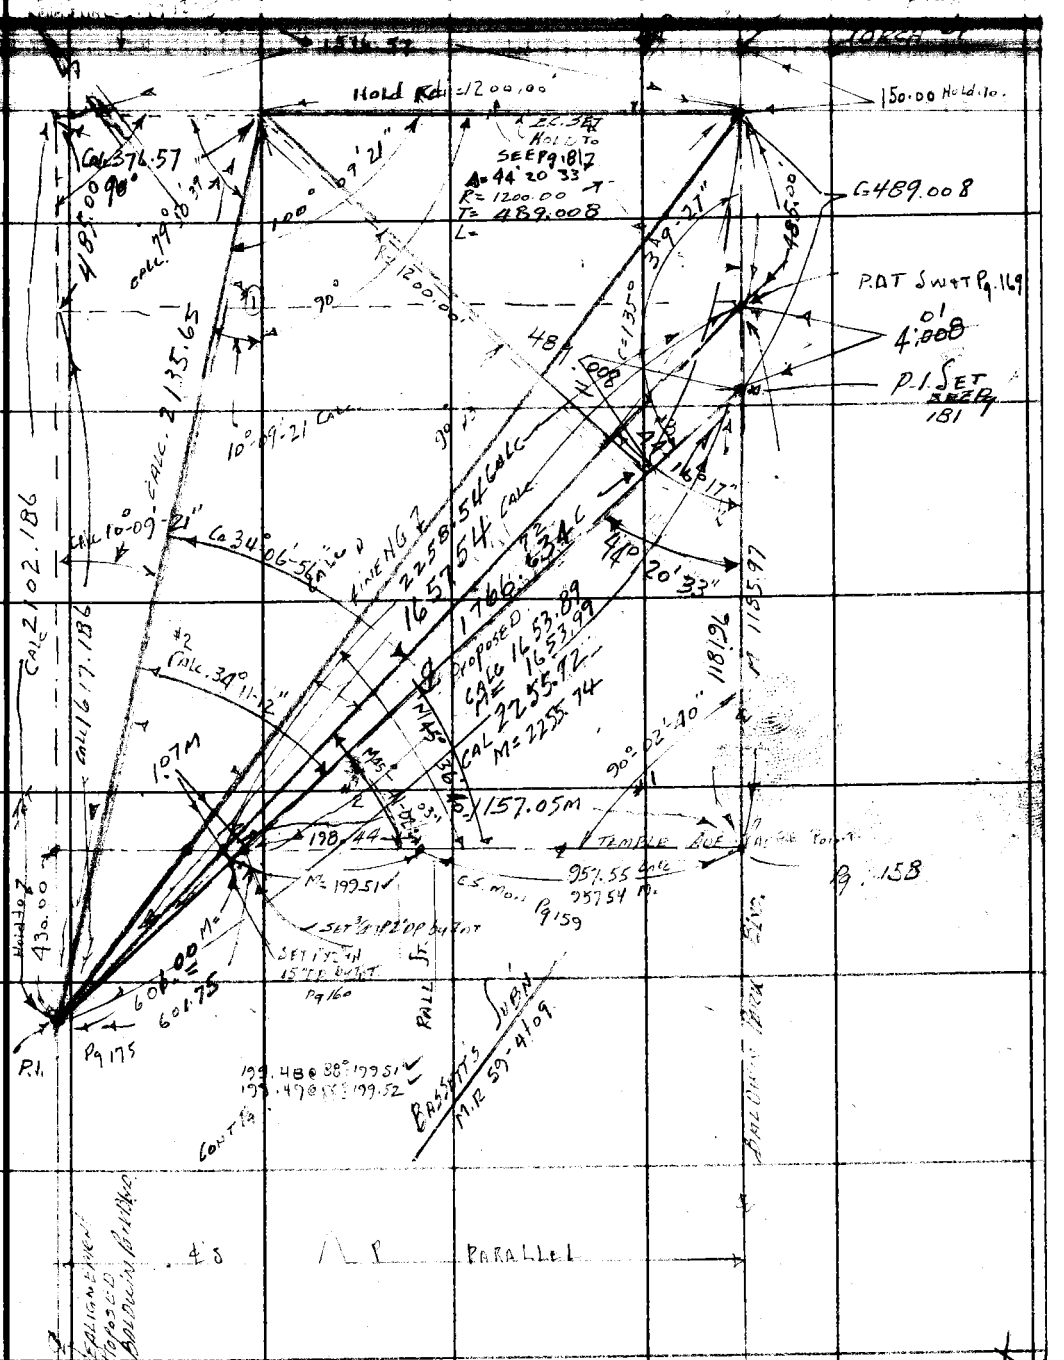

F. B. 1518 PG. 172

YELLOW △

△ 1
△ 2
△ 3

(2)

D 45-41-00
B 182-44-10
A 45-41-02½
C 274-06-10" ✓
A 45-41-01⅔ ✓

(3)

44-16-20" B
177-05-10 A
44-16-17½ A
265-37-40 D ✓
44-16-16⅔ A ✓

44°20-33
CALC & SET

BLUE

R1,

B 44-20-30
A 177-22-20
A 44-20-35 ✓
C 266-03-30 ✓
A 44-20-35 ✓

EAGLE Post
Int Temple Post

D 45°36-40
B 182-26-40
A 45-36-40 ✓
C 273-40-90
A 45-36-40 ✓

PLEASE RETURN TO
LOS ANGELES COUNTY ENGINEER
700 LOS ANGELES COUNTY ENGINEERING BLDG.

Do not extend this side of this line.

Note: Any Additions or Changes on This Sheet Must be Made or Circled in Red Ink With Date and Name of Person Making Change.

76F309S S&E #247 1-56

PLEASE RETURN TO
LOS ANGELES COUNTY ENGINEER
700 LOS ANGELES COUNTY ENGINEERING BLDG.

Note: Any Additions or Changes on This Sheet Must be Made or Circled in Red Ink With Date and Name of Person Making Change.

Do not extend this side of this line.

Notes Ck'd by
Map No.
Office Work
Checked
Date

Survey of
JN
Tape
Std
°F
Surveyed by
Notes
Date
Indexed

F. B. 1818 Pg. 173

PLEASE RETURN TO
LOS ANGELES COUNTY ENGINEER
700 LOS ANGELES COUNTY ENGINEERING BLDG.

Note: Any Additions or Changes on This Sheet Must be Made or Circled in Red Ink With Date and Name of Person Making Change.

Do not extend this side of this line.

F.B. 1018 Pg. 174

Notes Ck'd W. Brenner
Map No. C.S.B- 2497-1
Office Work Burns
Checked W. Brenner
Date

Survey of Baldwin Park Blvd. Realignment
JN 007403 Tape 0124' Std 6 8 °F
Surveyed by H.E. GRANDQUIST
Notes H E G Date 6/26/57
Indexed

F. B. 1818 Pg. 175

A	90-00-30	147-08-30
B	360-02-00	22B-33-40
C	90-00-30	147-08-25
D	180-02-30	162-50-40

Note: Any Additions or Changes on this Sheet Must be Made or Circled in Red Ink With Date and Name of Person Making Change.

PLEASE RETURN TO
LOS ANGELES COUNTY ENGINEER
700 LOS ANGELES COUNTY ENGINEERING BLDG.

Do not extend this side of this line.

76F309S S&E #247 1-56

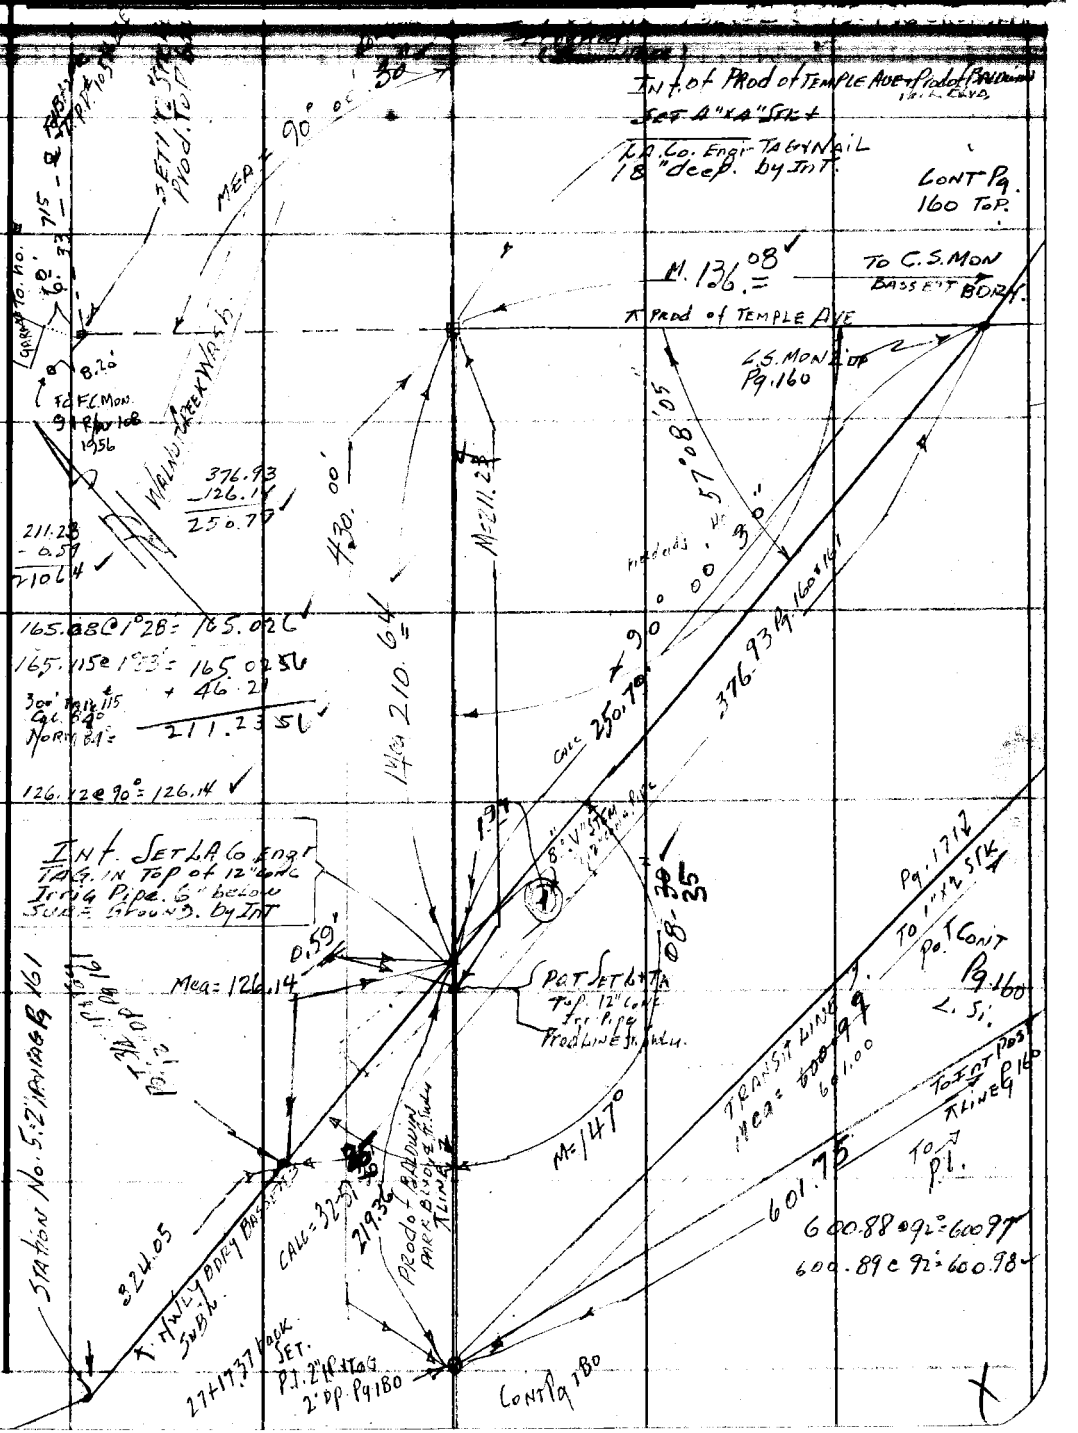

PLEASE RETURN TO
LOS ANGELES COUNTY ENGINEER
700 LOS ANGELES COUNTY ENGINEERING BLDG.

Note: Any Additions or Changes on This Sheet Must be Made or Circled in Red Ink With Date and Name of Person Making Change.

Do not extend this side of this line.

F. B. 1818 Pg. 776

Notes C'k'd by W. Brenner
Map No. C.S.D-2497-1
Office Work by W. Brenner
Checked W. Brenner

Survey of BALDWIN PARK BLVD.
JN 00774.03 Tape 0124 Std 68 °F
Surveyed by H.G. GIANNOULIS
Notes Date 6/29/67

F.B. 1818 Pg. 177
ANGLE POINT
F&LA Co. TRAV. STA
El Monte L-6. IN
FB 2117 Pg 9

Note: Any Additions or Changes on This Sheet Must be Made or Circled in Red Ink With Date and Name of Person Making Change.

Do not extend this side of this line.

PLEASE RETURN TO
LOS ANGELES COUNTY ENGINEER
700 LOS ANGELES COUNTY ENGINEERING BLDG.

353-09-20
BB-17-20"
BB-17-20"

TRACT No. 8227
M.B. 92/100

81.875 - 70 = 81.885

SAN GABRIEL RIVER PARKWAY.

(80')

(50')

124.82 FB 2117 Pg 8

L+T

Fd PUNCH MARK IN WASHER PER F.B. 2117 Pg 8. SEE F.B. 548 Pg 93 & B. 12.16-2

Fd L+T.

Fd BT STK+W. FL. by TIES F.B. 2117-B

0.25

OLD

SET BT PK PREMIT

SET LAG. END TAG

SET BT PK TAG

4725.18 & FB 2117 Pg 8

(ESB 1263-3 599.92)

79.55'

225'

55'

51'

67.25'

81.25'

SAN FIDEL AVE.

Fd L+T. 0.03+L.

4" Cl. Conc. Base Sta Light

0.03 of Trace Line Prog

BALDWIN PARK BLVD

M=BB° 17' 20"

63.34

46.

17' 20"

0.03

95.32

129.88

88°

26.01

100.00

58.46'

Prod. SET LAG. END TAG.

TO STA. 149.38

TO ANGLE PT 394.07

30

30

TANG 394.07

TANG 65.94

Fd L+T Conc base Traf Signal

1400.00 SET BT PK W. Disp.

100.00

CONT. NEXT PG

147.36

146.67

394.07

OLD SET BT PK & WASHER 1/2" DEEP

VALLEY BLVD.

(SEE) PAR. F.B. 2117 Pg 8

TANG 65.94

Fd L+T

SET TAG

76F3099 S&E #247 1-56

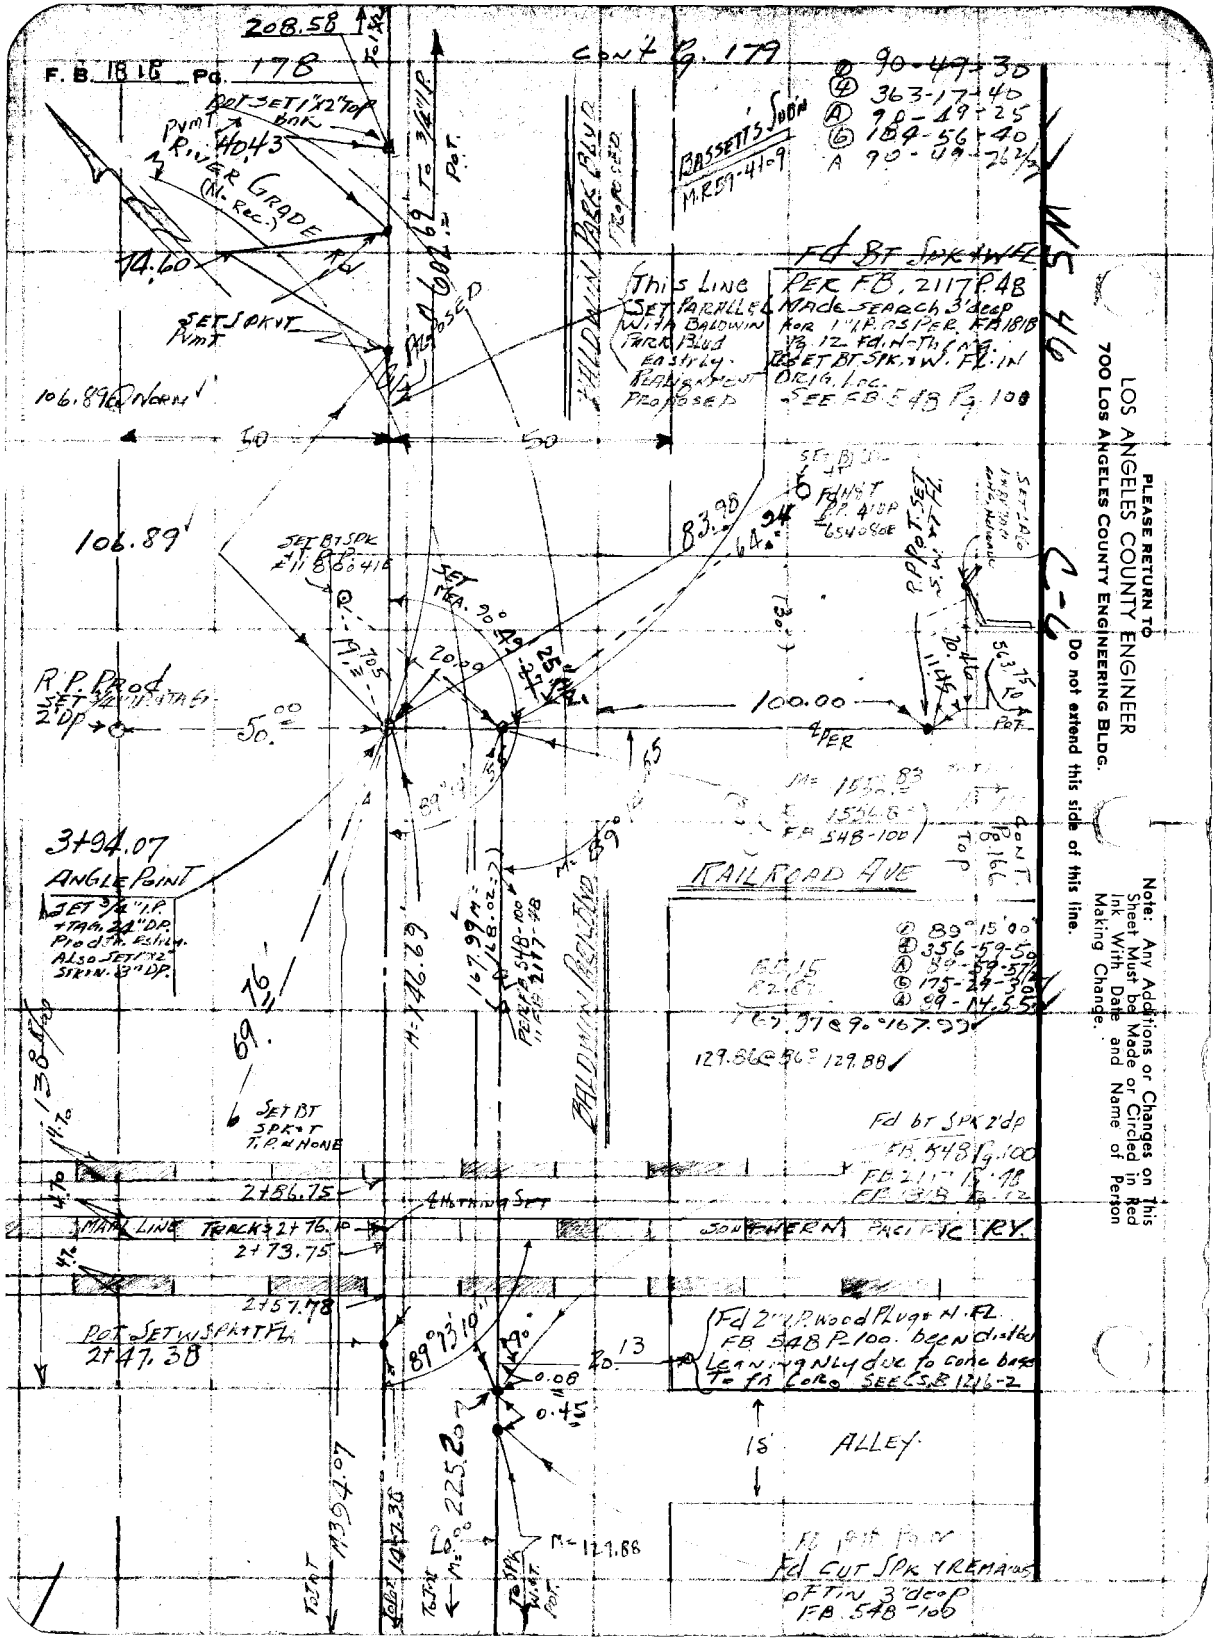
208.58
F.B. 1616 Pg. 178
Cont'd fr. 179
90-49-30
363-17-40
90-19-25
189-56-40
A 90-09-26½
Pvmt
R. RIVER GRADE (N. Rec.)
Set Spk YL
Set Spk Pvmt
106.89' NORM
50
50
106.89'
Set BT Spk
Set Pea. 30°
R.P. Prod
Set ¾" I.P. 2" D.P.
50.00
100.00 PER
3+94.07
ANGLE POINT
Set ¾" I.P. Tag 24" D.P. Prod. Fr. Sh. Also Set ½" Spk in 8" D.P.
RAILROAD AVE
89° 15' 00"
356-59-50
90-59-57
175-29-30
89-14-55
129.86 PER 129.88
Fd BT Spk 2" D.P.
Set BT Spk & T.P. in Hole
2756.75
MAIN LINE TRACK 2+76.10
2+73.75
SOUTHERN PACIFIC RY.
2757.78
POT Set W/Spk & Tag
2+47.38
89°13'10"
Fd 2" I.P. Wood Plug & N. Ft.
FB 548 P. 100. Bent Disturbed Leaning Slightly due to conc. base of Fa Conc.
SEE CSB 1216-2
ALLEY
Fd Cut Spk Yr Remains of Tin 3" Disc
FB 548-100
Set Spk & W. Ft. in Orig. Inc.
SEE FB 548 Pg. 100
Bassetts Subdn
M.R. 59-41-9
Baldwin Park Blvd
Proposed
This Line Set Parallel with Baldwin Park Blvd Easterly. Realignment Proposed
PER FB. 2117 P. 48
Made Search 3' deep for 1" I.P. as per FB 1818 V. 8 12 Fd. N-Th. & W. Reset BT Spk & W. Ft. in Orig. Inc.
SEE FB 548 Pg. 100

Notes Ck'd by W. Brenner
Map No. C.S.B-2497-1
Office Work Burns
Checked W. Brenner
Date

Survey of BALDWIN PARK BLVD.
JN 0074.02 Tape 0124 Std LB °F
Surveyed by H.E. GRANHOLM SR.
Notes Date 7/1/52
Indexed

F.B. 1818 Pg. 179
REALIGNMENT.

14+92.05
POT. SET 3/4" I.P. IN MON.

Note: Any Additions or Changes on this Sheet Must be Made or Circled in Red Ink With Date and Name of Person Making Change.

PLEASE RETURN TO
LOS ANGELES COUNTY ENGINEER
700 LOS ANGELES COUNTY ENGINEERING BLDG.
Do not extend this side of this line.

76F309S SAE #247 1-56

(30)
O.T. BASSETTS SUB'N
M.R. 59 4 to 9

R.P. POT. SET 3/4" I.P. TAG. 18" DP.

STATION No. 7. BASSETT'S SUB'N
Fd. Std C.S. Mon. 30" DP
With 2" I.P. Wood Plug in It.
Per Pg. 163
F.B. 529 Pg 34

M= 131.30

68.02

501.56
91.69
593.25

M= 593.25 (593.32 C.S.B. 12.08-2)
593.3' Calc. fr. Basis of Bearings per C.S.B. 12.08-2
593.3' of BASSETTS SUB'N PER C.S.B.

S 89° 31' W

SEE Pg. 163
STATION No. 8. BASSETT'S SUB'N
C.S. MON. 2' DEEP.
PER F.B. 520 Pg 34

63.28

208.58

M= 1437.68
M= 1208.32

12.18.05 @ 102° = 12.18.32
12.18.05 @ 102° = 12.18.32

50.00 50.00

90°

R.P. POT. SET 3/4" I.P. IN TAG, 24" Deep.

82.04

82.03 @ 82° = 82.04

14+17.01
POT. SET 1"X2" STK IN 12" DP.

90°

M= 502.29

502.24 @ 82° = 502.29
502.24 @ 82° = 502.29

PARK.

9+96.76
POT. SET 3/4" I.P. IN LEAD IN TAG. 2" Deep.

4.22
0.63

SET BT SPK WHT. 15" WALNUT.

PROPOSED REALIGNMENT

M= 172.19

602.69

BALDWIN

172.18 @ 80° = 172.19
172.19 @ 80° = 172.20

8+24.57
POT. SET 1"X2" STK IN 18" DP.

CONT PG 178

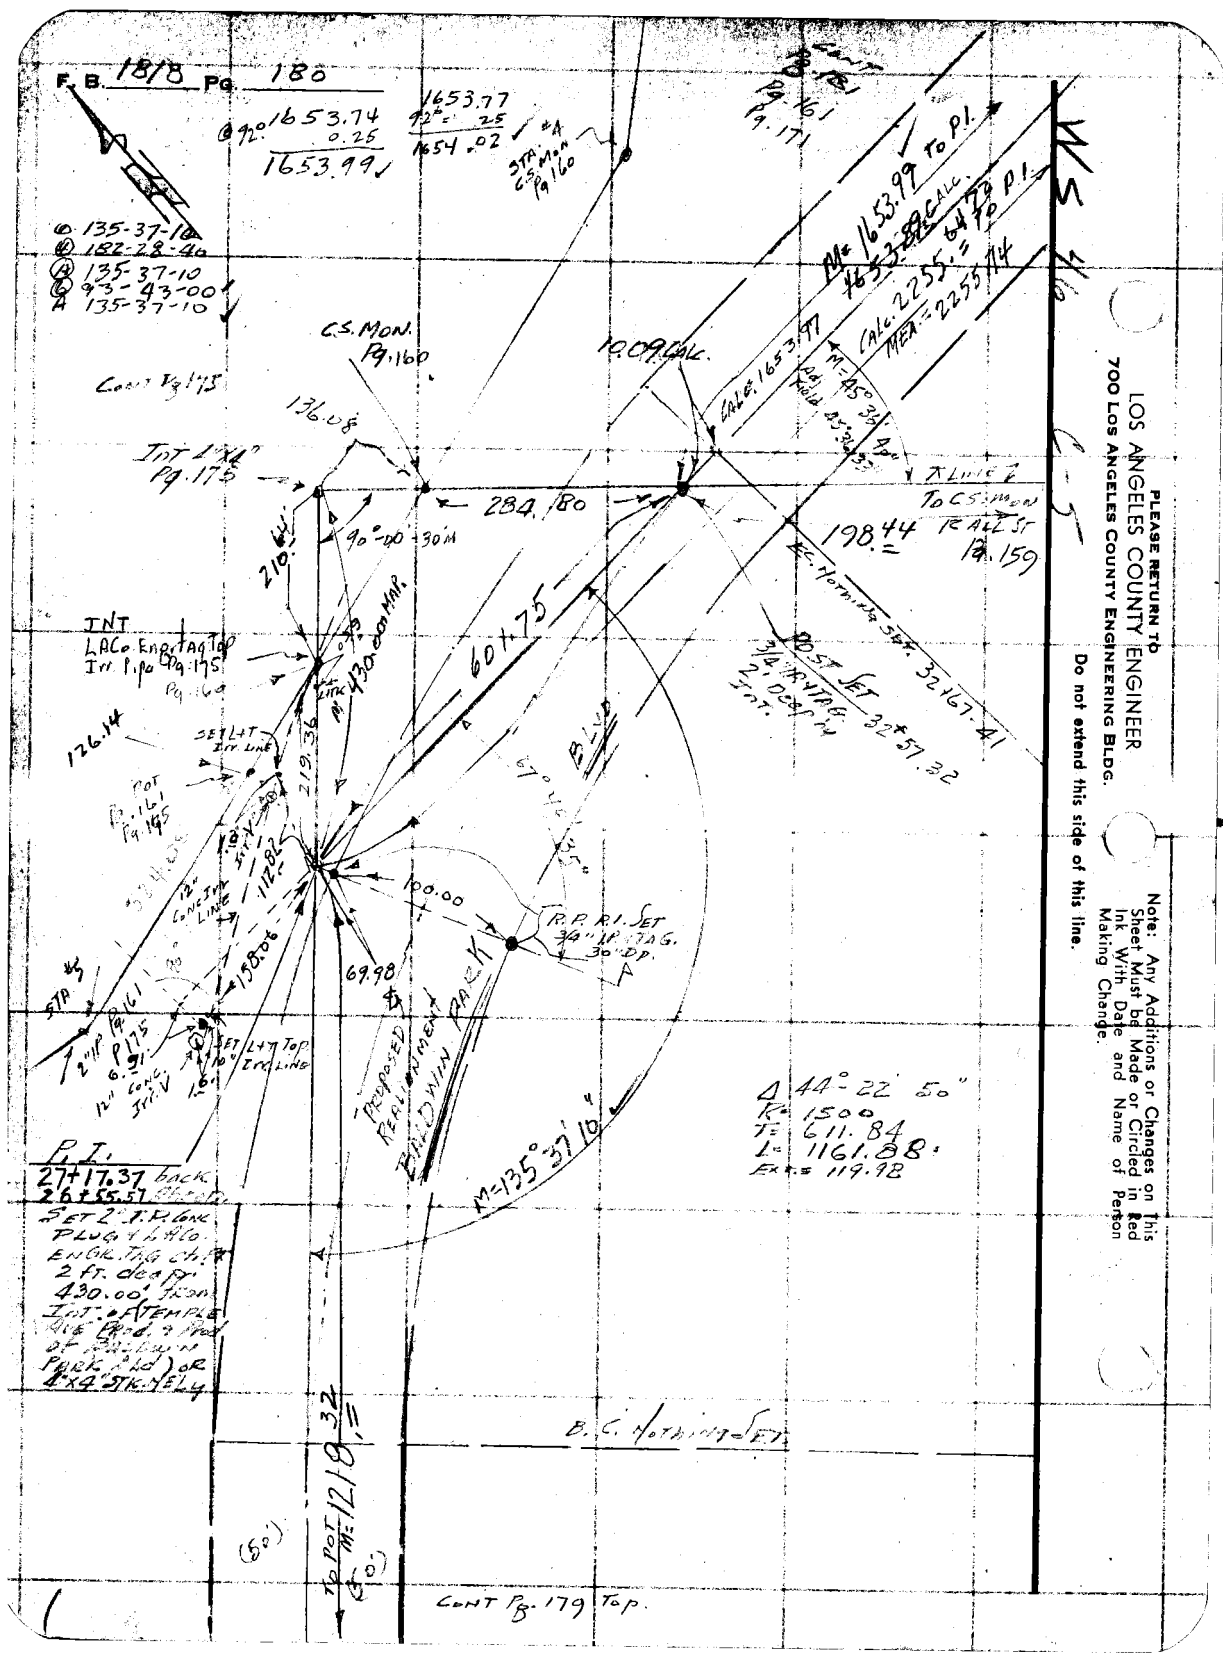

PLEASE RETURN TO
LOS ANGELES COUNTY ENGINEER
700 LOS ANGELES COUNTY ENGINEERING BLDG.

Do not extend this side of this line.

Note: Any Additions or Changes on This Sheet Must be Made or Circled in Red Ink With Date and Name of Person Making Change.

Notes Ck'd by W. Brenner
Map No. C.S.B. - 2497-1
Office Work Burns
Checked W. Brenner
Date

Survey of BALDWIN PARK BLVD
JN 0079 Tape 212' Std 68 °F
Surveyed by H.E. GRADY 9-17-57
Notes C Date
Indexed

F. B. 1818 Pg. 181
REALIGNMENT
CONT Pg. 180

Note: Any Additions or Changes on This Sheet Must be Made or Circled in Red Ink With Date and Name of Person Making Change.

PLEASE RETURN TO
LOS ANGELES COUNTY ENGINEER
700 Los Angeles County Engineering Bldg.
Do not extend this side of this line.

76F3088 S&E #247 1-56

53+51.01
E.C. Set Spkd Spk in Fl
Pg. 190

Δ = 44° 20' 33"
R = 1200.00
T = 489.01
L = 928.707
Extl 95.81

Bassett's Subd
(6)

Set Mt P.P. #1855516

Fd Spk & T. Pg. 169

C.M. = 45.81

11.61

Post Swt Pg. 169.

4.01

Set 3/4" I.P. + Tack 0.02' P

Bassett's M.R. 59-4 to 9
(5)

Set Jm. BC Spike & Tin P.P. #1855526

49+11.31 = 48+62.00 Ahead

Set 3/4" I.P. & Tag 3.00' Left of Long Tang Dist Holding from B.C.

W. Spk & T. Ft. Pg. 169

44° 20' 33"

Baldwin Park Blvd

Proposed Realignment Baldwin Park Blvd

M = 1655.99
Calc = 1653.97

M = 2255.74

To I.T. Line of Pkg of Temple Ave

(50)

Cont Pg 180 (50)
" Pg. 160

To P.I. Cont Pg 180 Pg. 175

Pg. 158

T. F.S.M. Temple Ave

11.81

9½'

30' x 30'

F. B. 1818 Pg. 182

W.S. 4G

PLEASE RETURN TO
LOS ANGELES COUNTY ENGINEER
700 Los Angeles County Engineering Bldg.

Do not extend this side of this line.

Note: Any Additions or Changes on this Sheet Must be Made or Circled in Red Ink With Date and Name of Person Making Change.

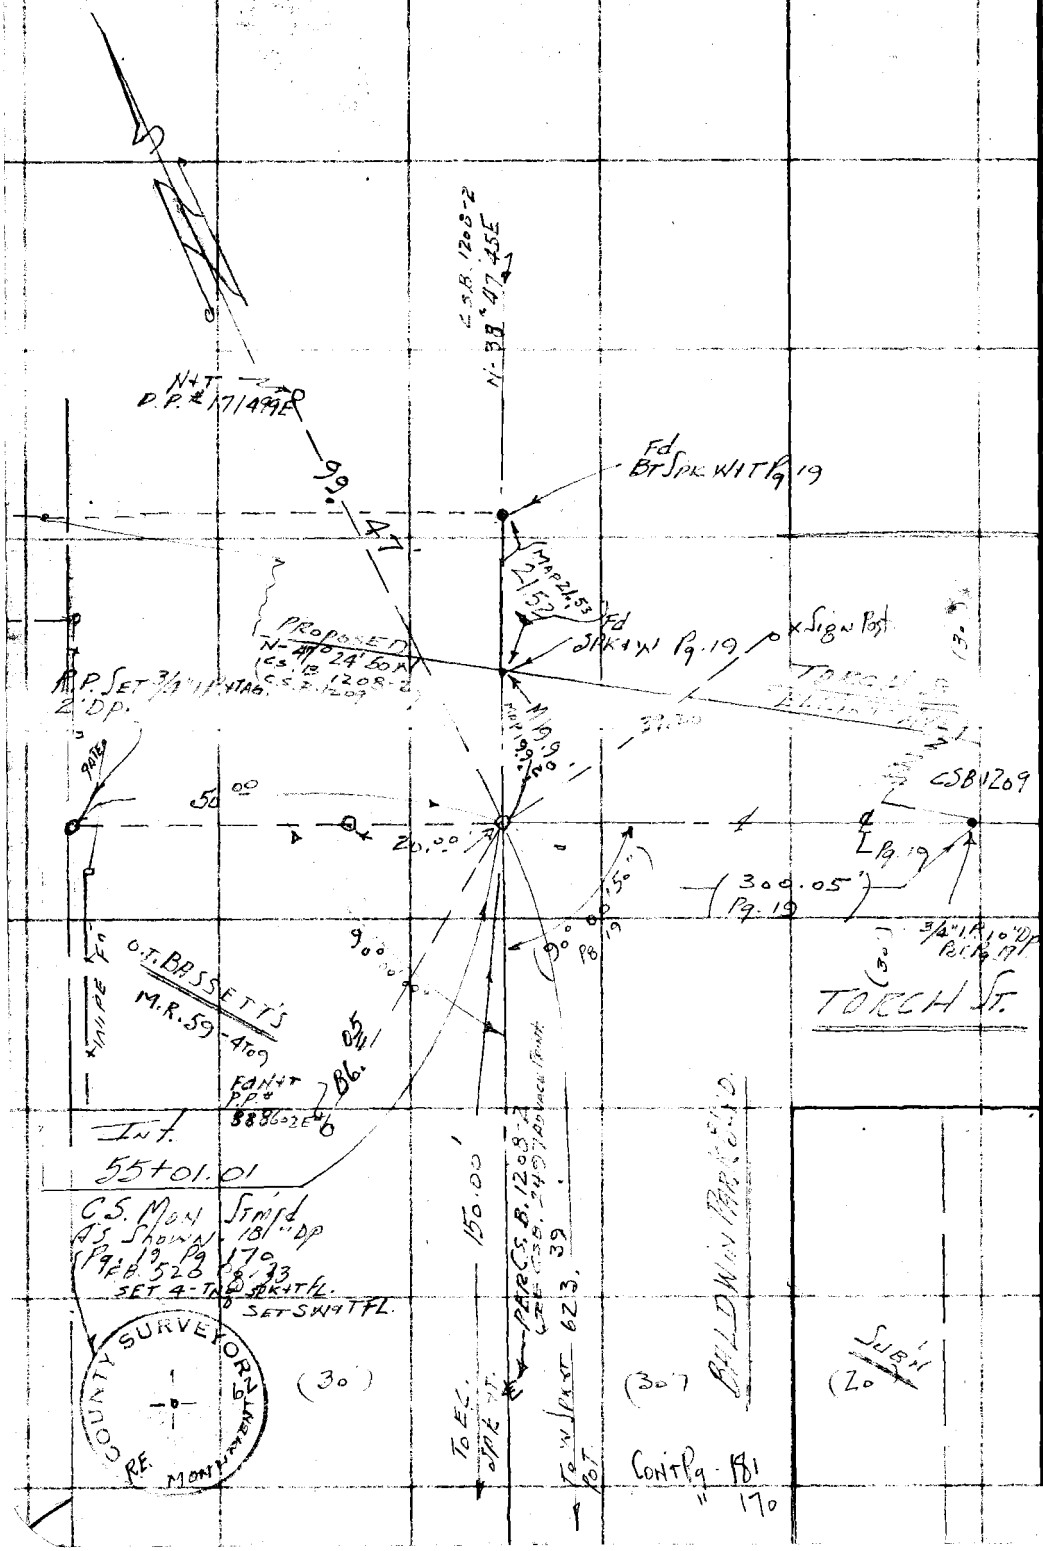

Notes Ck'd by _____
Map No. _____
Office Work _____
Checked _____
Date _____

Survey of BALDWIN PARK BLVD
JN 0074.00 Tape 0124 Std 68 °F
Surveyed by H. E. SKANGUY
Notes _____ Date 6/28/57
Indexed _____

F. B 1818 Pg. 183

Note: Any Additions or Changes on This Sheet Must be Made or Circled in Red Ink With Date and Name of Person Making Change.

Do not extend this side of this line.

PLEASE RETURN TO
LOS ANGELES COUNTY ENGINEER
700 LOS ANGELES COUNTY ENGINEERING BLDG.

76F309S SAE #247 1-56

PLEASE RETURN TO
LOS ANGELES COUNTY ENGINEER
700 LOS ANGELES COUNTY ENGINEERING BLDG.

Note: Any Additions or Changes on This Sheet Must be Made or Circled in Red Ink With Date and Name of Person Making Change.

Do not extend this side of this line.

F. B. 1818 Pg. 184

Notes Ck'd by W. Brenner
Map No. C.S.B-2497-1
Office Work by Burns
Checked W. Brenner
Date

Survey of BALDWIN PARK BLVD
JN 0074.03 Tape 0144 Std 68 °F
Surveyed by H.E. GRANQUIST
Notes N C G Date 7/10/57
Indexed

F. B. 1818 PG. 185

J.N. 0074.03

BALDWIN PARK BLVD.
REALIGNMENT.

LOCATION OF IMPROVEMENTS (NOTES)

FROM 0+00 + VALLEY BLVD.
N'ELY TO 55+01.01 ℄ INT. TORCH ST. + BALDWIN PARK BLVD.

Pg. 185 TO Pg. 197

H.E. GRANQUIST CHIEF
F.E. BROOKS, INSTR
E. MARTINEZ, HEAD CHAIN
B.M. VAN ALLEN, REAR "

PLEASE RETURN TO
LOS ANGELES COUNTY ENGINEER
700 LOS ANGELES COUNTY ENGINEERING BLDG.

Note: Any Additions or Changes on this Sheet Must be Made or Circled in Red Ink With Date and Name of Person Making Change.

Do not extend this side of this line.

76F3095 S&E #247 1-56

PLEASE RETURN TO
LOS ANGELES COUNTY ENGINEER
700 LOS ANGELES COUNTY ENGINEERING BLDG.

Note: Any Additions or Changes on This Sheet Must be Made or Circled in Red Ink With Date and Name of Person Making Change.

Do not extend this side of this line.

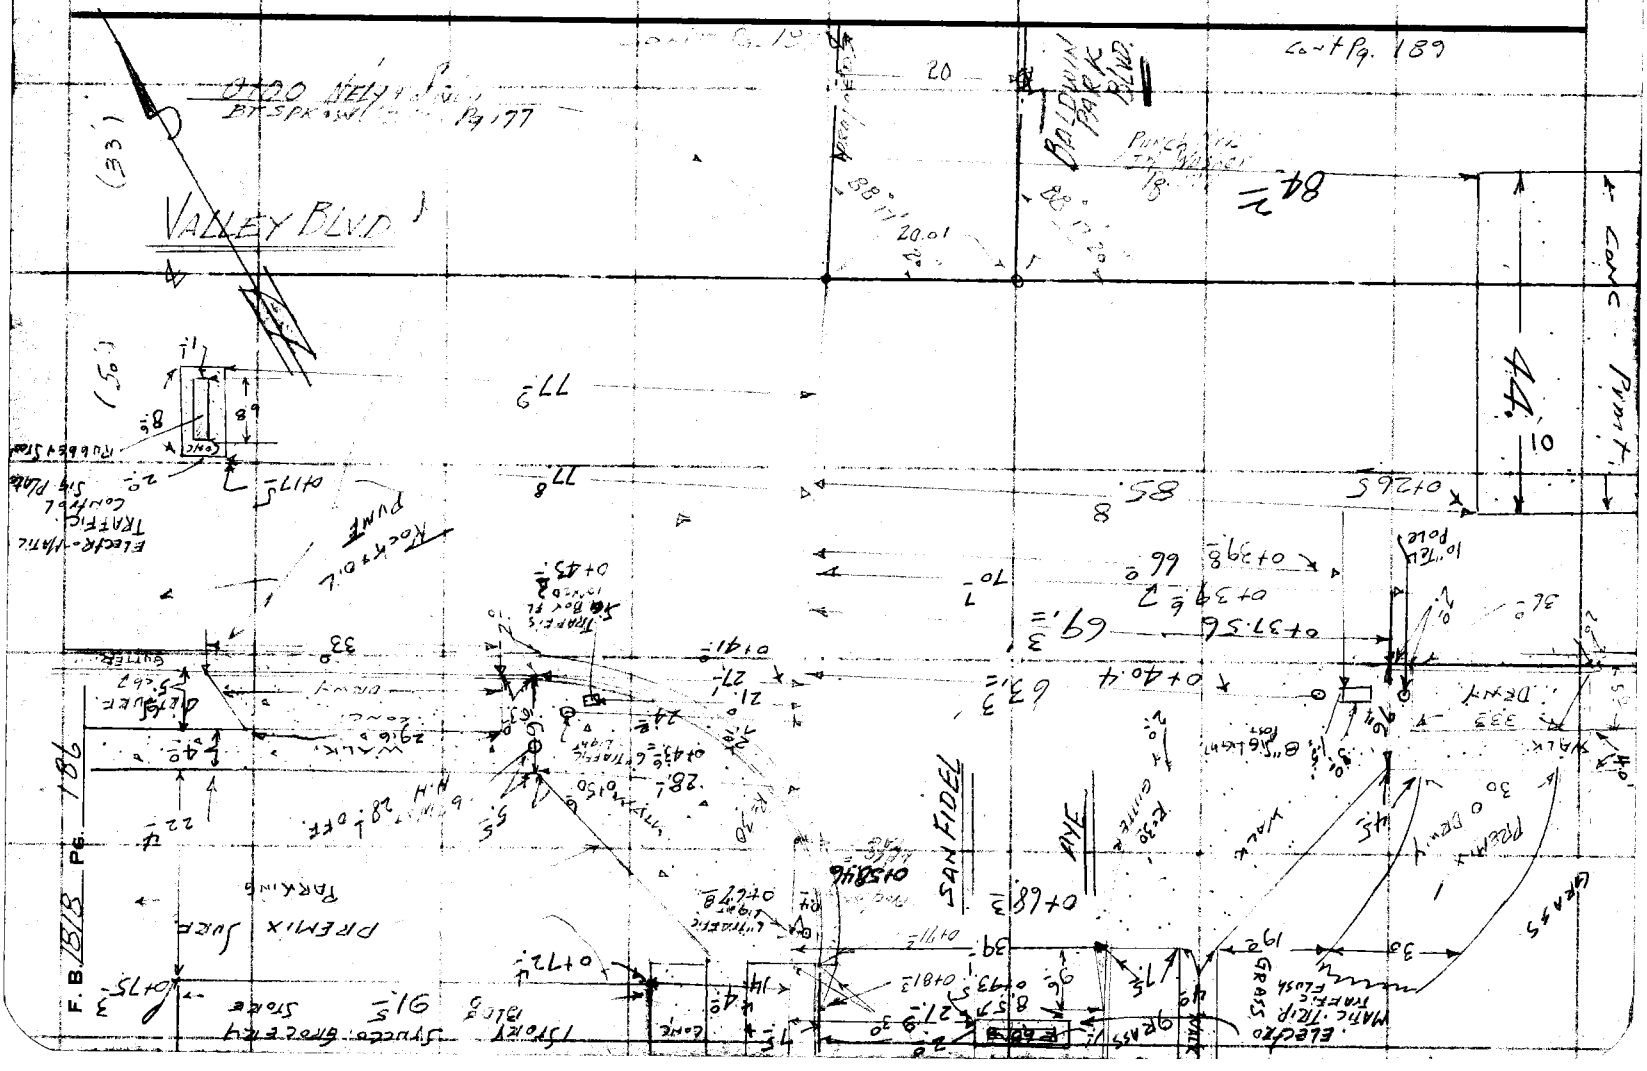

Notes Ck'd by W. Brenner
Map No. C.S.B - 2407-1
Office Work Burns
Checked W. Brenner
Date

Survey of BALDWIN PARK TRACT
JN 0074.03 Tape 0144 Std 66 9F
Surveyed by H.E. GRANQUIST
Notes PR 00X5 Date 7/12/57
Indexed

F. B. 1818 Pg. 157

Cont on Pg 188

Note: Any Additions or Changes on this Sheet Must be Made or Circled in Red Ink With Date and Name of Person Making Change.

PLEASE RETURN TO
LOS ANGELES COUNTY ENGINEER
700 LOS ANGELES COUNTY ENGINEERING BLDG.
Do not extend this side of this line.

76F3095 SAE #247 1-56

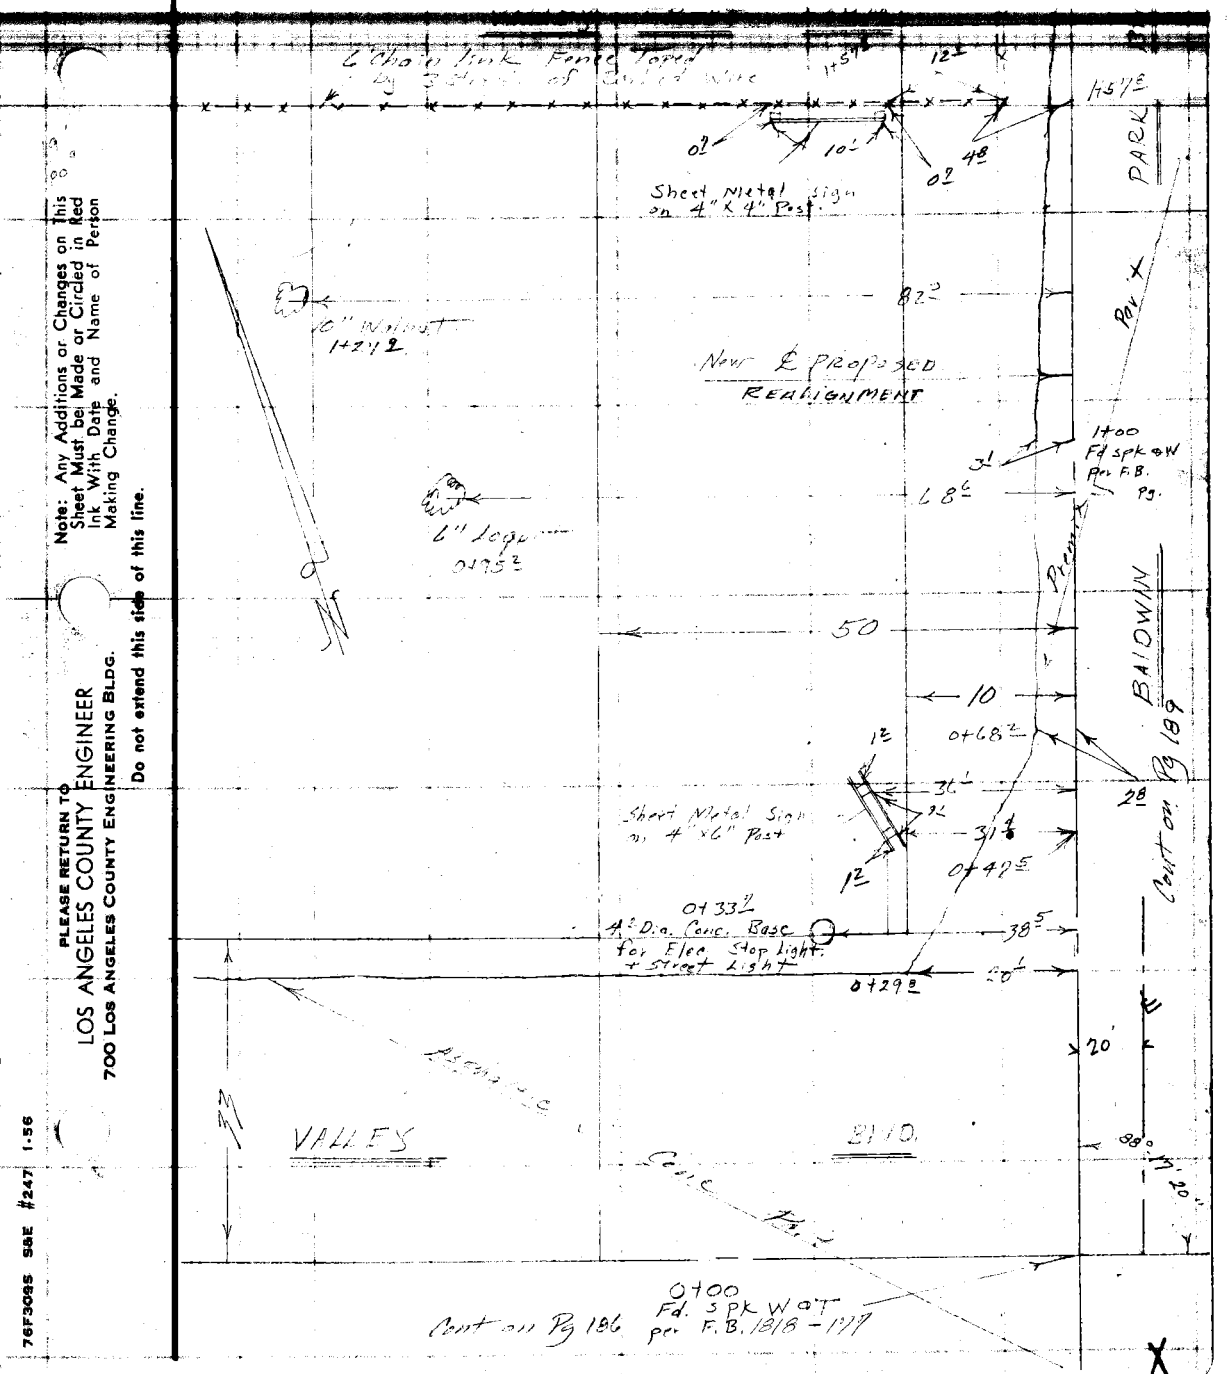

PLEASE RETURN TO
LOS ANGELES COUNTY ENGINEER
700 LOS ANGELES COUNTY ENGINEERING BLDG.

Note: Any Additions or Changes on This Sheet Must be Made or Circled in Red Ink With Date and Name of Person Making Change.

Do not extend this side of this line.

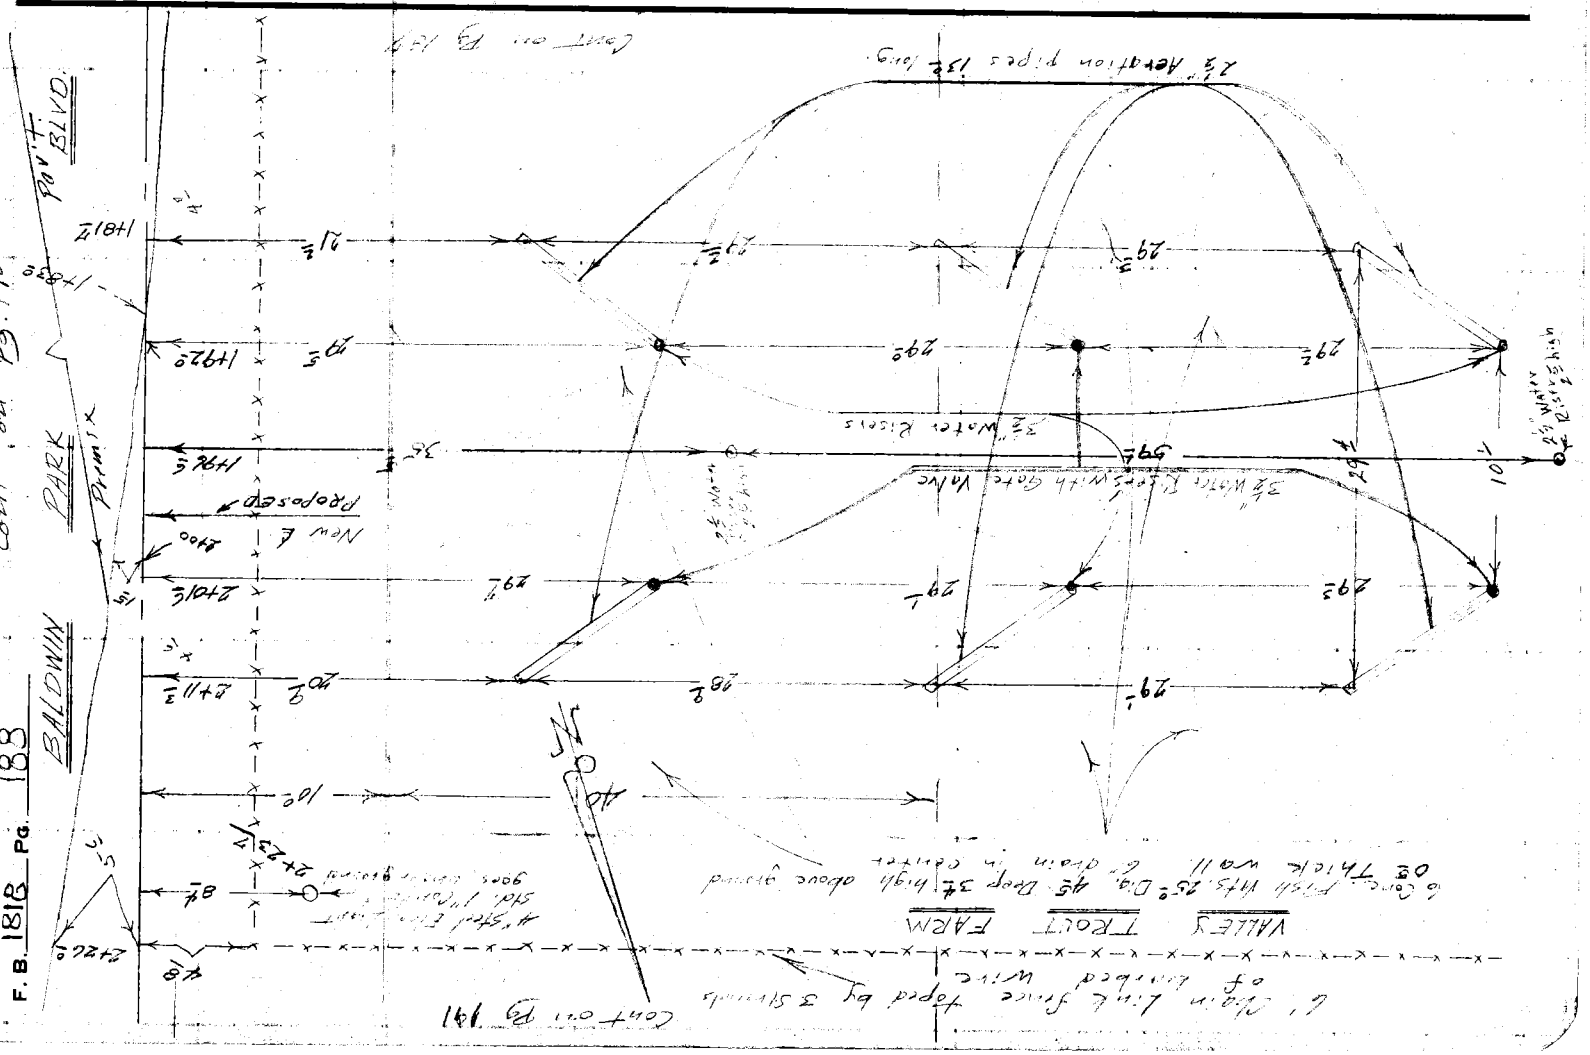

F.B. 1818 Pg. 188

Notes Ck'd by W. Brenner
Map No. C.S.A. 2407-1
Office Work Burns
Checked W. Brenner
Date

Survey of Baldwin Park Blvd.
JN 0074-43 Tape 0174 Std 68 °F
Surveyed by H.E. Quinquist
Notes F.E.B. Date 7/14/50
Indexed

F. B. 1818 PG. 184

Cont on Pg 190

Note: Any Additions or Changes on This Sheet Must be Made or Circled in Red Ink With Date and Name of Person Making Change.

Do not extend this side of this line.

PLEASE RETURN TO
LOS ANGELES COUNTY ENGINEER
700 LOS ANGELES COUNTY ENGINEERING BLDG.

76F309S S&E #247 1-56

4" Wire Fence
19 high 1' Wide Brick + Conc wall
6" F/m 1120'
3" Oleander 1117'
2" Pyracantha 1114'
Footing for Conc. Block Wall
1113'
1113'
1100
1101' Fillers for Storage Tanks
0+86
0+80
Trip Plate for Elec. Stop Light
Telephone booth 1754
0+75
1-Story Stucco Bldg
Cont on Pg 181
BALDWIN BLVD.
PARK
20
30
Pavement
Ball field
Gas Station
0+51
0+57
5" Steel post with elec. sign
Elec. Conduit goes underground
0+41
12" x 12" Conc. Street lighting box
1½" x 1½" Pipe Traffic Signal Light
0+29
12" P.P. with elec. meter
1" Conduit goes underground
0+30
4" Dia. Conc. base for elec. Stop Light
0+20
0+23
For Detail of Conc. Pavement see Pg 186
PROPOSED New ℄
Old ℄
VALLEY BLVD.
Detail of Pump Island Roof Line
4-1½" x 1½" Pumps
Gas
5" Steel Support for Roof
0+00
For Spk Set
Per F.B. 1818-177
Cont on Pg 186

F. B. 1818 Pg. 170

Cont on Pg 191

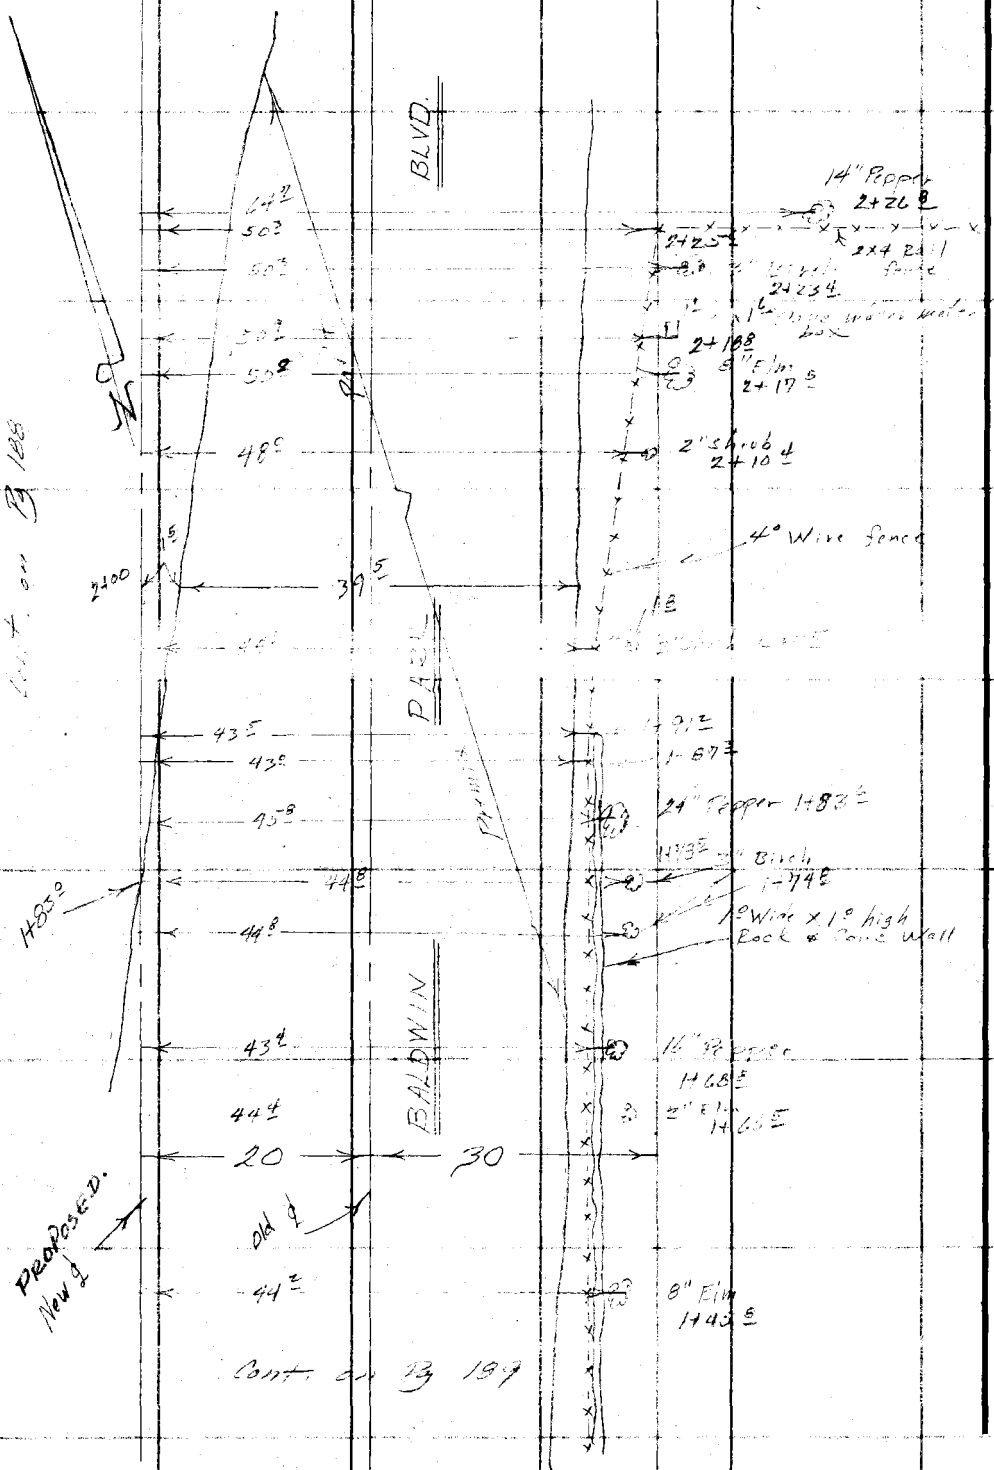

PLEASE RETURN TO
LOS ANGELES COUNTY ENGINEER
700 Los Angeles County Engineering Bldg.
Do not extend this side of this line.

Note: Any Additions or Changes on This Sheet Must be Made or Circled in Red Ink With Date and Name of Person Making Change.

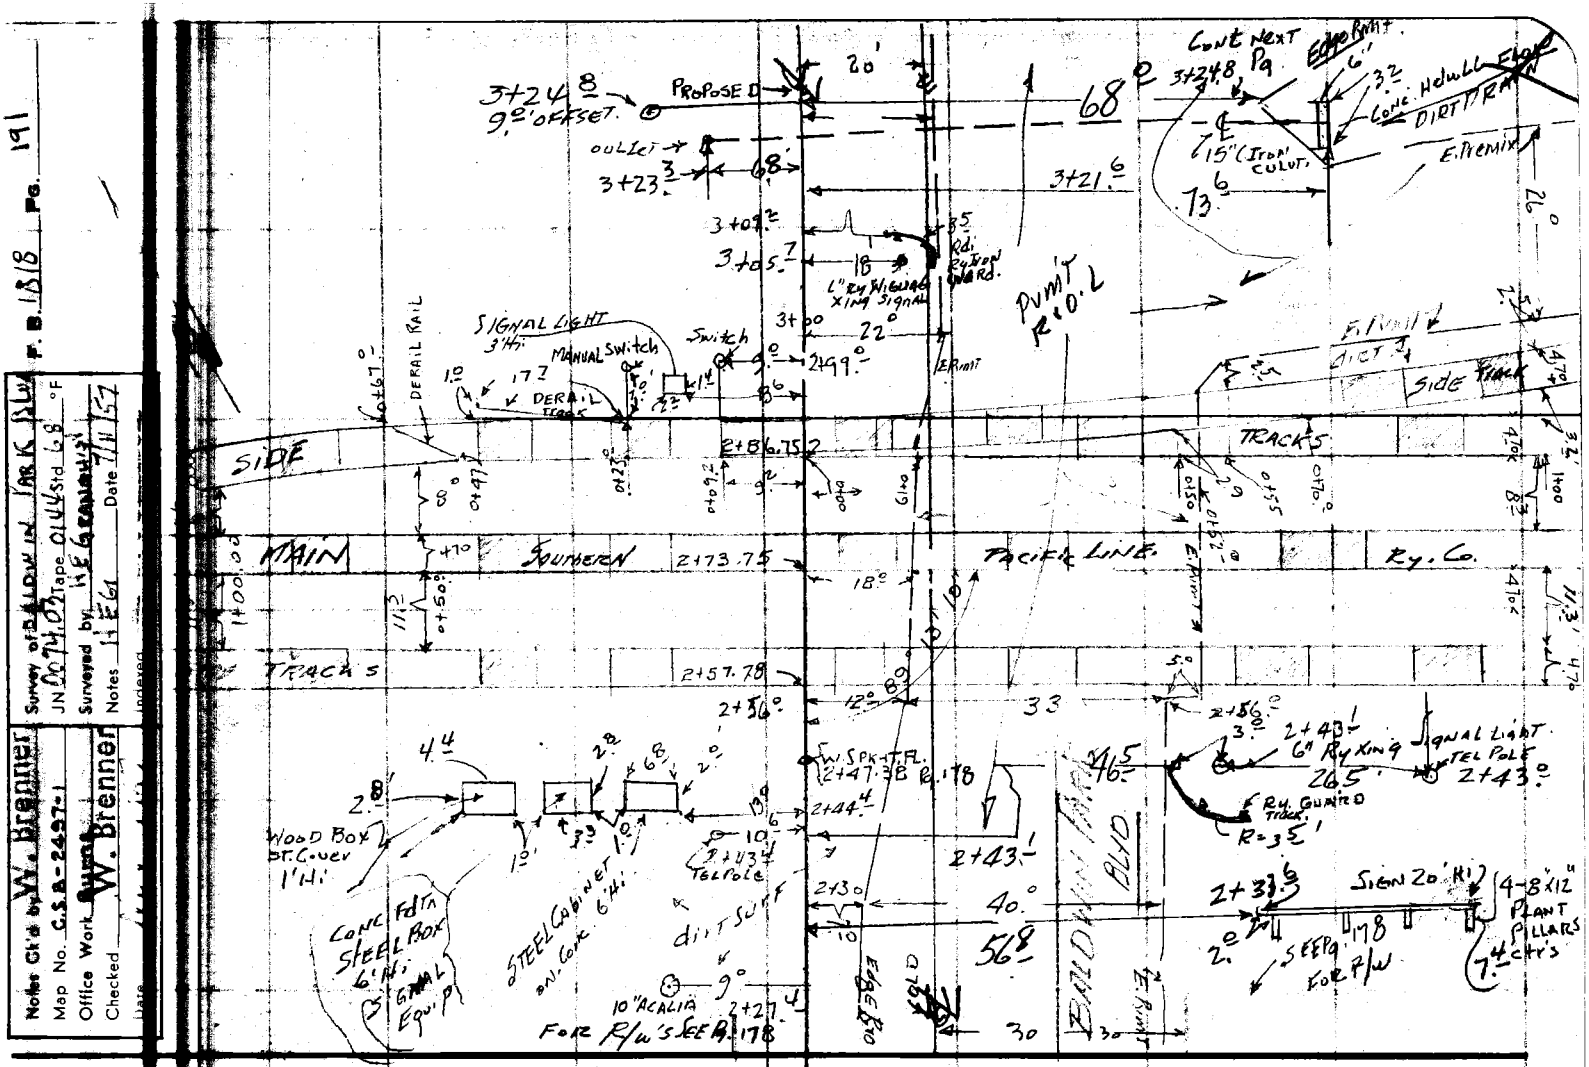
F. B. 1818 Pg. 191
Notes Ck'd by W. Brenner
Map No. C.S.B.-2427-1
Office Work W. Brenner
Checked
Date
Survey of BALDWIN PARK BLVD
JN 20740 Tape 0144 Std. 68 °F
Surveyed by H.E.G. & Crew
Notes H.E.G. Date 7/11/57
3+24.8 9.2' OFFSET
PROPOSED
OULLET
3+23.3
3+09.2
3+05.7
3+00
3+21.6
68'
20'
22°
18°
85 Rd. Ry Iron Guard Rd.
L" Ry W. Guard X'ing Signal
PVMT R'D.
E. PVMT
SIGNAL LIGHT 3'Hi
MANUAL Switch
Switch
DERAIL RAIL
DERAIL
SIDE TRACK
TRACK 5
MAIN
SOUTHERN PACIFIC LINE
Ry. Co.
2+86.75
2+73.75
2+57.78
2+56°
2+47.38 R.178
2+44.4
2+43.1
2+43°
2+40.1
6" Ry X'ing SIGNAL LIGHT STEEL POLE
R.H. GUNITE
R=35.1'
2+33.6
SIGN 20' Rt.
4-8"x12" PLANT PILLARS
7.4 c/c's
SEE Pg. 178 FOR R/W
WOOD BOX ST. Cover 1'Hi.
CONC. Fdtn STEEL BOX 6'Hi. SIGNAL Equip
STEEL CABINET BW. CONC. 6'Hi.
dirt SURF
10" ACACIA
FOR R/W'S SEE R. 178
EDGE RD
BALDWIN PARK BLVD
CONT NEXT Pg
EDGE PVMT
6"
3.2
CONC. HdWLL
DIRT TERRN
15" (IRON) CULVT.
E. PREMIX
26°
2.5
4.7%
3.2'
1400
8.3
11.3'
4.7%
1.8
2.8
4.4
2.8
6'
2'
19.6
10'
1'
1.3
1'
10'
9°
40°
56.8'
30
33
46.5'
26.5'
2.0
7.4
PLEASE RETURN TO
LOS ANGELES COUNTY ENGINEER
700 LOS ANGELES COUNTY ENGINEERING BLDG.
Note: Any Additions or Changes on This Sheet Must be Made or Circled in Red Ink With Date and Name of Person Making Change.
Do not extend this side of this line.
76F3095 SAE #247 1-56

PLEASE RETURN TO
LOS ANGELES COUNTY ENGINEER
700 LOS ANGELES COUNTY ENGINEERING BLDG.

Note: Any Additions or Changes on This Sheet Must be Made or Circled in Red Ink With Date and Name of Person Making Change.

Do not extend this side of this line.

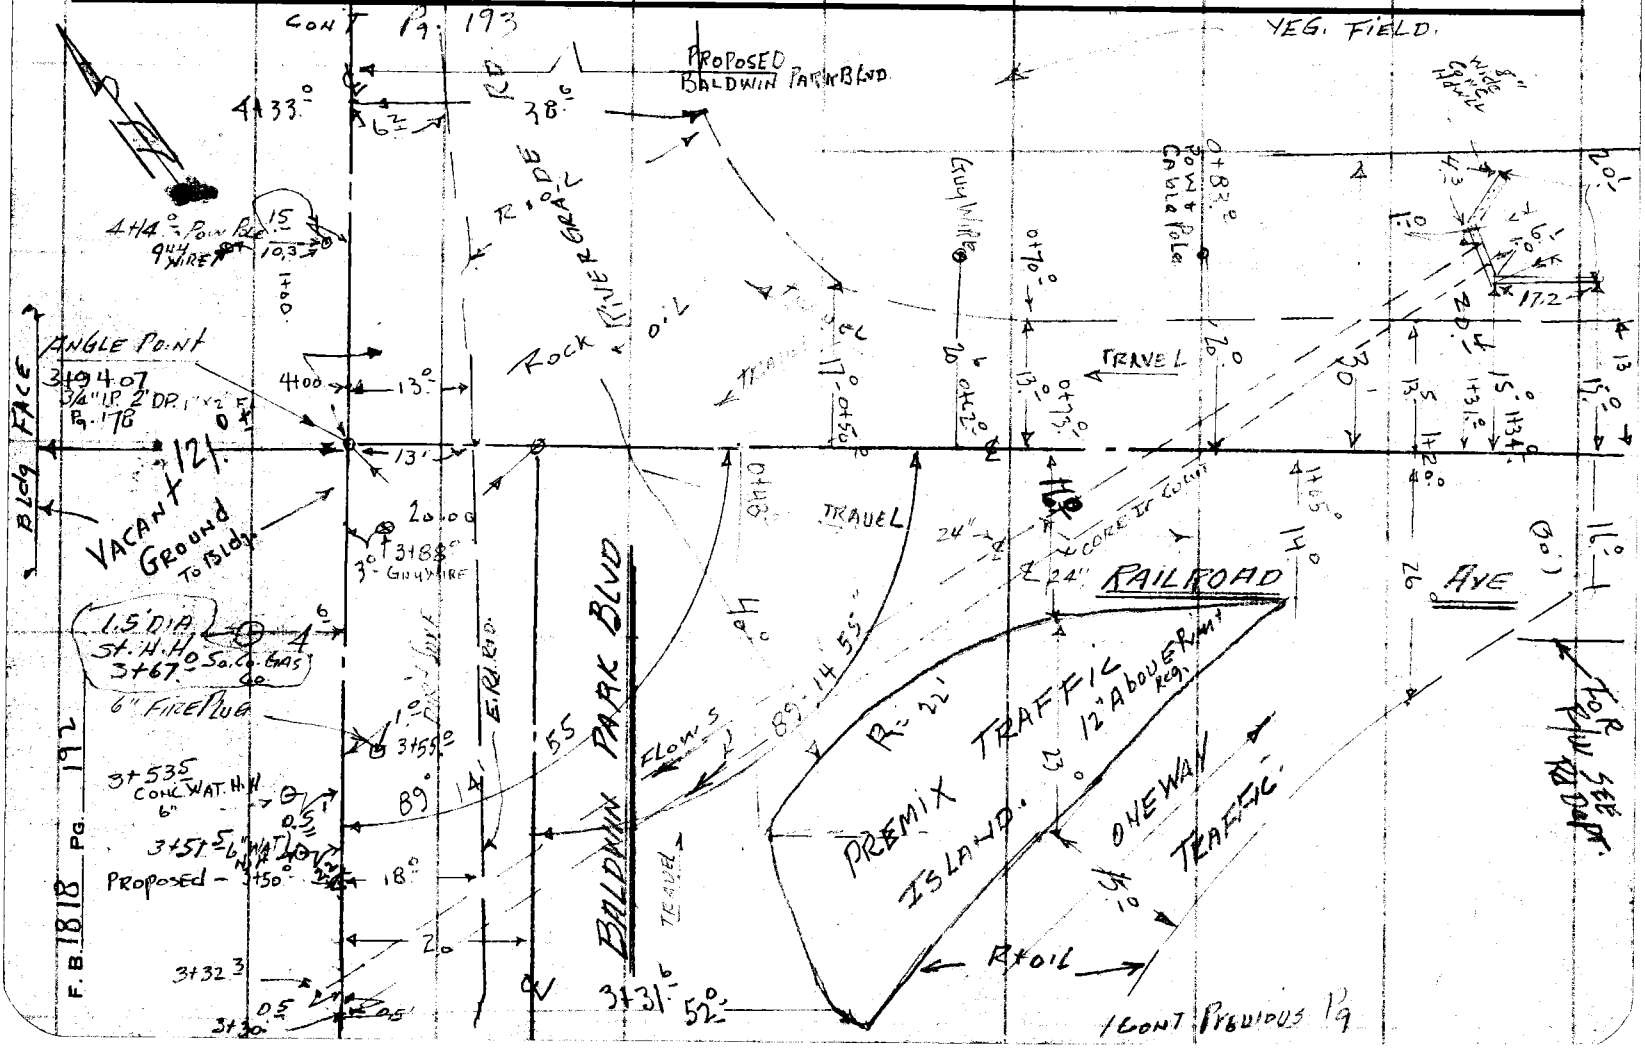

F.B. 1818 PG. 192

Notes Ck'd by W. Brenner
Map No. C.S.B-2497-1
Office Work Burns
Checked W. Brenner
Date

Survey of BALDWIN PARK BLVD
JN 0074.03 Tape 0144 Std 68 °F
Surveyed by H.E. GIKHNQUIST
Notes H E G Date 7/12/62
Indexed

F. B. 1818 Pg. 193
REALIGNMENT

Note: Any Additions or Changes on This Sheet Must be Made or Circled in Red Ink With Date and Name of Person Making Change.

Do not extend this side of this line.

PLEASE RETURN TO
LOS ANGELES COUNTY ENGINEER
700 LOS ANGELES COUNTY ENGINEERING BLDG.

76F3095 S&E #247 1-56

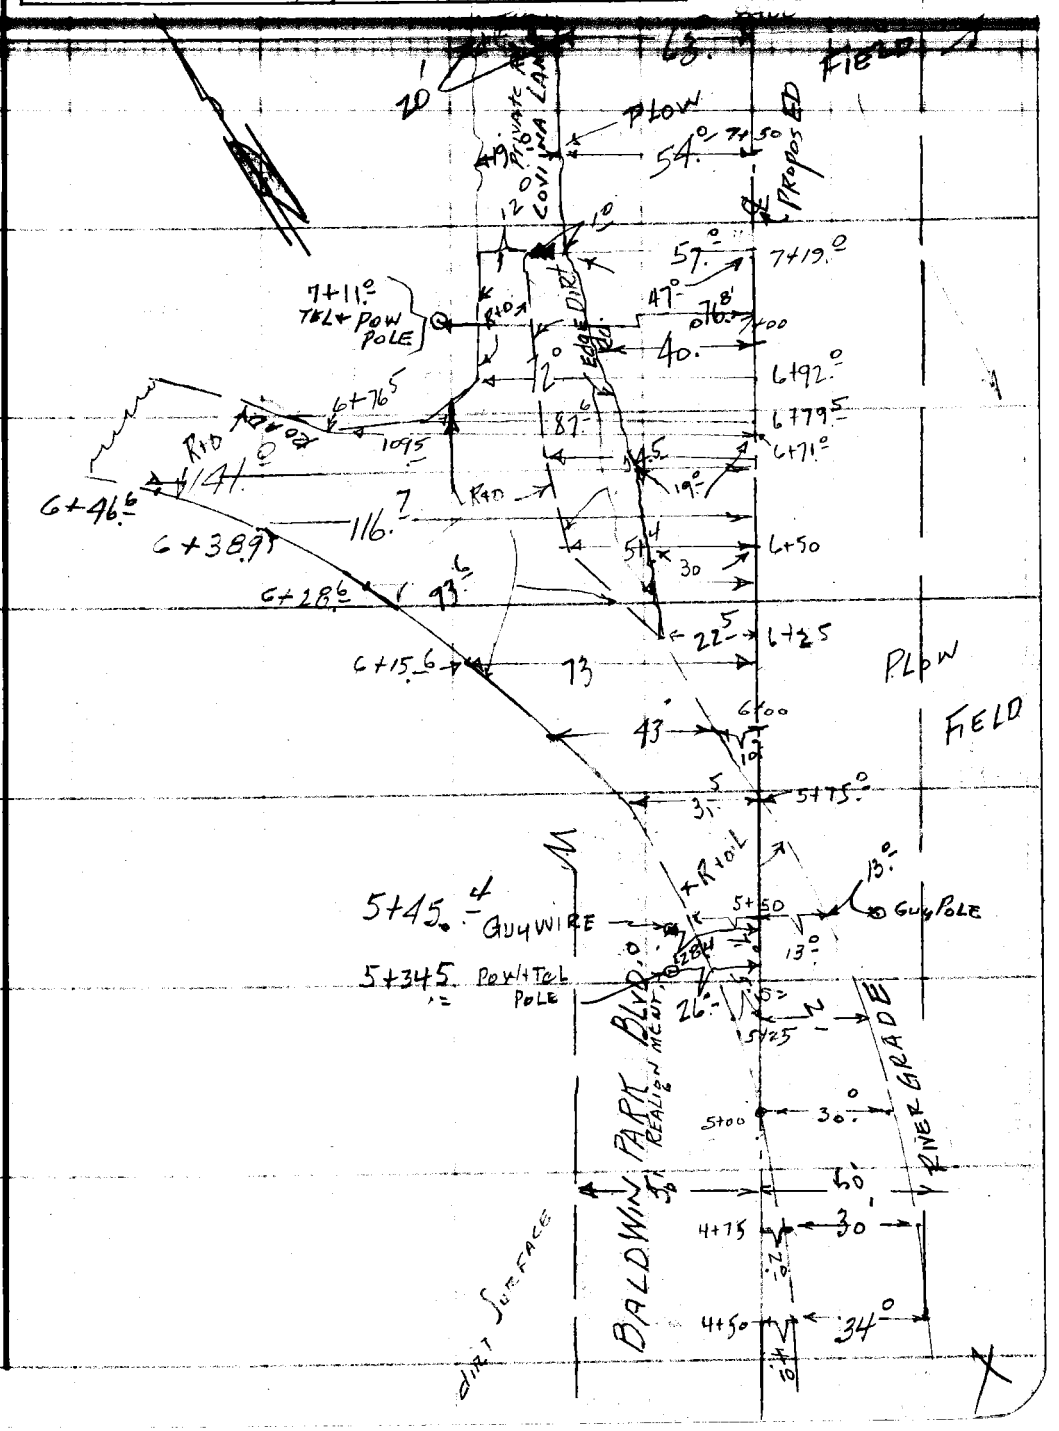

F. B. 1816 PG. 194

CONT. Pg. 195

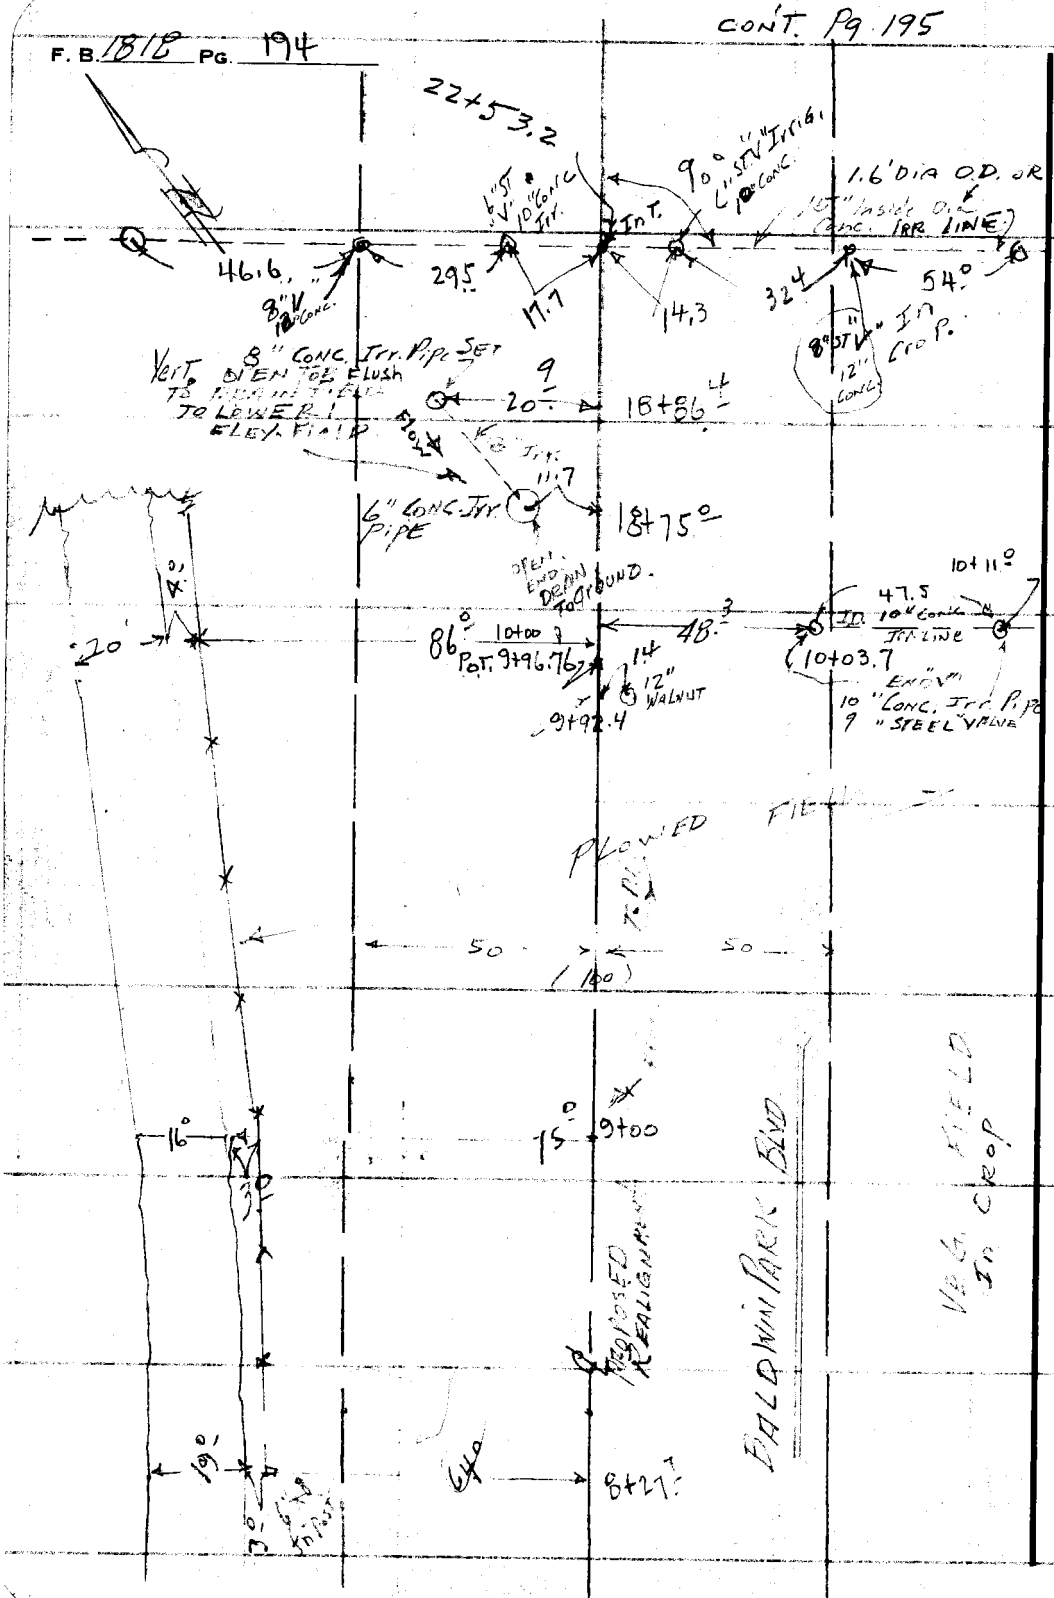

PLEASE RETURN TO
LOS ANGELES COUNTY ENGINEER
700 Los Angeles County Engineering Bldg.

Do not extend this side of this line.

Note: Any Additions or Changes on This Sheet Must be Made or Circled in Red Ink With Date and Name of Person Making Change.

Notes Ck'd by W. Brenner
Map No. C.S.B.-2497-1
Office Work Burns
Checked W. Brenner

Survey of BALDWIN PARK BLVD
JN 0079 03 Tape 14U Std. 68 °F
Surveyed by H.E. GRANOWITH
Notes [illegible] Date 11/12/57

F. B. 1818 PG. 195

Note: Any Additions or Changes on This Sheet Must be Made or Circled in Red Ink With Date and Name of Person Making Change.

PLEASE RETURN TO
LOS ANGELES COUNTY ENGINEER
700 LOS ANGELES COUNTY ENGINEERING BLDG.
Do not extend this side of this line.

76F3095 S&E #247 1.56

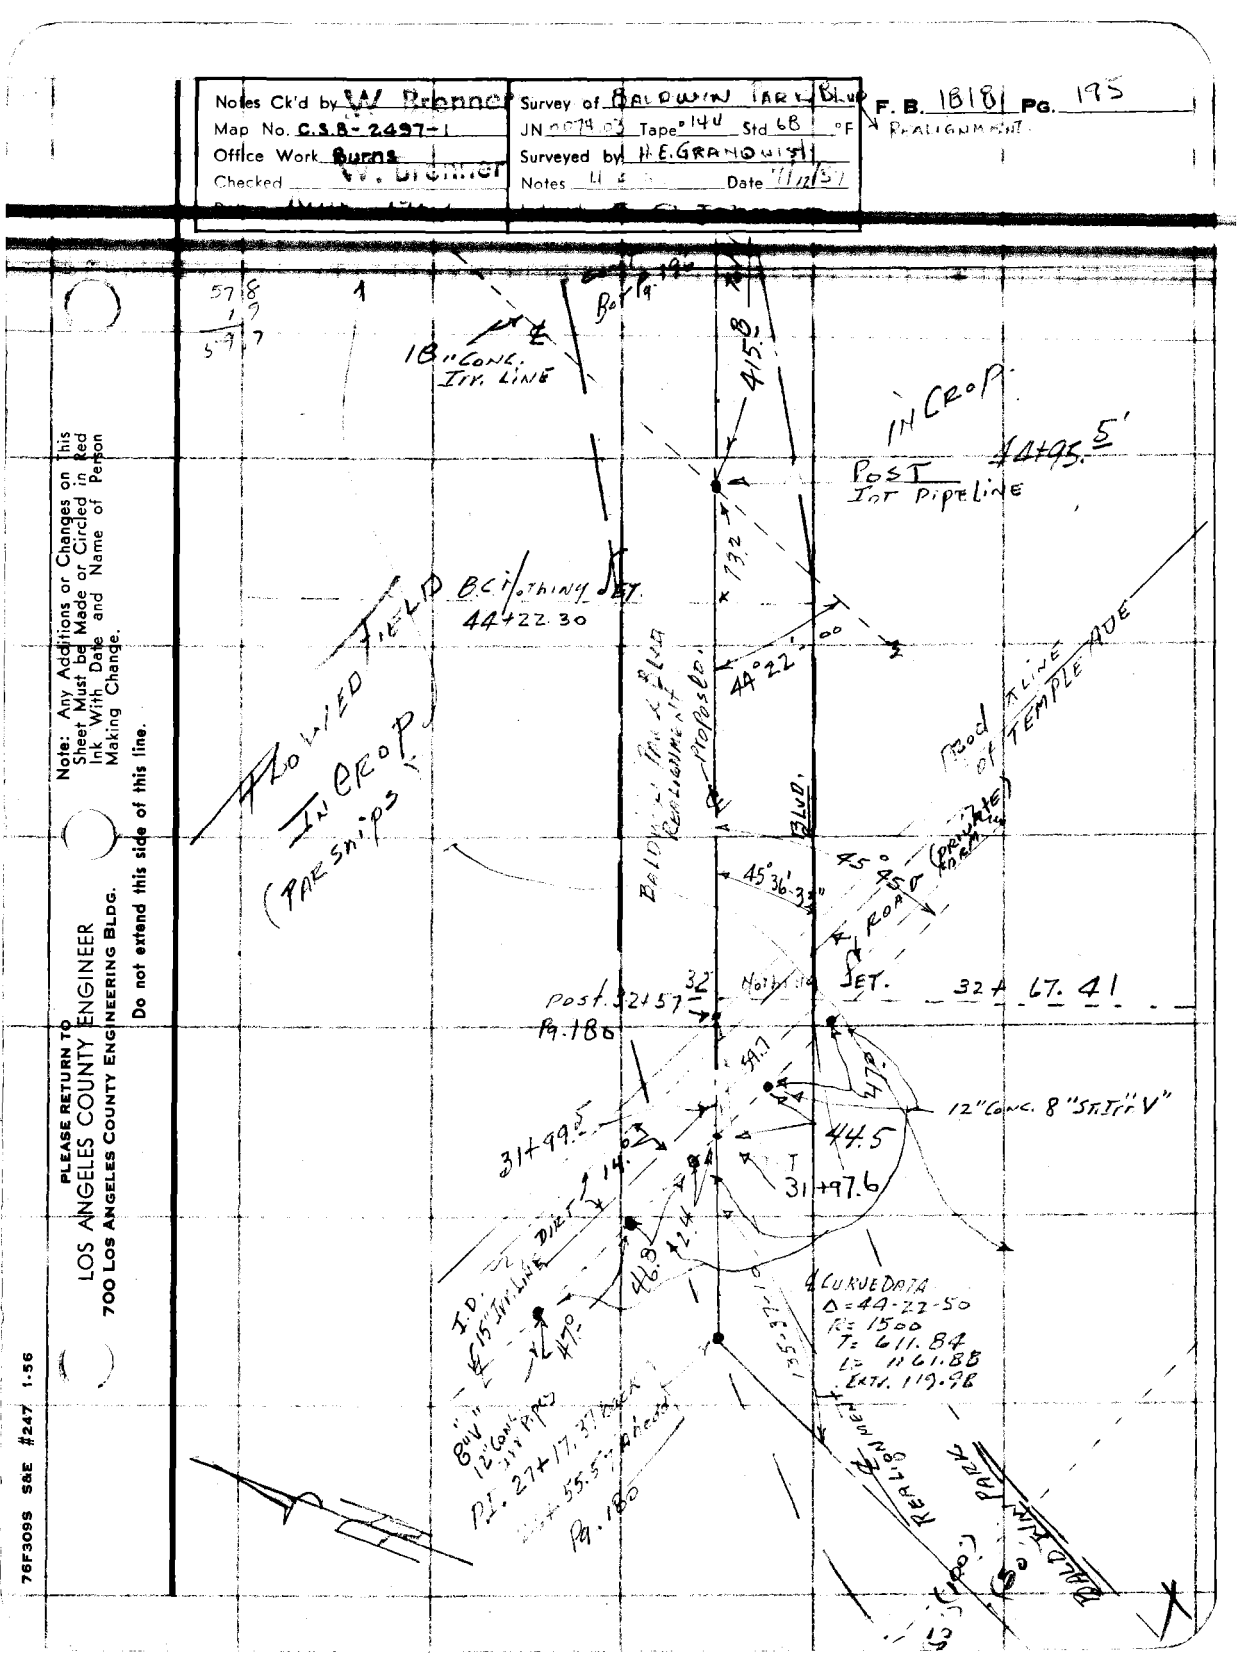

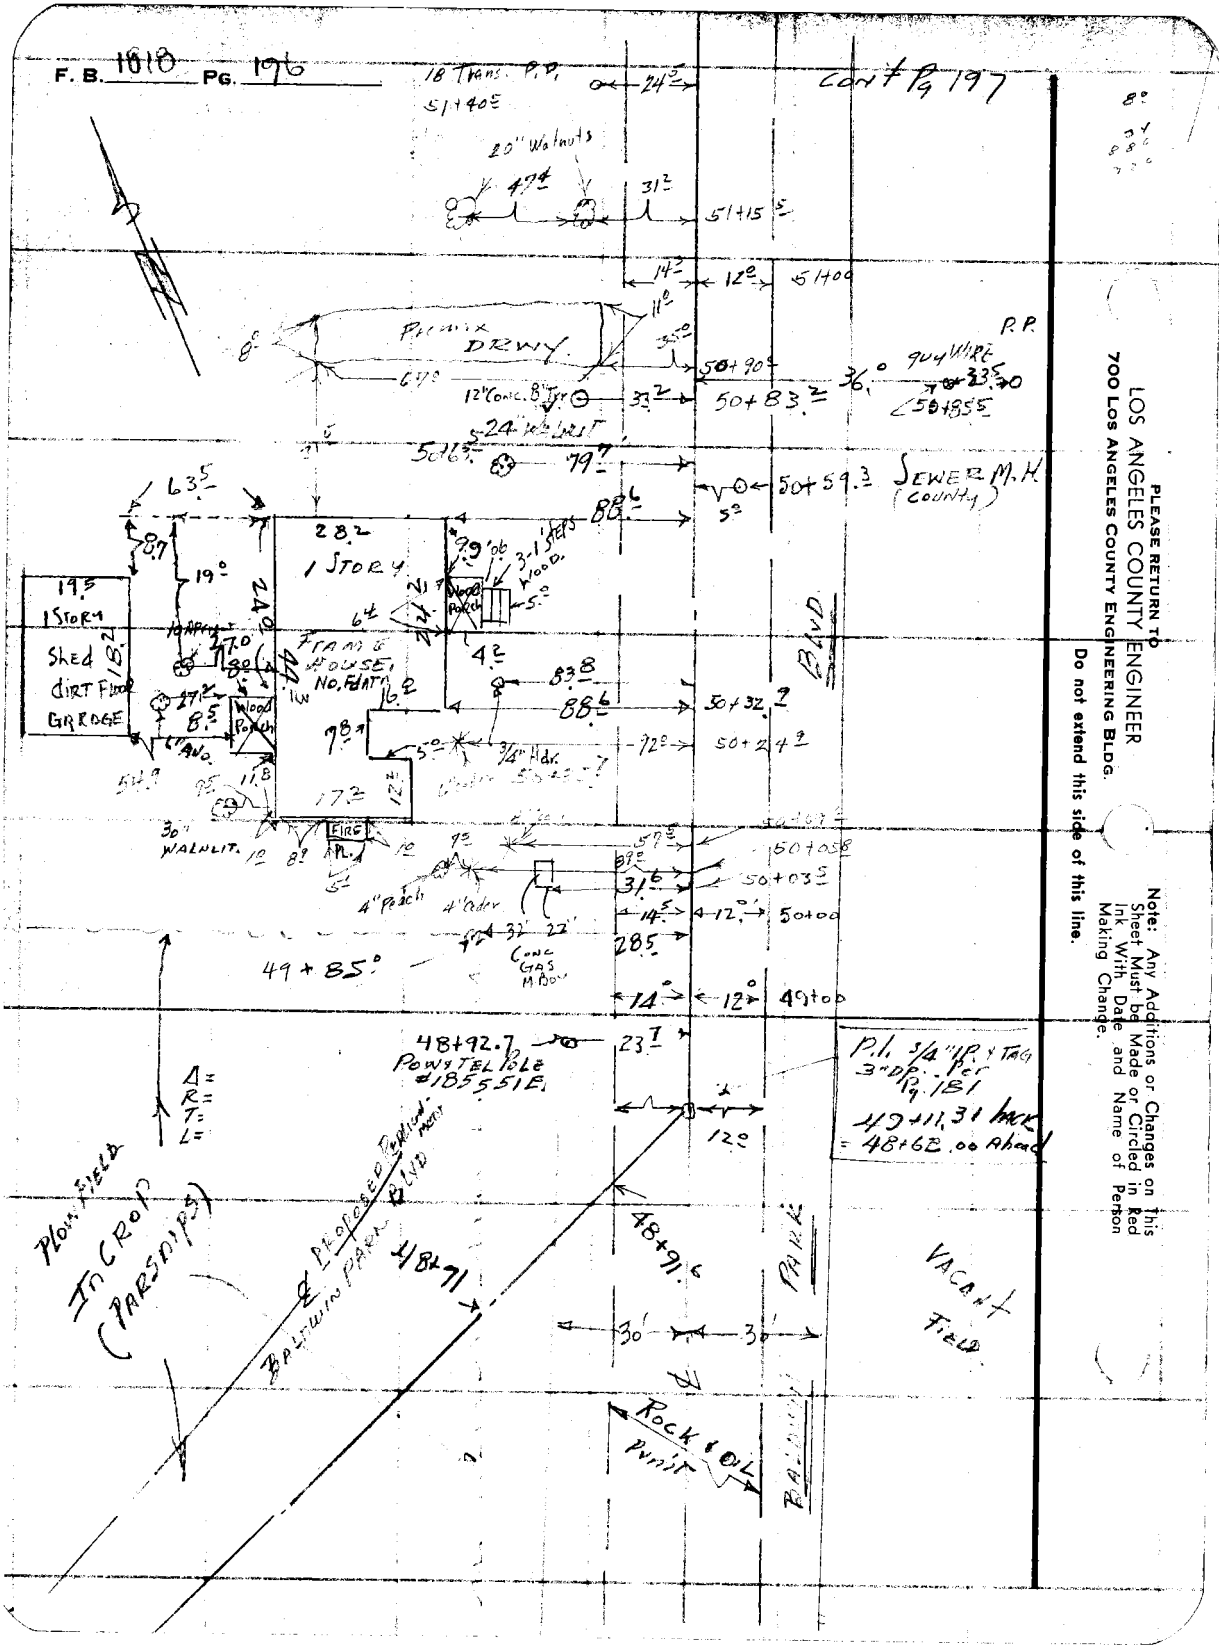
F. B. 1010 PG. 196
cont'd pg 197
18 Trans. P.P.
51+40E
24'
20" Walnuts
49'
31'
51+15
14'
12'
51+00
11'
8'
Private DRWY.
6.7%
12" Conif. 8' Tgt
33'
50+83
36.0
P.P.
904 Wire
50+85
5'
24" Ht. Wall
50+67
79'
50+59.3
SEWER M.H. (COUNTY)
5'
63'
8.7
19'
28'
1 STORY
99' ob
3-1 STEPS
Wood Porch
5.0
BB.6
19.5
1 STORY
Shed
DIRT FLOOR
GARAGE
181'
17.0
8.0
27'
8.5'
Wood Porch
64'
21'
4'
83.8
50+32.9
FRAME HOUSE, NO. FDATN
16'
78'
5.0
3/4" Hdr.
72°
50+24.9
5.9'
11.8
17.2'
12'
30" WALNUT
10'
8'
FIRE PL.
5'
4" Porch
4' Ladder
37'
22'
Conc. GAS MBox
50+05.8
31.6
50+03.5
14.5'
12.0'
50+00
28.5'
49+85.0
14'
12'
49+00
48+92.7
POWR TEL POLE #1855.51E.
23.7'
12.0'
P.I. 3/4" IR x Tag 3rd Pt. per R 19 181
49+11.31 back = 48+62.00 Ahead
A=
R=
T=
L=
PLOWED IN CROP (PARSNIPS)
℄ PROPOSED Parkway BALDWIN PARK BLVD
48+71
48+91.6
PARK
30'
3'
VACANT FIELD
Rock & Oil Paint
RAILROAD
PLEASE RETURN TO
LOS ANGELES COUNTY ENGINEER
700 Los Angeles County Engineering Bldg.
Do not extend this side of this line.
Note: Any Additions or Changes on this Sheet Must be Made or Circled in Red Ink With Date and Name of Person Making Change.

Notes Ck'd by W. Brenner
Map No. CSB-2497-1
Office Work Burns
Checked

Survey of Baldwin Park Blvd
JN 00774 03 Tape 0/24 Std °F
Surveyed by H.E. Stanquist
Notes F.B. 13 Date 7-12-51

F. B. 1818 PG. 197

INT.
55+20 ℓ
Fd Spk & W
Per F.B. 1818-182

Proposed
N. 44° 24' 50" W
CSB 1209-2
CSB 1209

Torch ST
E/line Ave

INT.
55+91 ℓ
Fd C.S. Mon
Per F.B. 1818-182

BLVD

55+75 ℓ
20'
55+30 ℓ
42'
WMH 55+24 ℓ
41'
55+18 ℓ
5'
S.S. M.H.
54+06 ℓ
55+00
14'
TORCH
ST.
55'
54+93 ℓ
28'
54+79 ℓ
12'
54+49 ℓ
90° 00' 15" (M)
15)

PARK

20 30 30 20

14" Trans. P.P.
54+18 ℓ
14'
14' 12' 54+00

E.C.
53+51 ℓ
Fd Sq hd Spk & T
Per F.B. 1818-181

5'
SS M.H. 53+09 ℓ
14' 17' 53+00

BALDWIN

Semi Tan
13'
12' 52+00
31'
Dead man
51+67 ℓ
23'
8" Guy Pole
51+22 ℓ

Proposed ℄

Cont Pg 196

Note: Any Additions or Changes on This Sheet Must be Made or Circled in Red Ink With Date and Name of Person Making Change.

Do not extend this side of this line.

PLEASE RETURN TO
LOS ANGELES COUNTY ENGINEER
700 LOS ANGELES COUNTY ENGINEERING BLDG.

76F3095 S&E #247 1-56

PLEASE RETURN TO
LOS ANGELES COUNTY ENGINEER
700 LOS ANGELES COUNTY ENGINEERING BLDG.

Note: Any Additions or Changes on This Sheet Must be Made or Circled in Red Ink With Date and Name of Person Making Change.

Do not extend this side of this line.

F. B. 1818 PG. 198

Notes Ck'd by		Survey of E.KON.	F. B. 1618 PG. 199
Map No.		JN 2-22 Tape Std °F	
Office Work		Surveyed by E. Fouch	
Checked		Notes Date 11-20-62	

REF

PUENTE B-5

INT OF BESS AVE
& BALDWIN PARK BLVD

11-20-1962

Note: Any Additions or Changes on This Sheet Must be Made or Circled in Red Ink With Date and Name of Person Making Change.

Do not extend this side of this line.

PLEASE RETURN TO
LOS ANGELES COUNTY ENGINEER
403 Los Angeles County Engineering Bldg.

76F3095 CE # 310 3-61

PLEASE RETURN TO
LOS ANGELES COUNTY ENGINEER
403 LOS ANGELES COUNTY ENGINEERING BLDG.

Note: Any Additions or Changes on This Sheet Must be Made or Circled in Red Ink With Date and Name of Person Making Change.

Do not extend this side of this line.

WS 46 C-5

 

F.B. 1818 PG. 200

Notes Ck'd by G. E. BARR
Map No. B-2 S-E-6
Office Work R. S. Lewis
Checked G. E. BARR

Survey of BARNES PARK
JN 20 5A 15 Tape #207 Std 68 °F
Surveyed by M. Sorko
Notes [illegible] Date 4-1-14
Indexed

F. B. 1010 Pg. 203

00 54. 15

SURVEY

OF

BARNES PARK

PROPERTY LINES

(BALDWIN PARK)

Note: Any Additions or Changes on This Sheet Must be Made or Circled in Red Ink With Date and Name of Person Making Change.

PLEASE RETURN TO
LOS ANGELES COUNTY ENGINEER
403 LOS ANGELES COUNTY ENGINEERING BLDG.

Do not extend this side of this line.

76F309S CE #310 6-62

SOTRO
BOWLES
MOODYMAN
LATTERI

P.T. 328 | P-74

PLEASE RETURN TO
LOS ANGELES COUNTY ENGINEER
403 LOS ANGELES COUNTY ENGINEERING BLDG.

Note: Any Additions or Changes on This Sheet Must be Made or Circled in Red Ink With Date and Name of Person Making Change.

Do not extend this side of this line.

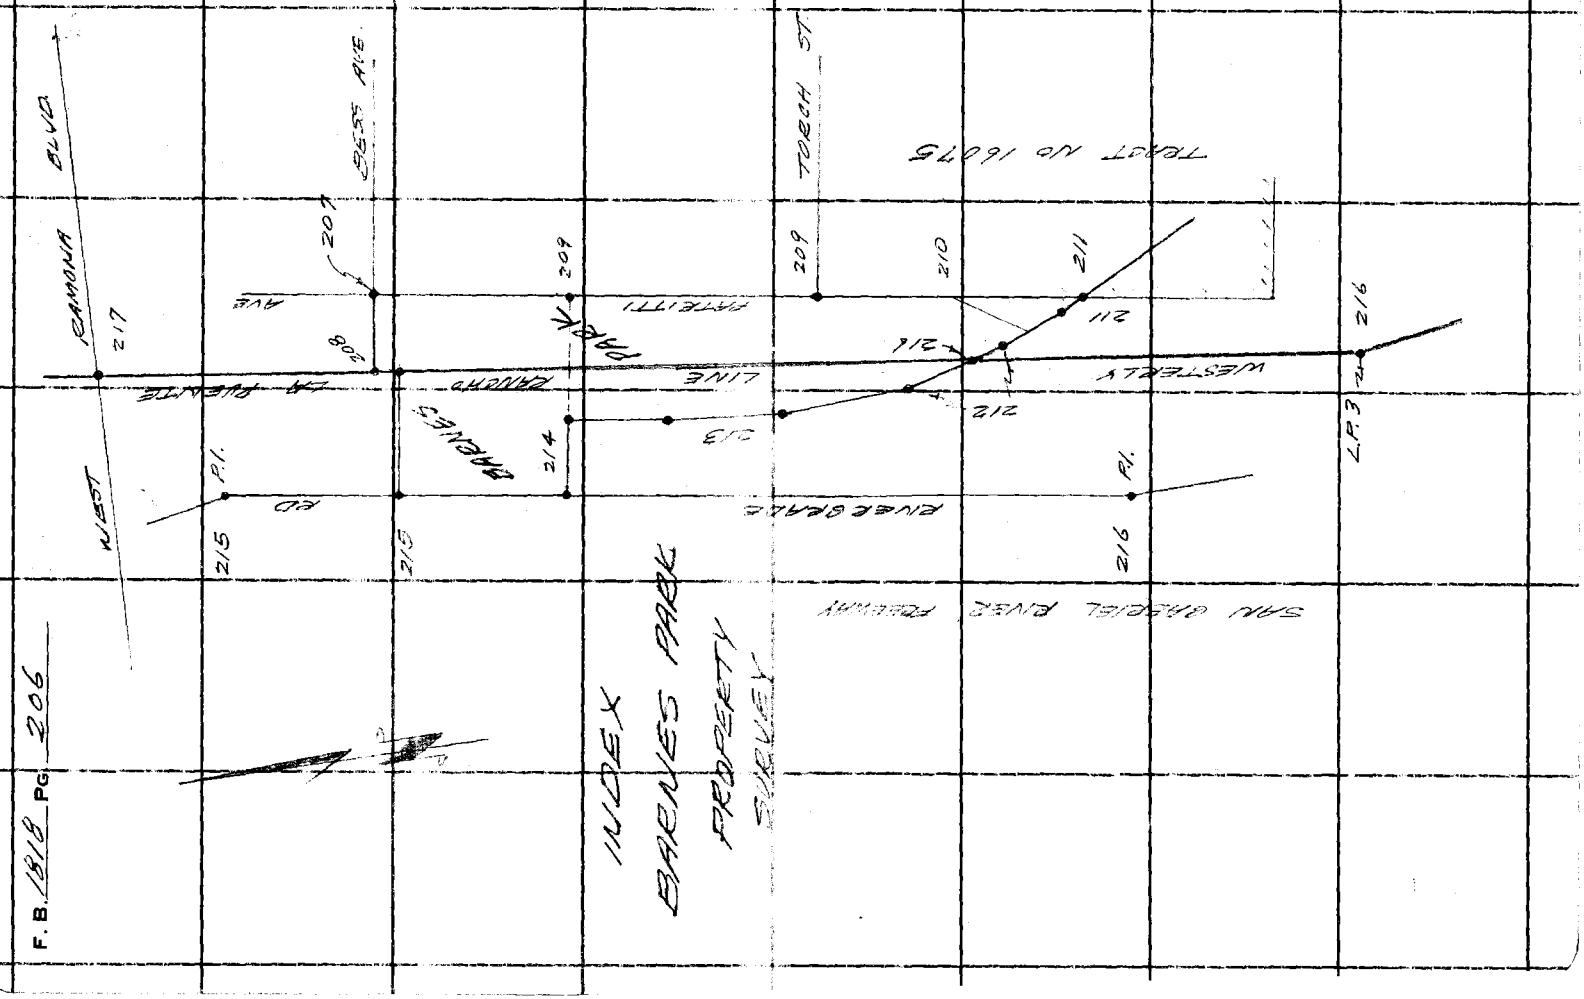

76F309S CE #310 6-62

PLEASE RETURN TO
LOS ANGELES COUNTY ENGINEER
403 LOS ANGELES COUNTY ENGINEERING BLDG.

Note: Any Additions or Changes on This Sheet Must be Made or Circled in Red Ink With Date and Name of Person Making Change.

Do not extend this side of this line.

WS 96

Notes Ck'd by G. E. BARR
Map No. B-2326
Office Work K. S. [illegible]
Checked G. E. BARR

JN 22545 Tape 0107 Std. 68 °F
Surveyed by M. COTTER
Notes [illegible] Date 4-1-64

F. B. 1015 PG. 2011

TO INT. BLENHEIM ST. (CRK W FL.
EB 2116-39

FD. 2" I.P. ON 3"
L.S. 2606
PER FB. 2116-41

98.48 @ 0° T 90° = 98.49

(1) 89° 59' 45"
(4) 359° 59' 00
(6) 179° 58' 30"

(1) 179° 59' 15"
(4) 359° 57' 30"
(6) 179° 59' 00"

TR. NO. 16075

AVE. 23

(30) (30)

FD. L. & T.

98.49

54.15

55.13

56.18

54.69

FD. L. & T.

TO INT. STRAUSE

145.57

BESS AVE.

300.32

(03)

FD. SPK. & W. FL.
FB. 2116-41

45" 36" 179° 59'

29.72

30

992.35 @ 0° T 72° = 992.38

PATTI

992.38

410.43

FD. L. & T.

300.31 @ 0° T 74°
= 300.32

FD. SPK. & W. FL.

N.E. COR. PARK
FD. C.S. MON.
DN. 16"
FB 1550-10
2116-41

COUNTY SURVEYOR
CE 329

CONT. TOP PAGE 209

TR. NO. 16075

PLEASE RETURN TO
LOS ANGELES COUNTY ENGINEER
403 LOS ANGELES COUNTY ENGINEERING BLDG.

Note: Any Additions or Changes on This Sheet Must be Made or Circled in Red Ink With Date and Name of Person Making Change.

Do not extend this side of this line.

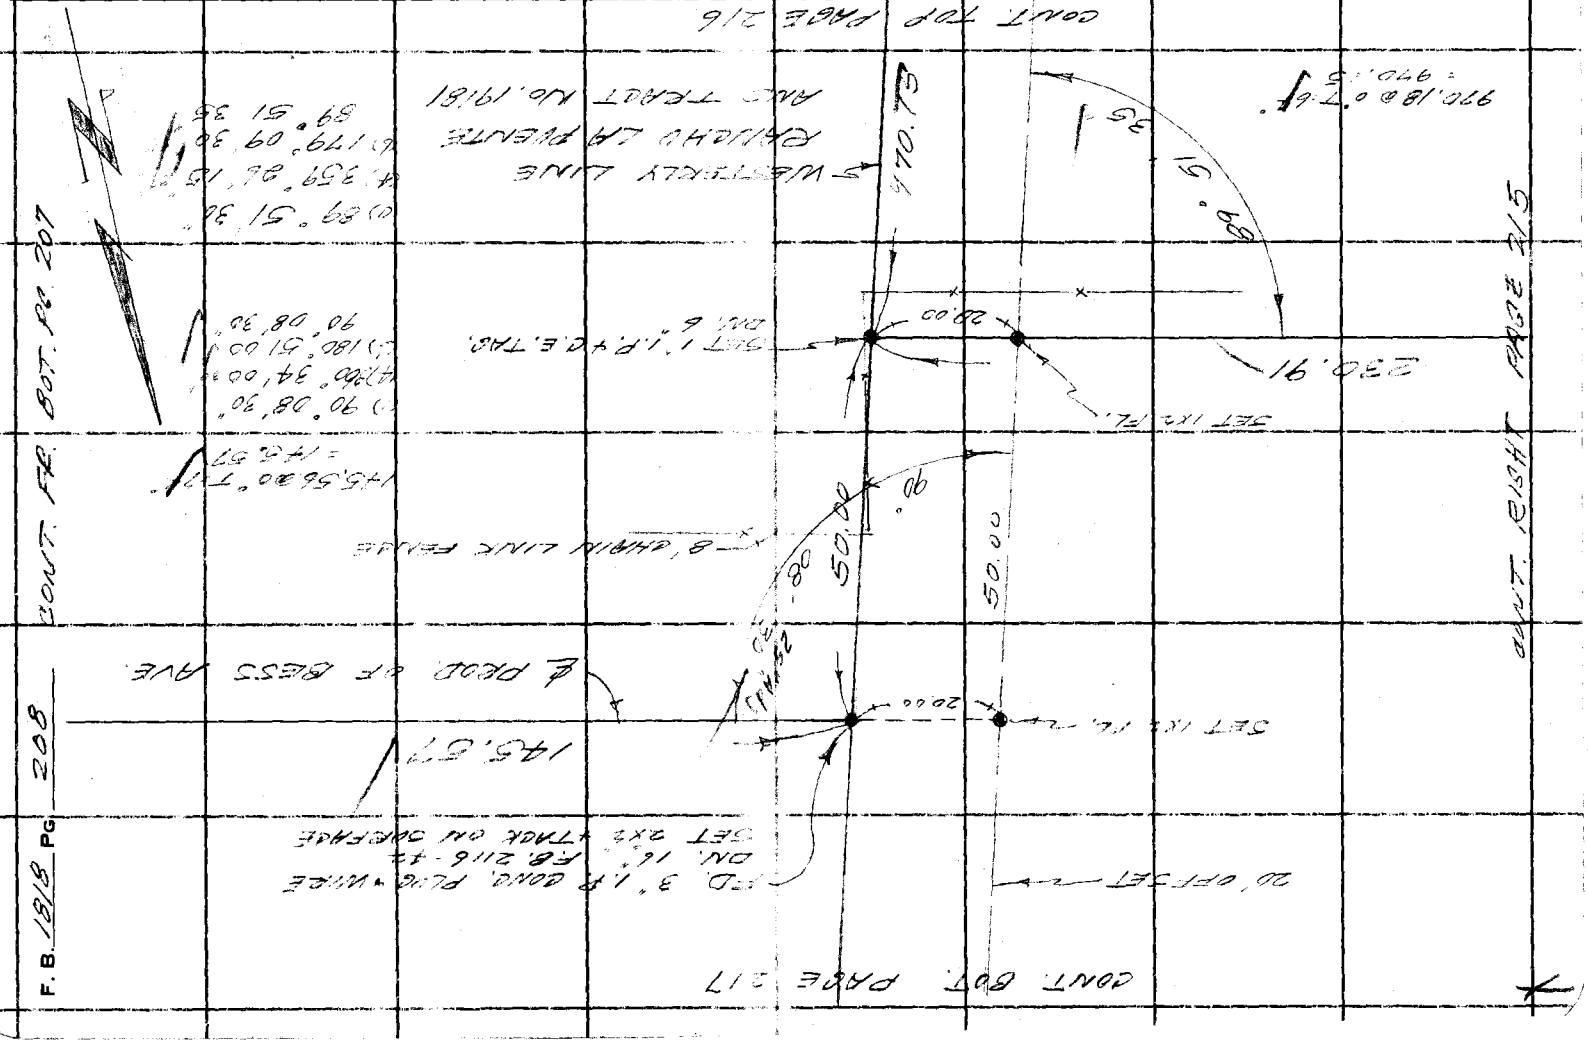

Notes Ck'd by G. E. BARR
Map No. B-2856
Office Work R. S. Downs
Checked G. E. BARR

Survey of BARNES PARK
JN 0054.15 Tape #0107 Std 68 °F
Surveyed by M. ST. RO
Notes SOFTCO Date 4-8-64

F. B. 1010 PG. 221

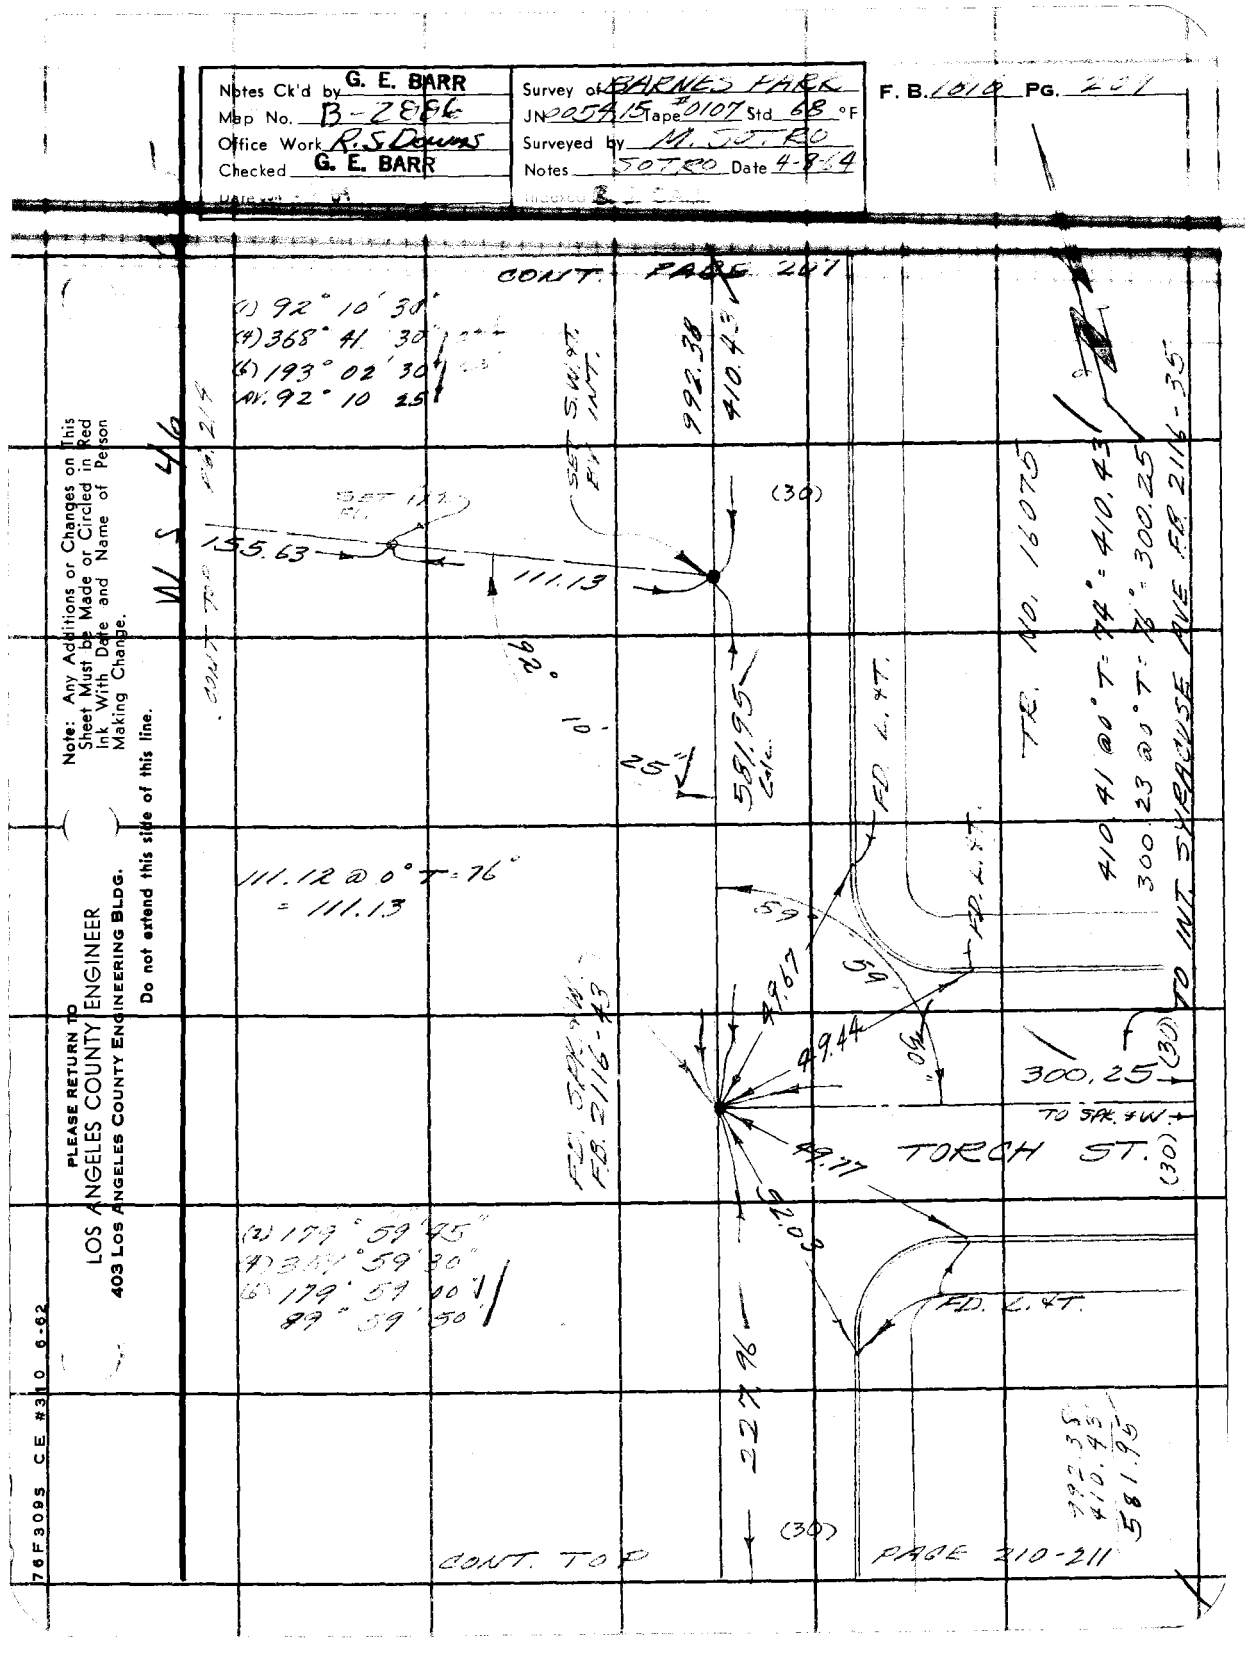

Note: Any Additions or Changes on This Sheet Must be Made or Circled in Red Ink With Date and Name of Person Making Change.

PLEASE RETURN TO
LOS ANGELES COUNTY ENGINEER
403 LOS ANGELES COUNTY ENGINEERING BLDG.

Do not extend this side of this line.

76F3095 CE #310 6-62

PLEASE RETURN TO
LOS ANGELES COUNTY ENGINEER
403 LOS ANGELES COUNTY ENGINEERING BLDG.

Note: Any Additions or Changes on This Sheet Must be Made or Circled in Red Ink With Date and Name of Person Making Change.

Do not extend this side of this line.

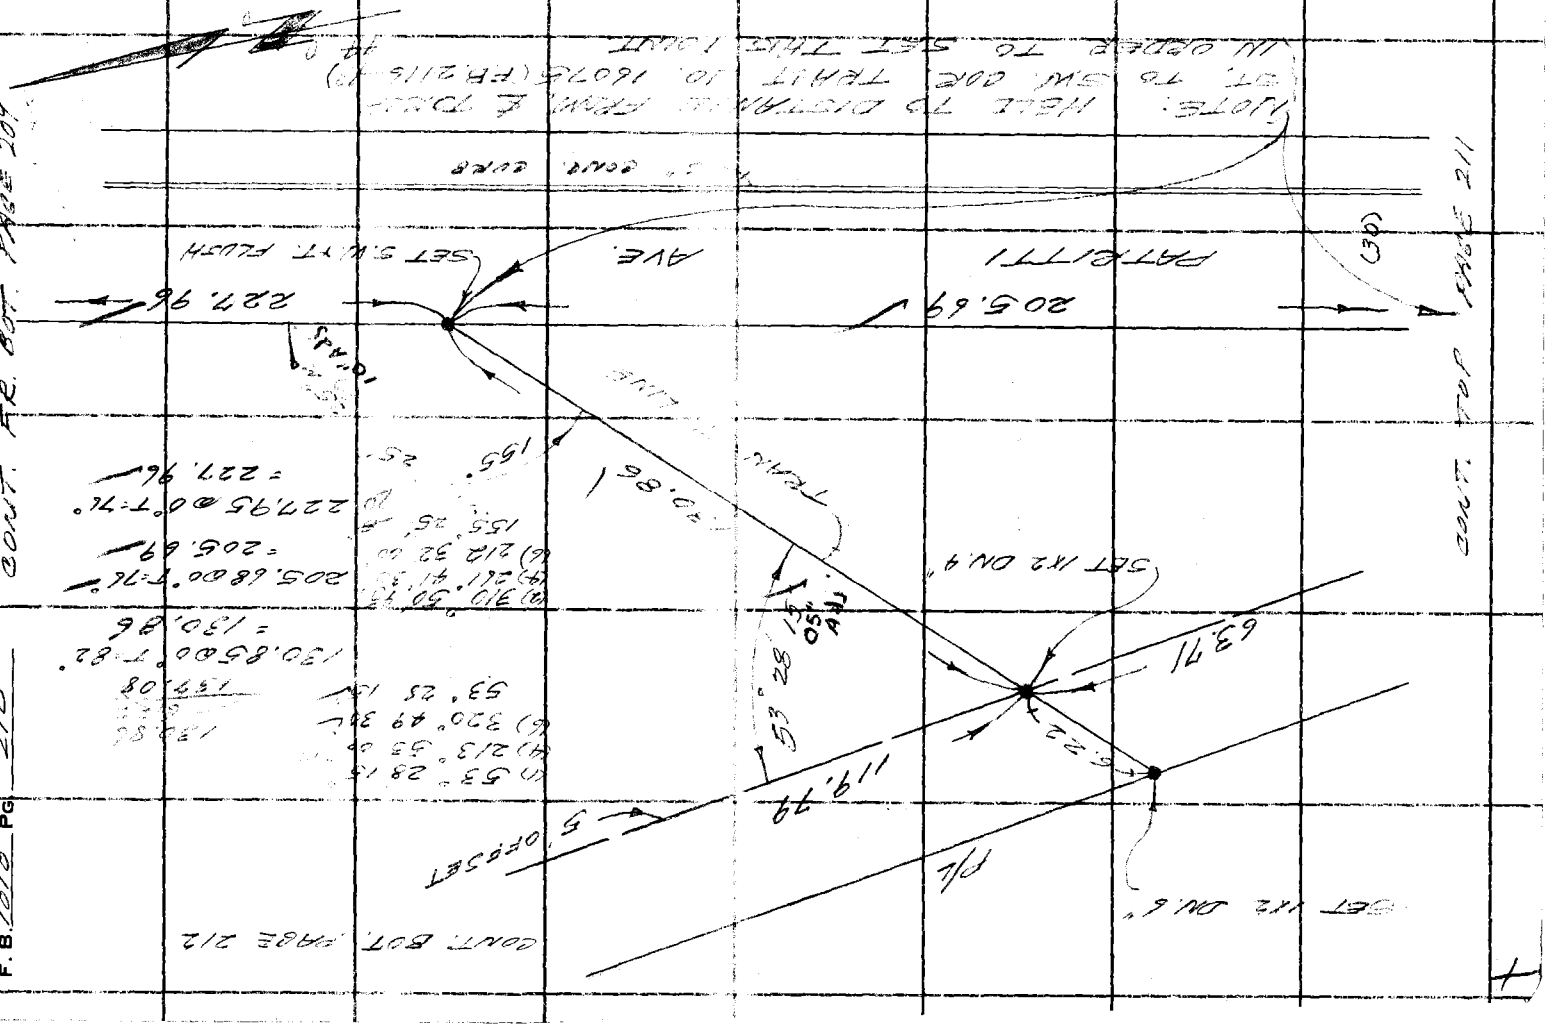

76F3095 CE #310 6-62

PLEASE RETURN TO
LOS ANGELES COUNTY ENGINEER
403 LOS ANGELES COUNTY ENGINEERING BLDG.

Note: Any Additions or Changes on This Sheet Must be Made or Circled in Red Ink With Date and Name of Person Making Change.

Do not extend this side of this line.

Notes Ck'd by G. E. BARR
Map No. B-2866
Office Work by G. E. BARR
Checked

JN 0554 '67 Tape #107 Std. 68 °F
Surveyed by [illegible] SUTTER
Notes Date 9 P.64

F. B. 1310 PG. 44


SET 1" I.P. W/ BRASS PLUG & C.E. TAG ON 6"

FD. 2"X2" CONC. TACK ON 2"

LINK FENCE

SAN GABRIEL RIVER (UNDER CONST.)

6' CHAIN

1.0' R PT.

4.92

90°

1X2

0.26

SAME

6.22

119.79

53° 28' R

BOUNT. AVE.

OFFSET ADJ 1.30, 0.86

63.71

SET 1X2 DN. 4"




P/L

38.90

171°

SET C.E. TAG IN LEAD & SCNC. @ BASE FENCE POST.

8.22

SET 1X2 DN. 4"

49" Adj. 45° R 49.2

205.69

PATRITTI AVE.

(30')

1' OFFSET

142° 33'

6" CONC. CURB


F. B. 1818 PG 212

CONT. BK. PG. 213

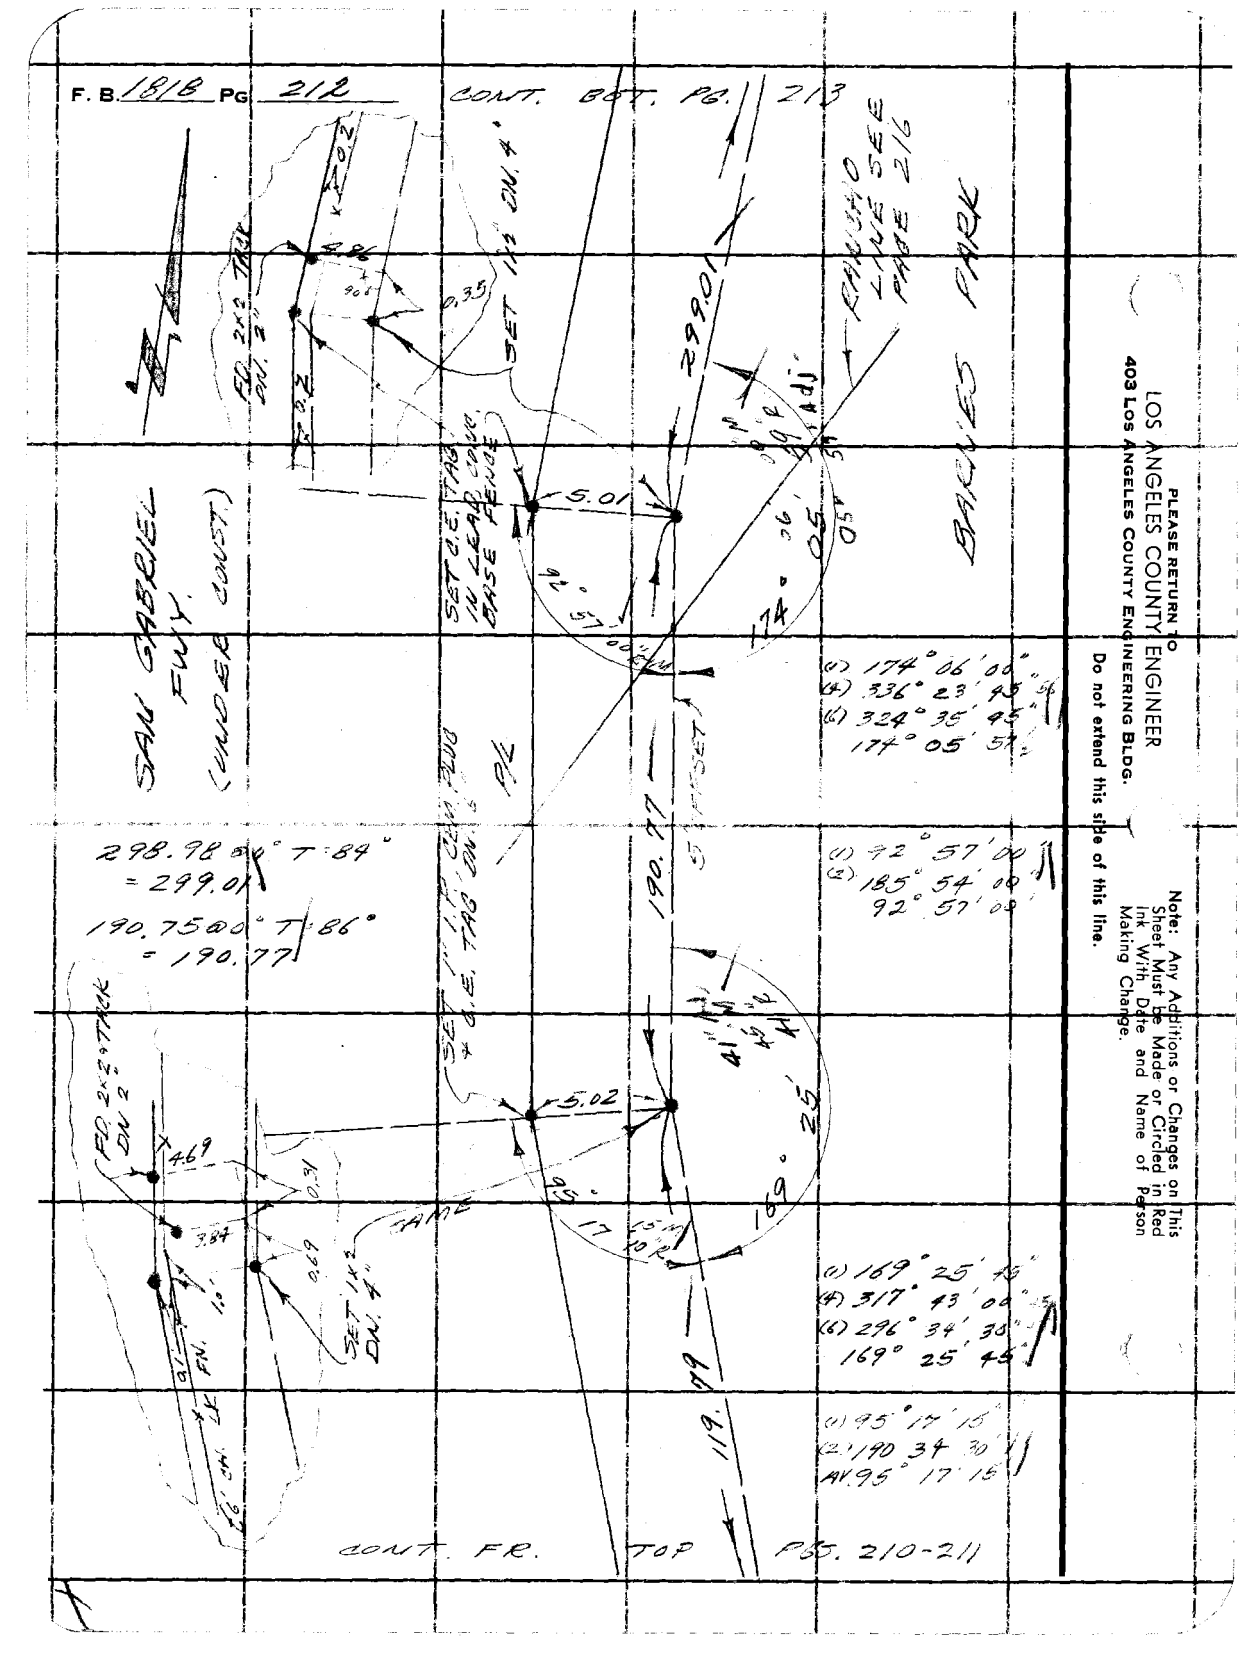

CONT. FR. TOP PGS. 210-211

PLEASE RETURN TO
LOS ANGELES COUNTY ENGINEER
403 Los Angeles County Engineering Bldg.
Do not extend this side of this line.

Note: Any Additions or Changes on This Sheet Must be Made or Circled in Red Ink With Date and Name of Person Making Change.

Notes Ck'd by G. E. BARR
Map No. B-2866
Office Work R. J. DOWNS
Checked G. E. BARR

Survey of BARNES PARK
JN 2054.15 Tape #0107 Std 68 °F
Surveyed by M. SOTRO
Notes SOTRO Date 4-9-14

F. B. 1016 PG. 213

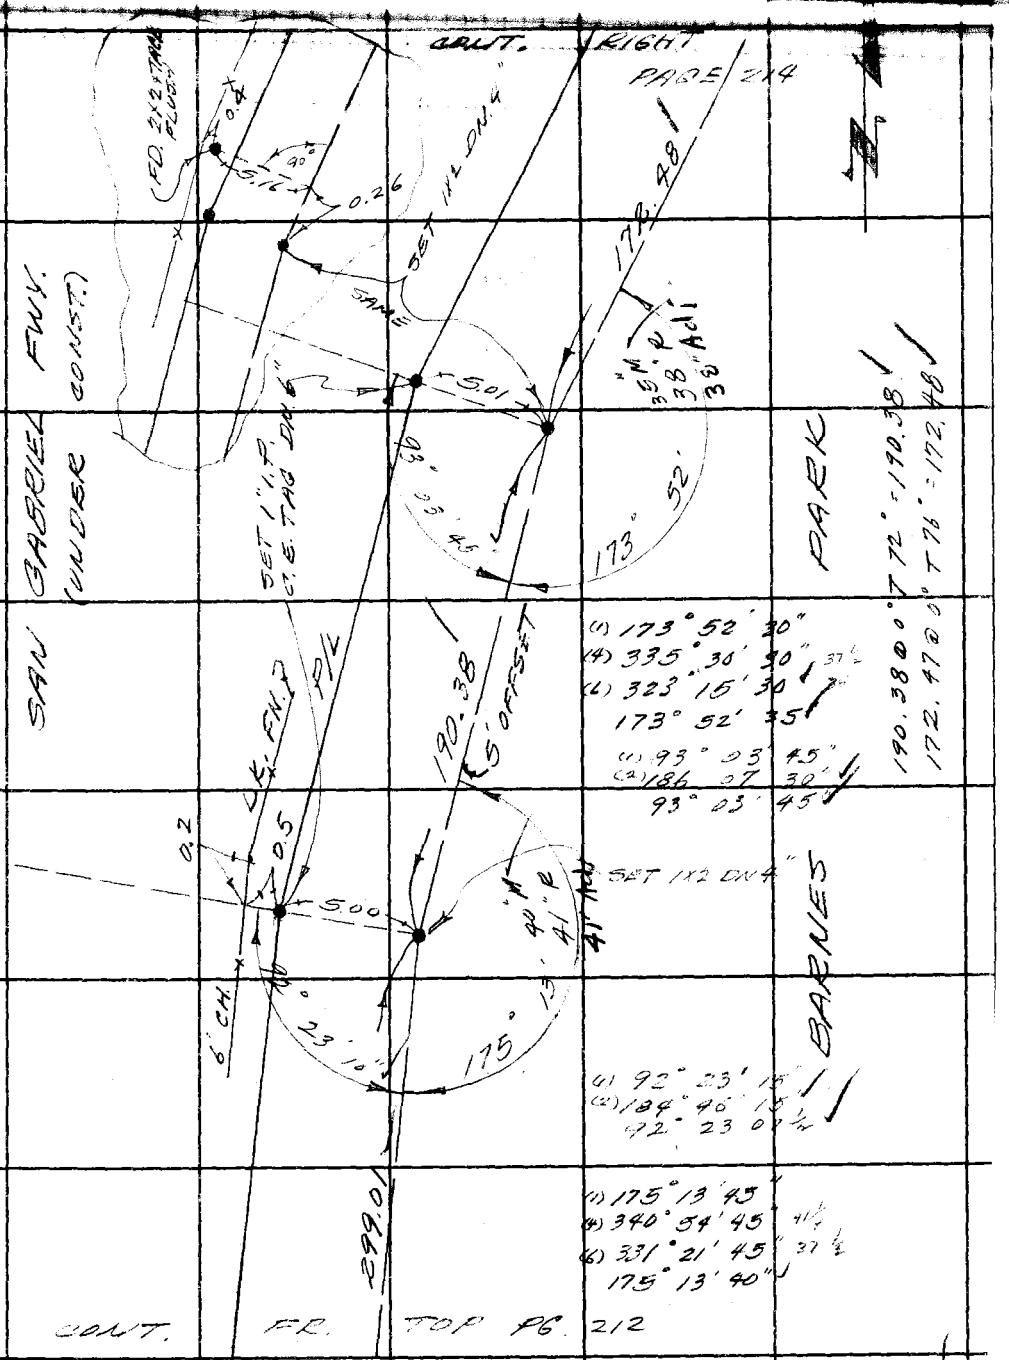

Note: Any Additions or Changes on This Sheet Must be Made or Circled in Red Ink With Date and Name of Person Making Change.

Do not extend this side of this line.

PLEASE RETURN TO
LOS ANGELES COUNTY ENGINEER
403 LOS ANGELES COUNTY ENGINEERING BLDG.

76F3095 CE #310 6-62

F. B. 1818 PG. 214

COURTLEIT AS. 209

PARK

BARNES

SET 1" I.P. CONC. PLUG X.C.E. THIS DIV. 3

SET 1" I.P. CONC. PLUG X.C.E. THIS DIV. 12

END 6" CHLORI

P/L

SAN GABRIEL RIVER FWY. (UNDER CONST.)

RIVERGRADE











344.36

EQ.

CONT.

EQ.

TOP

EQ.

CONC.

(40)

CONC.

BOT PC. 215

104.77 @ 0° 7' 94" = 104.77 95'
104.77 @ 0° 7' 94" = 104.77 95'
AV. 104.77 95'

Note: Any Additions or Changes on This Sheet Must be Made or Circled in Red Ink With Date and Name of Person Making Change.

PLEASE RETURN TO
LOS ANGELES COUNTY ENGINEER
403 Los Angeles County Engineering Bldg.
Do not extend this side of this line.

Notes Ck'd by G. E. BARR
Map No. B-2586
Office Work R. S. Downs
Checked G. E. BARR

Survey of BARNES PARK
JN 2259.15 Tape 4107 Std 68 °F
Surveyed by [illegible]
Notes [illegible] Date 4-64

F. B. 1010 PG. 215

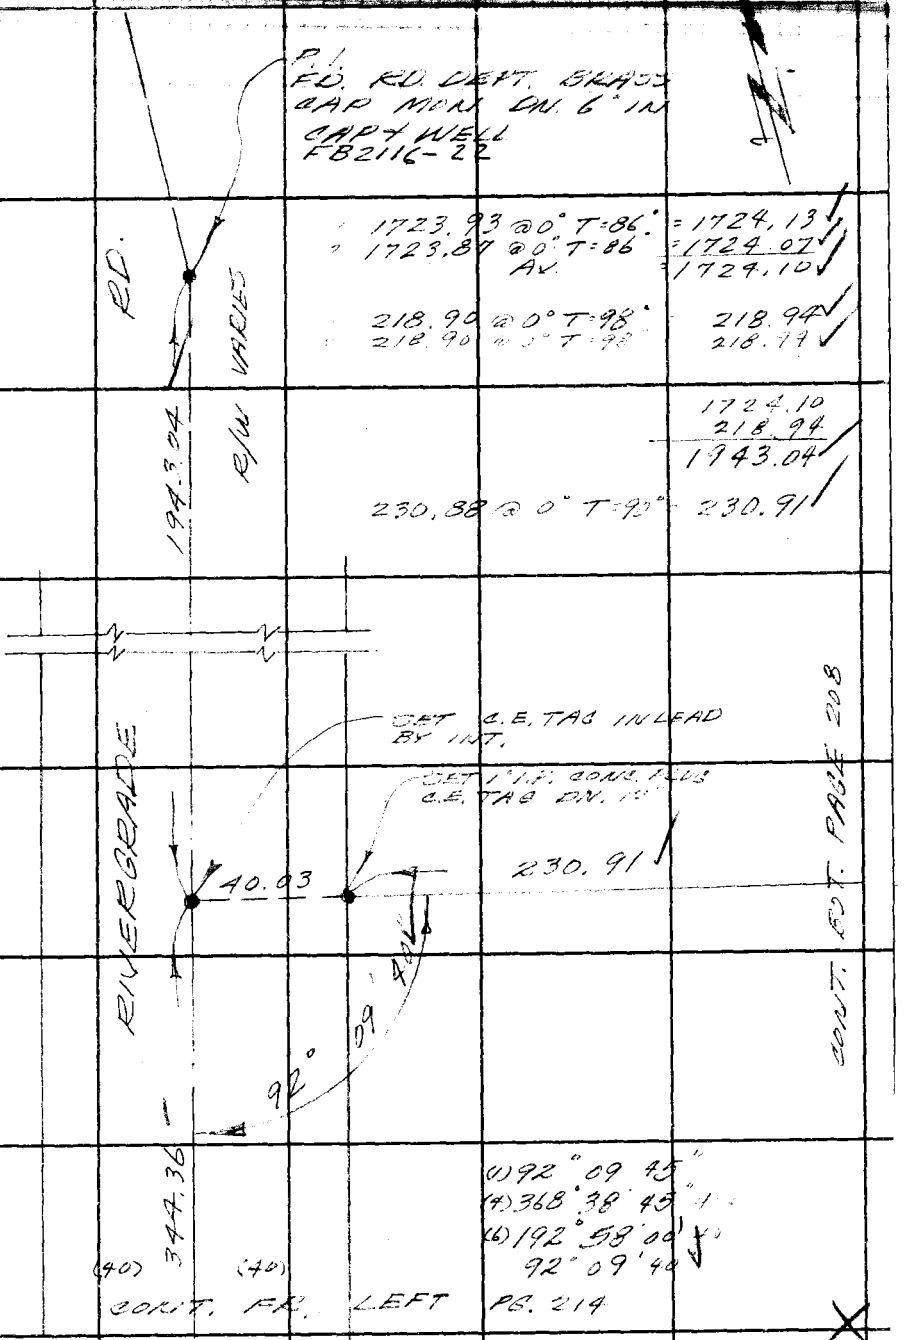

Note: Any Additions or Changes on This Sheet Must be Made or Circled in Red Ink With Date and Name of Person Making Change.

Do not extend this side of this line.

PLEASE RETURN TO
LOS ANGELES COUNTY ENGINEER
403 LOS ANGELES COUNTY ENGINEERING BLDG.

76F3095 CE #310 6-62

PLEASE RETURN TO
LOS ANGELES COUNTY ENGINEER
403 LOS ANGELES COUNTY ENGINEERING BLDG.

Note: Any Additions or Changes on This Sheet Must be Made or Circled in Red Ink With Date and Name of Person Making Change.

Do not extend this side of this line.

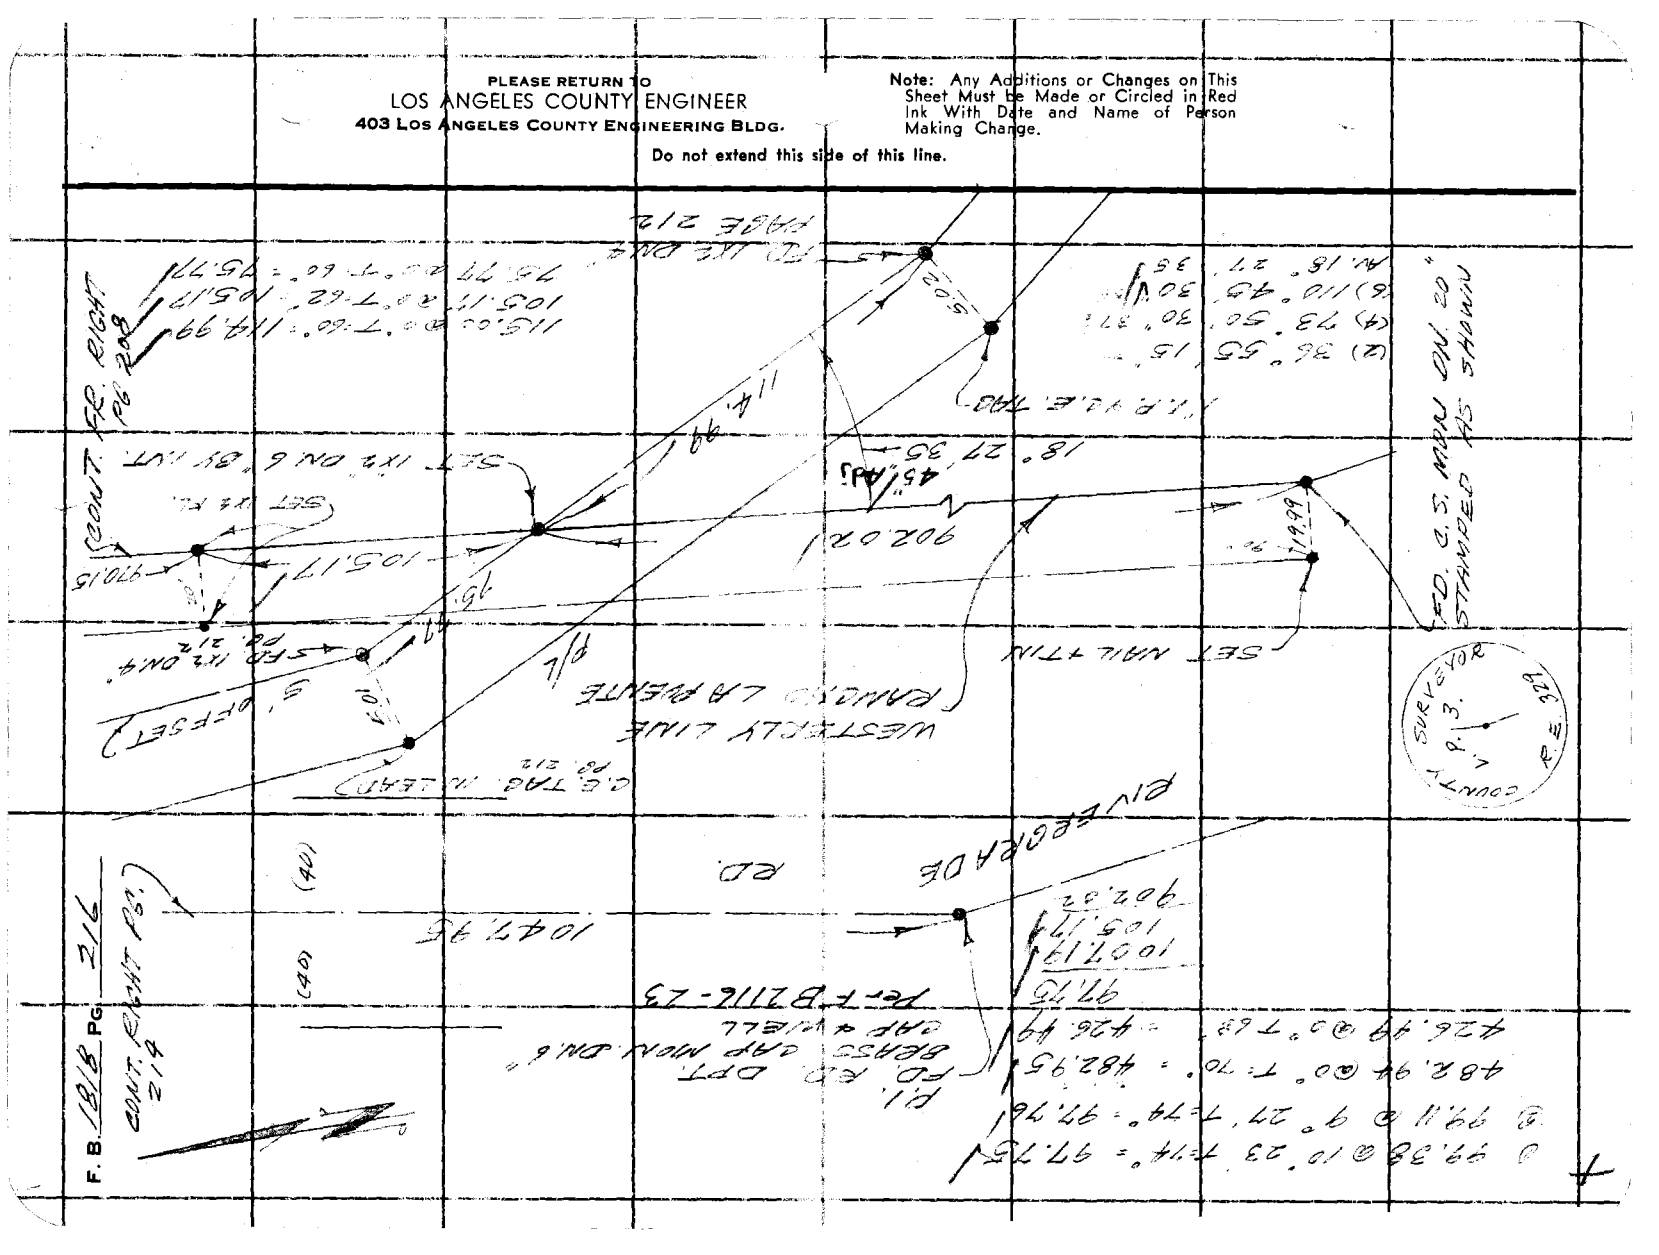

76F3095 CE #310 6-62

PLEASE RETURN TO
LOS ANGELES COUNTY ENGINEER
403 LOS ANGELES COUNTY ENGINEERING BLDG.

Note: Any Additions or Changes on This Sheet Must be Made or Circled in Red Ink With Date and Name of Person Making Change.

Do not extend this side of this line.

WS 96

Notes Ck'd by G. E. BARR
Map No. B-2666
Office Work R. S. Owens
Checked G. E. BARR

Survey of [illegible]
JN [illegible] Tape [illegible] Std. [illegible] °F
Surveyed by [illegible]
Notes [illegible] Date [illegible]

F. B. [illegible] Pg. [illegible]

20' OFFSET ?

CONT. LEFT ENTIRE 208

WESTERLY LINE
RANCHO LA PUENTE










PLEASE RETURN TO
LOS ANGELES COUNTY ENGINEER
403 LOS ANGELES COUNTY ENGINEERING BLDG.

Note: Any Additions or Changes on This Sheet Must be Made or Circled in Red Ink With Date and Name of Person Making Change.

Do not extend this side of this line.

F. B. 1818 PG 2/18

NOTES RED. _____ JOB NO. 0054.15 SURVEY OF. BARNES PARK

DATE _____ SURVEY BY. R.L. SUTRO

NOTES CHKD. G. E. BARR NOTES BY. SUTRO DATE 4-21-64

DATE MAY 15 64 INDEXED. C. J. GALLI DATE APR 23 64

F. B. 83 PG. 117

ao 54.15

DESCRIPTION

BARNES PARK

BENCH LEVELS

ADJ. ELEV.

3RD RUN

LENGTH OF LINE FROM B.M. 46-2 SOUTH TO BARNES PARK AND RETURN 1.35 MILES

2ND RUN

DIFF.

E.T.S. DRAWING LEWIS 101696

PARK. POLS # 231 + 236

SOTRO
BOWLES
LATTERI
MOODYMAN

1ST RUN

B.M.

NOTE: ANY ADDITIONS OR CHANGES ON THIS SHEET MUST BE MADE OR CIRCLED IN RED INK, WITH DATE AND NAME OF PERSON MAKING CHANGE.

Do not extend notes this side of this line

PLEASE RETURN TO
LOS ANGELES COUNTY ENGINEER
700 LOS ANGELES COUNTY ENGINEERING BLDG.

765420 S & E-353 9-55

76S420 S & E-353 9-55

PLEASE RETURN TO
LOS ANGELES COUNTY ENGINEER
700 LOS ANGELES COUNTY ENGINEERING BLDG.

NOTE: ANY ADDITIONS OR CHANGES ON THIS SHEET MUST BE MADE OR CIRCLED IN RED INK, WITH DATE AND NAME OF PERSON MAKING CHANGE.

Do not extend notes this side of this line


F.B. 1818 PG. 220

B.M.	1ST RUN	DIFF.	2ND RUN	3RD RUN	ADJ. ELEV.	DESCRIPTION
(FD.)						316.787
B.M. 46-1	316.879					B.M. 46-1, ELEV. 316.879, F.B. 1367 P. 53
+	6.012		5.995			(EL MONTE L-3) RAMONA BLVD. & GILMAN
	322.891	+2.372	2.391			RD., 30' S. & RAMONA, 10' W. & PP. GILMAN
-	3.620		3.304			
T.P.	319.271					SPK. FOR RAIL 4' W. OF BRIDGE
+	4.798		4.890			
	324.067	+1.714	1.715			
-	3.082		3.175			
T.P.	320.985					TOP BOLT ON BRIDGE
+	4.758		4.801			
	325.743	+0.618	0.619			
-	4.143		4.182			
T.P.	321.603					TOP BOLT ON BRIDGE
+	5.052		4.948			
	326.655	+0.401	0.400			
-	2.651		4.548			
T.P.	322.004					SPL. NAIL
-	5.012		5.079	4.742		
	327.016	+1.707	1.713	1.707		
-	3.305		3.366	3.035		
T.P.	323.711					BOLT W. SHK. BRIDGE & RIVERBOARD
+	3.434		3.328			
	327.145	-2.725	2.702			
-	5.140		6.030			
(FD.)	321.005					320.922
B.M. 46-2						B.M. 46-2, ELEV. 320.989, F.B. 1367 P. 55
						(PUENTE A-3) RAMONA BLVD. & RIVER-
						GRADE RD., S.E. COR. 45' S. OF E.
						RAMONA BLVD., 11' E. OF BRIDGE
						OVER RIVER GRADE RD.

769420 S & E-353 9-55

PLEASE RETURN TO
LOS ANGELES COUNTY ENGINEER
700 LOS ANGELES COUNTY ENGINEERING BLDG.

NOTE: ANY ADDITIONS OR CHANGES ON THIS SHEET MUST BE MADE OR CIRCLED IN RED INK, WITH DATE AND NAME OF PERSON MAKING CHANGE.

Do not extend notes this side of this line

B.M.	1ST RUN	DIFF.	2ND RUN	3RD RUN	ADJ. ELEV.	DESCRIPTION
B.M. 46-2	320.989					B.M. 46-2 ELEV. 320.989 PAGE 220
(FD.) +	3.390		3.527			
	324.379	-2.536	2.538	-2.535		
-	6.126		6.065			
T.P.	318.453					SPK.
+	3.461		3.548	3.491		
	321.914	-1.878	1.872	1.875		
-	5.378		5.420	5.366		
T.P.	316.575					SPK.
+	3.710		3.810			
	320.285	-1.980	1.981	-1.979		
-	5.690		5.791			
T.P.	314.595					SPK.
+	1.457		1.348			
	316.052	-4.778	4.781	-4.777		
-	6.235		6.129			
B.M. B-1	309.817				309.756	B.M. B-1, ELEV. 309.756, PATRITTI & BLENHEIM ST., S.E. COR., 18.5 E PATRITTI, 68'± S. OF BLENHEIM, A SPK. IN LEAD COVER. 12' S. OVER E.C.
(SET) +	3.618		3.664			
	313.515	-1.601	1.601	-1.600		
-	5.299		5.265			
T.P.	308.216					
+	4.261		4.330			
	312.477	-0.994	0.990	-.993		
-	5.255		5.320			
T.P.	307.222					SPK
+	4.401		4.341			
	311.623	-1.081	1.080	-1.080		
-	5.482		5.421			
T.P.	306.141					SPK
+	4.491		4.390			



768420 S & E-353 9-55

PLEASE RETURN TO
LOS ANGELES COUNTY ENGINEER
700 LOS ANGELES COUNTY ENGINEERING BLDG.

NOTE: ANY ADDITIONS OR CHANGES ON THIS SHEET MUST BE MADE OR CIRCLED IN RED INK, WITH DATE AND NAME OF PERSON MAKING CHANGE.

Do not extend notes this side of this line

JOB NO. 2534.15 SURVEY OF BARNES PARK NOTES RED. DATE
SURVEY BY M. SOTRO DATE 4-21-64 NOTES CHKD. G. E. BASS DATE MAY 15 '64
NOTES BY SOTRO DATE
INDEXED G. J. CALLI DATE

F.B. 1818 PG. 222

B.M.	1ST RUN	DIFF.	2ND RUN	3RD RUN	ADJ. ELEV.	DESCRIPTION
	310.612	-0.039	1.039	-1.039		
	- 5.510		5.429			
T.P.	305.102					SPK.
	+ 4.453		4.451	4.365		
	309.510	-0.252	0.237	0.232		
	- 4.674		4.688	4.60[illegible]		
B.M. B-2	304.836				304.812	B.M. B-2 ELEV. 304.812 PATRITTI AVE. & FINCHLEY ST., S.E. COR., 135'± E OF ℄ PATRITTI, 53.5'± S. OF ℄ FINCHLEY, SPK. IN LEAD IN CURB, 10' S. CURB E.C. SPK. (T.P.)
(SET)	+ 3.992		4.009			
	308.342	-1.168	1.170	-1.167		
	- 5.140		5.179			
T.P.	303.702					
	+ 4.791		4.750			
	308.192	-0.673	0.675	-0.673		
	- 5.163		5.125			
T.P.	303.029					SPK.
	+ 4.679		4.511			
	307.645	-0.736	0.739	-0.735		
	- 5.353		5.250			
T.P.	302.293					SPK.
	+ 4.640		4.544			
	306.933	-0.639	0.638	-0.639		
	- 5.279		5.182			
T.P.	301.654					SPK.
	+ 4.670		4.[illegible]			
	306.324	-0.324	0.320	-0.324		
	- 4.99[illegible]		5.[illegible]			
B.M. B-3	301.330				301.274	B.M. B-3 ELEV. 301.274 PATRITTI AVE. & BESS AVE., N.W. COR., 40'± W. ℄ PATRITTI, 19'± N. ℄ PROD. BESS S. E. OF END CURB, SPK. IN LEAD
(SET)	+ 5.36[illegible]		5.24[illegible]			
	306.677	+0.289	0.289	+0.289		
	- 5.080		4.959			

765420 S & E-353 9-55

PLEASE RETURN TO
LOS ANGELES COUNTY ENGINEER
700 LOS ANGELES COUNTY ENGINEERING BLDG.

NOTE: ANY ADDITIONS OR CHANGES ON THIS SHEET MUST BE MADE OR CIRCLED IN RED INK, WITH DATE AND NAME OF PERSON MAKING CHANGE.

Do not extend notes this side of this line

B.M.	1ST RUN	DIFF.	2ND RUN	3RD RUN	ADJ. ELEV.	DESCRIPTION
T.P.	301.619					SPK.
+	4.602		4.494	4.430		
	306.221	-0.765	0.791	.769		
-	5.370		5.285	5.199		
T.P.	300.851					SPK.
+	5.502		5.451			
	306.353	+1.070	1.069	+1.070		
-	4.432		4.382			
B.M. B-4	301.921				301.865	B.M. B-4 ELEV 301.865 71.5' W.
(SET) +	3.498		3.351			EDGE PAV. PATRITTI AVE, 47 ± S.
	305.409	-1.983	1.980	-1.962		REST ROOM BLDG. L.A. CO. NO. 4192
-	5.471		5.331			PARK SPK. SET IN LEAD E. 5 ±
T.P.	299.938					CONC BASE OF FLAG POLE.
+	3.885		3.815			
	303.823	-0.977	0.976	-.976		
-	4.862		4.791			
T.P.	298.961					SPK.
+	4.242		4.175			
	303.203	-0.627	0.627	-.627		
-	4.869		4.802			
B.M. B-5	298.334				298.280	B.M. B-5 ELEV. PATRITTI
(SET) +	3.874		3.750	3.664		& TORCH ST. 18.5' E. OF ℄ PATR.
	302.208	-0.984	0.976	-0.978		54 ± S. ℄ TORCH ST, 10 ± S.
-	4.858		4.726	4.642		B.C. SPK IN LEAD.
T.P.	297.350					S.W. & T. PAGE 210
+	5.041		5.104			
	302.391	+1.526	1.529	+1.526		
-	3.515		3.575			
T.P.	298.876					IRI & NAIL
+	5.040		4.931			

NOTES RED. JOB NO. SURVEY OF
DATE SURVEY BY
NOTES CHKD. G. E. BARR NOTES BY. DATE 4-22-64
DATE INDEXED E. J. GALLI DATE

F.B. PG.

76S420 S & E-353 9-55

PLEASE RETURN TO
LOS ANGELES COUNTY ENGINEER
700 LOS ANGELES COUNTY ENGINEERING BLDG.

NOTE: ANY ADDITIONS OR CHANGES ON THIS SHEET MUST BE MADE OR CIRCLED IN RED INK, WITH DATE AND NAME OF PERSON MAKING CHANGE.

Do not extend notes this side of this line

JOB NO. 0054.15 SURVEY OF BARNES PARK NOTES RED.
SURVEY BY M. SOTRO DATE G. E. Barnes
NOTES BY SOTRO DATE 4-22-64 NOTES CHKD. DATE 4/15/64
INDEXED G.J. GALLI DATE

F.B. 1818 PG. 224

B.M.	1ST RUN	DIFF.	2ND RUN	3RD RUN	ADJ. ELEV.	DESCRIPTION
	303.916	+1.150	1.150	+1.150		
-	3.890		3.781			
T.P.	300.026					1X1 & NAIL
+	5.741		5.609			
	305.767	+.845	0.849	+.845		
-	4.896		4.760			
T.P.	300.871					1X1 & NAIL NEAR Q PT.
+	4.917		4.841			
	305.790	+1.556	1.552	+1.556		
-	3.363		3.289			
T.P.	302.427					1X1 & NAIL
+	4.760		4.694			
	307.187	+0.395	0.394	+.395		
-	4.365		4.300			
B.M. B-6	302.822				302.774	B.M. B-6, ELEV. 302.774 BARNES PARK, W. END OF CONC. PAD FOR PARK STOVES, 2' E. OF W. EDGE CONC. (A SPK. IN LEAD.
(SET) +	4.304		4.250			SPK.
	307.126	+.094	0.096	+.094		
-	4.210		4.154			
T.P.	302.916					
+	3.009		2.913			
	305.925	-1.061	1.063	-1.060		
-	4.070		3.976			
T.P.	301.855					SPK.
+	4.531		4.452			
	306.386	+0.197	0.201	+.197		
-	4.334		4.251			
T.P.	302.052					SPK.
+	4.707		4.615	4.532		
	306.759	+1.308	1.313	~~1.312~~		
-	3.399		3.302	3.220		

769420 S & E-353 9-55

PLEASE RETURN TO
LOS ANGELES COUNTY ENGINEER
700 LOS ANGELES COUNTY ENGINEERING BLDG.

NOTE: ANY ADDITIONS OR CHANGES ON THIS SHEET MUST BE MADE OR CIRCLED IN RED INK, WITH DATE AND NAME OF PERSON MAKING CHANGE.

Do not extend notes this side of this line



B.M.	1ST RUN	DIFF.	2ND RUN	3RD RUN	ADJ. ELEV.	DESCRIPTION
T.P.	303.360					SPK.
+	5.248		5.175			
	308.608	+1.038	1.036			
-	4.210		4.139			
T.P.	304.398					SPK.
+	5.226		5.148			
	309.624	+1.361	1.358			
-	3.865		3.790			
T.P.	305.759					SPK.
+	5.039		4.950			
	310.798	+0.834	0.830			
-	4.205		4.120			
T.P.	306.593					SPK.
+	4.855		5.022			
	311.448	+0.853	0.852			
-	4.002		4.170			
T.P.	307.446					SPK.
+	4.790		4.730	4.580		
	312.236	+0.555	0.560	0.559		
-	4.235		4.170	4.021		
T.P.	308.001					SPK.
+	4.841		4.739			
	312.842	+0.053	0.049			
-	4.788		4.690			
T.P.	308.054					SPK
+	6.205		6.123			
	314.259	+5.190	5.193			
-	1.015		0.930			
T.P.	313.244					PK NAIL
+	6.052		5.920			

F.B. 1818 PG. 226

JOB NO. 0054.15 SURVEY OF BARNES PARK NOTES RED.
SURVEY BY M. SOTRO DATE
NOTES BY SOTRO DATE 9-22-64 NOTES
INDEXED C. J. GAIDI DATE DATE

G. E. BA...

B.M. 1st RUN DIFF. 2ND RUN 3RD RUN ADJ. ELEV.

T.P. - 317.27 0.954 316.316 4.987 323.299 2.330 320.969

SM 462

+ 320.969 6.571 327.540 2.655 324.885 2.174 322.711

320.122

PAGE 220

322.889

922

DESCRIPTION

768420 S 8-E-353 9-68

LOS ANGELES

LOS ANGELES COUNTY ENGINEER

818

Do not write in this space

LDG.

NO.

ORANGES

ENGINEER