Profile No. | Notes Red. ____ Date ____ | Plotted ____ Date ____ | Job No. 0054.45 | Division No. 10 | F. B. 1819 | Pg. 10

Survey of LAS TUNAS STATE BEACH

X-Sec. No. | Notes Chkd. FHS. Date 10-14-54 | Checked ____ Date ____ | Survey by L. BROWN Notes G. HARRIS Date 6/25/54

Map No. ____ Date 10-11-54

NOTE: ANY ADDITIONS OR CHANGES ON THIS SHEET MUST BE MADE OR CIRCLED IN RED INK, WITH DATE AND NAME OF PERSON MAKING CHANGE.

PLEASE RETURN TO
LOS ANGELES COUNTY SURVEYOR
726 LOS ANGELES COUNTY ENGINEERING BLDG.

Do not extend notes this side of this line.

LAS TUNAS BEACH PARK

J.N. 0054.45

BENCH LEVELS

STATION	B. S.	H. I.	F. S.	ELEV.
		L.L. BROWN G.O. HARRIS D.K. SMITH		

76L298 307 4-50

F. B. 1848 Pg. 3

INDEX

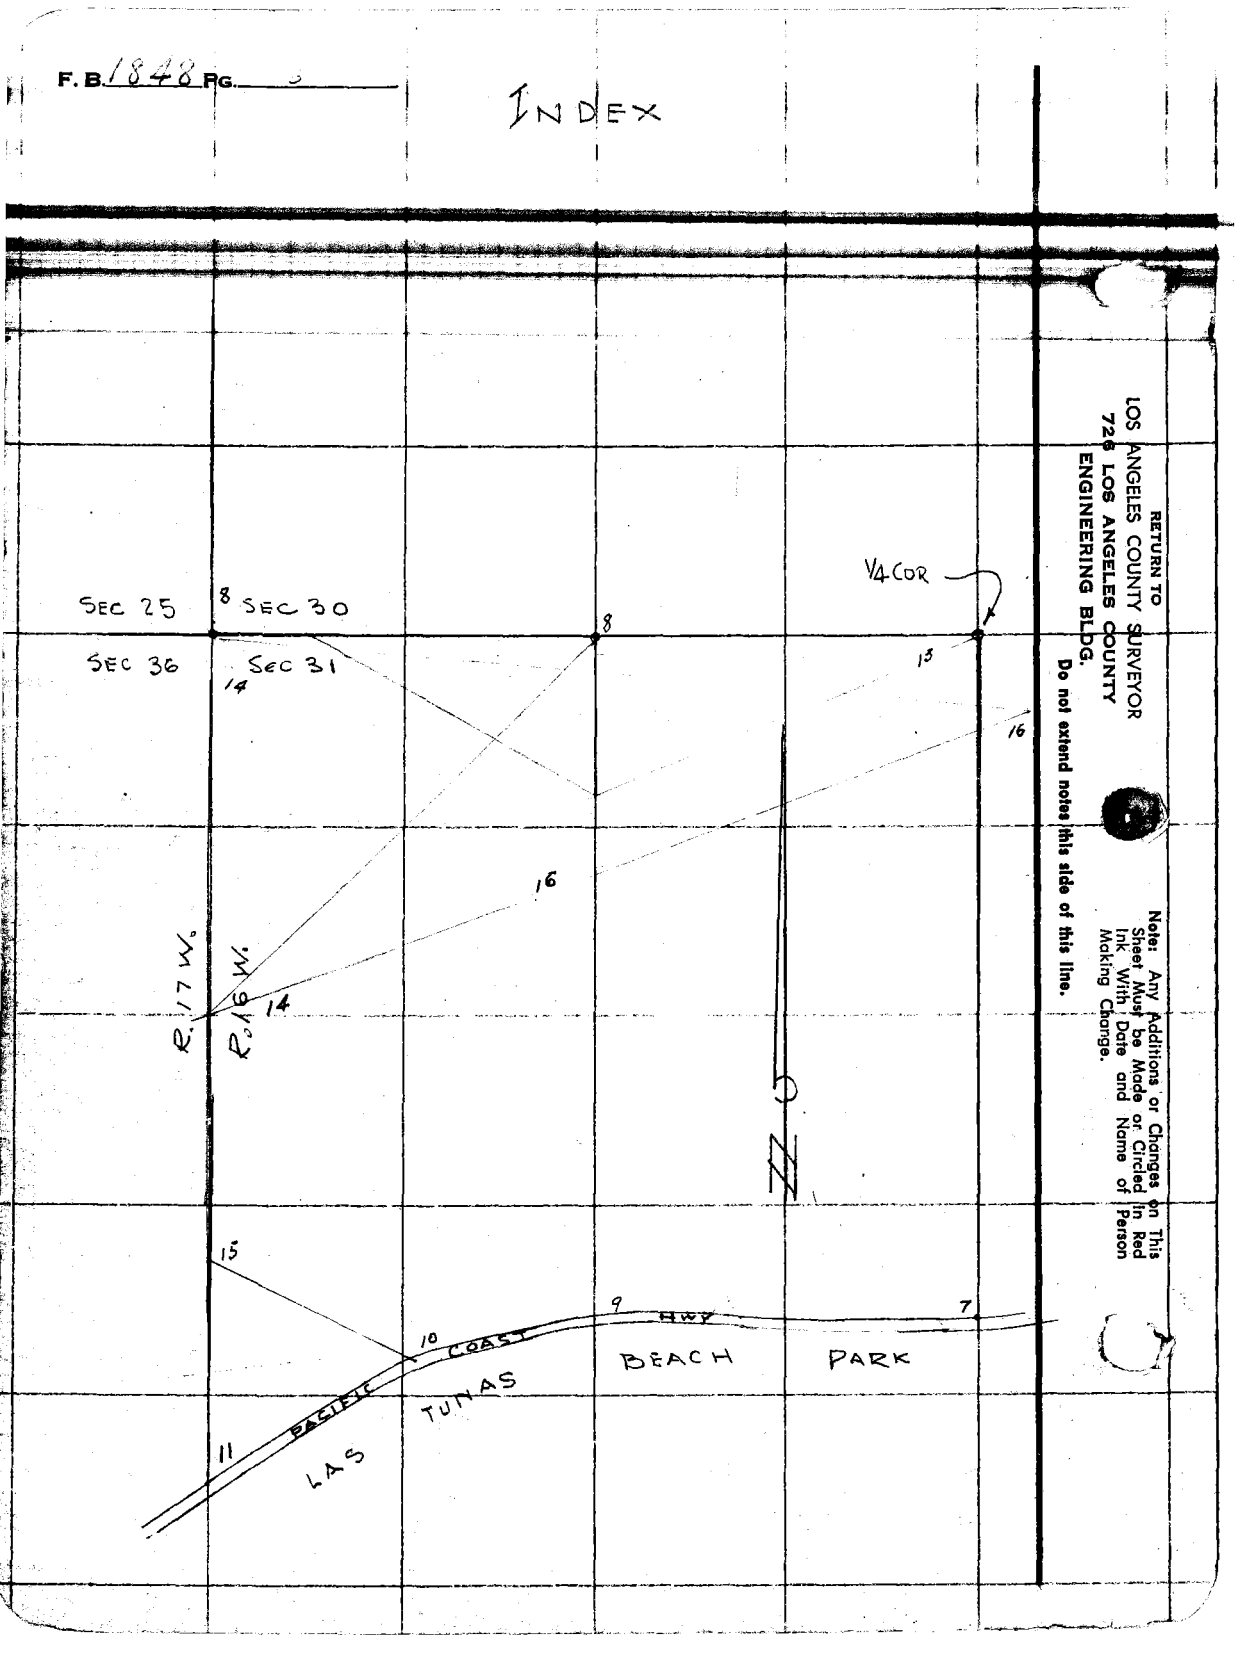

RETURN TO
LOS ANGELES COUNTY SURVEYOR
726 LOS ANGELES COUNTY
ENGINEERING BLDG.

Do not extend notes this side of this line.

Note: Any Additions or Changes on This Sheet Must be Made or Circled in Red Ink With Date and Name of Person Making Change.

Notes Ck'd by KRM	Survey of LAS TUNAS BEACH PARK
Map No. B-2499	W. O. 8681 Tape No. 103 St'd. 68 of
Office Work Green	Surveyed by Blanchard
Checked McPherson	Notes Blanchard Date 1-5-54
Date June '54	Indexed A. C. Johnson 4-15-54

F. B. 1848 PG. 5

LAS TUNAS BEACH PARK

J. N. 8681

J. N. 0054.45

Starting at Pena Canyon and the Pacific Coast Highway, west to R16W or about 2800 ft.

Ref
Stadia Traverse notes
F-

Party
Blanchard
Wharriet
Goodwin
Robbins
Oben

Microfilmed Nov. 85.

V.T. 64-25
C.S. B-2499

Notes Ck'd by KRM
Map No. B-2499
Office Work Green
Checked McPherson

Survey of LOS TUNAS BEACH PARK
W. O. 8681 Tape No. 0104 St'd. 68 °F
Surveyed by Blanchard
Notes Elevations Date 1-15-54
Indexed

F.B. 1048 Pg. 7
top pg 13

Note: Any Additions or Changes on This Sheet Must be Made or Circled in Red Ink With Date and Name of Person Making Change.

Do not extend notes this side of this line.

RETURN TO
LOS ANGELES COUNTY SURVEYOR
726 LOS ANGELES COUNTY
ENGINEERING BLDG.

76FBOBS 247 4.53

top pg 9

D-5886-313 the top of this mon. has been destroyed but the base appears to be in good shape, set survey nail in center of mon. would be well to replace this mon.

T-54
112.90 @ 0°00 = 112.89 ✓

T-64
998.45 @ 0°00 = 998.42 ✓

47.28

for Geodetic ties see pg 11

1) 175° 10' 00"
2) 350° 20' 00" ✓
3) 165° 30' 00"
87° 35' 00"

87° 35' 00"

112.89 ✓

PACIFIC COAST HIGHWAY

CENTER LINE

BC 122+95.93
fd. S.in & T. per
St. Hwy 4-92.001

30.00

Set sur. nail and tin

Set sur. nail and tin.

4.53

5.30

Set survey nail and tin by int.
N-4,126,866.23
E-4,107,073.96

998.42 ✓
ops. line

30'

9.98
0.04

9.96

fd. 4-22-76
fd. R/W mon.
E.T. 4" brass disc set
in conc. footing

set C.S. mon flush marked as shown

Nothing

39.68 @ 0°00 = 39.68 ✓

39.68

set 1/2

N.E. COR

T-52
63.57 @ 11°24 = 62.31 ✓

62.31

fd. broken remains of mon. 4-22-76 E.T.E.

set x on rock

2.21

4.95

5.00

R.E. 63

set C.S. mon on Property line
fd 2-L tags
RE-122. GB2
apart

1) 184° 53' 00"
2) 9° 46' 00"
92° 26' 30" ✓

92° 26' 30"

N.S. 89 C-5

F.B. 1848 Pg. 8

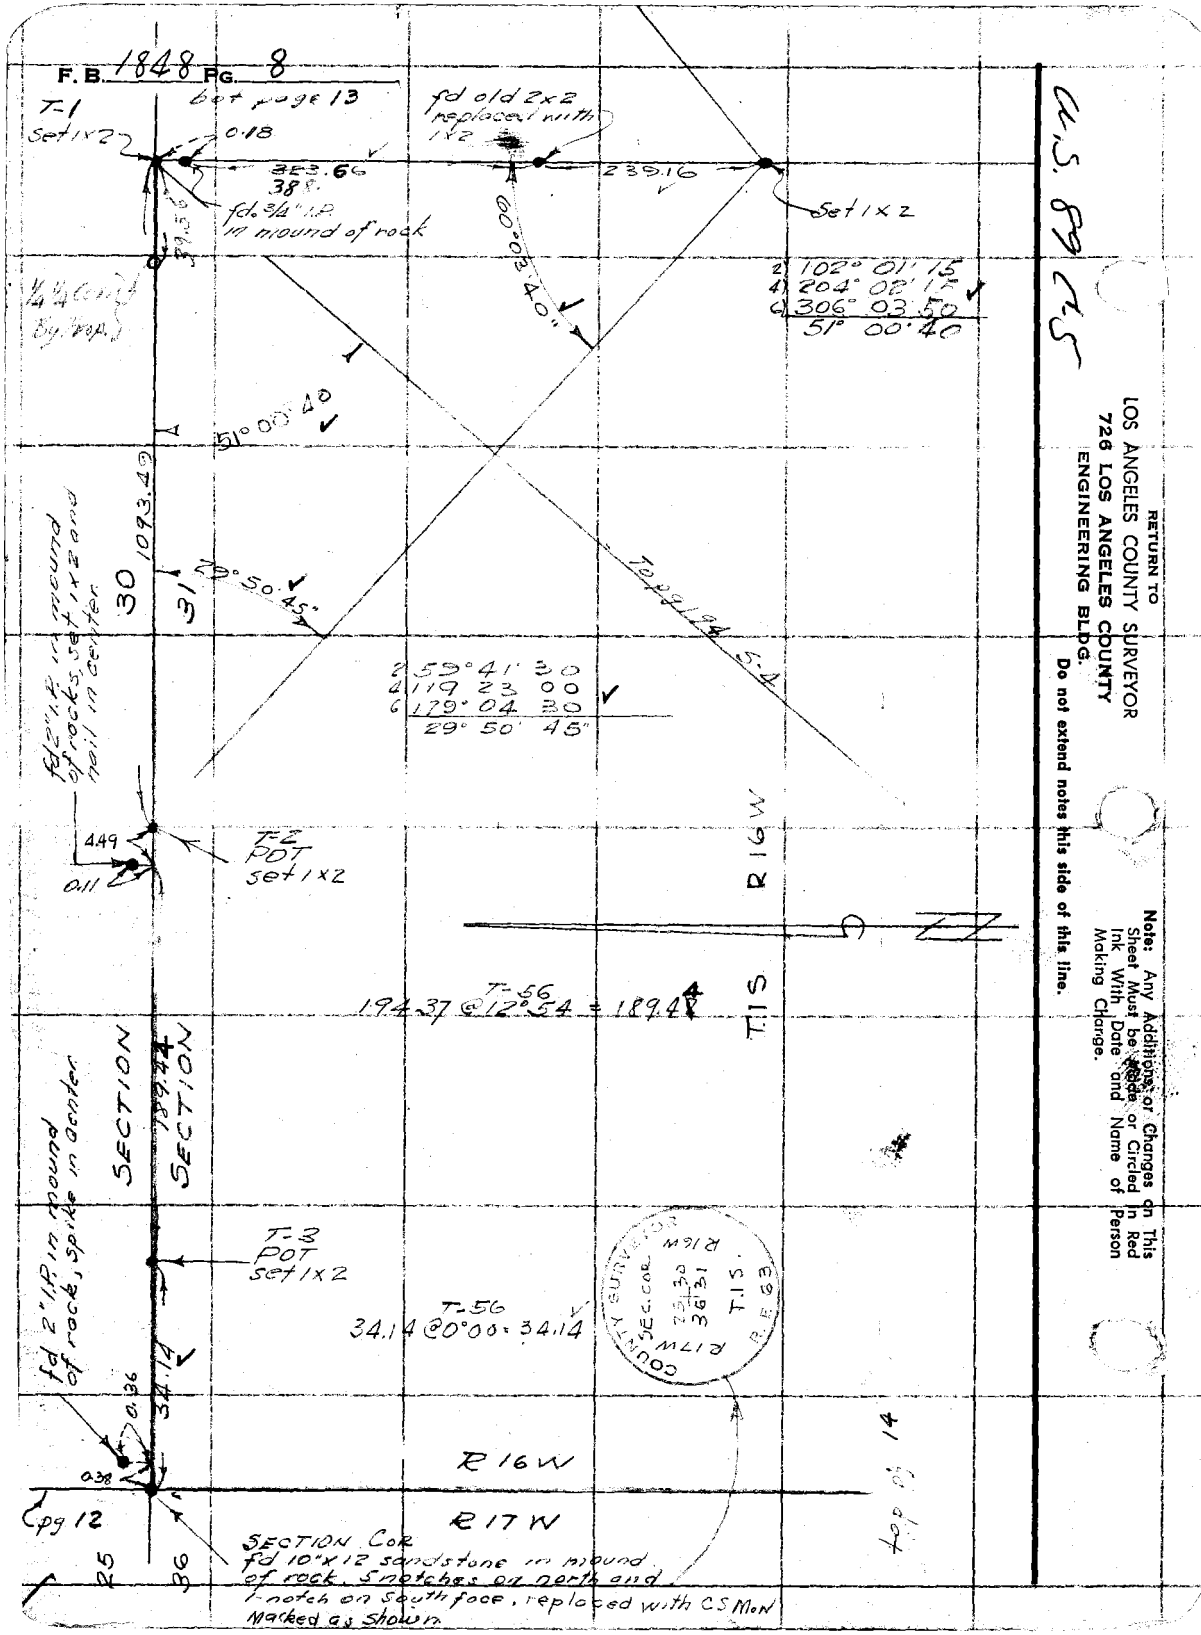

U.S. 89 RS

RETURN TO
LOS ANGELES COUNTY SURVEYOR
726 LOS ANGELES COUNTY
ENGINEERING BLDG.

Do not extend notes this side of this line.

Note: Any Additions or Changes on This Sheet Must be Made or Circled in Red Ink With Date and Name of Person Making Change.

Notes Ck'd by KRM
Map No. B-2499
Office Work Greene
Checked McPherson
Date

Survey of LAS TUNAS BEACH PARK
W. O. 8681 Tape No. 109 Std. 68 °F
Surveyed by FH Blanchard
Notes Blanchard Date 1-25-54
Indexed

F. B. 1818 PG. 9

Note: Any Additions or Changes on This Sheet Must be Made or Circled in Red Ink With Date and Name of Person Making Change.

Do not extend notes this side of this line.

RETURN TO
LOS ANGELES COUNTY SURVEYOR
726 LOS ANGELES COUNTY
ENGINEERING BLDG.

(40) (40)

99.42

N-4,126 079.99
E-4,106 067.28
Set sur. nail & tin

EC 112+96.79
fd 5/8" W. 10" down

30.00

9.96

fd R/W mon 2" down
a 5"x5" conc. post
with wire in cntr.

fd 1" brass disk set
in conc. 10" down.

fd. 4-28-76
E.T.E.

175° 58' 45"

9.20

T-58
575.56 @ 0000 = 575.52

PACIFIC COAST HWY

575.52
500.86 calc.

COUNTY SURVEYOR H.W. COR. F.E.

COUNTY SURVEYOR P.T. F.E. 63

Set CS mon
in 8" well with
cover and a 4'
slab of conc
around sewer
mh. as shown

set CS mon at
edge of bluff
flush mrkd
as shown

350° 30' 15"
341 00 30
331 30 45
17.51 5' 07"

90° 46' 30" calc.

13.83

BC 107+25.49
fd nothing

R 200

wly bdy of Park

34.57

T-68
AC 14 @ 34°53' = 34.57

175° 15' 10"

74.66
9.16

set sur. nail & tin
N-4,126 819.25
E-4,105 491.82

set L&T in
large boulder

10.00

0.48

fd R/W mon 12" down
a 5"x5" conc. post with
wire in center.

fd 1" brass disk set
in conc. 10" dn.

81.44
9.17

top page 10

U.S. 89 ALT

76FSOS 247 4-58

F.B. 1848 PG. 10

bot page 9

U.S. 89 N-S

81.44 T-60 20°00 = 81.44 ✓

(40)

(40)

81.44

EC 106+42.10
fd nothing

set sur. nail and tin

10.00

30 4.10 T-60 20°00 = 304.38 ✓

HWY

304.38

fd R/W mon. 12" down
3" brass d.sc. set
in conc.

COAST

Set sur nail & tin by int. note this is not a true picture, the int lands in 1st lane north of ℄.
N 412 887.80
E 4 105 187.90

150° 50' 45"

301° 41' 30"
243° 23' 00"
185 04 30
150 50 45" ✓
tape sta. 0+00
143.56 @ 76
= 143.57 ✓

PACIFIC

143.57

P1
set bt spk and tin
T-54
316.88 @ 0°00
= 316.85

90° 27 45"
180 00 00
271 28 30 ✓
45° 13' 55"

30.00

set sur nail & tin

.04

fd 2" IP set in conc. by R/W marker 4' down

BC 100+27.08
fd SUR. NAIL & WASHER 20 dn

45° 13' 55"

18.90

670.55

To S.C. @ 15

top page 11

RETURN TO
LOS ANGELES COUNTY SURVEYOR
726 LOS ANGELES COUNTY
ENGINEERING BLDG.
Do not extend notes this side of this line.

Note: Any Additions or Changes on This Sheet Must be Made or Circled In Red Ink With Date and Name of Person Making Change.

Notes Ck'd by KRM
Map No. B-2499
Office Work Gunn
Checked McKinnon
Date

Survey of Los Tunas Beach Pc
W. O. 668 Tape No. 109 St'd. 68 °F
Surveyed by Bloecoard
Notes Blo 12-30-53 Date 1-25-54
Indexed

F. B. 1848 Pg. 11

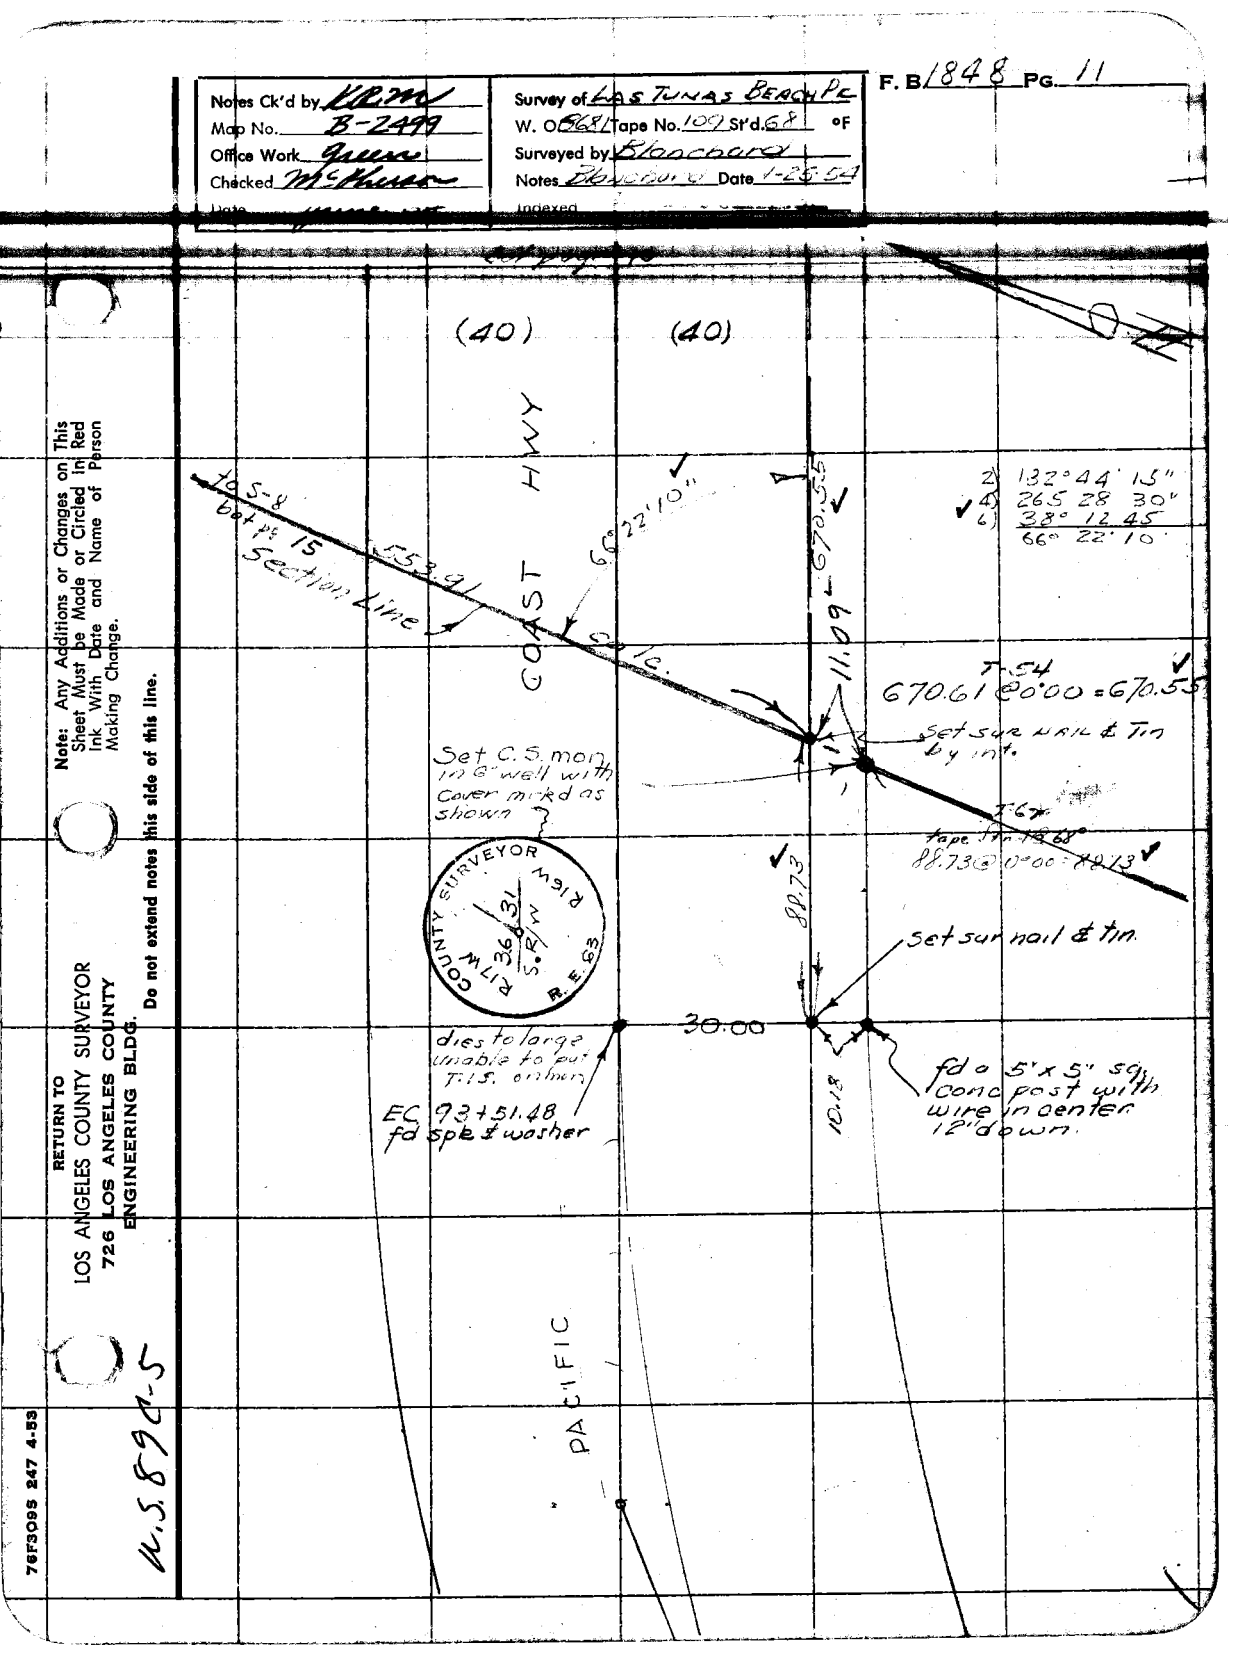

Note: Any Additions or Changes on This Sheet Must be Made or Circled in Red Ink With Date and Name of Person Making Change.

Do not extend notes this side of this line.

RETURN TO
LOS ANGELES COUNTY SURVEYOR
726 LOS ANGELES COUNTY
ENGINEERING BLDG.

N.S. 89 C-5

76F3095 247 4-53

F. B. 1848 PG. 12

LAS TUNAS CANYON ROAD

96 ±

24 | 19

25 | 30

fd C.S. mon mkd as shown

24 19 R16W
25 30 T1S.
MONUMENT

783.5 ±

Set 1" IP on ridge running E & W

R17W / R16W

Set 1" IP on S. side of wide ridge.

3216 ±

89°58'00"

2 179° 56' 00"
4 359° 57' 00"
1 179° 47' 58"
89° 57' 58"

25 | 30

pg. 8

36 | 31

N.S. 89 E.S.

RETURN TO
LOS ANGELES COUNTY SURVEYOR
726 LOS ANGELES COUNTY
ENGINEERING BLDG.
Do not extend notes this side of this line.

Note: Any Additions or Changes on This Sheet Must be Made or Circled in Red Ink With Date and Name of Person Making Change.

Notes Ck'd by KRM
Map No. B-2499
Office Work Guerra
Checked McPherson
Date

Survey of Las Tunas Beach Park
W. O. 868 Tape No. St'd. 84 °F
Surveyed by Blanchard
Notes Blanchard Date 1-25-54
Indexed

F.B. 1848 Pg. 13

¼ COR. SEC 30

Monument to consist of sandstone 2"x12"x24" buried to surface to

stone mound, cor is about 10 chains west of ridge replaced with 3"mon marked as shown

prod

84°16'10" ✓

compromise line per DS886-313 ✓

2 53°40'00	2 168°32'15
4 107°20'00 ✓	4 337°04'45 ✓
6 161°00'00 ✓	6 145°37'00 ✓
26°50'00	84°16'10

R.16W.

T.1 S.

26°50'00" ✓

SECTION 30

SECTION 31

Section Line

1242.45 calc

2 179°49'00	
4 359°37'45	
6 179°23'30" ✓	
89°54'25"	

2 126°31'15	
4 253°02'30	
6 19°33'45	
63°15'35"	

89°54'25" ✓

63°15'35" ✓

fd old 2x2 in small mound of rocks replaced with 1"x2"

Set 1x2

POT set 1x2

0.18

388.6 ✓

239.16

fd 3/4" I.P. in mound of rock no tag

60°03'40" ✓

1033.49 calc.

38.80 @ 0°00 =	38.80
287.56 @ 7°26 =	284.77
287.79 @ 8°15 =	284.76
	388
	323.56
-.59	65.10
6.51 @ 0°00 =	388.66
241.75 @ 8°19 =	239.16 ✓
241.56 @ 8°00 =	239.16 ✓

2 120°07'15"	
4 240°14'45"	
6 360°22'00"	
60°03'40"	

Tp pg 8

U.S. 89 A-5

Note: Any Additions or Changes on This Sheet Must be Made or Circled in Red Ink With Date and Name of Person Making Change.

Do not extend notes this side of this line.

RETURN TO
LOS ANGELES COUNTY SURVEYOR
726 LOS ANGELES COUNTY
ENGINEERING BLDG.

76F3095 247 2-51

F.B. 1848 PG. 14

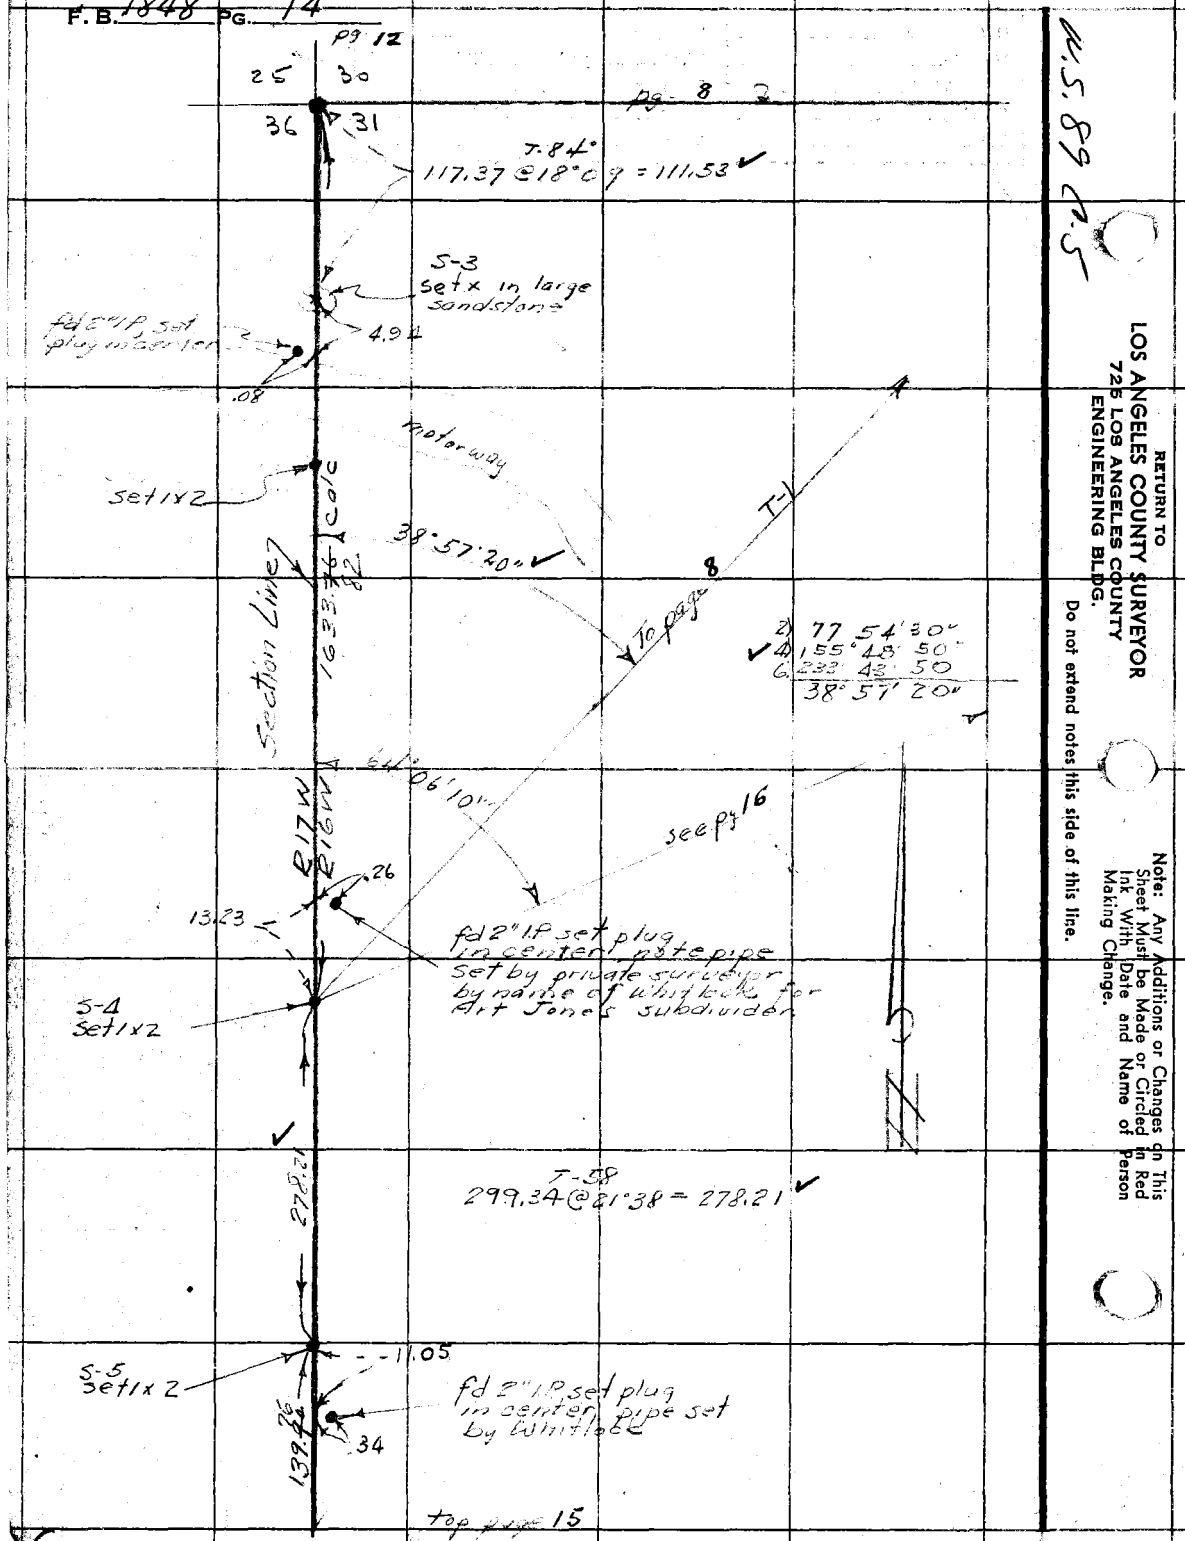

RETURN TO
LOS ANGELES COUNTY SURVEYOR
725 LOS ANGELES COUNTY
ENGINEERING BLDG.

Do not extend notes this side of this line.

Note: Any Additions or Changes on This Sheet Must be Made or Circled in Red Ink With Date and Name of Person Making Change.

W.S. 89 P.S.

Notes Ck'd by KRM
Map No. B-2499
Office Work Green
Checked McPherson

Survey of Los Cunas Beach Pk.
W. O. 868 Tape No. Blue St'd. 74 °F
Surveyed by Diamond S
Notes [illegible] Date 4-54

F. B. 1848 Pg. 15

Note: Any Additions or Changes on This Sheet Must be Made in Red Ink or Circled With Date and Name of Person Making Change.

Do not extend notes this side of this line.

RETURN TO
LOS ANGELES COUNTY SURVEYOR
726 LOS ANGELES COUNTY
ENGINEERING BLDG.

76F3096 247 4-53

S-6 Set 1x2

T.62
150.78 @ 22° 01 = 139.76 ✓

36° 05' ✓

139.23

1782

2) 223° 12' 15"
4) 86° 24 30' ✓
6) 309 36 30
111° 36' 05" ✓

S-7 Set 1x2

T.64
53.70 @ 27° 23 = 47.82 ✓

To R1 page 10

Section Line

113.43 ✓

553.90

T.60
139.53 @ 35° 36 = 113.43 ✓

0.68
1.95

S-8 Set 1x2

fd 2" I.P. set plug set in center pipe set by Art Jones not too accurate

Sec 31
T.15.
R.16 W.

Center Pg 11

RETURN TO
LOS ANGELES COUNTY SURVEYOR
726 LOS ANGELES COUNTY
ENGINEERING BLDG.

Note: Any Additions or Changes on This Sheet Must be Made or Circled In Red Ink With Date and Name of Person Making Change.

Do not extend notes this side of this line.

U.S. 89 A-5

page 8

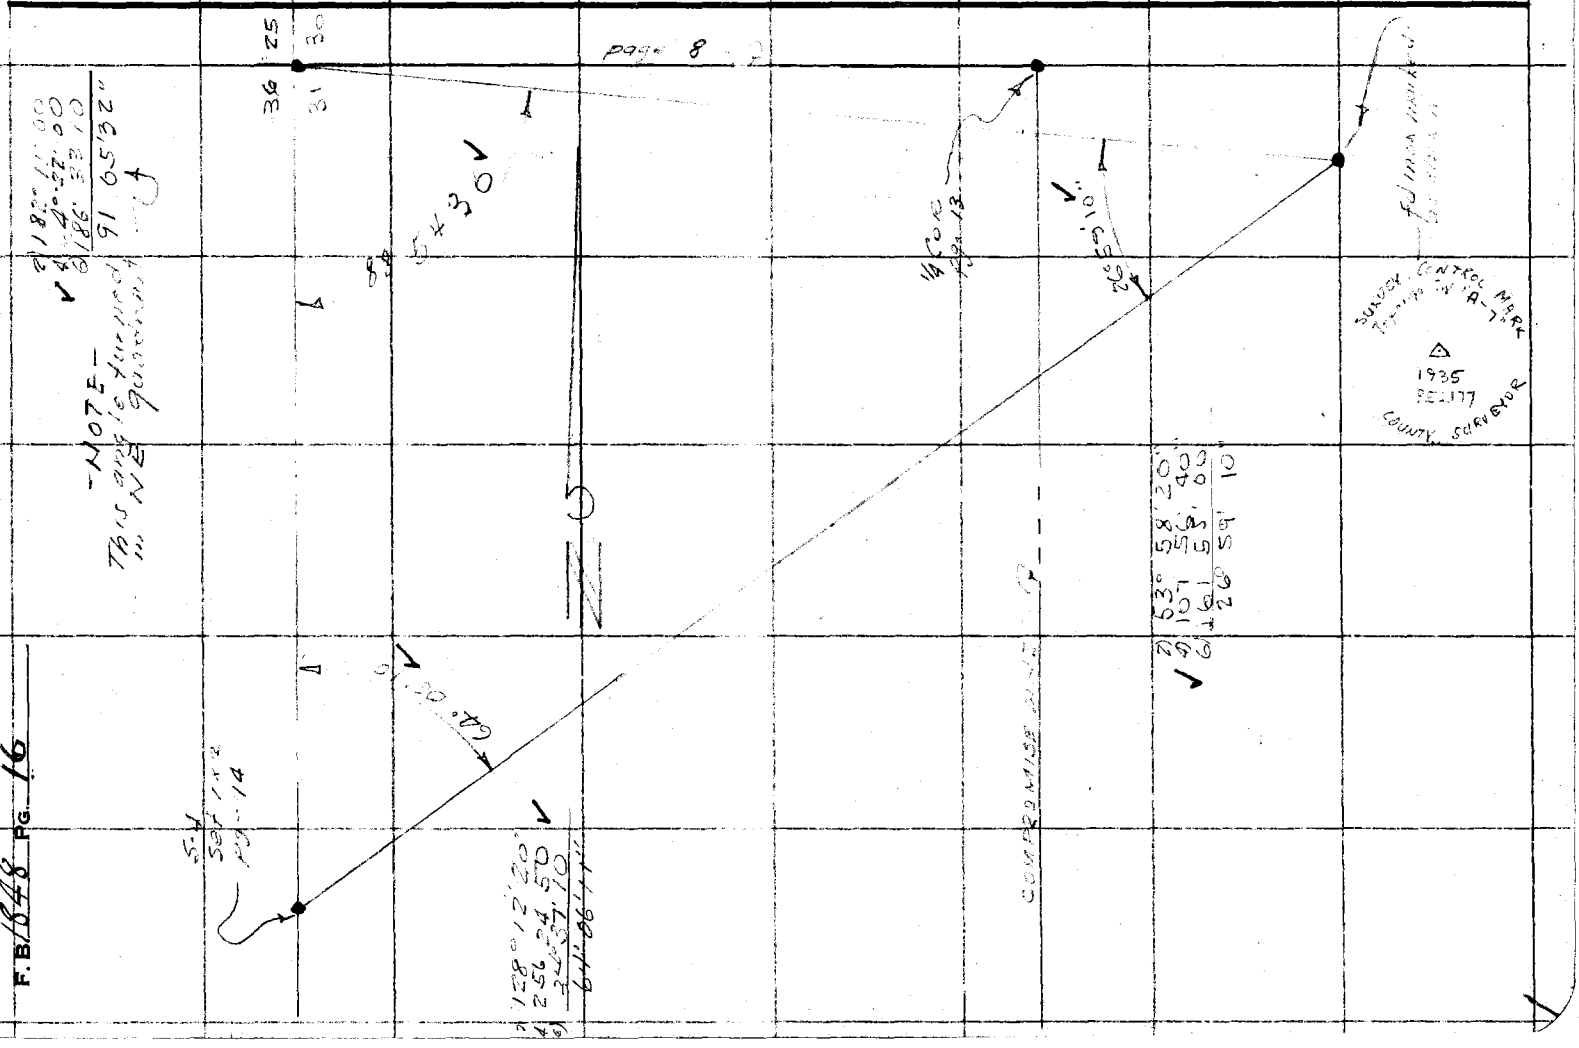
25
30
36
31
SURVEY CONTROL MARK
1935
RE 1177
COUNTY SURVEYOR

Notes Ck'd by		Survey of LAS TUNAS BEACH PARK	F. B. 18-5 Pg. 7
Map No. B-2499		W. O. Tape No. St'd. °F	
Office Work Quan		Surveyed by Blanchard	
Checked McPherson		Notes Blanchard Date 5-4-37	

Note: Any Additions or Changes on This Sheet Must be Made or Circled in Red Ink With Date and Name of Person Making Change.

Do not extend notes this side of this line.

RETURN TO
LOS ANGELES COUNTY SURVEYOR
726 LOS ANGELES COUNTY
ENGINEERING BLDG.

M. S. 89 A-5

76FS098 247 4-53

Centerline of Ocean Ave

Centerline of Seaward Ave

Centerline of Ocean Ave and Seaward Ave have been knocked out.

set sur nail

9.59

Let in headwall

157.21

157.17

Sur. nail & Tin pg 7

5.30 SUR NAIL

4.53 SUR NAIL

1/4 cor per pg 7

compromise cor per pg 7

Storm Drain MH #53-365 in headwall

47.28

set sur nail & Tin by int

2) 175°48' 15"
4) 351 36 30
6) 87 54 37

BC 122+95.73 pg-7

157.17 @ 90°00" = 157.17

47.28 @ 0°00" = 47.28

True line

1' offset

℄ COAST HIGHWAY

Power Pole on line

LAS FLORES L-81A
fd county surveyors mon. in wall per RB. 436-21

1" set sur nail

RETURN TO
LOS ANGELES COUNTY SURVEYOR
726 LOS ANGELES COUNTY
ENGINEERING BLDG.

Note: Any Additions or Changes on This Sheet Must be Made or Circled In Red Ink With Date and Name of Person Making Change.

Do not extend notes this side of this line.

F.B. 1848 PG. 18

1

76L298 307 4-50

PLEASE RETURN TO
LOS ANGELES COUNTY SURVEYOR
726 LOS ANGELES COUNTY ENGINEERING BLDG.

NOTE: ANY ADDITIONS OR CHANGES ON THIS SHEET MUST BE MADE OR CIRCLED IN RED INK, WITH DATE AND NAME OF PERSON MAKING CHANGE.

Do not extend notes this side of this line.

F. B. 1848 Pg. 20 | Job No. 005445 | Division No. 10 | Notes Red. | Plotted | No. | Profile
Survey of LAS TUNAS STATE BEACH | Date | Date | No. | X-Sec.
Survey by L. BERGEN Notes G. HARRIS | Notes Chkd. F.J.S. | Checked
Indexed R. C. JOHNSON | Date | Date 10-14-54 | Date

STATION	B. S.	H. I.	F. S.	ELEV.	LAS TUNAS STATE BEACH
FD B.M.#U.S.2699				28.652	FB B.M.#U.S.2699 P99 - AT TOPANGA BEACH ABT. 0.2 MI. (W) OF THE JUNCT. OF TOPANGA CN. RD. AND THE PACIFIC C. HWY., AT THE S.E. COR. OF THE CONC. BRIDGE OVER TOPANGA CRK. AND IN THE TOP OF THE CURB. A STD. DISK STAMPED "P 99 1932" 1934 ADJ. ELEV. 28.652
	5072	33 724			
T.P.			4235	29 489	BT. SPK. IN PAV.
	6952	36 441			
T.P.			4151	32 290	BT. SPK. IN PAV.
	4940	37 230			
T.P.			5438	31 792	BT. SPK. IN PAV.
	2568	34 360			
T.P.			9595	24 765	BT. SPK. IN PAV.
	3016	27 783			
T.P.			4942	22 841	BT. SPK. IN PAV.
	5975	28 816			
T.P.			4563	24 253	BT. SPK. IN PAV.
	4444	28 697			
T.P.			6218	22 479	BT. SPK. IN PAV.
	3913	26 392			
T.P.			5824	20 568	BT. SPK. IN PAV.
	4206	24 774			

76L298 307 4-50

PLEASE RETURN TO
LOS ANGELES COUNTY SURVEYOR
726 LOS ANGELES COUNTY ENGINEERING BLDG.

NOTE: ANY ADDITIONS OR CHANGES ON THIS SHEET MUST BE MADE OR CIRCLED IN RED INK, WITH DATE AND NAME OF PERSON MAKING CHANGE.

Do not extend notes this side of this line.

Profile No. Notes Red. Plotted
X-Sec. No. Date Date Job No. 20544 5
Notes Chkd. F.S. Checked Survey by L.L.B. Division No. 13
Date 10-14-54 Date Map No. Notes 30 H Date 6-54
F. B. 1344 Pg. 21

STATION	B. S.	H. I.	F. S.	ELEV.	LAS TUNAS BEACH PARK
		24 774			
FD C.S.B.M. 607			6083	18 691	FD C.S.B.M. 607 ELEV. "A" LINE ELEV 18. "B" " " 18. AT MOUTH OF LAS TUNAS CN. TOP, C SOUTH END CONCRETE BRIDGE OVE LAS TUNAS CN. ON COAST HWY. CHI SQ. CHISLED THUS: L.A. □ C.O. L.B.
	5232	23 923			
T.P.			5135	18 788	BT. SPK. IN PAV.
	4512	23 300			
T.P.			4952	18 348	BT. SPK. IN PAV.
	4821	23 172			
T.P.			4663	18 509	BT. SPK. IN PAV.
	5860	24 369			
T.P.			3839	20 530	BT. SPK. IN PAV.
	6302	26 832			
T.P.			4461	22 371	BT. SPK. IN PAV.
	4576	26 947			
T.P.			5982	20 965	BT. SPK. IN PAV.
	3945	24 910			
SET B.M.#			4927	19 983	SET B.M.# ELEV. 19.983 F.B. COAST HWY 0.9 M. (W) OF TOPANGA BT. SPK. SET IN (N) SD. OF P.P.# 61352 ON (S) SD. HWY IN FRONT OF HSE #
	3683	23 666			
SET B.M.#			4551	19 115	SET B.M.# ELEV. 19.115 F.B. (S) SD. COAST HWY 1.0 M. (W) OF TOPA JUNCT. BT. SPK. SET IN GUARD RAIL
+	4150	23 265			OF ENTRANCE TO HSE # 19252

76L298 307 4-50

PLEASE RETURN TO
LOS ANGELES COUNTY SURVEYOR
726 LOS ANGELES COUNTY ENGINEERING BLDG.

NOTE: ANY ADDITIONS OR CHANGES ON THIS SHEET MUST BE MADE OR CIRCLED IN RED INK, WITH DATE AND NAME OF PERSON MAKING CHANGE.

Do not extend notes this side of this line.

F. B. 1848 Pg. 22
Job No. 005445 Division No. 10 Notes Red. Plotted
Survey of LAS TUNAS BEACH PARK Date Date No. Profile
Survey by L. BROWN, Notes G. HARRIS Notes Chkd. 5/15 Checked Date X-Sec.
Indexed C. Johnson Date 10-14-54 Date No.

STATION	B. S.	H. I.	F. S.	ELEV.	LAS TUNAS BEACH PARK
		23 265			
T.P.			2948	20 317	BT SPK IN PAV.
SET B.M.#1	6 608	26 925	2912	24 013	SET B.M.#1 ELEV. 24 013 F.B. (S) SD. COAST HWY 1.1 MI. (W) OF TOPANGA JUNCT. PENA CN. BRIDGE. SET BT. SPK. IN LEAD IN TOP OF WALL 0.5 (E) OF (W) END OF CONC. WALL.
	3588	27 601			
T.P.			5953	21 648	BT. SPK IN PAV.
	4052	25 700			
T.P.			5579	20 121	BT. SPK. IN PAV.
	5038	25 159			
T.P.			4337	20822	BT SPK IN PAV.
	4799	25 621			
SET B.M.#			3655	21 966	SET B.M.# ELEV. 21.966 F.B. (S) SD COAST HWY 0.15 MI. (W) OF PENA CN. BRIDGE. BT. SPK. SET IN (N) SD. P.P.# 1027940 E 30'± (W) OF HSE# 19414
	4587	26 553			
SET T.B.M			3925	22628	SET T.B.M ELEV. 22 628 F.B. (S) SD COAST HWY 0.2 MI. (W) OF PENA PT CN. BRIDGE. BT. SPK. & TN. AT ANGLE PT ON 30' OFFSET LN. (S) OF & COAST HWY.
	5462	28 090			
T.P.			4459	23 631	BT. SPK. IN PAV.
	5747	29 378			

76L298 307 4-50

PLEASE RETURN TO
LOS ANGELES COUNTY SURVEYOR
726 LOS ANGELES COUNTY ENGINEERING BLDG.

NOTE: ANY ADDITIONS OR CHANGES ON THIS SHEET MUST BE MADE OR CIRCLED IN RED INK, WITH DATE AND NAME OF PERSON MAKING CHANGE.

Do not extend notes this side of this line.

Profile No. ____ Notes Red. ____ Plotted ____ Job No. 0051 Division No. 12 F. B. 1918 Pg. 23
X-Sec. No. ____ Date ____ Date ____ Survey dLAS TUNAS BEACH PARK
Notes Chkd. EJS Date 10-14-57 Checked ____ Survey by L.L.B. Notes GOH Date 4-54
Date ____ Map No. ____ Checked ____ Date ____

STATION	B. S.	H. I.	F. S.	ELEV.	LAS TUNAS BEACH PARK
		29378			
SET B.M.# 2			3688	25690	SET B.M.# 2 ELEV. 25.690 F.B. (S) SD. COAST HWY 0.3 MI. (W) OF [illegible] CN. BRIDGE. BRASS CAP C.S. MON. IN WELL - N.W. PROP COR. OF LAS TUNAS BEACH PARK
			RETURN		RUN
B.M.# 2				25690	B.M.# 2 (SEE ABOVE)
	3973	29663			
T.P.			6102	23561	1"x2"
	4235	27796			
SET T.B.M.			3495	24301	SET T.B.M. ELEV. 24.301 F.B. (S) SD. COAST HWY 0.2 MI. (W) OF [illegible] CN. BRIDGE. SET BT. SPK. IN TOP OF R/W MARKER 10± (W) OF HWY STATION MARKER B-113+00
	2274	26575			
T.P.			5162	21413	BT. SPK. IN PAV.
	4689	26102			
T.P.			5503	20599	BT. SPK. IN PAV.
	4518	25117			
T.P.			5579	19538	1"x2"
	5549	25087			

76L298 307 4-50

PLEASE RETURN TO
LOS ANGELES COUNTY SURVEYOR
726 LOS ANGELES COUNTY ENGINEERING BLDG.

NOTE: ANY ADDITIONS OR CHANGES ON THIS SHEET MUST BE MADE OR CIRCLED IN RED INK, WITH DATE AND NAME OF PERSON MAKING CHANGE.

Do not extend notes this side of this line.

F. B. 1848 Pg. 24 Job No. 005145 Division No. 10 Notes Red. Plotted. Profile
Survey of LAS TUNAS BEACH PARK Date. No. X-Sec.
Survey by L. BROWN Notes G. HARRIS Notes Chkd. Checked.
Indexed K. C. Johnson Date. Date. 10/4/54 No.

STATION	B. S.	H. I.	F. S.	ELEV.	LAS TUNAS BEACH PARK
		25 087'			
T.P.			3620	21 467'	BT. SPK IN POST
	6139	27 606'			
T.P.			4627	22979'	BT. SPK. IN PAV.
	4168	27 147'			
T.P.			6418	20 729'	BT. SPK. IN PAV.
	2763	23 492'			
T.P.			5182	18 310'	BT. SPK. IN PAV.
	5331	23 641'			
T.P.			4468	19 173'	BT. SPK. IN PAV.
	5672	24 845'			
SET B.M.#			3804	21 041'	SET B.M.# ELEV. 21.041 F.B. (S) SD. COAST HWY 0.2 MI. (E) OF PENA CN. BRIDGE. SET BT. SPK. IN (N) SD. P.P.# 770783E IN FRONT HSE.# 19206
	5837	26 878'			
T.P.			4547	22 331'	BT. SPK. IN PAV.
	4654	26 985'			
T.P.			6234	20 751'	BT. SPK. IN PAV.
	3726	24 477'			
T.P.			5883	18 594'	BT. SPK. IN PAV.
	4680	23 274'			

X.

76L298 307 4-50

PLEASE RETURN TO
LOS ANGELES COUNTY SURVEYOR
726 LOS ANGELES COUNTY ENGINEERING BLDG.

NOTE: ANY ADDITIONS OR CHANGES ON THIS SHEET MUST BE MADE OR CIRCLED IN RED INK, WITH DATE AND NAME OF PERSON MAKING CHANGE.

Do not extend notes this side of this line.

STATION	B. S.	H. I.	F. S.	ELEV.	LAS TUNAS BEACH PARK
		23 274			
T.P.			4898	18 376	BT. SPK. IN PAV.
	5129	23 505			
T.P.			4646	18 859	BT. SPK. IN PAV.
	5245	24 104			
T.P.			4802	19 302	BT. SPK. IN PAV.
	5193	24 495			
T.P.			3984	20 511	BT. SPK. IN PAV.
	5724	26 235			
T.P.			4150	22 085	BT. SPK. IN PAV.
	6197	28 282			
T.P.			4082	24 200	BT. SPK. IN PAV.
	4934	29 134			
T.P.			5462	23 672	BT. SPK. IN PAV.
	4299	27 971			
T.P.			5000	22 971	BT. SPK. IN PAV.
	6910	29 881			
T.P.			1569	28 312	BT. SPK. IN PAV.
	7564	35 876			
T.P.			3488	32.388	BT. SPK. IN PAV.
	5528	37 916			

Profile Notes Red Plotted Job No. 2351.43 Division No. 10 F. B. 1913 Pg. 22
No. Date Date Survey of LAS TUNAS BEACH PARK
X-Sec. Notes Chkd. Checked Survey by L. L. B. Notes 6-14 Date 6-54
No. Date 10-14-54 Date Map No. Inked Date

761.298 307 4-50

PLEASE RETURN TO
LOS ANGELES COUNTY SURVEYOR
726 LOS ANGELES COUNTY ENGINEERING BLDG.

NOTE: ANY ADDITIONS OR CHANGES ON THIS SHEET MUST BE MADE OR CIRCLED IN RED INK, WITH DATE AND NAME OF PERSON MAKING CHANGE.

Do not extend notes this side of this line.

F. B. 1848 Pg. 26 | Job No. 0054.45 | Division No. 10 | Notes Red. | Plotted | Profile
Survey of LAS TUNAS BEACH PARK | Date | No.
Survey by L. BROWN Notes G. HARRIS | Notes Chkd. KM | Checked | X-Sec.
Indexed J. C. Johnson Date | Date 10-14-54 | Date | No.

STATION	B. S.	H. I.	F. S.	ELEV.	LAS TUNAS BEACH PARK
		37 916			
T.P.			5299	32617	BT SPK IN PAV
FD.	3249	35 866			FD.
B.M. TCC-8-A			7165	28 701	B.M. T.C.C.-8A ELEV. 28.587 CITY F.B. 22106 (S) SD COAST HWY. 103.02 (W.) FROM L&T IN C8. (S) SD. TOPANGA CN. BRIDGE 10.5 (S) FROM (S) EDGE OF ASPHALT PAVEMENT. L. A. CO. TRAV. DISK. T.C.C.-8-A. ELEV. M.S.L. 28.587. 3.5 E'LY FROM N'LY PROLONGATION OF (E) SD. OF A 1-STORY STUCCO CAFE BLDG. AND IN A WELL CUT THRU ROADWAY.
FD.	5199	33 900			
U.S.B.M. 2699			5252	28 648 652	FD. U.S.B.M. 2699 ELEV. 28.652 F.B. (FOR DESCRIPTION SEE PG 20 OF THESE NOTES)

99-20

Notes Ck'd by Miller
Map No. 99-20
Office Work S. SHINODA
Checked
Date

Survey of Big Rock Drive
JN 0074.00 Tape Std °F
Surveyed by Unarriet
Notes Date
Indexed

F. B. 1848 Pg. 31

Note: Any Additions or Changes on This Sheet Must be Made in Red Ink or Circled With Date and Name of Person Making Change.

Do not extend notes this side of this line.

RETURN TO
LOS ANGELES COUNTY ENGINEER
700 LOS ANGELES COUNTY ENGINEERING BLDG.

BIG ROCK DRIVE
J.N.0074.00
AUG., 1958

Ref: Tract 13562
R.S. 66-2

Unarriet
Strader
Vaga
Duran

8-15-58
English
Londa
Garrison
Tolle
Tuxford

76F3095 CE #247—3-57

RETURN TO
LOS ANGELES COUNTY ENGINEER
700 LOS ANGELES COUNTY ENGINEERING BLDG.

Note: Any Additions or Changes on This Sheet Must be Made or Circled in Red Ink With Date and Name of Person Making Change.

Do not extend notes this side of this line.

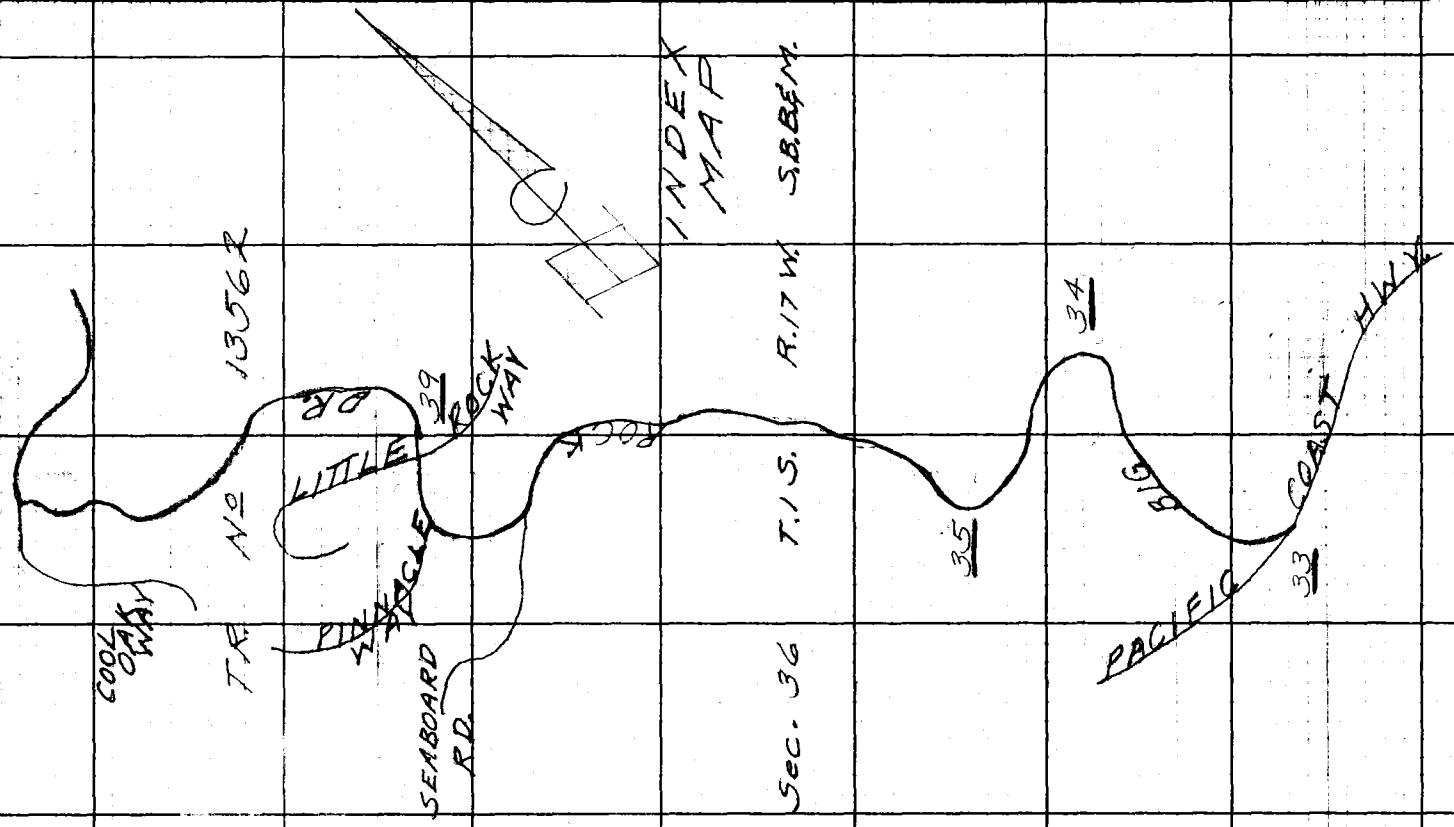

F.B. 1848 Pg. 32

Notes Ck'd by	Survey of Big Rock Drive
Map No. 99-20	JN0074-02 Tape ____ Std ____ °F
Office Work S. SHINODA	Surveyed by Chainmen
Ck'd	Notes ____ Date ____
Date	Indexed

F. B. 1848 PG. 33

Note: Any Additions or Changes on This Sheet Must be Made or Circled in Red Ink With Date and Name of Person Making Change.

Do not extend this side of this line.

PLEASE RETURN TO
LOS ANGELES COUNTY ENGINEER
700 LOS ANGELES COUNTY ENGINEERING BLDG.

U.S. 89 CAL

Ctr. Ln. pg. 35

P.I. #12
Fd. Spk. & W., 3' dn.
Hwy. F.B. A 92-001-14
F.B. 1320-57

B.C.
Fd. Spk. & W., 3' dn.
Hwy. F.B. A 92-001-14
F.B. 1320-57

E.C.
Fd. Spk. & W., 3' dn.
Hwy. F.B. A 92-001-13
F.B. 1320-56

194.67

(80)

(80)

1.02

96°43'

181.82

20.00
0+00 going N'thly
Set B.T. Spk. & Tin

2) 264°27'15"
4) 165°54'30"
132°13'37"

132°

88+70.06

13' 27"

8.24

2) 280°29'30"
4) 200°59'15"
140°14'49"

140°14'49"

PACIFIC COAST HWY.

2) 259°45'15"
4) 219°30'45"
144°52'41"

144°52'41"

1+42.8
P.I. #1
Set N. & T.

104.4

30°

110°

TRANSIT LINE
303.0

0+00 going
Set N. & T.

2+47.2
P.I. #2
Set N. & T.

2.43
1.00
1.43
} @ 2°15' = 142.8

11.43
10.00
1.43
} @ 1°30' = 142.9

} = 142.8

4.06
1.00
3.06
} @ 5°52' = 302.8

11.06
8.00
3.06
} @ 5°35' = 303.1

} = 303.0

2.05
1.00
1.05
} @ 5°09' = 104.2

12.05
11.00
1.05
} @ 3°42' = 104.6

} = 104.4

F. B. 1848 Pg. 34

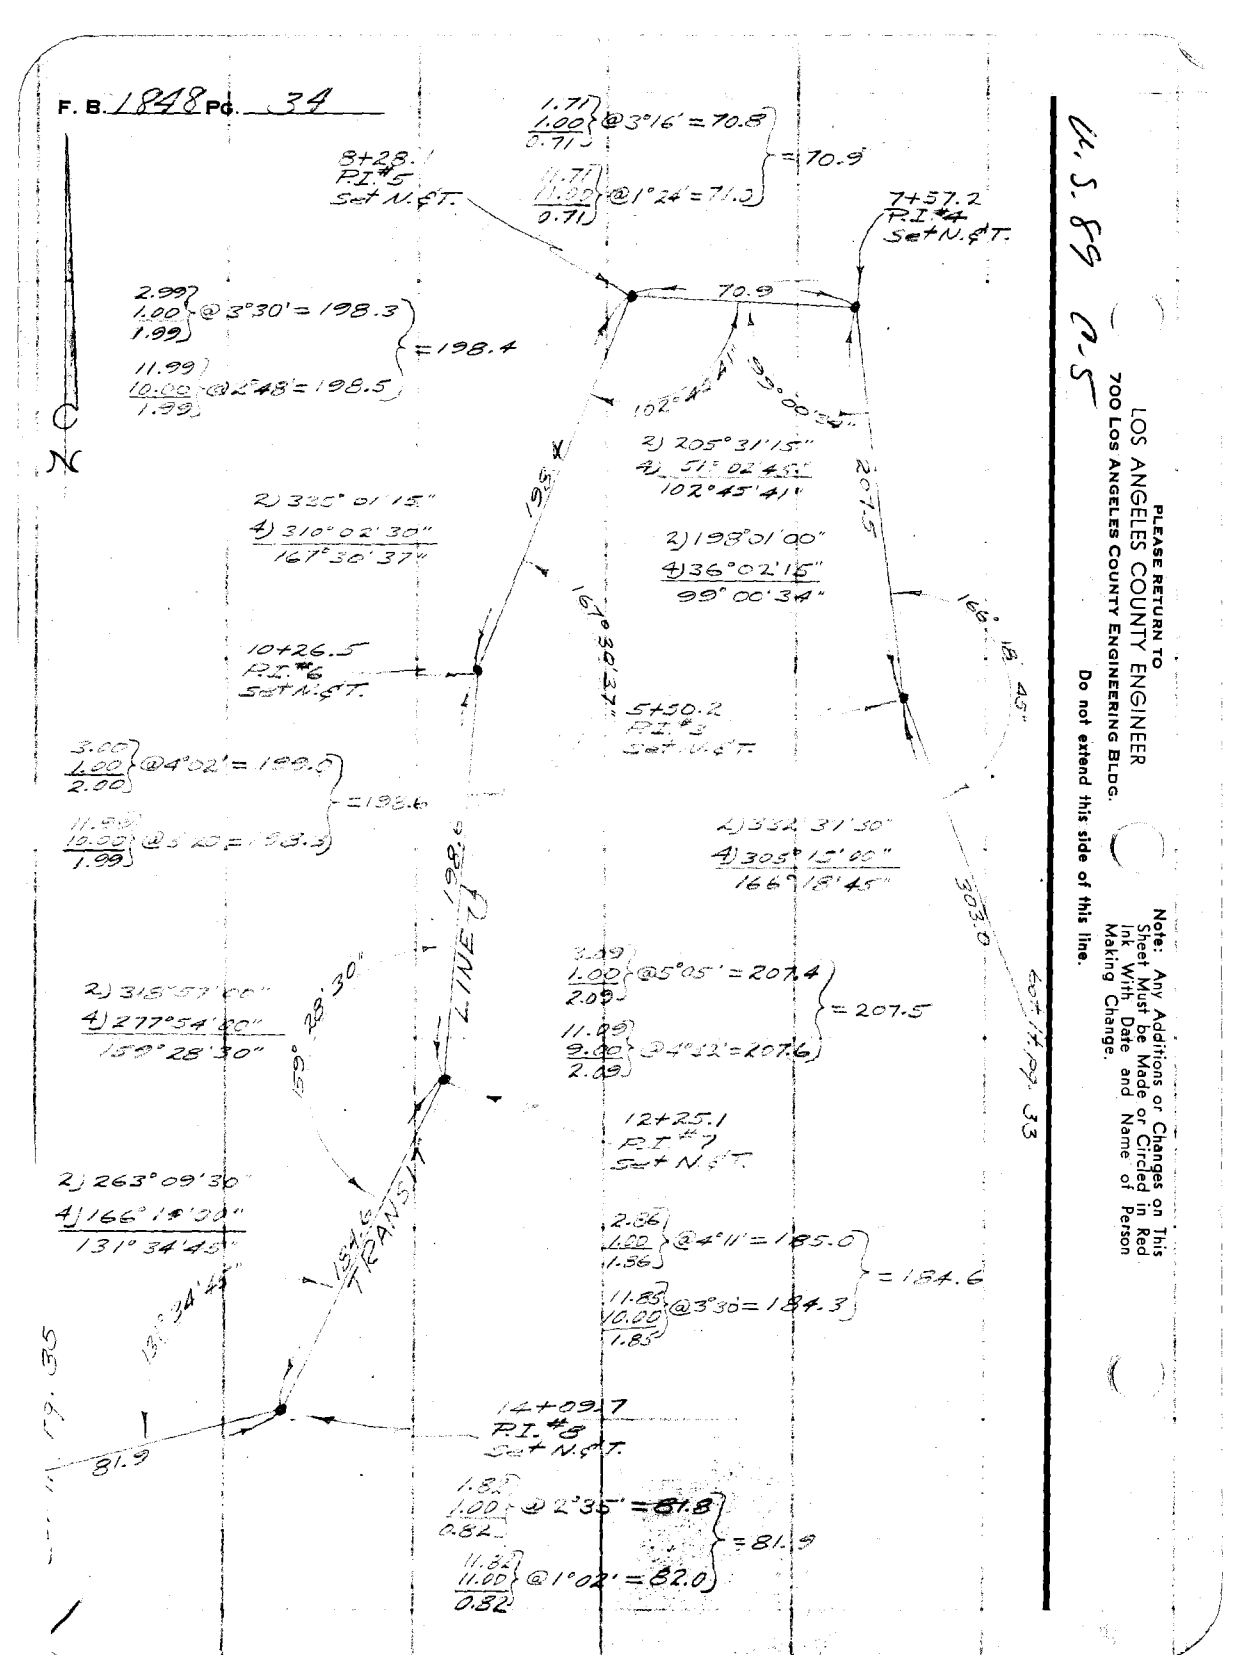

U. S. 89 - 05

PLEASE RETURN TO
LOS ANGELES COUNTY ENGINEER
700 Los Angeles County Engineering Bldg.

Do not extend this side of this line.

Note: Any Additions or Changes on This Sheet Must be Made or Circled in Red Ink With Date and Name of Person Making Change.

Notes Ck'd by	Survey of Big Rock Drive
Map No. 19-30	JN [illegible] Tape Std °F
Office Work S. SHINODA	Surveyed by Chevrier
Checked	Notes [illegible] Date [illegible]

F. B. 1848 PG. 35

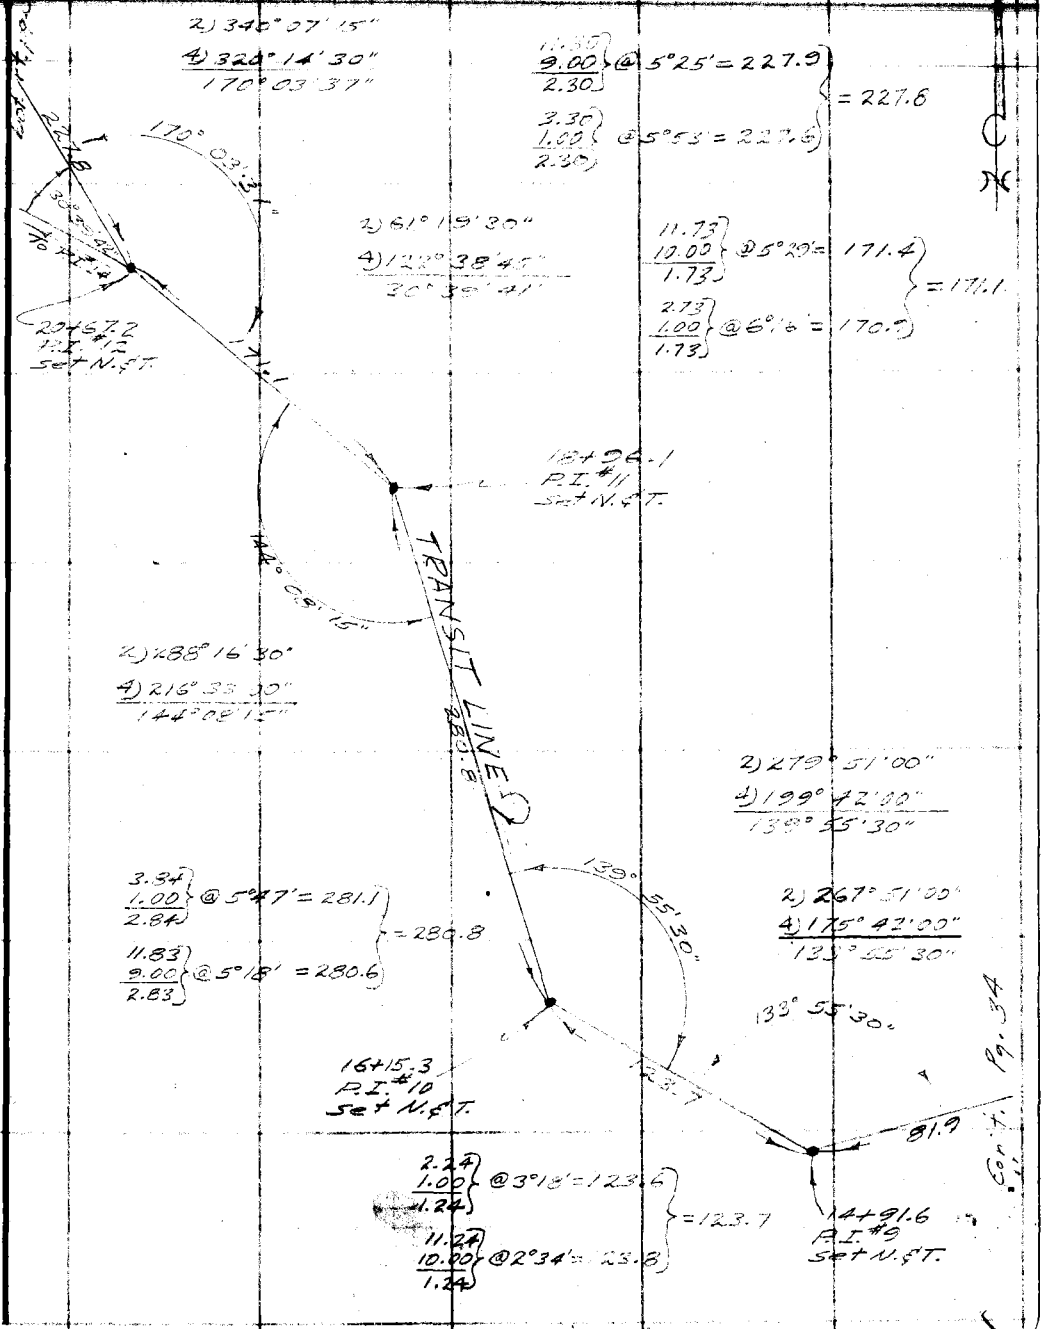

Note: Any Additions or Changes on This Sheet Must be Made or Circled in Red Ink With Date and Name of Person Making Change.

Do not extend this side of this line.

PLEASE RETURN TO
LOS ANGELES COUNTY ENGINEER
700 LOS ANGELES COUNTY ENGINEERING BLDG.

W.S. 69 C-5

76F3095 S&E #247 1.56

F. B. 1848 Pg. 36

PLEASE RETURN TO
LOS ANGELES COUNTY ENGINEER
700 Los Angeles County Engineering Bldg.

Note: Any Additions or Changes on This Sheet Must be Made or Circled in Red Ink With Date and Name of Person Making Change.

Do not extend this side of this line.

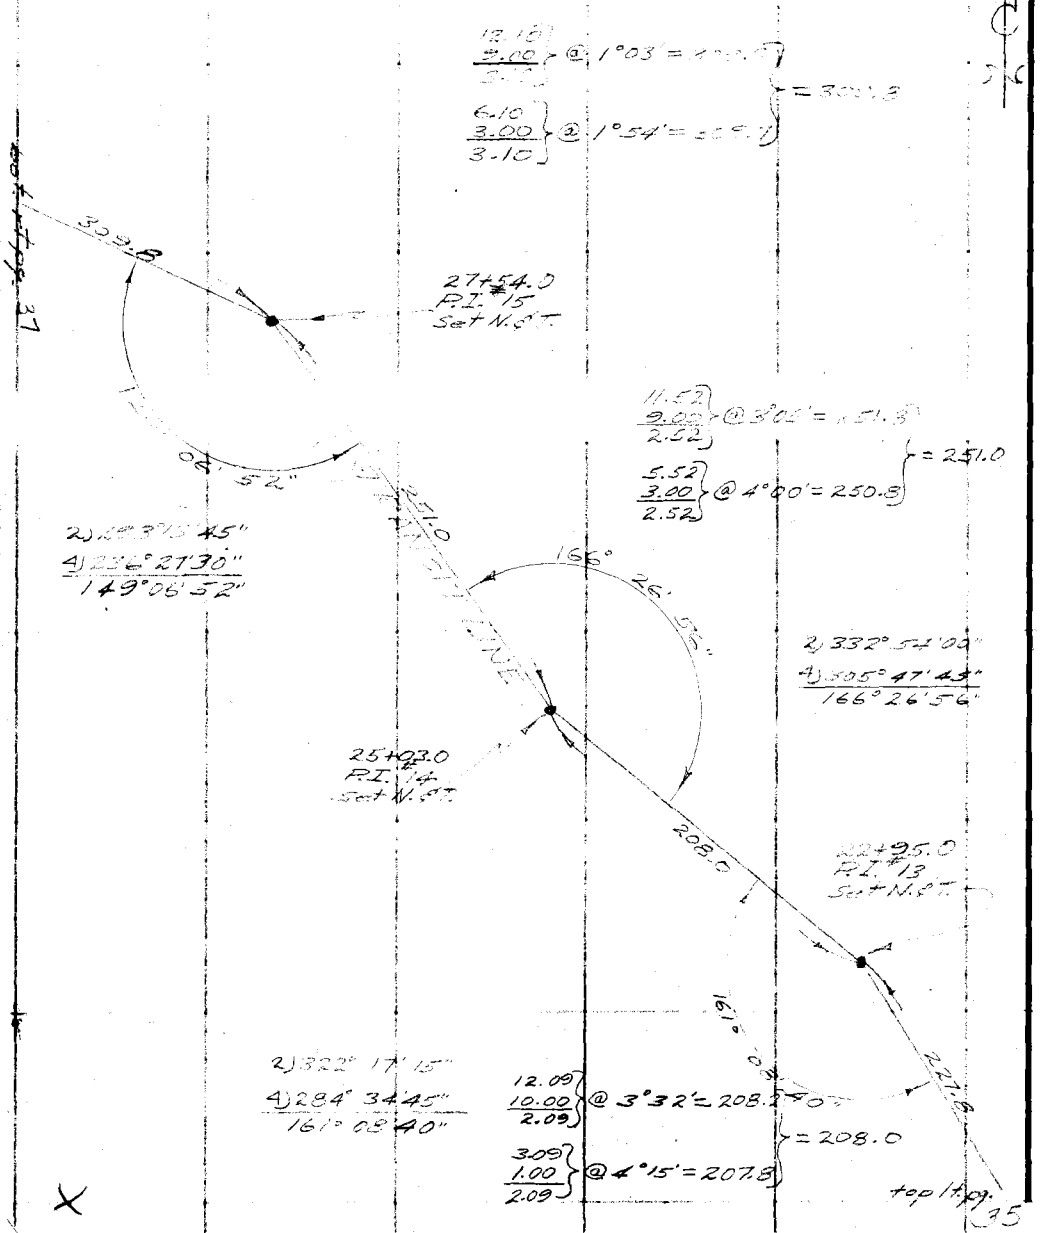

Notes Ck'd by
Map No. 91-20
Office Work S. SHINODA
Checked
Date

Survey of Big Rock Drive
JN 10241.00 Tape Std °F
Surveyed by Charriet
Notes Charriet Date 7-31-58
Indexed

F. B. 1898 Pg. 37

Note: Any Additions or Changes on This Sheet Must be Made or Circled in Red Ink With Date and Name of Person Making Change.

Do not extend notes this side of this line.

RETURN TO
LOS ANGELES COUNTY ENGINEER
700 Los Angeles County Engineering Bldg.

W.S. 89 C-5

76F3098 CE #247—3-57

2) 315° 48' 15"
4) 271° 36' 45"
157° 54' 11"

36+42.1
P.I. #19
Set N.&T.

3.39
1.00
2.39
@ 5°06' = 237.1

11.39
9.00
2.39
@ 4°42' = 237.4

= 237.2

Sta. 38

237.2

12.14
10.00
2.14
@ 4°14' = 212.8

3.14
1.00
2.14
@ 4°56' = 212.4

= 212.6

157° 54' 11"

212.6

34+02.5
P.I. #18
Set N.&T.

158° 07' 11"

TRANSIT LINE

187.0

2) 316° 14' 15"
4) 272° 28' 45"
158° 07' 11"

11.88
10.00
1.88
@ 3°38 = 197.2

= 187.0

2.88
1.00
1.88
@ 4°20' = 186.9

2) 330° 22' 00"
4) 300° 43' 45"
165° 10' 56"

165° 10' 56"

32+22.5
P.I. #17
Set N.&T.

156° 05' 07"

158.7

30+63.8
P.I. #16
Set N.&T.

309.8

2.59
1.00
1.59
@ 2°42' = 158.6

11.59
10.00
1.59
@ 1°57 = 158.8

= 158.7

2) 312° 10' 15"
4) 264° 25' 30"
156° 05' 07"

RETURN TO
LOS ANGELES COUNTY ENGINEER
700 LOS ANGELES COUNTY ENGINEERING BLDG.

Note: Any Additions or Changes on This Sheet Must be Made or Circled in Red Ink With Date and Name of Person Making Change.

Do not extend notes this side of this line.

U.S. 89 C-5

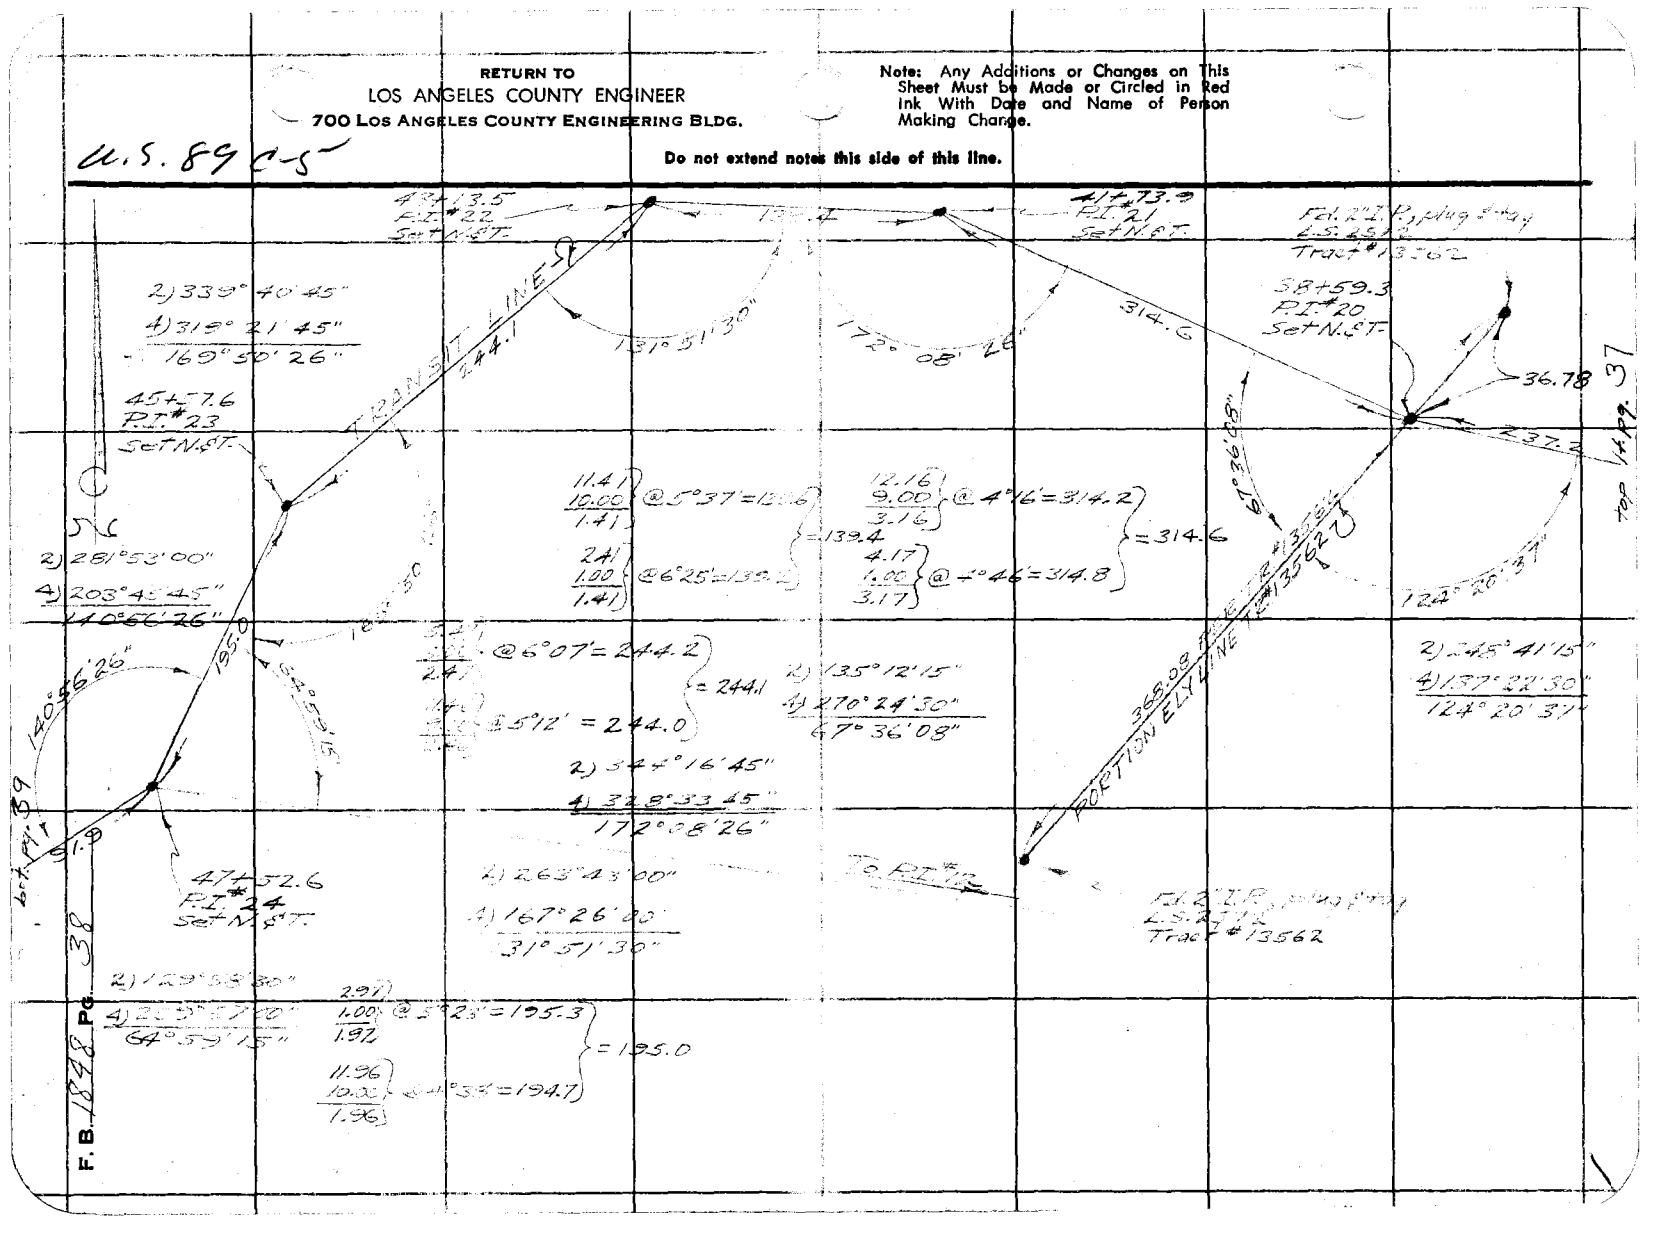

Notes Ck'd by _____
Map No. 94-20
Office Work S. SHINODA
Checked _____

JN _____ Tape _____ Std _____ °F
Surveyed by _____
Notes _____ Date 8-7-56
C. Johnson

F. B. 1898 PG. 39

Note: Any Additions or Changes on This Sheet Must be Made or Circled in Red Ink With Date and Name of Person Making Change.

PLEASE RETURN TO
LOS ANGELES COUNTY ENGINEER
700 Los Angeles County Engineering Bldg.

Do not extend this side of this line.

76F309S SAE #247 1-56

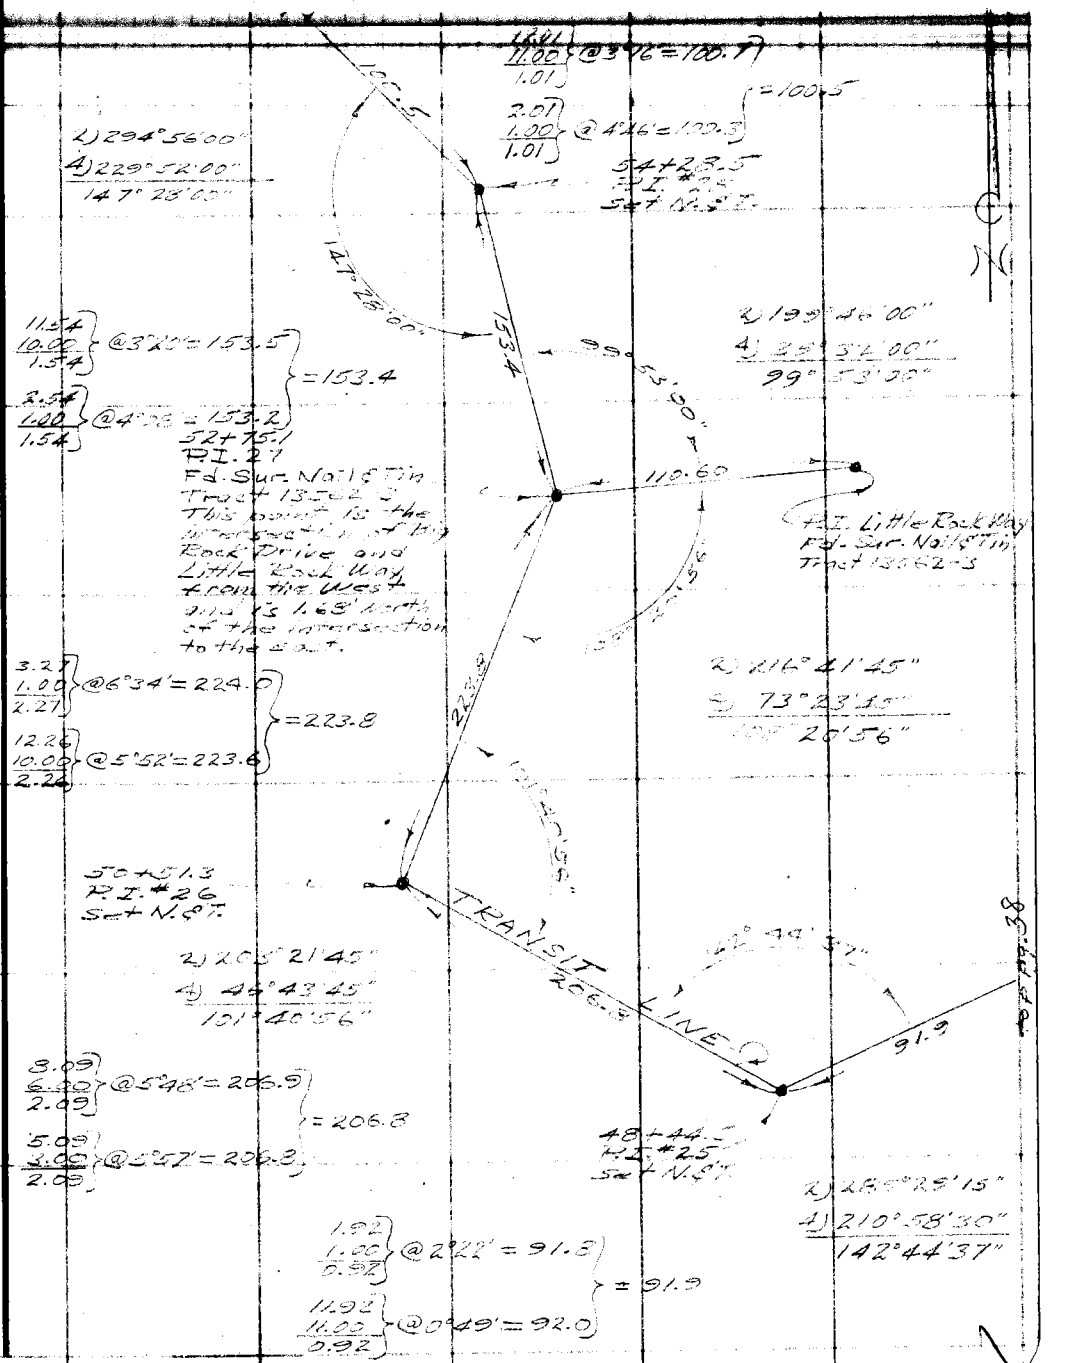

PLEASE RETURN TO
LOS ANGELES COUNTY ENGINEER
700 LOS ANGELES COUNTY ENGINEERING BLDG.
Do not extend this side of this line.

Note: Any Additions or Changes on This Sheet Must be Made or Circled in Red Ink With Date and Name of Person Making Change.

Bot Pg. 41

U.S. 59 & S

142° 25' 30"

2) 284° 51' 22"
4) 209° 42' 00"
142° 25' 30"

61+87.5
P.I. #32
Set N.G.T.

199.1

5.91
3.00
1.91
4.92
3.00
1.92
@ 6°43' = 183.4
=183.1

59+98.4
P.I. #31
Set N.G.T.

141° 14' 37"

4) 282° 29' 25"
4) 204° 44' 30"
141° 14' 37"

TRANSIT

2855.0

1.55
9.00
2.59
@ 7°03' = 255.0
5.60
3.00
2.60
@ 8°05' = 254.9
=255.0

161° 53' 04"

57+43.4
P.I. #30
Set N.G.T.

2) 345° 46' 00"
4) 237° 32' 15"
161° 53' 04"

214.4

11.17
9.00
2.17
@ 6°14' = 214.7
=214.4
5.18
3.00
2.18
@ 7°16' = 214.5

55+29.0
P.I. #29
Set N.G.T.

145°

2) 296° 08' 45"
4) 232° 07' 30"
148° 04' 22"

100.

top Pg. 39

Notes Ck'd by
Map No. 99.2a
Office Work S. SHINODA
Checked
Date

Survey of Big Rock Drive
JN 00174 Tape Std °F
Surveyed by CHANNEL
Notes CHANNEL Date
Indexed

F. B. 1848 Pg. 41

Note: Any Additions or Changes on This Sheet Must be Made or Circled in Red Ink With Date and Name of Person Making Change.

Do not extend notes this side of this line.

RETURN TO
LOS ANGELES COUNTY ENGINEER
700 LOS ANGELES COUNTY ENGINEERING BLDG.

15-5

U.S. 89

76F309S CE #247—3.57

152' @ 8°14' = 148.9

2.43 / 1.00 / 1.43 } @ 7°47' = 140.4
11.42 / 10.00 / 1.42 } @ 6°47' = 140.0
} = 140.2

2) 157°20'00"
4) 129°20'00"

11.97 / 9.00 / 2.97 } @ 5°06' = 293.8
3.97 / 1.00 / 2.97 } @ 6°28' = 293.2
} = 293.5

66+93.2
P.I. #34
5 ± N 5° E

153.2

Big Rock Dr.
50.56
Lot pg. 42

68+46.4
P.I. #35
Fd. spike &
Tin. in
Tract 13562-5

136° 55' 19"

2) 273°50'30"
4) 187°41'15"
136°55'19"

63+99.7
P.I. #33
Fd. 9x4 N. & T.
Tract 13562-5

TRANSIT LINE

293.5

14.14 / 10.00 / 2.14 } @ 4°24' = 212.5
3.14 / 1.00 / 2.14 } @ 5°30' = 212.0
} = 212.2

2) 269°13'00"
4) 178°38'00"
134°39'30"

134°39'30"

212.2

top pg. 40

RETURN TO
LOS ANGELES COUNTY ENGINEER
700 LOS ANGELES COUNTY ENGINEERING BLDG.

Note: Any Additions or Changes on This Sheet Must be Made or Circled in Red Ink With Date and Name of Person Making Change.

Do not extend notes this side of this line.

A.S. 89 B-5

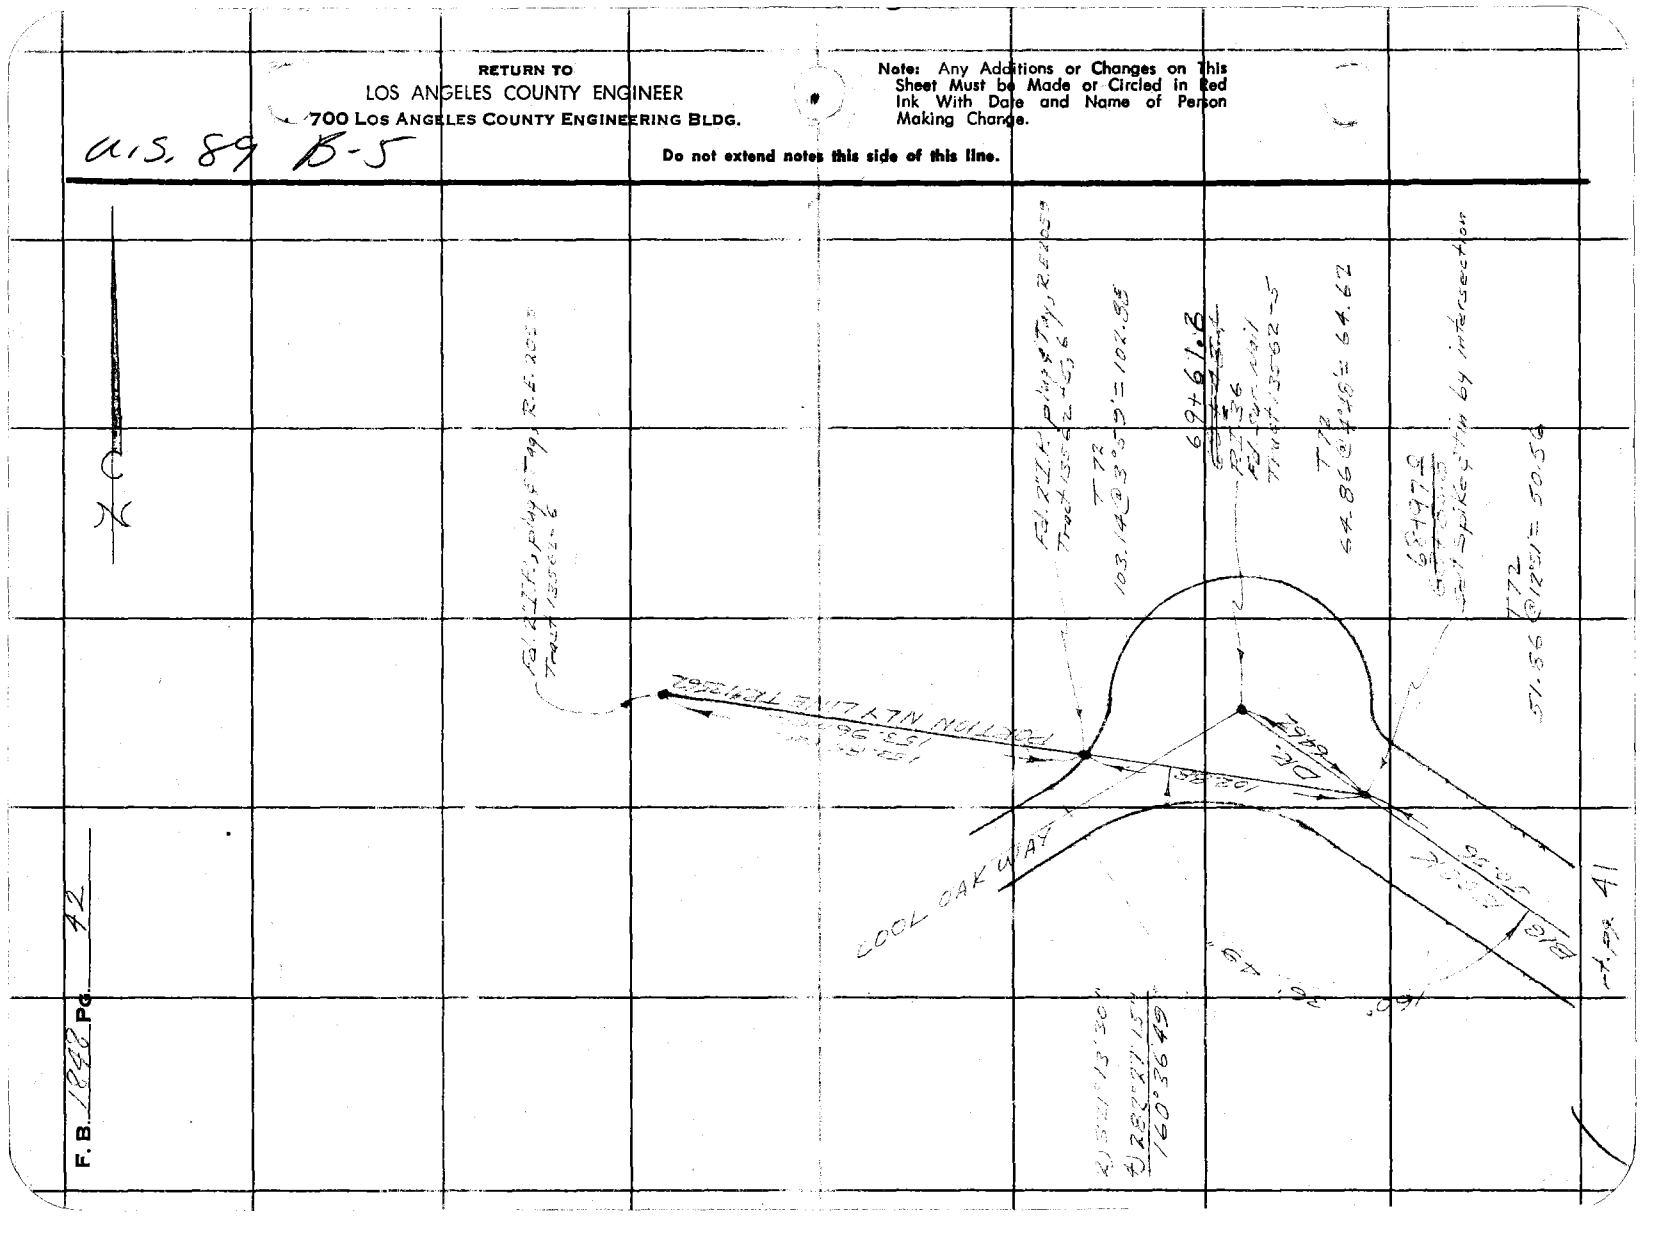

Notes Ck'd by
Map No. 74-23
Office Work S. SHINODA
Checked
Date

Survey of Big Rock Drive
JN Tape Std °F
Surveyed by
Notes C. Johnson
Date
Indexed

F. B. 1848 Pg. 43

RETURN TO
LOS ANGELES COUNTY ENGINEER
700 Los Angeles County Engineering Bldg.

Note: Any Additions or Changes on This Sheet Must be Made in Red Ink or Circled With Date and Name of Person Making Change.

Do not extend notes this side of this line.

76F3099 CE #247—3-57

RETURN TO
LOS ANGELES COUNTY ENGINEER
700 LOS ANGELES COUNTY ENGINEERING BLDG.

Note: Any Additions or Changes on This Sheet Must be Made or Circled in Red Ink With Date and Name of Person Making Change.

Do not extend notes this side of this line.

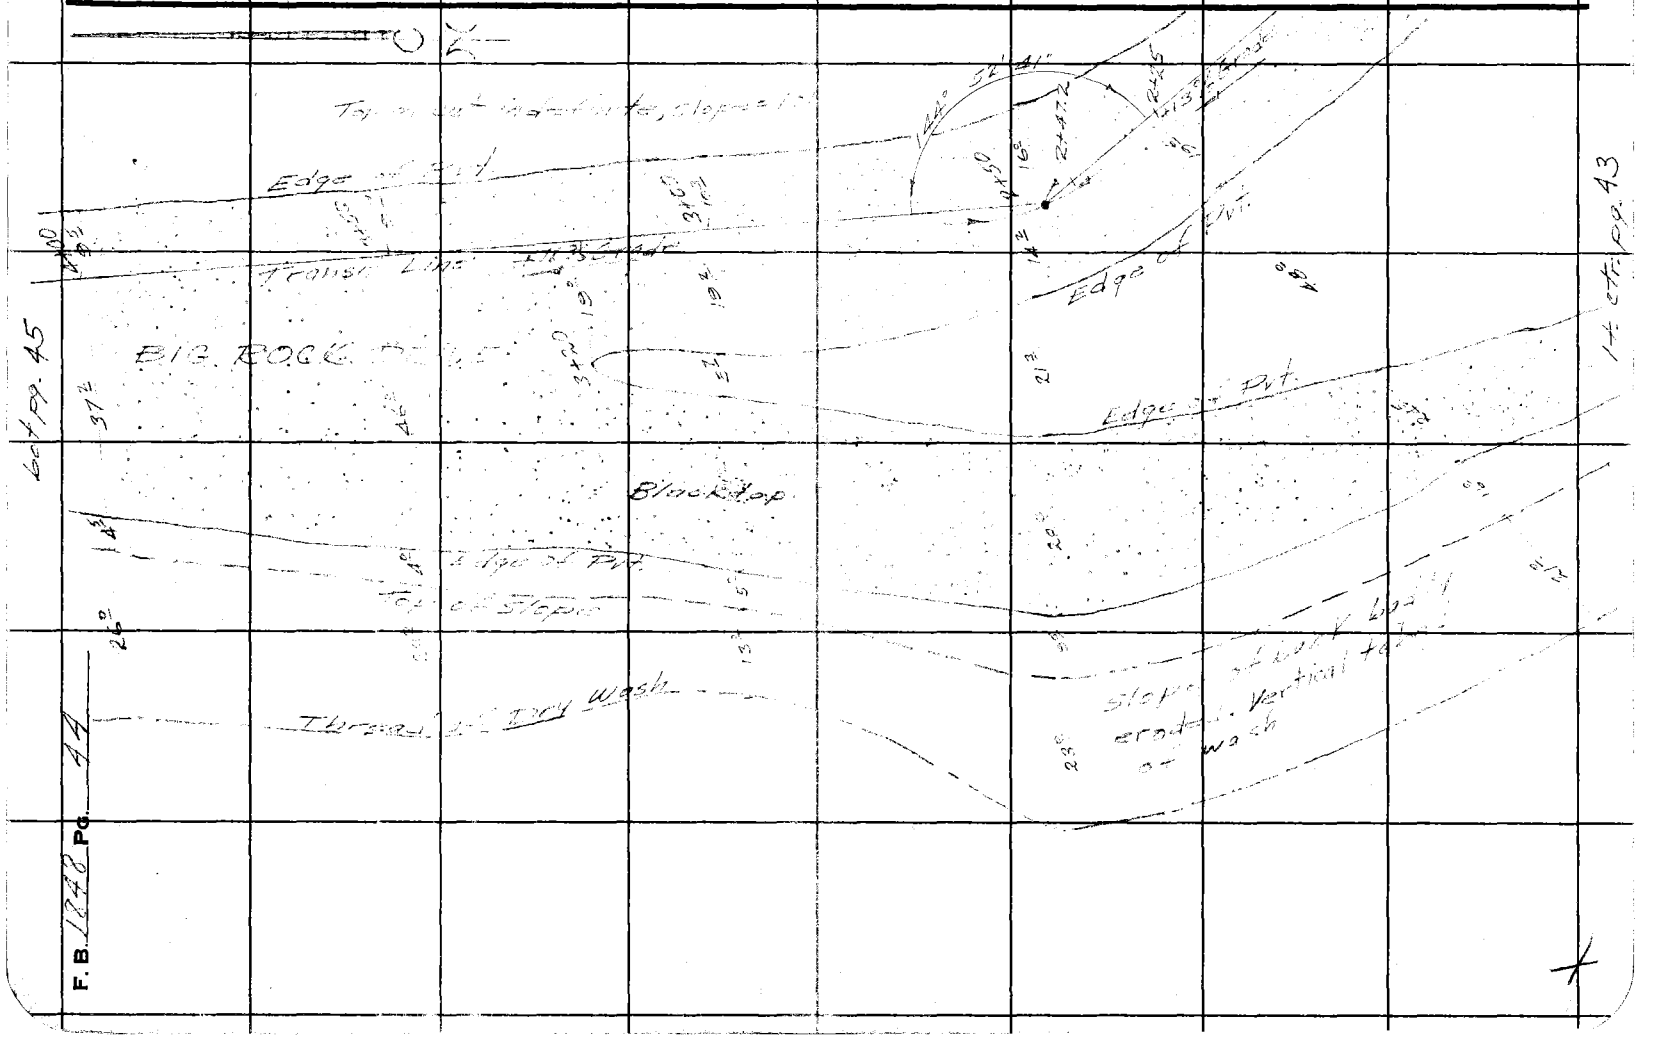

76F309S CE #247—3-57

RETURN TO
LOS ANGELES COUNTY ENGINEER
700 LOS ANGELES COUNTY ENGINEERING BLDG.

Note: Any Additions or Changes on This Sheet Must be Made or Circled In Red Ink With Date and Name of Person Making Change.

Do not extend notes this side of this line.

Notes Ck'd by
Map No. 77-20
Office Work S. SHINODA
Checked
Date

Survey of Big Rock Drive
JN
Surveyed by
Notes
Tape Std. °F
Date

F. B. 184 PG. 45

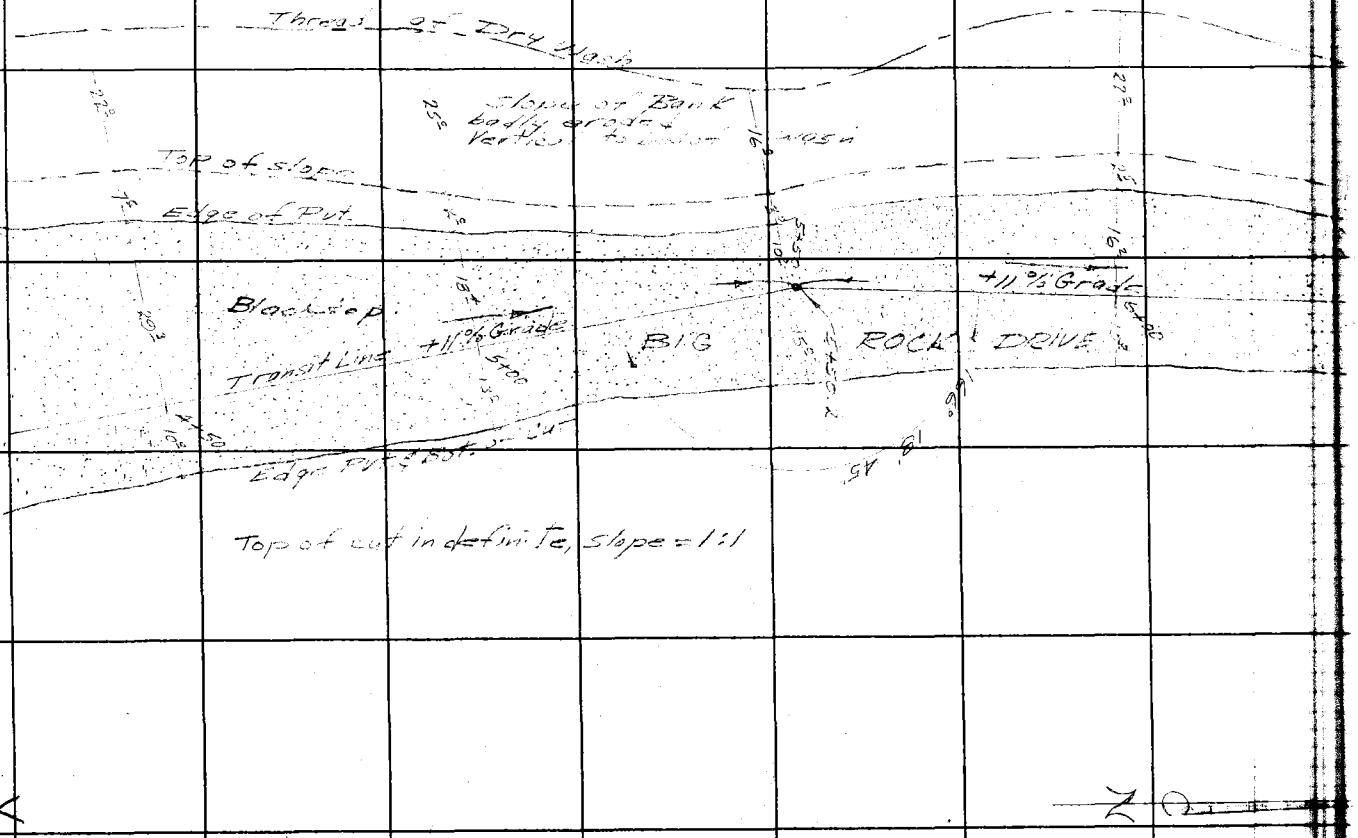

RETURN TO
LOS ANGELES COUNTY ENGINEER
700 LOS ANGELES COUNTY ENGINEERING BLDG.

Note: Any Additions or Changes on This Sheet Must be Made or Circled in Red Ink With Date and Name of Person Making Change.

Do not extend notes this side of this line.

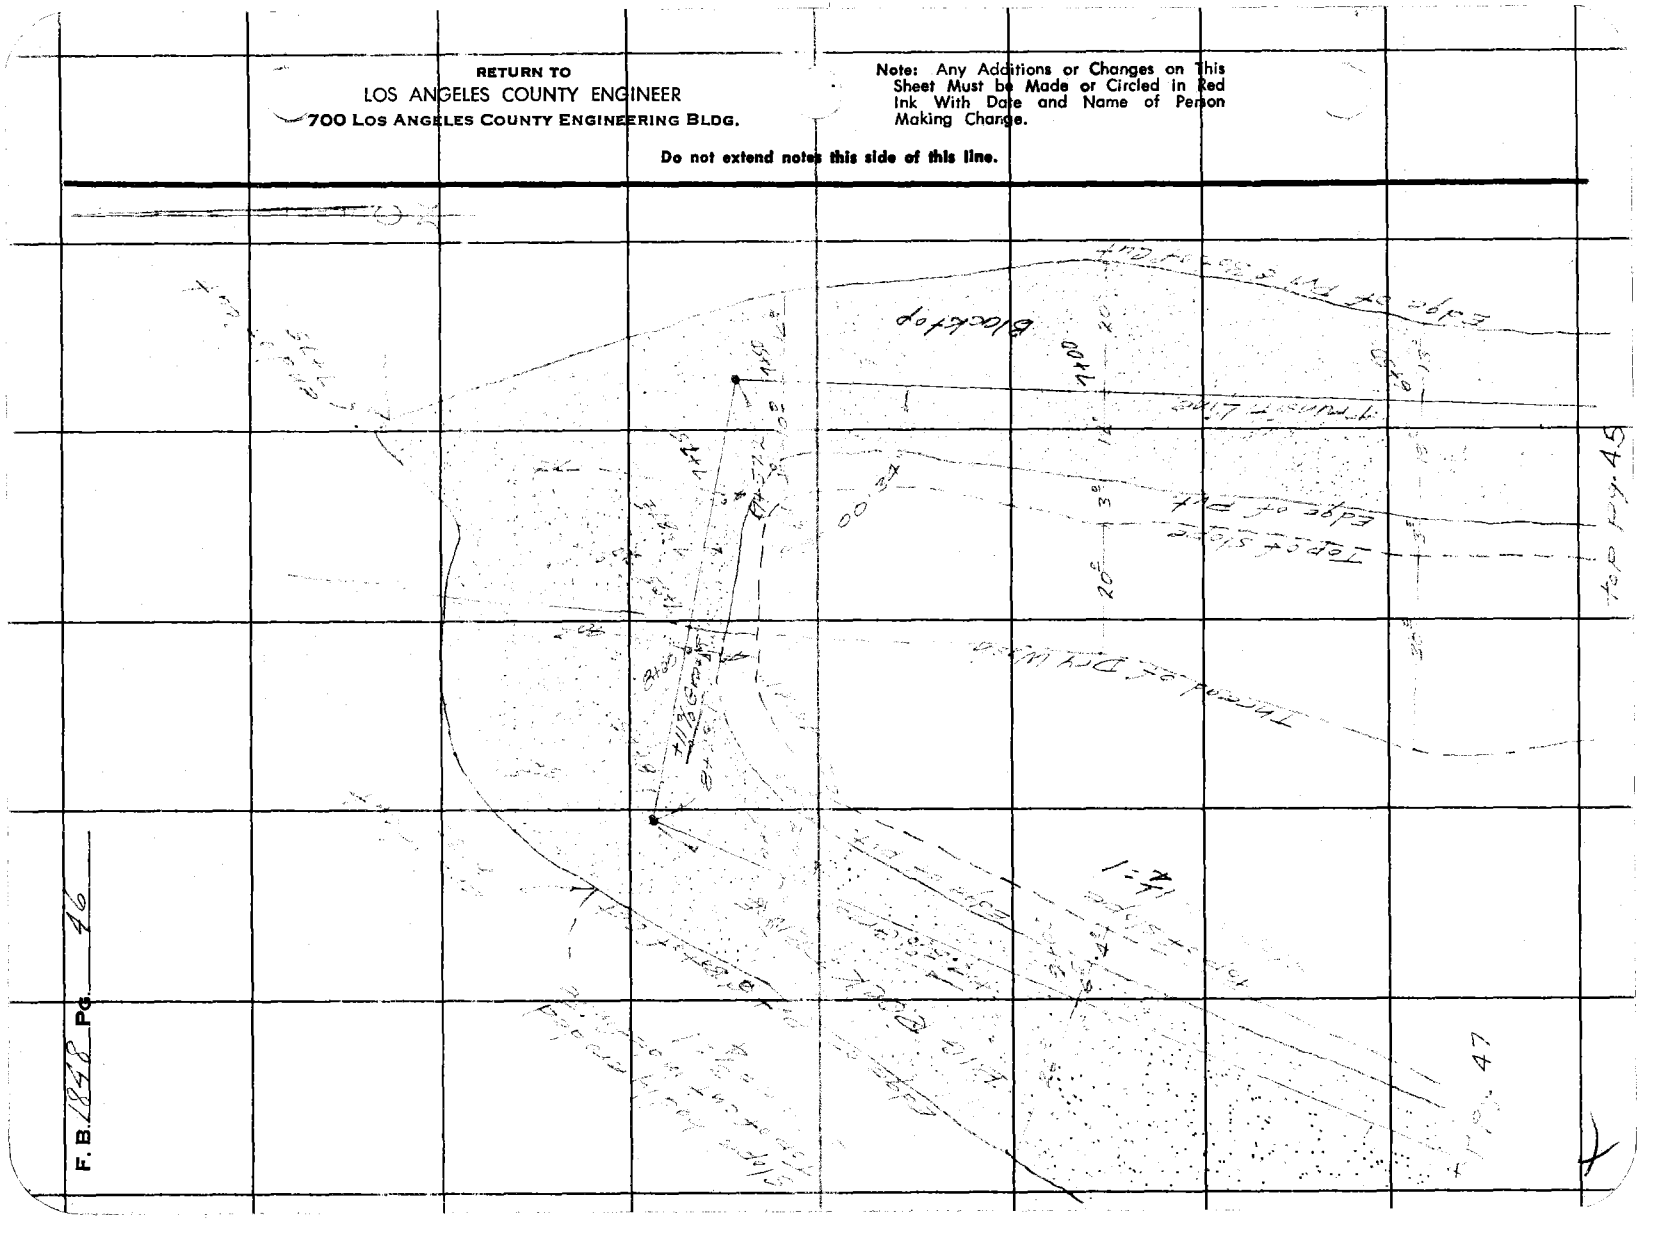
Block 70
Edge of Pvt.
Top of slope
Edge of Pvt.
Top of slope
Edge of Pvt.
Top of slope

Notes Ck'd by
Map No. 99-20
Office Work S. SHINODA
Checked

Survey of
JN Tape Std °F
Surveyed by
Notes Date

F. B. 1848 Pg. 47
Ext. to 48

Note: Any Additions or Changes on This Sheet Must be Made or Circled in Red Ink With Date and Name of Person Making Change.

Do not extend this side of this line.

PLEASE RETURN TO
LOS ANGELES COUNTY ENGINEER
700 LOS ANGELES COUNTY ENGINEERING BLDG.

76F3095 S&E #247 1-56

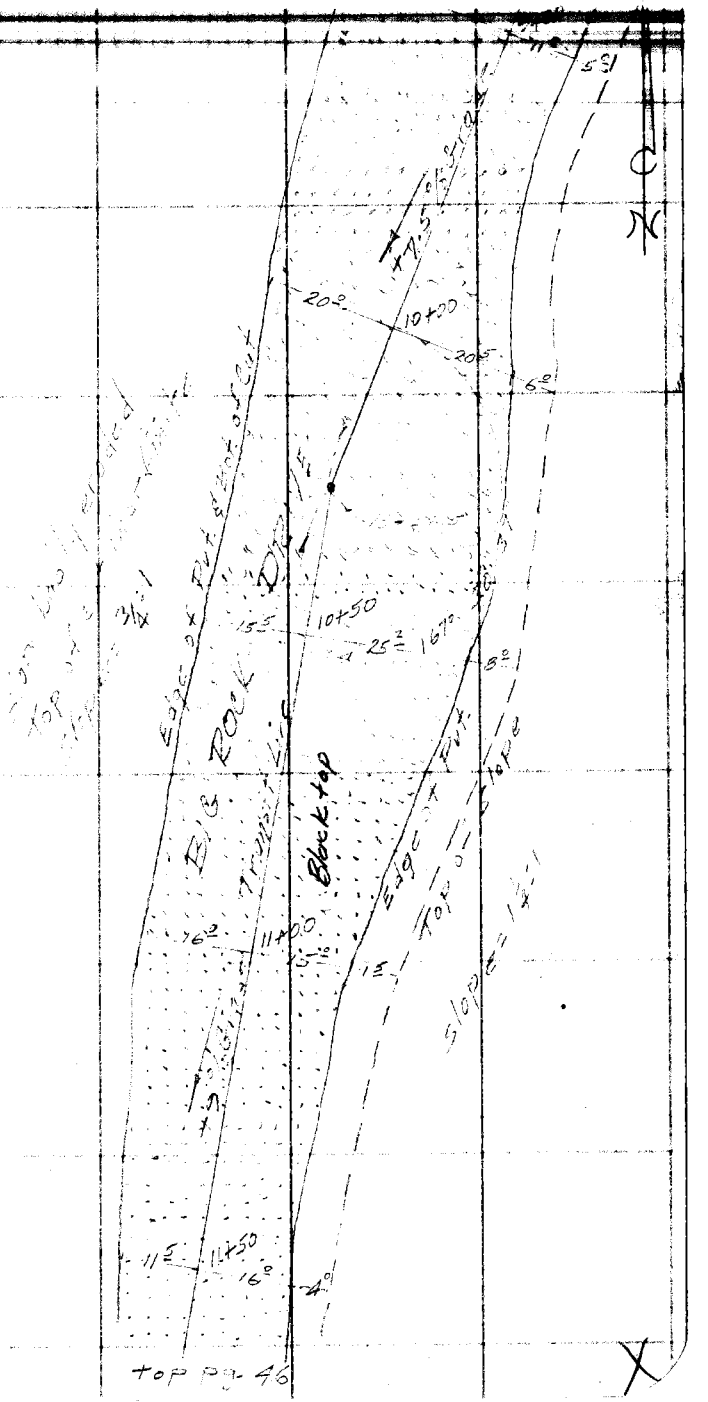

PLEASE RETURN TO
LOS ANGELES COUNTY ENGINEER
700 LOS ANGELES COUNTY ENGINEERING BLDG.

Note: Any Additions or Changes on This Sheet Must be Made or Circled in Red Ink With Date and Name of Person Making Change.

Do not extend this side of this line.

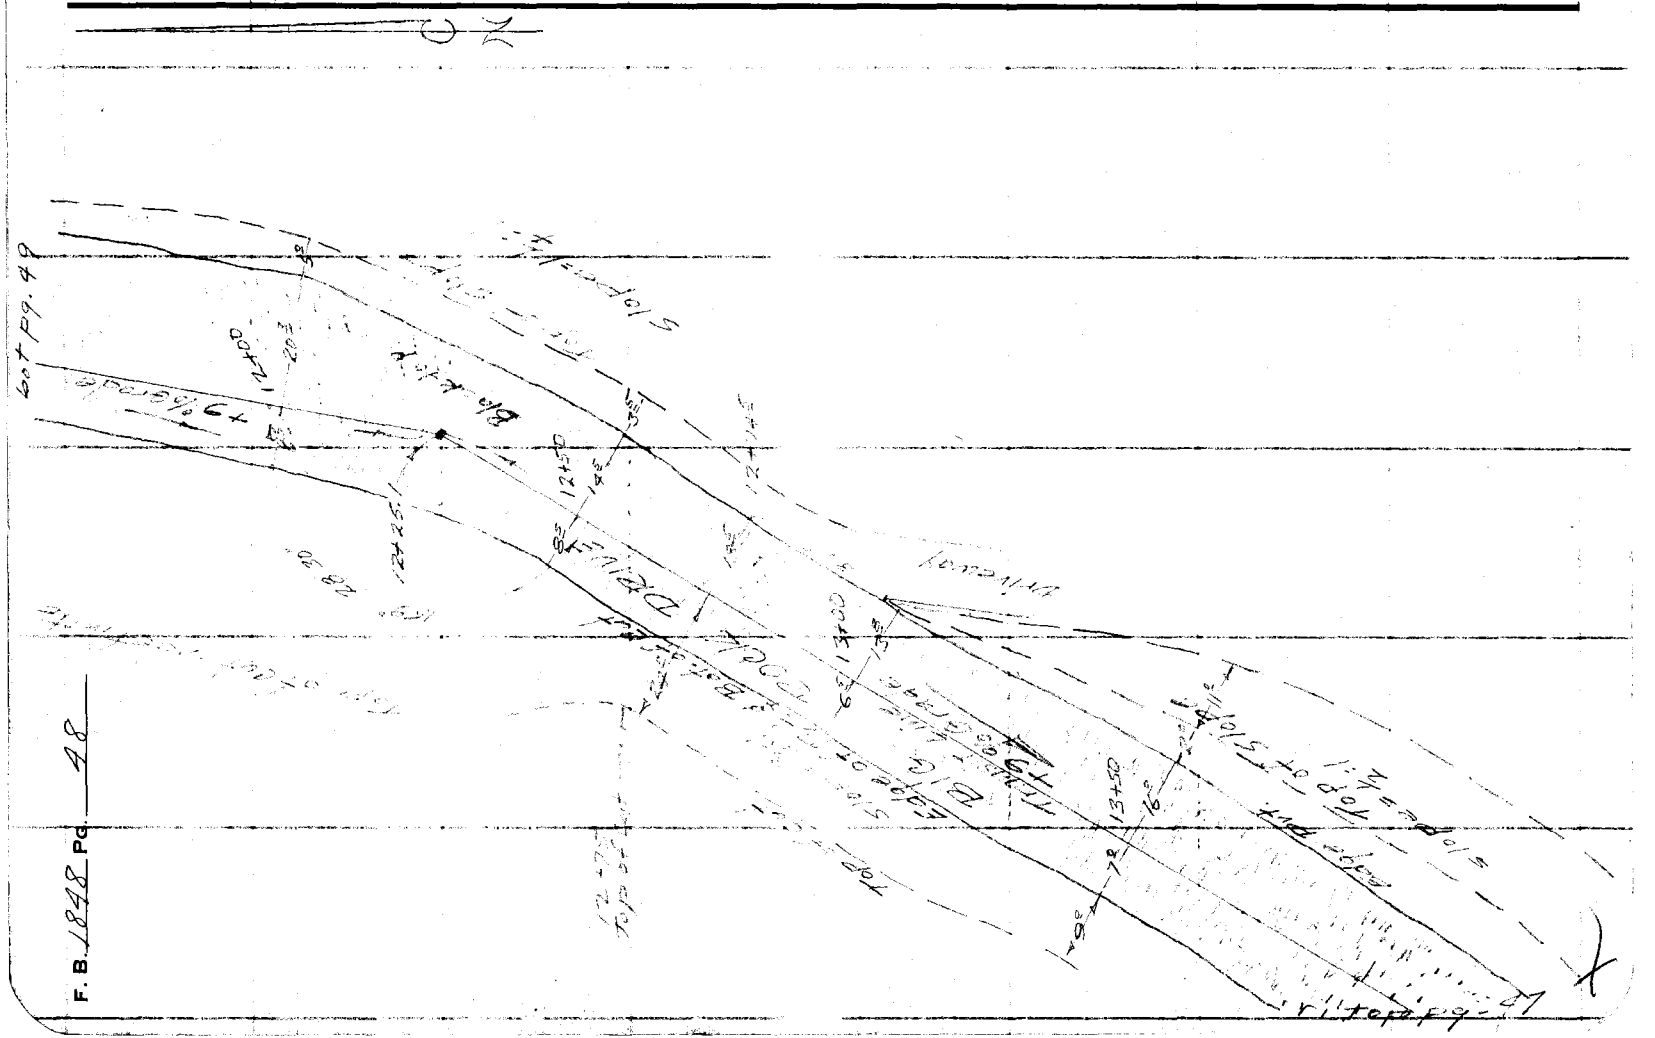

F. B. 1848 Pg. 48

Notes Ck'd by _____
Map No. 99-20
Office Work S. SHINODA
Checked _____

Survey of Big Rock Drive
JN 60480 Tape _____ Std _____ °F
Surveyed by _____
Notes _____ Date _____

F. B. 1848 Pg. 49
Surv. Sty. 50

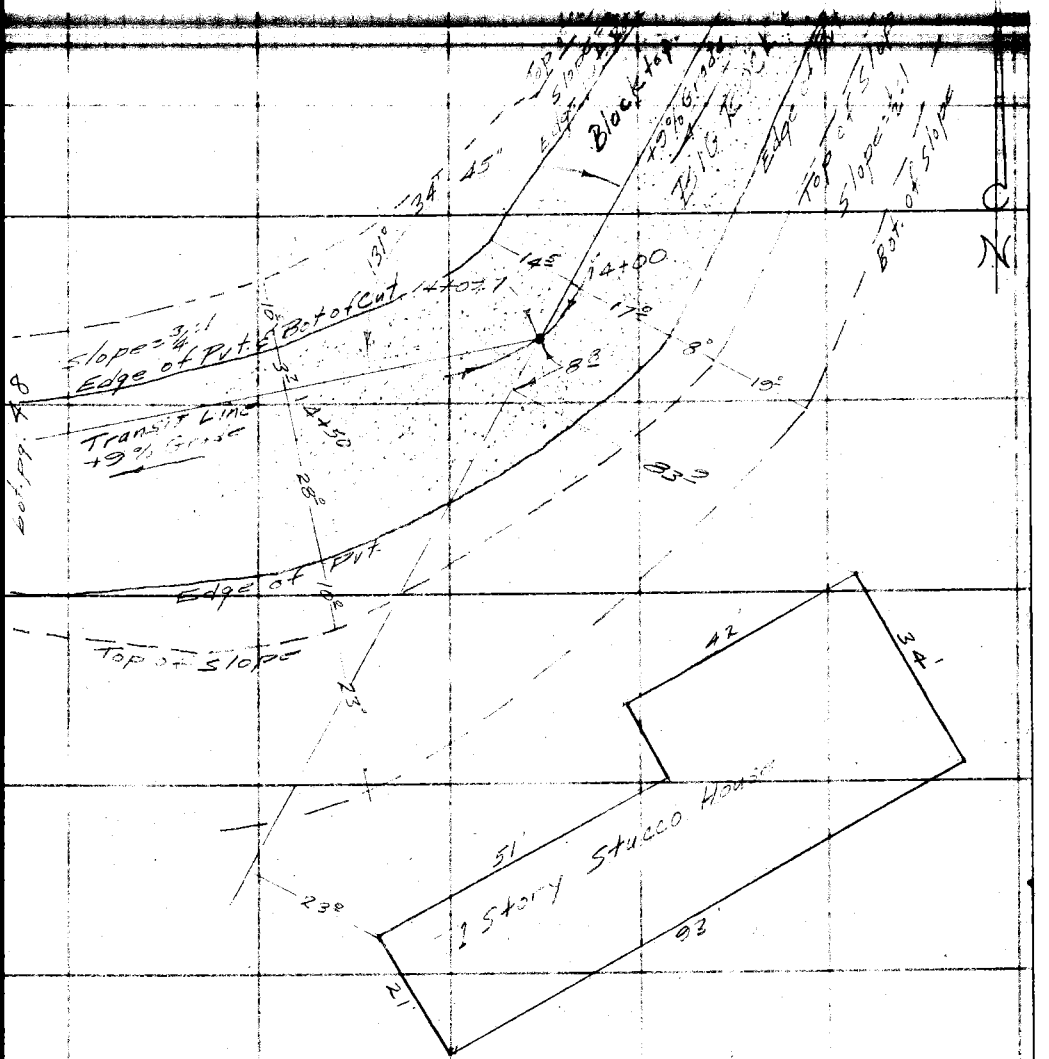

Note: Any Additions or Changes on this Sheet Must be Made or Circled in Red Ink With Date and Name of Person Making Change.

Do not extend this side of this line.

PLEASE RETURN TO
LOS ANGELES COUNTY ENGINEER
700 LOS ANGELES COUNTY ENGINEERING BLDG.

76F309S SAE #247 1-56

PLEASE RETURN TO
LOS ANGELES COUNTY ENGINEER
700 LOS ANGELES COUNTY ENGINEERING BLDG.

Note: Any Additions or Changes on This Sheet Must be Made or Circled in Red Ink With Date and Name of Person Making Change.

Do not extend this side of this line.

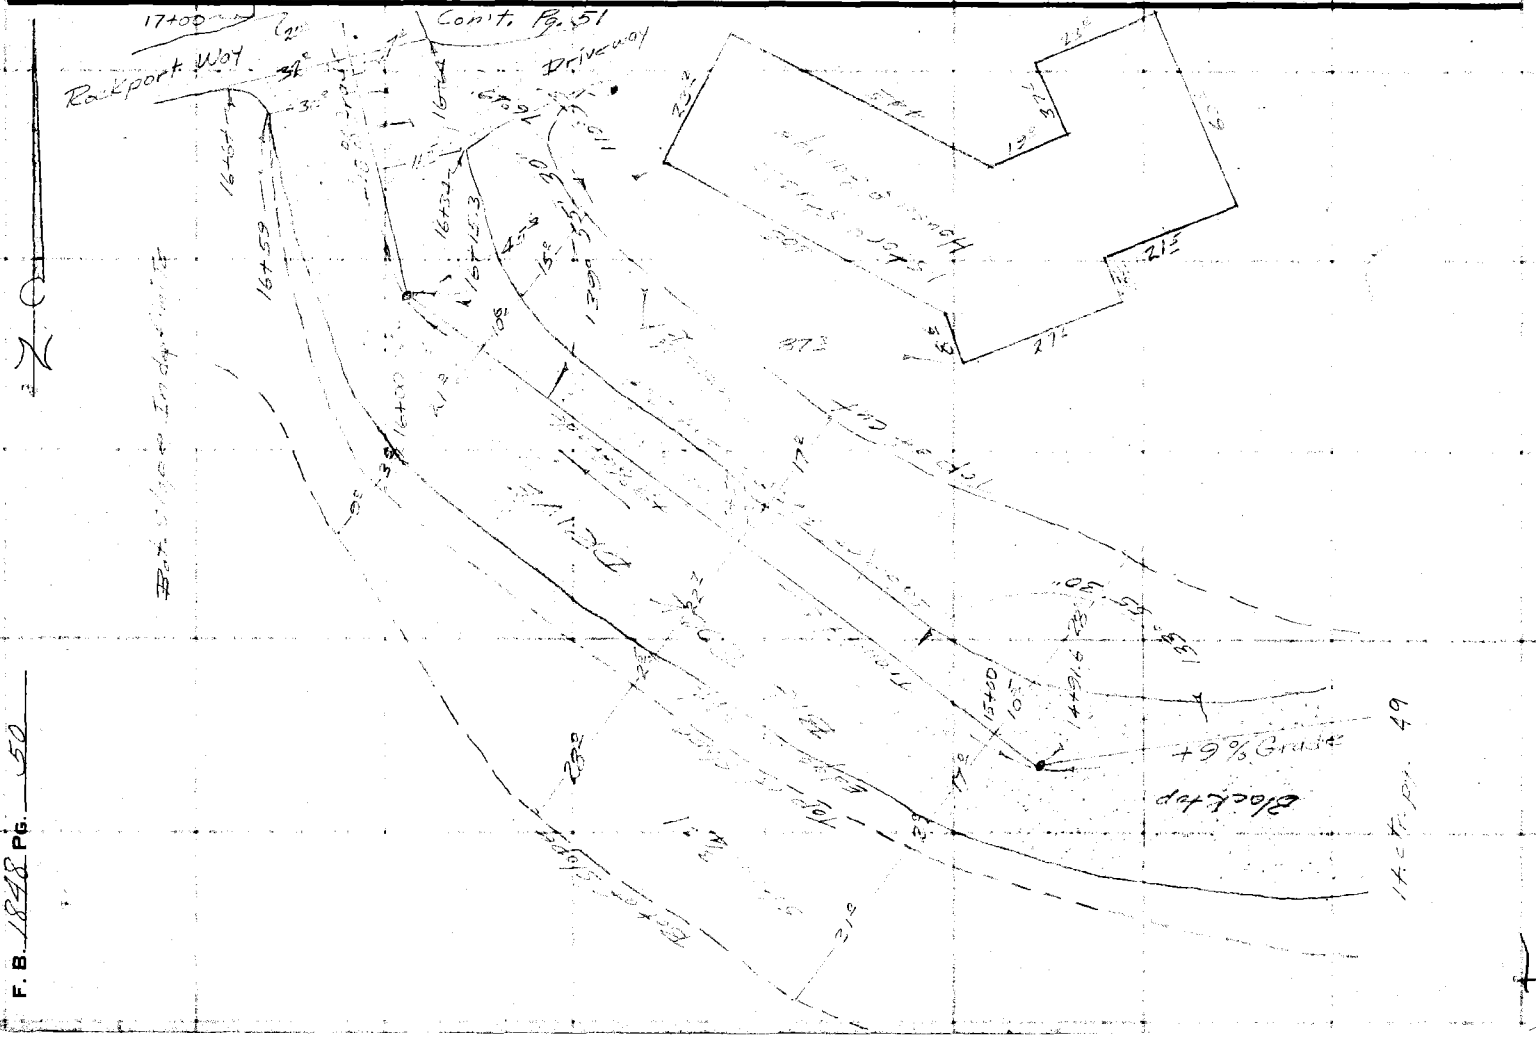

Notes Ck'd by
Map No. 99-23
Office Work S. SHINODA
Checked
Date

Survey of Big Rock Dr.
JN 007402 Tape Std °F
Surveyed by Engineer
Notes Date
Indexed

F. B. 1848 Pg. 51

Cont. fr. 52

Note: Any Additions or Changes on This Sheet Must be Made or Circled in Red Ink With Date and Name of Person Making Change.

Do not extend notes this side of this line.

RETURN TO
LOS ANGELES COUNTY ENGINEER
1700 LOS ANGELES COUNTY ENGINEERING BLDG.

140+50 92 R.
130+50 148 L.
Edge Pvmt.
T.S.
20+00 138 R.
12+50 182 R.
12+ Spiral
Pl. #11 13+96.1 Ld. N.81° E. f/us Pg. 35
20+00
T.S. 16 L.
19+50 62 L.
19+ Spiral
18+56
B.B. 61 L.
4 To 1 Slope
T.B. 62 L.
10 L.
18+50 13 R. - also T.S.
18+00 L.
18+50 20 R.
Top of Cut Indefinite ½ To 1 Slope
B.B. 10 L.
Edge Pvmt.
+10% Grade
17+50 16 L.
17+50 10 L.+
17+50 14± R. - also Toe of Slope
Rockvale Way
BIG ROCK RD
Edge Pvmt.
Ctr. of Pvmt.
16+98 265 L.
17+04.8 168 L.
16+80
16+13 442 L.
16+56 20 L.
Cont. Pg. 50
To: P.I. #10, 16+15

76F309S CE #247—3-57

F. B. 1848 Pg. 52 / 2

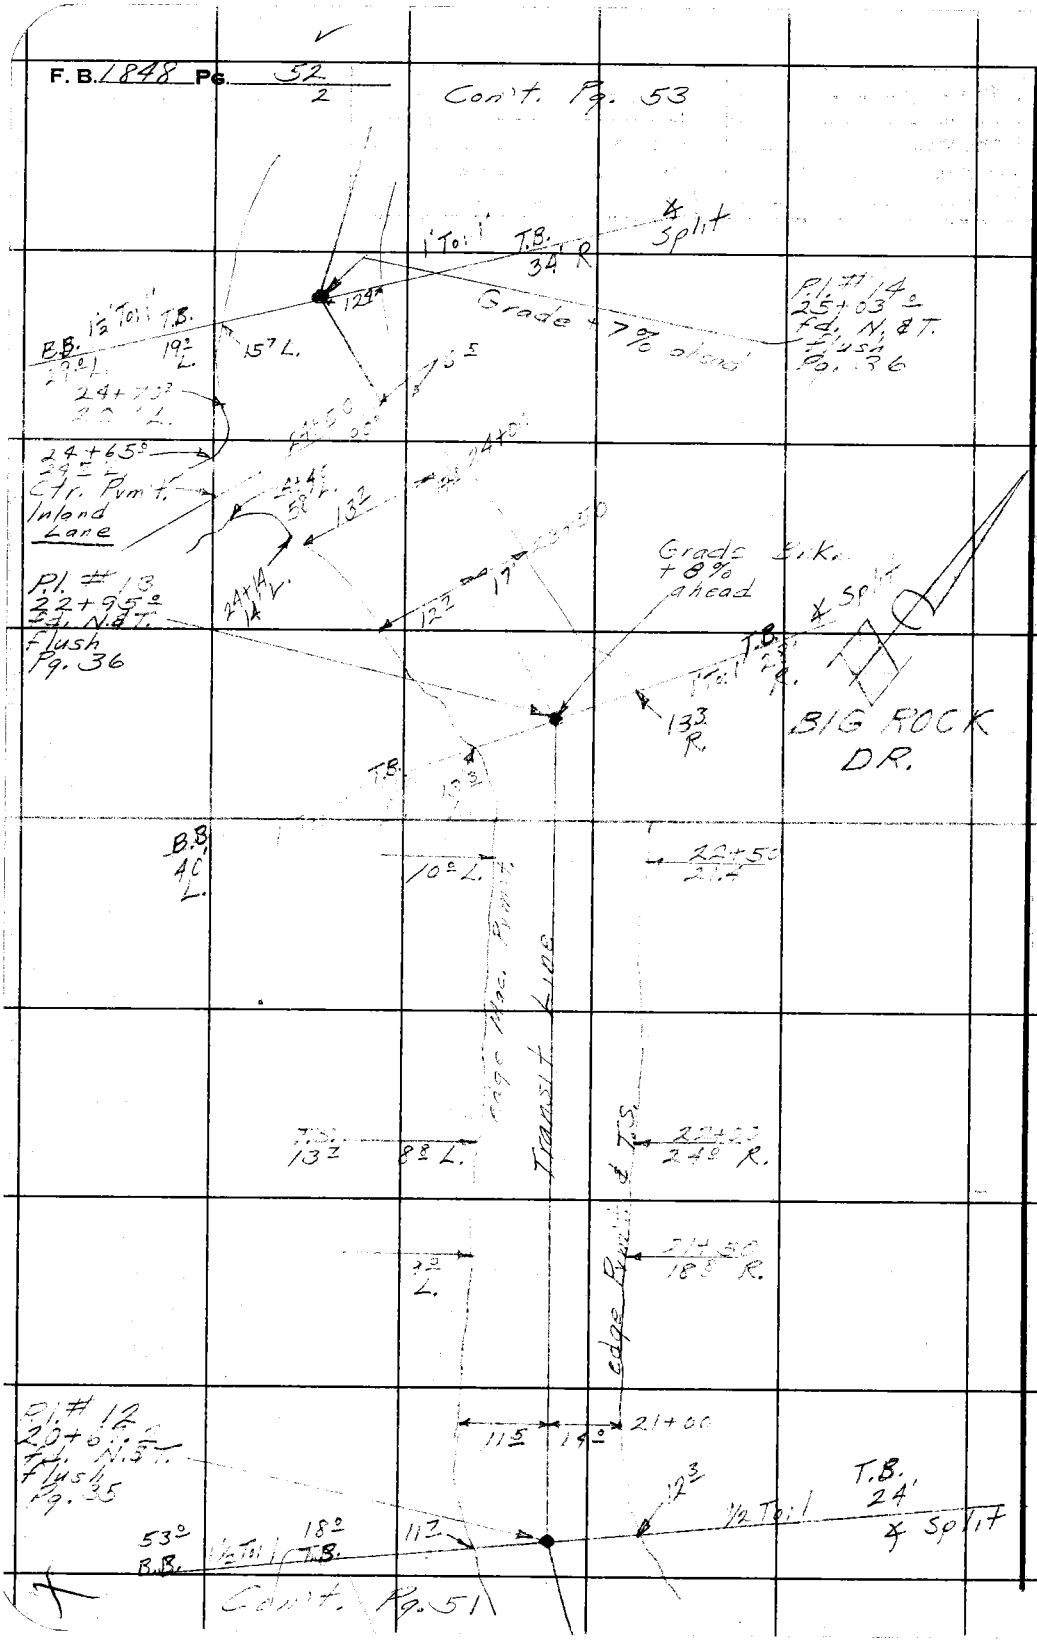

RETURN TO
LOS ANGELES COUNTY ENGINEER
700 LOS ANGELES COUNTY ENGINEERING BLDG.

Do not extend notes this side of this line.

Note: Any Additions or Changes on This Sheet Must be Made or Circled in Red Ink With Date and Name of Person Making Change.

Notes Ck'd by
Map No. 99-20
Office Work S. SHINODA
Checked
Date

Survey of
JN 2004.00 Tape Std °F
Surveyed by
Notes Date
Indexed

F. B. 1848 Pg. 53

Note: Any Additions or Changes on This Sheet Must be Made or Circled in Red Ink With Date and Name of Person Making Change.

Do not extend notes this side of this line.

RETURN TO
LOS ANGELES COUNTY ENGINEER
700 LOS ANGELES COUNTY ENGINEERING BLDG.

76F309S CE #247 3-57

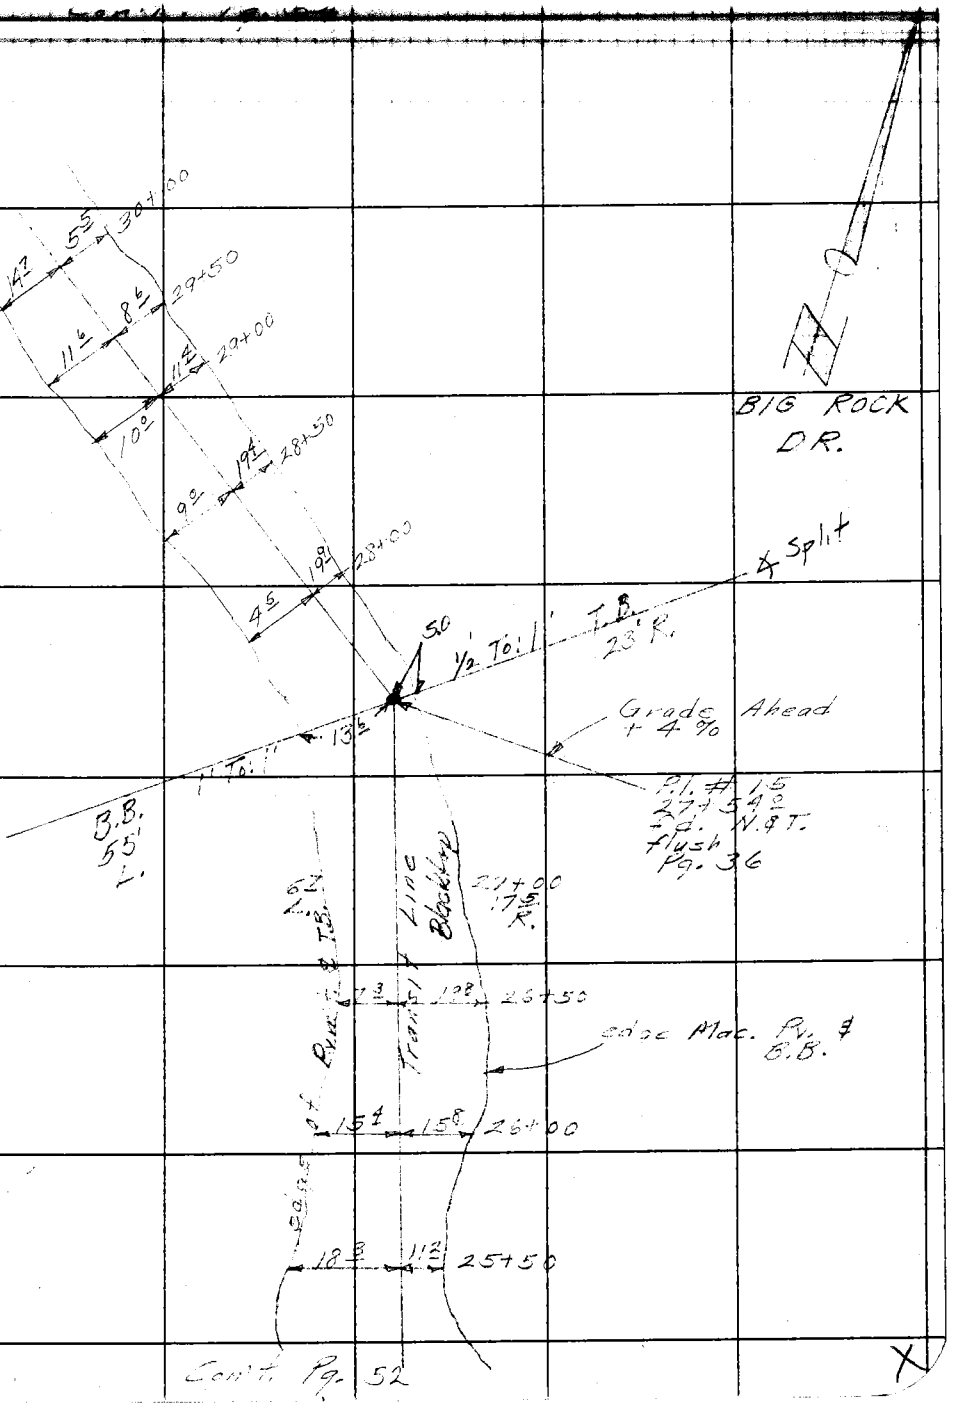

F. B. 1898 Pg. 54

Cont. Pg. 55

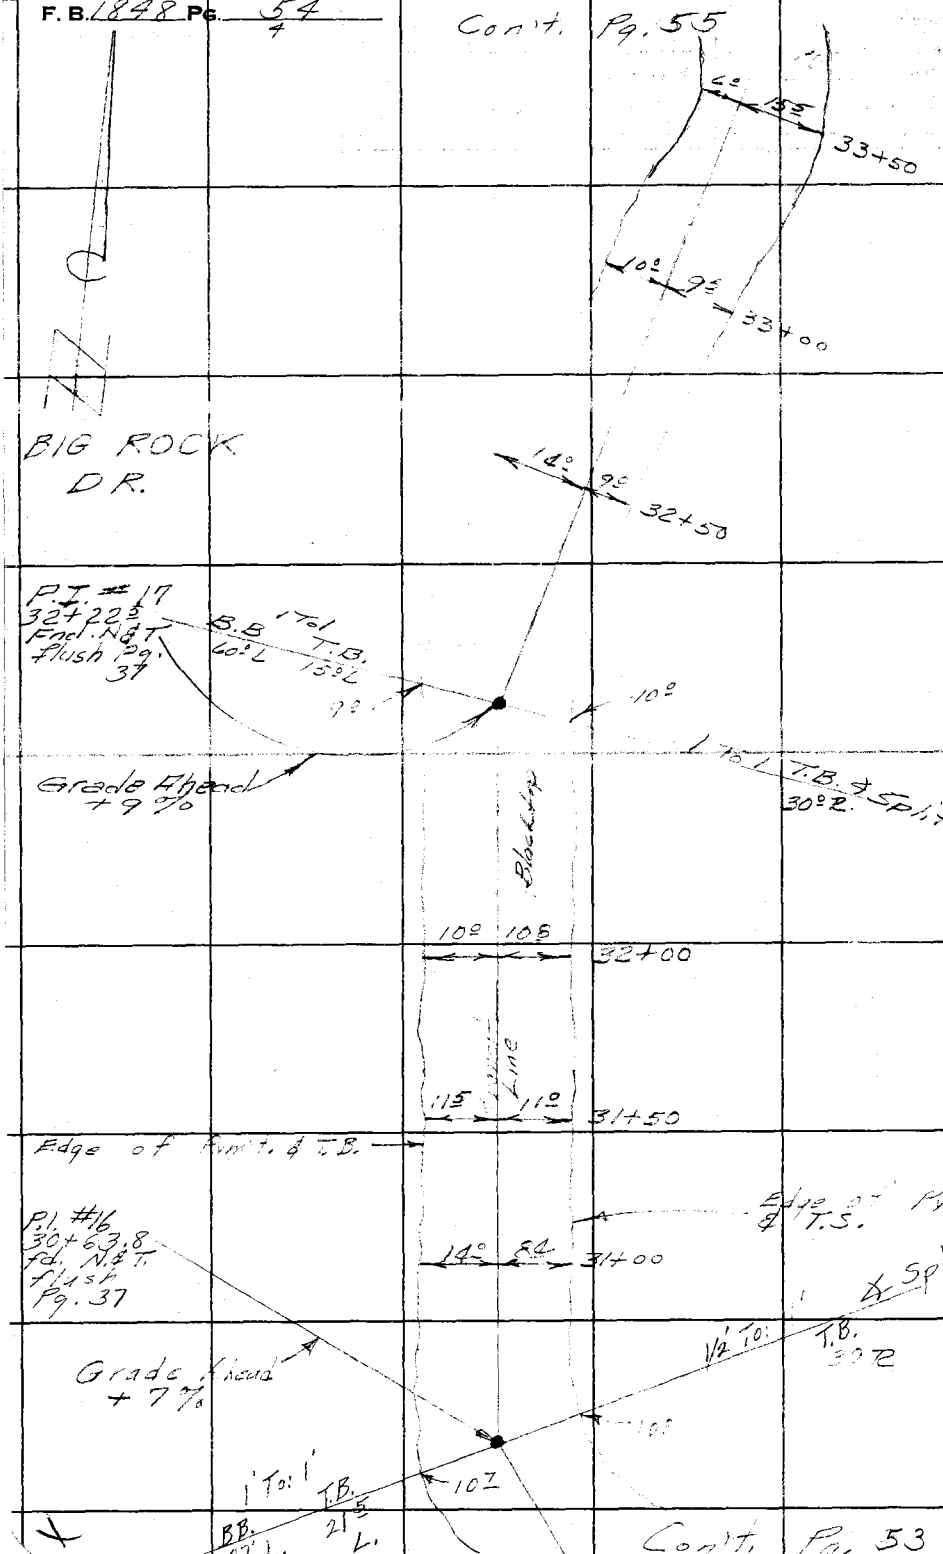

Cont. Pg. 53

RETURN TO
LOS ANGELES COUNTY ENGINEER
700 LOS ANGELES COUNTY ENGINEERING BLDG.

Note: Any Additions or Changes on This Sheet Must be Made or Circled in Red Ink With Date and Name of Person Making Change.

Do not extend notes this side of this line.

Notes Ck'd by
Map No. 99-20
Office Work S. SHINODA
Checked
Date

Survey of BIG ROCK DR.
JN 2074.00 Tape Std °F
Surveyed by Engineer
Notes Blank Date 8-50
Indexed

F. B. 1848 Pg. 55

Note: Any Additions or Changes on This Sheet Must Be Made or Circled In Red Ink With Date and Name of Person Making Change.

Do not extend notes this side of this line.

RETURN TO
LOS ANGELES COUNTY ENGINEER
700 LOS ANGELES COUNTY ENGINEERING BLDG.

76F3098 CE #247—3-57

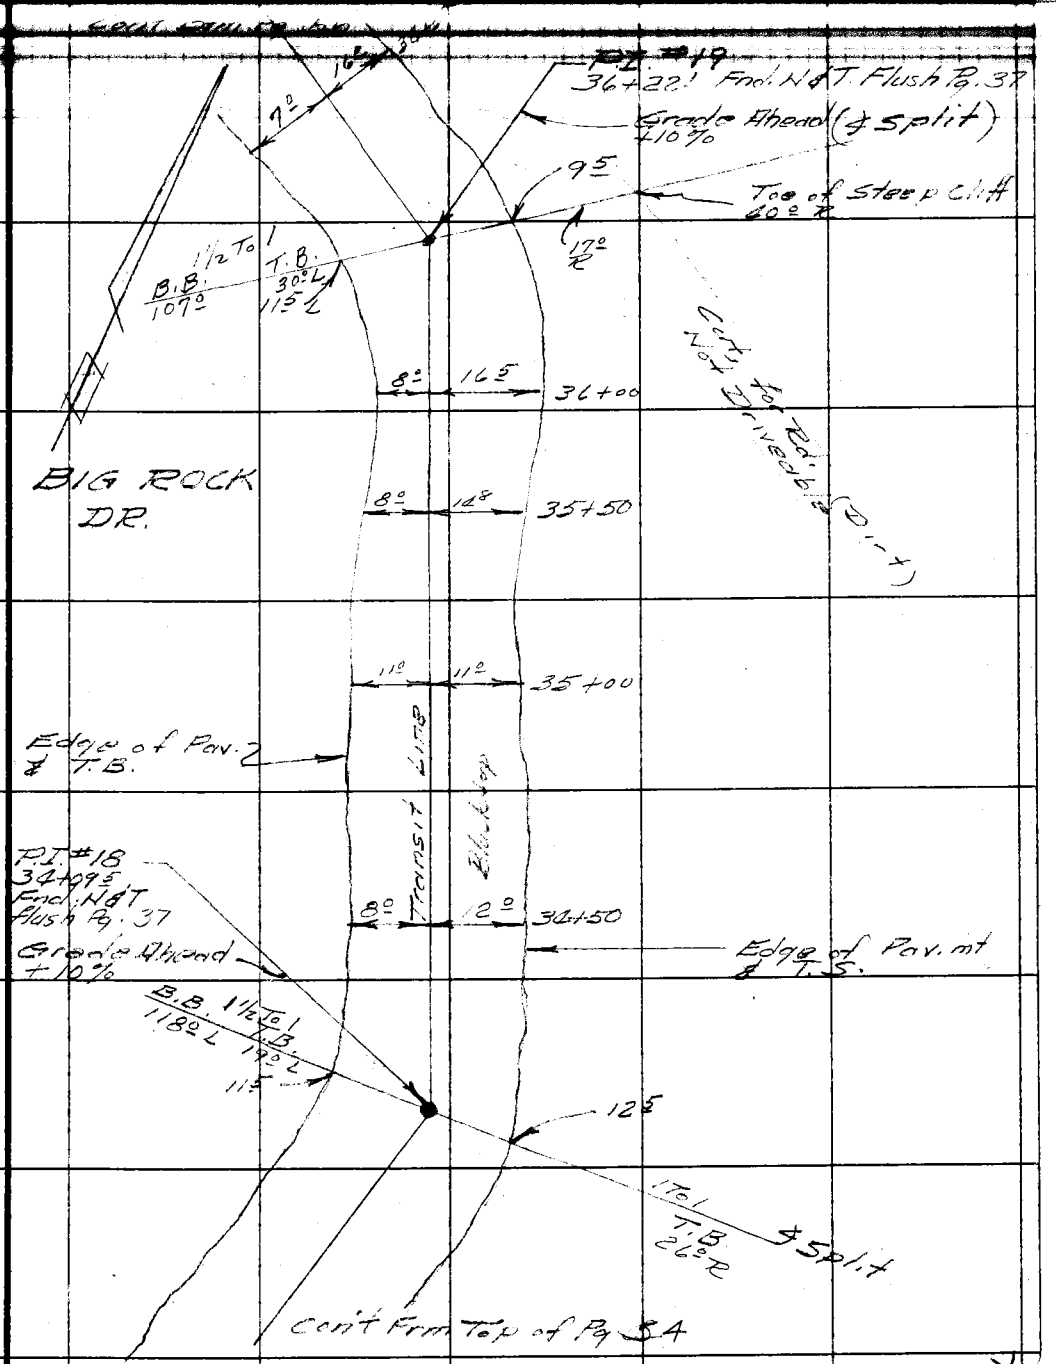

F. B. 1848 Pg. 56

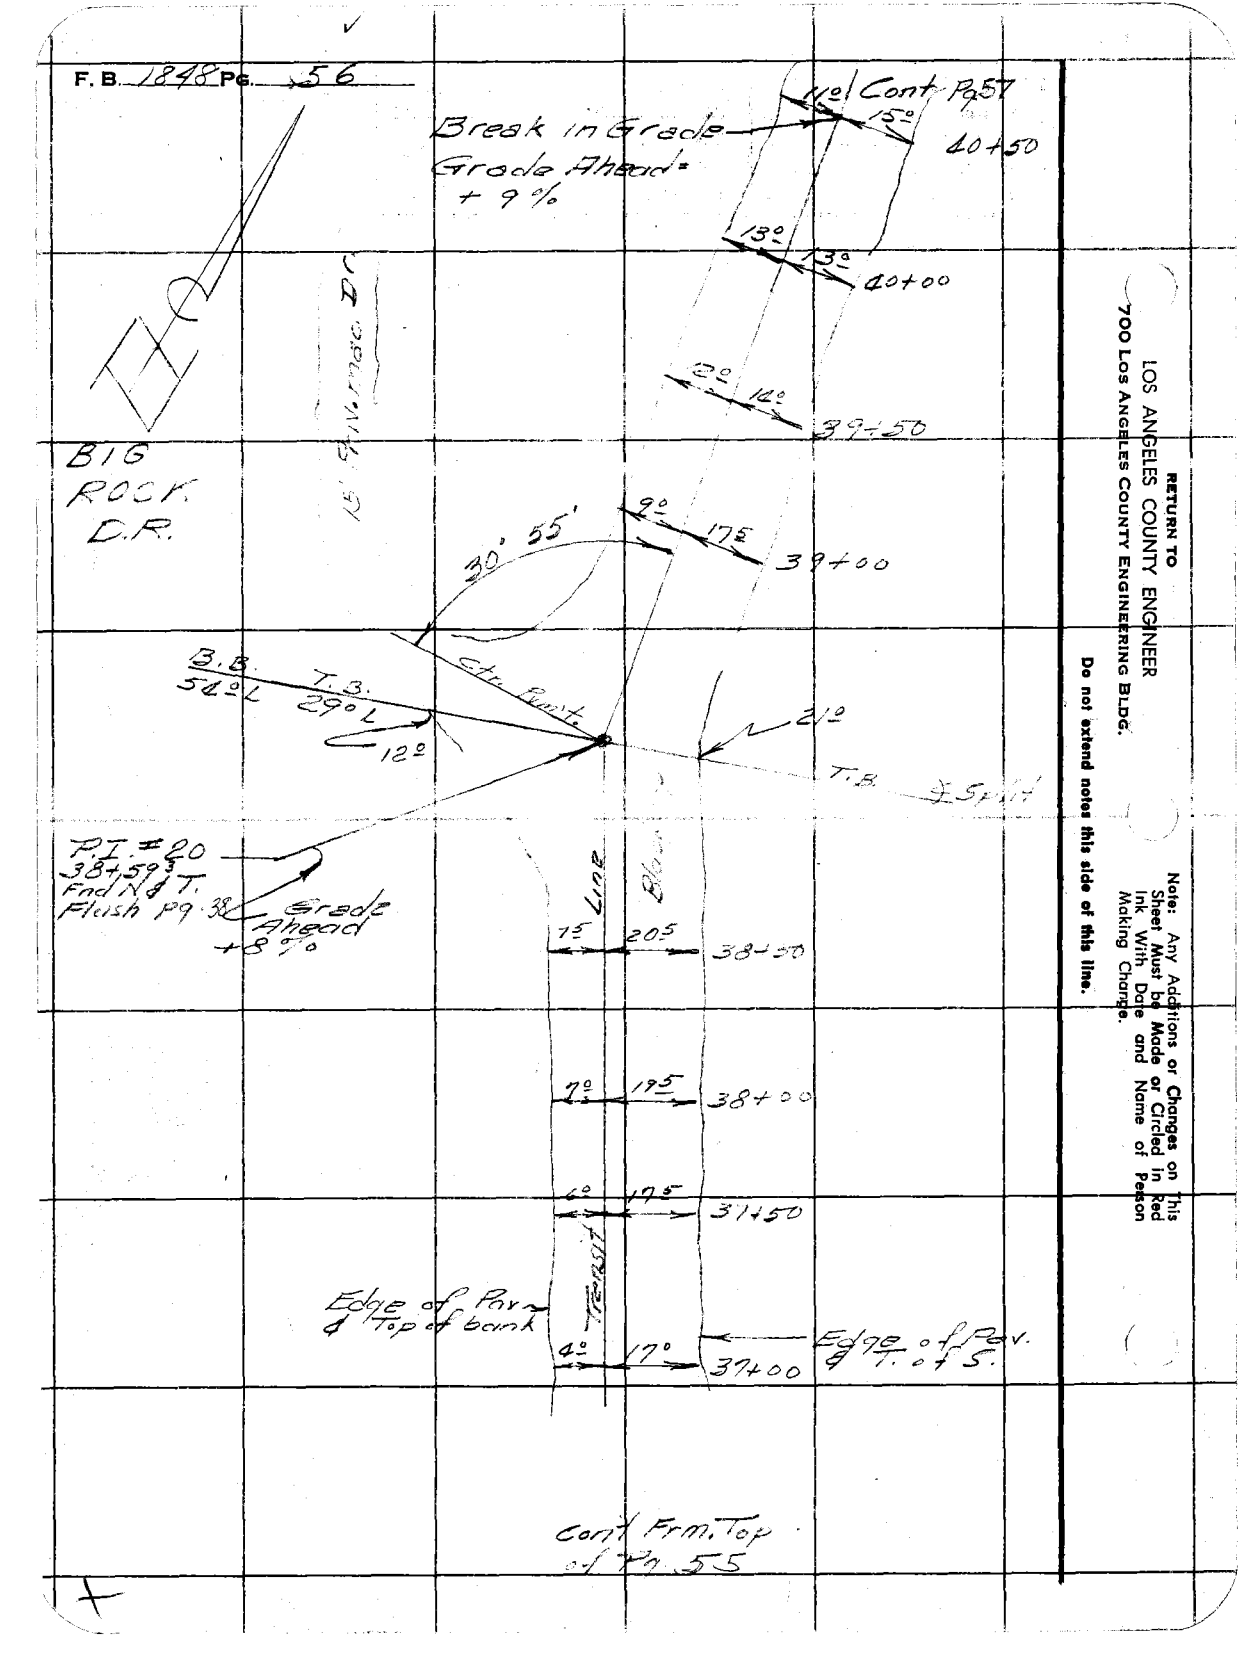

RETURN TO
LOS ANGELES COUNTY ENGINEER
700 LOS ANGELES COUNTY ENGINEERING BLDG.

Note: Any Additions or Changes on This Sheet Must be Made or Circled in Red Ink With Date and Name of Person Making Change.

Do not extend notes this side of this line.

Notes Ck'd by
Map No. 99-20
Office Work S. SHINODA
Checked
Date

Survey of
JN 007400 Tape Std. °F
Surveyed by
Notes Landa / C. Johnson Date 8-58
Indexed

F. B. 1848 Pg. 57

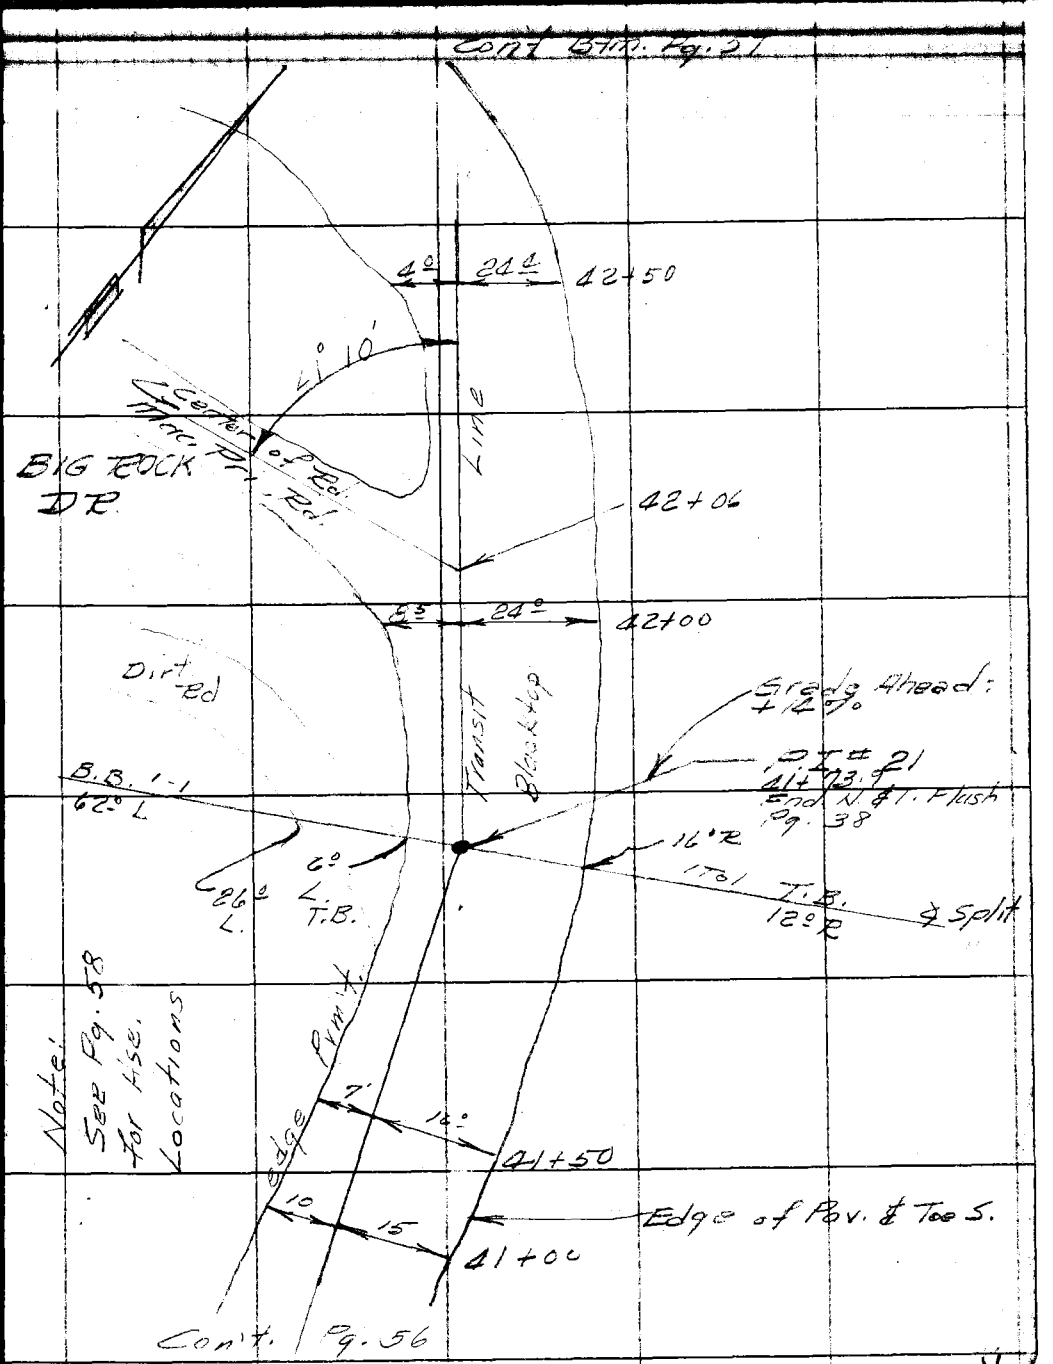

Note: Any Additions or Changes on This Sheet Must be Made or Circled in Red Ink With Date and Name of Person Making Change.

Do not extend notes this side of this line.

RETURN TO
LOS ANGELES COUNTY ENGINEER
700 LOS ANGELES COUNTY ENGINEERING BLDG.

76F3095 CE #247—3-57

RETURN TO
LOS ANGELES COUNTY ENGINEER
700 LOS ANGELES COUNTY ENGINEERING BLDG.

Note: Any Additions or Changes on This Sheet Must be Made or Circled in Red Ink With Date and Name of Person Making Change.

Do not extend notes this side of this line.

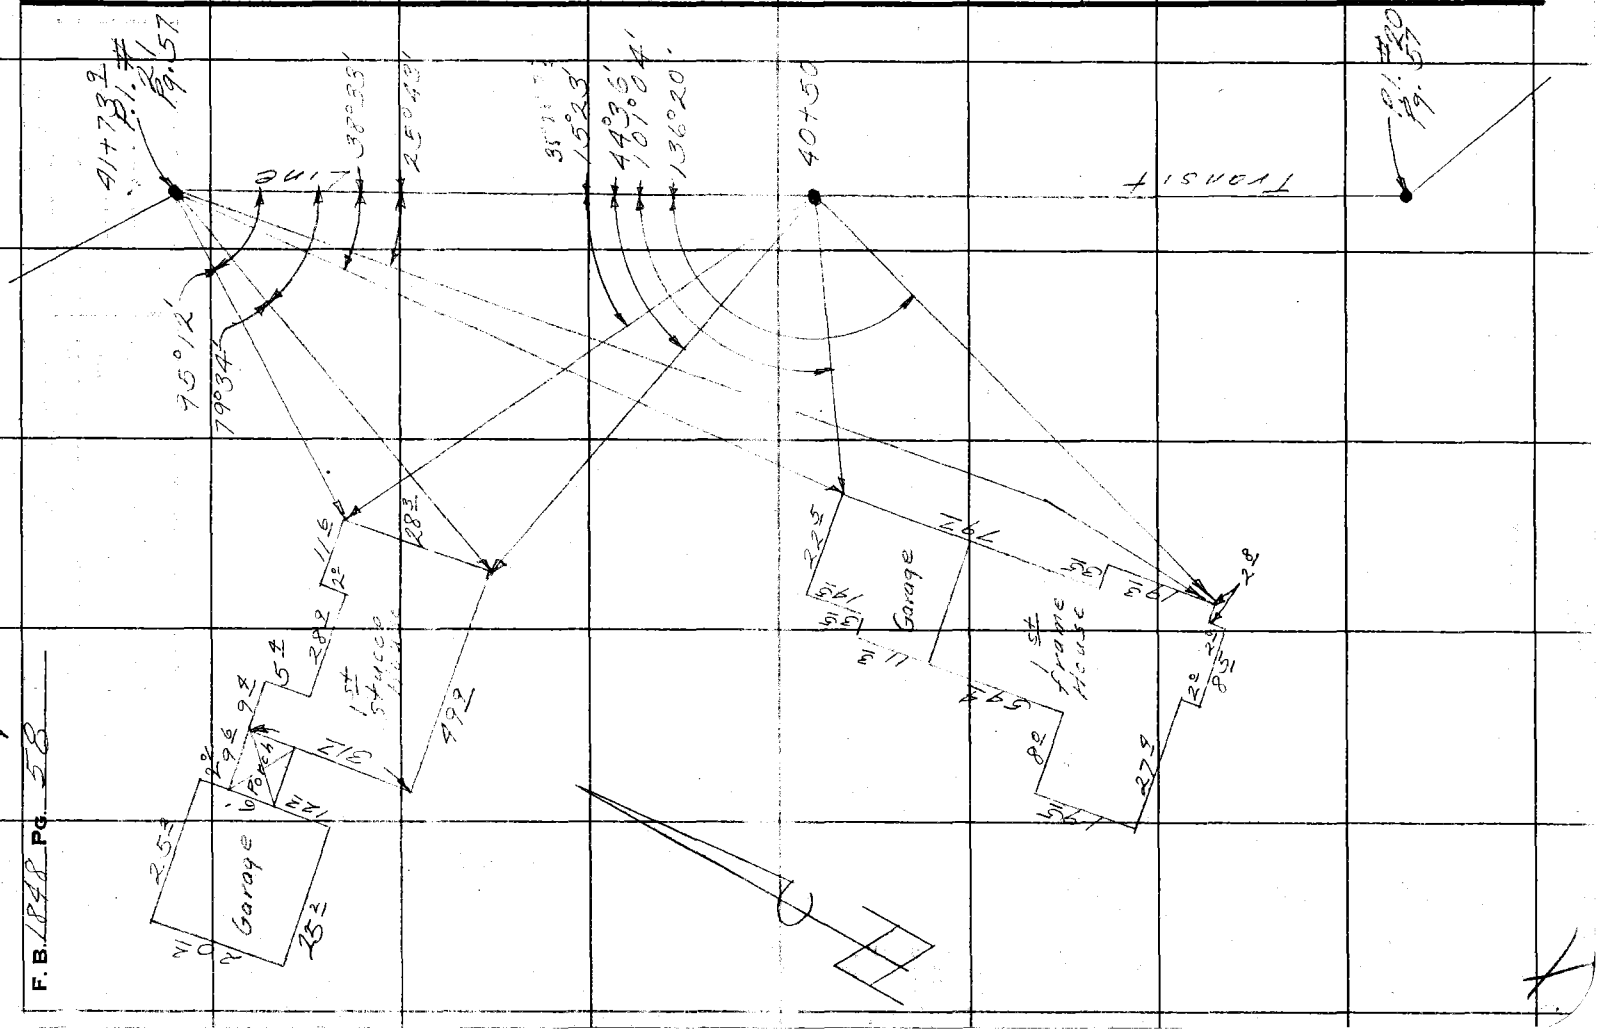

Notes Ck'd by
Map No. 95-2
Office Work S. SHINODA
Checked
Date

Survey of Big Rock Dr.
JN 0078.10 Tape Std °F
Surveyed by E. Englin
Notes 5 1/2" Date 2-58
S. C. Johnson
Indexed

F. B. 1848 Pg. 27

Note: Any Additions or Changes on This Sheet Must be Made or Circled in Red Ink With Date and Name of Person Making Change.

Do not extend notes this side of this line.

RETURN TO
LOS ANGELES COUNTY ENGINEER
700 LOS ANGELES COUNTY ENGINEERING BLDG.

76F309S CE #247—3-57

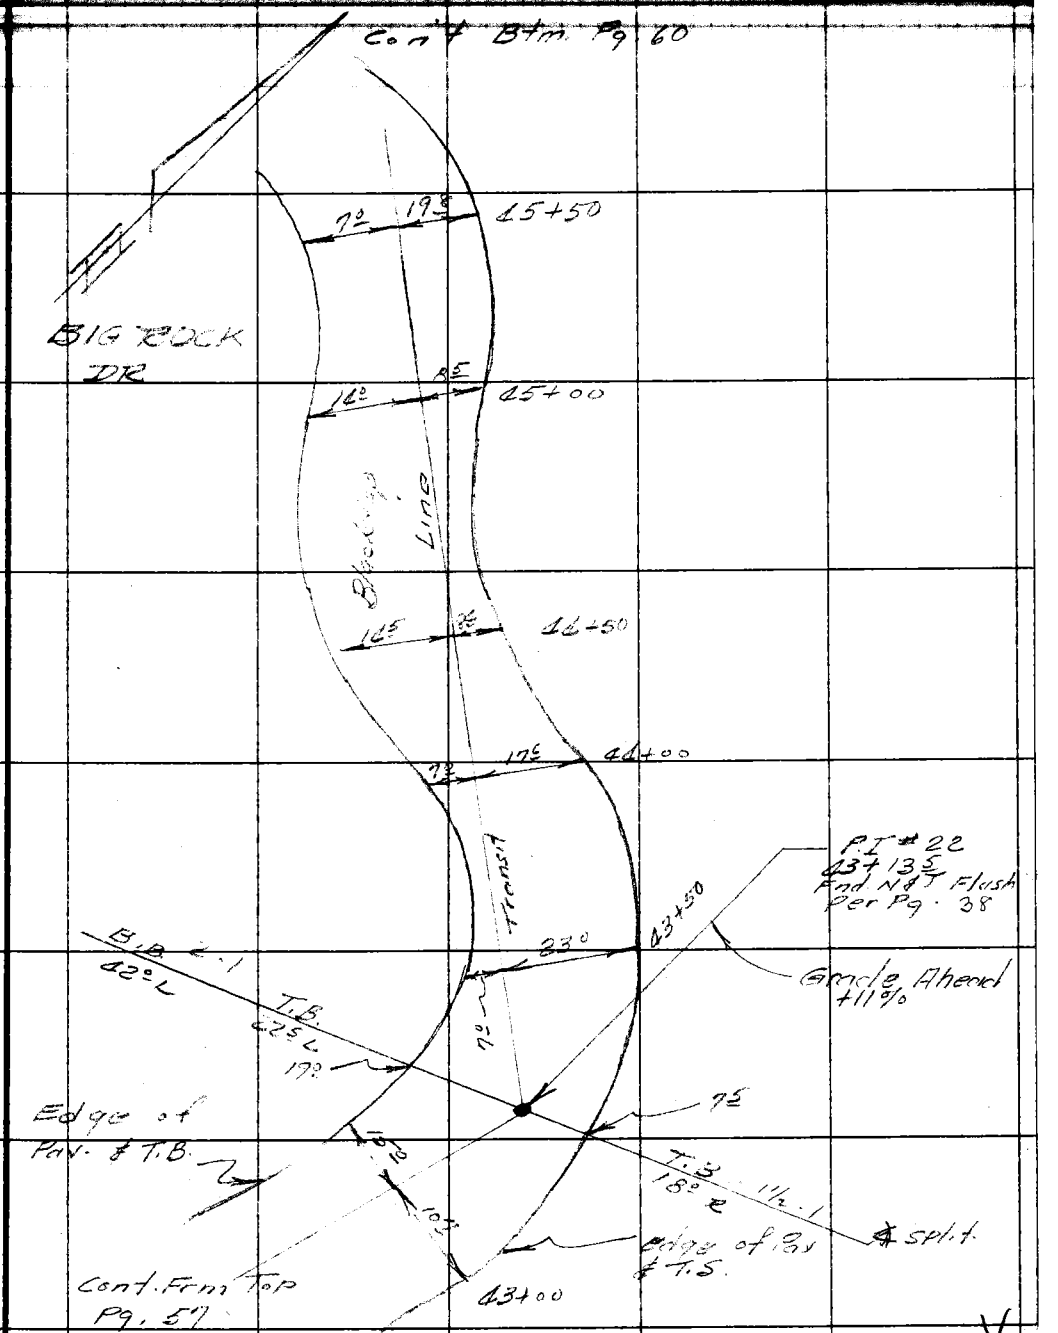

F. B. 1828 PG. 60

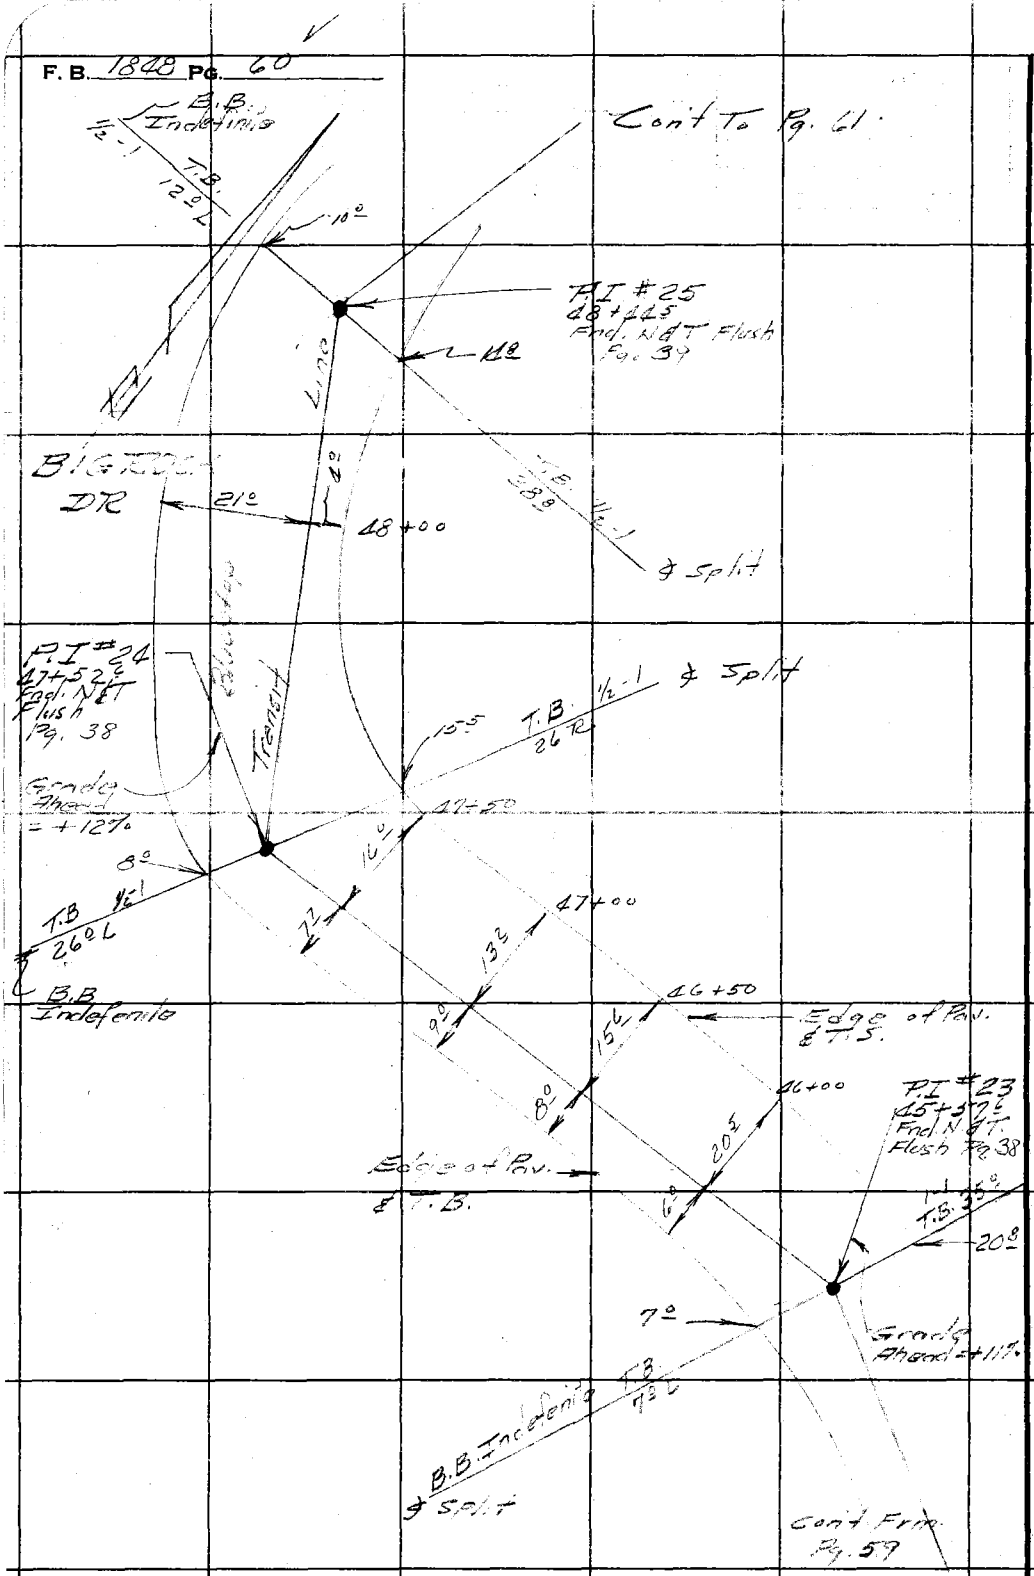

RETURN TO
LOS ANGELES COUNTY ENGINEER
700 LOS ANGELES COUNTY ENGINEERING BLDG.

Do not extend notes this side of this line.

Note: Any Additions or Changes on This Sheet, Must be Made or Circled in Red Ink With Date and Name of Person Making Change.

Notes Ck'd by _____
Map No. 99-20
Office Work S. SHING
Checked _____
Date _____

Survey of BIG ROCK DR.
JN _____ Tape _____ Std _____ °F
Surveyed by _____
Notes _____ Date 8-19-59
Indexed _____

F. B. 1848 Pg. 61

BIG ROCK DR. Cont. Pg. 72

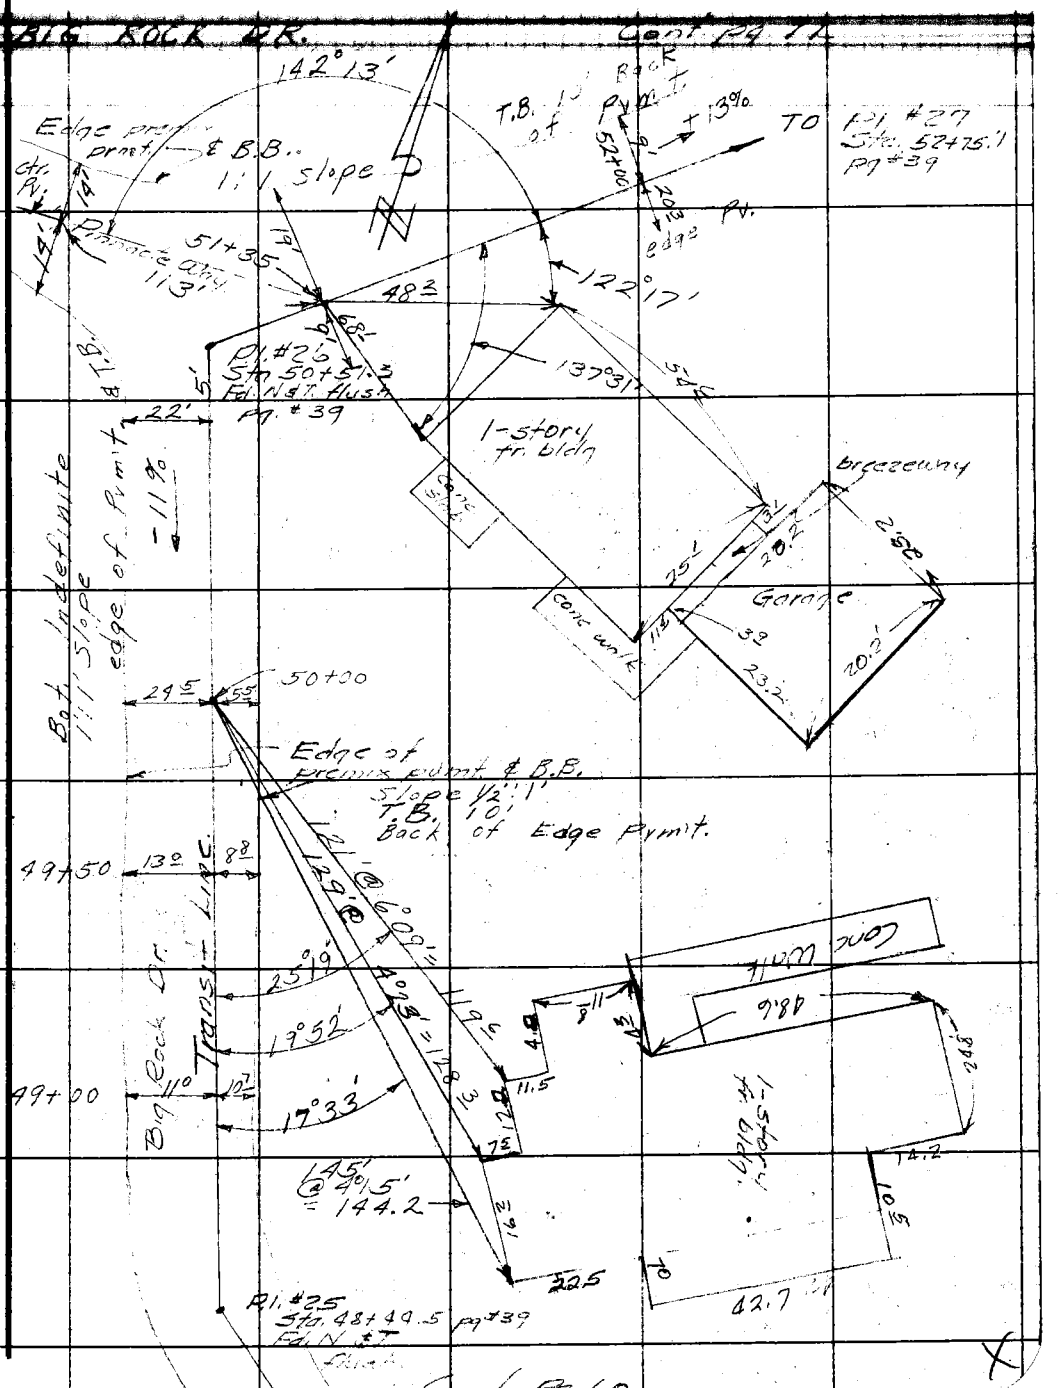

RETURN TO
LOS ANGELES COUNTY ENGINEER
700 LOS ANGELES COUNTY ENGINEERING BLDG.

Note: Any Additions or Changes on This Sheet Must be Made or Circled In Red Ink With Date and Name of Person Making Change.

Do not extend notes this side of this line.

76F309S CE #247—3-57

F. B. 1848 Pg. 62

1 - 88' @ 8°20' = 86.2
2 - 103' @ 5°54' = 101.5
3 - 119' @ 7°06' = 118.2

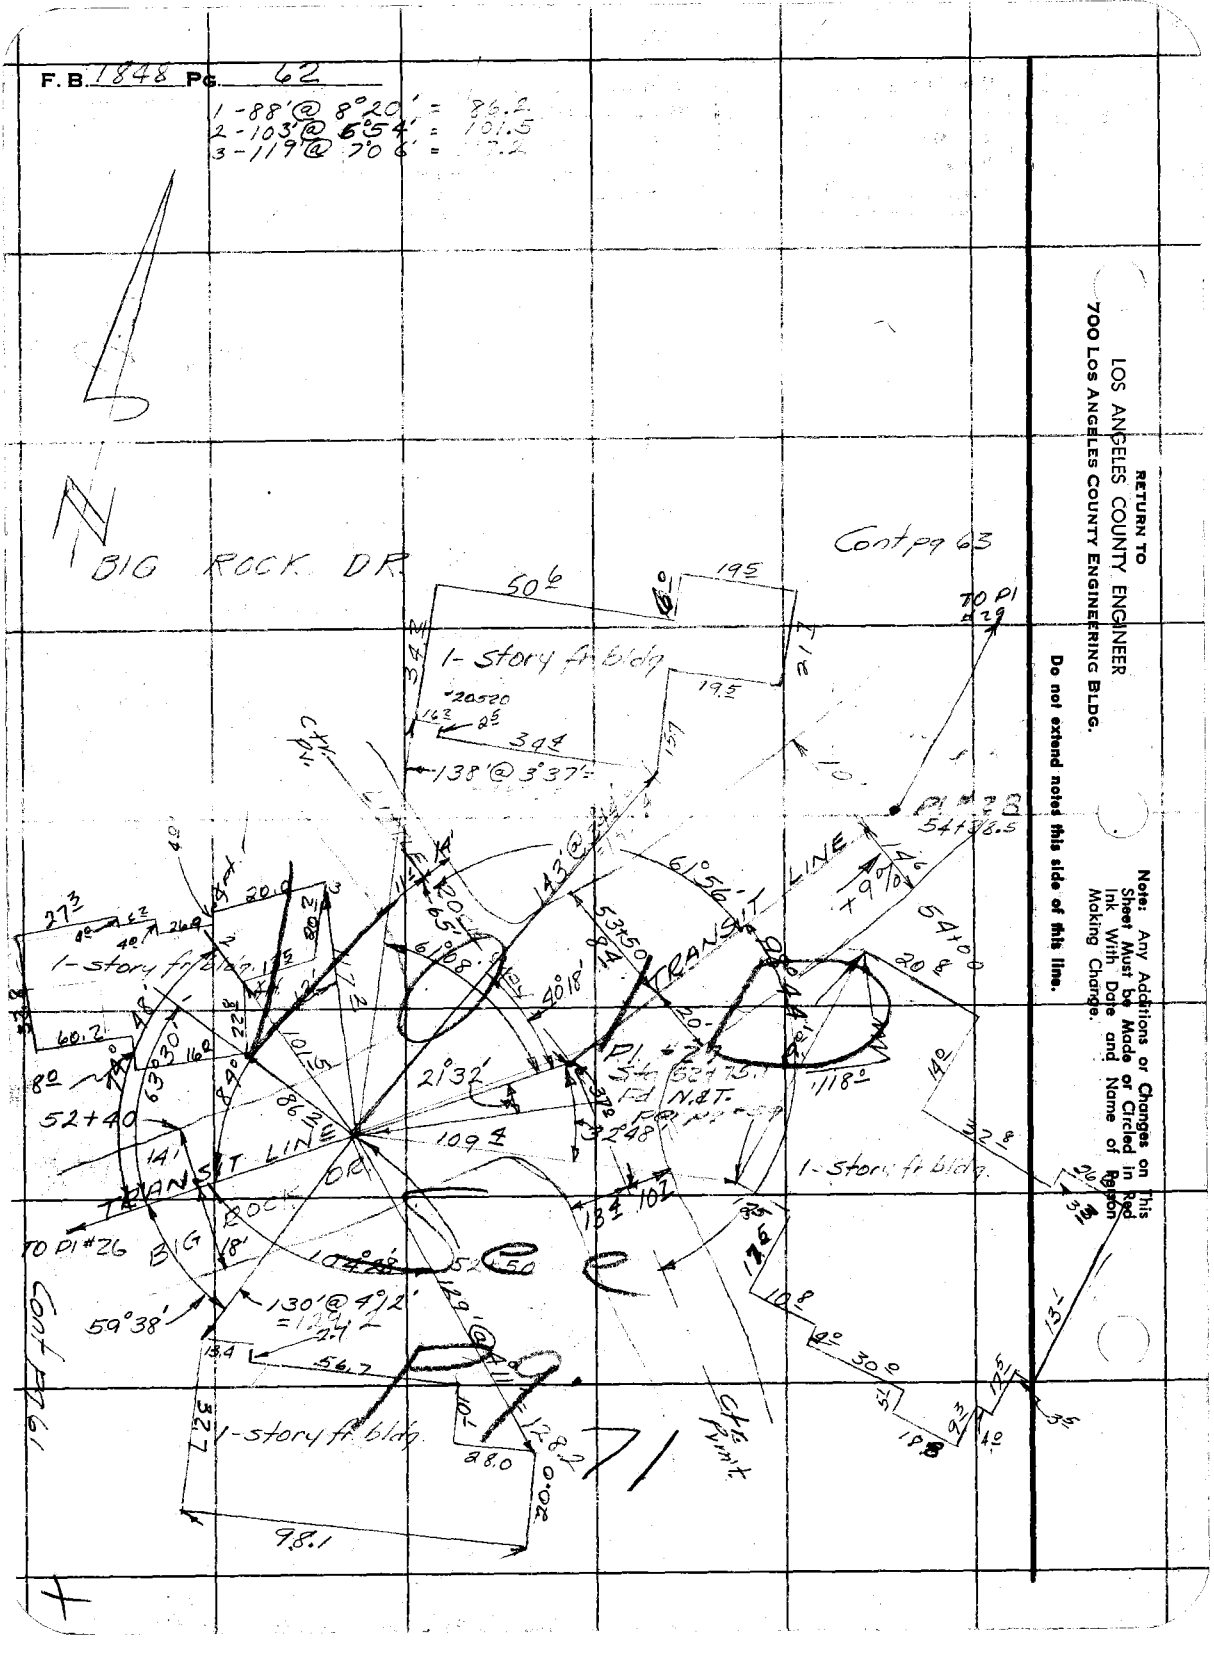

RETURN TO
LOS ANGELES COUNTY ENGINEER
700 LOS ANGELES COUNTY ENGINEERING BLDG.

Note: Any Additions or Changes on This Sheet Must be Made or Circled in Red Ink With Date and Name of Person Making Change.

Do not extend notes this side of this line.

Notes Ck'd by
Map No. 99-20
Office Work S. SHINODA
Checked
Date

Survey of
JN Tape Std °F
Surveyed by
Notes Date
A. C. Johnson
Indexed

F. B. 184 Pg. 63

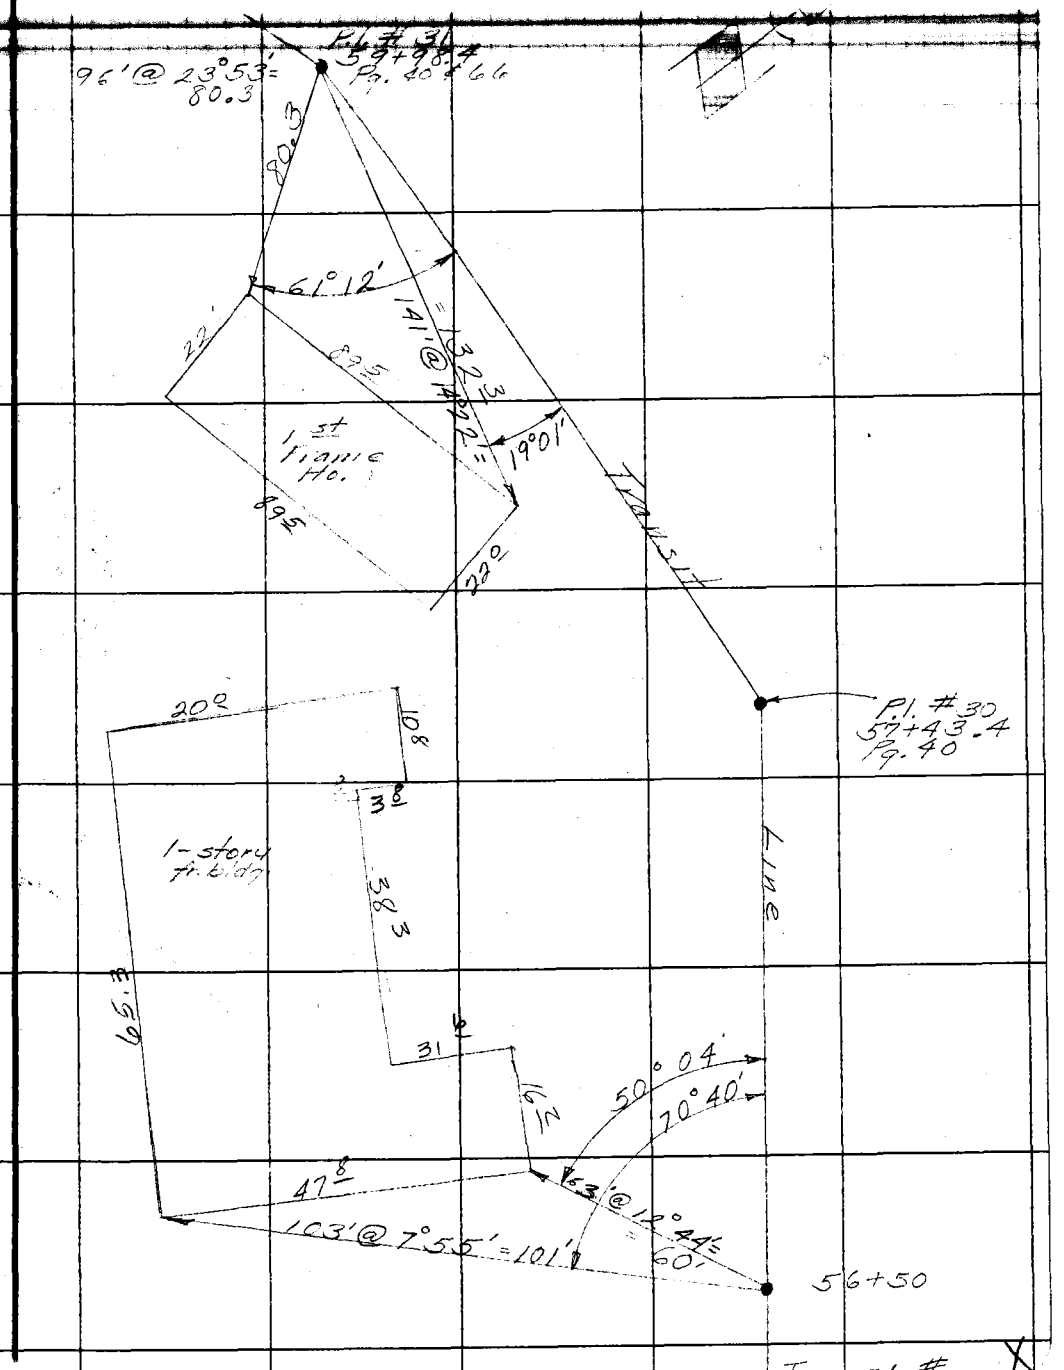

RETURN TO
LOS ANGELES COUNTY ENGINEER
700 LOS ANGELES COUNTY ENGINEERING BLDG.

Note: Any Additions or Changes on This Sheet Must be Made or Circled In Red Ink With Date and Name of Person Making Change.

Do not extend notes this side of this line.

76F309S CE #247—3-57

RETURN TO
LOS ANGELES COUNTY ENGINEER
700 LOS ANGELES COUNTY ENGINEERING BLDG.

Note: Any Additions or Changes on This Sheet Must be Made or Circled in Red Ink With Date and Name of Person Making Change.

Do not extend notes this side of this line.

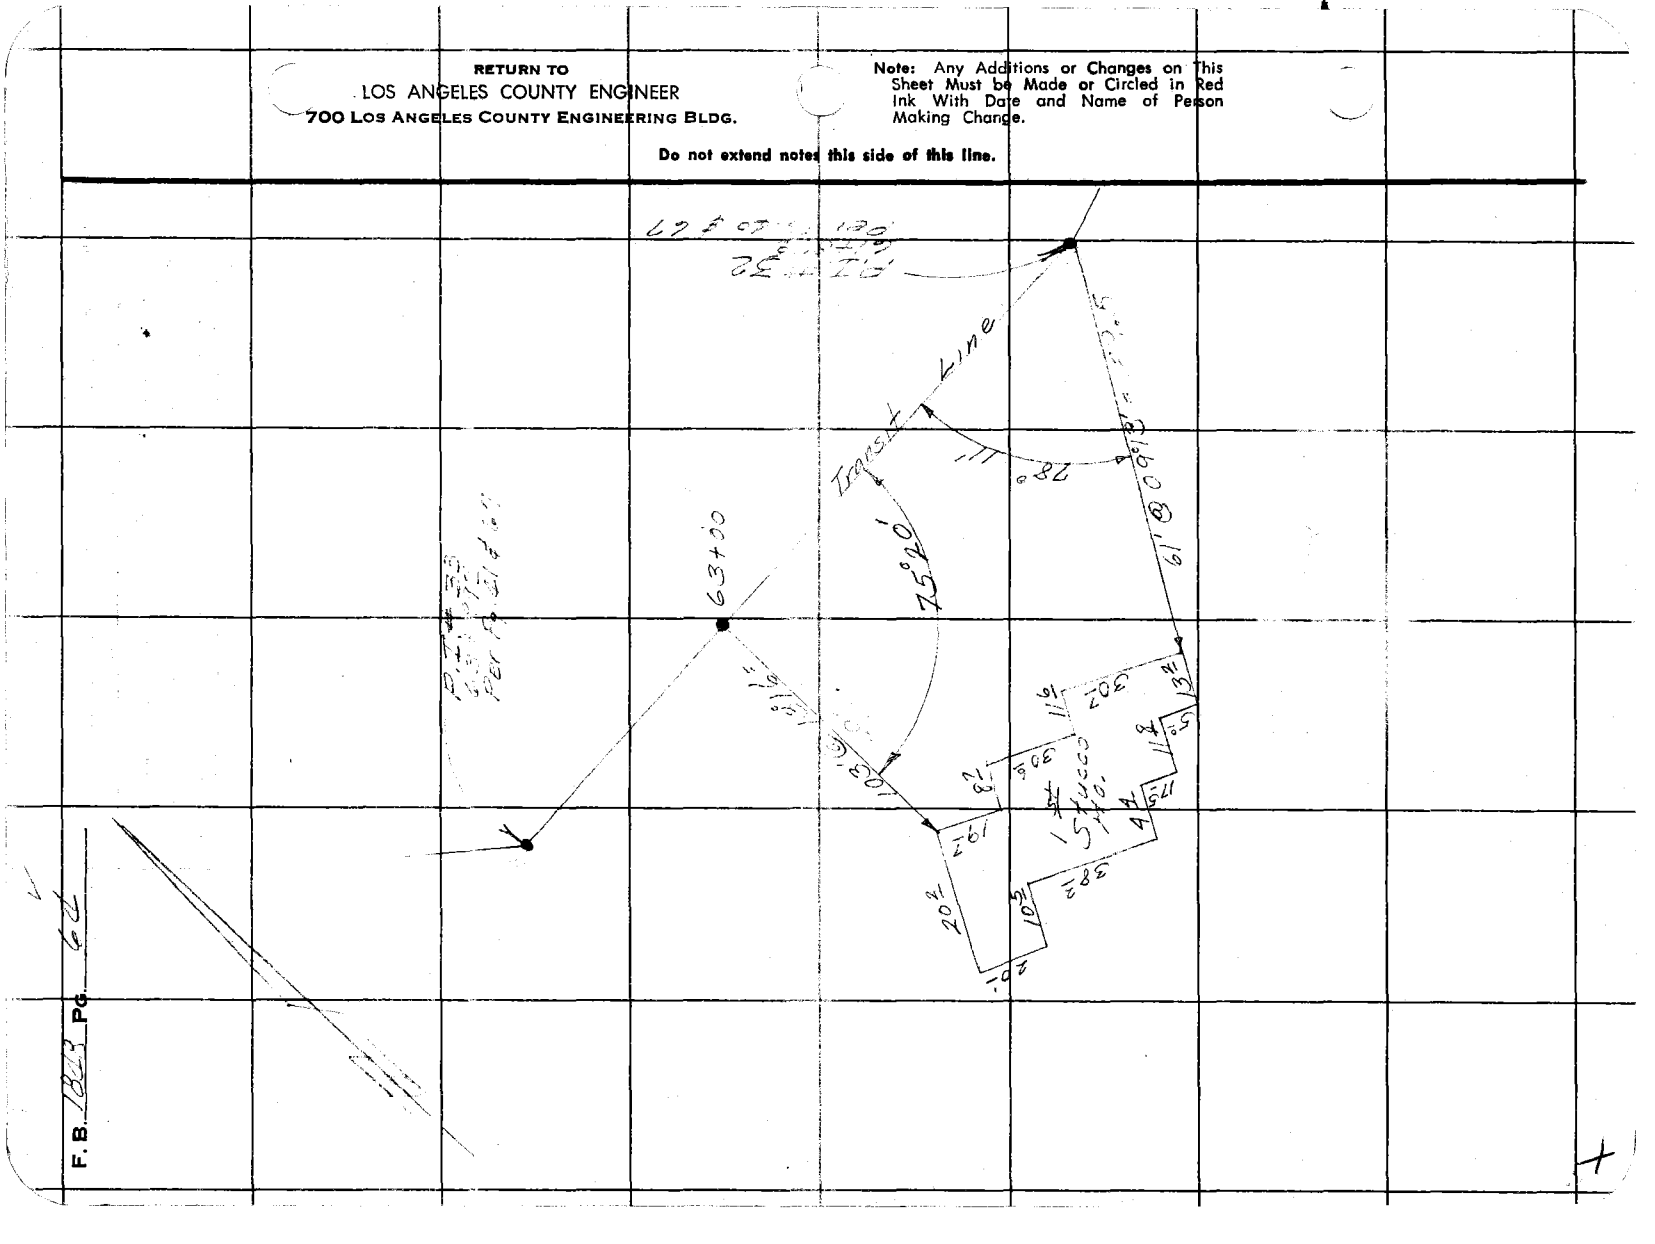

F.B. 1813 PG. 22

Notes Ck'd by
Map No. 99-20
Office Work S. SHINODA
Checked
Date

Survey of Big Rock Dr.
JN 00726 Tape Std °F
Surveyed by E Fiorito
Notes E Fiorito Date 8-5-8
A. C Johnson
Indexed

F. B. 1868 Pg. 63

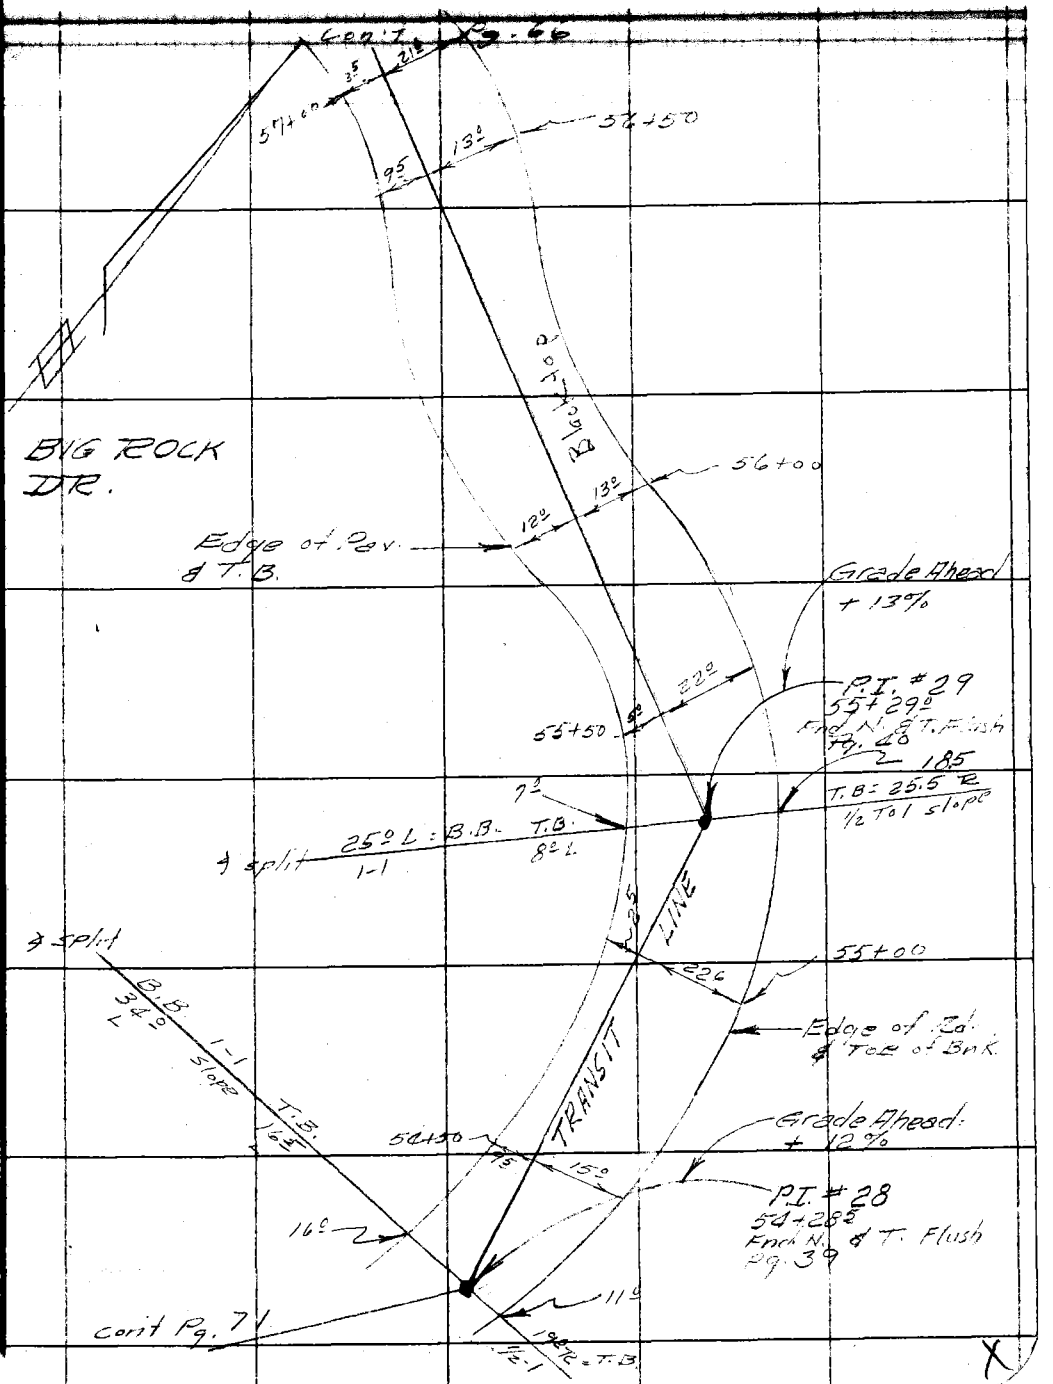

RETURN TO
LOS ANGELES COUNTY ENGINEER
700 Los Angeles County Engineering Bldg.

Note: Any Additions or Changes on This Sheet Must be Made or Circled in Red Ink With Date and Name of Person Making Change.

Do not extend notes this side of this line.

76FSOOS CE #247 3-57

F. B. 1848 Pg. 66

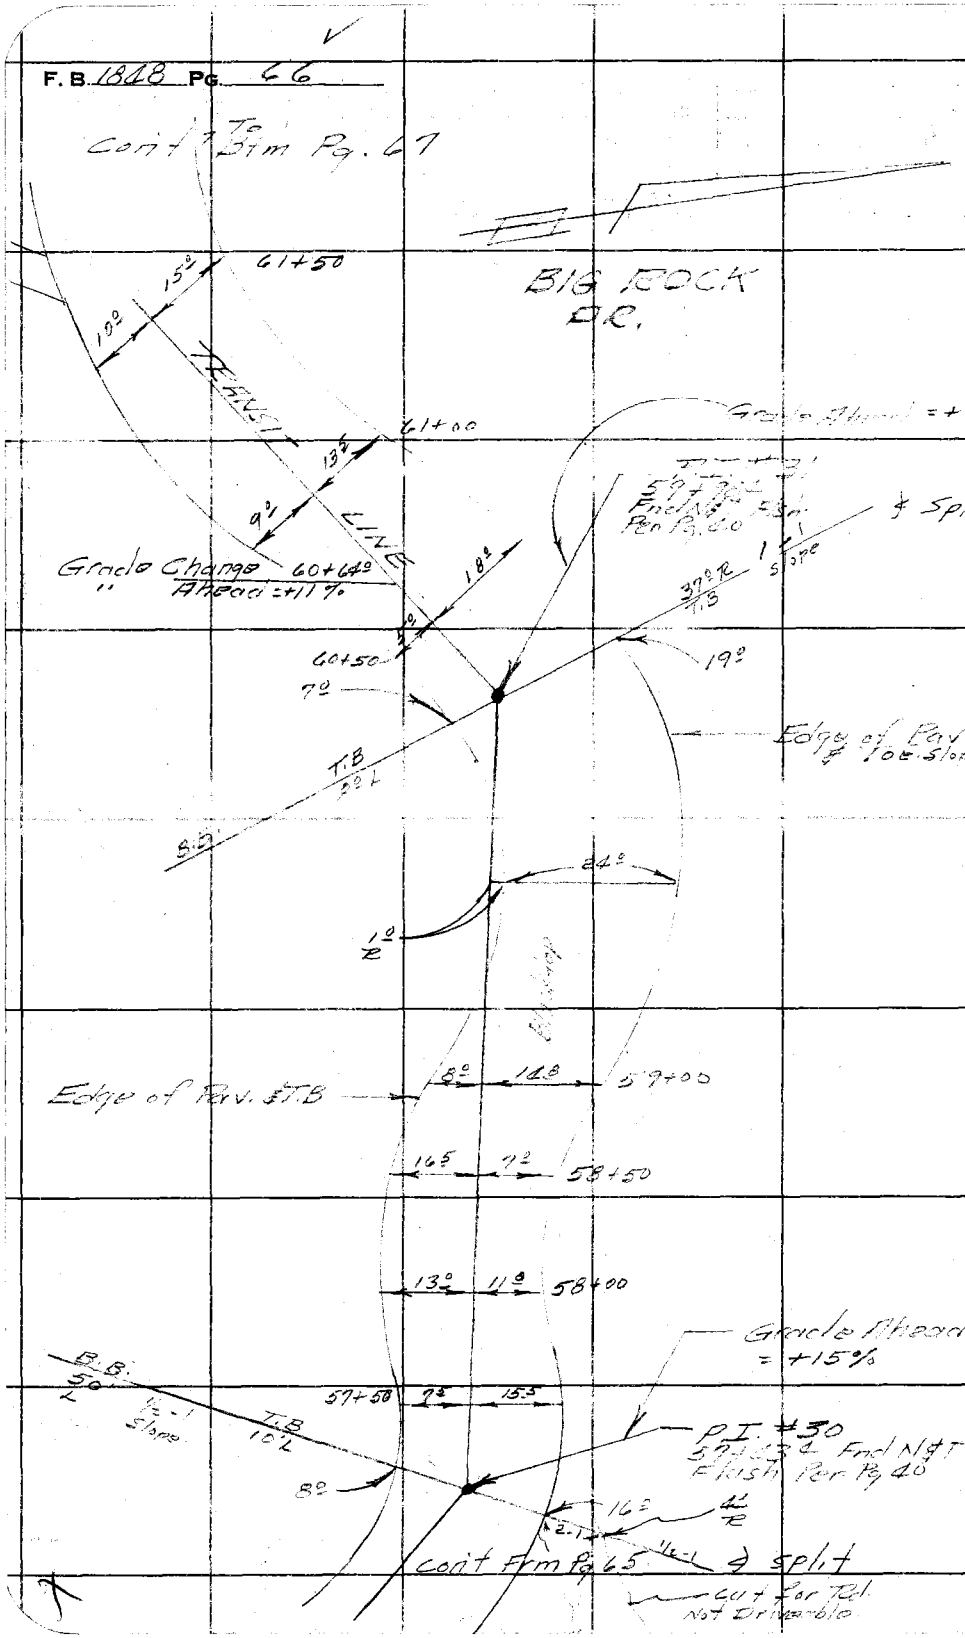

RETURN TO
LOS ANGELES COUNTY ENGINEER
700 LOS ANGELES COUNTY ENGINEERING BLDG.

Note: Any Additions or Changes on This Sheet Must be Made or Circled in Red Ink With Date and Name of Person Making Change.

Do not extend notes this side of this line.

Notes Ck'd by
Map No. 99-20
Office Work S. SHINODA
Checked
Date

Survey of BIG ROCK DR.
JN 00 74 08 Tape Std oF
Surveyed by
Notes C. Johnson Date

F. B 1848 Pg. 62

Indexed

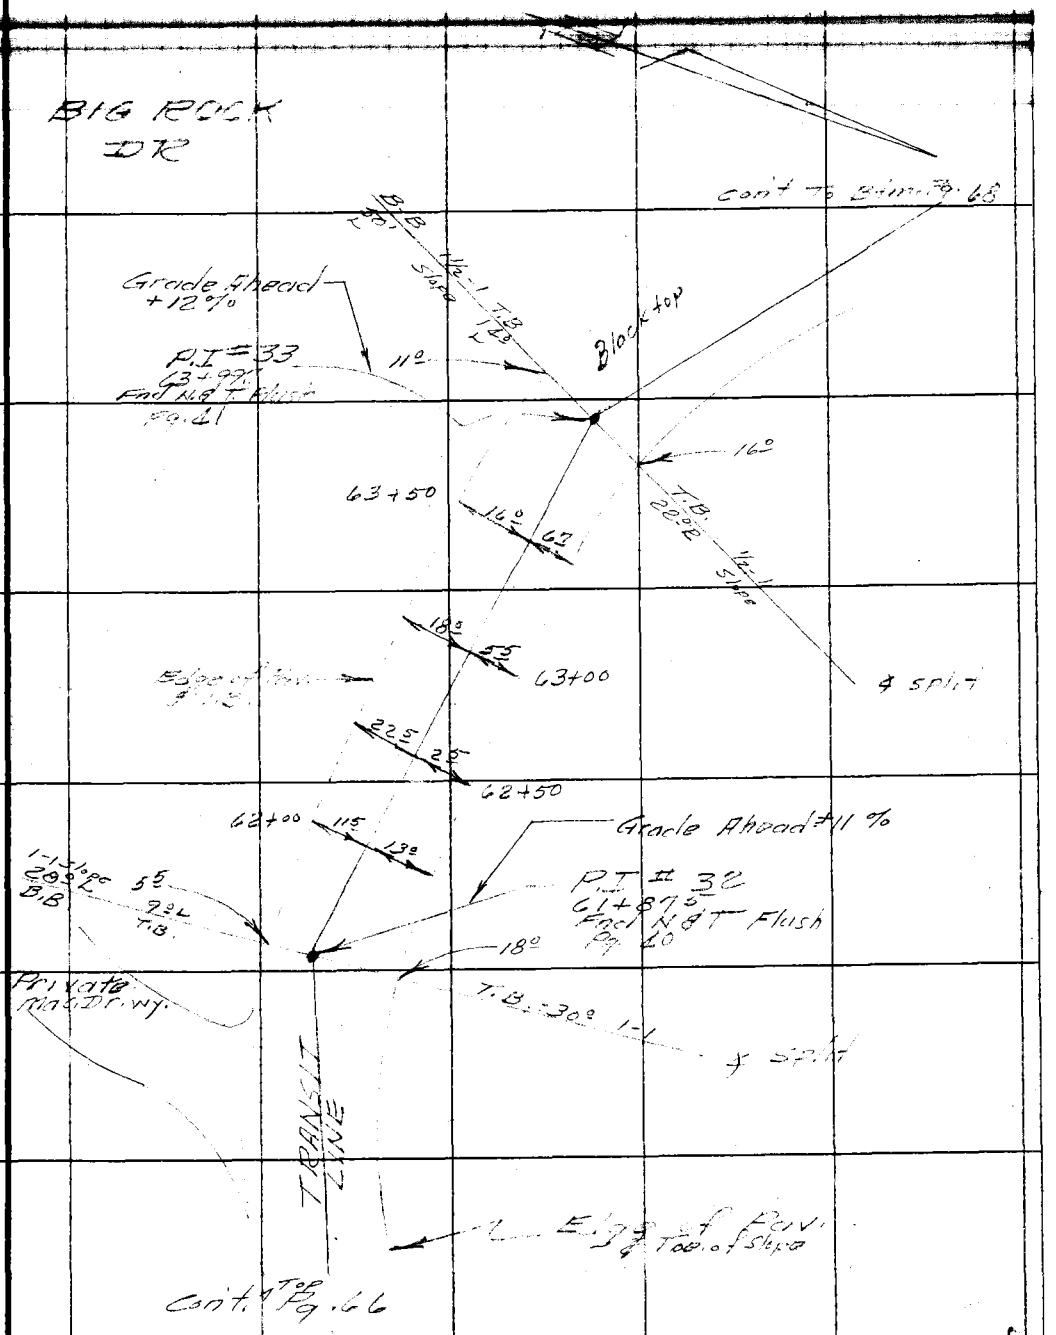

Note: Any Additions or Changes on This Sheet Must be Made or Circled in Red Ink With Date and Name of Person Making Change.

Do not extend notes this side of this line.

RETURN TO
LOS ANGELES COUNTY ENGINEER
700 LOS ANGELES COUNTY ENGINEERING BLDG.

76F309S CE #247—3-57

F. B 1848 PG. 68

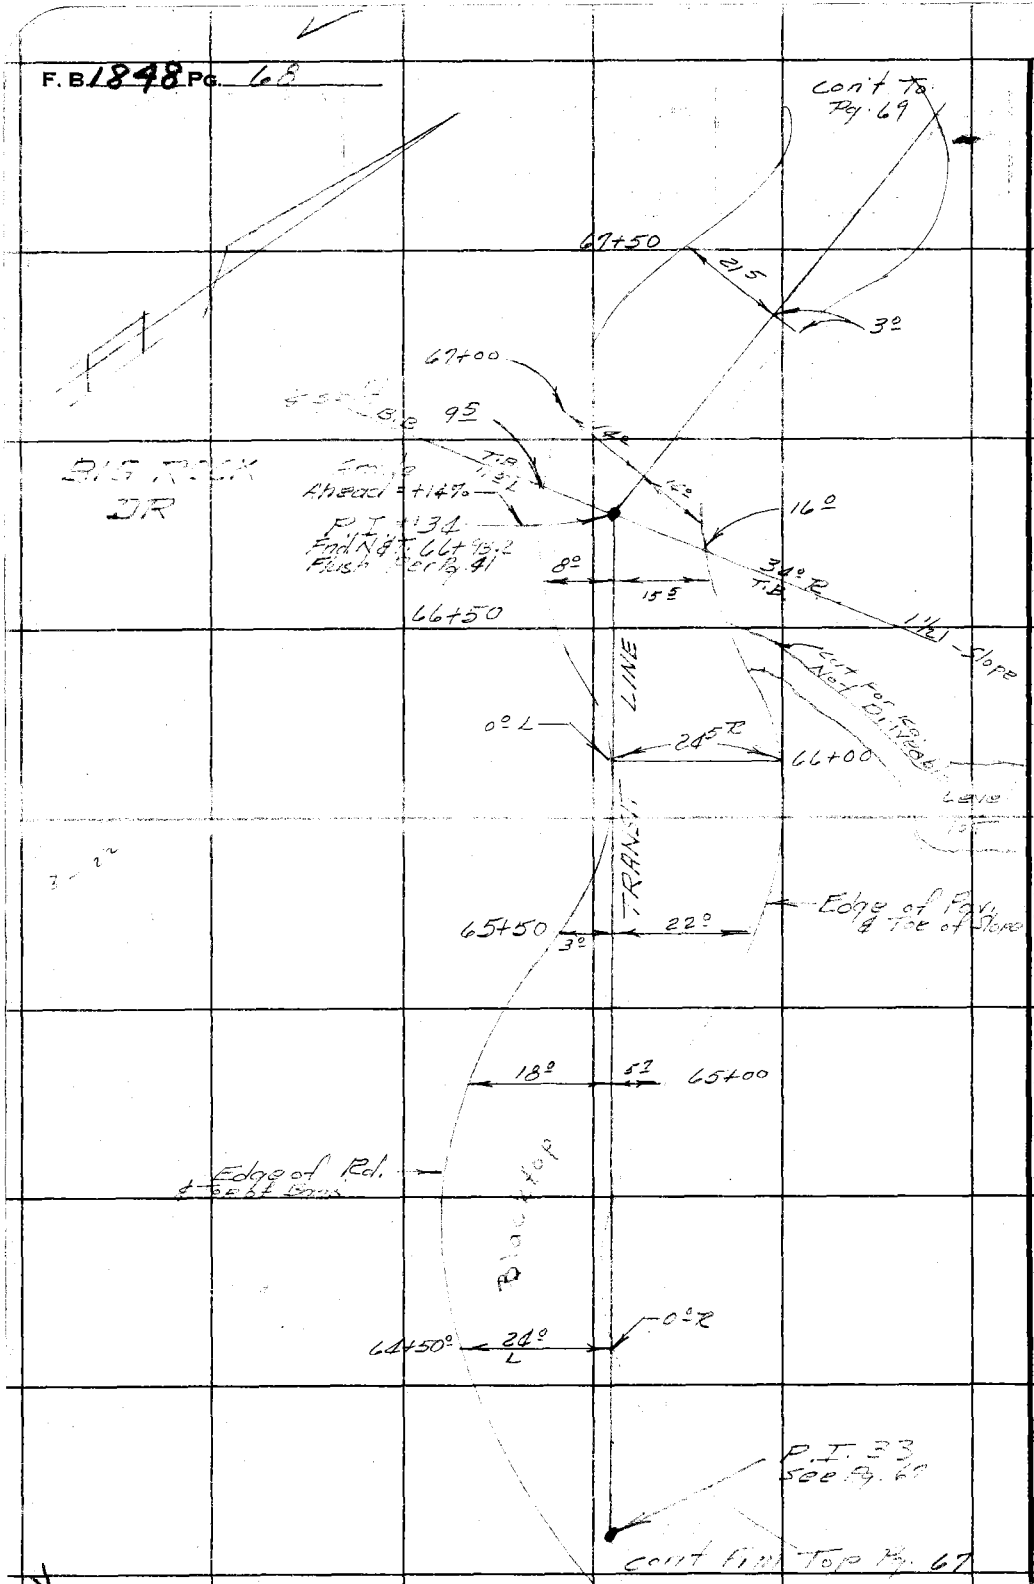

RETURN TO
LOS ANGELES COUNTY ENGINEER
700 LOS ANGELES COUNTY ENGINEERING BLDG.

Note: Any Additions or Changes on This Sheet Must be Made or Circled in Red Ink With Date and Name of Person Making Change.

Do not extend notes this side of this line.

Notes Ck'd by
Map No. 79-20
Office Work S. SHINODA
Checked
Date

Survey of Big Rock Dr
JN 0076.00 Tape Std °F
Surveyed by E. Ziglusin
Notes E. [illegible] Date 5-[illegible]
Indexed

F. B. 1848 Pg. 67

Note: Any Additions or Changes on This Sheet Must be Made or Circled in Red Ink With Date and Name of Person Making Change.

Do not extend notes this side of this line.

RETURN TO
LOS ANGELES COUNTY ENGINEER
700 Los Angeles County Engineering Bldg.

76F3098 CE #247—3-57

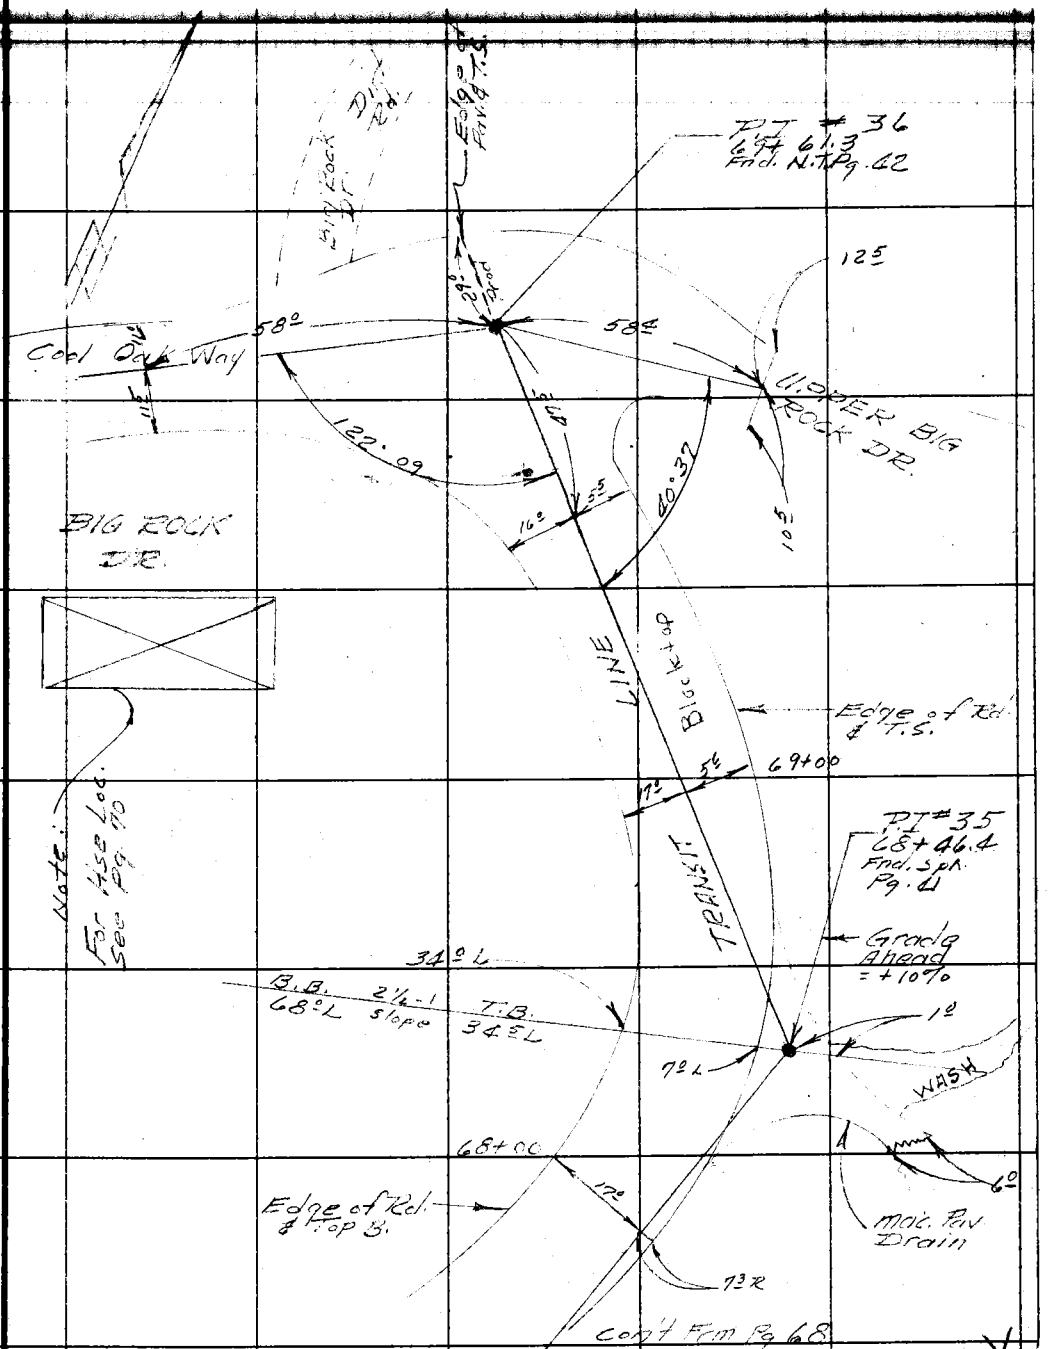

RETURN TO
LOS ANGELES COUNTY ENGINEER
700 LOS ANGELES COUNTY ENGINEERING BLDG.

Note: Any Additions or Changes on This Sheet Must be Made or Circled in Red Ink With Date and Name of Person Making Change.

Do not extend notes this side of this line.

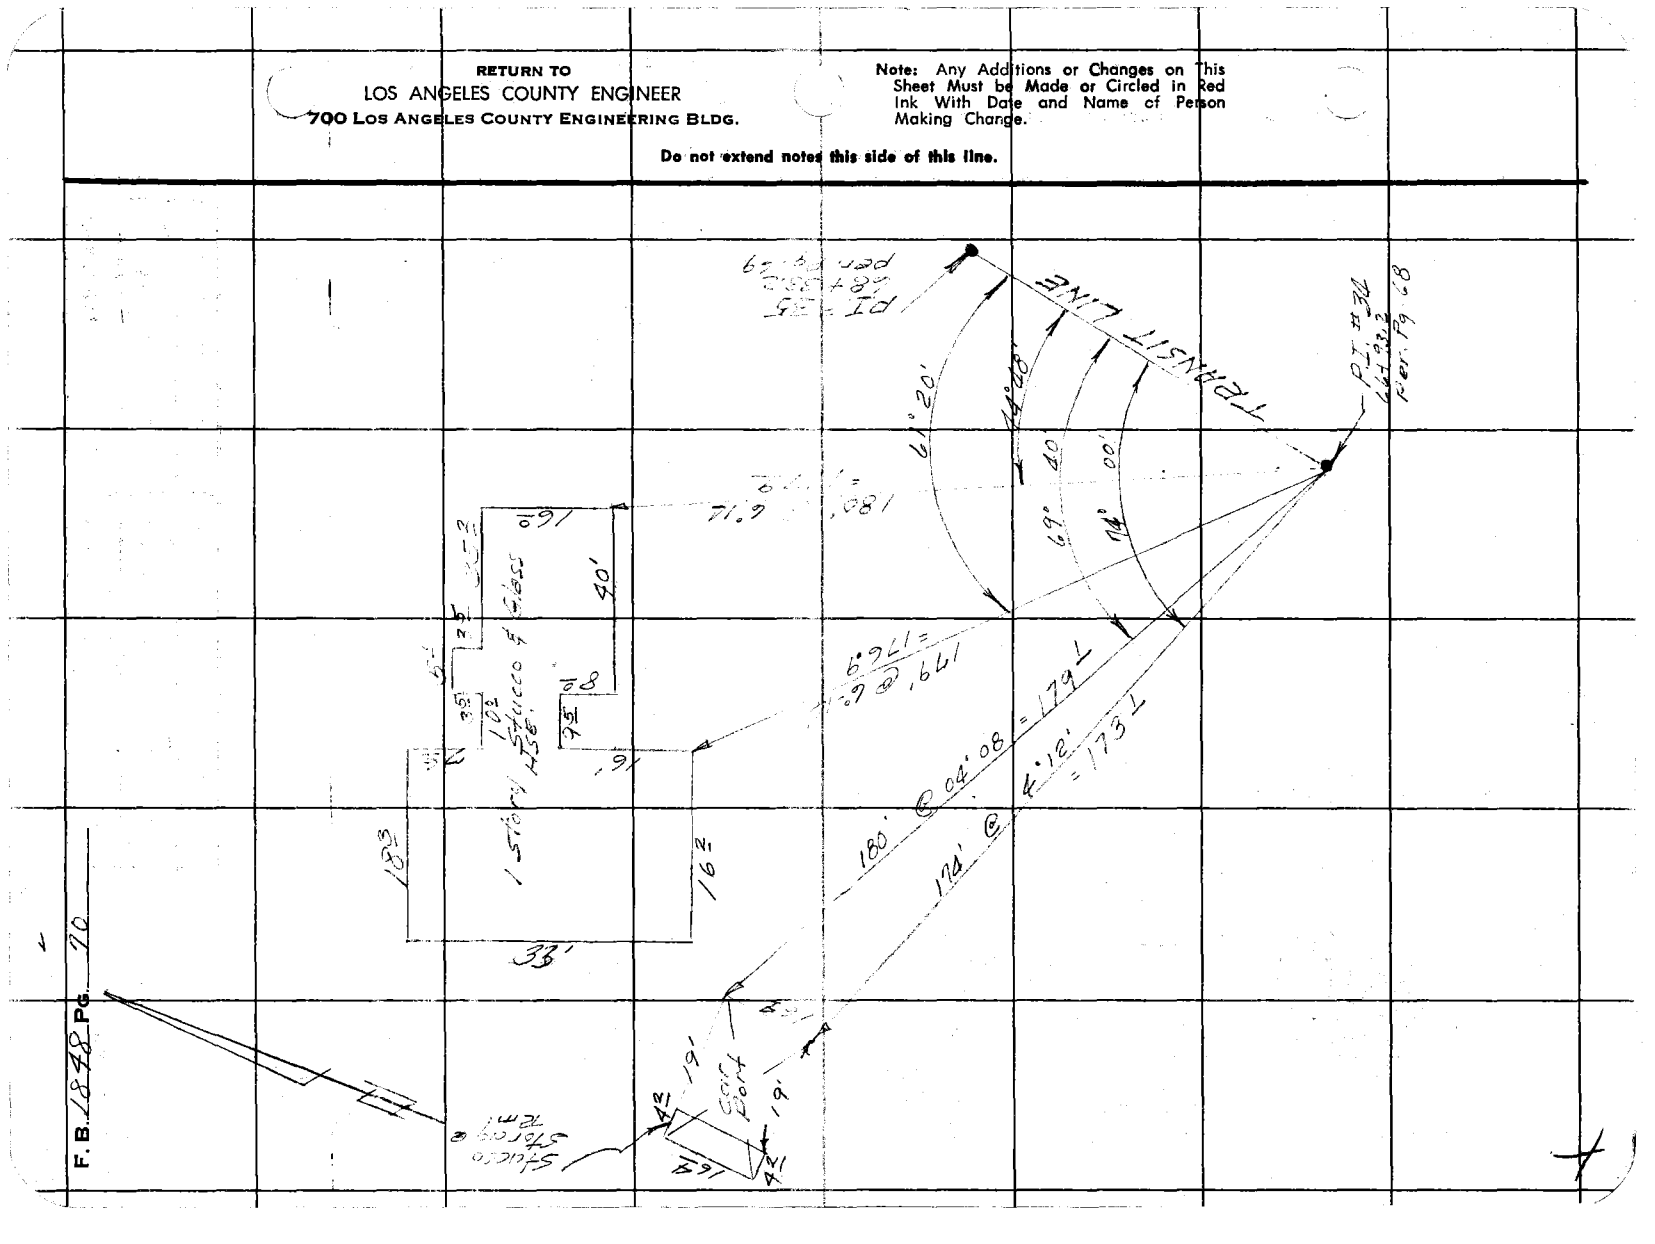

Notes Ck'd by
Map No. 99-20
Office Work S. SHINODA
Checked
Date

Survey of BIG ROCK DR.
JN Tape Std °F
Surveyed by
Notes GARDISKI Date
Indexed A. C. Johnson

F. B. 648 Pg. 11













Note: Any Additions or Changes on This Sheet Must be Made or Circled in Red Ink With Date and Name of Person Making Change.

Do not extend notes this side of this line.

RETURN TO
LOS ANGELES COUNTY ENGINEER
700 LOS ANGELES COUNTY ENGINEERING BLDG.

76F3095 CE #247—3-57

Cont. Pg. 61

RETURN TO
LOS ANGELES COUNTY ENGINEER
700 LOS ANGELES COUNTY ENGINEERING BLDG.

Note: Any Additions or Changes on This Sheet Must be Made or Circled in Red Ink With Date and Name of Person Making Change.

Do not extend notes this side of this line.

F. B. 1848 PG. 72

76L298 307 4-50

PLEASE RETURN TO

LOS ANGELES COUNTY SURVEYOR

726 Los Angeles County Engineering Bldg.

NOTE: ANY ADDITIONS OR CHANGES ON THIS SHEET MUST BE MADE OR CIRCLED IN RED INK, WITH DATE AND NAME OF PERSON MAKING CHANGE.

Do not extend notes this side of this line.

STATION	B. S.	H. I.	F. S.	ELEV.		

Profile Notes Red._____ Plotted_____ Job No._____ Division No._____ F. B._____ Pg._____

No._____ Date_____ Date_____ Survey of_____

X-Sec. Notes Chkd._____ Checked_____ Survey by_____ Notes_____ Date_____

No._____ Date_____ Date_____ Map No._____ Indexed_____ Date_____

F. B. Pg.

Job No. Division No. Notes Red. Plotted Profile

Survey of Date Date No.

Survey by Notes Notes Chkd. Checked X-Sec.

Indexed Date Date Date No.

STATION | B. S. | H. I. | F. S. | ELEV.

LOS ANGELES COUNTY

726 LOS ANGELES COUNTY ENGINEER

PLEASE RETURN

CHANGES MADE OR DATE AND CHANGE.

X