Map No. _____ JN _____ Tape _____ Std _____ °F
Office Work _____ Surveyed by _____
Checked _____ Notes _____ Date _____
Data _____ Indexed _____

LAWNDALE CO. BLDG. SITE 0021.28

	Bdry.	Survey on 147th St. at Grevilla Ave. and Burin Ave.
1-15	Elev.	Of rain run-off on 147th St. W. of Grevilla.
17-22	Const.	Loc. & staking & bench levels for Health and Library Building.
23-24	Const.	Stakes for buildings and walks.
25-54	Const.	Health & Library Bldg. Loc. & grades of curbs, walks, buildings & drive-ways.
55-57	Grad.	Grading for lawn area south of library building.
59-60		Index.
61-66	Bdry.	Survey between Lawndale Park & Lawndale Civic Center.

CITY of LAWNDALE 3464.39

67-69	B.M.	Levels for Civic Center
71-79	C.L	Bounded by Prairie, 166th, Osage, & 168th St.
80		Set lot corners-Lots #143 & #168 Tr. #8293

Microfilmed Feb 87

PLEASE RETURN TO
LOS ANGELES COUNTY ENGINEER
403 LOS ANGELES COUNTY ENGINEERING BLDG.

Note: Any Additions or Changes on this Sheet Must be Made or Circled in Red Ink With Date and Name of Person Making Change.

Do not extend this side of this line.

F.B. _____ Pg. _____

F. B. 127-1 Pg. 5

Map No. B 2909
Office Work CED
Checked D. M. Finley
Date Sept 1954

W. O. [illegible] Maps No. [illegible] Sht. [illegible]
Surveyed by Wallace
Notes E.C. Wallace Date 7-12-54
Indexed

J. N. 8021.28

LAWNDALE COUNTY BLDG. SITE

Boundary Survey

LAWNDALE
BLK. 14
LOTS 1 TO 10 INCL.

Wallace
Mankey
York
Bradach

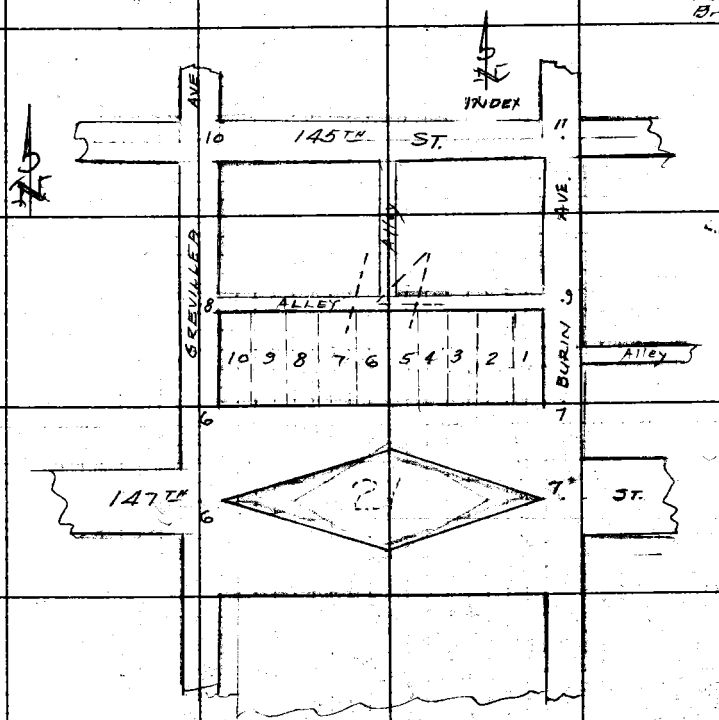

Note: Any Additions or Changes on This Sheet Must be Made or Circled In Red Ink With Date and Name of Person Making Change.

Do not extend notes this side of this line.

RETURN TO
LOS ANGELES COUNTY SURVEYOR
726 LOS ANGELES COUNTY
ENGINEERING BLDG.

767S098 247 4-53

RETURN TO
LOS ANGELES COUNTY SURVEYOR
726 LOS ANGELES COUNTY
ENGINEERING BLDG.

Note: Any Additions or Changes on This Sheet Must be Made or Circled in Red Ink With Date and Name of Person Making Change.

Do not extend notes this side of this line.

W.S. 25 C-2

RE 1302

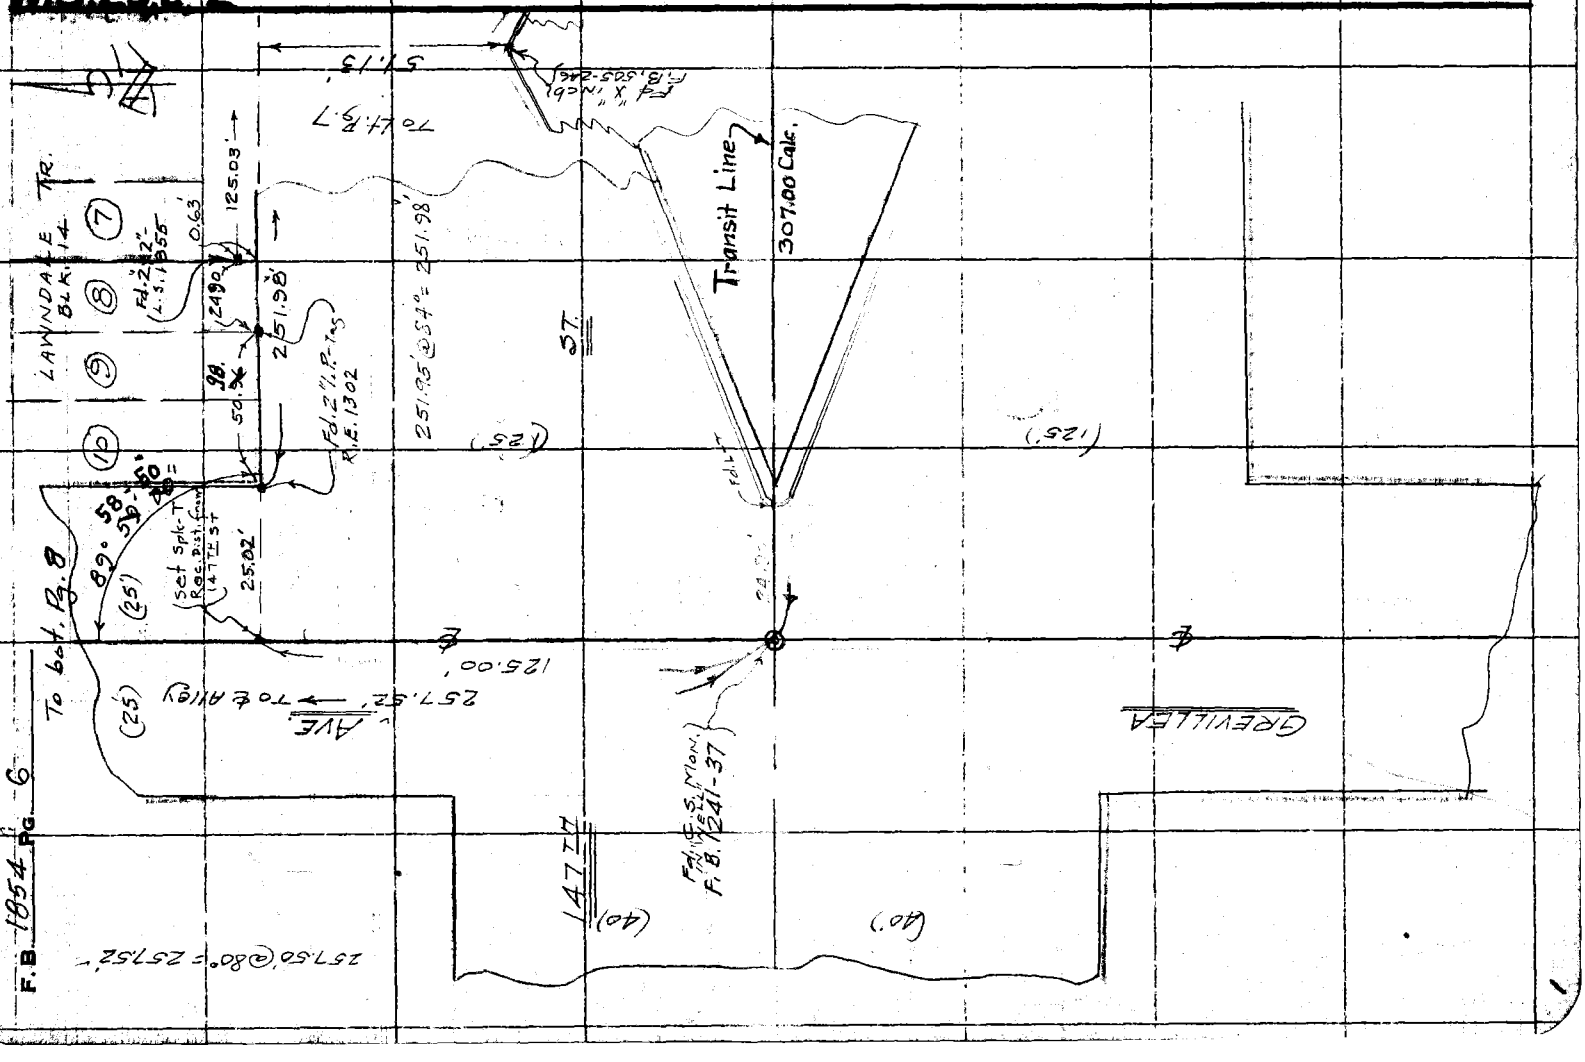

F. B. _____ Pg. _____

Map No. 12-2905 | W. O. _____ Tape No: 120 St'd. 60 °F

Office Work _____ | Surveyed by _____

Checked D. M. Finley | Notes _____ Date 7-12-54

Date _____ | Indexed _____

125.01' 51.07' 30.00'

251.98'

Fd. 2"x2" Tag L.S. 1855

Set 1" I.P.-cemplus 6" dp

Set Spk.-T Rec. Dist. from 147TH ST.

R=40' 89°58'30" C.S.B. 993

147TH

AVE.

125.00'

125.00' ST

(125')

(50')

To RH. B6

Transit Line

307.00 Calc.

27.38'

Fd. L

Fd. 3/4" I.P. TK - 2" dp F.B. 1241-31

R=20' 90°01'30" F.B. 1241-31

(125')

(50')

BURIN

Note: Any Additions or Changes on this Sheet Must be Made or Circled in Red Ink With Date and Name of Person Making Change.

Do not extend notes this side of this line.

RETURN TO
LOS ANGELES COUNTY SURVEYOR
726 LOS ANGELES COUNTY
ENGINEERING BLDG.

7675098 247 4-53

F. B. 1854 Pg. 8

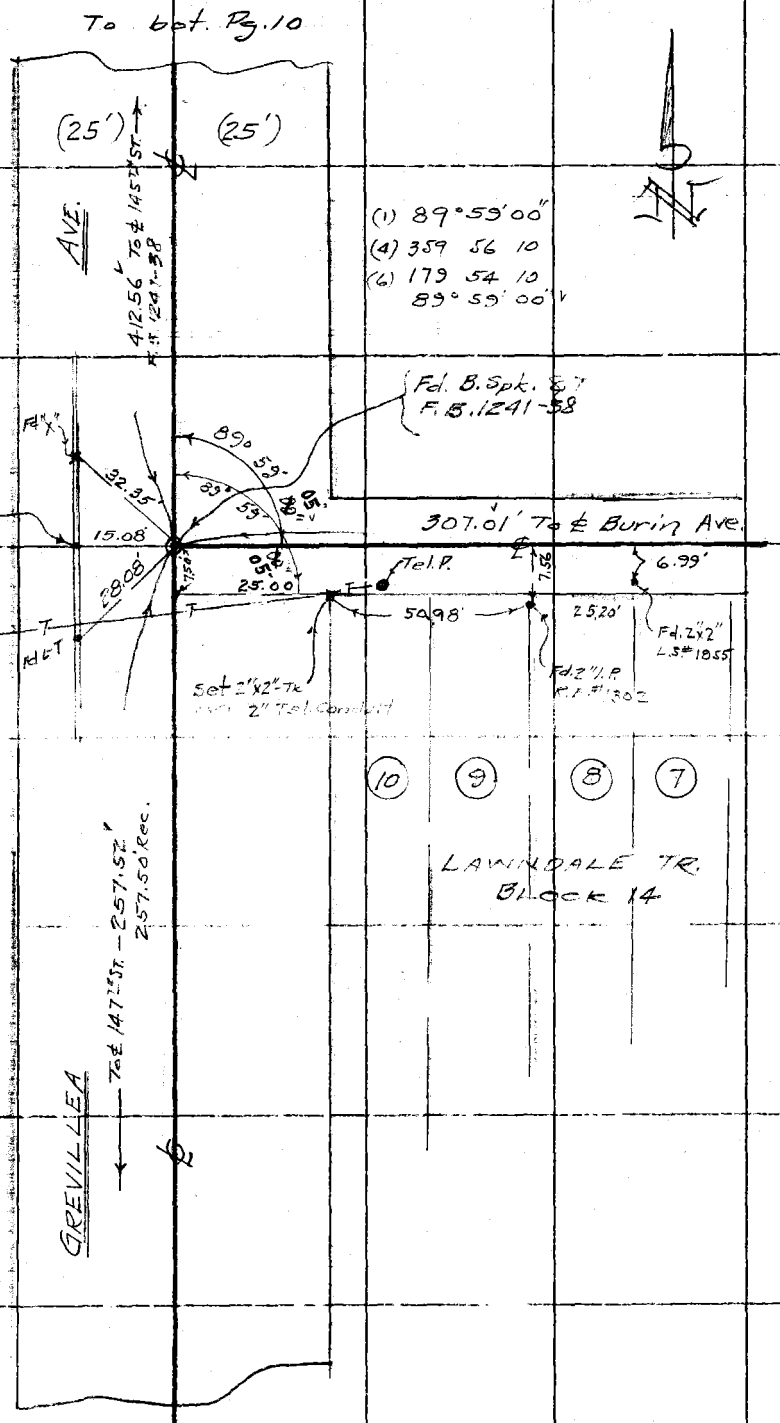

RETURN TO
LOS ANGELES COUNTY SURVEYOR
726 LOS ANGELES COUNTY
ENGINEERING BLDG.

Do not extend notes this side of this line.

Note: Any Additions or Changes on This Sheet Must be Made or Circled in Red Ink With Date and Name of Person Making Change.

B.M N 52 - E 1.60.35

[illegible] B&T in "X" @ Intsc. of curb on East side of Grevillea & Prod of 147th ST. from West

6035 - 5.50

65.85 - 1 FS

Floor 64.00
64.00
+1.66
65.66
+1

B.M. 6035

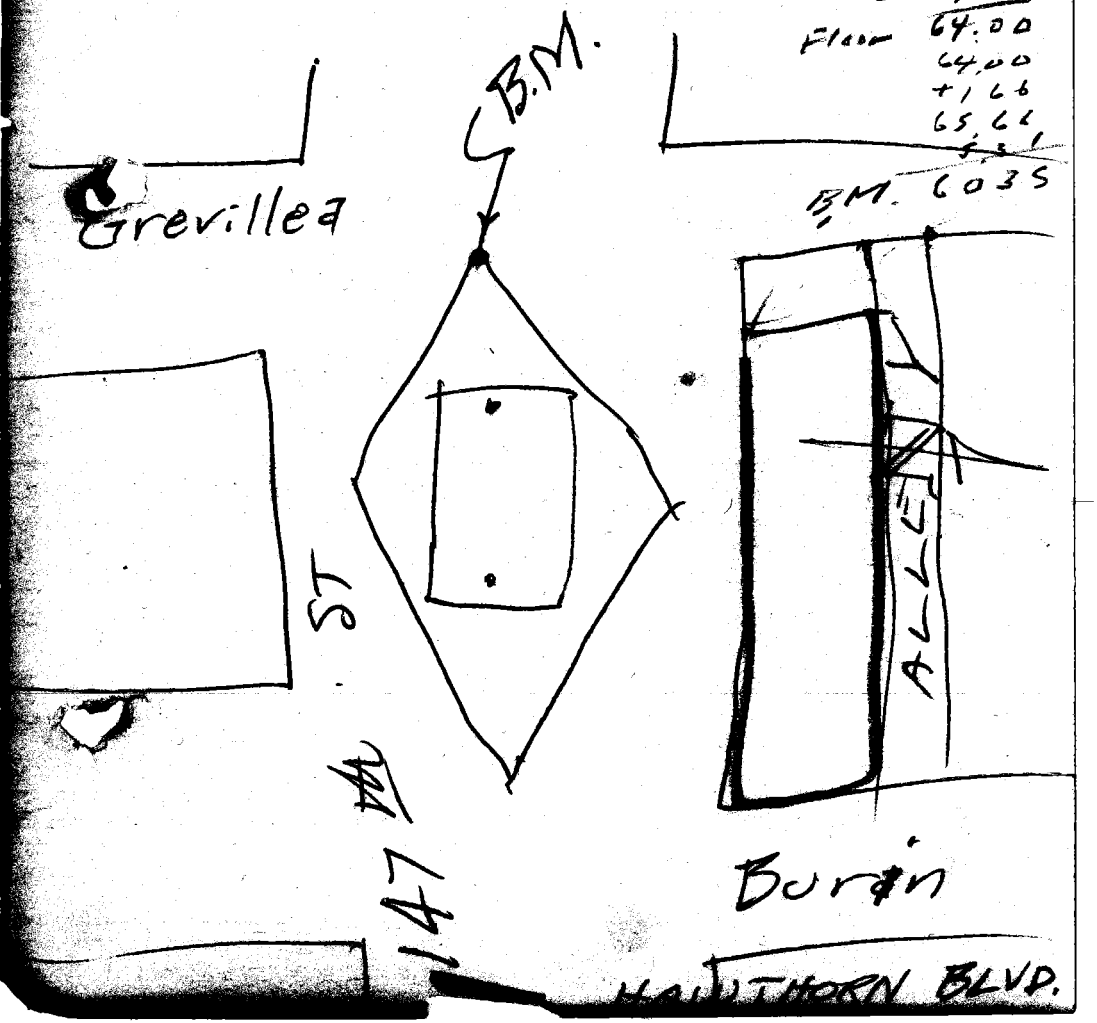

F. B. 1241 PG. 9

Map No. [illegible] W. O. [illegible] Maps No. [illegible]
Office Work CED Surveyed by [illegible]
Checked B. M. Finley Notes [illegible] Date 7-12-54
Date [illegible] Indexed

To Bet. Pg. 11

(38') (30')

412.47' @ 74°

AVE

412.49'

307.00 @ 74° = 307.01'

307.01' meas.

307.00 Rec.

(75') (75')

7.01'

Fd. 2½" I.S. "1955"

Set 3/4" I.P. cem plg 10" dp.

30.00

89° 58' 53"

89° 58' 35"

Fd. S.W.&T.

Set "□" Spk-T

74.98' @ 74° = 74.98'

LAWNDALE TR.
BLOCK 14

(1) 89° 58' 50"
(4) 359 55 40
(6) 179 53 20
89 58 53 1/3"

74.98'

Fd. R.R. Spk-W.T
F.B. 1241-32

Fd 4-Tan 0.3 Spk-T

(7½') (7½') (4½')

BURIN

57.50'

57.50 @ 74° = 57.50'

To Top Pg. 7

3 2 1

Note: Any Additions or Changes on This Sheet Must be Made or Circled In Red Ink With Date and Name of Person Making Change.

Do not extend notes this side of this line.

RETURN TO
LOS ANGELES COUNTY SURVEYOR
726 LOS ANGELES COUNTY
ENGINEERING BLDG.

78FB088 247 4-53

RETURN TO
LOS ANGELES COUNTY SURVEYOR
726 LOS ANGELES COUNTY
ENGINEERING BLDG.

Note: Any Additions or Changes on This Sheet Must be Made or Circled in Red Ink With Date and Name of Person Making Change.

Do not extend notes this side of this line.

W.S. 25, C-2

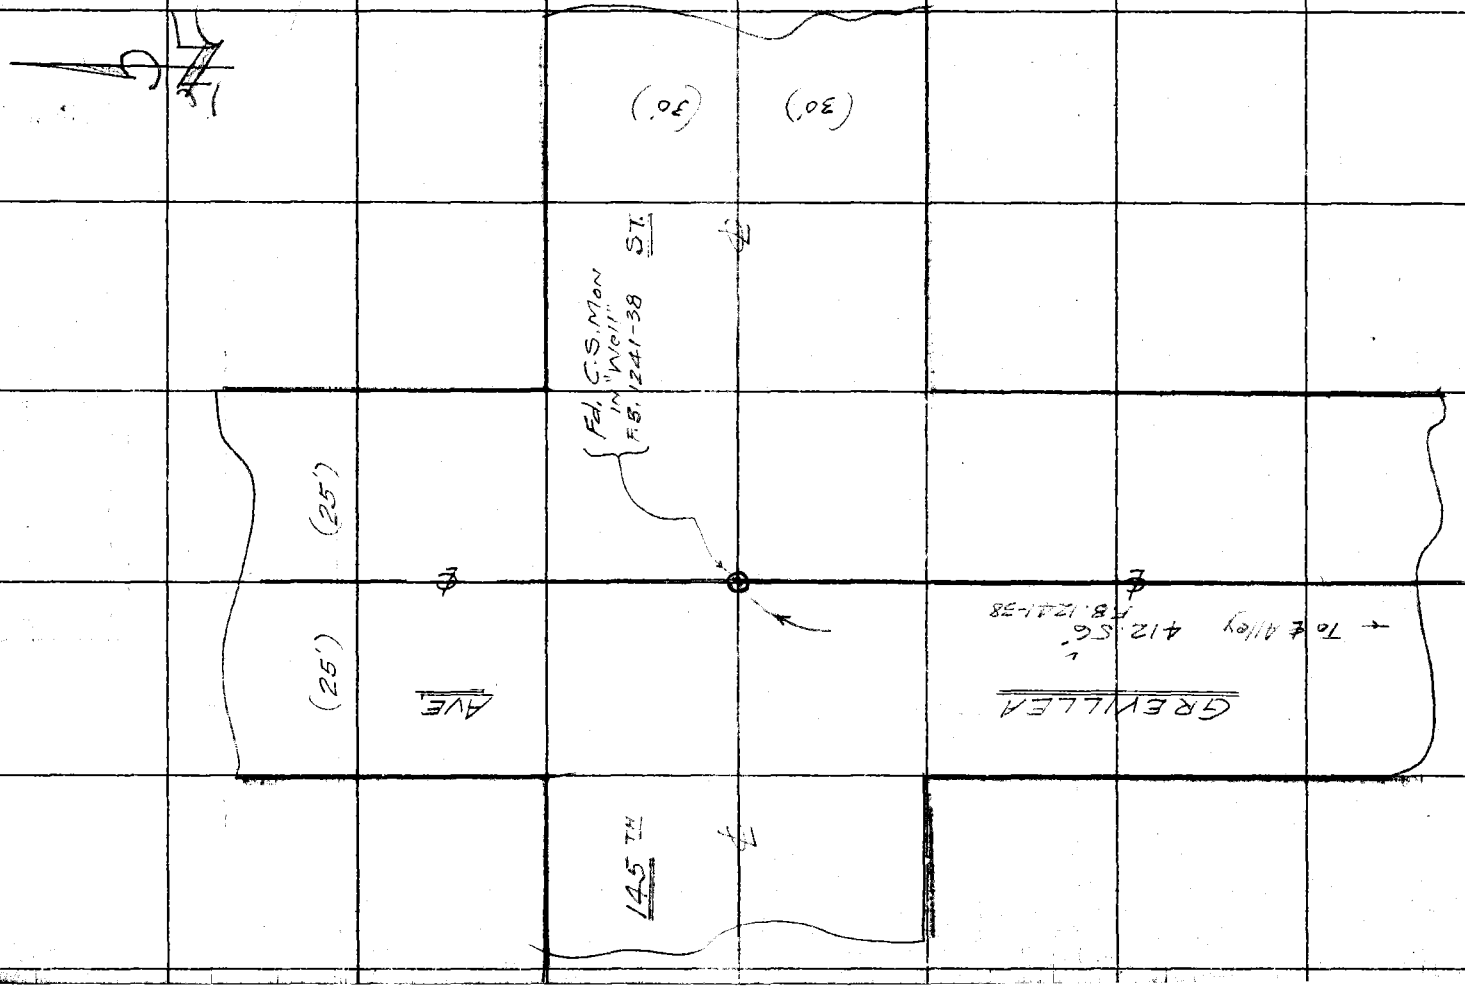

F.B. 1854 PG. 10

F. B. _____ PG. _____

Map No. D-2109 | W. O. _____ Tape No. 3750 Std. 60'
Office Work CED | Surveyed by Wallace
Checked D. M. Finley | Notes E.C.W. Date 7-17-54
Date Sept 1 1954 | Indexed

Fd Pin
T.L. RIM
F.B. 1241-33

0.15

℄ ℄ Pgr F.B. 1241-33

ROSECRANS AVE.

(30') (30')

AVE

145TH

℄

Fd. 3/4" I.P. TK
2" HP
F.B. 1241-32

ST.

(30')

(30')

℄

℄

BURIN

412.49

℄

To top Pg. 9

Note: Any Additions or Changes on This Sheet Must be Made or Circled In Red Ink With Date and Name of Person Making Change.

Do not extend notes this side of this line.

RETURN TO
LOS ANGELES COUNTY SURVEYOR
726 LOS ANGELES COUNTY
ENGINEERING BLDG.

76F3098 247 4-53

RETURN TO
LOS ANGELES COUNTY SURVEYOR
726 LOS ANGELES COUNTY
ENGINEERING BLDG.

Note: Any Additions or Changes on This Sheet Must be Made or Circled in Red Ink With Date and Name of Person Making Change.

Do not extend notes this side of this line.

F. B. 1854 PG. 12

Profile | Notes Red. | Plotted | Job No. | Division No. | F. B. 15[illegible] Pg. 15

X-Sec. No. | Notes Chkd. Date | Checked Date | Survey by [illegible] Notes [illegible] Date [illegible] | Map No. | Plotted A. C. Johnson Date 1-27-56

J.N. 002123

LAWNDALE COUNTY BLDG. SITE.

JAN. 26-1956

ELEVS. ON LOTS-1-10-LAWNDALE TRCT. BLCK. 14 AND LIBRARY BLDG. ON SO. SIDE 147th ST. BETWEEN GREVILLEA AVE. and BURIN AVE.

(DURING HEAVY RAIN TO CHECK STREET WATER LEVEL

A.N. HELLSTROM
J.M. MALDONADO
G.L. MATTHIESEN
R.E. DOVER

STATION	B. S.	H. I.	F. S.	ELEV.

NOTE: ANY ADDITIONS OR CHANGES ON THIS SHEET MUST BE MADE OR CIRCLED IN RED INK, WITH DATE AND NAME OF PERSON MAKING CHANGE.

Do not extend notes this side of this line.

PLEASE RETURN TO
LOS ANGELES COUNTY SURVEYOR
726 Los Angeles County Engineering Bldg.

76L298 S & E #307 9-54

76L298 S & E #307 9-54

PLEASE RETURN TO
LOS ANGELES COUNTY SURVEYOR
726 Los Angeles County Engineering Bldg.

NOTE: ANY ADDITIONS OR CHANGES ON THIS SHEET MUST BE MADE OR CIRCLED IN RED INK, WITH DATE AND NAME OF PERSON MAKING CHANGE.

Do not extend notes this side of this line.

F.B. 18554 Pg. 14 | Job No. 002128 Division No. 10 Notes Red ____ Plotted ____ No. ____ Profile
Survey of Lawndale Co. Bldg. Site Date ____ No. ____ X-Sec.
Survey by Hellstrom Notes A.M.H. Notes Chkd. K.K.M. Checked ____
Indexed A. C. Johnson Date ____ Date 12/30/56 Date ____

STATION	B. S.	H. I.	F. S.	ELEV.		
Fd. B.M. "N-52				60 35	B.M. "N-52 - Elev. 60.35 - F.B. 1241-11 Grevilla & 147th St. - Let in "X" @ Inters of Curbs on E. Sd. Grevilla, on S Prod. of 147th St. from W.	
	5.06	65 41				
			3 82	61 59	Floor Elev. @ W. Door of Library Bldg.	
			4 60	60 81	Tp. Crb. and Water Lev. @ Lots 1 To 10 at S.W. Cor.	
			4 50	60 91	Ground Elev. " " " " " "	
			4 53	60 88	Tp. Crb. and Wata. Lev. @ Lots 1 To 10 at S.E. Cor.	
			3 18	61 63	Water Lev. @ N.E. Cor. Lots 1 To 10	
			3 20	61 61	Ground Elev. @ " " "	
			3 60	61 21	Water Lev. @ N.W. Cor. Lots 1 To 10	
			3 50	61 31	Ground Elev. @ " " " "	
			4 23	61 18	Low Spot in Lots 1-10 Ground Elev.	6.5' E. of Retaining Wall and 20'± N. of 147th St.
			3 93	61 48	Water Elev. at Low Spot	" " "
			4 55	60 86	Top of Curb and Water Level on So. Side Lots 1-10 and Mid-way between Grevilla & Burin Sts.	
			5 33	60 08	Gutter " "	" "
			4 94	60 47	Water Lev. at Curb On N. Sd. Library Bldg.	
			5 54	59 87	Gutter " " " "	
T.P.			4 30	61 11		
	4 81	65 92				
			3 31	62 31	Floor Elev. at E. Door of Lib. Bldg.	

76L298 S & E #307 9-54

PLEASE RETURN TO
LOS ANGELES COUNTY SURVEYOR
726 Los Angeles County Engineering Bldg.

NOTE: ANY ADDITIONS OR CHANGES ON THIS SHEET MUST BE MADE OR CIRCLED IN RED INK, WITH DATE AND NAME OF PERSON MAKING CHANGE.

Do not extend notes this side of this line.

STATION	B. S.	H. I.	F. S.	ELEV.
B.M. N-62		65 92	5 58	60 34

B.M. N-62 - Elev. 60.35 pr. pg. 14

Note: North and South Doors are same Elev. as East Door of Library Bldg.

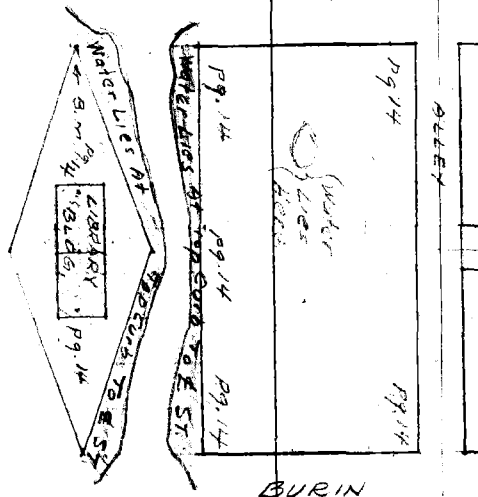

Profile Notes Red. Plotted Job No. Division No. F. B. Pg.

X-Sec. Notes Chkd. Checked Survey By

No. Date Date Map No. Drawn By Johnson Date 1-27-56

F. B. 1854 Pg. 16

Job No. Division No. Notes Red. Plotted Profile

Survey of Date Date No.

Survey by Notes Notes Chkd. Checked X-Sec.

Indexed Date Date Date No.

STATION	B. S.	H. I.	F. S.	ELEV.

Do not extend notes this side of this line.

NOTE: ANY ADDITIONS OR CHANGES ON THIS SHEET MUST BE MADE OR CIRCLED IN RED INK, WITH DATE AND NAME OF PERSON MAKING CHANGE.

PLEASE RETURN TO

LOS ANGELES COUNTY SURVEYOR

726 LOS ANGELES COUNTY ENGINEERING BLDG.

76L298 S & E #307 9-54

F. B. _____ Pg. 17

Map No. _____
Office Work _____
Checked _____
Date _____

Surveyed by A.S. Curtis
Notes ETM/JR Date 2-20-56
A. C. Johnson
Indexed

LAWNDALE ADMINISTRATION CENTER

HEALTH & LIBRARY BLDG.

Building Location & staking plan

Curtis
Markey
Martinez
Adams
Moore

Note: Any Additions or Changes on This Sheet Must be Made in Red Ink With Date and Name of Person Making Change.

Do not extend notes this side of this line.

RETURN TO
LOS ANGELES COUNTY SURVEYOR
726 LOS ANGELES COUNTY
ENGINEERING BLDG.

76F3098 247 4-53

F.B. 1854 Pg. 18

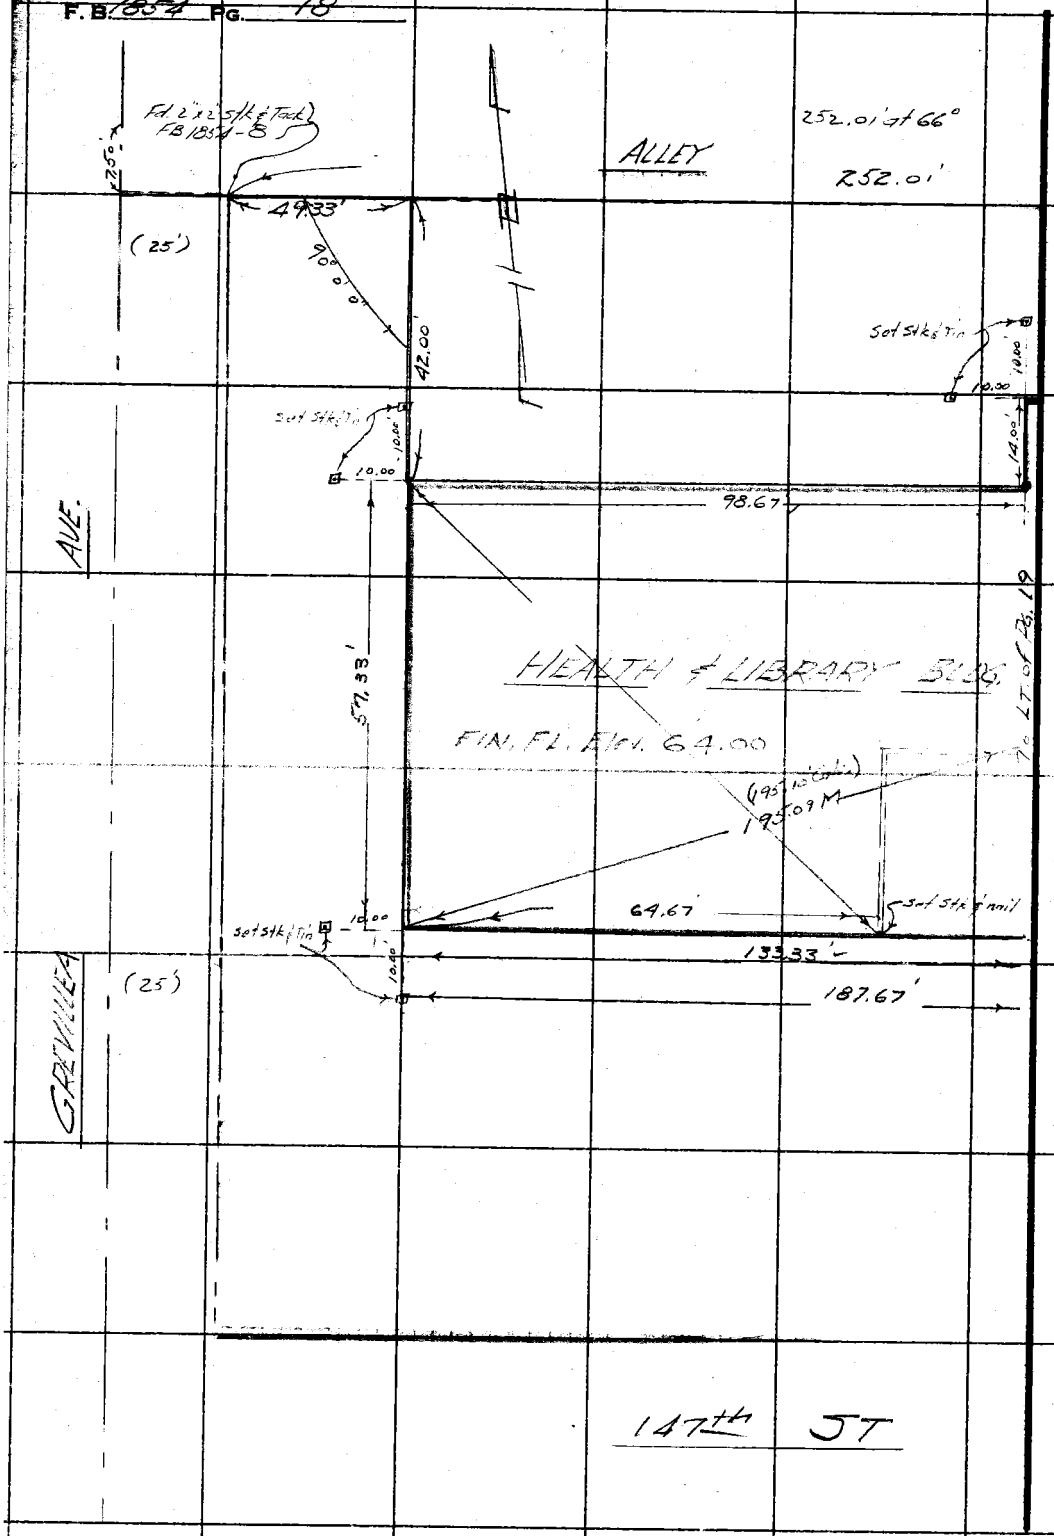

RETURN TO
LOS ANGELES COUNTY SURVEYOR
720 LOS ANGELES COUNTY
ENGINEERING BLDG.
Do not extend notes this side of this line.

Note: Any Additions or Changes on This Sheet Must be Made or Circled in Red Ink With Date and Name of Person Making Change.

F. B. 1854 PG. 19

Map No.
Office Work
Checked
Date

Survey of
W. O. Tape No. Sht.
Surveyed by
Notes EMM-1C Date 2-20-'68
Indexed

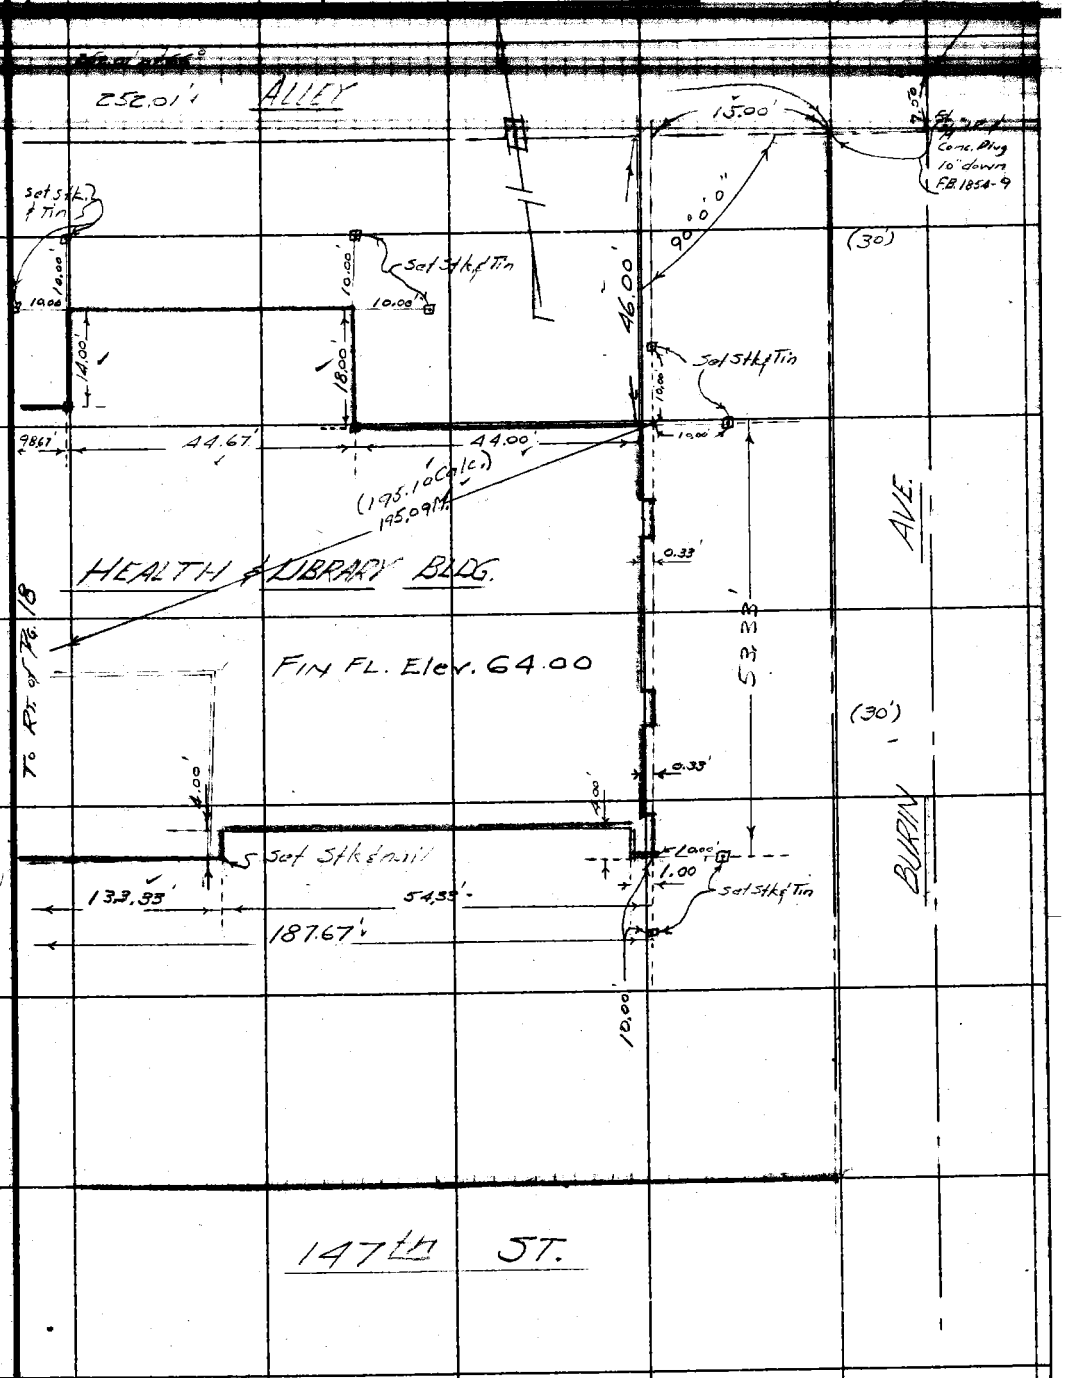

Note: Any Additions or Changes on This Sheet Must be Made in Red Ink With Date and Name of Person Making Change.

Do not extend notes this side of this line.

RETURN TO
LOS ANGELES COUNTY SURVEYOR
726 LOS ANGELES COUNTY
ENGINEERING BLDG.

76FS0S8 247 4-53

RETURN TO
LOS ANGELES COUNTY SURVEYOR
726 LOS ANGELES COUNTY
ENGINEERING BLDG.

Note: Any Additions or Changes on This Sheet Must be Made or Circled In Red Ink With Date and Name of Person Making Change.

Do not extend notes this side of this line.

F.B. 1854 PG. 20

Profile Notes Red. Plotted 7257.01 Job No. Division No. 10 F. B. 1854 Pg. 21

X-Sec. Notes Chkd. Checked Survey by [illegible] Notes [illegible] Date

No. Date Date Map No. Enderud Johnson Date FEB 21 '56

J.N. 7257.01

Lawndale Administration Center.

Health & Library Building.

Tem. Benches Set.

Curtis
Mankey
Martinez
Adams
Moore

STATION	B. S.	H. I.	F. S.	ELEV.

NOTE: ANY ADDITIONS OR CHANGES ON THIS SHEET MUST BE MADE OR CIRCLED IN RED INK, WITH DATE AND NAME OF PERSON MAKING CHANGE.

Do not extend notes this side of this line.

PLEASE RETURN TO
LOS ANGELES COUNTY SURVEYOR
726 Los Angeles County Engineering Bldg.

761.298 307 8-53

76L298 307 8-53

PLEASE RETURN TO
LOS ANGELES COUNTY SURVEYOR
726 Los Angeles County Engineering Bldg.

NOTE: ANY ADDITIONS OR CHANGES ON THIS SHEET MUST BE MADE OR CIRCLED IN RED INK, WITH DATE AND NAME OF PERSON MAKING CHANGE.

Do not extend notes this side of this line.

F. B. 1854 Pg. 22 Job No. 72571.01 Division No. 10 Notes Red. Plotted
Survey of Lawndale Adm. Center Date Date No. X-Sec.
Survey by Curtis Notes Curtis Notes Chkd. KBM Checked
Indexed A. C. Johnson Date Date Date No. Profile

STATION	B. S.	H. I.	F. S.	ELEV.	
		Finish Floor	Elev.	of Administration Bldg. is EL. 64.00	
B.M.# N-52 (Fd)				60.35	BM# N 52 El. 60.35 pg. 14 - Grevillea Ave & 147th ST. - L&T in "X" @ Inters. of curbs on E. side Grevillea, on & Prod. of 147th ST. from W.
	5.50	65.85			
T.B.M. (Set)	FIN FL Elev.		1.85	64.00	T.B.M. At First Alley No. of 147th ST & First Alley W. of Burin Ave. Large Bt. spk. in South side of Tel. Pole.
T.B.M. (Set)	FIN FL. Elev.		1.85	64.00	T.B.M. Burin Ave. W. Side & ± 80' No. of N. Curb Line of 147th ST. - Large Wire spk & T in W. Side Guy Pole.
	1.66	65.66			
B.M.# N-52			5.31	60.35	BM#
	5.405	65.755			
TBM (Set)			3.542	62.213	T.B.M. Grevillea Ave & 147th ST. (old Library Bldg.) Bt. spk & Lead in N.E. cor. top step - No. side building
	3.446	65.659			
T.P.			3.161	62.498	T.P. Wire spk in N. side Light pole
	3.975	65.573			
BM# N-52			5.225	60.348	BM# N-52 — 5 To be destroyed El. 60.35

F. B. _____ Pg. 22

Map No. _____ W. O. _____ Type No. _____ Sht. _____ of _____

Office Work _____ Surveyed by _____

Checked _____ Notes _____ Date 2-23-56

JN 7257.01

LAWNDALE ADMINISTRATION CENTER

HEALTH & LIBRARY BLDG.

Construction Stakes

for

Service Yard, Service Bldg, & Walks

Curtis
Mowbray
Mendenhall
Moore

Note: Any Additions or Changes on This Sheet Must be Made or Circled in Red Ink With Date and Name of Person Making Change.

Do not extend notes this side of this line.

RETURN TO
LOS ANGELES COUNTY SURVEYOR
726 LOS ANGELES COUNTY
ENGINEERING BLDG.

76F3095 S&E #247. 8-54

F. B. 1854 PG. 24

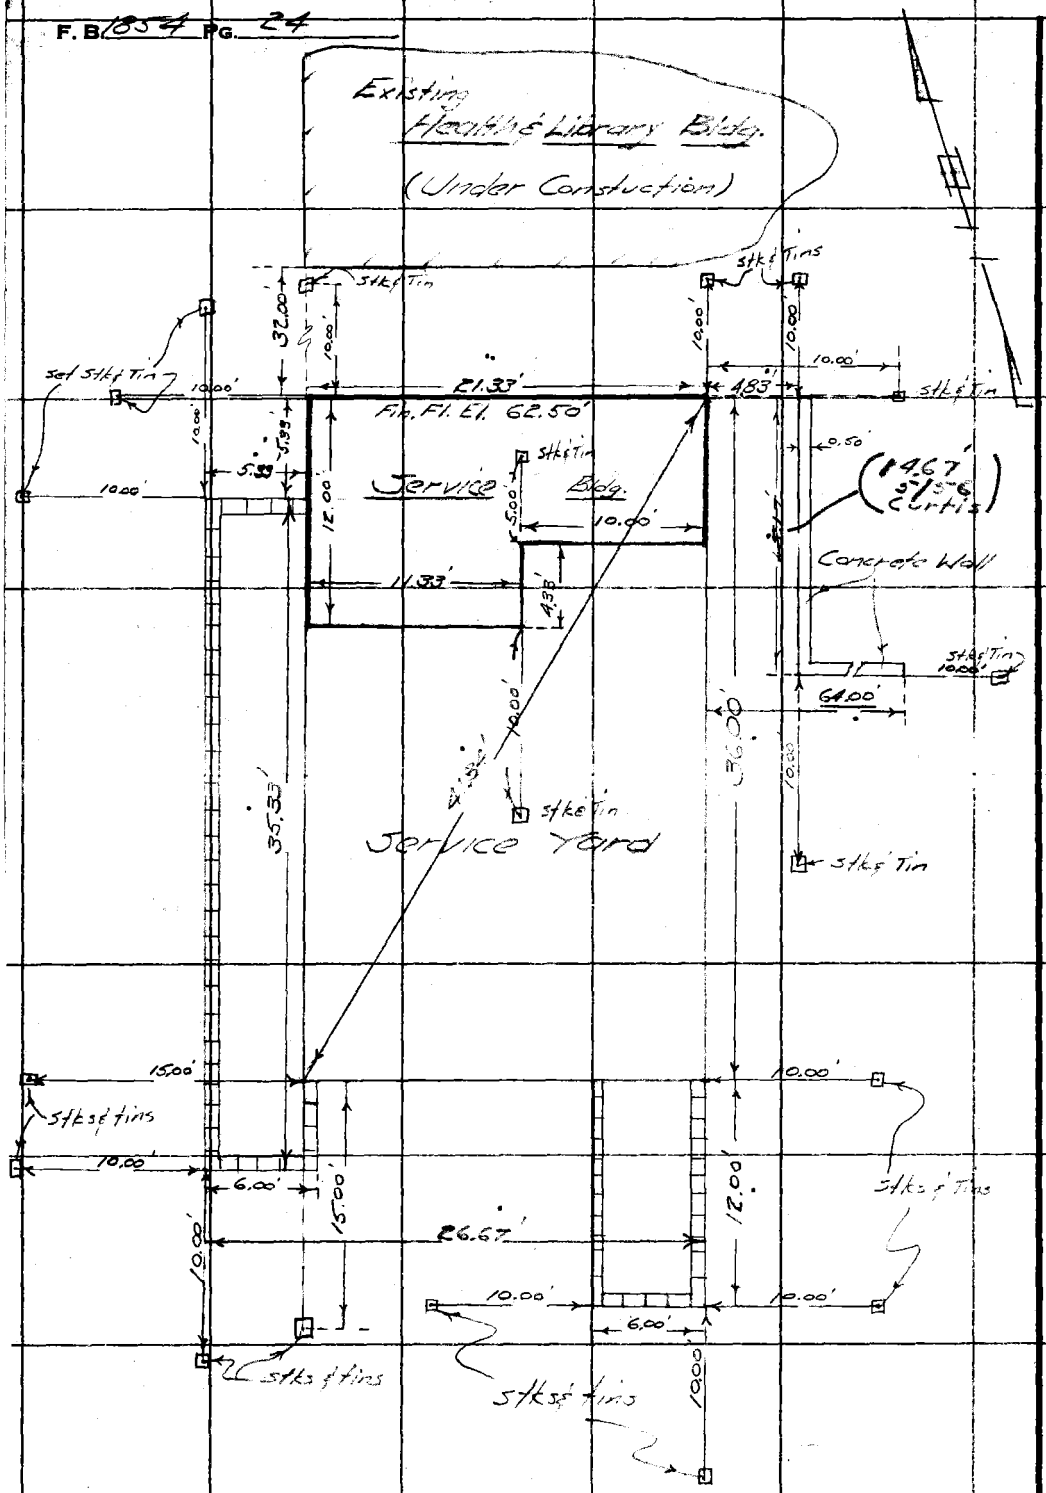

RETURN TO
LOS ANGELES COUNTY SURVEYOR
726 LOS ANGELES COUNTY
ENGINEERING BLDG.

Note: Any Additions or Changes on This Sheet Must be Made or Circled in Red Ink With Date and Name of Person Making Change.

Do not extend notes this side of this line.

Profile Notes Red. Plotted Job No. 7[illegible]01 Division No. F. B. 1854 Pg. 25

X-Sec. No. Notes Chkd. Checked Survey by [illegible] Notes [illegible]

Date Date Map No. Indexed Date 8-15-56

JN 7231.01

LAWNDALE ADMIN. CTR.

HEALTH & LIBRARY BLDG.

Curb Grades for Curb 20.00' West of ℄ of Burin Ave

West side from first Alley N. 147th St.

To N.W. Cor 147th St.

1"x2" Stks or Spks & Tins 4' Rt or West off face of curb

Curtis
Mankey
Martinez
Moore
Adams

NOTE: ANY ADDITIONS OR CHANGES ON THIS SHEET MUST BE MADE OR CIRCLED IN RED INK, WITH DATE AND NAME OF PERSON MAKING CHANGE.

Do not extend notes this side of this line.

PLEASE RETURN TO
LOS ANGELES COUNTY SURVEYOR
726 Los Angeles County Engineering Bldg.

STATION	B. B.	H. I.	F. S.	ELEV.

761296 S & E #307 9-54

76L298 S & E #307 9-54

PLEASE RETURN TO
LOS ANGELES COUNTY SURVEYOR
726 Los Angeles County Engineering Bldg.

NOTE: ANY ADDITIONS OR CHANGES ON THIS SHEET MUST BE MADE OR CIRCLED IN RED INK, WITH DATE AND NAME OF PERSON MAKING CHANGE.

Do not extend notes this side of this line.

F. B. 1854 Pg. 26 | Job No. 7257 | Division No. | Notes Red | Plotted | Profile
Survey by A.S. Cecil & S. Notes Manuscript | Date | X-Sec.
Indexed E. C. Tolmie | Date 8-23-54 | Notes Chkd. J.W.E. | Checked | Date | No.

STATION	B. S.	H. I.	F. S.	ELEV.	Burin Ave. %	Grade	+/- or Fill	W. Curb Grades
BM N-52				60.35'	SM N-52 ℄ 60.35' Top Brass Cap in Grevillea Ave ℄ 147th St. E Side on ℄ prod. 147th St. 2-T in curb.			
10+47.36	N. end W.W.C.G. of Alley			61.97'		61.71'	C-0.26'	Stk. 7' in 4' off ℄ face of
10+57.36	W. " " " "			62.15'		61.91'	C-0.24'	" " " " " "
10+72.36	W. " " " "			61.91'		61.84'	C-0.07'	" " " " " "
10+82.36	" " " "			61.46'		61.64'	F-0.18'	" " " " " "
11+00				61.75'		61.53'	C-0.22'	" " " " " "
+50						61.21'		" " " " " "
11+77	N. edge apron					61.04'		" " " " " "
12+09	S. " "			61.12'		60.84'	C-0.28'	" " " " " "
12+50				61.07'		60.88'	C-0.19'	Spk " " " "
12+83	N. edge apron			60.36'		60.37'	C-0.43'	" " " " " "
13+15	S " "			60.13'		60.17'	C-0.26'	" " " " " "
13+50				60.33'		59.94'	C-0.39'	" " " " " "
13+72.35	N. end W.W.C.G. of 147th St.			60.12'		59.80'	C-0.32'	" " " " " "
13+87.35 (TP)	W. " " " "			59.94'		59.90' (FL. Gr.)	C-0.04'	" " " " " " (Grade on Spk. 87)
14+12.35	E. end Cross Gutter			59.68'		59.98'	C-0.70'	Spk. 5' S. in S. 6 Rt. ℄ 147th St.
TBM				62.21'	TBM #27 Elev. 64.27' FB 1854-27 Grevillea Ave. ℄ prod. S. of Old Library Bldg. Bt. Spk. in lead in N.E. Cor. Top Step N. Side Bldg.			
TP				62.34'				
BM #27	Rd. Dept.			64.27'	BM #27 Elev. 64.35' Rd. Dept. BM. per C.I. 1653 Sh. 3 L-T W. corner Conc. Walk. Hse. #14933 147th St. 33 N.E. of E. ℄ St. N.W. Cor. Burin Ave. & 147th St.			

Profile Notes Red. Plotted Job No. 725701 Division No. F. B. 1854 Pg. 27

X-Sec. Notes Chkd. Checked Survey By [redacted]
No. Date Date Map No. Indexed C. Johnson Date

JN 725701

LAWNDALE ADMIN. CTR. HEALTH + LIBRARY BLDG.

Curb Grades for Curb 15.00' East of ℄ of Grevillea Ave (East side) from First Alley N. of 147th ST. to N.E. Cor of 147th ST.

Spks & Tins 5' Rt. & West of Curb face.

Curtis
Hankey
Martinez
Moore
Adams

STATION	B. S.	H. I.	F. S.	ELEV.

NOTE: ANY ADDITIONS OR CHANGES ON THIS SHEET MUST BE MADE OR CIRCLED IN RED INK, WITH DATE AND NAME OF PERSON MAKING CHANGE.

Do not extend notes this side of this line.

PLEASE RETURN TO
LOS ANGELES COUNTY SURVEYOR
726 Los Angeles County Engineering Bldg.

761-298 S & E #307 9-54

76L298 S & E #307 9-54

PLEASE RETURN TO
LOS ANGELES COUNTY SURVEYOR
726 LOS ANGELES COUNTY ENGINEERING BLDG.

NOTE: ANY ADDITIONS OR CHANGES ON THIS SHEET MUST BE MADE OR CIRCLED IN RED INK, WITH DATE AND NAME OF PERSON MAKING CHANGE.

Do not extend notes this side of this line.

F. B. 1854 Pg. 28 | Job No 7852.01 Division No | Notes Red | Plotted | Profile
Survey by ASCurtis Notes Maurice Causey C/C Notes Chkd. J.V.T. Checked
Indexed A. C. Johnson Date | Date 8-27-56 | Date | No.

Grevillea Ave

BM N-52 EL 60.35' FB 1854-14
Grevillea Ave & 147th St. E side cut prod of 147th St. Lip 1' in curb

STATION	B. S.	H. I.	F. S.	ELEV.	%	Grade	Cut or Fill	
BM N-52				60.35'				
10+47.56	N. end N.E.C.R. or Alley			62.14'		62.07'	C .07'	1x2 & Tin 5' Rt. & West
10+57.56	E. " " " "			62.37'		62.27'	C .10'	" " 3' N. face C6.
10+72.56	" " S.E.C.R. " "			61.69'		62.10'	E .41'	" " 8' S. face C6.
+82.56	S. " " " "			61.98'		61.90'	C .08'	Spk & Tin 8' Rt & West C6. Face
+95.06	N. edge Apron			61.97'		61.81'	C .16'	" " " " "
11+21.06	S. " "			61.56'		61.59'	F .03'	" " " " "
+50				61.56'		61.44'	F .08'	" " " " "
12+00				60.71'		61.10'	F .39'	" " " " "
12+50				60.71'		60.62'	C .12'	" " " " "
12+83	N edge Apron			60.34'		60.31'	C 0.26'	" " " " "
13+15	S " "			60.55'		60.00'	C 0.55'	" " " " "
+50				60.38'		59.66'	C .72'	" " " " "
13+72.59	N. end N.E.C.R. at 147th St.			60.03'		59.45'	C .58'	" " " " "
13+87.59	℄ Cross Gutter			59.93'		58.73' (Flow line)	C 1.20'	" " 8' Rt & West ℄ Gut
14+12.39	S. end of 6' cross Gutter			59.86'		58.66' "	C 1.20'	" " " " "
TBM				62.22'				

All Grades for Curb Grades

TBM EL 62.21' FB 1854-22
Grevillea Ave & 147th St. Old Library Bldg.
Brass pk in lead in N.E. Cor Top Step N. side Bldg.

Profile Notes Red. Plotted Job No. Division No. F. B. 1854 Pg. 29

X-Sec. No. Notes Chkd. Date Checked Date Survey by C. Johnson Map No. Indexed Date

JN 1237.01

LAWNDALE ADMIN. CTR. HEALTH & LIBRARY BLDG

Curb Grades for Curb 35.00' NE 147th St.
from
Grevillea Ave N.E.C.R.
to
Burin Ave N.W.C.R.

℄ of Grevillea Ave. assumed 0+00
Stationing going East
Spks & Tins 5' Rt. & Ahd.

Curtis
Plankey
Martinez
Moore
Adams

STATION	B. S.	H. I.	F. S.	ELEV.

NOTE: ANY ADDITIONS OR CHANGES ON THIS SHEET MUST BE MADE OR CIRCLED IN RED INK, WITH DATE AND NAME OF PERSON MAKING CHANGE.

Do not extend notes this side of this line.

PLEASE RETURN TO
LOS ANGELES COUNTY SURVEYOR
726 Los Angeles County Engineering Bldg.

761298 S & E #307 9-54

76L298 S & E #307 9-54

PLEASE RETURN TO
LOS ANGELES COUNTY SURVEYOR
726 LOS ANGELES COUNTY ENGINEERING BLDG.

NOTE: ANY ADDITIONS OR CHANGES ON THIS SHEET MUST BE MADE OR CIRCLED IN RED INK, WITH DATE AND NAME OF PERSON MAKING CHANGE.

Do not extend notes this side of this line.

F. B. 1854 Pg. 30 | Job No. 725.01 Division No. Notes Red. Plotted | Profile
Survey of Lawndale Addition Date Date No.
Survey by Curtis Notes Markers set Chkd. J.E. Checked X-Sec.
Indexed A. C. Johnson Date Notes Chkd. 8-23-56 Date Date No.

STATION	B. S.	H. I.	F. S.	ELEV.	147TH ST.
BM N62 (Fd)				60.35'	BM N62 El 60.35' FB 1854-14 Greenville Ave. & 147th St. E Side on E prod. 147th St. L-T in curb
					% Grade C-t or F.N
0+00	℄ Greenville Ave				
0+15 (TP)	N. end N.E.C.R. at Greenville			60.03'	59.45' C-0.58' Spk & T in 5' W. of cb. face
+30	E " " " " "			60.18'	59.53' C-0.63' " " 5' R.R.S. " "
+59				59.95'	59.59' C-0.36' " " " " " "
+65				59.96'	59.60' C-0.36' " " " " " "
+07.05				59.95'	59.66' C-0.29' " " " " " "
+49.09				60.00'	59.72' C-0.28' 1 1/2" " " " " "
+54.09				60.00'	59.73' C-0.23' 1 1/2" " " " " "
+87.24				59.76'	59.77' Grade " " " " "
2+20.40				59.91'	59.82' C-0.09' " " " " "
2+30.40				~~59.93~~	~~59.74' C-0.06'~~ " " " " " "
+57.20				59.90'	59.87' C-0.03' " " " " " "
2+72.00	N. end N.W.C.R. at Burin			59.91'	59.90' C-0.04' Spk & T in 4' Lt. & N. cb face
2+87.00	N, " " " " "			60.12'	59.80' C-0.32' Spk & T in 4' W. cb. face
3+07.00	℄ Burin Ave.				
T.B.M. (Fd)				62.21'	TBM El 62.21' FB 1854-22 Greenville Ave. at 147th St. On Library Bldg. Bt. Spk in Top of N. Side Bldg.
BM #23 (Fd)				61.46'	BM #23 El 61.46' L-T N.W. Cor. Conc Porch at W. end of L.A. County Library at 147th St. & Greenville Ave (From Resident Engineer 61 Jan 1953)

F. B. [illegible] Pg. [illegible]

Map No.
Office Work
Checked
Date

W. O. [illegible] Topo No. Sht.
Surveyed by [illegible]
Notes [illegible] Date April 2, 58
Indexed [illegible]

ON [illegible]

LAWNDALE ADMINISTRATION CENTER

HEALTH & LIBRARY BLDG.

Curbs, Walks, & Paving, Construction Stakes

Location

Curtis
Mankey
Martinez
Moore
Adams

Note: Any Additions or Changes on This Sheet Must be Made or Circled in Red Ink With Date and Name of Person Making Change.

Do not extend notes this side of this line.

RETURN TO
LOS ANGELES COUNTY SURVEYOR
726 LOS ANGELES COUNTY
ENGINEERING BLDG.

76F3095 S&E #247. 8-54

F. B. 1854 Pg. 32

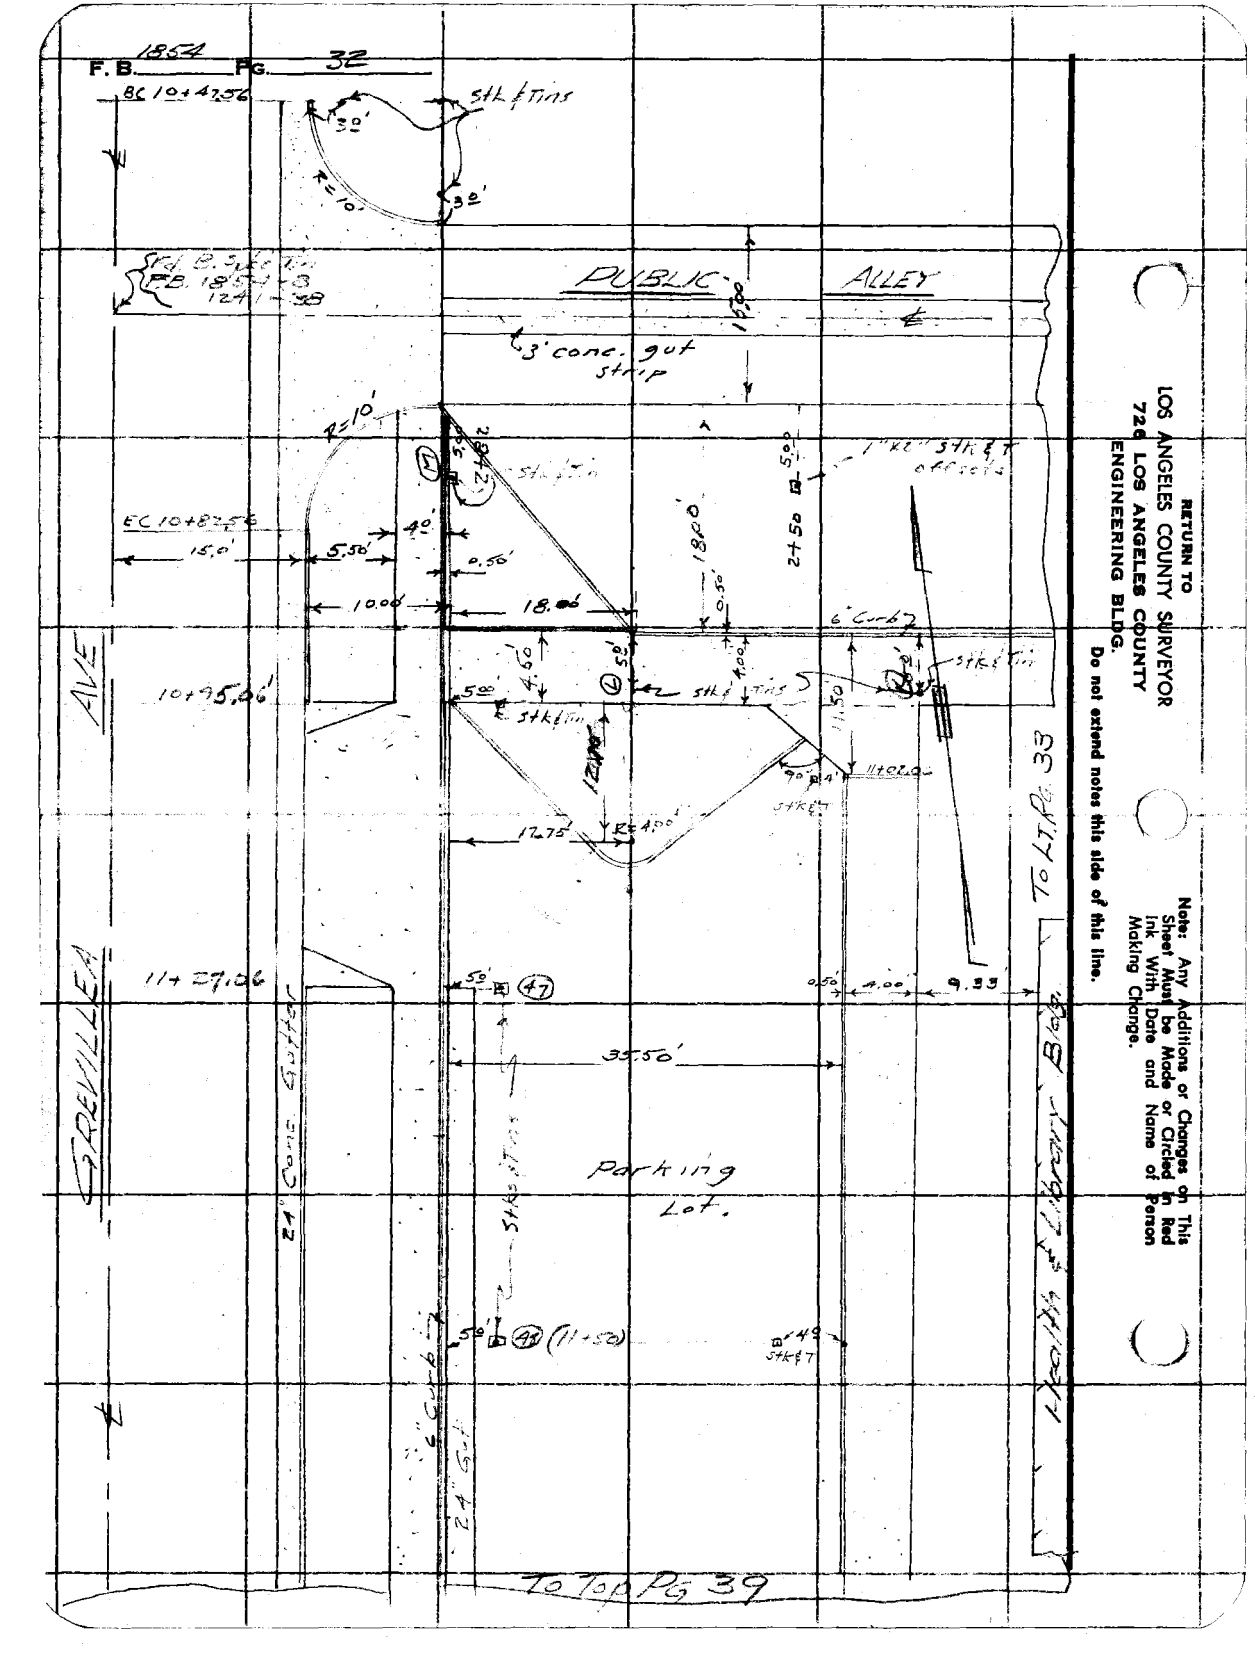
PUBLIC ALLEY
3' conc. gut strip
Parking Lot.
To Top Pg 39
To Lt. Pg 33
EC 10+87.56
10+95.06'
11+27.06
6" Curb
Stkd. Tins
1" Pkd. Stake & Tack
Stake & Tack
Stake & Tin
Stake
Stake & Tin
Stake & Tin
Stake & Tin

F. B. _____ PG. _____

Map No. _____
Office Work _____
Checked _____
Date _____

W. O. _____ Tape No. _____ Sht. _____
Surveyed by A.S. Curtis
Notes Mostly cl. Date _____
Indexed _____

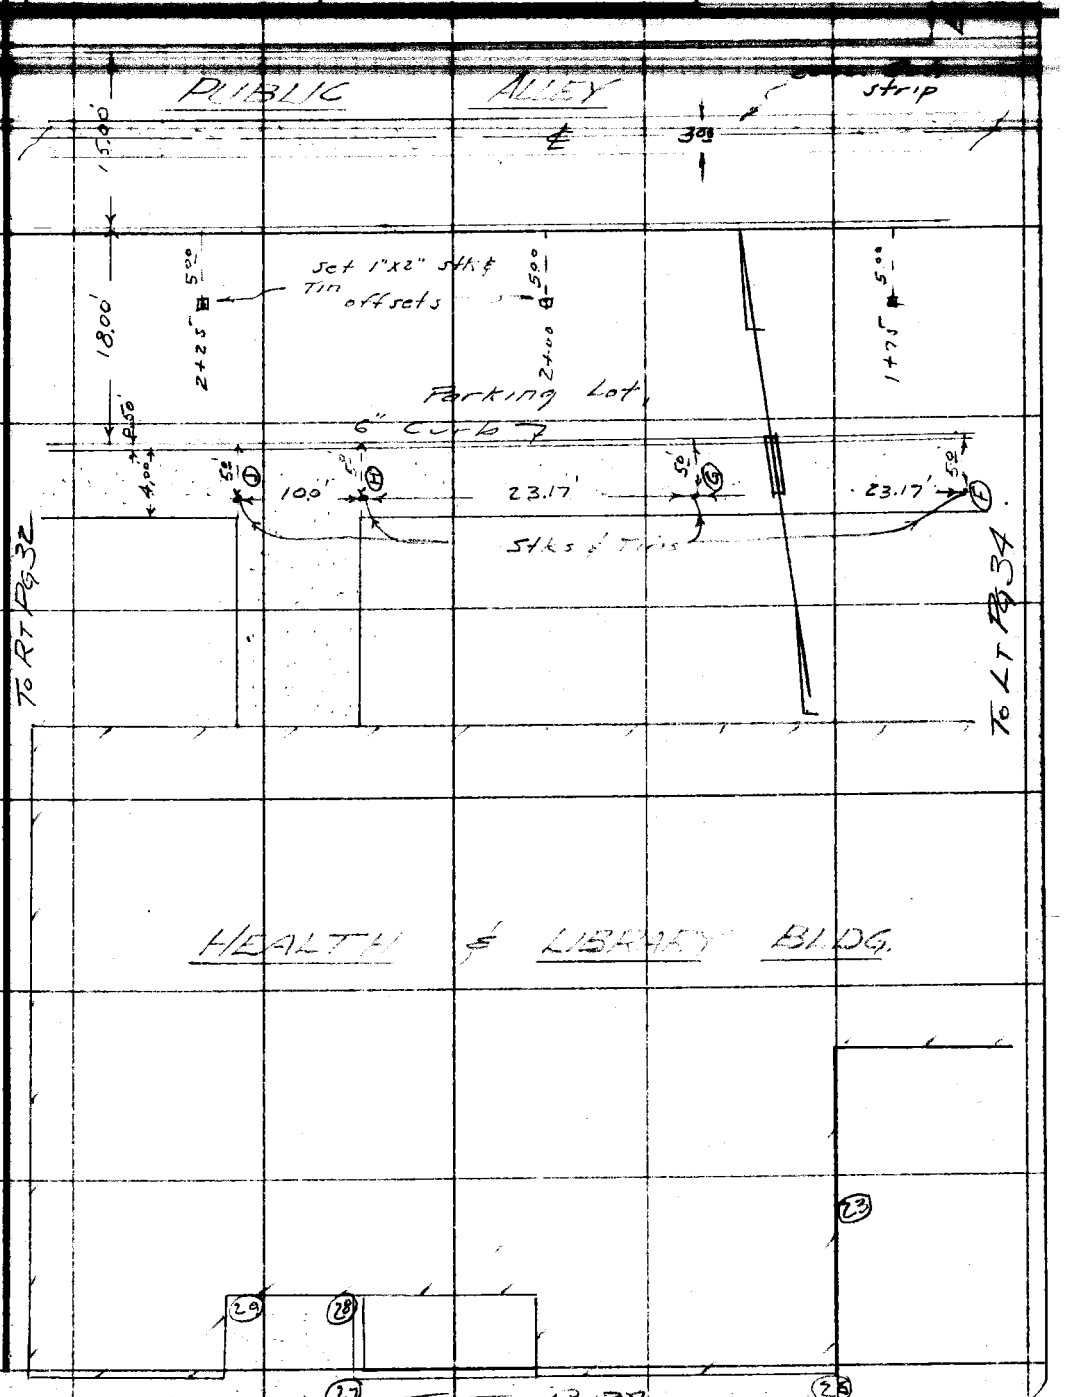

Note: Any Additions or Changes on This Sheet Must be Made or Circled in Red Ink With Date and Name of Person Making Change.

Do not extend notes this side of this line.

RETURN TO
LOS ANGELES COUNTY SURVEYOR
726 LOS ANGELES COUNTY
ENGINEERING BLDG.

76F3095 S&E #247. 8-54

RETURN TO
LOS ANGELES COUNTY SURVEYOR
726 LOS ANGELES COUNTY
ENGINEERING BLDG.

Note: Any Additions or Changes on This Sheet Must be Made or Circled in Red Ink With Date and Name of Person Making Change.

Do not extend notes this side of this line.

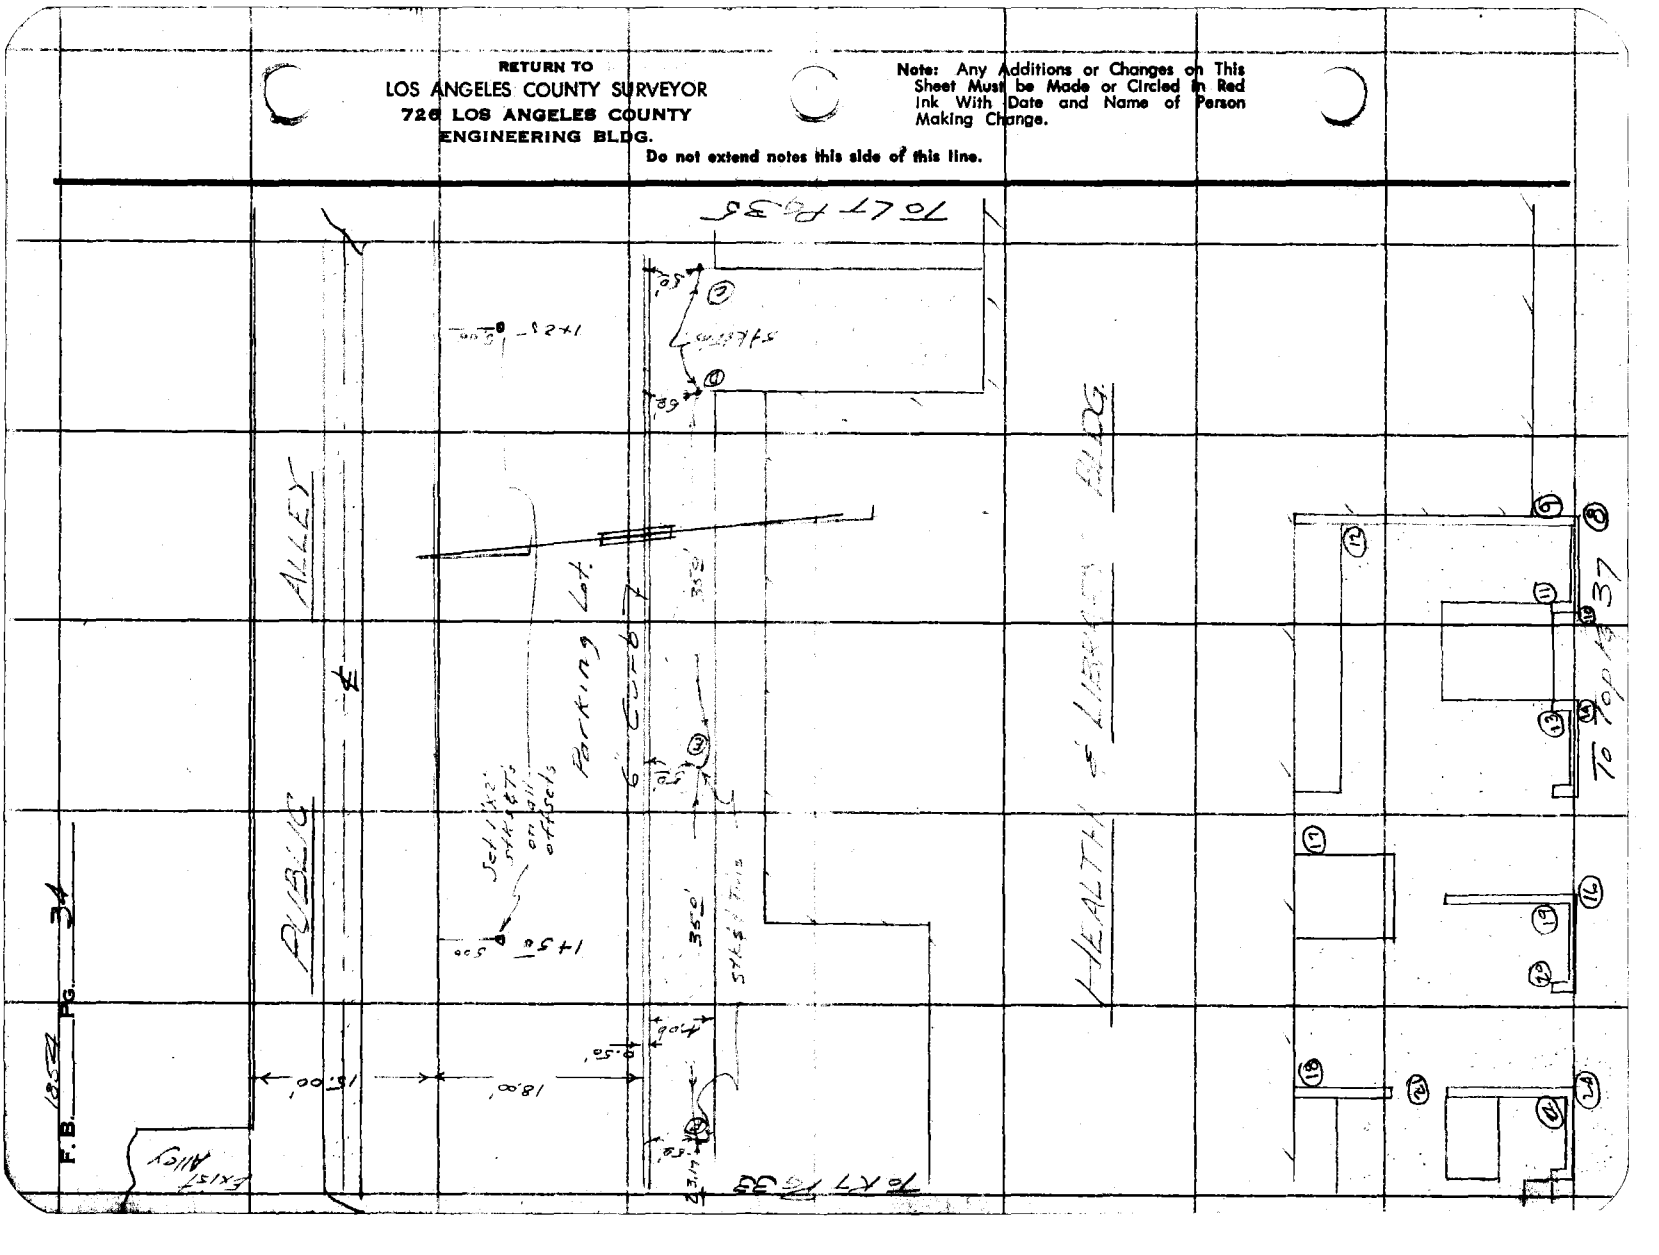

76F3095 S&E #247. 8-54

RETURN TO
LOS ANGELES COUNTY SURVEYOR
726 LOS ANGELES COUNTY
ENGINEERING BLDG.

Note: Any Additions or Changes on This Sheet Must be Made or Circled in Red Ink With Date and Name of Person Making Change.

Do not extend notes this side of this line.

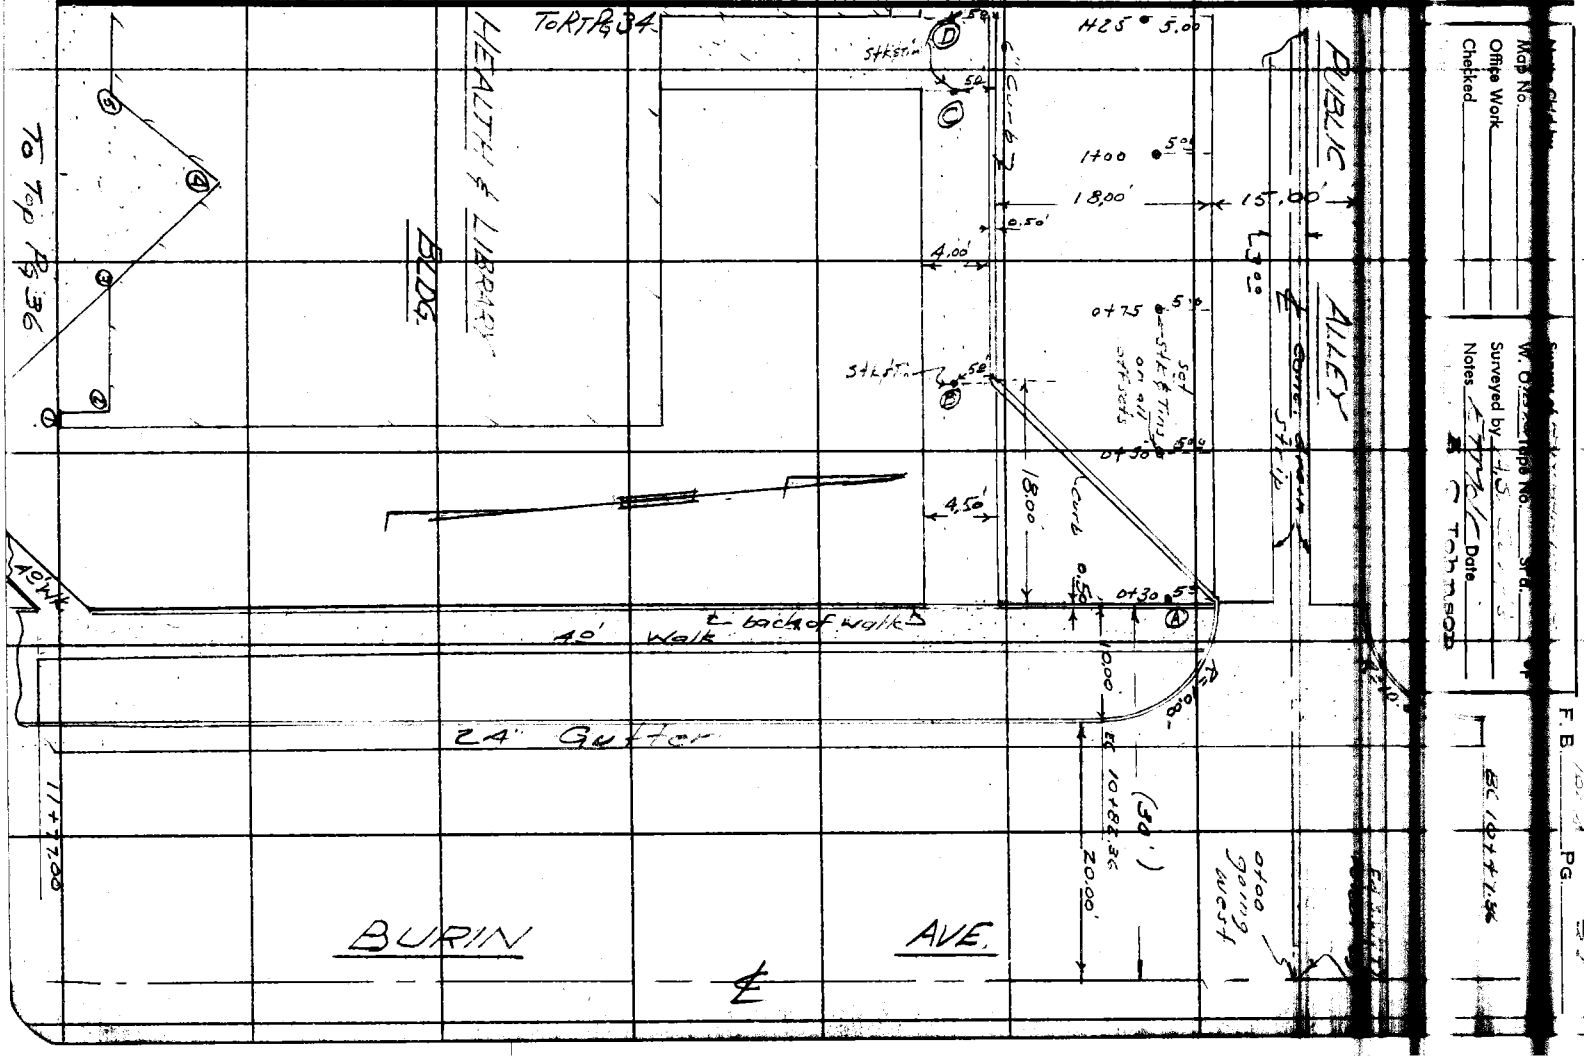

Map Ch'd by
Map No.
Office Work
Checked

Surveyed by W. O'Connor Type No. 3rd.
Notes
Date

F.B. Pg.

RETURN TO
LOS ANGELES COUNTY SURVEYOR
726 LOS ANGELES COUNTY
ENGINEERING BLDG.

Note: Any Additions or Changes on This Sheet Must be Made or Circled In Red Ink With Date and Name of Person Making Change.

Do not extend notes this side of this line.

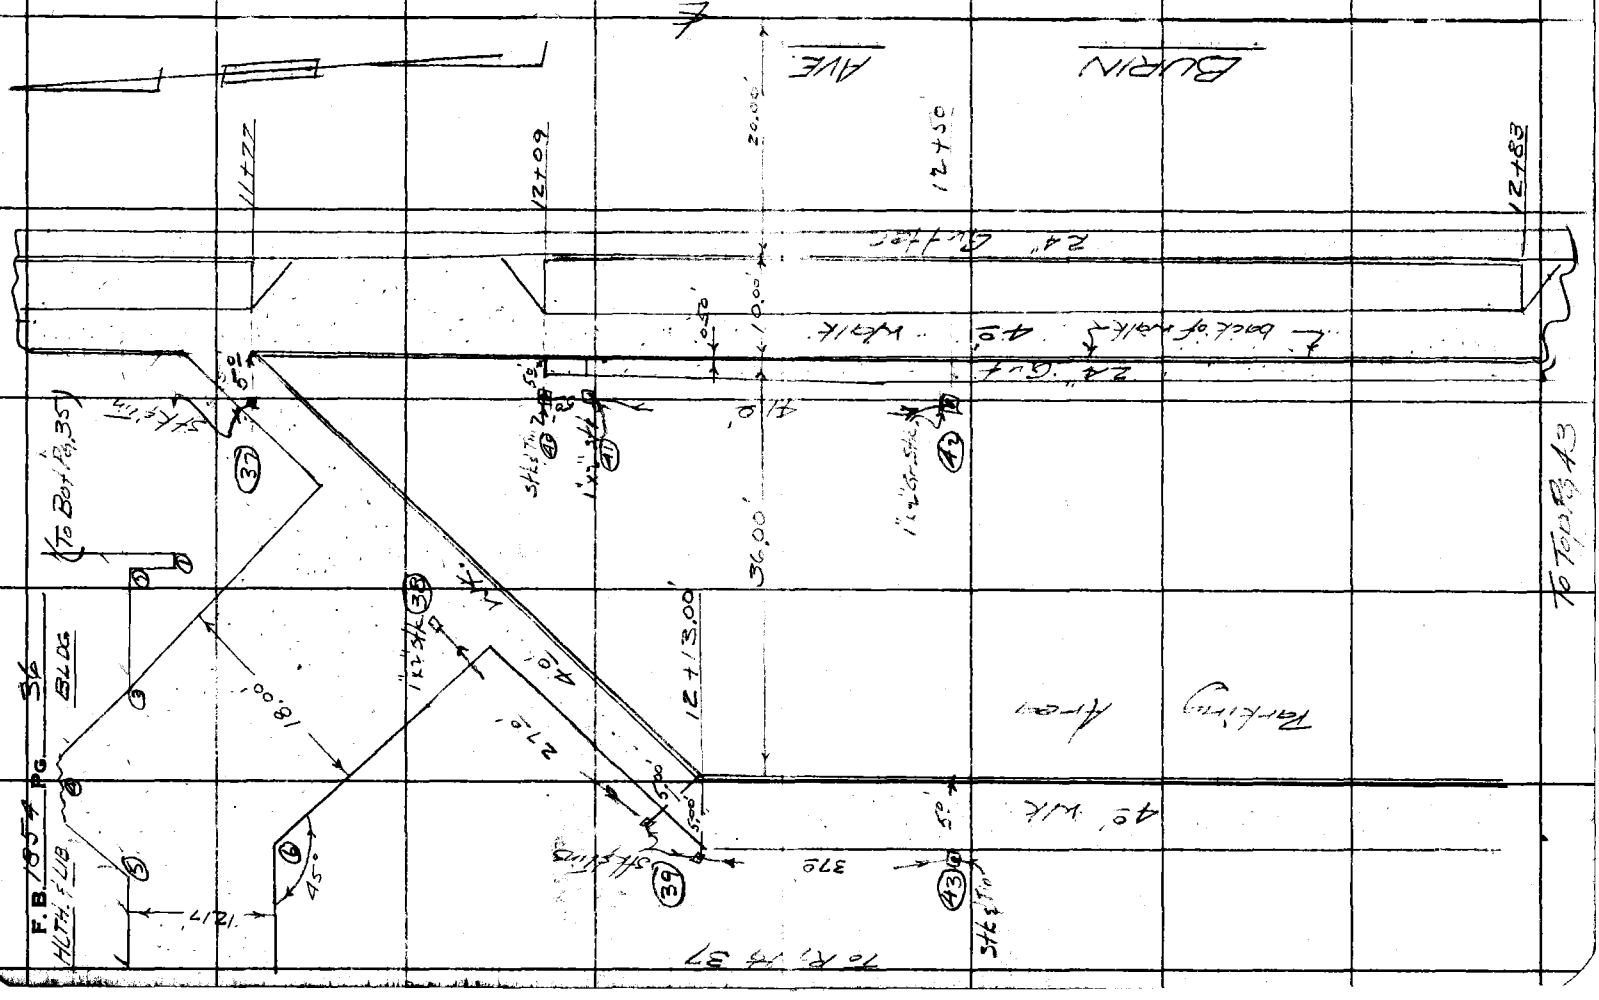

76F3095 S&E #247. 8-54

RETURN TO
LOS ANGELES COUNTY SURVEYOR
726 LOS ANGELES COUNTY
ENGINEERING BLDG.

Note: Any Additions or Changes on This Sheet Must be Made or Circled in Red Ink With Date and Name of Person Making Change.

Do not extend notes this side of this line.

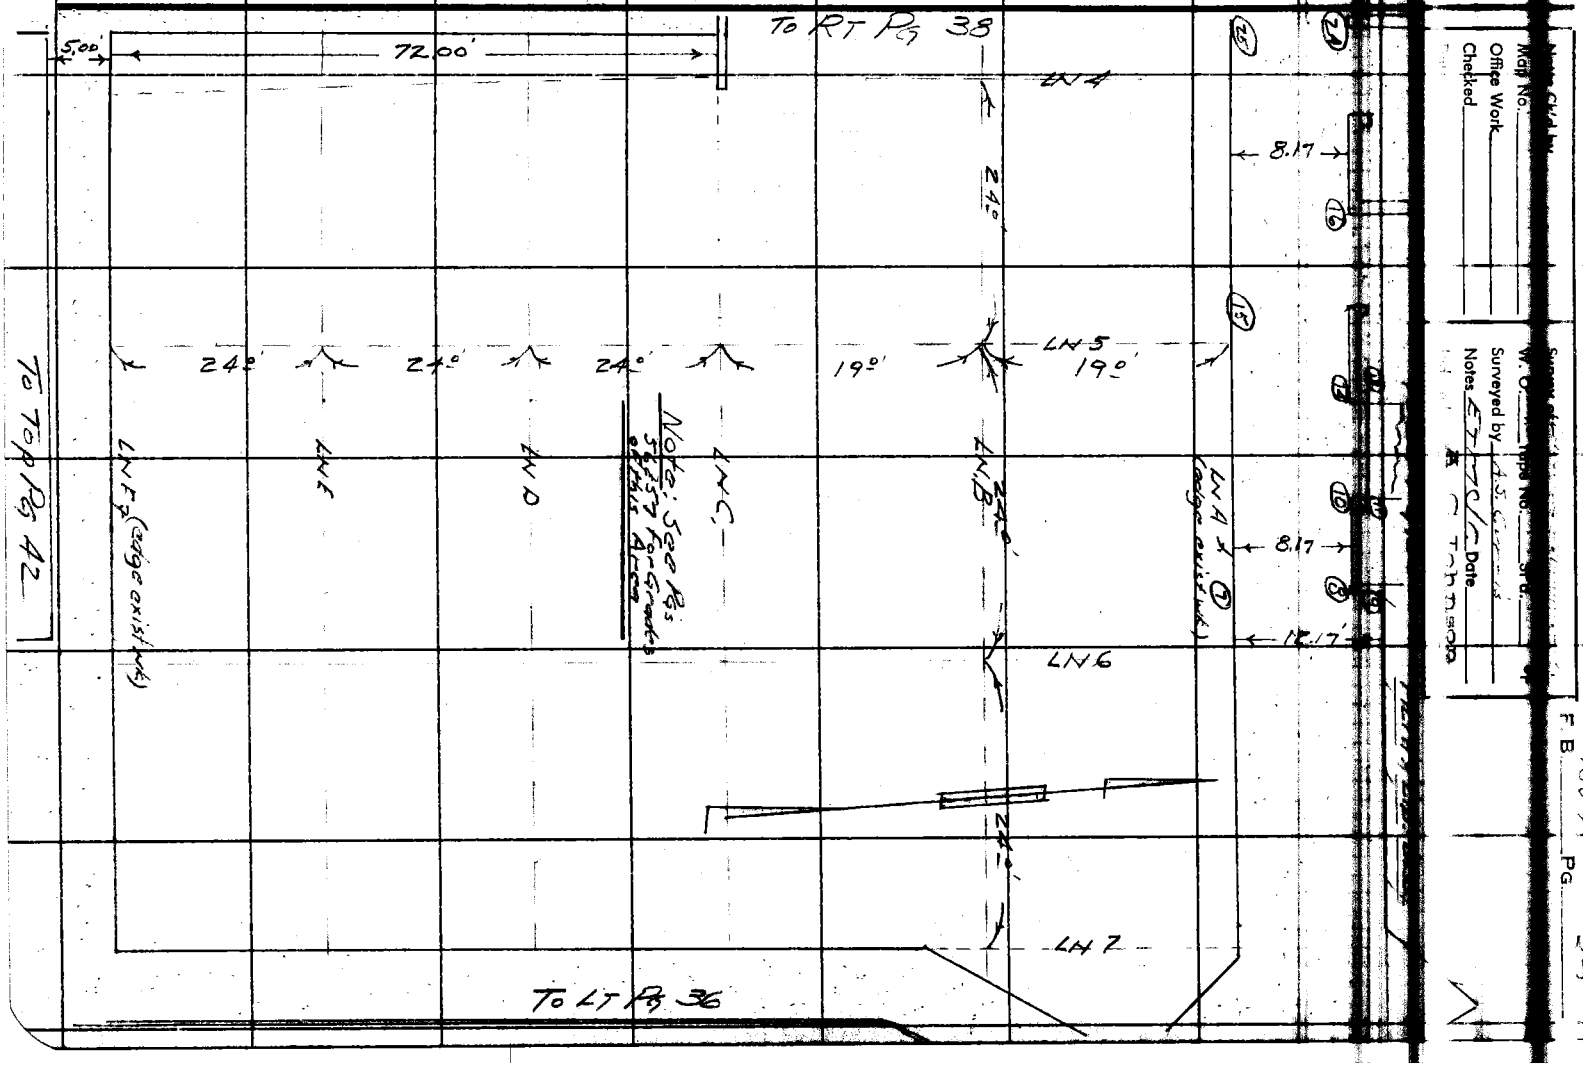

Name Ck'd by
Map No.
Office Work
Checked

Surveyed by
Notes
Date

W. O.
Type No.
Sht.

F B 1854 Pg 37

RETURN TO
LOS ANGELES COUNTY SURVEYOR
726 LOS ANGELES COUNTY
ENGINEERING BLDG.

Note: Any Additions or Changes on This Sheet Must be Made or Circled In Red Ink With Date and Name of Person Making Change.

Do not extend notes this side of this line.

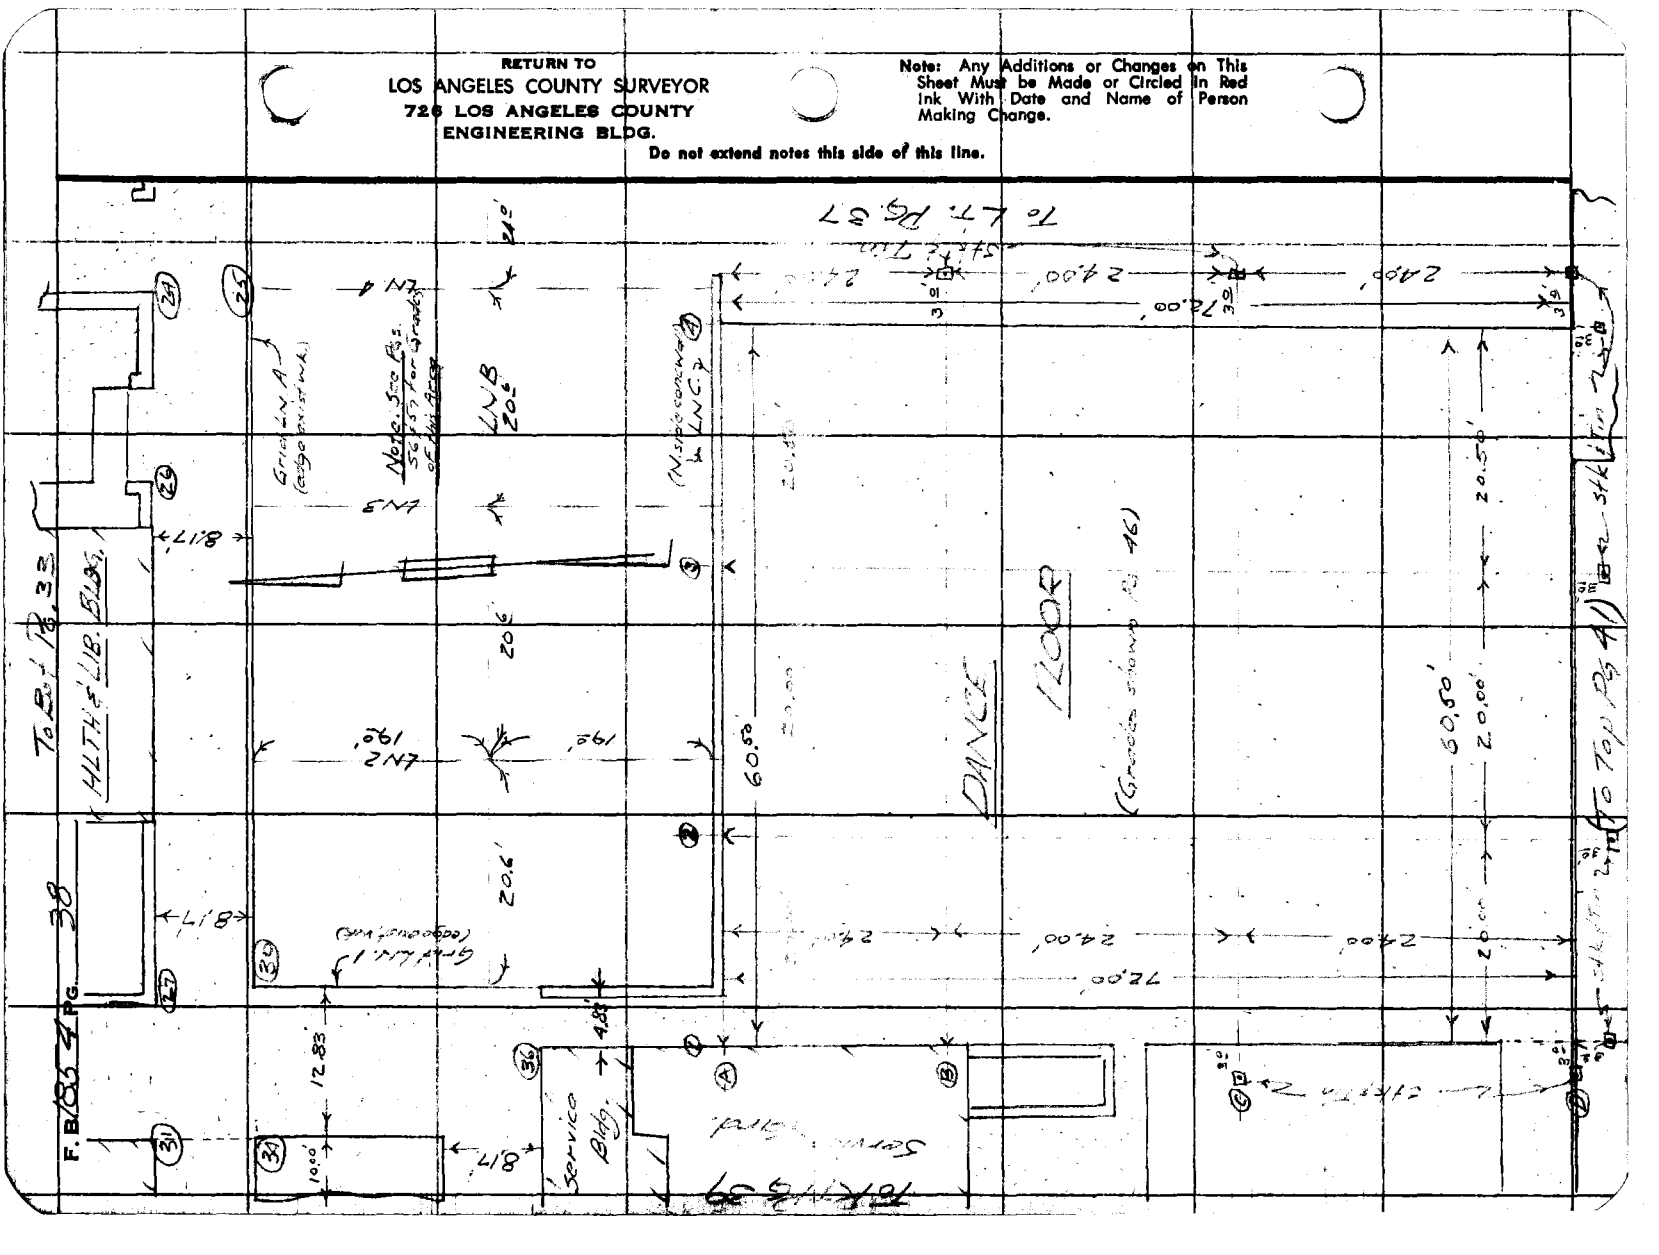

F. B. 10 Pg. 39

Map No.
Office Work
Checked

Surveyed by A.S.C.
Notes ETM/C.E. Date April 56
C. Johnson

RETURN TO
LOS ANGELES COUNTY SURVEYOR
726 LOS ANGELES COUNTY
ENGINEERING BLDG.

Note: Any Additions or Changes on This Sheet Must be Made or Circled In Red Ink With Date and Name of Person Making Change.

Do not extend notes this side of this line.

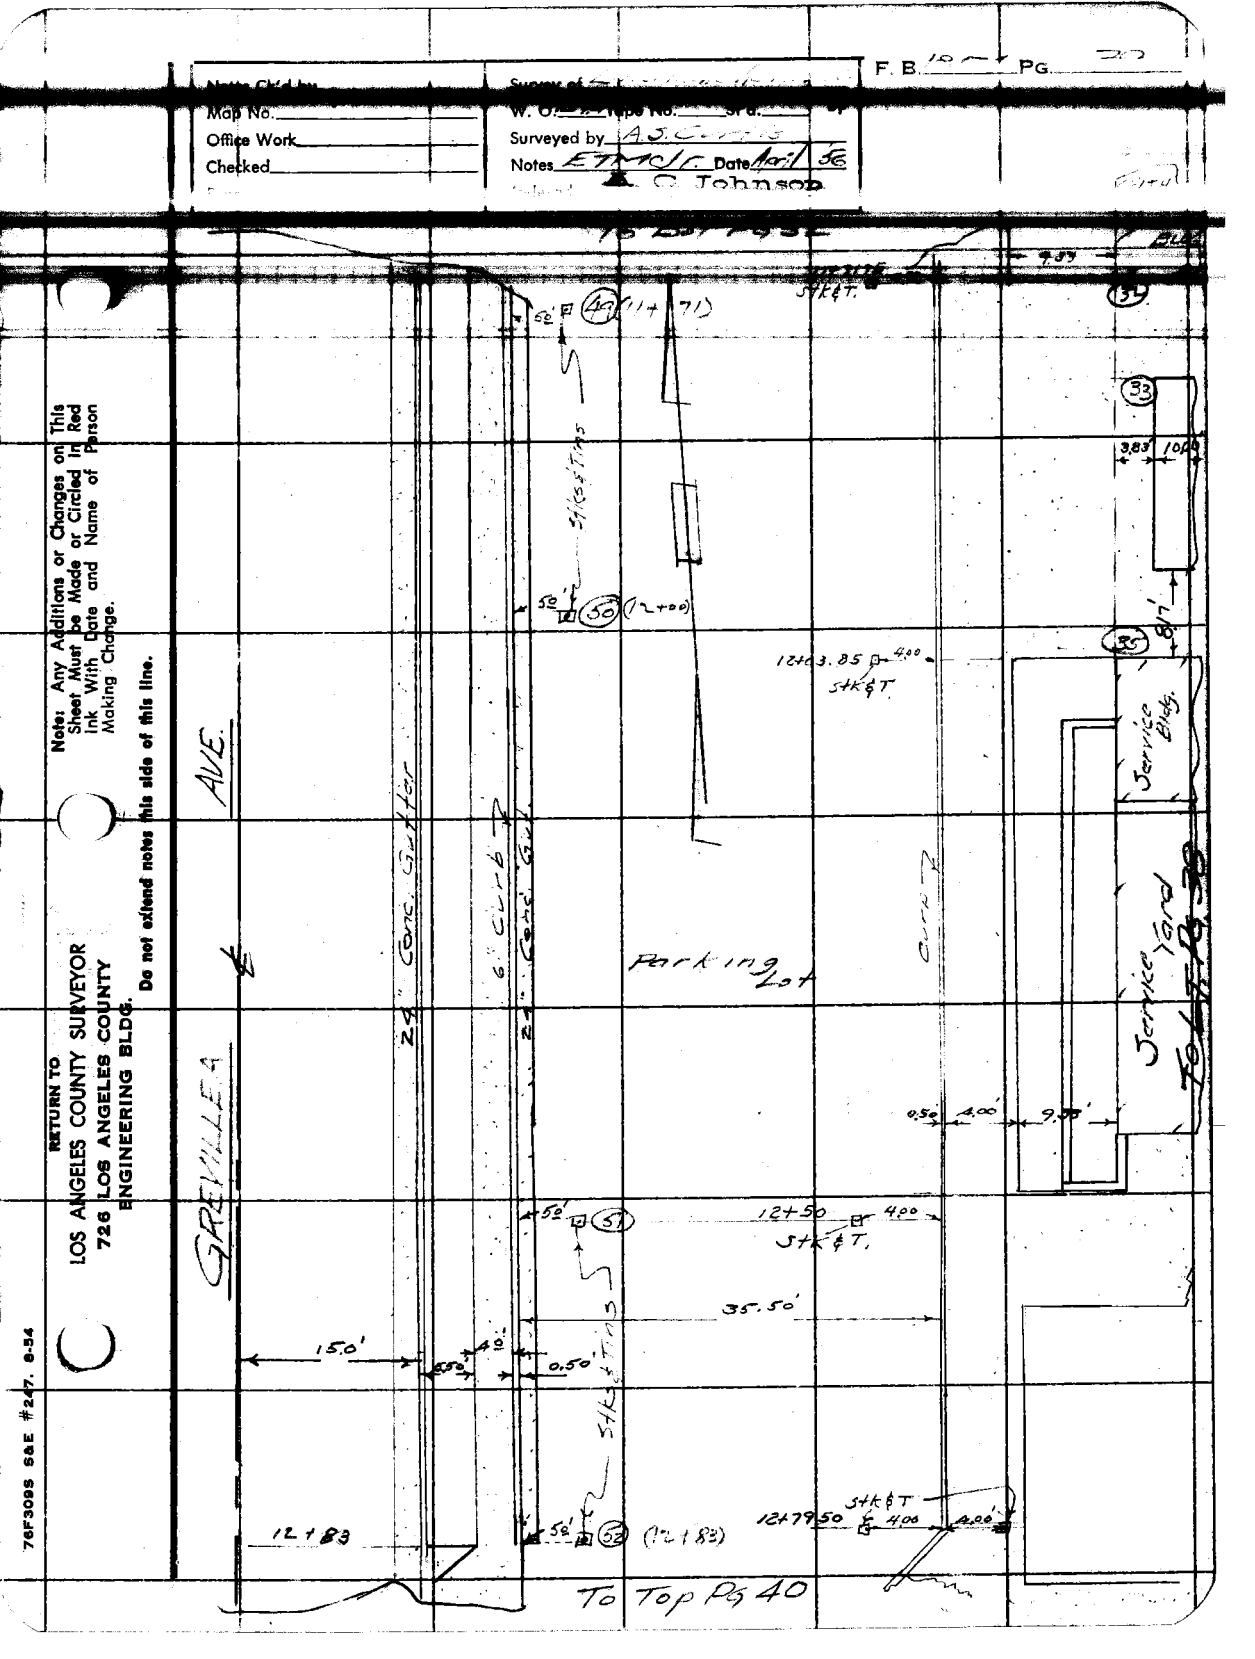

76F309 S&E #247. 8-54

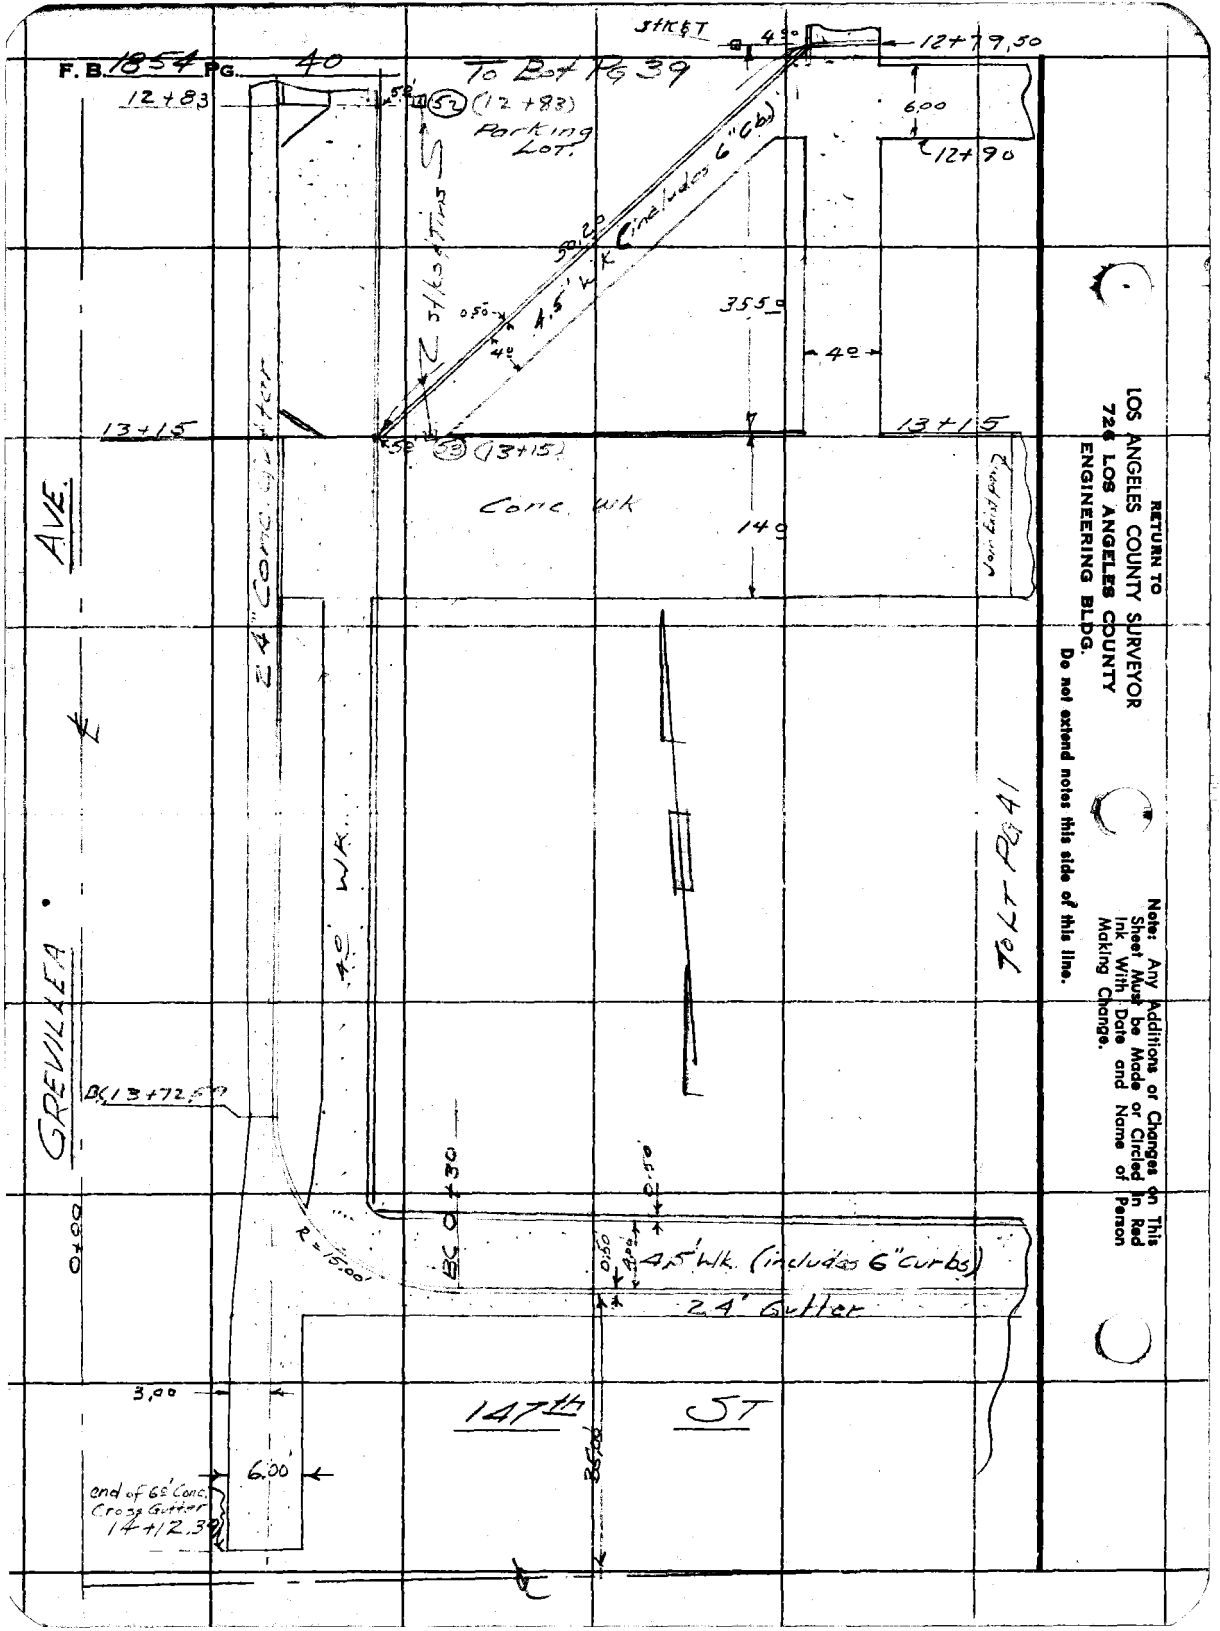
F.B. 1854 PG. 40
To Bk Pg 39
Stk & T
12+79.50
12+83
(12+83)
Parking Lot
6.00
12+90
Includes 6" Curb
4.5' Wk
355
40
13+15
(13+15)
Conc. Wk
14
24" Conc. Gutter
AVE.
GREVILLEA
40' Wk.
To Bk Pg 41
BC 13+72.50
BC 0+30
R=15.00'
0+00
0.50
4.5' Wk. (Includes 6" curbs)
2.4' Gutter
3.00
6.00
147th ST
End of 6' Conc. Cross Gutter 14+12.39
RETURN TO
LOS ANGELES COUNTY SURVEYOR
720 LOS ANGELES COUNTY
ENGINEERING BLDG.
Do not extend notes this side of this line.
Notes: Any Additions or Changes on This Sheet Must be Made or Circled in Red Ink With Date and Name of Person Making Change.

Notes Ck'd by
Map No.
Office Work
Checked

Survey of
W. O. Type No. Sht.
Surveyed by
Notes E.M.M/C Date April '56
A. C. Johnson

F. B. Pg.

Note: Any Additions or Changes on This Sheet Must be Made or Circled in Red Ink With Date and Name of Person Making Change.

Do not extend notes this side of this line.

RETURN TO
LOS ANGELES COUNTY SURVEYOR
726 LOS ANGELES COUNTY
ENGINEERING BLDG.

76F3095 S&E #247. 8-54

6.00

℄ 12+90

7.0

7.00

Join. Exist Pav.

EXIST L.A. COUNTY

RECREATION BLDG.

Join Exist Pav.

Conc. Wk

Join Exist Pav.

TO RT 40

TO LT 42

0.50

4.5' Wk (includes 6" curb)

24" Gutter

0.33

4.00

35.00

147th ST.

℄

F. B. 1854 PG. 42

To Bk Pg. 37

12790 P

Conc. Wk

Join Exist Pav't

7.00'

3.54'

12.50'

12.50'

Join Exist Pav't

EXIST. L.A. COUNTY RECREATION BLDG.

To Bk Pg. 14

EXIST PAV'T

Join

Join

Conc. Wk.

0.50'

4.00'

0.50'

24' Gutter

25.00'

147th ST

℄

RETURN TO
LOS ANGELES COUNTY SURVEYOR
720 LOS ANGELES COUNTY
ENGINEERING BLDG.

Do not extend notes this side of this line.

Note: Any Additions or Changes on This Sheet Must be Made or Circled In Red Ink With Date and Name of Person Making Change.

F. B. _____ Pg. 1

Name Ck'd by _____ Survey of _____

Map No. _____ W. O. _____ Tape No. _____ Sht. _____

Office Work _____ Surveyed by A.J. Cirillo

Checked _____ Notes E TM & I/C Date April 52

Date _____ Initial _____ C. Tahmoop

Note: Any Additions or Changes on This Sheet Must be Made or Circled in Red Ink With Date and Name of Person Making Change.

Do not extend notes this side of this line.

RETURN TO
LOS ANGELES COUNTY SURVEYOR
726 LOS ANGELES COUNTY
ENGINEERING BLDG.

76F3096 S&E #247. 8-54

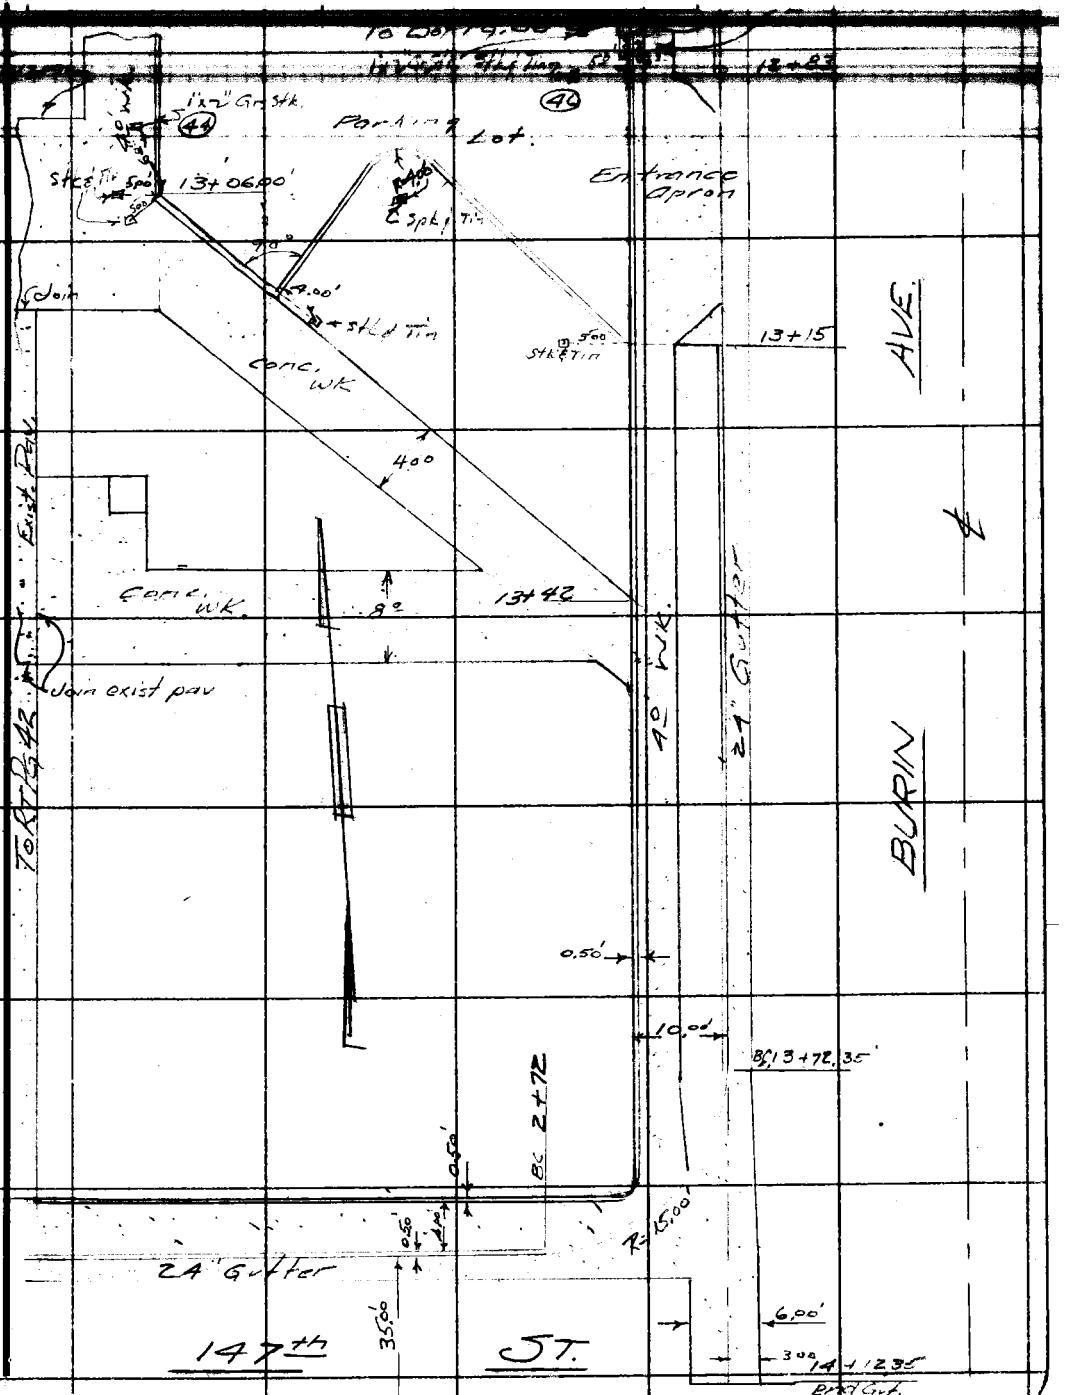

RETURN TO
LOS ANGELES COUNTY SURVEYOR
726 LOS ANGELES COUNTY
ENGINEERING BLDG.

Note: Any Additions or Changes on This Sheet Must be Made or Circled In Red Ink With Date and Name of Person Making Change.

Do not extend notes this side of this line.

F.B. 1854 Pg. 44

F. B. 1854 Pg. 45

Profile Notes Red. Plotted Job No. 7[illegible] Division No.

X-Sec. No. Notes Chkd. Date Checked Date Survey by [illegible] Notes [illegible] Date
Map No. Indexed A. C. Johnson Date

JN 7257.01

LAWNDALE ADMINISTRATION CENTER

HEALTH & LIBRARY BLDG.

Finished Grade for Concrete Floor
walks & etc.

Curtis
Manley
Rodriguez
Mandujano
Moore

NOTE: ANY ADDITIONS OR CHANGES ON THIS SHEET MUST BE MADE OR CIRCLED IN RED INK, WITH DATE AND NAME OF PERSON MAKING CHANGE.

PLEASE RETURN TO
LOS ANGELES COUNTY SURVEYOR
726 LOS ANGELES COUNTY ENGINEERING BLDG.

Do not extend notes this side of this line.

STATION	B. S.	H. I.	F. S.	ELEV.

761-298 S & E #307 8-54

76L298 S & E #307 9-54

PLEASE RETURN TO
LOS ANGELES COUNTY SURVEYOR
726 Los Angeles County Engineering Bldg.

NOTE: ANY ADDITIONS OR CHANGES ON THIS SHEET MUST BE MADE OR CIRCLED IN RED INK, WITH DATE AND NAME OF PERSON MAKING CHANGE.

Do not extend notes this side of this line.

F. B. 1854 Pg. 4C | Job No. 2576 | Division No. | Notes Red. | Plotted | No. | Profile
Survey of Lennox-Lake Los Angeles Co. | Date | Date | No. | X-Sec.
Survey by County's Notes Chkd. J.E.C. Checked
Indexed K. C. Johnson Date 8-23-56 Date

STATION	B. S.	H. I.	F. S.	ELEV.	Grade	Cut or Fill	
TBM				62.21	TBM EL 62.21 FB 1854 - 22 Crenshaw Ave & Imperial St. O/a Library Bldg. Br. Spk. in lead in N.E. Cor Top Step N. side Bldg.		
		Dance Floor			(shown page 38 of this book)		
A-1				61.42'	61.42'	Fin Grade	(X mark on wall)
A-2				61.53'	61.53'	" Grade	"
A-3				61.64'	61.64'	" "	"
A-4				61.75'	61.75'	" "	"
B-1				61.17'	61.17'	" "	"
B-2				61.28'	61.28'	" "	1"x2" Stk
B-3				61.39'	61.39'	" "	"
B-4				61.50'	61.56'	" "	"
C-1				60.92'	60.92'	" "	"
C-2				61.03'	61.03'	" "	"
C-3				61.14'	61.14'	" "	"
C-4				61.25'	61.25'	" "	"
D-1				60.67'	60.67'	" "	"
D-2				60.78'	60.78'	" "	"
D-3				60.89'	60.89'	" "	"
D-4				61.00'	61.00	" "	"

76L298 S & E #307 9-54

PLEASE RETURN TO
LOS ANGELES COUNTY SURVEYOR
726 Los Angeles County Engineering Bldg.

NOTE: ANY ADDITIONS OR CHANGES ON THIS SHEET MUST BE MADE OR CIRCLED IN RED INK, WITH DATE AND NAME OF PERSON MAKING CHANGE.

Do not extend notes this side of this line.

Profile Notes Red. Plotted Job No. Division No.
X-Sec. Notes Chkd. J.L.C. Checked Survey by Notes
No. Date 8-23-56 Date Map No. Indexed C. Johnson Date
F. B. 785 Pg. 49

STATION	B. S.	H. I.	F. S.	ELEV.			
		Walk on South side of New Main Information Bldg. (Shown on page 47)					
				Elev.	Grade	C-F or Fill	
①	Location Shown, Pg. 36		35	63.00'	63.00' finGr.	Gr.	1"x2" stk - ag. inside
②	"	" " "	"	63.40'	63.40' " "	Gr.	" " "
③	"	" " "	"	63.46'	63.40' Walk Gr.	Gr.	Nail & tack mark on
④	"	" " "	"	63.92'	63.92' " "	Gr.	" " "
⑤	"	" " "	"	63.72'	63.72' " "	Gr.	" " "
⑥	"	" "	36	63.46'	63.46' " "	Gr.	1"x2" stk 3' ± off
⑦	"	" "	37	63.43'	63.43' " "	Gr.	" " "
⑧	"	" "	37 & 34	63.60'	63.60' " "	Gr.	Horiz. mark on wall
⑨	"	" "	"	63.34'	63.34' " "	Gr.	" " "
⑩	"	" "	"	63.60'	63.60' " "	Gr.	" " "
⑭	"	" "	"	63.60'	63.60' " "	Gr.	" " "
⑮	"	" "	37	63.43'	63.43' " "	Gr.	1"x2" stk 3' ± off
⑯	"	" "	37 & 34	63.60'	63.60' " "	Gr.	Horiz. mark on wall
⑭	"	" "	37 & 34	63.60'	63.60' " "	Gr.	" " "
㉕	"	" "	37 & 38	63.43'	63.43' " "	Gr.	1"x2" stk 3' ± off
㉖	"	" "	38	63.60'	63.60' " "	Gr.	Horiz. mark on wall
㉗	"	" "	38 & 39	63.60'	63.60' " "	Gr.	" " "
㉘	"	" "	39	63.92'	63.92' " "	Gr.	" " "
㉙	"	" "	39	63.92'	63.92' " "	Gr.	" " "

76L298 S & E #307 9-54

PLEASE RETURN TO
LOS ANGELES COUNTY SURVEYOR
726 LOS ANGELES COUNTY ENGINEERING BLDG.

NOTE: ANY ADDITIONS OR CHANGES ON THIS SHEET MUST BE MADE OR CIRCLED IN RED INK, WITH DATE AND NAME OF PERSON MAKING CHANGE.

Do not extend notes this side of this line.

F. B. 1854 Pg. 48 Job No. 7257.01 Division No. Notes Red. Plotted
Survey of Lawndale Area Complete Date No.
Survey by Cuerli Notes Atkinson S/D Date X-Sec.
Indexed R. C. Johnson Date 8-23-56 Date Checked Date No.

Profile

STATION	B. S.	H. I.	F. S.	ELEV.	Grade	Cut or Fill	
(30)	Location shown Pg 38			63.13'	63.43' Wk Gr.	Gr	1x2' Stk 3' offset
(31)	"	" " 38		63.60'	63.60' "	Gr	Horiz mark on wall
(32)	"	" " 39		62.72'	62.72' "	Gr	" " " "
(33)	"	" " 38			"	Gr	1x2' Stk 3' offset
(34)	"	" " 39		63.13'	63.43' "	Gr	" " " "
(35)	"	" " 38		61.82'	61.82' "	Gr	Horiz mark on Serv. Bldg.
(36)	"	" " 39		62.56'	62.56' "	Gr	" " " "
	Point on South [illegible] of Main Admin. Bldg.						
(11)	Location shown Pg		34	63.68'	63.68' Wk Gr	Gr	Horiz. mark on wall
(12)	" " "			63.92'	63.92' "	Gr	" " " "
(13)	" " "			63.74'	63.74' "	Gr	" " " "
(17)	" " "			63.92'	63.92' "	Gr	" " " "
(18)	" " "			63.72'	63.72' "	Gr	" " " "
(19)	" " "			63.74'	63.74' "	Gr	" " " "
(20)	" " "			63.68'	63.68' "	Gr	" " " "
(21)	" " "			63.76'	63.76' "	Gr	" " " "
(22)	" " "			65.96'	65.96' "	Gr	" " " "
(23)	" " "		33	63.92'	63.92' "	Gr	" " " "
BM N-52				60.35'	BM N-52 El 60.35' FB 1854 - 12 Grevillea Ave & 147th St. E. side on Extend 147th St. L-T in Curb		

76L298 S & E #307 9-54

PLEASE RETURN TO
LOS ANGELES COUNTY SURVEYOR
726 LOS ANGELES COUNTY ENGINEERING BLDG.

NOTE: ANY ADDITIONS OR CHANGES ON THIS SHEET MUST BE MADE OR CIRCLED IN RED INK, WITH DATE AND NAME OF PERSON MAKING CHANGE.

Do not extend notes this side of this line.

Profile Notes Red. Plotted Job No. Division No.
X-Sec. Notes Chkd. Checked Survey by
No. Date 8-27-56 Date Map No. Indexed Johnson Date
F. B. Pg. 47

STATION	B. S.	H. I.	F. S.	ELEV.		
					Parking Area on East Side Bldg. (Burn Area (See Page 3	
TBM				62.21	TBM EL 62.21' FD 1857-22 Green Mon. Ave. & 14th St. Old Licensing Station. Bk. Sq. c. inland. in NE. Cor. Top. Step N. Side Bldg.	
					Curb Grades	Cut or Fill
37					62.36'	
38					61.74'	
39					61.04'	(Curb & Gut
40	S. end N. apron back				61.03'	(begin & Curb
41	5.5' " " " " "				60.99'	
42	back of Sta. 12+56				61.12'	
43					60.82'	
44					60.64'	Curb & Gut : drop 1
45	8' N. end S. apron				60.59'	
46	N. end apron B.S.					
	& pan on					
TBM				62.21	(See above)	

76L298 S & E #307 9-54

PLEASE RETURN TO
LOS ANGELES COUNTY SURVEYOR
726 LOS ANGELES COUNTY ENGINEERING BLDG.

NOTE: ANY ADDITIONS OR CHANGES ON THIS SHEET MUST BE MADE OR CIRCLED IN RED INK, WITH DATE AND NAME OF PERSON MAKING CHANGE.

Do not extend notes this side of this line.

F.B. 1854 Pg. 50 Job No. 2557 Division No. Plotted
Survey of Lawndale Acres Tract Date
Survey by Curtis Notes Chkd. J.J.E. Checked
Indexed C. Johnson Date 8-23-54 Date
Profile No. X-Sec. No.

STATION	B. S.	H. I.	F. S.	ELEV.		
				Grades for back of E. Street Sidewalk Greville Ave (Shown Pgs 32, 39, 40)		
				ELEV	Grade	Cut or Fill
TBM				62.21	TBM EL 62.21' FB. 1854-22	
(47)	(11+27.06 Sta on Nahrwold)			60.82	61.82'	F-1.0' - 1"x2" Stk
(48)	(11+50)			60.65	61.65'	F-1.0' - " "
(49)	(11+71)			60.52	61.52'	F-1.0' - " "
(50)	(12+00)			60.31	61.31'	F-1.0' - " "
(51)	(12+50)			59.83	60.83'	F-1.0' - " "
(52)	(12+83 Nahrwold)			59.58	60.58'	F-1.0' - " "
(53)	(13+ [illegible])			61.83	60.22'	C-1.61' - 1"x2" 5.0' off Stk
TBM				62.21	TBM EL 62.21' FB. 1854-22	
				Grades for East Curb of West Bordering Lot (Shown Pgs 32, 39, 40)		
TBM				62.21	TBM EL 62.21' FB 1854-22	
					Grade	Cut or Fill
11+02.06				61.59	62.76'	F-1.17' - 5 ft 4° Rt ℄ W.
11+50				61.33	61.91'	F-0.58' - " " " "
11+71.75				61.23	61.87'	F-0.64' - " " " "
12+03.85				60.80	61.42'	F-0.62' - " " " "

76L298 S & E #307 9-54

PLEASE RETURN TO
LOS ANGELES COUNTY SURVEYOR
726 LOS ANGELES COUNTY ENGINEERING BLDG.

NOTE: ANY ADDITIONS OR CHANGES ON THIS SHEET MUST BE MADE OR CIRCLED IN RED INK, WITH DATE AND NAME OF PERSON MAKING CHANGE.

Do not extend notes this side of this line.

STATION	B. S.	H. I.	F. S.	ELEV.	Grade	Cut or Fill
12+50				60.71'	61.17'	F-0.76' Stk & T. 4° Rt. ℄ M.
12+79.50	℄ pf in curb			60.39	61.10'	F-0.71'- " " " " 4° "
13+15	Join Back walk at S. edge Apron				60.22'	
TBM				62.21	TBM EL 62.21 F.B. 1854-22	
	Grades for South Curb of North Parking lot (Plan No. [illegible])					
TBM				62.21	TBM EL 62.21 FB 1854-22	
					Grade	Cut or Fill
(A)	W. end S.W.C.R. (0+30 Pg 35)				61.84'	Stk & T in 4° ℄ FF
(B)			" "	62.60'	62.92'	F- 0.32' " " 5° " Sou
(C)			" "	62.59	63.13'	F- 0.51'- " " " "
(D)			" " (31)	62.49	63.19'	F- 0.70'- " " " "
(E)			Pg 31	62.85'	63.43'	F- 0.58'- " " " "
(F)			" "	62.91	63.67'	F- 0.76'- " " " "
(G)				62.81	63.49	F- 0.68'- " " " "
(H)				63.08'	63.31	F- 0.23'- " " " "
(J)				62.79	63.24'	F- 0.45- " " " "
(K)				62.32'	63.07'	F- 0.75'- " " " "
(L)				61.60'	62.92'	F- 1.32'- " " " "
(M)				61.69'	62.10'	F-0.41'- " " " 5°
TBM				62.21	TBM EL 62.21' FB 1854-22	

Profile Notes Red. Plotted Job No. Division No.
X-Sec. Notes Chkd. J.N.J. Checked Survey by
No. Date 8-27-54 Date Map No. Traced Johnson Date
F. B. 1854 Pg. 57

F. B. 1854 Pg. 52

Job No. 22520 Division No. Notes Red. Plotted Profile

Survey of Lawson & Adair Etc. Date Date No.

Survey by Curtis Notes Mowbray Notes Chkd. Checked X-Sec.

Indexed Date Date Date No.

STATION	B. S.	H. I.	F. S.	ELEV.	

76L298 S & E #307 9-54

PLEASE RETURN TO

LOS ANGELES COUNTY SURVEYOR

726 LOS ANGELES COUNTY ENGINEERING BLDG.

NOTE: ANY ADDITIONS OR CHANGES ON THIS SHEET MUST BE MADE OR CIRCLED IN RED INK, WITH DATE AND NAME OF PERSON MAKING CHANGE.

Do not extend notes this side of this line.

Profile | Notes Red. | Plotted | Job No. 725101 | Division No. | F. B. 18542 Pg. 53

X-Sec. No. | Notes Chkd. | Checked | Survey by | Date | Map No. | Adolfo Johnson Date

J.N. 725.01

LAWNDALE ADMINISTRATION CR.

Flow Line Grades for

Concrete Gutter on E

of First Alley N. 147th St

from

Sunset Ave. ℄ (0+00) West

Gutter starts at 0+33

" ends " 2+82.5

to

Grevillea Ave ℄ (3+07.32)

Curtis
Mankey
Rodrigues
Martinez
Moore

Grades from Rd. Dept. Plan C.1.1653

STATION	B. B.	H. I.	F. S.	ELEV.

NOTE: ANY ADDITIONS OR CHANGES ON THIS SHEET MUST BE MADE OR CIRCLED IN RED INK, WITH DATE AND NAME OF PERSON MAKING CHANGE.

Do not extend notes this side of this line.

PLEASE RETURN TO
LOS ANGELES COUNTY SURVEYOR
726 Los Angeles County Engineering Bldg.

761296 S & E #307 9-54

761298 S & E #307 9-54

PLEASE RETURN TO
LOS ANGELES COUNTY SURVEYOR
726 LOS ANGELES COUNTY ENGINEERING BLDG.

NOTE: ANY ADDITIONS OR CHANGES ON THIS SHEET MUST BE MADE OR CIRCLED IN RED INK, WITH DATE AND NAME OF PERSON MAKING CHANGE.

Do not extend notes this side of this line.

F. B. 1854 Pg. 54 Job No. 25720 Division No. Notes Red Plotted
Survey of Lancaster Area Centers Date No. Profile
Survey by Curtis Notes Mar 2 by J.E. Checked X-Sec.
Indexed E. C. Johnson Date Notes Chkd. J.E. Checked
Date 5-23-56 Date No.

First Alley N. of 47th St.

TBM El 6221 FB 1854-22
Granville Ave. & 47th St. Old Library Bldg.
8" Spc. Im Iron in NE Con. Top Step N. ends Bldg.

STATION	B. S.	H. I.	F. S.	ELEV.	Grade	Cut or Fill
TBM				62.21		
0+00	℄ Burin Ave					
0+30	Beginning of Gutter			61.70	61.64	C-0.06 - Stk ℄ 7 in 12.5' Lts. ℄ Alley
+50				62.15	61.66	C-0.49 -
+75				62.18	61.69	C-0.49 -
1+00				62.38	61.72	C-0.66 -
+25				62.56	61.75	C-0.81 -
+50				62.54	61.78	C-0.76 -
+75				62.61	61.81	C-0.80 -
2+00				62.38	61.84	C-0.54 -
+25				61.98	61.87	C-0.11 -
+50				61.85	61.90	F-0.05 -
2+82.02	Point Curve			61.69	61.94	F-0.25 - Stk ℄ 7 in 12.5' Lts. ℄ Alley
3+07.02	℄ Granville Ave.					
T.P.				62.72		
BM #23				61.46		Bolt on Brn Fire El 61.49 2-T.P. on ℄ Granville Ave. 9' N and 14.5' W of SW cor. of 1900 Sq. Ft. Commercial Bldg. Rec. C.S. Plan 1653 Sh. 2

Profile Notes Red. Plotted Job No. Division No. F. B. 1854 Pg. 58

X-Sec. Notes Chkd. Checked Survey by

No. Date 11-28-56 Date Map No. Indexed C. Johnson Date 11-23-56

IN 7257.01

LAWNDALE ADMINISTRATION CTR

Grading for

Area Between Dance Floor & East

Parking Lot & Area Between Dance

Floor & New Building

Note: See pages 37 & 38 for location

Curtis
Mankey
Rodriguez
Martinez

STATION	B. B.	H. I.	F. B.	ELEV.

NOTE: ANY ADDITIONS OR CHANGES ON THIS SHEET MUST BE MADE OR CIRCLED IN RED INK, WITH DATE AND NAME OF PERSON MAKING CHANGE.

Do not extend notes this side of this line.

PLEASE RETURN TO
LOS ANGELES COUNTY SURVEYOR
726 LOS ANGELES COUNTY ENGINEERING BLDG.

761.298 S & E #307 9-54

76L298 S & E #307 9-54

PLEASE RETURN TO
LOS ANGELES COUNTY SURVEYOR
726 Los Angeles County Engineering Bldg.

NOTE: ANY ADDITIONS OR CHANGES ON THIS SHEET MUST BE MADE OR CIRCLED IN RED INK, WITH DATE AND NAME OF PERSON MAKING CHANGE.

Do not extend notes this side of this line.

F. B. 1854 Pg. 56 | Job No. 2527e / Division No. 10 | Notes Red | Plotted | Profile
Survey of Lennox Area Sts | Date | No. | X-Sec.
Survey by Curtis Notes Manning & Co | Date | Notes Chkd. MDF | Checked
Indexed C. Johnson Date | Date 11-28-56 | Date | No.

STATION	B. S.	H. I.	F. S.	ELEV.	Grade	Cut or Fill	
TBM				62.21	TBM EL 62.21 FB 1854-22 Graville Ave & 71st St. Old library Bldg. Et. Spk in lead in NE Con. Top Step N. side Bldg.		
A-1, 3, 4, 5, 6, 7	edge	exist walk		63.43	63.43	0.0	S. edge conc. wlk.
B-1				62.89	62.89	0.0	Exist Walk
-2				63.01	63.01	0.0	1" x 2" stk
-3				62.97	62.97	0.0	" "
-4				62.92	62.92	0.0	" "
-5				62.82	62.82	0.0	" "
-6				62.72	62.72	0.0	" "
C-1				62.70	62.70	0.0	" "
-2				62.61	62.61	0.0	" "
-3				62.52	62.52	0.0	" "
-4				62.43	62.43	0.0	" "
-5				62.22	62.22	0.0	" "
-6				62.02	62.02	0.0	" "
-7				61.82	61.82	0.0	Back of Walk
D- at Dancefloor (East side)				61.49	61.49	0.0	Exist conc. Corner
D-4							
-5				61.45	61.45	0.0	1" x 2" stk,
-6				61.41	61.41	0.0	" "
-7				61.37	61.37	0.0	Back of Walk

76L298 S & E #307 9-54

PLEASE RETURN TO
LOS ANGELES COUNTY SURVEYOR
726 Los Angeles County Engineering Bldg.

NOTE: ANY ADDITIONS OR CHANGES ON THIS SHEET MUST BE MADE OR CIRCLED IN RED INK, WITH DATE AND NAME OF PERSON MAKING CHANGE.

Do not extend notes this side of this line.

STATION	B. S.	H. I.	F. S.	ELEV.	Grade	Cut or Fill	
E - at Dance floor (East side)				61.26'	61.26'	0.0'	Exist. Conc.
E - 4							
-5				61.19'	61.19'	0.0'	1"x2" Stk
-6				61.14'	61.14'	0.0'	" "
-7				61.10'	61.10'	0.0'	Back Walk
F - at Dance floor (East Side)				61.05'	61.05'		Exist. Conc.
4							
5	North side walk.			60.94'	60.95'		Exist. Walk
-6	"	"	"	60.95'	60.95'		" "
7	"	"	"	60.95'	60.95'		" "
TBM				62.21'	TBM EL 62.21' FB 1854 - 22 Greville Ave. & 147th St. Old Library Bldg. Bt. Spk. in lead in N.E. Cor. Top Step N. side Bldg.		

Profile Notes Red. ____ Plotted ____ Job No. 7550 Division No. 12
Sec. Notes Chkd. ____ Checked ____ Survey by ____
No. ____ Date 11-28-56 Date ____ Map No. ____ Recorded ____ Date ____
F. B. 10354 Pg. 59

B. B. 1854 Pg. 58

Job No. Division No. Notes Red Plotted Profile

Survey of Date Date No.

Survey by Notes Notes Chkd. Checked X-Sec.

Indexed Date Date Date No.

STATION	B. S.	H. I.	F. S.	ELEV.	

76L298 S & E #307 9-54

PLEASE RETURN TO

LOS ANGELES COUNTY SURVEYOR

726 Los Angeles County Engineering Bldg.

Do not extend notes this side of this line.

NOTE: ANY ADDITIONS OR CHANGES ON THIS SHEET MUST BE MADE OR CIRCLED IN RED INK, WITH DATE AND NAME OF PERSON MAKING CHANGE.

Map No. _____
Office Work _____
Checked _____

JN 00.28 Tape _____ Std. 68 °F
Surveyed by U.H. Brown
Notes JH.B.T.C.P. Date 7-8-63

SURVEY
LAWNDALE CIVIC CENTER BOUNDARIES

ESTABLISHING A LINE BETWEEN LAWNDALE PARK & LAWNDALE CIVIC CENTER FOR USE OF MAINTENCE CREWS. FROM CITY OF LAWNDALE & L.A COUNTY

Sept 25 & 26 1963

NOTE: ALL POINTS FOUND HAVE BEEN SET OR REPLACED SINCE F.B. 1854 - 7 & 9

NO REF. IN FIELD.

PARTY
U. H. Brown
T.C. Peterson
A. CARO
R.C Clifford
R. L. STICH

Note: Any Additions or Changes on This Sheet Must be Made or Circled in Red Ink With Date and Name of Person Making Change.

Do not extend this side of this line.

PLEASE RETURN TO
LOS ANGELES COUNTY ENGINEER
403 Los Angeles County Engineering Bldg.

76F309S CE #3 0 0-62

M. B. 1854 PG 60

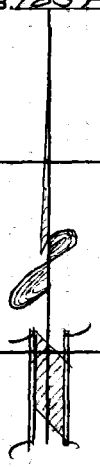

ALLEY

ALLEY

ALLEY

LAWNDALE CIVIC CENTER

LAWNDALE PARK

61

62

63

64

65

66

147TH ST

147TH ST

147TH ST

GREVILLEA

BURIN

PLEASE RETURN TO
LOS ANGELES COUNTY ENGINEER
403 Los Angeles County Engineering Bldg.

Do not extend this side of this line.

Note: Any Additions or Changes on This Sheet Must be Made or Circled in Red Ink With Date and Name of Person Making Change.

Map No. _____ JN 22212 Tape _____ Std 0.8 °F
Office Work _____ Surveyed by W. H. LEIGHTON
Checked _____ Notes J.H.B. + C.D. Date 9-25-63

OCT 8 '63

Note: Any Additions or Changes on this Sheet Must be Made or Circled in Red Ink With Date and Name of Person Making Change.

Do not extend this side of this line.

"PLEASE RETURN TO"
LOS ANGELES COUNTY ENGINEER
403 Los Angeles County Engineering Bldg.

76F3095 CE #310 6-62

W.5.25 C-2

RE RUN
3) 90° 01' 30"
4) 360° 06' 00"
6) 180° 00' 20"
Av. 90° 01' 33⅓"

FD BT SPK W/ TIN FLUSH NO REF.

SET CHIS X IN CB

FD L & TK

306.97

21.14

29.71

20.89

90°00'

CONC APRON

ALLEY

SET CHIS X IN CB
1) 90° 00' 40"
4) 360 05 20
6) 180 05 20
Avg = 90 00 53⅓

Set Punch mark in top of curb on LINE

R/C TO PARKING LAWNDALE CIVIC CENTER

SEMI OVAL

132.54 (T=76) Lev = 132.55
132.55 (T=76) Lev = 132.55
Avg = 132.55

CONC. CURB

ALLEY

132.55

Set Punch mark in top of curb on T LINE Prod
D) 90°00'50"
4) 360° 03' 20"
6) 180° 06' 00"
Av. 90° 00' 50"
RE-RUN

15.29

25.00

15.21

25.25

APPROX PK marked for mound
Set L.E. ENGR tag face of curb ON LINE
@ 25.00 from nail to West

R/C PARKING LAWNDALE PARK

CONC

45

90° 01'

Fd nothing set nail (middle one of three on Line) 125.00 N thly from BT SPK @ 4th ST from T Line
SEE FB 1854-G
EC S 13-2505

GREVILLEA

125.00

T LINE

CONC CURB

124.99 (T=78) LEV = 125.00
124.99 (T=78) Lev = 125.00
Avg = 125.00

1) 90 01 40
4) 360 07 00
6) 180 10 40
Avg = 90 01 46⅔

CONT PAGE 62

CONT PAGE 64

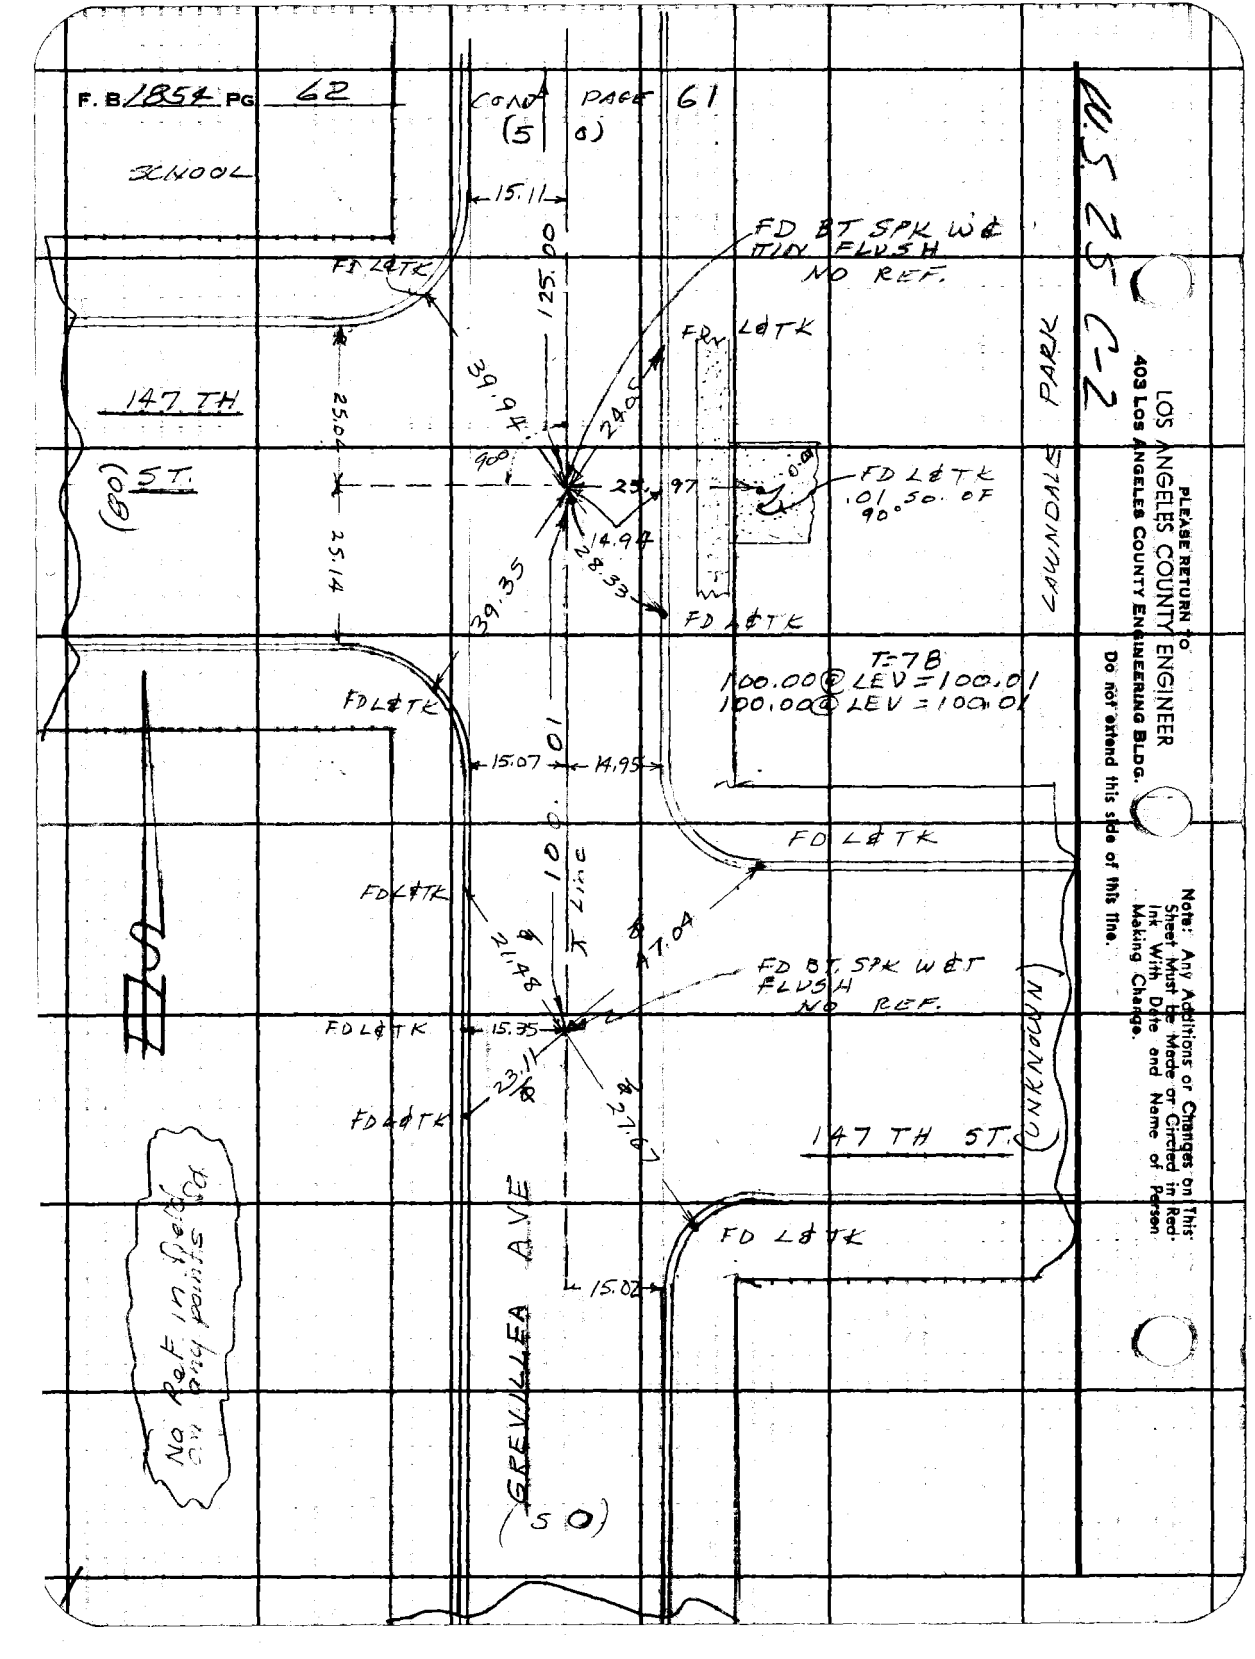
F. B. 1854 PG. 62
COND. (5 0)
PAGE 61
W.S. 25-C-2
LOS ANGELES COUNTY ENGINEER
403 Los Angeles County Engineering Bldg.
PLEASE RETURN TO
Do not extend this side of this line.
Note: Any Additions or Changes on This Sheet Must Be Made or Circled in Red Ink With Date and Name of Person Making Change.
KNOOL
147 TH
(60) ST.
PARK
LAWNDALE
CONDON
15.11
125.00
FD BT SPK W&T FLUSH NO REF.
FD L&TK
39.94
90°
25.97
FD L&TK .01 50. OF 90°
25.04
25.14
14.94
28.33
39.35
FD L&TK
T-78
100.00 @ LEV = 100.01
100.00 @ LEV = 100.01
FD L&TK
15.07
14.95
100.01
FD L&TK
FD L&TK
21.48
1.04
FD BT SPK W&T FLUSH NO REF.
FD L&TK
15.35
23.11
27.07
FD L&TK
147 TH ST.
FD L&TK
15.02
GREVILLEA AVE
(50)
No Ref on Curb Point

76F3095 C.E. #310 .6-62

PLEASE RETURN TO
LOS ANGELES COUNTY ENGINEER
403 LOS ANGELES COUNTY ENGINEERING BLDG.

Note: Any Additions or Changes on This Sheet Must be Made or Circled in Red Ink With Date and Name of Person Making Change.

Do not extend this side of this line.

W. S. 25 C-2

LAWNDALE PARK

(UNKNOWN)

147TH ST.

FD. BY SOIL WASH EXIN PUSH USED FOR LINE NOREF.

CONC. CURB

FD L & TK

124.99 (T=80) LEV = 125.00 } 125.00
124.99 (T=80) LEV = 125.00 }

R & O PARKING

CONC WALK

CONC CURB

100.00 K LINE

125.00

BURIN AVE

(60) END O

(100)

34.98 — 35.06

99.99 LEV (T=80) = 100.00 } 100.00
99.99 LEV (T=80) = 100.00 }

147TH ST

Map No. _____
Office Work _____
Checked _____

JN 002128 Tape _____ Std 20 of
Surveyed by Smith Brown
Notes W/BASED Date 2-14-63

POINT OF BEGINNING

F. B 1854 PG 64

END

NOTE
ALL POINTS THIS PAGE HAVE BEEN SET OR REPLACED SINCE FB 1654 pgs 7-9
NO REF IN FIELD

U.S. 51 Fwy

Pg. 61

306.91 (T=96) Lev = 306.97
306.92 (T=96) Lev = 306.97
Avg = 306.97

74.96 (T=80) Lev = 74.92
74.95 (T=80) Lev = 74.92
Avg = 74.94

FB 1854-9

(60)

CONC GUTT

(307.01)
306.97 M

(15) CONT

ALLEY

0.02

30.92

Fd. B/ spk w/ washer 9'N/W of ft. NO REF.

44.28

44.43

57.49 (T=80) Lev = 57.49

57.49 (T=80) Lev = 57.49
Avg = 57.49

Fd L & K
① 89°59'20"
④ 359°57'10"
⑥ 179°55'40"
89°59'17"

SET CHIS X IN CB

SET CHIS X IN CB

RE RUN
1) 89 59 20
4) 359 57 40
6) 179 55 40
89 59 20

NO REF
Fd. Spk Washer 9'N/W of ft. on line (FB 1854-9 calls for R R Spk)

20.04

20.24

Fd L & K
1) 89°58'30"
4) 359°54'00"
6) 179°51'20"
89°58'38"

(5)

ALLEY

90°

BURIN AVE

57.49

RE RUN
1) 89° 58' 30"
4) 359 54 40
6) 179 52 20
89 58 43

29.99 (T=96) Lev = 30.00
29.99 (T=96) Lev = 30.00
Avg = 30.00

CONC Apron

251.95

1" I.P Page 9 Set on Line

30.00

30.12

20.26

89 58 39

125.00

(60)

Fd Nothing Dug 4" (2"ø, 2" submerged) Set 60d spike w/in flush ON LINE & dist (125.00 from South) see FB 1849-7

SET ON LINE

CONT PAGE 63

Please Return To
LOS ANGELES COUNTY ENGINEER
403 Los Angeles County Engineering Bldg.

Note: Any Additions or Changes on This Sheet Must be Made or Circled in Red Ink With Date and Name of Person Making Change.

Do not extend this side of this line.

Map No. _____
Office Work _____
Checked _____

JN 2021 28 Tape _____ Std 68 °F
Surveyed by sh H. Bk Co. H.
Notes U.M.B. F.T.C.P. Date 9-25-63

HEALTH DEPT

L.A. CO. LIBRARY

LAWNDALE CIVIC CENTER

251.91 (T=9.9) Lev = 251.95
251.90 (T=9.9) Lev = 251.94
Avg = 251.95

Set 1" I.P. flush on C.L. ENGINEER'S ... 30.00 ft. from ... on line

30.00 Page 64 BORIN AVE

cont page 66

set chiseled line on edge of walk

25.95 APPROX P/L

WALK

30.43

CONC

set punch mark on line on top of curb

R 80 PARKING

cont page 64

LAWNDALE PARK (CITY)

Note: Any Additions or Changes on This Sheet Must be Made or Circled in Red Ink With Date and Name of Person Making Change.

Do not extend this line.

PLEASE RETURN TO
LOS ANGELES COUNTY ENGINEER
403 Los Angeles County Engineering Bldg.

78F3095 C.E. #310 9-62

F. B. 1854 PG. 66

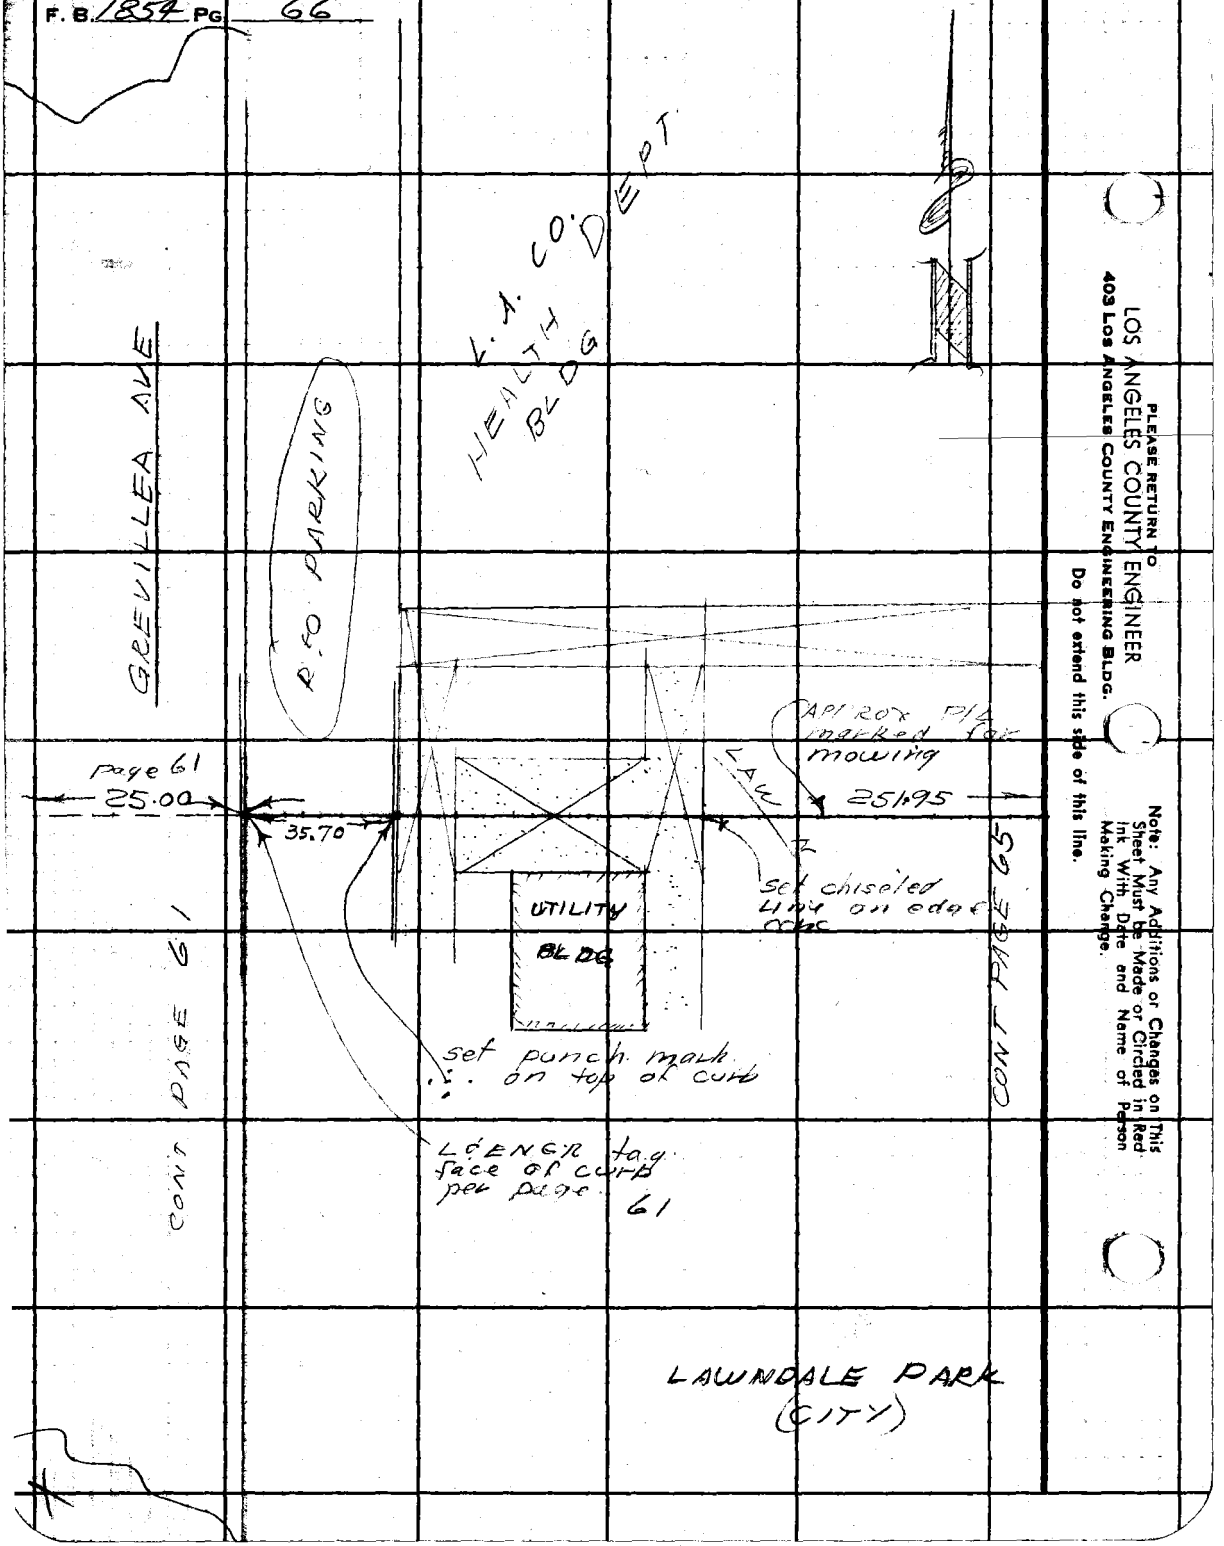

PLEASE RETURN TO
LOS ANGELES COUNTY ENGINEER
403 Los Angeles County Engineering Bldg.

Do not extend this side of this line.

Note: Any Additions or Changes on This Sheet Must be Made or Circled in Red Ink With Date and Name of Person Making Change.

Profile Notes Red____ Plotted____ Job No. 3464.24 Division No.____ F.B. 1854 Pg. 67

Date____ Date____ Survey of [redacted]

Notes Chkd.____ Checked____ Survey by [redacted]

No.____ Date AUG 16 '67 Date____ Map No.____ Indexed C. J. GALLI Date AUG 16 '67

CITY OF LAWNDALE CIVIC CENTER
J.N. 3464.24

LEVELS

FOR

+BM #1 TO +BM #2

SEE PT SHEET # H-157

PARTY

K MYERS
D LeGAULT
M BUSTRUM
B NUNEZ

DATE

Aug 15 - 1967

STATION	B.S.	H.I.	F.S.	ELEV.

NOTE: ANY ADDITIONS OR CHANGES ON THIS SHEET MUST BE MADE OR CIRCLED IN RED INK, WITH DATE AND NAME OF PERSON MAKING CHANGE.

Do not extend notes this side of this line.

PLEASE RETURN TO
LOS ANGELES COUNTY ENGINEER
403 Los Angeles County Engineering Bldg.

76-L-298 CE 307 2-63

X

76-L-298 CE 307 2-63

PLEASE RETURN TO
LOS ANGELES COUNTY ENGINEER
403 Los Angeles County Engineering Bldg.

NOTE: ANY ADDITIONS OR CHANGES ON THIS SHEET MUST BE MADE OR CIRCLED IN RED INK, WITH DATE AND NAME OF PERSON MAKING CHANGE

Do not extend notes this side of this line.

F.B. 1354 Pg. 68 | Job No. 3464 22 | Division No. | Notes Red | Plotted | Profile
Survey of LAWNDALE CIVIC CTR | Date | Date | No. | X-Sec.
Survey by K. MYERS | Notes D. LOPEZ | Notes Chkd. G. E. BARR | Checked
Indexed C. J. GRILLI | Date | Date AUG 1 67 | Date | No.

STATION	B.S.	H.I.	F.S.	ELEV.		
21-15A				63.517	BM 21-15A ELEV 63517 FB 3702 -34 ROSECRANS AVE & HAWTHORNE BLVD. CO. ENG MON. IN NORTH TRAFFIC ISLAND.	
	5748	69265				
21-15B			5658	63.606	BM 21-15B ELEV 63606 FB 3702 -34 ROSECRANS AVE & HAWTHORNE BLVD CO. ENG MON. IN SOUTH TRAFFIC ISLAND.	
	4459	68066				
+P.			5875	62191		
	4633	66824				
+P.			5170	61654		
	5409	67063				
+P.			5843	61220		
	4917	66137				
+P.			5461	60676		
	5337	66233				
+P.			4631	61602		
	5120	66722				
+P.			6357	60365		
	3900	64265		59.190 Adj		
+BM #1			5069	59196	+BM #1 ELEV	FB
	4783	63979		59.277 Adj.	INT. 147TH ST. & BURIN AVE	
+P.			4695	59284	1/2 ft. Pead. EAST CB.	
					RD F.B. 243-44	

4

76-L-298 CE 307 2-63

PLEASE RETURN TO
LOS ANGELES COUNTY ENGINEER
403 LOS ANGELES COUNTY ENGINEERING BLDG.

NOTE: ANY ADDITIONS OR CHANGES ON THIS SHEET MUST BE MADE OR CIRCLED IN RED INK, WITH DATE AND NAME OF PERSON MAKING CHANGE.

Do not extend notes this side of this line.

STATION	B. S.	H. I.	F. S.	ELEV.	
T.P.				59284	
	4421	63705		59.050 Adj	
+BM #2			4639	59066 BM #2 ELEV	FB
	4537	63603		59.387 147th St & GREVILLEA AVE. Adj	
T.P			4207	59396 L & T Read on W&T CB	
	5812	65208		RD Dept FB 243 - 7A	
T.P			4457	60751	
	6496	67247			
TP			4675	62572	
	5737	68309			
T.P			4832	63477	
	5659	69136			
T.P.			3871	65265	
	7167	72432			
T.P			3693	68739	
	6944	75683			
T.P			2646	72997	
	6183	79180		72.714	
21-16			6451	72729 BM 21-16 ELEV 72714 FB 1391	
				ROSECRANS AVE & NORWALK AVE	
				COMMON 3.5 W & 2.0 S 4A INT.	

Profile Notes Red Plotted Job No. 3441-21 Division No.
Notes Checked Survey by C. J. GALLI Date
No. Date Map No. Indexed C. J. GALLI Date
F.B. Pg.

F.B. 1154 Pg. 70 Job No. 34624 Division No. _____ Notes Red _____ Plotted _____ Profile

Survey of LANNDALE CIVIC CTR Date _____ Date _____ No. _____

Survey by K. Lowery Notes D.L. Notes Chkd. _____ Checked _____ X-Sec.

Indexed _____ Date _____ Date _____ Date _____ No. _____

STATION	B.S.	H.I.	F.S.	ELEV.

76-L-298 CE 307 2-63

PLEASE RETURN TO
LOS ANGELES COUNTY ENGINEER
403 Los Angeles County Engineering Bldg.

Do not extend notes this side of this line.

NOTE: ANY ADDITIONS OR CHANGES ON THIS SHEET MUST BE MADE OR CIRCLED IN RED INK, WITH DATE AND NAME OF PERSON MAKING CHANGE

Notes Ck'd by G. E. BARR
Map No.
Office Work
Checked

Survey of Lawndale
JN 3464.39 Tape 0146 Std 68 °F
Surveyed by English
Notes Date 5-67

LAWNDALE SURVEY

J.N. 3464.39

Street
Center Line
Survey

May 14, 1969.
English
Shoemaker
Clifford
Dupuis

Note: Any Additions or Changes on this Sheet Must be Made or Circled in Red Ink With Date and Name of Person Making Change.

PLEASE RETURN TO
LOS ANGELES COUNTY ENGINEER
403 Los Angeles County Engineering Bldg.

Do not extend this side of this line.

7858093 CE #310 9-67

F.B. 1854 Pg. 72

INDEX MAP

City of Lawndale

79 166 ±/ 5 ft. 76

78 167 ±/ 5 ft. 75

30

77 168 ±/ 5 ft. 74

169 ±/ 5 ft. 73

Sepulveda

Aviation

Prairie

Inglewood

Blvd.

Pacific

Beach

Redondo

LOS ANGELES COUNTY ENGINEER
403 Los Angeles County Engineering Bldg.

PLEASE RETURN TO

Do not extend this side of this line.

Note: Any Additions or Changes on this Sheet Must be Made or Circled in Red Ink With Date and Name of Person Making Change.

Notes Ck'd by G. E. BARR
Map No.
Office Work
Checked

Survey of
JN
Tape
Surveyed by
Notes
Date

Note: Any Additions or Changes on this Sheet Must be Made or Circled in Red Ink With Date and Name of Person Making Change.

Do not extend this side of this line.

PLEASE RETURN TO
LOS ANGELES COUNTY ENGINEER
403 Los Angeles County Engineering Bldg.

W. S. 25 D-3

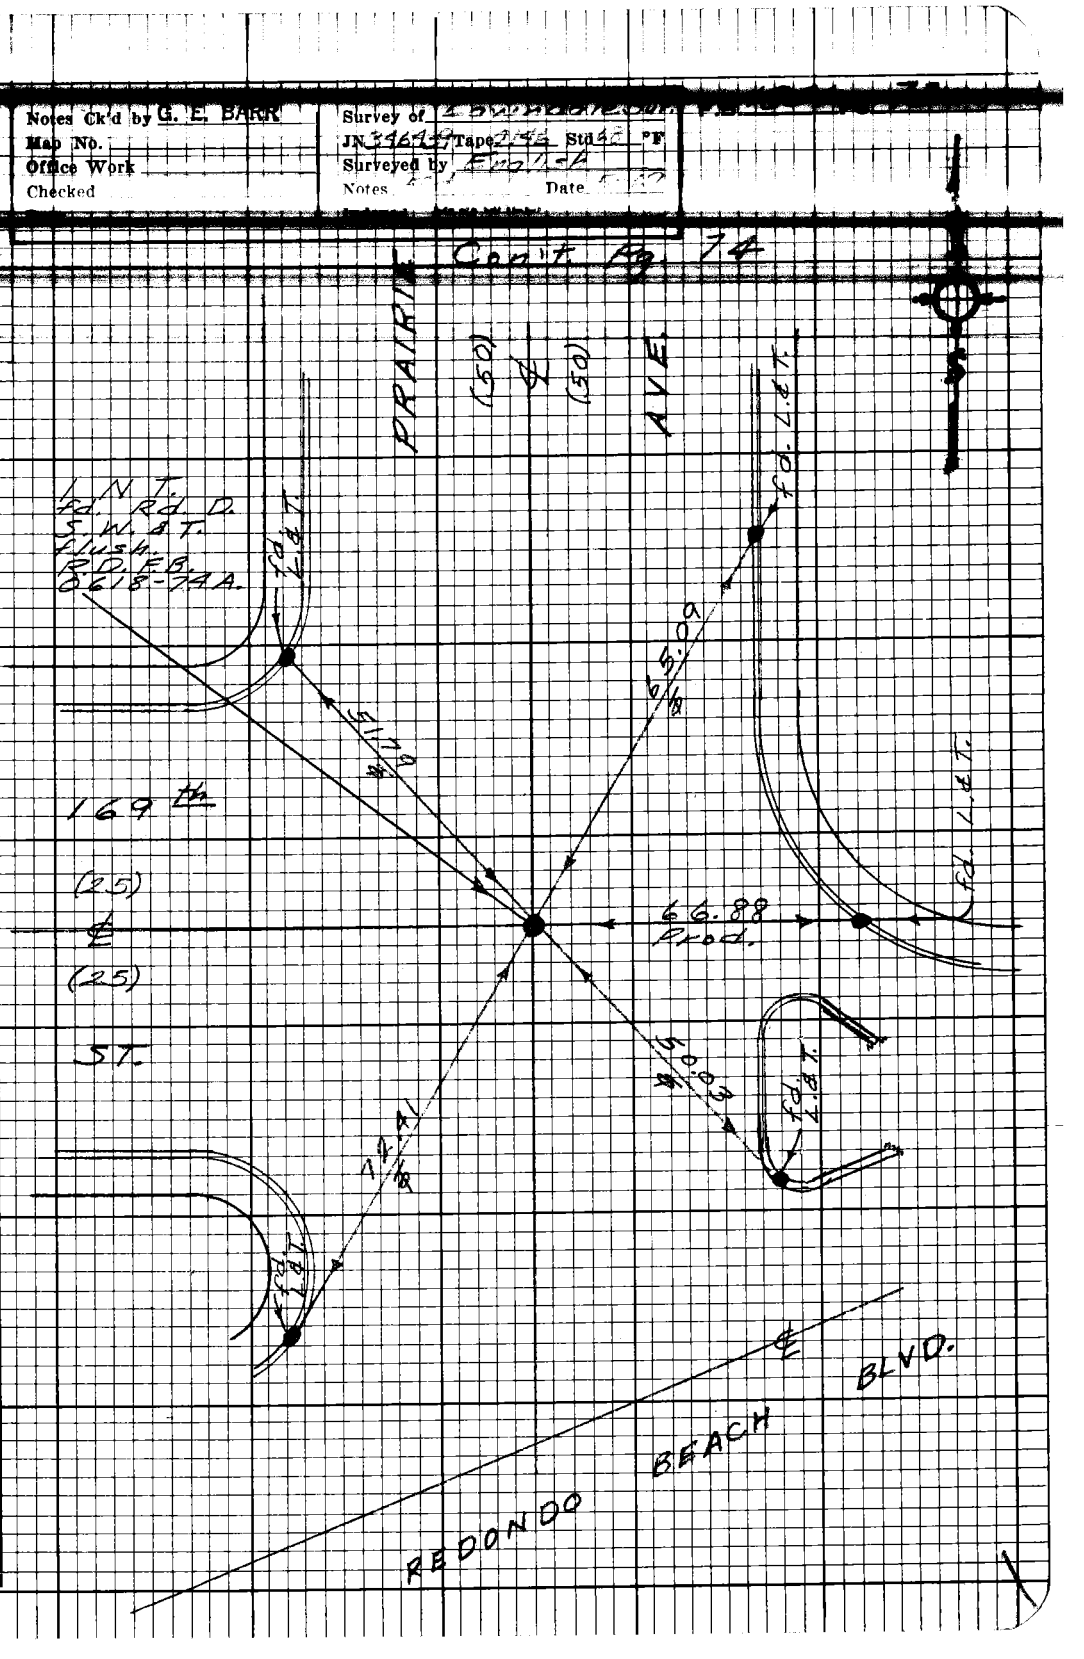

753098 CE# 310 9-67

F.B. 1854 Pg. 74

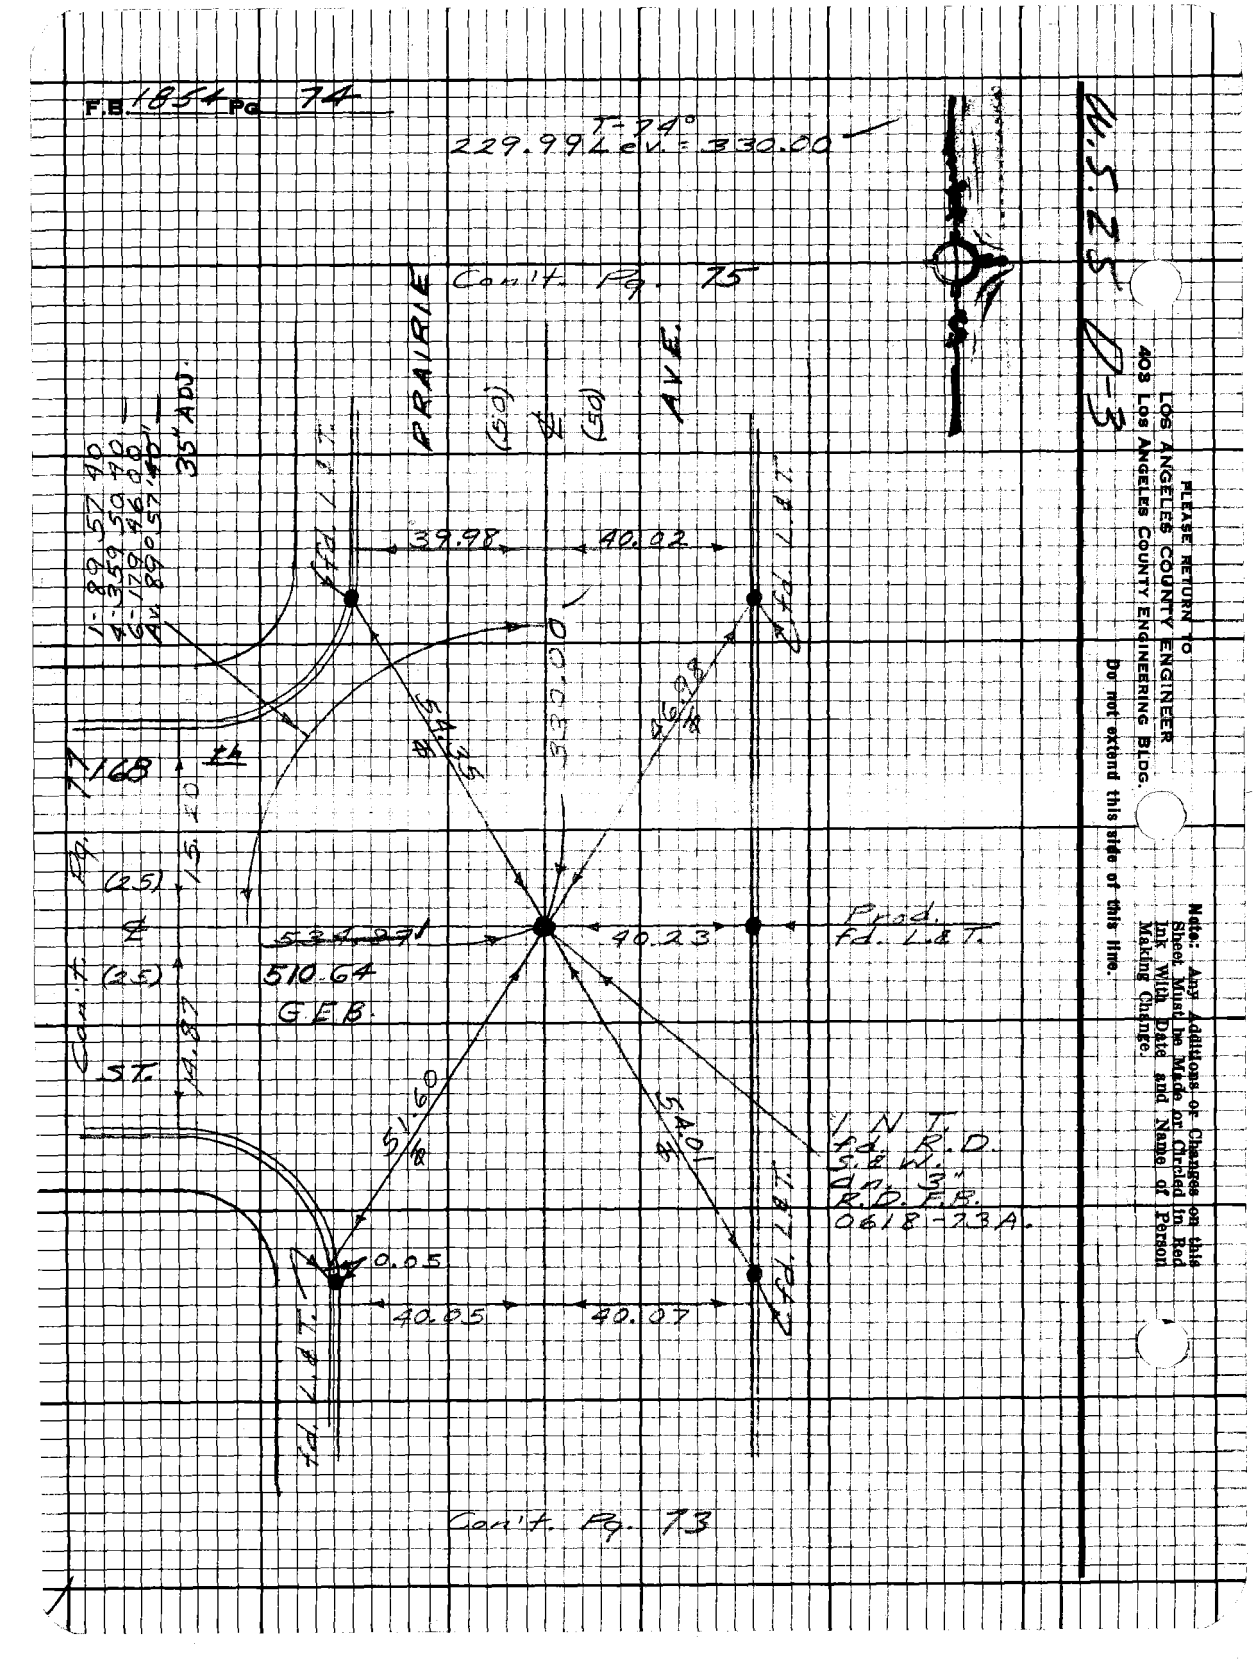

W.S.E. 10-3

LOS ANGELES COUNTY ENGINEER
403 Los Angeles County Engineering Bldg.

PLEASE RETURN TO

Note: Any Additions or Changes on this Sheet Must Be Made or Circled In Red Ink With Date and Name of Person Making Change.

Do not extend this side of this line.

Notes Ck'd by E. L. BARR
Map No.
Office Work
Checked

Survey of
JN 3469.39 Tape 100' Std 68 °F
Surveyed by English
Notes 5-12 Date 5-69

Cont. Pg. 16

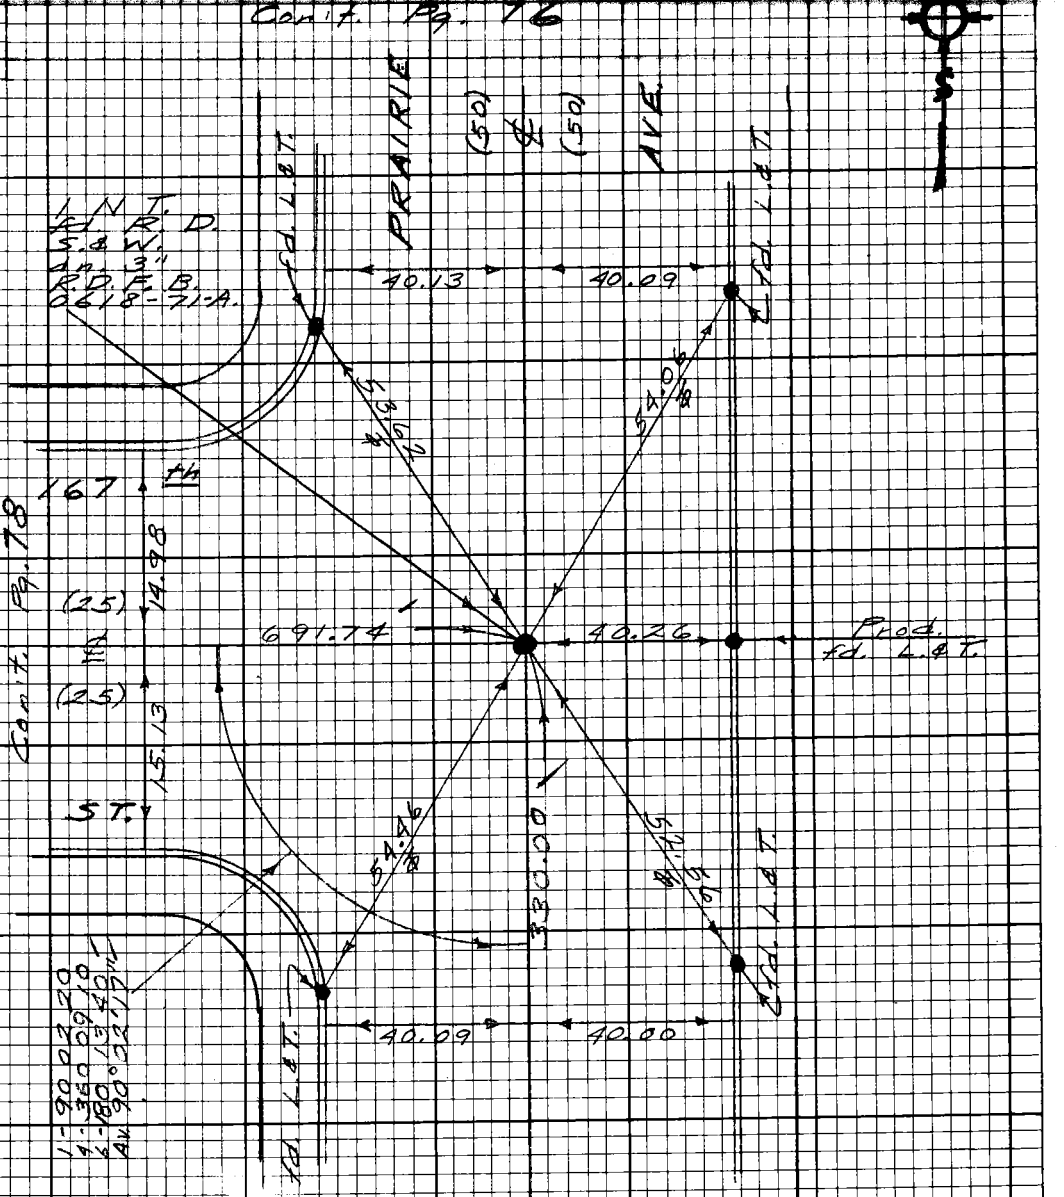

Note: Any Additions or Changes on this Sheet Must be Made or Circled in Red Ink With Date and Name of Person Making Change.

Do not extend this side of this time.

PLEASE RETURN TO
LOS ANGELES COUNTY ENGINEER
403 LOS ANGELES COUNTY ENGINEERING BLDG.

W. 5.25 D-13

ZEPHYR CE #310 8467

PLEASE RETURN TO
LOS ANGELES COUNTY ENGINEER
403 Los Angeles County Engineering Bldg.

Note: Any Additions or Changes on this Sheet Must be Made or Circled in Red Ink With Date and Name of Person Making Change.

Do not extend this side of this line.

W.S. 25 D-3

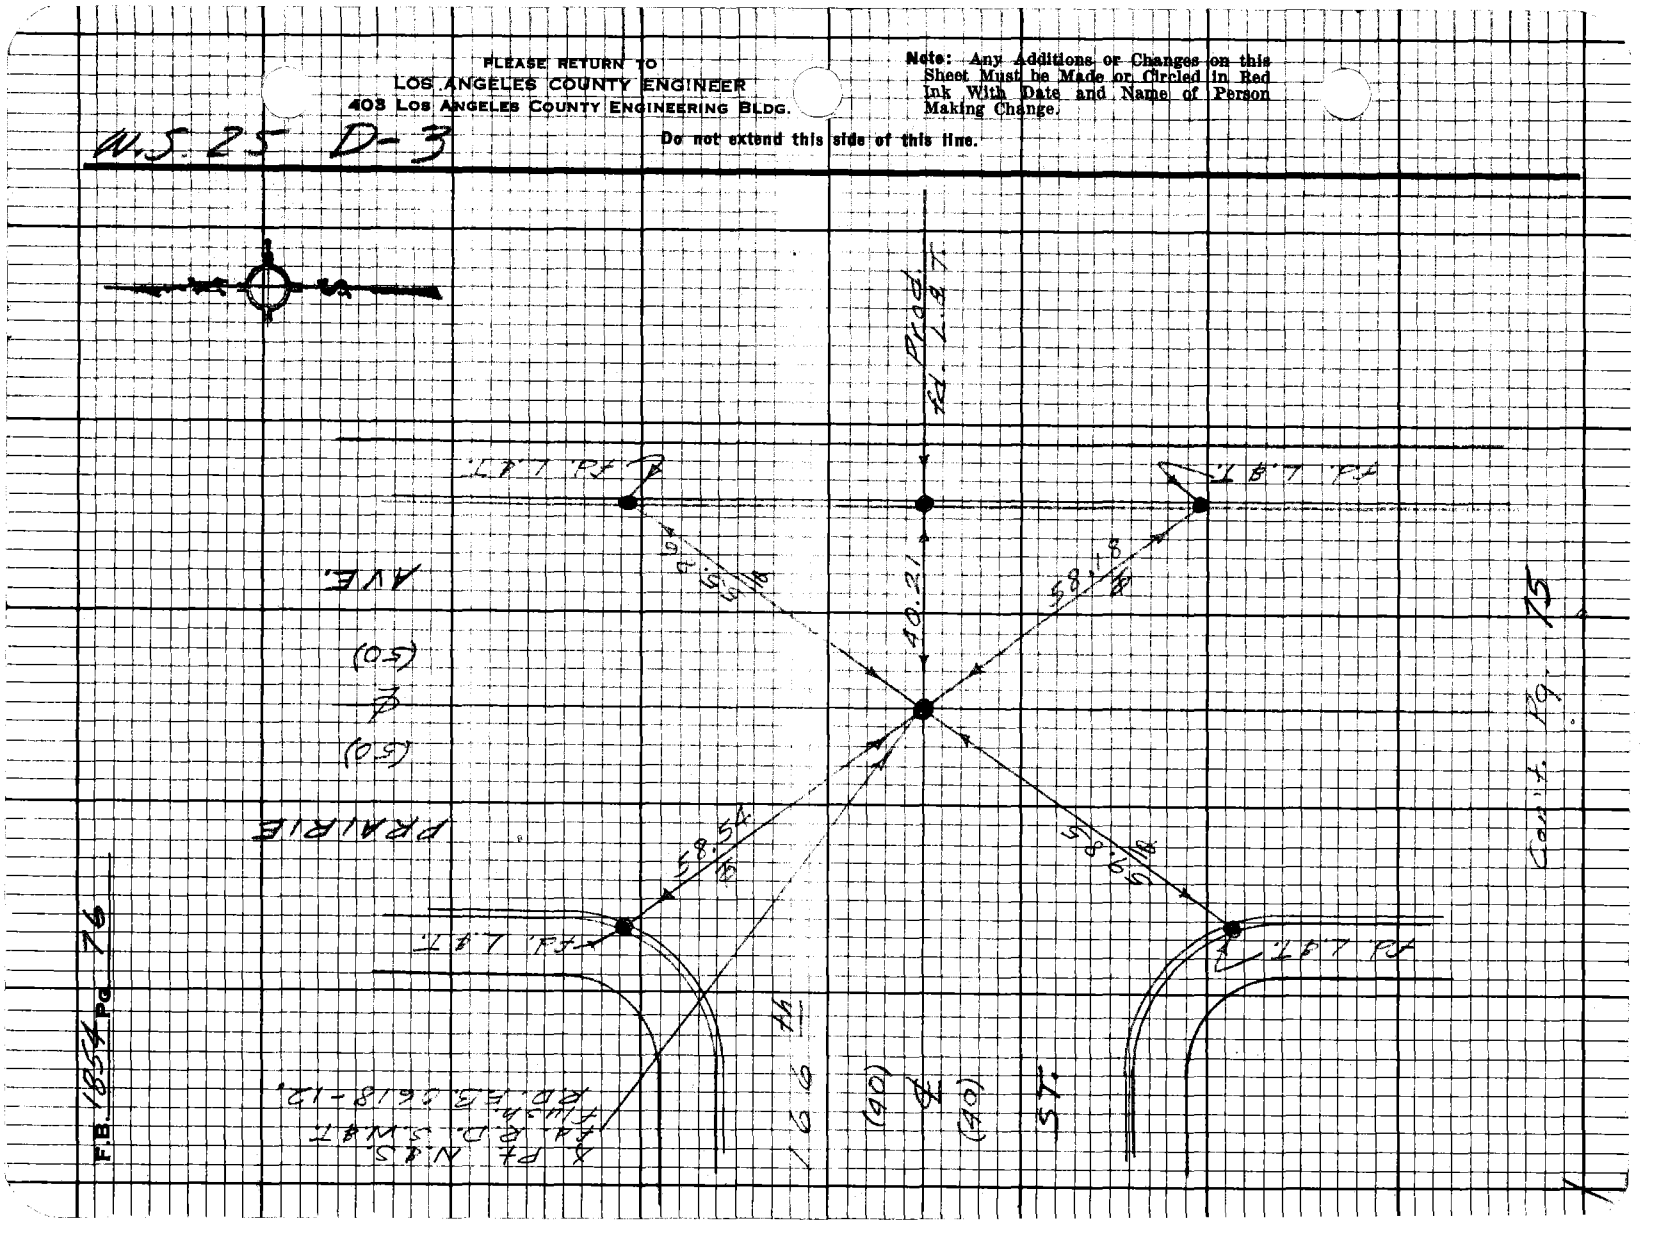

Notes Ck'd by G. E. BARR
Map No.
Office Work
Checked

Survey of Landdale Survey
JN 5-1439 Tape 0208 Std 68 °F
Surveyed by English
Notes Date 5-69

Note: Any Additions or Changes on this Sheet Must be Made or Circled in Red Ink With Date and Name of Person Making Change.

Do not extend this side of this line.

PLEASE RETURN TO
LOS ANGELES COUNTY ENGINEER
403 LOS ANGELES COUNTY ENGINEERING BLDG.

W.S. 25-D-3

Con't. Pg. 18

OSAGE AVE.

(25) (22)

T=68°
534.87 Adj. = 534.87
T=79°
510.62 Elev = 510.64
G.E.B.
5/16/69

1- 123 12 00
4- 133 08 00
6- 25 42 00
Av. 124 01 00

Set L.E. C.E. Tag

321.81

5.98

16.10

BA. 19

Set C.E. Tag

168 ft

Con't. Pg. 17

Prod. Fd. L.E.T.

15.95

534.87
510.64
G.E.B.

43.82

(25)

5 T.

14.80

Prod. - Fd. L.E.T.

Con't. Pg. 20

253098 CE #310 9-67

PLEASE RETURN TO
LOS ANGELES COUNTY ENGINEER
403 LOS ANGELES COUNTY ENGINEERING BLDG.

Note: Any Additions or Changes on this Sheet Must be Made or Circled in Red Ink With Date and Name of Person Making Change.

Do not extend this side of this line.

W.S.25 D-5

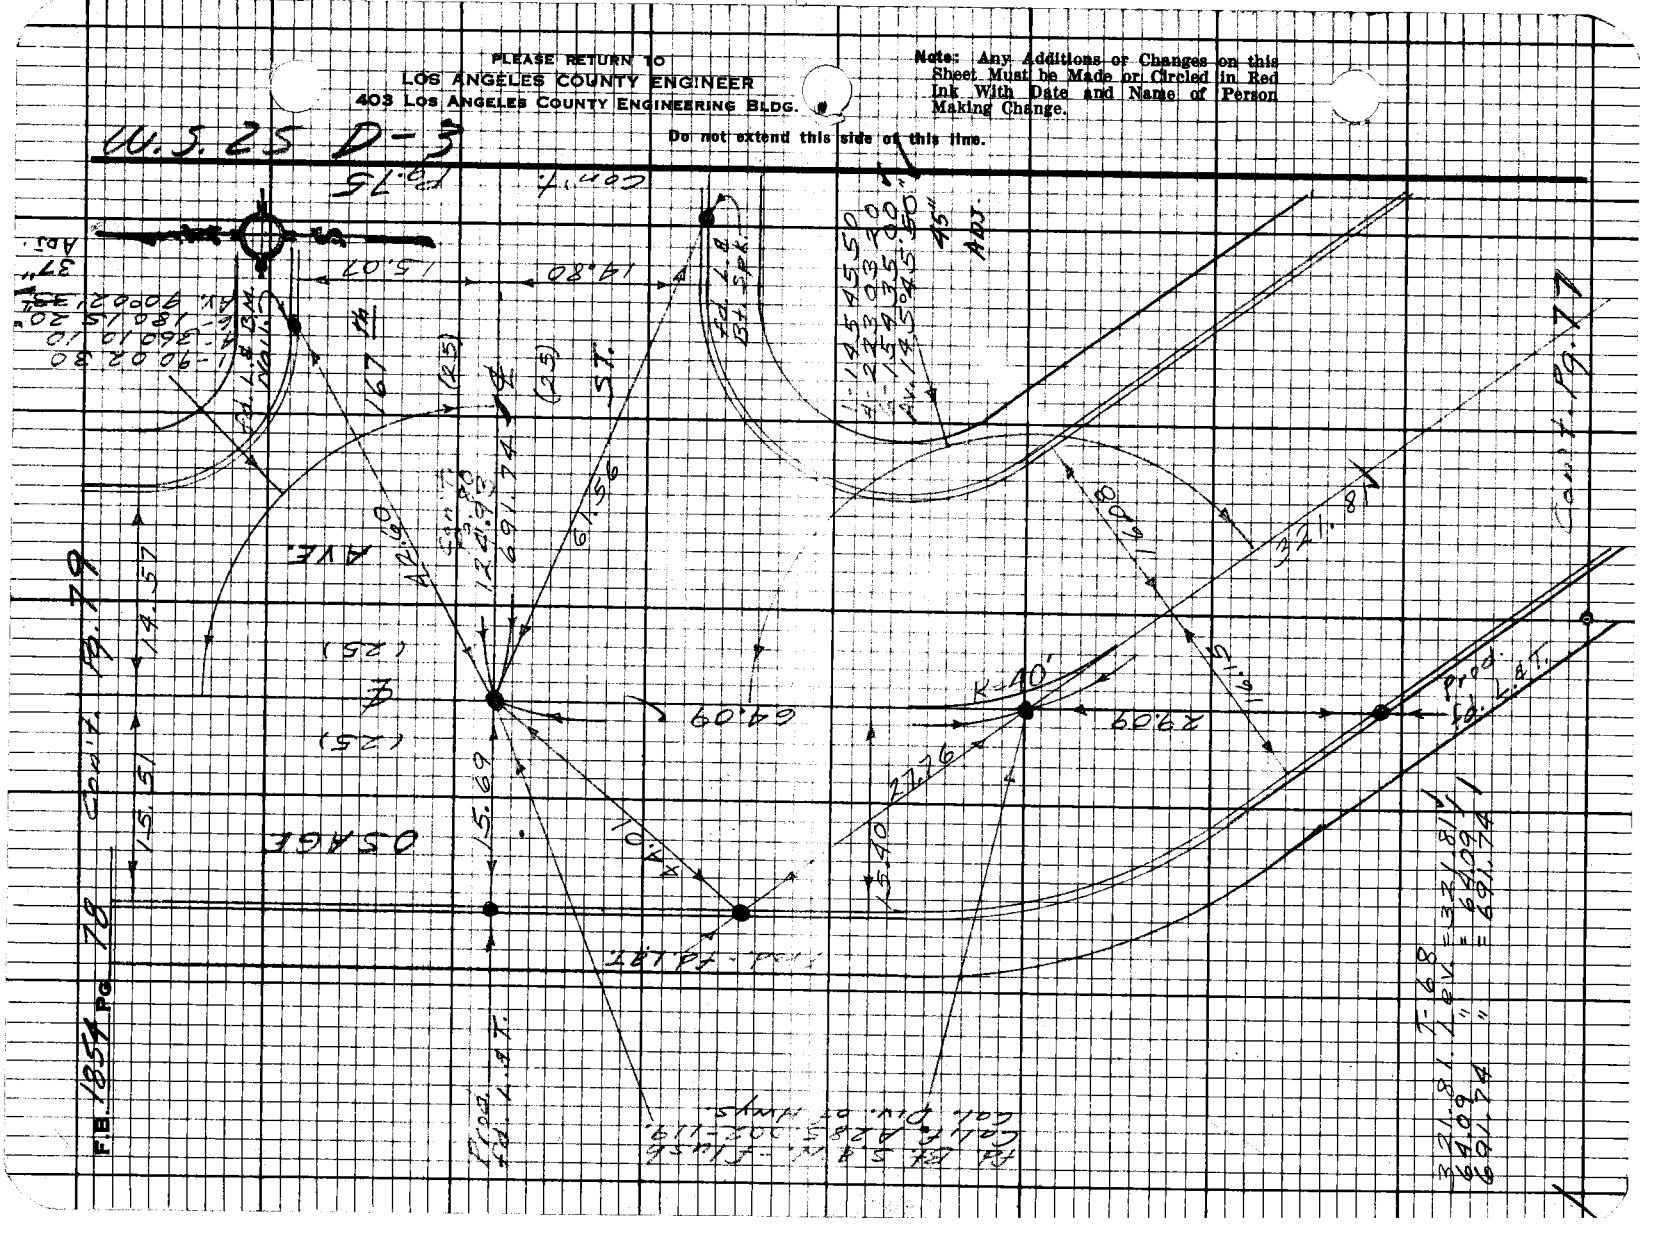
ST.
AVE.
OSAGE
K=10'
ADJ.
60.69
29.09
15.69
15.07
14.80
61.96
42.60
(25)
(25)
(25)
(25)
R=10'
R=10'
R=10'

Notes Ck'd by G. E. BARR
Map No.
Office Work
Checked

Survey of
JN
Surveyed by
Notes

Tape
Std
°F
Date

Note: Any Additions or Changes on this Sheet Must be Made or Circled in Red Ink With Date and Name of Person Making Change.

Do not extend this side of this line.

PLEASE RETURN TO
LOS ANGELES COUNTY ENGINEER
403 LOS ANGELES COUNTY ENGINEERING BLDG.

W. S. 25 D-3

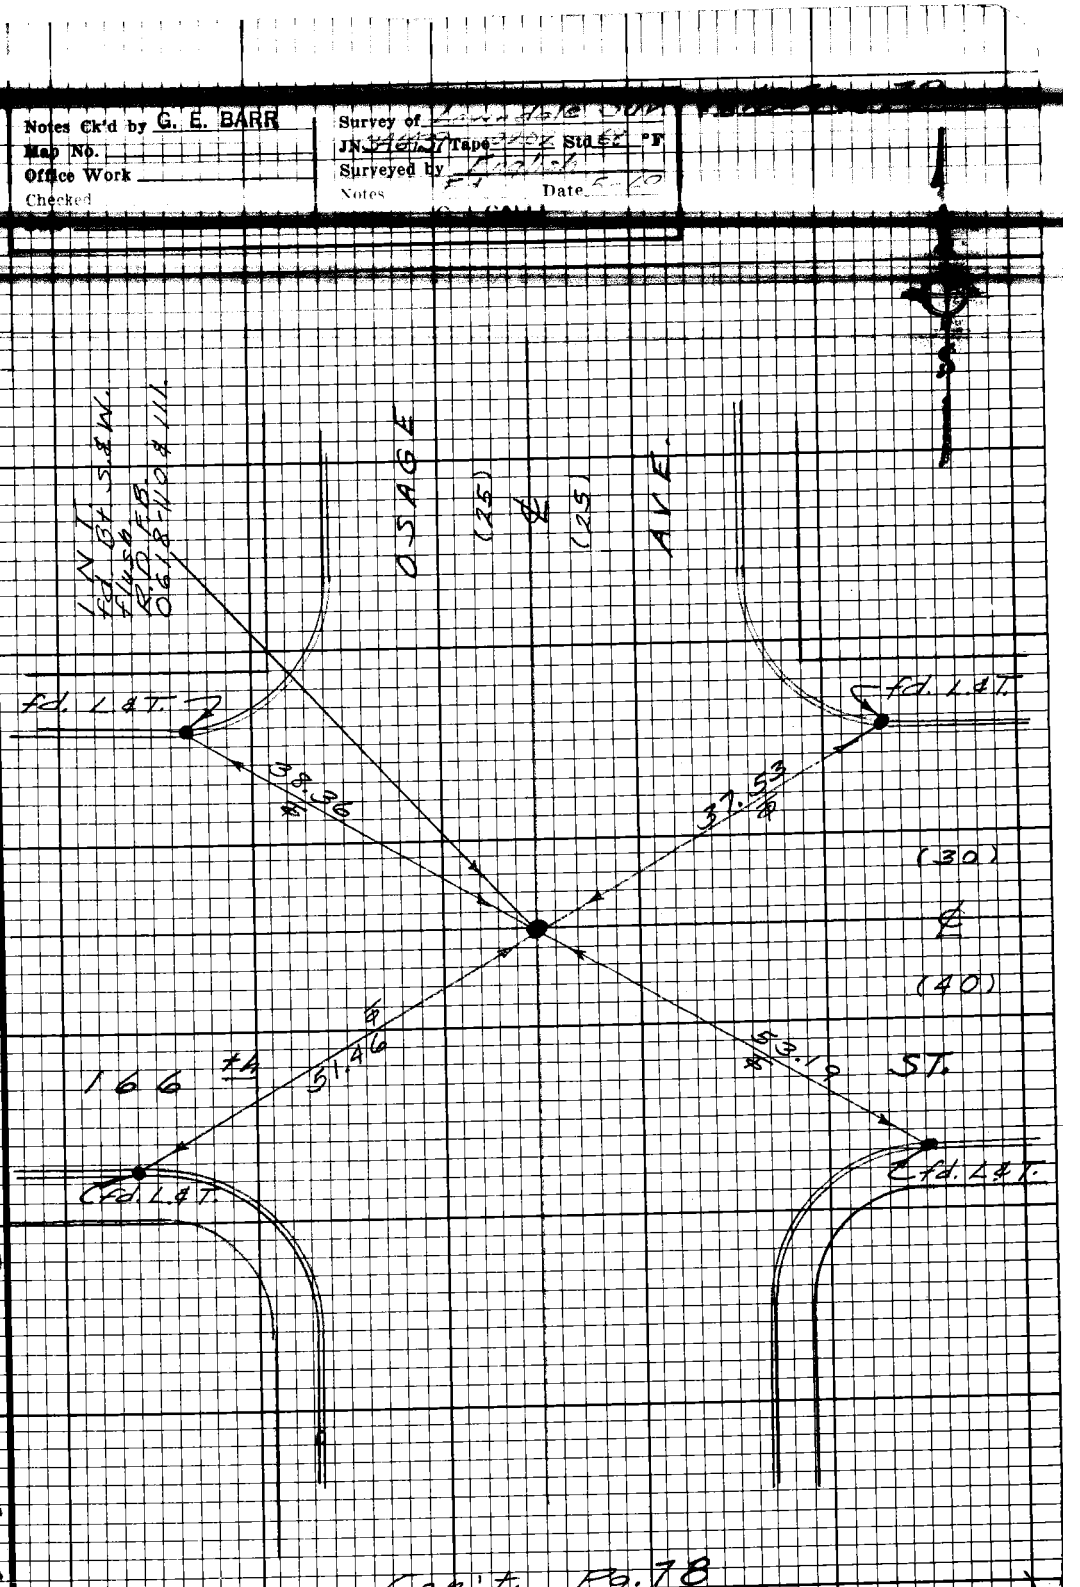

Cont. Pg. 78

JESCO CE #310 9-67

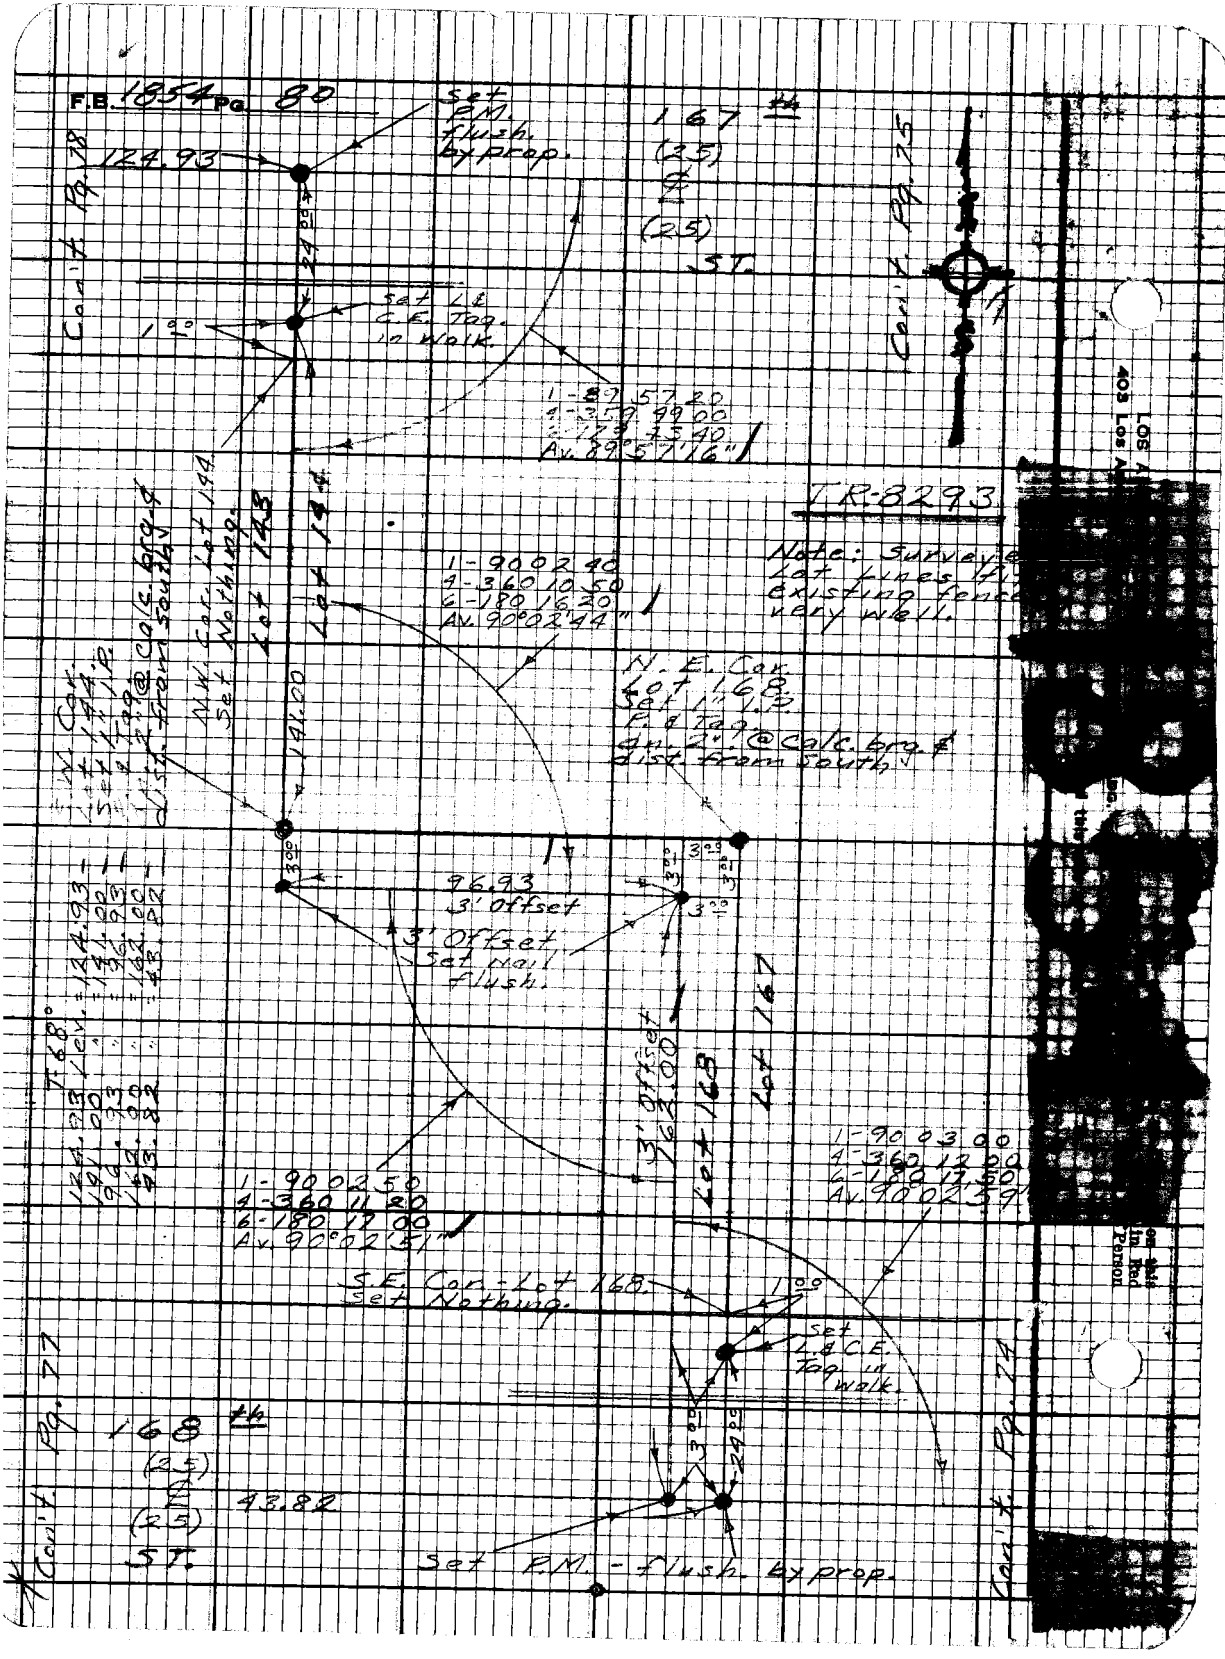
F.B. 1854 Pg. 80
Set P.K. flush by prop.
124.93
Cor. 1 Pg. 178
Set L.& C.E. Top in Walk.
1-89 57 20
4-359 59 00
6-179 59 40
Av. 89°59'16"
Cor. 1 Pg. 175
403 Los A
TR-8293
Note: Survey
lot lines
existing fence
very well.
1-90 02 40
4-360 10 50
6-180 16 20
Av. 90°02'44"
N. E. Cor. Lot 168
Set L.& C.E. Top @ Calc. Orig. & dist. from South
N. Cor. Lot 169
Set L.& C.E. Top @ Calc. Orig. & dist. from East
Set Nothing.
Lot 169
141.00
Lot 168
Lot 167
96.93
3' offset
3' offset
Set nail flush.
3' offset
142.00
1-90 02 50
4-360 11 80
6-180 17 00
Av. 90°02'57"
1-90 03 00
4-360 12 20
6-180 13 50
Av. 90°02'39"
S.E. Cor. Lot 168
Set Nothing.
Set L.& C.E. Top in Walk.
Cor. 1 Pg. 177
168
43.82
Set P.K. - flush. by prop.
Cor. 1 Pg. 174