by	Survey of JN Tape Std. °F Surveyed by Notes Date Indexed	F.B. 2228 Pg.

	Job	Description
		JOHN ANSON FORD PARK - J.N.005#.9
	Bdry.	Survey on Scout Ave. & Rio Hondo Channel south of Florence Avenue.
	B.M.	Levels.
	Topog.	Control line at old Boy Scout Camp site.
2	Bdry.	Of prop. W'ly boundary.
4	R/W	Flood Control R/W showing encroachments.
5	Loc. Imp.	12" Irrig. line nr. So. Bdry.
0	B.M.	Bench Levels.
8	Loc.& Grades	For west parking lot, buildings & ball diamonds.
16	Loc. & Grades	For play area fence, picnic shelter, directors bldg., elec. conduits, phone lines & lake drains.
32	Loc. & Grades	For mounds in park.
63	Loc. Imp.	Water & gas lines.
68	B.M.	Add'l. bench levels for baseball diamond.
72	Loc. Imp.	Loc. sewer lines at directors bldg.
78	Grades	Loc. & grades of walks.
81	Grades	See below.

Microfilmed May 86

(cont'd on next page)

F.B. 2228 Pg.

Page	Job	Description
183-186	Grades	Loc. & grades of drives.
187-209	Grades	For curbs, walks, & paving-W side of parking lot.
211-218	Loc. Imp.	Loc. of pool-drain lines, & walks around lake.
219-222	Grades	Loc. & grades of storm drain from Rio Hondo to park.
223-234	Loc. Imp.	Loc. for swimming pool, bath house, community bldg.
235-239	Grades	Loc. & grades of storm drains.
241-242	Topog.	Measurement of inside of swimming pool at water level.
243-244	Loc. Imp.	Location of section of 4" & 6" AC Water Lines.
245-246	Loc. Imp.	Location of 5' x 4' conc. pullbox near picnic shelter.
+179-181	Loc. Imp.	Loc. of edge of asphalt membrane.

PLEASE RETURN TO
LOS ANGELES COUNTY ENGINEER
403 LOS ANGELES COUNTY ENGINEERING BLDG.
Do not extend this side of this line.
Note: All Additions or Changes Must Be Made in Ink With Date And Name Of Person Making Change.

Notes Ck'd by KRM	Survey of John Anson Ford Pk	F.B. 2228 Pg. 5
Map No. C.S.B-2600	W. O. 08549 Tape No.	St'd. °F
Office Work Burns	Surveyed by D. Sappell	
Checked Galli	Notes D.S. Date 4-16-56	
Date March 1957	Indexed A. C. Johnson 5-1-56	

J.N. 0054.95

JOHN ANSON FORD PARK

BDRY. SURVEY

For Limits see index pgs. 6 & 7

party: Sappell
Shoemake
Myers
Siemann

Note: Any Additions or Changes on This Sheet Must be Made or Circled in Red Ink With Date and Name of Person Making Change.

Do not extend notes this side of this line.

RETURN TO
LOS ANGELES COUNTY SURVEYOR
725 LOS ANGELES COUNTY
ENGINEERING BLDG.

76F3008 SAE #247. 6-54

F. B. 2228 Pg. 6

INDEX

RETURN TO
LOS ANGELES COUNTY SURVEYOR
720 LOS ANGELES COUNTY
ENGINEERING BLDG.

Note: Any Additions or Changes on This Sheet Must be Made or Circled in Red Ink With Date and Name of Person Making Change.

Do not extend notes this side of this line.

RIO HONDO GOLF COURSE

RIO HONDO

SAN GABRIEL RIVER

SAN GABRIEL RIVER F.C.

CHANNEL

TR 10948

TR 10878

TR 10611

TR LINE

GILLILAND RD

SOUTHERN EDISON CO. (330)

CALIF. R/W

FELIX AVE ST

BUELL AVE

FOSTORIA AVE

SHULL ST

ALLEY

GRIFFITH AVE

SOUTH GATE BLVD

S.P.R.R.

F. B 2229 Pg. 7

Notes Ck'd by K R M	Survey of John Anson Ford Park
Map No. C.S.B. 2600	W. O. 0034.05 Tape No. 0144 Std. 68 °F
Office Work Burns	Surveyed by D. Sappell
Checked Galli	Notes D.S. Date 4-16-56
Date March 1957	Indexed C. Johnson

INDEX

TR. 1290

FLORENCE AVE

IRWINDALE DR.

SHERRY AVE

VIA RIO NIDO

RIO HONDO GOLF COURSE

RIO HONDO

PARAM DR

CLARA ST

SCOTT AVE

RAMISH AVE

CHANNEL

JOHN ANSON FORD PARK

GOTHAM ST

Note: Any Additions or Changes on This Sheet Must be Made or Circled in Red Ink With Date and Name of Person Making Change.

Do not extend notes this side of this line.

RETURN TO
LOS ANGELES COUNTY SURVEYOR
726 LOS ANGELES COUNTY
ENGINEERING BLDG.

76F3098 S&E #247. 8-54

8 3

F.B. 2228 PG. 9

Notes Ck'd by KRM
Map No. C.S.B - 2600
Office Work Burns
Checked Galli
Date March 1957

Survey of John Ansen Ford Park
W. O. 0054.95 Tape No. 0144 Std. 68 °F
Surveyed by D. Sappell
Notes D.S. Date 4-16-56
Indexed E. C. Johnson

W.S. 32-C-1

(To LFT PG 10)

ST

Fd L&T in cb

Fd L&T in conc. gutt

ALLEY

35.98

S.O. 5.89

10.64

20.60

Fd L&T in cb

Fd Bt spk W&T Flush per Rd FB 202-52

SHULL ST

50' OFF LINE

Fd Bt spk W&T Flush & 4 Tan Spk & T Ties per Rd FB 202-34

(30)

(50)

GARFIELD

R&M 144.00 T=68°

90

5.09

Spk Nail

AVE

(50)

(30) SHULL ST (30)

Note: Any Additions or Changes on This Sheet Must be Made or Circled in Red Ink With Date and Name of Person Making Change.

Do not extend notes this side of this line.

RETURN TO
LOS ANGELES COUNTY SURVEYOR
726 LOS ANGELES COUNTY
ENGINEERING BLDG.

75F3095 SBE #247. 8-54

F.B. 2228 Pg. 10

W.S. 32-D-1

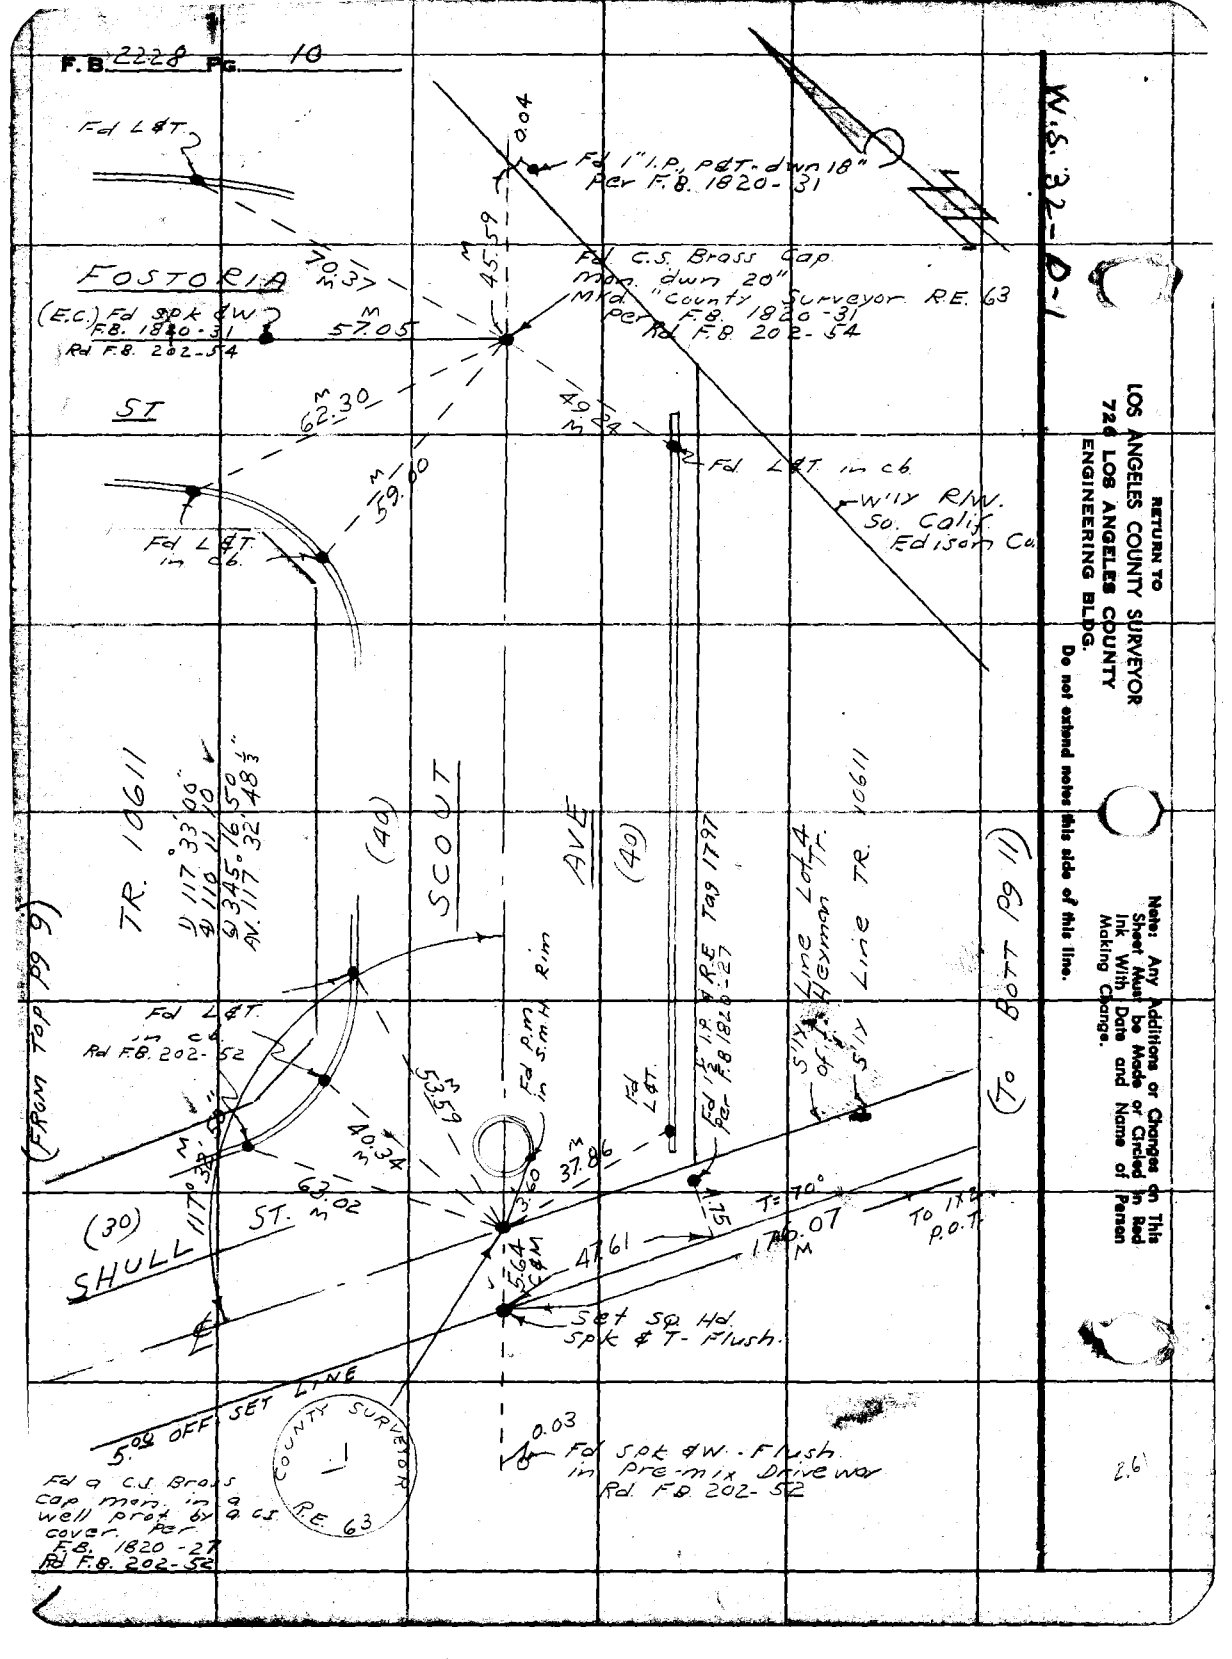

RETURN TO
LOS ANGELES COUNTY SURVEYOR
726 LOS ANGELES COUNTY
ENGINEERING BLDG.
Do not extend notes this side of this line.

Note: Any Additions or Changes on This Sheet Must be Made or Circled in Red Ink With Date and Name of Person Making Change.

2.6

Notes Ck'd by		Survey of John Gosen Ford Park	F. B. 2228 Pg. 11
Map No. C.S.B-2600		W. O. 9954.95 Tape No. 944 Std. 68 °F	
Office Work Burns		Surveyed by D. Sappell	
Checked Galli		Notes D.S. Date 4-17-56	
Date March 1957		Indexed C. Johnson	

W.S. 32-D-1

Note: Any Additions or Changes on This Sheet Must be Made or Circled in Red Ink With Date and Name of Person Making Change.

Do not extend notes this side of this line.

RETURN TO
LOS ANGELES COUNTY SURVEYOR
726 LOS ANGELES COUNTY
ENGINEERING BLDG.

7875008 SBE #247. 8-54

(To Top pg 13)

(To LFT pg 13)

Rio Hondo Channel
F.M. 11284.4
W'LY F.C. R/W

E'LY R/W Co.
Edison

Set L&T. Rec. S.E. cor. Lot 4 from I.N.V. Imon TR. L.S. 30-38

S.S. 30-38 R&M 33.69

C&M 66.34

Note - searched For 1x2's on 5' off Set Line per F.B. 1820-28 @ 33 Fd Nothing

Set chis'd

Bdry Cl'y. of South Gate

Searched for Edison Co. Mon. per L.S. 3439 Fd Mon. in B.

15' OFF-SET LINE

393.14 M

61.15 M

63.23 M

Set 1x2 N&T Flush By Int.

P.O.T. - set sq. hd. spk & T in top of levee.

FD. 1-3-61 0.03 WEST OF LINE R&M

Fd 2" I.P., Plug & 3/4" F.C. Tag "dwn 18" per F.B. 1820-28 F.M. 11284-4

Set L&T. in conc. River Bpth. By int.

P.O.T. - set 1x2 N-Flush.

P.O.T. - set 1x2 N&T. Flush for 5194

Levee

Set 1x2 N&T. Flush on ton prod. By Int.

D 43°46'40" L 175.06 50 Av. 43°46'41.3"
D 43°46'40" L 262.49 41.3 Av. 43°46'41.3"
D 135°45'10" L 183.01 00 Av 135°45'05"
D 135°45'10" L 194.31 30 Av 135°45'15"

Parcel 6

So. Calif. Edison R/W (330)

N 0°58'20" E 367.54 10 N 0°58'30" E 19.00

line lot 4 Tract Shuff

S'14 Heyman Prod

P.O.T. set 1x2 & N-dwn 6"

T = 74° std 68°
① 64.47 @ 11°14' = 63.24
② 64.96 @ 13°14' = 63.23
Av. = 63.235

① 65.23 @ 12°11' = 63.74
② 65.63 @ 13°42' = 63.76

139.09, T = 60° = 139.08
171.82 " = 171.81

8.36
4.94

w'ly R/w

Fd a 2" I.P. & Brass cap Mkd as shown F.B. 1820-L.S. 30-38

EDISON CO. SOUTHERN CALIFORNIA

5' OFF-SET LINE 176.07

(FROM RT PG 10)

RETURN TO
LOS ANGELES COUNTY SURVEYOR
720 LOS ANGELES COUNTY
ENGINEERING BLDG.

Note: Any Additions or Changes on This Sheet Must be Made or Circled in Red Ink With Date and Name of Person Making Change.

Do not extend notes this side of this line.

W.S. 32- D-1

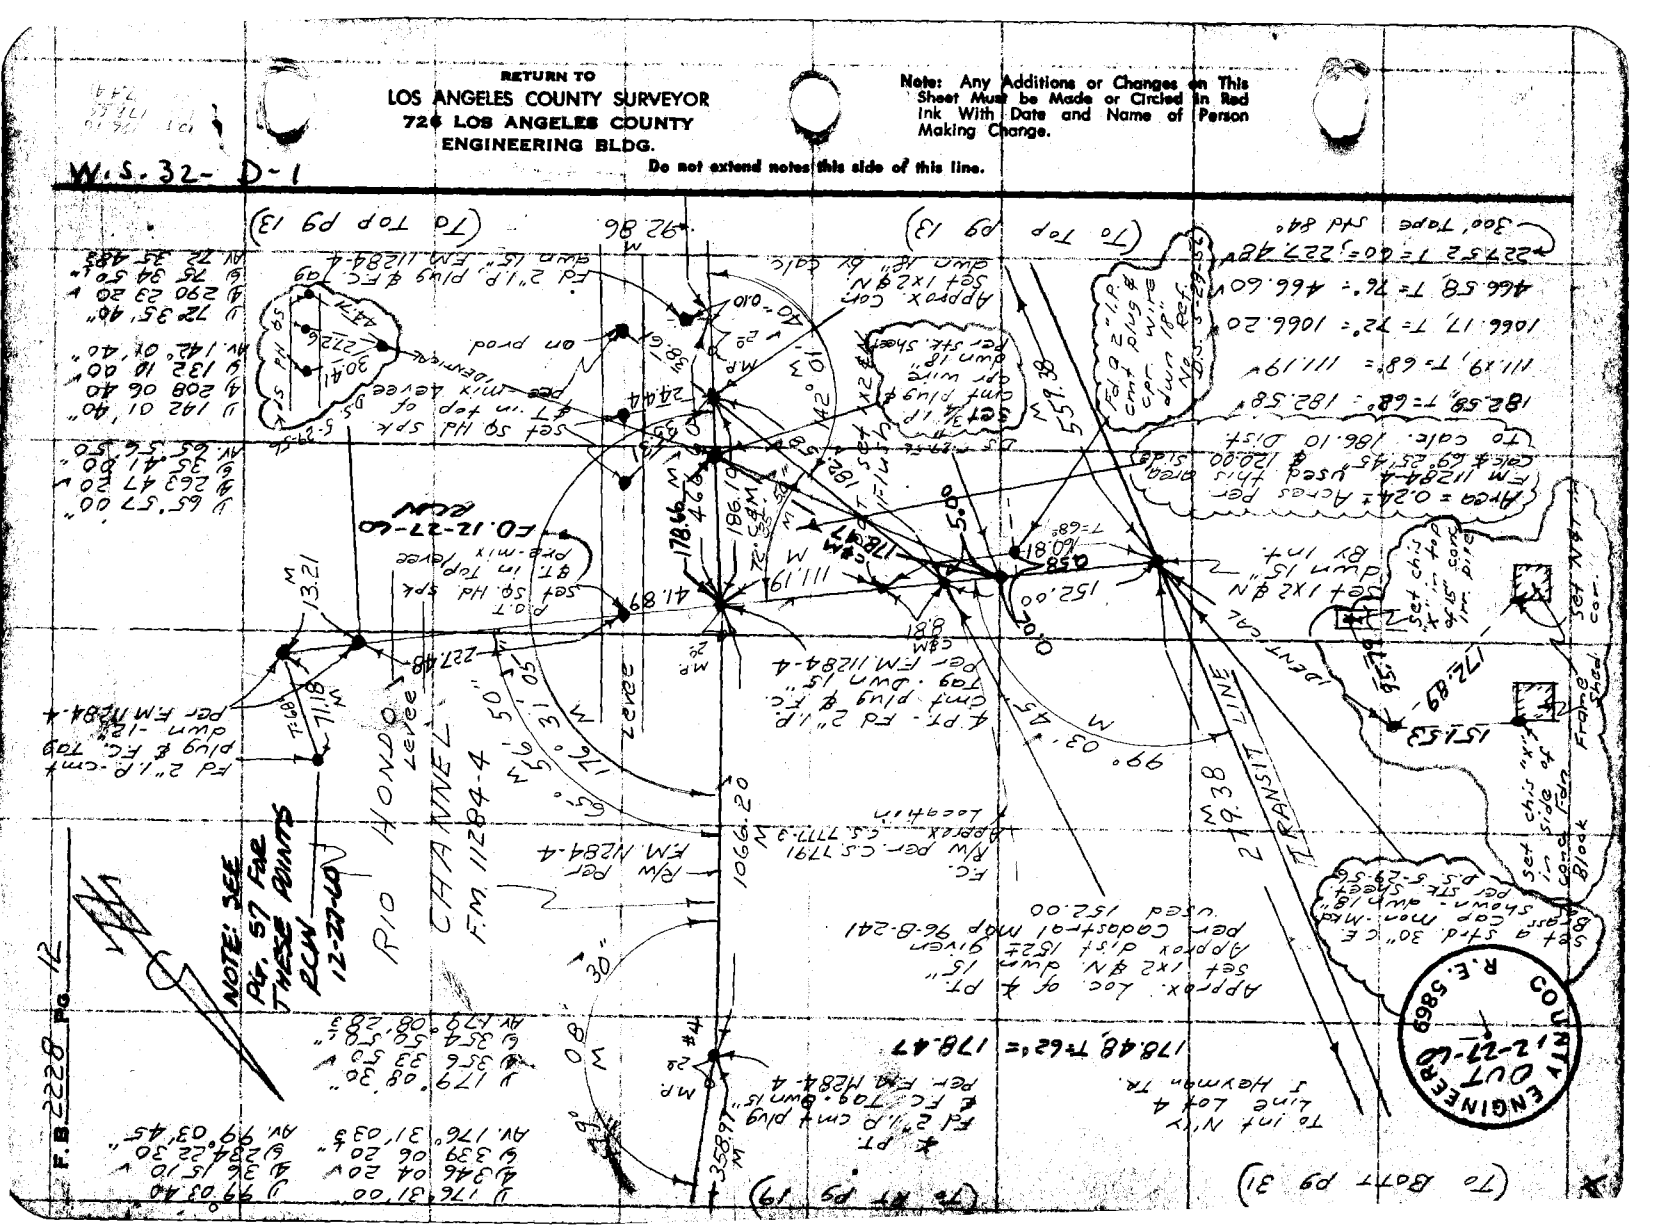
(To Top Pg 13)
(To Top Pg 13)
(To Top Pg 19)
(To Bott Pg 31)
RIO HONDO CHANNEL
F.M. 112884-4
TRANSIT LINE
NOTE: SEE Pg. 57 FOR THESE POINTS ECW 12-27-60
F.B. 2228 Pg 12
COUNTY ENGINEER OUT 12-27-60
R.E. 5869
Area = 0.24± Acres Per F.M. 112884-4 used this area & 120.00 Calc. 186.10 Dist
Set 1X2 ø N. & dwn 1.5' by int.

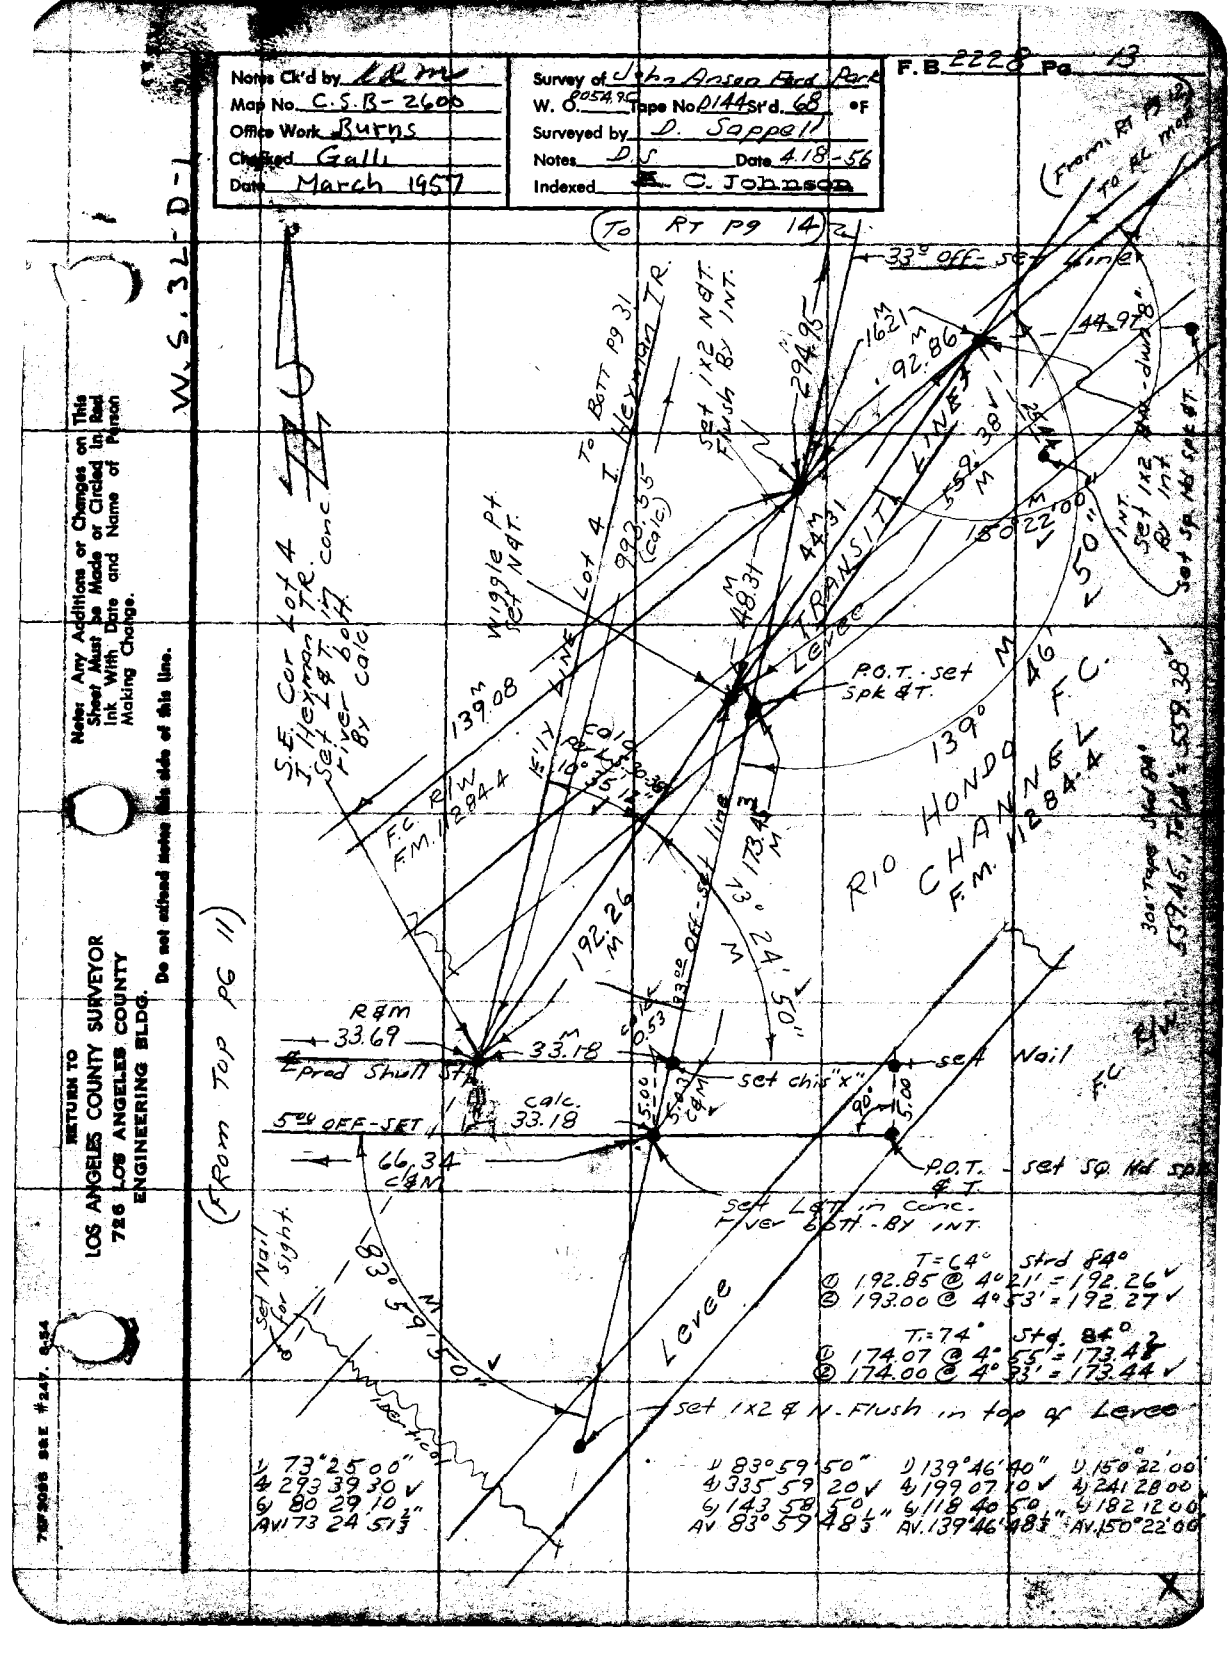
Notes Ck'd by LR mc
Map No. C.S.B-2600
Office Work Burns
Checked Galli
Date March 1957
Survey of John Anson Ford Park
W. O. 0054.96 Tape No. D144 Std. 68 °F
Surveyed by D. Soppeli
Notes D.S Date 4.18-56
Indexed C. Johnson
F.B. 2228 Pg. 13
W.S. 32-D-1
(From Top Pg 11)
(To RT Pg 14)
(From RT Pg 12)
To RL Mon
33° off-set Line
44.98
294.95
1621
92.86
559.38
Set 1x2 Nail Flush By Int.
Set Sq Nd Spk & T.
To Batt Pg 31
Set 1x2 Nail Flush By Int.
Wiggle Pt. Set Nail
Lot 4 I Heyman Tr.
993.55 (Calc)
4431
4831
Transit Lines
Levee
P.O.T. set Spk & T.
S.E. Cor Lot 4 I. Heyman Tr. Set L & T. in conc River calc By
139.08
Lot 4
F.C. R/W F.M. 1284.4
10° 00'
5° 17'
1784
192.26
N 3° 24' 05" W
Rad
33.69
Prod Shell Sta
33.18
83°02 Off-set Line
0.53
set Nail
set chis "x"
5.00
90°
5.00
5th Off-set
calc. 33.18
66.34 C&M
P.O.T. set Sq Nd Spk & T.
Set Lead in Conc. River Bath - By Int.
Set Nail & Tag Flush
Set 1x2 & N. Flush in top of Levee
T=64° Std 84°
① 192.85 @ 4°21' = 192.26
② 193.00 @ 4°53' = 192.27
T=74° Std 84°
① 174.07 @ 4°55' = 173.48
② 174.00 @ 4°53' = 173.44
① 73°25'00"
④ 293 39 30
⑥ 80 29 10
Av 73 24 51⅓
① 83°59'50"
④ 335 59 20
⑥ 143 58 50
Av 83°59'48⅓"
① 139°46'40"
④ 199 07 10
⑥ 118 40 50
Av 139°46'48⅓"
① 150°22'00
④ 241 28 00
⑥ 182 12 00
Av 150°22'00
RIO HONDO CHANNEL F.C. F.M. 1284.4
RETURN TO
LOS ANGELES COUNTY SURVEYOR
726 LOS ANGELES COUNTY
ENGINEERING BLDG.
Do not attach notes this side of this line.
Note: Any Additions or Changes on This Sheet Must be Made or Circled in Red Ink With Date and Name of Person Making Change.

RETURN TO
LOS ANGELES COUNTY SURVEYOR
726 LOS ANGELES COUNTY
ENGINEERING BLDG.

Note: Any Additions or Changes on This Sheet Must be Made or Circled In Red Ink With Date and Name of Person Making Change.

Do not extend notes this side of this line.

W.S. 34

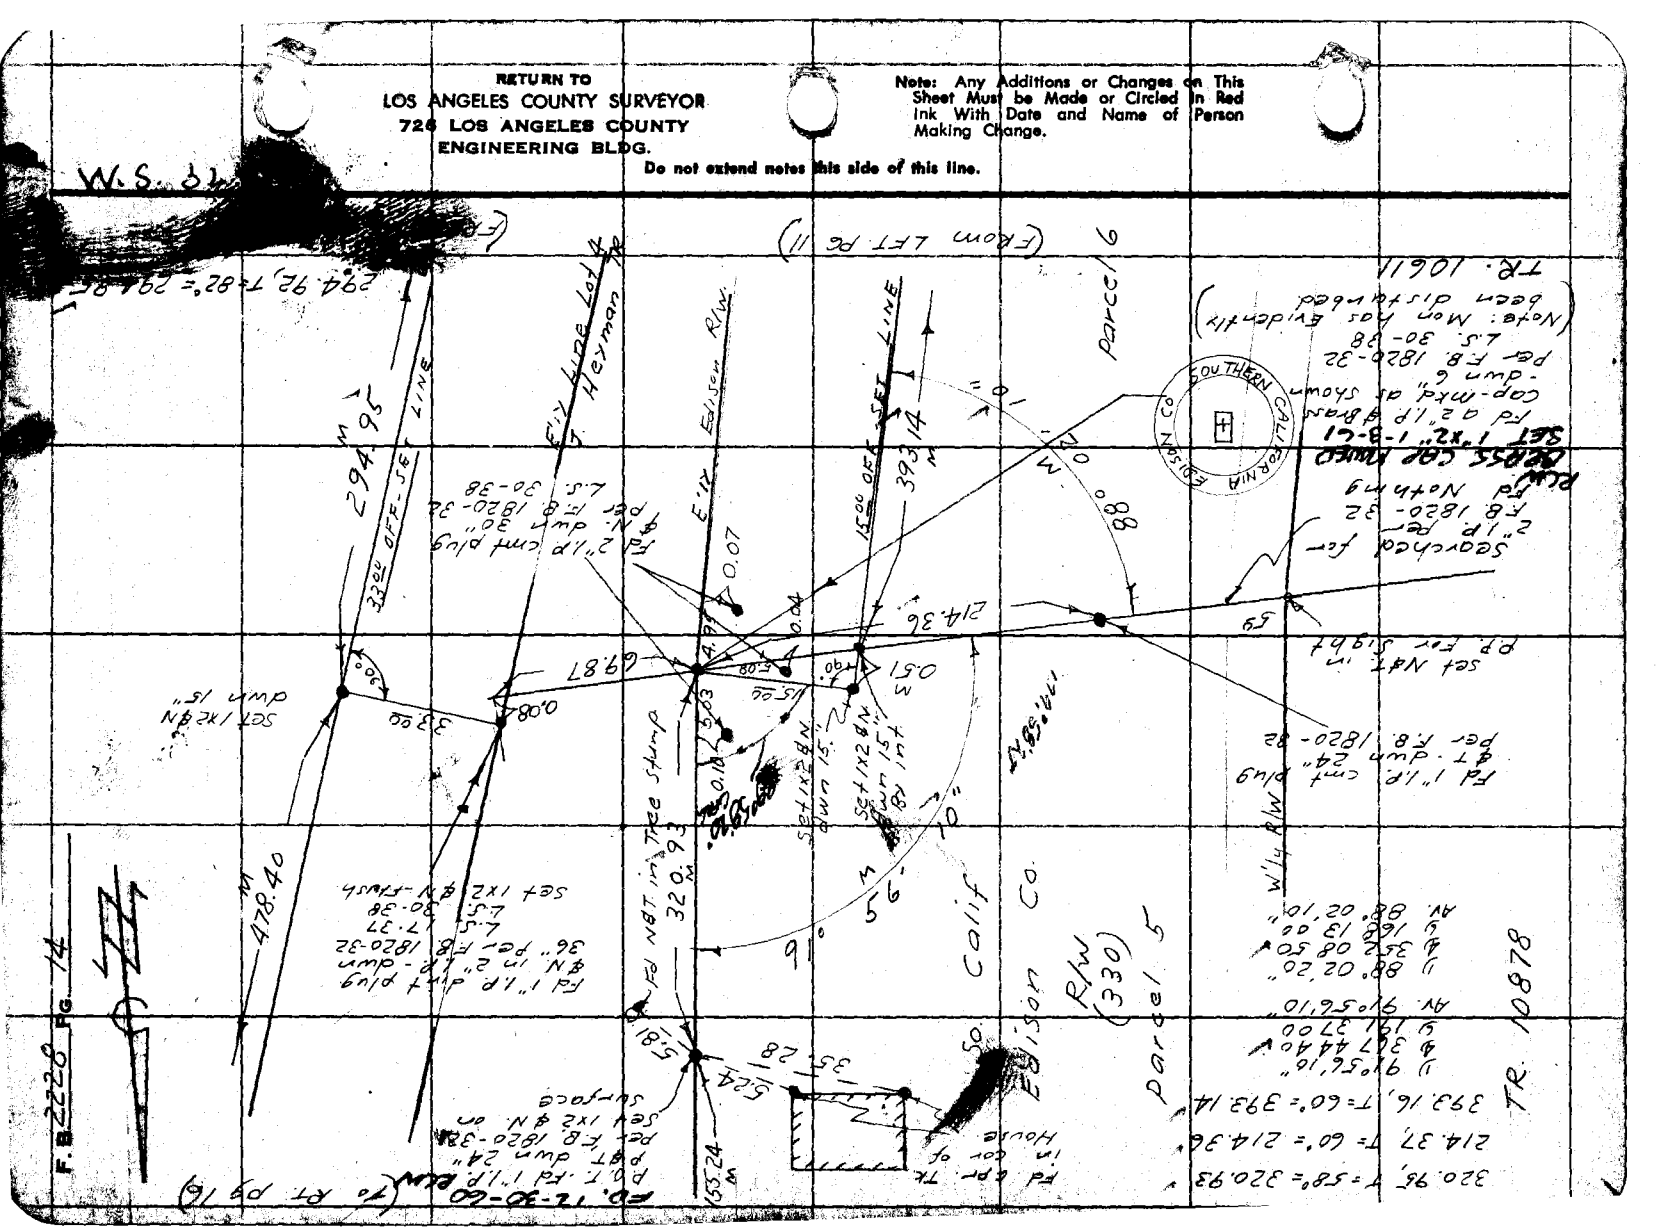
294.92, T=82°= 294.82'
(From LFT PC 11)
Parcel 6
TR. 10611
(Note: Mon Not Evidently Been Disturbed)
Set 1"x2" I-B-C1
Brass Cap Marked
Fd Nothing
Fd 2" I.P. Cap-Mkd. as shown
Per F.B. 1820-32
L.S. 30-38
Southern Cal Edison Co
Scratched for
2" I.P. Per
F.B. 1820-32
Set Nail in PP For Sight
Fd 1" I.P. cmt plug & T. dwn 24" Per F.B. 1820-32
W/L R/W
Parcel 5
Edison R/W (330)
Calif Co.
TR. 10878
320.93' Δ=5°= 320.93'
214.37' T=60°= 214.36'
393.16, T=60°= 393.14'
Δ 91°56'10"
R 367.44'
T 361.37.00
Ar. 91°56'10"
Δ 88°02'20"
R 168.13.00
T 327.08'50"
Ar. 88°02'10"
Fd 1" I.P. cmt plug & T. dwn 24" Per F.B. 1820-32
Fd 2" I.P. cmt plug & N. dwn 30" Per F.B. 1820-32 L.S. 30-38
Set 1x12 & N dwn 15"
Set 1x12 & N dwn 15"
Set 1x12 & N-Flush
Fd 1" I.P. cmt plug & N. in 2" I.P. dwn 36" Per F.B. 1820-32
L.S. 17.37
L.S. 30-38
Fd NAT in Tree Stump
Fd Spike & Tag in Top of House
Fd 1" I.P. Flush Surface
Set 1x2 & N. on Surface
P.O.T. Fd 1" I.P. 0.87' dwn 24" Per F.B. 1820-32
F.B. 12-30-60 Blue (To RT PG 16)
F.B. 22228 PG 14
294.82' M
478.40' M
69.87'
214.36'
393.14' M
15.00' OFF-SET LINE
E'LY Lane Lot & Heyman
Edison R/W
E'LY
33.00' OFF-SET LINE
0.07
0.04
0.08
0.03
0.10
0.08
0.08
0.08

5

Notes Ck'd by [illegible]
Map No. C.S.B. 2609
Office Work Burns
Checked Gall
Date March 1952

Survey of John Anson Park
W. O. 0054.95 Tape No. 0144 sht 38 °F
Surveyed by D. Sayen
Notes D.S. Date 4-19-56
Indexed C. Johnson

F. B. 2220 Pg. 15

W.S. 36-A-6

To Batt. Pg 16

Fd L&T.

Nothing Set

165.31 M To 20.27

Fd L&T.

(30)

FELIX

P.O.T. Fd L&T.

℄

17.47

20.27

Fd L&T. ℄ prod.

ST

(30)

48.85 M 84 R

S.M.H.

60.41

Set P.M. in S.M.H. Wld by Ties Per R.D. F.B. 202-35 C.S. F.B. 879-159 " " 1820-36

Fd L&T.

TR 10979

Fd L&T. in C.b.

(30)

BUELL

℄

ST

(30)

TR 11878

Fd L&T. in "X" guth.

11.40 M

Fd L&T. in C.b.

51.80 M

47.87 M

GARFIELD

AVE

Fd S.W.&T. Flush over C.S. mon. & 4 Tan 2" spk & T. Ties per R.D. F.B. 202-35

Note: Any Additions or Changes on This Sheet Must be Made or Circled in Red Ink With Date and Name of Person Making Change.

Do not extend notes this side of this line.

RETURN TO
LOS ANGELES COUNTY SURVEYOR
726 LOS ANGELES COUNTY
ENGINEERING BLDG.

76F3095 SSE #247

RETURN TO
LOS ANGELES COUNTY SURVEYOR
726 LOS ANGELES COUNTY
ENGINEERING BLDG.

Note: Any Additions or Changes on This Sheet Must be Made or Circled in Red Ink With Date and Name of Person Making Change.

Do not extend notes this side of this line.

L.S. 36-A-6

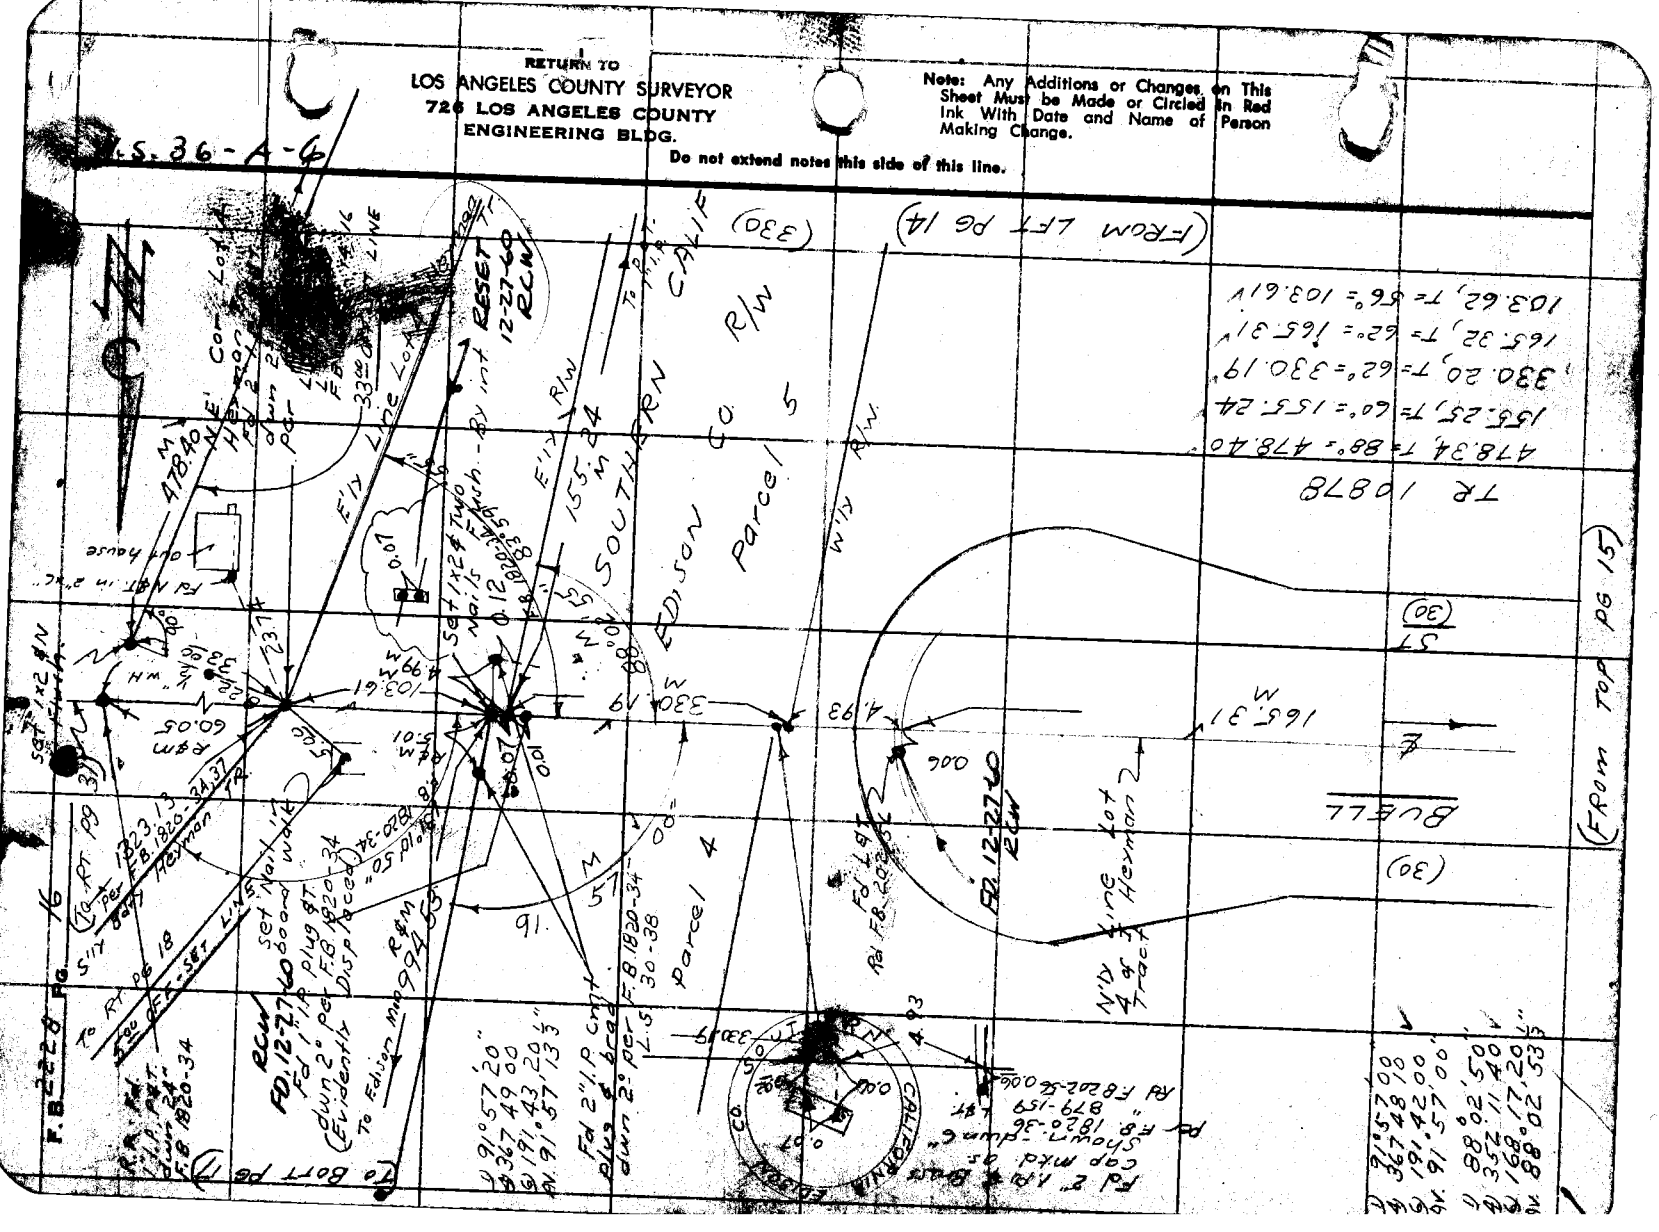
(330)
(FROM LEFT PG 14)
SOUTHERN CALIF EDISON CO R/W
Parcel 5
Parcel 4
E'LY R/W
W'LY R/W
N'LY LINE LOT 4 OF HERMAN TRACT
BUELL
(30)
(FROM TOP PG 15)
TR 10878
478.34, T=88°=478.40'
155.25, T=60°=155.24'
330.20, T=62°=330.19'
165.32, T=62°=165.31'
103.62, T=56°=103.61'
RCW FD. 12-2760
RESET 12-2760 RCW
FD. 12-2760 RCW
Set 1x2" Two Nails - Brass Plug

Office Work Burns	Surveyed by D. Sappell
Checked Galli	Notes P.S. Date 4-20-56
Date March 1957	Indexed E. C. Johnson

F. B. 2228 Pg. 47

W.S. 36-A-1

Fd L&T. on ℄ prod. - used for line Rd F.B. 202-58

GALENT ST.

Fd L&T

Set Nail by Tie Per Rd F.B. 202-59

(30) GILLILAND AVE (30)

(330' R/W) CO.

(30) GOTHAM

Fd L&T. in "X" gutter on ℄

42.07

28.20

20.29

21.91

36.85

37.84

Fd L&T in ch.

S. end

EDISON

E. R/W.

TR. 10948

ST (30)

Fd L&T

CALIFORNIA EDISON CO. SOUTHERN

0.07 M

87° M

222.57

222.58, T64°= 222.57'

994.53, T=62°= 994.53'

ECW FD-12-30-56

Fd. 2" I.P. & Brass cap - Mkd as Shown - Up 6" in ch. Per Per F.B. 545-13 L.S. 30.38 F.B. 1820-35

Fd L&T

S'LY Line of Said Lot 5 & N'LY Extension Thereof

TR. 10948 Tract

36.39

31.37

20.30

20.42

0.07

0.02

10.01 M

set Nail Flush

T=68° 195.06 M

10.01 R&M

T=68° 100.84 M

To R/W 1.26

10.00 OFF-SET LINE

Fd 1x2 & N-dwn F.B. 1820-35

Parcel 4

SOUTHERN CALIF EDISON

994.53 R&M

92° 03' M

Fd 3/4" I.P. - plug & T. dwn 20" per F.B. 1820-38

92° 03' 30"
2,368 13.50
N 92° 03' 26 3/8" W

87° 57' 10"
357.48 300
N 87° 57' 06 3/8" W

(FROM LFT. PG 16)

RETURN TO
LOS ANGELES COUNTY SURVEYOR
726 LOS ANGELES COUNTY
ENGINEERING BLDG.

Note: Any Additions or Changes on This Sheet Must be Made or Circled in Red Ink With Date and Name of Person Making Change.

Do not attach notes this side of this line.

70F3008 SAE. Rev.

RETURN TO
LOS ANGELES COUNTY SURVEYOR
726 LOS ANGELES COUNTY
ENGINEERING BLDG.

Note: Any Additions or Changes on This Sheet Must be Made or Circled in Red Ink With Date and Name of Person Making Change.

Do not extend notes this side of this line.

W.S. 36 - A 6

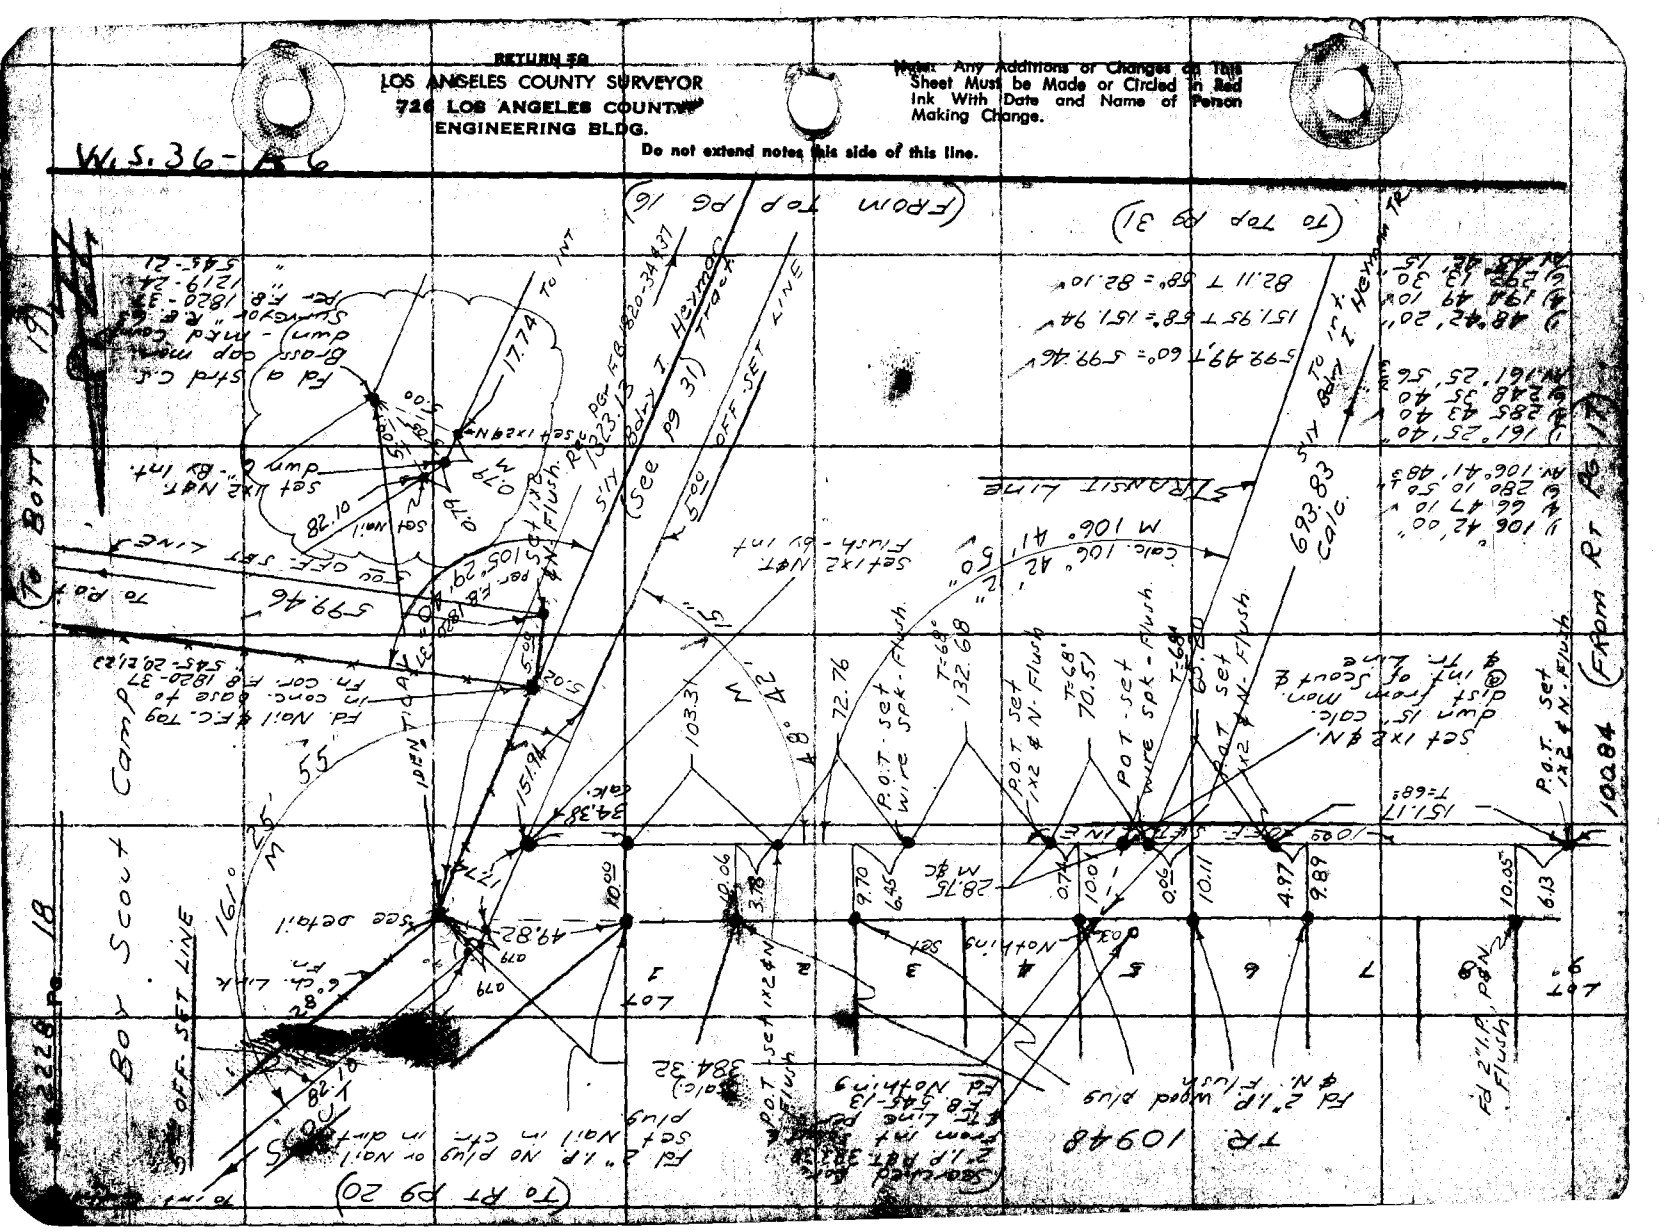
(From Top Pg 16)
(To Top Pg 31)
(To Rt Pg 20)
(To Bott Pg 19)
(From Rt Pg 17)
Set 1x2 Nail
Flush - by Int
Set 1x2 Nail
Flush
Set 1x2 Nail
Flush
Set 1x2 Nail
Flush

Notes Ck'd by KRM
Map No. C.S.B-2600
Office Work Burns
Checked Galli
Date March 1957

Survey of Johnson Anson Ford Park F.B. 2228 Pg. 11
W. O. 0054.75 Tape No. 0144 St'd. 68 °F
Surveyed by D. Sappell
Notes D.S. Date 4-20-56
Indexed C. Johnson

W.S. 32-D-1

Note: Any Additions or Changes on This Sheet Must be Made or Circled in Red Ink With Date and Name of Person Making Change.

Do not extend notes this side of this line.

RETURN TO
LOS ANGELES COUNTY SURVEYOR
726 LOS ANGELES COUNTY
ENGINEERING BLDG.

Fd 2" I.P. cmt plug & F.C. Tag - dwn 12" per F.B. 1820-47

5.00 set 1x2 ⊄N Flush.

15.11

13.10 Fd "X" in top of wier box

3.98

3.92

set spk ⊄T. in top of pre-mix levee.

Pre-mix Levee.

Fd std C.S. Brass Cap mon. - mkd as shown - dwn 18" per F.B. 1820-47 545-8, 16, 17, 23

SURVEYOR P.E. 12 COUNTY

358.96 T=74°= 358.97
737.21 T=74°= 737.24

RIO HONDO F.C. CHANNEL F.M. 11284-4

Pre-mix Levee

(To POT Pg. 23)

65° 51' 35" M 737.24

POT

55.01

37.06 set spk ⊄T.

35.43

725.55 M 80

M.P.

#1

calc. 2.31

2" ⊄

5.49

set 1x2 N⊄T by int.

40.00 OFF-SET LINE

Fd a 2" I.P. cmt plug & F.C. Tag - dwn 15" F.M. 11284-4

4.98 calc.

set 1x2 N⊄T. By int.

set 1x2 ⊄N Flush

358.97 M

W'ly R/W per F.M. 11284

To F.C. Mon.

179° 03' M

40°

165.16

22.35

FC. R/W. per C.S. 7791 & 7777-3

P.O.T. set 1x2 ⊄N - Flush.

19.20

4.96

16.67

Fd chis "X" in conc. wier box F.B. 1820-37

SURVEYOR P.E. 12 COUNTY

BOY SCOUT CAMP

1) 165° 57' 30"
2) 263° 50' 10"
Av. 65° 57' 33.5"

Fd 4 std C.S. Brass Cap mon. mkd as shown on F.B. 1820-37 F.B. 545-20, 23

T. 1x24N 599.46

5.00 OFF SET LINE old Fr. Line

1) 114° 52' 30"
2) 99° 30' 20"
3) 329° 15' 20"
Av. 114° 52' 33"

1) 179° 03' 20"
2) 356° 14' 00"
3) 354° 21' 00"
Av. 179° 03' 30"

TO TOP PG 18

PERSONS SEE PAGE

RETURN TO
LOS ANGELES COUNTY SURVEYOR
726 LOS ANGELES COUNTY
ENGINEERING BLDG.

Note: Any Additions or Changes on This Sheet Must be Made or Circled in Red Ink With Date and Name of Person Making Change.

Do not extend notes this side of this line.

W.S. 36-B-6

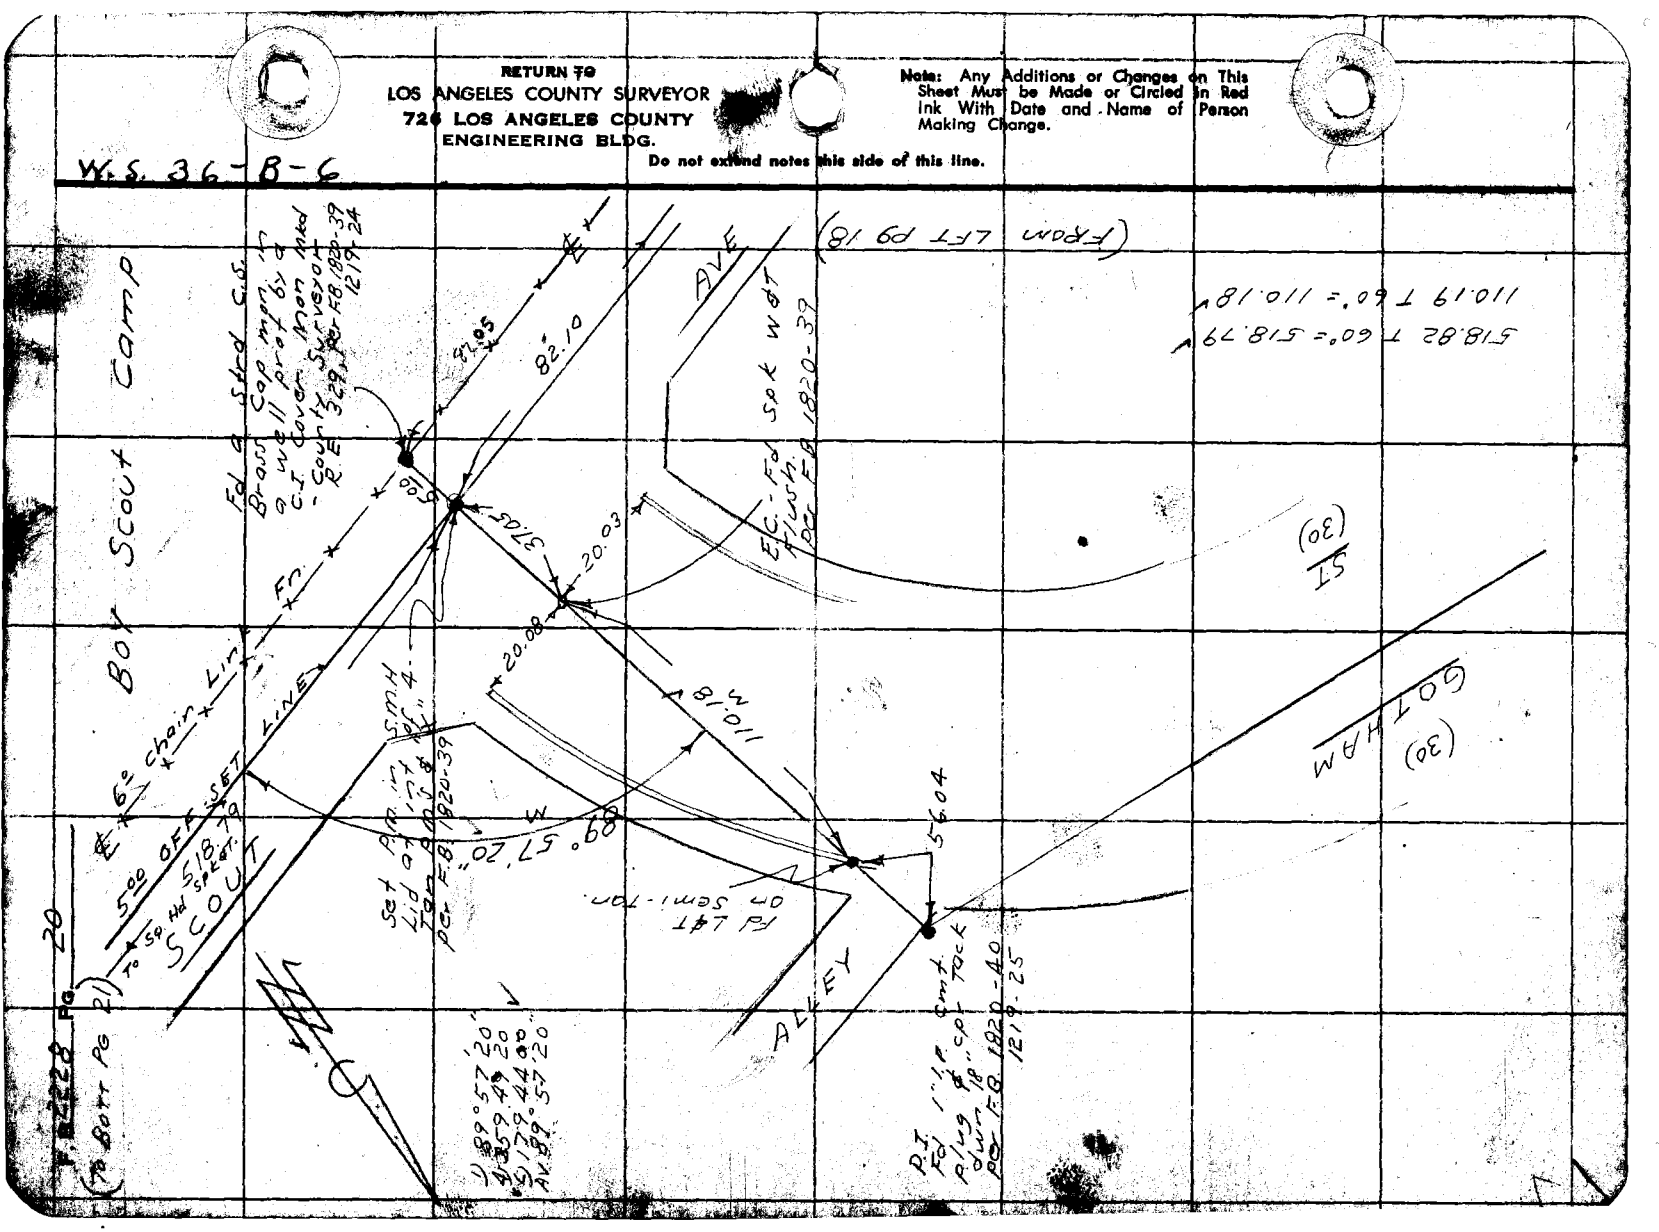

Notes Ck'd by		Survey of John Ansen Ford Park	
Map No. C.S. 8-2100		W. O. 0054.95 Tape No. 0144 St'd. 68 °F	
Office Work Burns		Surveyed by D. Sappek	
Checked Galli		Notes D.S. Date 4.28.56	
Date March 1957		Indexed C. Johnson	

F.B. 2228 Pg 21

1) 55° 07' 00"
2) 220 27 40
3) 330 41 30
Av. 55° 06' 55"

W. S. 36 B-6

(To RT PG 22)

SCOUT

443.82 To P.O.T.

AVE

5.5° 07' 00" M

75.00 OFF. SET LINE

To P.O.T.

504.54

(To BOTT Pg 23)

504.55, T = 66° = 504.54
443.84, T = 62° = 443.82

1) 90° 00' 30"
2) 360 02 10
3) 180 03 20
Av. 90° 00' 33"

35

90° 00' M

(30)

set sp Hd spk & Flush. by calc. offset

SURVEYOR COUNTY R.E. 329

RAMISH

175.56 T=64°

C&M 13.57

5.00

Fd a std C.S. Brass Cap mon. - mkd as shown - in a well prot by a C.I. cover. Per F.B. 1219-27 1820-41

AVE

(30)

Fd Spk & W. Flush. per F.B. 1820-41

15.73

6" chain Link Fence

SURVEYOR COUNTY R.E. 329

Fd a std C.S. Brass Cap mon. - mkd as shown - in a well prot by a C.I. cover. Per F.B. 1219-26 1820-42

T=60° 81.35

T=46° 77.86

Left in cwb

5.12

Calc. 36.5

DWN 15"

SURVEYOR COUNTY R.E. 64

Fd Sq Hd Spk & T. Flush. Per F.B. 1820-41

DWN 36"

5.98

Left in inch

Fd a std C.S. Brass cap mon. Mkd as shown. Per F.B. 1820-41 F.B 545, -19, 21, 22

5.00 OFF SET LINE

518.79 From INT Gotham

604.28

RIO HONDO BOY SCOUT CAMP

(FROM Top LFT Pg 20)

Note: Any Additions or Changes on This Sheet Must be Made in Red Ink With Date and Name of Person Making Change.

Do not extend notes this side of this line.

RETURN TO
LOS ANGELES COUNTY SURVEYOR
726 LOS ANGELES COUNTY
ENGINEERING BLDG.

76F3088 SAE #847. 8-54

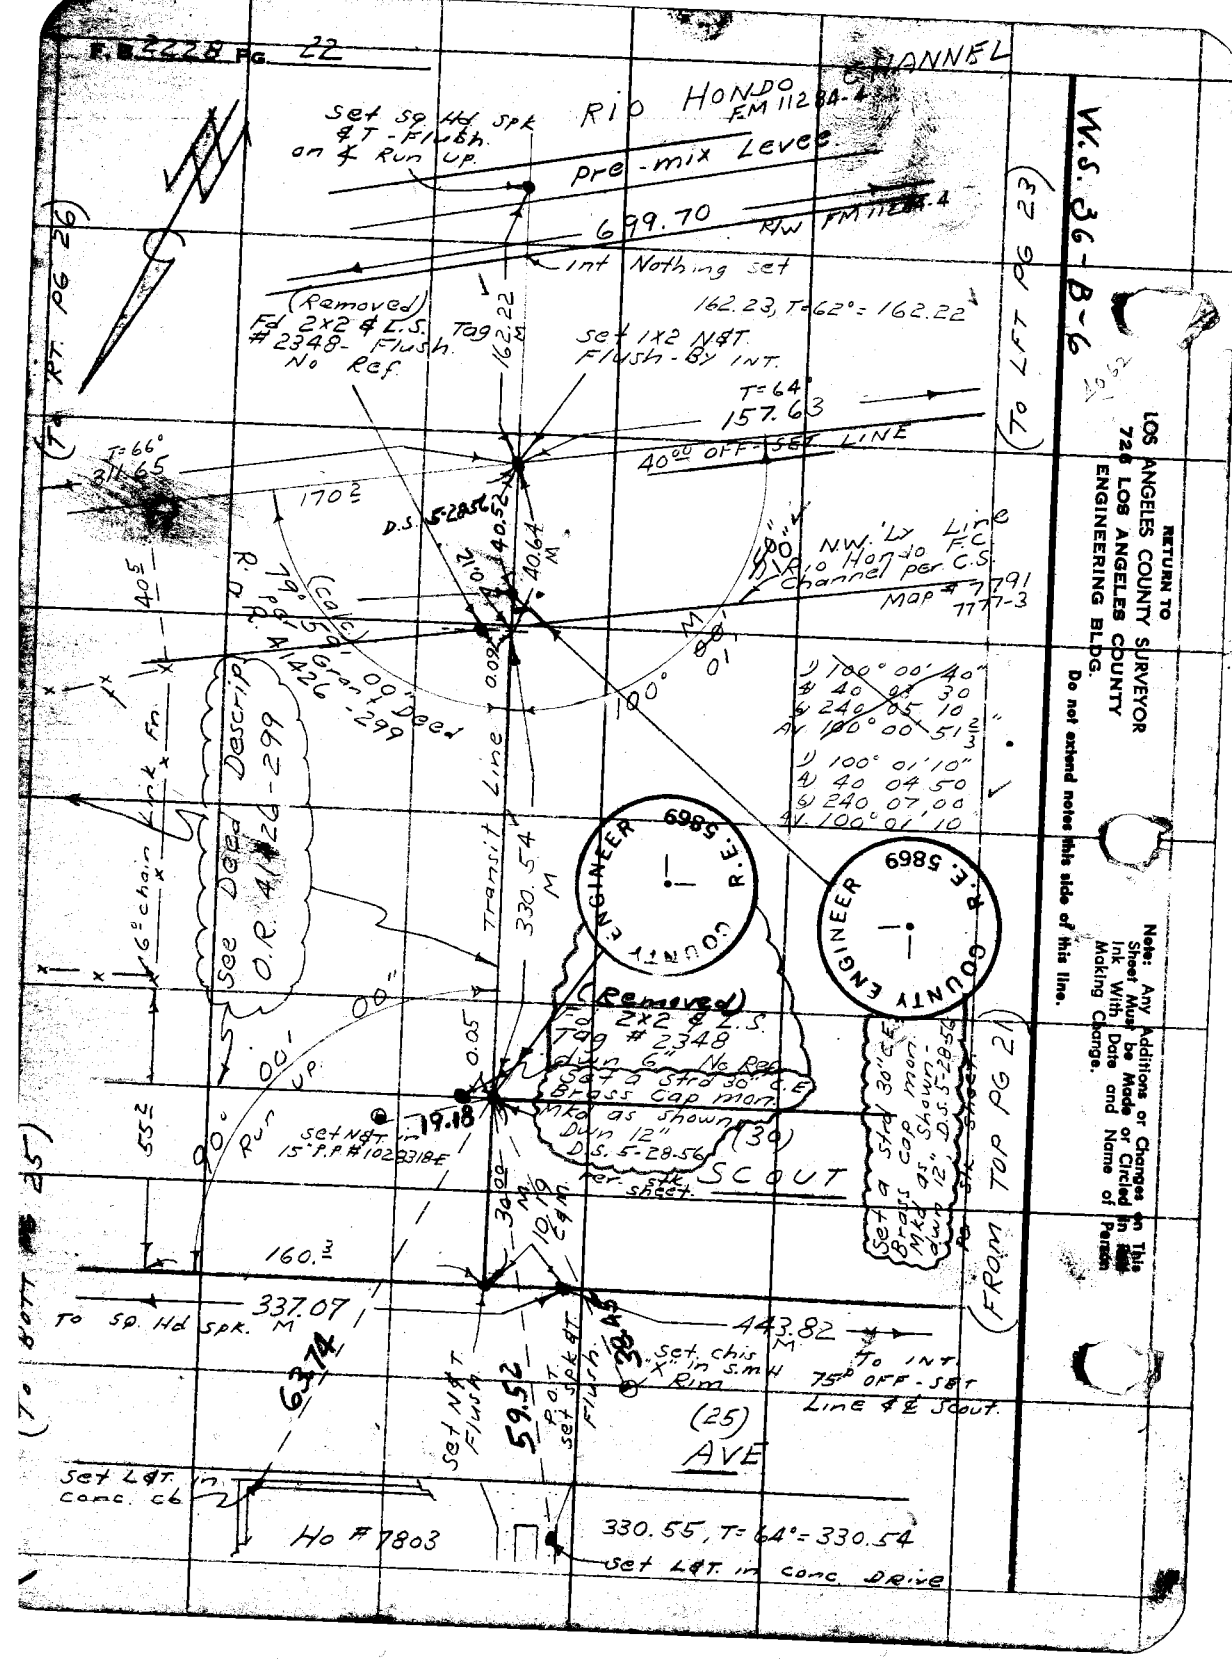
F.B. 2228 Pg. 22
CHANNEL
Rio HONDO
FM 11284-4
Set Sp. Hd Spk & T-Flush on ℄ Run Up.
Pre-mix Levee
699.70
RW FM 11284-4
Int Nothing set
(Removed) Fd 2x2 ℄ L.S. #2348 - Flush. Tag No Ref.
162.23, T=62°=162.22
Set 1x2 N&T Flush - By Int.
T=64°
157.63
40.00 OFF-SET LINE
T=66° 31.65
170℄
D.S. 5-28-56
40.52
40.64 M
40.12
N.W. 'LY Line SIA'o Hon'do F.C. Channel per C.S. Map # 7791 777-3
79° 59' 09" Deed R=426.299
(Co'ord) Calc.
100°
M 00° 01'
1) 100° 00' 40"
2) 40 04 30
3) 240 05 10
AV 100° 00' 51 2/3"
1) 100° 01' 10"
2) 40 04 50
3) 240 07 00
AV 100° 01' 10
See Deed Descrip. O.R. 4124-299
6° chain Link Fn.
Transit Line
330.54 M
0.05
(Removed) Fd 2x2 ℄ L.S. Tag # 2348 Dwn 6" No Rec.
Set 3 Std 30" C.E. Brass cap mon. Mkd as shown - Dwn 12" D.S. 5-28-56 (30) SCOUT
Set 4 Std 30" C.E. Brass cap mon. Mkd as shown - Dwn 12" D.S. 5-28-56
Set N&T in 15" F.P. #102331BE
19.18
160.3
337.07
To Sp. Hd Spk.
443.82
To INT 75° OFF-SET Line ℄ Scout.
Set chis X in S.M.H. Rim
59.52
Set N&T Flush
Pt. of Set Spk & T Flush
(25) AVE
Set L&T in Conc. C6
Ho # 7803
330.55, T=64°=330.54
Set L&T in Conc. DRIVE
(From Top Pg 25)
(To Top Pg 26)
(To Left Pg 23)
W.S. 36-B-6
RETURN TO
LOS ANGELES COUNTY SURVEYOR
726 LOS ANGELES COUNTY
ENGINEERING BLDG.
Do not extend notes this side of this line.
Note: Any Additions or Changes on This Sheet Must be Made or Circled in Ink With Date and Name of Person Making Change.

Notes Ck'd by K.R.M.
Map No. C.S.B-2600
Office Work Burns
Checked Galli
Date March 1957

Survey of Cabo Anson Ford Park
W. O. 0537.95 Tape No. 0144 Std. 68 °F
Surveyed by D. Sappell
Notes D.S. Date 4-23-56
Indexed K. C. Johnson

F. B. 2228 Pg. 23

W.S. 36-B-6

(To Bott Pg 24)

(To Rt Pg 26)

Note: Any Additions or Changes on This Sheet Must be Made or Circled in Red Ink With Date and Name of Person Making Change.

Do not extend notes this side of this line.

RETURN TO
LOS ANGELES COUNTY SURVEYOR
726 LOS ANGELES COUNTY
ENGINEERING BLDG.

76F3095 SAE #247. 8-54

R/W per F.M. 11284-4

699.70 M

Set 1x2 N&T Flush by int.

Set spk & T

P.O.T. set spk & T

Set spk & T

S'ly Bdry T.R. 9212 14227

R/O HONDO CHANNEL F.M. 11284-4

Pre. M. x Levee

32.96

33.11

82.68

51.09

160.01 M

75.07

set 1x2 N&T Flush by int

P.O.T. set 1x2 & N Flush

114° 51' 50" 15"

(To Rt Pg 22)

(From Rt Pg 19)

737.24 M

Fd 2" I.P. cmt plug & F.C. Tag dwn 15" per F.M. 11284-4

186.45 M

P.O.T. set 1x2 & N Flush

98.25

17.91

3.74

40.09

3 NIT set 1x2 & N Flush

725.55 M

61.10

75.15 S.O.

504.54 M

Zero OFF. SET LINE

6" chain Link Fn.

F.C. R/W per C.S. 7791 C.S. 7777-3

SURVEYOR COUNTY R.462

Boy Scout Camp

Fd a std. C.S. Brass cap mon. mkd as shown dwn 6" per F.B. 545-22 F.B. 1820-44

F.C.	R/W
1)	114°45'20"
4)	99 01 00
6)	328 31 20
Av.	114°45'13"
1)	114°52'00"
4)	99 27 20
6)	329 11 12
Av.	114°51'51"

160.02, T-58°= 160.01
186.45, T=64°= 186.45
98.25 T=66°= 98.25
725.56, T=66°= 725.55

(From RT PG 21)

RETURN TO
LOS ANGELES COUNTY SURVEYOR
726 LOS ANGELES COUNTY
ENGINEERING BLDG.

Note: Any Additions or Changes on This Sheet Must be Made or Circled In Red Ink With Date and Name of Person Making Change.

Do not extend notes this side of this line.

W.S. 32 - D-1

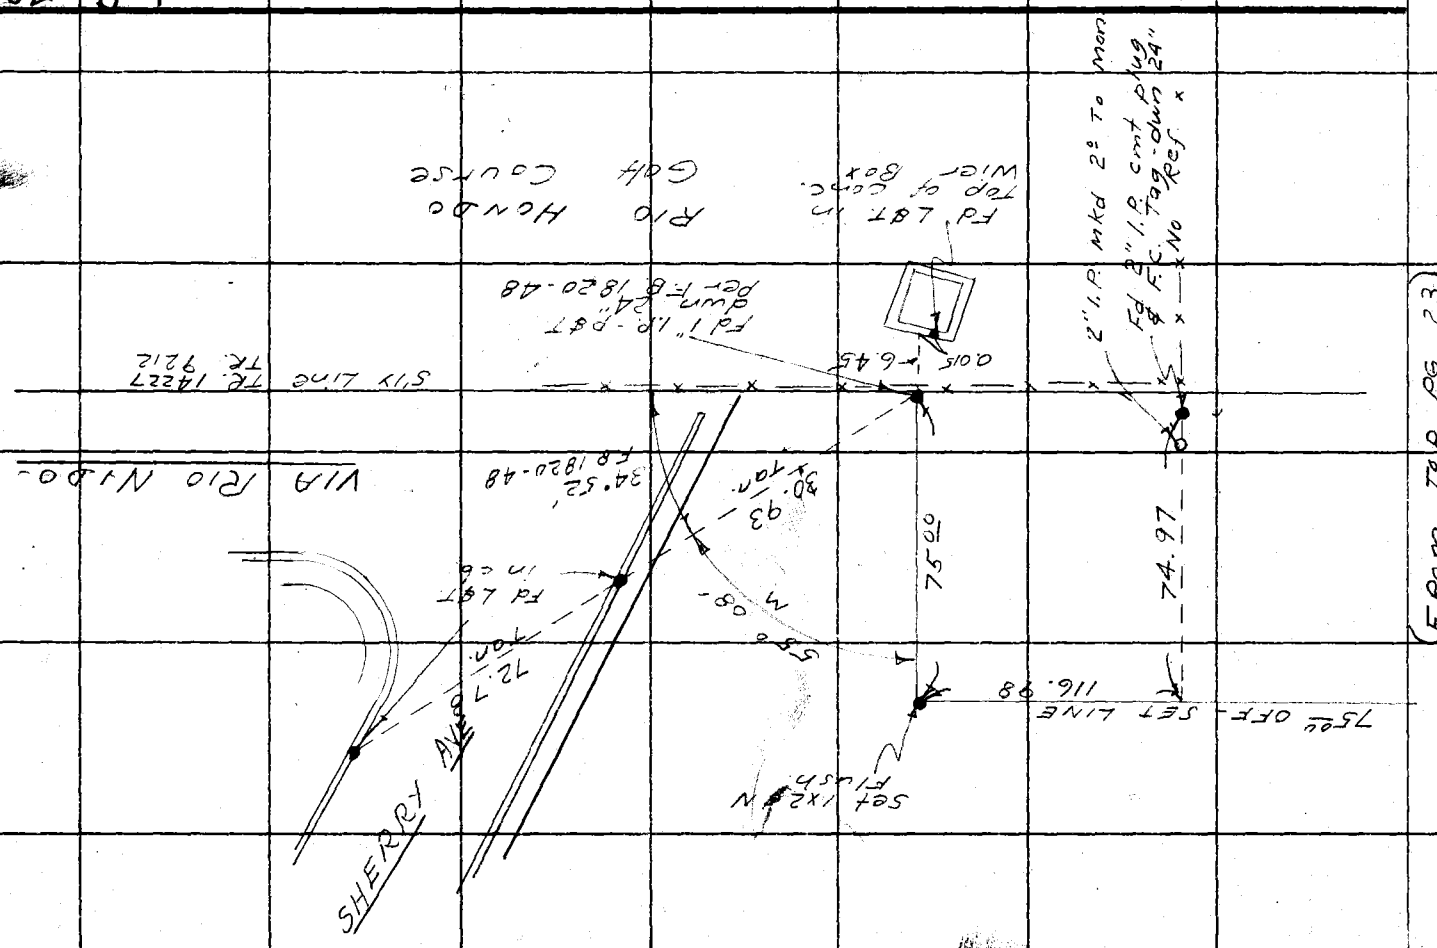

F.B. 2228 PG. 24

76F309S S&E #247. 8-54

RETURN TO
LOS ANGELES COUNTY SURVEYOR
726 LOS ANGELES COUNTY
ENGINEERING BLDG.

Note: Any Additions or Changes on This Sheet Must be Made or Circled in Red Ink With Date and Name of Person Making Change.

Do not extend notes this side of this line.

W.S. 36-B-6

Notes Ck'd by [illegible]
Map No. C.S.B-2600
Office Work Burns
Checked Gelli
Date March 1957

Survey of Arbola Acres Tract
W. 8334.85 Type No. 044 3rd. 68 of
Surveyed by L. Sappell
D.S. Date 4-24-56
Notes
Indexed C. Johnson

F. B. 2220 Pg. 25

15

prod.
Fd 3/4" I.P. cmt plug & T. dwn 15" per F.B. 1820-43

337.10, T=56°= 337.07

Fd 1½" I.P. batter Top with dmt plug & cor tack - dwn 10" per F.B. 1820-43 Set 2-3/8" spk & T. surface

Fd L&T. in conc. stem

SCOUT

M 443.35

(25) To int Clara St.

(To PT PG 27)

(FROM LFT PG 22)

To P.O.T.

337.07

41.49 M

50.00 M

0.02 N 0.02 S

Fd BT Spk W&T. F.B. 1820-43

26.88 C&M

Set N&T Flush 3½"

3.81 M

Fd. Sq Hd F.B. 1820-43

Set R.M. in Base of B.F.P.

24.09 M

0.02 S 0.02 N

AVE

(30)

Searched for cor. Fd Nothing

(75 RR)

12B°

N 57°

25

Searched for cor. - Fd Nothing

W 123° 57' 20" N
S 33° 49' 30" W
S 44° 20' 43" W
N 123° 57' 23½" W

504.13 per F.B. 504.19 calc.

Lot 3 TR. 1290

FM 1128A-K

1820'-57 To Int. TR. 1290 (To Bott Pg. 26)

341.30 20.00 OFF-SET

59 A' chain link fn.

LINE

To P.O.T.

443.37, T=62°= 443.35

341.29 T=72°=341.30

RETURN TO
LOS ANGELES COUNTY SURVEYOR
726 LOS ANGELES COUNTY
ENGINEERING BLDG.

Note: Any Additions or Changes on This Sheet Must be Made or Circled in Red Ink With Date and Name of Person Making Change.

Do not extend notes this side of this line.

W.S. 32-D-1

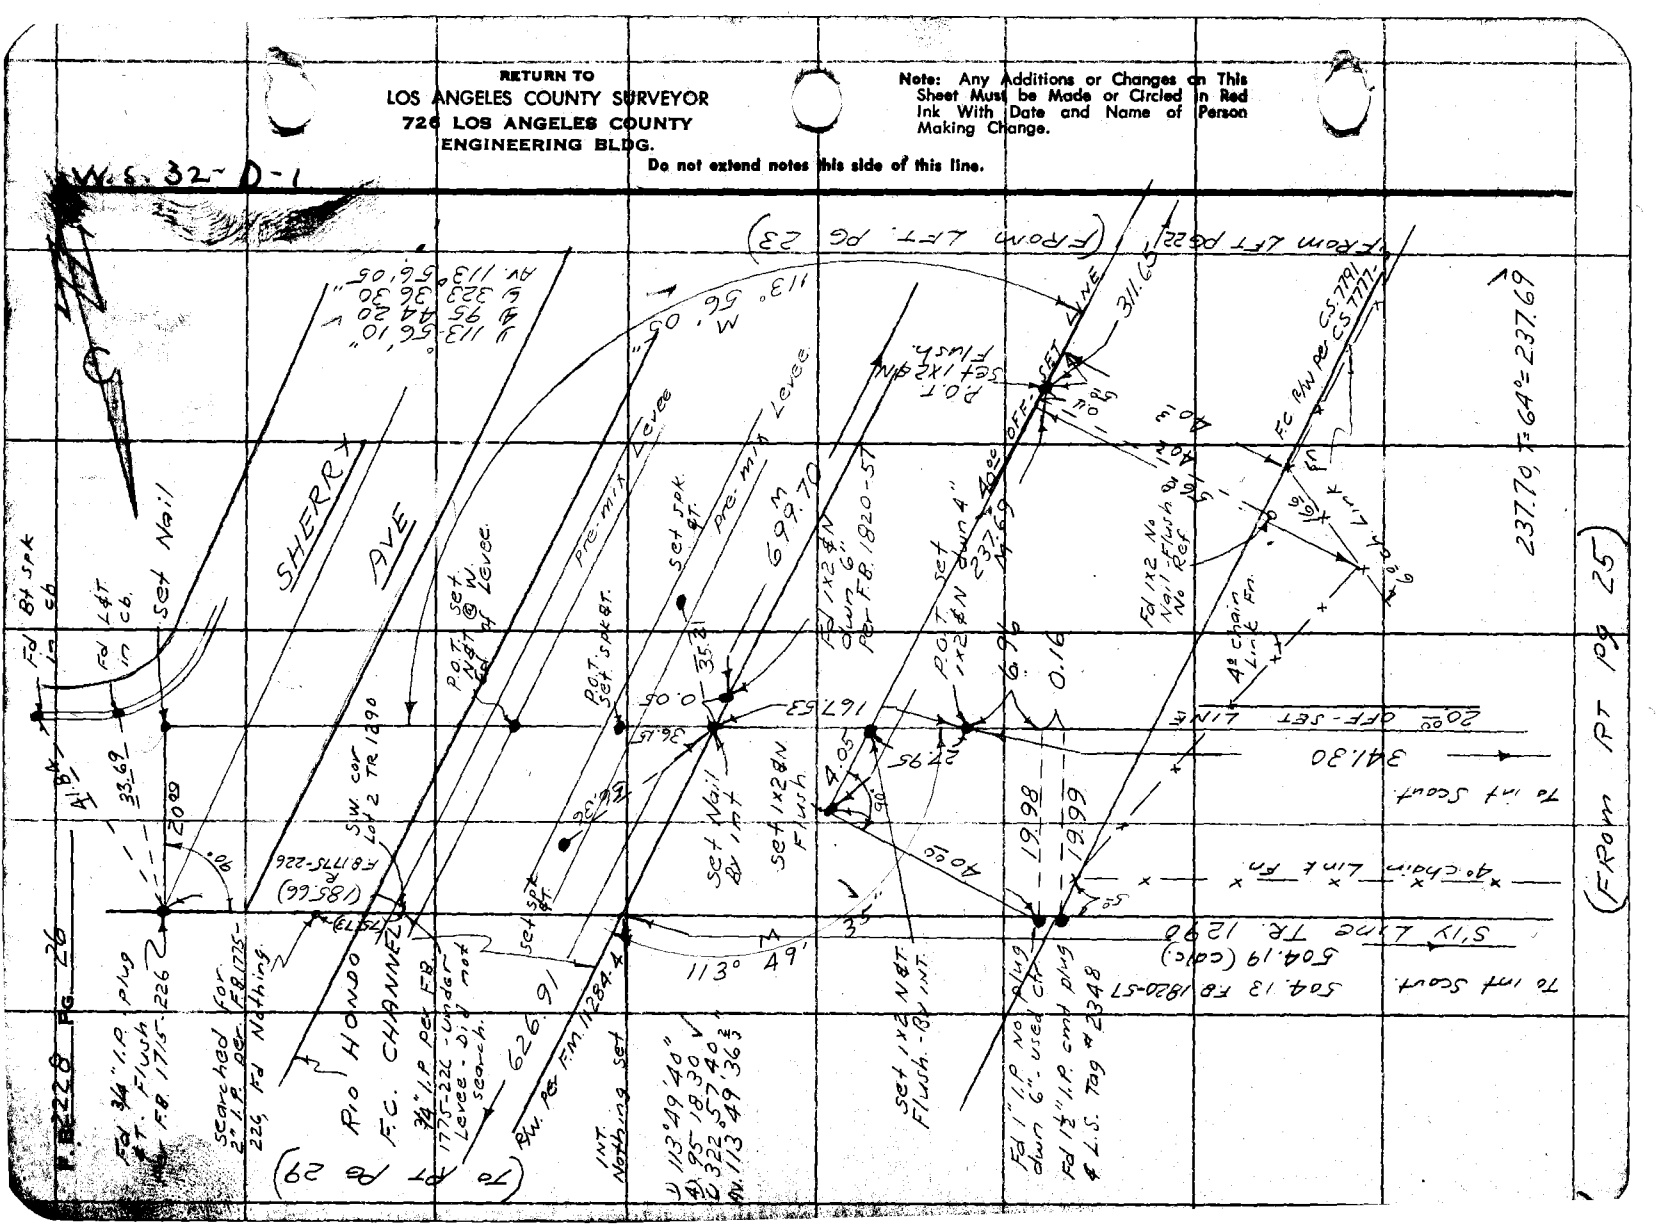
SHERRY AVE
Pre-mix Levee
Set Nail
Set 1x2 Flush
Set 1x2 & N Down 4" Set 237.69 M
Set 1x2 & N Down 6" Ref FB 1820-57
P.O.T. Set 1x2 & N Down 4"
P.O.T. Set 1x2 & N Down 6"

76F3095 S&E #247. 8-54

RETURN TO
LOS ANGELES COUNTY SURVEYOR
726 LOS ANGELES COUNTY
ENGINEERING BLDG.

Do not extend notes this side of this line.

Notes: Any Additions or Changes on This Sheet Must Be Made or Circled In Red Ink With Date and Name of Person Making Change.

W.S. 36-B-6

Notes Ck'd by [illegible]
Map No. C.S.B. 2600
Office Work Burns
Checked Galli
Date March 1957

Survey of Abbott Blasius Ford Park
W. O. 2874.95 Tape No. 0144 srd. 68 of
Surveyed by D. Sapoen
Notes
Date 4-25-56
Indexed C. Johnson

17

Fd L&T.

Fd L&T

Fd a Std C.S. Brass Cap Mon. - Mkd as Shown - in a well prot by a C.I. Cover per F.B. 1820-49 R.D. F.B. 202-64

COUNTY SURVEYOR
R.E. 63

PRIVATE DR

147 PJ

27.64

33.29

18.51

55.42

CLARA

(235.27) per F.B. 1820-54.49

Fd SPK W&T - dwn 1" per F.B. 1820-49

51.10

29.76

50.34

T=68°

19

ST

49.02

24.76

23.54

E Prod.

Fd L&T. in cb

Fd SPK W&T. Flush. per R/W F.B. 202-64 F.B. 1820-54

24.1

32.7

N 43° 35' E 296.

N 45° 149°

96°

AVE

SCOTT

30'

(FROM TOP PG 25)

(To BOTT PG 28)

F.B. 2600 Pg. 27

℄ 149° 45' 20"
℄ 239.01
℄ 178.20
32.00
AV. 149° 45' 20" W

RETURN TO
LOS ANGELES COUNTY SURVEYOR
726 LOS ANGELES COUNTY
ENGINEERING BLDG.

Note: Any Additions or Changes on This Sheet Must be Made or Circled in Red Ink With Date and Name of Person Making Change.

Do not extend notes this side of this line.

W.S. 36-B-6

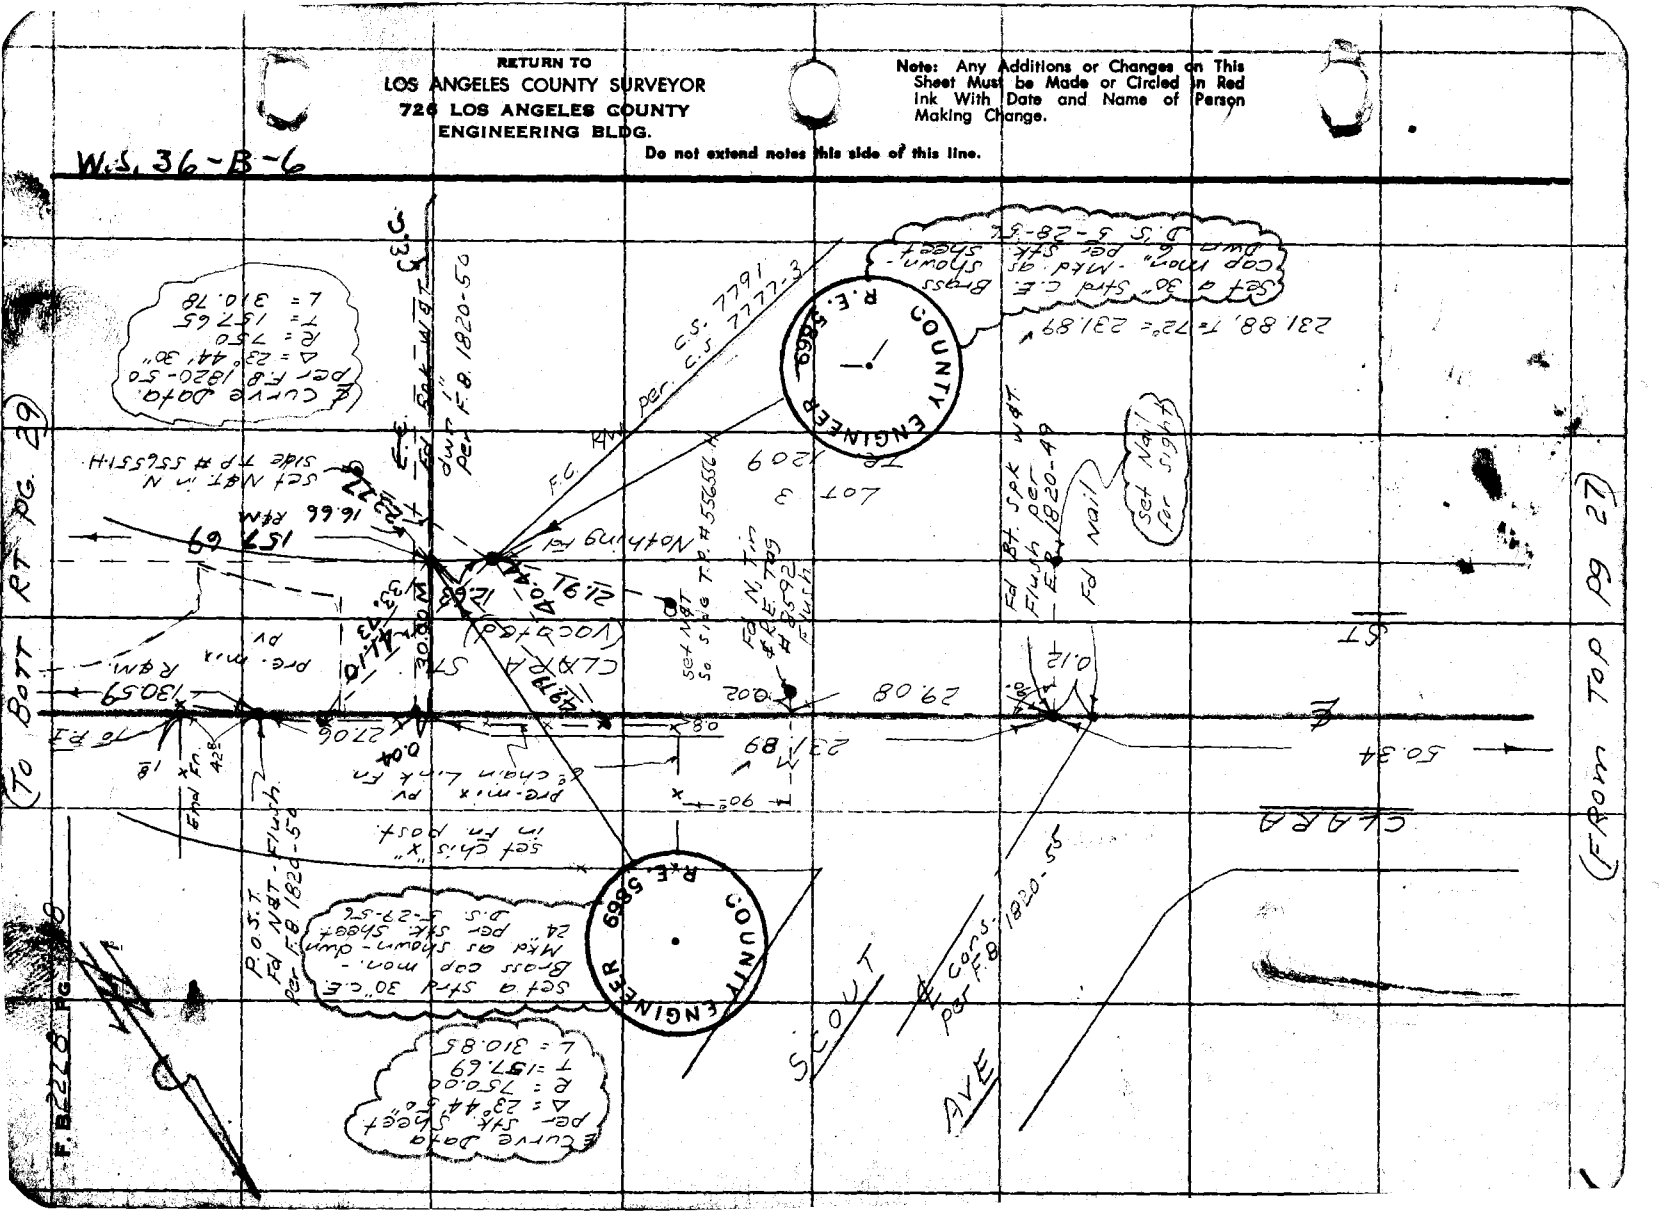
(From Top Pg 27)
(To Bott Rt Pg 39)
SCOUT AVE
CLARA ST
Nothing Fd
Set Nail For Sight
Fd Nail
Fd Bt. Spk W&T. Flush Over
Fd N. Tie #85892 Flush
Set Nail So Sides T.P. #55655 H

F3095 S&E #247. 8-54

RETURN TO
LOS ANGELES COUNTY SURVEYOR
726 LOS ANGELES COUNTY
ENGINEERING BLDG.

Note: Any Additions or Changes on This Sheet Must be Made or Circled in Red Ink With Date and Name of Person Making Change.

Do not extend notes this side of this line.

W.S. 36 - B - 6

① 36.41 @ 13° 35' = 35.38
② 36.79 @ 15° 54' = 35.38 ✓
T=74 AV. = 35.38

Notes Ck'd by
Map No. C.S.B.-2600
Office Work Burns
Checked Gall
Date March 1957

Survey of Florence Ford Park
W.O. 2057-1st Stage No. 44 Sht'd. 68 of
Surveyed by D. Sappell
Notes
Indexed Date 4-26-56

F. B. 2228 Pg. 29

(From Tap Pg 28)

FLORENCE AVE

CLARA ST. (Vacated)

RIO HONDO CHANNEL

conc. cb on Bridge (Bridge)

Fd 1" I.P.

Fd Mag. Nail & Shiner in cb 0.20 S & 0.20 W of P.I. F.B. 1820-51

Fd Mag. Nail & Shiner F.B. 1820-51

per F.M. 11284-4
179° 37' 01"
179° 37' 17"
F.C. 2049.82

Tan 27.82

53.86 Tan.

F.B. 1820-51, 52

To Rd Dept mon

638.90

(Note: Unable to locate ties in - Due to F.W. pers per F.B. 1820-58)

M 15.76

403.49 To Int Scout per F.B. 1820-51, 55

53.12 Tan.

Tan 27.77

Perf. Fd L&T in cb

0.69 S & 0.69 W of P.I.

Fd L&T

Perf in W.F.C. R/W. INT - dug 5" in search of 2" I.P. per F.B. 1820-50 Nothing Fd - set 1x2 N&T - Flush R dist. 87.82 From P.I. Per F.B. 1820-50, 58

A 51.40

conc. cb on bridge

Set P.K. in top guard rail

9.89

16.40 M

16.46

To Rd Dept mon

35.38 Tan.

T=68°

P.I. - Dug 5" in Search of 1x2 per F.B. 1820-50 Nothing Fd - Set 1x2 N&T Flush. Tan dist (157.65) From E.C.

87.82 R&M

E.C. Nothing

P.O.T. Fd L&T.

CLARA ST. (Vacated) (To Bott Pg 30)

Post. T. - set spk & washer in pvt

Pre-mix

Set spk & washer

Set 1x2 Nail

30.98

30.00

90°

1911 Rd.

10.62 Brg

30.59

CLARA (Vacated)

Set Sq. hd spk

Fd. P.C. Brass Cap Flush in Mo. Res.

Fd. P.C. Brass Cap Flush in Mo. Res.

F.C. R/W. F.M. 11284-4

R&M 157.0

156° 15' 05" 10" Adj.

115° 52' 55"

Nat. To P.O.T.

D.S. 5-28-56

Set a std. C.E. 3½" Brass cap mon. - mkd as shown Flush with top of 20" mon. Rd.

300' Tape Std 84°
① 161.78 @ 3° 26' T=58° = 161.46
② 161.70 @ 2° 54' " = 161.46
AV. = 161.46

451.42, T= 60° = 451.40 ✓

1) 156° 15' 00"
2) 265° 00' 20" ✓
3) 217° 30' 30"
AV. 156° 15' 05"

1) 115° 53' 40"
2) 103° 31' 40" ✓
3) 335° 17' 20"
AV. 115° 52' 53"

RETURN TO
LOS ANGELES COUNTY SURVEYOR
720 LOS ANGELES COUNTY
ENGINEERING BLDG.

Note: Any Additions or Changes on This Sheet Must be Made or Circled in Red Ink With Date and Name of Person Making Change.

Do not extend notes this side of this line.

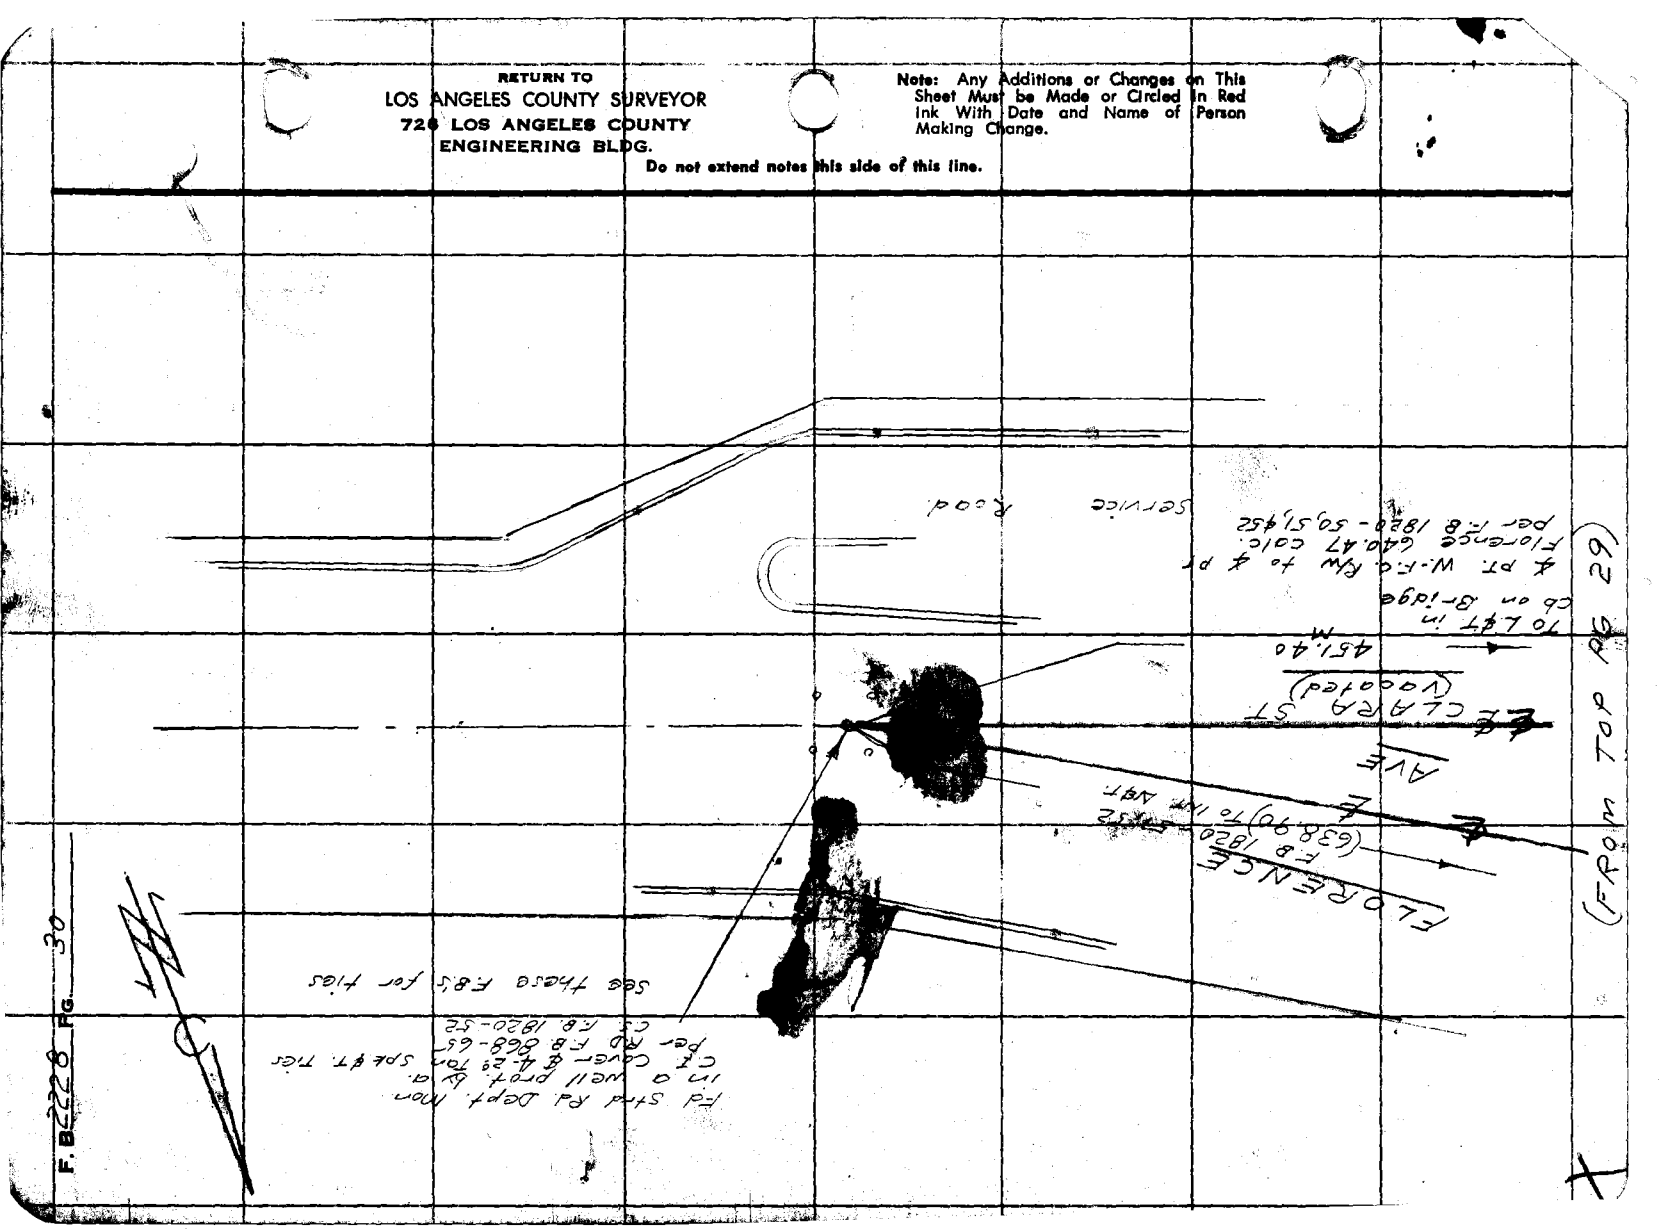

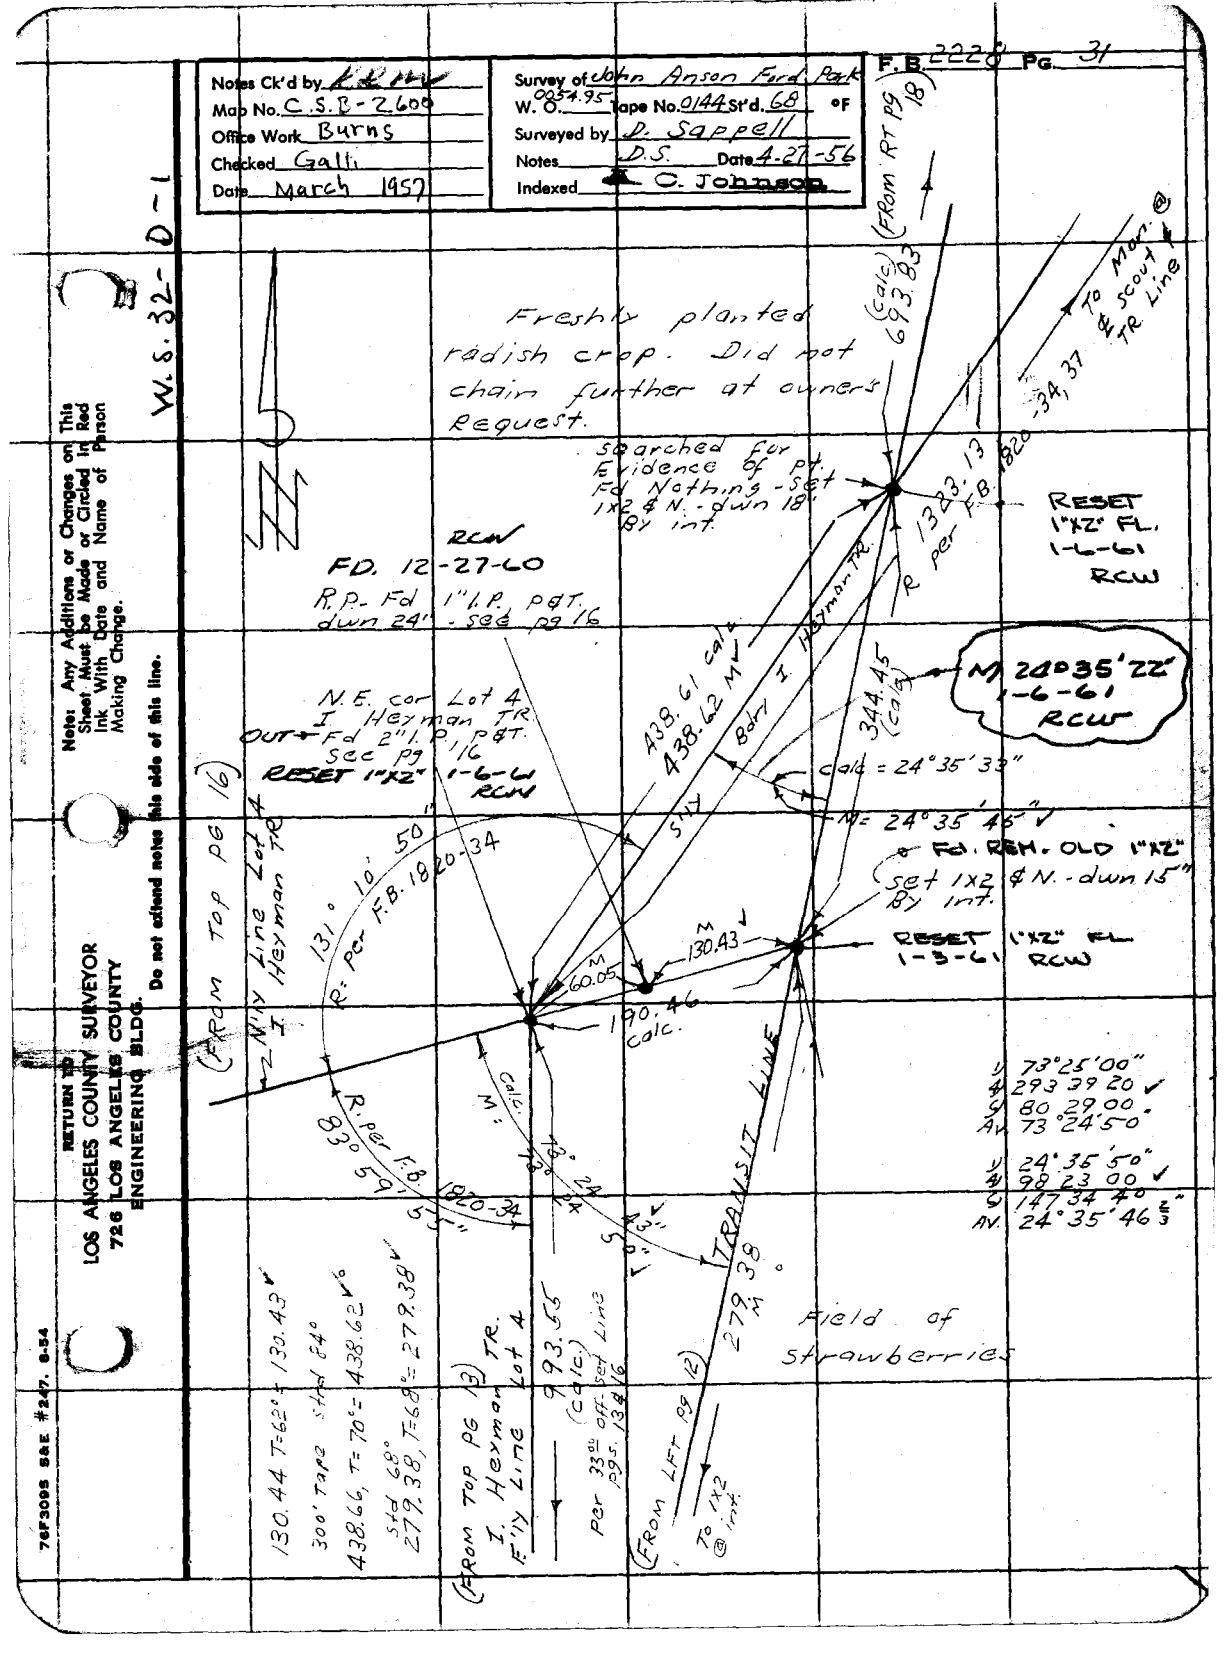
Notes Ck'd by
Map No. C.S.B-2.609
Office Work Burns
Checked Galli
Date March 1957
Survey of John Anson Ford Park
W. O. 0254.95 Tape No. 0144 Std. 68 °F
Surveyed by D. Sappell
Notes D.S. Date 4-27-56
Indexed C. Johnson
F.B. 2228 Pg. 31
W.S. 32-D-1
Note: Any Additions or Changes on This Sheet Must be Made or Circled in Red Ink With Date and Name of Person Making Change.
Do not extend notes this side of this line.
RETURN TO
LOS ANGELES COUNTY SURVEYOR
726 LOS ANGELES COUNTY
ENGINEERING BLDG.
76F3005 S&E #247. 8-54
Freshly planted radish crop. Did not chain further at owners request.
Searched for Evidence of pt. Fd Nothing - Set 1x2 & N. - dwn 18. By int.
RCW
FD. 12-27-60
R.P. - Fd 1" I.P. P&T. dwn 24" - See pg 16
N.E. cor Lot 4 I. Heyman TR. OUT - Fd 2" I.P. P&T. See pg 16 RESET 1"x2" 1-6-61 RCW
(From Top Pg 16)
W'ly Line Lot 4 I. Heyman TR.
131° 10' 50"
R: per F.B. 1820-34
R. per F.B. 1820-34
83° 59' 55"
(From Top Pg 13) I. Heyman TR. E'ly Line Lot 4
993.55 (Calc.)
Per 33rd off Sect Lines pgs 13 & 16
130.44 T=62° = 130.43
300' Tape Std @ 68°
438.66, T=70° = 438.62
Std 68°
279.38, T=68° = 279.38
(From Lft Pg 12)
To 1x2 @ Int.
TRANSIT LINE
Field of strawberries
279.38
N 0° 43' E
(From Rt Pg 18)
693.83 (Calc)
To Mon @ Scout & TR Line
-34.37
1383.13 R per F.B. 1820
RESET 1"x2" FL. 1-6-61 RCW
438.61 calc
438.62 M
S 1° W
Bdry I. Heyman TR.
344.45 (Calc)
N 24° 35' 22" 1-6-61 RCW
Calc = 24° 35' 33"
M = 24° 35' 46" ✓
Fd. REM. OLD 1"x2"
Set 1x2 & N. - dwn 15" By int.
RESET 1"x2" FL 1-3-61 RCW
130.43 ✓
60.05
190.46 Calc.
1820-34
1820-24
N 43' E
1.0'
1) 73° 25' 00"
4) 293 39 20 ✓
5) 80 29 00
AV. 73° 24' 50"
1) 24° 35' 50" ✓
4) 98 23 00 ✓
5) 147 34 40
AV. 24° 35' 46 2/3"

NOTES RED. _____ JOB NO. 0054.95 SURVEY OF John Anson Ford Park F.B. 2228 Pg. 33

DATE _____ SURVEY BY D. Sappell

NOTES CHKD. _____ NOTES BY D.S. DATE 5-29-56

DATE _____ INDEXED E. C. Johnson DATE 6-6-56

NOTE: ANY ADDITIONS OR CHANGES ON THIS SHEET MUST BE MADE OR CIRCLED IN RED INK, WITH DATE AND NAME OF PERSON MAKING CHANGE.

Do not extend notes this side of this line

PLEASE RETURN TO
LOS ANGELES COUNTY SURVEYOR
725 LOS ANGELES COUNTY ENGINEERING BLDG.

76420 353 3-51

B.M.	1ST RUN	DIFF.	2ND RUN	3RD RUN	ADJ. ELEV.	DESCRIPTION
						J.N. 0054.95
						John Anson Ford Park
						BENCH LEVELS
					Elevations based on L.A. Co. Engr. Precise Level Net - Line 7 1952 Adj.	
					Adj. 4-15-57 JC.	
					See AB-72 for Adj. Calc.	
		Party:	Sappell			
			Shoemaker			
			Myers			
			Siemann			

768420 353 3-51

PLEASE RETURN TO
LOS ANGELES COUNTY SURVEYOR
725 LOS ANGELES COUNTY ENGINEERING BLDG.

NOTE: ANY ADDITIONS OR CHANGES ON THIS SHEET MUST BE MADE OR CIRCLED IN RED INK, WITH DATE AND NAME OF PERSON MAKING CHANGE.

Do not extend notes this side of this line

JOB NO. 0054.85 SURVEY OF Glen Anson Ford Park NOTES RED. DATE
SURVEY BY D. Sappell NOTES CHKD. DATE 5-29-56
NOTES BY D. S. & C. Johnson DATE
INDEXED DATE

F.B. 2228 Pg. 34

B.M.	1ST RUN	DIFF.	2ND RUN	3RD RUN	ADJ. ELEV.	DESCRIPTION
BM 7-11	124.713				124.713	BM 7-N, El. 124.713, F.B. 1208-16 At the E int of Paramount Blvd & Florence Ave. In a well cut through the pvmt. and prot. by a C.I. Cover mkd. "County Surveyor Monument," a Std C.S. mon. mkd. "R.E 329" set in conc. 10" below the surface.
+	5.547		5.353	5.732		
⋀	130.260	+0.765 R	+0.769	+0.769	+0.7690	
−	4.784		4.584	4.963		
T.P	125.476					T.P. Spk No. Side Florence Ave
+	5.258		5.399			
⋀	130.734	+0.499	+0.498		+0.4985	
−	4.759		4.901			
T.P	125.975					T.P. - Spk. N.E. cor Florence & Tweedy
+	4.884		4.759			
⋀	130.859	+0.161	+0.162		+0.1615	
−	4.723		4.597			
T.P	126.136					T.P. - Spk. N. Side Florence.
+	5.023		4.677			
⋀	131.159	+0.199	+0.199		+0.1990	
−	4.824		4.478			
TP	126.335					T.P. - Spk. N. Side Florence in Front of Cameron's Pharmacy.
+	5.077		4.875	5.172		
⋀	131.412	+0.239	+0.231 R	+0.239	+0.2390	
−	4.838		4.644	4.933		
T.P.	126.574					T.P. - Spk No. Side Florence
+	4.827		4.617			
⋀	131.401	-0.269	-0.266		-0.2675	
−	5.096		4.883			
T.P.	126.305					T.P. - Spk. N. Side Florence @ int. Florence & Rives.

768420 353 3-51

PLEASE RETURN TO
LOS ANGELES COUNTY SURVEYOR
725 LOS ANGELES COUNTY ENGINEERING BLDG.

NOTE: ANY ADDITIONS OR CHANGES ON THIS SHEET MUST BE MADE OR CIRCLED IN RED INK, WITH DATE AND NAME OF PERSON MAKING CHANGE.

NOTES RED. JOB NO. 0054.95 SURVEY OF John Rasen Ford Park
DATE SURVEY BY D. Sappell
NOTES CHKD. NOTES BY D.S. DATE 5-29-56
DATE INDEXED C. Johnson DATE

F.B. 2228 PG. 35

Do not extend notes this side of this line

B.M.	1ST RUN	DIFF.	2ND RUN	3RD RUN	ADJ. ELEV.	DESCRIPTION
T.P.	126.305					T.P. Pg. 34
+	5.283		5.064			
π	131.588	-0.225	-0.227		-0.2260	
−	5.508		5.291			
T.P.	126.080					T.P - Spk. No. Side Florence.
+	5.013		4.792			℄ prod Hopeland Ave.
π	131.093	-0.269	-0.269		-0.2690	
−	5.282		5.061			
T.P.	125.811					T.P. N.E cor Florence ℄
+	5.585		5.384			Harley Ave.
π	131.396	-0.207	-0.205		-0.2060	
−	5.792		5.589			
T.P.	125.604					T.P. - Spk. No. Side Florence.
+	5.442		5.179			
π	131.046	-0.210	-0.210		-0.2100	
−	5.652		5.389			
T.P.	125.394					T.P. Spk. N.E cor Florence
+	4.868		4.619			℄ Wiley - Burke
π	130.262	-0.229	-0.230		-0.2295	
−	5.097		4.849			
T.P.	125.165					T.P. spk. No. Side Florence.
+	4.733		4.476			
π	129.898	-0.417	-0.415		-0.4160	
−	5.150		4.891			
T.P.	124.748					T.P. Spk N.E cor. Florence
+	5.108		4.904			℄ Pomering
π	129.856	-0.289	-0.289		-0.2890	
−	5.397		5.093			
T.P.	124.459					T.P. spk. No. side Florence.
						15° E of End cb.

765420 353 3-51

PLEASE RETURN TO
LOS ANGELES COUNTY SURVEYOR
725 LOS ANGELES COUNTY ENGINEERING BLDG.

NOTE: ANY ADDITIONS OR CHANGES ON THIS SHEET MUST BE MADE OR CIRCLED IN RED INK, WITH DATE AND NAME OF PERSON MAKING CHANGE.

Do not extend notes this side of this line

JOB NO. 0054.35 SURVEY OF John Bosen Ford Park NOTES RED.
SURVEY BY D. Sopoell D.S. DATE 5-29-56 NOTES CHKD.
NOTES BY C. Johnson DATE
INDEXED DATE
F.B. 2228 Pg. 36

B.M.	1ST RUN	DIFF.	2ND RUN	3RD RUN	ADJ. ELEV.	DESCRIPTION
T.P.	124.459					T.P. A9 35
+	4.964		4.743			
π	129.423	-0.314	-0.314		-0.3140	
−	5.278		5.057			
T.P.	124.145					T.P - Spk. N. side Florence.
+	4.918		4.618			150' E. of ℄ old River School Rd.
π	129.063	-0.669	-0.667		-0.6680	
−	5.587		5.285			
T.P.	123.476					T.P. - Spk. No. side Florence.
+	5.000		4.762			
π	128.476	-0.038	-0.037		-0.0375	
−	5.038		4.799			
T.P.	123.438					T.P. - Spk. " " "
+	5.363		5.440			Front of Silver Saddle Inn.
π	128.801	-0.316	-0.314		-0.3150	
−	5.679		5.754			
T.P.	123.122					T.P. Bt. Spk. 20' E. of E. end Catch
+	5.162		5.535			Basin, So. Side Florence Service
π	128.284	+1.529	+1.527		+1.5280	Rd.
−	3.633		4.008			
T.P.	124.651					T.P. - L&T. N. side Service Rd.
+	5.377		5.658			50± E of End culdesack
π	130.028	+1.406	+1.406		+1.4060	+1.3535 (20)
−	3.971		4.252			
BM #1	126.057				121.062	B.M. #1 - El. F.B.
						W. side F.C. Channel, 23' W. of W. edge pre-mix levee & 47' So. of So. Ed. conc. bridge (Florence Ave) at So. Ed pre-mix Rd.- A. C.E. Brass cap mon. - FLUSH - USCD So. Ed of CAP. F.B. 2228 pg. 29

768420 S & E-833 4-54

PLEASE RETURN TO
LOS ANGELES COUNTY SURVEYOR
725 LOS ANGELES COUNTY ENGINEERING BLDG.

NOTE: ANY ADDITIONS OR CHANGES ON THIS SHEET MUST BE MADE OR CIRCLED IN RED INK, WITH DATE AND NAME OF PERSON MAKING CHANGE.

NOTES RED_____ JOB NO. 0054.95 SURVEY OF John Anson Ford Park
DATE_____ SURVEY BY D. Sapell
NOTES CHKD._____ NOTES BY R. C. Johnson DATE 5-31-56
DATE_____ INDEXED_____ DATE_____

Do not extend notes this side of this line

B.M.	1ST RUN	DIFF.	2ND RUN	3RD RUN	ADJ. ELEV.	DESCRIPTION
Bm #1	126.057				121.062	Bm #1, See Pg 36 for descrip-
+	1.634		1.724			tion.
⋀	127.691	+0.898	+0.897		+0.8975	
−	0.736		0.827			
T.P.	126.955					T.P. Spk in wing wall W. end
+	3.778		3.587			bridge
⋀	130.733	+2.081	+2.080		+2.0805	+2.9780 (2)
−	1.697		1.507			
Bm #2	129.036				129.039	Bm #2, El. F.B.
+	2.993		2.915			Florence Ave. (So. Side) 50.5 W. of
⋀	132.029	-2.435	-2.439		-2.4370	W. end bridge - Bt spk in cb.
−	5.428		5.354			
T.P.	126.601					T.P.
+	2.891		2.693			
⋀	129.482	-2.165	-2.164		-2.1645	-4.6015 (2)
−	5.046		4.857			
Bm # 3	124.436				124.437	Bm #3 El. F.B.
						Park Cor. 219.3 E. of int Scout
+	3.557		3.748	3.756		Ave to the N. & Clara St.
⋀	127.993	~~-2.421~~ R	-2.416	-2.418	-2.4170	(Abandoned) & 30' So. of & Clara
−	5.978		6.164	6.174		St. - A C.E. Brass cap mon. - dwn
T.P.	122.015					12" - used No. Side cap, F.B. 2228-28
+	3.293		3.178			T.P. - 1x1 in field
⋀	125.308	+0.537	+0.536		+0.5365	-1.8805 (2)
−	2.756		2.642			
Bm #4	122.552				122.556	Bm #4 El. F.B.
						W. side F.C. Channel, 688.5 So. of So.
						Ed. bride (Florence Ave) - Bt Spk.
						W & T. - Flush in ctr of Arc. mtn
						Levee.

F.B. 2228 Pg. 37

765420 S & E-363 4-54

PLEASE RETURN TO
LOS ANGELES COUNTY SURVEYOR
725 LOS ANGELES COUNTY ENGINEERING BLDG.

NOTE: ANY ADDITIONS OR CHANGES ON THIS SHEET MUST BE MADE OR CIRCLED IN RED INK, WITH DATE AND NAME OF PERSON MAKING CHANGE.

Do not extend notes this side of this line

JOB NO 0054.85 SURVEY OF John Allen Ford Park NOTES RED. DATE
SURVEY BY D.S. Sappell DATE 5-31-56 NOTES CHKD. DATE
NOTES BY K. C. Johnson DATE
INDEXED

F.B. 2228 Pg. 38

B.M.	1ST RUN	DIFF.	2ND RUN	3RD RUN	ADJ. ELEV.	DESCRIPTION
BM #4	122.552				122.586	BM #4, See pg
+	1.662		1.468	1.716		
⊼	124.214	-3.545 R	-3.552	-3.551	-3.5515	
−	5.207		5.020	5.267		
T.P.	119.067					T.P. - 1x1 in field
+	4.499		4.337			
⊼	123.506	-0.619	-0.616		-0.6175	
−	5.118		4.953			
T.P.	118.388					T.P. " " "
+	4.166		3.923			
⊼	122.554	-1.929	-1.928		-1.9285	-6.0975 ③
−	6.095		5.851			
BM #5	116.459				116.458	BM #5, El. F.B. W. side F.C. Channel, 25' W. of W. ed pre-mix levee & 1441' So of S. Ed Bridge (Florence Ave) - a 2" I.P. cmt plug & F.C. Tag, dwn 15" F.B. 2228 - , use W. ed. pipe T.P. 1x1 in field
+	5.943		6.082			
⊼	122.402	+2.537	+2.529		+2.5300	
−	3.412		3.553			
T.P.	118.990					
+	5.704		5.886			
⊼	124.694	+1.339	+1.343		+1.3410	
−	4.365		4.543			
T.P.	120.329					T.P. " " "
+	4.355		4.136			
⊼	124.684	-1.526	-1.526		-1.5260	+2.3450 ③
−	5.881		5.662			
BM #6	118.803				118.802	BM #6, El. F.B. Park Cor., 467.6' N. of ℄ int Scout Ave & Ramish Ave, 30' E. of ℄ " A C.E. Brass Cap mon., dwn 24"

768420 S & E-883 4-54

PLEASE RETURN TO
LOS ANGELES COUNTY SURVEYOR
725 LOS ANGELES COUNTY ENGINEERING BLDG.

NOTE: ANY ADDITIONS OR CHANGES ON THIS SHEET MUST BE MADE OR CIRCLED IN RED INK, WITH DATE AND NAME OF PERSON MAKING CHANGE.

Do not extend notes this side of this line

DATE _____ SURVEY BY D. Sappell
NOTES CHKD _____ NOTES BY D.S. DATE 5-31-56
DATE _____ INDEXED R. C. Johnson DATE _____

B.M.	1ST RUN	DIFF.	2ND RUN	3RD RUN	ADJ. ELEV.	DESCRIPTION
BM #6	118.803.				118.802	BM #6 See pg 38
+	5.597		5.422			
⊼	124.400	+0.630	+0.631		+0.6305	
−	4.967		4.791			
T.P	119.433.					T.P - Spk E Side Scout
+	3.631		4.023			
⊼	123.064.	-2.194	-2.194		-2.1940	-1.5635 ②
−	5.825		6.217			
BM #7	117.239.				117.238	BM #7 El. F.B.
						℄ int. Scout Ave & Ramsh Ave.
						A C.S. Mon. in a well prot.
						by a C.I cover Mkd "County
+	5.706		5.467			Surveyor Monument" F.B 2228-21
⊼	122.945	+0.552	+0.555		+0.5535	(use East Ed cap)
−	5.154		4.912			
T.P.	117.791.					T.P. - Spk E-Side Scout.
+	4.643		4.385			
⊼	122.434	-0.505	-0.502		-0.5035	
−	5.148		4.887			
T.P	117.286.					T.P. " " "
+	4.802		4.643	4.487		
⊼	122.088.	+0.065	~~+0.053~~ +0.065		+0.0650	+0.1150 ③
−	4.737		4.590	4.422		
BM #8	117.351.				117.353	BM #8 El. F.B.
+	5.234		4.992			Scout Ave & Gotham Ave. - N.W
⊼	122.585.	-0.793	-0.793		-0.7930	cor. - Bt. Spk in c6 - 13' W. of
−	6.027		5.795			E. end. C6
T.P.	116.558.					T.P. - Spk S. side Gotham
+	5.474		5.351			
⊼	122.032.	-0.440	-0.439		-0.4395	
−	5.914		5.790			
T.P.	116.118.					T.P. - " N " "

F.B. 2228 Pg. 37

765420 S & E-353 4-54

PLEASE RETURN TO
LOS ANGELES COUNTY SURVEYOR
725 LOS ANGELES COUNTY ENGINEERING BLDG.

NOTE: ANY ADDITIONS OR CHANGES ON THIS SHEET MUST BE MADE OR CIRCLED IN RED INK, WITH DATE AND NAME OF PERSON MAKING CHANGE.

JOB NO. 0454.85 SURVEY OF John Anson Ford Park NOTES RED
SURVEY BY C. Sewell DATE
NOTES BY E. C. Johnson DATE NOTES CHKD.
INDEXED DATE

Do not extend notes this side of this line

B.M.	1ST RUN	DIFF.	2ND RUN	3RD RUN	ADJ. ELEV.	DESCRIPTION
T.P.	116.118					T.P.
+	5.168		5.274			
⋀	121.286	-0.378	-0.378		-0.3780	
−	5.546		5.652			
T.P.	115.740					T.P. - Spk. in front No 6317
+	5.403		5.239			Gotham
⋀	121.143	-0.205	-0.207		-0.2060	
−	5.608		5.437			
T.P.	115.535					T.P. - Spk in Gilland (W-side) No 7847
+	5.383		5.202			
⋀	120.918	+0.828	+0.828		+0.8280	-0.9885 ⑤
−	4.555		4.374			OUT 4-11-61 RCW
~~B.M. #9~~	116.363				~~116.363~~	B.m #9 El. F.B.
+	3.593		3.338			Gilkland Ave. (E-Side) So. End
⋀	119.956	-0.004	-0.004		-0.0040	of St at TR. Line, 8.0 N.
−	3.597		3.342			of So. End Cb. - 6t Spk in Cb.
~~B.M. #10~~	116.359			EL. N.G. 116.359		B.m #10, El. F.B.
				FD. DISTURBED 1-3-61 RCW		195.0 W of ℄ Gilkland Ave ℄ on TR Line - (Park Cor) -
+	3.684		3.882			A So Calf Edison Co. Brass
⋀	120.043	-1.379	-1.381		-1.3800	Cap mon. UP 8" F.B. 2228 -
−	5.063		5.263			(use No. side cap)
T.P.	114.980					T.P. 1x2 Ed of beet field
+	4.698		4.439			
⋀	119.678	+1.601	+1.599		+1.6000	+0.2200 ②
−	3.097		2.840			
B.m #11	116.581				116.578	B.m #11, El. F.B.
					FD. 1-3-61 OK.	S.E. cor. of E'lx Edison High Line Tower, 592.0 N. of ℄ prod Buell Ave. - 6t spk in conc base.

F.B. 2228 Pg. 40

765420 S & E 3-54

PLEASE RETURN TO
LOS ANGELES COUNTY SURVEYOR
725 LOS ANGELES COUNTY ENGINEERING BLDG.

NOTE: ANY ADDITIONS OR CHANGES ON THIS SHEET MUST BE MADE OR CIRCLED IN RED INK, WITH DATE AND NAME OF PERSON MAKING CHANGE.

Do not extend notes this side of this line

NOTES RED. DATE
NOTES CHKD. DATE
INDEXED. DATE

DATE SURVEY BY D. Sappell
NOTES BY D.J. DATE 5-31-56
C. Johnson DATE

F.B. 2228 PG. 41

B.M.	1ST RUN	DIFF.	2ND RUN	3RD RUN	ADJ. ELEV.	DESCRIPTION
B.m. #11	116.581.				116.578	B.m. #11 See pg 40
+	3.073		2.914			
⇈	119.654	-1.627 -0.627	-2.628 -0.628		-1.6275	
-	4.700		4.542			
T.P.	114.954.					T.P. 1x2 E. Edison R/W
+	4.545		4.378			
⇈	119.499.	-0.354	-0.355		-0.3545	
-	4.899		4.733			
T.P.	114.600.					T.P. " "
+	5.002		4.737			
⇈	119.602	+0.274	+0.275		+0.2745	
-	4.728		4.462			
T.P.	114.874.					T.P. 1x3, N. Ed. dirt Rd. on ℄ prod Buell
+	4.809		4.590			
⇈	119.683.	-0.434	-0.434		-0.4340	-2.1415 ④
-	5.243		5.024			
B.m. #12	114.440.				114.436	B.m. #12 - El. F.B. Buell St. (E. End), 134' E. of ℄ Inst Buell St & Felix AVE, 24' N of ℄ Buell St - Bf spk in co.
+	4.967		4.833			
⇈	119.407.	+0.102	+0.099		+0.1005	
-	4.865		4.734			
T.P.	114.542.					T.P. - 1x2 N. side dirt Rd
+	5.015		5.134			on ℄ prod Buell
⇈	119.557.	+0.433	+0.434		+0.4335	
-	4.582		4.700			
T.P.	114.975.					T.P. 1x2 in field
+	4.996		4.906			
⇈	119.971.	+0.532	+0.534		+0.5330	+1.0670 FD. DISTURBED 5-1-3-61 RCW
-	4.464		4.372			
B.M. #13	115.507.		EL. N.G.		115.502	El. F.B. Bm #13 476' E. So. of ℄ prod Buell St & on E. Edison Co. R/W, 412' W. & 92' N of 3/4" water Hyd., A Edison Co. Brass cap Mon. - Dwn 6" F.B. 2228-14
			(use N. Ed of cap)			

768420 P & E-353 4-54

PLEASE RETURN TO
LOS ANGELES COUNTY SURVEYOR
725 LOS ANGELES COUNTY ENGINEERING BLDG.

NOTE: ANY ADDITIONS OR CHANGES ON THIS SHEET MUST BE MADE OR CIRCLED IN RED INK, WITH DATE AND NAME OF PERSON MAKING CHANGE.

Do not extend notes this side of this line

JOB NO 0054.35 SURVEY OF Valyermo-Aqueduct Ford Rd NOTES RED
SURVEY BY D.S. Sappell DATE NOTES CHKD.
NOTES BY D.S. DATE 6-1-56
INDEXED A. C. Johnson DATE DATE

F.B. 2228 PG. 42

B.M.	1ST RUN	DIFF.	2ND RUN	3RD RUN	ADJ. ELEV.	DESCRIPTION
Bm #13	115.507				115.502	Bm #13 see p9
+	4.482		5.227			+ EL. N.G. DISTURBED 1-3-61 RCW
=	119.989	+0.537	+0.534		+0.5325	
-	3.951		4.693			
T.P.	116.038					T.P. 1x2 E- Edison R/W.
+	3.369		3.783			
=	119.407	-0.454	-0.451		-0.4525	
-	3.823		4.234			
T.P.	115.584					T.P. Spk Top Levee
+	0.347		0.550			
=	115.931	-4.981	-4.982		-4.9815	-4.9015 ③
-	5.328		5.532			T.P. GONE - EL. N.G. 1-3-61 RCW
Bm #14	110.603				110.600	Bm #14 El. F.B.
	|				(use W ed I.P)	W. side F.C. Channel, 16' W. of W.
+	5.536		5.714	6.102		edge pre-mix levee & 466' So. of &
=	116.139	+2.458	+2.454	+2.454	+2.4560	Pt. F.C. Channel, A 2" I.P. cemt. plug
-	3.078		3.263	3.648		& F.C. Tag dwn - 24", 22° E & 39° So. of
T.P.	113.061					12" Oak at W. ed of dirt Rd.
+	3.783		4.097			T.P. 1x2, Toe of Slope levee
=	116.844	-1.399	-1.398		-1.3985	+1.0575 ②
-	5.182		5.495			
Bm #15	111.662				111.657	Bm #15 El. F.B.
	|				OK. EL. FD. 1-3-61 RCW	4 Pt W. F.C. R/W, 429' So. of 4 Pt.
+	5.998		5.719			W&P. High line tower E. side F.C.
=	117.660	+1.620	+1.619		+1.6195	Channel & 13' W of W ed pre-mix
-	4.378		4.100			levee, A 2" I.P. cmt plug & F.C. Tag
TP	113.282					Dwn 15," (use N.E. Ed. I.P) F.B. 2228-
						T.P. 1x2 30' W. of toe Slope
						of levee

765420 S & E-383 4-54

PLEASE RETURN TO
LOS ANGELES COUNTY SURVEYOR
725 LOS ANGELES COUNTY ENGINEERING BLDG.

NOTE: ANY ADDITIONS OR CHANGES ON THIS SHEET MUST BE MADE OR CIRCLED IN RED INK, WITH DATE AND NAME OF PERSON MAKING CHANGE.

Do not extend notes this side of this line

NOTES RED _____ JOB NO. 0054.85 SURVEY OF John Aaron Ford Pgs
DATE _____ SURVEY BY D.S. Sappell
NOTES CHKD _____ NOTES BY D.S. DATE 6-1-56
DATE _____ INDEXED R.C. Johnson DATE _____

F.B. 2228 PG. 43

B.M.	1ST RUN	DIFF.	2ND RUN	3RD RUN	ADJ. ELEV.	DESCRIPTION
T.P.	113.282.					T.P. pg 42
+	4.972		5.115			
⊼	118.254	+0.752	+0.749		+0.7505	
−	4.220		4.366			
T.P.	114.034					TP 1x2 30' W. of toe slope
+	4.813		4.600			of Levee.
⊼	118.847	+3.103	+3.102		+3.1025	+5.4725 ③
−	1.710		1.498			
B.m. #16	117.137				117.129	Bm #16 El. F.B.
						125± N. of W# P. # PT. High
						Line Tower E. side F.C. Channel
+	1.798		1.533	1.173		A lg. Bt. Spk w# T. in ctr. of
⊼	118.935	~~2.534~~	-2.529	-2.531	-2.5300	pre-mix levee W. side F.C.
−	4.332		4.062	3.704		Channel.
T.P.	114.603.					T.P. 1x2 25' W of toe slope
+	5.110		4.854	5.399		of Levee.
⊼	119.713.	-0.008	~~-0.003~~	-0.008	-0.0080	-2.5380 ②
−	5.118		4.857	5.407		
Bm #17	114.595.				114.590	Bm #17 El. F.B.
						W. side F.C. Channel, 30' W. of
						W. ed. pre-mix Levee & 79± So. of
+	6.017		5.794			4TH N. & P. High Line Tower - So. of
⊼	120.612	+1.805	+1.808		+1.8065	Florence Ave, E. side F.C. Channel
−	4.212		3.986			A 2" I.P. cmt. plug & F.C. Tag F.B. 2228-12
TP	116.400					T.P. ~ Dwn 12"

765420 ◎ A E-363 4-54

PLEASE RETURN TO
LOS ANGELES COUNTY SURVEYOR
725 LOS ANGELES COUNTY ENGINEERING BLDG.

NOTE: ANY ADDITIONS OR CHANGES ON THIS SHEET MUST BE MADE OR CIRCLED IN RED INK, WITH DATE AND NAME OF PERSON MAKING CHANGE.

Do not extend notes this side of this line

JOB NO 0054.95 SURVEY OF Ashton-Avon Ford P&
SURVEY BY D. Soppell DATE
NOTES BY D.C. Johnson DATE 6-1-56 NOTES CHKD. DATE
INDEXED DATE NOTES RED DATE

F.B. 2228 Pg. 44

B.M.	1ST RUN	DIFF.	2ND RUN	3RD RUN	ADJ. ELEV.	DESCRIPTION
T.P.	116.400					T.P. P9 43
+	4.577		4.333			
π	120.977	-0.915	-0.915		-0.9150	+0.8915 ②
−	5.492		5.248			
B.m #18	115.485				115.481	B.m #18 El. F.B. 2178.2' So. of So. Ed. Bridge (Florence Ave) & 24' W. of W. ed pre-mix Levee., & PT. West. F.C. R/W. - A 2" I.P. cmt plug & F.C. Tag - Dwn 15" (use East Ed. I.P.) F.B. 2228-19
+	4.990		4.763			
π	120.475	+3.537	+3.535		+3.5360	
−	1.453		1.228			
T.P.	119.022					T.P. spk Top Levee.
+	3.173		2.838			
π	122.195	-0.859	-0.860		-0.8595	
−	4.032		3.698			
T.P.	118.163					T.P. spk Top Levee E. side
+	4.237		4.063			channel - 100' + So. of 4TH WAP
π	122.400	-0.626	-0.625		-0.6255	Tower S. of Florence.
−	4.863		4.688			
T.P.	117.537	—			Found →	T.P. - spk East Levee.
+	4.115		3.823			
π	121.652	-0.672	-0.670		-0.6710	
−	4.787		4.493			
T.P.	116.865					T.P. " " "
+	3.797		3.487			
π	120.662	-0.316	-0.316		-0.3160	
−	4.113		3.803			
T.P.	116.549				No. 5	T.P. " " "
+	3.984		3.618			
π	120.533	-0.658	-0.657		-0.6575	
−	4.642		4.275			
T.P.	115.891				No. 6	T.P. " " "

768420 S & E-693 4-54

PLEASE RETURN TO
LOS ANGELES COUNTY SURVEYOR
725 LOS ANGELES COUNTY ENGINEERING BLDG.

NOTE: ANY ADDITIONS OR CHANGES ON THIS SHEET MUST BE MADE OR CIRCLED IN RED INK, WITH DATE AND NAME OF PERSON MAKING CHANGE.

Do not extend notes this side of this line

NOTES RED _____ JOB NO. 0054.95 SURVEY OF John Nixon Ford Rd
DATE _____ SURVEY BY D.J. Sopec II F.B. 2228 Pg. 45
NOTES CHKD _____ NOTES BY D.J. DATE 6-1-56
DATE _____ INDEXED J. C. Johnson DATE

B.M.	1ST RUN	DIFF.	2ND RUN	3RD RUN	ADJ. ELEV.	DESCRIPTION
T.P.	115.891					T.P. P9 4 4
+	3.811		3.652			
∧	119.702	-0.213	-0.217		-0.2150	
−	4.024		3.869			
T.P.	115.678.					T.P - SpA E. Levee
+	3.224		3.033			
∧	118.902.	-1.549	-1.551		-1.5500	
−	4.773		4.584			
T.P.	114.129.					T.P. 1x2, 100± N. of ℄ prod.
+	3.542		3.342			Pellet St ℄ 100± W. of End St.
∧	117.671.	-1.142	-1.140		-1.1410	
−	4.684		4.482			
T.P.	112.987.					T.P. Spk in front of Ho. 7013
+	4.779		4.667			N. Side Pellet
∧	117.766.	+0.180	+0.179		+0.1795	
−	4.599		4.488			
T.P.	113.167.					T.P " " Ho. 7037
+	4.972		4.792			
∧	118.139.	-0.175	-0.175		-0.1750	
−	5.147		4.967			
T.P.	112.992.					T.P. " " Ho 7064
+	4.624		4.398			
∧	117.616.	-0.202	-0.200		-0.2010	
−	4.826		4.598			
T.P.	112.790.					TP " " Ho. 7124
+	4.409		4.239			
∧	117.199.	-0.373	-0.375		-0.3740	
−	4.782		4.613			
T.P.	112.417.					T.P. Spk Front Ho 7154

768420 S & E-383 4-54

PLEASE RETURN TO
LOS ANGELES COUNTY SURVEYOR
725 LOS ANGELES COUNTY ENGINEERING BLDG.

NOTE: ANY ADDITIONS OR CHANGES ON THIS SHEET MUST BE MADE OR CIRCLED IN RED INK, WITH DATE AND NAME OF PERSON MAKING CHANGE.

Do not extend notes this side of this line

JOB NO. 0054.25 SURVEY OF Gday Anson Ford Park NOTES RED
SURVEY BY D. Sapell DATE
NOTES BY D.J. NOTES CHKD.
INDEXED E. C. Johnson DATE 6-1-56 DATE

F.B. 2228 PG. 46

B.M.	1ST RUN	DIFF.	2ND RUN	3RD RUN	ADJ. ELEV.	DESCRIPTION
T.P.	112.417.					T.P. pg 45
+	4.388		4.163			
⊼	116.805.	-0.690	-0.688		-0.6890	
−	5.078		4.851			
T.P.	111.727.					T.P. Spk in Front of Ho 11010
+	4.463		4.397			Rxerson Ave.
⊼	116.190.	-0.388	-0.391		-0.3895	
−	4.851		4.698			
T.P.	111.339.					T.P. " " Ho. 11042
+	4.548		4.345			
⊼	115.887.	-0.106	-0.109		-0.1075	
−	4.654		4.454			
T.P.	111.233.					T.P. Spk. N. side Dinwiddie
+	4.846		4.688			
⊼	116.079.	+0.535	+0.536		+0.5355	
−	4.311		4.152			
T.P.	111.768.					T.P. Spk S " "
+	4.786		4.616			in Front of Ho # 7240
⊼	116.554	+0.298	+0.297		+0.2975	
−	4.488		4.319			
T.P.	112.066.					T.P. Spk N. side Dinwiddie
+	4.483		4.699			Front of Ho # 7303
⊼	116.549.	+0.055	+0.057		+0.0560	
−	4.428		4.642			
T.P.	112.121.					T.P. " " Ho # 7328
+	4.479		4.253			
⊼	116.600	-0.312	-0.313		-0.3125	
−	4.791		4.566			
T.P.	111.809.					T.P. Ho

765420 S & E, 853 4-54

PLEASE RETURN TO
LOS ANGELES COUNTY SURVEYOR
725 LOS ANGELES COUNTY ENGINEERING BLDG.

NOTE: ANY ADDITIONS OR CHANGES ON THIS SHEET MUST BE MADE OR CIRCLED IN RED INK, WITH DATE AND NAME OF PERSON MAKING CHANGE.

Do not extend notes this side of this line

NOTES RED. JOB NO. 0054.95 SURVEY OF John Ryan Ford Park
DATE SURVEY BY D. Sappell
NOTES CHKD. NOTES BY J.S. DATE 6-4-56
DATE INDEXED C. Johnson DATE

F.B. 2228 PG. 47

B.M.	1ST RUN	DIFF.	2ND RUN	3RD RUN	ADJ. ELEV.	DESCRIPTION
T.P.	111.309.					T.P. pg. 46.
+	4.825		4.626	4.418		
⇑	116.634.	+0.579	+0.608	+0.605	+0.6065	
−	4.226		4.019	3.813		
T.P.	112.408.					T.P. 1x2 50' S. of ℄ prkd
+	4.828		4.632			Dinwiddie & 100'± E of ℄ Old
⇑	117.236.	+0.596	+0.599		+0.5975	River School Rd.
−	4.232		4.033			
T.P. 113.002.10	113.004.	OK				T.P. BM spk. So. End Pacific
+	3.024		3.202			Sign Board - 400' E. of Old
⇑	116.028.	~~-1.596~~ -0.546	~~-1.545~~ -0.545		-1.5455	River Sch. Rd. / N. side Firestone
−	4.570		4.747			
T.P.	111.458.					T.P. spk Firestone Pl.
+	5.127		5.239			
⇑	116.585.	+0.936	+0.835		+0.8355	
−	4.291		4.433			
T.P.	112.294.					T.P. spk E. drive to
+	4.994		4.774			Hartons Market
⇑	117.288.	+0.410	+0.411		+0.4105	
−	4.584		4.363			
112.704.5 T.P.	112.704.					T.P. - spk. So. side Firestone
+	5.147		4.964			100'± E of ℄ Wiley Burke.
⇑	117.851.	+1.044	+1.545		+1.0445	
−	4.103		3.919			
T.P.	113.748.					T.P. spk. So. side Firestone
+	5.326		5.059			80'± E. of T.P. M-4115-Y
⇑	119.074.	+1.114	+1.115		+1.1145	
−	4.212		3.944			
T.P.	114.862.					T.P. - spk. So. side Fire-
						stone - OPP. T.P. No.? 4TH
						West of RIVES.

765420 S & E-353 4-54

PLEASE RETURN TO
LOS ANGELES COUNTY SURVEYOR
725 LOS ANGELES COUNTY ENGINEERING BLDG.

NOTE: ANY ADDITIONS OR CHANGES ON THIS SHEET MUST BE MADE OR CIRCLED IN RED INK, WITH DATE AND NAME OF PERSON MAKING CHANGE.

Do not extend notes this side of this line

JOB NO 0054.95 SURVEY OF John Anson Ford Park NOTES RED
SURVEY BY D. Sappell DATE
NOTES BY D.S. DATE 6-4-56 NOTES CHKD.
INDEXED A.C. Johnson DATE DATE
F.B. 2228 Pg. 48

B.M.	1ST RUN	DIFF.	2ND RUN	3RD RUN	ADJ. ELEV.	DESCRIPTION
T.P.	114.862					T.P. P9 47
+	5.294		5.007			
Λ	120.066	+0.725	+0.724		+0.7230	
−	4.492		4.293			
T.P.	115.584					T.P. S.P.K. So. Side Firestone
+	5.582		5.439			150'± W. of E. Drives.
Λ	121.166	+0.608	+0.606		+0.6070	
−	4.974		4.933			
T.P.	116.192					T.P. Spk. So. Side Firestone
+	5.177		4.870			25'± W. of T.P. M-640-K
Λ	121.369	+0.599	+0.598		+0.5985	
−	4.578		4.272			
T.P.	116.791					T.P. - Spk. So. Side Firestone
+	5.165		4.934			Drive . to # 7844
Λ	121.956	+0.295	+0.295		+0.2965	
−	4.867		4.639			
T.P.	117.089					T.P. Spk. So. Side Firestone,
+	4.721		4.479			E end "Andy" Anderson Elect Co.
Λ	121.810	-0.182	-0.179		-0.1805	7910
−	4.903		4.658			
T.P.	116.907					T.P. - Spk. So. Side Firestone,
+	4.688		4.419			E. End USGS car 1st, 7944
Λ	121.595	-0.776	-0.778		-0.7770	+0.6515 (23)
−	5.464		5.197			
Bm-7-8	116.131				116.125	Bm 7-8 El. 116.125 FB 1208-13 (Bell H-7) At Firestone & Paramount Blvd. 33.1' N.W'ly from the S.E. ∞ line of Paramount Blvd. produced N.E'ly & 14.2' N.E'ly from the ∞ Line of Firestone Blvd. produce S.E'ly in a well cut through the pvmt & brass by a cast iron cover mkd. "County Surveyor Monument" P. Std. 4" brass, toilet inscribed "L.A. County Control System Traverse Station Bell H-7 B.F. 2177 Set by County Surveyor 1938" set in conc. 2' [illegible] made on the Street

Notes Ck'd by	Survey of John Anson Ford Park
Map No.	W. O. 0054.95 Tape No. 0126 St'd. 68 °F
Office Work	Surveyed by J. P. Menne
Checked	Notes V. B. Anderson Date 8-6-56
Date	Indexed A. C. Johnson 8-28-56

F. B. 2230 Pg. 49

J.N. 0054.95

JOHN ANSON FORD PARK

SURVEY FOR TOPOG. CONTROL

INSIDE OLD BOY SCOUT CAMP SITE

Party J. Menne
V. Anderson
J. S. West
G. Guizado
H. L. Young

Note: Any Additions or Changes on This Sheet Must be Made or Circled in Red Ink With Date and Name of Person Making Change.

Do not extend notes this side of this line.

RETURN TO
LOS ANGELES COUNTY SURVEYOR
726 LOS ANGELES COUNTY
ENGINEERING BLDG.

76F3085 247 2-51

RETURN TO
LOS ANGELES COUNTY SURVEYOR
723 LOS ANGELES COUNTY
ENGINEERING BLDG.

Note: Any Additions or Changes on This Sheet Must be Made or Circled in Red Ink With Date and Name of Person Making Change.

Do not extend notes this side of this line.

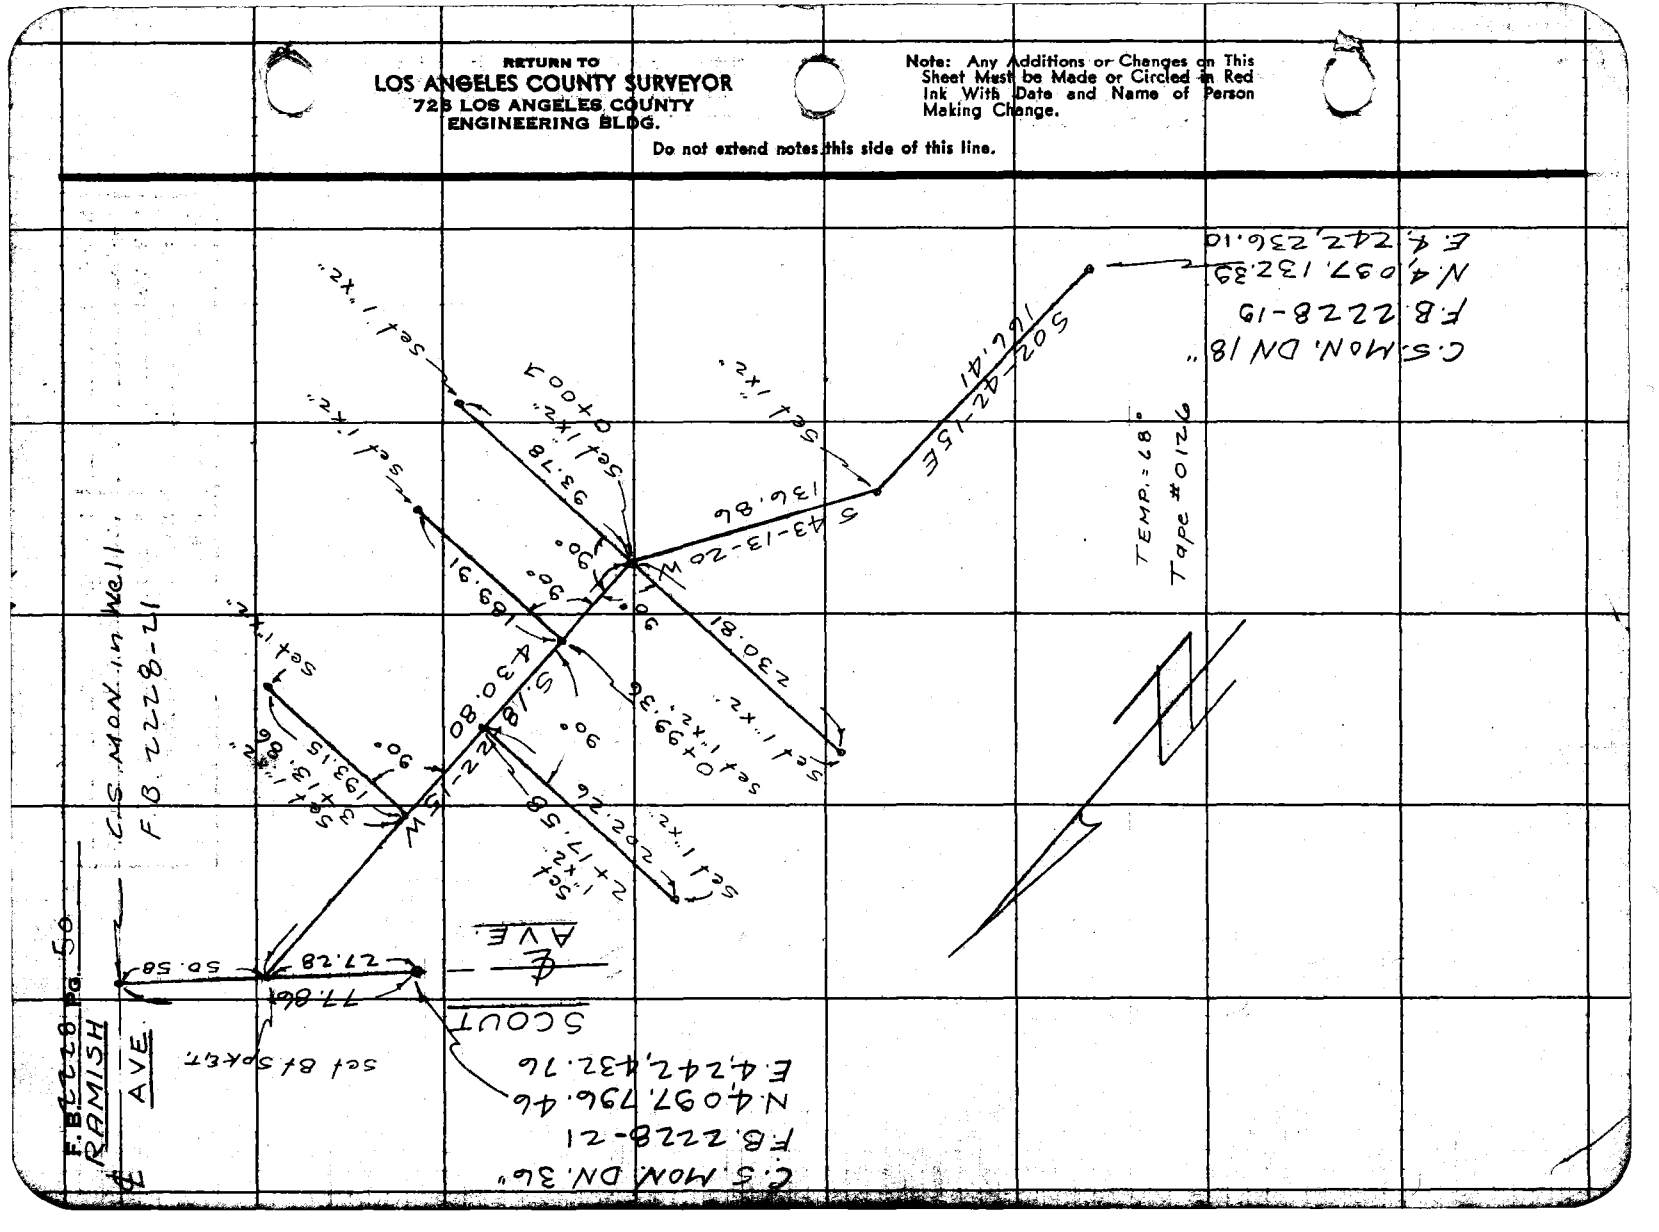

Notes Ck'd by: W. Brenner
Map No. C.S.B 2600
Office Work Burns
Checked Miller
Date May 1959

Survey of John Anson Ford Park
W. O. 0054 Tape No. 0135 Std. 68 °F
Surveyed by A.N. Hellstrom
Notes A.N.H. Date APR. 1958
Indexed L. C. Johnson 4-10-58

F. B. 2220 Pg. 1

J.N. #0054.95

JOHN ANSON FORD PARK

A SURVEY TO CHECK A DESCRIPTION TO BE USED IN FORM OF A DEED TO COUNTY OF LOS ANGELES FROM L.A.C.F.C.D. AS REGARDS TO EXISTING MONUMENTS ON THE GROUND. — DESCRIPTION MAY NEED TO BE ALTERED TO FIT MONS. AS THEY ARE EXISTING.

NOTE:
—— GREEN LINES = EXIST. PRK. BDRY.
YELLOW LINES = PROPOSED NEW BDRY.

A.N. HELLSTROM
F.E. BROOKS
T.J. MELENDEZ
J.W. POTTER

Note: Any Additions or Changes on This Sheet Must be Made or Circled in Red Ink With Date and Name of Person Making Change.

Do not extend notes this side of this line.

RETURN TO
LOS ANGELES COUNTY SURVEYOR
726 LOS ANGELES COUNTY
ENGINEERING BLDG.

76F3008 SEE #247. 8-54

RETURN TO
LOS ANGELES COUNTY SURVEYOR
726 LOS ANGELES COUNTY
ENGINEERING BLDG.

Notes: Any Additions or Changes on This Sheet Must be Made or Circled in Red Ink With Date and Name of Person Making Change.

Do not extend notes this side of this line.

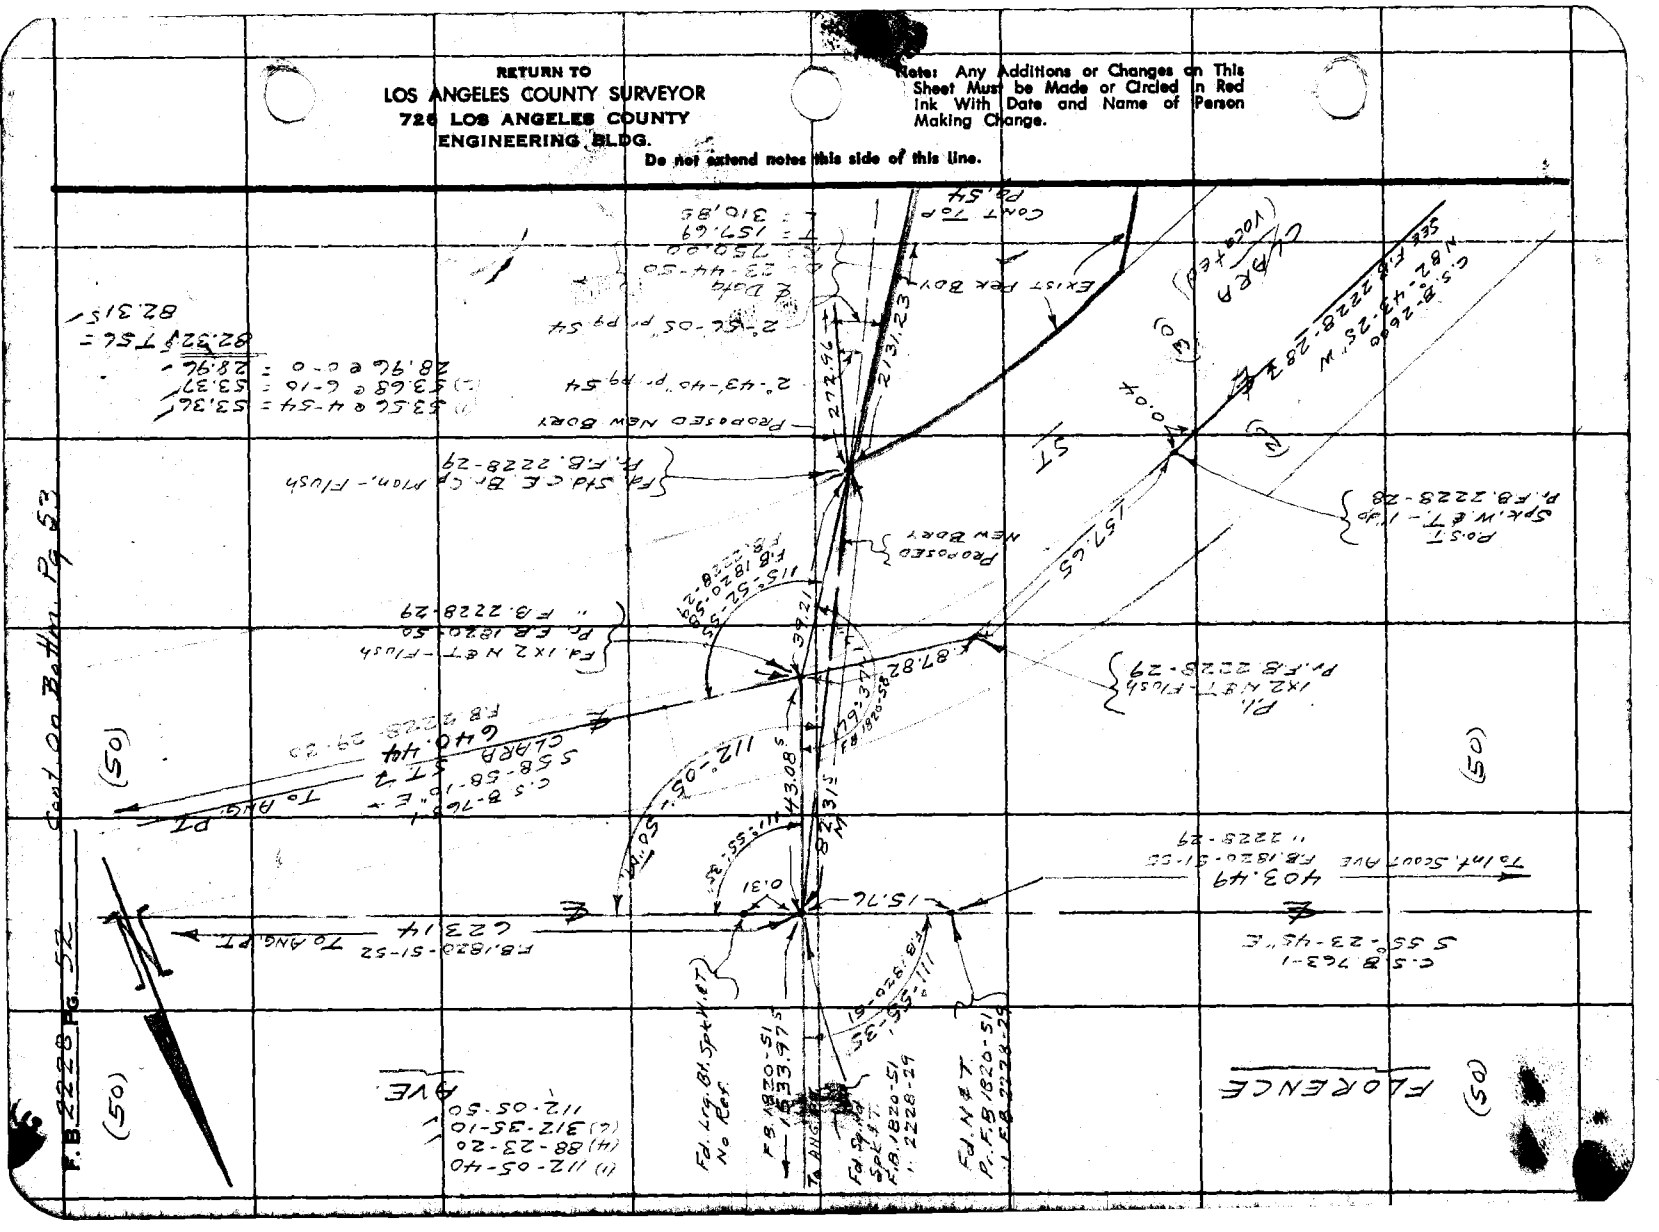
FLORENCE
AVE.
(50)
F.B. 2228 PG. 52
Cont. on Bottom Pg. 53
To Ang. PT
To Int. Scout Ave
To Ang. PT
To Ang. PT
Ex 137 Par Bdry
Proposed New Bdry
Proposed New Bdry

76F3099 S&E #247. 8-54

RETURN TO
LOS ANGELES COUNTY SURVEYOR
726 LOS ANGELES COUNTY
ENGINEERING BLDG.

Note: Any Additions or Changes on This Sheet Must be Made or Circled in Red Ink With Date and Name of Person Making Change.

Do not extend notes this side of this line.

Notes C'k'd by W. Brennel
Map No. C.S. B 2600
Office Work Burns
Checked Miller
Date May 1959

Survey of Work Assigned Form 74
W. O. 9544 Tape No. 9135 Srd. 68 of
Surveyed by A.N.Y. Hellstrom
Notes A.N.Y.
Indexed C. Jacobs Date Apr. 1958

F.B. 2228 Pg. 53

ANGLE POINT
190+67.48
Fd. Std. Road Dpt. Mon
In A Well With C.I. Cover
& 4 Spk's & T - 2" Tan Ties
On Surf
Pr. Rd. Dpt. F.B. 868-65
" C.S. F.B. 1820-52
" " F.B. 2228-30

(50) FLORENCE AVE. (50)

C.S. B 763-1
S 55°-23'-45" E
To Sq. Hd Spk & T F.B. 1820-51-52
623.14
S 55°-23'-45" E
Pr. C.S. B-763-1
℄ CLARA ST.
640.44
To IXZ N & T. Pr. F.B. 2228-29-30
S 58°-58'-10" E
C.S. B-763-1

176°-25'-26"
R. F.B. 1820-52

Pr C.S. B. 763-1
S 58°-58'-10" E
800.06
F.B. 1114-209
To later OLD RIVER SCHOOL ROAD - C.S. Mon.

(50) (50)

Cook From Top P.B. 52

F.B. 2228 Pg. 54

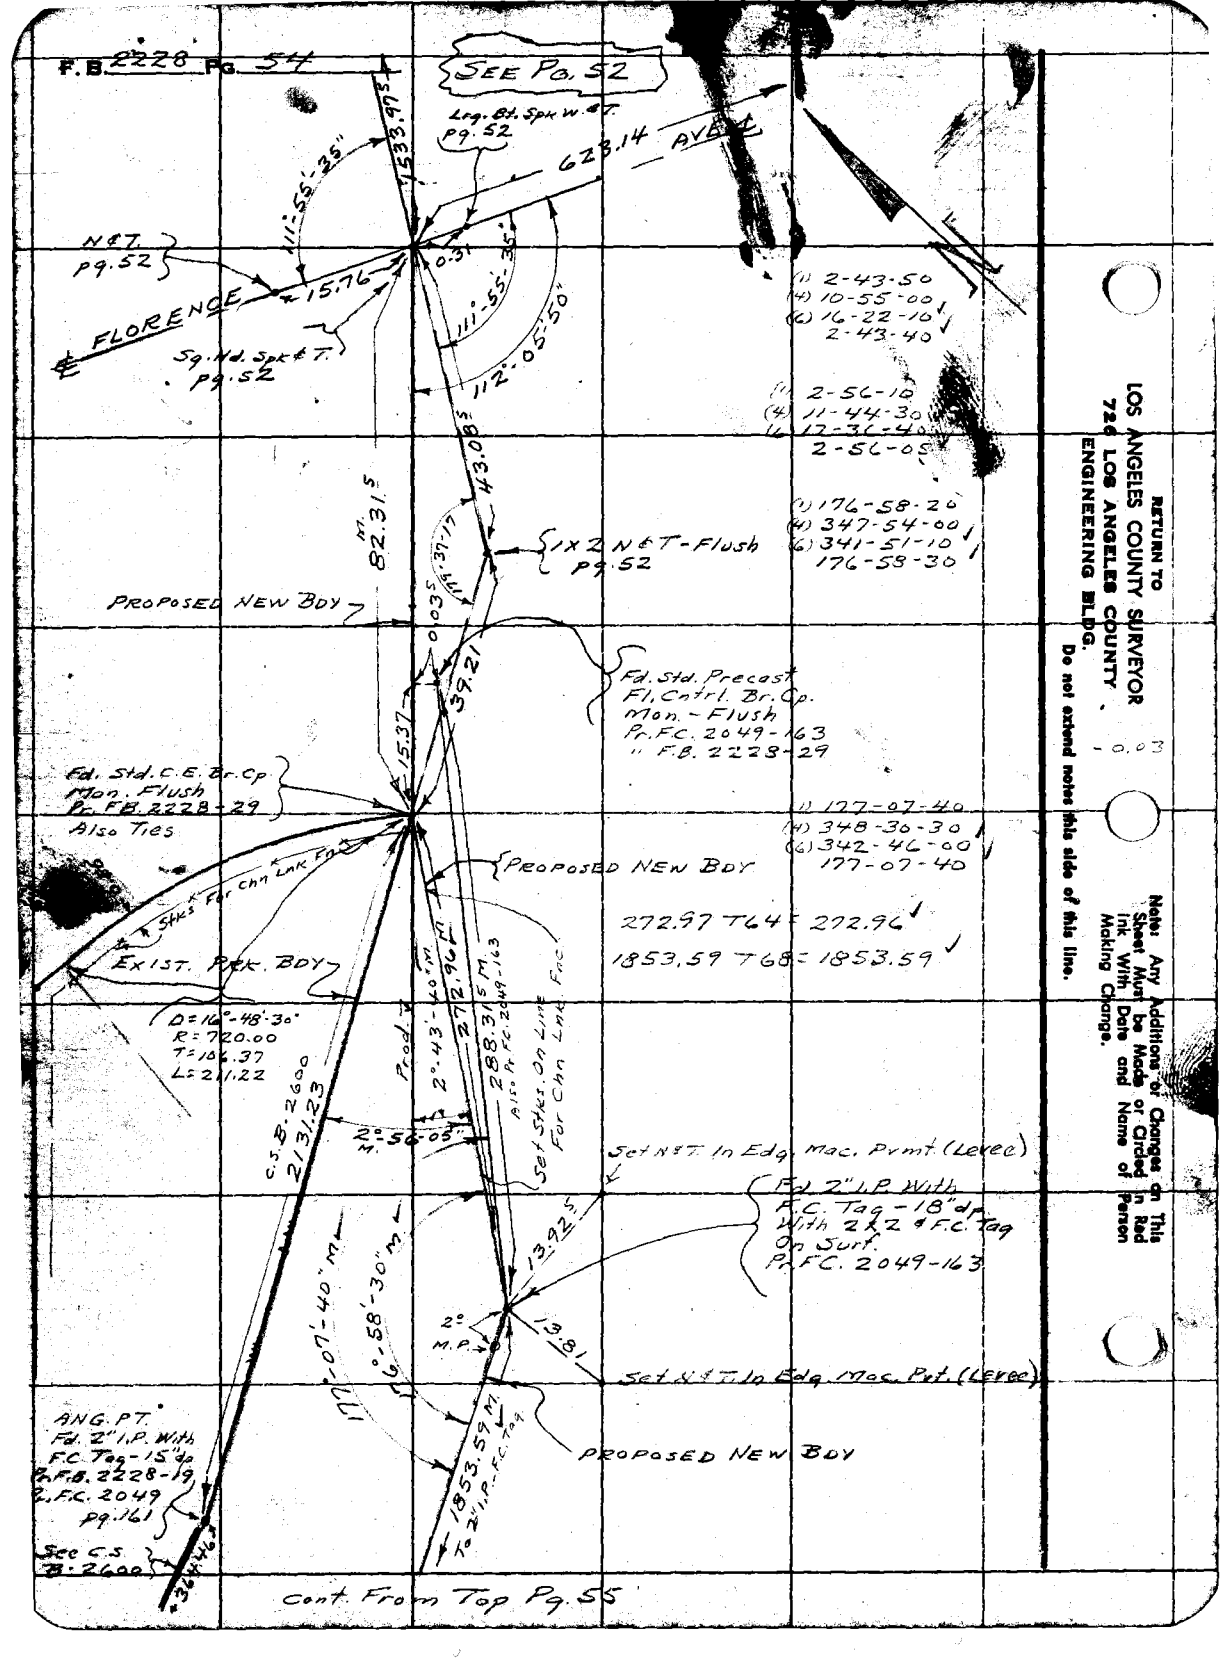

RETURN TO
LOS ANGELES COUNTY SURVEYOR
726 LOS ANGELES COUNTY
ENGINEERING BLDG.
Do not extend notes this side of this line.

Note: Any Additions or Changes on This Sheet Must be Made or Circled in Red Ink With Date and Name of Person Making Change.

Cont. From Top Pg. 55

Notes Ck'd by W. Brenner
Map No. C.S. B2600
Office Work Burns
Checked Miller
Date May 1959

Survey of John Anson Ford Park
JN 005495 Tape 0135 Std. 68 °F
Surveyed by A.N. Hellstrom
Notes A.N.H. Date Apr. 1958
Indexed C. Johnson

F. B. 222

Cont On Bottom 54

2" I.P. F.C. Tag -18" dp. pr. pg. 54 (Ties

To C.S. Br. Cp. Mon.

Pg. 54

Pr. Pg. 54

177°-07'-40"

176°-58'-30"

2° M.P.

Chain Link Fnc

(1) 177-26-10
(4) 349-44-40
(6) 344-37-00
177-26-10

369.77 T68 = 369.77

781.86 T68 = 781.86

814.85 T68 = 814.85

Note: Any Additions or Changes on This Sheet Must be Made or Circled in Red Ink With Date and Name of Person Making Change.

Do not extend this side of this line.

PLEASE RETURN TO
LOS ANGELES COUNTY ENGINEER
700 Los Angeles County Engineering Bldg.

Pg. 54

2131.25

Exist. Pier Boy

Proposed New Boy

ON LINE.
Fd. 2" I.P. With F.C. Tag -12" dp. With 2 x 2 on Surf
Pr. F.C. 2049 Pgs. 161 - 163

1153.76
F.C. 2049-161-163

1853.59 M

Fd. 2" I.P. With F.C. Tag -14" dp. Pr. F.C. 2049-161

ANG. PT.
2" I.P. With F.C. Tag 15" dp. Pr. Pg. 54

179°-26'-10" M.
114°-04'-00" M.

40.19

21.54

M.P.

179°-03'-30"
179°-28'-19"

12.17 M.

N 45° 51' 28" W

Fd. 5/8" I.P. Set In Mac. Pavmt. (Levee)

C.S.B. 2600

364.46

369.77 M.

781.86 M.

Line

Fd. 2" I.P. With F.C. Tag -15" dp. Pr. F.C. 2049-161

ANG. PT.
Fd. 2" I.P. With F.C. Tag - 15" dp. Pr. F.B. 222B-12

M.P.

F.B. 222 B-12
179°-08'-20"

C.S.B. 2600

1066.20

814.85 M

Stakes Set On

Cont. From Top Pg. 56

70F2035 SAE #247 1-86

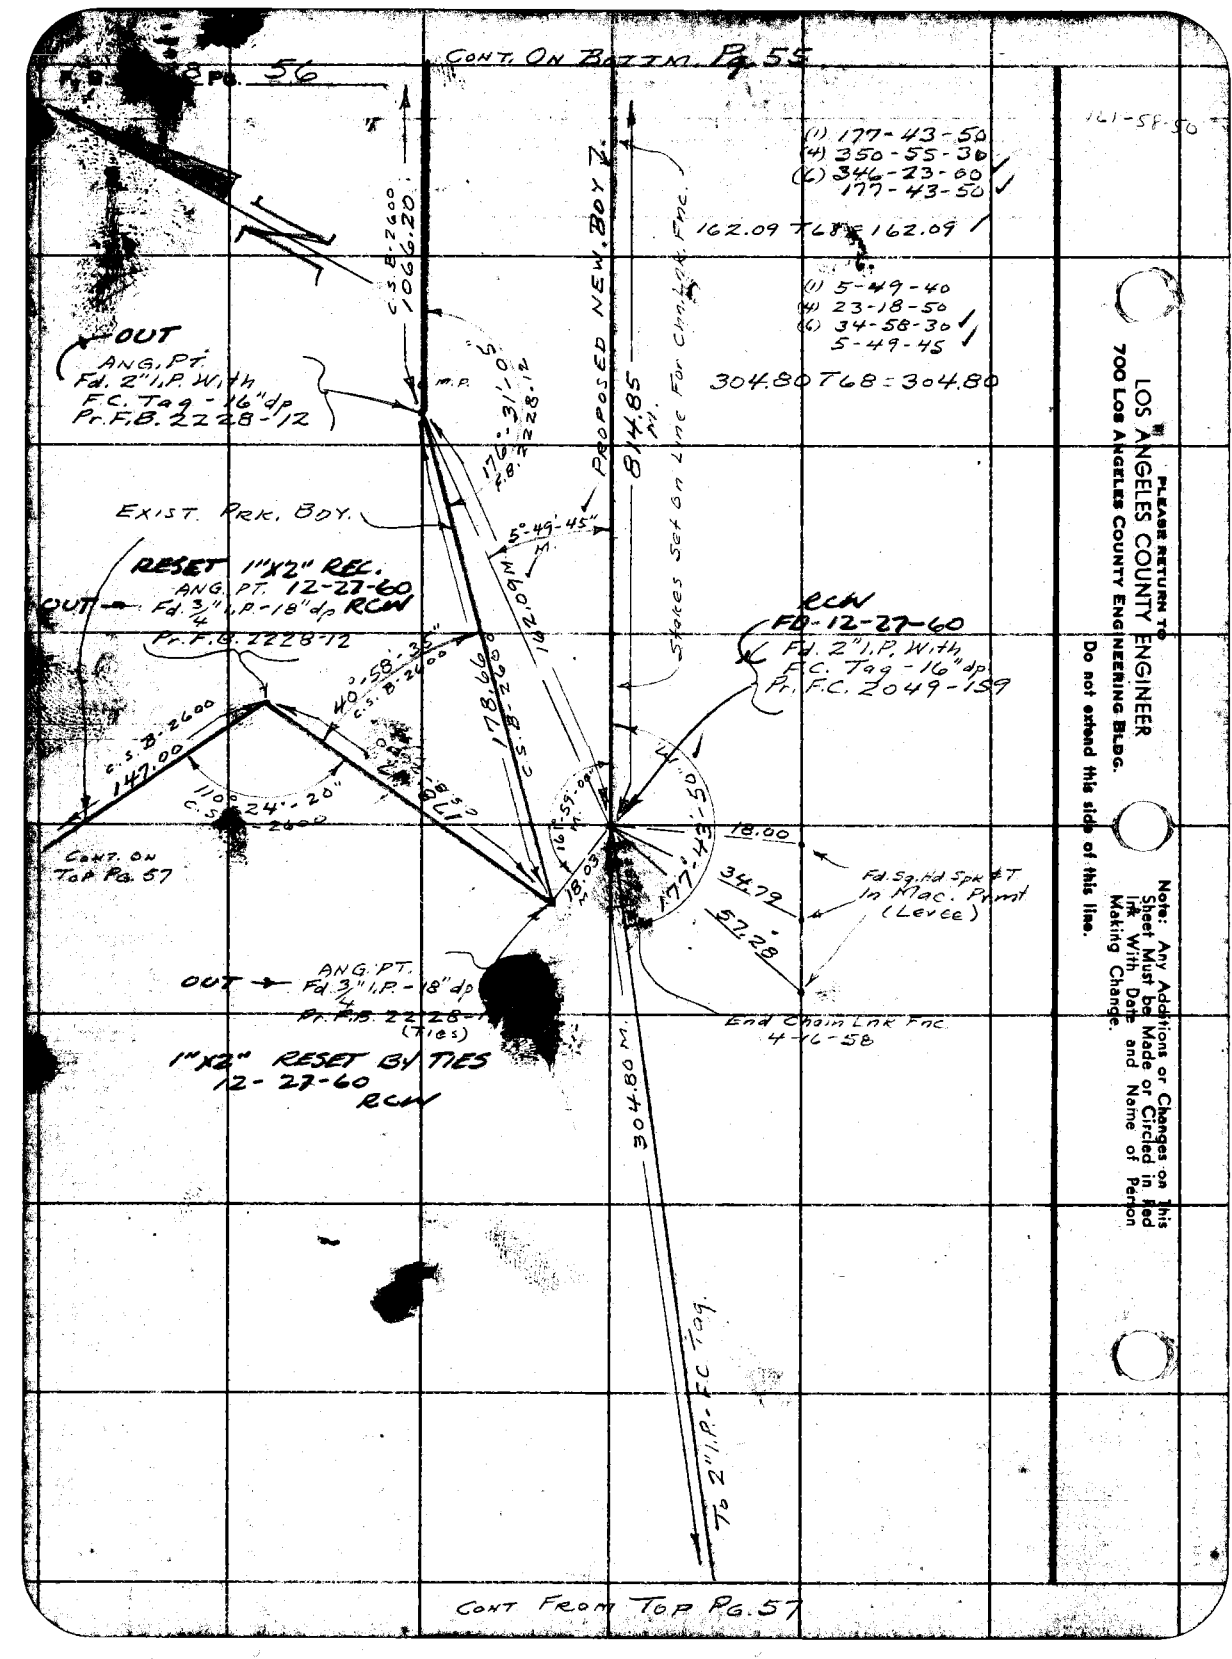
CONT. ON BOOK M. Pg. 55
F.B. 8 PG. 56
(1) 177-43-50
(4) 350-55-30
(6) 346-23-60
177-43-50
162.09 T68 = 162.09
(1) 5-49-40
(4) 23-18-50
(6) 34-58-30
5-49-45
304.80 T68 = 304.80
161-58-50
C.S. B-2600
1066.20
OUT
ANG. PT.
Fd. 2" I.P. With
F.C. Tag - 16" dp
Pr. F.B. 2228-12
M.P.
176°-31'-05"
F.B. 2228-12
PROPOSED NEW BDY.
814.85
N.
Stakes Set on Line For Chain Link Fnc.
EXIST. PRK. BDY.
5°-49'-45"
M.
RESET 1"X2" REC.
ANG. PT. 12-27-60
OUT → Fd. 3/4" I.P. - 18" dp RCW
Pr. F.B. 2228-12
RCW
FD-12-27-60
Fd. 2" I.P. With
F.C. Tag - 16" dp
Pr. F.C. 2049-159
1066.20
C.S. B-2600
40°-58'-35"
C.S. B-2600
147.00
110°-24'-20"
C.S. B-2600
CONT. ON TOP PG. 57
16°-59'-09"
18.03
177°-43'-50"
18.00
34.79
57.29
Fd. Sq. Hd Spk & T In Mac. Pvmt (Levee)
End Chain Link Fnc 4-16-58
OUT → ANG. PT. Fd. 3/4" I.P. - 18" dp
Pr. F.B. 2228-12 (Ties)
1"X2" RESET BY TIES 12-27-60 RCW
304.80 M.
To 2" I.P. - FC Tag.
CONT FROM TOP PG. 57
LOS ANGELES COUNTY ENGINEER
700 Los Angeles County Engineering Bldg.
PLEASE RETURN TO
Do not extend this side of this line.
Note: Any Additions or Changes on This Sheet Must be Made or Circled in Red Ink With Date and Name of Person Making Change.

Notes Ck'd by W. Breting
Map No. C.S. B2600
Office Work Burns
Checked Miller
Date May 1959

Survey of John Rosen Ford Park
W. O. 4495 Tape No. 0135 St'd. 68 °F
Surveyed by A.N. Hellstrom
Notes A. & H. Date Apr. 1958
Indexed C. Johnson

F.B. 2228 Pg. 57

CONT. ON BOTTM Pg. 56

CONT. LEFT SIDE PG. 56

P9.56
147.00

C.S.B. 2600
80°-56'-17"

EXIST. PRK BDY

ANG. PT.
Fd. SPIKE C.E. Co. Mon.
18"dp Pr. F.B. 2228-12

OUT

RESET 1"X2" STK.
12-27-60 BY FD.
TAPE TO PT. FD.
TO NORTH.

30°-51'-25" M.

304.80 M.

To ANG. PT.
2"I.P. = F.C. Tag

PROPOSED NEW BDRY.

(1) 149-08-40
(4) 236-34-30
(L) 174-51-30
149-08-35
30°-51'-25"

OUT
Fd. 2"I.P. With
F.C. Tag - 20"dp
Pr. F.C. 2049-159
RESET 1"X2" BY
TIES - 12-27-60
RCW

Fd. 2" I.P. - F.C. Tag - 20"dp.
Pr. Ties: 28 May 1958
F.B.

N.P. 28.04

21.02

Fd. N&T. In Mac. Pvt. = Levee

S 51°-08'-39" E
151.94

M. 74.10 Prod.

Sq. Hd. Spk & T. In Mac. Pvt. = Levee

178-47-08 1/2
Pr. F.C. 2049-159

#3/6

OUT → By Inters.
Set 2"I.P. With
Co. Eng. Tag - 18"dp
RESET 1"X2" BY TIES
12-27-60 RCW

27.15

Note
This Max
Be The Line Ex-
tended For The
New Park Bdry

Fd. N&T.
In Mac. Pvt. = Levee
Pr. F.B. 2228-12

S.E. Cor. Lot "4"
I. HEYMAN TRCT
Fd. L&T. In Conc. Bo&Hm
FL. CNTRL. CHANNEL
Pr. F.B. 2228-13

See F.C. 2049-159

400.75

192.00

To F.C. Mon

On Prod
Set 1"X2" N&T At Top Of
East Bank Of Channel
W. Edg. Of Levee (For Sight)

RETURN TO
LOS ANGELES COUNTY SURVEYOR
ROOM 752 LOS ANGELES COUNTY
ENGINEERING BLDG.

Notes: Any Additions or Changes on This Sheet Must be Made or Circled in Red Ink With Date and Name of Person Making Change.

Do not extend notes this side of this line.

TAYLOR 247 4-58

Notes Ck'd by Bremner	Survey of John Anson Ford Prk
Map No. C.S. 82600	JN 00549 Tape 0135 Std 68 °F
Office Work Burns	Surveyed by A.N. Hellstrom
Checked Miller	Notes A.N.H Date 4-10-58
Date May 1958	Indexed C. Johnson 4-11-58

F. B. [illegible] C.F.

SEE PG 57

THIS IS EXIST. F.C. R/W LINE INTERS. EXIST PRK BDRY + JOIN WITH Page 57

(1) 178-47-10
(4) 365-09-20
(6) 352-44-00
178-47-20

SEE PG 57

29.57
304.80 M
To 2" I.P. Ang. Pt
F.C. Tag Pr. Pg 57

PROPOSED NEW BDRY

N 88° 51' 25" E
To See F.B.

30° 51' 25"
F.B. 2228-57

EXIST. PARK BDRY

W 1.0

178-47-20

2" I.P. With F.C. Tag -18" dp Pr. F.B. 2228-57

Prod. 72.81 M

Which Line For New Park Bdry?

INTER 2" I.P. - C.S. Eng Tag 18" dp Pr. F.B. 2228-57

Set IXZ N & T. Flush By Inter

W 21.44

(Fd. N & T. In Mac. Pt. (Level) Pr. F.B. 2228-57

S.E. COR Lot 4 E. HEYMAN TR. F.B. 2228-57 In Conc. F.C. Channel

W 56.22 E

29° 38' 40"

(1) 29-38-40
(4) 118-34-50
(6) 177-52-00
29-38-40

Fd. 2" I.P With F.C. Tag 20 dp Pr. F.C. 2049-159

Sight on Bdy F.B. 2228-57

Note: Any Additions or Changes on This Sheet Must be Made or Circled in Red Ink With Date and Name of Person Making Change.

PLEASE RETURN TO
LOS ANGELES COUNTY ENGINEER
700 LOS ANGELES COUNTY ENGINEERING BLDG.

Do not extend this side of this line.

76P3095 SAE #242 1-56

Notes Ck'd by	Survey of John Anson Ford Park
Map No.	JN 0054.95 Tape Std °F
Office Work	Surveyed by A.N. Hellstrom
Checked	Notes A.N.H. Date 4-10-58
Date	Indexed C. Johnson

F. B. 2228 Pg. 61

J.N. *0054.95

JOHN ANSON FORD PARK

LOCATION SHOWING EXIST. BLDGS. ETC. THAT OBSTRUCT BUILDING OF FENCE ON PARK BDRY. — THESE BLDGS & FNCS. ARE INSIDE PARK BDRY. — What To Do?!+?+!

Pages 61-64

A.N. HELLSTROM
F.E. BROOKS
T.J. MELENDEZ
J.W. POTTER

Note: Any Additions or Changes on this Sheet Must be Made or Circled in Red Ink With Date and Name of Person Making Change.

Do not extend this side of this line.

PLEASE RETURN TO
LOS ANGELES COUNTY ENGINEER
700 Los Angeles County Engineering Bldg.

76F3088 S&E #247 1-56

PLEASE RETURN TO
LOS ANGELES COUNTY ENGINEER
700 LOS ANGELES COUNTY ENGINEERING BLDG.

Note: Any Additions or Changes on this Sheet Must be Made or Circled in Red Ink With Date and Name of Person Making Change.

Do not extend this side of this line.

New Fence Location shown in Red
Per plans - (Item Rickey-son) - Set Sept 18-1958
9-10-58

CONT ON BOTTN PG. 63

5+70.2 5+60.5 5+50 5+40.5 3+03.7 1+67.7 0+03.89 0+00 1"x2"-FLUSH

22.00 18.1 19.2 40.2 21.50 22.3 22.4 22.5 22.34

0.50 S 37°-37'-30" W 1057.80

LINE 2 OFFSET 22°

S 79°-59'-15" E 22.22

BDRY ? PARK

30.2' 1-STONE & STUCCO 24.2' 18.1'

SEMI-KNOT For Fnc Ln.

4° Chg. Link Fnc.

16"

6° Chg. Link Fnc.

C.S. MON 10"dp P.B. 22.28

S 79°-59'-15" E

S 22°-58'-55" E 330.66

PARK BDRY

Note: Fencing shown As Exist. At This Position On Architect's Plan — Does Not Exist New Fencing will Have To Be Set

S 90°

C.S. MON - 18"dp Pn. P.B. 22.28

SOUTH AVE

84 SYC W 87 - Pr

F.B. 2228 PG. 29

Notes Ck'd by	Survey of John Anson Ford Pk
Map No.	JN 005495 Tape Std °F
Office Work	Surveyed by A.N. Hellstrom
Checked	Notes A.N.H. Date 4-10-58
Date	Indexed R. C. Johnson

F. B. 2228 PG. 63

CONT. ON BOTTOM PG. 64

Note: Any Additions or Changes on This Sheet Must be Made or Circled in Red Ink With Date and Name of Person Making Change.

Do not extend this side of this line.

PLEASE RETURN TO
LOS ANGELES COUNTY ENGINEER
700 LOS ANGELES COUNTY ENGINEERING BLDG.

76F3095 SAE #247 1-56

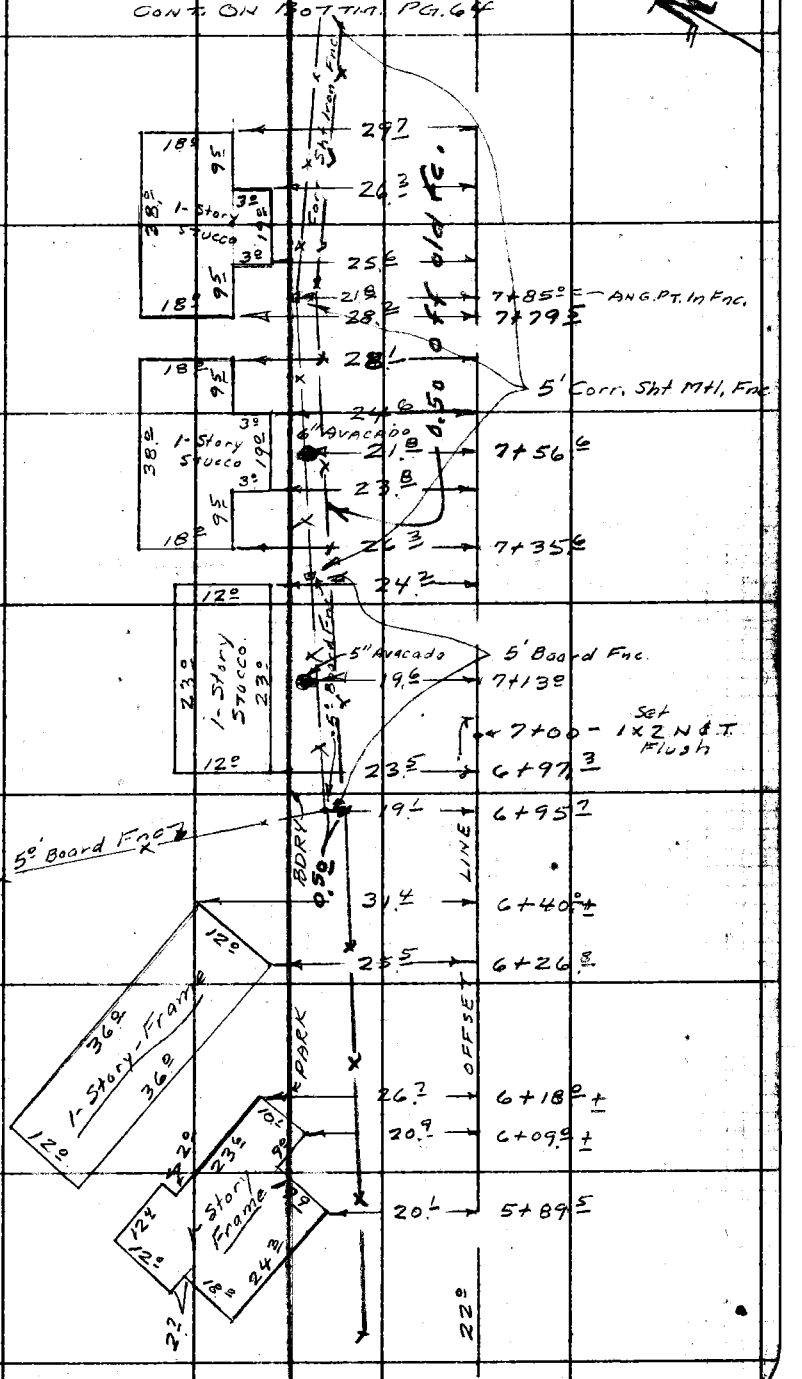

CONT. FROM TOP PG. 62

PLEASE RETURN TO
LOS ANGELES COUNTY ENGINEER
700 LOS ANGELES COUNTY ENGINEERING BLDG.

Note: Any Additions or Changes on This Sheet Must be Made or Circled in Red Ink With Date and Name of Person Making Change.

Do not extend this side of this line.

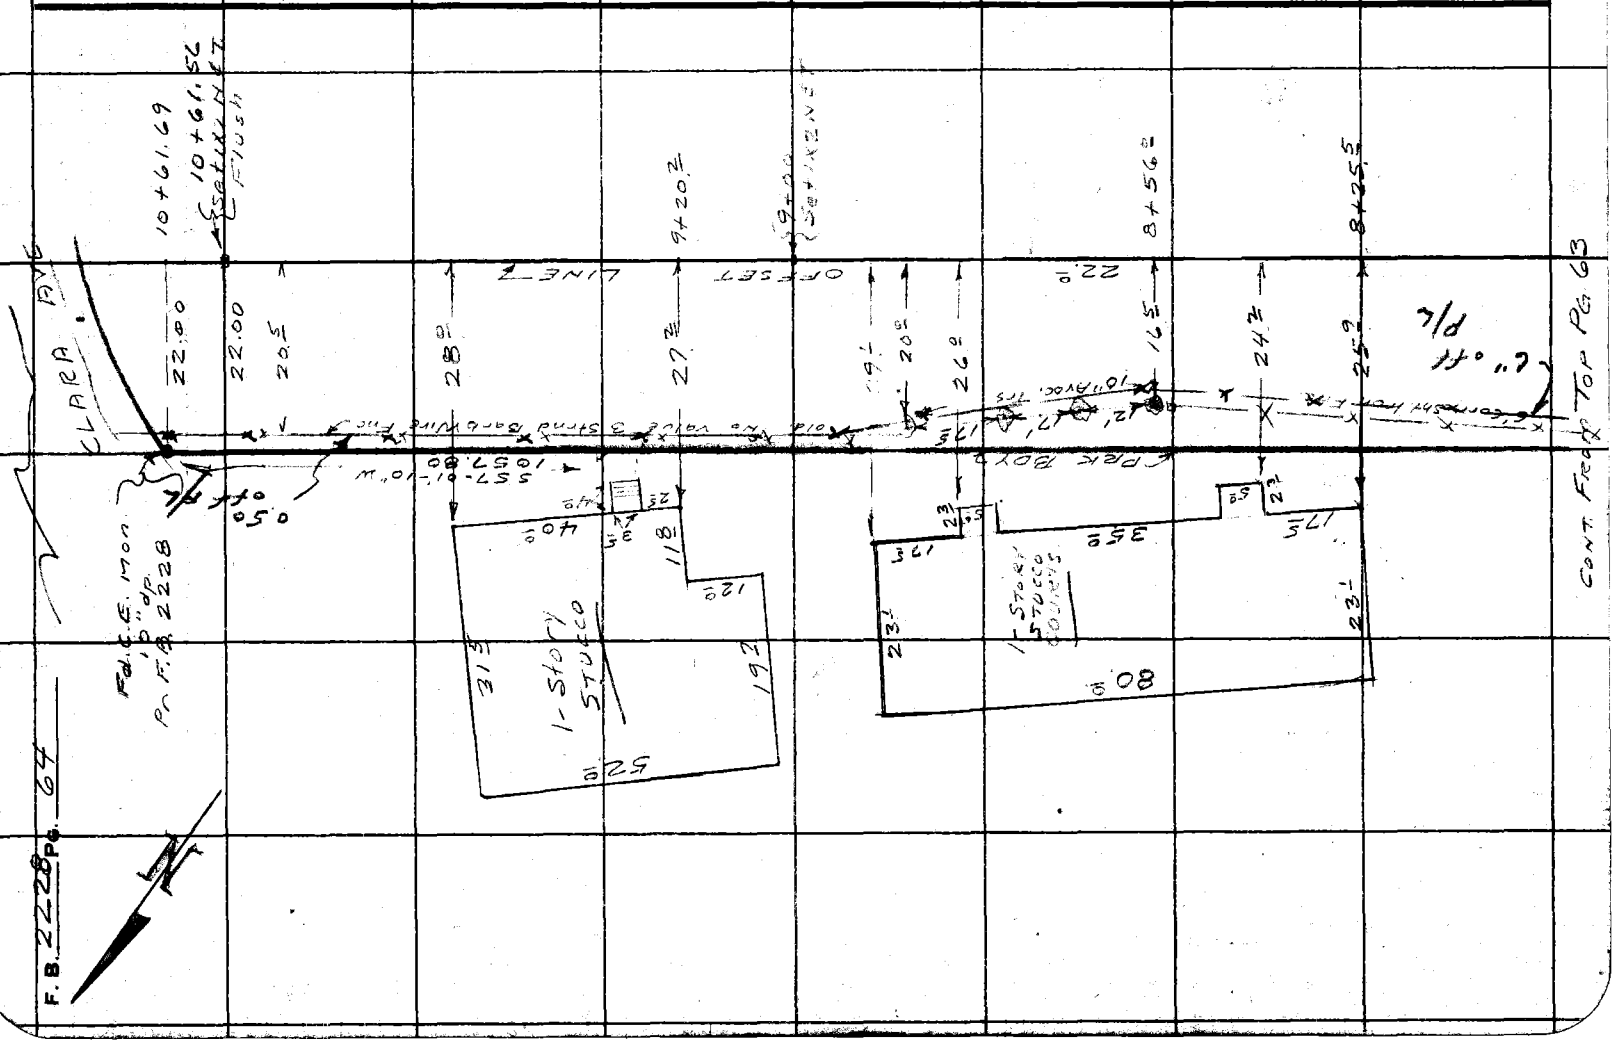

Notes Ck'd by	Survey of John Anson Fd. Park
Map No.	JN 8855.02 Tape Std °F
Office Work	Surveyed by A.S. Curtis
Checked	Notes Curtis Date Apr 58
Date	Indexed ~~C. Johnson~~ 4-30-58

F. B. 2228 Pg. 65

J.N. 8855.02
John Anson Ford Park.
Location of
12" Conc. Irrig Line
for
possible Removal.

Curtis
Mankay Jr.
Rodriguez

Note: Any Additions or Changes on this Sheet Must be Made or Circled in Red Ink With Date and Name of Person Making Change.

Do not extend notes this side of this line.

RETURN TO
LOS ANGELES COUNTY ENGINEER
700 LOS ANGELES COUNTY ENGINEERING BLDG.

78P3095 CE #247—3-57

RETURN TO
LOS ANGELES COUNTY ENGINEER
700 LOS ANGELES COUNTY ENGINEERING BLDG.

Note: Any Additions or Changes on This Sheet Must be Made or Circled in Red Ink With Date and Name of Person Making Change.

Do not extend notes this side of this line.

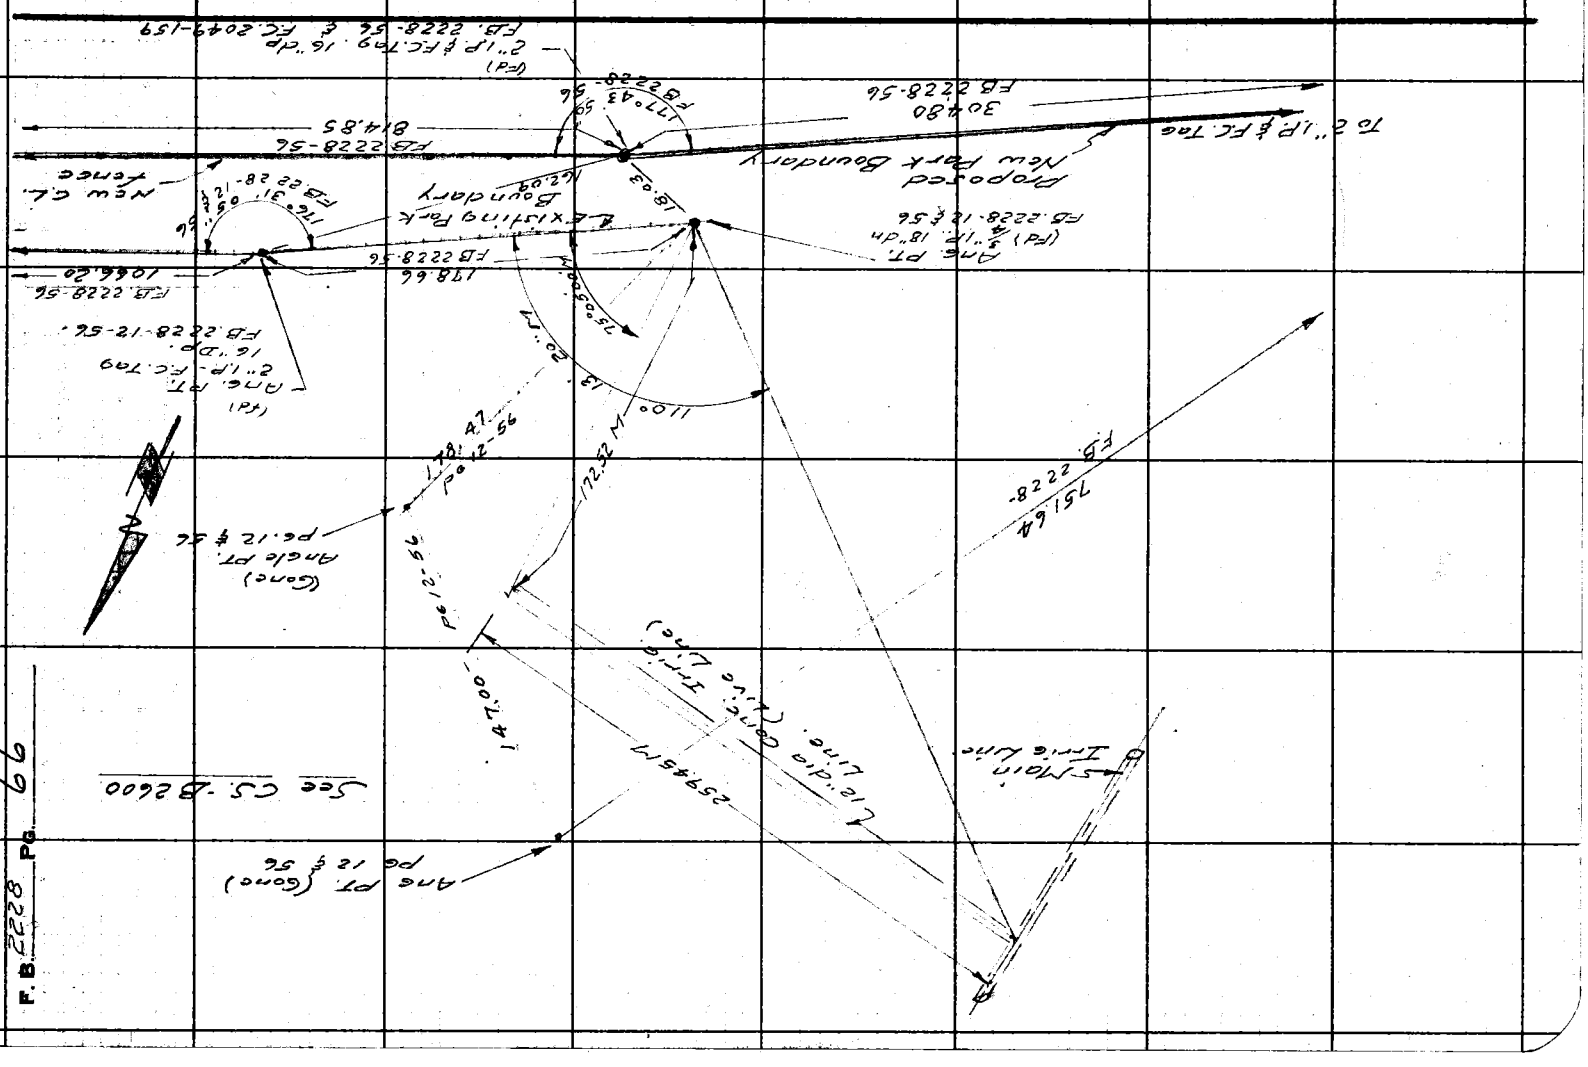

8855.02

F. B. 2228 Pg. 69

Profile No. | Notes Red. | Plotted | Job No. | Division No. 10

Date | Date | Survey of John Anson Ford Park

X-Sec. No. | Notes Chkd. | Checked | Survey by Curtis Notes Curtis Date Mar. 1958

Date | Date | Map No. | Indexed C. Johnson 1-16-59

NOTE: ANY ADDITIONS OR CHANGES ON THIS SHEET MUST BE MADE OR CIRCLED IN RED INK, WITH DATE AND NAME OF PERSON MAKING CHANGE.

PLEASE RETURN TO
LOS ANGELES COUNTY ENGINEER
700 Los Angeles County Engineering Bldg.

Do not extend notes this side of this line.

STATION	B. S.	H. I.	F. S.	ELEV.	
					J.N. 8855.02 John Anson Ford Park. Bench Levels
					Curtis Mankey Jr. Rodriguez Latteri

751-296 S & E #207—1-56

76L-298 S & E #307—1-56

PLEASE RETURN TO
LOS ANGELES COUNTY ENGINEER
700 LOS ANGELES COUNTY ENGINEERING BLDG.

NOTE: ANY ADDITIONS OR CHANGES ON THIS SHEET MUST BE MADE OR CIRCLED IN RED INK, WITH DATE AND NAME OF PERSON MAKING CHANGE.

Do not extend notes this side of this line.

F. B. 2228 Pg. 20 Job No 88550-2 Division No 10 Notes Red Plotted Profile
Survey by Curtis Notes Curtis Notes Chkd Checked No.
Indexed A. C. Johansen Date Date Date

STATION	B. S.	H. I.	F. S.	ELEV.		
B.M. #6 (Fd)				118.802	El. 118.802 F.B. 2228-38-22 - (Park Cor) B.M. "C" 467± N. & Int Scout Ave & Ramish Ave. 30' E. old & Scout Ave. - C.E. Brass Cap Mon. down 18" - (use E edge Cap.)	
T.P. (Fd)				118.960	T.P. "O" hd. Spk. in So. Gut. Scout Ave	
T.B.M.				118.354	TBM. S.E. Int's Scout Ave & Ramish Ave (Large Bt. spk - W & T.	
T.P. (Set)				117.20	T.P. Set Large Bt spk & W. in W. side	
T.B.M.				120.00	T.B.M. 20" Gum Tree.	
T.P. (Set)				117.16	T.P. 1"x2" Scout Ave (So. curb) ±5' W & pinned	
B.M.				117.20	B.M. Gotham Ave. Bt spk in Curb.	
T.P.				116.31	T.P. spk, @ Cutter & E. edge Conc. Drive	
T.P.				115.94	T.P. Bt. Spk @ So. side Rd - along Gut. Large Bt. spk in Exp.	
T.P. (Fd)				116.16	T.P. Scout Ave (So. side) Joint (Top Curb)	
TBM				115.66	TBM. Large Bt spk. W & T @ S.E. Int's Scout Ave & Gillland Ave.	
BM #10 (Fd)				116.34	BM #10 El. 116.359 F.B. 2228-40 Scout Ave Northly side ± 195' W. of Gillland Ave Edison Co. Mon. 8" high	

Notes Ck'd by	Survey of John Anson Ford Park
Map No.	JN 8855.02 Tape Std °F.
Office Work	Surveyed by A.S. Curtis
Checked	Notes Curtis Date Apr. 58
Date	Indexed ~~E. Johnson~~ 7-8-59

F. B. 2228 Pg. 71

Note: Any Additions or Changes on this Sheet Must be Made or Checked in Red Ink With Date and Name of Person Making Change.

Do not extend notes this side of this line.

RETURN TO
LOS ANGELES COUNTY ENGINEER
7700 LOS ANGELES COUNTY ENGINEERING BLDG.

7ERSPOS CK #247—9-57

J.N. 8855.02
John Anson Ford Park.
Grades for and
Location of
West Parking Lot.
Also. Buildings
& Ball Diamonds

Curtis
Markey Jr.
Rodriguez
Latteri

(See pages 79 thru 83 for Grades)
(See page 192 for Curb Grades on Planter Boxes)

F. B2228 Pg. 72

RETURN TO
LOS ANGELES COUNTY ENGINEER
700 LOS ANGELES COUNTY ENGINEERING BLDG.

Note: Any Additions or Changes on This Sheet Must be Made or Circled in Red Ink With Date and Name of Person Making Charge.

Do not extend notes this side of this line.

Existing Conc. Drive

To Gotham Ave

Scout Ave.

716.39 Inv. 714.65

E Park Boundary

178.32

Conc. Curb & Gutter top width = 0.42

Parking Lot

682.32

Conc. Walk

Conc. Walk

Tree planters

Conc. Walk

Bollard

Bollard

Conc. Walk

Conc. Walk

Conc. Walk

76F3095 CE #247—3-57

RETURN TO
LOS ANGELES COUNTY ENGINEER
700 LOS ANGELES COUNTY ENGINEERING BLDG.

Note: Any Additions or Changes on This Sheet Must be Made or Circled in Red Ink With Date and Name of Person Making Change.

Do not extend notes this side of this line.

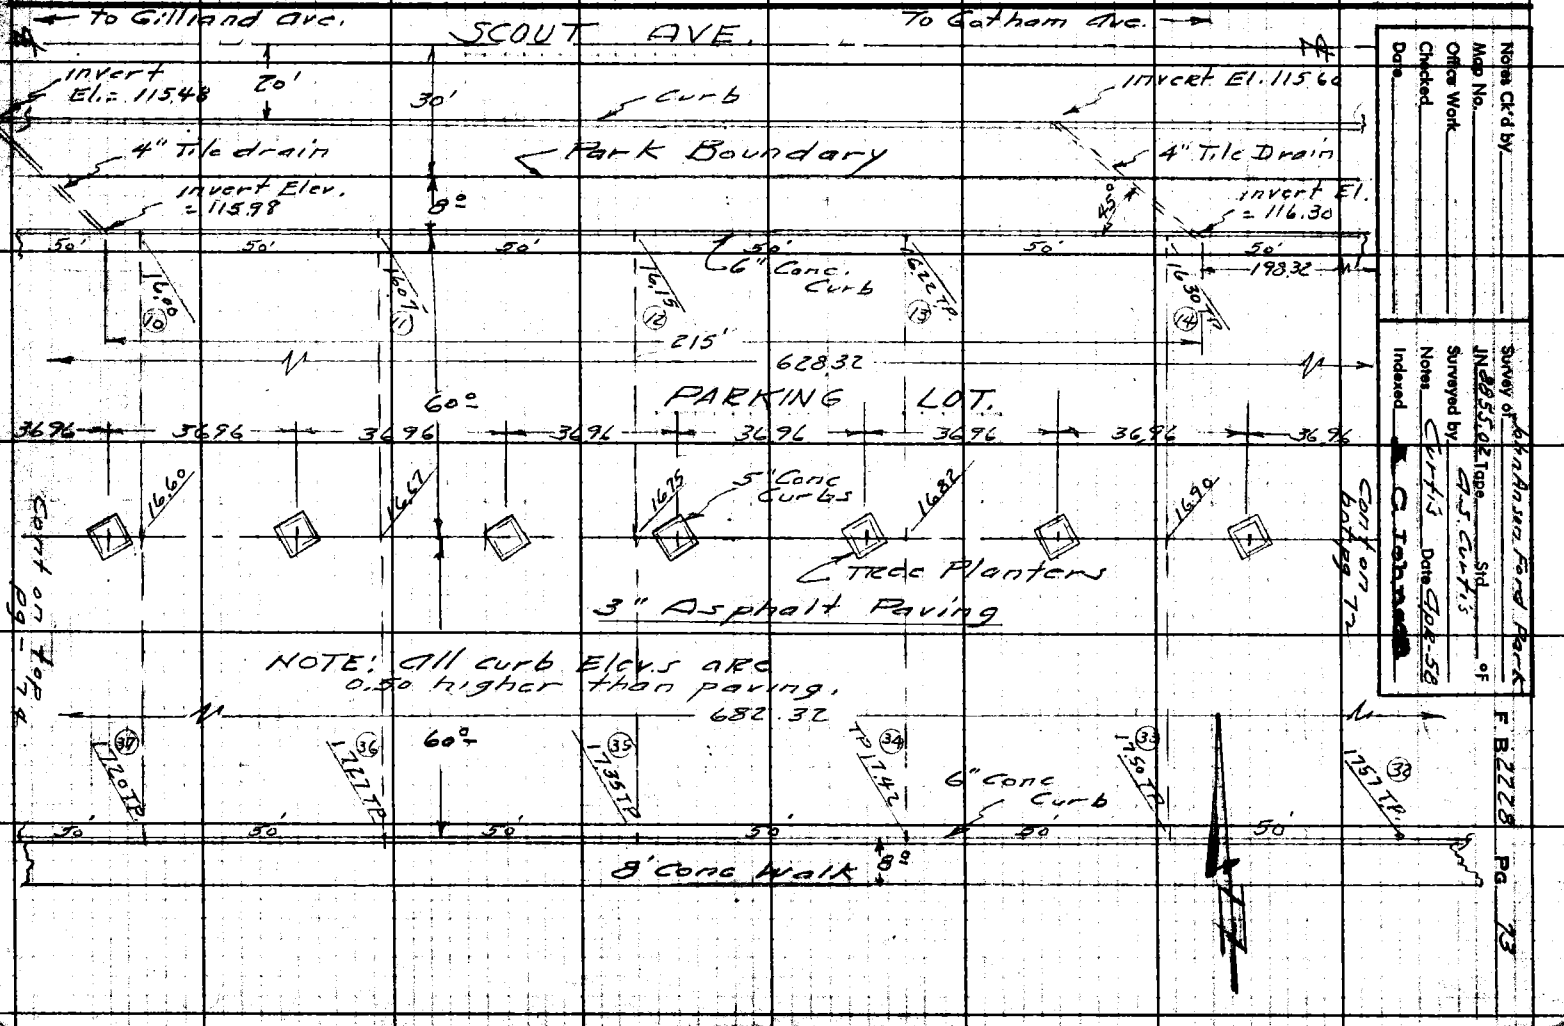

Notes
Indexed
Notes Ck'd by
Map No.
Office Work
Checked
Date

F. B. 2228 PG. 73

F. B. 2228 Pg. 74

Cont. from bot. pg. 73

RETURN TO
LOS ANGELES COUNTY ENGINEER
900 Los Angeles County Engineering Bldg.
Do not extend notes this side of this line.

Note: Any Additions or Changes on This Sheet Must be Made or Circled in Red Ink With Date and Name of Person Making Change.

SCOUT AVE.

PARKING LOT

3" Asphalt Paving

6" Conc. Curb

6" Conc. Walk

Park Boundary

2" Conc. Curb

Tree planters

NOTE- All curbs & gutters to be 6" Conc. paving

Cont. on bk. pg. 75

Notes Ck'd by
Map No.
Office Work
Checked
Date

Survey of John Anson Ford Park
JN 8855.02 Tape Std °F
Surveyed by G.S. Curtis
Notes Curtis Date Apr-58
Indexed C. Johnson

F.B. 2228 Pg. 75

Notes: Any Additions or Changes on This Sheet Must Be Made or Circled in Red Ink With Date and Name of Person Making Change.

Do not extend notes this side of this line.

RETURN TO
LOS ANGELES COUNTY ENGINEER
900 LOS ANGELES COUNTY ENGINEERING BLDG.

76F3095 CE #247—3-57

(Fd) 2" I.P. & Brass cap per page 17.
Edison Co. Mon.

(Fd) 3/4" I.P. dn 3'
(No Tag)

SCOUT AVE.

℄ P/L

Inv. Elev. 114.82

4" T.I.c drain

Inv. Elev. 115.36

Existing Conc. Drive

SIGN

60° T.P.

NOTE- All curb are 0.50 above finish paving grade

6" Conc Curbs

Park Boundary

Parallel to Park Boundary

Curb, Face to Face

6" Curbs (Typ.)

Tree planter curb 5' wide

PARKING LOT.

Asphalt Paving

Cont. from Pg. 74

8° Conc. Walk

Future Parking Lot.

Future 8' Conc. Walk

New Service Bldg Fin Floor El. = 118.00

New Service Yard

Cont on Pt. pg - 76

136.08

87° 56' 30"

100.29

628.32

682.32

41.58

28.32

32.32

215'

30'

45'

20°

60°

R=10'

R=5'

1566 T.P.

1568 T.P.

1564 T.P.

1579 T.P.

1587 T.P.

1586 T.P.

1596 T.P.

1605 T.P.

1602 T.P.

1604 T.P.

1609 T.P.

1620 T.P.

1654 T.P.

1665 T.P.

1550 T.P.

1536 T.P.

1547 T.P.

RETURN TO
LOS ANGELES COUNTY ENGINEER
700 LOS ANGELES COUNTY ENGINEERING BLDG.

Note: Any Additions or Changes on This Sheet Must be Made or Circled In Red Ink With Date and Name of Person Making Change.

Do not extend notes this side of this line.

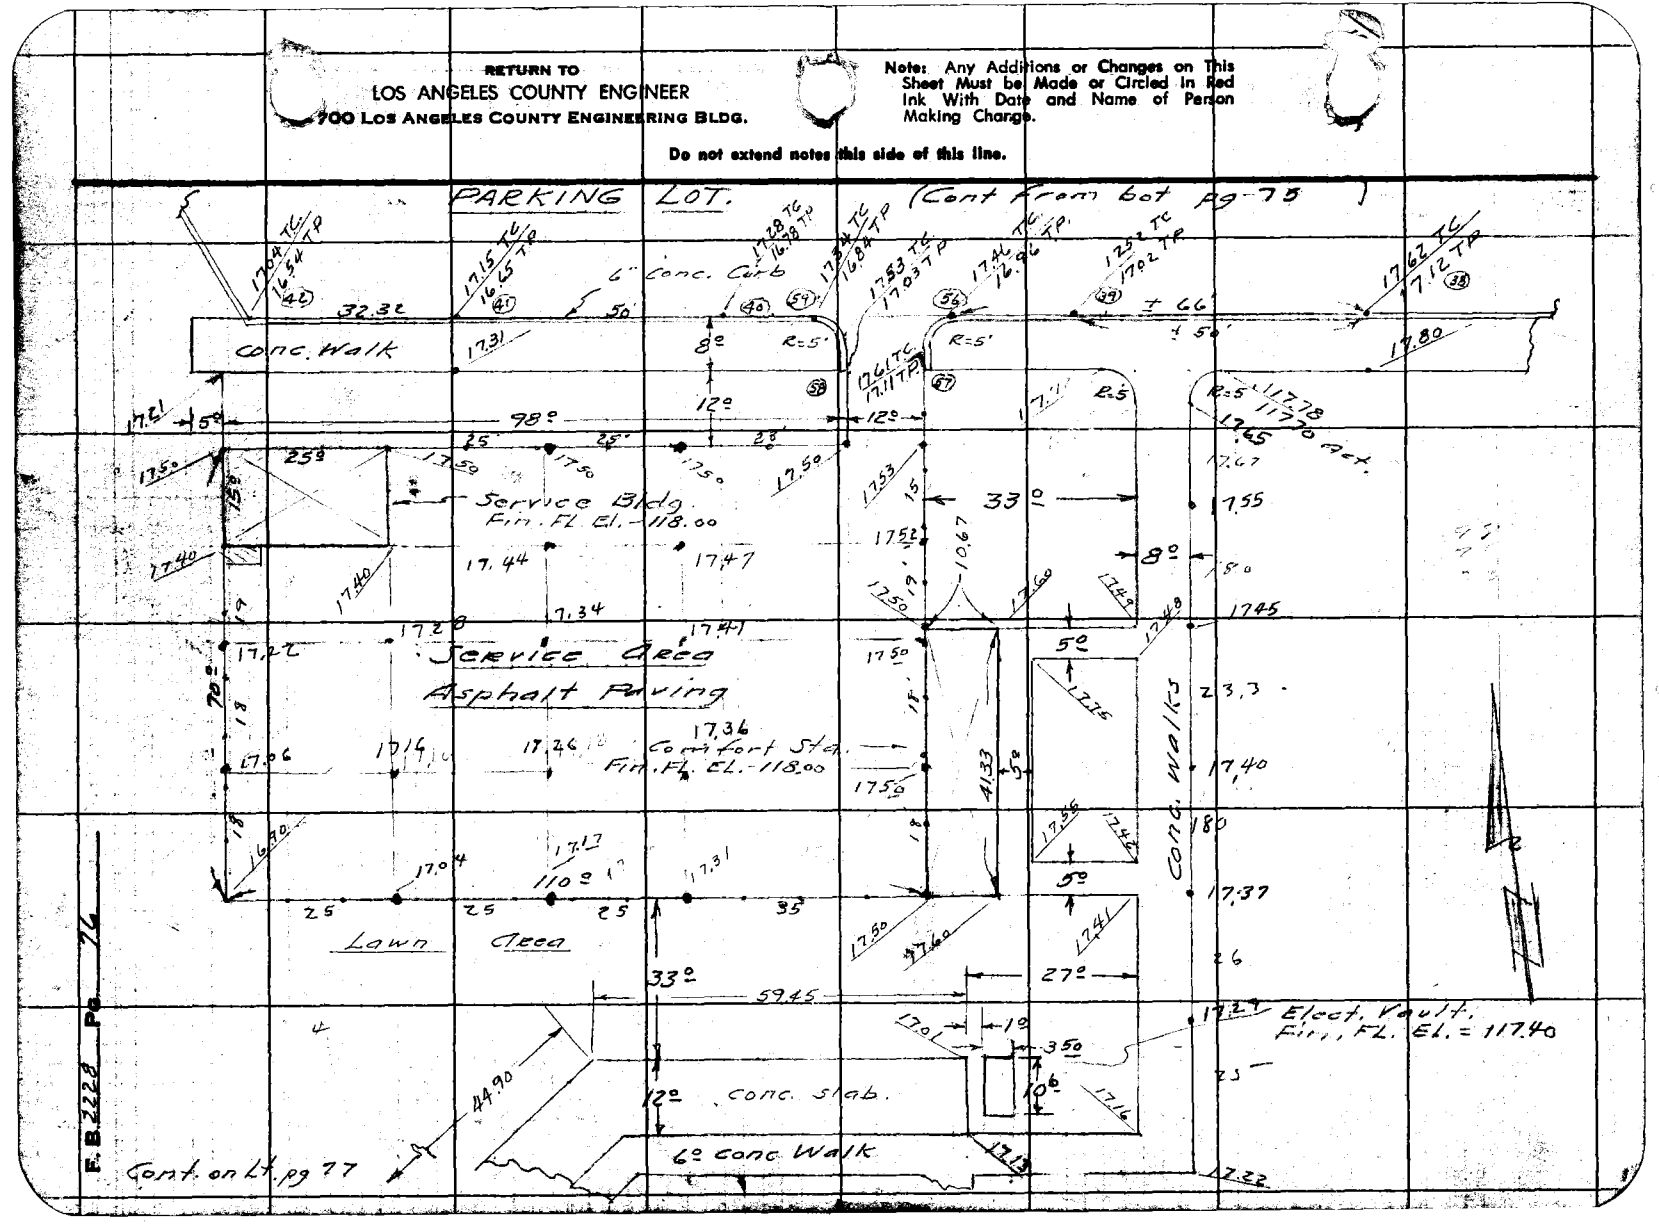

76F3098 CE #247—3-57

RETURN TO
LOS ANGELES COUNTY ENGINEER
700 LOS ANGELES COUNTY ENGINEERING BLDG.

Note: Any Additions or Changes on This Sheet Must be Made or Circled in Red Ink With Date and Name of Person Making Change.

Do not extend notes this side of this line.

3345
451
3795

Cont. from Lt pg-76

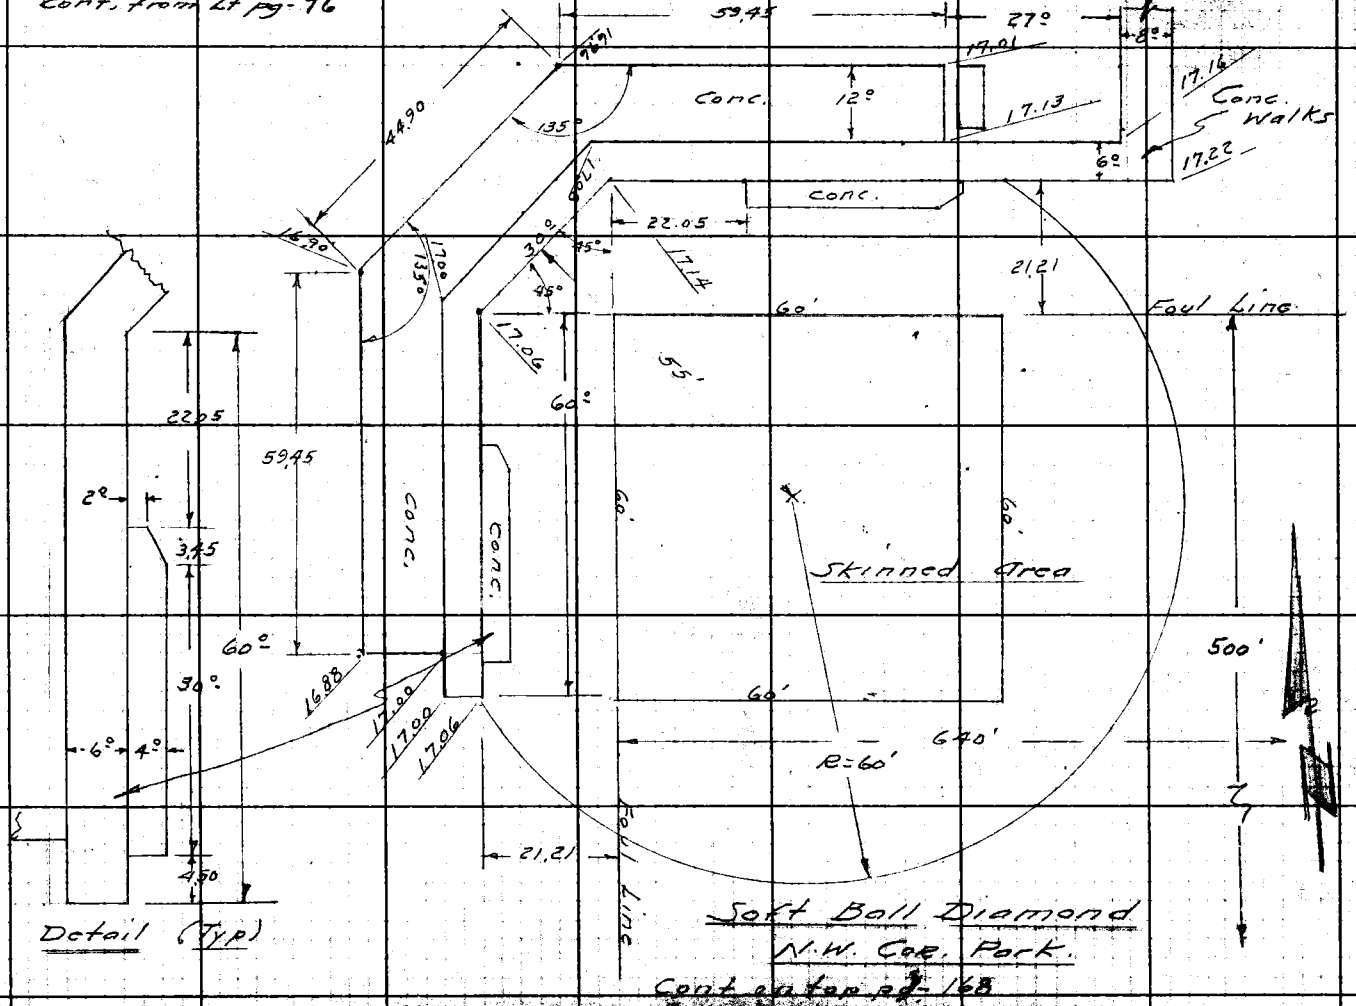

Taken Ck'd by
Map No.
Office Work
Checked
Date

Survey of John Anson Ford Park
JN 8855.62 Tape Std OF
Surveyed by C.S. Curtis
Notes Date Oct-59
Indexed C. Johnson


RETURN TO
LOS ANGELES COUNTY ENGINEER
700 LOS ANGELES COUNTY ENGINEERING BLDG.

Note: Any Additions or Changes on This Sheet Must be Made or Circled in Red Ink With Date and Name of Person Making Change.

Do not extend notes this side of this line.

SE. SOFT BALL DIAMOND.

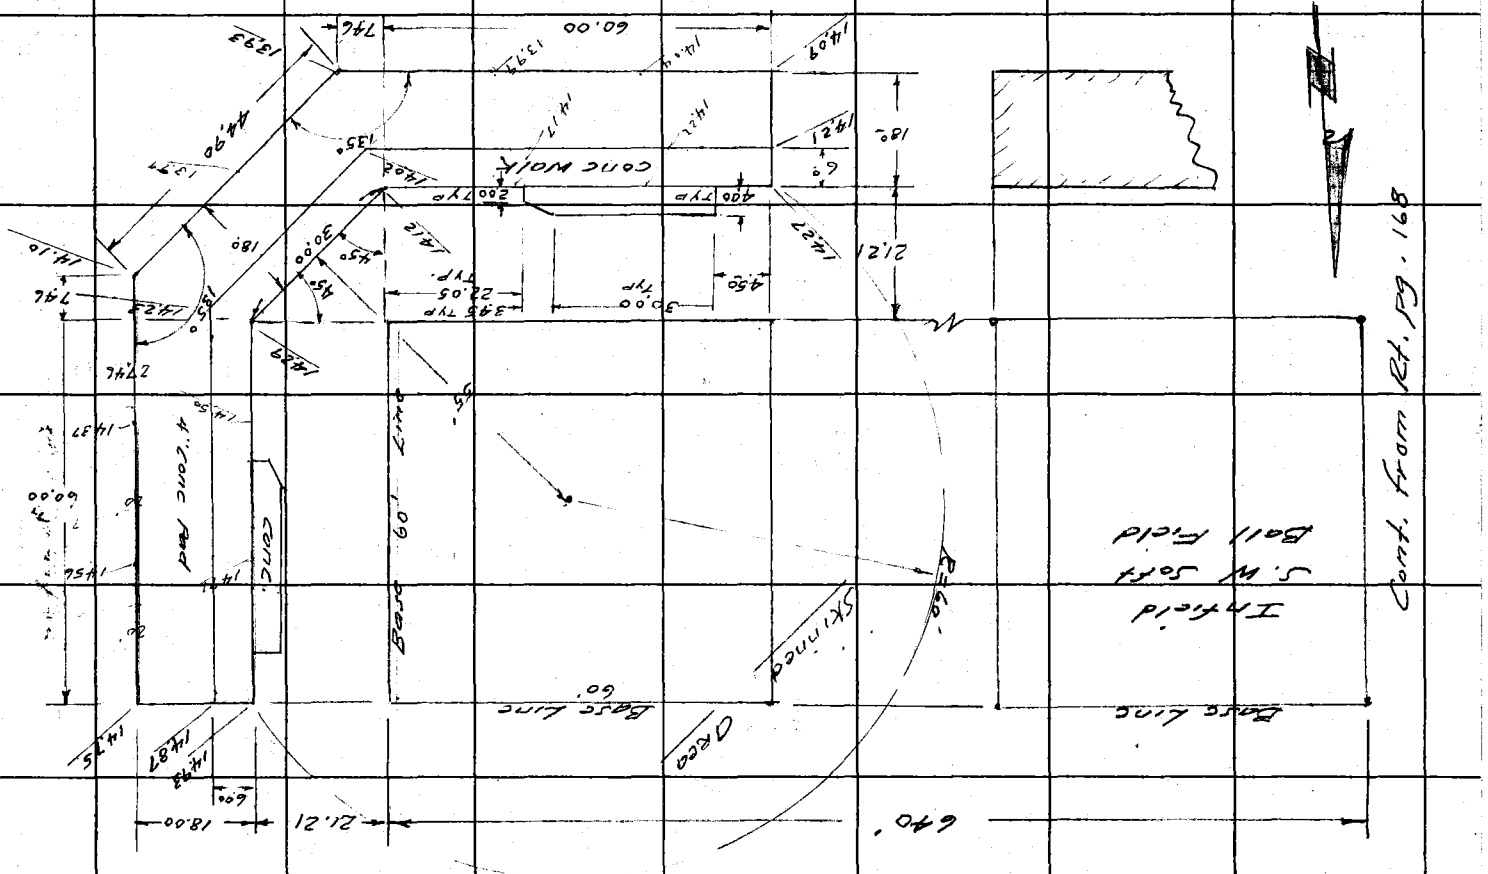

F.B. 2228 Pg. 78

76F3095 CE #247—3-57

RETURN TO
LOS ANGELES COUNTY ENGINEER
700 LOS ANGELES COUNTY ENGINEERING BLDG.

Note: Any Additions or Changes on This Sheet Must be Made or Circled in Red Ink With Date and Name of Person Making Change.

Do not extend notes this side of this line.

WEST PARKING LOT.

Cont from Rt. Pg - 72

160'
38.97
38.97
8' conc. walk
118.30
Conc. wk.
Conc. wk.
138'
70'
17.92
17.92
Hard Ball Diamond
NOTE- All Dim's shown are per our office and don't agree with plans.
127°01'20"
77.94'
18.0
60.90
Conc Slab
17.75
17.75
8.97
8.97
29.62
120°21'44"
120°21'44"
29.80
30.00
50°
17.52
5°
3.52
Conc. Slab
90.00
112.0
17.45
17.48
17.41
4.00
10.00
47.20
17.81
17.14
Cont on Rt. pg. 80

Notes Ck'd by
Map No.
Office Work
Checked
Date

Surveyed by: C.J. Curtis
Notes
Indexed
Date Checked


RETURN TO
LOS ANGELES COUNTY ENGINEER
700 LOS ANGELES COUNTY ENGINEERING BLDG.

Note: Any Additions or Changes on This Sheet Must be Made or Circled in Red Ink With Date and Name of Person Making Change.

Do not extend notes this side of this line.

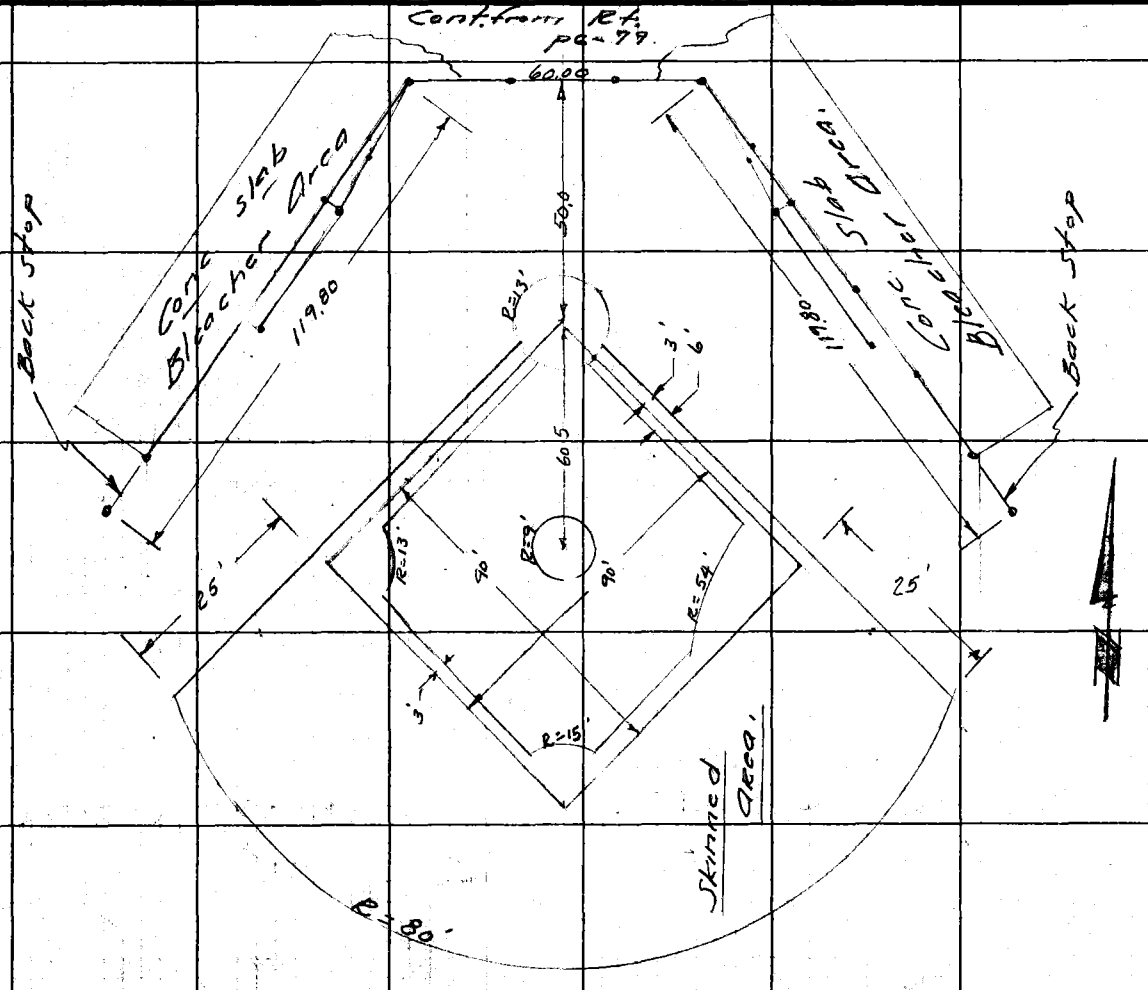

F.B. 2229 Pg. 80

F. B. 2228 Pg. 83

Profile No. | Notes Red. | Plotted | Job No. 8855.02 Division No.
Date | Date | Survey of John Anson Ford Park
X-Sec. No. | Notes Chkd. | Checked | Survey by Curtis Notes ETM Date 4/58
Date | Date | Map No. Indexed [redacted] Johnson

JN 8855.02

JOHN ANSON FORD PARK

WEST PARKING

LOT

GRADES

(See Pgs 71-76 for location)

Curtis
Mankey
Rodriguez
Latteri

STATION	B. S.	H. I.	F. S.	ELEV.

PLEASE RETURN TO
LOS ANGELES COUNTY ENGINEER
700 Los Angeles County Engineering Bldg.

NOTE: ANY ADDITIONS OR CHANGES ON THIS SHEET MUST BE MADE OR CIRCLED IN RED INK, WITH DATE AND NAME OF PERSON MAKING CHANGE.

Do not extend notes this side of this line.

76298 S & E #307—7-55

76298 S & E #307—7-55

PLEASE RETURN TO
LOS ANGELES COUNTY ENGINEER
700 LOS ANGELES COUNTY ENGINEERING BLDG.

NOTE: ANY ADDITIONS OR CHANGES ON THIS SHEET MUST BE MADE OR CIRCLED IN RED INK, WITH DATE AND NAME OF PERSON MAKING CHANGE.

Do not extend notes this side of this line.

F. B. 2228 Pg. 84 | Job No 88552 | Division No. | Notes Red. | Plotted | No. | Profile
Survey by Curtis Notes Mowrey & K.C. | Notes Chkd. | Checked | No.
Indexed J. C. Johnson Date | Date | Date

STATION	B. S.	H. I.	F. S.	ELEV.	GRADE	Cut or Fill	
TBM				115.66'	TBM 115.66 FB2228 65 large B/Spk on E Intr of Scout Ave & Gilliland Ave		
①				116.05'	116.05'	0.0	
②	BC 10' Rad			16.16	16.16'	0.0	
③	EC 10' Rad			16.14	16.14'	0.0	
④	EC 5' Rad			16.00	16.00'	0.0	
⑤	℄ PT			15.86	115.86	0.0	
⑥				15.95	15.95'	0.0	
⑦				16.14	16.14'	0.0	
⑧				16.32	16.32'	0.0	
⑨				16.42	16.42'	0.0	
⑩				16.50	16.50'	0.0	
⑪				16.57	16.57'	0.0	
⑫				16.65	16.65'	0.0	
⑬				16.72	16.72'	0.0	
⑭				16.80	116.80'	0.0	
⑮				16.87	16.87'	0.0	
⑯				16.95	16.95'	0.0	
⑰				17.02	17.02'	0.0	
⑱	℄ PT			17.10	17.10'	0.0	

76298 S & E #307—7-55

PLEASE RETURN TO
LOS ANGELES COUNTY ENGINEER
700 LOS ANGELES COUNTY ENGINEERING BLDG.

NOTE: ANY ADDITIONS OR CHANGES ON THIS SHEET MUST BE MADE OR CIRCLED IN RED INK, WITH DATE AND NAME OF PERSON MAKING CHANGE.

Do not extend notes this side of this line.

Profile Notes Red. Plotted Job No. 22532 Division No. F. B. 2228 Pg. 85
X-Sec. Notes Chkd. Checked Survey by Curtis Noted Date April '58
No. Date Date Map No. Indexed C. Johnson
Date

STATION	B. S.	H. I.	F. S.	ELEV.	GRADE	Cut or Fill
(19)	BC 5' Rad				117.25'	
(20)	EC 5' "			17.32	17.32'	0.0
(21)	BC 10' Rad			17.33	17.33'	0.0
(22)	EC " "			17.60	17.60'	0.0
(23)	End Curb & Exist. Driveway				17.48'	
(24)	" "	"	"		117.50'	
(25)				17.76	17.76'	0.0
(26)				17.96	17.96'	0.0
(27)				18.16	18.16'	0.0
(28)	S.E. Cor Parking Lot			18.37	18.37'	0.0
(29)				18.30	18.30'	0.0
(30)				118.22	118.22'	0.0
(31)				18.15	18.15'	0.0
(32)	(T.P.)			18.07	18.07'	0.0
(33)				18.00	18.00'	0.0
(34)				17.92	17.92'	0.0
(35)				17.85	17.85'	0.0
(36)				17.77	17.77'	0.0
(37)				17.70	17.70'	0.0
(38)				17.62	17.62'	0.0
(39)				1752	117.52'	0.0

76298 S & E #307—7-55

PLEASE RETURN TO
LOS ANGELES COUNTY ENGINEER
700 LOS ANGELES COUNTY ENGINEERING BLDG.

NOTE: ANY ADDITIONS OR CHANGES ON THIS SHEET MUST BE MADE OR CIRCLED IN RED INK, WITH DATE AND NAME OF PERSON MAKING CHANGE.

Do not extend notes this side of this line.

F. B. 2228 Pg. 86 | Job No. 8855.02 Division No. | Notes Red. | Plotted | Profile
Survey by K. C. Johnson Notes Markey S/C | Date | X-Sec.
Indexed | Notes | Chkd. | Checked
Date | Date | Date | No.

STATION	B. S.	H. I.	F. S.	ELEV.	GRADE	Cut or Fill	
(40)	T.P.			117.28	117.28	0.0	
(41)				117.15	17.15	0.0	
(42)	℄ PT			117.04	17.04	0.0	
(43)	EC 5' RAD			116.78	16.78'	0.0	
(44)	S.W. Cor Parking Lot			16.65	16.65'	0.0	
(45)				16.64	16.64'	0.0	
(46)				16.64	16.36'	0.0	
(47)				16.18	16.18'	0.0	
(48)	End Curb of Exist Driveway			15.98	15.98'	0.0	
(49)	East Pt. of Island on ℄ Park Lot			16.46	16.46'	0.0	
(50)	BC 5' Rad (Island)			16.37	1637	0.0	
(51)	BC 10' Rad			16.29	116.29'	0.0	
(52)	EC 10' Rad			16.40	16.40	0.0	
(53)	BC "			16.52	16.52'	0.0	
(54)	EC "			16.59	16.59'	0.0	
(55)	EC 5' Rad			1652	16.52	0.0	
TBM.				115.65	T.B.M. 115.66		F.B. 2228-65

76298 S & E #307—7-55

PLEASE RETURN TO
LOS ANGELES COUNTY ENGINEER
700 LOS ANGELES COUNTY ENGINEERING BLDG.

NOTE: ANY ADDITIONS OR CHANGES ON THIS SHEET MUST BE MADE OR CIRCLED IN RED INK, WITH DATE AND NAME OF PERSON MAKING CHANGE.

Do not extend notes this side of this line.

Profile Notes Red. Plotted Job No. 8855.02 Division No. 10 F. B. 2228 Pg. 87
No. Date Notes Chkd. Checked Survey by Curtis Notes Date Dec.-58
Date Map No. Index T. C. Johnson Date

STATION	B. S.	H. I.	F. S.	ELEV.			
			West Parking Lot (Cont)				(Curb Grades)
T.B.M.				115.66	T.B.M. FB. 2228-65		
					Grade	Cut or Fill	
(56)	BC 5° Rad.	Service Area Drive		117.46	117.46	0.0	1"x2" N&T 5° off.
(57)	End Curb	"	"	117.61	117.61	0.0	"
(58)	End Curb	"	"	117.53	117.53	0.0	"
(59)	BC 5° Rad	"	"	117.34	117.34	0.0	"

See Pg 76

Notes Ck'd by	Survey of John Anson Ford Park
Map No.	JN 8855.02 Tape Std °F
Office Work	Surveyed by C.S. Curtis
Checked	Notes Curtis Date Mar. 38
Date	Indexed C. Johnson

F. B. 2228 Pg. 89

Note: Any Additions or Changes on This Sheet Must be Made or Circled in Red Ink With Date and Name of Person Making Change.

Do not extend notes this side of this line.

RETURN TO
LOS ANGELES COUNTY ENGINEER
700 Los Angeles County Engineering Bldg.

J.N. 8855.02

John Anson Ford Park,

Grades for and Location of Improvements & Etc.

East Parking Lot & etc.

Curtis
Monkay Jr
Rodriguez
Latteri

(See pages 95 thru 98 for Grades)

(See page 100 for Location of Red Wood fence & Mowing Strip in play area.)

(See page (11.8 / 10.8) for "key" to Coordinate System.
(N.E. Cor. Park = N 1000 E 2000)

76F3083 CE #247—3-57

F.B. 2228 Pg. 90

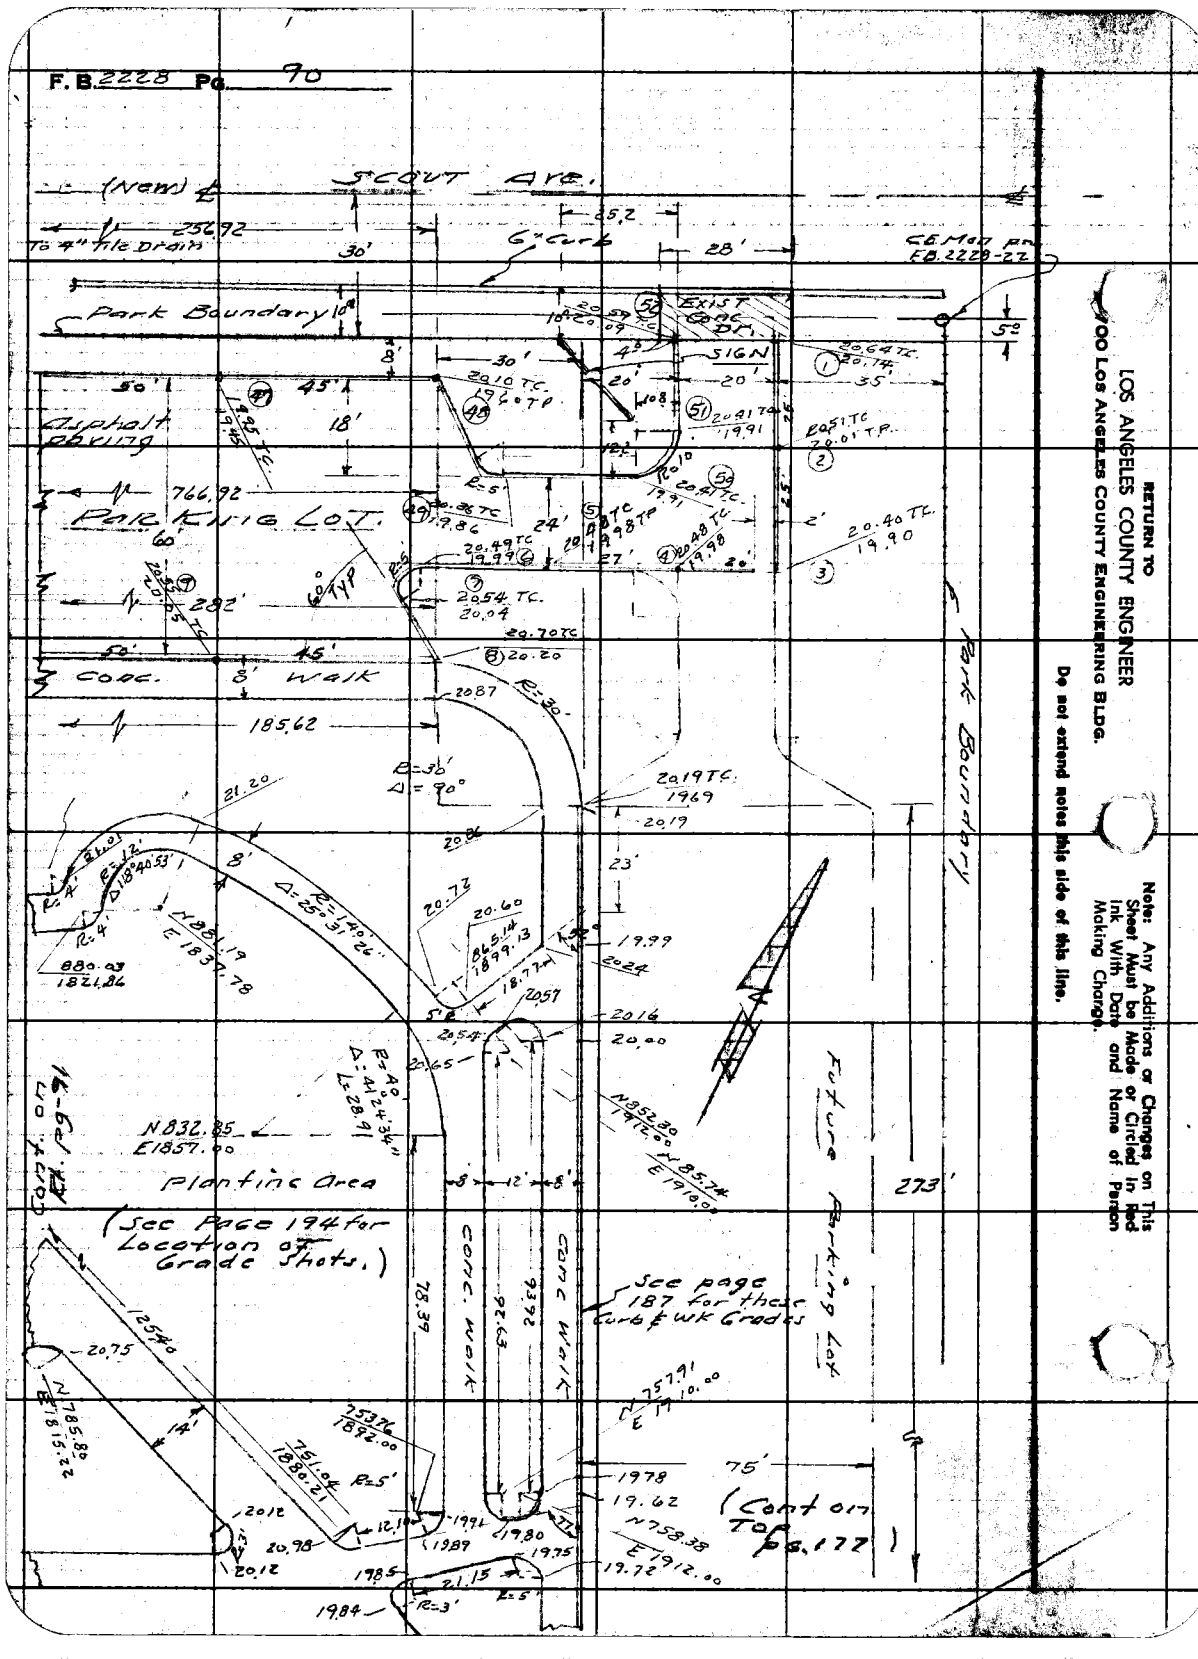
(New) ℄ Scout Ave.
256.92
To 4" f/s Drain
30'
6" Curb
35.2
28'
CE Map per F.B. 2228-22
Park Boundary
10'
EXIST CONC DR.
SIGN
50'
45'
Asphalt paving
18'
766.92
PARKING LOT
60'
282'
5% Typ
Conc.
8' walk
5'
185.62
R=30'
Δ=90°
Park Boundary
Future Parking Lot
273'
Planting Area
N832.85
E1857.00
N952.30
E1910.00
N785.74
E1910.0
Conc. Walk
78.39
92.63
92.92
See page 187 for finer curb & wk Grades
See Page 194 for Location of Grade Shots.)
125.40
N 18° 15' 22" E
785.80
753.74
1892.00
751.04
1880.21
R=5'
14'
12.10
20.12
20.98
19.84
R=3'
21.13
19.72
E 1912.00
N758.38
(Cont'd on Pg. 177)
RETURN TO
LOS ANGELES COUNTY ENGINEER
900 Los Angeles County Engineering Bldg.
Do not extend notes this side of this line.
Note: Any Additions or Changes on This Sheet Must be Made or Circled in Red Ink With Date and Name of Person Making Change.

Notes Ck'd by	Survey of John Anson Ford Park
Map No.	JN 8853.02 Tape Std °F
Office Work	Surveyed by A.S. Curtis
Checked	Notes Curtis Date Apr. 58
Date	Indexed C. Johnson

F. B. 2228 PG. 91

Note: Any Additions or Changes on This Sheet Must be Made or Circled in Red Ink With Date and Name of Person Making Change.

Do not extend notes this side of this line.

RETURN TO LOS ANGELES COUNTY ENGINEER 700 Los Angeles County Engineering Bldg.

76F3083 CE #247—3-57

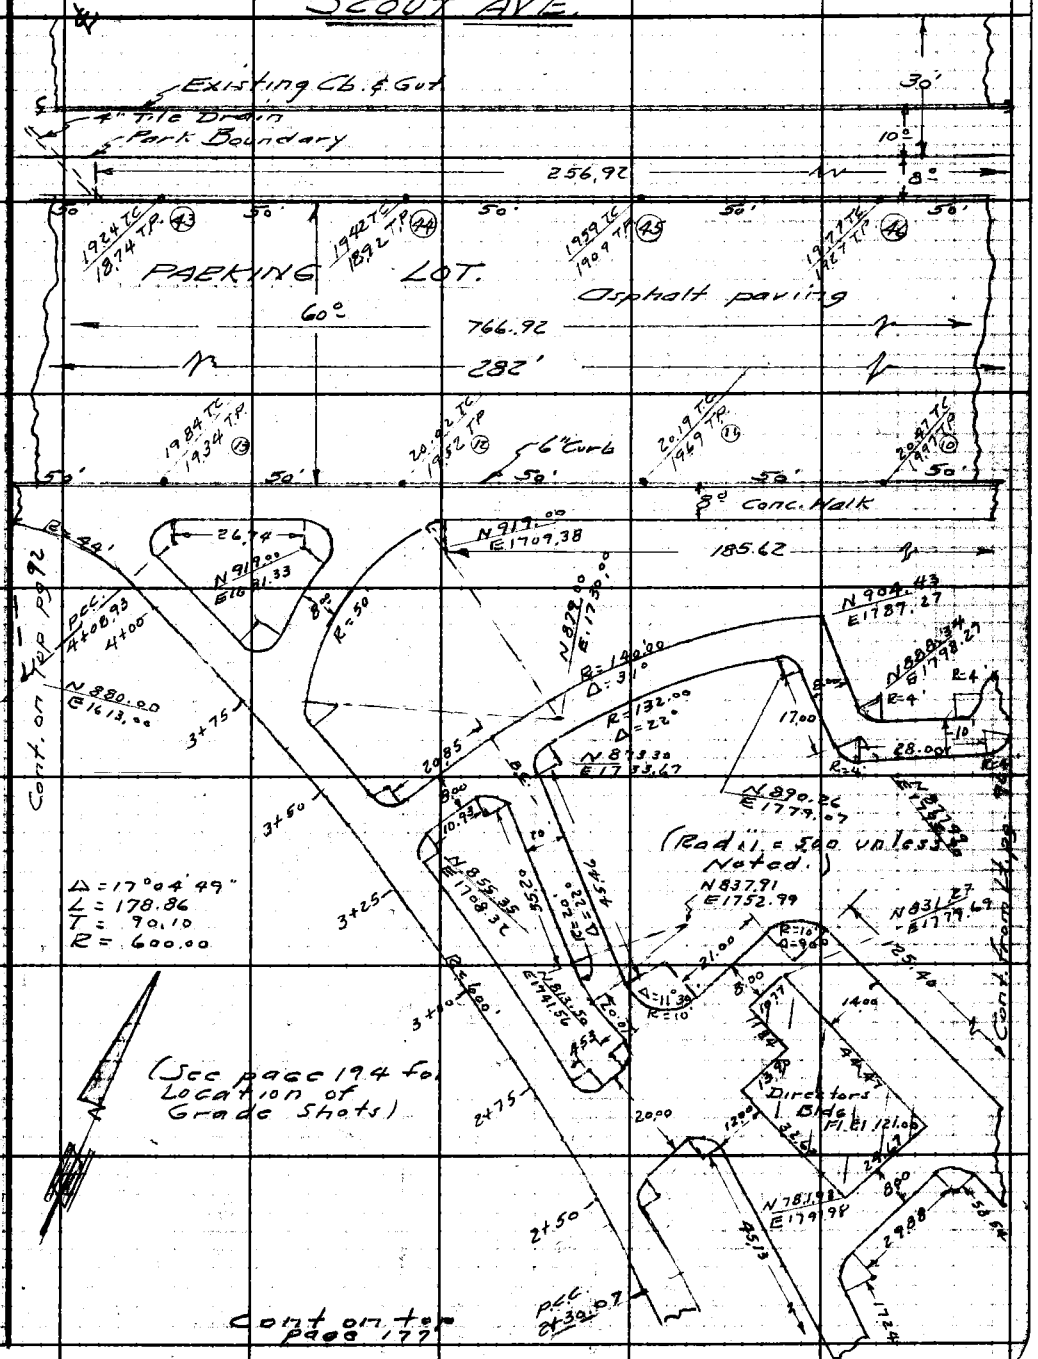

RETURN TO
LOS ANGELES COUNTY ENGINEER
900 LOS ANGELES COUNTY ENGINEERING BLDG.

Note: Any Additions or Changes on This Sheet Must be Made or Circled in Red Ink With Date and Name of Person Making Change.

Do not extend notes this side of this line.

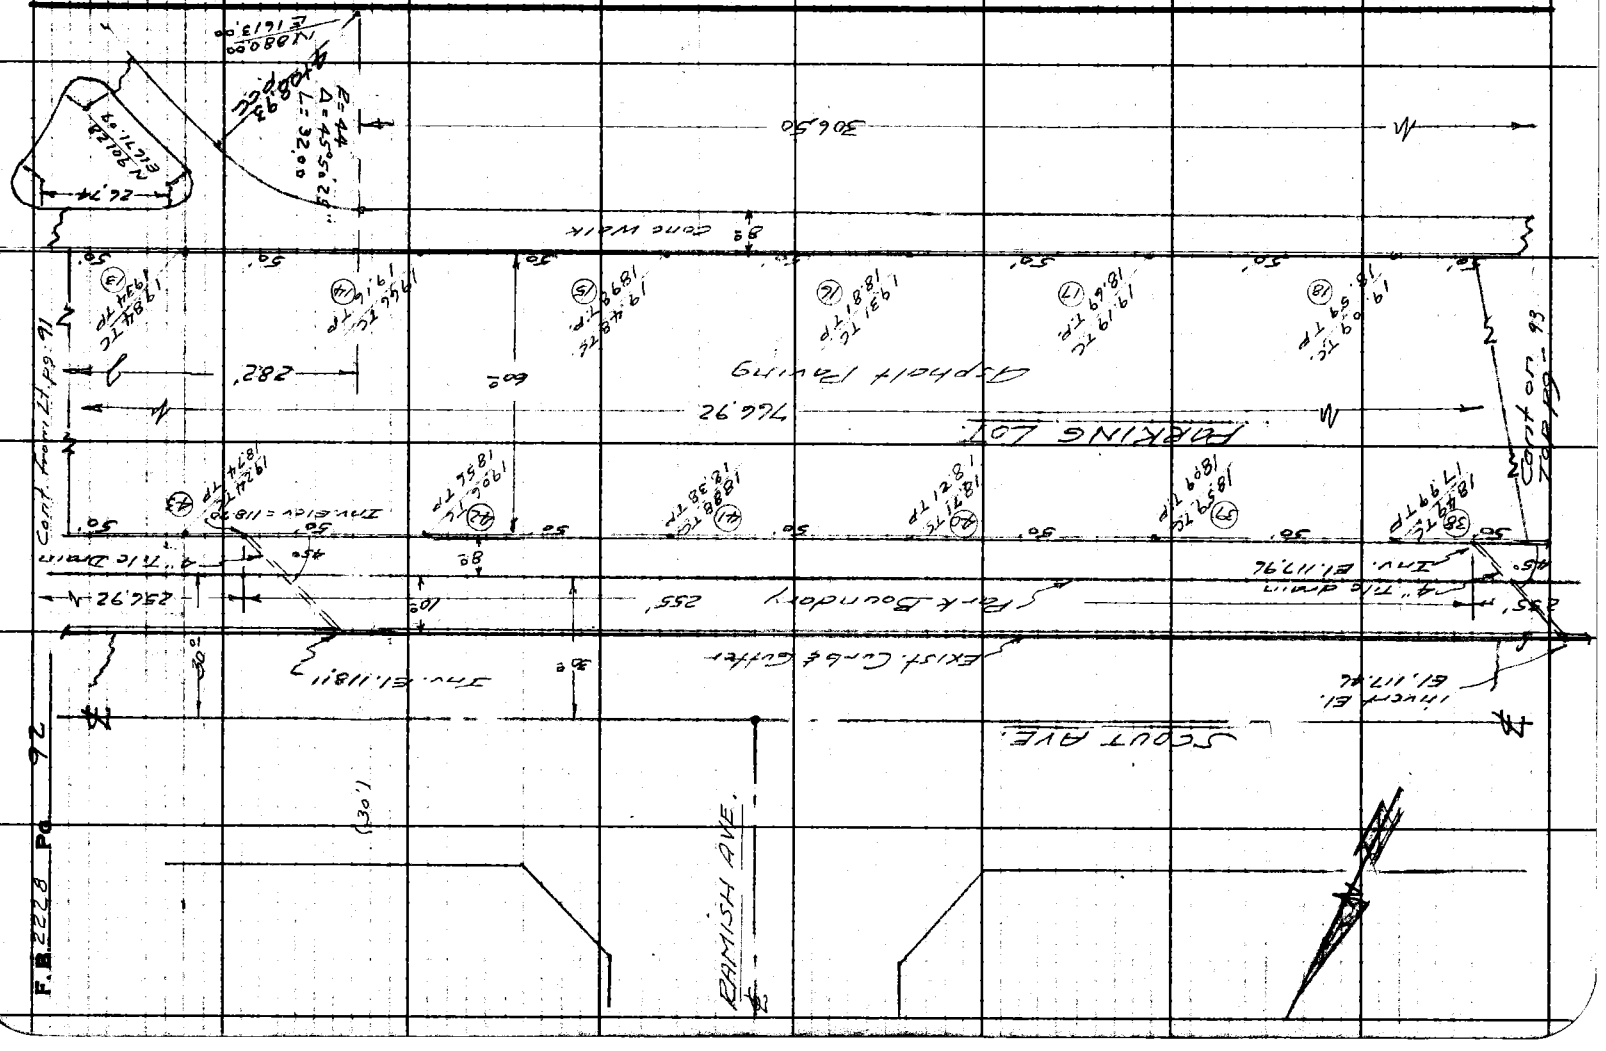

76F3098 CE #247—3-57

RETURN TO
LOS ANGELES COUNTY ENGINEER
700 LOS ANGELES COUNTY ENGINEERING BLDG.

Note: Any Additions or Changes on This Sheet Must be Made or Circled in Red Ink With Date and Name of Person Making Change.

Do not extend notes this side of this line.

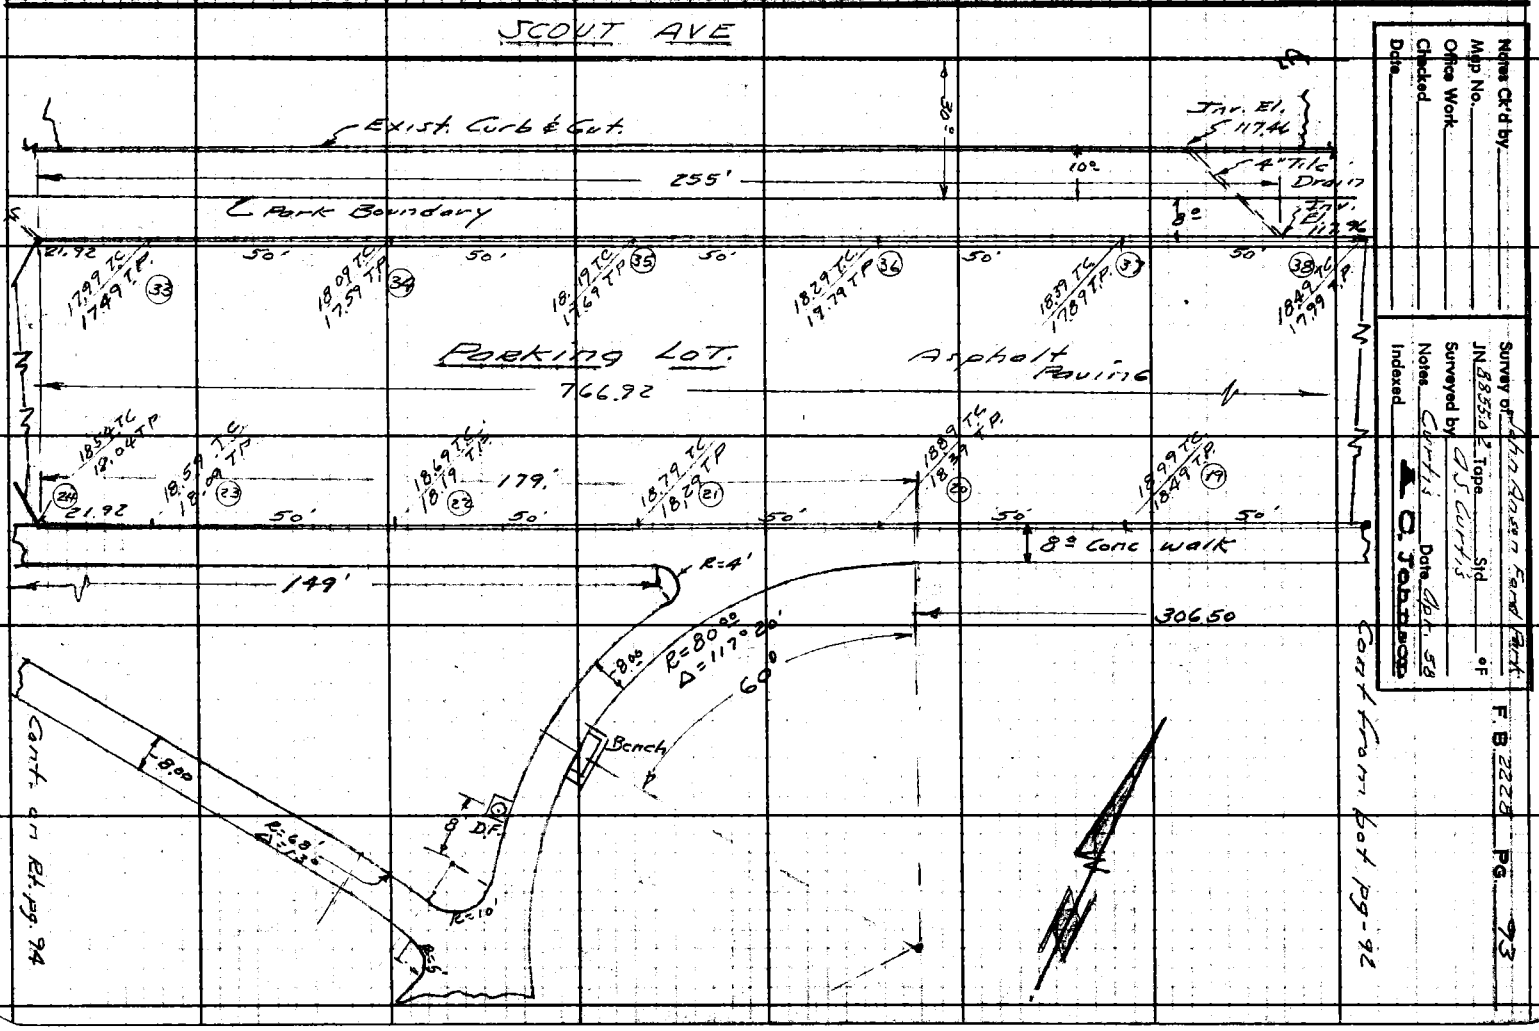

Notes Ck'd by _____
Map No. _____
Office Work _____
Checked _____
Date _____

JN 88552 Tape _____ Sid _____ ©F
Surveyed by C.J.S. Curtis
Indexed _____ L. C. Johnson

F. B. 2223 PG. 93

4

RETURN TO
LOS ANGELES COUNTY ENGINEER
7700 LOS ANGELES COUNTY ENGINEERING BLDG.

Note: Any Additions or Changes on This Sheet Must be Made or Circled in Red Ink With Date and Name of Person Making Change.

Do not extend notes this side of this line.

F.B. 2228 Pg. 94

FB 119

SCOUT AVE.

EXIST. Drive

Inv. El. 117.46

Inv. El. 117.96

4" Tile Dr.

Park Boundary

PARKING LOT.

766.92

Asphalt Paving

Conc. wk.

Conc. Walks

Future Swimming Pool

No. Line Prod

Picnic Shelter.

Bench

D.F.

Bench

Con on Lt pg 173

Profile No. | Notes Red. | Date | Plotted | Date | Job No: 8855.02 | Division No. 10 | F. B. 2228 | Pg. 95

X-Sec. No. | Notes Chkd. | Date | Checked | Date | Survey of John Anson Ford Park | Survey by Curtis | Notes Curtis | Date Apr. 1958 | Map No. | Indexed C. Johnson

NOTE: ANY ADDITIONS OR CHANGES ON THIS SHEET MUST BE MADE OR CIRCLED IN RED INK, WITH DATE AND NAME OF PERSON MAKING CHANGE.

PLEASE RETURN TO
LOS ANGELES COUNTY ENGINEER
700 Los Angeles County Engineering Bldg.

Do not extend notes this side of this line.

STATION	B. S.	H. I.	F. S.	ELEV.

J.N. 8855.02

John Anson Ford Park

Curb Grades For

East Parking Lot.

(See pages 89 thru 94 for Location)

Curtis
Markey Jr.
Rodriguez
Latteri

76298 S & E #307—7-55

76298 S & E #307—7-55

PLEASE RETURN TO
LOS ANGELES COUNTY ENGINEER
700 Los Angeles County Engineering Bldg.

NOTE: ANY ADDITIONS OR CHANGES ON THIS SHEET MUST BE MADE OR CIRCLED IN RED INK, WITH DATE AND NAME OF PERSON MAKING CHANGE.

Do not extend notes this side of this line.

F. B. 2228 Pg. 96 | Job No. 8855.02 Division No. 10

Survey of _____ Notes _____ Date _____

Survey by K. C. Tehranian Notes Chkd. _____ Date _____

Indexed _____ Date _____ Checked _____ Date _____

Profile _____ No. _____ Plotted _____ Date _____

X-Sec. _____ No. _____ Notes Red. _____ Date _____

STATION	B. S.	H. I.	F. S.	ELEV.	GRADE	Cut/Fill	
				EAST Parking LOT, Elev. 118.80 F.B. 2228 - 22 & 38.			
BM #6				118.80	BM #6 CE. Brass Cap Mon: N.E. Cor. Park.		
(1)	Beginning Curb at Exist Drive			120.64	120.64	0.0	
(2)				120.51	20.51	0.0	
(3)	& Pt (Cor)			120.40	20.40	0.0	
(4)				120 48	20.48	0.0	
(5)				120.48	20.48	0.0	
(6)	BC of 5° Road			20 49	120.49	0.0	
(7)	EC " "			20.54	20.54	0.0	
(8)	& PT.			20 .70	20.70	0.0	
(9)				20 55	20.55	0.0	
(10)	T.P.			120.37	120.37	0.0	
(11)				20.19	20.19	0.0	
(12)				20 02	20.02	0.0	
(13)				19.84	19.84	0.0	
(14)				19.66	19.66	0.0	
(15)				19.48	19.48	0.0	
(16)	T.P.			19.30	119.31	0.0	

76298 S & E #307—7-55

PLEASE RETURN TO
LOS ANGELES COUNTY ENGINEER
700 LOS ANGELES COUNTY ENGINEERING BLDG.

NOTE: ANY ADDITIONS OR CHANGES ON THIS SHEET MUST BE MADE OR CIRCLED IN RED INK, WITH DATE AND NAME OF PERSON MAKING CHANGE.

Do not extend notes this side of this line.

Profile Notes Red. Plotted Job No. 88550 Division No.
X-Sec. Notes Chkd. Checked Survey by Curtis Notes C. Johnson Date April 53
No. Date Date Map No. Index Date

STATION	B. S.	H. I.	F. S.	ELEV.	GRADE	cut / fill
(17)				119.19	119.19'	0.0
(18)				19.09	19.09'	0.0
(19)				18.99	18.99'	0.0
(20)	TP			18.89	18.89'	0.0
(21)				18.79	18.79'	0.0
(22)				18.69	18.69'	0.0
(23)				18.59	18.59'	0.0
(24)	℄ PT			18.54	18.54	0.0
(25)	℄ PT			18.26	18.26'	0.0
(26)	℄ PT			18.50	18.50'	0.0
(27)				18.36	1836	0.0
(28)	End Curb at Exist Drive			18.22	18.22	0.0
(29)	EC 16°RAD			18.21	18.21'	0.0
(30)	BC. 16° RAD			18.26	18.26	0.0
(31)	EC. " "			17.96	17.96'	0.0
(32)	℄ PT			17.94	17.94'	0.0
(33)				17.99	17.99'	0.0
(34)				18.09	18.09'	0.0
(35)				18.19	18.19'	0.0
(36)				18.29	18.29'	0.0
(37)				18.39	18.39'	0.0

76298 S & E #307—7-55

PLEASE RETURN TO
LOS ANGELES COUNTY ENGINEER
700 LOS ANGELES COUNTY ENGINEERING BLDG.

NOTE: ANY ADDITIONS OR CHANGES ON THIS SHEET MUST BE MADE OR CIRCLED IN RED INK, WITH DATE AND NAME OF PERSON MAKING CHANGE.

Do not extend notes this side of this line.

F. B. 2228 Pg. 98 | Job No. 895502 Division No. | Notes Red. | Date | Plotted | No. | Profile
Survey of John Anson Ford Park | Date | Date | No. | X-Sec.
Survey by Curtis | Notes | Notes Chkd. | Checked
Indexed J. C. Johnson | Date | Date | Date | No.

STATION	B. S.	H. I.	F. S.	ELEV.	GRADE	CUT FILL	
(38)				118.49	118.49'	0.0	
(39)				18.59	18.59'	0.0	
(40)				18.71	18.71'	0.0	
(41)				18.88	18.88'	0.0	
(42)				19.06	19.06'	0.0	
(43)				19.24	19.24'	0.0	
(44)				19.42	19.42'	0.0	
(45)				19.59	19.59'	0.0	
(46)				19.77	19.77'	0.0	
(47)				19.95	19.95'	0.0	
(48)	℄ PT.			20.10	20.10'	0.0	
(49)	EC 5° RAD			20.36	20.36'	0.0	
(50)	BC 10° "			20.41	20.41'	0.0	
(51)	EC " "			20.41	20.41'	0.0	
(52)	END Curb at Exist. Conc. Drive			20.59	20.59'	0.0	
T.P.				118.95	T.P. - Elev 118.96'		F.B. 2228-70

Notes Ck'd by
Map No.
Office Work
Checked
Date

Survey of John Anson Ford Park
JN 8855.02 Tape Std °F
Surveyed by A.S. Curtis
Notes Curtis Date Apr 58
Indexed C. Johnson 1-16-89

F. B. 2228 Pg. 99

J.N. 8855.02
John Anson Ford Park
Location of
Mowing Strips & Redwood Fence
around Play Area.

Curtis
Monkey
Rodriguez

Note: Any Additions or Changes on This Sheet Must be Made or Circled In Red Ink With Date and Name of Person Making Change.

Do not extend notes this side of this line.

RETURN TO
LOS ANGELES COUNTY ENGINEER
900 Los Angeles County Engineering Bldg.

76F3098 CE #247—3-87

F. B. 2228 Pg. 100

EAST PARKING LOT.

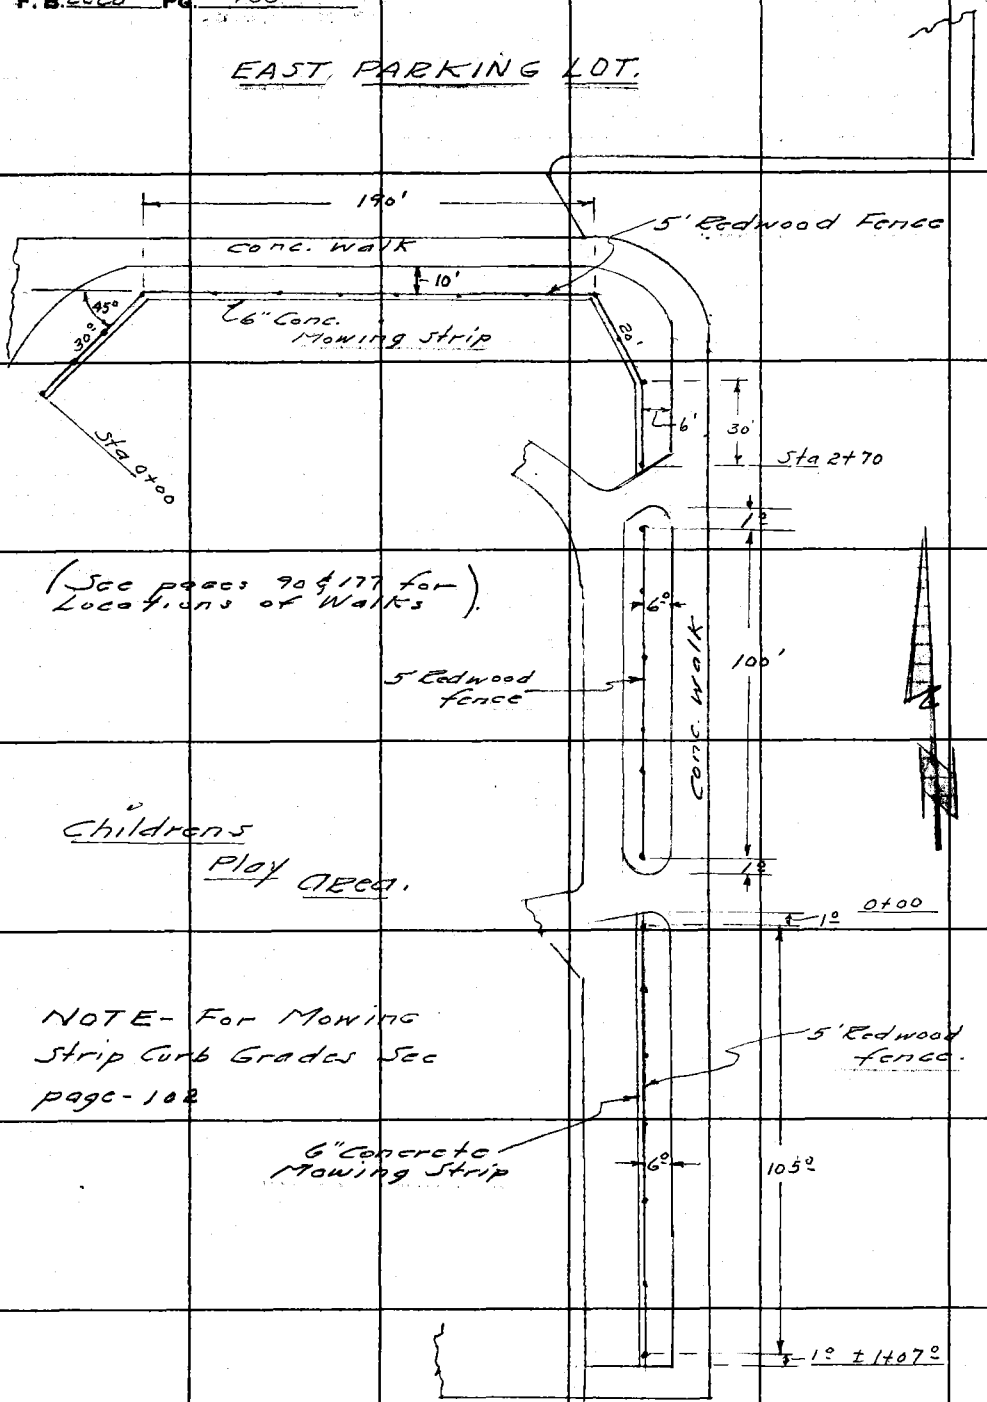

RETURN TO
LOS ANGELES COUNTY ENGINEER
700 LOS ANGELES COUNTY ENGINEERING BLDG.

Do not extend notes this side of this line.

Note: Any Additions or Changes on This Sheet Must be Made or Circled in Red Ink With Date and Name of Person Making Change.

F. B. 2228 Pg. 101

Profile No. | Notes Red. | Plotted | Job No 8855.02 Division No.
Date | Date | Survey of John Anson Ford Park
X-Sec. No. | Notes Chkd. | Checked | Survey by Curtis Notes ETM Date 4-'58
Date | Date | Map No. | Index Ck. John Bates

JN 8855.02

JOHN ANSON FORD PARK

GRADES for

MOWING STRIP at BASE of

REDWOOD FENCE in TINY TOTS AREA

See Pg 100 for location

Curtis
Monkey
Rodriguez
Latteri

STATION	B. S.	H. I.	F. S.	ELEV.

NOTE: ANY ADDITIONS OR CHANGES ON THIS SHEET MUST BE MADE OR CIRCLED IN RED INK, WITH DATE AND NAME OF PERSON MAKING CHANGE.

PLEASE RETURN TO
LOS ANGELES COUNTY ENGINEER
700 Los Angeles County Engineering Bldg.

Do not extend notes this side of this line.

76298 S & E #307—7-55

76298 S & E #307—7-55

PLEASE RETURN TO
LOS ANGELES COUNTY ENGINEER
700 LOS ANGELES COUNTY ENGINEERING BLDG.

NOTE: ANY ADDITIONS OR CHANGES ON THIS SHEET MUST BE MADE OR CIRCLED IN RED INK, WITH DATE AND NAME OF PERSON MAKING CHANGE.

Do not extend notes this side of this line.

F. B. 2228 Pg. 102 | Job No. 855902 Division No. Notes Red. Plotted. Profile
Survey by Cecil S Notes Date. Checked
Indexed K. C. Johnson Date. Notes Chkd. Date. No.

STATION	B. S.	H. I.	F. S.	ELEV.	GRADES Cut / Fill	
					TBM EL 118.354' FB 22-28-70	
TBM (Fd)				118.35'	Large Bf Spk on E/Intr. Scout Ave & Ramish Ave	
0+00	Begin 6" Mowing Strip			120.00'	120.00' 0.0'	1"X2" Stk
+30	Angle Point			20.25'	20.25' 0.0'	" "
+80				20.41'	20.41' 0.0'	" "
1+30				20.56'	20.56' 0.0'	" "
+80				20.72'	20.72' 0.0'	" "
2+20	Angle Point			120.85'	120.85' 0.0'	" "
+40	"	"		20.50'	20.50' 0.0'	" "
2+70	END of 1ST Mowing Strip			120.38'	120.38' 0.0'	" "
TP				120.52'	TP	
	SECOND MOWING STRIP STARTS NEAR NE. COR BASKETBALL COURT					
0+00	Begin 6" Mowing Strip			119.75'	119.75' 0.0'	1"X2" Stk
+35				19.63'	19.63' 0.0'	" "
+70				19.52'	19.52' 0.0'	" "
1+07	END 6" Mowing Strip			119.40'	119.40' 0.0'	" "
TP (Fd)				118.96'	TP EL 118.96 F.B. 22-28-70	59 Ht Spk Sq Cut Scout Ave.

Notes Ck'd by	Survey of John Anson Ford Park
Map No.	JN 8855.02 Tape Std °F
Office Work	Surveyed by Curtis
Checked	Notes Curtis Date
Date	Indexed K. C. Johnson

F. B. 2228 Pg. 103

J.N. 8855.02

Location of
Picnic Shelter

Note: Any Additions or Changes on This Sheet Must be Made or Circled in Red Ink With Date and Name of Person Making Change.

Do not extend notes this side of this line.

RETURN TO
LOS ANGELES COUNTY ENGINEER
700 Los Angeles County Engineering Bldg.

76F3098 CE #247—3-57

F. B. 2228 Pg. 104

RETURN TO
LOS ANGELES COUNTY ENGINEER
700 Los Angeles County Engineering Bldg.

Note: Any Additions or Changes on This Sheet Must be Made or Circled in Red Ink With Date and Name of Person Making Change.

Do not extend notes this side of this line.

NOTE: See page 118 for Coordinate Grid Locations.

Notes Ck'd by	Survey of John Anson Ford Park
Map No.	JN 8855.02 Tape Std °F
Office Work	Surveyed by G. S. Curtis
Checked	Notes Curtis Date Apr. '58
Date	Indexed K. C. Johnson

F. B. 2228 Pg. 105

J.N. 8855.02

John Anson Ford Park.

Location of Elect. Lines for Picnic Shelter.

Also Sewer Line

Curtis
Mankey
Rodriguez
Latteri

Note: Any Additions or Changes on This Sheet Must be Made in Red Ink With Date and Name of Person Making Change.

Do not extend notes this side of this line.

RETURN TO
LOS ANGELES COUNTY ENGINEER
700 LOS ANGELES COUNTY ENGINEERING BLDG.

76F309S CE #247 3-57

F.B. 2228 Pg. 106

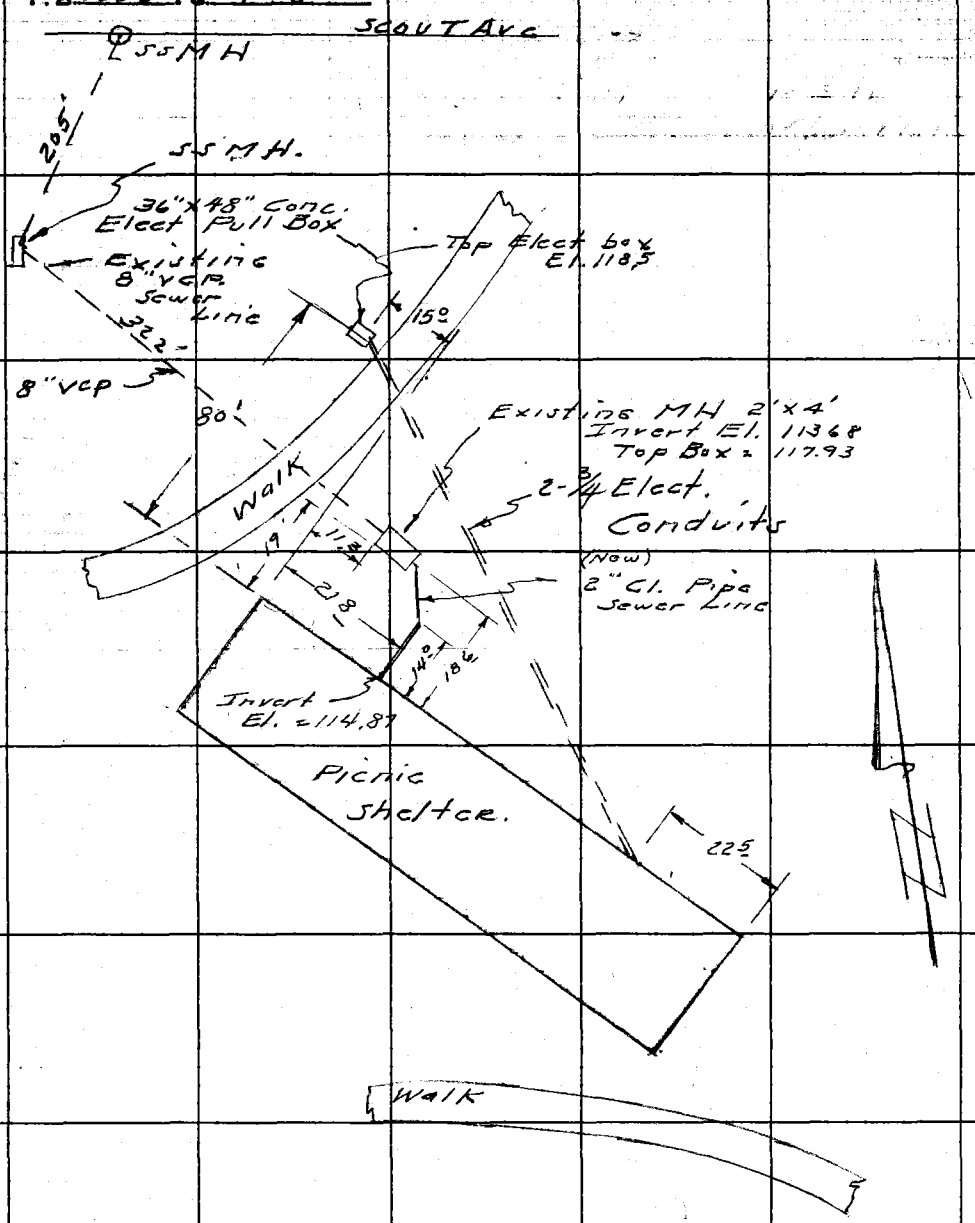

RETURN TO
LOS ANGELES COUNTY ENGINEER
700 Los Angeles County Engineering Bldg.

Do not extend notes this side of this line.

Notes: Any Additions or Changes on This Sheet Must be Made or Circled in Red Ink With Date and Name of Person Making Change.

Notes Ck'd by	Survey of John Anson Ford PK
Map No.	JN 8855.02 Tape Std °F
Office Work	Surveyed by A.S. Curtis
Checked	Notes Curtis Date Apr. 58
Date	Indexed A. C. Johnson

F. B 2228 Pg. 107

J.N. 8855.02
John Anson Ford Park.
Location of
Directors Bldg.
also
Elect & Phone Line

Curtis
Mankey
Rodriguez
Lotteri

Note: Any Additions or Changes on This Sheet Must be Made or Circled in Red Ink With Date and Name of Person Making Change.

Do not extend notes this side of this line.

RETURN TO
LOS ANGELES COUNTY ENGINEER
700 LOS ANGELES COUNTY ENGINEERING BLDG.

76F3088 GE #247—3-57

F. B. 2228 Pg. 108

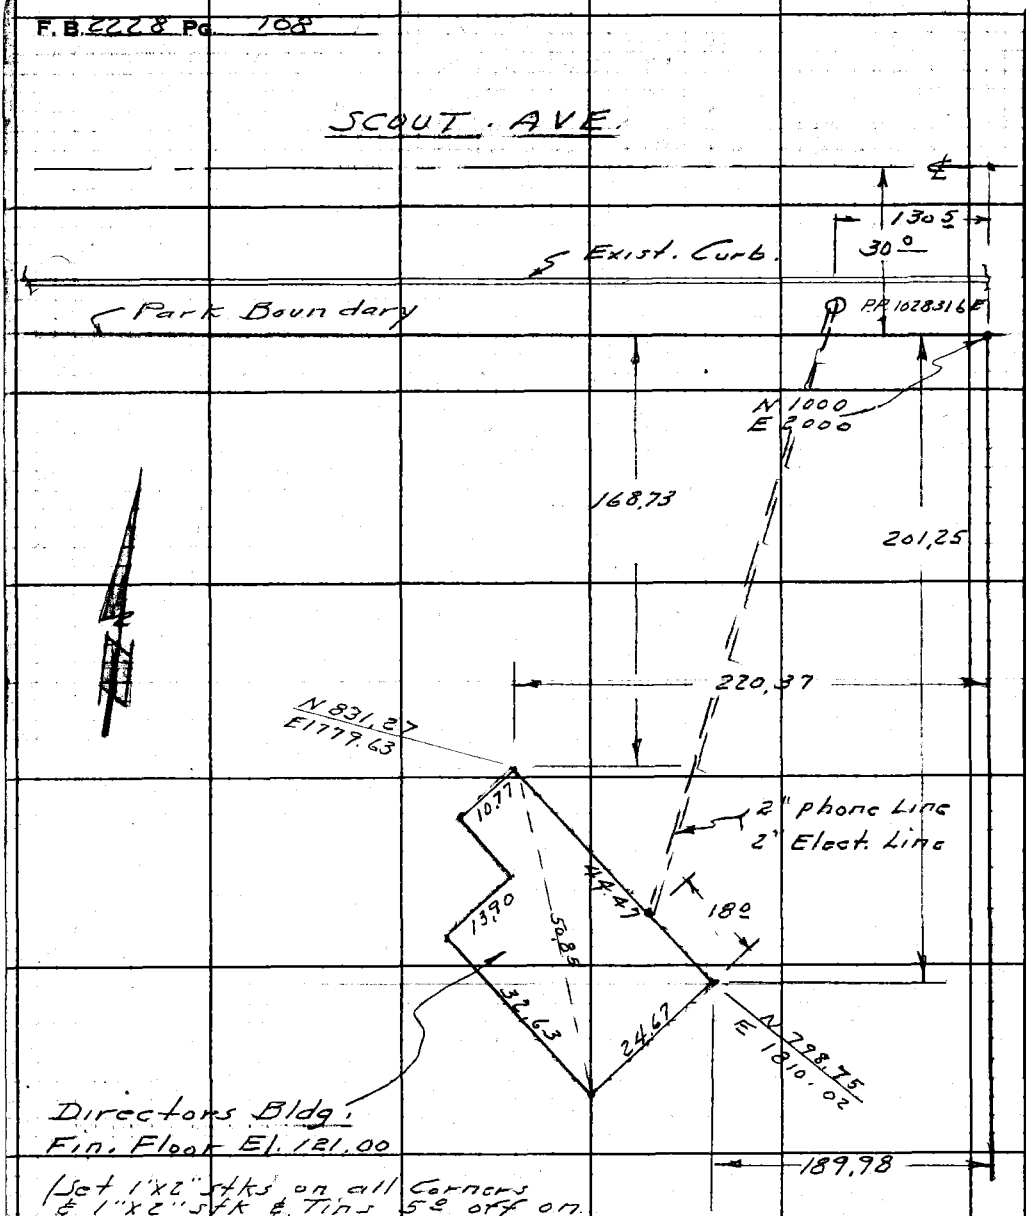

RETURN TO
LOS ANGELES COUNTY ENGINEER
700 LOS ANGELES COUNTY ENGINEERING BLDG.

Do not extend notes this side of this line.

Note: Any Additions or Changes on This Sheet Must be Made or Circled in Red Ink With Date and Name of Person Making Change.

Notes Ck'd by	Survey of JOHN ANSON FORD PARK
Map No.	JN 8855.02 Tape Std °F
Office Work	Surveyed by AS Curtis
Checked	Notes EFM JC Date 4/58
Date	Indexed C. Johnson

F. B 2239 Pg. 109

JN 8855.02

JOHN ANSON FORD PARK

LOCATION of ELECTRIC

CONDUITS

Curtis
Mankey
Rodriguez
Latteri

Note: Any Additions or Changes on This Sheet Must be Made or Circled in Red Ink With Date and Name of Person Making Change.

Do not extend notes this side of this line.

RETURN TO
LOS ANGELES COUNTY ENGINEER
700 LOS ANGELES COUNTY ENGINEERING BLDG.

76F3088 CE #247—9-57

RETURN TO
LOS ANGELES COUNTY ENGINEER
700 LOS ANGELES COUNTY ENGINEERING BLDG.

Note: Any Additions or Changes on This Sheet Must be Made or Circled in Red Ink With Date and Name of Person Making Change.

Do not extend notes this side of this line.

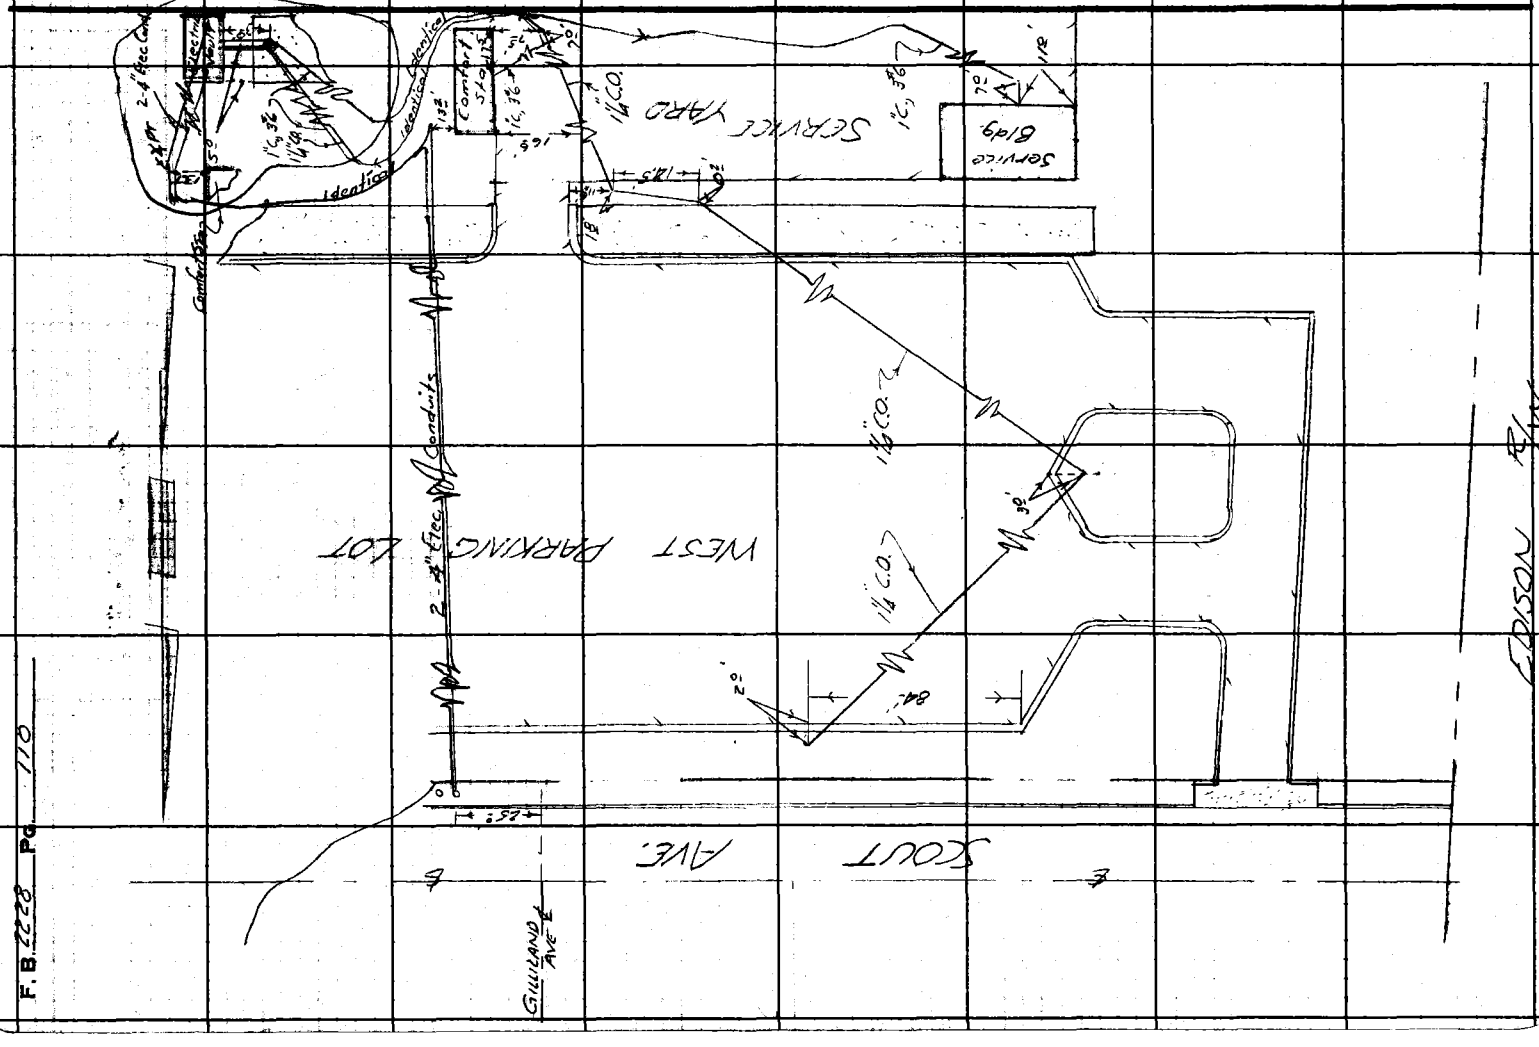

F.B. 2228 Pg. 110

76F3095 CE #247—3-57

RETURN TO
LOS ANGELES COUNTY ENGINEER
700 LOS ANGELES COUNTY ENGINEERING BLDG.

Note: Any Additions or Changes on This Sheet Must be Made or Circled in Red Ink With Date and Name of Person Making Change.

Do not extend notes this side of this line.

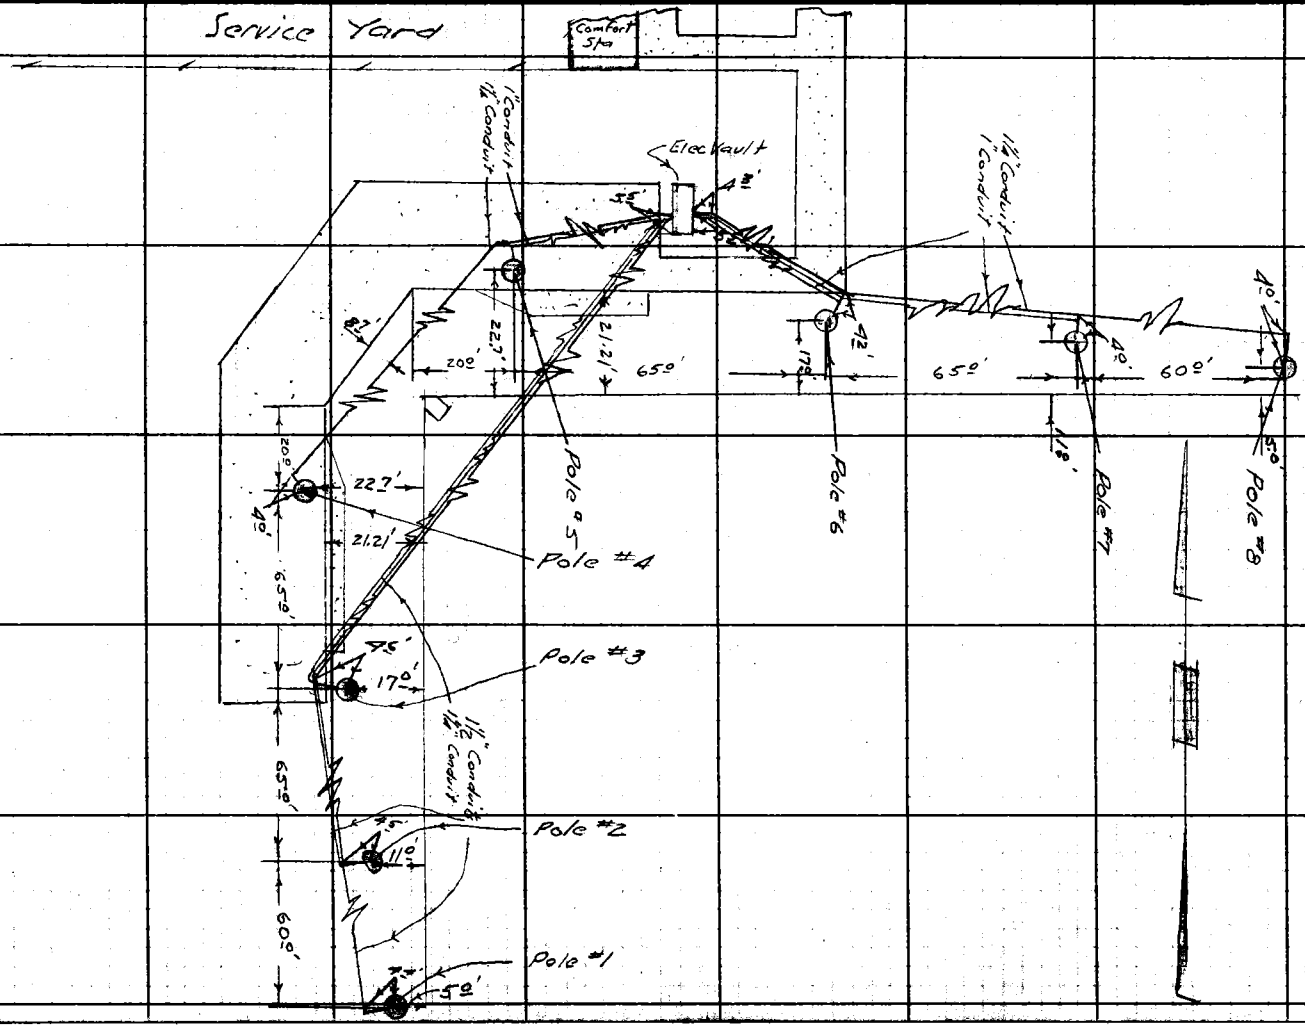

Notes Ck'd by
Map No.
Office Work
Checked
Date

Surveyed by Curtis
Notes
Indexed

F. B. 22 28 Pg. 111

Notes Ck'd by	Survey of John Anson Ford Park
Map No.	JN 8855.02 Tape Std °F
Office Work	Surveyed by A. S. Curtis
Checked	Notes Curtis Date Oct-58
Date	Indexed A. O. Johnson

F. B. 2228 Pg. 113

J.N. 8855.02

John Anson Ford Park.

Location of

Lake Drain Lines & Etc.

Curtis
Mankey
Ebdrigue
Lateral

Note: Any Additions or Changes on This Sheet Must be Made in Red Ink or Circled With Date and Name of Person Making Change.

Do not extend notes this side of this line.

RETURN TO
LOS ANGELES COUNTY ENGINEER
700 LOS ANGELES COUNTY ENGINEERING BLDG.

76F3098 CE #247—8-57

F. B. 2228 Pg. 114

NOTE -
See page 115 for Grades

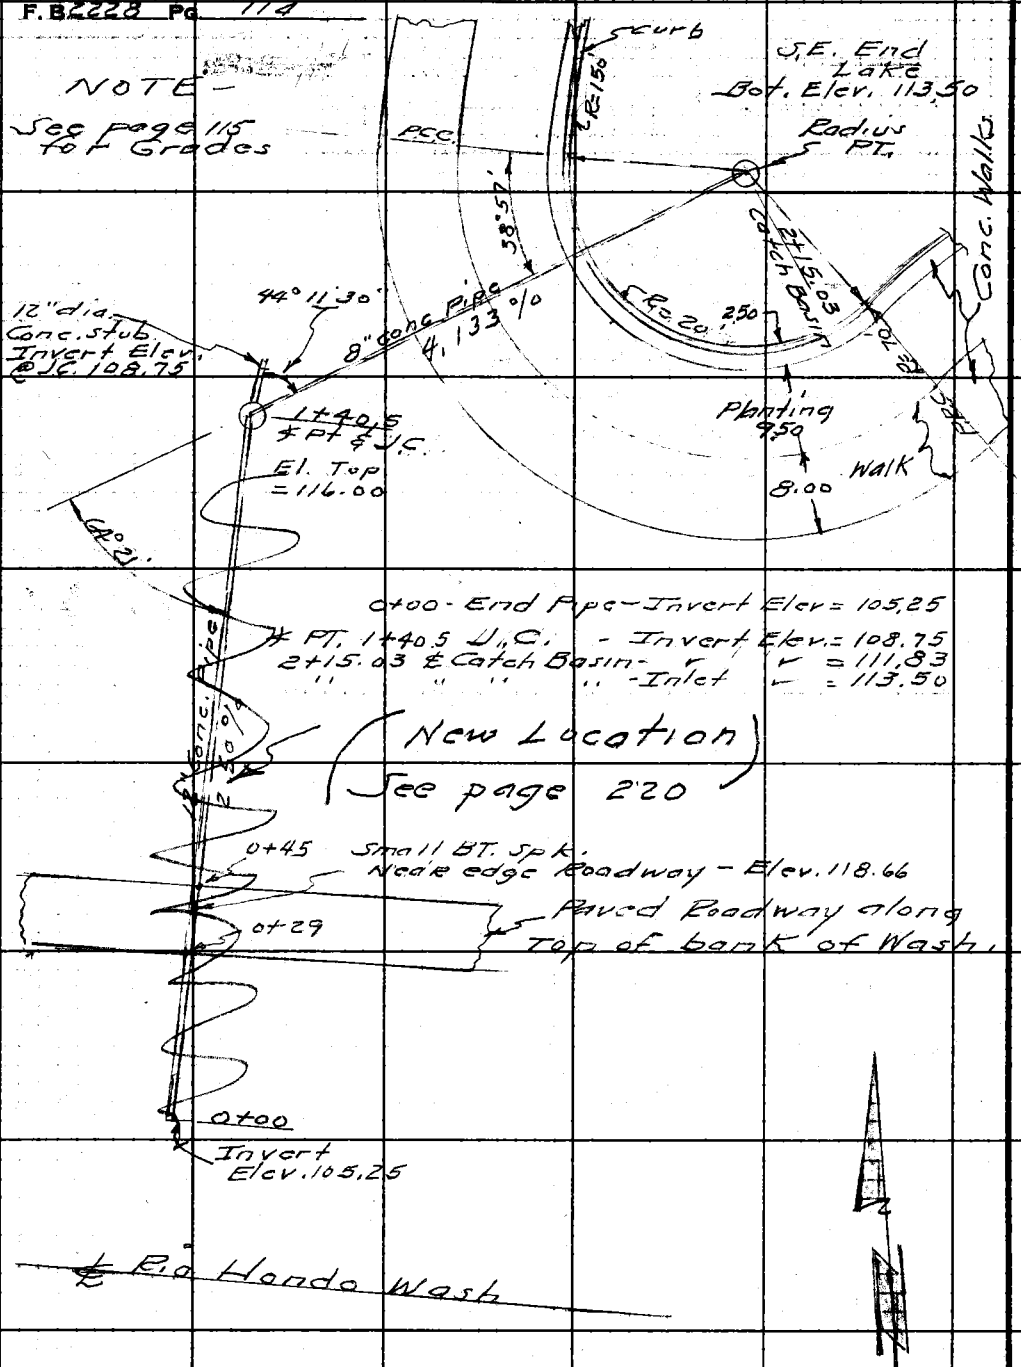

RETURN TO
LOS ANGELES COUNTY ENGINEER
900 Los Angeles County Engineering Bldg.

Do not extend notes this side of this line.

Note: Any Additions or Changes on This Sheet Must be Made or Circled in Red Ink With Date and Name of Person Making Change.

F. B. 2228 Pg. 115

Profile No. | Notes Red. | Date | Plotted | Date | Job No. 885502 | Division No. |
Survey of John Anson Ford Park
X-Sec. No. | Notes Chkd. | Date | Checked | Date | Survey by Curtis | Notes GTM | Date April '58
Map No. | Indexed C. Johnson

JN 885502

JOHN ANSON FORD PARK

CASTING LAKE

DRAIN

to

RIO HONDO

See page 114 for Location

Curtis
Mankey
Rodriguez
Latteri

STATION	B. B.	H. I.	F. B.	ELEV.

NOTE: ANY ADDITIONS OR CHANGES ON THIS SHEET MUST BE MADE OR CIRCLED IN RED INK, WITH DATE AND NAME OF PERSON MAKING CHANGE.

Do not extend notes this side of this line.

PLEASE RETURN TO
LOS ANGELES COUNTY ENGINEER
700 Los Angeles County Engineering Bldg.

76298 S & E #307—7-55

76298 S & E #307—7-55

PLEASE RETURN TO
LOS ANGELES COUNTY ENGINEER
700 LOS ANGELES COUNTY ENGINEERING BLDG.

NOTE: ANY ADDITIONS OR CHANGES ON THIS SHEET MUST BE MADE OR CIRCLED IN RED INK, WITH DATE AND NAME OF PERSON MAKING CHANGE.

Do not extend notes this side of this line.

Profile No. ____ X-Sec. No. ____

Plotted ____ Date ____ Notes Red ____ Date ____ Notes Chkd ____ Date ____ Checked ____ Date ____

Job No. 8855302 Division No. ____


Survey by Curtis Notes Mauzey

Indexed K. C. Johnson Date ____

F. B. 2228 Pg. 1/6

STATION	B. S.	H. I.	F. S.	ELEV.		%	Grade	Cut or Fill	
TBM				120.00	TBM Elev 120.00' AB2228 - large Bolt & Washer in W. side 20" Gum Tree				
TP				112.42					
TP				113.70					
TP									
0+00				105.55			105.25	C 0.30	Spk & Tin 10° Lt.
0+29	Top of Bank (So. side)			117.98			105.98	C 12.00	Spk & Tin 10° Lt. & Drain
0+45	" " " (No. side)			118.53			106.38	C-12.15	Stk & Tin "
+55	Bot. of Bank " "			115.36		2.38%	106.63	C-8.73	" "
+75				115.70			107.13	C-8.57	" "
1+00				115.69			107.75	C-7.94	" "
+25				116.55			108.37	C-8.18	" "
1+40.5	(Back) Angle Pt & Junction Chamber (Ahead)			116.80			108.75	C-8.05	" "
" "	" " " "			117.60			108.75	C-8.85	" "
1+40.5	Top I.C.			116.00			116.00	C 0.00	" "
1+75				117.97		4.13%	110.17	C-7.80	" "
2+00				117.03			111.20	C-5.83	" "
2+15.03	Invert of 8" Outlet			113.77			111.83	C-1.94	" "
2+15.03	Elev Top Catch Basin			113.50			113.50	C-0.00	1"x2" STK
TBM				120.01	TBM Elev 120.00' (See Above)				

Notes Ck'd by	Survey of John Anson Ford Park
Map No.	JN 8855.02 Tape Std °F
Office Work	Surveyed by AS Curtis
Checked	Notes ETM JC Date 3-'58
Date	Indexed C. Johnson 7-16-58

F. B. 2228 PG. 177

JN 8855.02

JOHN ANSON FORD PARK

GRID LAYOUT

Curtis
Mankey
Rodriguez
Lafferi

Note: Any Additions or Changes on This Sheet Must be Made in Red Ink or Circled With Date and Name of Person Making Change.

Do not extend notes this side of this line.

RETURN TO
LOS ANGELES COUNTY ENGINEER
700 LOS ANGELES COUNTY ENGINEERING BLDG.

76F309S CE #247—3-57

RETURN TO
LOS ANGELES COUNTY ENGINEER
700 LOS ANGELES COUNTY ENGINEERING BLDG.

Note: Any Additions or Changes on This Sheet Must be Made or Circled in Red Ink With Date and Name of Person Making Change.

Do not extend notes this side of this line.

RIO HONDO FLOOD CONTROL CHANNEL

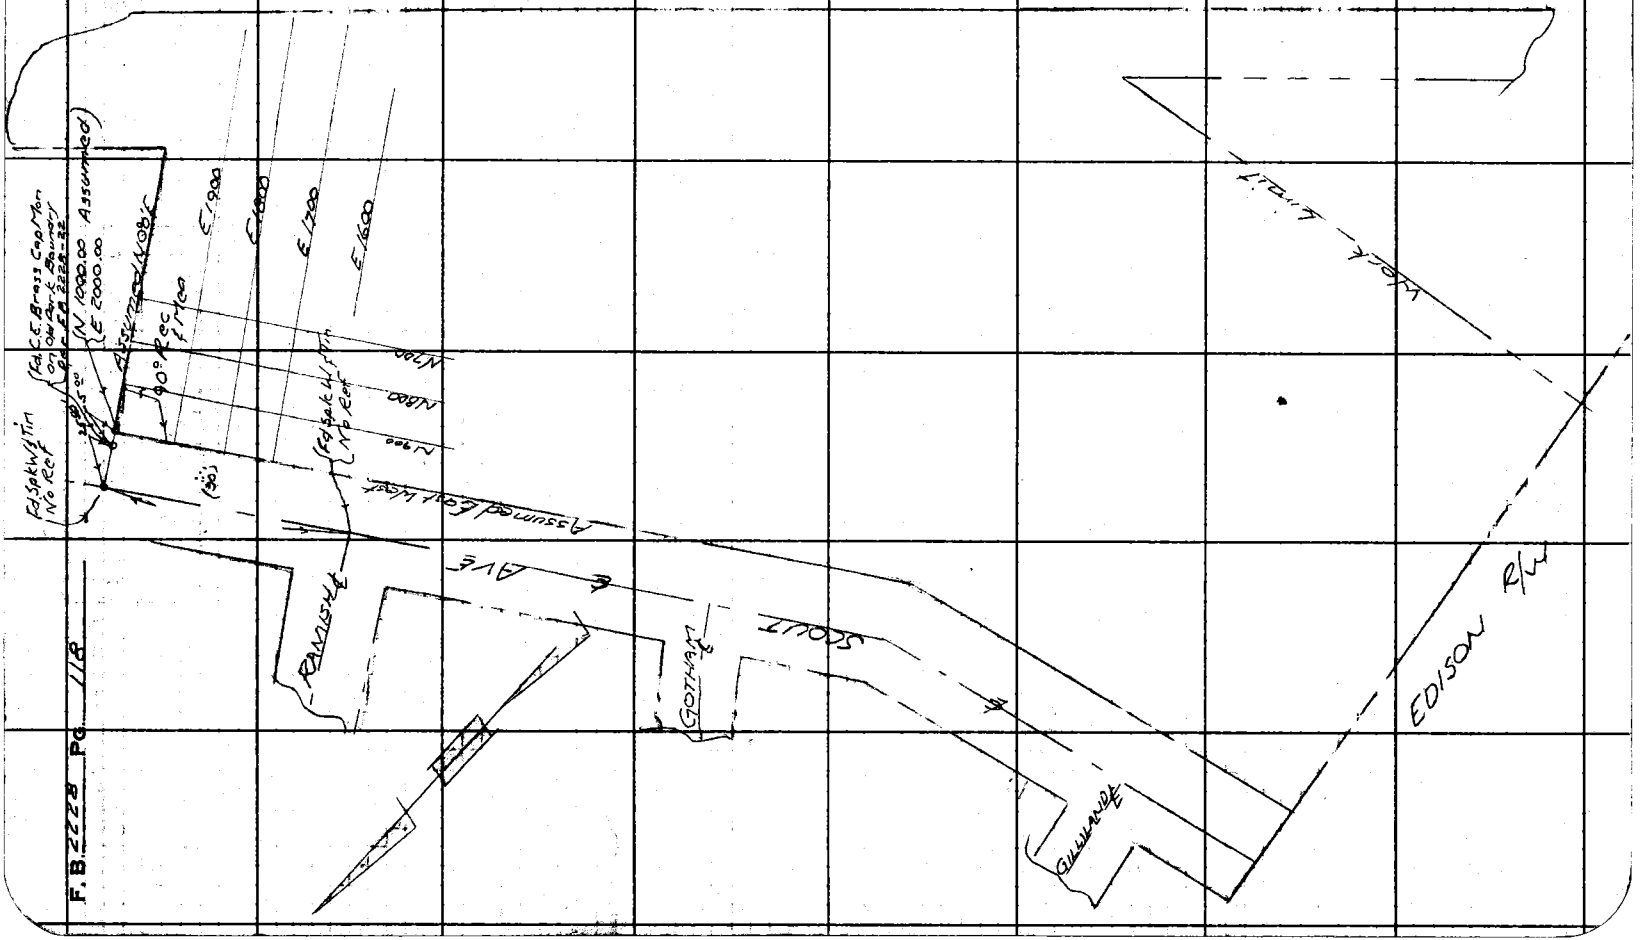

F.B. 2228 PG 118

Notes Ck'd by	Survey of John Anson Ford Park
Map No.	JN 8855.02 Tape Std °F
Office Work	Surveyed by Curtis
Checked	Notes FTM Jr. Date 5-'58
Date	Indexed A. C. Johnson

F. B. 2622 Pg. 119

JN 8855.02

JOHN ANSON FORD PARK

LOCATION OF

FREE FORM MOUNDS

WEST OF TINY TOTS PLAY AREA

(See Pg 118 for Grid Coordinate Bases)

Curtis
Mankey
Rodriguez
Carteri

Note: Any Additions or Changes on this Sheet Must be Made or Circled in Red Ink With Date and Name of Person Making Change.

Do not extend notes this side of this line.

RETURN TO
LOS ANGELES COUNTY ENGINEER
700 LOS ANGELES COUNTY ENGINEERING BLDG.

765SOS CE #247—3-57

RETURN TO
LOS ANGELES COUNTY ENGINEER
700 LOS ANGELES COUNTY ENGINEERING BLDG.

Note: Any Additions or Changes on This Sheet Must be Made or Circled in Red Ink With Date and Name of Person Making Change.

Do not extend notes this side of this line.

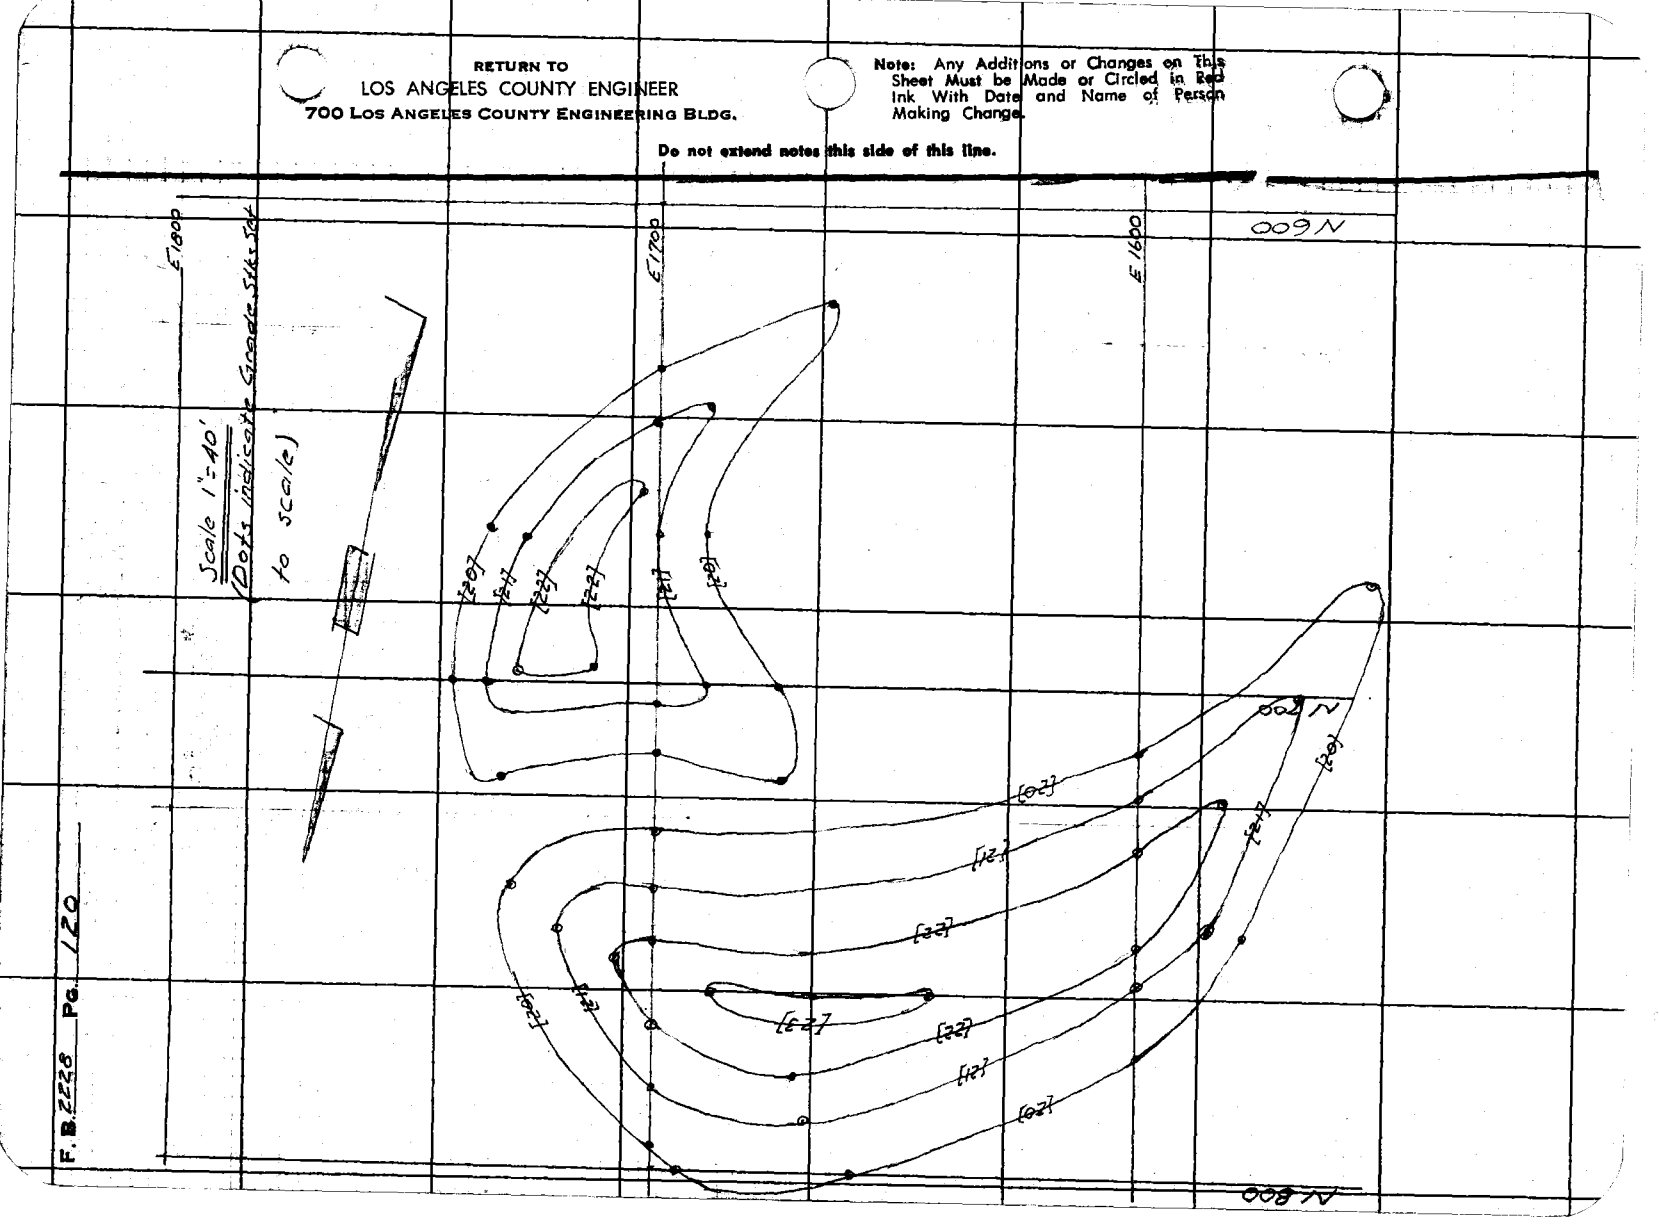

F.B. 2228 Pg. 120

Notes Ck'd by	Survey of John Anson Ford Park
Map No.	JN 8855.02 Tape Std. °F
Office Work	Surveyed by A.S. Curtis
Checked	Notes EFM Vol. Date 4-'58
Date	Indexed C. Johnson

F. B. 2228 Pg. 121

Scale 1" = 40'
(Circled Dots indicate Stks. Set to Grade)
(Scaled)

N 900

N 800

E 1600

E 1500

E 1400


















































Note: Any Additions or Changes on This Sheet Must be Made or Circled in Red Ink With Date and Name of Person Making Change.

Do not extend notes this side of this line.

RETURN TO
LOS ANGELES COUNTY ENGINEER
700 Los Angeles County Engineering Bldg.

76F3095 CE #247—3-57

RETURN TO
LOS ANGELES COUNTY ENGINEER
700 LOS ANGELES COUNTY ENGINEERING BLDG.

Note: Any Additions or Changes on This Sheet Must be Made or Circled in Red Ink With Date and Name of Person Making Change.

Do not extend notes this side of this line.

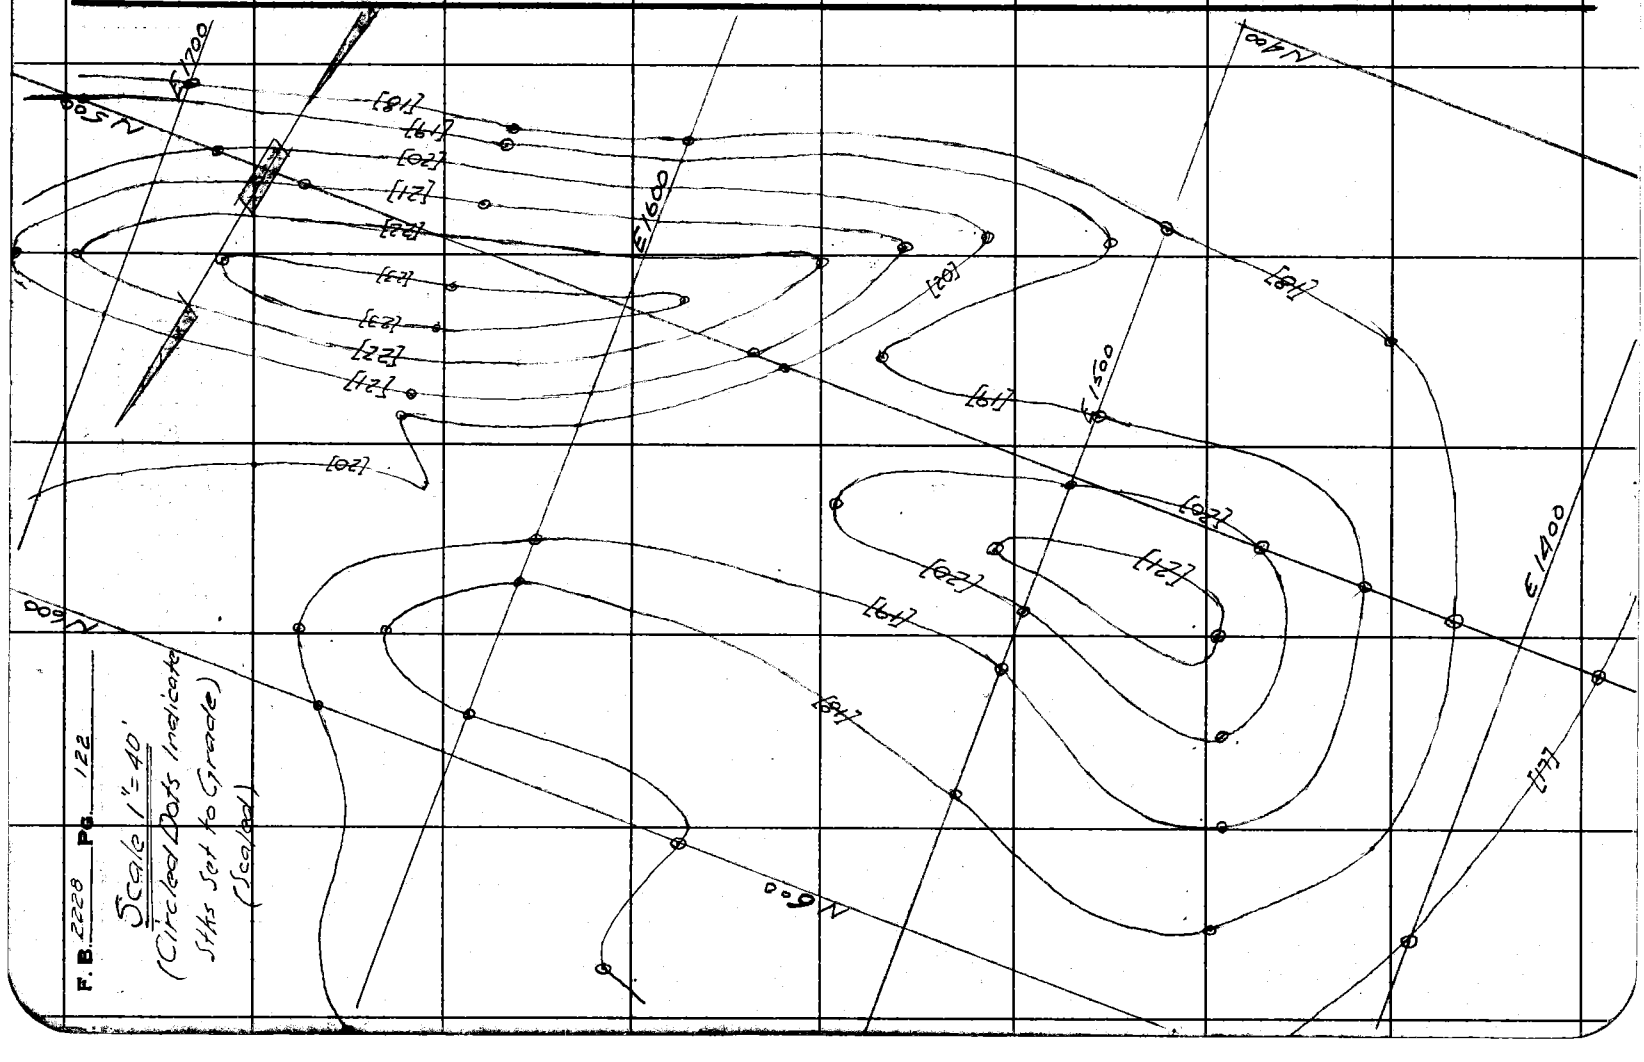

F.B. 2228 Pg. 122

Scale 1"=40'
(Circled Dots Indicate
Stks Set to Grade)
(Scaled)

Notes Ck'd by	Survey of John Anson Ford Park
Map No.	JN 88502 Tape Std °F
Office Work	Surveyed by Curtis
Checked	Notes ETM JG Date 3-58
Date	Indexed K. C. Johnson

F. B. 2228 Pg. 123

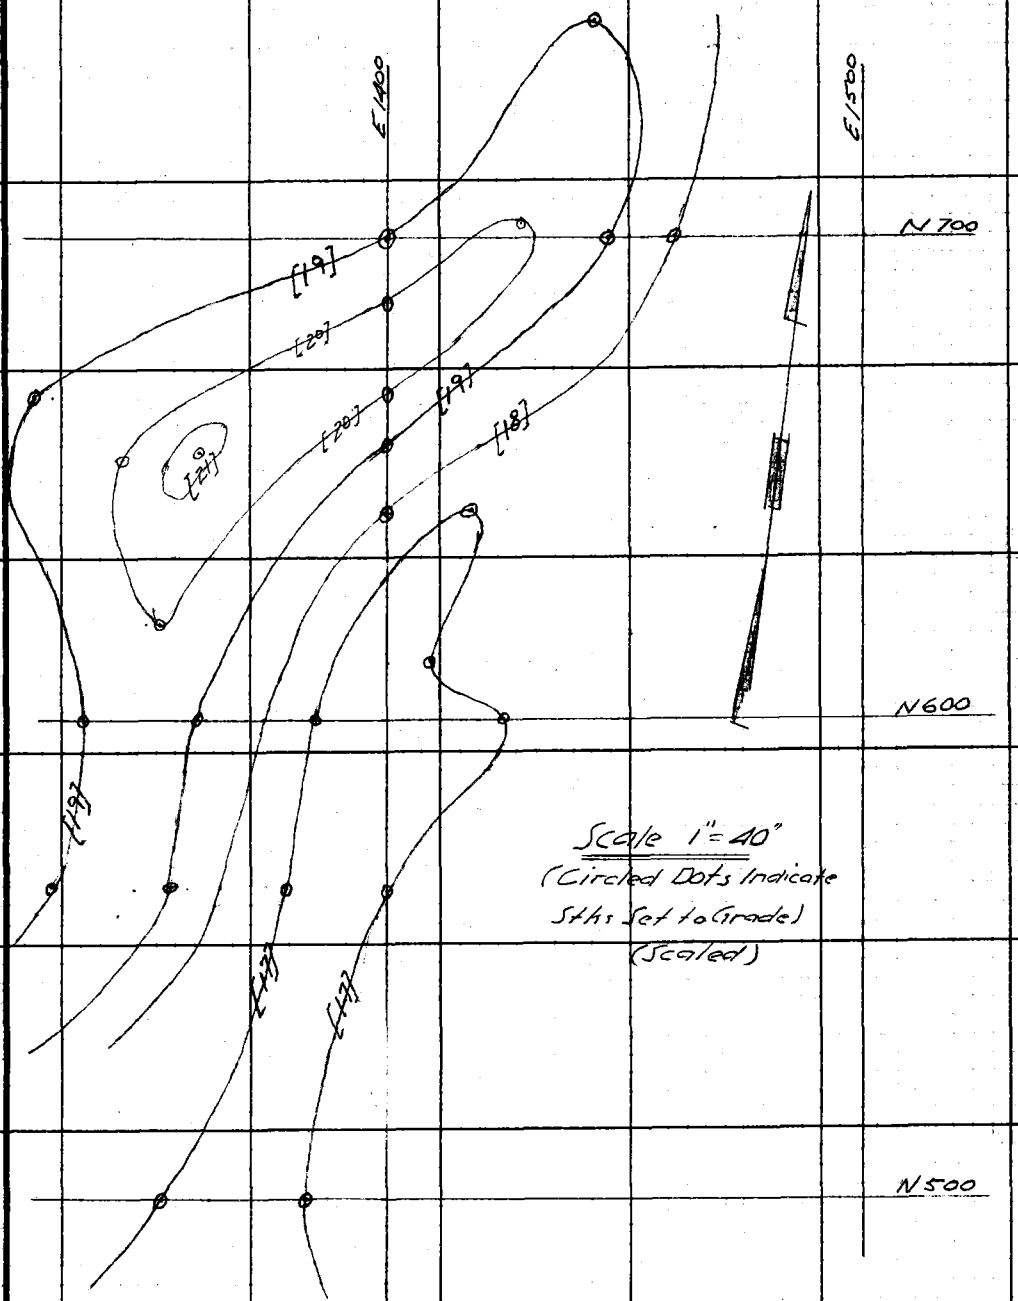

Note: Any Additions or Changes on This Sheet Must be Made or Circled in Red Ink With Date and Name of Person Making Change.

Do not extend notes this side of this line.

RETURN TO
LOS ANGELES COUNTY ENGINEER
700 LOS ANGELES COUNTY ENGINEERING BLDG.

76F3095 CE #247—3-57

RETURN TO
LOS ANGELES COUNTY ENGINEER
700 LOS ANGELES COUNTY ENGINEERING BLDG.

Note: Any Additions or Changes on This Sheet Must be Made or Circled in Red Ink With Date and Name of Person Making Change.

Do not extend notes this side of this line.

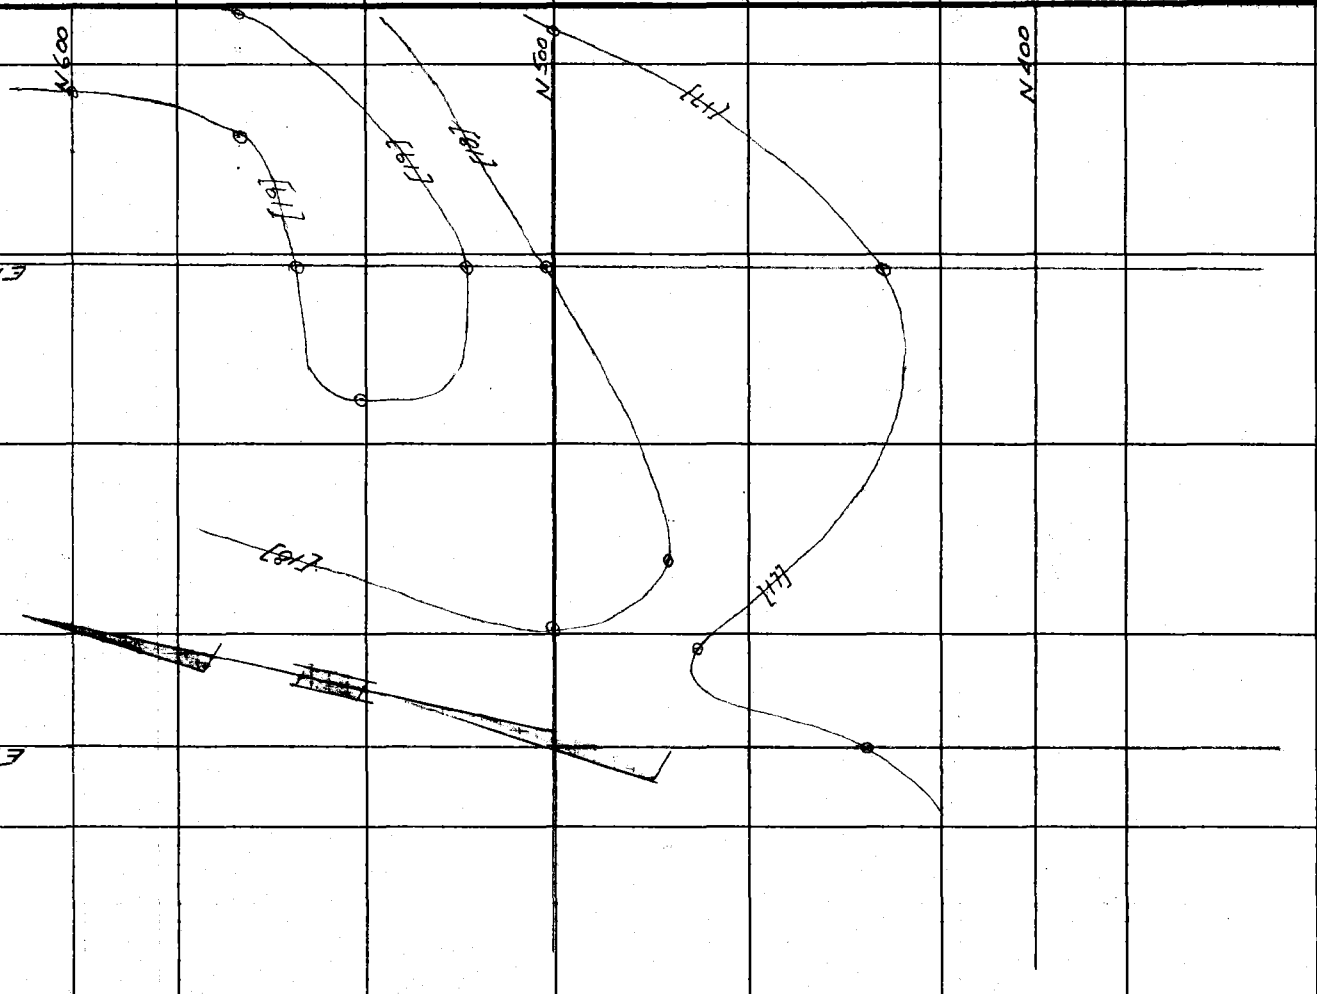

F. B. 2228 Pg. 122

Notes Ck'd by	Survey of John Anson Ford Park
Map No.	JN 8855.02 Tape Std °F
Office Work	Surveyed by A.S. Curtis
Checked	Notes Curtis Date Apr-58
Date	Indexed C. Johnson

F. B. 2228 PG. 125

NOTE-
Circled points indicate stakes set to Grade, on Contours 118° & 119°.

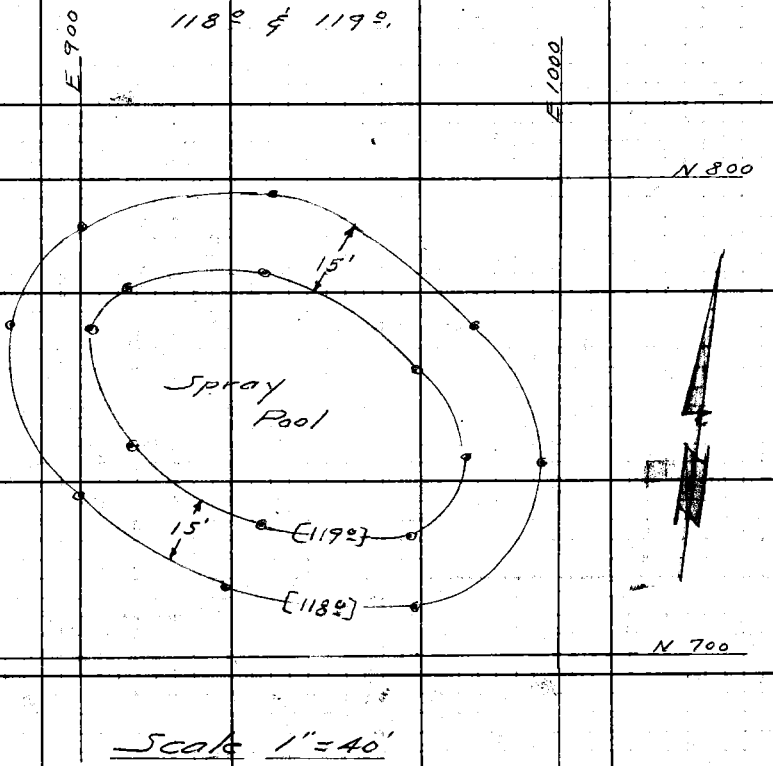

Scale 1"=40'

See page 108/118 for Grid Coordinates

NOTE- These Grade stakes set for Rough Preliminary Grade around the Spray Pool.

Note: Any Additions or Changes on This Sheet Must be Made or Circled in Red Ink With Date and Name of Person Making Change.

Do not extend notes this side of this line.

RETURN TO
LOS ANGELES COUNTY ENGINEER
700 Los Angeles County Engineering Bldg.

76F305S CE #247—3-57

F. B. 2228 Pg. 127

Profile No. ____ Notes Red. ____ Date ____ Plotted ____ Date ____ Job No. 885502 Division No. ____

X-Sec. No. ____ Notes Chkd. ____ Date ____ Checked ____ Date ____ Survey of JOHN FORD PARK

Survey by Curtis Noted Ettner Date March '58

Map No. ____ Indexed C. Johnson Date ____

JN 885.02

JOHN ANSON FORD PARK

GRADING GRID

See Pg. 118 for Location

Curtis
Manley
Rodriguez
Lastferi

STATION	B. S.	H. I.	F. S.	ELEV.

NOTE: ANY ADDITIONS OR CHANGES ON THIS SHEET MUST BE MADE OR CIRCLED IN RED INK, WITH DATE AND NAME OF PERSON MAKING CHANGE.

Do not extend notes this side of this line.

PLEASE RETURN TO
LOS ANGELES COUNTY ENGINEER
700 LOS ANGELES COUNTY ENGINEERING BLDG.

76L-298 S & E #307—1-56

76L-298 S & E #307—1-56

PLEASE RETURN TO
LOS ANGELES COUNTY ENGINEER
700 Los Angeles County Engineering Bldg.

NOTE: ANY ADDITIONS OR CHANGES ON THIS SHEET MUST BE MADE OR CIRCLED IN RED INK, WITH DATE AND NAME OF PERSON MAKING CHANGE.

Do not extend notes this side of this line.

F. B. 2228 Pg. 128
Survey of U.A. Ford Park
Survey by Curtis Notes Markey Alg
Indexed C. Johnson
Job No. 8855-02 Division No.
Notes Red. Date Notes Chkd. Date
Plotted Date Checked Date
Profile No. X-Sec. No.

STATION	B. S.	H. I.	F. S.	ELEV.				
BM								
		Elev	Grade		Sta	Elev	Grade	
N900					N800			
" E2000		120.0'	120.0'	Grade	" E1600	118.8'	118.8'	Gr 1x2 stk
" E1900		20.7'	120.7'	Gr 1x2 stk	" E1500	18.0'	18.0'	" " "
" E1800		20.6'	20.6'	" " "	" E1400	18.0	18.0'	
" E1700		19.7'	19.7'	"	" E1300	18.0	18.0'	
" E1600		19.2'	19.2'	" " "	" E1200	18.0	18.0'	
" E1500		119.7'	119.7'		" E1100	17.0	17.0'	
" E1400		120.3	20.3'		" E1000	17.0'	17.0'	
" E1300		18.0	18.0'		" E900	17.5'	17.5'	
" E1200		18.5	18.5'		" E800	17.5	17.5	
" E1100		18.0	18.0		N700			
" E1000		17.0	17.0		" E2000	119.0'	19.0'	Gr 1x2 stk
" E900		17.5	17.5'		" E1900	19.1	19.1'	
" E800		17.5	17.5'		" E1800	20.2	20.2'	" " "
N800				0.0	" E1700	21.0'	21.0'	" " "
" E2000		120.0'	120.0'	Gr 1x2 stk	" E1600	19.8'	19.8'	" " "
" E1900		19.7'	19.7'	" " "	" E1500	18.0'	18.0'	" " "
" E1800		20.5'	20.5'	" " "	" E1400	19.0	19.0'	
" E1700		120.0'	120.0'	" "	" E1300	18.3	118.3'	

76L-298 S & E #307—3-56

PLEASE RETURN TO
LOS ANGELES COUNTY ENGINEER
700 LOS ANGELES COUNTY ENGINEERING BLDG.

NOTE: ANY ADDITIONS OR CHANGES ON THIS SHEET MUST BE MADE OR CIRCLED IN RED INK, WITH DATE AND NAME OF PERSON MAKING CHANGE.

Do not extend notes this side of this line.

Profile Notes Red. Plotted Job No. 8855-2 Division No.
Notes Chkd. Checked Survey by Curtis Notes Entered Date March 58
No. Date Date Map No. Inked C. Johnson Date


STATION	B. S.	H. I.	F. S.	ELEV.	Sta	Elev	Grade
		Elev	Grade				
N700					N500		
" E 1200		118.0	118.0		" E2000	118.0	118.0'
" E 1100		17.7	17.7'		" E1900	118.0	18.0'
" E 1000		17.5	17.5'		" E1800	118.0	18.0'
" E 900		17.5	17.5'		" E1700	117.1	19.9'
" E 800		17.0	17.0'		" E1600	123.0	23.0' (N Mound)
N600							
" E 2000		18.6	18.6'		" E1500	120.0	120.0 (")
" E 1900		17.2	19.2'		" E1400		17.5'
" E 1800		17.8	19.8'		" E1300	18.0	18.0'
" E 1700		17.8	19.8'		" E1200	18.7	18.7'
" E 1600		18.5	18.5'		" E1100		Casting Pool
" E 1500		18.0	18.0'		" E1000		18.0'
" E 1400		18.0	17.0'		" E900		Casting Pool
" E 1300		18.5	18.5'		E800		118.0'
" E 1200		17.5	17.5'		N400		
" E 1100		18.0	18.0'		" E1400	17.0	17.0'
" E 1000		18.0	18.0'		" E1300	17.0	17.0'
" E 900			18.0'		" E1200	17.0	17.0'
" E 800			17.0'		" E1100	17.0	17.0'
					E1000/900/800		Casting Pool

76L-298 S & E #307—1-56

PLEASE RETURN TO
LOS ANGELES COUNTY ENGINEER
700 LOS ANGELES COUNTY ENGINEERING BLDG.

NOTE: ANY ADDITIONS OR CHANGES ON THIS SHEET MUST BE MADE OR CIRCLED IN RED INK, WITH DATE AND NAME OF PERSON MAKING CHANGE.

N 400
C 45 15'

Do not extend notes this side of this line.

F. B. 2228 Pg. 130 Job No 835502 Division No Profile
Indexed K. C. Johnson Date Notes Chkd Checked No.
Date

STATION	B. S.	H. I.	F. S.	ELEV.				
		Elev	GRADE					
N205 E 380'		14.0	14.0		N400	Elev	Grade	
N250 E300'		14.0	14.0		" E600	176	15.5	C 2.0
N220 E452'		14.0	14.0		" E700	155	16.5	0.0
N245 E452		14.0	14.0		N500 W100	16.9	14.9	C 2.0
N300 E200		14.3	14.3		" E00	16.6	14.6	C 2.0
" E300'		14.0	14.0		" E100	16.8	14.8	C 2.0
" E400		15.2	14.2	C 1.0	" E200	17.0	15.0	C 2.0
N361 E465		15.0	15.0	Natural Gr.	" E300	17.3	15.3	C 2.0
N325 E200			14.0		" E400	17.5	15.5	C 2.0
N338 E164			15.9		" E500	18.2	15.8	C 2.4
N350 E129			19.0	Natural Gr.	" E600	16.8	15.8	C 1.0
N380 E108			19.0	" "	" E700	16.8	15.8	C 1.0
N422 E 82'		17.9	14.0	C 3.9	N570 E205		16.0	
E 00		17.0	15.0	C 2.0	W240 N600	15.0	15.0	
N400					" W200	15.1	15.1	
" E100		17.1	14.1	C 3.0	" W100	15.2	15.2	0.0
" E200		17.3	14.3	C 3.0	" E00	16.2	15.2	C 1.0
" E300		17.6	14.6	C 3.0	" E100	15.7	15.2	C 0.5
" E400		17.7	15.2	C 2.5	" E200	16.3	15.3	C 1.0
" E500		17.0	15.5	C 1.5	E300	16.7	15.7	C 1.0

76L-298 S & E #307—1-56

PLEASE RETURN TO
LOS ANGELES COUNTY ENGINEER
700 LOS ANGELES COUNTY ENGINEERING BLDG.

NOTE: ANY ADDITIONS OR CHANGES ON THIS SHEET MUST BE MADE OR CIRCLED IN RED INK, WITH DATE AND NAME OF PERSON MAKING CHANGE.

Do not extend notes this side of this line.

Profile Notes Red. Plotted Job No. 8855.02 Division No. 10 F. B. 2228 Pg. 191
No. Notes Chkd. Checked Survey by Curtis Notes Curtis Date Mar-1958
Date Date Map No. Index C. Johnson Date

STATION	B. S.	H. I.	F. S.	ELEV.
		Elev	Grade	
N600				
" E400		16.9	115	C 1.0
" E500		17.2	16	C 1.0
" E600		17.3	16	C 1.0
" E700		18.3	16	C 2.0
N700 E793		17.5	16	C 1.0
" W300		15.0	15	
" W 200		15.6	15	
" W 100		15.7	15	
" E 00		15.8	15	
" E 100		15.8	15	
" E 200		15.9	15	
" E 300		16.1	16	
" E 400		16.4	16	
" E 500		16.6	16	
" E 600		16.7	16	
" E 700		17.2	17	
" E 800		17.0	17	
N800 W 400			"	
" W 300		15.5	15	

STATION	Elev	Grade
N800		
" W200	11.6	116
" W100	11.6	16
" E00	16.3	16
" E100	16.4	16
" E200	16.5	16
" E300	16.6	16
" E400	16.7	16
" E500	17.0	17
" E600	17.2	17
" E700	17.5	17
N900 E800	17.5	17
" W300	15.6	15
" W250	16.0	116
" W200	16.2	16
" W100	16.6	16
" E00	16.9	16
" E100	17.0	17
" E200	17.0	17
" E300	17.2	17

76L-298 S & E #307—1-56

PLEASE RETURN TO
LOS ANGELES COUNTY ENGINEER
700 LOS ANGELES COUNTY ENGINEERING BLDG.

NOTE: ANY ADDITIONS OR CHANGES ON THIS SHEET MUST BE MADE OR CIRCLED IN RED INK, WITH DATE AND NAME OF PERSON MAKING CHANGE.

Do not extend notes this side of this line.

F. B. 2228 Pg. 132 Job No 8855.02 Division No 10 Notes Red. Plotted Profile
Survey by Curtis Notes Monkey Va Notes Chkd. Checked
Indexed C. Johnson Date Date No

STATION	B. S.	H. I.	F. S.	ELEV.	Sta	Elev	Grade	
		Elev.	Grade					
N900 E400		17.3	117.3'		N1100 W100	16.7	116.7'	
E500		17.5	17.5'		E00	17.2	17.2'	
E600		18.0	18.0'		E100	17.4	17.4'	
E700		18.5	18.5'		E200	17.7	17.7'	
N1000 E800		17.5	17.5'	0.0	E300	18.0	18.0'	
" W300					E400		17.7'	Parking Lot
" W200		116.0	116.0'		E500		17.0'	" "
" W100		17.0	17.0'		N1300 W100			
" E00		17.2	17.2'		" W50		116.0'	
" E100		17.3	17.3'		" E00	17.9	17.0'	0.0
" E200		17.4	17.4'		" E100	18.4	17.4'	C1.0
" E300		17.6	17.6'		" E200		17.'	Parking Lot
" E400		17.8	17.8'		" E300		16.7'	" "
" E500		18.0	18.0'		N1300 E400		16.5'	" "
" E600			17.5'	Parking Lot	W60'		16.0'	
" E700		18.0	118.0'		N1300 E00	17.0	17.0'	
E800		Natural Gr.			E100		16.5'	Parking Lot
N1100 W200					N1400 E00	16.0	16.0'	
" W145		116.0	116.0'					

Notes Ck'd by	Survey of JOHN ANSON FORD PARK
Map No.	JN 8855.02 Tape Std °F
Office Work	Surveyed by A S Curtis
Checked	Notes E T M J C Date 4/58
Date	Indexed L. O. Johnson 1-16-59

F. B 2228 Pg. 133

JN 8855.02

JOHN ANSON FORD PARK

LOCATION of

WATER LINES

&

GAS LINES

Curtis
Markey
Rodriguez
Latteri

Note: Any Additions or Changes on This Sheet Must be Made in Red Ink With Date and Name of Person Making Change.

Do not extend notes this side of this line.

RETURN TO
LOS ANGELES COUNTY ENGINEER
700 LOS ANGELES COUNTY ENGINEERING BLDG.

76F3098 CE #247 3-57

RETURN TO
LOS ANGELES COUNTY ENGINEER
700 LOS ANGELES COUNTY ENGINEERING BLDG.

Note: Any Additions or Changes on This Sheet Must be Made or Circled in Red Ink With Date and Name of Person Making Change.

Do not extend notes this side of this line.

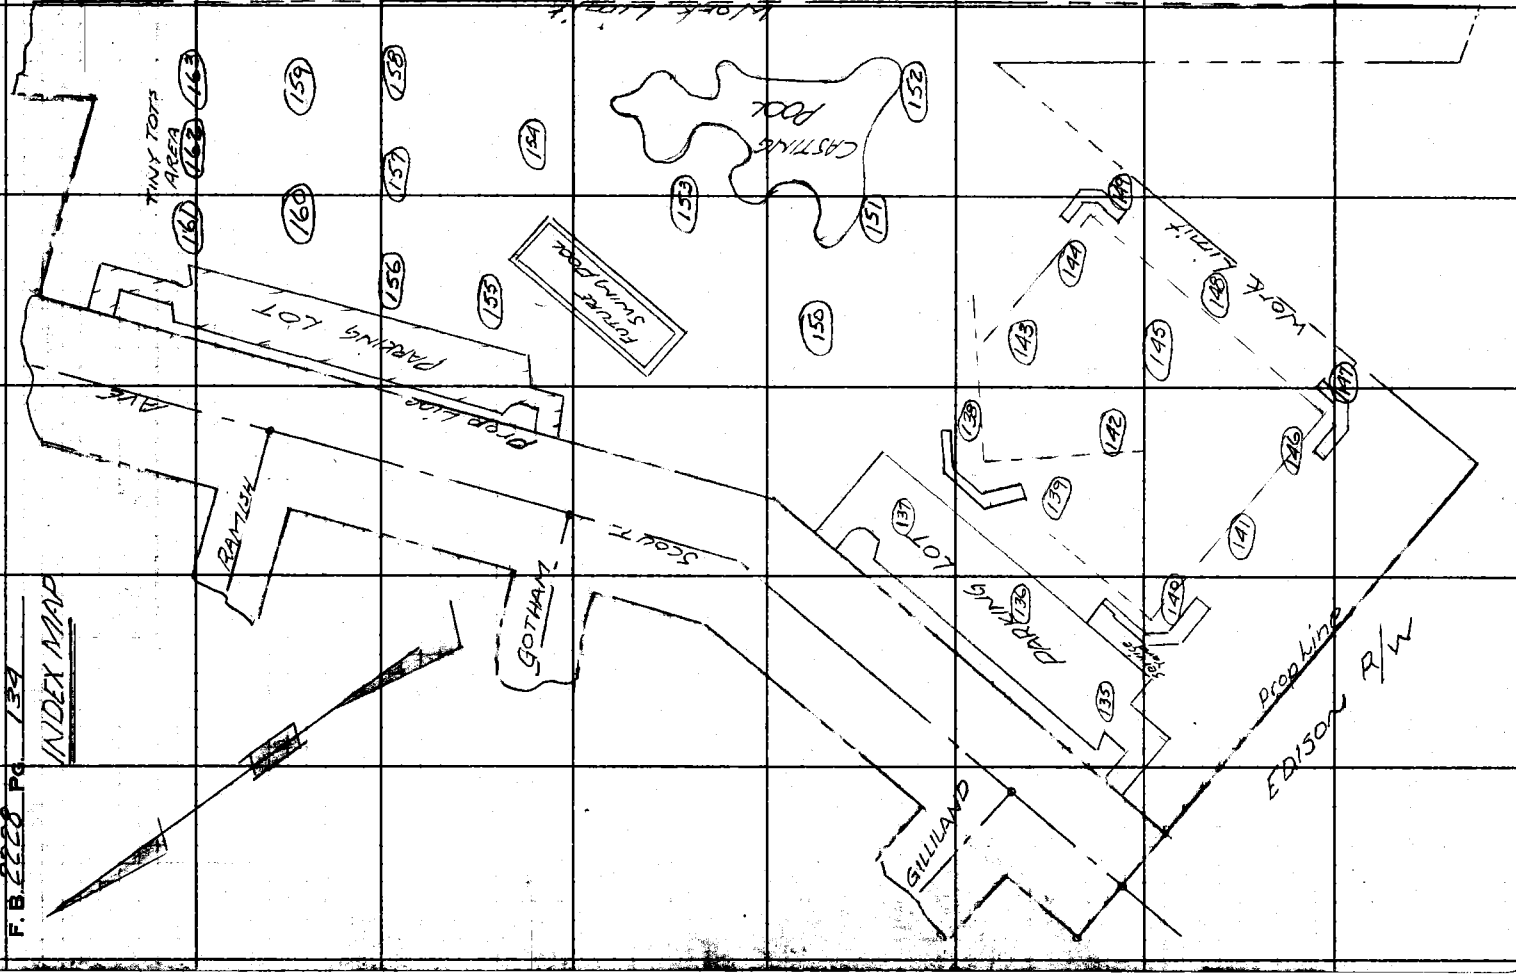

76F3098 CE #247—8-57

RETURN TO
LOS ANGELES COUNTY ENGINEER
700 LOS ANGELES COUNTY ENGINEERING BLDG.

Note: Any Additions or Changes on This Sheet Must be Made or Circled in Red Ink With Date and Name of Person Making Change.

Do not extend notes this side of this line.

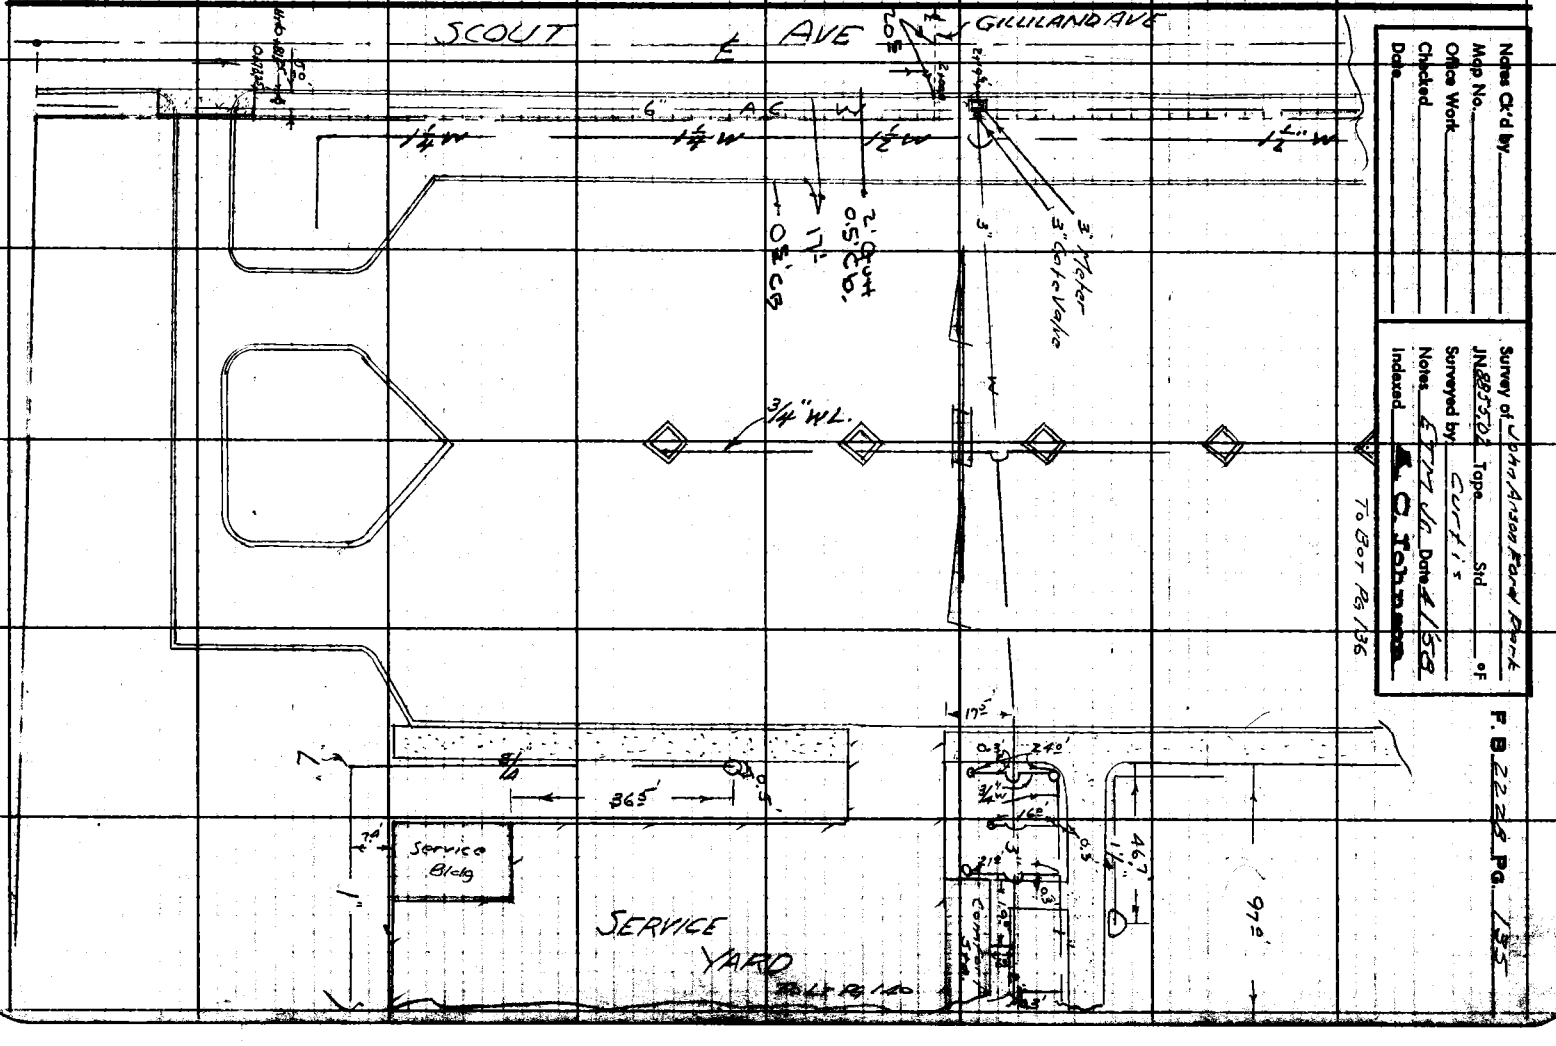

Notes Ck'd by _____
Map No. _____
Office Work _____
Checked _____
Date _____

Surveyed by Curtis Date 4/1/58
Notes _____
Indexed _____


RETURN TO
LOS ANGELES COUNTY ENGINEER
700 LOS ANGELES COUNTY ENGINEERING BLDG.

Note: Any Additions or Changes on This Sheet Must be Made or Circled In Red Ink With Date and Name of Person Making Change.

Do not extend notes this side of this line.

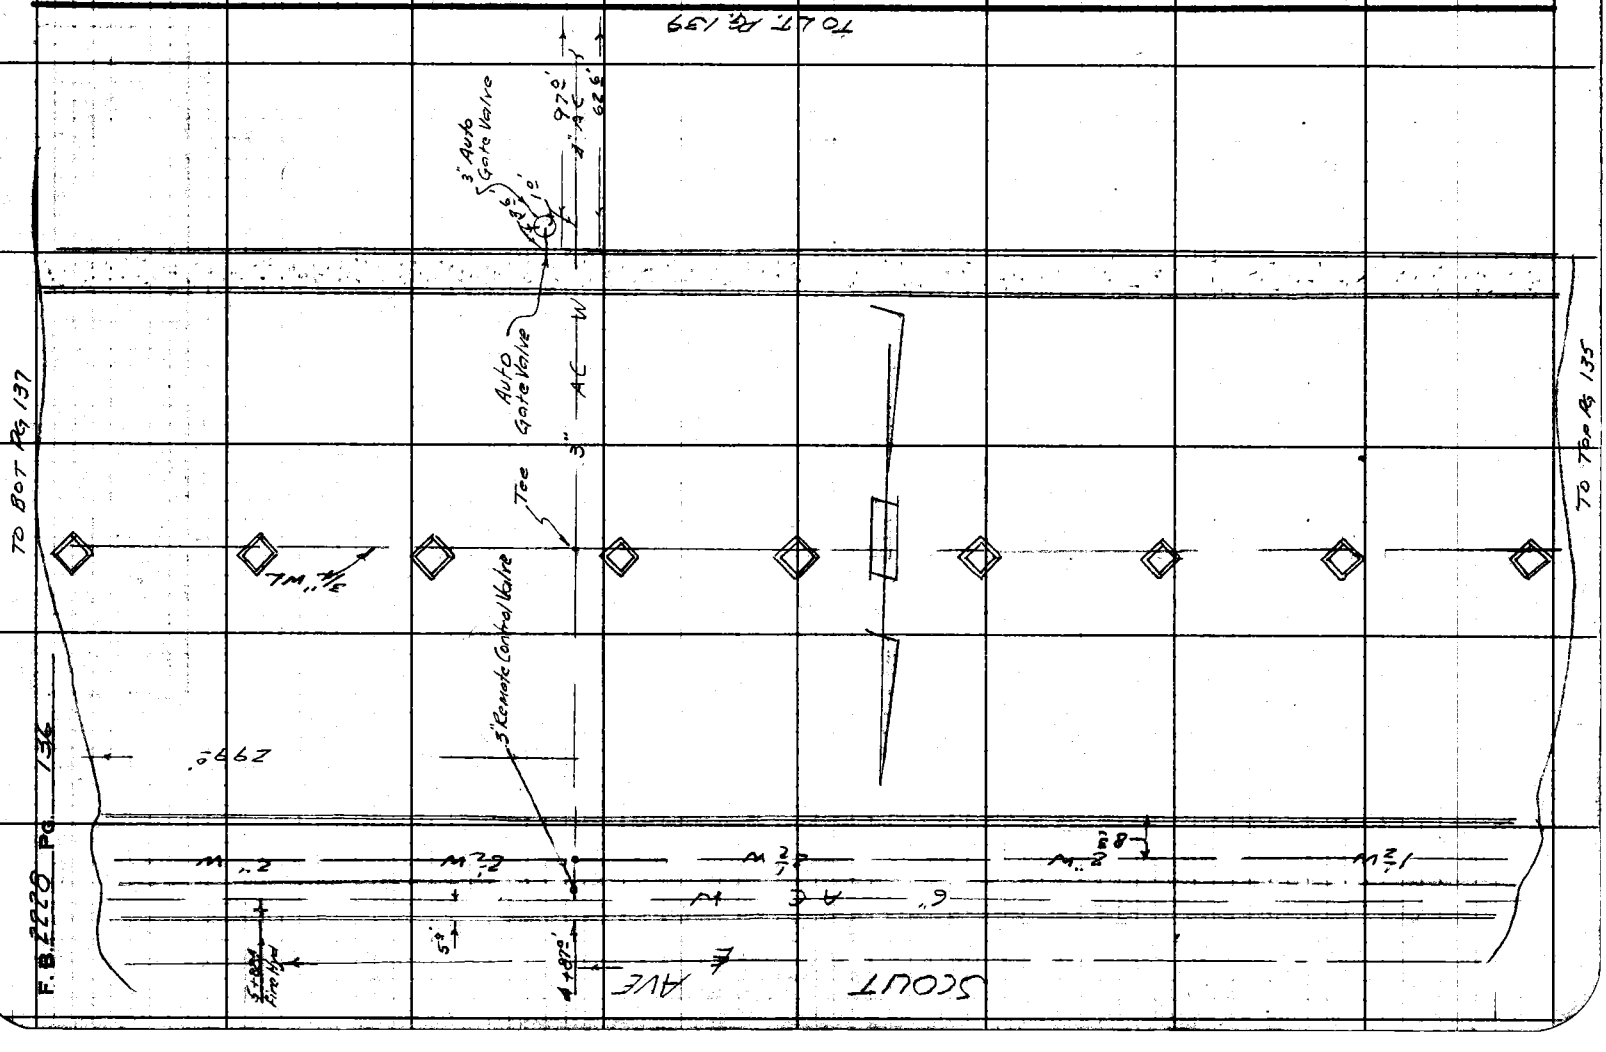

76F3095 CE #247—3-57

RETURN TO
LOS ANGELES COUNTY ENGINEER
700 LOS ANGELES COUNTY ENGINEERING BLDG.

Note: Any Additions or Changes on This Sheet Must be Made or Circled in Red Ink With Date and Name of Person Making Change.

Do not extend notes this side of this line.

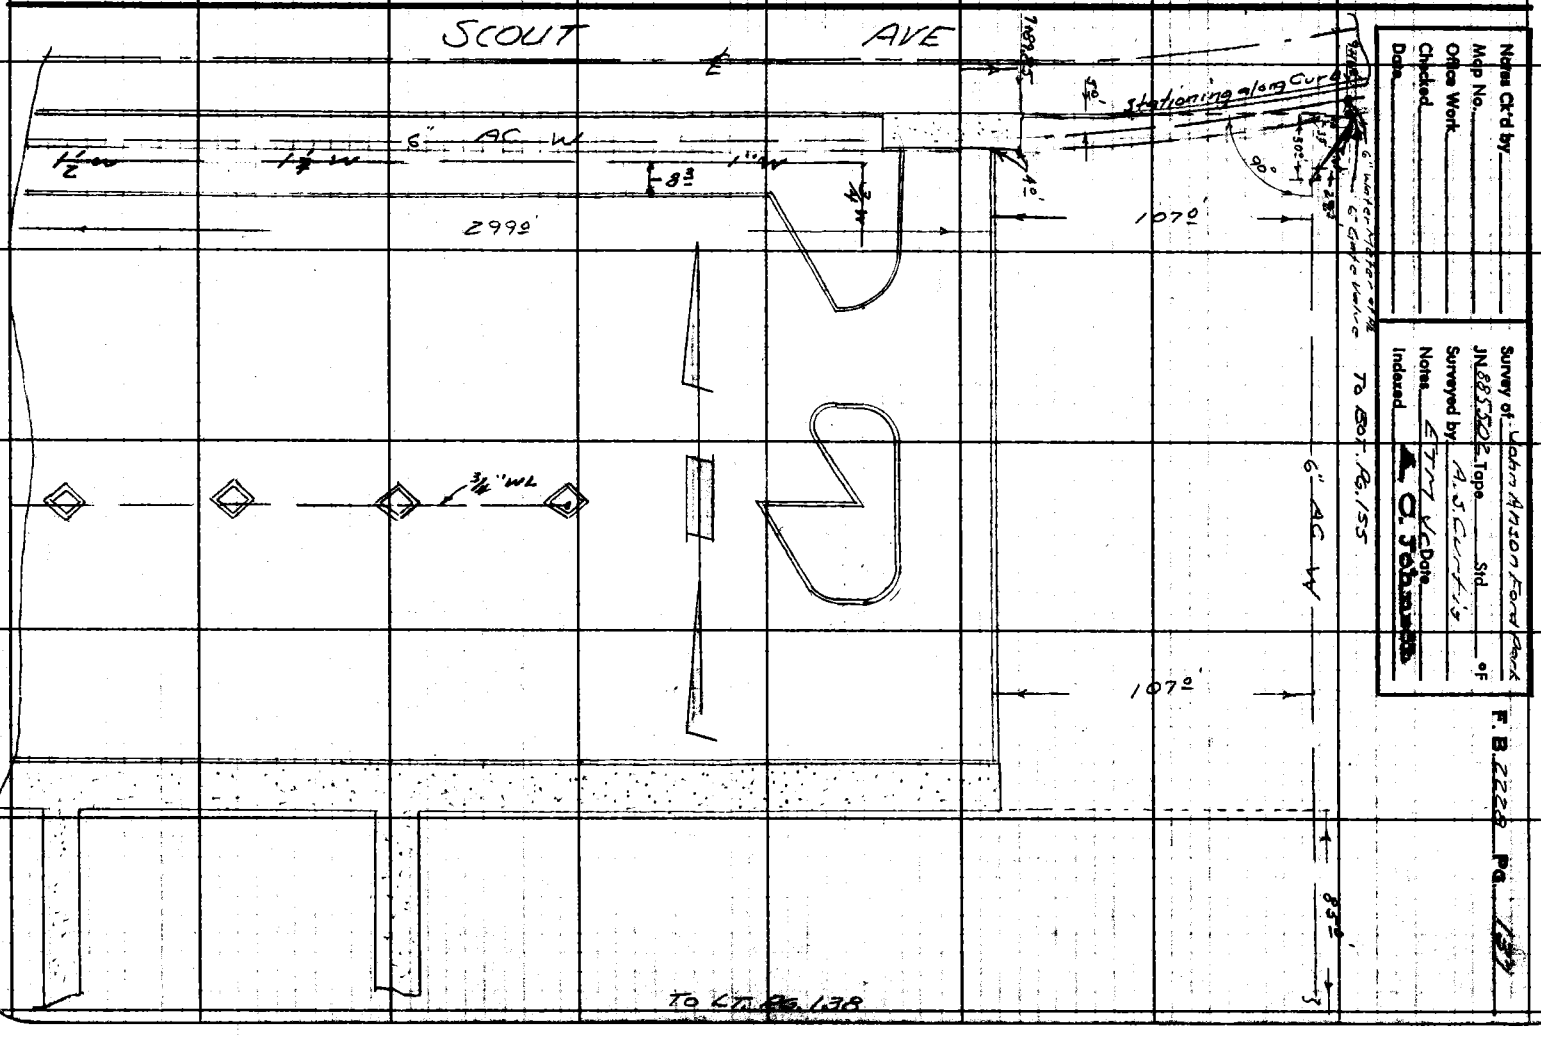

Notes Ck'd by
Map No.
Office Work
Checked
Date

JN 885202 Tape Std. oF
Surveyed by A. J. Curtis
Notes
Indexed A. C. Johnson

F. B. 2228 Pg. 137

RETURN TO
LOS ANGELES COUNTY ENGINEER
700 LOS ANGELES COUNTY ENGINEERING BLDG.

Note: Any Additions or Changes on This Sheet Must be Made or Circled in Red Ink With Date and Name of Person Making Change.

Do not extend notes this side of this line.

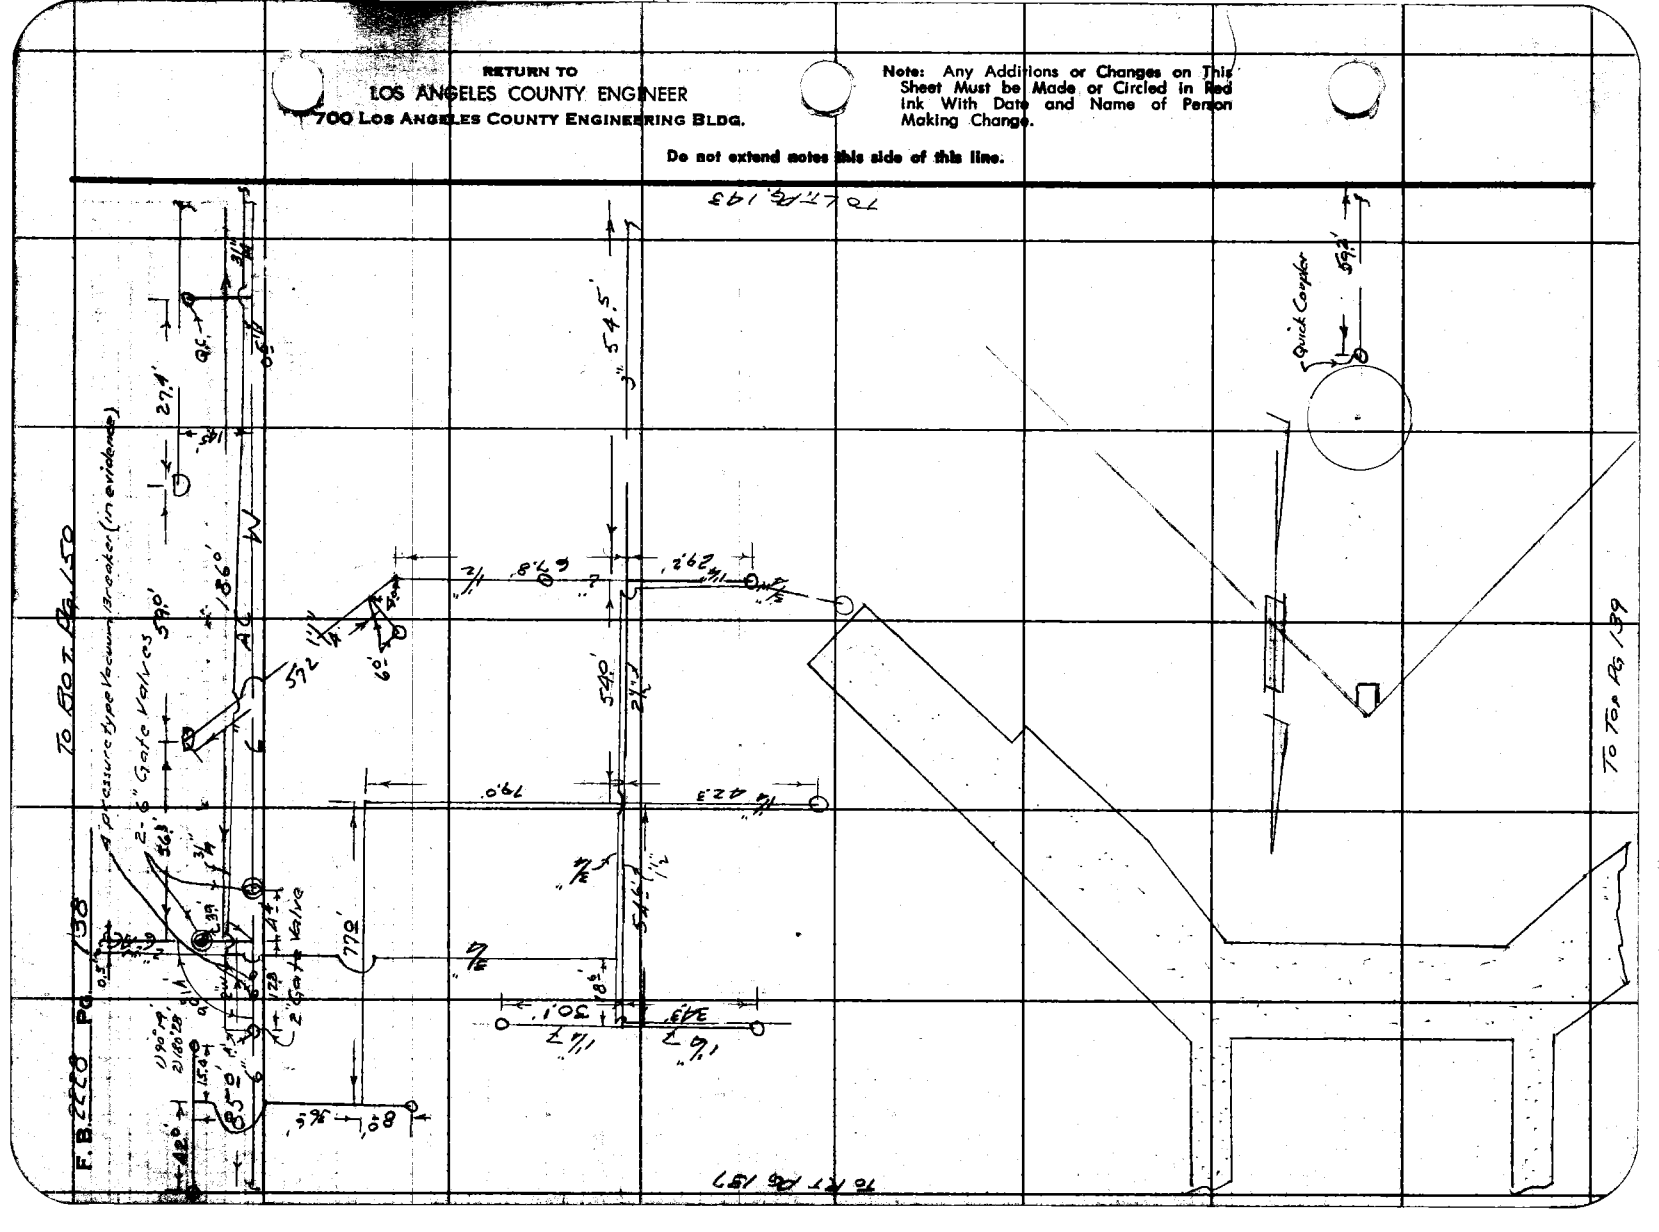

76F3095 CE #247—8-57

RETURN TO
LOS ANGELES COUNTY ENGINEER
700 LOS ANGELES COUNTY ENGINEERING BLDG.

Note: Any Additions or Changes on This Sheet Must be Made or Circled in Red Ink With Date and Name of Person Making Change.

Do not extend notes this side of this line.

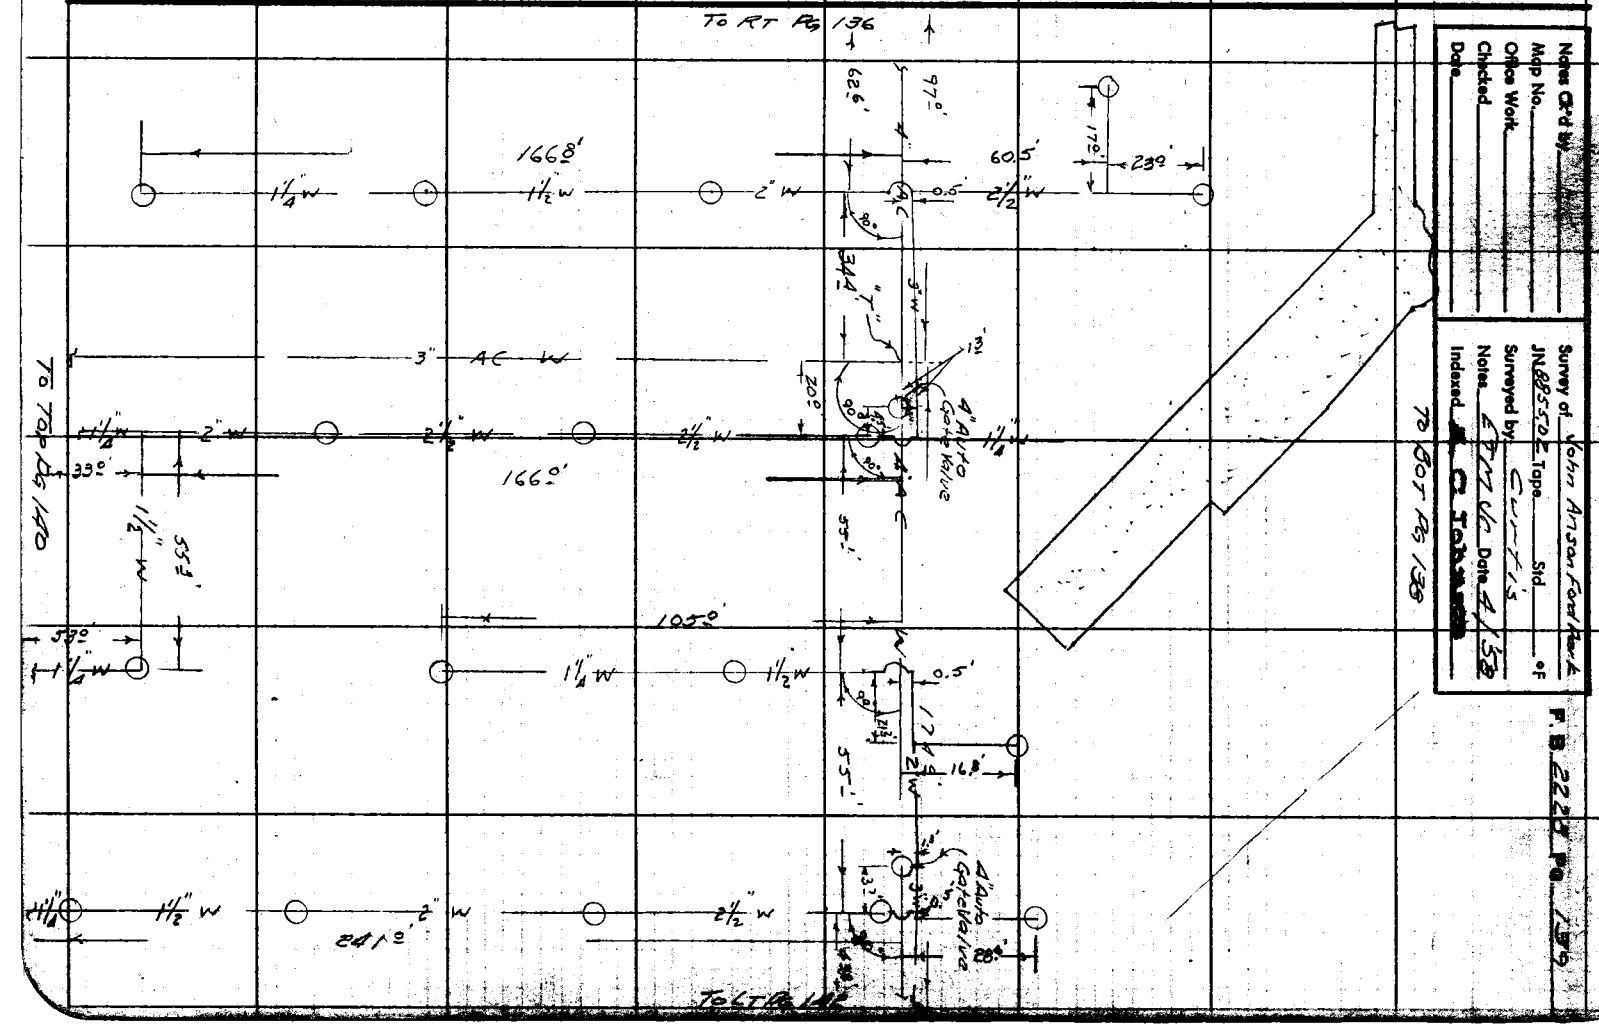

Notes Ck'd by _____
Map No. _____
Office Work _____
Checked _____
Date _____

Survey of John Anson Ford Park
JN 88552 Tape _____ Std. _____ of


RETURN TO
LOS ANGELES COUNTY ENGINEER
700 LOS ANGELES COUNTY ENGINEERING BLDG.

Note: Any Additions or Changes on This Sheet Must be Made or Circled in Red Ink With Date and Name of Person Making Change.

Do not extend notes this side of this line.

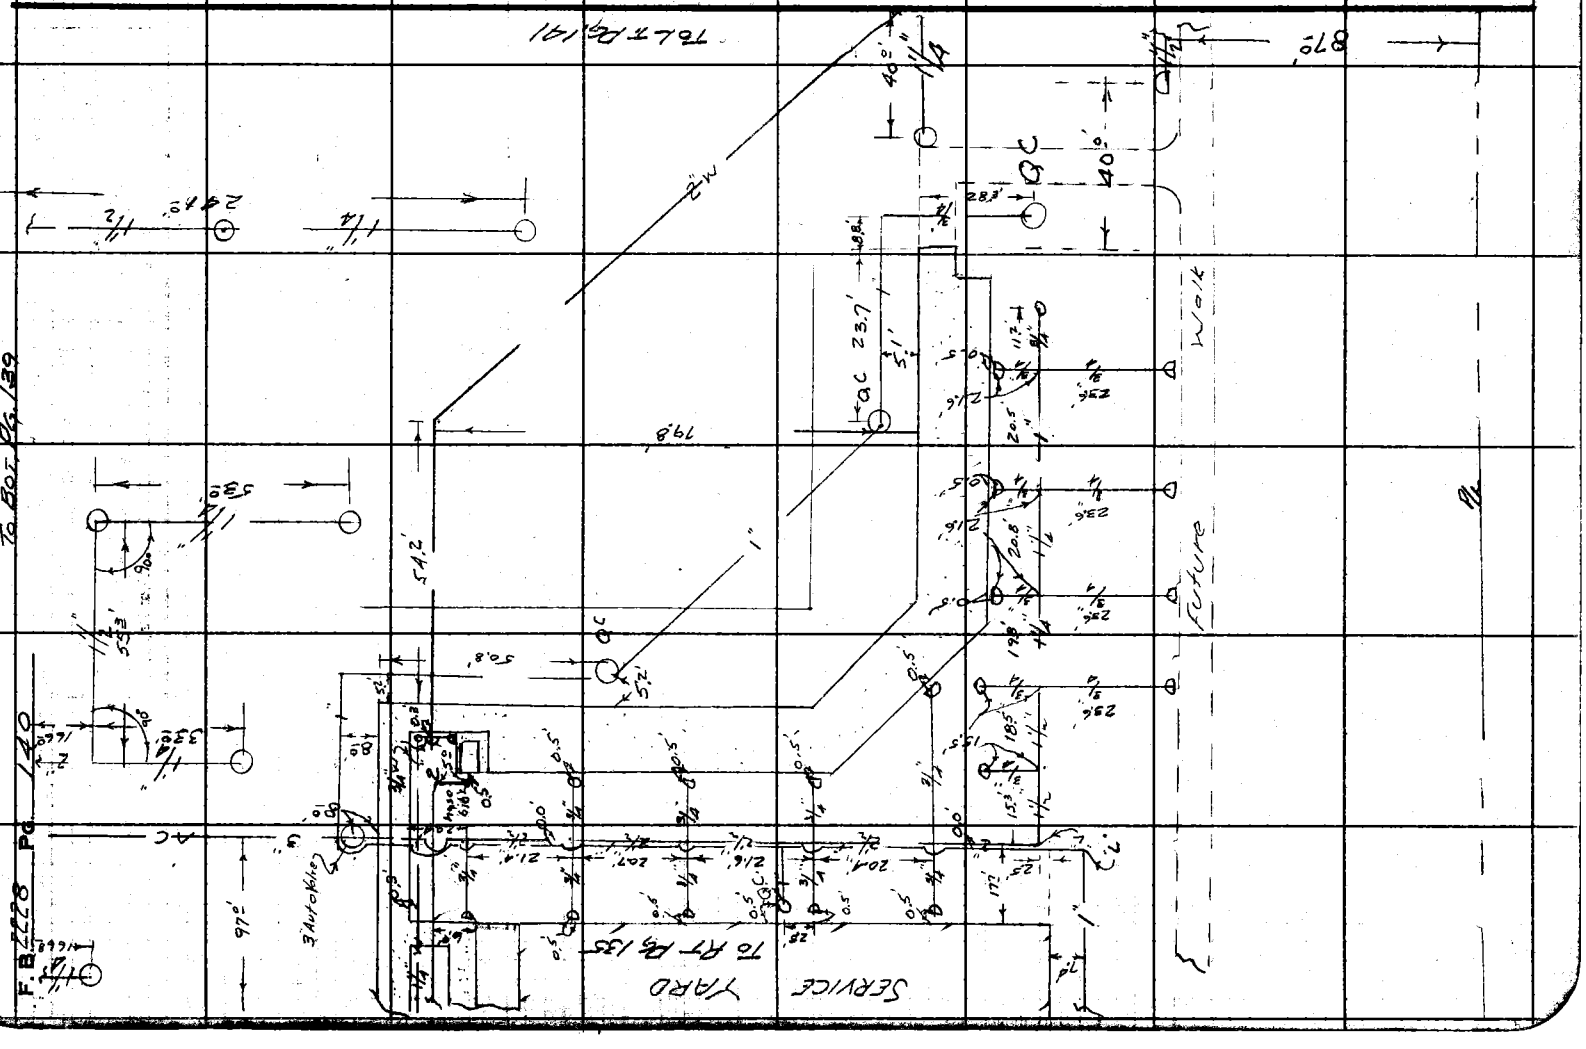

76F3095 CE #247—3-57

RETURN TO
LOS ANGELES COUNTY ENGINEER
700 LOS ANGELES COUNTY ENGINEERING BLDG.

Note: Any Additions or Changes on This Sheet Must be Made or Circled in Red Ink With Date and Name of Person Making Change.

Do not extend notes this side of this line.

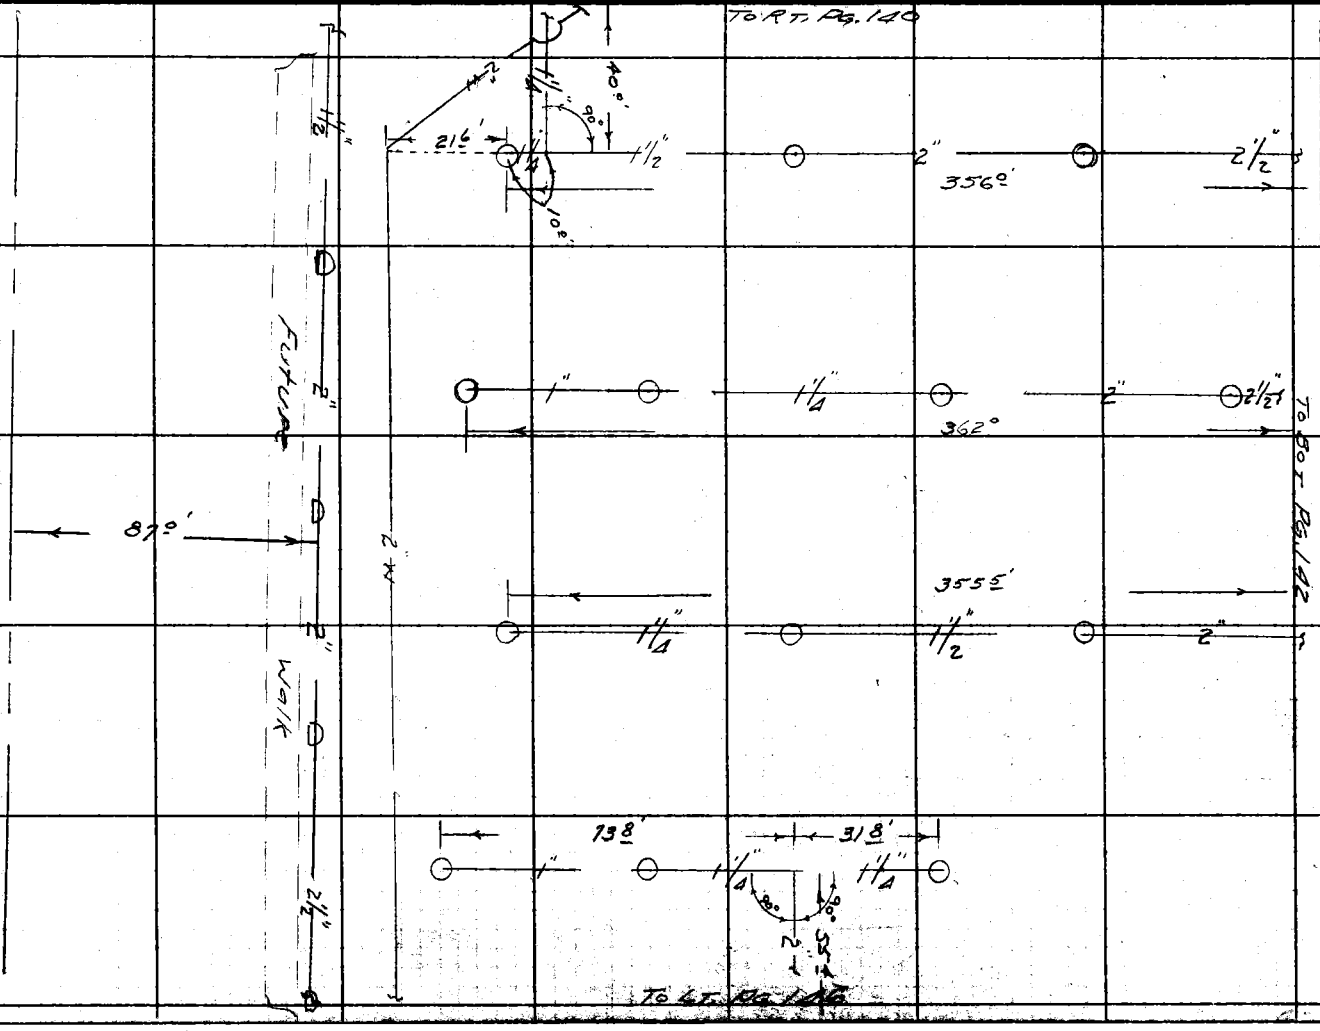

Notes Ck'd by
Map No.
Office Work
Checked
Date



RETURN TO
LOS ANGELES COUNTY ENGINEER
700 LOS ANGELES COUNTY ENGINEERING BLDG.

Note: Any Additions or Changes on This Sheet Must be Made or Circled in Red Ink With Date and Name of Person Making Change.

Do not extend notes this side of this line.

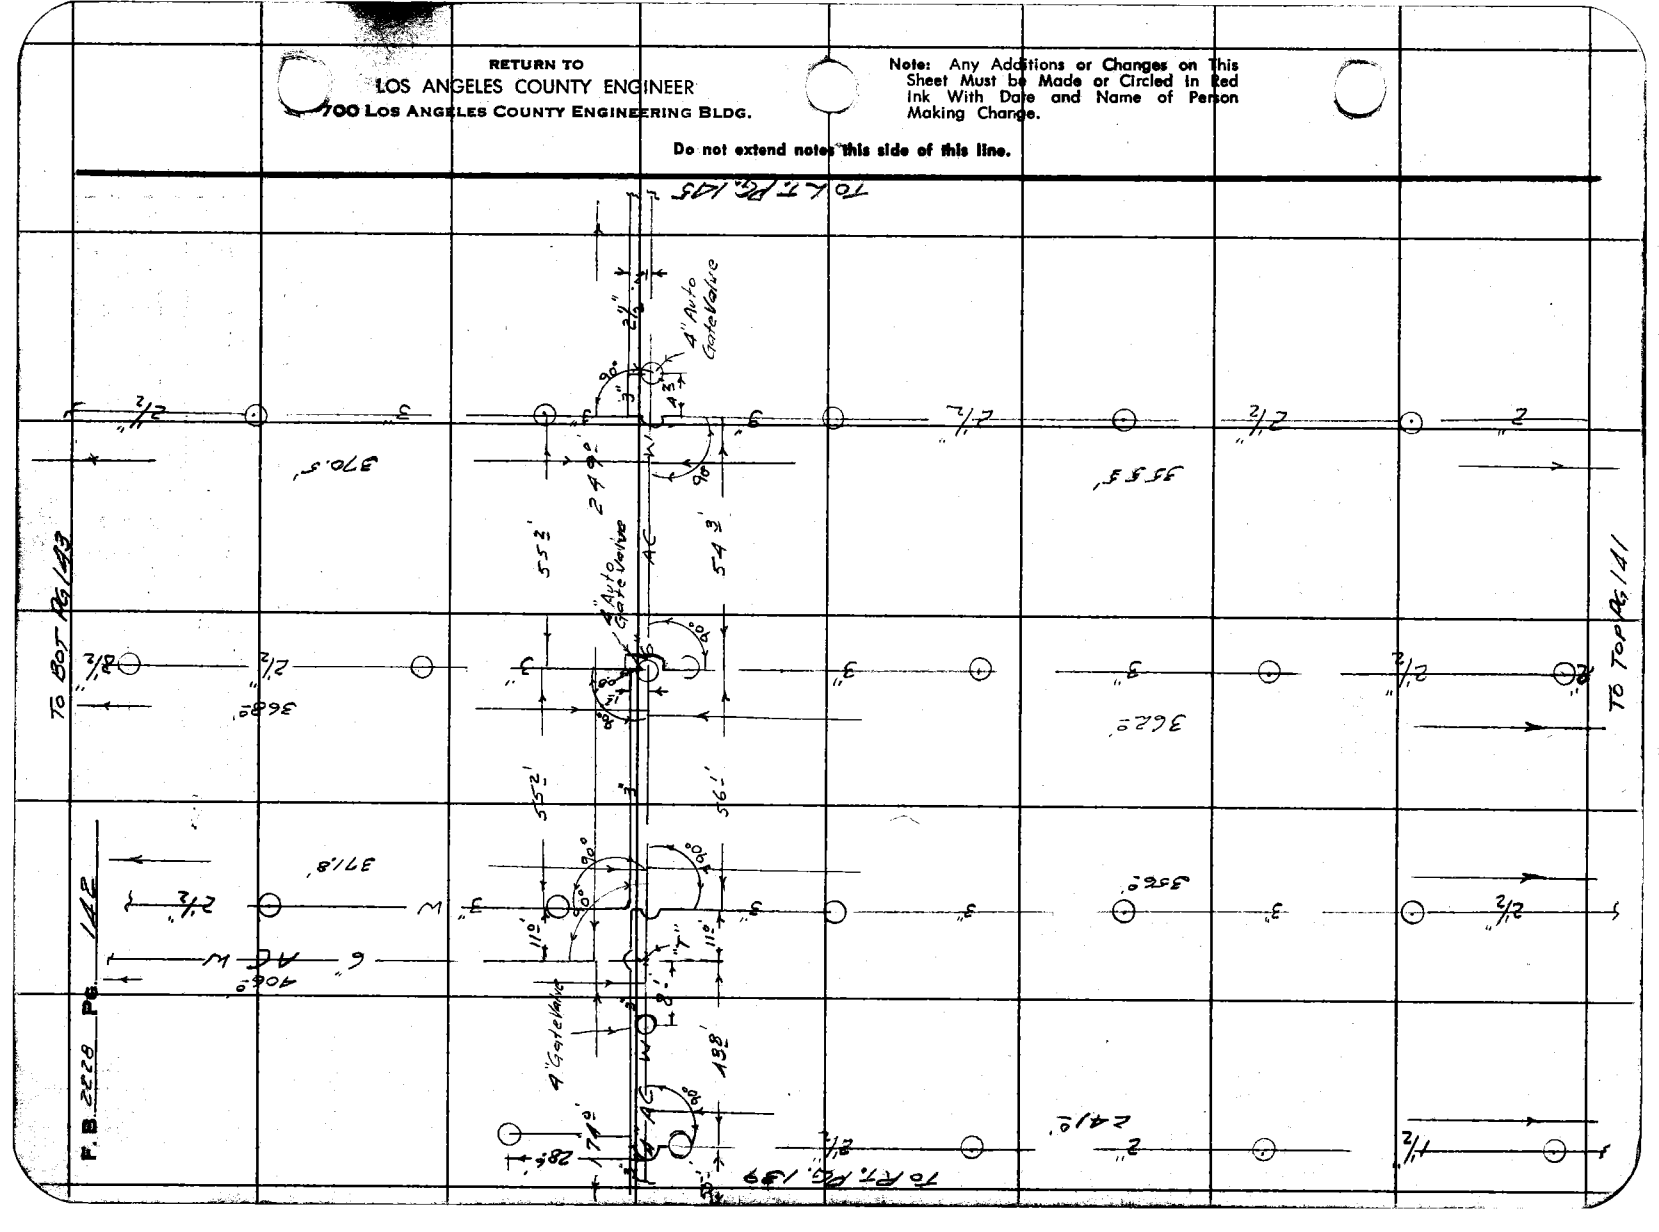
4" Auto Gate Valve
90°
24.9'
AC
55.2'
54.3'
4" Auto Gate Valve
90°
90°
90°

76F3095 CE #247—3-57

RETURN TO
LOS ANGELES COUNTY ENGINEER
700 LOS ANGELES COUNTY ENGINEERING BLDG.

Note: Any Additions or Changes on This Sheet Must be Made or Circled in Red Ink With Date and Name of Person Making Change.

Do not extend notes this side of this line.

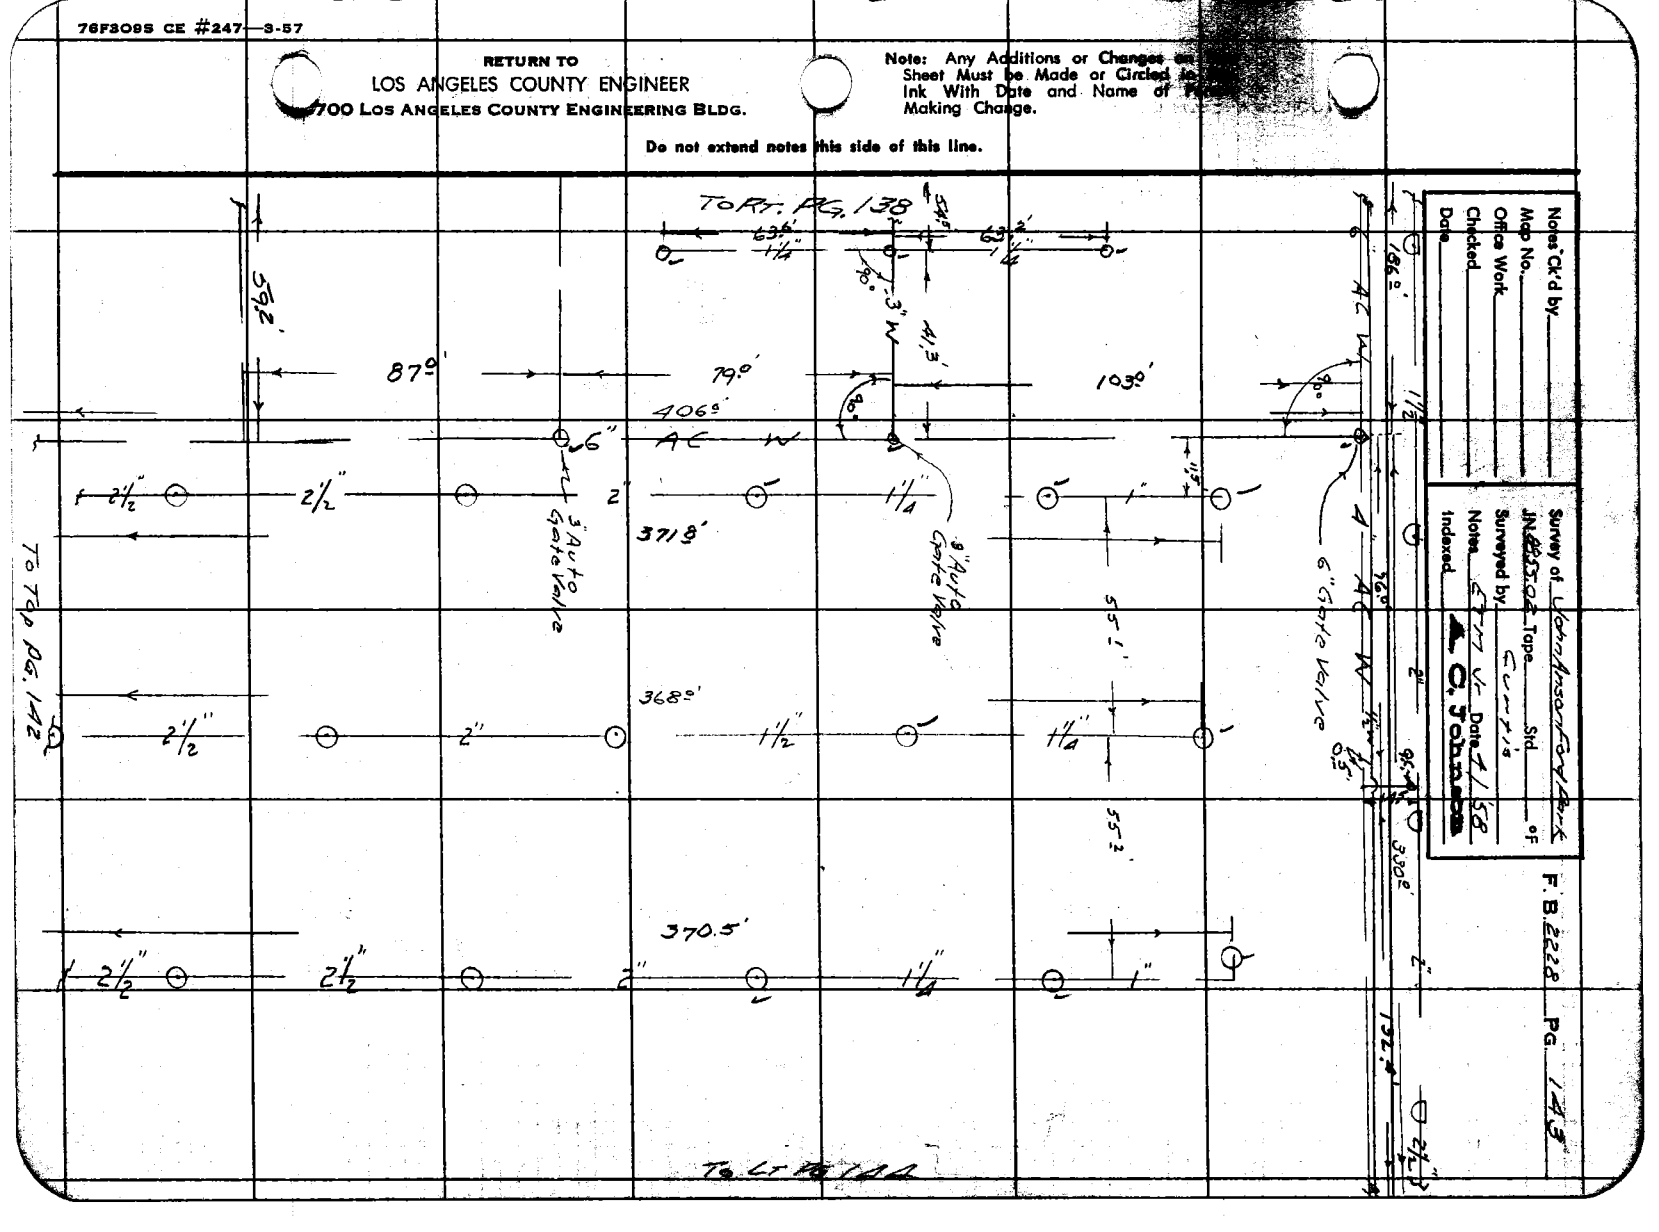

Notes Ck'd by _____
Map No. _____
Office Work _____
Checked _____
Date _____

Surveyed by Curtis
Indexed A. C. Johnson

F. B. 2228 PG. 143

RETURN TO
LOS ANGELES COUNTY ENGINEER
700 LOS ANGELES COUNTY ENGINEERING BLDG.

Note: Any Additions or Changes on This Sheet Must be Made or Circled in Red Ink With Date and Name of Person Making Change.

Do not extend notes this side of this line.

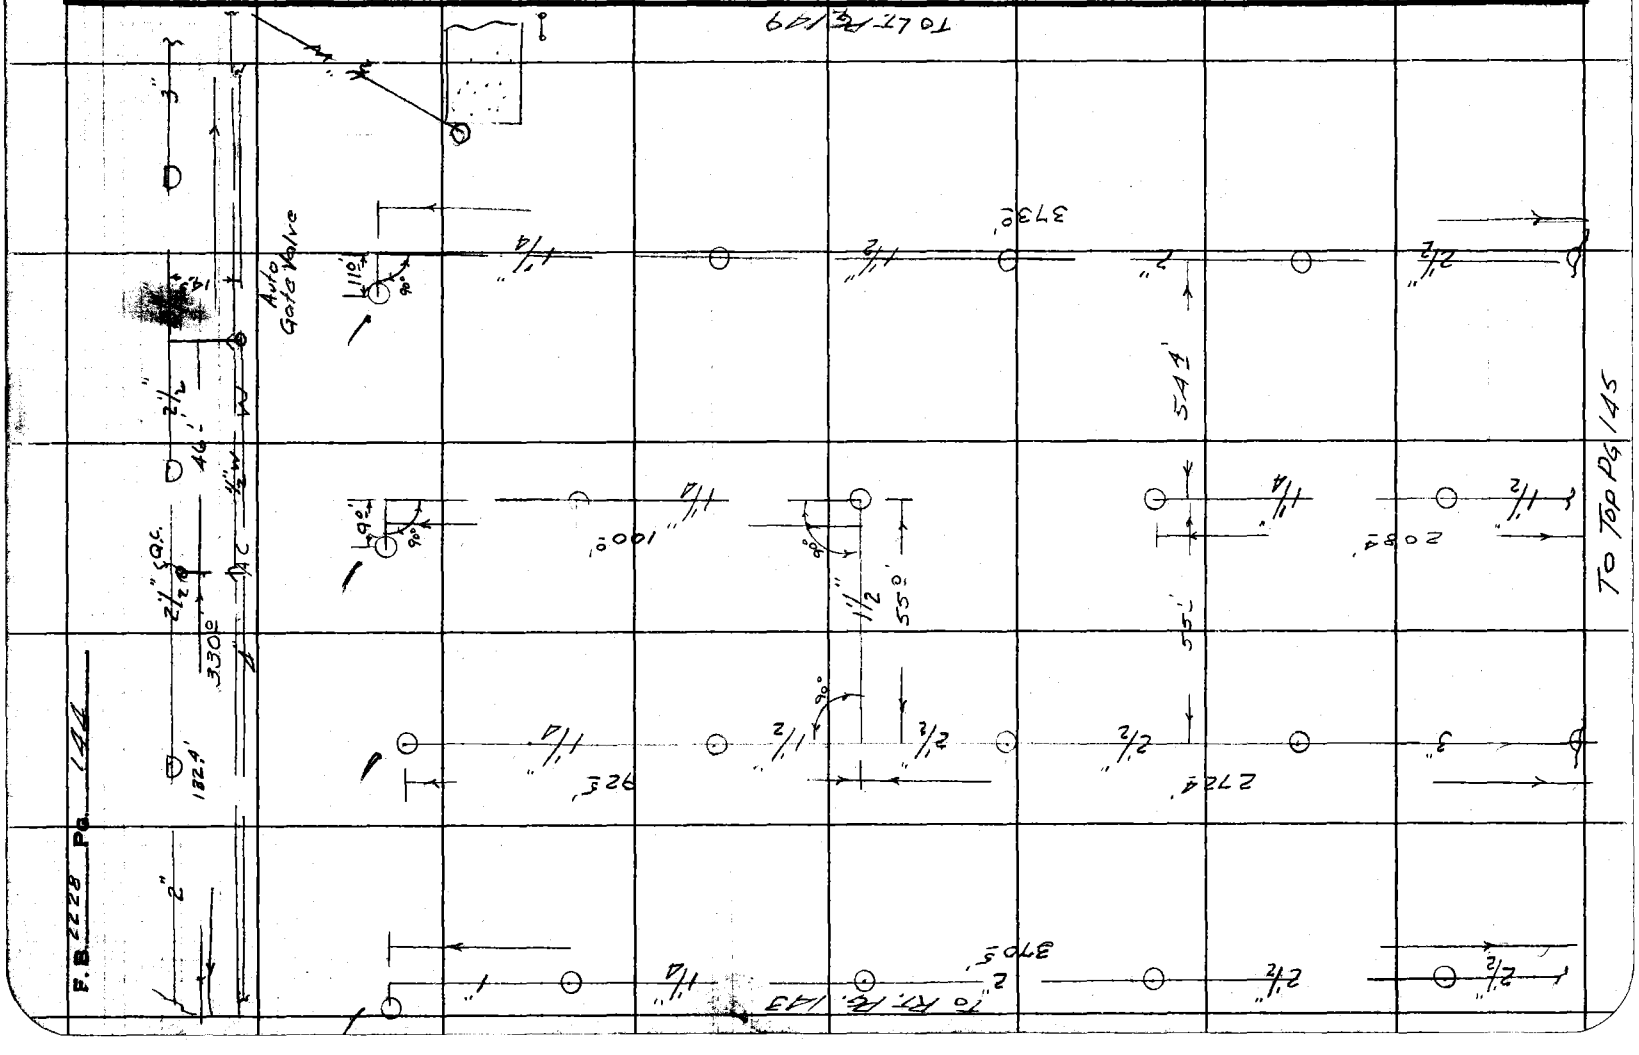

76F3095 CE #247—8-57

RETURN TO
LOS ANGELES COUNTY ENGINEER
700 LOS ANGELES COUNTY ENGINEERING BLDG.

Note: Any Additions or Changes on This Sheet Must be Made or Circled in Red Ink With Date and Name of Person Making Change.

Do not extend notes this side of this line.

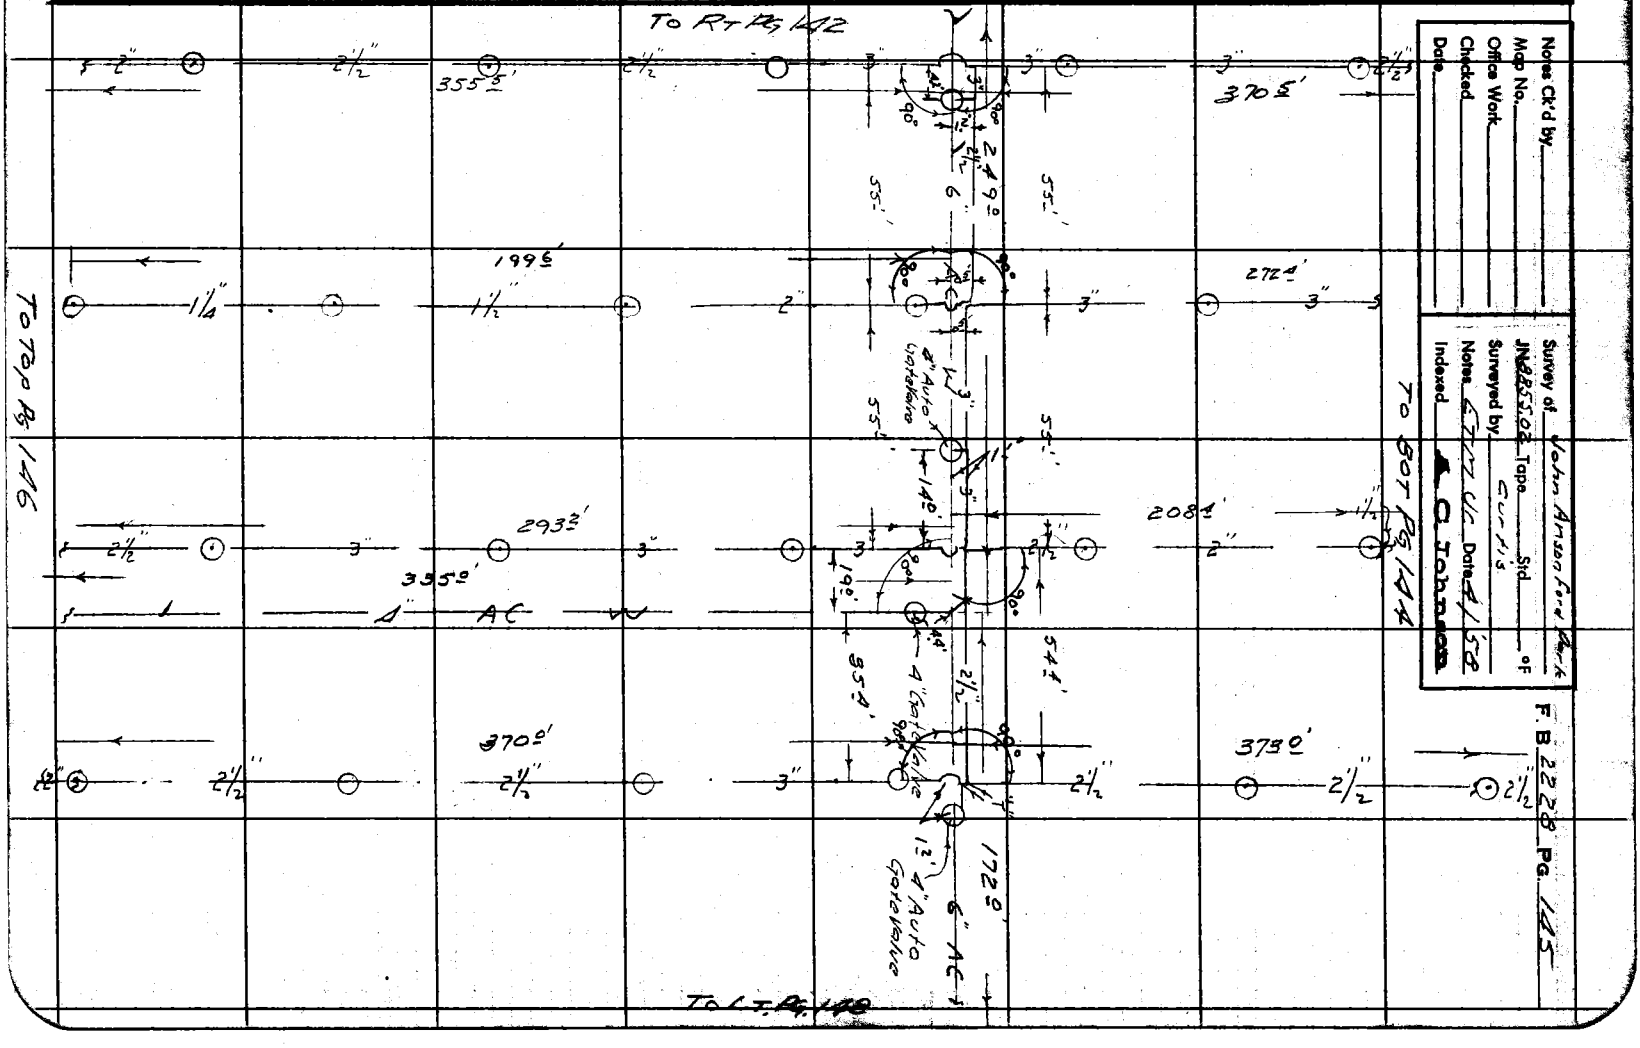

Notes Ck'd by _____
Map No. _____
Office Work _____
Checked _____
Date _____

Survey of John Anson Ford Park
Indexed A. C. Johnson


RETURN TO
LOS ANGELES COUNTY ENGINEER
700 LOS ANGELES COUNTY ENGINEERING BLDG.

Note: Any Additions or Changes on This Sheet Must be Made or Circled in Red Ink With Date and Name of Person Making Change.

Do not extend notes this side of this line.

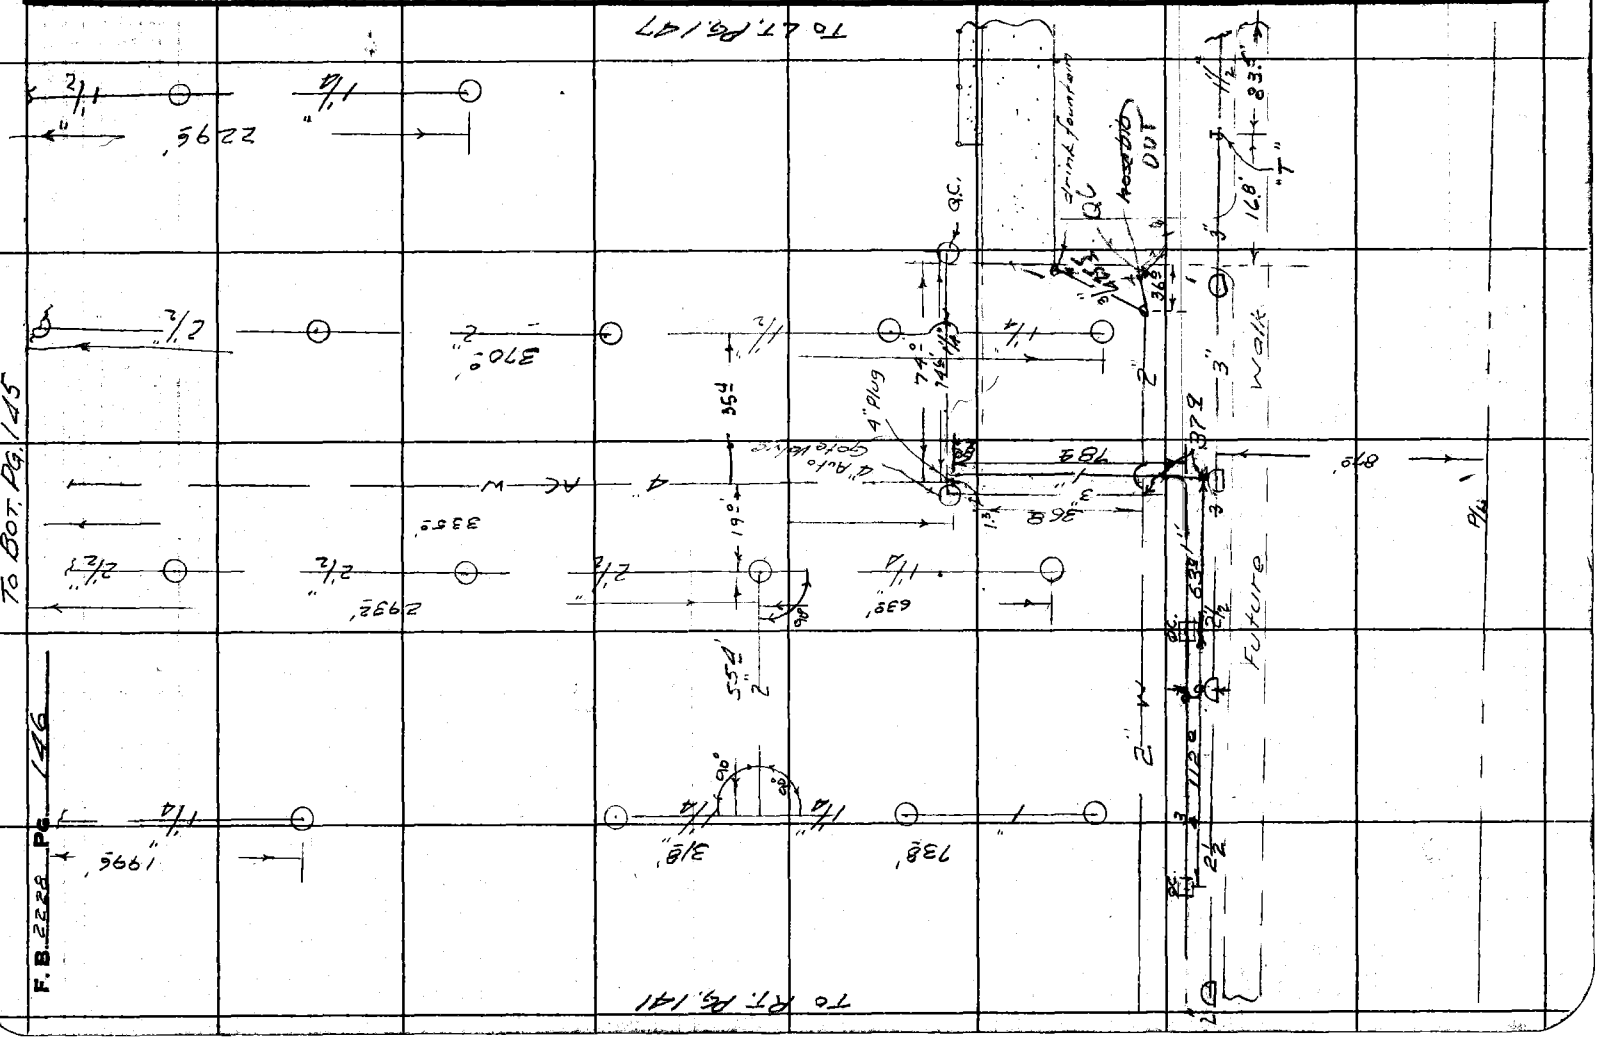

76F3098 CE #247—3-57

RETURN TO
LOS ANGELES COUNTY ENGINEER
700 LOS ANGELES COUNTY ENGINEERING BLDG.

Note: Any Additions or Changes on This Sheet Must be Made or Circled in Red Ink With Date and Name of Person Making Change.

Do not extend notes this side of this line.

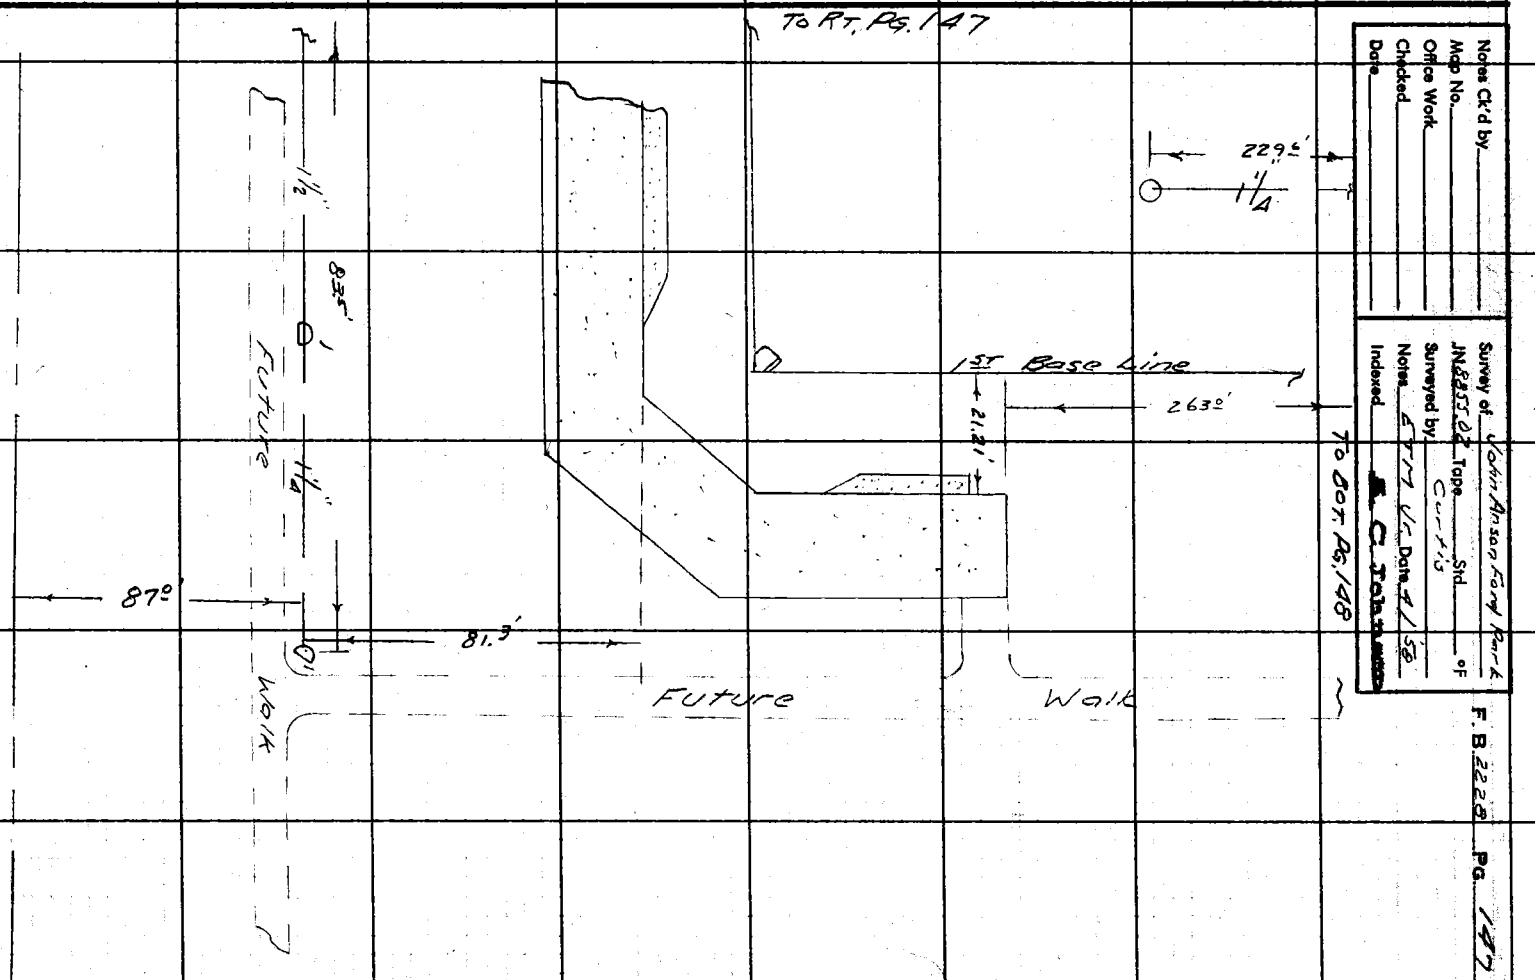

Notes Ck'd by
Map No.
Office Work
Checked
Date

JN 2222.02 Tape Std. °F
Surveyed by Curtis
Notes Date 4/58
Indexed R. C. Johnson

F. B. 2228 PG. 147

RETURN TO
LOS ANGELES COUNTY ENGINEER
700 LOS ANGELES COUNTY ENGINEERING BLDG.

Note: Any Additions or Changes on This Sheet Must be Made or Circled in Red Ink With Date and Name of Person Making Change.

Do not extend notes this side of this line.

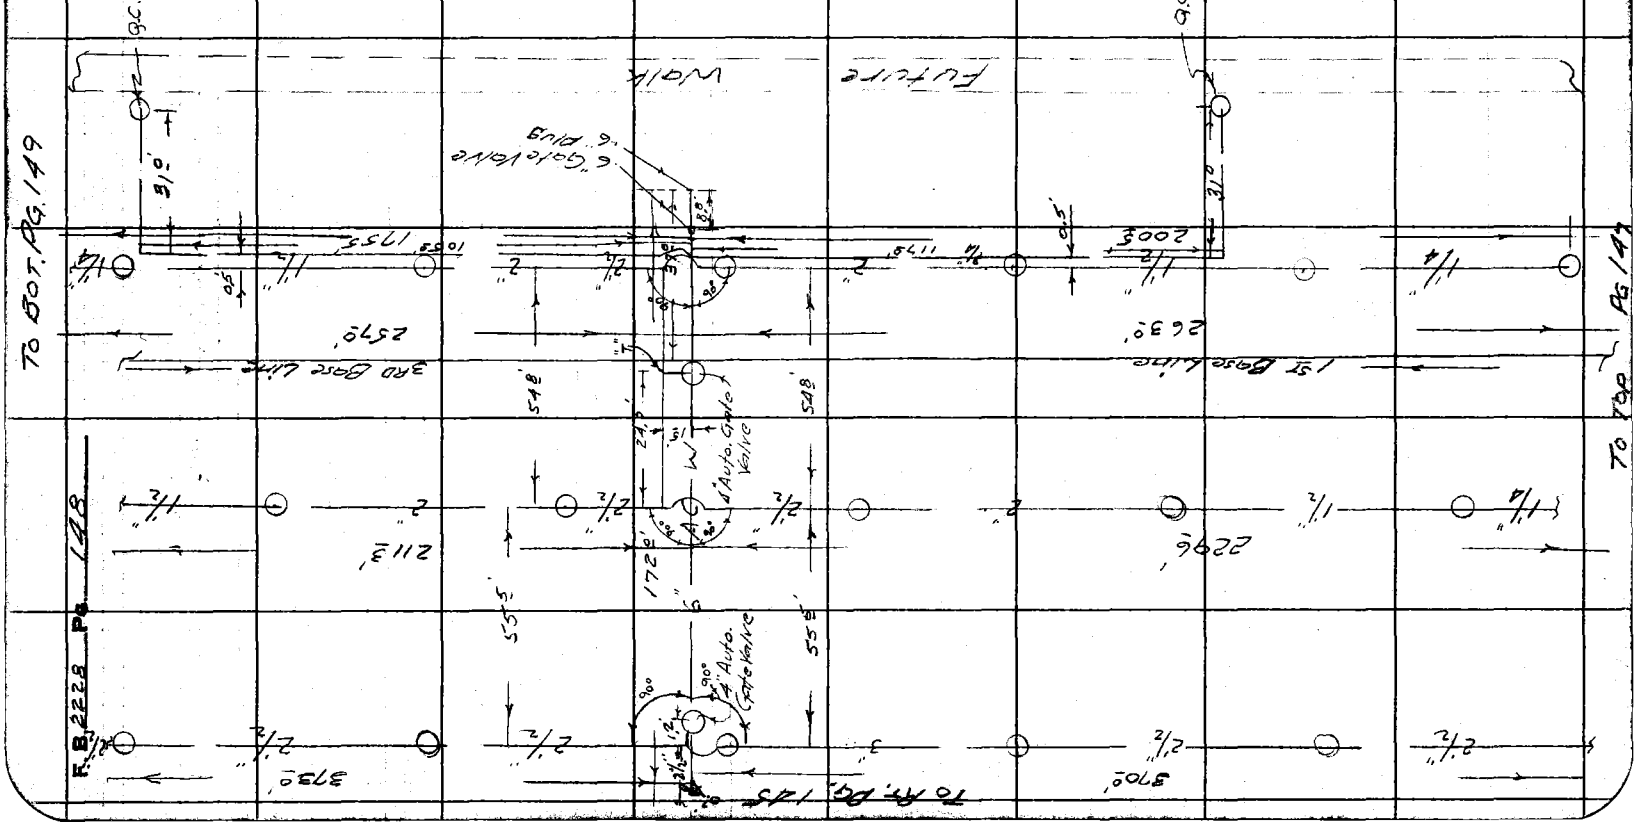

76F309S CE #247—8-57

RETURN TO
LOS ANGELES COUNTY ENGINEER
700 LOS ANGELES COUNTY ENGINEERING BLDG.

Note: Any Additions or Changes on This Sheet Must be Made or Circled in Red Ink With Date and Name of Person Making Change.

Do not extend notes this side of this line.

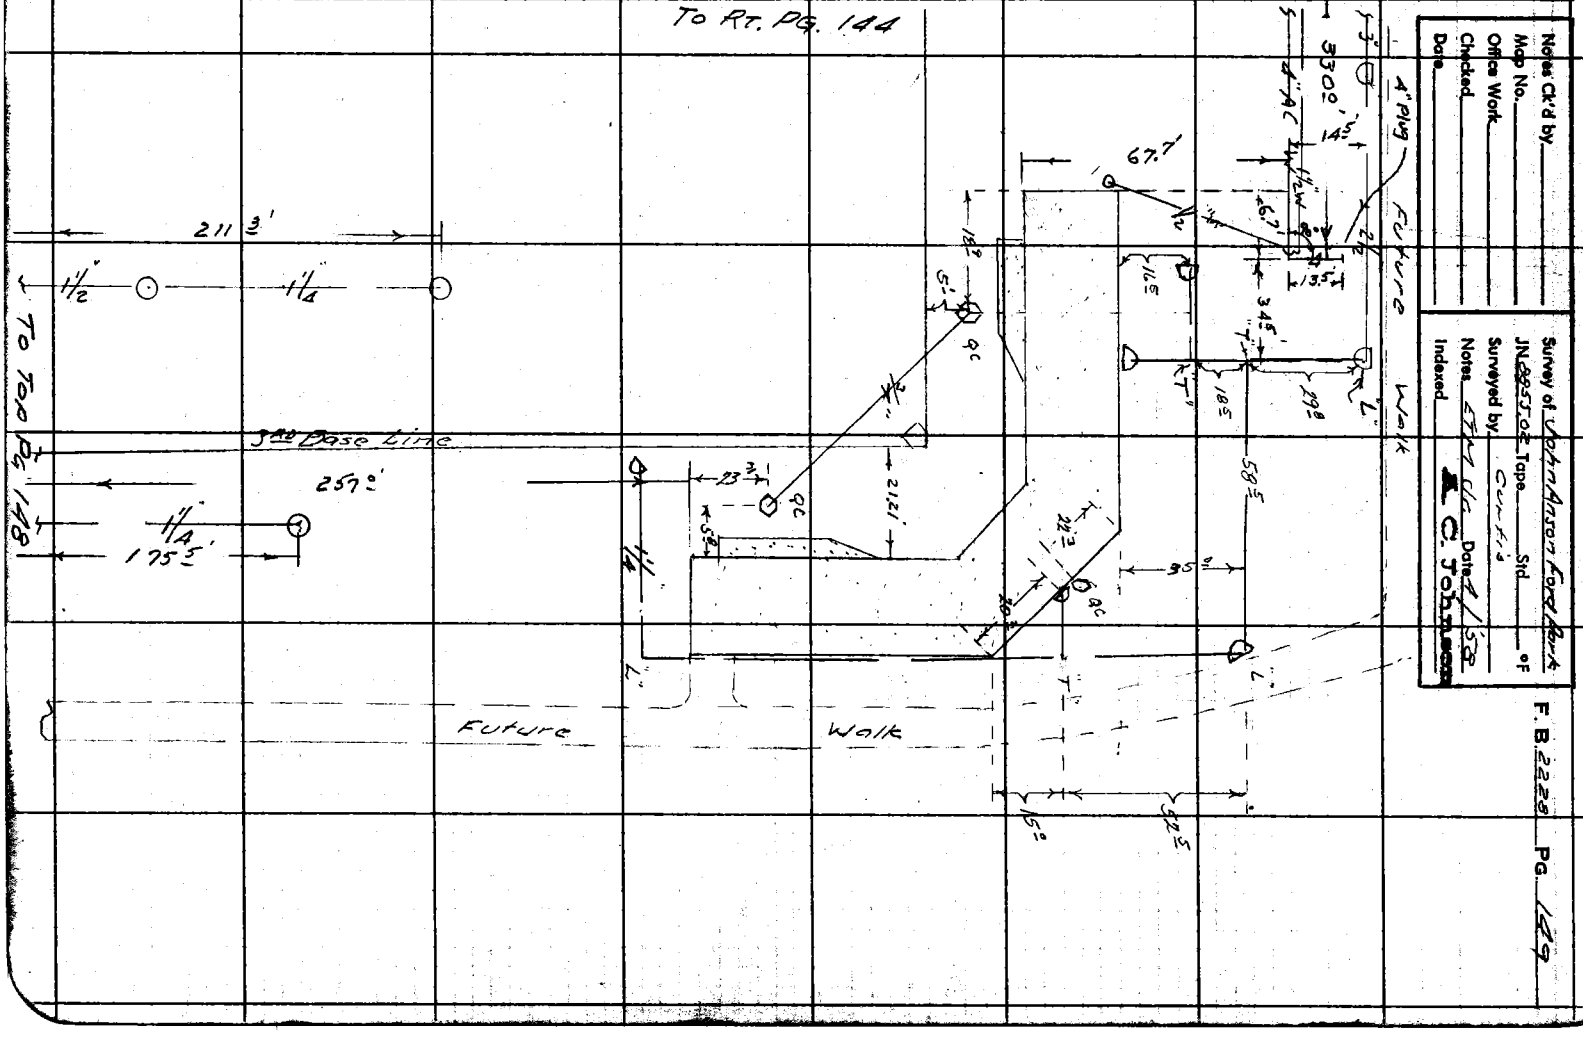

RETURN TO
LOS ANGELES COUNTY ENGINEER
700 LOS ANGELES COUNTY ENGINEERING BLDG.

Note: Any Additions or Changes on This Sheet Must be Made or Circled in Red Ink With Date and Name of Person Making Change.

Do not extend notes this side of this line.

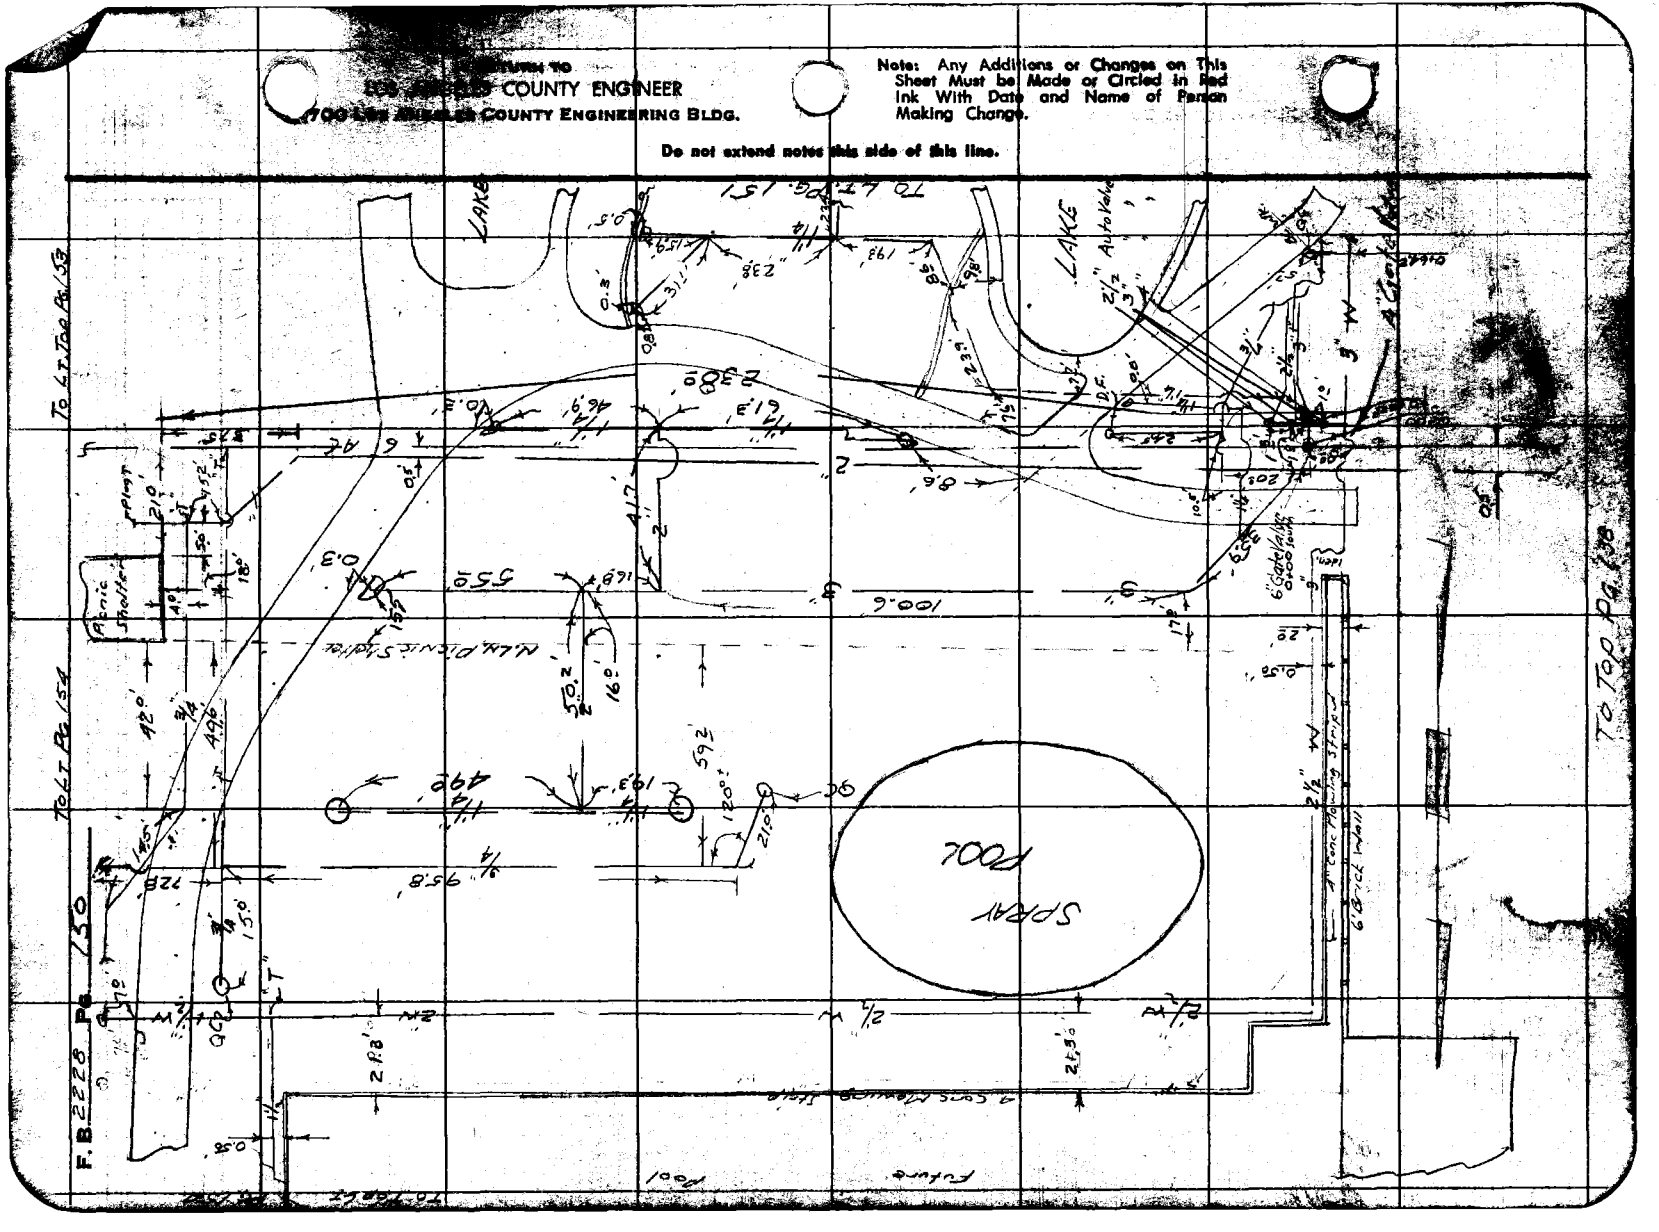

76F3098 CE #847—3-57

RETURN TO
LOS ANGELES COUNTY ENGINEER
700 LOS ANGELES COUNTY ENGINEERING BLDG.

Note: Any Additions or Changes to This Sheet Must be Made or Checked in Ink With Date and Name of Person Making Change.

Do not extend notes this side of this line.

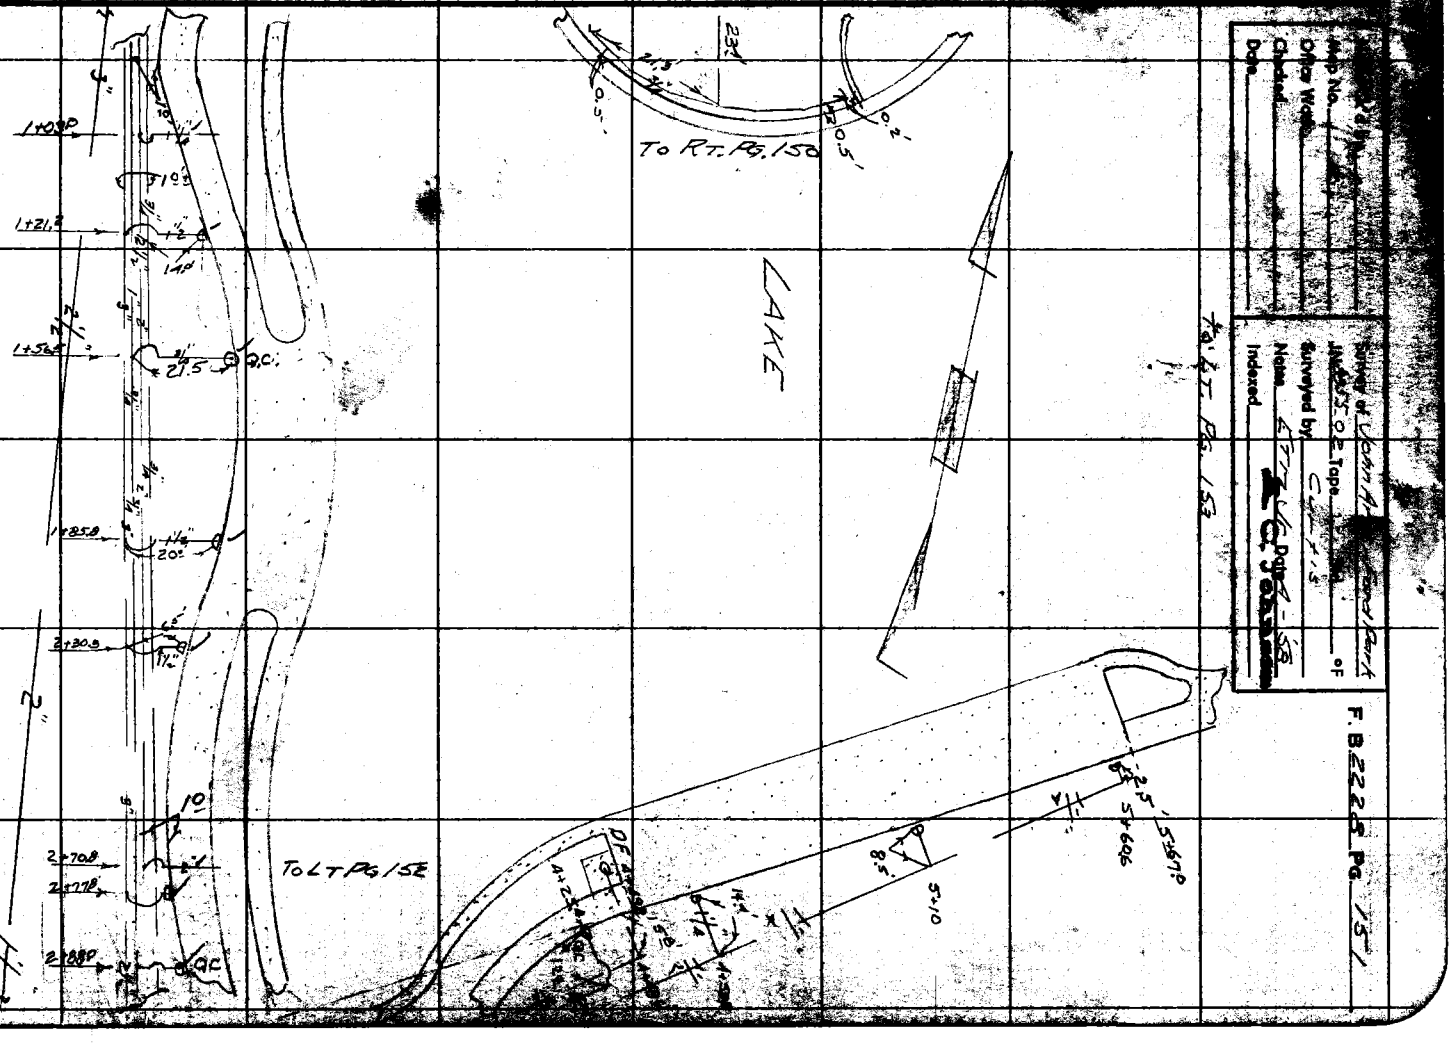

Office Work: Tape
Checked
Date
Surveyed by:
Notes
Indexed

RETURN TO
LOS ANGELES COUNTY ENGINEER
700 LOS ANGELES COUNTY ENGINEERING BLDG.

Note: Any Additions or Changes on This Sheet Must be Made or Circled in Red Ink With Date and Name of Person Making Change.

Do not extend notes this side of this line.

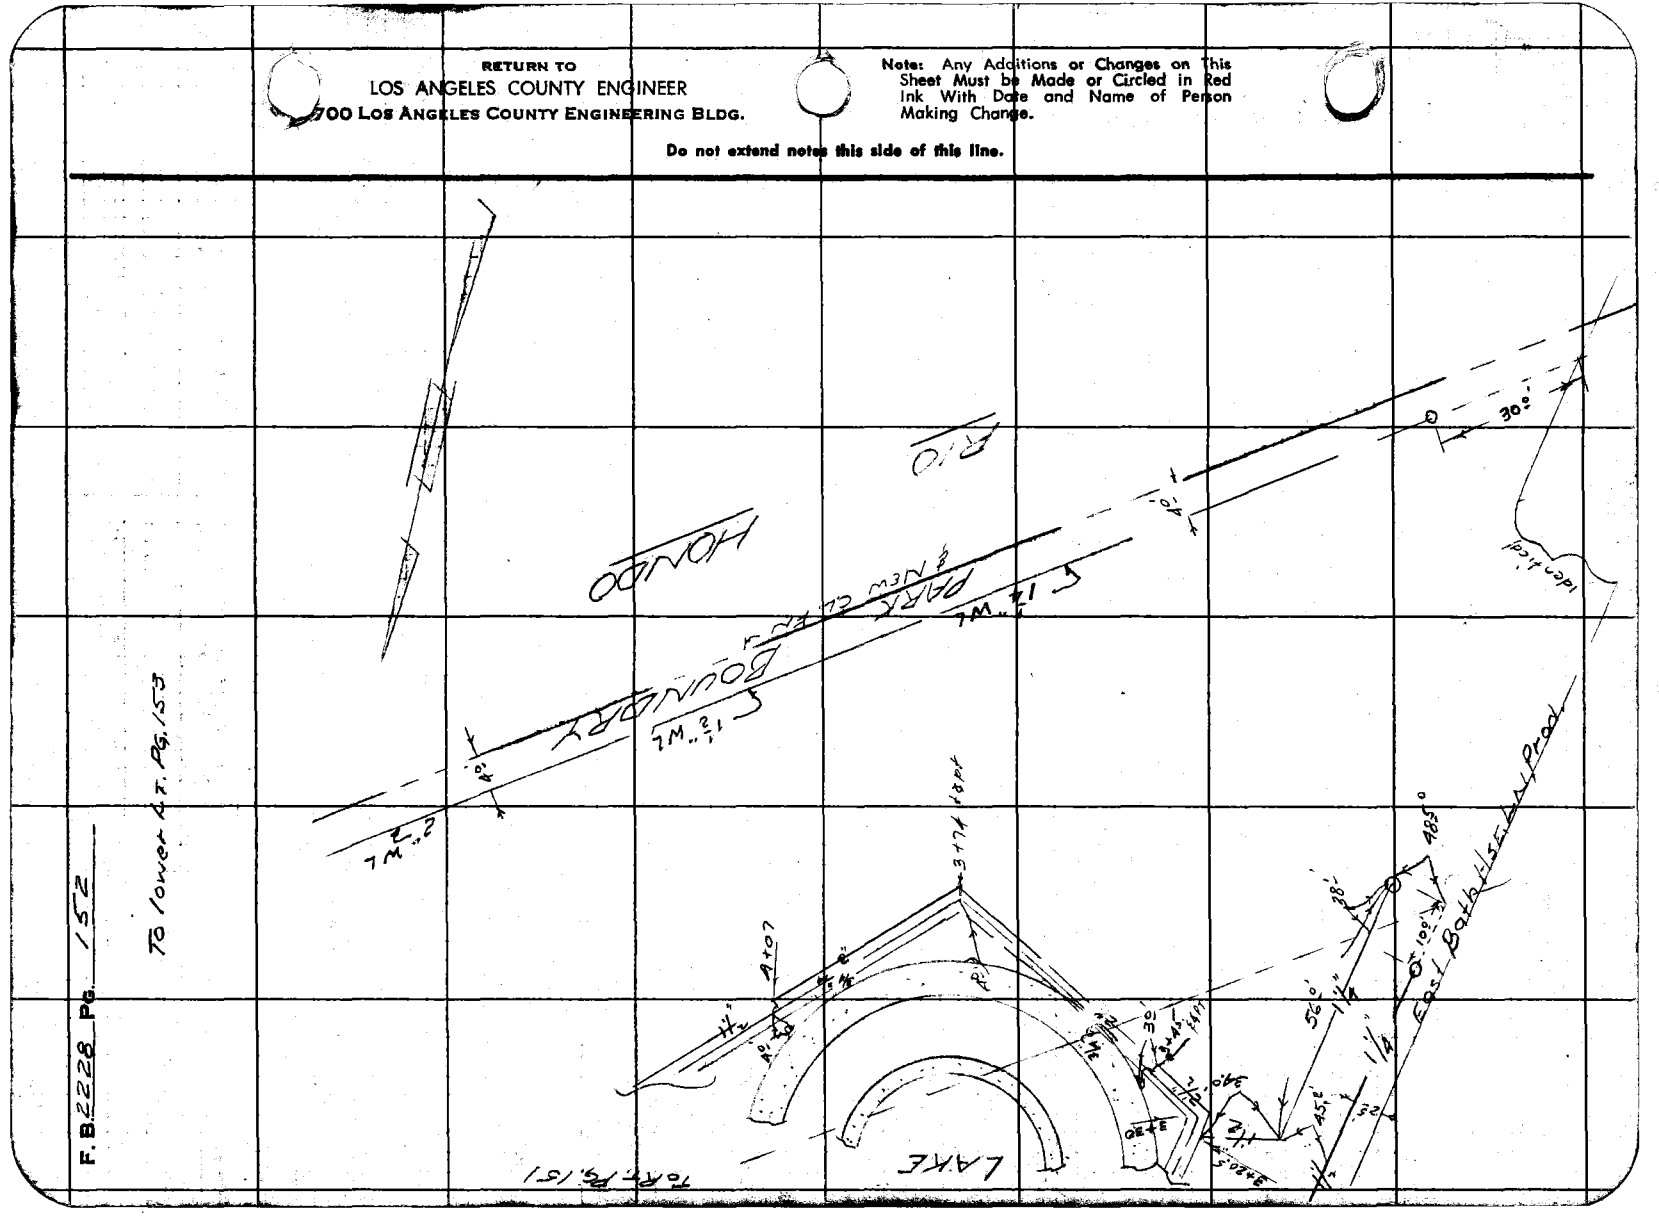

Notes Ck'd by	Survey of John Anson Ford Park
Map No.	JN 8855.01 Tape Std °F
Office Work	Surveyed by Curtis
Checked	Notes ETM UC Date 4-'58
Date	Indexed E. C. Johnson

F. B. 2228 Pg. 153

TO BOT. PG. 154

PICNIC SHELTER

+21.9'

6" AC

+21.0'

TO TOP PG. 150

LAKE

LAKE

TO TOP PG. 151

TO BOT. PG. 138

TO TOP PG. 152

2" WL

2½ WL

3" WL

2½ WL

2" WL

PARK BOUNDARY

49'

℄ NEW

℄ C.L. FN.

Note: Any Additions or Changes on This Sheet Must be Made or Circled in Red Ink With Date and Name of Person Making Change.

Do not extend notes this side of this line.

RETURN TO
LOS ANGELES COUNTY ENGINEER
700 LOS ANGELES COUNTY ENGINEERING BLDG.

76FB088 CE #247—3-57

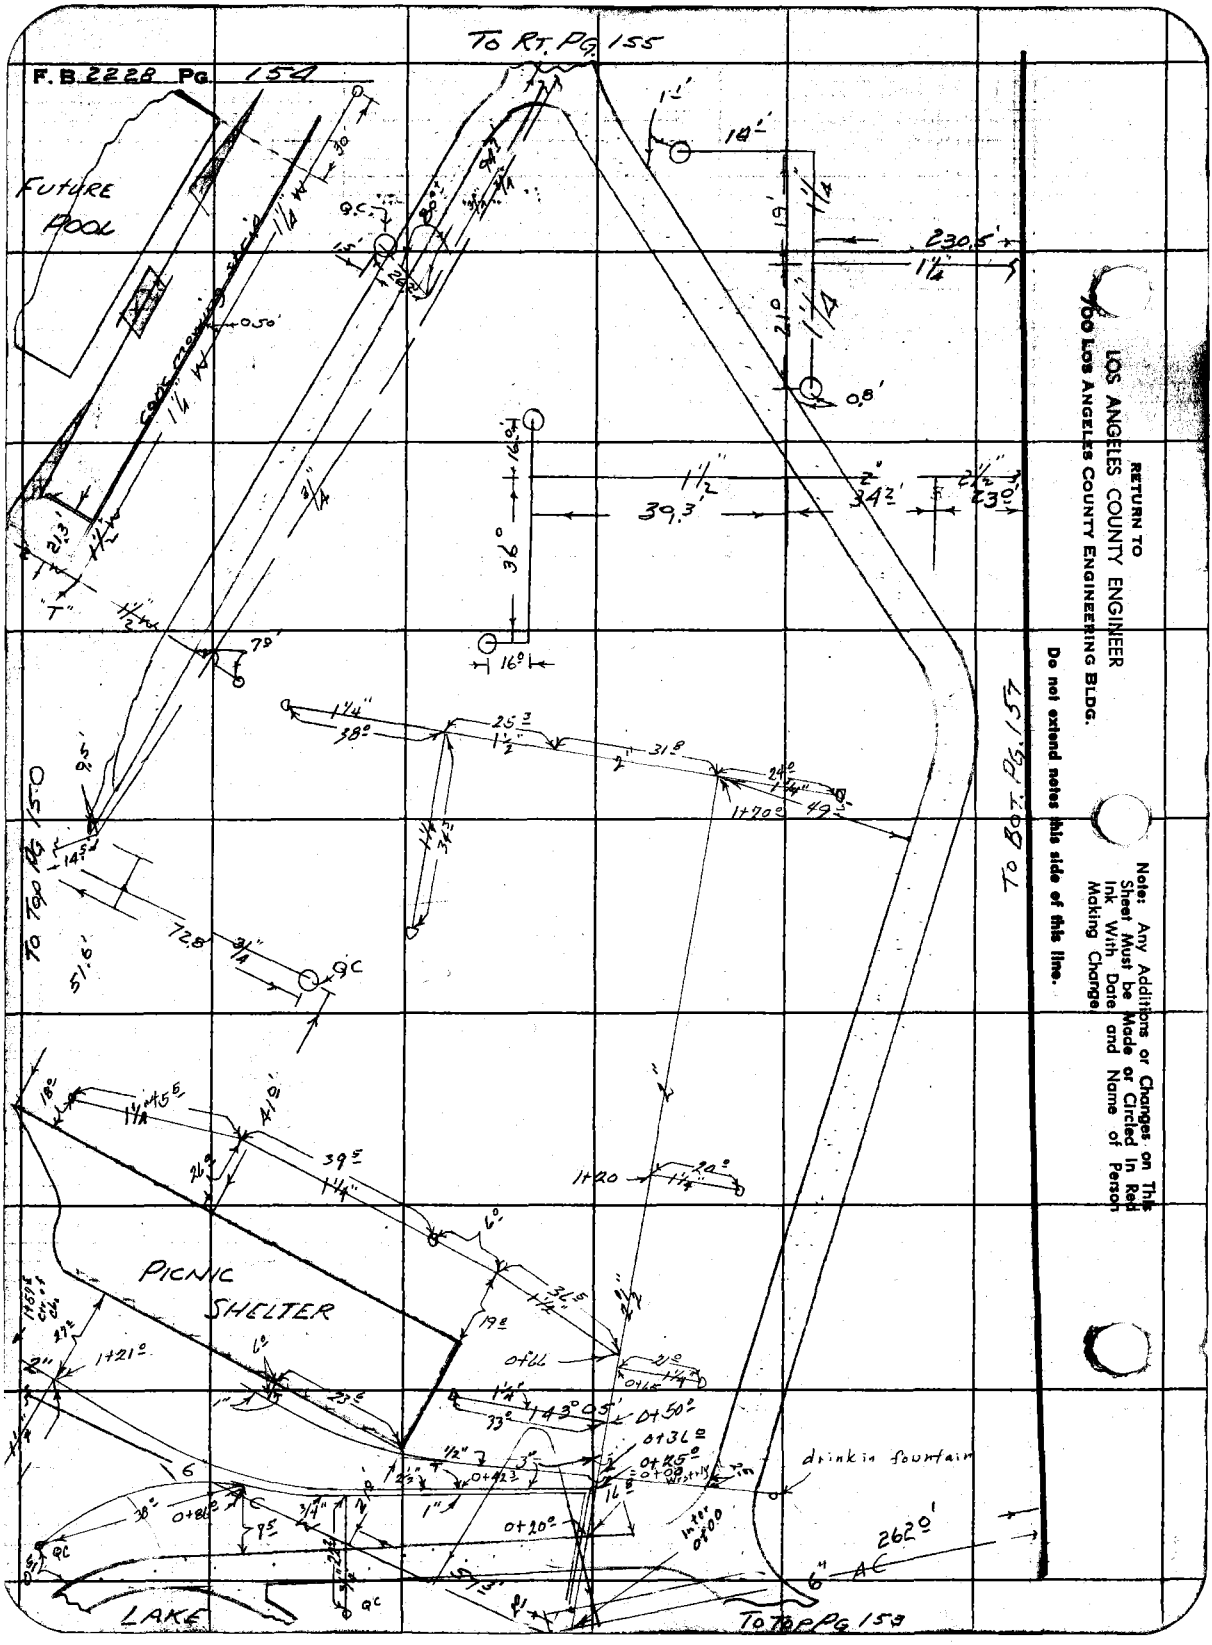
F.B. 2228 Pg. 154
To Rt. Pg. 155
FUTURE POOL
CONC. CURBING
PICNIC SHELTER
LAKE
drinking fountain
RETURN TO
LOS ANGELES COUNTY ENGINEER
900 LOS ANGELES COUNTY ENGINEERING BLDG.
Do not extend notes this side of this line.
Note: Any Additions or Changes on This Sheet Must be Made or Circled in Red Ink With Date and Name of Person Making Change.

76F3095 CE #247—3-57

RETURN TO
LOS ANGELES COUNTY ENGINEER
700 LOS ANGELES COUNTY ENGINEERING BLDG.

Note: Any Additions or Changes on This Sheet Must be Made or Circled in Red Ink With Date and Name of Person Making Change.

Do not extend notes this side of this line.

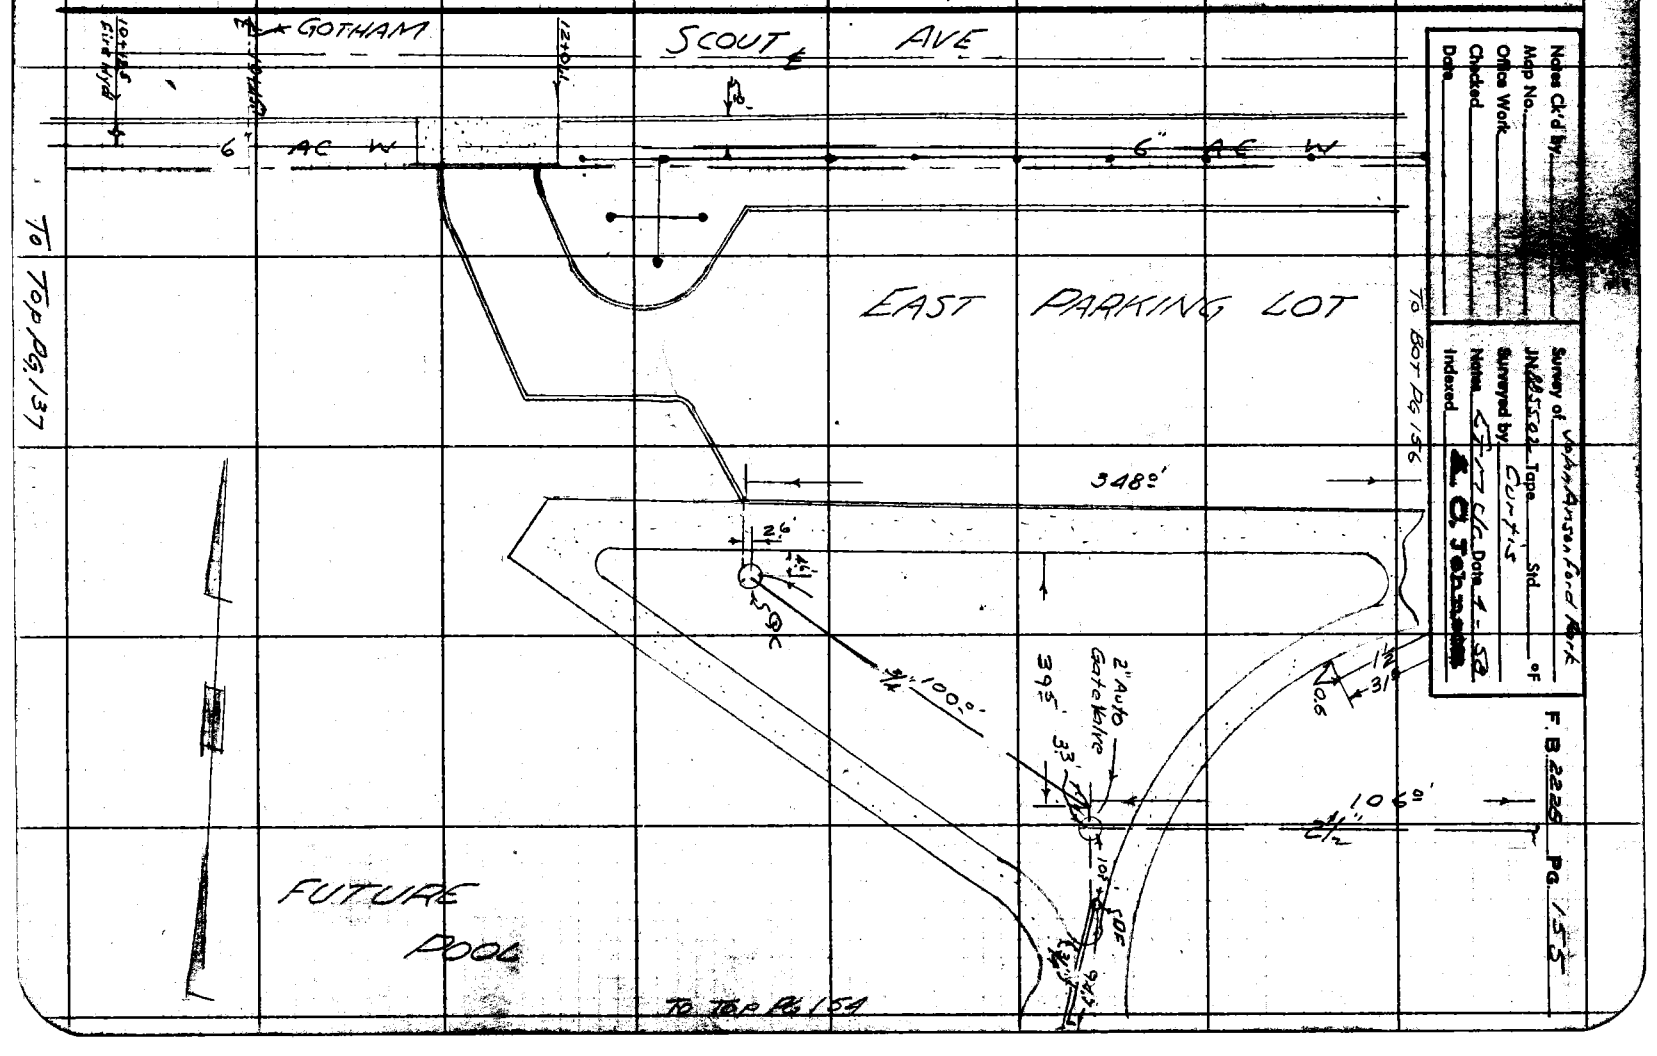

Notes Ck'd by
Map No.
Office Work
Checked
Date

JN 88522 Tape Std °F
Notes Crew C/C Date 4-52
Indexed R. C. Johnson

F. B. 2226 Pg. 155

RETURN TO
LOS ANGELES COUNTY ENGINEER
7700 LOS ANGELES COUNTY ENGINEERING BLDG.

Note: Any Additions or Changes on This Sheet Must be Made or Circled in Red Ink With Date and Name of Person Making Change.

Do not extend notes this side of this line.

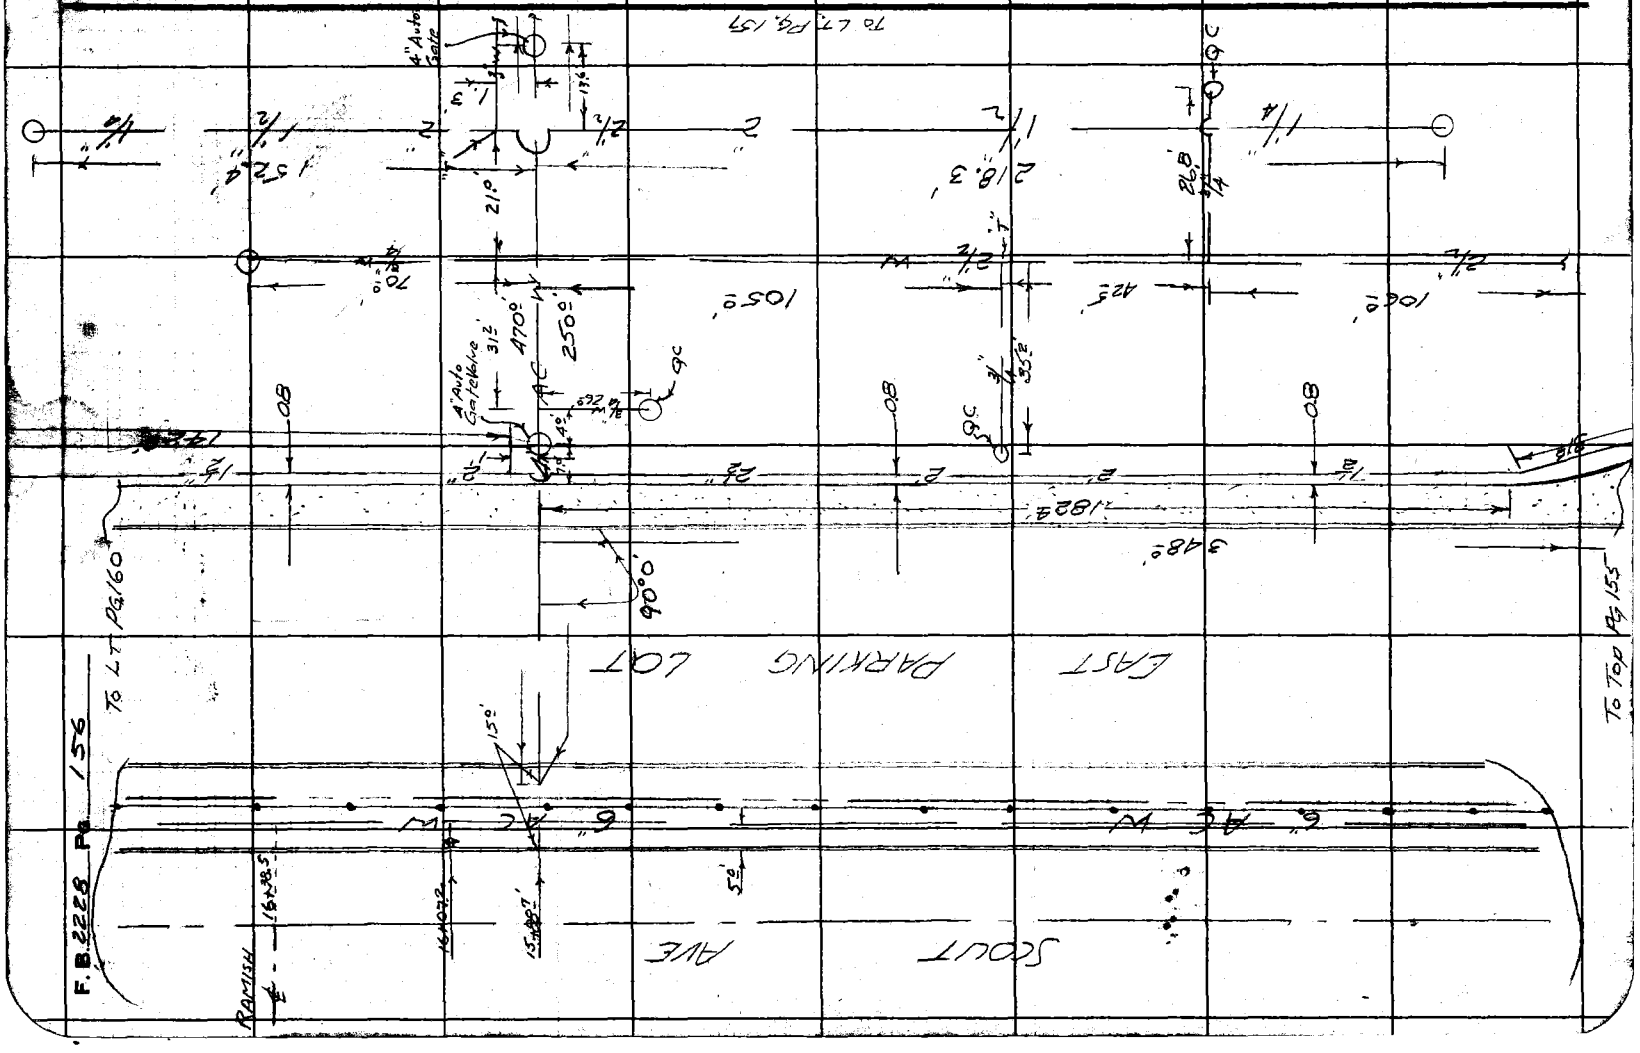

Notes Ck'd by
Map No.
Office Work
Checked
Date

Survey of John Anson Ford Park
JN 881-22 Tape Std °F
Surveyed by Curtis
Notes GTM 4/ Date 4-58
Indexed

F. B. 2228 Pg. 157

To Lt Pg. 160

To Lt. Pg. 159

199.0'

217'

252.0'

240.0'

2"

1½"

2"

2½"

2½"

4" Auto Gate Valve

3"

1½"

55.0'

41.0'

13.6'

"T"

4" AC

250.0'

37.0'

9.5'

9.9'

8.9'

98.0'

45.5'

55.0'

4" Auto Gate Valve

13.3"

3"

41.0'

5.3'

0.3'

220.0'

1½" W

To Rt Pg. 156

To Lt Pg. 158

182.0'

123.3'

230.5'

2½"

2"

1½"

25.4'

3/4

63.2'

3½"

23.0'

3½"

31.2'

24.0'

To Rt Pg 154

Note: Any Additions or Changes on This Sheet Must be Made or Circled in Ink With Date and Name of Person Making Change.

Do not extend notes this side of this line.

RETURN TO
LOS ANGELES COUNTY ENGINEER
700 LOS ANGELES COUNTY ENGINEERING BLDG.

76FS095 CE #247—3-

RETURN TO
ANGELES COUNTY ENGINEER
7[illegible] ANGELES COUNTY ENGINEERING BLDG.

Note: Any Additions or Changes on This Sheet Must be Made or Circled In Red Ink With Date and Name of Person Making Change.

Do not extend notes this side of this line.

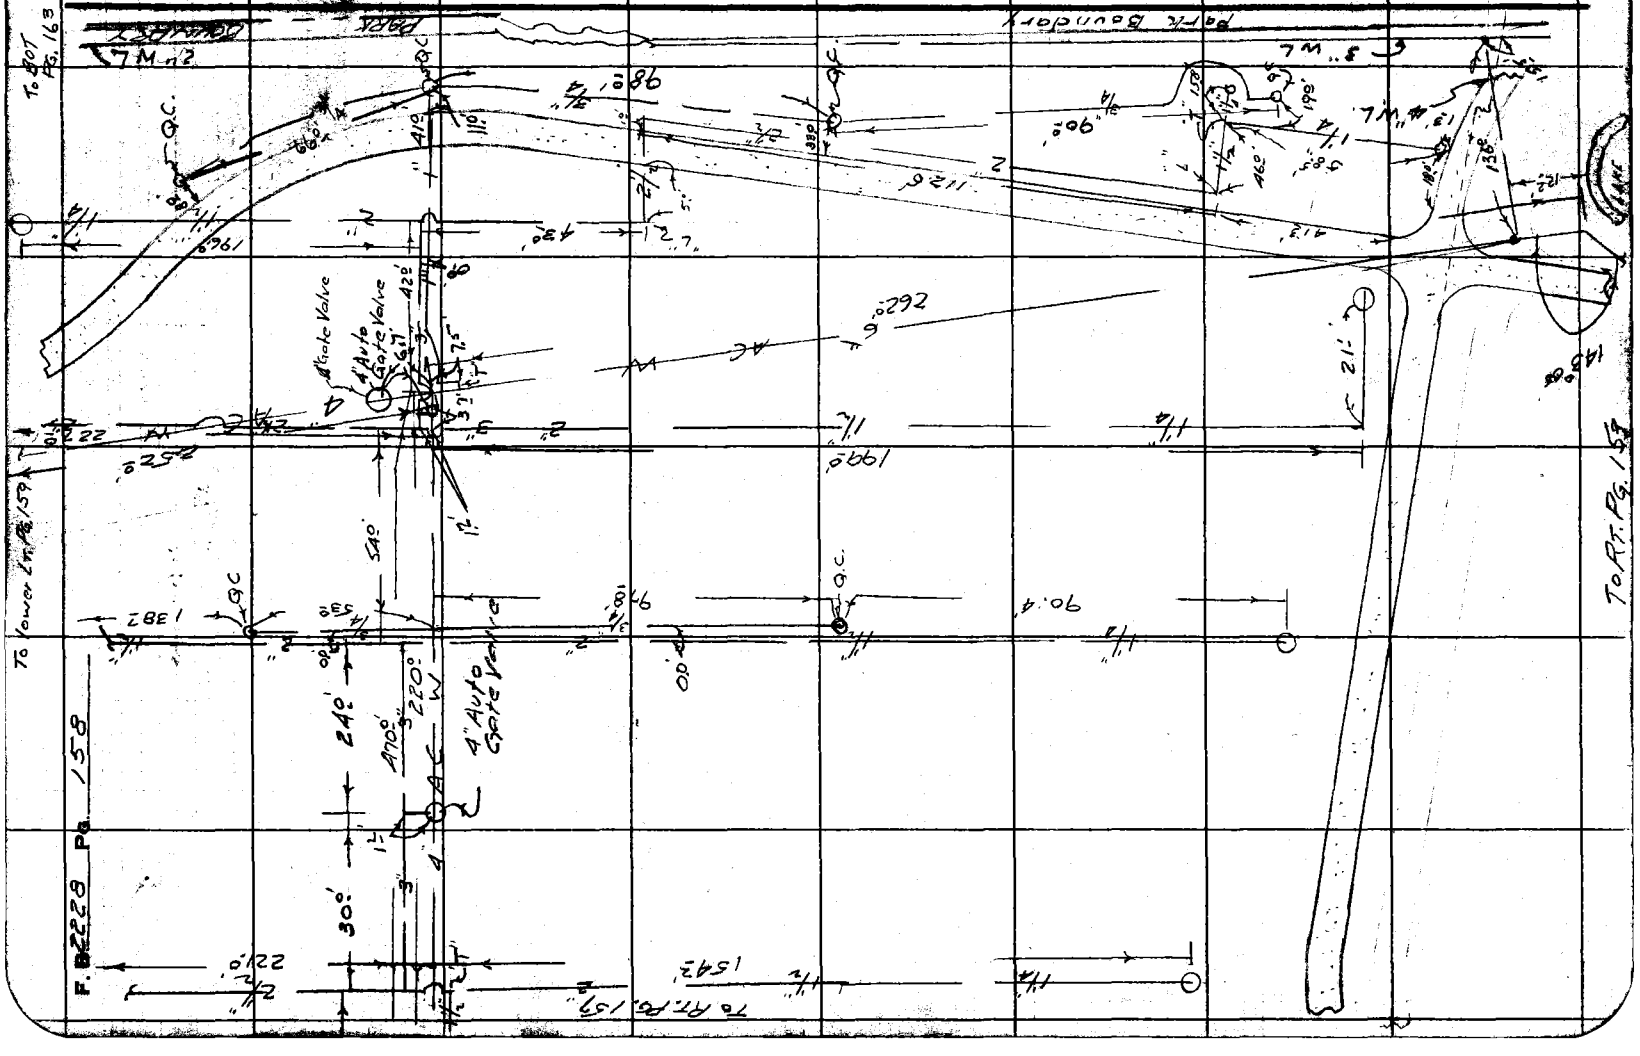

Notes Ck'd by
Map No.
Office Work
Checked
Date

Survey of John Anson Ford PARK
Surveyed by Curtis
Notes E.T.V.G. Date 4-58
Indexed C. Johnson

F. B. 2228 PG. 159

To Bot. Pg. 160

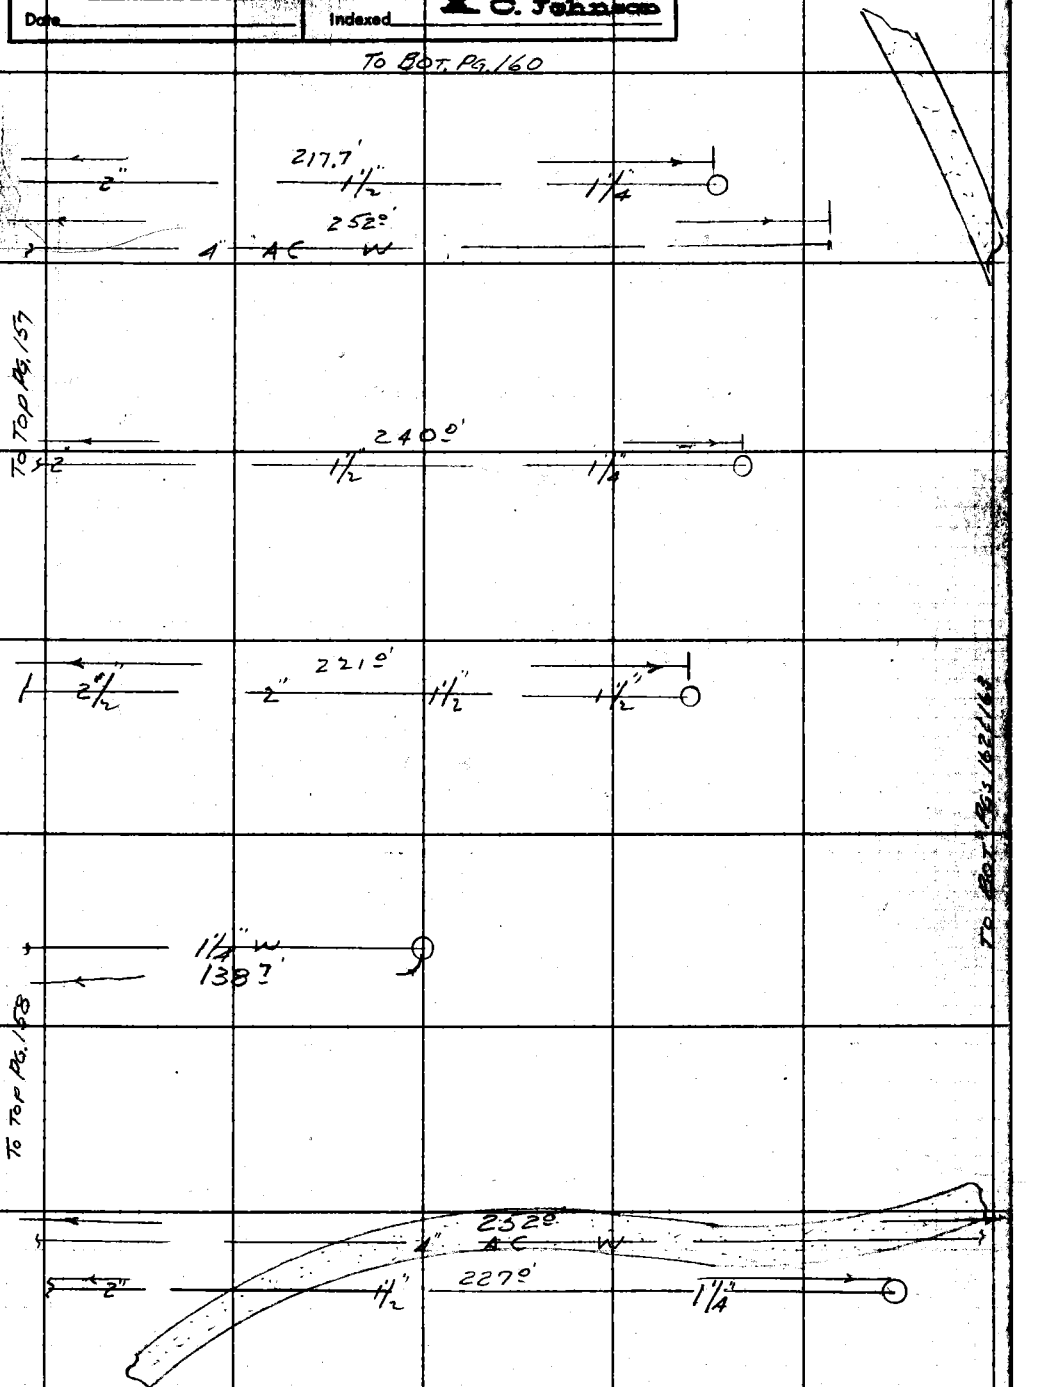

Note: Any Additions or Changes to this Sheet Must be Made or Circled in Ink With Date and Name of Making Change.

Do not extend notes this side of this line.

RETURN TO
LOS ANGELES COUNTY ENGINEER
700 LOS ANGELES COUNTY ENGINEERING BLDG.

78F3088 CE #247—3-57

RETURN TO
LOS ANGELES COUNTY ENGINEER
700 LOS ANGELES COUNTY ENGINEERING BLDG.

Note: Any Additions or Changes on This Sheet Must be Made or Circled in Red Ink With Date and Name of Person Making Change.

Do not extend notes this side of this line.

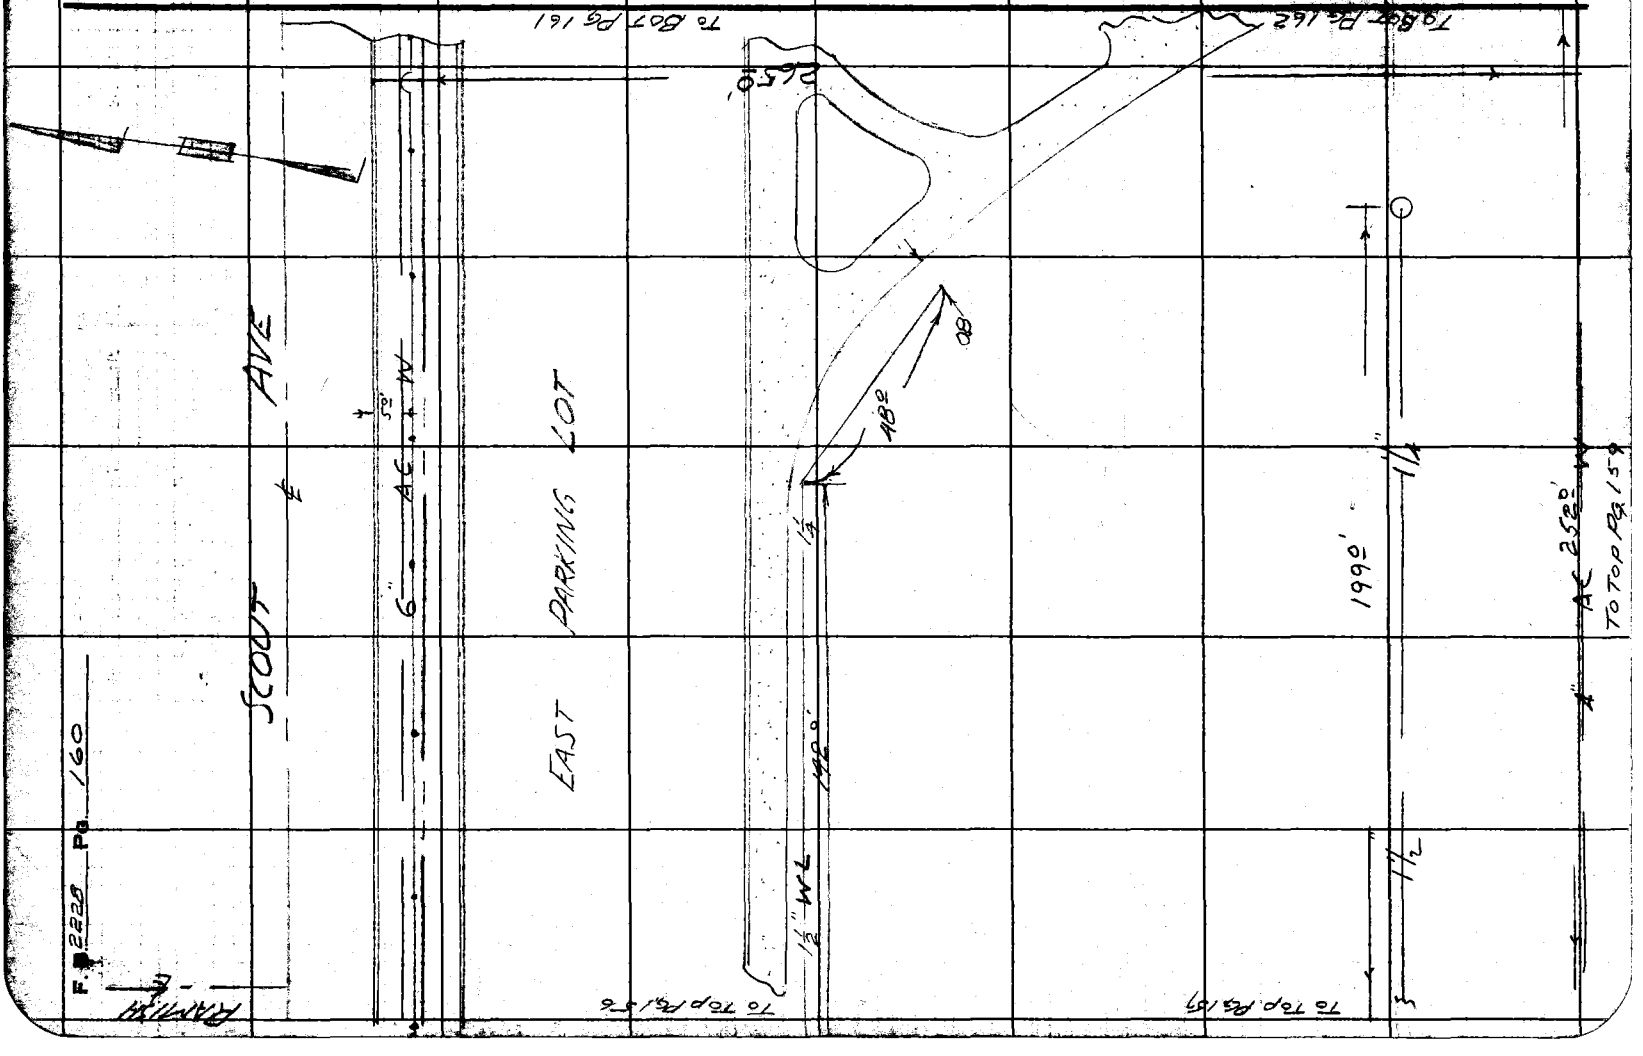

Notes Ck'd by	Survey of John Anson Ford Park
Map No.	JN 8825.02 Tape Std °F
Office Work	Surveyed by Curtis
Checked	Notes ETM UC Date 4-'58
Date	Indexed C. Johnson

F. B. 2228 Pg. 161

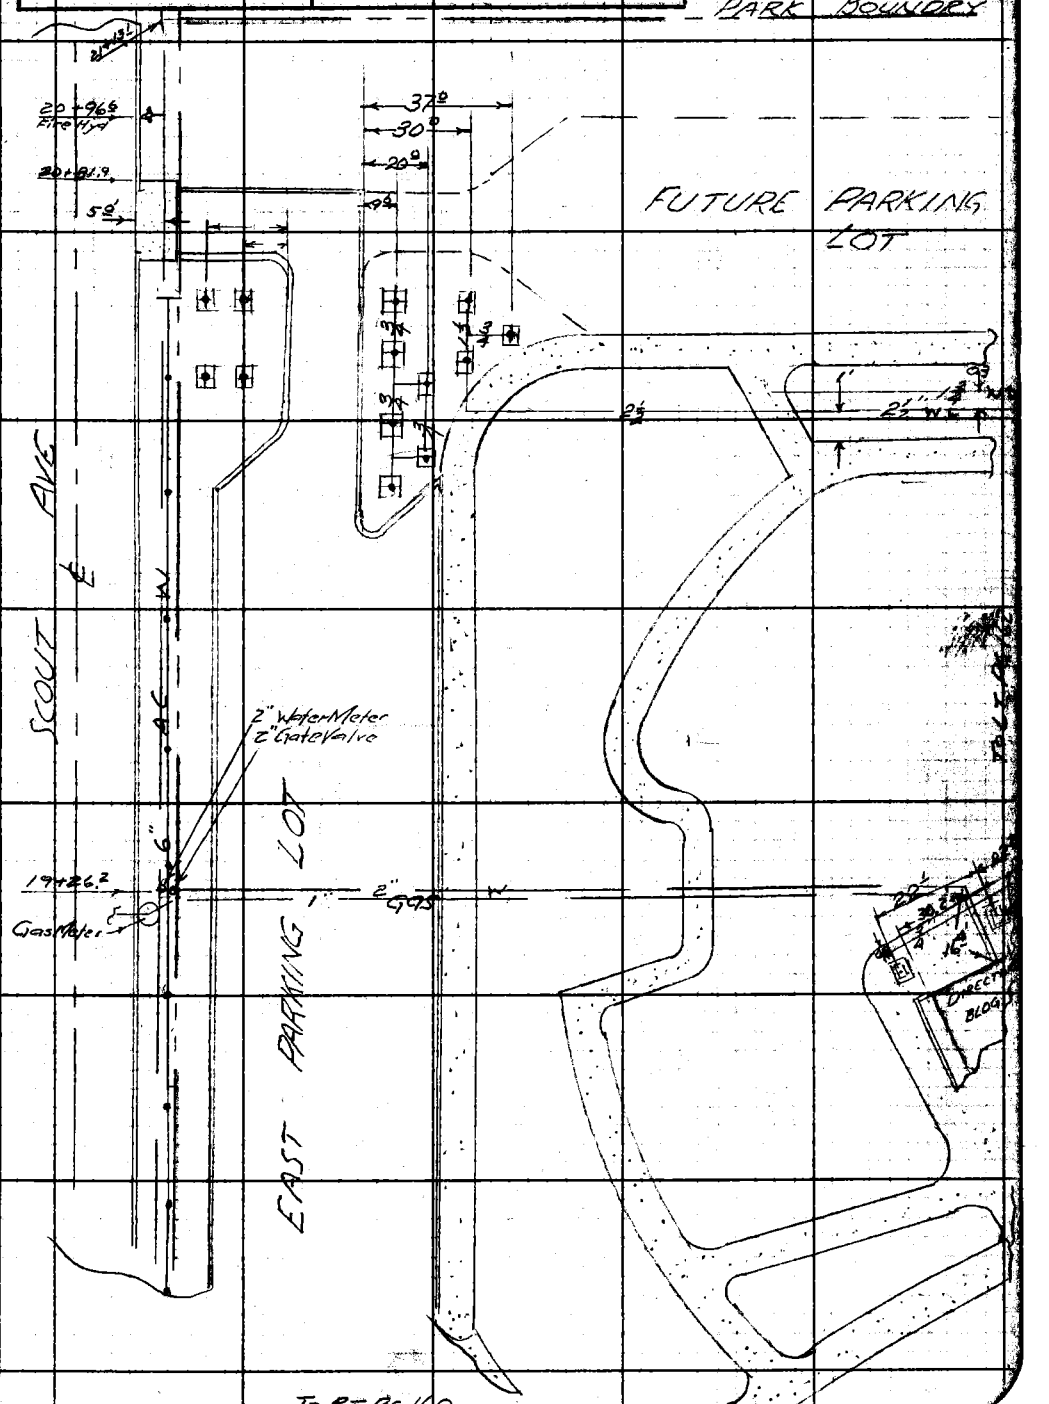

Note: Any Additions or Changes on This Sheet Must be Made or Circled in Red Ink With Date and Name of Person Making Change.

Do not extend notes this side of this line.

RETURN TO
LOS ANGELES COUNTY ENGINEER
700 LOS ANGELES COUNTY ENGINEERING BLDG.

76F9095 CE #247—9-57

RETURN TO
LOS ANGELES COUNTY ENGINEER
OLD LOS ANGELES COUNTY ENGINEERING BLDG.

Note: Any Additions or Changes on This Sheet Must be Made or Circled in Red Ink With Date and Name of Person Making Change.

Do not extend notes this side of this line.

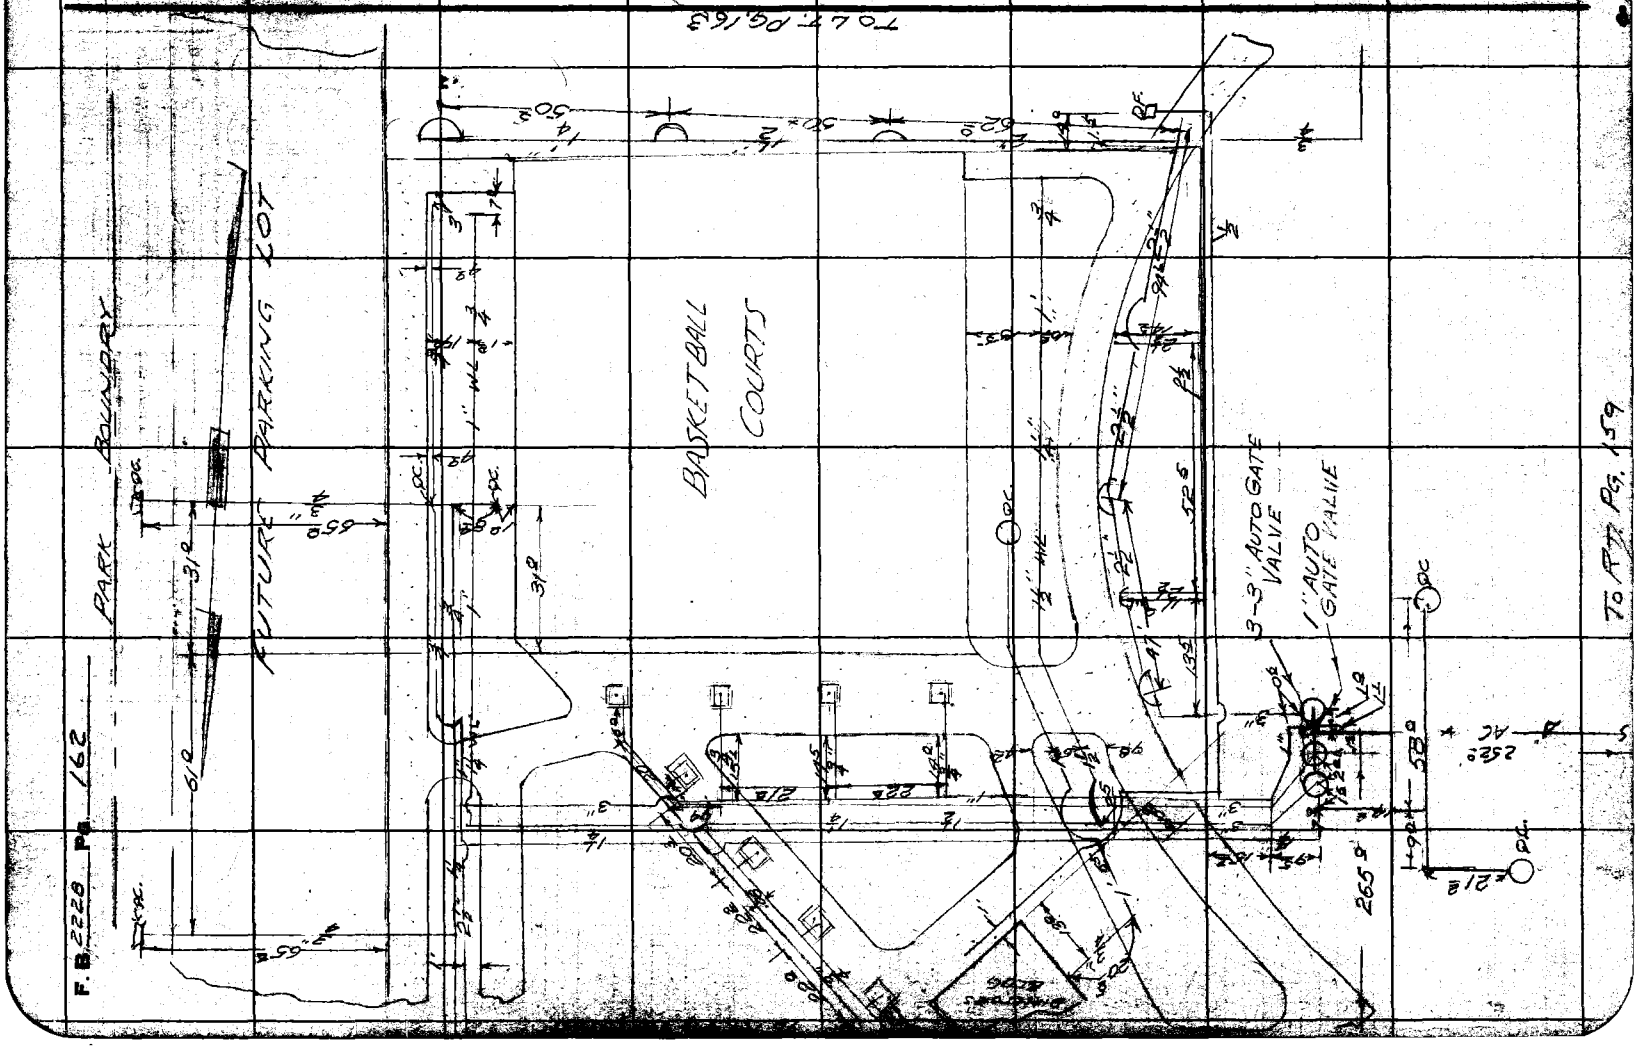

76F3095 CE #247—3-57

RETURN TO
LOS ANGELES COUNTY ENGINEER
700 LOS ANGELES COUNTY ENGINEERING BLDG.

Note: Any Additions or Changes on This Sheet Must be Made or Circled in Red Ink With Date and Name of Person Making Change.

Do not extend notes this side of this line.

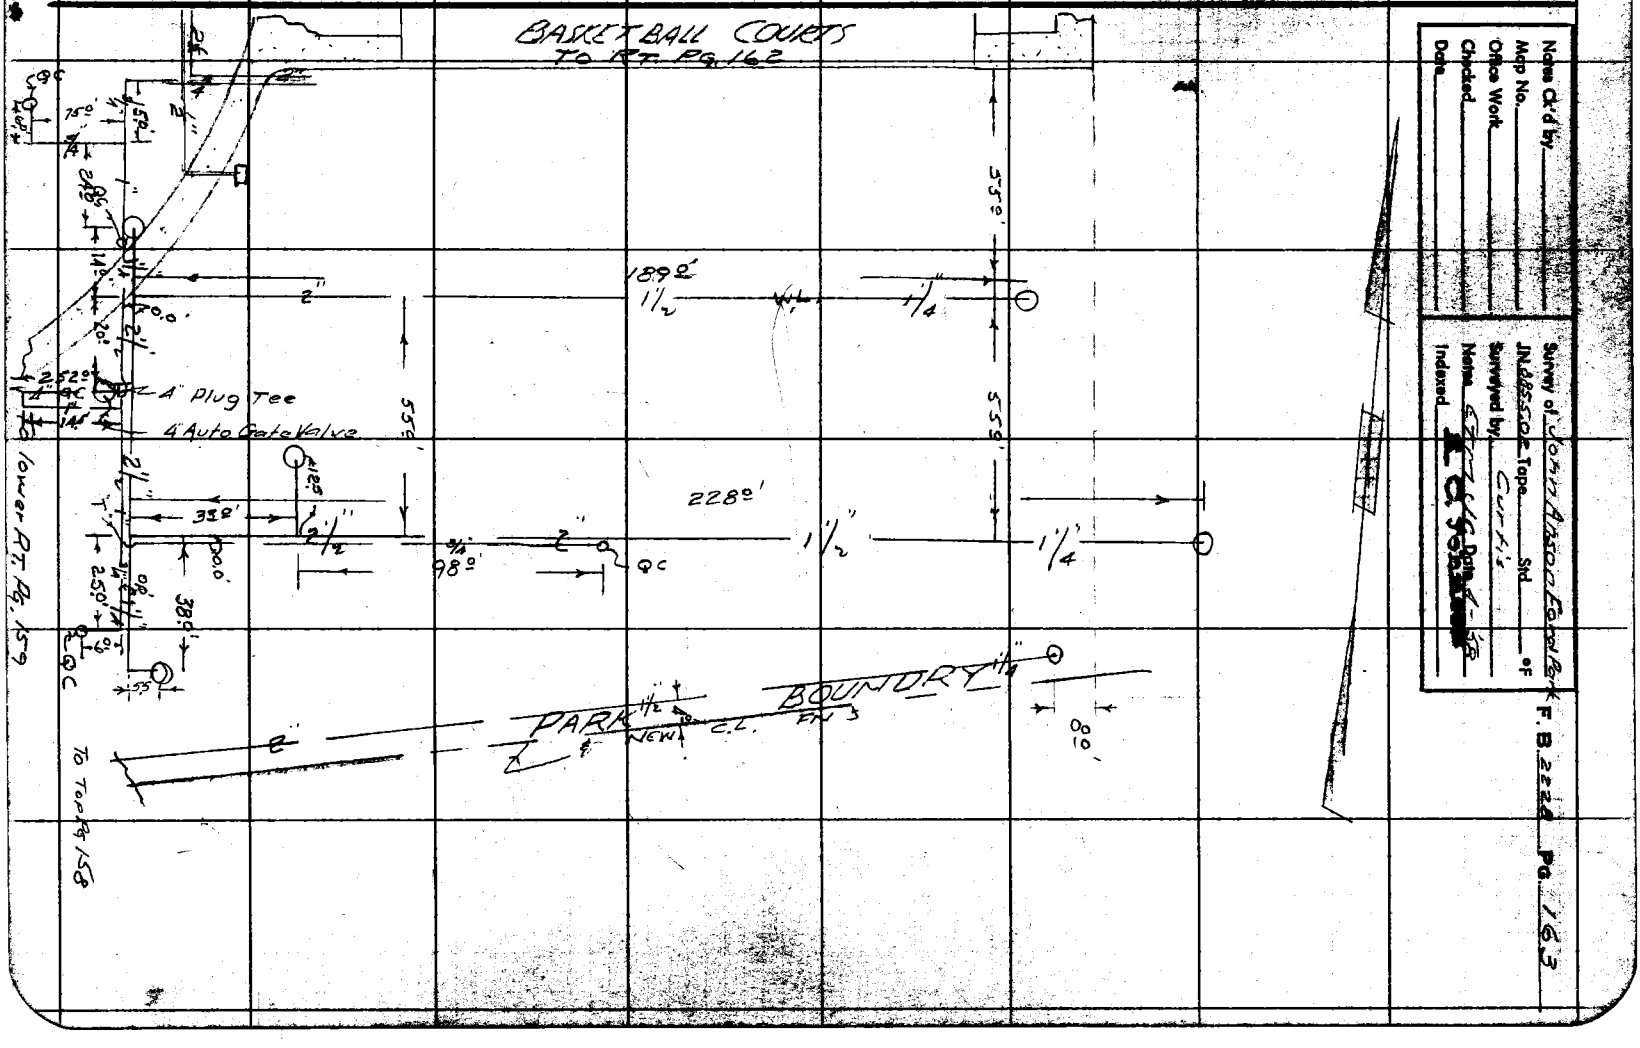

Notes Ck'd by _____
Map No. _____
Office Work _____
Checked _____
Date _____

Surveyed by: Curtis
Name
Indexed


8855.02

Profile No. | Notes Red. | Date | Plotted | Date | Job No. | Division No. 10 | F. B. 2228 | Pg. 165

X-Sec. No. | Notes Chkd. | Date | Checked | Date | Map No. | Survey of John Anson Ford Park | Survey by Curtis | Notes Curtis | Date Apr. 1958 | Index No. Job no. 1-16-59

NOTE: ANY ADDITIONS OR CHANGES ON THIS SHEET MUST BE MADE OR CIRCLED IN RED INK, WITH DATE AND NAME OF PERSON MAKING CHANGE.

PLEASE RETURN TO
LOS ANGELES COUNTY ENGINEER
700 Los Angeles County Engineering Bldg.

Do not extend notes this side of this line.

STATION	B. S.	H. I.	F. S.	ELEV.

J.N. 8855.02

John Anson Ford Park

Additional Bench Levels

for

Base Ball Diamonds

Curtis Mankey Jr.
Rodriguez

76298 S & E #307—7-55

76298 S & E #307—7-55

PLEASE RETURN TO
LOS ANGELES COUNTY ENGINEER
700 LOS ANGELES COUNTY ENGINEERING BLDG.

NOTE: ANY ADDITIONS OR CHANGES ON THIS SHEET MUST BE MADE OR CIRCLED IN RED INK, WITH DATE AND NAME OF PERSON MAKING CHANGE.

F. B. 2228 Pg. 166 Job No. 8855.02 Division No. 10 Notes Red. Plotted
Survey of John Anson Ford Park Date. No.
Survey by Curtis Notes Curtis Notes Chkd. Checked X-Sec.
Indexed C. Johnson Date. Date. Date. No.
Profile

Do not extend notes this side of this line.

STATION	B. S.	H. I.	F. S.	ELEV.		
					FB 2228-70 Lrg Bt. spk @ Int's of	
T.B.M.				115.66'	T.B.M Gilliland Ave & Scout Ave.	
		N.W. Soft Ball Diamond			1" I.P. dn 6"-18" Back of Home Plate	
T.B.M. (Set)				116.35	T.B.M. of NW Soft Ball Diamond	
T.P.				16.65	T.P.	
		S.W. Soft Ball Diamond			1" I.P. dn 6"-18" Back of Home	
(Set) TBM.		Fd. 1-9-61 RCW		114.72	TBM plate of S.W. Soft Ball Diamond	
T.P.				114.91	T.P.	
		S.E. Soft Ball Diamond			3/4" I.P. dn 6"-18" back of	
(Set) TBM.				114.10	TBM. Home Plate	
T.P.				116.33	T.P.	
					FB 2228-70	
(Fd) TBM				119.99	T.B.M. Elev. 120.00	

Notes Ck'd by	Survey of John Anson Ford Park
Map No.	JN 8855.02 Tape Std °F
Office Work	Surveyed by O. S. Curtis
Checked	Notes Curtis Date Dec. 58
Date	Indexed K. O. Johnson

F. B. 2228 Pg. 167

J.N. 8855.02
John Anson Ford Park
Location of
Soft Ball Diamond
in
S.W. Cor. Park.

Curtis
Mankey Jr.
Rodriguez

Note: Any Additions or Changes on This Sheet Must be Made or Circled in Red Ink With Date and Name of Person Making Change.

Do not extend notes this side of this line.

RETURN TO
LOS ANGELES COUNTY ENGINEER
700 Los Angeles County Engineering Bldg.

76F3093 CE #247—3-57

F. B. 2228 Pg. 168

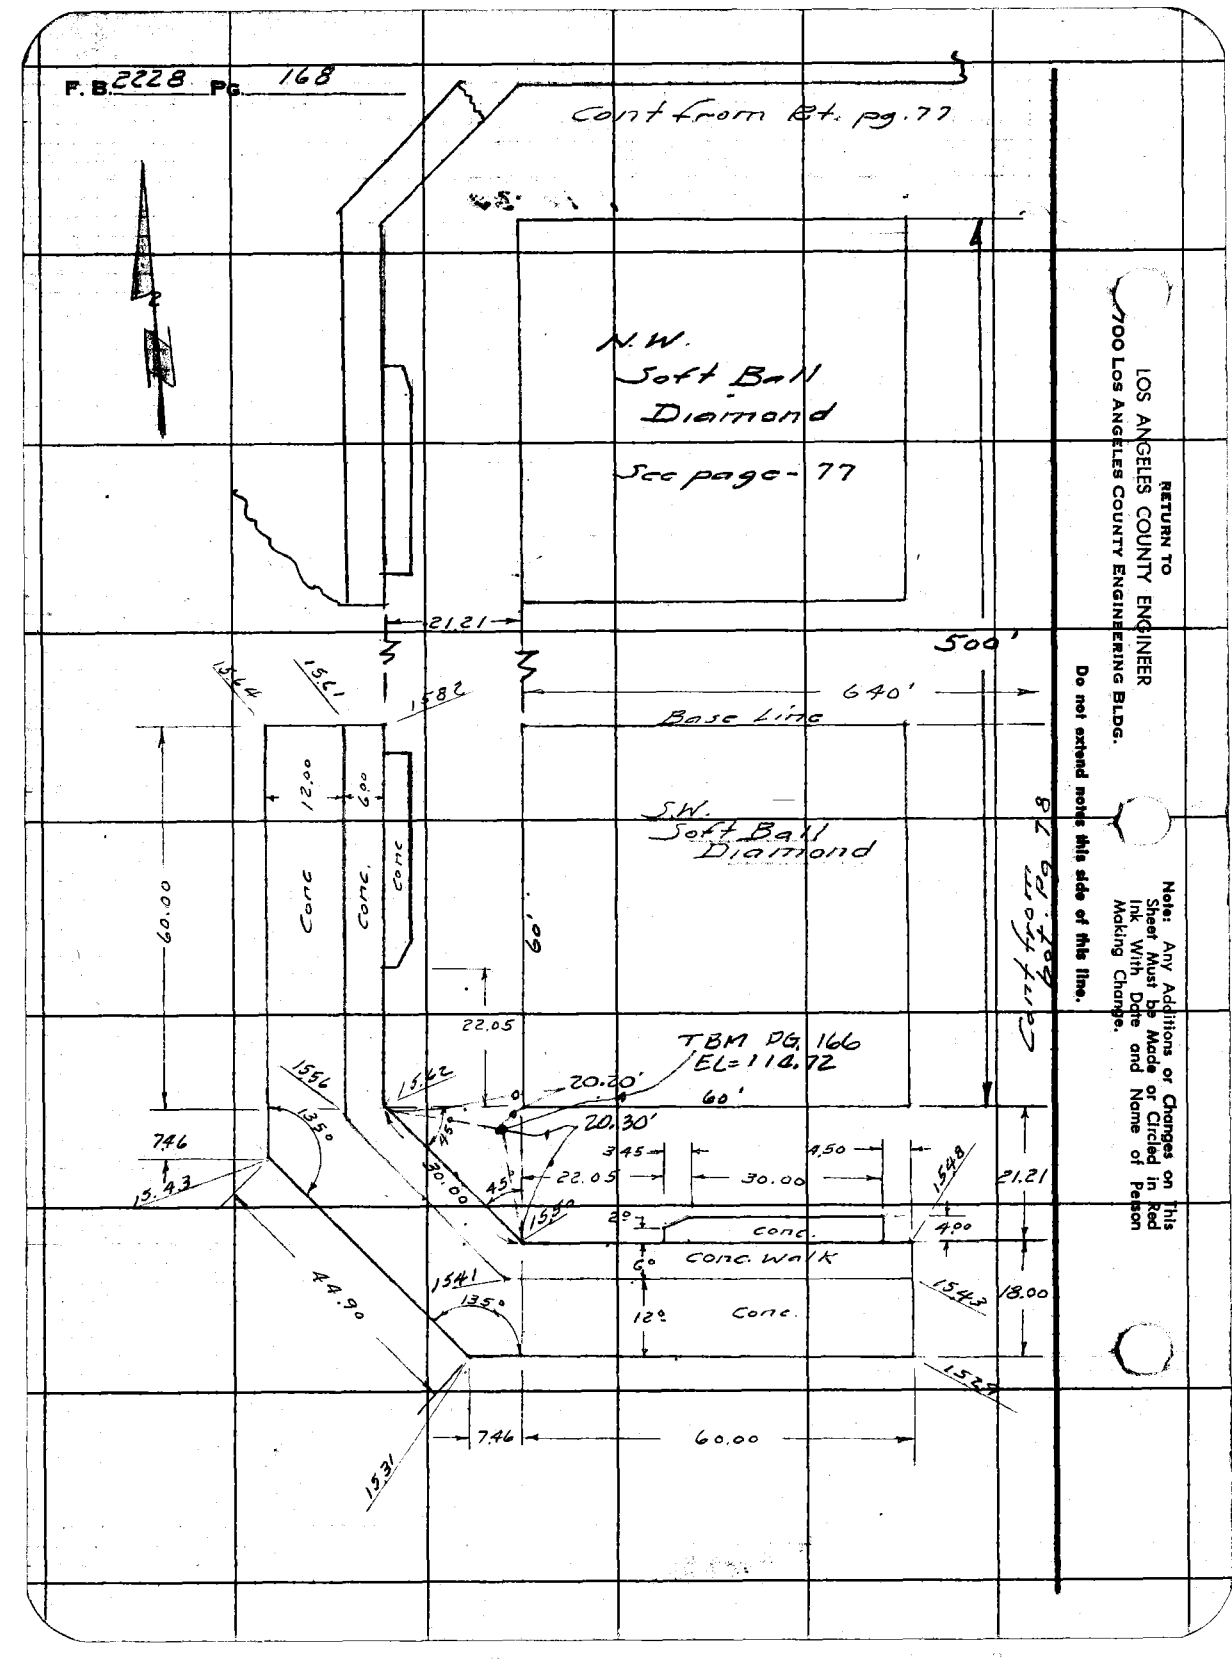

RETURN TO
LOS ANGELES COUNTY ENGINEER
700 Los Angeles County Engineering Bldg.

Do not extend notes this side of this line.

Note: Any Additions or Changes on This Sheet Must be Made or Circled in Red Ink With Date and Name of Person Making Change.

Notes Ck'd by	Survey of John Anson Ford Park
Map No.	JN 8855.02 Tape Std °F
Office Work	Surveyed by G.S. Curtis
Checked	Notes Curtis Date May 58
Date	Indexed A. C. Johnson 1-16-59

F. B. 2228 Pg. 169

J.N. 8855.02
John Anson Ford Park
Location of
Sewer Line for
Directors Bldg.

Curtis
Mankey Jr
Rodriquez
Lattati

Note: Any Additions or Changes on This Sheet Must be Made or Circled in Red Ink With Date and Name of Person Making Change.

Do not extend notes this side of this line.

RETURN TO
LOS ANGELES COUNTY ENGINEER
700 LOS ANGELES COUNTY ENGINEERING BLDG.

76FS098 CE #247—3-57

F.B. 2228 Pg. 170

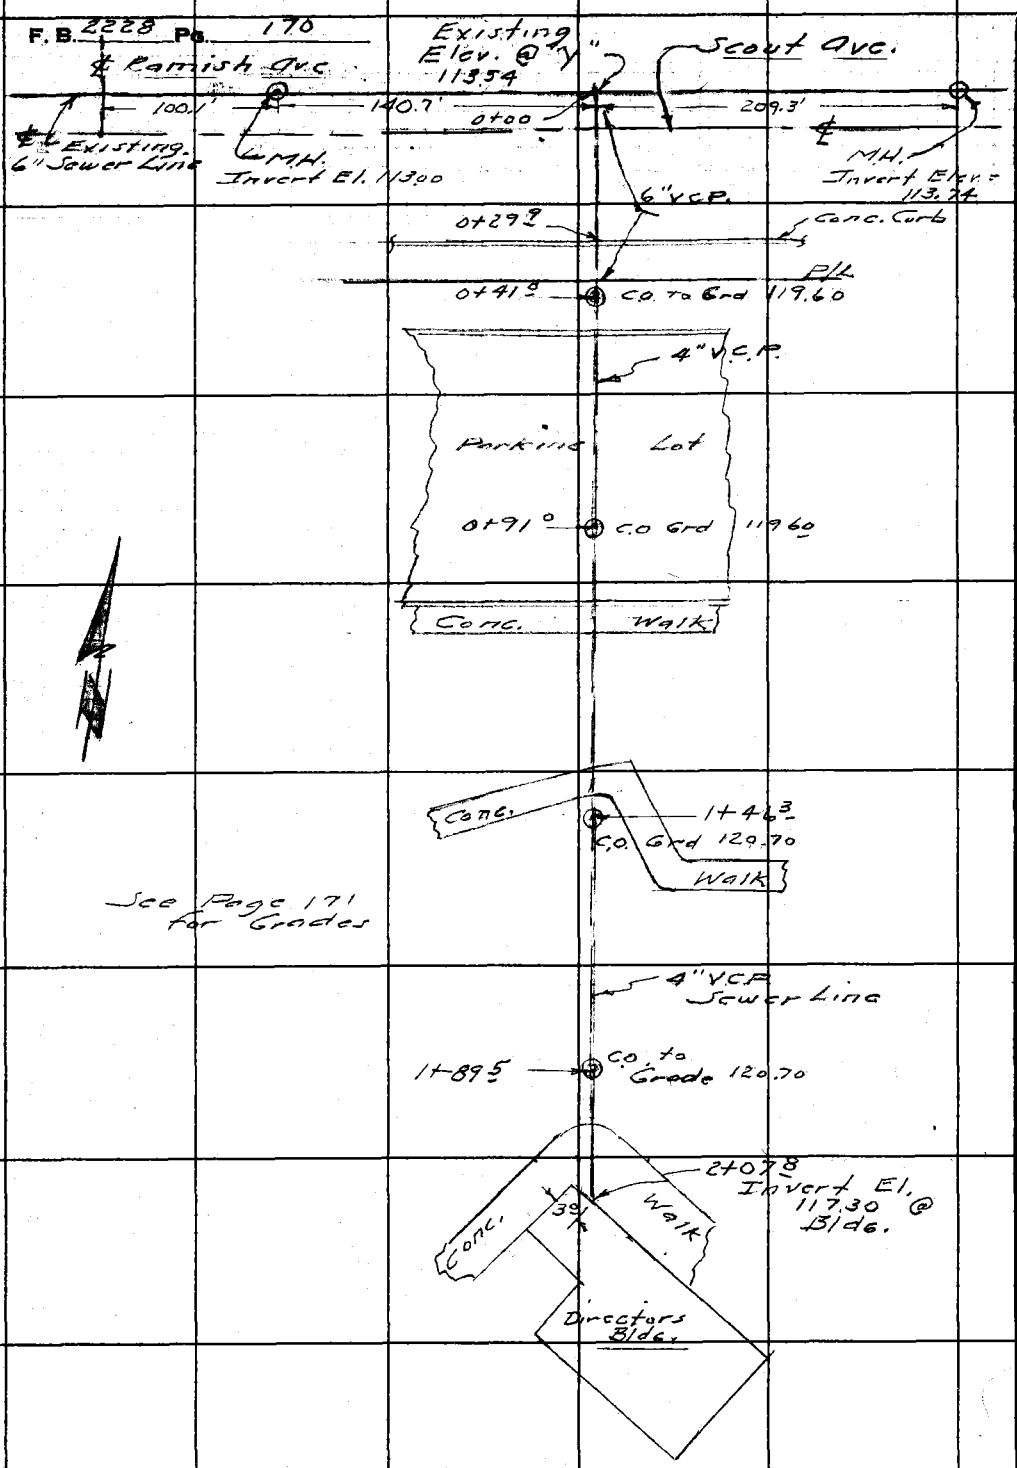

See Page 171 for Grades

RETURN TO
LOS ANGELES COUNTY ENGINEER
700 LOS ANGELES COUNTY ENGINEERING BLDG.

Note: Any Additions or Changes on This Sheet Must be Made or Circled in Red Ink With Date and Name of Person Making Change.

Do not extend notes this side of this line.

Profile No. ____ X-Sec. No. ____

Notes Red. ____ Date ____ Notes Chkd. ____ Date ____

Plotted ____ Date ____ Checked ____ Date ____

885502

Job No. ____ Division No. 10

Survey of John Anson Ford Park

Survey by Curtis Notes Curtis Date May 1958

Map No. ____ Inked C. John-Date ____

F. B. 2228 Pg. 171

NOTE: ANY ADDITIONS OR CHANGES ON THIS SHEET MUST BE MADE OR CIRCLED IN RED INK, WITH DATE AND NAME OF PERSON MAKING CHANGE.

Do not extend notes this side of this line.

STATION	B. S.	H. I.	F. S.	ELEV.

J.N. 8855.02

John Anson Ford Park

Geodes on Sewer Line to Director's Bldg.

(See page 170 for Location)

Curtis
Mankey Jr.
Rodriguez
Lattieri

PLEASE RETURN TO
LOS ANGELES COUNTY ENGINEER
700 LOS ANGELES COUNTY ENGINEERING BLDG.

76L-298 S & E #307—1-56

76L-298 S & E #307—1-56

PLEASE RETURN TO
LOS ANGELES COUNTY ENGINEER
700 LOS ANGELES COUNTY ENGINEERING BLDG.

NOTE: ANY ADDITIONS OR CHANGES ON THIS SHEET MUST BE MADE OR CIRCLED IN RED INK, WITH DATE AND NAME OF PERSON MAKING CHANGE.

Do not extend notes this side of this line.

F. B. 2228 Pg. 172 Job No 885502 Division No. 12 Notes Red Date Profile
Survey by Curtis Notes Notes Chkd. Checked
Indexed [redacted] Date Date No.

STATION	B. S.	H. I.	F. S.	ELEV.			
T.B.M.				118.35			T.B.M. Elev. 118.354 F.B. 2228-70 - St Spk @ Int's Bamish Ave & Scout Ave.
						Grade	actual invert Elev of Connecting
0+00				113.54		113.54	"Y" @ 8" Main Line on Scout Ave
+25						113.99	
+41 Clean out				119.60		119.60	Set 1"x2" @ Grade & Dist.
+50				114.44		114.44	Grade in Ditch - Actual
+75						114.89	
0+91 Clean out				119.60		119.60	Top (Set 1"x2" Grd. & Dist)
1+00				115.35	%	115.35	Grade in Ditch - Actual
1+25				115.80	1.81		
1+46.3 Cleanout				120.70		120.70	Top (Set 1"x2" Grade & Dist)
+50				116.25		116.25	Grade & Ditch - Actual
+75						116.70	
1+89.5 Cleanout				120.70		120.70	Top (Set 1"x2" Grade & Dist)
2+00						117.16	
2+07.8 End				117.30		117.30	Actual Grade in Ditch - at Bldg.
T.P.				118.96			T.P. F.B. 118.960 F.B. 2228-70 D hd. Spk in South Gut. of Scout ave

76F309S CE #247—3-57

RETURN TO
LOS ANGELES COUNTY ENGINEER
700 LOS ANGELES COUNTY ENGINEERING BLDG.

Note: Any Additions or Changes on This Sheet Must be Made or Circled in Red Ink With Date and Name of Person Making Change.

Do not extend notes this side of this line.

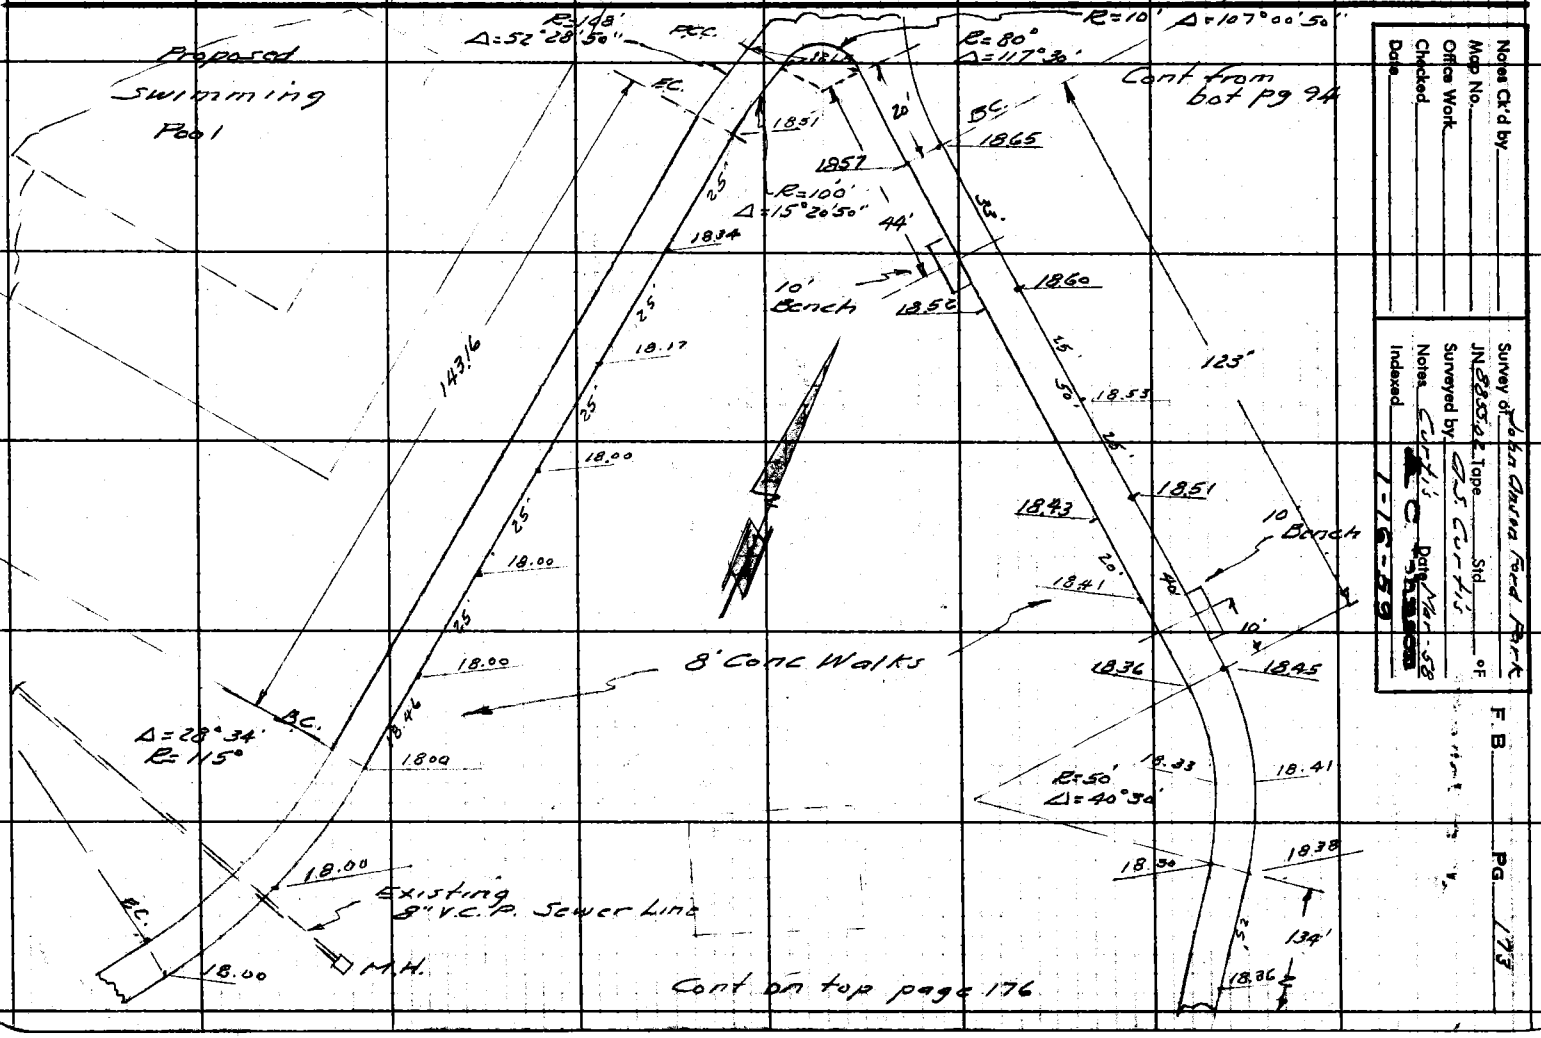

Notes Ck'd by _____
Map No. _____
Office Work _____
Checked _____
Date _____

Surveyed by D.S. Curtis
Notes Curtis Date Mar. 58
Indexed C.C. 7-16-59

F.B. _____ PG. 173

Notes Ck'd by	Survey of John Anson Ford Park
Map No.	JN 8855.02 Tape Std °F
Office Work	Surveyed by G.S. Curtis
Checked	Notes Curtis Date Apr. 58
Date	Indexed

F. B 2228 PG. 175

Cont from bot pg - 178

L = 171.74
R = 130.00

11974 1+00

11952 1+25

11930 1+50

Δ = 75° 11' 30"

T = 92.00

L = 171.74 P.C.C.

Δ = 52° 15' 00"

T = 45.18

R = 92.00

L = 102.50

P.C. 2+74.24

2+00 18.85

2+25 18.65

2+50 18.45

117.83 3+00

117.42 3+25

117.01 3+50

116.59 3+75

12'

Park Boundary

Rio Hondo Channel

Cont on Rt. pg - 176

RETURN TO
LOS ANGELES COUNTY ENGINEER
900 Los Angeles County Engineering Bldg.

Note: Any Additions or Changes on This Sheet Must be Made or Circled in Red Ink With Date and Name of Person Making Change.

Do not extend notes this side of this line.

78FJOBS CE #247 3-57

F.B. 2228 Pg. 176

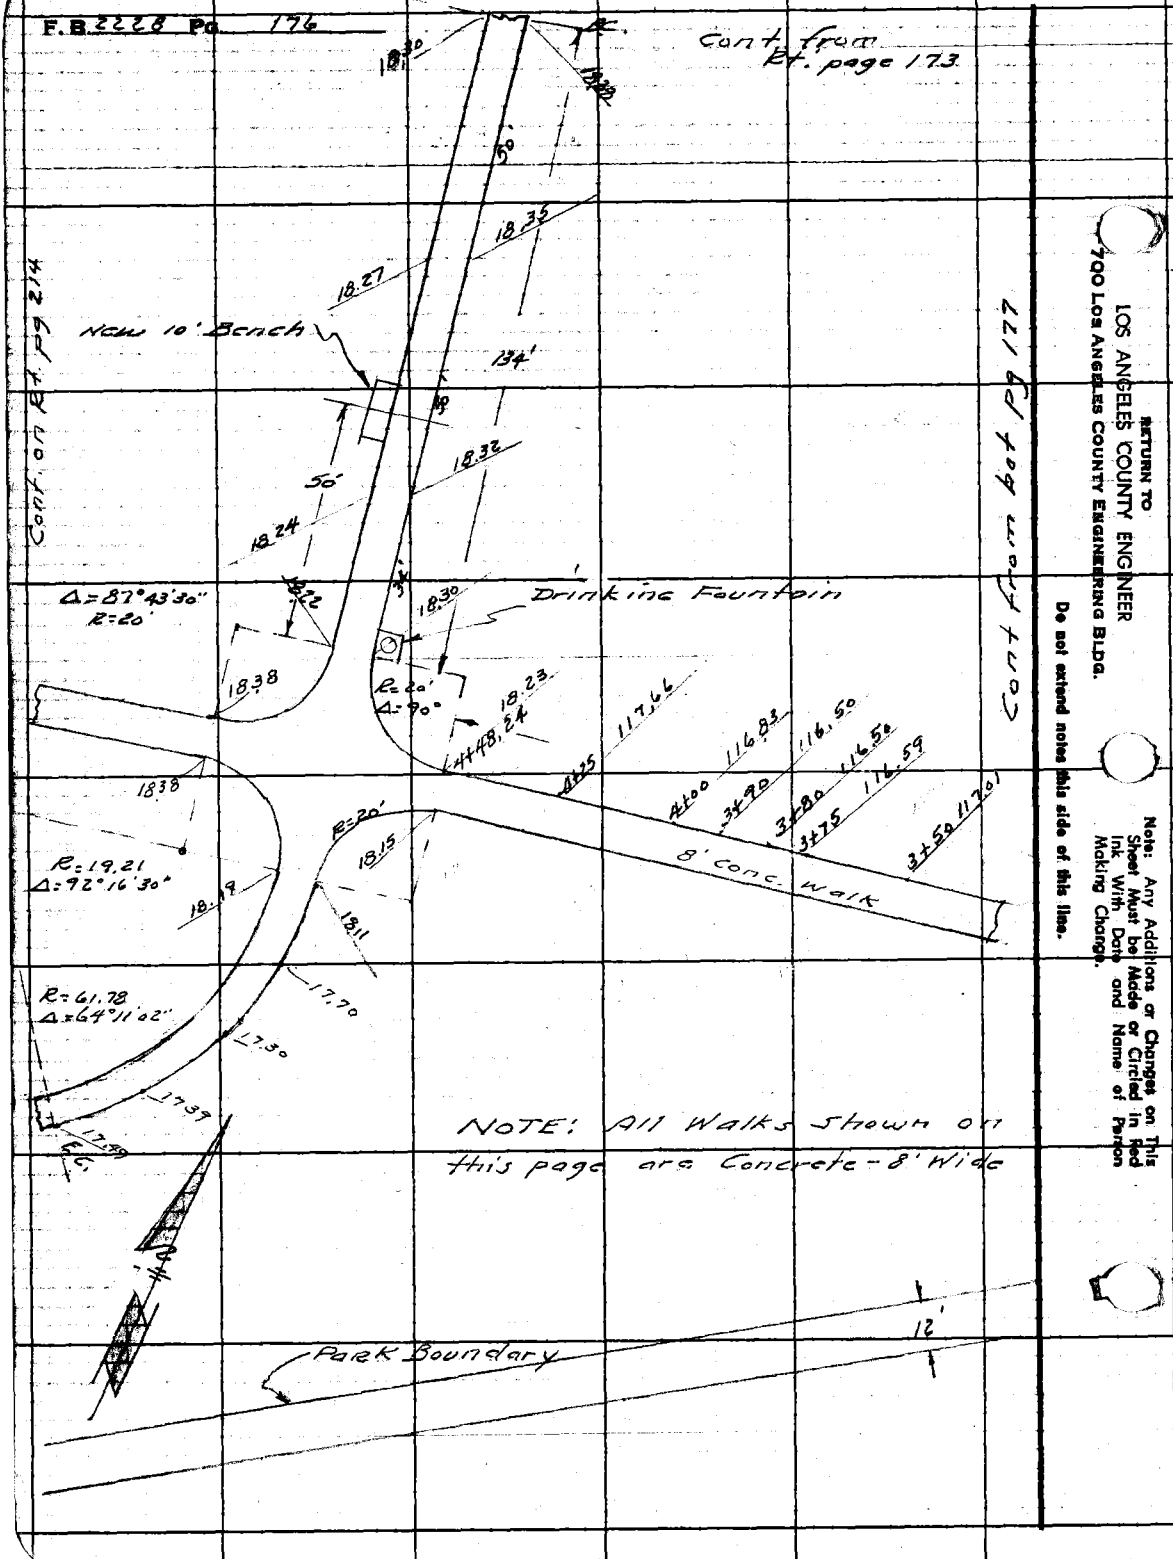

RETURN TO
LOS ANGELES COUNTY ENGINEER
700 Los Angeles County Engineering Bldg.

Do not extend notes this side of this line.

Note: Any Additions or Changes on This Sheet Must be Made or Circled in Red Ink With Date and Name of Person Making Change.

Notes Ck'd by	Survey of John Anson Ford Park
Map No.	JN 9855.01 Tape Std °F
Office Work	Surveyed by A.S. Curtis
Checked	Notes Curtis Date May 58
Date	Indexed C. Johnson

F. B 2229 Pg 177

Note: Any Additions or Changes on This Sheet Must be Made or Circled in Red Ink With Date and Name of Person Making Change.

Do not extend notes this side of this line.

RETURN TO
LOS ANGELES COUNTY ENGINEER
700 LOS ANGELES COUNTY ENGINEERING BLDG.

76F209 CE #247 3-57

Cont on bot pages 90 & 91

Directory Bldg.

Conc Walk

Planting

Conc Walks

Badminton & Basketball Courts

Asphalt Paving

Asphalt

Conc Wk

Conc

Cont on Lt, page 178

(See page 194 for Location of Grade Shots)

(See page 187 for Curb & Wk Grades)

RETURN TO
LOS ANGELES COUNTY ENGINEER
700 LOS ANGELES COUNTY ENGINEERING BLDG.

Note: Any Additions or Changes on This Sheet Must be Made or Circled in Red Ink With Date and Name of Person Making Change.

Do not extend notes this side of this line.

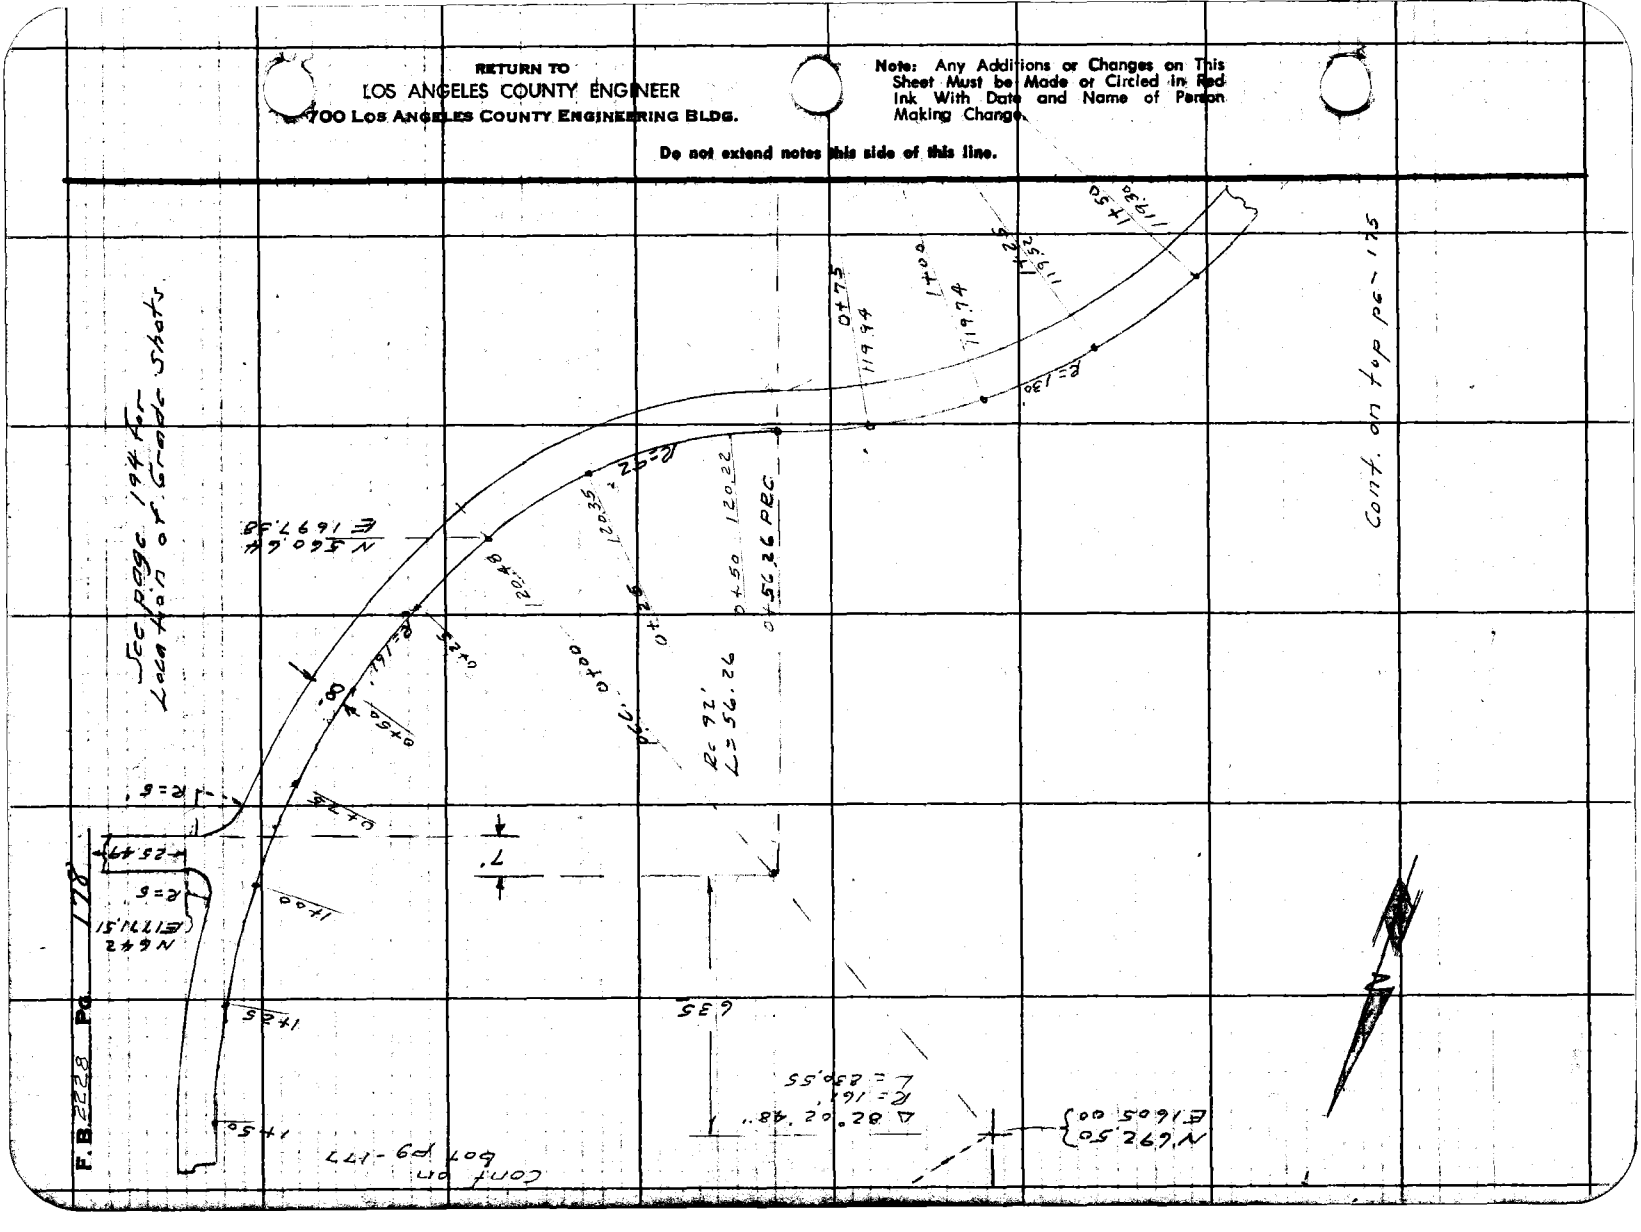

Notes Ck'd by	Survey of John Anson Ford Park
Map No.	JN 8855.02 Tape Std °F
Office Work	Surveyed by O.S. Curtis
Checked	Notes Curtis Date May 12-58
Date	Indexed C. Johnson

F. B. 2228 Pg. 179

J.N. 8855.02

John Anson Ford Park.

Showing the Location of the Edge of the Asphalt Membrance. This Section does not agree with Stakes set by Survey Party.

Curtis
Monkey Jr
Rodriguez
Latterl

Note: Any Additions or Changes on This Sheet Must be Made or Circled in Red Ink With Date and Name of Person Making Change.

Do not extend notes this side of this line.

RETURN TO
LOS ANGELES COUNTY ENGINEER
700 Los Angeles County Engineering Bldg.

78F3095 CE #247—3-57

RETURN TO
LOS ANGELES COUNTY ENGINEER
700 LOS ANGELES COUNTY ENGINEERING BLDG.

Note: Any Additions or Changes on This Sheet Must be Made or Circled in Red Ink With Date and Name of Person Making Change.

Do not extend notes this side of this line.

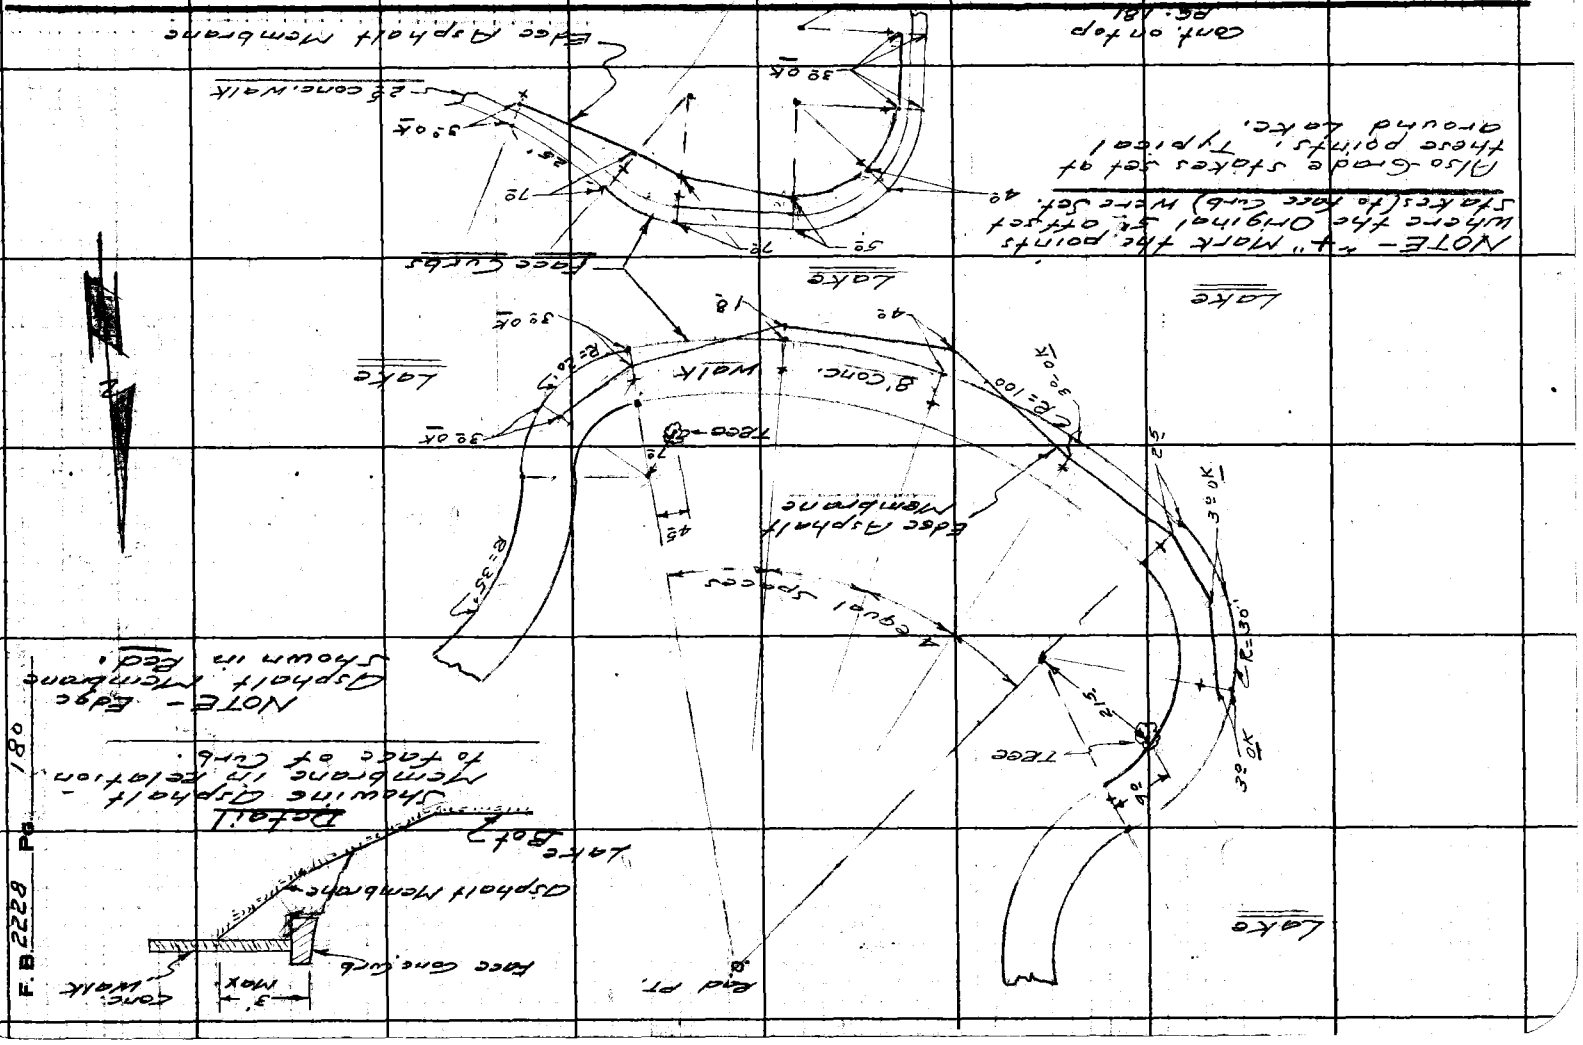

Notes Ck'd by	Survey of John Ansen Ford Park
Map No.	JN 8855.02 Tape Std °F
Office Work	Surveyed by A.S. Curtis
Checked	Notes Curtis Date May 12-58
Date	Indexed K. C. Johnson

F. B. 2228 PG. 181

(Cont. from Rt. pg-180)

Face Curb

2.5' Conc. Walk

3% ok

Lake

R=20'

3% ok

R=20'

35

8' conc Walk

115'

Face Curb

65

5°

R=20'

R=20'

35

8' Conc Walk

Conc. casting Pad

(cont'd)

Edco Asphalt Membrane

115'

Face Curb

45'

R=70'

3% ok

75

2.5 Conc. Wk.

RETURN TO
LOS ANGELES COUNTY ENGINEER
700 LOS ANGELES COUNTY ENGINEERING BLDG.

Note: Any Additions or Changes on This Sheet Must be Made or Circled in Red Ink With Date and Name of Person Making Change.

Do not extend notes this side of this line.

76F3095 CE #247 8-57

Notes Ck'd by		Survey of John Anson Ford Park	F. B. 2228 Pg. 183
Map No.		JN 8855.02 Tape Std °F	
Office Work		Surveyed by F.E. Brooks	
Checked		Notes F.E.B. Date 58	
Date		Indexed [redacted]	

JOHN ANSON FORD PARK
J.N. 8855.02

Location of Conc. Drives

on

South Side of Scout Ave

0+00 = int. of South curb line
of Scout Ave and East. P/L
Prod. of Park

Brooks
Melendez
PoHer

Note: Any Additions or Changes on This Sheet Must be Made or Circled in Red Ink With Date and Name of Person Making Change.

Do not extend this side of this line.

PLEASE RETURN TO
LOS ANGELES COUNTY ENGINEER
700 LOS ANGELES COUNTY ENGINEERING BLDG.

76F3095 SAE #247 1-56

F. B. 2228 Pg. 184

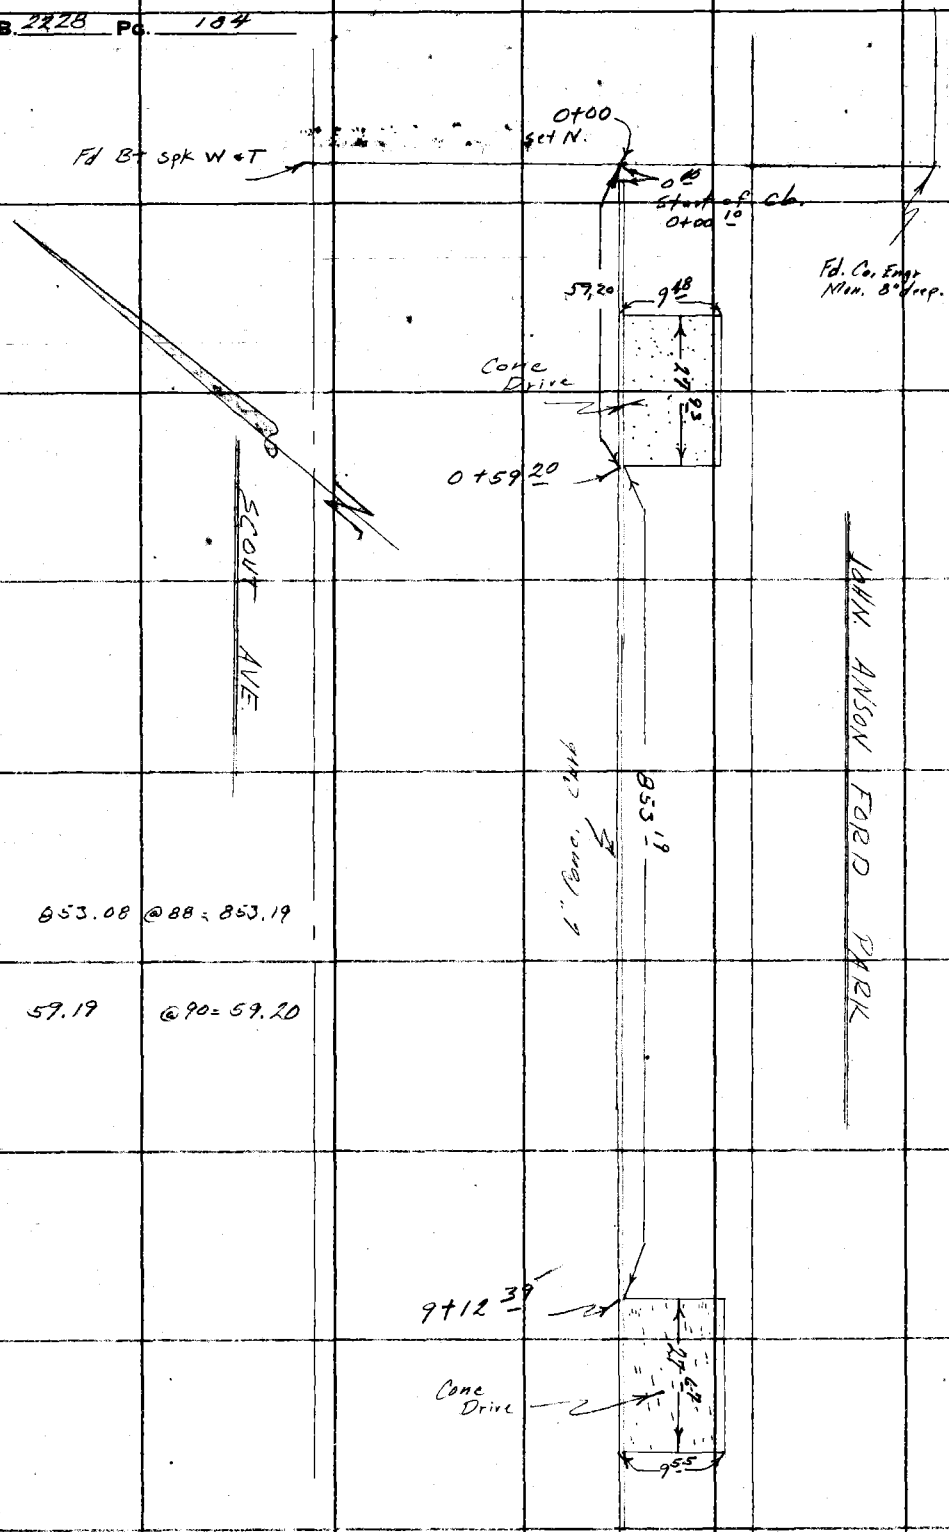

PLEASE RETURN TO
LOS ANGELES COUNTY ENGINEER
700 Los Angeles County Engineering Bldg.

Do not extend this side of this line.

Note: Any Additions or Changes on This Sheet Must be Made or Circled in Red Ink With Date and Name of Person Making Change.

Notes Ck'd by	Survey of John Anson Ford Park
Map No.	JN 8855.02 Tape Std °F
Office Work	Surveyed by F.E. Brooks
Checked	Notes F.E.B. Date 58
Date	Indexed A. C. Johnson

F. B. 2228 PG. 185

JOHN ANSON FORD PARK

J.N. 8855.02

Location of Conc Drives

on

South Side Scout Ave.

0+00 = Int. of East R/W line of Southern Calif Edison Co. and North P/L of Park

Brooks
Melendez
Potter

Note: Any Additions or Changes on This Sheet Must be Made or Circled in Red Ink With Date and Name of Person Making Change.

PLEASE RETURN TO
LOS ANGELES COUNTY ENGINEER
700 LOS ANGELES COUNTY ENGINEERING BLDG.
Do not extend this side of this line.

75F3095 SAE #247 1-56

F. B. 2228 Pg. 186

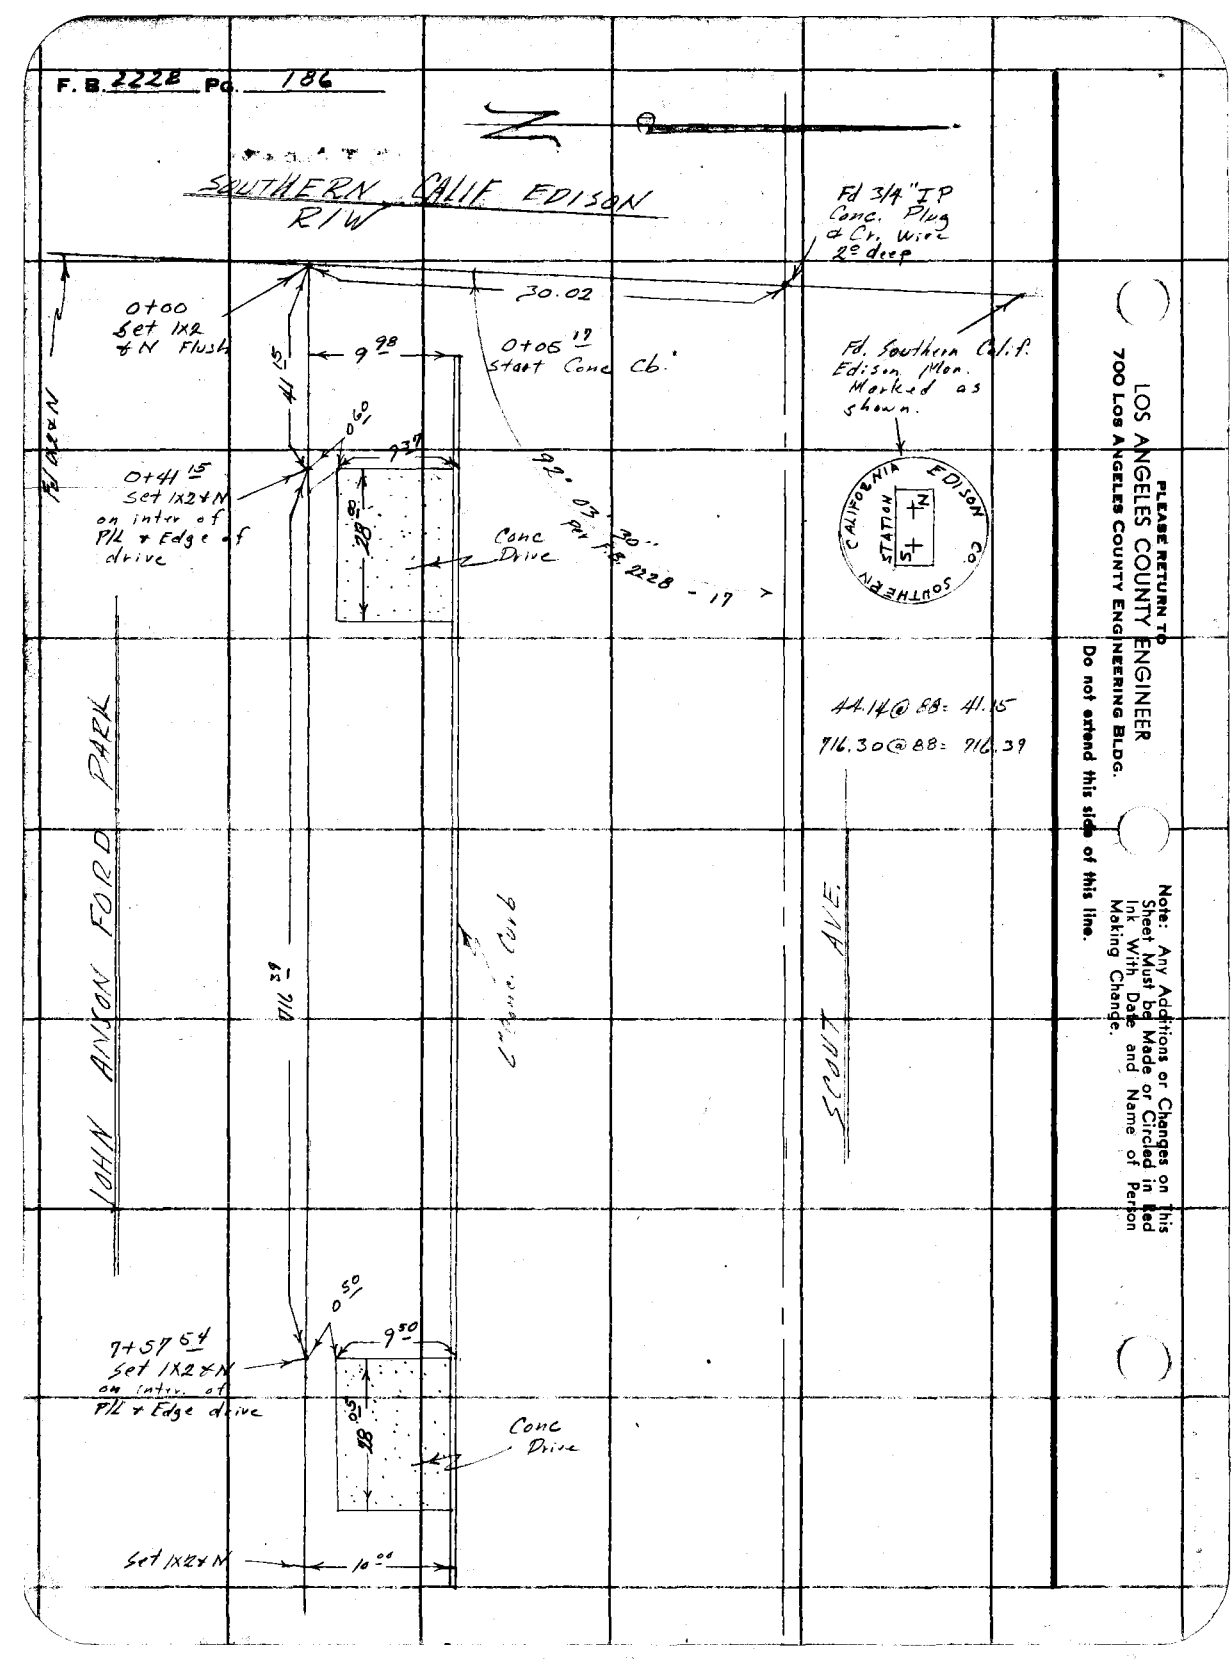

PLEASE RETURN TO
LOS ANGELES COUNTY ENGINEER
700 Los Angeles County Engineering Bldg.
Do not extend this side of this line.

Note: Any Additions or Changes on This Sheet Must be Made or Circled in Red Ink With Date and Name of Person Making Change.

Profile No. | Notes Red | Plotted | Job No. 3855.02 Division No. 110 | F. B. 2228 Pg. 187
X-Sec. No. | Notes Chkd | Checked | Survey of John Anson Ford Park
Date | Date | Date | Survey by Holstrom Notes F.E.B. Date 4-25-58
Map No. Indexed C. Johnson 1-16-59

NOTE: ANY ADDITIONS OR CHANGES ON THIS SHEET MUST BE MADE OR CIRCLED IN RED INK, WITH DATE AND NAME OF PERSON MAKING CHANGE.

PLEASE RETURN TO
LOS ANGELES COUNTY ENGINEER
700 Los Angeles County Engineering Bldg.

Do not extend notes this side of this line.

J.N. 3855.02

JOHN ANSON FORD PARK

GRADES FOR 6" CONC. CURB & 8.° CONC. WALK ALONG WEST SIDE OF FUTURE PARKING LOT IN N.E. COR. OF PARK.

A.N. Holstrom
J.L. Brooks
J.W. Potter

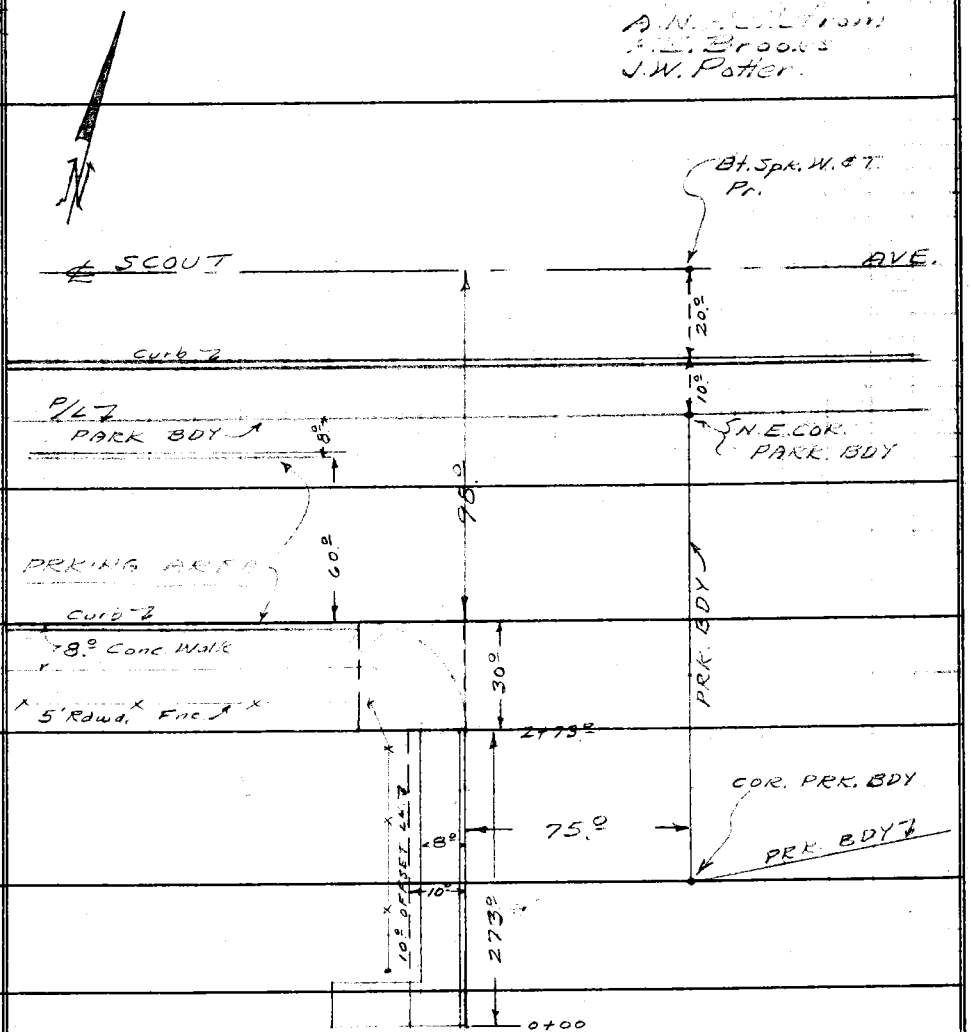

ELEV. | F. S. | H. I. | B. B. | STATION

76298 S & E #307—7-55

76298 S & E #307—7-55

PLEASE RETURN TO
LOS ANGELES COUNTY ENGINEER
700 Los Angeles County Engineering Bldg.

NOTE: ANY ADDITIONS OR CHANGES ON THIS SHEET MUST BE MADE OR CIRCLED IN RED INK, WITH DATE AND NAME OF PERSON MAKING CHANGE.

Do not extend notes this side of this line.

F. B. 2228 Pg. 188 | Job No. 885502 | Division No. 10 | Notes Red. | Plotted | No. | Profile
Survey of Johnson Ford Park | Date | Date | No. | X-Sec.
Survey by Hellstrom Notes F.B. | Notes Chkd. | Checked
Indexed C. Johnson Date | Date | Date

STATION	B. S.	H. I.	F. S.	ELEV.		
BM				118 35	B.M. Elev. 118.35 F.B. 2228 pg 52 Inter. Scout Ave & Romish Ave B+ spk W. of T.	
T.P.				120 37		
					Grade	cut
0 + 00					19.26	
+ 25					19.18	
+ 50					19.30	
+ 75					19.40	
1 + 00					19.50	
+ 25					19.60	
+ 50					19.70	
+ 75					19.80	
2 + 00					19.90	
+ 25					20.00	
+ 50					20.10	
+ 73					20.19	
T.P.				120 18		
BM					B.M. Elev. 118.35	

Set to grade

Profile No. | Notes Red. | Date | Plotted | Date | Job No. 8855.02 | Division No. 10 | F. B. 2228 | Pg. 189

X-Sec. No. | Notes Chkd. | Date | Checked | Date | Survey of Lots Anson Ford Park | Survey by Hallstrom | Notes ANH | Date Apr 58 | Map No. | Indexed C. Johnson | Date

J.N. 8855,02.

John Anson Ford Park.

Rough Grade For Sand Area
In N.E. Section Of Park.
Sub Grade = 18" Below Top Of Curb

STATION	B. S.	H. I.	F. S.	ELEV.

NOTE: ANY ADDITIONS OR CHANGES ON THIS SHEET MUST BE MADE OR CIRCLED IN RED INK, WITH DATE AND NAME OF PERSON MAKING CHANGE.

PLEASE RETURN TO
LOS ANGELES COUNTY ENGINEER
700 Los Angeles County Engineering Bldg.

Do not extend notes this side of this line.

76298 S & E #307—7-55

76298 S & E #307—7-55

PLEASE RETURN TO
LOS ANGELES COUNTY ENGINEER
700 Los Angeles County Engineering Bldg.

NOTE: ANY ADDITIONS OR CHANGES ON THIS SHEET MUST BE MADE OR CIRCLED IN RED INK, WITH DATE AND NAME OF PERSON MAKING CHANGE.

Do not extend notes this side of this line.

F. B. 2228 Pg. 190 Job No. 8855.02 Division No. 12 Notes Red. Plotted
Survey of Notes Date Date No. Profile
Survey by C. Johnson Notes Chkd. Checked No. X-Sec.
Indexed Date Date Date

STATION	B. S.	H. I.	F. S.	ELEV.			
BM				118 35	Elev. 118.35 ℄ inter. Scout Ave & Romish Ave Bt. Spk W&T, Per F.B. 2228 pg 52		
					Gr	Cut	
N.W. Cor 5'R B.C.				120 1	118.87	1.2	
" " " E.C.				120 1	118.90	1.2	
5'R B.C.				120 4	119.20	1.2	
" E.C.				120 4	119.28	1.1	
4R B.C.				120 3	119.46	0.8	
" E.C				120 4	119.46	0.9	
4'R B.C				120 5	119.60	0.9	
R.C				120 6	119.60	1.0	
P.C.C.				120 5	119.78	0.7	
P.C.C.				120 6	119.33	1.3	
E.C.				120 5	119.08	1.4	
5'R B.C.				119 3	118.41	1.4	
E.C.				119 3	118.39	1.4	
5'R B.C				120 2	118.44	1.6	
E.C.				119 3	118.48	1.3	
10'R B.C				120 3	119.26	1.0	
F.C				120 5	119.26	1.2	

Profile No. | Notes Red. | Plotted | Job No. 8855.02 | Division No. 10 | F. B. 2228 | Pg. 191
X-Sec. No. | Notes Chkd. | Checked | Survey of John Anson Ford Park
Date | Date | Survey by Curtis | Notes Curtis | Date May 1958
Date | Date | Map No. | Indexed C. Johnson | Date

NOTE: ANY ADDITIONS OR CHANGES ON THIS SHEET MUST BE MADE OR CIRCLED IN RED INK, WITH DATE AND NAME OF PERSON MAKING CHANGE.

PLEASE RETURN TO
LOS ANGELES COUNTY ENGINEER
700 Los Angeles County Engineering Bldg.

Do not extend notes this side of this line.

STATION	B. B.	H. I.	F. S.	ELEV.	
					J.N. 8855.02 John Anson Ford Park West Parking Lot. Curb Grades for Planter Boxes. Curtis Mankey Rodriguez Lattemi See pages 71 thru 75 for Location

76298 S & E #307—7.55

76298 S & E #307—7-55

PLEASE RETURN TO
LOS ANGELES COUNTY ENGINEER
700 LOS ANGELES COUNTY ENGINEERING BLDG.

NOTE: ANY ADDITIONS OR CHANGES ON THIS SHEET MUST BE MADE OR CIRCLED IN RED INK, WITH DATE AND NAME OF PERSON MAKING CHANGE.

Do not extend notes this side of this line.

F. B. 2228 Pg. 192 Job No 8855.02 Division No. 10 Notes Red Date Notes Chkd Date Notes Date
Survey of John Anson Ford Park Date Checked Date
Survey by C. Tomasini Notes Curtis Date
Indexed Date

Profile No.
X-Sec. No.

STATION	B. S.	H. I.	F. S.	ELEV.		
					El. 117.20 FB 2228-70 (So. Curb Scout Ave)	
B.M.				117.20	BM 5' W. & Prod. Gotham Ave. Bt spk in Cb.	
Planter No. 1 (Most Easterly Box)		Parking Lot No. Curb (Exist) 117.10		Planter Curb Grd. 117.68	Parking Lot. So. Curb (Exist) 118.26	1"x2" stks Set to Grade center Planter
2		117.04		117.63	118.22	"
3				117.58		"
4		116.89		117.51	118.15	"
5				117.45		"
6		116.82		117.41	118.00	"
						Scout Ave.
T.P.				116.16	T.P. Spk in FB 2228-70 Bt spk in Cut.	
7				117.36		"
8		116.75		117.31	117.87	"
9				117.26		"
10				117.19		"
11		116.55		117.11	117.67	"
12		116.47		117.05	117.63	"
13		116.36		116.96	117.55	"
14		116.25		116.89	117.53	"
15		116.14		116.78	117.28	"
16 (Most Westerly Box)		116.03		116.67	117.20	"
					El. 115.66 FB 2228-70 Bt spk in Cut.	
T.B.M.				115.65	T.B.M. So. Side Scout Ave.	

Notes Ck'd by	Survey of JOHN ANSON FORD PARK F.B. 2228 Pg. 193
Map No.	JN 8855.02 Tape 0173 Std 68 ea
Office Work	Surveyed by J.S. COATES
Checked	Notes J.S.C. Date 5/2/58
Date	Indexed A. C. Johnson

Note: Any Additions or Changes on This Sheet Must be Made in Red Ink or Circled With Date and Name of Person Making Change.

Do not extend notes this side of this line.

RETURN TO
LOS ANGELES COUNTY ENGINEER
700 Los Angeles County Engineering Bldg.

76F3008 CE #247—8.

J.N. 8855.02

JOHN ANSON FORD PARK

STAKING LOCATION OF CONC. WALKS

N.E. Cor. Park at Director's Bldg.

See pages 90, 91, 92, 177 & 178 for Location of Walks & Planting Areas

COATES
MOYA
SMITH
SPRIGGS

F. B. 2228 Pg. 194

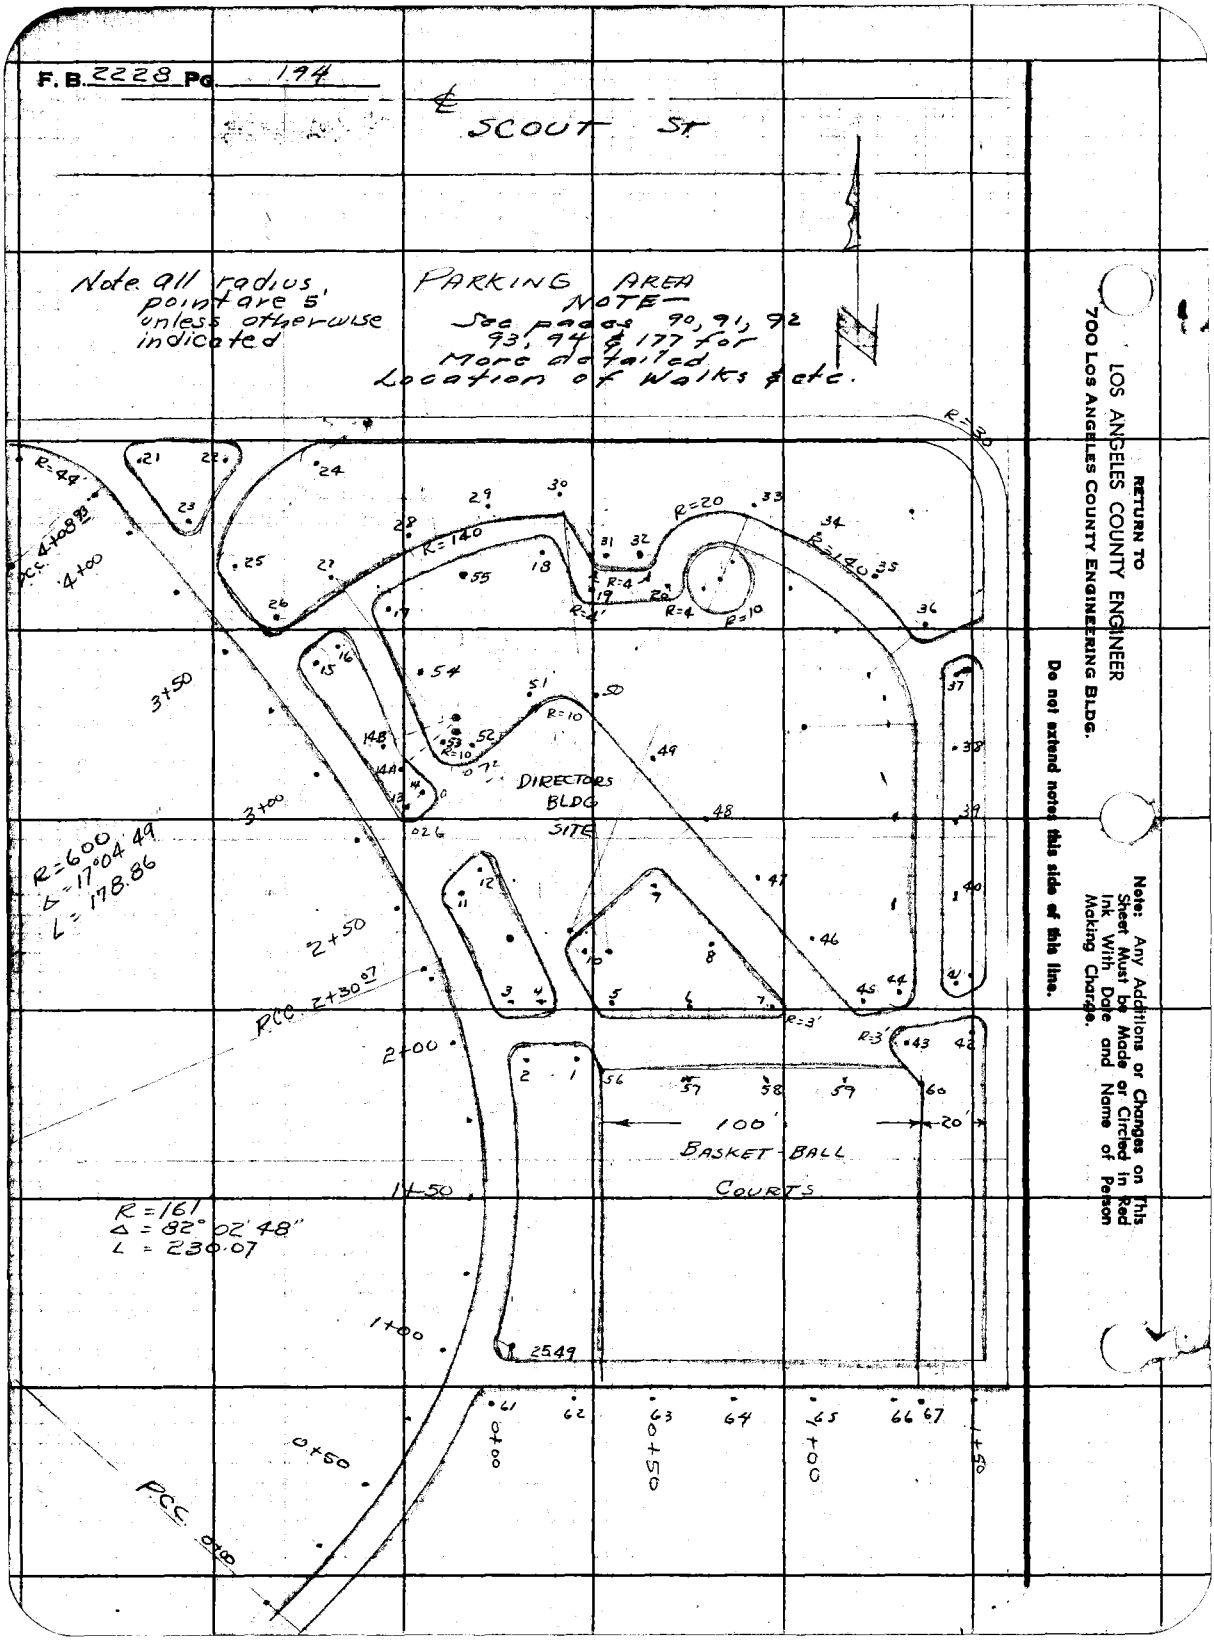

RETURN TO
LOS ANGELES COUNTY ENGINEER
700 LOS ANGELES COUNTY ENGINEERING BLDG.

Note: Any Additions or Changes on This Sheet Must be Made or Circled in Red Ink With Date and Name of Person Making Change.

Do not extend notes this side of this line.

F. B. 2228 Pg. 195

Profile No. | Notes Red. Date | Plotted Date | Job No. 8855.02 | Division No.
X-Sec. No. | Notes Chkd. Date | Checked Date | Survey of John Anson Ford Park
Survey by J S COATES | Notes JSC | Date 5-2-58
Map No. | Index C. Johnson

J.N. 8855.02

JOHN ANSON FORD PARK

ELEVATIONS
FOR
GRADE
ON
CONC WALKS
IN
N.E. Cor Park at Directors Bldg Area

See pages 194 for Location of Grade Shots

COATES
MOYA
SMITH
SPRIGGS

STATION	B. S.	H. I.	F. S.	ELEV.

NOTE: ANY ADDITIONS OR CHANGES ON THIS SHEET MUST BE MADE OR CIRCLED IN RED INK, WITH DATE AND NAME OF PERSON MAKING CHANGE.

Do not extend notes this side of this line.

PLEASE RETURN TO
LOS ANGELES COUNTY ENGINEER
700 Los Angeles County Engineering Bldg.

76L-298 S & E #307—1-56

76L-298 S & E #307—1-58

PLEASE RETURN TO
LOS ANGELES COUNTY ENGINEER
700 LOS ANGELES COUNTY ENGINEERING BLDG.

NOTE: ANY ADDITIONS OR CHANGES ON THIS SHEET MUST BE MADE OR CIRCLED IN RED INK, WITH DATE AND NAME OF PERSON MAKING CHANGE.

Do not extend notes this side of this line.

F. B. 2228 Pg. 196 Job No 8855.02 Division No
Survey of John Anson Ford Park
Survey by L.S.C. Jr. Notes
Indexed

Profile No Plotted
X-Sec. No Date
Notes Red Date
Notes Cbkd. Checked
Date Date

STATION	B. S.	H. I.	F. S.	ELEV.			
BM				118 35	BM Elev. 118.35 & INT Ramish St. & Scout St. Top Bt. Spk,		FB. 2228-70
					Finish Grade	Col F	
	W. Side 16½' R. Conc. walk						
0+00 P.C.C.					120.46		Set Stk & Tin 5' W. of W. edge walk
0+25					120.48		
0+50		(See pages 177, 178			120.50		
0+75		91, 92 & 194 for			120.53		
1+00		Location)			120.54		
+25					120.54		
+50					120.54		
+75					120.53		
2+00					120.50		
+25					120.45		
2+30.67 P.C.C.		Begin 600' R Walk			120.44		
+50					120.36		
+75					120.26		
3+00					120.16		
+25					120.06		
+50					119.96		
+75					119.86		

Set Blue Top to Finish Grade

76L-298 S & E #307—1-56

PLEASE RETURN TO
LOS ANGELES COUNTY ENGINEER
700 LOS ANGELES COUNTY ENGINEERING BLDG.

NOTE: ANY ADDITIONS OR CHANGES ON THIS SHEET MUST BE MADE OR CIRCLED IN RED INK, WITH DATE AND NAME OF PERSON MAKING CHANGE.

Do not extend notes this side of this line.

Profile Notes Red. Plotted Job No. 8855.02 Division No. F. B. 2228 Pg. 197
No. X-Sec. Date Date Survey of John Anson Ford Park
No. Notes Chkd. Checked Survey by JSC Notes JSC Date 5-2-58
Date Date Map No. Index M. C. Johnson

STATION		B. S.	H. I.	F. S.	ELEV.	Finish Grade	C or F		
4+00						119.80		Set Stk & Tin 5' W. of W edge walk	
4+08.93		P.C.C.				119.78			
4+19						119.71			
4+40.93		E.C.				119.88			
for Location of points below See Sketch page.									
1	E	5'R				120.47		Set Stk & Tin 5' off wall	
	N				✓	120.50			
2	N	5'R				120.57			
	W				✓	120.60			
3	W	5'R			✓	120.57			
"	S					"			
4	S	5'R			✓	120.57			
	E					120.56			
5	W	5'R			✓	120.52			
"	S					120.47			
6					✓	120.30			
7	S	3' Radius pt			✓	120.12			
"	E					120.12			
8					✓	120.43			

Set Blue top - Finish Grade

76L-298 S & E #307—1-56

PLEASE RETURN TO
LOS ANGELES COUNTY ENGINEER
700 LOS ANGELES COUNTY ENGINEERING BLDG.

NOTE: ANY ADDITIONS OR CHANGES ON THIS SHEET MUST BE MADE OR CIRCLED IN RED INK, WITH DATE AND NAME OF PERSON MAKING CHANGE.

F. B. 22228 Pg. 198 | Job No. 885502 | Division No. | Profile
Survey by JSC | Date | Date | X-Sec.
Notes Taken JSC | Notes Chkd. | Checked | No.
Indexed | Date | Date | No.

Do not extend notes this side of this line.

STATION	B. S.	H. I.	F. S.	ELEV.	Finish Grade	C or F		
9	5'R			✓	120.75			
10 N	5'R				120.70			
" S				✓	120.66			
11 W	5'R				120.48			
" N				✓	120.50			
12 N	5'R				120.61			
" E				✓	120.71			
13 W	5'R				120.37			
" S					120.47			
14 S	5'R				120.50			
E					120.53			
14A	EC } 20'R.				120.51			
14B	EC }				120.48			
15 W					120.16			
" N					120.19			
16 N					120.29			
" E					120.26			
17 W					120.37			
" N					120.40			

See Blue Top - Finish Grade

76L-298 S & E #307—1-56

PLEASE RETURN TO
LOS ANGELES COUNTY ENGINEER
700 LOS ANGELES COUNTY ENGINEERING BLDG.

NOTE: ANY ADDITIONS OR CHANGES ON THIS SHEET MUST BE MADE OR CIRCLED IN RED INK, WITH DATE AND NAME OF PERSON MAKING CHANGE.

Do not extend notes this side of this line.

Profile Notes Red. Plotted. Job No. 88 55.02 Division No. 10 F. B. 2228 Pg. 192
No. Date Checked Survey by Curtis Notes Curtis Date 5-7-58
Date Map No. Index C. Johnson Date

STATION		S. S.	H. I.	F. S.	ELEV.	Finish Grade	
18	N	5'R				120.70	
	E					120.78	
19		4'R				120.96	
20		4'R				121.10	
21	W	5'R				119.96	
"	N					120.02	
22	N	5'R				120.12	
"	E					119.83	
23	W	5'R				119.93	
"	E					119.96	
24	N	5'R				120.21	
✓	W					120.20	
25						120.10	
26	NW	5'R				120.00	
✓	SW					120.01	
27	W	5'R				120.09	
✓	S					120.11	
27A						120.27	
28						120.41	

76L-298 S & E #307—1-56

PLEASE RETURN TO
LOS ANGELES COUNTY ENGINEER
700 Los Angeles County Engineering Bldg.

NOTE: ANY ADDITIONS OR CHANGES ON THIS SHEET MUST BE MADE OR CIRCLED IN RED INK, WITH DATE AND NAME OF PERSON MAKING CHANGE.

Do not extend notes this side of this line.

F. B. 2228 Pg. 200 Job No. 8855.02 Division No. 10 Profile
Survey by Curtis Notes Plotted
Indexed K.C. Johnson Date Notes Chkd Date Checked Date

STATION	B. S.	H. I.	F. S.	ELEV.	Finish Grade
29					120.55
30 N	℄PT				120.70
31 W	4'R				120.85
" S					120.88
32 S	4'E	(BC 20'R)			120.90
" E					121.01
33		(EC 20'R)			121.20
34					121.04
35					120.88
36 SW	5'R				120.72
" SE					120.60
37 N	5'R				120.54
" W					
38					120.42

76298 S & E #307—7-55

PLEASE RETURN TO
LOS ANGELES COUNTY ENGINEER
700 LOS ANGELES COUNTY ENGINEERING BLDG.

NOTE: ANY ADDITIONS OR CHANGES ON THIS SHEET MUST BE MADE OR CIRCLED IN RED INK, WITH DATE AND NAME OF PERSON MAKING CHANGE.

Do not extend notes this side of this line.

STATION	B. S.	H. I.	F. S.	ELEV.	Finish Grade		
39					120.23		
40					120.04		
41 W	5'R				119.85		
✓ S					119.80		
42 N	5'R				119.75		
✓ E					119.72		
43 N	3'R				119.85		
✓ W					119.84		
44 E	5'R				119.91		
✓ S					119.89		
45 S	5'R				119.92		
✓ SW					119.98		
46					120.14		
47					120.29		
℄ — PT	N.E. for BB Court				119.79		

Profile Notes Red. Plotted Job No. 8855.02 Division No. 10 F. B. 2228 Pg. 201
X-Sec. Notes Chkd. Checked Survey by Curtis Notes Curtis Date May - 58
No. Date Date Map No. Index [illegible] Johnson

76298 S & E #307—7-55

PLEASE RETURN TO
LOS ANGELES COUNTY ENGINEER
700 LOS ANGELES COUNTY ENGINEERING BLDG.

NOTE: ANY ADDITIONS OR CHANGES ON THIS SHEET MUST BE MADE OR CIRCLED IN RED INK, WITH DATE AND NAME OF PERSON MAKING CHANGE.

Do not extend notes this side of this line.

F. B. 2228 Pg. 202 Job No 8035.02 Division No 10 Notes Red. Plotted
Survey of John Anson Ford Park Date. No.
Survey by Curtis Notes Chkd. Checked X-Sec.
Indexed C. Johnson Date. Date. No.
Profile

STATION	B. S.	H. I.	F. S.	ELEV.		
					Finish Grade	
48					120.45	
49					120.60	
50	(B.C. 10' Rad.)				120.76	
51	(E.C. 10' Rad.)				120.75	
52	(B.C. 10' Rad.)				120.73	
53	(E.C. 10' Rad.)				120.67	
54					120.82	New
55					120.55	New
56	℄ PT (NW Cor B.B. Court)				120.44	"
57					120.28	"

76298 S & E #307—7-55

PLEASE RETURN TO
LOS ANGELES COUNTY ENGINEER
700 LOS ANGELES COUNTY ENGINEERING BLDG.

NOTE: ANY ADDITIONS OR CHANGES ON THIS SHEET MUST BE MADE OR CIRCLED IN RED INK, WITH DATE AND NAME OF PERSON MAKING CHANGE.

Do not extend notes this side of this line.

STATION	B. S.	H. I.	F. S.	ELEV.	Finish Grade	
58					120.12	
59					119.96	
60		℄ PT NE Cor BB Court (Walk So. Side BB Court)			119.79	
61 E	5'R.				120.46	
N					120.40	
62					120.15	
BB. Court	(opp)	(SW Cor)			120.07	
63					119.93	
64					119.76	
65					119.62	
66					119.46	
67		(opp. SE Cor)	BB Court		119.40	

Profile Notes Red. Plotted Job No. 8855.02 Division No. 12 F. B. 2228 Pg. 203
X-Sec. Notes Chkd. Checked Survey by Curtis Notes Curtis Date May - 1958
No. Date Date Map No. Index H. C. Tolbert

Profile No. ____ X-Sec. No. ____

Notes Red. ____ Date ____ Notes Chkd. ____ Date ____

Plotted ____ Date ____ Checked ____ Date ____

8855.02 Job No. ____ Division No. 10

Survey of John Anson Ford Park

Survey by Curtis Notes Curtis Date May 1958

Map No. ____ Indexed C. Johnson Date ____

F. B. 2228 Pg. 205

NOTE: ANY ADDITIONS OR CHANGES ON THIS SHEET MUST BE MADE OR CIRCLED IN RED INK, WITH DATE AND NAME OF PERSON MAKING CHANGE.

Do not extend notes this side of this line.

PLEASE RETURN TO
LOS ANGELES COUNTY ENGINEER
700 Los Angeles County Engineering Bldg.

STATION	B. S.	H. I.	F. S.	ELEV.

J.N. 8855.02
John Anson Ford Park
Paving Grades for
West Parking Lot.

Curtis
Monkey
Rodriguez
Latteri

761-295 S & E #307—1-56

76L-298 S & E #307—1-56

PLEASE RETURN TO
LOS ANGELES COUNTY ENGINEER
700 LOS ANGELES COUNTY ENGINEERING BLDG.

NOTE: ANY ADDITIONS OR CHANGES ON THIS SHEET MUST BE MADE OR CIRCLED IN RED INK, WITH DATE AND NAME OF PERSON MAKING CHANGE.

Do not extend notes this side of this line.

F. B. 2228 Pg. 206 Job No. Division No. Notes Red. Plotted Profile
Survey of Date Date No. X-Sec.
Survey by C. Johnson Notes Notes Chkd. Checked
Indexed Date Date Date No.

STATION	B. S.	H. I.	F. S.	ELEV.				
					El. 117.20 FB 2228-70 Scout Arc—			
B.M.				117.20	B.M. So. Side- Bt. Spk in Cb 7.5' E. of Road Gotham Ave,			
T.P.				116.31	T.P. FB 2228-70 Bt spk in E. end Conc Cut.			
Lines are staked 90° to Curbs & in Line with West end of tree planters - (Lines are 37' ± apart E & W)								
		Pav Grd @ So. Curb	Pav Grd 20' No.	Pav. Grd. 40' No.	Pav. Grd. @ W. End of Planters	Pav Grd 80' No.	Pav Grd 100' No.	Pav Grd. @ N Curb
Line 1		117.76	117.56	117.37		116.97	116.80	116.58
" 2		117.71	117.53	117.34		116.94	116.73	116.53
" 3		117.68	117.50	117.28		116.86	116.65	116.43
" 4		117.65	117.44	117.23		116.79	116.58	116.37
" 5		117.58	117.38	117.19	116.98	116.75	116.55	116.34
" 6		117.48	117.29	117.09		116.70	116.51	116.32
" 7		117.40	117.23	117.03		116.63	116.47	116.27
" 8		117.38	117.19	116.98		116.62	116.41	116.22
" 9		117.28	117.10	116.90		116.52	116.32	116.12
" 10	(117.71 TP.)	117.21	117.02	116.84		116.47	116.30	116.09
" 11		117.16	116.98	116.79		116.41	116.23	116.03
" 12		117.14	116.93	116.74		116.32	116.13	115.93
" 13		117.05	116.85	116.64		116.24	116.05	115.85
" 14		117.03	116.82	116.59		116.16	115.96	115.74
" 15		116.77	116.61	116.45	116.32	116.07	115.84	115.60
" 16		116.68	116.51	116.33	116.15	115.93	115.73	115.50
					El. 115.66 FB 2228-70 Bt spk @ Int's			
T.B.M.					T.B.M. Scout Ave & Gilland Ave.			

Set 1"x2" stks. to Fin. Grade

8855.02

F. B. 2228 Pg. 207

Profile No. | Notes Red. | Plotted | Job No. | Division No. 10
Date | Date | Survey of John Anson Ford Park
X-Sec. No. | Notes Chkd. | Checked | Survey by Curtis | Notes Curtis | Date May 1958
Date | Date | Map No. | Indexed C. Johnson

NOTE: ANY ADDITIONS OR CHANGES ON THIS SHEET MUST BE MADE OR CIRCLED IN RED INK, WITH DATE AND NAME OF PERSON MAKING CHANGE.

Do not extend notes this side of this line.

STATION	B. S.	H. I.	F. S.	ELEV.

J.N. 8855.02

John Anson Ford Park

Paving Grades

for

East Parking Lot.

Curtis
Rodriguez
Lattari

Sta. No1. is 20' East of angle point in No. Curb @ E. End. Then West @ 25' spaces to West end. Lines are 90° to E & W Curbs.

(See page 90 for beginning PT.)

PLEASE RETURN TO
LOS ANGELES COUNTY ENGINEER
700 Los Angeles County Engineering Bldg.

761-295 S & E #307—1-56

76L-298 S & E #307—1-56

PLEASE RETURN TO
LOS ANGELES COUNTY ENGINEER
700 LOS ANGELES COUNTY ENGINEERING BLDG.

NOTE: ANY ADDITIONS OR CHANGES ON THIS SHEET MUST BE MADE OR CIRCLED IN RED INK, WITH DATE AND NAME OF PERSON MAKING CHANGE.

Do not extend notes this side of this line.

F. B. 2228 Pg. 208 Job No. 885503 Division No. 12 Notes Red. Date Plotted Profile
Survey of John Bacon Ford Park Date No. X-Sec.
Survey by Curtis Notes Chkd. Checked
Indexed K. C. Johnson Date Date No.

STATION	B. S.	H. I.	F. S.	ELEV.			
					El. 118.354 FB 2228-70 Lc. Bt Spk.		
T.B.M.		Paving Grd		118.35	TBM @ Int. Scout Ave. & Parrish Ave.		
Sta.		@ So. Curb		Pav. Grd 20' No.	Pav. Grd. 40' No.	Paving Grd @ No Curb	
1 East End		120.14		119.94	119.73	119.52	Set 1 "x2" stks to Grade
2		120.06		119.85	119.69	119.44	-
3		119.93		119.74	119.55	119.35	-
4		119.88		119.68	119.47	119.26	-
5		119.76		119.56	119.35	119.15	-
6		119.68		119.47	119.27	119.07	-
7		119.60		119.40	119.19	118.98	-
8		119.50		119.30	119.10	118.91	-
9		119.42		119.23	119.04	118.85	-
10		119.35		119.16	118.97	118.78	-
11		119.24		119.05	118.85	118.65	-
12		119.15		118.95	118.75	118.55	-
13		119.07		118.86	118.66	118.46	-
14		119.04		118.81	118.59	118.36	X -
15		118.92		118.71	118.49	118.27	-
16		118.82		118.59	118.37	118.15	-
17		118.79		118.56	118.33	118.10	-
18 TP		118.73		118.50	118.28	118.06	-
19		118.71		118.47	118.24	118.01	-

76L-298 S & E #307—1-56

PLEASE RETURN TO
LOS ANGELES COUNTY ENGINEER
700 LOS ANGELES COUNTY ENGINEERING BLDG.

NOTE: ANY ADDITIONS OR CHANGES ON THIS SHEET MUST BE MADE OR CIRCLED IN RED INK, WITH DATE AND NAME OF PERSON MAKING CHANGE.

Do not extend notes this side of this line.

Profile Notes Red. Date Plotted
No. X-Sec. Notes Chkd. Date Checked
No. Date Map No. Index

Job No. 8855.02 Division No. 10 F. B. 2228 Pg. 202
Survey by Curtis Notes Curtis Date May-1952
C. Jensen Date

STATION	B. S.	H. I.	F. S.	ELEV.			
					El. 117.20 FB 2228-70 BM spk-So Curb		
BM. Sta		Pav. Grd. So. Curb		117.20 Grade 20' No.	BM Grade 40' No	Scout Ave Pav. Grd. No Curb	& Gotham Ave.
20		118.67		1844	1820	117.96	Set 1"x2" stks to Grade
21		118.60		1837	1813	117 90	"
22		118.55		1832	1808	117.84	"
23		118.47		1824	1802	117.80	"
24		118.42		1820	1798	117.77	"
25		118.33		1814	1792	117 70	"
	T.P.	118.80					"
26		118 30		1810	1791	117.72	"
27		118.25		1804	1783	117.62	"
28		118.20		1800	1780	11760	"
29		118.14		11793	117.74	11755	"
30	West End.	118.09		117.89	11769	117.50	"

Notes Ck'd by:	Survey of John Anson Ford Park
Map No.	JN 8855.02 Tape Std °F
Office Work	Surveyed by A. S. Curtis
Checked	Notes Curtis Date May-58
Date	Indexed C. Johnson 7-16-58

F. B. 2228 PG. 271

J.N. 8855.02
John Anson Ford Park
Location of
Spray Pool
and
4" drain Line from Spray
Pool to Lake.

Curtis
Mankey Jr
Rodriguez
Latter

Note: Any Additions or Changes on This Sheet Must be Made or Circled in Red Ink With Date and Name of Person Making Change.

Do not extend notes this side of this line.

RETURN TO
LOS ANGELES COUNTY ENGINEER
700 LOS ANGELES COUNTY ENGINEERING BLDG.

76F3088 GE #247—8-57

F. B. 2228 Pg. 212

RETURN TO
LOS ANGELES COUNTY ENGINEER
900 Los Angeles County Engineering Bldg.

Note: Any Additions or Changes on This Sheet Must be Made or Circled in Red Ink With Date and Name of Person Making Change.

Do not extend notes this side of this line.

Picnic Shelter

Conc. Walk

174'

El. Conc. Slab @ edge = 118.90
El. Conc. Slab @ Center = 119.50
(Slope to Center)

10' TYP.

10' Benches

20'

11.77

11.71

4" Asbestos drain line

11.74

119.70

Inv. of El. 117.58

LAKE

Conc Walks

22° Typ

22° Typ

Spa

20'

20'

Pool

20'

60° Typ

Invert El. Drain pipe = 117.83 pipe

50.75

22° Typ

22° Typ

84'

Notes Ck'd by	Survey of John Anson Fd. Park
Map No.	JN 8855.02 Tape Std °F
Office Work	Surveyed by A.S. Curtis
Checked	Notes Curtis Date June-58
Date	Indexed A. Johnson

F. B 2228 Pg. 213

J.N. 8855.02
John Anson Ford Park.
Location of Walks
around Lake.
Grades Shown

Curtis
Monkey Jr
Rodriguez
Latteri

Note: Any Additions or Changes on This Sheet Must be Made or Circled in Red Ink With Date and Name of Person Making Change.

Do not extend notes this side of this line.

RETURN TO
LOS ANGELES COUNTY ENGINEER
700 Los Angeles County Engineering Bldg.

76F3095 CE #247—8-57

F.B. 2228 Pg. 214

Cont from pg 173

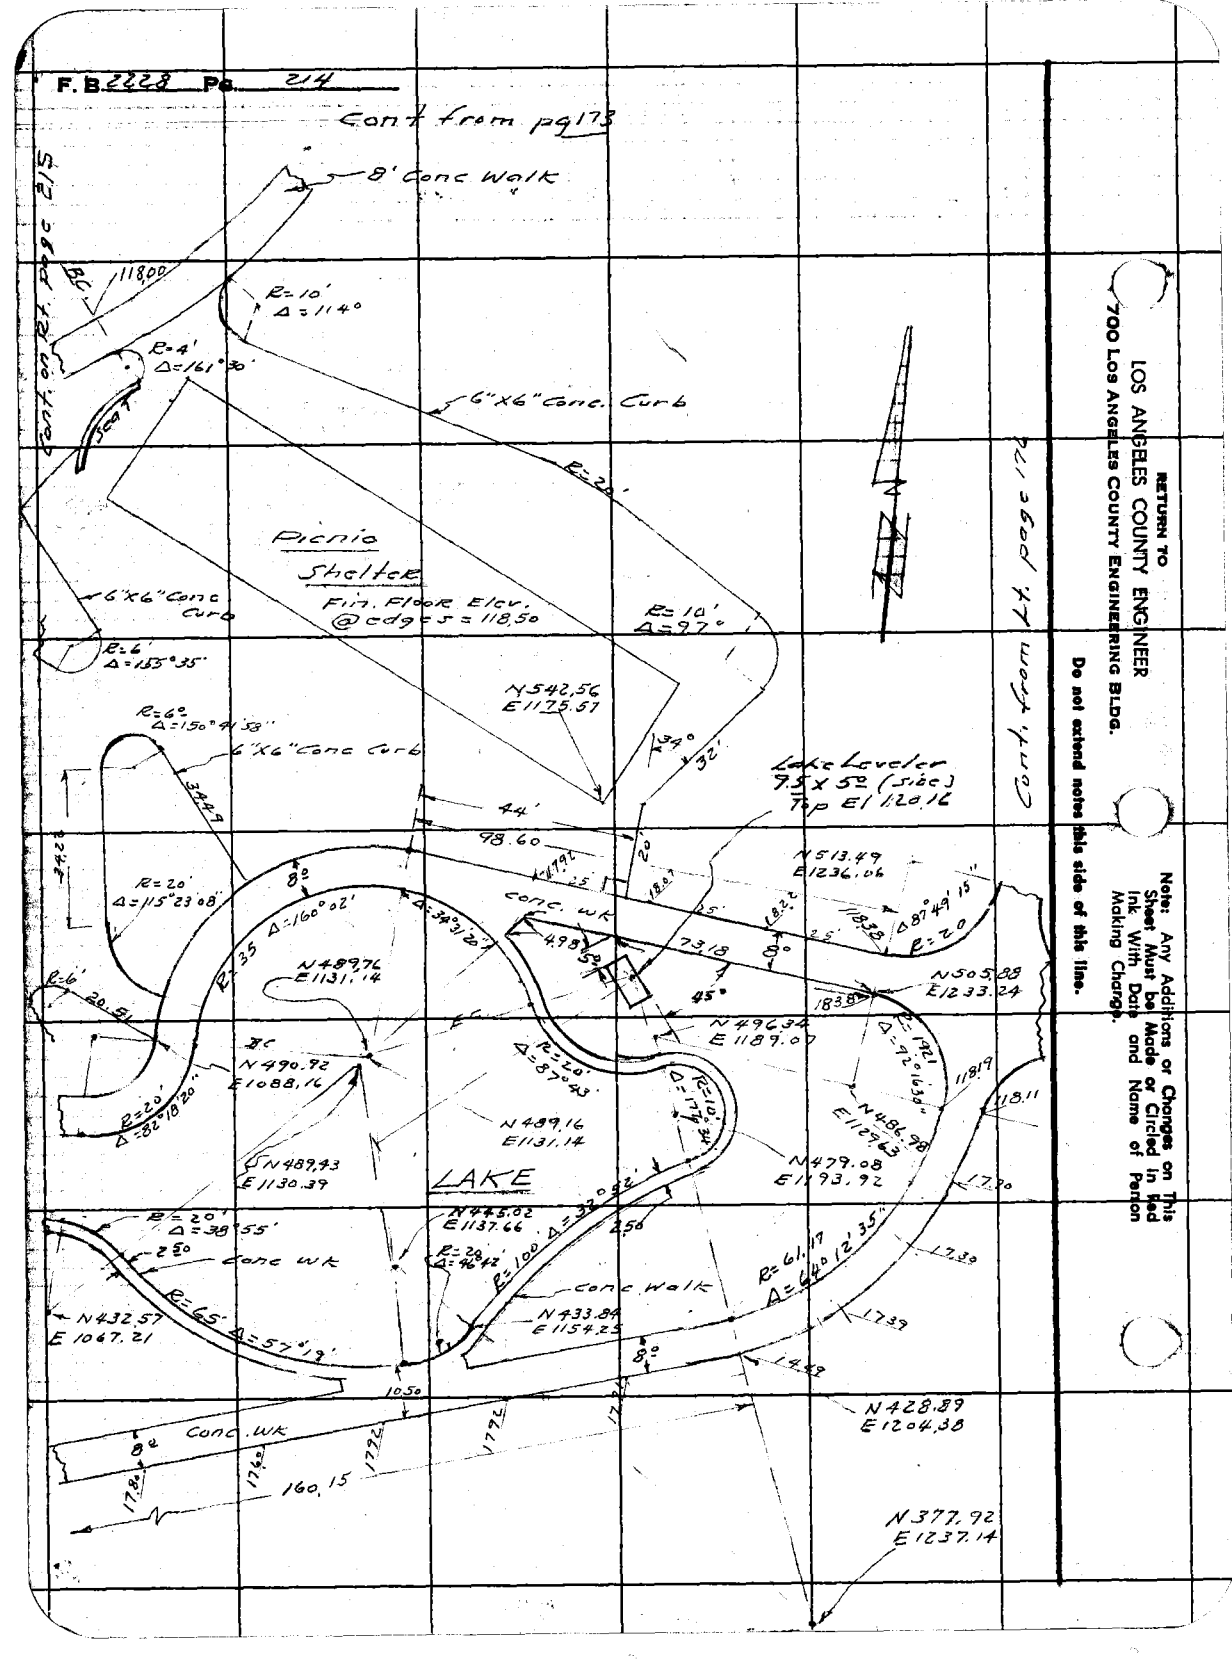

RETURN TO
LOS ANGELES COUNTY ENGINEER
700 Los Angeles County Engineering Bldg.

Do not extend notes this side of this line.

Note: Any Additions or Changes on This Sheet Must be Made or Circled in Red Ink With Date and Name of Person Making Change.

Notes Ck'd by	Survey of John Anson Ford Park
Map No.	JN 8855.02 Tape Std °F
Office Work	Surveyed by A.S. Curtis
Checked	Notes Curtis Date June 1958
Date	Indexed K. C. Johnson

F.B. 2228 Pg. 215

Cont from pg 173

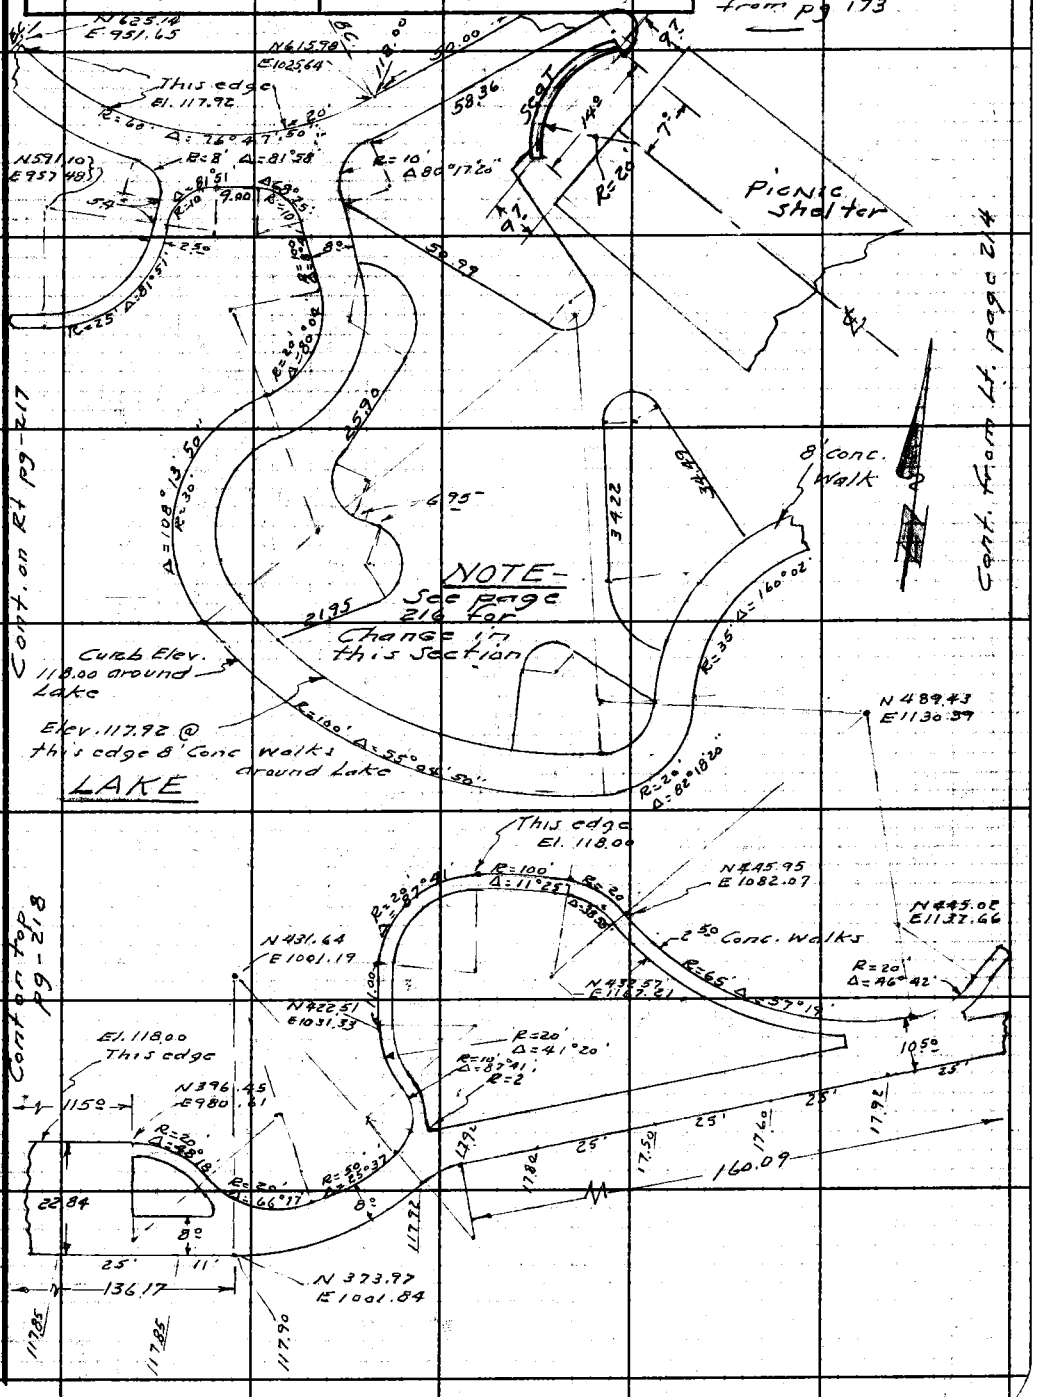

Note: Any Additions or Changes on This Sheet Must be Made or Circled in Red Ink With Date and Name of Person Making Change.

Do not extend notes this side of this line.

RETURN TO
LOS ANGELES COUNTY ENGINEER
7700 LOS ANGELES COUNTY ENGINEERING BLDG.

76F2095 CE #247—8-57

F.B. 2228 Pg. 216

RETURN TO
LOS ANGELES COUNTY ENGINEER
700 Los Angeles County Engineering Bldg.

Note: Any Additions or Changes on This Sheet Must be Made or Circled in Red Ink With Date and Name of Person Making Change.

Do not extend notes this side of this line.

See page 215 for Original Location of Walks in This Section.

Notes Ck'd by
Map No.
Office Work
Checked
Date

Survey of Jno Anson Ford Park
JN 88.55.02 Tape Std °F
Surveyed by A.S. Curtis
Notes Curtis Date 6-1958
Indexed K. C. Johnson

F. B. 2228 PG. 217

Note: Any Additions or Changes on This Sheet Must be Made or Circled in Red Ink With Date and Name of Person Making Change.

Do not extend notes this side of this line.

RETURN TO
LOS ANGELES COUNTY ENGINEER
700 Los Angeles County Engineering Bldg.

76FSOSS CE #247—3-57

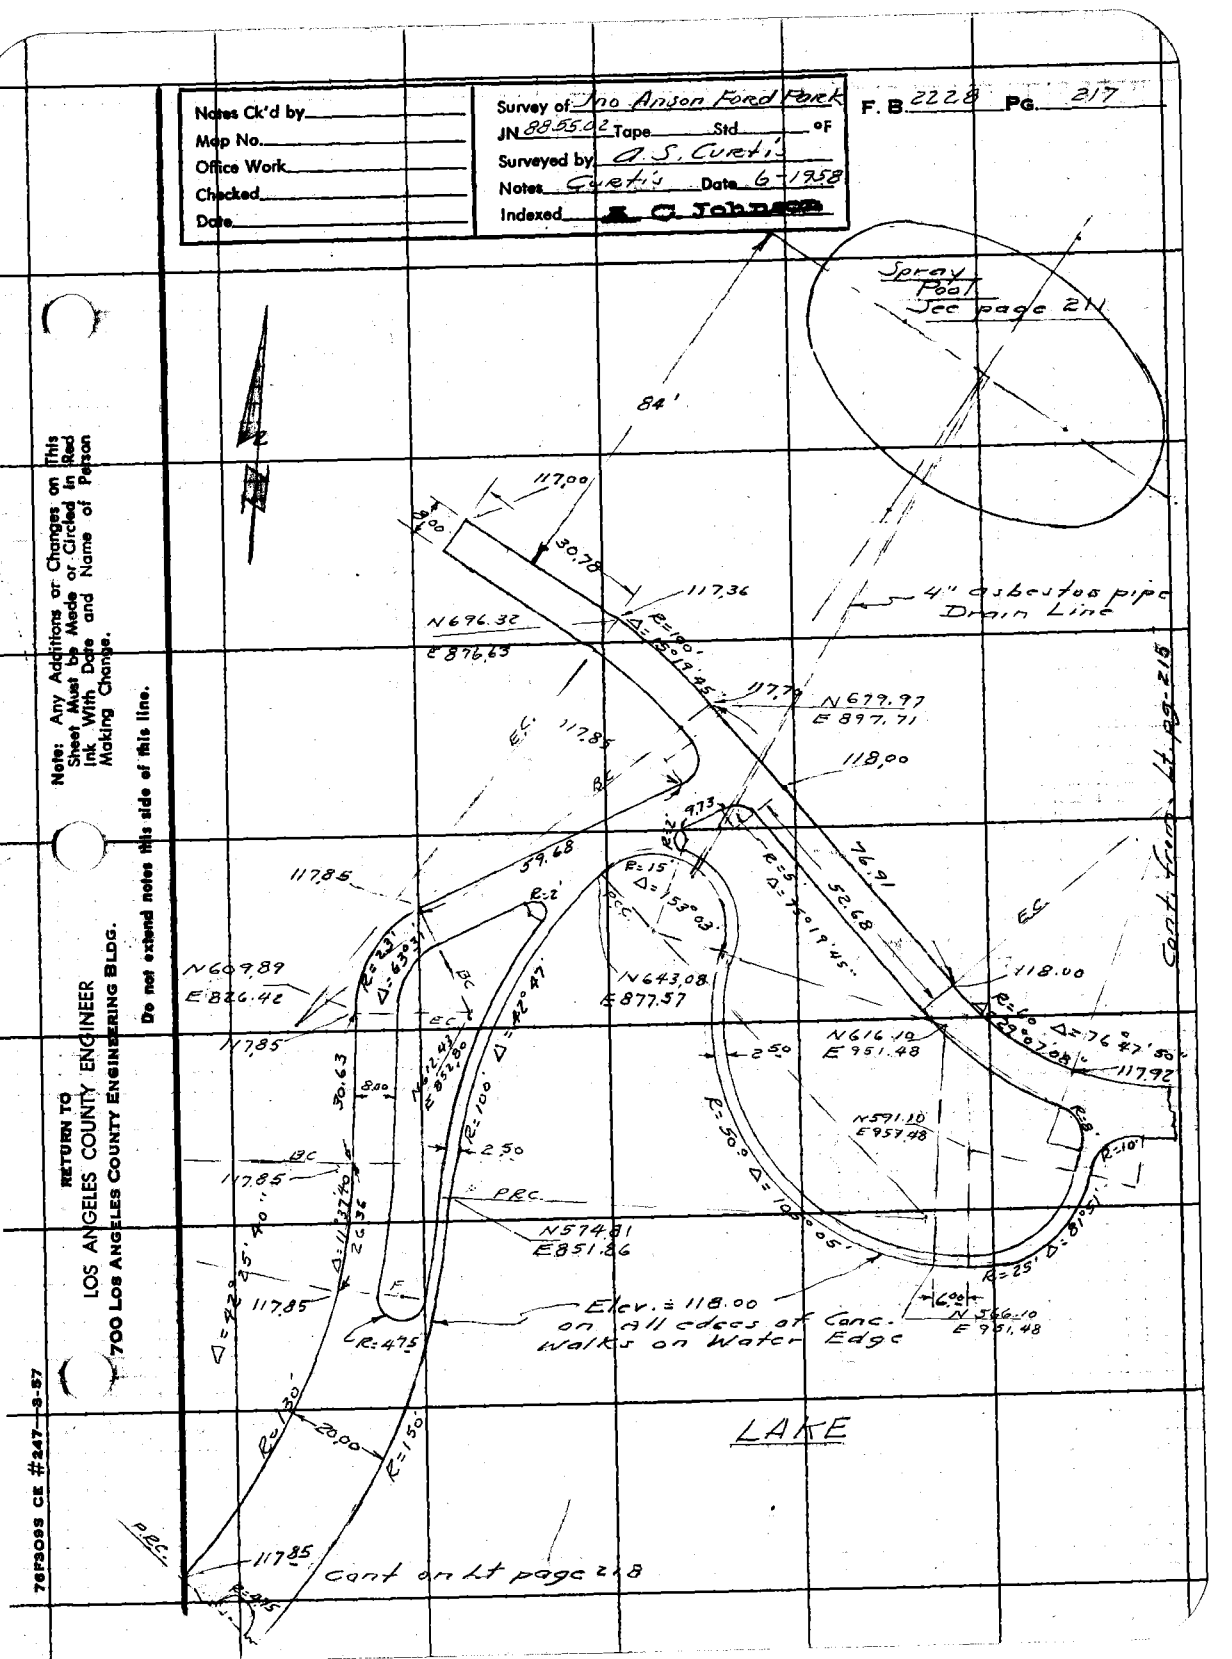

RETURN TO
LOS ANGELES COUNTY ENGINEER
700 LOS ANGELES COUNTY ENGINEERING BLDG.

Note: Any Additions or Changes on This Sheet Must be Made or Circled in Red Ink With Date and Name of Person Making Change.

Do not extend notes this side of this line.

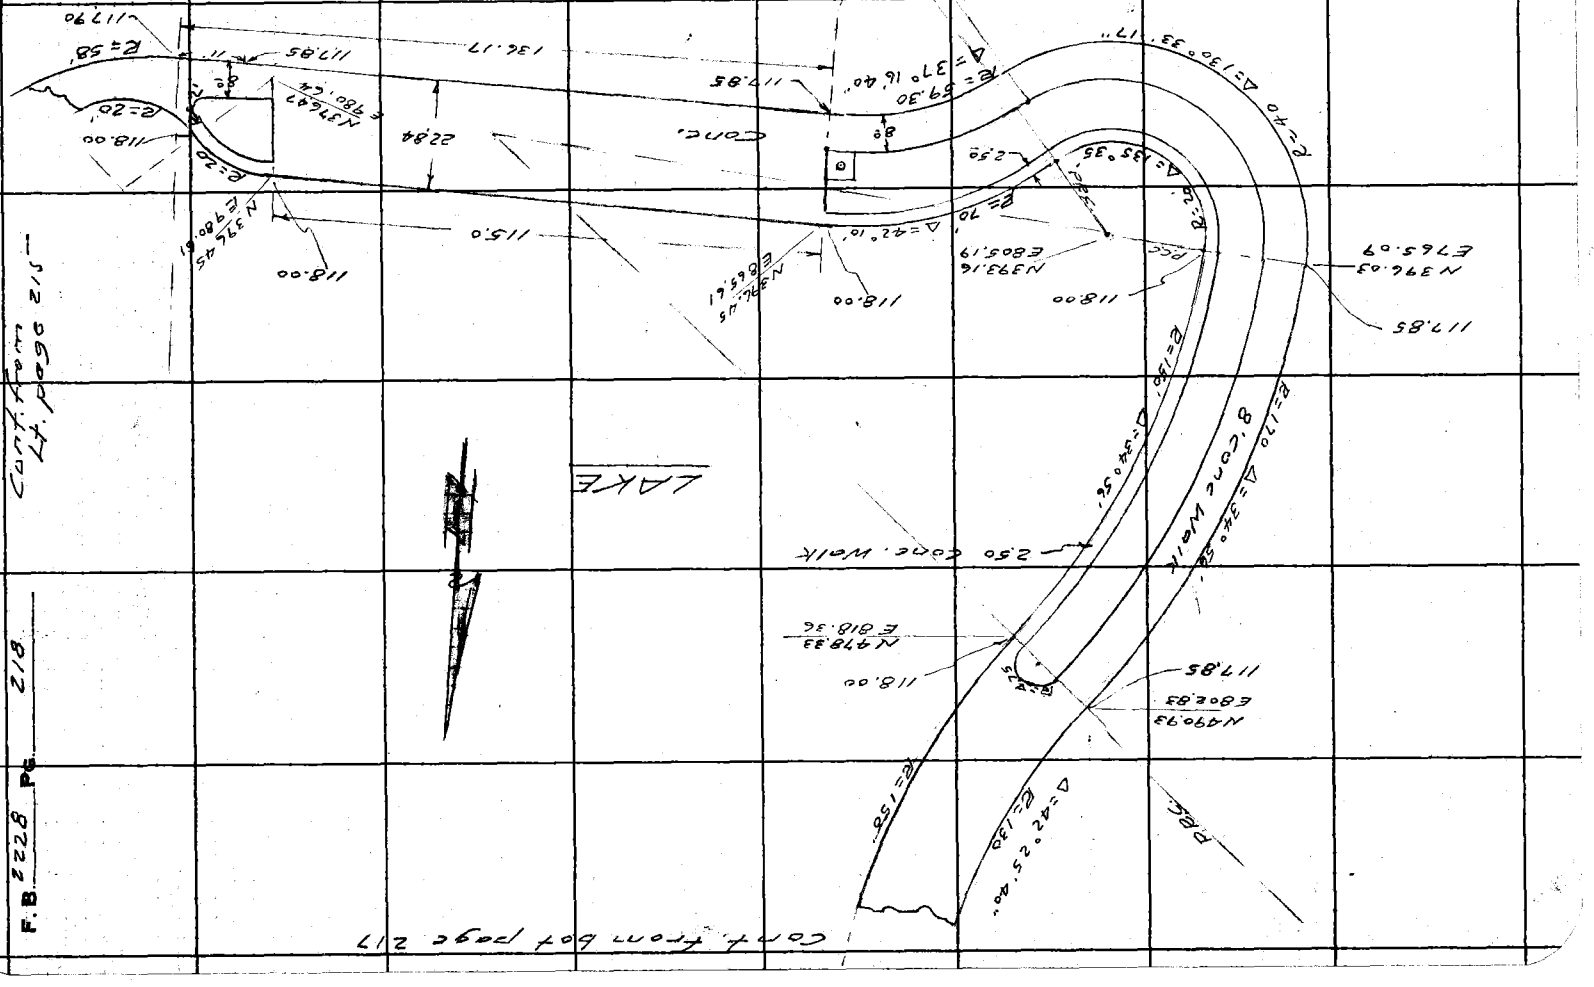

F.B. 2228 Pg. 218

Notes Ck'd by	Survey of J.A. Ford Park
Map No.	JN 8855.02 E Tape Std °F
Office Work	Surveyed by Curtis
Checked	Notes ETM J.C. Date Sept 18, '58
Date	Indexed C. Johnson 1-16-59

F. B. 2268 PG. 219

JN 8855.02

J.A. FORD PARK

STORM DRAIN

From

RIO HONDO

To

S.D.M.H. (shown PG 114 this book)

Curtis
Mankey
Rodrigues
Spriggs

Note: Any Additions or Changes on This Sheet Must be Made in Red Ink or Circled With Date and Name of Person Making Change.

Do not extend notes this side of this line.

RETURN TO
LOS ANGELES COUNTY ENGINEER
700 LOS ANGELES COUNTY ENGINEERING BLDG.

78F208B CE #847 8-57

RETURN TO
LOS ANGELES COUNTY ENGINEER
700 LOS ANGELES COUNTY ENGINEERING BLDG.

Note: Any Additions or Changes on This Sheet Must be Made or Circled in Red Ink With Date and Name of Person Making Change.

Do not extend notes this side of this line.

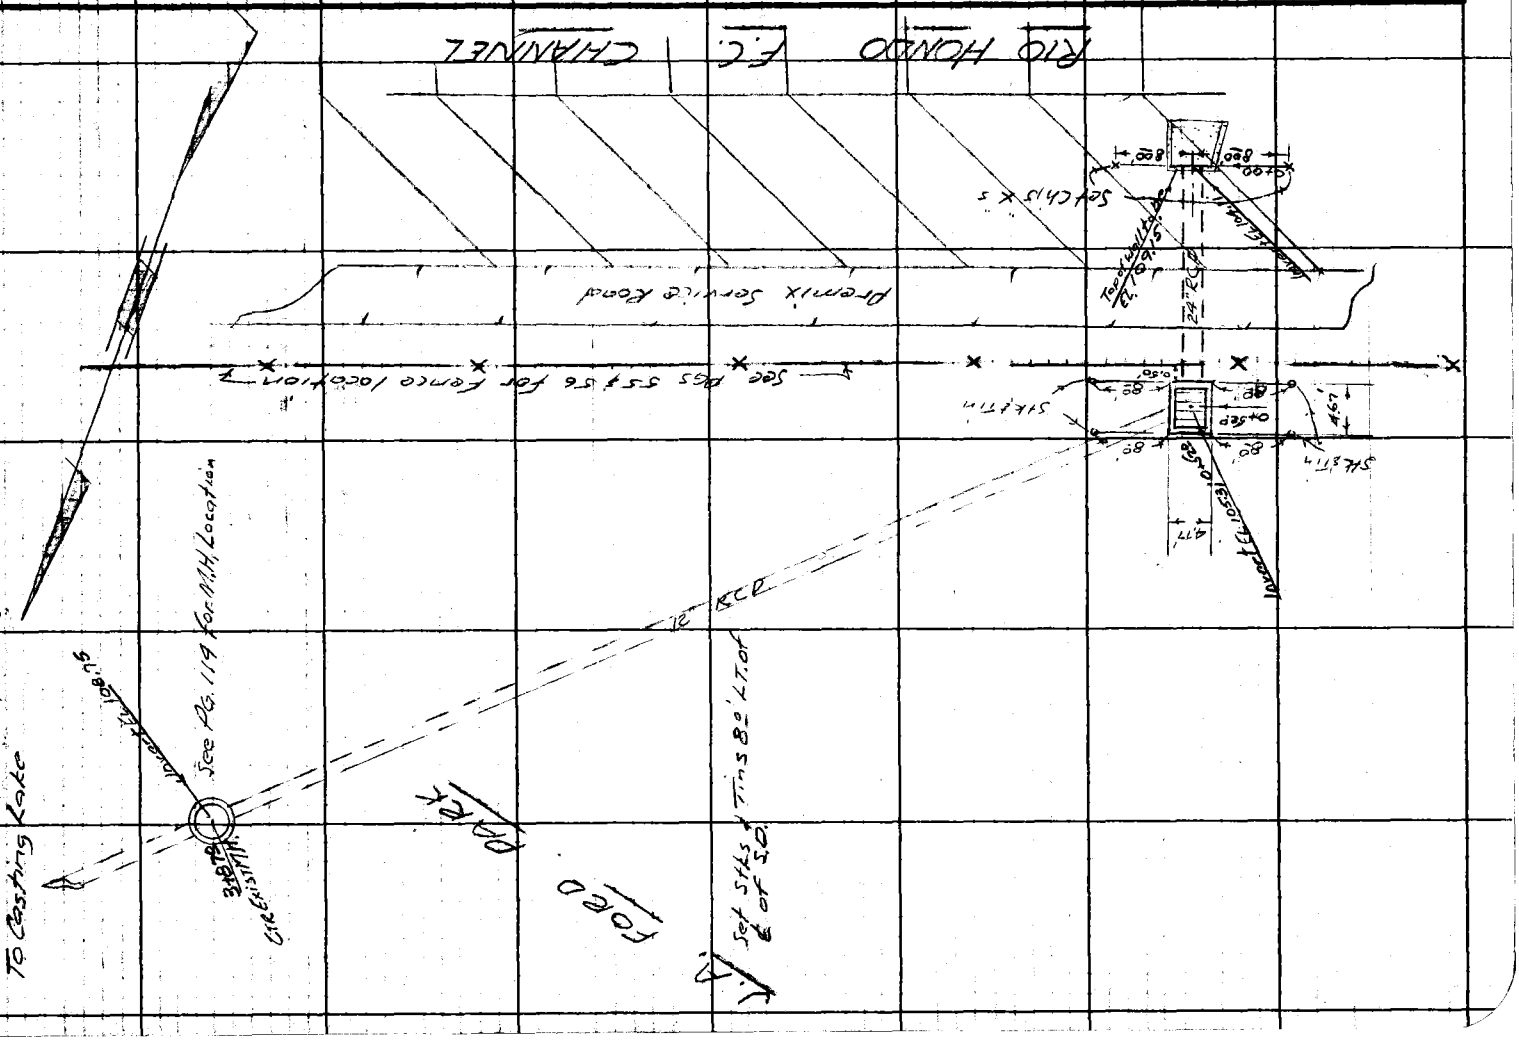

8855.02 | F. B. 2228 Pg. 221

Profile No. | Notes Red. | Plotted | Job No. 8855.02 | Division No. 10
Date | Date | Survey of John Anson Ford Park
X-Sec. No. | Notes Chkd. | Checked | Survey by | Notes | Date
Date | Date | Map No. | Indexed | Date

JN8855.02

JOHN ANSON FORD PARK

STORM DRAIN
~~from~~
RIO HONDO F.C. CHANNEL
to
EXIST S.D. M.H. (see pg 114 for M.H. location)
(see " " New location S4)

STATION	B. B.	H. I.	F. B.	ELEV.

Do not extend notes this side of this line.

NOTE: ANY ADDITIONS OR CHANGES ON THIS SHEET MUST BE MADE OR CIRCLED IN RED INK, WITH DATE AND NAME OF PERSON MAKING CHANGE.

PLEASE RETURN TO
LOS ANGELES COUNTY ENGINEER
700 Los Angeles County Engineering Bldg.

76298 S & E #307—7-55

76298 S & E #307—7-55

PLEASE RETURN TO
LOS ANGELES COUNTY ENGINEER
700 LOS ANGELES COUNTY ENGINEERING BLDG.

NOTE: ANY ADDITIONS OR CHANGES ON THIS SHEET MUST BE MADE OR CIRCLED IN RED INK, WITH DATE AND NAME OF PERSON MAKING CHANGE.

Do not extend notes this side of this line.

F. B. 2229 Pg. 22 Job No. 2855 Division No. Profile
Survey of No. X-Sec.
Survey by Notes Notes Chkd. Checked Plotted
Indexed E. C. Johnson Date Notes Red
Date Date Date Date

STATION	B. S.	H. I.	F. S.	ELEV.	(Invert Grade)	CUT or FILL	
T.B.M.				114.10	TBM pg 166		3/4" IP Dn 6" 18" Back Homr S.E. Soft Ball Diamond
0+00	Invert of 24" RCP at F.C. (Chan)			109.40	104.11	C5.29	Chis "X" 80' Lt. ℄ 24" SD.
+25				17.38	104.68	C12.70	Spk. Tin " " " "
+52	(Back) CTR of Catch Basin			114.42	105.31	C9.11	Spk " " " " "
+52	(Ahead) " "			114.77	105.31	C9.46	" " " " " "
1+				114.50	105.76	C8.74	" " " " " "
+50				15.08	106.25	C8.83	" " " " " "
2+				15.26	106.75	C8.51	" " " " " "
+50				115.40	107.23	C8.17	" " " " " "
3+				15.77	107.72	C8.05	" " " " " "
+50				16.04	108.47	C7.57	" " " " " "
3+87.0	CTR Exist S.D. M.H.	Lic. Pg 114 Invert = 116		117.88	108.75	C9.13	Direct to flow line
T.P.				114.72	T.P.		
T.B.M.				114.11	TBM El. 114.10		

Notes Ck'd by	Survey of Jno. Anson Ford Park
Map No.	JN 8855.03 Tape Std °F
Office Work	Surveyed by Curtis
Checked	Notes Curtis Date Aug 11-58
Date	Indexed A. C. Johnson 1-16-59

F. B. 2228 Pg. 223

Note: Any Additions or Changes on This Sheet Must be Made or Circled In Red Ink With Date and Name of Person Making Change.

Do not extend notes this side of this line.

RETURN TO
LOS ANGELES COUNTY ENGINEER
700 LOS ANGELES COUNTY ENGINEERING BLDG.

76F1088 CE #247 3-57

J.N. 885503

JOHN ANSON FORD PARK

Location of

Swimming Pool - Bath House

Community Bldg & ETC.

Curtis
Mankey Jr
Rodriguez
Latteri

RETURN TO
LOS ANGELES COUNTY ENGINEER
700 LOS ANGELES COUNTY ENGINEERING BLDG.

Note: Any Additions or Changes on This Sheet Must be Made or Circled in Red Ink With Date and Name of Person Making Change.

Do not extend notes this side of this line.

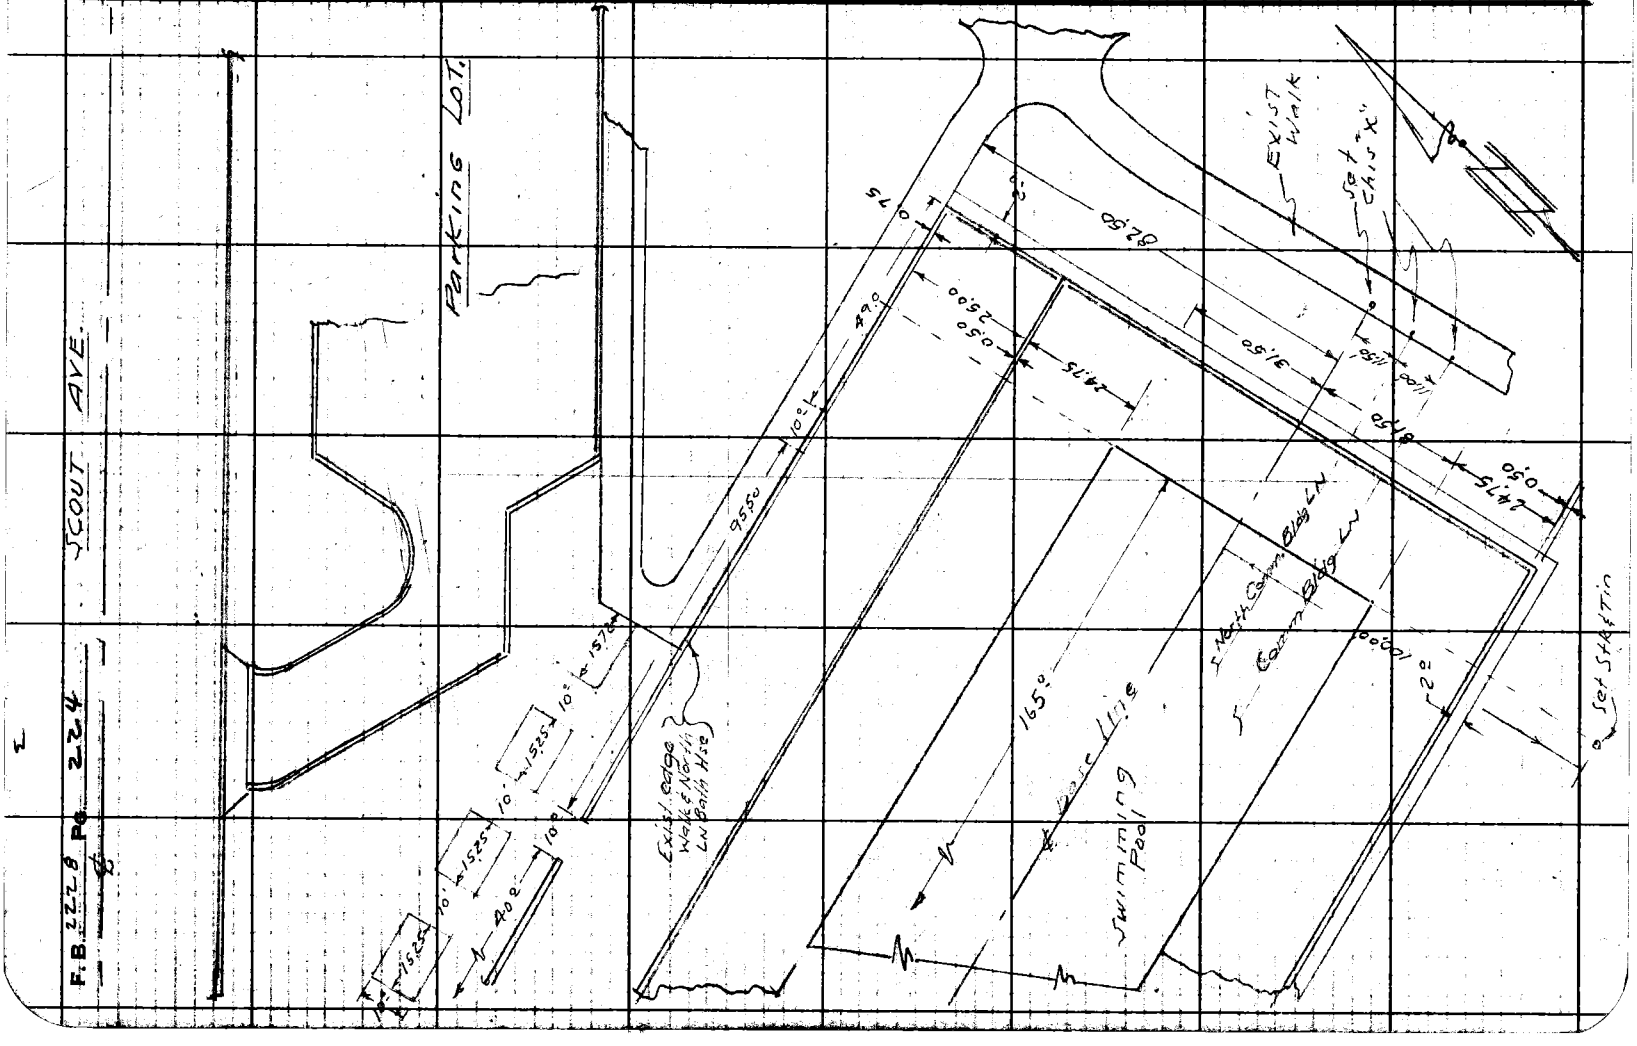

Notes Ck'd by:
Map No.
Office Work
Checked
Date

Survey of John Anson Ford Park
JN 8855.03 Tape Std °F
Surveyed by A.S. Curtis
Notes Curtis Date Aug
Indexed C. Johnson

F. B. 2229 PG. 225

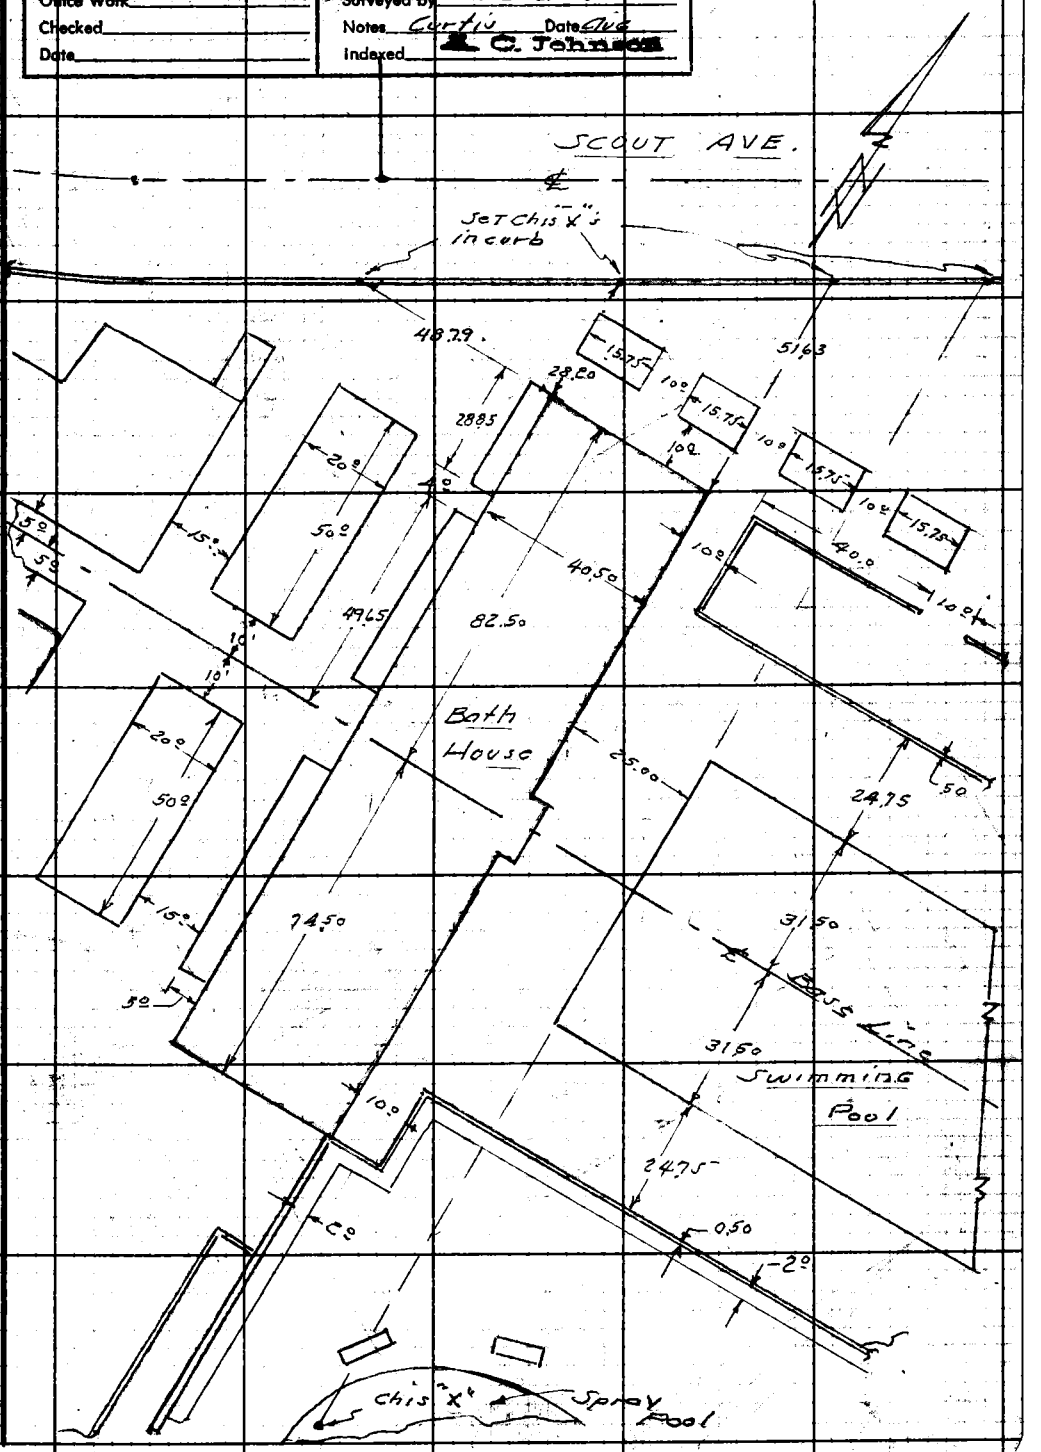

Note: Any Additions or Changes on This Sheet Must be Made or Circled in Red Ink With Date and Name of Person Making Change.

Do not extend notes this side of this line.

RETURN TO
LOS ANGELES COUNTY ENGINEER
700 Los Angeles County Engineering Bldg.

78FA088 CE #247 8-87

RETURN TO
LOS ANGELES COUNTY ENGINEER
700 LOS ANGELES COUNTY ENGINEERING BLDG.

Note: Any Additions or Changes on This Sheet Must be Made or Circled in Red Ink With Date and Name of Person Making Change.

Do not extend notes this side of this line.

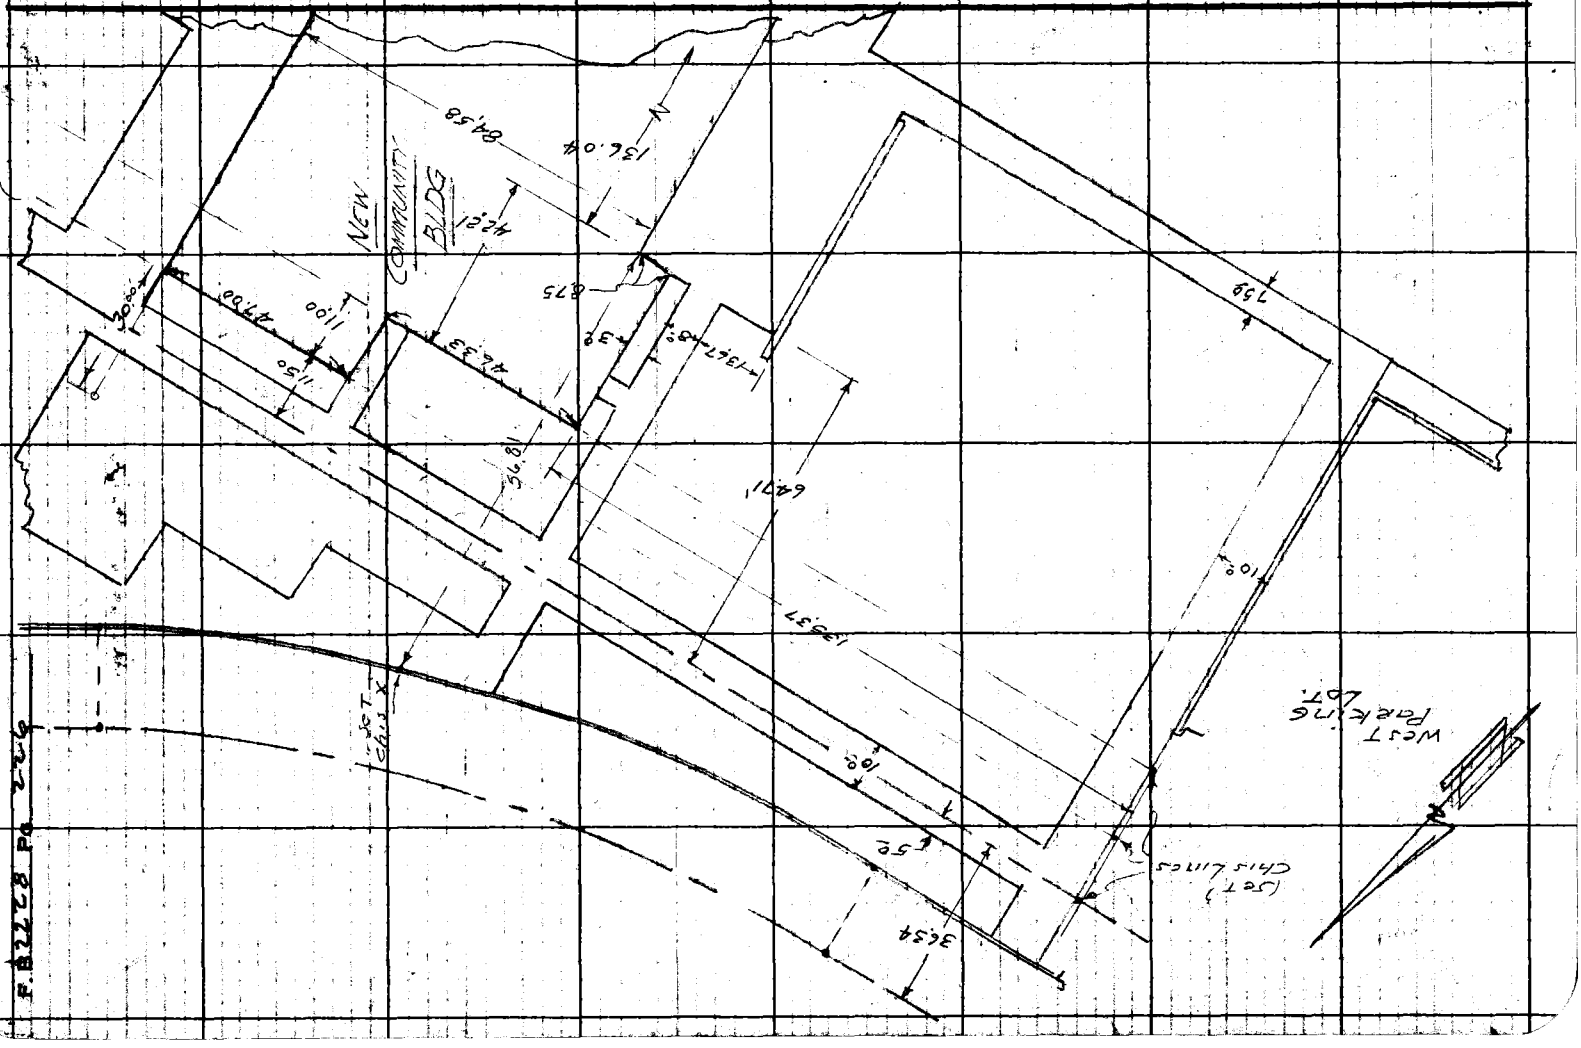

Notes Ck'd by
Map No.
Office Work
Checked
Date

JN 885503 Tape Std °F
Surveyed by A.S. Curtis
Notes Curtis Date Aug
Indexed

F. B. 2228 Pg. 227

Note: Any Additions or Changes on This Sheet Must be Made or Circled in Red Ink With Date and Name of Person Making Change.

Do not extend notes this side of this line.

RETURN TO
LOS ANGELES COUNTY ENGINEER
700 Los Angeles County Engineering Bldg.

78F10SS CE #247 8-82

F.B. 2228 PG. 229

Notes Ck'd by	Survey of JOHN ANSON FORD PARK
Map No.	W. O. 8855.03 Tape No. St'd. °F
Office Work	Surveyed by ETM JC
Checked	Notes ETM/JC/Ray R. Date 8-14-58
Date	Indexed L. O. Johnson

JN. 8855.03

JOHN ANSON FORD PARK

COMMUNITY BLDG. & BATH HSE.

Location of Pile

Monkey
Brooks
Gilfoy
Springs

Note: Any Additions or Changes on This Sheet Must be Made or Circled in Red Ink With Date and Name of Person Making Change.

Do not extend notes this side of this line.

RETURN TO
LOS ANGELES COUNTY SURVEYOR
726 LOS ANGELES COUNTY
ENGINEERING BLDG.

76F3095 247 4-53

F. B. 2228 Pg. 230

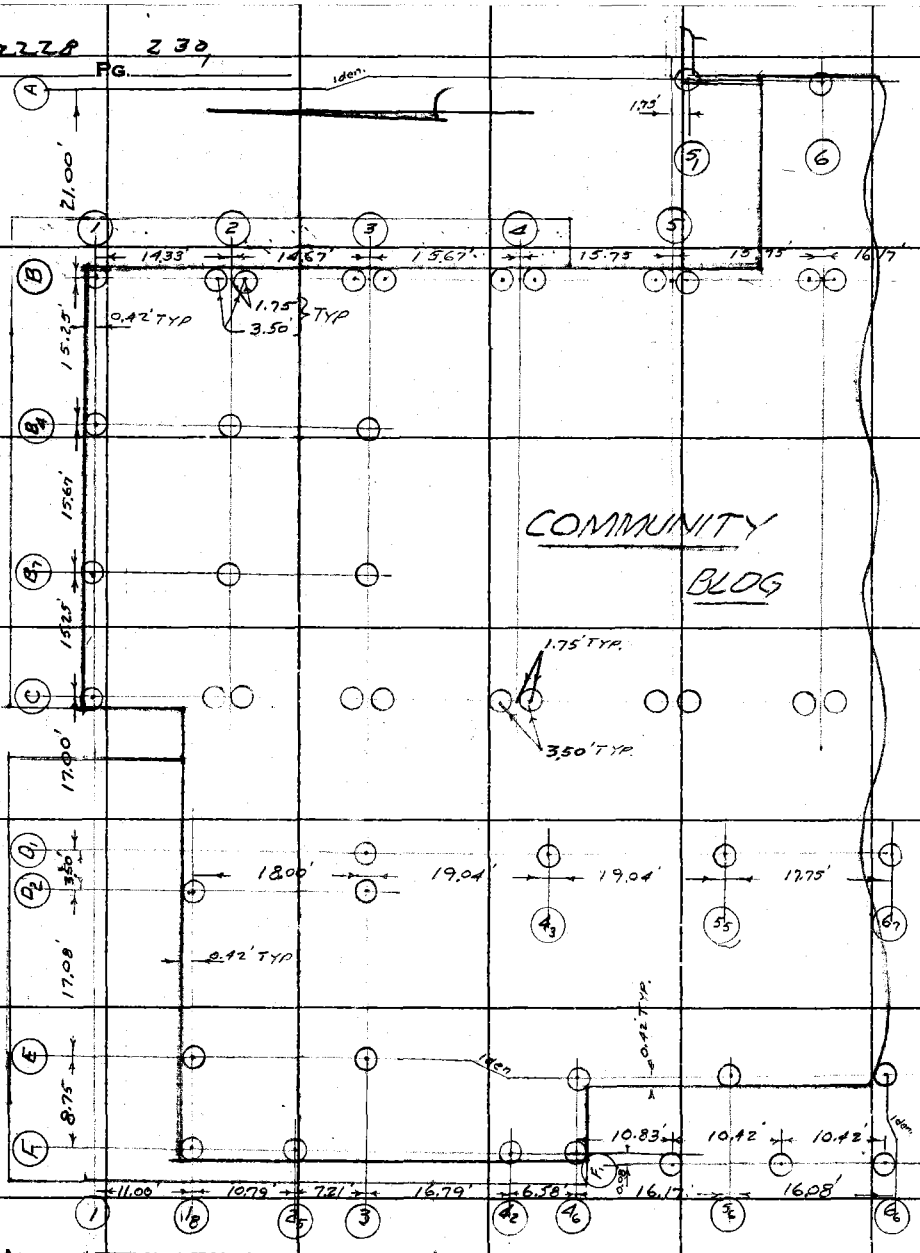

RETURN TO
LOS ANGELES COUNTY SURVEYOR
726 LOS ANGELES COUNTY
ENGINEERING BLDG.
Do not extend notes this side of this line.

Note: Any Additions or Changes on This Sheet Must be Made or Circled in Red Ink With Date and Name of Person Making Change.

⊙ = location of pile: set stk nail & tin on all shown

Notes Ck'd by	Survey of John Anson Ford Park
Map No.	W. O. 885503 Tape No. St'd. °F
Office Work	Surveyed by Mankey Jr.
Checked	Notes ETM Jr. Ray R. Date Aug 18, 58
Date	Indexed J. C. Johnson

F.B. 2278 PG. 291

Note: Any Additions or Changes on This Sheet Must be Made or Circled in Red Ink With Date and Name of Person Making Change.

Do not extend notes this side of this line.

RETURN TO
LOS ANGELES COUNTY SURVEYOR
726 LOS ANGELES COUNTY
ENGINEERING BLDG.

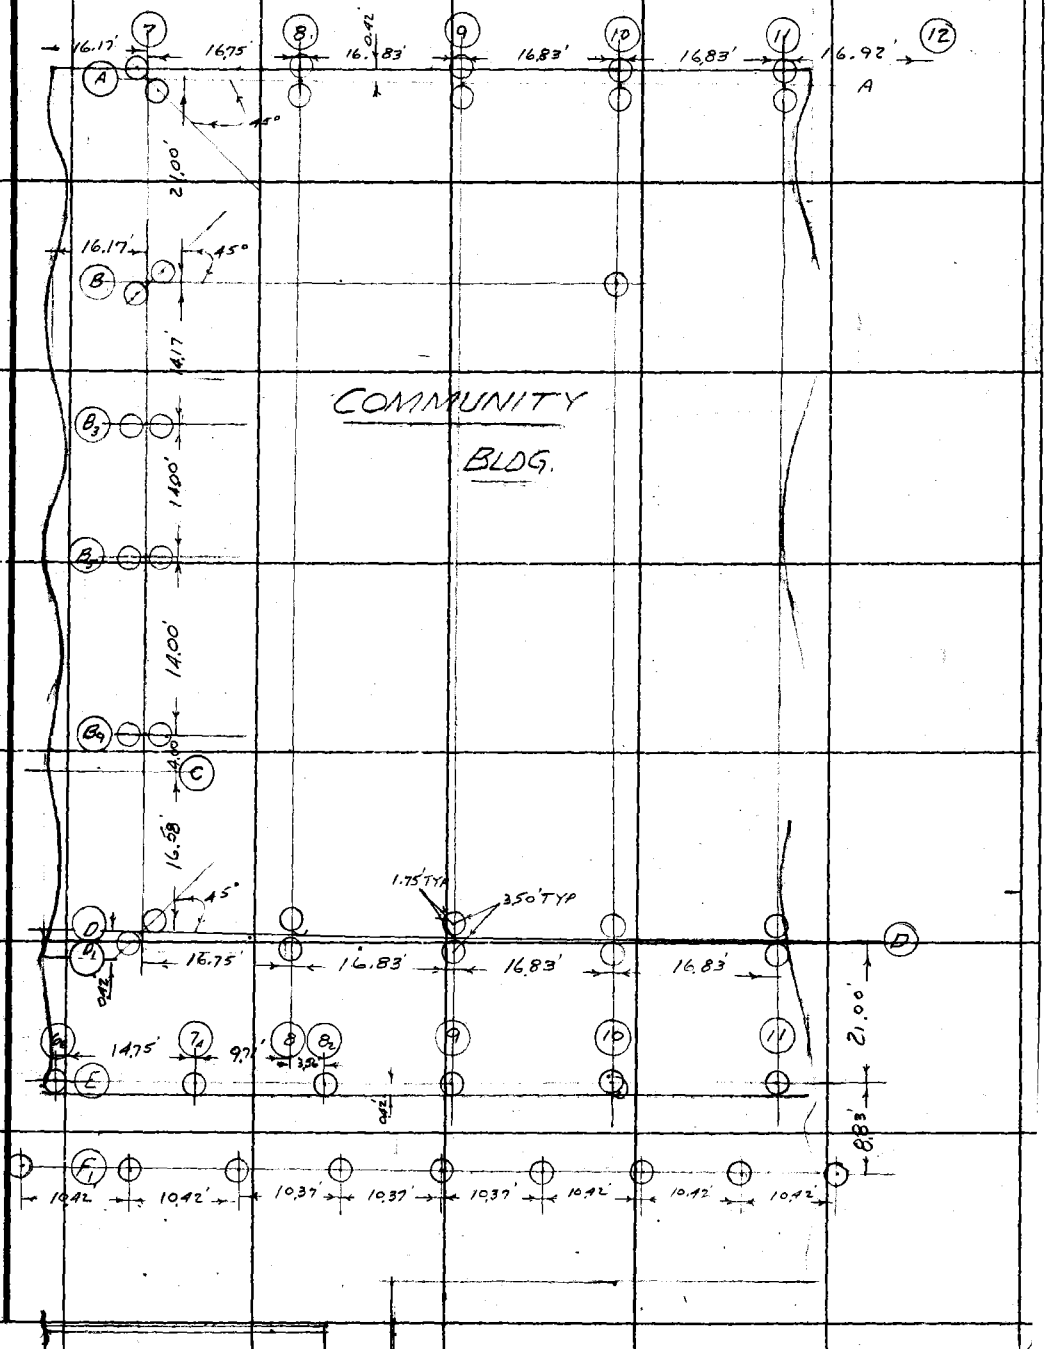

76F3095 247 4-58

F.B. 2228 PG. 232

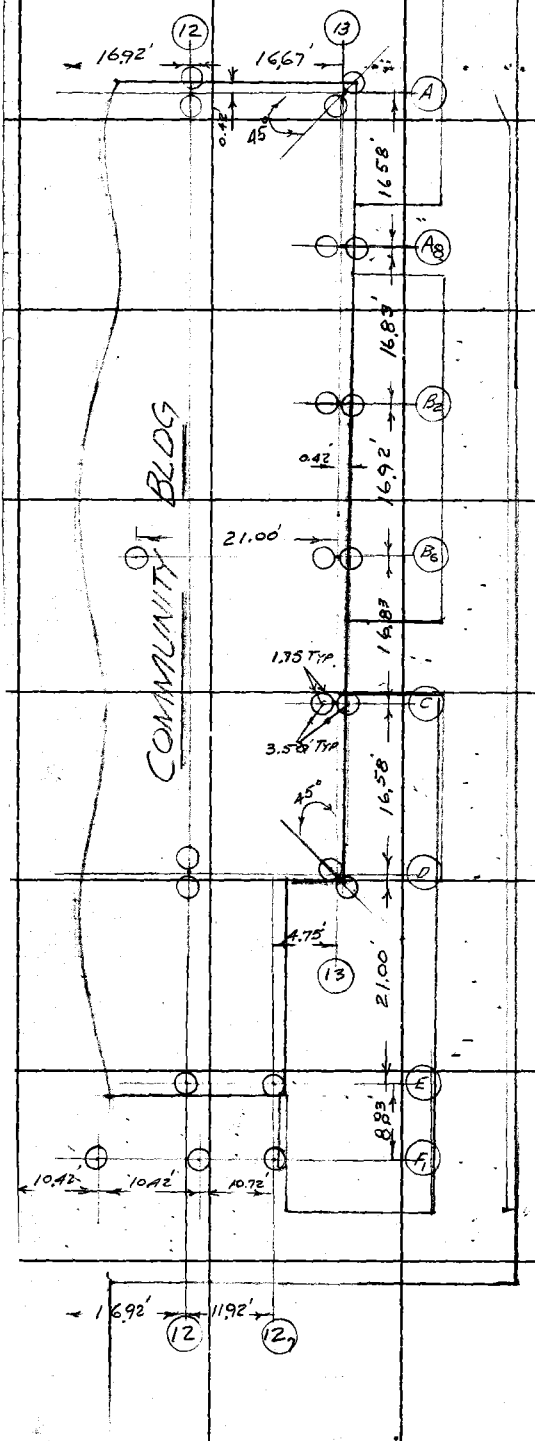

RETURN TO
LOS ANGELES COUNTY SURVEYOR
726 LOS ANGELES COUNTY
ENGINEERING BLDG.

Do not extend notes this side of this line.

Note: Any Additions or Changes on This Sheet Must be Made or Circled in Red Ink With Date and Name of Person Making Change.

76F3095 CE #247—3-57

RETURN TO
LOS ANGELES COUNTY ENGINEER
700 LOS ANGELES COUNTY ENGINEERING BLDG.

Note: Any Additions or Changes on This Sheet Must be Made or Circled in Red Ink With Date and Name of Person Making Change.

Do not extend notes this side of this line.

Notes Ck'd by
Map No.
Office Work
Checked
Date

Survey of John Ansenford Block
JN 88550 E Tape Std
Surveyed by Mooney VC
Notes Fld Vfc Date 8-20-58
Indexed M. C. Johnson

F. B. 2278 Pg. 233

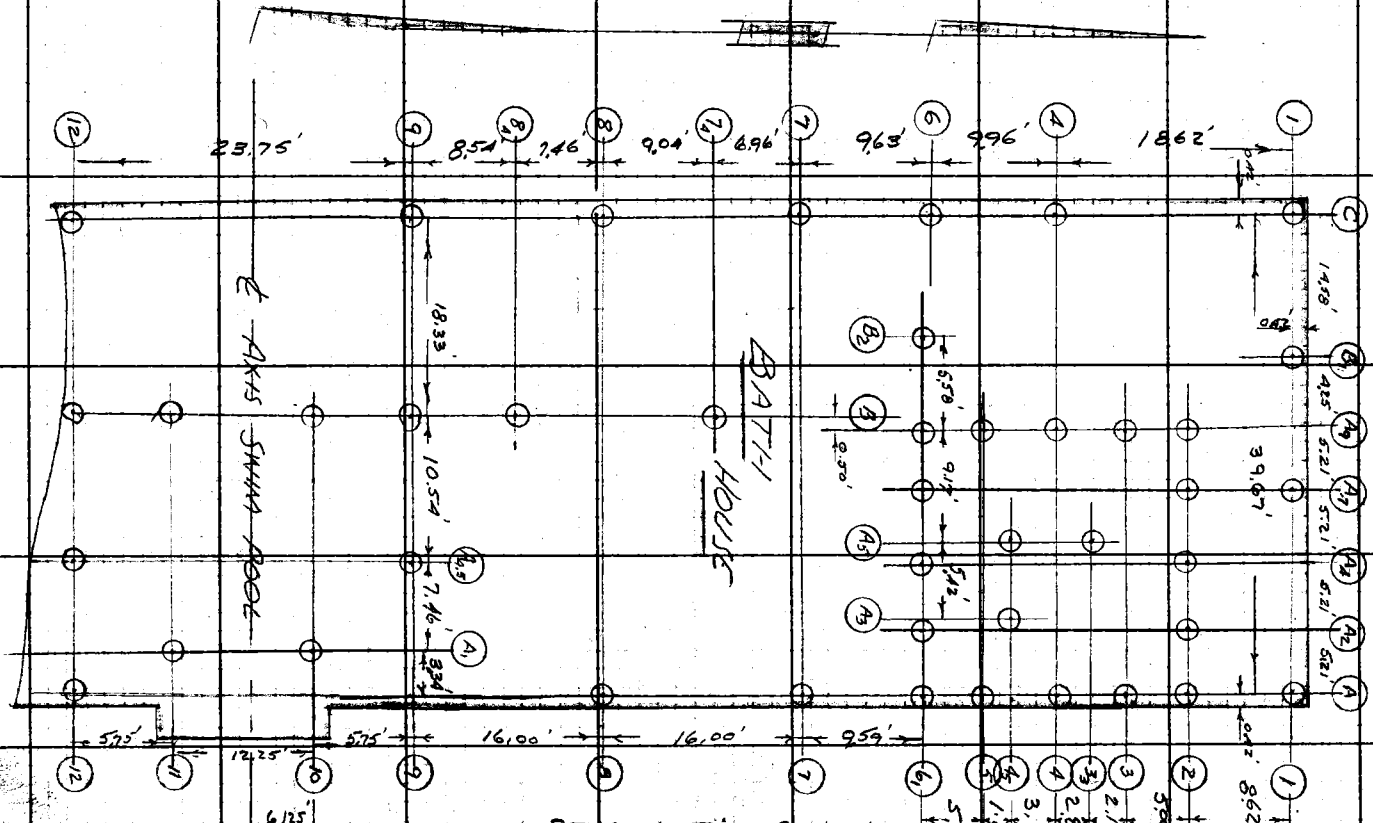

F. B 2228 Pg. 234

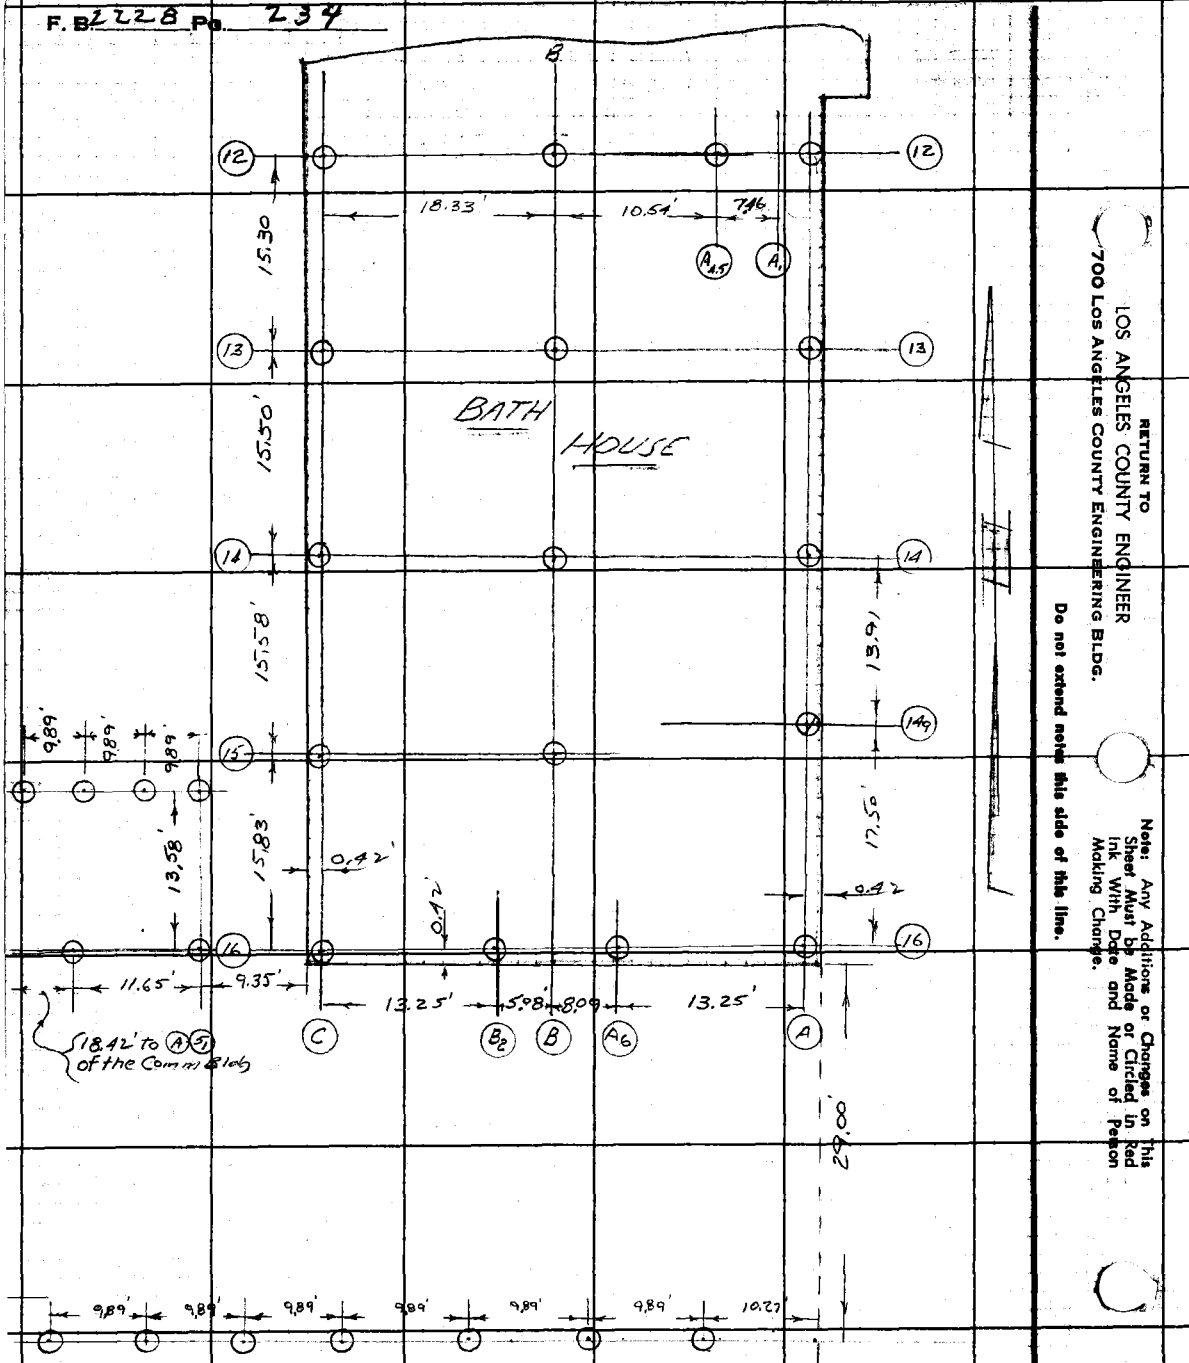

RETURN TO
LOS ANGELES COUNTY ENGINEER
700 Los Angeles County Engineering Bldg.

Do not extend notes this side of this line.

Note: Any Additions or Changes on This Sheet Must be Made or Circled in Red Ink With Date and Name of Person Making Change.

Notes Ck'd by	Survey of Jno. Anson Ford PK
Map No.	JN 8855.03 Tape Std °F
Office Work	Surveyed by Curtis
Checked	Notes Curtis Date 10-31-58
Date	Indexed 4-G Johnson 4-16-59

F. B. 2228 PG. 235

J.N. 8855.03
John Anson Ford Park
Location of
Storm DRAINS

SEWER LOCATIONS around
COMMUNITY BLDG & BATH HOUSE

Curtis
Monkey Jr
Rodriguez
Spriggs

(See pages 238 & 239
for Grades on STORM DRAIN)

Note: Any Additions or Changes on this Sheet Must be Made or Circled in Red Ink With Date and Name of Person Making Change.

Do not extend this side of this line.

PLEASE RETURN TO
LOS ANGELES COUNTY ENGINEER
700 Los Angeles County Engineering Bldg.

6F3098 S&E #247 1-56

F. B. 2228 Pg. 236

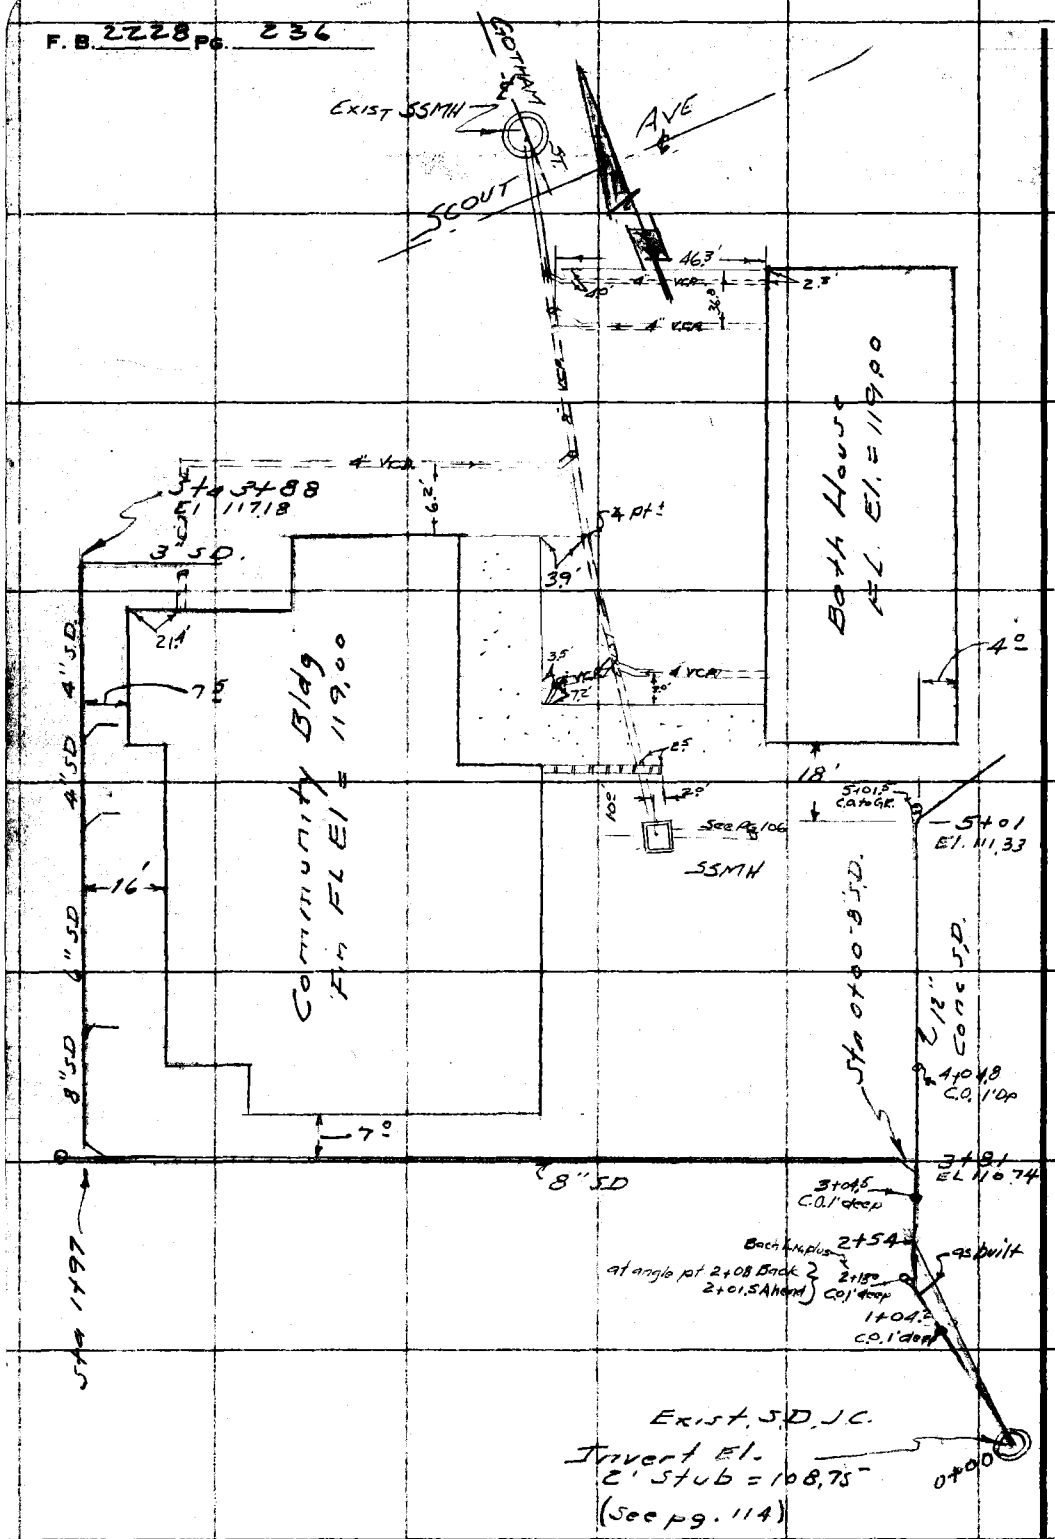

PLEASE RETURN TO
LOS ANGELES COUNTY ENGINEER
700 Los Angeles County Engineering Bldg.

Do not extend this side of this line.

Note: Any Additions or Changes on This Sheet Must be Made or Circled in Red Ink With Date and Name of Person Making Change.

F. B. 2228 Pg. 237

Profile No. | Notes Red. | Date | Plotted | Date | Job No 8855.03 Division No. 10
X-Sec. No. | Notes Chkd. | Date | Checked | Date | Survey of J.A. FORD PARK
Survey by Curtis Notes Date Oct 31, '58
Map No. Indexed C. Johnson

JN 8855.03

J.A. FORD PARK

12" STORM DRAIN (Stkd 8°Lt & West.) (Location on Pg 236)
from
EXIST S.D.M.H. (Shown in FB 2228 Pg 114)
to
BATH HOUSE
&
8" BRANCH LINE (Stkd 8°Lt & So. & West.) (Location on Pg 236).
to
COMMUNITY BLDG.

Curtis
Mankey
Rodriguez
Spriggs

STATION	B. S.	H. I.	F. S.	ELEV.

NOTE: ANY ADDITIONS OR CHANGES ON THIS SHEET MUST BE MADE OR CIRCLED IN RED INK, WITH DATE AND NAME OF PERSON MAKING CHANGE.

Do not extend notes this side of this line.

PLEASE RETURN TO
LOS ANGELES COUNTY ENGINEER
700 Los Angeles County Engineering Bldg.

76298 S & E #307—7-55

76298 S & E #307—7-55

PLEASE RETURN TO
LOS ANGELES COUNTY ENGINEER
700 LOS ANGELES COUNTY ENGINEERING BLDG.

NOTE: ANY ADDITIONS OR CHANGES ON THIS SHEET MUST BE MADE OR CIRCLED IN RED INK, WITH DATE AND NAME OF PERSON MAKING CHANGE.

Do not extend notes this side of this line.

F. B. 2228 Pg. 238 | Job No. 8855.03 | Division No. 10 | Notes Red. | Date | Plotted | Date | No.
Survey of Jno. Anson End Park | Notes | Notes Chkd. | Checked | Date | X-Sec. | No.
Survey by Curtis | Indexed J. C. Johnson | Date | Profile

STATION	B. S.	H. I.	F. S.	ELEV.			
					El. 117.20 pg-70 Scout Ave S. Side		
B.M.				117.20	B.M. 15 in E Prod Ramish Ave. (8th spk in Ch)		
T.P.				117.55	TP		
S.D. J.C.				117.38	El. rim S.D. J.C. (Existing) pg-114.		
		Invert		108.75'	S.D. J.C. (stub)		
					% Grade	Cut	
0+00 J.C.				116.85	108.75'	C 8.10	
0+50				117.57	109.02	C 8.55	
1+00				117.42	109.29	C 8.13	
1+50				117.57	109.56	C 8.01	
2+00				117.59	109.83	C 7.76	
2+54 ± PT back				117.23	110.13	C 7.10	
" " ahead				117.23	110.13	C 7.10	
3+00				117.06	110.35	C 6.71	
3+50 T.P.				117.33	TP 110.59	C 6.74	
3+81 Int. 8" Pipe to South (See page 239)				117.17	110.74	C 6.43	
4+00				117.49	110.83	C 6.43	
4+50				117.26	111.08	C 6.18	
5+01 ± PT				116.86	111.33	C 5.53	
TP				117.40			
B.M.				117.20	B.M. (See above)		

-.543%
+.0048

76298 S & E #307—7-55

PLEASE RETURN TO
LOS ANGELES COUNTY ENGINEER
700 LOS ANGELES COUNTY ENGINEERING BLDG.

NOTE: ANY ADDITIONS OR CHANGES ON THIS SHEET MUST BE MADE OR CIRCLED IN RED INK, WITH DATE AND NAME OF PERSON MAKING CHANGE.

Do not extend notes this side of this line.

STATION	B. S.	H. I.	F. S.	ELEV.			
3+81 ℄	12" Drain E ℄ W = 0+00 8" Drain Going South						
					o/o Grade Cut		
B.M.				117.20	B.M. EL 117.20 pg-70		
0+00					110.74		1"x2" S℄T 8° Lt ℄ SD.
0+50				17.26'	111.57	C5.69	"
1+00				17.57'	112.40	C5.17	"
1+50				17.64'	113.23	C4.41	"
							"
1+97° ℄ PT (90°) (T.P)				17.65'	114.01	C3.64	1"x2" S℄T 8° Lt to Brooklyn.
2+50				17.77'	114.89	C2.88	"
3+00				18.12'	115.72	C2.40	"
3+50				17.83'	116.56	C1.27	"
3+88 ± P.T. (TP)				17.34'	117.18	C0.16	1"x2" S℄T 8° Lt. to Brooklyn
BM				117.20'	BM EL. 117.20 pg-70.		

o/o 1.69

Profile Notes Red. Plotted Job No. 8855.03 Division No. 10 F. B. 2228 Pg 239
No. Date Survey of John Anson Ford Park
X-Sec. Notes Chkd. Checked Survey by Curtis Notes Date 10-31-58
No. Date Date Map No. Index C. Jones Date

Notes Ck'd by
Map No.
Office Work
Checked
Date

Survey of John Anson FORD PARK F. B. 2228 PG. 241
JN Tape Std °F
Surveyed by Snyder
Notes RRS Date 4-27-60
Indexed C. Johnson
APR 2 9 '60

Note: Any Additions or Changes on This Sheet Must Be Made or Circled In Red Ink With Date and Name of Person Making Change.

Do not extend notes this side of this line.

RETURN TO
LOS ANGELES COUNTY ENGINEER
700 Los Angeles County Engineering Bldg.

JOHN ANSON FORD PARK SWIMMING POOL

Measurement of inside of Pool at Water level

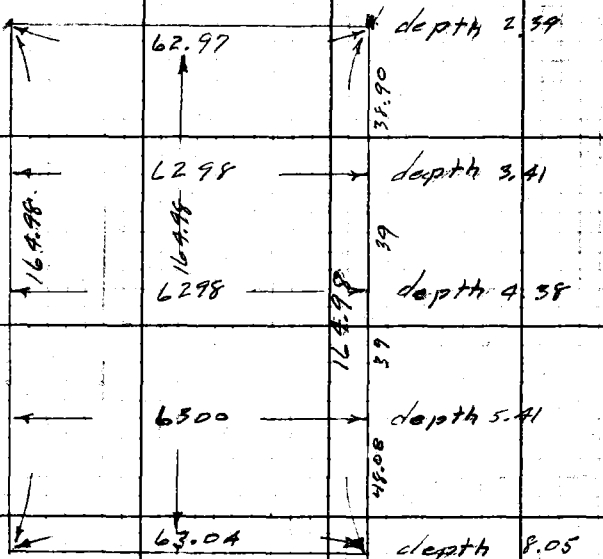

PSOOS CE #247—7-58

Notes Ck'd by	Survey of John Anson Ford Park
Map No.	JN 8855.02 Tape Std °F
Office Work	Surveyed by F.E. Brooks
Checked	Notes FEB Date 4-14-52
Date	Indexed C. Johnson

F. B. 1128 PG. 243

JN 8855.02

JOHN ANSON FORD PARK

Location

of

Section of

4" & 6" AC

Water lines

Brooks
Hernandez
Potter

Note: Any Additions or Changes on this Sheet Must be Made or Circled in Red Ink With Date and Name of Person Making Change.

Do not extend this side of this line.

PLEASE RETURN TO
LOS ANGELES COUNTY ENGINEER
700 Los Angeles County Engineering Bldg.

76F3095 SAE #242 1-56

PLEASE RETURN TO
LOS ANGELES COUNTY ENGINEER
700 Los Angeles County Engineering Bldg.

Note: Any Additions or Changes on this Sheet Must be Made or Circled in Red Ink With Date and Name of Person Making Change.

Do not extend this side of this line.

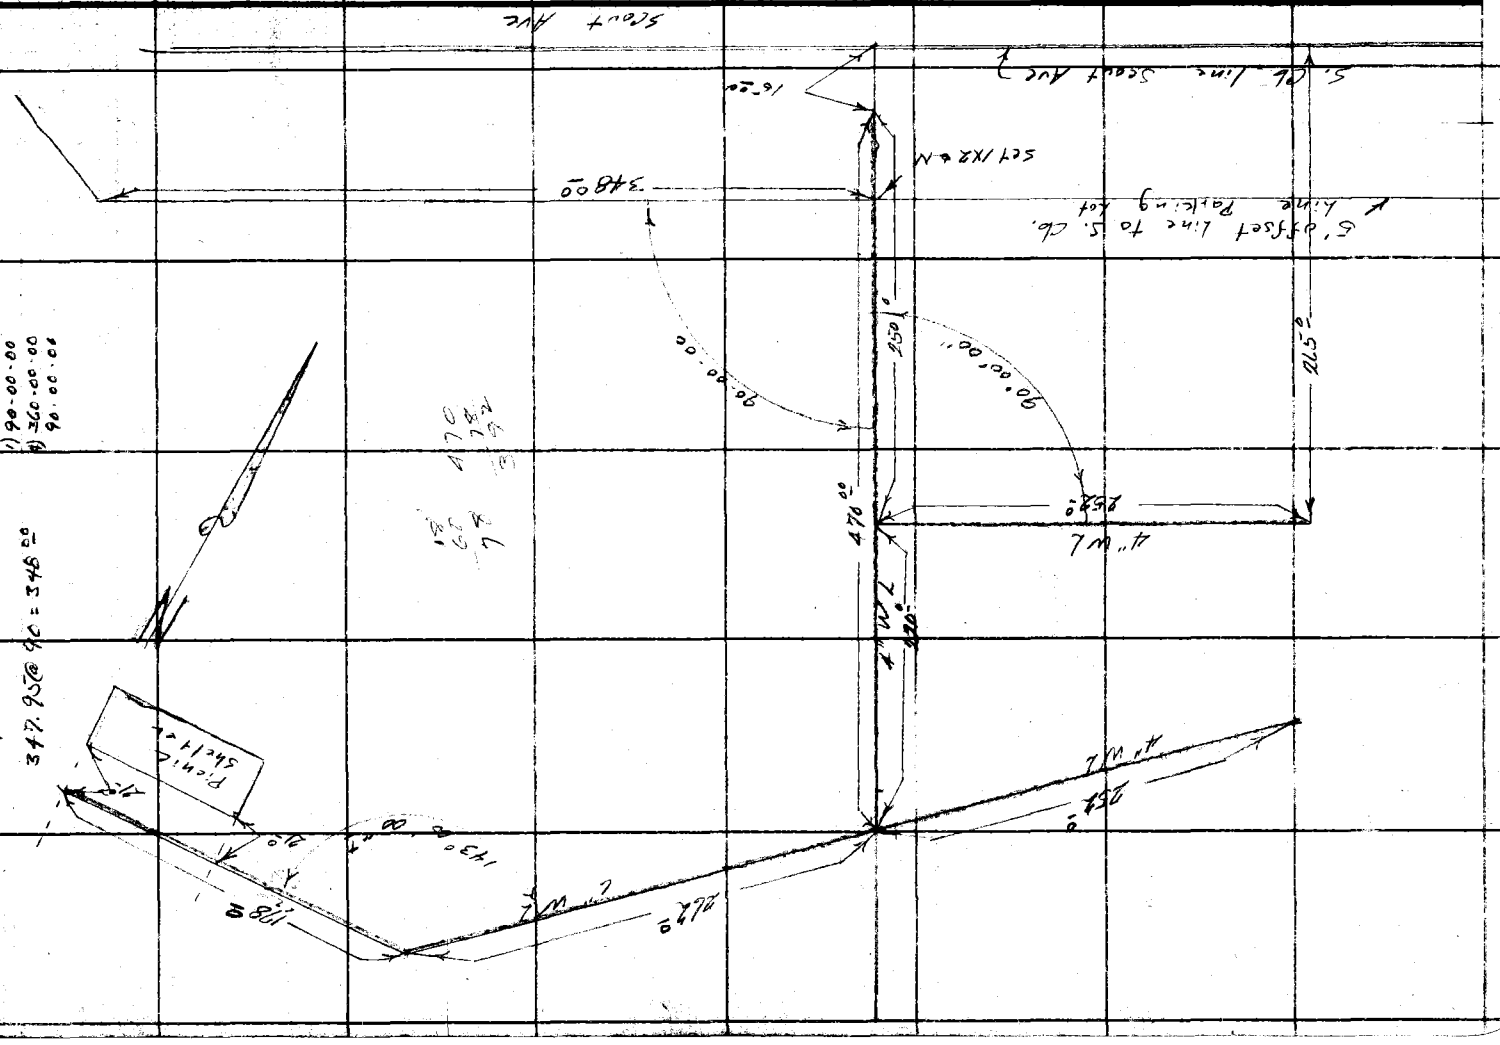

F.B. 2228 Pg. 244

Notes Ck'd by
Map No.
Office Work
Checked
Date

Survey of FORD PK
W. O. Tape No. St'd. °F
Surveyed by Hellstrom
Notes Date
Indexed A. C. Johnson

F. B. 1220 Pg. 245

JOHN ANSON FORD PARK

J.N. 8855.02

{LOCATION OF 5'X4' CONC. PULLBOX NEAR PICNIC SHELTER}

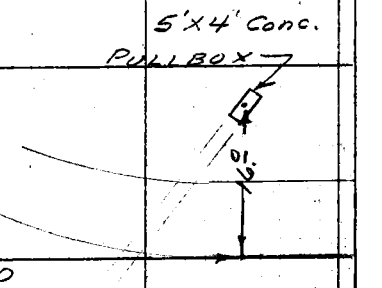

PICNIC SHELTER

ELEC. CONT. CAB

Note: Any Additions or Changes on This Sheet Must Be Made in Red Ink With Date and Name of Person Making Change.

Do not extend notes into this area at this time.

LOS ANGELES COUNTY SURVEYOR
ROOM 320 HALL OF RECORDS BLDG.
LOS ANGELES COUNTY ENGINEERING BLDG.

7 4-58
 
F. B 2228 PG. 246