by.

Survey of
JN Tape Std. °F
Surveyed by
Notes Date
Indexed

P.B. 2230 Pg.

Job Description

RANCHO LOS AMIGOS
JUVENILE HALL FACILITY-J.N. 83B201

Index

Bdry. Bdry. line survey.

Stak. Buildings.

Stak. Sewer lines.

Stak. Main water system.

Stak. Water line laterals.

Grades For fire hydrant.

Stak. Security walls.

Stak. Durant hot & cold water system for heating & cooling.

Stak. Domestic hot water system.

Stak. Soft water line.

Stak. Signal system.

Stak. Electrical service.

Loc. Imp. Parking lot light standards.

Grades For parking lot light standards.

Grades Security lighting.

Loc. Oil gas lines.

Stak. Underground oil storage & brine tank

Microfilmed May 86

(cont'd on next page)

F.B. 2230 Pg.

Page	Job	Description
121-130	Grades	Building floor grades.
131-134	B.M.	Additional bench levels.
135-158	Grades	Landscaping grades.
159-163	C.L.	Survey for service road.
165-170	Grades	Service road grades.
171-172	Grades	Admission yard & entrance road grades.
173-174	Grades	
175-178	Stak.	Pilings for covered walk.
179-184	Grades	
185-214	Stak.	Sprinkler system.
215-242	Topog.	Of walks, fences, etc. laid out by contractor.
243-244	Topog.	Of manholes nr. Biggy St. & East-Lake Ave.
245-246	Stak.	Emergency telephone for Recreation yard.
247-248	Grades	Sewer line #4 grade stakes.
249-258	Bdry.	Survey & mons. for Camp Hondo on Quill Dr. west of Old River School Road.
259-261	Elev.	Horizontal control for Plane Table Sheets F-92-9,10,11.

PLEASE RETURN TO
LOS ANGELES COUNTY ENGINEER
403 LOS ANGELES COUNTY ENGINEERING BLDG.
Do not extend beyond edge of this title.
Notes: Any Additions or Changes to this Sheet Must Be Made by County Engineer Only With Date and Name of Person Making Change

Notes Ck'd by	Survey of
Map No.	JN Tape Std °F
Office Work	Surveyed by
Checked	Notes Date
Date	Indexed E. C. Johnson 8-2-82

F. B. 2230 PG. 1

JN 8382.01

INDEX: JUVENILE HALL FACILITY AT RANCHO LOS AMIGOS

Bdry line survey PG	3 TO 16
Staking Bldgs. "	17 TO 28
" sewer lines "	29 TO 34
Main water sys.	35 TO 44
water line laterals	45 TO 64
Grades for Fire Hyd	65 to 67
Staking Security walls	69 TO 71
Durant Hot & Cold water sys. for Heating & cooling	73 TO 82
Domestic Hot water sys.	83 TO 87
Soft water line	PG 88
Signal system	89 TO 96
Electrical service	97 TO 102
Parking lot light standards	103 TO 104
Grades " "	105 TO 106
Security Lighting	107 TO 114
underground oil storage & Brine Tank	119 TO 120
Bldg flour grades	121 TO 130
Add. Bench levels	131 TO 134
Landscaping Grades	135 TO 158
& survey for service Rd.	159 TO 163
Service Rd grades	165 TO 170
Admission Yard & Ent Rd grades	171 TO 172
Grades	173 TO 174
Loc. of gas line	115 TO 118 out
Pilings for covered walk	175 TO 178 out
Grades	179 TO 184
Sprinkler system	185 TO 214
Loc. of walks, fences & ect laid out by contractor.	215 TO 242 out.

Note: Any Additions or Changes on This Sheet Must be Made or Circled in Red Ink With Date and Name of Person Making Change.

Do not extend this side of this line.

PLEASE RETURN TO
LOS ANGELES COUNTY ENGINEER
700 LOS ANGELES COUNTY ENGINEERING BLDG.

78F2095 SSE #247 1-80

Notes Ck'd by: W. E. STEPHENS	Survey of: Juvenile Hall
Map No. B-1035	W. O. Maps No. 019 St'd. 66 °F
Office Work: N. D. REYNOLDS	Surveyed by: M. A. Van Deren
Checked: B. H. MILLER	Notes: Van Date: 3-29-56
Date: 10/58	Indexed: A. C. Johnson 8-5-57

F. B. 2230 Pg. 4

J.N. 8382.01

BOUNDARY LINE SURVEY

FOR

JUVENILE HALL FACILITY

AT

RANCHO LOS AMIGOS

3-29-56
M. A. Van Deren
W. Richards
J. Bazen
R. Turrill

Note: Any Additions or Changes on This Sheet Must be Made or Circled in Red Ink With Date and Name of Person Making Change.

Do not expand notes this side of this line.

RETURN TO
LOS ANGELES COUNTY SURVEYOR
736 LOS ANGELES COUNTY
ENGINEERING BLDG.

75F3088 SAE #247. 6-54

RETURN TO
LOS ANGELES COUNTY SURVEYOR
726 LOS ANGELES COUNTY
ENGINEERING BLDG.

Note: Any Additions or Changes on This Sheet Must be Made or Circled in Red Ink With Date and Name of Person Making Change.

Do not extend notes this side of this line.

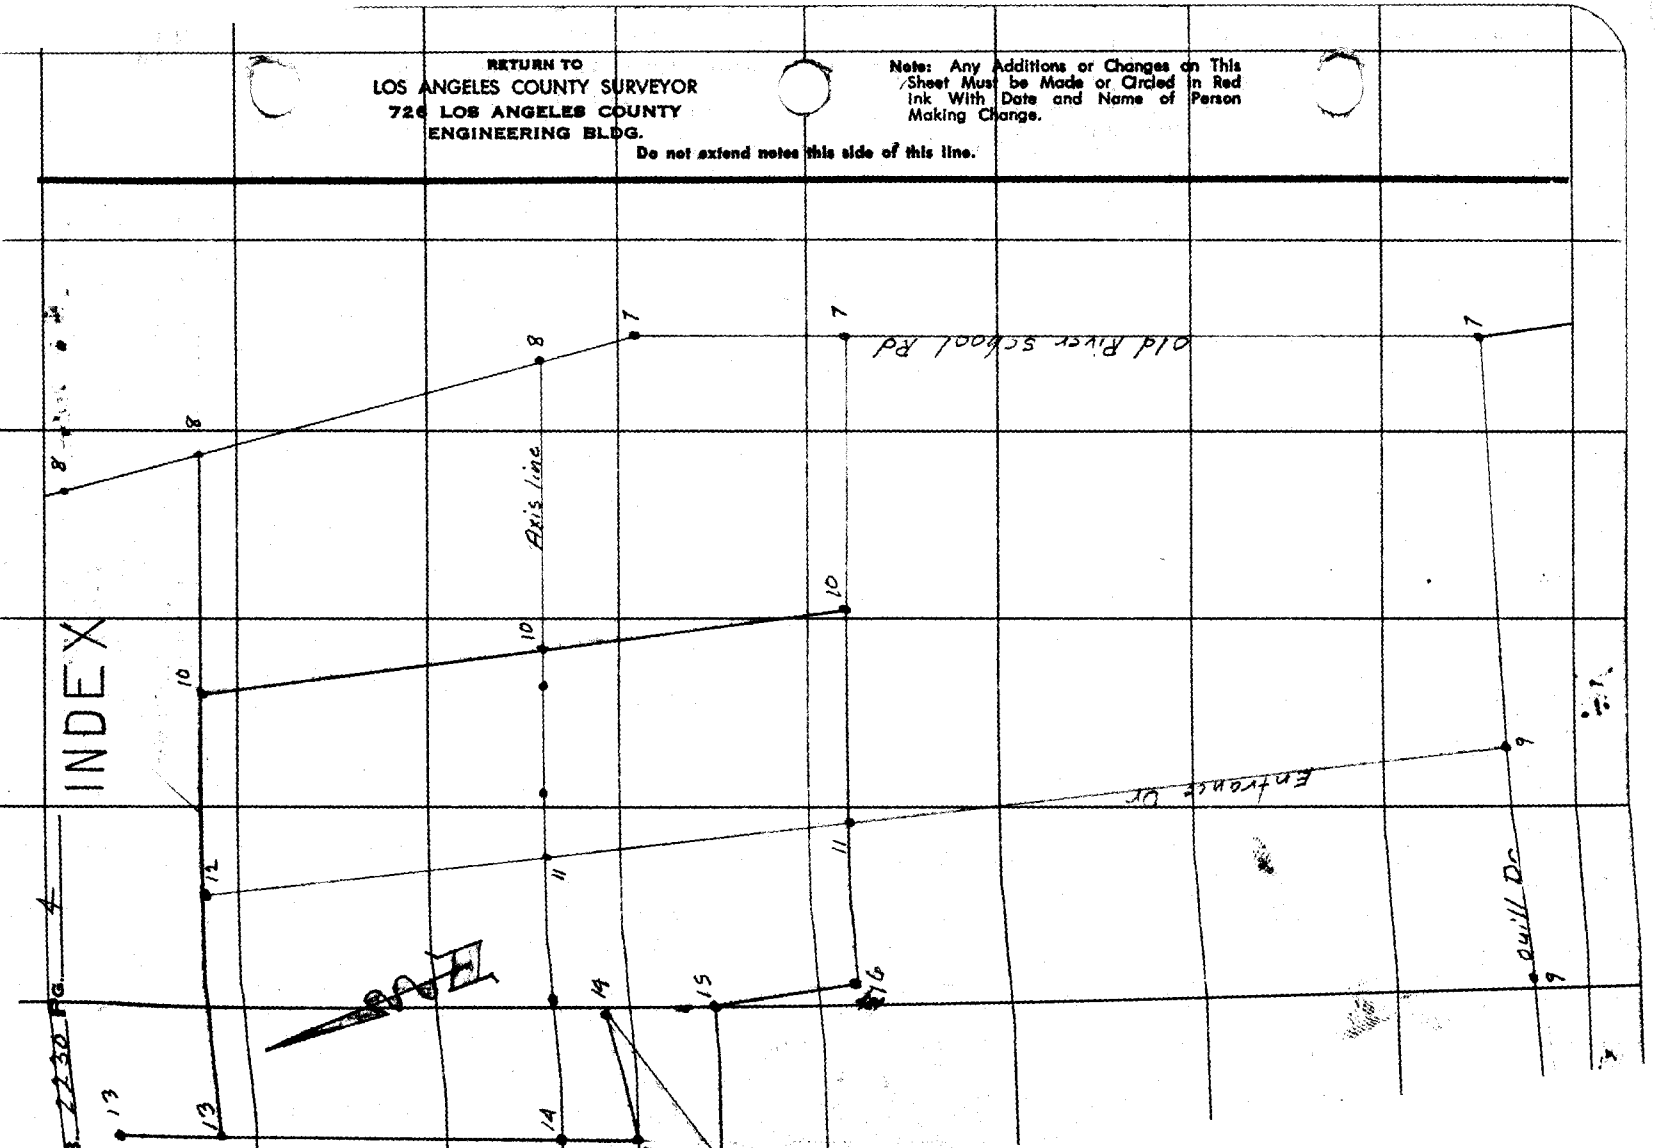

Notes Ck'd by J. BRENNER
Map No. B-1035
Office Work W. D. REYNOLDS
Checked B. H. MILLER
Date 10/58

Survey of JUVENILE HALL
W. O. 8382.0 Tape No. 0145 St'd. 68 °F
Surveyed by M.A. Van Doran
Notes Fitchards Date 6-8-56
Indexed C. Johnson

F. B. 2230 Pg. 5

TO BOT. PG.

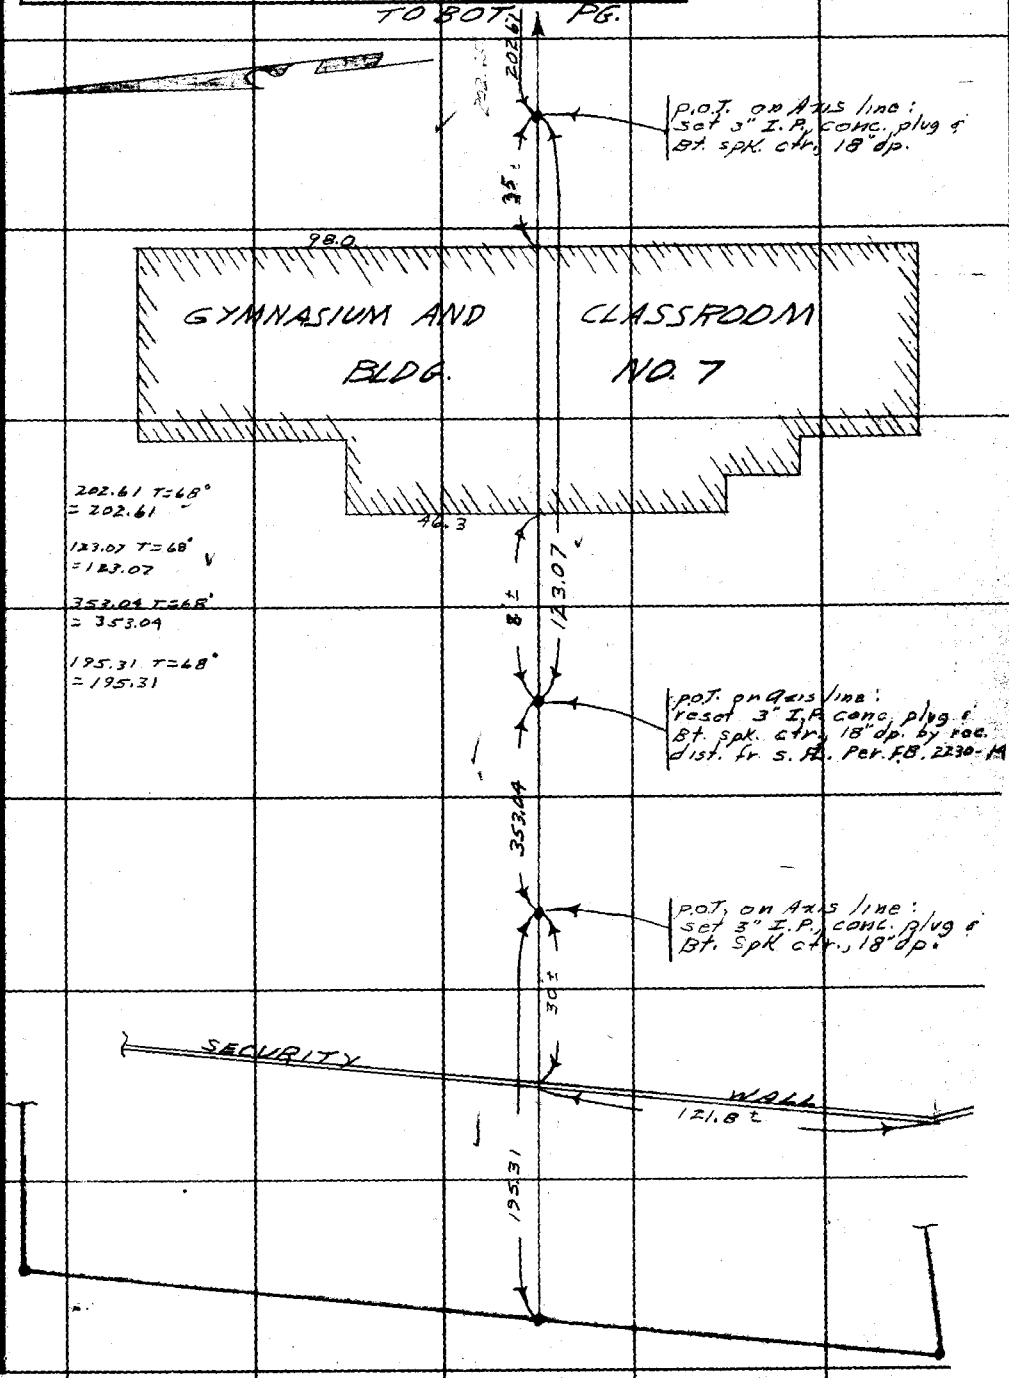

202.61 T=68°
= 202.61

123.07 T=68°
= 123.07

353.04 T=68°
= 353.04

195.31 T=68°
= 195.31

Note: Any Additions or Changes on This Sheet Must be Made or Circled in Red Ink With Date and Name of Person Making Change.

Do not offset notes this side of this line.

RETURN TO
LOS ANGELES COUNTY SURVEYOR
726 LOS ANGELES COUNTY
ENGINEERING BLDG.

76F2005 S&E #247. 8-54

F. B 2230 PG. 6

TO RT. PG 11.

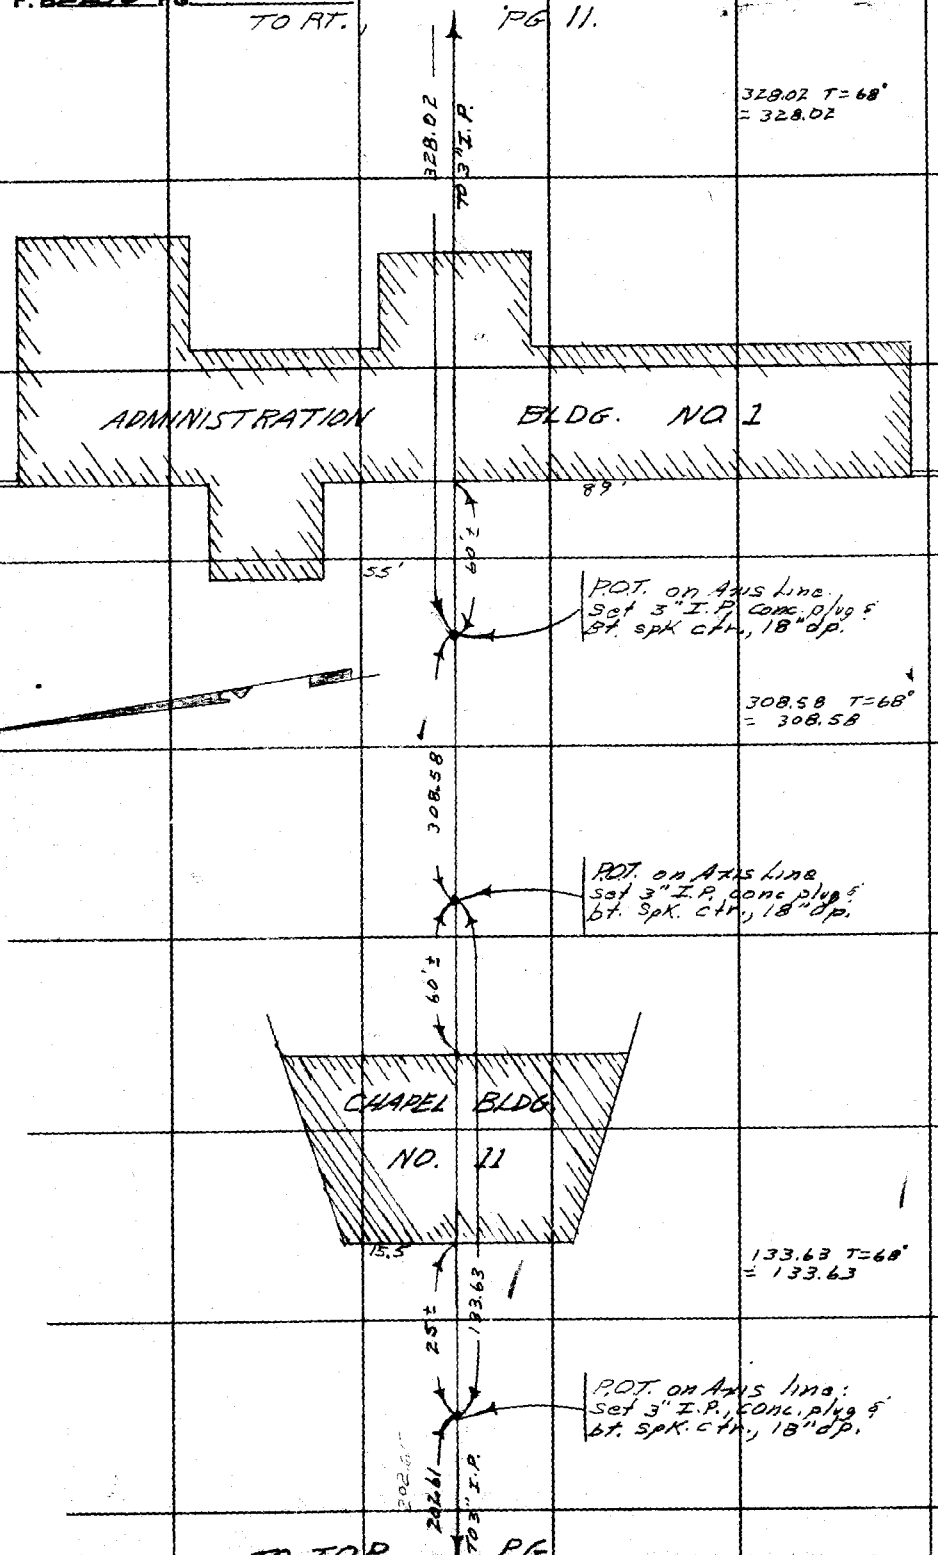

TO TOP PG.

RETURN TO
LOS ANGELES COUNTY SURVEYOR
720 LOS ANGELES COUNTY
ENGINEERING BLDG.
Do not extend notes this side of this line.

Notice: Any Additions or Changes on This Sheet Must be Made or Circled in Red Ink With Date and Name of Person Making Change.

Notes Ck'd by W. J. BRENNER
Map No. B-1035
Office Work W. D. REYNOLDS
Checked R. H. MILLER
Date 10/5?

Survey of Juvenile Hall
W. O. 8382.0 Tape No. 2195 Std. 68 °F
Surveyed by M. A. Van Deren
Notes Van Date 3-30-56
Indexed J. C. Johnson

F. B. 2230 Pg. 7

W. S. 37 - C2 #D2

To hot pg 8

473.22 tie

Angle point Fd 4 ton P.M. on S.M.H. ring per F.B. 1600-162 F.B. 153-14-15 set P.M. a/ int. and used for line

178° 33' 05" F.B. 153-14-15

344.20 calc

1 - 90-51-00
4 - 363-24-00
90-51-00
6 - 185-06-00
90-51-00

90° 51' 00"

To P.T. pg 10

SCHOOL RD

Set L&T on calc dist For South P.L. prod

To C.S. Mon 491.33

1 - 91-37-40
4 - 366-31-30
91-37-52½"
6 - 189-47-00
91-37-50"

752.175 T=68.752.175

OLD RIVER

To Top pg 9

91° 37' 50"

752.175 CH

Fd L&T per F.B. 1600-167 F.B. 153-34

1200

Angle point Fd 4 ton P.M. on S.M.H. ring per F.B. 1600-167 F.B. 153-12-14-34 set P.M. a/ int. and used for line

To S.W.T. 1201.87

QUILL DR

RETURN TO
LOS ANGELES COUNTY SURVEYOR
726 LOS ANGELES COUNTY
ENGINEERING BLDG.

Note: Any Additions or Changes on This Sheet Must be Made or Circled in Red Ink With Date and Name of Person Making Change.

Do not extend notes this side of this line.

76FS095 SAE #247. 8-54

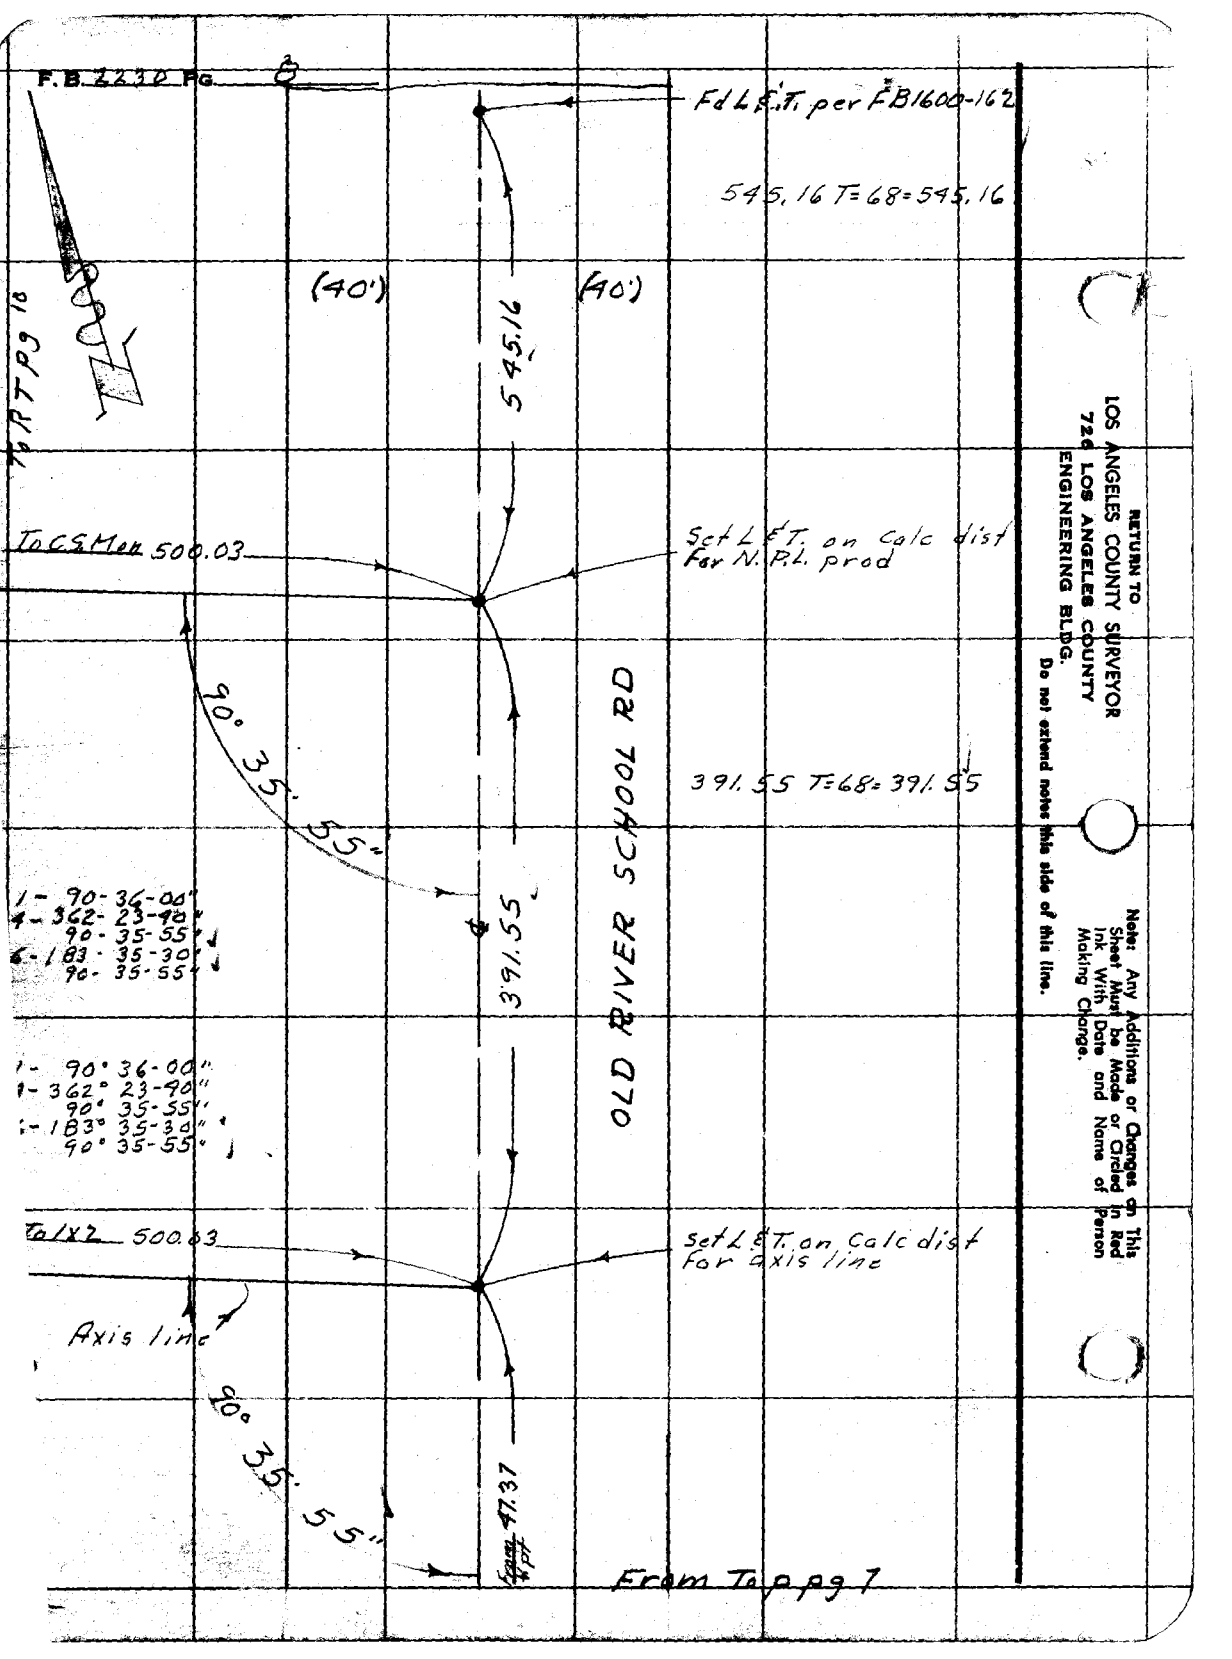
F.B. 2230 Pg.
Fd L.E.T. per F.B. 1600-162
545.16 T=68=545.16
(40')
(40')
545.16
To T pg 18
To C.S. Mon 500.03
Set L.E.T. on Calc dist For N.P.L. prod
391.55 T=68=391.55
90° 35' 55"
391.55
1 - 90-36-00"
4 - 362-23-90"
90-35-55"
6 - 183-35-30"
90-35-55"
OLD RIVER SCHOOL RD
1 - 90° 36-00"
1 - 362° 23-90"
90° 35-55"
1 - 183° 35-30"
90° 35-55"
To I X 2 500.03
Set L.E.T. on Calc dist For axis line
Axis line
90° 35' 55"
471.37
From To pg 7
RETURN TO
LOS ANGELES COUNTY SURVEYOR
726 LOS ANGELES COUNTY
ENGINEERING BLDG.
Do not extend notes this side of this line.
Note: Any Additions or Changes on This Sheet Must be Made or Circled in Red Ink With Date and Name of Person Making Change.

Notes Ck'd by J. BRENNER
Map No. B-1035
Office Work W. D. REYNOLDS
Checked E. H. MILLER
Date 10/58

Survey of Juvenile Hall
W. O. 8382.0 Tape No. 2195 Std. 68 °F
Surveyed by M. A. Van Deren
Notes Van Date 3-30-56
Indexed A. C. Johnson

F. B. 2230 Pg. 9

From LT pg 7

1201.87 T=68=1201.87

(30') (30')

From RM at angle point

1201.87 Calc. C.L.

QUILL DR

[See FB 2319-18]

1- 89-51-40"
4- 359-27-00"
89-51-45"
6- 179-10-30"
89-51-45"

To LT pg 11

51' 45"

89°

Fd L.S.T.

Fd Spk w. L.T. no ref

0.82

10.00

30.085

Set Spk w. T. on Calc C/L

18.305

18.28

Fd L.T.

0.82

Set L.S.T. on line prod

29.125

To LT 1160.11

ENTRANCE DR

5574

Fd C.S. Brass Cap Mon. Flush per FB 1600-168 used for line

KS 33-C2

Note: Any Additions or Changes on This Sheet Must be Made or Circled in Red Ink With Date and Name of Person Making Change.

Do not extend notes this side of this line.

RETURN TO
LOS ANGELES COUNTY SURVEYOR
726 LOS ANGELES COUNTY
ENGINEERING BLDG.

76F3098 SSE #247. 8-54

F.B. 2230 Pg. 10

To 3" I.P. 657.39

500.03 From L&T
Calc & Meas

500.03 T=68=500.03

To R 12

90° 35' 55"

1 - 90-36-00"
4 - 362-23-40"
90-35-55"
6 - 183-35-40"
90-35-56½"

Set 30" C.S. Brass Cap Mon Flush on Calc dist From E old River School Rd N.E. Prop Cor

COUNTY ENGINEER
R.E. 5869

From LT PG 8

RETURN TO
LOS ANGELES COUNTY SURVEYOR
726 LOS ANGELES COUNTY
ENGINEERING BLDG.

Do not extend notes this side of this line.

Note: Any Additions or Changes on This Sheet Must be Made or Circled in Red Ink With Date and Name of Person Making Change.

491.84

730.58 T=68=730.58

391.54 T=68=391.54

90° 35' 50"

1 - 90-35-40"
4 - 362-23-20"
90-35-50"
6 - 183-35-00"
90-35-50"

To IX2 730.58

500.03 From L&T

10.57

P.O.T. set 3" I.P. Conc plug & wire 24" dp

Axis line

Set IX2 & Tk Flush by int

500.03 T=68=500.03

To NT PG 11

1 - 89-24-00"
1 - 357-36-30"
89-24-07½"
1 - 176-24-40"
89-24-06½"

391.54

491.33 T=68
491.33

391.54 T=68=391.54

From LT PG 8

89° 24' 05"

COUNTY ENGINEER
R.E. 5869

From LT PG 7

Set C.S. Mon Flush on calc dist From L&T on E old River school Rd

491.33 From L&T

IX2 730.25

Notes Ck'd W. J. BRENNER
Map No. B-1035
Office Work W. D. REYNOLDS
Checked S. H. MILLER
Date 10/58

Survey of Juvenile Hall
W. C. 8382 Tape No. 01953 Tr'd. 68 °F
Surveyed by M.A. VanDeren
Notes Van Date 3-30-56
Indexed C. Johnson

F.B. 2230 Pg. 11

To bk + pg 12

From LT pg 10

To RT pg 14

To 3" I.P. 996.68

Set 1X2 Tk Flush by int

391.525 Tk 12

730.58 From 1X2

99.23

Set 3" I.P. conc Plug & wire 24" dp

Axis line

90° 38' 35" (20')

(20')

391.53

1160.11 T=68=1160.1

391.53 T=68=391.5

730.25 T=68=730.2

1- 90-38-40"
4- 362-34-30"
90-38-37½"
6- 183-51-48"
90-38-36"

Set 1X2 5' Tk Flush by int

1160.11

To C.S. Mon 1354.19

730.25 From C.S. Mon

120.69

[See FB 2319-21]

To RT pg 16

P.O.T. Set 3" I.P. Conc plug & copwire 24" dp

72'

90° 38' 35"

Barn

ENTRANCE RD

From S.W.T.

From S.W.T. 769.58

120.69 T=68=120.69

768.58 T=68=768.58

1- 90-38-40"
4- 362-34-20"
90-38-35"
6- 188° 51-30"
90-38-35"

From LT pg 9

Note: Any Additions or Changes on This Sheet Must be Made or Circled in Red Ink With Date and Name of Person Making Change.

Do not extend notes this side of this line.

RETURN TO
LOS ANGELES COUNTY SURVEYOR
726 LOS ANGELES COUNTY
ENGINEERING BLDG.

76P3005 SAE #247, B-54

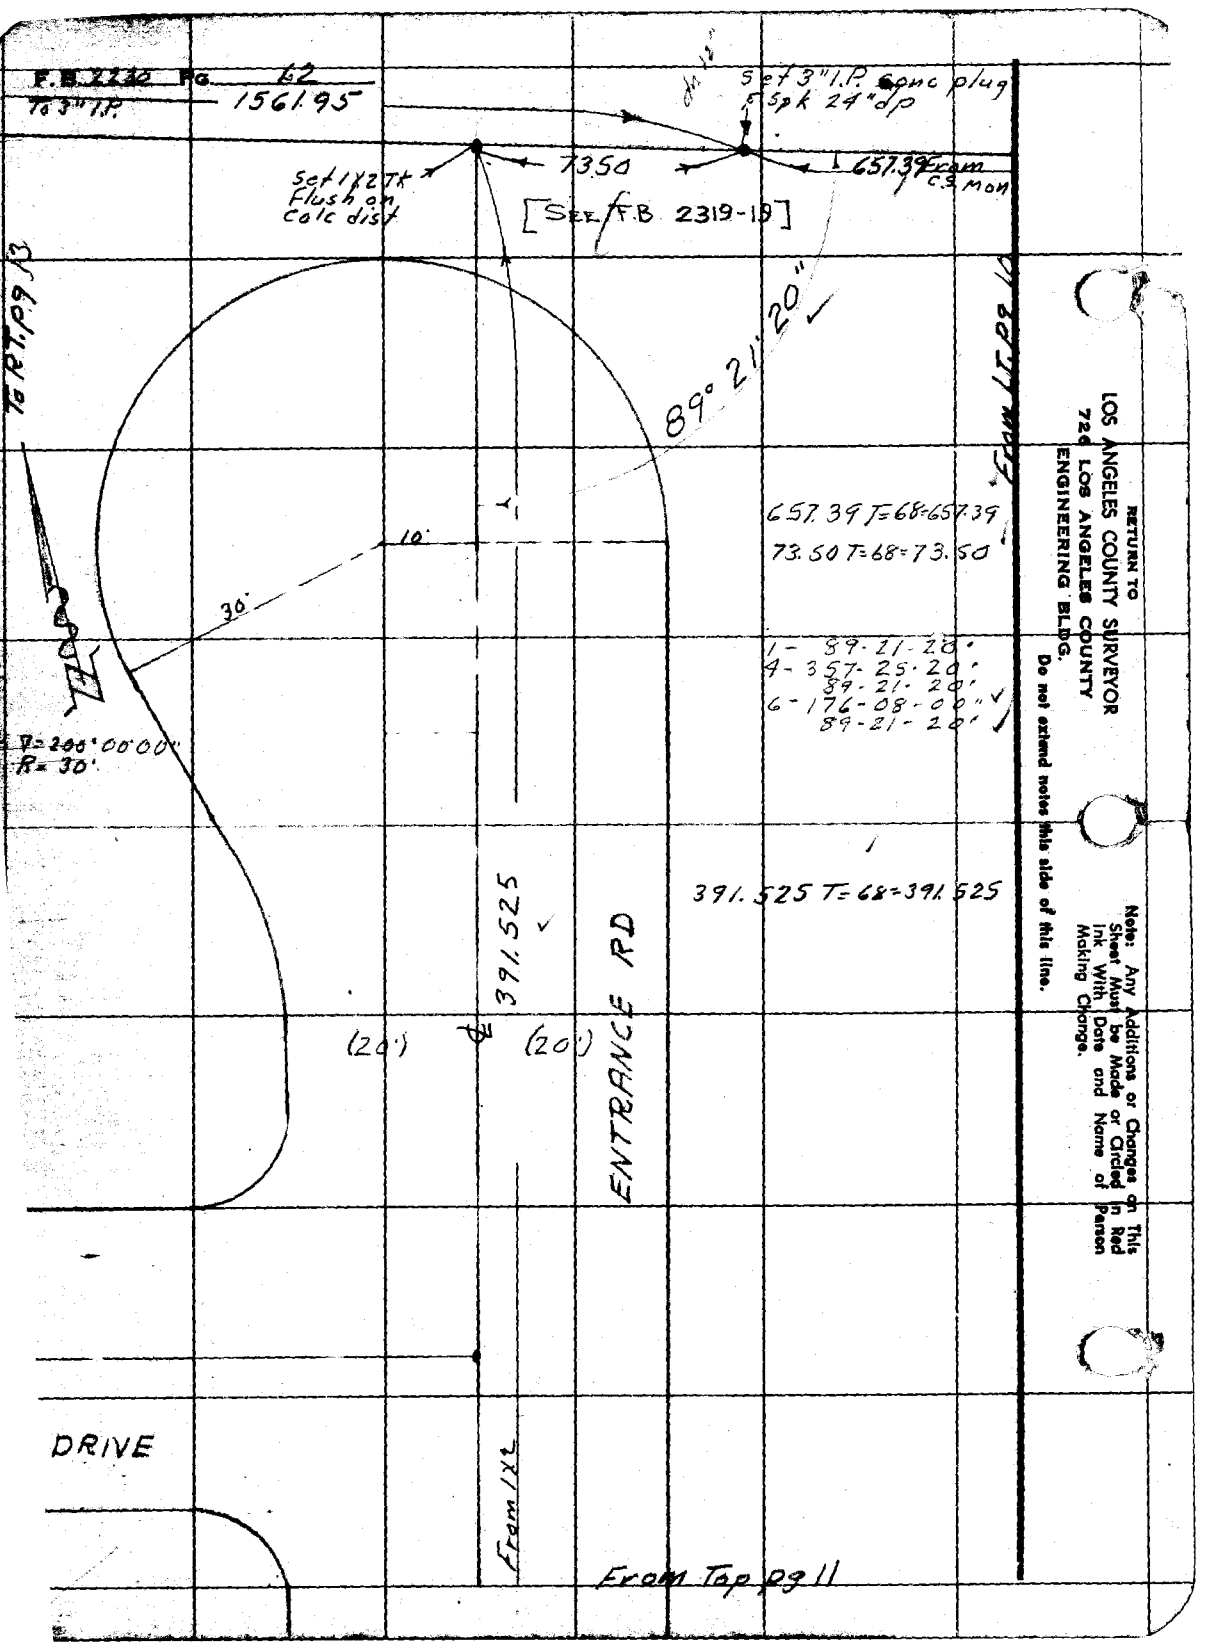
F.B. 2230 Pg. 62
To 3" I.P.
156.95'
Set 1"x2" Tk Flush on calc dist
1350
5 of 3" I.P. conc plug & Spk 24" dp
657.39' From C.S. Mon
[See F.B. 2319-19]
89° 21' 20"
657.39 T=68=657.39
73.50 T=68=73.50
1- 89-21-20"
4- 357-25-20"
89-21-20"
6- 176-08-00"
89-21-20"
391.525 T=68=391.525
391.525
ENTRANCE RD
(20')
(20')
10'
30'
R=30'
DRIVE
From 1"x2"
From Top pg 11
RETURN TO
LOS ANGELES COUNTY SURVEYOR
720 LOS ANGELES COUNTY
ENGINEERING BLDG.
Do not extend notes this side of this line.
Note: Any Additions or Changes on This Sheet Must be Made or Circled in Red Ink With Date and Name of Person Making Change.

Notes Ck'd J. BRENNER	Survey of Juvenile Hall	F.B. 2230 Pg. 13
Map No. B-1035	W. 6282 Tape No. 0145 St'd. 68 °F	
Office Worked D. REYNOLDS	Surveyed by M.A. VanDeren	
Checked H. MILLER	Notes Van Date 3-30-56	
Date 10/58	Indexed C. Johnson	

Fd 2" I.P. & New L.S. Tag L.S. 1488 Flush per FB 153-18 used for line

12/5.52 per FB 153-18

0.90

set nail chks line OK

Fd 2" I.P. no plug or nail. 12" dp. 0.90 W. of line per FB 153-18 used center of pipe

108.21 T=68=108.21 ✓

1561.95 T=68=1561.95 ✓

451.585 T=68=451.585 ✓

108.21 ✓

1561.95

To 3" I.P.

451.585

R.O.T. Set 3" I.P. Conc plug & spk 30" dp

Set 3" I.P. Conc plug & wire 24" dp on calc dist from 1" I.P. to the South

1 97-35-40"
4 30-22-20"
97-35-35"
6 225-33-20"
97-35-35"

97°35'35"

0.29

221.63 Calc P.O.T.

Fd 1" I.P. pplug & nail 1/2" dp & 0.29 W. of line per FB 153-18

set nail & used for line

221.63 T=68=221.63 ✓

173.33 T=68=173.33

173.33 P.O.T.

To Top pg 14

Note: Any Additions or Changes on This Sheet Must be Made in Red Ink With Date and Name of Person Making Change.

Do not extend notes this side of this line.

RETURN TO
LOS ANGELES COUNTY SURVEYOR
726 LOS ANGELES COUNTY
ENGINEERING BLDG.

76F3008 SAE #247. 8-54

F.B. 2230 Pg. 14

From bot pg 13

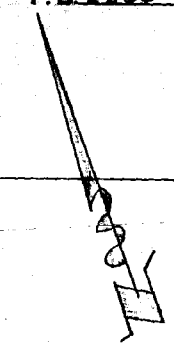

Esmn Nail

82° 24' 30"

173.33

Axis line

From LTP 8 11

1- 84-24-30"
4-329-38-00"
84-24-30"
6-134-27-00"
84-24-30"

548.35 T=68=548.35

996.68 T=68=996.68

Set 3" I.P. conc plug & wire 24" dp at int of Axis line & w. prop. line on calc dist from 1" I.P. To the North

548.35

996.68

To 1X2

T.B.M.

P.O.T. on Axis line set 3" I.P. conc plug & wire 24" dp

1- 81-49-00"
4-327-16-00"
81-49-00"
6-130-54-00"
81-49-00"

81° 49' 00"

71.96

71.96 T=68=71.96

72.41 T=68=72.41

201.60 T=68=201.60

COUNTY ENGINEER R.E. 5869

72.41

8.18

520 46'

Set C.S. Mon Flush by line & dist from 1" I.P. on Axis line

62° 57' 15"

201.60

194.48

Set C.S. Mon Flush by Plus & Offset from 2X2 per FB 153-20

Fd 2X2 & TK 16" dp per FB 153-20 This point replaced with 3/4" I.P. conc plug & wire 18" dp

COUNTY ENGINEER R.E. 5869

62-57-20"
-251-49-00"
62-57-15"
-117-43-30"
62-57-15"

To C.S. Mon

To 2X2

To Top pg 15

RETURN TO
LOS ANGELES COUNTY SURVEYOR
726 LOS ANGELES COUNTY
ENGINEERING BLDG.

Do not extend notes this side of this line.

Notes: Any Additions or Changes on This Sheet Must be Made or Circled in Red Ink With Date and Name of Person Making Change.

Notes Ck'd by J. BRENNER
Map No. B-1035
Office Work W. D. REYNOLDS
Checked S. H. MILLER
Date 10/58

Survey of Juvenile Hall
W. C. 382.0 Tape No. 2145 Std. 68 °F
Surveyed by M. A. Van Deren
Notes Van Date 3-30-56
Indexed C. Johnson

F.B. 2230 Pg. 15

W.S. 32-C2

COUNTY ENGINEER
R. E. 5869

From bot pg 14

From C.S. Mon
5.00
From 2x2

20.60

194.43

Set C.S. Mon Flush by plus and offset from 2x2 per FB 153-20

15.35
S 60° W
15.35
S 30° W

Fd 2x2 E TK Flush per FB 153-19-20
This point replaced with 3/4" I.P conc plug. E wire 18" dp

117.66

128.11

36° 04' 40"

201.60 T=68=201.60
194.43 T=68=194.43
117.66 T=68=117.66
128.11 T=68=128.11
227.21 T=68=227.21

This point replaced with 3/4" I.P conc plug E wire 18" dp

Fd 2x2 E TK 18" dp per FB 153-20

4.90
S 60° W
4.90
90°
S 00° E

Set Spk E.W. in Top of Fence post by plus and offset from 2x2 per FB 153-20

91° 02' 55"

227.16

232.06

1- 36-04-40"
4-144-18-40"
36-04-40"
6-216-28-00"
36-04-40"

1- 91-03-00"
4-364-11-40"
91-02-55"
6-186-17-30"
91-02-55"

227.16 T=68=227.16
232.06 T=68=232.06

To Mon

To 1x2

To Top pg 16

Note: Any Additions or Changes on This Sheet Must be Made or Circled in Red Ink With Date and Name of Person Making Change.

Do not extend notes this side of this line.

RETURN TO
LOS ANGELES COUNTY SURVEYOR
726 LOS ANGELES COUNTY
ENGINEERING BLDG.

70F3008 SAE #247. 8-54

F.B. 2110 Pg. 16

From bot pg 15

W.S. 32-C2

227.16 ch From S'ly

232.06 ch From N'ly

From 1X2

RETURN TO
LOS ANGELES COUNTY SURVEYOR
726 LOS ANGELES COUNTY
ENGINEERING BLDG.
Do not extend notes this side of this line.

Note: Any Additions or Changes on This Sheet Must be Made or Circled in Red Ink With Date and Name of Person Making Change.

COUNTY ENGINEER
R.E. 5869

1354.19 T=68=1354.19

5.00

1354.19

To 1X2

769.30

45"

61° 28

769.30 T=68=769.30

1- 61- 28- 40"
4- 245- 54- 50"
61- 28- 42½"
6- 368- 52- 30"
61- 28- 45"

set C.S. Mon Flush on Cgle dist from 2X2 to the North so that South P.L. is parallel with the North P.L. & the Axisline

Fd 2X2 & TK 14" dp per FB 153-20, this point replaced with ¾" I.P. conc plug & wire 18" dp

8.76

5.00

d 2" I.P. Conc plug Tag L.S. 7488 this c 2" I.P. called for FB 153:20 Pipe Flush see Tr #19627

Notes Ck'd by	Survey of Juvenile Hall	F.B. 2230 Pg. 11
Map No.	W. O. 6382.01 Tape No. 2145 Std. 68 °F	
Office Work	Surveyed by M. A. Van Deren	
Checked	Notes Vam Date 4-17-56	
Date	Indexed C. Jobin	

J.N. 8382.01

STAKING SKETCH OF BUILDINGS AT JUVENILE HALL AT RO LOS AMIGOS

"Note" all cor of Buildings set & ref out 10' with 1X2.ETK

All lines for Buildings are to ℄ of piling

all buildings staked per plan

4-13-56
M. A. Van Deren
W. Richards
J. Bazen
R. Turrill

Note: Any Additions or Changes on This Sheet Must be Made or Circled in Red Ink With Date and Name of Person Making Change.

Do not extend notes this side of this line.

RETURN TO
LOS ANGELES COUNTY SURVEYOR
726 LOS ANGELES COUNTY
ENGINEERING BLDG.

76F3095 S&E #247, 8-54

F. B. 2230 Pg. 18

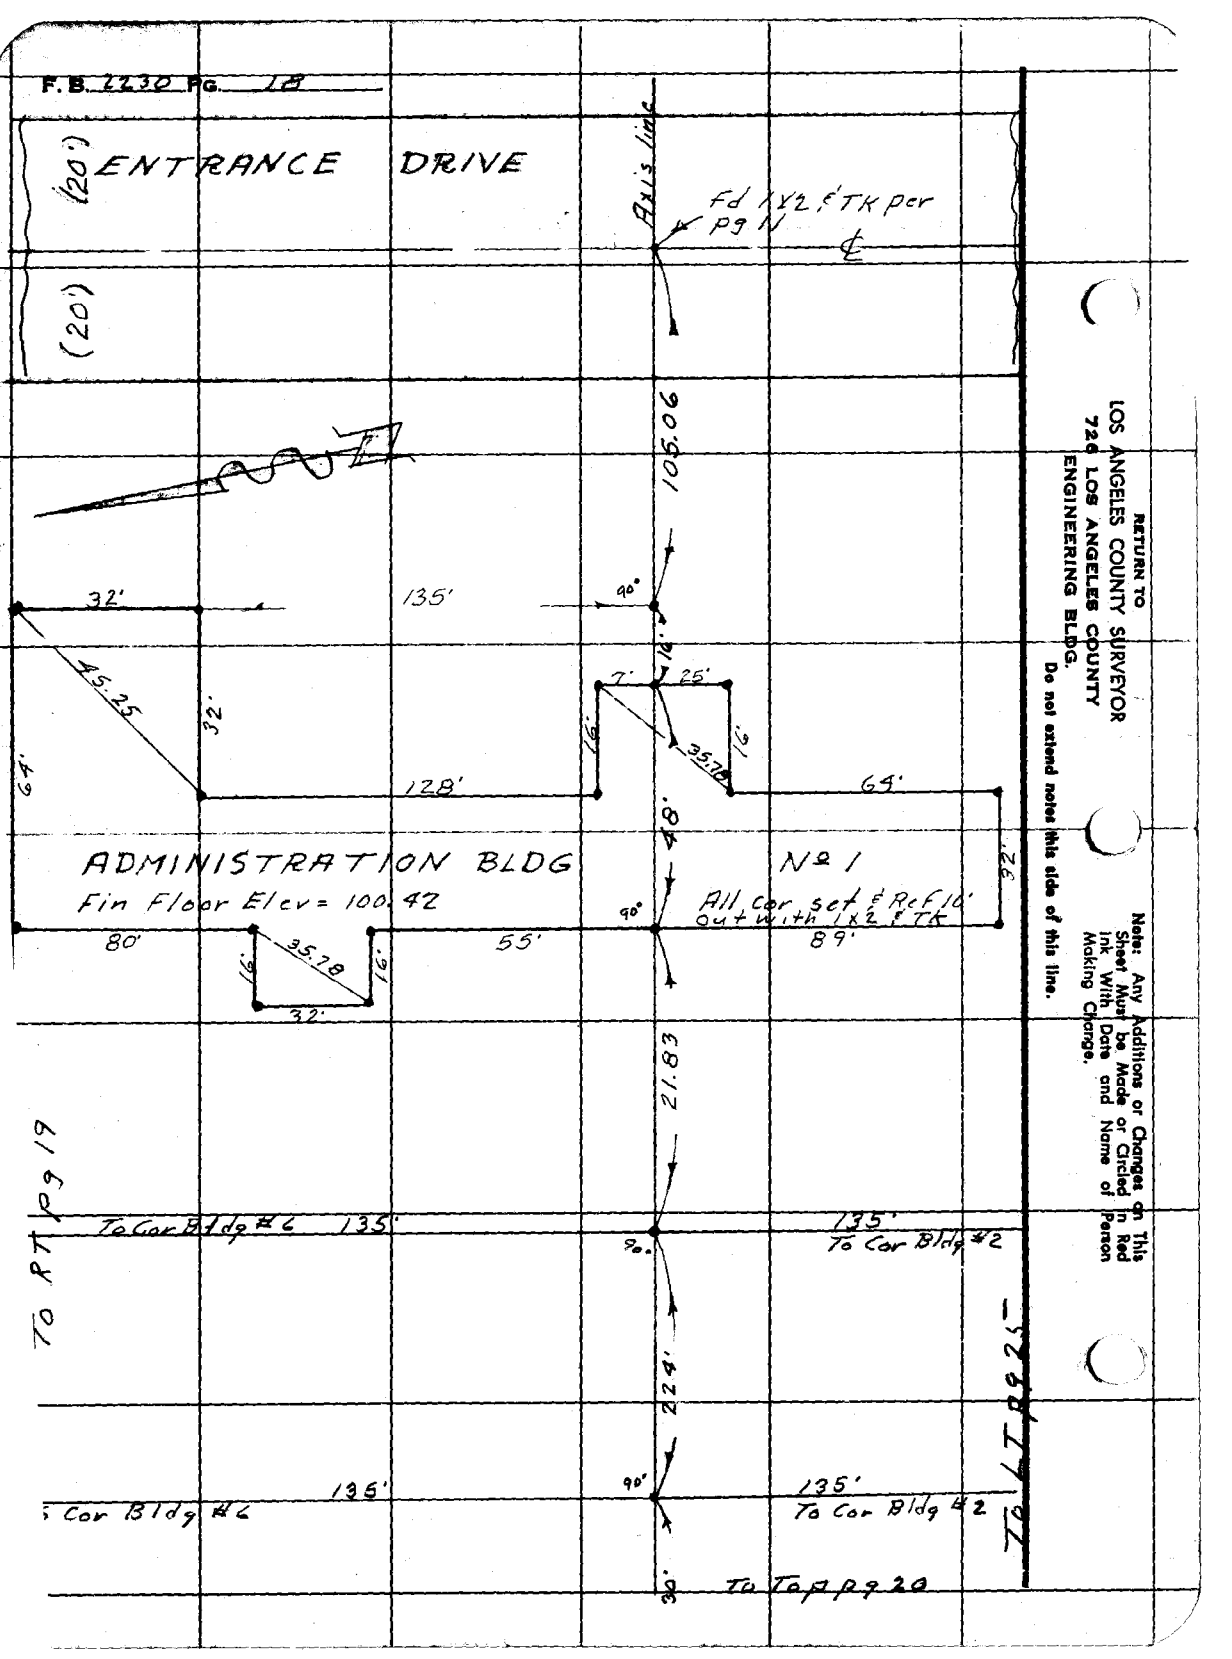

RETURN TO
LOS ANGELES COUNTY SURVEYOR
726 LOS ANGELES COUNTY
ENGINEERING BLDG.
Do not extend notes this side of this line.

Note: Any Additions or Changes on This Sheet Must be Made or Circled in Red Ink With Date and Name of Person Making Change.

76F3099 S&E #247. 8-54

RETURN TO
LOS ANGELES COUNTY SURVEYOR
726 LOS ANGELES COUNTY
ENGINEERING BLDG.

Note: Any Additions or Changes on This Sheet Must be Made or Circled in Red Ink With Date and Name of Person Making Change.

Do not extend notes this side of this line.

Notes Ck'd by
Map No.
Office Work
Checked
Date

Survey of Juvenile Hall
W. O. 8232 Type No. 4135 Std. 68 of
Surveyed by M. Allan Derr
Notes Date 4-12-56
Indexed C. Johnson

F.B. 2130 Pg. 19

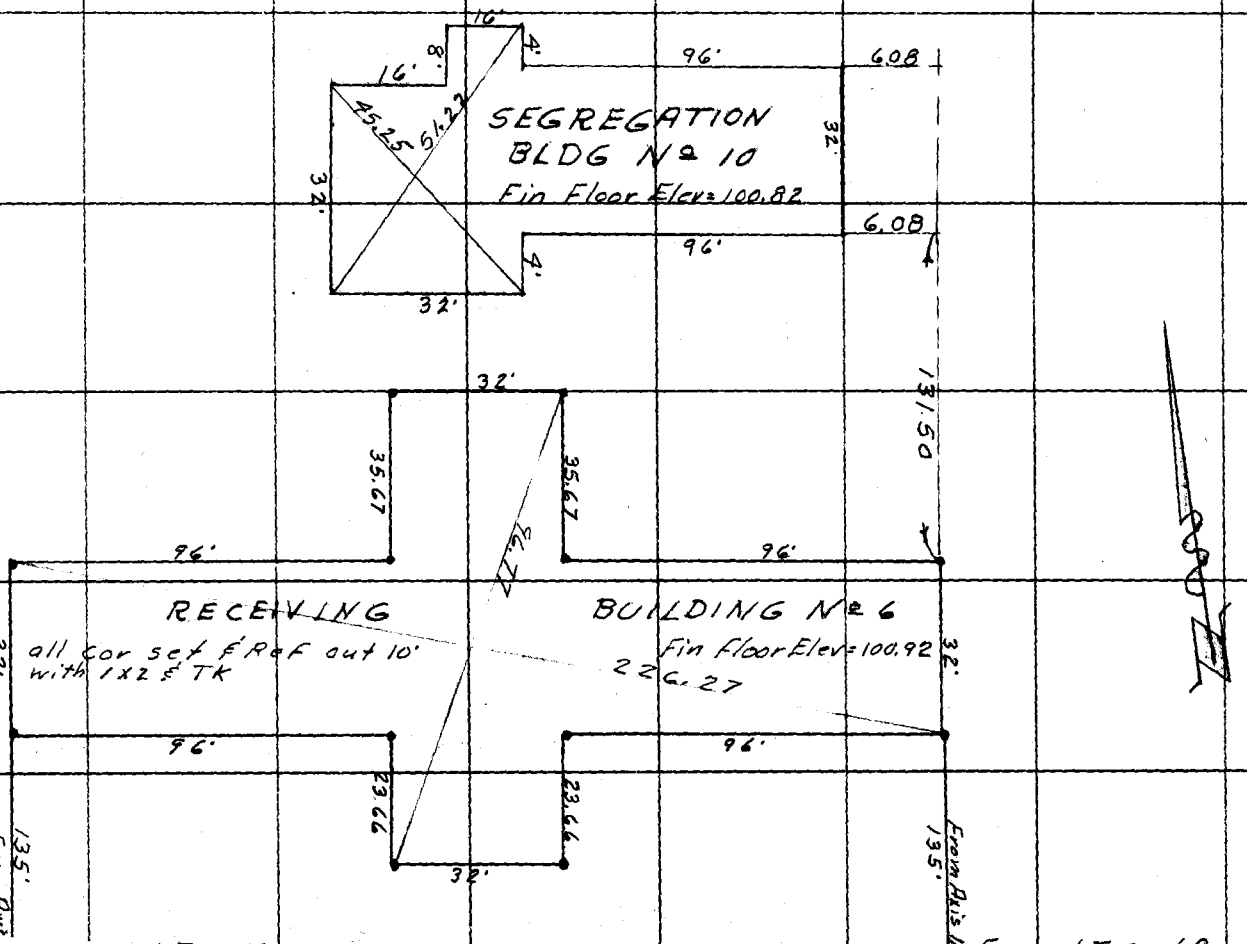

RETURN TO
LOS ANGELES COUNTY SURVEYOR
726 LOS ANGELES COUNTY
ENGINEERING BLDG.

Note: Any Additions or Changes on This Sheet Must be Made or Circled in Red Ink With Date and Name of Person Making Change.

Do not extend notes this side of this line.

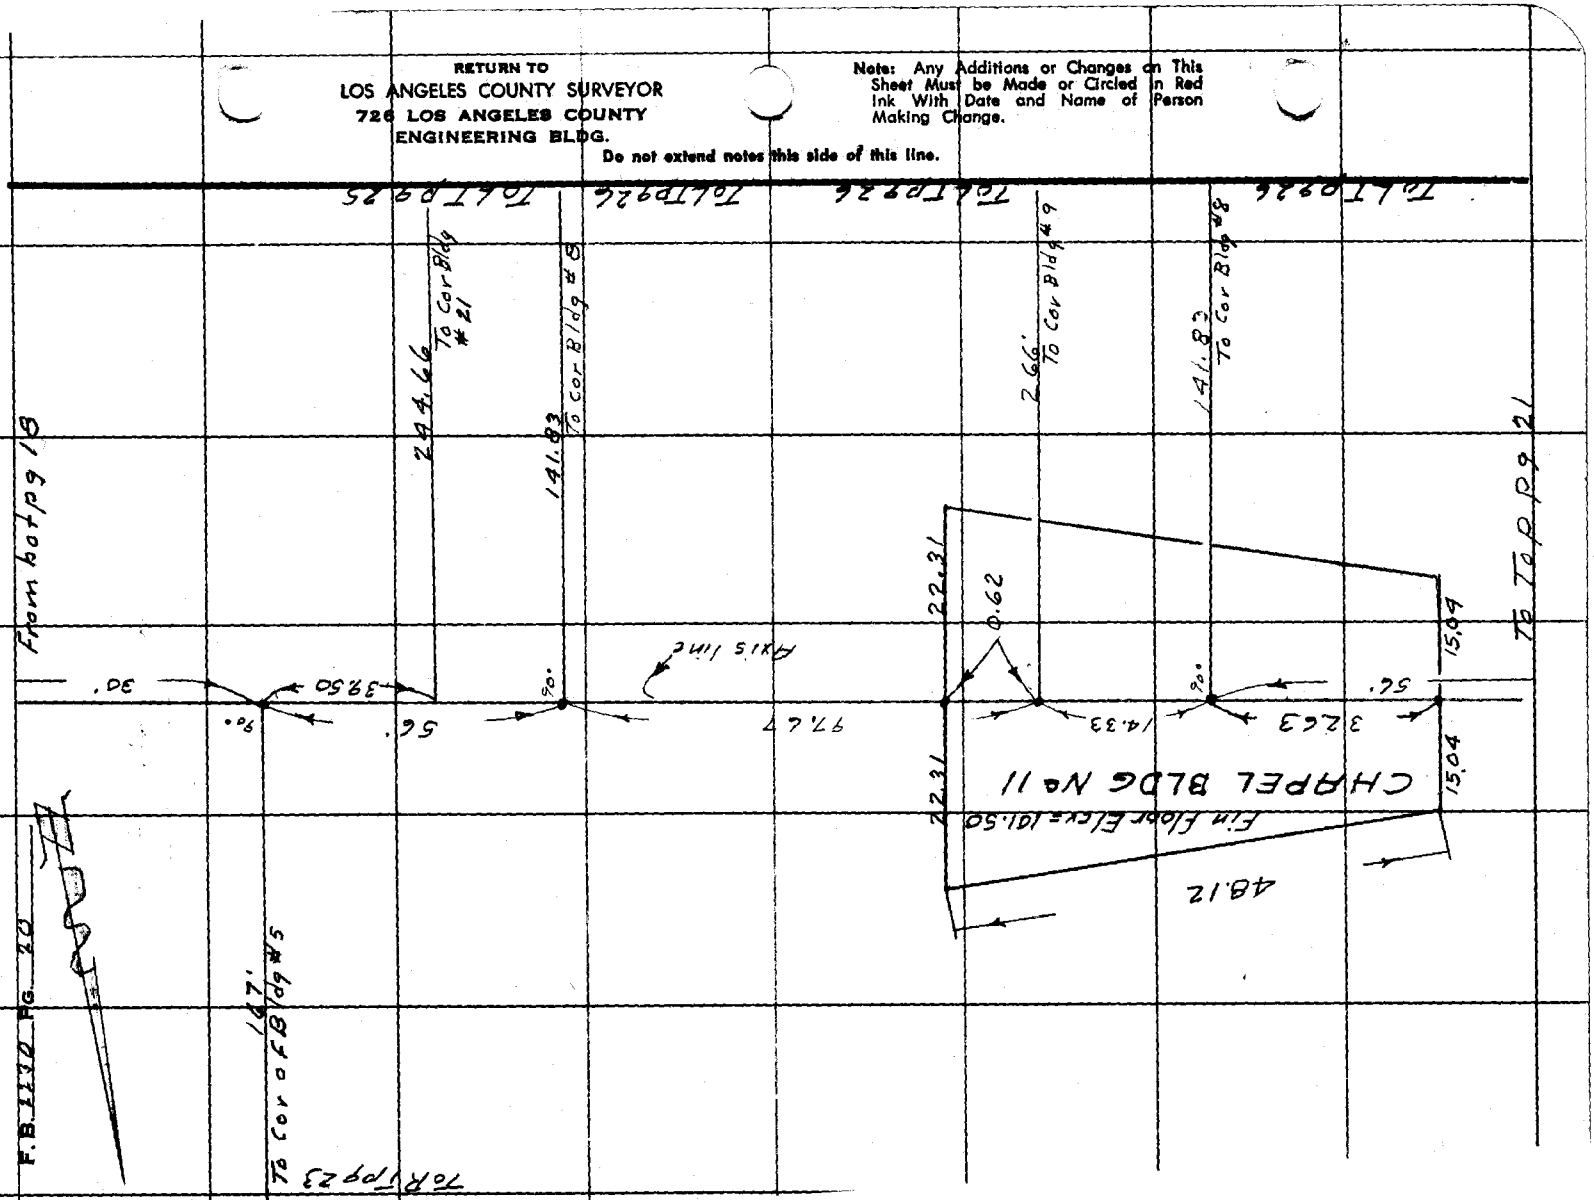

Notes Ck'd by
Map No.
Office Work
Checked
Date

Survey of Juvenile Hall
W. O. 8382 Tape No. 0195 Sr'd. 68 °F
Surveyed by M. A. Van Deren
Notes Van Date 9-13-54
Indexed C. Johnson

F. B. 2230 Pg. 21

From bot pg 20

To R/W pg 23

Axis line

56'

To Cor Bldg #5
167'

30'

139'
To Cor Bldg #4

0.34

To L/W pg 21

To R/W pg 24

To Cor Bldg #3
139'

208.83

To top pg 22

Note: Any Additions or Changes on This Sheet Must be Made or Circled in Red Ink With Date and Name of Person Making Change.

Do not extend notes this side of this line.

RETURN TO
LOS ANGELES COUNTY SURVEYOR
726 LOS ANGELES COUNTY
ENGINEERING BLDG.

78F3095 S&E #247. 8-54

F.B. 2230 Pg. 22

From hot pg 21

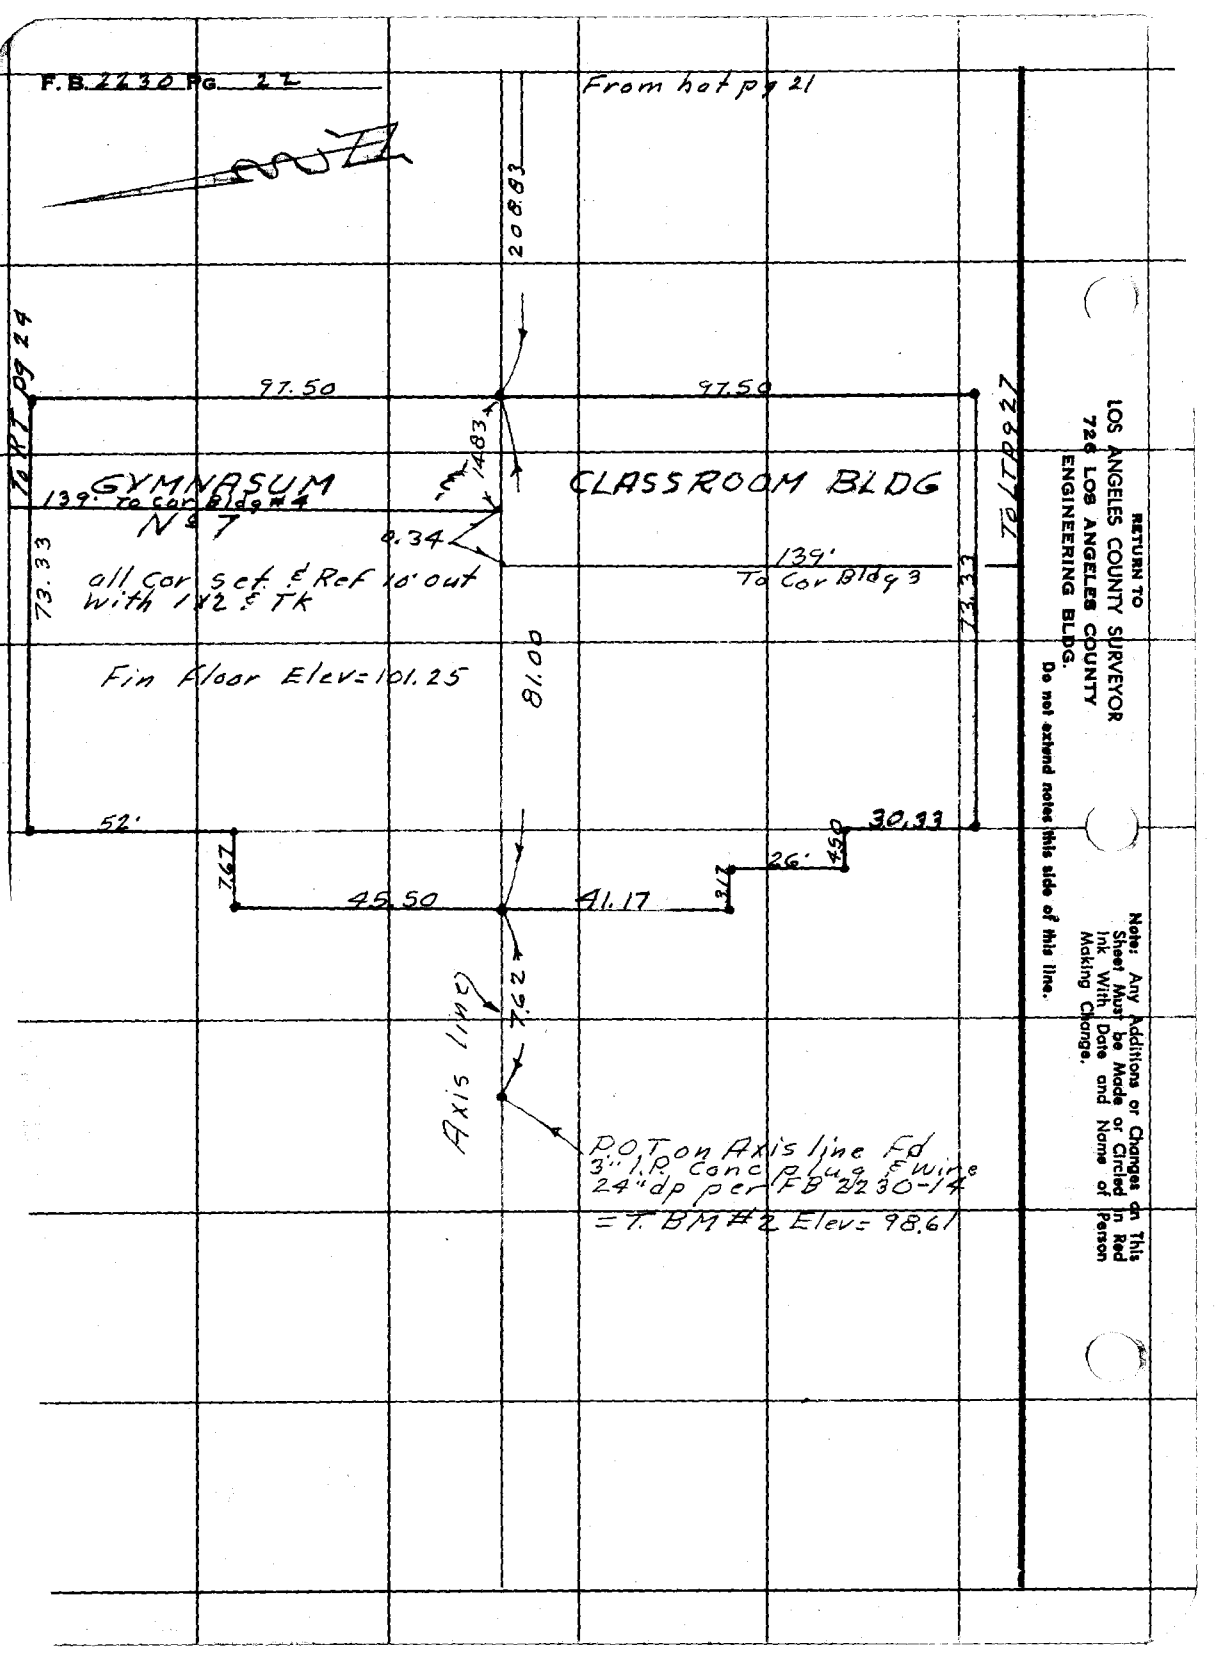

RETURN TO
LOS ANGELES COUNTY SURVEYOR
720 LOS ANGELES COUNTY
ENGINEERING BLDG.
Do not extend notes this side of this line.

Note: Any Additions or Changes on This Sheet Must be Made or Circled in Red Ink With Date and Name of Person Making Change.

76F309S S&E #247. 8-54

RETURN TO
LOS ANGELES COUNTY SURVEYOR
726 LOS ANGELES COUNTY
ENGINEERING BLDG.

Note: Any Additions or Changes on This Sheet Must be Made or Circled in Red Ink With Date and Name of Person Making Change.

Do not extend notes this side of this line.

Notes Ck'd by
Map No.
Office Work
Checked
Date

Survey of Juvenile Hall
W. O. 3382 Type No. 245 Std. 68 of
Surveyed by M. Khan Dec'd
Notes Date 7-13-56
Indexed C. Johnson

F. B. 2230 Pg. 23

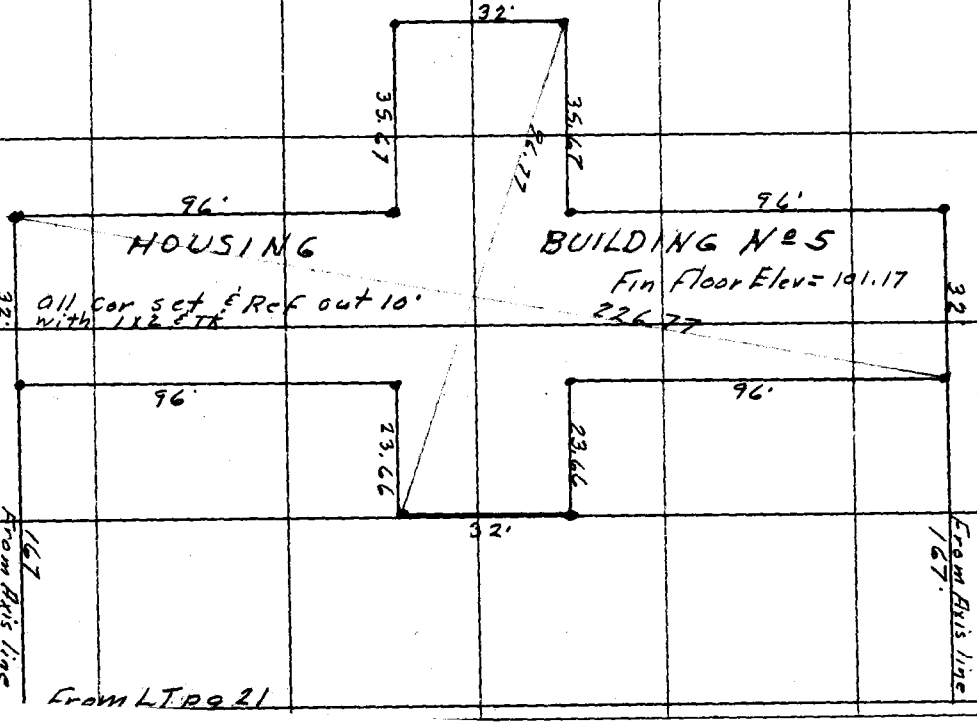

F. B. 2230 PG. 29

RETURN TO
LOS ANGELES COUNTY SURVEYOR
720 LOS ANGELES COUNTY
ENGINEERING BLDG.

Do not extend notes this side of this line.

Note: Any Additions or Changes on This Sheet Must be Made or Circled in Red Ink With Date and Name of Person Making Change.

Notes Ck'd by	Survey of Juvenile Hall
Map No.	W. O. 83820 Tape No. 0195 St'd. 68 °F
Office Work	Surveyed by M. A. VanDercn
Checked	Notes Van Date 9-13-56
Date	Indexed C. Johnson

F. B. 2230 Pg. 25

Note: Any Additions or Changes on This Sheet Must be Made in Red Ink With Date and Name of Person Making Change.

Do not extend notes this side of this line.

RETURN TO
LOS ANGELES COUNTY SURVEYOR
726 LOS ANGELES COUNTY
ENGINEERING BLDG.

From Axis line
135'
From RTpg 18
From RTpg 18
From RTpg 20
From Axis line
244.66
From Axis line
135'
32'
86'
86'
HOUSING BLDG N°2
Fin Floor Elev = 100.58
23.66
35.67
96.77
32'
32'
23.66
35.67
GIRLS RECEIVING
all cors set & Refourtd.
with 1x2 & Tk
226.77
86'
86'
69.50
0.50
77.66
0.50
32'
77.66
100.34
121.77
69'
69'
Fin Floor Elev = 100.25
MAINTENANCE
BLDG N°12
100.34

76F3085 SAE #247. 8-54

F.B. 2230 PG. 26

From RTPT 20 Axis

To Axis line 141.83

50'

32'

28'

48'

49.57

122.65

112

KITCHEN & DINING BLDG N 98

Fin Floor Elev = 101.00

To Axis line

28'

32'

24.6'

.67

141.83

50'

25.33

BLDG N 49

05.12

From RTPT 20

75.34

112.63

MECHANICAL

Fin Floor Elev = 100.25

100.67

To Cor Bldg #3 73.50

05.05

RETURN TO
LOS ANGELES COUNTY SURVEYOR
720 LOS ANGELES COUNTY
ENGINEERING BLDG.

Do not extend notes this side of this line.

Note: Any Additions or Changes on This Sheet Must be Made or Circled in Red Ink With Date and Name of Person Making Change.

Notes Ck'd by
Map No.
Office Work
Checked
Date

Survey of Juvenile Hall
W. O. 83820 Tape No. 0145 St'd. 68 °F
Surveyed by M. A. VanDercen
Notes Van Date 9-13-56
Indexed C. Johnson

F. B. 2230 PG. 27

To LT pg 26

From RT pg 21

From Axis line

139'

32'

To Car Bldg # 9

73.50

96'

96'

Fin Floor Elev = 101.33

HOUSING BLDG No 3

23.66

35.67

32'

96.77

32'

23.66

35.67

96'

96'

226.77

From RT pg 22

139'

To Axis line

32'

Note: Any Additions or Changes on This Sheet Must be Made in Red Ink With Date and Name of Person Making Change.

Do not extend notes this side of this line.

RETURN TO
LOS ANGELES COUNTY SURVEYOR
726 LOS ANGELES COUNTY
ENGINEERING BLDG.

76F309S S&E #247. 8-54

Notes Ck'd by	Survey of Juvenile Hall	F.B. 2230 Pg. 29
Map No.	W. O. 8382 Tape No. 145 Std. 68 °F	
Office Work	Surveyed by M. A. Van Deren	
Checked	Notes Vn Date 4-17-56	
Date	Indexed C. Johnson	

J.N. 8382.01

STAKING SKETCH OF SEWER LINES AT

JUVENILE HALL AT RO LOS AMIGOS

4-17-56
Van Deren
Richards
Bazen
Turrill

Note: Any Additions or Changes on This Sheet Must be Made or Circled In Red Ink With Date and Name of Person Making Change.

Do not extend notes this side of this line.

RETURN TO
LOS ANGELES COUNTY SURVEYOR
726 LOS ANGELES COUNTY
ENGINEERING BLDG.

76F3098 247 4-53

F. B. 2230 PG. 30

To bot pg 31

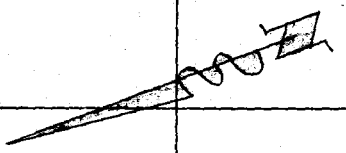

3+140

3+13.5

4" V.C.P.

75'

BLDG #3

5'

8" V.C.P.

45'

4" V.C.P.

30'

2+44.5

2+44.0

16.5

BLDG #7

86.4

32.1

2+41 = end of 8" C.I.P.

135.8" C.I.P.

45'

03° 00"

90°

32.5

1+00.00 = ℄ T.M.H.

135°

Axis Line

8" V.C.P. Extra Strength

58° 17'

0+73.00

Exist Standard S.J.C. Station 205+98.46 = 0+71.00

Exist 42" Dist #2 Main Trunk Sewer line

RETURN TO
LOS ANGELES COUNTY SURVEYOR
720 LOS ANGELES COUNTY
ENGINEERING BLDG.

Do not extend notes this side of this line.

Note: Any Additions or Changes on This Sheet Must be Made or Circled in Red Ink With Date and Name of Person Making Change.

Notes Ck'd by	Survey of Juvenile Hall
Map No.	W. O. 8382.0 Shape No. 0145 Std. 68 °F
Office Work	Surveyed by M. A. Van Deren
Checked	Notes Van Date 9-17-54
Date	Indexed E. C. Johnson

F.B. 2230 Pg. 31

To bot pg 32

BLDG #5

4.5'

4" V.C.P.
175'

5+88.5

5+88.0

BLDG #11

4" V.C.P.
10'
5'
2'

5+35.5

5+35.0

8" V.C.P.

To LT pg 33

4+66.5

4+66.0

205'

6" V.C.P.
To BLDG #9

3+50.00 = S.M.H.

BLDG #4

4'

4" V.C.P.
145'

3+36.5

3+36.0

8" V.C.P.

From Top pg 30

Note: Any Additions or Changes on This Sheet Must be Made or Circled in Red Ink With Date and Name of Person Making Change.

Do not extend notes this side of this line.

RETURN TO
LOS ANGELES COUNTY SURVEYOR
726 LOS ANGELES COUNTY
ENGINEERING BLDG.

767306 247 4-53

F. B. 2230 PG. 32

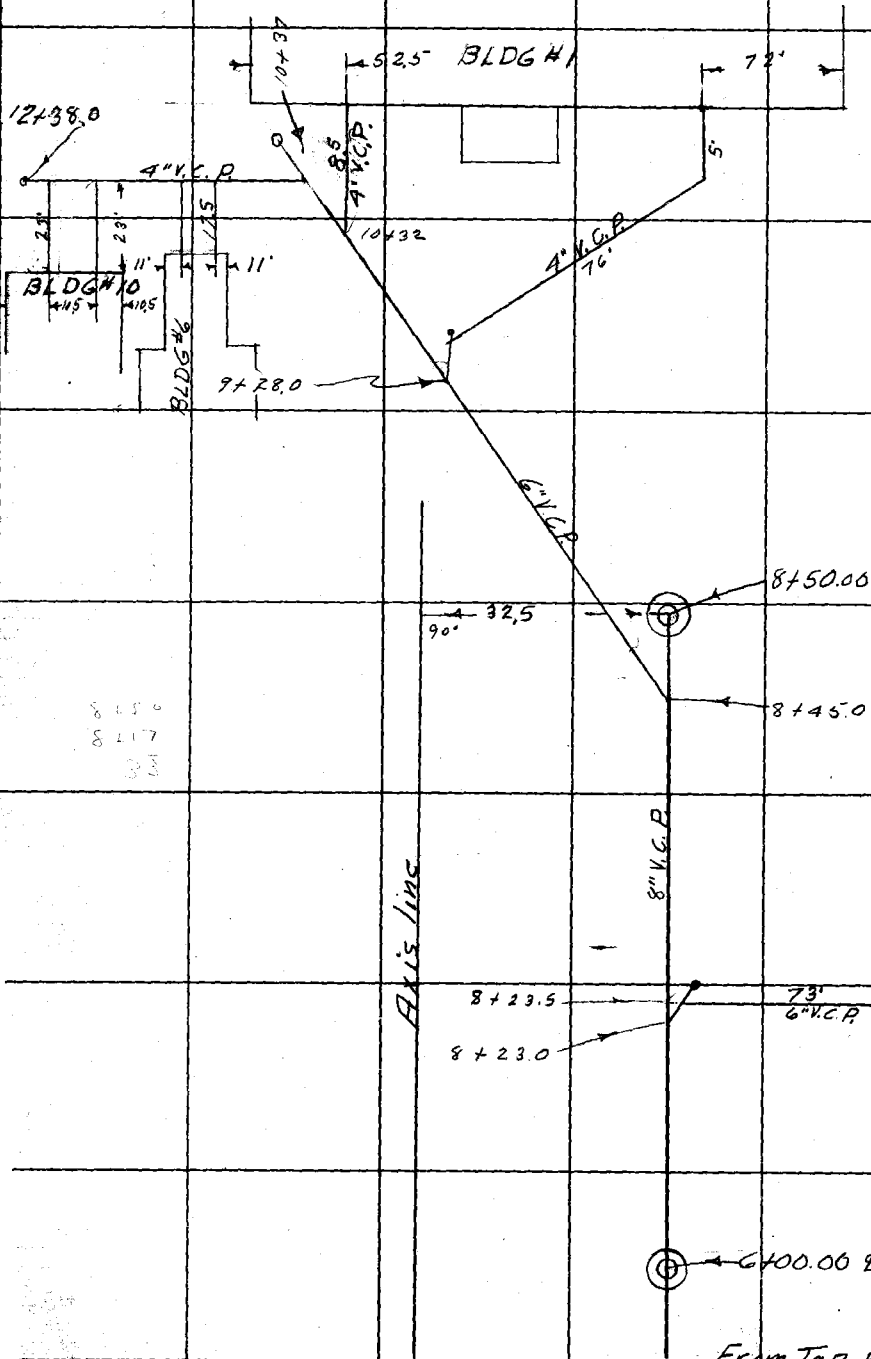

RETURN TO
LOS ANGELES COUNTY SURVEYOR
726 LOS ANGELES COUNTY
ENGINEERING BLDG.

Do not extend notes this side of this line.

Note: Any Additions or Changes on This Sheet Must be Made or Circled in Red Ink With Date and Name of Person Making Change.

Notes Ck'd by	Survey of Juvenile Hall
Map No.	W. O. 838201 Tape No. 1145 Std. 68 °F
Office Work	Surveyed by M. A. Van Deren
Checked	Notes Van Date 4-18-56
Date	Indexed C. Johnson

F. B. 2230 Pg. 33

Note: Any Additions or Changes on This Sheet Must be Made or Circled in Red Ink With Date and Name of Person Making Change.

Do not extend notes this side of this line.

RETURN TO
LOS ANGELES COUNTY SURVEYOR
726 LOS ANGELES COUNTY
ENGINEERING BLDG.

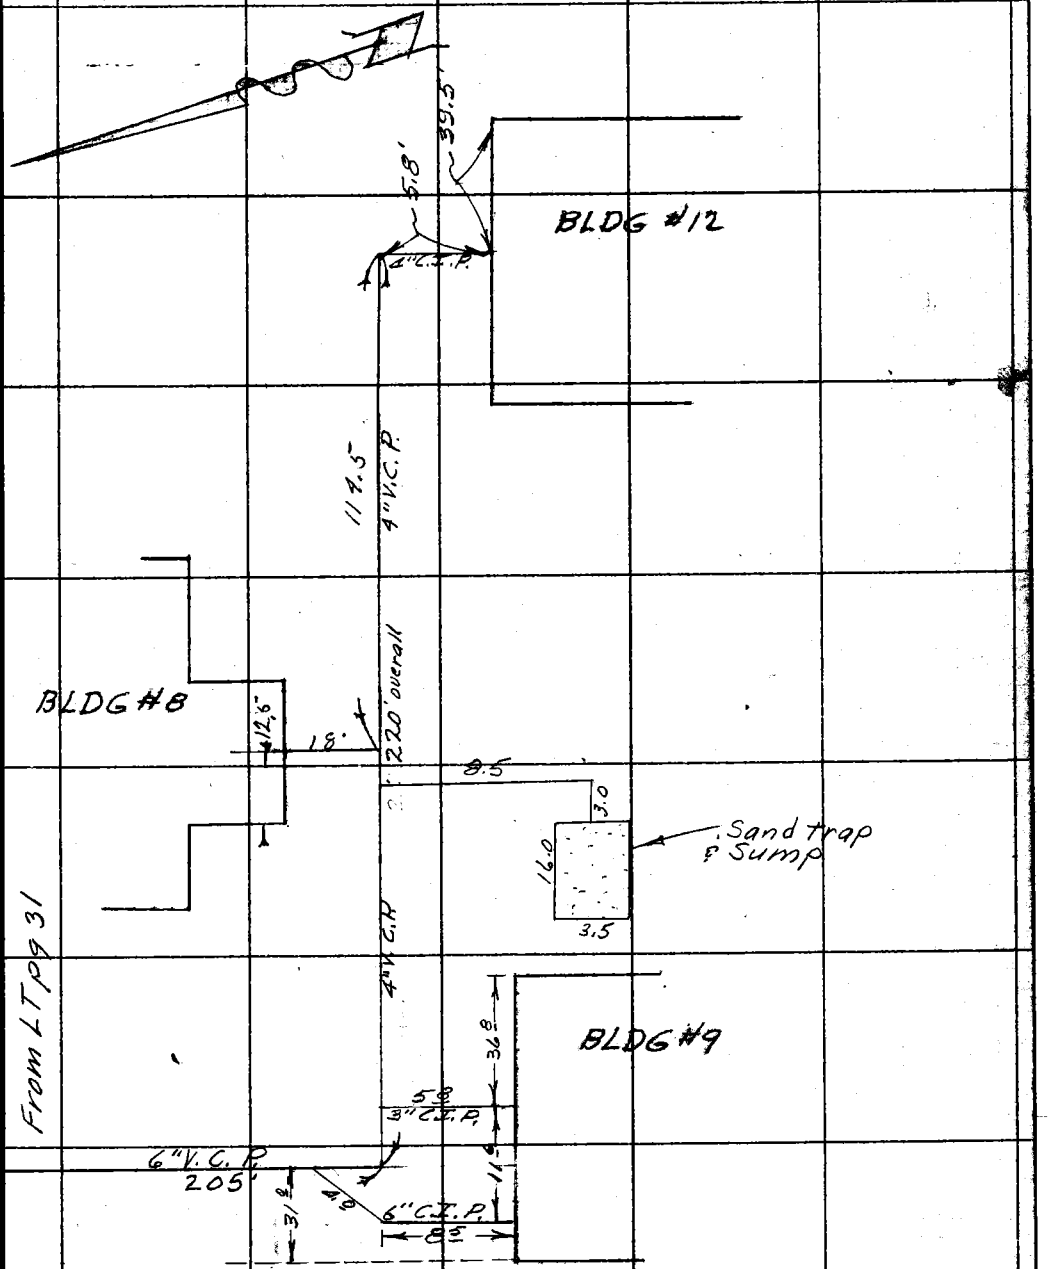

76F3098 247 4-53

Notes Ck'd by
Map No.
Office Work
Checked
Date

Survey of Juvenile Hall
W. O. 8382.01 Tape No. 0145 Std. 68 °F
Surveyed by M. A. Van Deren
Notes J. J. BAZEN Date 4-18-56
Indexed C. Johnson

F. B. 2230 Pg. 35

J.N. - 8382.01

STAKING SKETCH OF MAIN WATER SYSTEM

OF JUVENILE HALL

AT

RANCHO LOS AMIGOS

Van Deren
Richards
Bazen
Turril

Note: Any Additions or Changes on This Sheet Must be Made or Circled In Red Ink With Date and Name of Person Making Change.

Do not school notes this side of this line.

RETURN TO
LOS ANGELES COUNTY SURVEYOR
726 LOS ANGELES COUNTY
ENGINEERING BLDG.

76F3095 S&E #247. 8-54

F. B. 2230 Pg. 36

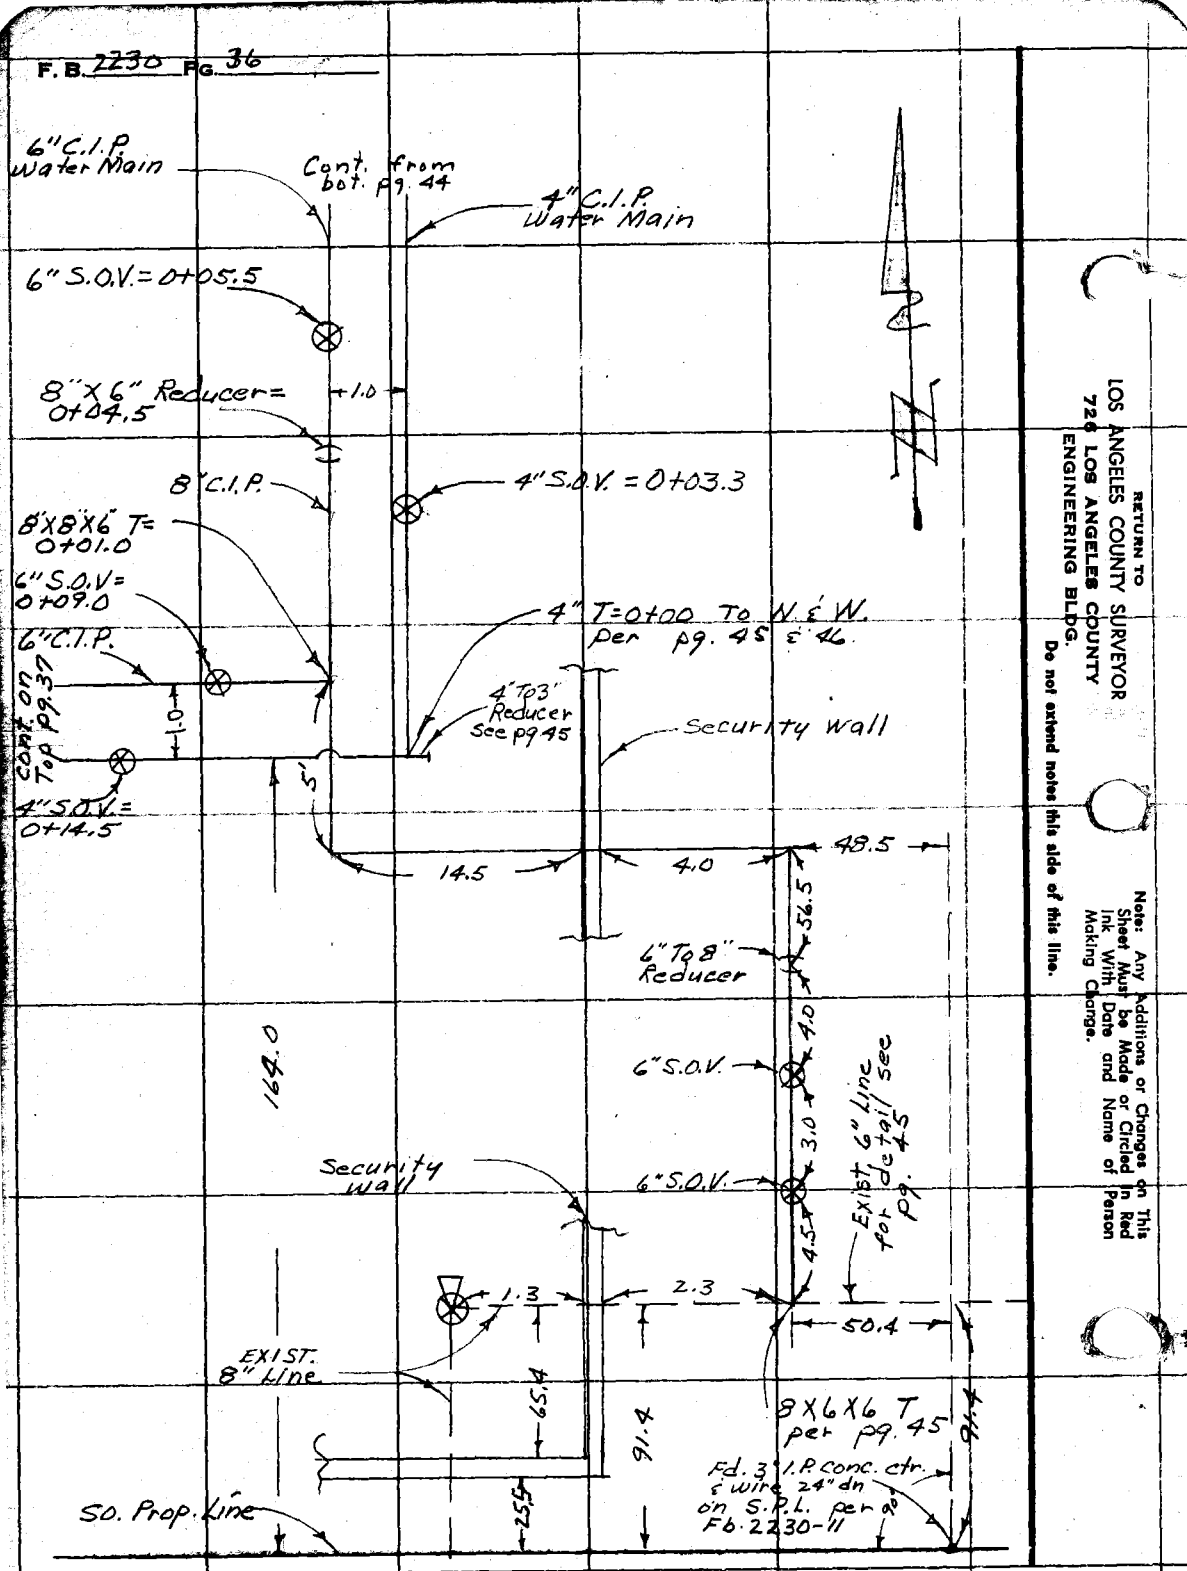

RETURN TO
LOS ANGELES COUNTY SURVEYOR
726 LOS ANGELES COUNTY
ENGINEERING BLDG.
Do not extend notes this side of this line.

Note: Any Additions or Changes on This Sheet Must be Made or Circled in Red Ink With Date and Name of Person Making Change.

Notes Ck'd by	Survey of Juvenile Hall
Map No.	W. O. 8382.01 Tape No. 0145 St'd. 68 °F
Office Work	Surveyed by M.A. Van Deren
Checked	Notes J.J. BAZEN Date 4-23-56
Date	Indexed C. Johnson

F. B. 2230 Pg. 37

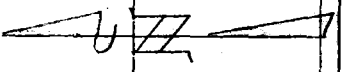

cont. from left side pg. 36

6"x6"x3" T=0+96.0 per pg. 46

6" C.I.P. Water Main

4"x4"x2½" T=0+97.0 per pg. 46

4" C.I.P. Water Main

12

4"x4"x1" T=1+33.0 per pg. 46

6"x6"x6" T=1+75.0 per pg. 47

4x4x2½ T=1+90.5 per pg. 47

4x4x1 T=2+62.5 per pg. 47

So. Prop. Line

4x4x4 T=2+77.5 per pg. 47

6x6x2 T=2+93.9 per pg. 47

4x4x1¼ T=3+43.5 per pg. 48

6x6x6 T=3+54.0 per pg. 48

165.0

6x6x2 T=3+96.2 per pg. 48

4x4x1 T=4+05.5 per pg. 48

4x4x1x1 cross = 4+25.5 per pg. 48

6x6x2 T=4+42.5 per pg. 48

4x4x1¼ T=4+42.5 per pg. 48

10

Cont. Top pg. 38

Note: Any Additions or Changes on This Sheet Must be Made in Red Ink With Date and Name of Person Making Change.

Do not extend notes this side of this line.

RETURN TO
LOS ANGELES COUNTY SURVEYOR
726 LOS ANGELES COUNTY
ENGINEERING BLDG.

75F3098 S&E #247. 4-54

F. B. 2230 PG. 38

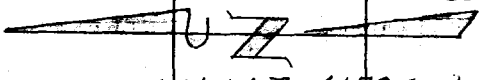

cont. from bot pg. 37

1.0

6X6X4 T=4+78.6
per pg. 49

165.5

4X4X4 T=4+96.5
per pg. 49

S.O.V.
5+05.0

S.O.V. = 5+19.0
per pg. 49

6X6X6 T=5+21.0
per pg. 49

4X4X6 T=5+24.3
per pg. 49

4" S.O.V. = 5+26.0
per pg. 49

6" C.I.P Water Line

4" C.I.P. Water Line

4X4X2½ T=5+47.0
per pg. 49

4X4X1¼ T=5+86.0
per pg. 50

6X6X6 T=6+09.0
per pg. 50

6X6X3 T=6+05.0
per pg. 50

4X4X2½ T=
6+20.0 per pg. 50

4X4X3 T=7+07.0
per pg. 50

4X4X2½ T=7+48.0
per pg. 52

4X4X2 T=8+06.5
per pg. 52

1.0

166.5

cont. on bot. Rt. pg. 39

RETURN TO
LOS ANGELES COUNTY SURVEYOR
720 LOS ANGELES COUNTY
ENGINEERING BLDG.
Do not extend notes this side of this line.

Note: Any Additions or Changes on This Sheet Must be Made or Circled in Red Ink With Date and Name of Person Making Change.

Notes Ck'd by	Survey of Juvenile Hall
Map No.	W. O. 8382.4 Tape No. 0145 Std. 68 °F
Office Work	Surveyed by M.A. Van Deren
Checked	Notes JJBAZEN Date 4-23-56
Date	Indexed C. Johnson

F. B. 2230 Pg. 39

cont. on bot. pg. 40

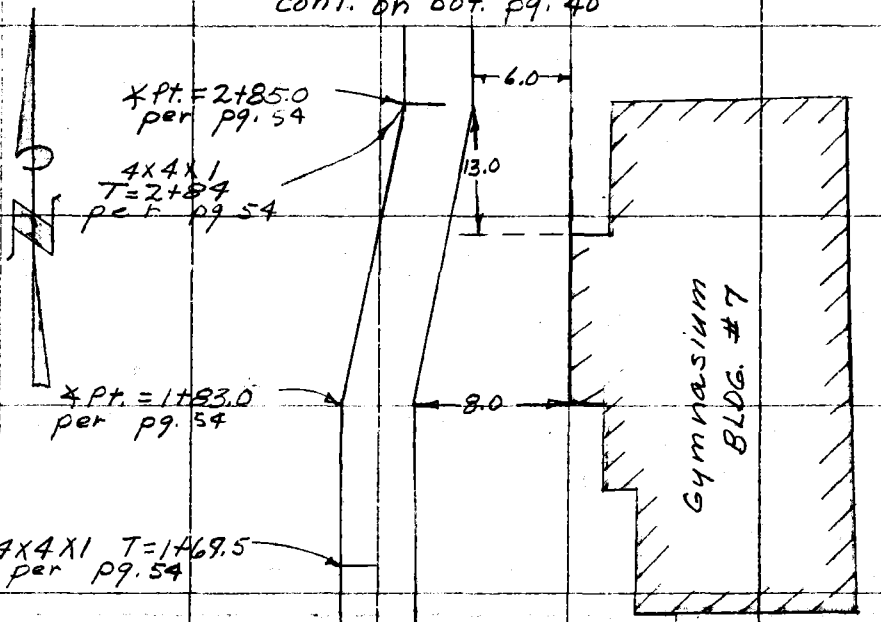

Cont. from bot. pg. 38

Note: Any Additions or Changes on This Sheet Must be Made or Circled in Red Ink With Date and Name of Person Making Change.

Do not extend notes this side of this line.

RETURN TO
LOS ANGELES COUNTY SURVEYOR
726 LOS ANGELES COUNTY
ENGINEERING BLDG.

7AF3098 SAF #247 8-54

F.B. 2230 PG. 40

See 55

No. Prop. Line

143.1

S.O.V. 8+11.6 PG 55

4X4X2½ T=8+08.5 PG 55

4X4X2½ T=7+51.0 per pg. 55

4X4X2½ T=7+18.5 per pg. 55

4X4X1 T=6+46.0 per pg. 57

142.6

℄ PT. = 4+75.5 from The So. & 8+31.0 from The E. per pg. 55

1.0

℄ Pt. = 4+74.5 from So. or 8+30.0 from E.

cont. on bot. pg. 41

4X4X1 T=4+66.0 per pg. 55

4X4X4 T=4+20.0 per pg. 55

6" C.I.P Water Main

1.0

6X6X3 T=6+47.5 per pg. 57

41.5

4" C.I.P Water Main

6X6X6 T=4+02.5 per pg. 54

4X4X2½ T=3+87.5 per pg. 54

Housing Bldg. # 4

73.0

cont. from Top pg 39

RETURN TO
LOS ANGELES COUNTY SURVEYOR
726 LOS ANGELES COUNTY
ENGINEERING BLDG.
Do not extend notes this side of this line.

Note: Any Additions or Changes on This Sheet Must be Made or Circled in Red Ink With Date and Name of Person Making Change.

Notes Ck'd by	Survey of Juvenile Hall
Map No.	W. O. 8382.04 Tape No. 0195 Std. 68 °F
Office Work	Surveyed by M.A. Van Deren
Checked	Notes J.J. Bazen Date 4-23-56
Date	Indexed C. Johnson

F. B. 2230 Pg. 41

Cont. on bot pg. 42

8.6

45.0

℄ Pt. = 3+03.5 per pg. 59

6X6X6 T= 3+40.5 per pg. 59

41.0

1.0

℄ Pt. = 3+63.5 per pg. 59

10.0

Housing Bldg. #5

141.5

4X4X1 T=3+81.0 per pg. 59

13.0

4" C.I.P. Water main

6X6X3 T=4+10.5 per pg. 59

4X4X2½ T=4+45 per pg. 58

4X4X2½ T=4+68.5 per pg. 58

6" C.I.P. Water Main

4X4X4 T=5+14.5 per pg. 58

4X4X2½ T=5+97.5 per pg. 57

6X6X6 T=6+26.0 per pg. 57

142.6

Cont. from Rt side of pg. 40

RETURN TO
LOS ANGELES COUNTY SURVEYOR
726 LOS ANGELES COUNTY
ENGINEERING BLDG.

Note: Any Additions or Changes on This Sheet Must be Made or Circled in Red Ink With Date and Name of Person Making Change.

Do not extend notes this side of this line.

78F3095 S&E #247. 8-54

F. B. 2230 PG. 42

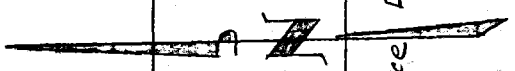

Dr.

183.5 To ℄ Entrance

4X4X2½X1½ Cross T = 7+26.0 per pg. 62

℄ PT = 0+00 To the W. ℄ 4+47.6 from So.

4X3X4 T=0+00 per pg. 62

1.0

℄ Pt. - 0+10.0 To W. ℄ 4+46.6 from So.

6.0

4" C.I.P. Water Main

6" C.I.P. Water Main

1.0

6X6X6 T=0+30.0 per pg. 61

4X4X2 T=0+76.0 per pg. 61

6.0

4X4X1 T=1+25.0 per pg. 61

6X6X3 T=1+27.5 per pg. 61

6X6X4 T=1+49.0 per pg. 61

4X4+2 T=1+73.3 per pg. 61

S.O.V. 2+15° pg 60

4X4X2½ T=2+30.0 per pg. 60

4X4X4 T=2+34.5 per pg. 60

Cont. from Top pg. 41

RETURN TO
LOS ANGELES COUNTY SURVEYOR
720 LOS ANGELES COUNTY
ENGINEERING BLDG.
Do not extend notes this side of this line.

Note: Any Additions or Changes on This Sheet Must be Made or Circled in Red Ink With Date and Name of Person Making Change.

Notes Ck'd by	Survey of Juvenile Hall
Map No.	W. O. 6882.01 Tape No. 0145 Std. 68 °F
Office Work	Surveyed by M.A. Van Deren
Checked	Notes JJ BAZEN Date 4-23-56
Date	Indexed C. Johnson

F. B. 2230 Pg. 43

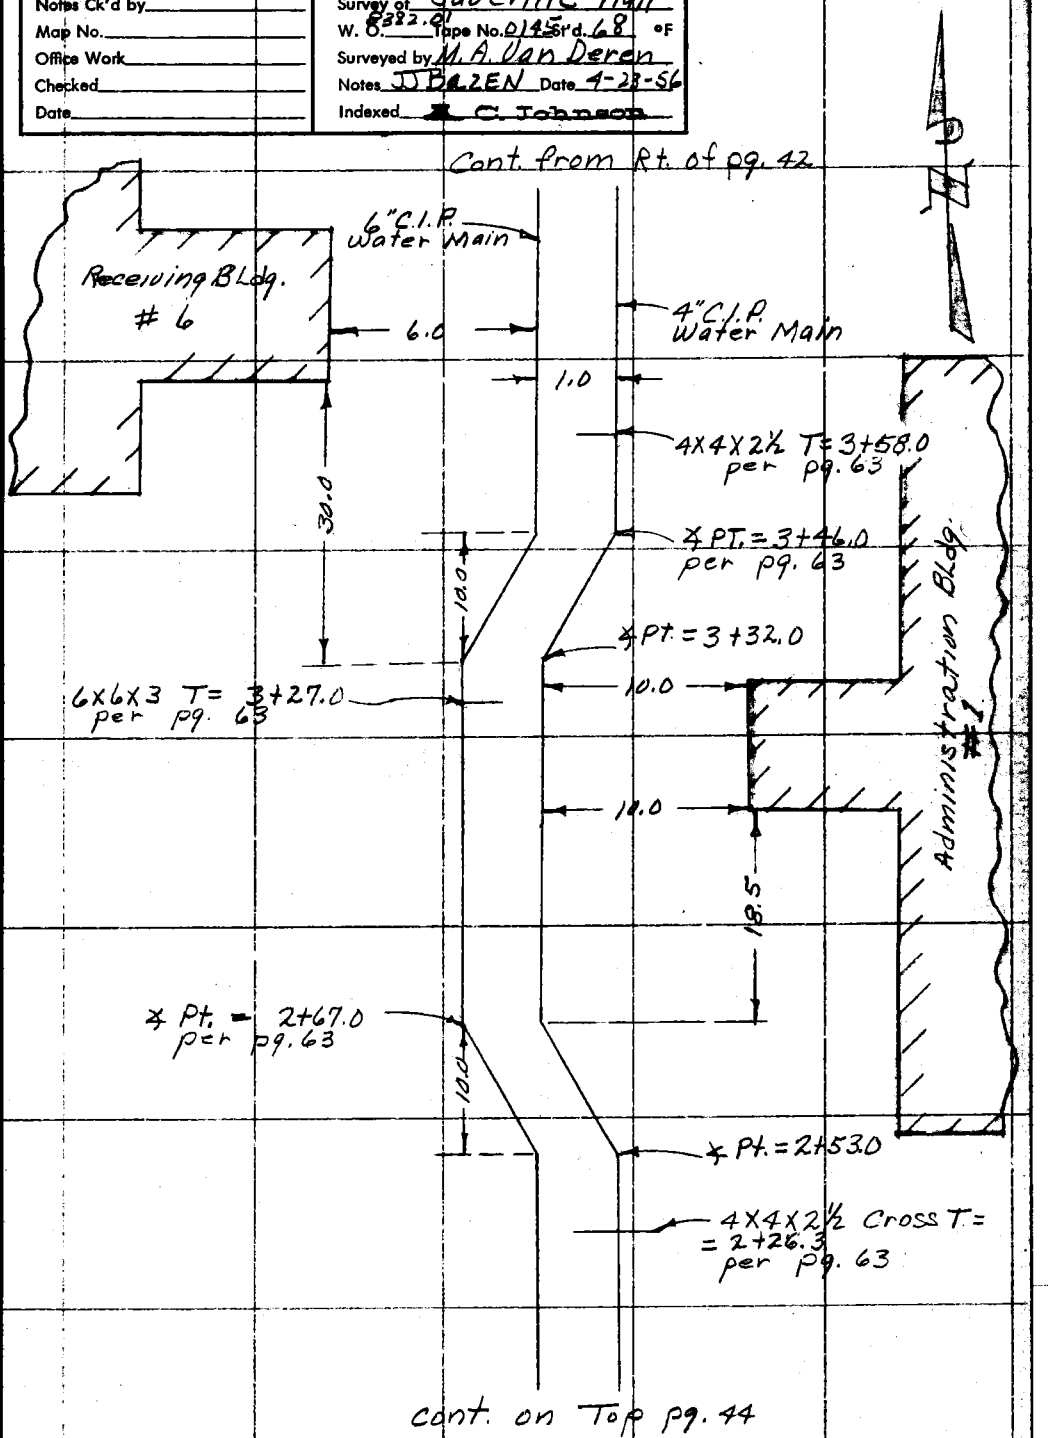

Note: Any Additions or Changes on This Sheet Must be Made or Circled in Red Ink With Date and Name of Person Making Change.

Do not extend notes this side of this line.

RETURN TO
LOS ANGELES COUNTY SURVEYOR
726 LOS ANGELES COUNTY
ENGINEERING BLDG.

75F3095 SAE #247. 8-54

F.B. 2230 PG. 44

cont. from bot. pg. 43

4x4x2½ T=1+85.3
per pg. 64

6" C.I.P. Water main

4x4x2½ T=1+30.4
per pg. 64

4x4x4 T=1+27.6
per pg. 64

Housing Bldg.
#2

4" C.I.P. Water Main

10

4x4x1¼ T=0+12.3
per pg. 46

4x4x2 T=0+09.3
per pg. 46

cont. on Top of pg. 36

RETURN TO
LOS ANGELES COUNTY SURVEYOR
720 LOS ANGELES COUNTY
ENGINEERING BLDG.

Do not extend notes this side of this line.

Note: Any Additions or Changes on This Sheet Must be Made or Circled in Red Ink With Date and Name of Person Making Change.

Notes Ck'd by	Survey of Juvenile Hall
Map No.	W. O. 8382.01 Tape No. 0145 Std. 68 °F
Office Work	Surveyed by M. A. Van Deren
Checked	Notes J. J. Bazen Date 4-23-56
Date	Indexed K. C. Johnson

F. B. 2230 Pg. 45

SKETCH OF LATERALS WHICH CONNECT TO MAIN WATER LINES

Note: All water lines are down 36" unless other wise noted.

⊙ = Fire Hyd.
○ = Snap Valves
⊗ = Shut off Valves
● = Lawn Spk. outlets

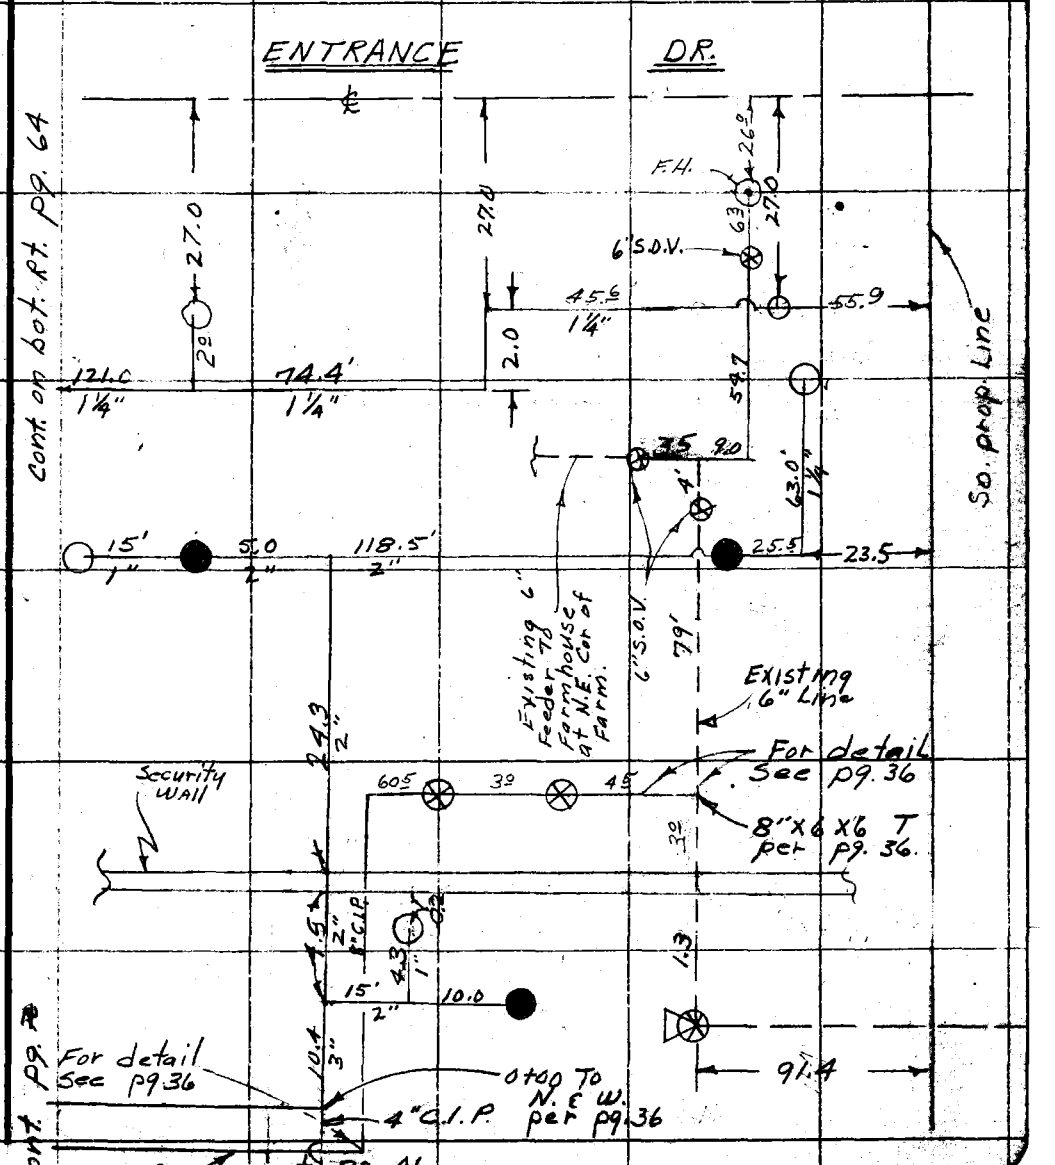

Note: Any Additions or Changes on This Sheet Must be Made or Circled In Red Ink With Date and Name of Person Making Change.

Do not extend notes this side of this line.

RETURN TO
LOS ANGELES COUNTY SURVEYOR
726 LOS ANGELES COUNTY
ENGINEERING BLDG.

74F3095 8&E #247 8-54

F.B. 2230 PG. 46

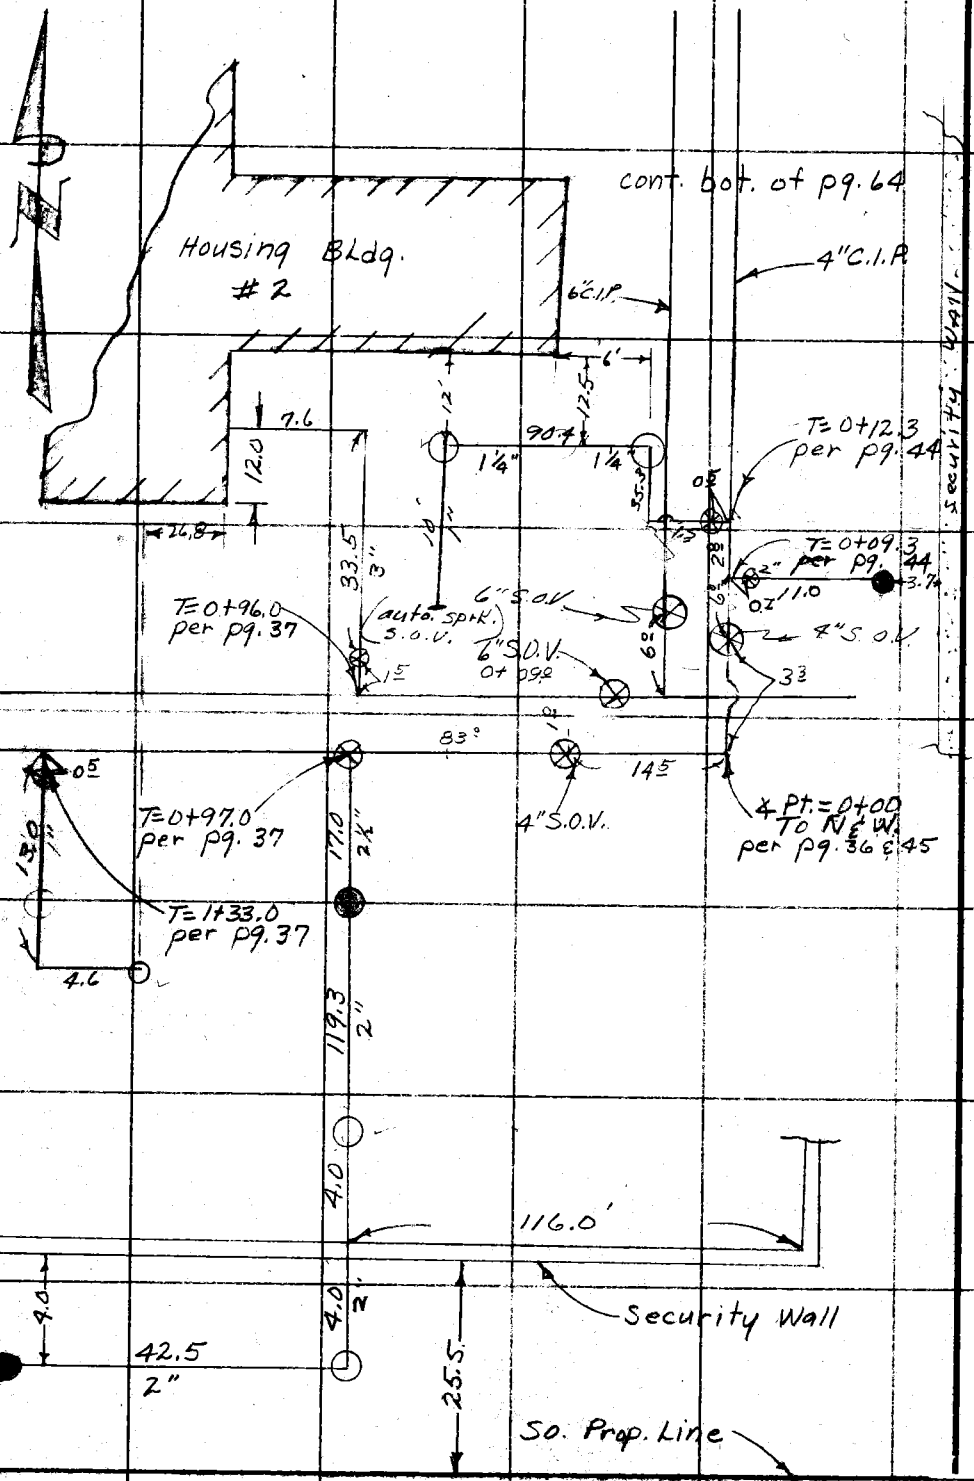

RETURN TO
LOS ANGELES COUNTY SURVEYOR
726 LOS ANGELES COUNTY
ENGINEERING BLDG.
Do not extend notes this side of this line.

Note: Any Additions or Changes on This Sheet Must be Made or Circled in Red Ink With Date and Name of Person Making Change.

Notes Ck'd by	Survey of Juvenile Hall
Map No.	W. O. 8382.01 Tape No. 0145 St'd. 68 °F
Office Work	Surveyed by M. A. Jan Deren
Checked	Notes J. Bazen Date 5-8-56
Date	Indexed K. C. Johnson

F. B. 2230 Pg. 17

Cont. on bot. pg. 60

N

4" C.I.P. Water Line

11.5 2½"

4 X 2½" Cross T.

48.3 4"

95.0

2.0 1"

21.5 2½"

13.5

68.0 4"

17.0

18.3

Housing Bldg. #2

5.3

31.4 1¼"

38.7

36.4

20.7

Bldg. #8

2 2½" Riser

45.6

40'

T=2+93.9 per pg. 37

T=2+77.5 per pg. 37

4" S.D.V.

T=1+75.0 per pg. 37

5.0

6" C.I.P.

Cont. Rt. of pg. 48

1.0

2.0

20.5 2"

7.0

Maintanence Bldg. #12

T= per pg. 37

D.S. 5-9-57

4" C.I.P.

25.0 2½"

T=1+90.5 per pg. 37

21.5

18.5

Cont. from Lt. of pg. 48

Note: Any Additions or Changes on This Sheet Must be Made or Circled in Red Ink With Date and Name of Person Making Change.

Do not extend notes this side of this line.

RETURN TO
LOS ANGELES COUNTY SURVEYOR
726 LOS ANGELES COUNTY
ENGINEERING BLDG.

76F3095 S&E #247, 8-54

F.B. 2230 PG. 48

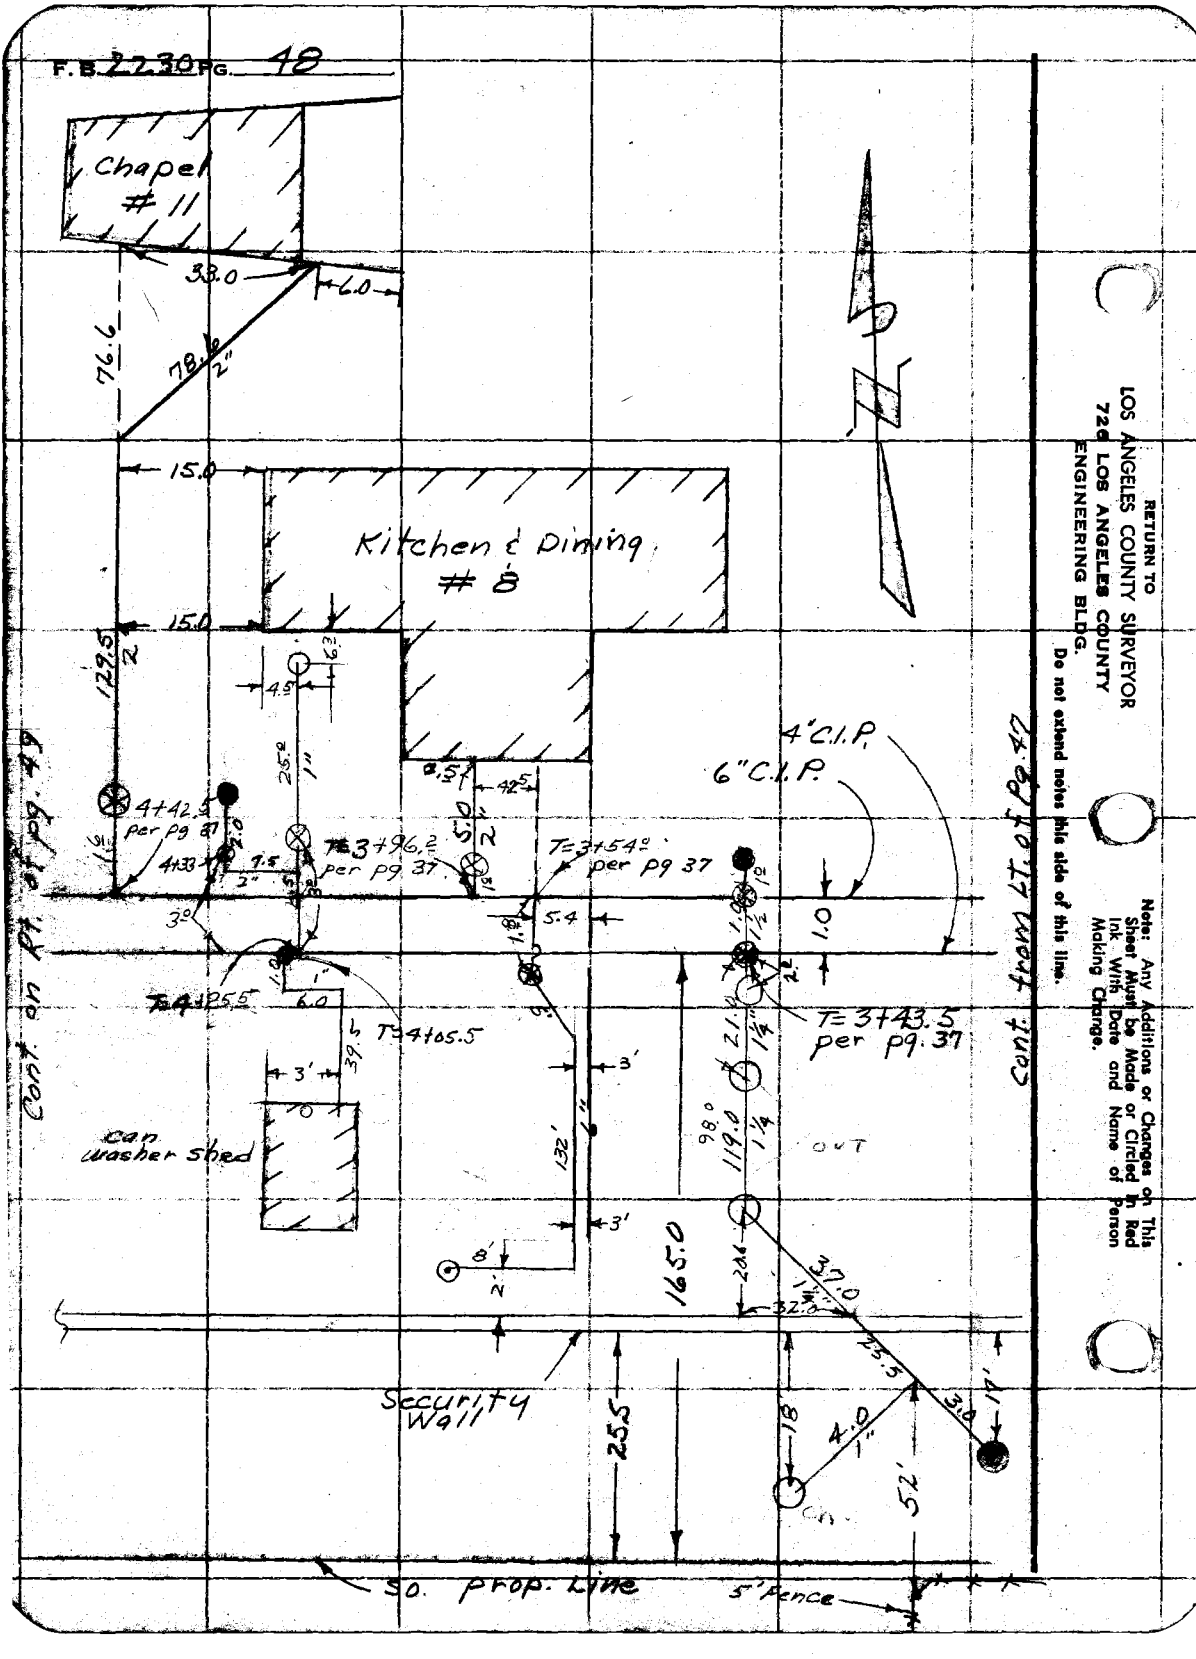

RETURN TO
LOS ANGELES COUNTY SURVEYOR
720 LOS ANGELES COUNTY
ENGINEERING BLDG.
Do not extend notes this side of this line.

Note: Any Additions or Changes on This Sheet Must be Made or Circled in Red Ink With Date and Name of Person Making Change.

Notes Ck'd by	Survey of Juvenile Hall
Map No.	W. O. 8382.01 Tape No. 2145 Std. 68 °F
Office Work	Surveyed by M.A. Van Deren
Checked	Notes JJ Bazen Date 5-8-56
Date	Indexed E. C. Johnson

F. B. 2230 Pg. 49

Note: Any Additions or Changes on This Sheet Must be Made in Red Ink With Date and Name of Person Making Change.

Do not extend notes this side of this line.

RETURN TO
LOS ANGELES COUNTY SURVEYOR
726 LOS ANGELES COUNTY
ENGINEERING BLDG.

76F3095 S&E #247. 8-54

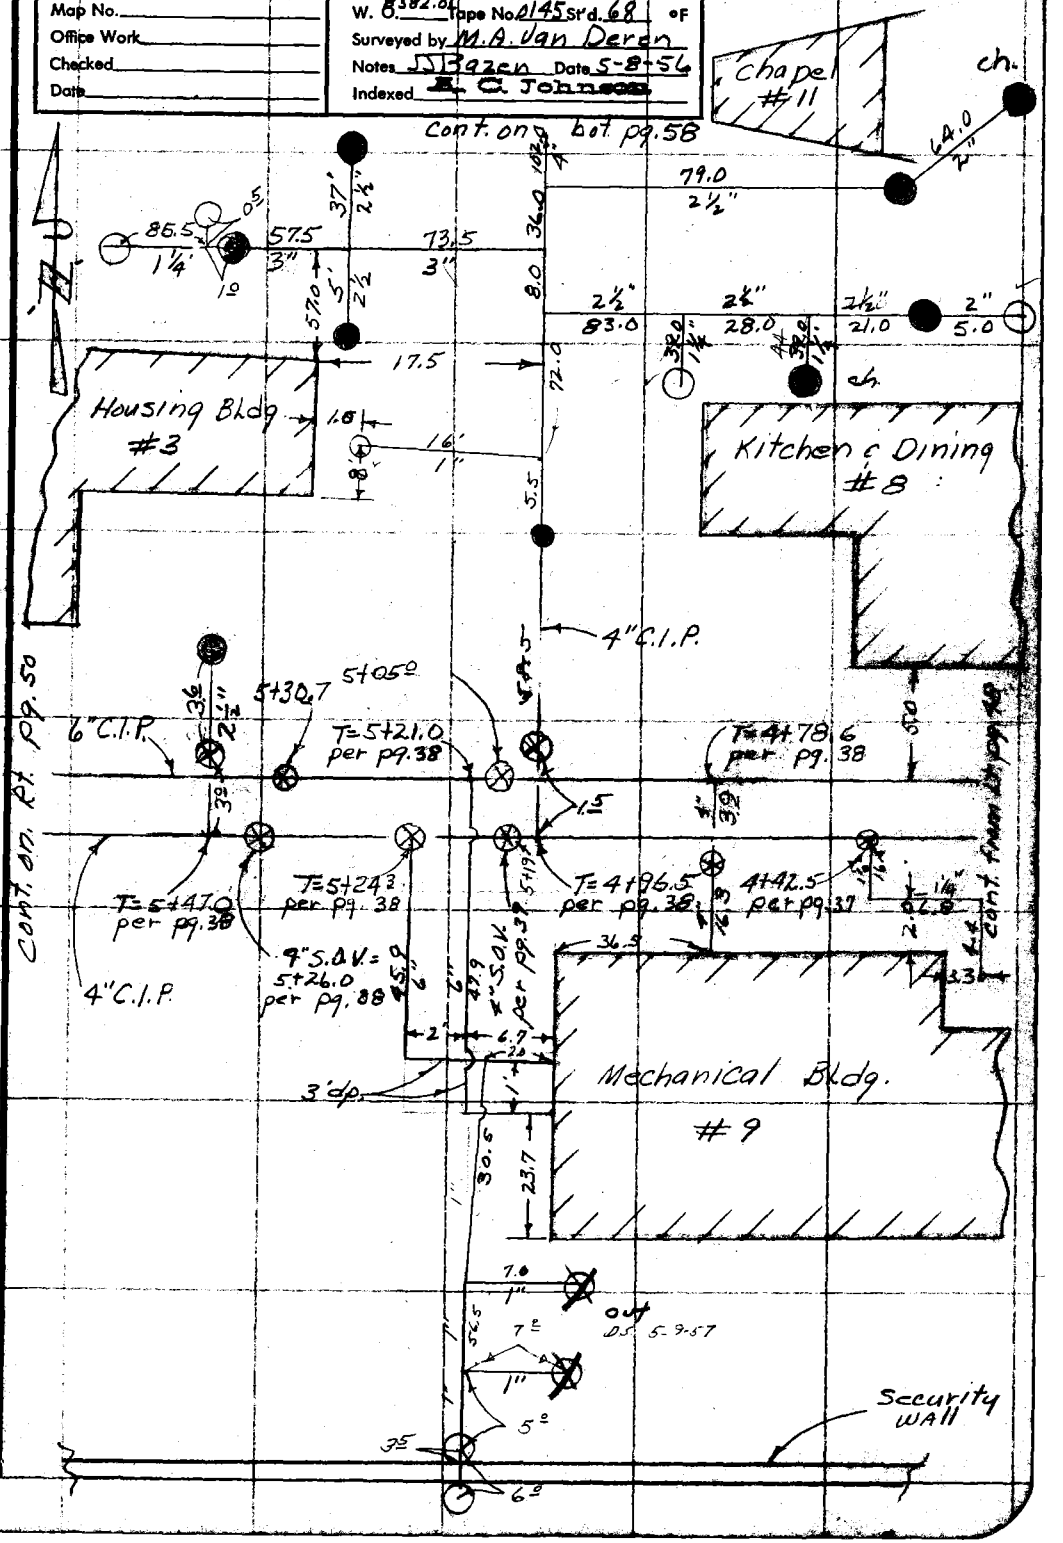

RETURN TO
LOS ANGELES COUNTY SURVEYOR
726 LOS ANGELES COUNTY
ENGINEERING BLDG.

Note: Any Additions or Changes on This Sheet Must be Made or Circled in Red Ink With Date and Name of Person Making Change.

Do not extend notes this side of this line.

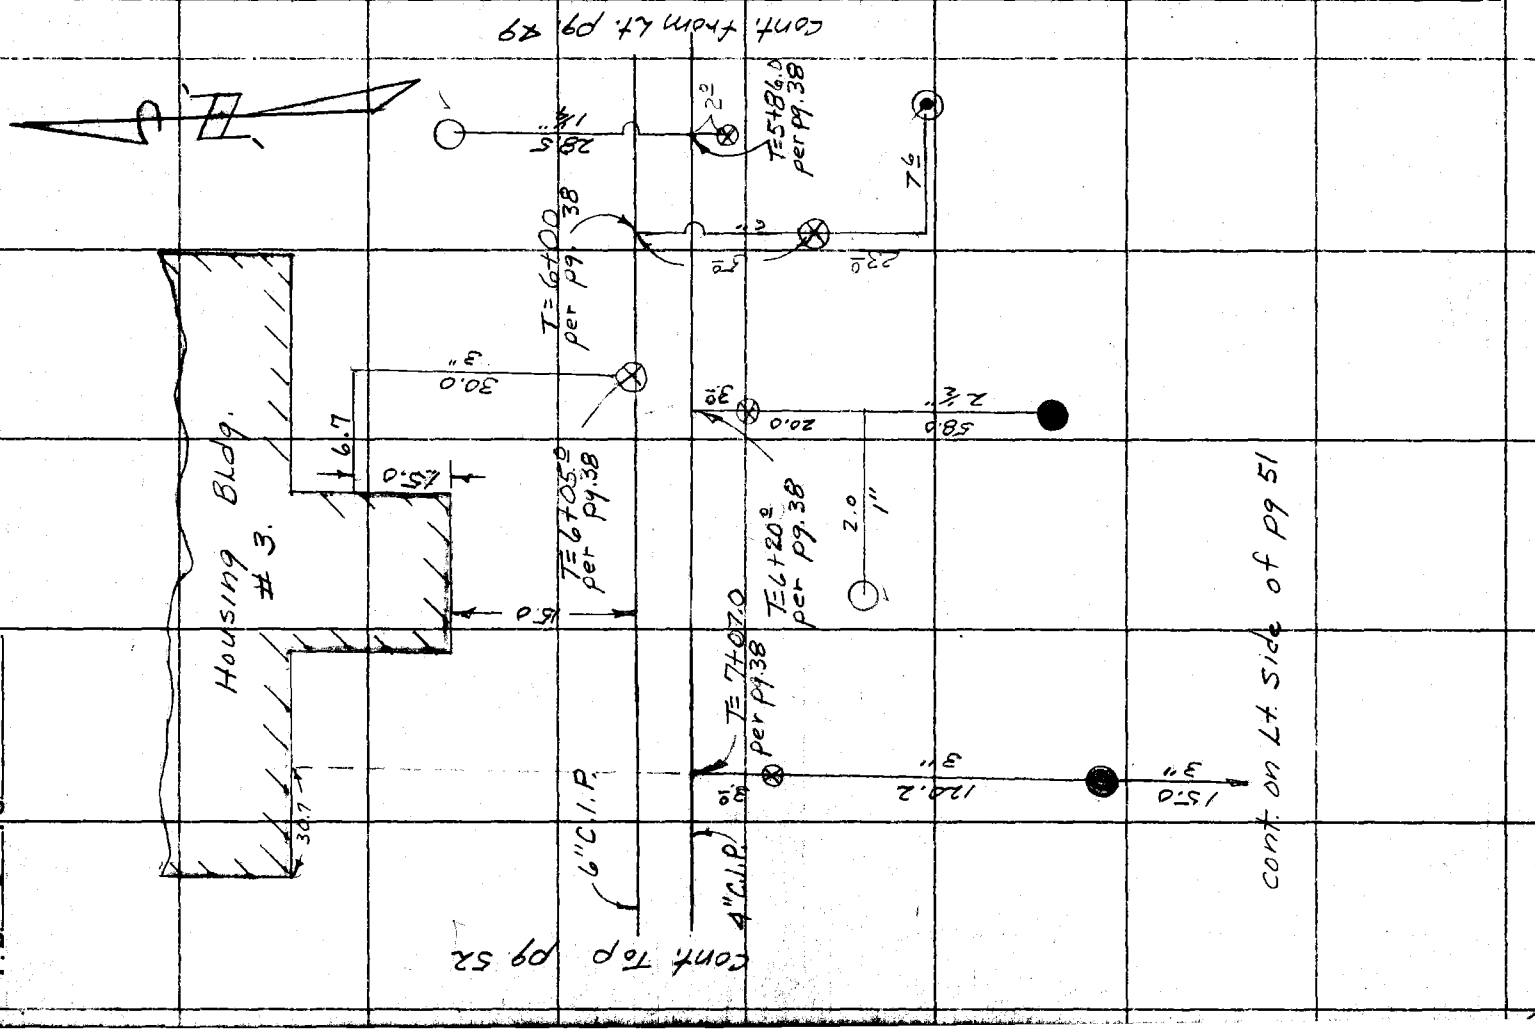

Notes Ck'd by	Survey of Juvenile Hall
Map No.	W. O. 8382.2 Tape No. 0195 Std. 68 °F
Office Work	Surveyed by M. A. Van Deren
Checked	Notes JBALEN Date 5-8-56
Date	Indexed L. C. Johnson

F. B. 2230 Pg. 51

Note: Any Additions or Changes on This Sheet Must be Made or Circled in, Red Ink With Date and Name of Person Making Change.

Do not extend notes this side of this line.

RETURN TO
LOS ANGELES COUNTY SURVEYOR
726 LOS ANGELES COUNTY
ENGINEERING BLDG.

76F3095 SSE #247. 8-54

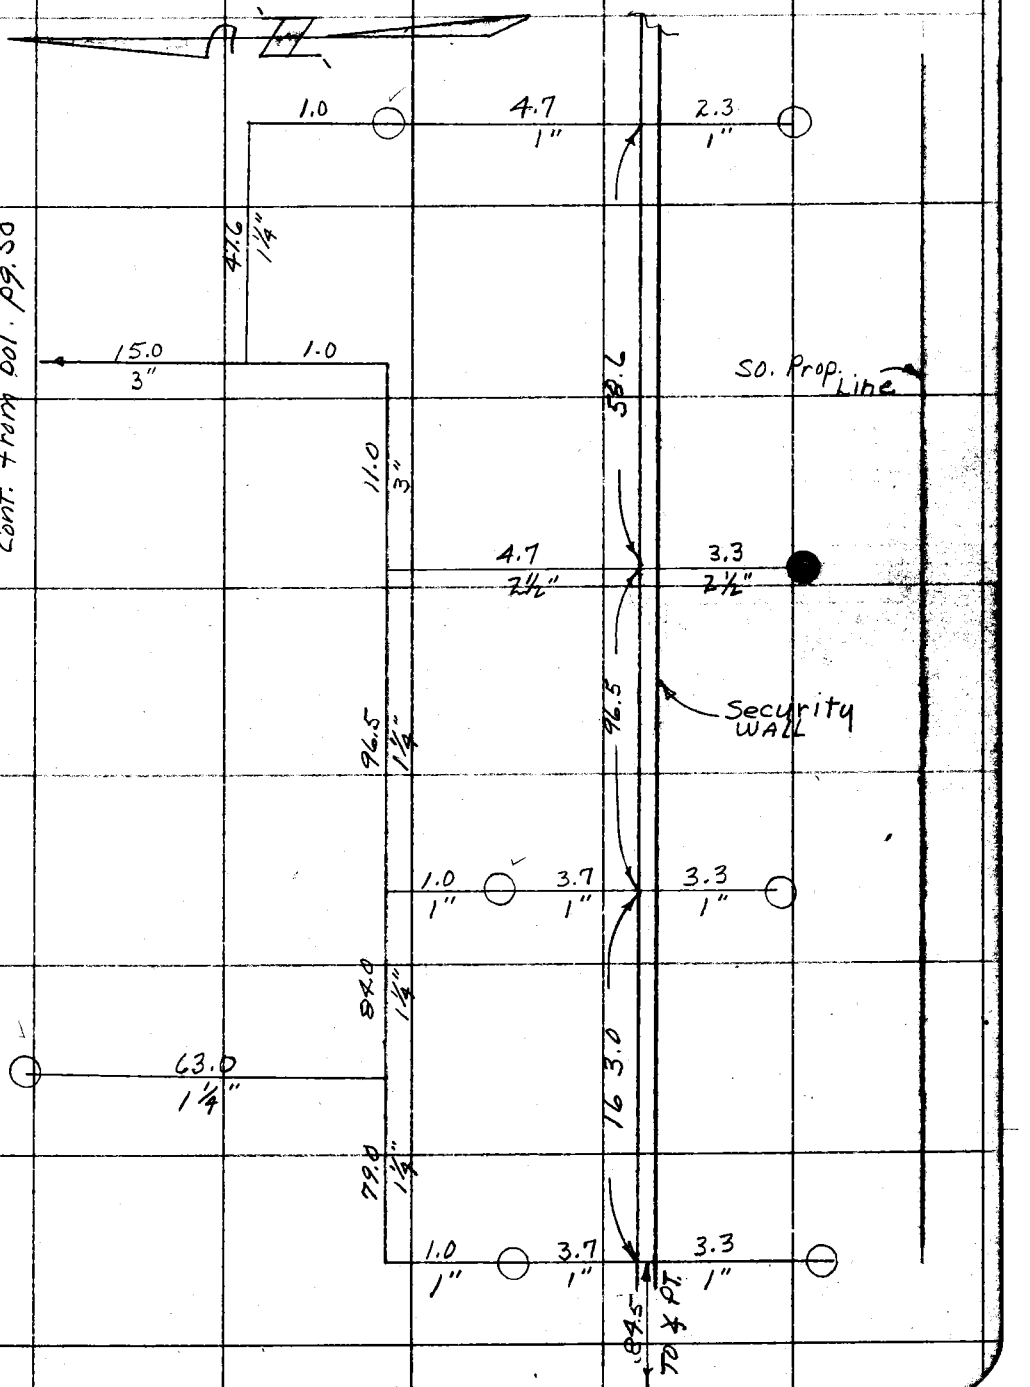

F.B. 2230 PG. 52

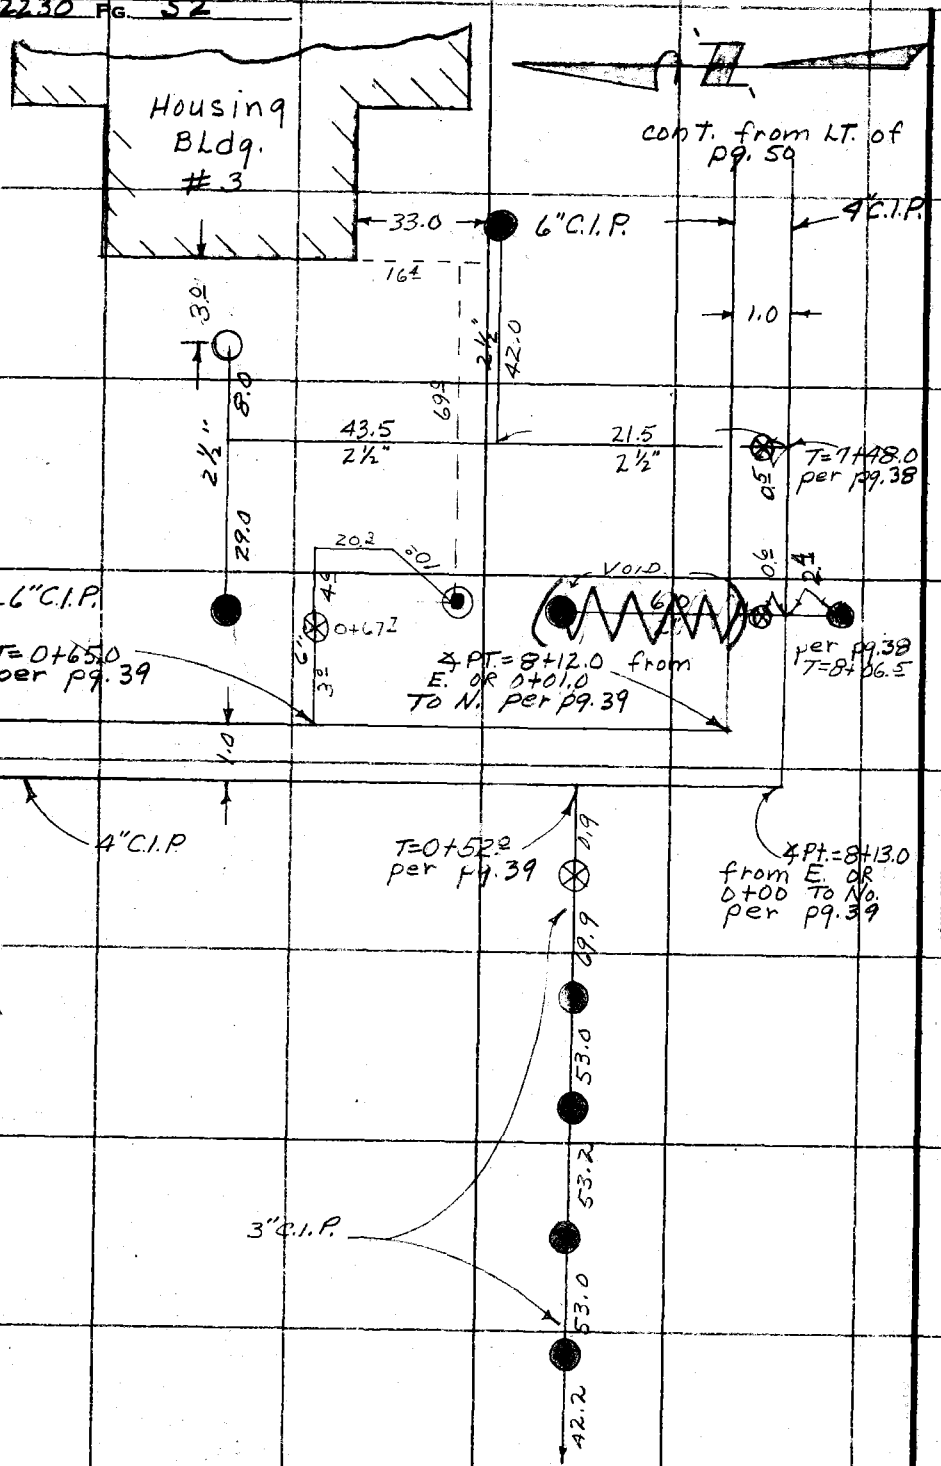

RETURN TO
LOS ANGELES COUNTY SURVEYOR
720 LOS ANGELES COUNTY
ENGINEERING BLDG.
Do not extend notes this side of this line.

Note: Any Additions or Changes on This Sheet Must be Made in Red Ink With Date and Name of Person Making Change.

Notes Ck'd by
Map No.
Office Work
Checked
Date

Survey of Juvenile Hall
W. O. 8382.01 Tape No. 0145 Str'd. 68 °F
Surveyed by M.A. Van Deren
Notes JS Azen Date 5-8-57
Indexed

F. B. 2230 Pg. 53

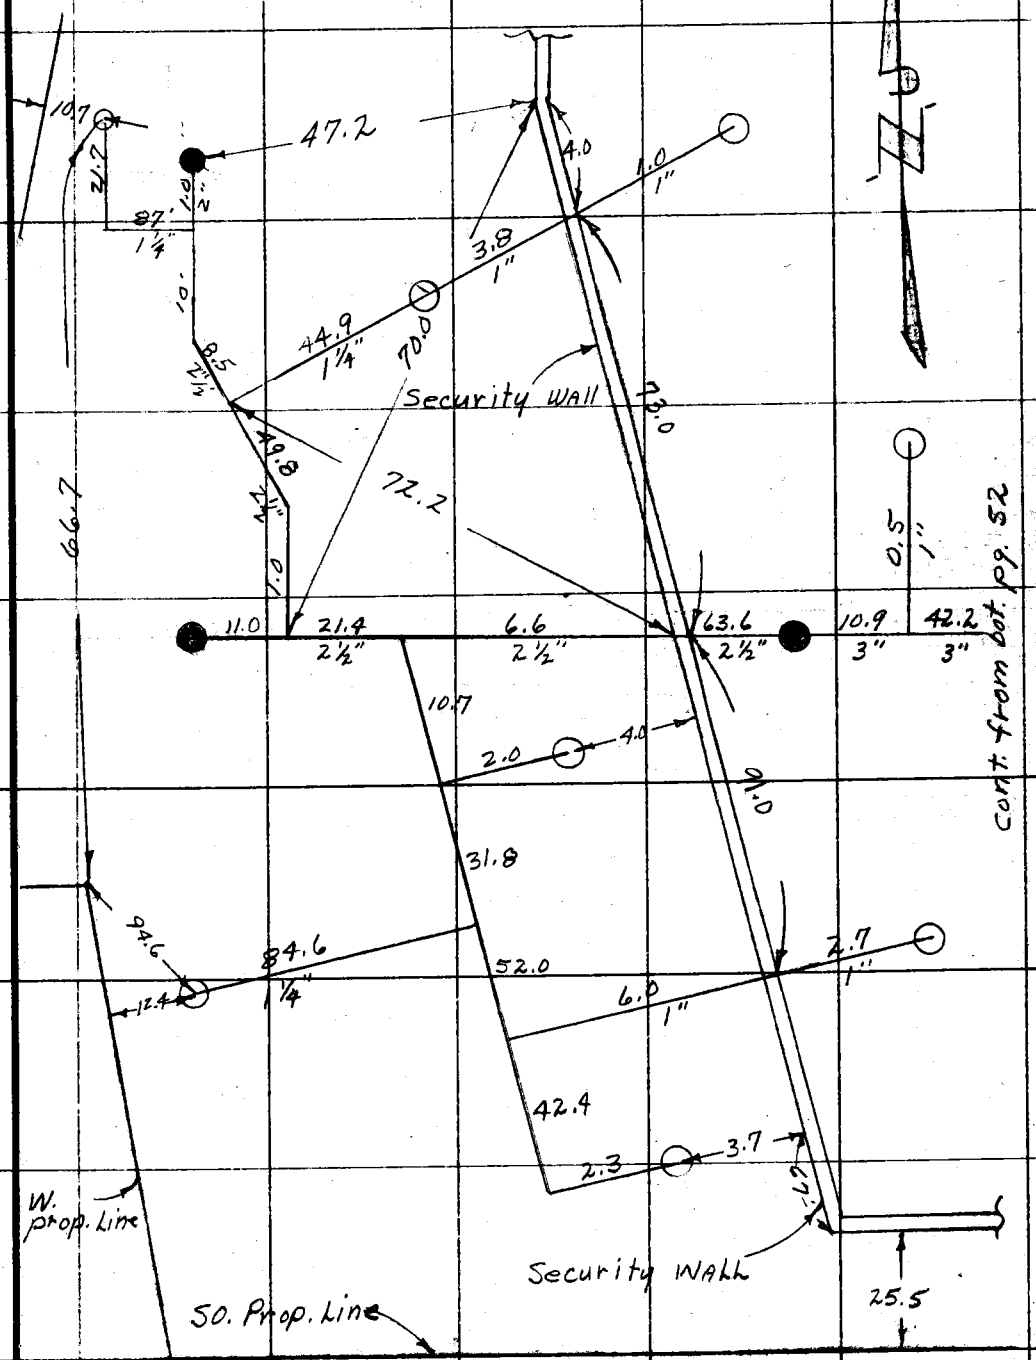

Note: Any Additions or Changes on This Sheet Must be Made or Circled in Red Ink With Date and Name of Person Making Change.

Do not extend notes this side of this line.

RETURN TO
LOS ANGELES COUNTY SURVEYOR
726 LOS ANGELES COUNTY
ENGINEERING BLDG.

Cont. from bot. pg. 52

76F308S S&E #247. 8-54

F. B. 2230 Pg. 54

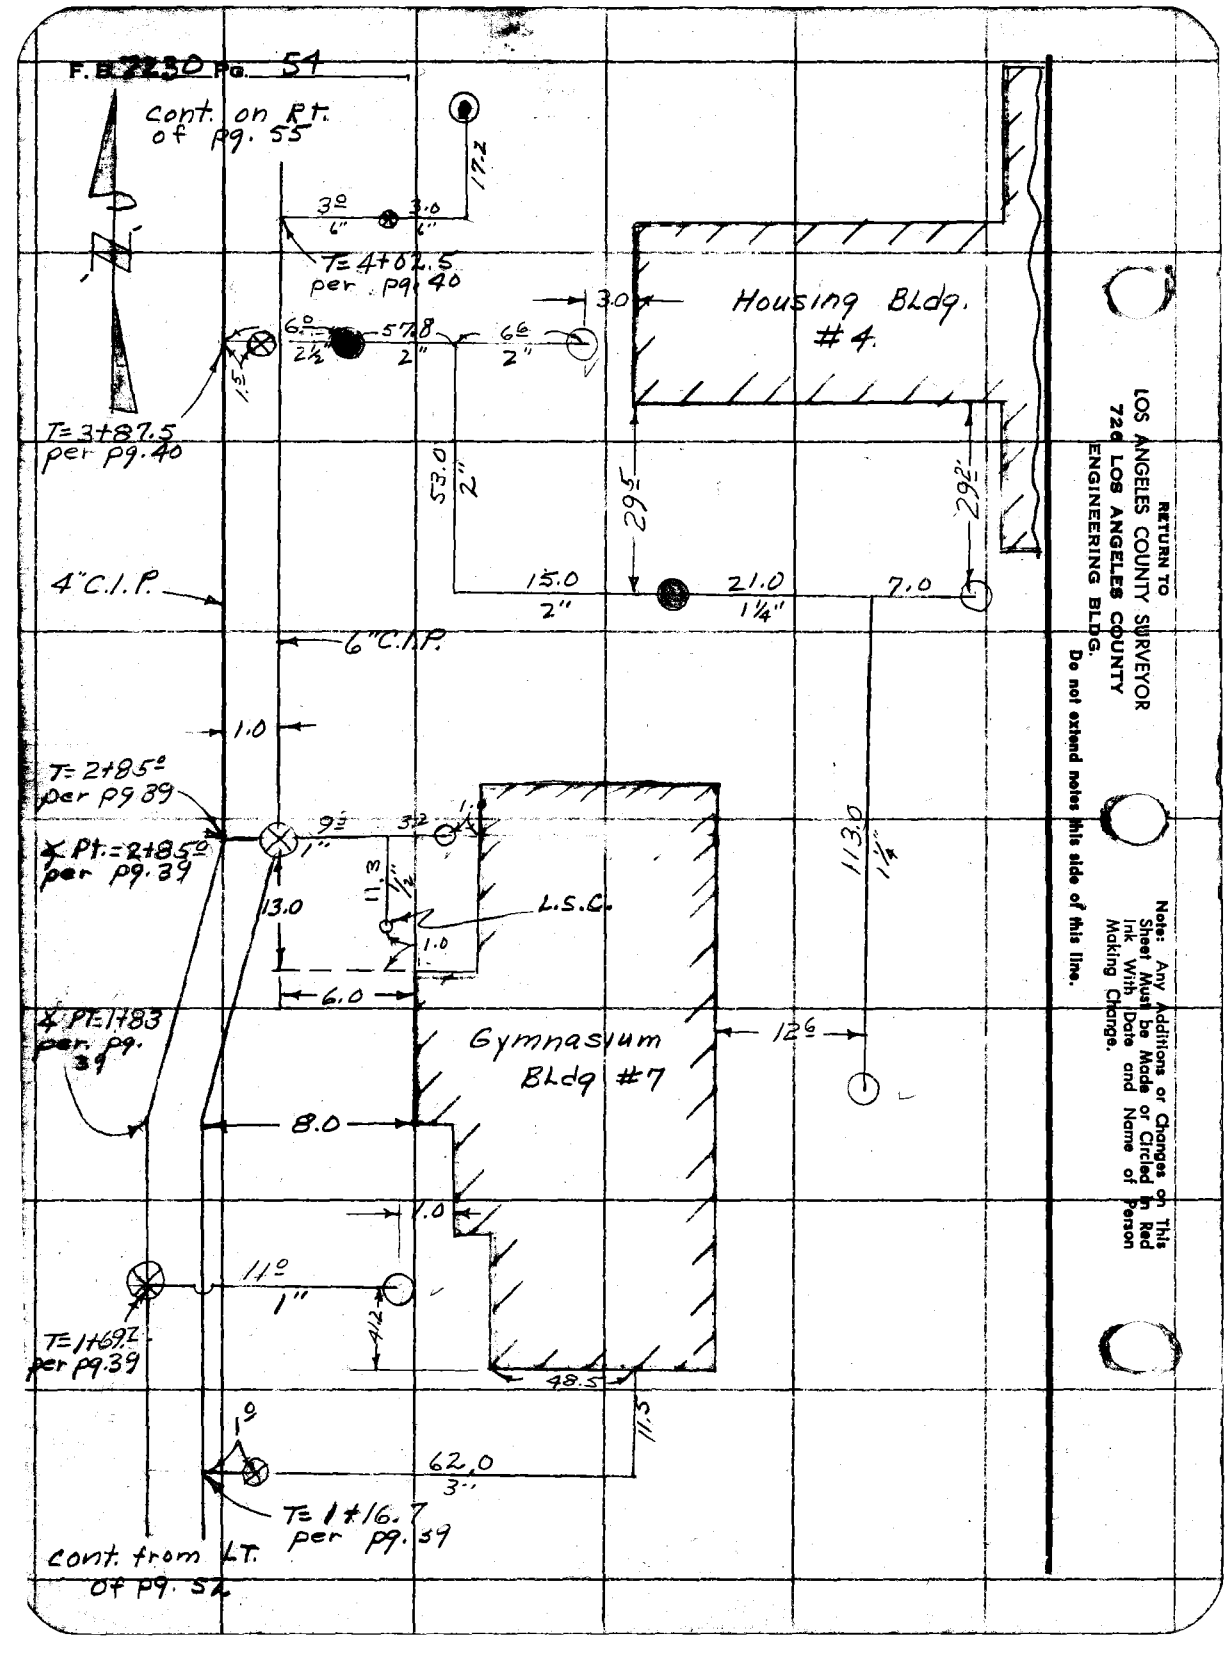

RETURN TO
LOS ANGELES COUNTY SURVEYOR
720 LOS ANGELES COUNTY
ENGINEERING BLDG.
Do not extend notes this side of this line.

Note: Any Additions or Changes on This Sheet Must be Made or Circled in Red Ink With Date and Name of Person Making Change.

Notes Ck'd by	Survey of Juvenile Hall
Map No.	W. O. 4382.01 Tape No. 145 Std. 68 °F
Office Work	Surveyed by M.A. VAN Deren
Checked	Notes J.J. BALEN Date 5-8-56
Date	Indexed C. Johnson

F. B. 2239 Pg. 55

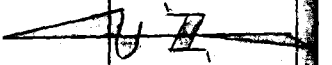

cont. on LT. of pg. 57

T= 7+18.5 per pg. 40

4" C.I.P.

T= 7+51 per pg. 40

6" C.I.P.

25.5

1.0

8.0

154.0' TO 2½ W.L. P.I. per pg. 51

2½"

65.5

79.5

17.5

7.0

98.0

T= 8+08.5

S.O.V. = 8+11.6

5.0

1.0

P.I. = 4+75.5 from So. OR 8+30.0 From E. per pg. 40

T= 4+66.0 per pg. 40

T= 4+20.0 per pg. 40

Cont. from Top pg. 58

1¼"

48.0

146.0

1¼"

18.5

1¼"

44.5

1¼"

10.6

320' To End of Security WALL

Security Wall

No. Prop. Line

25.5

4" 68.7

4" 54.6

4" 54.4

4" 54.6

3" 53.5

3" 53.0

Cont. on Top pg. 56

Note: Any Additions or Changes on This Sheet Must be Made or Circled in Red Ink With Date and Name of Person Making Change.

Do not attach notes this side of this line.

RETURN TO
LOS ANGELES COUNTY SURVEYOR
726 LOS ANGELES COUNTY
ENGINEERING BLDG.

765008 SAF #847 8-54

F.B. 2230 PG. 56

cont. from bot. of pg. 55

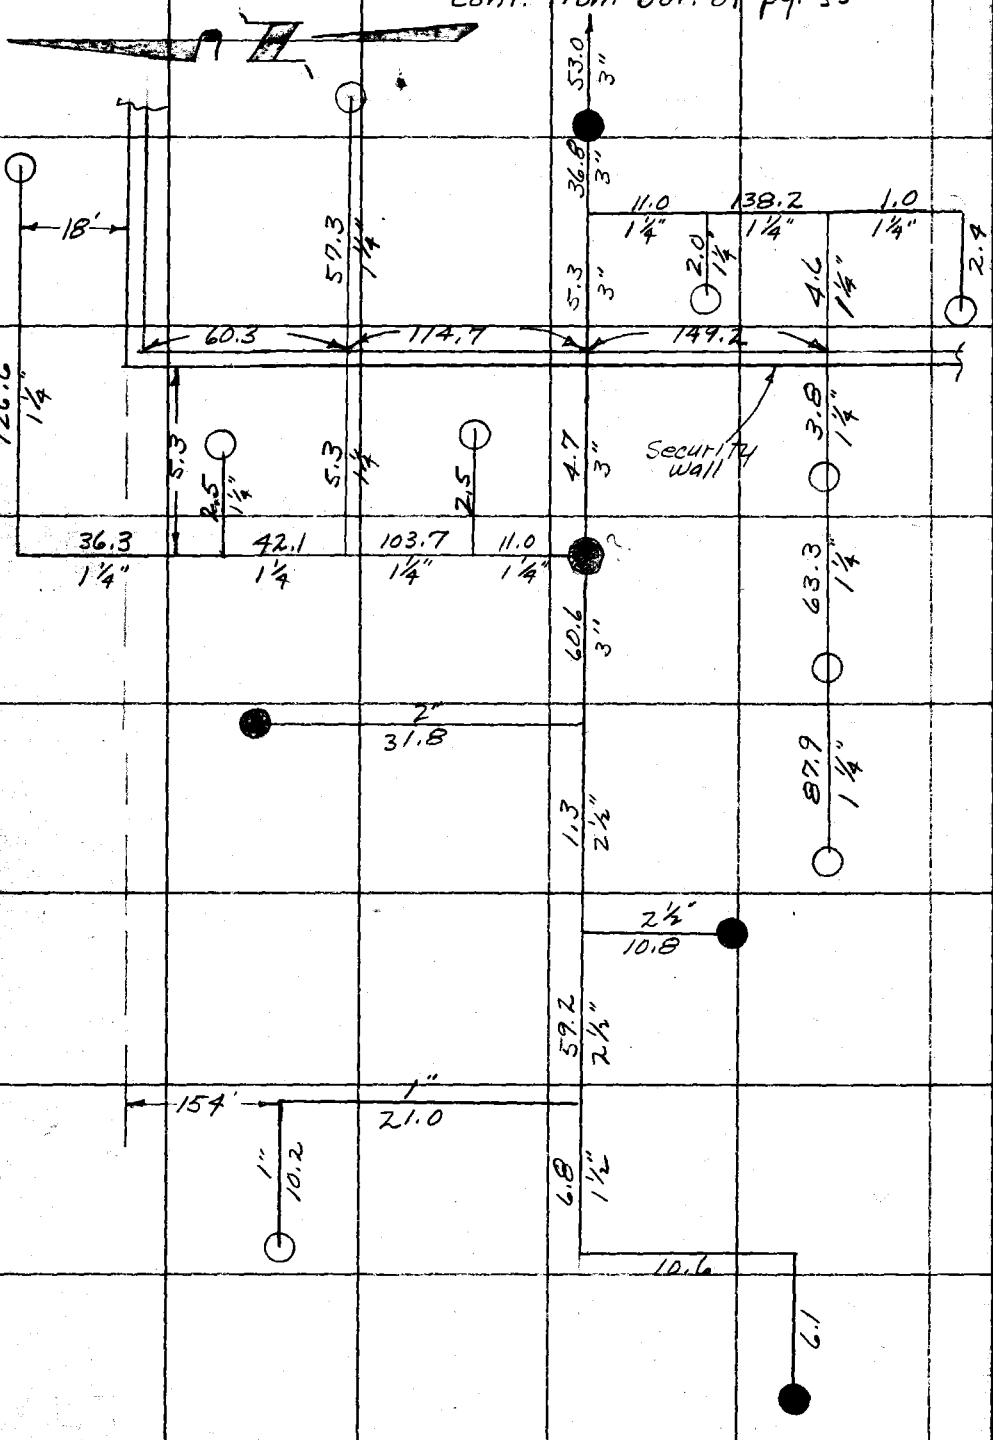

RETURN TO
LOS ANGELES COUNTY SURVEYOR
726 LOS ANGELES COUNTY
ENGINEERING BLDG.
Do not extend notes this side of this line.

Note: Any Additions or Changes on This Sheet Must be Made or Circled in Red Ink With Date and Name of Person Making Change.

Notes Ck'd by	Survey of Juvenile Hall	F.B. 2230 Pg. 57
Map No.	W. O. 8382.01 Tape No. 0145 Std. 68 °F	
Office Work	Surveyed by M.A.VAN Deren	
Checked	Notes JBAZEN Date 5-8-56	
Date	Indexed C. Johnson	

Note: Any Additions or Changes on This Sheet Must be Made or Circled in Red Ink With Date and Name of Person Making Change.

Do not extend notes this side of this line.

RETURN TO
LOS ANGELES COUNTY SURVEYOR
726 LOS ANGELES COUNTY
ENGINEERING BLDG.

No. Prop. Line

9.3

9.3

135.0
1¼"

142
1¼"

Security Wall

To 2½" water Line
344.5
per pg. 60.

154' To 2½"
water Line
per pg 55 - Top

199.3
1¼"

42.4±
2½"

0.5'

4"C.I.P.

T= 6+46.0
per Pg. 40

T= 5+97.5
per pg. 41

cont. from Top pg. 55

1.0

0.5

0.5

1.5

T= 6+65.5
per pg. 40

T= 6+26.0
per Pg. 41

6"C.I.P.

cont. on LT pg. 58

14'

33.4

4.15

12.5

3'

12.0

22.8

54.0
3"

15.0

12.5

3"

3.0

Housing Bldg. #4

76F3095 SAE #247. 8-54

RETURN TO
LOS ANGELES COUNTY SURVEYOR
726 LOS ANGELES COUNTY
ENGINEERING BLDG.

Note: Any Additions or Changes on This Sheet Must be Made or Circled In Red Ink With Date and Name of Person Making Change.

Do not extend notes this side of this line.

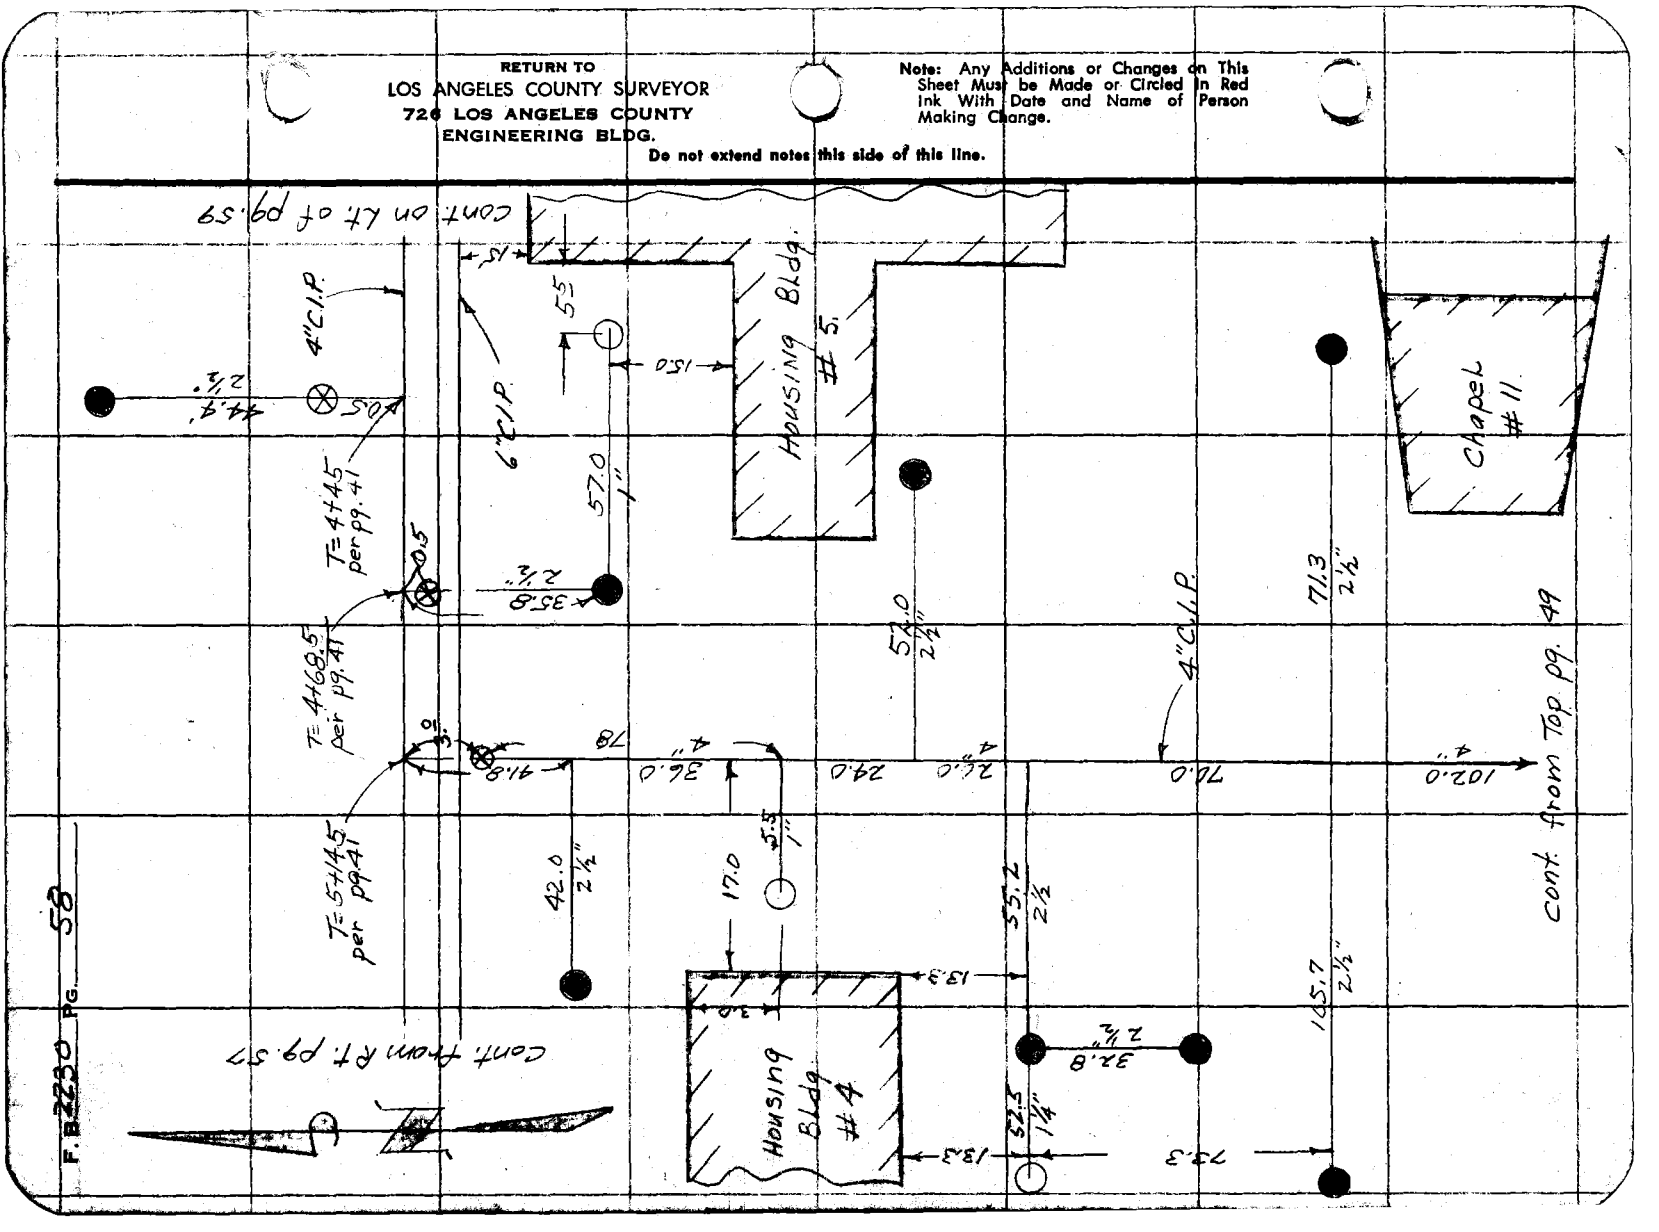

Notes Ck'd by
Map No.
Office Work
Checked
Date

Survey of Juvenile Hall
W. O. 8382.01 Tape No. 0145 Std. 68 °F
Surveyed by M.A. Van Deren
Notes J.J. Bazen Date 5-29-56
Indexed C. Johnson

F. B. 2230 Pg. 59

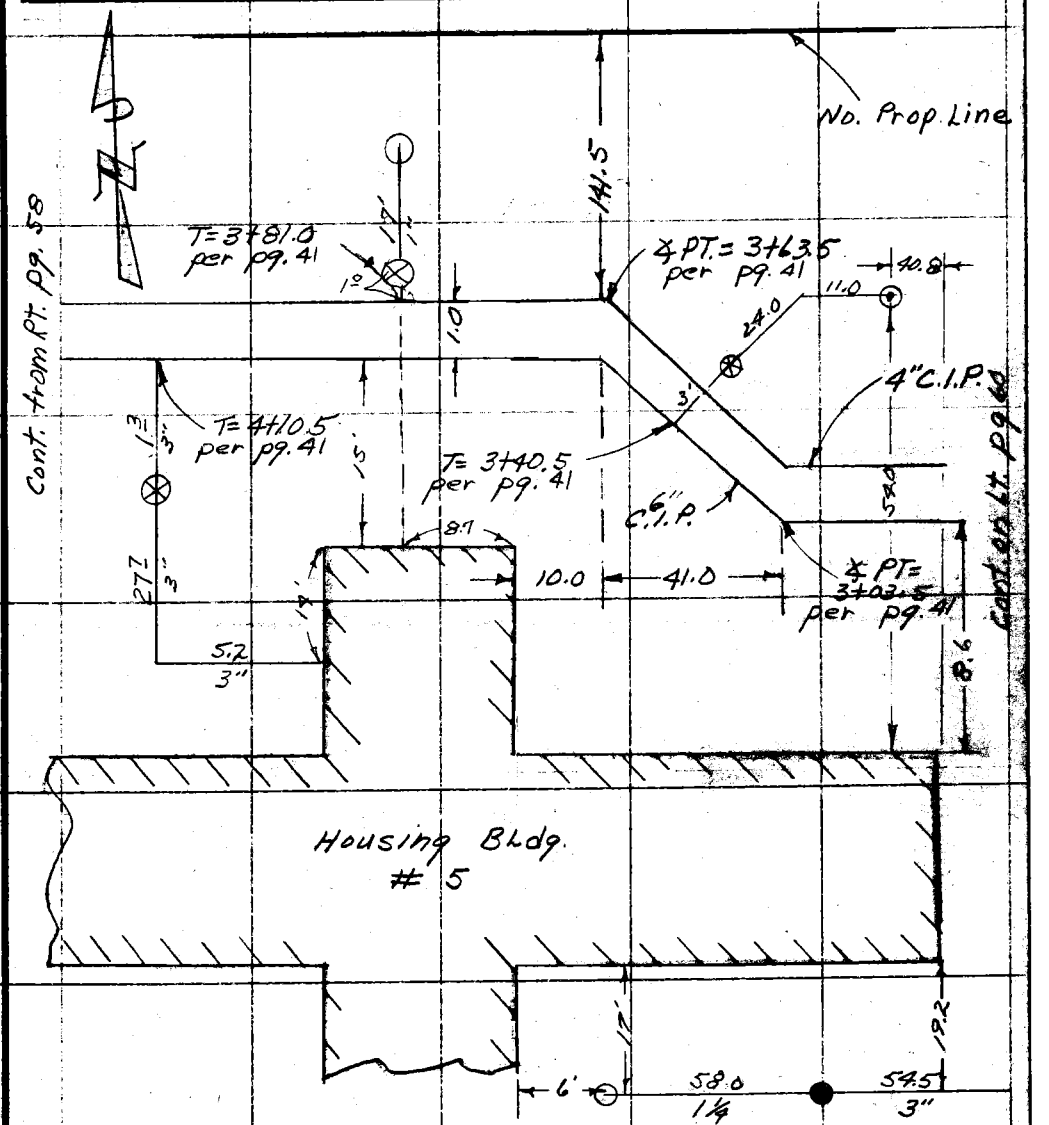

Note: Any Additions or Changes on This Sheet Must be Made or Circled in Red Ink With Date and Name of Person Making Change.

Do not extend notes this side of this line.

RETURN TO
LOS ANGELES COUNTY SURVEYOR
726 LOS ANGELES COUNTY
ENGINEERING BLDG.

76F309S S&E #247, 8-54

F. B. 2230 PG. 60

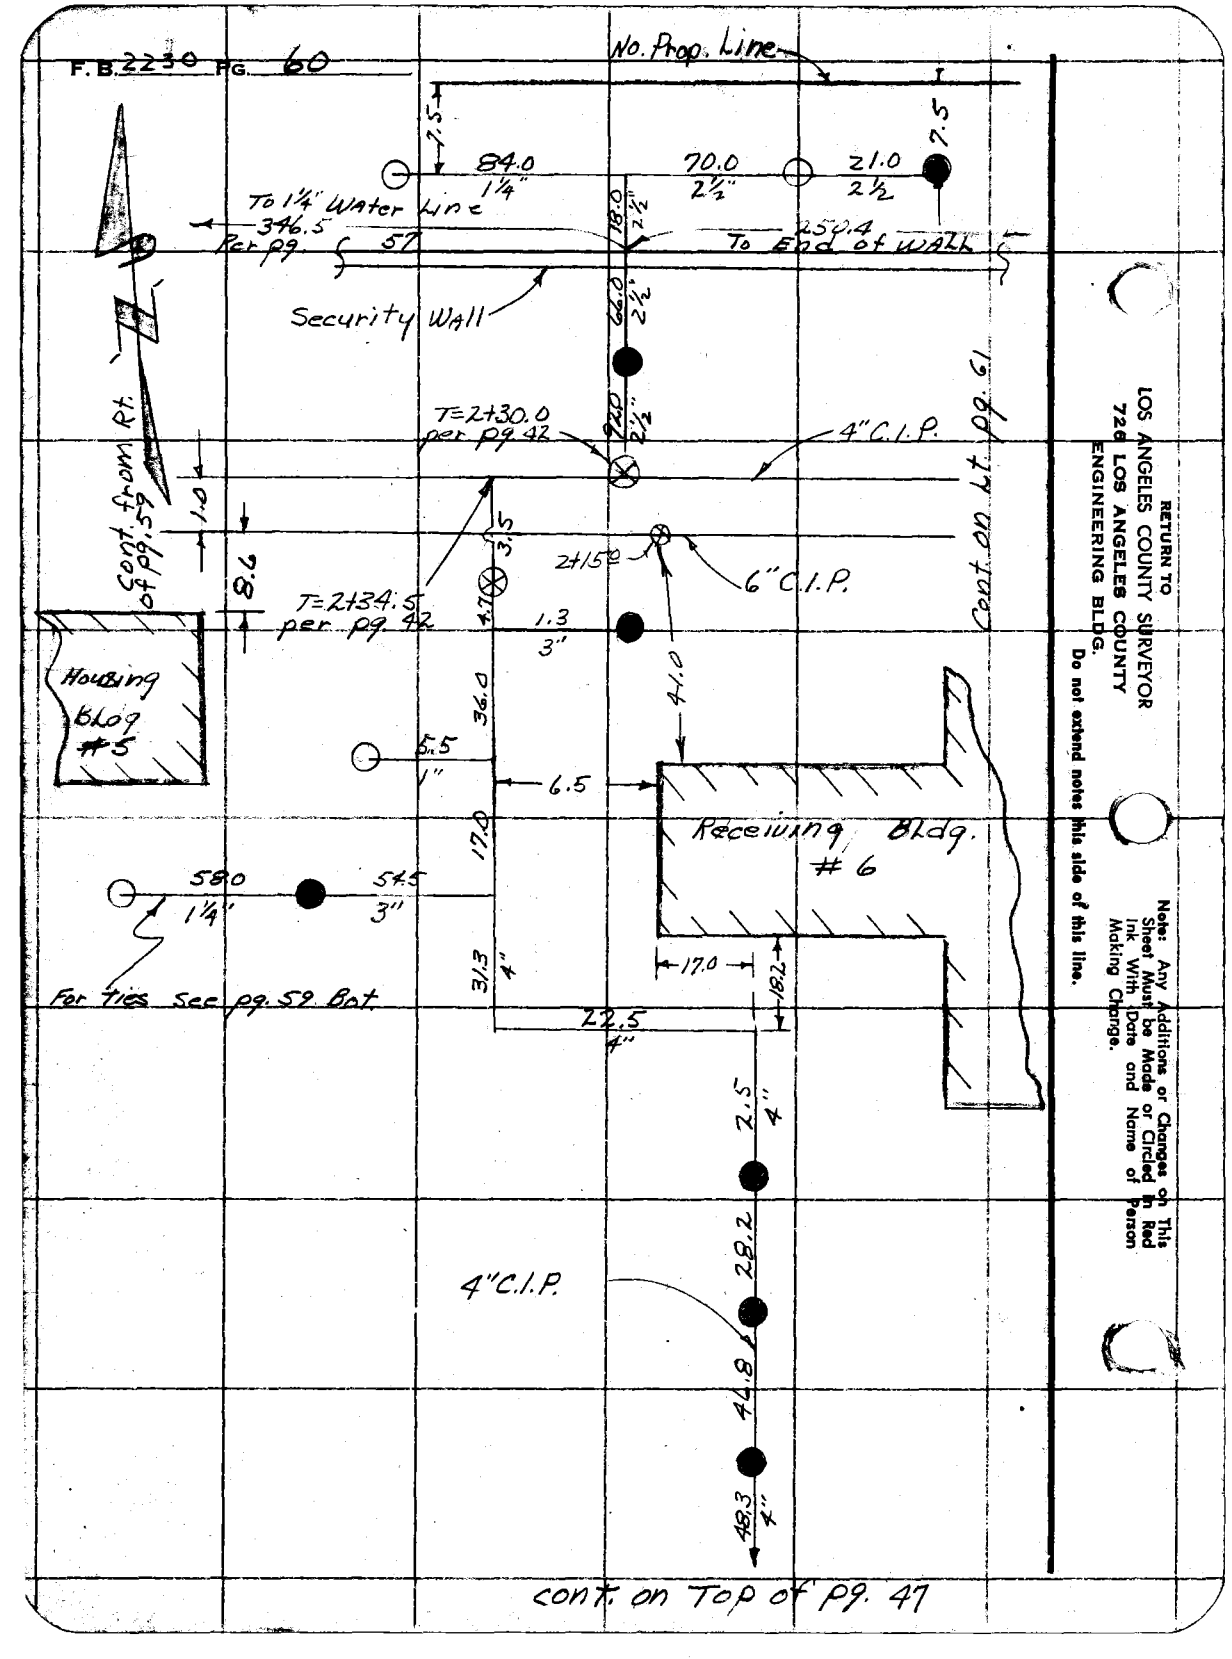

RETURN TO
LOS ANGELES COUNTY SURVEYOR
720 LOS ANGELES COUNTY
ENGINEERING BLDG.
Do not extend notes this side of this line.

Note: Any Additions or Changes on This Sheet Must be Made or Circled in Red Ink With Date and Name of Person Making Change.

Notes C'd by
Map No.
Office Work
Checked
Date

Survey of Juvenile Hall
W. O. 9392.01 Tape No. 0145 Std. 68 °F
Surveyed by M.A. Van Deren
Notes JJB 6ZEN Date 5-29-56
Indexed C. Johnson

F.B. 2230 Pg. 61

Segregation Bldg. #10

Receiving Bldg. #6

Secur. Wall

T=17+33.3 per P9.42

T=17+25.0 per P9.42

T=17+26 per P9.42

T=17+49.0 per P9.42

T=17+27.5 per P9.42

4" C.I.P.

6" C.I.P.

Cont. from Rt. P9.60

Cont. on Lt. of P9.62

Side view (2" line directly over 4" line)

Note: Any Additions or Changes on This Sheet Must be Made or Circled in Red Ink With Date and Name of Person Making Change.

Do not extend notes this side of this line.

RETURN TO
LOS ANGELES COUNTY SURVEYOR
726 LOS ANGELES COUNTY
ENGINEERING BLDG.

76F3098 S&E #247. 8-54

F.B. 2230 PG. 62

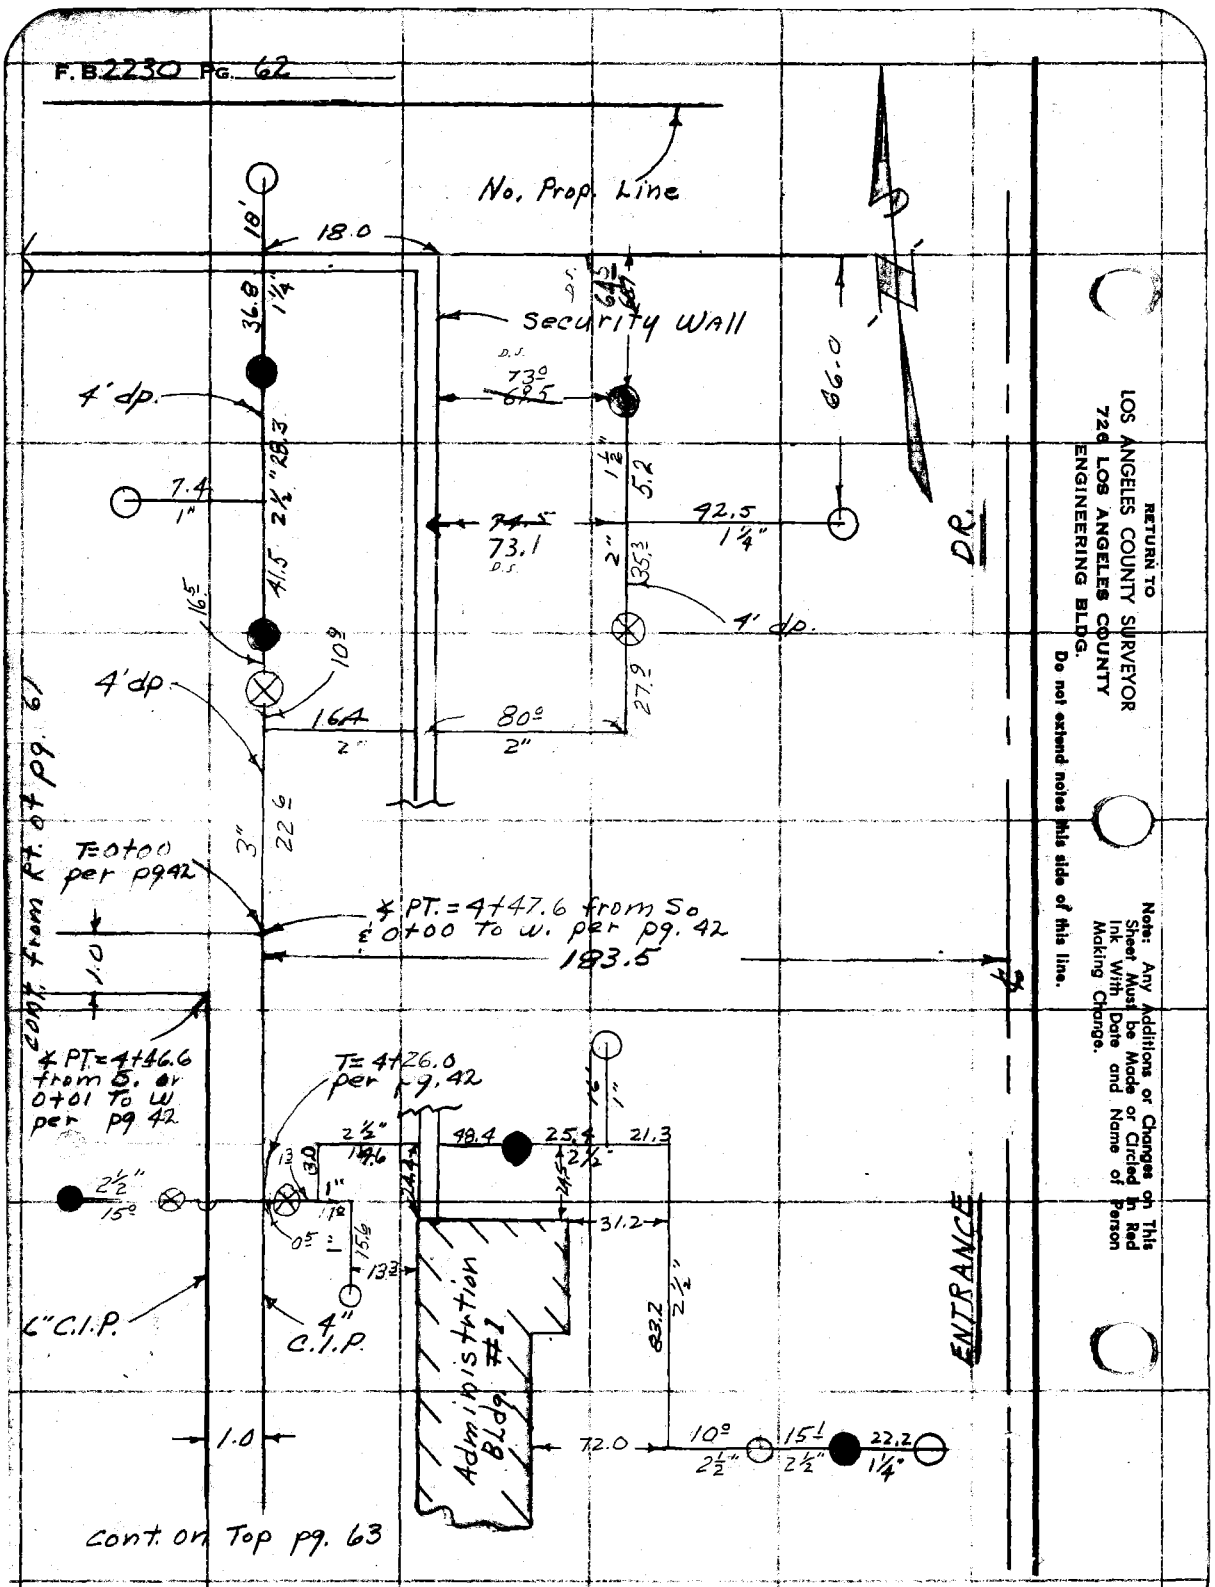

RETURN TO
LOS ANGELES COUNTY SURVEYOR
720 LOS ANGELES COUNTY
ENGINEERING BLDG.
Do not extend notes this side of this line.

Note: Any Additions or Changes on This Sheet Must be Made or Circled in Red Ink With Date and Name of Person Making Change.

Notes Ck'd by	Survey of Juvenile Hall
Map No.	W. O. 8382.01 Tape No. 0145 Std. 68 °F
Office Work	Surveyed by M.A. VAN Deren
Checked	Notes JJ Bazen Date 5-29-56
Date	Indexed K. O. Johnson

F. B. 2230 Pg. 63

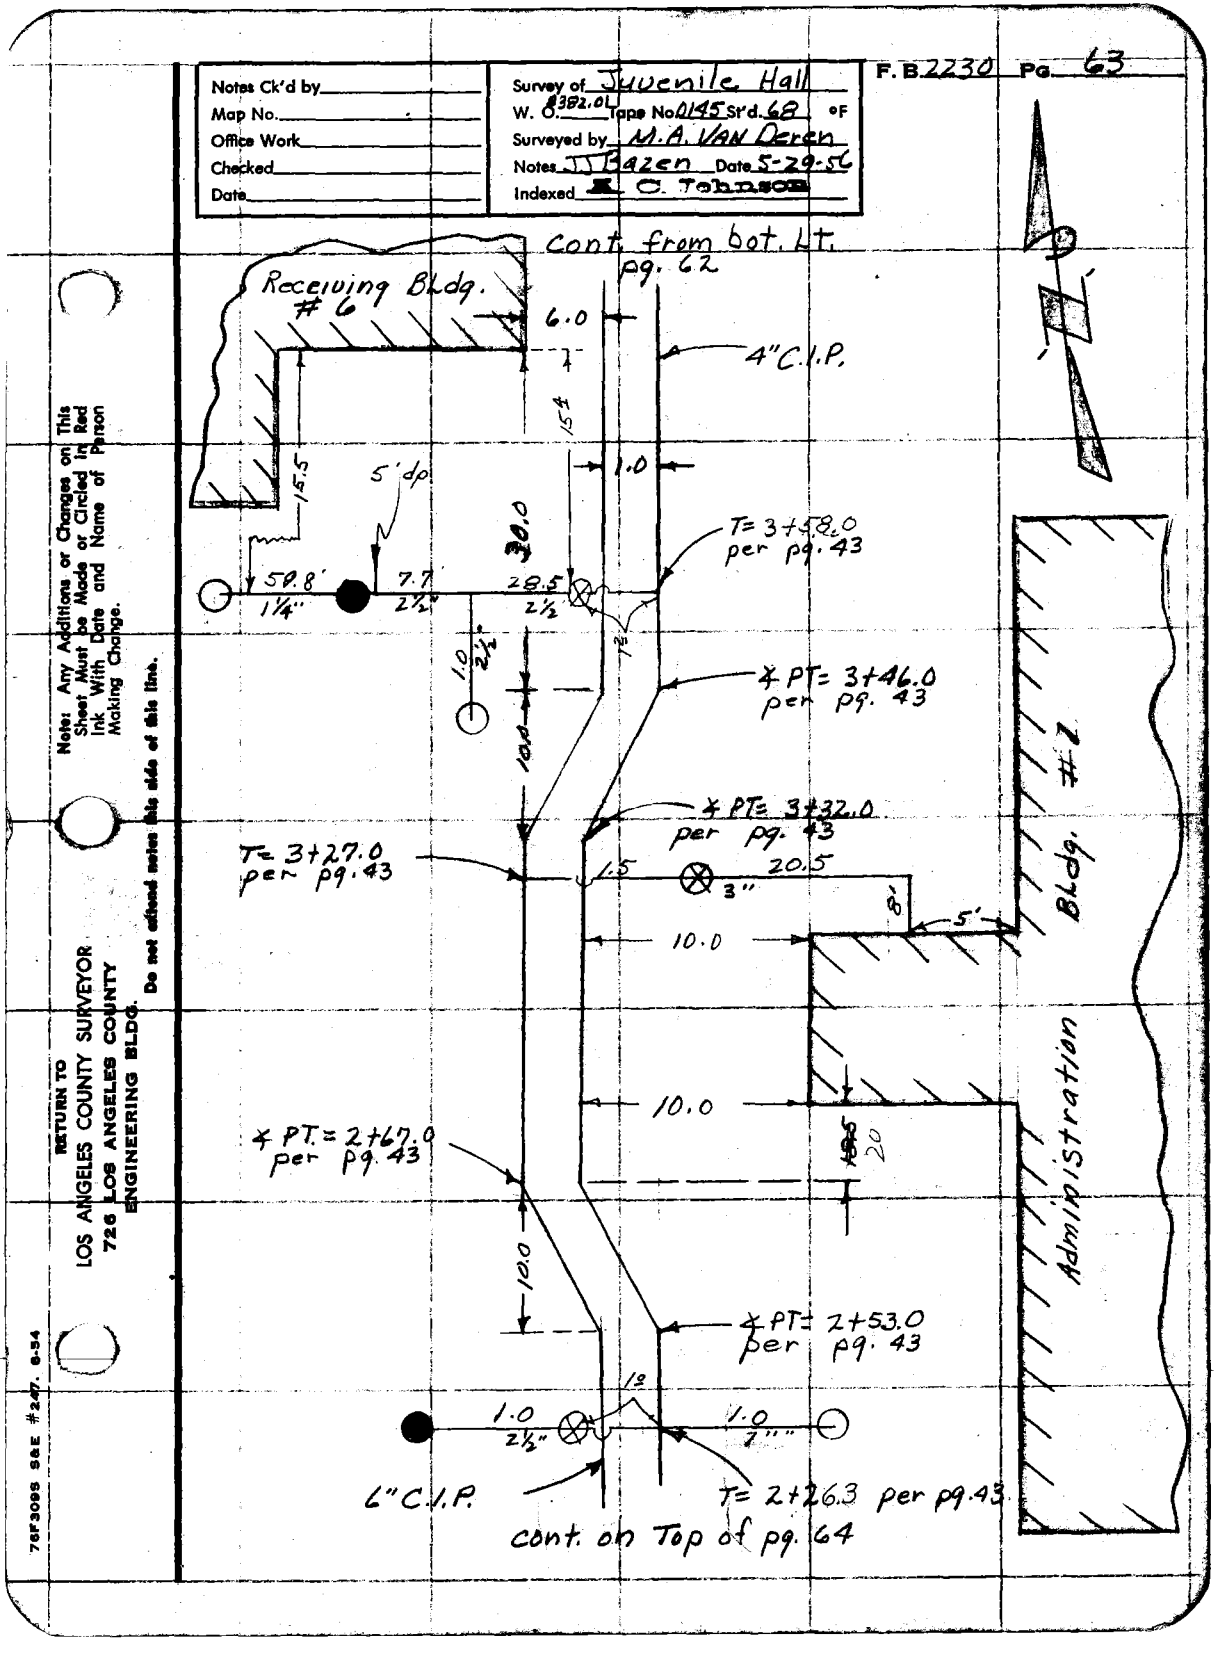

Note: Any Additions or Changes on This Sheet Must be Made or Circled in Red Ink With Date and Name of Person Making Change.

Do not extend notes this side of this line.

RETURN TO
LOS ANGELES COUNTY SURVEYOR
726 LOS ANGELES COUNTY
ENGINEERING BLDG.

76F3095 S&E #247. 6-54

F.B. 2230 PG. 64

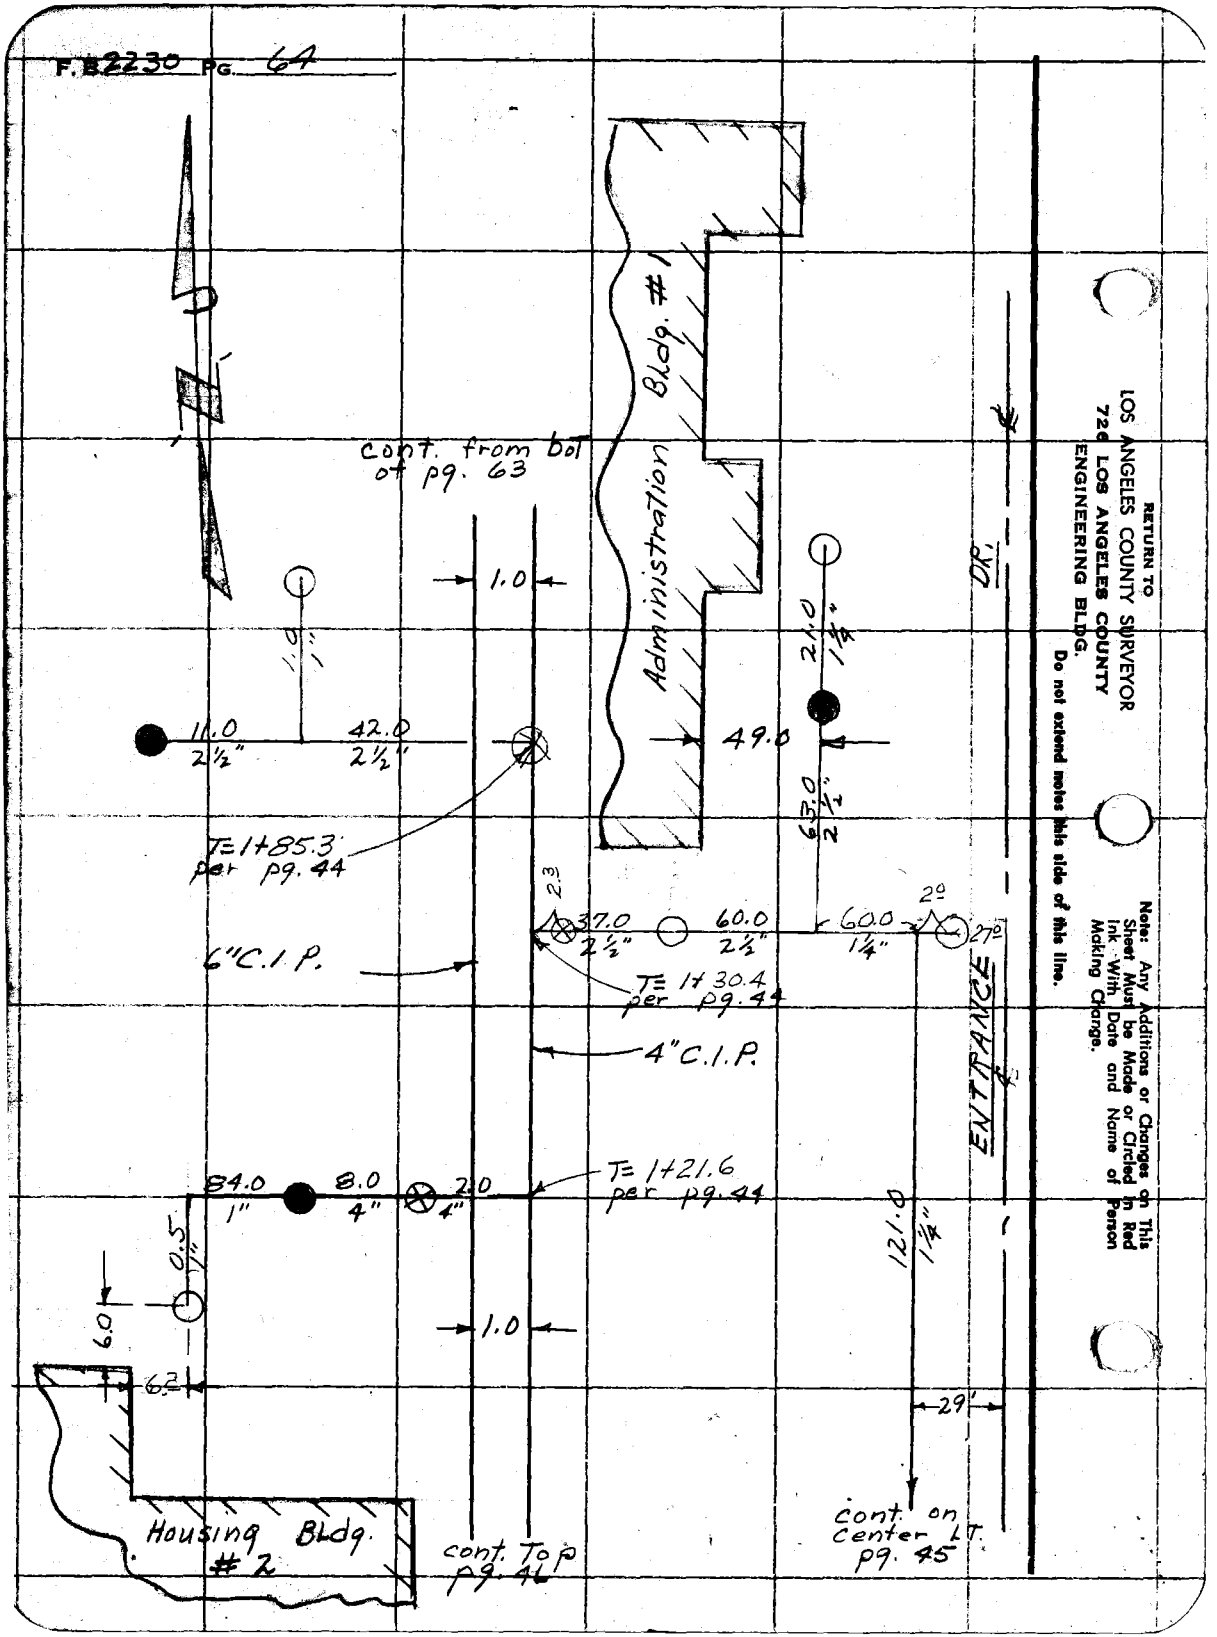

RETURN TO
LOS ANGELES COUNTY SURVEYOR
720 LOS ANGELES COUNTY
ENGINEERING BLDG.

Do not extend notes this side of this line.

Note: Any Additions or Changes on This Sheet Must be Made or Circled in Red Ink With Date and Name of Person Making Change.

Profile No.	Notes Red.	Plotted	Job No. 9382.01	Division No. 10	F. B. 2230	Pg. 65
	Date	Date	Survey of Juvenile Hall			
X-Sec. No.	Notes Chkd.	Checked	Survey by Sappell	Notes D.S.	Date 11-	-56
	Date	Date	Map No. Indexed Johnson		Date	

J.N. 9382.01

JUVENILE HALL

Finish Grade at Ed. Service Rd.
1st From Fire Hyd.

Part: Sappell
Myers
Bazer
Siemann
Turrill

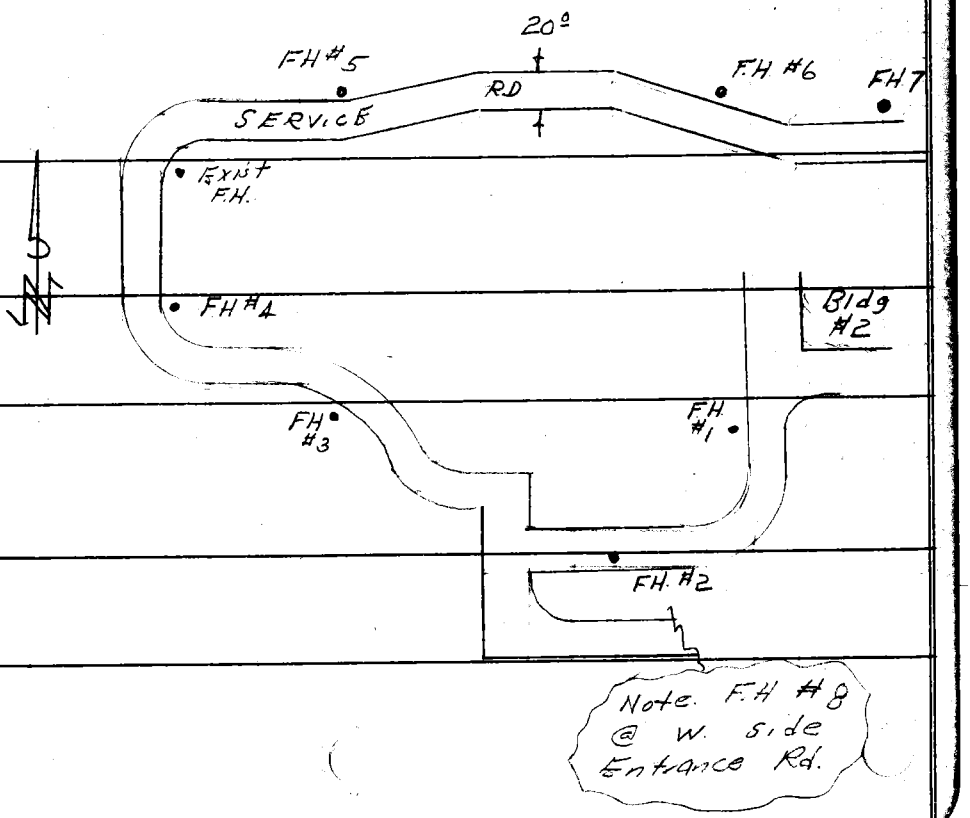

STATION	B. B.	H. I.	F. B.	ELEV.

NOTE: ANY ADDITIONS OR CHANGES ON THIS SHEET MUST BE MADE OR CIRCLED IN RED INK, WITH DATE AND NAME OF PERSON MAKING CHANGE.

Do not extend notes this side of this line.

PLEASE RETURN TO
LOS ANGELES COUNTY ENGINEER
700 Los Angeles County Engineering Bldg.

76298 S & E #307—7-55

76298 S & E #307—7-55

PLEASE RETURN TO
LOS ANGELES COUNTY ENGINEER
700 LOS ANGELES COUNTY ENGINEERING BLDG.

NOTE: ANY ADDITIONS OR CHANGES ON THIS SHEET MUST BE MADE OR CIRCLED IN RED INK, WITH DATE AND NAME OF PERSON MAKING CHANGE.

Do not extend notes this side of this line.

F. B. 2230 Pg. 66 Job No. 83201 Division No. 10
Survey by D. Sargent
Indexed C. Forrest
Profile No. X-Sec. No.
Plotted Date
Notes Red. Date
Notes Chkd. Date
Checked Date

STATION	B. S.	H. I.	F. S.	ELEV.	Grade	C & F	
TBM #1				96 02			T.B.M. #1 El. 96.022 F8.2230 -11, So. Side 3" I.P. 24" DP. on S P/L
	742	103 44					
N.E. 4' Tie To F.H. #1			600	97 44	99.58	F-2.14	N.E. 4' Tie to F.H.
T.P.	711	104 55					T.P.
N.E. 4' Tie To F.H. #2			619	98 36	99.26	F-0.90	N.E. 4' Tie to F.H.
T.P.	522	103 58					T.P.
S.W. 4' Tie To F.H. #3			371	99 87	99.76	C-0.11	S.W. 4' Tie to F.H.
T.P.	546	105 33					T.P.
S.E. 4' Tie To F.H. #4			550	99 83	100.58	F-0.75	S.E. 4' Tie to F.H.
T.P.	589	105 72					T.P.
Stk. 4' N. of Exist. F.H.			491	100 81	100.81	Grade	Stk 4' N of Exist F.H.
T.P.	463	105 44					T.P.
Blue Top @ S.E. 4' Tie to F.H. #5			529	100 15	100.15	Grade	blue top @ S.E. 4' Tie
T.P.	401	104 16					T.P.
So. 4' Tie to F.H. #6			500	99 16	99.60	F-0.44	So. 4' Tie to F.H.
T.P.	625	105 41					T.P.
TP.			454	100 87			TP.
TP.	162	102 49	447	98 02			TP.
TBM #1	497	102 99	699	96 00			TBM #1 El. 96.022 see Descrip Above.

76298 S & E #307—7-55

PLEASE RETURN TO
LOS ANGELES COUNTY ENGINEER
700 LOS ANGELES COUNTY ENGINEERING BLDG.

NOTE: ANY ADDITIONS OR CHANGES ON THIS SHEET MUST BE MADE OR CIRCLED IN RED INK, WITH DATE AND NAME OF PERSON MAKING CHANGE.

Do not extend notes this side of this line.

STATION	B. S.	H. I.	F. S.	ELEV.	Grade	C. or F		
TBM #1				96 02			T.Bm #1	El 96.022 FB 2230-1 Sa side 3" I.P. 24" Dwn. on Sa P/L
	662	102 64						
W 4° Tie to F.H. #8			664	96 00	96.65	F 0.65	Top of C6.	F.H. #8
T.P.	514	103 28	450	98 14			T.P.	
N.E. 4° Tie To F.H. #7			290	100 38	99.28	C 1.10	F.H. #7	
T.P.			575	97 53			T.P.	
T.Bm #1	504	102 57	656	96 01			T.Bm #1	Descrip Above.

Profile Notes Red. Plotted Job No. 8382 Division No. 10
X-Sec. Notes Chkd. Checked Survey by Sprague & Nybakken Date 11-23-55
No. Date Date Map No. Indexed C. Johnson Date

F. B. 2230 Pg. 67

Notes Ck'd by	Survey of Juvenile Hall	F.B. 223 Pg. 69
Map No.	W. O. 8382 Tape No. 145 Std. 68 °F	
Office Work	Surveyed by M. A. Van Deren	
Checked	Notes Van Date 4-30-56	
Date	Indexed A. C. Johnson	

J.N. 8382.01

STAKING SKETCH OF SECURITY WALL

AT

JUVENILE HALL FACILITY - Ro LOS AMIGOS

STAKED PER PLAN

— = Security Wall

4-30-56
Van Deren
Richards
Bazem
Turrill

Note: Any Additions or Changes on This Sheet Must be Made or Circled In Red Ink With Date and Name of Person Making Change.

Do not extend notes this side of this line.

RETURN TO
LOS ANGELES COUNTY SURVEYOR
726 LOS ANGELES COUNTY
ENGINEERING BLDG.

76F309S S&E #247. 8-54

RETURN TO
LOS ANGELES COUNTY SURVEYOR
726 LOS ANGELES COUNTY
ENGINEERING BLDG.

Note: Any Additions or Changes on This Sheet Must be Made or Circled in Red Ink With Date and Name of Person Making Change.

Do not extend notes this side of this line.

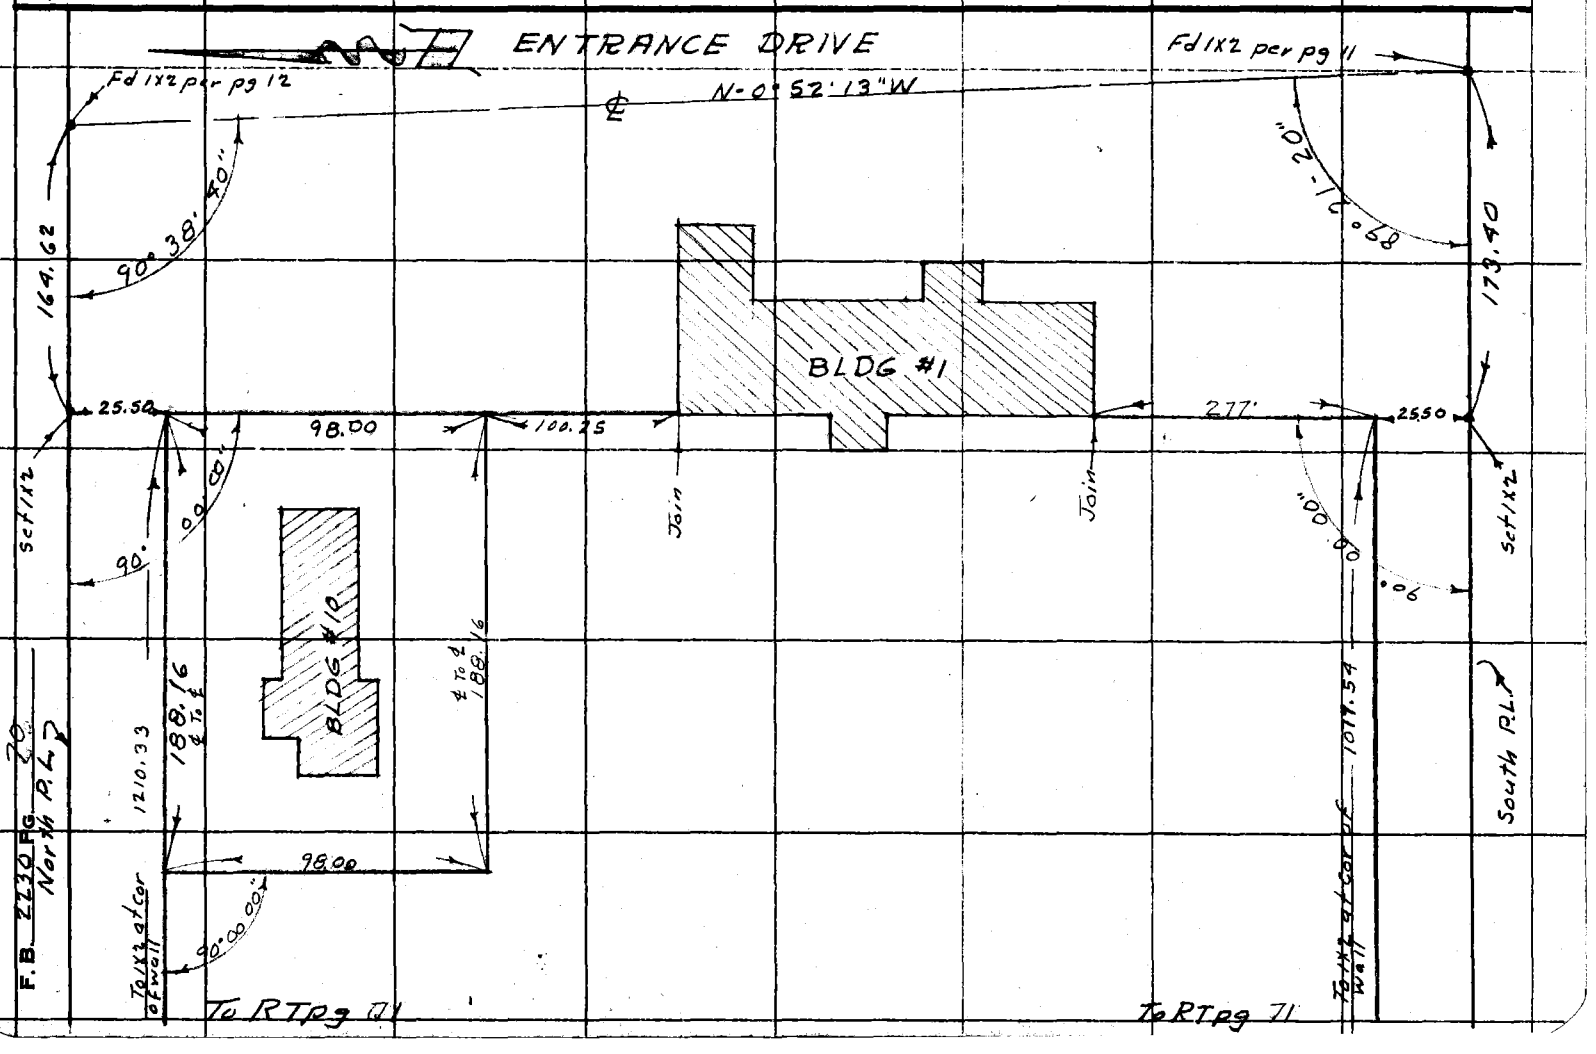

Notes Ck'd by	Survey of Juvenile Hall
Map No.	W. O 8382 Tape No 2195 St'd. 68 °F
Office Work	Surveyed by M.A. VanDercy
Checked	Notes Van Date 4-30-86
Date	Indexed C. Johnson

F.B. 2230 PG. 71

Note: Any Additions or Changes on This Sheet Must be Made or Circled in Red Ink With Date and Name of Person Making Change.

Do not extend notes this side of this line.

RETURN TO
LOS ANGELES COUNTY SURVEYOR
726 LOS ANGELES COUNTY
ENGINEERING BLDG.

76F3008 685 #247 8-84

Notes Ck'd by
Map No.
Office Work
Checked
Date

Survey of JUVENILE HALL
W. O. 8382 Tape No. 2145 St'd. 68 °F
Surveyed by M.A. Van Deren
Notes Van Date 6-56
Indexed C. Johnson

F.B. 2230 Pg. 73

JN 8382.01

STAKING SKETCH OF DURANT INSULATED PIPE. FOR HOT & COLD WATER SYSTEM AT JUVENILE HALL AT RANCHO LOS AMIGOS

"Note" all lines staked per plan (drawing number 3244) FOR HEATING & COOLING SYSTEM

Van Deren
Richards
Bazen
Turrill

Note: Any Additions or Changes on This Sheet Must be Made or Circled in Red Ink With Date and Name of Person Making Change.

Do not extend notes this side of this line.

RETURN TO
LOS ANGELES COUNTY SURVEYOR
726 LOS ANGELES COUNTY
ENGINEERING BLDG.

76F308S S&E #247. 8-54

F.B. 2230 Pg. 74

RETURN TO
LOS ANGELES COUNTY SURVEYOR
726 LOS ANGELES COUNTY
ENGINEERING BLDG.

Do not extend notes this side of this line.

Note: Any Additions or Changes on This Sheet Must be Made or Circled in Red Ink With Date and Name of Person Making Change.

76F3095 S&E #247 [illegible] 74

RETURN TO
LOS ANGELES COUNTY SURVEYOR
726 LOS ANGELES COUNTY
ENGINEERING BLDG.

Note: Any Additions or Changes on This Sheet Must be Made or Circled in Red Ink With Date and Name of Person Making Change.

Do not extend notes this side of this line.

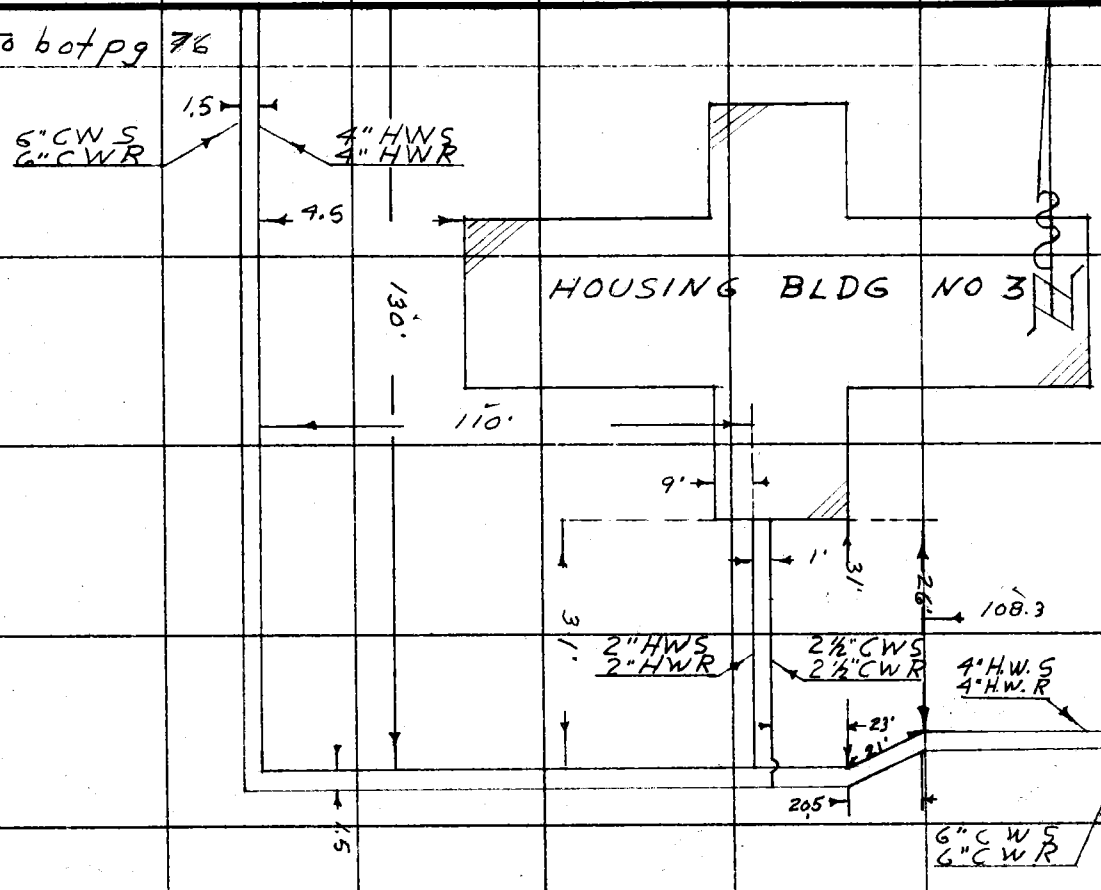

Notes Ck'd by
Map No.
Office Work
Checked
Date

Survey of Juvenile Hall
W. O. 3826-69 Dpe No. 4145 Std. 69 of F
Surveyed by H.A. Van Deren Date 6-56
Notes Van & C. Johnson
Indexed

F.B. 2230 Pg. 75
From bot Pg 74

F.B. 2230 PG. 76. To RT pg 77

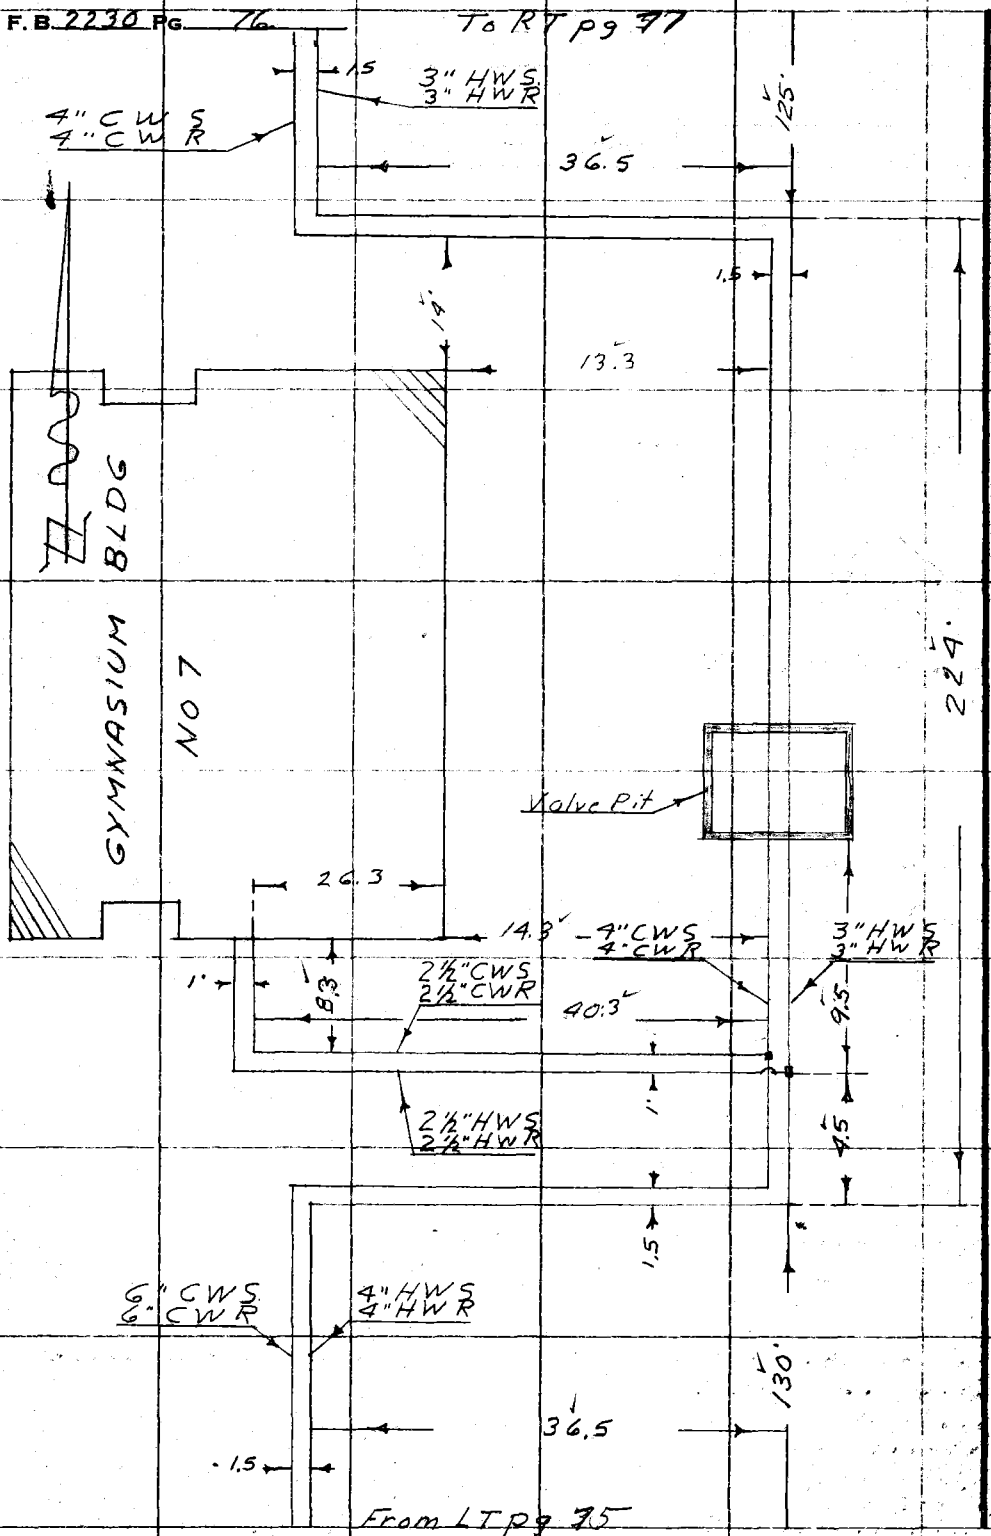

RETURN TO
LOS ANGELES COUNTY SURVEYOR
720 LOS ANGELES COUNTY
ENGINEERING BLDG.
Do not extend notes this side of this line.

Note: Any Additions or Changes on This Sheet Must be Made or Circled in Red Ink With Date and Name of Person Making Change.

76F309S S&E #247. 8-54

RETURN TO
LOS ANGELES COUNTY SURVEYOR
726 LOS ANGELES COUNTY
ENGINEERING BLDG.

Note: Any Additions or Changes on This Sheet Must be Made or Circled In Red Ink With Date and Name of Person Making Change.

Do not extend notes this side of this line.

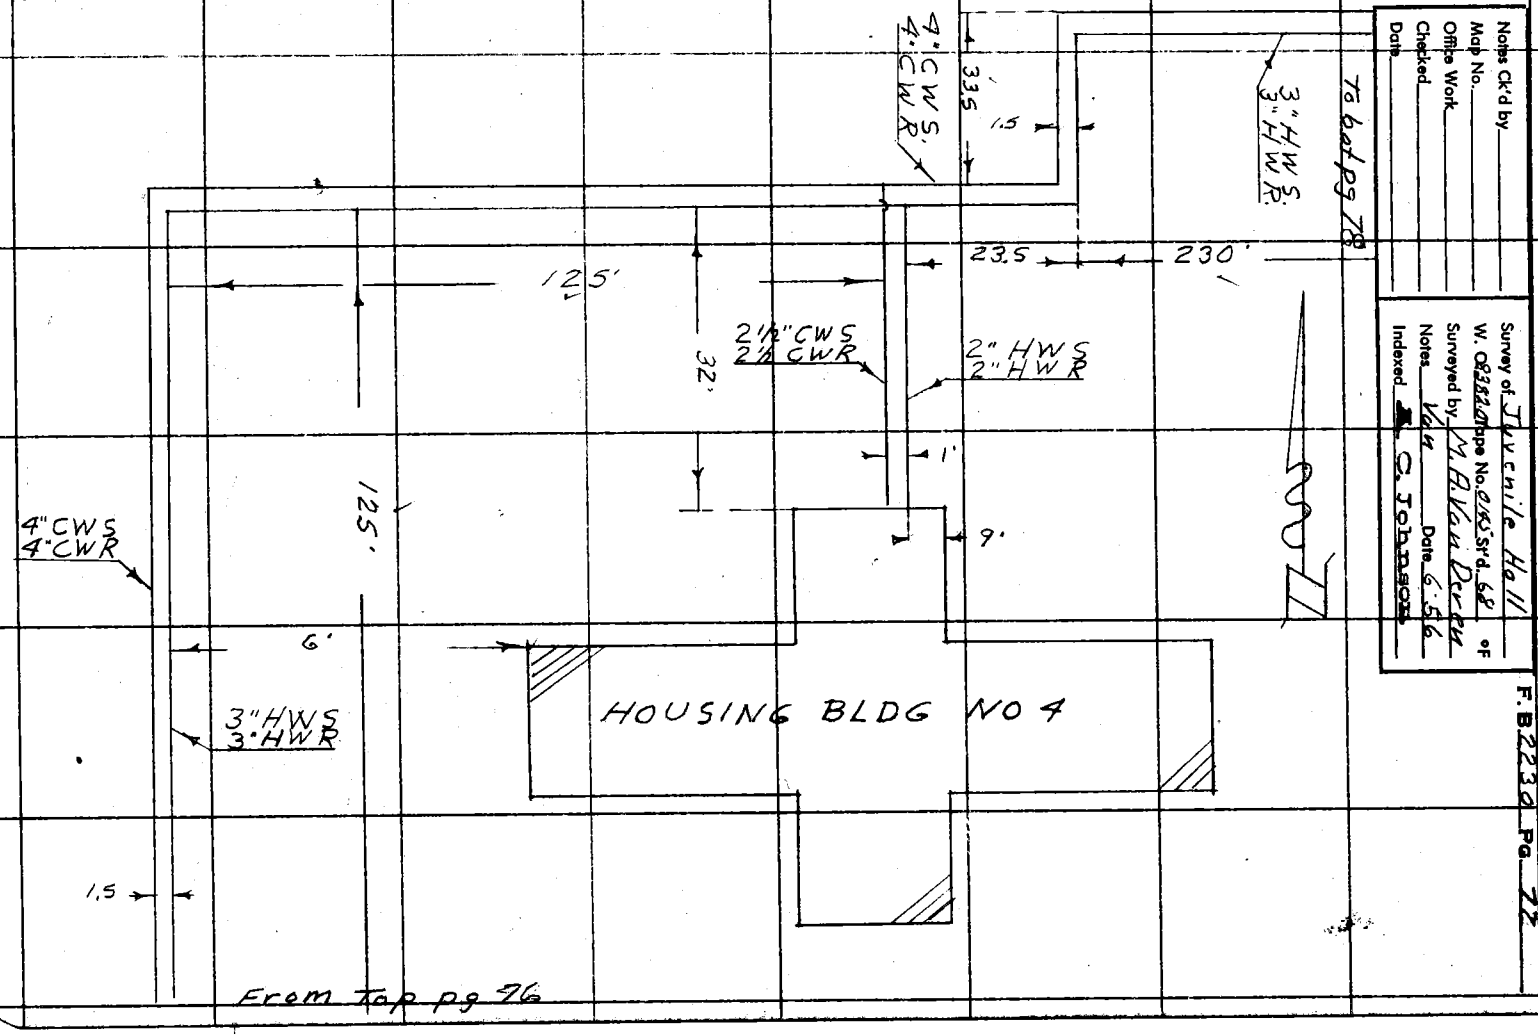

Notes Ck'd by
Map No.
Office Work
Checked
Date

Survey of Juvenile Hall
W. O. 8223 Type No. 6"x5"x4'-6" Std. 68 of F
Surveyed by W. H. Haun Date 6-56
Notes
Indexed C. Johnson

F. B. 2230 Pg. 72

RETURN TO
LOS ANGELES COUNTY SURVEYOR
726 LOS ANGELES COUNTY
ENGINEERING BLDG.

Note: Any Additions or Changes on This Sheet Must be Made or Circled in Red Ink With Date and Name of Person Making Change.

Do not extend notes this side of this line.

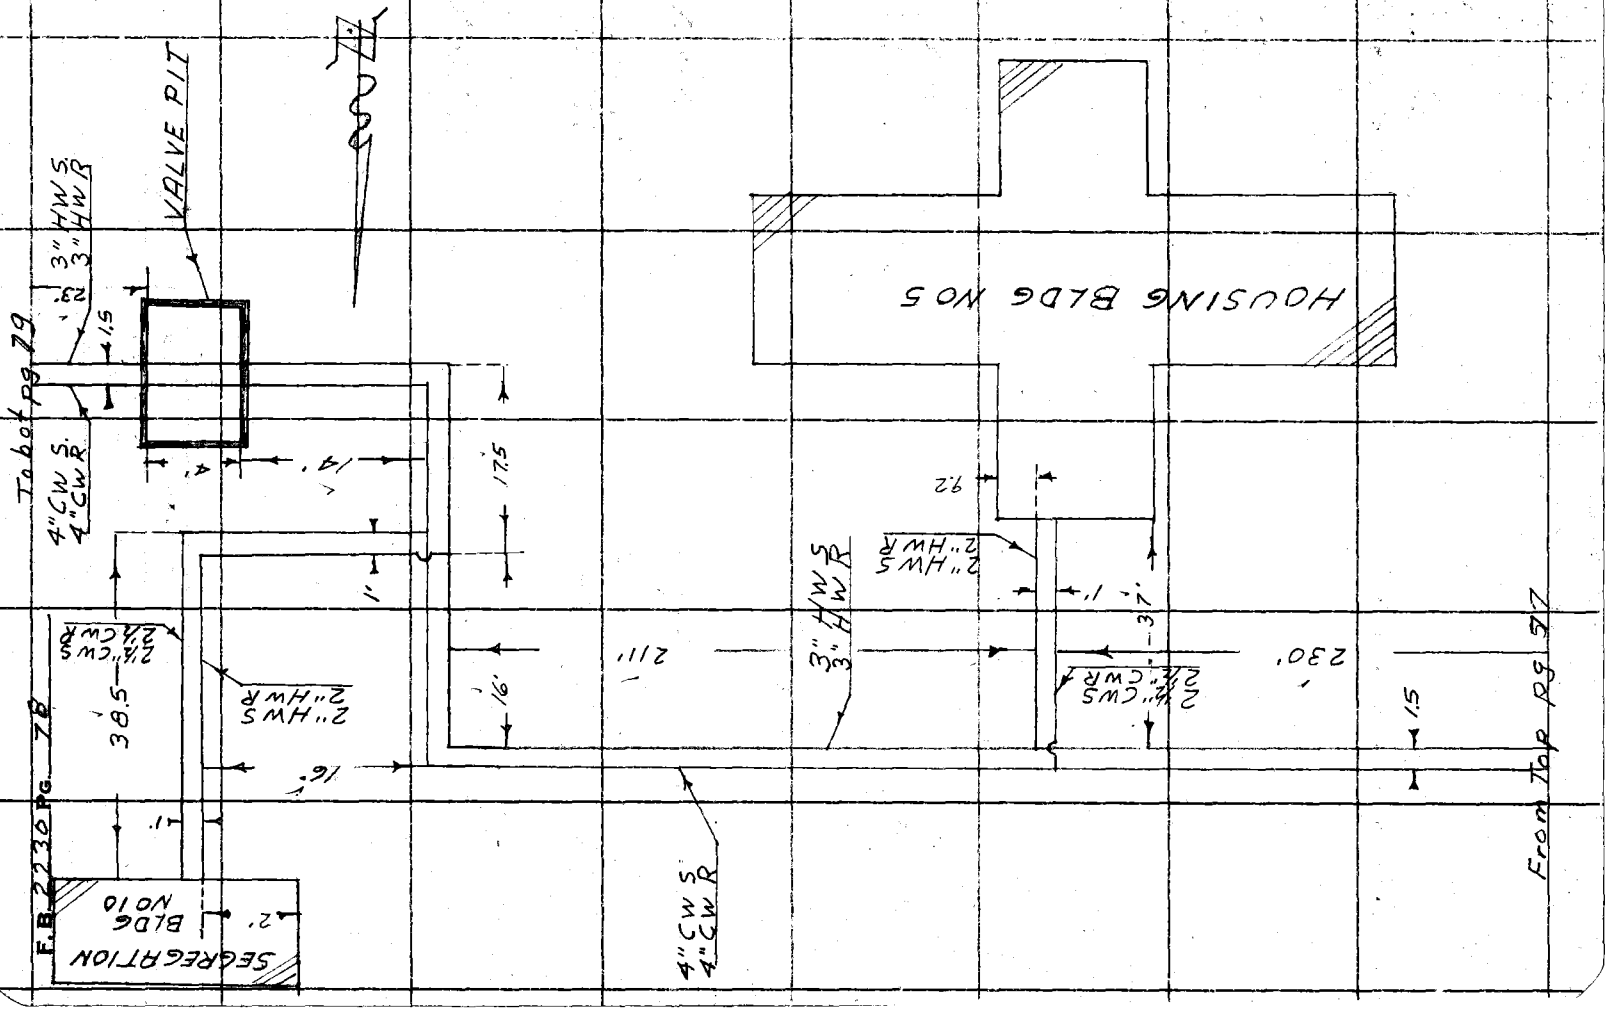

76F3095 S&E #247. 8-54

RETURN TO
LOS ANGELES COUNTY SURVEYOR
726 LOS ANGELES COUNTY
ENGINEERING BLDG.

Note: Any Additions or Changes on This Sheet Must be Made or Circled In Red Ink With Date and Name of Person Making Change.

Do not extend notes this side of this line.

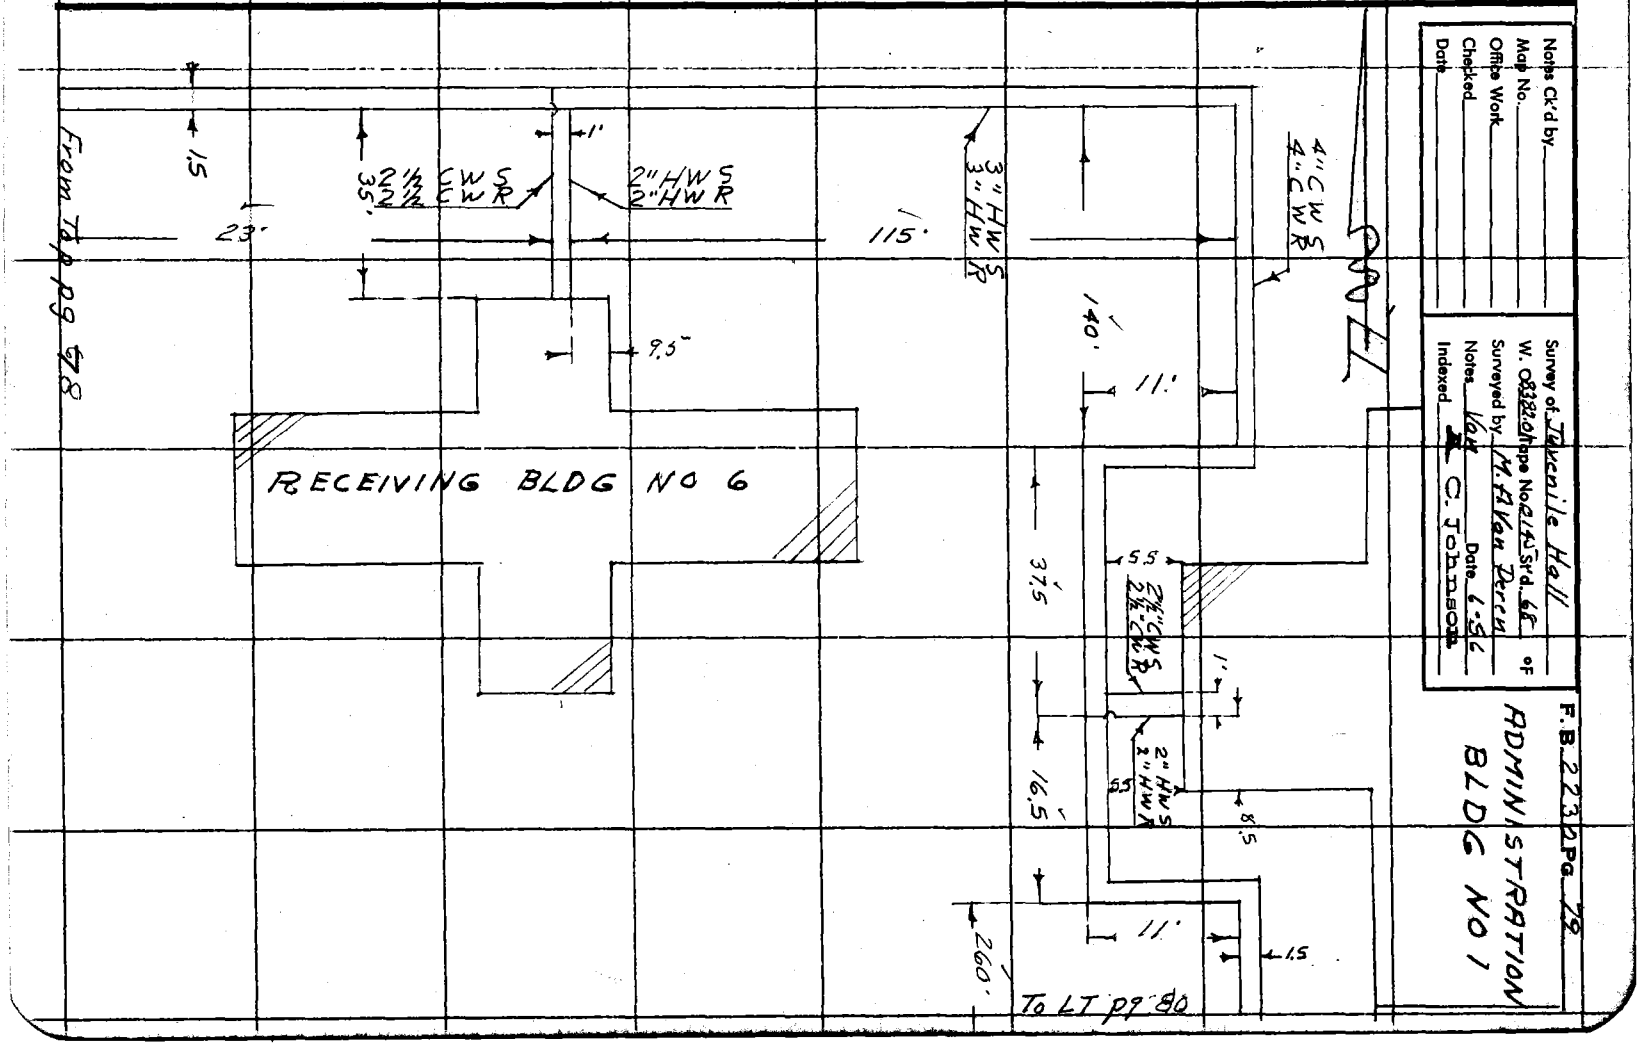

Notes Ck'd by
Map No.
Office Work
Checked
Date

Notes Date 6-56
Indexed C. Johnson

of


ADMINISTRATION
BLDG NO 1

F.B. 2230 Pg. 88

From RT Pg 79

1.5

26'

GIRLS RECEIVING AND HOUSING BLDG NO-2

8.2

93'

3" HWS
3" CWR

4" CWS
4" CWR

PIT

4'

2¾" CWS.
2¾" CWR.

9" HWS
4" HWR

30'

1'

9.9

2" HWS
2" HWR

5' CWS
2" CWR

5'

176.5

TOLT

10'

RETURN TO
LOS ANGELES COUNTY SURVEYOR
726 LOS ANGELES COUNTY
ENGINEERING BLDG.

Do not extend notes this side of this line.

Note: Any Additions or Changes on This Sheet Must be Made or Circled in Red Ink With Date and Name of Person Making Change.

76F3095 S&E #247. 8-54

RETURN TO
LOS ANGELES COUNTY SURVEYOR
726 LOS ANGELES COUNTY
ENGINEERING BLDG.

Note: Any Additions or Changes on This Sheet Must be Made or Circled In Red Ink With Date and Name of Person Making Change.

Do not extend notes this side of this line.

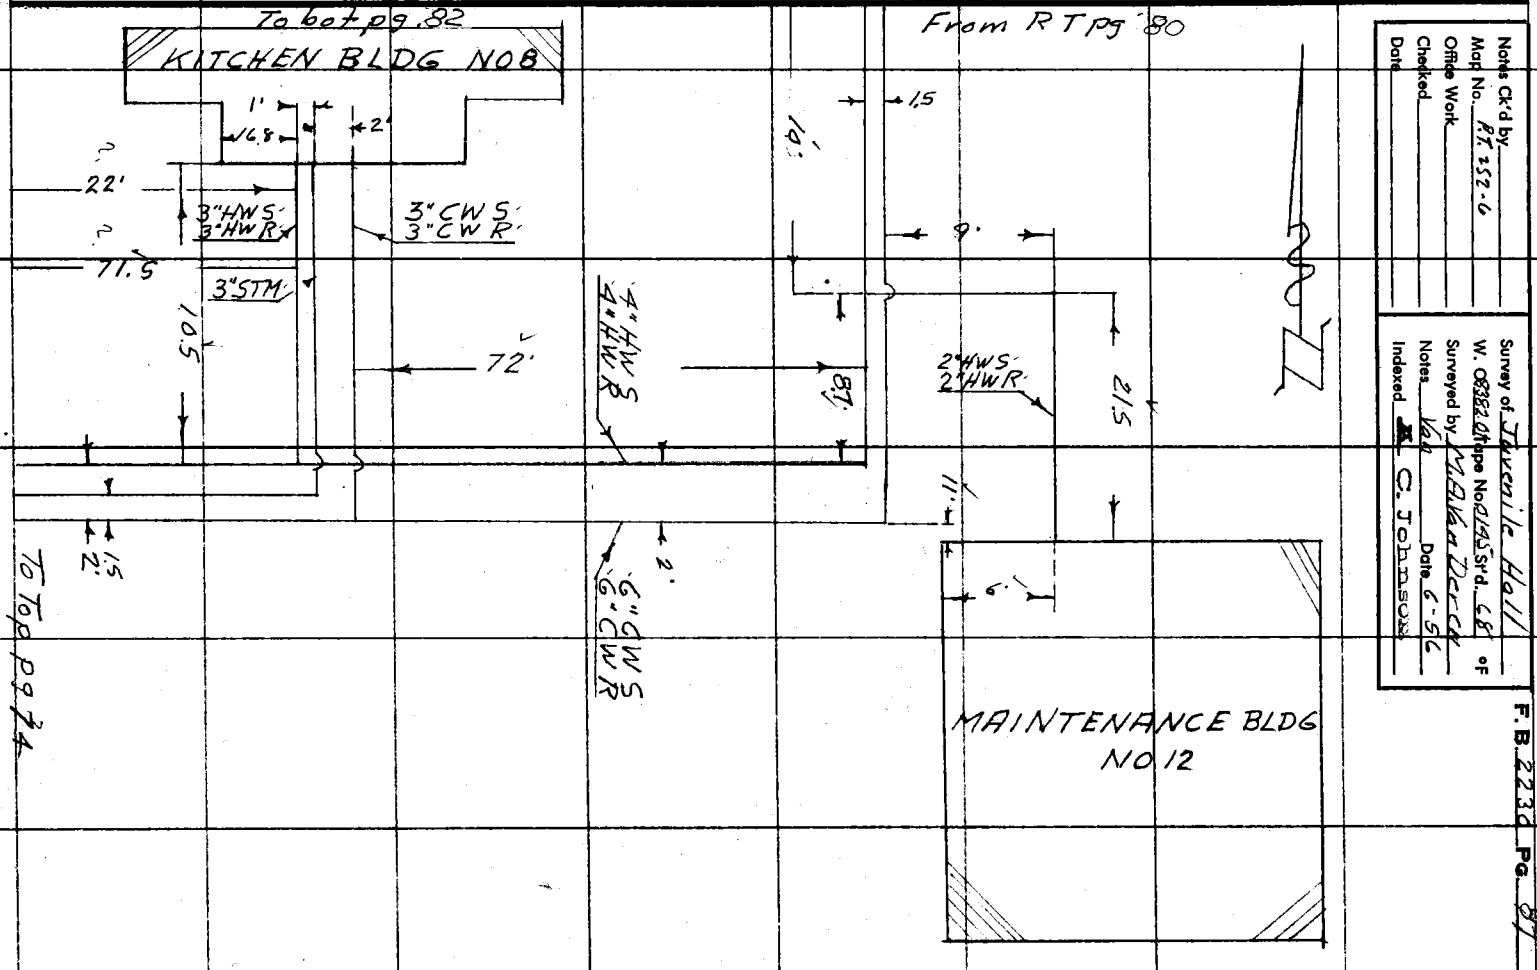

Notes Ck'd by
Map No. R.T. 252-6
Office Work
Checked
Date

Notes Date 6-56
Indexed C. Johnson


F. B. 2230 Pg. 82

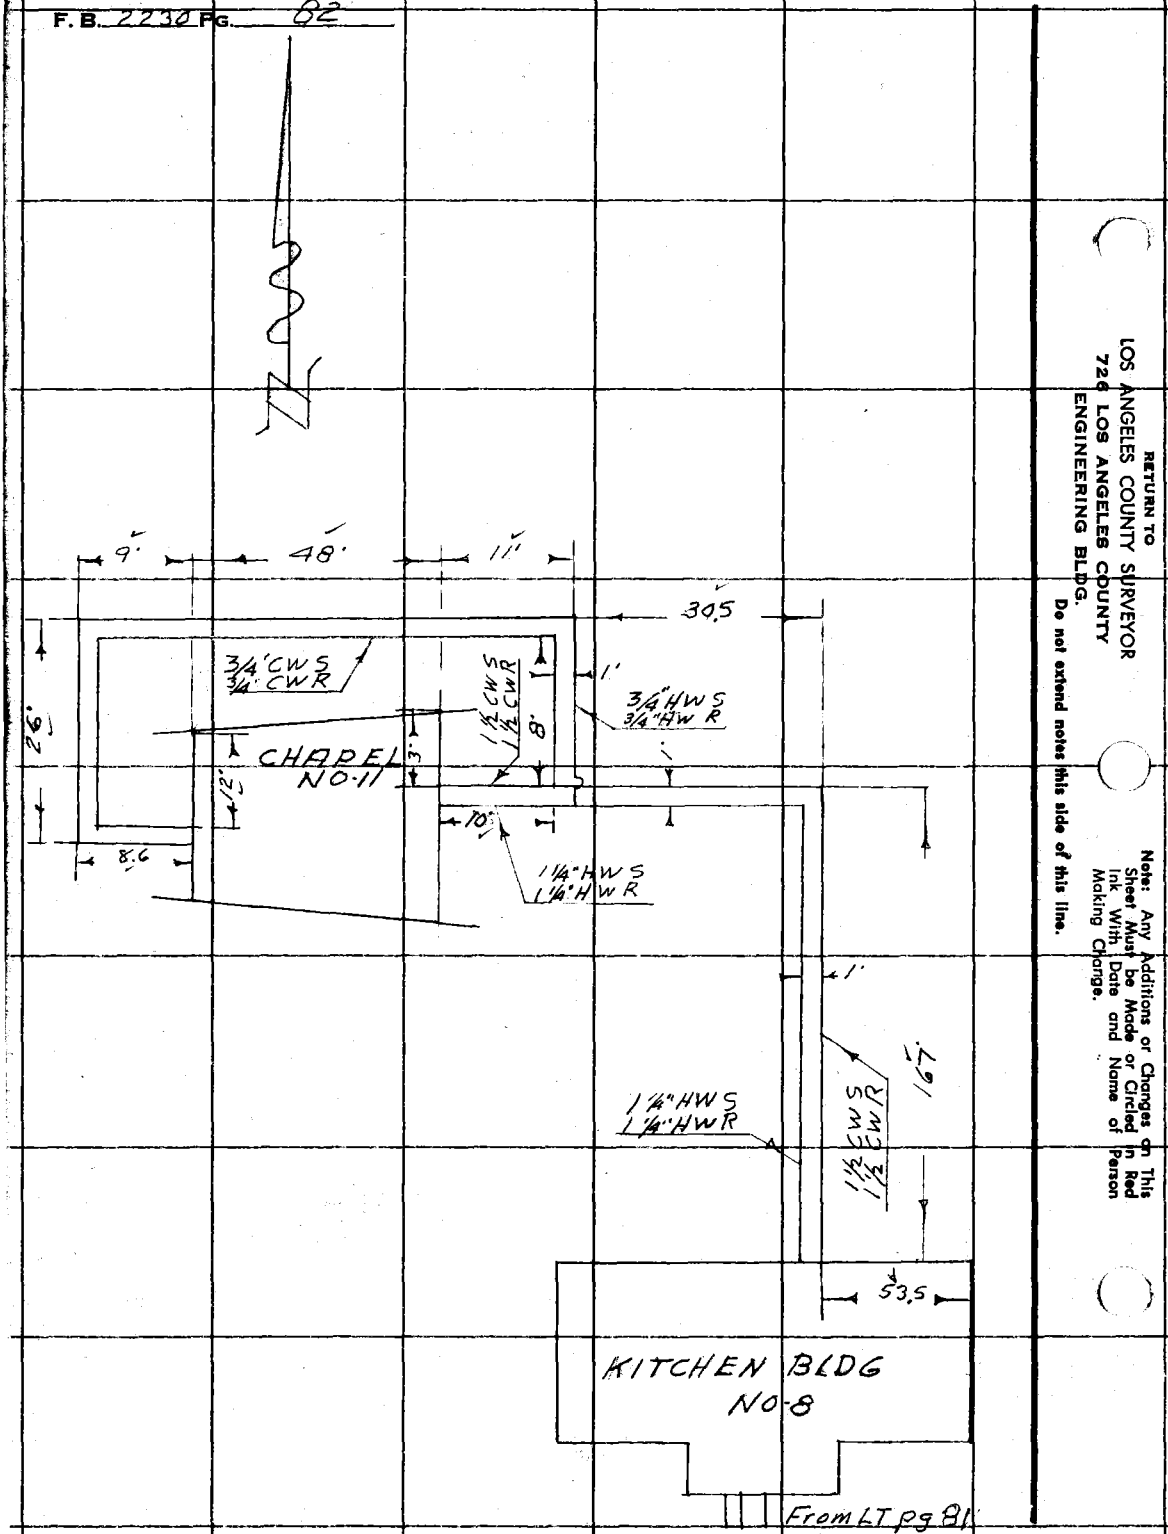

RETURN TO
LOS ANGELES COUNTY SURVEYOR
726 LOS ANGELES COUNTY
ENGINEERING BLDG.
Do not extend notes this side of this line.

Note: Any Additions or Changes on This Sheet Must be Made or Circled in Red Ink With Date and Name of Person Making Change.

Notes Ck'd by	Survey of Juvenile Hall
Map No.	W. O. 8382.01 Tape No. 0145 St'd. 68 °F
Office Work	Surveyed by M.A. Van Deren
Checked	Notes Van Date
Date	Indexed K. C. Johnson

F. B. 2230 Pg. 83

JN 8382.01

STAKING SKETCH OF DURANT INSULATED PIPE FOR HOT WATER SYSTEM.

AT

JUVENILE HALL AT RANCHO LOS AMIGOS

"Note" all lines staked per plan (drawing Number 3244)

DOMESTIC HOT WATER SYSTEM

Van Deren
Landa
Bazen
Turrill

See pg 88 For loc. of 2" cpr. soft water line from Bldg. 9 To #8

Note: Any Additions or Changes on This Sheet Must be Made in Red Ink or Circled With Date and Name of Person Making Change.

Do not extend notes this side of this line.

RETURN TO
LOS ANGELES COUNTY SURVEYOR
726 LOS ANGELES COUNTY
ENGINEERING BLDG.

76F309 S&E #247. 8-84

F.B. 2230 PG. 84

RETURN TO
LOS ANGELES COUNTY SURVEYOR
726 LOS ANGELES COUNTY
ENGINEERING BLDG.

Note: Any Additions or Changes on This Sheet Must be Made or Circled in Red Ink With Date and Name of Person Making Change.

Do not extend notes this side of this line.

76F309S S&E #247. 8-54

RETURN TO
LOS ANGELES COUNTY SURVEYOR
726 LOS ANGELES COUNTY
ENGINEERING BLDG.

Note: Any Additions or Changes on This Sheet Must be Made or Circled In Red Ink With Date and Name of Person Making Change.

Do not extend notes this side of this line.

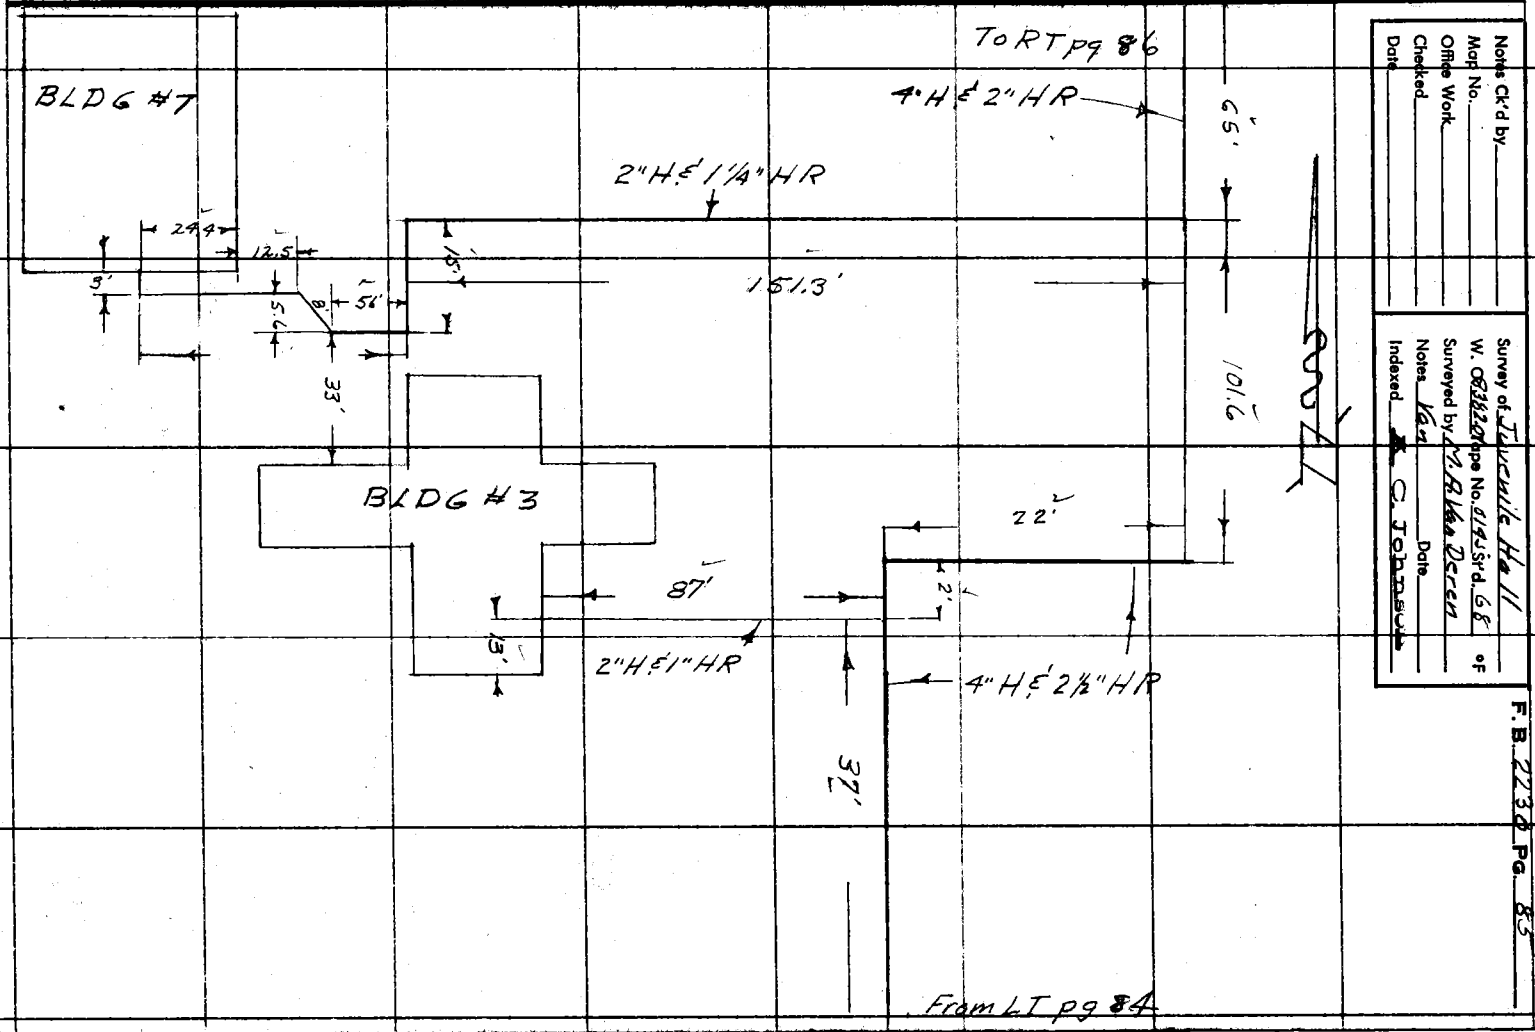

Notes Ck'd by _____
Map No. _____
Office Work _____
Checked _____
Date _____

Notes Kan Date
Indexed C. Johnson

F.B. 2230 Pg. 83

RETURN TO
LOS ANGELES COUNTY SURVEYOR
726 LOS ANGELES COUNTY
ENGINEERING BLDG.

Note: Any Additions or Changes on This Sheet Must be Made or Circled In Red Ink With Date and Name of Person Making Change.

Do not extend notes this side of this line.

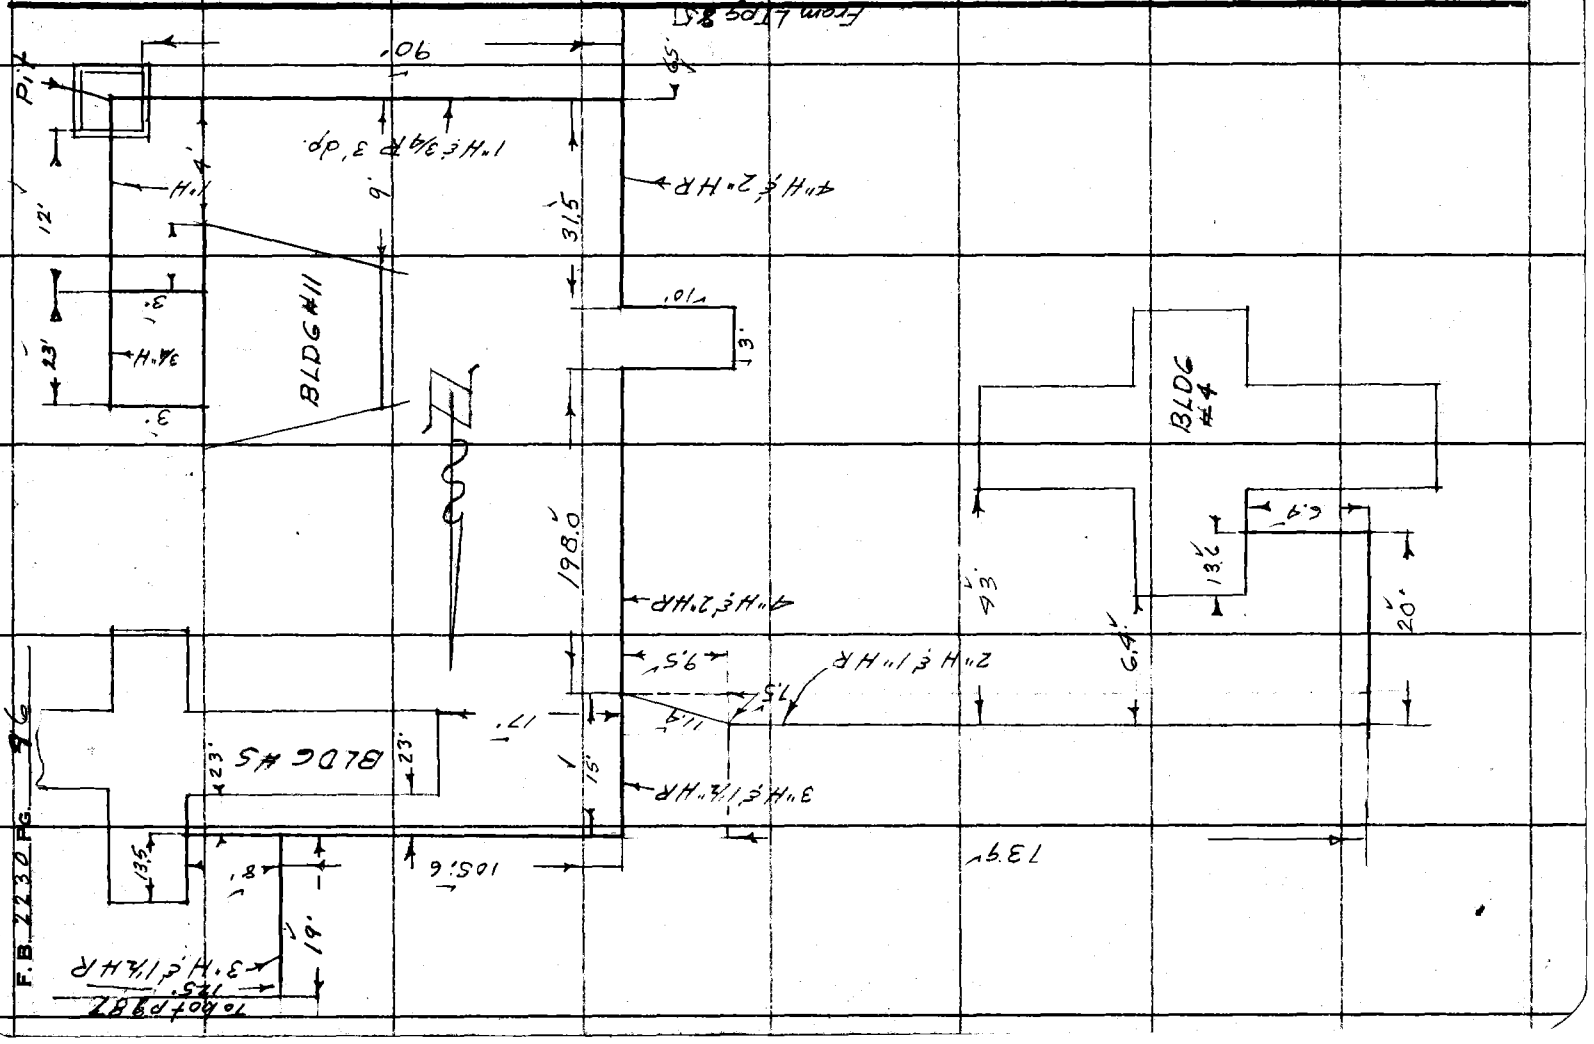

76F3095 S&E #247. 8-54

RETURN TO
LOS ANGELES COUNTY SURVEYOR
726 LOS ANGELES COUNTY
ENGINEERING BLDG.

Note: Any Additions or Changes on This Sheet Must be Made or Circled in Red Ink With Date and Name of Person Making Change.

Do not extend notes this side of this line.

Notes Ck'd by
Map No.
Office Work
Checked
Date

Survey of Juvenile Hall
W. O. 8332 Type No. 0145 rd. 68 of
Surveyed by M. A. Vaughn Dorey
Notes Date
Indexed C. Johnson

F. B. 2230 Pg. 82

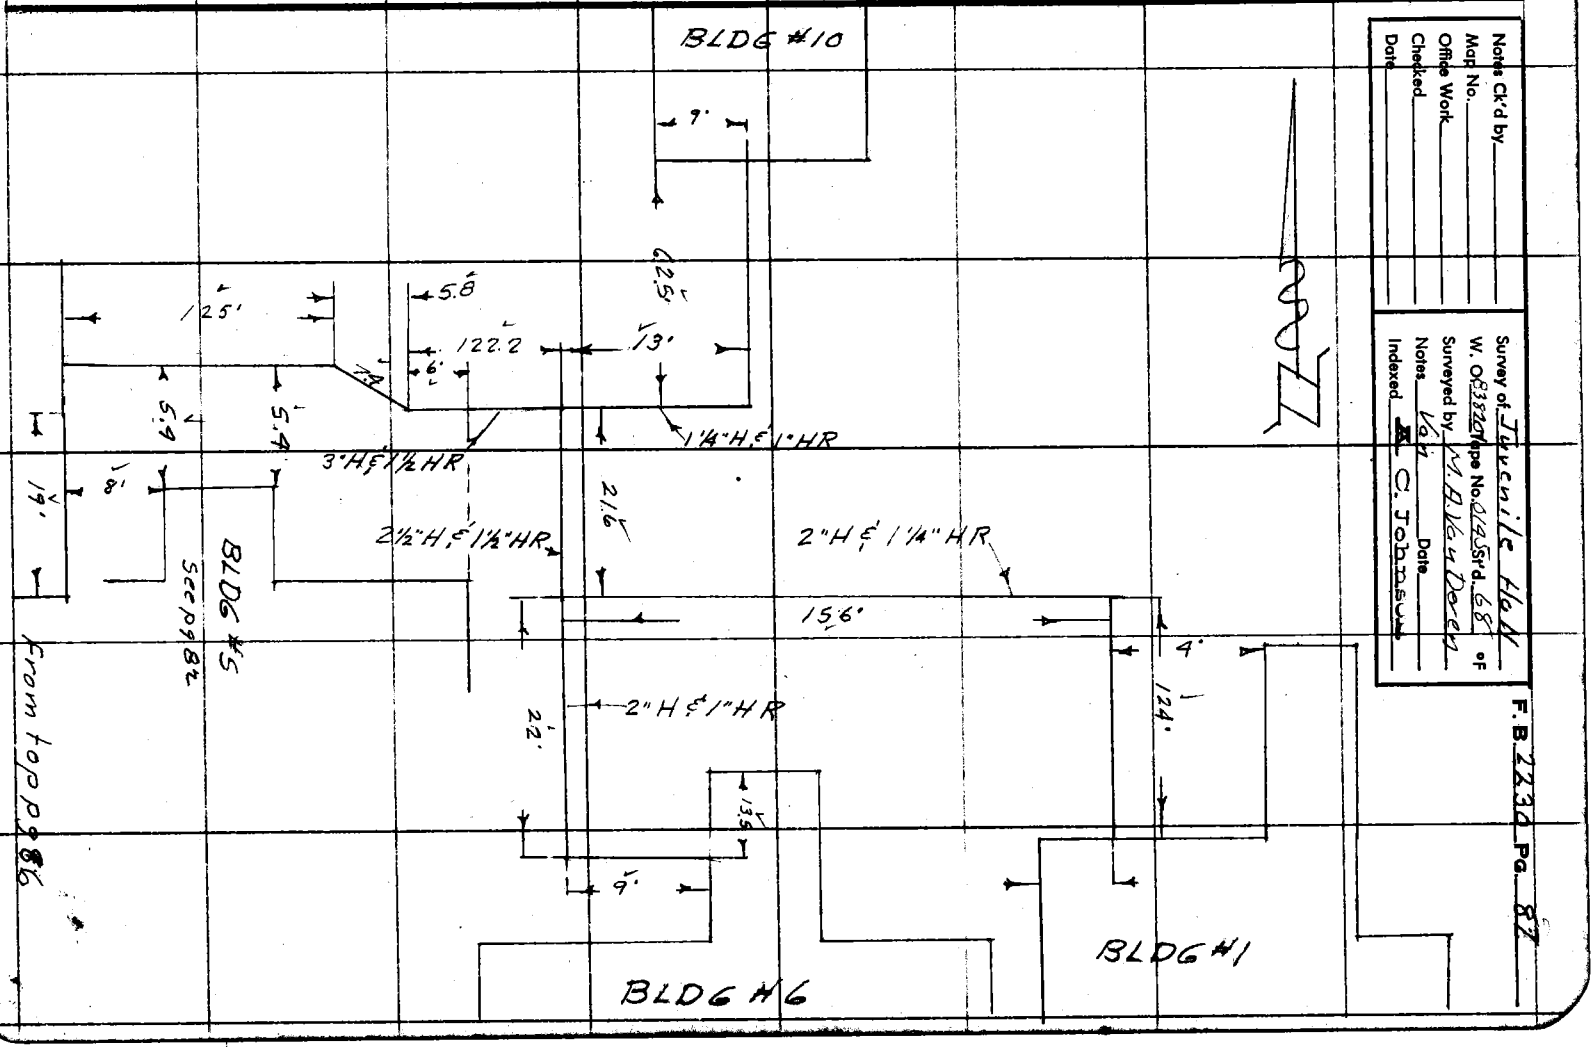

F. B. 1230 PG. 88

RETURN TO
LOS ANGELES COUNTY SURVEYOR
720 LOS ANGELES COUNTY
ENGINEERING BLDG.
Do not extend notes this side of this line.

Note: Any Additions or Changes on This Sheet Must be Made or Circled in Red Ink With Date and Name of Person Making Change.

Notes Ck'd by	Survey of Juvenile Hall	F. B. 2230 Pg. 89
Map No.	W. O. 8382.01 Tape No. 0145 Sr'd. 68 °F	
Office Work	Surveyed by M.A. Van Deren	
Checked	Notes Van Date 7-31-56	
Date	Indexed K. C. Johnson	

JN 8382.01

PLOT PLAN SIGNAL SYSTEMS

AT

JUVENILE HALL FACILITY RANCHO LOS AMIGOS

SEE SHEET E3-A-R

7-31-56
Van Deren
Landa
Bazen
Turrill

Note: Any Additions or Changes on This Sheet Must be Made or Circled in Red Ink With Date and Name of Person Making Change.

Do not extend notes this side of this line.

RETURN TO
LOS ANGELES COUNTY SURVEYOR
726 LOS ANGELES COUNTY
ENGINEERING BLDG.

76F309S S&E #247. 6-54

RETURN TO
LOS ANGELES COUNTY SURVEYOR
726 LOS ANGELES COUNTY
ENGINEERING BLDG.

Do not extend notes this side of this line.

Note: Any Additions or Changes on This Sheet Must be Made or Circled in Red Ink With Date and Name of Person Making Change.

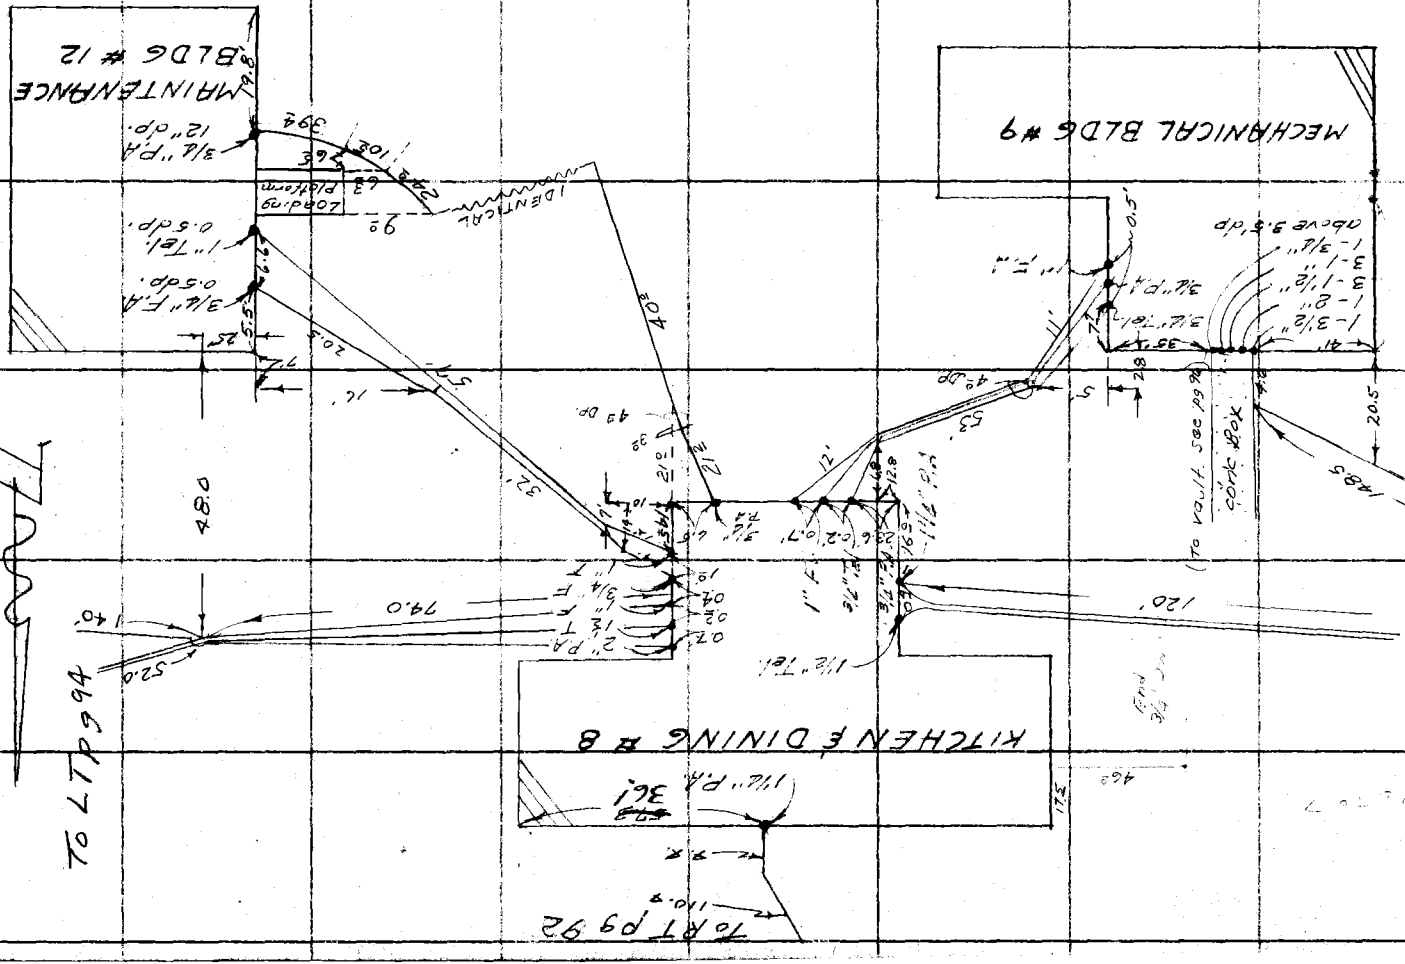

Notes Ck'd by	Survey of Juvenile Hall
Map No.	W. O. 6382.0 Tape No. 0145 Std. 68 °F
Office Work	Surveyed by M.A. Van Deren
Checked	Notes Van Date 7-31-56
Date	Indexed E. C. Johnson

F. B. 2230 Pg. 91

To bot Rt pg 92

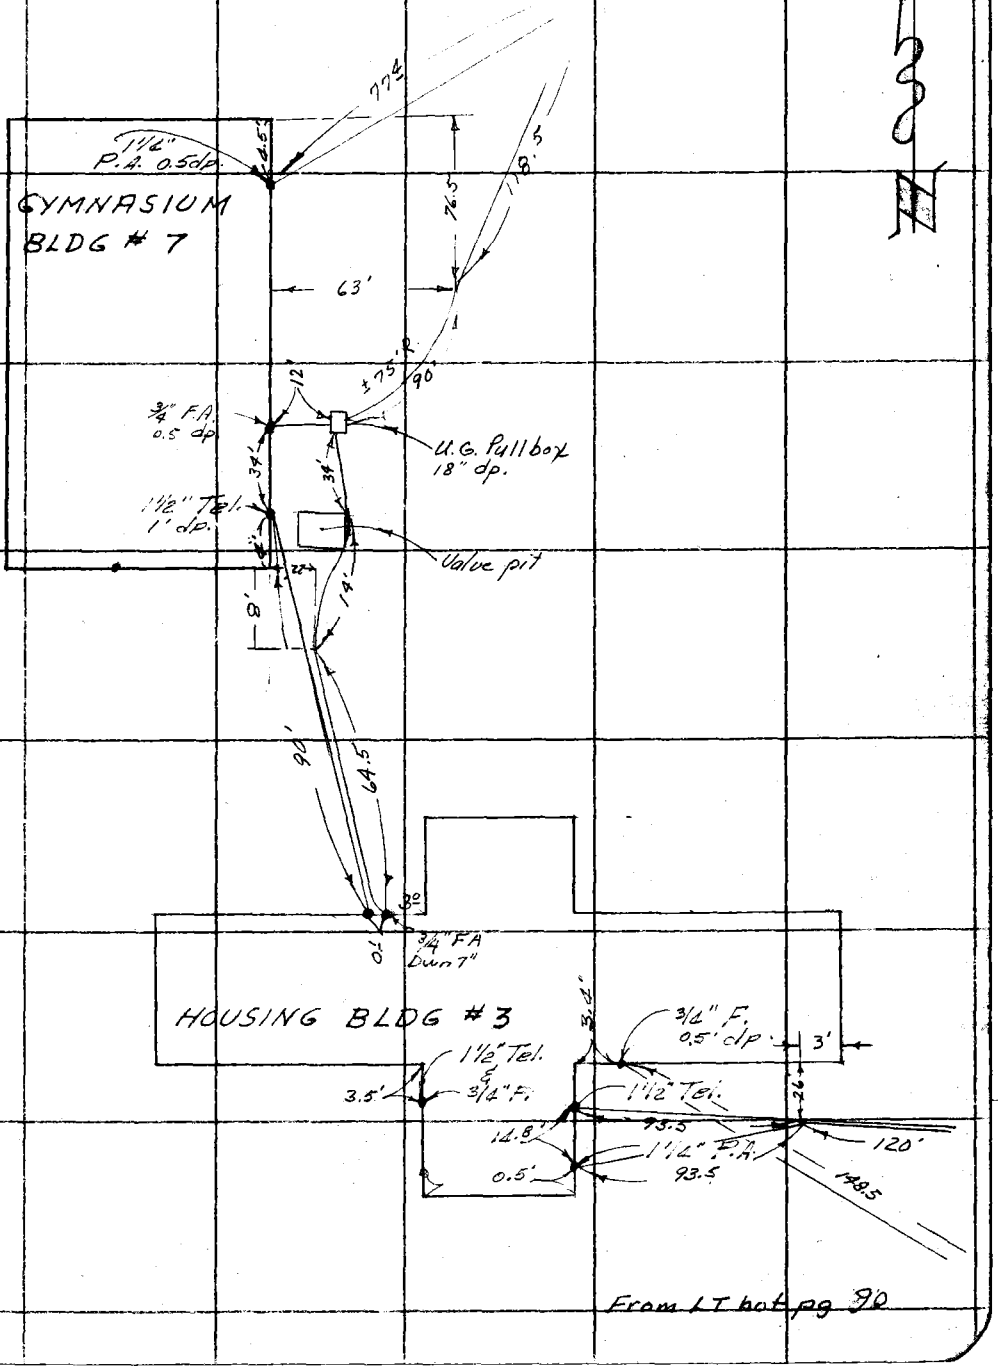

From LT bot pg 90

Note: Any Additions or Changes on This Sheet Must be Made or Circled in Red Ink With Date and Name of Person Making Change.

Do not extend notes this side of this line.

RETURN TO
LOS ANGELES COUNTY SURVEYOR
726 LOS ANGELES COUNTY
ENGINEERING BLDG.

76F3095 S&E #247. 6-54

F. B. 2230 Pg. 92

To bot pg 93

From LI pg 90

RETURN TO
LOS ANGELES COUNTY SURVEYOR
720 LOS ANGELES COUNTY
ENGINEERING BLDG.

Do not extend notes this side of this line.

Note: Any Additions or Changes on This Sheet Must be Made or Circled in Red Ink With Date and Name of Person Making Change.

HOUSING BLDG #5

HOUSING BLDG #4

CHAPEL #11

(See pg 52-8 For vault details)

To top pg 91

From T. pg 91

Notes Ck'd by	Survey of Juvenile Hall
Map No.	W. O. 8382 0 Tape No. 0145 St'd. 68 °F
Office Work	Surveyed by M. Alan Deren
Checked	Notes Van Date 7-31-56
Date	Indexed K. C. Johnson

F. B. 2230 Pg. 93

RETURN TO
LOS ANGELES COUNTY SURVEYOR
726 LOS ANGELES COUNTY
ENGINEERING BLDG.

Note: Any Additions or Changes on This Sheet Must be Made or Circled in Red Ink With Date and Name of Person Making Change.

Do not extend notes this side of this line.

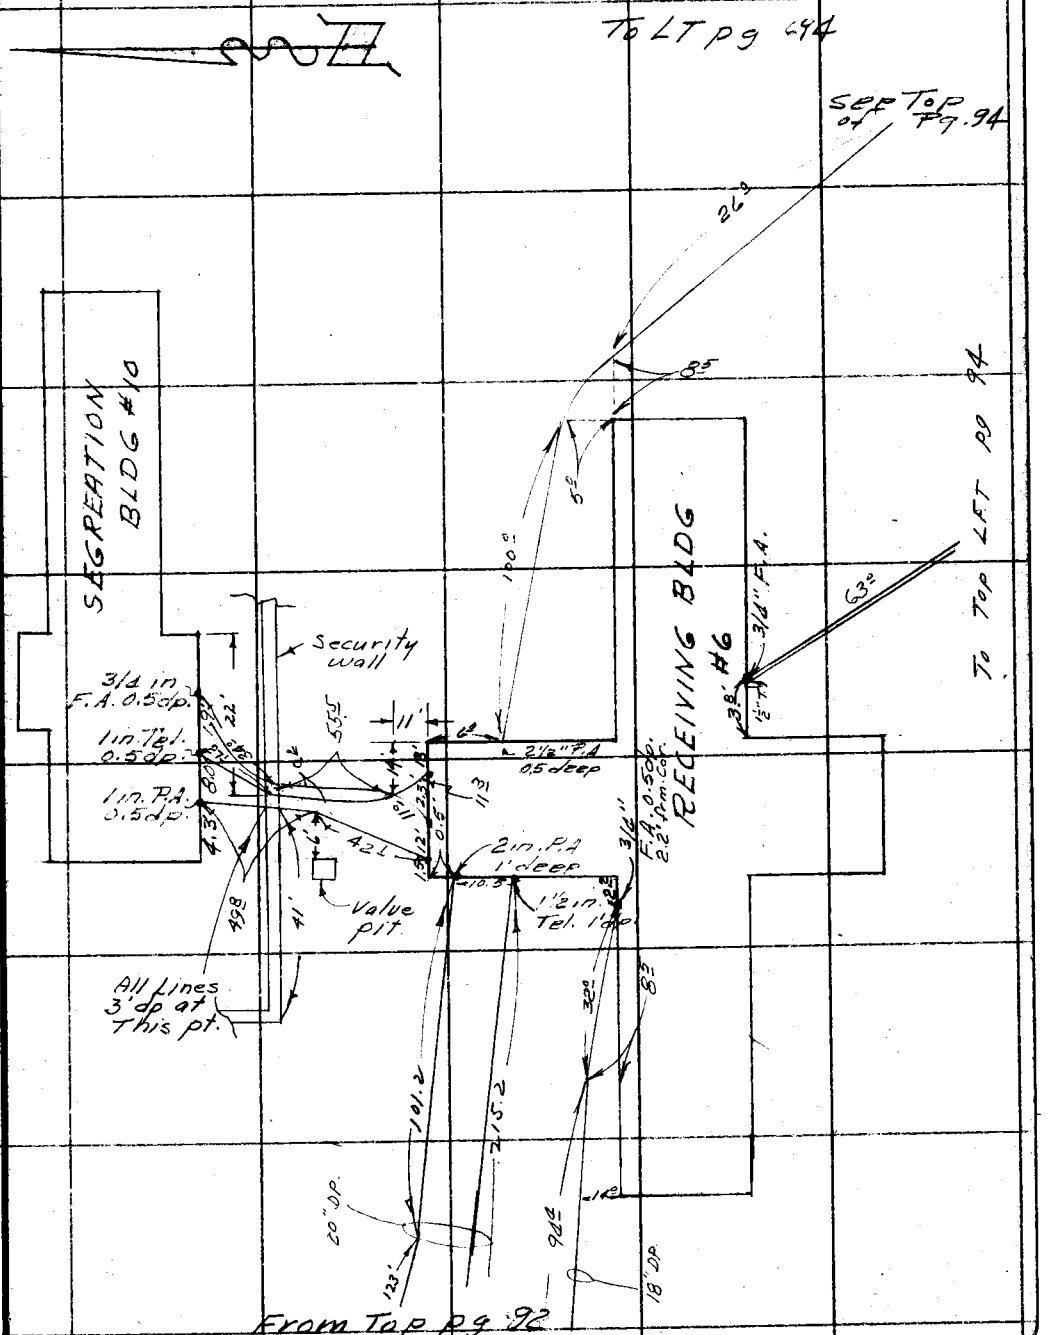

76F3098 S&E #247. 8-54

RETURN TO
LOS ANGELES COUNTY SURVEYOR
726 LOS ANGELES COUNTY
ENGINEERING BLDG.

Note: Any Additions or Changes on This Sheet Must be Made or Circled in Red Ink With Date and Name of Person Making Change.

Do not extend notes this side of this line.

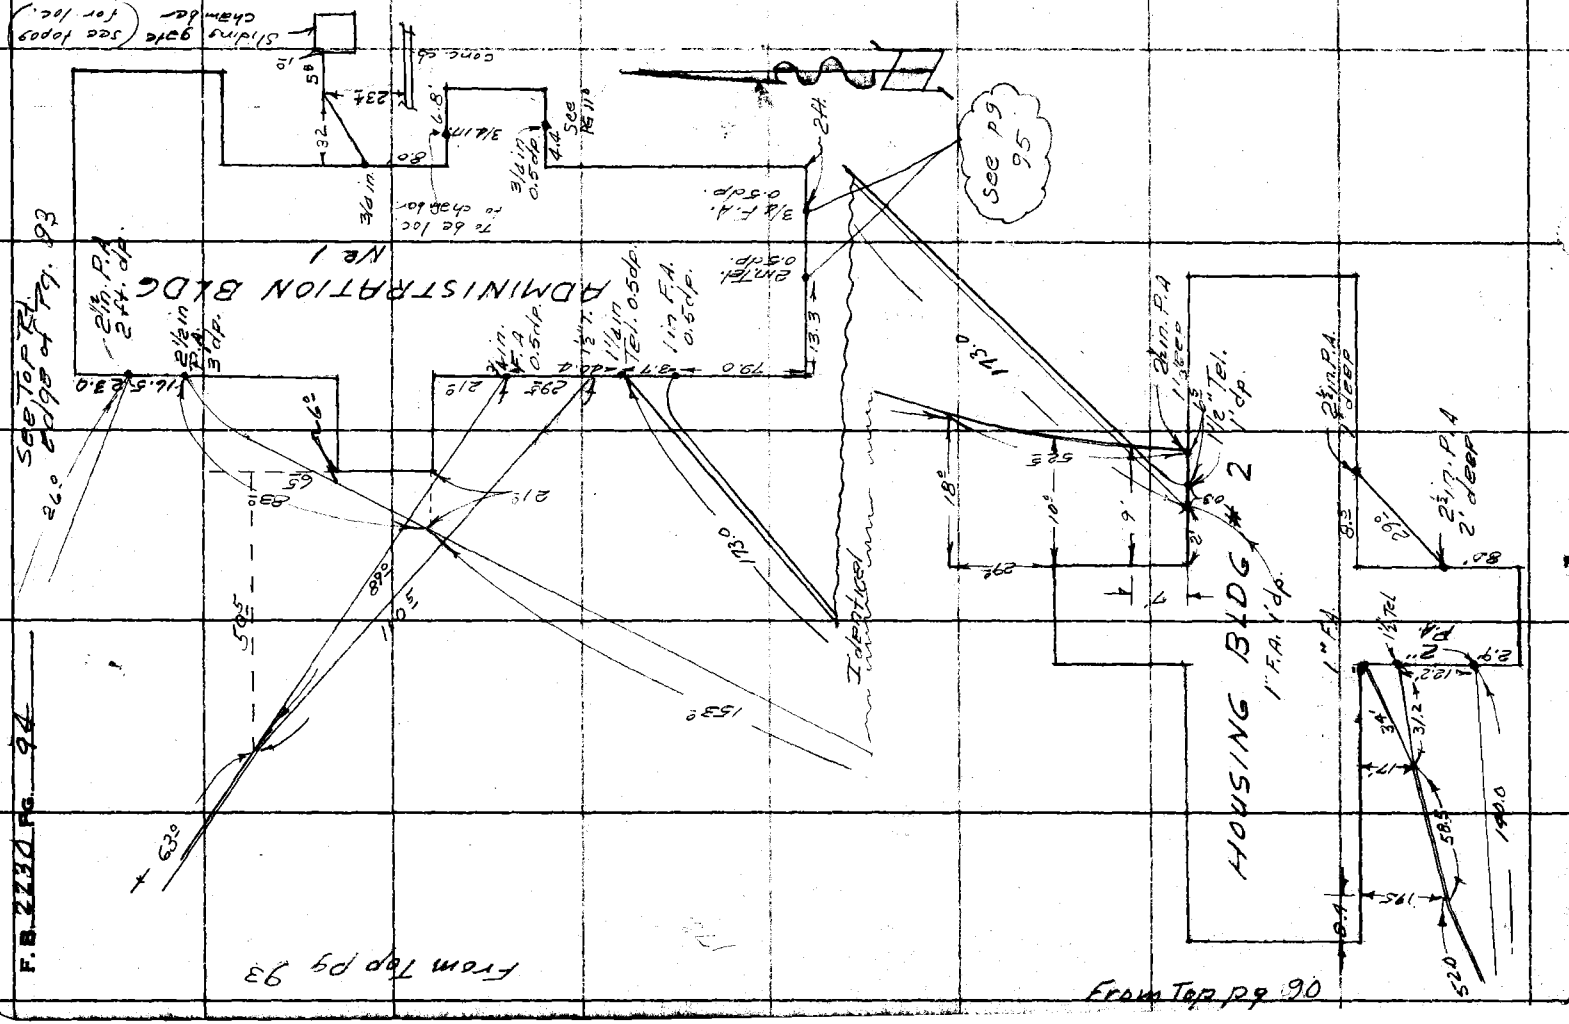

Notes Ck'd by	Survey of Juvenile Hall
Map No.	JN 8382.01 Tape Std °F
Office Work	Surveyed by D. Sappell
Checked	Notes D.S. Date 10-25-56
Date	Indexed A. C. Johnson

F. B. 2230 Pg. 95

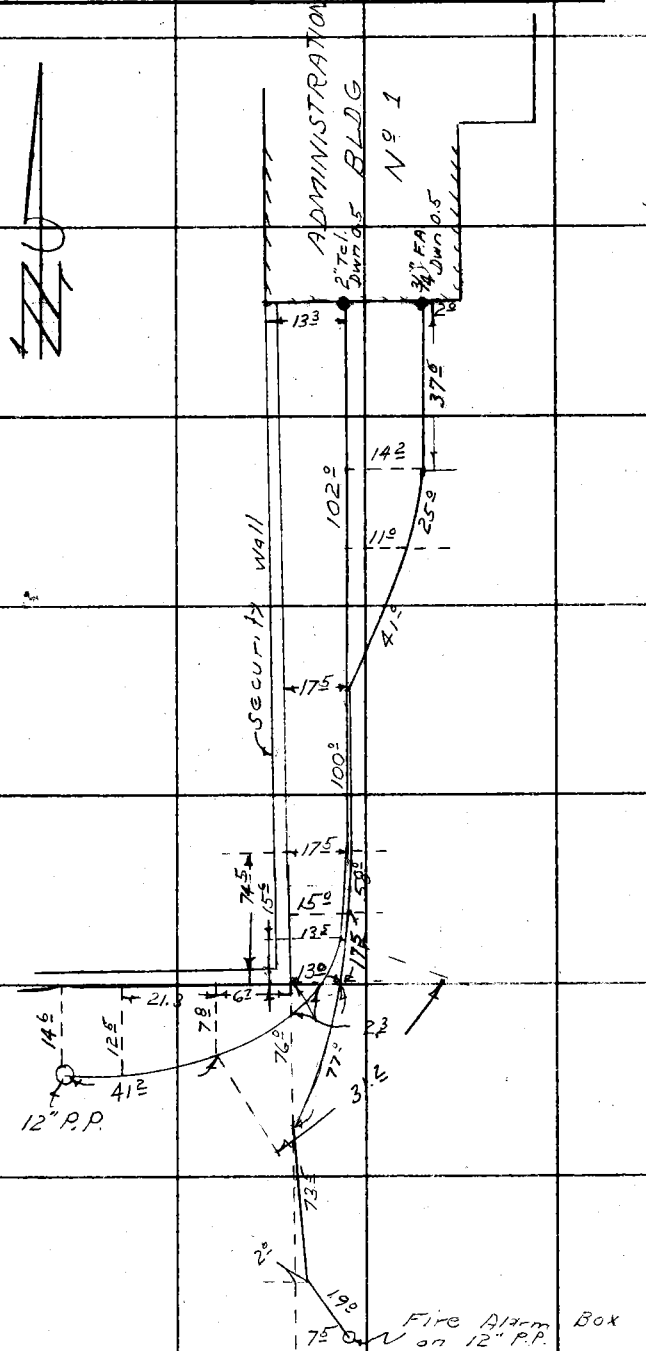

Note: Any Additions or Changes on This Sheet Must be Made or Circled in Red Ink With Date and Name of Person Making Change.

Do not extend this side of this line.

PLEASE RETURN TO
LOS ANGELES COUNTY ENGINEER
700 Los Angeles County Engineering Bldg.

76F3098 SEE #247 1-56

PLEASE RETURN TO
LOS ANGELES COUNTY ENGINEER
700 LOS ANGELES COUNTY ENGINEERING BLDG.

Note: Any Additions or Changes on This Sheet Must be Made or Circled in Red Ink With Date and Name of Person Making Change.

Do not extend this side of this line.

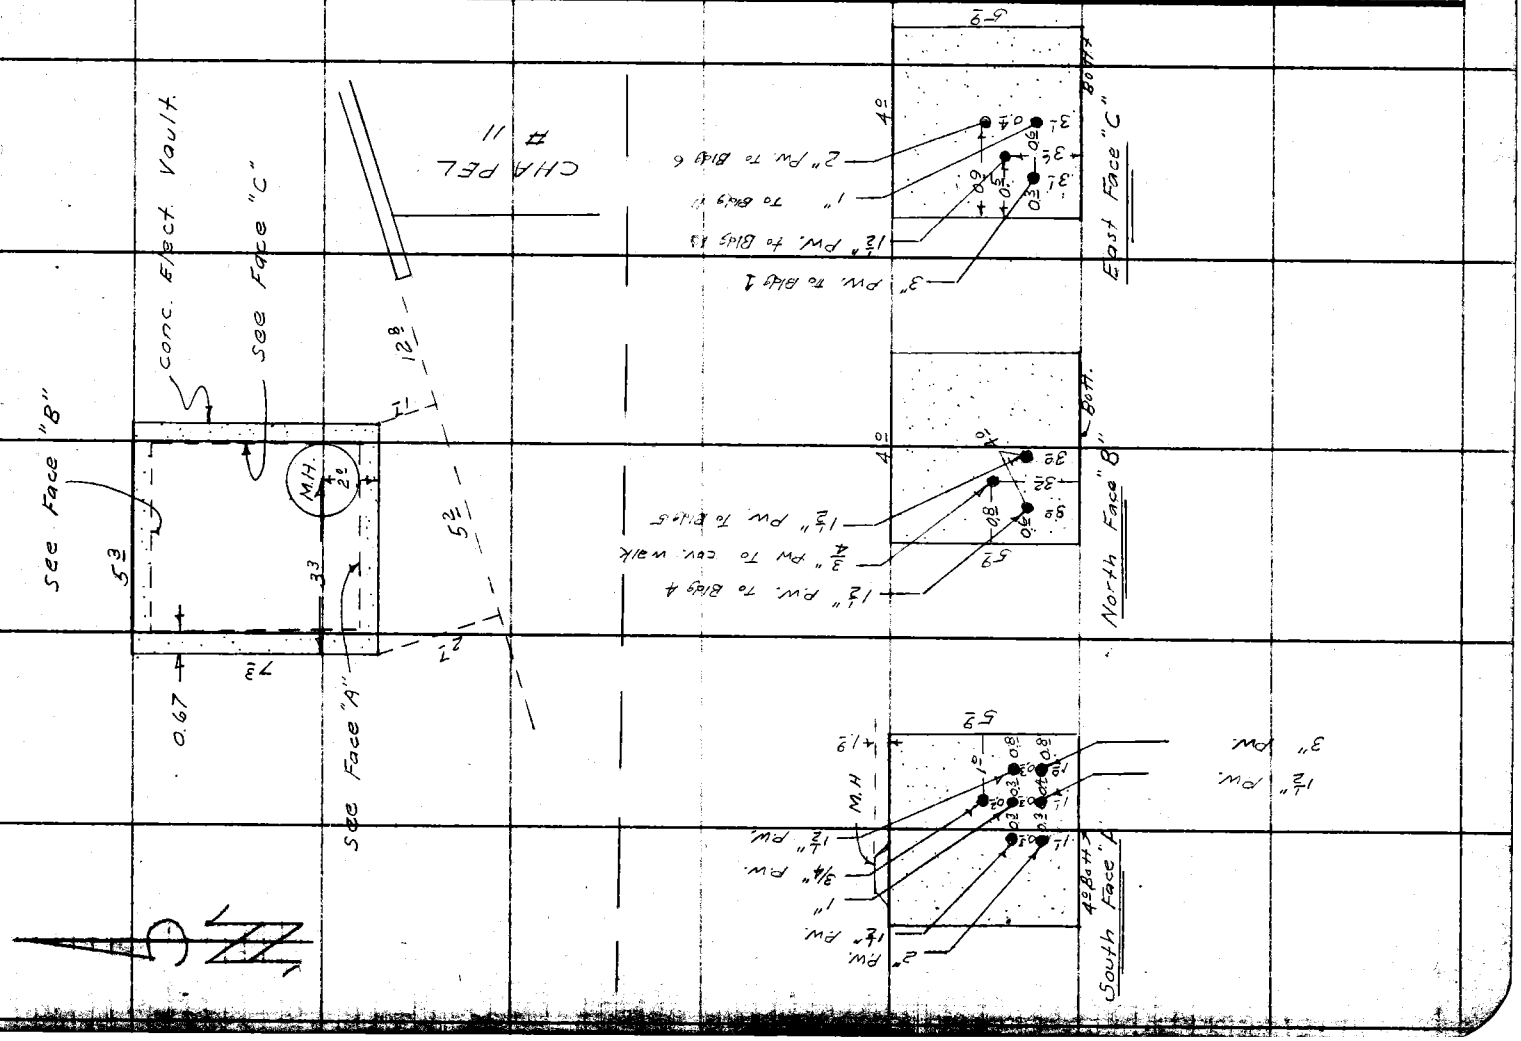

F.B. 2230 Pg. 996

Notes Ck'd by	Survey of Juvenile Hall
Map No.	W. O. 8382.01 Tape No. 0145 Std. 68 °F
Office Work	Surveyed by Van Deren
Checked	Notes E. Londa Date Aug. 56
Date	Indexed ~~K C Johnson~~

F. B. 2230 Pg. 91

PLOT PLAN

ELECTRICAL SERVICE

BRANCH JUVENILE HALL FACILITY
Rancho Los Amigos

J.N. 8382.01

See Sheet E1-A-R

Party:
Van Deren
Londa
Basin
Turrill

UNIT Nº	Pg.
8, 9, & 12	92
3 & 7	93
4, 5, & 11	94
1, 6, & 10	95
2	96

Note: Any Additions or Changes on This Sheet Must be Made in Red Ink With Date and Name of Person Making Change.

Do not attach notes this side of this line.

RETURN TO
LOS ANGELES COUNTY SURVEYOR
726 LOS ANGELES COUNTY
ENGINEERING BLDG.

76F3095 S&E #247. 8-54

F.B. 2230 PG. 98

RETURN TO
LOS ANGELES COUNTY SURVEYOR
720 LOS ANGELES COUNTY
ENGINEERING BLDG.
Do not extend notes this side of this line.

Note: Any Additions or Changes on This Sheet Must be Made or Circled in Red Ink With Date and Name of Person Making Change.

815
180
78 2
259.7

See Pg. 102

To Lt. Pg 102

See Pg. 102 for Pg. 100

See Pg. 102 for Pg. 100

Security Wall

MAINTEN-ANCE BUILDING No 12

Loading Ramp

UNIT No 8

KITCHEN & DINING BLDG

1½" Ip. Power 1' dp.

1½" Ip. Power

3/8 in. C.S. Post Mean no each 4' dp.

Post

1½" Pk. Top. 1½" Pw. 1' dp.

MECH BLDG

UNIT No 9

Cont. Rot Pg 99

52'
48.
25'
4'
38.0
8'
4½
61'
27½
89.
9'
4½
3.4'
45°
5'
8½
3.0
6.5
82'
33½
28'
12½
22½" Power
1½
44'
70'
42.5
6.8
25
0.5
0.5
0.5
B.F.
Down 3°
Down 4°
Down 1°
Down 4°
Down 3°
Down 3°

Notes Ck'd by	Survey of Juvenile Hall
Map No.	W. O. 8382.01 Tape No. 0145 St'd. 68 °F
Office Work	Surveyed by VanDeren
Checked	Notes E. Londo Date Aug 56
Date	Indexed C. Johnson

F. B 2230 Pg. 99

See bottom of Pg 100

GYMNASIUM & CLASSROOM BLD. No 7

26'

2½ Pw. 4 dp.

20.5

HOUSING UNIT No 3 BUILDING

75

13°

1½" Pw. 0.5 dp

See Pg. 92 @ bottom, left edge

331'

Dwn 3°

20°

Dwn 2°

82'

cont from bot Pg. 98

Note: Any Additions or Changes on This Sheet Must be Made or Circled in Red Ink With Date and Name of Person Making Change.

Do not extend notes this side of this line.

RETURN TO
LOS ANGELES COUNTY SURVEYOR
726 LOS ANGELES COUNTY
ENGINEERING BLDG.

76F3008 SAE #247. 8-54

F. B. 2230 Pg. 100

RETURN TO
LOS ANGELES COUNTY SURVEYOR
720 LOS ANGELES COUNTY
ENGINEERING BLDG.

Do not extend notes this side of this line.

Note: Any Additions or Changes on This Sheet Must be Made or Circled in Red Ink With Date and Name of Person Making Change.

HOUSING UNIT No 5 BUILDING

HOUSING UNIT No 4 BUILDING

CHAPEL No 11

See Page 99

See Pg 101

See Pg 98

See Pg 98 for South Detail

Manhole

1782

186

181

155

135

123

115

24'

3" P.W.

1" P.W.

1½" P.W.

1½" P.W.

S 24° W

N 66° E

N 24° E

N 66° W

S 66° E

S 24° W

S 66° W

N 24° W

N 66° E

N 24° E

Notes Ck'd by	Survey of Juvenile Hall
Map No.	W. O. 8382.61 Tape No. 0185 St'd. 68° °F
Office Work	Surveyed by Von Deren
Checked	Notes E. Londe Date Aug. 54
Date	Indexed C. Johnson

F. B. 2230 Pg. 101

Note: Any Additions or Changes on This Sheet Must be Made or Circled in Red Ink With Date and Name of Person Making Change.

Do not extend notes this side of this line.

RETURN TO
LOS ANGELES COUNTY SURVEYOR
726 LOS ANGELES COUNTY
ENGINEERING BLDG.

76F3095 SSE #247. 8-54

SEGREGATION BLDG No 10

0.5' 1 1/2 in Pw. 3.5dp.

31.5

4'dp

Security Wall

2'dp

133'

9'

Valve Pit

See Top Sh. 100

2in Pw. Dwn 0.5

100'

Dwn 2°

10'

24.5

48'

RECEIVING BUILDING UNIT No 6

3" Pw. 1' dp.

3" Pw. dp.

48.52

3in. Pw. 3'dp.

104°

30°

36.5

Dwn 2°

130°

See Top Sh. 100

ADMINISTRATION BUILDING UNIT No

See Pg.

RETURN TO
LOS ANGELES COUNTY SURVEYOR
726 LOS ANGELES COUNTY
ENGINEERING BLDG.

Note: Any Additions or Changes on This Sheet Must be Made or Circled In Red Ink With Date and Name of Person Making Change.

Do not extend notes this side of this line.

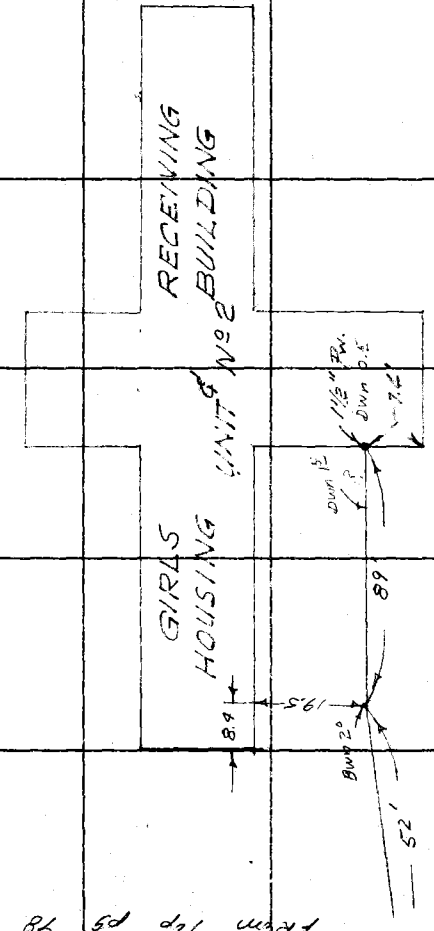

F.B. 2230 Pg. 102

86 From Top of Pg

Notes Ck'd by		Survey of Juvenile Hall	F. B. 2230 Pg. 103
Map No.		JN 8382.01 Tape Std °F	
Office Work		Surveyed by D. Sappell	
Checked		Notes D.S Date 11-56	
Date		Indexed L. C. Johnson	

J. N. 8382.01

JUVENILE HALL

RANCHO LOS AMIGOS

LOC. OF LIGHT STANDARDS

IN PARKING AREA.

party: Sappell
Maldonado
Myers
Razen.

Note: Any Additions or Changes on this Sheet Must be Made or Circled in Red Ink With Date and Name of Person Making Change.

Do not extend this side of this line.

PLEASE RETURN TO
LOS ANGELES COUNTY ENGINEER
700 Los Angeles County Engineering Bldg.

76F3095 S&E #247 1-56

PLEASE RETURN TO
LOS ANGELES COUNTY ENGINEER
700 LOS ANGELES COUNTY ENGINEERING BLDG.

Note: Any Additions or Changes on This Sheet Must be Made or Circled in Red Ink With Date and Name of Person Making Change.

Do not extend this side of this line.

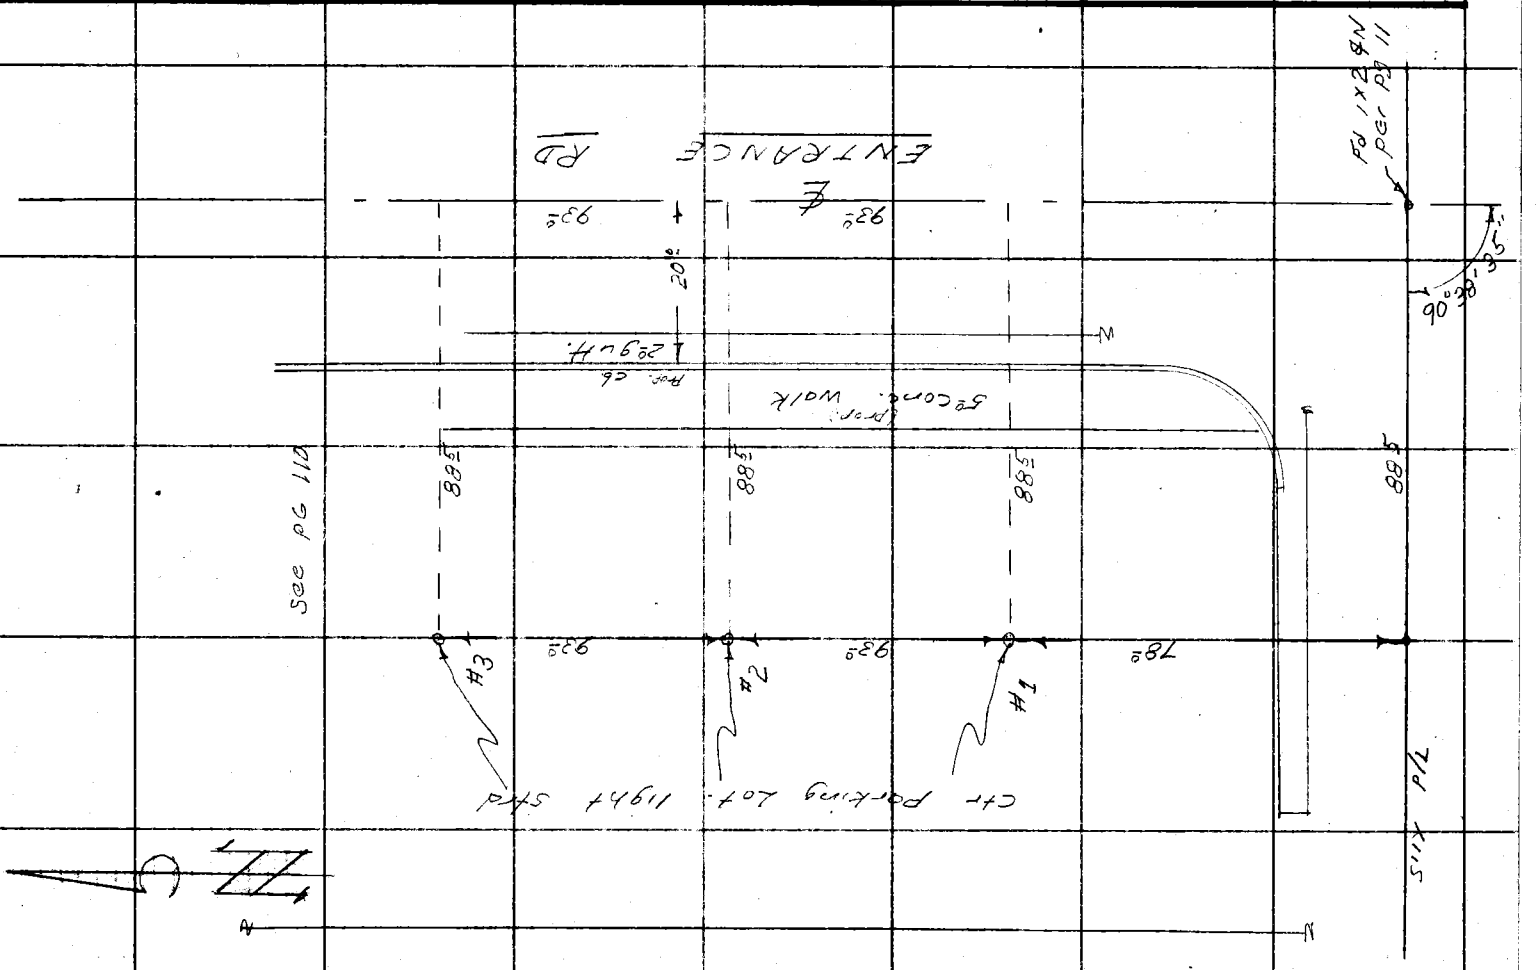

F.B. 2230 Pg. 104

Profile No. | Notes Red. | Plotted | Job No. 8382.01 | Division No. 10 | F. B. 2230 | Pg. 105

Date | Date | Survey of Juvenile Hall

X-Sec. No. | Notes Chkd. | Checked | Survey by Sappell | Notes D.S. | Date 11- -56

Date | Date | Map No. ~~Indexed~~ K. C. Johnson | Date

J.N. 8382.01

Juvenile Hall - Rancho Los Amigos

Grades for Light Standards in parking Area.

party: Sappell
Maldonado
Bazen
Myers.

STATION	B. S.	H. I.	F. S.	ELEV.

NOTE: ANY ADDITIONS OR CHANGES ON THIS SHEET MUST BE MADE OR CIRCLED IN RED INK, WITH DATE AND NAME OF PERSON MAKING CHANGE.

PLEASE RETURN TO
LOS ANGELES COUNTY ENGINEER
700 Los Angeles County Engineering Bldg.

Do not extend notes this side of this line.

76298 S & E #307—7-55

76298 S & E #307—7-55

PLEASE RETURN TO
LOS ANGELES COUNTY ENGINEER
700 LOS ANGELES COUNTY ENGINEERING BLDG.

NOTE: ANY ADDITIONS OR CHANGES ON THIS SHEET MUST BE MADE OR CIRCLED IN RED INK, WITH DATE AND NAME OF PERSON MAKING CHANGE.

Do not extend notes this side of this line.

F. B. 2230 Pg. 106 Job No. 8382A Division No. 10 Profile
Survey of Juvenile Hall No. X-Sec.
Survey by Sagrell Notes D.C. Notes Red. Notes Chkd. Notes
Indexed K. C. Johnson Date Plotted Date Checked Date Date

STATION	B. S.	H. I.	F. S.	ELEV.	Pvmt. Grade	C & F	
TBM #1				96 02			T.B.M. #1, El. 96.022 F.B. 2230-11
	700	103 02					So. side 3" I.P. 24" dp. on S.P.L.
Lt. Strd #1			5 33	97 69	97.69	Pvmt. Grade	set blue top 1° E. of So. 4° Tie.
Lt Strd #2			5 40	97 62	98.03	F-0.41	So. 4° Tie.
Lt strd #3			4 65	98 37	98.37	Pvmt. Grade	No. 4° Tie (grade)
T.P.	4 22	103 97	3 27	99 75			T.P.
BM #4			3 80	100 17			BM #4 - P.M. in So. Rim of
Sec PG 133	4 04	104 21					S.M.H. on S'ly line of
T.P.	2 80	105 18	1 83	102 38		T.P.	Chapel & 64' E of E. Face.
T.B.M. #3			7 78	97 40			T.B.M. No 3, El. 97.417, F.B.
							2230-11, So. side 3" I.P. 24"
							Dp. on axis line.

Notes Ck'd by	Survey of Juvenile Hall
Map No.	W. O. 8382.01 Tape No. 0145 St'd. 68 °F
Office Work	Surveyed by M.A. Van Deren
Checked	Notes E. Landa Date Aug 56
Date	Indexed A. C. Johnson

F. B. 2230 Pg. 107

BRANCH JUVENILE HALL
FACILITY
RANCHO LOS AMIGOS
J.N. 8382.01

PLOT PLAN
SECURITY LIGHTING

See Sheet E2-A:R

Note: Any Additions or Changes on This Sheet Must be Made or Circled in Red Ink With Date and Name of Person Making Change.

Do not extend notes this side of this line.

RETURN TO
LOS ANGELES COUNTY SURVEYOR
726 LOS ANGELES COUNTY
ENGINEERING BLDG.

PARTY:	UNIT Nº	Page
M.A. VAN DEREN	9512	2
E. LANDA	208	3
J. BAZEN	1	4
R. TURRILL	6810	5
	455	6
	387	7

76F309 S&E #247. 8-54

F.B. 2230 PG. 108

RETURN TO
LOS ANGELES COUNTY SURVEYOR
726 LOS ANGELES COUNTY
ENGINEERING BLDG.

Do not extend notes this side of this line.

Note: Any Additions or Changes on This Sheet Must be Made or Circled in Red Ink With Date and Name of Person Making Change.

See 100 Pg 109
Rf. edge

Trans. 480 V.
enclosed on wall

14 Ft. High Security Wall

MAINTENANCE
BLDG.
UNIT No 12

MECH.
UNIT No 9

BLDG.

Kuhlman & Murray

See 8 Pg 109

See 100 Pg 109

1°
31°
19°
5.5
24.5
8°
27.2'
39.5
42.5
8.9
27.5'
27'
14
1°
3/4" Mon.
35° 35 Dp.
3/4"
9.18

76F3095 S&E #247. 8-54

RETURN TO
LOS ANGELES COUNTY SURVEYOR
726 LOS ANGELES COUNTY
ENGINEERING BLDG.

Note: Any Additions or Changes on This Sheet Must be Made or Circled In Red Ink With Date and Name of Person Making Change.

Do not extend notes this side of this line.

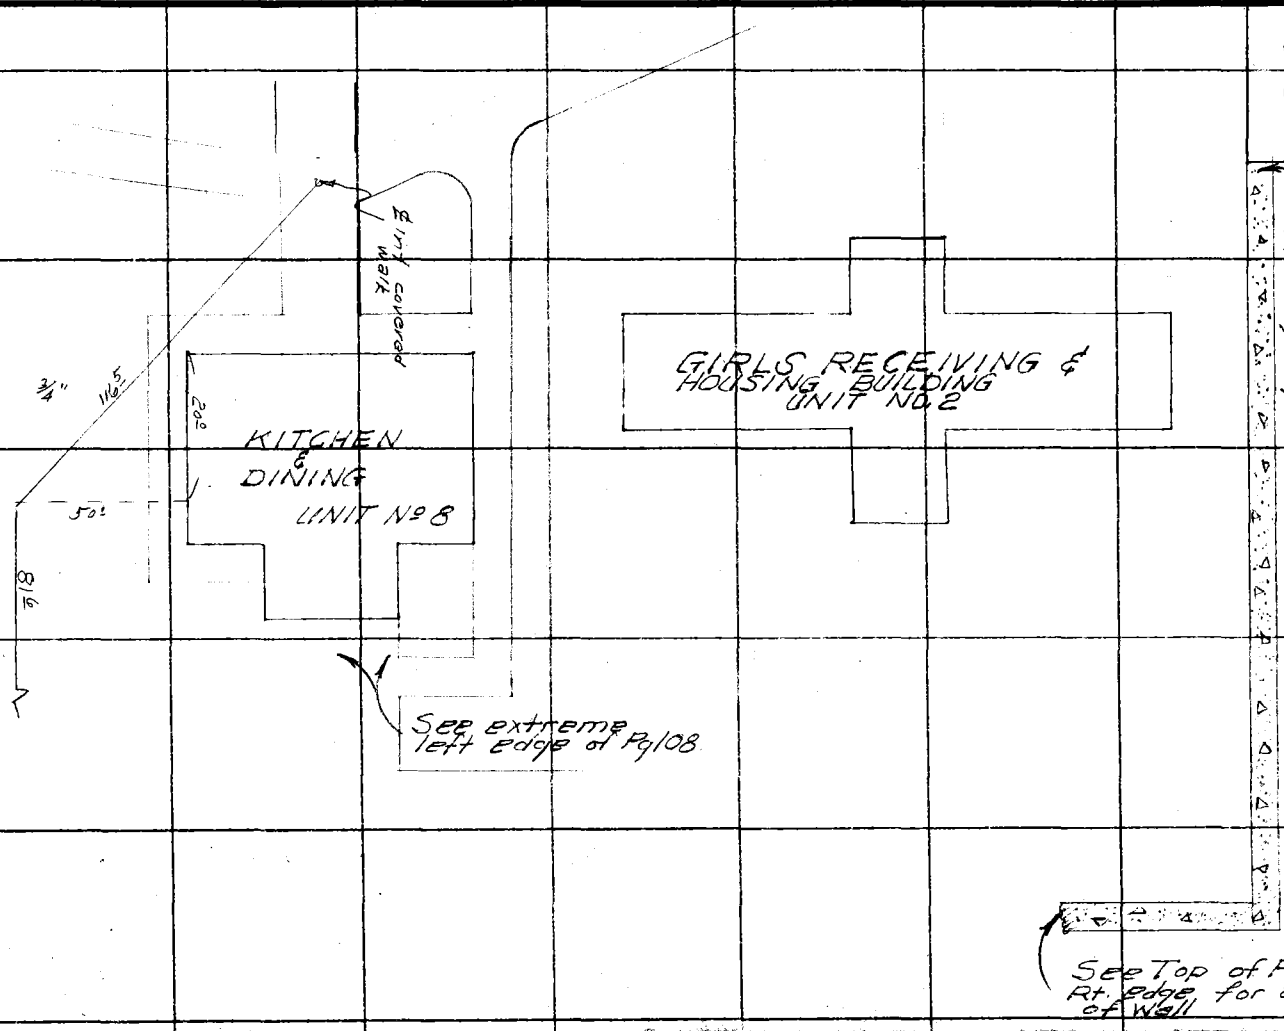

Notes Ck'd by
Map No.
Offsite Work
Checked
Date

Survey of Juvenile Hall
W. O. 83807 Tape No. 0165 Std. 66 oF
Surveyed by W.H. Van Dorn
Notes E. Lords Date Aug. 52
Indexed C. Johnson

F. B. 2230 Pg. 107

RETURN TO
LOS ANGELES COUNTY SURVEYOR
726 LOS ANGELES COUNTY
ENGINEERING BLDG.

Note: Any Additions or Changes on This Sheet Must be Made or Circled in Red Ink With Date and Name of Person Making Change.

Do not extend notes this side of this line.

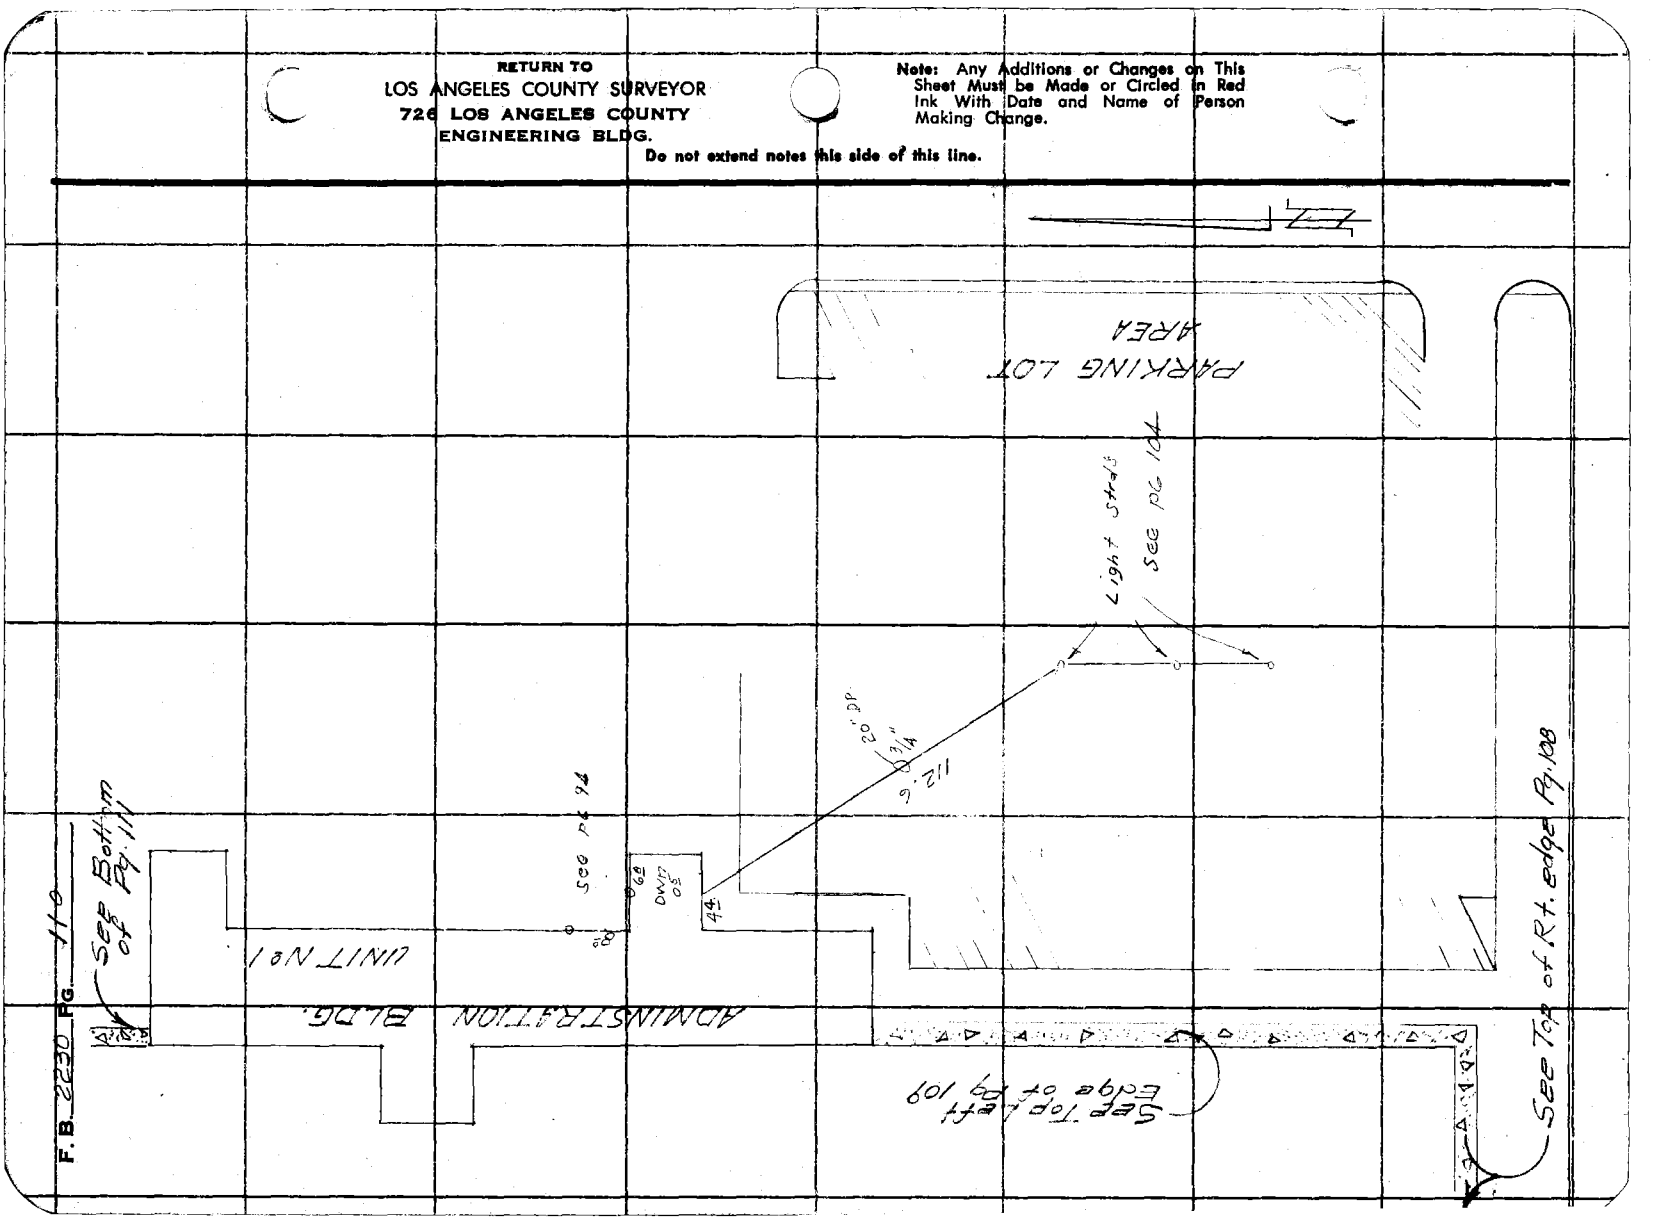

F.B. 2230 PG. 110

Notes Ck'd by	Survey of Juvenile Hall
Map No.	W. O. 8382.01 Tape No. 0145 St'd. 68 °F
Office Work	Surveyed by M.A. VanDeren
Checked	Notes E. Lander Date Aug. 56
Date	Indexed C. Johnson

F. B. 2230 Pg. 111

480 V. Trans. Enclosed on wall

SEGREGATION BLDG. UNIT Nº 10

41'

3' deep at This pt

68°

4'

Valve pit

3/4"

2.0

RECEIVING BUILDING UNIT Nº 6

ADMIN. BLDG. See Top of Pg. 110

Note: Any Additions or Changes on This Sheet Must be Made or Circled In Red Ink With Date and Name of Person Making Change.

Do not extend notes this side of this line.

RETURN TO
LOS ANGELES COUNTY SURVEYOR
726 LOS ANGELES COUNTY
ENGINEERING BLDG.

76F3095 S&E #247. 8-54

F. B. 2230 Pg. 112

RETURN TO
LOS ANGELES COUNTY SURVEYOR
720 LOS ANGELES COUNTY
ENGINEERING BLDG.

Note: Any Additions or Changes on This Sheet Must be Made or Circled in Red Ink With Date and Name of Person Making Change.

Do not extend notes this side of this line.

BUILDING
UNIT No. 5
HOUSING

UNIT No. 4
BUILDING
HOUSING

SECURITY WALL

148°

34"

49

101.3

45°

76F309S S&E #247. 8-54

RETURN TO
LOS ANGELES COUNTY SURVEYOR
726 LOS ANGELES COUNTY
ENGINEERING BLDG.

Note: Any Additions or Changes on This Sheet Must be Made or Circled In Red Ink With Date and Name of Person Making Change.

Do not extend notes this side of this line.

5045
4113
936

Notes Ck'd by
Map No.
Office Work
Checked
Date

Survey of Alexander Hall
W.O. 5045 Type No. ones Std. 68 of
Surveyed by Van Doren
Notes E. Lamb Date Sept. 57
Indexed C. Jabbum

F.B. 2230 Pg. 113

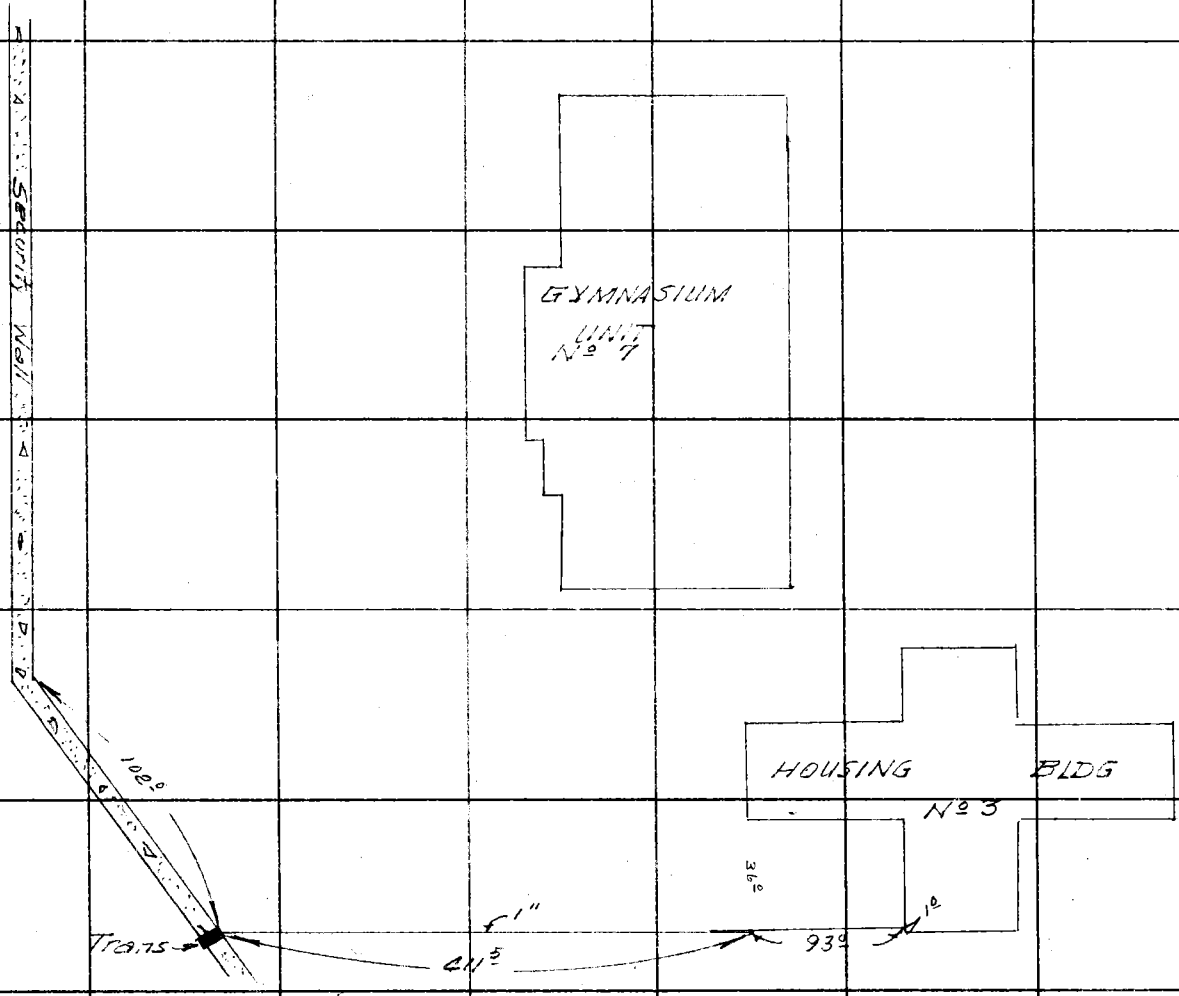

RETURN TO
LOS ANGELES COUNTY SURVEYOR
726 LOS ANGELES COUNTY
ENGINEERING BLDG.

Do not extend notes this side of this line.

Note: Any Additions or Changes on This Sheet Must be Made or Circled in Red Ink With Date and Name of Person Making Change.

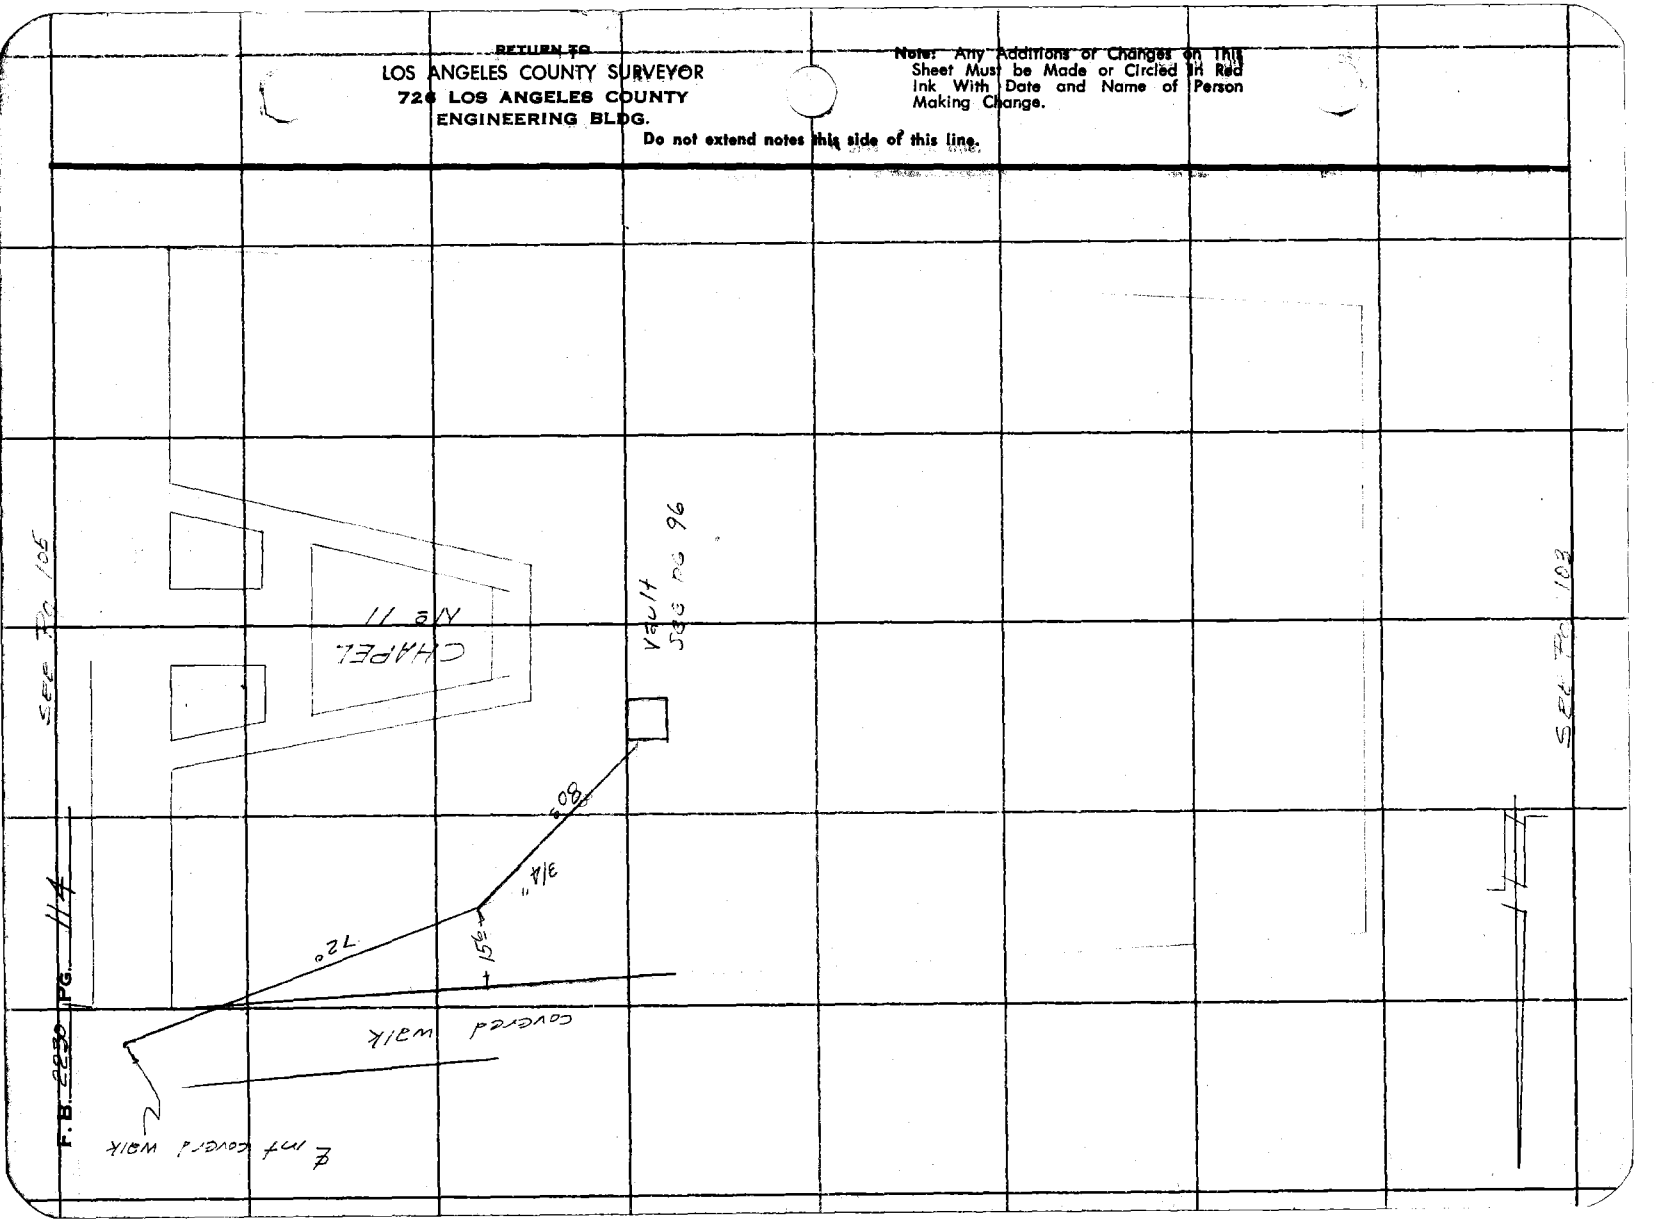

Notes Ck'd by
Map No.
Office Work
Checked
Date

Survey of Juvenile Hall
W. O. 8382.0 Tape No. St'd. °F
Surveyed by D. Sappell
Notes D.S. Date 2-57
Indexed C. Johnson

F. B. 2230 Pg. 115

BRANCH JUVENILE HALL FACILITY

LOCATION OF GAS LINE

J.N. 8382.01

PARTY:
Sappell
Shoemaker
Myers
Caro

Note: Any Additions or Changes on This Sheet Must be Made or Circled In Red Ink With Date and Name of Person Making Change.

Do not extend notes this side of this line.

RETURN TO
LOS ANGELES COUNTY SURVEYOR
726 LOS ANGELES COUNTY
ENGINEERING BLDG.

76F3095 SAE #247. 8-54

F.B. 2250 PG. 116

RETURN TO
LOS ANGELES COUNTY SURVEYOR
726 LOS ANGELES COUNTY
ENGINEERING BLDG.

Do not extend notes this side of this line.

Note: Any Additions or Changes on This Sheet Must be Made or Circled in Red Ink With Date and Name of Person Making Change.

Kitchen & Dining
Unit # 8

Mech.
Bldg # 9

2" Gas Line

Kaja Service Road

Housing Bldg No 3

GYM
BLDG
7

Regulator Valve

2" Gas Line Dwn 24"

+ 2.6
15°
17.3'
6.7
5.9
5.9
3.2
5.8°
14.1
6.9'
4.9
4.6
4.9
25.7
11.2
6.9.4
33.7

76F309S S&E #247, 8-54

RETURN TO
LOS ANGELES COUNTY SURVEYOR
726 LOS ANGELES COUNTY
ENGINEERING BLDG.

Note: Any Additions or Changes on This Sheet Must be Made or Circled in Red Ink With Date and Name of Person Making Change.

Do not extend notes this side of this line.

Notes Ck'd by
Map No.
Office Work
Checked
Date

W. O. 5382 Tape No. 2115 Std. 66 °F
Surveyed by Von Dreen
Notes E. 4 angle Date Sept. 52
Indexed [redacted] C. Johnson

F. B. 2230 PG. 117

Section No 4 Alt. 104

N 0° 2
Sec 7 T 9

RETURN TO
LOS ANGELES COUNTY SURVEYOR
726 LOS ANGELES COUNTY
ENGINEERING BLDG.

Note: Any Additions or Changes on This Sheet Must be Made or Circled in Red Ink With Date and Name of Person Making Change.

Do not extend notes this side of this line.

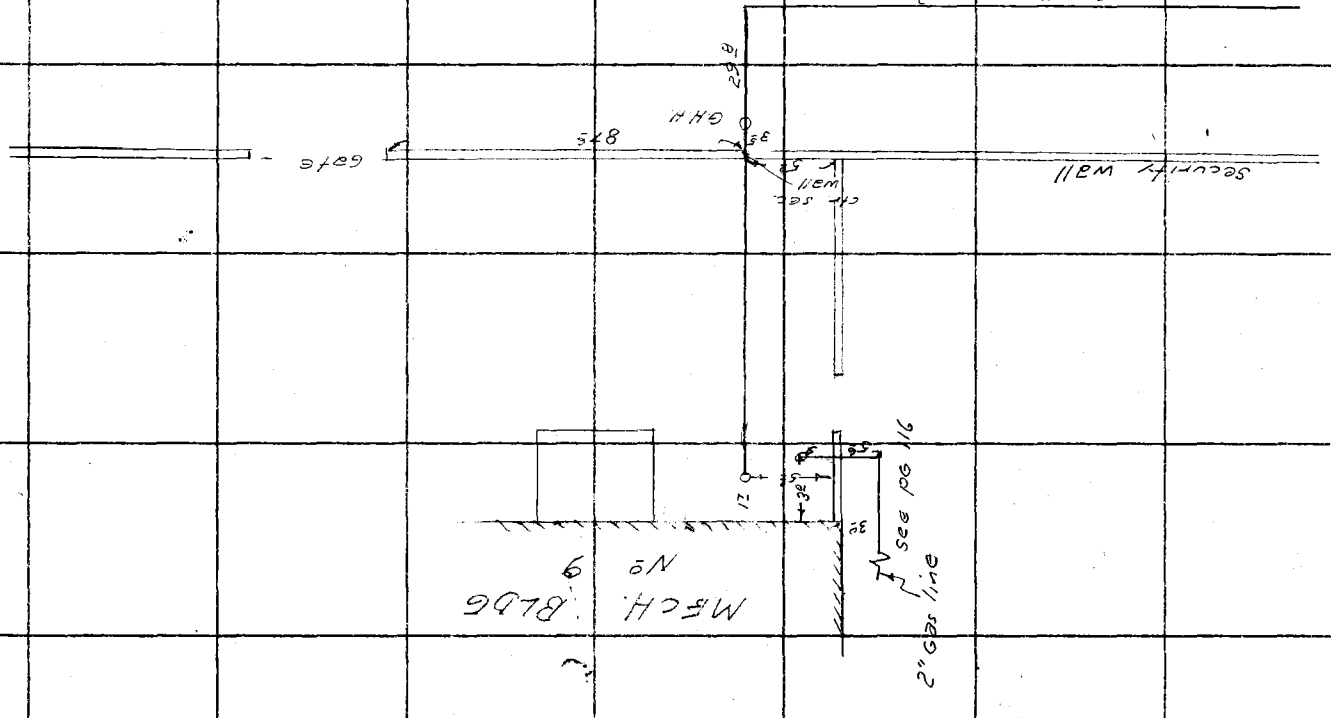

F.B. 2230 PG. 118

Notes Ck'd by	Survey of Juvenile Hall
Map No.	W. O. 8382 Tape No. 9195 Std. 68 °F
Office Work	Surveyed by M. A. Van Deren
Checked	Notes Van Date 5-28-56
Date	Indexed C. Johnson

F. B. 2230 Pg. 119

J.N. 8382.01

STAKING SKETCH OF UNDERGROUND OIL STORAGE TANK-AND UNDERGROUND BRINE STORAGE TANK

AT

JUVENILE HALL FACILITY - Ro LOS AMIGOS

STAKED PER PLAN

5-28-56
Van Deren
Richards
Bazen
Turrill

Note: Any Additions or Changes on This Sheet Must be Made or Circled in Red Ink With Date and Name of Person Making Change.

Do not extend notes this side of this line.

RETURN TO
LOS ANGELES COUNTY SURVEYOR
726 LOS ANGELES COUNTY
ENGINEERING BLDG.

76F3095 S&E #247. 8-54

RETURN TO
LOS ANGELES COUNTY SURVEYOR
726 LOS ANGELES COUNTY
ENGINEERING BLDG.

Note: Any Additions or Changes on This Sheet Must be Made or Circled In Red Ink With Date and Name of Person Making Change.

Do not extend notes this side of this line.

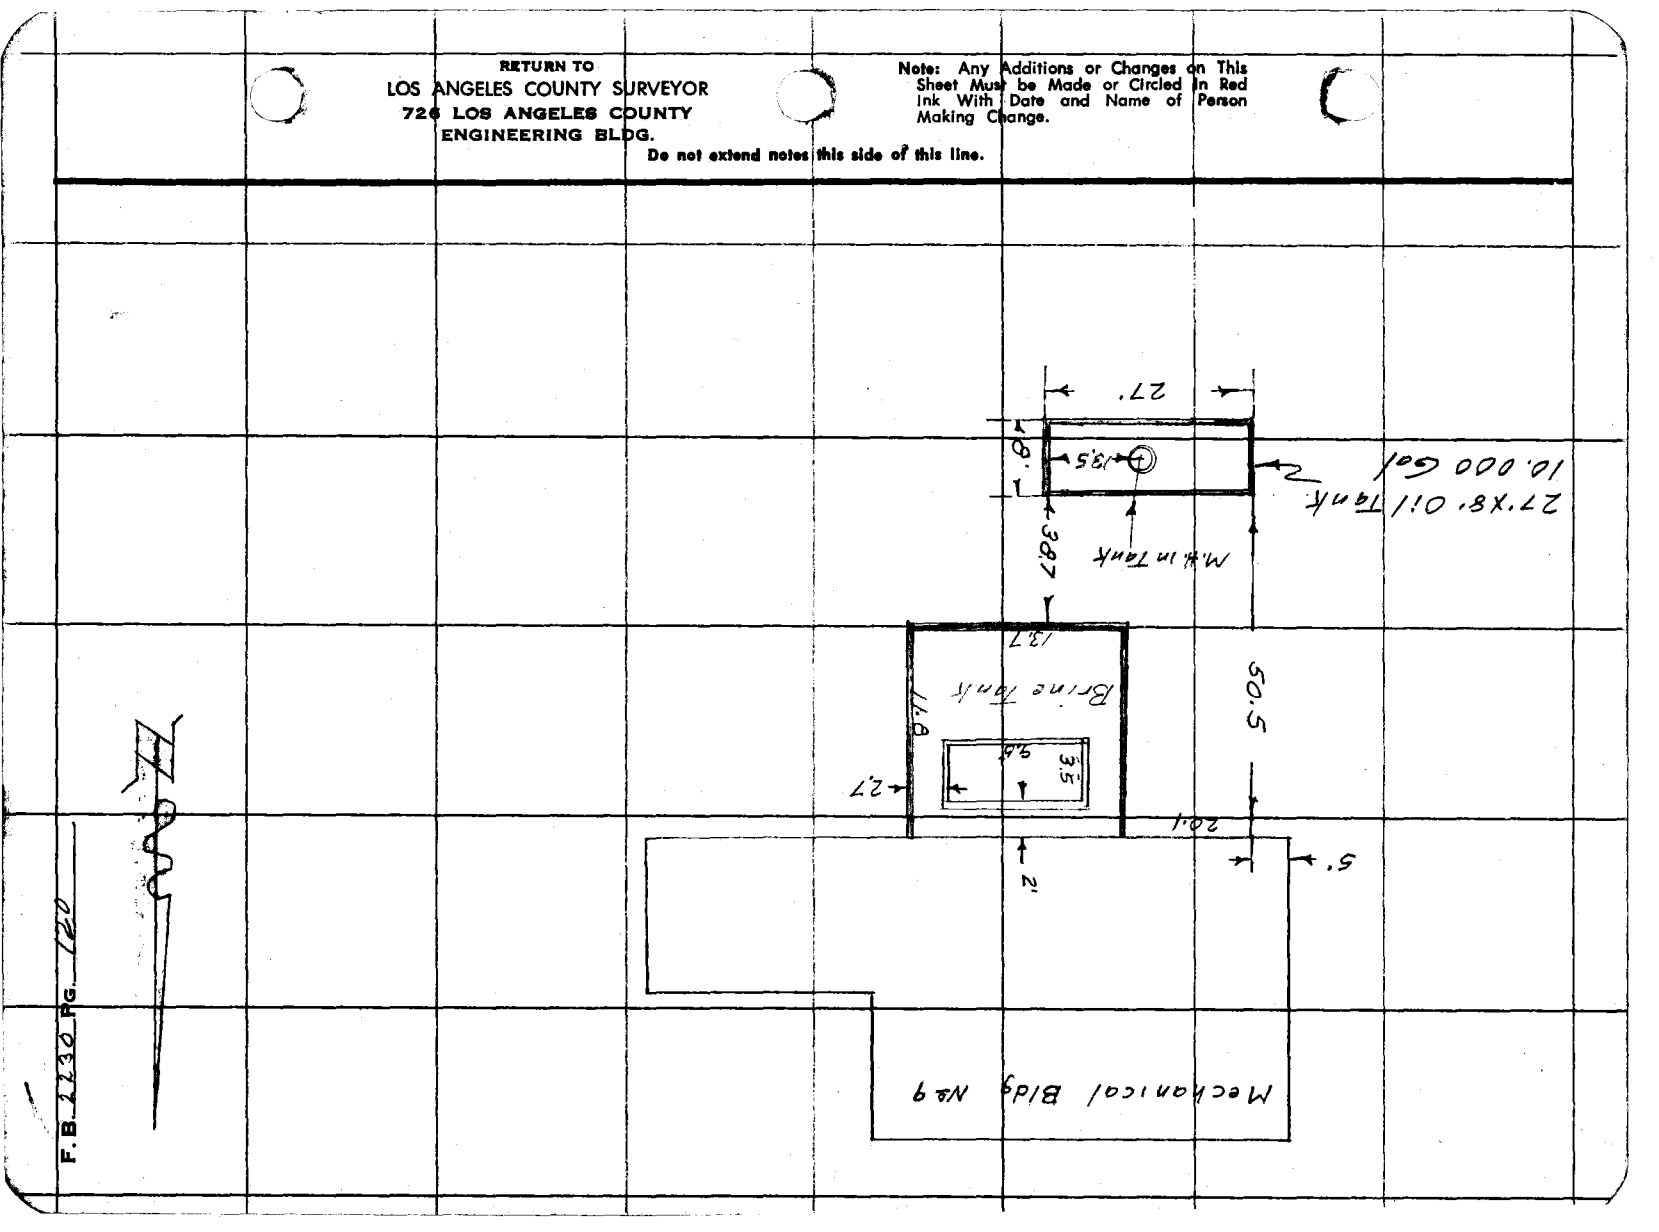

F.B. 1230 Pg. 120

Profile No. | Notes Red. | Date | Plotted | Date | Job No. 8382.01 | Division No. 10 | F. B. 2230 | Pg. 121

X-Sec. No. | Notes Chkd. | Date | Checked | Date | Survey of Juvenile Hall | Survey by Van Dercn | Notes Van | Date 4-56 | Map No. | Indexed C. Johnson | Date

J.N. 8382.01

Finish Floor Grades on Bldgs No 6

JUVENILE HALL AT RO LOS AMIGOS

4-56

Van Dercn
Richards
Bazen
Turrill

STATION	B. S.	H. I.	F. S.	ELEV.

NOTE: ANY ADDITIONS OR CHANGES ON THIS SHEET MUST BE MADE OR CIRCLED IN RED INK, WITH DATE AND NAME OF PERSON MAKING CHANGE.

Do not extend notes this side of this line.

PLEASE RETURN TO
LOS ANGELES COUNTY SURVEYOR
726 Los Angeles County Engineering Bldg.

761.298 S & E #307 9-54

76L298 S & E #307 9-54

PLEASE RETURN TO
LOS ANGELES COUNTY SURVEYOR
726 LOS ANGELES COUNTY ENGINEERING BLDG.

NOTE: ANY ADDITIONS OR CHANGES ON THIS SHEET MUST BE MADE OR CIRCLED IN RED INK, WITH DATE AND NAME OF PERSON MAKING CHANGE.

Do not extend notes this side of this line.

F. B. 1230 Pg. 122 Job No. 6302.0 Division No. 10 Notes Red. Plotted
Survey by VanDeren Notes Kan Notes Chkd. Checked
Indexed R. C. Johnson Date Date
Profile No. X-Sec. No.

STATION	B. S.	H. I.	F. S.	ELEV.	
B.M. No. 6	4175	102 027		97 852	B.M. No. 6 Elev. = 97.852 LB. 671-29-37
T. P.	5145	102 617	4555	97 472	Bronze tablet in conc. foundation of
T. P.	5105	103 387	4335	98 282	water Tower, N.W. leg
T. P.	4970	104 937	3420	99 967	grade set 1X2 stk. To Finish grade
S.E. cor., Bldg. No. 6			402	100 917	100.920 " " " " "
N.E. " " " "			402	100 917	" " " " " "
N.E. Wing - cor. "			402	100 917	" " " " " "
N.W. " "			402	100 917	" " " " " "
N.W. cor. Bldg. #6			402	100 917	" " " " " "
S.W. " " "			402	100 917	" " " " " "
S.W. wing - cor			402	100 917	" " " " " "
S.E. wing cor.			402	100 917	" " " " " "
T. P.	4890	104 872	4955	99 982	—
T. P.	4930	105 632	4170	100 702	—
T.B.M. No. 2	6790	105 402	7020	98 612	T.B.M. No. 2. Elev. = 98.612
T. P.	4755	104 637	5520	99 882	Fd. 3" I.P. 24" dp. on 2-4 1/8 line - FB.
T. P.	3020	101 832	5825	98 812	south side of pipe
T. P.	4560	103 012	3380	98 452	—
T. P.	4810	102 147	5675	97 337	—
B.M. No. 6			4295	97 852	B.M. No. 6. Elev. = 97.852 LB. 671-29-37
					Bronze Tablet in conc. base of water Tower, N.W. leg

Profile No. | Notes Red. | Date | Plotted | Date | Job No. 8382.01 | Division No. 10 | F. B. 2230 | Pg. 123
X-Sec. No. | Notes Chkd. | Date | Checked | Date | Survey of Juvenile Hall | Survey by Van Deren | Notes Van | Date 4--56 | Map No. [redacted] Johnson | Date

J.N. 8382.01

Finish Floor Grades on Bldgs 4 & 5

AT

JUVENILE - HALL - AT - RO LOS AMIGOS

4-56

Van Deren
Richards
Bazen
Turrill

STATION	B. B.	H. I.	F. B.	ELEV.

NOTE: ANY ADDITIONS OR CHANGES ON THIS SHEET MUST BE MADE OR CIRCLED IN RED INK, WITH DATE AND NAME OF PERSON MAKING CHANGE.

Do not extend notes this side of this line.

PLEASE RETURN TO
LOS ANGELES COUNTY SURVEYOR
726 Los Angeles County Engineering Bldg.

76L298 S & E #307 9-54

76L298 S & E #307 9-54

PLEASE RETURN TO
LOS ANGELES COUNTY SURVEYOR
726 Los Angeles County Engineering Bldg.

NOTE: ANY ADDITIONS OR CHANGES ON THIS SHEET MUST BE MADE OR CIRCLED IN RED INK, WITH DATE AND NAME OF PERSON MAKING CHANGE.

Do not extend notes this side of this line.

F. B. 2230 Pg. 124 Job No. 8368 Division No. 10 Notes Red. Plotted Profile
Survey by Van Derna Notes Van Notes Chkd Checked No.
Indexed C. Johnson Date Date Date

STATION	B. S.	H. I.	F. S.	ELEV.		
T.B.M. No.2	701	10562		9861	T.B.M. No.2 - Elev. = 98.612	FB.2230-14
					3" I.P., S. side - 24" dp. on axis line.	
T. P.	445	10508	499	10063		
S.E. cor., Bldg #5			391	101 17	set 1x2 stk. To finish grade	
N.E. " " "			391	" "	" "	"
N.E. wing cor.			391	" "	" "	"
N.W. " "			391	" "	" "	"
S.E " "			391	" "	" "	"
S.W. " "			391	" "	" "	"
S.W. cor. Bldg. #5			391	" "	" "	"
N.W. " " "			391	" "	" "	"
T. P.	474	105 54	428	10080	——	4-10-56
T.B.M. #2.	6.97	105.58	693	98 61	T.B.M. No 2 Elev. = 98.612	FB.2230-14
					3" I.P., South side - 24" dp. on axis line.	
S.W. cor Bldg 4			4.08	101.50	Fin Floor Grade = 101.50 set 1x2	
N.W. " " "			4.08	101 50	"	"
S.E. " " "			4.08	101.50	"	"
N.E. " "			4.08	101 50	"	"
T.B.M. #2					T.B.M. #2 Elev = 98.61	FB2230-14

Profile No. | Notes Red. | Plotted | Job No. 8382.01 Division No. 10 | F. B. 2230 Pg. 125
Date | Date | Survey of Juvenile Hall
X-Sec. No. | Notes Chkd. | Checked | Survey by Van Deren Notes Van Date 4-56
Date | Date | Map No. Added Johnson Date

J.N. 8382.01

Finish Floor Grades on Bldg 3-8-9

JUVENILE HALL AT RO LOS AMIGOS

4-5C
Van Deren
Richards
Bazen
Turri 11

STATION	B. S.	H. I.	F. S.	ELEV.

NOTE: ANY ADDITIONS OR CHANGES ON THIS SHEET MUST BE MADE OR CIRCLED IN RED INK, WITH DATE AND NAME OF PERSON MAKING CHANGE.

Do not extend notes this side of this line.

PLEASE RETURN TO
LOS ANGELES COUNTY SURVEYOR
726 Los Angeles County Engineering Bldg.

761.298 S & E #307 9-54

76L298 S & E #307 9-54

PLEASE RETURN TO
LOS ANGELES COUNTY SURVEYOR
726 LOS ANGELES COUNTY ENGINEERING BLDG.

NOTE: ANY ADDITIONS OR CHANGES ON THIS SHEET MUST BE MADE OR CIRCLED IN RED INK, WITH DATE AND NAME OF PERSON MAKING CHANGE.

#3 = 101.33
#9 = 100.25
#8 = 101.00

Do not extend notes this side of this line.

F. B. 2230 Pg. 126 Job No 8382-01 Division No. 10 Notes Red. Plotted
Survey by Kay C. Johnson Notes Van Notes Chkd. Checked
Indexed Date Date Date
Profile No. X-Sec. No.

STATION	B. S.	H. I.	F. S.	ELEV.		
T.B.M. #2	6.89	105.50		98.61	T.B.M #2 Elev = 98.612	
					3" I.P on Axis line 24" dp FB	
Cor of Bldg #3			4.17	101.33	Fin Floor Grade = 101.33	set 1X2 To Grade
" "			4.17	101.33	"	"
" "			4.17	101.33	"	"
" "			4.17	101.33	"	"
T. P.	4.48	104.95	5.03	100.47	T.P.	
Cor of Bldg #9			4.70	100.25	Fin Floor Grade = 100.25	set 1X2 To grade
" "			4.70	100.25	"	"
" "			4.70	100.25	"	"
" "			4.70	100.25	"	"
Cor of Bldg #8			3.95	101.00	Fin Floor Grade = 101.00	set 1X2 To Grade
" "			3.95	101.00	"	"
" "			3.95	101.00	"	"
" "			3.95	101.00	"	"
T.P	4.93	105.38	4.50	100.45		
			6.77	98.61	T.B.M. #2	

Profile No. ____ X-Sec. No. ____

Notes Red. ____ Date ____ Notes Chkd. ____ Date ____

Plotted ____ Date ____ Checked ____ Date ____

Job No 8382.01 Division No. 10

Survey of Juvenile Hall

Survey by Van Deren Notes Rich Date 4-18-56

Map No. ____ Traced Johnson Date ____

F. B. 2230 Pg. 127

J.N. 8382.01

Finish Floor Grades on Bldgs # 2-12-10-1

at

JUVENILE HALL AT RO LOS AMIGOS

4-18-56

Van Deren
Richards
Bazen
Turrill

STATION	B. S.	H. I.	F. S.	ELEV.

Do not extend notes this side of this line.

NOTE: ANY ADDITIONS OR CHANGES ON THIS SHEET MUST BE MADE OR CIRCLED IN RED INK, WITH DATE AND NAME OF PERSON MAKING CHANGE.

PLEASE RETURN TO
LOS ANGELES COUNTY SURVEYOR
726 LOS ANGELES COUNTY ENGINEERING BLDG.

761.298 S & E #307 9-54

76L298 S & E #307 9-54

PLEASE RETURN TO
LOS ANGELES COUNTY SURVEYOR
726 LOS ANGELES COUNTY ENGINEERING BLDG.

NOTE: ANY ADDITIONS OR CHANGES ON THIS SHEET MUST BE MADE OR CIRCLED IN RED INK, WITH DATE AND NAME OF PERSON MAKING CHANGE.

Do not extend notes this side of this line.

F. B. 2230 Pg. 120 | Job No. 8382.0 Division No. 20 | Notes Red. | Plotted | Profile
Survey by Van Dercen Notes Rich | Notes Chkd. | Checked | X-Sec.
Indexed C. Johnson Date | Date | Date | No.

STATION	B. S.	H. I.	F. S.	ELEV.	
BM#6	4355	102 207		97 852	BM #6 Elev = 97.852 LB 671-29-37
T. P.	5715	103 052	4870	97 337	Bronze tablet in conc foundation of
T. P.	3935	101 897	4590	98 462	Water tower N.W. leg of tower
Bldg. No. 12.			165	100 25	Set 1x2 stk. To finish grade = 100.25
"			165	100 25	" " " " " "
"			165	100 25	" " " " " "
"			165	100 25	" " " " " "
T.B.M. No. 1	8595	104 617	5875	96 022	T.B.M. No. 1. Elev. =
					S. Side 3" I.P. 24" d/p. FB. 2230-11. On S. R.
Bldg. NO. 2			404	100 58	Set 1x2 stake To finish grade = 100.58
"			404	100 58	" " " "
"			404	100 58	" " " "
"			404	100 58	" " " "
T. P.	4760	104 507	4870	99 791	—
Bldg. No. 1			409	100 42	Set 1x2 stake To finish grade = 100.42
"			409	100 42	" " " "
"			409	100 42	" " " "
"			409	100 42	" " " "
T. P.	5765	105 372	4900	99 607	—
Bldg. No. 10			455	100 82	Set 1x2 stake To finish grade = 100.82
"			455	100 82	" " " "

76L298 S & E #307 9-54

PLEASE RETURN TO
LOS ANGELES COUNTY SURVEYOR
726 LOS ANGELES COUNTY ENGINEERING BLDG.

NOTE: ANY ADDITIONS OR CHANGES ON THIS SHEET MUST BE MADE OR CIRCLED IN RED INK, WITH DATE AND NAME OF PERSON MAKING CHANGE.

Bldg. No. 11 = 101.50
" " 7 = 101.25

Do not extend notes this side of this line.

Profile Notes Red. Plotted Job No. 8382 Division No. 10
X-Sec. Notes Chkd Checked Survey by Van Deren Notes Rick Date 4-12-56
No. Date Date Map No. Inked Checked Date

F. B. 2230 PG. 129

STATION	B. S.	H. I.	F. S.	ELEV.		
Bldg. No. 10		105 372	455	100 82	Set 1X2 stake To finish grade = 100.82	
"			455	100 82	" "	" "
T. P.	2200	102 832	4740	100 632	—	
T. B. M. No. 3	4715	102 132	5415	97 417	T. B. M. No. 3 Elev. =	
T. P.	4890	103 117	3905	98 227	S. side 3" I. P. 24" dp. on axis line. FB 2230-11	
T. B. M. No. 1	6565	102 617	7065	96 052	T. B. M. No. 1 Elev. =	
T. P.	4255	101 872	5000	97 617	S. side 3" I. P. 24" dp. on S. R. per FB. 2230-11	
B. M. No. 6			402	97.85	B. M. #6 Elev = 97.852 LB 671-29-37 Bronze tablet in conc foundation of water Tower N.W. leg of tower	
Fin floor Grades on Bldg # 7-11 5-8-56						
T. B. M. #1	667	102 69		96.02	T. B. M. #1 Elev = 96.02 per pg 11	
T. P.	568	105 51	286	99 83	S. S. side 3" I. P. on S. P. L.	
Bldg No. 11			401	101 50	Bldg. No. 11. Finish grade = 101.50. - Set 1x2 stake To grade	
"			401	101 50	" " " " "	
"			401	101 50	" " " " "	
"			401	101 50	" " " " "	
Bldg. No. 7			426	101 25	Bldg No. 7. Fin. grade = 101.25 - Set 1x2 stk. To fin. grade	
"			426	101 25	" " " "	
"			426	101 25	" " " "	

76L298 S & E #307 9-54

PLEASE RETURN TO
LOS ANGELES COUNTY SURVEYOR
726 LOS ANGELES COUNTY ENGINEERING BLDG.

NOTE: ANY ADDITIONS OR CHANGES ON THIS SHEET MUST BE MADE OR CIRCLED IN RED INK, WITH DATE AND NAME OF PERSON MAKING CHANGE.

Do not extend notes this side of this line.

F. B. 2230 Pg. 130 Job No 83820 Division No. 10 Notes Red Plotted Profile
Survey of Juvenile Hall Date 4-19-56 Date No. X-Sec.
Survey by Van Dervet Notes Rick Notes Chkd. Checked
Indexed C. Johnson Date Date Date No.

STATION	B. S.	H. I.	F. S.	ELEV.		
Bldg. No. 7		105 51	426	101 25	Bldg. No. 7 - Fin. grade = 101.25 - Set 1x2 stk. To grade	
T. P.	317	102 94	574	99 77		
T.B.M. No. 1			692	96 02	T.B.M. No. 1 Elev. = 96.02	F.B. 2230 - 11

Profile Notes Red. Plotted Job No. 8382.01 Division No. 10 F. B. 2230 Pg. 131
Date Date Survey of Juvenile Hall
X-Sec. Notes Chkd. Checked Survey by Sappell Notes DS Date 12-14-56
No. Date Date Map No. Indexed by C. Johnson Date

J.N. 8382.01

JUVENILE HALL FACILITY

AT

RANCHO LOS AMIGOS

ADDITIONAL BENCH MARKS

party: Sappell
Shoemaker
Myers
Bostrom

STATION	B. S.	H. I.	F. B.	ELEV.

NOTE: ANY ADDITIONS OR CHANGES ON THIS SHEET MUST BE MADE OR CIRCLED IN RED INK, WITH DATE AND NAME OF PERSON MAKING CHANGE.

Do not extend notes this side of this line.

PLEASE RETURN TO
LOS ANGELES COUNTY ENGINEER
700 Los Angeles County Engineering Bldg.

76298 S & E #307—7-55

76298 S & E #307—7-55

PLEASE RETURN TO
LOS ANGELES COUNTY ENGINEER
700 LOS ANGELES COUNTY ENGINEERING BLDG.

NOTE: ANY ADDITIONS OR CHANGES ON THIS SHEET MUST BE MADE OR CIRCLED IN RED INK, WITH DATE AND NAME OF PERSON MAKING CHANGE.

Do not extend notes this side of this line.

F. B. 2230 Pg. 132 | Job No. 8220 | Division No. 10 | Notes Red. | Plotted | No.
Survey of Juvenile Hall | Date | Date | No.
Survey by D. Sapell | Notes D.S. | Notes Chkd. | Checked | X-Sec.
Indexed C. Johnson | Date | Date | Date | Profile

STATION	B. S.	H. I.	F. S.	ELEV.		
TBM #1				96 022	TBm #1, El 96.022, F.B. 2230-11, 128 So.	
	5 849	111 871			side 3" I.P. 24" d/p on S. P/L	
T.P.			3 087	99 784	T.P.	
	5515	104 299				
T.P.			4 541	99.758	T.P.	
(set)	3886	10 3 644				
BM #1			3260	100.384	Bm #1 - Strd. C.E. Brass cap mon - Flush.	
	4449	104 833			S.W. Bdry Cor per F.B. 2230-16	
T.P.			4753	100 080	T.P.	
	4606	104 686				
(set)						
BM #2			3898	100788	Bm #2 - Strd C.E. Brass cap mon - Flush.	
	3922	104 710			E'ly & pt. in W'ly Bdry F.B. 2230-14	
T.P.			4 353	100 357	T.P.	
	5209	105 566				
set.						
Bm #3			5202	100 364	Bm #3, 3" I.P. (N. edge) N.W Bdry	
	5359	105 723			Cor, Dwn 24", F.B. 2230-13	
T.P.			4 195	101 528	T.P.	
	2693	104 221				
T.B.M.			2222	101 999	TBM- Chis cross in No. Side Conc.	
					Security wall	

76298 S & E #307—7-55

PLEASE RETURN TO
LOS ANGELES COUNTY ENGINEER
700 LOS ANGELES COUNTY ENGINEERING BLDG.

NOTE: ANY ADDITIONS OR CHANGES ON THIS SHEET MUST BE MADE OR CIRCLED IN RED INK, WITH DATE AND NAME OF PERSON MAKING CHANGE.

Do not extend notes this side of this line.

STATION	B. S.	H. I.	F. S.	ELEV.		
T.B.M.				101 999	T.B.M	
	2942	104 941				
T.P.			4220	100 721	T.P.	
	3223	103 950				
T.P.			5102	98 848	T.P.	
	3753	102 601				
T.B.M #3			5197	97 404	T.B.M #3 El. 97.417, S. Side 3" I.P. on Axis Line, Dum 24", F.B. 2230-11-129	
T.B.M #1				96 02	T.B.M #1, El. 96.022, F.B. 2230-11, So Side 3" I.P., 24" dp on So. P/L	
	700	103 02				
T.P.			327	99 75	T.P.	
	422	103 97				
(set) BM #4			380	100 17	BM #4 - P.M. in So. Rim of S.M.H. on S'ly Line of Chapel & 64.0 E. of E. Face. F.B. 2230-106	
	404	104 21				
T.P.			183	102 38	T.P.	
	280	105 18				
T.B.M #3			778	97 40	T.B.M #3 El. 97.417, F.B. 2230-11, So. Side 3" I.P. 24" dp. on Axis Line	
				over		

Profile Notes Red. Plotted Job No. 8282.01 Division No. 10 F. B. 2230 Pg. 133
No. Date Survey of Juvenile Hall
X-Sec. Notes Chkd. Checked Survey by Seagell Notes D.J. Date 12-14-54
No. Date Date Map No. Traced Johnson Date

76298 S & E #307—7-55

PLEASE RETURN TO
LOS ANGELES COUNTY ENGINEER
700 Los Angeles County Engineering Bldg.

NOTE: ANY ADDITIONS OR CHANGES ON THIS SHEET MUST BE MADE OR CIRCLED IN RED INK, WITH DATE AND NAME OF PERSON MAKING CHANGE.

Do not extend notes this side of this line.

F. B. 2230 Pg. 134 | Job No. 8362.01 | Division No. 10 | Notes Red. | Plotted | No. | Profile
Survey of Juvenile Hall | Date | Notes Chkd. | Date | No. | X-Sec.
Survey by L. Sagaser, D. S. | Notes | Checked | Date
Indexed L. C. Johnson | Date

STATION	B. S.	H. I.	F. S.	ELEV.		
T.B.m #2				98.612	T.B.m #2 El. 98.612, F.B. 2230-14	
	5.800	104.412			3" I.P., So. side - 24 dp. on Axis Line	
(set) Bm #5 (See F.B. 2230-106)			4.583	99.829	Bm #5 - p.m. in No. Rim S.m.H. 66° No. of So. face & 45' W. of W. face 9xm & Classroom Bldg #7.	
T.B.m #2			5.800	99.612	T.B.m #2 El. 98.612 (as above)	
Bm #4				100.17	Bm #4 El. 100.17, Pg 133	
	5.47	105.64				
(set) Bm #6			4.93	100.71	Bm #6, 114.5 No. of Axis line at int of 11° conc. walks in front of Bldg 5 - bt spk in walk.	
Bm #7			5.12	100.52	Bm #7, 114.5 So of Axis line at int of 11° conc. walks in front of Bldg 8 - bt spk in walk	
Bm #4			5.47	100.17	Bm #4 El. 100.17 Pg 133	

Profile No. | Notes Red. | Plotted | Job No. 8382.01 | Division No. 10 | F. B. 2230 | Pg. 135
X-Sec. No. | Notes Chkd. | Checked | Survey of Juvenile Hall
Date | Date | Survey by Sappell | Notes D.S. | Date 12-11-56
Date | Date | Map No. | Redrafted Johnson | Date

NOTE: ANY ADDITIONS OR CHANGES ON THIS SHEET MUST BE MADE OR CIRCLED IN RED INK, WITH DATE AND NAME OF PERSON MAKING CHANGE.

PLEASE RETURN TO
LOS ANGELES COUNTY ENGINEER
700 Los Angeles County Engineering Bldg.

Do not extend notes this side of this line.

STATION | B. S. | H. I. | F. B. | ELEV.

J.N. 8382.01

JUVENILE HALL

AT

RANCHO LOS AMIGOS

GRADES

FOR

GRID AREA "A" - COMPOUND

AXIS LINE USED FOR CONTROL - 50' STA. ON AXIS LINE & LINES N & S OF AXIS LINE

LINE "A" (STARTING PT.) 45° E. OF GYMNASIUM BLDG #7 - LINE "O" (End PT.) 37'± W. OF ADMINSTRATION BLDG #1

SEE ALSO PAGE 179 - CFR - 1960 Oct.

Party:
Sappell
Shoemaker
Myers
Bustrum

76298 S & E #307—7-55

76298 S & E #307—7-55

PLEASE RETURN TO
LOS ANGELES COUNTY ENGINEER
700 LOS ANGELES COUNTY ENGINEERING BLDG.

NOTE: ANY ADDITIONS OR CHANGES ON THIS SHEET MUST BE MADE OR CIRCLED IN RED INK, WITH DATE AND NAME OF PERSON MAKING CHANGE.

Do not extend notes this side of this line.

F. B. 2230 Pg. 136 Job No. 23201 Division No. 10 Notes Red. Plotted Profile
Survey by D. Speegle Notes 12-11-56 Notes Chkd. Checked
Indexed K. C. Johnson Date Date Date No.

STATION	B. S.	H. I.	F. S.	ELEV.				
BM #4				100.17	Bm #4, El. 100.17, Sq. Rim S.M.H. on S'ly Line of Chapel & 61' E. of E. Face.			F.B. 2230-106, 133 P.M. in
					Grade	C or F.		
A				1000	101.2	F-1.2	1 x 1	- Axis Line
A-1-N				995	101.1	F-1.6	1 x 2	Stk.
A-2-N				1008	101.1	F-0.3		
A-1-S			Rod	1002	101.2	F-1.0	"	"
A-2-S				1012	101.1	C-0.1	"	"
B				998	101.2	F-1.4	"	" Axis Line
B-1-N					101.1	—	Falls in pile of dirt & conc.	
B-2-N				1004	101.0	F-0.6	"	"
B-1-S				1002	101.2	F-1.0	"	"
B-2-S			Self. comp	1007	101.1	F-0.4	"	"
C				1006	101.2	F-0.6	"	"
C-1-N				.997	101.1	F-1.4	"	"
C-2-N				1003	100.9	F-0.6	"	"
C-1-S				1000	101.1	F-1.1	"	"
C-2-S				1006	101.0	F-0.4	"	"
D				1006	101.2	F-0.6	"	"

76298 S & E #307—7-55

PLEASE RETURN TO
LOS ANGELES COUNTY ENGINEER
700 LOS ANGELES COUNTY ENGINEERING BLDG.

NOTE: ANY ADDITIONS OR CHANGES ON THIS SHEET MUST BE MADE OR CIRCLED IN RED INK, WITH DATE AND NAME OF PERSON MAKING CHANGE.

Do not extend notes this side of this line.

Profile Notes Rod_____ Plotted_____ Job No. 8282-01 Division No. 10 F. B. 2230 Pg. 137
No._____ Date_____ Date_____ Survey of Juvenile Hall
X-Sec. Notes Ckd._____ Checked_____ Survey by Sapsell Notes D.S. Date 12-11-56
No._____ Date_____ Date_____ Map No. [illegible] Date_____

STATION	B. S.	H. I.	F. S.	ELEV.	Grade	C. or F.		
D-1-N				996	101.1	F-1.5	1x2	stk.
D-2-N				999	100.8	F-0.9	1x2	"
D-1-S				1000	101.1	F-1.1	1x2	
D-2-S				1007	100.9	F-0.2	1x2	stk.
E				998	101.2	F-1.4	1x1	Axis Line
E-1-N			Self - comp Pool	997	101.1	F-1.4	1x2	
E-2-N				1002	100.8	F-0.6	1x2	
E-3-N				1010	101.0	Grade	1x2	
E-1-S				999	101.1	F-1.2	1x2	
E-2-S				1001	100.8	F-0.7	1x2	
E-3-S				1004	100.6	F-0.2	1x2	
E-4-S				1002	100.3	F-0.1	1x2	
F					—			Falls in chapel
F-1-N				1004	101.0	F-0.6	1x2	
F-2-N				1001	100.7	F-0.6	1x1	
F-3-N				1003	101.0	F-0.7	1x1	
F-1-S				997	101.0	F-1.3	1x2	
F-2-S				1001	100.6	F-0.5	1x2	
G				1008	101.0	F-0.2	1x1	
G-1-N				1000	100.9	F-0.9	1x2	
G-2-N				1005	100.7	F-0.2	Fall on	conc. Slab.
G-1-S				999	100.8	F-0.9	1x2	

76298 S & E #307—7-55

PLEASE RETURN TO
LOS ANGELES COUNTY ENGINEER
700 LOS ANGELES COUNTY ENGINEERING BLDG.

NOTE: ANY ADDITIONS OR CHANGES ON THIS SHEET MUST BE MADE OR CIRCLED IN RED INK, WITH DATE AND NAME OF PERSON MAKING CHANGE.

Do not extend notes this side of this line.

F. B. 2230 Pg. 138 Job No. 8382.01 Division No. 10 Notes Red. Plotted
Survey of Juvenile Hall Date Date
Survey by D. Sagrell Notes S.S. Notes Chkd. Checked
Indexed J. C. Johnson Date Date
Profile No. X-Sec. No.

STATION	B. S.	H. I.	F. S.	ELEV.	Grade	C or F		
G-2-S				100 2	100.5	F-0.3	on	conc. slab.
H				99 3	100.9	F-1.6	1x1	
H-1-N				99 4	100.8	F-1.4	1x1	
H-2-N				100 0	100.6	F-0.6	1x1	
H-3-N				100 2	100.7	F-0.5	1x1	
H-1-S				99 7	100.8	F-1.1	1x1	
H-2-S				99 6	100.4	F-0.8	1x1	
J				99 0	100.8	F-1.8	1x1	Axis Line
J-1-N				99 6	100.7	F-1.1	1x1	
J-2-N				100 0	100.5	F-0.5	1x1	
J-3-N				100 4	100.6	F-0.2	1x1	
J-1-S				99 2	100.7	F-1.5	1x2	
J-2-S				99 2	100.2	F-1.0	1x2	
J-3-S				100 1	100.1	Grade	1x2	
~~J-4-S~~					~~100.0~~			
K				99 1	100.7	F-1.6	1x1	Axis Line
K-1-N				99 2	100.6	F-1.4	1x2	
K-2-N				99 6	100.5	F-0.9	1x2	
K-1-S				99 3	100.6	F-1.3	1x2	
K-2-S				99 6	100.1	F-0.5	1x2	
L				99 2	100.6	F-1.4	1x1	Axis Line

Self-Comp Rod

76298 S & E #307—7-55

PLEASE RETURN TO
LOS ANGELES COUNTY ENGINEER
700 LOS ANGELES COUNTY ENGINEERING BLDG.

NOTE: ANY ADDITIONS OR CHANGES ON THIS SHEET MUST BE MADE OR CIRCLED IN RED INK, WITH DATE AND NAME OF PERSON MAKING CHANGE.

Do not extend notes this side of this line.

STATION	B. S.	H. I.	F. S.	ELEV.	GRADE	C. or F.	
L-1-N				99.4	100.5	F-1.1	1x2 Stk.
L-2-N				99.6	100.4	F-0.8	1x2 "
L-1-S				99.2	100.5	F-1.3	1x2 "
L-2-S				99.5	100.0	F-0.5	1x2 "
M				99.3	100.4	F-1.1	1x1 " Axis Line
M-1-N				99.4	100.3	F-0.9	1x1 Stk.
M-2-N			Set	99.7	100.5	F-0.9	1x2 "
M-1-S				99.2	100.3	F-1.1	1x2 "
M-2-S				99.5	100.1	F-0.6	1x2 "
N			Iron	99.7	100.1	F-0.4	Axis Line
N-1-N				99.6	100.1	F-0.5	1x2 Stk.
N-2-N				100.3	100.3	Grade	1x2 "
N-1-S					99.9		Falls in pile of dirt & rock
N-2-S			Pad	99.6	99.7	F-0.1	1x2 "
"O"				100.3	99.9	C-0.4	1x1 Axis Line
O-1-N				99.8	100.2	C-0.4	1x2 Stk.
O-2-N				100.4	100.1	C-0.3	1x2 "
O-1-S				100.1	99.8	C-0.3	1x2 "
O-2-S				99.5	99.7	F-0.2	1x2 "
T.B.M.				100.17			T.B.M. El 100.17

Profile Notes Rod_____ Plotted_____ Job No. 83201 Division No. 10 F. B. 2230 Pg. 139
No._____ Date_____ Date_____ Survey of Juvenile Hall
X-Sec. Notes Chkd._____ Checked_____ Survey by Sappell Notes 2-5 Date 12-11-56
No._____ Date_____ Map No._____ Date_____

Profile No.	Notes Red.	Plotted	Job No. 8382.01	Division No. 10	F. B. 2230	Pg. 141
	Date	Date	Survey of Juvenile Hall			
X-Sec. No.	Notes Chkd.	Checked	Survey by Sappell	Notes D.S.	Date 12-12-56	
	Date	Date	Map No.	Indexed J. C. Johnson	Date	

J.N. 8382.01

JUVENILE HALL

AT

RANCHO LOS AMIGOS

GRADES

FOR GRID AREA "B"

AXIS LINE USED FOR CONTROL.
AREA WITHIN W'LY BDRY OF
GYM & CLASSROOM BLDG

Party: Sappell
Shoemaker
Myers
Bustrum

STATION	B. S.	H. I.	F. B.	ELEV.

NOTE: ANY ADDITIONS OR CHANGES ON THIS SHEET MUST BE MADE OR CIRCLED IN RED INK, WITH DATE AND NAME OF PERSON MAKING CHANGE.

Do not extend notes this side of this line.

PLEASE RETURN TO
LOS ANGELES COUNTY ENGINEER
700 Los Angeles County Engineering Bldg.

76298 S & E #307—7-55

76298 S & E #307—7-55

PLEASE RETURN TO
LOS ANGELES COUNTY ENGINEER
700 LOS ANGELES COUNTY ENGINEERING BLDG.

NOTE: ANY ADDITIONS OR CHANGES ON THIS SHEET MUST BE MADE OR CIRCLED IN RED INK, WITH DATE AND NAME OF PERSON MAKING CHANGE.

Do not extend notes this side of this line.

F. B. 2230 Pg. 42 Job No 83820 Division No. 10 Notes Red. Date Notes Chkd. Date
Survey of Juvenile Hall Notes D.S. Profile No. X-Sec. No.
Survey by D. Sagel / C. Johnson Date Plotted Date Checked Date
Indexed

STATION	B. S.	H. I.	F. S.	ELEV.					
BM #1				100 38	BM #1, El. 100.384, F.B. 2230-132, Std. C.E. Brass cap mon. Flush - S.W. Bdry Cor. per F.B. 2230-16				
					Grade	C or F.			
A				99.8	1004	F-0.6	1x2	STK.	AXIS LINE
A-1-N				100 0	1005	F-0.5	"	"	
A-2-N				100 1	1006	F-0.5	"	"	
A-3-N				100 3	1007	F-0.4	1x1	"	
A-4-N				100 4	1008	F-0.4	1x2	"	
A-5-N				100 4	1009	F-0.5	"	"	
A-6-N				100 3	1010	F-0.7	"	"	
A-7-N				100 3	1011	F-0.8	"	"	
A-1-S				99.9	1004	F-0.5	"	"	
A-2-S				100.5	1006	F-0.1	"	"	
A-3-S				100 8	1006	C-0.2	"	"	
B				100 2	1004	F-0.2	"	"	AXIS LINE
B-1-N				100 2	1005	F-0.3	"	"	

76298 S & E #307—7-55

PLEASE RETURN TO
LOS ANGELES COUNTY ENGINEER
700 LOS ANGELES COUNTY ENGINEERING BLDG.

NOTE: ANY ADDITIONS OR CHANGES ON THIS SHEET MUST BE MADE OR CIRCLED IN RED INK, WITH DATE AND NAME OF PERSON MAKING CHANGE.

Do not extend notes this side of this line.

STATION	B. S.	H. I.	F. S.	ELEV.	Grade	C or F.		
B-2-N				100 5	1006	F-0.1	1×2	stk.
B-3-N				100 7	1007	Grade	"	"
B-4-N				100 4	1008	F-0.4	"	"
B-5-N				100 6	1009	F-0.3	"	"
B-6-N				100 7	1010	F-0.3	"	"
B-7-N				100 9	101 1	F-0.2	"	"
B-1-S				100 0	100 3	F-0.3	"	"
B-2-S				100 0	100 2	F-0.2	"	"
B-3-S				100 4	100 2	C-0.2	"	"
B-4-S				100 4	999	C-0.5	"	"
C				100 1	99.7	C-0.4	1×2	stk. Axis Line
C-1-N				100 0	99.8	C-0.2	"	"
C-2-N				100 1	99.9	C-0.2	"	"
C-3-N				100 4	100.0	C-0.4	"	"
C-4-N				100 4	100.1	C-0.3	"	"
C-5-N				99 8	100.2	F-0.4	"	"
C-6-N				100 1	100.3	F0.2	"	"
C-7-N				100 6	100.4	C-0.2	"	"
C-1-S				100.3	99.6	C-0.7	"	"
C-2-S				100.0	99.5	C-0.5	"	"
C-3-S				100.3	99.5	C-0.8	"	"

Profile Notes Red. Plotted Job No. 8382.0 Division No. 10 F. B. 2230 Pg. 143
X-Sec. Notes Clkd. Checked Survey by Sappell Notes D.S. Date 12-12-56
No. Date Map No. Traced Date Checked Date

76298 S & E #307—7-55

PLEASE RETURN TO
LOS ANGELES COUNTY ENGINEER
700 LOS ANGELES COUNTY ENGINEERING BLDG.

NOTE: ANY ADDITIONS OR CHANGES ON THIS SHEET MUST BE MADE OR CIRCLED IN RED INK, WITH DATE AND NAME OF PERSON MAKING CHANGE.

Do not extend notes this side of this line.

F. B. 2230 Pg. 144 Job No. 8382.01 Division No. 10 Notes Red. Plotted
Survey of Juvenile Hall Date Date
Survey by D. Sapsell Notes D.S. Notes Chkd. Checked
Indexed K. C. Johnson Date Date Profile No. X-Sec. No.

STATION	B. S.	H. I.	F. S.	ELEV.	Grade	C or F		
C-4-S				100 2	99.9	C-0.3	1 x 2	Stk
C-5-S				100 1	99.7	C-0.4	"	"
C-6-S				100 7	99.5	C-1.2	"	"
C-7-S				100 2	100.0	C-0.2	"	"
D				100 2	99.7	C-0.5	"	" AXIS Line
D-1-N				100 2	99.8	C-0.4	"	"
D-2-N				100 2	99.9	C-0.3	"	"
D-3-N				100 6	100.0	C-0.6	"	"
D-4-N				100 7	100.1	C-0.6	"	"
D-5-N				100 0	100.2	F-0.2	"	"
D-6-N				100 3	100 3	Grade	"	"
D-7-N				100 7	100.4	C-0.3	"	"
D-1-S				100.0	99.6	C-0.4	"	"
D-2-S				100.5	99.5	C-1.0	"	"
D-3-S				100.6	99.4	C-1.2	"	"
D-4-S				100.0	99.3	C-0.7	"	"
D-5-S					99.8	Grade	Mk	on sec. line
D-6-S				100 0	99.5	C-0.5		
D-7-S				100 3	99.5	C-0.8		
E				100 1	99.7	C-0.4	"	" AXIS Line
E-1-N				100 2	99.8	C-0.4	"	"

Set - Cross Road

76298 S & E #307—7-55

PLEASE RETURN TO
LOS ANGELES COUNTY ENGINEER
700 Los Angeles County Engineering Bldg.

NOTE: ANY ADDITIONS OR CHANGES ON THIS SHEET MUST BE MADE OR CIRCLED IN RED INK, WITH DATE AND NAME OF PERSON MAKING CHANGE.

Do not extend notes this side of this line.

Profile Notes Red. Plotted Job No. 8382.01 Division No. 10 | F. B. 2230 Pg. 145
X-Sec. Notes Chkd. Checked Survey by Sapsell Notes D.S. Date 12-12-56
No. Date. Date. Map No. Indexed Johnson Date.

STATION	B. S.	H. I.	F. S.	ELEV.	Grade	C or F		
E-2-N				100.6	99.9	C-0.7	1x2	STK.
E-3-N				100.7	100.0	C-0.7	"	"
E-4-N				100.8	100.1	C-0.7	"	"
E-5-N				101.3	100.2	C 1.1	"	"
E-6-N				100.8	100.3	C-0.5	"	"
E-7-N				101.6	100.4	C-1.2	"	"
E-1-S				100.4	99.6	C-0.8	"	"
E-2-S				100.2	99.5	C-0.7	"	"
E 3-S				99.8	99.4	C-0.4	"	"
E-4-S				100.1	99.3	C-0.8	"	"
E-5-S				100.6	99.2	C-1.4	"	"
E-6-S				100.1	99.1	C-1.0	"	"
E-7-S				99.8	99.1	C-0.7	"	"
F				100.4	99.7	C-0.7	"	Axis Line
E-1-N				100.3	99.8	C-0.5	"	"
E-2-N				———	99.9	———	———	Fall in pole of conc.
E-3-N				100.7	100.0	C-0.7	"	"
E-4-N				100.7	100.1	C-0.6	"	"
E-5-N				101.2	100.2	C-1.0	"	"
E-6-N				101.6	100.3	C-1.3	"	"
E-7-N				101.3	100.4	C-0.9	"	"

76298 S & E #307—7-55

PLEASE RETURN TO
LOS ANGELES COUNTY ENGINEER
700 Los Angeles County Engineering Bldg.

NOTE: ANY ADDITIONS OR CHANGES ON THIS SHEET MUST BE MADE OR CIRCLED IN RED INK, WITH DATE AND NAME OF PERSON MAKING CHANGE.

Do not extend notes this side of this line.

F. B. 2230 Pg. 46 | Job No. 8382.01 | Division No. 10 | Notes Red. | Plotted | Profile
Survey of Juvenile Hall | Date | Date | No.
Survey by D. Sapell | Notes D.S. | Notes Chkd. | Checked | X-Sec.
Indexed K. C. Johnson | Date | Date | Date | No.

STATION	B. S.	H. I.	F. S.	ELEV.	Grade	C. or F.		
F-1-S				100.4	99.6	C-0.8	1x2	STK
F-2-S				99.9	99.5	C-0.4	"	"
F-3-S				99.3	99.4	F-0.1	"	"
F-4-S				99.0	99.3	F-0.3	"	"
F-5-S				99.7	99.2	C-0.5	"	"
F-6-S				100.6	99.1	C-1.5	"	"
F-7-S				99.6	99.1	C-0.5	"	"
G				100.2	99.7	C-0.5	"	" Axis Line
G-1-N				100.2	99.8	C-0.4	"	"
G-2-N				———	99.7	———	———	Falls in d/s of conc.
G-3-N				100.6	100.0	C-0.6	1x2	STK
G-4-N				101.0	100.1	C-0.9	"	"
G-5-N				100.9	100.2	C-0.7	"	"
G-6-N				101.5	100.3	C-1.2	"	"
G-7-N				101.4	100.4	C-1.0	"	"
G-1-S				100.5	99.6	C-0.9	"	"
G-2-S				100.1	99.5	C-0.6	"	"
G-3-S				99.7	99.4	C-0.3	"	"
G-4-S				99.8	99.3	C-0.5	"	"
G-5-S				99.6	99.2	C-0.4	"	"
G-6-S				———	99.1	———	Falls on conc. slab	
G-7-S				99.7	99.1	C-0.6	1x2	STK

76298 S & E #307—7-55

PLEASE RETURN TO
LOS ANGELES COUNTY ENGINEER
700 LOS ANGELES COUNTY ENGINEERING BLDG.

NOTE: ANY ADDITIONS OR CHANGES ON THIS SHEET MUST BE MADE OR CIRCLED IN RED INK, WITH DATE AND NAME OF PERSON MAKING CHANGE.

Do not extend notes this side of this line.

STATION	B. S.	H. I.	F. S.	ELEV.	Grade	C. or F.		
H				100 3	99.7	C-0.6	1x2	STK. Axis Line
H-1-N				100 6	99.8	C-0.8	"	"
H-2-N				———	99.9	———		Falls in p/c of slab
H-3-N				100 8	100 3	C-0.3	1x2	Stk
H-4-N				100 8	100.1	C-0.7	"	"
H-5-N				101 2	100.2	C-1.0	"	"
H-6-N			Set Conc. Plug	———	100.3	———		Fall on conc. slab.
H-7-N				101 6	100.4	C-1.2	1x2	Stk
H-1-S				100.5	99.6	C-0.9	"	"
H-2-S				100.1	99.5	C-0.6	"	"
H-3-S				100.1	99.4	C-0.7	"	"
H-4-S				99.9	99.3	C-0.6	"	"
H-5-S				99.9	99.2	C-0.7	"	"
H-6-S				———	99.1	———	Falls on conc. slab	
H-7-S				99.5	99.1	C-0.4	1x2	Stk
J				100 3	99.7	C-0.6	"	"
J-1-N				100 7	99.8	C-0.9	"	"
J-2-N				100 6	99.9	C-0.7	"	"
J-3 N				100 8	100 0	C-0.8	"	"
J-4 N				101 1	100 1	C-1.0	"	"
J-5-N				101 1	100.2	C-0.9	"	"

Profile Notes Red. Plotted Job No. 8382-01 Division No. 10 F. B. 2230 Pg. 147
X-Sec. Notes Chkd. Checked Survey by Sapoe // Notes R.J. Date 12-12-56
No. Date Date Map No. Andrew Johnson Date

76298 S & E #307—7-55

PLEASE RETURN TO
LOS ANGELES COUNTY ENGINEER
700 LOS ANGELES COUNTY ENGINEERING BLDG.

NOTE: ANY ADDITIONS OR CHANGES ON THIS SHEET MUST BE MADE OR CIRCLED IN RED INK, WITH DATE AND NAME OF PERSON MAKING CHANGE.

Do not extend notes this side of this line.

F. B. 2230 Pg. 148 | Job No. 8382.01 Division No. 10 Notes Red. Plotted Profile
Survey of Juvenile Hall Date Date No. X-Sec.
Survey by P. Sappell Notes D.S. Notes Chkd. Checked No.
Indexed C. Johnson Date Date Date

STATION	B. S.	H. I.	F. S.	ELEV.	Grade	C or F		
J-6-N				101.0	100.3	C-0.7	1 x 2.	STK.
J-7-N				101.9	100.4	C-1.4	"	"
J-1-S				100.2	99.6	C-0.6	"	"
J-2-S				100.5	99.5	C-1.0	"	"
J-3-S				100.2	99.4	C-0.6	"	"
J-4-S				99.8	99.3	C-0.5	"	"
J-5-S				100.0	99.2	C-0.8	"	"
J-6-S				100.0	99.1	C-0.9	"	"
J-7-S				99.5	99.1	C-0.4	"	"
BM #5				99.82			BM #5, El. 99.829, F.B. 2230-134	
							P.M. in No. Rim S.M.H. 66°	
							N. of Sa. face ℄ 45' W. of	
							W. face gym ℄ classroom	
							Bldg #7	

Scale Comp. Plan

Profile No. | Notes Red. | Plotted | Job No. 8382.01 | Division No. 10 | F. B. 2230 | Pg. 149

X-Sec. No. | Notes Chkd. | Checked | Survey of Juvenile Hall

Date | Date | Survey by Sappell | Notes D.S. | Date 12-12-56

Map No. | Indexed C. Johnson | Date

J.N. 8382.01

JUVENILE HALL

AT

RANCHO LOS AMIGOS

GRID AREA "C"

ALONG No SEC. WALL FROM GYM & CLASSROOM BLDG TO SEGREGATION WALL.

Party: Sappell
Shoemake
Myers
Bustrum

STATION	B. S.	H. I.	F. S.	ELEV.

NOTE: ANY ADDITIONS OR CHANGES ON THIS SHEET MUST BE MADE OR CIRCLED IN RED INK, WITH DATE AND NAME OF PERSON MAKING CHANGE.

Do not extend notes this side of this line.

PLEASE RETURN TO
LOS ANGELES COUNTY ENGINEER
700 Los Angeles County Engineering Bldg.

76298 S & E #307—7-55

76298 S & E #307—7-55

PLEASE RETURN TO
LOS ANGELES COUNTY ENGINEER
700 LOS ANGELES COUNTY ENGINEERING BLDG.

NOTE: ANY ADDITIONS OR CHANGES ON THIS SHEET MUST BE MADE OR CIRCLED IN RED INK, WITH DATE AND NAME OF PERSON MAKING CHANGE.

Do not extend notes this side of this line.

F. B. 2230 Pg. 150 Job No. 6382-01 Division No. 10 Notes Red. Date Notes Chkd. Date
Survey of Juvenile Hall Date Checked Date
Survey by D. Sapell Notes J.S. Plotted Date
Indexed K. C. Johnson Date Profile No. X-Sec. No.

STATION	B. S.	H. I.	F. S.	ELEV.	Grade	C. or F.		
BM #5				99.93	BM#5 El. 99.929 F.B. 2230-134 P.M. in No. Rim S.M.H., 66' N. of So. face & 45' W. of W. face gym. & Classroom Bldg #7			
A				101.5	101.5	Grade		Mark on wall
A-1-S				[illegible]	101.0	F-1.2	1x1	Stk.
A-2-S				[illegible]	100.3	F-0.4	"	"
A-3-S				100.7	100.5	C-0.2	"	"
B			Road	101.4	101.4	Grade		Mark on wall
B-1-S				99.2	100.9	F-1.7	1x1	Stk.
B-2-S				99.3	100.3	F-1.0	"	"
B-3-S				99.3	99.6	F-0.3	"	"
C			Self-comp	101.3	101.3	Grade		Mark on wall
C-1-S				99.2	100.7	F-1.5	1x1	Stk.
C-2-S				99.1	100.3	F-1.2	"	"
C-3-S				99.1	100.4	F-1.3	"	"
D				101.2	101.2	Grade.		Mark on wall
D-1-S				[illegible]	100.5	F-1.3	1x1	Stk.
D-2-S				99.2	100.2	F-1.0	"	"
D-3-S				99.1	100.3	F-1.2	"	"
E				101.1	101.1	Grade		Mark on wall
E-1-S				99.2	100.4	F-1.2	1x1	Stk.

76298 S & E #307—7-55

PLEASE RETURN TO
LOS ANGELES COUNTY ENGINEER
700 LOS ANGELES COUNTY ENGINEERING BLDG.

NOTE: ANY ADDITIONS OR CHANGES ON THIS SHEET MUST BE MADE OR CIRCLED IN RED INK, WITH DATE AND NAME OF PERSON MAKING CHANGE.

Do not extend notes this side of this line.

Profile Notes Rod. Plotted Job No. 8362.01 Division No. 10 F. B. 2230 Pg. 157
No. Date Survey of Juvenile Hall
X-Sec. Notes Chkd. Checked Survey by Sapsell & Co. Notes Checked DJS Date 12-12-56
No. Date Date Map No. Indexed Date

STATION	B. S.	H. I.	F. S.	ELEV.				
E-2-S				99.0	100.0	F-1.0	1x1	Stk.
E-3-S				99.6	100.2	F-0.6	"	"
E				——	101.0	——	Mark on wall	
F-1-S				99.1	100.3	F-1.2	1x1	Stk.
F-2-S				99.0	100.2	F-1.2	"	"
F-3-S			Self-contd Rod	99.0	100.1	F-1.1	"	"
G				——	100.9	——	Mark on wall	
G-1-S				99.3	100.2	F-0.9	1x1	Stk.
G-2-S				98.7	100.1	F-1.4	"	"
G-3-S				98.9	100.0	F-1.1	"	"
H				——	100.8	——	Mark on wall	
H-1-S				99.2	100.1	F-0.9	1x1	Stk.
H-2-S				98.9	100.0	F-1.1	"	"
H-3-S				98.3	99.9	F-1.1	"	"
J				——	100.7	——	Mark on wall	
J-1-S				99.2	100.1	F-0.9	1x1	Stk.
J-2-S				99.0	99.9	F-0.9	"	"
J-3-S				99.2	99.8	F-0.6	"	"
K				——	100.6	——	Mark on wall	
K-1-S				99.1	100.0	F-0.9	1x1	Stk.
K-2-S				98.9	99.8	F-0.9	1x1	"

76298 S & E #307—7-55

PLEASE RETURN TO
LOS ANGELES COUNTY ENGINEER
700 LOS ANGELES COUNTY ENGINEERING BLDG.

NOTE: ANY ADDITIONS OR CHANGES ON THIS SHEET MUST BE MADE OR CIRCLED IN RED INK, WITH DATE AND NAME OF PERSON MAKING CHANGE.

Do not extend notes this side of this line.

F. B. 2230 Pg. 152 | Job No. 8382.0 | Division No. 10 | Notes Red. | Plotted | Profile
Survey by D. Sapsell Notes | Date | X-Sec.
Indexed E. C. Johnson Date | Notes Chkd. | Checked
Date | Date | No.

STATION	B. S.	H. I.	F. S.	ELEV.	grade	C. or F.		
L				——	100.5	——		
L-1-S				99.2	100.0	F-0.8	1 x 2	Stk.
L-2-S				110	99.7	F-0.1	"	"
L-3-S			Self - Comp Rod.	99.1	99.6	F-0.5	"	"
M				——	100.4	——		
M-1-S				99.9	100.0	F-0.1	"	"
M-2-S				99.3	99.6	F-0.3	"	"
M-3-S				99.2	99.5	F-0.3	"	"
N				——	100.3	——		
N-1-S				99.7	100.0	F-0.3	"	"
N-2-S				99.8	99.5	C-0.3	"	"
N-3-S				99.4	99.5	F-0.1	"	"
T.P.				99.50			T.P.	
BM #4				100.17			BM #4	El. 100.17 F.B 2230-133
							P.M. in	So. Rim of S.M.H.
							on S'LY	Line of chapel
							& 61°	E. of E. face.

Profile No. | Notes Red. | Plotted | Job No. 8382.01 | Division No. 10 | F. B. 2230 Pg. 153

X-Sec. No. | Notes Chkd. | Checked | Survey of Juvenile Hall

Date | Date | Survey by Sappell | Notes D.S. | Date 12-17-56

Date | Date | Map No. ~~A. G. Johnson~~ Indexed | Date

J.N. 8382.01

JUVENILE HALL

AT

RANCHO LOS AMIGOS

GRID AREA "D"

ALONG So. SEC. WALL FROM GYM & CLASSROOM BLDG F'LY to SEC. WALL

Party: Sappell
Shoemaker
Myers
Bustrum

STATION	B. S.	H. I.	F. S.	ELEV.

NOTE: ANY ADDITIONS OR CHANGES ON THIS SHEET MUST BE MADE OR CIRCLED IN RED INK, WITH DATE AND NAME OF PERSON MAKING CHANGE.

Do not extend notes this side of this line.

PLEASE RETURN TO
LOS ANGELES COUNTY ENGINEER
700 Los Angeles County Engineering Bldg.

76298 S & E #307—7-55

76298 S & E #307—7-55

PLEASE RETURN TO
LOS ANGELES COUNTY ENGINEER
700 Los Angeles County Engineering Bldg.

NOTE: ANY ADDITIONS OR CHANGES ON THIS SHEET MUST BE MADE OR CIRCLED IN RED INK, WITH DATE AND NAME OF PERSON MAKING CHANGE.

Do not extend notes this side of this line.

F. B. 2230 Pg. 134 | Job No. 8382.01 Division No. 10 | Notes Red. | Plotted | Profile
Survey of D. Sewell Hall | Date | No.
Survey by D. Sewell Notes D.S. | Notes Chkd. | Checked | X-Sec.
Indexed C. Johnson Date | Date | Date | No.

STATION	B. S.	H. I.	F. S.	ELEV.				
BM#5				99.88	BM#5, El 99.88, F.B. 2230-134 Rm in N. Rim SMH 66' N of So face & 45' W. of W. face Dim 6'S			
					Grade	Cor. F		
A				99.1	99.1	grade	Mark	on wall
A-1-N				99.5	99.5	C-0.3	1x1	Stk
A-2-N			Red	99.6	99.6	grade	"	"
B				99.2	99.2	"	Mark	on wall
B-1-N				99.9	99.4	C-0.5	1x1	Stk
B-2-N			self-comp	99.9	99.6	C-0.3	"	"
C				99.0	99.0	grade	Mark	on wall
C-1-N				99.7	99.3	C-0.4	1x1	Stk
C-2-N				100.0	99.6	C-0.4	"	"
D				99.0	99.0	grade	Mark	on wall
D-1-N				99.7	99.2	C-0.5	1x1	Stk
D-2-N				100.2	99.6	C-0.6	"	"
E				99.0	99.0	grade	Mark	on wall
E-1-N				99.0	99.3	F-0.3	1x1	Stk
E-2-N				99.5	99.5	grade	"	"
F				99.2	99.2	grade	Mark	on wall
F-1-N				99.3	99.4	F-0.1	1x1	Stk
F-2-N				99.6	99.4	C-0.2	1x1	"

76298 S & E #307—7-55

PLEASE RETURN TO
LOS ANGELES COUNTY ENGINEER
700 LOS ANGELES COUNTY ENGINEERING BLDG.

NOTE: ANY ADDITIONS OR CHANGES ON THIS SHEET MUST BE MADE OR CIRCLED IN RED INK, WITH DATE AND NAME OF PERSON MAKING CHANGE.

Do not extend notes this side of this line.

STATION	B. S.	H. I.	F. S.	ELEV.	Grade	C or F		
G				99 3	993	grade	Mark on wall	
G-1-N				99.2	995	F-0.3	1x1	stk.
H				991	991	grade	"	"
H-1-N				98.7	994	F-0.7	"	"
J				989	989	grade	Mark on wall	
J-1-N				99.7	991	C-0.6	1x1	stk.
K				991	991	grade	Mark on wall	
K-1-N				99.5	992	F-0.3	1x1	stk.
K-2-N			Self-Comp	100.7	992	C-1.5	"	"
L				998	998	grade	Mark on wall	
L-1-N				99.4	997	F-0.3	1x1	stk.
L-2-N			Rod	100.05	100.05	grade	Mark on cb	
M				995	995	grade	Mark on wall	
M-1-N				99.4	996	F-0.2	1x1	stk
M-2-N				99.4	997	F-0.3	"	"
M-3-N				99.3	998	F-0.5	"	"
N				991	991	grade	Mark on wall	
N-1-N				981	994	F-1.3	1x1	stk
N-2-N				97.4	996	F-2.2	"	"
N-3-N				99.2	998	F-0.6	"	"

File
Notes Rod. Plotted Job No. 8382.01 Division No. 10 F. B. 22330 Pg. 155
Date Date Survey of Covenie Hall
Sec. Notes Chkd. Checked Survey by Sapoff Notes Date 12-17-56
Date Date Map No. Indexed Johnson Date

76298 S & E #307—7-55

PLEASE RETURN TO
LOS ANGELES COUNTY ENGINEER
700 LOS ANGELES COUNTY ENGINEERING BLDG.

NOTE: ANY ADDITIONS OR CHANGES ON THIS SHEET MUST BE MADE OR CIRCLED IN RED INK, WITH DATE AND NAME OF PERSON MAKING CHANGE.

Do not extend notes this side of this line.

F. B. 2230 Pg. 157 | Job No. 9282.01 Division No. 10 | Notes Red. | Plotted | Profile
Survey of Juvenile Hall | Date | No.
Survey by D. Sapsell Notes D.J.S. | Notes Chkd. | Checked | X-Sec.
Indexed A. C. Johnson Date | Date | Date | No.

STATION	B. S.	H. I.	F. S.	ELEV.				
O				98.7	98.7	grade	Mark on wall	
O-1-N				97.7	99.3	F-1.6	1x1	Stk.
O-2-N				97.5	99.6	F-2.1	"	"
P				98.5	98.5	grade	Mark on wall	
P-1-N				98.1	99.1	F-1.0	1x1	Stk.
P-2-N				98.3	99.5	F-1.2	"	"
P-3-N				100.2	100.0	C-0.2	"	"
Q				98.3	99.3	grade	Mark on wall	
Q-1-N				98.0	99.0	F-1.0	1x1	Stk.
" 2 "				98.8	99.4	F-0.6	"	"
" 3 "				100.2	99.9	C-0.3	"	"
T.P.				100.16			T.P.	
BM #4				100.17			BM #4, El. 100.17, F.B. 2230-133 P.M. in So. Rim of S.M.H. on S'LY Line of chapel & 61' E. of E. face	
		continuation		Grid	AREA "D"			
T.B.M. #1							T.B.M. #1.	

76298 S & E #307—7-55

PLEASE RETURN TO
LOS ANGELES COUNTY ENGINEER
700 LOS ANGELES COUNTY ENGINEERING BLDG.

NOTE: ANY ADDITIONS OR CHANGES ON THIS SHEET MUST BE MADE OR CIRCLED IN RED INK, WITH DATE AND NAME OF PERSON MAKING CHANGE.

Do not extend notes this side of this line.

STATION	B. S.	H. I.	F. S.	ELEV.	Grade	C. or F.		
R				98 19	97.63	C-0.51	1X2	W. header parking
R-1-11				98 63	98.15	C-0.48	"	Lot Area.
" 2 "				98 11	98.48	F-0.37	"	
" 3 "				98 58	98.31	F-0.23	"	
" 4 "				98 34	99.14	F-0.80	"	
" 5 "				100 02	99.50	C-0.52	"	
S				98 04	97.49	C-0.55		F/L parking Lot.
S-1-11				98 05	96.99	C-1.06	"	" Ed cutt.
" 2 "				98 21	97.16	C-1.05	"	" pk. Lot.
" 3 "				97 99	97.33	C-0.66	"	"
" 4 "				98 06	97.50	C-0.56	"	"
" 5 "				98 35	97.67	C-0.68	"	"
" 6 "				98 14	97.81	C-1.33	"	"
T				97 99	97.31	C-0.68	"	Ctr. " "
T-1-N				97 62	97.62	Grade	"	"
" 2 "				97 76	97.76	"	"	" H.P.
" 3 "				97 94	97.94	"	"	"
" 4 "				98 12	98.12	"	"	"
" 5 "				98 30	98.30	"	"	"
" 6 "				99 62	98.50	C-1.12	"	" H.P.

Profile Notes Rod. Plotted Job No. 8222 Division No. 10 F. B. 2230 Pg. 157
X-Sec. Notes Chkd. Checked Survey by Sapoch Notes PS Date 12-56
No. Date Date Map No. Traced Checked Date

76298 S & E #307—7-55

PLEASE RETURN TO
LOS ANGELES COUNTY ENGINEER
700 Los Angeles County Engineering Bldg.

NOTE: ANY ADDITIONS OR CHANGES ON THIS SHEET MUST BE MADE OR CIRCLED IN RED INK, WITH DATE AND NAME OF PERSON MAKING CHANGE.

Do not extend notes this side of this line.

F. B. 2230 Pg. 158 Job No. 8282 Division No. 10 Notes Red. Date Checked Date
Survey of Juvenile Hall Notes Chkd. Date
Survey by D. Sapsell Notes D.S. Date
Indexed K. C. Johnson Date

Profile No. X-Sec. No. Plotted Date

STATION	B. S.	H. I.	F. S.	ELEV.	Grade	C. or F		
U				97.13	97.13	Grade	1 x 2	F/L parking Lot
U-1-N				97.44	96.82	C-0.62	"	"
" 2 "				97.58	97.00	C-0.58	"	"
" 3 "				97.84	97.18	C-0.66	"	"
" 4 "				97.91	97.36	C-0.45	"	"
" 5 "				[illegible]	97.54	Grade	"	"
" 6 "				97.70	97.70	Grade	"	"
"V"								
2				[illegible]	97.04	F-0.37	"	E. Header on lot.
3				[illegible]	97.23	F-1.06	"	
4				96.43	97.40	F-0.77	"	
5				96.34	97.58	F-1.24	"	
T.B.m.#1				96.32			T.B.m.#1	El. 96.322 T.B. 2230-128
							So. Side	3" I.P. 24" D.P. on S. P/L

Notes Ck'd by	Survey of Juvenile Hall
Map No.	W. O. 8382.01 Tape No. St'd. 68 °F
Office Work	Surveyed by D. Sappell
Checked	Notes DS Date 1- -57
Date	Indexed E. C. Johnson

F. B. 7230 PG. 159

J.N. 8382.01

BRANCH JUVENILE HALL

RANCHO LOS AMIGOS

CENTER LINE SURVEY

OF

SERVICE ROAD

Party: Sappell
Shoemaker
Myers
Bustrum

Note: Any Additions or Changes on This Sheet Must be Made in Red Ink With Date and Name of Person Making Change.

Do not extend notes this side of this line.

RETURN TO
LOS ANGELES COUNTY SURVEYOR
726 LOS ANGELES COUNTY
ENGINEERING BLDG.

76F309S S&E #247. 8-54

RETURN TO
LOS ANGELES COUNTY SURVEYOR
726 LOS ANGELES COUNTY
ENGINEERING BLDG.

Note: Any Additions or Changes on This Sheet Must be Made or Circled in Red Ink With Date and Name of Person Making Change.

Do not extend notes this side of this line.

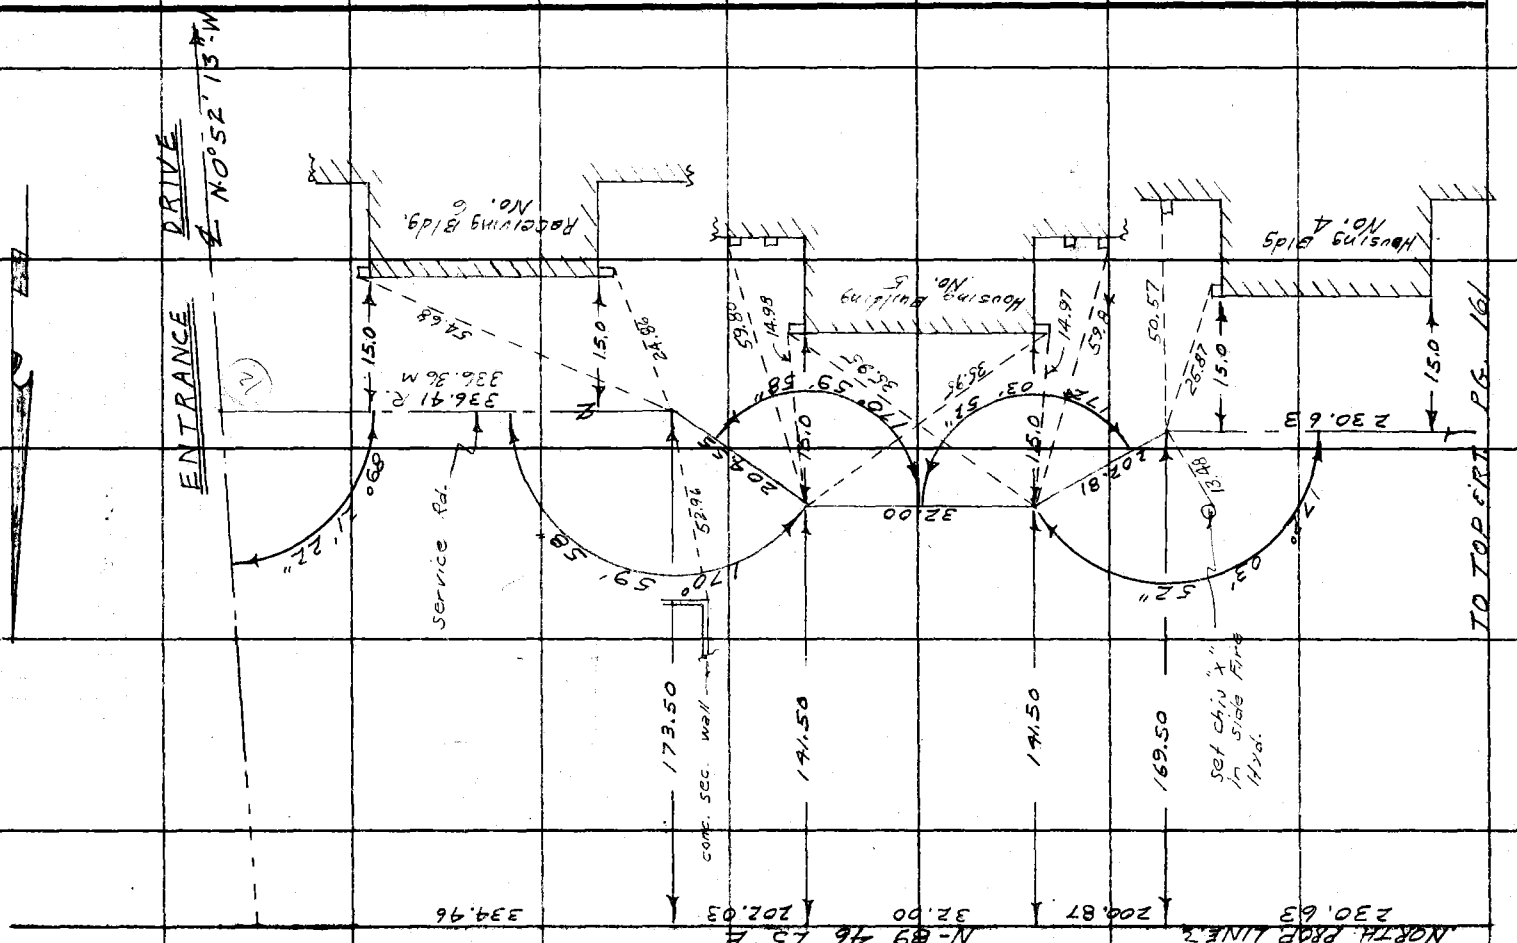

Notes Ck'd by	Survey of Juvenile Hall
Map No.	W. O. 8382.01 Tape No. 145 St'd. 68 °F
Office Work	Surveyed by L.D. Seppell
Checked	Notes D. Date 1-57
Date	Indexed K. C. Johnson

F.B. 2230 PG. 161

Note: Any Additions or Changes on This Sheet Must be Made or Circled in Red Ink With Date and Name of Person Making Change.

Do not extend notes this side of this line.

RETURN TO
LOS ANGELES COUNTY SURVEYOR
726 LOS ANGELES COUNTY
ENGINEERING BLDG.

76F3085 S&E #247. 8-54

50.00
24.66
90°
28.70
51.65
60.68
security wall
N. 89-46-25 E
230.63
North R/W
Fd 3" I. P.
F.B. 2230 -
119.50
Δ = 90-00-00
R = 35.00
T = 35.00
L = 54.98
230.63
℄
Service Rd.
TO Pt.
FROM BOTT. PG 160
15.3
444.00
15.3
Gymnasium Bldg. No. 7
Housing Building No. 3
68.92
Δ = 60-14-11
R = 60.00
T = 34.81
L = 63.08
15.0
52.12
15.0
22.98
Service Rd.
℄
226.44
Δ = 90-00-00
R = 35.00
T = 35.00
L = 54.98
133.50
Fd 3" I. R
F.B. 2230 -
46.72
52.80
11.53
36.00
90°
18.82
security wall
226.44
N-89-46-25 E
S. R/W
169.50
90°
107.36
53.795
TO LEFT PG. 162

RETURN TO
LOS ANGELES COUNTY SURVEYOR
726 LOS ANGELES COUNTY
ENGINEERING BLDG.

Note: Any Additions or Changes on This Sheet Must be Made or Circled in Red Ink With Date and Name of Person Making Change.

Do not extend notes this side of this line.

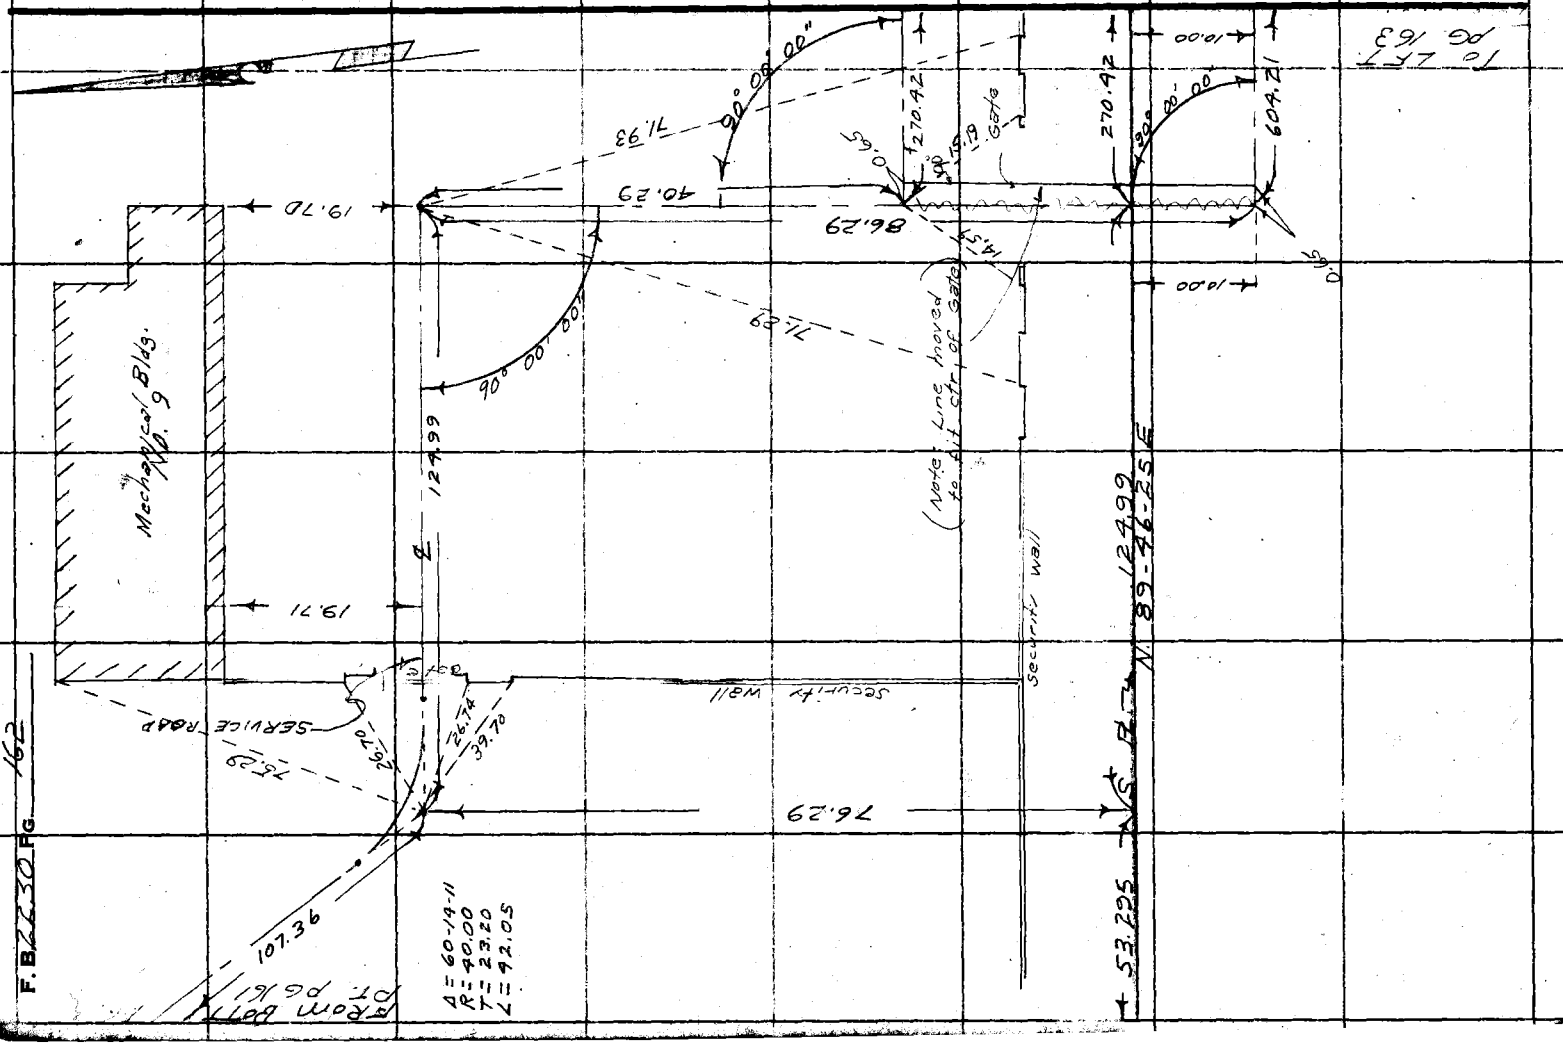

Notes Ck'd by	Survey of Juvenile Hall
Map No.	W. O. 8282.01 Tape No. 0145 St'd. 68 °F
Office Work	Surveyed by D. Sappell
Checked	Notes RS Date 1-57
Date	Indexed J. C. Johnson

F. B. 2230 PG. 163

Note: Any Additions or Changes on This Sheet Must be Made or Circled in Red Ink With Date and Name of Person Making Change.

Do not extend notes this side of this line.

RETURN TO
LOS ANGELES COUNTY SURVEYOR
726 LOS ANGELES COUNTY
ENGINEERING BLDG.

76F3098 S&E #247 8-54

Housing Building No. 2

86.00

10.00

46.05

62.1

set chis "x" in side Fire Hyd

11.84

Maintenance Building No. 12

Δ = 90-00-00
R. = 40.00
T. = 40.00
L. = 62.83

188.50

10.00

10.00

℄

270.42

From PT. pg 162

41.93

9.65

27.96

18.38

N-0°52'13"W

℄ ENTRANCE DRIVE

S.E. → N-89-46-25-E

270.42

90°

80° 21' 22"

333.68

N-89°46'25"E ℄

SERVICE ROAD

604.21

1008

758.33

QUILL DRIVE
N-89-00-00E

76298 S & E #307—7-55

PLEASE RETURN TO
LOS ANGELES COUNTY ENGINEER
700 LOS ANGELES COUNTY ENGINEERING BLDG.

NOTE: ANY ADDITIONS OR CHANGES ON THIS SHEET MUST BE MADE OR CIRCLED IN RED INK, WITH DATE AND NAME OF PERSON MAKING CHANGE.

Do not extend notes this side of this line.

Profile Notes Red. Plotted Job No. 53226 Division No. 10 F. B. 2230 Pg. 165
No. Date Date Survey of Vurenite Hill
X-Sec. Notes Chkd. Checked Survey by Sapell Notes by JS Date 4-27
No. Date Date Map No. Checked Date

STATION	B. S.	H. I.	F. S.	ELEV.	Top Cb. GRADE	C. or F.		
0+00							Int.	Entrance Rd & Parking Lot Rd.
0+42				97.03	98.31	F-1.28		13' R
				97.08	98.14	F-1.06	13' L	
1+28.5				99.74	99.88	F-0.14		20' R
		Grades		for	Service		Rd.	
0+00								(North) & Int. Ent & Service Rd.
0+40				98.39	98.39	GRADE		10 R Ed. pv.
				98.39	98.39	"	13' L	
0+50				98.75	98.75	"		10' R Ev. Rd & Ditch
				99.09	99.09	"	13' L	
1+20				99.02	99.02	"		10' R
				99.36	99.36	"	13' L	
1+66				99.21	99.21	"		10' R Sec. wall
				99.55	99.55	"	10' L	Sec. wall
2+43.4				100.33	99.33	C-1.00		B.C. 10' R
				100.52	99.67	C-0.85	13' L	
3+06.4				98.95	99.40	F-0.45		B.C. 10' R
				100.70	99.74	C-0.96	13' L	

76298 S & E #307—7-55

PLEASE RETURN TO
LOS ANGELES COUNTY ENGINEER
700 LOS ANGELES COUNTY ENGINEERING BLDG.

NOTE: ANY ADDITIONS OR CHANGES ON THIS SHEET MUST BE MADE OR CIRCLED IN RED INK, WITH DATE AND NAME OF PERSON MAKING CHANGE.

Do not extend notes this side of this line.

F. B. 2230 Pg. 166 Job No. 2220 Division No. 10 Profile
Survey by P. Sagehill Notes D.S. Date Notes Red. Date Notes Chkd. Date Checked Date No.
Indexed K. C. Johnson Date

STATION	B. S.	H. I.	F. S.	ELEV.	GR.	C or F.		
3+36.41								℄ P.T.
3+73.4				99 52	99.52	GR.		10'R E.C.
				99 37	99.86	F-0.49	13'L	
4+40.9				99 30	99.63	F-0.33		10'R
				99 71	99.97	F-0.26	13'L	
4+94.9				99 19	99.72	F-0.53		10'R
				100 06	100.06	GR.	13'L	
5+40.9				99 13	99.79	F-0.66		10'R ℄ P.T.
				100 13	100.13	GR.	13'L	
5+72.9				99 26	99.84	F-0.58		10'R
				99 78	100.18	F-0.40	13'L	
6+22.9				99 99	99.92	F-0.83		10'R
				100 26	100.26	GR.	13'L	
6+72.9				99 10	99.99	F-0.89		10'R
				100 33	100 33	GR	13'L	
7+59.2					100.12			10'R
				100 17	100.46	F-0.29	13'L	
7+75.2				100 15	100.15	GR.		10'R ℄ P.T.
				100 49	100.49	GR.	13'L	
8+25.2				100 22	100.22	GR.		10'R
					100.56		13'L	

76298 S & E #307—7-55

PLEASE RETURN TO
LOS ANGELES COUNTY ENGINEER
700 LOS ANGELES COUNTY ENGINEERING BLDG.

NOTE: ANY ADDITIONS OR CHANGES ON THIS SHEET MUST BE MADE OR CIRCLED IN RED INK, WITH DATE AND NAME OF PERSON MAKING CHANGE.

Do not extend notes this side of this line.

Profile Notes Red. Plotted Job No. 8320 Division No. 10 F. B. 2230 Pg. 167
No. Date Date Survey of Juvenile Hall
X-Sec. Notes Chkd. Checked Survey by Sappell Notes D.S. Date 1-57
No. Date Date Map No. Mad. Tabulation Date

STATION	B. S.	H. I.	F. S.	ELEV.	GR.	C or F.		
8+70.3				99.52	100.29	F-0.77		10' R
				100.12	100.63	F-0.51	13' L	
9+36.8				99.72	100.39	F-0.67		10' R
				99.40	100.73	F-1.33	13' L	
9+70.8				99.65	100.45	F-0.80		BC 13' R.
				99.70	100.79	F-1.09	13' L	
10+25.6				100.07	100.47	F-0.40		EC 13 R
				100.81	100.81	Grade	13' L	
10+97.6				100.47	100.47	"		13' R
				100.77	100.77	"	13' L	
11+20.6				100.47	100.47	"		13 R
				100.76	100.76	"	13' L	
11+69.6				100.39	100.39	"		13 R
				101.17	101.17	"	13' L	Top cb.
BM#5				99.83			BM#5 El. 99.829 F.B. 2230-134	
							P.M. in N.a. Rim S.M.H 66° N/E of Sq. face & 45' W. of W. face Classroom	
12+12.6				100.37	100.37	Grade		13' R Axis Line
				101.17	101.17	"	13' L	Top cb.
12+79.6				100.33	100.33	"		13 R
				100.17	101.17	"	13' L	Top cb.

76298 S & E #307—7-55

PLEASE RETURN TO
LOS ANGELES COUNTY ENGINEER
700 Los Angeles County Engineering Bldg.

NOTE: ANY ADDITIONS OR CHANGES ON THIS SHEET MUST BE MADE OR CIRCLED IN RED INK, WITH DATE AND NAME OF PERSON MAKING CHANGE.

Do not extend notes this side of this line.

F.B. 2230 Pg. 168 | Job No. 63201 | Division No. 10 | Notes Red. | Plotted | No. | Profile
Survey of Juvenile Hall | Date | Date | X-Sec.
Survey by 2 Squad | Notes D.S. | Notes Chkd. | Checked | No.
Indexed [redacted] | Date | Date | Date

F.H. 102.17 Sta. 68+

Br. B.C. 1694 101.94

STATION	B. S.	H. I.	F. S.	ELEV.	G.R.	C. or F.		
13+03.6				100.32	100.32	Grade		13 R
					100.62		13'L	
13+38.6				100.61	100.61	"		13 R
				100.61	100.61	"	13'L	
13+99.6				100.58	100.58	"		13 R - B.C.
				100.58	100.58	"	13 L	
14+54.6				100.48	100.48	"		13 R E.C.
				100.43	100.48	"	13 L	
15+11.2				100.28	100.28	"		13 R
				100.28	100.28	"	13 L	
15+61.2				100.11	100.11	"		13 R
				100.11	100.11	"	13 L	
16+11.2				99.94	99.94	"		13 R
				100.69	99.69	C-1.00	13 L	F/L B.C.
BC to Service Rd to Bldg #3				100.24	99.84	C-0.40		
EC " "	" "	" "		100.54	100.54	Grade		
16+74.29				99.71	99.71	Grade		13 R E.C.
				99.71	99.71	"	13 L	
17+23.64				99.58	99.58	"		13 R. B.C.
				99.58	99.58	"	13'L	

76298 S & E #307—7-55

PLEASE RETURN TO
LOS ANGELES COUNTY ENGINEER
700 LOS ANGELES COUNTY ENGINEERING BLDG.

NOTE: ANY ADDITIONS OR CHANGES ON THIS SHEET MUST BE MADE OR CIRCLED IN RED INK, WITH DATE AND NAME OF PERSON MAKING CHANGE.

Do not extend notes this side of this line.

STATION	B. S.	H. I.	F. S.	ELEV.	GR.	C or F.		
17+65.69								P.C.
17+68.44				99.50	99.50	Grade		10 R sec. wall
				99.50	99.50	"	10'L	
		See		Grid	Area	"D"		(Service yard)
18+67.48								P.I.
19+17.77								P.I.
20+33.77				99.80	99.80	Grade		10'R W. side Maintenance Bldg # 12
				99.80	99.80	"	10'L	
21+02.77				99.58	99.58	"		10'R (E. Face)
				99.58	99.58	"	10'L	
21+48.19				99.31	99.31	"		10'R B.C.
				99.31	99.31	"	13'L	
21+79.51				98.62	98.62	"		13'R F/L conc. gutt
				99.49	98.70	C-0.79	13'L	" " "
22+10.83				99.30	99.30	Grade		13'R EC
				99.30	99.30	"	13'L	
22+76.33				99.58	99.58	"		13 R B.C.
					99.58		13'L	
22+93.3				99.71	99.71	"		30'R E.C.
				99.71	99.71	"		47.5 R

Profile Notes Red. ____ Plotted ____ Job No. 8281 Division No. 10 F. B. 2230 Pg. 169
No. ____ Date ____ Date ____ Survey of Juvenile Hall
X-Sec. Notes Chkd. ____ Checked ____ Survey by Sapsell Notes by A.S. Date 1-27-57
No. ____ Date ____ Date ____ Map No. ____ Date ____

76298 S & E #307—7-55

PLEASE RETURN TO
LOS ANGELES COUNTY ENGINEER
700 LOS ANGELES COUNTY ENGINEERING BLDG.

NOTE: ANY ADDITIONS OR CHANGES ON THIS SHEET MUST BE MADE OR CIRCLED IN RED INK, WITH DATE AND NAME OF PERSON MAKING CHANGE.

F. B. 2230 Pg. 170 Job No. 82220 Division No. 10 Notes Red. Date Notes Chkd. Date
Survey of Juvenile Hall
Survey by D. Sapsell Notes D.S. Date
Indexed C. Johnson Date
Profile No. X-Sec. No.

Do not extend notes this side of this line.

STATION	B. S.	H. I.	F. S.	ELEV.	GR.	C or F.		
23+21.3				100.13	100.13	Grade		8'R Cor Bldg 2 End Buff. Line.
				99.79	99.79	"	13'L	
Bm. #4				100.16			Bm #4 El. 100.17, F.B. 2230-133 P.m. in So. Rim S.M.H. on S'ly line of chapel 61° E. of E. face.	

Profile No. | Notes Red. | Date | Plotted | Date | Job No. 8382.01 | Division No. 10 | F. B. 2230 Pg. 171

X-Sec. No. | Notes Chkd. | Date | Checked | Date | Survey of Juvenile Hall | Survey by Sappell | Notes D.S. | Date 1-17-57 | Map No. Edd Johnson | Date

J.N. 8382.01

BRANCH JUVENILE HALL

RANCHO LOS AMIGOS

FINISH GRADES

ADMISSION YARD & ENT. RD.

STATION	B. B.	H. I.	F. B.	ELEV.
		Party: Sappell Shoemaker Myers Bustrum		

NOTE: ANY ADDITIONS OR CHANGES ON THIS SHEET MUST BE MADE OR CIRCLED IN RED INK, WITH DATE AND NAME OF PERSON MAKING CHANGE.

Do not extend notes this side of this line.

PLEASE RETURN TO
LOS ANGELES COUNTY ENGINEER
700 Los Angeles County Engineering Bldg.

7628 S & E #307—7-55

76298 S & E #307—7-55

PLEASE RETURN TO
LOS ANGELES COUNTY ENGINEER
700 LOS ANGELES COUNTY ENGINEERING BLDG.

NOTE: ANY ADDITIONS OR CHANGES ON THIS SHEET MUST BE MADE OR CIRCLED IN RED INK, WITH DATE AND NAME OF PERSON MAKING CHANGE.

Do not extend notes this side of this line.

F. B. 2230 Pg. 172 Job No. 8232.01 Division No. 10 Profile
Survey by E. C. Johnson Date Notes Red. Date X-Sec.
Indexed E. C. Johnson Date Notes Chkd. Date Checked Date No.

STATION	B. S.	H. I.	F. S.	ELEV.				
T.B.m #3				97.42	T.B.m #3 El. 97.417, 3" I.R. on Axis line - dwn 24"			F.B. 2230-11 9129, S. side
					GRADE TO.	C. or F.		℄ Rd.
0+40				97.61	98.02	F-0.41		9' R
				97.55	98.02	F-0.47	9'L	
0+61.77				99.52	99.64	F-1.12		34.17 R
				99.21	99.97	F-1.76		54.17 R
				98.24	100.05	F-1.81		79.17 R
				98.24	100.13	F-1.89		104.17 R
				98.29	100.17	F-1.88		121.17 R
				98.76	100.23	F-1.47		129.17 R
				98.85	100.39	F-1.54		159.17 R
0+99.77				99.56	100.02	F-0.46		6 R
				99.49	99.73	F-0.24		34.17 R
				99.60	100.02	F-0.42	9'L	
1+34.77				99.35	100.39	F-1.04		159.17 R
1+68.77				99.94	100.30	F-0.36		13 R
				99.68	100.30	F-0.62	9'L	
T.B.m #3				97.42			T.B.m.	#3

Profile No. | Notes Red. | Plotted | Job No. 8382.01 | Division No. 10 | F. B. 2230 | Pg. 173

X-Sec. No. | Notes Chkd. | Checked | Survey of Juvenile Hall

Date | Date | Survey by Sappell | Notes D.S. | Date 1-57

Date | Date | Map No. [redacted] Johnson | Date

JN. 8382.01

BRANCH JUVENILE HALL

RANCHO LOS AMIGOS

FINISH GRADE

OF

SERVICE RD FROM ENTRANCE RD. TO GATE IN SO. SECURITY WALL.

STATION	B. S.	H. I.	F. S.	ELEV.

Party: Sappell
Shiemaker
Myers
Bustrum

NOTE: ANY ADDITIONS OR CHANGES ON THIS SHEET MUST BE MADE OR CIRCLED IN RED INK, WITH DATE AND NAME OF PERSON MAKING CHANGE

PLEASE RETURN TO
LOS ANGELES COUNTY ENGINEER
700 Los Angeles County Engineering Bldg.

Do not extend notes this side of this line.

76298 S & E #307—7-55

76298 S & E #307—7-55

PLEASE RETURN TO
LOS ANGELES COUNTY ENGINEER
700 LOS ANGELES COUNTY ENGINEERING BLDG.

NOTE: ANY ADDITIONS OR CHANGES ON THIS SHEET MUST BE MADE OR CIRCLED IN RED INK, WITH DATE AND NAME OF PERSON MAKING CHANGE.

Do not extend notes this side of this line.

F. B. 2230 Pg. 174 | Job No. R3201 Division No. 10 | Profile | Plotted | Notes Red. | No. | X-Sec.
Survey of Juvenile Hall | Date | Date | No.
Survey by D. Sapsell Notes DS | Notes Chkd. | Checked
Indexed R. C. Johnson | Date | Date | Date

STATION	B. S.	H. I.	F. S.	ELEV.				
T.B.M #1				96.02	T.B.M #1 El. 96.022 Side 3" H.P., 24" DP			F.B. 2230-11 & 128 So. on So. P/L (So. of S'ly Security Wall)
0+00 int.		Service & Entrance		RL	Grade	C or F		& Service Rd.
0+40				95.86	96.36	F-0.50		10' R
				96.77	96.53	C-0.24	13' L	
0+60				96.94	97.17	F-0.43		10' R
					9		13' L	
1+00				97.70	97.37	C-0.33		10' R
				97.71	97.71	Grade	13' L	
2+00				97.93	97.72	C-0.21		10' R
				98.06	98.06	Grade	13' L	
3+00				97.51	97.98	F-0.47		10' R
				97.60	98.32	F-0.72	13' L	
4+00				97.43	98.24	F-0.81		10' R
				97.67	98.58	F-0.91	13' L	
5+00				98.91	98.39	C-0.52		10' R
				98.85	98.73	C-0.12	13' L	
5+63.56				99.43	98.67	C-0.76		BC. 10' R.
				99.30	99.01	C-0.29	13' L	
T.B.M #1				96.02			T.B.M #1	

Notes Ck'd by		Survey of Juvenile Hall	F. B. 2230 Pg. 175
Map No.		JN 8382.01 Tape Std °F	
Office Work		Surveyed by D. Sappell	
Checked		Notes D.S. Date 2-57	
Date		Indexed C. Johnson	

J.N. 8382.01

BRANCH JUVENILE HALL

RANCHO LOS AMIGOS

LOCATION OF PILINGS

FOR COVERED WALK

PER SHEET NO. S-11 B-R.

Party: Sappell
Shoemaker
Myers
Bustrum

Note: Any Additions or Changes on this Sheet Must be Made or Circled in Red Ink With Date and Name of Person Making Change.

Do not extend this side of this line.

PLEASE RETURN TO
LOS ANGELES COUNTY ENGINEER
700 Los Angeles County Engineering Bldg.

76F3093 SAE #247 1-56

PLEASE RETURN TO
LOS ANGELES COUNTY ENGINEER
700 LOS ANGELES COUNTY ENGINEERING BLDG.

Note: Any Additions or Changes on This Sheet Must be Made or Circled in Red Ink With Date and Name of Person Making Change.

Do not extend this side of this line.

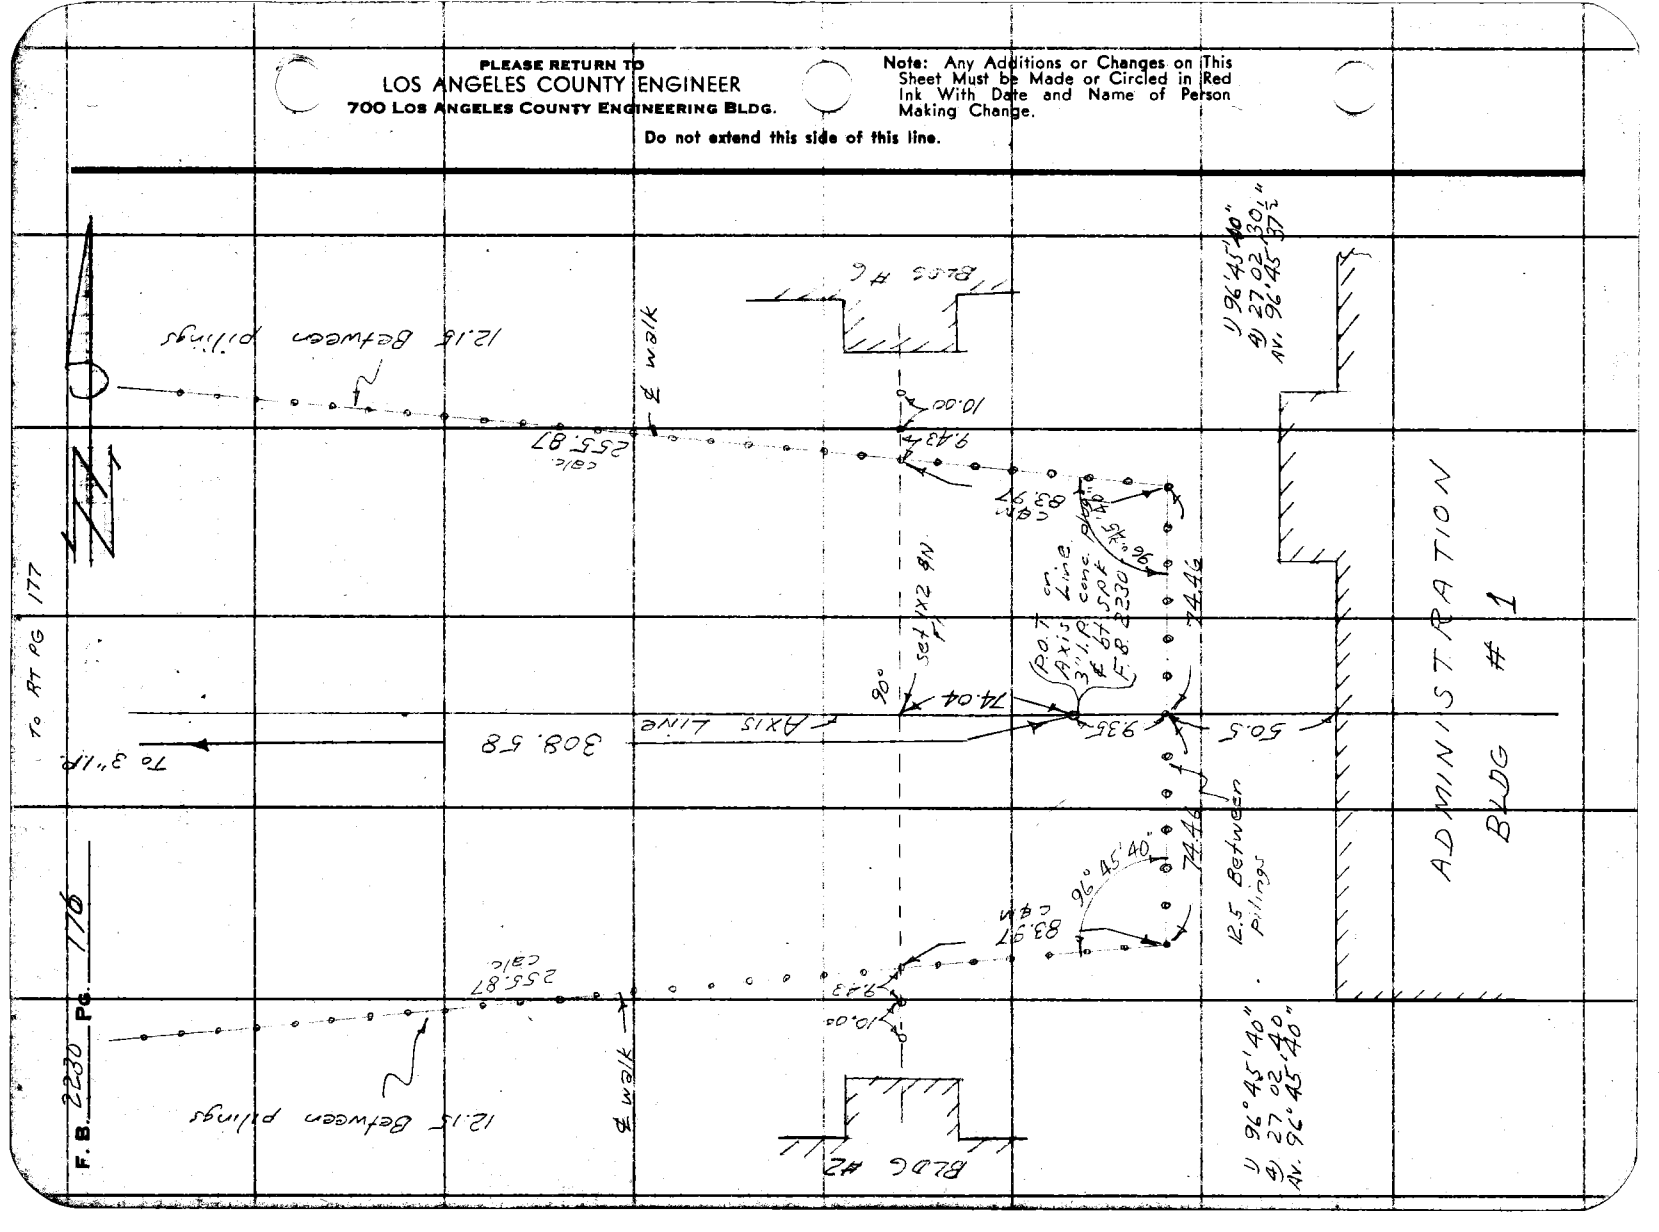

Notes Ck'd by		Survey of Juvenile Hall	F. B. 2230 Pg. 177
Map No.		JN 2282.01 Tape 0.44 Std 68 °F	
Office Work		Surveyed by D Sappell	
Checked		Notes D.S. Date 2-57	
Date		Indexed	

C. Johnson

HOUSEING BLDG # 5

Δ 170° 24' 10"
Δ 321 36 00
Av. 170° 24' 00"

11.82 Between pilings

℄ walk

236.44

10.71 19.71 28.70

12.15 Between pilings

255.87 calc

170° 24' 00"

114.46

83° 14' 20" (calc)

From Top Pg 176

To Bott Pg 178

CHAPEL BLDG # 11

40.55

19.55

℄ AXIS LINE

90°

℄ I.P.

308.58

236.14

℄ walk

89° (calc) 14' 20"

170° 25' 00"

114.46

237.16

℄ walk

11.82 Between pilings

Δ 170° 25' 00"
Δ 321 40 10
Av. 170° 25 02½

10.04 10.04 27.41

(calc) 255.87

12.15 Between pilings

KITCHEN & DINING BLDG. # 8

Note: Any Additions or Changes on This Sheet Must be Made or Circled in Red Ink With Date and Name of Person Making Change.

Do not extend this side of this line.

PLEASE RETURN TO
LOS ANGELES COUNTY ENGINEER
700 Los Angeles County Engineering Bldg.

76F3098 S&E #247 1-56

PLEASE RETURN TO
LOS ANGELES COUNTY ENGINEER
700 LOS ANGELES COUNTY ENGINEERING BLDG.

Note: Any Additions or Changes on This Sheet Must be Made or Circled in Red Ink With Date and Name of Person Making Change.

Do not extend this side of this line.

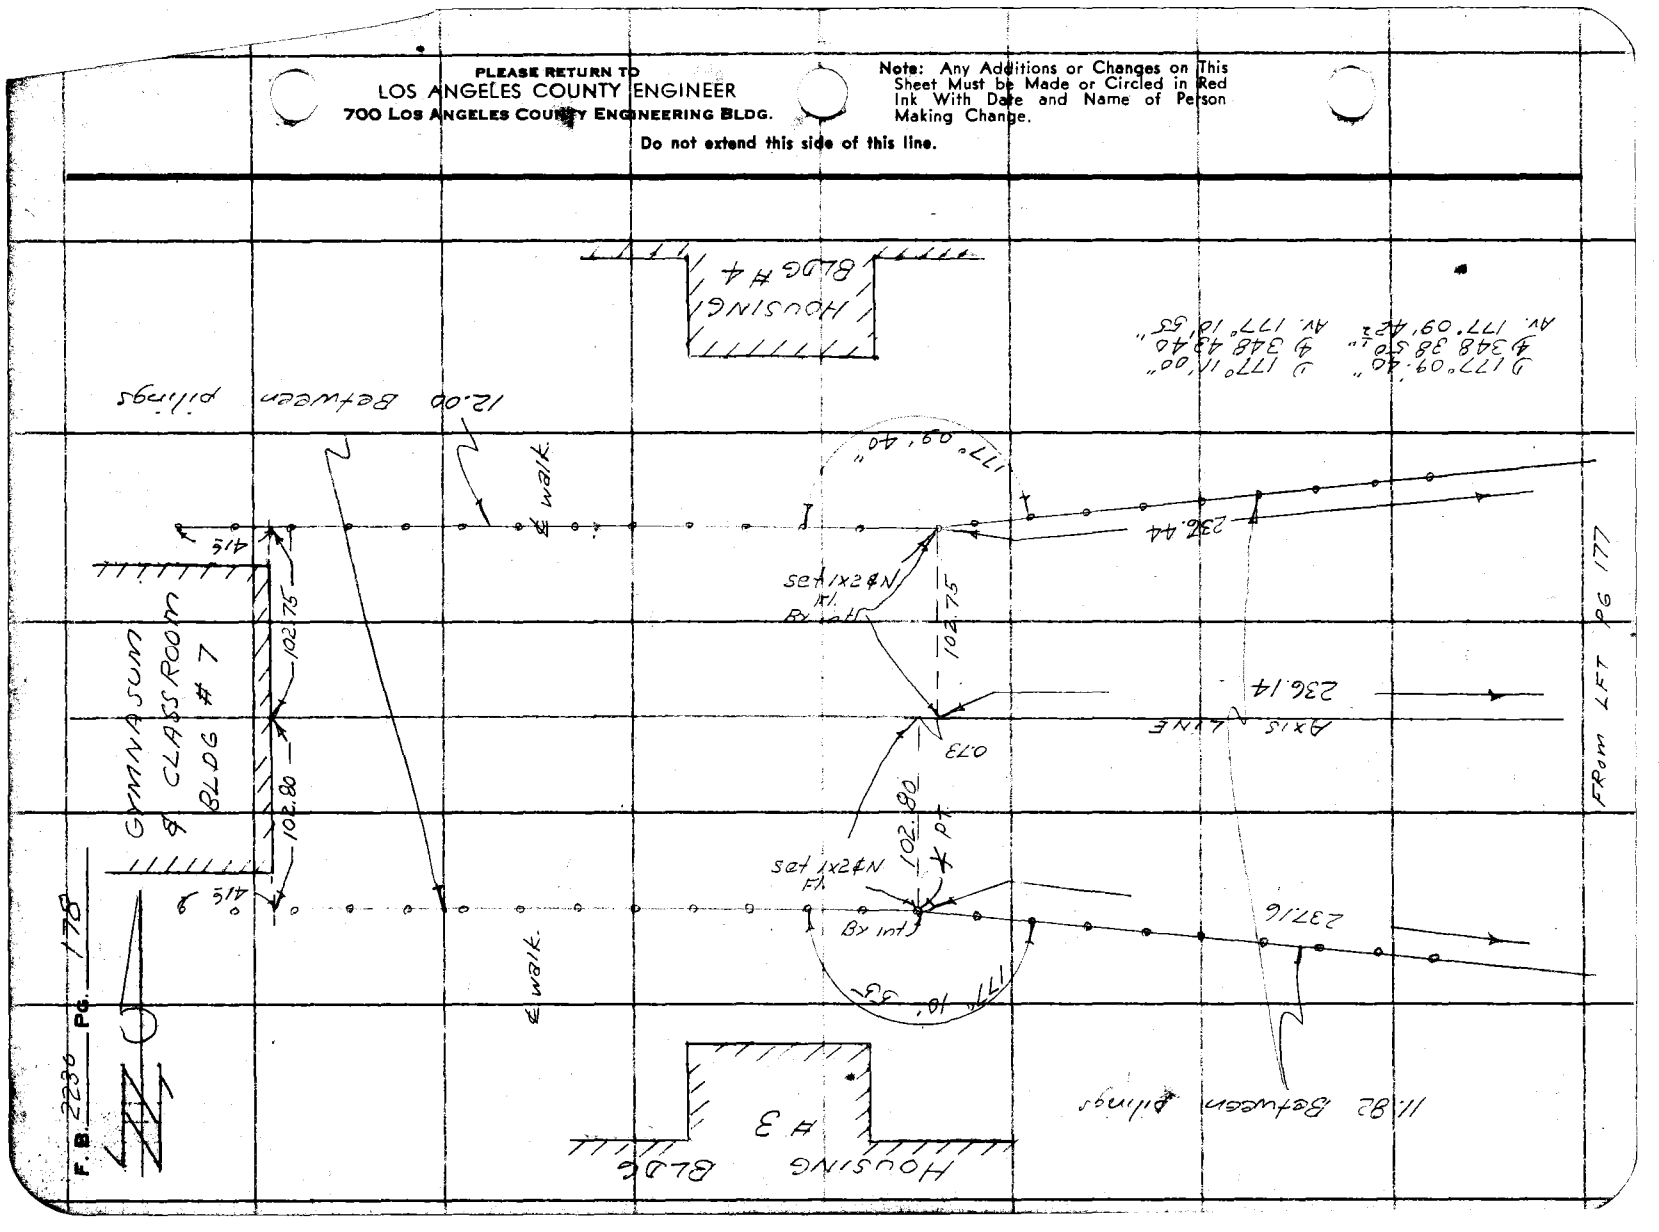

Profile No. | Notes Red. Date | Plotted Date | Job No. 8382.01 Division No. 10 | F. B. 2230 Pg. 179
X-Sec. No. | Notes Chkd. Date | Checked Date | Survey of Juvenile Hall | Survey by Sappell Notes D.S. Date 3-3-57 | Map No. Edsel Johnson Date

NOTE: ANY ADDITIONS OR CHANGES ON THIS SHEET MUST BE MADE OR CIRCLED IN RED INK, WITH DATE AND NAME OF PERSON MAKING CHANGE.

PLEASE RETURN TO
LOS ANGELES COUNTY ENGINEER
700 Los Angeles County Engineering Bldg.

Do not extend notes this side of this line.

STATION	B. S.	H. I.	F. S.	ELEV.

J. N. 8382.00

BRANCH JUVENILE HALL

AT

RANCHO LOS AMIGOS

FINISH GRADES

FOR

GRID AREA "A" COMPOUND

SEE PAGE 135

Party: Sappell
Shoemaker
Myers
Caro

76298 S & E #307—7.55

76298 S & E #307—7-55

PLEASE RETURN TO
LOS ANGELES COUNTY ENGINEER
700 LOS ANGELES COUNTY ENGINEERING BLDG.

NOTE: ANY ADDITIONS OR CHANGES ON THIS SHEET MUST BE MADE OR CIRCLED IN RED INK, WITH DATE AND NAME OF PERSON MAKING CHANGE.

Do not extend notes this side of this line.

F. B. 2230 Pg. 180 Job No. 6382.01 Division No. 10 Notes Red. Plotted. Profile No.
Survey by J. Sapell Notes D.S Date Notes Chkd. Checked
Indexed K. C. Johnson Date Date

STATION	B. S.	H. I.	F. S.	ELEV.				
Bm #4				100 [illegible]	Bm #4 El 100.17, F.B. 2230-106, 133, P.M. in So. Rim S.M.H. on S'ly line of Chapel @ 61' E. of E. Face.			
					Grade	C. or F.		
A				1007	101.2	F 0.5		
A-1-N				1006	101.1	F 0.5		
-		Ed.	walk	101.07	101.07	Grade	Mark on 6" I.P.	covered walk support
A-1-S				1012	101.2	Grade		
-		Ed.	walk	101.14	101.14	Grade	"	"
B				1012	101.2	Grade		
B-1-N				1011	101.1	Grade		
-		Ed.	walk	100.98	100.98	Grade	"	"
B-1-S				1012	101.2	"		
-		Ed.	walk	101.11	101.11	"	"	"
C				1012	101.2	"		
C-1-N				1011	101.1	"		
-		Ed.	walk	100.91	100.91	"	"	"
C-1-S				1011	101.1	"		
-		Ed.	walk	100.99	100.99	"	"	"
D				1012	101.2	"		
D-1-N				1011	101.1	"		

76298 S & E #307—7-55

PLEASE RETURN TO
LOS ANGELES COUNTY ENGINEER
700 LOS ANGELES COUNTY ENGINEERING BLDG.

NOTE: ANY ADDITIONS OR CHANGES ON THIS SHEET MUST BE MADE OR CIRCLED IN RED INK, WITH DATE AND NAME OF PERSON MAKING CHANGE.

Do not extend notes this side of this line.

Profile Notes Red. Plotted Job No 8382-01 Division No. 10 F. B. 2230 Pg. 181
X-Sec. Notes Chkd. Checked Survey by Sewell Notes S.V. Date 2-27-57
No. Date Date Map No. Kingsford Johnson Date

STATION	B. S.	H. I.	F. S.	ELEV.	Grade	C or F		
–		Ed	walk	100 84	100.84	Grade	Mark	on 6" I.P. cover walk support
D-1-S				101 1	101.1	"		
–		Ed	walk	100 87	100.87	"	"	"
E				101 8	101.2	C-0.6		
E-1-N				101 1	101.1	Grade		
–		Ed	walk	100 77	100.77	"	"	"
E-1-S				101 1	101.1	"		
=		Ed	walk	100 75	100.75	"	"	"
F-1-N				101 0	101.0	"		
–		Ed	walk	100 71	100.71	"	"	"
F-1-S				101 0	101.0	"		
–		Ed	walk	100 63	100.63	"	"	"
5.5 E. of G		Ed.	walk	101 02	101.02	"	"	"
G-1-N		Ed	walk	100 87	100.87	"	"	"
–				100 70	100.70	"	@ int	walks
G-1-S		Ed	walk	100 81	100.81	"		
–				100 55	100.55	"	@ int	walks
H				100.9	100.9	"		
H-1-N				100.8	100.8	"		
		Ed	walk	100 59	100.59	"	Mark	on 6" I.P.
H-1-S				100.8	100.8	"		

76298 S & E #307—7-55

PLEASE RETURN TO
LOS ANGELES COUNTY ENGINEER
700 LOS ANGELES COUNTY ENGINEERING BLDG.

NOTE: ANY ADDITIONS OR CHANGES ON THIS SHEET MUST BE MADE OR CIRCLED IN RED INK, WITH DATE AND NAME OF PERSON MAKING CHANGE.

Do not extend notes this side of this line.

F. B. 2230 Pg. 182 Job No. 8220 Division No. 10 Notes Red Date Notes Chkd Date Plotted Date Checked Date
Survey by Sapoell Notes Date
Indexed C. Johnson

STATION	B. S.	H. I.	F. S.	ELEV.				
—		Ed.	walk	100.35	100.35	Grade	Mk on	6" I.P.
J				100.8	100.8	Grade		
J-1-N				100.7	100.7	"		
—		Ed.	walk	100.54	100.54	"	"	"
J-1-S				100.7	100.7	"		
1 —		Ed.	walk	100.22	100.22	"	"	"
K				100.7	100.7	"		
K-1-N				100.6	100.6	"		
—		Ed.	walk	100.48	100.48	"	"	"
K-1-S				100.6	100.6	"		
—		Ed.	walk	100.11	100.11	"	"	"
L				100.6	100.6	"		
L-1-N				100.5	100.5	"		
—		Ed.	walk	100.39	100.39		"	"
L-1-S				100.5	100.5	"		
—		Ed.	walk	100.00	100.00			
M				100.4	100.4	"		
M-1-N				100.3	100.3	"		
—		Ed.	walk	100.36	100.36		"	"
M-1-S				100.3	100.3	"		
—		Ed.	walk	98.89	98.89		"	"

76298 S & E #307—7-55

PLEASE RETURN TO
LOS ANGELES COUNTY ENGINEER
700 LOS ANGELES COUNTY ENGINEERING BLDG.

NOTE: ANY ADDITIONS OR CHANGES ON THIS SHEET MUST BE MADE OR CIRCLED IN RED INK, WITH DATE AND NAME OF PERSON MAKING CHANGE.

Do not extend notes this side of this line.

STATION	B. S.	H. I.	F. S.	ELEV.	Grade	C or F.		
N				100.1	100.1	Grade		
N-1-N				100.1	100.1	"		
—		Ea.	walk	100.23	100.23	"	MK on	6" I.P.
N-1-S				99.9	99.9	"		
—		Ea.	walk	99.78	99.78	"	"	" "
0								
0-1-N				100.2	100.2	"		
0-1-S				99.8	99.8	"		
0-2-S				99.7	99.7	"		

Profile Notes Red. Plotted Job No. 8282-01 Division No. 10 F. B. 2230 Pg. 183
No. Date Date Survey of Vuvenile Hall
X-Sec. Notes Chkd. Checked Survey by Seipell Notes P.C. Date 4-27-57
No. Date Date Map No. Checked Notes Date

Notes Ck'd by		Survey of Juvenile Hall	F. B. 2230 Pg. 185
Map No.		JN 0022.10 Tape Std °F	
Office Work		Surveyed by D. Sappell	
Checked		Notes DS Date 3-57	
Date		Indexed C. Johnson	

JN 0022.10

JUVENILE HALL FACILITY

AT

RANCHO LOS AMIGOS

SPRINKLER SYSTEM

SEE PLAN P1-B-R

GREEN LINE INDICATES COPPER TUBE FOR REMOTE CONTROL VALVES - TUBE IN SAME DITCH AS SPRINKLER LINE, UNLESS OTHERWISE SHOWN.

SYM	SPAC	NOZ. SIZE	MAKE	
X	63'	1/4"	THOMPSON	No 184 SRC - SRFC
(X)	42'	5/32"	SKINNER	No PRJR
X	42'	3/16" x 3/32"	RAINBIRD	No 40
X	10'-12'		FEBCO	No 150 F
(V)	52'-6"	17/64"	THOMPSON	No 183 SRC - SRFC
(V)	42'	5/32"	SKINNER	No PRJR 1/2 SRC
V	42'	3/16"	RAINBIRD	No 45 - SHRUB AREA
V	35'	3/16"	"	No 25
V	10'-12'		F.E.BCO.	No 150 H
O	21'		FEBCO	No 210 F
D	21'		FEBCO	No 210 A
▽			FEBCO	No 210 Q
•			FEBCO	No 110 F-H-Q
●			FEBCO	No 25
A			AUTOMATIC	CONTROLER
R			ALL RAINBIRD	HEADS
S			ALL SKINNER	"
T			ALL THOMPSON	"

NOTE- OFFSETS TO SECURITY WALL TAKEN TO CENTER

FOR LOCATION OF SNAP VALVES SEE PGS 45-64

Party: Sappell
Shoemaker
Myers
Caro

Note: Any Additions or Changes on This Sheet Must be Made or Circled in Red Ink With Date and Name of Person Making Change.

Do not extend this side of this line.

PLEASE RETURN TO
LOS ANGELES COUNTY ENGINEER
700 LOS ANGELES COUNTY ENGINEERING BLDG.

76F3095 SAE #241 1-56

PLEASE RETURN TO
LOS ANGELES COUNTY ENGINEER
700 LOS ANGELES COUNTY ENGINEERING BLDG.

Do not extend this side of this line.

Note: Any Additions or Changes on This Sheet Must be Made or Circled in Red Ink With Date and Name of Person Making Change.

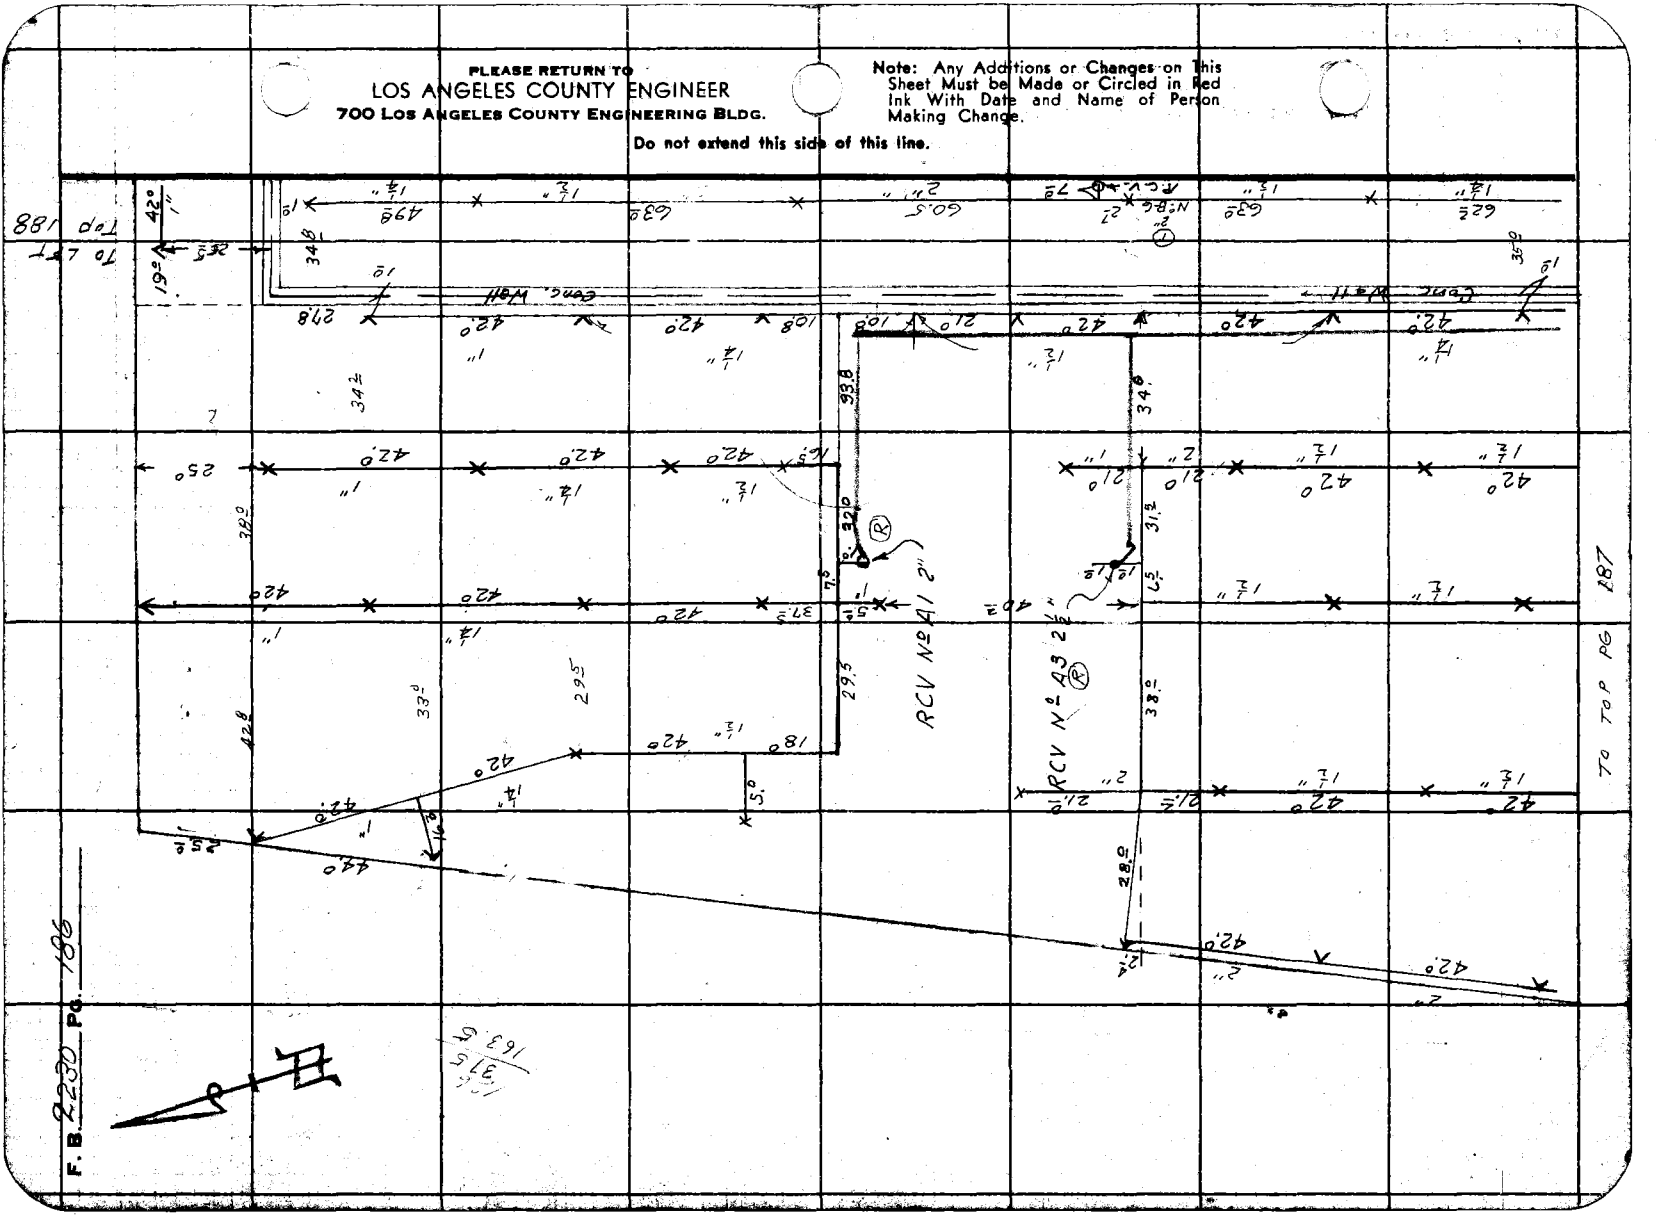

Notes Ck'd by	Survey of Juvenile Hall
Map No.	JN 0022.10 Tape Std °F
Office Work	Surveyed by D. Sappell
Checked	Notes D.S. Date 3-57
Date	Indexed H. C. Johnson

F. B. 2230 Pg. 187

FROM BOTT PG 186

TO LFT PG 188

Note: Any Additions or Changes on This Sheet Must be Made or Circled in Red Ink With Date and Name of Person Making Change.

Do not extend this side of this line.

PLEASE RETURN TO
LOS ANGELES COUNTY ENGINEER
700 Los Angeles County Engineering Bldg.

78F3098 SSE #247 1-56

PLEASE RETURN TO
LOS ANGELES COUNTY ENGINEER
700 LOS ANGELES COUNTY ENGINEERING BLDG.

Note: Any Additions or Changes on This Sheet Must be Made or Circled in Red Ink With Date and Name of Person Making Change.

Do not extend this side of this line.

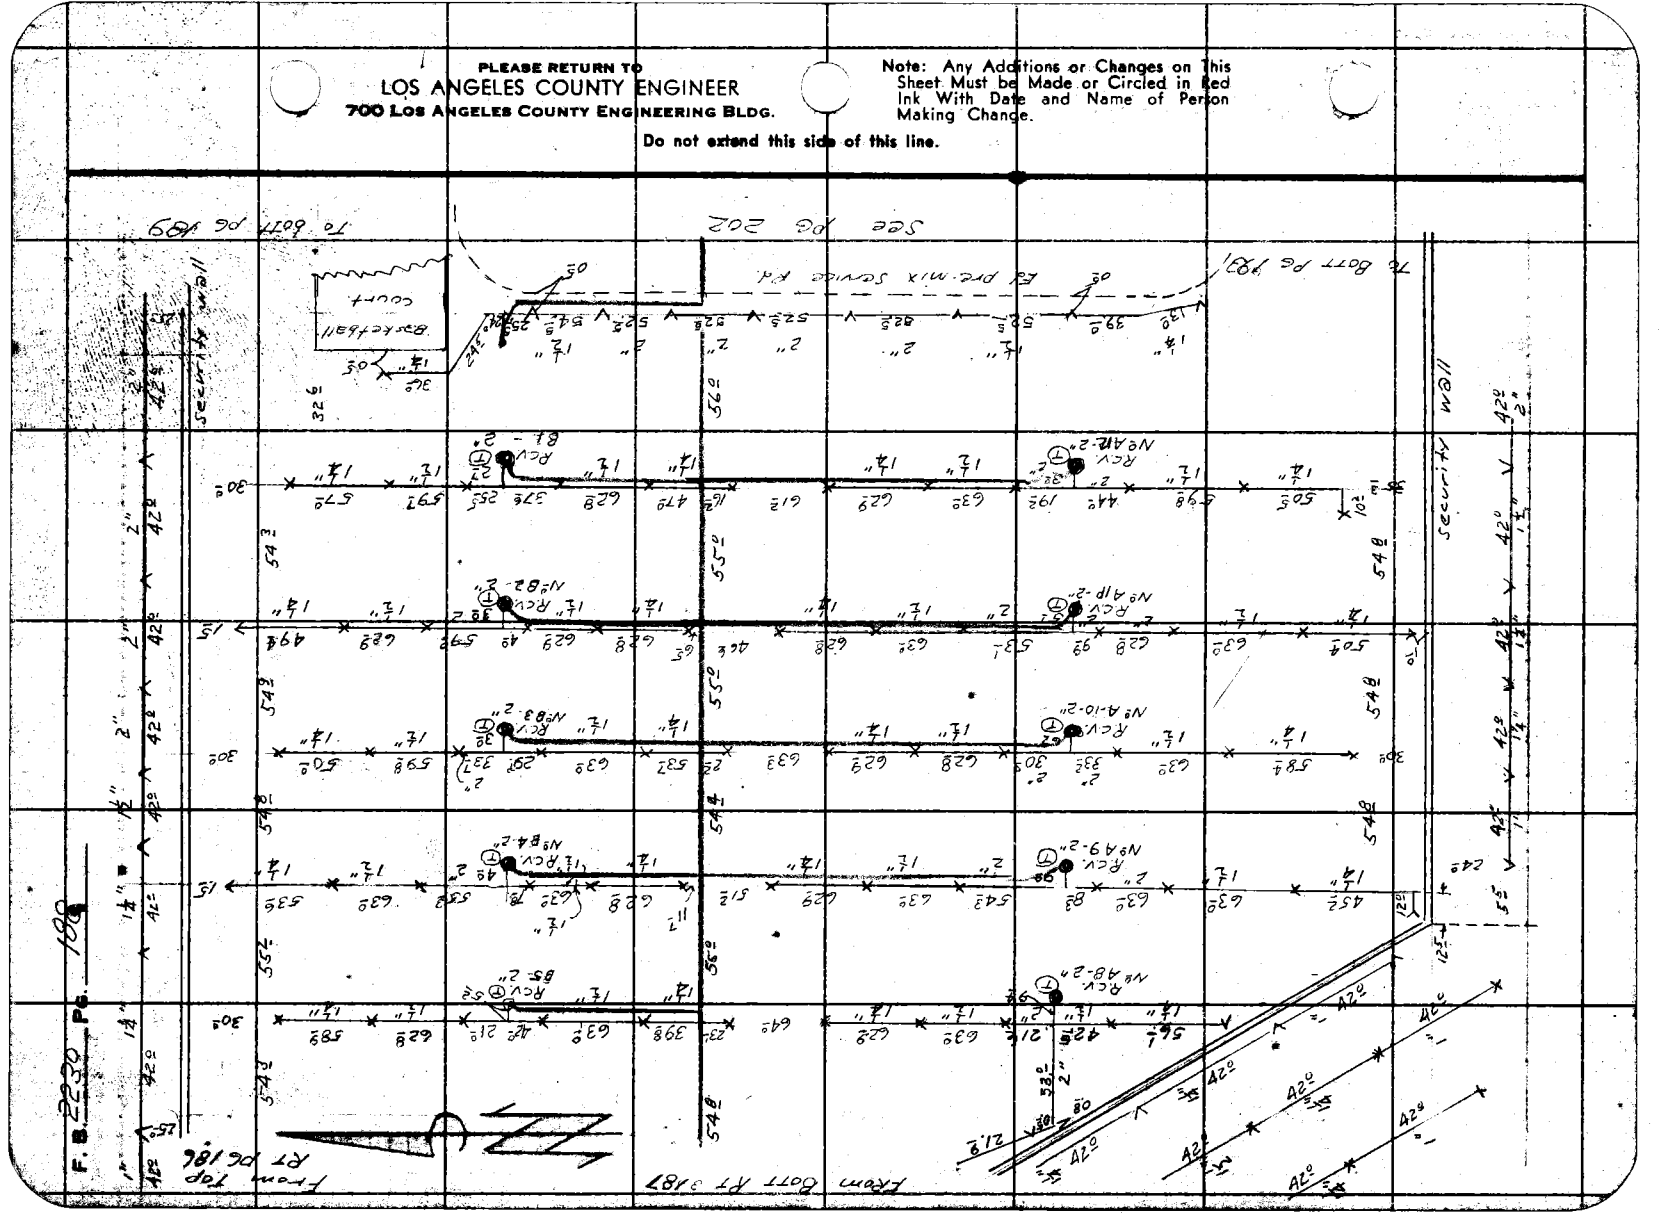

76F2086 SAE #247 1-56

PLEASE RETURN TO
LOS ANGELES COUNTY ENGINEER
700 LOS ANGELES COUNTY ENGINEERING BLDG.

Note: Any Additions or Changes on This Sheet Must be Made or Circled in Red Ink With Date and Name of Person Making Change.

Do not extend this side of this line.

Notes Ck'd by
Map No.
Office Work
Checked
Date

JN 0022 Tape Std °F
Notes Date 2-57
Indexed C. Johnson

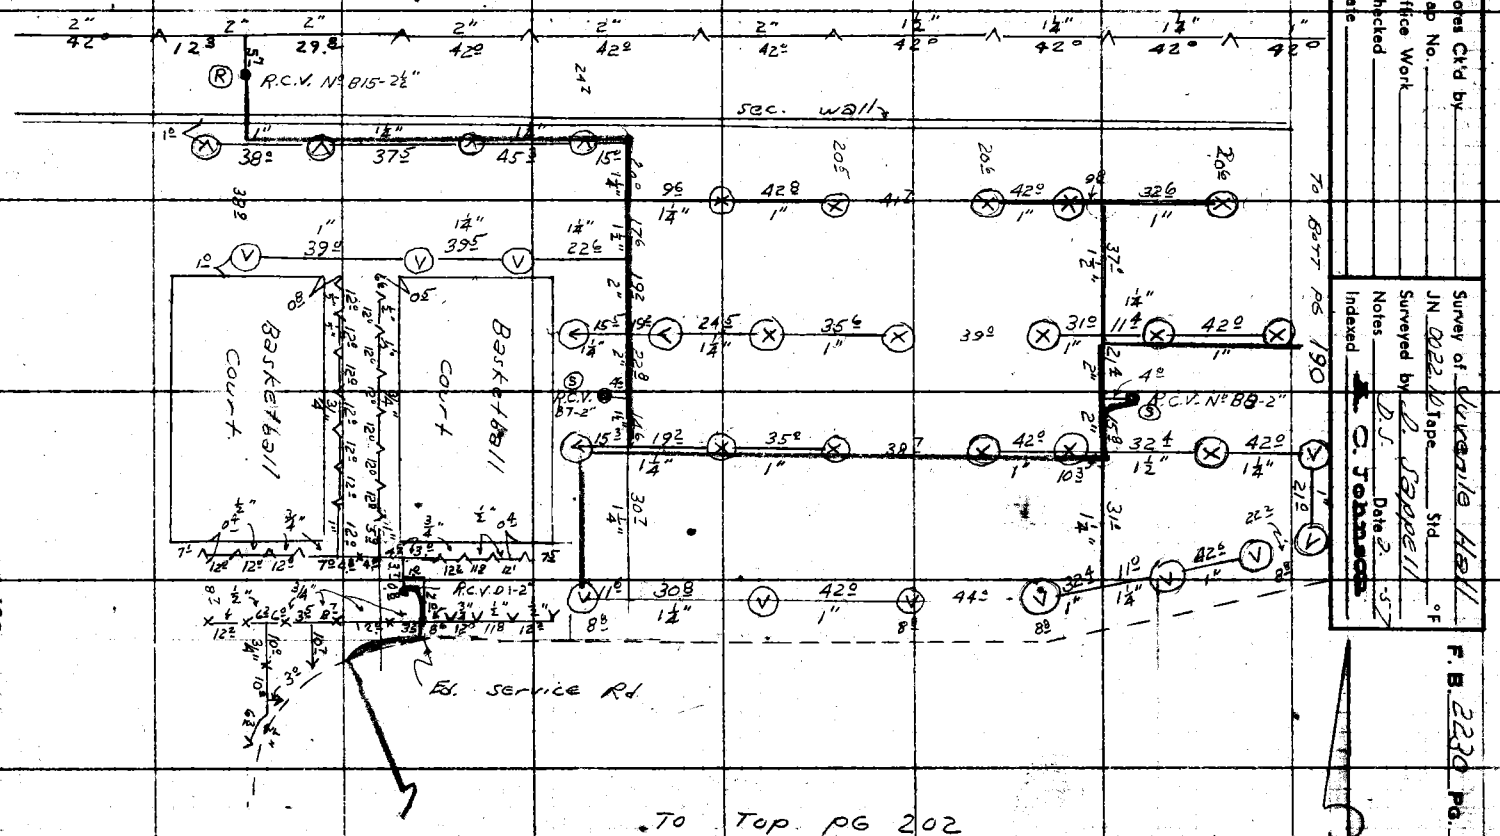

F. B. 2230 Pg. 189

PLEASE RETURN TO
LOS ANGELES COUNTY ENGINEER
700 LOS ANGELES COUNTY ENGINEERING BLDG.

Note: Any Additions or Changes on This Sheet Must be Made or Circled in Red Ink With Date and Name of Person Making Change.

Do not extend this side of this line.

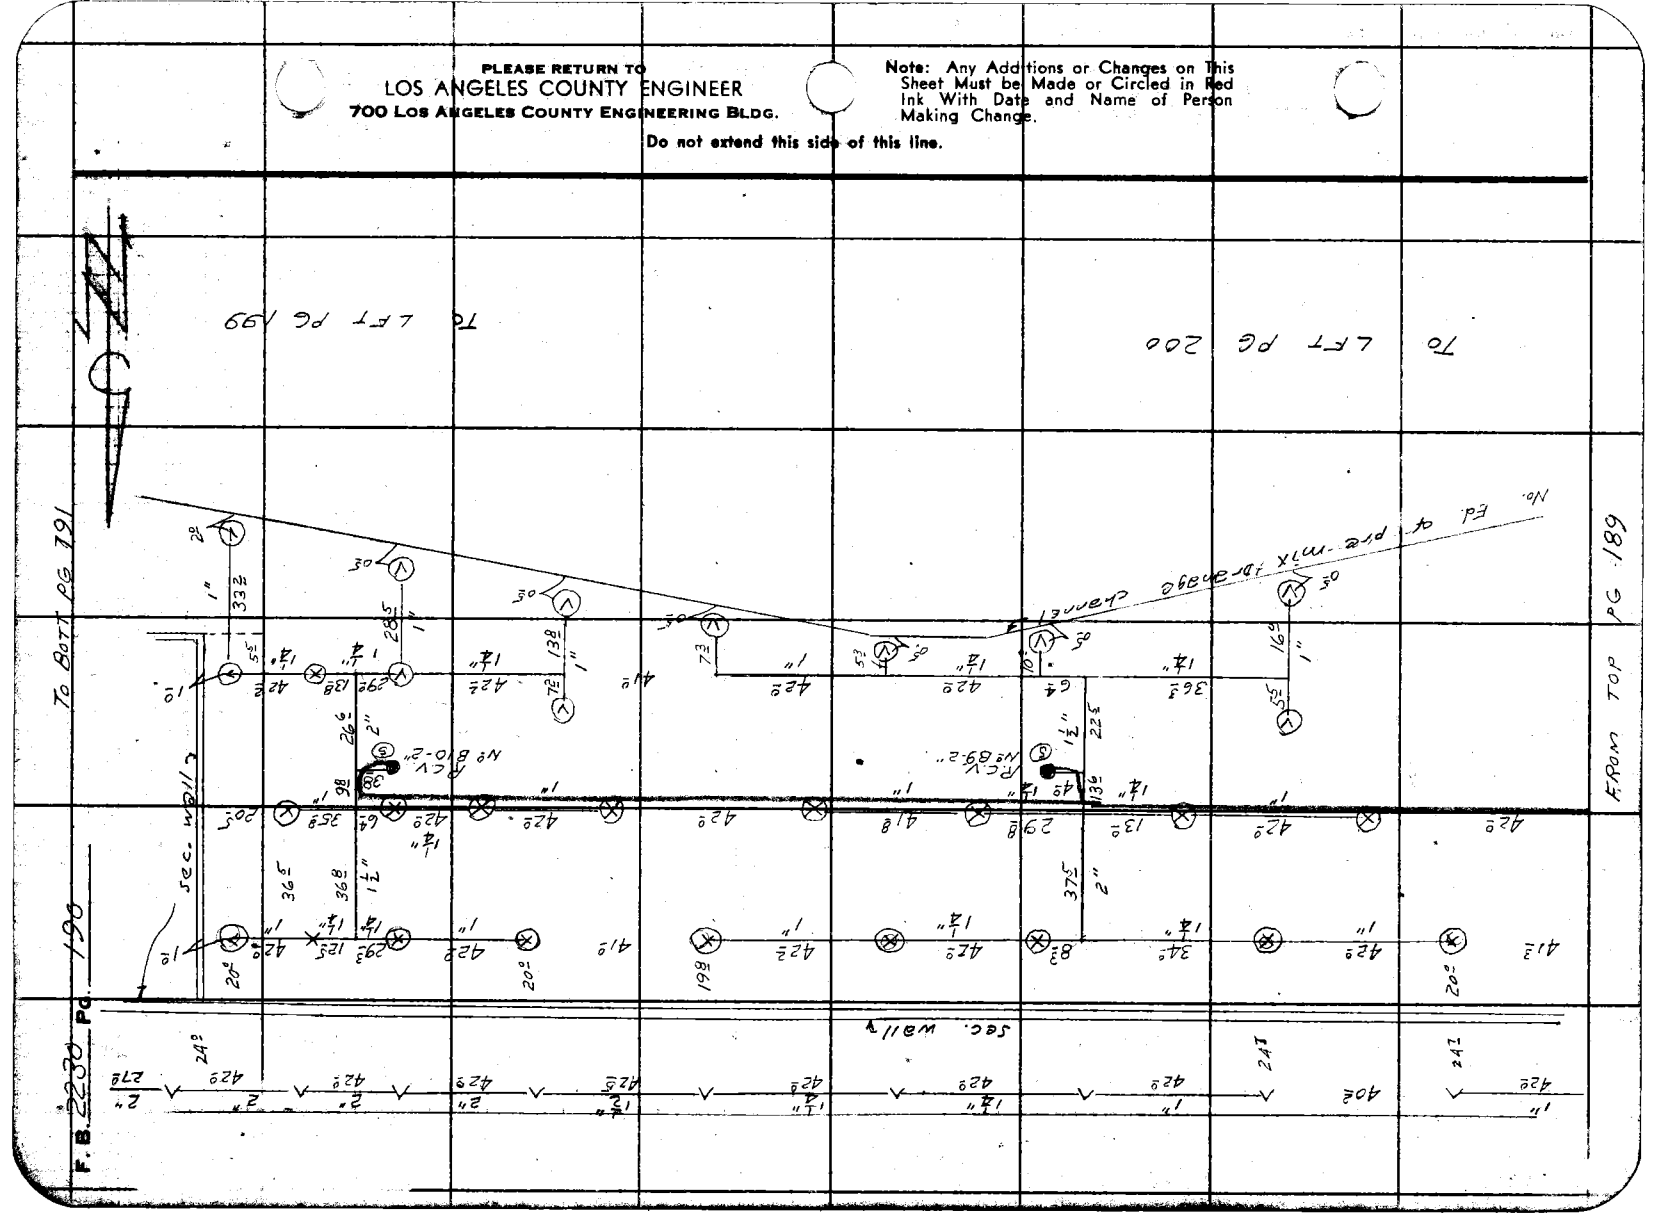

Notes Ck'd by
Map No.
Office Work
Checked
Date

Survey of Juvenile Hall
JN 0022.10 Tape Std °F
Surveyed by D. Sappell
Notes D.S. Date 2-57
Indexed C. Johnson

F. B. 2230 Pg. 191

To Bott Pg 192

Note: Any Additions or Changes on This Sheet Must be Made or Circled in Red Ink With Date and Name of Person Making Change.

Do not extend this side of this line.

PLEASE RETURN TO
LOS ANGELES COUNTY ENGINEER
700 LOS ANGELES COUNTY ENGINEERING BLDG.

76F209S SAE #247 1-56

Segregation Bldg Unit No. 10

Security wall

Conc. walk

PC-mix DC

RCV

Sec. wall

From Top Pg 190

To Left Pg 198

PLEASE RETURN TO
LOS ANGELES COUNTY ENGINEER
700 LOS ANGELES COUNTY ENGINEERING BLDG.

Note: Any Additions or Changes on This Sheet Must be Made or Circled in Red Ink With Date and Name of Person Making Change.

Do not extend this side of this line.

8-91
4-97 8-91

F.B. 2230 Pg. 192

FROM TOP PG 197

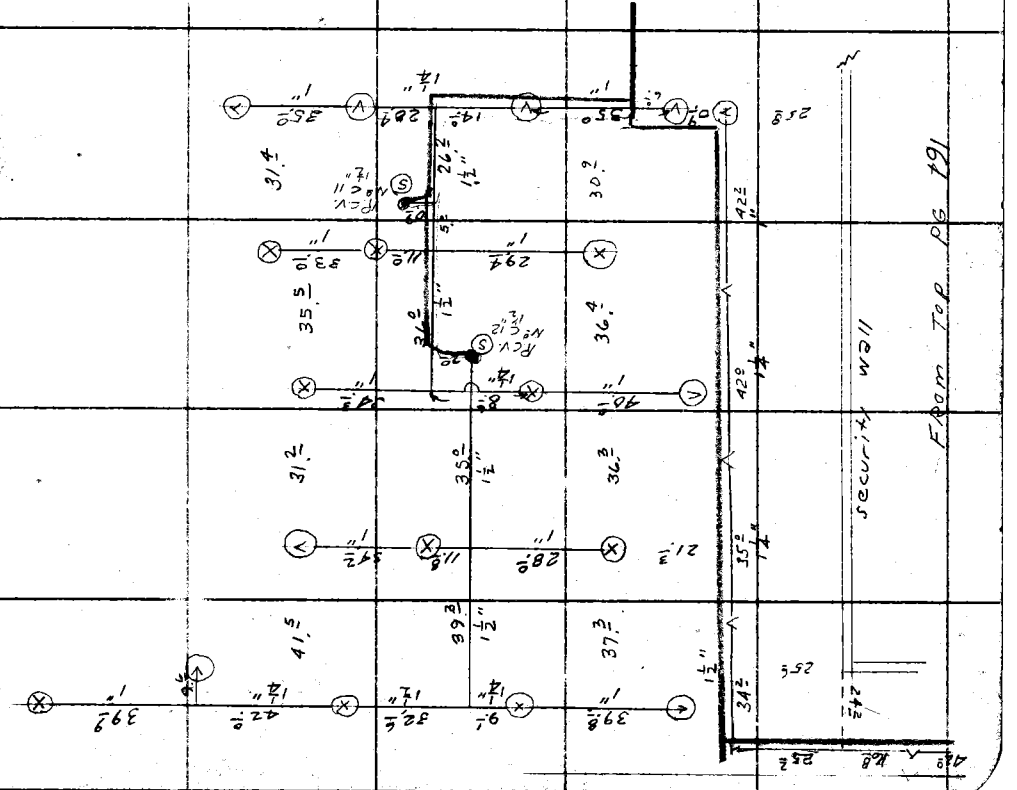

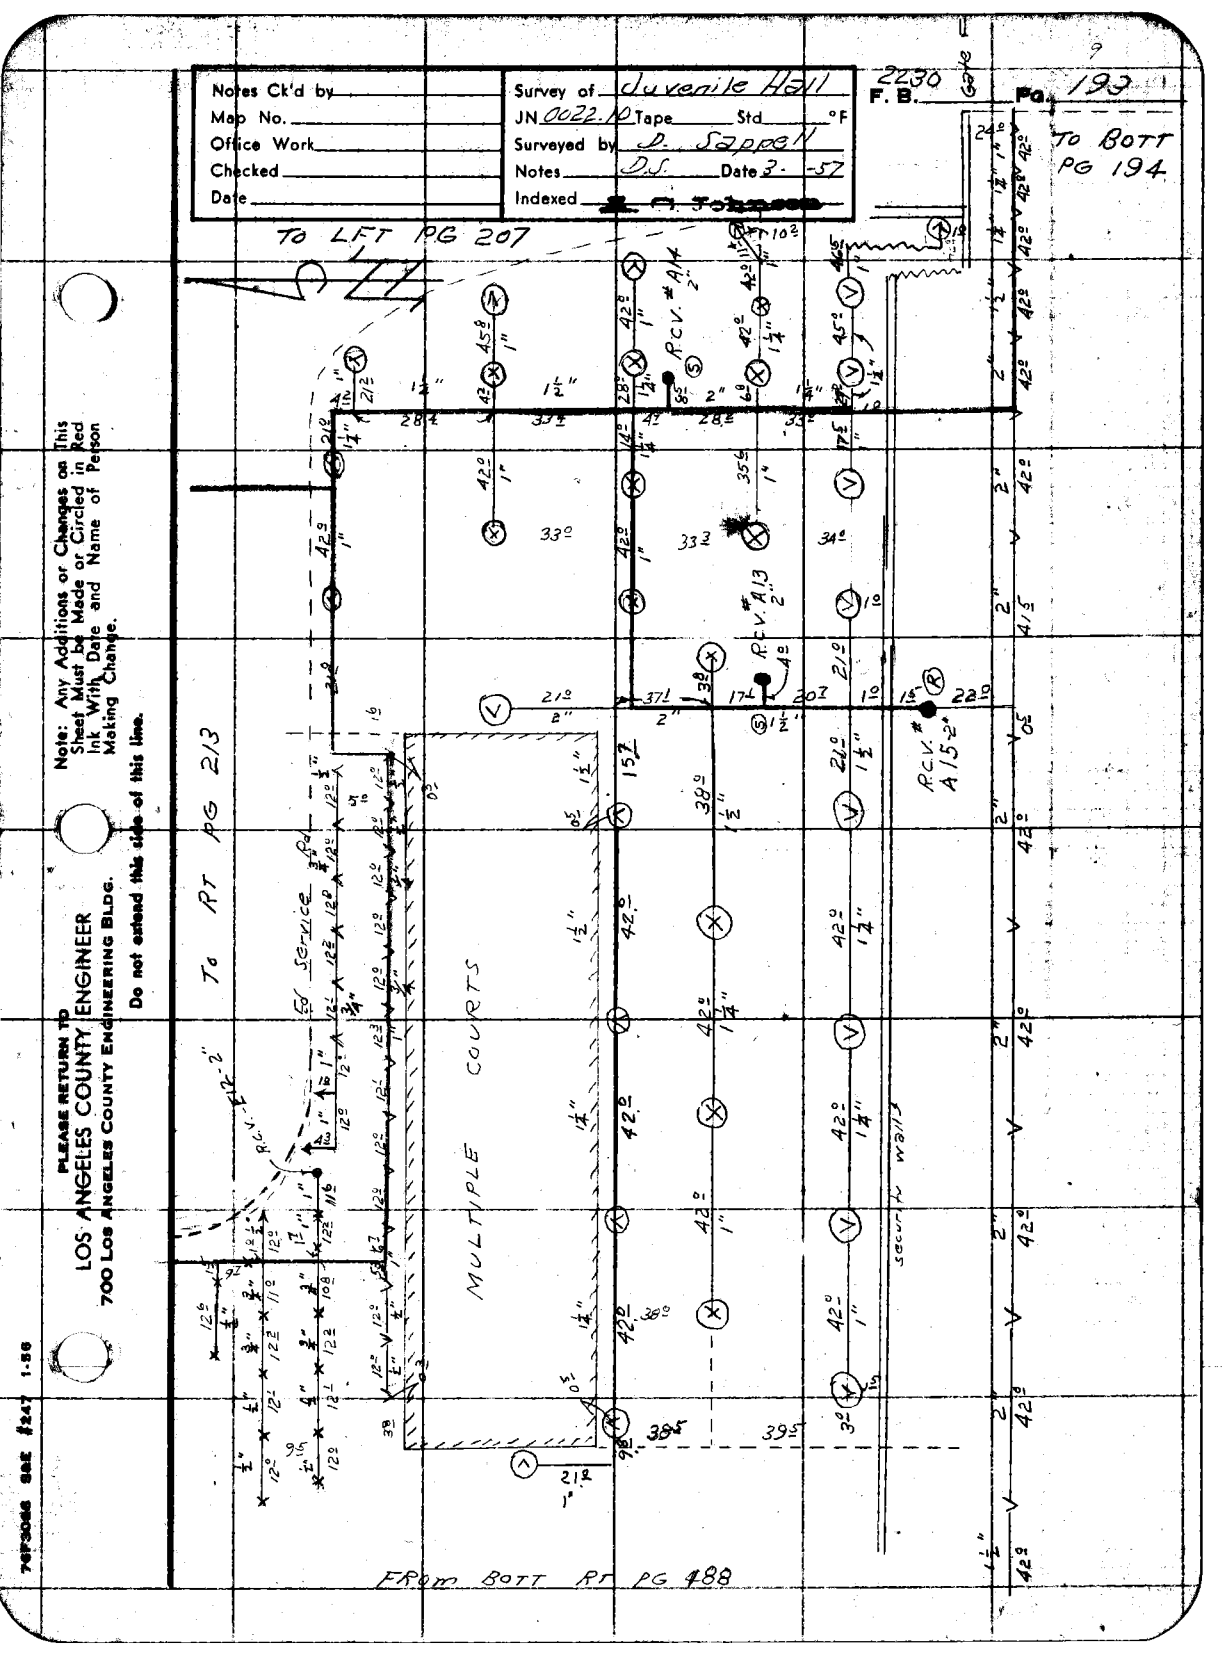
Notes Ck'd by
Map No.
Office Work
Checked
Date
Survey of Juvenile Hall
JN 0022.10 Tape Std °F
Surveyed by D. Szpell
Notes D.S. Date 2-57
Indexed
2230 F. B. Pg. 193
TO LFT PG 207
TO BOTT PG 194
TO RT PG 213
EOS
MULTIPLE COURTS
RCV. #A14
RCV. #A13
RCV. #A15-2
RCV. #A12-2
Security Walls
FROM BOTT RT PG 488
PLEASE RETURN TO
LOS ANGELES COUNTY ENGINEER
700 Los Angeles County Engineering Bldg.
Note: Any Additions or Changes on This Sheet Must be Made or Circled in Red Ink With Date and Name of Person Making Change.
Do not extend this side of this line.
76F3066 SAE #247 1-56

PLEASE RETURN TO
LOS ANGELES COUNTY ENGINEER
700 LOS ANGELES COUNTY ENGINEERING BLDG.

Note: Any Additions or Changes on This Sheet Must be Made or Circled in Red Ink With Date and Name of Person Making Change.

Do not extend this side of this line.

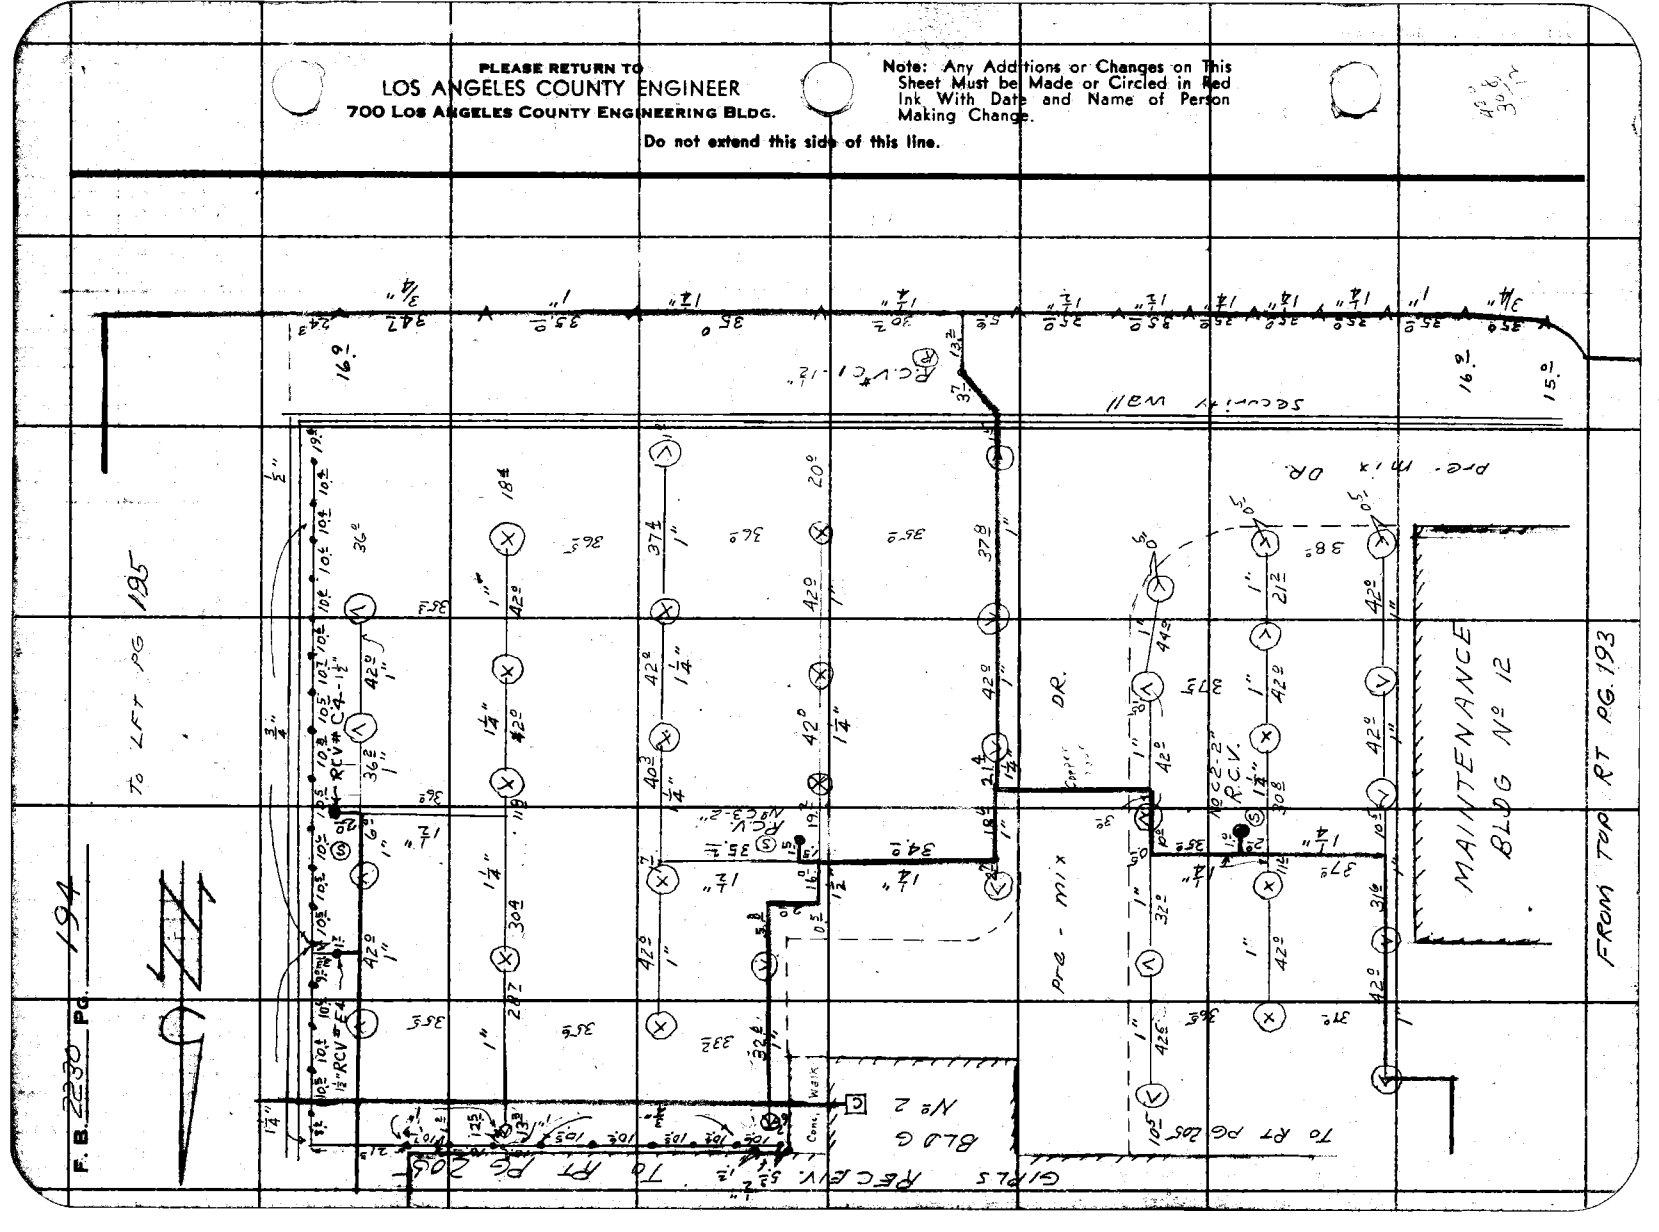

Notes Ck'd by	Survey of Juvenile Hall
Map No.	JN 0022.10 Tape Std °F
Office Work	Surveyed by D. Sappell
Checked	Notes E. Shoemaker Date 2-57
Date	Indexed E. C. Johnson

F. B. 2230 PG. 195

To Rt Pg 196

Administration Bldg Unit No 1

Conc Walk

From Top Pg 194 & 205

Parking Area (Pre-mix)

R.C.V. #C-5-1½"

Riser

R.C.V. #E5-1½"

Premix Drain

Premix Drive

EP

Note: Any Additions or Changes on This Sheet Must be Made or Circled in Red Ink With Date and Name of Person Making Change.

Do not extend this side of this line.

PLEASE RETURN TO
LOS ANGELES COUNTY ENGINEER
700 LOS ANGELES COUNTY ENGINEERING BLDG.

76F3095 SAE #247 1-56

PLEASE RETURN TO
LOS ANGELES COUNTY ENGINEER
700 LOS ANGELES COUNTY ENGINEERING BLDG.

Note: Any Additions or Changes on This Sheet Must be Made or Circled in Red Ink With Date and Name of Person Making Change.

Do not extend this side of this line.

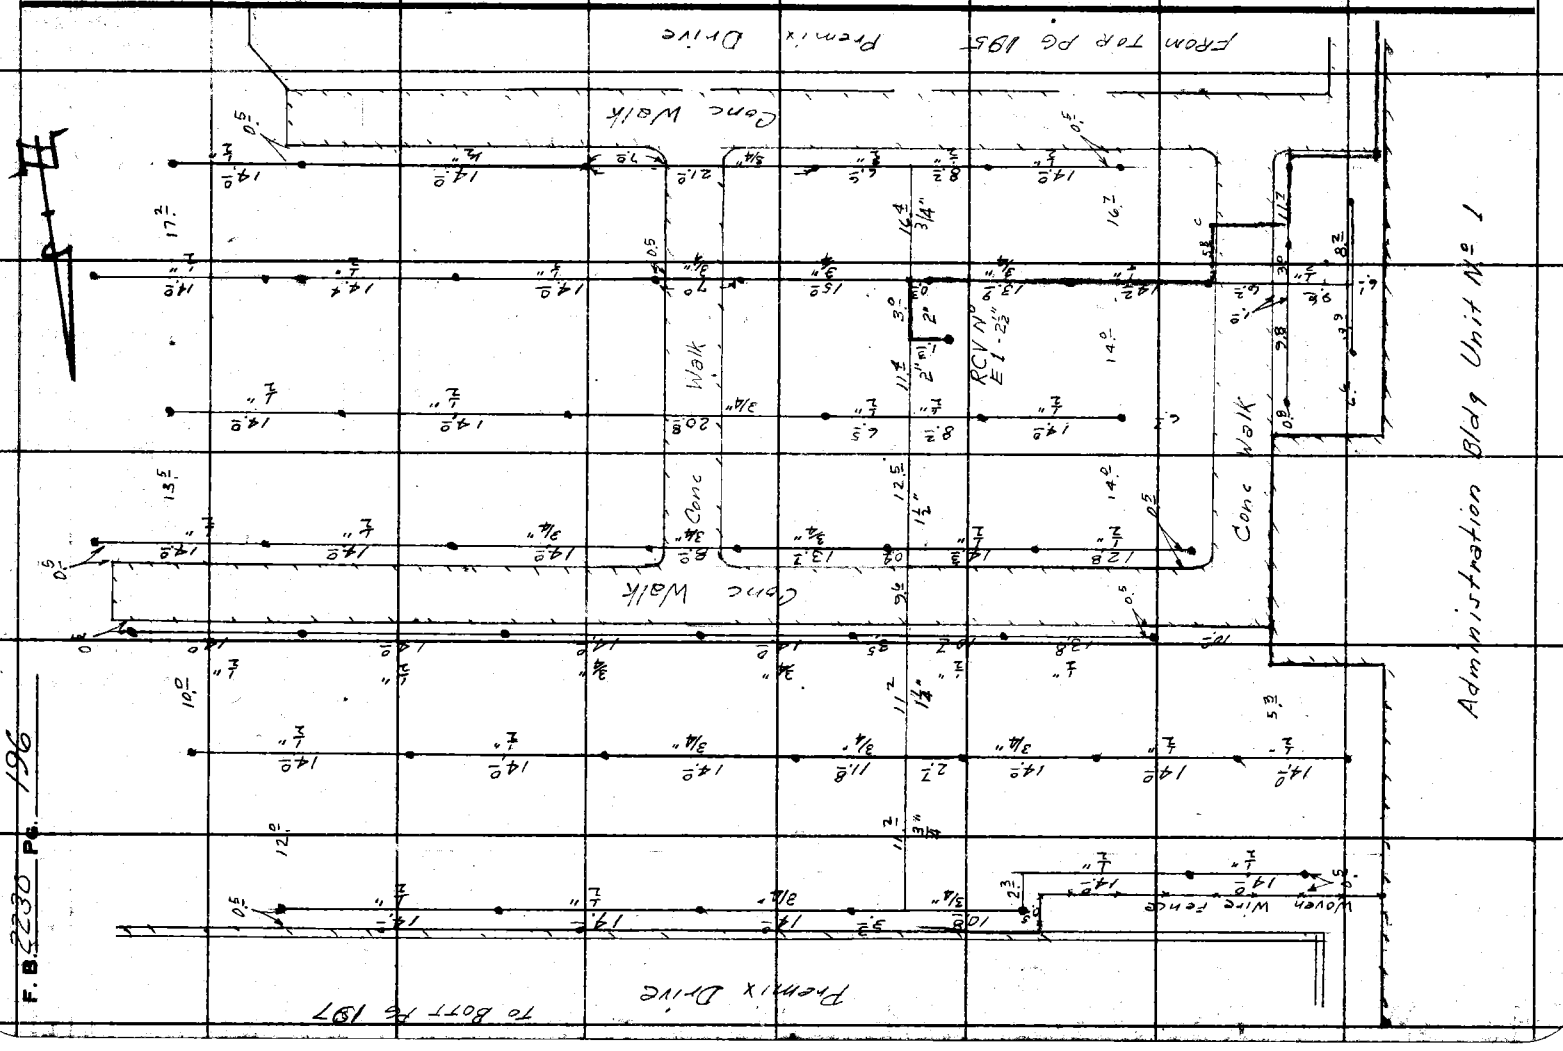

F.B. 2230 Pg. 196

Notes Ck'd by	Survey of Juvenile Hall
Map No.	JN 0022.10 Tape Std °F
Office Work	Surveyed by D. Sappen
Checked	Notes E Shoemaker Date 4-57
Date	Indexed C. Johnson

F. B. 2230 PG. 197

To RT. PG 192

Note: Any Additions or Changes on This Sheet Must be Made or Circled in Red Ink With Date and Name of Person Making Change.

Do not extend this side of this line.

PLEASE RETURN TO
LOS ANGELES COUNTY ENGINEER
700 LOS ANGELES COUNTY ENGINEERING BLDG.

76F3098 SAE #247 1-56

Premix Drive

To Top PG 198

R.C.V. 10-15-

Administration Bldg Unit No 1

Administration Yard (Pre-mix)

R.C.V. D 16-24

Riser

Premix Drive

FROM TOP PG 196

PLEASE RETURN TO
LOS ANGELES COUNTY ENGINEER
700 LOS ANGELES COUNTY ENGINEERING BLDG.

Note: Any Additions or Changes on This Sheet Must be Made or Circled in Red Ink With Date and Name of Person Making Change.

Do not extend this side of this line.

RE 14161

To Top Pg 206

ADMINISTRATION BLDG No 1

RECEIVING BLDG No 6

FROM TOP LFT PG 197

To Top Pg 199

Service Rd

Drainage Ditch

GATE

F.B. 2230 Pg. 198

From Pg 191

Notes Ck'd by	Survey of Juvenile Hall
Map No.	JN 0022.10 Tape Std °F
Office Work	Surveyed by D. Sappell
Checked	Notes D.S. Date 4-57
Date	Indexed C. Johnson

F. B. 2230 Pg. 199

FROM BOTT PG 198

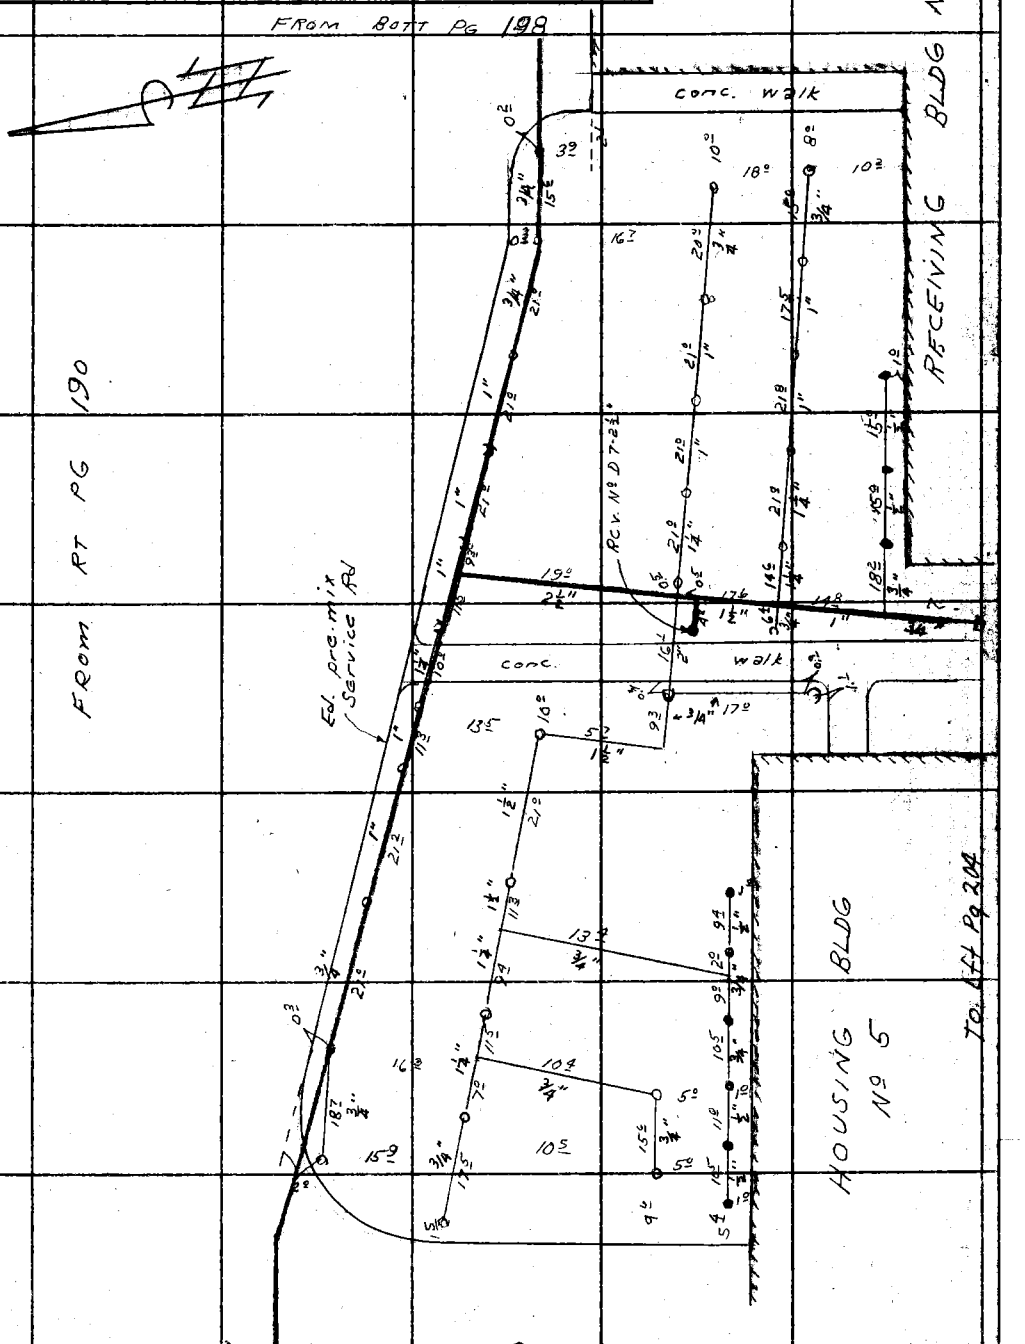

FROM RT PG 190

Note: Any Additions or Changes on This Sheet Must be Made or Circled in Red Ink With Date and Name of Person Making Change.

Do not extend this side of this line.

PLEASE RETURN TO
LOS ANGELES COUNTY ENGINEER
700 Los Angeles County Engineering Bldg.

76F3096 SEE #247 1-56

PLEASE RETURN TO
LOS ANGELES COUNTY ENGINEER
700 LOS ANGELES COUNTY ENGINEERING BLDG.

Note: Any Additions or Changes on This Sheet Must be Made or Circled in Red Ink With Date and Name of Person Making Change.

Do not extend this side of this line.

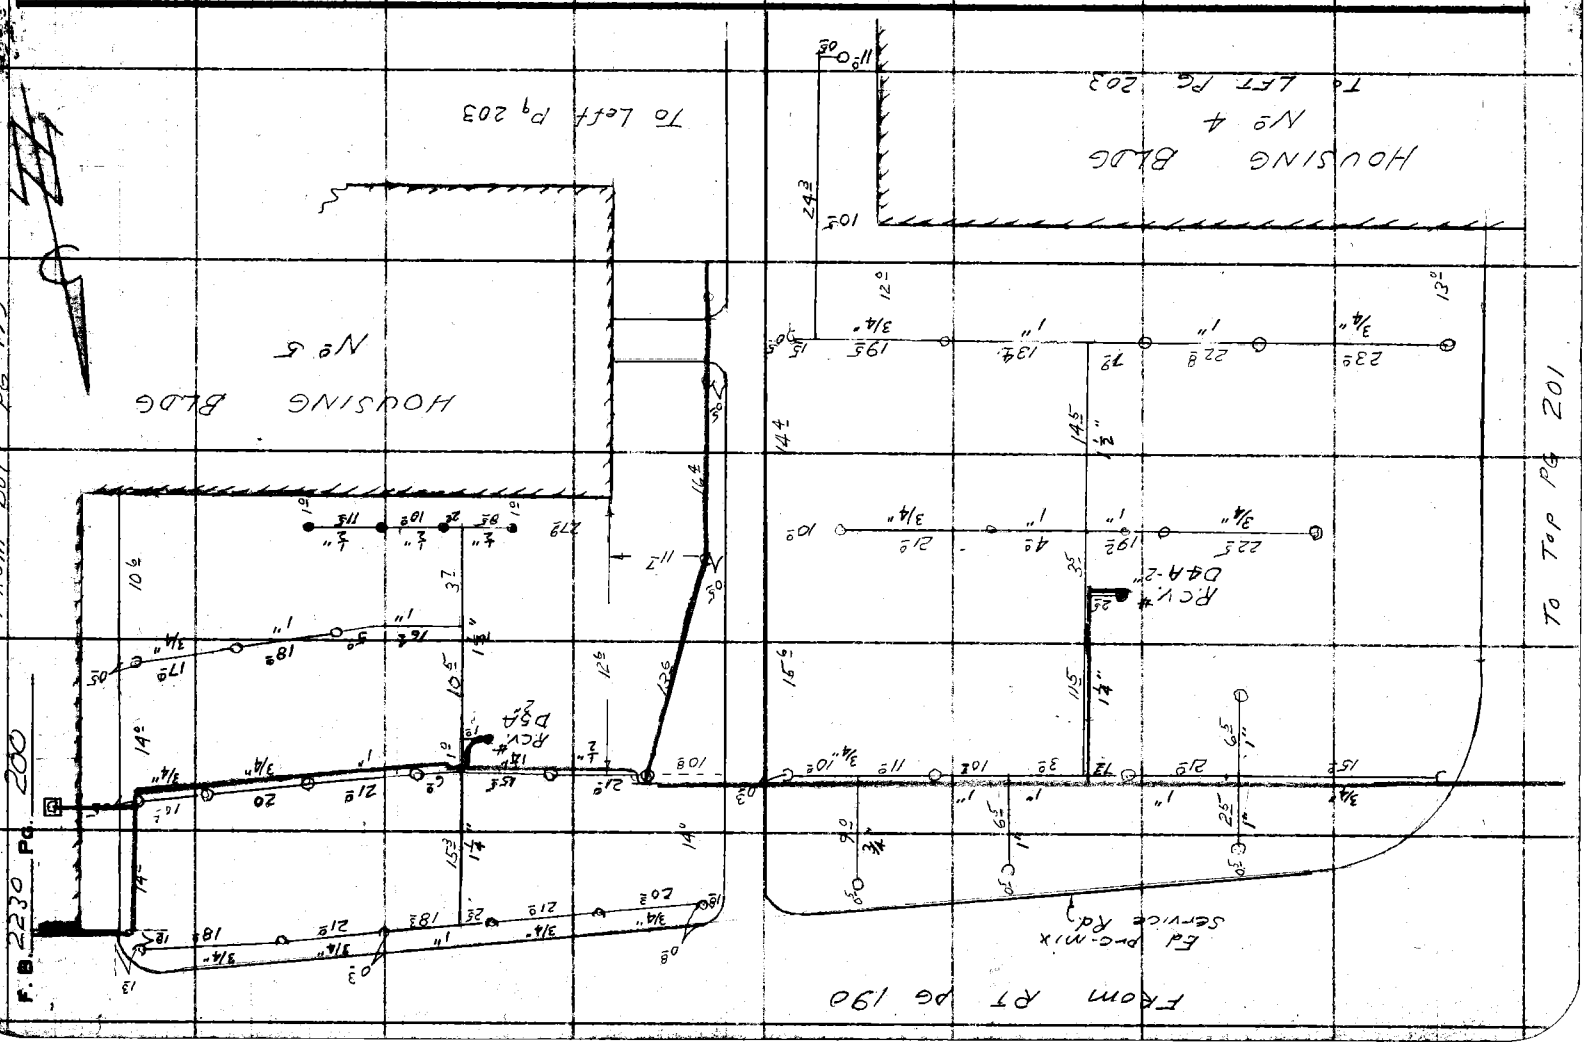

Notes Ck'd by	Survey of Juvenile Hall
Map No.	JN 0022.10 Tape Std °F
Office Work	Surveyed by D. Sappell
Checked	Notes D.S. Date 4-57
Date	Indexed K. C. Johnson


FROM BOTT PG 200
& TO BOTH PG 203

Note: Any Additions or Changes on This Sheet Must be Made or Circled in Red Ink With Date and Name of Person Making Change.

Do not extend this side of this line.

PLEASE RETURN TO
LOS ANGELES COUNTY ENGINEER
700 LOS ANGELES COUNTY ENGINEERING BLDG.

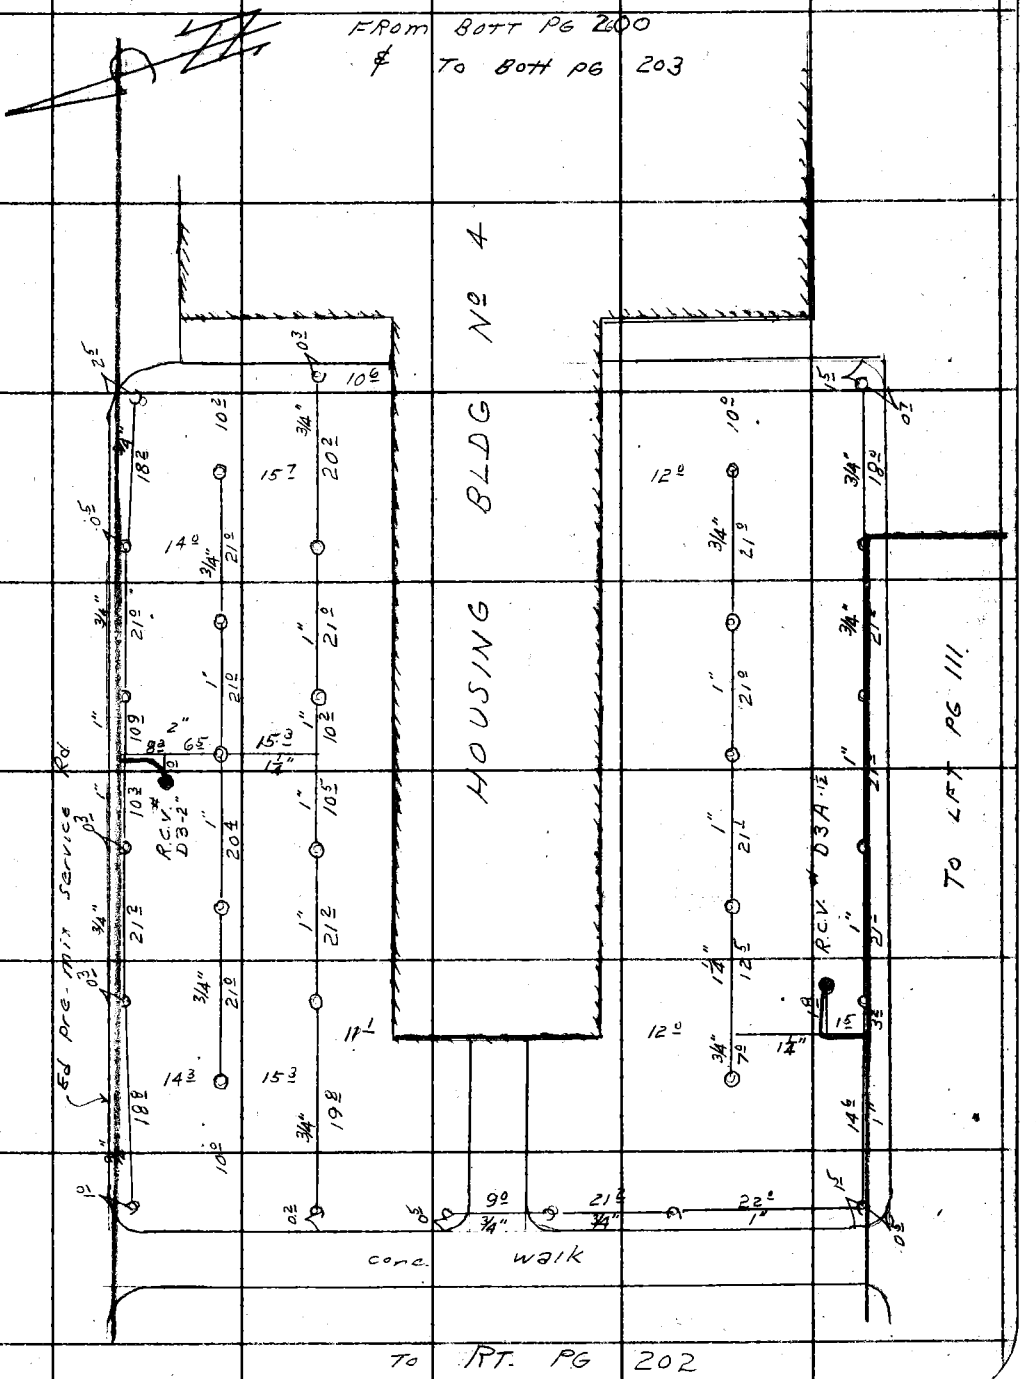

78F3098 SAE #247 1-56

PLEASE RETURN TO
LOS ANGELES COUNTY ENGINEER
700 LOS ANGELES COUNTY ENGINEERING BLDG.

Note: Any Additions or Changes on This Sheet Must be Made or Circled in Red Ink With Date and Name of Person Making Change.

Do not extend this side of this line.

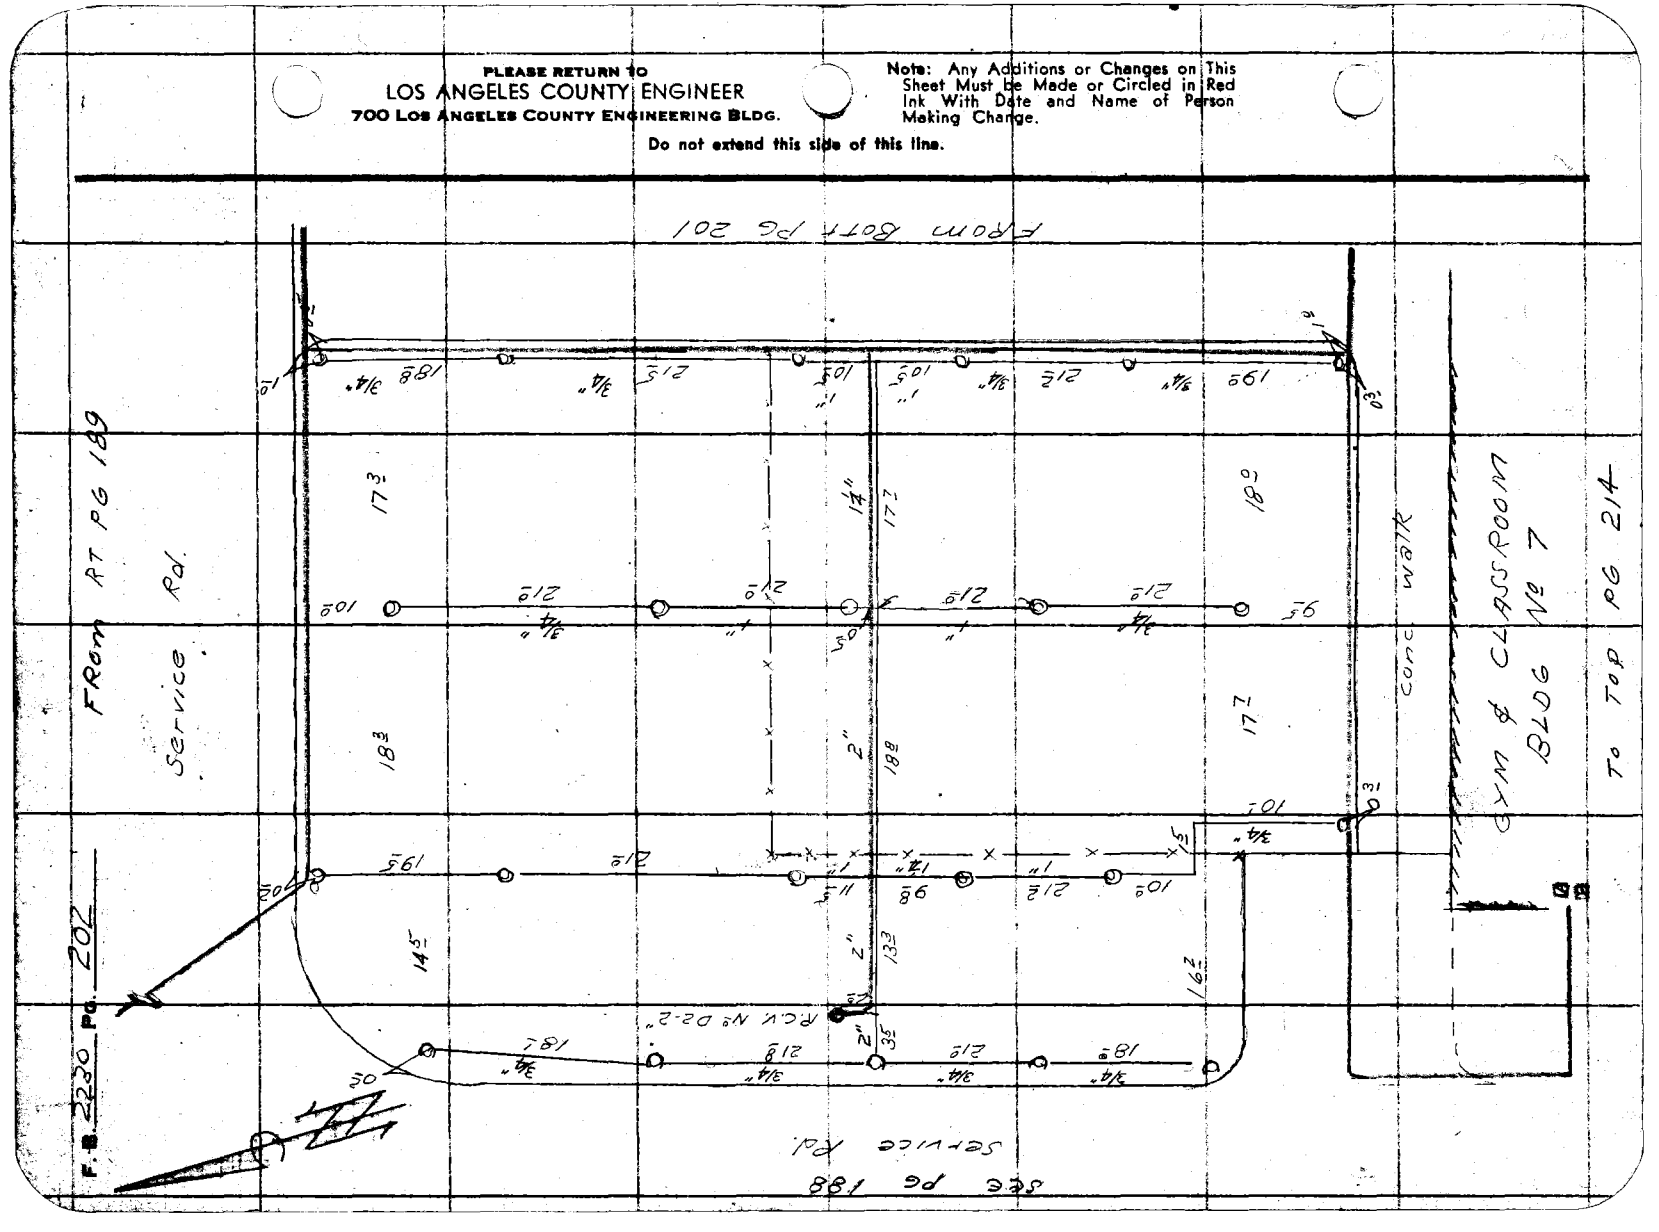

76F3098 S&E #247 1-56

PLEASE RETURN TO
LOS ANGELES COUNTY ENGINEER
700 LOS ANGELES COUNTY ENGINEERING BLDG.

Note: Any Additions or Changes on This Sheet Must be Made or Circled in Red Ink With Date and Name of Person Making Change.

Do not extend this side of this line.

2 3

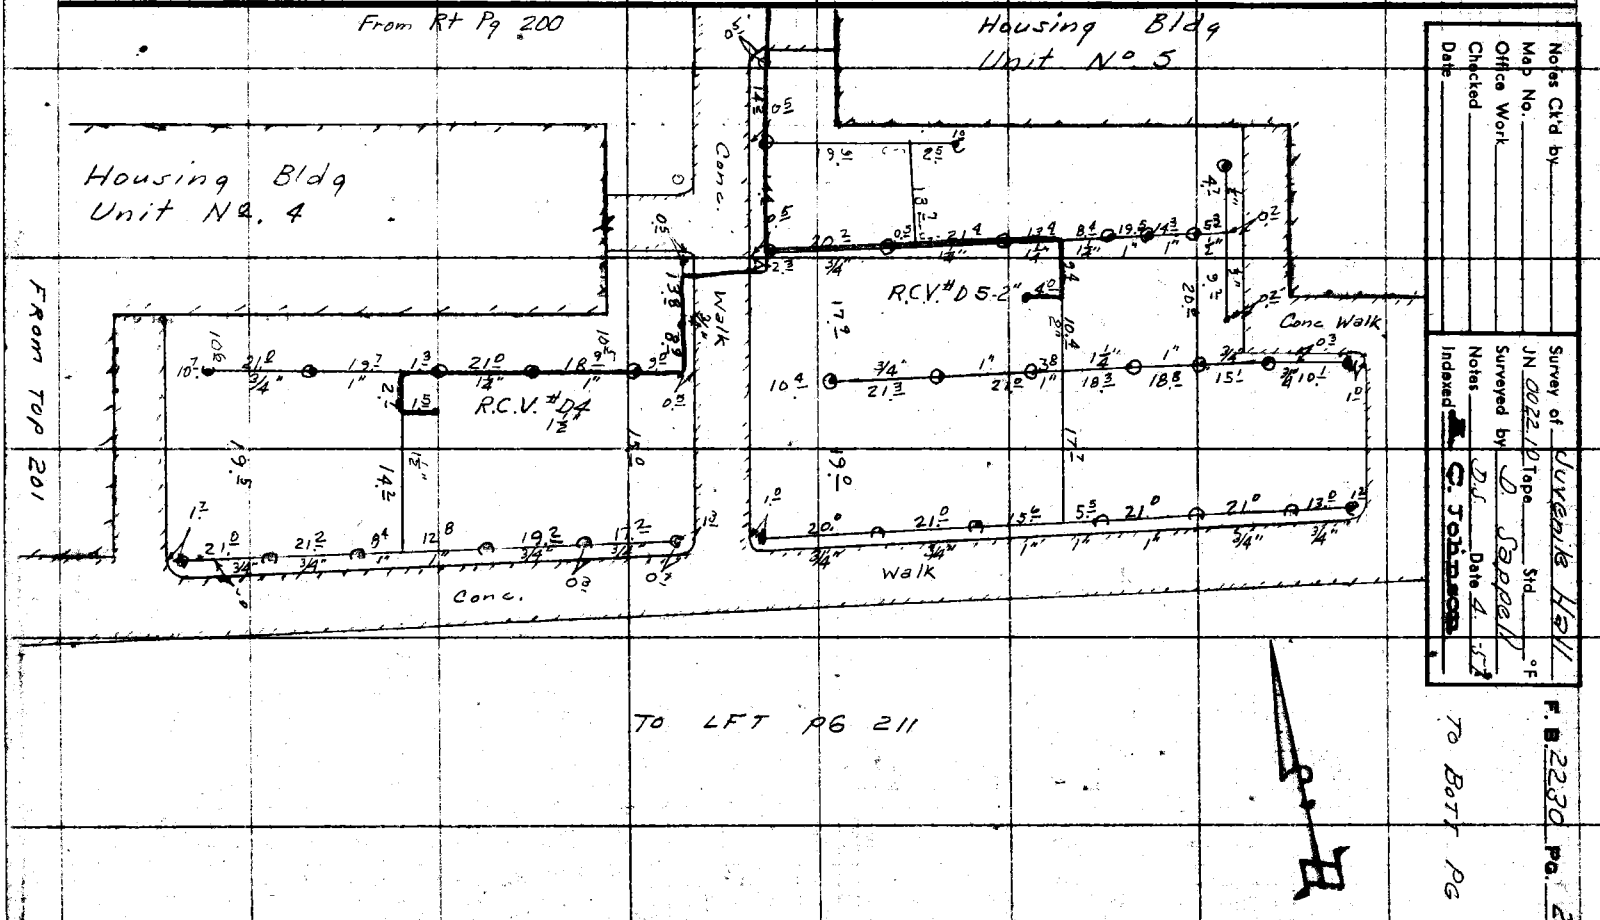

Notes Ck'd by _____
Map No. _____
Office Work _____
Checked _____
Date _____

Survey of Jurenis Hall
JN 0022.10 Tape _____ Std. _____ °F
Notes _____
Indexed _____ Date _____
C. Johnson

F. B. 2230 Pg. 203

PLEASE RETURN TO
LOS ANGELES COUNTY ENGINEER
700 LOS ANGELES COUNTY ENGINEERING BLDG.

Do not extend this side of this line.

Note: Any Additions or Changes on This Sheet Must be Made or Circled in Red Ink With Date and Name of Person Making Change.

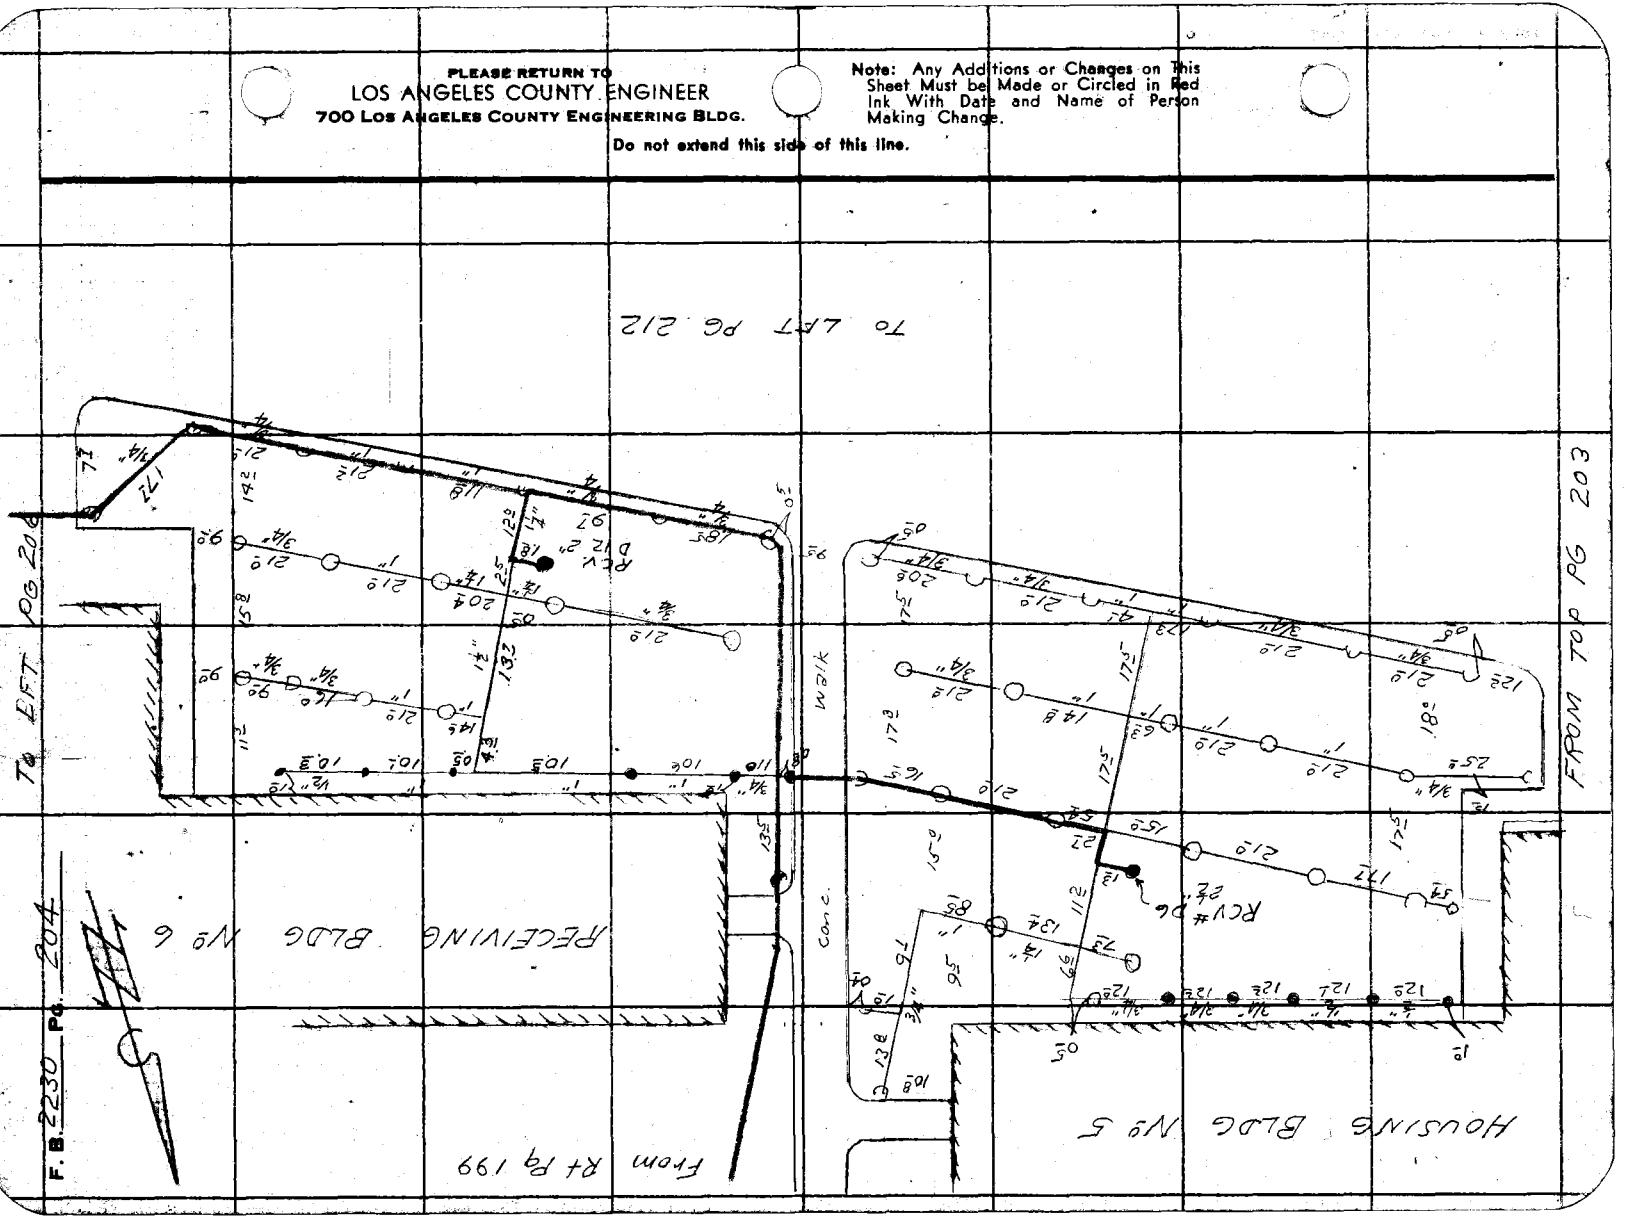

76F3098 S&E #247 1-56

PLEASE RETURN TO
LOS ANGELES COUNTY ENGINEER
700 LOS ANGELES COUNTY ENGINEERING BLDG.

Note: Any Additions or Changes on This Sheet Must be Made or Circled in Red Ink With Date and Name of Person Making Change.

Do not extend this side of this line.

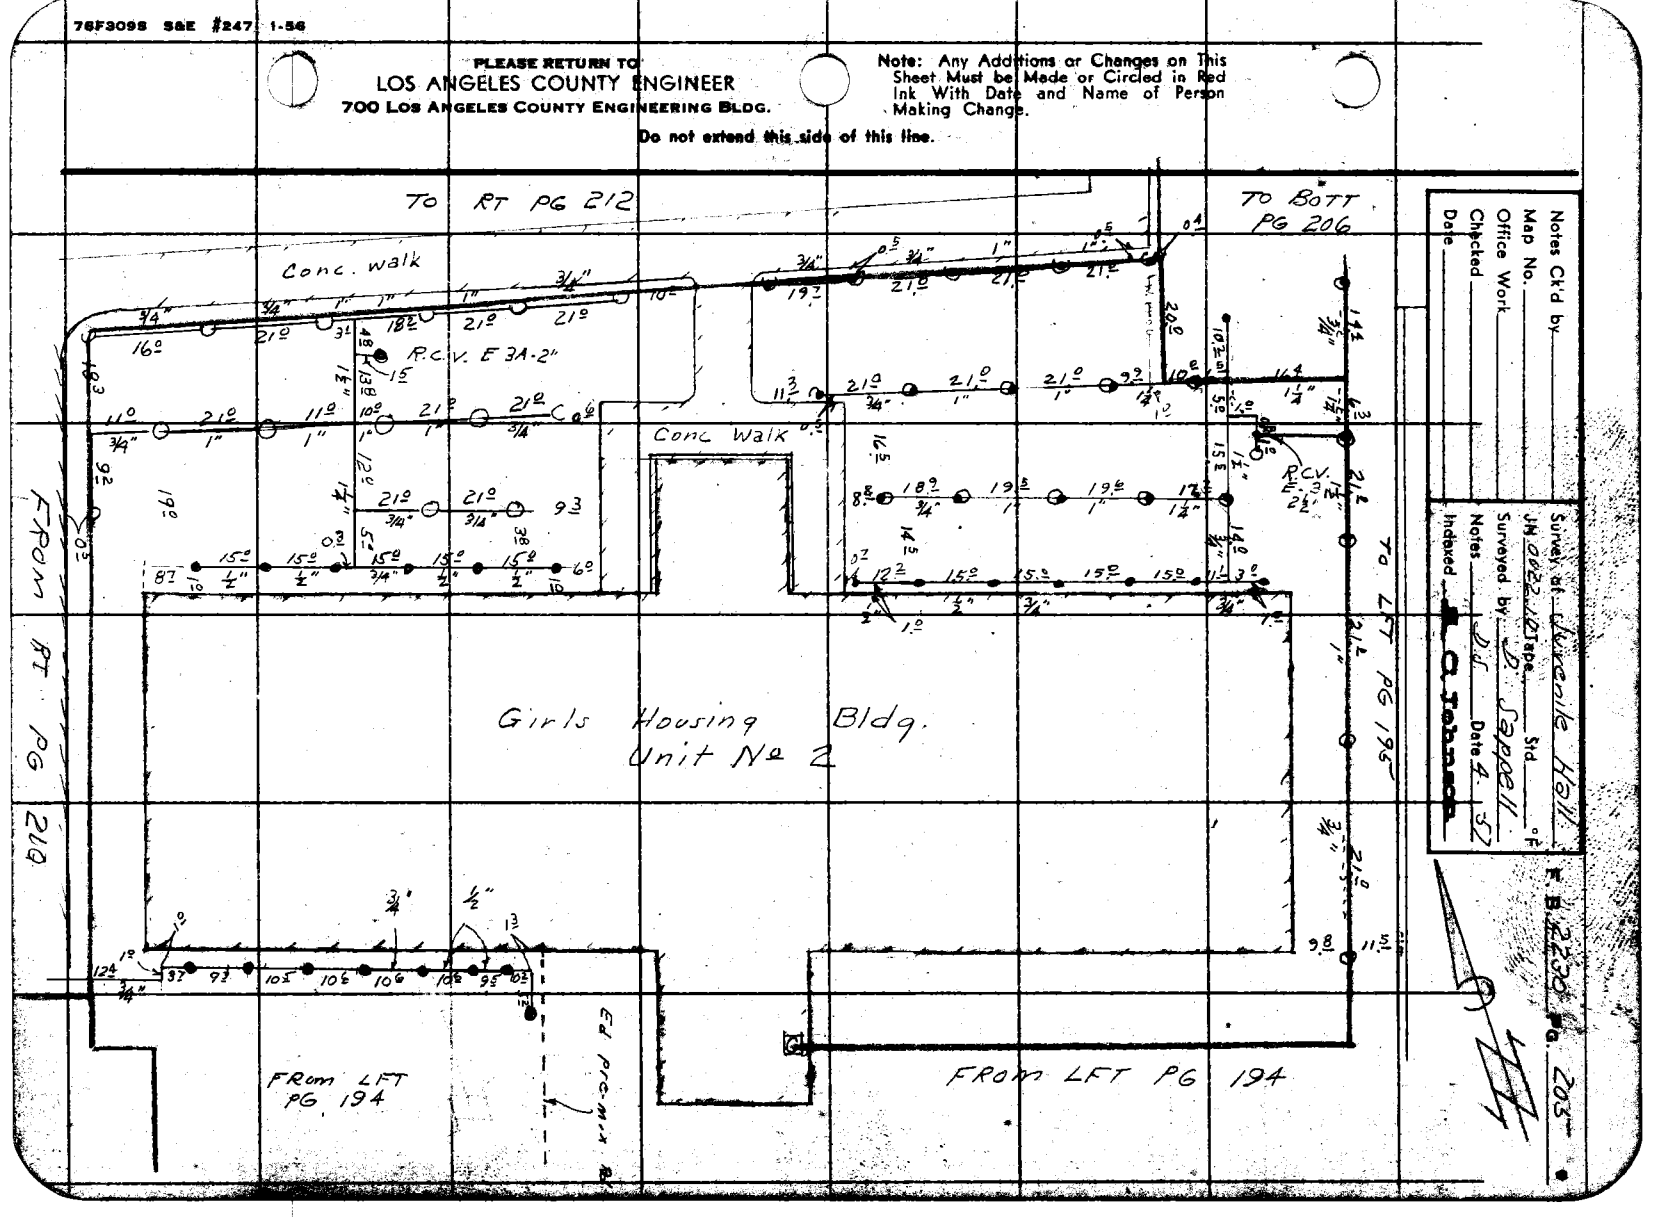

Notes Ck'd by
Map No.
Office Work
Checked
Date

Survey of Juvenile Hall
J.N. 0822-10 Tape Std °F
Surveyed by D. Sapell
Notes D.L. Date 4-52
Indexed C. Johnson

F.B. 22306 Pg. 203

PLEASE RETURN TO
LOS ANGELES COUNTY ENGINEER
700 LOS ANGELES COUNTY ENGINEERING BLDG.

Note: Any Additions or Changes on This Sheet Must Be Made or Circled in Red Ink With Date and Name of Person Making Change.

Do not extend this side of this line.

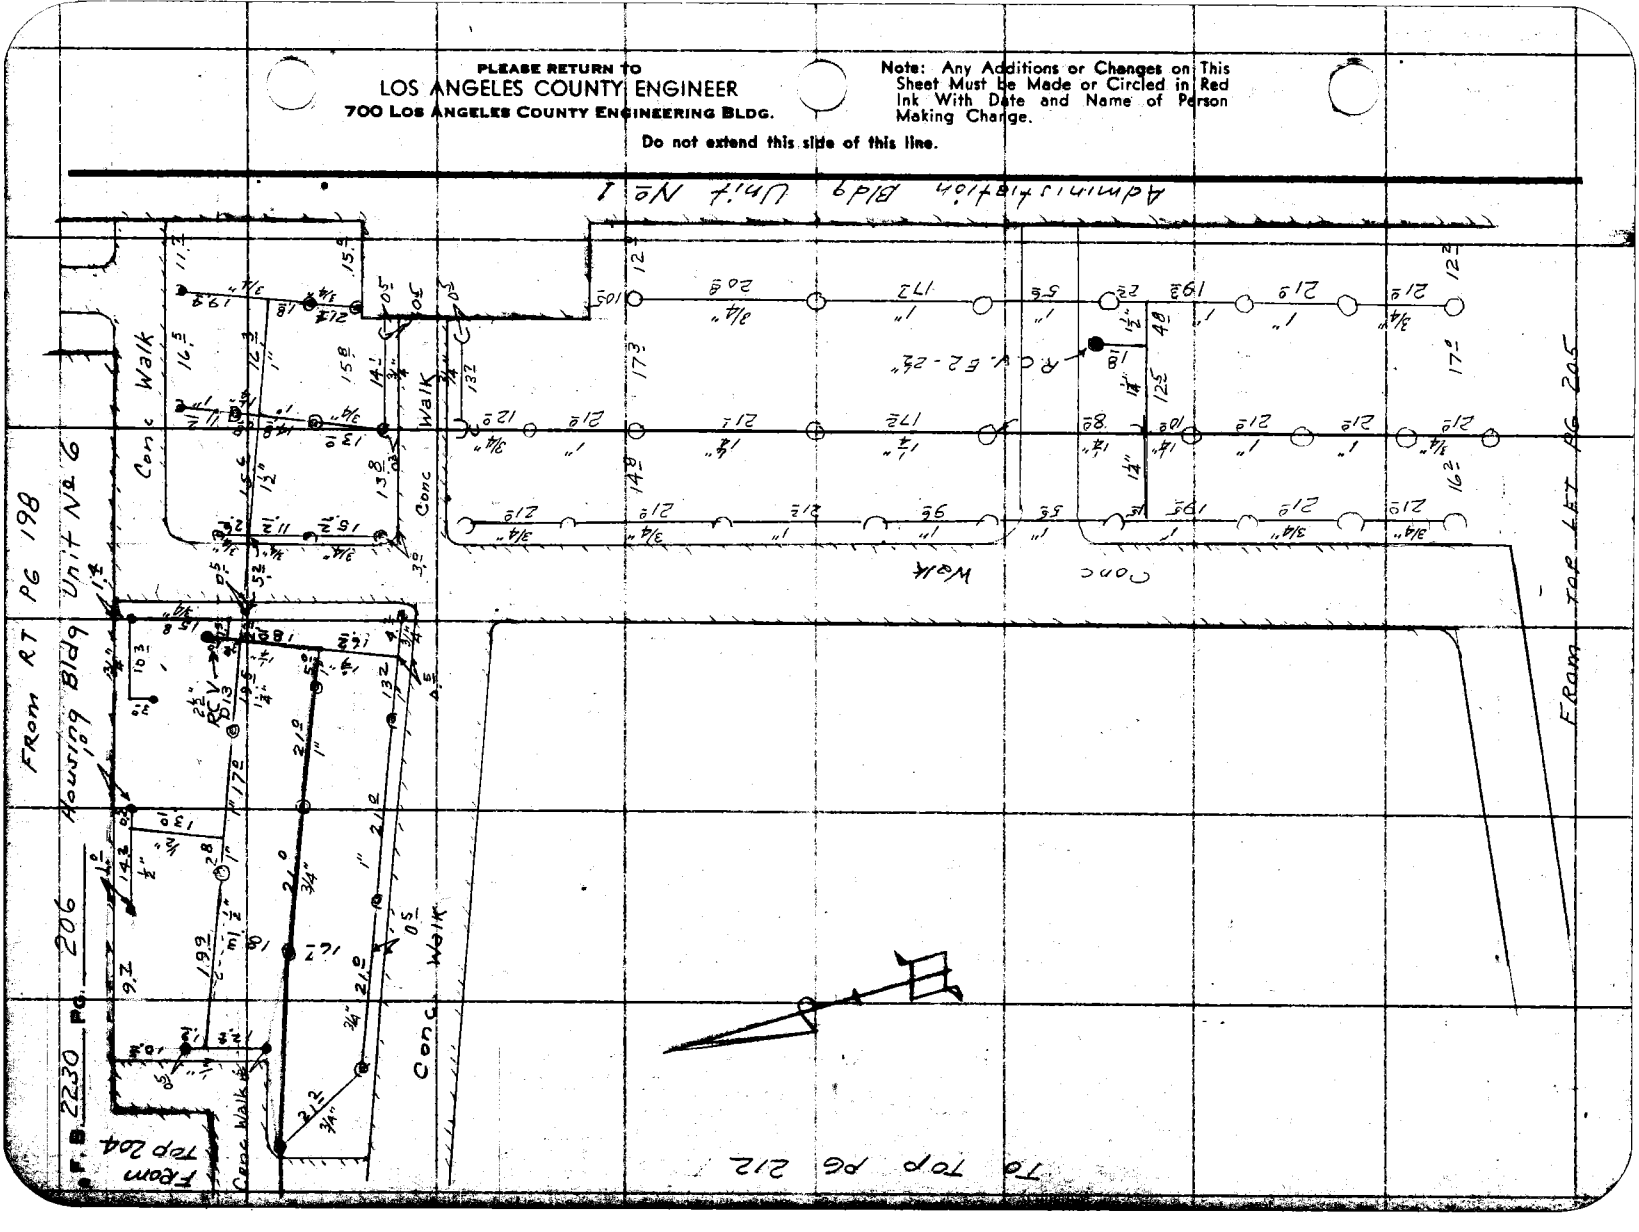

Notes Ck'd by
Map No.
Office Work
Checked
Date

Survey of Juvenile Hall
JN 0022.10 Tape Std °F
Surveyed by D. Sappell
Notes E. Shoemaker Date 4-57
Indexed G. Johnson

F. B. 2230 Pg. 207

To RT PG 211

Conc Walk

Conc walk

Bldg No 3

From TOP LFT PG 193
& To Top PG 213

To LFT PG 208

Remix Drive

Pipe
RCV - E9-28

MECH.
Bldg No

Note: Any Additions or Changes on This Sheet Must be Made or Circled in Red Ink With Date and Name of Person Making Change.

Do not extend this side of this line.

PLEASE RETURN TO
LOS ANGELES COUNTY ENGINEER
700 Los Angeles County Engineering Bldg.

7572008 SAE #247 1-56

F. B. 2230 Pg. 208

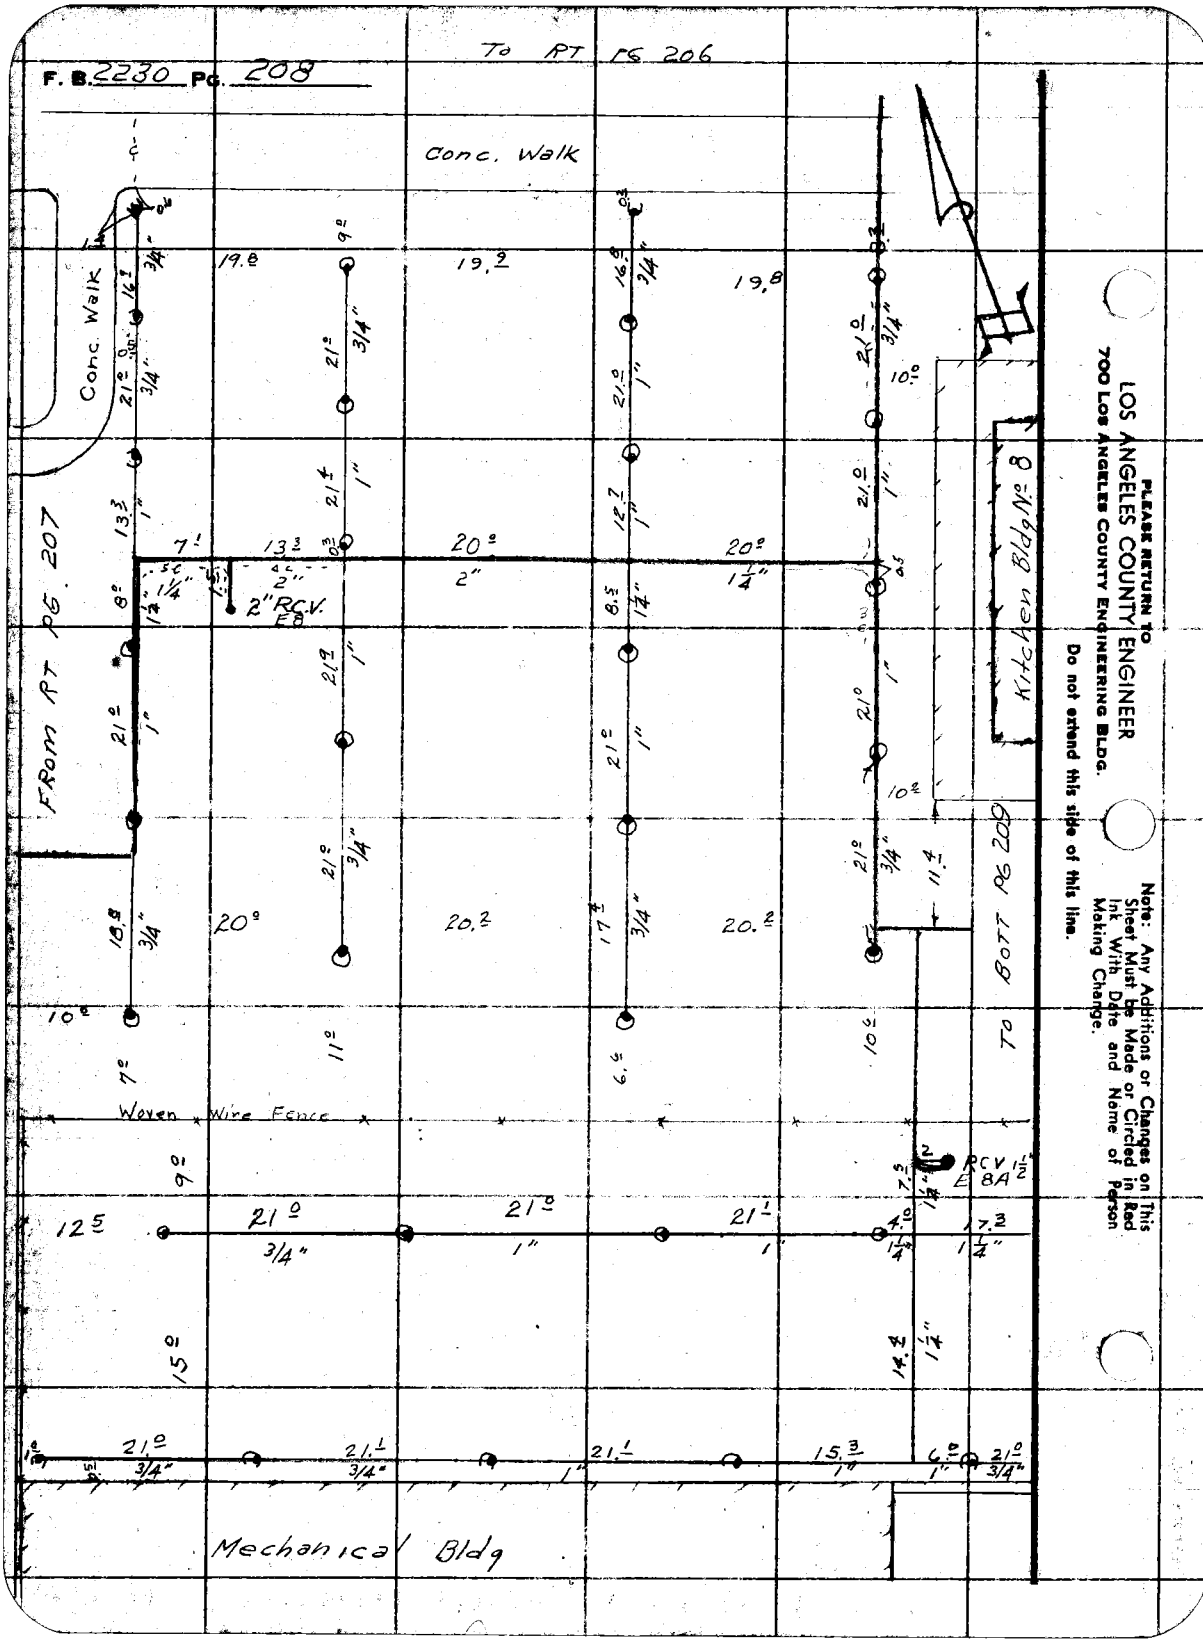

PLEASE RETURN TO
LOS ANGELES COUNTY ENGINEER
700 Los Angeles County Engineering Bldg.

Do not extend this side of this line.

Note: Any Additions or Changes on This Sheet Must be Made or Circled in Red Ink With Date and Name of Person Making Change.

76F3095 S&E #247 1-56

PLEASE RETURN TO
LOS ANGELES COUNTY ENGINEER
700 LOS ANGELES COUNTY ENGINEERING BLDG.

Note: Any Additions or Changes on This Sheet Must be Made or Circled in Red Ink With Date and Name of Person Making Change.

Do not extend this side of this line.

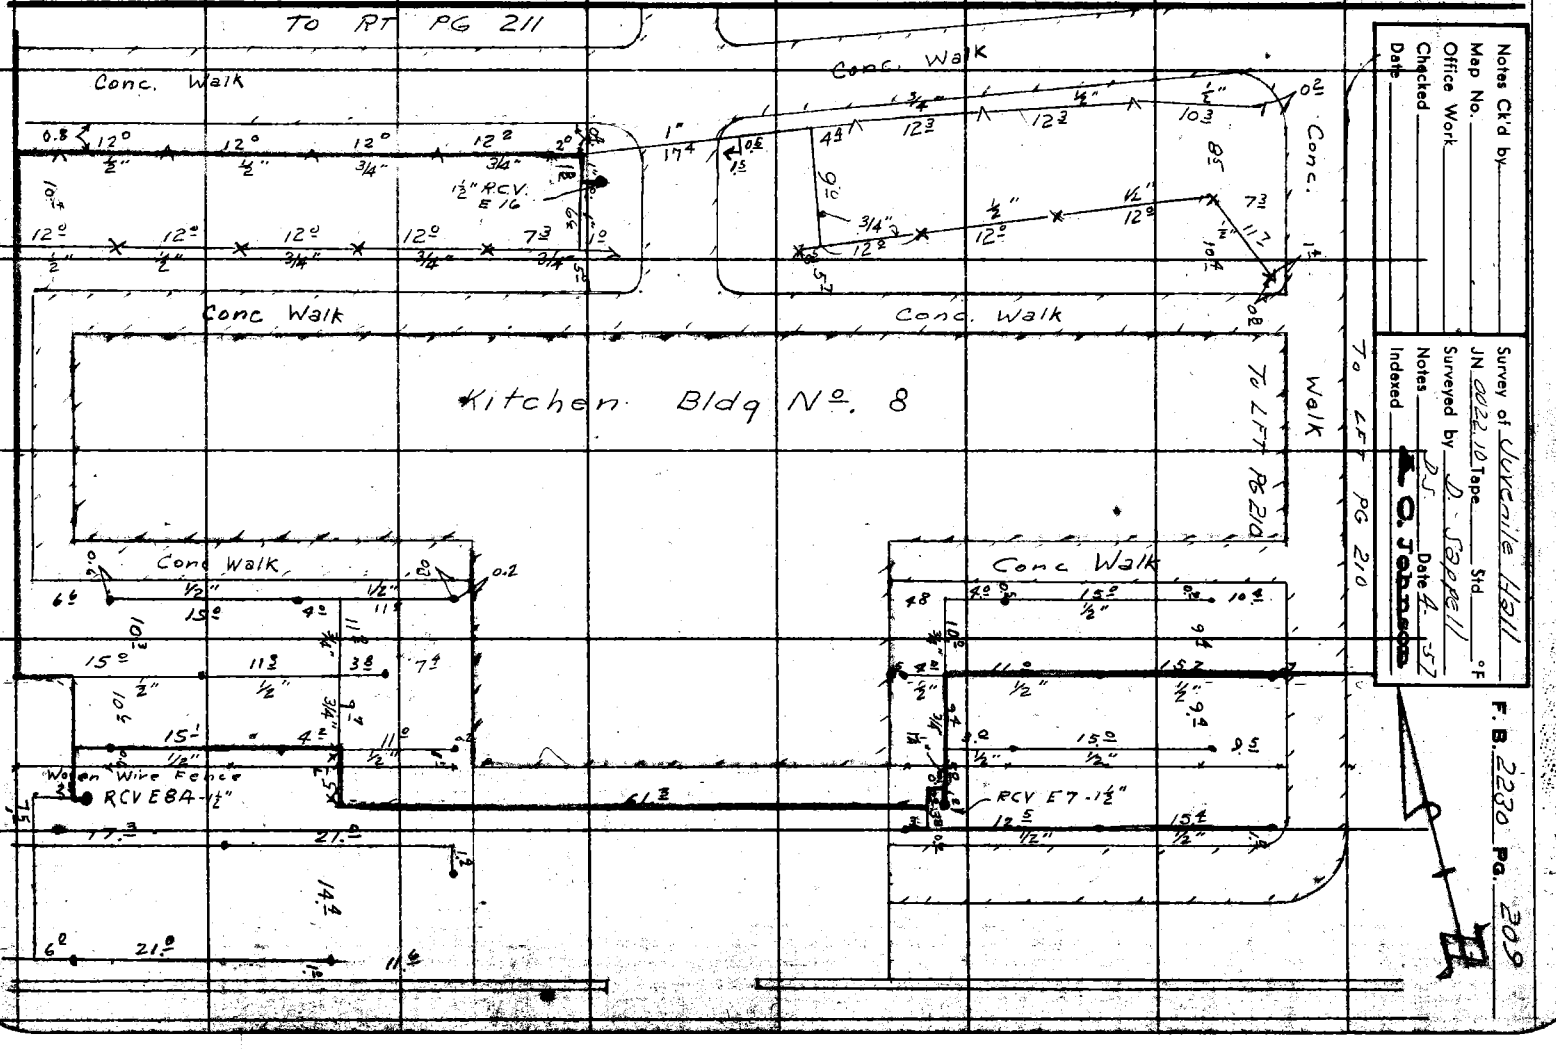

Notes Ck'd by _____
Map No. _____
Office Work _____
Checked _____
Date _____

Surveyed by D. Sapell
DJ
Notes _____ Date 4-57
Indexed _____
K. O. Johnson

F. B. 2230 Pg. 209

F. B. 2230 Pg. 210

To RT PG 212

covrd conc walk.

PLEASE RETURN TO
LOS ANGELES COUNTY ENGINEER
700 Los Angeles County Engineering Bldg.

Do not extend this side of this line.

Note: Any Additions or Changes on This Sheet Must be Made or Circled in Red Ink With Date and Name of Person Making Change.

KITCHEN & DINING BLDG No 8

cont. walk.

BLDG No 2

conc. walk.

To BOTT PG 205

From Top PG 209

Ch. Link Fn.

chain link Fn.

R.C.V. "E6" 22

196 207 207

76F3098 SBE 247 1-56

PLEASE RETURN TO
LOS ANGELES COUNTY ENGINEER
700 LOS ANGELES COUNTY ENGINEERING BLDG.

Note: Any Additions or Changes on This Sheet Must be Made or Circled in Red Ink With Date and Name of Person Making Change.

Do not extend this side of this line.

Notes Ck'd by
Map No.
Office Work
Checked
Date

JN 2022.16 Tape Std °F
Surveyed by P. Sapoff Date 4-57
Notes
Indexed C. Johnson

F.B. 2230 Pg. 211

FROM RT. PG 201 & 203

TO BOTT PG 212

FROM TOP 207 & TO LFT PG 213

FROM LFT 209

conc. walk

BLDG 11
CHAPEL

conc. walk

conc. walk

conc. walk

GYM & CLASSROOM BLDG #7

R.C.V. 13 11-2"

R.C.V. NO B 12-2"

R.C.V. E14A

R.C.V. B13

R.C.V. E14-2"

R.C.V. E15

R.C.V. E13

R.C.V. B14

R.C.V. C7-2"

IDENT.

PLEASE RETURN TO
LOS ANGELES COUNTY ENGINEER
700 LOS ANGELES COUNTY ENGINEERING BLDG.

Note: Any Additions or Changes on This Sheet Must be Made or Circled in Red Ink With Date and Name of Person Making Change.

Do not extend this side of this line.

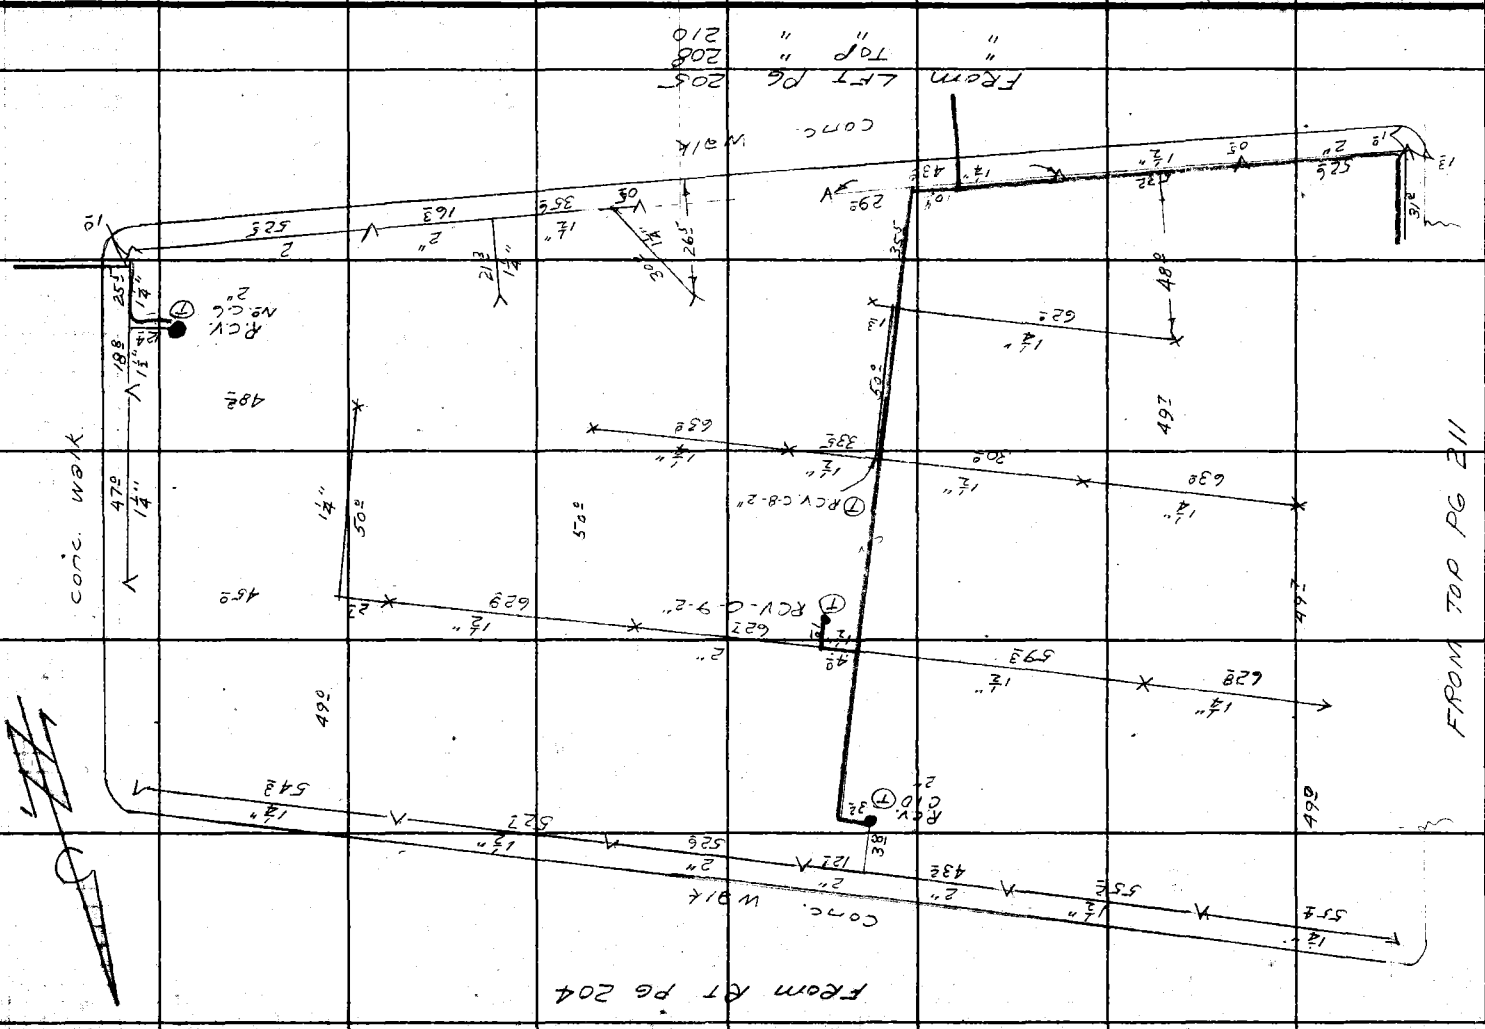

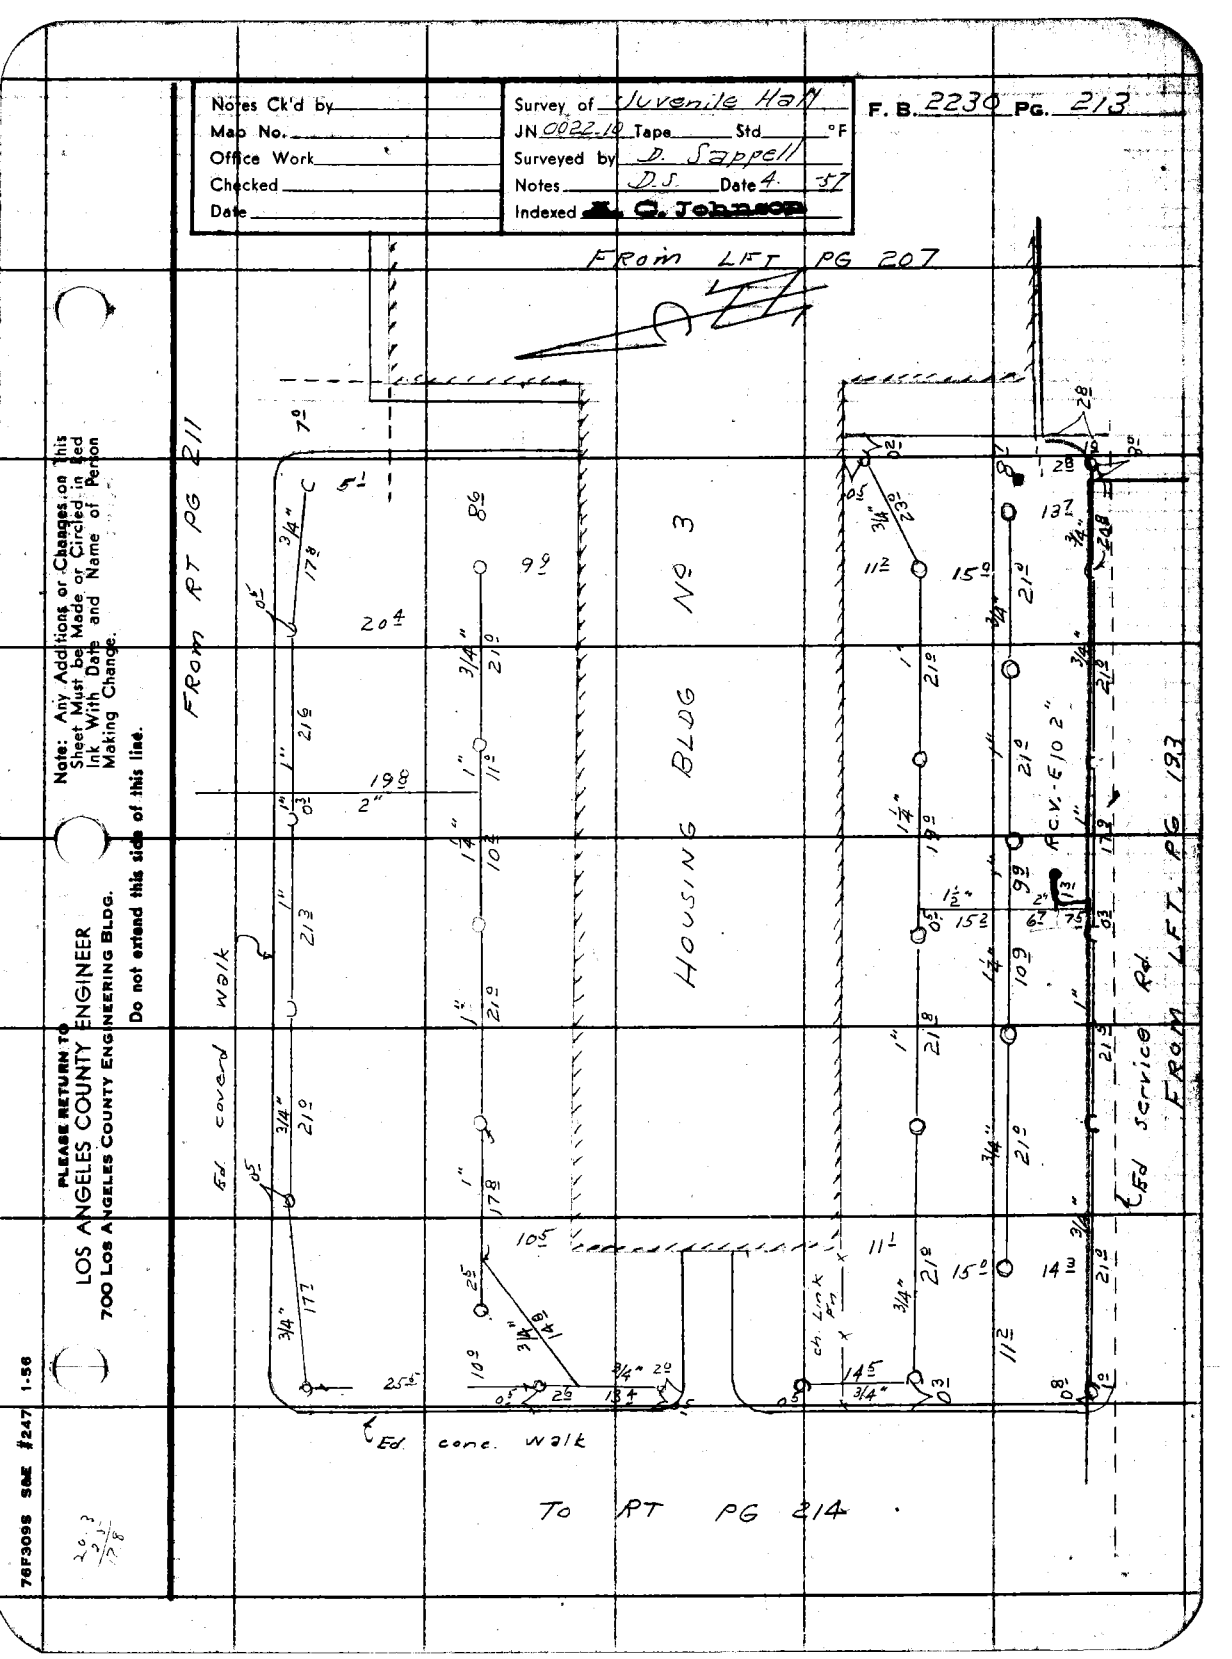
Notes Ck'd by
Map No.
Office Work
Checked
Date
Survey of Juvenile Hall
JN 0022.10 Tape Std °F
Surveyed by D. Sappell
Notes D.S. Date 4-57
Indexed C. Johnson
F. B. 2230 PG. 213
FROM LFT PG 207
FROM RT PG 211
HOUSING BLDG NO 3
Ed cover walk
Ed service Rd
FROM LFT. PG 193
R.C.V.-E 10 2"
Ch. Link Fence
Ed. conc. walk
TO RT PG 214
Note: Any Additions or Changes on this Sheet Must be Made or Circled in Red Ink With Date and Name of Person Making Change.
Do not extend this side of this line.
PLEASE RETURN TO
LOS ANGELES COUNTY ENGINEER
700 Los Angeles County Engineering Bldg.
76F3098 SAE #247 1-56

PLEASE RETURN TO
LOS ANGELES COUNTY ENGINEER
700 LOS ANGELES COUNTY ENGINEERING BLDG.

Note: Any Additions or Changes on This Sheet Must be Made or Circled in Red Ink With Date and Name of Person Making Change.

Do not extend this side of this line.

From Bott pg 202

GYM & CLASSROOM BLDG No 7

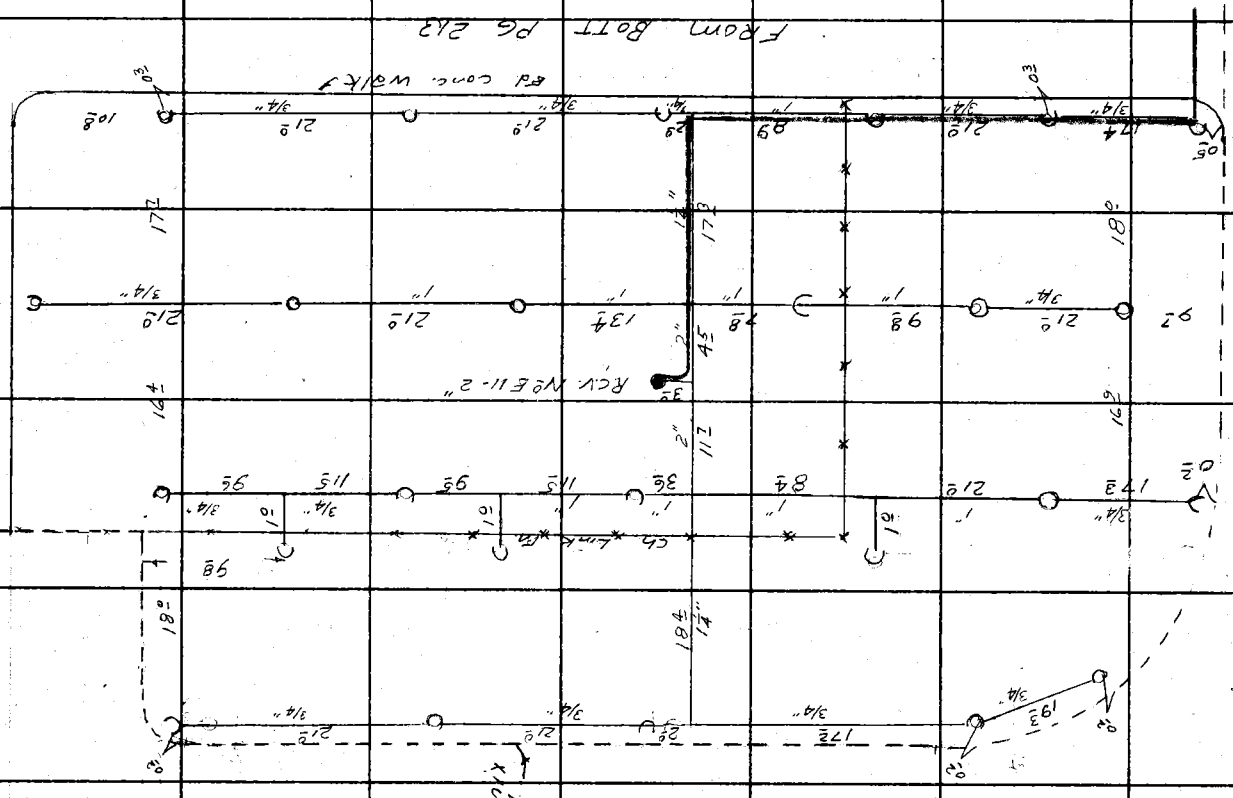

F.B. 2230 PG. 214

Notes Ck'd by	Survey of Juvenile Hall
Map No.	JN 0022.10 Tape Std °F
Office Work	Surveyed by D. Sappell
Checked	Notes CE Shoemaker Date 5-57
Date	Indexed ~~K. C. Johnson~~

F. B. 2230 Pg. 215

J.N. 0022.10

JUVENILE HALL FACILITY

AT

RANCHO LOS AMIGOS

LOCATION of walks, fences & ect.
Tied into Exist. Bldg. & security walls.

See pgs.	17 to 27	for location of bldgs.
	29 to 33	" sewer lines
	35 to 44	" Main water sys.
	45 to 64	" water line laterals
	69 to 71	" security wall
	73 to 88	" Durant lines
	89 to 96	" signal systems
	97 to 102	" Electrical service
	107 to 113	" Security Lighting
	116 to 118	" gas line
	159 to 163	" ℄ Service Rd.
	175 to 178	" covered walk
	185 to 214	" Sprinkler system

Note: Distances Taken to ℄ security wall
unless otherwise shown.

Partx: Sappell
Shoemaker
Myers
Caro

Note: Any Additions or Changes on This Sheet Must be Made or Circled in Red Ink With Date and Name of Person Making Change.

Do not extend this side of this line.

PLEASE RETURN TO
LOS ANGELES COUNTY ENGINEER
700 Los Angeles County Engineering Bldg.

76F3098 SAE #247 1-56

7 OF 2065 SAE 2247 1-56

PLEASE RETURN TO
LOS ANGELES COUNTY ENGINEER
700 LOS ANGELES COUNTY ENGINEERING BLDG.

Note: Any Additions or Changes on This Sheet Must be Made or Circled in Red Ink With Date and Name of Person Making Change.

Do not extend this side of this line.

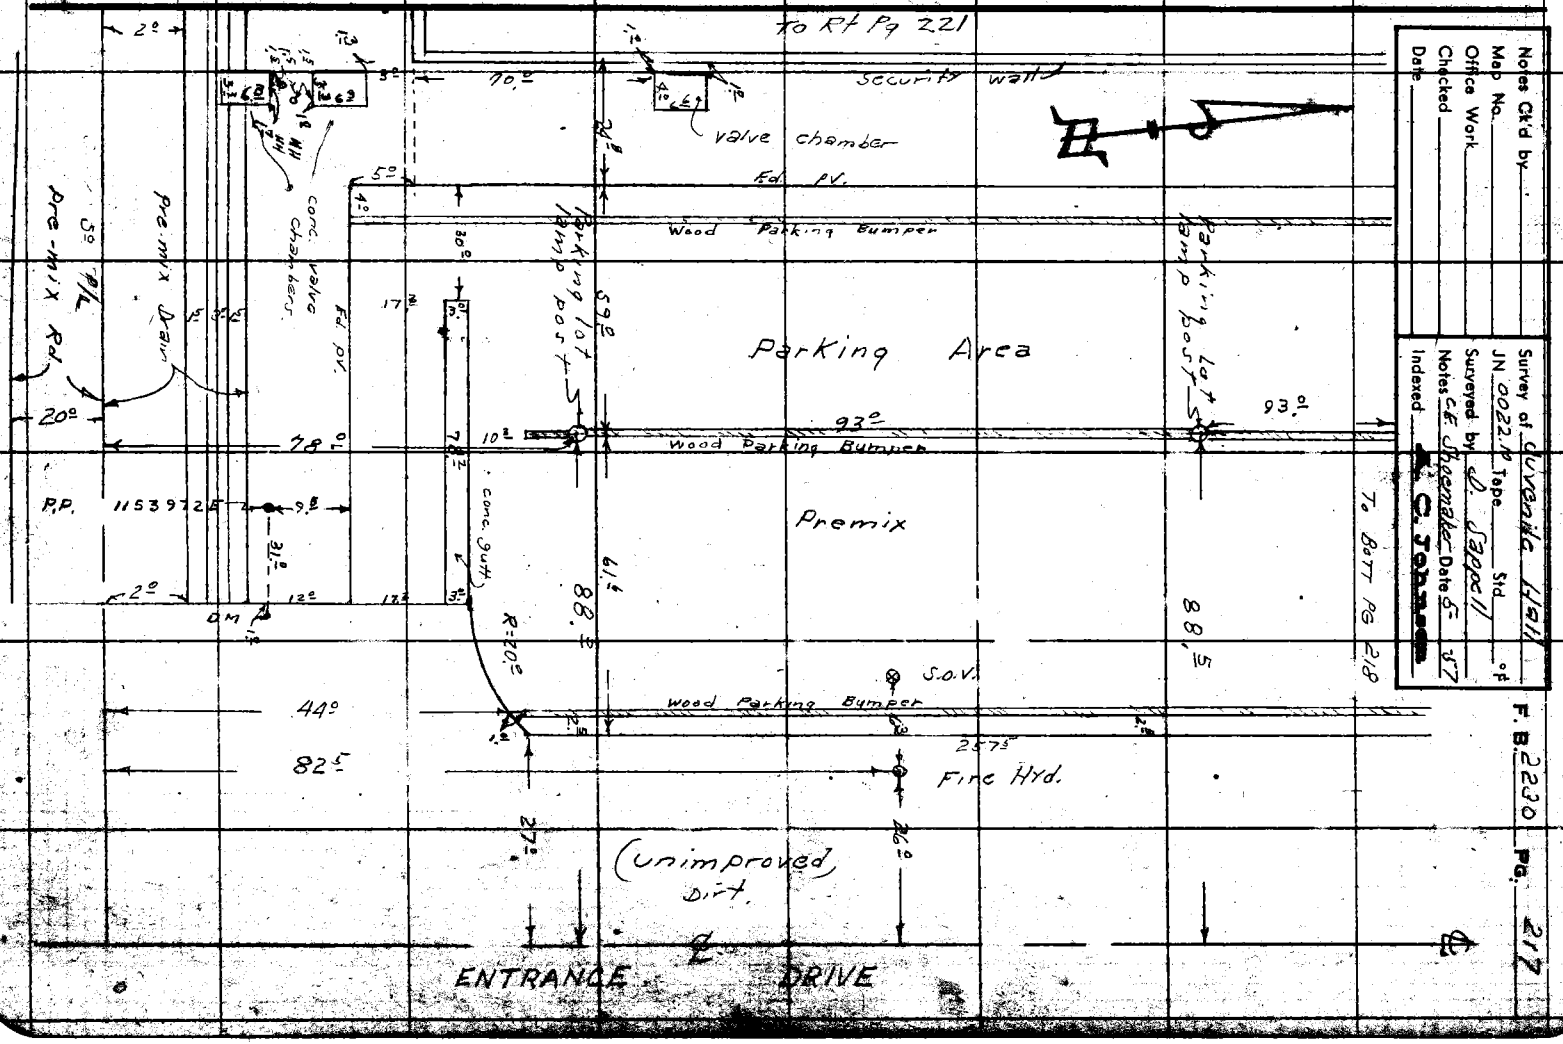

Notes Ck'd by
Map No.
Office Work
Checked
Date


F. B. 2230 Pg. 217

F. B. 2280 PG. 218

To BOTT PG 219

96'

8" conc. walk

38'

R=39'

Administration Bldg Unit No 1

272'

16'

24'

5" conc walk

40'

5'-0" conc walk

18'±

12'

R=39'

13'

5" conc. Walk &cb

86'

38'

19'±

36.7'

Conc Walk &cb

36'

5.5'

19'

3'

24'

1'

27'

DRIVE

ENTRANCE

(Unimproved)

To PG 222

Parking lot lamp post

24'

57.3'

26'

88.5'

67'

Security Wall

Ed. DV.

Wood parking bumper

Pre-mix

73.0'

Wood parking bumper

Parking Lot

FROM TOP PG 217

PLEASE RETURN TO
LOS ANGELES COUNTY ENGINEER
700 Los Angeles County Engineering Bldg.
Do not extend this side of this line.

Note: Any Additions or Changes on This Sheet Must be Made or Circled in Red Ink With Date and Name of Person Making Change.

Notes Ck'd by	Survey of Juvenile Hall
Map No.	JN 0022.10 Tape Std °F
Office Work	Surveyed by D. Sapell
Checked	Notes C.E. Shoemake Date 6-57
Date	Indexed E. C. Johnson

F. B. 2230 Pg. 219

10 12.6 12.2

To Bot Pg 220

10° chain link fn.

Security wall

32.6

64.5

32.9

17.5

9.3

10°

10.2

13.7

4.9

conc. landing

4.5

13.7

32.3

6" conc. cb.

6" ch. link fn.

145.9

To Pt Pg 223

80.2

Pre-mix pv.

Administration Yard

125.9

(Unimproved)

ENTRANCE DRIVE

16.1

32.8

16.1

Administration Bldg. Unit No 1

89.6

40°

32°

10.2

10°

5.9

4.3

6.2

conc. vault for sliding gate

sliding gate

10° ch. Link Fn.

6.0

6.0

conc.

14.3

56.6

25.3

Pre-mix

6" conc. cb

12.9

39.4

57.6

15.3

16°

5.8

96.2

FROM TAP PG 218

conc. walk

To Tap Pg 218

PLEASE RETURN TO
LOS ANGELES COUNTY ENGINEER
700 Los Angeles County Engineering Bldg.

Note: Any Additions or Changes on This Sheet Must be Made or Circled in Red Ink With Date and Name of Person Making Change.

Do not extend this side of this line.

76F-3088 SOE (5x7) 1-56

F. B. 2230 Pg. 220

PLEASE RETURN TO
LOS ANGELES COUNTY ENGINEER
700 Los Angeles County Engineering Bldg.
Do not extend this side of this line.

Note: Any Additions or Changes on This Sheet Must be Made or Circled in Red Ink With Date and Name of Person Making Change.

DRIVE

ENTRANCE

(Paved)

13.6

14.0

Security Mall

conc. box drain
See pg 224

124.0

Drainage (Premix) Ditch

124.0

1.5

1.5

5.5

3.2

Premix Service Rd

22.0

3.2

124.9

To Top Pg 219

To Top Pg 224

Notes Ck'd by	Survey of Juvenile Hall
Map No.	JN 0022.12 Tape Std °F
Office Work	Surveyed by D. Sappell
Checked	Notes C.E. Schumaker Date 5-57
Date	Indexed C. Johnson

F. B. 2230 Pg. 221

To Bot Pg 222

5' conc. walk

Conc. Pad

conc. valve chamber

Fire Hyd.

To Rt Pg 225

20' Premix Drive

5' conc. curb

catch Basin 2'x2' outside meas.

ch. link back stop

Pre-mix

security wall

127±

5' pre-mix drain

12" RCP @ 1.15%

15" C.M.P.

Premix Drain

pre-mix service Rd.

5' P.U.E.

To Rt Pg 217

security wall

Note: Any Additions or Changes on This Sheet Must be Made or Circled in Red Ink With Date and Name of Person Making Change.

Do not extend this side of this line.

PLEASE RETURN TO
LOS ANGELES COUNTY ENGINEER
700 LOS ANGELES COUNTY ENGINEERING BLDG.

78F3088 SEE #247 1-56

F. B. 2230 Pg. 222

To Bot. Pg 223

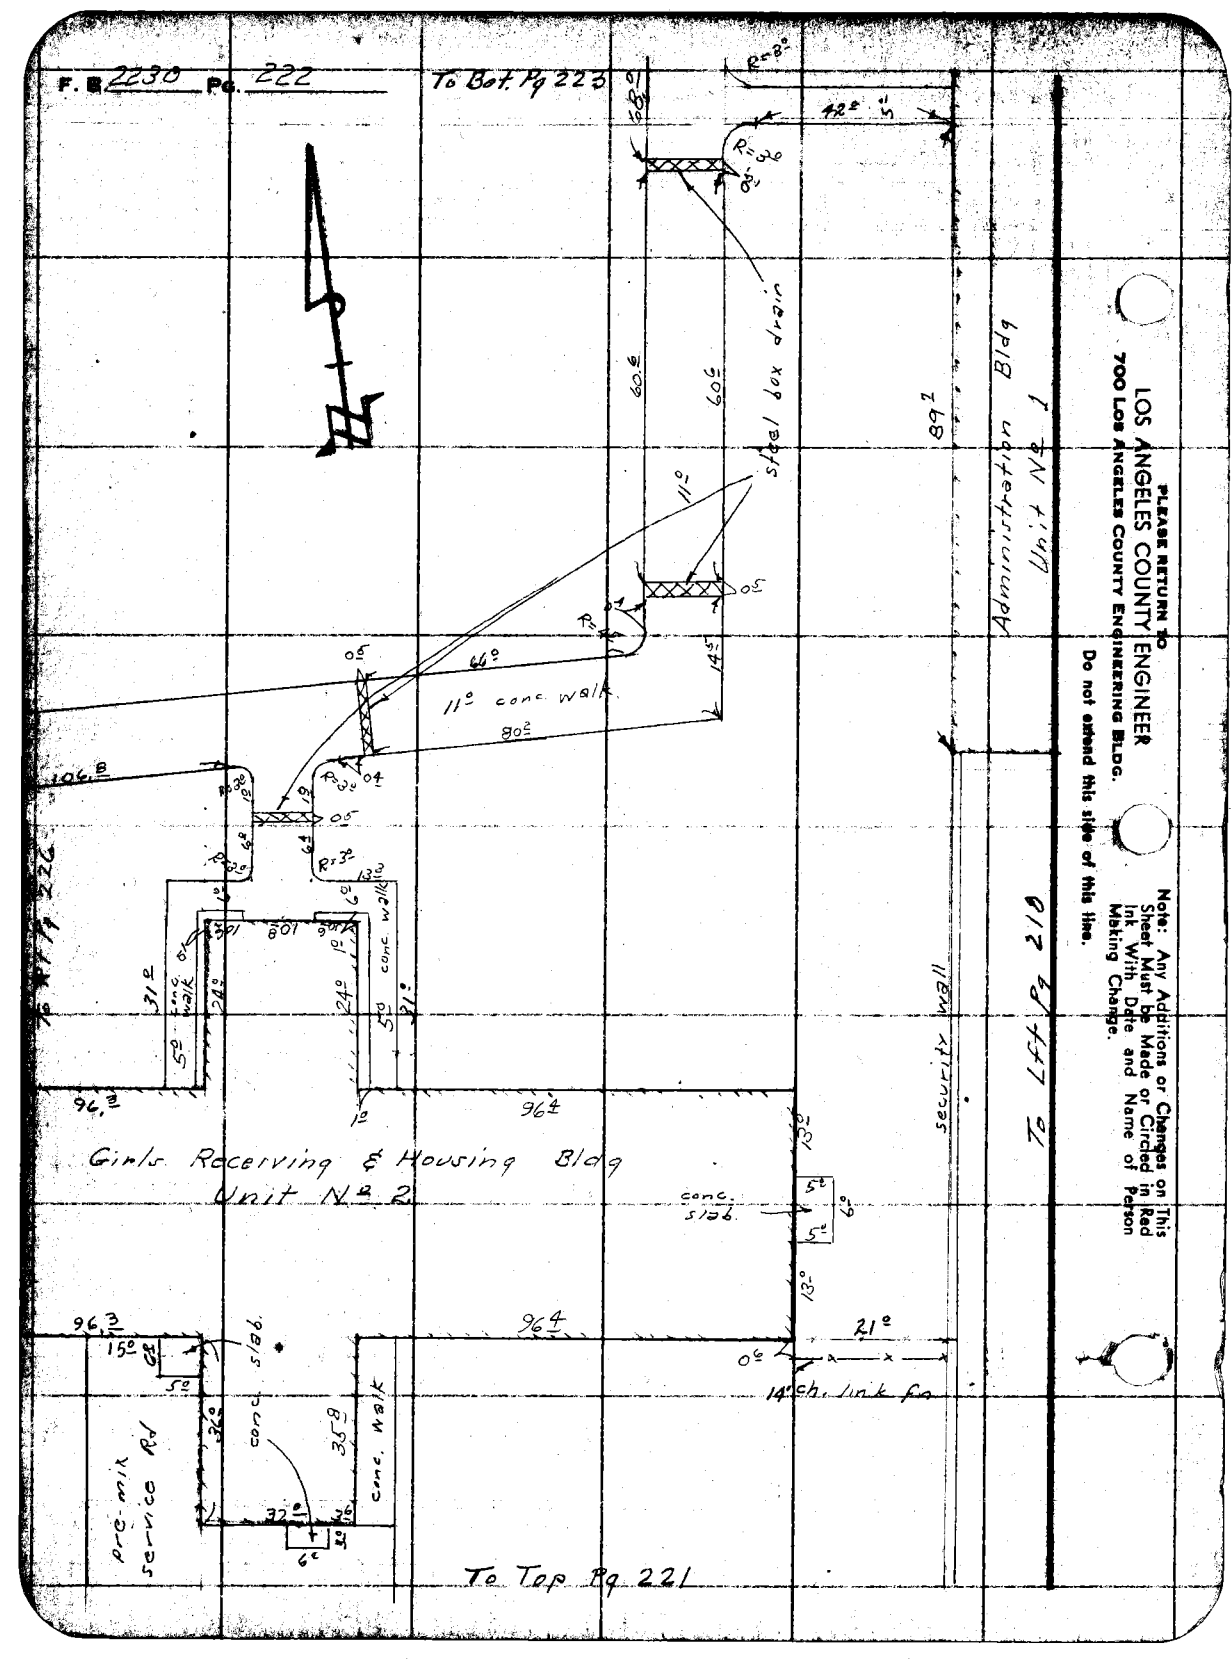

To Top Pg 221

PLEASE RETURN TO
LOS ANGELES COUNTY ENGINEER
700 LOS ANGELES COUNTY ENGINEERING BLDG.

Do not extend this side of this line.

Note: Any Additions or Changes on This Sheet Must be Made or Circled in Red Ink With Date and Name of Person Making Change.

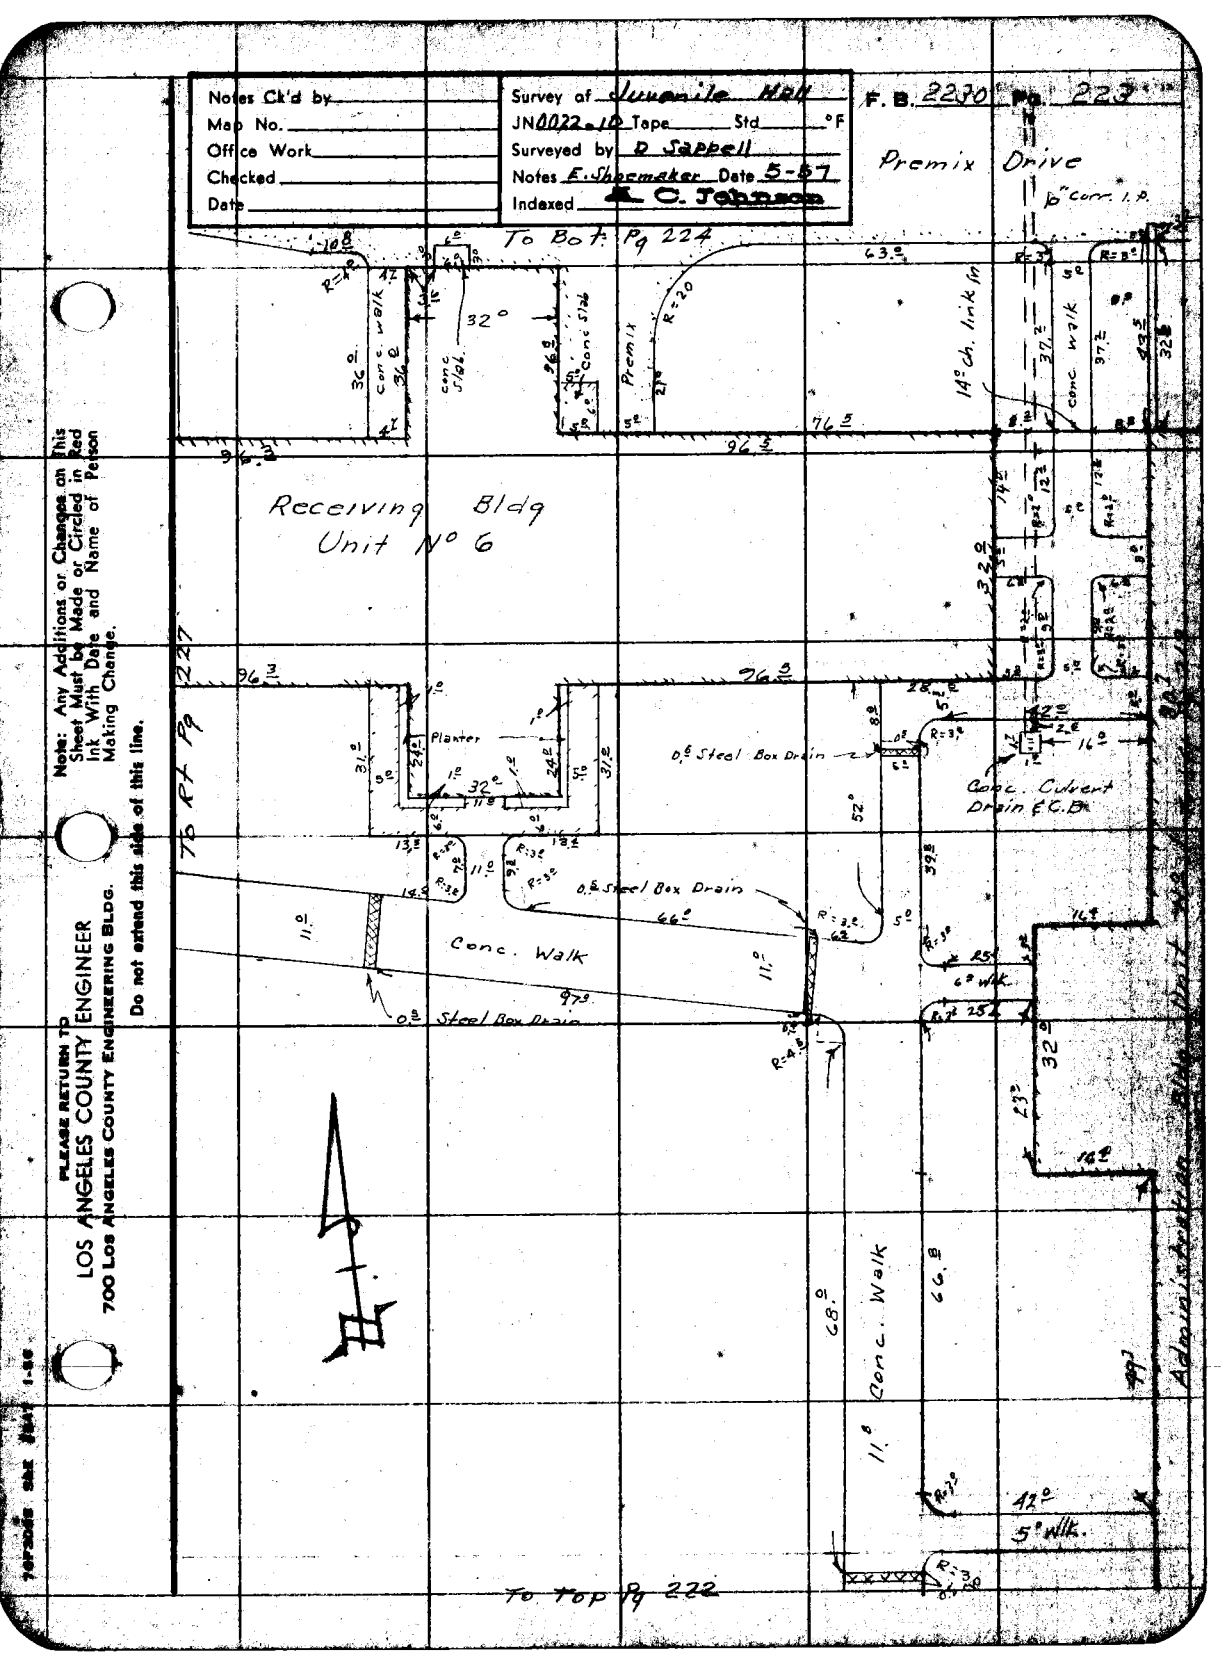
Notes Ck'd by
Map No.
Office Work
Checked
Date
Survey of Juvenile Hall
JN 0022-10 Tape Std °F
Surveyed by D Sappell
Notes E. Shoemaker Date 5-57
Indexed C. Johnson
Premix Drive
To Bot. Pg 224
Receiving Bldg
Unit No 6
To Rt Pg 227
To Top Pg 222
Planter
Conc. Walk
Conc. Culvert Drain E.C.B.
0.8 Steel Box Drain
14" Ch. link fn
Conc. Walk
Admin. Addition
Note: Any Additions or Changes on this Sheet Must be Made or Circled in Red Ink With Date and Name of Person Making Change.
Do not extend this side of this line.
PLEASE RETURN TO
LOS ANGELES COUNTY ENGINEER
700 Los Angeles County Engineering Bldg.

PLEASE RETURN TO
LOS ANGELES COUNTY ENGINEER
700 LOS ANGELES COUNTY ENGINEERING BLDG.

Note: Any Additions or Changes on This Sheet Must be Made or Circled in Red Ink With Date and Name of Person Making Change.

Do not extend this side of this line.

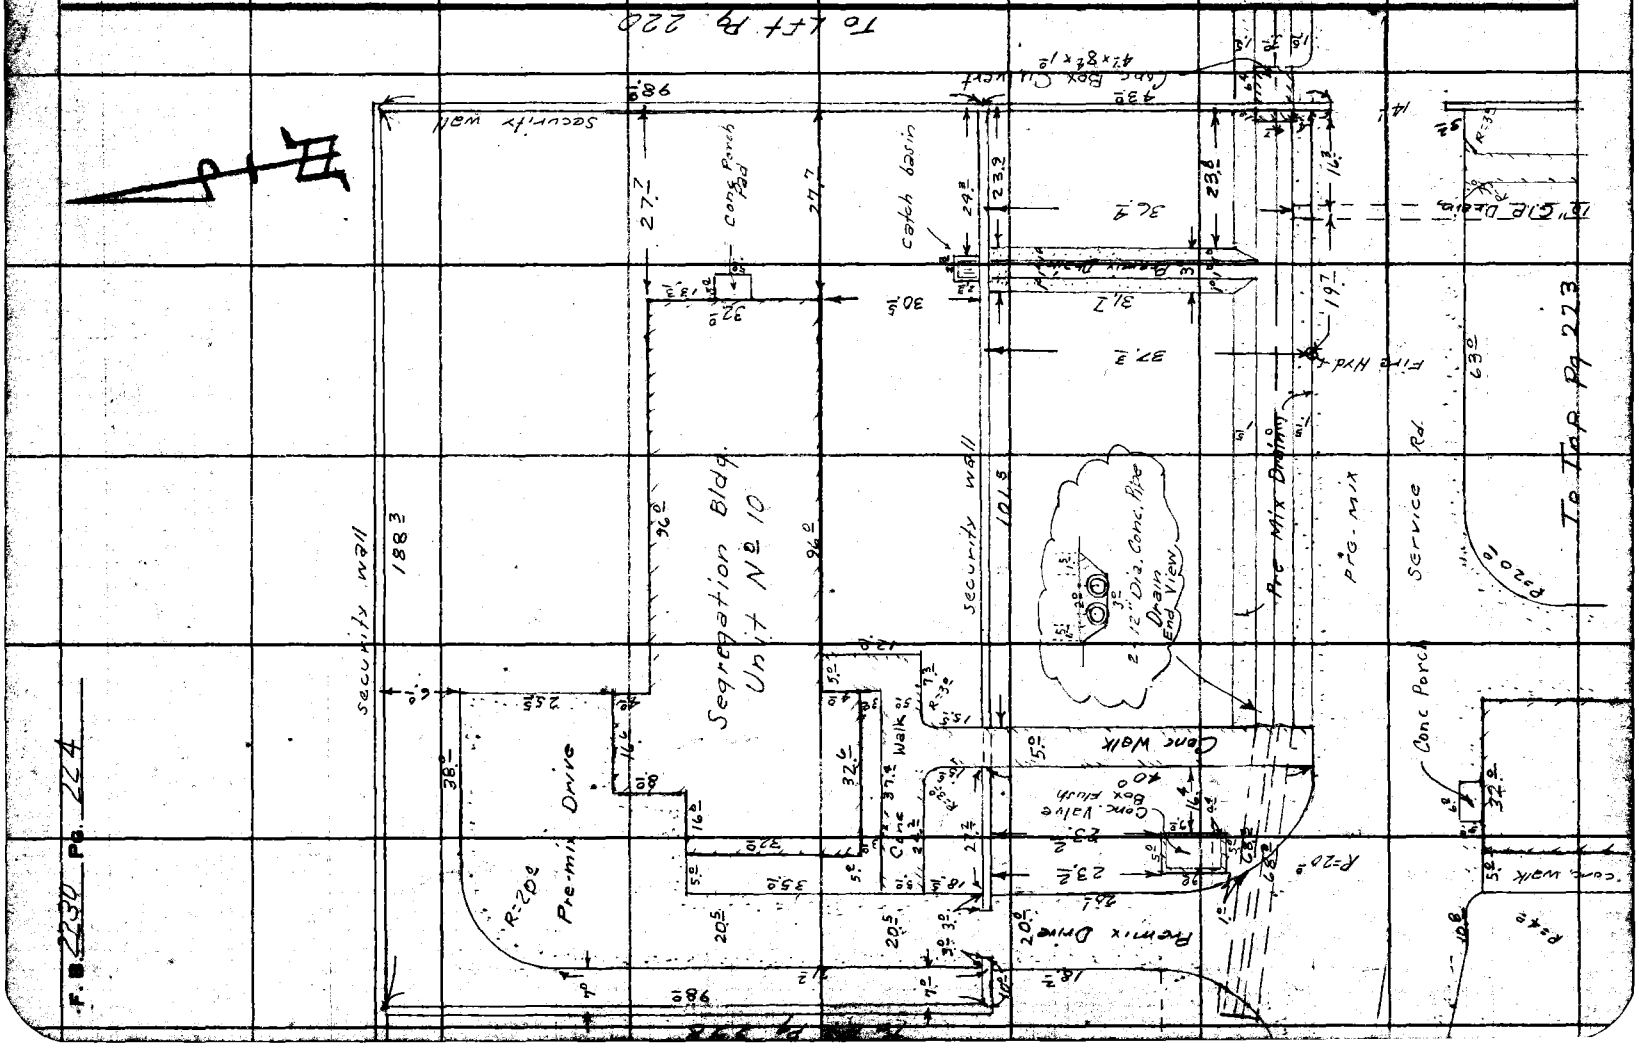

Notes Ck'd by	Survey of Juvenile Hall
Map No.	JN 0°22.10 Tape Std °F
Office Work	Surveyed by D. Sappell
Checked	Notes E. Sheemaker Date 5-57
Date	Indexed C. Johnson

F. B. 2230 PG. 225

To Bot Pg 236

81° chain link fn.

Premix Yard

24.4

29°

Conc. wall

11.2

70°

security wall

Conc. wall

37.5

23.5

Steel grated C.B.

Maintenance Bldg Unit No 12

101.3

To Rt Pg 221

To Rt Pg 229

39.2

37.5

20.5

70°

46°

20°

pre-mix Service Rd

14°

68.5

security wall

12" P.P. 1153975-E

12" P.P. 1153974-E

150°

17.6

pre-mix Drain

Se Plt

pre-mix Service Rd.

24.2

20°

Note: Any Additions or Changes on This Sheet Must be Made or Circled in Red Ink With Date and Name of Person Making Change.

Do not extend this area of this line.

PLEASE RETURN TO
LOS ANGELES COUNTY ENGINEER
700 Los Angeles County Engineering Bldg.

7875068 SAE #247 1-58

PLEASE RETURN TO
LOS ANGELES COUNTY ENGINEER
700 LOS ANGELES COUNTY ENGINEERING BLDG.

Do not extend this side of this line.

Note: Any Additions or Changes on This Sheet Must be Made or Circled in Red Ink With Date and Name of Person Making Change.

F.B. 2230 Pg. 226

To Bk Pg 227

To Lft Pg 222

To Rt Pg 230

To Top Pg 225

106.8

Girls Recreation Center No 2

96.3

96.3

18.2

5.0

20

5°

R=30

38.5

38.5

So Conc. Walk

Steel grid box drain

11.0 Conc Walk

59.2

R=10.0

10.0 Ch. Link

50.2

5° Conc Walk

Notes Ck'd by	Survey of Juvenile Hall
Map No.	JN 00221 Tape Std °F
Office Work	Surveyed by D. Sappell
Checked	Notes E. Shoemaker Date 5-57
Date	Indexed C. Johnson

F. B. 2270 Pg. 227
To Bot Pg 228

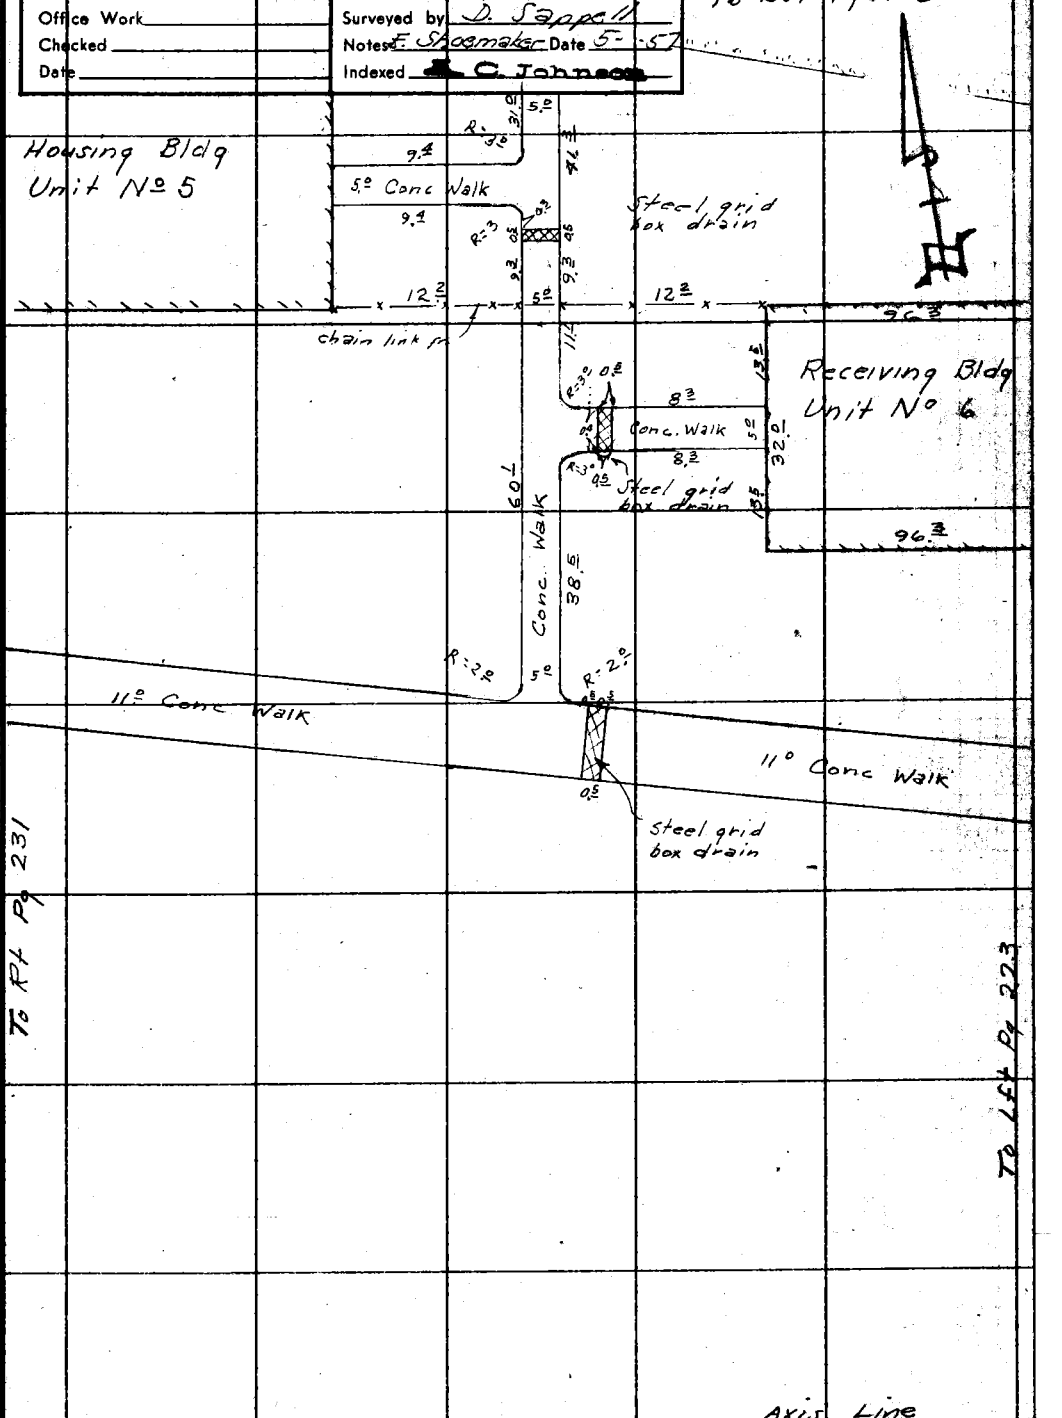

To Rt Pg 231

To Lft Pg 223

To Top Pg 226

Note: Any Additions or Changes on This Sheet Must be Made or Circled in Red Ink With Date and Name of Person Making Change.

Do not extend this side of this line.

PLEASE RETURN TO
LOS ANGELES COUNTY ENGINEER
700 LOS ANGELES COUNTY ENGINEERING BLDG.

76P3056 SAE #847 1-58

PLEASE RETURN TO
LOS ANGELES COUNTY ENGINEER
700 LOS ANGELES COUNTY ENGINEERING BLDG.

Note: Any Additions or Changes on This Sheet Must be Made or Circled in Red Ink With Date and Name of Person Making Change.

Do not extend this side of this line.

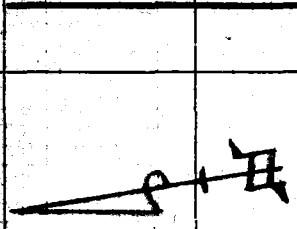

To Rt Pg 224

98'

10'

18½'

R = 240'

12" conc. pipe

End VIEW

6"

Conc

2'-6"

1'-3"

1'-3"

54.8'

78'

Conc C.B.

To Top Pg 227

Conc Walk

41.13'

31.0'

R=24'

Security Wall

F.B. 2230 Pg. 228

Premix

Drainage Ditch

Fire Hyd

Premix

Service Rd.

62'

R=20'

Housing Bldg No 5

To Rt Pg 232

Map No.		JN 0022.10 Tape Std °F	
Office Work		Surveyed by D. Sappell	
Checked		Notes E. Shoemaker Date 5-57	
Date		Indexed C. Johnson	

Note: Any Additions or Changes on This Sheet Must be Made or Circled in Red Ink With Date and Name of Person Making Change.

PLEASE RETURN TO LOS ANGELES COUNTY ENGINEER
700 LOS ANGELES COUNTY ENGINEERING BLDG.
Do not extend this side of this line.

70F3095 SSE #247 1-56

To Bot Pg 230

48.8

Pre-Mix pvmt.

10" ch. link fn.

Conc Resavour

Cooling Tower

Mechanical Bldg. N° 9

Can Washing shed

To Rt. Pg. 233

To Left Pg. 225

(Premix)

Service Yard

10" corr. I.P.

Conc. C.B.

Fire Hyd

Security wall

Pre-mix Drain

Pre-mix Drain

R=25.0

Pre. Mix

Service Rd.

Dirt Road

S.B. P/L.

45.7

20.0

F. B. 2230 Pg. 230

To Bot Pg 231

Chapel Bldg. Unit No. 11

Axis line

Conc. Plan Conc. Steps

conc. chamber

Steel grid box drain

11¢ conc. walk

11¢ conc. walk

To Top Pg 229

To Bot Pg 234

Kitchen & Dining Bldg. Unit No 8

conc. walk

conc. walk

To Top Pg 229

LOS ANGELES COUNTY ENGINEER
700 Los Angeles County Engineering Bldg.

PLEASE RETURN TO

Note: Any Additions or Changes on This Sheet Must be Made or Circled in Red Ink With Date and Name of Person Making Change.

Do not extend this side of this line.

Notes Ck'd by
Map No.
Office Work
Checked
Date

Survey of Juvenile Hall
JN 0022.10 Tape Std °F
Surveyed by D. Sappell
Notes E. Shoemaker Date 5-57
Indexed C. Johnson

F. B. 2230 Pg. 23

To Bot Pg 232

Housing Bldg Unit No 5

To Rt Pg 235

conc. walk

Steel grid conc box gutter

Flag pole

To Lft Pg 227

Conc planter box

Chapel Bldg Unit No 11

To Top Pg 230

Note: Any Additions or Changes on This Sheet Must be Made or Circled in Red Ink With Date and Name of Person Making Change.

Do not extend this side of this line.

PLEASE RETURN TO
LOS ANGELES COUNTY ENGINEER
700 LOS ANGELES COUNTY ENGINEERING BLDG.

76F3098 SAE #247 1-56

PLEASE RETURN TO
LOS ANGELES COUNTY ENGINEER
700 LOS ANGELES COUNTY ENGINEERING BLDG.

Note: Any Additions or Changes on This Sheet Must be Made or Circled in Red Ink With Date and Name of Person Making Change.

Do not extend this side of this line.

To Ft Pg 228

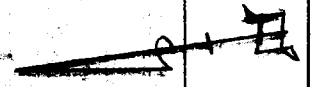

Security Wall

Pre-Mix Drain

E.P.

1:1

R=20'

96.3'

Conc Pad

Housing Bldg Unit No 5

To Top Pg 231

32'

Conc. Walk

To Ft Pg 236

Pre-mix Rd.

Service

97.7

E.P.

To End C.I.P.

F.B. 2230 Pg. 232

Notes Ck'd By		Survey of Juvenile Hall	F. B. 2230 Pg. 238
Map No.		JN 0022.10 Tape Std °F	
Office Work		Surveyed by L. Sappell	
Checked		Notes E. Shoemake Date 5-57	
Date		Indexed C. Johnson	

Note: Any Additions or Changes on This Sheet Must Be Made or Circled in Red Ink With Date and Name of Person Making Change.

Do not extend this side of this line.

PLEASE RETURN TO
LOS ANGELES COUNTY ENGINEER
700 LOS ANGELES COUNTY ENGINEERING BLDG.

76F3095 SAE #247 1-56

To Bat Pg 234

32°

20°

R=30'

5¢

100.3

Pre-Mix Service Rd

117.1

75¢

Mechanical Bldg Unit No. 9

80

R=50'

51¢

20°

R=30°

10.1°

19¢

T.S. Con. Chamber 13.5

2.5 x 2.5 Catch Basin

19°

2°

20°

14°

To Rt. Pg 237

To Lft Pg 239

Yard

2

40

18" corr. S.D.

Pre-Mix Service

Security wall

159.4

29°

Guy Wire

End of Pre-Mix Train

PP #1153977

15°

24¢

Guy Wire

15°

21¢

PP #1153976

Transformer Cage

13¢

27¢

25¢

So. P/L

PLEASE RETURN TO
LOS ANGELES COUNTY ENGINEER
700 LOS ANGELES COUNTY ENGINEERING BLDG.

Note: Any Additions or Changes on This Sheet Must be Made or Circled in Red Ink With Date and Name of Person Making Change.

Do not extend this side of this line.

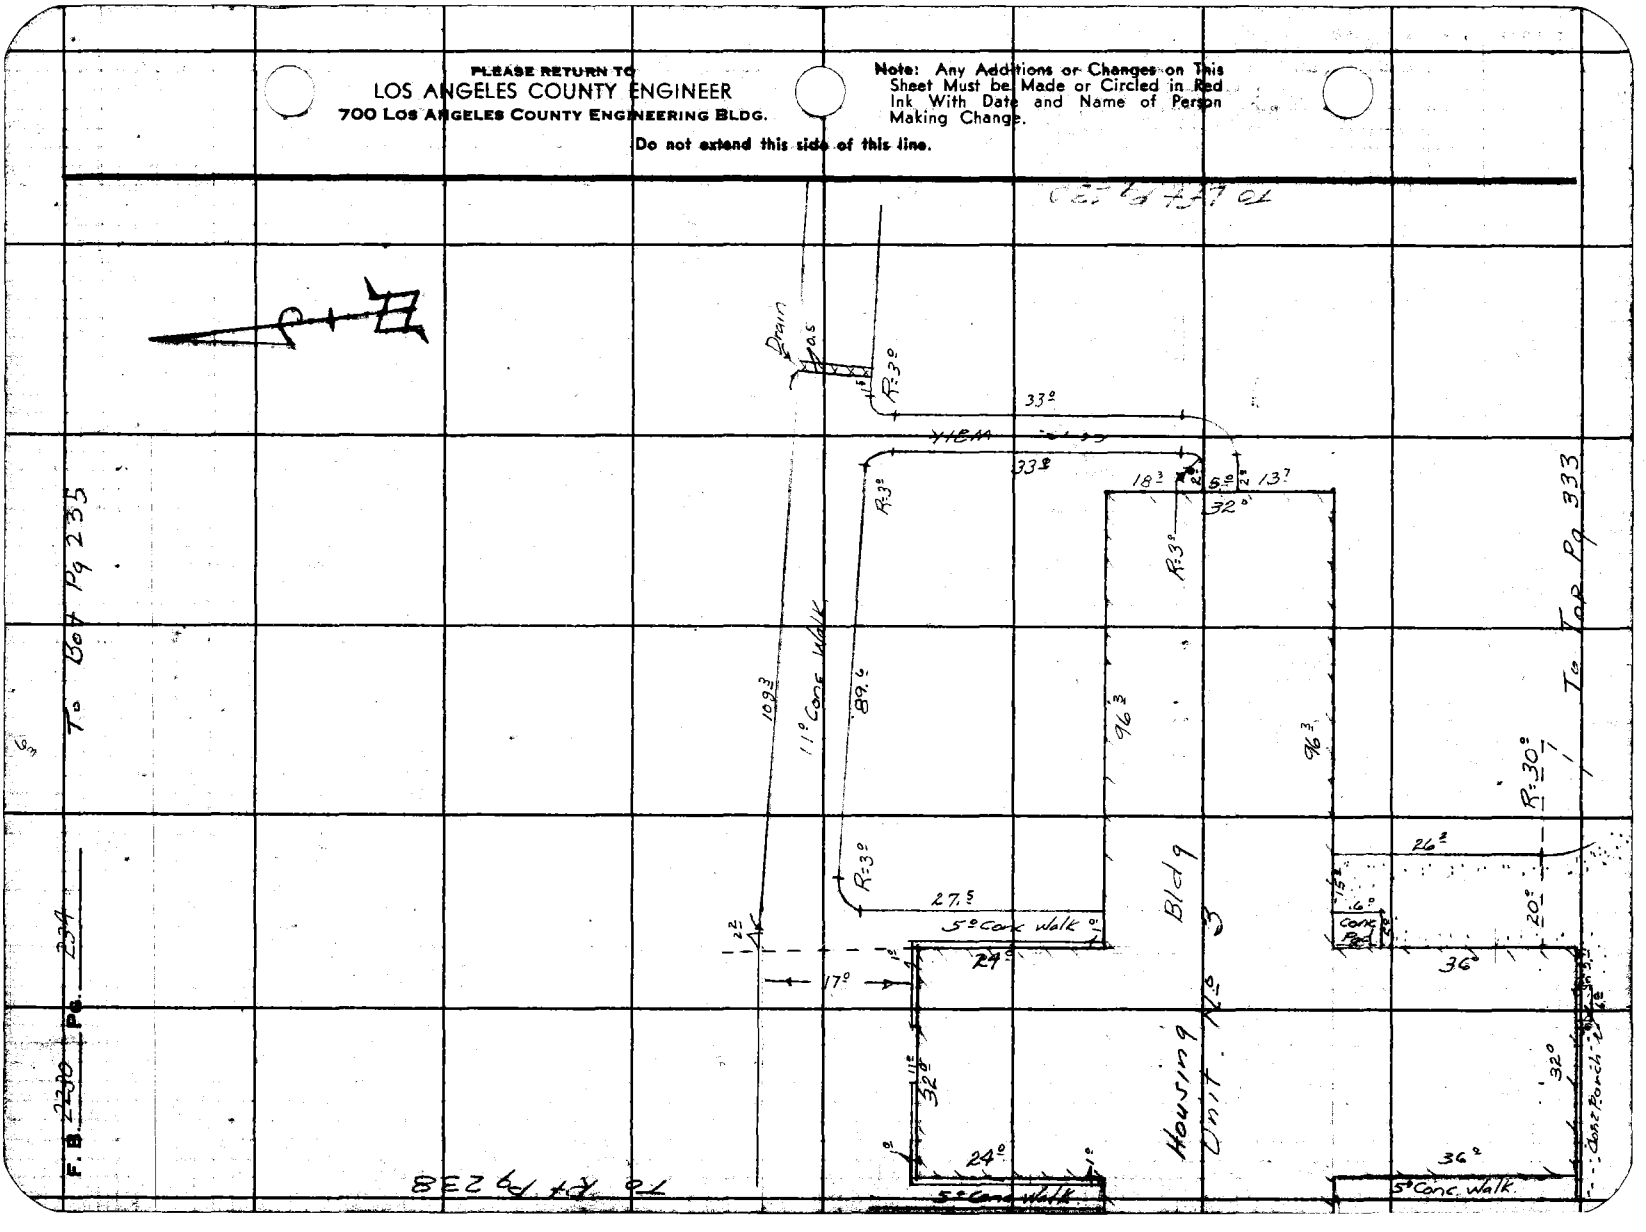

F.B. 2230 Pg. 234

Notes Ck'd by
Map No.
Office Work
Checked
Date

Survey of Juvenile Hall
JN 0022.10 Tape Std °F
Surveyed by D. Sappell
Notes E. Shoemaker Date 5-57
Indexed C. Johnson

F. B. 2230 Pg. 235

To Bot Pg 236

Housing Bldg. Unit Nº 4

0.5 Steel Grid & Conc. Box Gutter

5' Conc. Walk

conc. pad

10' chain link fence

11' Conc. walk

106.4

To Pt Pg 239

To Rt Pg 231

To Top Pg 234

Note: Any Additions or Changes on This Sheet Must be Made or Circled in Red Ink With Date and Name of Person Making Change.

Do not extend this side of this line.

PLEASE RETURN TO
LOS ANGELES COUNTY ENGINEER
700 Los Angeles County Engineering Bldg.

76F3088 SSE #247 1-56

PLEASE RETURN TO
LOS ANGELES COUNTY ENGINEER
700 LOS ANGELES COUNTY ENGINEERING BLDG.

Note: Any Additions or Changes on This Sheet Must be Made or Circled in Red Ink With Date and Name of Person Making Change.

Do not extend this side of this line.

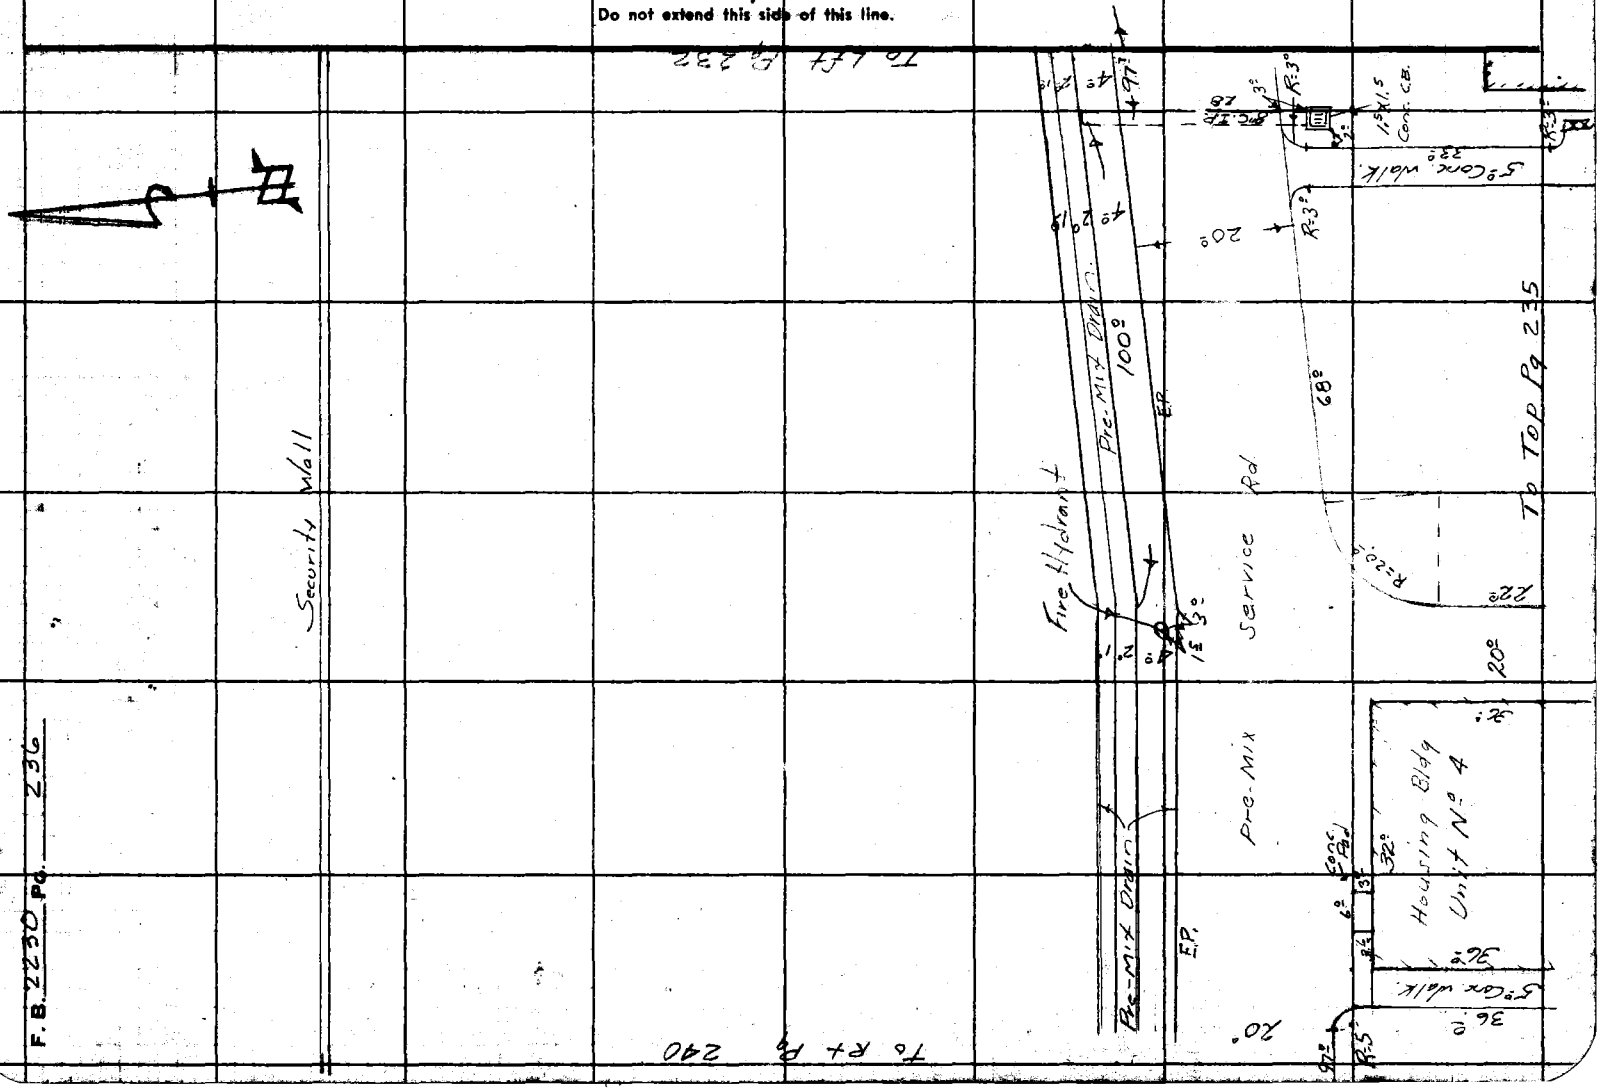

F.B. 2230 Pg. 236

Notes Ck'd by
Map No.
Office Work
Checked
Date

Survey of Juvenile Hall
JN 0022.10 Tape Std °F
Surveyed by D. Sappell
Notes E. Shecnaker Date 5-57
Indexed C. Johnson

F. B. 2230 Pg. 237

To Bot Pg 238

100 3/4

-35°

10.0

Pre-Mix

10.0

Service Rd.

117.1

19.6

50.0

4 Multiple Use Courts

30.0

30.0

150.0

To Pg 241

To Pg 233

2 2 x 2.2 Conc C.B.

To Wall

To CB.

280.0

Security Wall

200.0

6.0

159.6

PP-1153978 E

25-0

So. P/L

Note: Any Additions or Changes on This Sheet Must be Made or Circled in Red Ink With Date and Name of Person Making Change.

Do not extend this side of this line.

PLEASE RETURN TO
LOS ANGELES COUNTY ENGINEER
700 Los Angeles County Engineering Bldg.

76F3098 SBE #247 1-56

PLEASE RETURN TO
LOS ANGELES COUNTY ENGINEER
700 LOS ANGELES COUNTY ENGINEERING BLDG.

Note: Any Additions or Changes on This Sheet Must Be Made or Circled in Red Ink With Date and Name of Person Making Change.

Do not extend this side of this line.

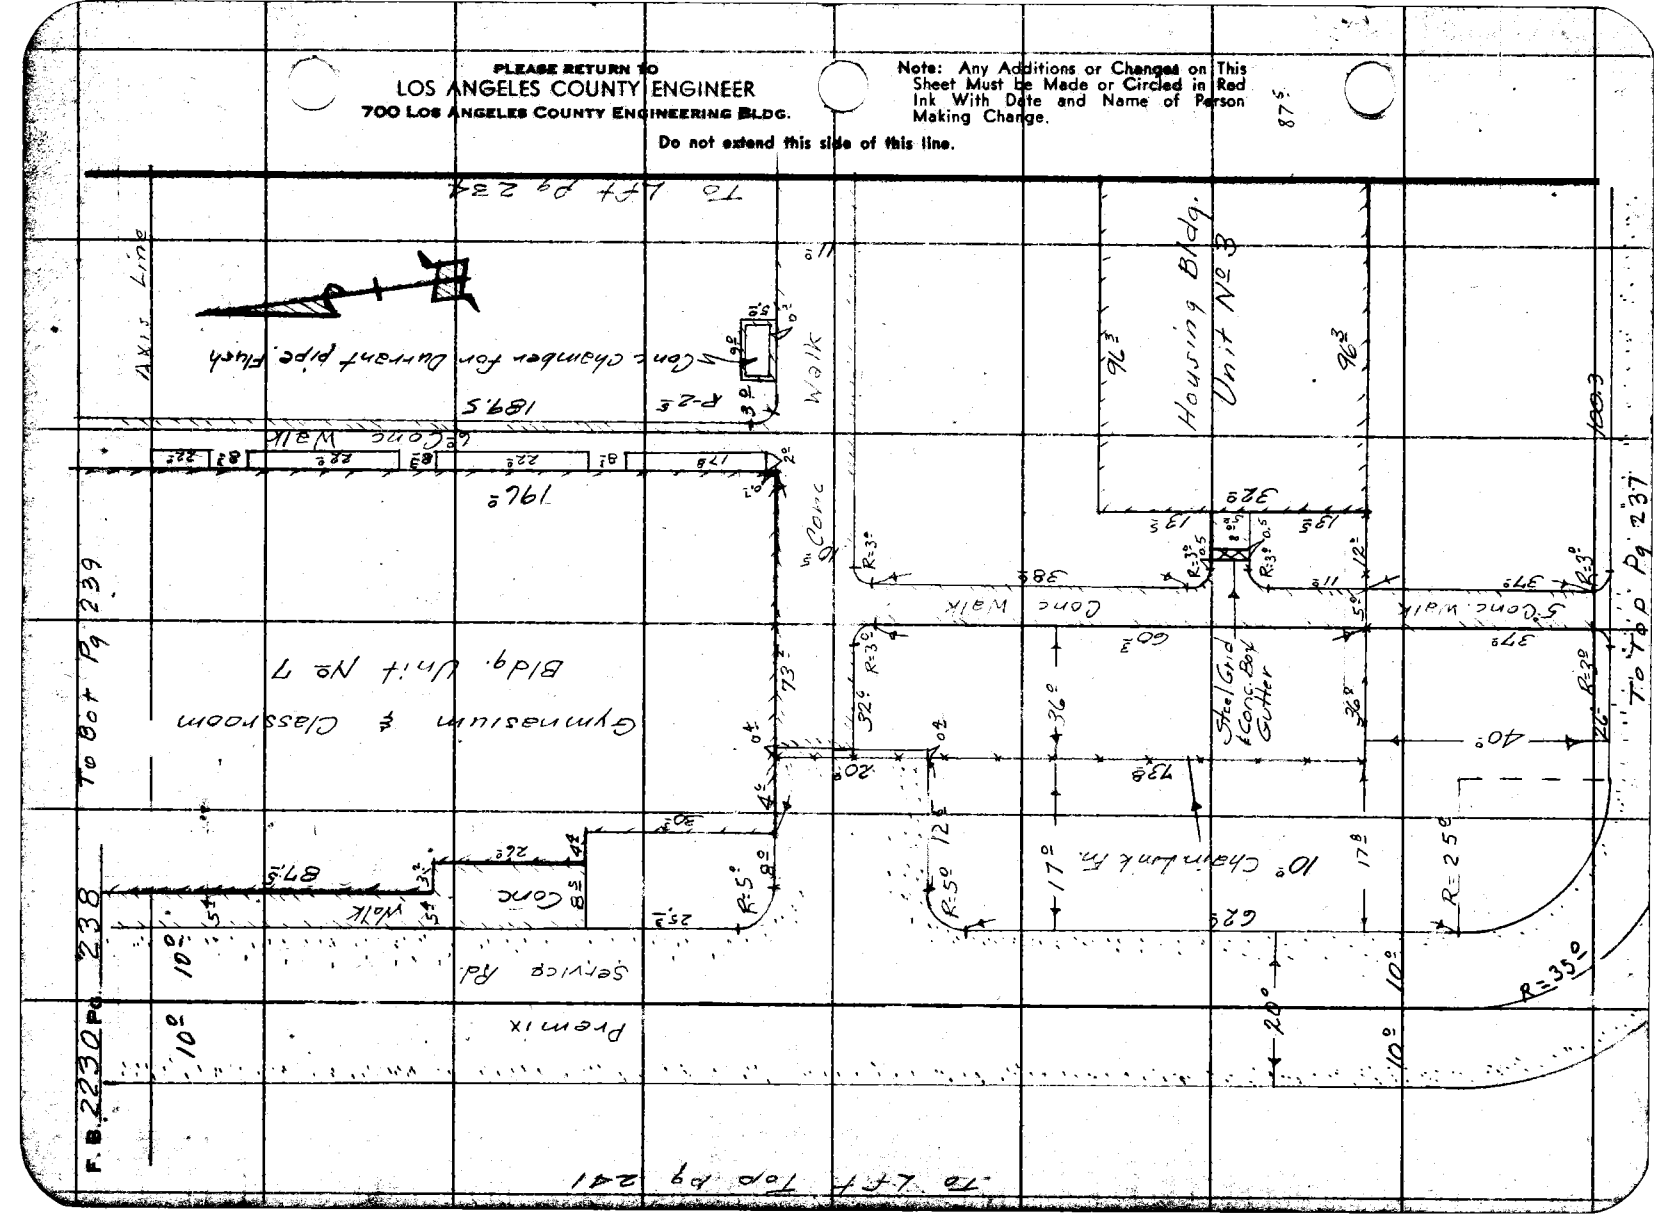

76F3095 S&E #247 1-56

PLEASE RETURN TO
LOS ANGELES COUNTY ENGINEER
700 LOS ANGELES COUNTY ENGINEERING BLDG.

Note: Any Additions or Changes on This Sheet Must be Made or Circled in Red Ink With Date and Name of Person Making Change.

Do not extend this side of this line.

To Rt Bot Pg 242

Pre-mix Service Rd.

20'

20'

Conc Walk

87.5

47.2

52.2

5.4

4.5

R=5.0

R=5.0

62.2

13.2

10' ch link Fn

53.5

Gymnasium & Classroom Bldg. Unit No 7

To Top Pg 238

73.4

10' Conc Walk

33.0

R=5.0

Steel grid conc box drain

36.0

61.0

37.4

5' Conc Walk

38.5

R=3.0

115

37.4

196.0

2.4

22.0

8.3

17.8

8.3

17.8

8.3

17.8

2.4

6' Conc. Walk

189.5

R=3.0

Steel Grid & Conc. Box Gutter

10'

Axis Line

35.5

13.7

32.0

Housing Bldg. Unit No 4

76.2

9.C.

To Bot Pg 240

To Lft Pg 235

Notes Ck'd by
Map No.
Office Work
Checked
Date

Survey of Juvenile Hall
JN 0822.10 Tape Std. °F
Surveyed by D. Sappell
Notes E. Shumaker Date 5-57
Indexed K.C. Johnson

F. B. 2230 Pg. 239

PLEASE RETURN TO
LOS ANGELES COUNTY ENGINEER
700 LOS ANGELES COUNTY ENGINEERING BLDG.

Note: Any Additions or Changes on This Sheet Must Be Made or Circled in Red Ink With Date and Name of Person Making Change.

Do not extend this side of this line.

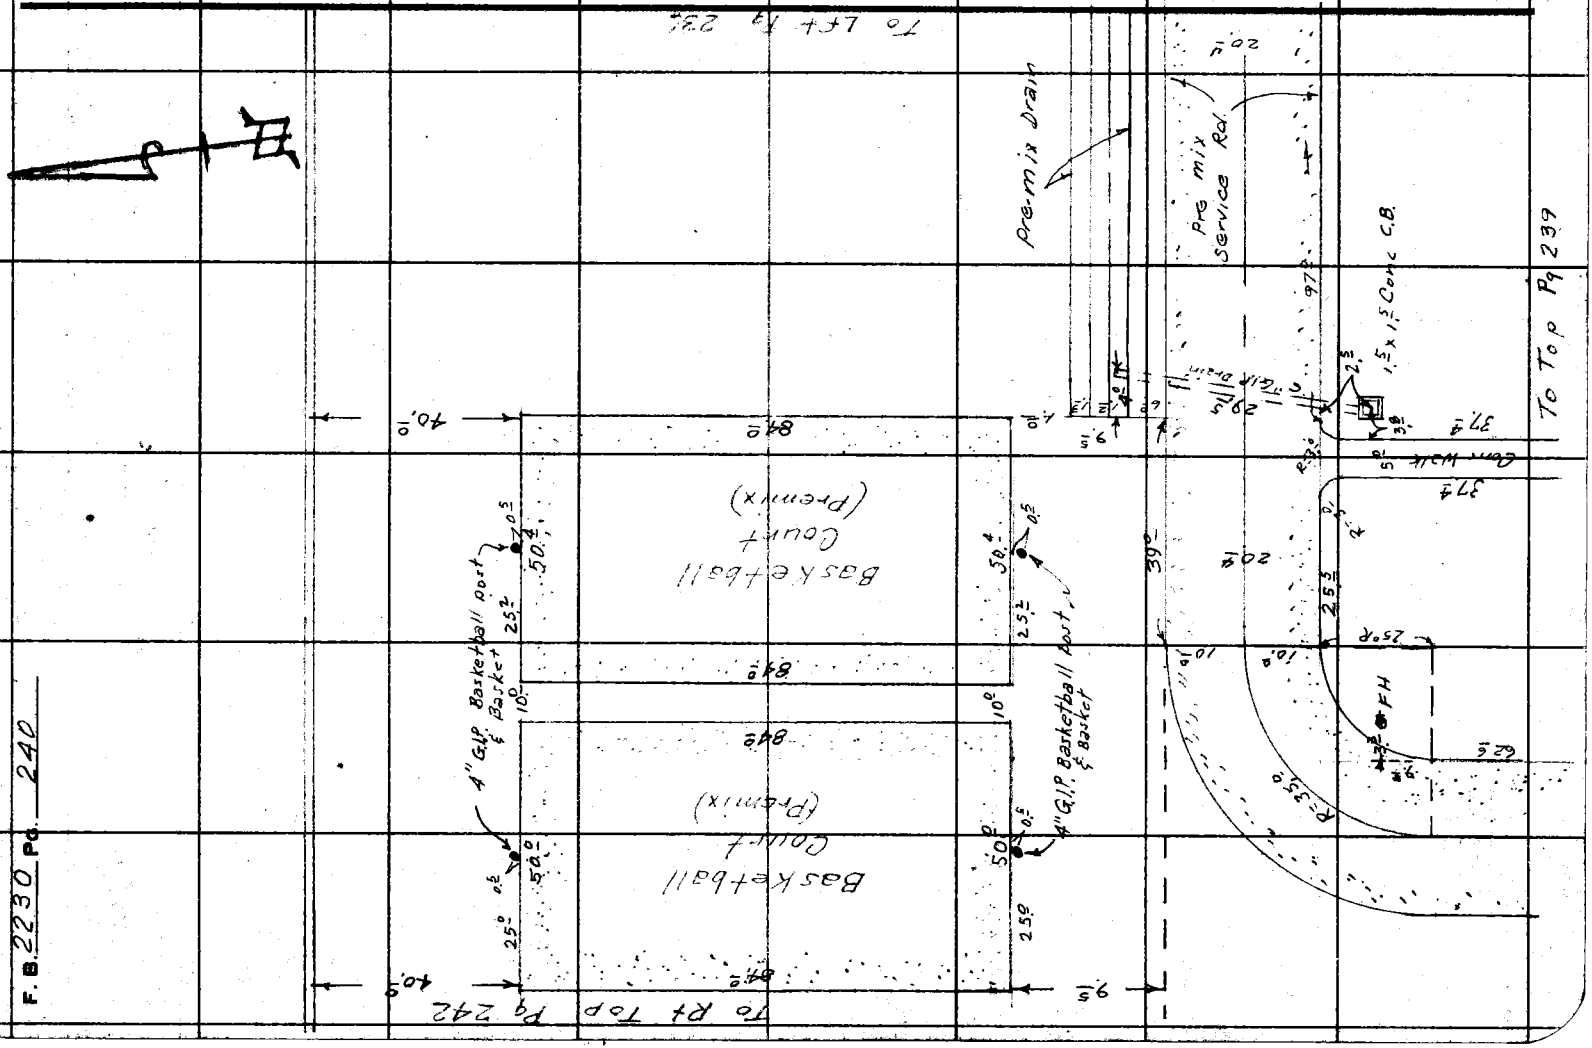

Notes Ck'd by	Survey of Juvenile Hall
Map No.	JN 002212 Tape Std °F
Office Work	Surveyed by D. Sapnell
Checked	Notes D.S. Date 5-57
Date	Indexed C. Johnson

F. B. 2230 Pg. 241

To Bat Pg 242

To Lft Pg 238

3"G.I.P. Foot ball Goal Posts

Chain Link Baseball Backstop

Multi Use Courts

security wall

Chain Link Baseball Backstop

2"x2" Conc CB

PP 1153980 E

PP 1153979 E

SB. P/L

From Lft 237

Note: Any Additions or Changes on This Sheet Must be Made or Circled in Red Ink With Date and Name of Person Making Change.

Do not extend this side of this line.

PLEASE RETURN TO
LOS ANGELES COUNTY ENGINEER
700 Los Angeles County Engineering Bldg.

76F3095 SEE #247 1-56

F. B. 2230 Pg. 242

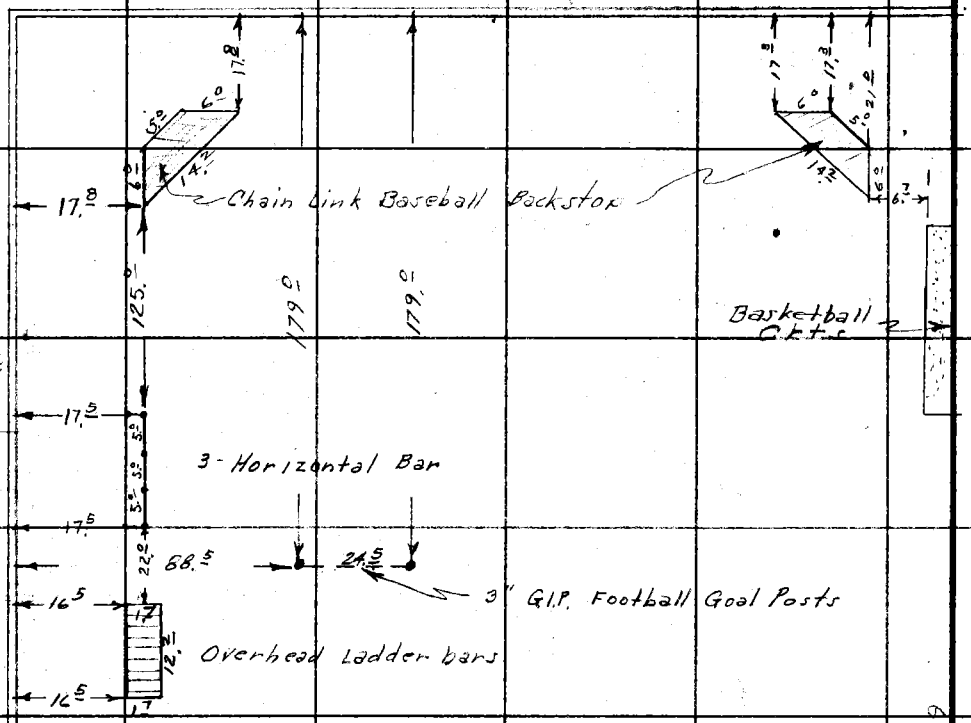

Axis Line

To top Pg 241

To Pg 239

PLEASE RETURN TO
LOS ANGELES COUNTY ENGINEER
700 Los Angeles County Engineering Bldg.

Do not extend this side of this line.

Note: Any Additions or Changes on This Sheet Must be Made or Circled in Red Ink With Date and Name of Person Making Change.

Notes Ck'd by	Survey of Juvenile Hall
Map No.	JN Tape Std °F
Office Work	Surveyed by Menne
Checked	Notes [illegible] Date 4-28-58
Date	Indexed 4-30-58

F. B. 2230 Pg. 243

LOCATION OF 2 manholes
For Mr. Zadra (Dunkirk 71328)
Plane Table Sheet E-508

Line No. 4
Manhole
See Plane Table Sheet E-508
327
20.85
90°
64.83
N 77° 16' 6" E 550.40
S 28° 29' 35" E 315.00
Rim El - 337.38
Flow Line E 326.74
92.50
EAST LAKE AVE
S 31° 29' 35" E
92.50 offset line
S 31° 29' 35" E
90°
173.54
26.50 offset line
26.50
26.50
BIGGY ST.

Note: Any Additions or Changes on this Sheet Must be Made or Circled in Red Ink With Date and Name of Person Making Change.

PLEASE RETURN TO
LOS ANGELES COUNTY ENGINEER
700 Los Angeles County Engineering Bldg.

Do not extend this side of this line.

76F3098 SSE. #247 1-56

PLEASE RETURN TO
LOS ANGELES COUNTY ENGINEER
700 LOS ANGELES COUNTY ENGINEERING BLDG.

Note: Any Additions or Changes on This Sheet Must be Made or Circled in Red Ink With Date and Name of Person Making Change.

Do not extend this side of this line.

Existing Manhole on 10" Sewer Trunck Line
Begin of 8" Sewer Line No. 4 - F.B. 1688-24
Rim El. = 333.43
Flow Line 10" Line = 308.03

℄ - 0+00
100.00
N 7511.00
E. 5364.26

Flow Line of 8" opening on S. Easterly Side of manhole = 323.18

Chief Maint. man states he remembers Sewer Line being put in - New 8" Line came within 4 to 6' of existing 10" Line @ manhole & dropped to Flow Line of 10" Line

See Plane Table Sheet No. E-508

334.20
N 61-32-44 E

Exist. S.S.m.H.
8" V.C.P.
F.B. 844-266
Flow
El. - 323.18
8" opening
El. - 308.03
L & T.
N 6945.93
E 5290.41
S 28-27-16 E
391.62
230.00

L & T.
N 7290.23
E. 5103.79
30.00
295.04
F.B. 844-266

F.B. 2230 Pg. 244

78F3095 S&E #247 1-56

PLEASE RETURN TO
LOS ANGELES COUNTY ENGINEER
700 LOS ANGELES COUNTY ENGINEERING BLDG.

Note: Any Additions or Changes on This Sheet Must be Made or Circled in Red Ink With Date and Name of Person Making Change.

Do not extend this side of this line.

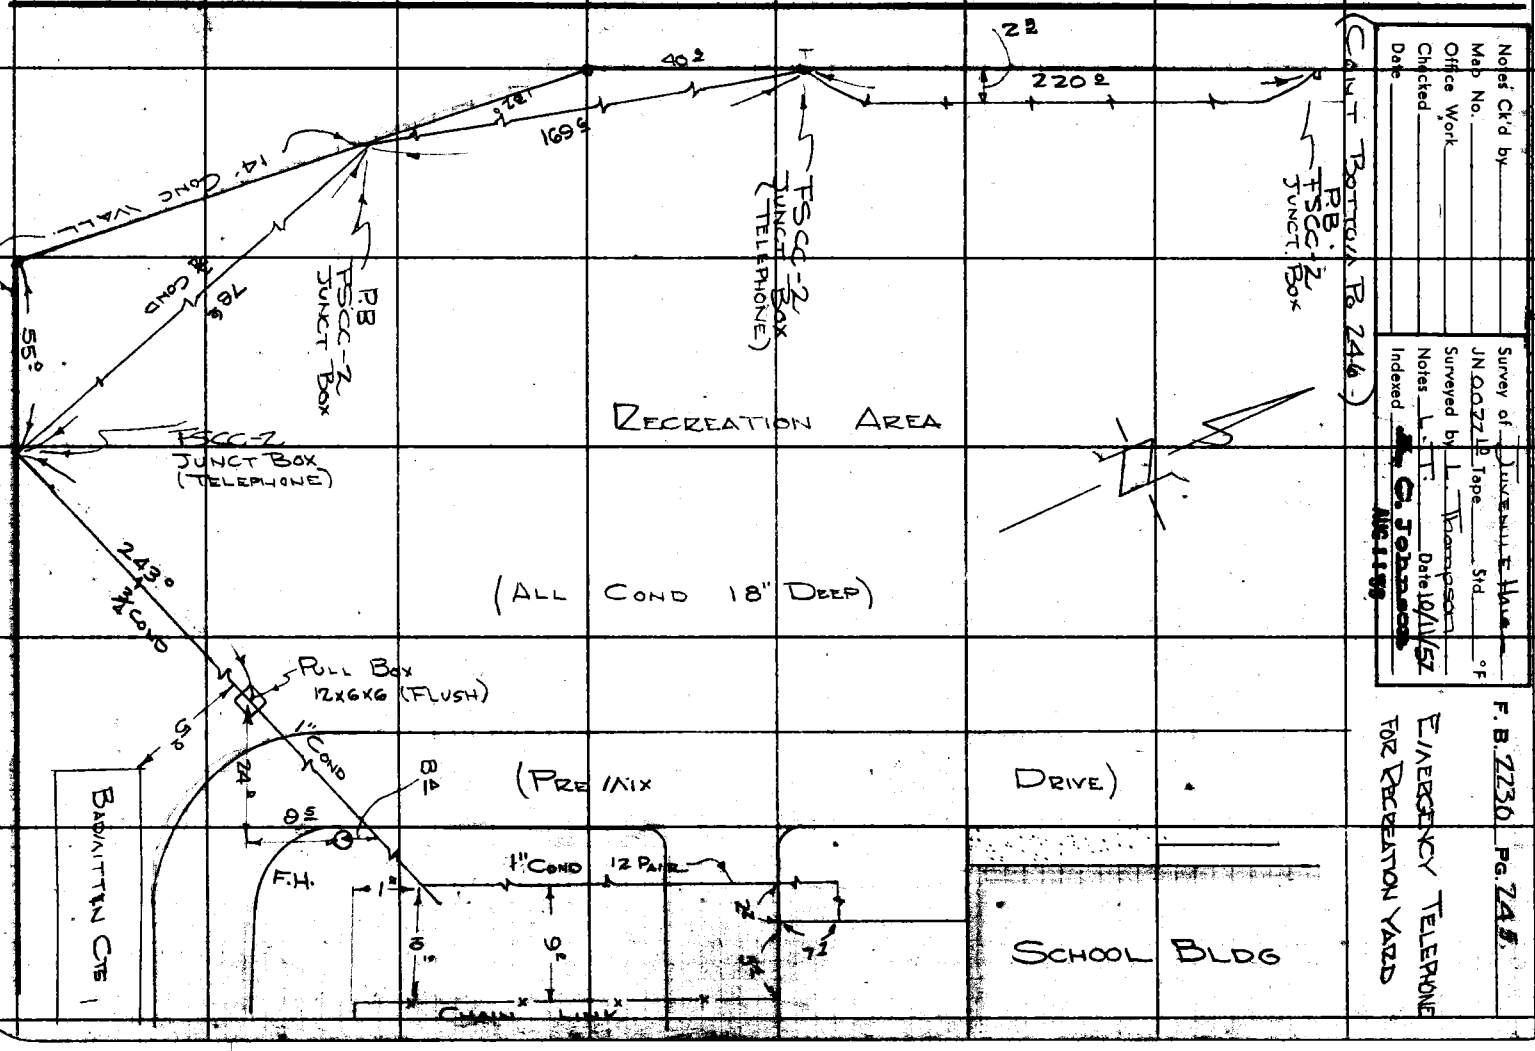

Notes Ck'd by
Map No.
Office Work
Checked
Date

Survey of Juvenile Hall
JN 00772 Tape Std. °F
Surveyed by L. T. Thompson
Notes L. T. Date 10/11/52
Indexed A. C. Jobson
ANG 1199

F. B. 2230 PG. 245

EMERGENCY TELEPHONE FOR RECREATION YARD

PLEASE RETURN TO
LOS ANGELES COUNTY ENGINEER
700 LOS ANGELES COUNTY ENGINEERING BLDG.

Note: Any Additions or Changes on This Sheet Must be Made or Circled in Red Ink With Date and Name of Person Making Change.

Do not extend this side of this line.

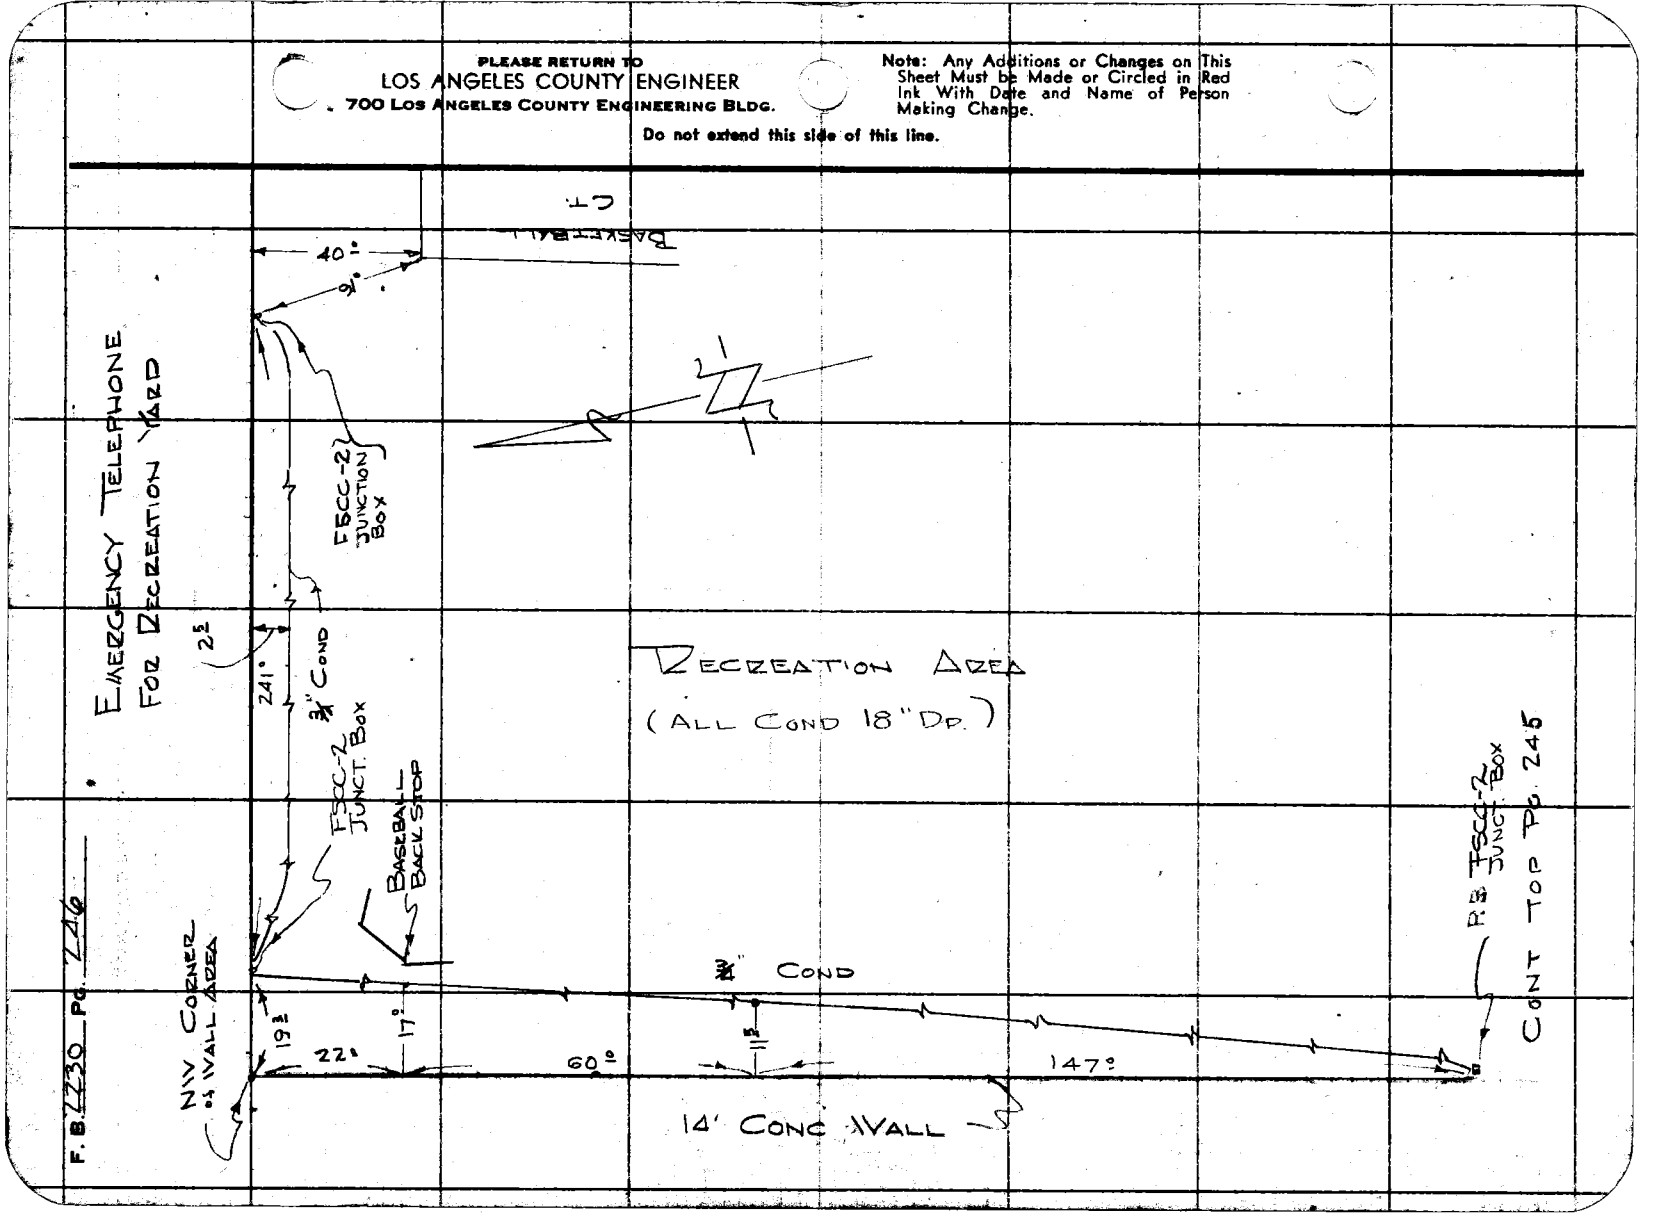

F. B. 2230 Pg. 246

76L298 307 10-51

PLEASE RETURN TO
LOS ANGELES COUNTY SURVEYOR
726 LOS ANGELES COUNTY
ENGINEERING BLDG.

NOTE: ANY ADDITIONS OR CHANGES ON THIS SHEET MUST BE MADE OR CIRCLED IN RED INK, WITH DATE AND NAME OF PERSON MAKING CHANGE.

Do not extend notes this side of this line.

Profile No. Red____ Plotted____ Job No.____ Division No.____ F.B. 2230 Pg. 247
No.____ Date____ Date____ Survey of Juvenile Hall
X-Sec. Notes Chkd____ Checked____ Survey by Munns Notes Anderson Date 4-29-58
No.____ Date____ Date____ Map No.____ Index C. Johnson

SEWER LINE No. 4 - 8" V.C.P.

T.B.M. #10 — 339.64 — T.B.M. #10 El. 339.64 Pg. 13
T.P. — 339.81

GRADE STAKE SHEET
COPIED FROM FB. 1688-41-42

STATION	B. S.	H. I.	F. S.	ELEV.	GR.	CUT	
0+00	& EXIST. TRUNK M.H.						
+02	NOT SET				323.42		
+04				333 19	23.44	9.75	
+25				33 29	23.65	9.64	5' Rt.
+50				33 68	23.90	9.78	
+75				33 78	24.15	9.63	
1+00				33 66	24.40	9.26	"X" ON pav.
~~+05~~	NOT SET				24.45		
+10				32 27	24.50	7.77	9%
+25				32 40	24.65	7.75	1.00 - 11.1 STA.
+50		NOT set			24.90		
+75				31 38	25.15	9.23	
2+00				35 00	25.40	9.60	
+25				35 55	25.65	9.90	
+50				36 10	25.90	10.20	
+75				35 88	26.15	9.73	

76L298 307 10-51

PLEASE RETURN TO
LOS ANGELES COUNTY SURVEYOR
726 LOS ANGELES COUNTY
ENGINEERING BLDG.

NOTE: ANY ADDITIONS OR CHANGES ON THIS SHEET MUST BE MADE OR CIRCLED IN RED INK, WITH DATE AND NAME OF PERSON MAKING CHANGE.

Do not extend notes this side of this line.

Profile No. X-Sec. No.
Plotted Date Checked Date
Notes Red Date Notes Chkd Date
Division No.
Job No.
Survey of
Survey by C. Jennings Notes Date
Indexed

F.B. 2230 Pg. 248

LINE No. 4 (cont.)

STATION	B. S.	H. I.	F. S.	ELEV.		G.R.	CUT	
3+00				335.95	1.00%	326.40	9.55	Sta. - 12 5' Rt.
3+25.0				337.44		326.65	10.79	
3+27.0	℄ M.H.			337.39		336.60	0.79	Top of M.H.

Notes Ck'd by Miller	Survey of Camp Honda Ranch Los Amigos	F. B. 2230	Pg. 249
Map No. B-1035	JN 00 22 10 Tape 0135 Std. 68 °F		
Office Work T.H. Burns	Surveyed by H.E. Granquist		
Checked Miller	Notes H.E.G. Date 3/16/60 C. Johnson		
Date April 1960	Indexed 7-21-60		

J.N. 00 22.10

RANCHO LOS AMIGOS - DOWNEY

CAMP HONDO

PROPOSED REASSIGNMENT OF LAND.

INDEX Pg. 250

Pg. 249 to Pg. 254

Note: Any Additions or Changes on this Sheet Must be Made or Circled in Red Ink With Date and Name of Person Making Change.

Do not extend this side of this line.

PLEASE RETURN TO
LOS ANGELES COUNTY ENGINEER
700 Los Angeles County Engineering Bldg.

H.E. GRANQUIST Chief
J. MALDONADO Instr.
E. MARTINEZ Head Chain
G.E. Cook Rear Chain

70F3098 SAE 1247 14-58

F. B. 2230 PG. 250

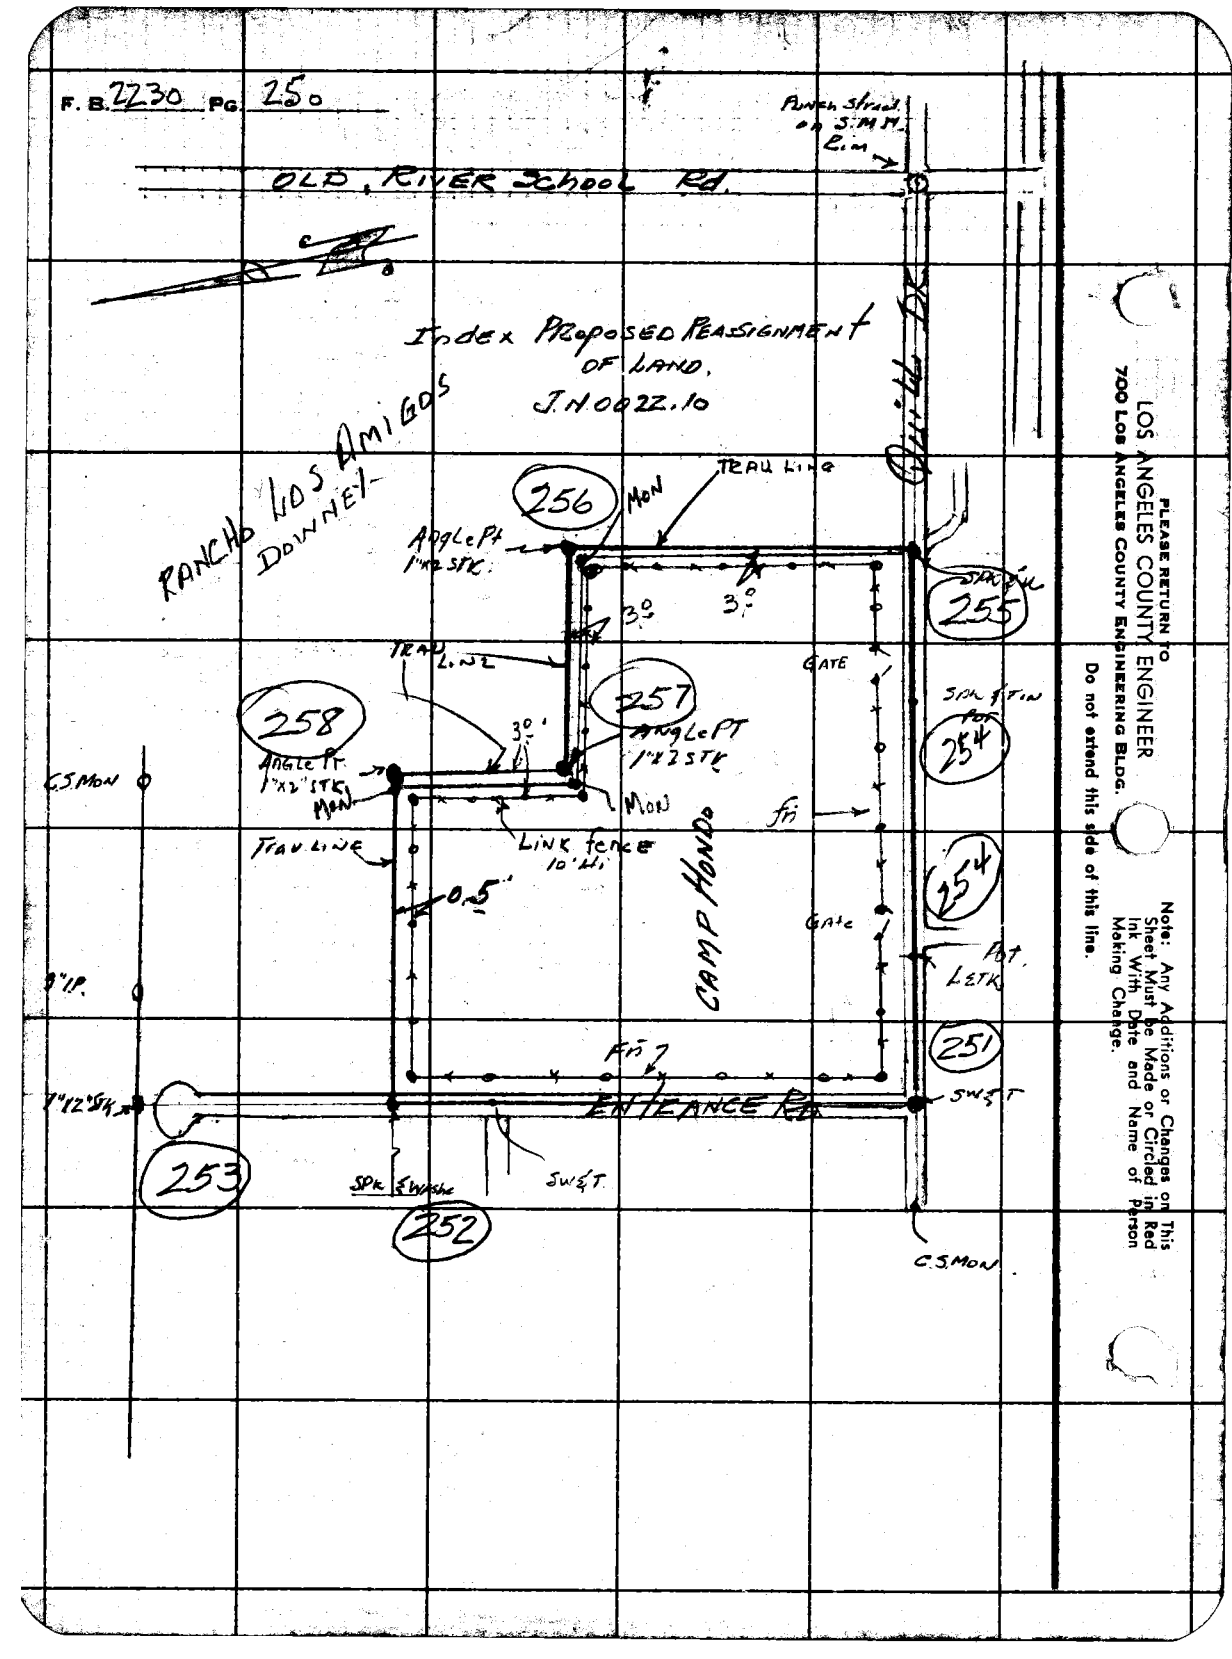

PLEASE RETURN TO
LOS ANGELES COUNTY ENGINEER
700 LOS ANGELES COUNTY ENGINEERING BLDG.

Do not extend this side of this line.

Note: Any Additions or Changes on This Sheet Must be Made or Circled in Red Ink With Date and Name of Person Making Change.

Notes Ck'd by H. E. AUSTIN
Map No. B-1035
Office Work F.M. BURNS
Checked Miller
Date April 60

Survey of Rancho Las Amigos Camp Hondo
JN 0022.10 Tape 0135 Std 68 °F
Surveyed by H.E. GRANQUIST
Notes H.E.G. Date 3/16/60
Indexed C. Johnson

F.B. 2230 Pg. 251

89-51-30
359-26-10
89-51-32
179-09-50
89-51-38

WS, 32 C-2

2" Link fence 10' High

Camp Hondo

3½" Pipe Fm. Cor. 10 Ft. High

Meas to outside edge of Pipe

Meas to outside Edge

Cont'd pg. 254 bot

To L&TK Post

Fd Nothing Set SPK W/ Tin Tag by Ties Per RB 2230 pg. 9 Of 00 Going Ally Easterly

59.54 70°

0.97

Pot Set Spk & Tin Fl.

Set L&TK

89° 51'-40"

M=

35.46

31.00

30.00

Fd L&Tk.

31.40

70°

1.76 Pot Set Spk & Tin Fl.

50.00

18° 30'

Fd L&Tk.

0.82'

Fd L&Tk Prod.

1828

926.31

To Spk & W Pg. 252

ENTRANCE RD.

29.14

Fd L&Tk.

63.5

TANG 35.

Set L.A. Co. Engr. Tag

Quail Dr

55.73

Fd. 2" DR Cap Mon. 6" D.P. Stmpd As Shown Per F.B. 2230 pg. 7

SURVEYOR COUNTY R.E. 6

Note: Any Additions or Changes on this Sheet Must be Made or Circled in Red Ink With Date and Name of Person Making Change.

Do not extend this side of this line.

PLEASE RETURN TO
LOS ANGELES COUNTY ENGINEER
700 LOS ANGELES COUNTY ENGINEERING BLDG.

76F3095 SEE 1247 F-58

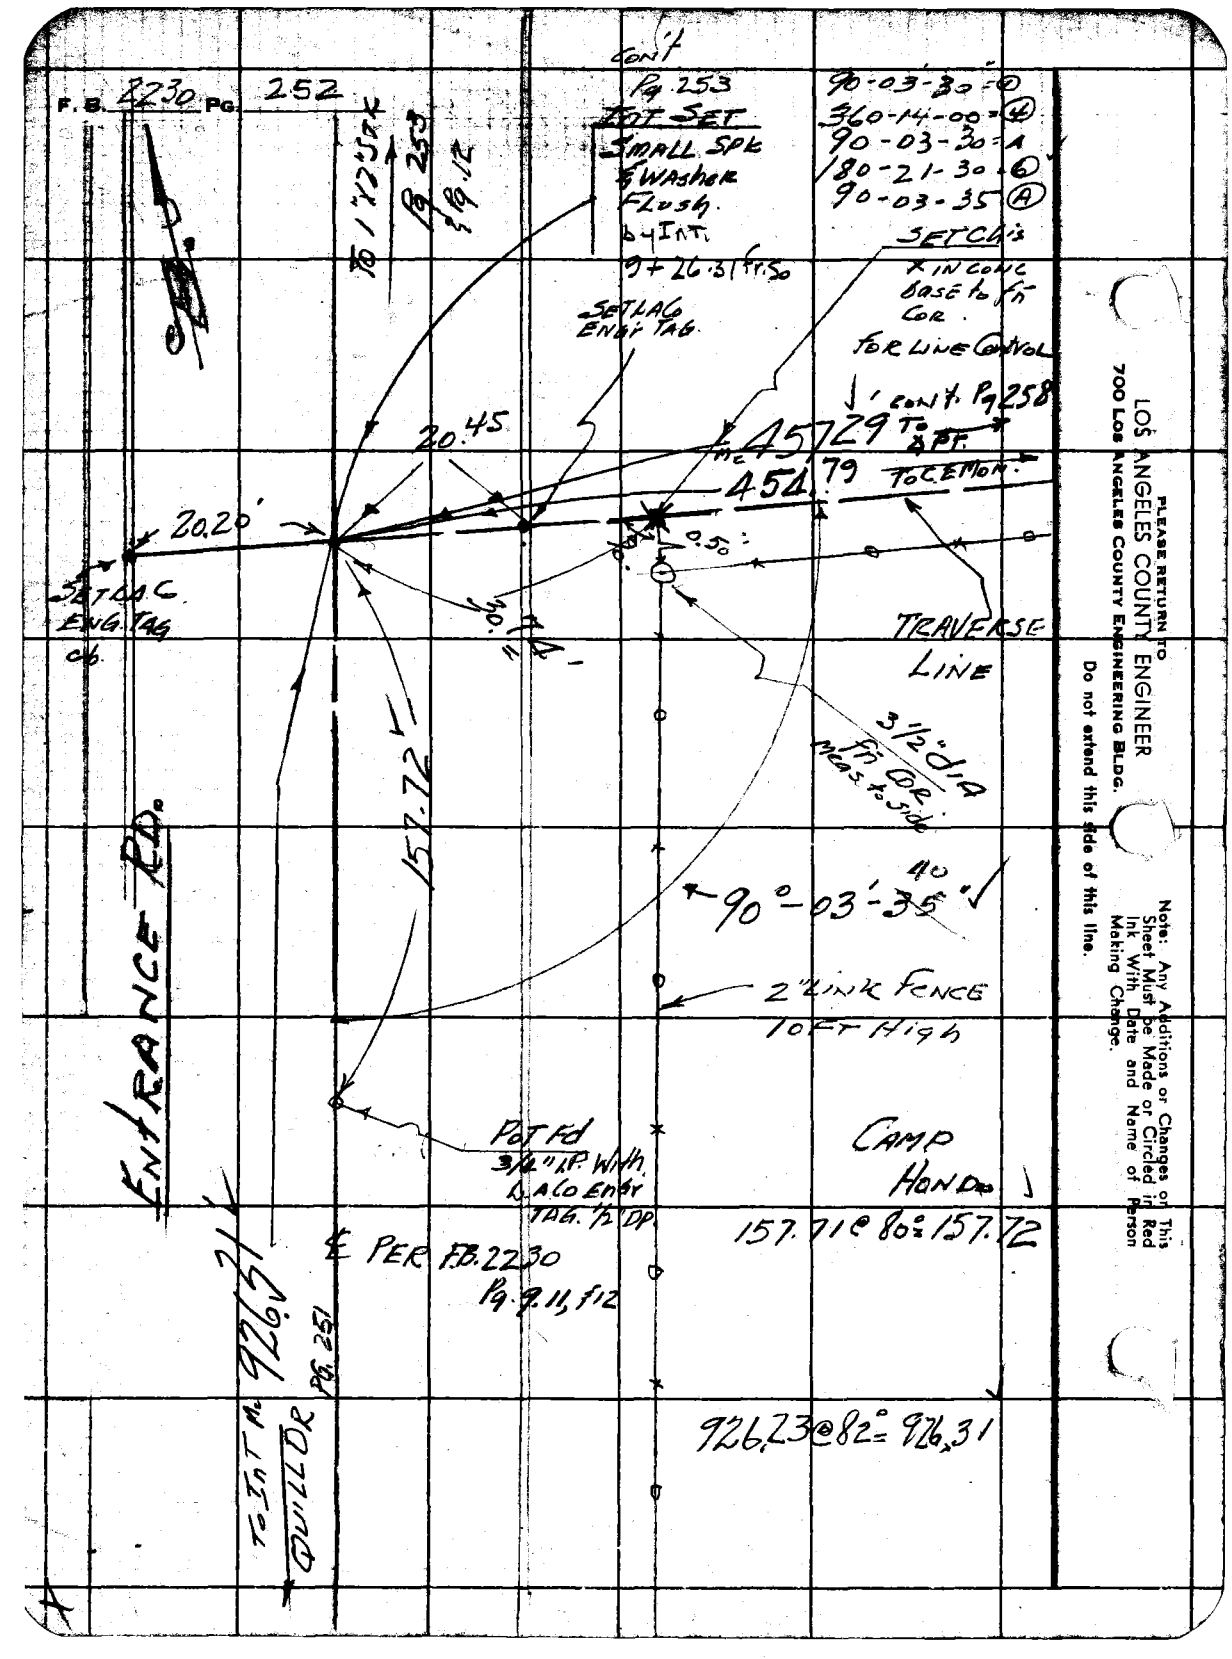

PLEASE RETURN TO
LOS ANGELES COUNTY ENGINEER
700 LOS ANGELES COUNTY ENGINEERING BLDG.

Do not extend this side of this line.

Note: Any Additions or Changes on This Sheet Must be Made or Circled in Red Ink With Date and Name of Person Making Change.

Notes Ck'd by W. E. AUSTIN
Map No. B-1036
Office Work T.H. BURNS
Checked Miller
Date April 1960

Survey of Rancho Los Amigos Annexation No.
JN 002210 Tape 135 Std 68 °F
Surveyed by A.E. GRANQUIST
Notes N.E.G. Date
Indexed K. C. Johnson

F. B. 2230 PG. 253

Fd 3" IP Conc. Plug
& SPK 10" deep
PER FB 2230 Pg. 12

Fd 1"X2" STK. & NAIL 6" DP.
PER FB 2230 Pg. 12
HELD FOR THIS STA.
LINE CONTROL

73.50'

1551.635
FB 2230, Pg. 9, 11 & 12

TO INT CURVE DR

89°-21'-20" ✓ Pg. 12

10'

Δ = 90°-00'-00"
R = 30'

PER F.B. 2230 Pg. 12

ENTRACE DR.

(20'

TO SM. SPK & W. Pg. 252 TOP.

20')

Note: Any Additions or Changes on this Sheet Must be Made or Circled in Red Ink With Date and Name of Person Making Change.

Do not extend this side of this line.

PLEASE RETURN TO
LOS ANGELES COUNTY ENGINEER
700 Los Angeles County Engineering Bldg.

F.B. 2230 PG. 254

To Spk & Washer
Cont Pg. 255

220.39 @ 82 = 220.41 ✓

220.41

(30')

(30')

60'

LINE PER
FB 2230 Pg.
799

26.0'

1/2 wide
Gate

1/2 wide

59.8

Pot
SET: SMALL SPK.
& TIN FLUSH,
458.16 from
West.

467.2

3 1/2 I Pos

QUILL DR.

244.09 ✓

244.07 @ 82 =
244.09 ✓

1/2 wide

59.8

10'

Gate

59.8

2458 ℄

Post

2" LINK FENCE
10 Ft high

CONC

GUTTER

214.07

Pot SET
L & TIN
CONC GUTTER

214.07 ✓

214.05 @ 82 =
214.07 ✓

Cont Pg 251 Top

LOS ANGELES COUNTY ENGINEER
700 LOS ANGELES COUNTY ENGINEERING BLDG.

PLEASE RETURN TO

Do not extend this side of this line.

Note: Any Additions or Changes on This Sheet Must be Made or Circled in Red Ink With Date and Name of Person Making Change.

Notes Ck'd by H. E. AUSTIN
Map No. 8-1035
Office Work F.H. Burns
Checked Miller
Date April 1960

Survey of Rancho Los Amigos (Camp Hondo)
JN 0022-10 Tape 0135 Std 68 °F
Surveyed by H.E. Granquist
Notes H.E.G. Date 3/16/60
Indexed C. Johnson

F.B. 223 Pg. 255
B7 - 57 - 540
B55 - 52 - 00 (B)
183 - 38 - 00 A
184 - 38 - 10 (B) ✓
B5 - 58 - 01 A

Cont Pg 7

Set 1"x12" Stk. Flush 3 Feet Offset Traverse Line

To Set T 4" Punch Marks on

Set Sm. Spk & Washer Fl. 64 Int. 0+00 Grand Avenue 6+78.87 Ft. West

Set Tag

Cont Pg. 256 Bot

To 1"x12" Stk. & Pt.

Set Tag

Tang

Set A.C. Engr. Tag

J

28.69'

16'

I = 60° 9'

20.295

39.80

Prod. Set L.A. Co. Engr. Tag

42° 50'

24.55

66'

2.50

606.

2.50

Toe Fnce.

3.0'

3/4" St. Fin. Post

Nothing Set.

Tang

30°

57'

Set Tag 6+76.07

Set Bf. Spk in W. 3 in Flush

M = 99° 58' 05"

35.30

Set Tag

Camp Hondo

Rancho Los Amigos 2" Link fc 10 Ft High

2" Link Fence 10 Ft. High

Quill Dr.

To Pot. Spk. Set in

220.41

Cont Pg. 254

Note: Any Additions or Changes on this Sheet Must be Made or Circled in Red Ink With Date and Name of Person Making Change.

Do not extend this data beyond this line.

PLEASE RETURN TO
LOS ANGELES COUNTY ENGINEER
700 Los Angeles County Engineering Bldg.

76F3008 SBE #287 11-60

F.B. 223 Pg. 256

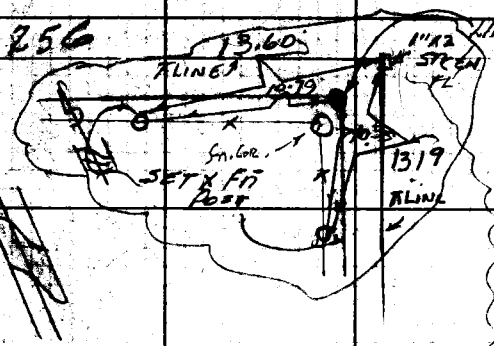

SET 1"x2" Stk
& N. Flush
64 INT
64 inc 9/25/60
RJM

Cont. Pg. 257
R. Side.

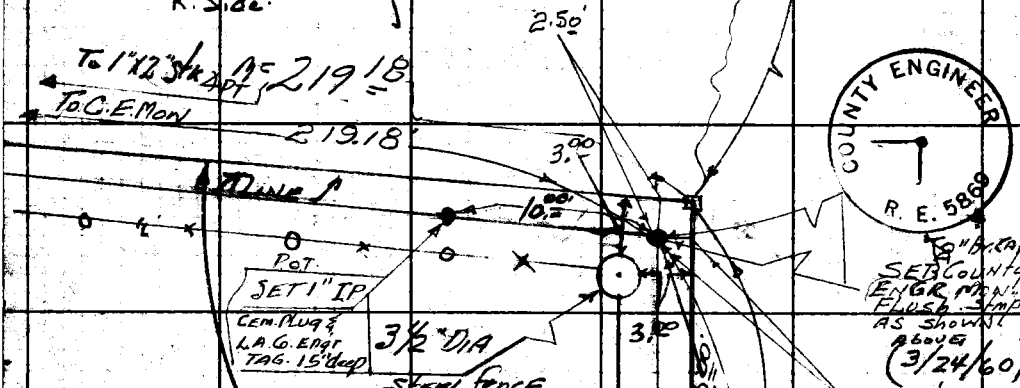

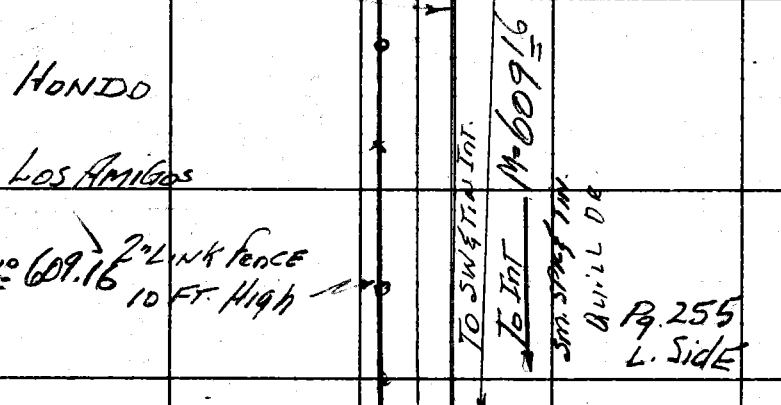

CAMP HONDO

RANCHO LOS AMIGOS

609.10 ~ 609.16 2" Link Fence
10 FT. High

LOS ANGELES COUNTY ENGINEER
PLEASE RETURN to
700 Los Angeles County Engineering Bldg.

Do not extend this add of this line.

Note: Any Additions or Changes on This Sheet Must be Made or Circled in Red Ink With Date and Name of Person Making Change.

Notes Ck'd by H. E. AUSTIN
Map No. B-1035
Office Work T.H. Burns
Checked Miller
Date April 1960

JN 6422.10 Tape 0135 Std 66 °F
Surveyed by H.E. Grandquist
Notes H.E.G. Date 3/7/60
Indexed E. C. Johnson

F.B. 223 PG. 257

89-58-50 = B
359-55-40 = B
89-58-55 = A
179-54-00 = C
89-59-00 = A

Cont. Pg 258 bot

3 FOOT OFFSET TRAVERSE LINE

318.81' To C.E. Mon

316.31' To 1/2" I.P.

2 Link Fence 10 Ft High

SET Co. Engr 2" Br. Cap in Conc. Flush & Stmpd As Shown (3/24/60)


M = 89° 58'

50' to Pt

To 4 Pt.

M = 219.18'

Pg 256 Link 10 CE Mon

219.18'

Prod 3.00

2.50'

10'

60'

Prod 3.00

Ref R.P. Set I.P. Cem Plug & L.A. Co. Engr Tag 1.5" deep

R.P. Pt. Set 1" I.P. Cem Plug & L.A. Co. Engr Tag 1.5" deep

2" Link Fence 10 Ft High

3 1/2" dia Steel Fence Corner Mons. to Edge

ANGLE POINT Set 1"x2" Stk & N FL by Int.

SET 1" I.P. 4 Pt

T Link

1.45

9.38

4 Pt. 1"x2" Stk & N FL

SAME

SAME

7.47

Tr Cor

9.55 Set 1" I.P.

CAMP RONDO

219.16 @ 84° = 219.18 ✓

Note: Any Additions or Changes on this Sheet Must be Made or Circled in Red Ink With Date and Name of Person Making Change.

Do not extend this plat of this line.

PLEASE RETURN TO LOS ANGELES COUNTY ENGINEER 700 Los Angeles County Engineering Bldg.

76F3098 SEE 1247 11-58

F.B. 2230 Pg 258

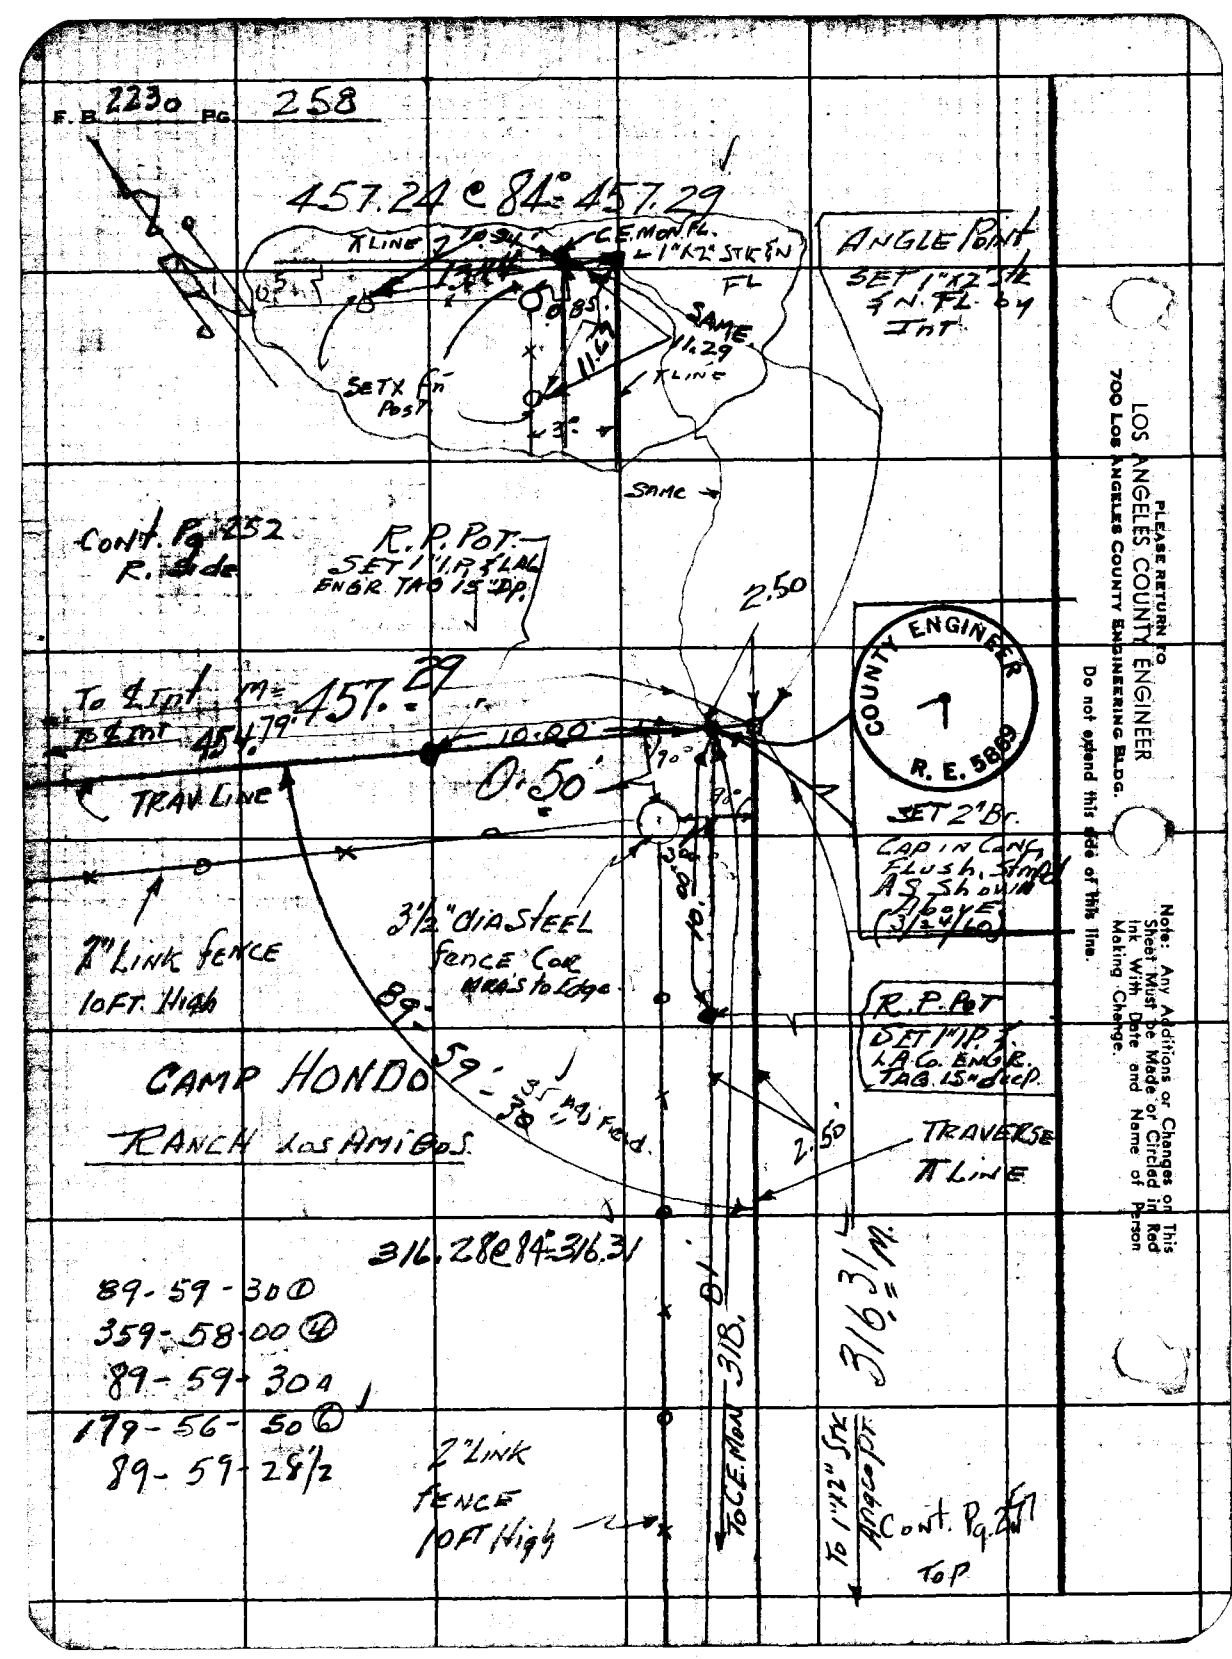

PLEASE RETURN TO
LOS ANGELES COUNTY ENGINEER
700 LOS ANGELES COUNTY ENGINEERING BLDG.

Do not extend this side of this line.

Note: Any Additions or Changes on This Sheet Must be Made or Circled in Red Ink With Date and Name of Person Making Change.

Notes Ck'd by	Survey of Los Padrinos Juv
Map No.	W.O. 986029 Tape No. 81 29 St'd. 68° °F
Office Work	Surveyed by M. Sotro
Checked	Notes Sotro Date 12-22-60
Date	Indexed [illegible]

F.B. 2230 Pg. 259

J.N. 0060.20

LOS PADRINOS JUV. HALL

HORIZONTAL CONTROL

FOR

PLANE TABLE SHEETS

F-92-9, 10, 11

Sotro
Frank
Moodyman

2330

Note: Any Additions or Changes on This Sheet Must be Made or Circled in Red Ink With Date and Name of Person Making Change.

Do not extend notes this side of this line.

RETURN TO
LOS ANGELES COUNTY SURVEYOR
726 LOS ANGELES COUNTY
ENGINEERING BLDG.

76F3095 SBE #847. 8-54

F.B. 2230 Pg. 260

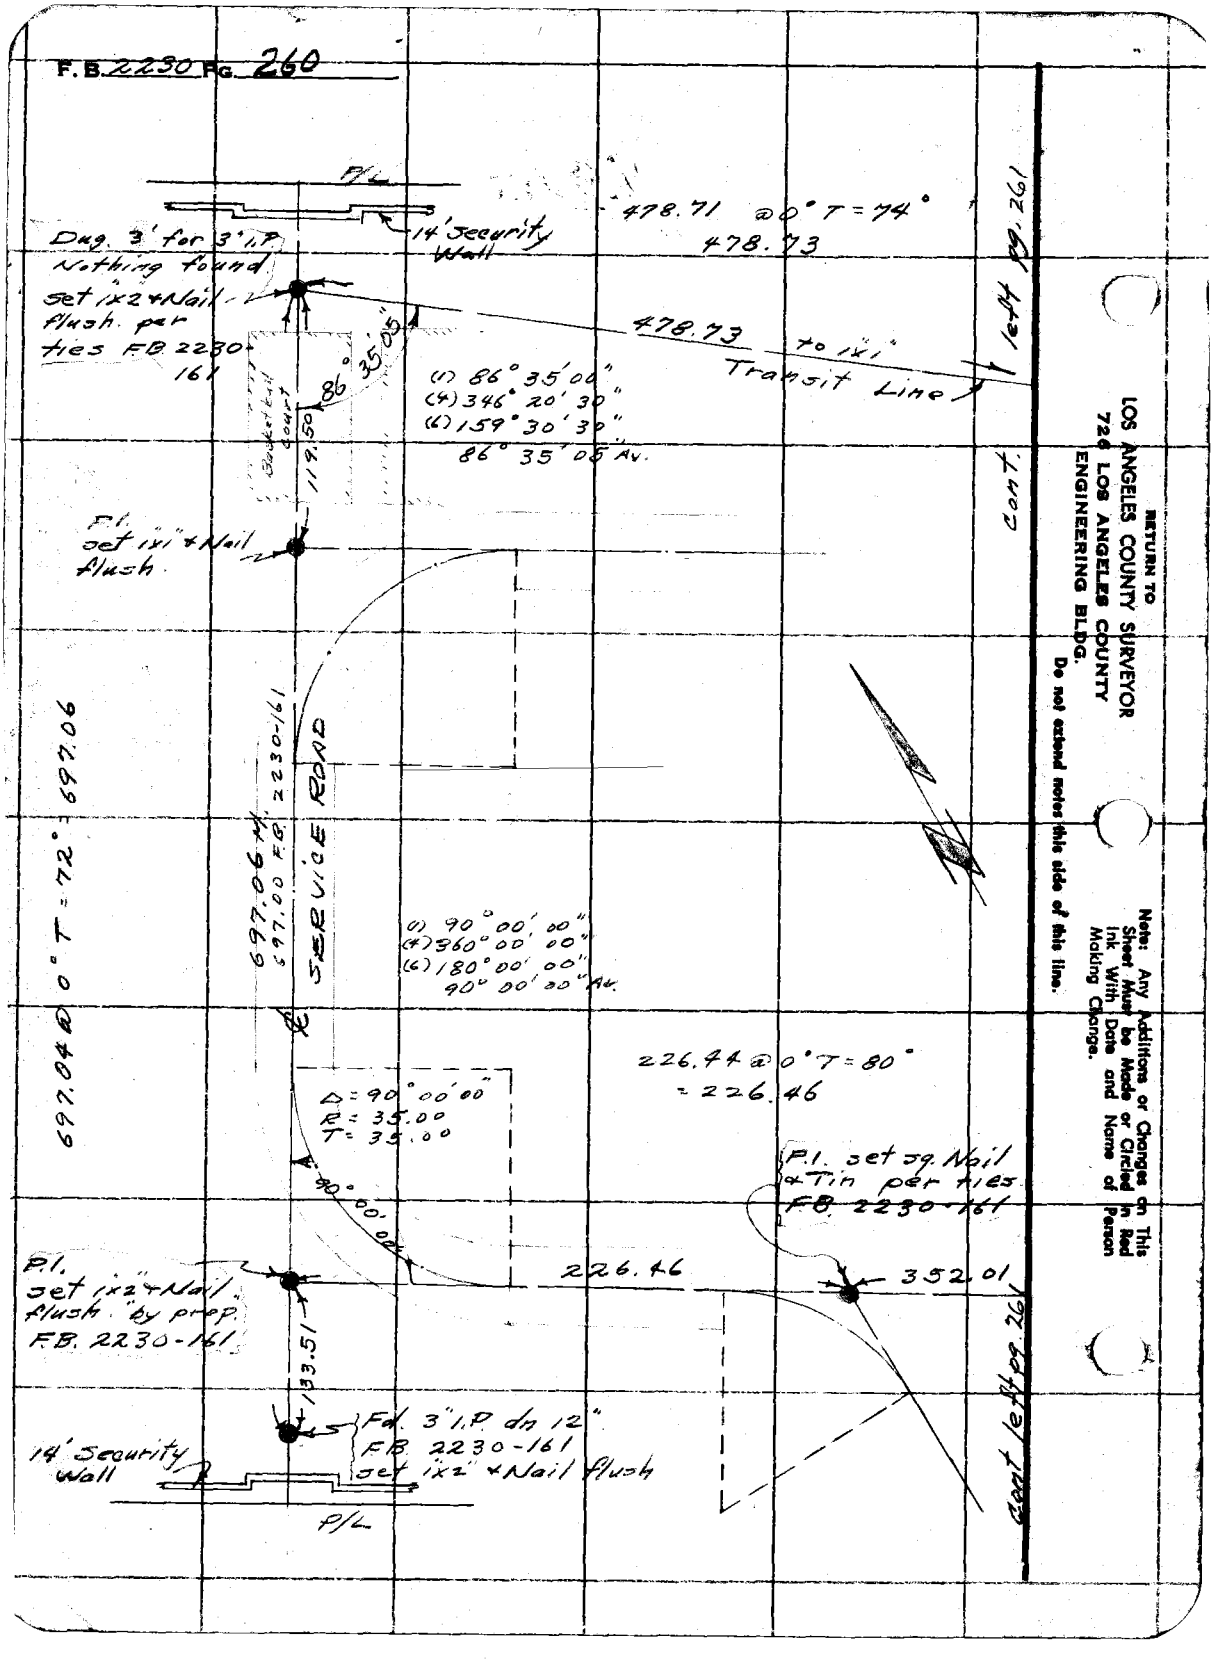

RETURN TO
LOS ANGELES COUNTY SURVEYOR
720 LOS ANGELES COUNTY
ENGINEERING BLDG.
Do not extend notes this side of this line.

Note: Any Additions or Changes on This Sheet Must be Made or Circled in Red Ink With Date and Name of Person Making Change.

Notes Ck'd by
Map No.
Office Work
Checked
Date

Survey of Los Padrinos Jun.
W.O. 8060.20 Tape No. 129 St'd. 68° °F
Surveyed by M. Sotro
Notes Sotro Date 12-22-60
Indexed H. E. OTT

F. B. 2230 Pg. 261

Note: Any Additions or Changes on this Sheet must be Made in Black Ink Only and Name of Person Making Change

LOS ANGELES COUNTY SURVEYOR
ENGINEERING BLDG.
LOS ANGELES COUNTY

Revised Sht. #247. 8-54

Rt. of Way 220

Cent. Ln.

(1) 94° 03' 20"
(2) 16° 13' 00" 15"
(6) 204° 19' 20" 10½
94° 03' 15" Av.

Set 1"x1" Nail Flush

#28.73

94° 03' 15"

100.00

90° 00' 00"

15.5'

Set Sq. Nail & Tin

94.56

Bldg #5
L.A. Co. # 3828

140.59 @ 0° T = 70° = 140.59
169.77 @ 0° T = 72° = 169.77
258.61 @ 0° T = 72° = 258.62
94.56 @ 0° T = 72° = 94.56
100.00 @ 0° T = 74° = 100.00

Set chiseled cross in conc. walk

258.62

Transit Line

Gate

169.77

90° 00' 00"

8.5'

Set Sq. Nail & Tin

32.09

Fd. Chiseled Cross in conc. curb F.B. 2664-19

140.59

Dr.

(2) Ent.

LOS PADRINOS
(Sentmanat)

(1) 90° 00' 00"
(4) 360° 00' 00"
(6) 180° 00' 00"
90° 00' 00"

436.13

Transit Line

436.15 @ 0° T = 62° = 436.13

(1) 89° 21' 40"
(4) 357° 26' 40"
(6) 176° 10' 00"
89° 21' 40" Av.

89° 21' 40"

11.2

2.3'

352.01

Set Sq. Nail & Tin

352.02 @ 0° T = 62° = 352.01

Fd. 1" I.P. Co. Engr. tag & Nail F.B. 2664-17