Box

Survey of
JN Tape Std °F
Surveyed by
Notes Date
Indexed

F.B. 2293 Pg.

Job	Description
Index	
Sec. Lines	T5N R12W-Sec. 23-0302.01-Remeasure lines.
Sec. Line	T6N R10W-Check on Section Line-W. side Sec. 15.
C.L.	35th St. E.-C.L. Survey from Ave. R to Palmdale Blvd.
Ties	T7N R12W-Reties to cors. 29/28; 29/32/33; 28; 32/33; 25/30.
Sec. Cor.	T7N R12W-Replace Cor. 14/23 (Ave. J & 5th St. E.).
Sec. Cor.	T6N R9W-Reset Cor. 7/8. 18/17
Sec. Cor.	T5N R11W-Sec. Mons & ties on Ave. T from 87th St. E. to 87th St. E. Sec. 6/5 to 1/6. 7/8 12/10
Sec. Cor.	T5N R11W-Sec. Mons & ties on Ave. S from 55th to 60th St. E. Cor. cc to Cor. 34/35 4/3 S.C.
Ties	T5N R10W-Reties at Cor. 27/34 and Ctr. 34.
Sec. Cor.	T5N R8W-N ¼ Cor. Sec. 6.
Sec. Cor.	T7N R11,12W-Reset Cor. 24/19 at 20th St. E. & Ave. J-8.

Microfilmed Feb 86

(cont'd on next page)

F.B. 2293 Pg.

Page	Job	Description
71-94	Sec. Lines	T4N R8W-Retracement Sec. Lines, Sec's. 11, 12, 13, 14 23, & 24.
95-96	Sec. Lines	Reseting Sec. Cor. 11,12,13,14, T4N., R8W.
105-106	Sec. Cor.	T7N R12W-Reset Cor. 4/ 3 at Ave. H & 10th St. 9/10
107-110	Ties	T8N R9W-Ties at Cor. 30; 19/20; 30/29; 30/29. 31 30/29 31/32
111-114	C.L.	R.S. 73-37-C.L. ties on Ave. X-3 & 131st St. E.
119-128	Align.	7th St. E-Prop. align. & Loc. Imp. from Ave. K to Ave. K-8.
129-133	Sec. Line	T7N R11W-N'ly & S'ly lines Sec. 30 Reties Aves. K & L from 20th St. t 30th St. E.
135-150	C.L.	Third St. E.-C.L. Survey on 3rd St E. & Foxton Ave. between Nugent St & Ave. J.
151-158	Loc.Imp	Hagenbaugh Cistern-NW ¼ Sec. 18, T4N R8W-Site & loc. Cistern.
159-164	Bdry.	Ave. I-Survey of Block 26, Town of Lancaster.
165-167	Sec. Line	T4N R8W, Sec. 7-Rerun Line 6/7,
169-172	Bdry.	T5N R10W, Sec. 4,-Remeasure west bdrys from Ave. S to Ave. T & from 116th St. E. to 111th St. E.

(cont'd on next page)

Notes Ck'd by _____ Survey of _____ F.B. 2293 Pg. _____
Map No. _____ IN _____ Tape _____ Std _____ °F
Office Work _____ Surveyed by _____
Checked _____ Notes _____ Date _____
Date _____ Indexed _____

Page	Job	Description
173-193	Bdry.	Tract 17500-Monumenting tract after bond forteiture, from Ave. P-8 to Ave. Q between 8th St. E. to 9th St. E.
195-196	Ties	T7N R11W-Ties at Cor. 30 29/31 32.
197-202		See end of indexing.
203-204	Ties	T6N R9W-0302.01-Reties 1/4 Cor. 8/17
205-206	Index	Fire Cistern-Darling.
207-215	Bdry.	Survey of tank site Parcel 7, S.W. Cor. Sec. 22, T6N, R14W. Aqua Dulce Area 0038.06.
217-218	Ties	T6N R9W-0302.01-Ties at Cor. 9/16.
219-220	Ties	T7N R12W-0302.01-Reties Sec. 14-Ave. 1-4 & 5th St. E.
221-	Ties	T6N R9W-0302.01-Reties Cor. 9/10; & 10/15. 16/15
223-224	Ties	T7N R11W-0302.01-Ties at Cors. 22/23; 22/23; 15/14. 22/23 27/26
225-229	Sec. Cor.	T5, 6N R10W-0302.01-Std. Sec. Cor. 34, 35, N ¼ Cor. Sec. 3 & E ¼ Cor. Sec. 34.
231-245	Sec. Lines	T7N R9W-Sec. Lines around Secs. 23, 24, 25 & 26.

(cont'd on next page)

Note: Any Additions or Changes on this Sheet Must be Made or Circled in Red Ink With Date and Name of Person Making Change

Do not extend this side of this line.

PLEASE RETURN TO
LOS ANGELES COUNTY ENGINEER
1403 Los Angeles County Engineering Bldg.

7EP3018 CK #310 8-68

F.B. 2293 Pg.

Page	Job	Description
247-250	C.S.Mon	Tr. 22670:-Monumenting: Set mons. on Ave. Q-4 from 30th St. to Pond Ave.
251-258	C.L.	35th Street East-Proposed new C.L. between Ave. O and Ave. R.
259-263	C.L.	35th Street East-Proposed new C.L. between Ave. Q & Ave. Q-8 and 33th St. E. and 36th St. E.
265-	Ties	T7N R9W-Ties at cor. 13, 18, 24 & 19.
267-268	Ties	T7N R8W-Ties at Cor. 26/25.
269-270	Ties	T6N R9W-Reties at Cor. 8, 9, 17 & 16.
197-200	Ties	T5N R10, 11W-Ties at Cors. 11/12; 12/13; 7/18; 22/23; 22/23/27/26; 14/13.
201-202	Ties	T6N R12W-Ties at Cor. 13/18/24/19.

PTO last page.

PLEASE RETURN TO
LOS ANGELES COUNTY ENGINEER
403 Los Angeles County Engineering Bldg.
Do not extend this side of this line.
Note: Any Additions or Changes on this Sheet Must be Made or Circled in Red Ink With Date and Name of Person Making Change

Notes Ck'd by	Survey of
Map No.	JN Tape Std °F
Office Work	Surveyed by
Checked	Notes Date
Date	Indexed

F. B. 2293 PG. 1

INDEX

ANTELOPE VALLEY MISC. NOTES IN RANGES 8, 9, 10, 11, 12 W

Note: Any Additions or Changes on this Sheet Must be Made or Circled in Red Ink With Date and Name of Person Making Change.

Do not extend this side of this line.

PLEASE RETURN TO
LOS ANGELES COUNTY ENGINEER
700 LOS ANGELES COUNTY ENGINEERING BLDG.

A

B

C CEDAR AVE AT AVE I, JACKMAN ST., 162, 18

D DATE AVE AT AVE I, JACKMAN ST. 18, 18

E 82nd 87th STS. E. AT AVE. T 5
E, E-8 AVES. AT 150th ST. E. 10
E.y. LINE TR#10448 AT AVES K, K-4, K-8 12
8th ST. E. AT AVES P-8, P-12, Q 175, 18
82nd ST. E. AT AVE. U

F 40th ST. E AT AVE R PALMDALE BLVD. (AVE Q-8) 26, 2
40th ST. E. AT AVES. K-8, L, L-8 36
5th ST. E. AT AVE J
40th, 42nd, 47th STS. E. AT AVE. T 44
52nd, 57th STS. E AT AVE. T 46
F AVE. AT [illegible] STS. E. 10
FOXTON AVE. AT AVE J NUGENT ST, OLDFIELD ST, PALMDALE ST, 141-144,
FIRE CISTERN SITE IN NW¼ SEC. 18, T4N, R8W

70F3005 2M 1-58

F. B. 2293 PG. 2

G

H

H, AVE AT 10th ST. W 106
H-8, AVE. AT 10th ST. E 118
HAGENBAUGH FIRE CISTERN SITE IN NW¼ SEC. 18, T4N, R8W 151-158

I

I, AVE. AT 10th ST E 118
I, AVE. AT BEECH, CEDAR, DATE AVES.; 10th ST. W 161-162
I, AVE AT 5TH ST. E; I-4 AT 5 1/2 ST E. 243, 242
180th, 185th STS. E. AT AVE K 237, 235
190th, 195th STS. E. AT AVE K

J

J, AVE AT 5th ST. E 40
J-8, AVE., AT 20th ST. E 68
J AVE. AT 3RD ST. E.; FOXTON AVE, KIRKLAND AVE 138, 141-142, 150
JACKMAN ST. AT CEDAR, DATE AVES 163-164
J AVE. AT 200th ST. E 205
J, J-8, AVES. AT 60th ST. E 224

K

K, AVE. AT 180th, 185th, 190th, 195th, 200th STS. E. 233, 235-237, 242, 243
K-8 AVE AT 20th, 40th STS E 36, 38
K, AVE, AT 20th ST. E 69
K, K-4, K-8, AVES., AT STREET EAST OF 7th ST. E 120-123
KIRKLAND AVE AT AVE J 142
K, AVE, AT 7th ST. E. 124-128
K, AVE. AT 25th, 30th STS. E 130
K-8 AVE AT 30th ST. E 133
K, AVE AT 60th ST. E 223

L

L, L-8 AVES. AT 40th ST. E. 36-37
LANCASTER HEIGHTS TR # 10448 120-123
L AVE AT 20th, 25th, 30th STS. E 131-132, 196
L, 245 TH ST E 213-214

M

PLEASE RETURN TO
LOS ANGELES COUNTY ENGINEER
700 Los Angeles County Engineering Bldg.

Do not extend this side of this line.

Note: Any Additions or Changes on this Sheet Must be Made or Circled in Red Ink With Date and Name of Person Making Change.

Notes Rec'd by
Map No.
Office Work
Checked
Date

Survey of
JN ____ Tape ____ Std ____ °F
Surveyed by
Notes ____ Date ____
Indexed

F. B. 2293 PG. 3

N

NUGENT ST. AT 3RD ST. E, FOXTON AVE; 4TH ST. E 139-140, 143, 146
9TH ST. E, AT AVES P-12, P-15 177, 180, 183
92ND ST. E. AT AVE U 199

O

150TH ST. E AT AVE O
110TH ST. E AVE. O TO AVE P-8
114TH ST. E. AVE. O & AVE P
O AVE, AT 150TH ST. E, 155TH, 160TH, 165TH STS. E 42, 204, 216,
120TH ST. E AT AVES. X, X-8
120TH ST. E AT AVE X-3
130TH ST. E AT AVES. E, E-8, F
145TH ST. E AT AVE. F
111TH, 112TH, 113TH, 115TH, 116TH STS. E. AT AVES S, S-2, S-5, S-8, S-12, T 169-172
155TH ST. E & AVE O
160TH, 165TH STS. E. AT AVE O
O, AVE AT 170TH, 175TH STS. E
115TH, 116TH STS E. AT AVE S
120TH, 121ST STS. E. AT AVES. R, R-8, S 227, 228
125TH, 126TH STS. E. AT AVE. S

P

P AVE AT 20TH ST. E
P AVE AT APPLEBLOSSOM HWY. AT 126TH ST. E
P AVE. AT 110TH & 115TH ST. E.
P-8 AVE AT 110TH ST. E.
PALMDALE BLVD. AT 30TH, 35TH, 40TH STS. E
PANORAMA MOTORWAY (FIRE TRAIL) IN NW¼ SEC. 18, TWN, RGE W
P-8, AVE. AT 9TH ST. E, 10TH ST. E. 182, 187,
P-12, AVE AT 8TH, 9TH STS. E.; RAMBLER AVE
P-15, AVE AT 9TH ST. E.; RAMBLER AVE

Q

Q-8, AVE (PALMDALE BLVD) AT 30TH, 35TH 40TH STS. E.
Q, AVE AT 8TH ST. E.; RAMBLER AVE, 10TH ST. E 181, 184,
Q-4, AVE, AT 30TH, 31ST, 32ND STS. E.

R

R, AVE. AT 30TH 35TH, 40TH STS. E 26-28, 34
RAMBLER AVE AT AVES P-12, P-15, Q 176, 184-185
R, R-8, AVES., AT 120TH ST. E 229

Note: Any Additions or Changes on this Sheet Must be Made or Circled in Red Ink With Date and Name of Person Making Change.

Do not extend this side of this line.

PLEASE RETURN TO
LOS ANGELES COUNTY ENGINEER
700 Los Angeles County Engineering Bldg.

7673098 SBE #242 1-56

F. B. 2293 Pg. 4

	62nd, 67½ STS E. AT AVE T		48
	72nd, 77½ STS. E AT AVE T		49-50
	S AVE. 204TH TO 214TH STS. E.		66
	S-8 AVE & 214TH ST. E.		67
	S, AVE. AT 10th, 12th STS. W		116
	STREET EAST OF 7th ST. E. AT AVES. K, K-4, K-8	120-123	
	S½ S-2, S-5, S-8, S-12 AVES. AT 111th, 112th, 113th, 115th, 116th STS. E	169-17	
	7th ST. E AT AVE K	124-12	
	77th ST. E AT AVE U		19
	S, AVE. AT 115th, 116th, 120th, 121st, 125th, 126th STS. E.	226-2	
	60th ST. E. AT AVES J, J-8, K	223-2	
T	20th ST. E. AT AVE K-8		3
	20th, 25th, 30th STS. E AT AVE L	131-13	
	25th, 30th STS. E AT AVE K		130
	TRACT #17500, #18786		185
	30th, 35th STS. E. AT PALMDALE BLVD, AVE R	27-28, 30-31, 34	
	35th ST. E. AT AVE R, PALMDALE BLVD (AVE Q-8)	27, 30-38	
	T, AVE., BET. 37th & 87th STS E.	43-51	
	37th ST. E. AT AVE T		44
	204TH 214TH STS. E. AT AVE. T.	64-65	
	204TH TO 214TH STS. E. AT AVE. S.	61-63	
	20th ST. E. AT AVES. J-8, K	68-69	
	264th ST E AT AVES Z-8, "Z-16"		73
	10th ST. W, AT AVE H		106
	10th, 12th STS. W. AT AVE. S		116
	10th ST. E. AT AVES. H-8, I		118
	TRACT #10448 Ely LINE OF, AT AVES. K, K-4, K-8	120-123	
	3RD ST. E. AT AVE. J NUGENT ST	138-140, 150	
	204th, 209th 214th STS. E AT AVE. Z-16	151-158	
	204th, 209th STS. E AT AVE Z	166-167	
	T, AVE. AT 116th ST E		172
	30th ST. E AT AVES K, K-8, L	130, 132-133, 19	
	10th ST. E AT AVES P-8, Q	189-190	
	20th ST. E. AT AVE. P		207
	254th ST E AT 3½ M. So. OF AVE Z	90-94	
	200th ST. E. AT AVES J, K	205, 233	
	245th ST E. AT AVE J, L		214
	30th, 31st, 32nd STS. E. AT AVE. Q-4	246-248	
U	U, AVE. AT 77th, 82nd, 92nd STS. E	198-199	
V	V-8, AVE., AT 126th ST. E		200
W	W, AVE., AT 126th ST. E		200
X Y Z			
	X, X-8, AVES, AT 121st ST. E		58
	Z-8, "Z-16", AVES AT 264th ST. E		73
	X-3, AVE. AT 131st ST E	111-114	
	Z-16, AVE. AT 204th, 209th, 214th STS. E.	151-158	
	Z, AVE. AT 204th, 209th STS E	166-167	
	Z (3 to 3½ mi. So OF) AT 254th ST E	90-94	

LOS ANGELES COUNTY ENGINEER
700 Los Angeles County Engineering Bldg.
PLEASE RETURN TO
Do not extend this side of this line.

Note: Any Additions or Changes on this Sheet Must be Made or Circled in Red Ink With Date and Name of Person Making Change.

Notes Ck'd by Miller
Map No.
Office Work
Checked
Date

Survey of E. Line Sec 23 T5N R12W
JN 0302.01 Tape 102 Std. 84 °F
Surveyed by Burkholder
Notes D.L.B. Date 8-14-57
Indexed A. C. Johnson 8-16-57

F. B. 2293 PG. 7

SECTION LINES

JN 030291

SECTION 23 T5N R12W

8-7-57
R.L. Willey
R.O. Anderson
D.L. Burkholder
J.A. McCall
R.A. Swann

Note: Any Additions or Changes of this Sheet Must be Made as Circled in Red Ink With Date and Name of Person Making Change.

Do not extend this side of this line.

PLEASE RETURN TO
LOS ANGELES COUNTY ENGINEER
700 Los Angeles County Engineering Bldg.

76F3098 SAE 12x2 1-56

CONT bottom Pg 9

F. B. 2293 Pg. 8

534.22

N 65° E 5

T = 90° = 411.59 / 411.63

145.83 @ 5° 34' = 145.14 ✓
269.94 @ 9 15 = 266.43 ✓
411.57 ✓

POT #2
Set 1x2 LS
8+26.58 / 8+26.98

7°

411.59 / 411.63 Lines

2 Strand barbed Wire Fence

LOS ANGELES COUNTY ENGINEER
700 Los Angeles County Engineering Bldg.

PLEASE RETURN TO

Do not extend this side of this line.

Note: Any Additions or Changes on this Sheet Must be Made or Circled in Red Ink With Date and Name of Person Making Change.

SEC 23 T5N R12W

SEC 24

7°

POT #1
Set 1x2
4+15.35

COUNTY SURVEYOR
T5N
R12W | 23 | 24
26 | 25
1926
MONUMENT

T = 92° = 415.31 / 415.35

161.84 @ 17° 15' = 153.80 ✓
197.24 @ 18 12 = 187.37 ✓
76.98 @ 15 40 = 74.12 ✓
415.29 ✓

415.31 / 415.35 TANGENT

Sec. Line

COUNTY SURVEYOR
T5N
Sec 23
R12W
Sec 26
WIT. COR
MONUMENT

Fd 2" I.P. & B.C.
Set 17 Conc.
Marked as Shown

90° 07' 27"

Set Nail
0+00.00

5.00

Fd 2" I.P. & B.C.
Set in Conc.
Mkd as Shown
0+00.01

90-07-30
360-00-00
180-44-40
90-07-26 ✓

Note
Δ = 90°-07-30"
Per C.S. 8739

Notes Ck'd by Miller
Map No.
Office Work
Checked
Date

Survey of E. Line Sec 23 T5N R12W F. B. 2293 PG. 9
JN 0302.01 Tape 102 Std. 84 °F
Surveyed by Burkholder
Notes D.A.B. Date 8-14-57
Indexed C. Johnson

Note: Any Additions or Changes on this Sheet Must be Made or Circled in Red Ink With Date and Name of Person Making Change.

Do not extend this sketch beyond this line.

PLEASE RETURN TO
LOS ANGELES COUNTY ENGINEER
700 LOS ANGELES COUNTY ENGINEERING BLDG.

Cont bot Pg 10

299.07 45

POT #4
Set 1x2 + N
16+59.74 57

Line

T = 88° = 298.48 45
163.20 @ 8°48' = 161.28 ✓
138.40 @ 7°40' = 137.16 ✓
298.44 ✓

SEC 23 T5N R12W

SEC 24

298.48 45

Sec Line

T: 88° = 534.28 22
300.75 @ 1°21' = 300.67 ✓
242.95 @ 16°00' = 233.54 ✓
534.21 ✓

POT #3
Set 1x2 + N
13+61.26 12

Transit

48 ℓ

100 ℓ

2 Strand barbed wire fence

50 ℓ

5 ℓ

534.28 22

From top Pg 8

F. B. 2293 Pg. 10

Cont bot pg 11

WS 65 B-5

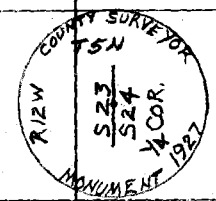

fd 2" I.P. & B.C.
Set in Conc.
Marked as shown

NOTE
This ¼ cor MONUMENT removed for new position see FB 2293-14.
9-20-57. R.L.W.

POT #7
Set 1x2 ± N
24+11.34~~3~~
T=92° = 151.50
152.08 @ 5° 06' = 151.48 ✓

SEC 23 T5N R12W

POT #6
Set 1x2 ± N
22+59.~~24~~63
T=92° = 301.~~05~~
301.00 @ 0° 35 = 300.~~98~~99

POT #5
Set 1x2 ± N
19+58.~~81~~62
T=88° = 299.~~04~~05
300.74 @ 6° 07 = 299.~~03~~04

1.02
+8.05
314.~~60~~57
151.50 ✓ Line
301.~~03~~01 Tangent
299.05

from top pg 9

PLEASE RETURN TO
LOS ANGELES COUNTY ENGINEER
700 Los Angeles County Engineering Bldg.
Do not extend this side of this line.

Note: Any Additions or Changes on This Sheet Must be Made or Circled in Red Ink With Date and Name of Person Making Change.

Notes Ck'd by Miller
Map No.
Office Work
Checked
Date

Survey of E Line Sec 23 T5N R12W. B 2293 Pg. 11
JN 0302.01 Tape 102 Std 84 °F
Surveyed by Bunkholder
Notes DAB Date 8-14-57
Indexed C. Johnson

WS 65-B-5

Cont bot pg 12

T=92° : 149.87
81.73@21.01 = 76.29
79.25@21.51 = 73.56
149.85

POT #11
Set 1x2 + N
33+14.25 13.96
T=92 = 98.50
101.45@12°53' = 98.88

SEC 23 T5N R12W

SEC 24

POT #10
Set 1x2 + N
32+15.57
T=92° = 388.87
300.53@19°32' = 283.23
113.44@21°27' = 105.58
388.81

POT #9
Set 1x2 + N
28+26.48
T=92° = 100.54
103.31@13°21' = 100.52

POT #8
Set 1x2 + N
27+25.94
T=92° = 314.57
300.69@2°03 = 300.50
14.05@ Lev = 14.05
314.55

149.87
98.89
388.81
100.54
314.57

from top pg 10

Note: Any Additions or Changes on This Sheet Must be Made or Circled in Red Ink With Date and Name of Person Making Change.

Do not extend this side of this line.

PLEASE RETURN TO
LOS ANGELES COUNTY ENGINEER
700 LOS ANGELES COUNTY ENGINEERING BLDG.

7673068 SEE #247 1-56

F. B. 2293 Pg. 12

Cont. to pg 13

535.45

POT # 15
Set 1x2 + N
41+99.35
98.98 .50

T = 84° = 237.30
42.09 @ 10°20' = 41.41 ✓
200.68 @ 12°34" = 195.87 ✓
237.28 ✓

237.28

SEC 23 T5N R12W

SEC 24

POT # 14
Set 1x2 + N
39+62.85 6.70
.15

T = 84° = 175.17
176.68 @ 7°33 = 175.15 ✓

175.15

POT # 13
Set 1x2 + N
37+86.88 55
.73

T = 92° = 322.76
300.85 @ 10°17 = 296.02 ✓
26.69 @ Lev = 26.69 ✓
322.71 ✓

322.73

POT # 12
Set 1x2 + N
34+64.12
63.82

149.86

from top pg 11

WS 65-B-5

LOS ANGELES COUNTY ENGINEER
700 Los Angeles County Engineering Bldg.

PLEASE RETURN TO

Do not extend this side of this line.

Note: Any Additions or Changes on This Sheet Must be Made or Circled in Red Ink With Date and Name of Person Making Change.

Notes Ck'd by Miller	Survey of E. Line Sec 23 T5N R12W F.B. 2298 Pg. 13
Map No.	JN 0302.01 Tape 102 Std 84 °F
Office Work	Surveyed by Burkholder
Checked	Notes DB Date 8-14-57
Date	Indexed C. Johnson

WS 65 B-5

COUNTY SURVEYOR
T5N
SEC
14 13
23 24
COR
R12W
MONUMENT 1927

fd 2" I.P. + B.C.
Set in conc.
Marked as shown

COUNTY SURVEYOR
T5N
13
24
R12W
¼ SEC. COR.
1926
MONUMENT

fd 2" I.P. + B.C.
Set in conc
Marked as shown

4.55

POT #18
Set 1X2 & N
by Intersection
53+16.95
47
T=90°=13.71
13.71@Lev.=13.71 ✓

13.71

89-57-25 ✓

89°57'30"
359 49 40
179 44 30
89-57-25

POT #17
Set 1X2 & N
53+03.24
02.76.33
T=90°=568.39
124.62@15°45'=119.94 ✓
206.04@15°45'=198.79 ✓
254.07@10°47'=249.58 ✓
568.31 ✓

SEC 23 T5N R12W

568.33
568.39
Transit Line
Sec. Line

SEC 24

POT #16
Set 1X2 & N
47+34.95 43
45
T=86°=535.50
300.48@18°17'=285.31 ✓
194.29@Lev=194.29 ✓
56.14@5°54'=55.84 ✓
535.44 ✓

535.45
535.50

from top pg 12

Note: Any Additions or Changes on This Sheet Must be Made or Circled in Red Ink With Date and Name of Person Making Change.

Do not extend this side of this line.

PLEASE RETURN TO
LOS ANGELES COUNTY ENGINEER
700 LOS ANGELES COUNTY ENGINEERING BLDG.

75F3098 SEE #247 1-56

F. B. 2293 Pg. 19

WS 65-B-5

P.O.T. #8
fd 1x2 + Nail
27+25.70
see FB 2293-11

B12W. COUNTY SURVEYOR 1927
S 23
S 24
1/4 COR
MONUMENT

set 1x24 Nail
28+58.23
6

set 2" I.P. + BC
in conc stmped
as shown.
28+58.23
per. office
instructions.
This Monument
Reset from orig-
nal position
9-20-57 R.L.W.

247.79

247.10

4.78

SEC 23 T5N R12W

SEC. 24

T = 24° =
247.41 @ 253' = 247.10

P.O.T. #7
fd 1x2 + Nail
24+11.13
see FB 2293-10

PLEASE RETURN TO
LOS ANGELES COUNTY ENGINEER
700 Los Angeles County Engineering Bldg.

Do not extend this side of this line.

Note: Any Additions or Changes on This Sheet Must Be Made or Circled in Red Ink With Date and Name of Person Making Same.

Notes Ck'd by Gose	Survey of	F. B. 2293 Pg. 17
Map No. C.S. 8733	JN Tape Std °F	
Office Work L.C. Wilson	Surveyed by	
Checked Miller	Notes Date	
Date Dec. 1957	Indexed A. C. Johnson	

SEP 25 '57

J.N. 0302.01

SECTION LINES

IN

T. 6 N. R. 10 W.

FIELD CHECK OF ANGLES AND DISTANCES ON WEST SIDE OF SECTION 15

PARTY

PIERCE
REERS
RANDALL
MENDONCA
STROMBERG

Note: Any Additions or Changes on This Sheet Must be Made or Circled in Red Ink With Date and Name of Person Making Change.

PLEASE RETURN TO
LOS ANGELES COUNTY ENGINEER
700 Los Angeles County Engineering Bldg.
Do not extend this side of this line.

785036 SAE 1247 1-58

F. B. 2293 Pg. 18

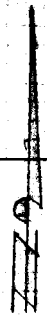

AVE 'O'

(22) (23)

(21)

SEC. 15

T-6 N
R-10 W

110TH ST. E.

(19)

AVE. P

(24)

SEC. 22

(20)

PLEASE RETURN TO
LOS ANGELES COUNTY ENGINEER
700 Los Angeles County Engineering Bldg.

Do not extend this side of this line.

Note: Any Additions or Changes on This Sheet Must be Made or Circled in Red Ink With Date and Name of Person Making Change.

Notes Ck'd by Goss
Map No. C.S. 8733
Office Work L. C. WILSON
Checked Miller
Date Dec 1957

Survey of T. 6 N. R. 10 W.
JN 0302.0 Tape 16 Std 84 °F
Surveyed by J. C. PIERCE
Notes PIERCE Date 9-6-57
Indexed C. Johnson

F. B. 2293 Pg. 19

W. S. 6-6-B-2

Note: Any Additions or Changes on This Sheet Must be Made or Circled in Red Ink With Date and Name of Person Making Change.

Do not extend this side of this line.

PLEASE RETURN TO
LOS ANGELES COUNTY ENGINEER
700 Los Angeles County Engineering Bldg.

76F3095 SBE #247 1-56

TO BOT PG. 21

SEC. 15

109.92
150.45
150.76
150.83
150.62
150.34
150.44
150.68
150.67
150.71
150.85
150.47
150.34
150.64
150.48
150.58
150.66
150.78
2670.16 (CT=78) = 2670.06 ✓

EAST 2670.06 SEC. LINE

SEC. 16
T. 6 N. R. 10 W.

ST.

SET 2" I.P. CEM. PLUG & TAG UP 6"

90° 07' 47"
56.57 TAN.

AVE. 'P'

SEC. LINE

0+00.00 T.6 N. & S.
SECTION CORNER
SECS. 15, 16, 21, & 22
T.6 N., R. 10 W.
FD. A 2" I.P. & B.C.
SET IN CONC. DN. 4"
PER F.B. 77-140
SEE C.S. 8733
MKD.

56.57 TAN.
45°00'
89° 09' 30"

SET 2" I.P. CEM. PLUG & TAG UP 6"

1) 90° 07' 40"
2) 00° 31' 00"
3) 180° 46' 40"
AVE) 90° 07' 46⅔" ✓

1) 89° 09' 30"
2) 356° 38' 00"
3) 174° 57' 00"
AVE) 89° 09' 30" ✓

SEC. 22

COUNTY SURVEYORS
T. 6 N.
R. 10 W.
16 | 15
21 | 22
1927
MONUMENT

SEC. 21

110 TH
2668.65
SEC. LINE

75.29
150.48
150.67
150.51
150.70
150.41
150.39
150.48
150.50
150.04
150.78
150.72
150.33
150.60
150.63
150.83
150.80
78.52
2668.62 (CT=86) = 2668.65 ✓

TO TOP PG. 20

F. B. 2293 Pg. 20

TO BOT PG. 19

KS. 66-8-2

PLEASE RETURN TO
LOS ANGELES COUNTY ENGINEER
700 Los Angeles County Engineering Bldg.
Do not extend this side of this line.

Note: Any Additions or Changes on This Sheet Must be Made or Circled in Red Ink With Date and Name of Person Making Change.

SEC. 21
T. 6N. R. 10 W.

110 TH ST. EAST

2668.65
SEC. LINE

SEC. 22

F.D. 4X4 STK. & N. PER F.B. 77 PG. 143

90° 00'

SET 2" I.P. CEM PLUG & TAG UP 6"

10.00 TAN.

30.00

40.00 TAN.

SET 2" I.P. CEM PLUG & TAG UP 6"

48.60

SET N & T IN PP & 10 E 148, E SW. SIDE UP 12"

26+68.65
¼ SECTION CORNER SECS. 20 & 21 T. 6N. R. 10 W. FD. PIECES OF CONC. IN HOLE BUT NO EVIDENCE OF 2" I.P. & B.C. I SET A 2" I.P. & B.C. SET IN CONC. DN 15". RECORD ANGLE & DISTANCE FROM 4X4 STK. PER F.B. 77 PG. 143 SEE C.S. 8733 MON. MKD.

R. 10 W. ¼ COR.
R.E. 5869

Notes Ck'd by Goss
Map No. C.S. 8793
Office Work L. C. WILSON
Checked Miller
Date Dec. 1957

Survey of T.6N. R.10W.
JN 0302.01 Tape 16 Std 84 °F
Surveyed by J.C. PIERCE
Notes PIERCE Date 9-13-57
Indexed C. Johnson

F. B. 2293 Pg. 21

TO BOT PG. 22

W.366-B-2

Note: Any Additions or Changes on this Sheet Must be Made or Circled in Red Ink With Date and Name of Person Making Change.

Do not extend this side of this line.

PLEASE RETURN TO
LOS ANGELES COUNTY ENGINEER
700 Los Angeles County Engineering Bldg.

SEC. 16
T. 6 N. R. 10 W.

EAST
2675.44

SEC. 15

1) 179-32-10
2) 358-08-50
3) 357-13-00
AVE 179-32-10

SET 2" I.P. CEM. PL. & TAG UP 6"

40.00 TAN.

40.00 TAN.

SET 2" I.P. CEM. PL. & TAG UP 6"

179° 32' 10"

26+70.06
1/4 CORNER SECTIONS 15 & 16 T. 6 N. R. 10 W.
FD. 2" I.P. & B.C. SET IN CONC. UP 6"
PER F.B. 77-142
SEE C.S. 8793
LOWERED MON. TO 15' BELOW SURFACE
MKD.

COUNTY SURVEYORS T.6N. R.10W. 16 | 15 1/4 SEC. COR. 1925 MONUMENT

110TH ST.
2670.06
SEC. LINE

115.42
150.64
150.70
150.51
150.79
150.70
150.41
150.60
150.56
150.92
150.55
150.49
150.56
150.30

2675.44 (CT=84) = 2675.44

TO TOP PG. 19

76F3098 SBE #247 1-56

F. B. 2293 Pg. 22

T.O 1/4 SECTION COR
SECS. 9 & 10 T.6N., R.10W.
FD. 2" I.P. & BC. SET IN
CONC. DN. 12
PER F.B. 74-142

W.S. 66-B-2

SEC. 10

SEC. 9

SEC. LINE

EAST

FD. 2" I.P.
PLUG & N.
UP 6"

D 89-59-10
D 359-56-00
D 179-54-00
AVE. 89-59-00

SET N&T IN
PP# 1062411-E
SE SIDE

89° 59' 50"

56.57
TAN.

408.7

AVE. 'O'

TO PG. 23

SEC. LINE

53+45.56
SECTION CORNER
SECS. 9, 10, 15 & 16
T.6N., R.10W., FD. A
2" I.P. & BC. SET IN
CONC. DN. 18"
PER F.B.
SEE C.S. 8733
MON. N.K.D.

39.29

37° 20"

90°

56.62
TAN.

FD. 2" I.P. PLUG
& N. UP 6"

SET N&T IN
PP# 1062188-E

COUNTY SURVEYORS
T. 6N.
R. 10W.
9 | 10
16 | 15
1927
MONUMENT

110TH ST.

SEC. LINE

2675.44'

D 90-37-20
D 02-29-20
D 183-44-00
AVE. 90-37-20

SEC. 16

SEC. 15

T.6N. R.10W.

TO TOP PG. 21

PLEASE RETURN TO
LOS ANGELES COUNTY ENGINEER
700 Los Angeles County Engineering Bldg.

Note: Any Additions or Changes on This Sheet Must be Made or Circled in Red Ink With Date and Name of Person Making Change.

Do not extend this side of this line.

Notes Ck'd by Goss
Map No. C.S. 8733
Office Work L. C. WILSON
Checked Miller
Date Dec. 1957

Survey of T.6N. R.10W.
JN 0302.01 Tape 16 Std 84 °F
Surveyed by J.C. PIERCE
Notes PIERCE Date 9-13-57
Indexed C. Johnson

F. B. 2293 Pg. 23

WS. 66-B-2

SEC. 10
T.6N. R.10W.

SEC. 15

FD. 2" IP PLUG & N. UP 9"

56.56 TAN.

56.56 TAN.

1/4 SECTION CORNER
SECS. 10 & 15 T.6N. R.10W.
FD. 2" I.P. & B.C. SET IN CONC.
FLUSH (POOR CONDITION) REPLACED
WITH A NEW 2" I.P. & B.C. IN CONC.
DN. 15" SEE FB 77-134
SEE C.S. 8733
MON. MKD.

FD. 2" IP PLUG
& N. UP 9"

AVE. "O"

SEC. LINE

T.6N. R.10W. COUNTY ENGINEER
10/15
1/4 COR.
RE 5866

TO PG. 22

Note: Any Additions or Changes on this Sheet Must be Made or Circled in Red Ink With Date and Name of Person Making Change.

Do not use this side of this line.

PLEASE RETURN TO
LOS ANGELES COUNTY ENGINEER BLDG.
700 Los Angeles County Engineer Bldg.

76F3098 SAE #247 1-56

F. B. 2293 Pg. 24

WS. 66-B-2

SEC. 15 T.6N. R.10W.

SEC. 22

SET 2" I.P. CEM. PL. & TAG UP 6"

40.00 TAN.

40.00 TAN.

SET 2" I.P. CEM PLUG & TAG UP 6"

90° 00'

¼ SECTION CORNER SECS. 15 & 22 T.6N. R.10W. FD. 2" I.P. & B.C. SET IN CONC. UP 6" PER FB 77-141 SEE C.S. 8733 LOWERED MON TO 15" BELOW SURFACE MON. MKD.

SURVEYORS T.6N. R.10W. COUNTY 15/22 1927 MONUMENT

A.V.E. P.

TO PG. 19

PLEASE RETURN TO
LOS ANGELES COUNTY ENGINEER
700 LOS ANGELES COUNTY ENGINEERING BLDG.
Do not extend this side of this line.

Note: Any Additions or Changes on This Sheet Must be Made or Circled in Red Ink With Date and Name of Person Making Change.

Notes Ck'd by C. J. GALLI	Survey of 35th St E
Map No.	JN 0021.60 Tape 121 Std 84 °F
Office Work	Surveyed by MACK
Checked	Notes m Date 9-17-57
Date	Indexed C. Johnson SEP 27 '57

F. B. 2293 PG. 25

J.N. 0021.60

35th St. E.

BET. PALMDALE BLVD & AVE R

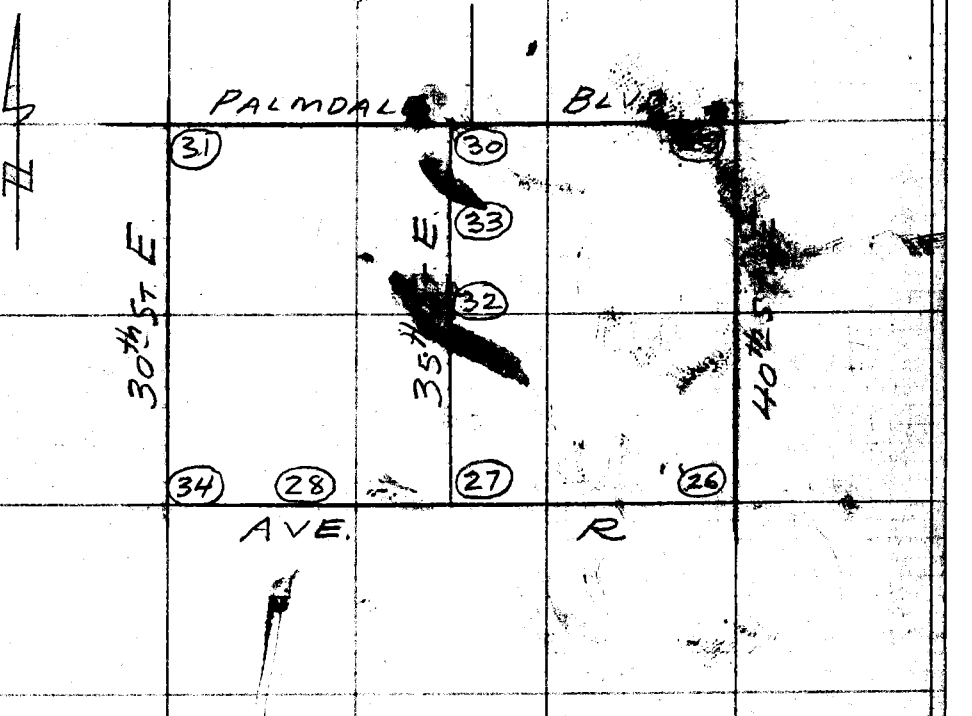

PARTY.
MACK
HALISCKY
RITTER
HUBBARD

Note: Any Additions or Changes on This Sheet Must be Made or Circled in Red Ink With Date and Name of Person Making Change.

Do not extend this side of this line.

PLEASE RETURN TO
LOS ANGELES COUNTY ENGINEER
700 LOS ANGELES COUNTY ENGINEERING BLDG.

767309 S&E #247 1-58

F.B. 2293 Pg. 26

To Bot Pg 27

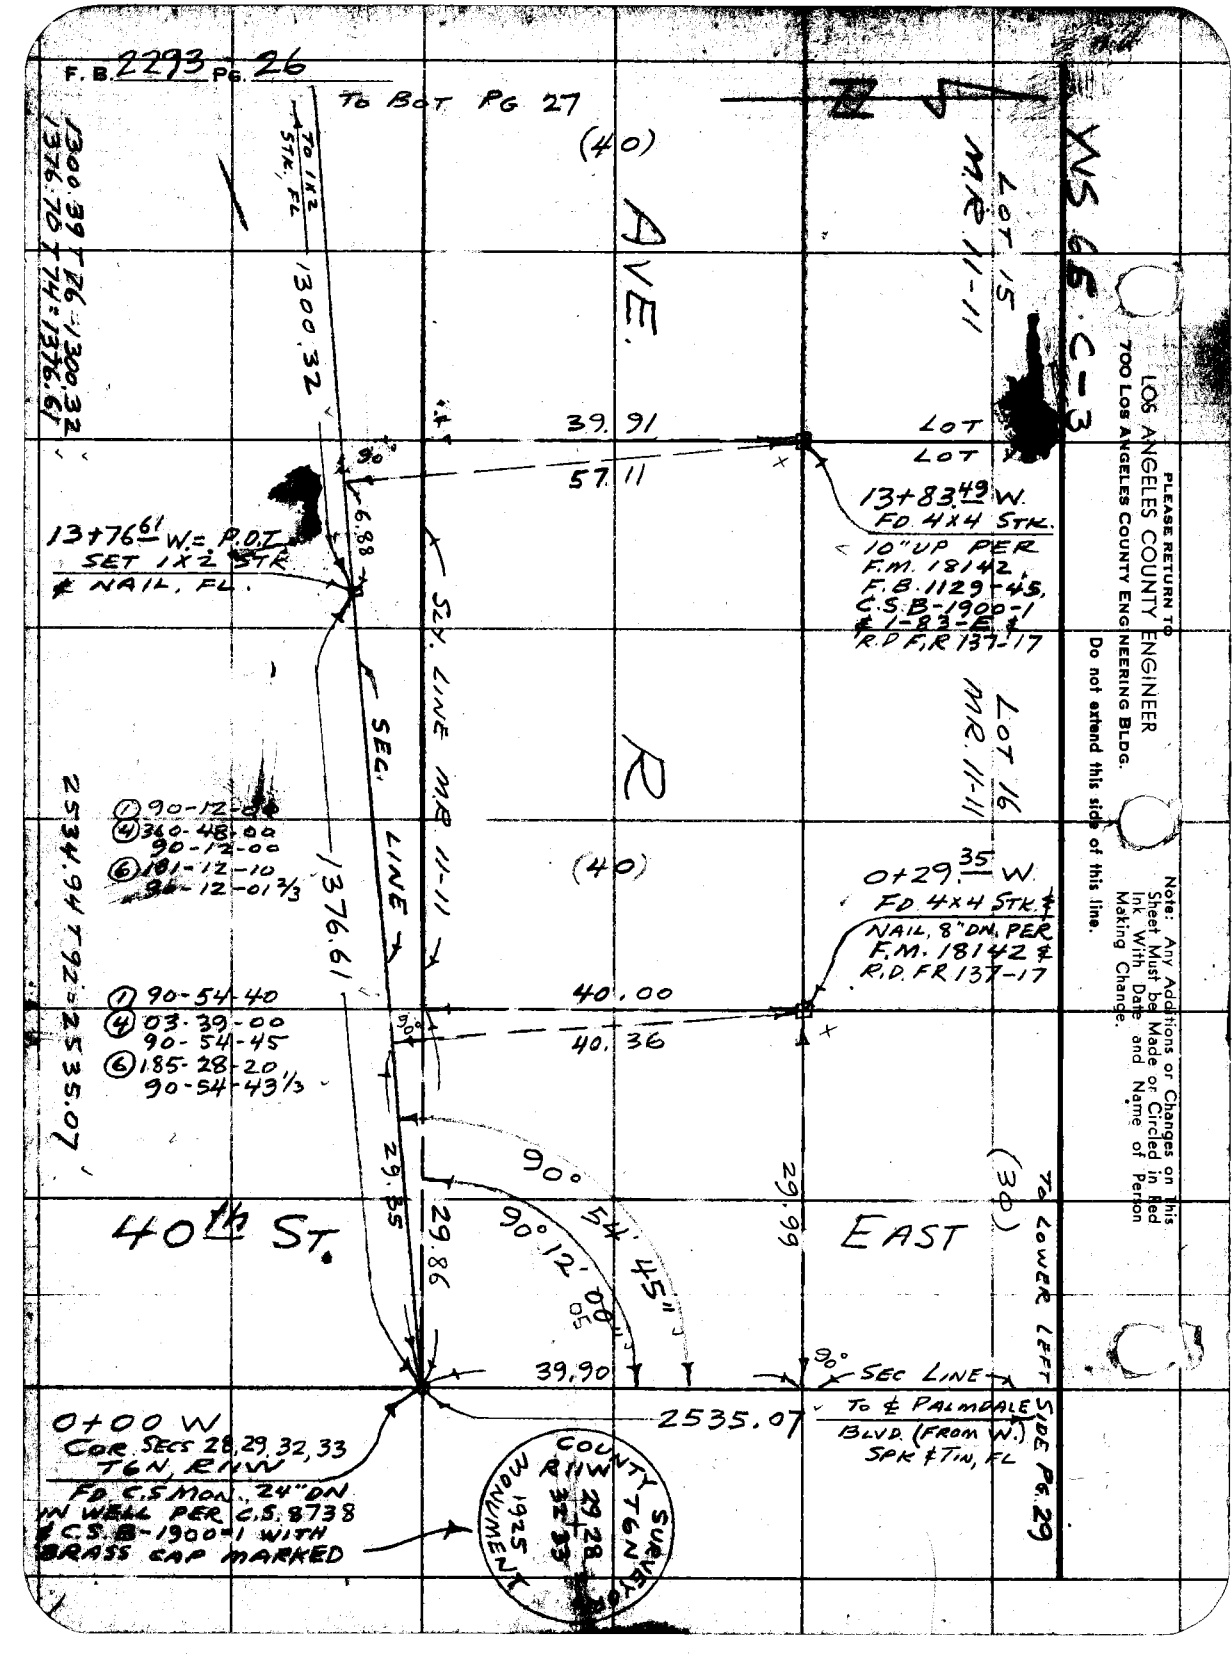

PLEASE RETURN TO
LOS ANGELES COUNTY ENGINEER
700 Los Angeles County Engineering Bldg.
Do not extend this side of this line.

Note: Any Additions or Changes on this Sheet Must be Made or Circled in Red Ink With Date and Name of Person Making Change.

Notes Ck'd by C. J. GALLI
Map No.
Office Work
Checked
Date

Survey of 35th St E
JN 6021.00 Tape 12Y Std 84 °F
Surveyed by MACK
Notes M Date 3-17-57
Indexed C. Johnson

F. B. 2293 Pg. 27

W 5 65 - C-3

To Bot Pg 28

SEC. LINE

① 91-22-10
④ 05-29-00
91-22-15
⑥ 188-13-30
91-22-15

8" P.C. SET 2" I.P. CONC. PLUG & NAIL, 10" UP

① 90-39-50
④ 02-39-10
90-39-47½
⑥ 183-58-20
90-39-43⅓

(40)

27+54.50 W. FD REMAINS OF OLD 4X4 STK. 12" DN. BY INT. S.E.M. 8142 & E.O. AR. 137-17

27+56.09 W FD CUT SPK & TIN FL. NO REF.

40.0

S 47½ Y. LINE M.R 11-11

34.29

40.10

74.26

28.46

INT. = 25+89.28 SET 2" I.P. CONC. PLUG & NAIL, TAGGED "L.A. CO. ENGR." 18" DN. BY INT. SET 1X2, FL.

INT. 27+26.04 W. = 26+23.11 So. SET 2" I.P. CONC. PLUG & NAIL TAG "L.A. CO. ENGR." 18" DN. BY INT. SET 1X2 STK., FL.

50.00

34.27

91° 42' 20"

77.69

& PROD.

90° 39' 45"

AVE.

35th ST. E.

30

40

225

33.83

39.97

211.83

45°

45°

27+21.82 W FD 2X2 STK & NAIL, 24" DN. NO REF.

21.39

77.69

41.62

27+00.43 W FD 1" I.P. FL.; NO REF.

0.07

90°

50.00

25.00

33.61

PROD. FROM N.

30.00

25+18.54 SET NAIL IN TOP OF CURB DIST. IN LINE FOR & 35.00 FROM M.P. 11-11

0.15

0.75

0.69

0.05

89° 10'

30'

27+00.37 W FD OLD 2X2 STK 10" DN. PER F.B. 1129-45

39.64

73.11

INT. = 27+00.98 W. SET 1" I.P. CONC. PLUG & NAIL TAG "L.A.C. ENGR." 12" DN. BY INT. SET 1X2, FL.

① 89-10-20
④ 356-41-30
89-10-22½
⑥ 175-02-30
89-10-25

1387.46

15.95

17.25

9.51

26+99.00 W FD 2X3 STK & NAIL, 12" DN NO REF

0.07

33.42

26+84.74 W FD 4X4 STK, FL.; NO REC.

P.P. SET 2" I.P. CONC. PLUG & NAIL, 8" UP

26+83.73 W. FD 3/4" I.P., PLUG & NAIL, FL. PER C.S.B-1900-L.S. F.B. 1129-45, 48

7.81

6.80

26+76.93 W FD 1X2 STK & NAIL, FL. PER F.B. 1129-48

SLY. LINE M.R 11-11

LOT 15 M.R 11-11

(40)

SEC. LINE

1300.32

To Top Pg 26

Note: Any Additions or Changes on this Sheet Must Be Made or Circled in Red Ink With Date and Name of Person Making Change.

Do not extend this side of this line.

PLEASE RETURN TO LOS ANGELES COUNTY ENGINEER 700 Los Angeles County Engineering Bldg.

767-3068 SAE #247 1-56

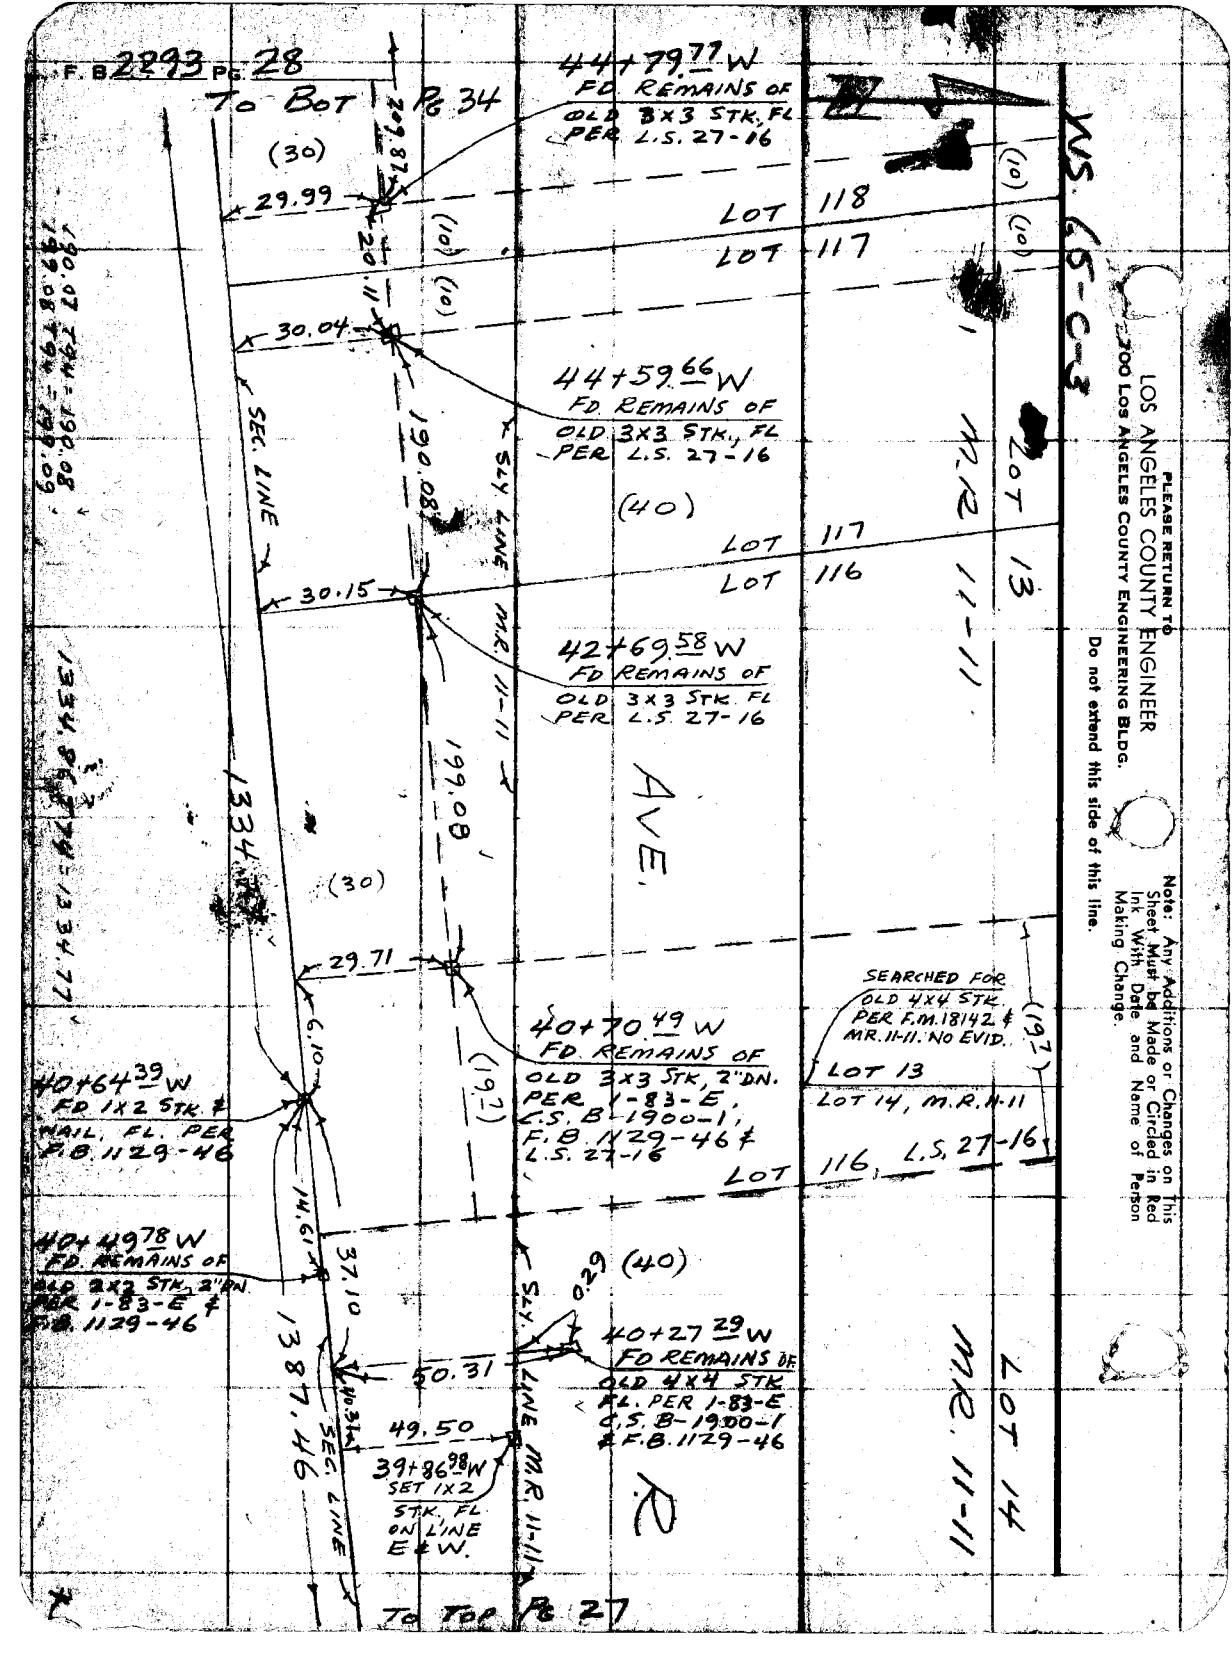
F.B. 2293 PG. 28
To Bot Pg 34
(30)
29.99
20.11
(10)
(10)
30.04
44+79.77 W
FD. REMAINS OF
OLD 3X3 STK. FL
PER L.S. 27-16
LOT 118
LOT 117
LOT 117
LOT 116
44+59.66 W
FD. REMAINS OF
OLD 3X3 STK., FL
PER L.S. 27-16
(40)
SLY. LINE
SEC. LINE
190.08
190.08
190.08
30.15
42+69.58 W
FD REMAINS OF
OLD 3X3 STK. FL
PER L.S. 27-16
MR. 11-11
AVE.
1334.77
(30)
29.71
6.10
(19.7)
40+64.39 W
FD 1X2 STK. &
NAIL, FL. PER
F.B. 1129-46
40+70.49 W
FD. REMAINS OF
OLD 3X3 STK, 2"DN.
PER 1-83-E,
L.S. B-1900-1,
F.B. 1129-46 &
L.S. 27-16
SEARCHED FOR
OLD 4X4 STK.
PER F.M. 18142 &
MR. 11-11. NO EVID.
(19.7)
LOT 13
LOT 14, M.R. 11-11
LOT 116, L.S. 27-16
40+49.78 W
FD. REMAINS OF
OLD 2X2 STK, 2"DN.
PER 1-83-E &
F.B. 1129-46
14.61
37.10
50.31
49.50
40.31
SEC. LINE
1387.46
0.29
(40)
S.L.Y. LINE M.R. 11-11
40+27.29 W
FD REMAINS OF
OLD 4X4 STK.
FL. PER 1-83-E
L.S. B-1900-1
& F.B. 1129-46
39+86.98 W
SET 1X2
STK., FL
ON LINE
E & W.
LOT 13
M.R. 11-11
LOT 14
M.R. 11-11
To Top Pg 27
LOS ANGELES COUNTY ENGINEER
900 Los Angeles County Engineering Bldg.
PLEASE RETURN TO
Do not extend this side of this line.
Note: Any Additions or Changes on This Sheet Must be Made or Circled in Red Ink With Date and Name of Person Making Change.

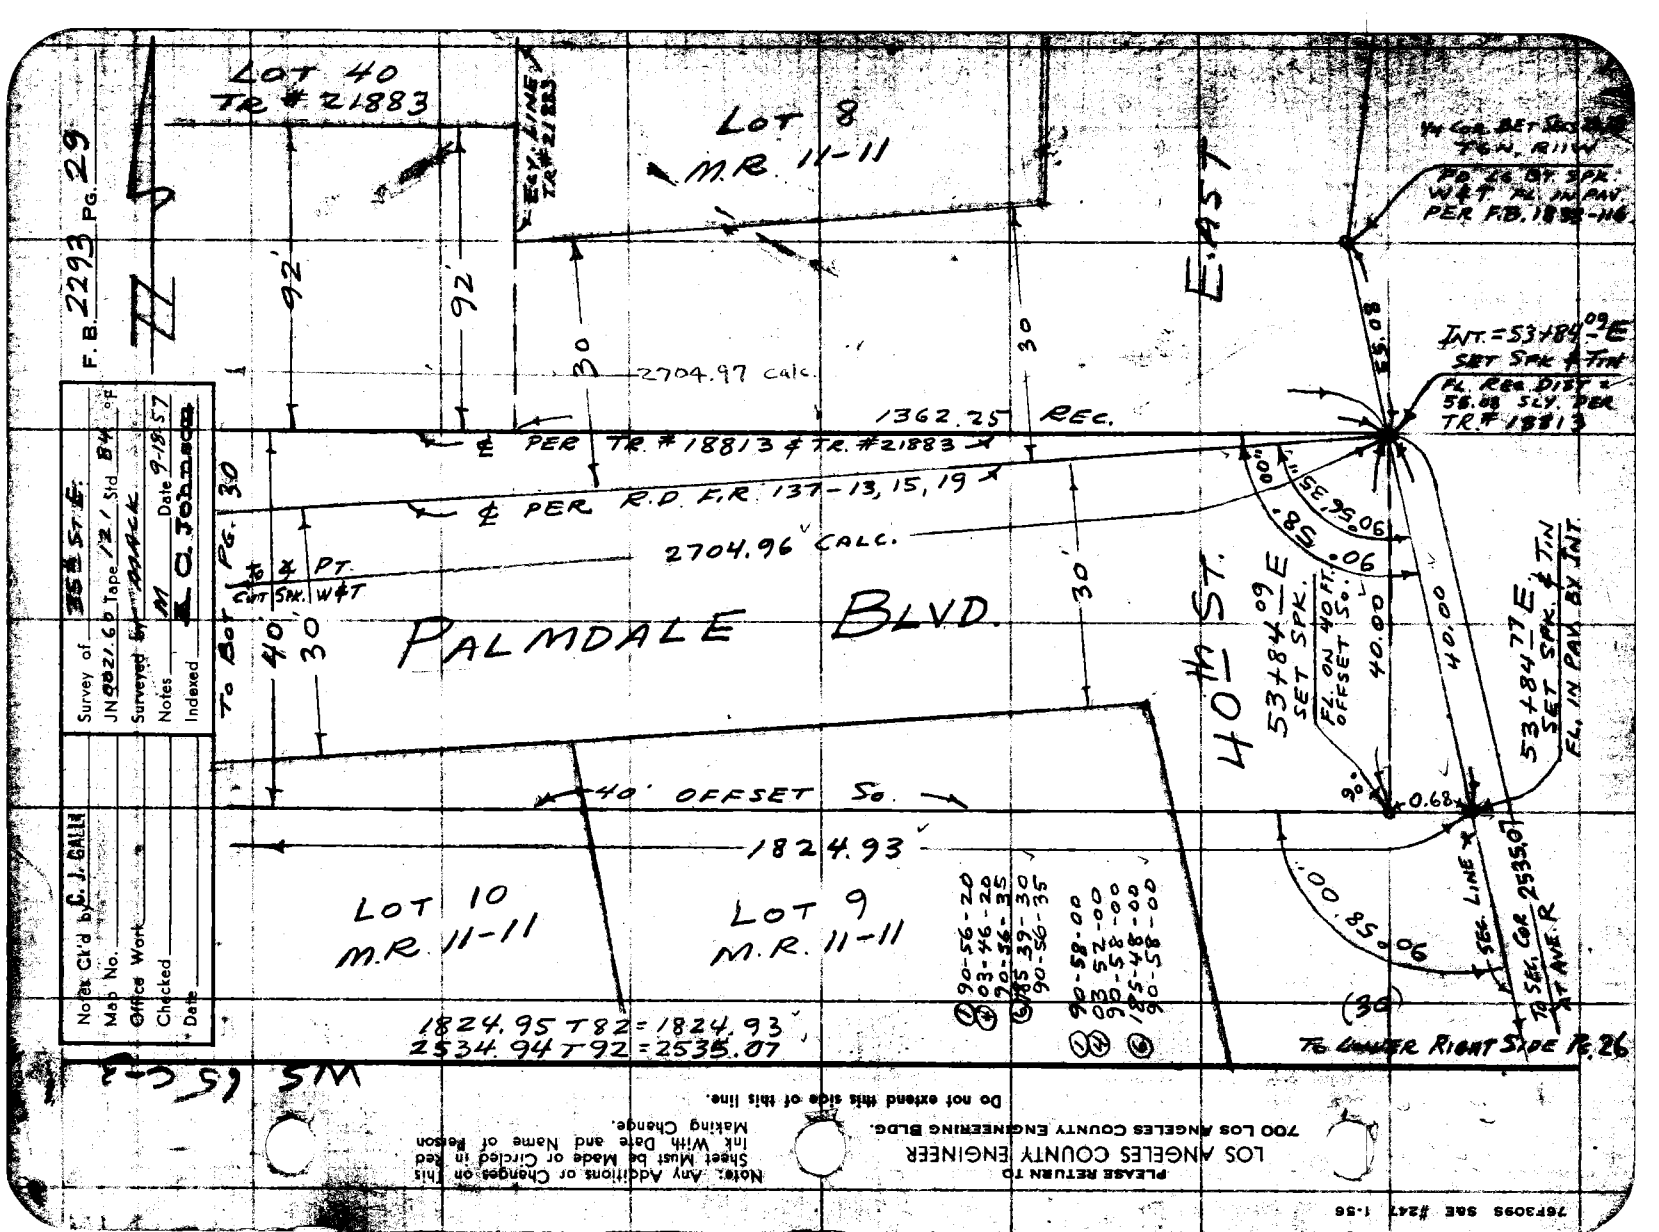
LOT 40
TR # 21883
LOT 8
M.R. 11-11
E'LY. LINE TR# 21883
EAST
92'
92'
30
2704.97 calc.
1362.25 REC.
℄ PER TR. # 18813 & TR. # 21883
℄ PER R.D. F.R. 137-13, 15, 19
2704.96' CALC.
30
30
PALMDALE BLVD.
40' OFFSET So.
1824.93
40TH ST.
53+84.09 E
SET SPK.
FD. ON 40 FT. OFFSET So.
40.00
40.00
53+84.77 E
SET SPK. & TIN
EL. IN PAV. BY INT.
INT. = 53+84.09 E
SET SPK & TIN
FL. REC. DIST. = 58.08 SCY. PER TR.# 18813
S 89° 35' 35" E 95.06
S 0° 00' 06" E 58.08
0.68
N 85° 00' 06" E
TO SEC. COR.
TO SEC. LINE
LOT 10
M.R. 11-11
LOT 9
M.R. 11-11
90-56-20
03-46-20
90-36-35
85 39-30
90-56-35
90-58-00
00-52-00
90-58-00
85-48-00
90-58-00
1824.95 T82 = 1824.93
2534.94 T92 = 2535.07
(36)
F.B. 2293 PG. 29
To Bot. Pg. 30
CNTR
SPK.
W&T
PT.
Survey of 35th ST. E.
JN 8821.6 b Tape 12 / Std. 84 off
Indexed
Notes Ck'd by C. J. CALIN
Map No.
Office Work
Checked
Date
PLEASE RETURN TO
LOS ANGELES COUNTY ENGINEER
700 LOS ANGELES COUNTY ENGINEERING BLDG.
Note: Any Additions or Changes on This Sheet Must Be Made or Circled in Red Ink With Date and Name of Person Making Change.
Do not extend this side of this line.
76F3095 SAE #247 1-56

PLEASE RETURN TO
LOS ANGELES COUNTY ENGINEER
700 LOS ANGELES COUNTY ENGINEERING BLDG.

Note: Any Additions or Changes on this Sheet Must be Made or Circled in Red Ink With Date and Name of Person Making Change.

Do not extend this side of this line.

W.S. 65 - C-3

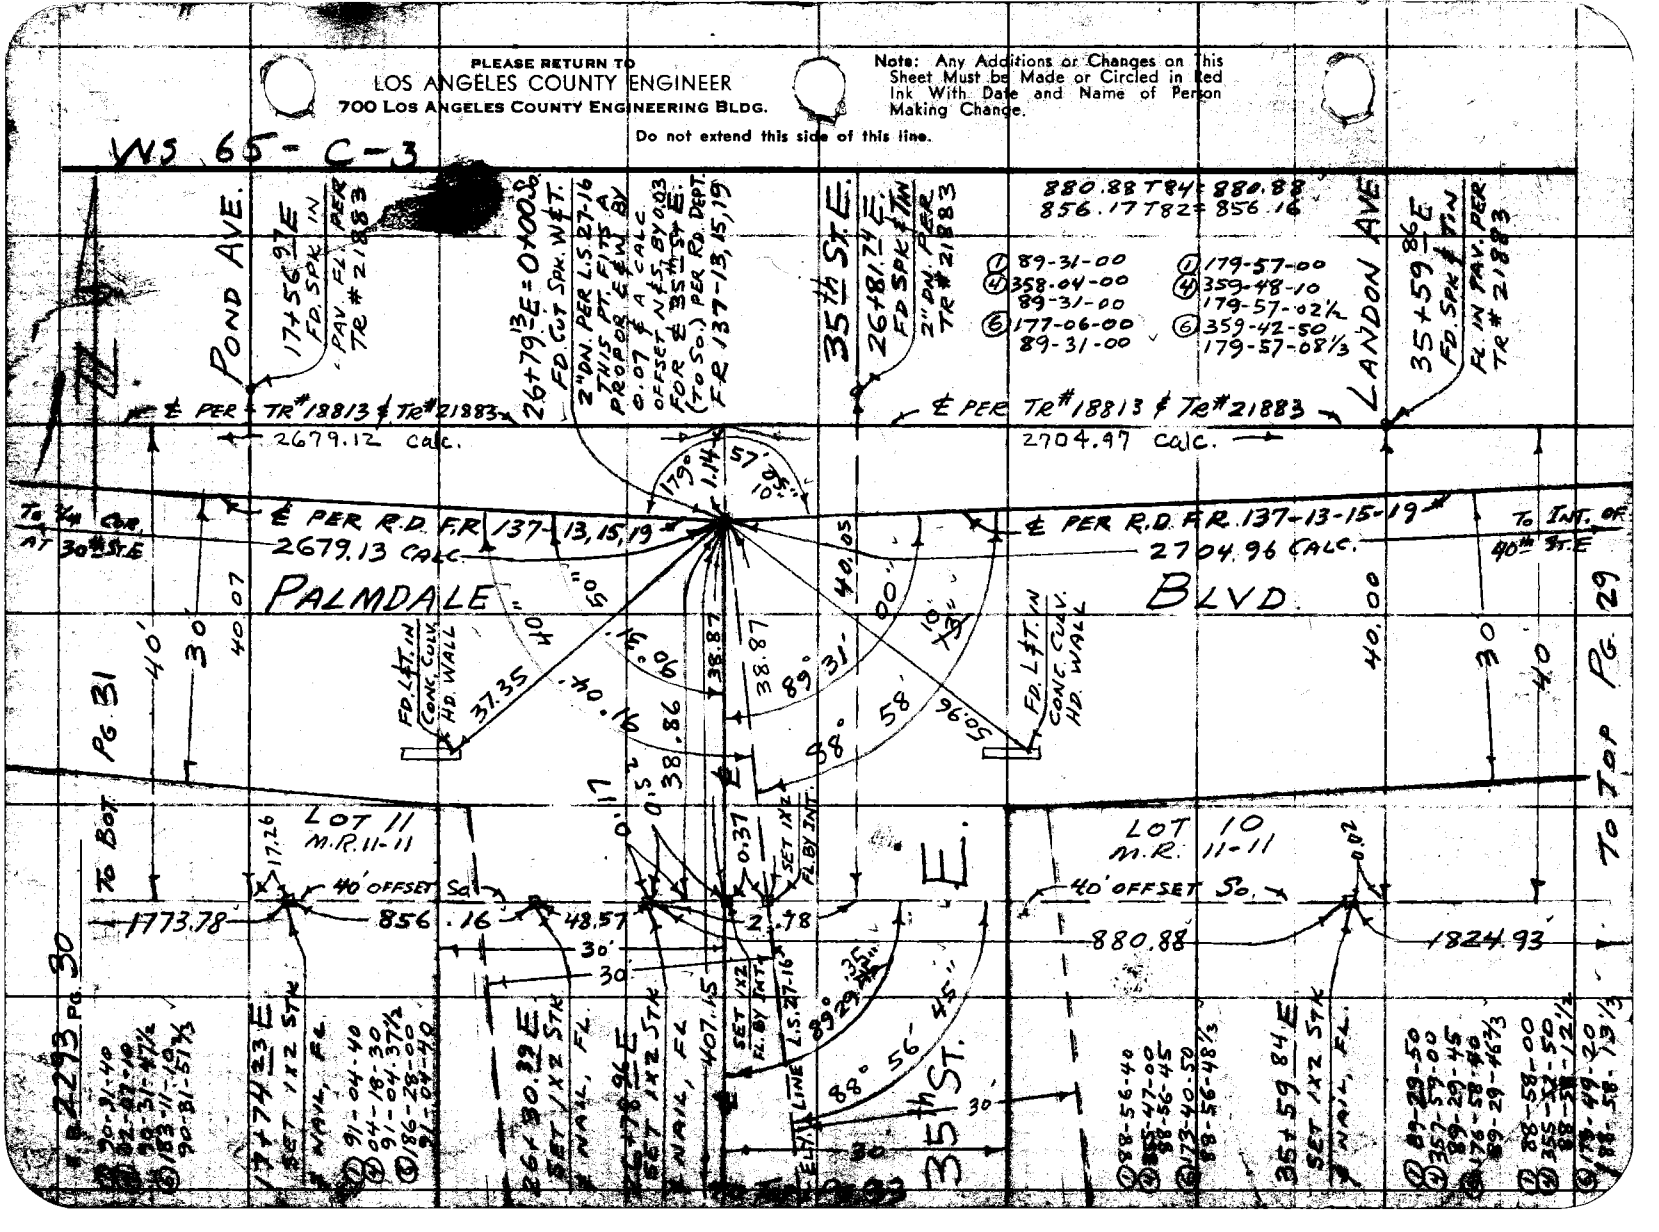

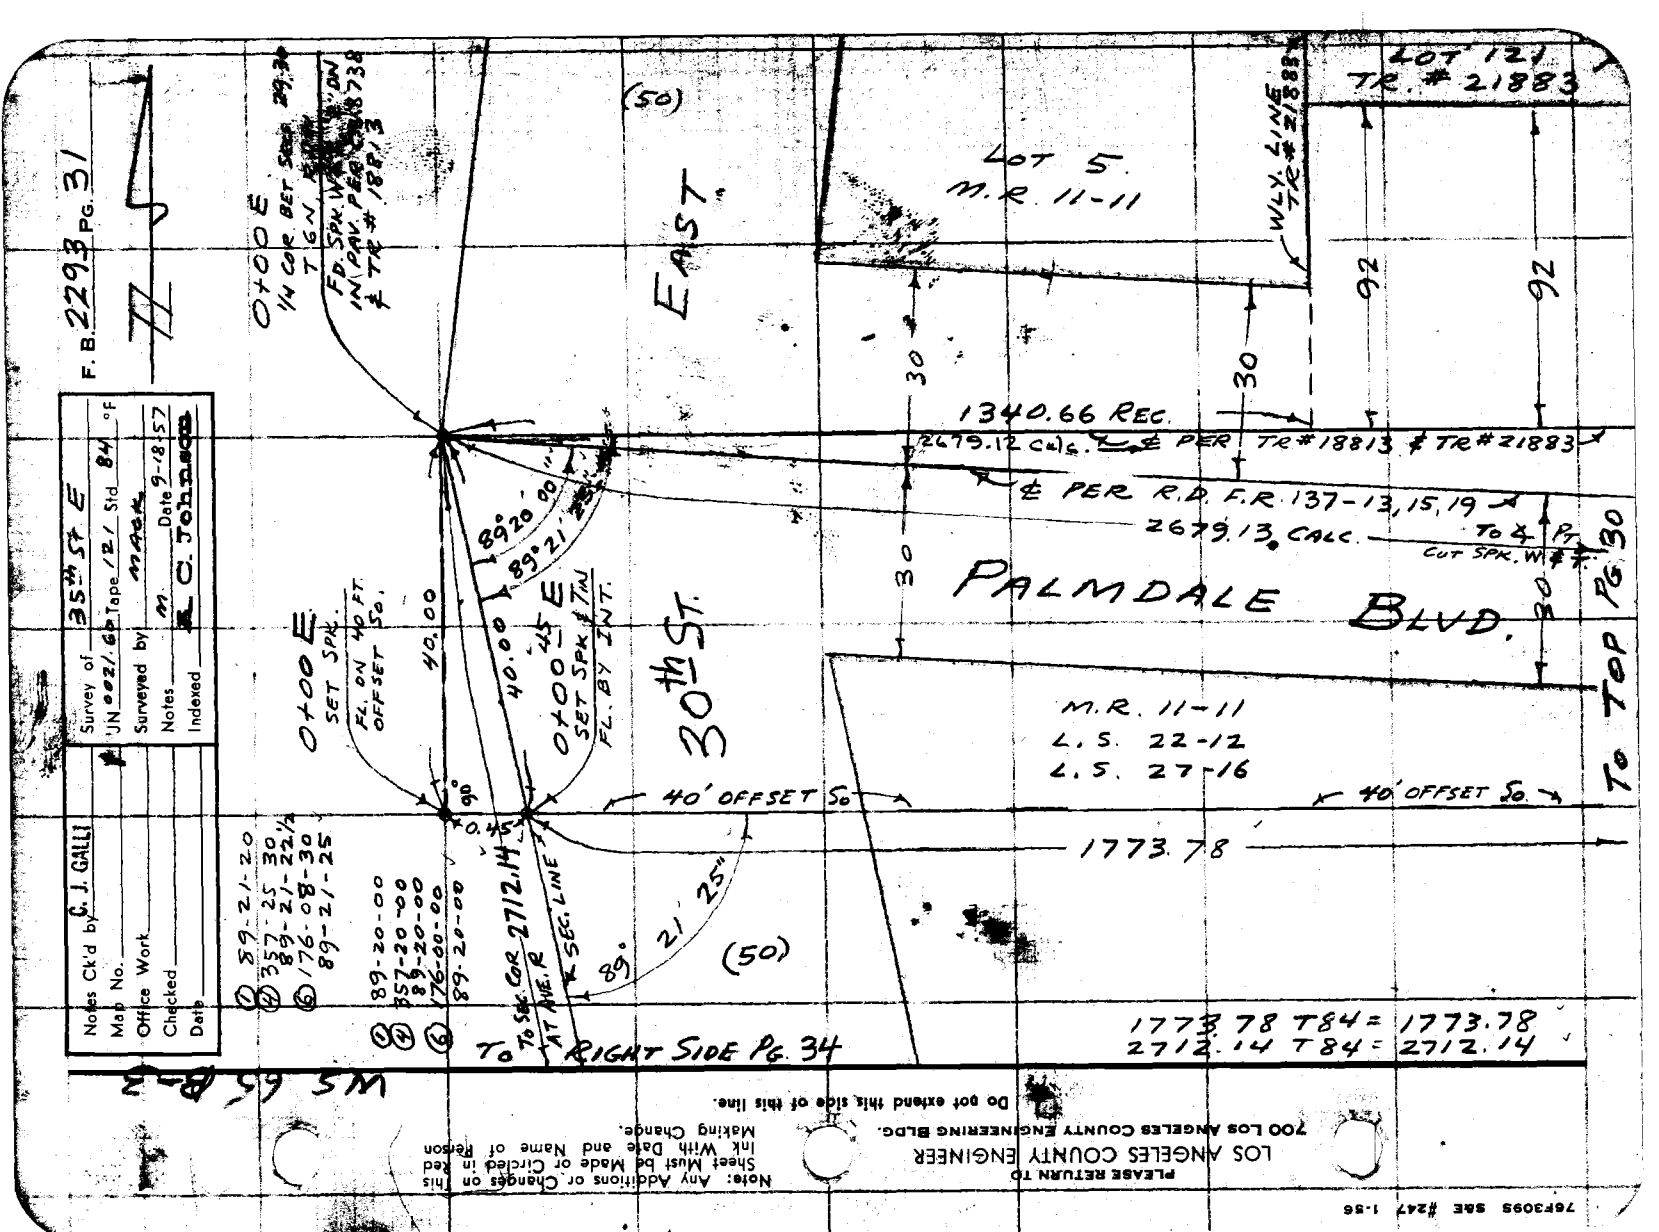
F.B. 2293 Pg. 31
Survey of 35th St E
Tape 12/ Std 84 °F
Surveyed by mass Date 9-18-57
Notes R. C. Johnson
Indexed
Notes Ck'd by C. J. GALLI
Map No.
Office Work
Checked
Date
0+00 E
1/4 COR BET SEC 29 & 30 T 6N R 11W
FD. SPK. W/ WASH. ON IN PAV. PER CS 8738 & TR # 18813
EAST
LOT 5 M.R. 11-11
LOT 121 TR. # 21883
W'LY LINE TR # 21883
92
92
30
30
1340.66 REC.
2679.12 CALC. ℄ PER TR # 18813 & TR # 21883
℄ PER R.S. F.R. 137-13, 15, 19
2679.13 CALC.
TO ℄ PT CUT SPK. W/ # 30
PALMDALE BLVD.
30
30
89°20'00"
89°21'25"
0+00 E SET SPK. FL. ON 40 FT. OFFSET So.
40.00
40.00
0+00.45 E SET SPK. & TW FL. BY INT.
30th ST.
M.R. 11-11
L.S. 22-12
L.S. 27-16
90°
40' OFFSET So.
40' OFFSET So.
0.45
1773.78
89° 21' 25"
(50)
(50)
① 89-21-20
② 357-25-30
89-21-22½
⑥ 176-08-30
89-21-25
① 89-20-00
② 357-20-00
89-20-00
⑥ 176-00-00
89-20-00
To SEC. COR 2712.14 AT INTER. R SEC. LINE
To RIGHT SIDE PG. 34
To Top Pg 30
1773.78 T84 = 1773.78
2712.14 T84 = 2712.14
W5 65 SM
PLEASE RETURN TO
LOS ANGELES COUNTY ENGINEER
700 LOS ANGELES COUNTY ENGINEERING BLDG.
Do not extend this side of this line.
Note: Any Additions or Changes on This Sheet Must Be Made or Circled in Red Ink With Date and Name of Person Making Change.
76F3095 SAE #247 1-56

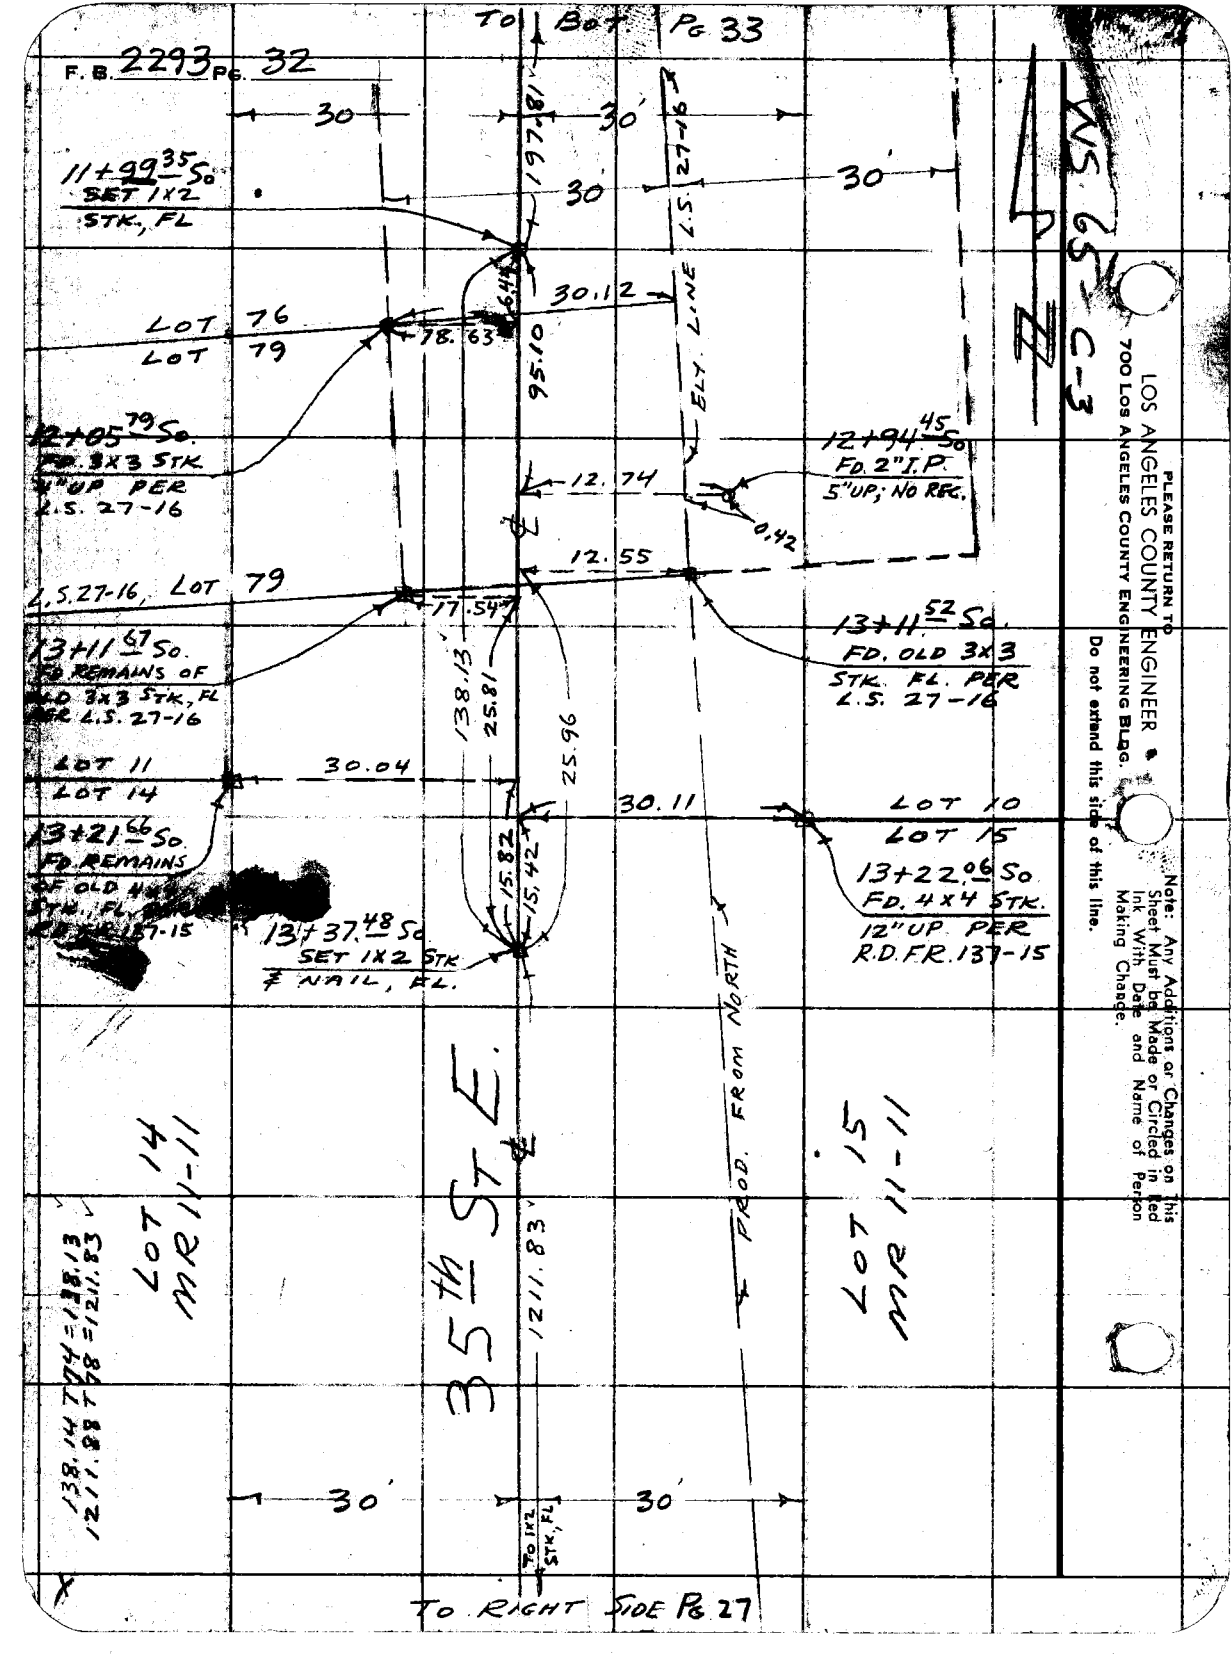
TO Bot. PG 33
F.B. 2293 PG. 32
30
30
30
30
197.81
27-16
11+99.35 So.
SET 1X2
STK., FL
30.12
ELY. LINE L.S. 27-16
LOT 76
LOT 79
78.63
6.44
95.10
12+05.79 So.
FD. 3X3 STK.
5" UP PER
L.S. 27-16
12+94.45 So
FD. 2" I.P.
5" UP; NO REC.
12.74
0.42
12.55
L.S. 27-16, LOT 79
17.54
13+11.67 So.
FD REMAINS OF
OLD 3X3 STK, FL
PER L.S. 27-16
13+11.52 So.
FD. OLD 3X3
STK. FL. PER
L.S. 27-16
138.13
25.81
25.96
LOT 11
LOT 14
30.04
30.11
LOT 10
LOT 15
13+21.66 So.
FD. REMAINS
OF OLD 4X4
STK. FL. PER
R.D.F.R. 137-15
15.82
15.42
13+37.48 So
SET 1X2 STK
W NAIL, FL.
13+22.06 So
FD. 4X4 STK.
12" UP PER
R.D.F.R. 137-15
PROD. FROM NORTH
35TH ST E.
LOT 14
MR 11-11
LOT 15
MR 11-11
1211.83
138.14 TOT = 138.13
1211.88 = 1211.83
30
30
TO 1X2 STK, FL
TO RIGHT SIDE PG 27
LOS ANGELES COUNTY ENGINEER
700 Los Angeles County Engineering Bldg.
PLEASE RETURN TO
Do not extend this side of this line.
Note: Any Additions or Changes on this Sheet Must be Made or Circled in Red Ink With Date and Name of Person Making Change.

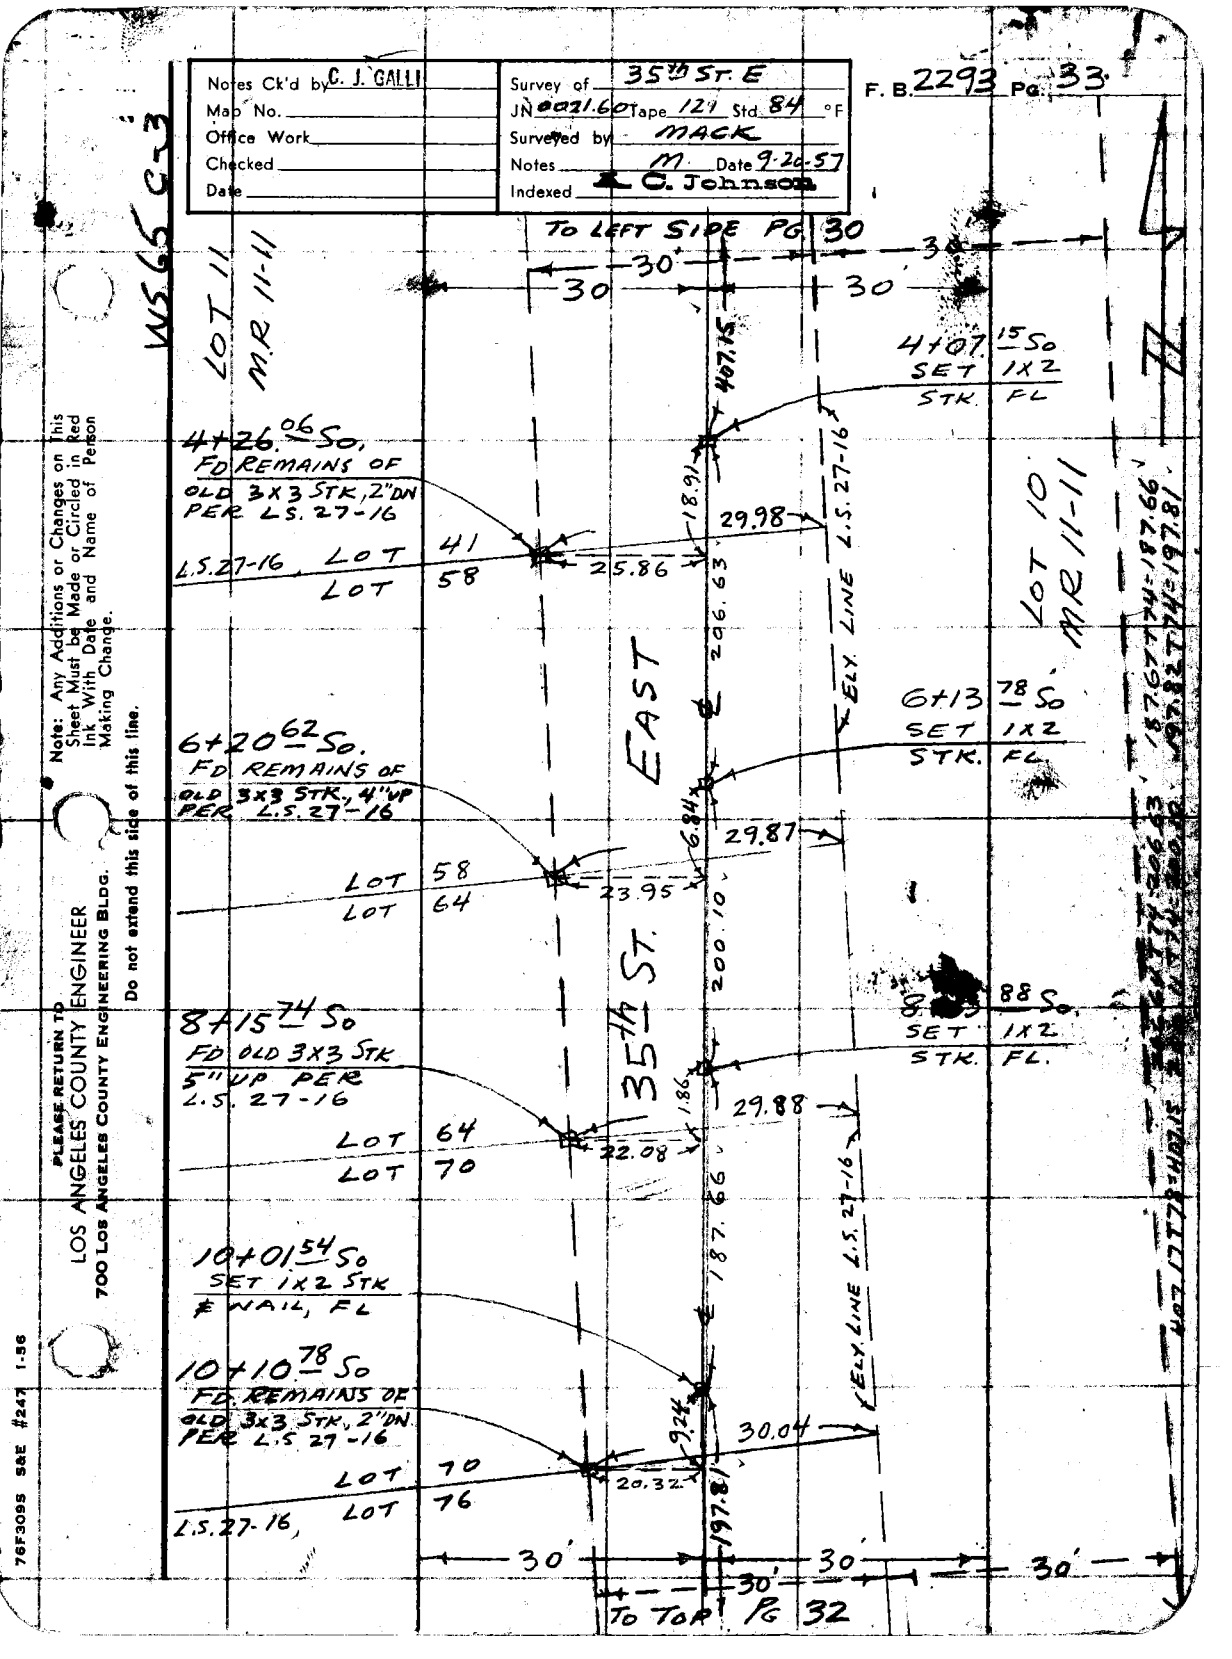
Notes Ck'd by C. J. GALLI
Map No.
Office Work
Checked
Date
Survey of 35th ST. E
JN 0021.60 Tape 121 Std 84 °F
Surveyed by MACK
Notes M. Date 9-26-57
Indexed C. Johnson
F. B. 2293 Pg. 33
WS 65 C-3
TO LEFT SIDE PG 30
LOT 11 MR 11-11
4+07.15 So SET 1X2 STK. FL
4+26.06 So, FD REMAINS OF OLD 3X3 STK, 2"DN PER L.S. 27-16
L.S.27-16, LOT 41 / LOT 58
18.91
29.98
25.86
407.15
ELY. LINE L.S. 27-16
206.63
EAST
35th ST.
LOT 10 MR 11-11
6+13.78 So SET 1X2 STK. FL
6+20.62 So. FD REMAINS OF OLD 3X3 STK, 4"UP PER L.S. 27-16
LOT 58 / LOT 64
6.84
29.87
23.95
200.10
8+15.74 So FD OLD 3X3 STK 5"UP PER L.S. 27-16
LOT 64 / LOT 70
1.86
29.88
22.08
187.66
ELY. LINE L.S. 27-16
10+01.54 So SET 1X2 STK # NAIL, FL
10+10.78 So FD. REMAINS OF OLD 3X3 STK, 2"DN PER L.S 27-16
LOT 70 / LOT 76
L.S. 27-16,
9.24
30.04
20.32
197.81
30'
TO TOP PG 32
Note: Any Additions or Changes on this Sheet Must be Made or Circled in Red Ink With Date and Name of Person Making Change.
Do not extend this side of this line.
PLEASE RETURN TO
LOS ANGELES COUNTY ENGINEER
700 Los Angeles County Engineering Bldg.
76F3095 S&E #247 1-56

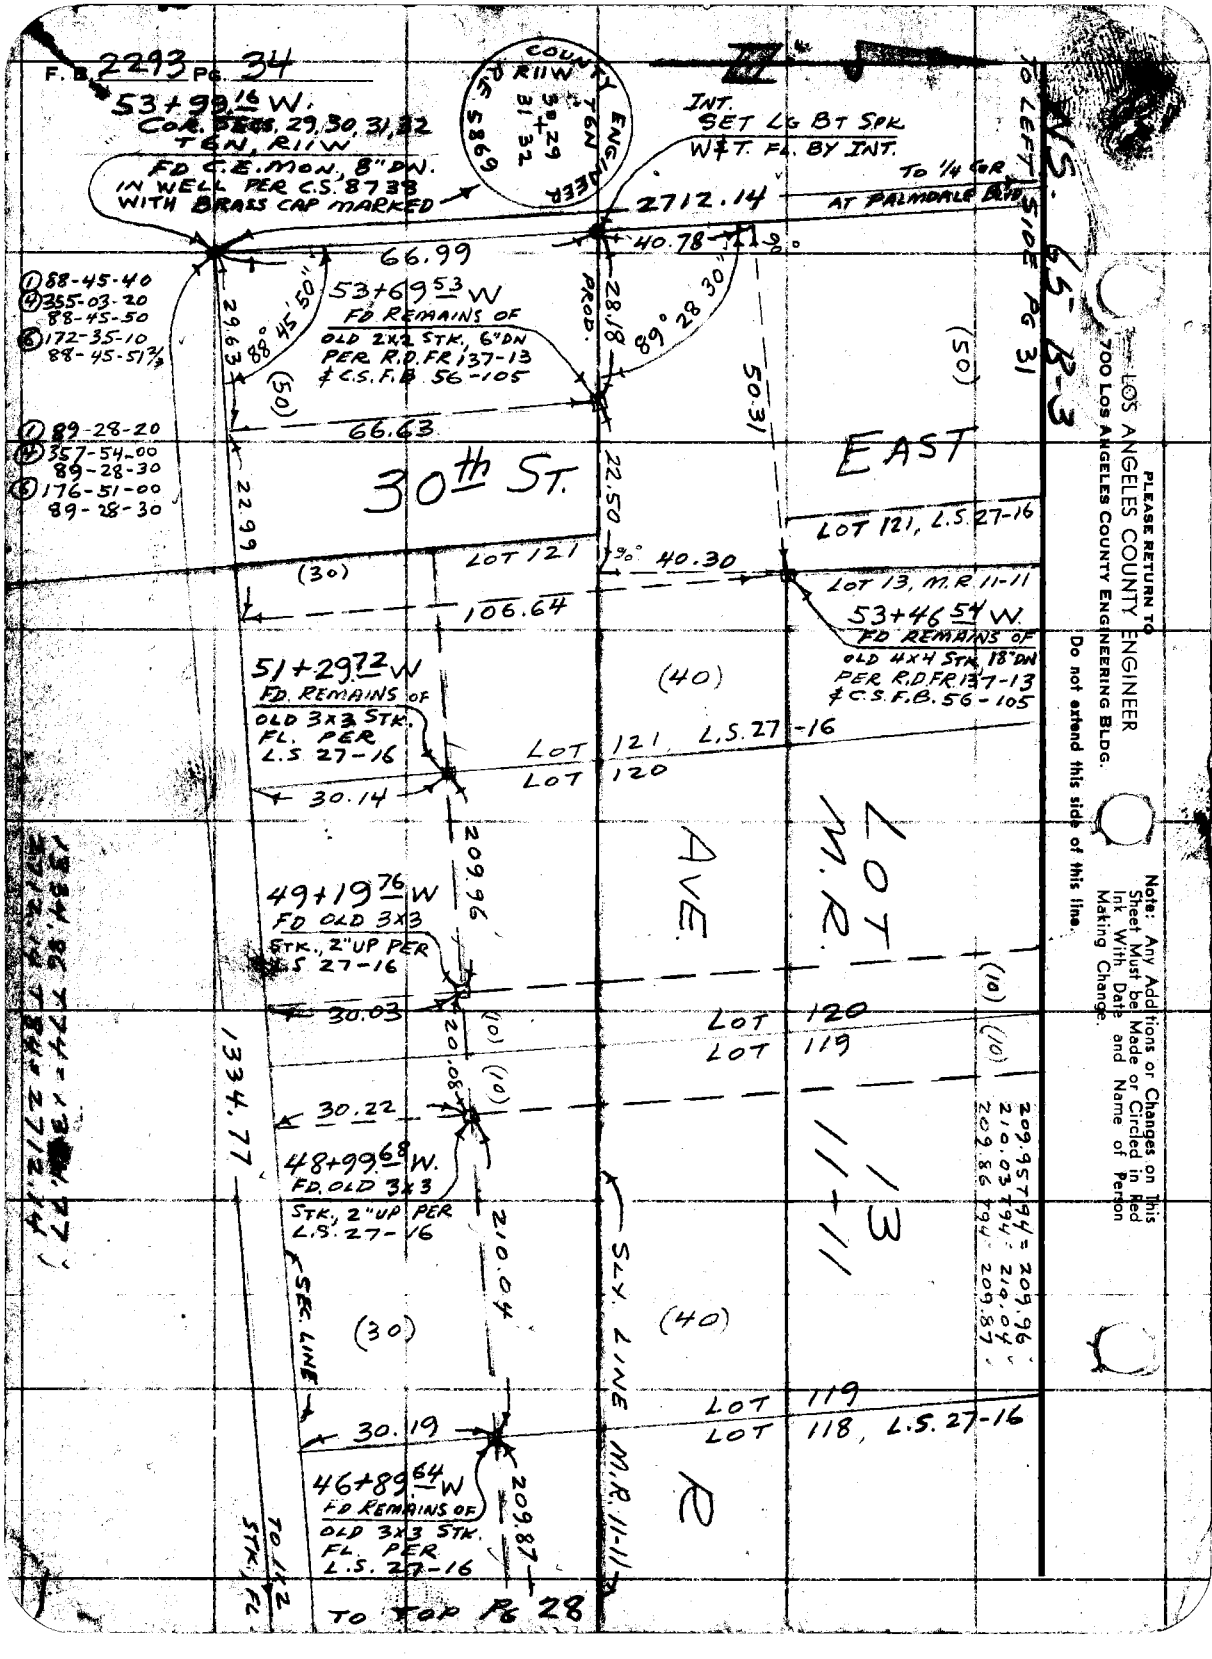
F.B. 2293 PG. 34
53+99.16 W.
COR. DEGS. 29,30,31,32
T6N, R11W
FD C.E. MON. 8" DN.
IN WELL PER C.S. 8738
WITH BRASS CAP MARKED
COUNTY ENGINEER
T6N R11W
Sec. 29 31 32
5869
INT.
SET LG BT SPK.
W.T. FA. BY INT.
TO 1/4 COR. AT PALMDALE BLVD.
2712.14
40.78
112°
TO LEFT SIDE PG 31
LOS ANGELES COUNTY ENGINEER
700 LOS ANGELES COUNTY ENGINEERING BLDG.
PLEASE RETURN TO
Note: Any Additions or Changes on This Sheet Must be Made or Circled in Red Ink With Date and Name of Person Making Change.
Do not extend this side of this line.
66.99
53+69.53 W
FD REMAINS OF
OLD 2x2 STK, 6" DN
PER R.D.FR 137-13
& C.S.F.B. 56-105
(50)
88° 45' 50"
29.63
PROD.
28.18
89° 28' 30"
50.31
(50)
EAST
66.63
30th ST.
22.99
22.50
LOT 121, L.S. 27-16
LOT 121
(30)
9°
40.30
LOT 13, M.R. 11-11
106.64
53+46.54 W
FD. REMAINS OF
OLD 4x4 STK, 18" DN
PER R.D.FR 137-13
& C.S.F.B. 56-105
51+29.72 W
FD. REMAINS OF
OLD 3x3 STK.
FL. PER
L.S. 27-16
(40)
LOT 121, L.S. 27-16
LOT 120
30.14
209.96
AVE.
LOT 13 M.R. 11-11
49+19.76 W
FD OLD 3x3
STK., 2" UP PER
L.S. 27-16
30.03
(10)
(10)
LOT 120
LOT 119
209.95 + 0.94 = 209.96'
210.03 + 0.94 = 210.04'
209.86 + 0.94 = 209.87'
30.22
20.08
48+99.69 W.
FD. OLD 3x3
STK, 2" UP PER
L.S. 27-16
1334.77'
1334.77' = 1334.77' = 2712.14'
210.04
SLY. LINE M.R. 11-11
(30)
(40)
SER. LINE
LOT 119
LOT 118, L.S. 27-16
30.19
209.87
46+89.64 W
FD REMAINS OF
OLD 3x3 STK.
FL. PER
L.S. 27-16
TO 1/2 STK. FL.
TO TOP PG 28
(1) 88-45-40
(4) 355-03-20
88-45-50
(5) 172-35-10
88-45-51 1/2
(1) 89-28-20
(4) 357-54-00
89-28-30
(5) 176-51-00
89-28-30

Notes Ck'd by	Survey of SEC. LINES, T7N, R11W
Map No.	JN 0302.01 Tape 121 Std. 84 °F
Office Work	Surveyed by MACK
Checked	Notes M Date 9-26-57
Date	Indexed C. Johnson 7-6-59

F. B. 229 PG. 35

J.N. 0302.01

SEC. LINE TIES

ON

40th ST. E.

BET. AVES. K-8 & L-8

Note: Any Additions or Changes on this Sheet Must be Made or Circled in Red Ink With Date and Name of Person Making Change.

Do not extend this side of this line..

PLEASE RETURN TO
LOS ANGELES COUNTY ENGINEER
700 LOS ANGELES COUNTY ENGINEERING BLDG.

PARTY
MACK
HALISCKY
RITTER
HUBBARD

76F3095 S&E #247 1-56

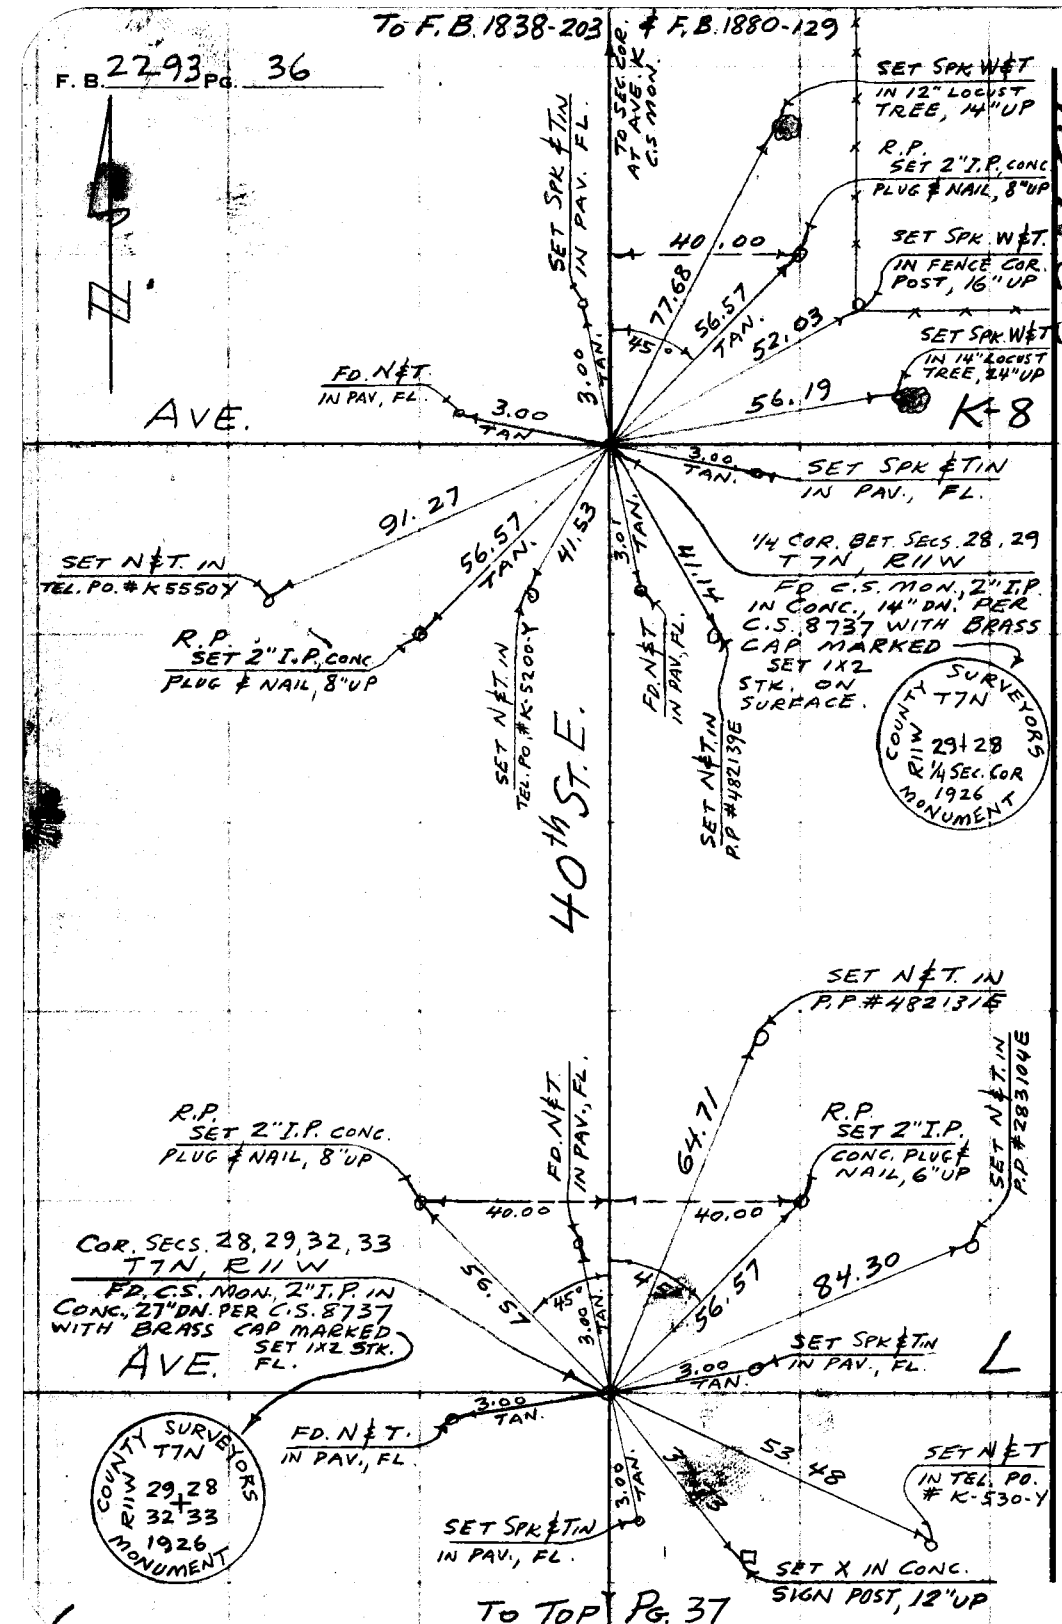
To F.B. 1838-203
To F.B. 1880-129
F.B. 2293 PG. 36
AVE.
SET SPK. W/ ET. IN 12" LOCUST TREE, 14" UP
R.P. SET 2" I.P. CONC PLUG & NAIL, 8" UP
SET SPK. W/ ET. IN FENCE COR. POST, 16" UP
SET SPK. W/ ET IN 14" LOCUST TREE, 24" UP
K 8
TO SEC. COR. AT AVE. K & C.S. MON.
SET SPK & TIN IN PAV. FL.
FD. N & T. IN PAV. FL.
3.00 TAN.
40.00
77.68
56.57 TAN.
52.03
56.19
45°
SET SPK & TIN IN PAV., FL.
91.27
SET N & T. IN TEL. PO. # K 5550 Y
R.P. SET 2" I.P. CONC PLUG & NAIL, 8" UP
41.53
SET N & T. IN TEL. PO. # K 5200 Y
40TH ST. E.
41.11
FD. N & T. IN PAV. FL.
SET N & T. IN R.P. # 482139 E
1/4 COR. BET. SECS. 28, 29 T 7N, R 11 W
FD. C.S. MON. 2" I.P. IN CONC., 14" DN. PER C.S. 8737 WITH BRASS CAP MARKED SET 1X2 STK. ON SURFACE.
COUNTY SURVEYORS T 7N R 11 W 29 28 1/4 SEC. COR 1926 MONUMENT
SET N & T. IN R.P. # 482131 E
64.71
R.P. SET 2" I.P. CONC. PLUG & NAIL, 8" UP
FD. N & T. IN PAV., FL.
40.00
40.00
R.P. SET 2" I.P. CONC. PLUG & NAIL, 6" UP
SET N & T. IN R.P. # 482136 E
COR. SECS. 28, 29, 32, 33 T 7N, R 11 W
FD. C.S. MON. 2" I.P. IN CONC. 27" DN. PER C.S. 8737 WITH BRASS CAP MARKED SET 1X2 STK.
AVE.
56.57
45°
3.00 TAN.
84.30
SET SPK & TIN IN PAV., FL.
L
3.00 TAN.
FD. N & T. IN PAV., FL.
COUNTY SURVEYORS T 7N R 11 W 29 28 + 32 33 1926 MONUMENT
53.48
SET N & T IN TEL. PO. # K-530-Y
SET SPK & TIN IN PAV., FL.
SET X IN CONC. SIGN POST, 12" UP
To Top Pg. 37
WS 70 C-5
PLEASE RETURN TO LOS ANGELES COUNTY ENGINEER 700 LOS ANGELES COUNTY ENGINEERING BLDG.
Do not extend this side of this line.
Note: Any Additions or Changes on This Sheet Must be Made or Circled in Red Ink With Date and Name of Person Making Change.

Notes Ck'd by	Survey of SEC. LINES, T7N, R11W
Map No.	JN 0302.01 Tape 121 Std 84 °F
Office Work	Surveyed by MACK
Checked	Notes M. C. Johnson Date 9-26-57
Date	Indexed

F. B. 2293 PG. 37

TO BOT. PG. 36

WS. 20 C-6

SET SPK. W.&T. IN 30" ELM TREE, 16"UP

SET N&T IN P.P. # 282899E

SET SPK & TIN IN PAV., FL.

TO SEC. COR. AT AVE L, C.S. MON.

EAST

SET N&T IN P.P. # 482123E

64.51

65.61

3.00

41.53

AVE.

40.48

3.00

SET SPK & TIN IN PAV., FL.

L-8

SET SPK. W&T. IN 30" ELM TREE, 15"UP

35.89

94.00

SET SPK W&T. IN 18" ASH TREE, 9"UP

64.24

1/4 COR. BET. SECS. 32, 33 T7N, R11W FD. C.S. MON., 2" I.P. IN CONC., 12" DN PER C.S. 8737 WITH BRASS CAP MARKED SET 1X2 STK. ON SURFACE

SET N&T. IN P.P. # 970883E

SET N&T. IN P.P. # 970884E

40th ST.

COUNTY SURVEYORS T7N R11W 32+33 R1/4 SEC. COR. 1926 MONUMENT

TO SEC. COR. AT AVE. M, C.S. MON.

Note: Any Additions or Changes on this Sheet Must be Made or Circled in Red Ink With Date and Name of Person Making Change.

PLEASE RETURN TO LOS ANGELES COUNTY ENGINEER 700 LOS ANGELES COUNTY ENGINEERING BLDG.

Do not extend this side of this line.

76F3095 S&E #247 1-56

TO UPPER LEFT SIDE F.B. 1838-134

To F.B. 1838 - 44

F. B. 2293 Pg. 38

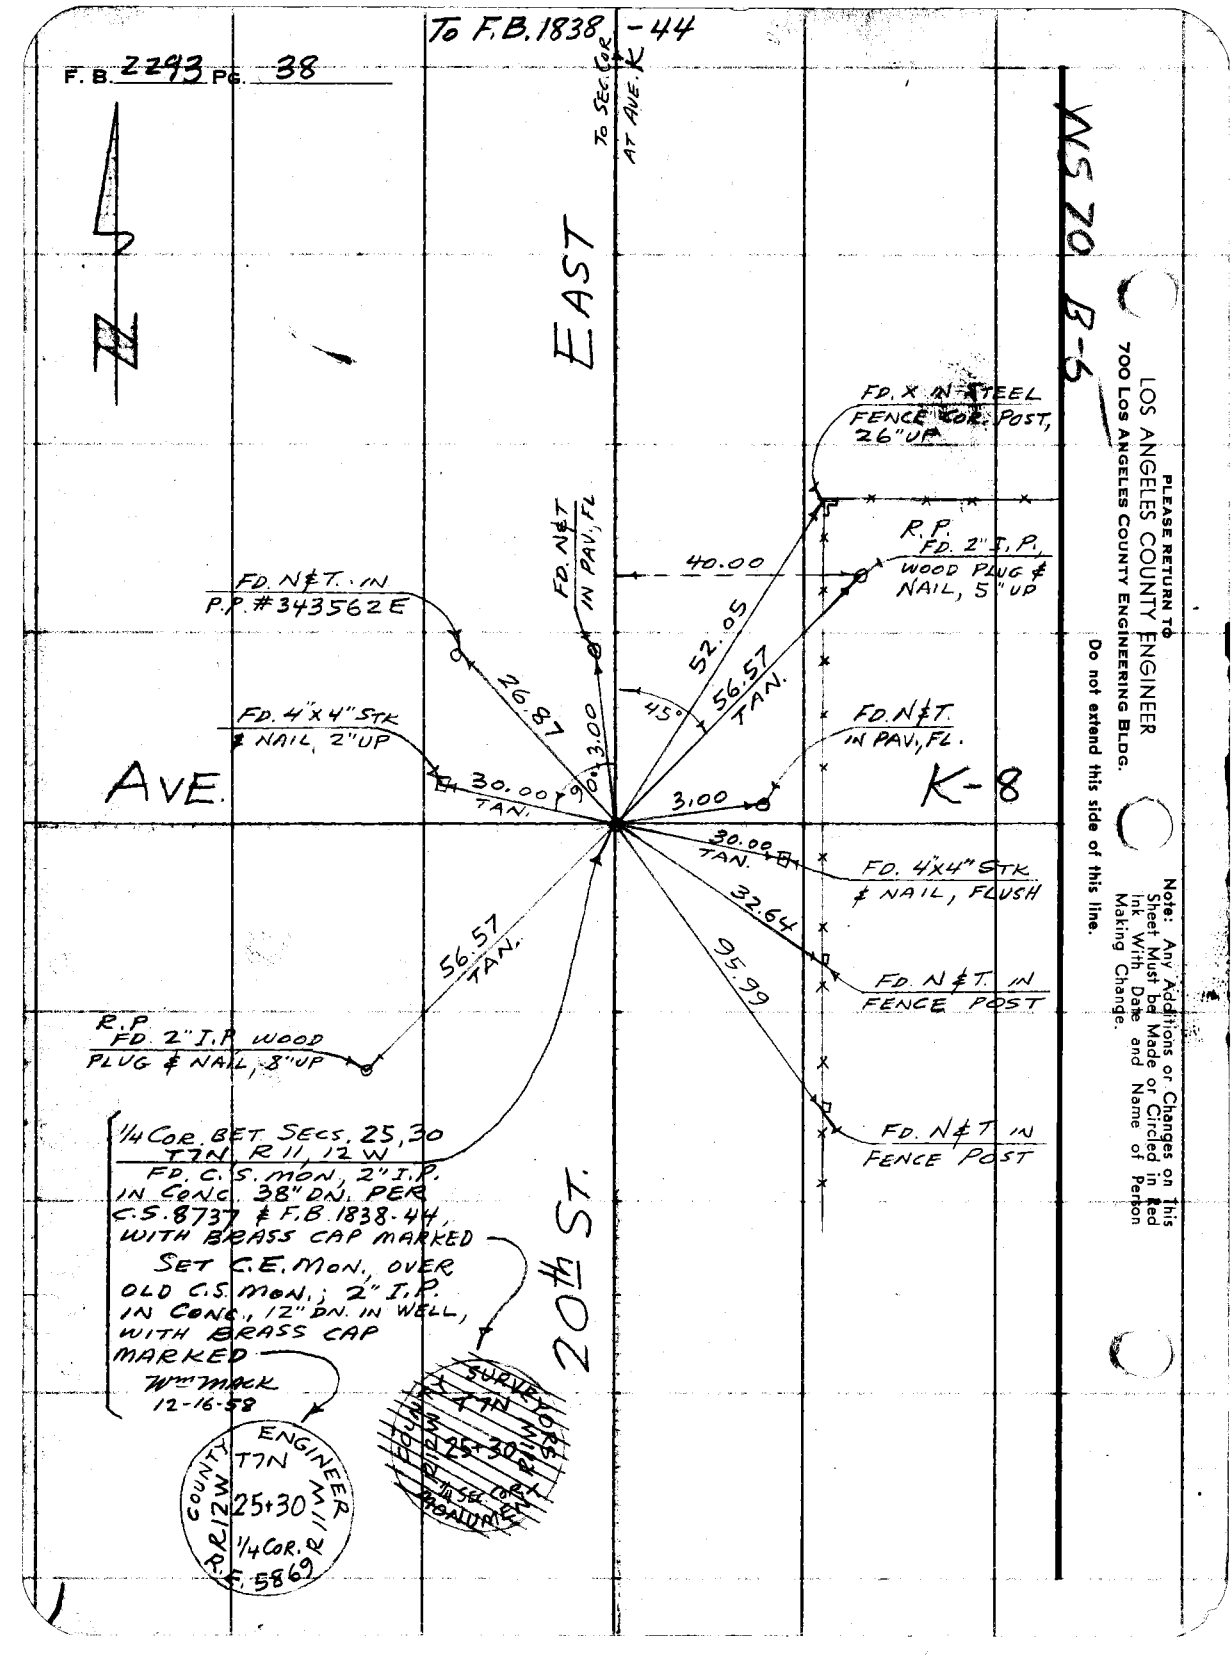

LOS ANGELES COUNTY ENGINEER
700 Los Angeles County Engineering Bldg.

PLEASE RETURN TO

Note: Any Additions or Changes on This Sheet Must be Made or Circled in Red Ink With Date and Name of Person Making Change.

Do not extend this side of this line.

Notes Ck'd by Galli	Survey of SEC. LINES, T7N, R12W
Map No. CSC-831-1	JN 0302.01 Tape 121 Std 84 °F
Office Work Ichien	Surveyed by MACK
Checked C.J. Galli	Notes M Date 10-24-57
Date 11-7-57	Indexed A C. Johnson 11-8-57

F. B. 2293 PG. 39

JN. 0302.01

REPLACEMENT OF 1/4 SEC. COR. MON.

WITH

C.E. MON.

ON

AVE. J & 5th ST E.

PARTY
MACK
HALISCKY
RITTER
HUBBARD

Note: Any Additions or Changes on This Sheet Must be Made or Circled in Red Ink With Date and Name of Person Making Change.

Do not extend this side of this line.

PLEASE RETURN TO
LOS ANGELES COUNTY ENGINEER
700 Los Angeles County Engineering Bldg.

76F309S S&E #247 1-56

PLEASE RETURN TO
LOS ANGELES COUNTY ENGINEER
700 LOS ANGELES COUNTY ENGINEERING BLDG.

Note: Any Additions or Changes on This Sheet Must be Made or Circled in Red Ink With Date and Name of Person Making Change.

Do not extend this side of this line.

WS 70 A5

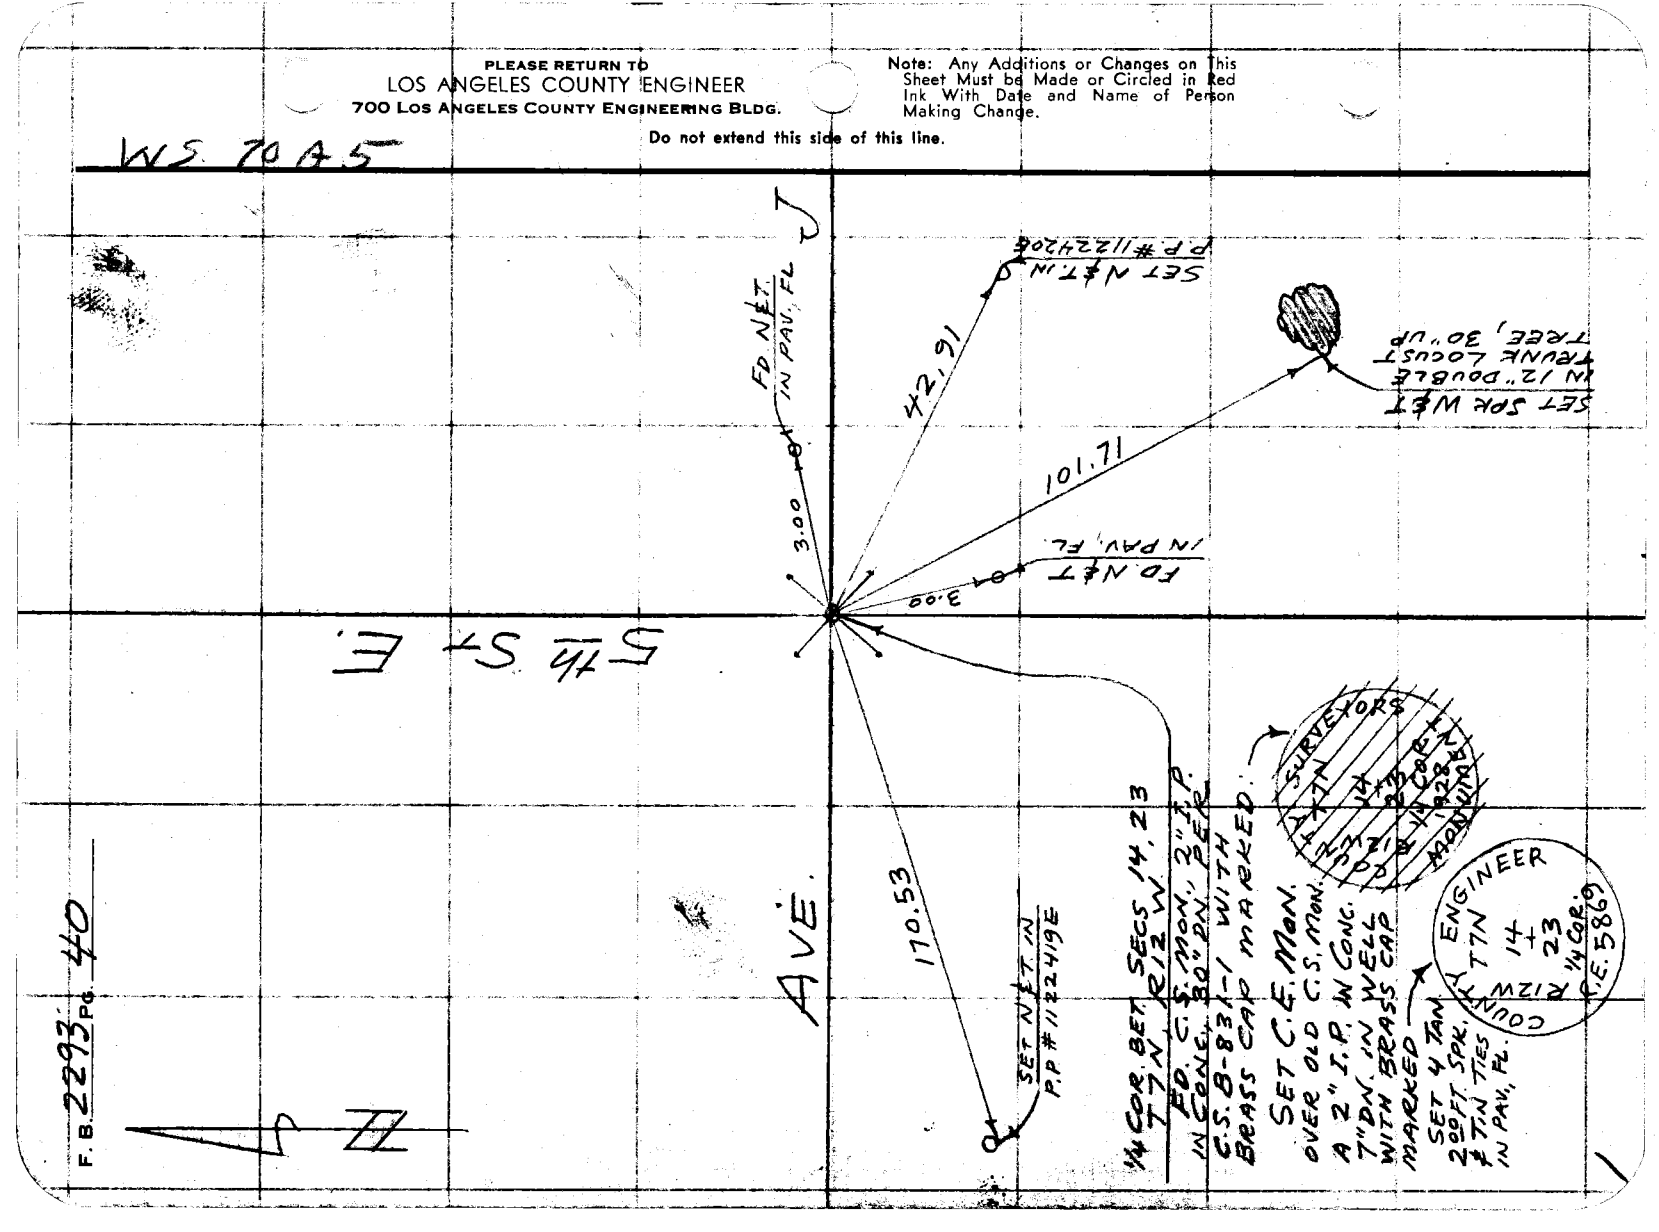

F.B. 2293 Pg. 40

Notes Ck'd by Goss	Survey of SEC. LINES, T6N, R9W
Map No. C.S 8733	JN 0302.01 Tape 121 Std 84 °F
Office Work Ichien	Surveyed by MACK
Checked Goss	Notes M Date 11-20-57
Date Dec 57	Indexed C. Johnson 12-4-57

F. B. 2293 PG. 41

J. N. 0302.01

RE-ESTABLISHMENT

OF

SEC. COR.

ON

AVE. O & 150th ST. E.

FOR

COR. SECS. 7, 8, 17, 18 IN T6N. R9W.

Note: Any Additions or Changes on this Sheet Must be Made or Circled in Red Ink With Date and Name of Person Making Change.

Do not extend this side of this line.

PLEASE RETURN TO
LOS ANGELES COUNTY ENGINEER
700 LOS ANGELES COUNTY ENGINEERING BLDG.

76F3095 SAE #241 1-56

PARTY:
MACK
HALISCKY
RITTER
HUBBARD

PLEASE RETURN TO
LOS ANGELES COUNTY ENGINEER
700 LOS ANGELES COUNTY ENGINEERING BLDG.

Note: Any Additions or Changes on This Sheet Must be Made or Circled in Red Ink With Date and Name of Person Making Change.

Do not extend this side of this line.

W.S. 66 D-1

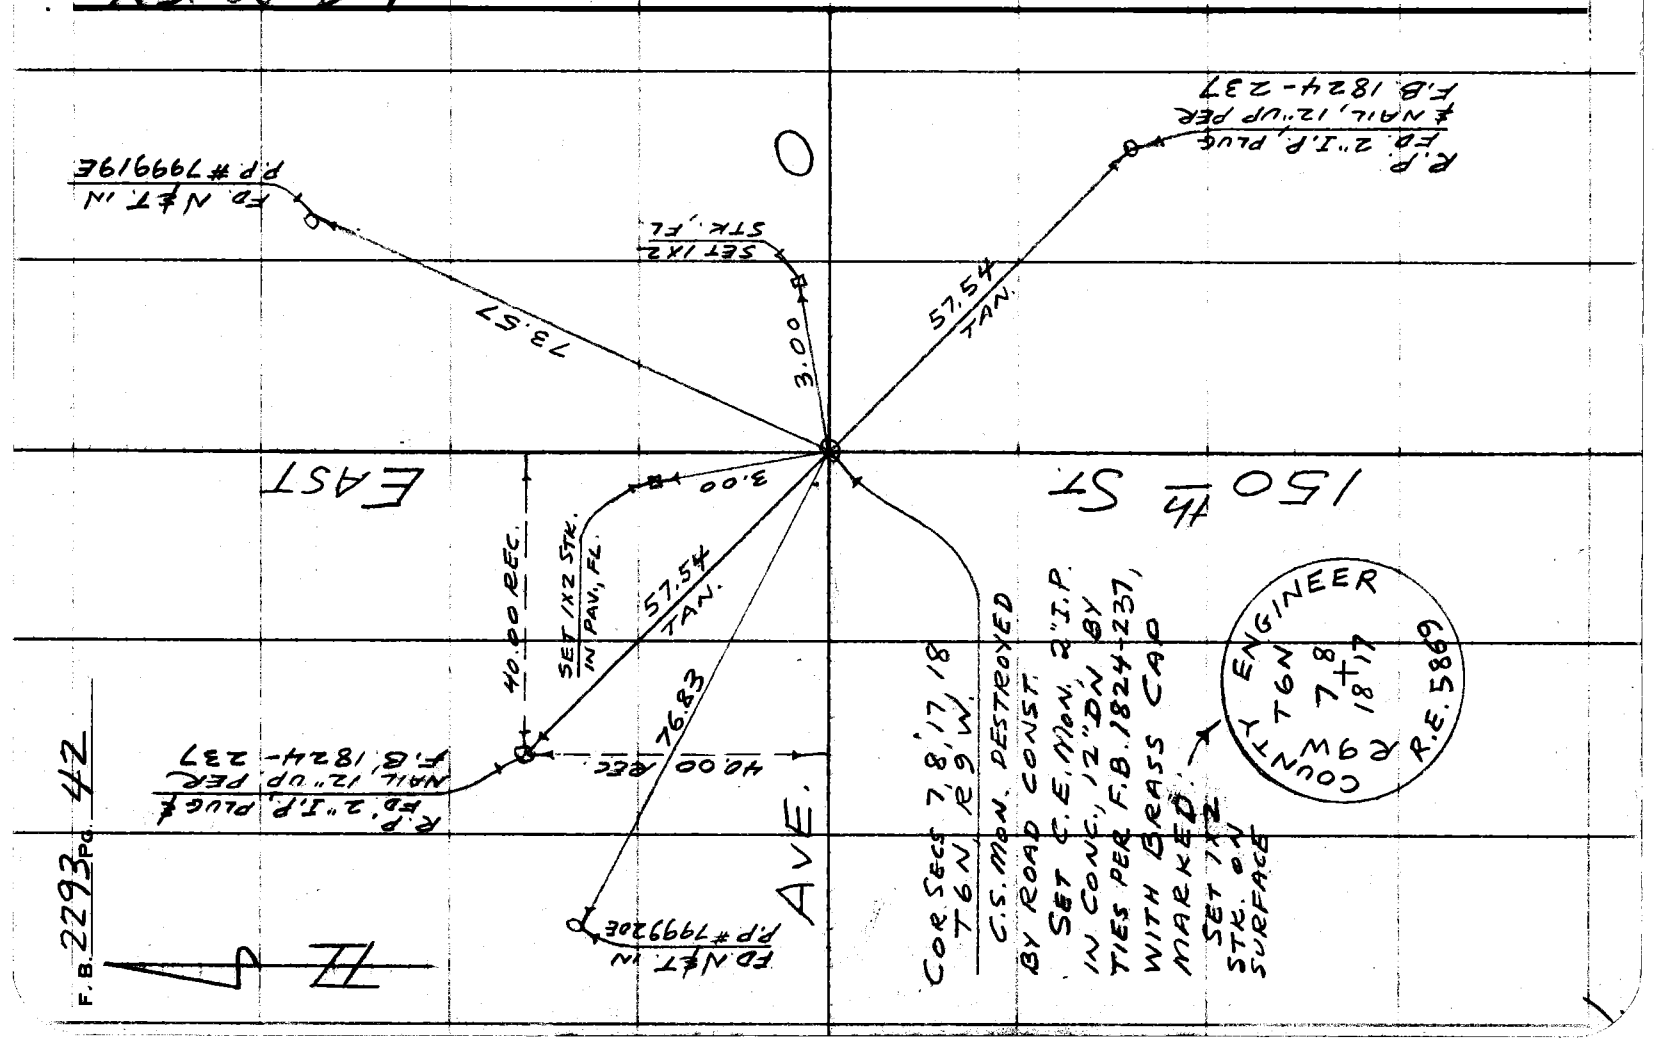

Notes Ck'd by W. Brenner	Survey of SEC. LINES, T5N, R11W
Map No. B-1710	JN 0302.01 Tape 121 Std 84 °F
Office Work G. D. BAILEY	Surveyed by MACK
Checked	Notes m Date 11-25-57
Date	Indexed [redacted] of D "F" 1-13-58

F. B. 2293 Pg. 43

J. N. 0302.01

SEC. LINE TIES

ON

AVE T

BET 37th & 87th STS. E.

PARTY
MACK
HALISCKY
RITTER
HUBBARD

Note: Additions or Changes on this Sheet must be Made or Circled in Red With Date and Name of Person Making Change.

PLEASE RETURN TO
LOS ANGELES COUNTY ENGINEER
700 Los Angeles County Engineering Bldg.

Do not extend this side of this line.

76F309S S&E #247 1-56

F. B. 2293 PG. 44

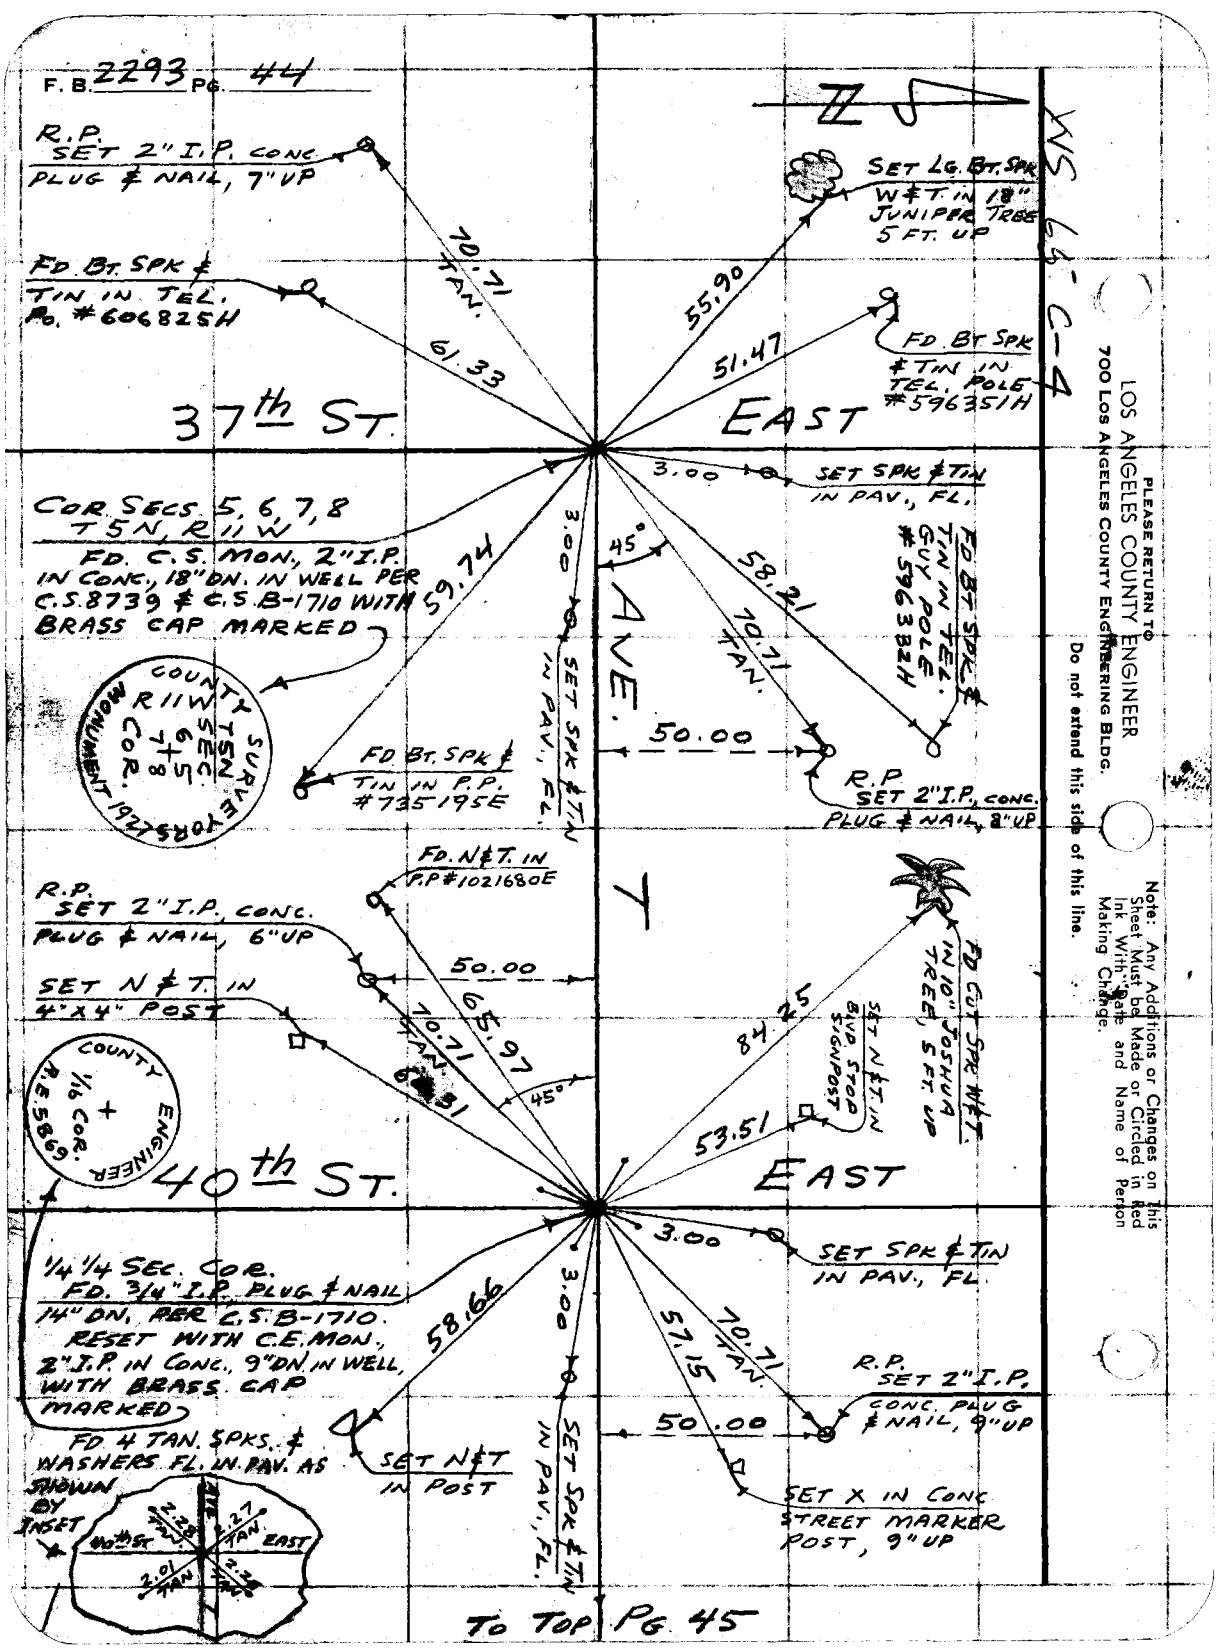

TO TOP PG. 45

PLEASE RETURN TO
LOS ANGELES COUNTY ENGINEER
700 LOS ANGELES COUNTY ENGINEERING BLDG.
Do not extend this side of this line.

Note: Any Additions or Changes on This Sheet Must be Made or Circled in Red Ink With Date and Name of Person Making Change.

Notes Ck'd by W. Brenner
Map No. G. D. BAILEY
Office Work B-1710
Checked
Date

Survey of Sec. Lines, T5N, R11W
JN 0302.01 Tape 121 Std 84 °F
Surveyed by MACK
Notes C. Johnson Date 11-25-57
Indexed

F. B. 2293 PG. 45

TO BOT. PG 44

WS 65 C-4

AVE.

42nd ST.

EAST

T

R.P. SET 2" I.P. CONC. PLUG & NAIL, 8" UP

FD. N & T. IN 4"x4" STREET MARKER POST

SET N & T. IN P.P. #1001926E

SET N & T. IN P.P. #1001926E

50.00

70.71

60.42

51.85

143.47

SET SPK. & TIN IN PAV., FL.

3.00

45.69

SET N & T. IN 8" TAMARACK TREE

1/4 COR. BET. SECS 5, 8 T5N, R11W
FD. C.S. MON. 2" I.P. IN CONC., 14" DN., IN WELL PER C.S. 873'9 & C.S. B-1710 WITH BRASS CAP MARKED

COUNTY SURVEYOR'S MONUMENT R11W 1/4 COR T5N R10W 8+5 1927

45°

45.22

3.00

42.87

70.71

50.00

SET SPK & TIN IN PAV., FL.

FD. N & T. IN FENCE POST

FD. N & T. IN P.P. #709744E

R.P. SET 2" I.P. CONC. PLUG & NAIL, 9" UP

FD. 4 TAN. SPKS. & WASHERS IN PAV. FL. AS SHOWN BY INSET

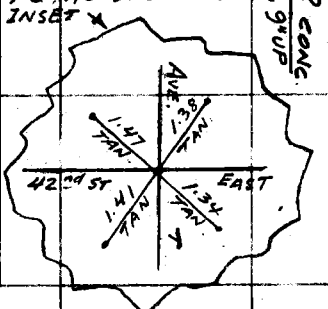

TO TOP PG 46

Note: Any Additions or Changes on this Sheet Must be Made or Circled in Red Ink With Date and Name of Person Making Change.

Do not extend this side of this line.

PLEASE RETURN TO
LOS ANGELES COUNTY ENGINEER
700 Los Angeles County Engineering Bldg.

76F309S SAE #247 1-56

PLEASE RETURN TO
LOS ANGELES COUNTY ENGINEER
700 LOS ANGELES COUNTY ENGINEERING BLDG.

Note: Any Additions or Changes on This Sheet Must be Made or Circled in Red Ink With Date and Name of Person Making Change.

Do not extend this side of this line.

WS 65 C-4

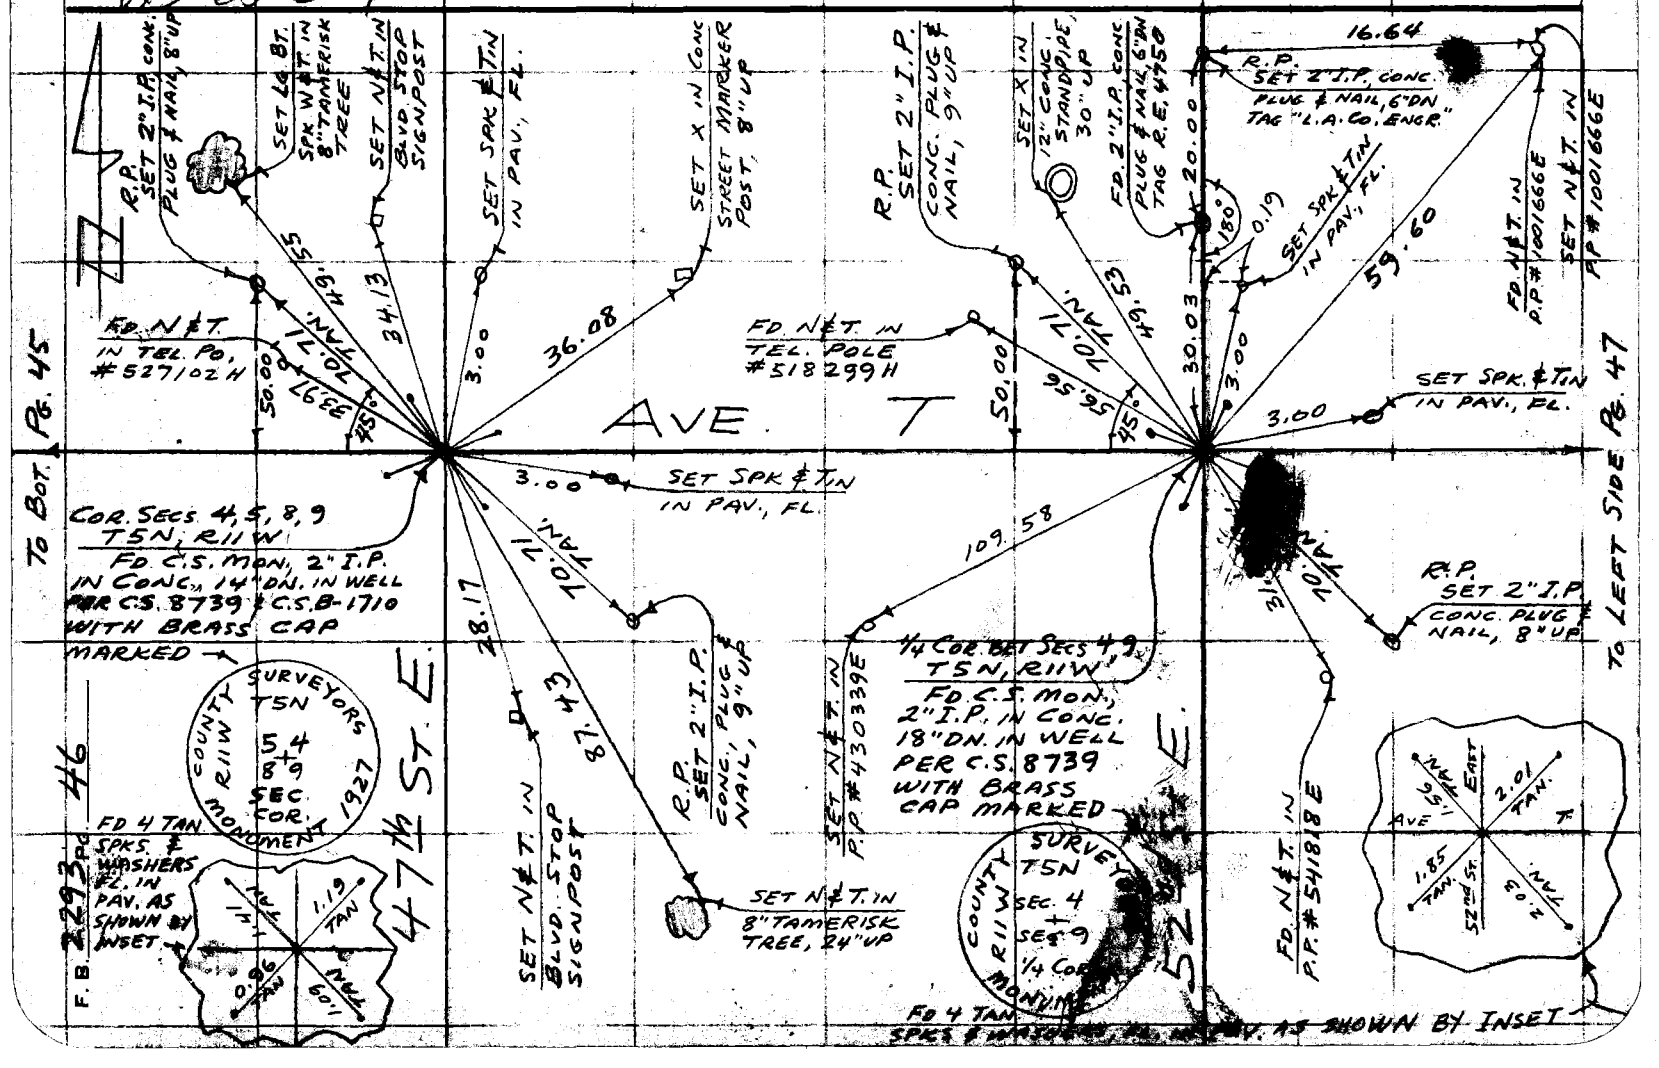

Notes Ck'd by W. Brenner
Map No. C.S. 8739
Office Work G. D. BAILEY
Checked
Date

Survey of SEC. LINES, T5N, R11W
JN 0302.01 Tape 121 Std 84 °F
Surveyed by MACK
Notes m Date 11-26-57
Indexed C. Johnson

F. B. 2293 PG. 47

W5 65 D-4

AVE. S-8

1/4 COR. BET SECS 3, 4 T5N, R11W
FD. C.S. MON. 2" I.P. IN CONC., 3" DN. PER C.S. 8739 WITH BRASS CAP MARKED
SEE PG. 56

COUNTY SURVEYORS T5N R11W 4+3 1/4 COR. MONUMENT

① 90-09-20
④ 360-37-00
90-09-15
⑥ 180-55-00 ✓
90-09-10 ✓

① 89-56-30
④ 359-46-40
89-56-40
⑥ 179-39-50 ✓
89-56-38½ ✓

EAST

FD. N&T. IN P.P. #951784E

SET SPK & TIN IN PAV. FL.

P.O.T. SET 2" I.P. CONC. PLUG & NAIL, 6" UP

AVE.

1.42 TAN.
1.92 TAN.
1.86 TAN.
57th ST.

FD. N&T IN TEL. PO. #583811H

09° 15' ADJ

89°

73.53

50.00

3.00

90° SET N&T IN FENCE COR. POST

39.80

20.11

81.89

SET N&T IN TEL. PO. #4685 E 21

3.00

SET SPK & TIN IN PAV. FL.

AVE.

To Bot. Pg. 46

FD. N&T IN P.P. #778189E

60°

32.49

12"

45°

50"

70.71

50

75.69

41-15"

89°

57th ST.

COR. SECS. 3, 4, 9, 10 T5N, R11W
FD. SPK & WASHER IN PAV. FL. PER C.S. 8739
RE SET WITH C.E. MON. 2" I.P. IN CONC. 12" DN., IN WELL, WITH BRASS CAP MARKED
FD. 4 TAN. SPKS. & WASHERS IN PAV. FL. AS SHOWN BY INSET, UPPER RIGHT

COUNTY ENGINEER T5N R11W 4 3 9 10 R.E. 3.69

① 89-41-00
④ 358-45-00
89-47-15
⑤ 178-07-30
89-41-15½ ✓

① 90-12-50
④ 360-51-30
90-12-52½
⑥ 181-17-00 ✓
90-12-50

FD. N&T IN 6" SQ. FENCE POST

R.P. SET 2" I.P. CONC. PLUG & NAIL, 6" UP

COUNTY SURVEYORS T5N R11W 9+10 R.E. 2177 1/4 COR. MONUMENT

1/4 COR. BET. SECS. 9, 10 T5N, R11W
FD. C.S. MON. 2" I.P. IN CONC., 18" DN. IN WELL PER C.S. 8739 WITH BRASS CAP MARKED

AVE.

T-8

Note: Any Additions or Changes on this Sheet Must be Made or Circled in Red Ink With Date and Name of Person Making Change.

Do not extend this side of this line.

PLEASE RETURN TO LOS ANGELES COUNTY ENGINEER 700 LOS ANGELES COUNTY ENGINEERING BLDG.

76F3095 S&E #247 1-56

TO RIGHT SIDE PG. 47

F. B. 2293 PG. 48

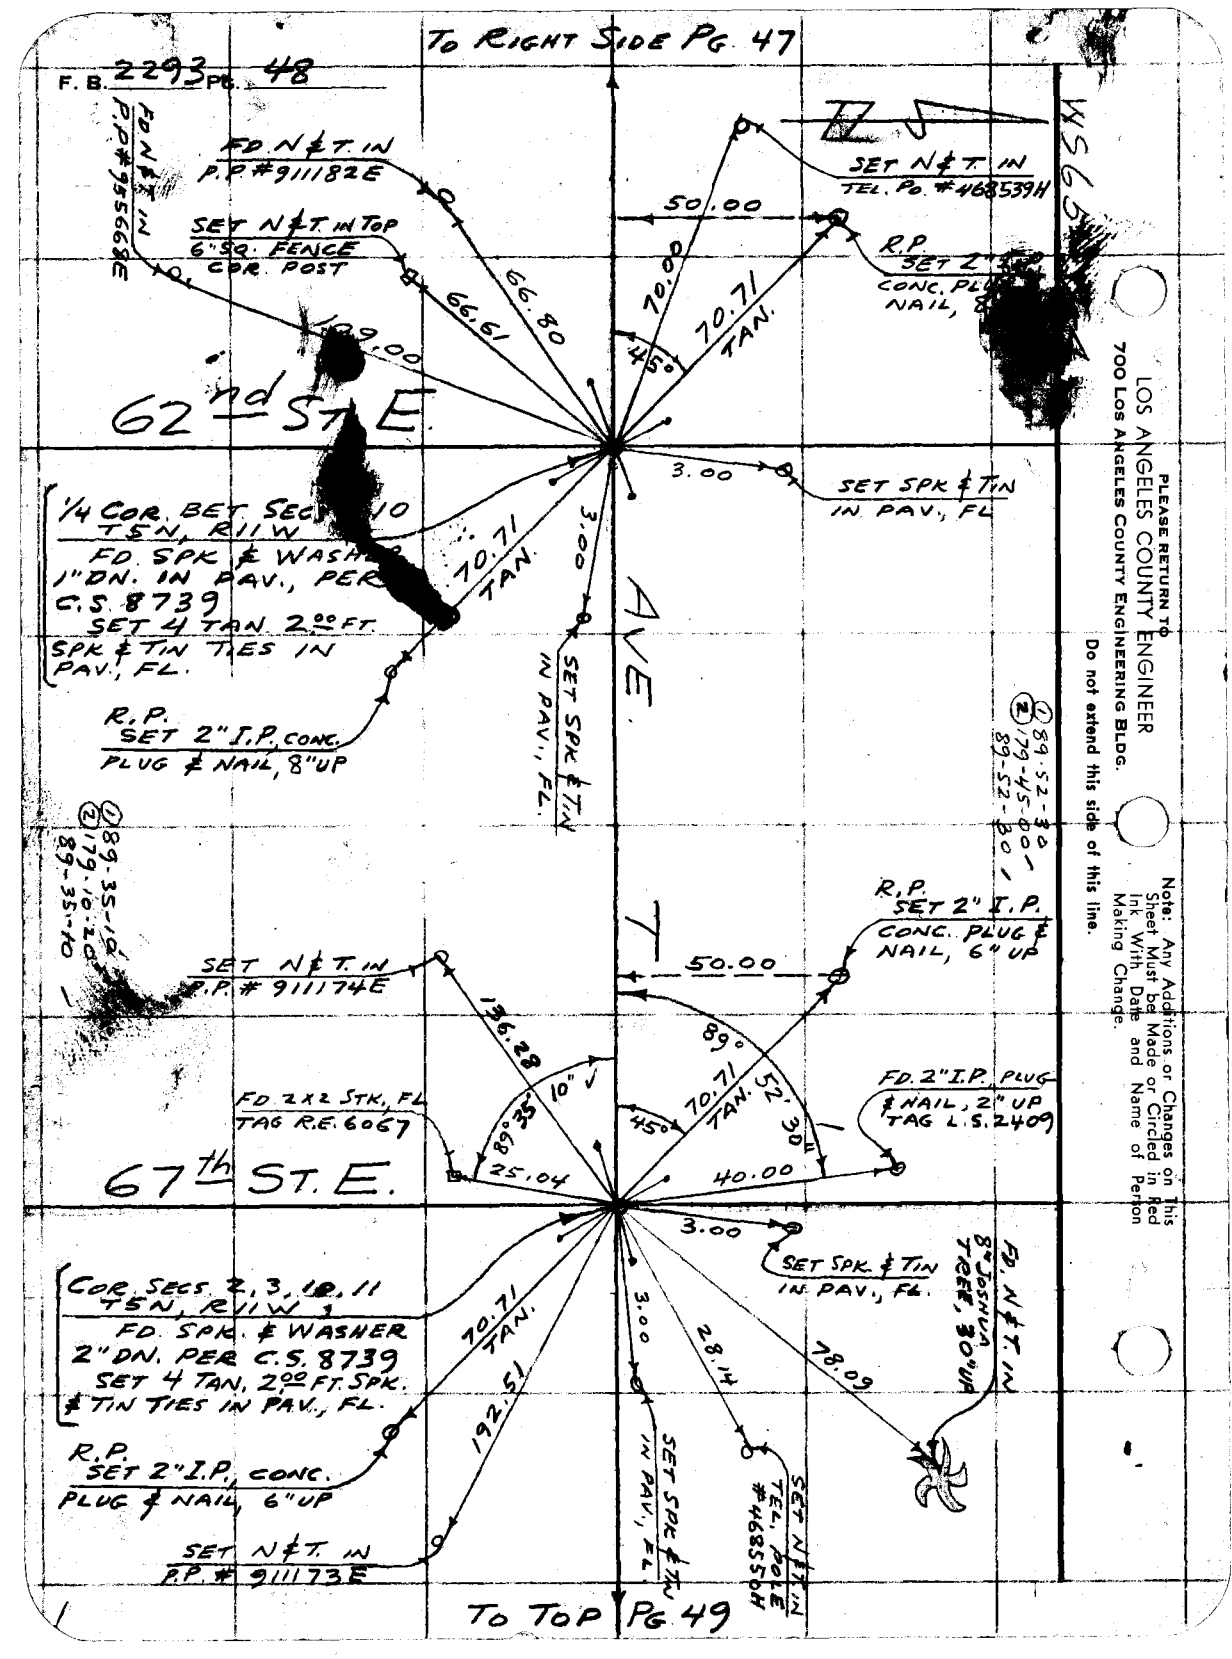

TO TOP PG 49

PLEASE RETURN TO
LOS ANGELES COUNTY ENGINEER
700 LOS ANGELES COUNTY ENGINEERING BLDG.
Do not extend this side of this line.
Note: Any Additions or Changes on This Sheet Must be Made or Circled in Red Ink With Date and Name of Person Making Change.

Notes Ck'd by W. [redacted]mer
Map No. C.S. 8739
Office Work [redacted] BAILEY
Checked
Date

Survey of SEC. LINES, T5N, R11W
JN 0302.01 Tape 121 Std 84 °F
Surveyed by MACK
Notes [redacted] C. Johnson
Date 12-3-57
Indexed

F. B. 2293 Pg. 49

To BOT Pg. 48

WS 65 D-4

SET N&T. IN P.P# 911166E

AVE.

165.60

R.P. SET 2" I.P. CONC. PLUG & NAIL, 8" UP

50.00

90° 20'

70.71 TAN. 50

SET SPK & TIN IN PAV., FLUSH

45°

3.00

72nd ST.

EAST

40.05

FD. 2" I.P. PLUG & NAIL 8" UP. TAG L.S. 2409

1/4 COR. BET SECS 2, 11 T5N, R11W FD. SPK. & WASHER 1" ON PER C.S. 8739. SET 4 TAN. 2nd FT. SPK & TIN TIES IN PAV., FL.

10.71 TAN.

3.00

30.49

127.65

SET N&T. IN 8" JOSHUA TREE, 46" UP

50.00

R.P. SET 2" I.P. CONC. PLUG & NAIL, 8" UP

165.10

SET SPK & TIN IN PAV., FLUSH

SET N&T. IN TEL. POLE #4549721

SET N&T IN P.P. # 911165E

T

90-20-50
90-41-40
90-20-50

Note: Any Additions or Changes on This Sheet Must be Made or Circled in Red Ink With Date and Name of Person Making Change.

Do not extend this side of this line.

PLEASE RETURN TO
LOS ANGELES COUNTY ENGINEER
700 LOS ANGELES COUNTY ENGINEERING BLDG.

76F309S S&E #247 1-56

To TOP Pg. 50

To Bot. Pg 49

F. B. 2293 Pg. 50

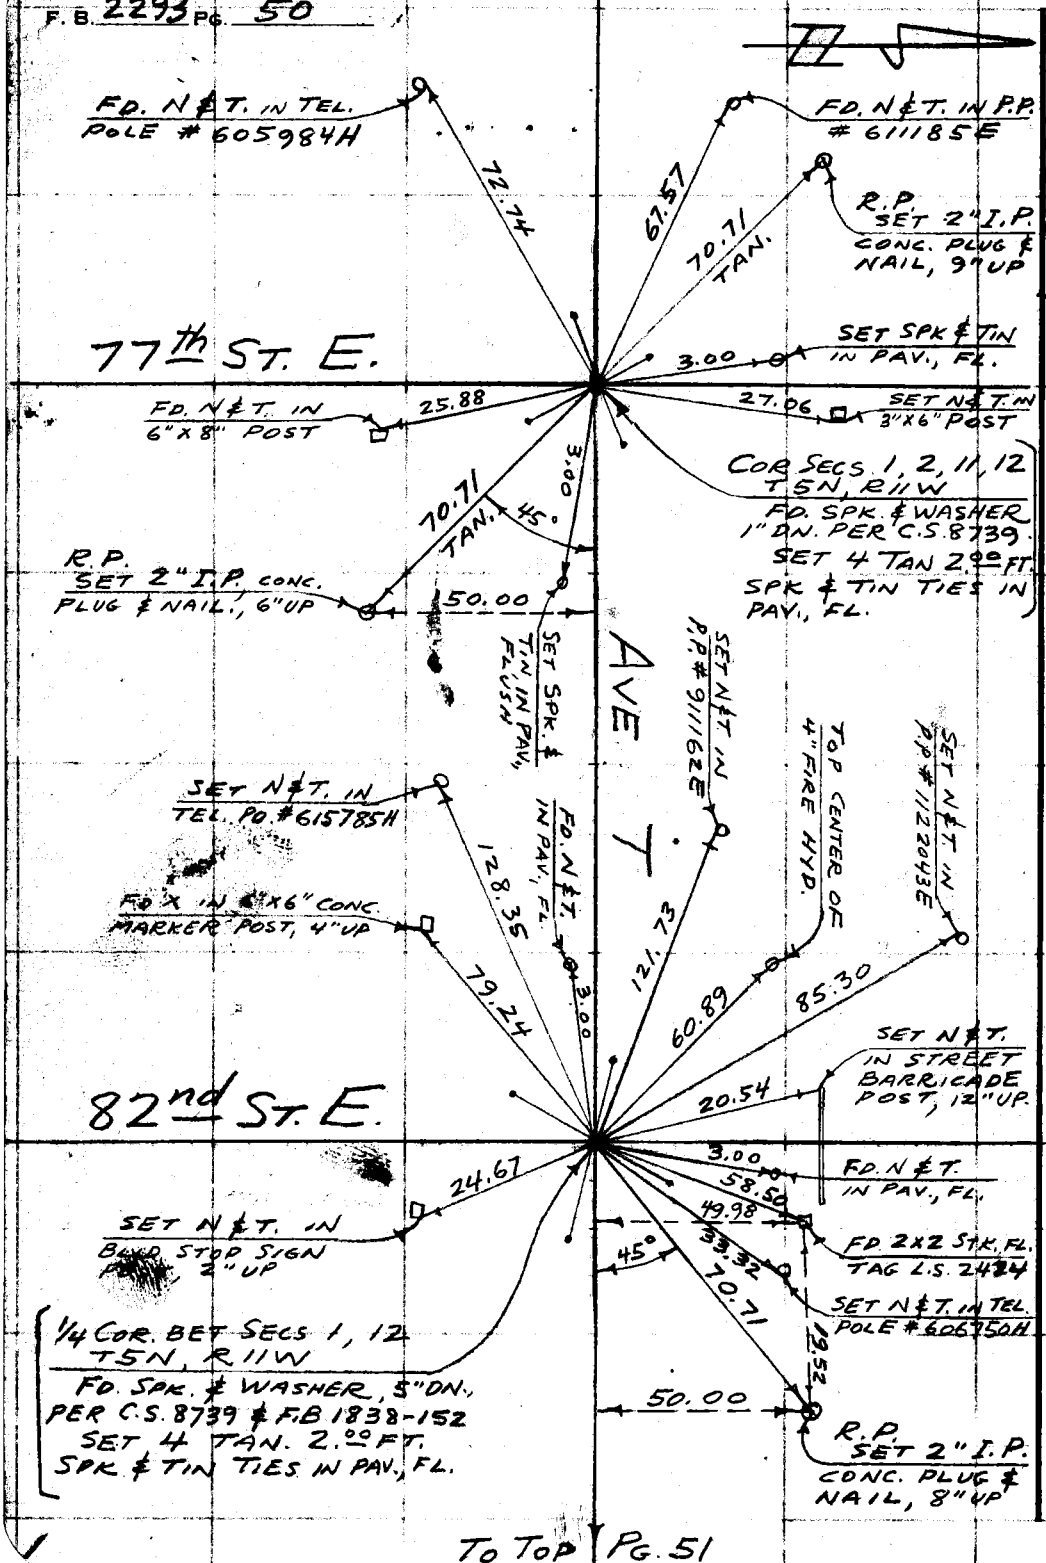

To Top Pg. 51

PLEASE RETURN TO
LOS ANGELES COUNTY ENGINEER
700 Los Angeles County Engineering Bldg.
Do not extend this side of this line.

Note: Any Additions or Changes on This Sheet Must be Made or Circled in Red Ink With Date and Name of Person Making Change.

Notes Ck'd by W. Brenner
Map No. C.S. 8739
Office Work G. D. BAILEY
Checked
Date

Survey of SEC. LINES, T5N, R11W
JN 0302.01 Tape 121 Std 84 °F
Surveyed by MACK
Notes M. Date 12-9-57
Indexed E. Johnson

F. B. 2293 PG. 51

WS 660-4

TO BOT. PG. 50

Note: Any Additions or Changes on This Sheet Must be Made or Circled in Red Ink With Date and Name of Person Making Change.

Do not extend this side of this line.

PLEASE RETURN TO
LOS ANGELES COUNTY ENGINEER
700 Los Angeles County Engineering Bldg.

AVE.

R.P. SET 2" I.P. CONC. PLUG & NAIL, 10" UP

FD. N & T. IN TEL. POLE #607411H

50.00

81.17

10.71 TAN.

45°

87th ST. E.

FD. N & T. IN P.P. #911158E

60.47

SET X IN TOP CENTER OF 4" WATER RISER CAP

FD N & T IN POW. POLE #1103901E

84.91

88.17

90th ST. E.

3.00

FD. BT. SPK & TIN IN PAV. FLUSH

COR. SECS 1, 6, 7, 12 T5N, R10, 11W
FD. C.S. MON. 2" IP. IN CONC. 10" DN IN WELL PER C.S. 8739 WITH BRASS CAP MARKED

COUNTY SURVEYORS MONUMENT R11W 1 6 7 12 R10W T5N

10.71 TAN.

59.76

3.00

81.74

FD. N & T. IN TEL. POLE #615798H

FD. BT. SPK & TIN IN PAV., FLUSH

R.P. SET 2" I.P. CONC. PLUG & NAIL, 10" UP

TOP CENTER OF 4" FIRE HYD.

T

76F309S S&E #247 1-56

Notes Ck'd by W. Brenner
Map No.
Office Work G. D. BAILEY
Checked
Date

Survey of SEC. LINES, T5N, R11W F. B. 2293 PG. 53
W. O. 0302-01 Tape No. 121 St'd. 84 °F
Surveyed by MACK
Notes M Date 12-17-57
Indexed L. C. Johnson 1-15-58

J.N. 0302.01

SECTION LINE TIES

ON

AVE. S

BET. 55th & 60th STS. E.

PARTY
MACK
HALISCKY
RITTER
HUBBARD

Note: Any Additions or Changes on This Sheet Must be Made or Circled In Red Ink With Date and Name of Person Making Change.

Do not extend notes this side of this line.

RETURN TO
LOS ANGELES COUNTY SURVEYOR
726 LOS ANGELES COUNTY
ENGINEERING BLDG.

76F3095 247 4-58

RETURN TO
LOS ANGELES COUNTY SURVEYOR
726 LOS ANGELES COUNTY
ENGINEERING BLDG.

Note: Any Additions or Changes on This Sheet Must be Made or Circled in Red Ink With Date and Name of Person Making Change.

Do not extend notes this side of this line.

WS 65 D-3

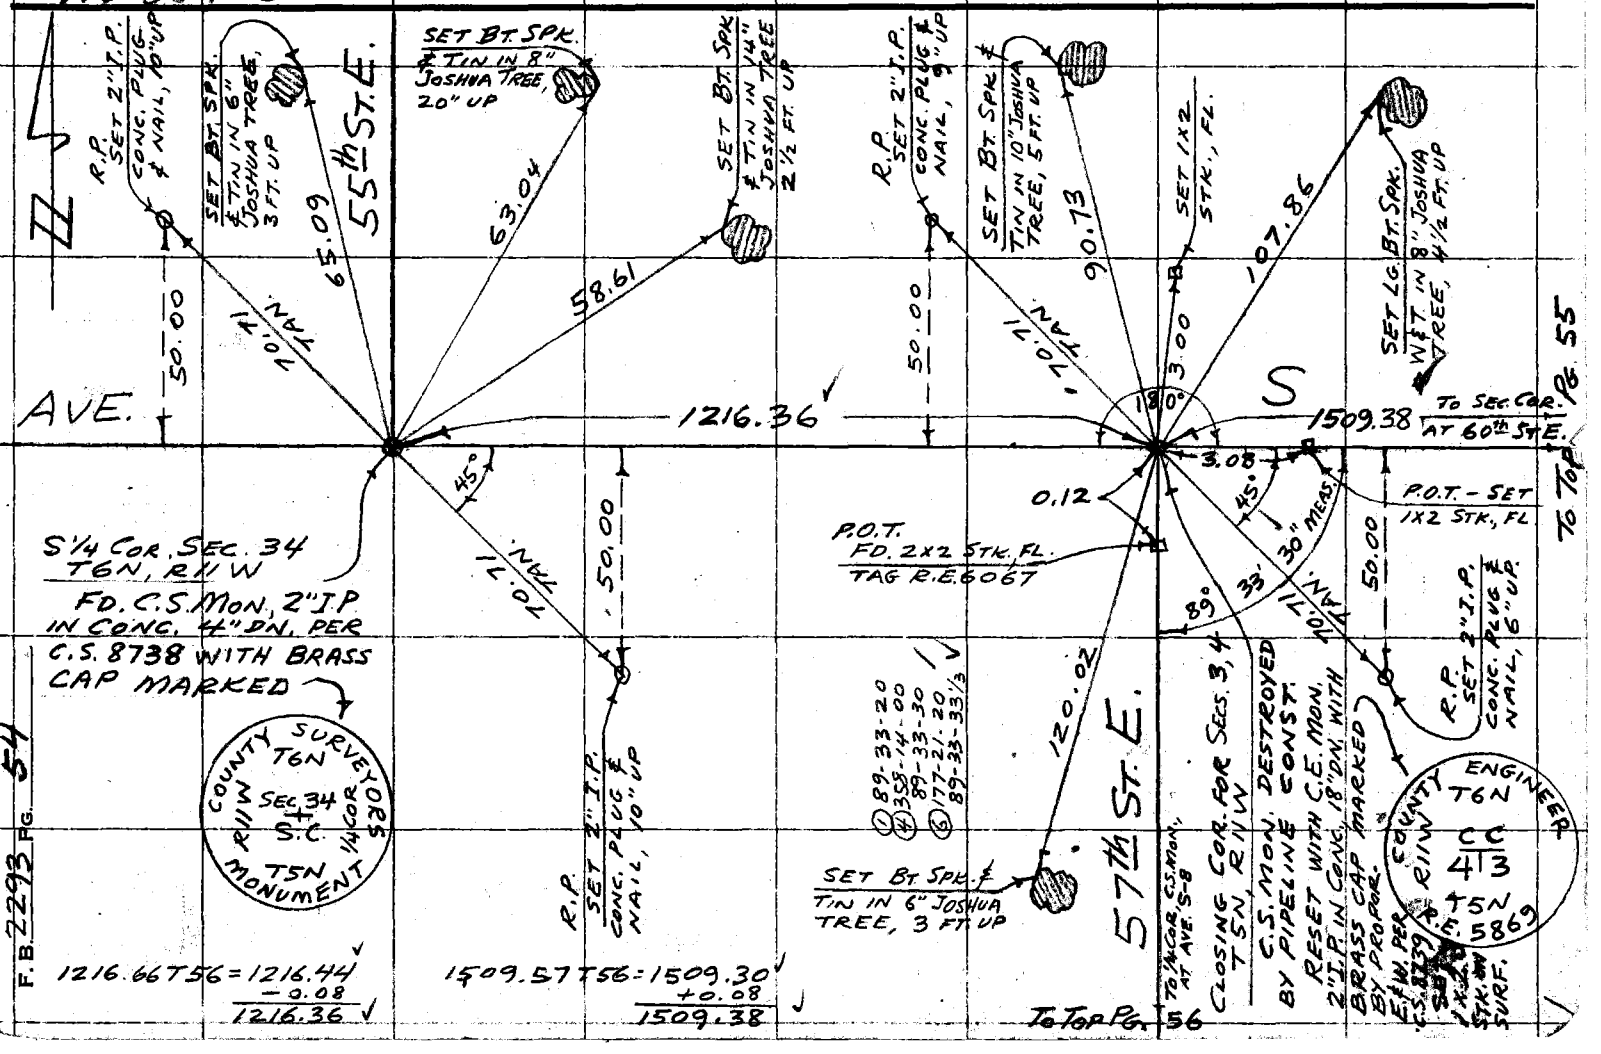

F.B. 2293 Pg. 54

1216.66 T56 = 1216.44
−0.08
1216.36 ✓

1509.57 T56 = 1509.30
+0.08
1509.38

Notes Ck'd by W. Brenner
Map No.
Office Work G. D. BAILEY
Checked
Date

Survey of SEC LINES T3N, R11W
W. O. 0302 01 Tape No. 121 St'd. 84 °F
Surveyed by MACK
Notes M Date 12-17-57
Indexed O. Johnson

F. B. 2293 PG. 55

WS. 65 D-3

To BOT. PG. 54

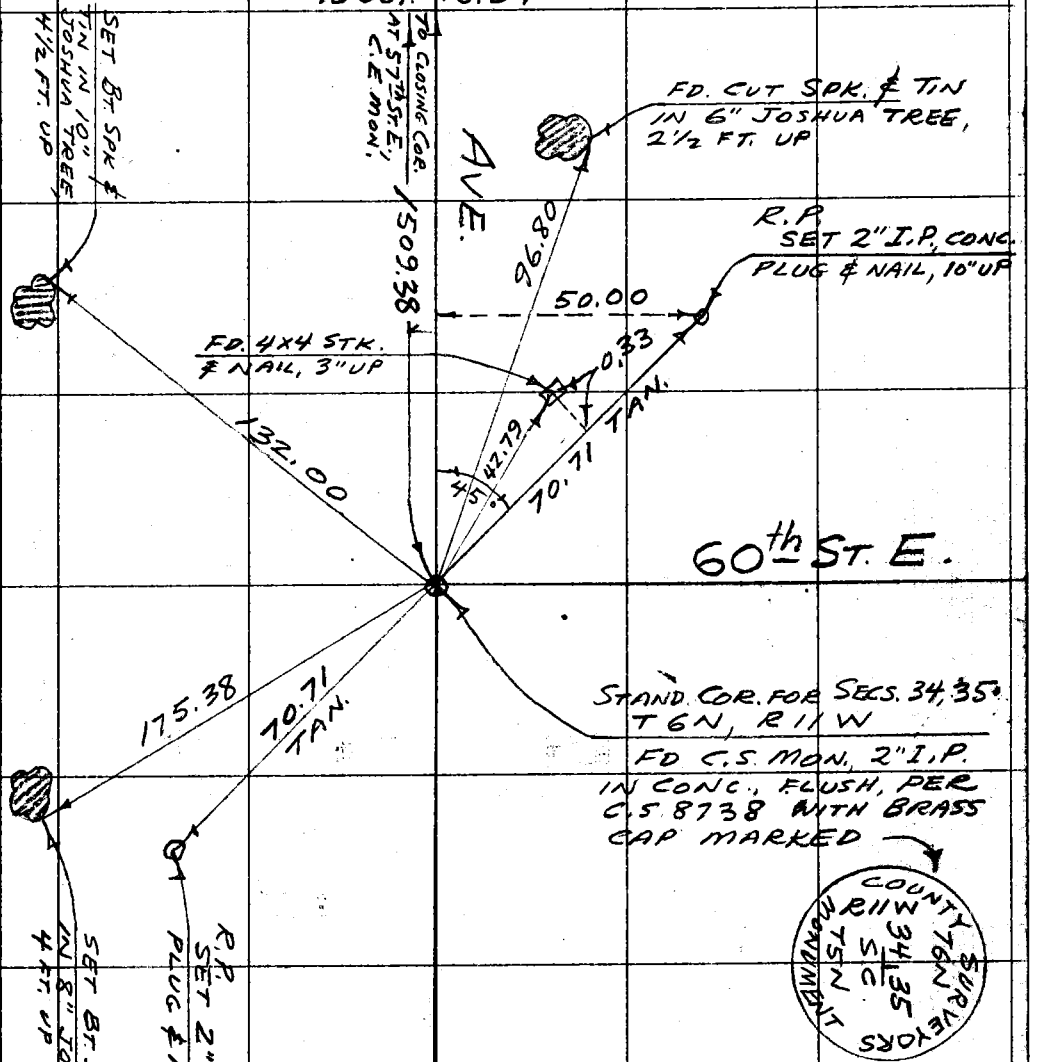

Note: Any Additions or Changes on This Sheet Must be Made in Red Ink With Date and Name of Person Making Change.

Do not extend notes this side of this line.

RETURN TO
LOS ANGELES COUNTY SURVEYOR
726 LOS ANGELES COUNTY
ENGINEERING BLDG.

76F3098 247 4-53

RETURN TO
LOS ANGELES COUNTY SURVEYOR
726 LOS ANGELES COUNTY
ENGINEERING BLDG.

Note: Any Additions or Changes on This Sheet Must be Made or Circled in Red Ink With Date and Name of Person Making Change.

Do not extend notes this side of this line.

WS 65-D-4

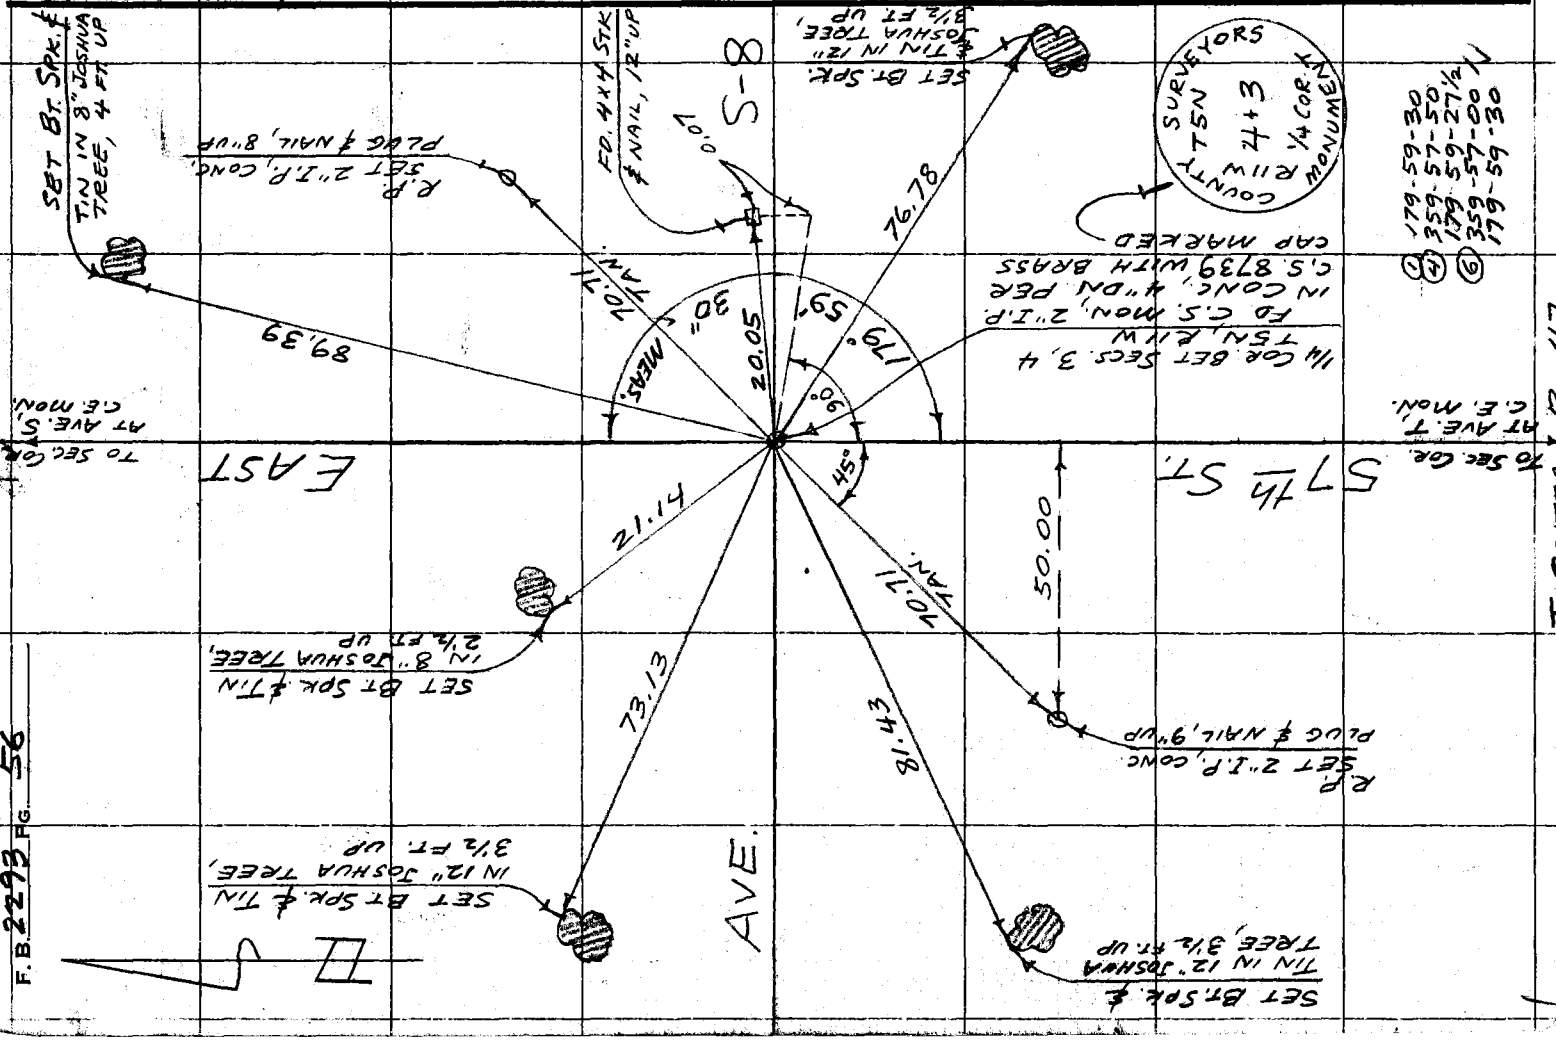

F.B. 2293 PG. 56

Notes Ck'd by	Survey of SEC. LINES, T5N, R10W
Map No.	JN 0302.01 Tape 121 Std 84 °F
Office Work	Surveyed by MACK
Checked	Notes M Date 12-18-57
Date	Indexed C. Tonnam 2-6-58

F. B. 2293 PG. 57

J.N. 0302.01

SECTION LINE TIES

ON

121ST ST. E.

AT AVES. X & X-8

Note: Any Additions or Changes on This Sheet Must be Made or Circled in Red Ink With Date and Name of Person Making Change.

Do not extend this side of this line.

PLEASE RETURN TO
LOS ANGELES COUNTY ENGINEER
700 LOS ANGELES COUNTY ENGINEERING BLDG.

PARTY
MACK
RITTER
HUBBARD

76F309S S&E #247 1-56

F. B. 2293 PG. 58

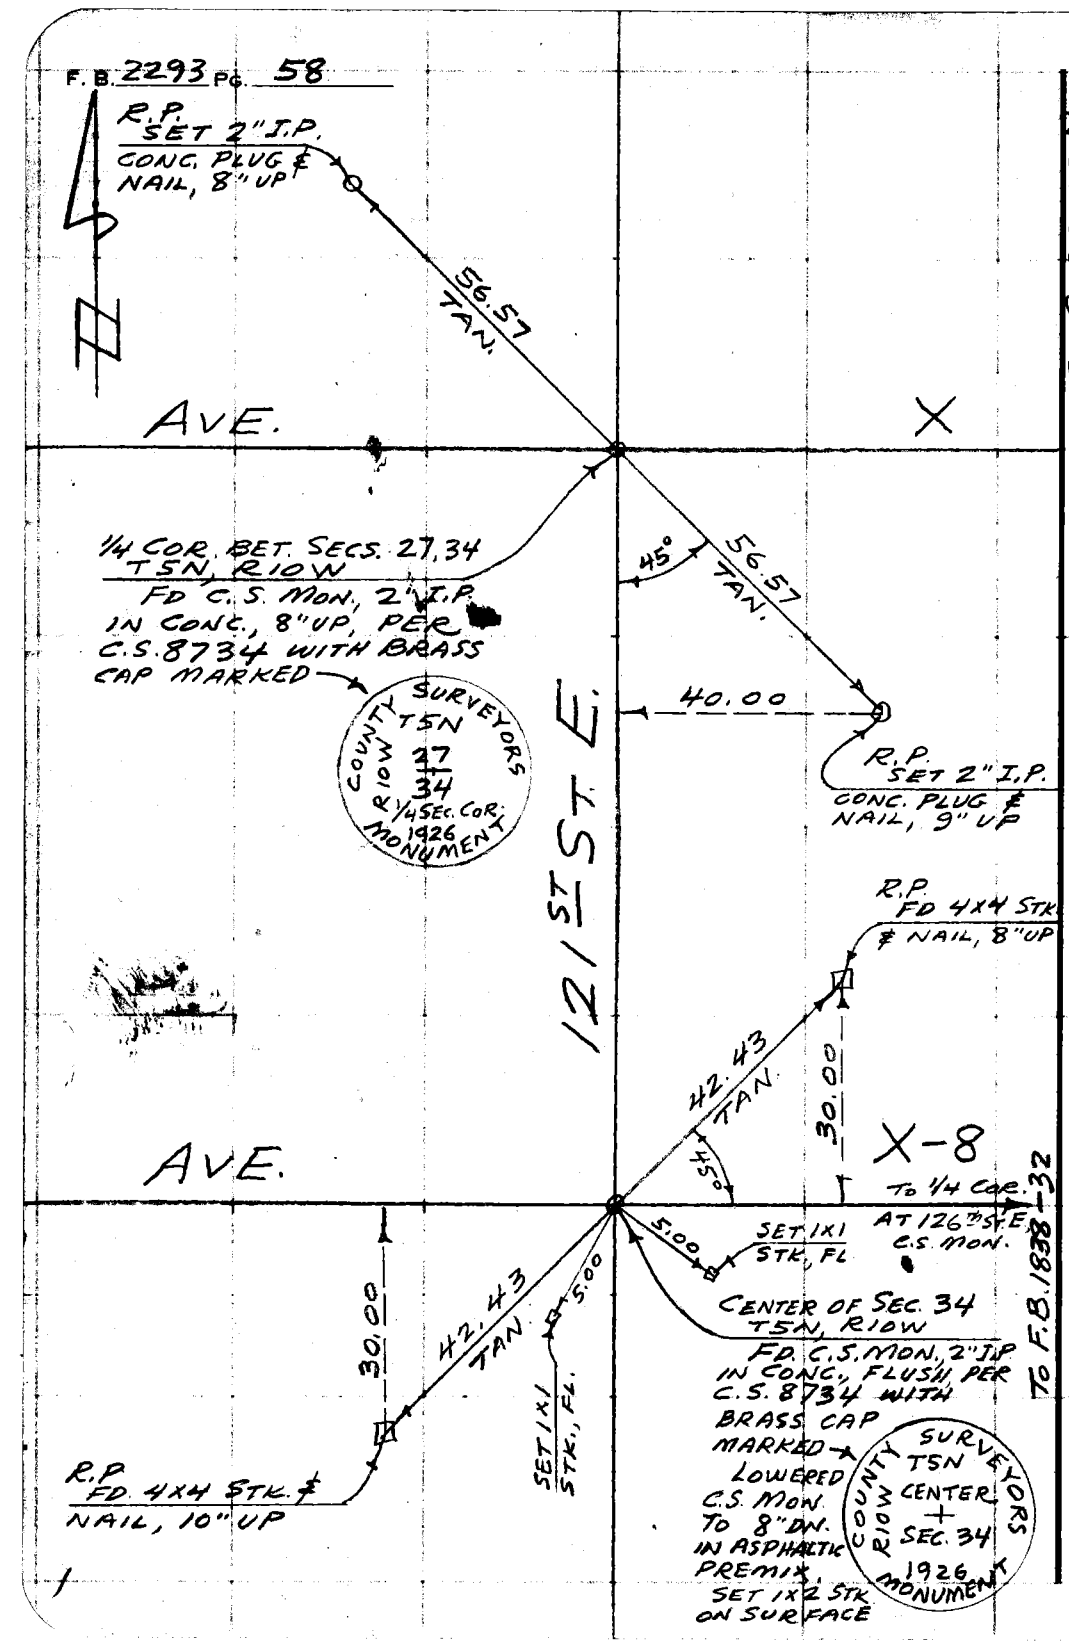

PLEASE RETURN TO
LOS ANGELES COUNTY ENGINEER
700 LOS ANGELES COUNTY ENGINEERING BLDG.

Do not extend this side of this line.

Note: Any Additions or Changes on This Sheet Must be Made or Circled in Red Ink With Date and Name of Person Making Change.

Notes Ck'd by J. F. McMILLAN	Survey of SEC. LINES T.5N.R.3W.
Map No. B-2120	JN 0302.01 Tape 39 Std 84 °F
Office Work G. D. BAILEY	Surveyed by J. C. PIERCE
Checked	Notes PIERCE Date 12-13-57
Date	Indexed L. O. Johnson 1-13-58

F. B. 2293 PG. 5

J.N. 0302.01

N. 1/4 CORNER SECTION 6

T.5N. R.3W.

12-13-57

PIERCE L.C.
MENDONCA G.
RANDALL, C.G.

Note: Any Additions or Changes on This Sheet Must be Made or Circled in Red Ink With Date and Name of Person Making Change.

Do not extend this side of this line.

PLEASE RETURN TO
LOS ANGELES COUNTY ENGINEER
700 Los Angeles County Engineering Bldg.

76F309S S&E #247 1-56

PLEASE RETURN TO
LOS ANGELES COUNTY ENGINEER
700 LOS ANGELES COUNTY ENGINEERING BLDG.

Note: Any Additions or Changes on This Sheet Must be Made or Circled in Red Ink With Date and Name of Person Making Change.

Do not extend this side of this line.

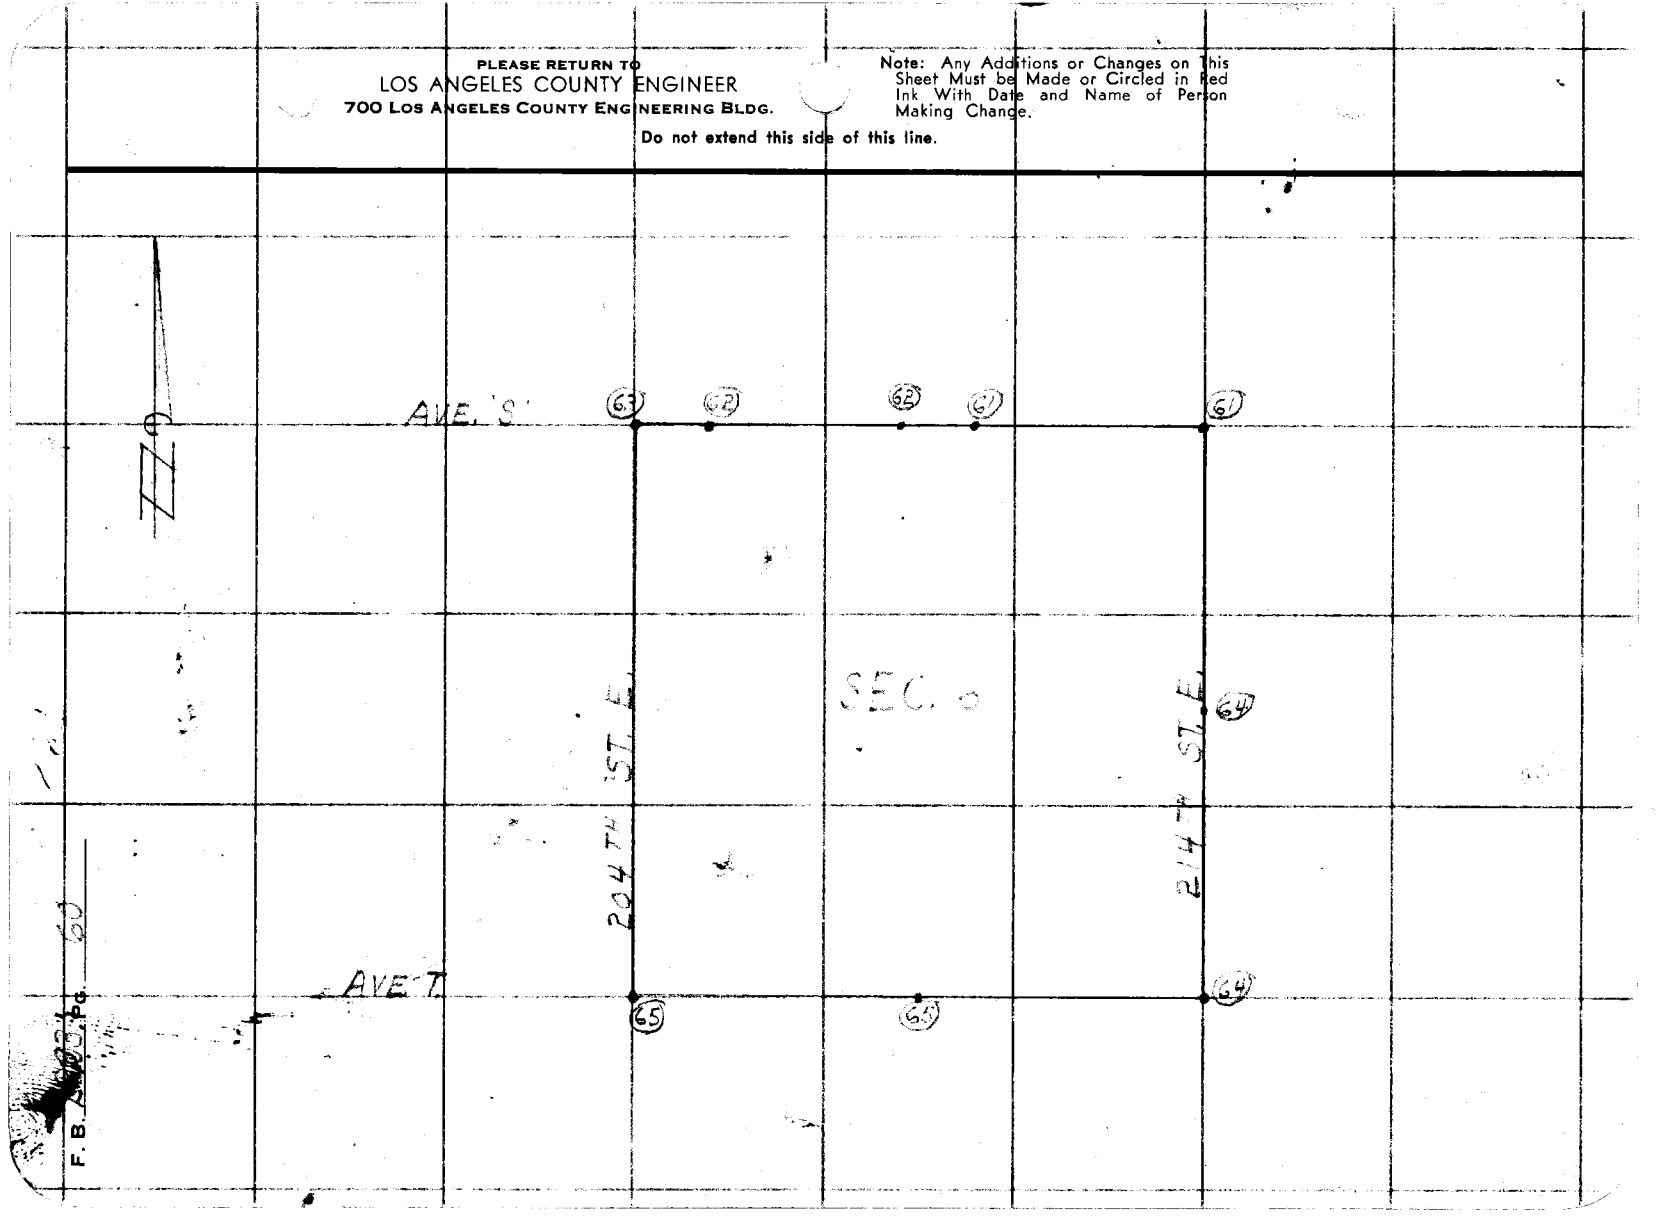

WS 67 C-3

Notes Ck'd by J. F. McMILLAN
Map No. B-2120
Office Work G. D. BAILEY
Checked
Date

Survey of T. 5 N. R. 8 W.
JN 0302.01 Tape 39 Std 24 °F
Surveyed by J. C. PIERCE
Notes J. C. PIERCE Date 12-13-57
Indexed O. Johnson

F. B. 2293 PG. 61

TO 25[illegible] PG. 62

AVE.
522.64

SET 2" I.P. CEM. PL. & TAG L.A. CO. ENG. R. UP 6"

56.57 TAN.

150.51
190.31
181.88
522.74 (T=56) = 522.64

P.O.T. 21+41.3[illegible]
SECTION CORNER
SEC. 31 & 32 T.6N.
R.8W. FD. A 2" I.P. WD. PLUG & NAIL IN [illegible] 6"
PER RS 162-93
SEE C.S.B. [illegible]-1

R.&W. COUNTY SURVEY T.6N. STATE CO. R.8W.
MONUMENT
T.5N.
6/132

150.74
150.81
150.59
150.46
150.45
150.83
150.75
150.83
150.96
150.22
[illegible]
150.46
170.89
78.52
2141.64 (T=42) = 2141.33

2141.33

(SET 2" I.P. CEM. PL. & TAG L.A. CO. ENG. UP 6")

FD. A 2" I.P. WD. PLUG & NAIL UP 6"

42.43 TAN.

214TH ST. E.

0+00.00 P.W.
CLOSING COR. TO SEC. 5 & 6 T.5N. R.8W. FD. A 2" I.P. P.L. SET IN CONC. DN. 1.5
REF. RS 126-92
SEE C.S.B. 2120-1

56.57 TAN.

42.39

SET R.&W. 1" I.P. CEM. PL. TAG DN. 3

R.&W. COUNTY SURVEY T.6N. STATE CO. R.E. 3.2'
6/15

FD. A 2" I.P. WOOD PLUG & NAIL UP 6"

Note: Any Additions or Changes on this Sheet Must be Made or Circled in Red Ink With Date and Name of Person Making Change.

Do not extend this side of this line.

PLEASE RETURN TO
LOS ANGELES COUNTY ENGINEER
700 Los Angeles County Engineering Bldg.

76F309S S&E #247 1-56

F. B. 2293 Pg. 62

TO BOT. PG. 63

LOS ANGELES COUNTY ENGINEER
700 LOS ANGELES COUNTY ENGINEERING BLDG.

PLEASE RETURN TO

Do not extend this side of this line.

Note: Any Additions or Changes on This Sheet Must be Made or Circled in Red Ink With Date and Name of Person Making Change.

WS 67 R-3

AVE.

150.42
142.70
293.12
(CT=56) = 293.07

FD. 2" I.P. & TAG L.A. CO. ENG'R.

293.07

(56.51)

P.O.T. 48+06.47
¼ SECTION CORNER
SEC. 31 T.6N. R.8W.
FD. A 2" I.P. & B.C. SET IN CONC. DN. 12" PER F.B. 74-33
SEE SURVEY 2720-1

COUNTY ENGINEER'S SURVEY NO. 4731
R.8W.
MONUMENT
T.5N.

150.66
150.66
150.78
150.66
150.66
150.66
150.66
150.66
150.78
150.66
2142.89
(CT=56) = 2142.50

FD. 2" I.P. & TAG L.A. CO. ENG'R.

2142.50

8.04 @ LEV. (CT=58) = 8.04

SET A 2" I.P. CEM. PLUG & TAG MKD. L.A. CO. ENG'R. UP 6"

40.00 TAN.

40.00 TAN.

SET A 2" I.P. CEM. PL. & TAG MKD. L.A. CO. ENG'R. UP 6"

8.04

P.O.T. 26+72.01
N. ¼ CORNER SEC. 6
T.5N. R.8W.
SET A 2" I.P. & B.C. IN CONC. DN. 15" BY PROPORTION MON. MKD.

POT 26+63.97
SET ½" CPT & NAIL FL.

533.64

S.

COUNTY ENGINEER'S
N. ¼ COR. SEC. 6
T.5N. R.8W.
R.E. 5869

TO TOP PG. 61

WS.67-B-3

Notes Ck'd by J. F. McMILLAN
Map No. B-2120
Office Work G. D. BAILEY
Checked
Date

Survey of T.5N. R.8W.
JN 0302.01 Tape 39 Std 84 °F
Surveyed by J.C. PIERCE
Notes PIERCE Date 12-13-57
Indexed M. C. Johnson

F. B. 2293 PG. 63

Note: Any Additions or Changes on this Sheet Must be Made or Circled in Red Ink With Date and Name of Person Making Change.

Do not extend this side of this line.

PLEASE RETURN TO
LOS ANGELES COUNTY ENGINEER
700 LOS ANGELES COUNTY ENGINEERING BLDG.

AVE.

FD. 2" IP & TAG L.A. CO. ENG'R.

56.57

204TH ST. E.

56.57

FD. 2" IP & TAG L.A. Co. ENG'R.

293.07

S.

50 + 99.54

SECS. 1 & 6 T.5N. R.8 & 9W.
FD. A 2" IP & BC SET IN CONC.
DN. 12'
PER FB 79-83 FB 1262-72
SEE CSB 2120-1
MKD.

R.9W. COUNTY SURVEYORS T.G.N. 3/16 C.C. T.5N. MONUMENT R.8W.

TO TOP PG. 62

76F3098 SAE #247 1-56

F. B. 2293 Pg. 64

N

WS 67 C-3

LOS ANGELES COUNTY ENGINEER
700 Los Angeles County Engineering Bldg.

PLEASE RETURN TO

Do not extend this side of this line.

Note: Any Additions or Changes on This Sheet Must be Made or Circled in Red Ink With Date and Name of Person Making Change.

FD. 2" I.P. PL. & NAIL UP 6"

30.00 TAN.

30.01 TAN.

FD. 2" I.P. PL. & N. UP 6"

1/4 SECTION CORNER
FD. A 2" I.P. & B.C. SET IN CONC. DN. 12
PER F.B. 1262-91
SEE C.S.B. 2120-1
MON. MKD.

COUNTY ENGINEER T.5N. R.8W. 6 | 5 1/4 COR R.E. 329

EAST

SET 2" I.P. CEM. PL. & TAG L.A. CO. ENG'R. UP 6"

45°00'

56.57 TAN.

AVE.

T.

SECTION CORNER
FD. A 2" I.P. & B.C. SET IN CONC. UP 3" LOWERED MON. TO 15" BELOW SURFACE
PER F.B. 1262-91, 92, 114, & 115
SEE C.S.B. 2120-1
MON MKD.

56.57 TAN.

SET 2" I.P. CEM PL. & TAG, L.A. Co. ENG'R. UP 6"

214TH ST.

COUNTY SURVEYOR T.5N. R.8W. 6 | 5 7 | 8 R.E. 329

Notes Ck'd by J. F. McMILLAN
Map No. B-2120
Office Work G. D. BAILEY
Checked
Date

Survey of T 5N. R 8W.
JN 0302.01 Tape 39 Std 84 °F
Surveyed by J. C. PIERCE
Notes PIERCE Date 12-24-57
Indexed K. O. Johnson

F. B. 2293 Pg. 65

WS 6 B-4

Note: Any Additions or Changes on This Sheet Must be Made or Circled in Red Ink With Date and Name of Person Making Change.

Do not extend this side of this line.

PLEASE RETURN TO
LOS ANGELES COUNTY ENGINEER
700 Los Angeles County Engineering Bldg.

SET

S 55° 52' TAN.

S 55° 57' TAN.

SET

204TH ST. EAST

AVE. T.

SECTION CORNER
FD. A 2" I.P. & B.C. SET IN CONC. UP 3"
PER F.B. 79-83
SEE F.B. 1262 - 71, 72, 114
SEE C.S.B. 2120-1
LOWERED MON. TO 15" BELOW SURFACE 12-24-57 G.C.A.
MON. MKD.

R.9W. COUNTY SURVEYOR T.5N. 1925 12 7 1 6 R.8W.

FD. 2" I.P. PLUG & NAIL UP 6"

30.00 TAN.

30.00 TAN.

FD. 2" I.P. PLUG & N. UP 6"

¼ SECTION CORNER
FD. A 2" I.P. & B.C. SET IN CONC. DN. 12"
PER F.B. 1262 - 114
SEE C.S.B. 2120 - 1
MON. MKD.

R.8W. COUNTY SURVEYOR T.5N. R.E. 329 ¼ COR. 7 6

76F3095 SEE #247 1-58

Notes Ck'd by	Survey of Sec. 2 INES, T7N, R11W
Map No.	J.N. 0302.01 Tape 121 Std. 84 °F
Office Work	Surveyed by MACK
Checked	Notes M. Date 2-6-58
Date	Indexed A. C. Johnson 4-11-58

F. B. 2293 PG. 67

J.N. 0302.01

RE-ESTABLISHMENT OF 1/4 SEC. COR.

ON

20th ST. E. & AVE J-8

PARTY
MACK
HALISCKY
RITTER
HUBBARD

Note: Any Additions or Changes on this Sheet Must be Made as Circled in Red Ink With Date and Name of Person Making Change.

Do not extend this side of this line.

PLEASE RETURN TO
LOS ANGELES COUNTY ENGINEER
700 Los Angeles County Engineering Bldg.

78F3098 SAE #247 1-58

PLEASE RETURN TO
LOS ANGELES COUNTY ENGINEER
700 Los Angeles County Engineering Bldg.

Note: Any Additions or Changes on This Sheet Must be Made or Circled in Red Ink With Date and Name of Person Making Change.

Do not extend this side of this line.

WS 70 B-6

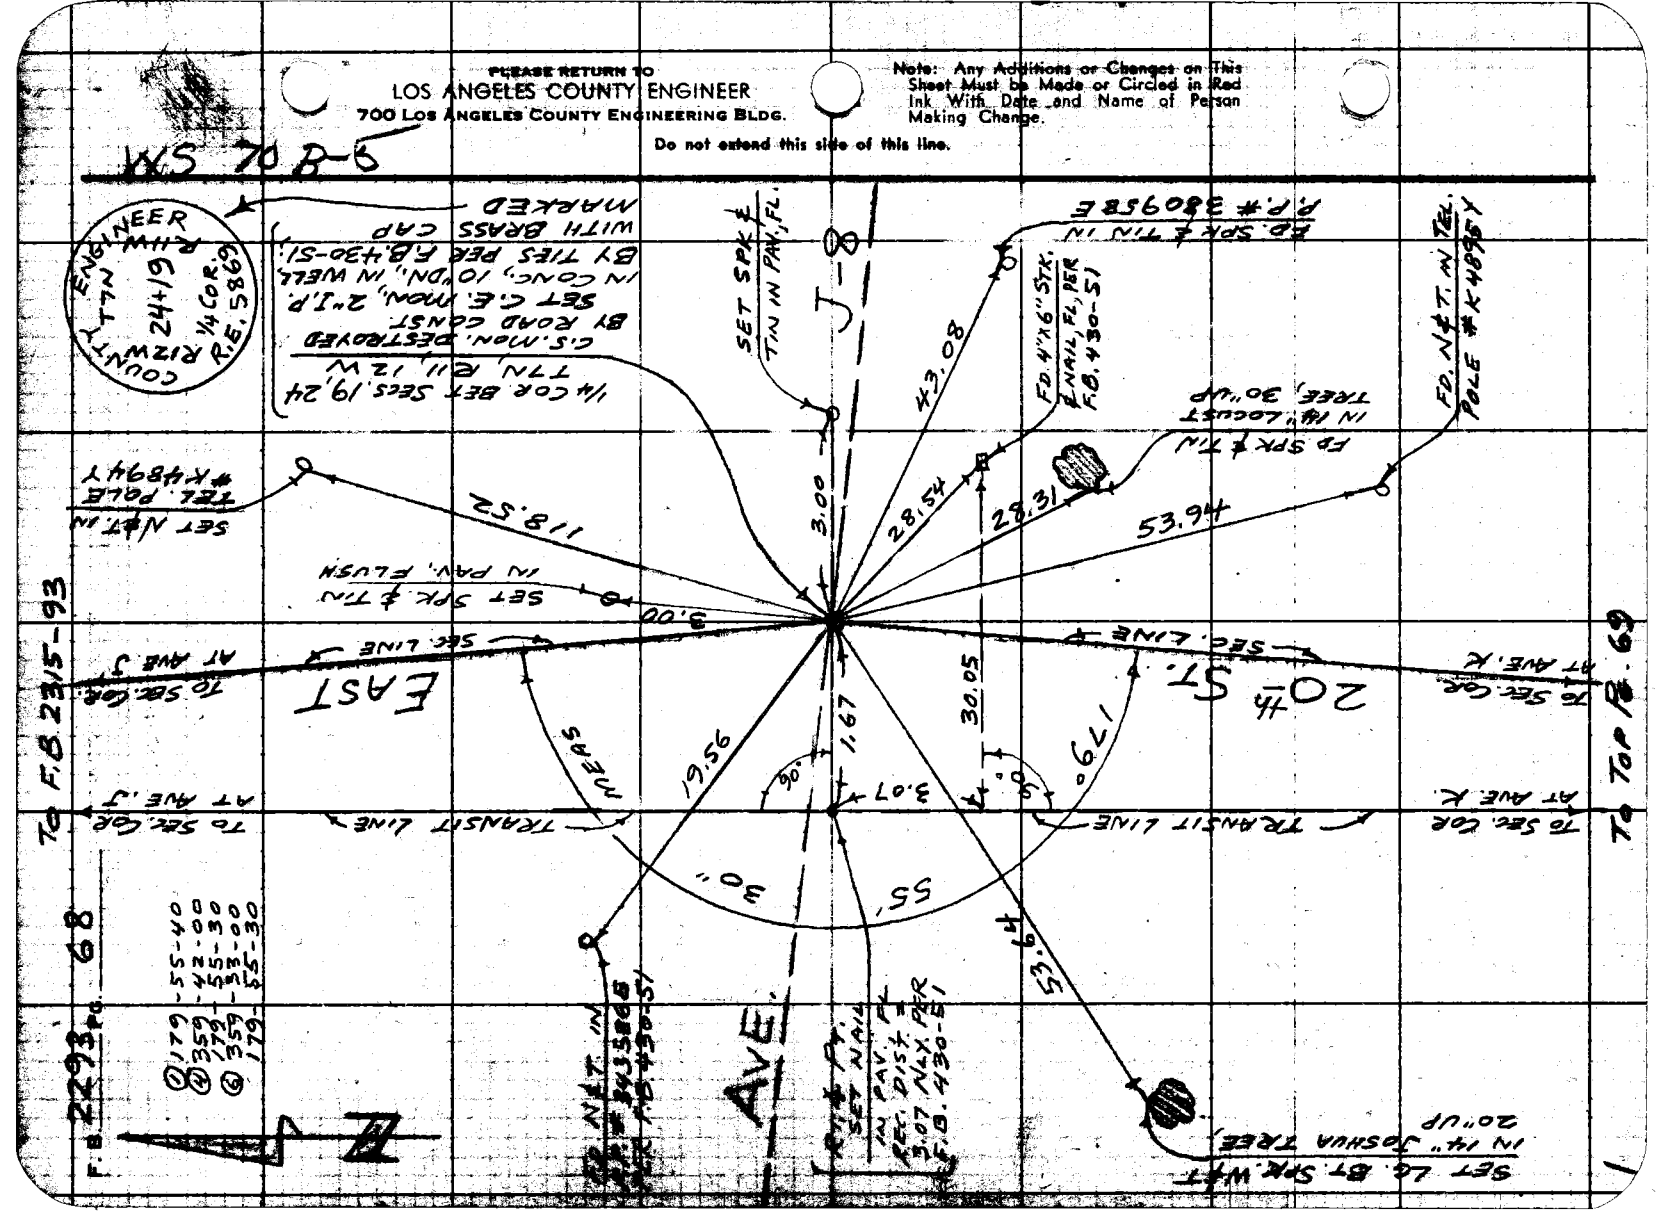

Notes Ck'd by
Map No.
Office Work
Checked
Date

Survey of Sec. LINES, T7N, R11W F. B. 2293 Pg. 69
JN 0502.01 Tape 121 Std 84 °F
Surveyed by MACK
Notes M Date 2-5-58
Indexed L. A. Johnson

To Bot. Pg. 68

W.S. 70 B-6

COUNTY SURVEYORS MONUMENT
T7N
R12W 24 19
25 30
R11W
1930

COR. SECS. 19, 24, 25, 30
T7N, R11, 12W
FD. C.S. Mon, 2" I.P.
IN CONC., 15" DN IN WELL
PER C.S. 8737 & F.B. 430-50
WITH BRASS CAP
MARKED

TRANSIT LINE

EAST

SEC. LINE

To Sec. Cor. AT AVE. J

To 1/4 Cor. AT AVE J8

SET N#T. IN TEL POLE #K-4867Y

FD. N#T. IN P.P. #343574E

FD. 2" I.P. PLUG & LEAD, 6" DP

FD. X IN 12" CONC. STANDPIPE, 20" DP

FD. N#T. IN P.P. #343574E

AVE. K

34.41

86.58

106.57

56.43

71.02

106.21

SET SPK #TIN IN PAV., FL.

78.99

85.23

40.87

3.00

86.20

20TH ST.

FD. N#T. IN TEL. POLE #K-1849-Y

SET X IN TOP OF 6"x6" CONC. MARKER POST

SET SPK #TIN IN PAV., FL.

FD. N#T. IN TEL. POLE #K-1850-Y

FD. N#T. IN TEL. POLE (NO NUMBER)

RECORD RETURN TO
LOS ANGELES COUNTY ENGINEER
700 Los Angeles County Engineering Bldg.

Do not extend this side of this line.

Note: Any Addition or Change to this Sheet Must be Made or Circled in Red Ink With Date and Name of Person Making Change.

787-3008 SAE #247 1-58

Notes Ck'd by	Survey of SEC LINES, T4N, R8W
Map No.	J.N. 0302.01 Taps 12 & 84 °F
Office Work	Surveyed by MACK
Checked	Notes M Date 2-18-58
Date	Indexed K. Johnson 4-20-59

F. B 2293 Pg. 71

J.N. 0302.01

RE-TRACEMENT OF SEC. LINES IN PORTION OF T4N, R8W.

Party
MACK
HALISCKY
RITTER
HUBBARD
H.E. MITCHELL
TEMPLETON

Note: Any Additions or Changes on This Sheet Must be Made or Circled In Red Ink With Date and Name of Person Making Change.

Do not extend notes this side of this line.

RETURN TO
LOS ANGELES COUNTY ENGINEER
700 Los Angeles County Engineering Bldg.

76F309S CE #247—3-57

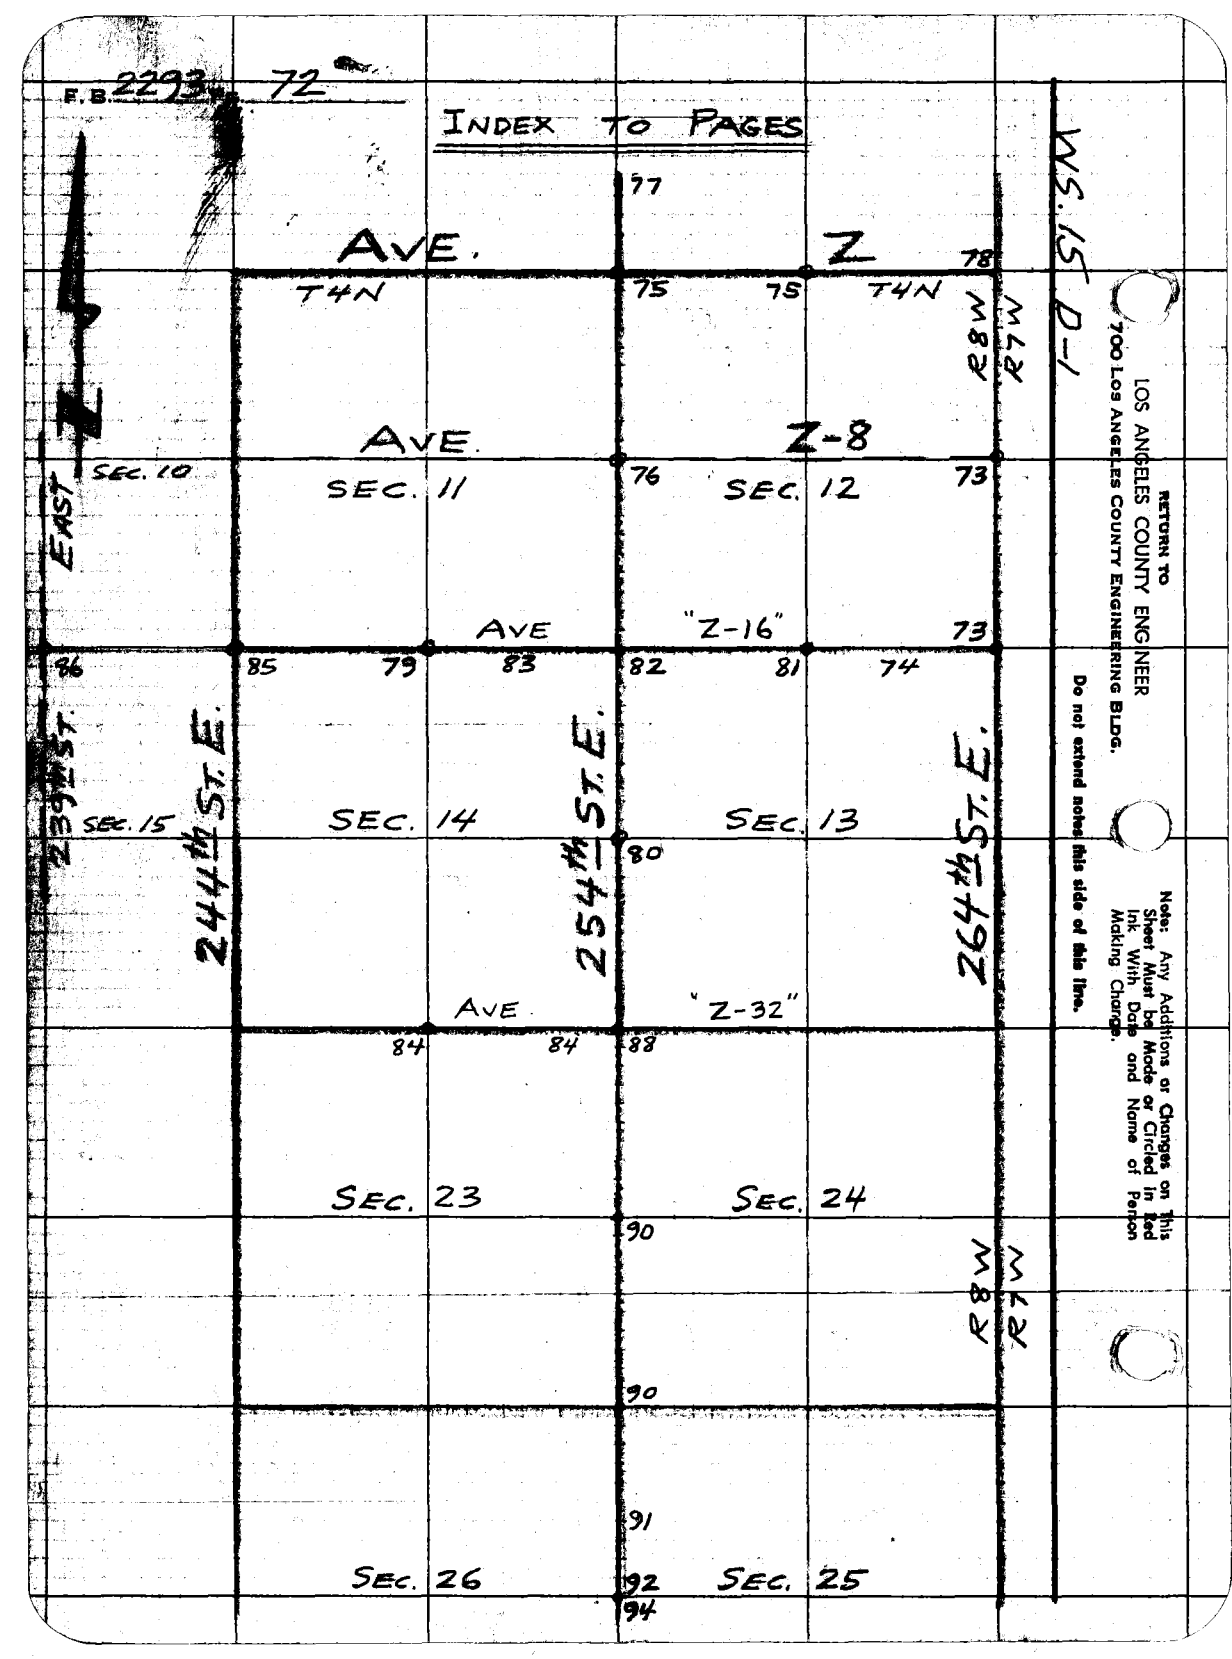
F.B. 2293 - 72
INDEX TO PAGES
AVE.
Z
77
78
75
75
T4N
T4N
R8W
R7W
W.S. 15 D-1
AVE.
Z-8
SEC. 10
SEC. 11
76
SEC. 12
73
EAST
AVE
"Z-16"
73
96
85
79
83
82
81
74
239th ST.
SEC. 15
244th ST. E.
SEC. 14
254th ST. E.
SEC. 13
264th ST. E.
80
AVE
"Z-32"
84
84
88
SEC. 23
SEC. 24
90
90
R8W
R7W
91
SEC. 26
92
SEC. 25
94
RETURN TO
LOS ANGELES COUNTY ENGINEER
700 LOS ANGELES COUNTY ENGINEERING BLDG.
Do not extend notes this side of this line.
Note: Any Additions or Changes on This Sheet Must be Made or Circled in Red Ink With Date and Name of Person Making Change.

Notes Ck'd by
Map No.
Office Work
Checked
Date

Survey of SEC. LINES, TWN, RNW F.B. 2293 Pg. 73
JN 02302.01 Tape 17.1 Std 84 °F
Surveyed by MARK
Notes M. & O. Johnson Date 2-18-58
Indexed

To Bot. Pg. 78

Z-8

SET 4x4 BY SPK W&T IN P.P.# 693411E, 3 FT. UP

35.62

AVE.

30.74

1/4 COR. BET. SECS. 7, 12 T4N, R7, 8W FD C.S. MON. 2" I.P. IN CONC., 6" DN. PER C.S.B. 157 1-9 & F.B. 56-92 WITH BRASS CAP MARKED

COUNTY SURVEYORS T4N R8W 12 7 1/4 SEC. COR. 1926 MONUMENT R7W

SET 4x4 BY SPK W&T IN 12" JUNIPER TREE. 18" UP

① 179-44-20
④ 358-57-20
179-44-20
⑥ 358-25-50
179-44-18 1/3

① 90-00-00
④ 359-59-40
89-59-55
⑥ 179-59-30
89-59-55

263 rd (C.S.B. 1571-9)

264th St.

FD 4"x4" STK. & NAIL, 10" UP

2630.23 REC. AND F.B. 56-92 S. 0°14'30"E. (CALC.)

SET X IN COR. OF PAVE. BOULDER, TYP

FD 4"x4" STK. & NAIL, 10" UP

20" ALM

6.41

42.68

52.12

FD 4"x4" STK. & NAIL, 10" UP

59'

55"

45°

42.38 TAN.

135.98

89°

AVE.

SEC. LINE

RANDOM LINE

384.46

To Bot. Pg. 74

5+03.42 W. = P.O.T. SET 1"x2" STK. & NAIL, FD.

0+00 W.

42.38 TAN.

6.51

SET 4x4 BY SPK W&T IN 12" JUNIPER, 6" UP

FD 4"x4" STK. & NAIL, 10" UP

227.95 @ 1°30'782 = 227.84
276.00 @ 3°00'764 = 275.58
50.342

Notes: Any Additions or Changes on this Sheet Must be Made or Crated in Red Ink With Date and Name of Person Making Change.

Do not extend this slip of this line.

PLEASE RETURN TO
LOS ANGELES COUNTY ENGINEER
700 LOS ANGELES COUNTY ENGINEERING BLDG.

PLEASE RETURN TO
LOS ANGELES COUNTY ENGINEER
700 LOS ANGELES COUNTY ENGINEERING BLDG.

Note: Any Additions or Changes on This Sheet Must Be Made or Circled in Red Ink With Date and Name of Person Making Change.

Do not extend this side of this line.

WS 15 D-1

219.83 @ 1°45' T64 = 219.70
213.51 LEVEL T66 = 213.48
433.18

178.05 LEVEL T64
262.98 " "
206.88 " "
219.41 " "
867.32 LEVEL T64 = 867.21
163.23 @ 3°00' T66 = 162.99
1030.20

294.46 @ 2°30' T64 = 294.14
90.33 LEVEL T64 = 90.32
384.46

SEC. 12
T4N, R8W

AVE.

"Z-16"

SEC. LINE

RANDOM LINE

433.18

1030.20

384.46

19+18.08 W = P.O.T
SET 1"x2" STK. & NAIL, FL.

9+87.88 W = P.O.T
SET 1"x2" STK. & NAIL, FL.

SEC. 13
T4N, R8W

To Lower Left Side Pg. 73

To Lower Left Pg. 74

Notes Ck'd by
Map No.
Office Work
Checked
Date

Survey of SEC. LINES, T4N, R8W
IN 0302.01 Tape 121 Std 84 °F
Surveyed by MACK
Notes M. C. JOB
Date 2-23-38
Indexed

F. B. 2293 Pg. 75

SET LG. BT. SPK. WET IN 8" JOSHUA TREE, 30" UP

FD. 4X4 STK. & NAIL, 6" UP

COR SECS 1, 2, 11, 12 T4N R8W
FD. C.S. MON. 2" I.P. IN CONC. 12" BN. PER C.S.B. 157-1, WITH BRASS CAP MARKED

TO 1/4 COR AT AVE 57

(C.S.B. 717)

57th St. E.

S. 0° 38' 55" E. (REC.)

TO 1/4 COR AT AVE 58

COUNTY SURVEYORS MONUMENT R8W T4N 2 11 12

91.21

42.38 TAN.

2645.44

89° 12.75

SET LG. BT. SPK. WET IN 5" JOSHUA TREE, 4 FT. UP

179°

35" MEAS.

42.44

45°

TAN.

90° 38' 05" MEAS.

76.43

89° 16' 55" MEAS.

FD. 4X4 STK. & NAIL, 5" UP

① 89-17-00
④ 357 07-40
89-16-55
⑥ 175-41-20
89-16-53⅓

① 179-54-50
④ 359-39-20
179-54-50
⑥ 359-29-20
179-54-53⅓

SET LG. BT. SPK. WET IN 5" JOSHUA TREE, 3 FT. UP

① 90-38-00
④ 02-82-20
90-38-05
⑥ 183-48-30
90-38-05

AVE

N. 89° 59' 30" E. (REC.)

SET N.T. IN P.P. #693396E, 3 FT. UP

1/4 COR. BET SECS. 1, 12 T4N R8W
FD. C.S. MON. 2" I.P. IN CONC. 12" BN. PER C.S.B. 157-1, WITH BRASS CAP MARKED

COUNTY SURVEYORS MONUMENT R8W T4N 1 12 1/4 SEC. COR

262nd (C.S.B. 157-9)

259th St.

134.53

124.69

SET LG. BT. SPK. WET IN 8" JOSHUA TREE, 5½ FT. UP

EAST

29.40

141.98

SET N.T. IN FENCE POST 8" UP

48.53

134.47

TO SEC. COR AT 259th St.

SET N.T. IN P.P. #693396E, 6 FT. UP

SET LG. BT. SPK. W.T. IN 8" JOSHUA TREE, 6" UP

To Upper Left Side Pg 78

Note: Any Additions or Changes on This Sheet Must be Made or Circled in Red Ink With Date and Name of Person Making Change.

Do not extend above this line.

LOS ANGELES COUNTY ENGINEER
900 Los Angeles County Engineering Bldg.

7-37 GE #247 TELFORD

RETURN TO
LOS ANGELES COUNTY ENGINEER
700 LOS ANGELES COUNTY ENGINEERING BLDG.

Note: Any Additions or Changes on This Sheet Must be Made or Circled in Red Ink With Date and Name of Person Making Change.

Do not extend notes this side of this line.

WS. 15 D-1

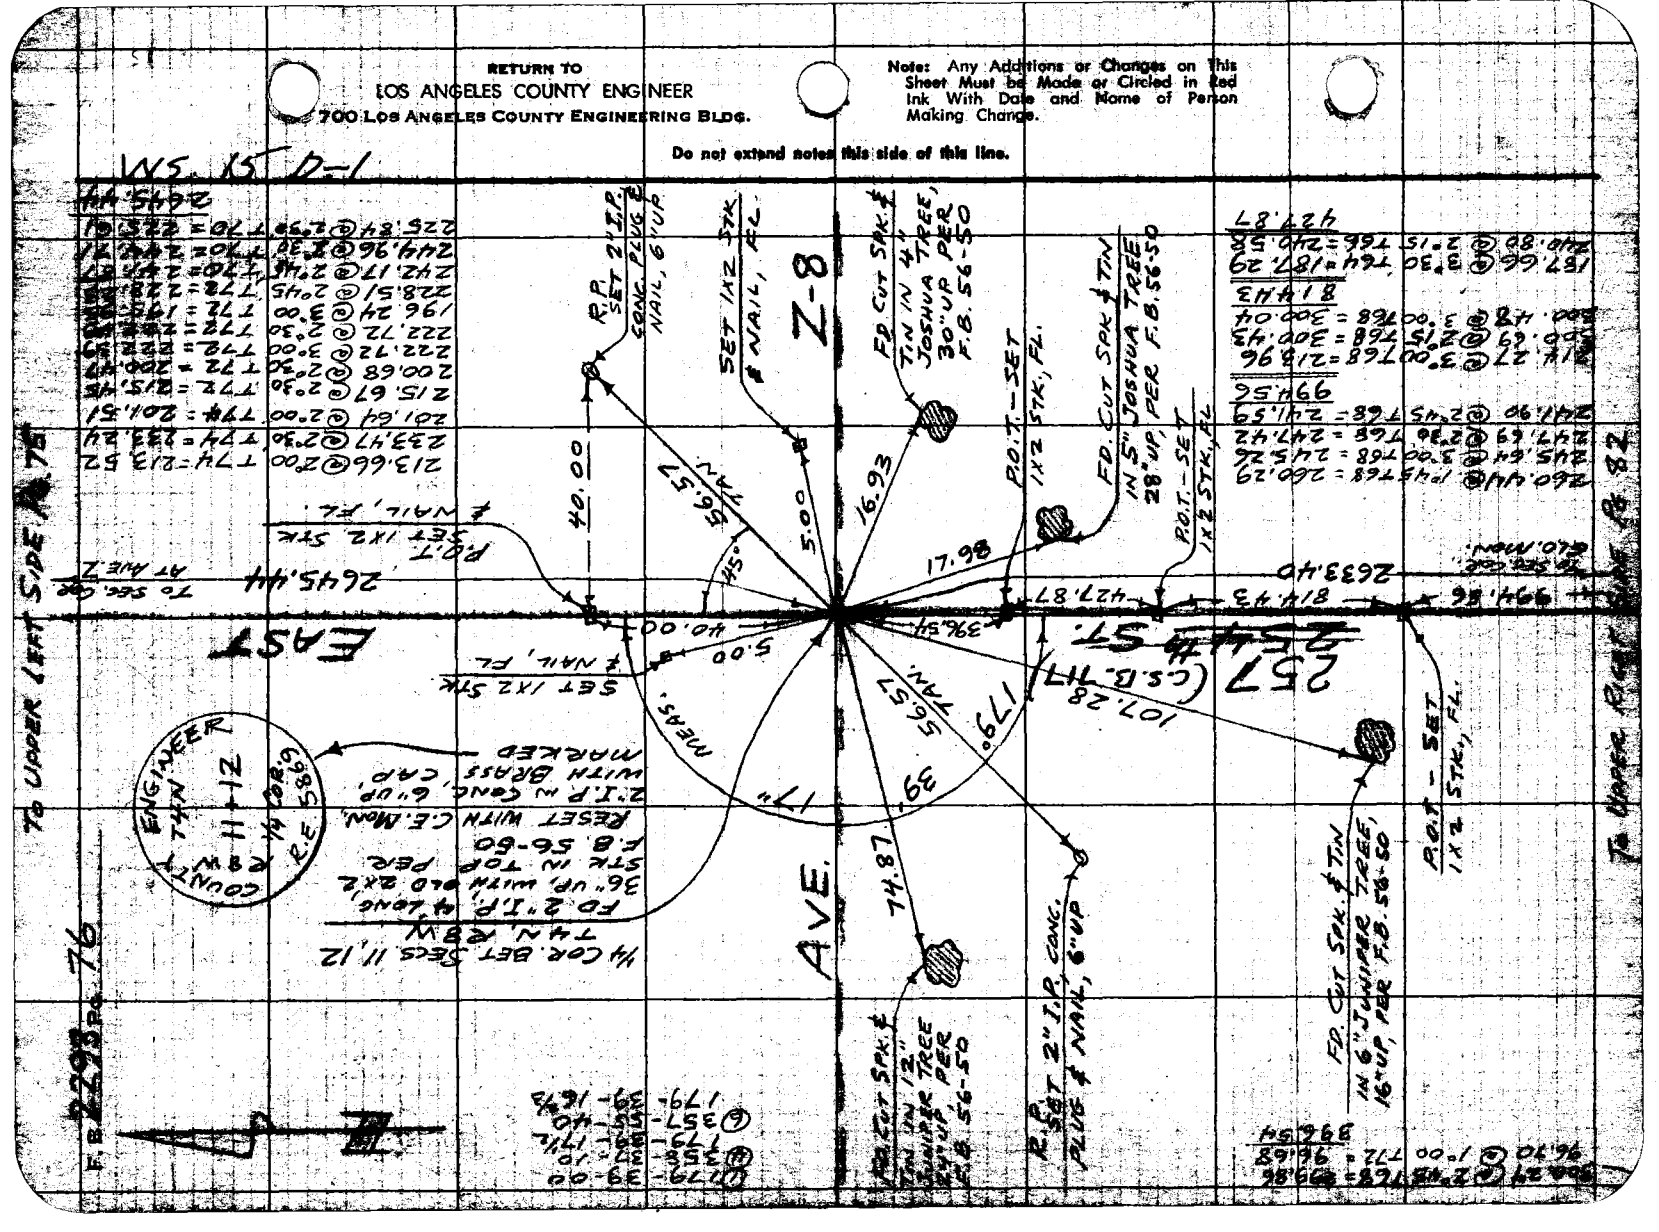

Notes Ck'd by	Survey of SEC. LINES, T1N, R8W
Map No.	JN 2303.91 Tape 12.1 Std. 84 °F
Office Work	Surveyed by MACK
Checked	Notes Date 2-21-58
Date	Indexed C. Johnson

F.B. 2293 Pg. 77

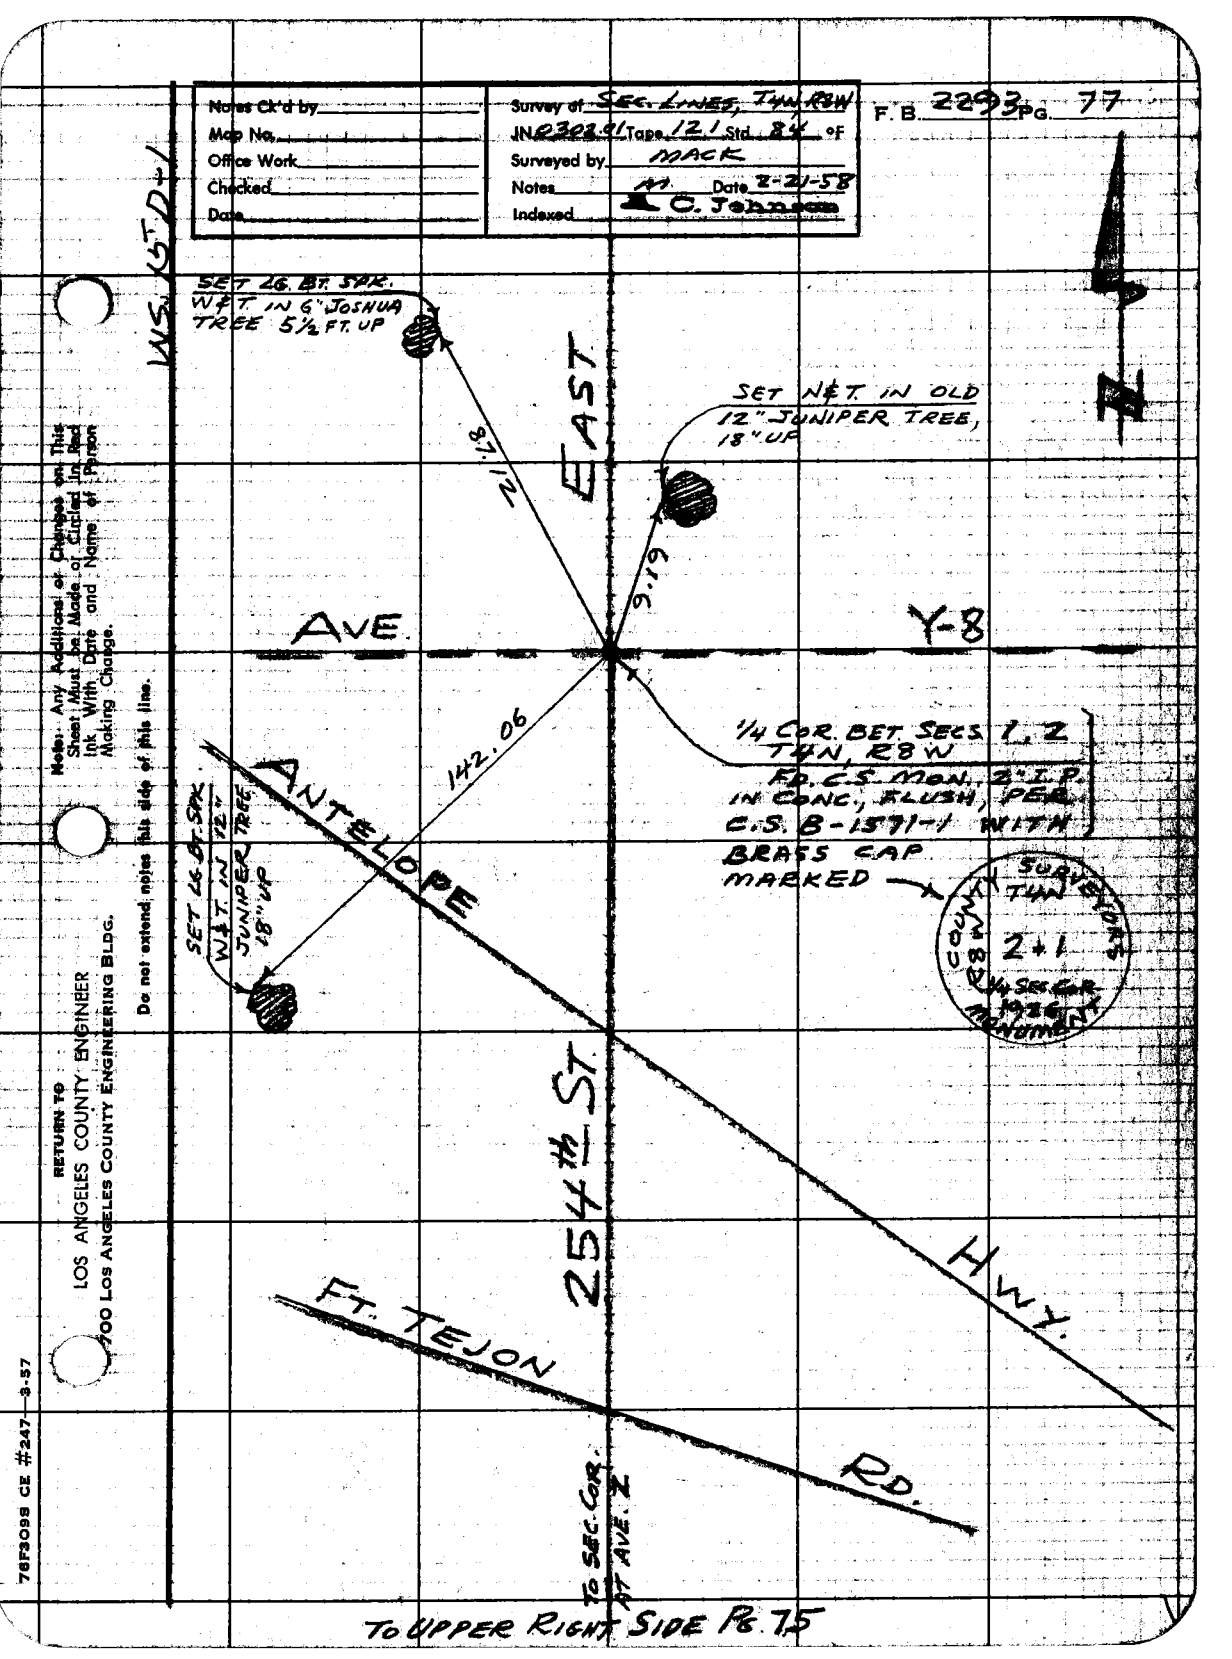

Note: Any Additions or Changes on This Sheet Must be Made or Called in and Ink With Date and Name of Person Making Change.

Do not extend notes this side of this line.

RETURN TO
LOS ANGELES COUNTY ENGINEER
900 LOS ANGELES COUNTY ENGINEERING BLDG.

78F3098 CE #247—3-57

TO UPPER RIGHT SIDE PG. 75

RETURN TO
LOS ANGELES COUNTY ENGINEER
700 LOS ANGELES COUNTY ENGINEERING BLDG.

Note: Any Additions or Changes on this Sheet Must be Made or Circled in Red Ink With Date and Name of Person Making Change.

Do not extend notes this side of this line.

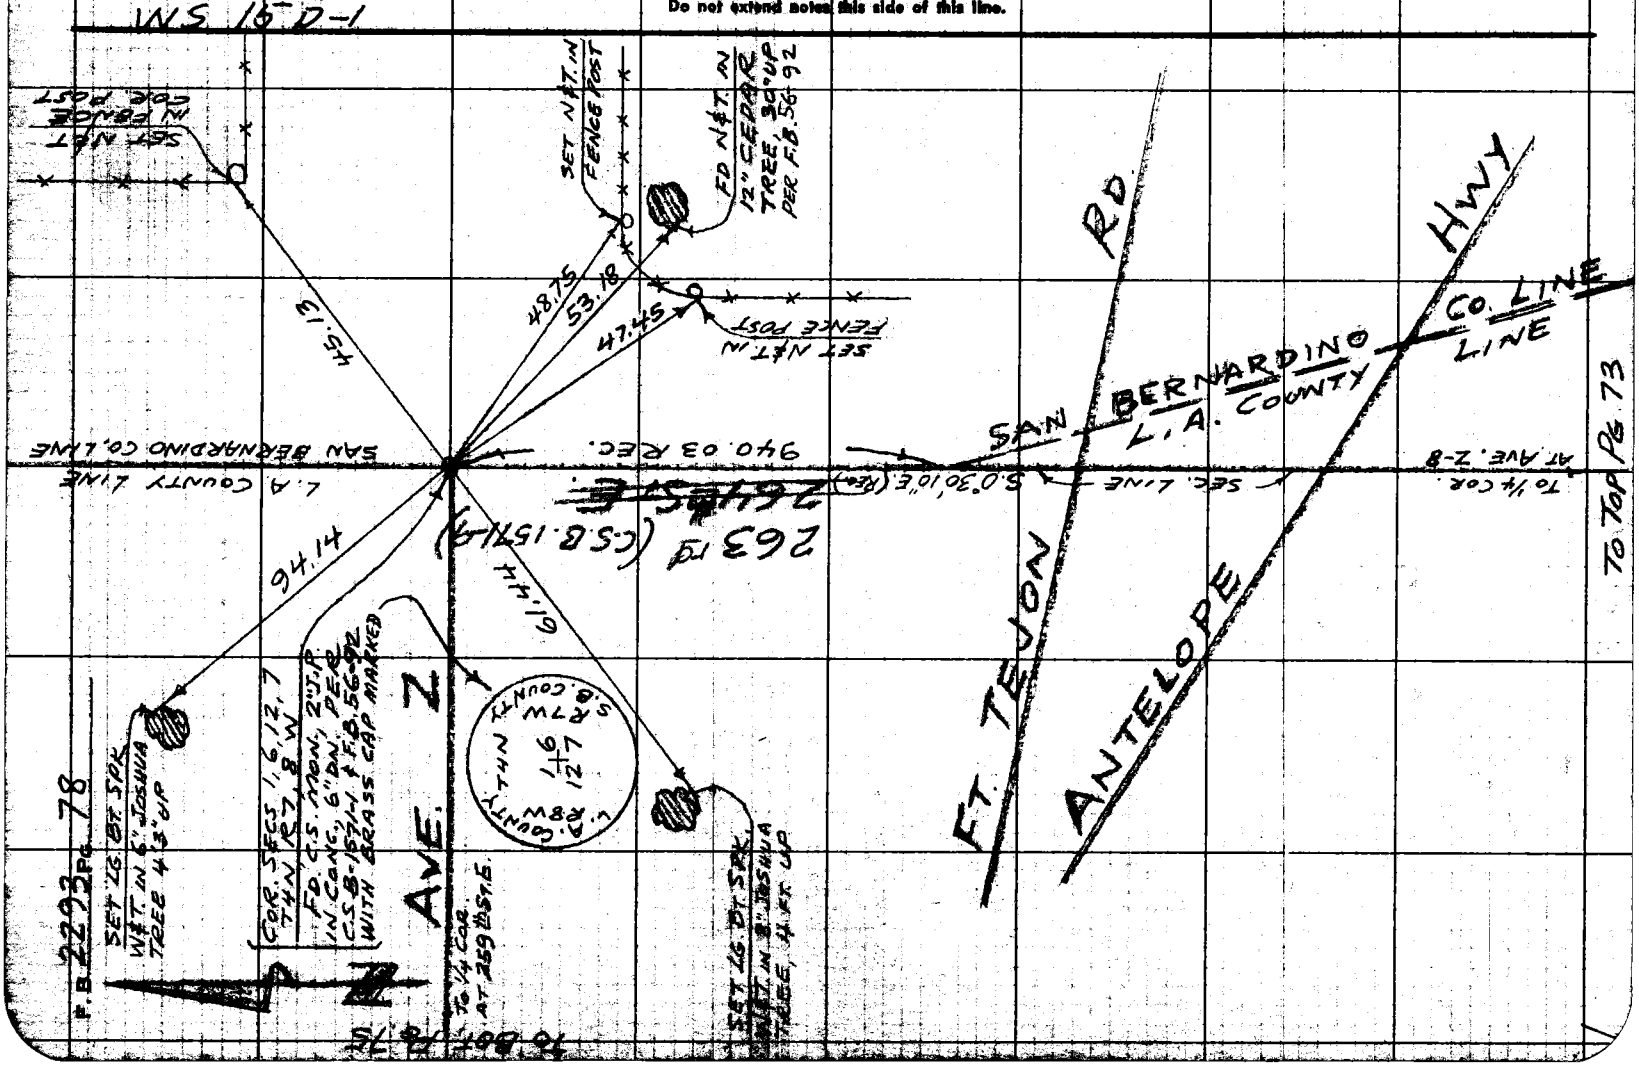

Notes Ck'd by
Map No.
Office Work
Checked
Date

Survey of SEC. LINES, T4N, R8W
W. O. 852.01 Tape No. 121 Std. 84 °F
Surveyed by MMCA
Notes M. C. Johnson Date 2-24-58
Indexed

F. B. 2293 Pg. 79

WS 15-D-1

TO BOT. PG. 85

PROD. FROM E. SEC. LINE 548.16

26+41.85 W. (From E.) = 0+00 GOING W.
¼ COR. BET. SECS 11, 14 T4N, R8W
ED. G.L.O. MON., 1" I.P. 12" UP, PER C.S. 9161-4 WITH BRASS CAP MARKED

U.S. GENERAL LAND OFFICE SURVEY 1918 ¼ SEC 11 SEC 14

249th ST.

EAST

180°

14.11

90°

10.66

AVE. SEC. LINE

26+30.86 W.
SET 1X2 STK., FL

133.85

"Z-16"

90°

P.O.T. SET 1X2 STK. FL. ON TRUE LINE BY CALC. OFFSET

13.33

24+97.01 W
SET 1X2 STK., FL.

543.54

TO TOP PG. 83

133.32 @ 2.00 T/00 = 133.85

RETURN TO
LOS ANGELES COUNTY SURVEYOR
726 LOS ANGELES COUNTY
ENGINEERING BLDG.

Note: Any Additions or Changes on This Sheet Must Be Made or Circled in Red Ink With Date and Name of Person Making Change.

Do not extend notes this side of this line.

76FSOSS 247 4-58

RETURN TO
LOS ANGELES COUNTY SURVEYOR
726 LOS ANGELES COUNTY
ENGINEERING BLDG.

Note: Any Additions or Changes on This Sheet Must be Made or Circled in Red Ink With Date and Name of Person Making Change.

Do not extend notes this side of this line.

W.S. 15 D-1

F.B. 2293 Pg. 80

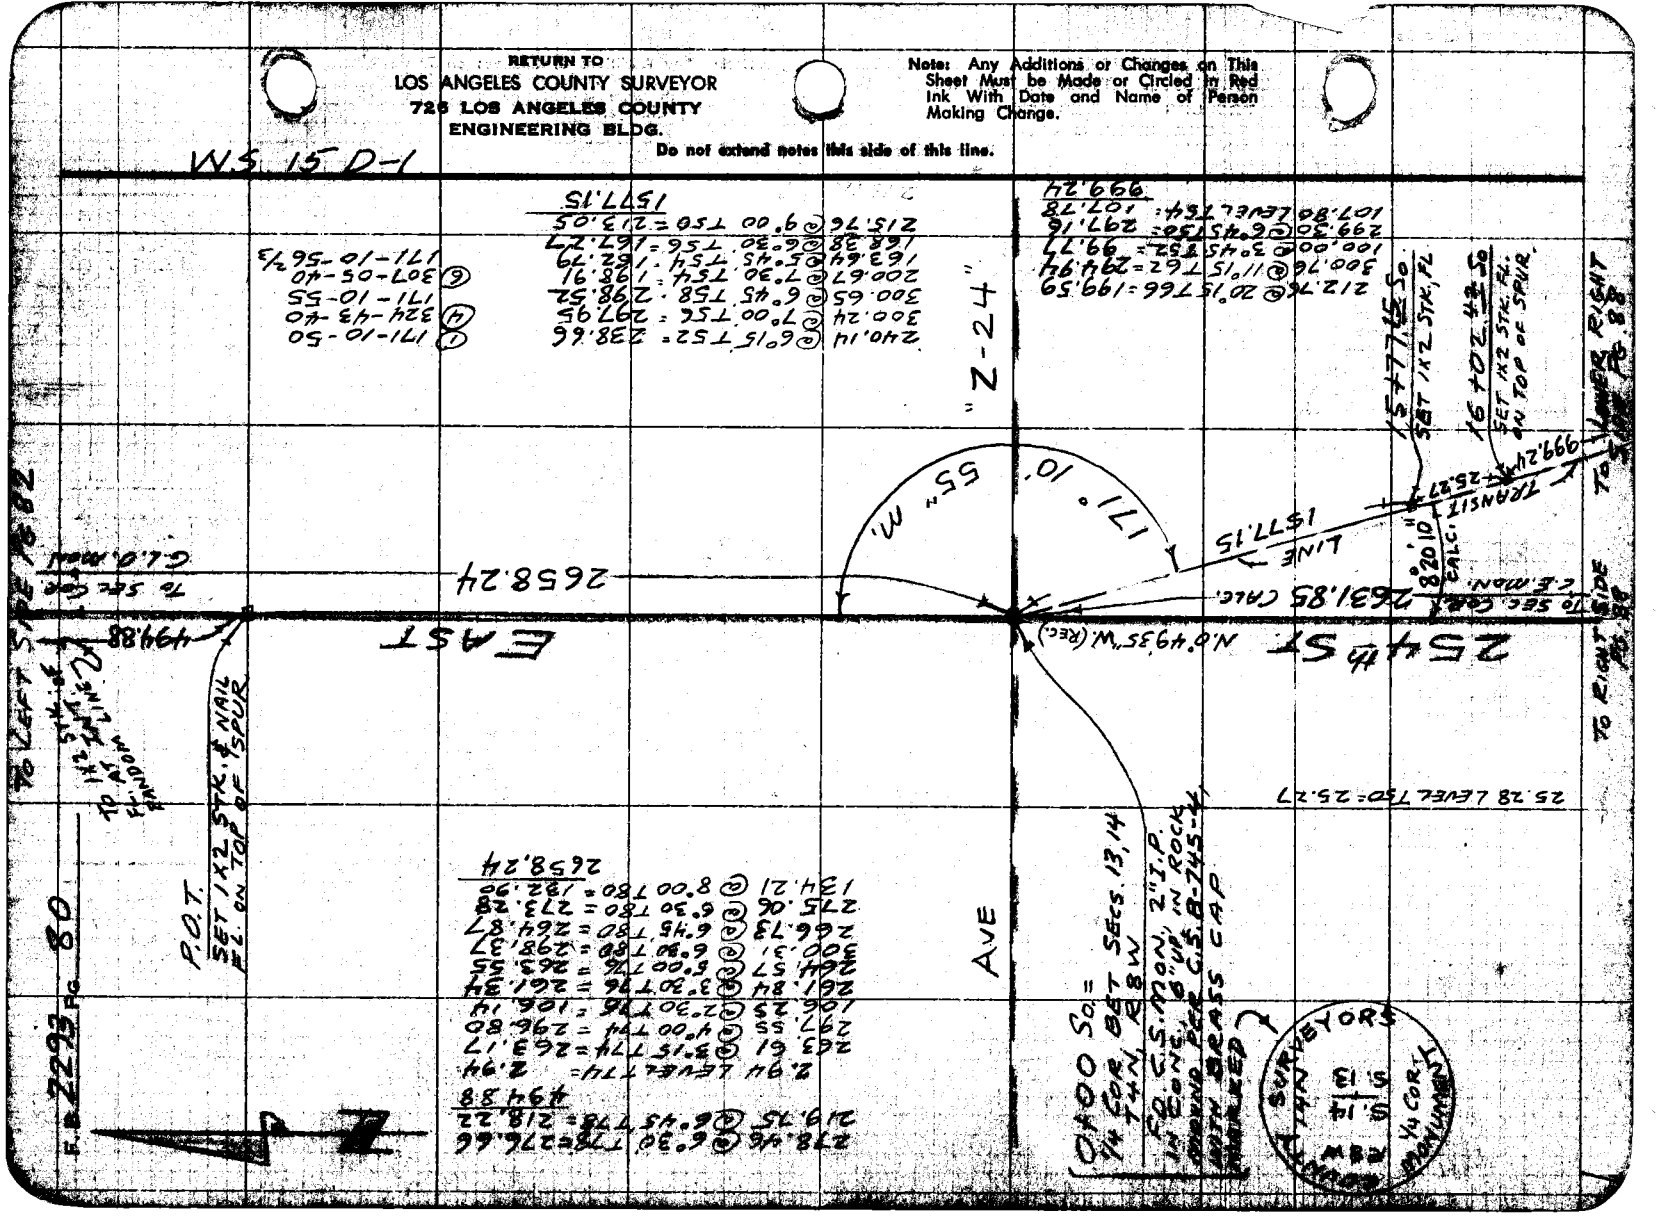

2.94 ELEVEL T74 =			2.94
263.61	@	3°15' T74 =	263.17
297.55	@	4°00' T74 =	296.80
106.25	@	2°30' T76 =	106.14
261.84	@	3°30' T76 =	261.34
264.57	@	5°00' T76 =	263.55
300.31	@	6°30' T80 =	298.37
266.73	@	6°45' T80 =	264.87
275.06	@	6°30' T80 =	273.28
13H.21	@	8°00' T80 =	182.90
			2658.24

278.46	@	6°30' T78 =	276.66
219.75	@	6°45' T78 =	218.22
			494.88

212.76	@	20°15' T66 =	199.59
300.76	@	11°15' T62 =	294.94
100.00	@	3°45' T52 =	99.77
299.30	@	6°45' T50 =	297.16
107.80	LEVEL T54 =		107.78
			999.24

215.76	@	9°00 T50 =	213.05
			1577.15

240.14	@	6°15' T52 =	238.66
300.24	@	7°00' T52 =	297.95
300.65	@	6°45' T58 =	298.52
200.67	@	7°30' T54 =	198.91
163.44	@	5°45' T54 =	162.79
168.38	@	6°30' T56 =	167.27

(1)	171-10-50		
(H)	324-43-40		
	171-10-55		
(6)	307-05-40		
	171-10-56 2/3		

Notes Ck'd by	Survey of SEC. LINES, T4N, R8W
Map No.	JN 0302 01 Tape 121 Std 84 °F
Office Work	Surveyed by MACK
Checked	Notes M. Date 2-24-58
Date	Indexed C. Johnson

F. B. 2293 Pg. 81

To Bot. Pg. 82

SET BT. SPK W&T. IN 6" JUNIPER TREE, 2½ FT UP

1080.23

RANDOM LINE

SEC. LINE AVE

SEC. 12, T4N, R8W

26+34.48 W FD. OLD JUNIPER POST 24" UP, WITH TRACES OF SCRIBINGS ON N. SIDE

SET BT. SPK W&T. IN 8" JUNIPER TREE, 4½ FT UP

228.09 LEVEL T68
" " " "
190.25 " " "
219.35 " " "
129.94 " " "
225.51 " " "
84.20 " " "
1080.34 LEVEL T68 = 1080.23

26+44.43 W. = P.O.T. SET 1X2 STK, FL

SET BT. SPK W&T. IN 6" JUNIPER TREE, 9" UP

9.95

2.05

SET 1X1 STK & NAIL, FL

10.00

43.31

4.50

47.25

26+29.98 W FD. REMAINS OF OLD ROCK MOUND PER C.S. 9161-42

57.15

180°

2.00

0.06

1.47

259th ST.

10.04

SET 1X1 STK & NAIL, FL

EAST

32.38

SET BT. SPK W&T. IN 8" JUNIPER TREE, 4½ FT UP

168.85 LEVEL T64
124.36 " " "
293.21 LEVEL T64 = 293.17

26+29.92 W = 1/4 COR. BET SECS. 12, 13 T4N, R8W

SET C.E. MON, 2" I.P. IN CONC., FLUSH, WITH BRASS CAP MARKED: AT MIDPOINT E & W BET. ADJACENT SEC. CORS. ON CALC. OFFSET NLY. OF RANDOM LINE, IN EXISTING ROCK MOUND OF ORIGINAL 1/4 SEC. COR. PER C.S. 9161-42

COUNTY SURVEYOR R8W 1/4 COR 12 13 T4N ENGINEER 3.586

293.17

32.57

SET W&T. IN 6" JUNIPER TREE, 20" UP

47.00

RANDOM LINE

SEC. LINE

SET BT. SPK. W&T. IN 12" JUNIPER TREE, 4½ FT. UP

23+51.26 W. = P.O.T. SET 1X2 STK & NAIL, FL

433.18

SEC. 13, T4N, R8W

To Top Pg. 74

NOTE: MRS. J. BUCHANAN, PROPERTY OWNER IN SEC. 12, T4N, R8W STATES THAT S¼ COR. OF SEC. 12 WAS A 4X4 POST, 24" UP WITH SCRIBINGS, SET IN A LARGE ROCK MOUND. HE MAINTAINS SAID ¼ COR. REMAINED IN THIS CONDITION TO HIS KNOWLEDGE FOR 35 YRS BET. 1923 & 1956. SINCE THE OLD 4X4" POST HAS DISAPPEARED, SAYS THAT TIME THE OLD POST WAS 4.50 NLY. OF THE BRACED ROCK AROUND WAS THE LAST TIME THERE WITHIN THE LAST FEW YES. RECOVERED 3-21-58

Note: Any Additions or Changes on This Sheet Must be Made or Circled in Red Ink With Date and Name of Person Making Change.

Do not extend this side of this line.

PLEASE RETURN TO LOS ANGELES COUNTY ENGINEER 700 Los Angeles County Engineering Bldg.

76F3098 SBE #247 1-56

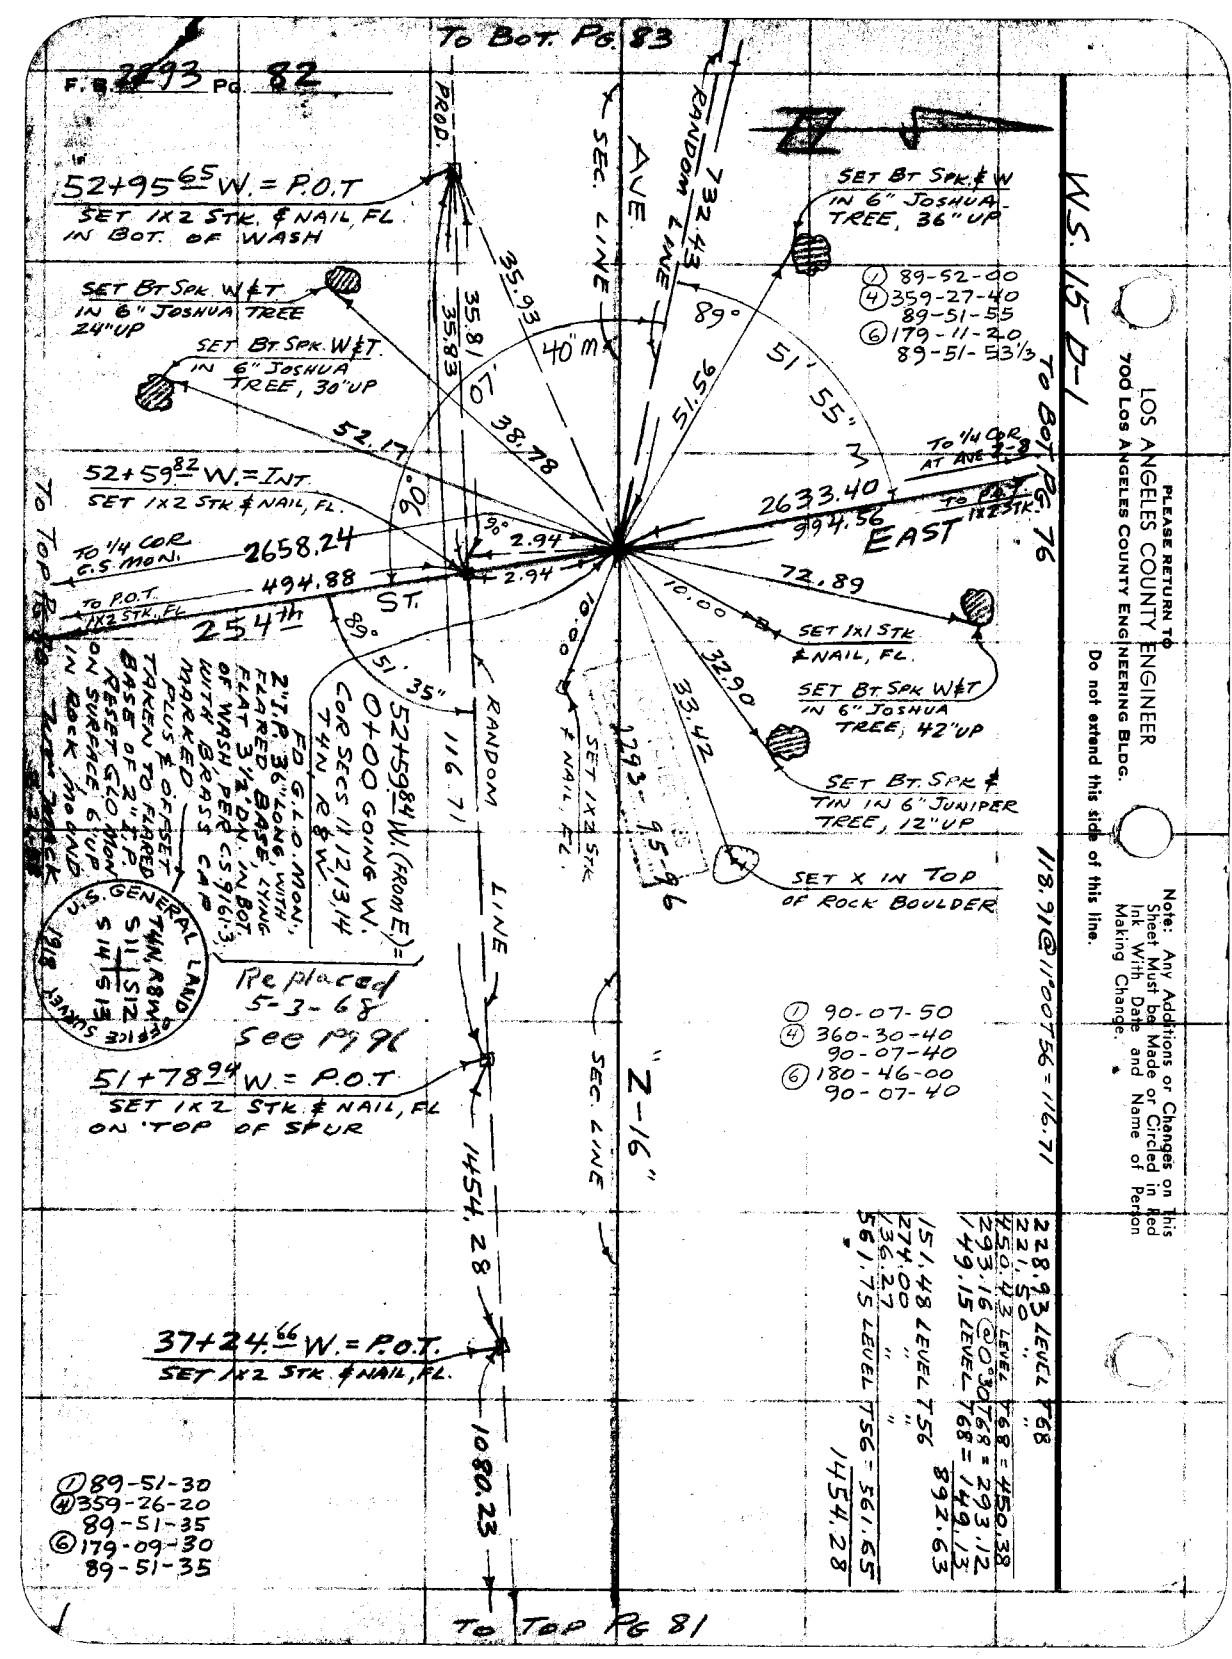
F.B. 2893 Pg. 82
To Bot. Pg. 83
PROD.
SEC. LINE
AVE.
RANDOM LINE
732.43
52+95.65 W. = P.O.T
SET 1X2 STK. & NAIL, FL. IN BOT. OF WASH
SET BT SPK. & W IN 6" JOSHUA TREE, 36" UP
① 89-52-00
④ 359-27-40
89-51-55
⑥ 179-11-20
89-51-53½
SET BT SPK. W&T IN 6" JOSHUA TREE 24"UP
SET BT SPK. W&T IN 6" JOSHUA TREE, 30"UP
35.93
35.81
35.83
40' M
89°
51° 55"
51.56
38.78
52.17
90°
52+59.82 W. = INT.
SET 1X2 STK & NAIL, FL.
To 1/4 COR AT AVE 7-8
2633.40
994.56
EAST
To Top Pg. 84
To 1/4 COR C.S. MON.
2658.24
494.88
To P.O.T. 1X2 STK. FL.
254th ST.
3°
2.94
2.94
89°
51° 35"
72.89
10.00
32.90
33.42
SET 1X1 STK & NAIL, FL.
SET BT SPK W&T IN 6" JOSHUA TREE, 42"UP
SET BT. SPK & TIN IN 6" JUNIPER TREE, 12"UP
SET X IN TOP OF ROCK BOULDER
1293.95-96
SET 1X2 STK & NAIL, FL.
RANDOM LINE
116.71
52+59.84 W. (FROM E.) = 0+00 GOING W.
COR SECS 11, 12, 13, 14 T 4N, R 8W.
FD G.L.O. MON. 2" I.P. 36" LONG, WITH FLARED BASE, LYING FLAT 3½' DN. IN BOT. OF WASH PER C.S. 9161-3. WITH BRASS CAP MARKED PLUS X OFFSET
TAKEN TO FLARED BASE OF 2" I.P. RESET G.L.O. MON. ON SURFACE 6' UP IN ROCK MOUND
GENERAL LAND OFFICE SURVEY
T4N R8W
S11 S12
S14 S13
U.S.
Replaced 5-3-68 See pg 96
51+78.94 W. = P.O.T
SET 1X2 STK & NAIL, FL ON TOP OF SPUR
SEC. LINE
1454.28
37+24.66 W. = P.O.T.
SET 1X2 STK & NAIL, FL.
1080.23
① 89-51-30
④ 359-26-20
89-51-35
⑥ 179-09-30
89-51-35
To Top Pg 81
W.S. 15 D-1
To Bot. Pg. 76
Z-16"
1/8.91@11.60T56 = 116.71
228.93 LEVEL T68
221.50 " "
450.38 LEVEL T68 = 450.38
293.16 @ 0°30'T68 = 293.12
149.15 LEVEL T68 = 149.13
151.48 LEVEL T56 892.63
274.00 " "
136.27 " "
561.75 LEVEL T56 = 561.65
1454.28
① 90-07-50
④ 360-30-40
90-07-40
⑥ 180-46-00
90-07-40
PLEASE RETURN TO
LOS ANGELES COUNTY ENGINEER
700 Los Angeles County Engineering Bldg.
Do not extend this side of this line.
Note: Any Additions or Changes on This Sheet Must be Made or Circled in Red Ink With Date and Name of Person Making Change.

Notes Ck'd by	Survey of SEC. LINES, T4N, R8W
Map No.	JN 0302.01 Tape 121 Std. 84 °F
Office Work	Surveyed by MACK
Checked	Notes M Date 3-21-58
Date	Indexed C. Johnson

F. B. 2293 PG. 83

N

TO BOT PG 79

SEC. 11, T4N, R8W

SEC. LINE AVE

543.54 RANDOM LINE

P.O.T SET 1X2 STK. FL. ON TRUE LINE BY CALC. OFFSET

10.43

90°

19+53.47 W. SET 1X2 STK. FL. ON TOP W. BANK OF WASH

374.58

15+78.89 W SET 1X2 STK., FL. ON TOP E. BANK OF WASH

671.02

SEC. 14, T4N, R8W

Z-16"

9+07.87 W SET 1X2 STK, FL.

175.44

7+32.43 W SET 1X2 STK, FL.

732.43

5.82

PROD. FROM E. SET 1X2 STK. FL. ON RANDOM LINE PROD. FROM E.

2.80

90°

PROD. TO TOP PG. 82

W S 15 D

Note: Any Additions or Changes on this Sheet Must be Made or Circled in Red Ink With Date and Name of Person Making Change.

Do not extend this side of this line.

PLEASE RETURN TO
LOS ANGELES COUNTY ENGINEER
700 LOS ANGELES COUNTY ENGINEERING BLDG.

76F309S S&E #247 1-56

PLEASE RETURN TO
LOS ANGELES COUNTY ENGINEER
700 LOS ANGELES COUNTY ENGINEERING BLDG.

Note: Any Additions or Changes on This Sheet Must be Made or Circled in Red Ink With Date and Name of Person Making Change.

Do not extend this side of this line.

WS 15-D-1

116.19 @ 17°00' T44 = 111.08
294.12 @ 27°00' T52 = 262.00
82.77 @ 28°00' T56 = 73.06
446.14

239.72 @ 6°45' T54 = 238.25
271.63 @ 1°45' T54 = 271.45
509.70

97.24 @ 25°00' T48 = 88.11
139.78 @ 24°00' T48 = 127.66
215.77
- 40.60 @ 24°00' T48 = - 37.08
178.69
9.35 LEVEL T48 = 9.35

154.57 @ 2°15' T54 = 154.42
150.95 LEVEL T52 = 150.92
241.72 @ 13°00' T54 = 235.47
171.33 @ 25°45' T46 = 154.28
202.90 @ 30°00' T46 = 175.67
870.76

① 179-47-50
④ 359-12-00
179-48-00
⑥ 358-48-00
179-48-00

SEC. 14, T4N, R8W

SEC. 23, T4N, R8W

23+89.76 W SET 1X2 STK., FL.

20+51.72 W SET 1X2 STK. FL. ON TOP OF SPUR

20+51.12 W R-13 J6IR Fd. 1X2 STK. & TK., FL. PER F.B. 488-108

4.32

15+42.02 W SET 1X2 STK. FL. ON TOP OF SPUR

10+95.88 W SET 1X2 STK. FL.

10+86.53 W SET 1X2 STK. FL. ON TOP OF SPUR

10+49.45 W SET 1X2 STK., FL.

8+70.76 W. SET 1X2 STK. FL.

0+00 W = WITNESS COR. Fd. E.S. MON. 2" I.P. IN CONC. 6" UP PER F.B. 488-107 & C.S.B-745-4, WITH BRASS CAP MARKED

COUNTY SURVEYORS T4N R8W 14 13 23 24 W.C. MONUMENT

238.04

509.70

0.60

8.88

0.29

90°

0.25

90°

446.14

9.35

37.08

178.69

870.76

0.13

RANDOM LINE

TRANSIT LINE

179° 48' 00" M.

176° 30' 25" M

176° 30' 00" CALC.

N.89°17'45"W. (Rec.)

SEC. LINE

AVE. "Z-32"

255.42 TO SEC. COR.

SEC. LINE N.85°47'45"W. (Rec.)

TO Tdp P.B.88

F.B. 2293 Pg. 84

23+98.64 W S.1/4 COR. SEC. 14 T4N, R8W FD. G.L.O. MON. 1" I.P. 12" UP WITH 2" BRASS CAP MARKED PER F.B. 488-109 & C.S.B-745-4

20+51.12 W J-61 F.B. Fd. 2X2 STK. 3" UP PER F.B. 488-108

U.S. GENERAL LAND OFFICE SURVEY 1918 S.14 1/4 S.23

NOTE: THIS BRASS CAP MARKED "S.23" ON SOUTH, ALTHO GOV'T. NOTES, C.S. 916-10, SHOW THIS MON. FOR SEC. 14 ONLY. ALSO F.B. 488-109 & C.S.B-745-4 SHOW NO MARK ON SD. FOR SEC. 23 W.MARK 2-20-59

82.45 @ 28°30' T50 = 72.44
293.82 @ 27°15' T52 = 265.60
338.04

① 176-30-20
④ 346-01-40
176-30-25
⑥ 339-02-40
176-30-26⅔

Notes Ck'd by	
Map No.	
Office Work	
Checked	
Date	

Survey of SEC. LINES, T4N, R8W
JN 0302.01 Tape 121 Std 84 °F
Surveyed by MACK
Notes M. O. Johnson Date 7-9-58
Indexed

F. B. 2293 Pg. 85

To Bot. Pg. 86

26+59.40 W
SET 1X2 STK., FL.

244th ST.

16.53

SEC. LINE

1476.08

18°00'

34.00

532.52

EAST

26+42.87 W. (FROM E.) =
0+00 GOING W.
COR. SECS. 10, 11, 14, 15
T4N, R8W
FD. G.L.O. MON., 2" I.P.,
12" UP, IN ROCK MOUND,
PER C.S. 9161-4 WITH
BRASS CAP MARKED

AVE.

21+26.88 W
SET 1X2 STK., FL.
ON TOP RIM OF E.
BANK OF CANYON

27.36

90°

P.O.T.
SET 1X2 STK., FL.
ON TRUE LINE
BY CALC. OFFSET

U.S. GENERAL LAND OFFICE SURVEY 1918 T4N R8W S10 S11 S14 S15

21+14.40 W
SET 1X2 STK., FL.
ON TOP OF E. BANK
OF CANYON

12.48

666.24 PROD.

SEC. LINE

14+48.16 W
SET 1X2 STK., FL.
ON TOP OF SPUR

FROM 900.00 E.

"Z-16"

5+48.16 W
SET 1X2 STK., FL

548.16

To Top Pg. 79

12.48 LEVEL T98 = 12.48

257.78 @ 24°15' T98 = 235.01
298.85 @ 5°30' T98 = 29.47
532.52

900.00

Note: Any Additions or Changes on This Sheet Must be Made or Circled in Red Ink With Date and Name of Person Making Change.

Do not extend notes this side of this line.

RETURN TO
LOS ANGELES COUNTY ENGINEER
700 Los Angeles County Engineering Bldg.

76F3095 CE #247—3-57

RETURN TO
LOS ANGELES COUNTY ENGINEER
700 LOS ANGELES COUNTY ENGINEERING BLDG.

Note: Any Additions or Changes on This Sheet Must be Made or Circled in Red Ink With Date and Name of Person Making Change.

Do not extend notes this side of this line.

W.S. 15 D-4

214.51 @ 24° 15' T88 = 195.59

P.O.T. SET 1x2 STK. FL. ON TOP OF SPUR

① 179-55-30
② 359-41-50
179-55-27½
③ 359-33-00
179-55-30

EAST

26+59.32 W. = 15 1/4 COR. BET. SECS. 10, 15 T4N R8W

FD. 6" L.C.O. MON., I" I.P. 16" D/P PER C.S.B-798-2, WITH 2" BRASS CAP MARKED

U.S. GENERAL LAND OFFICE SURVEY 1918
1/4 S 10 | S 15

652.43

20+01.73 W. SET 1x2 STK. FL. ON TOP OF SPUR

281.56

17+20.17 W SET 1x2 STK. FL. ON TOP OF SPUR

244.09

14+76.08 W SET 1x2 STK. FL. ON TOP OF SPUR

1476.08

"Z-16"

6.66

8.85

5.16

90°

179°

55'

30'

AVE.

195.59

N 89° 56' 15" E. REC. 2646.48 REC. PER C.S.B-798-2

TO SEC. COR., G.L.O. MON.

26+54.16 W SET 1x2 STK. FL. IN BOT. OF DRAW

P.O.T. SET 1x2 STK. FL. ON TRUE LINE BY CALC. OFFSET

239½ ST.

244.45 @ 3°15 T102 = 244.09

281.75 @ 2°15 T100 = 281.56

97.93 @ 2°00 T100 = 97.88
168.71 LEVEL T100 = 168.73
193.36 @ 1°30 T100 = 193.31
291.56 @ 12°30 T102 = 284.68
100.51 @ 20°00 T102 = 94.46
120.53 @ 1°15 T102 = 120.51
296.40 @ 4°15' T100 = 295.61
133.92 @ 28°00' T100 = 118.25
106.64 @ 15°45' T100 = 102.65
1476.08

114.65 @ 6°45' T82 = 113.86
290.75 @ 2°00 T80 = 290.56
255.61 @ 14°00 T80 = 248.01
652.43

F.B. 2293 PG. 86

PG. 87

FROM TOP PG. 85

Notes Ck'd by	Survey of SEC. LINES, T4N, R8W
Map No.	JN 0302.0 / Tape 121 Std 84 °F
Office Work	Surveyed by MACK
Checked	Notes M Date 7-17-58
Date	Indexed L. O. Johnson

F. B. 2293 PG. 87

Note: Any Additions or Changes on this Sheet Must be Made or Circled in Red Ink With Date and Name of Person Making Change.

Do not extend this side of this line.

PLEASE RETURN TO
LOS ANGELES COUNTY ENGINEER
700 LOS ANGELES COUNTY ENGINEERING BLDG.

76F309S S&E #247 1-56

W.S. 15D-1

SET LG. BT. SPK. W&T IN 6" JOSHUA TREE, 30" UP

SET LG. BT. SPK. W&T IN 6" JOSHUA TREE, 48" UP

37.20

AVE

51.65

SET 1X1 STK. & NAIL, FL.

3.00

SET 1X1 STK. & NAIL, FL.

3.00

234th ST.

EAST

38.04

COR. SECS. 9, 10, 15, 16 T4N, R8W FD. G.L.O. MON., 2" I.P. 20" DN PER C.S.B-798-2 WITH BRASS CAP MARKED FD 4X4 POST WITH N&T ON TOP, 8" UP, OVER G.L.O. MONUMENT

U.S. GENERAL LAND OFFICE SURVEY T4N R8W 9 10 15 16 1878

SET LG. BT. SPK. W&T IN 4" JOSHUA TREE, 16" UP

96.76

(N89°56'15"E. Rec.)

2646.48 REC. PER C.S.B-798-2

"Z-16"

SET LG. BT. SPK. W&T. IN 6" JOSHUA TREE 44" UP

TO 1/4 COR. G.L.O. MON.

TO TOP PG. 86

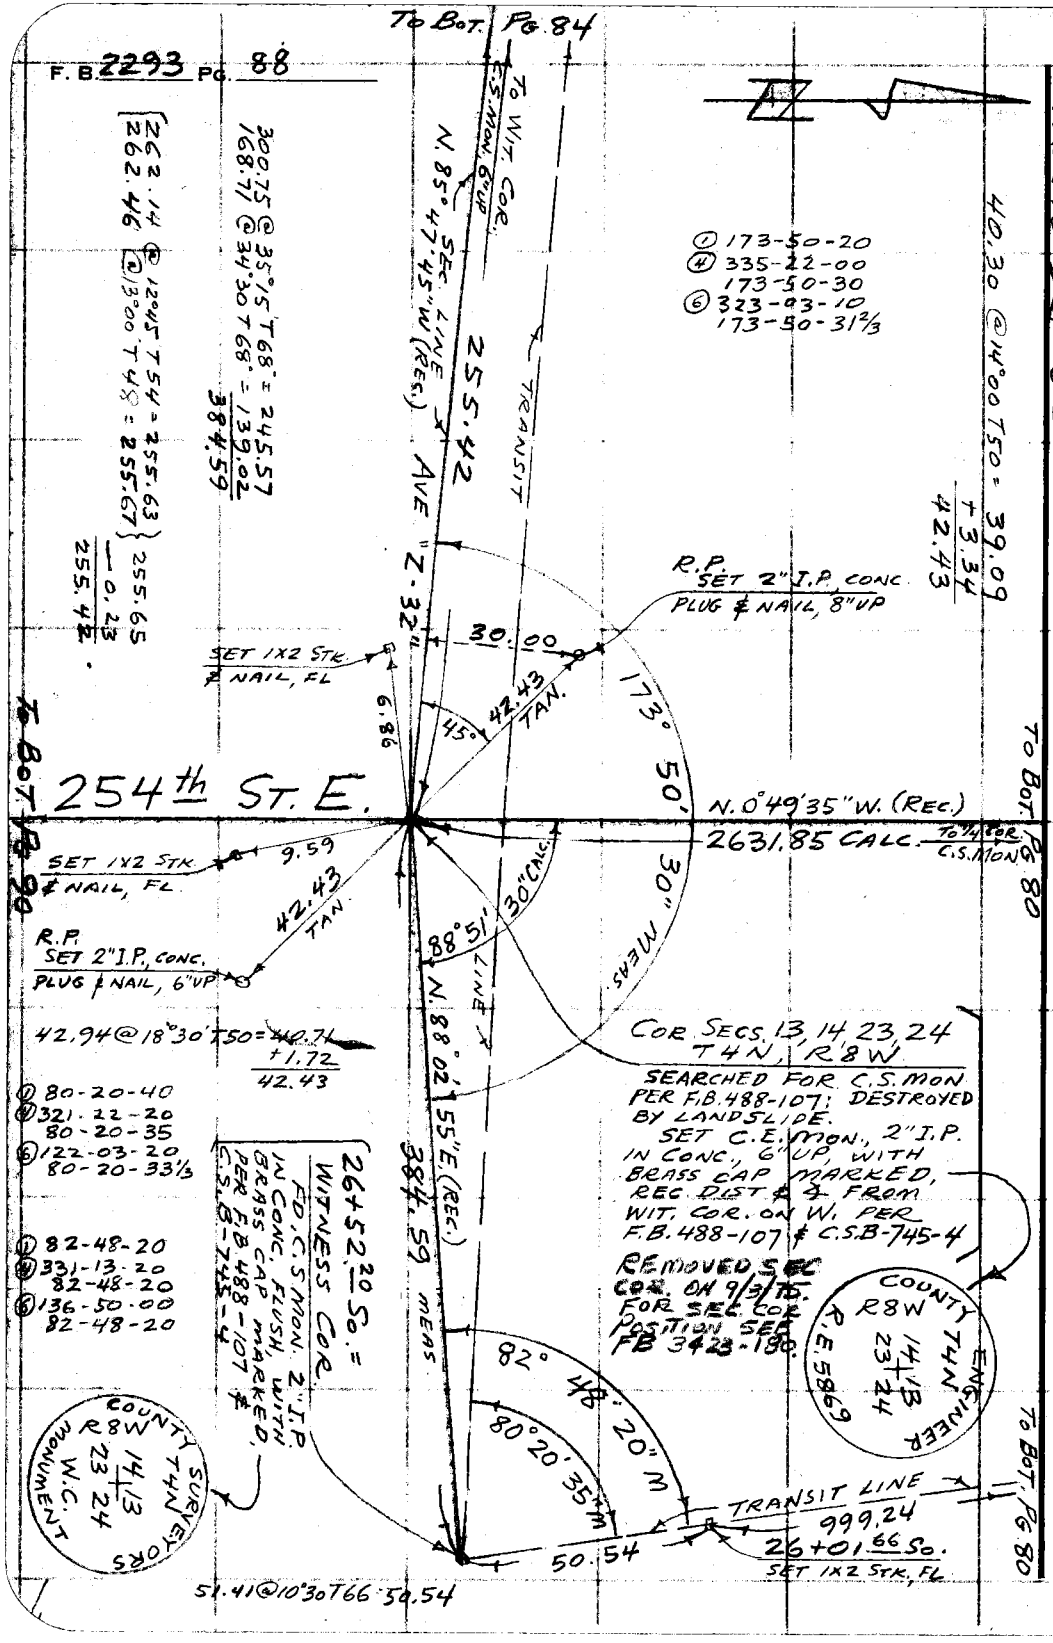

PLEASE RETURN TO
LOS ANGELES COUNTY ENGINEER
700 LOS ANGELES COUNTY ENGINEERING BLDG.

Do not extend this side of this line.

Note: Any Additions or Changes on This Sheet Must be Made or Circled in Red Ink With Date and Name of Person Making Change.

Notes Ck'd by	Survey of SEC 26, T4N, R8W
Map No.	JN 0302.01 Tape 144 Std. 84 °F
Office Work	Surveyed by HALISCKY
Checked	Notes HALISCKY Date 3-12-59
Date	Indexed C. Johnson

F. B 2293 Pg. 89

W.S. 15 D-1

J.N. 0302.01

SECTION LINE SURVEY

ELY. LINE OF THE N.E. 1/4 OF

SEC. 26, T4N, R8W.

PARTY:
HALISCKY
RITTER
TALBOT
H.E. MITCHELL
TEMPLETON

Notes: Any Additions or Changes on This Sheet Must be Made or Circled in Red Ink With Date and Name of Person Making Change.

Do not extend notes this side of this line.

RETURN TO
LOS ANGELES COUNTY ENGINEER
700 LOS ANGELES COUNTY ENGINEERING BLDG.

76S09S CE #247—7-53

To Bot. Pg. 91

F.B. 2293 Pg. 90

SEC. 25, T4N, R8W

SEC. 26, T4N, R8W

W.S. 15 D-1

SET 1x28" I.P. ST. 0+99.95 ✓

114.30 @ 29°60' T
99.95

NOTE;
PRODUCED RANDOM LINE FROM SEC. COR (SECS. 23, 24, 26 & 25, T4N R8W) S'LY. ALONG NATIONAL FOREST BOUNDRY MARKERS (4 & 4)

1) 177°49'40"
2) 351°18'20" ✓
3) 177°49'35" ✓
4) 346°51'40" ✓
177°49'36"

RANDOM LINE

S 177°49'33" E

ST. 0+00

3 Mi. So. of Ave. Z

FD. 2" I.P. SET IN CONC. WITH BRASS CAP MARKED: REF: C.S.B-745-4

MONUMENT
R8W
COUNTY
T4N
SURVEYORS
23 24
26 25

¼ SEC. LINE

2547' ST. E

T4N R8W

SEC. 23

SEC. 24 T4N R8W

FD. BRASS CAP SET IN ROCK FL. MARKED:

REF C.S.B-745-4

MONUMENT
R8W
COUNTY
T4N
SURVEYORS
W.C. IVCOR.
S-23
S-24

To Left Side Pg. 88

RETURN TO
LOS ANGELES COUNTY ENGINEER
700 Los Angeles County Engineering Bldg.

Do not extend notes this side of this line.

Note: Any Additions or Changes on This Sheet Must be Made or Circled in Red Ink With Date and Name of Person Making Change.

Notes Ck'd by
Map No.
Office Work
Checked
Date

Survey of SEC. 26, T4N, R8W
JN0202 01 Tape #144 Std 84 °F
Surveyed by HALISCKY
Notes HALISCKY Date 3-18-59
C. Johnson
Indexed

F. B 2293 Pg. 91

TO BOT PG 92

Note: Any Additions or Changes on This Sheet Must Be Made or Circled in Red Ink With Date and Name of Person Making Change.

Do not extend notes this side of this line.

RETURN TO
LOS ANGELES COUNTY ENGINEER
900 Los Angeles County Engineering Bldg.

78S09S CE #247—7-58

SEC. 25, T4N, R8W

W'LY 1/2 SEC. 26, T4N, R8W

RANDOM LINE

{166 37 @ 8°29' T66}
{166 28 @ 8 09}

{166 07 @ 5° T66} = 165.42 / 165.40 } 165.41
{166 00 @ 4°47' } =

84.43
84.80
16+10.55
FD. 1X2; 4" UP REF. FB. 488-112
STAKE LEANING
NO EVID. OF NAIL

{162.00 / 162.01} 162.00

{51.42 / 51.41} 51.41

55 77 @ 22°45' T64
55 58 @ 22°48'
60
ST. 16+02 58
SET 1X2 PK

7.95
-0.22 56

298 73 @ 7° T64 = 296.46

SAME {143 99 @ 26°56 / 143 87 @ 26°50} T58 = 128.35 / = 128.36 } 128.35

SAME {170 40 @ 11°29' / 170 11 @ 11°39'} T58 = 166.57 / = 166.58 } 166.57

SAME {149 75 @ 24°01 / 149 83 @ 24°08} T66 = 136.75 / = 136.71 } 136.73

8+91.37
FD. 1X2 N. 3" UP REF. FB 488-112
(GOOD FOUND 1"IPON)

53 78
1688

ST. 8+74 49 SET 1X2 PK N. 90°

298 32 @ 10° T62 = 297.79
278 47 @ 14° T60 = 270.16
88 13 @ 21° T60 = 82.27
646.18

ST. 2+28 31 SET 1X2 PK

1294 9 @ 7°30' T60° =
128.36

FROM TOP OF Pg. 90

F.B. 2293 PG. 92

REPLACED 1X2 8N WITH 2" IPINCONC. WITH BRASS CAP MARKED. 6" UP

177°50 20 RECORD ∠

177°49'35 ∠ TURNED AT SEC COR 23,24,26 & 25 T4N R8W FR. N. AT W.C. TO RANDOM LINE

00° 00'45" ✓

0.000218 X 260086 = 0.57 ✓

RANDOM LINE

NOTE: TIES FOR THIS COR. SEE F.B. 2293-94

NOTE: SET N. IN 4"X4" POST ST. 26+00.91

FD. TWO 4"X4" STAKES WITH CHARRED TOPS FL. - EVID. OF WHITE PAINT. ASSUMED TO BE ORIGINAL FORESTRY BOUNDARY MARKERS ONE FOR THE NORTH LINE & THE OTHER FOR THE EAST LINE.

26+00.91

SET 1X2 8N. 0.57 W. OF NAIL IN 4X4 FOR RECORD DIST. & ANGLE (267008G) REF: CSB 745-4; FB 4488-112, 113

FD TREE STUMP WITH THREE LEADERS ABOUT 24" UP NO EVIDENCE OF BLAZE MARKS FOR ANY OF THE TREES.

THE ∠ OF INCLINATION AT A HEIGHT OF 4' FOR THE MOST SLY STUMP WOULD PLACE THAT PT. OVER 1X2 8N SET FOR 1/4 SEC COR. 25, 26 T4N R8W

10.32

ST. 25+90.59 SET 1X2" & N. FL.

SAME { 99 17 @ 24°49 T76 = 90.00 ✓ / 99 62 @ 25°22 = 90.00 } 90.00 ✓

ST. 25+00.59 SET 1X2" & N. FL.

SAME { 162 77 @ 26 37' T70 = 145.51 ✓ / 162 45 @ 26°22 = 145.54 } 145.52 ✓

ST. 23+55.07 SET 1X2" & N FL.

22+84.64

SAME { 88 89 @ 17 07 T66 / 88 25 @ 16°49 } 113.99

FD. 1X2 8N 2" UP GOOD COND.

14.51 90° 114.91

ST. 22+70.13 SET 1X2 8N. FL.

{ 84.94 / 84.94 } 84.94 ✓

97°15'10"

SAME { 298 41 @ 14°38' T66 / 298 55 @ 14°43 } = 288.70 / = 288.72 } 288.71 ✓

ST. 19+81.42 SET 1X2 8N FL.

FROM TOP PG. 91

RETURN TO LOS ANGELES COUNTY ENGINEER 900 Los Angeles County Engineering Bldg.

Do not extend notes this side of this line.

Note: Any Additions or Changes on This Sheet Must be Made or Circled in Red Ink With Date and Name of Person Making Change.

ENGINEER RE 5869 COUNTY OF LOS ANGELES T4N R8W 25 26 WCOR

MBR. W. 4 T. 25 S. R. 8 W. SECTION LINE

Notes Ck'd by		Survey of SEC. 26, T4N, R8W	F.B. 2293 PG. 93
Map No.		JN 030201 Tape 144 Std 84 °F	
Office Work		Surveyed by HALISCKY	
Checked		Notes SH Date 3-18-59	
Date		Indexed C. Talbot	

W.S. 15-01

JN 030201

1/4 SEC COR TIES
BETWEEN
SEC. 25 & 26, T4N, R8W

PARTY:
HALISCKY
RITTER
TALBOT
H.E. MITCHELL
Ttempleton

Note: Any Additions or Changes on This Sheet Must be Made or Circled in Red Ink With Date and Name of Person Making Change.

Do not extend notes this side of this line.

RETURN TO
LOS ANGELES COUNTY ENGINEER
900 Los Angeles County Engineering Bldg.

769098 CE #247—7-53

F.B. 2293 PG. 94

RETURN TO
LOS ANGELES COUNTY ENGINEER
900 Los Angeles County Engineering Bldg.

Do not extend notes this side of this line.

Note: Any Additions or Changes on This Sheet Must be Printed or Circled in Red Ink With Date and Name of Person Making Change

NOTE FOR FURTHER INFORMATION FOR THIS COR SEE FB 2293-92 CSB 745-4, FB 488-112,113

REPLACED 1X2 IN WITH 2" PIN CONC. WITH BRASS CAP MARKED 6 UP
SEE PG. 92

T4N R8W
25 26
WCOR
COUNTY ENGINEER
RE 5869

FD. CHARRED 4X4" SET N.

SET 1X2" N. FOR TRUE 1/4 COR. SEC 25, 26 T4N R8W

SET X ON HUGE FLAT ROCK FL WITH GR.

SET NAT ON TOP STUMP

FD. BLEADER STUMP

SET 1X2 3" N. FL.

RANDOM LINE

SET X ON HUGE BOULDER 42" UP (W. END)

Notes Ck'd by	Survey of SECT. LINES
Map No.	JN 0302 01 Tape 133 Sht 84 "F
Office Work	Surveyed by JS COATES
Checked	Notes JSC Date 5/3/68
Date	Indexed C. J. GALLY MAY 9 68

2293 95
F.B. 3118 Pg. 193

J.N 030201

SECTION LINE SURVEY

Sec 11 - T 4N - R 8W

RESETING SECTION CORNER

DISTROYED BY FLOODING

AS

REPORTED BY PROPERTY OWNER in 1967

COATES
ADAMS

Note: Any Additions or Changes on this Sheet Must be Made or Circled in Red Ink With Date and Name of Person Making Change

Do not extend this side of this line.

PLEASE RETURN TO
LOS ANGELES COUNTY ENGINEER
403 Los Angeles County Engineering Bldg.

7262-08 ct #310 A-66

2293 96
F.B. 3118 Pg 194

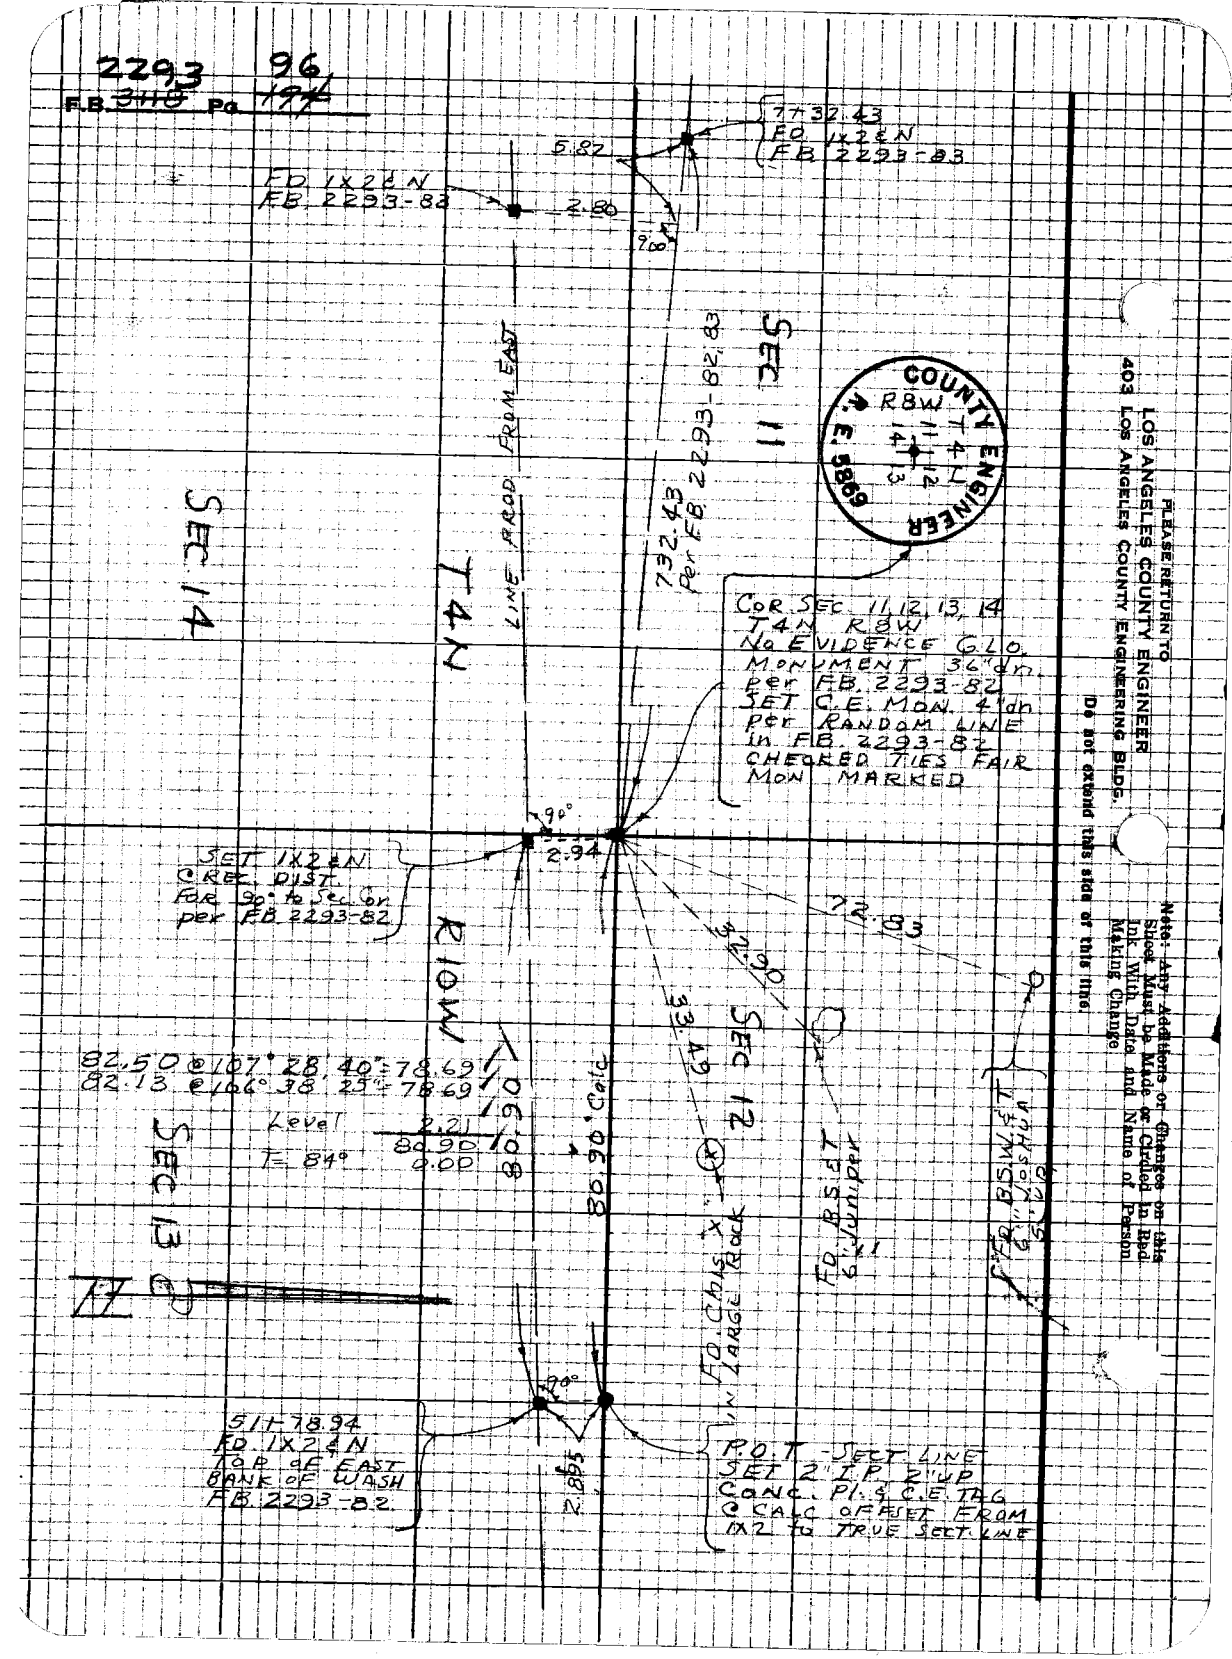

Notes Ck'd by	Survey of SEC. LINES TO ... AVE W
Map No.	W. O. 0302.01 Tape No. 1 2 ... F
Office Work	Surveyed by M ...
Checked	Notes M 8-27-58
Date	Indexed J.C. Johnson 4-11-58

F. B. 2293 Pg. 105

W.S 70-9-8

J.N. 0302.01

REPLACEMENT OF SEC. COR. MON.

WITH C.E. MON.

ON

AVE. H & 10th ST. W.

Note: Any Additions or Changes on This Sheet Must be Made or Circled in Red Ink With Date and Name of Person Making Change.

Do not extend notes this side of this line.

RETURN TO
LOS ANGELES COUNTY SURVEYOR
726 LOS ANGELES COUNTY
ENGINEERING BLDG.

PARTY:
MACK
HALISCKY
RITTER
H.E. MITCHELL

76F3085 247 4-59

F.B. 2293 PG. 106

RETURN TO
LOS ANGELES COUNTY SURVEYOR
720 LOS ANGELES COUNTY
ENGINEERING BLDG.

Note: Any Additions or Changes on This Sheet Must be Made or Circled in Red Ink With Date and Name of Person Making Change.

Do not extend notes this side of this line.

W.S. 7A 4-4

WEST

AVE. H

10th ST.

FD. N&T. IN P.P.# 907896 E

FD. N&T. IN P.P.# 1117403 E

FD. N&T. IN P.P.# 315198 E

119.26

32.47

50.09

SET SPK. & TAG IN PAV., FL.

3.00

FD. N&T. IN P.P.# 1102496 E

118.86

76.49

63.17

76.10

SET L&T IN CURB

SET L&T IN CURB

SET L&T IN CURB

SET SPK. & TAG IN PAV., FL.

3.00

COR SECS. 3, 4, 9, 10 T7N, R12W

FD C.S. MON. 2" I.P. IN CONC. 36' "D.N." PER C.S. B-83-1 WITH BRASS CAP MARKED

SET C.E. MON. OVER OLD C.S. MON.: 2" I.P. IN CONC. 9' "AW" WITH BRASS CAP MARKED SET 1962, FT.

42.12

SET N&T. IN TEL. POLE #K-3066-Y

2-27-62

COUNTY SURVEYOR
R12W
T7N
4 3
9 10
R.E. 5869

COUNTY ENGINEER
T7N
R12W
4 3
9 10
R.E. 5869

Notes Ck'd by	Survey of SEC. LINES, T8N, R9W
Map No.	JN 0302.01 Tape 121 Std. 84 °F
Office Work	Surveyed by MACK
Checked	Notes M. Date 7-3-58
Date	Indexed C. Jennon 7-9-58

F. B. 2293 PG. 107

W.S. 6B2-5

J.N. 0302.01

SEC. LINE TIES

ON

150th ST. E.

BET. AVES. E & F

Note: Any Additions or Changes on this Sheet Must be Made or Circled in Red Ink With Date and Name of Person Making Change.

Do not extend this side of this line.

PLEASE RETURN TO
LOS ANGELES COUNTY ENGINEER
700 Los Angeles County Engineering Bldg.

PARTY
MACK
HALISCKY
RITTER
HUBBARD
H.E. MITCHELL

78F3098 SAE #247 1-58

PLEASE RETURN TO
LOS ANGELES COUNTY ENGINEER
700 LOS ANGELES COUNTY ENGINEERING BLDG.

Note: Any Additions or Changes on This Sheet Must be Made or Circled in Red Ink With Date and Name of Person Making Change.

Do not extend this side of this line.

W.S. 69 P.

E

2" I.P. CONC. PLUG NAIL, 9" UP

0+00 So. = Cor. SEC. 19 20 29, 30 T 8 S., R 9 W. FD C.S. MON. 2" I.P. IN CONC. FLUSH, PETE C.S. 8731 & F.B. 480-126 WITH BRASS CAP MARKED

SURVEYORS T 8 S R 9 W 19 20 30 29 COUNTY MONUMENT

14+55.40 = P.O.T. FD 2"x2" STK. & NAIL FL. ON TOP OF RIDGE

22+48.11 So. = P.O.T. SET 1"x2" STK. & NAIL FLUSH ON TOP OF SPUR

N 69° 51' W 1455.40

S 69° 51' E 40.00

S 34° 09' E 792.71

N 69° 51' W 442.51

EAST

150th ST

AVE

R.P. SET 2" I.P. CONC. NAIL, PLUG & 9" UP

To Top

F.B. 2293 Pg. 108

F.B. 109

1455.40

166.27 @ 30°45' 7.60 = 165.88
197.98 @ 3°00' 7.60 = 197.68
255.53 @ 3°45' 7.58 = 254.94
299.38 @ 4°45' 7.58 = 298.30
271.52 @ 7°30' 7.54 = 269.15
119.95 @ 6°30' 7.54 = 119.16
151.89 @ 8°30' 7.56 = 150.29

792.71

298.69 @ 7°30' 7.56 = 294.08
65.33 @ 7°00' 7.56 = 64.83
296.85 @ 2°30' 7.56 = 296.52
135.30 LEVEL 7.56 = 135.28

442.51

281.00 @ 5°30' 7.62 = 279.67
163.02 @ 2°30' 7.58 = 162.84

Notes Ck'd by	Survey of Sec. Lines T8N R9W
Map No.	F. B. 2293 Pg. 109
Office Work	Surveyed by MACK
Checked	Notes
Date	Indexed

Date 8-2-54 C. Johnson

WS. 69-8

To Bot. Pg 108

R.P. SET 2" I.P. CONC. PLUG & NAIL, 10" UP

40.00

56.57 TAN.

45°

A.O.T. SET 1x2 STK. & NAIL, FL.

5.00

28.28

AVE.

E-8

26+64.87 So.= 1/4 COR. BET SECS. 29, 30 T8N R9W

FD. C.S. MON., WASHED OUT IN BOT. OF DRAIN. RESET C.S. MON., 2" I.P. IN CONC., FLUSH, BY PROPORTION N & S. PER F.B. 430-126; WITH BRASS CAP MARKED

56.57 TAN.

R.P. SET 2" I.P. CONC. PLUG & NAIL, 8" UP

40.00

25.75

26+90.62 So.= COR. SECS. 28, 29, 32, 33 T8N R9W FD. 2" I.P. IN CONC. FLUSH WITH TOP OF CURB AT BANK OF DRAIN

6411.72

E.

33+32.42 So. FD. 2" I.P. IN CONC. 2" UP, TIE P.

COUNTY SURVEYORS T8N R9W 30+29 1/4 SEC. COR. MONUMENT

0.05

150th ST.

2000.01

2000.01

214.93 @ 0°00' TSC = 214.86
154.83 LEVEL TSC = 154.80
272.39 @ 2°16' TSC = 272.33
641.79

300.82 @ 2°45' T62 = 300.43
300.10 LEVEL T62 = 300.06
299.84 @ 2°30' T60 = 299.51
98.07 LEVEL T60 = 98.05
300.52 LEVEL T60 = 300.47
300.26 @ 1°15' T62 = 300.15
234.98 LEVEL T62 = 234.95
166.41 LEVEL T62 = 166.39
2000.01

53+32.42 So. = COR. SECS. 29, 30, 31, 32 T8N R9W

FD. C.S. MON., 2" I.P. IN CONC., 3" UP PER C.S. 8731 & F.B. 430-126 WITH BRASS CAP MARKED

40.00

R.P. SET 2" I.P. CONC. PLUG & NAIL, 10" UP

45°

56.57 TAN.

F

AVE.

To Bot. Pg 110

70 1/4 COR. AT 145th ST. E.

COUNTY SURVEYORS T8N R9W 30, 29 + 31, 32 MONUMENT

56.57 TAN.

R.P. SET 2" I.P. CONC. PLUG & NAIL, 10" UP

PLEASE RETURN TO
LOS ANGELES COUNTY ENGINEER
700 LOS ANGELES COUNTY ENGINEERING BLDG.

Note: Any Additions or Changes on this Sheet Must Be Made or Circled in Red Ink With Date and Name of Person Making Change.

Do not extend this side of this line.

PLEASE RETURN TO
LOS ANGELES COUNTY ENGINEER
700 LOS ANGELES COUNTY ENGINEERING BLDG.

Note: Any Additions or Changes on This Sheet Must be Made or Circled in Red Ink With Date and Name of Person Making Change.

Do not extend this side of this line.

WS. 69 D-3

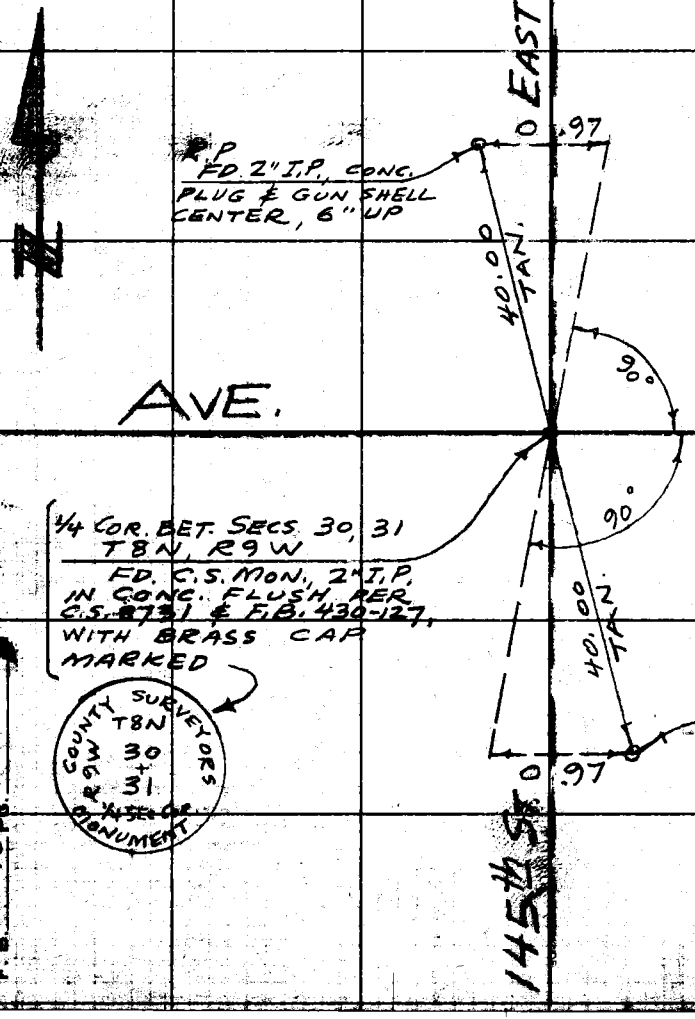

Notes Ck'd by	Survey of SUBDIV MON INSP
Map No.	JN 0209.00 Tape 121 Std 84 °F
Office Work	Surveyed by MACK
Checked	Notes M.C. Date 3-4-58
Date	Indexed MAR 6 '58

F. B. 2293 Pg. 111

WS 66 C-6

J.N. 0209.00

CHECKING OF 8 TIES

ON

AVE X-3 & 131ST ST E.

IN

R.S. 73-37 (R.S. 2082)

PARTY
MACK
HALISCKY
RITTER
HUBBARD
H.E. MITCHELL

Note: Any Additions or Changes on This Sheet Must Be Made or Circled in Red Ink With Date and Name of Person Making Change.

Do not extend notes this side of this line.

RETURN TO
LOS ANGELES COUNTY ENGINEER
700 LOS ANGELES COUNTY ENGINEERING BLDG.

76F3095 CE #247—3-57

F.B. 2293 PG. 112

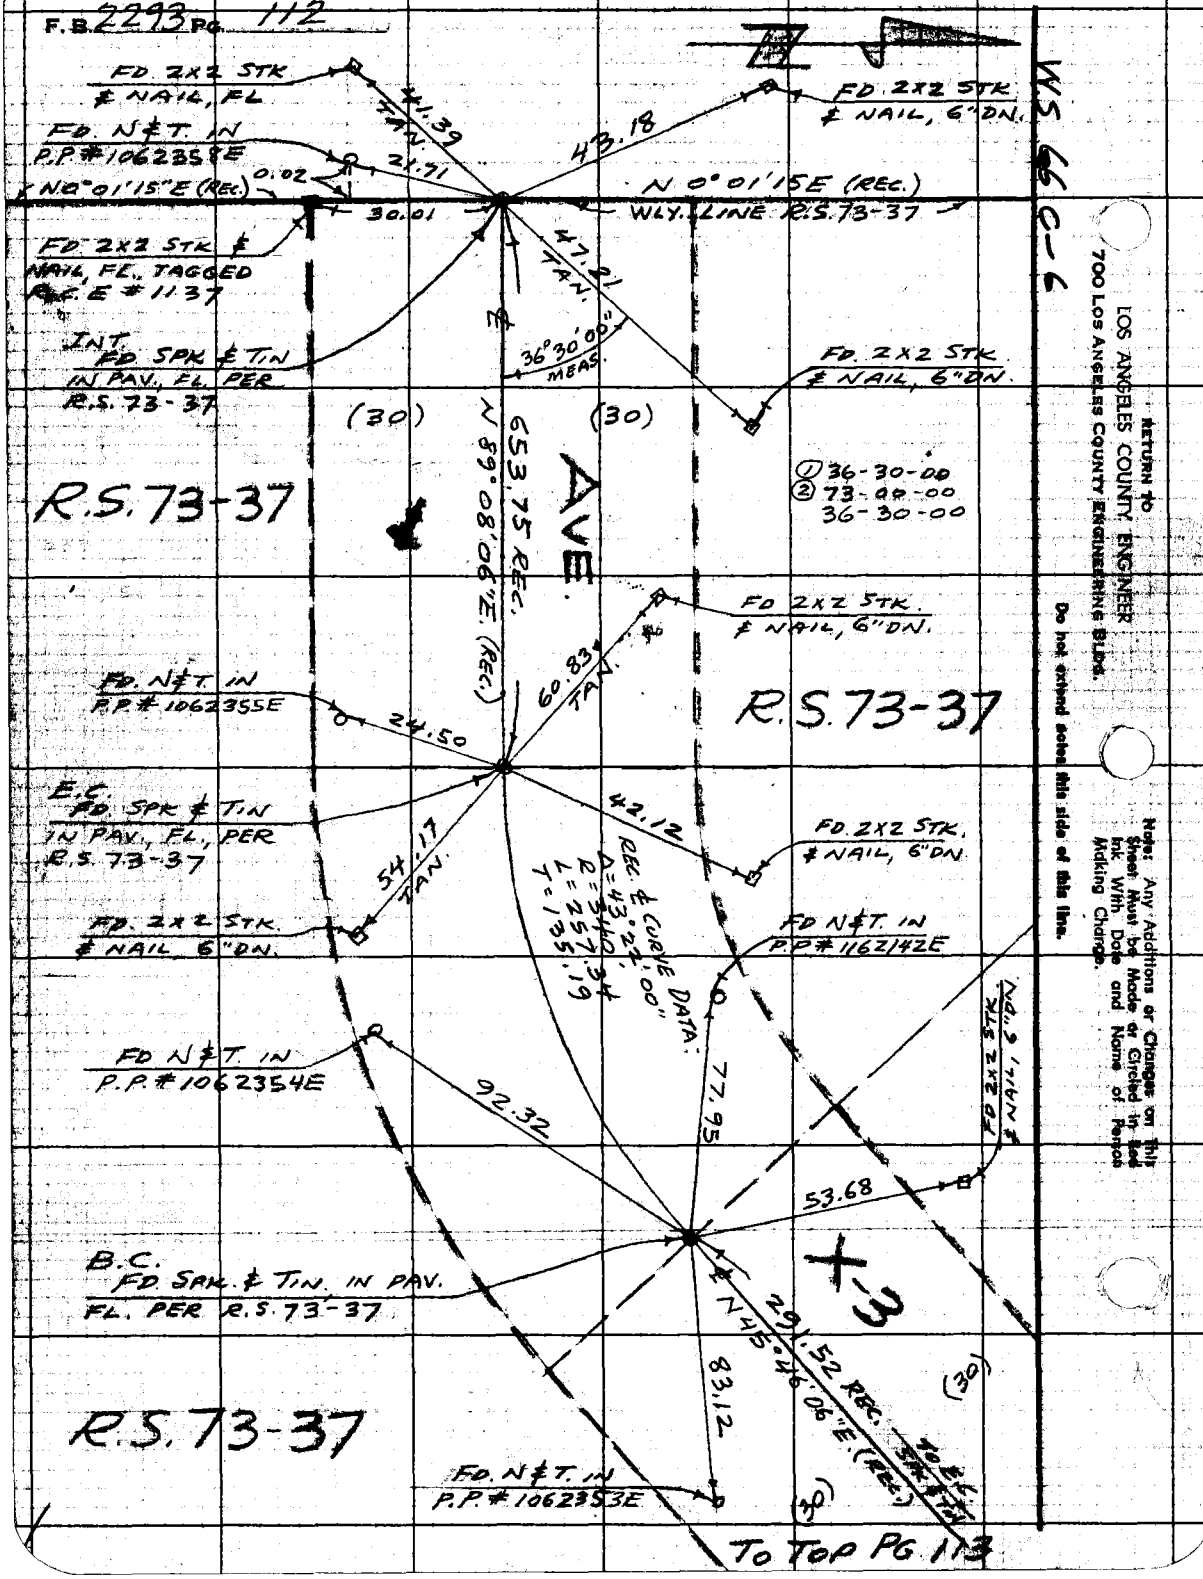

Notes Ck'd by
Map No.
Office Work
Checked
Date

Survey of SYBRON MON INSP
IN 209.00 Tape 1/2 Std. 84 °F
Surveyed by MACK
Notes M Date 3-4-58
Indexed C. Johnson

F. B. 2293 PG. 113

7-3-59 - M-35

TO BOT. PG. 112

TO B.C. SPK & TIN

N 45° 46' 00" E. 291.52 REC. (REC.)

(30)

(30)

R.S. 73-37

83.57 TAN.

FD 2x2 STK. # NAIL, 6" DN.

68.12 TAN.

FD 2x2 STK. # NAIL, 6" DN.

E.C. FD. SPK & TIN IN PAV. FL. PER R.S. 73-37

22.24 TAN.

74.88 TAN.

FD NET. IN P.P. #1062352E

AVE. X-3

FD 2X2 STK. # NAIL, 8" DN.

82.62 MEAS.

7.41 TAN.

REC. & CURVE DATA:
Δ = 48°48'24"
R = 100'
T = 45.37
L = 85.14

51.66

R.S. 73-37

B.C. FD. SPK. & TIN IN PAV. FL. PER R.S. 73-37

FD 1" I.P. STANDARD 5 FT. HIGH, WITH SIGN LETTERED "HILTBRAND"

71.80 TAN.

55.10 TAN.

156.70 REC. S 82.58 E (REC.)

TO SPK & TIN

FD 2X2 STK. # NAIL, 8" DN.

(30)

(30)

TO UPPER LEFT SIDE PG 114

Note: Any Additions or Changes on This Sheet Must Be Made or Circled In Red Ink With Date and Name of Person Making Change.

Do not extend across this side of this line.

RETURN TO
LOS ANGELES COUNTY ENGINEER
700 LOS ANGELES COUNTY ENGINEERING BLDG.

76F3005 CE #247—3-57

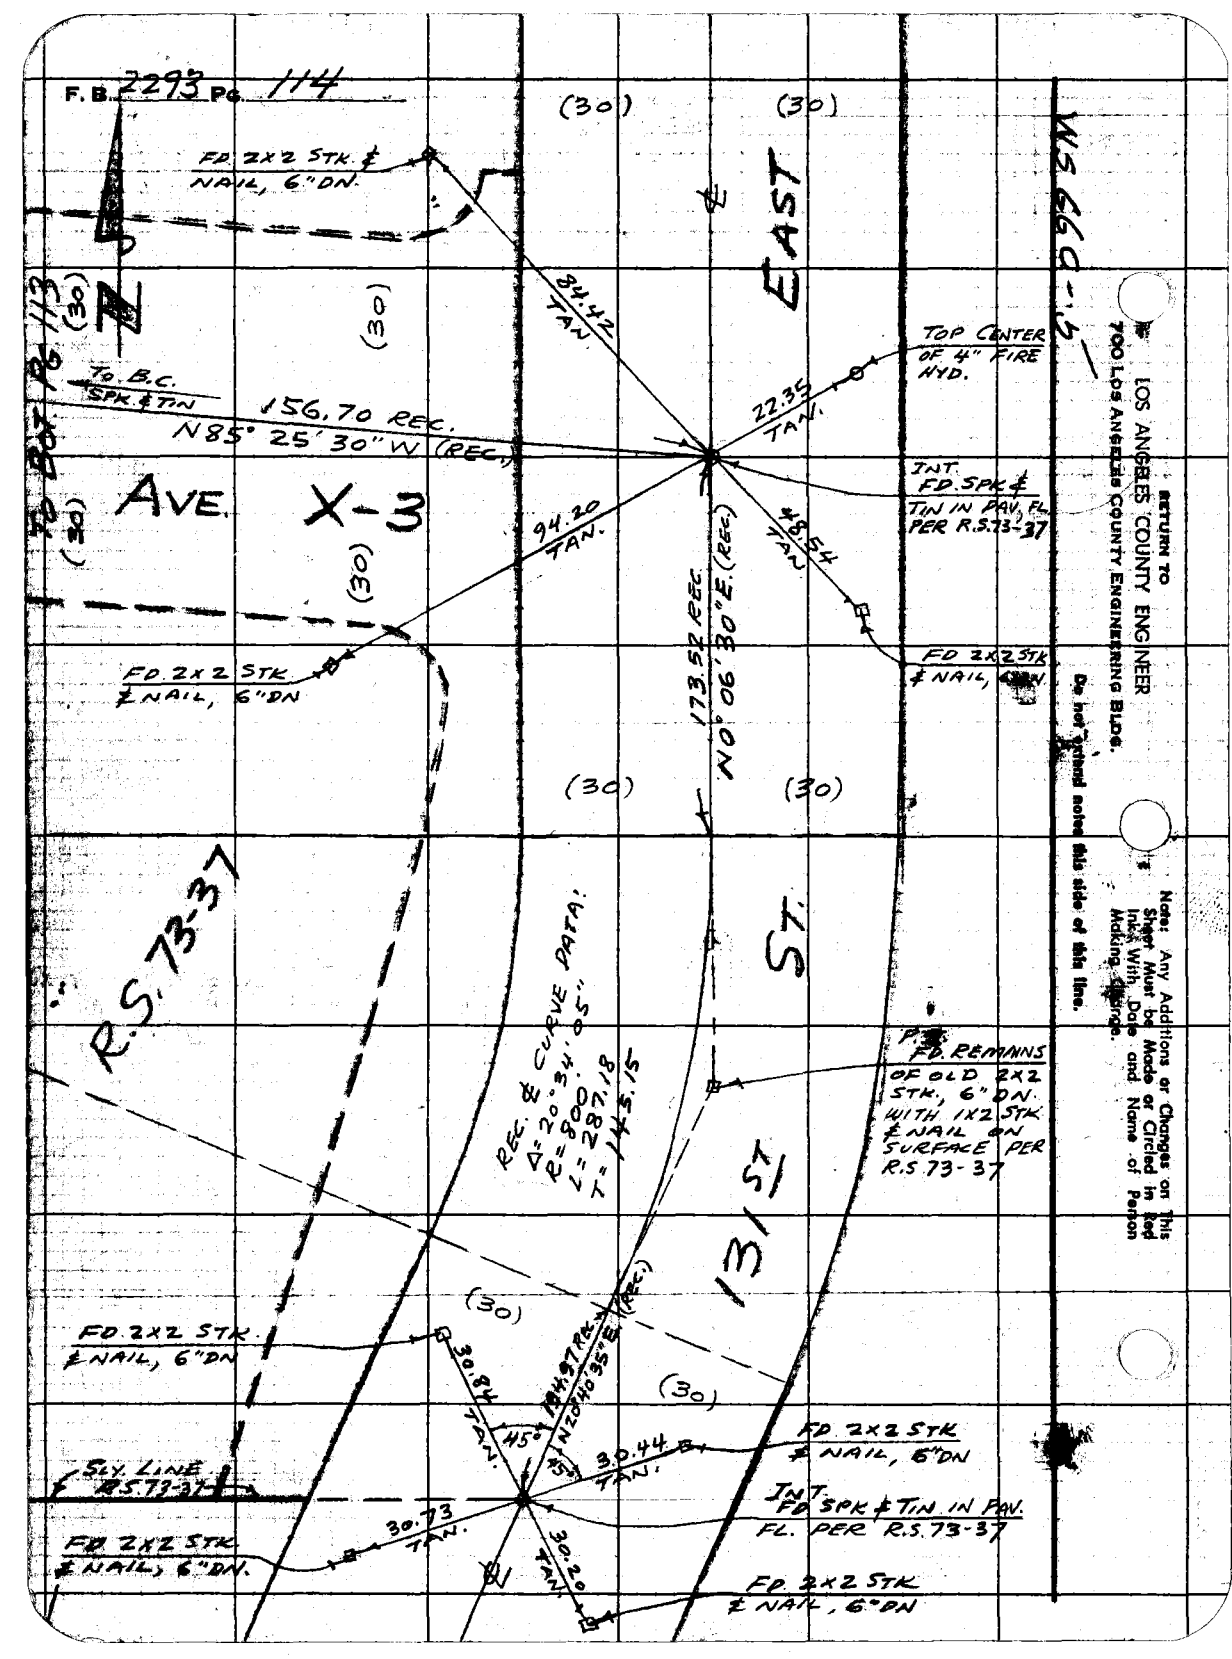
F.B. 2293 Pg. 114
(30)
(30)
FD. 2x2 STK. & NAIL, 6" DN.
84.42 TAN.
EAST
W.S. 66 0-1/2
TOP CENTER OF 4" FIRE HYD.
22.36 TAN.
TO B.C. SPK. & TIN
156.70 REC.
N85° 25' 30" W (REC.)
INT. FD. SPK & TIN IN PAV. FL. PER R.S. 73-37
AVE. X-3
94.20 TAN.
48.54 TAN.
FD. 2x2 STK & NAIL, 6" DN
FD. 2x2 STK & NAIL, 6" DN
173.52 REC.
N0° 06' 30" E. (REC.)
(30)
(30)
R.S. 73-37
ST.
REC. & CURVE DATA:
Δ = 20° 34' 05"
R = 800.18
L = 287.18
T = 145.15
P.C.
FD. REMAINS OF OLD 2x2 STK., 6" DN. WITH 1x2 STK. & NAIL ON SURFACE PER R.S. 73-37
13 ST.
(30)
FD. 2x2 STK. & NAIL, 6" DN
30.84 TAN.
N20° 40' 35" E. (REC.)
45°
45°
30.44 TAN.
FD. 2x2 STK & NAIL, 6" DN
SLY. LINE R.S. 73-37
30.73 TAN.
INT. FD. SPK & TIN IN PAV. FL. PER R.S. 73-37
FD. 2x2 STK & NAIL, 6" DN.
30.20 TAN.
FD. 2x2 STK & NAIL, 6" DN
RETURN TO
LOS ANGELES COUNTY ENGINEER
700 Los Angeles County Engineering Bldg.
Do not extend notes this side of this line.
Note: Any Additions or Changes on This Sheet Must be Made or Circled in Red Ink With Date and Name of Person Making Change.

Notes Ck'd by		Survey of SEC. LINES, T6N, R12W	F. B. 2293 Pg. 115
Map No.		JN 0302.01 Tape 121 Std. 84 °F	
Office Work		Surveyed by MACK	
Checked		Notes M. Date 3-7-68	
Date		Indexed 7-6-68	

M.S 65-A-3

J.N. 0302.01

TIES TO SEC. CORNS.

ON

AVE S AT 10th & 12th STS. W

Note: Any Additions or Changes on this Sheet Must be Made or Circled in Red Ink With Date and Name of Person Making Change.

Do not extend this side of this line.

PLEASE RETURN TO
LOS ANGELES COUNTY ENGINEER
700 Los Angeles County Engineering Bldg.

PARTY:
MACK
WALISCKY
RITTER
HUBBARD
H.E. MITCHELL

76F309S SAE #247 1-56

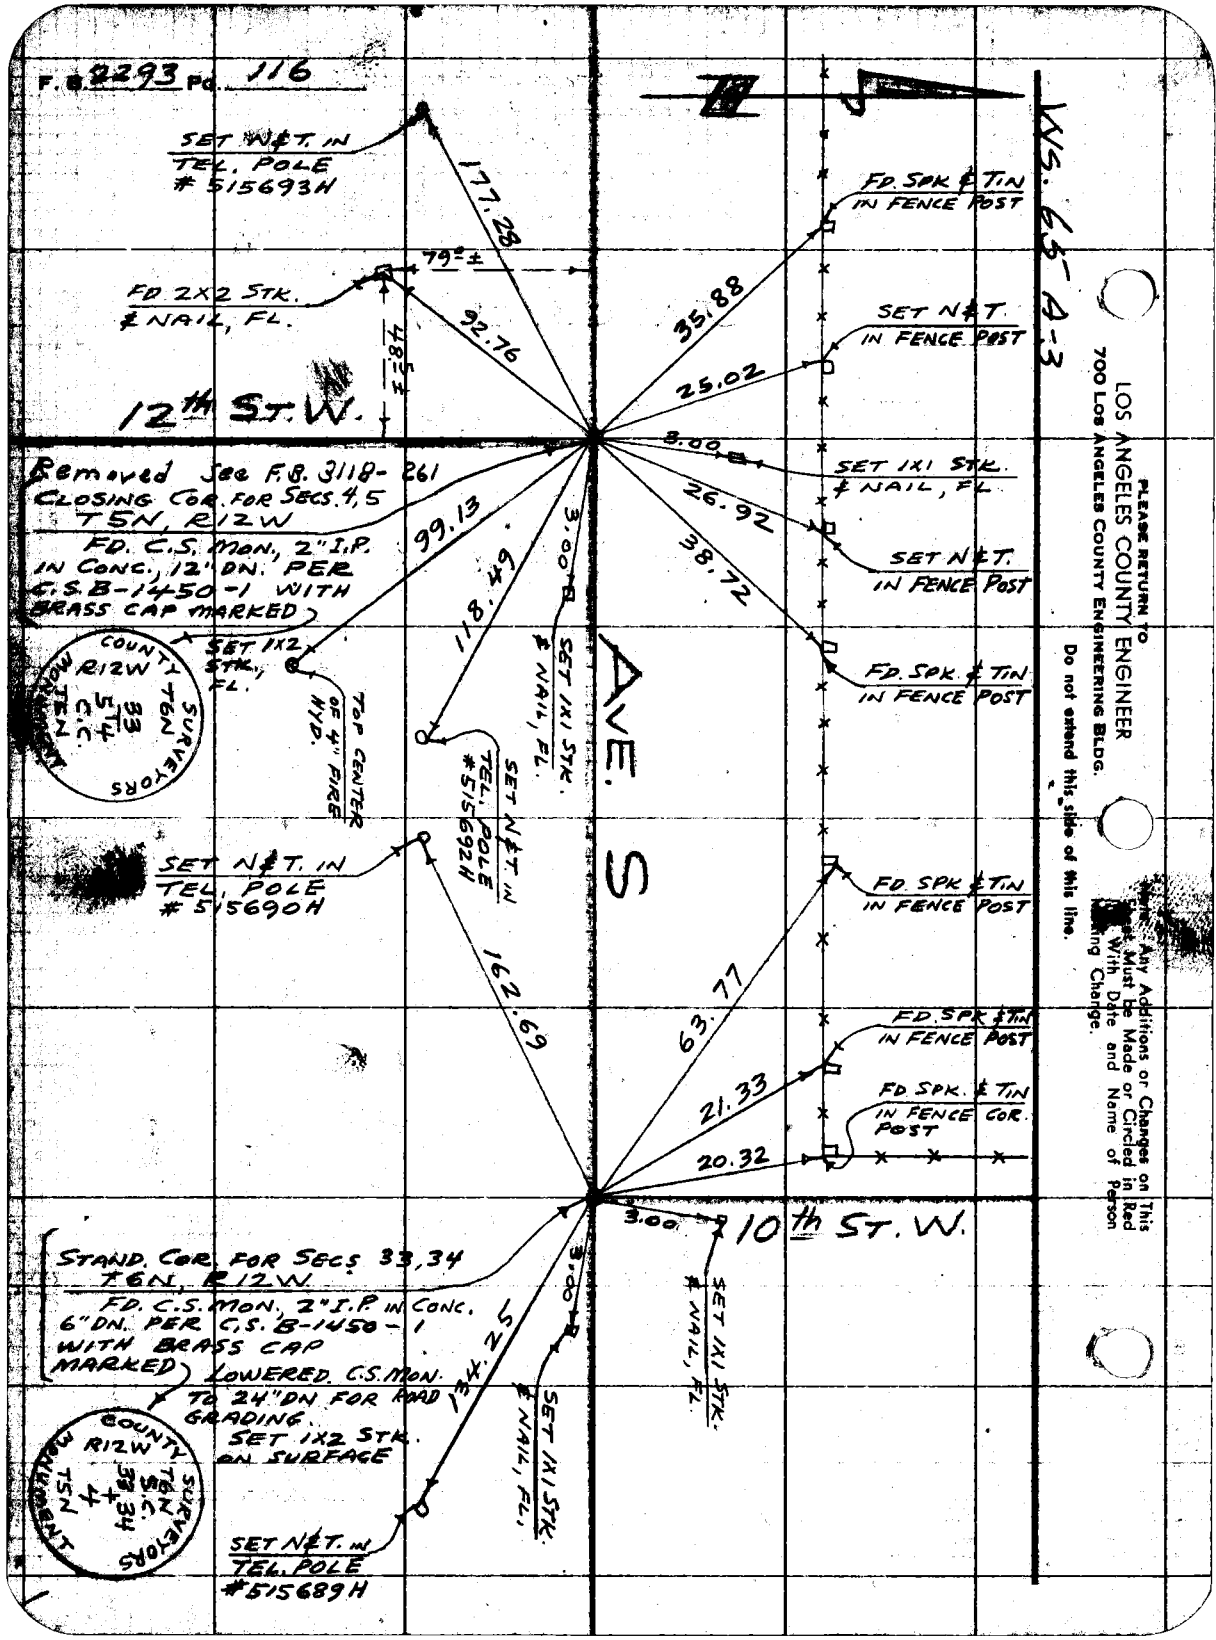
F.B. 2293 Pg. 116
SET N¢T. IN TEL. POLE # 515693H
177.28
79°±
FD 2X2 STK. & NAIL, FL.
48.5±
92.76
12th ST. W.
Removed See F.B. 3118-261
CLOSING COR. FOR SECS. 4, 5 T5N, R12W
FD. C.S. MON, 2" I.P. IN CONC., 12" DN. PER C.S.B-1450-1 WITH BRASS CAP MARKED)
99.13
118.49
3.00
SET 1X2 STK., FL.
COUNTY R12W T5N T6N SURVEYORS 33 34 5 4 C.S.C. KNOW TEN
TOP CENTER OF 4" FIRE HYD.
SET 1X1 STK. & NAIL, FL.
SET N¢T. IN TEL. POLE #515692H
AVE. S
SET N¢T. IN TEL. POLE #515690H
162.69
FD. SPK & TIN IN FENCE POST
35.88
SET N¢T. IN FENCE POST
25.02
3.00
SET 1X1 STK. & NAIL, FL.
26.92
SET N¢T. IN FENCE POST
38.72
FD. SPK. & TIN IN FENCE POST
FD. SPK & TIN IN FENCE POST
63.77
FD. SPK & TIN IN FENCE POST
21.33
FD. SPK. & TIN IN FENCE COR. POST
20.32
3.00
10th ST. W.
SET 1X1 STK. & NAIL, FL.
STAND. COR. FOR SECS 33, 34 T6N, R12W
FD. C.S. MON, 2" I.P. IN CONC. 6" DN. PER C.S.B-1450-1 WITH BRASS CAP MARKED)
LOWERED C.S. MON. TO 24" DN FOR ROAD GRADING. SET 1X2 STK. ON SURFACE
134.25
3.00
SET 1X1 STK. & NAIL, FL.
COUNTY R12W T6N T5N SURVEYORS 33 34 4 5 C.S.C. MONUMENT
SET N¢T. IN TEL. POLE #515689H
Ws. 65-A-3
PLEASE RETURN TO LOS ANGELES COUNTY ENGINEER 700 Los Angeles County Engineering Bldg.
Do not extend this slide of this line.
NOTE: Any Additions or Changes on This Must be Made or Circled in Red With Date and Name of Person Making Change.

Notes Ck'd by	
Map No.	
Office Work	
Checked	
Date	

Survey of	SEC. LINES, T7N R12W
J.N.	0302.01 Tape 72 Std. 84 °F
Surveyed by	MACK
Notes	M. Date 4-2-58
Indexed	

F. B. 2293 Pg. 117

J. N. 0302.01

SEC. LINE TIES

ON

10th ST. E.

AT AVES. H-8 & I

PARTY

MACK
HALISCKY
RITTER
HUBBARD
H.E. MITCHELL

Notes: Any Additions or Changes on This Sheet Must be Made or Circled in Red Ink With Date and Name of Person Making Change.

Do not extend this side of this line.

PLEASE RETURN TO
LOS ANGELES COUNTY ENGINEER
700 Los Angeles County Engineering Bldg.

76F3093 SAE #247 1-60

F. B. 2293 Pg. 118

Ⓞ 68-20-00
Ⓑ 136-40-00
68-20-00

N

AVE.

FD 2x2 STK & NAIL, TAGGED R.E. 6067

SET 1x1 STK. & NAIL, FL.

3.00

69.80

71.80

20'

68.8°

45°

56.57 TAN.

56.57 TAN.

R.P. SET 2" I.P. CONC. PLUG & NAIL, 9" UP

SET 1x1 STK. & NAIL, FL.

3.00

H-8

1/4 COR. BET SECS. 11, 12 T7N, R12W FD. C.S. MON., 2" I.P. IN CONC., 4" DN. PER C.S. 8737 WITH BRASS CAP MARKED LOWERED C.S. MON. TO 10" DN. SET 1x2 STK. ON SURFACE.

MONUMENT T7N R12W 11+12 1/4 SEC. COR'S SURVEYOR'S COUNTY

R.P. SET 2" I.P. CONC. PLUG & NAIL, 7" UP

40.00

10th ST. E.

FD. N&T. IN P.P. # 1121208E

FD. N&T. IN FENCE COR. POST

64.77

36.42

82.41

FD. N&T. IN TEL. POLE #K3255-Y

AVE.

P.O.T. FD SPK & TN IN PAV., FL

MONUMENT W.C. COUNTY SURVEYORS

WITNESS COR. FD. C.S. MON. 2" I.P. IN CONC. 4" DN. PER F.B. 430-81 WITH BRASS CAP MARKED

30.00

42.43

45°

3.00

64.11

FD. N&T. IN TEL. PO. # K3256-Y

I

3.00

FD. SPK & TN IN PAV., FL.

COR. SECS. 11, 12, 13, 14 T7N, R12W FD. C.E. MON., 2" I.P. IN CONC., 10" DN. IN WELL PER F.B. 2315-107, WITH BRASS CAP MARKED

COUNTY ENGINEER T7N R12W 11+12 14 13 R.E. 5869

66.66

48.23

54.56

54.38

92.52

FD. N&T. IN P.P. # 192532E

FD. X IN STEEL FENCE COR. POST, 15" UP

FD. BRASS DISK IN 10" CONC. CYLINDER, 8" UP STAMPED, U.S.C.&G.S. B.M. T 488 1955

FD. N.&T. IN P.P. # 2648406E

FD. N&T. IN TEL. POLE # K3738-Y

LOS ANGELES COUNTY ENGINEER
700 LOS ANGELES COUNTY ENGINEERING BLDG.

PLEASE RETURN TO

Do not extend this side of this line.

Note: Any Additions or Changes on This Sheet Must be Made or Circled in Red Ink With Date and Name of Person Making Change.

LYS. 20 4-4

Notes Ck'd by
Map No.
Office Work
Checked
Date

Survey of STREET E. OF 7TH ST. E.
JN 0440.00 Loose 121 Std. 84 of F
Surveyed by MACK
Notes M Date 4-7-58
Indexed C. Johnson 8-18-58

F. B. 2293 PG. 119

WS. 78 A-1

J.N. 0440.00

PROPOSED STREET EAST OF 7TH ST. E.

ON

ELY. LINE TR. # 10448

BET.

AVES K & K-8

Note: Any Additions or Changes on This Sheet Must be Made of Circled in Red Ink With Date and Name of Person Making Change.

Do not extend notes this side of this line.

RETURN TO
LOS ANGELES COUNTY ENGINEER
900 Los Angeles County Engineering Bldg.

PARTY
MACK
HALISCKY
RITTER
HUBBARD
H.E. MITCHELL

76R205 CE #247—3-57

F.B. 2293 Pg. 120

(4) 89-34-00
(5) 269-16-00
89-34-00
(6) 177-24-00
89-34-00

AVE. (30)

[26+47.78 N = INT SET BT. STK W. ET. IN PAV. FL., CALC. DIST.

26+47.70 N SET P.K. CEM. SPK IN ASPH. FL., BY INK.

To Sec. Cor. at 7th St. E.

1335.76 REC.

335.27 MEAS.

10.00

To P.O.T. SPK. IN PAV. FL. AT 7th ST. E.

26+47.73 N FD. NAIL IN PAV., 1" DN

0.05

0.08

89°34'00" 89°34'00"

(40)

40.07

26+07.71 N FD. 2" I.P. PLUG & NAIL, 6" DN. PER TR. # 10448

10.00

0.04

26+07.67 N SET 1X1 STK. FL

(30)

(30)

K

LOS ANGELES COUNTY ENGINEER
700 Los Angeles County Engineering Bldg.

RETURN TO

Do not extend noted title data beyond this line.

Notice: Any Additions or Changes on This Sheet Must be Made or Circled in Red Ink With Date and Name of Person Making Change.

(3) 90-25-10
(4) 91-41-10
90-25-17½
(6) 182-31-30
90-25-15

TRACT #10448

LOT 2

LOT 1

TR # 10448

10' OFFSET LINE E.

1,147.00' = S 88°22'39" E 1,147.69'

0+10.49 W TO OLD 2X2 TR. # 10448

LOT 2

LOT 1

PROPOSED STORM DRAIN EASEMENT

99.92

100.41

(5)

0.35

9.65

23+52.62 N SET 1X1 STK., FL

LOT 97

9.36

0+10.53 W 23+51.70 N SET STK & TIN FL

10' OFFSET LINE

10.00

10.98

0+09.73 W = 23+51.70 N FD 2X2 STK & NAIL, FL.

9.73

0+00 W = 23+41.64 N SET 1X2 STK FL. BY INT.

1+00 W SET 1X1 STK, FL

LOT 97

50.

PROPOSED 60.

25'

STREET

15'

23+00 N SET STK & TIN FL

9.86

22+49.90 N FD 2X2 STK, 6" DN. TAG L.S. 2409

TRACT #10448

LOT 98 (30)

(30)

To Top Pg. 121

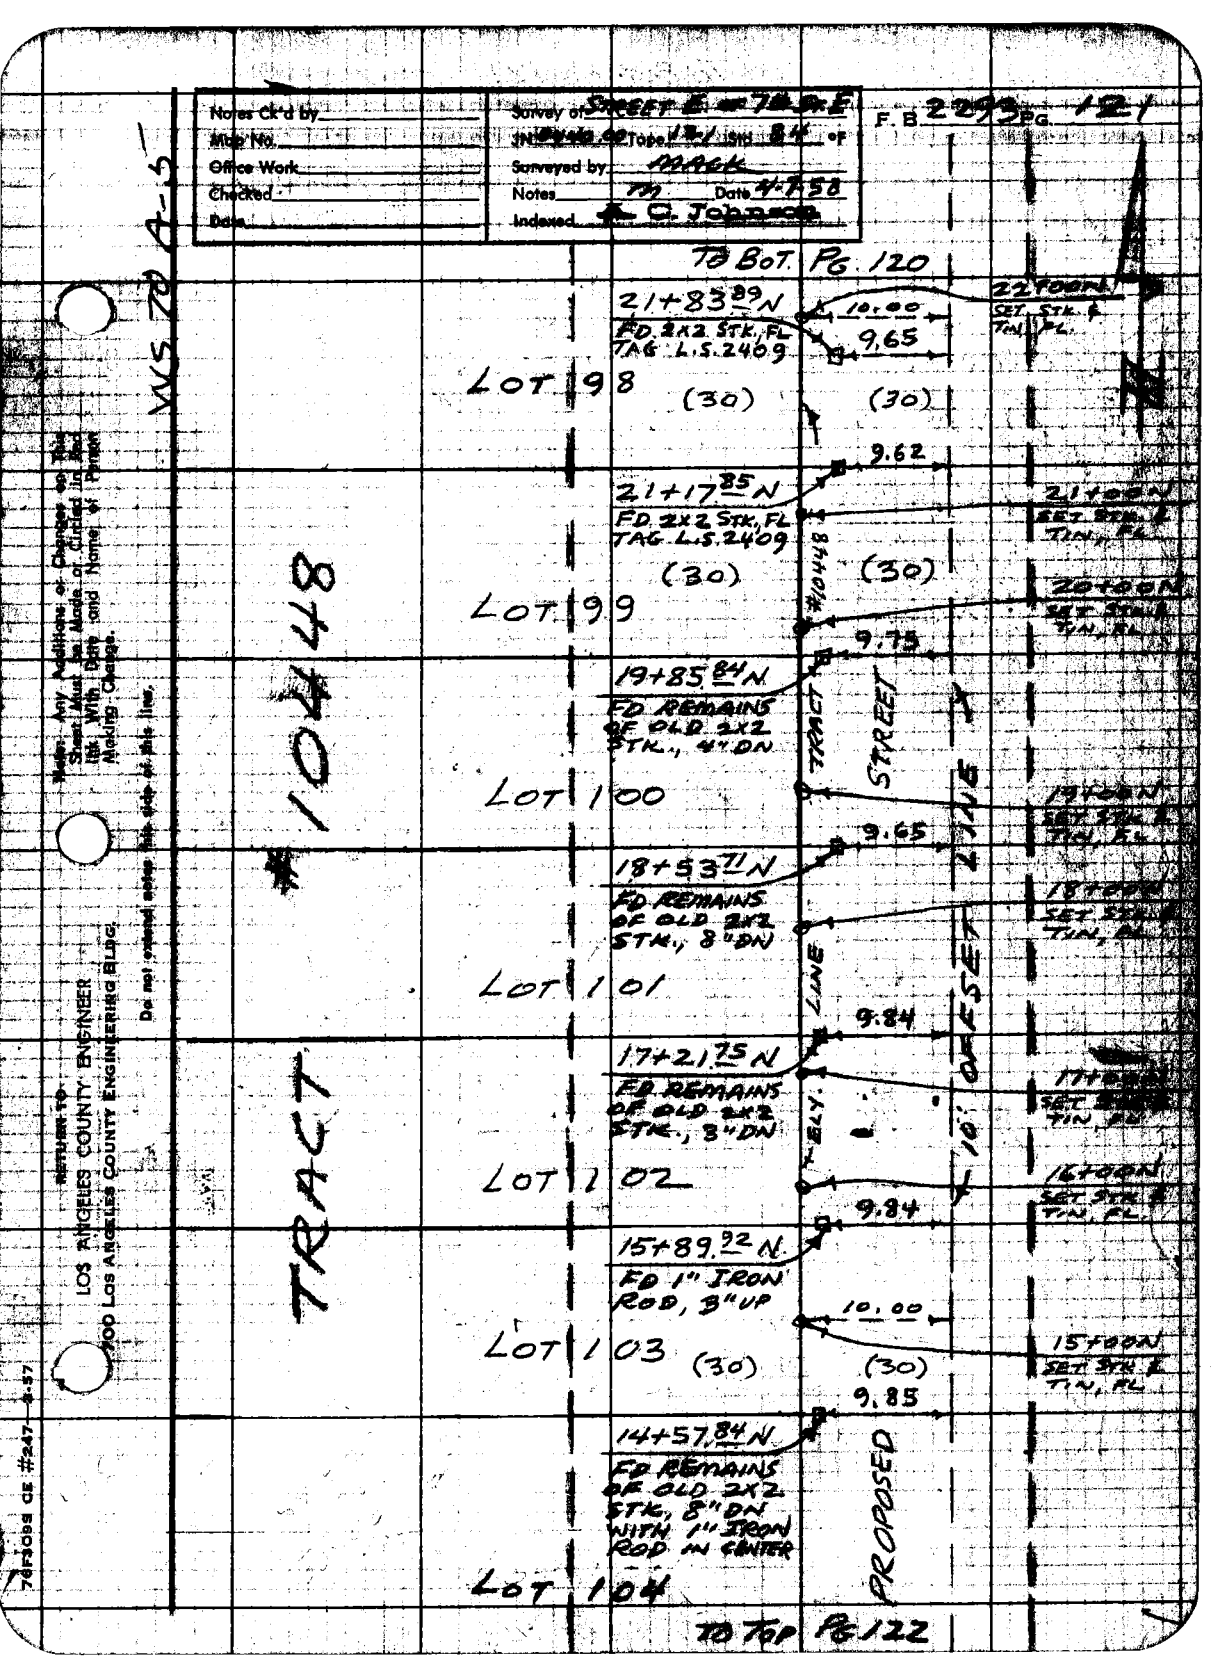
Notes Ck'd by
Map No.
Office Work
Checked
Date
Survey of STREET E. of 7th St. E.
Tape 1"=1' 1st 84 °F
Surveyed by MACK
Notes 7th Date 4-7-58
Indexed C. Johnson
F.B. 2273 PG. 121
TO BOT. PG 120
TO TOP PG 122
21+83.89 N
FD. 2X2 STK, FL
TAG L.S.2409
LOT 98
(30)
21+17.85 N
FD. 2X2 STK, FL
TAG L.S.2409
LOT 99
19+85.84 N
FD REMAINS OF OLD 2X2 STK., 4" DN
LOT 100
18+53.71 N
FD REMAINS OF OLD 2X2 STK., 8" DN
LOT 101
17+21.75 N
FD REMAINS OF OLD 2X2 STK., 3" DN
LOT 102
15+89.92 N
FD 1" IRON ROD, 3" UP
LOT 103
(30)
14+57.84 N
FD REMAINS OF OLD 2X2 STK, 8" DN WITH 1" IRON ROD IN CENTER
LOT 104
10.00
9.65
9.62
9.75
9.65
9.84
9.84
10.00
9.85
22 FOON
SET STK & TIN, FL
21+00N
SET STK & TIN, FL
20+00N
SET STK & TIN, FL
19+00N
SET STK & TIN, FL
18+00N
SET STK & TIN, FL
17+00N
SET STK & TIN, FL
16+00N
SET STK & TIN, FL
15+00N
SET STK & TIN, FL
TRACT #10448
STREET
LINE
10' OFFSET
PROPOSED
TRACT #10448
LOS ANGELES COUNTY ENGINEER
900 Los Angeles County Engineering Bldg.
RETURN TO
Make Any Additions or Changes on This Sheet Must Be Made or Dictated In Red Ink With Date and Name of Person Making Change.
Do not extend notes this side of this line.
VVS 70 A-5
7870-08 CE #247 8-57

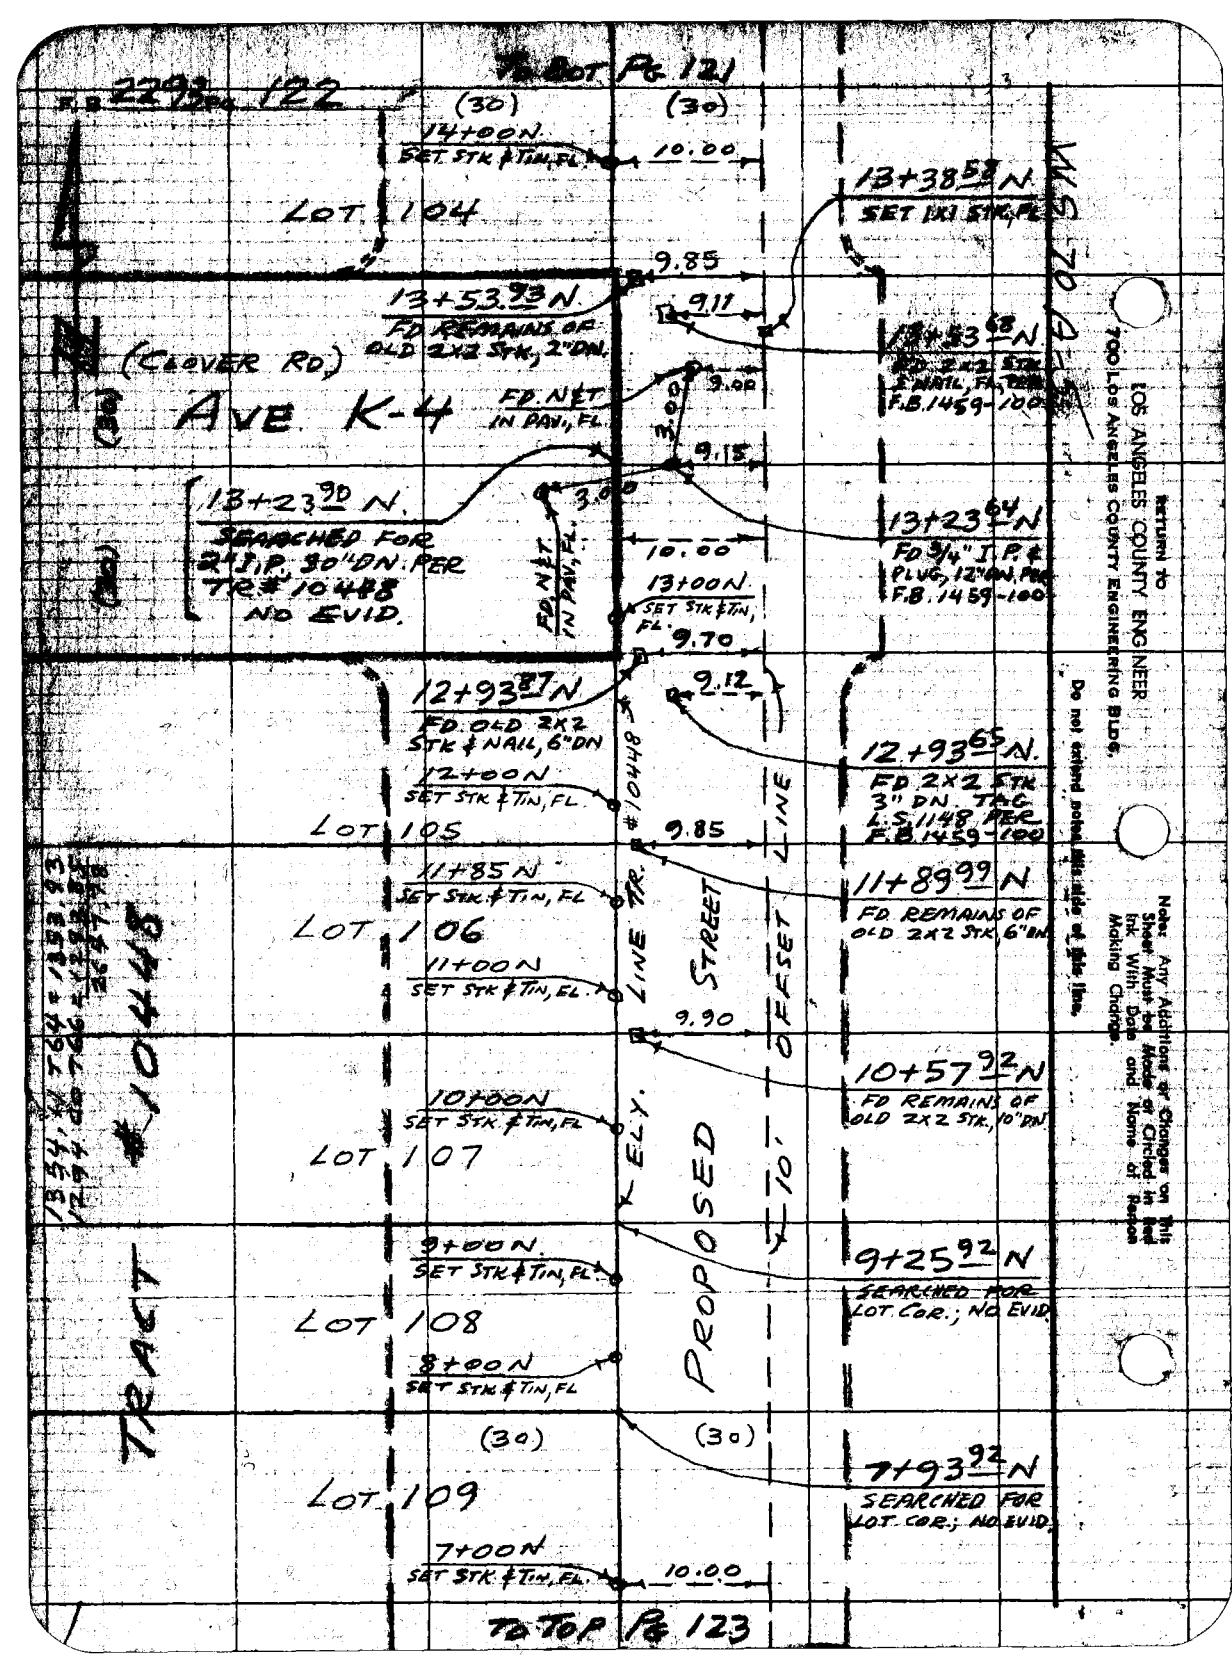
To Bot Pg 121
F.B. 2293 Pg. 122
(30)
14+00N
SET STK & TIN, FL
10.00
13+38.53N
SET 1X1 STK, FL
LOT 104
9.85
9.11
13+53.93N
FD REMAINS OF OLD 2X2 STK, 2"DN.
13+53.68N
FD 2X2 STK & NAIL, FL. TIES F.B. 1459-100
3.00
3.00
FD. NET IN PAV., FL.
AVE. K-4 (CLOVER RD.)
9.15
13+23.90N
SEARCHED FOR 2" I.P. 30"DN. PER TIE # 10448 NO EVID.
3.00
FD. NET IN PAV., FL.
13+23.64N
FD 3/4" I.P. & PLUG, 12"DN, PER F.B. 1459-100
10.00
13+00N
SET STK & TIN, FL
9.70
9.12
12+93.87N
FD. OLD 2X2 STK & NAIL, 6"DN
12+93.65N
FD 2X2 STK 3" DN. TIE L.S. 1148 PER F.B. 1459-100
12+00N
SET STK & TIN, FL
#10448
LOT 105
9.85
11+85N
SET STK & TIN, FL
11+89.99N
FD. REMAINS OF OLD 2X2 STK, 6"DN
LOT 106
11+00N
SET STK & TIN, FL
9.90
10+57.92N
FD REMAINS OF OLD 2X2 STK, 10"DN
10+00N
SET STK & TIN, FL
LOT 107
9+25.92N
SEARCHED FOR LOT COR.; NO EVID.
9+00N
SET STK & TIN, FL
LOT 108
8+00N
SET STK & TIN, FL
(30)
(30)
7+93.92N
SEARCHED FOR LOT COR.; NO EVID.
LOT 109
7+00N
SET STK & TIN, FL
10.00
To Top Pg 123
TRACT #10448
13+54.63 Eq. to 12+93.87
12+54.63 Eq. to 12+00
PROPOSED 10' OFFSET STREET LINE
ELY. LINE TR.
LOS ANGELES COUNTY ENGINEER
700 Los Angeles County Engineering Bldg.
RETURN TO
Do not extend notes this side of this line.
Note: Any Additions or Changes on This Sheet Must be Made in Red Ink With Date and Name of Person Making Change.

Notes Ck'd by
Map No.
Office Work
Checked
Date

Survey of STREET E of 7th St
JN 0440.00 Tape 12 Std 84 °F
Surveyed by MACK
Notes M Date 4-7-58
Indexed J. C. Johnson

F. B. 2293 PG. 123

To Bot. Pg 122

6+61.92 N
FD. 2X2 STK & NAIL, FL

LOT 109

9.33

(30) (30)

LOT 110

10.00

6+00 N
SET N&T IN BOT. OF FENCE

5+29.83 N
FD. REMAINS OF OLD 2X2 STK., 3" DN.

9.95

5+00 N
SET STK & TIN, FL

LOT 111

4+00 N
SET STK & TIN, FL

TR #10448

STREET

3+00 N
SET STK & TIN, FL

3+97.75 N
SEARCHED FOR LOT COR. NO EVID.

LOT 112

PROPOSED LINE

2+65.75 N
SEARCHED FOR LOT COR. NO EVID.

TRACT #10448

2+00 N
SET STK & TIN, FL

ELY.

OFFSET

1+33.75 N
FD. 2X2 STK, FL. TAG L.S. 2409

LOT 113

10.03

(30) (30)

10'

LOT 114

1+00 N
SET STK & TIN, FL.

0+30.99 N
FD 2X2 STK & AN IN TOP, FLUSH FOR F.B. 2293

10.02

0+25 N
SET STK & TIN, FL

10.00

0+25.99 N
SET 1X2 STK, FL

(DENHAM RD)

AVE. K-8

1339.92 REC.

1339.92 REC.

FD N&T IN PAV, FL

3.05

10.02

0+00 N = BOT.
FD 2" IP WITH 2" BRASS SCREW IN TOP, FLUSH W/ PAVEMENT SURFACE, IN PAV., FL. TRACT #10448

FD N&T IN PAV., F.L.

10.05

0-29.96 N
FD 2X2 STK & SMALL 2 PON TAG

10.05

LOT 115

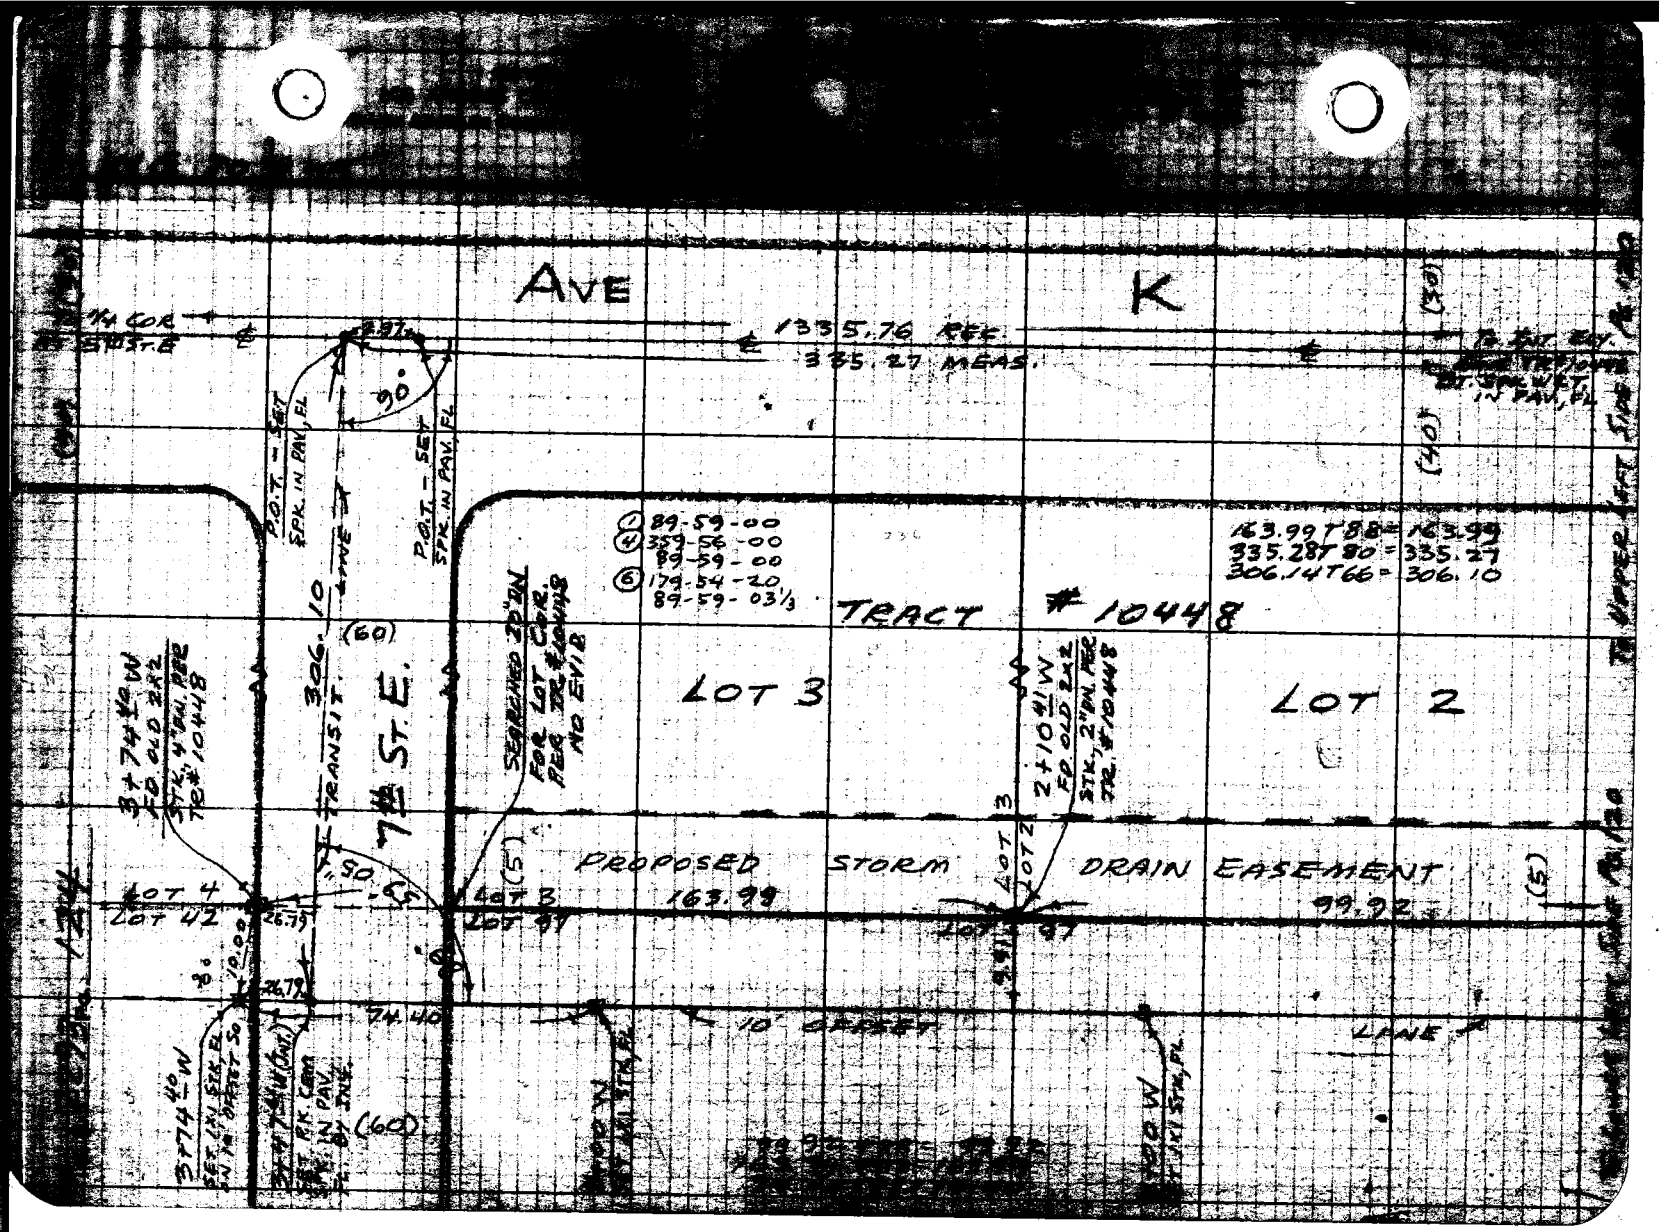
AVE K
1335.76 REC
335.27 MEAS.
1/4 COR
S30°-E
30.
P.O.T. - SET SPK. IN PAV. EL
P.O.T. - SET SPK. IN PAV. EL
(1) 89-59-00
(4) 359-56-00
(5) 89-59-00
(6) 179-54-20
89-59-03 1/3
163.99 T 88 = 163.99
335.28 T 90 = 335.27
306.14 T 66 = 306.10
LOT 3
LOT 2
7th ST. E.
306.10 TRANSIT
(60)
SET'LY LINE
SEARCHED 20' ON FOR LOT COR. PER ERRANTS NO EVID
3+74.40 W FD OLD 2½" STK, 4" PAV. PER TR# 1048
2+10.41 W FD OLD 2½" STK, 2" PAV. PER TR. # 1048
PROPOSED STORM DRAIN EASEMENT
163.99
99.92
LOT 4
LOT 42
LOT 3
LOT 2
LOT 3
LOT 41
26.79
10.00
74.40
10' OFFSET
LANE
3+74.40 W SET 1/2" REBAR IN 4" SQUARE SET'LY SIDE EL.
3+74.40 W (Ant.) FACE BK. CURB IN PAV. BY INSP.
(60)
2+10.41 W SET 1/2" REBAR IN 4" SQUARE SET'LY SIDE EL.
(5)
(30)
(40)
TO HOPPER LEFT SIDE

Notes Ck'd by
Map No.
Office Work
Checked
Date

Survey of STREET E. OF 7TH ST. E
JN 0440.00 Tape 121 Std. 84 °F
Surveyed by: MACK
Notes M. Date 5-12-58
Indexed C. Johnson

F. B. 2295 Pg. 125

J.N. 0440.00

STREET E. OF 7TH ST. E

LOCATION OF IMPROVEMENTS ALONG

SLY. LINE LOTS 1, 2, 3, TR. #10448

FROM: ELY. LINE TR #10448

WLY TO: 7TH ST. E.

PARTY:
MACK
HALISCKY
RITTER
HUBBARD
H.E. MITCHELL

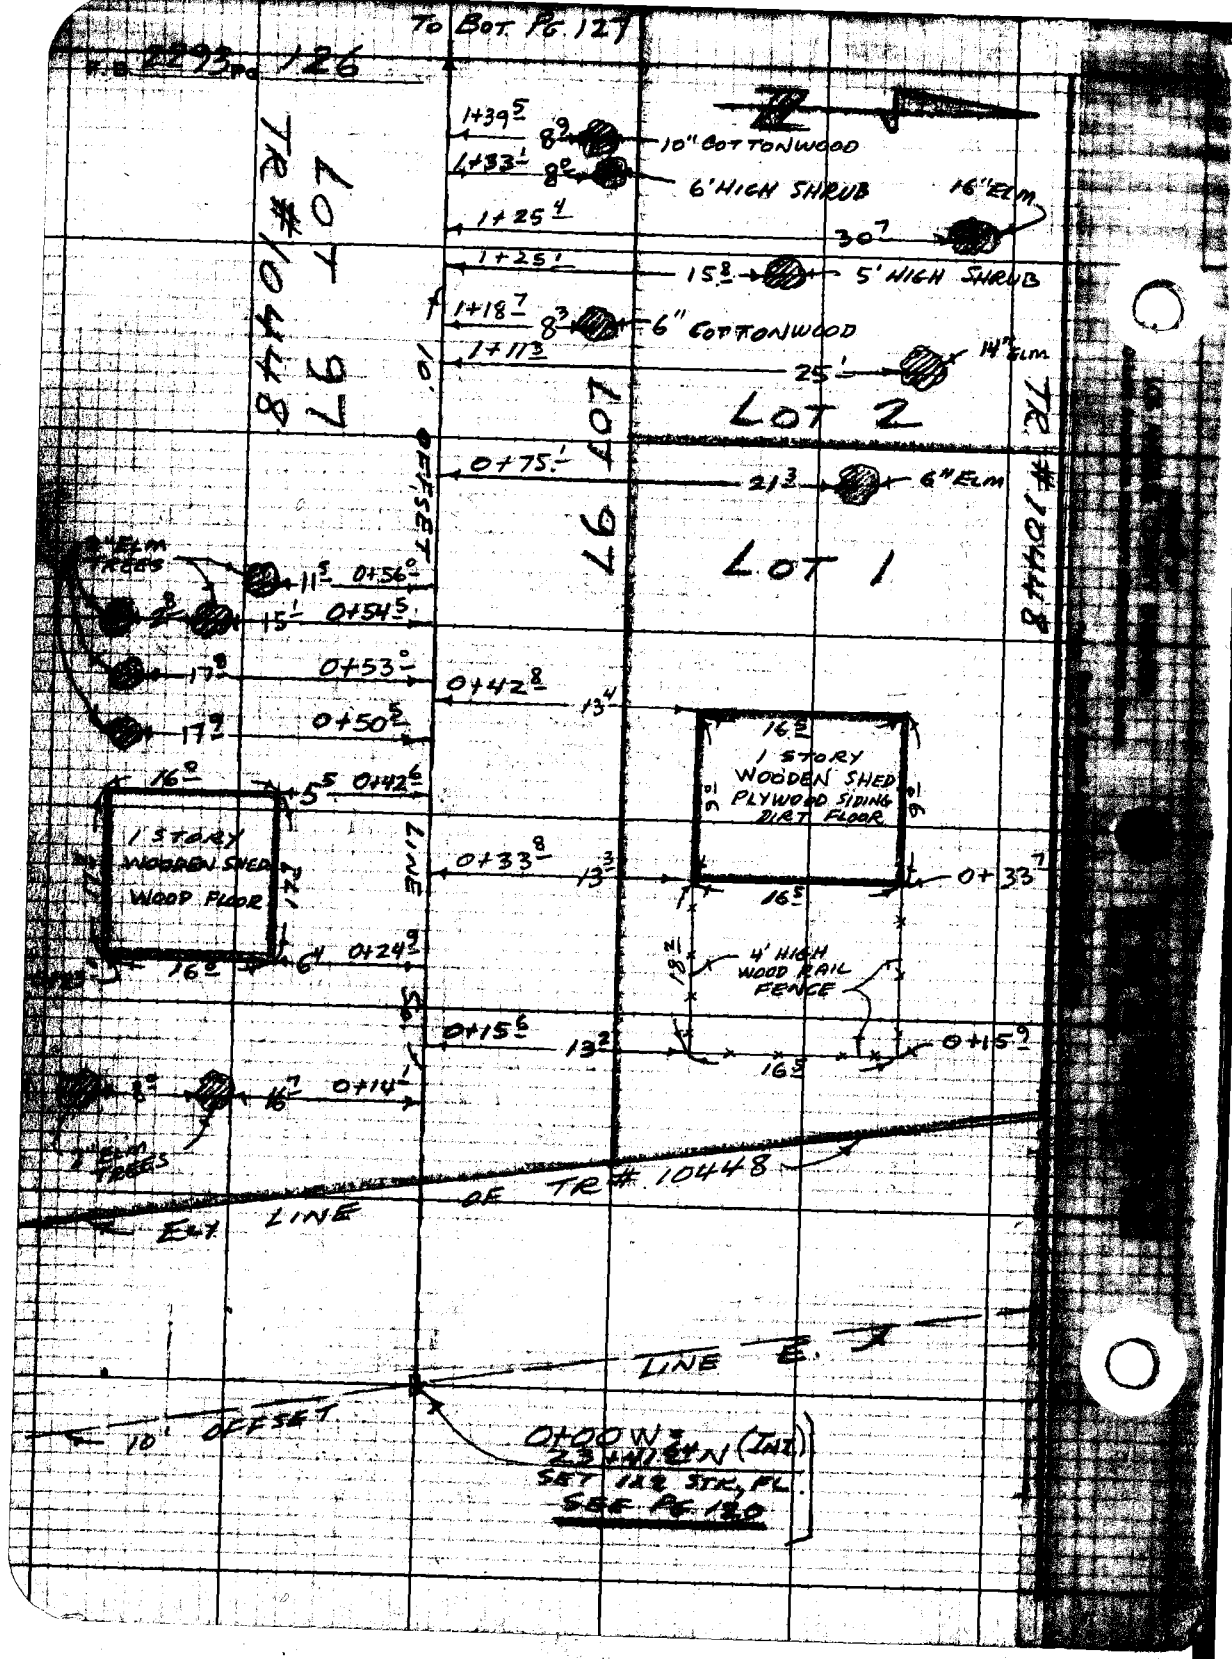
To Bot. Pg. 127
B.B. 2293 Pg. 126
LOT 1
Tr. #10448
LOT 97
10' OFFSET
LOT 2
Tr. #10448
LOT 1
1+39.5
8"
10" COTTONWOOD
1+33.1
8"
6' HIGH SHRUB
16" ELM
1+25.4
30"
1+25.1
15.8
5' HIGH SHRUB
1+18.7
8"
6" COTTONWOOD
1+11.3
25'
14" ELM
0+75.1
21.3
6" ELM
ELM TREES
11.5
0+56.0
15.1
0+54.5
17.8
0+53.0
0+42.8
13.4
17.2
0+50.5
16.0
5.5
0+42.6
1 STORY WOODEN SHED WOOD FLOOR
16.2
16.2
1 STORY WOODEN SHED PLYWOOD SIDING DIRT FLOOR
16.5
0+33.8
13.3
0+33.7
16.5
4' HIGH WOOD RAIL FENCE
18.2
6.4
0+24.9
0+15.6
13.2
16.5
0+15.9
8.5
16.7
0+14.1
2 ELM TREES
E-W LINE
OF TR #10448
LINE E.
10' OFFSET
SET 1/2 STK, FL.
SEE PG. 130

Notes Ck'd by
Map No.
Office Work
Checked
Date

Survey of STREET E. OF 7TH STE
JN CW40.00 Tape 121 Std 84 °F
Surveyed by MACE
Notes C. Johnson Date 5-12-58
Indexed

F.B. 2293 Pg. 127

To Bot Pg. 128

2+56.8 — 9.3 — 2" — 2" I.P. GUARD BRACKET FOR GAS METER
2+53.6 — 10.5 — GAS METER
2+51.8 — 9.2 — 2"
2+44.5 — 8.5 — 2" ELM
2+27.5 — 8.3 — 6" COTTONWOOD
2+27.1 — 26.8 — 8" COTTONWOOD
2+16.7 — 8.9 — 5' HIGH SHRUB
2+07.3 — 8.8 — 8" COTTONWOOD
1+92.6 — 26 — 16" COTTONWOOD
1+91.8 — 8.9 — 8" COTTONWOOD
1+78.3 — 9.0 — 10" COTTONWOOD
1+74.7 — 7.7 — 2" LOCUST
1+59.3 — 8.8 — 8" COTTONWOOD
1+49.7 — 9.3 — 8' HIGH SHRUB

10' OFFSET 1 LINE

LOT 3
LOT 2
LOT 1

TR # 8401

To Top Pg. 126

Note: Any Additions or Changes on This Sheet Must Be Made or Circled in Red Ink With Date and Name of Person Making Changes.

Do not extend notes this side of this line.

RETURN TO
LOS ANGELES COUNTY ENGINEER
700 LOS ANGELES COUNTY ENGINEERING BLDG.

70 F 2008 CE #247—3-57

F.B. 2293 Pg. 128

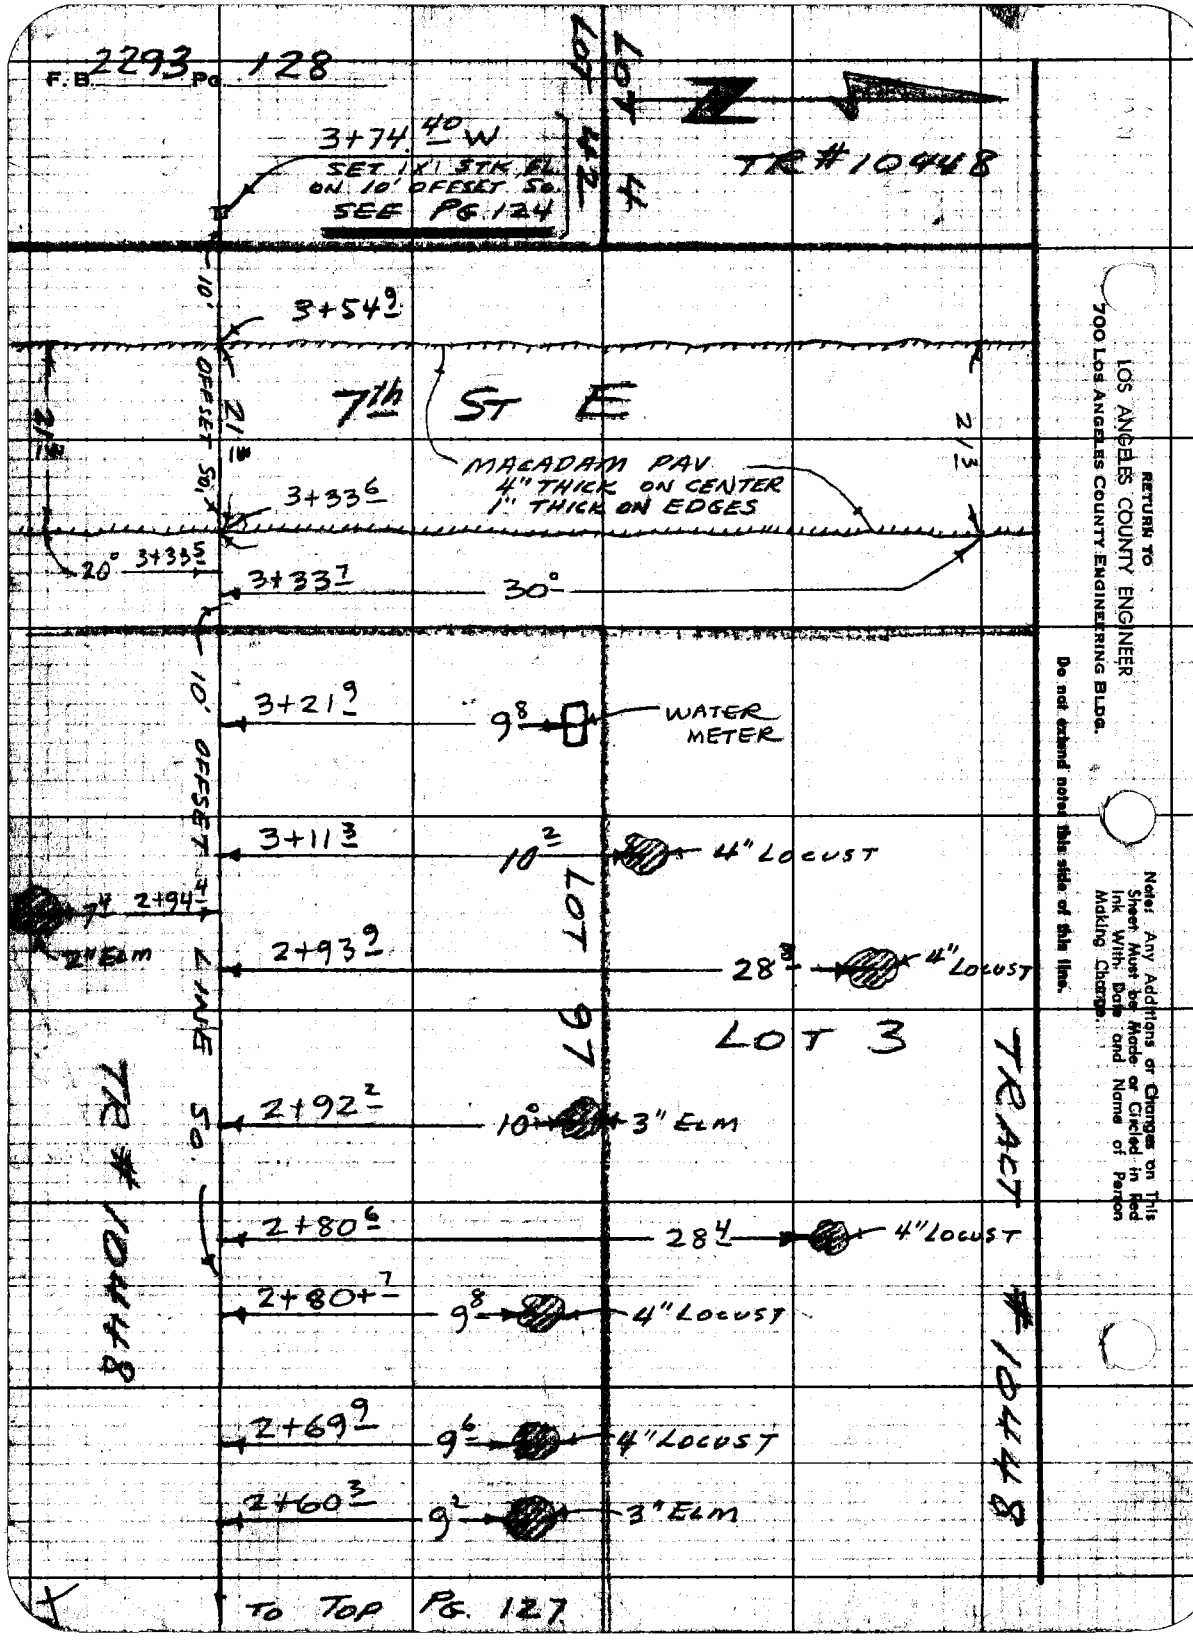

RETURN TO
LOS ANGELES COUNTY ENGINEER
700 Los Angeles County Engineering Bldg.

Note: Any Additions or Changes on This Sheet Must be Made or Circled in Red Ink With Date and Name of Person Making Change.

Do not extend notes this side of this line.

Notes Ck'd by: Miller	Survey of SEC LINES, T7N, R11W
Map No. C-3-B737	JN 0302.01 Tape 144 Std 84 oF
Office Work: S. H. BURNS	Surveyed by MACK
Checked Miller	Notes m Date 11-26-58
Date Dec. 1958	Indexed A. S. Johnson 12-3-58

F. B. 2293 Pg. 129

J.N. 0302.01

NLY. & SLY. LINES SEC. 30, T7N, R11W

ON

AVES. K & L

BET. 20TH & 30TH STS. E.

Note: Any Additions or Changes on This Sheet Must be Made in Red Ink With Date and Name of Person Making Change.

Do not extend notes this side of this line.

RETURN TO
LOS ANGELES COUNTY ENGINEER
700 Los Angeles County Engineering Bldg.

PARTY:
MACK
HALISCKY
RITTER
H.E. MITCHELL
TEMPLETON

76F3095 CE #247 3-57

RETURN TO
LOS ANGELES COUNTY ENGINEER
700 LOS ANGELES COUNTY ENGINEERING BLDG.

Note: Any Additions or Changes on This Sheet Must be Made or Circled in Red Ink With Date and Name of Person Making Change.

Do not extend notes this side of this line.

WS 70 B-6

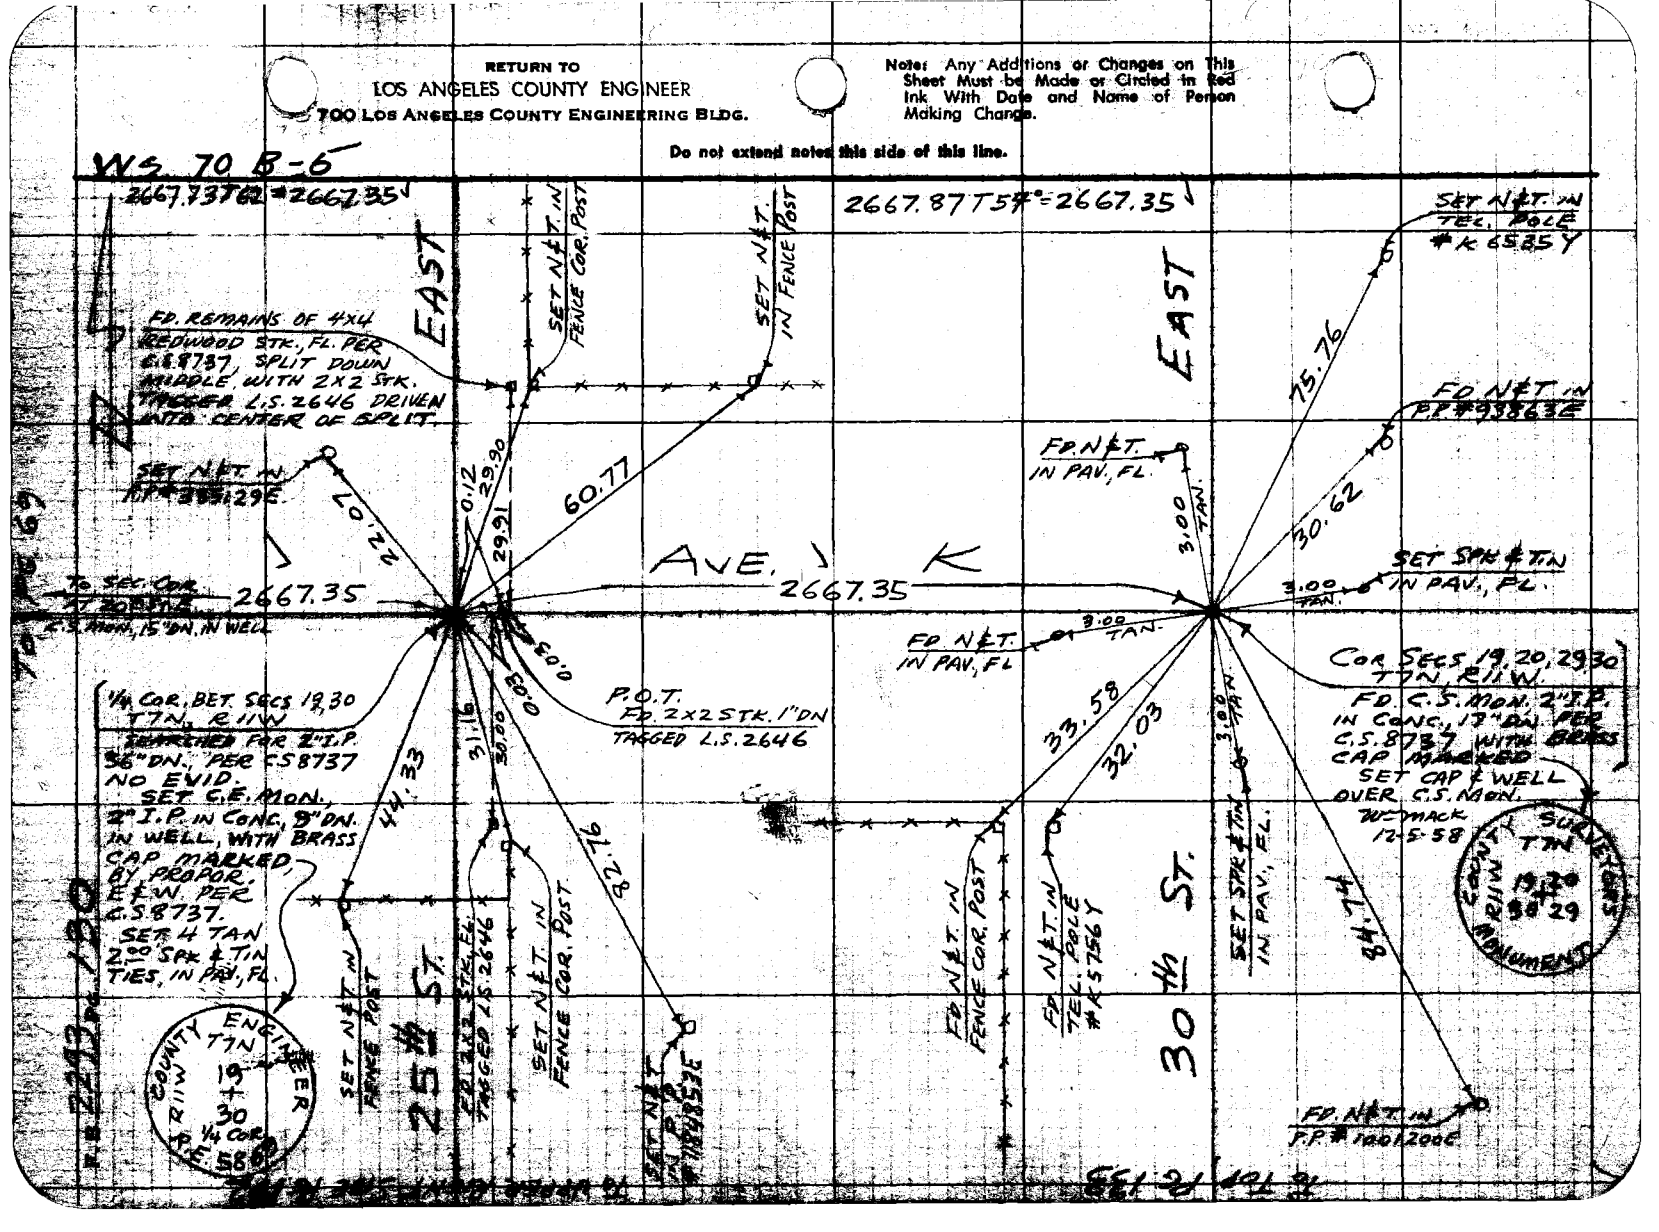

Notes Ck'd by Miller
Map No. C.S. 6737
Office Work L. H. Burns
Checked Miller
Date Dec. 1958

Survey of SEC. LINES T7N R11W
JN 0820.01 Tape 174 Std 84 °F
Surveyed by MACK
Notes [illegible] Date 11-21-58
Indexed R. A. Johnson

F. B. 2293 Pg. 131

W.S. 70-13-6

Note: Any Additions or Changes on this Sheet Must be Made or Circled in Red Ink With Date and Name of Person Making Change.

Do not extend this side of this line.

PLEASE RETURN TO
LOS ANGELES COUNTY ENGINEER
700 LOS ANGELES COUNTY ENGINEERING BLDG.

AVE.

FD. NAIL IN P.P. #938282E

FD. NAIL IN P.P. #343505E

R.P. FD. 2" I.P. CONC. PLUG & NAIL, 7" UP

86.29

56.56 TAN.

30.49

3.00

SET SPK. & TIN IN PAV., FL.

20th ST.

EAST

TO ℄ IN COR. AT AVE. K-2

45°

56.56 TAN.

3.00

40.00

65.23

SET SPK. & TIN IN PAV., FL.

R.P. FD. 2" I.P., CONC. PLUG & NAIL, 3" UP

SET BT. SPK. W&T. IN 12" JOSHUA TREE, 36" UP

Cor. Secs. 25, 30, 31, 36 T7N, R11, 12W
SEARCHED FOR C.S. MON., 36" DN. NO EVID. DESTROYED BY ROAD CONST.
SET C.E. MON., 2" I.P. IN CONC., 10" DN., IN WELL WITH BRASS CAP MARKED, BY TIES PER F.B. 1838-45

COUNTY ENGINEER
T7N R12W
T7N R11W
25 30 31 36
R.P. 5869

To ℄ IN COR. AT 2.5% STA.

To Top Pg 132

PLEASE RETURN TO
LOS ANGELES COUNTY ENGINEER
700 LOS ANGELES COUNTY ENGINEERING BLDG.

Note: Any Additions or Changes on This Sheet Must be Made or Circled in Red Ink With Date and Name of Person Making Change.

Do not extend this side of this line.

W.S 70 B-5

TO UPPER LEFT SIDE PG. 130

TO BOT. PG. 133

TO BOT. PG. 131

EAST

EAST

AVE.

L

SET NAIL W. FENCE ANCHOR POST

R.P. SET 2"I.P. CONC. PLUG & NAIL, 6" UP

42.43 TAN

42.43 TAN

45°

30.00

TO SEC. COR. AT 20TH ST. E.

1/4 COR. BET. SEC. 30, 31 T 3 N, R 11 W, 2"I.P. FD. C.S. MON. IN CONC. 12" DN. PER C.S. 8737 WITH BRASS CAP MARKED +

COUNTY SURVEYORS T 3 N 30 31 R 11 W 1/4 SEC. COR. 1926 MONUMENT

R.P. SET 2"I.P. CONC. PLUG & NAIL, 10" UP

25th ST.

30th ST.

F.B. 2293 PG. 182

Notes Ck'd by Miller	Survey of SEC. LINES, T7N, R11W
Map No. C.S. 8737	JN 0302.01 Tape 144 Std. 84 °F
Office Work T. H. BURNS	Surveyed by MACK
Checked Miller	Notes M Date 12-8-58
Date Dec. 1958	Indexed E. C. Johnson

F. B. 2293 Pg. 133

TO LOWER LEFT SIDE PG. 130

K-7.70 B-5

EAST

FD. 2" I.P. WOOD PLUG & NAIL, 10" UP

FD. NAIL IN PAV., FL.

SET X IN 3/6" CONC. IRRIG. STANDPIPE, 40" UP

57.31

3.00

AVE.

40.00

3.01

FD. NAIL IN PAV., FL.

K-8

1/4 COR. BET. SECS. 29, 30 T7N, R11W

FD. C.S. MON. 2" I.P. IN CONC., 30" DN. PER C.S. 8737 WITH BRASS CAP MARKED

SET C.E. MON. OVER OLD C.S. MON. 2" I.P. IN CONC., 6" DN. IN WELL WITH BRASS CAP MARKED

"K" MACK 12-5-58

SURVEYORS T7N R11W 30+29 1/4 SEC. COR. MONUMENT

81.01

30th ST.

SET NAIL IN P.P. #10011906

COUNTY ENGINEER T7N R11W 30+29 1/4 COR R.E. 5869

TO LOWER RIGHT SIDE PG. 132

PLEASE RETURN TO:
LOS ANGELES COUNTY ENGINEER
700 Los Angeles County Engineering Bldg.

Note: Any Additions or Changes on this Sheet Must be Made or Circled in Red Ink With Date and Name of Person Making Change.

Do not extend this side of this line.

76F3068 SAE #247 1-58

Notes Ck'd by AUSTIN '58	Survey of 3rd St. E.
Map No.	JN 1977.34 Tape 121 Std 84 °F
Office Work	Surveyed by MACK
Checked	Notes M Date 4-14-58
Date	Indexed C. Johnson

F. B. 2293 Pg. 135

J. N. 1977.34

3RD ST. E. (C.I. 1977-M)

℄ SURVEY

PARTY:
MACK
HALISKY
RITTER
HUGGARD
H.E. MITCHELL

RETURN TO
LOS ANGELES COUNTY ENGINEER
900 Los Angeles County Engineering Bldg.

Note: Any Additions or Changes on This Sheet Must Be Made or Circled in Red Ink With Date and Name of Person Making Change.

Do not extend notes this side of this line.

76F3095 CE #247—3-57

F.B. 2293 PG. 136

INDEX TO PAGES

LANCASTER BLVD.

147

ALLEY

ALLEY 147

137

AVE

LINGARD ST 147

EAST

FOXTON

4TH ST. E.

NUGENT ST.

140 143 146

NUGENT ST

145 139

144

OLDFIELD ST. 149

3RD ST

AVE

FOXTON

PONDERA ST. 148

138 142

EAST

5TH ST.

150 141 142

DIVISION ST.

3RD ST. E.

FOXTON AVE

KIRKLAND AVE.

RETURN TO
LOS ANGELES COUNTY ENGINEER
700 Los Angeles County Engineering Bldg.

Do not extend notes this side of this line.

Note: Any Additions or Changes on this Sheet Must be Made or Circled in Red Ink, With Date and Name of Person Making Change.

Notes Ck'd by Austin
Map No.
Office Work
Checked
Date

Survey of 3RD ST. E.
JN 1977-34 Tape 121 Std. 84 °F
Surveyed by MACK
Notes M Date 4-14-58
Indexed C. Johnson

Pg. 137

WSTA 1-4

LANCASTER BLVD

3RD ST. E.

ALLEY

ALLEY

30.11 REC.

FD. L&T IN CURB

30.98

FD. L&T IN CURB

23.25

REC. & CURVE DATA
Δ = 9°00'00"
R = 150
L = 23.56
T = 11.81

B.C. FD. SPK. & TIN IN PAV., FL. PER TR# 18636 & TR# 17314

18.24

FD. L&T IN CURB

22.09

30.48

FD. L&T IN CURB

FD. L&T IN CURB

(30)

(30)

3RD ST. E.

992.74'

TO E'LY'T. OF NUGENT ST. (50 E.)

TR# 18636

TR# 17314

To Upper Side Pg. 140

Note: Any Additions or Changes on this Sheet Must be Made or Circled in Red Ink. With Date and Name of Person Making Change.

Do not extend this side of this line.

PLEASE RETURN TO
LOS ANGELES COUNTY ENGINEER
700 LOS ANGELES COUNTY ENGINEERING BLDG.

78P095 SEE #227 1-58

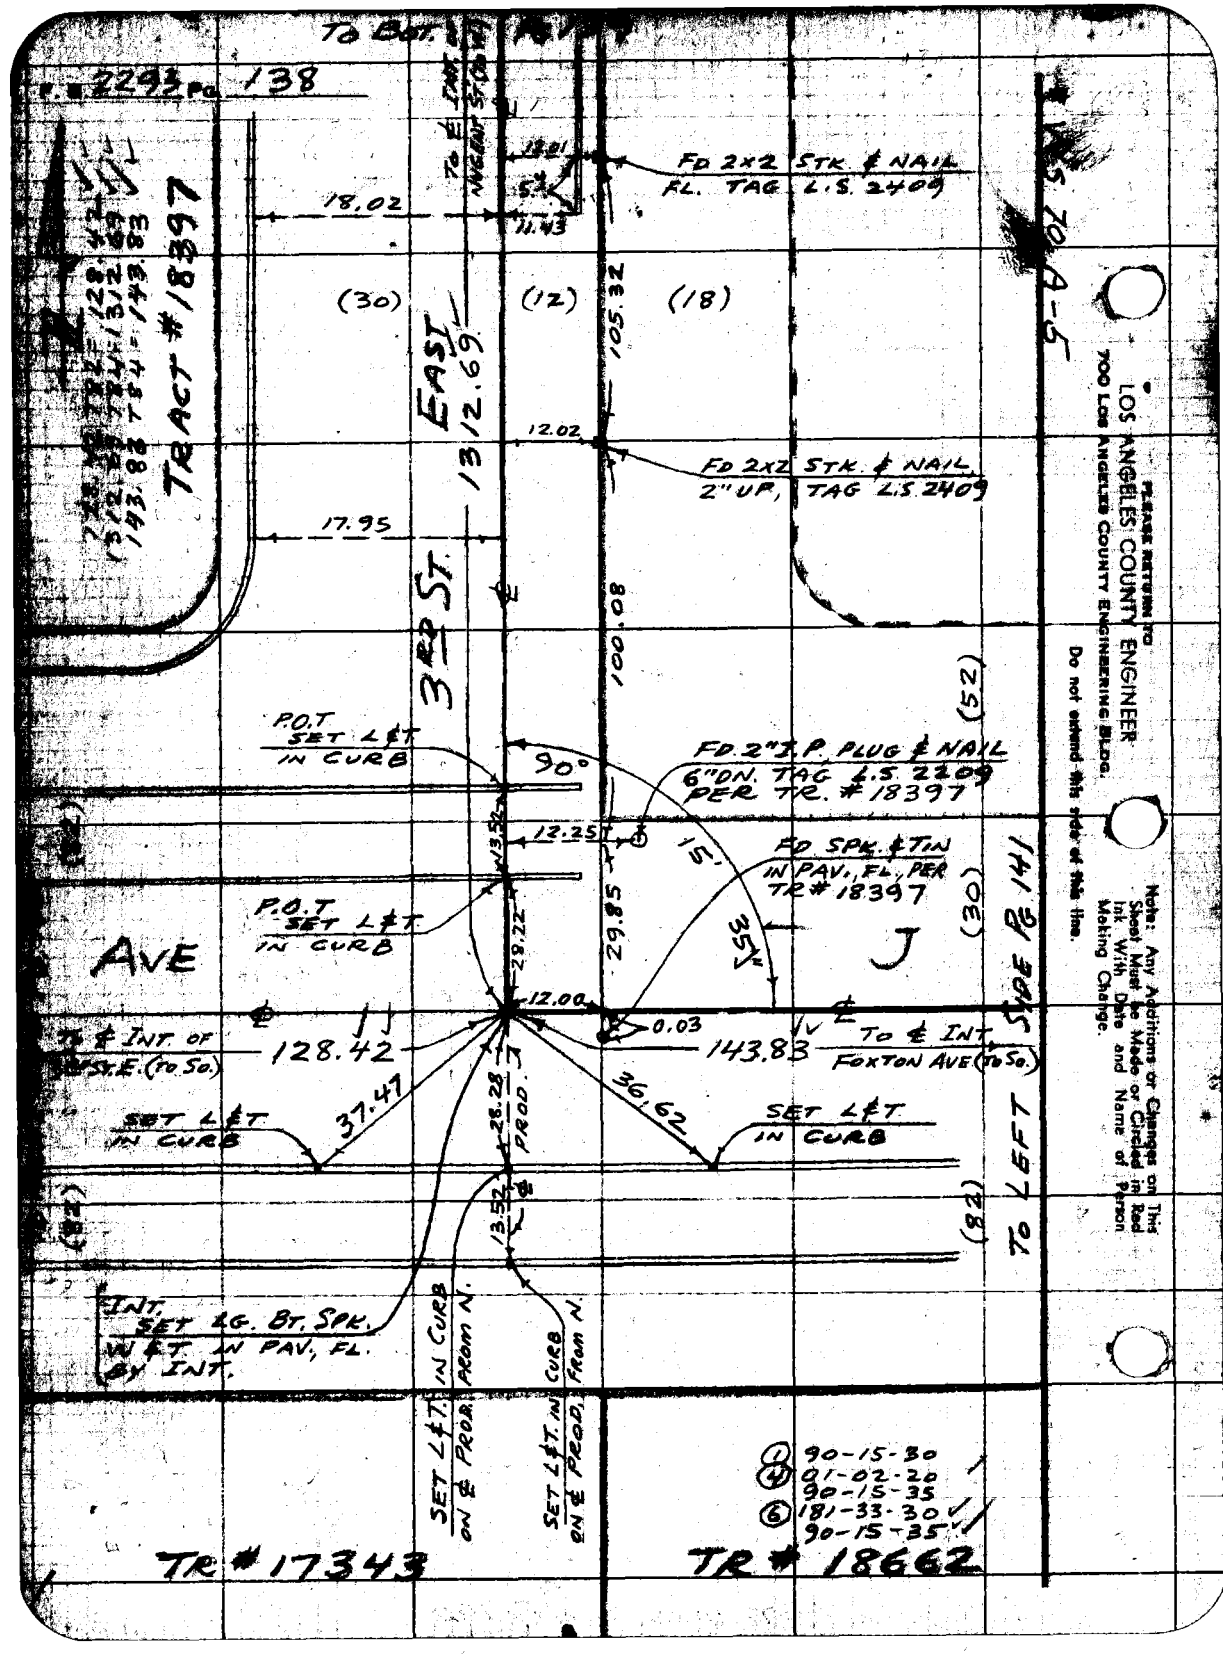
To Bot. Pg
R. 2293 Pg. 138
TRACT #18397
(30)
(12)
(18)
EAST
1312.69
3RD ST.
105.32
100.08
18.02
11.43
FD 2x2 STK & NAIL
FL. TAG L.S. 2409
12.02
FD 2x2 STK. & NAIL
2" UP, TAG L.S. 2409
17.95
P.O.T
SET L&T
IN CURB
90°
FD 2" I.P. PLUG & NAIL
6" DN. TAG L.S. 2209
PER TR. #18397
(52)
12.25
FD SPK. & TIN
IN PAV., FL., PER
TR # 18397
15'
35'
29.85
29.22
AVE
J
(30)
12.00
0.03
128.42
143.83
To ℄ INT
FOXTON AVE (To So.)
37.41
36.62
SET L&T
IN CURB
26.28
PROD.
13.52
(82)
To LEFT SEE Pg 141
INT.
SET L.G. BT. SPK.
W&T IN PAV., FL.
BY INT.
SET L&T. IN CURB
ON ℄ PROD. FROM N.
SET L&T. IN CURB
ON ℄ PROD. FROM N.
TR # 17343
TR # 18662
(1) 90-15-30
(4) 01-02-20
90-15-35
(6) 181-33-30
90-15-35
LOS ANGELES COUNTY ENGINEER
700 Los Angeles County Engineering Bldg.
PLEASE RETURN TO
Do not extend this side of this line.
Note: Any Additions or Changes on This Sheet Must be Made or Circled in Red Ink With Date and Name of Person Making Change.

Notes Ck'd by Austin
Map No.
Office Work
Checked
Date

Survey of 3rd St. E.
IN 197734 Tape 121 Std 84 °F
Surveyed by MACK
Notes M Date 4-14-58
Indexed C. Johnson

F. B. 2293 Pg. 139

TO UPPER LEFT SIDE PG. 140

18.30 (30) | 11.40 (12) | (18)

TR # 18397

SET L&T IN CURB

SET L&T IN CURB

To ℄ INT NUGENT ST.

P.O.T. SET L&T IN CONC. X-GUT.

51.32

51.73

EAST 145.72

90.48

19.33

(30) 18.06

NUGENT ST.

PG 145

FD. 2" I.P. TUBE & NAIL & "LS 2309" TAG L.F. 2.30 PAR. TR. #18397

11.97 PROD.

To ℄ INT STANRIDGE AVE 261.60

90.

16.

15"

18.16

INT. WEST LINE OF ST. STR. WITH IN PAV. FL., BY L&T

51.45

51.90

(30) 18.03

P.O.T. SET L&T IN CONC. X-GUT.

SET L&T IN CURB

SET L&T IN CURB

ST.

18.03 | 11.45

261.62 TR = 261.60

TR # 18397

3RD 1312.69

℄ ELY. LINE TR # 18397

(1) 90-16-10
(2) 01-05-10
90-16-17½
(3) 184-37-30
90-16-15

(30) | To ℄ INT AVE J | (12) | (18)

TO TOP PG. 138

RETURN TO
LOS ANGELES COUNTY ENGINEER
900 Los Angeles County Engineering Bldg.

Do not extend notes past this side of this line.

Notes Are Required of Changes on This Sheet Must Be Made or Copied in Red Ink, With Date and Name of Person Making Changes.

76F308 DE #247—3-57

RETURN TO
LOS ANGELES COUNTY ENGINEER
7700 LOS ANGELES COUNTY ENGINEERING BLDG.

Notes: Any Additions or Changes on This Sheet Must be Made or Circled in Red Ink With Date and Name of Person Making Change.

Do not extend notes this side of this line.

WS 70A-4

To BOT. PG 137

18.25 (30) 18.12 (30)

EAST To B.C. SPK. & TIN, FD.

FD. L&T IN CURB

TR.#17314

TR.#15467

(1) 89-51-40
(4) 359-26-10
89-51-35
(6) 179-09-20
89-51-33 1/3

FD. L&T IN CURB

145.72 782 = 145.72
992.74 784 = 992.74

TR.#18636

35.11

992.74

48.97

47.96

15°46'

17.95 (30)

FD. L&T IN CURB

NUGENT ST.

18.00

To ℄ INT. FORTON AVE

266.02

18.47 ℄ PROD.

133.96

5.00

129.06

SET L&T. IN CURB ON ℄ PROD. FROM ℄.

34.97

(12)

0.07

90°

3RD ST

145.72

35.13

(18)

80.00

P.O.T. FD SPK. & TIN IN PAV. FL. PER TR.#15467 & TR.#17314

P.O.T. FD SPK. & TIN IN PAV. FL.

PER TR.#15467 & TR.#17314

18.00

TO LEFT SIDE PG 143

FD. L&T IN CURB

18.23

INT. SET LG. BT. SPK. NAIL IN PAV. FL. BY INT.

TR.#15467

P.O.T. FD SPK. & TIN IN PAV. FL. TR.#18636

18.35

12.00

11.50

90.48

FD. 2" I.P. PLUG & NAIL P.N. PAC. L.S. 3209 PER TR.#18397

FD 2" I.P. PLUG & NAIL P.N. PAC. L.S. 3209 PER TR.#15467

133.96782
132.06782
266.02782 = 266.02

TR.#18397

To Top of Bk. (18)

Notes Ck'd by Austin
Map No.
Office Work
Checked
Date

Survey of 3rd St. E
JN 197734 Tape 121 Std 82 °F
Surveyed by MACK
Notes M. Date 4-16-58
Indexed C. Johnson

F. B. 2293 Pg. 141

W.S. 70 A-4

(52)

(30)

AVE. J

(52)

(30)

Sht. Ahead Pg. 138

To ℄ Int. 3rd St E. (To N.)

143.83

210.78

To ℄ Int. Foxton Ave.

0.02

FD. R.R. SPK. & TIN IN PAV., FL. PER TR. #18662

To Right

(82)

(82)

FOXTON AVE.

TR. #18662

TR. #18662

(27)

(27)

Notes: Any Additions or Changes on this Sheet Must be Made in Ink With Date and Name of Person Making Change.

Do not extend this data off this line.

PLEASE RETURN TO
LOS ANGELES COUNTY ENGINEER
700 Los Angeles County Engineering Bldg.

7813095 SAE 1247 1-58

PLEASE RETURN TO
LOS ANGELES COUNTY ENGINEER
700 LOS ANGELES COUNTY ENGINEERING BLDG.

Note: Any Additions or Changes on This Sheet Must be Made or Circled in Red Ink With Date and Name of Person Making Change.

Do not extend this side of this line.

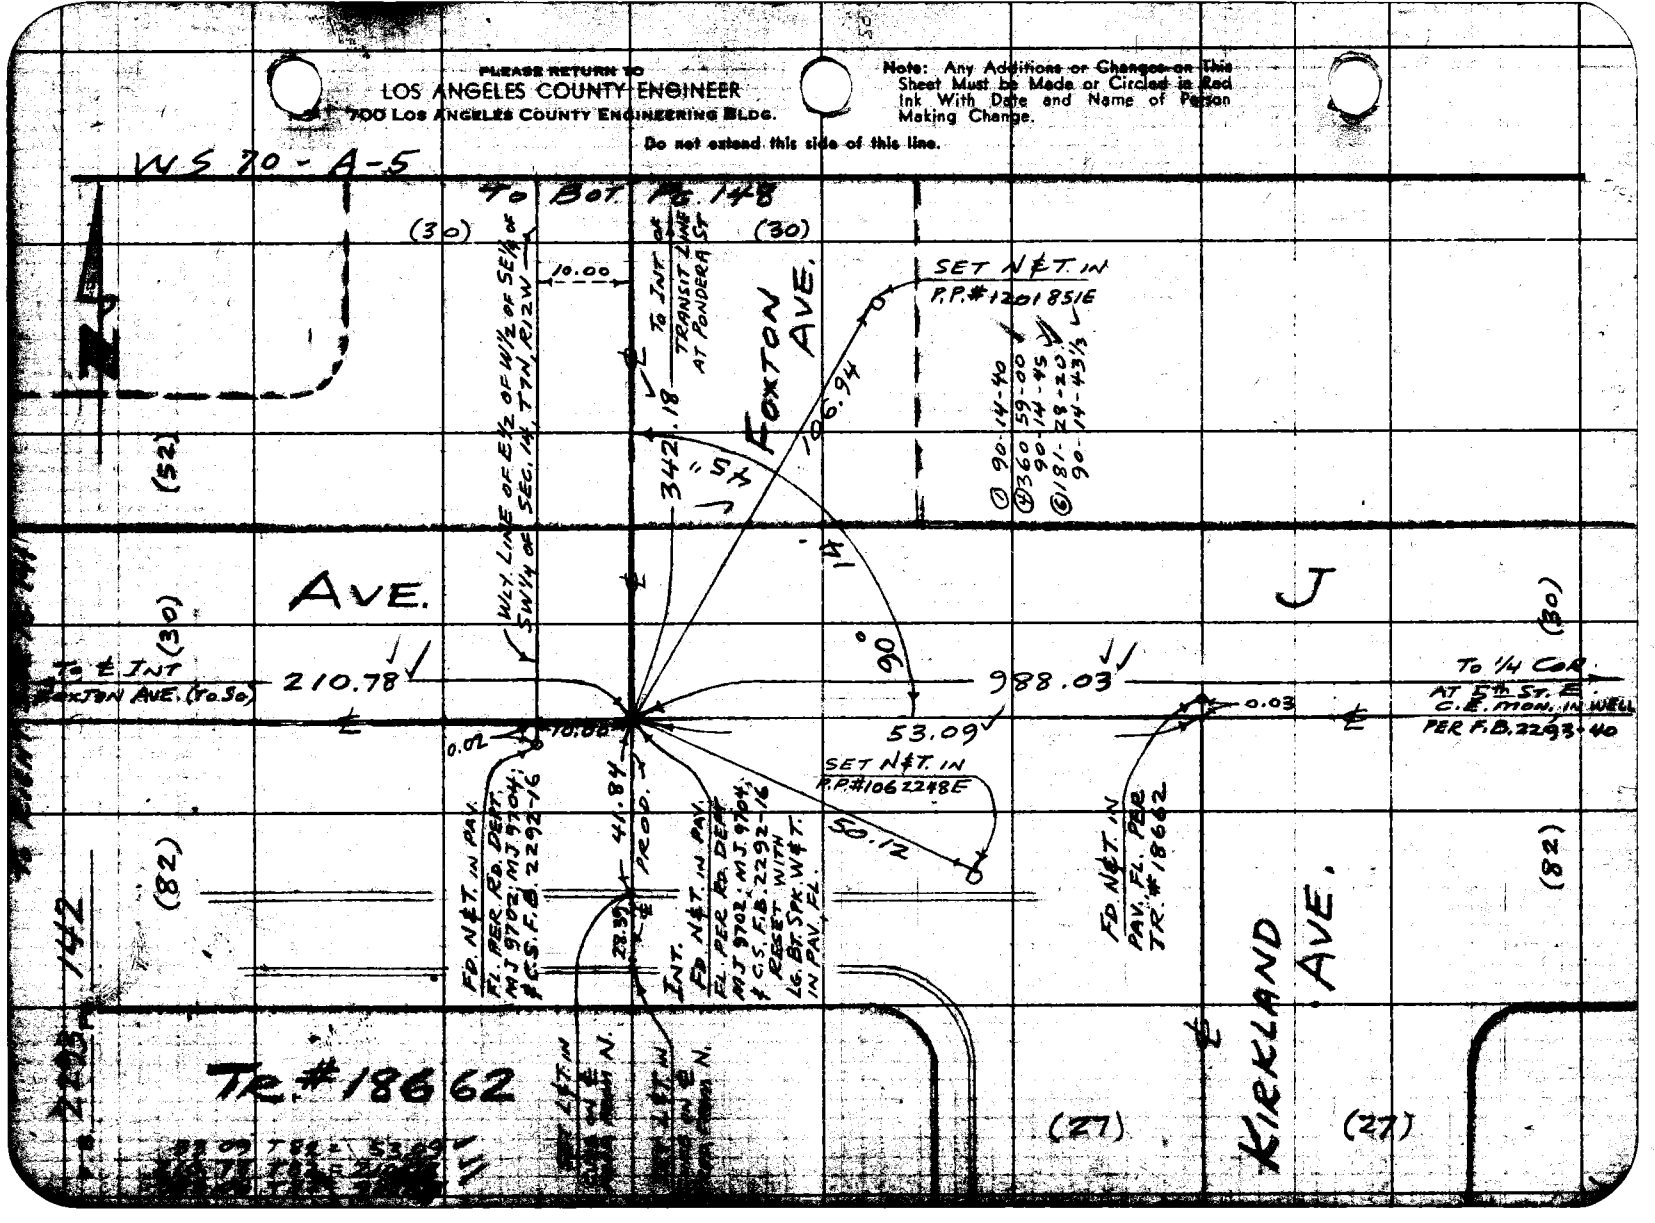

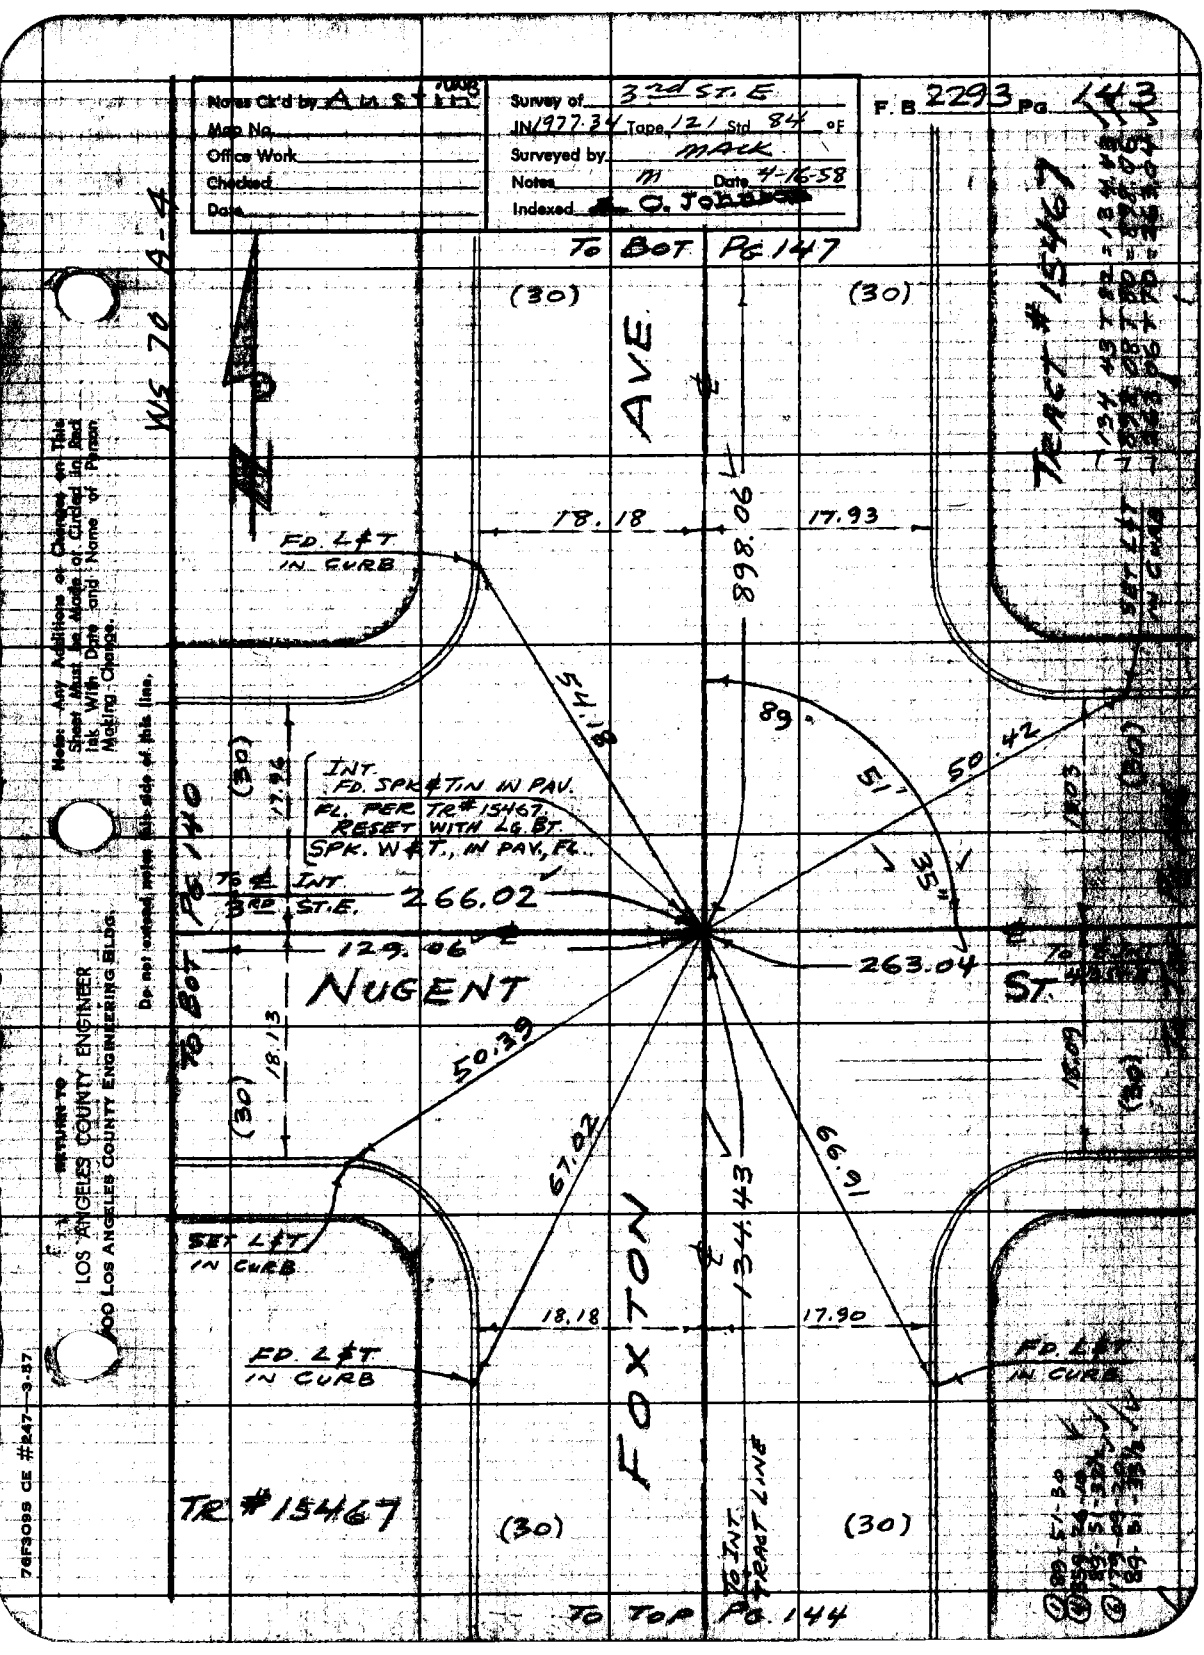
Notes Ck'd by A. In. S. T.
Map No.
Office Work
Checked
Date
Survey of 3rd St. E
JN 1977.34 Tape 121 Std 84 °F
Surveyed by MACK
Notes M Date 4-16-58
Indexed C. Johnson
F. B. 2293 Pg. 143
To Bot Pg 147
(30)
AVE
898.06
18.18
17.93
FD. L & T IN CURB
TRACT #15467
SET L&T IN CURB
WLS 70 A-4
INT. FD. SPK & TIN IN PAV. FL. PER TR #15467. RESET WITH L & BT. SPK. W & T., IN PAV. FL.
To Pg 140
To INT. 3RD ST. E.
266.02
129.06
NUGENT
263.04
ST.
To Bot
18.13
50.39
67.02
66.91
134.43
FOXTON
SET L&T IN CURB
FD. L & T IN CURB
18.18
17.90
TR #15467
To INT.
To Top Pg. 144
Note: Any Additions or Changes on This Sheet Must Be Made or Ordered In Red Ink With Date and Name of Person Making Change.
Do not extend notes this side of this line.
RETURN TO
LOS ANGELES COUNTY ENGINEER
900 LOS ANGELES COUNTY ENGINEERING BLDG.
76F3088 CE #247—3-57.

RETURN TO
LOS ANGELES COUNTY ENGINEER
700 LOS ANGELES COUNTY ENGINEERING BLDG.

Notes: Any Additions or Changes on This Sheet Must be Made or Circled in Red Ink With Date and Name of Person Making Change.

Do not extend notes this side of this line.

W.S. 70 A-4

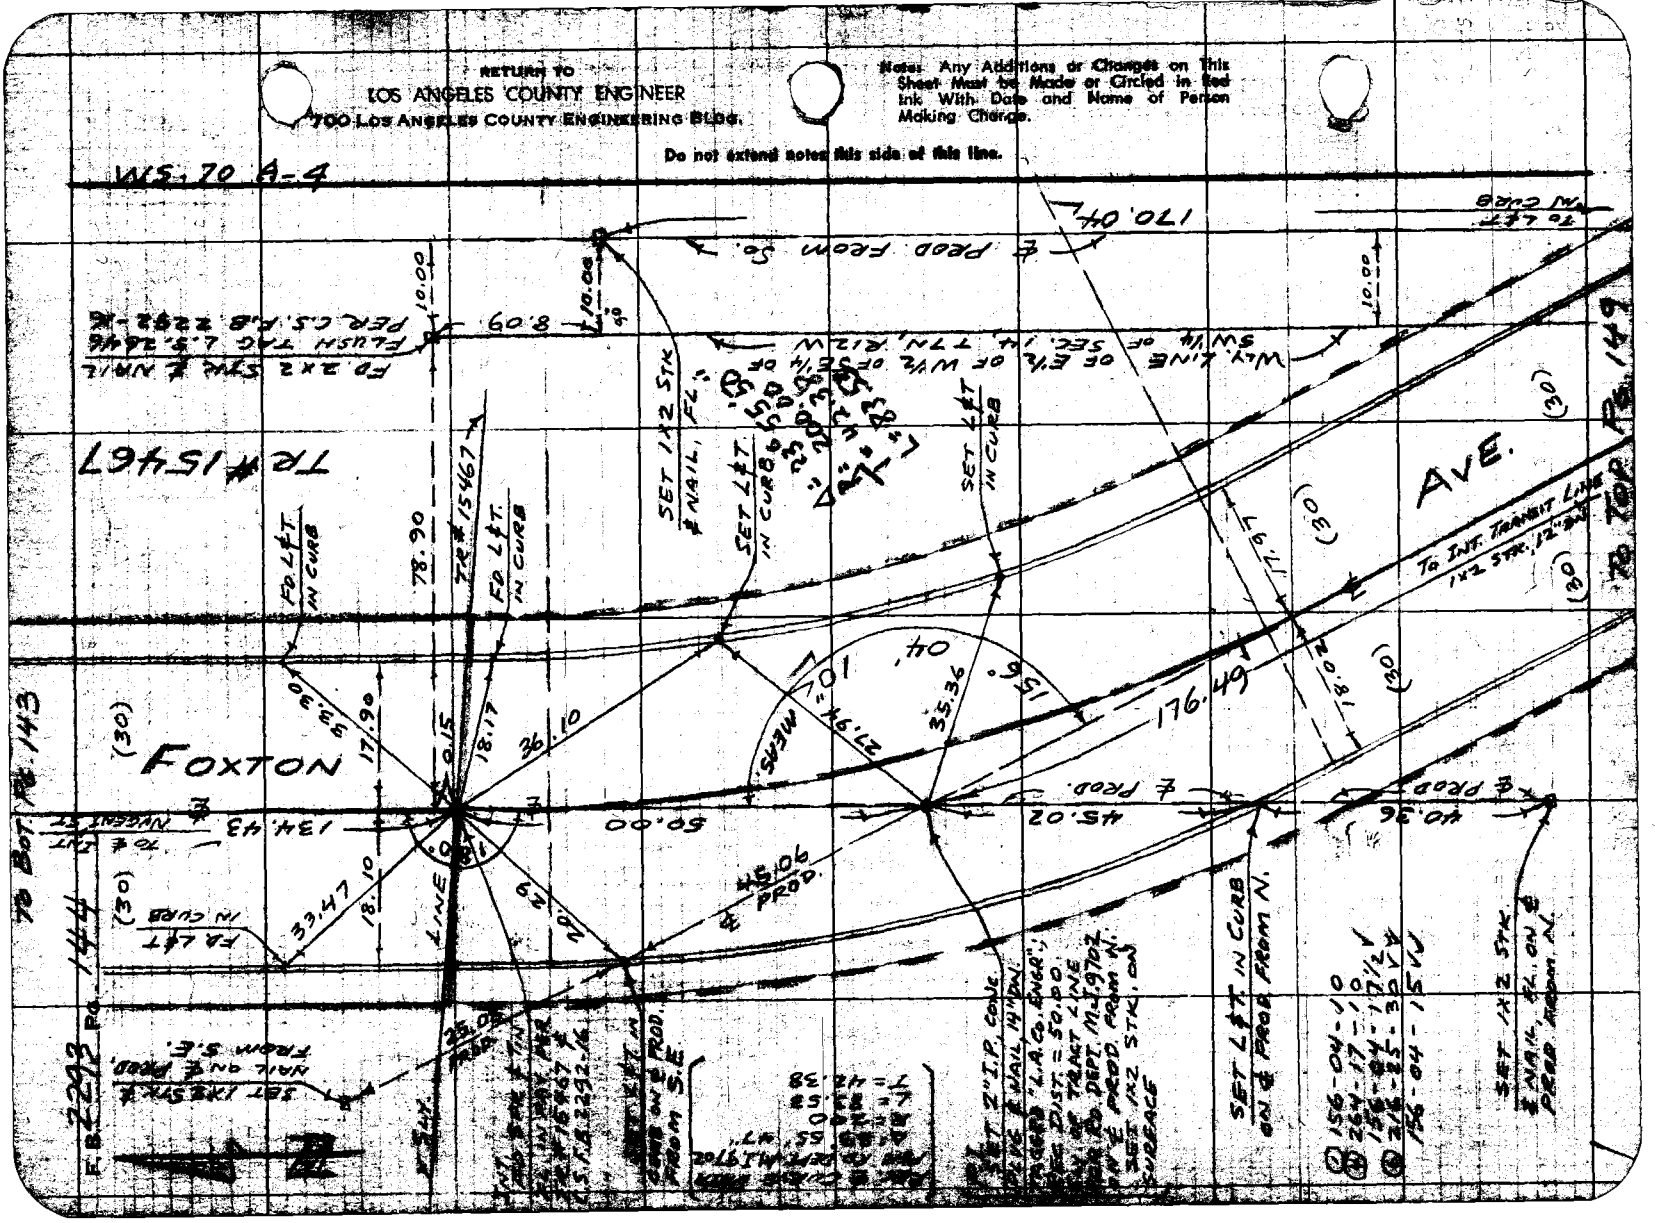
TR # 15467
FOXTON
AVE.
SET 1/2 STK. FLUSH
SET 1" I.P. COND. FLUSH
SET NAIL, FLUSH
SET L&T IN CURB
FD L&T IN CURB
FD 3/4" I.P. COND. FLUSH
FD 3x3 STK & NAIL PER C.S. 2292-M
FD 3x3 STK & NAIL PER C.S. 2292-M
SET 1/2 STK. & NAIL ON ℄ PROD FROM N.
SET L&T IN CURB ON ℄ PROD FROM N.
SET 1/2 STK. & NAIL ON ℄ PROD FROM S.E.
℄ PROD FROM S.E.
℄ PROD
℄ PROD
℄ PROD

Notes Ck'd by Austin
Map No.
Office Work
Checked
Date

Survey of 3rd St. E
JN 197134 Tape 121 Std 84 °F
Surveyed by MACK
Notes M Date 4-15-58
Indexed

F. B 2293 Pg 145

FD. 2X2 STK. & NAIL 12" DN. TAG L.S. 2209 PER TR # 18397

30.00 → ← WLY. LINE OF TR # 18397

FD 2X2 STK & NAIL, 6" DN. TAG L.S. 2209; W/LIN SPK & TIN ON SURFACE IN PAV., FL. PER TR # 18397

W.S. 70 A-4

130.47 REC.

2nd ST. EAST

SEARCHED FOR SLT. PER TR # 18397 NO EVID.

NUGENT

261.60 REC.

FD SPK & TIN IN PAV. FL. PER TR # 18397

STANRIDGE AVE.

(30) (30)

261.60 M/E TO E'LY'T 3RD ST. E

ST.

TO LEFT SIDE PG 139

Note: Any Additions or Changes on This Sheet Must be Made or Ruled in Red Ink With Date and Name of Person Making Change.

Do not extend notes this side of this line.

RETURN TO
LOS ANGELES COUNTY ENGINEER
ROOM 108 LOS ANGELES COUNTY ENGINEERING BLDG.

76F3085 CE #242 3-57

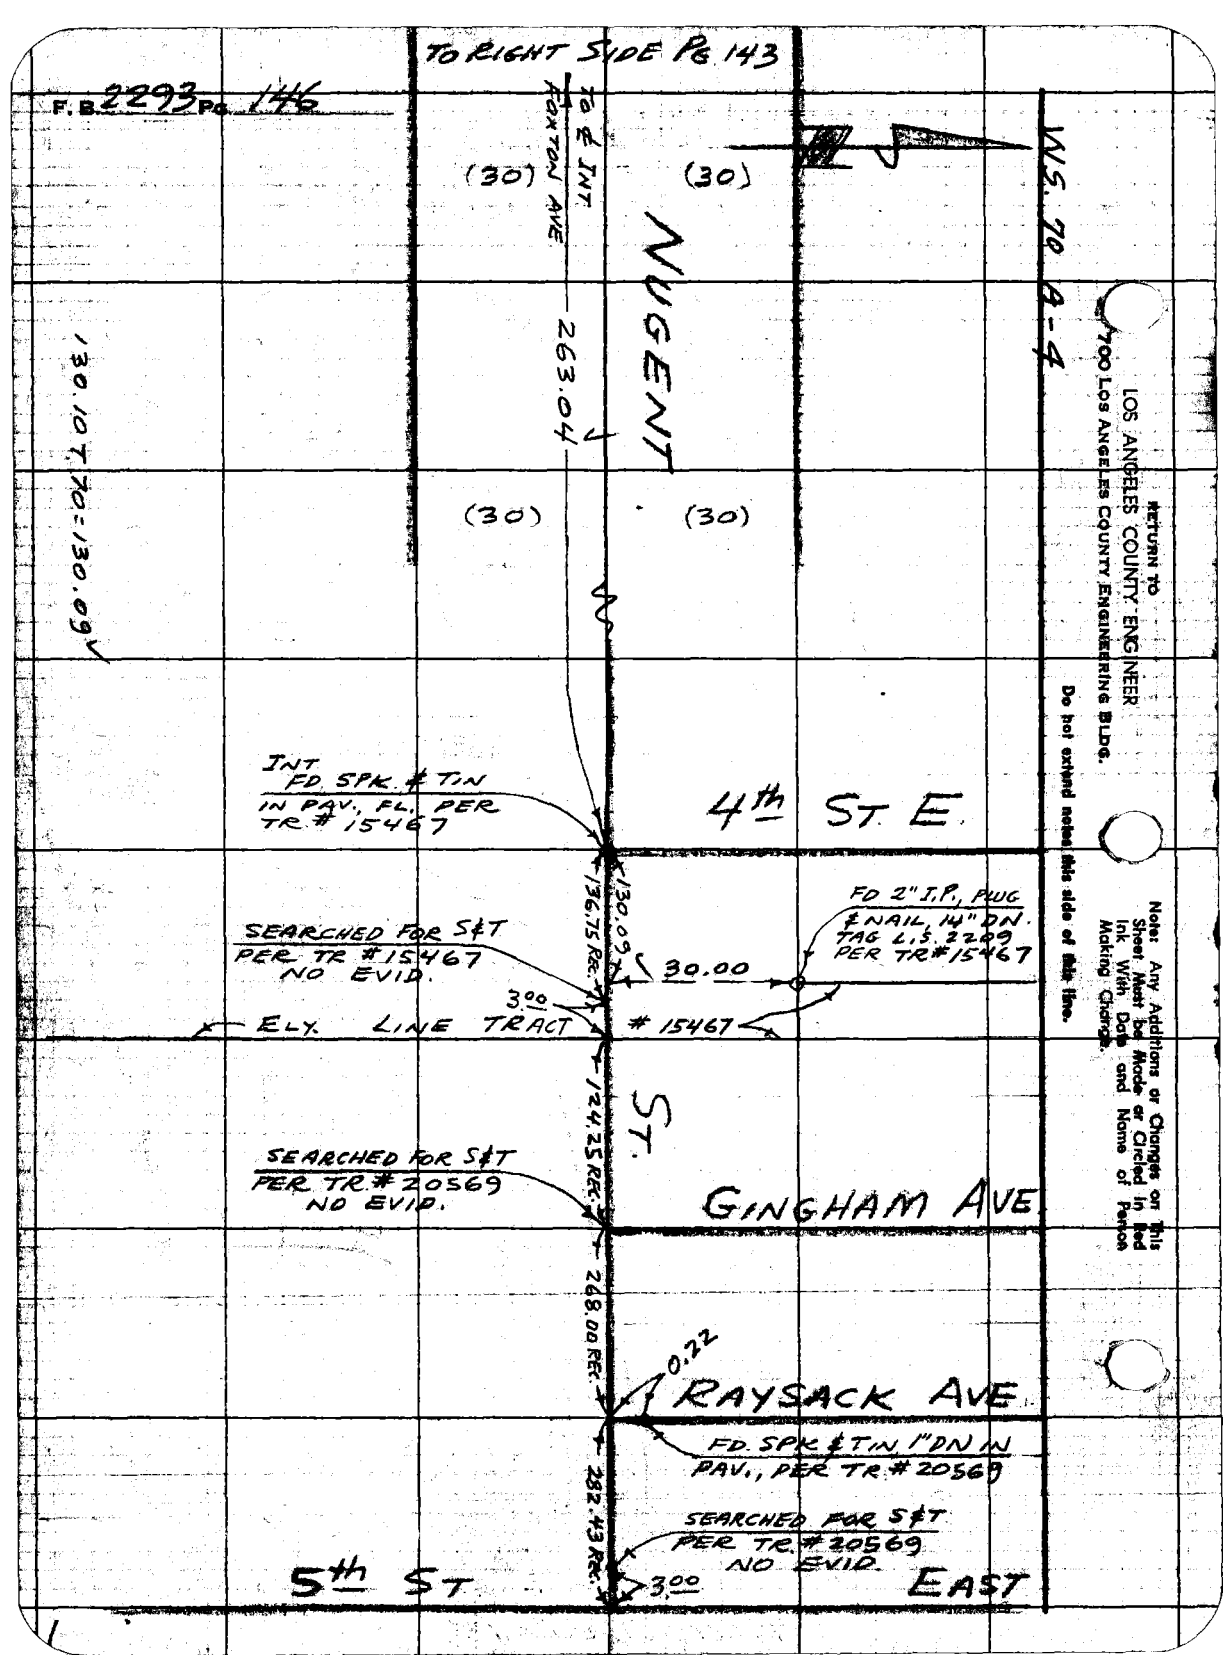
TO RIGHT SIDE PG 143
F. B. 2293 Pg. 146
To E Int Foxton Ave
(30)
(30)
NUGENT
263.04
W.S. 70 A-4
(30)
(30)
130.10 T.70=130.09
RETURN TO LOS ANGELES COUNTY ENGINEER 700 LOS ANGELES COUNTY ENGINEERING BLDG.
Do not extend notes this side of this line.
Note: Any Additions or Changes on This Sheet Must be Made or Circled in Red Ink With Date and Name of Person Making Change.
INT FD SPK. & TIN IN PAV., FL. PER TR. # 15467
4th ST E.
130.09
136.75 REC.
FD 2" I.P., PLUG & NAIL, 14" DN. TAG L.S. 2209 PER TR. # 15467
SEARCHED FOR S&T PER TR. # 15467 NO EVID.
30.00
3.00
ELY. LINE TRACT
15467
ST.
124.25 REC.
SEARCHED FOR S&T PER TR. # 20569 NO EVID.
GINGHAM AVE
268.00 REC.
0.22
RAYSACK AVE
FD. SPK & TIN 1" DN IN PAV., PER TR. # 20569
282.43 REC.
SEARCHED FOR S&T PER TR. # 20569 NO EVID.
3.00
5th ST
EAST

Notes Ck'd by Austin
Map No.
Office Work
Checked
Date

Survey of 32nd St. E
JN 197734 Tape 82' Std 84 °F
Surveyed by MACK
Notes M Date 4-15-58
Indexed C. Johnson

F. B. 2293 PG. 147

WS. 70 - A - 4

LANCASTER BLVD.

INT. FD SPK & TIN IN PAV. FL. PER TR. #15467

149.99

ALLEY

INT FD SPK & TIN IN PAV. FL. PER TR #15467

AVE.

144.00

LINGARD ST.

INT FD SPK & TIN IN PAV. FL. PER TR #15467

149.99 T.B.Z. = 149.99
144.00 T.B.Z. = 144.00

(30) (30)

FOXTON

898.06

TO ℄ INT. NUGENT ST.

(30) (30)

TO TOP PG. 143

Note: Any Additions or Changes on This Sheet Must be Made or Circled in Red Ink With Date and Name of Person Making Change.

Do not extend notes this side of this line.

RETURN TO
LOS ANGELES COUNTY ENGINEER
900 LOS ANGELES COUNTY ENGINEERING BLDG.

76F309S CE #247 3-57

RETURN TO
LOS ANGELES COUNTY ENGINEER
700 LOS ANGELES COUNTY ENGINEERING BLDG.

Notes: Any Additions or Changes on This Sheet Must be Made or Circled in Red Ink With Date and Name of Person Making Change.

Do not extend notes this side of this line.

W.S. 70 A-5

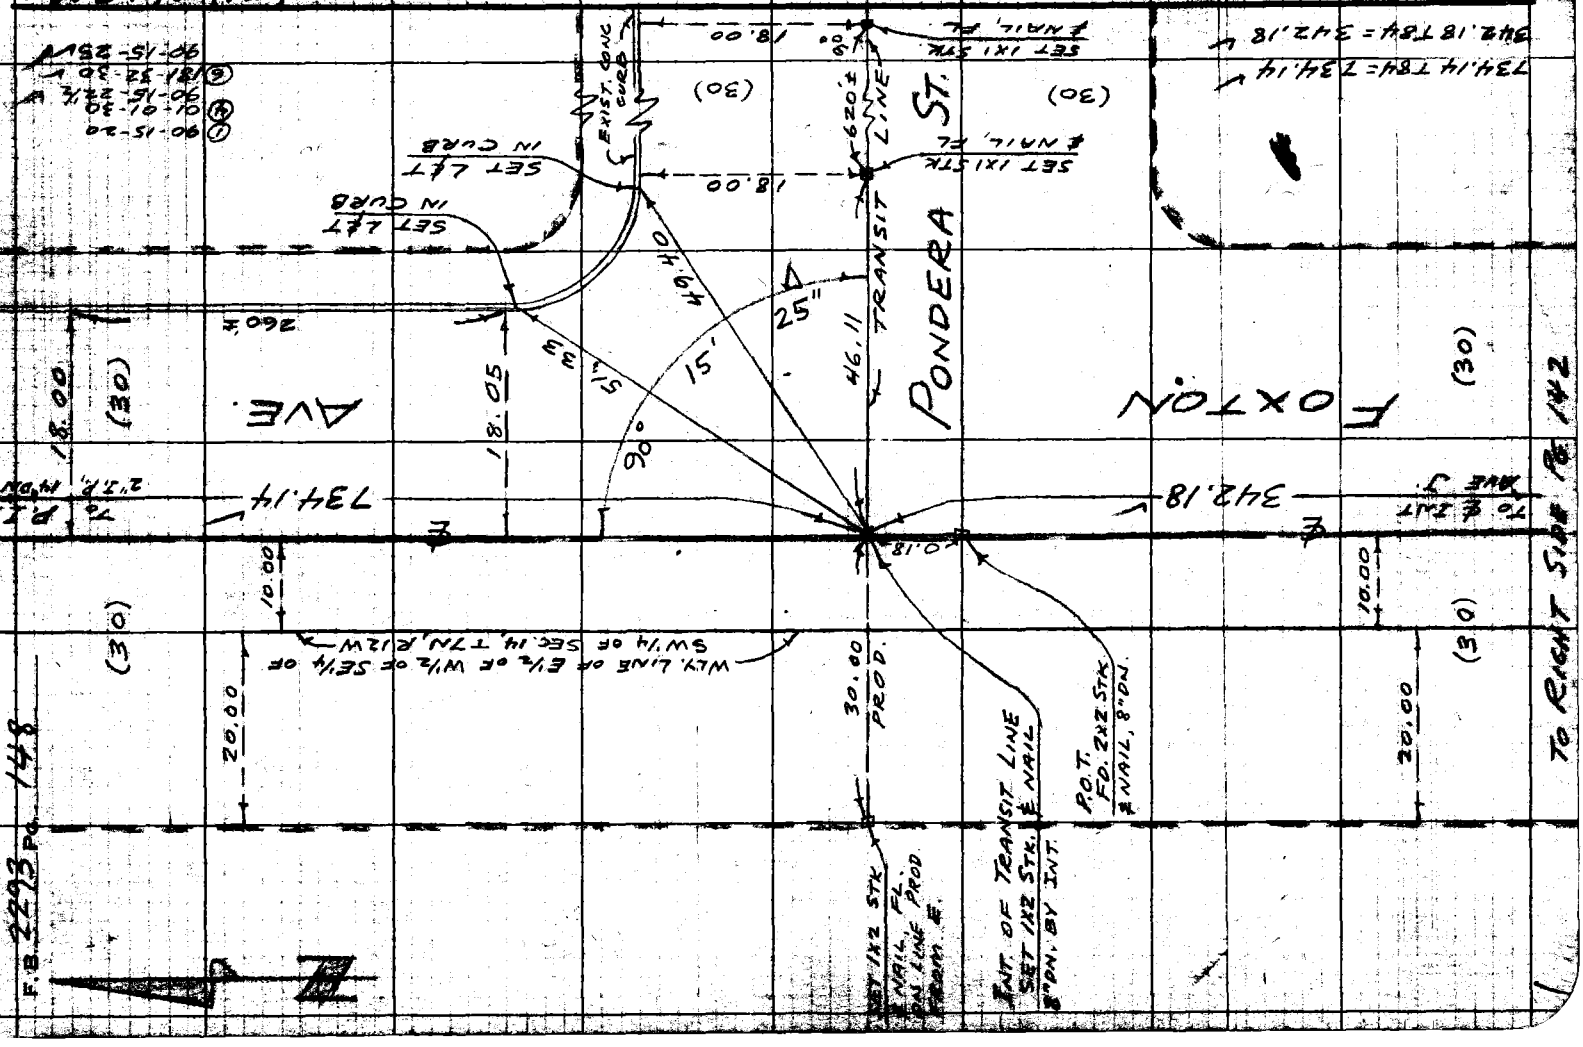

Notes Ck'd by AUSTIN
Map No.
Office Work
Checked
Date

Survey of 32nd St. E.
INV 9773 Tape 12Y Stn 84 of
Surveyed by MACK
Notes M Date 4-18-58
Indexed

F.B. 2293 Pg. 149

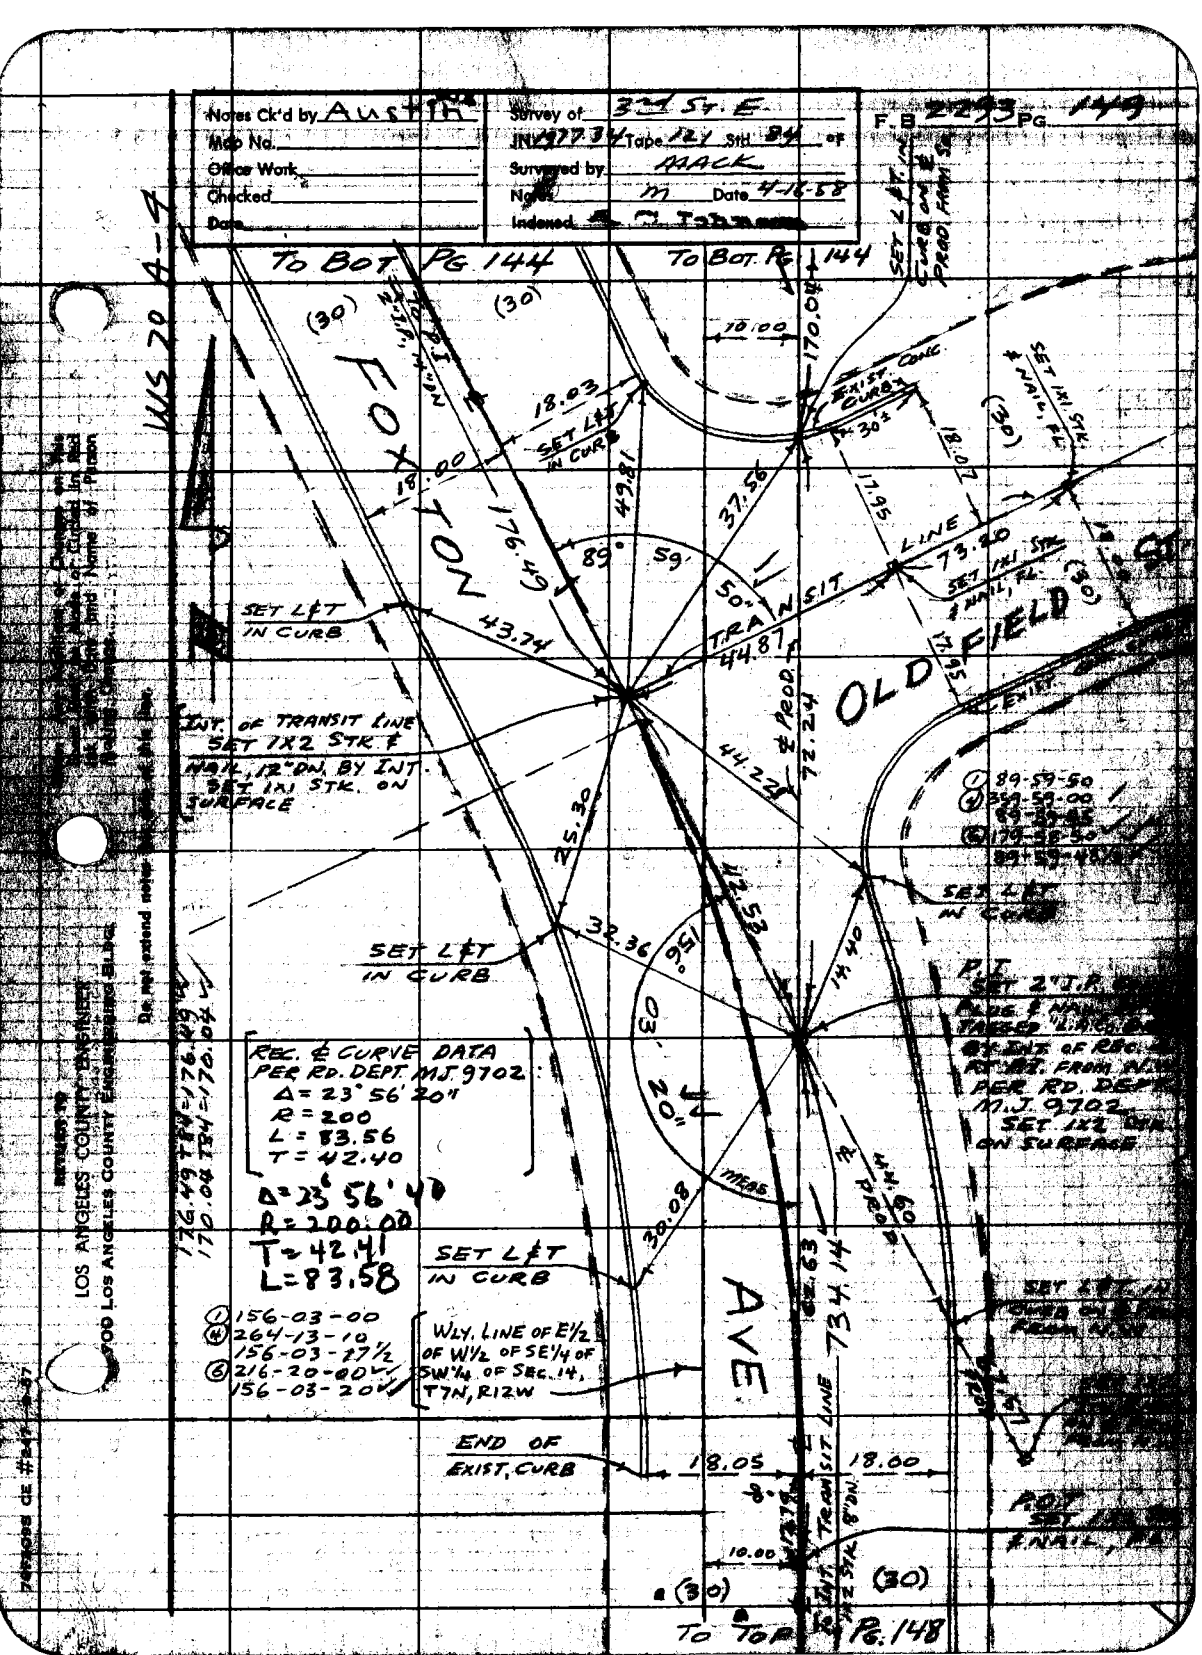

LOS ANGELES COUNTY ENGINEER
COD Los Angeles County Engineering Bldg.
Do not extend note
176.49 TB4 = 176.49
170.04 TB4 = 170.04
Photostat CE #24-37

F.B. 2293 Pg. 150

TRACT # 18397

W.S. 70 A-5

RETURN TO
LOS ANGELES COUNTY ENGINEER
700 LOS ANGELES COUNTY ENGINEERING BLDG.

Do not extend notes this side of this line.

Note: Any Additions or Changes on This Sheet Must be Made or Circled in Red Ink With Date and Name of Person Making Change.

(82)

AVE. J

(82)

88' I.P. STOF

To SEC. COR AT DIVISION ST. & E. MON. IN WELL PER C.S. F.B. 2315-8

1190.08 REC.

INT. FD. 2" I.P. CONC. PLUG & NAIL IN PAV., FL. TAG L.S. 2495 PER TR. # 17343

128.42 To ℄ INT 3RD ST. E. (TO N.)

(82)

(82)

TO LEFT

3RD ST. E.

TR. # 17343

TR. # 17343

(30)

(30)

Notes Ck'd by L. W. Brenner	Survey of HAGENBAUGH FIRE CISTERN
Map No. 92-40	J.N. 0038.06 Tape 4.24 Sht. 8.4 at E
Office Work HAMASU	Surveyed by [redacted]
Checked W. Brenner	Notes M. [redacted] 4-23-58
Date MAY 58	Indexed [redacted] C. Johnson

F. B. 2293 Pg. 151

J.N. 0038.06

HAGENBAUGH FIRE CISTERN

IN

NW 1/4 OF SEC. 18,

T4N, R8W

PARTY:
MACK
HALISCKY
RITTER
HUBBARD
H.E. MITCHELL

Note: Any Additions or Changes on This Sheet Must be Made or Circled In Red Ink With Date and Name of Person Making Change.

Do not extend notes this side of this line.

RETURN TO
LOS ANGELES COUNTY ENGINEER
1700 Los Angeles County Engineering Bldg.

76F3055 CE #847—8-57

F.B. 2293 Pg. 152

INDEX TO PAGES

AVE Z-8

EAST 153

155 EAST 214th ST.

SEC. 7
T4N, R8W

ST. 204th

SLY. LINE SEC. 7 T4N, R8W

153 154 154 155

155

HAGENBAUGH FIRE CISTERN SITE

156 156 158

157 157

ROAD (MOTORWAY)

FIRE (PANORAMA

SEC. 18,
T4N, R8W

RETURN TO
LOS ANGELES COUNTY ENGINEER
900 LOS ANGELES COUNTY ENGINEERING BLDG.

Do not extend notes this side of this line.

Note: Any Additions or Changes on This Sheet Must be Made or Circled in Red Ink With Date and Name of Person Making Change.

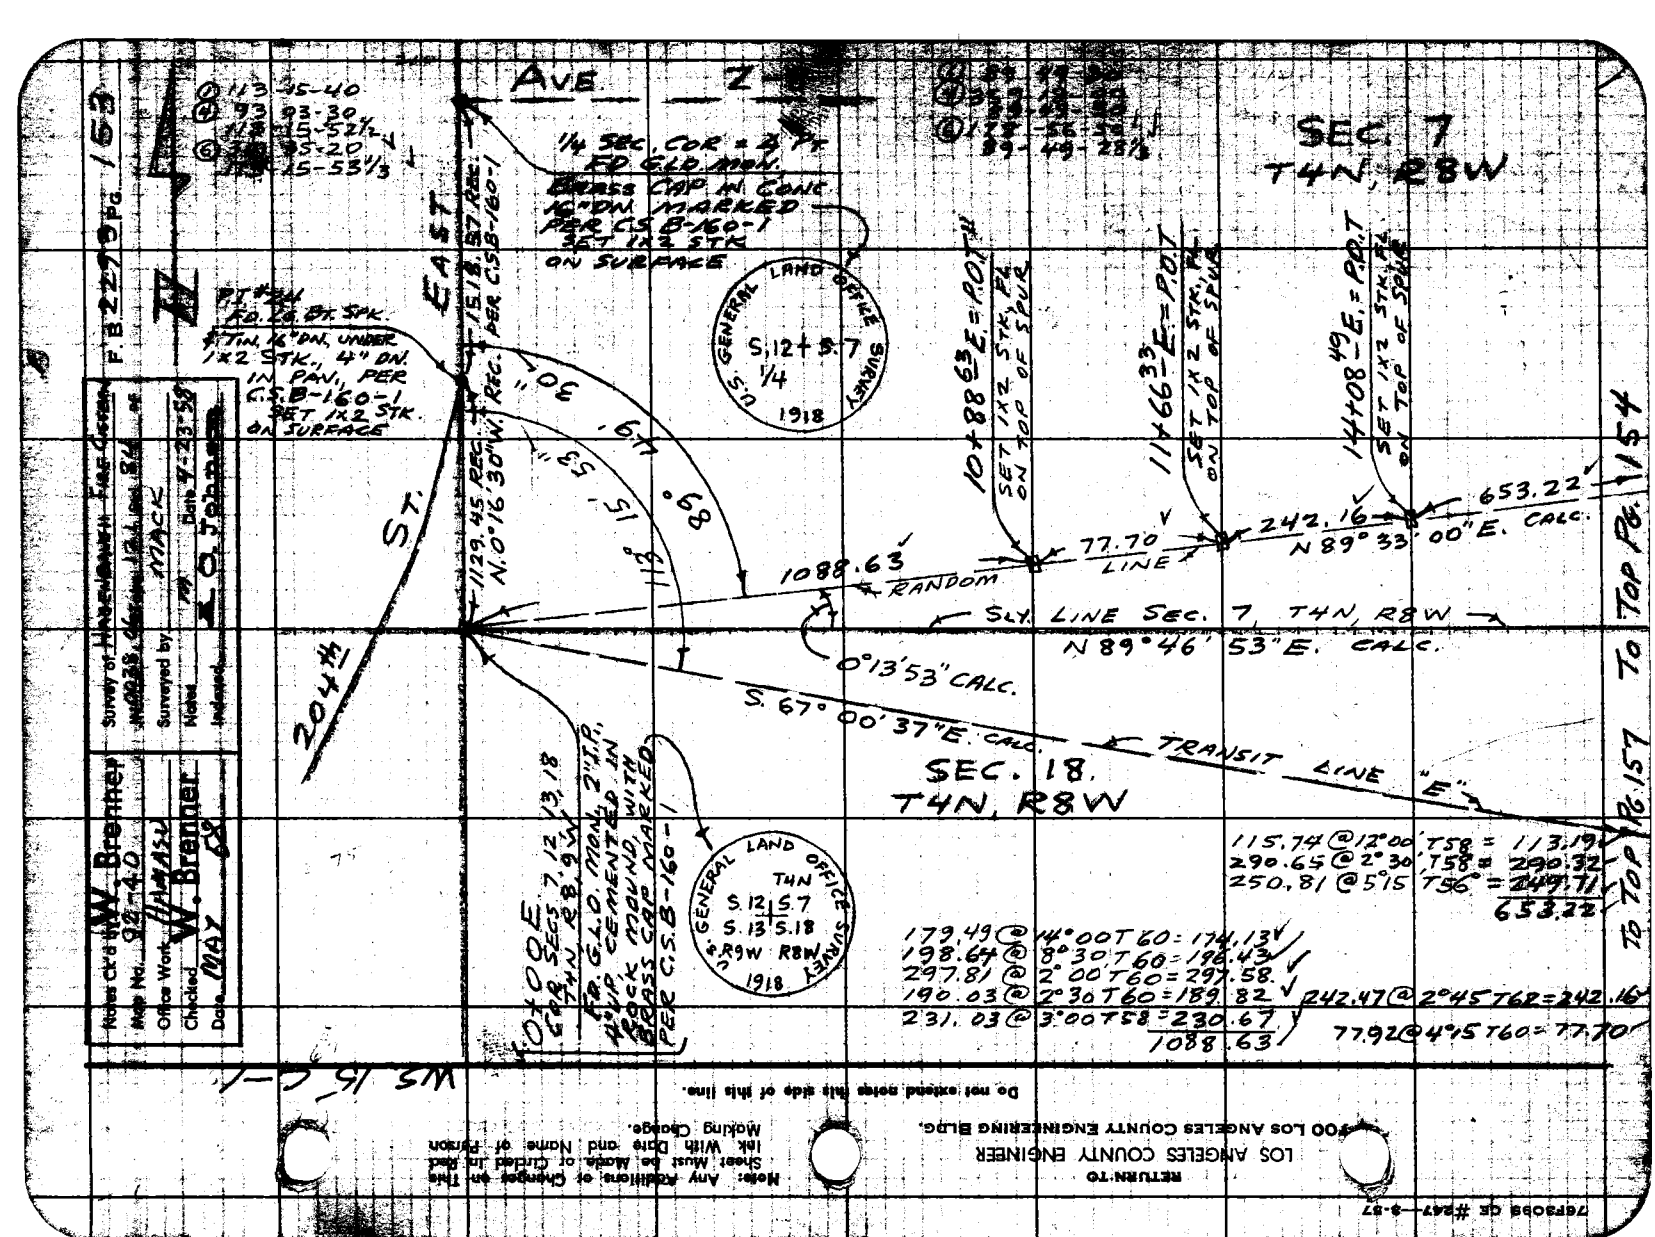
AVE Z
SEC. 7
T4N, R8W
EAST
1/4 SEC. COR = 3" PK
FD ELD. MON.
BRASS CAP IN CONC.
16"DN. MARKED
PER C.S.B-160-1
SET 1x2 STK
ON SURFACE
PT #24
FD. 2" BR. SPK.
TIN, 16"DN. UNDER
1x2 STK., 4" DN.
IN PAV., PER
C.S.B-160-1
SET 1x2 STK.
ON SURFACE
ST.
1129.45 REC.
N.0°16'30"W. REC.
1088.63
RANDOM
SLY. LINE SEC. 7, T4N, R8W
N 89°46' 53" E. CALC.
0°13'53" CALC.
S. 67° 00' 37" E. CALC.
TRANSIT LINE "E"
SEC. 18,
T4N, R8W
204 M
1.0 E OF SEC'S 7, 12, 13, 18 T4N, R8W
M.P. CEMENTED IN
ROCK MOUND, WITH
BRASS CAP MARKED
PER C.S.B-160-1
GENERAL LAND OFFICE SURVEY
S.12 & S.7
1/4
1918
GENERAL LAND OFFICE SURVEY
T4N
S.12 & S.7
S.13 & S.18
R9W R8W
1918
10+88.63 E. = P.O.T.
SET 1x2 STK. FD.
ON TOP OF SPUR
11+66.33 E. = P.O.T.
SET 1x2 STK. FD.
ON TOP OF SPUR
14+08.49 E. = P.O.T.
SET 1x2 STK. FD.
ON TOP OF SPUR
77.70
LINE
242.16
653.22
N 89° 33' 00" E. CALC.
TO TOP PT. 1154
TO TOP PT. 1157
179.49 @ 14°00 T60 = 174.13
198.64 @ 8°30 T60 = 196.43
297.81 @ 2°00 T60 = 297.58
190.03 @ 2°30 T60 = 189.82
231.03 @ 3°00 T58 = 230.67
1088.63
242.47 @ 2°45 T62 = 242.16
77.92 @ 4°15 T60 = 77.70
115.74 @ 12°00 T58 = 113.19
290.65 @ 2°30 T58 = 290.32
250.81 @ 5°15 T56 = 249.71
653.22
@ 113 35-40
@ 93 93-30
@ 15-52½
@ 95-20
@ 15-53⅓
@ 89-49-28½
Map No. 92-740
Office Work HMASU
Checked W. Brenner
Date MAY 68
Surveyed by
Notes
Date 7-23-58
Indexed
W. Brenner
LOS ANGELES COUNTY ENGINEER
RETURN TO
900 LOS ANGELES COUNTY ENGINEERING BLDG.
Note: Any Additions or Changes on This Sheet Must be Made of Circled in Red Ink With Date and Name of Person Making Change.
Do not extend notes this side of this line.
WS 15 C-1
7675088 CE #247 - 3-67

RETURN TO
LOS ANGELES COUNTY ENGINEER
7700 LOS ANGELES COUNTY ENGINEERING BLDG.

Note: Any Additions or Changes on This Sheet Must be Made or Circled in Red Ink With Date and Name of Person Making Change.

Do not extend notes this side of this line.

VOL. 15 G-1

60.85 @ 10°00' T60 = 59.92'
96.94 @ 5°00' T60 = 96.65'

98.24 @ 25°45' T60 = 88.46'

SEC. 7
T4N, R8W

① 128-40-20
④ 154-40-40
⑥ 128-40-10
52-00-50
128-40-08⅓

20+61.71 E. = P.O.T. SET 1x2 STK. FL. ON TOP OF BRK.

21+21.63 E. = P.O.T. SET 1x2 STK. FL. ON TOP OF SPUR

22+18.18 E. = P.O.T. SET 1x2 STK. FL. ON TOP OF SPUR

24+33.88 E. = 0+00.05 = INT. SET 1x2 STK., FL. ON TOP OF SPUR

1.68

27+71.64 E. = P.O.T. SET 1x2 STK., FL. ON TOP OF SPUR

27+91.21 E. = P.O.T. SET 1x2 STK. FL. ON TOP OF BRK.

N 89° 33' 00" E. CALC. 88.47

22.91

20.27

2H5.33

RANDOM LINE

69.22

59.92

96.55

215.70

217.38 CALC.

226.41

226.66 MEAS.

10.75

12.54

26.12

N 38° 13' 05" W CALC.

10.10

40

128

SLY. LINE SEC. 7 T4N, R8W

N 89° 46' 53" E. CALC

15.50

N 1°

99° 13' 25"

CALC. 25" W

88.46

SEC. 18
T4N, R8W

0+98.02 SO
SET 1x2 STK. FL. ON TOP OF SPUR ON TRANSIT LINE

508

TRANSIT LINE

175.36

24+35.56 E. SET 1x2 STK. FL. ON TOP OF SPUR

99-13-20
36-53-30
99-13-22½
235-20-20
99-13-23⅓

0+60.29 E. S¼ Cor. Sec. 7 T4N, R8W Fd G.L.O. mon. 1" I.P. 6" in mound 2½" BRASS CAP MARKED C.S. 961-21

S. LINE

27+48.73 E. W¼ Cor. Sec. 18 T4N, R8W Fd G.L.O. mon. 1" I.P. 0.4' in rock mound with 2½" BRASS CAP MARKED C.S. 961-21

GENERAL LAND OFFICE SURVEY U.S. 1918 1/4 S.7

GENERAL LAND OFFICE SURVEY U.S. 1918 S.18 1/4

98.40 @ 5°00' T68 = 98.02'
271.67 @ 18°30' T80 = 217.93'
226.10 @ 22°30' T80 = 172.53'

To Bot. Pg. 154

To Top Pg. 155

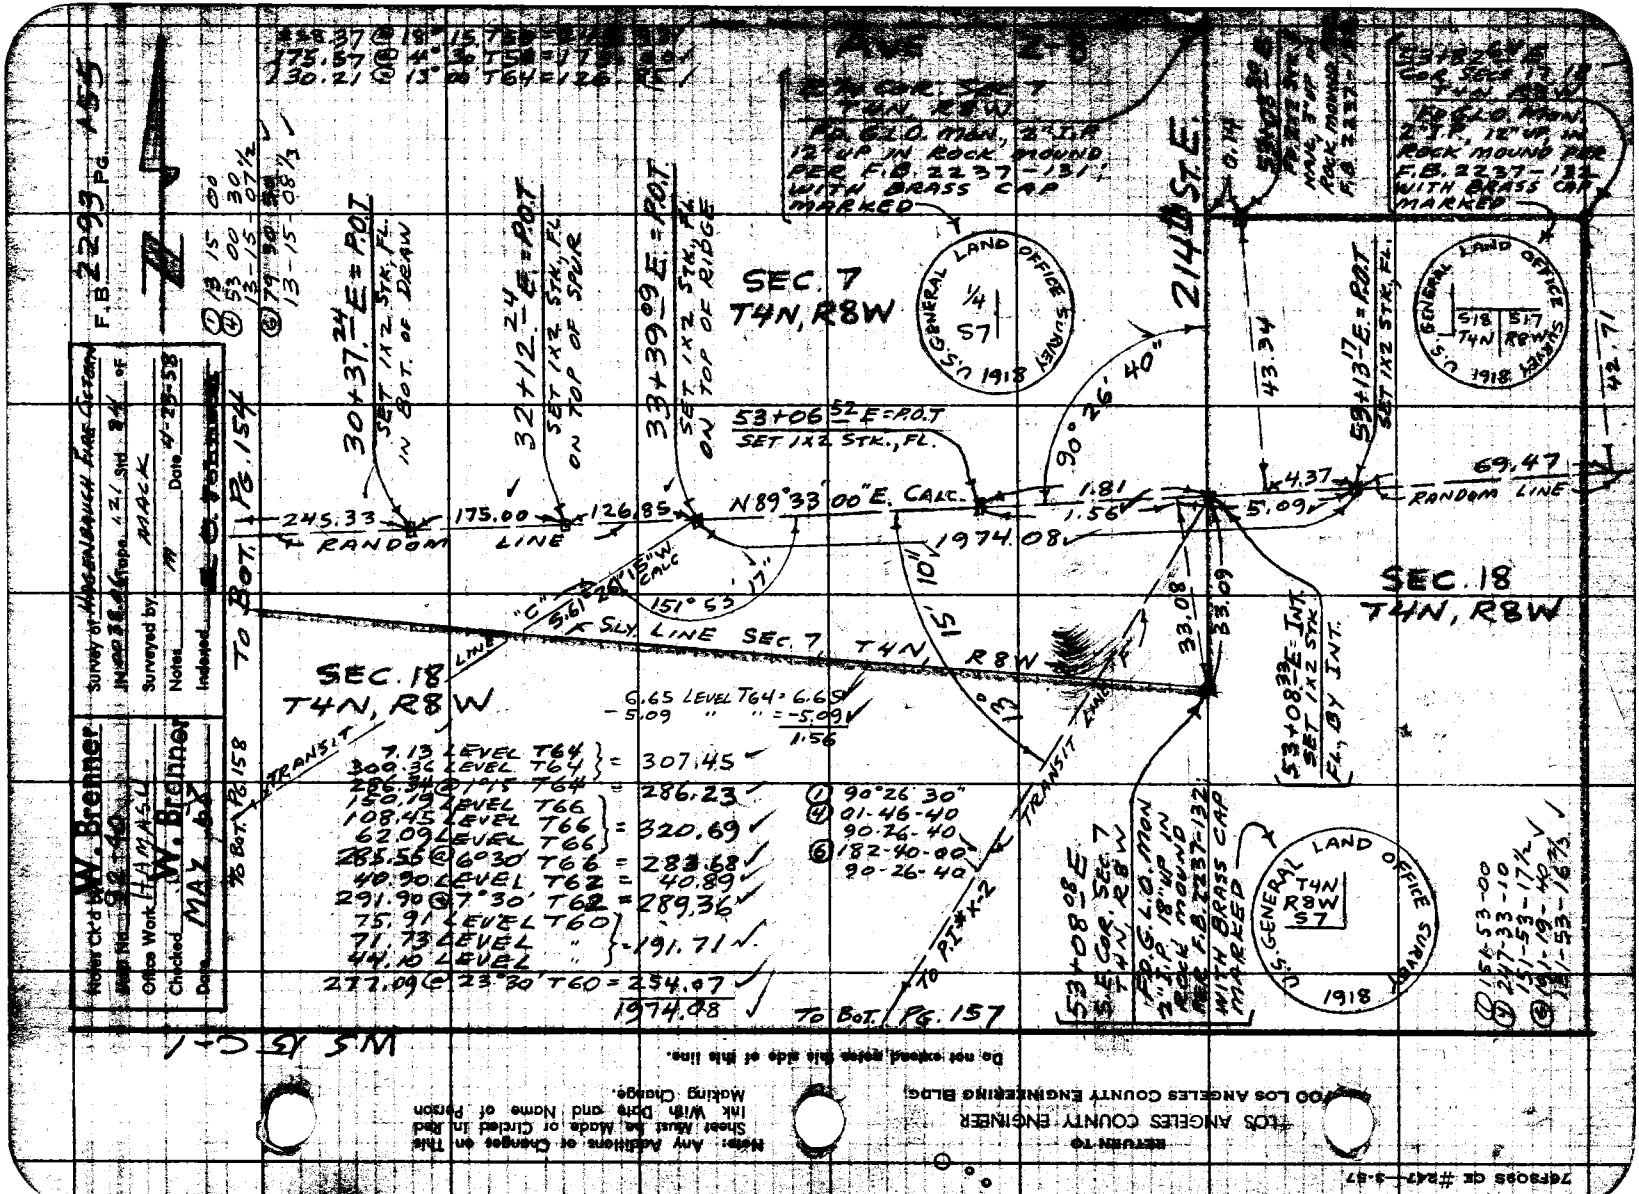
Ave 2+0
SEC. 7
T4N, R8W
SEC. 18
T4N, R8W
SEC. 18
T4N, R8W
SW COR. SEC. 7 T4N, R8W
U.S.G.L.O. MON. 2" I.P. 18" IN ROCK MOUND PER F.B. 2237-132 WITH BRASS CAP MARKED
U.S. GENERAL LAND OFFICE SURVEY 1918
T4N R8W S7
S18 S17 T4N R8W
1/4 S7
30+37.24 E = P.O.T. SET 1X2 STK., FL. IN BOT. OF DRAW
32+12.24 E = P.O.T. SET 1X2 STK., FL. ON TOP OF SPUR
33+39.09 E = P.O.T. SET 1X2 STK., FL. ON TOP OF RIDGE
53+06.52 E = P.O.T. SET 1X2 STK., FL.
53+08.08 E = INT. SET 1X2 STK. FL., BY INT.
59+13.17 E = P.O.T. SET 1X2 STK., FL.
245.33 RANDOM LINE
175.00
126.85
N 89°33'00" E. CALC.
1974.08
69.47 RANDOM LINE
42.71
43.34
214.8
S.H.
SET 1X2 STK. FL. IN ROCK MOUND PER F.B. 2237-131 WITH BRASS CAP MARKED
"C" L = 561.26 R = 2291.83 CALC
151°53'
SLY. LINE SEC. 7 T4N R8W
TRANSIT LINE
TO BOT. PG. 158
TO BOT. PG. 157
TO BOT. PG. 154
TO BOT. PG. 155
F.B. 2293 Pg.
Surveyed by: MACK
Notes
Indexed
Notes Ck'd W. Brenner
Office Work HAMASU
Checked W. Brenner
Date MAY 61
Do not extend entry this side of this line.
Note: Any Additions or Changes on This Sheet Must be Made or Circled in Red Ink With Date and Name of Person Making Change.
RETURN TO LOS ANGELES COUNTY ENGINEER 900 LOS ANGELES COUNTY ENGINEERING BLDG.
76P8095 CR #247 - 3-87

RETURN TO
LOS ANGELES COUNTY ENGINEER
700 LOS ANGELES COUNTY ENGINEERING BLDG.

Note: Any Additions or Changes on This Sheet Must be Made or Circled in Red Ink With Date and Name of Person Making Change.

Do not extend notes this side of this line.

WS. 15C-1

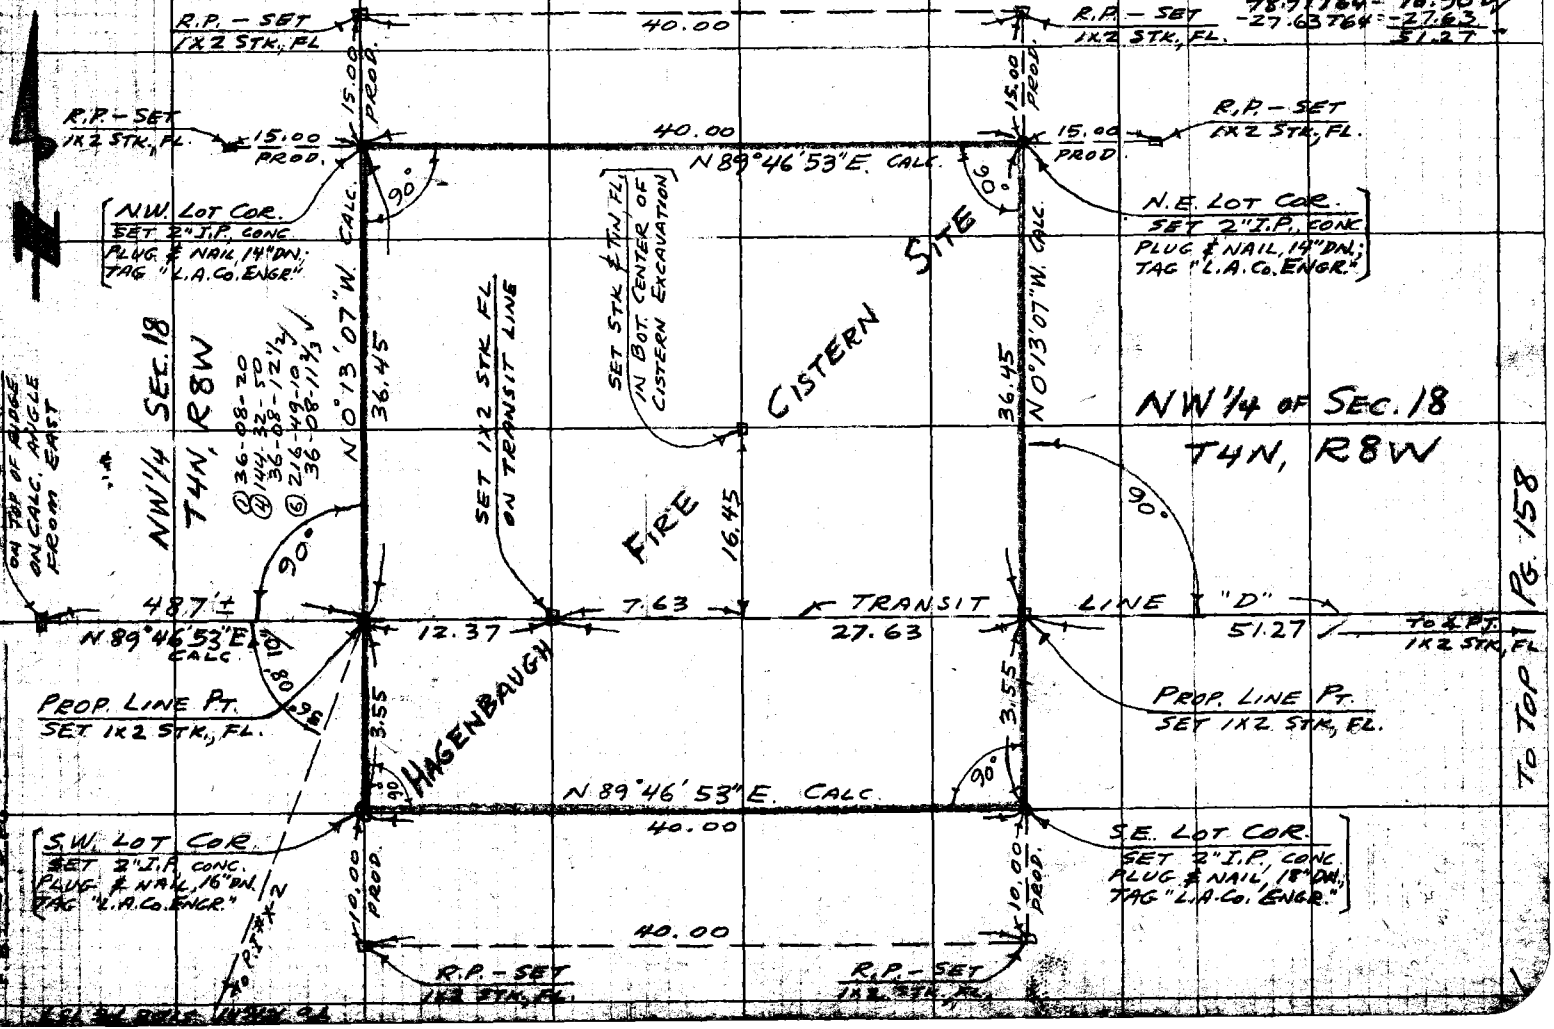

B.Z. 2293 Pg. 156

TO TOP T PG. 158

Notes Ck'd by W. Brenner
Map No. 22-40
Office Work HAWASU
Checked W. Brenner
Date MAY 58

Parcel 13, Sht. 24 of 4F
Surveyed by MACK
Notes Date 4-25-58
Indexed C. Johnson

F.B. 2293 Pg. 157

To Bot. / Pg. 153

PANORAMA

MOTORWAY

(L.A. Co. FIRE DEPT.)

GRADED

DIRT

ROAD

R.P.-P.I. SET 1" I.P. CONC. PLUG & NAIL, 2" UP

TRANSIT LINE "B" S 67°00'37" E.

35.90 TAN.

20

39' 23"

10+91.94 So. = P.I. # X-2 SET 2" I.P. CONC. PLUG & NAIL, 14" DN., TAGGED "L.A. Co. ENGR." SET 1X2 STK. ON SURFACE

36.23 TAN.

90°

R.P.-P.I. SET 1" I.P. CONC. PLUG & NAIL, 2" UP

S 53° 59' 15" W.

N 53° 38' 50" E. CALC.

0°33'25"

452.88 MEAS.

452.7 CALC.

18

143

R.P.-P.I. SET 2" I.P. CONC. PLUG & NAIL, 2" UP

NW 1/4 SEC. 18 T4N, R8W

TRANSIT LINE "E"

17° 05' 15"

N 76° 17' 38" E. CALC.

45°

34.85 TAN.

6+39.05 So. = P.I. # X-1 SET 2" I.P. CONC. PLUG & NAIL, FLUSH, TAGGED "L.A. Co. ENGR."

37.04 TAN.

77.74

S 59° 19' 15" E. CALC.

246.27 @ 2°18' 766 = 246.05
206.87 @ 0°45' 766 = 206.82
452.88

R.P.-P.I. SET 1" I.P. CONC. PLUG & NAIL, 2" UP

POINT OF CANDON LINE 1X2 STK.

To Left Side Pg. 155

To Upper Left Side Pg. 155

05-33-30
22-13-40
05-33-20-40
05-53-26 1/2

17-05-10
68-20-05-50
17-31-30

102-39-30
20-59-26 1/2

Note: Any Changes or Corrections on This Sheet Must Be Made in Red Ink With Date and Name of Person Making Changes.

Do not extend notes into this area of this line.

Returned to
LOS ANGELES COUNTY ENGINEER
700 Los Angeles County Engineering Bldg.

Parsons CE #849—8-57

RETURN TO
LOS ANGELES COUNTY ENGINEER
700 LOS ANGELES COUNTY ENGINEERING BLDG.

Note: Any Additions or Changes on This Sheet Must be Made or Circled in Red Ink With Date and Name of Person Making Change.

Do not extend notes this side of this line.

W15, 1.5 Cs-1

103.98 @ 25°15' T60 = 94.02'
174.63 @ 19°30' T68 = 169.05'
175.66 @ 3°30' T68 = 175.31'

TO UPPER LEFT SIDE PG. 154

NW 1/4 OF SEC. 18
T4N, R8W

2+73 33 So
SET 1X2 STK. FL
ON TOP OF SPUR
ON TRANSIT LINE

175.31
TRANSIT LINE "A"
169.05

① 129-34-00
② 158-16-40
④ 129-34-10
⑥ 57-26-00
⑥ 129-34-10

① 29-26-30
④ 117-46-40
29-26-40
⑥ 176-40-00
29-26-40

TO LOWER LEFT SIDE OF PG. 154

TRANSIT LINE "B"
S 38° 13' 05" W. CALC.

29° 26' 40"

10"

4+42 38 So.
SET 1X2 STK. FL
ON TOP OF SPUR
ON TRANSIT LINE

34'

94.02
S 08° 46' 25" W. CALC.

① 23-13-20
④ 52-13-10
29-19-50
⑥ 133-23-10
29-19-50

TO LEFT TOP PG. 155

561° 26' 15" CALC
TRANSIT LINE "C"

TO P.L. PT.
1X2 STK. FL
51.27
TRANSIT LINE "D" N. 89° 46' 53" E. CALC.

TO BOT PG. 156

TO PG. 158

129°

30° 34' 38"

24.92
TAN. PROD.

177°

55"

45

① 30° 34' - 40"
④ 122-18-30
30-34-37½
⑥ 183-27-40
30-34-36⅔

77.74
TAN. PROD.
S 59° 12' 15" W. CALC.

5+61 39 So.
SET 1X2 STK. FL

5+36 40 So.
ANGLE PT.
SET 1X2 STK. FL.

① 177-45-40
④ 351-03-30
177-45-52½
⑥ 346-51-20
177-45-33⅓

Notes Ck'd by Miller	Survey of AVE. I	F. B. 2293 Pg. 159
Map No.	JN 092324 Tape 12 / Std 84 °F	
Office Work	Surveyed by MACK	
Checked	Notes M Date 5-5-58	
Date	Indexed K. C. Johnson	

J.N. 0923.24

AVE. I

SURVEY OF BLOCK 26
TOWN OF LANCASTER
M.R. 5-470, 471

PARTY:
MACK
HALISCKY
RITTER
HUBBARD
H.E. MITCHELL

Note: Any Additions or Changes on This Sheet Must Be Made or Circled in Red Ink With Date and Name of Person Making Change.

Do not extend notes this side of this line.

RETURN TO
LOS ANGELES COUNTY ENGINEER
700 Los Angeles County Engineering Bldg.

7675005 CE #247—8-57

F. B. 2293 Pg. 160

INDEX TO PAGES

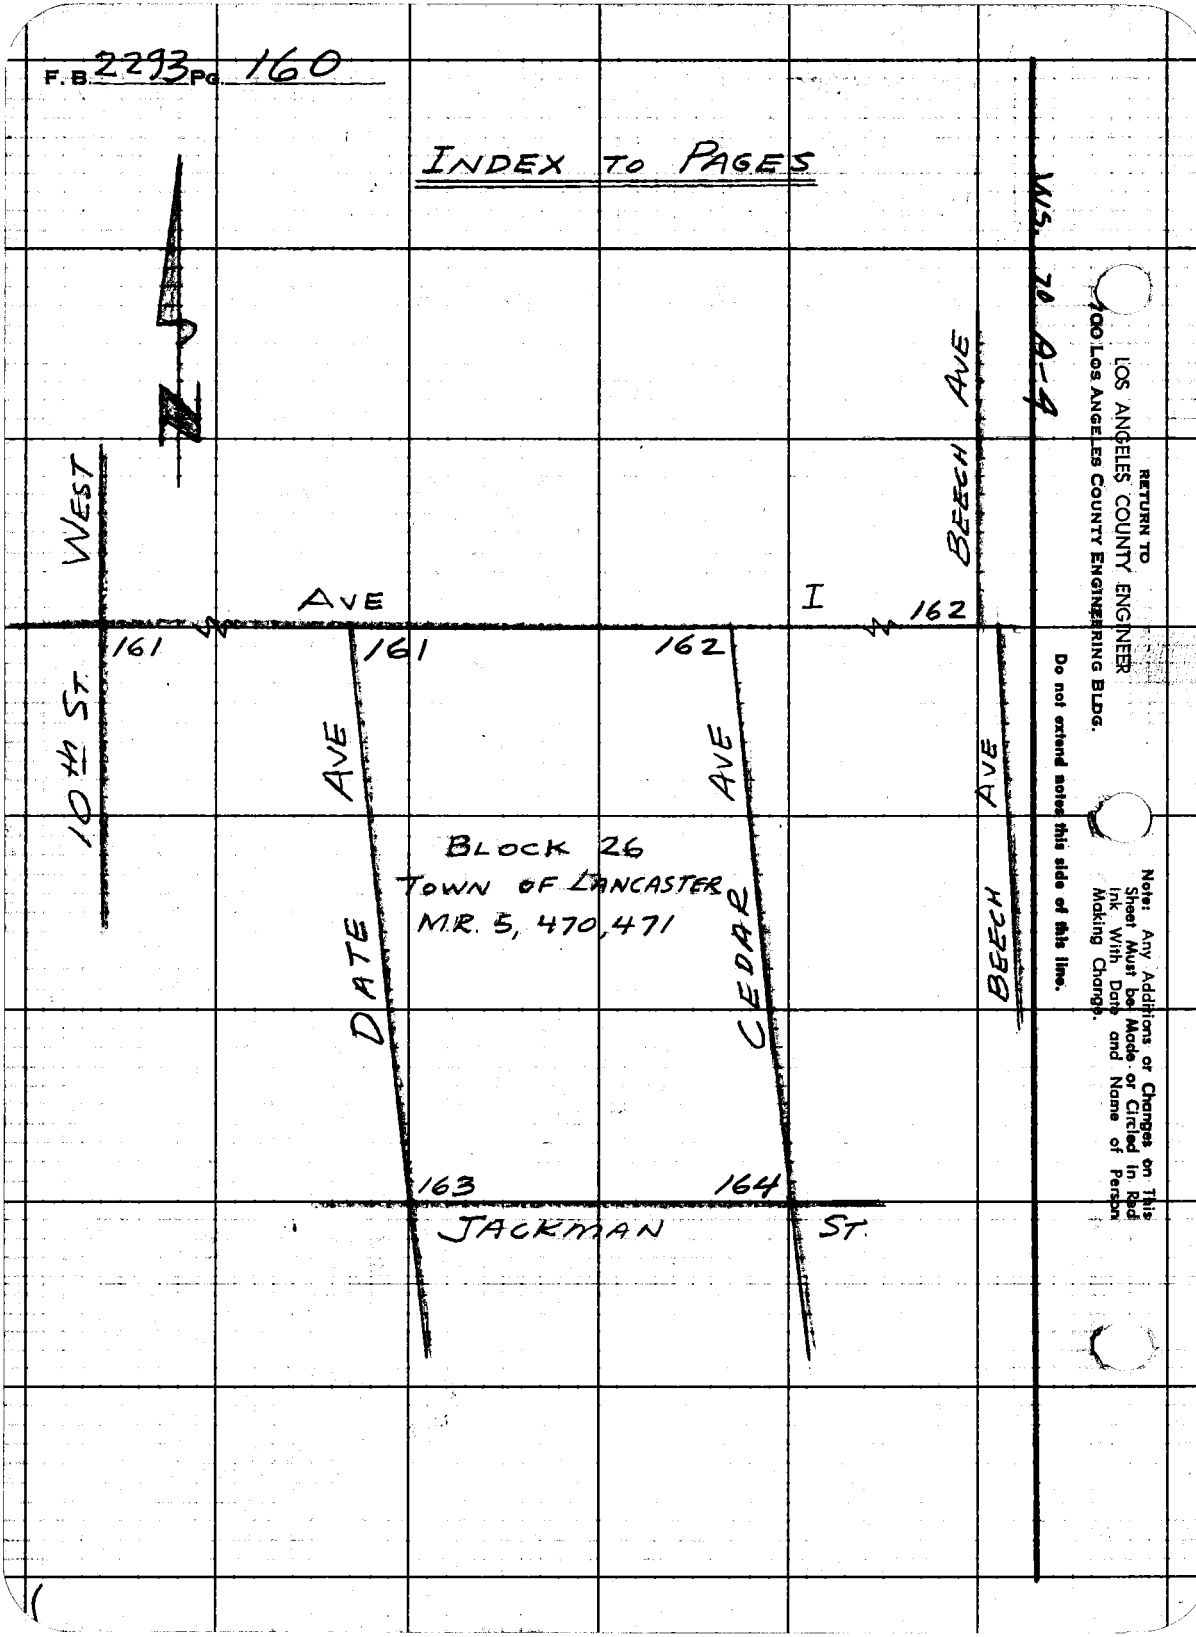

RETURN TO
LOS ANGELES COUNTY ENGINEER
100 LOS ANGELES COUNTY ENGINEERING BLDG.

Do not extend notes this side of this line.

Note: Any Additions or Changes on This Sheet Must be Made or Circled in Red Ink With Date and Name of Person Making Change.

Notes Ck'd by Miller
Map No.
Office Work
Checked
Date

Survey of AVE I
IN 23324 Tape 121 Std 84 °F
Surveyed by MACK
Notes M. Date 5-5-58
Indexed C. Johnson

F. B. 2293 Pg. 161

NORTH

WEST

W.S. 70 A-4

COUNTY SURVEYORS MONUMENT 1922 6 1615

COR SECS 9 10 15 16 T1N R12W FD. C.S. MON. 2" I.P. IN CONC. 14" DN. IN WELL. PER C.S. B-831-1; WITH BRASS CAP MARKED

1 97-45-10
4 31-00-00
6 97-45-00
226-30-20 ✓
97-45-03 1/3 ✓

(30)

50 L.F. IN CURB

FD. L.F. IN CURB

1928.58 REC.

AVE. I

(30)

P.O.T. - FD. SPK. & WASHER, FL.

45° 05" 29.96

FD. SPK. & WASHER, FL.

31.65

97

2.00 TAN.

2.01 TAN.

DATE AVE.

(30)

872.91

To Top Pg 163

To ℄ INT JACKMAN ST.

(30)

35.60

FD. L.F. IN CURB

P.O.T. - FD. SPK. & WASHER, FL.

383.54

℄ I

BLOCK 26 TOWN OF LANCASTER MR 5-470, 471

To ℄ INT CEDAR AVE.

(30)

(30)

To Top Pg 162

RETURN TO LOS ANGELES COUNTY ENGINEER 700 Los Angeles County Engineering Bldg.

Do not extend inked title sides of this line.

Note: Any Additions or Changes on This Sheet Must Be Made or Called in And Ink With Date and Name of Person Making Change.

Records Of #247 5-57

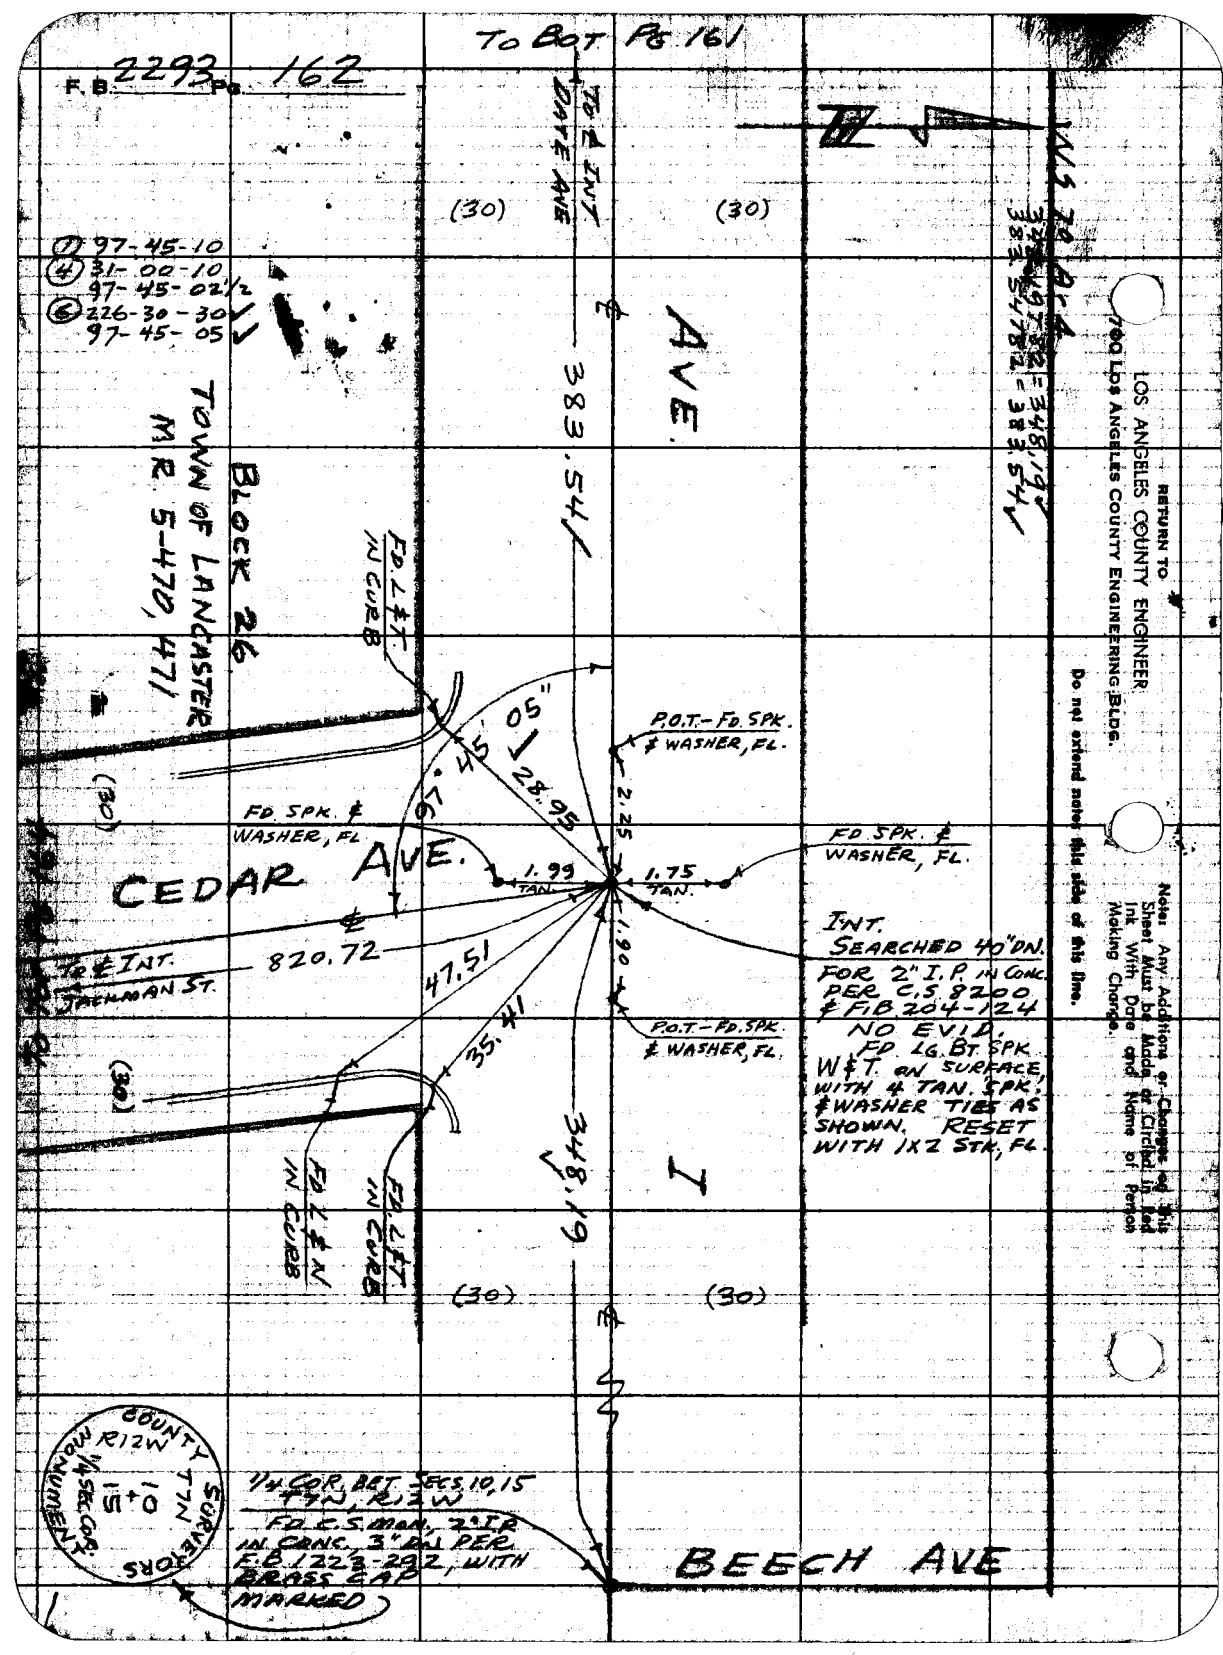
To Bot Pg 161
F.B. 2293 Pg. 162
(1) 97-45-10
(4) 31-00-10, 97-45-02½
(6) 226-30-30, 97-45-05
TOWN OF LANCASTER
M.R. 5-470, 471
BLOCK 26
(30)
FD. L & T. IN CURB
FD. SPK. & WASHER, FL
CEDAR AVE.
℄
To ℄ Int. Jaehman St.
820.72
383.54
To ℄ Int. Date Ave
AVE.
(30)
P.O.T. - FD. SPK. & WASHER, FL.
45° 05" 28.95
2.25
1.99 TAN.
1.75 TAN.
1.90
FD. SPK. & WASHER, FL.
INT. SEARCHED 40" DN. FOR 2" I.P. IN CONC. PER C.S. 8200 & F.B. 204-124
NO EVID. FD. LG. BT. SPK. W & T. ON SURFACE, WITH 4 TAN. SPK. & WASHER TIES AS SHOWN. RESET WITH 1X2 STK, FL.
47.51
35.41
348.19
I
FD. L & T. IN CURB
FD. L & T. IN CURB
(30)
(30)
℄
BEECH AVE
COUNTY SURVEYORS MON. 1/4 SEC. COR. MONUMENT
R12W T7N
10 15
1/4 COR. BET. SECS. 10, 15 T7N, R12W
FD. C.S. MON. 2" I.P. IN CONC. 3" DIA PER F.B. 1223-292, WITH BRASS CAP MARKED
RETURN TO LOS ANGELES COUNTY ENGINEER 1100 Los Angeles County Engineering Bldg.
Do not extend notes this side of this line.
Notes: Any Additions or Changes to this Sheet Must be Made or Circled in Red Ink With Date and Name of Person Making Change.

Name Ck'd by Miller
Map No.
Office Work
Checked
Date

Survey of AVE. I
IN 0923.24 Tape 121 Std. 84 °F
Surveyed by MACK
Notes M. C. Johnson Date 5-5-58
Indexed

293 Pg. 163

TO LEFT SIDE PG 161

N 1°-40' 20" W 1315.04

(30) (30)

TO E INT AVE. I

872.91 ℄

DATE

BLOCK 26
TOWN OF LANCASTER
M.R. 5-470, 471

① 89-55-10
④ 359-41-40
89-55-25
⑥ 179-32-30
89-55-25

872.89 R&M = 872.91 M

FD. ℄ ET IN CURB

FD. X IN TOP OF CURB

89°

38.36

31.83

55

25"

℄

380.04

TO ℄ INT CEDAR AVE

ST.

31.98

FD. X IN TOP OF CURB

JACKMAN

AVE

(30) (30) (30) (30) (30) (30)

INT
FD 2" I.P. CONC. PLUG
℄ NAIL, 0.4' DN. PEAR
C.S. B200 ℄ E. B20+-11.0
SET 1X2 STK ON SURFACE WITH 4" TAN
2½" SPK & TIN TIED PK.

Note: Any Additions or Changes on This Sheet Must Be Made or Dated In and Initialed With Date and Name of Person Making Change.

Do not instruct person this side of this line.

RETURN TO
LOS ANGELES COUNTY ENGINEER
700 Los Angeles County Engineering Bldg.

76F3095 CE #247—4-57

TO LEFT SIDE PG 162

F.B. 2293 PG 164

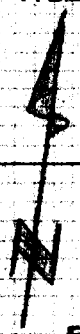

BLOCK 26
TOWN OF LANCASTER
M.R. 5-470, 471

(1) 90-04-30
(2) 360-17-30
90-04-27½
(3) 180-27-00 ✓
90-04-30 ✓

RETURN TO
LOS ANGELES COUNTY ENGINEER
900 LOS ANGELES COUNTY ENGINEERING BLDG.

Do not extend notes this sheet. Use separate line.

Note: Any Additions or Changes on This Sheet Must be Made or Circled in Red With Date and Name of Person Making Change.

T.S. 2A A-4

380.04 T86 = 380.04
820.70 788 = 820.72

CEDAR

820.72

℄

(30) (30)

TO ℄ INT. AVE. Z

FD L&T IN CURB

FD L&T IN CURB

0° 30"

31.88

33.35

90°

(03)

(DE)

TO ℄ INT DATE AVE.

380.04

JACKMAN

ST.

31.90

31.87

40.53

FD L&T IN CURB

FD L&T. IN CURB

FD L&T IN CURB

INT
FD 2" I.P. CONC.
PLUG & NAIL, .8" DN
PER C.S. 8200
& F.B. 204-124
SET 1½2 STK ON
SURFACE WITH
4 TAN. 2.00 SPK
& TIN TIES, FL.

AVE

(30) (30)

Notes Ck'd by	Survey of Sec. 7, T4N, R9W
Map No.	JN 0302.01 Tape 121 Std. 84 of
Office Work	Surveyed by MACK
Checked	Notes R. O. Johnson Date 5-6-58
Date	Indexed 5-16-58

F. B. 2293 PG. 165

W.S. 15-C-1

J.N. 0302.01

NLY. LINE OF NW 1/4 OF SEC. 7
T4N, R9W
ON
AVE. Z
BET 204th & 209th STS. E

PARTY:
MACK
HALISCKY
RITTER
HUBBARD
H.E. MITCHELL

Note: Any Additions or Changes on This Sheet Must be Made or Circled in Red Ink With Date and Name of Person Making Change.

Do not extend notes this side of this line.

RETURN TO
LOS ANGELES COUNTY ENGINEER
700 LOS ANGELES COUNTY ENGINEERING BLDG.

7672OSS CE #247—3-57

RETURN TO
LOS ANGELES COUNTY ENGINEER
700 LOS ANGELES COUNTY ENGINEERING BLDG.

Note: Any Additions or Changes on This Sheet Must be Made or Circled in Red Ink With Date and Name of Person Making Change.

Do not extend notes this side of this line.

W.S 15 C-1

① 179-33-40
④ 358-14-20
179-33-35
⑥ 357-21-30
179-33-35

267.63 @ 3°30' T70 = 267.11
257.24 LEVEL T70 } = 390.47
133.27 LEVEL T70 }
657.58

80.29 LEVEL T70
168.15 "
87.74 "
336.18 LEVEL T70 = 336.15

SEC. 6
T4N, R8W

EAST

40+02.83 W
FD. 1X2 STK, FL.
PER F.B. 2237-130

38+31.93 W
FD. 1X2 STK, FL.
PER F.B. 2237-130

AVE.

179° 33' 35"

RANDOM LINE FROM EAST
PER F.B. 2237-130

Z

610.44

WEST
336.15

RANDOM LINE TO
657.58

+373.61

TO BOT. @ 167

16+04.17 W
SET 1X2 STK, FL

9+46.59 W
SET 1X2 STK, FL

6+10.44 W
SET 1X2 STK, FL

52+96.88 W
1/4 COR. BET SECS. 6, 7
T4N, R8W
FD. G.L.O. MON., 1" I.P.,
20" UP IN ROCK MOUND
PER F.B. #2237-130;
WITH 2½" BRASS CAP
MARKED

U.S. GENERAL LAND OFFICE SURVEY
S6
S7
¼
1918

F.B. 2293 Pg. 166

SEC. 7,
T4N, R8W

209TH ST.

236.52 LEVEL T70
49.42 "
298.01 "
26.55 "
610.50 LEVEL T70 = 610.44

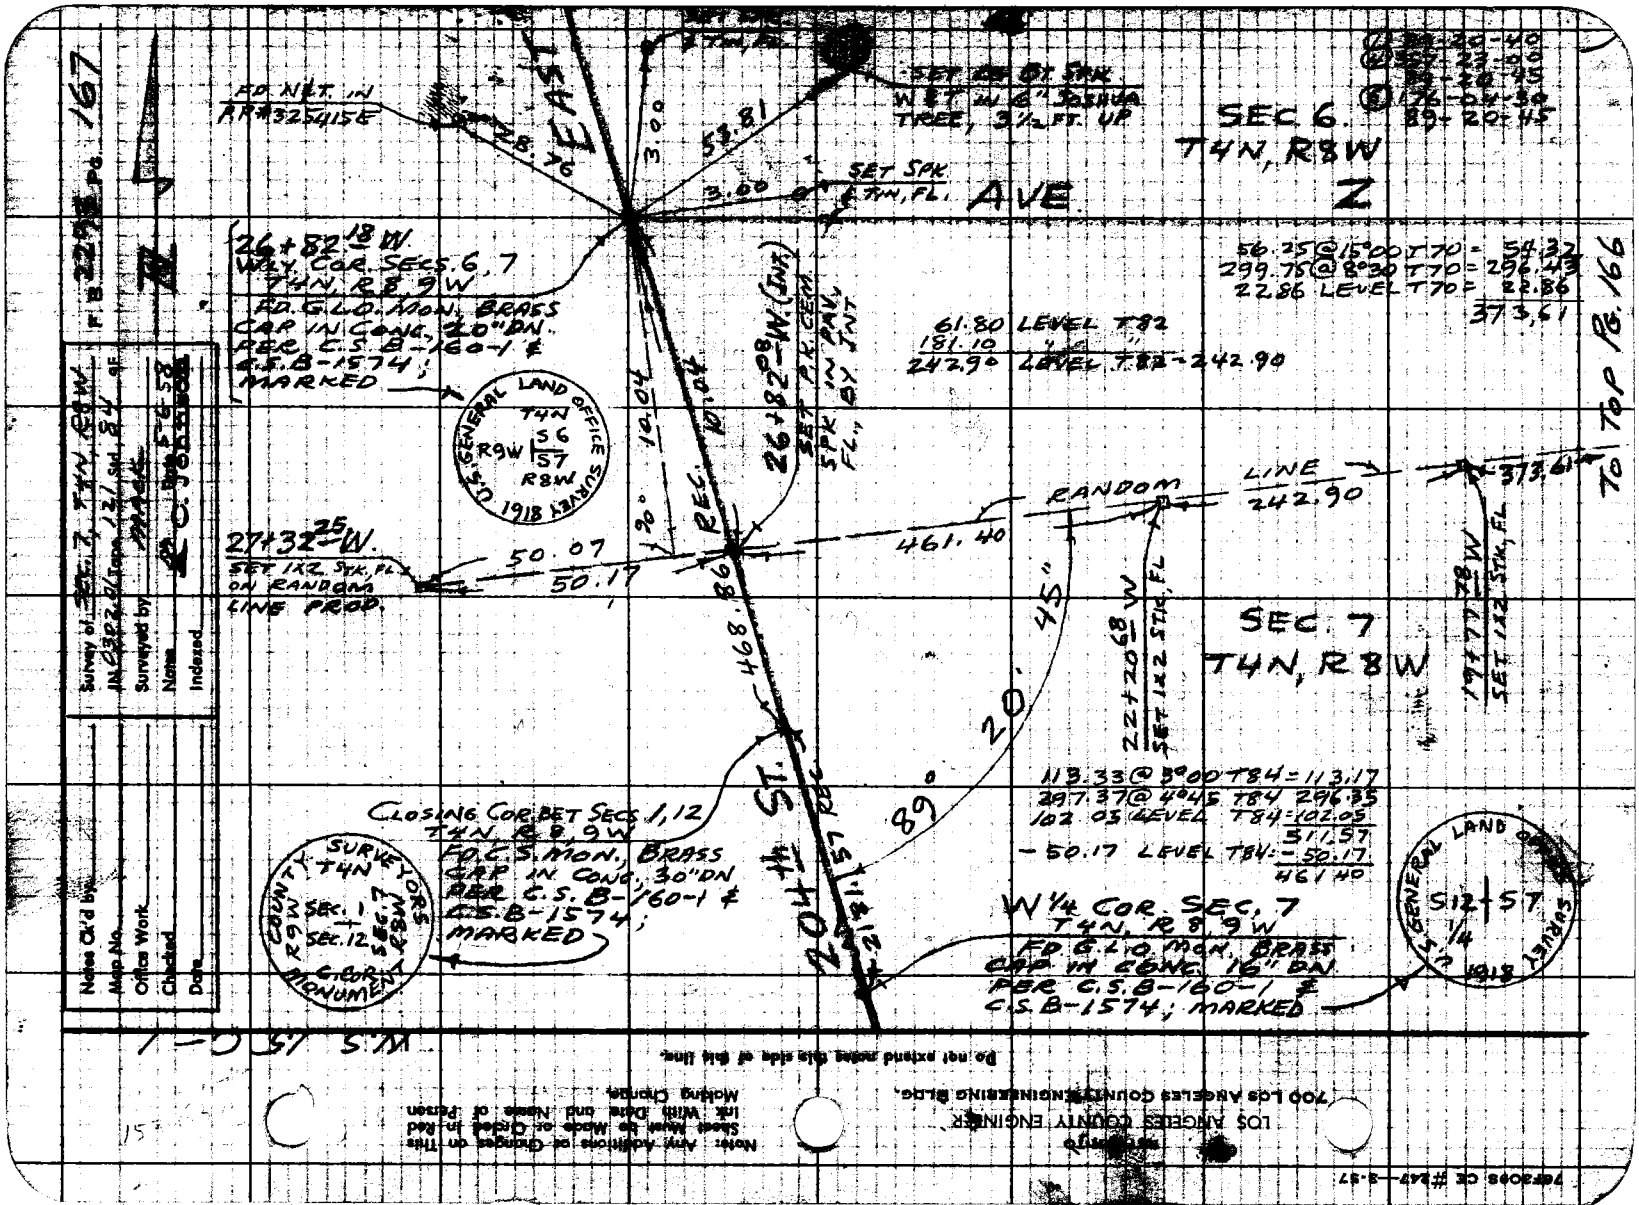
SEC 6.
T4N, R8W
SEC. 7
T4N, R8W
AVE Z
EAST
RANDOM LINE
242.90
461.40
50.07
50.17
26+82.18 W.
27+32.25 W.
W 1/4 COR. SEC. 7
T4N, R8W
FD. G.L.O. MON. BRASS CAP IN CONC. 16" DN.
PER C.S.B-160-1 &
C.S.B-1574; MARKED
CLOSING COR. SET SECS 1, 12
T4N, R8W
FD. C.S. MON. BRASS CAP IN CONC. 30" DN
PER C.S.B-160-1 &
C.S.B-1574;
MARKED
SET 1X2 STK, FL
ON RANDOM LINE PROP.
SET 1X2 STK, FL
SET 2" DIA. IRON PIPE, 3½ FT. UP
SET SPK IN TOP OF STK
SET SPK IN TOP OF STK, FL.
SET 1X2 STK, FL
AD NAIL IN AR #32541156
AD G.L.O. MON. BRASS CAP IN CONC. 20" DN. PER C.S.B-160-1 & C.S.B-1574; MARKED
U.S. GENERAL LAND OFFICE SURVEY 1918
T4N R9W 56 57 R8W
COUNTY SURVEYORS MONUMENT
T4N R9W SEC. 1 SEC. 12 T4N R8W SEC. 7
S12-S7 1/4
56.25 @ 15°00' T70 = 54.32
299.75 @ 8°30' T70 = 296.43
22.86 LEVEL T70 = 22.86
373.61
61.80 LEVEL T82
181.10
242.90 LEVEL T82 = 242.90
113.33 @ 5°00' T84 = 113.17
297.37 @ 40°45' T84 296.35
102.05 LEVEL T84 = 102.05
511.57
- 50.17 LEVEL T84 = - 50.17
461.40
TO TOP P.B. 166
Surveyed by
Name
Indexed
Notes Ck'd by
Map No.
Office Work
Checked
Date
LOS ANGELES COUNTY ENGINEER
700 Los Angeles County Engineering Bldg.
Do not extend notes this side of this line.
Note: Any Additions or Changes on This Sheet Must Be Made or Cited in Red Ink With Date and Name of Person Making Change.
P.B. 229/167
P.B. 166/18
7673098 CE #847 - 3-87

Notes Ck'd by	Survey of Wly Line R.S. 2415
Map No.	Surveyed by MACK
Office Work	Notes M. C. Johnson Date 5-8-58
Checked	Indexed MAY 1958
Date	

F.B. 2293 Pg. 169

W.S. 66

J. N. 0209.00

SUBDVN. MON. INSP.

ON

WLY. LINE R.S. 2415

FROM: AVE. S & 111th ST. E.

SLY. TO: AVE S-12 & 116th ST. E.

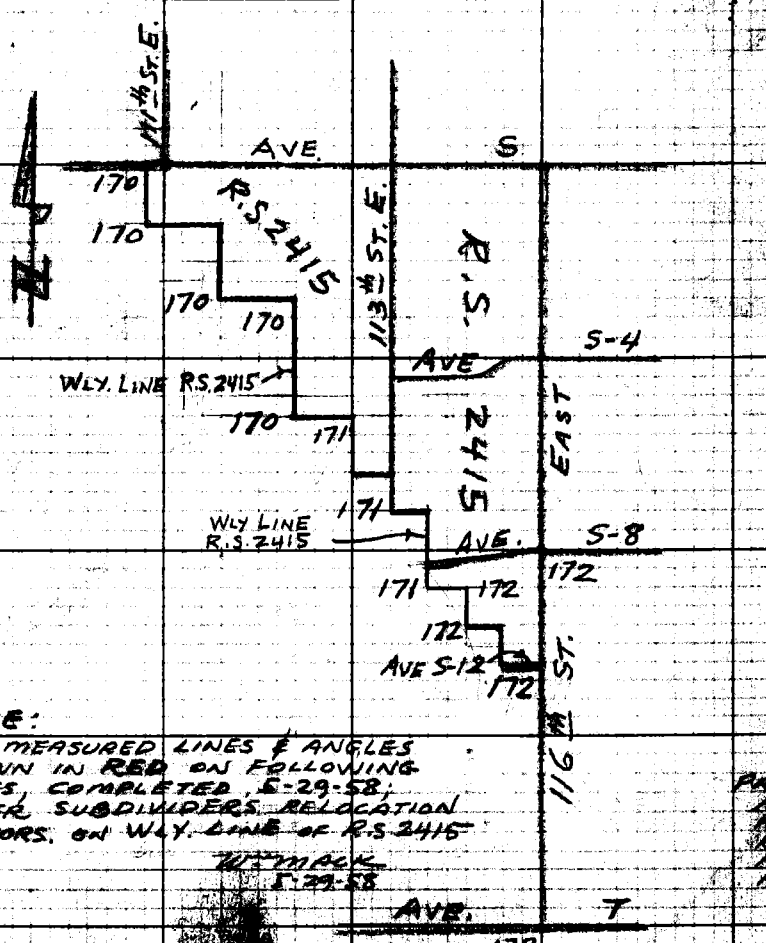

NOTE:

REMEASURED LINES & ANGLES SHOWN IN RED ON FOLLOWING PAGES, COMPLETED 5-29-58; AFTER SUBDIVIDERS RELOCATION OF CORS. ON WLY. LINE OF R.S. 2415

W. MACK 5-29-58

PARTY: MACK, HARRISON, WATTS, HAGGARD, M.E. MITCHELL

Note: Any Additions or Changes on This Sheet Must Be Made or Ordered In Red Ink With Date and Name of Person Making Change.

Do not extend notes this side of this line.

RETURN TO LOS ANGELES COUNTY ENGINEER 7700 Los Angeles County Engineering Bldg.

7-58 3095 CE #347 5-57

F.B. 2293 Pg. 170

4 N

111th St. E

112½ St. E

112th St. E

AVE. S

AVE. S-2

AVE. S-5

R.S. 2415

WLY. LINE R.S. 2415

2038.15 REC.

N¼ COR. SEC. 4 T6N, R10W FD. C.S. MON. IN CONC. 8" DN. PER C.S. 8734; WITH BRASS CAP MARKED

SURVEYORS T6N R10W COUNTY

SEC. 4 ¼ COR. TSN MONUMENT

SEC. 34 S.C. TSN MONUMENT ¼ COR.

T6 S¼ COR. SEC. 34 T6N, R10W FD. C.S. MON. 2" IPPC PER C.S. 8736 AT 115.2 FT. E. MARKED

FD 2" I.P. PLUG & NAIL 12" DN. TAG R.E. 509, PER R.S. 2415

FD 2" J.P. PLUG & NAIL, 12" DN., TAG R.E. 509, PER R.S. 2415

FD 2" J.P. PLUG & NAIL 12" DN. TAG R.E. 509 PER R.S. 2415

FD 2" J.P. PLUG & NAIL, 12" DN., TAG R.E. 509, PER R.S. 2415

FD 2" J.P. PLUG & NAIL 12" DN. TAG R.E. 509 PER R.S. 2415

FD 2" J.P. PLUG & NAIL 12" DN. TAG R.E. 509 PER R.S. 2415

FD 2" J.P. PLUG & NAIL 12" DN. TAG R.E. 509 PER R.S. 2415

FD 2" J.P. PLUG & NAIL 12" DN. TAG R.E. 509 PER R.S. 2415

FD 2" J.P. PLUG & NAIL 12" DN. TAG R.E. 509 PER R.S. 2415

422.68 T82 = 422.67
330.87 T76 = 330.85
454.04 T82 = 454.03
300.86 T82 = 300.86

783.45 T84 = 783.45
361.10 T90 = 361.11

WLY. LINE R.S. 2415

RETURN TO LOS ANGELES COUNTY ENGINEER 900 LOS ANGELES COUNTY ENGINEERING BLDG.

Do not extend notes this side of this line.

Note: Any Additions or Changes on This Sheet Must be Made or Circled in Red Ink With Date and Name of Person Making Change.

Notes C'd by
Map No.
Other Work
Checked
Survey of WLY. LINE R.S. 2415
Surveyed by
Notes
Indexed
F.B. 2273 Pg. 17A

AVE. S-5

R.S. 2415

FD. 2" I.P. PLUG
& NAIL, 12"DN, TAG
R.E. 609, PER R.S. 2415

R.S. 2415

WLY. LINE
R.S. 2415

FD. 2" I.P. PLUG &
NAIL, 12"DN, TAG
R.E. 609, PER R.S. 2415

FD. 2" I.P. PLUG
& NAIL, 12"DN, TAG
R.E. 609, PER R.S. 2415

FD. 2" I.P. PLUG
& NAIL, 12"DN, TAG
R.E. 609, PER R.S. 2415

WLY. LINE
R.S. 2415

FD. 2" I.P. PLUG &
NAIL, 12"DN, TAG
R.E. 609, PER R.S. 2415

FD. 2" I.P. PLUG &
NAIL, 12"DN, TAG
R.E. 609, PER R.S. 2415

570.77 T82 = 570.76
360.60 T82 = 360.60
332.94 T81 = 332.94
300.64 T82 = 300.44
362.76 T82 = 362.76
360.78 T84 = 360.78

FD. 2" I.P. PLUG &
NAIL, 12"DN, TAG
R.E. 609, PER R.S. 2415

FD. 2" I.P. PLUG &
NAIL, 12"DN, TAG
R.E. 609, PER R.S. 2415

Tenneco CE #44-47

F.B. 2293 Pg. 172

R.S. 2415

AVE. 5-8

EAST

1320.45 REC.

1320.45 REC.

WEST

EAST

AVE 5-12

AVE

T

T5N R10W

T5N R11W

T6N R10W

T6N R11W

S 1/4 COR BET SECS 3, 4 T5N R10W FD C.S. MON, BRASS CAP, FL PER C.S. 8734 MARKED

NOTE: BRASS CAP ERRONEOUSLY MARKED T6N

FD 2" I.P. PLUG & NAIL, 12" DN., TAG R.E. 509, PER R.S. 2415

FD 2" I.P. PLUG & NAIL, 12" DN. TAG R.E. 509 PER R.S. 2415

FD 2" I.P. PLUG & NAIL, 18" DN. TAG R.E. 509 PER R.S. 2415

FD 2" I.P. PLUG & NAIL, 12" DN. TAG R.E. 509, PER R.S. 2415

COR. SECS. 3, 4, 9, 10 T5N R10W FD C.E.A. MON, BRASS CAP IN CONC, 18" DN; A REPLACEMENT OF C.S. MON PER C.S. 8734; MARKED

SURVEYORS MONUMENT T5N R10W 4 3 9 10

COUNTY ENGINEER T5N R10W 4 3 9 10 R.E. 5869

WLY. LINE R.S. 2415

WLY. LINE R.S. 2415

R.S. 2415

R.S. 2415

① 87-19-20
④ 349-18-10
87-19-32½
⑥ 163-57-30
87-19-35

① 86-56-00
④ 347-43-40
86-55-55
⑥ 161-35-20
86-55-53⅓

① 90-50-40
④ 03-22-50
90-50-42½
⑥ 185-04-20
90-50-43⅓

① 90-57-30
④ 03-50-10
90-57-32½
⑥ 185-45-10
90-57-31⅔

① 90-55-00
④ 03-40-20
90-55-05
⑥ 185-30-30
90-55-05

① 91-27-30
④ 05-50-10
91-27-32½
⑥ 188-45-00
91-27-30

① 91-24-00
④ 05-36-40
91-24-10
⑥ 188-25-20
91-24-13⅓

① 91-22-10
④ 05-29-20
91-22-20
⑥ 188-14-10
91-22-21⅔

331.16 T96 = 331.19
471.40 T74 = 471.37
361.04 T78 = 361.03
814.29 T78 = 814.26
301.25 T78 = 301.24

360.58
361.03

471.37
473.00

331.04
331.19

90°55'05"
90°57'32"

91°27'30"
91°21'45"

91°24'10"
91°22'20"

30.00
29.97
0.17

Return to Los Angeles County Engineering Bldg. 700

Note: Any Additions or Changes on this Sheet Must be Noted or Circled in Red Ink With Date and Notice of Person Making Change.

Do not extend notes this side of this line.

Notes Ck'd by Austin	Survey of TRACT # 17500
Map No.	JN 0036.02 Tape 144 Std 84 °F
Office Work	Surveyed by MACK
Checked	Notes M Date 10-1-58
Date	Indexed A. O. Johnson 10-20-58

F. B. 2293 Pg. 173

J.N 0036.02

MONUMENTING TRACT # 17500

Note: Any Additions or Changes on This Sheet Must Be Made or Circled In Red Ink With Date and Name of Person Making Change.

Do not extend notes this side of this line.

RETURN TO
LOS ANGELES COUNTY ENGINEER
900 Los Angeles County Engineering Bldg.

PARTY
MACK
HALISCKY
RITTER
H.E. MITCHELL
TEMPLETON

76FS098 CE #247—3-57

F.B. 2293 Pg. 174

INDEX TO PAGES

AVE.

P-8

182
187

192

190

193

℄ NLY. LINE TR #17500

178
187

179
191

179

190

AVE.

P-12

175

176

177

EAST

AVE

EAST

ELY. LINE TR #17500

EAST

SLY. LINE TR #17500

180

181

185

180

8th ST.

RAMBLER

9th ST

10th ST

AVE P-15

184

183

AVE

Q

181
187

184

188

189

RETURN TO
LOS ANGELES COUNTY ENGINEER
900 Los Angeles County Engineering Bldg.

Do not extend notes this side of this line.

Note! Any Additions or Changes on This Sheet Must be Made or Circled in Red Ink With Date and Name of Person Making Change.

Notes Ck'd by Austin
Map No.
Office Work
Checked
Date

Survey of TRACT # 17500
JN [illegible] Tape [illegible] of
Surveyed by MAC
Notes M Date 10-1-58
Indexed C. Johnson

F.B. 2293 Pg. 175

130.02 T 78 = 130.02 ✓
530.10 T 78 = 530.08 ✓

INT. = 11+90.20 ± N
SET 2" I.P. CONC. PLUG & NAIL, 12" DN., TAGGED "L.A. Co. ENGR.", BY PROPOR. N.E. So. PER TR # 17500

8th ST.

EAST

(25)

TO TOP PG 181

TO SPK & TIN AT TRACT LINE

530.08 ✓

130.02 ✓

TO SPK & TIN AT TRACT LINE

(20)

20.00

52.19

51.28

SET L&T IN CURB

SET L&T IN CURB

(30)

18.00

17.97

SET SPK & TIN IN PAV., PL. CALC. DIST.

SET L&T IN CURB

(30)

Ave. P-12

137.50 ✓

257.01 ✓

29.85

50.00

SET SPK & TIN IN PAV., PL. CALC. DIST.

TO ℄ INT. REMAINDER ANGLE

(30)

(30)

TO TOP PG 176

① 89-31-20
④ 358-06-20
89-31-35
⑥ 177-09-40 ✓
89-31-36 2/3 ✓

137.50 ✓ = 137.50 ✓

TR. # 17500

RETURN TO
LOS ANGELES COUNTY ENGINEER
900 Los Angeles County Engineering Bldg.

Do not extend notes into this area.

Note: Any Alteration or Changes on This Sheet Must Be Made or Dated in Red Ink With Clear Title Name of Person Making Change.

MR. 21 A-2

TRACING CE #247—3-57

RETURN TO
LOS ANGELES COUNTY ENGINEER
1100 LOS ANGELES COUNTY ENGINEERING BLDG.

Note: Any Additions or Changes on This Sheet Must be Made or Circled in Red Ink With Date and Name of Person Making Change.

Do not extend notes beyond ends of this line.

W.S. 11A-2

257.02 T76 = 257.01

TR#17500

SET L&T IN CURB

SET L&T IN CURB ON ℄ PROD. FROM So.

257.05 T74 = 257.03

TR#17500

SET L&T IN CURB

AVE.

(30)

18.09

46.01 TAN

18.33 ℄ PROD.

47.40 TAN

18.10

P-12

(30)

To Bnd. Pg 175

To ℄ INT 9th St. E.

257.01

℄

257.03

℄

To ℄ INT 9th St. E.

To Top Pg 177

INT. SET 2" I.P. CONC. PLUG & NAIL, 12" BN. TAGGED L.A. Co. ENGR; BY INT. SET 1 x 2" STK. ON SURFACE, IN PAV., FL.

(30)

18.00

47.00 TAN

45.74 TAN

17.90

(30)

530.03

℄ RAMBLER AVE

SET L&T IN CURB

15.08

15.07

SET L&T IN CURB

TR#17500

F.B. 2293 Pg 176

(2) 89-31-40 E 530.04

(3) 177.09-40 S

89-31-50 W

530.04 T82 = 530.03

TR#17500

(27)

TR#17500

~~528.64 T90 = 528.66~~

Notes Ck'd by Austin
Map No.
Office Work
Checked
Date

Survey of TRACT # 17500
Tape/Rod 2nd 3rd °F
Surveyed by MACK
Notes
Date 10-1-58
Indexed

F.B. 2293 Pg. 177

To Bot Pg 176

N 57° 47' 22" W

① 89-31-30
② 358-06-30
89-31-37½
③ 177-09-56
89-31-38½

TR #17500

(30)

To ℄ Int Pamplico Ave

17.90

18.15

(30)

TR #17500

SET L&T IN CURB

SET L&T IN CURB

257.03

61.94

38"

51'

59.38

89°

INT. SET 2" I.P, CONC. PLUG & NAIL, 2" BW, TAGGED "L.A. CO ENGR."; BY INT. SET 1x2 STK. ON SURFACE, IN PAV., FL.

19.75 ℄ PROD.

SET L&T IN CURB IN DRWY. on ℄ PROD. FROM So.

To 19th St. E. (80)

18.02

INT. 2" I.P.

TR. LINE 12" DN

529.98 CALC.

18.00

1.40

1.81

10' OFFSET E. (PROD)

525.06

140.02

To Spk, FL

To Spk, FL (80)

19.75 ℄ PROD.

SET SPK & TIN IN PAV'T. AT INTERSECTION OF ℄ PROD. & TR. #17500

SET L&T IN CURB on ℄ PROD. from W.

TR #17500

TR #17500

525.02 T96 = 525.06
140.01 T96 = 140.02

Notes: Any Additions or Changes on This Sheet Must Be Made or Dated in Ink With Date and Name of Person Making Change.

Do not exceed neat limits this side of this line.

LOS ANGELES COUNTY ENGINEER
900 LOS ANGELES COUNTY ENGINEERING BLDG.

7952065 CE #247-9-57

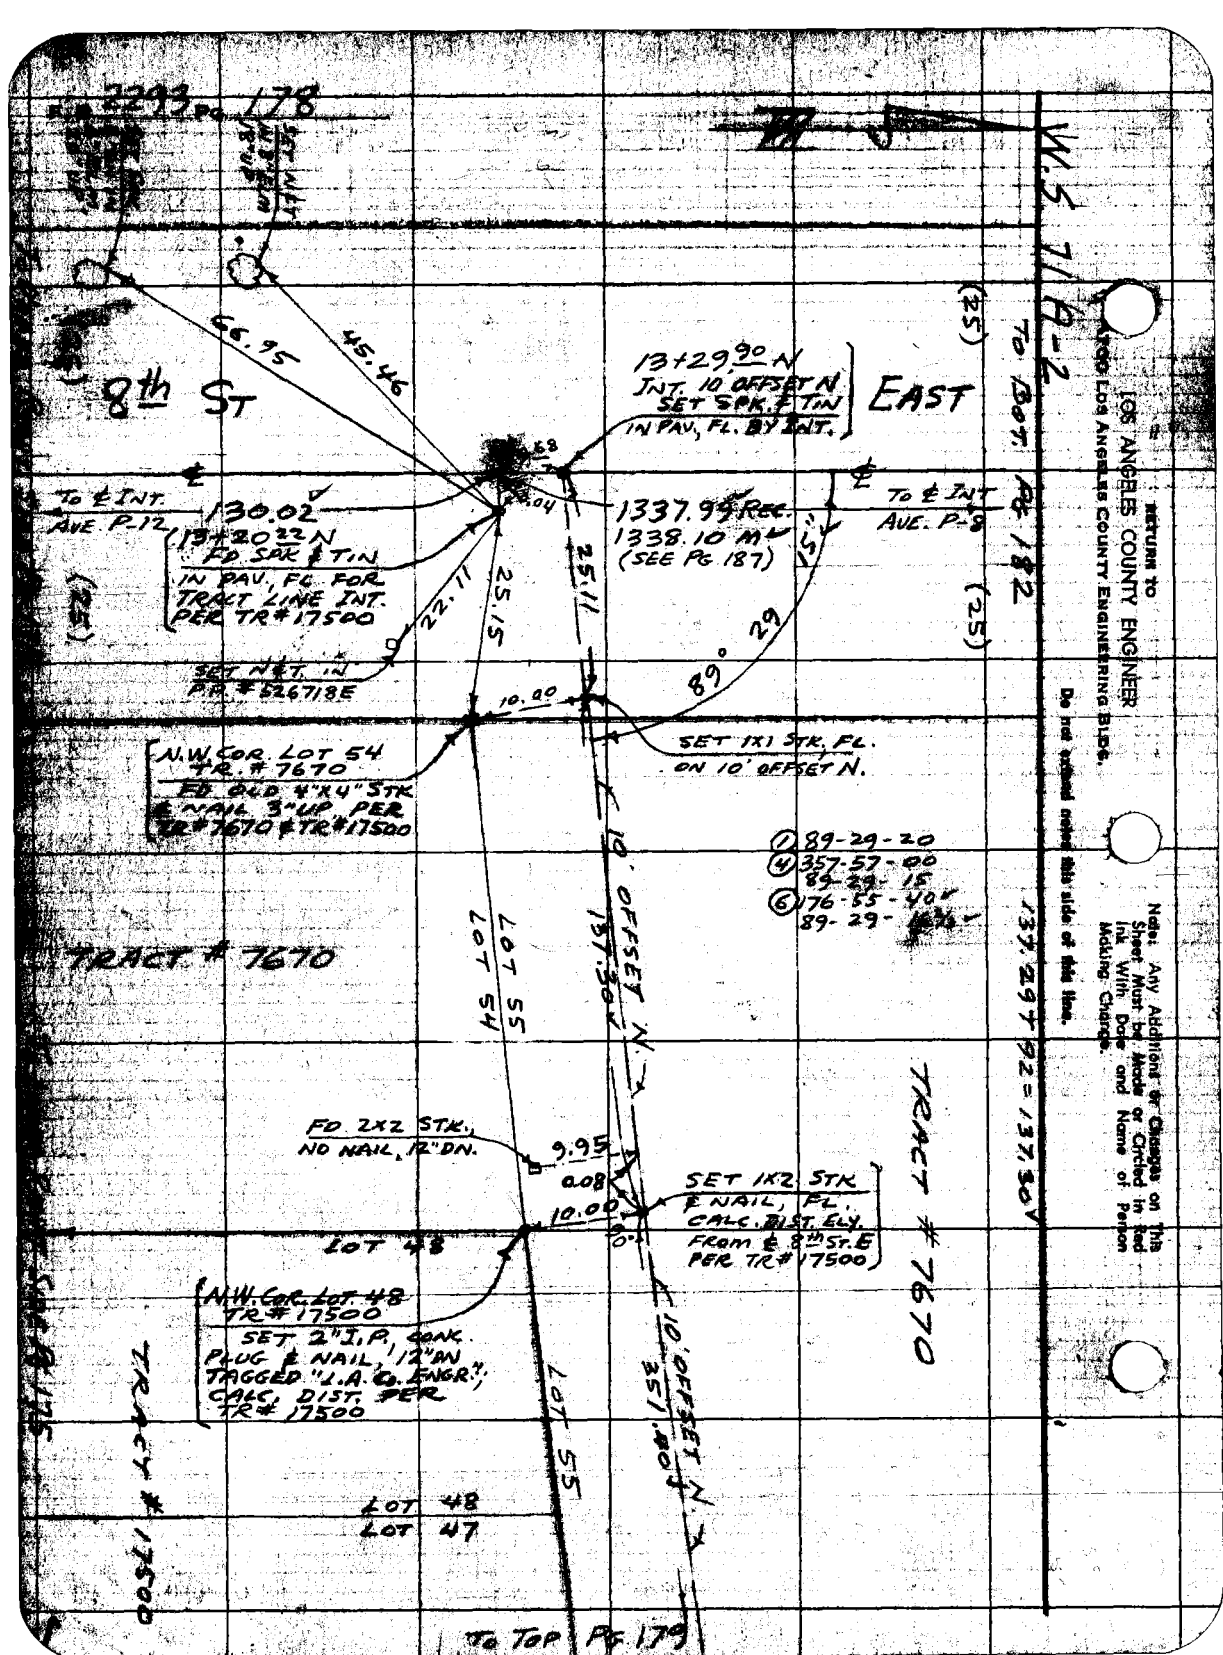
B 2293 Pg. 178
W.S. T.I.P.-2
To Bot. Pg 182
(25)
(25)
8th St
66.95
45.46
13+29.90 N
INT. 10' OFFSET N
SET SPK. & TIN
IN PAV., FL. BY INT.
EAST
℄
℄
To ℄ INT.
AVE. P-12
130.02
13+20.22 N
FD SPK & TIN
IN PAV., FC FOR
TRACT LINE INT.
PER TR # 17500
1337.99 Rec.
1338.10 M
(SEE PG 187)
To ℄ INT
AVE. P-8
(N)
22.11
25.15
25.11
89° 29' 45"
SET N&T. IN
P.B. # 526/18E
10.00
SET 1X1 STK. FL.
ON 10' OFFSET N.
N.W. COR. LOT 54
TR. # 7670
FD OLD 4"X4" STK
& NAIL 3" UP PER
TR # 7670 & TR # 17500
1 89-29-20
4 357-57-00
89-29-15
6 176-55-40
89-29-45
10' OFFSET N.
137.30'
TRACT # 7670
LOT 55
LOT 54
1337.29' 92 = 137.30'
FD 2X2 STK.
NO NAIL, 12" DN.
9.95
0.08
10.00
SET 1X2 STK
& NAIL, FL.
CALC. DIST. ELY.
FROM ℄ 8th ST. E
PER TR # 17500
LOT 48
N.W. COR. LOT 48
TR # 17500
SET 2" I.P. CONC.
PLUG & NAIL, 12" IN
TAGGED "L.A.C. ENGR."
CALC. DIST. PER
TR # 17500
10' OFFSET N.
357.80'
LOT 55
TRACT # 17500
LOT 48
LOT 47
To Top Pg 179
RETURN TO
LOS ANGELES COUNTY ENGINEER
900 Los Angeles County Engineering Bldg.
Do not extend notes this side of this line.
Note: Any Additions or Changes on This Sheet Must be Made or Circled in Red Ink With Date and Name of Person Making Change.

Notes Ck'd by Austin
Map No.
Office Work
Checked
Date

Survey of TRACT # 17500
JN [illegible] Tape 100' Std. #4 °F
Subsequent by TRACK
Notes M Date 10-1-58
Indexed [illegible]

F.B. 2293 Pg. 179

To BOT PG 178

① 89-22-20
② 357-57-20
89-22-20
③ 176-55-50
89-22-20

LOT 44
LOT 43

351.60'

89°22'20"

SET 1x1 STK
& NAIL, PE

10.25'

10' OFFSET E. (PROD)
1140.02'

SET 1x2 STK
FL BY INT

TO EIGHT SIDE PG 177

LOT 43
LOT 42

TRACT #17500

LOT 55

TRACT #7670

135.75'

SET NAIL IN
P.P. #1014752E

SET X IN 1/2"
CONC. STANDPIPE
24" UP

LOT 42
LOT 41

36.44'

SET NAIL IN
P.P. #1014752E

37.39

10.00

SET 1x2 STK
& NAIL
10' FROM M

LOT 55
LOT 56

LOT 67

2.55'

SET X IN 30"
CONC. WELL BOX,
18" UP

N.E. COR. LOT 54
TRACT #7670
FD OLD 4"X4" STK.
& NAIL 8" DN. WITH
DOUBLE TAGS MARKED
L.S. 2415 & L.S. 2521
PER TR # 7670 &
TR # 17500
RESET WITH 2" I.P.
CONC. PLUG & NAIL, 12" DN.
TAGGED "L.A. Co. ENGR."
PG 191

LOT 67
LOT 66

TRACT # 7670

Note: Any Additions or Changes on this Sheet Must Be Made or Dated In and Initialed With Date and Name of Person Making Change.

Do not extend notes on this side of this line.

RETURN TO
LOS ANGELES COUNTY ENGINEER
900 Los Angeles County Engineering Bldg.

7876-B6 CE #247 3-57

RETURN TO
LOS ANGELES COUNTY ENGINEER
700 LOS ANGELES COUNTY ENGINEERING BLDG.

Note: Any Additions or Changes on This Sheet Must be Made or Circled in Red Ink With Date and Name of Person Making Change.

Do not extend notes this side of this line.

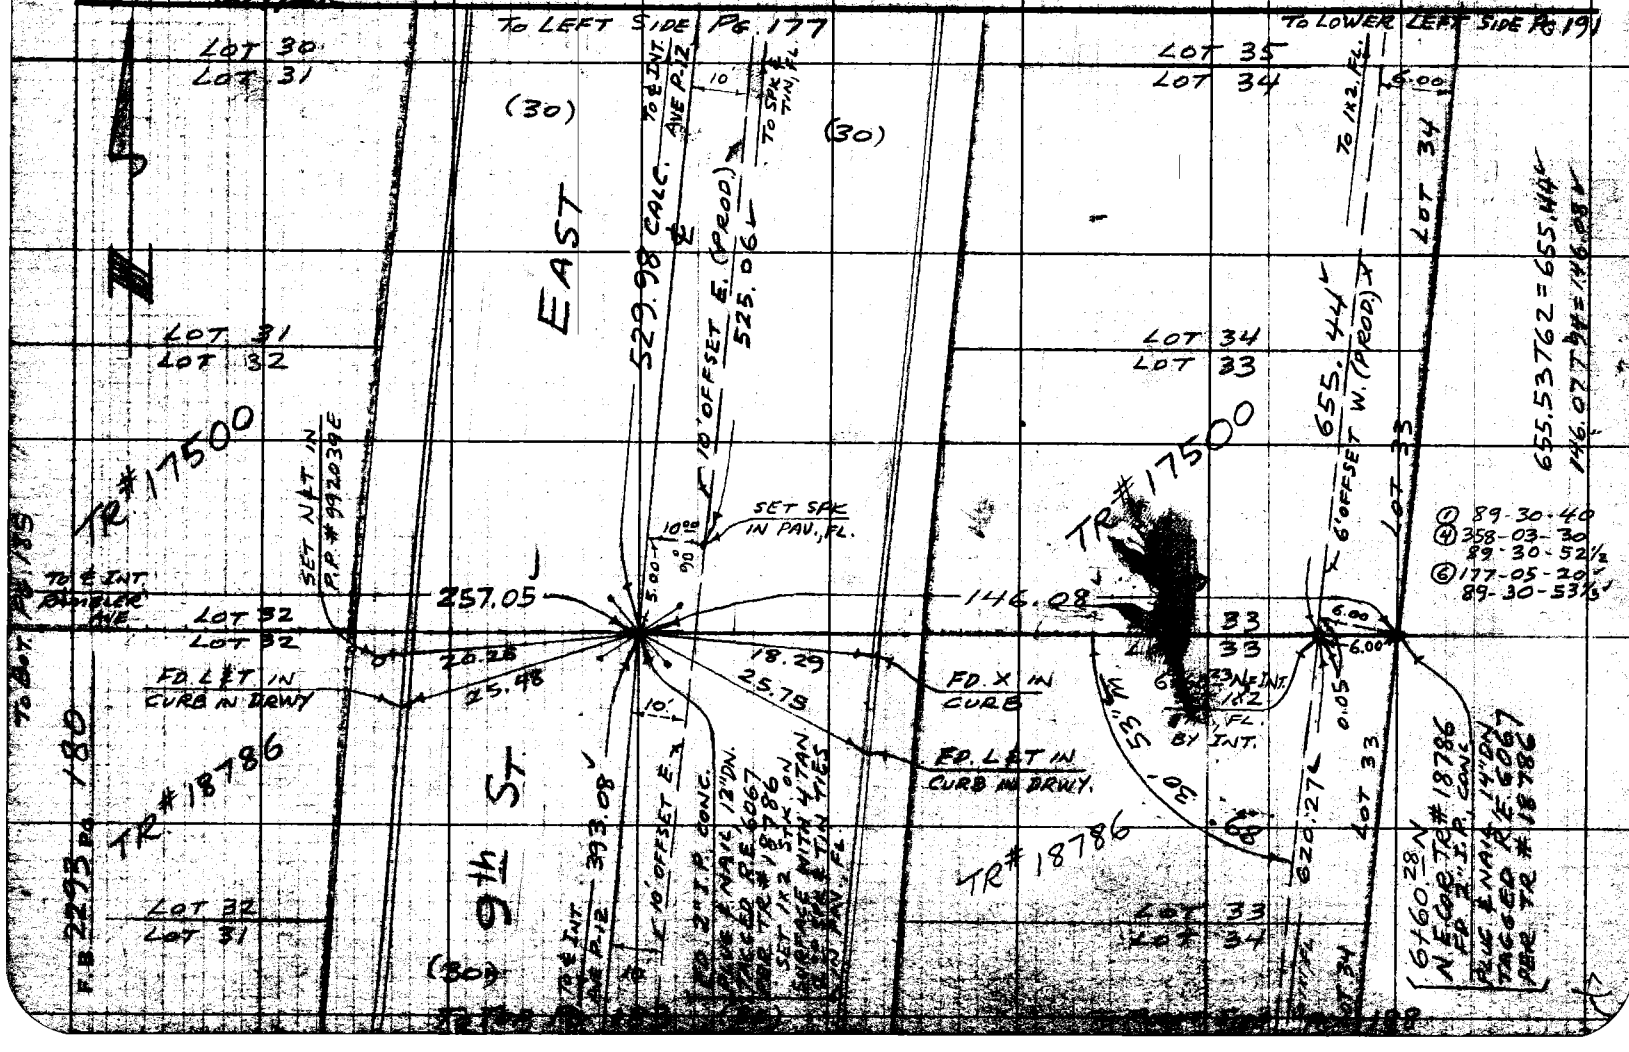
W.S. 65th St.
TO LEFT SIDE Pg. 177
TO LOWER LEFT SIDE Pg. 191
LOT 30
LOT 31
LOT 31
LOT 32
LOT 32
LOT 32
LOT 35
LOT 34
LOT 34
LOT 33
LOT 33
LOT 33
LOT 33
LOT 34
LOT 34
(30)
(30)
(30)
EAST
529.98 CALC. (PROD)
525.06
10' OFFSET E.
655.44'
6' OFFSET W. (PROD)
655.53762 = 655.44'
146.07 Bal = 146.08'
TR #17500
TR #18786
TR #18786
TR #18786
TR #18786
9th St.
257.05
146.08
393.08'
SET NAIL IN P.P. #992039E
SET SPK IN PAV., FL.
FD. L&T IN CURB IN DRWY
FD. X IN CURB
FD. L&T IN CURB IN DRWY.
FD. 2" I.P. CONC. TAGGED RE 6067
SET 1"x2" STK. ON TAGGED WITH TACK
SET NAIL, 12"DN. TAGGED RE 6067 PER T/R #18786
TO ℄ INT. ALAMEDER AVE.
TO ℄ INT. ALAMEDER AVE.
TO ℄ INT. ALAMEDER AVE.
TO SPK. IN FL.
TO INT. FL.
TO INT. FL.
TO INT.

Notes Ck'd by Austin
Map No.
Office Work
Checked
Date

Survey of TRACT #17500
JN 0036 02 Tape 100' Std. 59 °F
Surveyed by: GRACE
Notes
Indexed

FB 2293 Pg. 18'

To LEFT SHEET Pg. 175

WS 65-A-2

(25) (30)

EAST

530.08 — TR. #17500

INT = 6760'12"N
FD. BT. SQK. & TIN
IN PAV. AT FITTING
INT. PER TR. #18786
& TR #17500

89°

SET L&T IN CURB

35.19

TR. #17500

LOT 1
LOT 2

20.20 PROP.

256.98

22.03

SET L&T IN CURB ON TRACT LINE FROM FENCE

(25) (30)

8th ST.

SET L&T IN CURB

FD. STK. & TIN IN TR. #5574 TIE

89-31-30
358-05-30
89-31-22½
177-08-00
89-31-20

660.08 REC. PER TR. #18786
660.12 M. (SEE Pg. 177)

FD. L&T IN CURB

69.39

51.97

63.99

(0+00 N = 13+20.19 W. = INT.

FD. 2" I.P. conc. plug & nail & tin tag stamped "L.A. Co. Rd. Dept." Also R.E.F.B. 337-76
SET 1X2 STK. on surface in pav., FL.

AVE.

257.02

FD. punch mk. in top

SET NAIL & TIN

Property of LOS ANGELES COUNTY ENGINEER
900 Los Angeles County Engineering Bldg.

Note: Any Additions or Changes on this Sheet Must Be Made or Circled In Red Ink With Date and Name of Person Making Change.

Do not expand notes this side of this line.

76F2095 CE #847 4-67

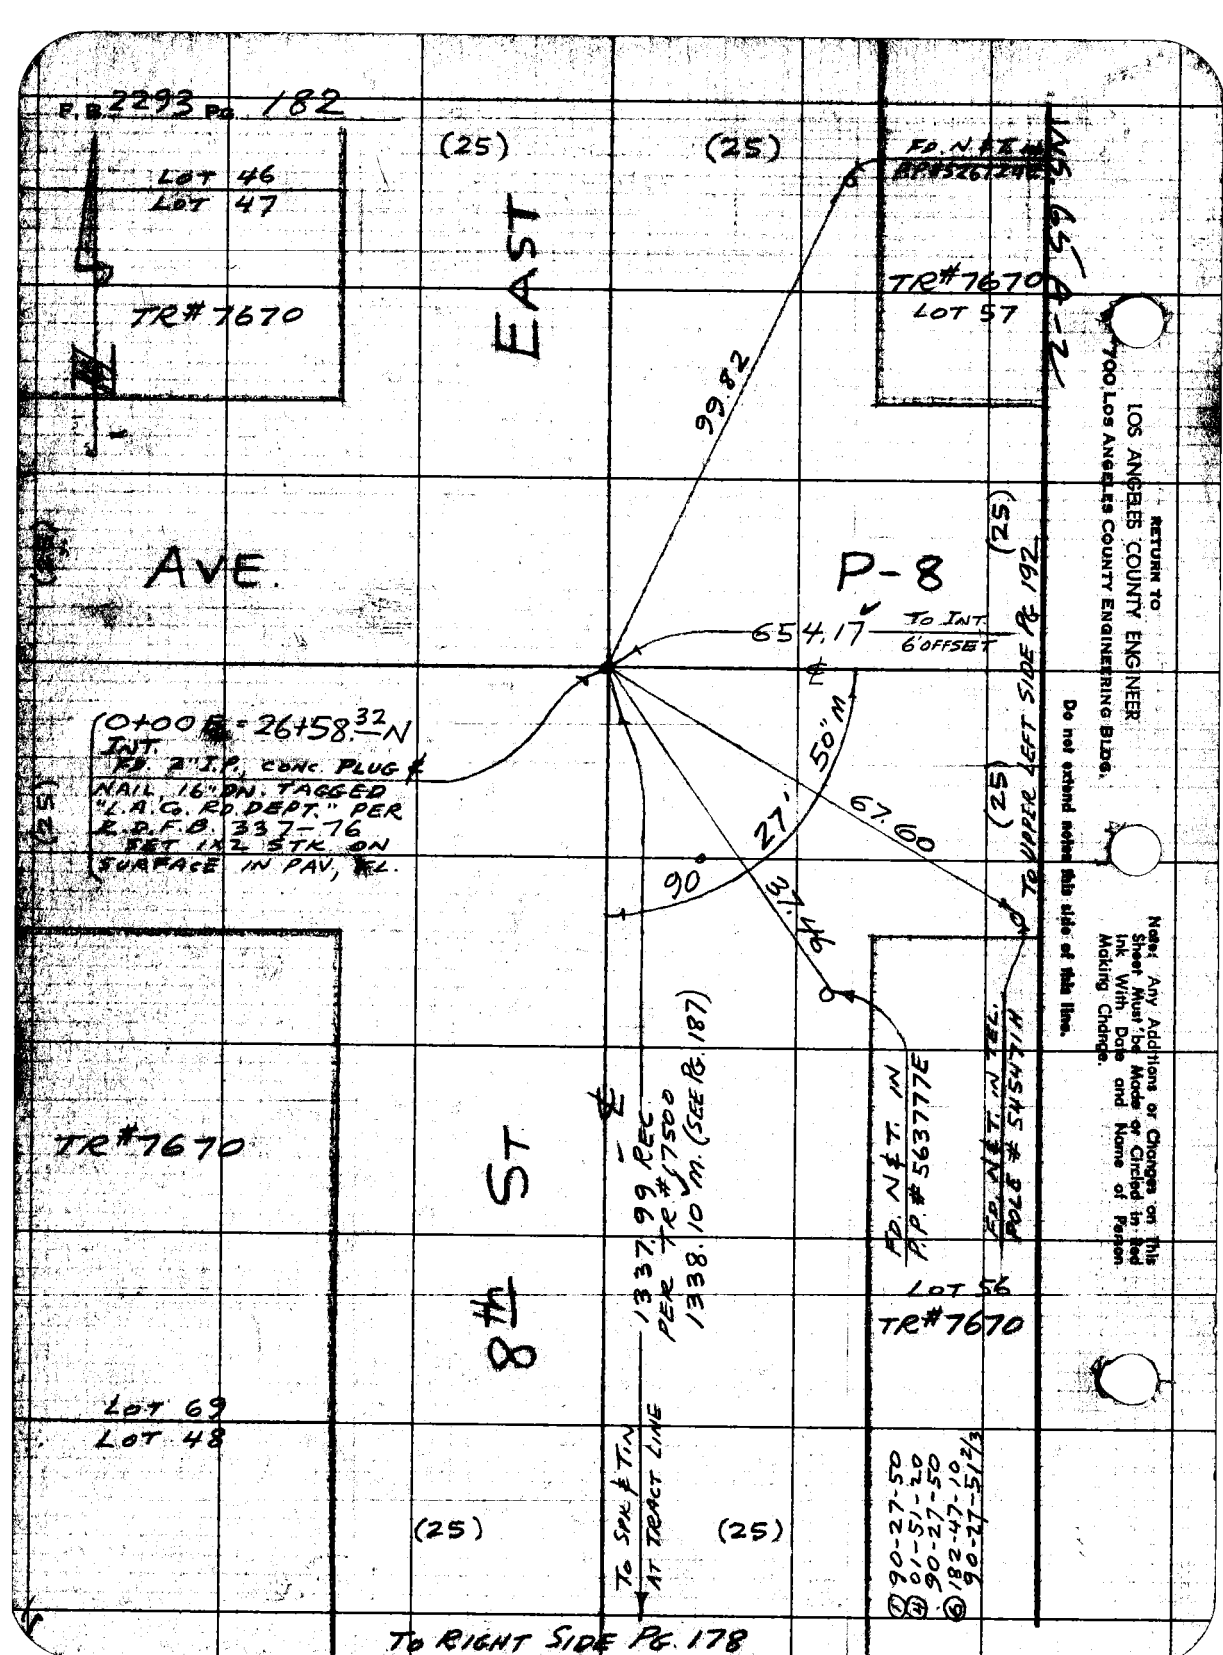
P.B. 2293 Pg. 182
LOT 46
LOT 47
TR# 7670
(25)
(25)
EAST
FD. N&T. IN
AP. #5267 2 NE
TR# 7670
LOT 57
99.82
LOS ANGELES COUNTY ENGINEER
700, Los Angeles County Engineering Bldg.
Do not extend notes this side of this line.
RETURN TO
Note: Any Additions or Changes on This Sheet Must be Made or Circled in Red Ink With Date and Name of Person Making Change.
AVE.
P-8
654.17 TO INT 6' OFFSET
(25)
TO UPPER LEFT SIDE PG. 177
(0+00 E = 26458.32 N
INT.
FD. 2" I.P. CONC. PLUG &
NAIL, 16" DN. TAGGED
"L.A.C. RD. DEPT." PER
L.D.F.B. 337-76
SET IN 2 STK. ON
SURFACE IN PAV, EL.
67.60
27' 50" M
90°
37.46
TR# 7670
8th ST
1337.99 REC.
PER TR# 17500
1338.10 M. (SEE PG. 187)
FD. N&T. IN
AP. #5637 7E
LOT 56
TR# 7670
LOT 69
LOT 48
(25)
(25)
90-27-50
01-51-20
90-27-50
182-47-10
90-27-51 1/2
TO RIGHT SIDE PG. 178

Notes Ck'd by: Austin
Map No.
Office Work
Checked
Date

Survey of: Tract #17500
JN: 0036.02 Tape: 144 Std. 84 of
Surveyed by: MACK
Notes: M Date: 10-3-58
Indexed: C. Johnson

F. B. 2895 Pg. 183

TO LEFT SIDE PG 180

W.S. 9 ST. A-2

② 90-28-40
Ⓦ 01-55-20
90-28-50
② 152-53-10
90-28-51⅓

TRACT #18786

(30) (30)

9th ST. E.

10.00

393.08

℄

10' OFFSET E.

FD L&T IN CURB

INT FD ℄ TAN X'S IN RUN OF SEWER PER F.B. 2009-10H

39.98 TAN

48.41 N.W.

50"

90° 28'

AVE. P-15

℄

To ℄ INT RAMBLER AVE 257.04

To RUBY ST SIDE MS 184 (27)

(27)

21.65 ℄ PROP

FD L&T IN CURB

17.89 N.W.

44.31 TAN

23.14 ℄ PROD

FD L&T IN CURB

FD. L&T IN CURB ON ℄ PROD FROM N.

TRACT #18786

T.B.M. EL. T.96 = 393.08

RETURN TO
LOS ANGELES COUNTY ENGINEER
900 LOS ANGELES COUNTY ENGINEERING BLDG.

Do not inspect above this line.

Note: Any Additions or Changes on This Sheet Must be Printed or Circled in Red Ink With Date and Name of Person Making Change.

78F3095 CE #247—3-57

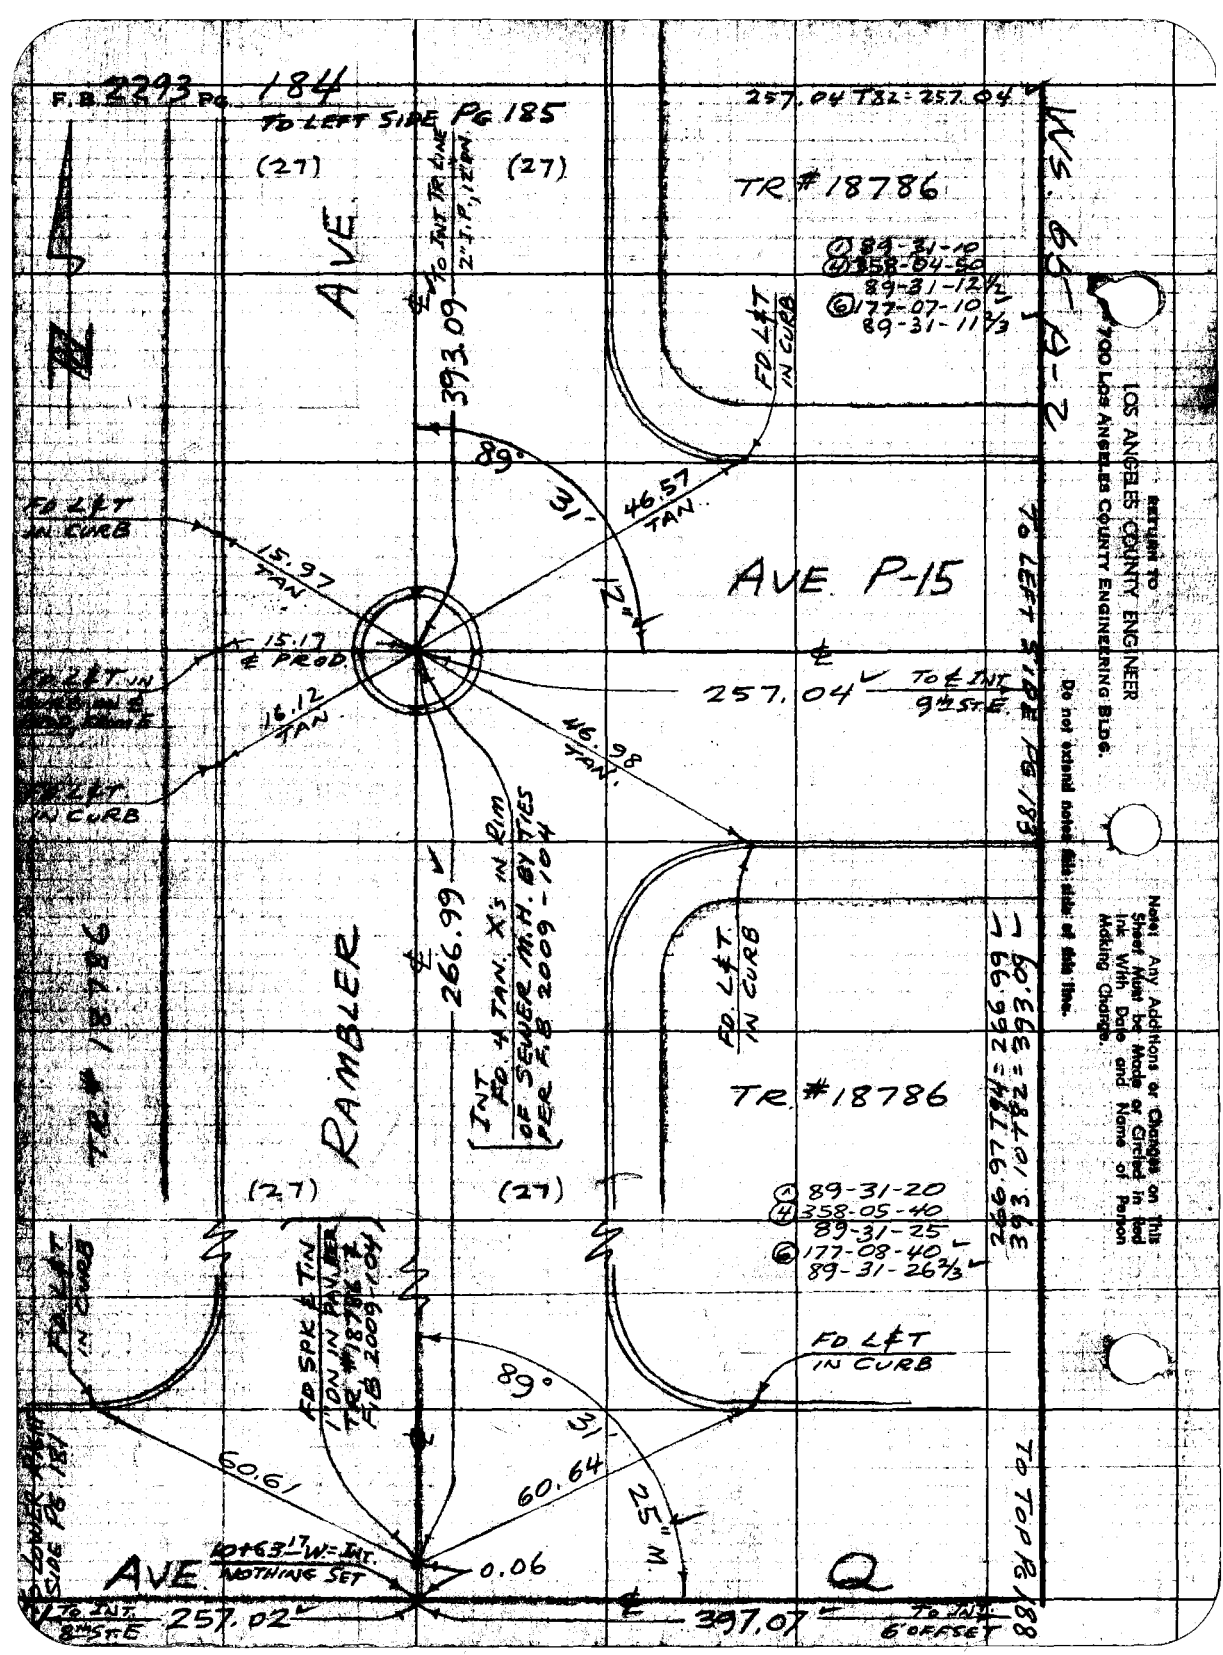
F.B. 2293 PG. 184
TO LEFT SIDE PG 185
(27)
(27)
AVE
TO INT. TR LINE 2.1' F, 1.2' M.
393.09
89°
31'
12"
46.57 TAN.
TR # 18786
① 89-31-10
④ 358-04-56
89-31-12½
⑥ 177-07-10
89-31-11⅔
FD L&T IN CURB
TO LEFT SIDE PG 187
AVE. P-15
257.04 TIE: 257.04
TO ℄ INT 9TH ST E.
RETURN TO LOS ANGELES COUNTY ENGINEER 900 Los Angeles County Engineering Bldg.
Do not extend notes this side of this line.
Note: Any Additions or Changes on This Sheet Must be Made or Circled in Red Ink With Date and Name of Person Making Change.
FD L&T IN CURB
15.97 TAN.
15.17 ℄ PROD.
16.12 TAN.
46.98 TAN.
FD L&T IN CURB
TR # 18786
RAMBLER
266.99
[INT FD 4 TAN. X'S IN RIM OF SEWER M.H. BY TIES PER F.B. 2009-104]
(27)
(27)
FD L&T IN CURB
TR. #18786
393.07 TIE: 393.07
① 89-31-20
④ 358-05-40
89-31-25
⑥ 177-08-40
89-31-26⅔
FD L&T IN CURB
FD L&T IN CURB
FD SPK & T.N. 1' ON IN PAVER TR #18786 F.B. 2009-104
89°
31'
60.61
60.64
25" N.
0.06
AVE
L0+63.17 W = INT. NOTHING SET
℄
℄ TO INT. 8TH ST E 257.02
℄ 397.07 TO INT. 6' OFFSET
Q
TO TOP PG 188
TO LOWER RIGHT SIDE PG 187

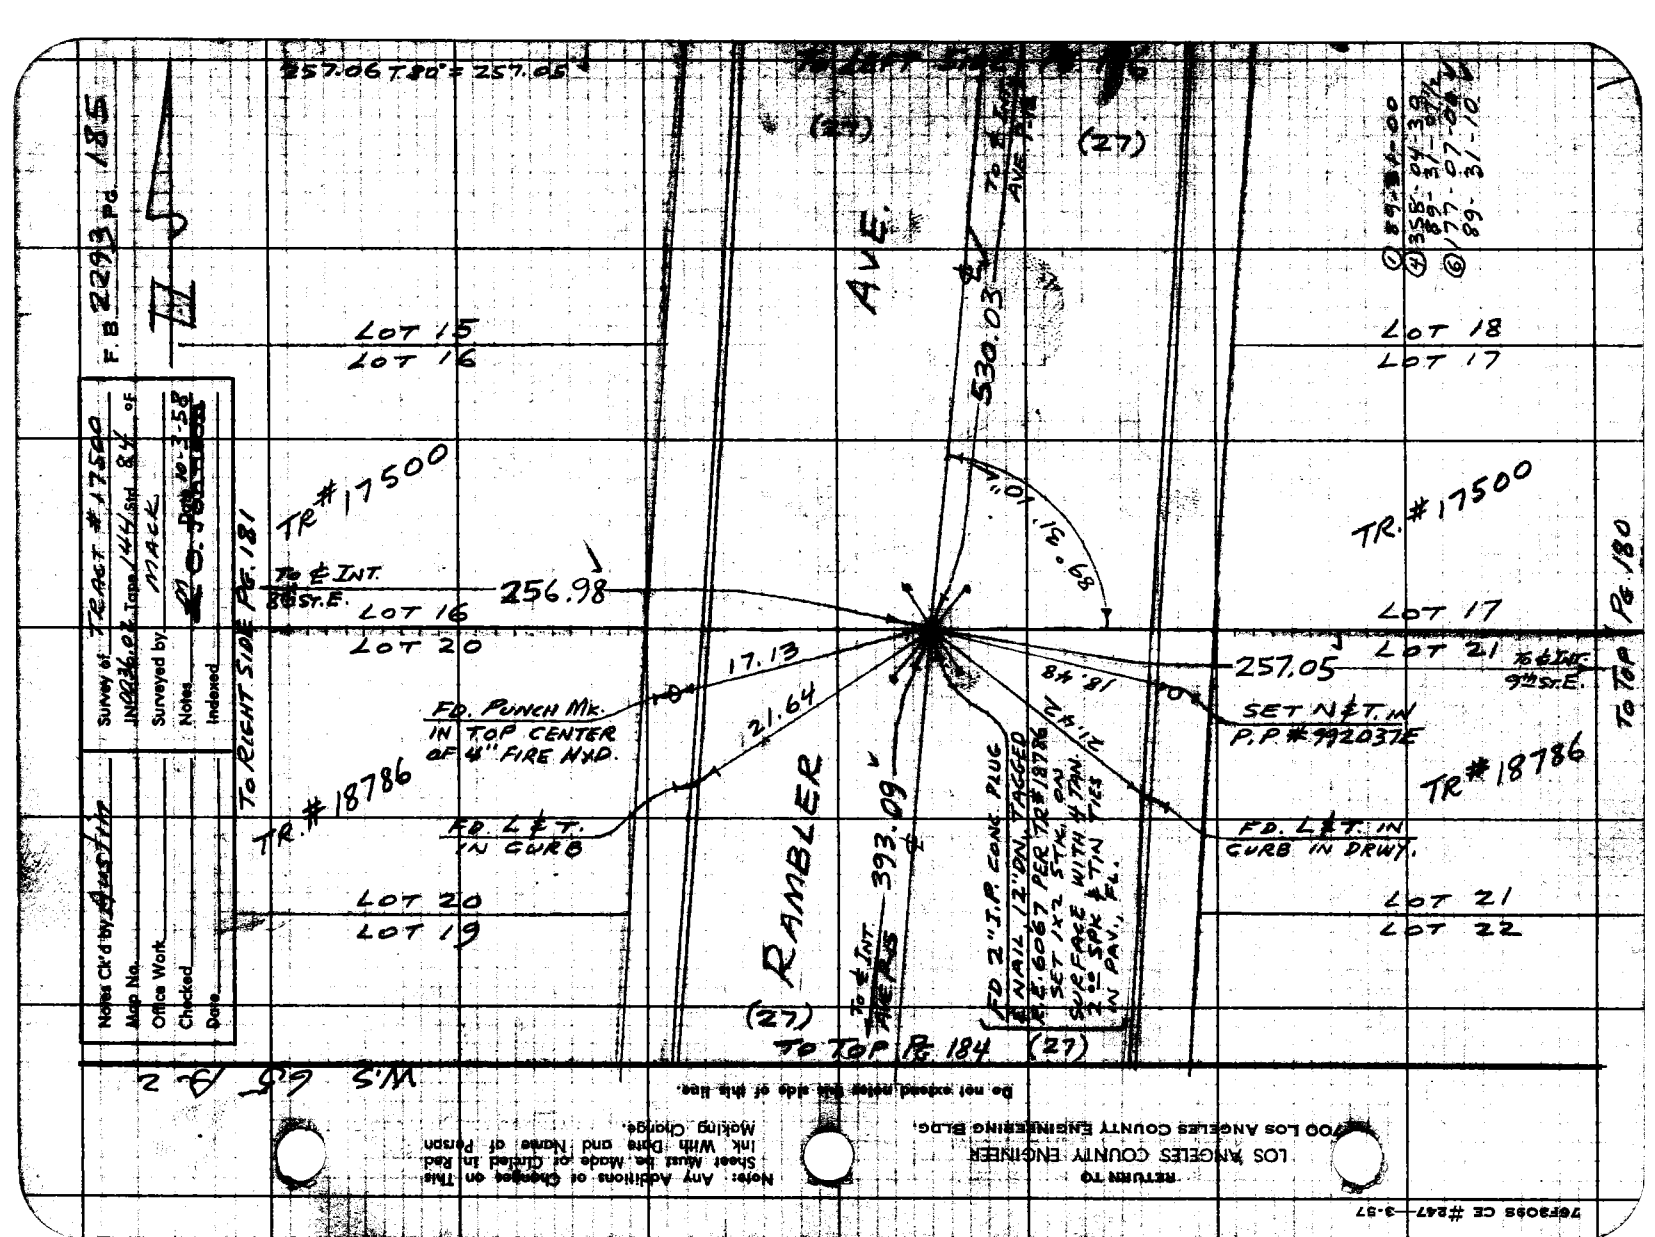
257.06 T.80' = 257.05
AVE.
(27)
To ℄ Ave.
530.03
N 89° 31' 10" E
(4) 358.64-00
89-31-10
(6) 177.07-00
89-31-10
LOT 15
LOT 16
LOT 18
LOT 17
TR #17500
TR. #17500
256.98
LOT 16
LOT 20
LOT 17
LOT 21
To TOP Pg. 180
17.13
21.64
84.81
21.14
257.05
SET N℄ T.W. P.P. #992037E
FD. PUNCH MK. IN TOP CENTER OF 4" FIRE HYD.
FD. L℄T. IN CURB
FD. L℄T. IN CURB IN DRWY.
TR #18786
TR #18786
LOT 20
LOT 19
LOT 21
LOT 22
RAMBLER
393.09
FD 2" I.P. CONC. PLUG & NAIL, 12" DN. TAGGED R.E. 6067 PER TR #18786 SET 1x2 STK. ON SURFACE WITH 4 TIN ℄ SPK ℄ TIN IN PAV., FL.
(27)
To TOP Pg. 184
(27)
To RIGHT SIDE Pg. 181
W.S. 6.5 B-2
F.B. 2293 Pg. 185
Survey of TRACT #17500
IN 1/4 Sec. 2 Twp. 1N Rng. 8W
Surveyed by: MACK
Notes
Checked
Date
Notes Ck'd by: Austin
Map No.
Office Work
Indexed
Rec. Feb 10-3-58
RETURN TO LOS ANGELES COUNTY ENGINEER 900 Los Angeles County Engineering Bldg.
Note: Any Additions or Changes on This Sheet Must be Made of Called in Red Ink With Date and Name of Person Making Change.
Be not extend beyond this side of this line.
7695095 CE #247—3-57

Notes Ck'd by Austin
Map No.
Office Work
Checked
Date

Survey of TR#17500
JN 0036.02 Tape 144 Std 84 °F
Surveyed by MACK
Notes M. Date 10-31-
Indexed C. Jahn

F. B. 2298 Pg. 18

F-8

AVE.

(26+58.22 N
INT
FD 2" I.P. CONC
REIG & NAIL, 16" DN
TAGGED "L.A.C.
RD. DEPT." PER
R.D.F.B. 337-76.
SET 1X2 STK.
ON SURFACE
SEE PG. 182

W.S. 6.0 - P-12

1338.26 M = 1338.10'

EAST

1338.10' M.

NW COR LOT 54
FD OLD 4X4 STK
PER TR# 7670
SEE PG. 178

NE. COR LOT 54
FD OLD 4X4 STK
PER TR# 7670
SEE PG. 179

NE. COR LOT 67
SEARCHED FOR 2" I.P.
PER TR# 7670
NO FIND.

EAST

(13+20.22 N
FD SPK & TIN, FL
PER TR#17500
SEE PG. 178

0.04'

(25)

AVE.

P-12

(11+90 N
INT
2" I.P. "DN
TAG "L.A.C. ENGR."
SEE PG. 175

N35.00 REC. — 640.00 REC. (20)

LOT 54 LOT 67

TRACT #7670

530.08 M = 530.08' REC.

(25)

(6+60.12 N
FD. BT. SPK & TIN
FL. PER TR#17500
SEE PG. 181

(20)

8th St.

660.12 M

660.20 M = 660.12'

10th St.

INT: 0+00 N
FD 2" I.P. 16" DN
TAG "L.A.C. ENG. DEPT."
PER R.D.F.B 337-76
SET 1X2 STK. FL.
SEE PG 181

AVE.

Q

℄

RETURN TO
LOS ANGELES COUNTY ENGINEER
900 Los Angeles County Engineering Bldg.

Do not remove any data tie sheets of this kind.

Note: Any Additions or Changes on This Sheet Must Be Made or Circled in Red Ink With Date and Name of Person Making Change.

76F209S CE #247—3-57

RETURN TO
LOS ANGELES COUNTY ENGINEER
700 LOS ANGELES COUNTY ENGINEERING BLDG.

NOTE: Any Additions or Changes on This Sheet Must be Made or Circled in Red Ink With Date and Name of Person Making Change.

Do not extend notes this side of this line.

WS. 66 Az
620.36 T62 = 620.27 V

To LOWER LEFT SIDE PG 180

TR #18786

LOT 49

0+40.01 N
S.E. Cor. LOT #49
TR # 18786
FD 2" I.P. CONC.
PLUG & NAIL, 1.2' N
TAG R.E. 6.67
PER TR # 18786

620.27 To 62 FA
6.00 OFFSET W.

0+39.96 N
SET 1X1 STK. FL.
ON 6' OFFSET W.

0.05
6.00

LOT 68

TRACT # 7670

LOT 68

FD. LEAD IN CURB

45° 11" M

42.55

28°

90°

39.96

23.31

SET X IN CONC
WEIR BOX, 18" UP

(40)
(40)
(20)
(20)

To INT.
RAMBLER AVE
397.07

60.19

666.10 V

To SEC. COR.
AT 10th ST E

INT = 7+26.29 W.
FD 4 TAN SPK
4 TIES IN
PAV, FL

0+00 N = 6+66.10 W =
INT 6' OFFSET W
SET BT. SPK. W & T.
IN PAV, FD. BY INT.

14.97
PROD.

SET 1X2 STK. FL.
ON PROD. FROM N

SET NAIL IN
STEL. POLE
#605998 H

9th ST E

To LOWER RIGHT SIDE PG 184

To LOWER RIGHT SIDE PG 188

R 2293 Pg 188

336.92 T66 = 336.88 V
60.24 T66 = 60.19 V
397.07 V

To TOP PG 181

Noted Ck'd by: [illegible]
Map No.
Office Work
Checked
Pone

Survey of: TR #17699
JN 0036.02 Tape 144 Sht. 84 °F
Surveyed by MACK
Notes M. Date 12-12-58
Indexed C. Jo[illegible]

F. B. 2293 PG 189

To Bot. Pg. 188

To Int. 6' Offset

(20)

AVE.

TR # 7610

666.18 = 666.10

666.10

Q

SET SPK & TIN IN PAV., PT.

SET N.E.T.IN P.P. #1070643E.

(20)

90°

28'

66.71

43.00

3.00

30'

10TH ST. E.

1313.19

To SPK in Pav., Pt.

SET SPK & TIN IN PAV., PT.

32.35

08.42

SET N.E.T.IN TEL. POLE #5643514

0+00 ON = 0+00 W = Cor. Secs 23, 24, 25, 26 T6N R12W

FD. C.S. MON. 2" I.P. IN CONC. 10' ON & IN WELL PER C.S. 87.38, WITH BRASS CAP MARKED

COUNTY T6N R12W 23 24 25 26

SURVEY MONUMENT

FD. 3/4" IN 2" STEEL FENCE COR. PIPE 7" UP

FD. X IN WIRE 12" UP PEAK

1313.29 T72 - 1313.19

Note: Any Additions or Changes on This Sheet Must Be Made or Dated In Red Ink With Date and Name of Person Making Change.

Do not extend notes left side of this line.

LOS ANGELES COUNTY ENGINEER
900 Los Angeles County Engineering Bldg.

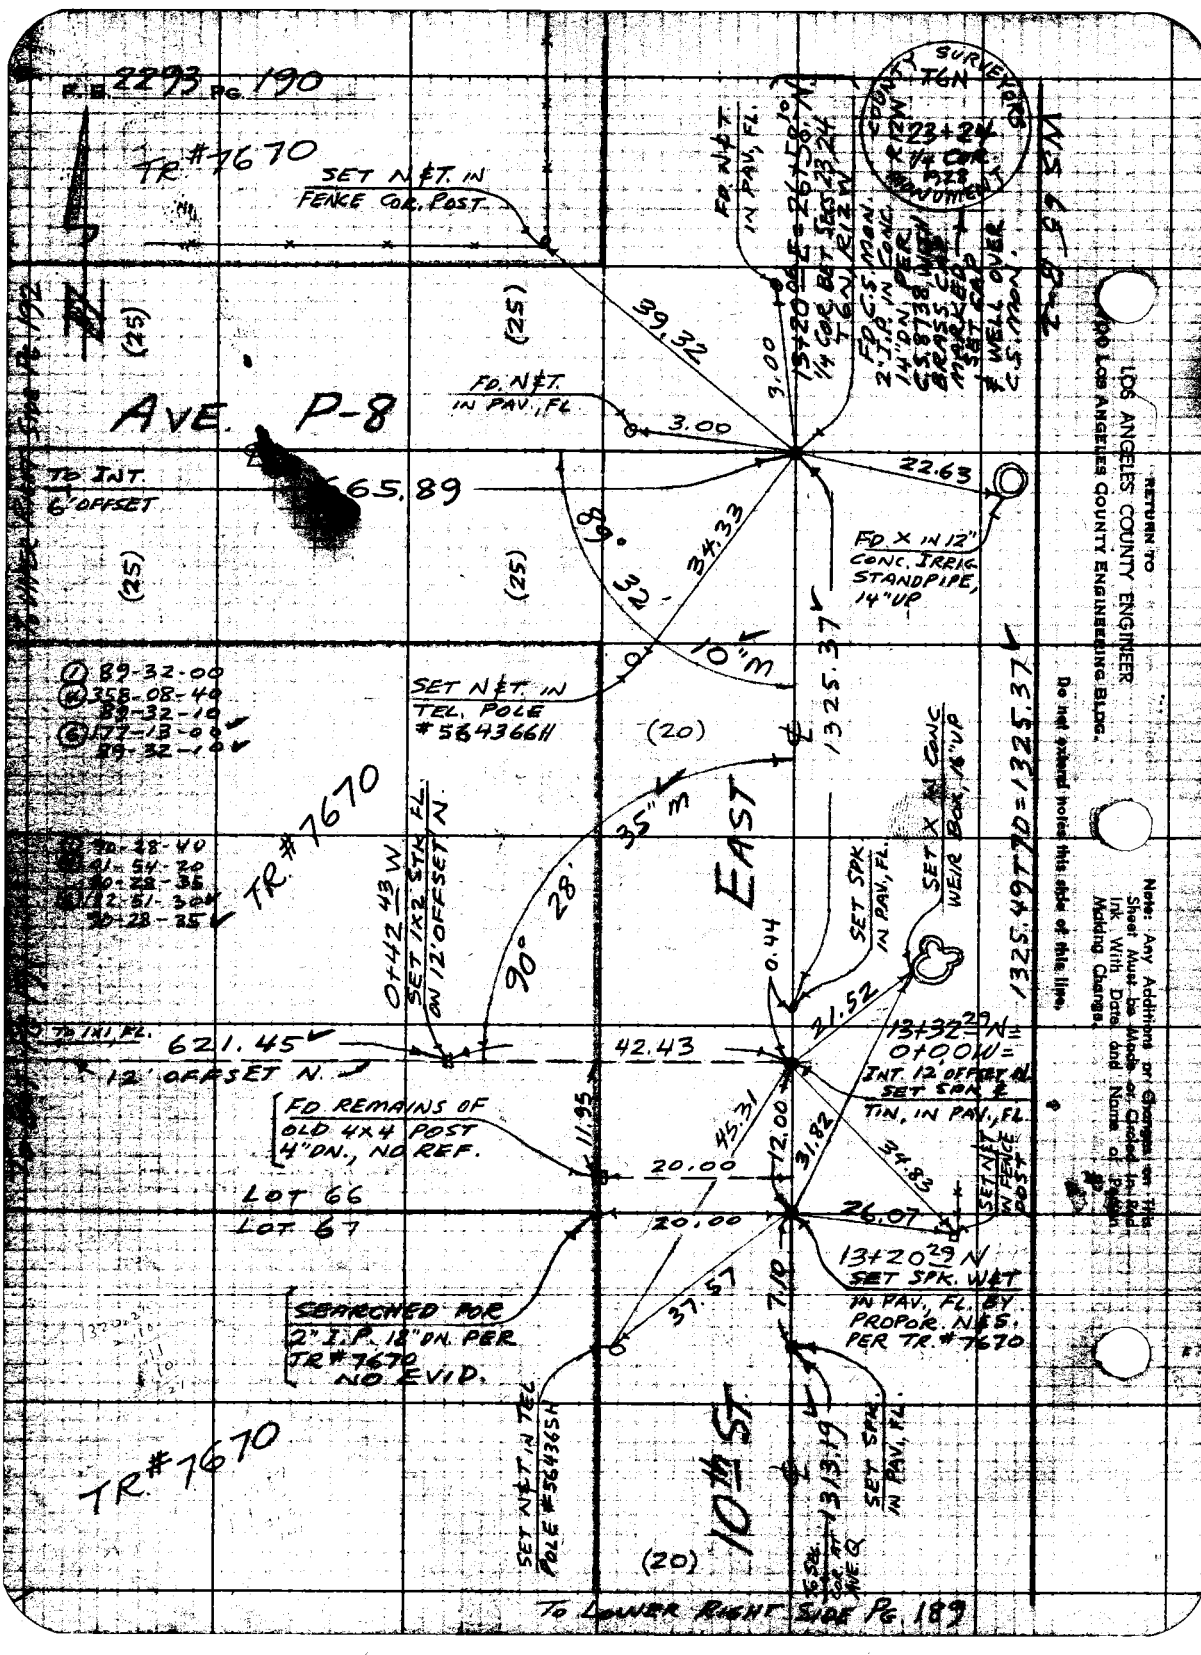
P.B. 2273 Pg. 190
TR #7670
SET N.ET. IN FENCE COR. POST
FD. N.ET. IN PAV., FL.
FD. N.ET. IN PAV., FL.
SURVEY TGN
N23+24
1/4 COR. SEC. 23
FD C.S.MON. 2" I.P. IN CONC. 14" DN. PER C.S. 8738 (1967) BRASS CAP MARKED SET CAD & WELL OVER C.S.MON.
99.32
3.00
3.00
22.63
65.89
TO INT. 6' OFFSET
AVE. P-8
(25)
(25)
(25)
89-32-00
358-08-40
89-32-10
177-13-00
89-32-10
FD. X IN 12" CONC. IRRIG. STANDPIPE, 14" UP
34.33
89° 32'
10" M
SET N.ET. IN TEL. POLE #5643661
(20)
1325.37
1325.49 TO = 1325.37
LOS ANGELES COUNTY ENGINEER
900 Los Angeles County Engineering Bldg.
RETURN TO
Do not extend notes this side of this line.
Note: Any Additions or Changes on This Sheet Must be Made or Dated and Initialed in Ink With Date and Name of Person Making Changes.
TR #7670
EAST
35" M
SET X IN CONC WEIR BOX, 16" UP
SET SPK IN PAV., FL.
0.44
21.52
90° 28'
0+42.43 W SET 1"x2" STK FL. ON 12' OFFSET N.
42.43
13+32.29 N = 0+00.00 W = INT. 12' OFFSET N. SET SPK & TIN, IN PAV., FL.
621.45
TO INT. FL.
12' OFFSET N.
FD. REMAINS OF OLD 4"x4" POST 4" DN., NO REF.
11.95
45.31
12.00
31.82
34.83
SET N.ET. IN FENCE POST
20.00
20.00
26.07
LOT 66
LOT 67
13+20.29 N SET SPK. WET IN PAV., FL. BY PROPOR. N&S, PER TR. #7670
SEARCHED FOR 2" I.P. 18" DN. PER TR #7670 NO EVID.
37.57
7.10
SET N.ET. IN TEL. POLE #5643635
10TH ST.
(20)
SET SPK. IN PAV., FL.
13+13.19
TO LOWER RIGHT SIDE Pg. 189

Notes Ck'd by: Smith
Map No.
Office Work
Checked
Date

Survey of: TR#17500
JN0036.02 Tape, 144 Std., 84 of E
Surveyed by: MACK
Notes: M. Date: 12-12-58
Indexed: C. Johnson

F.B. 2293 Pg. 191

To Bot Pg 193

(4) 89-31-10
(4) 358-05-30
89-31-22½
(6) 177-08-40
89-31-26⅔

LOT 44
LOT 43

TR# 7670

12' OFFSET N

355.13

SET 1X1 STK. FL ON 12' OFFSET N.

89-31-25

2.23

355.13

TR#17500

7+96.16 W
SET 1X2 STK, FL. BY INT.

2.02

140.02

To SPARLETTA AVE R-12
10' OFFSET E. (PROD.)

SET 1X2 STK. FL. BY INT.
SEE Pg. 179

LOT 43
LOT 42

SET 1X1 STK. FL ON 10' OFFSET N.

130.11

129.82

89-31-03

LOT 55

13+15.67 N.
SET 1X2 STK. FL ON PROD. Florin St.

TP# 17500

16.68

655.44

To 1X2 STK FL
6' OFFSET W. (PROD.)

4.75

90°

6766.05 W = 13+32.35 N. INT.
SET 1X2 STK.
FL. BY INT.

310.30

6' OFFSET W. (PROD.)

(1) 89-30-50
(4) 358-04-10
89-31-02½
(6) 177-08-20
89-31-03⅓

5.71

6+63.88 W
SET 1X1 STK. FL ON 12' OFFSET N.

3.45

LOT 42
LOT 41

11.96

LOT 67

6+60.43 W = 13+20.42 N.
N.E. COR LOT 54
TR. #7670
SET 2" I.P. CONC. PLUG & NAIL, 12" DN. TAGGED "L.A.C. ENGR.", A REPLACEMENT OF OLD 4X4 STK. PER TR#7670
SEE Pg. 179

LOT 55
LOT 66

621.45

12' OFFSET N

TR# 7670

LOT 67
LOT 66

To Lower Left Side Pg 190

To Lower Right Side Pg 179

N 89-31-10 W 1320.00

Notes: Any Additions or Changes on This Sheet Must Be Made or Ordered by Red Ink With Date and Name of Person Making Change.

Do not extend notes into this area of this sheet.

Surveyor to ...
LOS ANGELES COUNTY ENGINEER
2200 Los Angeles County Engineering Bldg.

7500S CE #47 7-55

F.B. 2293 PG. 192

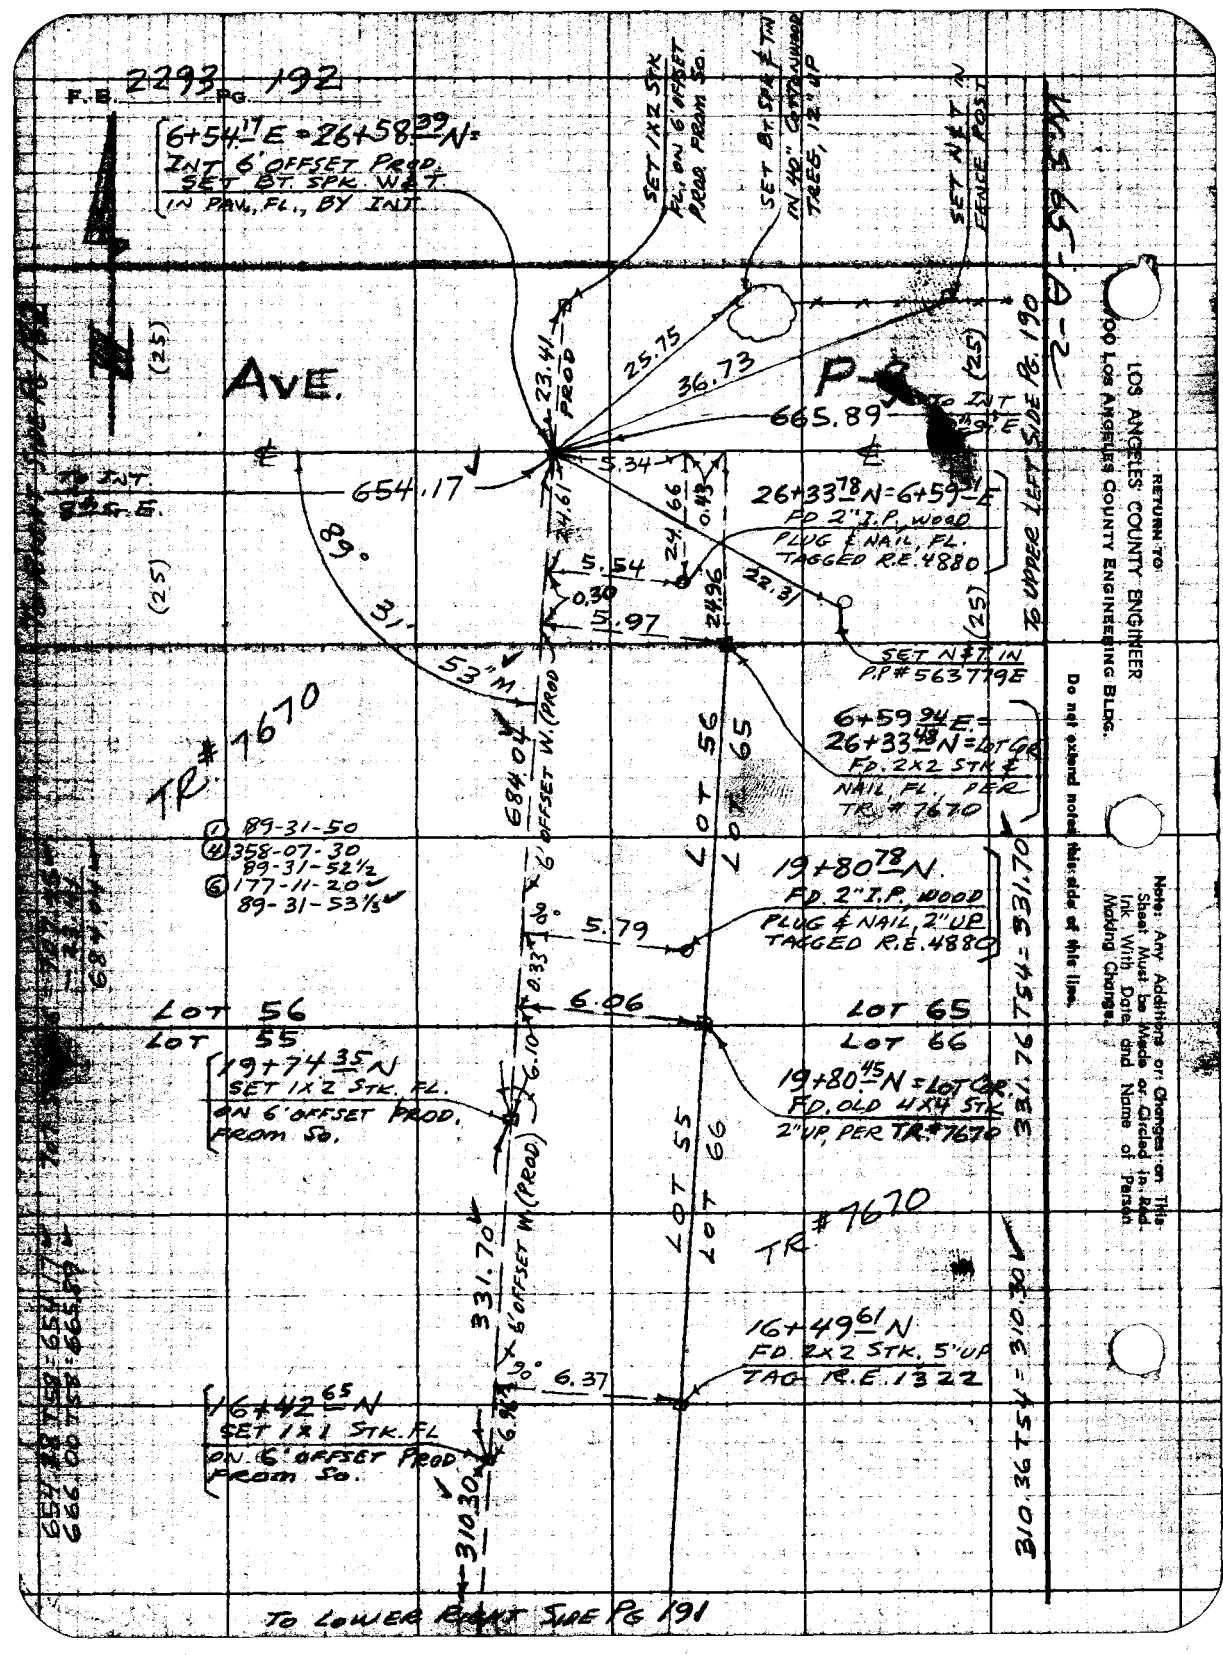

Notes Ck'd by: Austin
Map No.
Office Work
Checked
Date

Survey of: TR. #17500
JN 0036.02 Tape: 144 Std. 84 °F
Surveyed by: MACK
Notes: M. C. Johnson Date: 12-12-58
Indexed

F. B. 2293 Pg. 193

To Top Pg. 182

(25)

8th ST

EAST

SET SPK & TIN IN PAV., FL. BY INT. SEE PG. 178

13+20.21 W. INT. 12' OFFSET N. SET BT. SPK & TIN IN PAV., FL.

9.68 2.31

130.02 E INT. AVE P.12

0.04 12.00 12.00 90°

13+20.26 W. FD. SPK & TIN IN PAV., FL. FOR TR. LINE INT. PER TR.# 17500 SEE PG. 178

25.15 29.23 90°

12.29

31° 10" M

89°

12.97

4.13

12+95.11 W. N.W. COR LOT 54 TR. # 7670 FD. OLD 4X4 STK & NAIL, 3" UP PER TR.# 7670 SEE PG. 178

① 89-31-00
④ 358-04-40
89-31-10
⑥ 177-07-00
89-31-10

12+90.98 W. SET 1X1 STK, FL ON 12' OFFSET N.

Lot 54

Lot 55

TR # 7670

12' OFFSET N.

139.69

11+57.84 W. N.W. COR LOT 48 TR.#17500 SET 2" I.P. CONC PLUG & NAIL, 12" ON TAGGED "L.A.CO. ENGR." SEE PG. 178

12.22

6.55

11+51.29 W. SET 1X1 STK, FL. ON 12' OFFSET N.

Lot 48

TR # 17500

Lot 48
Lot 47

Lot 55

TR # 7670

355.13

To Top Pg. 191

Note: Any Additions or Changes on this Sheet Must be Made or Dated in Red Ink With Date and Name of Person Making Change.

Do not extend notes this side of this line.

RETURN TO
LOS ANGELES COUNTY ENGINEER
900 Los Angeles County Engineering Bldg.

7-58
765008 CE #247

Notes Ck'd by		Survey of SEC. LINES, T7N, R11W	F. B. 2293 PG. 195
Map No.		JN 0302.01 Tape 144 Std. 84 °F	
Office Work		Surveyed by MACK	
Checked		Notes M Date 12-18-58	
Date		Indexed J. C. Johnson 7-6-59	

J.N. 0302.01

TIES TO C.E. MON.

REPLACING C.S. MON.

ON

30th ST E & AVE L

PARTY:
MACK
HALISCKY
RITTER
H.E. MITCHELL
TEMPLETON

Note: Any Additions or Changes on This Sheet Must be Made or Circled in Red Ink With Date and Name of Person Making Change.

Do not extend notes this side of this line.

RETURN TO
LOS ANGELES COUNTY ENGINEER
900 LOS ANGELES COUNTY ENGINEERING BLDG.

785098 CE #247—7-57

F.B. 2293 PG. 196

EAST

SET N&T IN P.P. #426786

SET N&T IN P.P. #735728

58.54

SET SPK. & TIN IN PAV., FL.

43.05

3.00

66.01

3.00

SET SPK. & TIN IN PAV., FL.

SET X IN 4 FT. CONC. IRRIG STANDPIPE, 1.4' UP

FD. X IN CONC. BASE OF WATER TOWER

50.54

AVE.

COR. SECS 29, 30, 31, 32 T7N, R11W

FD. C.S. MON., 2" I.P. IN CONC., 37" DN., PER C.S. 8737, WITH BRASS CAP MARKED

SET C.E. MON. OVER OLD C.S. MON.; 2" I.P. IN CONC., 10" DN. IN WELL, WITH BRASS CAP MARKED

WM MACK 12-18-58

SURVEY MON. T7N R11W 30 29 31 32 1926 LOS ANGELES CO. ENGR.

COUNTY ENGINEER T7N R11W 30 29 31 32 R.E. 5869

58.82

SET N&T IN P.P. #938154

30th ST.

INVITO B-5

RETURN TO
LOS ANGELES COUNTY ENGINEER
900 Los Angeles County Engineering Bldg.

Do not extend notes this side of this line.

Note: Any Additions or Changes on This Sheet Must be Made or Circled in Red Ink With Date and Name of Person Making Change.

Notes Ck'd by
Map No.
Office Work
Checked
Date

Survey of SEC. LINES T5N, R10, 11W
JN 0302.01 Tape 144 Std. 84 °F
Surveyed by MACK
Notes [illegible] Date 1-16-59
Indexed [illegible] C. Johnson

F. B. 2293 Pg. 197

J.N. 0302.01

SEC. LINE TIES

ON

AVE. U

BET. 77th & 92nd STS. E.

Note: Any Additions or Changes on This Sheet Must be Made or Circled in Red Ink With Date and Name of Person Making Change.

Do not extend notes this side of this line.

RETURN TO
LOS ANGELES COUNTY ENGINEER
900 LOS ANGELES COUNTY ENGINEERING BLDG.

PARTY:
MACK
HALISCKY
H.E. MITCHELL
TEMPLETON

76F3095 CE #247—3-57

F. B. 2293 Pg. 198

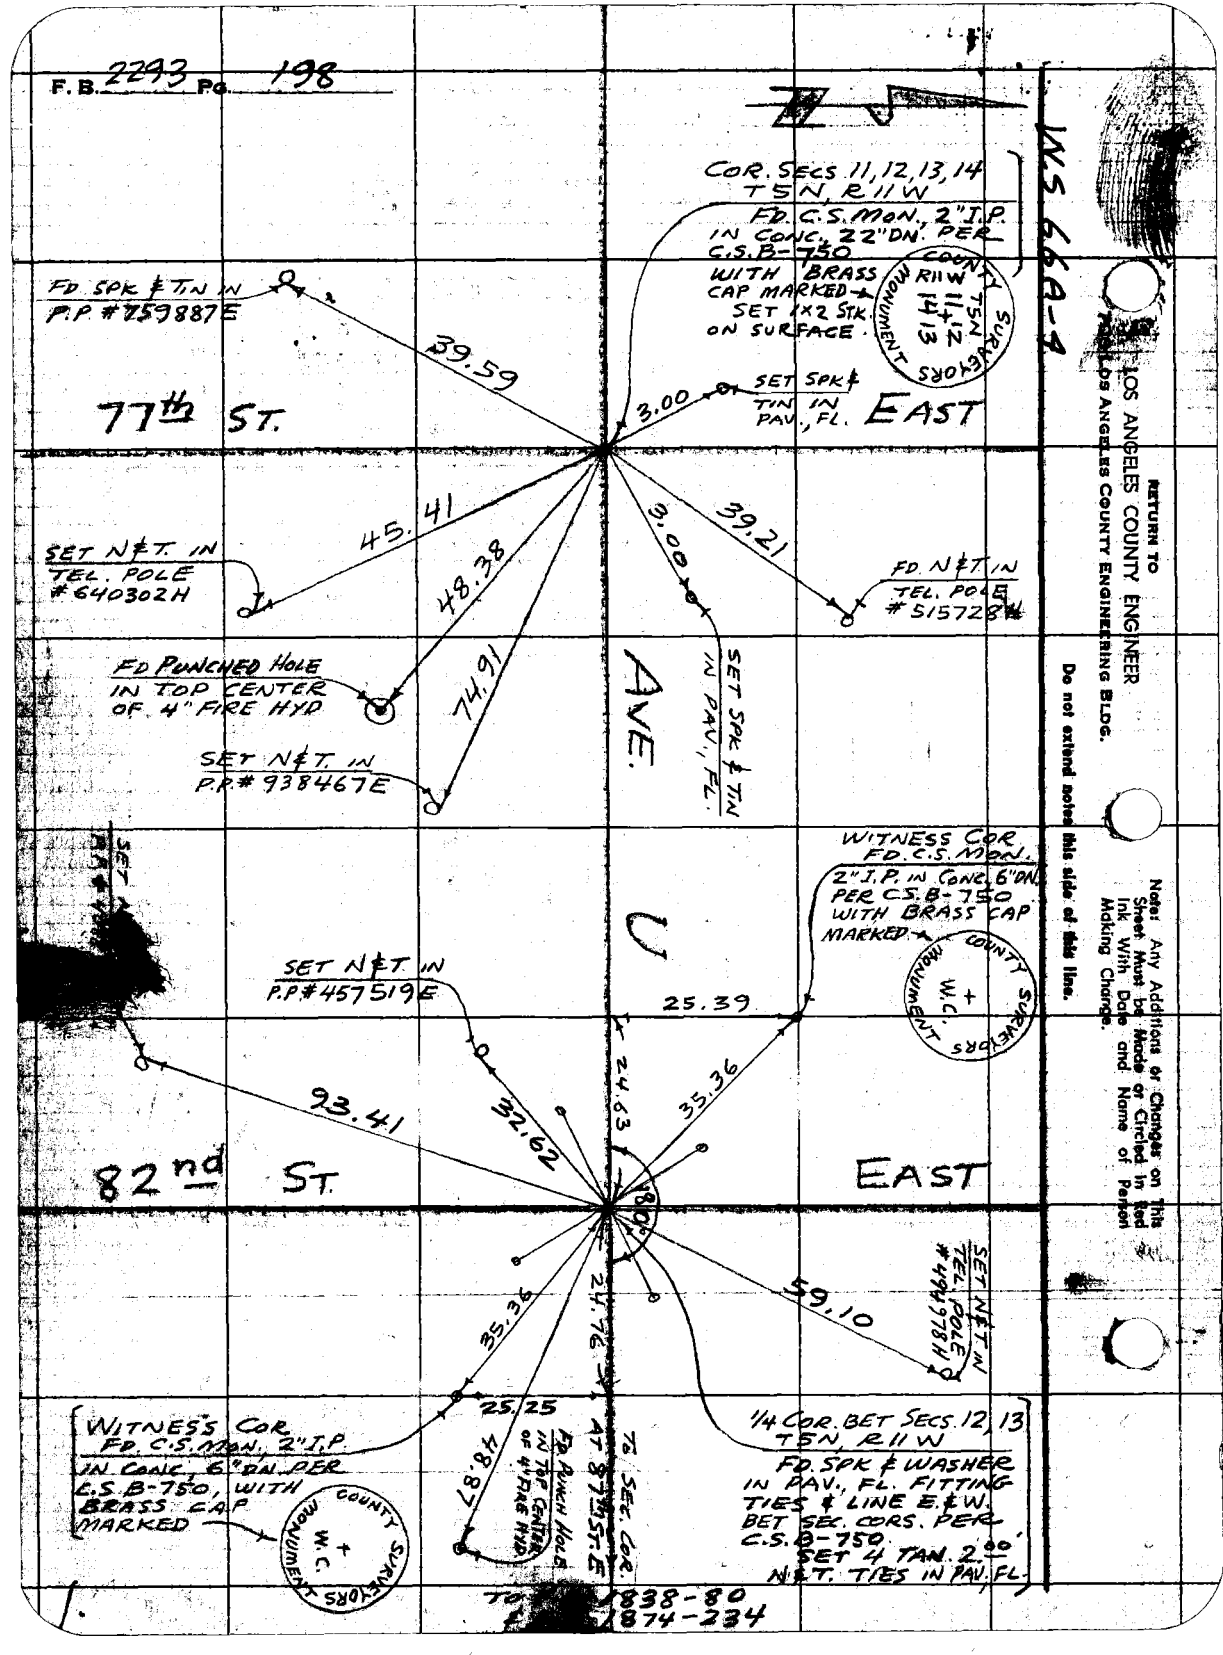

WS 66A-4

RETURN TO
LOS ANGELES COUNTY ENGINEER
LOS ANGELES COUNTY ENGINEERING BLDG.

Do not extend notes this side of this line.

Note: Any Additions or Changes on This Sheet Must be Made or Circled in Red Ink With Date and Name of Person Making Change.

Notes Ck'd by
Map No.
Office Work
Checked
Date

Survey of SEC. LINES, T5N, R10,11W
JN 0302.01 Tape 144 Std 84 °F
Surveyed by MACK
Notes M Date 1-16-59
Indexed C. Johnson

F. B. 2293 Pg. 199

To F.B. 1838-80
& F.B. 1874-234

To Sec. Cor. at 87th St. E

SET N¢T IN P.P. # 390432E

FD PUNCH HOLE IN TOP CENTER OF 4" FIRE HYD.

FD. X IN 36" CONC. STANDPIPE, 24" UP

78.76
58.94
51.60

AVE.

92nd ST.

EAST

1/4 COR. BET SECS 7, 18 T5N, R10W
FD. C.S. MON. 2" I.P. IN CONC., 8" DN., PER C.S. 8734, WITH BRASS CAP MARKED ↑ SET 1x2 STK. ON SURFACE WITH 4 TAN. 200' STK. & TIN TIES, FL.

COUNTY SURVEYORS MONUMENT R10W T5N 18 7 1/4 COR.

74.30

SET N¢T IN 390[illegible]

136.28

SET N¢T IN P.P. # 390420E

To Sec. Cor. at 96th St. E

To F.B. 1824-22

Notes: Any Additions or Changes on This Sheet Must Be Made or Circled In Red Ink With Date and Name of Person Making Change.

Do not extend notes this side of this line.

RETURN TO
LOS ANGELES COUNTY ENGINEER
900 Los Angeles County Engineering Bldg.

76F3098 CE #247—3-57

F.B. 2293 Pg. 200

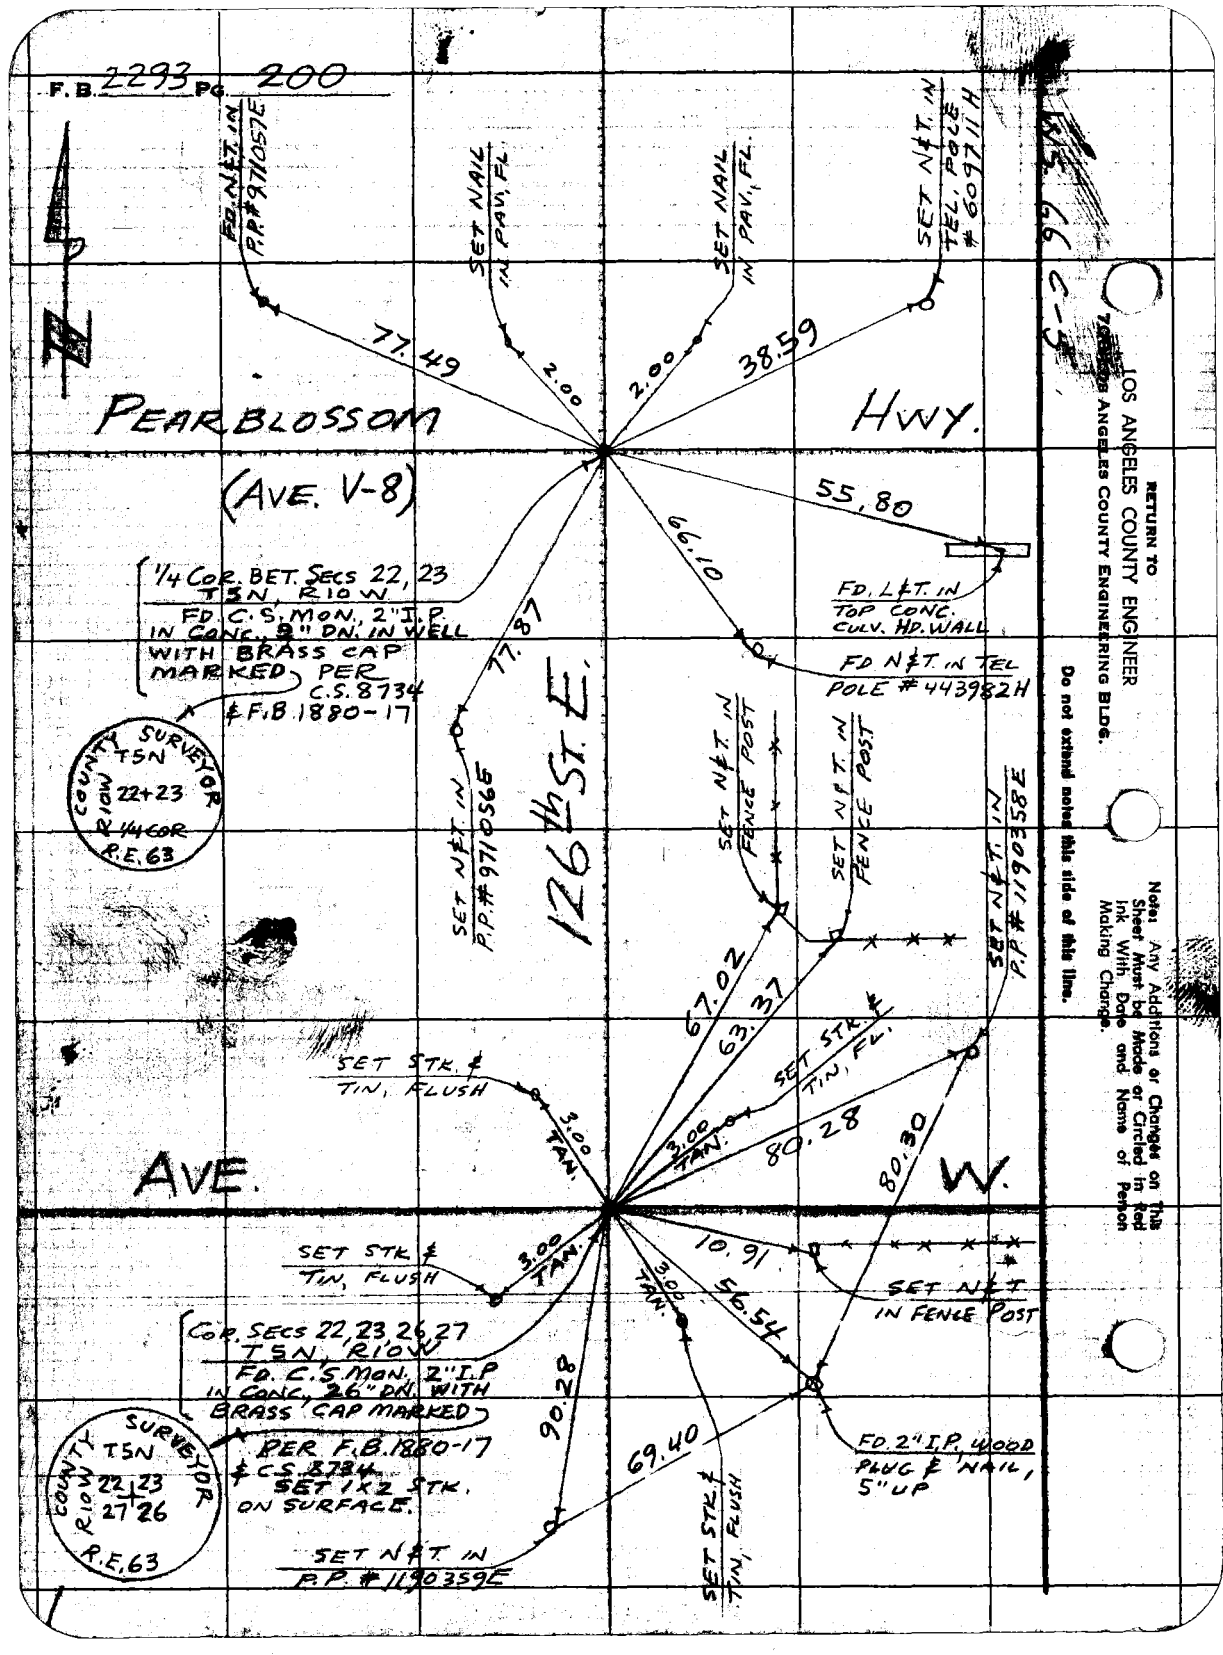

RETURN TO
LOS ANGELES COUNTY ENGINEER
LOS ANGELES COUNTY ENGINEERING BLDG.

Do not extend noted this side of this line.

Note: Any Additions or Changes on This Sheet Must be Made or Circled in Red Ink With Date and Name of Person Making Change.

Notes Ck'd by		Survey of SEC. LINES, T6N, R11W	F. B. 2293 PG. 201
Map No.		JN 0302.01 Tape 144 Std 84 °F	
Office Work		Surveyed by MACK	
Checked		Notes M Date 2-13-59	
Date		Indexed C. Johnson 7-2-59	

J.N. 0302.01

RE-ESTABLISHMENT OF C.E. MON. ON AVE. P & 20TH ST. E.

Notes: Any Additions or Changes on This Sheet Must Be Made or Circled in Red Ink With Date and Name of Person Making Change.

Do not extend notes this side of this line.

RETURN TO
LOS ANGELES COUNTY ENGINEER
2700 LOS ANGELES COUNTY ENGINEERING BLDG.

PARTY
MACK
HALISCKY
RITER
H.E. MITCHELL
TEMPLETON

763098 CE #247—7-59

RETURN TO
LOS ANGELES COUNTY ENGINEER
700 LOS ANGELES COUNTY ENGINEERING BLDG.

Note: Any Additions or Changes on This Sheet Must be Made or Circled in Red Ink With Date and Name of Person Making Change.

Do not extend notes this side of this line.

W.S 65 B-2

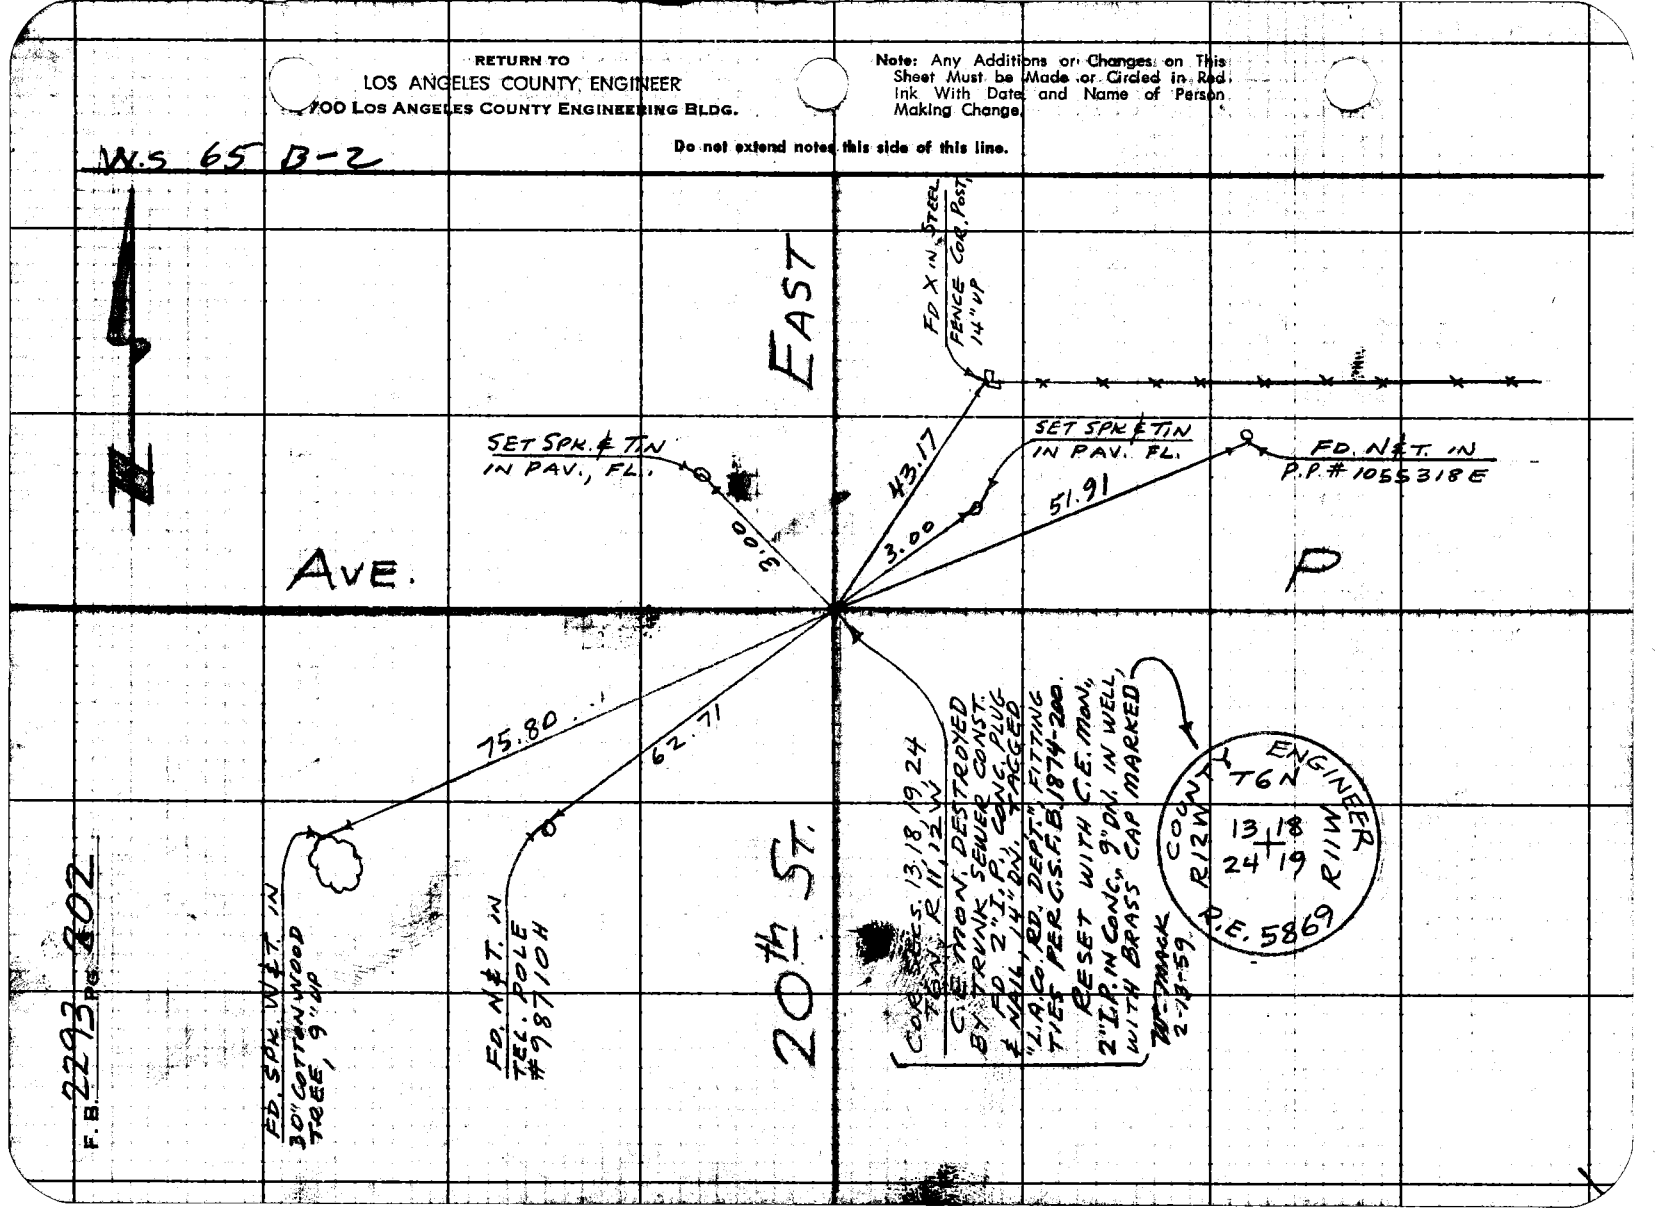


Notes Ck'd by	Survey of SECS 8 & 17 T6N R9W	F. B 2293 Pg. 203
Map No.	JN 0302.01 Tape 144 Std. 84 °F	
Office Work	Surveyed by S. HALISCKY	
Checked	Notes S. H Date 3-9-59	
Date	Indexed A. C. Johnson 4-20-59	

J.N. 0302.01

1/4 SECTION CORNER TIES BET SECS. 8 & 17 T6N, R9W

PARTY
HALISCKY
RITTER
TALBOT
MITCHELL
TEMPLETON

Note: Any Additions or Changes on This Sheet Must Be Made or Circled In Red. Ink With Date and Name of Person Making Change.

Do not extend notes this side of this line.

RETURN TO
LOS ANGELES COUNTY ENGINEER
700 LOS ANGELES COUNTY ENGINEERING BLDG.

765098 CE #247—7-58

RETURN TO
LOS ANGELES COUNTY ENGINEER
700 LOS ANGELES COUNTY ENGINEERING BLDG.

Note: Any Additions or Changes on This Sheet Must be Made or Circled in Red Ink With Date and Name of Person Making Change.

Do not extend notes this side of this line.

W.3 66 D-1

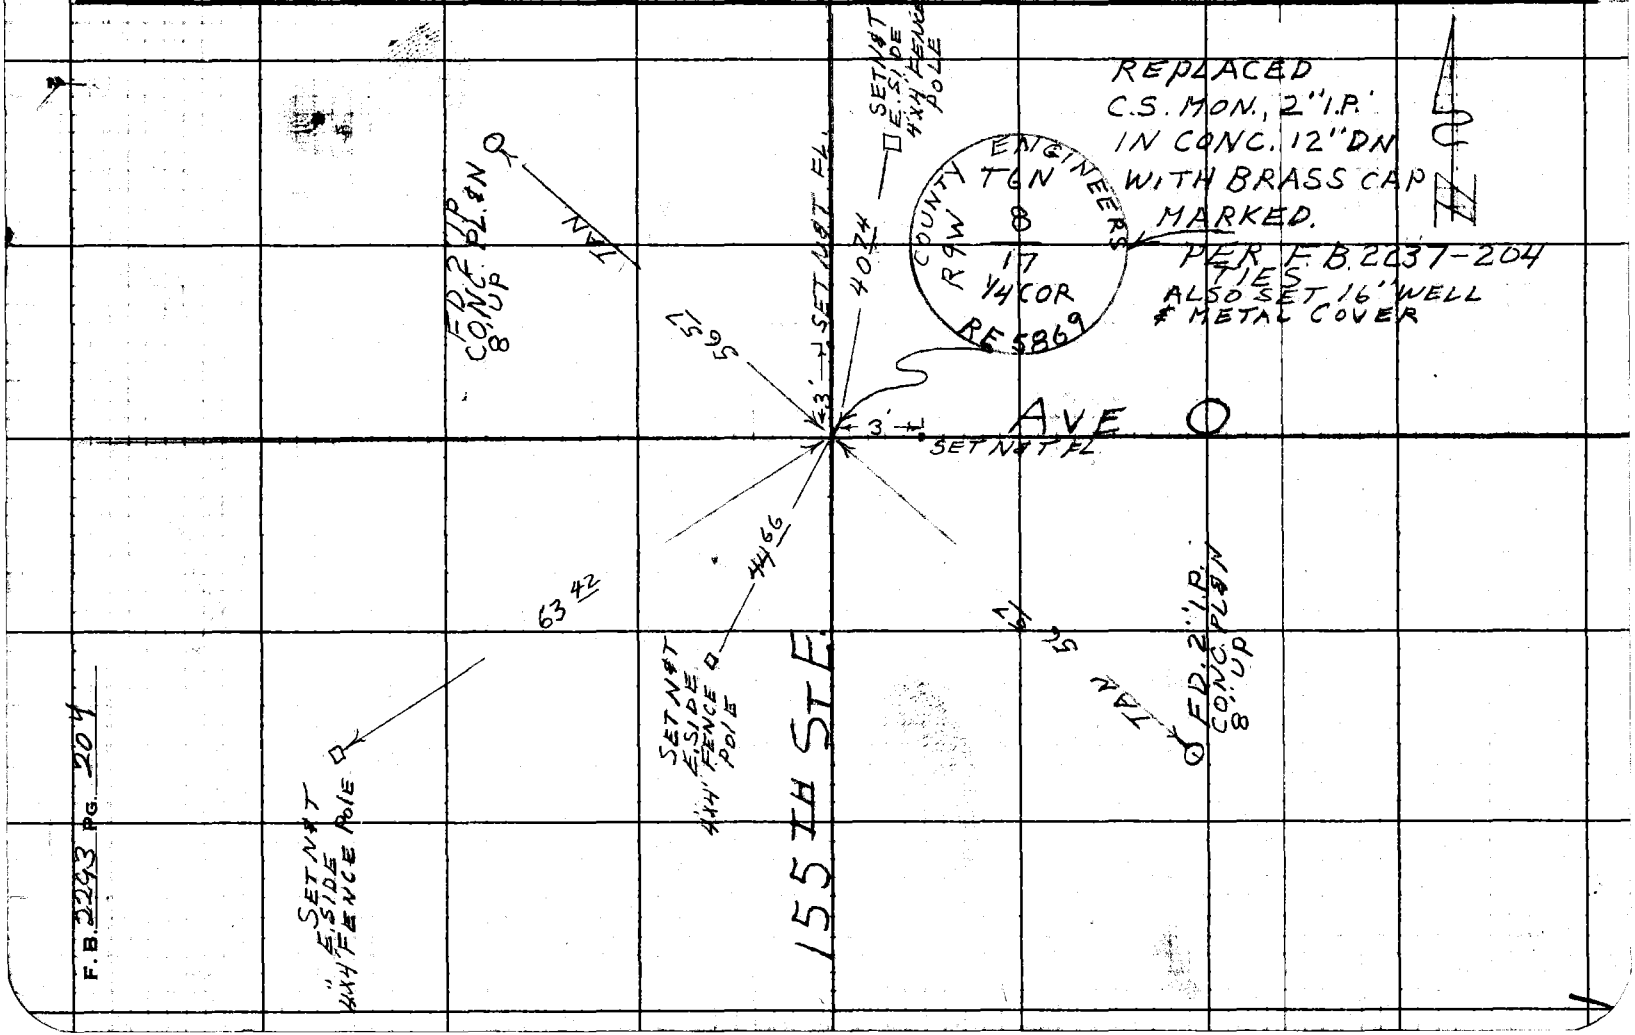
REPLACED
C.S. MON., 2" I.P.
IN CONC. 12" DN
WITH BRASS CAP
MARKED.
PER F.B. 2037-204
TIES
ALSO SET 16" WELL
& METAL COVER
COUNTY ENGINEERS
T6N
R9W
8
17
1/4 COR
RE 5869
SET NAIL & TAG
SET NAIL
SET NAIL & TAG
SET NAIL & TAG
FD 2" I.P. CONC. PLUG
FD 2" I.P. CONC. PLUG & TAG
SET NAIL & TAG
SET NAIL & TAG
SET NAIL

Notes Ck'd by H.E. AUSTIN	Survey of FIRE CISTERN DARLING #179	F.B. 2293 PG. 205
Map No. S.D. 149-37-65	JN 0038.06 Tape 196 Std 84 °F	
Office Work J.J. EDWARDS	Surveyed by J.C. PIERCE	
Checked H.E. AUSTIN	Notes J.C. PIERCE Date 10-28-63	
Date JAN. 1964	Indexed [illegible] NOV 5. 63	

J.N. 0038.06

FIRE CISTERN - DARLING #179

PARCEL 7 OF SECTION 22 T.5N. R.14W.

PIERCE
MENDONCA
TALBOT
HILL
ALBRIGHT

Note: Any Additions or Changes on This Sheet Must be Made or Circled in Red Ink With Date and Name of Person Making Change.

Do not extend this side of this line.

PLEASE RETURN TO
LOS ANGELES COUNTY ENGINEER
403 LOS ANGELES COUNTY ENGINEERING BLDG.

76F309S CE #310 8-62

F. B. 2293 PG 206

213

214 214

210 215

207 208 209

SEC. 22

T. 5 N. R. 14 W.

PLEASE RETURN TO
LOS ANGELES COUNTY ENGINEER
403 Los Angeles County Engineering Bldg.

Do not extend this side of this line.

Note: Any Additions or Changes on This Sheet Must be Made or Circled in Red Ink With Date and Name of Person Making Change.

Notes Ck'd by H. E. AUSTIN
Map No. S.D. 149-37-65
Office Work J.J. EDWARDS
Checked H.E. AUSTIN
Date JAN., 1962

Survey of FIRE CISTERN DARLING IT
JN 0038.06 Tape 196' Std 84 °F
Surveyed by J.C. PIERCE
Notes J.C. PIERCE Date 10-28-63
Indexed E. J. GALLI NOV 8 '63

F. B. 2293 PG. 207

W.S. 78 D-5

TO BOT PG. 210

COUNTY ENGINEER S.W. COR. PARCEL 7 R.E. 5869

SEC. 22
T. 5 N. R. 14 W.

SET N & T PK 640353 H

200.00

SEC. LINE

S.W. COR. PARCEL 7
SET A STD. C.E. MON.
DN. 6" MARKED AS SHOWN
11-29-63 J.M.

SET 1" I.P. & CO. ENG'R. TAG FLUSH FOR SW COR. LOT #7

15.00

90°

57.74

33.42

30.00

26.50" ✓

DARLING ROAD (30)

336.64 REC.
336.66 MEAS. ✓

SEC. LINE

(25)

TO BOT PG. 208

32.96

30.00

SET N & T 640352 H

FD 2x2 STK & TAG FL. L.S. 2646

0+00.00 TO N. CORNER SECTIONS. 21, 22, 27, 28, T. 5 N. R. 14 W. FD. A STD. CO. SURVEYORS B.C. MON. IN CONC. DN. 3" PER F.B. 97-69 SEE C.S.E. 900-2 STAMPED AS SHOWN

200.02 @ LEVEL (T=72) = 200.00 ✓

181.25 @ LEVEL =
156.64 @ 7°09' = 155.43 ✓
156.46 @ 6°36' = 155.42 ✓

181.25
155.42
336.67
(T=80) = 336.66 ✓

1) 90-26-40
4) 91-47-10
90-26-47½
6) 182-41-00
AVE) 90-26-50 ✓

COUNTY SURVEYORS 21 22 28 27 MONUMENT

PLEASE RETURN TO
LOS ANGELES COUNTY ENGINEER
403 LOS ANGELES COUNTY ENGINEERING BLDG.

Note: Any Additions or Changes on This Sheet Must be Made or Circled in Red Ink With Date and Name of Person Making Change.
Do not extend this side of this line.

76F3095 C.E. #310 8-62

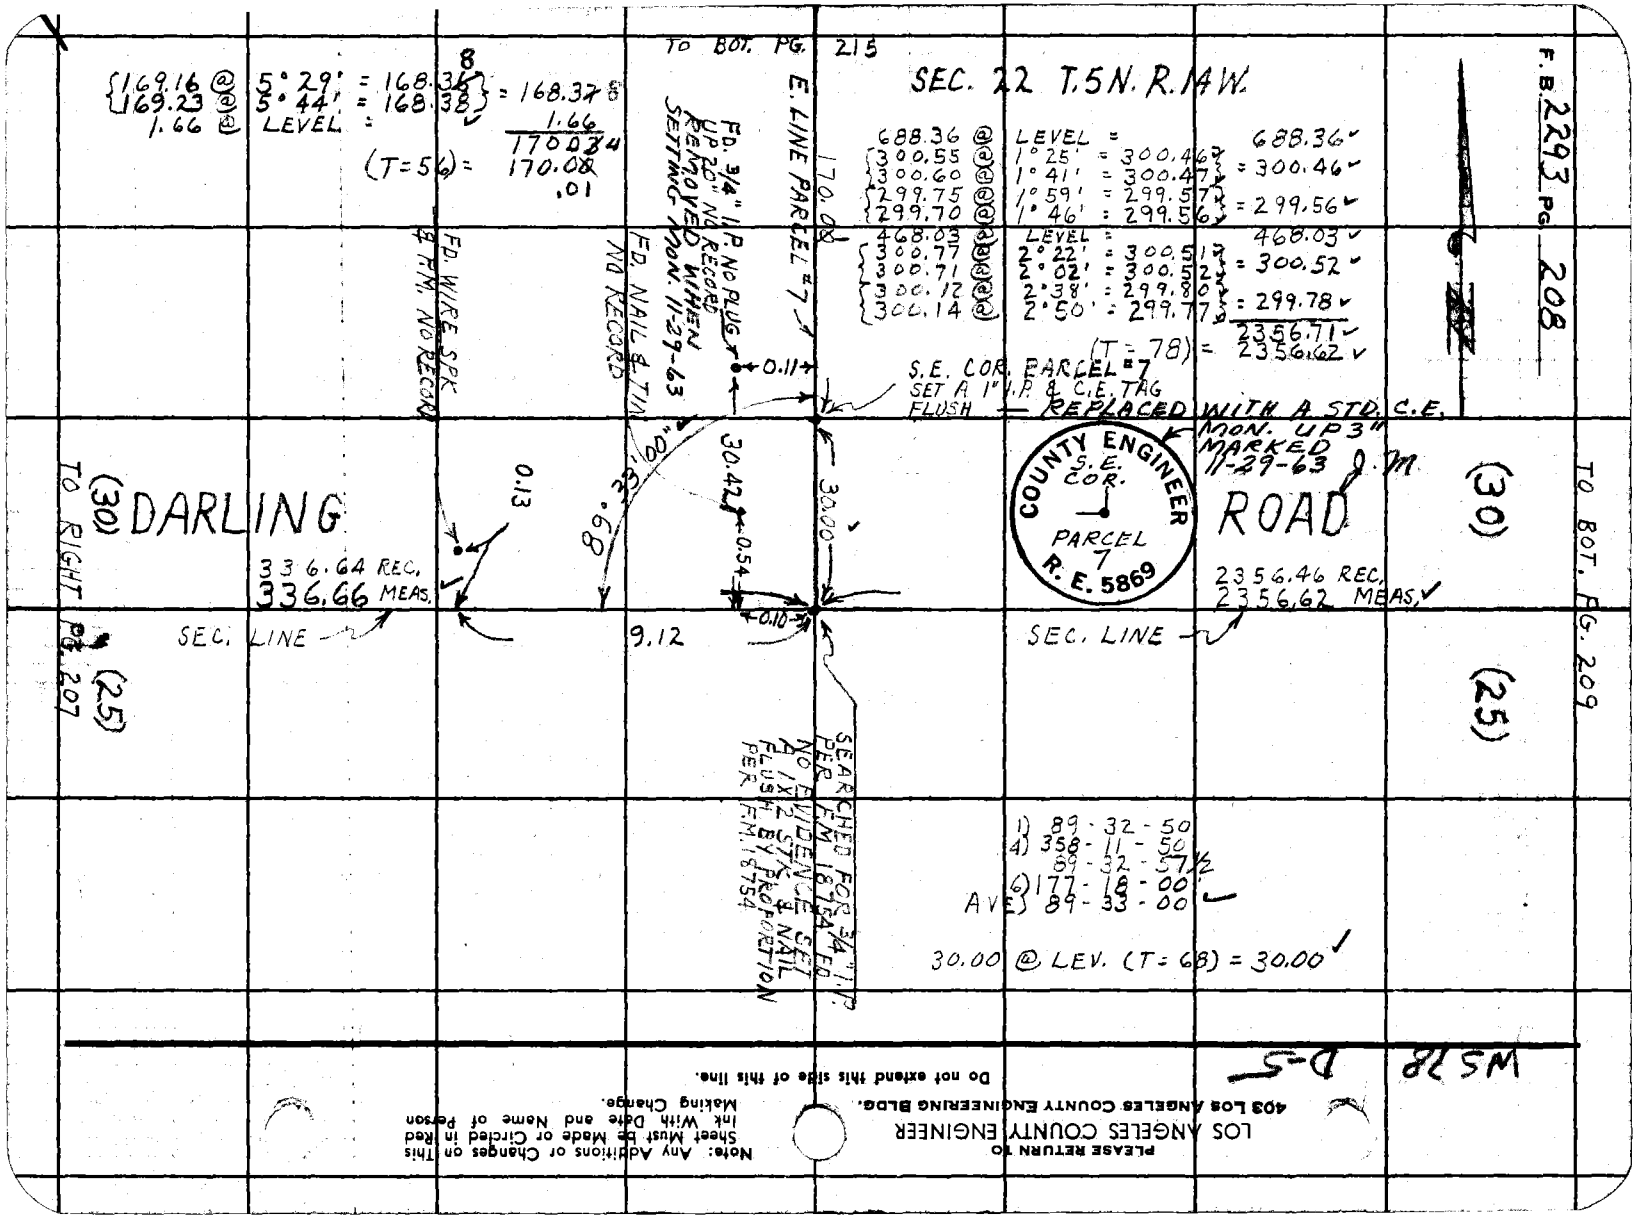
F.B. 2293 PG. 208
SEC. 22 T.5N. R.14W.
TO BOT. PG. 215
E. LINE PARCEL "7"
170.00
688.36 @@@@@ LEVEL = 688.36
300.55 1° 25' = 300.46
300.60 1° 41' = 300.47 = 300.46
299.75 1° 59' = 299.57
299.70 1° 46' = 299.56 = 299.56
468.03 @@@@@ LEVEL = 468.03
300.77 2° 22' = 300.51
300.71 2° 02' = 300.52 = 300.52
300.12 2° 38' = 299.80
300.14 2° 50' = 299.77 = 299.78
2356.71
(T = 78) = 2356.62
169.16 @@@@ 169.23 1.66
5° 29' = 168.36
5° 44' = 168.38 = 168.37
1.66
170.03
(T = 56) = 170.08
.01
FD. 3/4" I.P. NO PLUG UP 20" NO RECORD REMOVED WHEN SETTING MON. 11-29-63
FD. NAIL & TIN NO RECORD
FD. WIRE SPK & TIN NO RECORD
0.11
S.E. COR. PARCEL "7" SET A 1" I.P. & C.E. TAG FLUSH — REPLACED WITH A STD. C.E. MON. UP 3" MARKED 11-29-63 J.M.
COUNTY ENGINEER S.E. COR. PARCEL 7 R.E. 5869
30.42
0.13
89° 33' 00"
0.54
30.00
0.10
9.12
(30) DARLING ROAD (30)
TO RIGHT PG. 207
(25)
336.64 REC. 336.66 MEAS.
2356.46 REC. 2356.62 MEAS.
SEC. LINE
SEC. LINE
SEARCHED FOR 3/4" I.P. PER F.M. 18754 NO EVIDENCE SET 4"x4" STK. & NAIL FLUSH BY PROPORTION PER F.M. 18754
1) 89 - 32 - 50
4) 358 - 11 - 50
89 - 32 - 57½
6) 177 - 18 - 00
AVE) 89 - 33 - 00
30.00 @ LEV. (T = 68) = 30.00
TO BOT. PG. 209
(25)
D-5
M528
PLEASE RETURN TO
LOS ANGELES COUNTY ENGINEER
403 LOS ANGELES COUNTY ENGINEERING BLDG.
Note: Any Additions or Changes on This Sheet Must be Made or Circled in Red Ink With Date and Name of Person Making Change.
Do not extend this side of this line.

76F3095 CE #310 6-62

PLEASE RETURN TO
LOS ANGELES COUNTY ENGINEER
403 LOS ANGELES COUNTY ENGINEERING BLDG.

Note: Any Additions or Changes on This Sheet Must be Made or Circled in Red Ink With Date and Name of Person Making Change.

Do not extend this side of this line.

WS 78 D-5

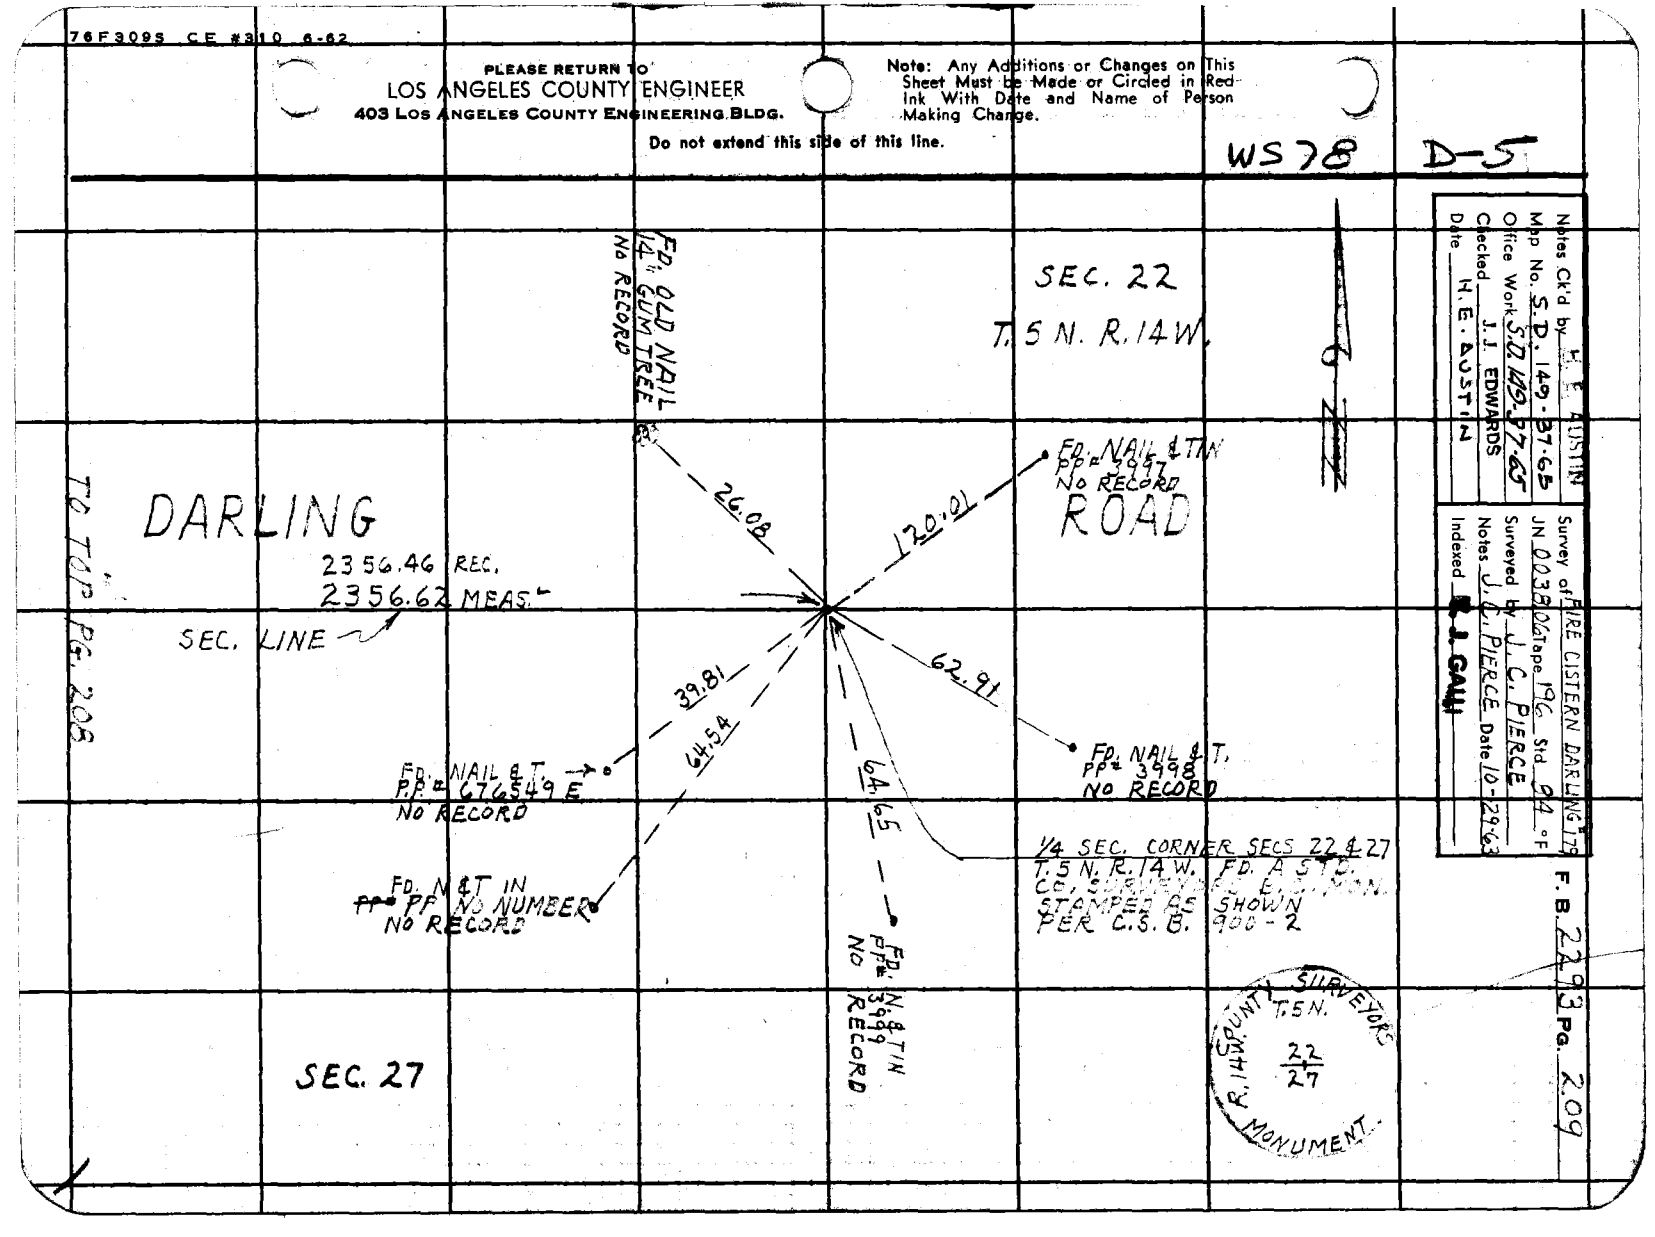

Notes Ck'd by H. E. AUSTIN
Map No. S.D. 149-B7-62
Office Work S.D. 149-B7-62
Checked J. J. EDWARDS
Date H. E. AUSTIN

Survey of FIRE CISTERN DARLING LTD
JN 0038 Tape 196 Std. 94 °F
Surveyed by J. C. PIERCE
Notes J. C. PIERCE Date 10-29-63
Indexed R. J. GALL

F. B. 2293 Pg. 209

TO BOT. PG. 211

F. B. 2293 PG. 210

SEC. ~~23~~ 21

T. 5 N. R. 14 W.

SEC. 22

W.S. 78 D-5

LOS ANGELES COUNTY ENGINEER
403 Los Angeles County Engineering Bldg.

PLEASE RETURN TO

Do not extend this side of this line.

Note: Any Additions or Changes on This Sheet Must Be Made or Circled in Red Ink With Date and Name of Person Making Change.

108.50

P.O.L. #1 (7+44.54)
SET 1X2 STK. & NAIL FLUSH

1) 89 - 33 - 30
4) 358 - 13 - 20
89 - 33 - 20
6) 177 - 20 - 00
89 - 33 - 20 ✓

544.54

SEC. LINE

336.7% @ LEVEL (T=58) = 336.70

COUNTY ENGINEER
N.W. COR.
PARCEL 7
R.E. 5869

REPLACED 1X2 STK. WITH A STD. C.E. MON. DN. 6" MARKED
11-29-63 J.M.

P.O.L. #1 (2+00.00)
SET 1X2 STK. & NAIL FLUSH FOR TEMP. NW COR. PARCEL #7 SEC. 22

15.00

336.70

N. LINE PARCEL #7

TO LEFT PG. 215

89° 33' 20"

200.00

SEC. LINE

(15)

SET 1" I.P. & C.E. TAG FLUSH

T=?

4° 24' = 298.12
4° 18' = 298.14
4° 38' = 246.45
4° 32' = 246.45
(T = 04) = 544.54

7° 43' = 108.51
7° 18' = 108.51
(T = 72) = 108.50

{299.00 @@@@
{298.98
{247.26
{247.34

{109.51 @@
{109.36

TO TOP PG. 207

Notes Ck'd by H. E. AUSTIN	Survey of FIRE CISTERN DARLING 179
Map No. 3.D.149-37-65	JN 0038.06 Tape 196 Std. 84 °F
Office Work J. J. EDWARDS	Surveyed by J. C. PIERCE
Checked H. E. AUSTIN	Notes J. C. PIERCE Date 10-30-63
Date JAN., 1964	Indexed J. J. GALLI

F. B. 2293 Pg. 211

TO BOT. PG. 212

283.88

0.02 ← 15+95.11
FD. 1¾" I.P. WOOD PL. & TAG
L.S. 2572 UP 3" NO REC.

P.O.L. # 4 (15+21.95)
SET 1X2 STK. & NAIL
FLUSH

SEC. 22

SEC. ~~23~~ 21

T. 5 N. R. 14 W.

0.12 ← 14+28.20
FD. 1¾" I.P. WOOD PLUG & TAG
L.S. 2572 UP 3" NO REC.

668.91

0.19 ← 10+71.21
FD. 2" I.P. WOOD PLUG & TAG
L.S. 2572 UP 3" NO REC.

668.91 .89
251.74 .89
668.44

218.18
199.02

SEC. LINE

P.O.L. # 3 (8+53.04)
SET 1X2 STK. & NAIL
FLUSH

= 218.18
= 218.18
= 199.02
= 199.02

@ 00° 46'
@ 1° 29'
@ 4° 11'
@ 3° 29'
@ LEVEL

(T = 72) =

108.50

{218.20
{218.25
{199.55
{199.39
251.74

283.91 @ LEVEL (T = 70) = 283.88

TO TOP PG. 210

PLEASE RETURN TO
LOS ANGELES COUNTY ENGINEER
403 LOS ANGELES COUNTY ENGINEERING BLDG.

Note: Any Additions or Changes on This Sheet Must be Made or Circled in Red Ink With Date and Name of Person Making Change.

Do not extend this side of this line.

76F3095 CE #310 8-62

TO BOT. PG. 213

F. B. 2293 PG 212

SEC. 21

SEC. 22

SEC. 21
T. 5 N. R. 14 W.

P.O.L. #6 (26+83.87)
FOUND 3/4" I.P. WOOD PLUG & TAG L.S. 2572 FLUSH

141.42

155.05 @ 24° 12' = 141.42
154.72 @ 23° 55' = 141.42
(T = 74)

141.42

0.11

21+10.99
FD. 2" I.P. WOOD PLUG & TAG L.S. 2572 UP .3"
NO REC.

878.04

0.24

19+98.56
FD. 2" I.P. WOOD PLUG & TAG L.S. 2572 UP 3"
NO REC.

192.75
112.44
295.90
277.01
878.13
(T = 68) = 878.04

P.O.L. #5 (18+05.83)
SET 1X2 STK. & NAIL FLUSH

SEC. LINE

0.02

17+62.12
FD. 1 3/4" I.P. WOOD PLUG & TAG L.S. 2572 FLUSH
NO REC.

283.88

6° 01' = 192.74
5° 34' = 177.53
LEVEL = 295.90
LEVEL = 277.01
10° 15' = 110.19

192.81
193.68
192.44
295.90
277.03
278.13

TO TOP PG. 211

X

LOS ANGELES COUNTY ENGINEER
403 Los Angeles County Engineering Bldg.

PLEASE RETURN TO

Do not extend this side of this line.

Note: Any Additions or Changes on This Sheet Must Be Made or Circled in Red Int With Date and Name of Person Making Change.

D-5

WS 28

Notes Ck'd by H. E. AUSTIN	Survey of FIRE CISTERN DARLING '79
Map No. SD 149-37-65	JN 0038.06 Tape 196 Std 84 °F
Office Work J. J. EDWARDS	Surveyed by J. C. PIERCE
Checked H. E. AUSTIN	Notes J. C. PIERCE Date 10-31-63
Date JAN., 1964.	Indexed [redacted]

F. B. 2293 PG. 213

53+62.02
SECTION CORNER
FD. A STD. CC, SURVEYORS
B.C. MONUMENT FLUSH
STAMPED AS SHOWN
PER F.B. 512-88
SEE C.S.B. 900-2

COUNTY SURVEYORS
T. 5 N
R. 14 W.
16 | 15
21 | 22
MONUMENT

2031.29

33+48.30
FD. 3/4" I.P. NO PLUG
FLUSH NO REC.

1445

P.O.L. # 8 (33+30.73)
SET 1X2 STK. & NAIL
FLUSH (WIGGLE POINT)

505.48

SEC. LINE

299.11
206.37
505.48
(T=70)= 505.56

P.O.L. # 7 (28+25.28)
SET 1X2 STK. & NAIL
FLUSH

299.12
206.38
206.48

141.4X

top pg. 212

40.73
68.40
125.73
130.09
270.55
292.08
291.35
30.59
73.29
114.97
188.08
295.42
110.25
2031.53
(T=66) = 2031.29

Note: Any Additions or Changes on This Sheet Must be Made or Circled in Red Ink With Date and Name of Person Making Change.

Do not extend this side of this line.

PLEASE RETURN TO
LOS ANGELES COUNTY ENGINEER
403 LOS ANGELES COUNTY ENGINEERING BLDG.

76F3095 C.E. #310 0-62

F. B. 2293 PG. 214

3) 90 - 41' 10"
4) 02 - 45' 10"
5) 90 - 41 17½ ✓
6) 184 - 07 - 20
AVE) 90 - 41 - 13⅓

3) 90 - 41 - 00
4) 02 - 44 - 20
5) 90 - 41 - 05 ✓
6) 184 - 06 - 50
90 - 41 - 08⅓

TO P.O.L. #6 ¾" I.P. SEE PG. 212

SEC. LINE

SEC. 21 ~~23~~

90° 41' 01" ✓

SEC. 22
T. 5 N. R. 14 W.

FD 1¾" I.P. WOOD PLUG NO NAIL PER F.M. 18754

336.85

(20 + 10.76)
P.O.L. #5A
SET 1X2 STK. & NAIL FLUSH

90° 41' 10" ✓

204.93

(18 + 05.83)
P.O.L. #5
A 1X2 STK. & NAIL FLUSH
SEE PG. 212

193.81 @ 6' 01" = 192.74 ✓
193.68 S 5° 34' 77 = 192.75 ✓
12.20 LEVEL = 12.20 ✓
204.93 (T = 70) = 204.93 ✓

336.87 @ LEVEL (T = 74) = 336.85 ✓

E. LINE PARCEL #11

TO P.O.L. #4 1X2 STK. SEE PG. 211

SEC. LINE

TO TOP PG. 215

PLEASE RETURN TO
LOS ANGELES COUNTY ENGINEER
403 Los Angeles County Engineering Bldg.
Do not extend this side of this line.

Note: Any Additions or Changes on This Sheet Must be Made or Circled in Red Ink With Date and Name of Person Making Change.

Notes Ck'd by H. E. AUSTIN
Map No. S.D. 149-37-65
Office Work J. J. EDWARDS
Checked H. E. AUSTIN
Date JAN., 1964

Survey of FIRE CISTERN DARLING "B"
JN 0038.06 Tape 196 Std 84 °F
Surveyed by J. C. PIERCE
Notes J. C. PIERCE Date 11-1-63
Indexed R. J. GALLI

F. B. 2293 PG. 215

D-5

WS 78

TO BOT PG. 214

SEC. 22
T. 5 N. R. 14 W.

1) 89 - 33 - 20
4) 358 - 12 - 40
89 - 33 - 10
4) 177 - 19 - 00
AVE) 89 - 33 - 10 ✓

89° 33' 10" ✓
00"

336.70
N. LINE PARCEL #7

TEMP N.E. COR. PARCEL #7, SEC. 22
SET A 1" I.P. & C.E. TAG FLUSH
REPLACED PIPE WITH A STD. C.E. MON. UP 2" MARKED 11-29-63 P.M.

COUNTY ENGINEER N.E. COR. PARCEL 7 R.E. 5869

170.08'
E. LINE PARCEL #7

TO RIGHT PG. 210

TO LEFT PG. 208

Note: Any Additions or Changes on This Sheet Must be Made or Circled in Red Ink With Date and Name of Person Making Change.

Do not extend this side of this line.

PLEASE RETURN TO
LOS ANGELES COUNTY ENGINEER
403 Los Angeles County Engineering Bldg.

76F3095 CE #3190 6-62

Notes Ck'd by	Survey of SEC 9, 16 T6N, R9W
Map No.	JN 03020 Tape Std °F
Office Work	Surveyed by HALISCKY
Checked	Notes HALISCKY Date 3-19-59
Date	Indexed C. Johnson 7-2-59

F. B. 2293 Pg. 217

J.N. 03020.01

¼ SEC. COR. TIES FOR AVE O & 165TH ST. E.

PARTY
HALISCKY
RITTER
TALBOT
H.E. MITCHELL
TEMPLETON

Note: Any Additions or Changes on This Sheet Must Be Made or Circled in Red Ink With Date and Name of Person Making Change.

Do not extend notes this side of this line.

RETURN TO
LOS ANGELES COUNTY ENGINEER
700 LOS ANGELES COUNTY ENGINEERING BLDG.

763098 CE #247—7-53

F. B. 2293 PG. 218

W.S. 66 D-1

RETURN TO
LOS ANGELES COUNTY ENGINEER
700 LOS ANGELES COUNTY ENGINEERING BLDG.

Do not extend notes this side of this line.

Note: Any Additions or Changes on This Sheet Must be Made or Circled in Red Ink With Date and Name of Person Making Change.

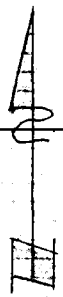

FD. 2" I.P. CONC. PL. 8" N. 8" UP

IAW

56.57

SET N&T FL.

SET CAP & WELL

3.1'

3'

SET N&T FL.

AVE. SEC. LINE

COUNTY SURVEYORS T6N R9W 9/16 1/4 COR. MONUMENT RE. 2177

90° 90°

56.52

IAW

40.27

54.58

FENCE

SET N&T W. Side

FD. 2" I.P. CONC. PL. 8" N. 8" UP

LINE

SET N&T W. Side

SET N&T E. Side

FD. 2" I.P. IN CONC. WITH BRASS CAP MARKED: 8" DN.

NOTE: N&T'S ARE ON 4"x4" FENCE POLES

165TH ST. E.

Notes Ck'd by		Survey of AVE I	F. B 2293 Pg. 219
Map No.		JN 030201 Tape 144 Std.	°F
Office Work		Surveyed by HALISCKY	
Checked		Notes HALISCKY Date 2-26-59	
Date		Indexed A.C. Johnson 4-20-59	

JN 030201

SEC. COR. TIES FOR AVE I & 5TH ST. E. AND 5TH ST E & AVE I-4

PARTY
HALISCKY
RITTER
TALBOT
HE. MITCHELL
TEMPLETON

Note: Any Additions or Changes on This Sheet Must Be Made or Circled in Red Ink With Date and Name of Person Making Change.

Do not extend notes this side of this line.

RETURN TO
LOS ANGELES COUNTY ENGINEER
700 LOS ANGELES COUNTY ENGINEERING BLDG.

763088 CE #247—7-53

RETURN TO
LOS ANGELES COUNTY ENGINEER
700 LOS ANGELES COUNTY ENGINEERING BLDG.

Note: Any Additions or Changes on This Sheet Must be Made or Circled In Red Ink With Date and Name of Person Making Change.

Do not extend notes this side of this line.

WS 70-A-4

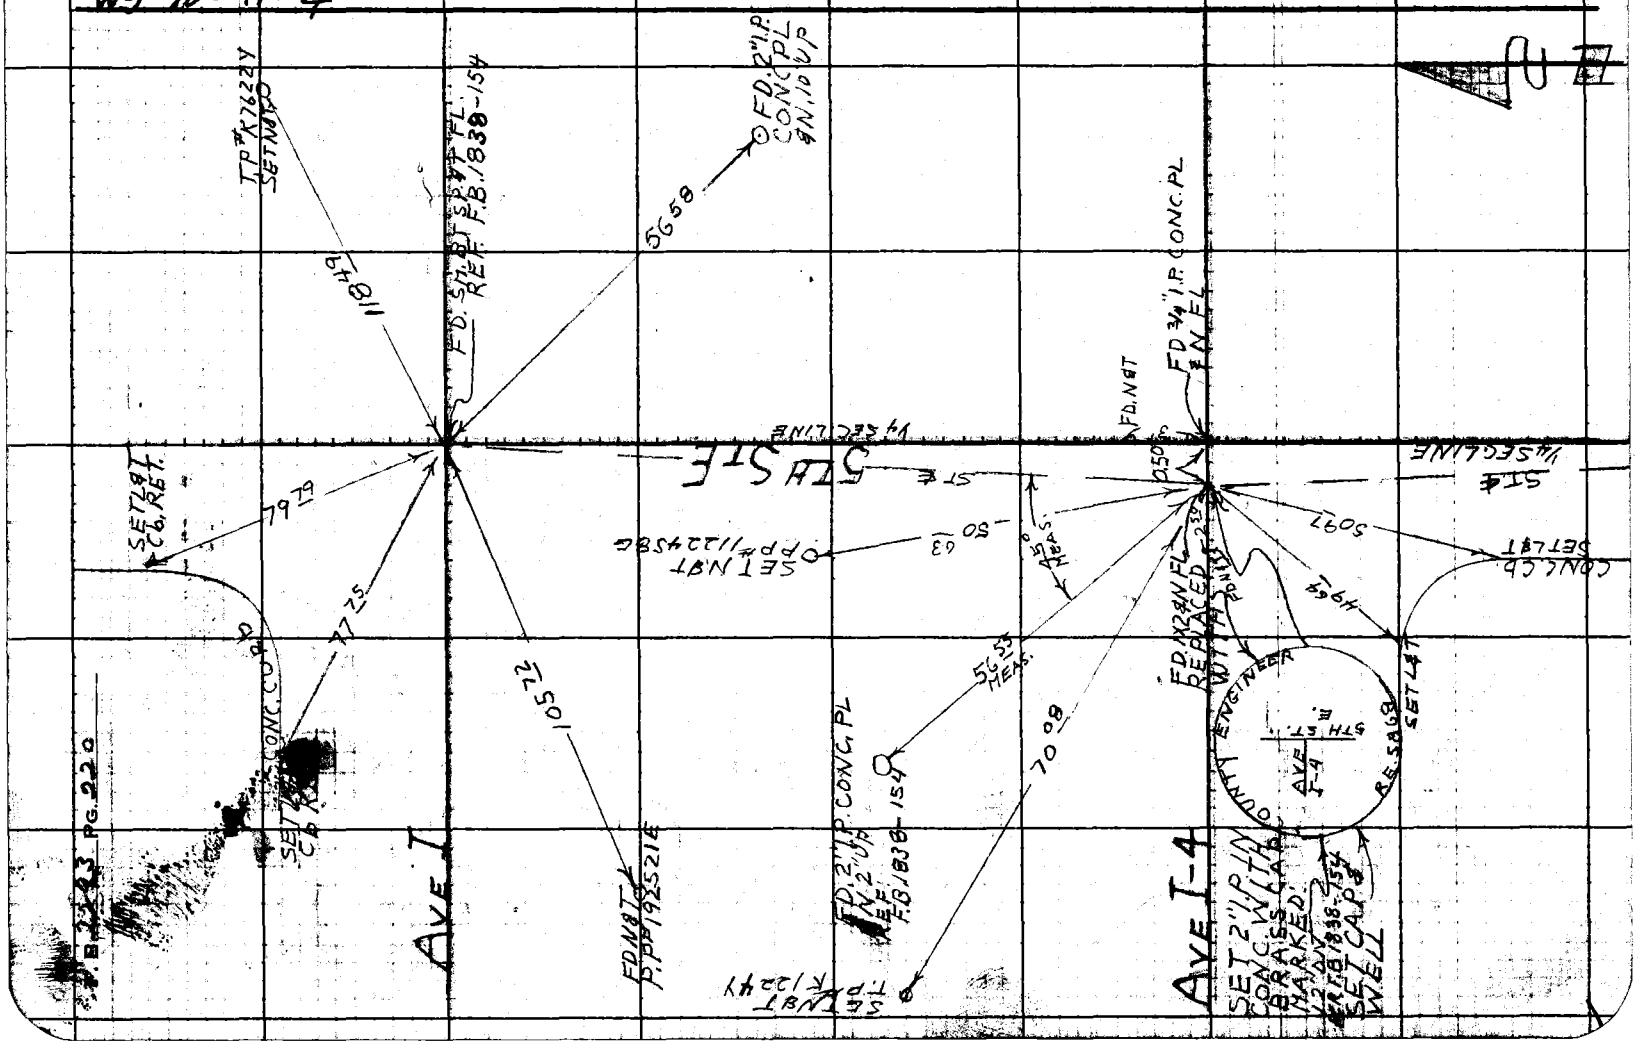
TP "K 1622 Y"
SET NAIL
FD. 2" I.P. CONC. PL
REF. F.B. 1838-154
FD. 2" I.P. CONC. PL
REF. F.B. 1838-154
FD. 3/4" I.P. CONC. PL
FD. NAIL
1/4 SEC. LINE

Notes Ck'd by
Map No.
Office Work
Checked
Date

Survey of T6N R9W
JN 0302.01 Tape 144 Std 84 °F
Surveyed by HALISEKY
Notes Date 4-9-59
Indexed K. C. Johnson

F. B 2293 Pg. 221

WS. 67 - A-1

Note: Any Additions or Changes on This Sheet Must Be Made or Circled in Red Ink With Date and Name of Person Making Change.

Do not extend notes this side of this line.

RETURN TO
LOS ANGELES COUNTY ENGINEER
900 LOS ANGELES COUNTY ENGINEERING BLDG.

7630SS CE #247—7-58

SET N&T IN FENCE POST

R.P. FD. 2" I.P., CEM. PLUG & NAIL, 6" UP

FD. N&T IN FENCE POST

75.56

56.57 TAN.

56.35

61.20

SET N&T IN FENCE POST

COR. SECS. 9, 10, 15, 16 T6N, R9W
FD. C.S. MON. 2" I.P. IN CONC., 3½" DN. PER C.S. 8733 WITH BRASS CAP MARKED

SET CHIS. CROSS (+) IN 6"x6" CONC. RD. MARKER POST

51.46

SET NEW C.E. MON. OVER OLD

170TH ST. E.

3.00

SET SQ. H. SPK. & TIN, FL.

56.57 TAN.

R.P. FD. 2" I.P., CEM. PLUG & NAIL, 6" UP

3.00

SET SQ. H. SPK. & TIN, FL.

AVE. O

COUNTY ENGINEER R9W T6N 10 15 SEC. COR. 1959

COR. SECS. 9, 10, 15, 16 T6N, R9W
SET C.E. MON., 2" I.P. IN CONC., 8" DN. PER C.S. 8733 WITH BRASS CAP MARKED SET WELL & COVER ON SURFACE

R.P. SET 2" I.P. CEM. PLUG & NAIL, 6" UP

56.57 TAN.

SET SQ. H. SPK. & TIN, FL.

175TH ST. E.

3.00

COR. RET. SECS. 10, 15 T6N, R9W
FD. C.S. MON., 2" I.P. IN CONC., 4" DN. PBR C.S. 8733 WITH BRASS CAP MARKED SET WELL & COVER ON SURFACE

COUNTY ENGINEER R9W T6N 10 15 SEC. COR. 1959

56.57 TAN.

45°

3.00

40.00

R.P. SET 2" I.P. CEM. PLUG & NAIL, 6" UP

SET SQ. H. SPK. & TIN, FL.

Notes Ck'd by	Survey of SEC. 23 T2N R11W
Map No.	JN 0302.01 Tape 144 Std. 54 °F
Office Work	Surveyed by HALISCKY
Checked	Notes HALISCKY Date 4-23-59
Date	Indexed K.O. Johnson 2-6-59

F. B. 2293 Pg. 223

J.N. 0302.01

SEC. COR TIES 60TH ST E FROM AVE K TO AVE J

PARTY
HALISCKY
RITTER
TALBOT
H.E. MITCHELL
TEMPLETON

W.S. 70 D-6

FD N&T P.P. # 800196E

WIRE FENCE

SET 2" I.P CONC. PLAG FL.

FD N&T P.P. 393440E

FD N&T P.P. 536308E

67.20

56.57 TAN

94.20

31.46

FD. SPK. 9TH PL

AVE K

SET TACK IN

FD 2" I.P. WITH BRASS CAP MARKED LSDN

FD SPK 8TH PL

COUNTY SURVEYORS T7N R11W 22 23 27 26 1927 MONUMENT

56.61 TAN

FD. 2" I.P CONC. PLAG. TO UP

60TH ST E

W.S. 70

Note: Any Additions or Changes on This Sheet Must be Made or Circled in Red Ink With Date and Name of Person Making Change.

Do not extend notes this side of this line.

RETURN TO
LOS ANGELES COUNTY ENGINEER
1700 LOS ANGELES COUNTY ENGINEERING BLDG.

76FS0SS CE #247—3.57

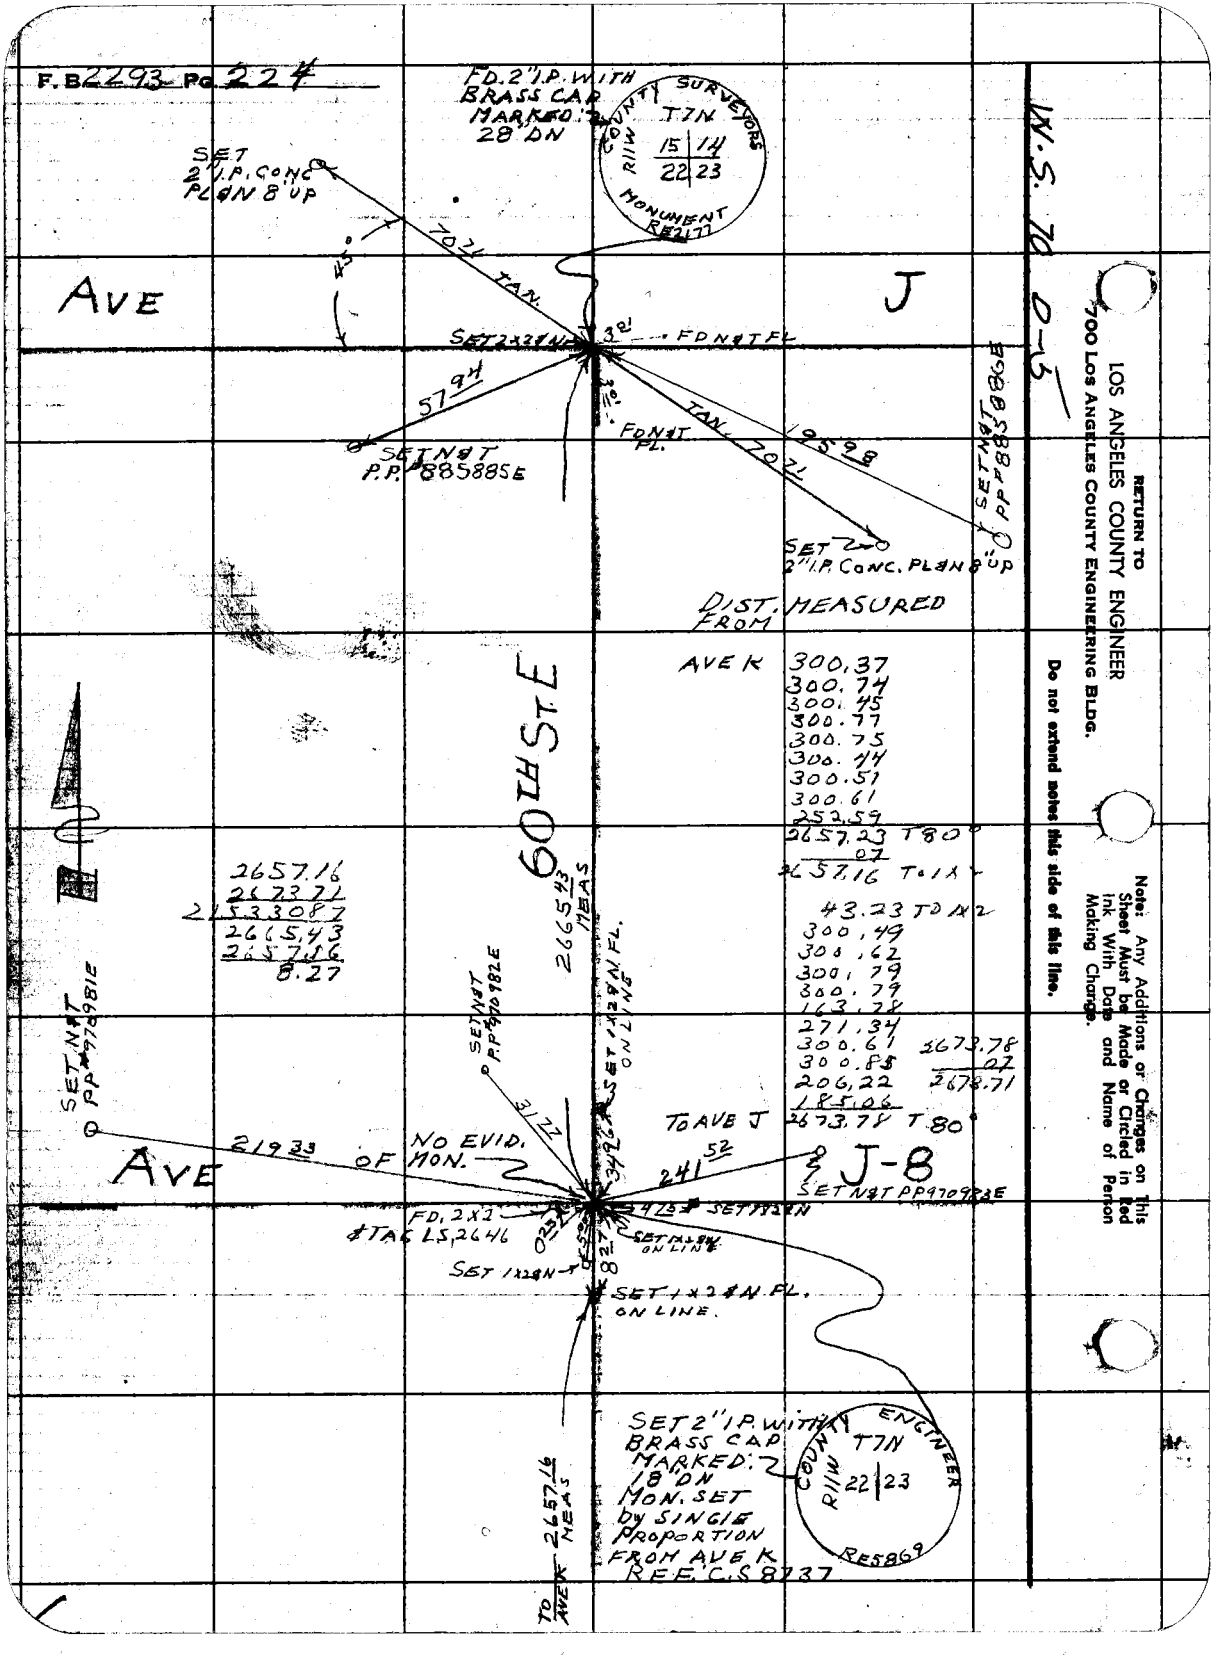
F.B 2293 Pg 224
FD. 2" I.P. WITH BRASS CAP MARKED: 28 DN
COUNTY SURVEYORS
T7N
R11W
15 14
22 23
MONUMENT RE 177
SET 2" I.P. CONC PLAG 8" UP
70.71 TAN.
45°
AVE
SET 2"I.P.
FD NAIL FL
J
W.S. 70 0-3
57.94
SET NAIL P.P. 885885E
FD NAIL FL.
TAN. 70.71
95.98
SET NAIL P.P. 885885E
SET 2" I.P. CONC. PLAG 8" UP
RETURN TO LOS ANGELES COUNTY ENGINEER 700 Los Angeles County Engineering Bldg.
Do not extend notes this side of this line.
Note: Any Additions or Changes on This Sheet Must be Made or Circled in Red Ink With Date and Name of Person Making Change.
DIST. MEASURED FROM
AVE K
300.37
300.74
300.45
300.77
300.75
300.74
300.51
300.61
252.59
2657.23 T80°07
2657.16 T0 1X
43.23 TO N2
300.49
300.62
300.79
300.79
163.28
271.34
300.61
300.85
206.22
185.06
2673.78
07
2673.71
2673.78 T80°
TO AVE J
52
241
J-8
SET NAIL PP970982E
60TH ST E
2657.16
2673.71
2653.308.7
2665.43
2657.16
8.27
2665.43 MEAS
SET NAIL PP970981E
SET NAIL P.P. 970982E
SET 1 X 2 # ON FL. ON LINE
31.72
NO EVID. OF MON.
21933
AVE
FD. 2 X 2 # TAG LS 2646
SET 1 X 2 # ON FL.
SET TACK ON LINE
SET 1 X 2 # ON FL. ON LINE.
SET 2" I.P. WITH TAG BRASS CAP MARKED: 7 18 DN MON. SET by SINGLE PROPORTION FROM AVE K REF. C.S. 8737
COUNTY ENGINEER
T7N
R11W
22 23
RE 5869
TO AVE K 2657.16 MEAS

Notes Ck'd by	Survey of SECTION LINES T6N R10W F. B 2293 Pg. 225
Map No.	JN 0302.01 Tape 151 Std 84 °F
Office Work	Surveyed by J.S. COATES
Checked	Notes J.S.C. Date
Date	Indexed K. O. Johnson

W 566

J.N. 0302.01
SECTION LINES
T5N, T6N R10W
REPLACEMENT
OF
STANDARD SECTION COR 34,35, N 1/4 COR SEC 3 & E 1/4 COR SECT 34

Note: Any Additions or Changes on This Sheet Must Be Made or Circled in Red Ink With Date and Name of Person Making Change.

PLEASE RETURN TO
LOS ANGELES COUNTY ENGINEER
700 LOS ANGELES COUNTY ENGINEERING BLDG.
Do not extend this side of this line.

COATES
BEERS
HUBBARD
KING
VAN NESS

78F3095 SAE #247 1-58

F. B. 2293 · Pg. 226

SECTION COR
3 & 2 T5, 6N
R10W
FD. C.S. MON 12"DN
marked as
shown
C.S. 8733
C.S. 8734

SURVEYOR T6N T5N R10W COUNTY MONUMENT

Set Spk & Tin
6" Joshua
Tree

FD 4"x4" RWD
Post 6" UP

125TH ST. E.

96.26

30.02

70.71

45°

59.45

179°

1/4 Sec. Cor.
FD. C.S. Mon Fl.
marked as shown
ReSet Mon 12"DN
C.S. 8733
C.S. 8734

SURVEYOR T6N T5N R10W 1/4 COR SEC 35 S.C. COR MONUMENT

70.71 TAN

45°

Set 2" I.P. 6" UP
Conc. Pl. & L.A.
Co. Eng. tag

682.61

179° 59' 40"
359° 59' 00"
179° 59' 45"
359° 58' 30"
179° 59' 45"

682.64 @ 78°-

Set 2" I.P. 6" UP
Conc. Pl. & L.A.
Co. Eng. tag

Set B.S. M.T. 2"
6" Joshua

1403.45 @ 82°-

1403.43

AVE

P.O.T. Top of Break
Set 1"x2" EN Fl.

1403.43

TO N1/4 Cor Sec 3

CONT. TOP

PG. 227

W.S. 66 - 13

LOS ANGELES COUNTY ENGINEER
700 Los Angeles County Engineering Bldg.

PLEASE RETURN TO

Do not extend this side of this line.

Note: Any Additions or Changes on This Sheet Must be Made or Circled in Red Ink With Date and Name of Person Making Change.

Notes Ck'd by	Survey of Sect. Lines T5N R10W
Map No.	JN 0302 a/ Tape 151 Std 84 °F
Office Work	Surveyed by J.S. COATES
Checked	Notes J.S.C Date 4-23-59
Date	Indexed C. Johnson

F. B. 2293 Pg. 227

W.S. 68 B-3

FROM BOT PG 226

FD 4"x4" RWD POST 6" up with nail

N 1/4 COR SEC 3 T5N R10W FD C.S. Mon Knocked out Reset C.S. Mon 12" dn by Prop Bet S.C. 34 35 S 1/4 Sect 35 marked as Shown C.S. 8793 C.S. 8794

1403.13' To POT

Set 2" I.P. 6" up Conc. Pl. E L.A. Co. Eng. tag

70.71 TAN

121ST ST. E.

599.14'

599.15 @ 82° =

SURVEYOR T6N R10W 3 T5N MONUMENT COUNTY

70.71

S 75.65

Set 2" I.P. 6" up Conc Pl E L.A Co Eng. tag

90° 05' 20" 360° 21' 40" 90° 05' 25" 180° 32' 20" 90° 05' 23"

599.14

AVE

Set N&T PP#

Set 2" I.P. 6" up Conc. Pl. E L.A. Co. Eng. tag

FD 4"x4" RWD POST 4" up no Nail used on

42.69

90° 05' 25"

70.71 TAN

Std. Sect. Cor. S.C. Mon. Knocked out S.E. Cor. Sec 34 T6N R10W Reset C.S. Mon 12" dn 0.13 S. of Line & by Proportionate Dist. Bet. S 1/4 Cor. Sect 34 & S 1/4 Cor Sect 35 Per C.S. 8793 C.S. 8794 marked as Shown

2636.21 @ 66° = 2635.90

To 1/4 Cor 2635.96

PG. 229

CONT BOT

120th ST E

70.71

89° 54' 15"

70.08

SURVEYOR T6N R10W 34 35 S.C. T5N MONUMENT COUNTY

2078.39 @ 84° = 2078.39

89° 54' 10" 359° 37' 00" 89° 54' 14" 179° 25' 20" 89° 54' 12"

Set 2" I.P. 6" up Conc. Pl. E L.A. Co. Eng. tag

To C.C. 2078.39 4.3

Set N&T PP# 1103381E

CONT TOP PG 228

PLEASE RETURN TO LOS ANGELES COUNTY ENGINEER 700 Los Angeles County Engineering Bldg.

Do not extend this side of this line.

Note: Any Additions or Changes on This Sheet Must be Made or Circled in Red Ink With Date and Name of Person Making Change.

78F3098 S&E #247 1-56

F. B. 2293 PG. 228 FROM BOT. PG. 227

W.S. 66 B-3

LOS ANGELES COUNTY ENGINEER
700 Los Angeles County Engineering Bldg.

PLEASE RETURN

Note: Any Additions or Changes on This Sheet Must be Made or Circled in Red Ink With Date and Name of Person Making Change.

Do not extend this side of this line.

R.P. Set 2" I.P. 6' up Conc. Pl & L.D. Co. Eng. tag

To S.E. Cor. Sec 34

2078.39

FD. N&T Guy Pole # 970830E

70.71

45°

72.71

116th ST E

SECTION CORNER CLOSING CORNER FD C.S. Mon Fl. C.S. 8733, 8734 Reset C.S. Mon 12"ø marked as Shown

SURVEYOR T6N R10W C.C. 4 T3 T.M01 2 00 T5N R10W MONUMENT

46.39

FD. N&T Guy Pole # 970823E

44.72

44.49

FD. N&T P.P. 970828E

Set B&T in TAN to 21" P. in P.P. 970822E

606.80 S 84° 00' 30" E 606.80

R.P. Set 2" I.P. 6' up Conc. Pl & L.A. Co. Eng. tag.

606.80

AVES

FD 4" X 4" RWD Post 6" up Spk & Tin on Top

10"

70.71

45°

66.78

FD. N&T P.P. # 970826E

115th ST. E

30.05

So. 1/4 Sect Cor 34 T6N R10W FD. C.S. Mon Fl. C.S. 8733 C.S. 8734 Reset C.S. Mon 12"ø marked as Shown

70.71

SURVEYOR T6N R10W Sec 34 10 T5N R10W MONUMENT

SURVEYOR T6N R10W 33 34 SC T.M01 2 T5N R10W MONUMENT

Standard Section Corner FD C.S. Mon & Tag C.S. 8733, 8734 marked as Shown

R.P. Set 2" I.P. 6" up C[redacted] Pl L.H. [redacted] tag

① 180° 00' 10"
② 360° 00' 50" ✓
③ 180° 00' 12½
④ 360° 01' 00" ✓
⑤ 180° 00' 10"

110th ST E

✓

Notes Ck'd by	Survey of Sect. Lines T5,6N R10W F. B. 2293 PG. 229
Map No.	JN 0302.01 Tape 151 Std 84 °F
Office Work	Surveyed by J S COATES
Checked	Notes: JSC Date 4-24-59
Date	Indexed C. Johnson

Note: Any Additions or Changes on This Sheet Must be Made or Circled in Red Ink With Date and Name of Person Making Change.

Do not extend this side of this line.

PLEASE RETURN TO
LOS ANGELES COUNTY ENGINEER
700 Los Angeles County Engineering Bldg.

76F3095 SAE #247 1-56

W.5 66 B-3

R.P. Set 2" I.P. 6" up Conc. P.L. & L.A. Co. Eng tag

AVE R

70.71

37.42

Set 24996E

Section Corner 26, 27, 34, 35 T6N R10W Fd. C.S. Mon 12" dn per C.S. 8733 Marked as Shown

20.71 TAN

45°

R.P. Set 2" I.P. 6" up Conc. P.L. & L.A. Co Eng. tag

COUNTY SURVEYOR T6N R10W 27 26 34 35 MONUMENT

120TH ST E 2635.90

2636.21 @ 66°-2635.90

45°

R.P. Set 2" I.P. 6" up Conc. P.L. & L.A. Co Eng tag

56.57

AVE R-8

56.57 TAN

106.89

E 1/4 Cor Sect 34 T6N R10W Fd. C.S. Mon broken & knocked over W Ly 1' Reset C.E. Mon 12" dn by Prop bet. S.E. & N.E. Cor. Sect 34 per C.S. 8733 marked as shown

R.P. Set 2" I.P. 6" up Conc. P.L. & L.A. Co Eng. tag

To Sect Cor. 2635.90

Set B.S.W.C.T. 18" Joshua

COUNTY ENGINEER T6N R10W 34 35 1/4 Cor R.E. 5869

FROM LEFT SIDE PG. 227

Notes Ck'd by	Survey of SECTION LINES
Map No.	JN 0302.01 Tape 81 Std 84° F
Office Work	Surveyed by J.S. COATES
Checked	Notes J.S.C. Date 7-15-58
Date	Indexed K.C. Johnson 6-11-59

F. B. 2293 Pg. 231

W.S. 68

J.N. 0302.01

SECTION LINES

SURVEY OF SOUTH LINE SECTIONS 23 & 24 T7N R9W

Note: Any Additions or Changes on This Sheet Must be Made or Circled in Red Ink With Date and Name of Person Making Change.

Do not extend notes this side of this line.

RETURN TO
LOS ANGELES COUNTY ENGINEER
700 LOS ANGELES COUNTY ENGINEERING BLDG.

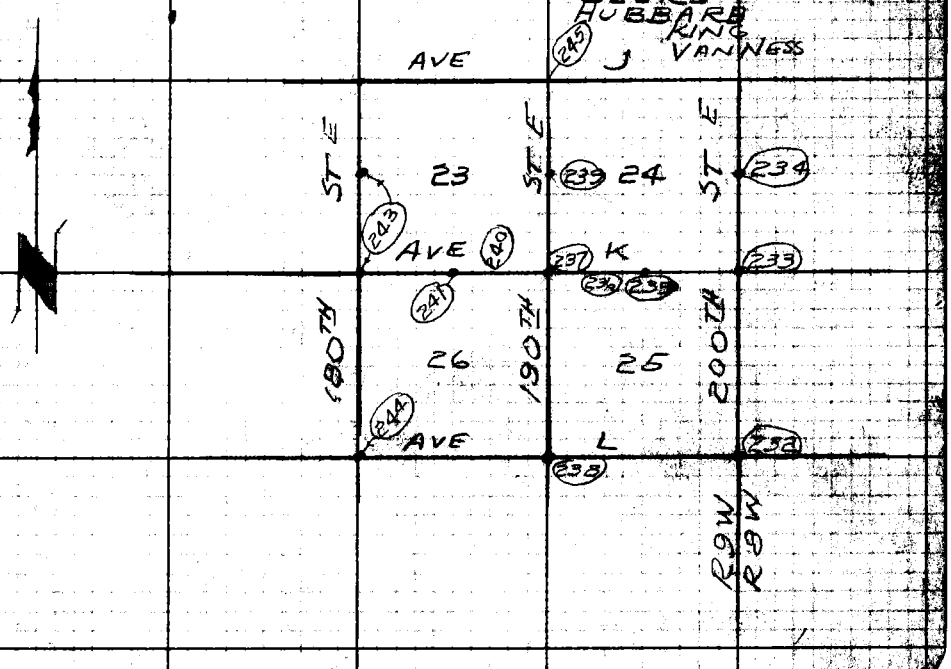

78F2095 CE #247—8-57

F. B. 2293 Pg. 232

CONT BOT PG 233

W.S 68 B-5

RETURN TO
LOS ANGELES COUNTY ENGINEER
900 LOS ANGELES COUNTY ENGINEERING BLDG.

Do not extend notes this side of this line.

Note: Any Additions or Changes on This Sheet Must be Made or Circled in Red Ink With Date and Name of Person Making Change.

T 7 N

ST E

SECT 25

SECT 30

SECTION COR.
FD C.S. MON 12"dn
2" I.P with BRASS-CAP
MARKED AS SHOWN
Per C.S. B 833

COUNTY SURVEYOR MONUMENT

T 7 N
Sec. 25 | Sec. 30
R 9 W | R 8 W
Sec. 36 | Sec. 31

56.57
TAN

RP
FD 2" I.P. 6" up
CONC PL & L.A.
Co. Eng tag

AVE

L

56.57

45°00

40.00

R.P.
FD 2" I.P 6" up
CONC. PL &
L.A. Co. ENG. TAG

200 TH

SECT 36

SECT 31

R 9 W

R 8 W

Notes Ck'd by	Survey of SECTION LINES
Map No.	JN 0202.01 Tape 81 Std. 84 °F
Office Work	Surveyed by J.S. COATES
Checked	Notes J.S.C. Date 7-16-58
Date	Indexed G. Johnson

F. B. 2293 Pg. 233

VOL. 68 B-3

CONT. BOT. PG. 234

Note: Any Additions or Changes on This Sheet Must be Made or Circled in Red Ink With Date and Name of Person Making Change.

Do not extend notes this side of this line.

RETURN TO
LOS ANGELES COUNTY ENGINEER
700 LOS ANGELES COUNTY ENGINEERING BLDG.

R9W R8W

ST. E

SECT 24

SECT 19

Set 2" I.P. 8'Lg. & Tag L.S. 3333

Found 2" I.P. 8'Lg. & Tag L.S. 3333 Stamped 0+00 Section Corner Fd. U.S.B.L.M. Marked B.S. shown

COUNTY SURVEYOR MONUMENT T7N R9W 24 19 25 30 K

BOT PG 235

CONT

Ⓓ	91° 00' 40"	
Ⓐ	04° 03' 00"	
Ⓒ	91° 00' 45"	✓
Ⓑ	186° 04' 20"	
	91° 00' 45 1/3"	✓

45" 00' 45°

91°

AVE 1109.72'

TO P.O.T. 1"=2'

56.57 TAN 56.57

Ⓓ	89° 32' 20"	
Ⓐ	358° 09' 40"	✓
Ⓒ	89° 32' 25"	
Ⓑ	177° 14' 20"	
	89° 32' 23 1/3"	✓

89°

56.57

32' 25"

216.74	Level	=	216.74 ✓
295.25	6°15'	=	293.50 ✓
295.14	6°01'	=	293.51 ✓
237.00	5°27'	=	235.93 ✓
237.09	5°46'	=	235.89 ✓
75.24	level	=	75.24 ✓
290.72	7°24'	=	288.30 ✓
290.58	7°10'	=	288.31 ✓

1109.69 @ 89° = 1109.72 ✓

200' M

Set 2" I.P. 8'Lg. & Tag L.S. 3333

SECT 25

FROM TOP PG 232

SECT 30

76F3095 CE #247—3-57

RETURN TO
LOS ANGELES COUNTY ENGINEER
700 LOS ANGELES COUNTY ENGINEERING BLDG.

Note: Any Additions or Changes on This Sheet Must be Made or Circled in Red Ink With Date and Name of Person Making Change.

Do not extend notes this side of this line.

WS 68 B-5

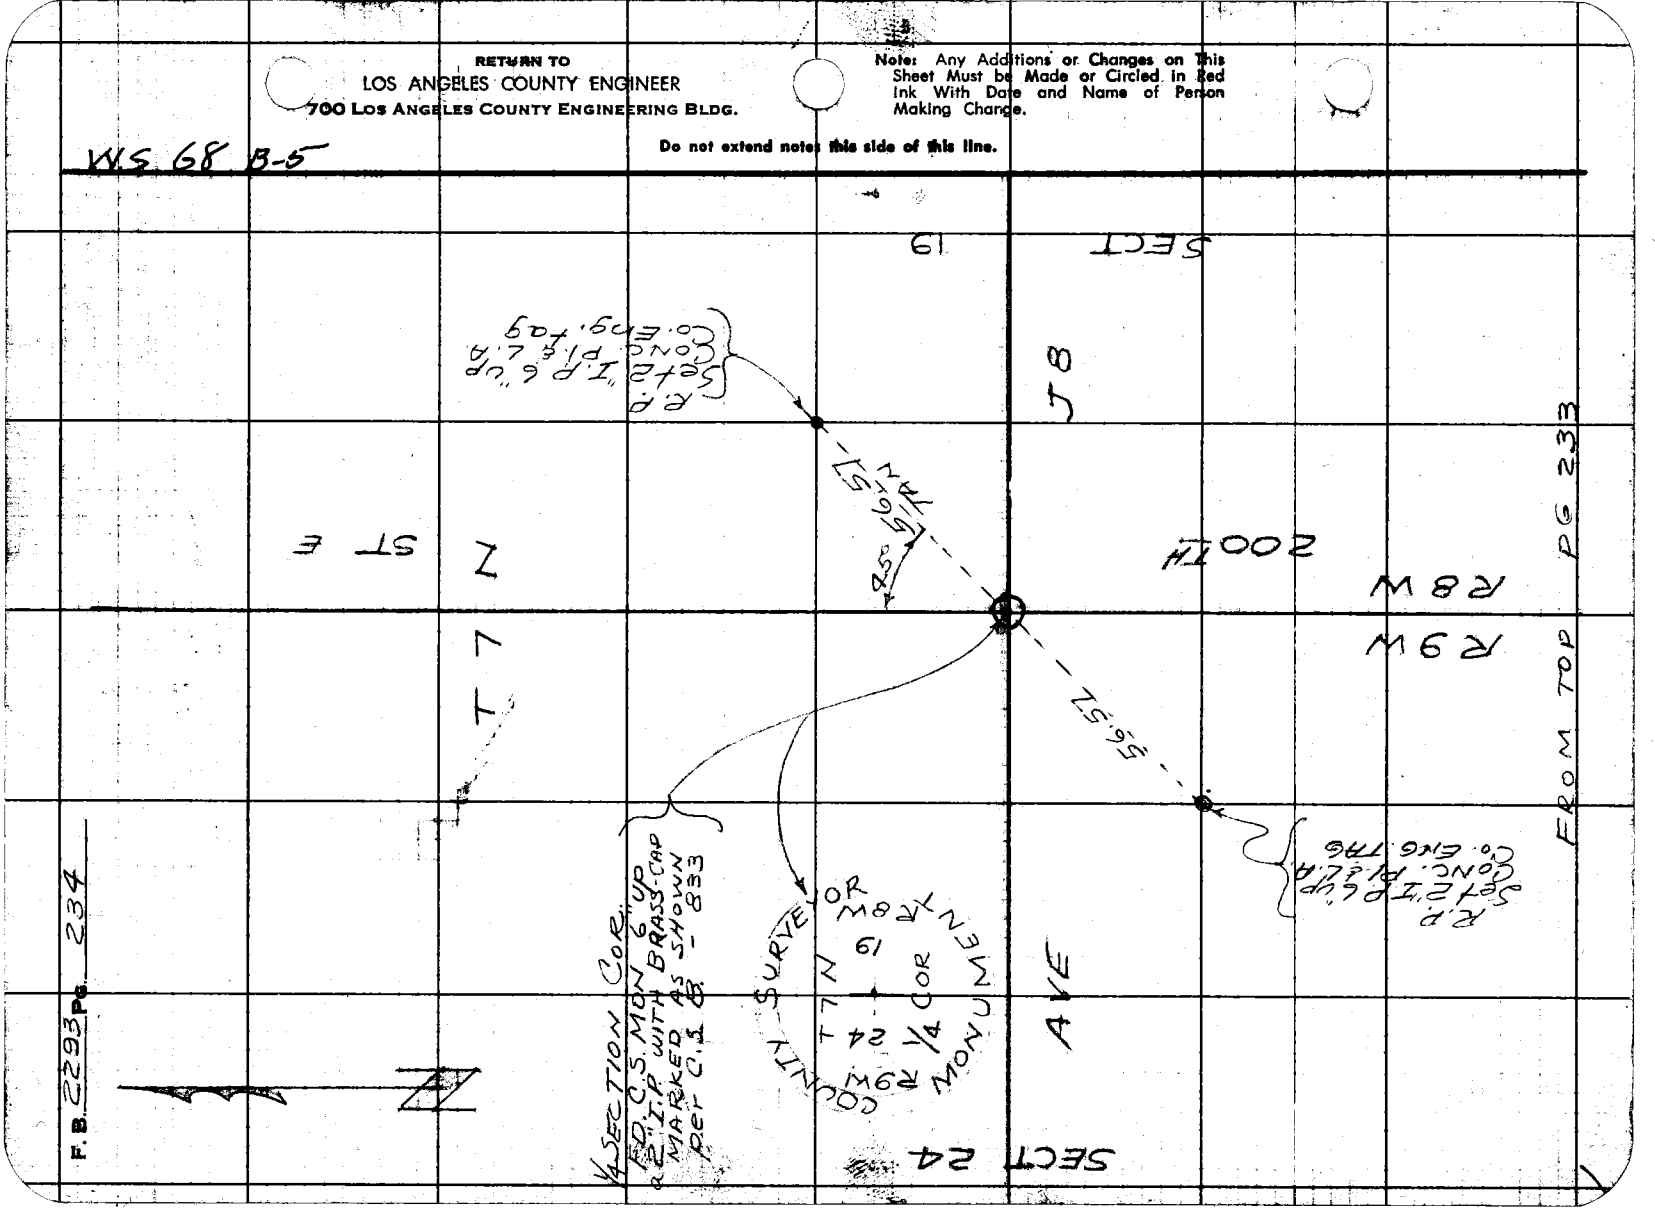

Notes Ck'd by	Survey of SECTION LINES
Map No.	JN 0302.01 Tape 81 Std 84 °F
Office Work	Surveyed by J.S. COATES
Checked	Notes J.S.C. Date 7-16-58
Date	Indexed C. Johnson

F. B. 2293 Pg. 235

CONT. BOT. PG. 236

W.S. 68 B-15

26+43.72
1/4 SECTION COR.
NO EVIDENCE of Rock Mound, trench or pits.
SET C.E. MON FLUSH
BY PROPORTION
Between Sect. CORNERS
a 2" I.P. with BRASS-CAP
MARKED AS SHOWN,
per C.S. 9166-1

COUNTY ENGINEER
R.E. 5869
R9W
T1N
S25
S24
ALCOR

Set L.L.A.G. Eng tag in Boulder

483.31 To P.O.T.

P.O.T.
26+73.30
Set 1"x2" ℄N

29.58
19.61

244.31 Level = 244.31

170.70 2°00' = 170.60 .58
170.76 2°44' = 170.57

207.30 1°46' = 207.20 .19
207.37 2°23' = 207.19

214.57 4°55' = 213.78 .76
214.72 5°27' = 213.75

835.84 @ 88° = 835.86

SECT 25

835.86

SECT 24

Set L.L.A.G. Eng tag on Rock ledge

Set Nail & Washer

AVE.

up ridge

64.01 13°21' = 62.28 .29
63.67 11°55' = 62.30

261.32 Level = 261.32
36.40 " = 36.40
104.25 " = 104.25

266.82 9°07 = 263.45 1.44
266.65 8°55 = 263.43

727.70 @ 88° = 727.72

727.72

P.O.T.
18+37.44
Set 1"x2" ℄N

up ridge

P.O.T.
11+09.72
Set 1"x2" ℄N
on spur

1109.72 To Set Cor.

FROM LEFT SIDE PG 233

Note: Any Additions or Changes on This Sheet Must be Made or Circled in Red Ink With Date and Name of Person Making Change.

Do not extend notes this side of this line.

RETURN TO
LOS ANGELES COUNTY ENGINEER
1700 LOS ANGELES COUNTY ENGINEERING BLDG.

76F3095 CE #247—3-57

F. B. 2288 Pg. 236

CONT. BOT. PG. 237

1595.89 To Set. Cor.

P.O.T. 36+91.54
Set 1"x2" & Nail
Top of Spur

down

274.86 7° 34' = 272.47 ✓.46 ✓
274.66 7° 15' = 272.46 ✓

215.30 9° 31' = 212.34 ✓.33 ✓
215.72 10° 10' = 212.33 ✓

484.79 ✓ @ 70° = 484.75 ✓

484.75 ✓

SECT 25 T7N R9W

K AVE.

SECT 24

P.O.T. 32+06.79
W'ly edge ridge
Set 3/4" UP
Conc. Pl. & L.A.Co.
ENG. TAG

50.18 @ 84° = 50.18 ✓

50.18 ✓

Ridge

P.O.T.
E. edge Ridge
31+56.61 ✓
Set L & L.A.Co.
ENG TAG
IN BOULDER

35.18 Level = 35.18 ✓

274.48 16° 15' = 263.51 ✓
274.09 16° 00' = 263.47 ✓.49 ✓

194.77 18° 35' = 184.61 ✓
193.41 19° 07' = 184.63 ✓.62 ✓

483.29 ✓ @ 90° = 483.31 ✓

483.31

To P.O.T. 1"x2"

FROM TOP PG. 235

RETURN TO
LOS ANGELES COUNTY ENGINEER
700 Los Angeles County Engineering Bldg.

Do not extend notes this side of this line.

Note: Any Additions or Changes on This Sheet Must be Made or Circled in Red Ink With Date and Name of Person Making Change.

Notes Ck'd by	Survey of SECTION LINES
Map No.	JN 0302 01 Tape 81 Std. 84 °F
Office Work	Surveyed by J.S. COATES
Checked	Notes J.S.C. Date 7-17-58
Date	Indexed L. G. Johnson

F. B. 2293 PG. 237

CONT. BOT. PG. 240

Note: Any Additions or Changes on This Sheet Must Be Made or Circled in Red Ink With Date and Name of Person Making Change.

Do not extend notes this side of this line.

RETURN TO
LOS ANGELES COUNTY ENGINEER
700 Los Angeles County Engineering Bldg.

76F3095 CE #247—3-57

CONT. TOP PG. 238

CONT. TOP PG. 239

R 9 W

SECT. 24

SECT. 23

SECT. 25

SECT. 26

T 2 N

To P.O.T.

To P.O.T.

1" x 2"

Set 2" I.P. 12" up Conc. P. & L.A. Co. ENG. TAG

Section Corner 52+87.43 = 0.00 West Fd. C.S. Mon. 4" up 2" I.P. with Brass-Cap Marked as Shown per C.S.B. 833

COUNTY SURVEY MONUMENT R9W T2N 23 24 25 26

190 TH ST (E)

2076.94

1954.24

R.P. Set 2" I.P. 16" up Conc. P. & L.A. Co. ENG. TAG

40.00

1595.89

88° 55' 00"
355° 40' 00"
88° 55' 00"
173° 30' 00"
98° 55' 00"

90° 52' 00"
363° 29' 20"
90° 52' 20"
185° 13' 50"
90° 52' 18"

91° 07' 10"
364° 28' 30"
91° 07' 10"
186° 43' 00"
91° 07' 10"

89° 05' 20"
355° 21' 30"
89° 05' 20"
174° 32' 00"
89° 05' 20"

55° 00" 05" Adj.
56.57
88°
90° 52' 20" 25" Adj.
91° 07' 10"
56.57
45°
89° 05' 20"

282.14 3° 53' = 281.49
282.08 3° 40' = 281.50

300.30 2° 42' = 299.97
300.32 2° 54' = 299.94 1.95

127.27 Level = 127.27

297.56 Level = 297.56

299.11 4° 08' = 298.33
298.96 3° 48' = 298.30 1.31

296.02 10° 09' = 291.39
296.22 10° 21' = 291.40

1595.97 @ 176° = 1595.89

FROM TOP PG. 236

AVE.

296.75 @ 3° 25' = 296.22
296.73 @ 3° 18' = 296.24 } 296.23

190.75 @ 3° 48' = 190.33
190.87 @ 4° 16' = 190.34 } 190.33

226.48 @ 1° 30' = 226.40
226.50 @ 1° 44' = 226.40 } 226.40

295.52 @ 5° 30" = 294.16
295.45 @ 5° 22' = 294.15 } 294.15

278.34 @ 12° 30' = 271.74
278.42 @ 12° 36' = 271.71 } 271.72

137.56 @ 8° 00' = 136.22
137.32 @ 7° 15' = 136.22 } 136.22

T96° 1415.05
1415.14

F.B. 2293 Pg. 238

FROM LEFT SIDE PG. 237

W.S. 6 B-5

RETURN TO
LOS ANGELES COUNTY ENGINEER
700 LOS ANGELES COUNTY ENGINEERING BLDG.

Do not extend notes this side of this line.

Note: Any Additions or Changes on This Sheet Must be Made or Circled in Red Ink With Date and Name of Person Making Change.

T 7 N

ST. (E)

COUNTY SURVEYOR
T 7 N
R 9 W
26 25
35 36
MONUMENT

SECTION CORNER
FD. C.S. MON. 12" dn.
2" I.P. WITH BRASS-CAP
PER C.S. B 833
FB. 2264-

R.P.
FD. 2" I.P. 6" UP
PL & TAG
CONC.
L.A. CO. ENG

56.57'

56.57'

Δ 45°00'

R.P.
FD. 2" I.P. 6" UP
PL & TAG
CONC.
L.A. CO. ENG

AVE

L

M

9

R

190 M

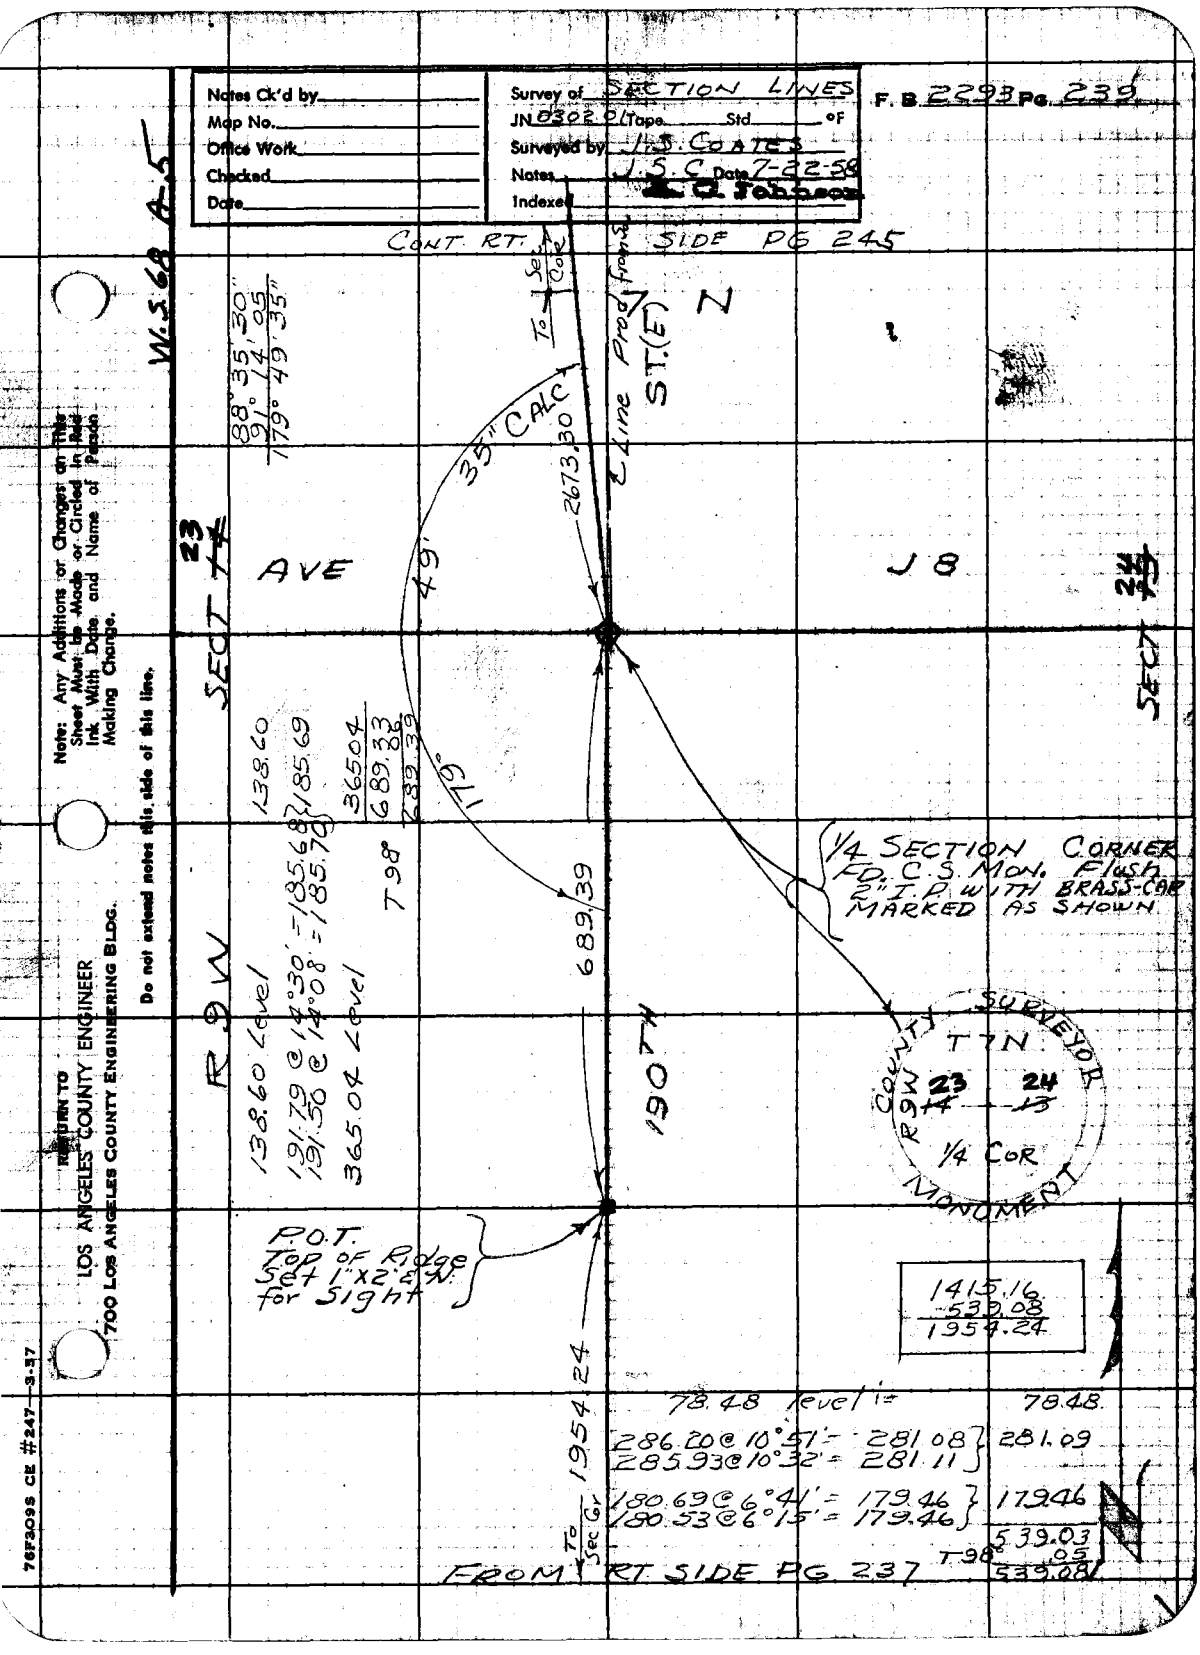
Notes Ck'd by
Map No.
Office Work
Checked
Date
Survey of SECTION LINES
JN 0302.01 Tape Std °F
Surveyed by J.S. COATES
Notes J.S.C. Date 7-22-58
Indexed
F.B. 2293 Pg. 239
CONT. RT. SIDE PG 245
W.S.68 A-5
88°35'30"
91°14'05"
179°49'35"
To Set Cor
N
ST.(E)
℄ Line Prod. Across
2673.30
35" CALC
49'
SECT 23
AVE
J8
SECT 24
119°
138.60
185.69
365.04
689.33
689.39
798°
R 9 W
138.60 Level
191.79 @ 14°30' = 185.68
191.50 @ 14°08' = 185.70
365.04 Level
689.39
190.74
1/4 SECTION CORNER
F.D. C.S. MON. FLUSH
2" I.P. WITH BRASS COR
MARKED AS SHOWN
COUNTY SURVEYOR
T 7 N
R 9 W
23
24
14
13
1/4 COR
MONUMENT
P.O.T.
Top of Ridge
Set 1"x2" N.
for Sight
1415.16
539.08
1954.24
78.48 Level = 78.48
286.20 @ 10°51' = 281.08
285.93 @ 10°32' = 281.11
281.09
180.69 @ 6°41' = 179.46
180.53 @ 6°15' = 179.46
179.46
539.03
.05
539.08
T 98
To Sec Cor
1954.24
FROM RT SIDE PG 237
Note: Any Additions or Changes on This Sheet Must be Made or Circled in Red Ink With Date and Name of Person Making Change.
Do not extend notes this side of this line.
RETURN TO
LOS ANGELES COUNTY ENGINEER
700 LOS ANGELES COUNTY ENGINEERING BLDG.
76F3098 CE #247—3-57

RETURN TO
LOS ANGELES COUNTY ENGINEER
700 LOS ANGELES COUNTY ENGINEERING BLDG.


Do not extend notes this side of this line.

WS 68

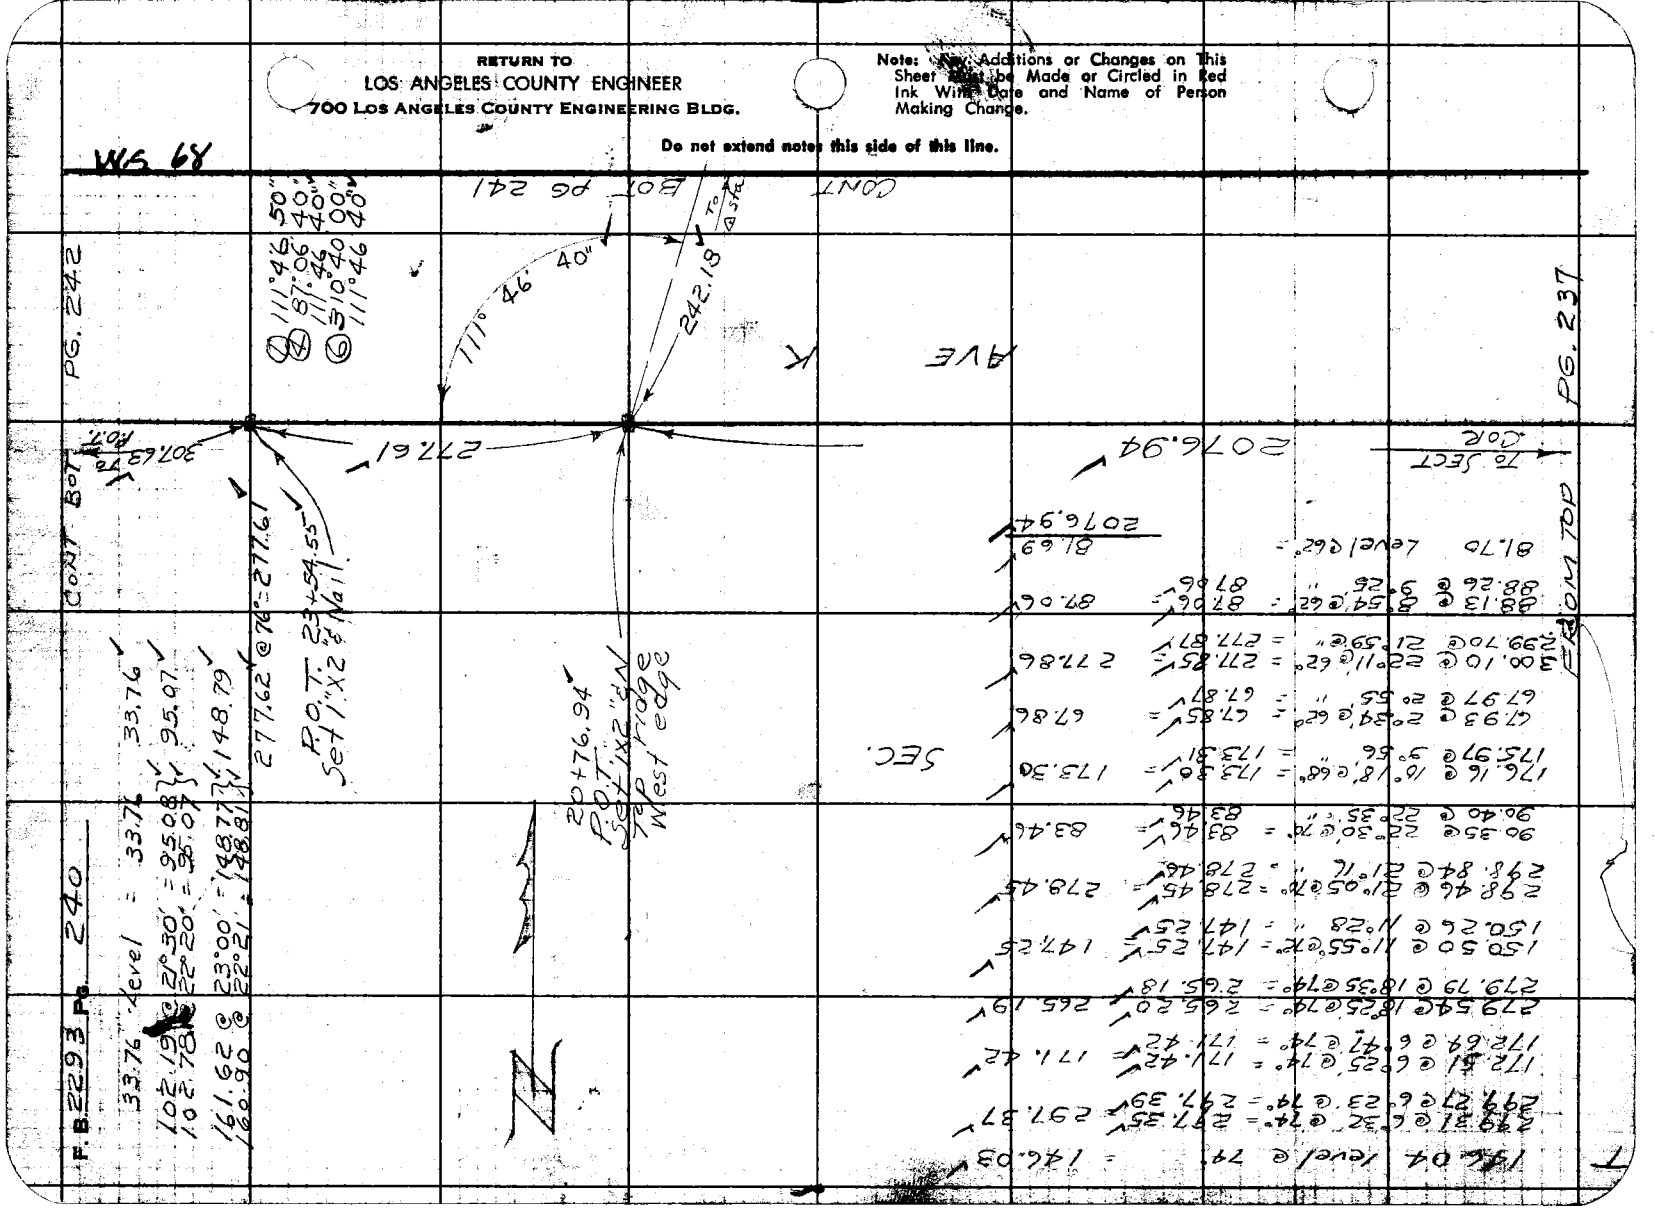

Notes Ck'd by	Survey of Sect Lines T7N R9W
Map No.	JN 0302.01 Tape 151 Std 84 °F
Office Work	Surveyed by J.S. COATES
Checked	Notes J.S.C. Date 5-5-59
Date	Indexed

F. B. 2293 Pg. 241

W.S. 68 A-5

Note: Any Additions or Changes on This Sheet Must be Made or Circled in Red Ink With Date and Name of Person Making Change.

Do not extend notes this side of this line.

RETURN TO
LOS ANGELES COUNTY ENGINEER
700 Los Angeles County Engineering Bldg.

76F2095 CE #247—3-57

U.S. GEOLOGICAL SURVEY COOPERATION WITH LOS ANGELES COUNTY
Elev ▲ ABOVE SEA FEET
SADDLEBACK
250 DOLLARS FINE FOR DISTURBING THIS MARK

TRIANGULATION STATION
FD U.S.G.S. Brass-Cap
Set in Boulder
Marked as Shown
Top of SADDLEBACK

To Sect Cor. 22, 23, T 7N R 9W 27, 26
See left side PG 243

To 1"x2" Pot. 242.18 on Sect Line

FROM RT SIDE PG 240

135 30 @ 23° 39' = 123.94
134 84 @ 23° 13' = 123.93

120.08 @ 14° 19' = 116.29
119.78 @ 13° 47' = 116.30

2.00 Level = 2.00

242.22 + 60 = 242.18

F.B. 2293 Pg. 242

CONT. RT. SIDE

PG. 243

W.S. 58.0-U

949.23 To Sta Ahead

P.O.T. 44+55.08 Set 1"X2" N Top Sandy Spur W. edge of rain

754.00

298.63 @ 14°20' = 289.33 ✓
298.90 @ 14°32' = 289.34 ✓ 289.33 ✓

109.68 @ 22°42' = 101.18 ✓
109.18 @ 22°01' = 101.22 ✓ 101.20 ✓

75.98 @ 23°27' = 69.70 ✓
76.13 @ 23°45' = 69.68 ✓ 69.69 ✓

141.70 @ 11°40' = 138.77 ✓
141.32 @ 10°53' = 138.78 ✓ 138.77 ✓

75.32 Level = 75.32 ✓ 75.32 ✓

81.66 @ 12°33' = 79.71 ✓
81.40 @ 11°40' = 79.72 ✓ 79.71 ✓

754.02 @ 80° = 754.00 ✓

P.O.T. 37+01.08 ✓ Set 1"X2" N ✓

T 7N R9W

SECT 26

SECT 23

K

556.99 ✓

293.57 @ 4°12' = 292.78 ✓
293.62 @ 4°20' = 292.78 ✓ 292.78 ✓

264.63 @ 3°08' = 264.23 ✓
264.59 @ 3°04' = 264.21 ✓ 264.22 ✓

557.00 @ 80° = 556.99 ✓

P.O.T. Set 1"X2" W ✓ 31+44.09

Set B.S.W.E.T. 6" JOSHUA

Set L.E.L.A.Co. ENG. TAG IN BOULDER

214.14 @ 19°42' = 201.61 ✓
214.45 @ 19°55' = 201.62 ✓ 201.61 ✓

298.93 @ 20°19' = 280.33 ✓
298.23 @ 19°57' = 280.33 ✓ 280.33 ✓

481.94 @ 76° = 481.91 ✓

12.88

33.34

481.91

AVE

39.97

27+02.15 Sq. 1/4 Cor. Sect 23 T 7N R9W Set C.E.M on Flush By Proportion bet S.E. Cor & S.W. Cor Sec. 23 marked as shown per C.S. 9166-4

COUNTY R9W

T 7N

23

26

1/4 Cor

N 5.8°E

ENGINEER

P.O.T. Set 1"X2" S ✓ 26+62.18

61.42 @ 28°50' = 53.81 ✓
62.13 @ 30°02 = 53.79 ✓ 53.80 ✓

294.36 @ 30°25' = 253.85 ✓
293.32 @ 30°04' = 253.85 ✓ 253.85 ✓

307.65 @ 76° = 307.63 ✓

307.63

To P.O.T.

FROM TOP PG. 240

RETURN TO LOS ANGELES COUNTY ENGINEER 700 LOS ANGELES COUNTY ENGINEERING BLDG.

Do not extend notes this side of this line.

Note: Any Additions or Changes on This Sheet Must be Made or Circled in Red Ink With Date and Name of Person Making Change.

Notes Ck'd by	Survey of Sect Line T7N R9W
Map No.	JN 0302.01 Tape 151 Std 84 °F
Office Work	Surveyed by J.S. COATES
Checked	Notes J.S.C. Date 5-
Date	Indexed G. Johnson

F. B. 2293 Pg. 243

W/4 Cor. Sect. 23
FD C.S. Mon. 6"UP
PB 497-154 - C.S.B. 833
Marked as shown

T 7 N

143.18 @ 5°06' = 142.56
143.24 @ 5°33' = 142.58 / 1425X

299.11 @ 4°37' = 298.14 / 298.13
298.90 @ 4°09' = 298.12

278.52 @ 7°05' = 276.39 / 276.38
278.63 @ 7°17' = 276.38

197.08 @ 6°55' = 195.65 / 195.65
196.86 @ 6°20' = 195.60

36.48 Level = 36.48
949.23 / 949.23

SURVEYOR T7N R9W 22 23 1/4 SEC. COR MONUMENT

SECT 22

SECT 23

ST (E)

Note: Any Additions or Changes on This Sheet Must be Made or Circled in Red Ink With Date and Name of Person Making Change.

Do not extend notes this side of this line.

①	88°27'40"
④	333°50'00"
	88°27'30" ✓
⑥	170°45'20"
	88°27'33⅓

①	84°42'00"
④	338°47'40"
	84°41'55" ✓
⑥	169°11'20"
	84°41'55⅓ ✓

R.P. Set 2"I.P. 8"UP Conc. P.L.A. Co. ENG TAG

88° 27

84°41'55"

See Left Side Pg 241 for Sta. To Saddleback

W 55.56' Adv.

56.57 TAN

40" ✓

AVE.

K

949.23 To Pg 241

R.P. Set 2"I.P. 8"UP Conc. P.L.A. Co. ENG TAG

45°

56.57

45°

52'

54+04.29

SECTION CORNER FD. C.S. MON. PUNCH 2"I.P. WITH BRASS CAP MARKED AS SHOWN

90°

R 9 W

180.08

①	180°39'40"
④	362°38'40"
	180°39'40" ✓
⑥	303°57'50"
	180°39'38⅓ ✓

SECT 27

SECT 26

①	98°52'40"
④	363°31'00"
	90°52'45" ✓
⑥	185°16'30"
	90°52'45⅓

SURVEYOR T7N R9W 22 23 27 26 COUNTY MONUMENT

180.08

CONT TO PG 244

RETURN TO
LOS ANGELES COUNTY ENGINEER
700 Los Angeles County Engineering Bldg.

76F3095 CE #247—3-57

F. B. 2293 Pg. 244

T 7 N

FROM BOT. PG. 243

W.S. 68 R-5

Set 1"x2" E.N. Top Ridge for Sight

RETURN TO
LOS ANGELES COUNTY ENGINEER
700 Los Angeles County Engineering Bldg.

Do not extend notes this side of this line.

Note: Any Additions or Changes on This Sheet Must be Made or Circled in Red Ink With Date and Name of Person Making Change.

180' St E

SECT 27

SECT 26

RP
FD 2" I.P. 6" UP
COINC. PI & L.A.
CO. ENG. TAG

56.57
TAN

AVE

L

R 9 W

56.57

45°

SECTION CORNER
FD. C.S. MON. FLUSH
2" I.D. W. 7/16 BRASS-CAP
per C.S.B. 833
per F.B. 2264
Marked as Shown

RP
FD 2" I.P. 6" UP
COINC. PI & L.A.
CO. ENG. TAG

COUNTY SURVEYOR'S MONUMENT
T 7 N
R 9 W
27 | 26
34 | 35

SECT 34

SECT 35

Notes Ck'd by	Survey-by SECT. LINE T 7N R 9 W
Map No.	JN 0302.0 Tape 151 Std. 84 °F
Office Work	Surveyed by J.S. COATES
Checked	Notes J.S.C. Date 6-22-59
Date	Indexed L.O. Johnson 7-2-59

F.B. 2293 Pg. 245

1/4 Cor Sec 13, 24
T 7N R 9 W
F.D.C.S. Mon. 12" dm.
marked as shown
F.B. 2237-182

SURVEYOR'S LINE
T 7 N
13 + 24
M 62 1/4 COR
MONUMENT
COUNTY

15.22 level 15.22

144.44 @ 9°45' = 142.35 } 142.35
144.31 @ 9°26' = 142.36 }

265.21 @ 14°56' = 256.25 } 256.24
264.96 @ 14°45' = 256.23 }

20.68 level 20.68

300.92 @ 9°14' = 297.02 } 297.02
301.05 @ 9°23' = 297.02 }

300.20 @ 5°20' = 298.90 } 298.90
300.12 @ 5°10' = 298.90 }

300.15 @ 4°54' = 299.05 } 299.06
300.23 @ 5°02' = 299.07 }

300.45 @ 4°12' = 299.67 } 299.65
300.41 @ 4°00' = 299.67 }

T 106 1766.12
1766.37

300.96 @ 3°08' = 300.57 } 300.52
301.05 @ 3°23' = 300.53 }

606.34 @ Level 606.34
906.87
T 96 906.93
906.93

Sum
1766.37
906.93
2673.30

5.14 Sec. line Prod
2673.30
To 1/4 Cor

SURVEYOR'S LINE
T 7 N
13 + 24
M 62 23
MONUMENT

SECT. CORNER
13 24 T 7N R 9W
F.D.C.S. Mon. 6" dm.
Marked as shown
F.B. 2237-181

RP
FD 2" I.P. F/L
CONC. PL. & TK

RP
FD 2" I.P. & Up
CONC. PL. & TK

FD 2" I.P. & Up
CONC PL. & TK

Set 1"x 2" I.P.
& Tag

U.S. 68 B-9

91°24'40" 365°38'00" 91°24'30" 188°24'30" 91°24'30"
91°14'00" 364°56'20" 91°14'05" 187°14'30" 91°14'05"

(50) (50)

AVE J

190th St

7.60 50.00 56.57

RETURN TO
LOS ANGELES COUNTY ENGINEER
900 LOS ANGELES COUNTY ENGINEERING BLDG.

Note: Any Additions or Changes on This Sheet Must be Made as Circled in Red Ink With Date and Name of Person Making Change.

Do not extend notes this side of this line.

From 702

769CES CE #247 7-59

Notes Ck'd by Miller	Survey of TR # 22670	F. B. 2293 Pg. 247
Map No.	JN 030700 Tape 0176 Std 6.8 OF	
Office Work	Surveyed by J.S COATES	
Checked	Notes L.S.C. Date 5-3-59	
Date	Indexed L.C. Johnson 5-11-59	

J.N. 030700

TR # 22670

REPLACEMENT

OF

2" I.P. @ N.W. COR. OF TR. 22670

12' S. of ℄ AVE. Q-4

COATES
KING
VAN NESS

Notes: Any Additions or Changes on This Sheet Must Be Made or Circled in Red Ink With Date and Name of Person Making Change.

Do not extend notes this side of this line.

RETURN TO
LOS ANGELES COUNTY ENGINEER
900 LOS ANGELES COUNTY ENGINEERING BLDG.

769098 CE #247—7-55

F.B. 2293 PG. 248 CONT. F.B. PG. 249

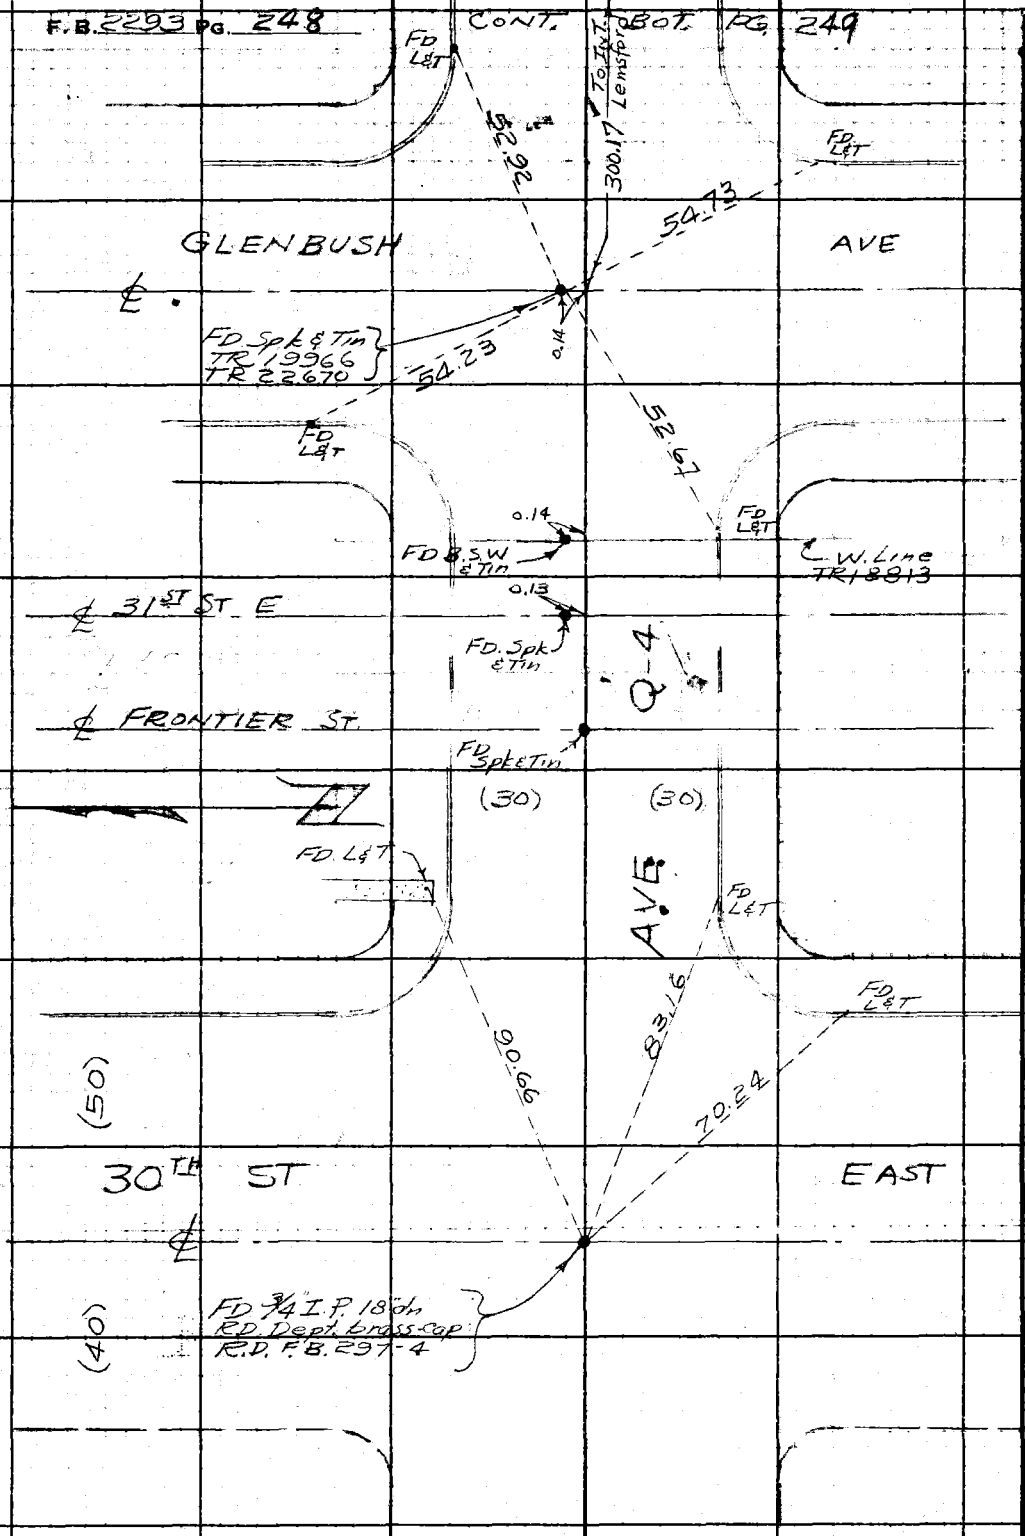

LOS ANGELES COUNTY ENGINEER
900 LOS ANGELES COUNTY ENGINEERING BLDG.
RETURN TO

Do not extend notes this side of this line.

Note: Any Additions or Changes on This Sheet Must be Made or Circled in Red Ink With Date and Name of Person Making Change.

LAS 65 B-2 C-2

Notes Ck'd by Miller
Map No.
Office Work
Checked
Date

Survey of TR#22670
JN 0307.00 Tape 0126 Std 68 °F
Surveyed by J.S. COATES
Notes J.S.C. Date 6-3-59
Indexed G. Johnson

F. B. 2293 Pg. 249

WS 65C-7

CONT. TO BOT. PG. 250

(30) 128.68 70 32 SE ST (30)

Set Spk

90° 12.00

W Line TR 22670

Set 2" I.P 12"dn Conc Fl & L.A. Co. Eng Tag By PROPORTIONED DIST. Between Spk & Tins @ Lemsford AVE & 32ND ST. E. per TR 22670

21.35 Set S&W 21.42

30.02 11.92

90°

FD 2" I.P 12"dn CONC Fl & TAG RE 6067 TR 19965

Set S&W

FD 2" I.P 12"dn CONC Fl & TAG RE 6067 TR 13966 TR 22670

Q-4

171.52@84°= 171.54

171.54

FD L&T

51.43

54.60

FD L&T

(30)

FD Spk & Tin TR 19966 TR 22670

LEMSFORD

55.19

.08

AVE

(30)

FD L&T

51.44

FD L&T

AVE

TO INT 300.17 GLENGROVE

300.14@84°= 300.17

FROM TOP PG 248

Note: Any Additions or Changes on This Sheet Must be Made or Circled in Red Ink With Date and Name of Person Making Change.

Do not extend this side of this line.

PLEASE RETURN TO
LOS ANGELES COUNTY ENGINEER
700 LOS ANGELES COUNTY ENGINEERING BLDG.

76F3095 SSE #247 1-56

F. B. 2293 Pg. 250

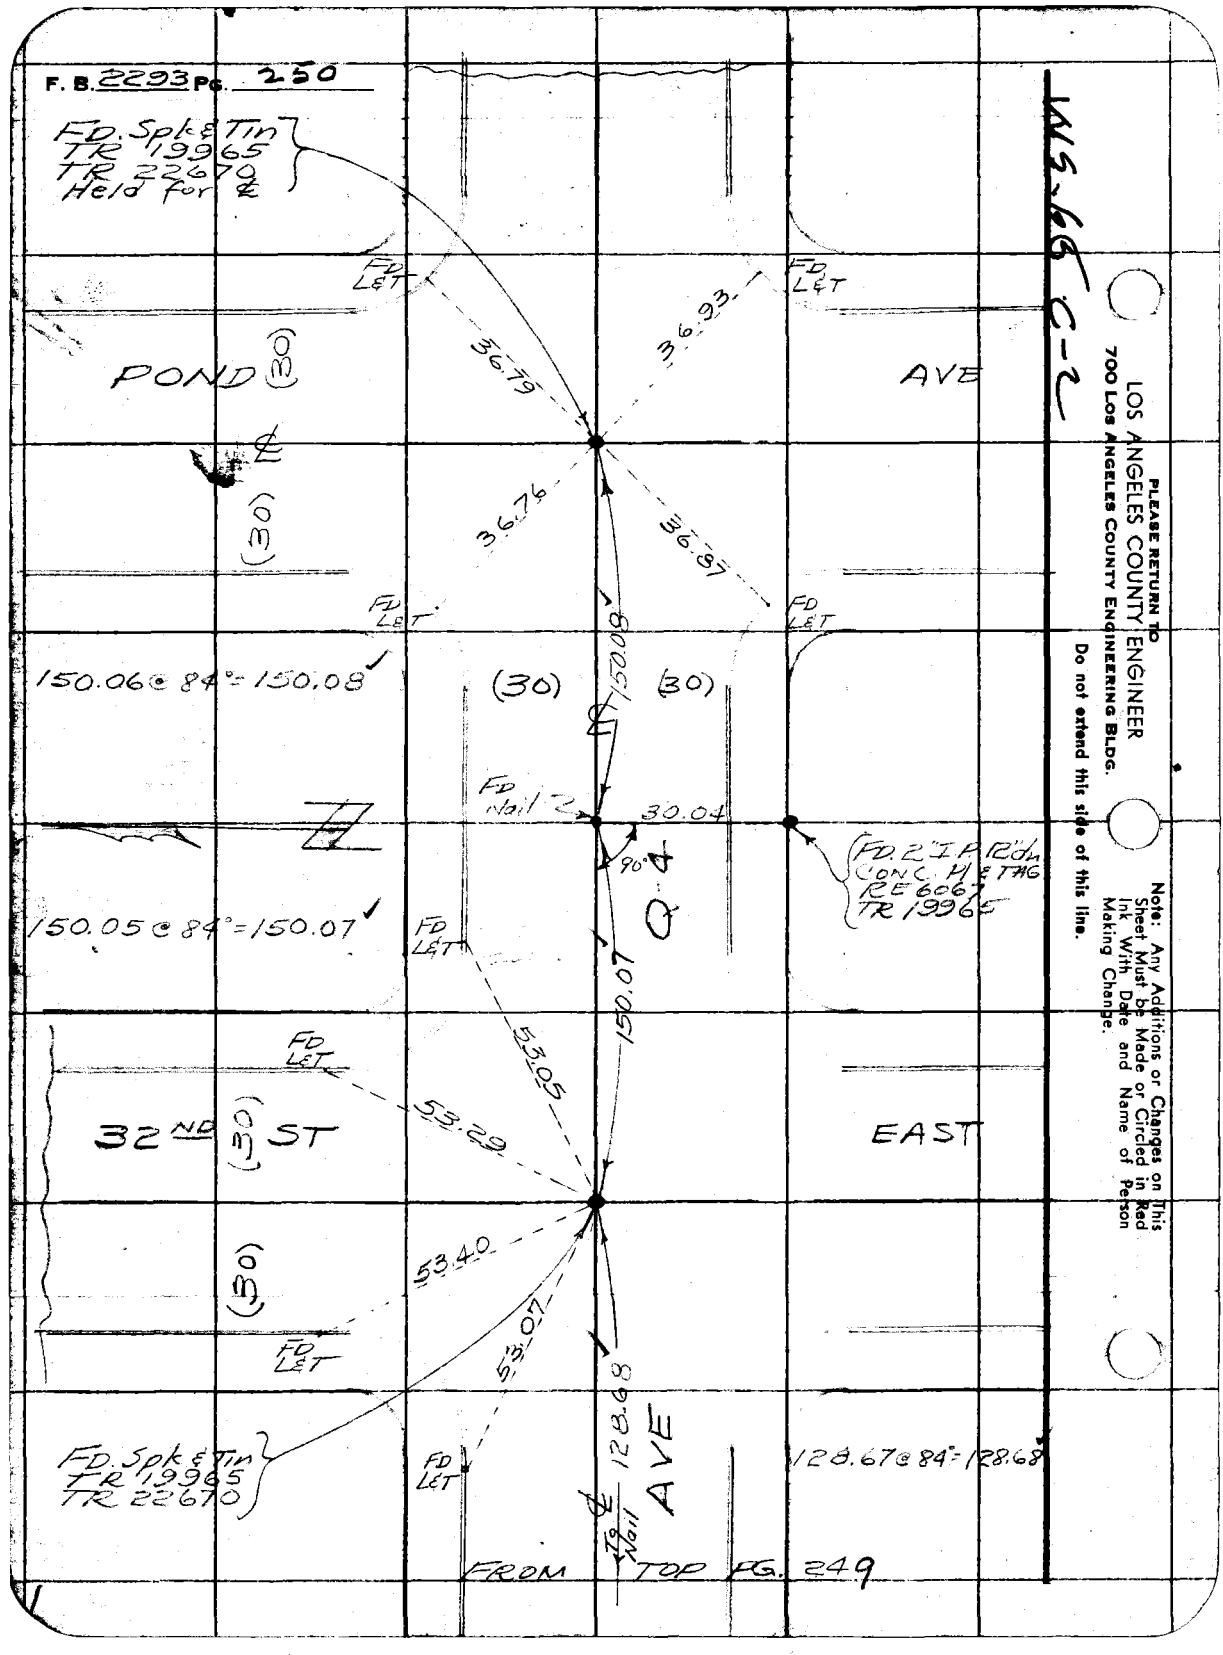

PLEASE RETURN TO
LOS ANGELES COUNTY ENGINEER
700 LOS ANGELES COUNTY ENGINEERING BLDG.
Do not extend this side of this line.

Note: Any Additions or Changes on This Sheet Must be Made or Circled in Red Ink With Date and Name of Person Making Change.

WS 66 C-2

Notes Ck'd by	Survey of Antelope VALLEY & SURVEY F. B. 2293 Pg. 251
Map No.	JN 0021.60 Tape 101 Std 84 °F
Office Work	Surveyed by JS COATES
Checked	Notes JSC Date 10-3-60
Date	Indexed W. E. OCT 7 '60

J. N. 0021.60

ANTELOPE VALLEY & SURVEY

PROPOSED NEW CENTER-LINE OF 35TH ST E BETWEEN AVE. Q & AVE. R

COATES
BEERS
KING
HUBBARD
VAN NESS

Note: Any Additions or Changes on this Sheet Must be Made or Circled in Red Ink With Date and Name of Person Making Change.

Do not extend this side of this line.

PLEASE RETURN TO
LOS ANGELES COUNTY ENGINEER
700 Los Angeles County Engineering Bldg.

76F3098 SSE #247 11-58

F. B. 2293 Pg. 252

CONT. BOT. PG. 253

To Spk. Eln. PALMDALE BLVD

35TH ST. E

℄ per F.B. 2293-27

2589.28 per F.B. 2293-27, 30

PROPOSED NEW ℄

AVE R

LAS 69 C-3

PLEASE RETURN TO
LOS ANGELES COUNTY ENGINEER
700 Los Angeles County Engineering Bldg.

Do not extend this side of this line.

Note: Any Additions or Changes on This Sheet Must be Made or Circled in Red Ink With Date and Name of Person Making Change.

④ 88° 39' 00"
④ 354° 37' 00"
88° 39' 00"
⑥ 171° 56' 00"
88° 39' 00"

FD. 2" I.P. 18" dn
CONC. PL. & L.A.
CO. ENG. TAG
F.B. 2293-27

AVE

FD. 2" I.P. 12" dn
CONC. PL. & L.A.
CO. ENG. TAG
F.B. 2636-12

33.83

88° 39' 20"

FD 3/4" I.P. Fl.
used as Ctr.
F.B. 1129-45, 48

NEW ℄ AVE R ?

3.85

4.22

38.08

20.84

To Cor. Sec 28, 29, 32, 33

SECT. LINE

FD 1" I.P. 12" dn.
CONC. PL. & L.A.
CO. ENG. TAG
F.B. 2293-27

FD. 2" I.P. 18" dn
CONC. PL. & L.A.
CO. ENG. TAG

50.00

53.13

49.99

47.18

NEW INT.
SET 2" I.P. 12" dn
CONC. PL. & L.A.
CO. ENG. TAG
per OFFICE CALC Sheet

R.P.
FD. 2" I.P.B" up
CONC. PL. & L.A.

Notes Ck'd by
Map No.
Office Work
Checked
Date

Survey of A.V. & Surveys
JN 0021.60 Tape 101 Std. 84 °F
Surveyed by J.S. COATES
Notes JSC Date 10-3-60
Indexed H. E. on

F. B. 2293 Pg. 253

Note: Any Additions or Changes on This Sheet Must be Made or Circled in Red Ink With Date and Name of Person Making Change.

Do not extend this plan of this time.

PLEASE RETURN TO
LOS ANGELES COUNTY ENGINEER
700 Los Angeles County Engineering Bldg.

CONT. BOT. PG 257

To Nail

749.44 T LINE

PROPOSED ℄ 35TH ST E

FD. Spk. W.L.&T. 20th F.B. 2293-30

FD L&T

FD L&T

To Spk. W 2.84 & ST. E @ 1.30

87.59

55" 45"

89° 29' 40"
357° 55' 00"
89° 30' 40"
179° 59' 55"
89° 29' 46"
179° 59' 56"
89° 29' 46"

81.02

PALMDALE

BLVD

1.18

2.85

PITCH 0-15

58

179°

63.68

Set L&L.A.Co. Eng. Tag Conc. Headwall

Set L&L.A.Co. Eng. Tag Conc. Headwall (New)

FD. Spk. W.L.&T. Tan "B" F.B. 2293-30

25'89 28 Per FB 2293-30

PROPOSED ℄

179° 58' 20"
359° 53' 40"
179° 58' 25"
359° 50' 30"
179° 58' 25"

179° 58' 10"
359° 53' 00"
179° 58' 15"
359° 50' 40"
179° 58' 16 2/3"

NOTE:
This intersection was not possible at this time due to construction of new INTERSECTION by State Hwy. AT 40TH ST. E by J.S.C. 10-3-60

90° 31' 40"
362° 07' 10"
90° 31' 47 1/2"
103° 10' 40"
90° 31' 46 2/3"

To 2" I.P.

FROM TOP

PG 208

76F3008 SAE #247

PLEASE RETURN TO
LOS ANGELES COUNTY ENGINEER
700 LOS ANGELES COUNTY ENGINEERING BLDG.

Note: Any Additions or Changes on This Sheet Must be Made or Circled in Red Ink With Date and Name of Person Making Change.

Do not extend this side of this line.

WS 65-C-7

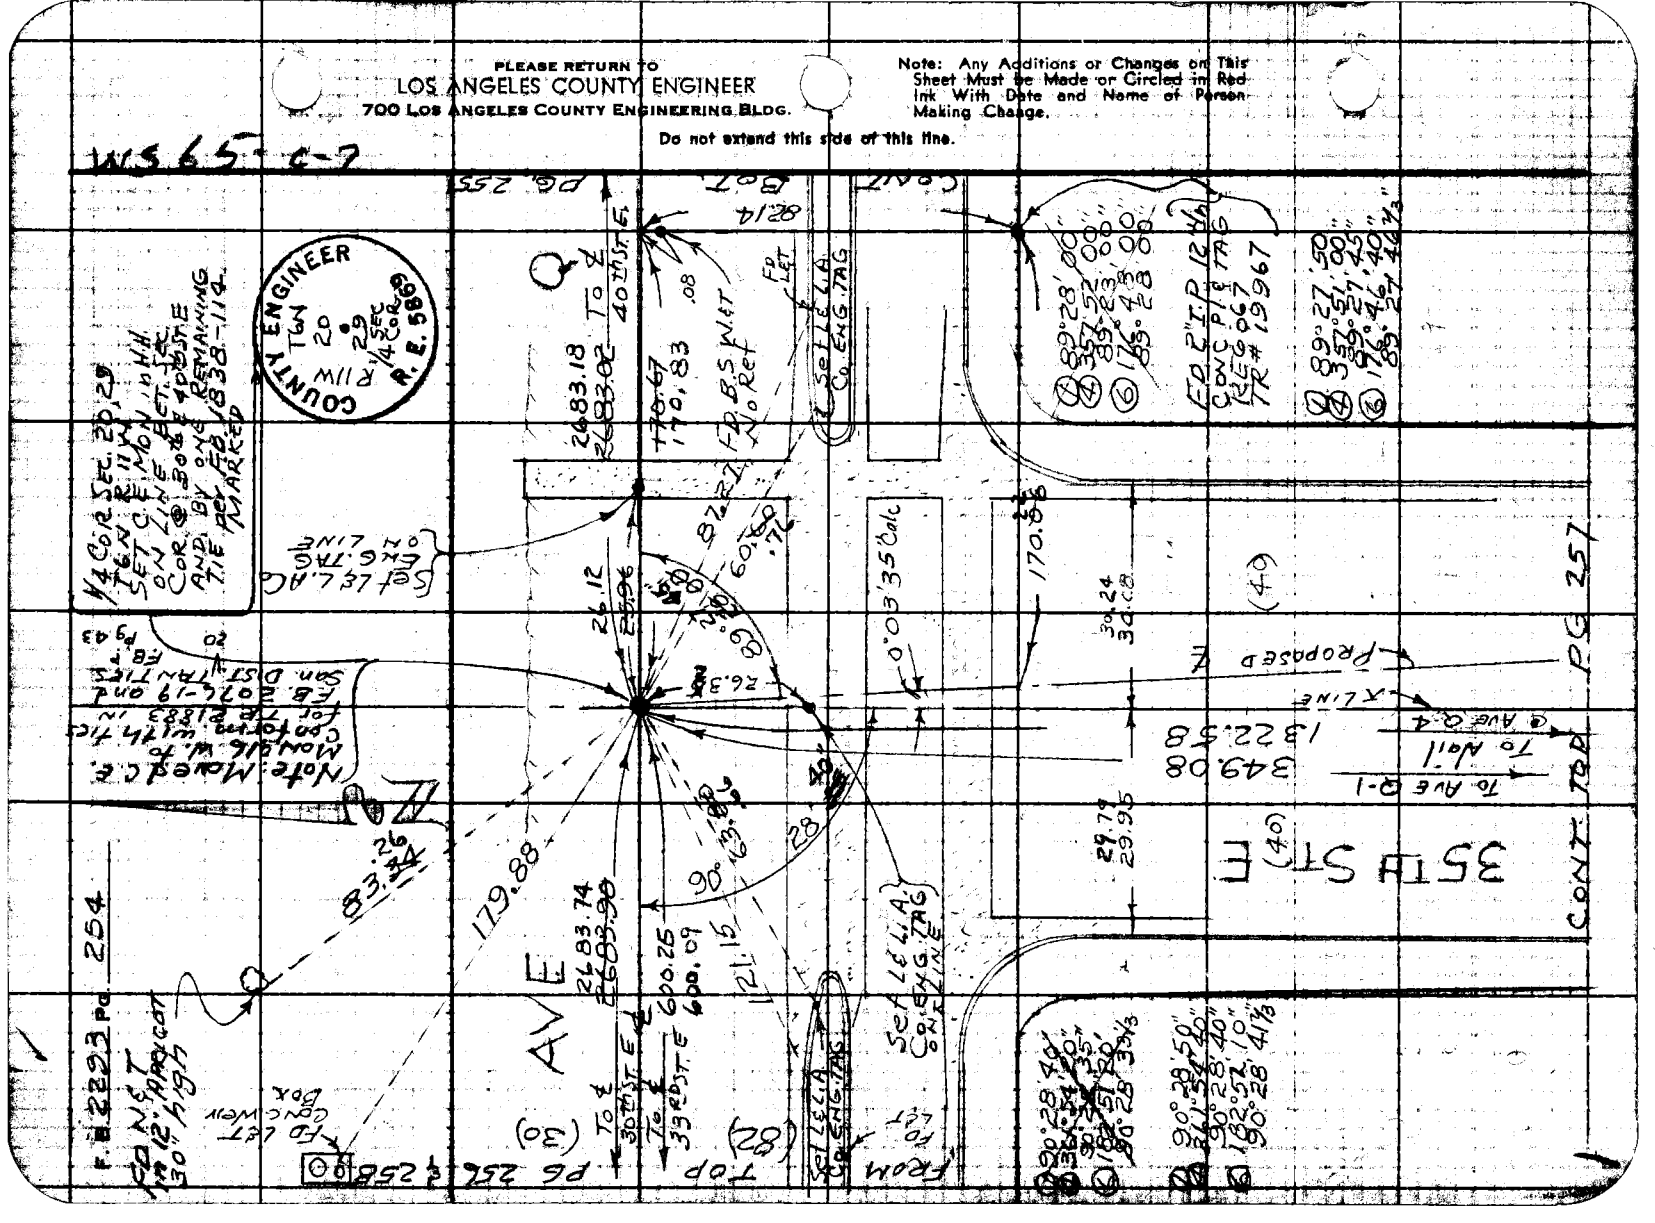
COUNTY ENGINEER
T2N R11W
20
29
1/4 SEC
R.E. 5869
N4 COR SEC. 20, T2N, R11W, IN H.H. SET CENTER MON. IN BOX ON LINE BET. SEC. COR. @ 200' & 400' FROM SAME AND BY ONE REMAINING TIE PER RECORD MARKED
1838-114
Set L.E.L.A. Co. ENG. TAG ON LINE
Set L.E.L.A. Co. ENG. TAG
Set L.E.L.A. Co. ENG. TAG
FROM
Set L.E.L.A. Co. ENG. TAG
FD 2"IP 12" LONG PIPE TAG RCE 6067 TR# 19967
FD 2"IP 12" LONG PIPE TAG RCE 6067 TR# 19967
FD B.S. NAIL & WASHER
FD B.S. NAIL & WASHER
FD B.S. NAIL & WASHER

Notes Ck'd by	Survey of A.V. & SURVEY
Map No.	JN 0021.60 Tape 101 Std 89 °F
Office Work	Surveyed by J.S. COATES
Checked	Notes J.S.C. 10-3-60
Date	Indexed

F. B. 2293 PG. 255

Note: Any Additions or Changes on This Sheet Must Be Made or Circled in Red Ink With Date and Name of Person Making Change.

Do not extend this side of this line.

PLEASE RETURN TO
LOS ANGELES COUNTY ENGINEER
700 LOS ANGELES COUNTY ENGINEERING BLDG.

7BF2098 SAE #247 11-60

SURVEYOR'S MONUMENT
COUNTY
T6N R11W
20 21 28 29

Cor. SEC. 20, 21, 28, 29
T6N R11W
FD C.S. MON. 12" dm
per F.B. 1838-62
MARKED

SET N&T
TP #53 80.35H

SET N&T
TP #24 120.1E

86.91

72.23

65.86

40TH

SET N&T
TP 70 213.4H

ST. E

AVE Q

(30)

(30)

2683.02
2683.18

2682.99 @ 86°-26'-37.02

To 35th St E

(82)

FROM RT. SIDE PG. 254

PLEASE RETURN TO
LOS ANGELES COUNTY ENGINEER
700 LOS ANGELES COUNTY ENGINEERING BLDG.

Note: Any Additions or Changes on This Sheet Must be Made or Circled in Red Ink With Date and Name of Person Making Change.

Do not extend this side of this line.

W.S 65-B-2

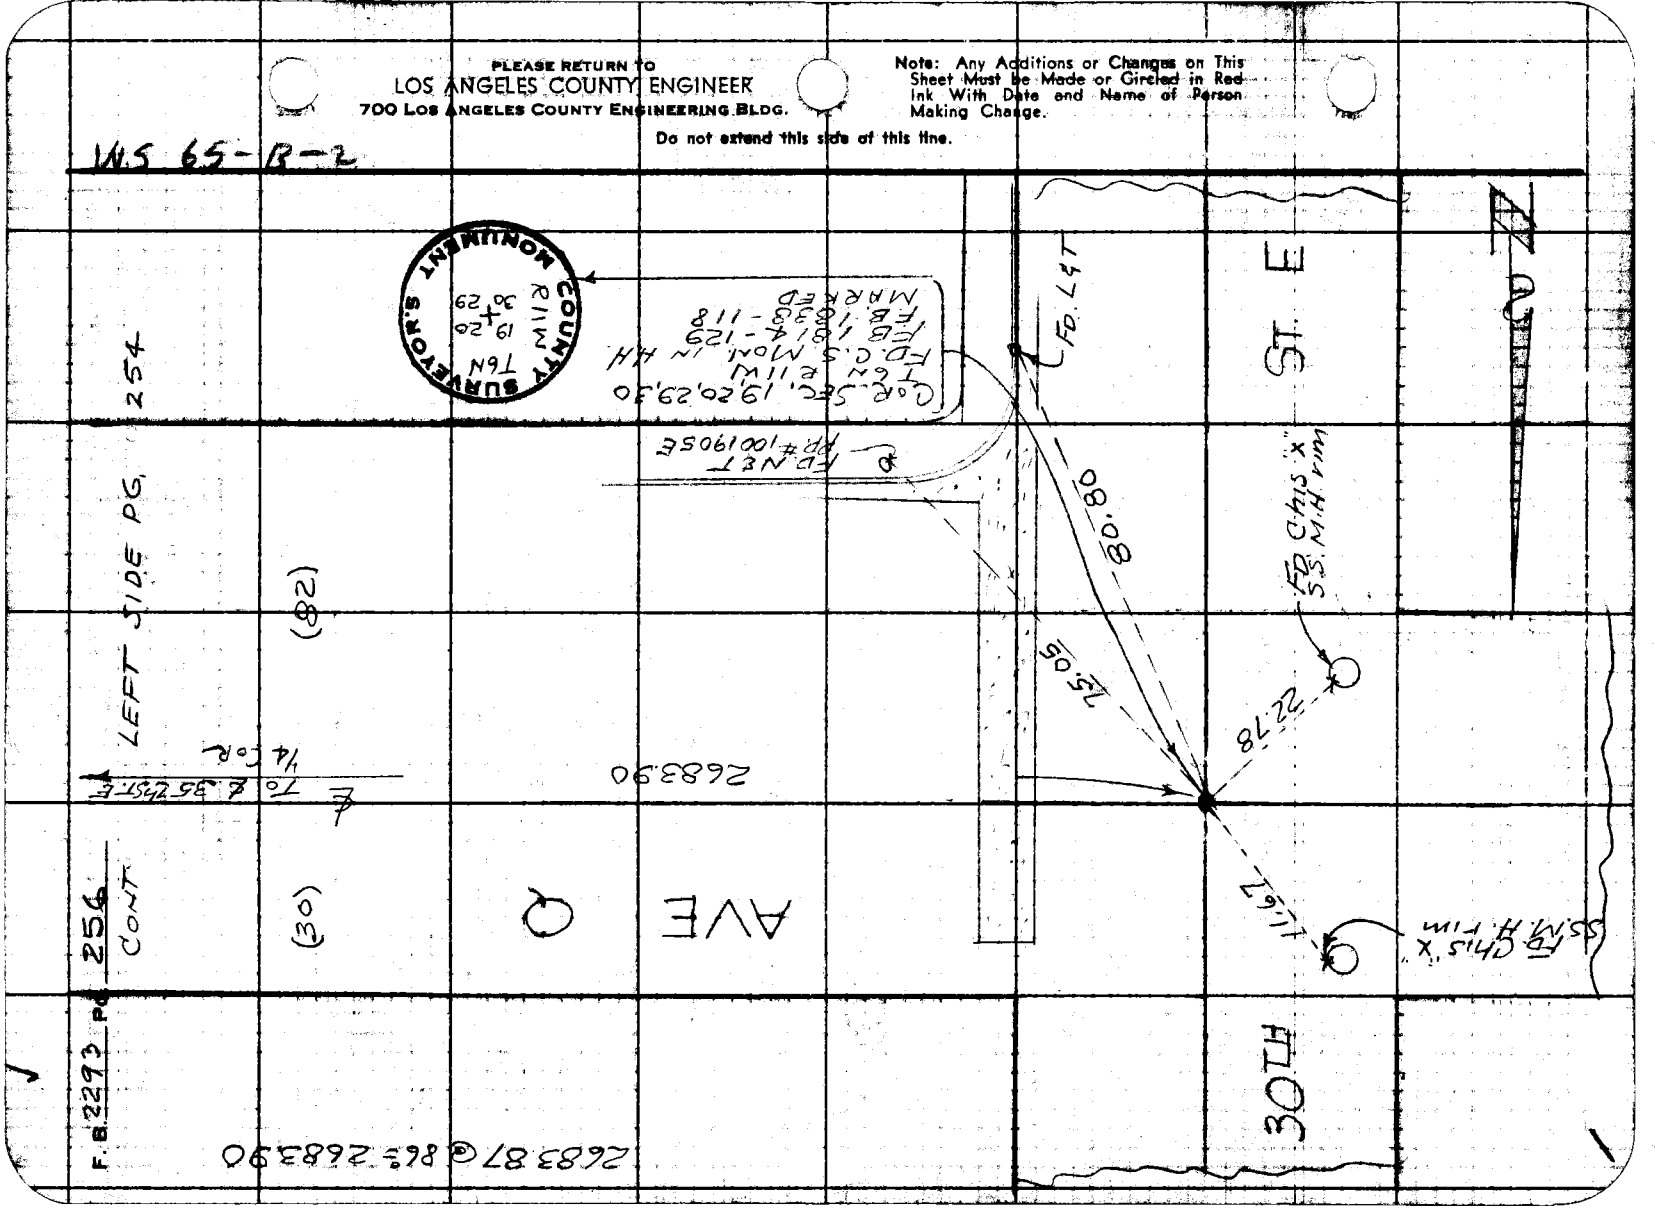

Notes Ck'd by
Map No.
Office Work
Checked
Date

Survey of A.V. & SURVEY
JN 2021.60 Tape 107 Std 84 °F
Surveyed by J.S. COATES
Notes JSC Date 10-3-66
Indexed

F. B. 2293 Pg. 257

FROM BOT PG. 254

W.S. 65 G-7

AVE Q-1 ℄

TO 1/4 COR

FD. Nothing
SEE PG 263

PROPOSED ℄ PER TR 19967 ST E

SET L&L.A.CO. ENG. TAG ON

1322.58

1322.58 @ 84° = 1322.58
573.83 @ 84° = 573.83
749.44 @ 84° = 749.44
312.26 @ 84° = 312.26
155.60 @ 84° = 155.60

LILACVIEW AVE

AVE Q ℄

312.26

155.60

FD L&T
FD Spk&Tin TR 19967

Set Nail

SET Spk By INT. OF ℄ OF DUNMORE AVE & ℄ OF AVE Q-1 PER TR 19967

FD Spk&Tin TR 19967

DUNMORE AVE ℄

℄ LINE 573.83

35TH

89° 30' 45"

① 89° 30' 50"
④ 358° 30' 10"
89° 30' 47½"
⑥ 177° 04' 40"
89° 30' 46½"

155.28

Set Nail

749.44

149.08

TO AVE Q-1

S.E. COR TRACT
FD 2" I.P. IN C.M.
CONC PI & TAG
RE 68567
TR. 19967

FROM TOP PG 253 & 260

Note: Any Additions or Changes on This Sheet Must be Made or Circled in Red Ink With Date and Name of Person Making Change.

Do not extend this title.

PLEASE RETURN TO
LOS ANGELES COUNTY ENGINEER
700 Los Angeles County Engineering Bldg.

70F3008 SAE #247 11-66

PLEASE RETURN TO
LOS ANGELES COUNTY ENGINEER
700 LOS ANGELES COUNTY ENGINEERING BLDG.

Note: Any Additions or Changes on This Sheet Must be Made or Circled in Red Ink With Date and Name of Person Making Change.

Do not extend this side of this line.

W.S 65 C-2

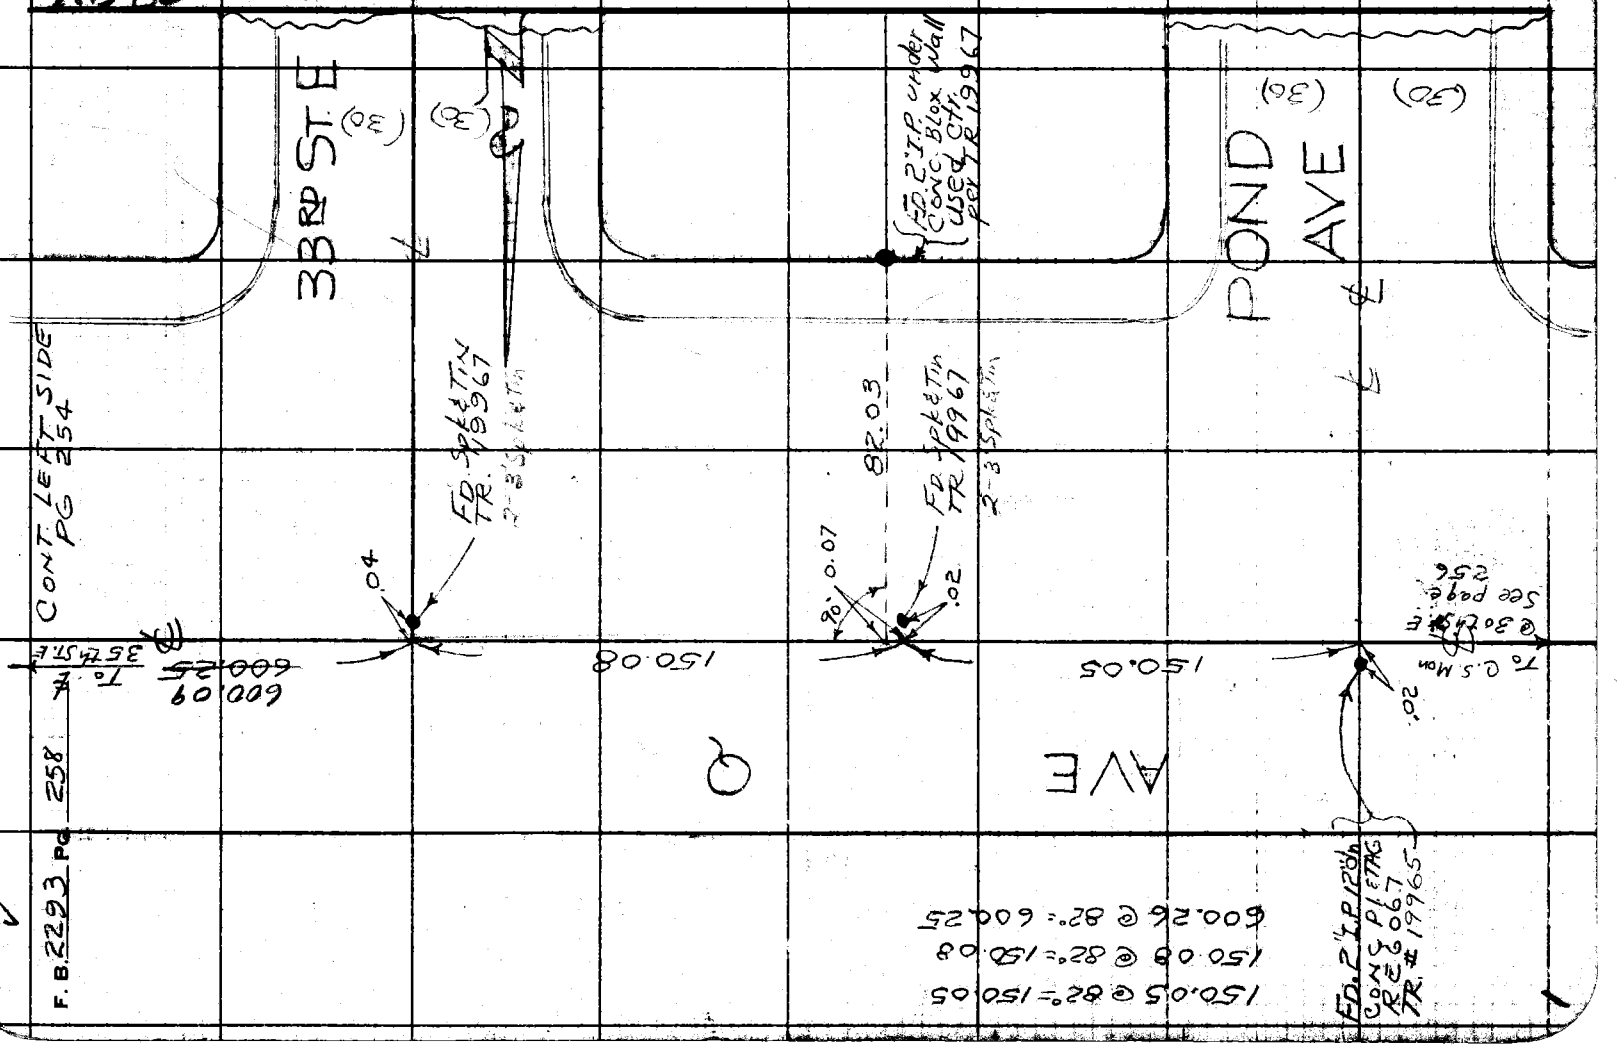

F.B. 2293 Pg 258

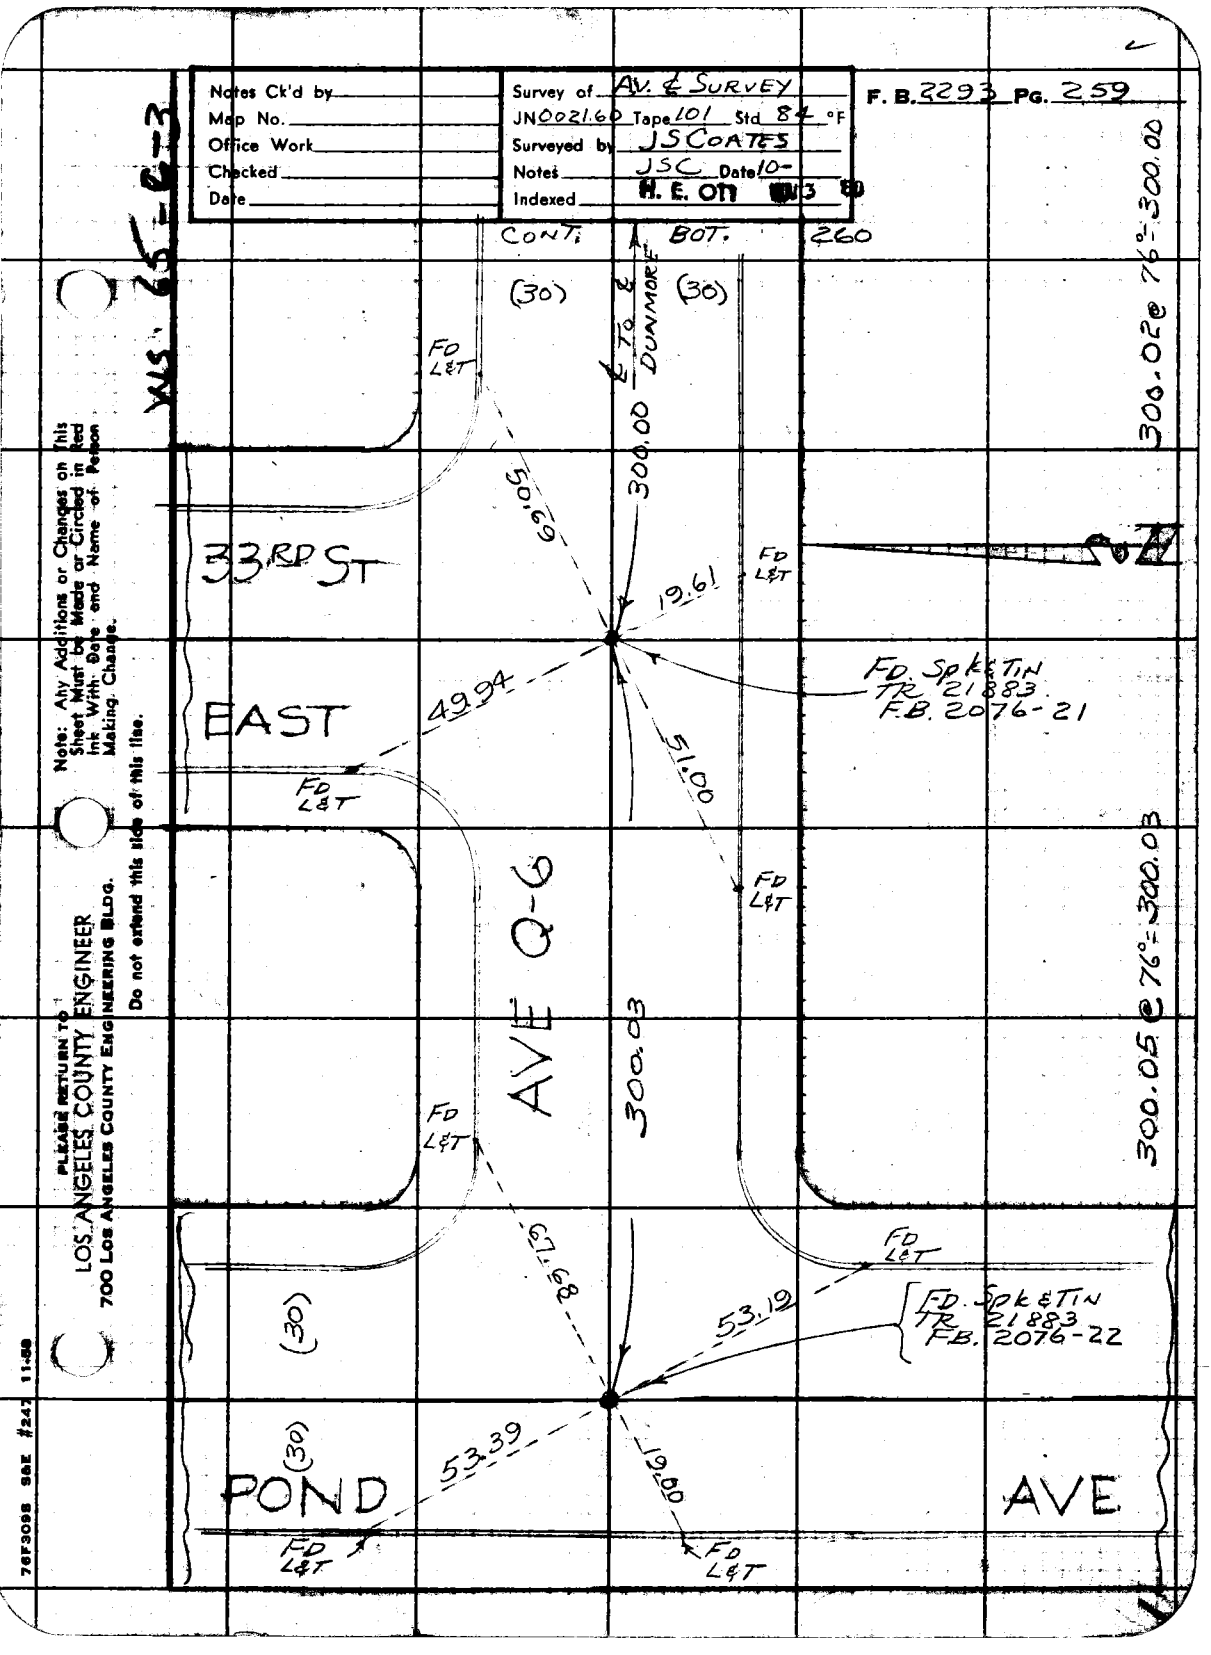
Notes Ck'd by
Map No.
Office Work
Checked
Date
Survey of AV. & SURVEY
JN 002160 Tape 101 Std 84 °F
Surveyed by JSCOATES
Notes JSC Date 10-
Indexed H. E. ON 3 80
F. B. 2293 PG. 259
WS 65-6-3
CONT.
BOT.
260
(30)
(30)
℄ TO ℄ DUNMORE
FD L&T
300.00
50.69
19.61
33RD ST
EAST
49.94
51.00
FD Spk&TIN TR 21883 F.B. 2076-21
AVE Q-6
300.03
300.02 @ 76°=300.00
300.05 @ 76°=300.03
53.12
FD Spk&TIN TR 21883 F.B. 2076-22
(30)
POND
53.39
19.00
AVE
Note: Any Additions or Changes on This Sheet Must be Made or Circled in Red Ink With Date and Name of Person Making Change.
Do not extend this line of this line.
PLEASE RETURN TO
LOS ANGELES COUNTY ENGINEER
700 LOS ANGELES COUNTY ENGINEERING BLDG.
76F3098 SAE #247 11-58

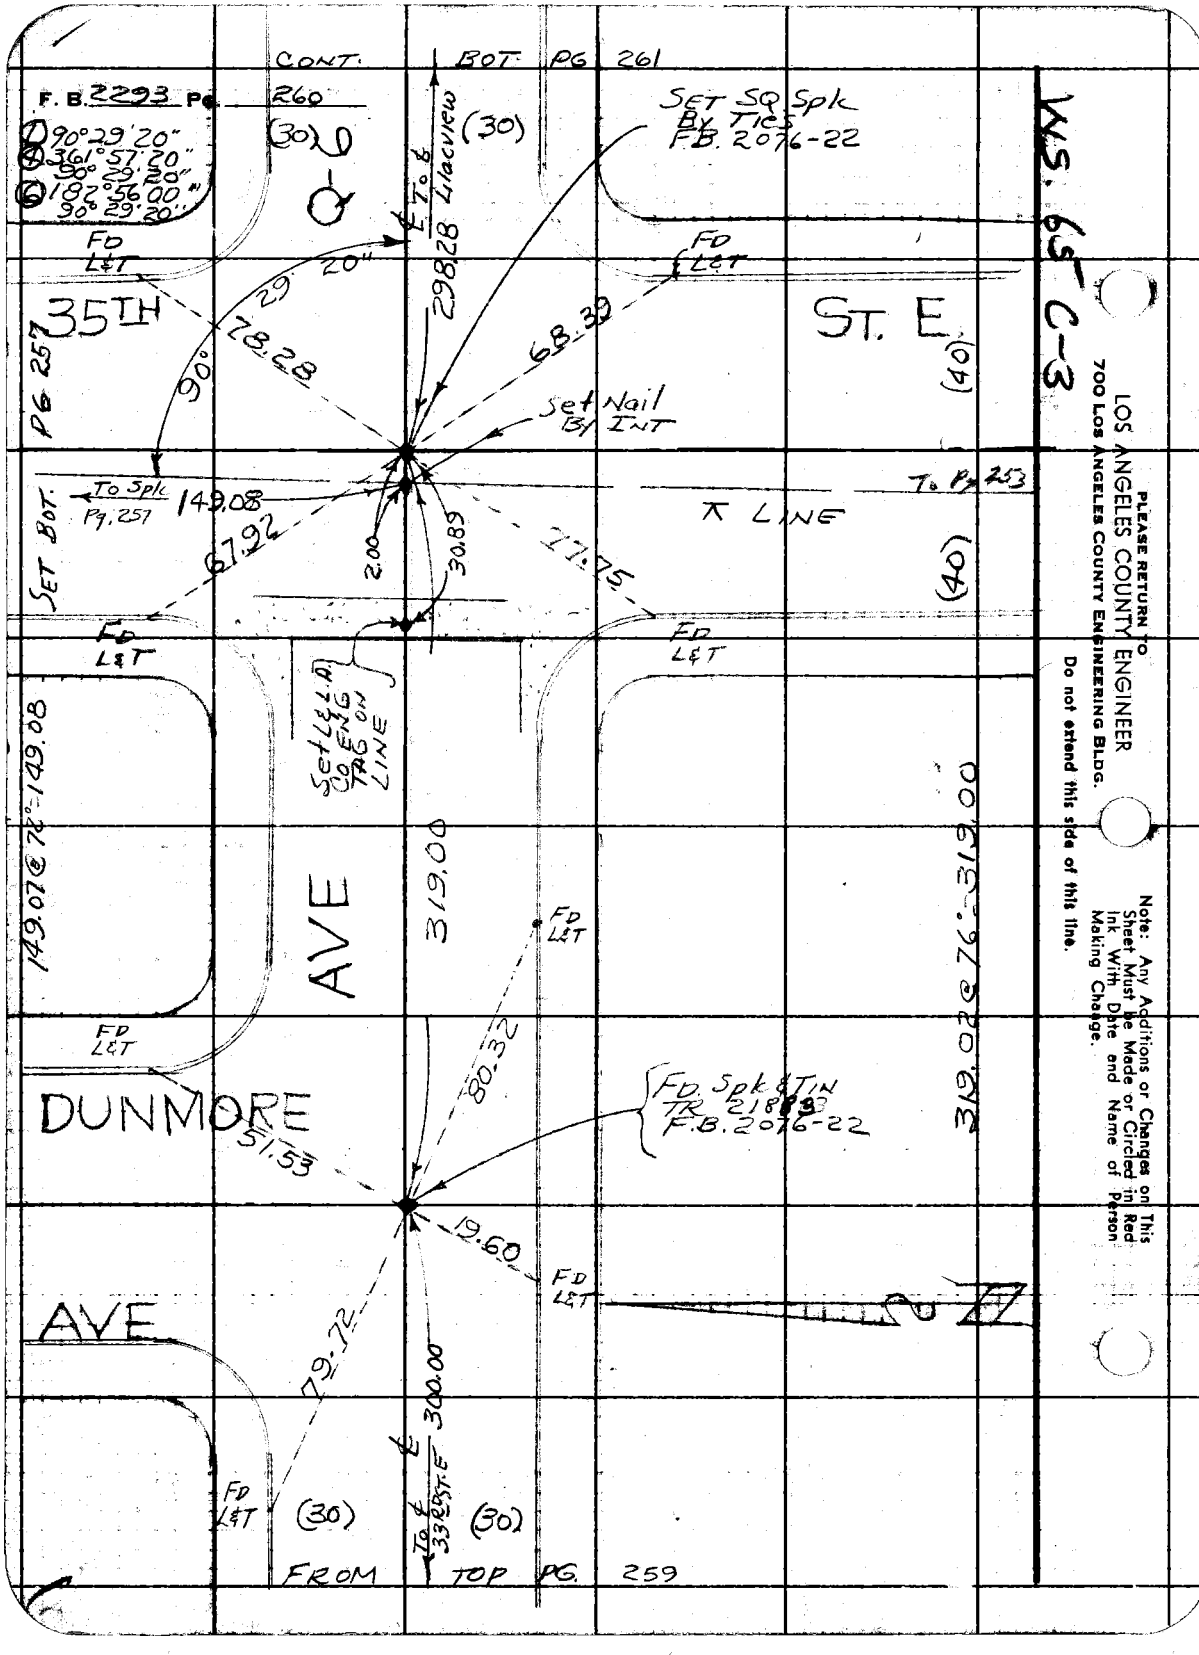
CONT. BOT. PG 261
F.B. 2293 Pg. 260
90°29'20"
361°57'20"
90°29'20"
182°56'00"
90°29'20"
(30)
Q
℄ To & Lilacview
298.28
SET SQ Spk BY TIES F.B. 2076-22
FD L&T
35TH
29 20"
78.28
90°
68.30
ST. E.
(40)
Set Nail B/ INT
P.B. 257
To Spk Pg. 257
149.08
67.92
200
30.89
71.75
T. P.B. 253
X LINE
SET BOT.
SET L&T ON TAN ON LINE
149.07 @ 78°-149.08
AVE
319.00
319.02 @ 76°-319.00
DUNMORE
51.53
80.32
FD Spk & TIN TR F.B. 2076-22
19.60
79.72
AVE
℄ 33rd ST E
300.00
(30)
FROM TOP PG. 259
W.S. 65 C-3
LOS ANGELES COUNTY ENGINEER
700 LOS ANGELES COUNTY ENGINEERING BLDG.
PLEASE RETURN TO
Do not extend this side of this line.
Note: Any Additions or Changes on This Sheet Must be Made or Circled in Red Ink With Date and Name of Person Making Change.

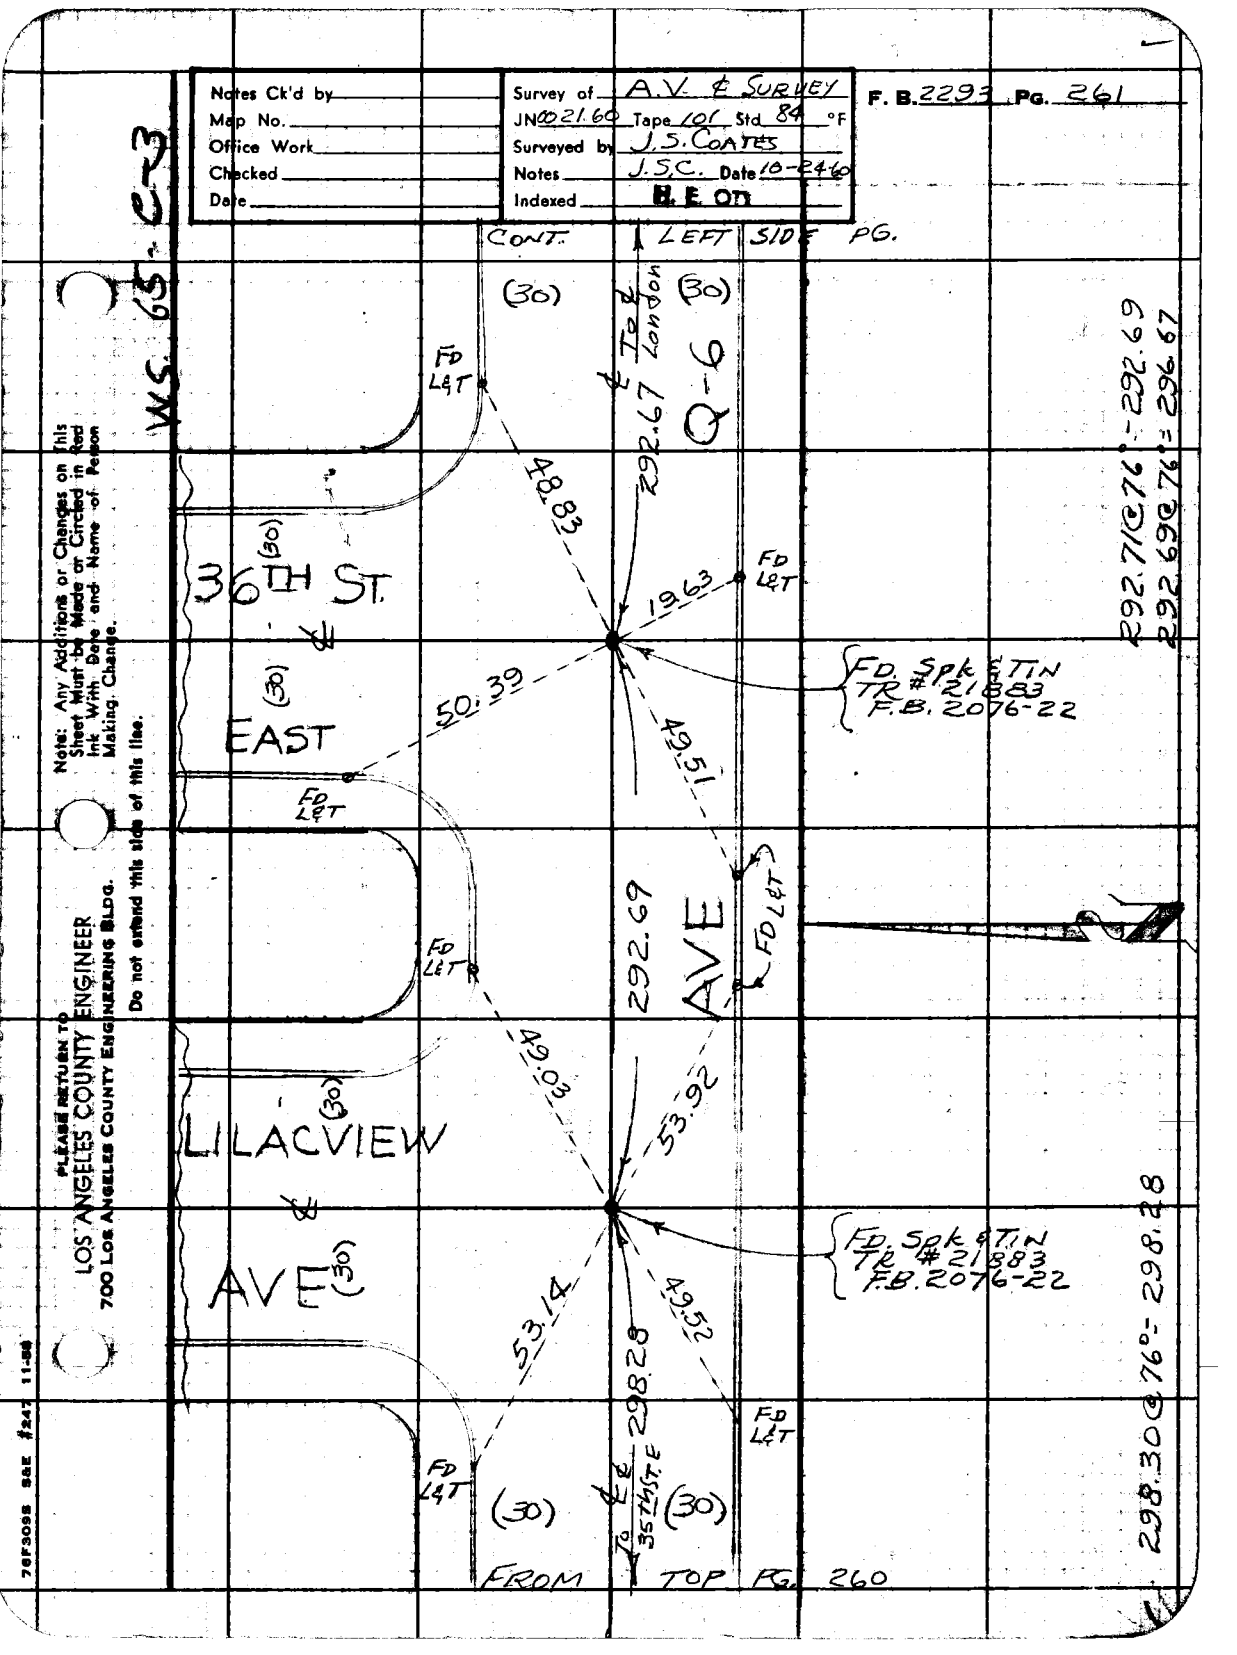
Notes Ck'd by
Map No.
Office Work
Checked
Date
Survey of A.V. & SURVEY
JN 021.60 Tape 101 Std 84 °F
Surveyed by J.S. COATES
Notes J.S.C. Date 10-24-60
Indexed H.E. on
F. B. 2293 PG. 261
CONT. LEFT SIDE PG.
WS. 65-23
(30)
FD L&T
48.83
292.67 E to London
Q-6
(30)
36TH ST.
(30)
EAST
FD L&T
19.63
FD L&T
FD Spk & TIN TR # 21883 F.B. 2076-22
50.39
49.51
FD L&T
FD L&T
292.69
AVE
FD L&T
49.03
53.92
LILACVIEW
(30)
AVE
FD Spk & TIN TR # 21883 F.B. 2076-22
53.14
49.52
298.28
E to 35TH/TE
FD L&T
FD L&T
(30)
(30)
FROM TOP PG. 260
292.7/@76°-292.69
292.69@76°=296.67
298.30@76°-298.28
Note: Any Additions or Changes on This Sheet Must be Made or Circled in Red Ink With Date and Name of Person Making Change.
Do not extend this side of this line.
PLEASE RETURN TO
LOS ANGELES COUNTY ENGINEER
700 LOS ANGELES COUNTY ENGINEERING BLDG.
70F3098 SAE #247 11-80

F. B. 2293 Pg. 262

VS 65 - E-3

PLEASE RETURN TO
LOS ANGELES COUNTY ENGINEER
700 Los Angeles County Engineering Bldg.
Do not extend this side of this line.

Note: Any Additions or Changes on This Sheet Must be Made or Circled in Red Ink With Date and Name of Person Making Change.

AVE

(30) (30)

FD LET

FD LET

50.12

51.04

FD Spike TIN
TR 21883
F.B. 2076-23

To ℄ 36th ST. E (30)

29267

AVE Q-6 (30)

51.38

49.34

FD LET

FD LET

LANDON

Notes Ck'd by	
Map No.	
Office Work	
Checked	
Date	

Survey of	A.V. & SURVEY
JN 0021.00	Tape 101 Std. 84 °F
Surveyed by	J S COATES
Notes	JSC Date 10-25-60
Indexed	B. E. OT

F. B. 2293 Pg. 263

WS 65-C-3

Note: Any Additions or Changes on This Sheet Must be Made or Circled in Red Ink With Date and Name of Person Making Change.

Do not extend this side of this line.

PLEASE RETURN TO
LOS ANGELES COUNTY ENGINEER
700 LOS ANGELES COUNTY ENGINEERING BLDG.

76F3095 SAE #247 11-58

254

Bot. Pg.

35TH

FD LET

63.18

SET L&TAG R.C. ENG THS & DIOD

30.27

62.32

ST. E (40)

Proposed ℄

X LINE

SEE TOP PG. 257

(40)

FD LET

AVE Q

34908

62.72

Set Nail 0.45 E/W

63.57

FD LET

Set Spk By Ties T.B. 19967 F.B. 2067-19

29.00

(27)

℄

(27)

AVE Q-1

603.38

603.43 @ 72°=603.38

349.11 @ 72°=349.08

① 90° 29' 00"
② 361° 56' 00"
③ 90° 29' 00"
④ 182° 54' 00"
90° 29' 00"

FD Spk & Tin T.B. 19967 F.B. 2076-20

FD LET

50.09

FD LET

76.79

(30)

(30)

77.62

19.2

33RD ST E

℄

FD LET

FD LET

Notes Ck'd by	
Map No.	
Office Work	
Checked	
Date	

Survey of AVE J 200 TH ST E
JN 03202 Tape 144 Std 84 °F
Surveyed by S. HALISCKY
Notes S H Date 3-11-59
Indexed S. C. Johnson

F. B 2293 Pg. 265 ~~105~~

W.S. 68 - B

Note: Any Additions or Changes on This Sheet Must be Made or Circled in Red Ink With Date and Name of Person Making Change.

Do not extend notes this side of this line.

RETURN TO
LOS ANGELES COUNTY ENGINEER
900 Los Angeles County Engineering Bldg.

765098 CE #247—7-59

FD 3/4" I.P. N
8" UP
PER F.B 2237-182

FD 2" I.P. CEM. PL.
& N. 8" UP
PER F.B 2237-182

56 57

56 57 TAN

200 TH S

SET 1/2" I.P. N

SET 1/2" I.P. & TAG

3' E

EAST

56 57

SET 1/2" I.P. & TAG FL

FD. C.S MON.
2" I.P. IN CONC.
WITH BRASS
CAP MARKED
ALONG SIDE
ROAD.

COUNTY SURVEYORS MONUMENT 29W 13 19 2H 19 R8W

SET

FD 2" I.P CEM PL
& N 8" UP.
PER F.B 2237-182

RESET MON
PER F.B 2237-182
TIES. 16" DN.

AVE J

PARTY
HALISCKY
RITTER
TALBOT
MITCHELL
TEMPLETON

Notes Ck'd by	Survey of SEC 26, 3S T 7N R 8W
Map No.	JN 030201 Tape 144 Std. °F
Office Work	Surveyed by HALISCKY
Checked	Notes HALISCKY Date 3-19-59
Date	Indexed C. Johnson 7-16-59

F. B. 2293 Pg. ~~213~~ 267

J.N. 030201

1/4 SEC. COR. TIES FOR 245TH ST. E. & AVE L

PARTY:
HALISCKY
RITTER
TALBOT
H.E. MITCHELL
Ttempleton

Notes: Any Additions or Changes on This Sheet Must Be Made or Circled in Red Ink With Date and Name of Person Making Change.

Do not extend notes this side of this line.

RETURN TO
LOS ANGELES COUNTY ENGINEER
900 LOS ANGELES COUNTY ENGINEERING BLDG.

763098 CE #247—7-53

268

F. B. 2293 Pg. 277

W.S. 68 D-5

RETURN TO
LOS ANGELES COUNTY ENGINEER
900 Los Angeles County Engineering Bldg.

Do not extend notes this side of this line.

Note: Any Additions or Changes on This Sheet Must be Made or Circled in Red Ink With Date and Name of Person Making Change.

D. 2" I.P. IN CONC.
WITH BRASS CAP
MARKED: 14" DN.

COUNTY SURVEYORS
T 1N
R 8W
26
35
MONUMENT

SET 2" I.P. CONC.
PL. & N 8" UP

TAN

0 32

FD 4"X4" N
STAKE 6" UP
SCRIBED ON 4
SIDES: COUNTY SURV-
EYOR WITNESS
CORNER

70 71
42 45

FD 1"X2" N FL.

3'

3'

FD 1"X2" N FL

SET 1"X2" N FL

SEC. LINE

AVE

TAN

70 71

42 45

8 30

FD 4"X4" N
STAKE 6" UP
SCRIBED ON 4
SIDES: COUNTY
SURVEYORS
WITNESS
CORNER

SET 2" I.P. CONC.
PL. & N. 8" UP

245TH ST. E

Notes Ck'd by	Survey of SEC 8,9,17&16 T6N R9W
Map No	JN 0302.01 Tape Std °F
Office Work	Surveyed by HALISCKY
Checked	Notes HALISCKY Date 3-19-59
Date	Indexed C. Johnson 4-20-59

F. B. 2293 Pg. 269 ~~245~~

JN. 0302.01

SEC. COR TIES FOR AVE O & 160TH ST E.

PARTY

HALISCKY

R. TALBOT

H.E. MITCHELL

TEMPLETON

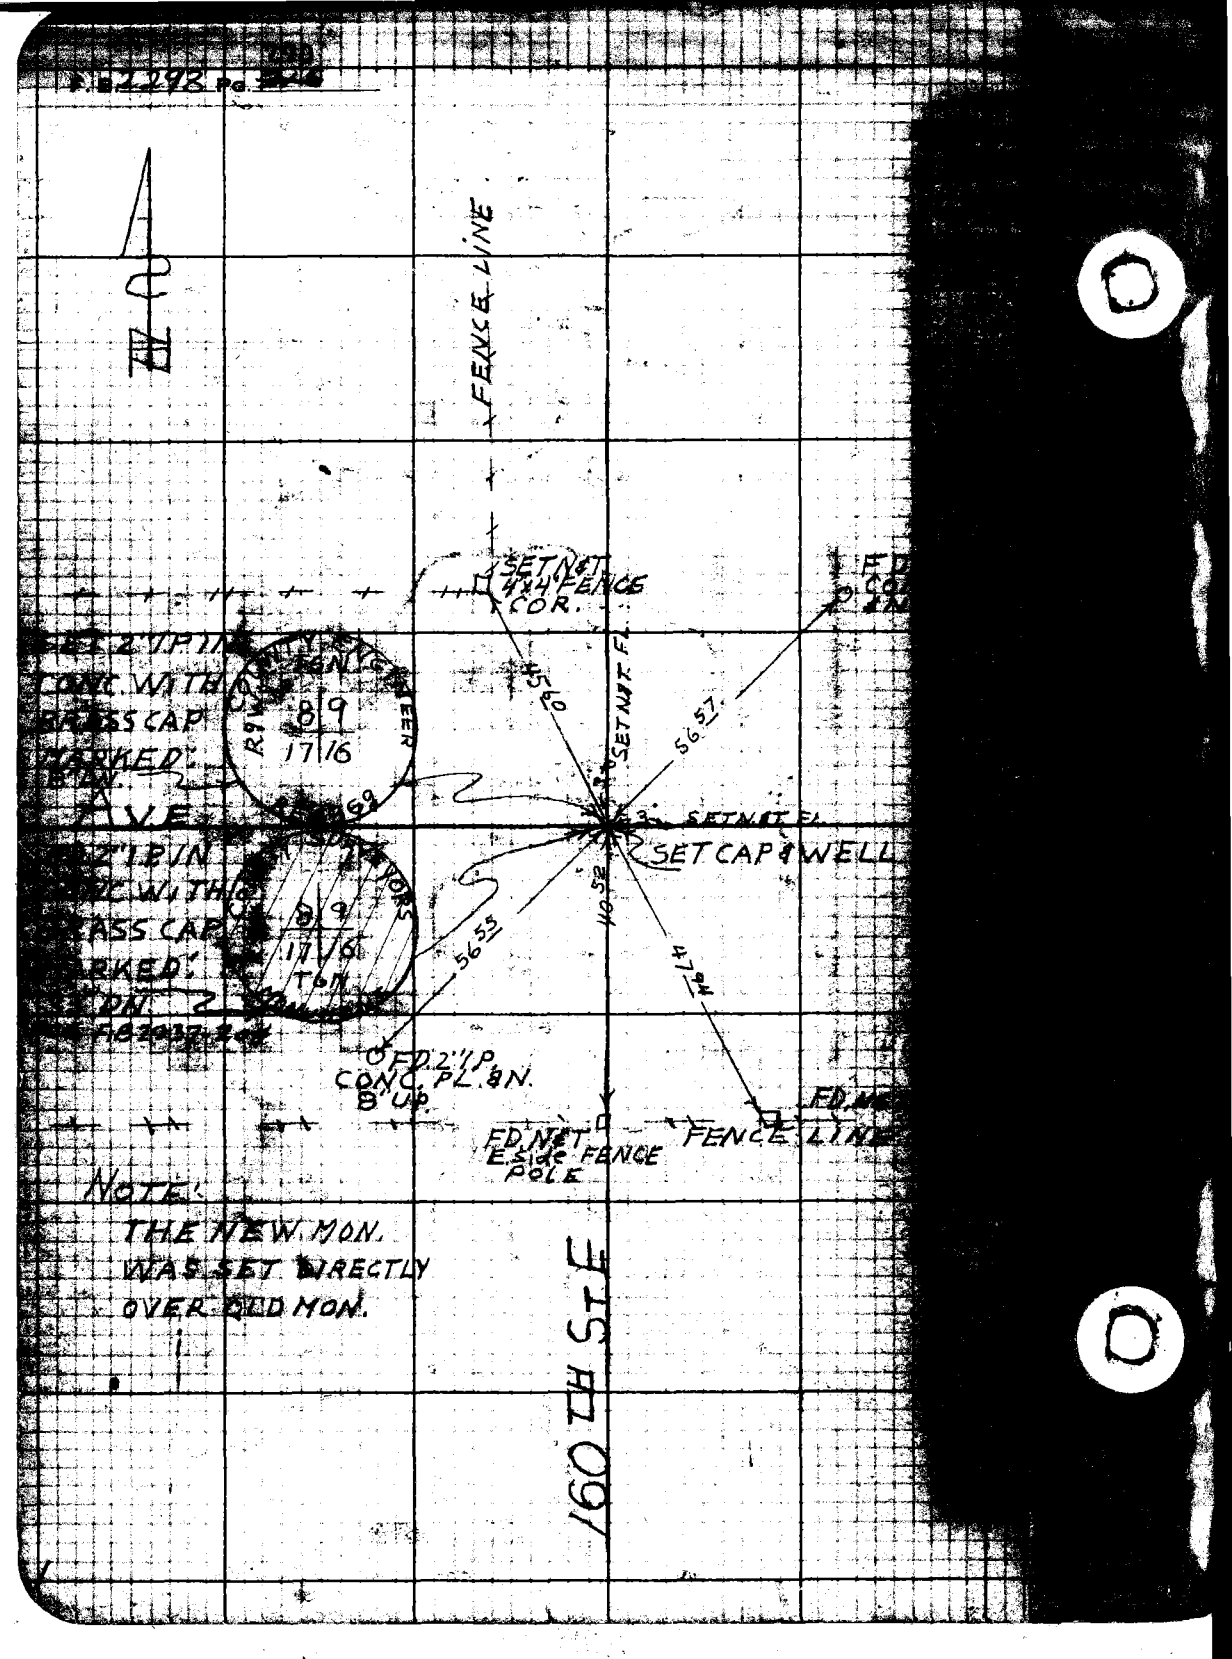
FENCE LINE
SET NET
4"x4" FENCE
COR.
SET NET FE.
SET CAP & WELL
FD. NET
E side FENCE
POLE
FENCE LINE
FD. 2" I.P.
CONC. PL. & N.
8" Up.
NOTE:
THE NEW MON.
WAS SET DIRECTLY
OVER OLD MON.
56.57
56.55
110.52
69.54
