Ck'd by

Survey of

JN Tape Std °F

Surveyed by

Notes Date

Indexed

F.B. 2346 Pg.

Job	Description
	ALONDRA PARK - J.N. 0054.06
B.M.	Bench levels at N.W. Cor. of park.
Loc.Imp	Loc. of 6" water main near Comfort Sta. & Boat House
Topog. Cont.	Plane table sheet control at Manhattan Beach Blvd. & Prairie Ave.
Elev.	On valves & meter nr. Boat House.
Loc.Imp	Loc. & grades for foot bridge across Flood Control channel at El Camino College grounds.
Loc.Imp	Conc. walk at Flood Control channel Loc. & grades.
Elev.	On water well pump bases.
Loc.Imp	Loc. & grades for Rec. & Activity Bldg.
Loc.Imp	Loc. & grades for conc. near Activity Bldg.
Ties	New ties ¼ Sec. Cor. on Manhattan Beach Blvd. at F.C. R/W.
Grades	Parking lot grades.
Loc.Imp	Softball Field lighting.
Loc.Imp	Sketch of Ball Field lighting plan.
Surv.	Survey for protective fencing.
Loc.Imp	Loc. of 12" conc. slabs covering existing 42" & 48" S. sewer line.

Incorporated Jan 86

(cont'd on next page)

F.B. 2346 Pg.

Page	Job	Description
67-76	Loc.Imp	In the park.
77-78	B.M.	Bench levels.
79-80	Loc.Imp	Conc. walk from Manhattan Beach Blvd. to the baseball diamond.
81-82	Loc.Imp	Comfort station.
83-84	Grades	Curb grades for sand area.
85-88	Grades	Parking lot grades.
89-90	Loc.	Softball diamond.
91-93	Grade	Parking lot grade check "as built"
95-97	Loc.	Gen. development of Sr. Citizens Area.
99-101	B.M.	Bench levels on above Alondra.
103-104	Loc.	Light poles; hardball diamond.
		ALONDRA COUNTY PARK- J.N.8771.54
		Drainage Improvements
105-108		Control for P.T. 240 update
109-110		levels
111-114		Grade stakes for storm drain.
115-126		Survey to locate existing fence boundary around Golf Course.

PLEASE RETURN TO
LOS ANGELES COUNTY ENGINEER
403 Los Angeles County Engineering Bldg.

Do not detach this slip or the ink.

Note: Any Additions or Changes on this Sheet Must be Checked in Red Ink With Date and Name of Person Making Change

F. B. 2346 Pg 5

Profile No. ____ X-Sec. No. ____
Notes Red ____ Date ____ Plotted ____ Date ____
Notes Chkd. Miller Date April 1958 Checked ____ Date ____
Job No 2059-06 Division No. ____
Survey of ALONDRA PARK
Survey by J.P.MENNE Noted C.O.GUIZADO Date 4-7-58
Map No. ____ Indexed C. Johnson Date 4-16-58

NOTE: ANY ADDITIONS OR CHANGES ON THIS SHEET MUST BE MADE OR CIRCLED IN RED INK, WITH DATE AND NAME OF PERSON MAKING CHANGE.

PLEASE RETURN TO
LOS ANGELES COUNTY ENGINEER
700 LOS ANGELES COUNTY ENGINEERING BLDG.

Do not extend notes this side of this line.

STATION	B. S.	H. I.	F. S.	ELEV.

BENCH LEVELS

NORTHWEST CORNER
ALONDRA PARK
PT. SHEET # E-394-A

J.P. MENNE
R.D. ANDERSON
C.O. GUIZADO
W.R. ELLIOTT

76298 S & E #907—7.35

76298 S & E #307—7-55

PLEASE RETURN TO
LOS ANGELES COUNTY ENGINEER
700 LOS ANGELES COUNTY ENGINEERING BLDG.

NOTE: ANY ADDITIONS OR CHANGES ON THIS SHEET MUST BE MADE OR CIRCLED IN RED INK, WITH DATE AND NAME OF PERSON MAKING CHANGE.

F. B. 1346 Pg. 6 | Job No 2923.06 Division No. | Notes Red | Plotted | No. | Profile
Survey of ALONDRA PARK | Date | Date | No. | X-Sec.
Survey by J. P. MENNE | Notes G. O. SILVEIRA | Notes Chkd. A. Miller | Checked
Tiddered C. O. Johnson | Date | Date April 1955 | Date | No.

Do not extend notes this side of this line.

STATION	B. S.	H. I.	F. S.	ELEV.	
TORRANCE K-2				47.353 ✓	PRAIRIE AVE. AND MANHATTEN BEACH BLVD. ℄(+) F.B. 492-108 Elev. 47.353
	5.849	53.202 ✓			
T.B.M. No. 3			3.621	49.581 ✓	75'S. & 85'E. OF ℄(+) PRAIRIE AVE. & MANHATTEN BEACH BLVD. BT. SPK. IN P.P.# 501234-E F.B. 492-108 Elev. 49.626
	3.378	52.959 ✓			
B.M. ✓			4.792	48.167 ✓	50'S. & 220 E. PRAIRIE AVE. & MANHATTEN BEACH ℄(+) E. END dug out OF SOFTBALL BACKSTOP. SET SM. BT. SPK. IN Ld. Elev. 48.167
	4.599	52.766 ✓			
B.M. No. 5-A-2			6.402	46.364 ✓	C.S. MON. A-2 F.B. 492-6-108 Elev. 46.357
	6.619	52.983 ✓			
T.B.M.			4.545	48.438 ✓	75'S. & 405'E. PRAIRIE AVE. & MANHATTEN BEACH BLVD. ℄(+) SET BT. SPK. IN P.P.# 501235E - SET BT. SPK. N. Side Pole El. 48.438
	4.777	53.215 ✓			
T.B.M.			3.515	49.700 ✓	75'S. & 725'E. PRAIRIE AVE. & MANHATTEN BEACH ℄(+) SET 2 LARGE BT. SPK. S. Side P.P.# 501236E Elev. 49.700
	3.521	53.221 ✓			
B.M. No. 4-A-3			5.568	47.653 ✓	C.S. MON. A-3 F.B. 493-6-108 El. - 47.624
	5.302	52.970 ✓			
T.B.M. #2			3.521	49.449 ✓	F.B. 492-108 P.P.# 501237E EL. - 49.445
	3.722	53.172 ✓			
			4.479	48.693 ✓	
	4.750	53.143 ✓			
B.M.			4.298	48.845 ✓	825'S. & Due E. PRAIRIE & MANHATTEN BEACH BLVD. ℄(+) BALLFIELD WEST OF GOLF COURSE S. END OF E. dug out OF BASEBALL BACKSTOP. SET SM. BT. SPK. IN LD. CENTER WALK. El. - 48.845
	4.700	53.545 ✓			
			5.309	48.236 ✓	

76298 S & E #307—7-55

PLEASE RETURN TO
LOS ANGELES COUNTY ENGINEER
700 LOS ANGELES COUNTY ENGINEERING BLDG.

NOTE: ANY ADDITIONS OR CHANGES ON THIS SHEET MUST BE MADE OR CIRCLED IN RED INK, WITH DATE AND NAME OF PERSON MAKING CHANGE.

Do not extend notes this side of this line.

STATION	B. S.	H. I.	F. S.	ELEV.		
				48.236 ✓		
	4.312	52.548 ✓				
			5.283	47.265 ✓		
	4.062	51.327 ✓				
B.M.			5.242	46.085	495 S. & 1505 S. PACIFIC AVE. & MANHATTAN BEACH ℄(+) N. END CURB OUT OF SOFTBALL BACKSTOP SET BY SPK. IN LD. Elev. = 46.085	
	5.481	51.566 ✓				
			4.138	47.428 ✓		
	5.358	52.786 ✓				
			4.002	48.784 ✓		
	4.521	53.305 ✓				
T.B.M.#3			3.729	49.576 ✓	SEE PAGE	FOR DESCRIPTION. F.B.

Profile Notes Red. Plotted Job No 0934-06 Division No.
No. Date Date Survey of ALONDRA PARK F. B. 2346 Pg. 7
X-Sec. Notes Chkd. Miller Checked Survey by T. PINENNE Notes Checked Date 4-7-58
No. Date April 1958 Date Map No. Index C. 4-3655 Date

Notes Ck'd by	Survey of Alondra Park
Map No.	JN 8771.09 Tape Std °F
Office Work	Surveyed by A.N. Hellstrom
Checked	Notes F.F.B. Date 5-29-58
Date	Indexed C. Johnson 6-26-58

F. B. 2346 PG. 9

ALONDRA PARK

J. N. 8771.09

Location of ✱ pts on 6" Water main.

(See Page 15-16 For Elevs.)

Hellstrom
Brooks
Melendez
Potter

Note: Any Additions or Changes on This Sheet Must be Made or Circled in Red Ink With Date and Name of Person Making Change.

Do not extend this side of this line.

PLEASE RETURN TO
LOS ANGELES COUNTY ENGINEER
700 LOS ANGELES COUNTY ENGINEERING BLDG.

76F3095 SAE #247 1-56

F. B. 2346 Pg. 10

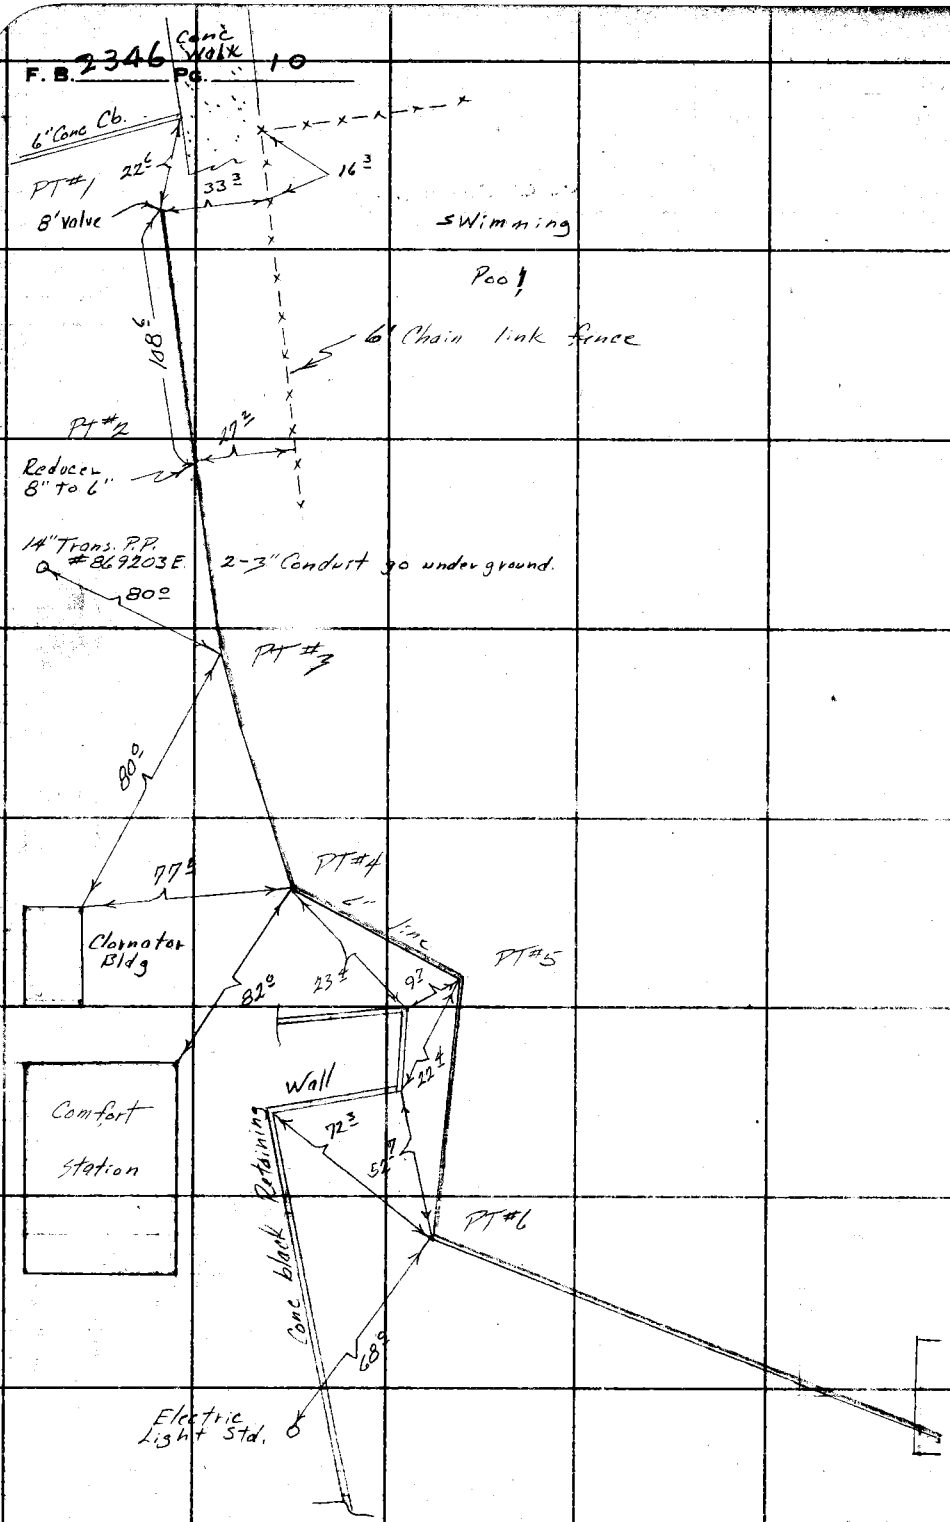

PLEASE RETURN TO
LOS ANGELES COUNTY ENGINEER
700 Los Angeles County Engineering Bldg.
Do not extend this side of this line.

Note: Any Additions or Changes on This Sheet Must be Made or Circled in Red Ink With Date and Name of Person Making Change.

Notes Ck'd by	Survey of Alondra Park
Map No.	JN Tape Std °F
Office Work	Surveyed by A.N. Hillstrom
Checked	Notes F.F.B. Date 5-29-58
Date	Indexed C. Johnson

F. B. 2346 Pg. 11

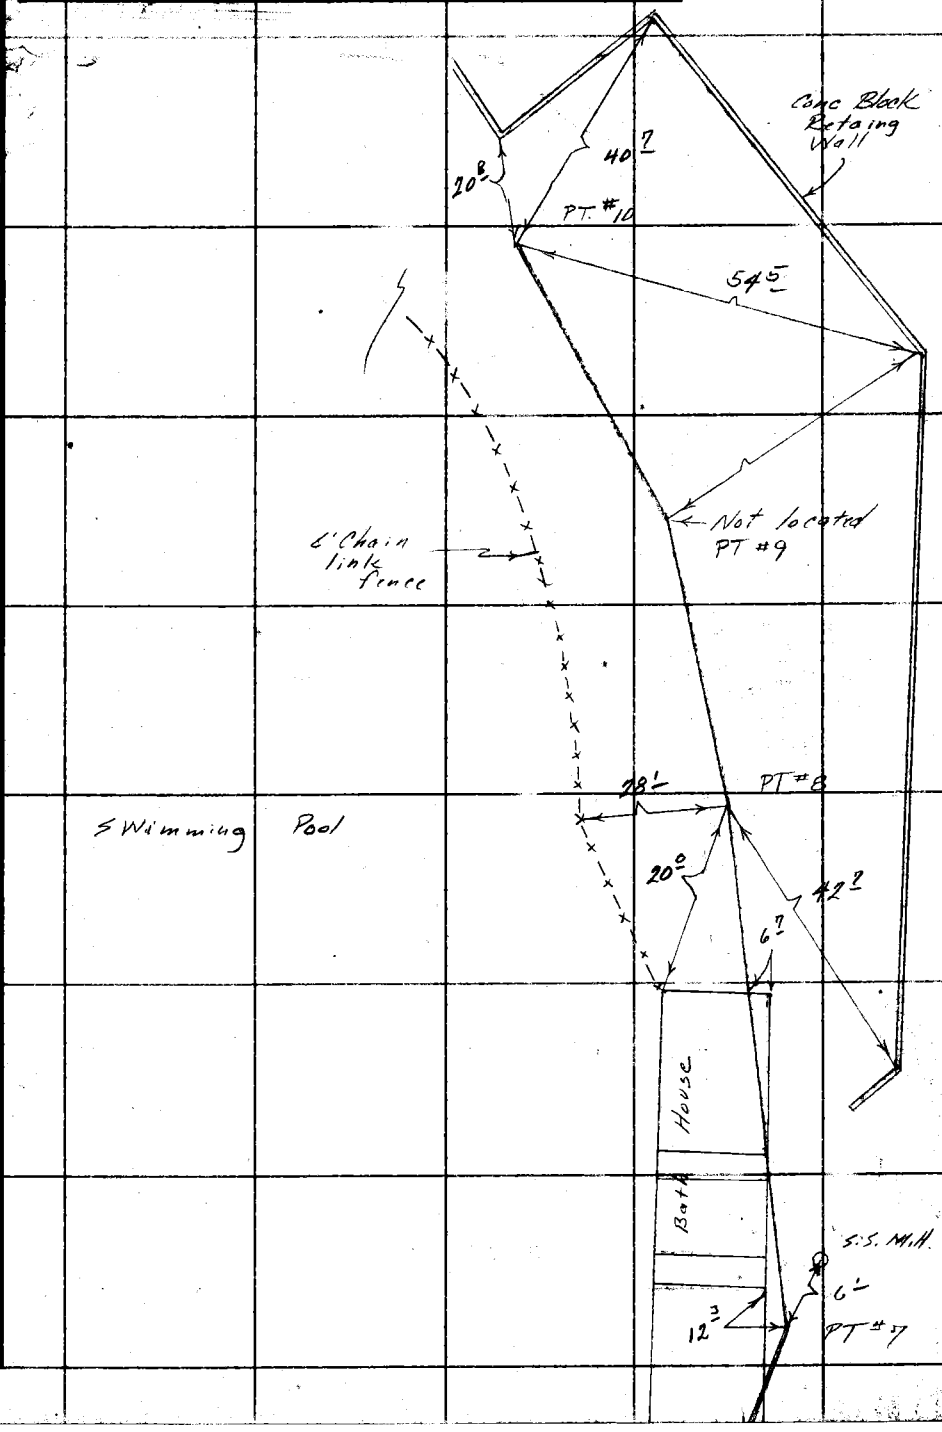

Note: Any Additions or Changes on this Sheet Must be Made or Circled in Red Ink With Date and Name of Person Making Chande.

Do not extend this side of this line.

PLEASE RETURN TO
LOS ANGELES COUNTY ENGINEER
700 LOS ANGELES COUNTY ENGINEERING BLDG.

76F309S S&E #247 1-58

F. B. 2346 Pg. 13

Profile No. | Notes Red. | Date | Plotted | Date | Job No. 8771.09 | Division No. 10
X-Sec. No. | Notes Chkd. | Date | Checked | Date | Survey of Alondra Park
Survey by A.N. Hellstrom Notes F.E.B. Date 5-29-58
Map No. | Indexed C. Johnson 10-27-58

ALONDRA PARK

J.N. #8771.09

Elevations of valves & pt. in 6" Water Main

(See Page 9 FOR LOCATIONS)

STATION	B. S.	H. I.	F. S.	ELEV.

Hellstrom
Brooks
Melendez
Po Hrr

NOTE: ANY ADDITIONS OR CHANGES ON THIS SHEET MUST BE MADE OR CIRCLED IN RED INK, WITH DATE AND NAME OF PERSON MAKING CHANGE.

Do not extend notes this side of this line.

PLEASE RETURN TO
LOS ANGELES COUNTY ENGINEER
700 Los Angeles County Engineering Bldg.

761-298 8 & E #807—1-56

76L-298 S & E #307—1-56

PLEASE RETURN TO
LOS ANGELES COUNTY ENGINEER
700 Los Angeles County Engineering Bldg.

NOTE: ANY ADDITIONS OR CHANGES ON THIS SHEET MUST BE MADE OR CIRCLED IN RED INK, WITH DATE AND NAME OF PERSON MAKING CHANGE.

Do not extend notes this side of this line.

F. B. 2346 Pg. 14 | Job No. 8771.09 Division No. 10 Notes Red. Date Plotted Date Profile
Survey of Alondra Park E.E.B. Notes Date No. X-Sec.
Survey by Hellstrom Notes Date Notes Chkd. Date Checked Date No.
Indexed K. C. Johnson Date

STATION	B. S.	H. I.	F. S.	ELEV.		
BM				46 12	TBM 13 B Elev. 46.12 F.B. BT. Spk. in P.P. 96 92 06 E.	19
T.P.				33 18	Conc cb.	
PT #1				30 30	Top of 8" Water valve	
PT #2				29 10	" " 8" to 6" reducer	
PT #3				29 70	⊄ in transit pipe	
PT #4				30 50	Top of 2" pipe riser from 6" pipe	
PT #5				30 30	⊄ in transit pipe	
PT #6	T.P.			32 25	Top of 6" Cast Iron pipe	
PT #7				32 05	⊄ pt in cast iron pipe	
PT #8				32 20	⊄ pt. in cast iron pipe	
PT #9					not found	
PT #10				30 40	end of 6" line	
				33 00	Top of S.S. M.H. in front of Bathhouse	
BM				36 51	TBM Elev	

Notes Ck'd by	Survey of Alondra Park
Map No.	JN 005496 Topo 0137 Std. 60 B 05
Office Work	Surveyed by J.P.menne
Checked	Notes J.P.M. Date
Date	Indexed A. C. Johnson 5-30-38

F. B. 3396 PG. 15

CONTROL FOR

PLANE TABLE

SHEET NO.

N. W. COR. OF PARK

MANHATTEN BEACH BLVD.

&

PRARIE AVE

J. P. menne

R. D. Anderson

C. O. Guizado

W. R. ELLIOT

Note: Any Additions or Changes on This Sheet Must be Made or Circled in Red Ink With Date and Name of Person Making Change.

Do not extend this side of this line.

PLEASE RETURN TO
LOS ANGELES COUNTY ENGINEER
700 Los Angeles County Engineering Bldg.

76F3088 SBE #247 1-56

PLEASE RETURN TO
LOS ANGELES COUNTY ENGINEER
700 LOS ANGELES COUNTY ENGINEERING BLDG.

Note: Any Additions or Changes on This Sheet Must be Made or Circled in Red Ink With Date and Name of Person Making Change.

Do not extend this side of this line.

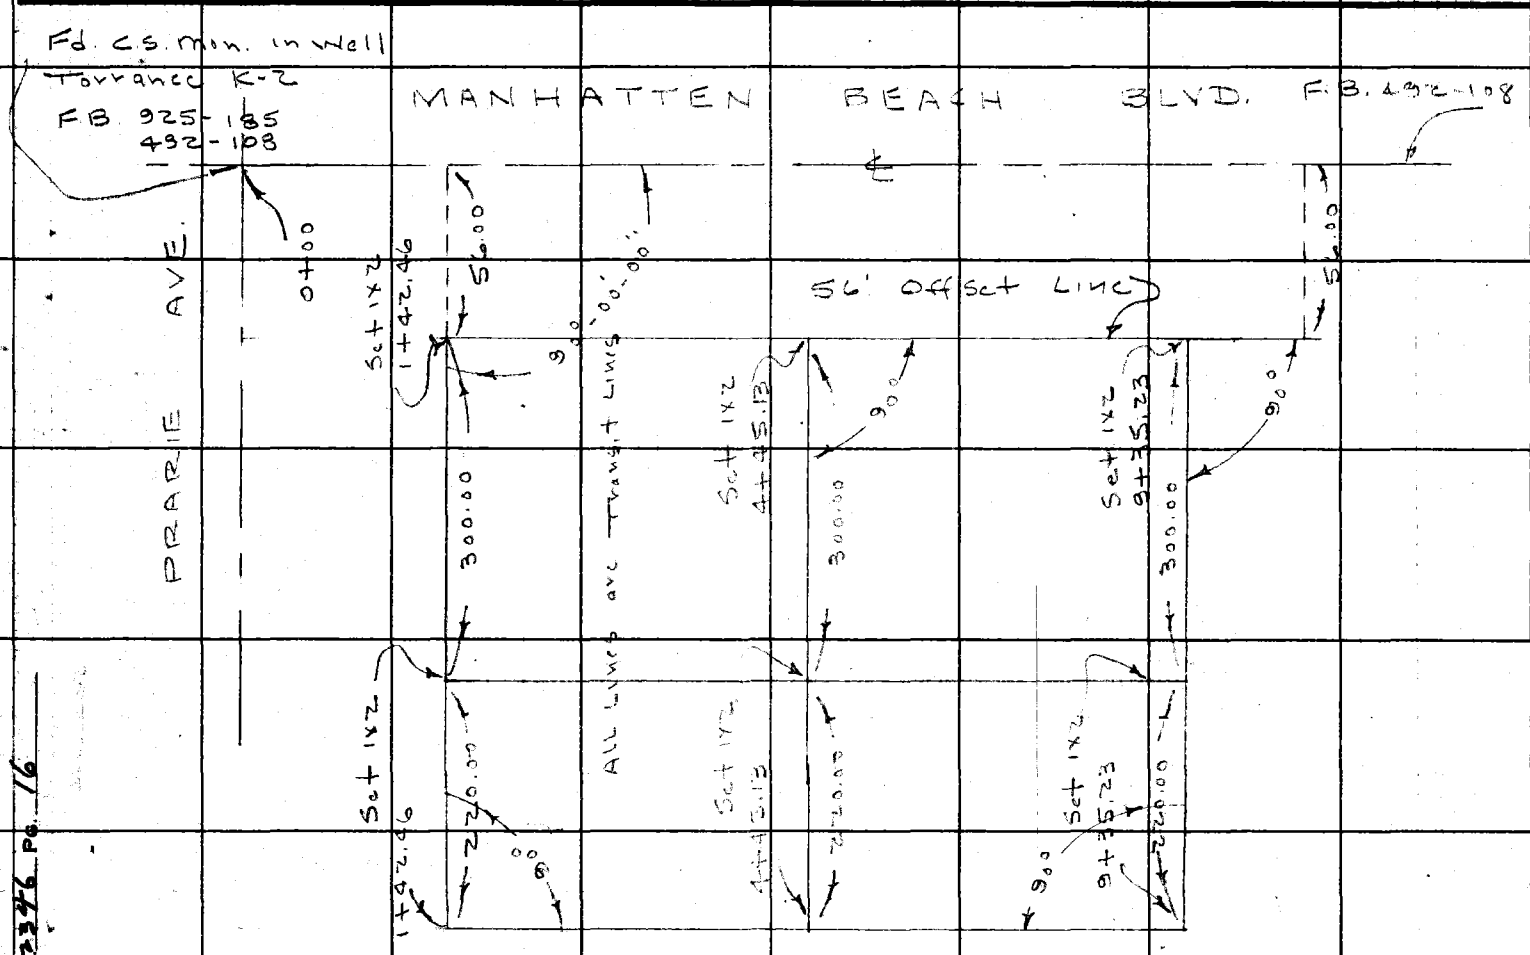

Notes Ck'd by	Survey of ALONDRA PARK
Map No.	J.N. 8771.04 Tape Std °F
Office Work	Surveyed by A.N. Hellstrom
Checked	Notes A.N.H. Date 1-28-59
Date	Indexed E. C. Tabrah 7-29-59

F. B 2946 Pg. 17

J.N. 8774.01

ALONDRA PARK

PEDESTRIAN FOOT BRIDGE

A FOOT BRIDGE ACROSS DOMINGUEZ CHANNEL FLOOD CONTROL; FROM ALONDRA PARK TO EL CAMINO COLLEGE GROUNDS.

SEE PG. 18 - FOR LOCATION

SEE PG

A.N. HELLSTROM
F.E. BROOKS
J.W. POTTER
P.A. LATTERI

Note: Any Additions or Changes on This Sheet Must be Made or Circled in Red Ink With Date and Name of Person Making Change.

Do not extend notes this side of this line.

RETURN TO
LOS ANGELES COUNTY ENGINEER
700 LOS ANGELES COUNTY ENGINEERING BLDG.

76P3095 CE #247—3-57

RETURN TO
LOS ANGELES COUNTY ENGINEER
700 LOS ANGELES COUNTY ENGINEERING BLDG.

Note: Any Additions or Changes on This Sheet Must be Made or Circled in Red Ink With Date and Name of Person Making Change.

Do not extend notes this side of this line.

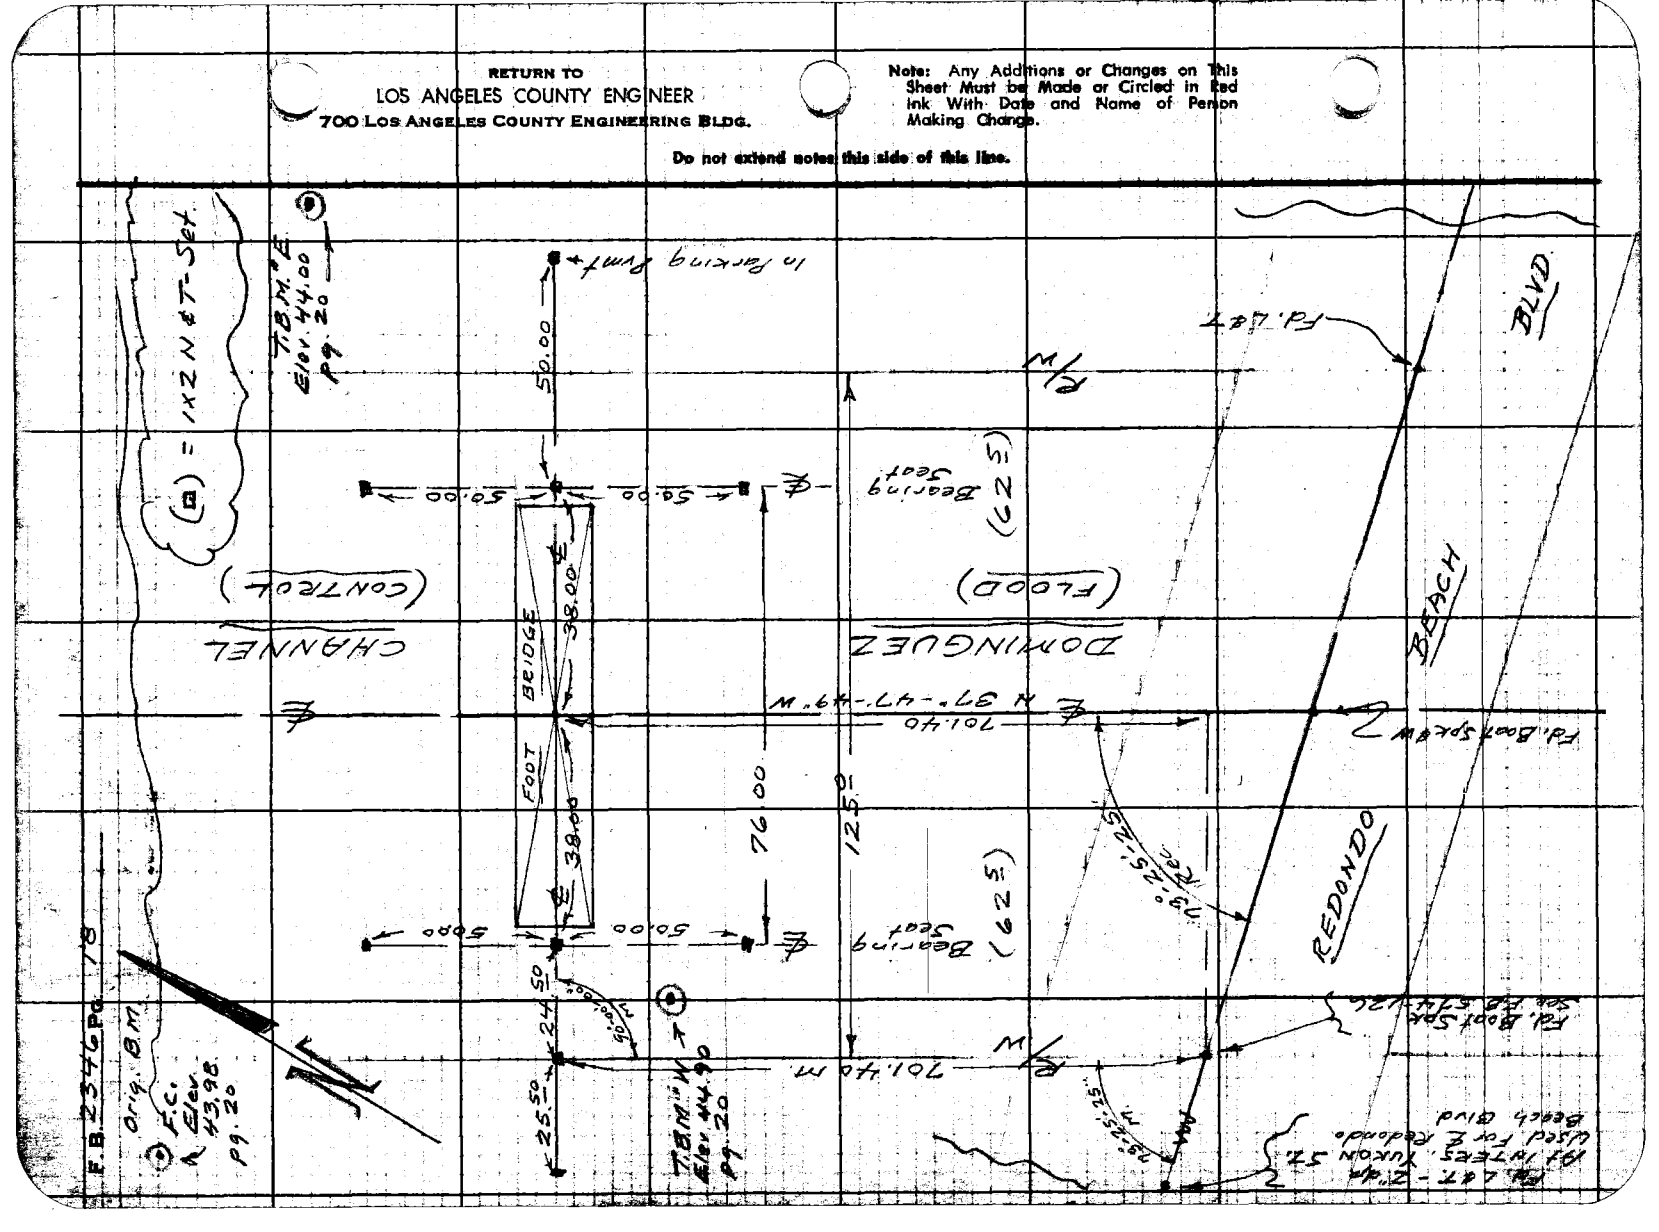

Profile No. ____ X-Sec. No. ____ | Notes Red. ____ Date ____ | Notes Chkd. ____ Date ____ | Plotted ____ Date ____ | Checked ____ Date ____ | Job No. 8771.04 Division No. 10 | Survey of ALONDRA PARK | Survey by Hellstrom Notes A.N.H. Date 1-27-59 | Map No. ____ Indexed C. Johnson Date ____

F. B. 2346 Pg. 19

J.N. "8771.04

ALONDRA PARK

PEDESTRIAN FOOT BRIDGE

T.B.M.'s FOR CONTRACTOR - Pages -19-20

SEE Pg. 18 FOR LOCATION OF BRIDGE

Note - County Surveyor's Datum is 0.22 Ft. Higher Than Flood Control Datum

A.N. Hellstrom
F.E. Brooks
J.W. Potter
P.A. Lafferi

STATION	B. S.	H. I.	F. S.	ELEV.

NOTE: ANY ADDITIONS OR CHANGES ON THIS SHEET MUST BE MADE OR CIRCLED IN RED INK, WITH DATE AND NAME OF PERSON MAKING CHANGE.

Do not extend notes this side of this line.

PLEASE RETURN TO
LOS ANGELES COUNTY ENGINEER
700 Los Angeles County Engineering Bldg.

76L-298 S & E #307—1-56

76L-298 S & E #307—1-56

PLEASE RETURN TO
LOS ANGELES COUNTY ENGINEER
700 LOS ANGELES COUNTY ENGINEERING BLDG.

NOTE: ANY ADDITIONS OR CHANGES ON THIS SHEET MUST BE MADE OR CIRCLED IN RED INK, WITH DATE AND NAME OF PERSON MAKING CHANGE.

F. B. 2346 PG. 20 | Job No. 9721.04 Division No. 10 Notes Red. Plotted Profile
Survey of Alondra Park Date Date No. X-Sec.
Survey by Hellstrom Notes A.M.H. Notes Chkd. Checked No.
Indexed K. C. Johnson Date Date Date

Do not extend notes this side of this line.

STATION	B. S.	H. I.	F. S.	ELEV.	
Fd. F.C.-B.M. 113-52				43 98	F.C.-B.M. "113-52 - Elev. 43.98 - Fd 5/8 in. Round Head Spk. in W. End Conc. Hdwall. At Outlet Gate For Alondra Lake. - This is B.M. "13 pr County Surveyor F.B. 492-111 County Surveyor's Elev. = 44.201 It is Approx. 100'± N. & 85'± W. of W. End of Pedestrian Bridge.
Set T.B.M. "W"				44 90	T.B.M. "W" - Elev. 44.90 - Set 2-Chis. Lines On N. Rim of Exist S.S.M.H. - 20'± South Of W. End Of Bridge On W. Sd. Of Channel
Set T.B.M. "E"				44 00	T.B.M. "E" - Elev. 44.00 - Set Chis. Line On Lamp Post Standard On E. Sd Of Channel 60'± E & 25'± N. Of E. End of Bridge.

Notes Ck'd by
Map No.
Office Work
Checked
Date

Survey of Alondra Pk
JN 87704 Tape Std 1 of 1
Surveyed by Willey
Notes Date 4-4-59
Indexed K. C. Johnson 4-6-59

F. B. 234 Pg. 27

87704

ALONDRA PARK

CONC. WALK AT
DOMINGUEZ FLOOD CONTROL
CHANNEL

4-4-59
Willey
Manley
McCall
Swaim

Note: Any Additions or Changes on This Sheet Must be Made or Circled in Red Ink With Date and Name of Person Making Change.

Do not extend notes this side of this line.

RETURN TO
LOS ANGELES COUNTY ENGINEER
900 Los Angeles County Engineering Bldg.

763098 CE #247—7-58

F. B 2346 Pg. 22

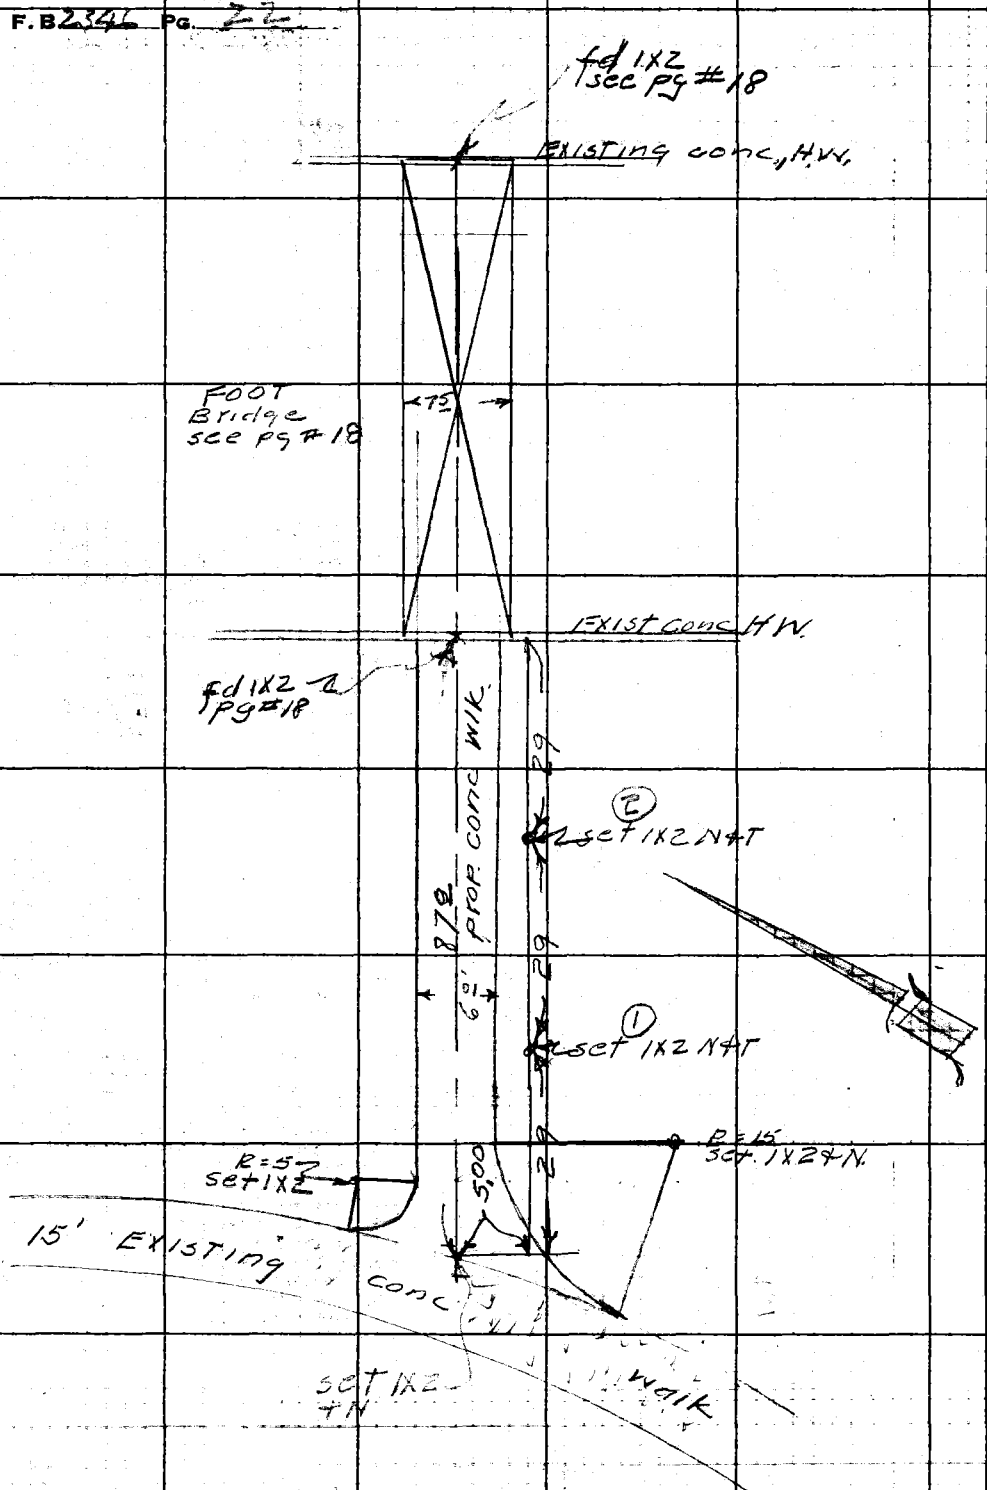

RETURN TO
LOS ANGELES COUNTY ENGINEER
700 Los Angeles County Engineering Bldg.

Do not extend notes this side of this line.

Note: Any Additions or Changes on This Sheet Must be Made or Circled in Red Ink With Date and Name of Person Making Change.

F. B. 234C Pg. 23

Profile No. ____ X-Sec. No. ____
Notes Red. ____ Date ____ Notes Chkd. ____ Date ____
Plotted ____ Date ____ Checked ____ Date ____
Job No. ____ Division No. ____
Survey of ALONDRA PARK
Survey by Miley Notes C. Johnson Date
Map No. ____ Indexed ____ Date ____

8771.04

ALONDRA PARK

GRADE STAKES

FOR CONCRETE

FROM EXISTING 16' WALK

TO FOOT BRIDGE

AT EL CAMINO COLLEGE

GOLF LINKS.

4-4-59

Miley
Manley
McCall
Smith

STATION	B. S.	H. I.	F. S.	ELEV.

NOTE: ANY ADDITIONS OR CHANGES ON THIS SHEET MUST BE MADE OR CIRCLED IN RED INK, WITH DATE AND NAME OF PERSON MAKING CHANGE.

Do not extend notes this side of this line.

PLEASE RETURN TO
LOS ANGELES COUNTY ENGINEER
700 Los Angeles County Engineering Bldg.

76L-298 S & E #307—1-56

76L-298 S & E #307—1-56

PLEASE RETURN TO
LOS ANGELES COUNTY ENGINEER
700 LOS ANGELES COUNTY ENGINEERING BLDG.

NOTE: ANY ADDITIONS OR CHANGES ON THIS SHEET MUST BE MADE OR CIRCLED IN RED INK, WITH DATE AND NAME OF PERSON MAKING CHANGE.

Do not extend notes this side of this line.

F. S. 2342 Pg. 24 | Job No. 8771-4 | Division No. | Notes Red. | Plotted | Profile
Survey of Flood Control Dist. | Date | No. | X-Sec.
Survey by Miller & Oxford | Notes Chkd. | Checked | No.
Indexed | Date | Date | Date

STATION	B. S.	H. I.	F. S.	ELEV.		
F.C.B.M. 13-S				43.98	SUBGRADE cut or Fill	
					Exist CONC.	
East edge Exist Wk. & Ent.				44.24		
①				46.88	43.15 | C-3.73	1X15-K ② 3 Rebkk.
②				44.24	41.89 | C-2.35	
Top of West Bridge Seat				39.15	TBM EL 43.47 FS	
TBM (set)				43.47	30' S. of West end bridge Top of steel rail at N.W. corner of Sta. Ana River Bridge	

F. B. 2346 Pg. 25

Profile No. / X-Sec. No.

Notes Red. / Date / Notes Chkd. / Date

Plotted / Date / Checked / Date

Job No. 0435.00 Division No.

Survey of COUNTY INSTITUTIONS

Survey by RICHARDS Notes J.O. Date 3-59

Map No. Indexed J. O. Jones Date 4-9-59

J.N. 0435.00

COUNTY INSTITUTIONS

"ALONDRA PARK"

ELEVATIONS ON WATER WELL PUMP BASE & BOOSTER PUMP BASES FOR WATERWORKS & UTILITIES DIV.

DATUM: MEAN SEA LEVEL. PRECISE LEVEL NET, LINE 22 1953 ADJ.

3-59

RICHARDS
OCHSNER
HARRINGTON
BANKSON

STATION	B. S.	H. I.	F. S.	ELEV.

NOTE! ANY ADDITIONS OR CHANGES ON THIS SHEET MUST BE MADE OR CIRCLED IN RED INK, WITH DATE AND NAME OF PERSON MAKING CHANGE.

Do not extend notes this side of this line.

PLEASE RETURN TO
LOS ANGELES COUNTY ENGINEER
700 Los Angeles County Engineering Bldg.

761-298 S & E #307—1-56

F. B. 2344 Pg. 26 | Job No. | Division | Notes Red. | Plotted | Profile
Survey of ALONDRA P/P. | Date | No. | X-Sec.
Survey by Rich. | Notes Chkd. | Checked
Indexed C. Johnson | Date | Date | No.

76L-298 S & E #307—1-56

PLEASE RETURN TO
LOS ANGELES COUNTY ENGINEER
700 Los Angeles County Engineering Bldg.

NOTE: ANY ADDITIONS OR CHANGES ON THIS SHEET MUST BE MADE OR CIRCLED IN RED INK, WITH DATE AND NAME OF PERSON MAKING CHANGE.

Do not extend notes this side of this line.

STATION	B. S.	H. I.	F. S.	ELEV.	ALONDRA P/P
BM. 1A	5 73	49 82		44 09	BM 1-A ELEV. = 44.086 FB 492-107 S. End Culvert H'D WL. S.E. Cor BRIDGE.
T. P.	5 50	52 34	2 98	46 84	MANHATTEN BEACH BLVD.
			5 08	47 26	BASE of PUMP @ WATER WELL N.E. Cor. PROP.
T P.	4 80	49 92	7 22	45 12	
T. P.	5 53	49 17	5 98	43 94	
T P.	7 84	51 92	5 39	44 08	
T. P.	4 93	50 54	6 31	45 61	
			17 22	33 32	BASE of BOOSTER PUMP for GOLF COURSE
B.M. 13-B	5 20	51 32	4 42	46 12	BM 13-B ELEV. = 46.120 FB 492-238+118
T. P.	5 07	46 41	9 98	41 34	
			4 56	41 85	BASE of BOOSTER PUMP BEHIND FISH POND + Swim Pool
BM 13-D			1 74	44 67	BM. 13-D ELEV. = 44.682 F.B. 492-118 Sm. D. Spike in S. Side TRANS POLE # 869203 E. N & W. of CLOCKHOUSE BLDG

Notes Ck'd by		Survey of Alondra Park	F.B. 2346 Pg. 27
Map No.		JN 8771.06 Tape Std °F	
Office Work		Surveyed by AN Hellstrom	
Checked		Notes Mankey Jr Date Sept 14 59	
Date		Indexed A. C. Johnson 9-27-59	

JN 8771.06

ALONDRA PARK

RECREATION & ACTIVITY BLDG.

LOCATION

Hellstrom
Mankey Jr.,
Swann
Ryle

Note: Any Additions or Changes on This Sheet Must be Made or Circled in Red Ink With Date and Name of Person Making Change.

Do not extend notes this side of this line.

RETURN TO
LOS ANGELES COUNTY ENGINEER
700 LOS ANGELES COUNTY ENGINEERING BLDG.

76F309S CE #247—3-57

RETURN TO
LOS ANGELES COUNTY ENGINEER
700 LOS ANGELES COUNTY ENGINEERING BLDG.

Note: Any Additions or Changes on This Sheet Must be Made or Circled in Red Ink With Date and Name of Person Making Change.

Do not extend notes this side of this line.

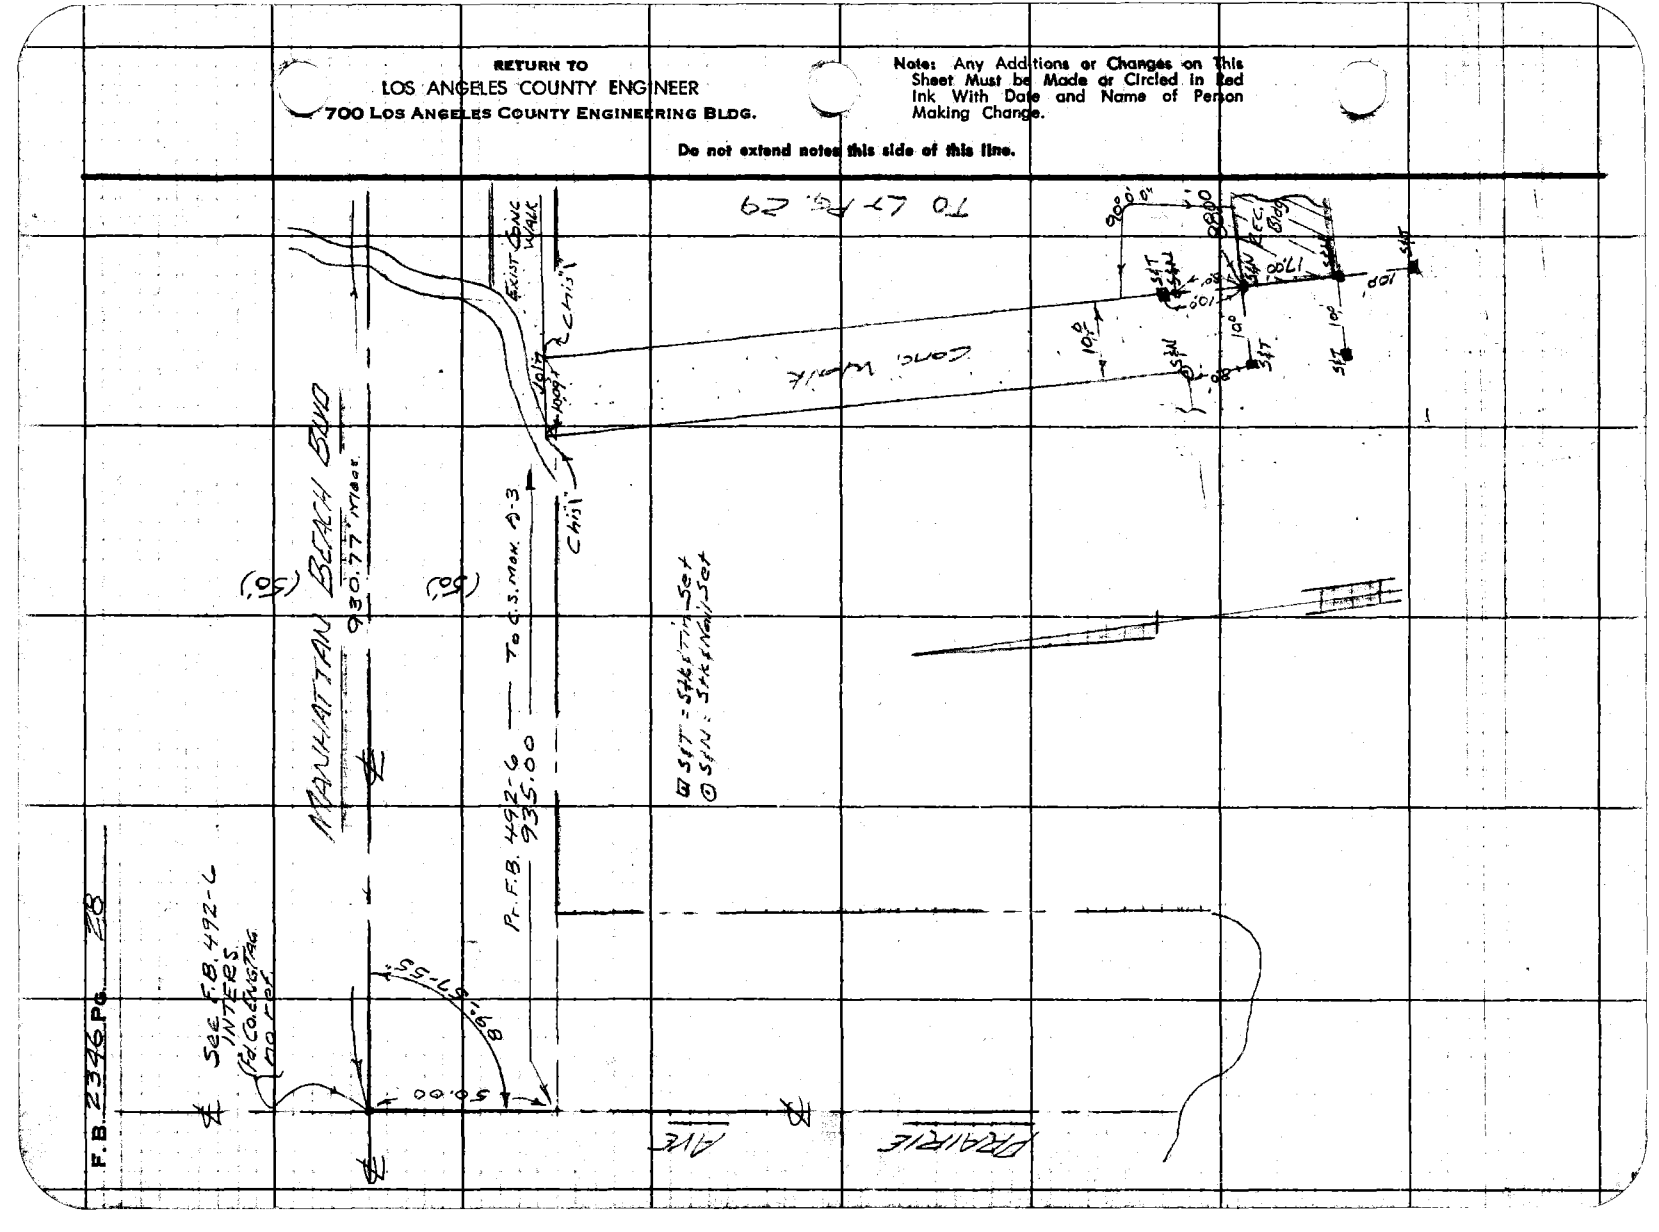

F.B. 2346 Pg. 28

Notes Ck'd by
Map No.
Office Work
Checked
Date

Survey of Alondra Park
JN 2224.66 Tape Std °F
Surveyed by A.N. Hellstrom
Notes Monkey Jr. Date Sept 14, '59
Indexed

F. B. 2345 PG. 29

DOTY AVE

(50')

930.77'

MANHATTAN BEACH BLVD

Fd. Spk. W/T No Ref.

Set Spk & Tin

97°38'-00"

Set Punched B.A. Spot in lead & Cross Elev. = 49.11

(50')

To E PRAIRIE AVE. - Pr. F.B. 492-6

935.00

2.35'

A-3 Cs. Mon's Out. Notes: Ground Elev. now 47.6'

55.22'

■ S&T = Spk & Tin Set
● S&N = Spk & Nail Set

TO RT Pg. 28

S&T

S&N

10.0'

36.00'

100.03'

100.03'

51.67'

90°0'0"

ACTIVITY BLDG. Finished Floor Elev. = 49.50'

93.35'

8.00'

88.00'

RECREATION BLDG. Finished Floor Elev 49.50

12.00

Note: Any Additions or Changes on This Sheet Must be Made or Circled In Red Ink With Date and Name of Person Making Change.

Do not extend notes this side of this line.

RETURN TO
LOS ANGELES COUNTY ENGINEER
900 LOS ANGELES COUNTY ENGINEERING BLDG.

76F3095 CE #247—3-57

76L-298 S & E #307—1-56

PLEASE RETURN TO
LOS ANGELES COUNTY ENGINEER
700 Los Angeles County Engineering Bldg.

NOTE: ANY ADDITIONS OR CHANGES ON THIS SHEET MUST BE MADE OR CIRCLED IN RED INK, WITH DATE AND NAME OF PERSON MAKING CHANGE.

Do not extend notes this side of this line.

Profile Notes Red. Plotted. Job No. 8711.06 Division No. 10
No. X-Sec. Date Date Survey of ALONDRA PARK F. B. 2346 Pg. 31
No. Notes Chkd. Checked Survey by Hall-Lyon Notes A.N.N. Date 9-16-59
Date Date Map No. Index C. J. Date

STATION	B. S.	H. I.	F. S.	ELEV.	
	T.B.M.'s As Set For Contractor				
(Fd.) B.M.				48.845	B.M. - Elev. 48.845 - F.B. 2346-6 - (325'± S & 900'± E of ℄ Inter of Prairie Ave. & Manhattan Beach Blvd. In Ballfield Near N.W. Cor. of Golf Course. - Boat Spk In Cntr. of Conc. Walk S. End of E. Dugout of Baseball Backstop
(Set.) T.B.M.				49.50	T.B.M. - Elev. 49.50 Fin. Fl. Grd. - Set 2" I.P. With Boat Spk. Up 14" At S.W. Cor. Contractors Office - Shed
(Set) T.B.M.				47.11	T.B.M. - Elev. 47.11 - Set Boat Spk. In Curb @ 40.65 Dist From ℄ Manhattan Beach Blvd. and on E Bldg Line of Activity Bldg. (See Pg. 29)
(Fd) T.B.M.				49.445	T.B.M. - Elev. 49.445 - F.B. 492-108 & F.B. 2346-6 Boat Spk In N. Sd. P.P. "501237-E At N.W. Cor. Golf Crs 75'± S. of Manhattan Beach Blvd.

Notes Ck'd by	Survey of ALONDRA PRK	F. B. 2346 Pg. 33
Map No.	W. O. 8771.06 Tape No. St'd. °F	
Office Work	Surveyed by A.N. Hellstrom	
Checked	Notes A.N.H. Date 9-16-59	
Date	Indexed G. Johnson 10-22-59	

J.N. # 8771.06

ALONDRA PARK

LOCATION & FIN. GRDS. FOR CONCRETE AREA AROUND ACTIVITY & RECREATION BLDG. – PG. 34

A.N. Hellstrom
E.T. Monkey - Jr.
R.A. Swann
C.A. Pyle

Note: Any Additions or Changes on This Sheet Must be Made or Circled in Red Ink With Date and Name of Person Making Change.

Do not extend notes this side of this line.

RETURN TO
LOS ANGELES COUNTY SURVEYOR
726 LOS ANGELES COUNTY
ENGINEERING BLDG.

76F309S S&E #247. 8-54

F. B. 2346 PG. 34

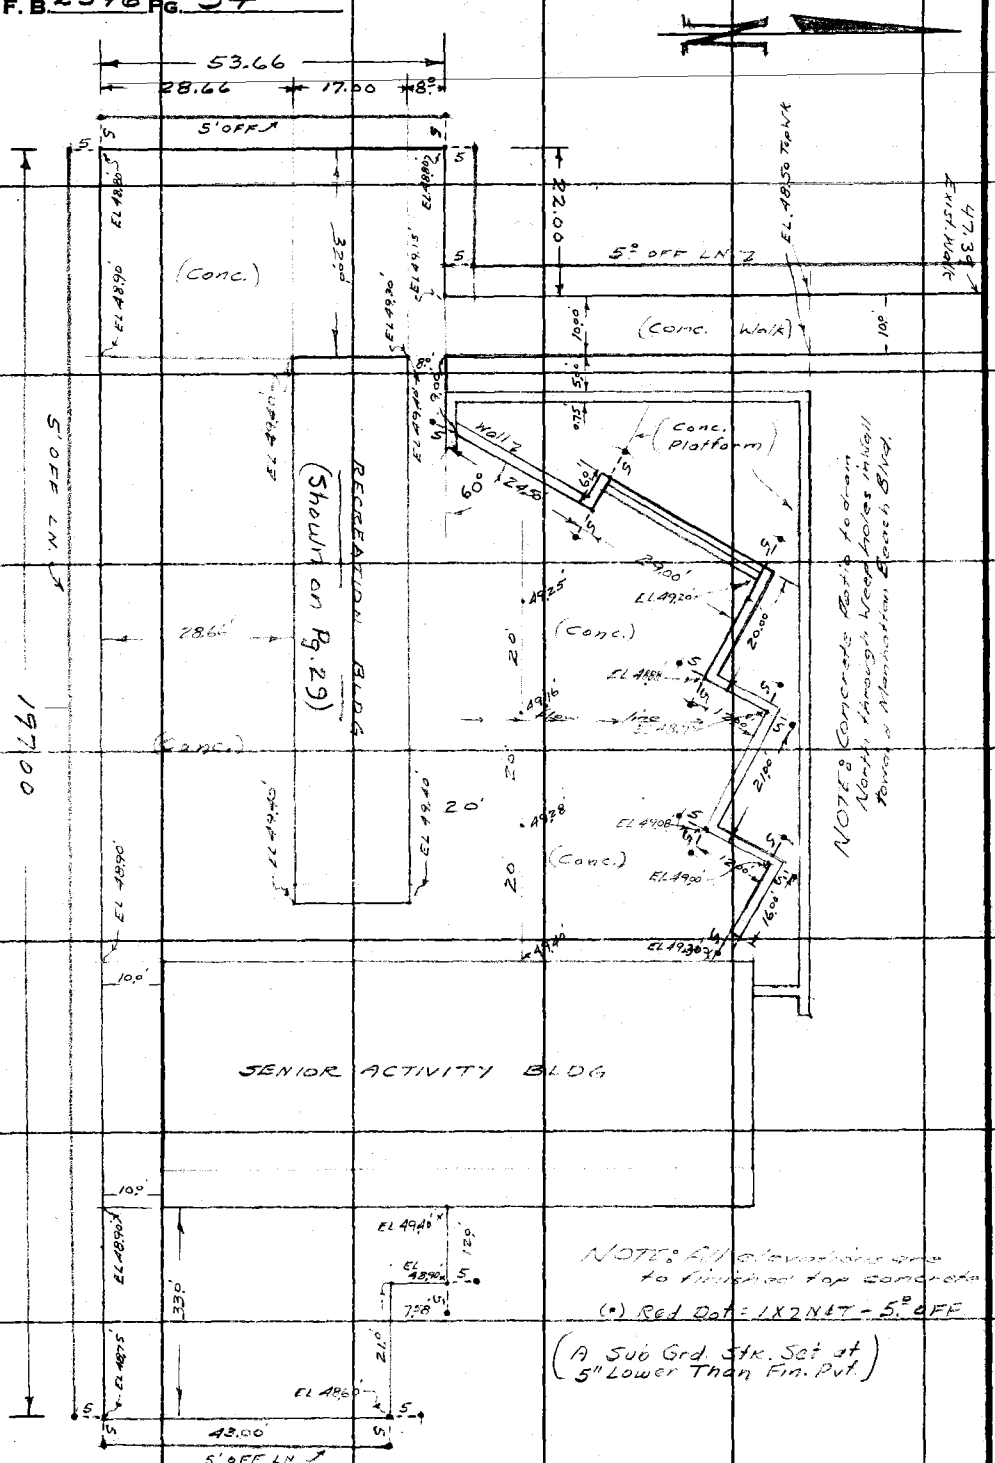

RETURN TO
LOS ANGELES COUNTY SURVEYOR
726 LOS ANGELES COUNTY
ENGINEERING BLDG.

Do not extend notes this side of this line.

Note: Any Additions or Changes on This Sheet Must be Made or Circled in Red Ink With Date and Name of Person Making Change.

Notes Ck'd by
Map No.
Office Work
Checked
Date

Survey of ALONORA PARK
JN 2658.06 Tape V96 STH 84 °F
Surveyed by R.C. WILSON
Notes M.A. Walsh Jr Date 2-60
Indexed R.C. Johnson 3-15-60

F. B. 2346 Pg. 35

ALONORA PARK

R.C. WILSON
M.A. WALSH JR
M.E. WACKER

Note: Any Additions or Changes on This Sheet Must be Made or Circled in Red. Ink With Date and Name of Person Making Change.

Do not extend notes this side of this line.

RETURN TO
LOS ANGELES COUNTY ENGINEER
700 Los Angeles County Engineering Bldg.

763095 CE #247—7-58

F. B. 2346 PG. 36

WS 25-03

RETURN TO
LOS ANGELES COUNTY ENGINEER
900 LOS ANGELES COUNTY ENGINEERING BLDG.

Note: Any Additions or Changes on This Sheet Must be Made or Circled in Red Ink With Date and Name of Person Making Change.

Do not extend notes this side of this line.

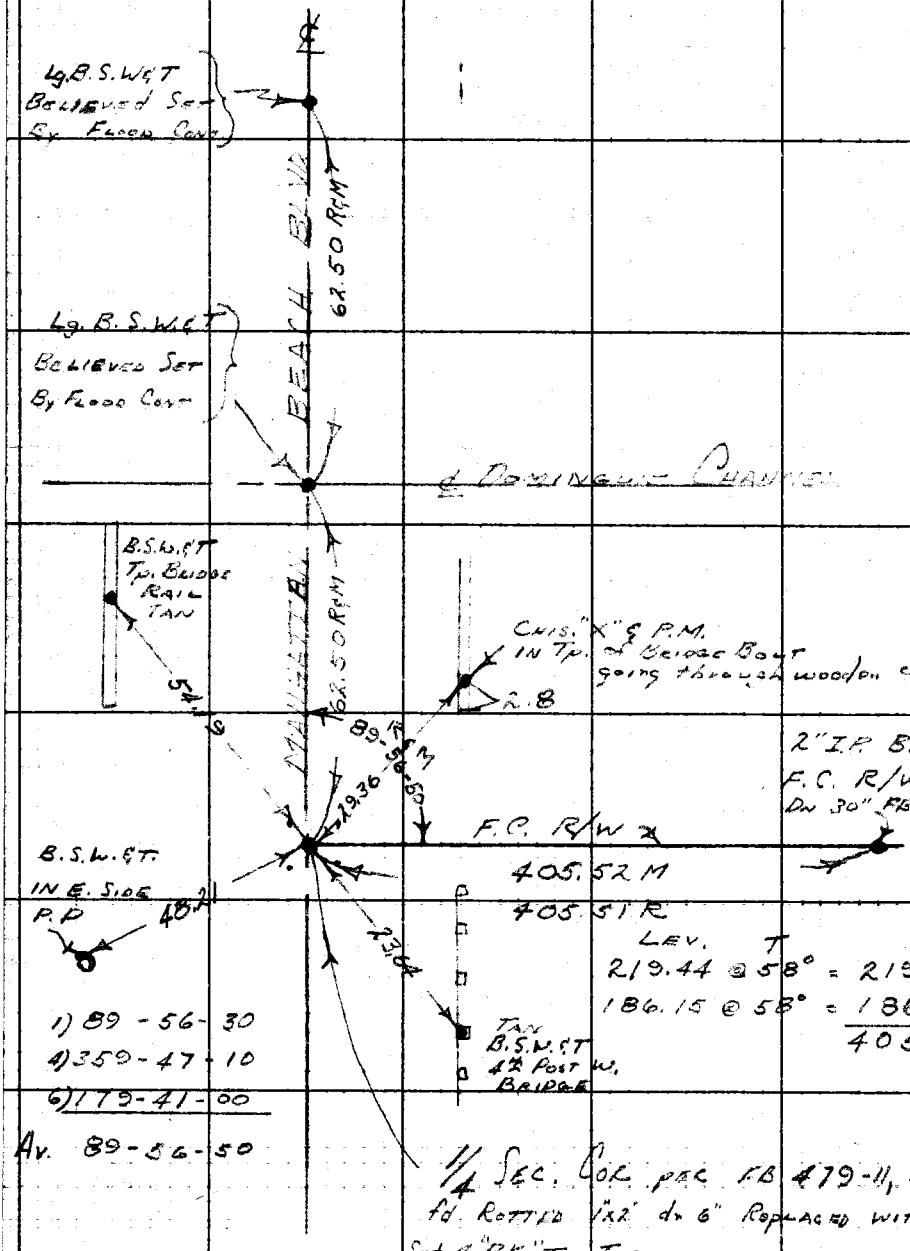

F. B. 2346 Pg. 37

Profile No. ____ X-Sec. No. ____ | Notes Red. ____ Date ____ | Notes Chkd. ____ Date ____ | Plotted ____ Date ____ | Checked ____ Date ____ | 8771.21 Job No. ____ Division No. 11 | Survey of ALONDRA PARK | Survey by HOLLSTROM Notes A.N. 11 Date 10-13-60 | Map No. ____ Indexed ____ | E. E. ON Date 12 8'61

J.N. 8771.21

ALONDRA PARK.

PARKING-AREA.

PARKING AREA ALONG EAST SIDE OF EXIST. ADM. BLDG. & W. SIDE OF GOLF COURSE.

These Are Grades For Parking Area Pgs. 37-42

GRADES FOR PRKNG. LOT ALONG WEST SD. GOLF COURSE & EAST SIDE KITCHEN Pgs. 37-48

SKETCH FOR SCHEME OF STATIONING FOR PARK. AREA ON EAST SD. PRAIRIE AVE Pgs 49-50

GRADES FOR PRKNG. AREA ON E. SD. PRAIRIE AVE pgs 51-57

STATION	B. S.	H. I.	F. S.	ELEV.

NOTE: ANY ADDITIONS OR CHANGES ON THIS SHEET MUST BE MADE OR CIRCLED IN RED INK, WITH DATE AND NAME OF PERSON MAKING CHANGE.

Do not extend notes this side of this line.

PLEASE RETURN TO
LOS ANGELES COUNTY ENGINEER
700 Los Angeles County Engineering Bldg.

76L-298 S & E #307—1-56

76L-298 S & E #307—1-56

PLEASE RETURN TO
LOS ANGELES COUNTY ENGINEER
700 LOS ANGELES COUNTY ENGINEERING BLDG.

NOTE: ANY ADDITIONS OR CHANGES ON THIS SHEET MUST BE MADE OR CIRCLED IN RED INK, WITH DATE AND NAME OF PERSON MAKING CHANGE.

Do not extend notes this side of this line.

F. B. 2346 Pg. 58 — Job No. 87121 — Division No. 11 — Notes Red. — Date — Plotted — Date — Profile — No. —
Survey of Alondra Park — Date — Checked — Date — X-Sec. — No. —
Survey by Hellstrom — Notes A.M.H. — Notes Chkd. — Date — Date —
Indexed H. E. Ott

STATION	B. S.	H. I.	F. S.	ELEV.	PP "S" 3013.29 E FINS. GRADE TOP PAVT.	C. or F.	
T.B.M. "Z"				49.445	T.B.M. "Z" - Elev. = 49.445 pr F.B. 2346 - 6 - 31 - Boot Spk. in		
P.I. Sta. 0+00				47.26			
"A" — 2' OFF N. Edg. Walk				48.23	47.41	C - 0.82	✓
"B" — 2' " " "				48.40	47.81	C - 0.59	✓
"C" — 2' " " "				48.59	48.50	C - 0.09	✓
3 Spkrs. (0+00) C 0+00 - 2' OFF				48.60	48.33	C - 0.27	✓
0+21½ N. Edg. Exist. Conc.				48.78	48.60	C - 0.18	✓
0+25 — 2' OFF " " Conc.				48.77	48.60	C - 0.17	✓
0+33½ S. Edg. Exist. Conc.				48.73	48.60	C - 0.13	✓
0+50 2' OFF				48.60	48.75	F - 0.15	✓
S. Edg. Exist. Conc. Walk - 2' OFF				48.87			
1+00 1 X 2 NST				47.98	48.30	F - 0.32	✓
1+50				47.88	47.86	C - 0.02	✓
2+00				47.80	47.76	C - 0.04	✓
2+50				47.69	47.71	F - 0.02	✓
3+00				47.65	47.67	F - 0.02	✓
3+50				47.83	47.63	C - 0.20	✓

76L-298 S & E #307—1-56

PLEASE RETURN TO
LOS ANGELES COUNTY ENGINEER
700 LOS ANGELES COUNTY ENGINEERING BLDG.

NOTE: ANY ADDITIONS OR CHANGES ON THIS SHEET MUST BE MADE OR CIRCLED IN RED INK, WITH DATE AND NAME OF PERSON MAKING CHANGE.

Do not extend notes this side of this line.

Profile Notes Red. Plotted Job No. 8771-1 Division No. 11 F. B. 2346 Pg. 39
No. X-Sec. Date Date Survey of Alondra Park
No. Notes Chkd. Checked Survey by Hallstrom Notes A.N.H. Date 10-13-64
Date Date Map No. Indexed H. E. OTT Date

STATION	B. S.	H. I.	F. S.	ELEV.	FINS. GRADE Top Pavt	C. of F.
3+64	2' DAF... W. Stk			47.76	47.61	C-0.15
B-0+00				48.09	48.44	F-0.35
+50				48.01	48.52	F-0.51
1+00				47.74	48.12	F-0.38
+50				47.63	47.76	F-0.13
(2+00				47.57	47.63	F-0.06
+50				47.36	47.55	F-0.19
3+00				47.33	47.47	F-0.14
+50				47.65	47.38	C-0.27
3+64	End			47.69	47.35	C-0.34
C-0+00				48.12	48.33	F-0.21
+50				47.99	48.30	F-0.31
1+00				47.73	47.94	F-0.21
+50				47.51	47.65	F-0.14
2+00				47.34	47.51	F-0.17
+50				47.27	47.38	F-0.11
(3+00				47.14	47.26	F-0.12
+50				47.30	47.13	C-0.17

F. B. 2346 Pg. 40 | Job No. 8771-21 Division No. 11 Notes Red. Plotted Profile
Survey of ALONDRA PARK Date Date No X-Sec.
Survey by Hellstrom Notes B.N.H. Notes Chkd. Checked No.
Indexed O.K. for O.H. Date Date Date

76L-298 S & E #307—1-56

PLEASE RETURN TO
LOS ANGELES COUNTY ENGINEER
700 LOS ANGELES COUNTY ENGINEERING BLDG.

NOTE: ANY ADDITIONS OR CHANGES ON THIS SHEET MUST BE MADE OR CIRCLED IN RED INK, WITH DATE AND NAME OF PERSON MAKING CHANGE.

Do not extend notes this side of this line.

STATION	B. S.	H. I.	F. S.	ELEV.		FINS. GRADE TOP PAVT.	C. or F.
3+64	End			47.42		47.09	C- 0.33
3+64 2'	OFF ON East STK "D"			46.67			
B.M.				48.85	B.M. ELEV = 48.845 - F.B. 2346 - Pg. 31.		
						FINS. GRADE TOP PAVT.	C. or F.
D-0+00	-2' OFF LN - (East)			48.15		48.00	C- 0.15
+50				48.03		48.14	F- 0.11
1+00				47.87		47.82	F- 0.13
+50				47.41		47.58	F- 0.17
2+00				47.23		47.42	F- 0.19
+50				47.20		47.27	F- 0.07
3+00				46.89		47.12	F- 0.23
3+20	NOT SET						
3+64				46.68			
3+34	B.C. "D" LN. - 30' RAD.			46.84		47.00	F- 0.16
E.C.	= 30' RAD.			47.46		47.21	C- 0.25
B.M.				48.85	B.M. ELEV. = 48.845 - F.B. 2346 - Pg. 31.		

76L-298 S & E #307—1-56

PLEASE RETURN TO
LOS ANGELES COUNTY ENGINEER
700 LOS ANGELES COUNTY ENGINEERING BLDG.

NOTE: ANY ADDITIONS OR CHANGES ON THIS SHEET MUST BE MADE OR CIRCLED IN RED INK, WITH DATE AND NAME OF PERSON MAKING CHANGE.

Do not extend notes this side of this line.

STATION	B. S.	H. I.	F. S.	ELEV.	F.N.S. GRADE TOP PAVT.	C. or F.
T.B.M.#2				47.45	T.B.M.#2 ELEV = 49.225 per F.B. 2346-6-31 BR. SPK. IN A.P. #50 23 E.	
W.#1 EXPT.		2'OFF		48.39	48.10	F 0.31
W.#2 E.C.		" "		46.31	47.50	C 1.51
W.#3 P.I.	2'OFF	" "		47.95	47.37	C 0.53
W.#4 INT. WLKS.				47.26		
E.#5 INT. & B.C.S. EDGE WLK				47.19		
E.#6 EXT. 2'OFF				48.19	47.70	C 0.47
E.#7 E.C.	"	"		48.14	48.21	F 0.07
E.#8 EXPT.	"	"		48.17	48.30	F 0.13
E.#9 EXPT. 2' OFF (EAST)				48.19	47.90	C 0.29
T.B.M.#2				47.45	T.B.M.#2 ELEV: 49.225 per F.B. 2346-31.	

Profile Notes Red. Plotted Job No. 2772 Division No.
No. X-Sec. Date Date Survey of
Notes Chkd. Checked Survey by Notes D.N.M. Date 10-
No. Date Date Map No. Indexed E. E. Date

F. B. 2346 Pg. 47

76L-298 S & E #307—1-56

PLEASE RETURN TO
LOS ANGELES COUNTY ENGINEER
700 Los Angeles County Engineering Bldg.

NOTE: ANY ADDITIONS OR CHANGES ON THIS SHEET MUST BE MADE OR CIRCLED IN RED INK, WITH DATE AND NAME OF PERSON MAKING CHANGE.

Do not extend notes this side of this line.

Profile Notes Red. Plotted Job No. 877.2 Division No. 11
No. X-Sec. Date Date Survey of ALONDRA PARK
Notes Chkd. Checked Survey by A.N.H. Notes A.N.H. Date 12-16-60
No. Date Date Map No. Indexed H.E.OH Date

F. B. 2346 Pg. 43

FINAL GRADES ON EAST PARKING AREA
NEAR KITCHEN BLDG. & ON W. SIDE GOLF CRT

S. End of E. Dugout Sm. Bk. Spk. to End Conc. Walk
Ba. Diam. 30.5' So. 3' Comm. Kitchen F.F. El. of Slab 55

STATION	B. S.	H. I.	F. S.	ELEV.		9" Sub Sub Gr.
B.M				48.85	B.M. = Elev. 48.845 - F.B. 2346-6	
					Fin. Grd.	
A 0+00				48.75	48.30	
+25				48.79	48.60	
+50				48.85	48.75	
+75					48.65	
1+00					48.39	
+25					47.95	
+50					47.86	
+75					47.78	
2+00					47.72	
A						

76L-298 S & E #307—1-56

PLEASE RETURN TO
LOS ANGELES COUNTY ENGINEER
700 Los Angeles County Engineering Bldg.

NOTE: ANY ADDITIONS OR CHANGES ON THIS SHEET MUST BE MADE OR CIRCLED IN RED INK, WITH DATE AND NAME OF PERSON MAKING CHANGE.

Do not extend notes this side of this line.

F. B. 2346 Pg. 44 | Job No. 877.21 Division No. 11 Notes Red. Plotted Profile
Survey of ALONDRA PARK Date Date No. X-Sec.
Survey by A.N.H. Notes A.N.H. Notes Chkd. Checked No.
Indexed [illegible] Date Date Date

STATION	B. S.	H. I.	F. S.	ELEV.	Fin. Grd.	9" Sub Sub Gr.
9 2+25					✓ 47.74	
+50					✓ 47.71	
+75					✓ 47.69	
3+00					✓ 47.67	
+25					✓ 47.65	
+50					✓ 47.63	
+64					✓ 47.62	
B 0+00					48.44	✓ 47.69
+25					48.49	✓ 47.74
+50					48.52	✓ 47.77
+75					48.40	✓ 47.65
1+00					48.12	✓ 47.37
+25					47.81	✓ 47.09
+50					47.76	✓ 47.01
+75					47.65	✓ 46.93
2+00					47.53	✓ 46.88
B +25					47.60	✓ 46.95

76L-298 S & E #307—1-56

PLEASE RETURN TO
LOS ANGELES COUNTY ENGINEER
700 Los Angeles County Engineering Bldg.

NOTE: ANY ADDITIONS OR CHANGES ON THIS SHEET MUST BE MADE OR CIRCLED IN RED INK, WITH DATE AND NAME OF PERSON MAKING CHANGE.

Do not extend notes this side of this line.

Profile Notes Red. Plotted Job No. 8731-21 Division No. 11 F. B. 2346 Pg. 45
No. X-Sec. Date Date Survey of ALONDRA PARK
Notes Chkd. Checked Survey by A.M.H. Notes A.M.H. Date 12-14-60
No. Date Date Map No. Indexed R. E. Ott Date

STATION	B. S.	H. I.	F. S.	ELEV.	Fin. Grd.	9" Sub Sub Grd.
B 2+50					47.55	✓ 46.80
+75					47.51	✓ 46.76
3+00					47.47	✓ 46.72
+25					47.42	✓ 46.67
+50					47.38	✓ 46.63
B +64					47.35	✓ Grd.
C 0+00					48.33	✓ 47.58
+25					48.33	✓ 47.58
+50					48.30	✓ 47.55
+75					48.25	✓ 47.50
1+00					48.21	✓ 47.46
+25					48.13	✓ 47.38
+50					48.08	✓ 47.33
+75					48.04	✓ 47.29
2+00					47.99	✓ 47.24
+25					47.95	✓ 47.20
C +50					47.90	✓ 47.15

76L-298 S & E #307—1-56

PLEASE RETURN TO
LOS ANGELES COUNTY ENGINEER
700 Los Angeles County Engineering Bldg.

NOTE: ANY ADDITIONS OR CHANGES ON THIS SHEET MUST BE MADE OR CIRCLED IN RED INK, WITH DATE AND NAME OF PERSON MAKING CHANGE.

Do not extend notes this side of this line.

F. B. 2346 Pg. 46 | Job No. 87121 Division No. 11 Notes Red Date Plotted Profile No.
Survey of Alondra Blvd. Date No. X-Sec.
Survey by A.N.H. Notes A.N.H. Notes Chkd. Checked
Indexed [illegible] Date Date Date

STATION	B. S.	H. I.	F. S.	ELEV.	FIN. Grd.	9" Sub Sub Grd.
C - 2+75					47.35	✓ 46.58
3+00					47.26	✓ 46.51
+25					47.20	✓ 46.45
+50					47.13	✓ 46.38
C 3+64					47.09	Grd.
D - 0+00					47.90	
+25					✓ 48.30	
+50					✓ 48.19	
+75					✓ 47.98	
1+00					✓ 47.8[illegible]	
+25					✓ 47.62	
+50					✓ 47.58	
+75					✓ 47.50	
2+00					✓ 47.42	
+25					✓ 47.35	
+50					✓ 47.27	
D 2+78					✓ 47.20	

76L-298 S & E #307—1-56

PLEASE RETURN TO
LOS ANGELES COUNTY ENGINEER
700 Los Angeles County Engineering Bldg.

NOTE: ANY ADDITIONS OR CHANGES ON THIS SHEET MUST BE MADE OR CIRCLED IN RED INK, WITH DATE AND NAME OF PERSON MAKING CHANGE.

Do not extend notes this side of this line.

STATION	B. S.	H. I.	F. S.	ELEV.	Fin. Grd.	9" Sub Sub Grd.
D-3+00					✓ 47.12	
1 +25					✓ 47.04	
1 +34	BC					
1 +50					✓ 46.96	
D +64						

Profile Notes Red. Plotted Job No. 8771.21 Division No. 11 F. B. 2342 Pg. 47
No. X-Sec. Date Date Survey of ALONDRA PARK
No. Notes Chkd. Checked Survey by A.N.H. Notes A.N.H. Date 12-16-60
Date Date Map No. Indexed H. E. OH Date

76F3095 CE #247—3-57

RETURN TO
LOS ANGELES COUNTY ENGINEER
700 LOS ANGELES COUNTY ENGINEERING BLDG.

Note: Any Additions or Changes on This Sheet Must be Made or Circled In Red Ink With Date and Name of Person Making Change.

Do not extend notes this side of this line.

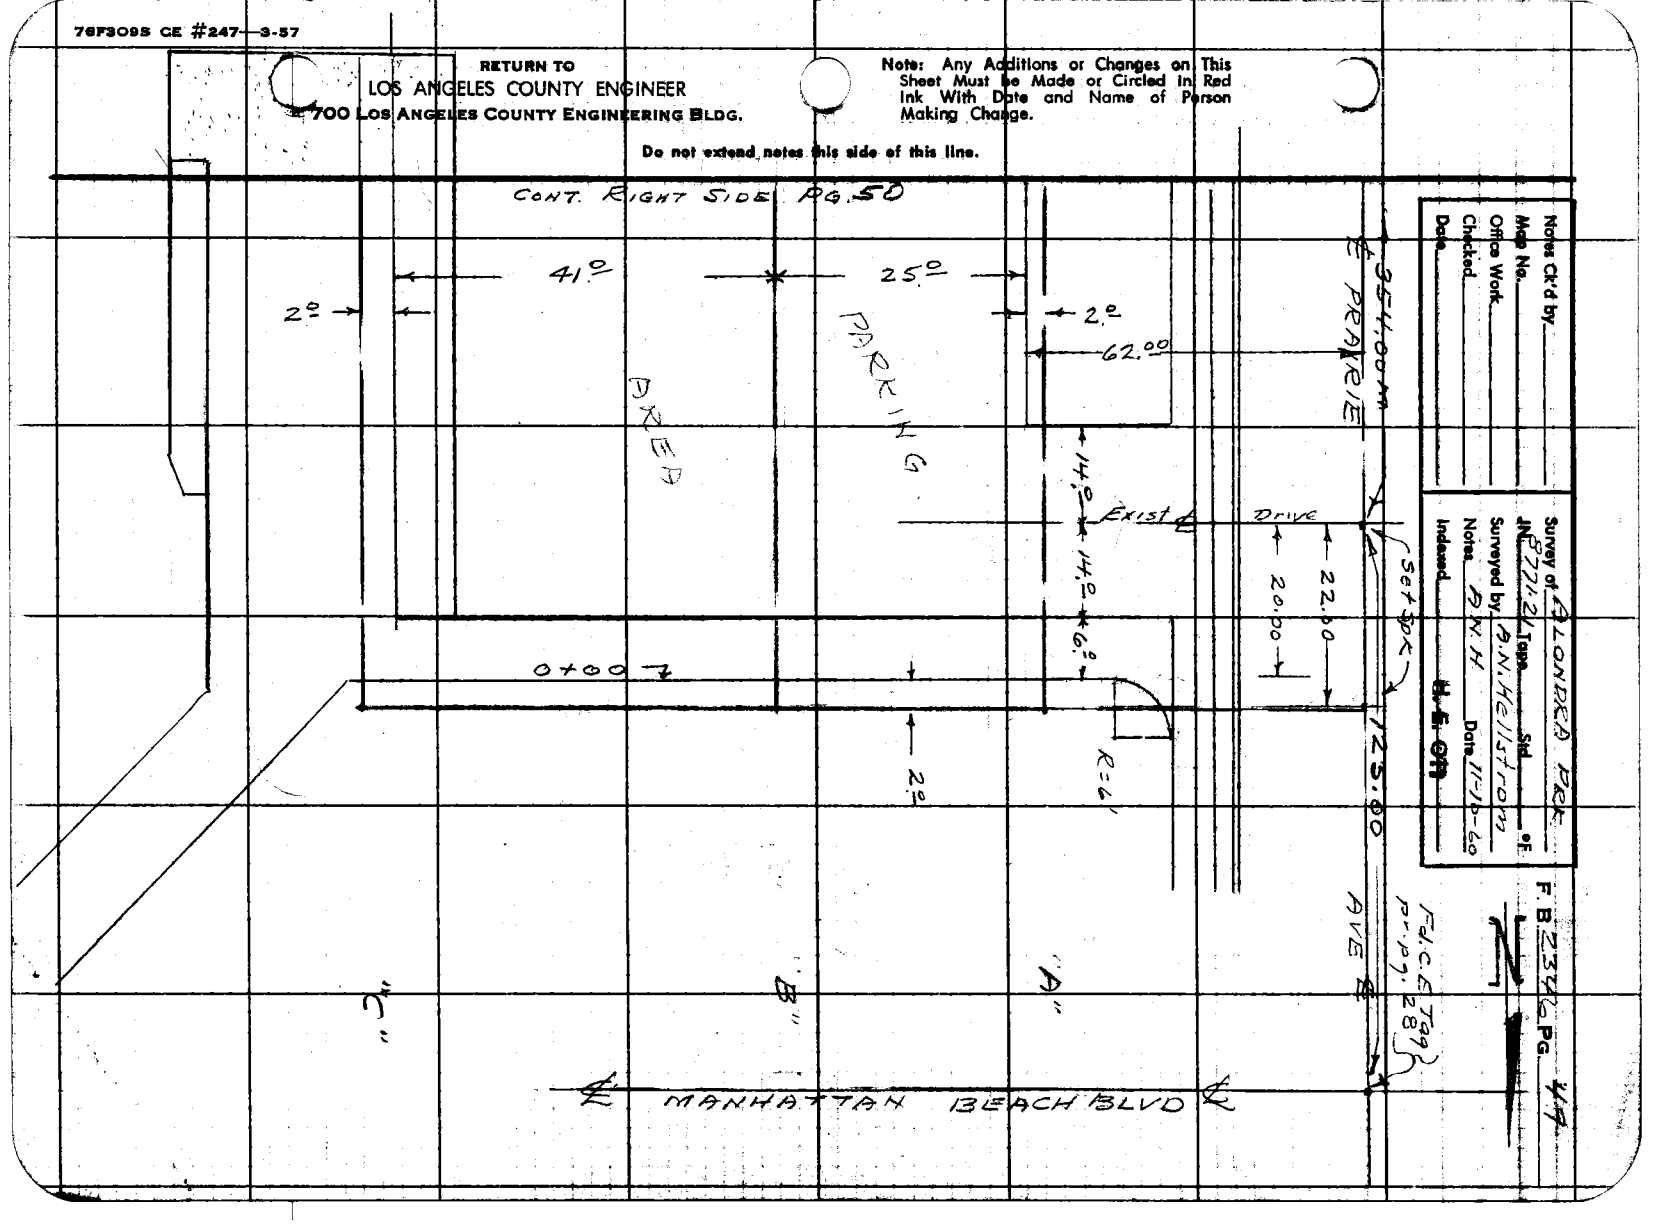

Notes Ck'd by
Map No.
Office Work
Checked
Date

Survey of ALONDRA PARK
JN 8771.21 Topo Std °F.
Surveyed by B.N. HELLSTROM
Notes B.M. Date 11-16-60
Indexed H.E. Ott


RETURN TO
LOS ANGELES COUNTY ENGINEER
700 LOS ANGELES COUNTY ENGINEERING BLDG.

Note: Any Additions or Changes on This Sheet Must be Made or Circled in Red Ink With Date and Name of Person Making Change.

Do not extend notes this side of this line.

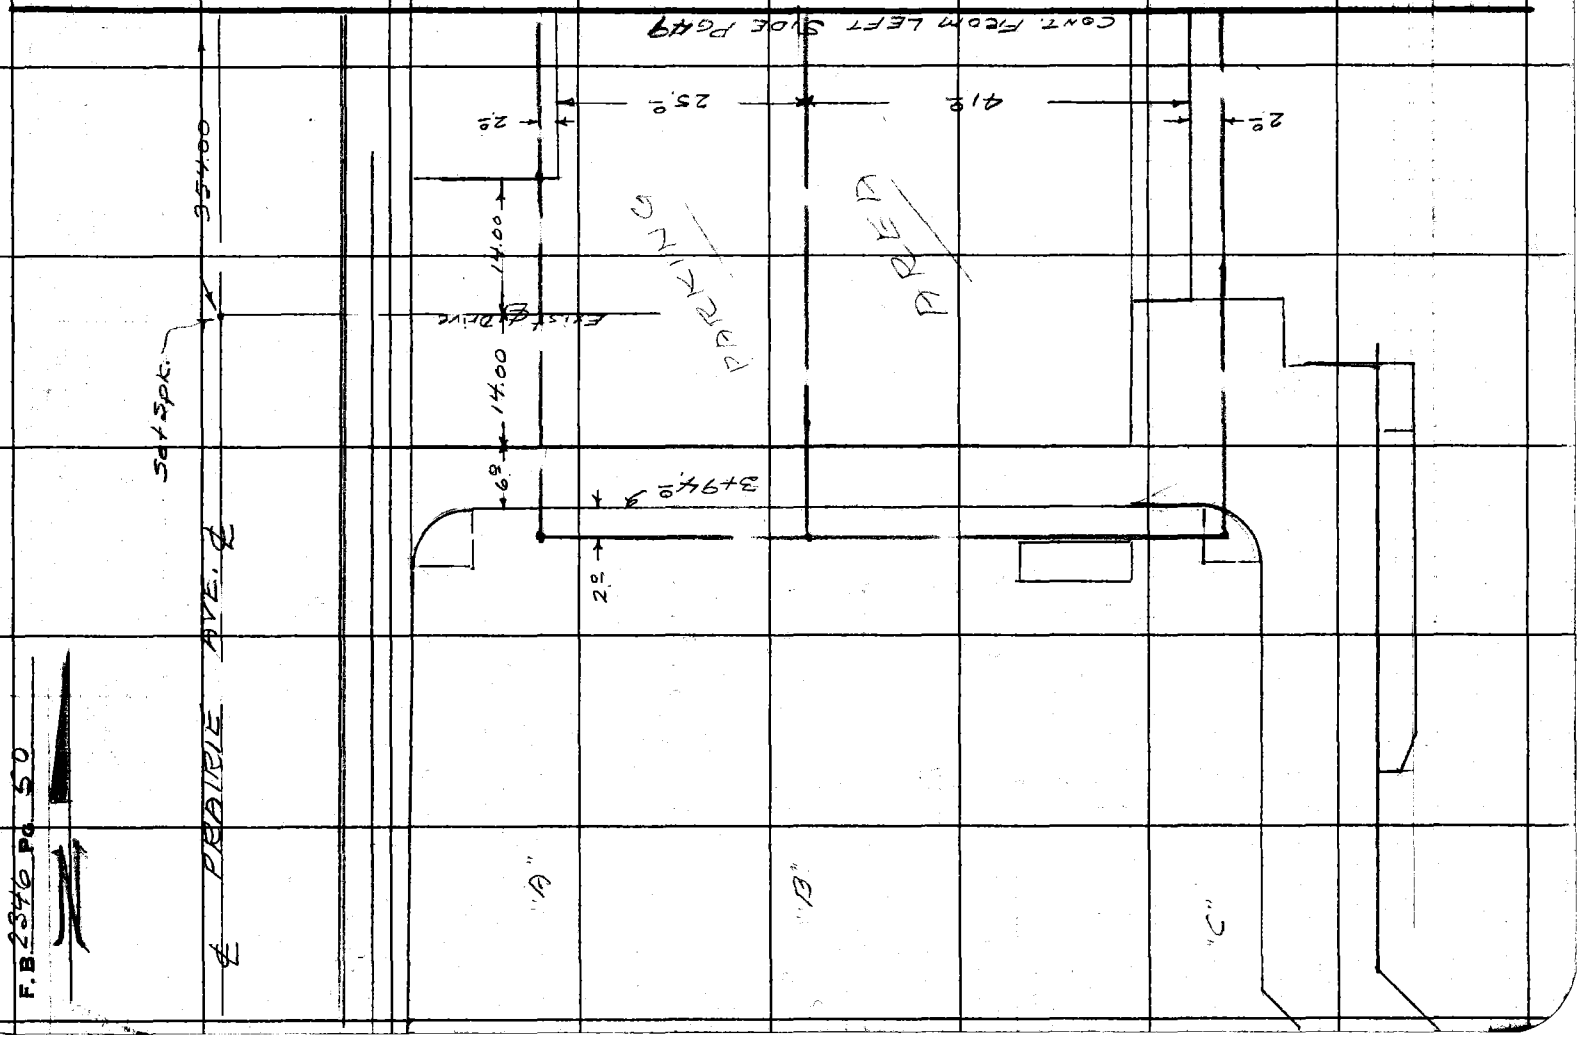

F.B. 2846 Pg. 50

76L-298 S & E #307—1-56

PLEASE RETURN TO
LOS ANGELES COUNTY ENGINEER
700 Los Angeles County Engineering Bldg.

NOTE: ANY ADDITIONS OR CHANGES ON THIS SHEET MUST BE MADE OR CIRCLED IN RED INK, WITH DATE AND NAME OF PERSON MAKING CHANGE.

Do not extend notes this side of this line.

F.B. 2346 Pg. 52 | 8771.21 Job No. Division No. 11 Notes Red. Plotted Profile
Survey by A.N.H. Notes A.N.H. Notes Chkd. Checked
Indexed E.E.O.N. Date Date Date No.

STATION	B. S.	H. I.	F. S.	ELEV.		
B.M.				49.17	B.M. - Elev. 49.167 - F.B. 2346-L - Boat Spk. in lead in Conc. At E. End of Dugout S.E. Cor. Prairie Ave & Manhattan Blvd	
					Fin. Grd	C/F
N. Drive N. End Exist. Conc. Dr. Pan				48.38		
S. " " "				48.22		
A 0+00	-2' Offset to N.			48.43	48.52	F .09
0+20	- 2' W. Offset			48.49	48.16	C .33
+34	"			48.37	48.11	C .48
+58				48.61	48.30	C .31
1+08				48.42	48.16	C .26
+58				48.20	48.00	C .20
2+08				48.07	47.85	C .32
"	Adj. Station -15' W			47.52		
2+58				47.75	47.70	C .05
3+08				47.58	47.55	C .03

76L-298 S & E #307—1-56

PLEASE RETURN TO
LOS ANGELES COUNTY ENGINEER
700 LOS ANGELES COUNTY ENGINEERING BLDG.

NOTE: ANY ADDITIONS OR CHANGES ON THIS SHEET MUST BE MADE OR CIRCLED IN RED INK, WITH DATE AND NAME OF PERSON MAKING CHANGE.

Do not extend notes this side of this line.

Profile Notes Red. Plotted Job No. 871.21 Division No. 11 F. B. 2346 Pgs. 53
No. X-Sec. Date Date Survey of ALONDRA PARK
No. Notes Chkd. Checked Survey by A.N.H. Notes A.N.H. Date 11-21-60
Date Date Map No. Indexed Date

STATION	B. S.	H. I.	F. S.	ELEV.		
					∠ 97.21 — FINAL	
T.B.M.				48.00	ON E. Sd. Pkwy. 1.1' S. of Top of Curb & 1.6' E. of Face of Curb T.B.M. - Cut on Top of Curb Opp. SW. Cor. Toilets Bldg.	
					Fin. Grd	9" Sub-Gr.
B-0+00	- 2' N			48.38		
B-0+00	- N. Edg. Exist Wlk.			48.25		
B-0+00	S "				48.19	47.44 ✓
B-0+50					48.19	47.44 ✓
1+00					48.05	47.30 ✓
+50					47.85	47.10 ✓
2+00					47.65	46.90 ✓
+50					47.46	46.71 ✓
3+00					47.21	46.46 ✓
+50					46.97	46.22 ✓
+88					46.69	45.94
+94				46.66		
+94	- 2' S.			46.18		

76L-298 S & E #307—1-56

PLEASE RETURN TO
LOS ANGELES COUNTY ENGINEER
700 Los Angeles County Engineering Bldg.

NOTE: ANY ADDITIONS OR CHANGES ON THIS SHEET MUST BE MADE OR CIRCLED IN RED INK, WITH DATE AND NAME OF PERSON MAKING CHANGE.

Do not extend notes this side of this line.

F. B. 2346 Pg. 54 | 97121 Division No. 11 Notes Red. Plotted Profile
Job No. 0281 Date Date No.
Survey of ALONDRA AVE. Notes C.W.H. Notes Chkd. Checked X-Sec.
Survey by C.W.H. Date Date No.
Indexed H. E. Ott Date Date

STATION	B. S.	H. I.	F. S.	ELEV.		
					Fin. Grd.	
A-0+00	-2' N. 1x2			+48.44		
A-0+00	-N. Edg. Exist C'Walk			+48.58		
"	-12' W- Tp Wlk			+48.31		
A-0+06	-S. Edg. Exist C'Walk			+48.42		
"	-12' W- Top Wlk			+48.30		
A-0+20	S Drwy Exist			+48.41	48.41	Subg. +47.66'
A-0+38	N/C			+48.58	48.36'	
"	12' W Tp. Exist Conc. Dr			48.22		
A-0+50					48.30'	
1+00					48.16'	
+50					48.00'	
2+00					47.85'	
+50					47.70'	
3+00					47.55'	
+50						
3+60					47.40'	
"	12' W Ex. Conc.			47.00		

76L-298 S & E #307—1-56

PLEASE RETURN TO
LOS ANGELES COUNTY ENGINEER
700 LOS ANGELES COUNTY ENGINEERING BLDG.

NOTE: ANY ADDITIONS OR CHANGES ON THIS SHEET MUST BE MADE OR CIRCLED IN RED INK, WITH DATE AND NAME OF PERSON MAKING CHANGE.

Do not extend notes this side of this line.

STATION	B. S.	H. I.	F. S.	ELEV.	FN. GRD	C/F
A 3+60	Edg. Dr.	- 2' OFF - W.		46.96	47.40	F .44
3+74	E "			47.12	47.35	F .23
3+94	- 2' S. Edg. Dr.			46.93	47.20	F .27
N. End Edg. Dr.				47.02		
E "	" "	" "		47.34		
B- 0+00	2' OFF N. Edg. Dr.			48.39	48.19	C .20
0+14				48.34	48.34	C .38
0+58				47.98	48.19	F .21
1+08				47.90	48.05	F .15
1+58				47.60	47.85	F .20
2+08				47.68	47.65	C .03
2+58				47.13	47.46	F .33
3+08				46.90	47.21	F .31
3+58				46.47	46.97	F .50
3+94	- 2' S. OFFSET			46.13	46.64	F .51

Profile Notes Red. Plotted Job No. 6771-21 Division No. 11 F. B. 2346 Pg. 55
No. X-Sec. Date Date Survey of ALONDRA PARK
Notes Chkd. Checked Survey by A.M.H. Notes A.M.H. Date 11-10-60
No. Date Date Map No. Indexed H. E. OD Date

F. B. 23468 pg. 56 | 8771.21 Division No. 11 Notes Red. Plotted Profile
Survey of ALONDRA PARK Job No. Date No. X-Sec.
Survey by C.W.H. Notes R.W.H. Notes Chkd. Checked
Indexed Date Date Date No.

76L-298 S & E #307—1-56

PLEASE RETURN TO
LOS ANGELES COUNTY ENGINEER
700 Los Angeles County Engineering Bldg.

NOTE: ANY ADDITIONS OR CHANGES ON THIS SHEET MUST BE MADE OR CIRCLED IN RED INK, WITH DATE AND NAME OF PERSON MAKING CHANGE.

Do not extend notes this side of this line.

STATION	B. S.	H. I.	F. S.	ELEV.		
					Fin. Grd	C/F
C- 0+00	2'N + 0 Off			47.36	48.19	F .33
0+34				47.85	48.15	F .35
0+58				47.69	48.05	F .36
1+08				47.55	47.86	F .31
+59				47.27	47.60	F .33
2+08				47.19	47.35	F .16
+58				47.83	47.06	F .23
3+08				47.33	46.65	F .32
+58				46.38	46.23	F .17
3+94	2'5. + 0 Off			45.83	45.94	F .26
N.W. Cor. Sec.				47.30		
S.W. "				47.56		

76L-298 S & E #307—1-56

PLEASE RETURN TO
LOS ANGELES COUNTY ENGINEER
700 Los Angeles County Engineering Bldg.

NOTE: ANY ADDITIONS OR CHANGES ON THIS SHEET MUST BE MADE OR CIRCLED IN RED INK, WITH DATE AND NAME OF PERSON MAKING CHANGE.

Do not extend notes this side of this line.

STATION	B. S.	H. I.	F. S.	ELEV.		
A-3+58	C'N	Ex'st A.C.		4704		
A-3+98	N.E.	C.L.		4734		
" "	S "	"		4738		
					Fin. Grd.	
T.B.M				4817	T.B.M - Bk. in Conc. Dwy. E. End Pan to S'W	
C-0+00	- 2'N	"		4791		
C-0+00	N 52½	Conc.		4817		
"	"	"	7'E Valley	4813		
"	"	"	2'W	4820		
C-0+06	- 6	W Edge Conc.		4821		
C-0+50	- 6	W "		4808		
C- "	7'E	Ex'st Ground		4794		
C-0+70	- 6	W Ex'st		4805		
"	7E	"		4787		
1+00					47.86	
+50					47.60'	
2+00					47.35-	
+50					47.06'	
3+00					46.65-	
+50					46.25'	

Profile Notes Red. Plotted Job No. Division No.
No. X-Sec. Date Date Survey of Conc. Dwy. P.R.
Notes Chkd. Checked Survey by Notes
No. Date Date Map No. Indexed E. E. OTT Date Date

F. B. 4J 46 Pg. 57

Notes Ck'd by		Survey of ALONDRA PARK	F. B 2346 Pg. 59
Map No.		JN 8771.21 Tape Std °F	
Office Work		Surveyed by Manley Jr.	
Checked		Notes EXIT Jr. Date FEB 21 61	
Date		Indexed B. E. ON FEB 28 61	

JN 8771.21

ALONDRA PARK

SOFTBALL FIELD LIGHTING

Note: Any Additions or Changes on This Sheet Must be Made or Circled in Red Ink With Date and Name of Person Making Change.

Do not extend notes this side of this line.

RETURN TO
LOS ANGELES COUNTY ENGINEER
700 Los Angeles County Engineering Bldg.

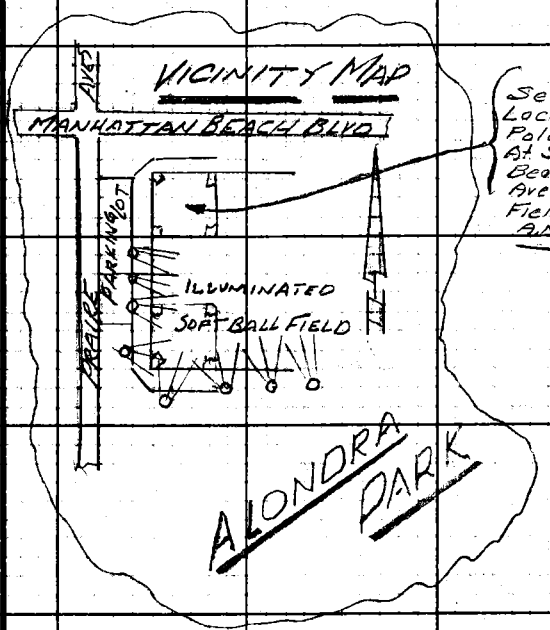

See Pg. 60 For Location of Light Poles For Ball Diamond At S.E. Cor. Manhattan Beach Blvd. & Prairie Ave., As Staked In Field 7-5-61
A.N. Hellstrom

Manley Jr.
McCall
Swann
Manley
Jones

76F3098 CE #247—3-57

RETURN TO
LOS ANGELES COUNTY ENGINEER
700 LOS ANGELES COUNTY ENGINEERING BLDG.

Note: Any Additions or Changes on This Sheet Must be Made or Circled in Red Ink With Date and Name of Person Making Change.

Do not extend notes this side of this line.

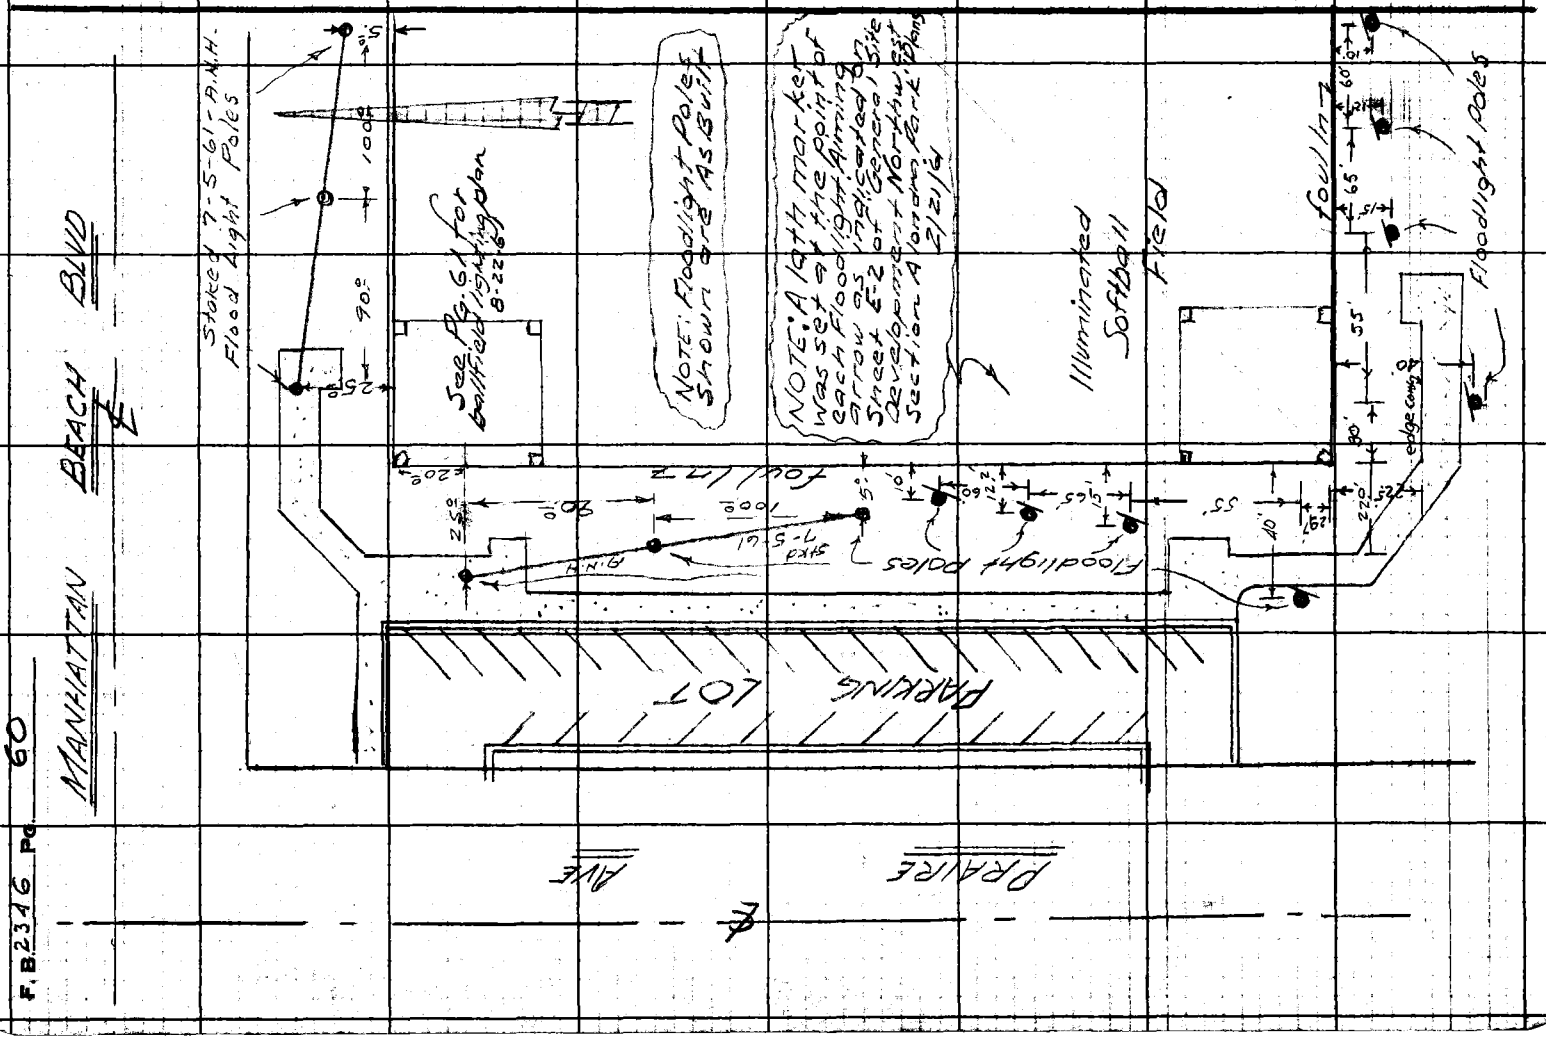
MANHATTAN BEACH BLVD
PRAIRIE AVE
PARKING LOT
Illuminated Softball Field
Floodlight Poles
Floodlight Poles
Floodlight Poles

Notes Ck'd by	Survey of Alondra Park
Map No.	JN 8771.21 Tape Std °F
Office Work	Surveyed by Mankey Jr.
Checked	Notes Comp'd Date Aug 22, 61
Date	Indexed AUG 30 61

F. B. 2396 Pg. 61

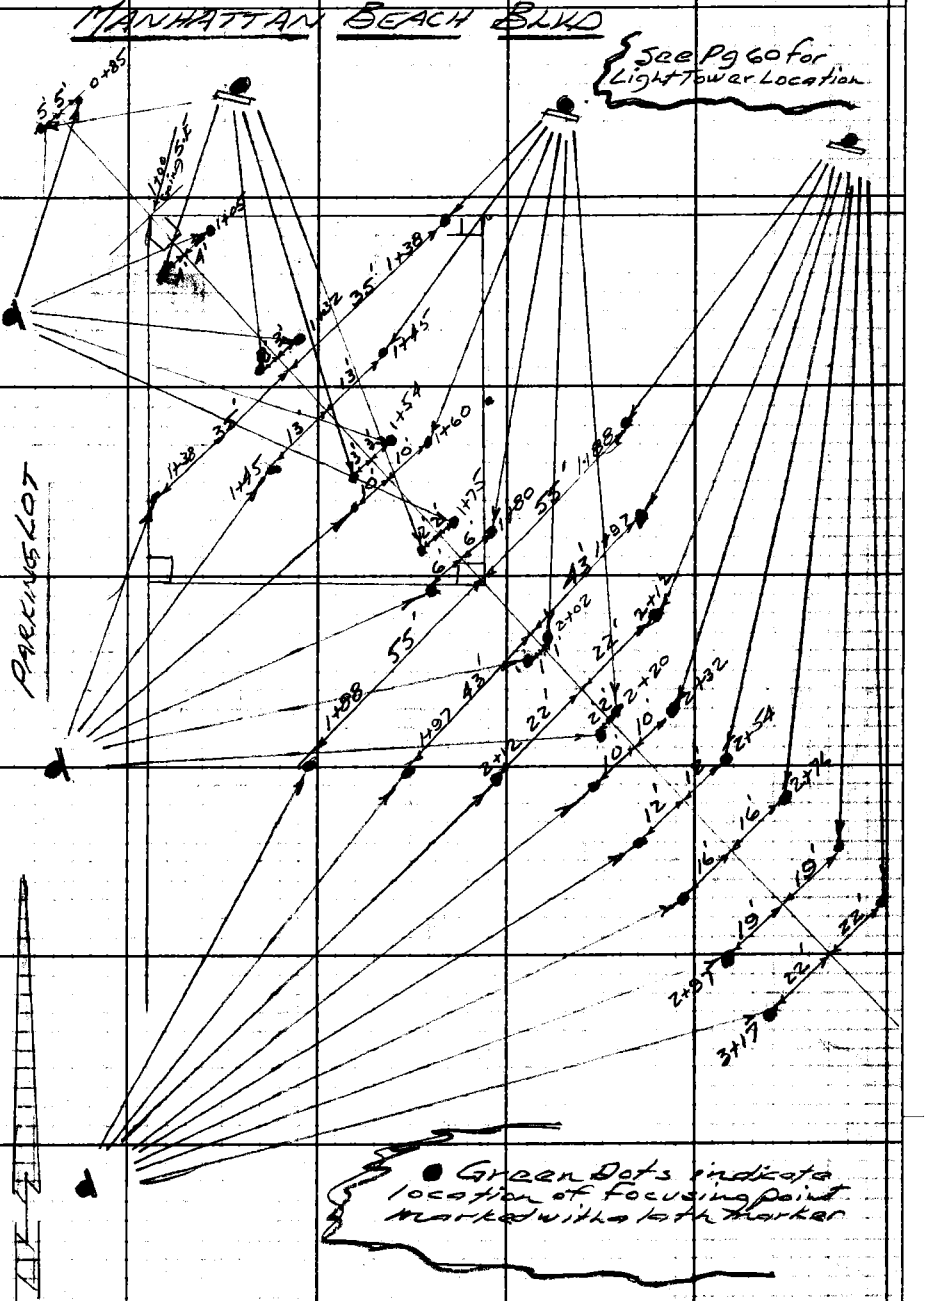

Note: Any Additions or Changes on This Sheet Must be Made in Red Ink or Circled With Date and Name of Person Making Change.

Do not extend notes this side of this line.

RETURN TO
LOS ANGELES COUNTY ENGINEER
700 LOS ANGELES COUNTY ENGINEERING BLDG.

76F309S CE #247—3-57

Notes Ck'd by	Survey of ALONDRA PARK	F. B. 2344 Pg. 63
Map No.	JN 8791.2 Tape — Std — °F	
Office Work	Surveyed by W. A. RICHARDS	
Checked	Notes W.A.R. Date 5-21-62	
Date	Indexed H. E. OTT JUN 11 62	

J. N. 8791.12

ALONDRA PARK

STAKING SURVEY

FOR

PROTECTIVE FENCING

RICHARDS
OCHSNER
TURRILL
CROWDER
SIENDAHN

Note: Any Additions or Changes on This Sheet Must Be Made or Circled in Red Ink With Date and Name of Person Making Change.

Do not extend notes this side of this line.

RETURN TO
LOS ANGELES COUNTY ENGINEER
700 LOS ANGELES COUNTY ENGINEERING BLDG.

763098 CE #247—7-58

F. B. 2346 PG. 64

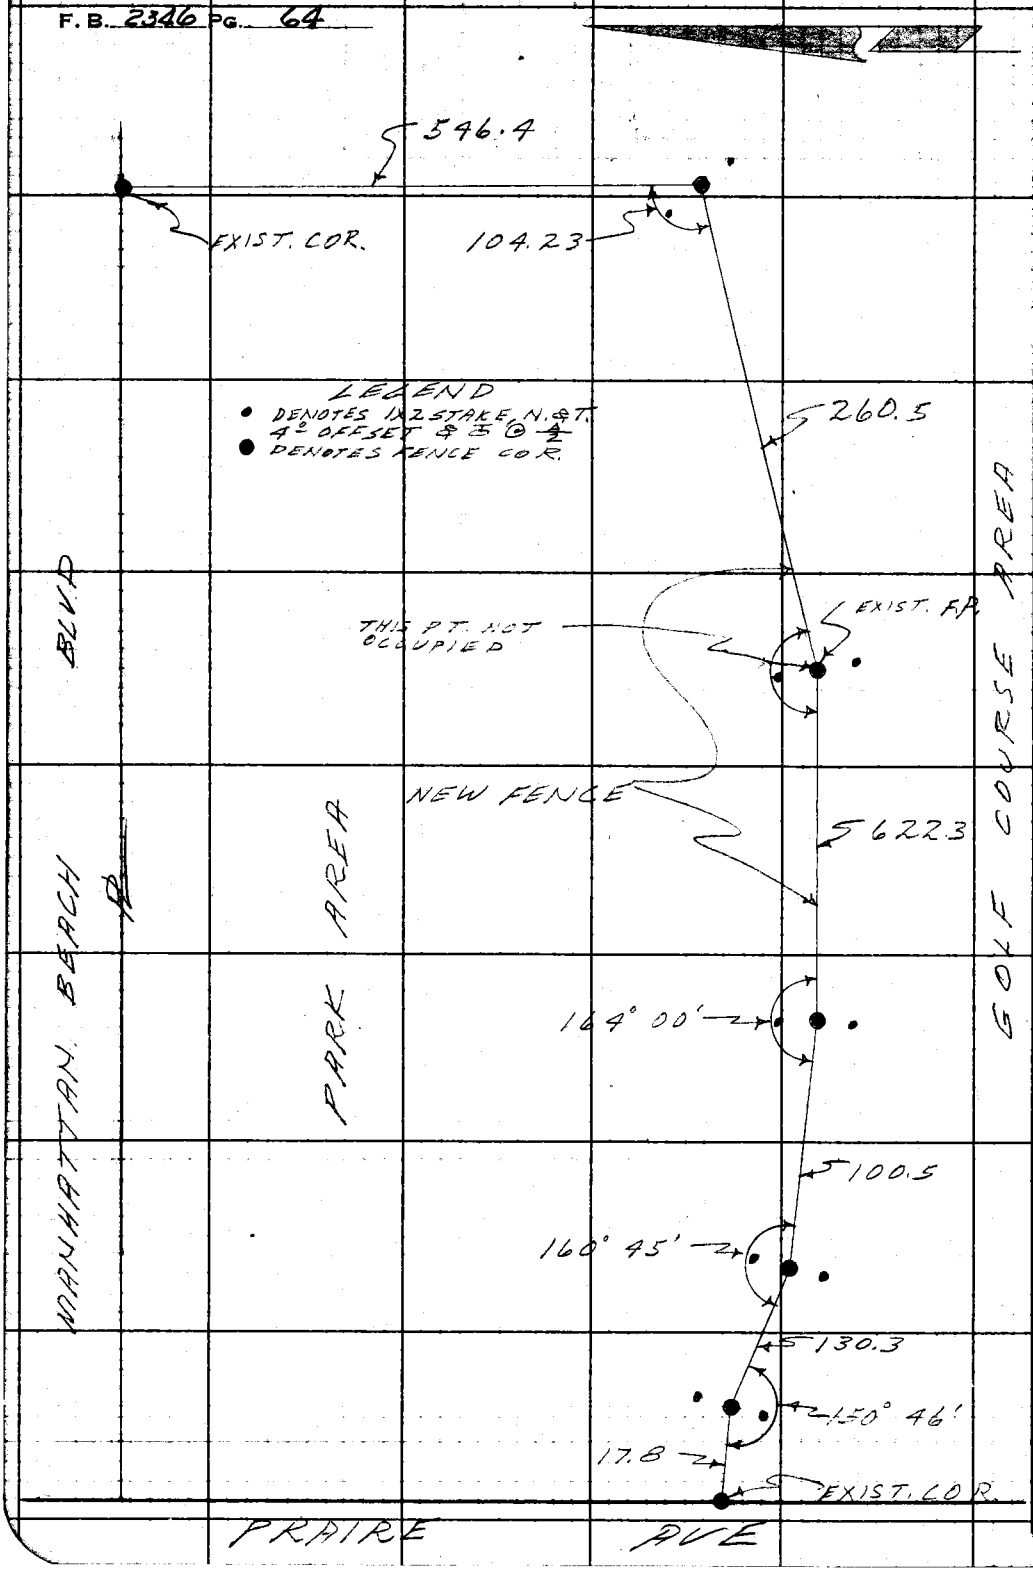

RETURN TO
LOS ANGELES COUNTY ENGINEER
700 Los Angeles County Engineering Bldg.

Note: Any Additions or Changes on This Sheet Must be Made or Circled in Red. Ink With Date and Name of Person Making Change.

Do not extend notes this side of this line.

Notes Ck'd by	Survey of Alondra Park
Map No.	JN 8771.22 Tape Std °F
Office Work	Surveyed by Curtis
Checked	Notes Curtis Date 10-9-62
Date	Indexed J. OALL FEB 2 0 '63

F. B. 2396 PG. 65

J.N. 8771.22
ALONDRA PARK.
Showing location of
12" Conc. Slabs Covering
Existing 42" & 48" Sewer.
Lines

Curtis
Cox
Yasui
Goshorn
Beck

Note: Any Additions or Changes on This Sheet Must be Made or Circled in Red Ink With Date and Name of Person Making Change.

Do not extend this side of this line.

PLEASE RETURN TO
LOS ANGELES COUNTY ENGINEER
403 Los Angeles County Engineering Bldg.

76F3095 CE # 310 3-61

PLEASE RETURN TO
LOS ANGELES COUNTY ENGINEER
403 LOS ANGELES COUNTY ENGINEERING BLDG.

Note: Any Additions or Changes on This Sheet Must be Made or Circled in Red Ink With Date and Name of Person Making Change.

Do not extend this side of this line.

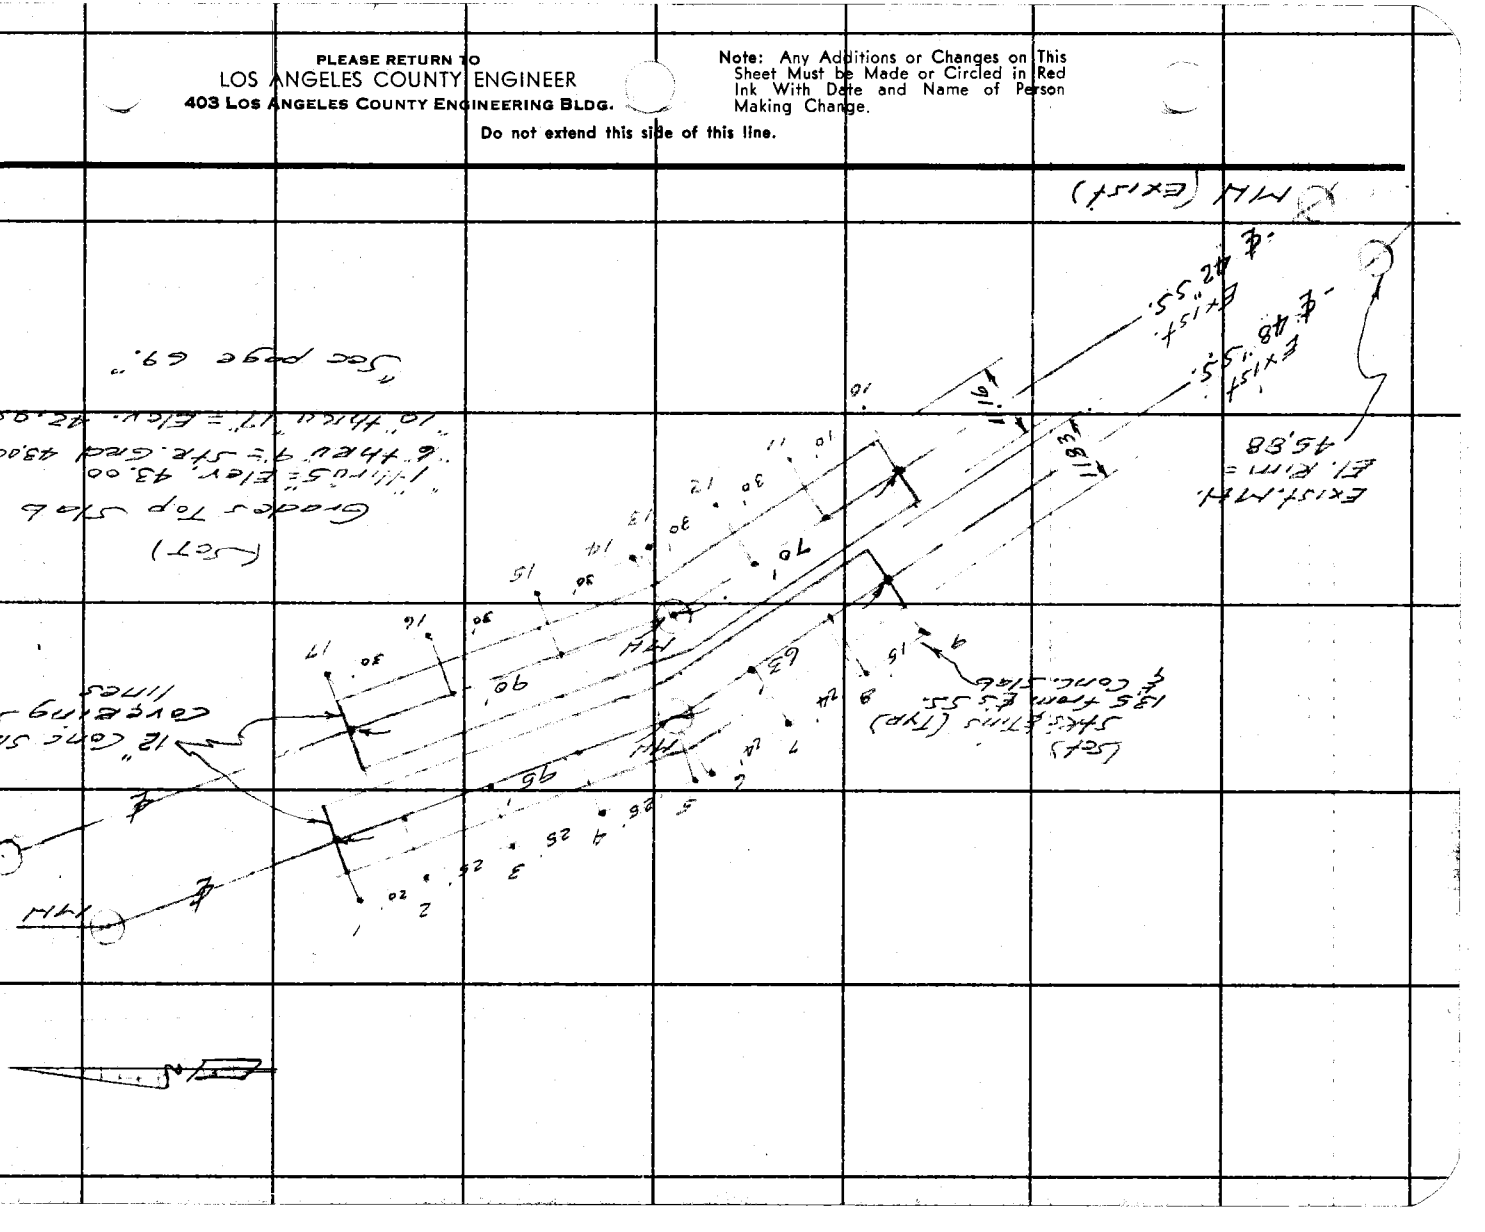

Notes Ck'd by	Survey of Alondra Park
Map No.	JN 8771.22 Tape Std °F
Office Work	Surveyed by Curtis
Checked	Notes Curtis Date 11-15-62
Date	Indexed C. J. GALLI FEB 20 '63

F. B. 2346 PG. 67

Note: Any Additions or Changes on this Sheet Must be Made or Circled in Red Ink With Date and Name of Person Making Change.

Do not extend this side of this line.

PLEASE RETURN TO
LOS ANGELES COUNTY ENGINEER
403 Los Angeles County Engineering Bldg.

J.N. 8771.22
ALONDRA PARK.
Location of
Bldg's; Walk's; Parking Lot;
Curbs; Water Lines; Elect
Lines; Play Areas; Stage;
S, Drains & ETC.

Curtis
Compass
Vasui
Goshorn

NOTE-
See page 78 for BM's in
this Area.

76F3095 CE # 310 1-61

PLEASE RETURN TO
LOS ANGELES COUNTY ENGINEER
403 LOS ANGELES COUNTY ENGINEERING BLDG.

Note: Any Additions or Changes on This Sheet Must be Made or Circled in Red Ink With Date and Name of Person Making Change.

Do not extend this side of this line.

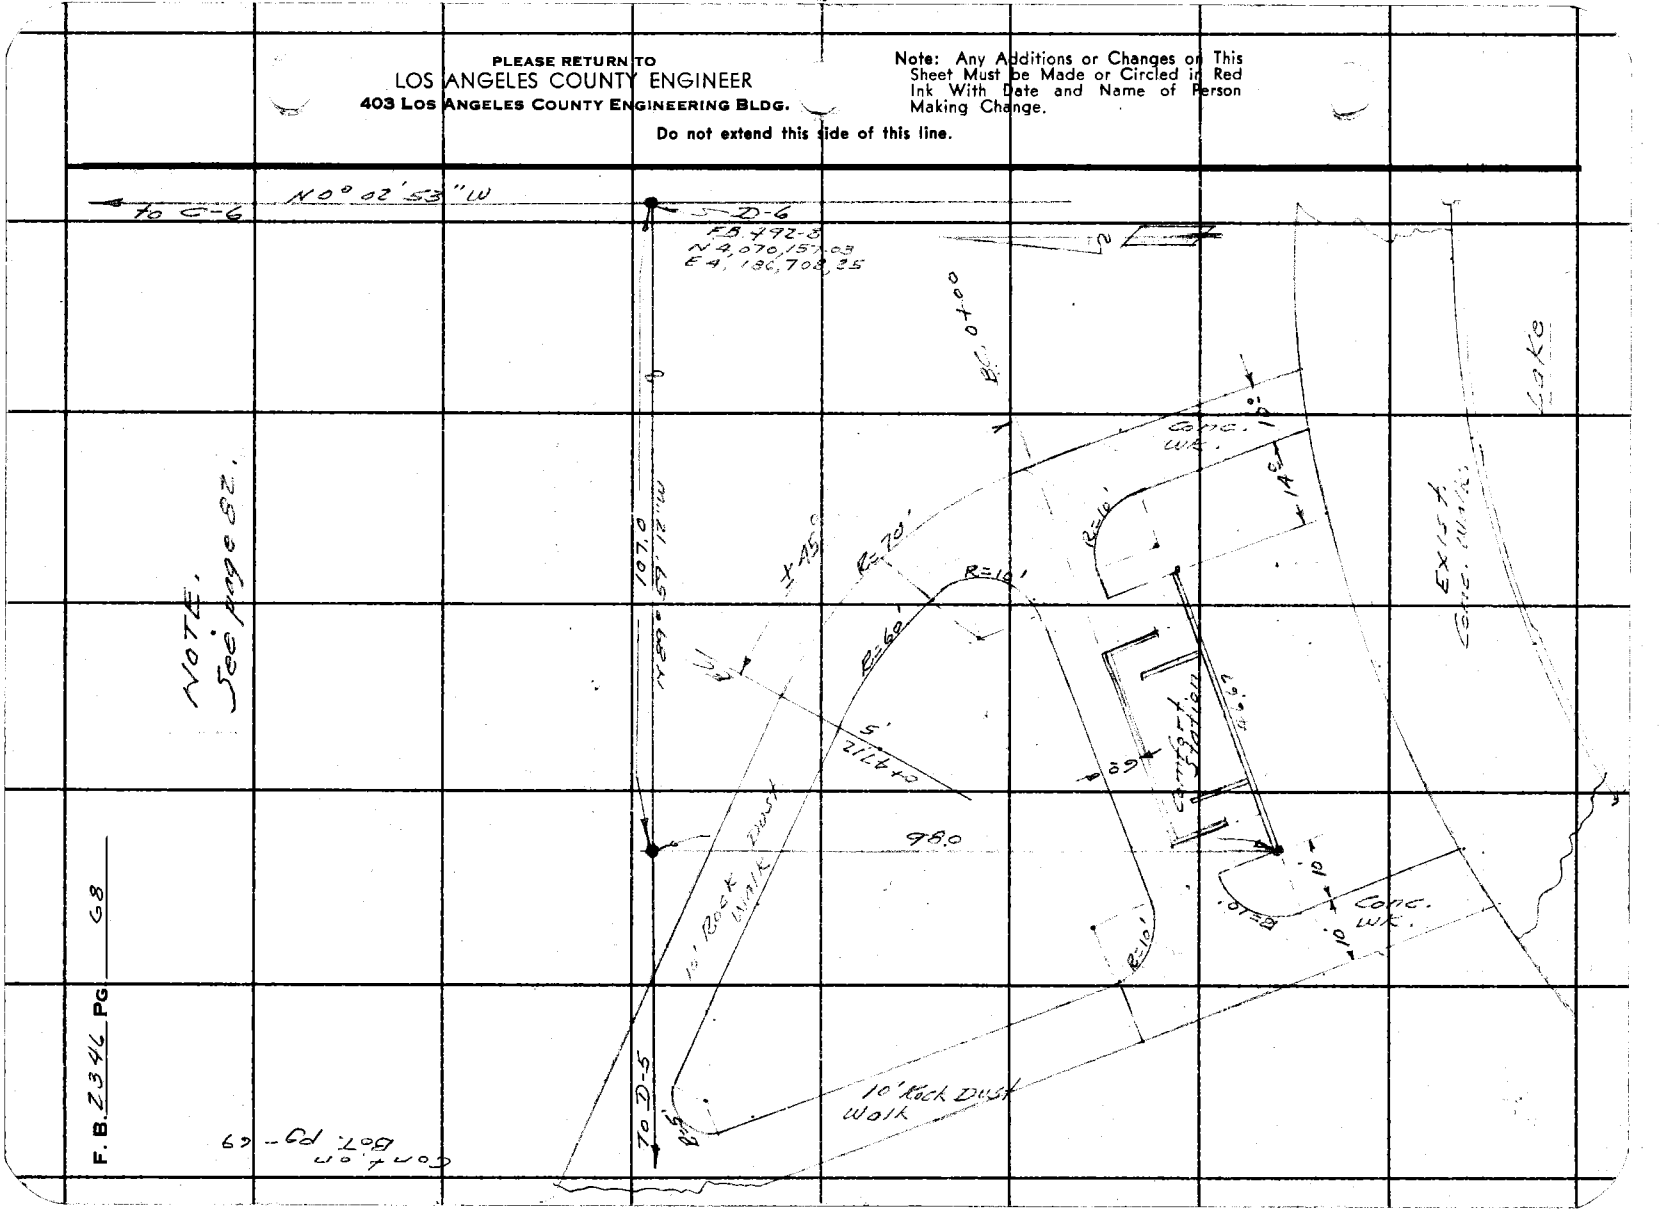

76F3095 CE # 310 3-61

PLEASE RETURN TO
LOS ANGELES COUNTY ENGINEER
403 LOS ANGELES COUNTY ENGINEERING BLDG.

Note: Any Additions or Changes on This Sheet Must be Made or Circled in Red Ink With Date and Name of Person Making Change.

Do not extend this side of this line.

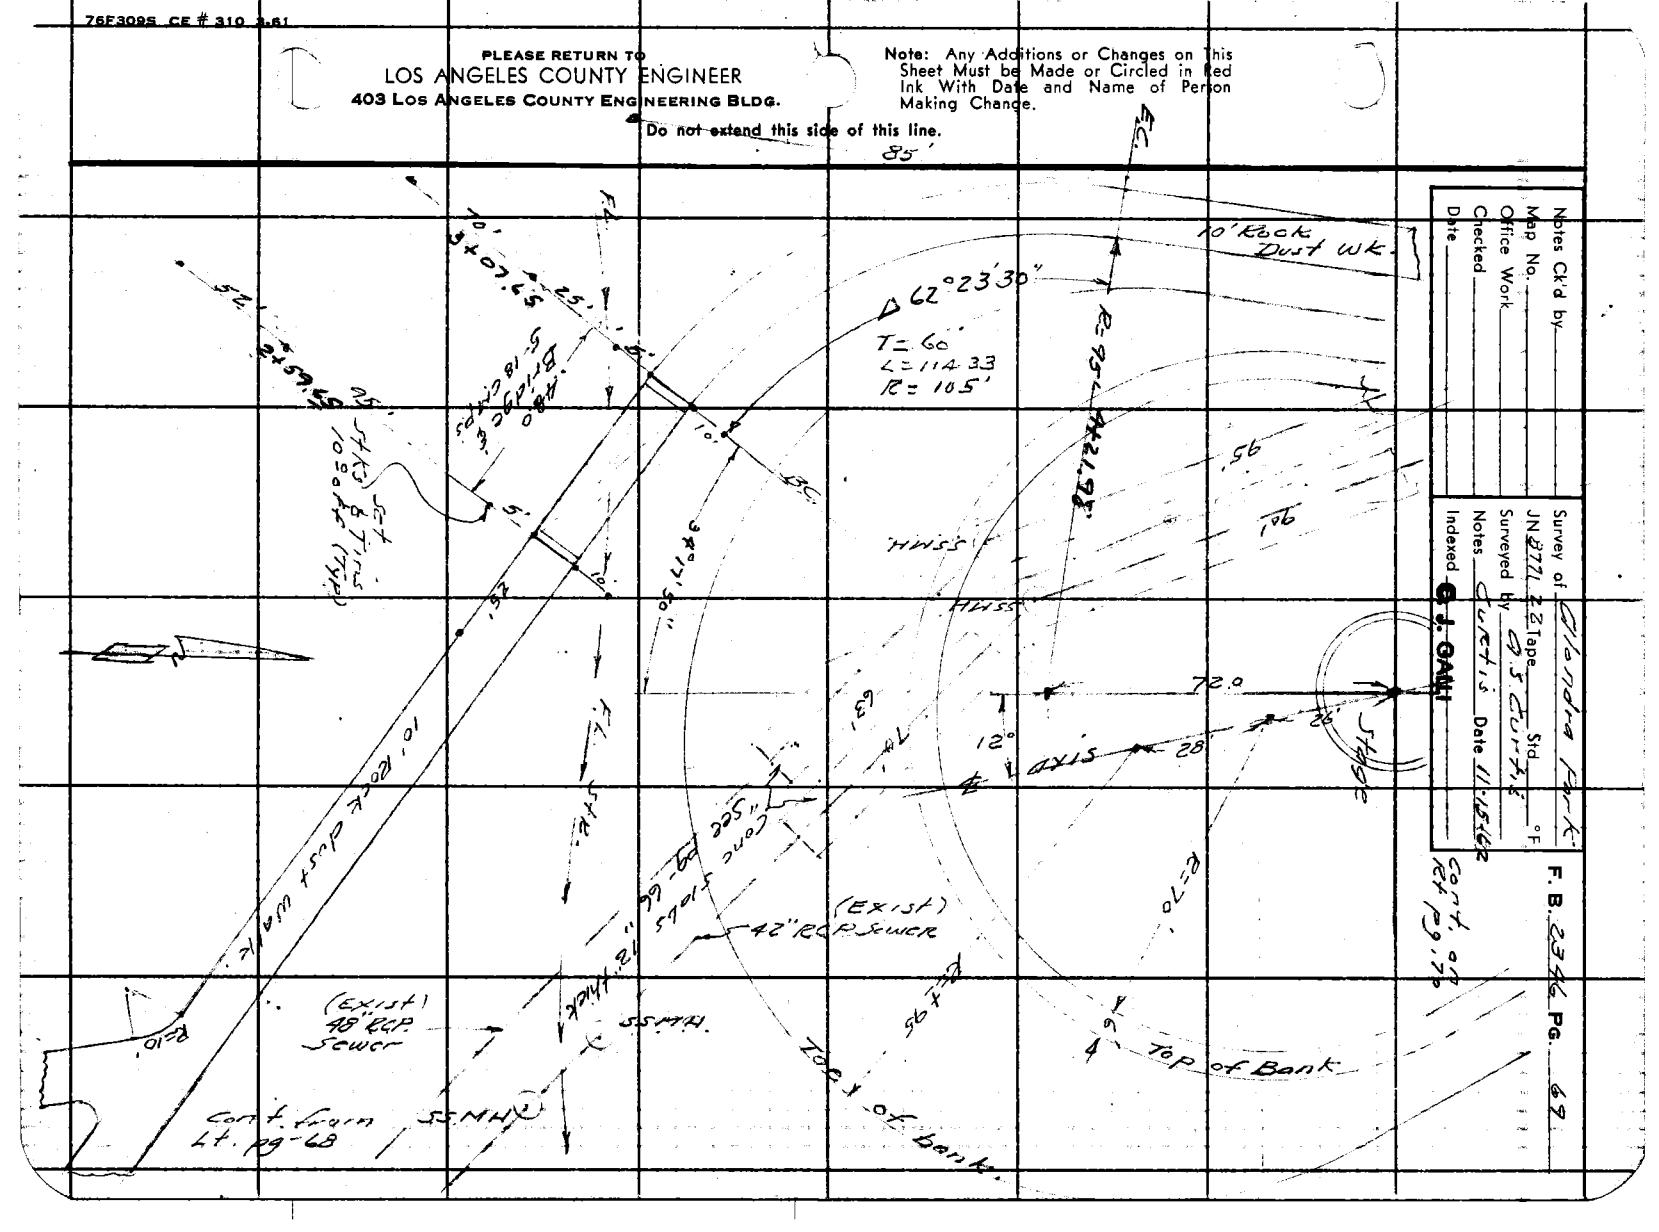
85'
10' Rock Dust Wk.
62°23'30"
T = 60'
L = 114.33'
R = 105'
R=25'
442.92'
10'x07.5'
25'
6'
10'
5'
Bldg. Lines
10'
5'
10'
6'x0'x17.50'
10'
10'
10

PLEASE RETURN TO
LOS ANGELES COUNTY ENGINEER
403 LOS ANGELES COUNTY ENGINEERING BLDG.

Note: Any Additions or Changes on This Sheet Must be Made or Circled in Red Ink With Date and Name of Person Making Change.

Do not extend this side of this line.

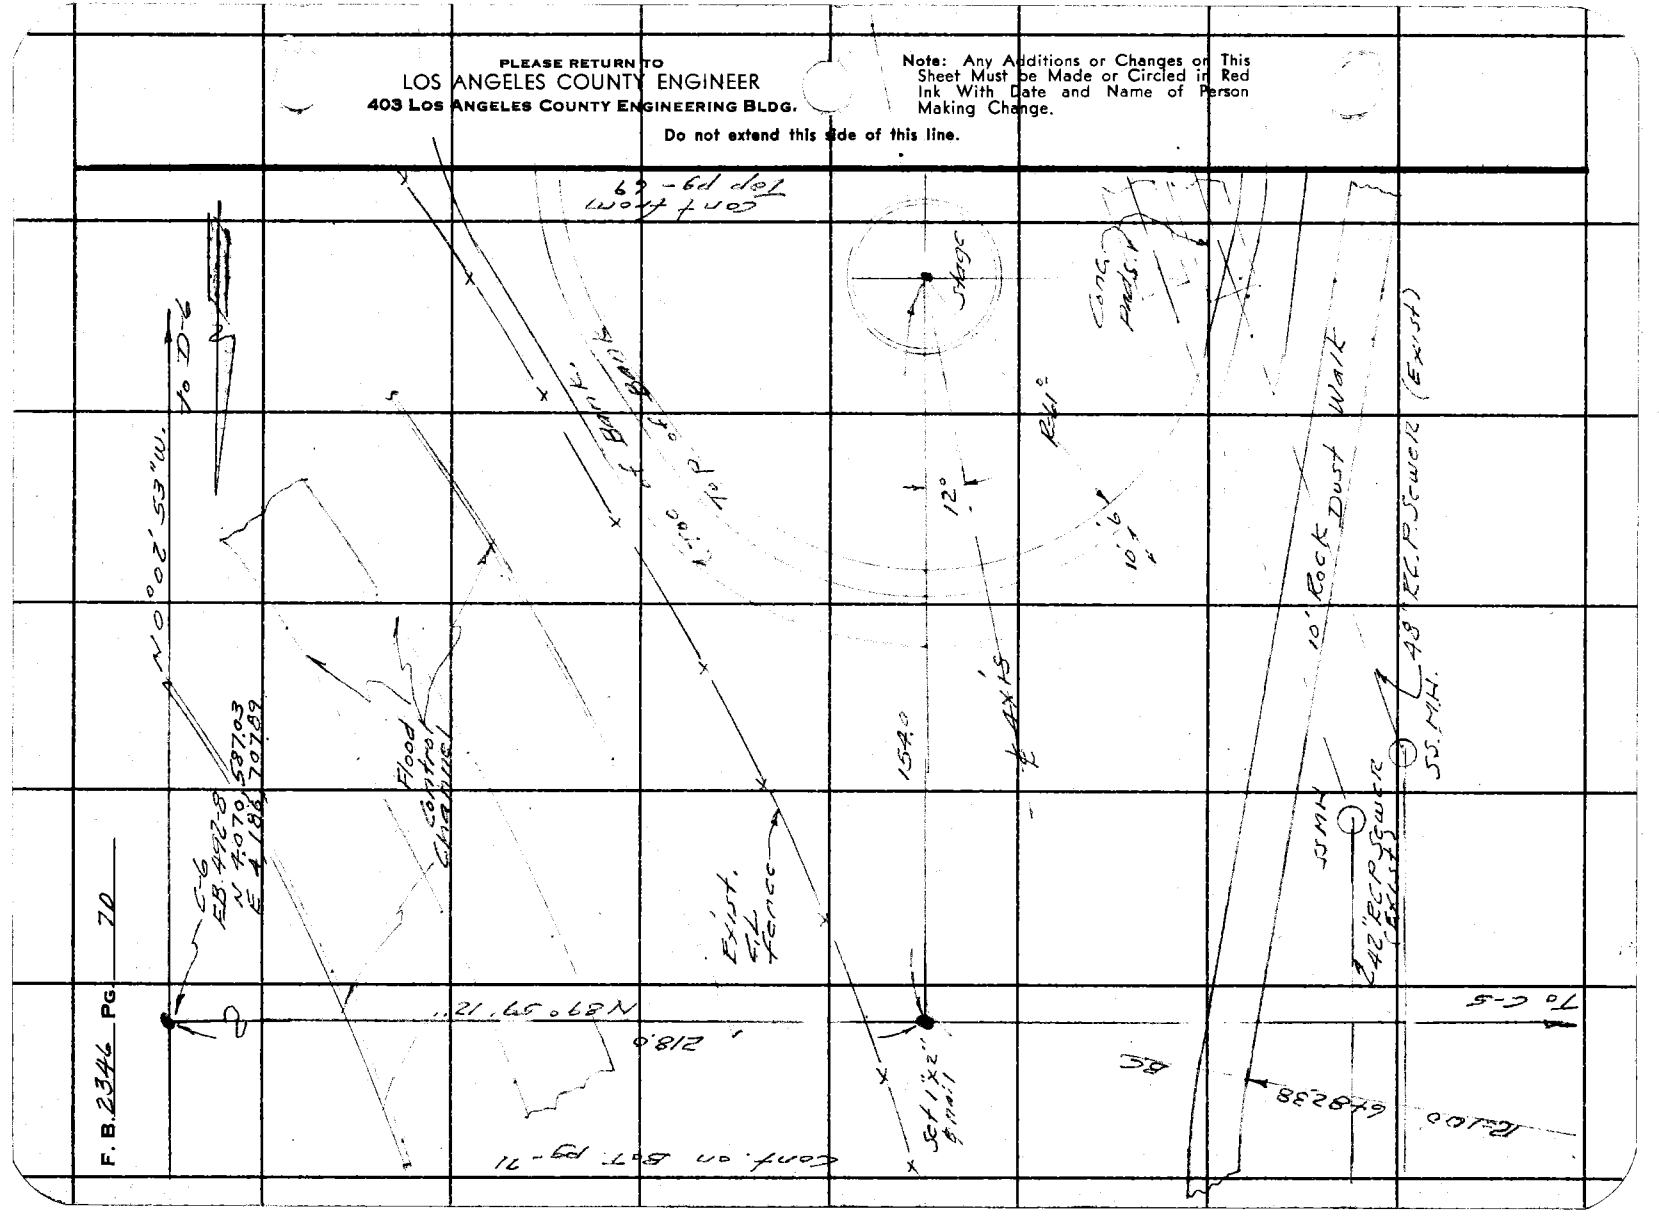

763098 CE #247—7-53

RETURN TO
LOS ANGELES COUNTY ENGINEER
700 LOS ANGELES COUNTY ENGINEERING BLDG.

Note: Any Additions or Changes on This Sheet Must be Made or Circled in Red Ink With Date and Name of Person Making Change.

Do not extend notes this side of this line.

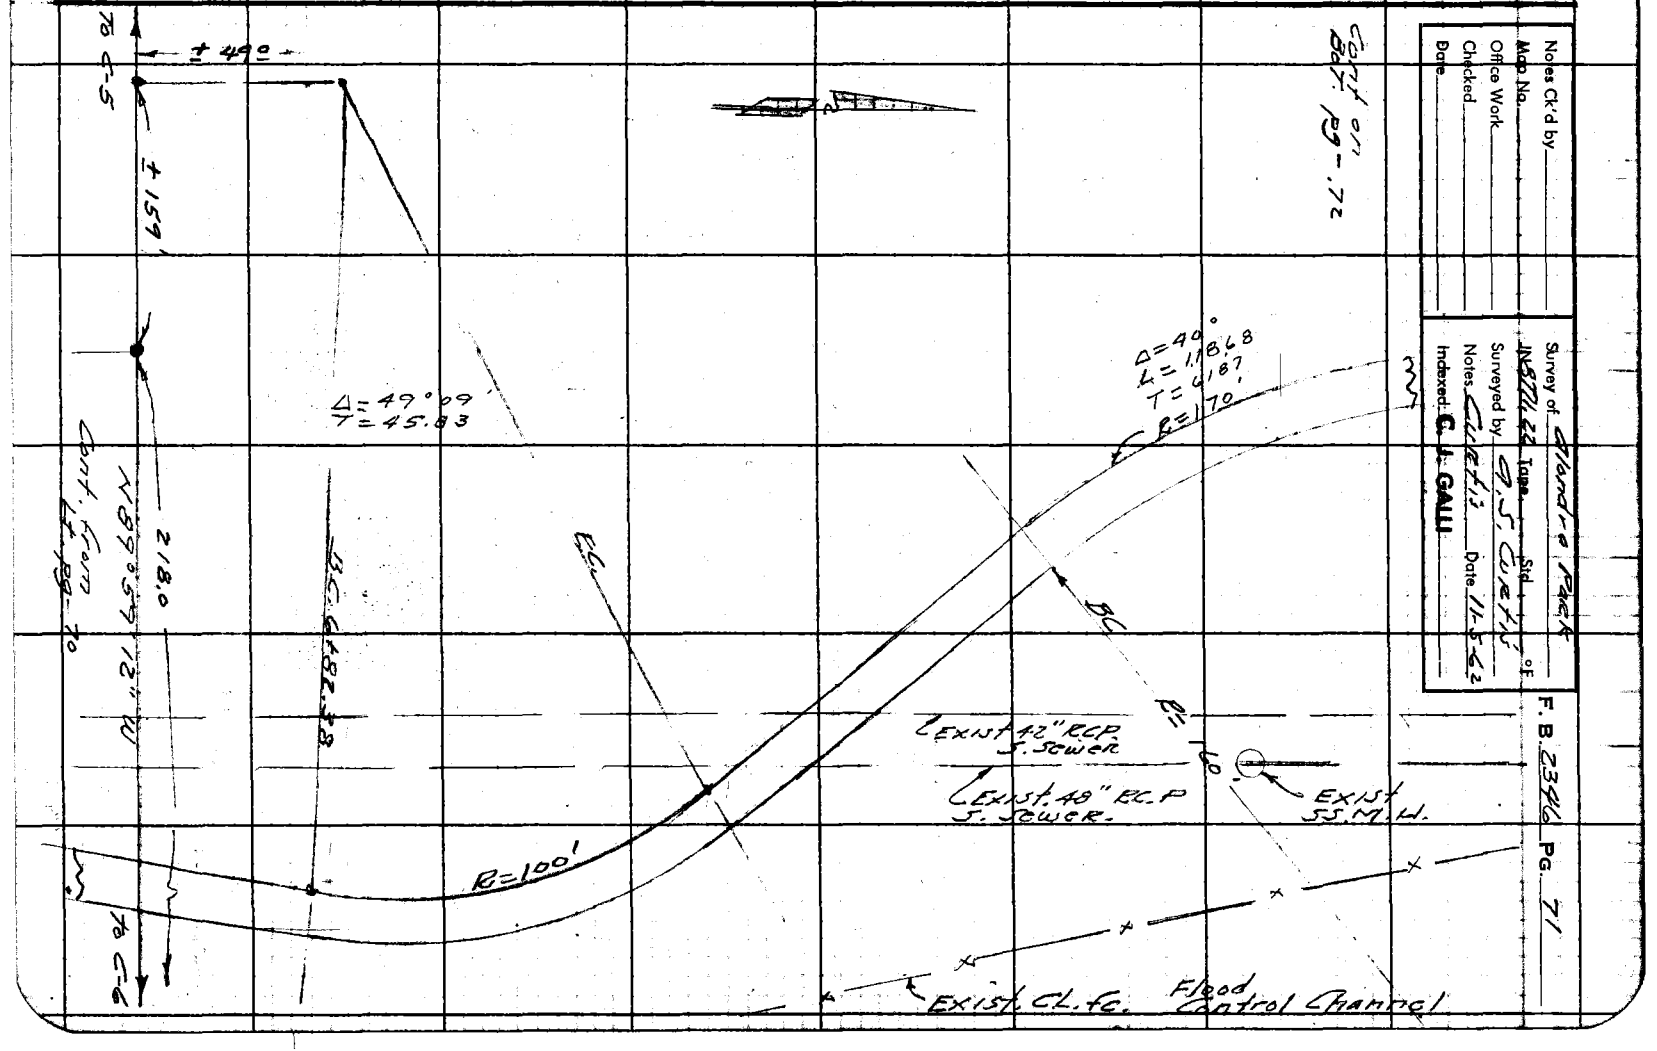

Notes Ck'd by _____
Map No. _____
Office Work _____
Checked _____
Date _____

Surveyed by D.S. Curtis
Notes Curtis Date 11-5-62
Indexed C. J. GALLI

F. B. 2346 PG. 71

RETURN TO
LOS ANGELES COUNTY ENGINEER
900 LOS ANGELES COUNTY ENGINEERING BLDG.

Note: Any Additions or Changes on This Sheet Must be Made or Circled In Red Ink With Date and Name of Person Making Change.

Do not extend notes this side of this line.

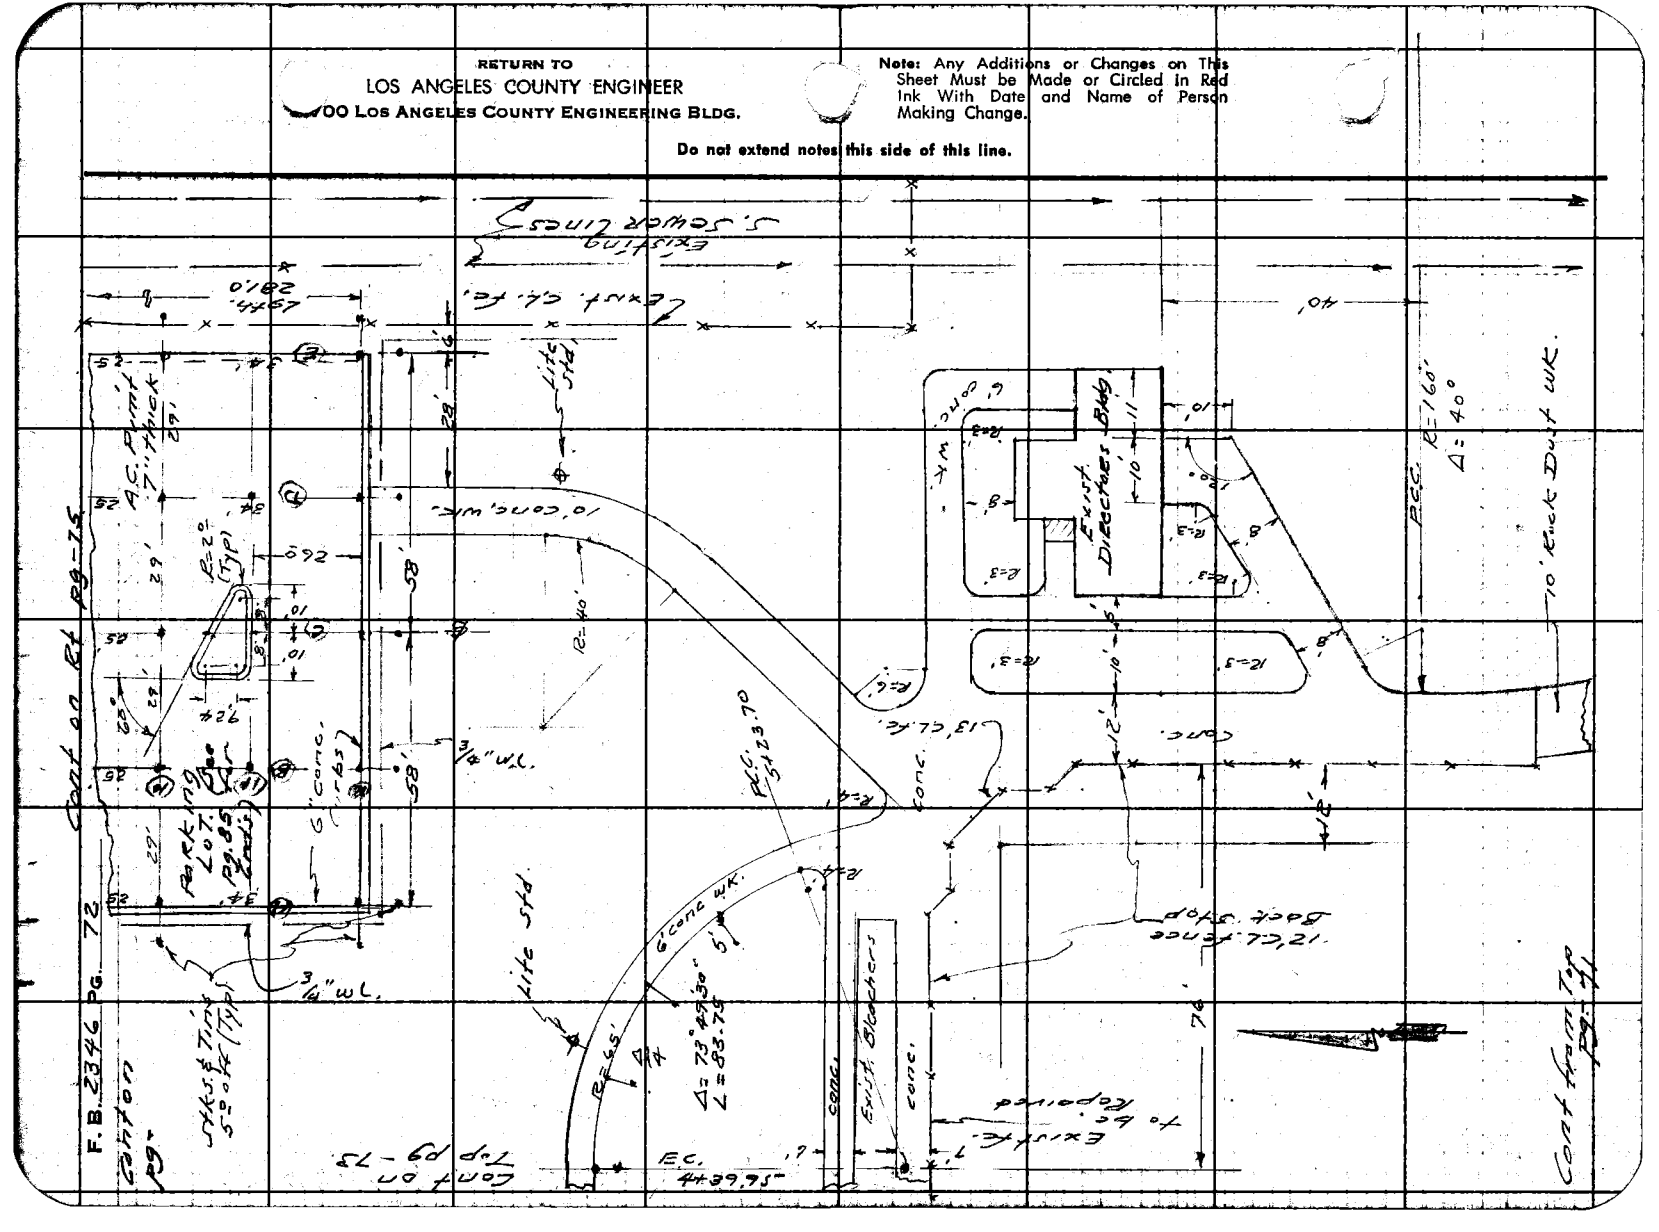

Notes Ck'd by	Survey of Glendora Park
Map No.	JN 8771, 22 Tape Std °F
Office Work	Surveyed by A.S. Curtis
Checked	Notes Curtis Date 11-5-62
Date	Indexed J. GALLI

F. B. 2346 PG. 73

PLEASE RETURN TO
LOS ANGELES COUNTY ENGINEER
403 LOS ANGELES COUNTY ENGINEERING BLDG.

Note: Any Additions or Changes on This Sheet Must be Made or Circled in Red Ink With Date and Name of Person Making Change.

Do not extend this side of this line.

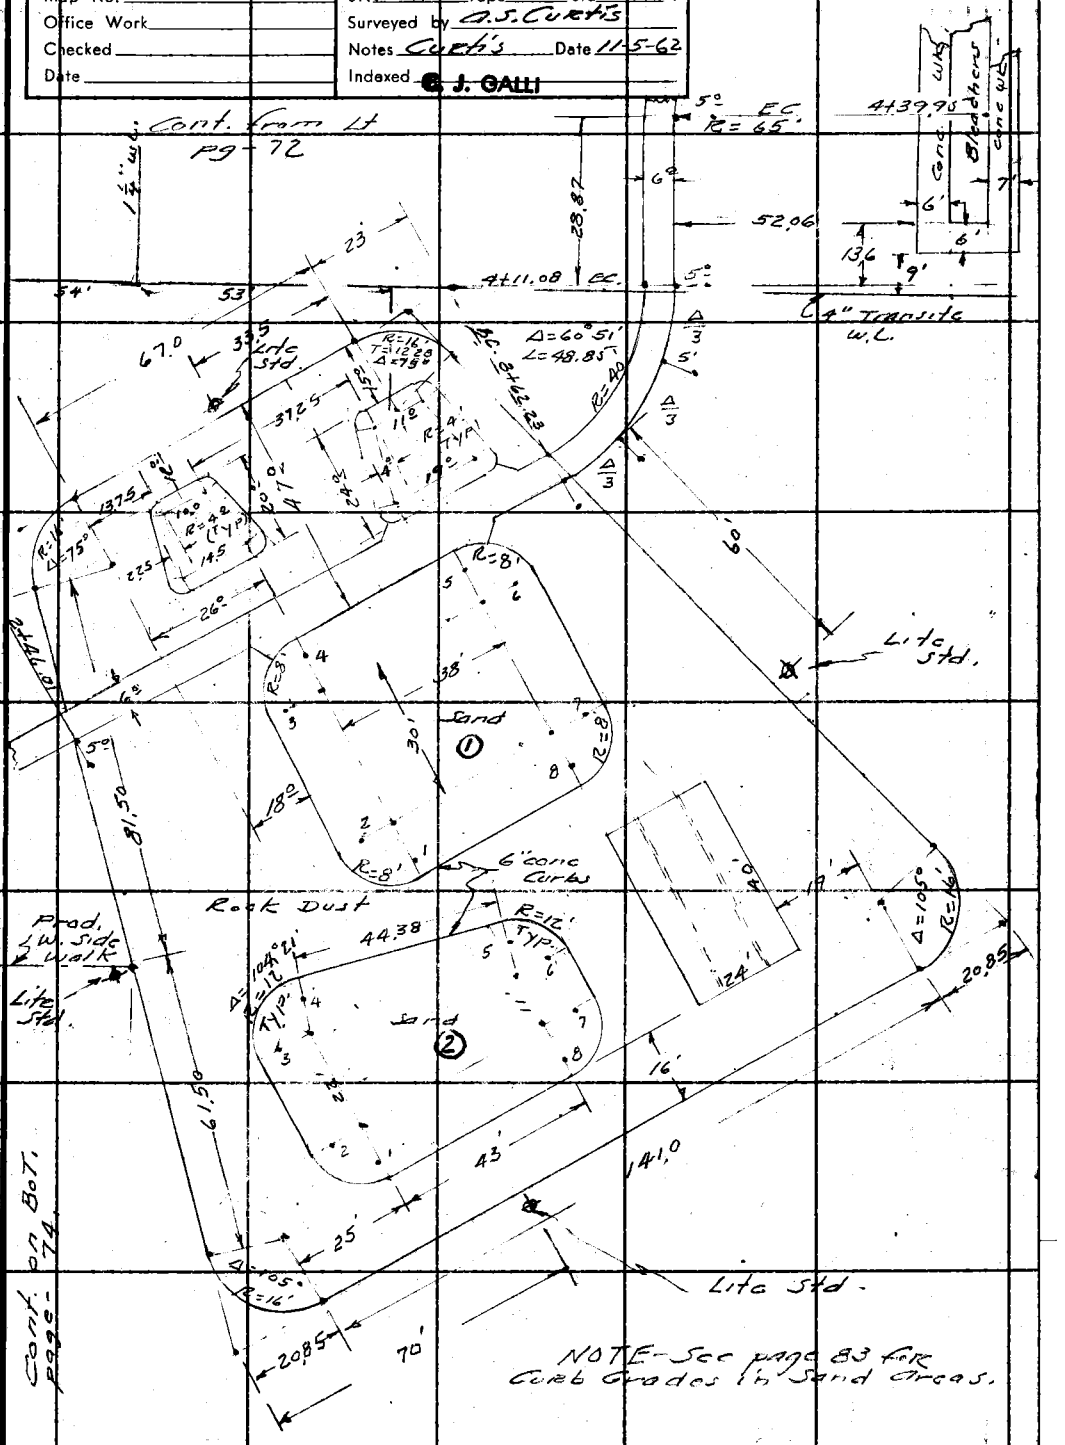

76F3085 CE # 310 8-61

F. B 2346 PG. 74


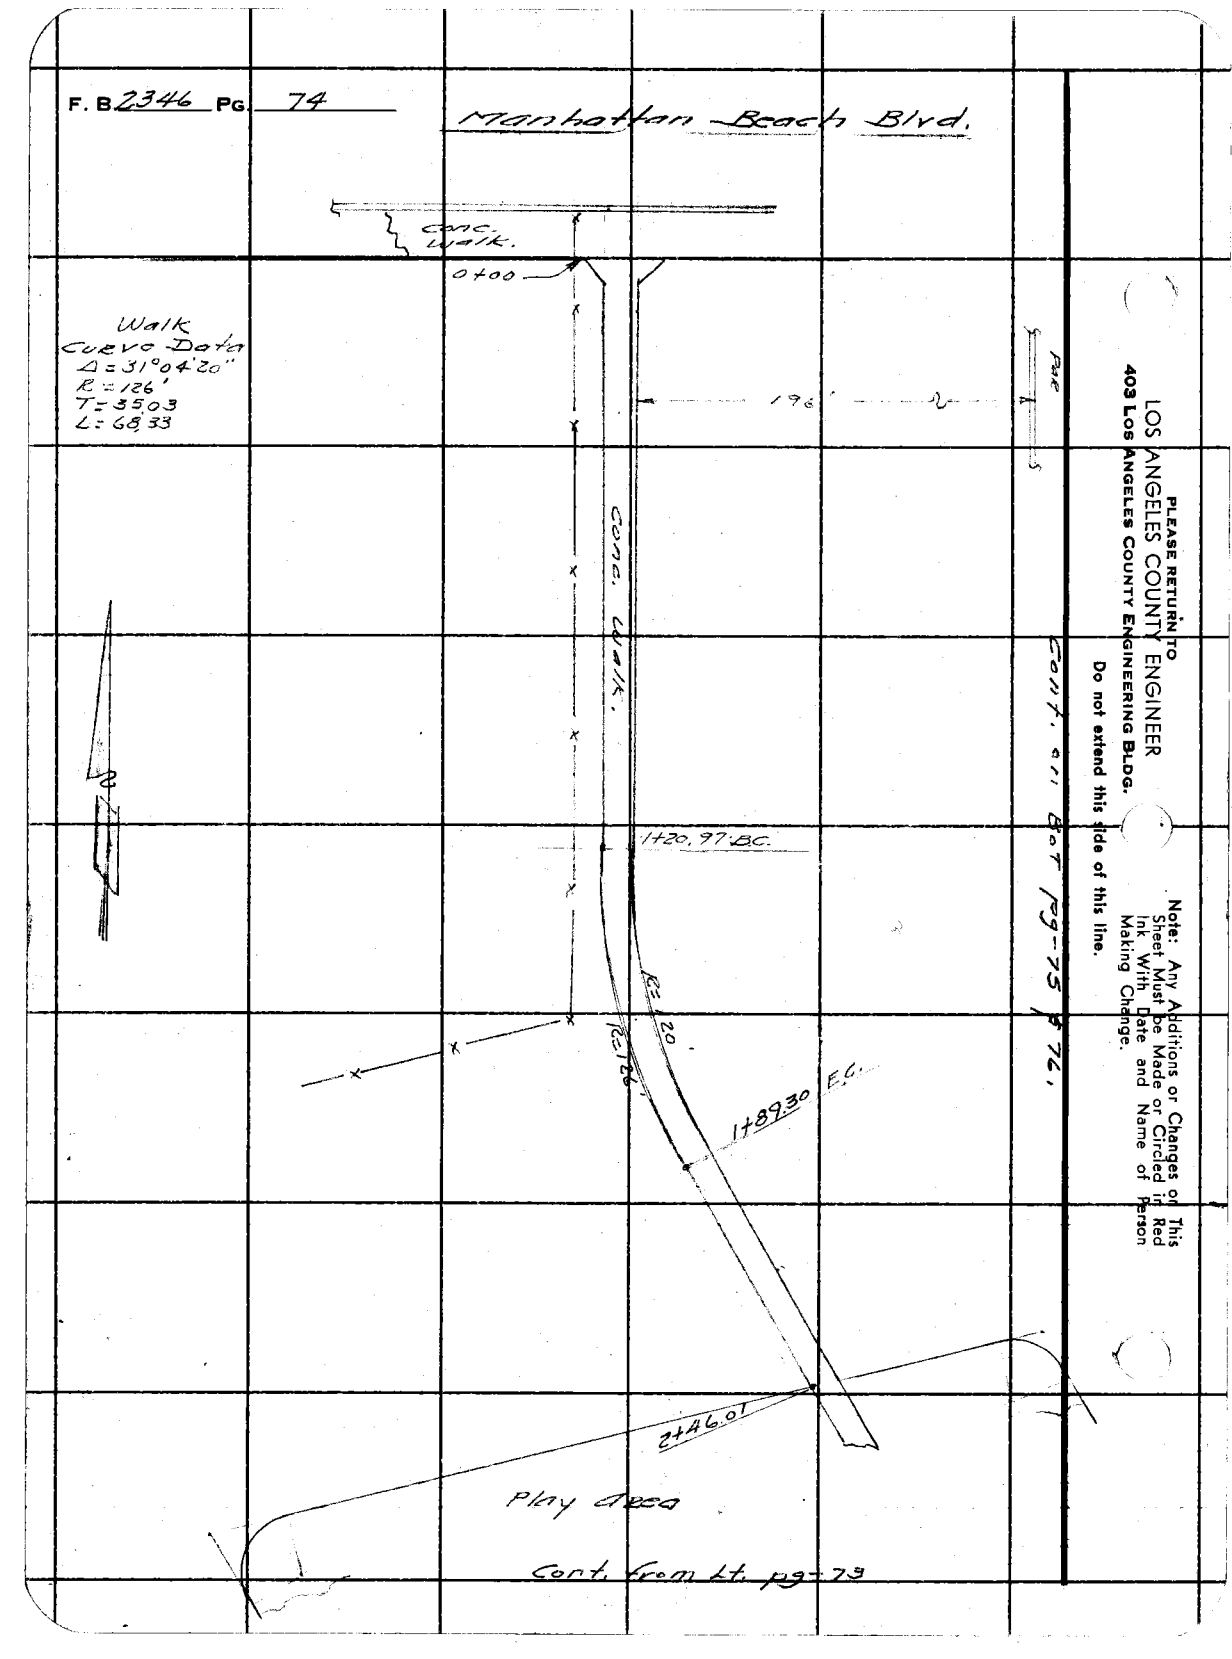

LOS ANGELES COUNTY ENGINEER
403 Los Angeles County Engineering Bldg.

PLEASE RETURN TO

Do not extend this side of this line.

Note: Any Additions or Changes on This Sheet Must be Made or Circled in Red Ink With Date and Name of Person Making Change.

Notes Ck'd by
Map No.
Office Work
Checked
Date

Survey of Alondra Park
JN 8771.22 Tape Std °F
Surveyed by A.S. Curtis
Notes Curb 3 Date 11-5-62
Indexed J. GALLI

F. B. 3346 Pg. 75

Lgth. = 281.00

Level 46.42 T.P.

Level 46.57 T.P.

Parking Lot.
4" Rock
3" A.C.

See pg - 85 for Grades

Cont. from Rt pg-72

Level 46.71 T.P.

Level 46.85 T.P.

Level
TC = 47.50
TP = 47.00

Conc. Curb.

Cont. from Rt pg-73

60°

12'

15'

25'

3/4" W.L.

1 1/4" W.L.

1 1/4" K.C.V.

42'

52'

49'

54'

53'

4" transite W.L.

1" W.L.

2" W.L.

3/4" W.L.

Play Area

Conc. Walk

Cont. from Rt pg-74

Note: Any Additions or Changes on This Sheet Must be Made or Circled in Red Ink With Date and Name of Person Making Change.

Do not extend this side of this line.

PLEASE RETURN TO
LOS ANGELES COUNTY ENGINEER
403 LOS ANGELES COUNTY ENGINEERING BLDG.

76F308S CE # 310 2-61

PLEASE RETURN TO
LOS ANGELES COUNTY ENGINEER
403 LOS ANGELES COUNTY ENGINEERING BLDG.

Do not extend this side of this line.

Note: Any Additions or Changes on This Sheet Must be Made or Circled in Red Ink With Date and Name of Person Making Change.

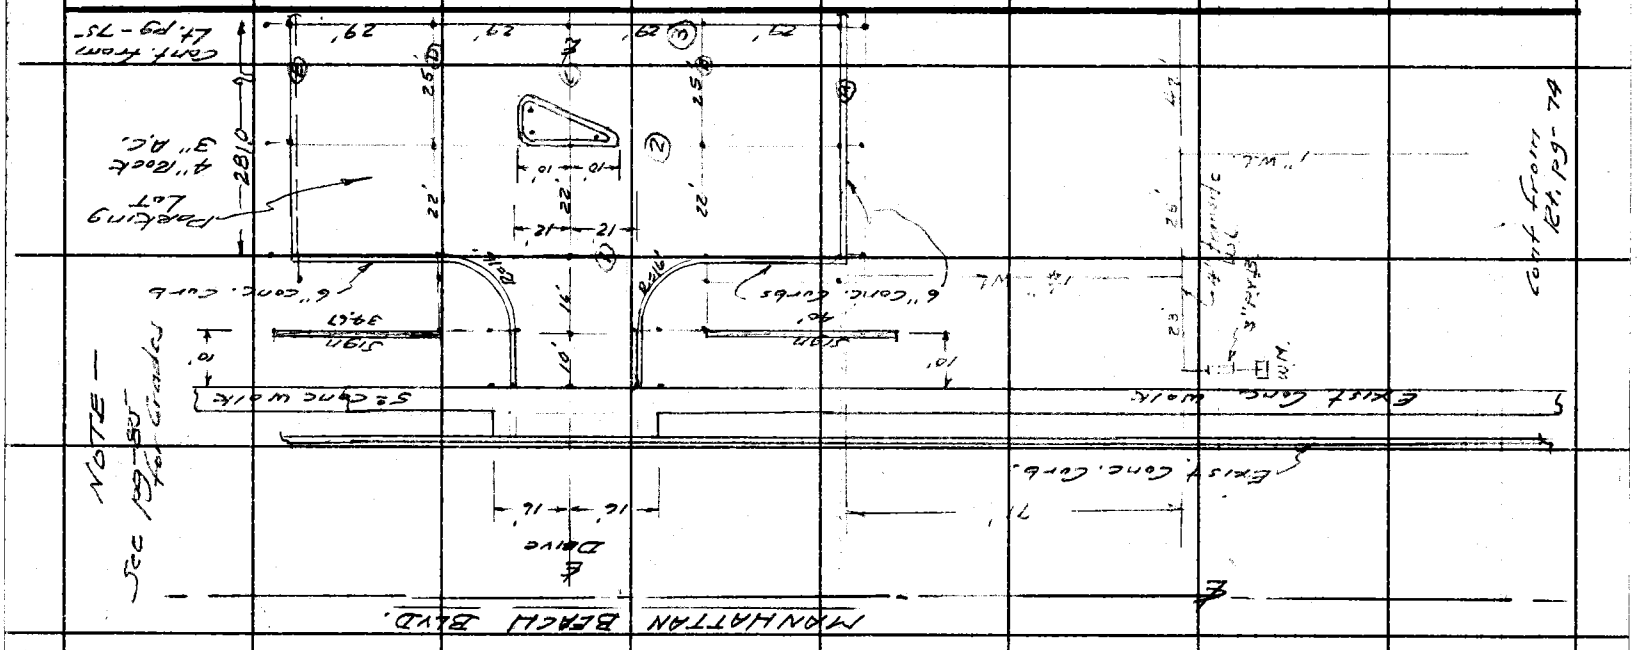

F. B. 2346 PG. 74

Profile No. _____ X-Sec. No. _____

Notes Red _____ Date _____ Notes Chkd. _____ Date _____

Plotted _____ Date _____ Checked _____ Date _____

Job No. 8771.22 Division No. 11 Map No. _____

F.B. 2346 Pg. 77

Survey of Alondra Park

Survey by Curtis Notes Curtis Date 10-7-62

Indexed C. J. GALLI Date FEB 20 '63

J.N. 8771.22

ALONDRA PARK.

Bench Levels

STATION	B.S.	H.I.	F.S.	ELEV.

NOTE: ANY ADDITIONS OR CHANGES ON THIS SHEET MUST BE MADE OR CIRCLED IN RED INK, WITH DATE AND NAME OF PERSON MAKING CHANGE.

Do not extend notes this side of this line.

PLEASE RETURN TO
LOS ANGELES COUNTY ENGINEER
403 Los Angeles County Engineering Bldg.

76-L298 CE 307 3-61

76-L298 CE 307 3-61

PLEASE RETURN TO
LOS ANGELES COUNTY ENGINEER
403 Los Angeles County Engineering Bldg.

NOTE: ANY ADDITIONS OR CHANGES ON THIS SHEET MUST BE MADE OR CIRCLED IN RED INK, WITH DATE AND NAME OF PERSON MAKING CHANGE

Do not extend notes this side of this line.

F.B. 2346 Pg. 78 Job No. 877.22 Division No. 11 Notes Red Plotted Profile No.
Survey of Alondra Park Date Date No. X-Sec.
Survey by Cuetis, Notes Notes Chkd. Checked No.
Indexed E. J. Gaiu Date Date Date

STATION	B.S.	H.I.	F.S.	ELEV.		
(Fd)						El. 44.201 FB 492-111 & FB. 2346-20
B.M. #13				44.20	B.M. #13 Rd. Hd spk & lead in Conc. Wd. Wall @ outlet Gate for lake. ± 100' N & 85± W. of W. end of Pedestrian bridge.	
T.P.				41.09	T.P. Bt spk in wk.	
T.P. (Set)				41.50	T.P. ✓ - E Side Wk @ Lite Std. No. End Lake, @ No Edge Wk.	
T.B.M.				43.50	T.B.M. line in No. Side Lite Std. ± 25' So. & ± 25' W. of Proposed Rest Rooms.	
(Fd) # (Reset)						El. 46.279 FB. 492-118 - Bt. spk in So.
B.M. 13-A (been disturbed)				46.28	B.M. Side PP #3109285E - Near N.E. Cor. Lake.	
T.P.				43.17	T.P. Rim M.H.	
T.P. (Set)				45.67	T "X" Stk - & N. PP. ± 50' E & ± 25' S. of Center Stage.	
T.B.M. (Set)				46.85	TBM Bt. spk W Side P.P. PP. ± 125' N. Center Stage - Bt spk.	
T.B.M.				46.90	T.B.M. in W. Side P.P. #1318595 - PP. ± 200' So. of Directors Bldg.	
T.B.M. (Set)				47.00	T.B.M. Bt. spk in W. Side PP. @ ± Pt. in pole Line.	
T.B.M. (Set)				47.00	T.B.M. PP #1318594E ± 60' So. of Directors Bldg. Bt spk in W. Side.	
T.B.M. (Set)				45.61	T.B.M. Bt. in NE. Cor Conc. base Flag Pole ± 20' W & ± 190' N. Directors Bldg.	
T.B.M.				46.93	T.B.M. S.E. Cor - Conc. base of Stone Bar - B-9 ± 130' So. Manhattan Beach Blvd & ± 30' W. - W. Side Park Lot..	
T.P. (Set)				45.60	T.P. Floor El. Directors Bldg. (Exist)	
TBM				48.00	± 90' N & ± 18' W - of S.W. Cor - Parking Lot. - Bt spk in E. Side - Lite pole,	
T.P.				45.56	T.P.	
BM #13 A				46.27	BM #13-A El. 4628 (as above.)	

Profile No. ____ X-Sec. No. ____

Notes Red ____ Date ____ Plotted ____ Date ____ Job No. 8771.22 Division No. 11 Survey of Alondra Park

Notes Chkd. ____ Date ____ Checked ____ Date ____ Survey by Curtis Notes ASC Date NOV.-5-62 Map No. ____ Indexed C. J. CALLI Date FEB 20 '63

F.B. 2346 PG. 79

NOTE: ANY ADDITIONS OR CHANGES ON THIS SHEET MUST BE MADE OR CIRCLED IN RED INK, WITH DATE AND NAME OF PERSON MAKING CHANGE.

PLEASE RETURN TO
LOS ANGELES COUNTY ENGINEER
403 Los Angeles County Engineering Bldg.

Do not extend notes this side of this line.

STATION	B.S.	H.I.	F.S.	ELEV.	
					J.N. 8771.22 Alondra Park Conc. Walk from Manhattan Beach Blvd. to the Base ball Diamond. Curtis Carrasco Yasui Eastham Beek

76-L298 CE 307 3-61

76-L298 CE 307 3-61

PLEASE RETURN TO
LOS ANGELES COUNTY ENGINEER
403 Los Angeles County Engineering Bldg.

NOTE: ANY ADDITIONS OR CHANGES ON THIS SHEET MUST BE MADE OR CIRCLED IN RED INK, WITH DATE AND NAME OF PERSON MAKING CHANGE

Do not extend notes this side of this line.

F.B. 2346 Pg. 80 | Job No. 877.22 | Division No. 11 | Notes Red | Plotted | Profile
Survey of Glendora Area | Date | No. | X-Sec.
Survey by Cert. | Notes B.S.C. | Notes Chkd. | Checked | No.
Indexed C.J. Oath | Date | Date | Date

STATION	B. S.	H. I.	F. S.	ELEV.					
									Stk'ed 5° Rt-Ed WK.
T.B.M. (Fd)				46.93	El. 46.93 Pg 66 - Bt. spk in Conc. base				
					T.B.M. Stone Bar B.O-P.T.C.				
		Elev.	Grade	Cut or Fill	Station	Elev	Grade	Cut or Fill	
So. Side 0+00 Walk,					4+11.08 E.C.	45.70	45.70	Grd	Stk ℄ T in 5° off
0+05		45.55	/	Grd.	4+39.95 B.C.	45.55	45.55	"	"
0+25		46.70	"	"	4+60.89 P.O.C.	45.40	45.40	"	"
0+50		46.75	"	"	4+81.83 "	45.25	45.25	"	"
0+75		46.85	"	"	5+02.77 "	45.20	45.20	"	"
1+00		47.00	"	"	5+23.70 P.C.C.	45.15	45.15	Grd.	Stk ℄ T 4° off ℄ 4° Rad.
1+20.97 B.C.		47.15	"	"					
1+55.13 M.O.C.		47.50	"	"					
1+89.30 E.C.		47.55	"	"					
2+00		47.55	"	"					
2+25		47.44	"	"					
2+46.01 Edge Play Area.		47.35	"	"					
2+75 in Play Area.		47.10	"	"					
3+00		46.95	"	"					
3+25		46.75	"	"					
3+50		46.50	"	"					
3+62.23 Edge Play Area B.S.		46.35	/	Grd.					
3+78.51 P.O.C.		46.14	/						
3+94.79 P.O.C.		45.92	/		T.B.M. 45.61				Pot Pg-66 - Bt spk in base Flag Pole

Notes Ck'd by
Map No.
Office Work
Checked
Date

Survey of Glandra Park
JN 8771.22 Tape Std °F
Surveyed by A.S. Curtis
Notes Curtis Date 10-2-62
Indexed C. J. GALL

FEB 20 '63

F. B. 2346 PG. 81

JN. 8771.22
Glandra Park
Comfort Station

NOTE-
See pg-68

Curtis
Carrasco
Yasui
Gastborn
Beck

Note: Any Additions or Changes on This Sheet Must be Made or Circled in Red Ink With Date and Name of Person Making Change.

Do not extend this side of this line.

PLEASE RETURN TO
LOS ANGELES COUNTY ENGINEER
403 Los Angeles County Engineering Bldg.

76F3095 CE # 310 3-61

PLEASE RETURN TO
LOS ANGELES COUNTY ENGINEER
403 LOS ANGELES COUNTY ENGINEERING BLDG.

Note: Any Additions or Changes on This Sheet Must be Made or Circled in Red Ink With Date and Name of Person Making Change.

Do not extend this side of this line.

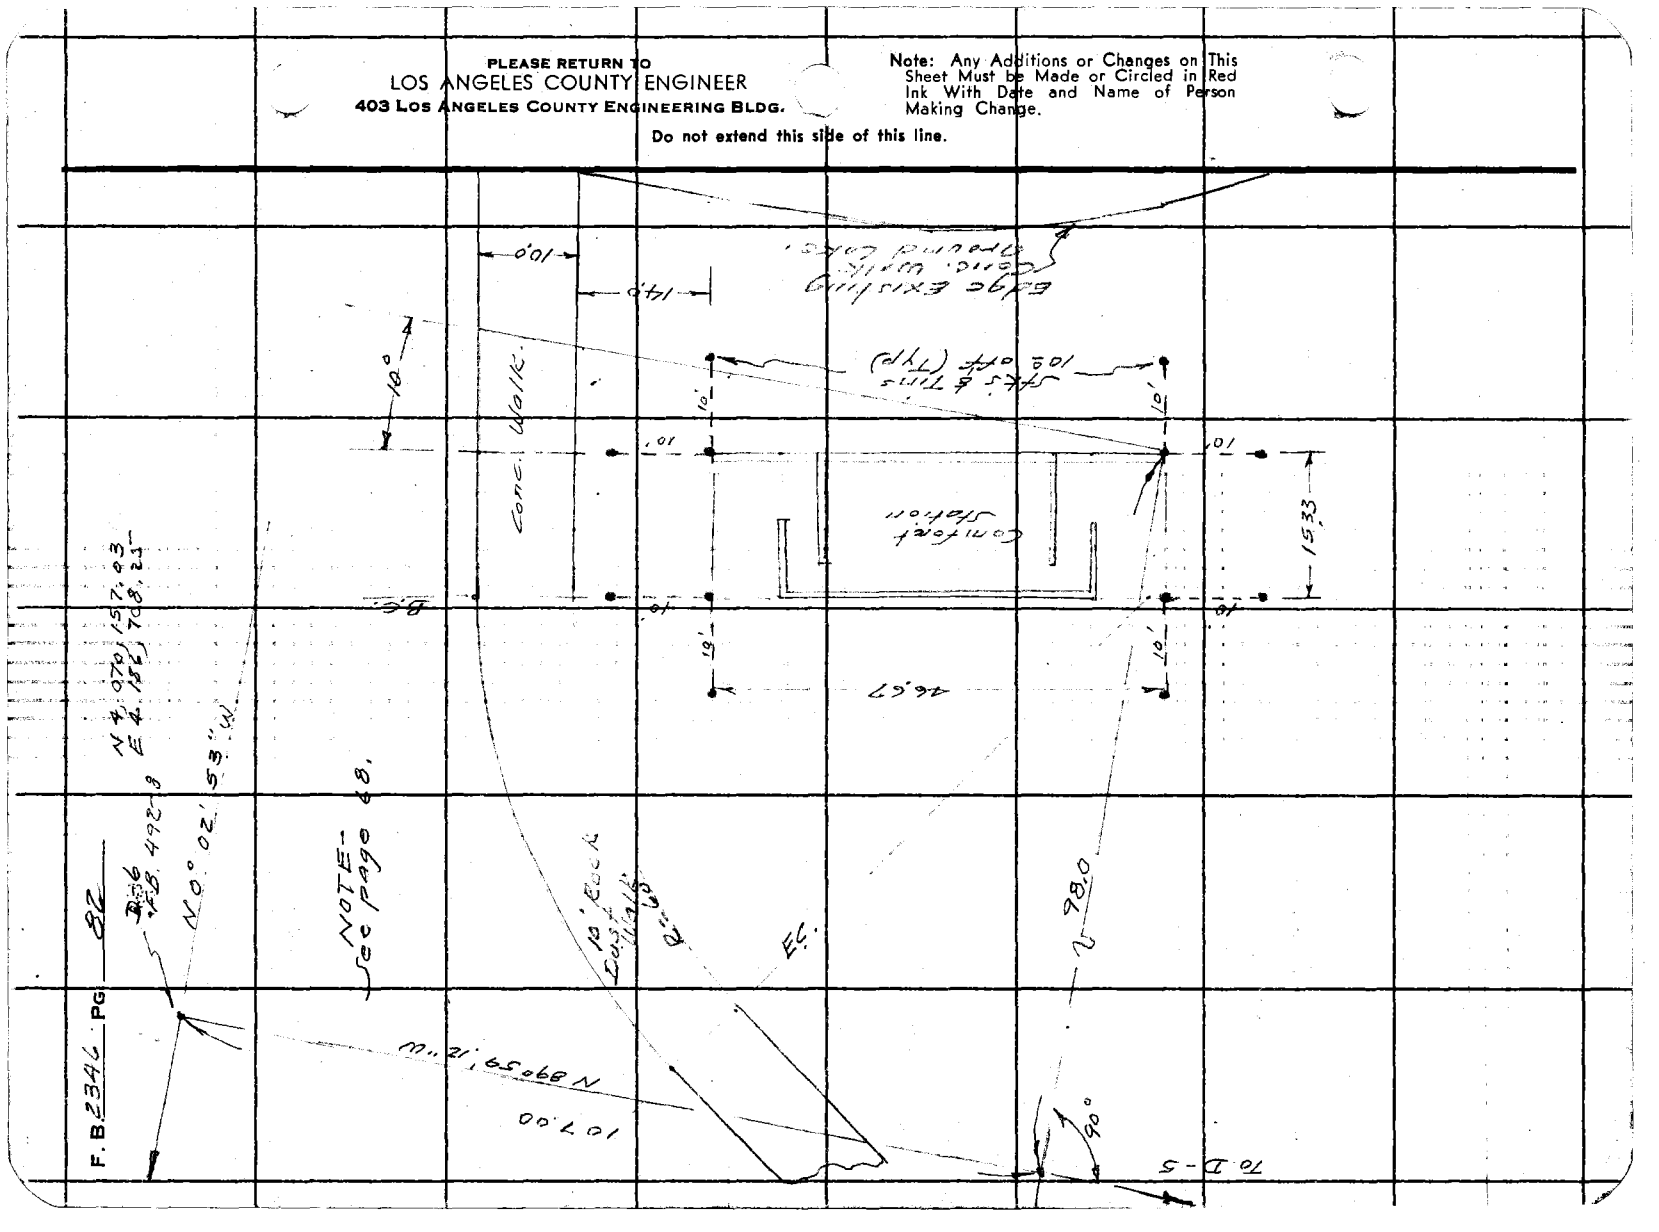

F.B. 2346 PG. 82

Profile No. ____ Notes Red ____ Plotted ____ Job No. 8771.22 Division No. 11 F. B. 2346 Pg. 83

X-Sec. No. ____ Notes Chkd. ____ Checked ____ Survey of Alondra Park

Date ____ Date ____ Survey by Curtis Notes A.S.C. Date Nov. 8-1962

Date ____ Date ____ Map No. ____ Indexed J. J. GALLI Date FEB 20 '63

J.N. 8771.22

Alondra Park.

Curb Grades for Sand Area.

(See page 73 for location of Sand Areas)

Curtis
Carrasco
Yasui
Goshorn
Beck.

STATION	B.S.	H.I.	F.S.	ELEV.

NOTE: ANY ADDITIONS OR CHANGES ON THIS SHEET MUST BE MADE OR CIRCLED IN RED INK, WITH DATE AND NAME OF PERSON MAKING CHANGE.

Do not extend notes this side of this line.

PLEASE RETURN TO
LOS ANGELES COUNTY ENGINEER
403 Los Angeles County Engineering Bldg.

76-L298 CE 307 3-61

76-L298 CE 307 3-61

PLEASE RETURN TO
LOS ANGELES COUNTY ENGINEER
403 Los Angeles County Engineering Bldg.

NOTE: ANY ADDITIONS OR CHANGES ON THIS SHEET MUST BE MADE OR CIRCLED IN RED INK, WITH DATE AND NAME OF PERSON MAKING CHANGE

Do not extend notes this side of this line.

F.B. 2346 Pg. 84 | Job No. 8771.22 | Division No. 11 | Notes Red | Plotted | Profile
Survey of Alondra Park | Date | No. | X-Sec.
Survey by Curtis | Notes Curtis | Notes Chkd. | Checked
Indexed C. K. Cahill | Date | Date | Date | No.

STATION	B.S.	H.I.	F.S.	ELEV.			
TBM. (A)				45.61	El. 45.61 per pg. 78 TBM. Bt. spk in Conc. base - flag pole.		
					"Sand Area ① per pg. 73"		
					Curb Grade	C. of F	Stks & Tins 3' off out side face Curb
1 BC.				47.77	47.77	Grd	–
2 EC.				48.02	48.02	–	–
3 BC.				47.82	47.82	–	–
4 EC.				47.77	47.77	–	–
5 BC.				47.47	47.47	–	–
6 EC.				47.47	47.47	–	–
7 BC.				47.57	47.57	–	✓
8 EC.							✓
					"Sand Area ② per pg. 73"		
1 BC.				48.15	48.15	Grd	–
2 EC.				48.20	48.20	–	✓
3 BC.				48.20	48.20	–	–
4 EC.				48.15	48.15	–	–
5 BC.				47.92	47.92	–	–
6 EC.				47.87	47.87	–	✓
7 BC.				47.87	47.87	–	✓
8 EC.				47.92	47.92	–	✓
TBM. (A)				46.93	El. 46.93 per pg. 78 – Bt. spk: in Conc. TBM. Base Bac. B.Q.		

8771.22

Profile No.	Notes Red	Plotted	Job No.	Division No. 11	F. B. 2346	Pg. 85
	Date	Date	Survey of Alondra Park		11-5-62	
X-Sec. No.	Notes Chkd.	Checked	Survey by Curtis	Notes Curtis	Date 11-26-62	
	Date	Date	Map No.	Indexed	Date	

E. J. CAULI

J.N. 8771.22

Alondra Park

Parking Lot

Grades

See pages 72, 75 & 76 for location

STATION	B.S.	H.I.	F.S.	ELEV.

NOTE: ANY ADDITIONS OR CHANGES ON THIS SHEET MUST BE MADE OR CIRCLED IN RED INK, WITH DATE AND NAME OF PERSON MAKING CHANGE.

Do not extend notes this side of this line.

PLEASE RETURN TO
LOS ANGELES COUNTY ENGINEER
403 Los Angeles County Engineering Bldg.

76-L298 CE 307 3-61

76-L298 CE 307 3-61

PLEASE RETURN TO
LOS ANGELES COUNTY ENGINEER
403 LOS ANGELES COUNTY ENGINEERING BLDG.

NOTE: ANY ADDITIONS OR CHANGES ON THIS SHEET MUST BE MADE OR CIRCLED IN RED INK, WITH DATE AND NAME OF PERSON MAKING CHANGE

Do not extend notes this side of this line.

F. B. 2346 PG. 86 Job No. 877.22 Division No. 11 Notes Red Plotted Profile
Survey of Alondra Park Date Date No. X-Sec.
Survey by Crews Notes Notes Chkd. Checked No.
Indexed C.F. Date Date Date

STATION	B. S.	H. I.	F. S.	ELEV.					
(Fd)								FB. 2346-78 Spk S.E. Cor	
T.B.M. (Fd)				46.93	T.B.M. El. 46.93 ± 40' N & ± 18' W of K.K. S.W. Cor.			B-9.	
T.B.M.				48.00	T.B.M. Parking Lot. - Bt. Spk-E. Side-Lite pole				
					Fin. Grade.	Cor F	Elev.	Sub Grade	Cor F
A-1 N.W. Cor.				47.00	47.00	Grd.			
A-2 @ W. Curb				"	"	"			
A-3				"	"	"			
A-4				"	"	"			
A-5				"	"	"			
A-6				"	"	"			
A-7				"	"	"			
A-8				"	"	"			
A-9				"	"	"			
A-10				"	"	"			
A-11				"	"	"			
A-12 S.W. Cor.				47.00	47.00	Grd			
B-1 B.C. @ C.L.				46.64	46.64	"			
B-2					46.85		46.27	46.27	Grd.
B-3					"		"	"	"
B-4					"		"	"	"
B-5					"		"	"	"
B-6					"		46.27	46.27	Grd

76-L298 CE 307 3-61

PLEASE RETURN TO
LOS ANGELES COUNTY ENGINEER
403 LOS ANGELES COUNTY ENGINEERING BLDG.

NOTE: ANY ADDITIONS OR CHANGES ON THIS SHEET MUST BE MADE OR CIRCLED IN RED INK, WITH DATE AND NAME OF PERSON MAKING CHANGE.

Do not extend notes this side of this line.

Profile Notes Red____ Plotted____ Job No. 8771.22 Division No. 11 F.B. 2346 Pg. 87
X-Sec. No.____ Date____ Date____ Survey of Glendora Ave. to Azusa
Notes Chkd.____ Checked____ Survey by Clerks Notes Curtis Date 11-26-62
Date____ Date____ Map No.____ Indexed C. J. Curtis Date____

STATION	B. S.	H. I.	F. S.	ELEV.	Fin. Grade	Cor F	Elev.	Sub Grade	Cor F
B-7					46.85		46.27	46.27	Grd
B-8					"		"	"	"
B-9					"		"	"	"
B-10					"		"	"	"
B-11					"		46.27	46.27	Grd
B-12 @ C6.				46.85	46.85	Grd			
C-1					46.30		45.72	45.72	Grd
C-2 Isle C6.				46.71	46.71	Grd.			
C-3					46.71		46.13	46.13	Grd
C-4					"		"	"	"
C-5					"		"	"	"
C-6					"		"	"	"
C-7					"		"	"	"
C-8					"		"	"	"
C-9					"		"	"	"
C-10					"		46.13	46.13	Grd
C-11 Isle @ C6				46.71	46.71	Grd.			
C-12 @ C6.				46.71	46.71	Grd.			

76-L298 CE 307 3-61

PLEASE RETURN TO
LOS ANGELES COUNTY ENGINEER
403 Los Angeles County Engineering Bldg.

NOTE: ANY ADDITIONS OR CHANGES ON THIS SHEET MUST BE MADE OR CIRCLED IN RED INK, WITH DATE AND NAME OF PERSON MAKING CHANGE

Do not extend notes this side of this line.

F.B. 2346 Pg. 88 | Job No. 877.22 | Division No. 11 | Notes Red | Plotted | Profile
Survey of Glendale Park | Date | Date | No.
Survey by Curtis Notes Curtis | Notes Chkd. | Checked | X-Sec.
Indexed C.J. GALLI | Date | Date | No.

STATION	B. S.	H. I.	F. S.	ELEV.	Fin. Grade	Cor F	Elev.	Sub. Grade	Cor F
D-1 BC @ Curb				46.57	46.57	Grd.			
D-2					46.57		46.00	46.00	Grd.
D-3					"		"	"	"
D-4					"		"	"	"
D-5					"		"	"	"
D-6					"		"	"	"
D-7					"		"	"	"
D-8					"		"	"	"
D-9					"		"	"	"
D-10					"		"	"	"
D-11					"		46.00	46.00	Grd
D-12 @ Curb				46.57	46.57	Grd			
E-1 Cor.				46.42	46.42	Grd			
E-1 THRU E-12-Level				"	"	"			
				"	"	"			
				"	"	"			
				"	"	"			
				"	"	"			
E-12- Cor (Fd)				46.42	46.42	Grd.			
TBM.				45.61	TBM. E1 45.61 pg-72- Bt spk in base Flag Pole.				

Notes Ck'd by	Survey of Alondra Park
Map No.	JN 8771.22 Tape Std °F
Office Work	Surveyed by A.S. Curtis
Checked	Notes Curtis Date 1-21-63
Date	Indexed J. GALLI FEB 2 0 63

F. B. 2346 Pg. 89

J.N. 8771.22
Alondra Park.
Soft Ball Diamond

Curtis
Carrasco
Yasui
Eastborn

Note: Any Additions or Changes on This Sheet Must be Made in Red Ink With Date and Name of Person Making Change.

Do not extend notes this side of this line.

RETURN TO
LOS ANGELES COUNTY ENGINEER
700 Los Angeles County Engineering Bldg.

76F305S CE #247—3-57

F. B. 2346 Pg. 90

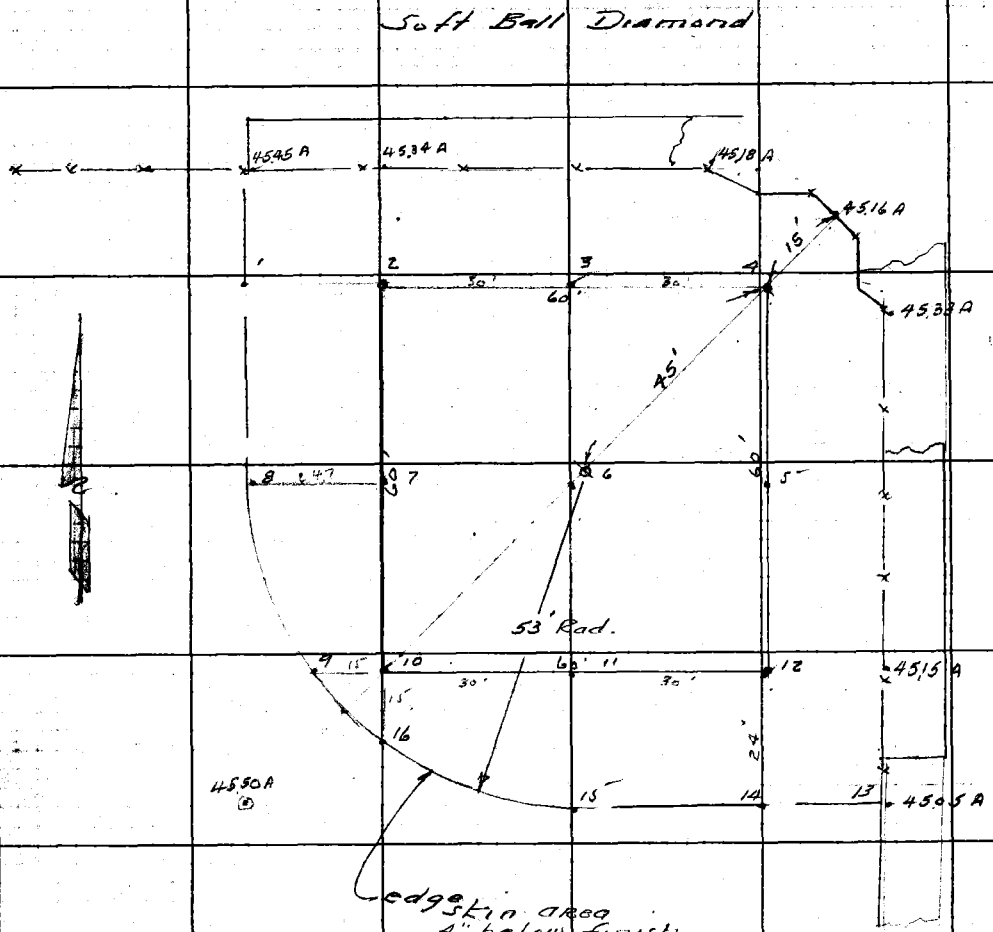

NOTE -
Dims. shown are per "Williamson - Arch" 1-21-63

	Fin. Grd	Sub Grd.	Elev.	Cut Sub Grd
1	45.25	44.92		
2	45.18	44.85		
3	45.06	44.73		
4	45.10	44.77		
5	44.89	44.56		
6	44.84	44.51		
7	44.93	44.60		
8	44.93	44.60		
9	44.68	44.35		
10	44.68	44.35		
11	44.63	44.30		
12	44.68	44.35		
13	44.98			
14	44.58	44.20		
15	44.50	44.17		
16	44.55	44.22		

RETURN TO
LOS ANGELES COUNTY ENGINEER
700 LOS ANGELES COUNTY ENGINEERING BLDG.

Do not extend notes this side of this line.

Note: Any Additions or Changes on This Sheet Must be Made or Circled in Red Ink With Date and Name of Person Making Change.

Notes Ck'd by	Survey of Alondra Park	F. B. 2396 Pg. 91
Map No.	JN 8771.22 Tape Std °F.	
Office Work	Surveyed by A.S. Curtis	
Checked	Notes Curtis Date 7-2-63	
Date	Indexed C. J. GALLI MAR 29 '63	

J.N. 8771.22
ALONDRA PARK,
Parking Lot.

Grade Check or "as built."
for
Drainage Check.

NOTE—
Paving was not
built to Grades Given.

NOTE—
See pg's 75 & 85 for
Grades "as set."

Curtis
Carrasco
Yasui
Goshorn.

Note: Any Additions or Changes on this Sheet Must be Made or Circled in Red Ink With Date and Name of Person Making Change.

Do not extend this side of this line.

PLEASE RETURN TO
LOS ANGELES COUNTY ENGINEER
403 Los Angeles County Engineering Bldg.

76F3095 CE # 310 3-61

PLEASE RETURN TO
LOS ANGELES COUNTY ENGINEER
403 LOS ANGELES COUNTY ENGINEERING BLDG.

Note: Any Additions or Changes on This Sheet Must be Made or Circled in Red Ink With Date and Name of Person Making Change.

Do not extend this side of this line.

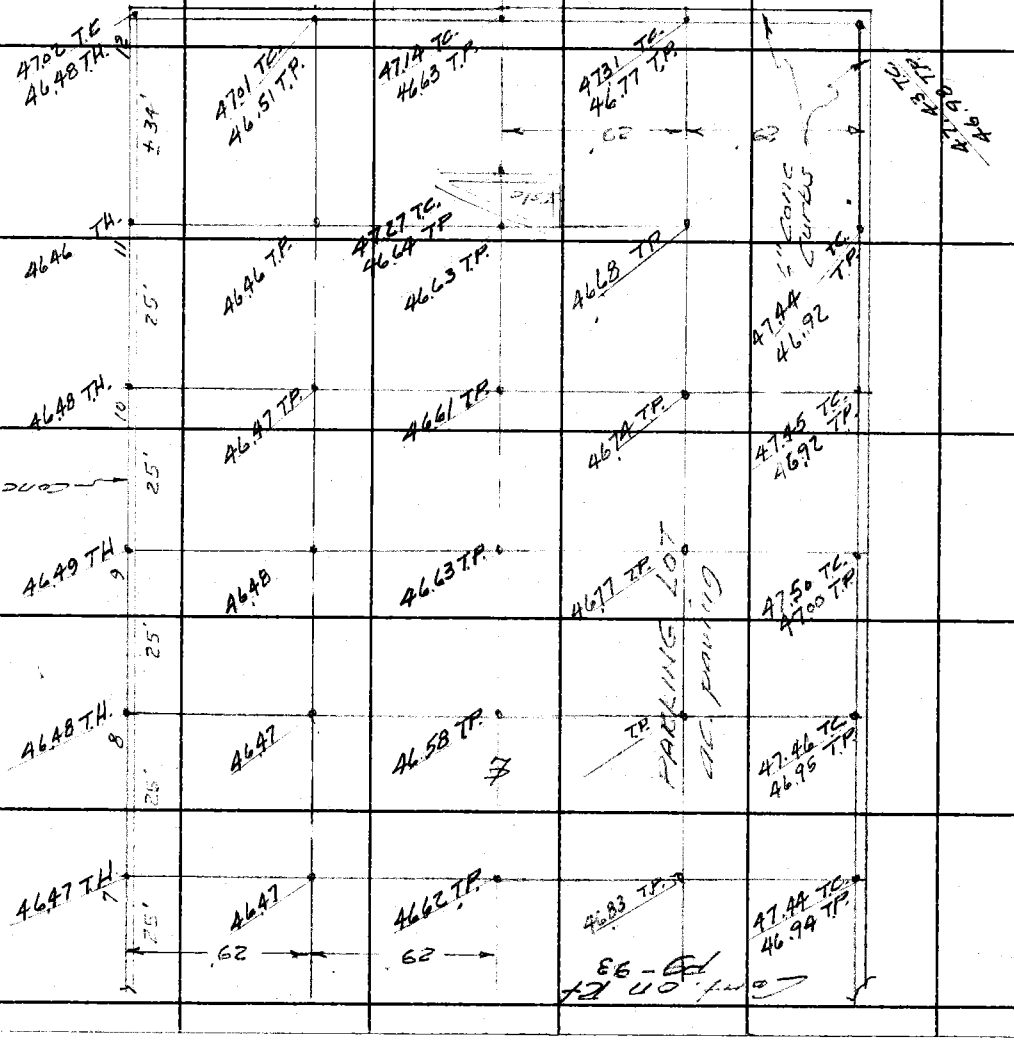

F.B. 2346 PG 92

Notes Ck'd by
Map No.
Office Work
Checked
Date

Survey of Alondra Park
JN 8771.22 Tape Std °F
Surveyed by G.S. Curtis
Notes Curtis Date 3-6-63
Indexed C. J. GALLI

F. B. 2346 PG. 93

Note: Any Additions or Changes on this Sheet Must be Made or Circled in Red Ink With Date and Name of Person Making Change.

Do not extend this side of this line.

PLEASE RETURN TO
LOS ANGELES COUNTY ENGINEER
403 Los Angeles County Engineering Bldg.

78F309S CE # 310 3-61

Notes Ck'd by	Survey of Alondra Park
Map No.	JN 8771.34 Tape Std °F
Office Work	Surveyed by A.S. CURTIS
Checked	Notes CURTIS Date 10-21-63
Date	Indexed E. J. GALLI APR 1 3 1964

F. B. 2346 Pg. 95

J.N. 8771.34
ALONDRA PARK.
Senior Citizens Area.
Location

CURTIS
CARRASCO
YASUI
DOVER

Note: Any Additions or Changes on This Sheet Must be Made or Circled in Red Ink With Date and Name of Person Making Change.

Do not extend this side of this line.

PLEASE RETURN TO
LOS ANGELES COUNTY ENGINEER
403 Los Angeles County Engineering Bldg.

76F3095 CE #310 6-62

F. B 2346 PG 96

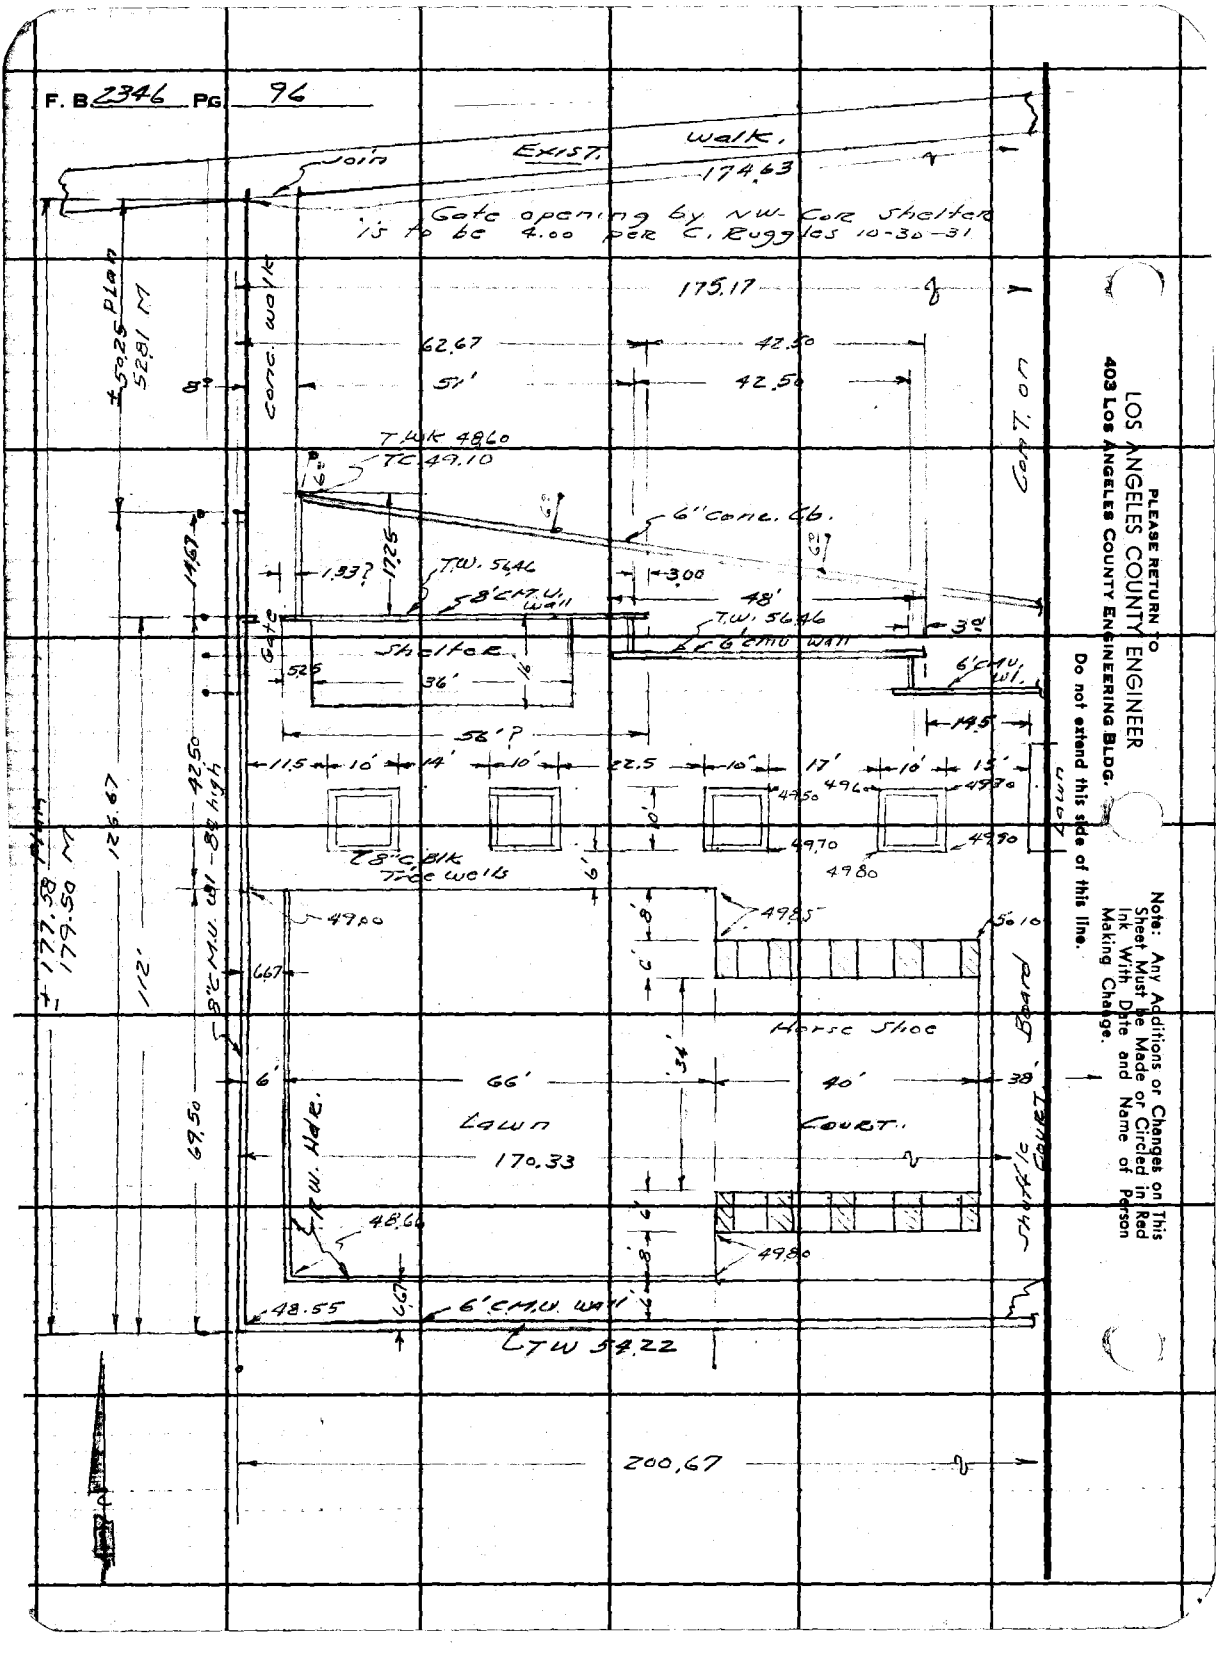
Exist. walk.
174.63
Gate opening by N.W. Cor Shelter is to be 4.00 per C. Ruggles 10-30-31
175.17
Conc. walk
62.67
51'
42.50
42.50
T.W. 49.60
TC 49.10
6" conc. 66.
T.W. 56.46
8" C.M.U. Wall
48'
6" C.M.U. Wall
Shelter
36'
58'?
11.5
10'
14'
10'
22.5
10'
17'
10'
15'
8" C.M.U. Wall
Tree Wells
49.70
49.80
49.80
49.80

Notes Ck'd by
Map No.
Office Work
Checked
Date

Survey of Alondra Park
JN 8711.39 Tape Std °F
Surveyed by AS Curtis
Notes Curtis Date 10-21-63
Indexed E. J. CALL

F. B. 2346 PG. 97

Manhattan Beach Blvd

EXIST. C&G.
EXIST Conc wk
174.63
25.50
Gate openings @ N&S ends of E. wall are to be 4.50 by C. Ruggles 10-30-63
EXIST. Conc. wk.
175.17
42.50
70.00
42.50
6" conc. curb
2.50
TC 49.76
TP. 49.26
48.70
EXIST. Conc. wk.
54.67
T.W. 54.16
0.67
6" C.M.U. Wall
Gate 4.50
8.0
49.60
49.70
49.50
45.50
49.50
4.83
49.70
50.00
30.00
El. 50.00
49.80
15'
14'
40.0
38.0
19.0
0.67
50.10
100.00
49.87 T.C.
170.33
Conc blk Wall
54.67
T.W. 54.67
50.00
50.10
4.50
4.67
49.07 T.C.
6" C.M.U. Wall
0.67
T.W. 54.22
Gate
10.67
48.57
28.0
200.67
EXIST. Conc. Walk

Note: Any Additions or Changes on this Sheet Must be Made or Circled in Red Ink With Date and Name of Person Making Change.

PLEASE RETURN TO
LOS ANGELES COUNTY ENGINEER
403 LOS ANGELES COUNTY ENGINEERING BLDG.
Do not extend this side of this line.

7GF3095 CE # 310 3-61

F.B. 2346 Pg. 99

Profile No. ____ X-Sec. No. ____
Notes Red ____ Date ____ Notes Chkd. ____ Date ____
Plotted ____ Date ____ Checked ____ Date ____
Job No. 8771.34 Division No. 11
Survey of Alondra Park
Survey by Curtis Notes A.C. Date 10-21-63
Map No. ____ Indexed C. J. GALLI Date ____

IN. 8771.34

Alondra Park

Senior Citizens Area

Bench Levels

Curtis
Carrasco
Yasui
Dover

STATION	B.S.	H.I.	F.S.	ELEV.

NOTE: ANY ADDITIONS OR CHANGES ON THIS SHEET MUST BE MADE OR CIRCLED IN RED INK, WITH DATE AND NAME OF PERSON MAKING CHANGE.

Do not extend notes this side of this line.

PLEASE RETURN TO
LOS ANGELES COUNTY ENGINEER
403 Los Angeles County Engineering Bldg.

76-L296 CE 307 3-61

76-L298 CE 307 3-61

PLEASE RETURN TO
LOS ANGELES COUNTY ENGINEER
403 LOS ANGELES COUNTY ENGINEERING BLDG.

NOTE: ANY ADDITIONS OR CHANGES ON THIS SHEET MUST BE MADE OR CIRCLED IN RED INK, WITH DATE AND NAME OF PERSON MAKING CHANGE

Do not extend notes this side of this line.

F.B. 2346 Pg. 109

Survey of Alondra Park Division No. 4 Notes Red Plotted Profile
Survey by Curtis Notes A. Caccese Notes Chkd. Checked X-Sec.
Indexed C. J. GALLI Date Date Date No.
Job No 8171.3

STATION	B. S.	H. I.	F. S.	ELEV.		
B.M.				48.845	325' S & 900' E Prairie Ave & Manhatten Blvd E inter Ball Field west of Golf Course S. End of East dugout of Baseball Back Stop Fd Small BT. SPK in Lead Center of	
	5.364	54.209			Conc. Sidewalk per	F.B. 2346-6; Elev. 48.845
			5.372	48.837	T.P. 1x2	
	5.078	53.935				
T.B.M.			4.342	49.593	75' S. & 725' E. of Prairie Ave & Manhatten Beach Blvd & Inter Fd 2-Larg pBt SPK S. Side of	
	3.986	53.579			P.P.# 501236E Elev. 49.70, F.B. 2346-6	
			5.270	48.309	T.P. 1x2	
	4.806	53.115				
T.B.M.			4.722	48.393	75' S. & 405' E of Prairie Ave & Manhatten Beach Blvd & Inter. Fd BT SPK on P.P.# 501235E Fd BT. SPK N. Side Pole	
					Elev. 48.438 Per F.B. 2346-6	
	4.531	52.924				
B.M.			4.770	48.154	90' S & 220' E of Prairie Ave & Manhatten Beach Blvd. & Inter. E. End of dug-out of Soft Ball Back Stop Fd Small Bt. SPK in Lead. Elev. 48.167 Per F.B. 2346-6	
T.B.M.				48.393	T.B.M. Bt. SPK in P.P.#	501235E See above
	5.182	53.575				

76-L298 CE 307 3-61

PLEASE RETURN TO
LOS ANGELES COUNTY ENGINEER
403 LOS ANGELES COUNTY ENGINEERING BLDG.

NOTE: ANY ADDITIONS OR CHANGES ON THIS SHEET MUST BE MADE OR CIRCLED IN RED INK, WITH DATE AND NAME OF PERSON MAKING CHANGE.

Do not extend notes this side of this line.

STATION	B. S.	H. I.	F. S.	ELEV.		
		53.575				
T.B.M.			3.575	50.000	T.B.M. For Construction Set Bt. Spk. in So. Side of P. Pole # 501235E	
	3.713	53.713				
T.B.M.			3.713	50.00	T.B.M. For Construction Set Chisel Cut Line on W. Side of Steel Lite Standard at N.E. Cor. of Senior Citizen Construction Site	
	4.035	54.035				
T.B M.			4.035	50.00	T.B.M. For Construction Set Chisel Cut Line on W. Side of Steel Lite Standard at S.E. Cor. of Senior Citizens Construction Site	
	3.707	53.707				
T.B.M.			4.112	49.595	Check Back Elev. To P. Pole # 501236E Elev. 49.593 See Page 100	

Profile Notes Red Plotted Job No. 7717.34 Division No. 11
No. X-Sec. Date Date Survey of Alondra Park
No. Notes Chkd. Checked Survey by Curtis Notes A.C. Date 10-21-63
Date Date Map No. Indexed ~~C.J. CALL~~ Date

F.B. 2346 Pg. 101

Notes Ck'd by	Survey of Alondra Park	F.B. 2346 Pg. 103
Map, No.	J.N. 9771.29 Tape Std °F	
Office Work	Surveyed by O.S. CURTIS	
Checked	Notes CURTIS Date 10-29-43	
Date	Indexed C. J. GALLI APR 1 3 '64	

J.N. 9771.29
Alondra Park
Location of
Lite Pole for Hand
Ball Diamond near
Recreation Bldg.
North Side Park.

CURTIS
Compasco
1931
Book

Note: Any Additions or Changes on This Sheet Must be Made or Circled in Red Ink With Date and Name of Person Making Change.

Do not extend this side of this line.

PLEASE RETURN TO
LOS ANGELES COUNTY ENGINEER
403 LOS ANGELES COUNTY ENGINEERING BLDG.

70F3095 CE #310 6-62

F. B 2346 Pg. 109

NOTE—

Set Stk. & Tins - 5' off Center Poles as shown & in line with the direction of the Lite Arm or Platform.

LOS ANGELES COUNTY ENGINEER
403 Los Angeles County Engineering Bldg.

Please Return To

Do not extend this side of this line.

Note: Any Additions or Changes on This Sheet Must be Made or Circled in Red Ink With Date and Name of Person Making Change.

Notes Ck'd by	Survey of ALONDRA PARK
Map No.	JN 8771.54 Tape Std 68 °F
Office Work	Surveyed by W. A. RICHARDS
Checked	Notes W. A. R. Date 12-73
Date	Indexed G. D. BAILEY JAN 15 1974

F. B. 2346 PG. 105

J. N. 8771, 54

ALONDRA COUNTY PARK

DRAINAGE IMPROVEMENTS

CONTROL LINE SURVEY FOR P.T. # 240 UPDATE

RICHARDS
LEGAULT
NUNEZ
TURRILL
BUSTRUM

Note: Any Additions or Changes on This Sheet Must be Made or Circled in Red Ink With Date and Name of Person Making Change.

Do not extend this side of this line.

PLEASE RETURN TO
COUNTY OF LOS ANGELES
DEPARTMENT OF COUNTY ENGINEER
403 LOS ANGELES COUNTY ENGINEERING BLDG.

26F3095 CE#310 3-68

F. B. 2346 PG. 106

AREA INDEX MAP
NO SCALE

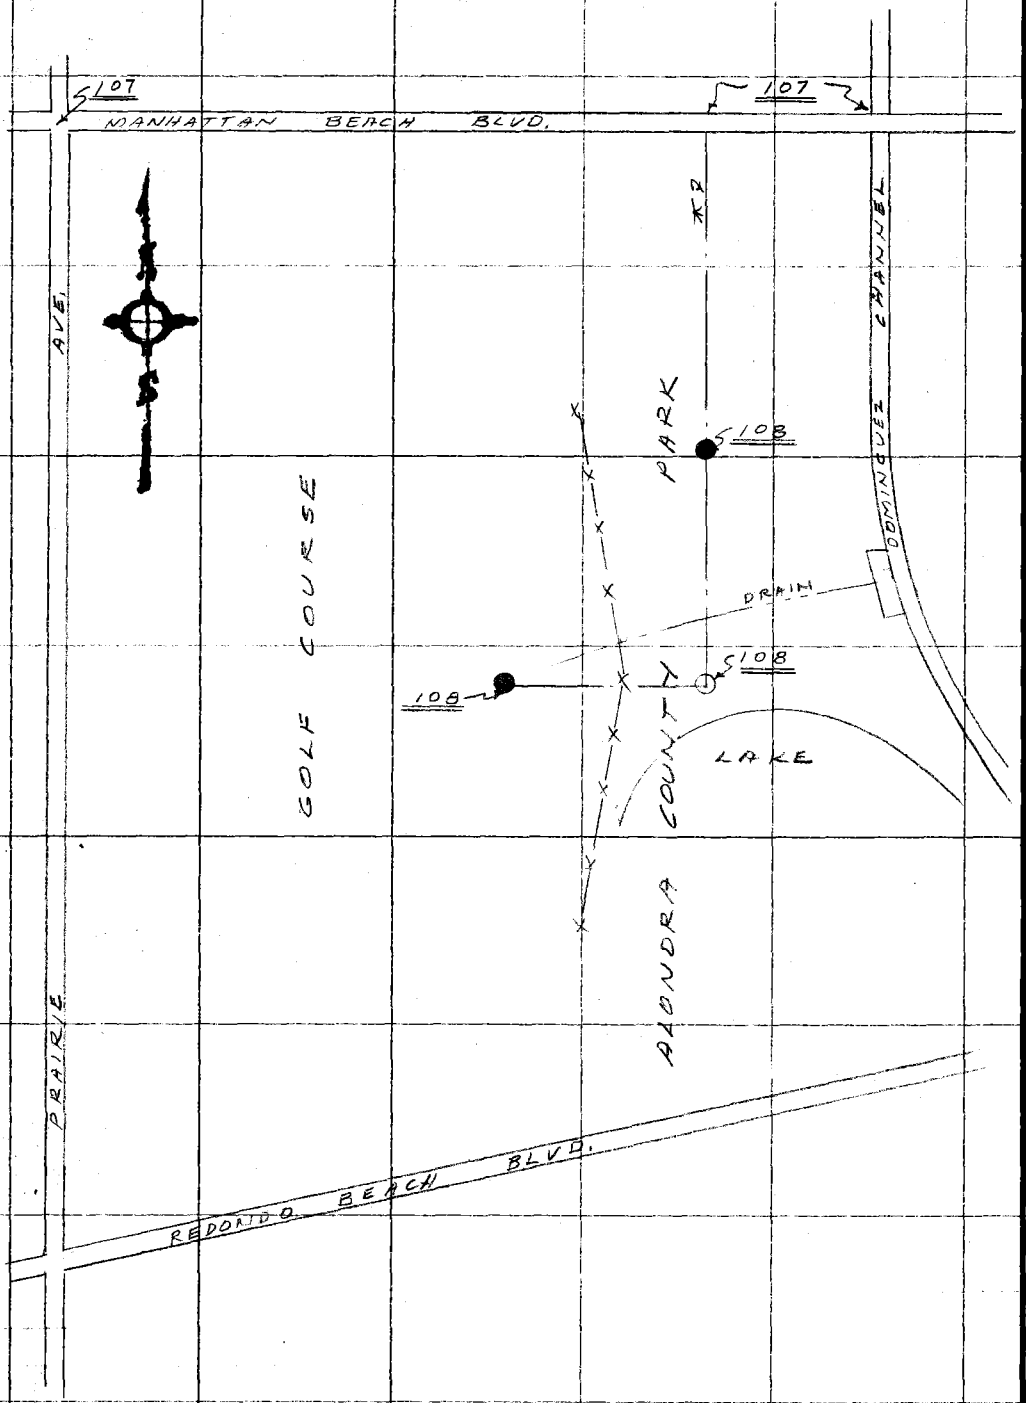

PLEASE RETURN TO
COUNTY OF LOS ANGELES
DEPARTMENT OF COUNTY ENGINEER
403 LOS ANGELES COUNTY ENGINEERING BLDG.

Do not extend this side of this line.

Note: Any Additions or Changes on This Sheet Must be Made or Circled in Red Ink With Date and Name of Person Making Change.

Notes Ck'd by	Survey of ALONDRA CO. PARK
Map No.	JN 8771-54 Tape Std 68 °F
Office Work	Surveyed by W. A. RICHARDS
Checked	Notes W.A.R. Date 12-73
Date	Indexed L. D. BAILEY JAN 15 1974

F. B 2346 Pg. 107

W.S.25.D.3

Note: Any Additions or Changes on This Sheet Must be Made or Circled in Red Ink With Date and Name of Person Making Change.

Do not extend this side of this line.

PLEASE RETURN TO
COUNTY OF LOS ANGELES
DEPARTMENT OF COUNTY ENGINEER
403 LOS ANGELES COUNTY ENGINEERING BLDG.

DOMINGUEZ

BLVD

MANHATTAN BEACH

PRAIRIE AVE.

ALONDRA GOLF COURSE

ALONDRA PARK

TO TOP PG. 108

FD. F.C.D. ST. B.M. MON. B.M. 113 - 0313D - 1977 IN CONC. W.K. CHANNEL

1/4 COR. PER FB. 574-128, P.97 FD, BT. SPK. & W. FLUSH NO REC. USED FOR & CONTROL

Ad. A.C. 7-9-75

50.18

43.91

73.73

SET L.&C.C.E. TAG

FD. L. & T.

19.22

INT. SET C.N. FLUSH

N - 4,071,421.96
E - 4,186,390.89

767.17

S 0° 02' 53" E

90° 02' 05"

767.19 T=64°=767.17

1 90° 02' 00"
4 0° 08' 20"
6 180° 12' 30"
1 90° 02' 05"

2605.70 MEAS. S 89° 59' 12" W.

2606.60 T=74°=2605.70

(50) (50)

INTERMEDIATE POINTS NOT CHECKED FOR LINE

89° REC. FB.

FD. L. & C.E. TAG

0.05

INT. FD. TRAV. STA. MON. ON 12" IN H.H. PER FB. 574-196-130 TORRANCE K-2 USED FOR & CONTROL 1961

FD. L. & T.

41.86

72.89

S 92° E

55.

NO SURVEY

73.03

71.37

FD. L. & C.E. TAG

0.02

FD. L. & C.E. TAG

76F3095 CE#310 3-68

F. B. 2346 PG. 108

TO RT. PG. 107

SET SQ. HD. SPK. & T. IN TRANS. P. P. @ PT. IN POLE LINE

767.17

PARK

SET CHI. "+" IN LIGHT POLE

50.16

P. O. T.
SET 1X2 & N. FLUSH TOP OF HILLOCK

N - 4,070, 654.79
E - 4,186, 391.53

GOLF COURSE

CHANNEL

S 0° 02' 53" E
497.83

1. 89° 58' 40"
4. 359° 55' 00"
6. 179° 52' 30"
5. 89° 58' 45"

507.06 T = 62° = 507.04
STRAD. = 9.21
497.83

8' C.L. FN. 2

ALONDRA

DOMINGUEZ

45"

58'

57' 35" (REG)

89° 58' (REG)

43.97

SET CHI. "+" IN F. P.

9.94

470.69 M.
(470.70 CALC.)

(316.30 CALC.)

98.01

SET N. FT. IN P. P.

D-5
FD. G.S. MON. DN. 16"
FB. 492-6

N - 4,070, 156.85
E - 4,185, 921.25

SET 1X2 & N. FLUSH
REC. DIST. (1265.00)
FR. & MANHATTAN BEACH BLVD.
PER FB. 492-6, 8

N - 4,070, 156.96
E - 4,186, 391.95

D-6
NO EVID. OF C.S. MON.
DUG 48" DEEP.
SEE FB. 492-8

N - 4,070, 157.03
E - 4,186, 708.25
GD. EL. = 45.2
MON. " = 42.2 (REC.)

LAKE AREA

PLEASE RETURN TO
COUNTY OF LOS ANGELES
DEPARTMENT OF COUNTY ENGINEER
403 LOS ANGELES COUNTY ENGINEERING BLDG.

Do not extend this side of this line.

Note: Any Additions or Changes on This Sheet Must be Made or Circled in Red Ink With Date and Name of Person Making Change.

8771.54

F.B. 2346 Pg. 109

Profile No. ____ Notes Red ____ Plotted ____ Job No. ____ Division No. 11 Survey of ALONDRA COUNTY PARK

Date ____ Date ____ Survey by RICHARDS Notes N.A.R. Date 12-14-73

X-Sec. No. ____ Notes Chkd. M. DEL REAL Checked C. ROMACH Date 1-17-74 Map No. ____ Indexed G. D. BAILEY Date JAN 15 1974

J. N. 8771.54

ALONDRA COUNTY PARK

DRAINAGE IMPROVEMENTS

LEVELS FOR P.T. 240 UPDATE

N/O. N. SIDE OF LAKE, BET. GOLF COURSE BDRY. & DOMINGUEZ CHANNEL

RICHARDS
LEGAULT
NUNEZ
TURRILL
BUSTRUM

STATION	B.S.	H.I.	F.S.	ELEV.

NOTE! ANY ADDITIONS OR CHANGES ON THIS SHEET MUST BE MADE OR CIRCLED IN RED INK, WITH DATE AND NAME OF PERSON MAKING CHANGE.

Do not extend notes this side of this line.

PLEASE RETURN TO
LOS ANGELES COUNTY ENGINEER
403 Los Angeles County Engineering Bldg.

76-L-298 CE 307 2-63

76-L-298 CE 307 2-63

PLEASE RETURN TO
LOS ANGELES COUNTY ENGINEER
403 LOS ANGELES COUNTY ENGINEERING BLDG.

NOTE: ANY ADDITIONS OR CHANGES ON THIS SHEET MUST BE MADE OR CIRCLED IN RED INK, WITH DATE AND NAME OF PERSON MAKING CHANGE

Do not extend notes this side of this line.

F.B. 2346 PG. 110
Job No. 8771.54 Division No. // Notes Red ____ Plotted ____ Profile
Survey of ALONDRA COUNTY PARK Date ____ No. ____ X-Sec.
Survey by RICHARDS Notes W.A.B. Notes Chkd. ____ Checked ____ No.
Indexed J.D. BAILEY Date JAN 15 1974 Date ____ Date ____

STATION	B.S. +	H.I.	— F.S.	ELEV.	
(FD)					(ALSO = F.C. B.M. 113-52 EL. = 43.98 PER PG. 20)
B.M. 13	5.349	49.550 ✓		44.201	B.M. 13 ELEV. = 44.201 FB. 492-111 BT. SPK. IN LEAD, 4' S/O N. END CONC. HDWL,
T.P.	1.950	49.010 ✓	2.490 ✓	47.060 ✓	@ OVERFLOW GATE, ELY. SIDE OF LAKE
(SET) B.M. # 101	6.530	49.879 ✓	5.661	43.349 ✓	B.M. # 101 ELEV. = 43.349 FB 2346 PG. 110 BT. SPK. IN LEAD, IN CONC. WK., 5' N & 1' W/O N.E. COR. RESTROOM BLDG. @ N. SIDE OF LAKE
(FD) BM 13 A (SET)	(SIDE SHOT)		3.618	46.261 ✓	BM. 13-A EL. = 46.29 FB. 2346-78 BT. SPK. S. SIDE P.P. (NO #) @ N. W. COR LAKE V.C.
B.M. # 102	3.418	49.862 ✓	3.435	46.444 ✓	B.M. # 102 EL. = 46.444 FB. 2346-110 BT. SPK. IN P.P. # 13 1598E, 16.0' ± NE OF N.E. COR OF RESTROOM BLDG @ N. SIDE OF LAKE
T.P. (FD)	3.940	50.329 ✓	3.473	46.389 ✓	—
B.M. 13			6.120	44.209 ✓	B.M. 13 EL. = 44.201 14 LINES U.P.

Profile No. | Notes Red | Plotted | 8771.54 Job No. | Division No. 11 | F.B. 2346 | Pg. 111
Date | Date | Survey of ALONDRA CO. PARK
X-Sec. No. | Notes Chkd. | Checked | Survey by RICHARDS Notes W.A.R. Date 7-22-74
Date | Date | Map No. | Indexed R. M. PALMERI Date DEC 4 1974

J. N. 8771.54

ALONDRA COUNTY PARK

GRADE STAKES

FOR

STORM DRAIN

FROM EXIST. S.D. @ STA. 1485.00

TO END OF S.D. @ " ~~5404.00~~ 4+98.7

R.P. $\underline{S}$ 10.00 LT. & S.D.

R.D. $\underline{S}$ ARE 1X2 STAKES, N. & TIN ON. 1"

RICHARDS
NUNEZ
TURRILL
BUSTRUM

STATION	B.S.	H.I.	F.S.	ELEV.

NOTE: ANY ADDITIONS OR CHANGES ON THIS SHEET MUST BE MADE OR CIRCLED IN RED INK. WITH DATE AND NAME OF PERSON MAKING CHANGE.

Do not extend notes this side of this line.

PLEASE RETURN TO
LOS ANGELES COUNTY ENGINEER
403 Los Angeles County Engineering Bldg.

76-L-296 CE 307 2-63

76-L-298 CE 307 2-63

PLEASE RETURN TO
LOS ANGELES COUNTY ENGINEER
403 LOS ANGELES COUNTY ENGINEERING BLDG.

NOTE: ANY ADDITIONS OR CHANGES ON THIS SHEET MUST BE MADE OR CIRCLED IN RED INK, WITH DATE AND NAME OF PERSON MAKING CHANGE

Do not extend notes this side of this line.

F.B. 2346 Pg. 112 | Job No. 8771.54 | Division No. 11 | Notes Red | Plotted | Profile
Survey of ALONDRA CO. PARK | Date | Date | No.
Survey by RICHARDS | Notes W.I.R.K. | Notes Chkd. 12-5-74 | Checked G. KURACH | X-Sec.
Indexed E. H. PALMERI | Date DEC 4 1974 | Date | Date | No.

STATION	B.S.	H.I.	F.S.	ELEV.	%	GRADE	C/F
T.B.M. # 101				43.35		T.B.M. # 101 EL. = 43.349	
						BT. SPK. IN WK., 5' N.F 1' W/O N.E. COR. RESTROOM	

76-L-298 CE 307 2-63

PLEASE RETURN TO
LOS ANGELES COUNTY ENGINEER
403 LOS ANGELES COUNTY ENGINEERING BLDG.

NOTE: ANY ADDITIONS OR CHANGES ON THIS SHEET MUST BE MADE OR CIRCLED IN RED INK, WITH DATE AND NAME OF PERSON MAKING CHANGE.

Do not extend notes this side of this line.

Profile No. ____ Notes Red. ____ Plotted ____ Job No. 8771.54 Division No. 11
X-Sec. No. ____ Date ____ Date ____ Survey of ALONDRA CO. PARK Date 7-22-74
Notes Chkd. 12-5-74 Checked G. [illegible] Survey by RICHARD S. [illegible] Notes by K.G.P. Date 7-22-74
Date ____ Date ____ Map No. ____ Indexed L. PALMER Date DEC 4 1974
F.B. 2346 PG. 1/3

STATION	B. S.	H. I.	F. S.	ELEV.	STORM DRAIN GRADES
					% GRADE C/F,
4+00				40 60	37.37 C 3.23'
"	24" R.C.P. ON N.			—	—
4+25				40 26	37.40 C 2.86'
+50				3960	37.44 C 2.16'
+75				3921	37.47 C 1.74'
4+~~87~~ 85.7				3872	37.50 C 1.22'
~~5+84~~ 4+98.7	END 9X7 BOX INLET	NOT SET		—	37.60 —

± 0.13%

R.D. = 0.17 @ S.D.

Notes Ck'd by T. ABE
Map No. B-5288
Office Work C. MOTEN
Checked J. ABE
Date SEP 21 1976

Survey of Alondra Park F.B. 2346 Pg. 115
J.N. 0054.06 Tape 2/46 Stad 8 "F
Surveyed by English
Notes Ed Date 7-25
Indexed By B.D. BAILEY Rec. 1-76

ALONDRA PARK GOLF COURSE BOUNDARY

J.N. 0054.06

Survey for location of existing boundary fences.

July 9, 1975.
English
Caro
Stroud
Bradley
Simpson

Ref.:
C.S.B. 1985.
F.B. 2346.
F.B. 574.

Note: Any Additions or Changes on this Sheet Must be Made or Circled in Red Ink With Date and Name of Person Making Change.

Do not extend this side of this line.

PLEASE RETURN TO
LOS ANGELES COUNTY ENGINEER
403 LOS ANGELES COUNTY ENGINEERING BLDG.

7870098 CE#310 9.67

F.B. 2346 Pg. 116

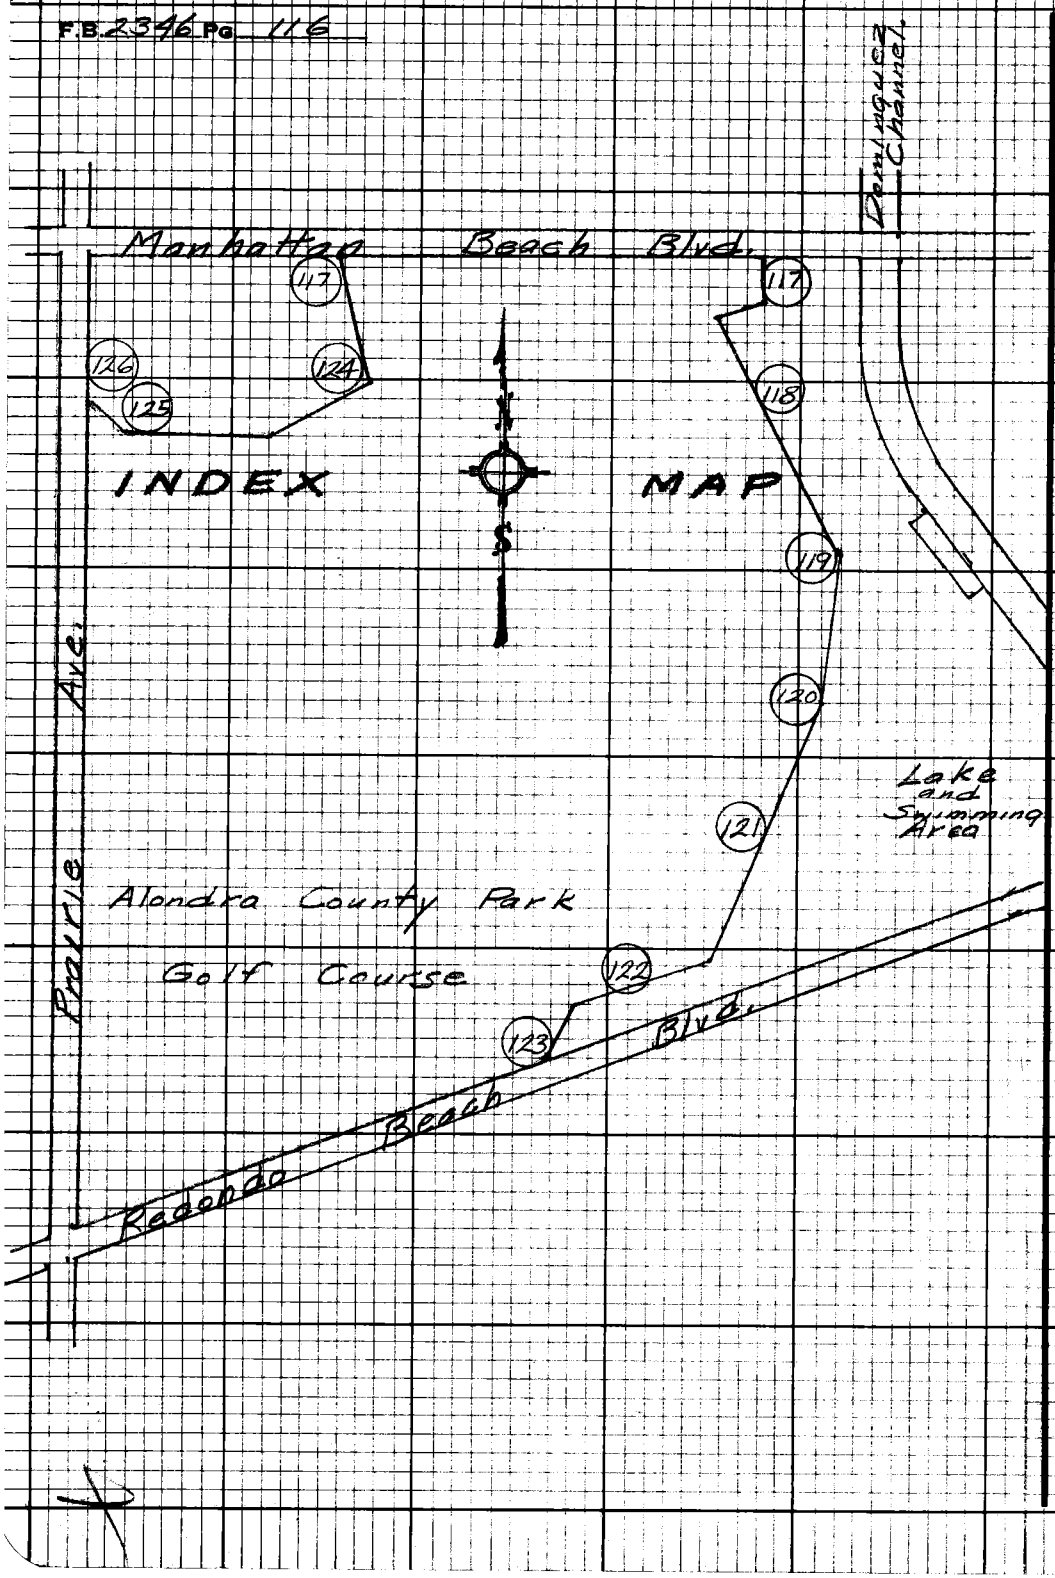

PLEASE RETURN TO
LOS ANGELES COUNTY ENGINEER
403 Los Angeles County Engineering Bldg.

Note: Any Additions or Changes on this Sheet Must be Made or Circled in Red Ink With Date and Name of Person Making Change.

Do not extend this side of this line.

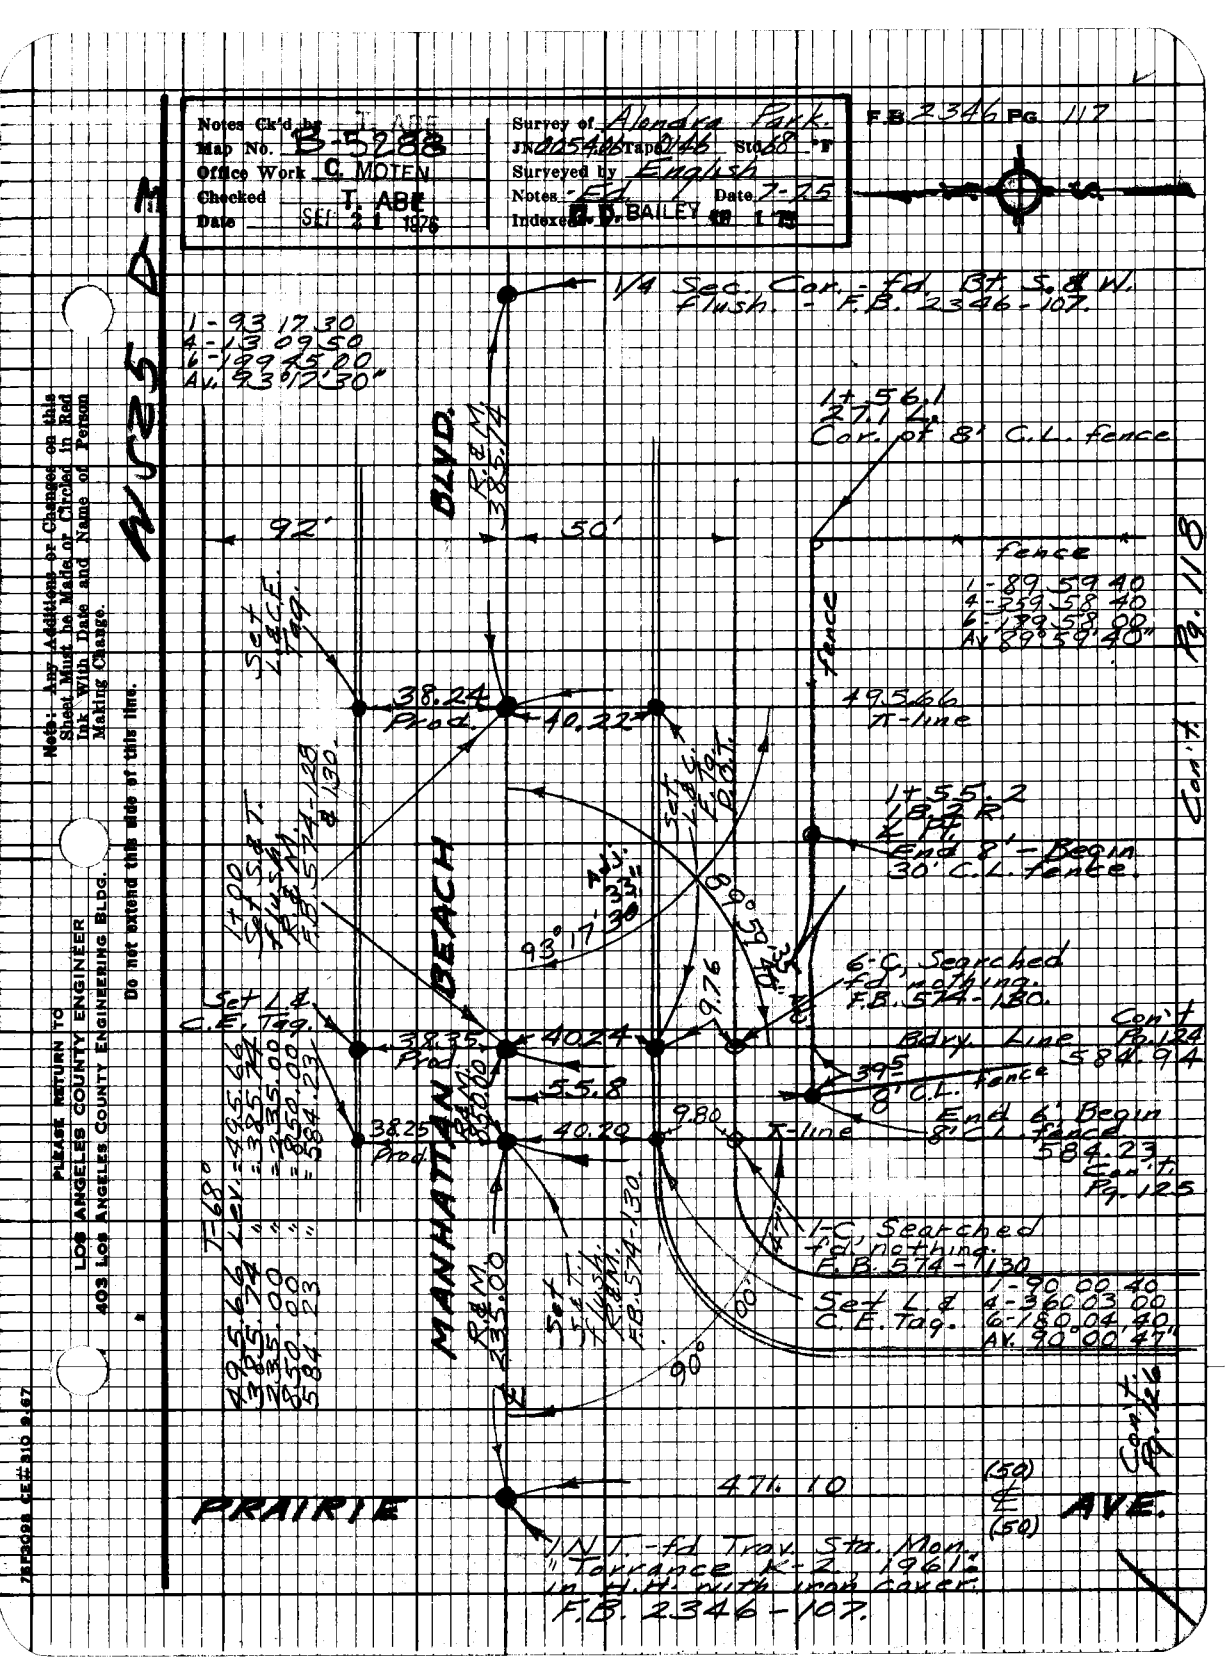
Notes Ck'd by T. ABT
Map No. B-5788
Office Work C. MOTEN
Checked T. ABT
Date SEP 21 1976
Survey of Alondra Park
Surveyed by English
Notes Ed
Date 7-25
Indexed by D. BAILEY
F.B. 2346 Pg. 117
1/4 Sec. Cor. - fd. Cut 5.8 W. Flush. - F.B. 2346 - 107.
1 - 93 17 30
4 - 13 09 50
6 - 179 25 00
Av. 93 12 30
1+56.1
27.1 Lt.
Cor. of 8' C.L. fence
fence
1 - 89 59 40
4 - 239 58 40
6 - 179 58 00
Av. 89 59 40
Con't Pg. 118
19.56 ℄-line
1+55.2
19.2 Rt.
℄ Pl.
End 8' - Begin 30' C.L. fence.
6-C, Searched fd. nothing. F.B. 574-180.
Con't Pg. 124
Bdry. Line
584.94
39.5
8' C.L. fence
End 6', Begin 8' C.L. fence
584.23
Con't Pg. 125
1-C, Searched fd. nothing. F.B. 574-130
Set L.& C.E. Tag.
1 - 90 00 40
4 - 360 03 00
6 - 180 04 40
Av. 90 00 47"
Con't Pg. 126
92'
50'
BLVD.
MANHATTAN BEACH
PRAIRIE
AVE.
(50)
(50)
R=35.74
38.24 Prod.
10.22
Set 1/4" I.P. Flush
38.35 Prod.
40.24
55.8
38.25 Prod.
40.29
9.80
9.76
Set L.& C.E. Tag.
Set 1/4" I.P. Flush F.B. 574-130.
R=33.00
T=180°
Dev. = 3 35 54.66
= 3 35 00.00
= 0 54.66
= 3 35 00.23
0 54.43
N 89 59 59.77 E
S 89 59 59.77 W
S 0 00 00.23 E
S 89 59 59.77 W
471.10
1 N.T. - fd Trav. Sta. Mon. Torrance K-2 1961 in M.H. with iron cover. F.B. 2346-107.
Note: Any Additions or Changes on this Sheet Must be Made or Circled in Red Ink With Date and Name of Person Making Change.
Do not extend this side of this line.
PLEASE RETURN TO
LOS ANGELES COUNTY ENGINEER
403 LOS ANGELES COUNTY ENGINEERING BLDG.
FB 598 CE #310 9-67

F.B. 2346 Pg. 118

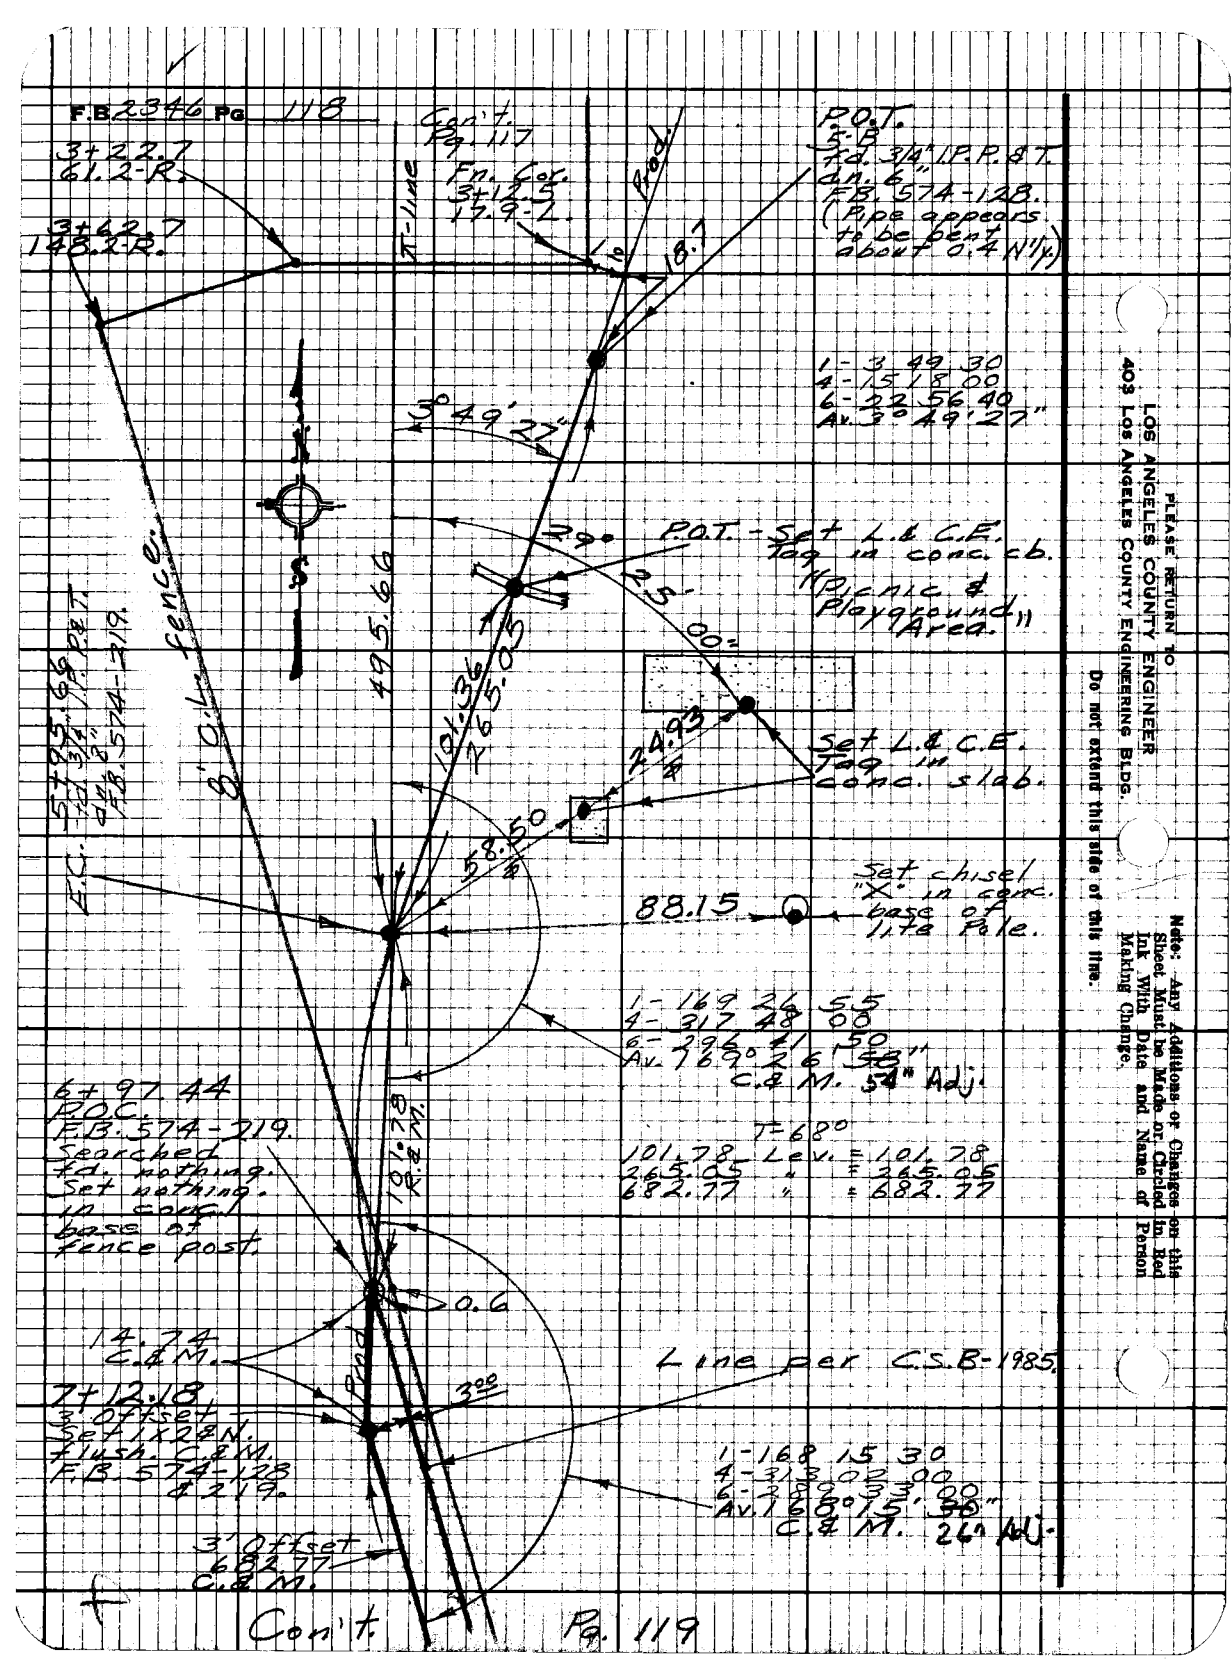

Cont'd Pg. 119

PLEASE RETURN TO
LOS ANGELES COUNTY ENGINEER
403 Los Angeles County Engineering Bldg.

Do not extend this side of this line.

Note: Any Additions or Changes on this Sheet Must be Made or Circled in Red Ink With Date and Name of Person Making Change.

Notes Ck'd by T. ABE
Map No. B-5288
Office Work C. MOTEN
Checked T. ABE
Date SEP 21 1976

Survey of Alonda Co. Park
JN 025406 Tape 01-46 Sta 68 "F"
Surveyed by English
Notes Ed. Date 7-25
Indexed G. D. BAILEY

F.B. 2346 Pg. 119

Note: Plus & offsets are from 3rd offset line.

Con't. Pg. 118

N

S

X Pt. 12+77.2 3.1 L.

line per C.S.B-1985.

134+26.0 X Pt. 13.9 L.

3.29

300 offset Set 1/2 C.E. Tag. in conc. Smale.

Conc. S.D.

X Pt. 13+34.1 14.0 L.

Conc. W.ing Wall

682.8 N.

3' Offset Set 1/2 C.E. Tag. - flush. C.L.M. from E.C. - Pg. 118. 13+94.9.5

14-A FB. 574-129 C.S.B-1985. Fd. nothing. (under fa. post base) Set Nothing FB. 574 -220 & 221.

3.11 C.L.M. at A. Sp. Lt.

1-148 45 30
4-235 02 30
4-172 33 30
Av 148° 45' 35" .39" Adj.
C.L.M.

560.70 Offset

300 C.L. Fence S.B-1985. Line per C.S.B-1985.

T=68°
560.70 Len = 560.70

Con't. Pg. 120

PLEASE RETURN TO
LOS ANGELES COUNTY ENGINEER
403 LOS ANGELES COUNTY ENGINEERING BLDG.

Note: Any Addition or Change on this Sheet Must be Made or Circled in Red Ink With Date and Name of Person Making Change.

Do not extend this side of this line.

26F3098 CE#310 9.67

F.B. 2346 Pg. 120

Cont. Pg. 119

Note: Plus & Offsets are from 3' offset line.

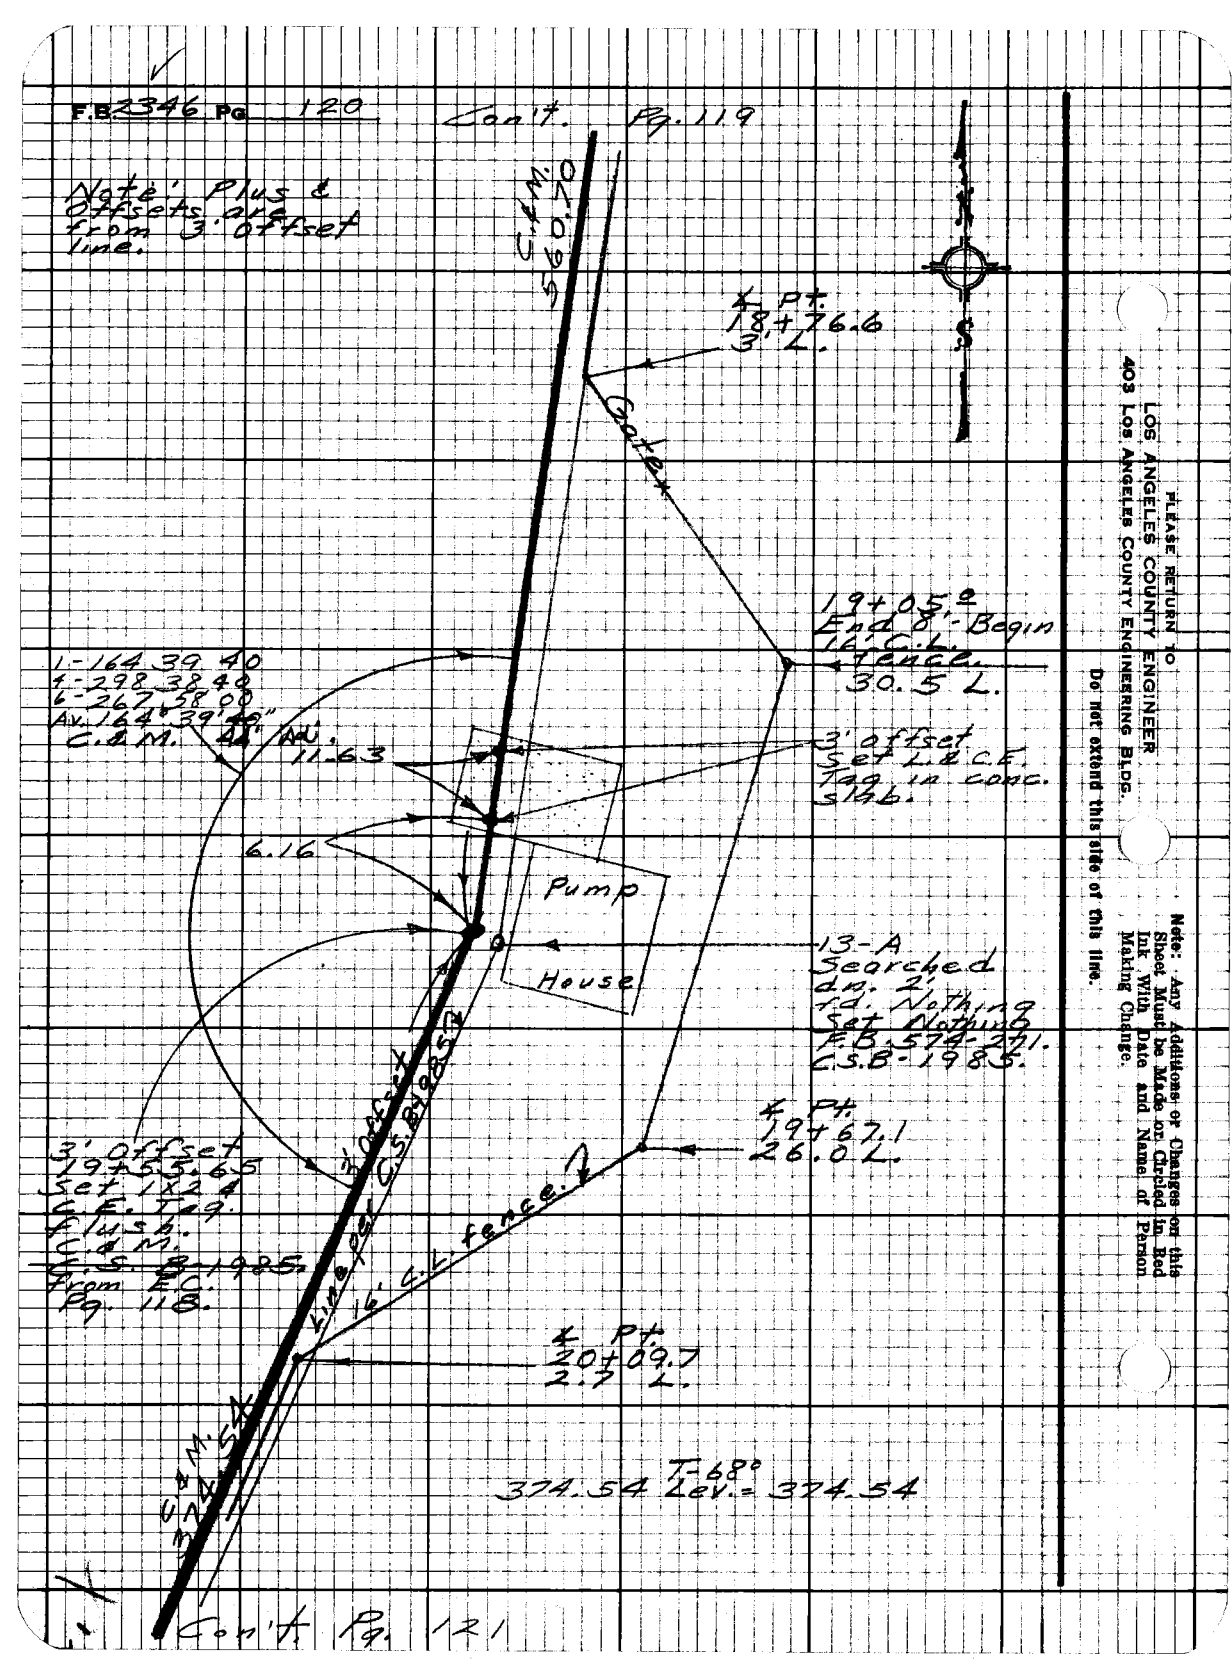

Cont. Pg. 121

PLEASE RETURN TO
LOS ANGELES COUNTY ENGINEER
403 Los Angeles County Engineering Bldg.

Note: Any Additions or Changes on this Sheet Must be Made on Circled in Red Ink with Date and Name of Person Making Change.

Do not extend this side of this line.

Notes Ck'd by T. Abe
Map No. B-5288
Office Work C. MOTEN
Checked T. ABE
Date SEP 21 1976

Survey of Alondra Co. Park F.B. 2346 Pg. 121
JN 00514 Shape City Stake "T"
Surveyed by English
Notes Ed. 1 Date 7-25
Indexed by D. BAILEY AS 1"=

Con't. Pg. 120

C.S.B.-1985 Plus 16' C.L. Fence Offset 3.07 Left

1 - 177 06 30
4 - 348 25 50
6 - 342 38 50
Av. 177 06 28
C.& M. 32' Adj.

12 - A Searched Ft. nothing Set nothing under large Ft. Post (Foot. mg) C.S.B. 1985 F.B. 574:270.

End 16' Begin 20' C.L. Fence.

2.37+30.19
3.07 Left
Sat 1424
C.E. Pag
Plus 4.1
C.S.B. 1985.
From E.C.
Pg. 118.

End 20' Begin 30'± C.L. Fence. 24+88.7

End 30'± Begin 8' C.L. Fence. 26+69.2 2.9 L.

589.10 T-68° Lev. = 589.10

Con't. Pg. 122

Note: Any Additions or Changes on this Sheet Must be Made or Circled in Red Ink With Date and Name of Person Making Change.

Do not extend this title of this line.

PLEASE RETURN TO
LOS ANGELES COUNTY ENGINEER
403 LOS ANGELES COUNTY ENGINEERING BLDG.

75FSG98 CE#810 2-67

F.B. 2346 Pg. 122

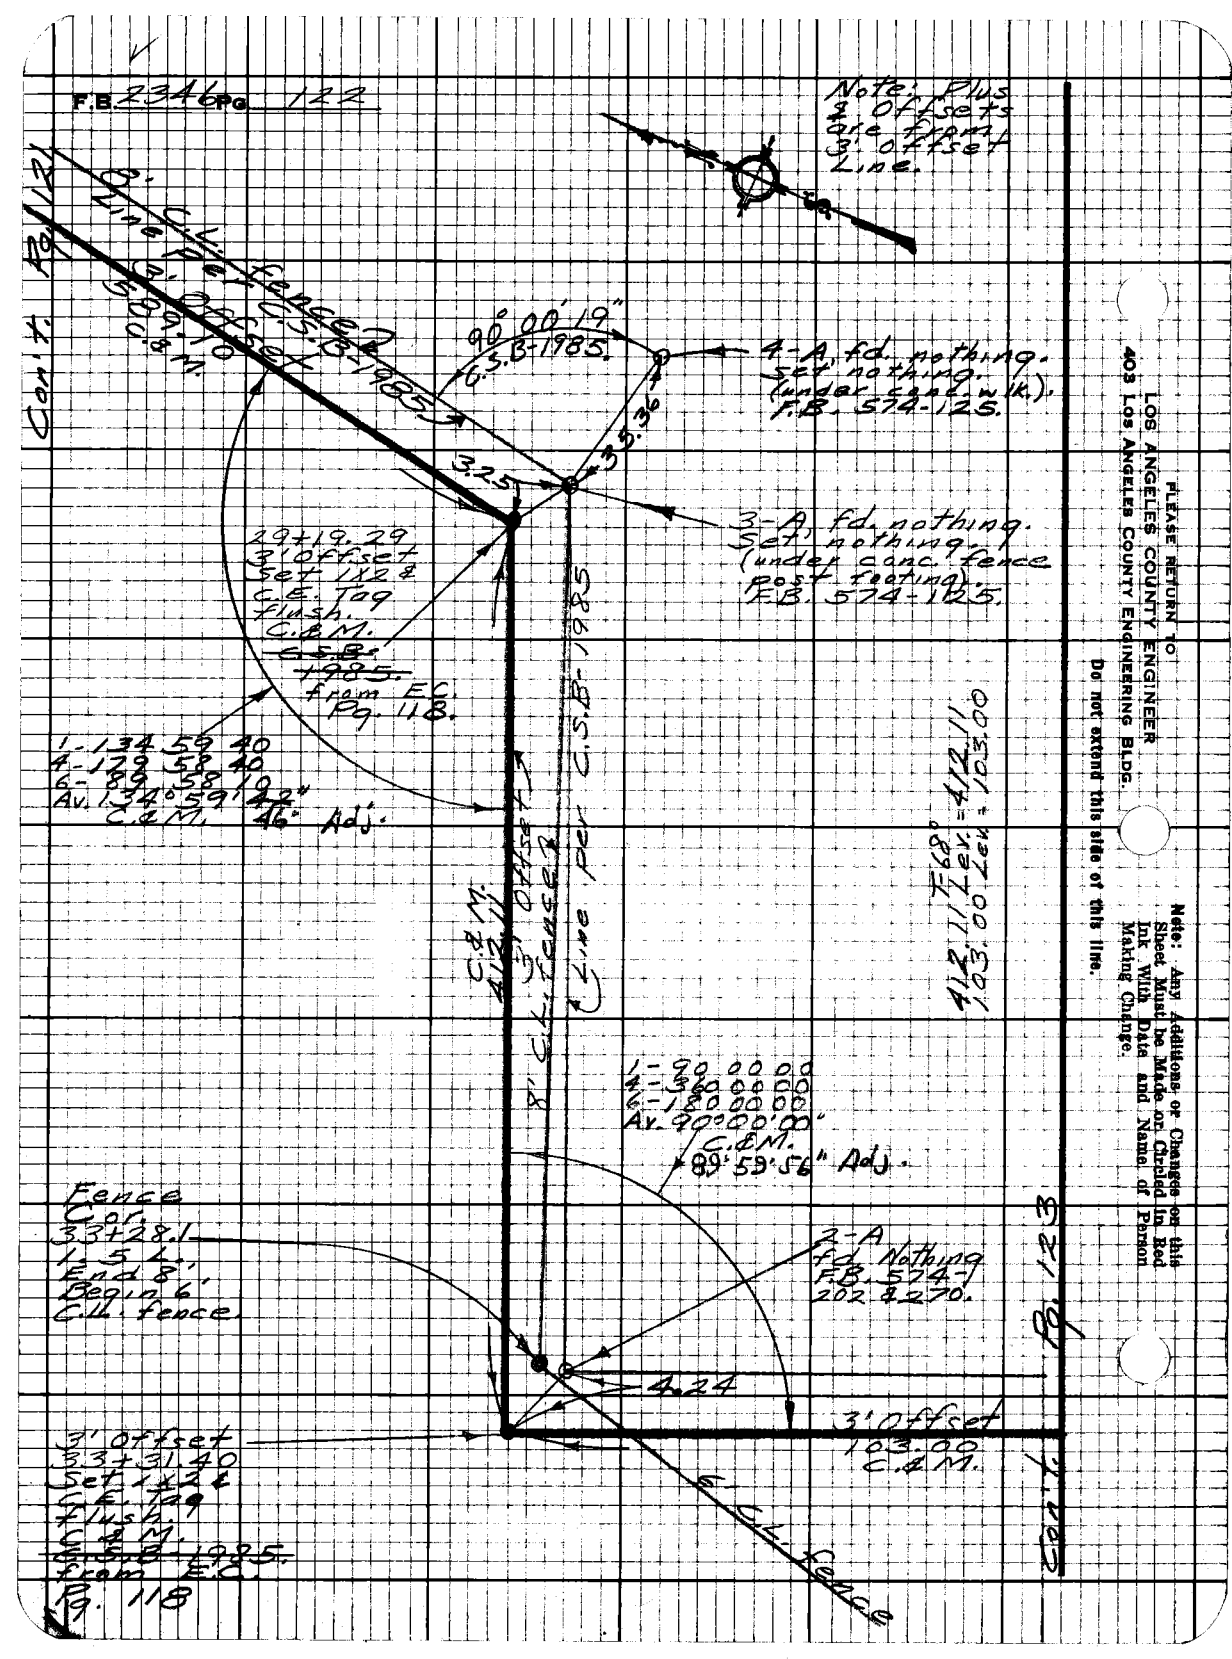

PLEASE RETURN TO
LOS ANGELES COUNTY ENGINEER
403 Los Angeles County Engineering Bldg.

Do not extend this side of this line.

Note: Any Additions or Changes on this Sheet Must be Made on Circled in Red Ink With Date and Name of Person Making Change.

Notes Ck'd by T. ABE
Map No. B-2488
Office Work C. WOTEN
Checked SEP. T. ABE
Date

Survey of Alondra Co. Pk. A.
JN 085106 Tape 0146 Sur 68 "B"
Surveyed by English
Notes Ed. Date 2-25
Index G. D. BAILEY

F.B. 2346 Pg. 123

Note: Any Additions or Changes on this Sheet Must be Made or Circled in Red Ink With Date and Name of Person Making Change.

Do not extend this side of this line.

PLEASE RETURN TO
LOS ANGELES COUNTY ENGINEER
403 Los Angeles County Engineering Bldg.

7ERSCOR CE#310 9-67

M 1425

Fd. L & T. - dn. 3" in conc. Pvm't.
F.B. 574-195.
-185

Fd L & T dn 4"
F.B. 454 - 127, 132

Searched through 3" of P.M. pvm't. to old conc. pvm't. fd. nothing.

2.85
2.81
.82

F 68°
856.83 Lev. = 856.83
764.89 Lev. = 764.89
1197.69 " = 1197.69

YUKON AVE.

REDONDO BEACH BLVD.

856.83

1-A, Searched fd. nothing. Set nothing. F.B. 574-195.

3' Offset Set.

3' Offset Set 3/4" I.P. Flush. By Int. C.S.B.-1985. See 3' Offset Line Mons. From P.C. Pg. 118.

Line Per C.S.B.-1985.

C.L. M. 10300

3' Offset Set Nail.

40.18

38.12 Prod.

9.51

Con't. Pg. 122

Cor. C.L. Fence.

50±

975

764.89 C.L.M.

(50)

(50)

1197.69

Set 1" I.P. Tag.

Int. Redondo Beach Blvd. & Greenleaf Drive. Searched fd. Nothing. F.B. 574-195. Set 3/4" I.P. Flush. C & M. C.S.B.-1985.

1-89°59'20"
4-359°57'40"
6-179°58'30"
Av. 89°59'30"
29.4' Adj.

PRAIRIE AVE.

(50)

(50)

Trav. Sta. "Torrance K-3" O.E. 2177. Set 1942. fd. Br. cp. mon. Stamped as shown in well with iron cover. C.S.B.-1985. F.B. 2455-59.

F.B. 2346 Pg. 124

T=68°
141.47 Lev. = 141.47
584.94 " = 584.94
650.00 " = 650.00

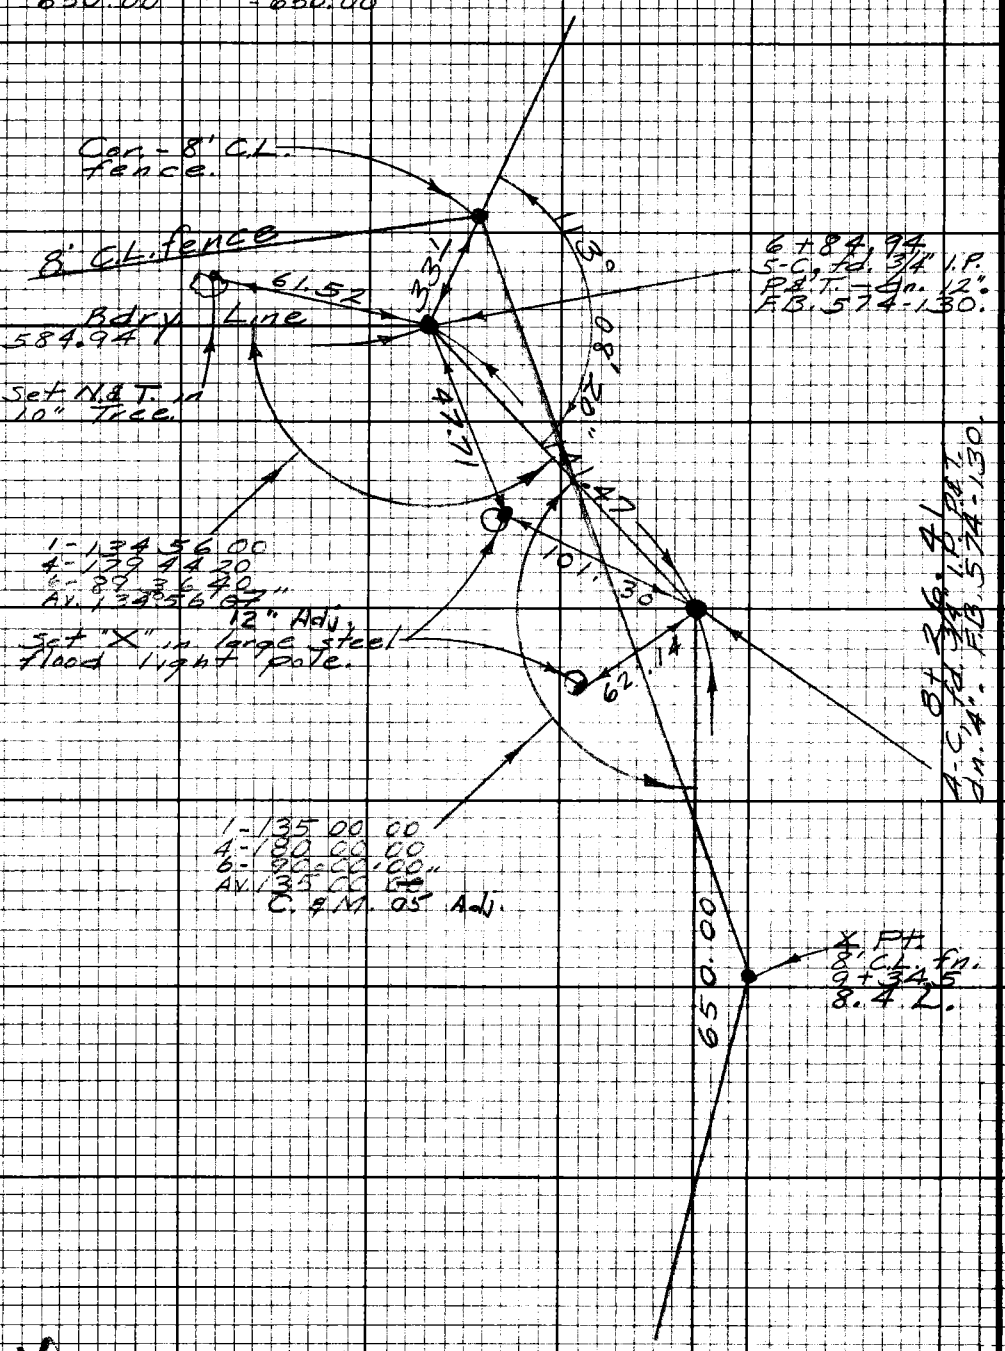

PLEASE RETURN TO
LOS ANGELES COUNTY ENGINEER
403 Los Angeles County Engineering Bldg.

Note: Any additions or Changes on this Sheet Must be Made in Circled in Red Ink With Date and Name of Person Making Change.

Do not extend this side of this line.

Notes Ck'd by T. A. P.
Map No. D-52-88
Office Work C. MOTEN
Checked T. A. P.
Date SEP 21 1979

Survey of Alondra Co. Park
Job 5406 Tape 9 1/2 Sta 18 "F"
Surveyed by English
Notes Date 7-25
Indexed D. BAILEY

F.B. 3346 Pg. 125

Note: Any Additions or Changes on this Sheet Must be Made or Circled in Red Ink With Date and Name of Person Making Change.

Do not extend this side of this line.

RETURN TO
LOS ANGELES COUNTY ENGINEER
403 Los Angeles County Engineering Bldg.

Cont. Pg. 124

Set L & C.E. Tag Lead Ltg. A.F.

1-L 135 00 00
1-R 180 00 00
Δ 135 00 00
C. & M. 45' Adv.

Set L & C.E. Tag in Conc. base at 19+17.83 Adv. 45.00' Adv.

Set L & C.E. Tag in Conc. base at 14+76.41

3-C. Sewer head 12" Vit. clay pipe 10" N. 12° E. 574-130 E. 8.5

T = 68°
Adv. 141.42
204.88

Set Sq. Hd. S.&T. in Pvmt.

8" S.C. Sewer Line 650.00

38.12 Adv.

67.87

49.59

P.O.T.

Set L & C.E. Tag in Conc. base at 19+17.83 Adv. 45.00' Adv

F.B. 3346 Pg. 126

Cont'd Pg. 117

55.84 Δ = 68° 4 = 55.84
471.10 L = 471.10

471.10

For Ties to Conc. Mon. See Pg. 135

Set PK Nail in S.W. ℄ T. Husn. Br. in T. C.S.B - 1985.

S 57.5K Line

1 - 64 15
4 - 257 00
6 - 250 31
Av. 64 15
14

PRAIRIE (150) ℄ (50) AVE.

Fd. L & T.

166th (40) ℄ (40) ST.

55.84

40.21 Prod.

Fd. L & T.

Fd. L & T.

X Pt - fd R.D. Bt. S.W. ℄ T. Husn. F.B. 1854 - 76.