Notes Ck'd by

Survey of

JN Tape Std °F

Surveyed by

Notes Date

Indexed

E. P. Pg.

Microfilmed Jan 86

Notes Ck'd by Miller		Survey of Potrero Grande	L.D. 25'18 Pg. 5
Map No.		IN 1253.90 Map 0192 Std. 68 °F	
Office Work		Surveyed by F.E. Brooks	
Checked		Notes F.E.B. Date 5 May 60	
Date		Indexed C. Johnson 6-3-60	

J.N. 0X52.90

POTRERO GRANDE STORM DRAIN

Project # 529

& Survey of Line C

Brooks
LeGault
Turrill
Sherman
Bicksler

RETURN TO
LOS ANGELES COUNTY ENGINEER
900 LOS ANGELES COUNTY ENGINEERING BLDG.

Note: Any Additions or Changes on This Sheet Must be Made or Circled in Red Ink With Date and Name of Person Making Change.

Do not extend notes this side of this line.

763068 CE #247—7-58

F.B. 1570 Pg. 6

Cont 1507 Pg 7

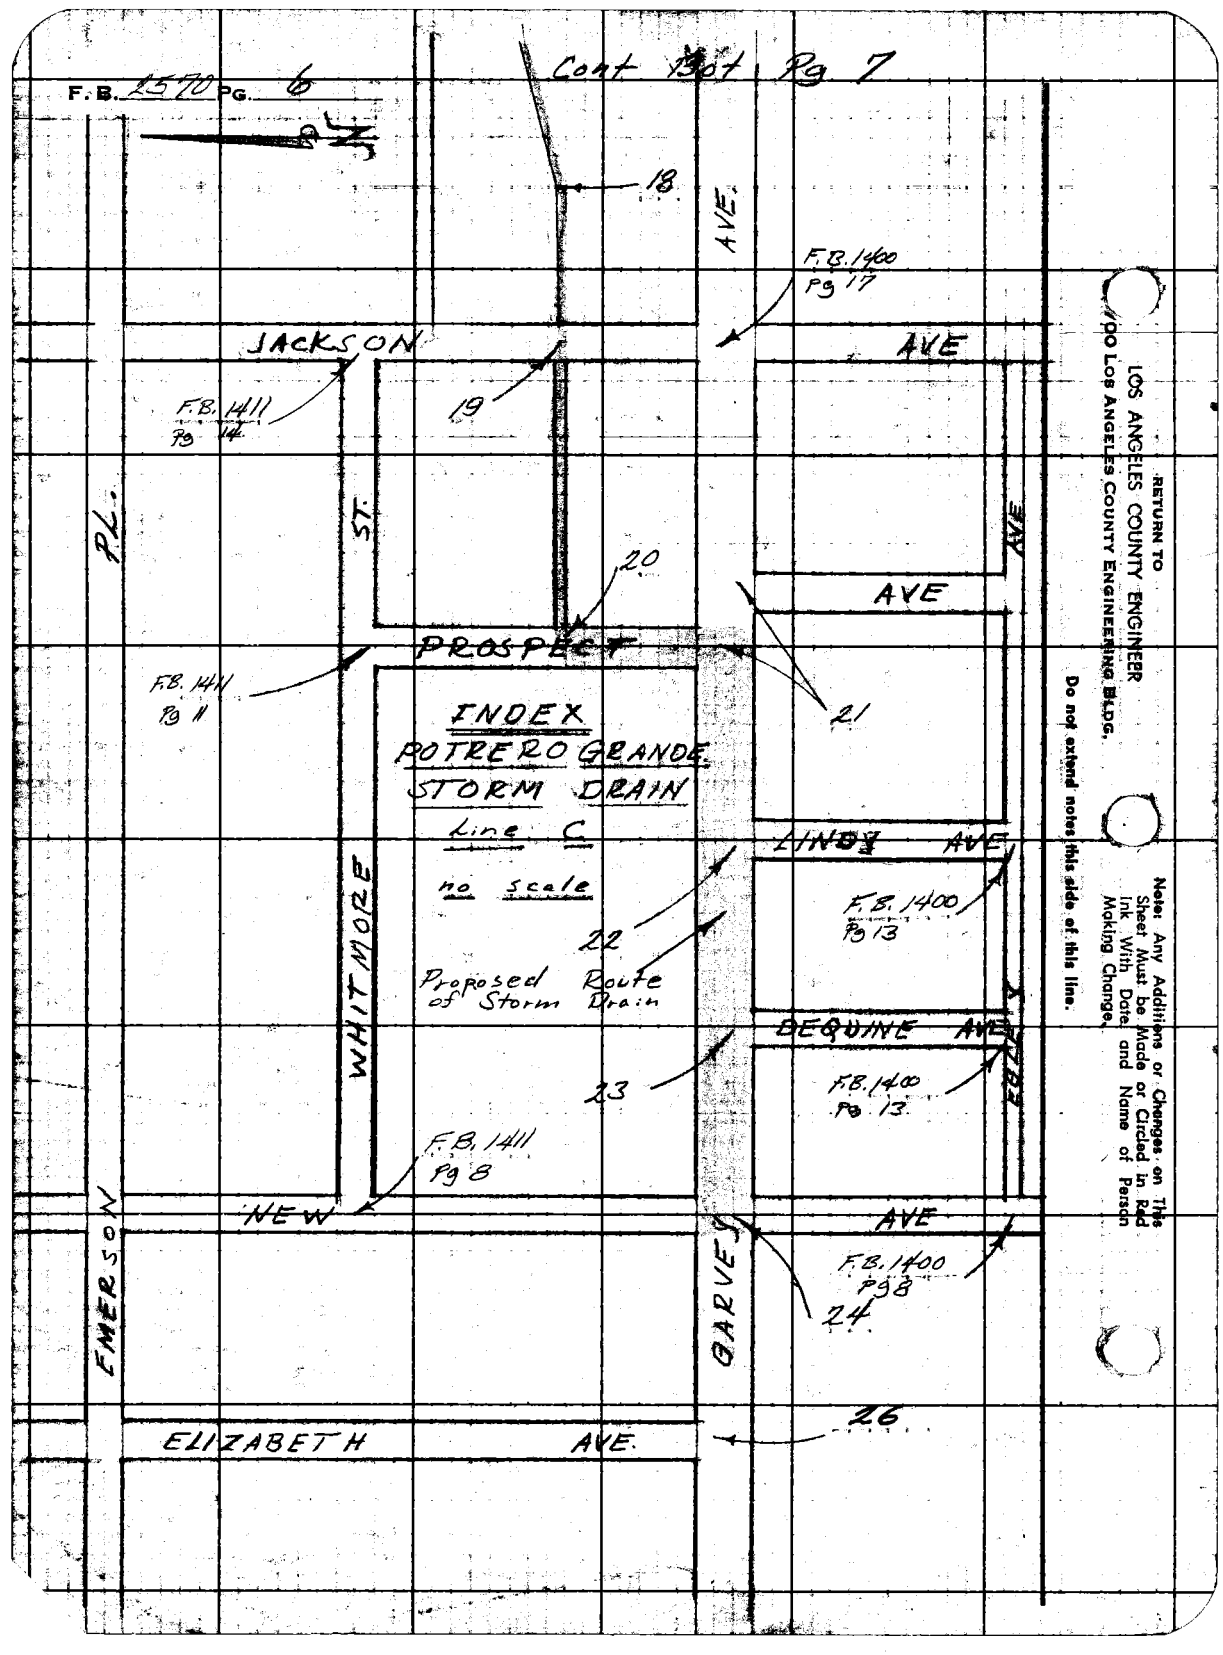

RETURN TO
LOS ANGELES COUNTY ENGINEER
900 Los Angeles County Engineering Bldg.

Do not extend notes this side of this line.

Note: Any Additions or Changes on This Sheet Must be Made or Circled in Red Ink With Date and Name of Person Making Change.

Notes Ck'd by Miller | Survey of Potrero Grande Storm Drain Line C
Map No. | JN 6252.30 Tape 0.92 Std. 66 °F
Office Work | Surveyed by F.E. Brooks
Checked | Notes F.B. Date 5 May 10
Date | Indexed C. Johnson

INDEX
POTRERO GRANDE STORM DRAIN
Line C.

no scale

DOROTHY AVE.

PL.

WHITMORE ST.

AVE.

B

F.B. 1435 Pg 29

9

11

DEL

MAR

AVE

C.S.B. 2232

10

F.B. 872 Pg 6

Proposed Route of Storm Drain

12

F.B. 872 Pg 6

EVELYN

AVE

F.B. 1282 Pg 12

14

13

F.B. 1282 Pg 11

15

16

EMERSON

GARVEY

ISABELL

AVE.

25

18

Const Top Pg 6

Note: Any Additions or Changes on This Sheet Must be Made or Circled in Red Ink With Date and Name of Person Making Change.

Do not extend notes this side of this line.

RETURN TO
LOS ANGELES COUNTY ENGINEER
900 LOS ANGELES COUNTY ENGINEERING BLDG.

76308 CE #247—7-53

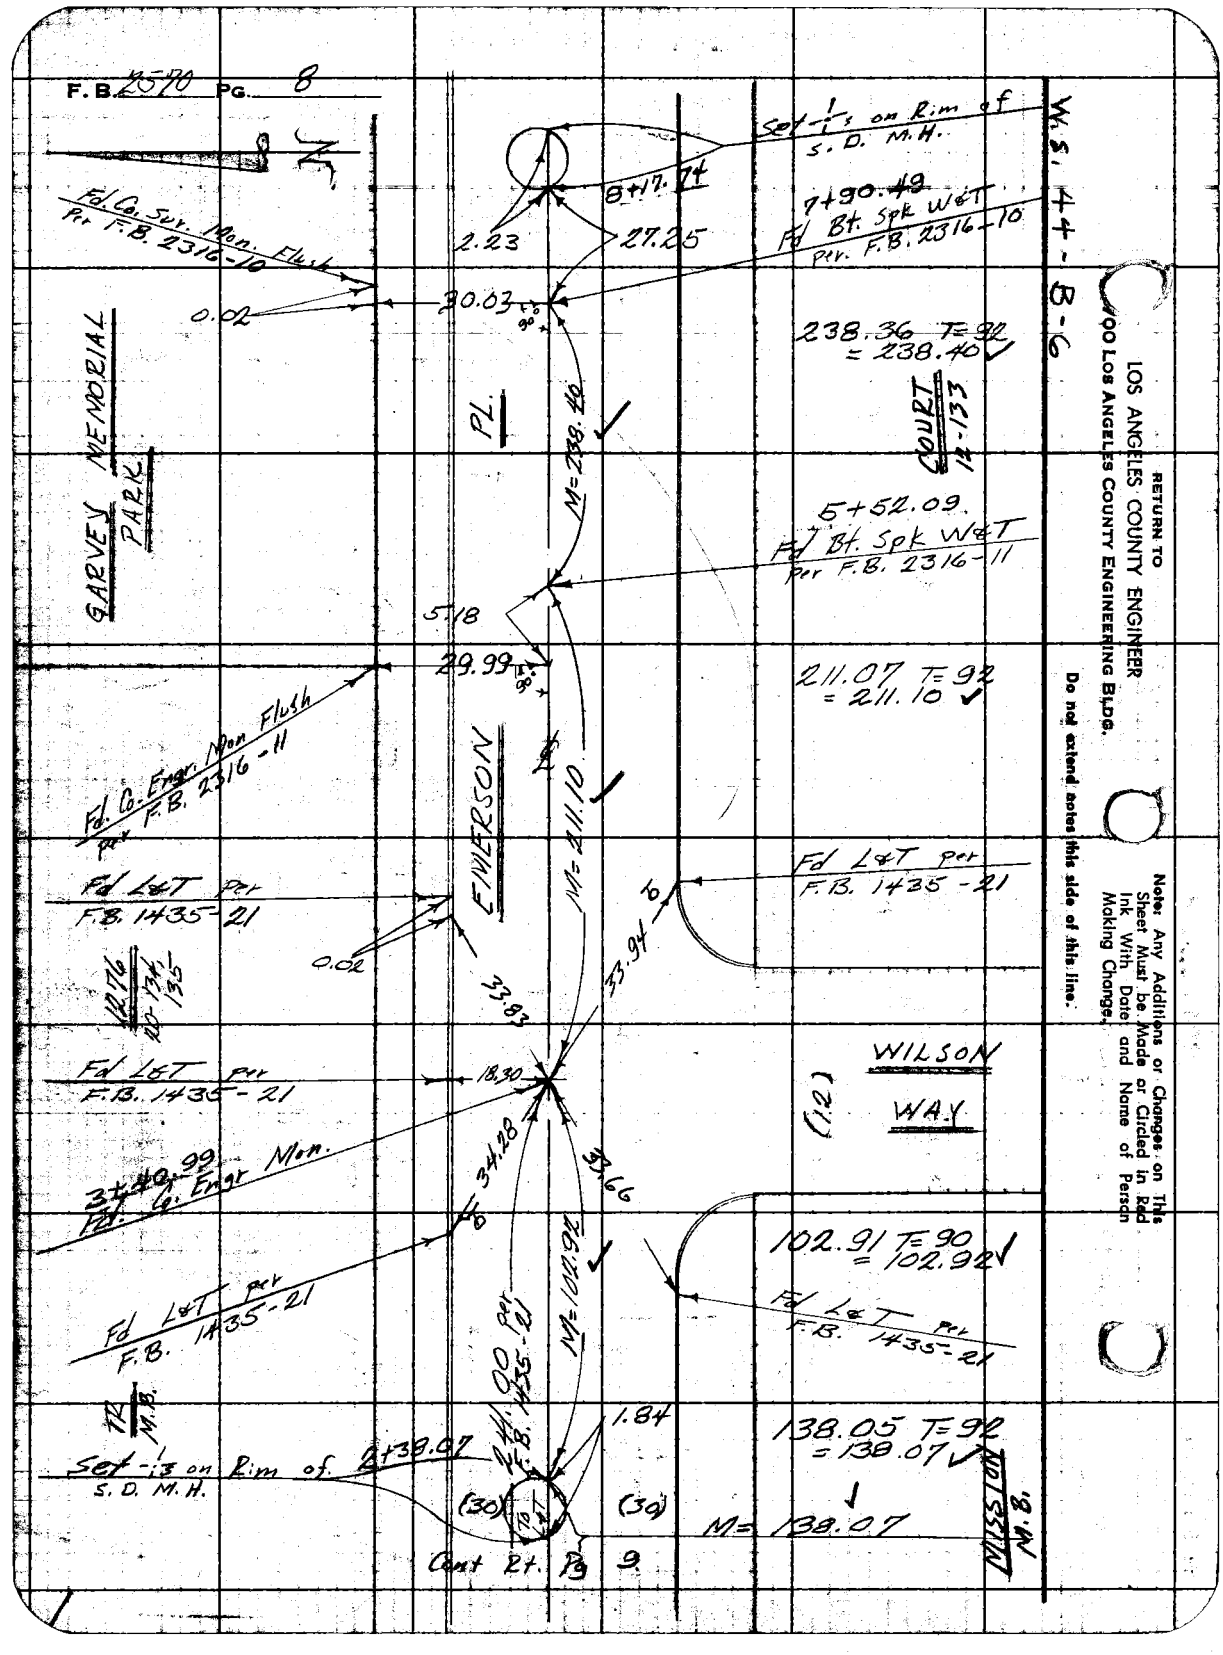
F.B. 2570 PG. 8
W.S. 44 - B-6
Set - 1's on Rim of S.D. M.H.
8+17.74
27.25
2.23
7+90.49
Fd Bt. Spk W&T
per F.B. 2316-10
Fd. Co. Surv. Mon. Flush
Per F.B. 2316-10
0.02
30.03
238.36 T=92
= 238.40
133-11
COURT
PL.
M=238.40
GARVEY MEMORIAL PARK
5+52.09
Fd Bt. Spk W&T
Per F.B. 2316-11
5.18
29.99
211.07 T=92
= 211.10
Fd. Co. Engr. Mon Flush
F.B. 2316-11
Per
EMERSON
M=211.10
Fd L&T per
F.B. 1435-21
Fd L&T per
F.B. 1435-21
0.02
33.94
12.76
RD 134-135
33.83
WILSON
WAY
(12)
Fd L&T per
F.B. 1435-21
18.30
3+40.99
Fd. Co. Engr Mon.
34.28
33.66
102.91 T=90
= 102.92
Fd L&T per
F.B. 1435-21
Fd L&T per
F.B. 1435-21
M=102.92
M.B.
Set - 1 on Rim of S.D. M.H.
2+39.07
(30)
(30)
1.84
138.05 T=92
= 138.07
M= 138.07
Cont 27. PB 9
RETURN TO
LOS ANGELES COUNTY ENGINEER
900 LOS ANGELES COUNTY ENGINEERING BLDG.
Do not extend notes this side of this line.
Note: Any Additions or Changes on This Sheet Must be Made or Circled in Red Ink With Date and Name of Person Making Change.

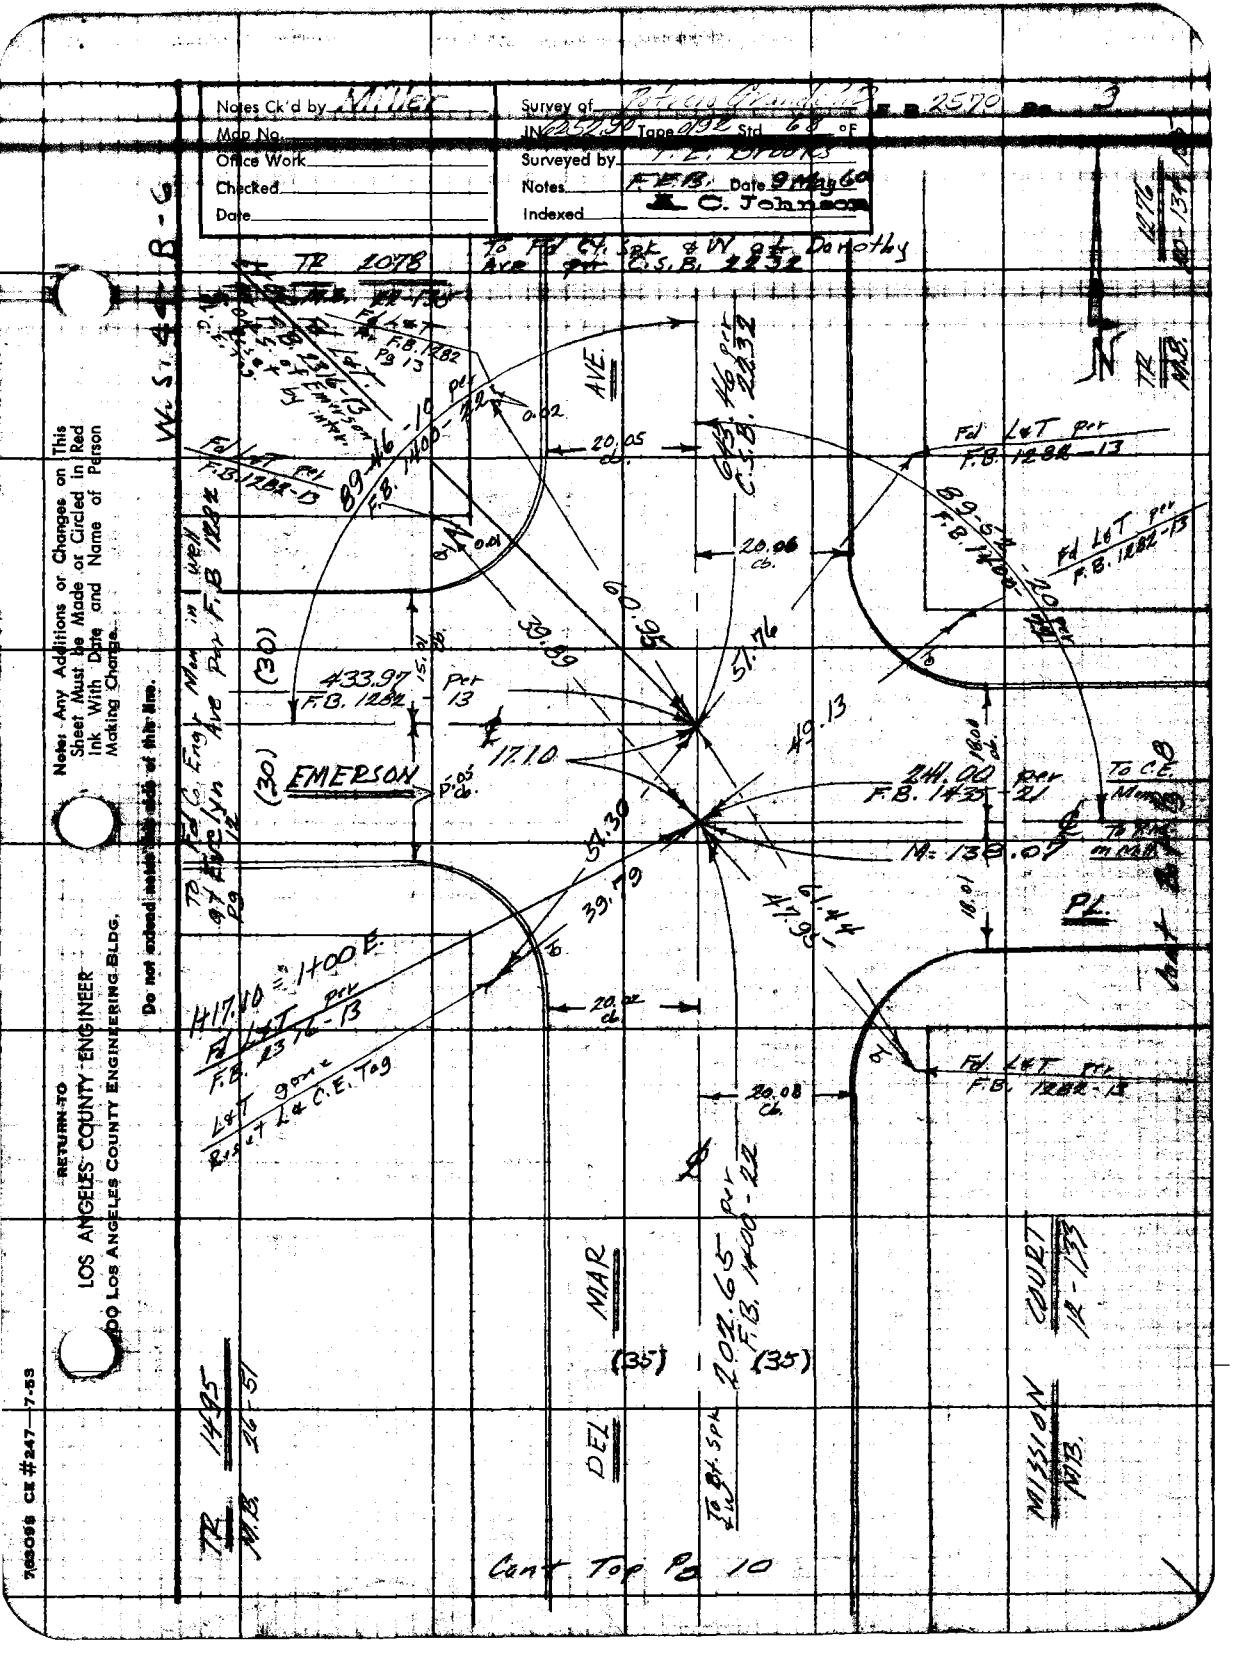

Notes: Any Additions or Changes on This Sheet Must be Made or Circled in Red Ink With Date and Name of Person Making Change.

Do not extend notes to back of this film.

RETURN TO
LOS ANGELES COUNTY ENGINEER
900 Los Angeles County Engineering Bldg.

765055 CE #247—7-55

RETURN TO
LOS ANGELES COUNTY ENGINEER
700 LOS ANGELES COUNTY ENGINEERING BLDG.

Note: Any Additions or Changes on This Sheet Must be Made or Circled in Red Ink With Date and Name of Person Making Change.

Do not extend notes this side of this line.

W.S. 44 - B-6

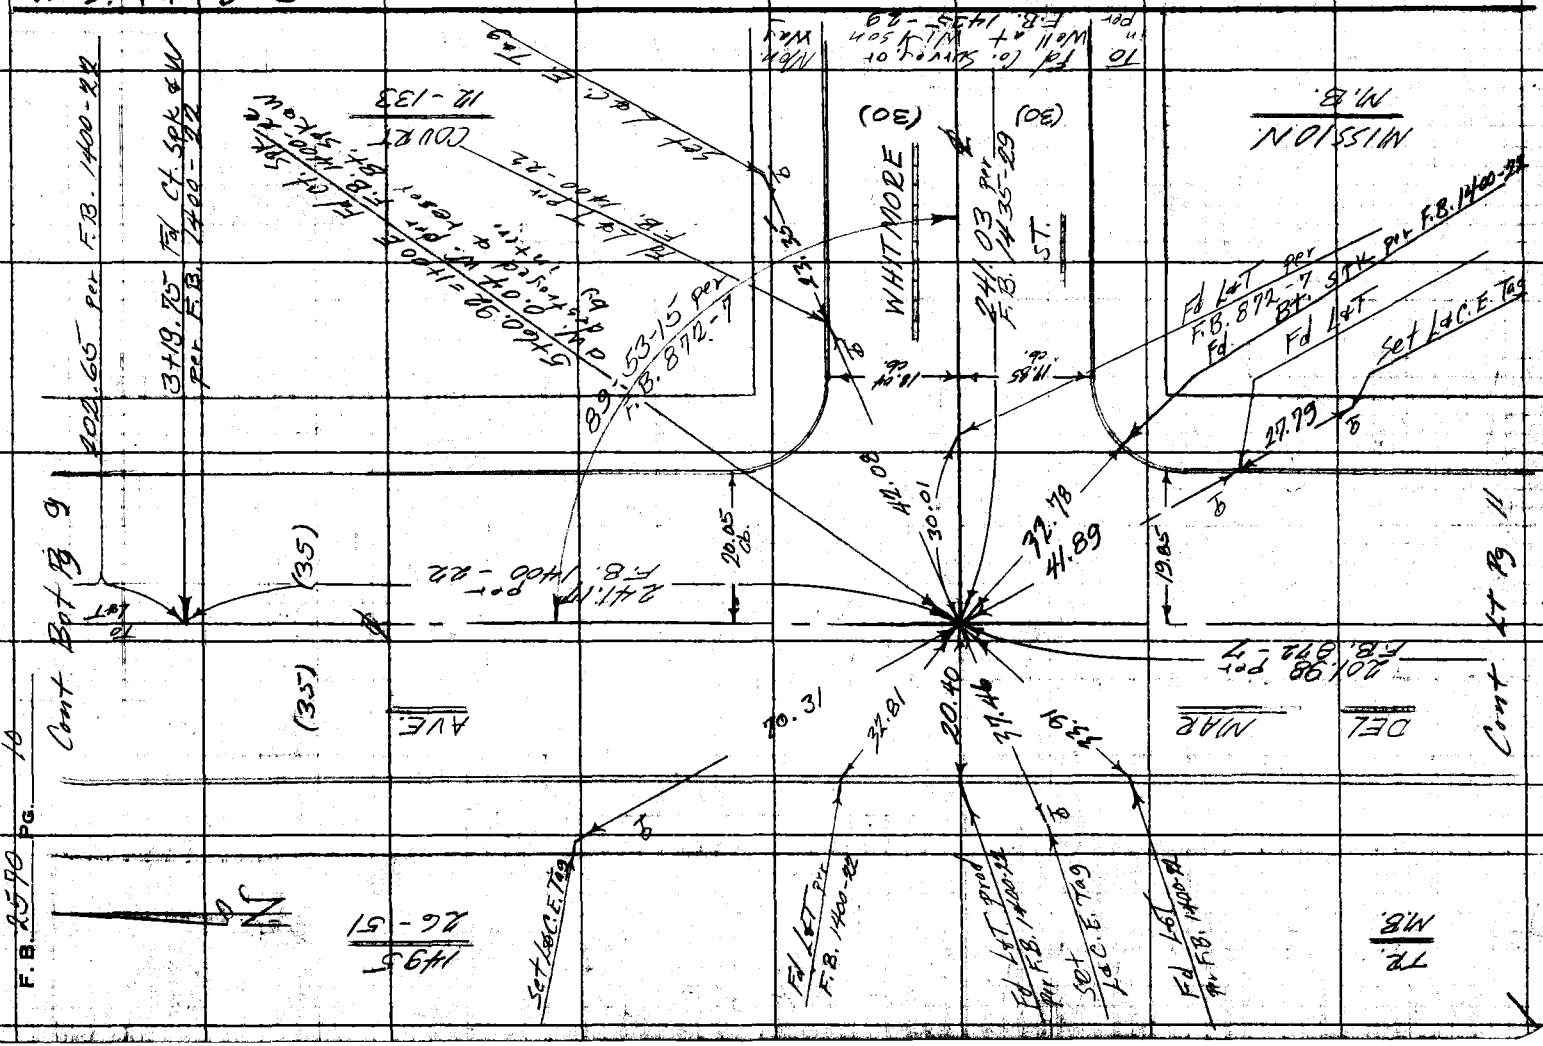
WHITMORE
ST.
(30)
(35)
Cont Bdy
Cont Lt
Bdy
Set L&C.E. Tag
Fd L&T per F.B. 1400-22
Fd L&T per F.B. 872-7
Fd L&T
Set L&C.E. Tag
Fd L&T per F.B. 1400-22
Set L&C.E. Tag
Fd L&T per F.B. 1400-22

Notes Ck'd by Miller
Map No.
Office Work
Checked
Date

Survey of P.L. Sta. 1
JN 1252.20 Tape 100 Std. 62 °F
Surveyed by F.E.B.
Notes F.E.B. Date 9 May 60
C. Johnson
Indexed

F.B. 1570 Pg. 11

VWS 44-B-3

Note: Any Additions or Changes on this Sheet Must be Made or Circled in Red Ink With Date and Name of Person Making Change.

Do not extend inside this line.

RETURN TO
LOS ANGELES COUNTY ENGINEER
900 LOS ANGELES COUNTY ENGINEERING BLDG.

76308 CE #247—7-53

Set L.E. Tag
MISSION
M.B.
Fd Ct. 3/4" I.P. F.B. 872-7
Set L.E. Tag
COURT
12-133
DEL
MAR
Fd L&T.
Fd L&T.
Set L&T
F.B. 872-7
201.98
Fd L&T.
31.84
36.00
20.05 ch.
36.66
10.00
65.01
AVE.
Fd L&T.
Set L&T
F.B. 872-7
5.03 ch.
5.00 ch.
20.04 ch.
Set L&T
F.B. 872-7
460.85
F.B. 872-7
Set L&T
F.B. 872-7
TR.
M.B.
(5)
TR. 1495
(5)
1495
26-51
(Cont Top Pg 12)

RETURN TO
LOS ANGELES COUNTY ENGINEER
900 LOS ANGELES COUNTY ENGINEERING BLDG.

Note: Any Additions or Changes on This Sheet Must be Made or Circled in Red Ink With Date and Name of Person Making Change.

Do not extend notes this side of this line.

W.O. S 44 - B-6

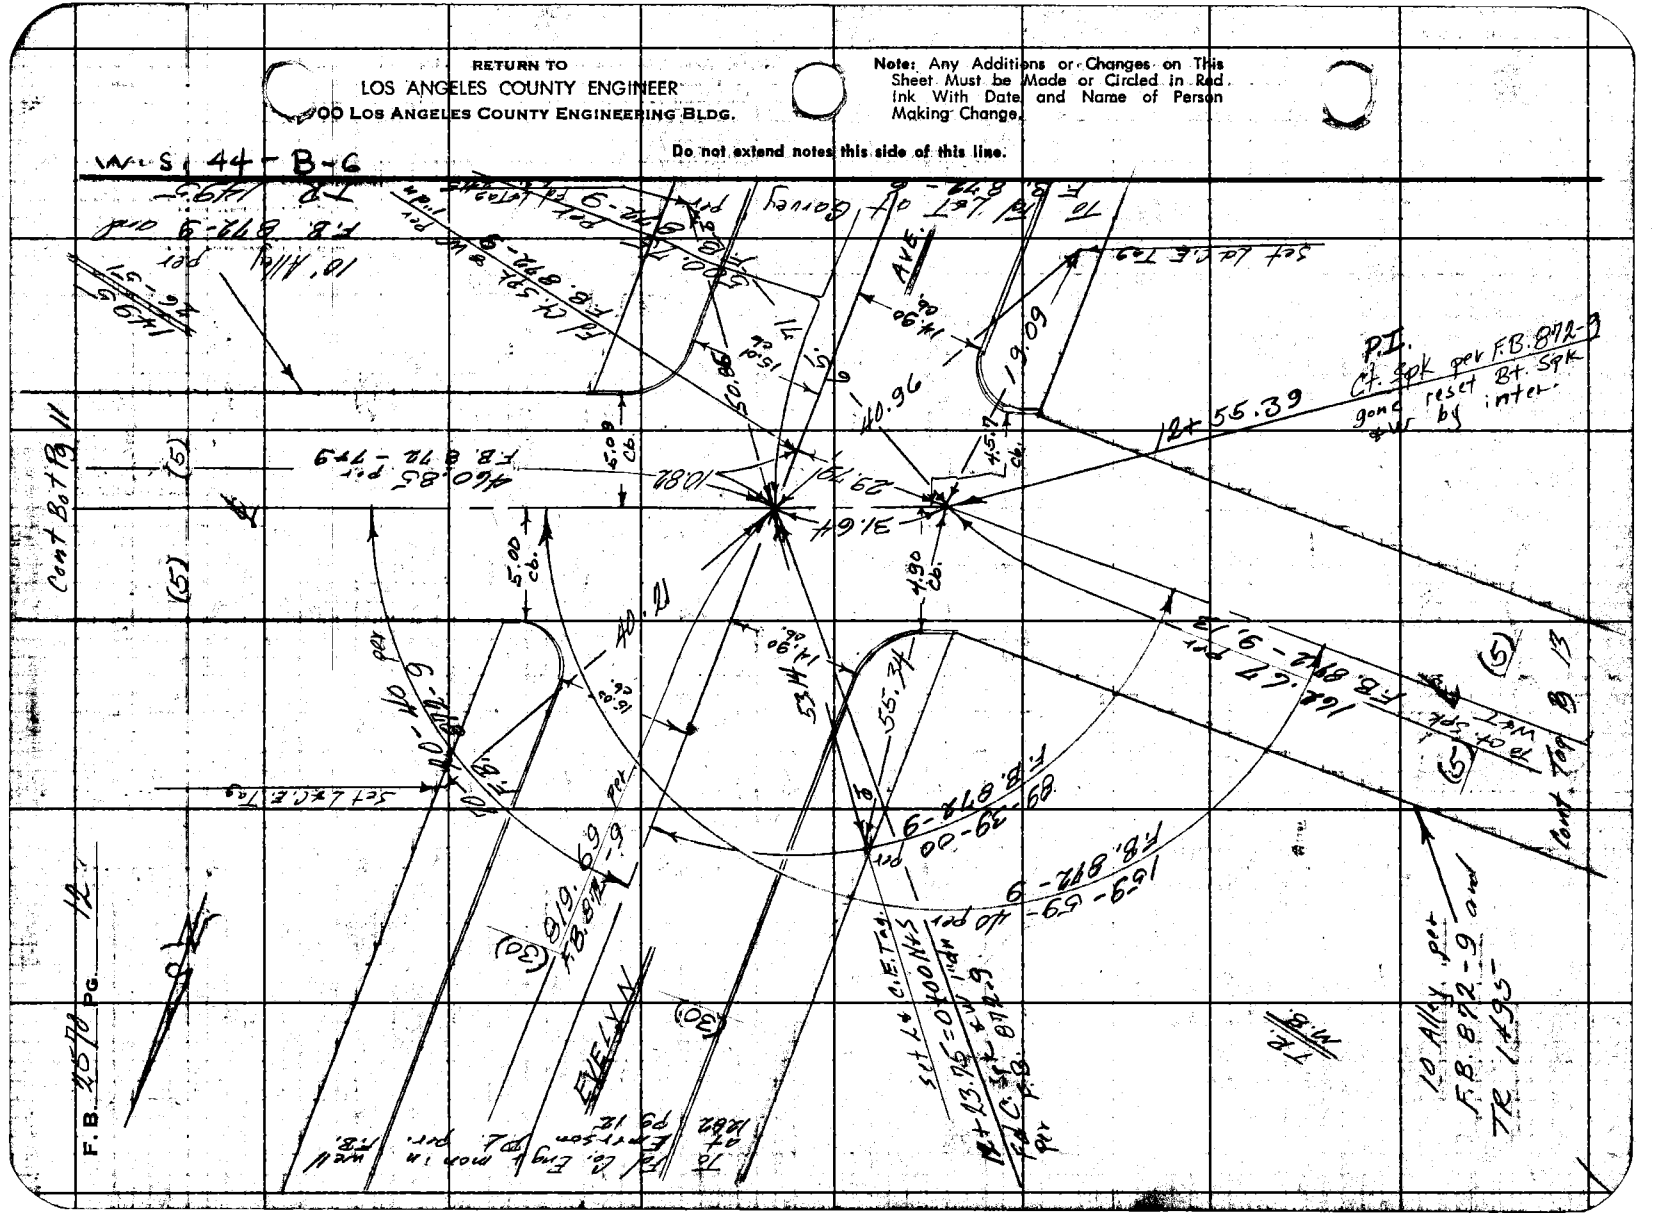
P.I.
Ct. Spk per F.B. 892-9
gone reset Bt. Spk
& W by inter.
Ex 55.39
Cont Bot Fig II
Cont Top Fig II
Set Lot C.E. Top
Ave.
EVELYN
F.B. 892-9
F.B. 878-9
F.B. 872-9




Cont Bot Pg 12

TR 1495
M.B. 26 - 54

To Spk

(5) (5)

10' Alley per F.B. 872-13 and TR 1495

1642.67 P't F.B. 872-9,13

Fd Bt. Spk & T.

Note: Any Additions or Changes on This Sheet Must Be Made or Circled in Red Ink With Date and Name of Person Making Change.

Do not extend notes past this line.

RETURN TO
LOS ANGELES COUNTY ENGINEER
900 LOS ANGELES COUNTY ENGINEERING BLDG.

W.L.S. 44-6

14+18.06 P't Fd Ct. F.B. 872-13 per

Set 3/4" I.P. Conc. Plug & Tag

C" Rock dr.

89 43 F.B. 872-13 per

11.79

78.26 per M=28.26

1/4=06-46 P't F.B. 872-13

F.B. 872-13

Cont. Lt. Pg 14

25.25 T=96 =28.26

26.84

16.3

11.88

90-00-00

Fd Bt Spk & T

49.30

2" Lemon

8.42 Drain per F.B. 872-13 & TR 5152

(4.21)

2" Apricot

25.2

9.8

2" Rock

5152 57-39

Set 3/4" I.P. Conc. Plug & Tag Illegible

Set 3/4" I.P. Conc. Plug & Tag Illegible

Cont. Lt. Pg 14

TR
M.B.

763098 CE #247—7-53

RETURN TO
LOS ANGELES COUNTY ENGINEER
900 LOS ANGELES COUNTY ENGINEERING BLDG.

Note: Any Additions or Changes on This Sheet Must be Made or Circled In Red Ink With Date and Name of Person Making Change.

Do not extend notes this side of this line.

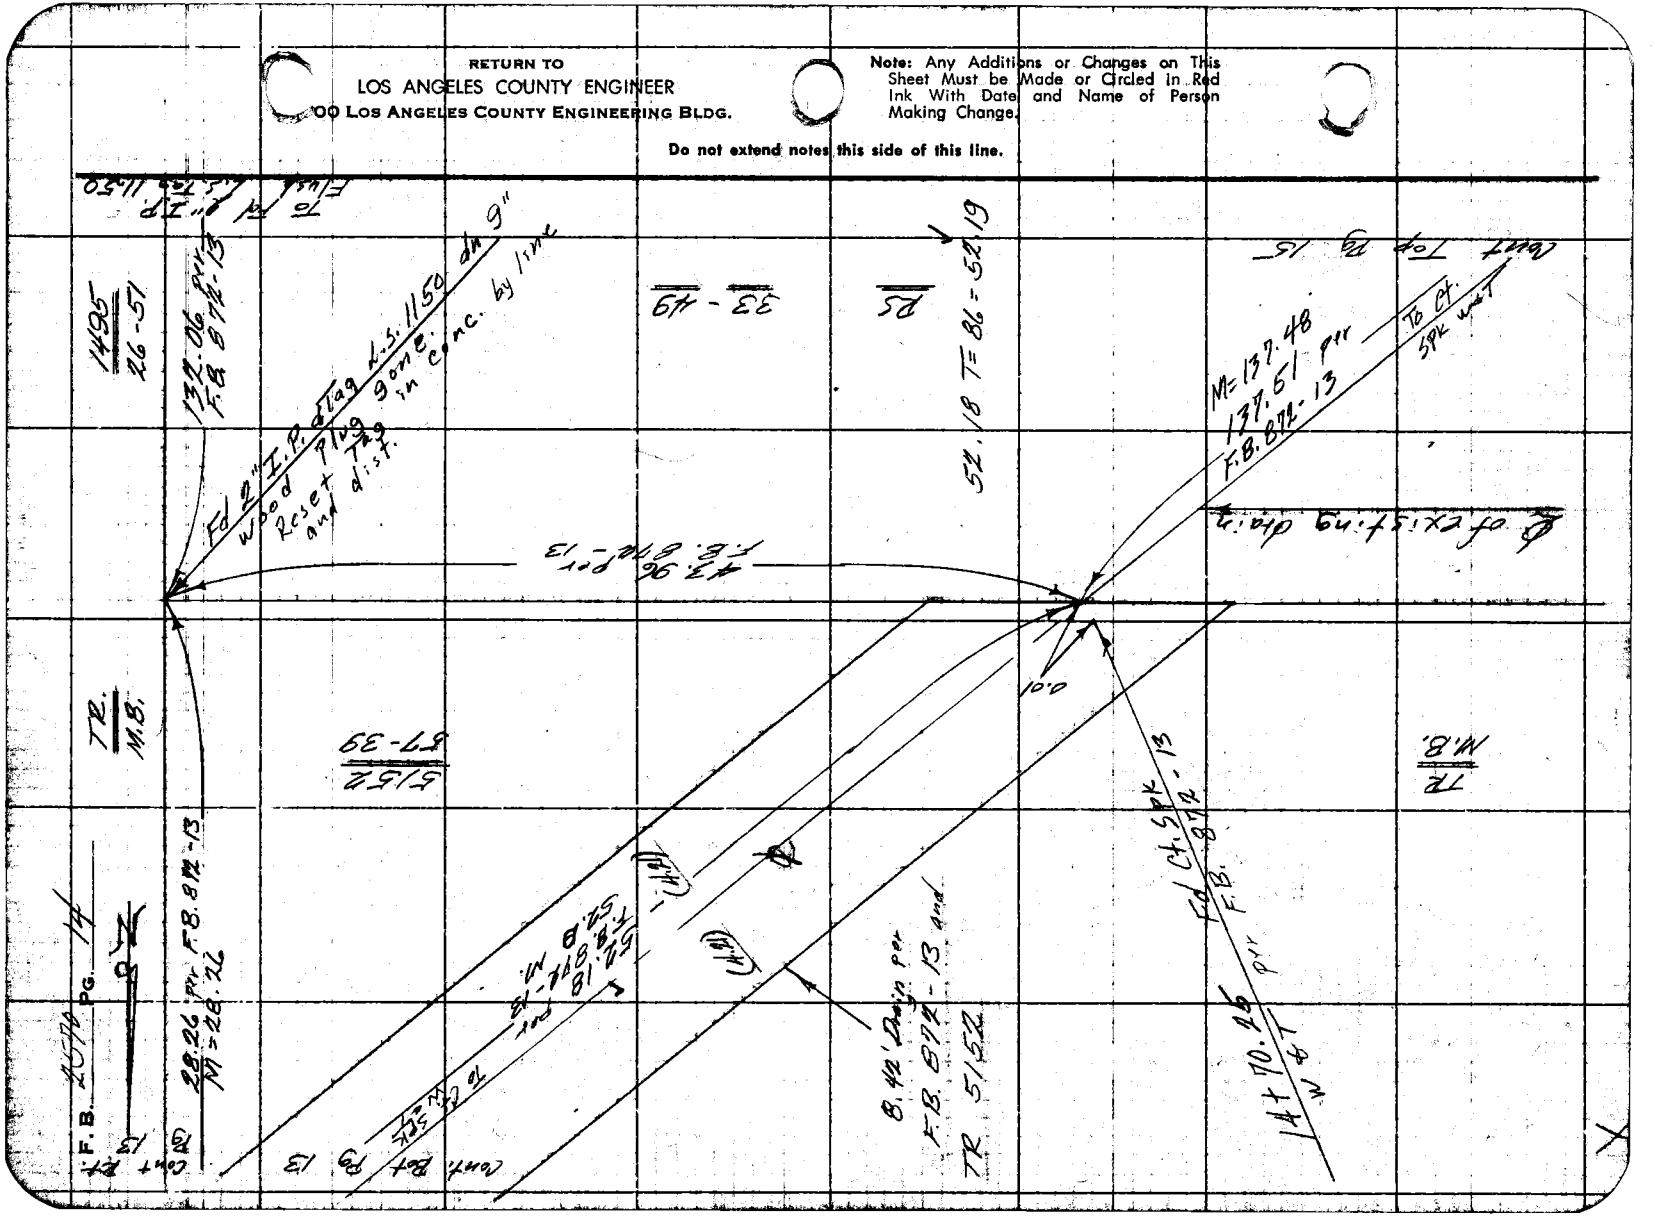

763095 CE #247—7-55

RETURN TO
LOS ANGELES COUNTY ENGINEER
900 LOS ANGELES COUNTY ENGINEERING BLDG.

Note: Any Additions or Changes on This Sheet Must be Made or Circled in Red Ink With Date and Name of Person Making Change.

Do not extend notes this side of this line.

W.S. 4[illegible] - B - 6

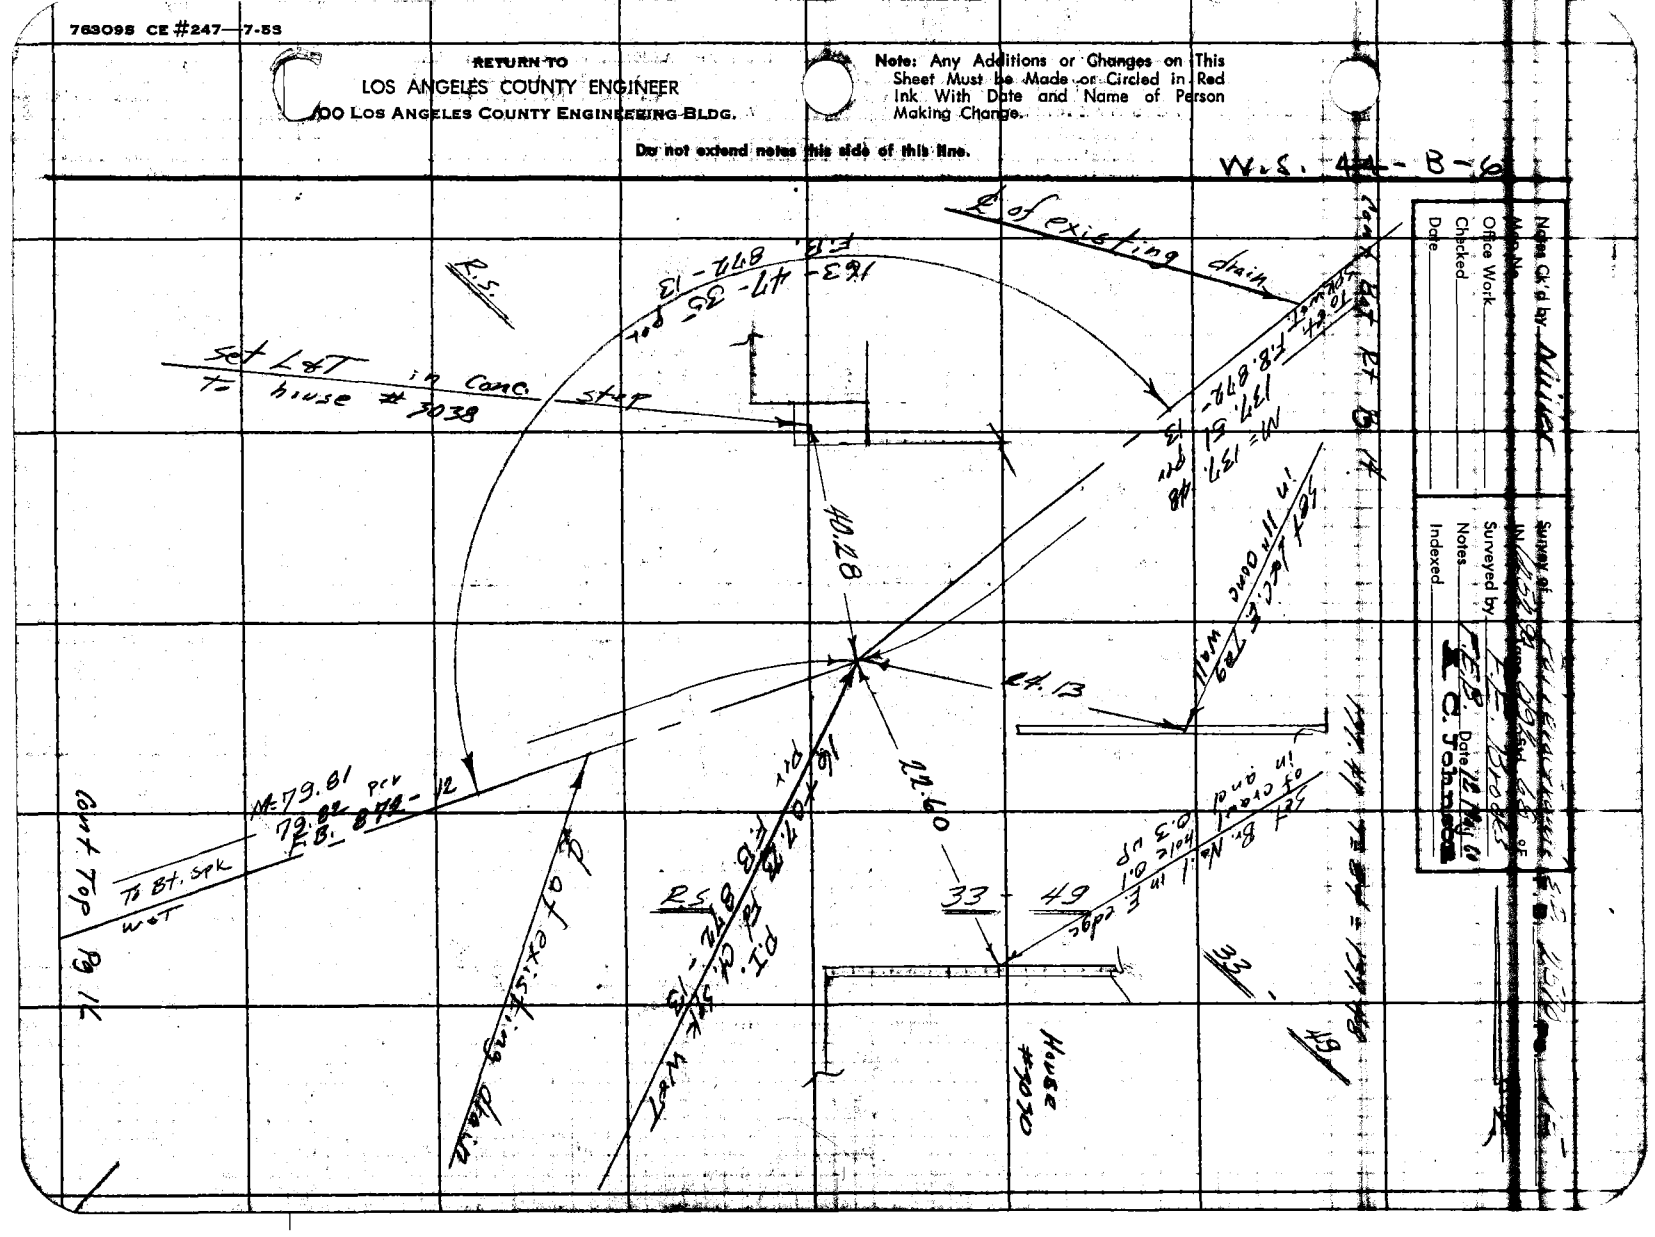

Notes Ck'd by
Map No.
Office Work
Checked
Date

Survey of
Surveyed by
Notes
Indexed
Date

RETURN TO
LOS ANGELES COUNTY ENGINEER
700 LOS ANGELES COUNTY ENGINEERING BLDG.

Note: Any Additions or Changes on This Sheet Must be Made or Circled in Red Ink With Date and Name of Person Making Change.

Do not extend notes this side of this line.

W.S. 44-B-6

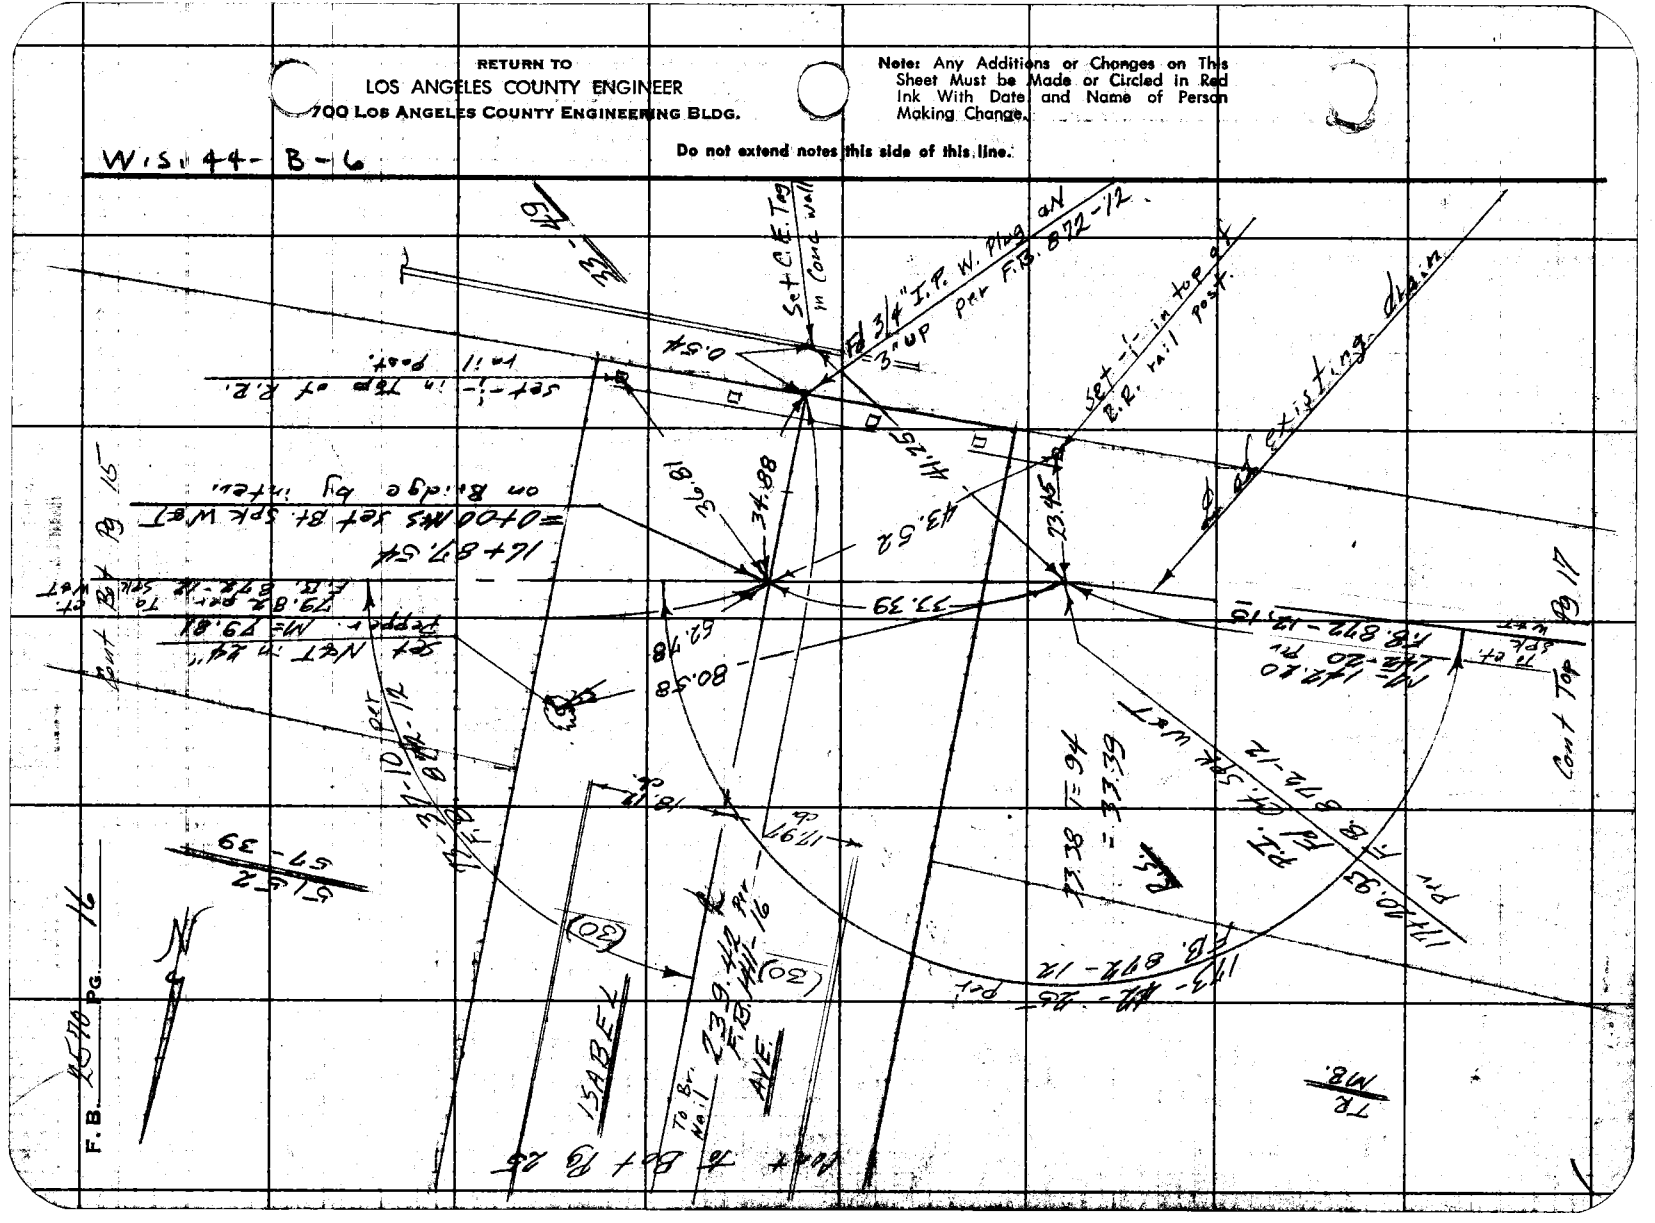
Set C.E. Tag in Conc. wall
Fd 3/4" I.P. W. Plug on 3" U.P. per F.B. 872-12
Set +/- in top of R.R. rail post.
Existing dbl. w.
Cont Top
Fd. 3/4" I.P. in Top of R.R. rail post.
Set +/- in Top of R.R. rail post.
Fd. 3/4" I.P. W. Plug on 3" U.P. per F.B. 872-12

Notes Ck'd by [illegible]
Map No.
Office Work
Checked
Date

Survey of [illegible] F.B. 252 Pg. 17
IN 1933 Maps 070 Std. 66' of F
Surveyed by [illegible]
Notes F.E.B. Date 12 May 46
Indexed C. Johnson

Cont Bk Pg 16

142.18 T=94
=142.20 ✓
88.35 T=94=88.37 ✓

N 142.20 ✓
142.20 per
F.B. 872-12, 15

℄ of existing drain

1" W. Riser

14" Pine

Wooden shed

12" Pine

48.3

46.7

47.1

169-30-40 W
F.B. 872-15

44.61 per

Set 3/4" I.P. Conc. Plug & C.E. Tag 12 in.

18+63.15
Fd Ch. Spk W&T
per F.B. 872-15

Set 3/4" I.P. & C.E. Tag 12" in Rod.

Set 3/4" I.P. Conc. Plug C.E. Tag 12 in

16.0

16.98

16.95

31.47

15.98

11.0

49

33

4.0 Wire fence

14" Poplar

4.0 chain link fence

N=146.41
146.41 per
F.B. 872-15

To Ch. Spk West

Fd Ch. Spk per 1945

℄ of existing drain

Cont Top Bk 18

RETURN TO
LOS ANGELES COUNTY ENGINEER
900 LOS ANGELES COUNTY ENGINEERING BLDG.

Note: Any Additions or Changes on This Sheet Must be Made or Circled in Red Ink With Date and Name of Person Making Change.

Do not extend notes this side of this line.

763095 CE #247—7-59

F.B. 2590 PG. 18

Cont Bot Pg 17

106.42 T=86 = 106.43 ✓

To Ct. Spk

M= 106.43 ✓ Fd. per F.B. 892-15

℄ of existing drain

R.S.

33 - 49

P.I.
20+57.93 Fd Ct. Spk W
℄T per F.B. 892-15

149-14-50 per F.B. 892-15

Line Prod.

M= 64.03 ✓

℄ of existing drain

To ℄T

64.02 T=86 = 64.03 ✓

74.66 T=86 = 74.67 ✓

M= 74.67 ✓

74.69 per F.B. 892-15

To ℄T Spk West

Cont Top Pg 19

Cont Top Pg 19

RETURN TO
LOS ANGELES COUNTY ENGINEER
900 Los Angeles County Engineering Bldg.

Do not extend notes this side of this line.

Note: Any Additions or Changes on This Sheet Must be Made or Circled in Red Ink With Date and Name of Person Making Change.

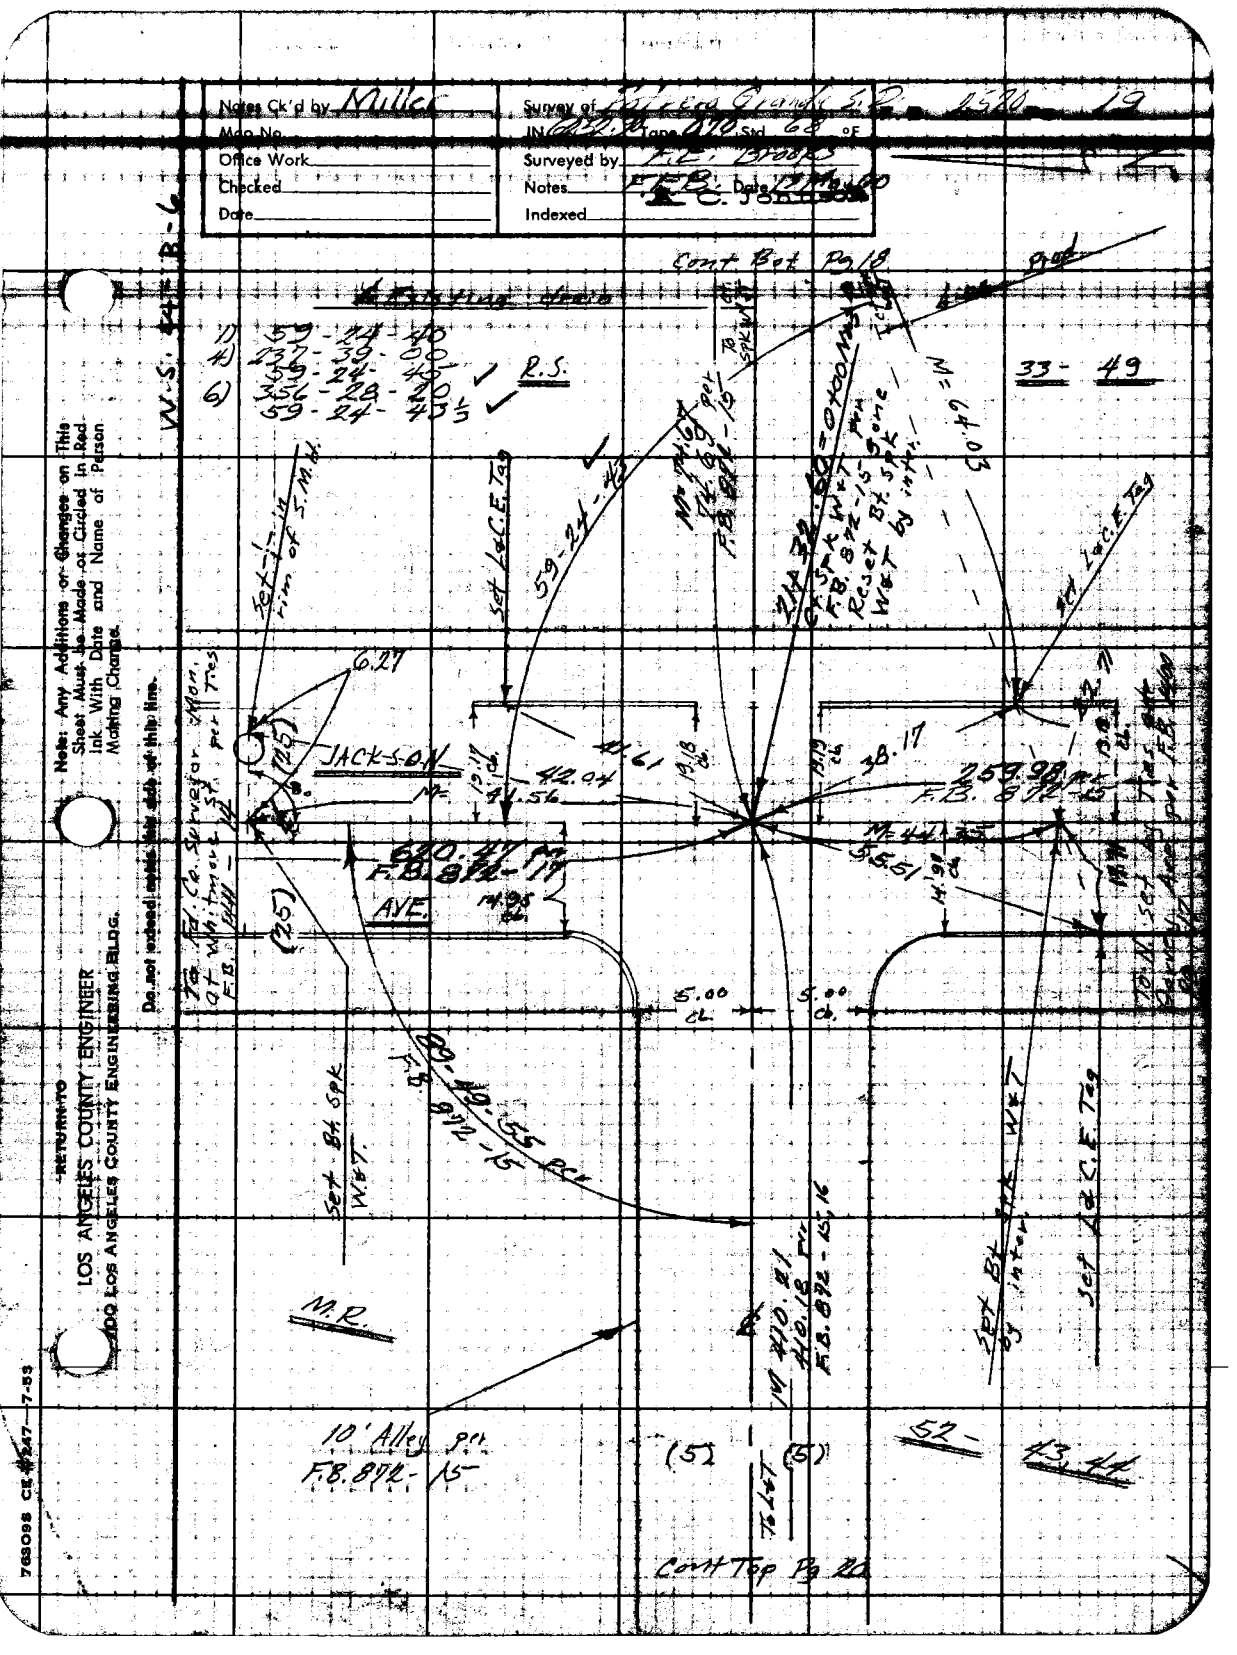
Notes Ck'd by Miller
Map No.
Office Work
Checked
Date
Surveyed by F.E. Brooks
Notes F.E.B. Date 7/14/60
C. Johnson
Indexed
W.S. 64 B-6
Cont Bet Pg 18
Existing Streets
1) 59-24-40
2) 237-39-00
3) 59-24-45
6) 356-29-20
59-24-42½
R.S.
33-49
Set Loc.C.E. Tag
59-24-45
Set 1-in. rim of S.M.H.
Set Loc.C.E. Tag
Set Loc.C.E. Tag
Set Loc.C.E. Tag

RETURN TO
LOS ANGELES COUNTY ENGINEER
700 LOS ANGELES COUNTY ENGINEERING BLDG.

Note: Any Additions or Changes on This Sheet Must be Made or Circled in Red Ink With Date and Name of Person Making Change.

Do not extend notes this side of this line.

W.S. 44 - B - 6

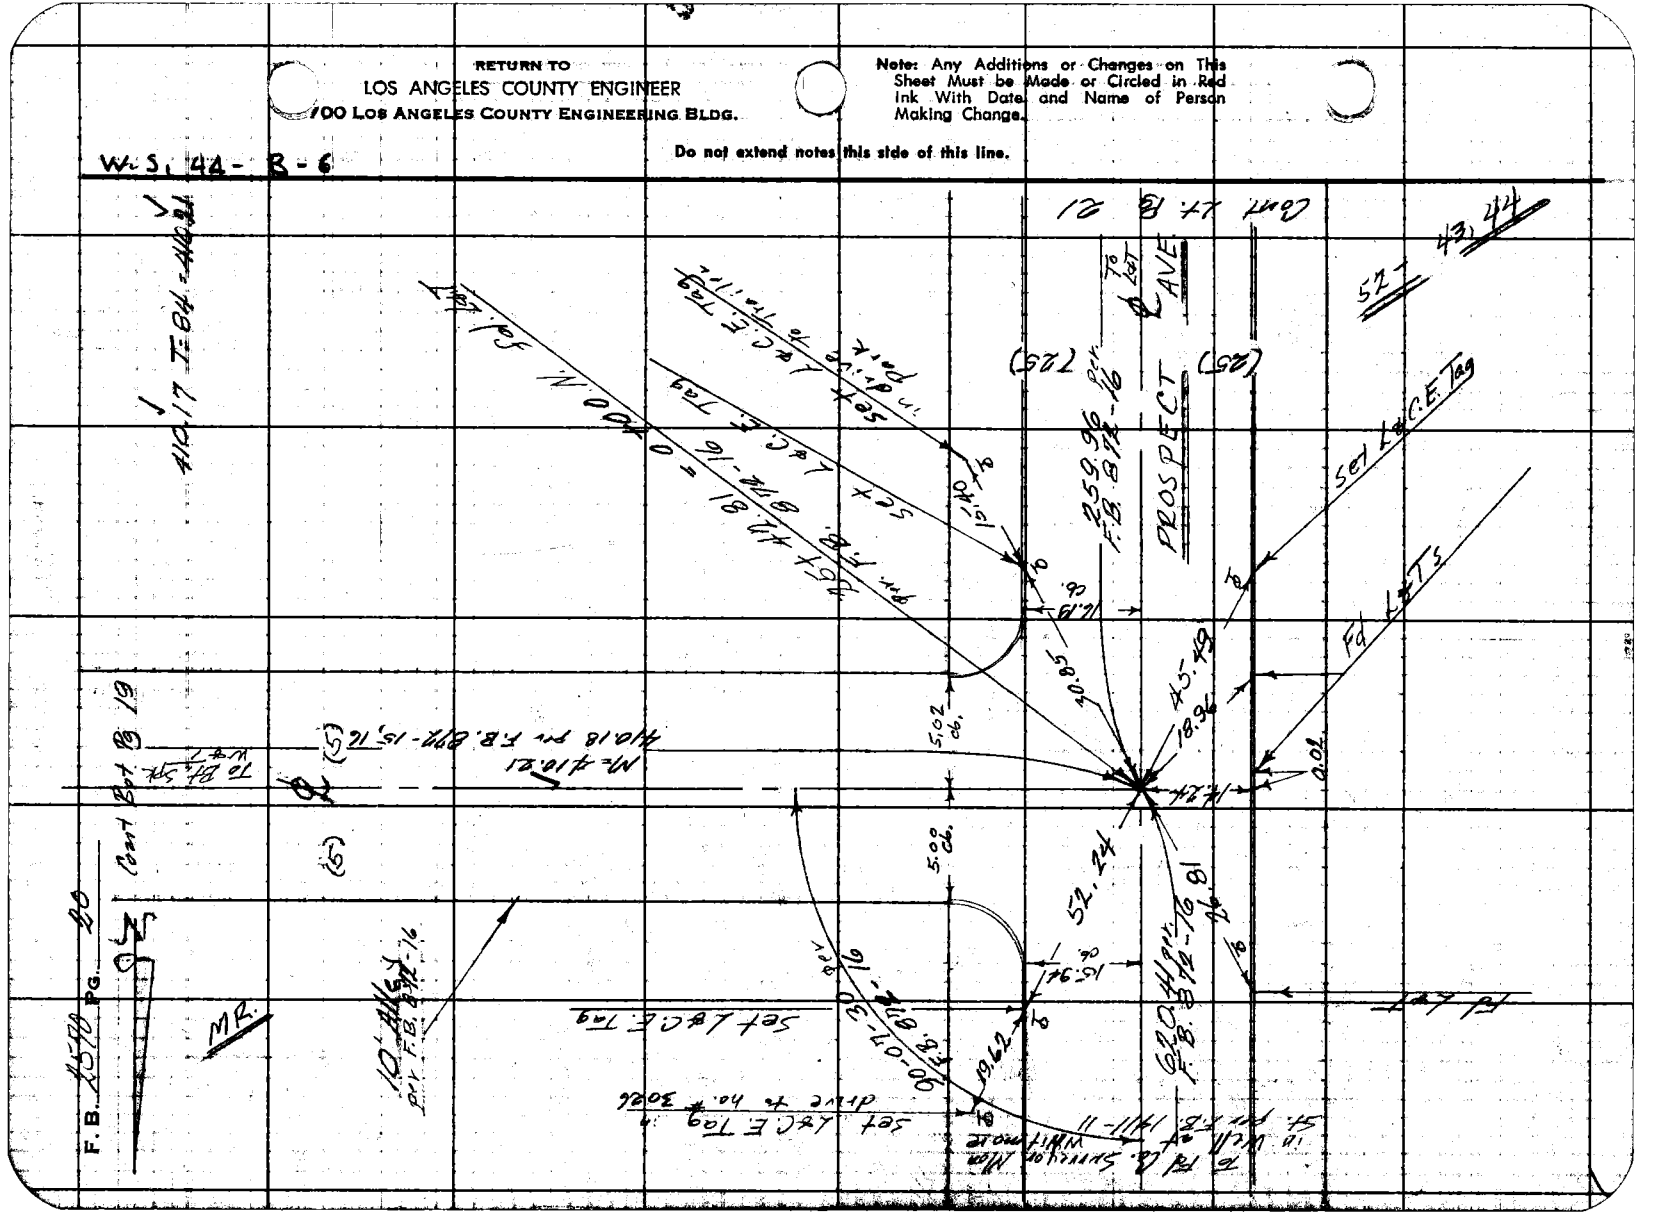

Notes Ck'd by Miller

Map No.

Office Work

Checked

Date

Survey of Rancho La Ballona

Surveyed by F. E. Brooks

Notes F.E.B. Date 16 May 60

Indexed J. C. Johnson

W. S. 44 - B - 6

To Nail set by T.C.S. at Jackson Ave. Pk. F.B. 1400-16

Fd Bd. Spk. Pr. F.B. 1400-16

63-90

0.03 Fd L&T Pr. F.B. 1400 Pg 16

0.02 Fd L&T Pr. F.B. 1400 Pg 16

Line to be by inter.

38.00 ch.

90-01 F.B. 1400-16 Pr.

75.00 Pr. F.B. 1400-16

AVE.

(12.5)

38.21

Set Lead Tag

S.R. 43.44

Fd L&T Pr. F.B. 1400-16

56.40

10.41

0.02

38.09 ch.

AVE.

38.00 ch.

8.75

Fd L&T Pr. F.B. 1400-16

Set Lead Tag

(12.5)

59.16

59.91

(25)

259.96 F.B. 87 Pg 16

38.33

Fd L&T end Pr. F.B. 1411-10

PROSPECT

Cont Rt 28.20 To Lot

28+02.77 Pt on E. Fd L&T Pr. F.B. 1400-16

44.91

59.89

5.00

Fd L&T

(25)

37.99 ch.

Set Lead Tag

Set Lead Tag

M.R.

To Lot F.B. 1411-18

GARVEY

TR M.B.

Cont Top Pg 22

Note: Any Additions or Changes on This Sheet Must be Made or Circled in Red Ink With Date and Name of Person Making Change.

Do not extend notes this side of this line.

RETURN TO LOS ANGELES COUNTY ENGINEER 500 LOS ANGELES COUNTY ENGINEERING BLDG.

763098 CE #247—7-59

RETURN TO
LOS ANGELES COUNTY ENGINEER
700 LOS ANGELES COUNTY ENGINEERING BLDG.

Note: Any Additions or Changes on This Sheet Must be Made or Circled in Red Ink With Date and Name of Person Making Change.

Do not extend notes this side of this line.

W.S. 44 - B - 6

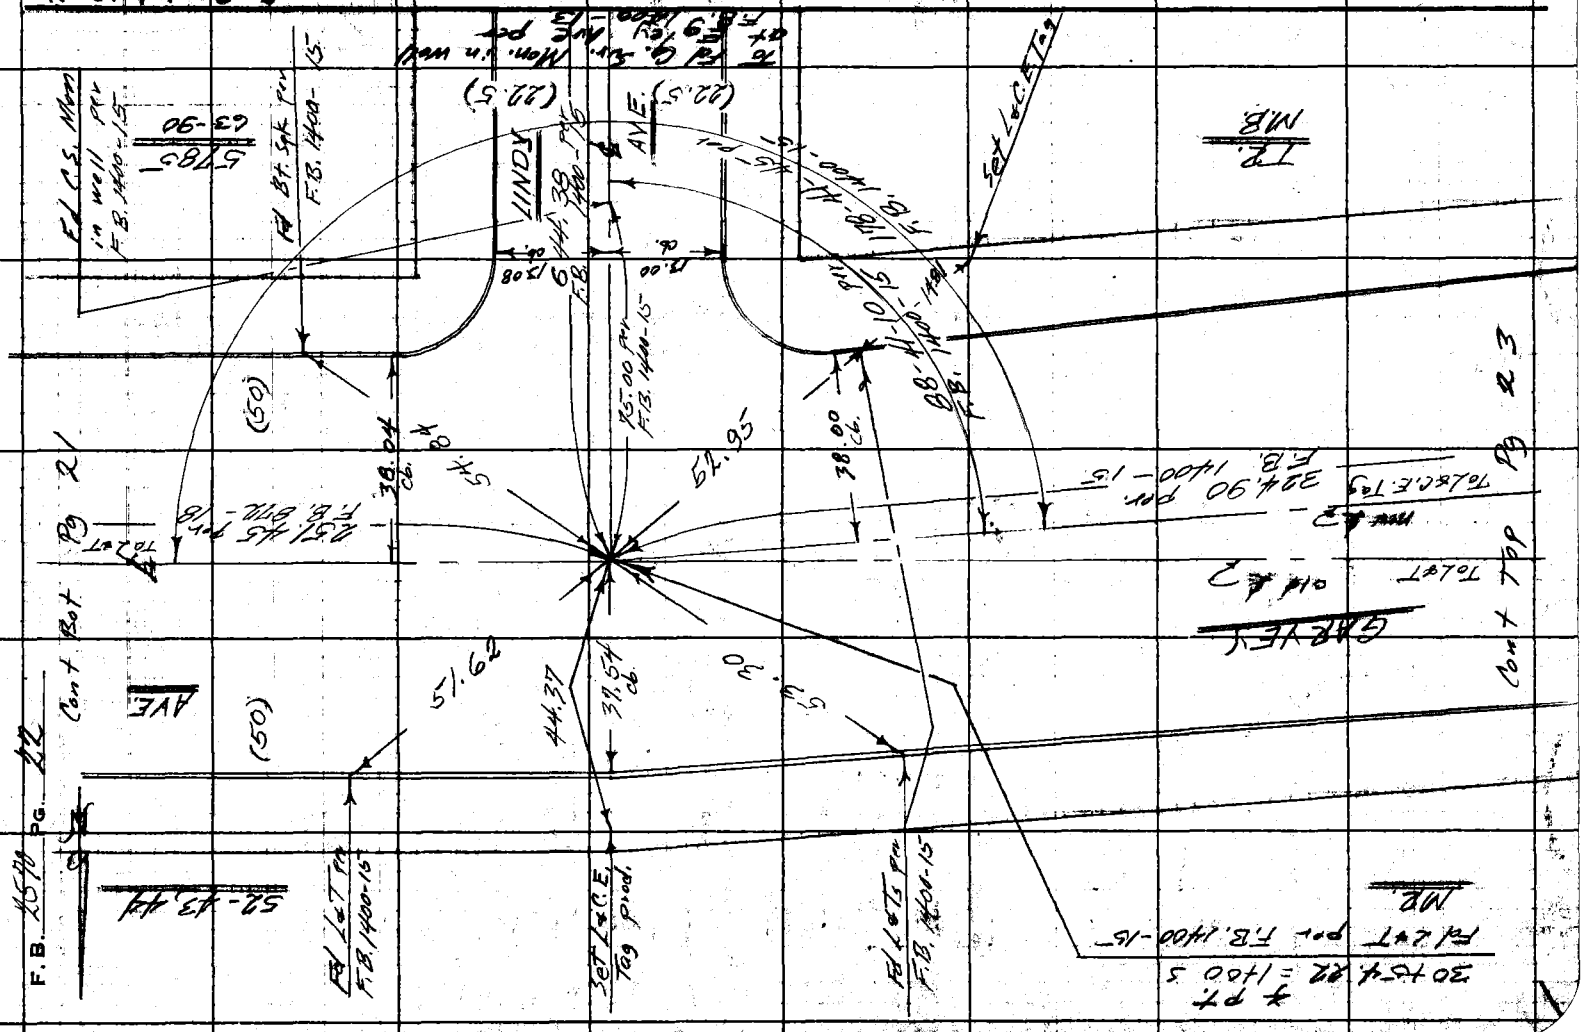
AVE.
(50)
(22.5')
RADIAL
AVE.
GARVEY
Const. Top
Const. Top
Set L.C.E. Tag Prod.
F.B. 1400-15'
F.B. 1400-15'
F.B. 1400-15'

763098 CE #247—7-58

RETURN TO
LOS ANGELES COUNTY ENGINEER
900 LOS ANGELES COUNTY ENGINEERING BLDG.

Note: Any Additions or Changes on This Sheet Must be Made or Circled in Red Ink With Date and Name of Person Making Change.

Do not extend notes this side of this line.

W.S. 44-B-6

Notes Ck'd by
Map No.
Office Work
Checked
Date

Survey of
Surveyed by
Notes
Indexed

M.R.

Set L&C.E. Tag

Fd Nail & Tag per F.B. 1400-15

52-43 44

Fd Nail per F.B. 1400-15

Set L&C.E. Tag

ON ℄

Tg. N in

Now ℄

337.02 per F.B. 1400-8

7.36

324.90 per F.B. 1400-15

To Left

To Left

GARVEY

38.03 ch.

15.00 per F.B. 1400-15

38.02 ch. 60.88

AVE.

(50)

Set L&C.E. Tag

12.91 ch.

12.97 ch.

DEQUINE

AVE.

33+79.12 = 1400 S

Fd chiseled + per F.B. 1400-15 Replaced with L&C.E. Tag

T.R.
M.B.

Fd Left per F.B. 1400-15

(22.5)

(22.5)

To Fd 6" Sur. Mon. in well at Bailey Ave. per F.B. 1400-15

Fd C.S. Mon. in well per F.B. 1400-15

Fd Bt. Spk per F.B. 1400 Pg 15

5785
63-90

RETURN TO
LOS ANGELES COUNTY ENGINEER
100 LOS ANGELES COUNTY ENGINEERING BLDG.

Note: Any Additions or Changes on This Sheet Must be Made or Circled in Red Ink With Date and Name of Person Making Change.

Do not extend notes this side of this line.

W. S. 44 - A - 6

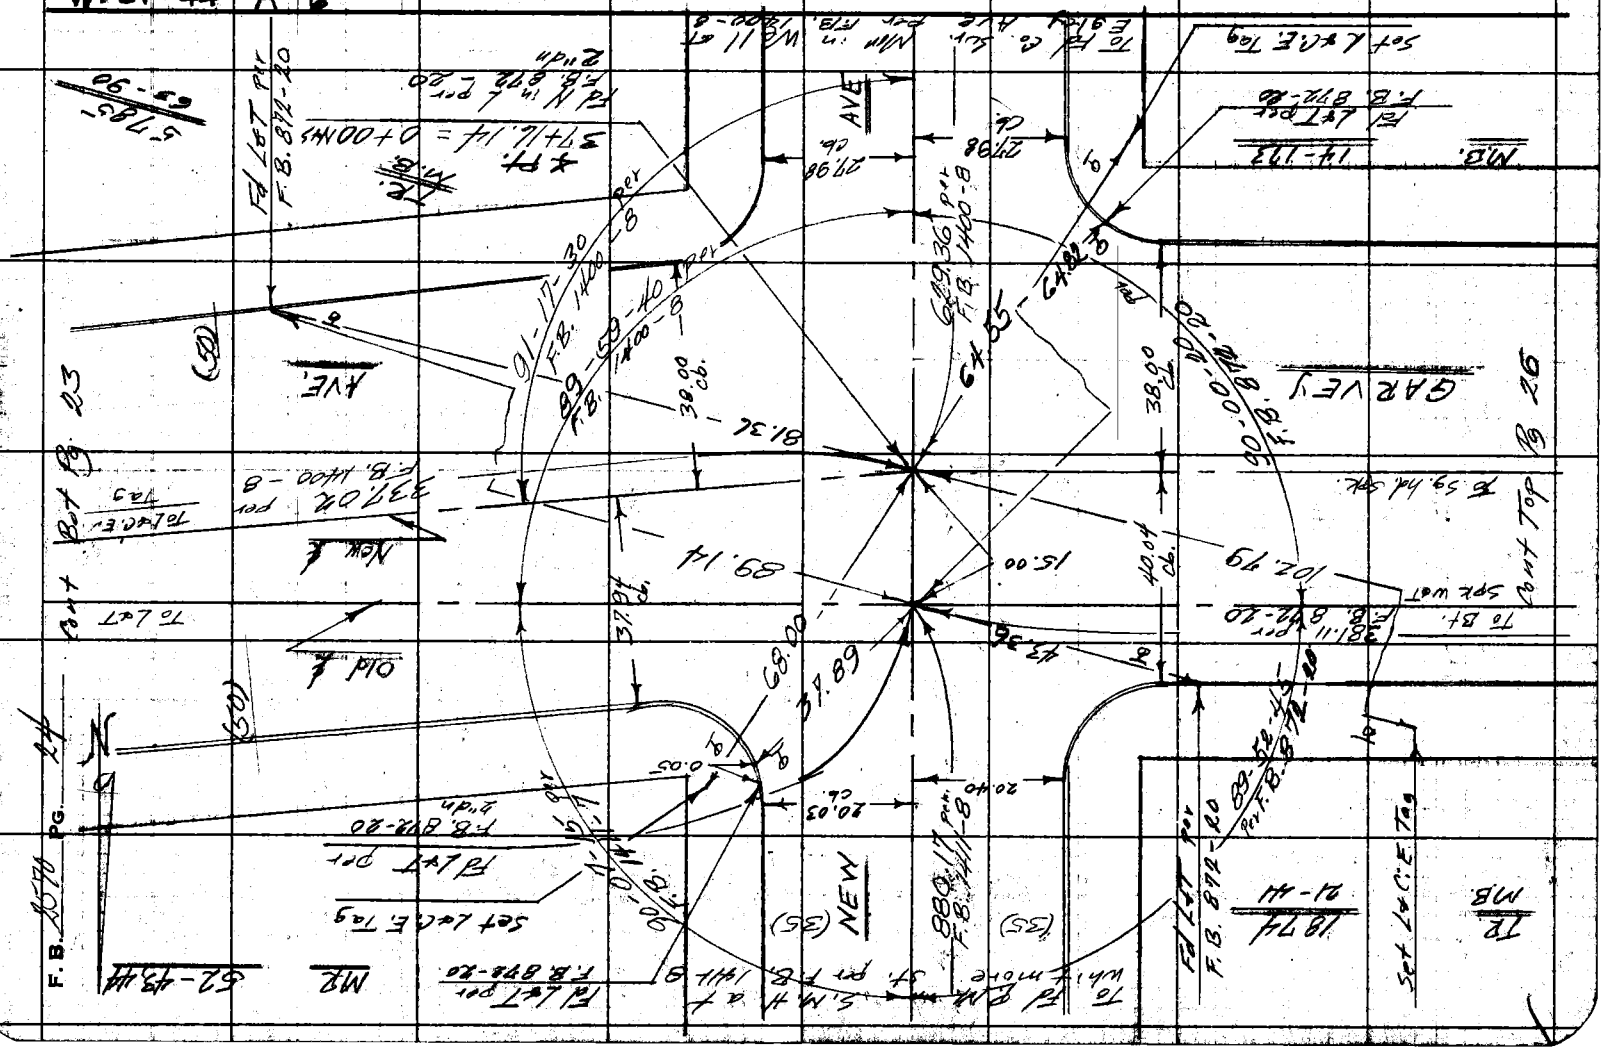
AVE.
GARVEY
NEW (35)
Old ℄
New ℄
To ℄
To Lot
To Lot
To Lot

Notes Ck'd by Miller
Map No.
Office Work
Checked
Date

Surveyed by F.E. Brooks
Notes F.E.B. Date 8 May 60
Indexed C. Johnson

W.S. 44 A-6

To Fd Co. Engr. Mon in Well
at Intersection P.C. per
F.B. 1282 - 11

AVE

Fd L&T per F.B. 1411-16

951.08 per F.B.

Fd L&T per F.B. 1411-16

111.41

41.64

18.27

Fd L&T per F.B. 1411-16

ALLEY

(15)

24.20

47.10

Lot B No. 1 per T.S. F.B. 1411-16

Fd L&T per F.B. 1411-16

Fd L&T per F.B. 1411-16

(30) (30)

IR N1.13

239.44 per F.B. 1411-16

15 3/4" I.P.

ISA BEL

Cont Lt Pg. 16

Note: Any Additions or Changes on This Sheet Must Be Made or Circled in Red Ink With Date and Name of Person Making Change.

Do not extend notes this side of this line.

RETURN TO
LOS ANGELES COUNTY ENGINEER
900 LOS ANGELES COUNTY ENGINEERING BLDG.

763098 CE #247

RETURN TO
LOS ANGELES COUNTY ENGINEER
900 LOS ANGELES COUNTY ENGINEERING BLDG.

Note: Any Additions or Changes on This Sheet Must be Made or Circled in Red Ink With Date and Name of Person Making Change.

Do not extend notes this side of this line.

W.S. 44-A-6

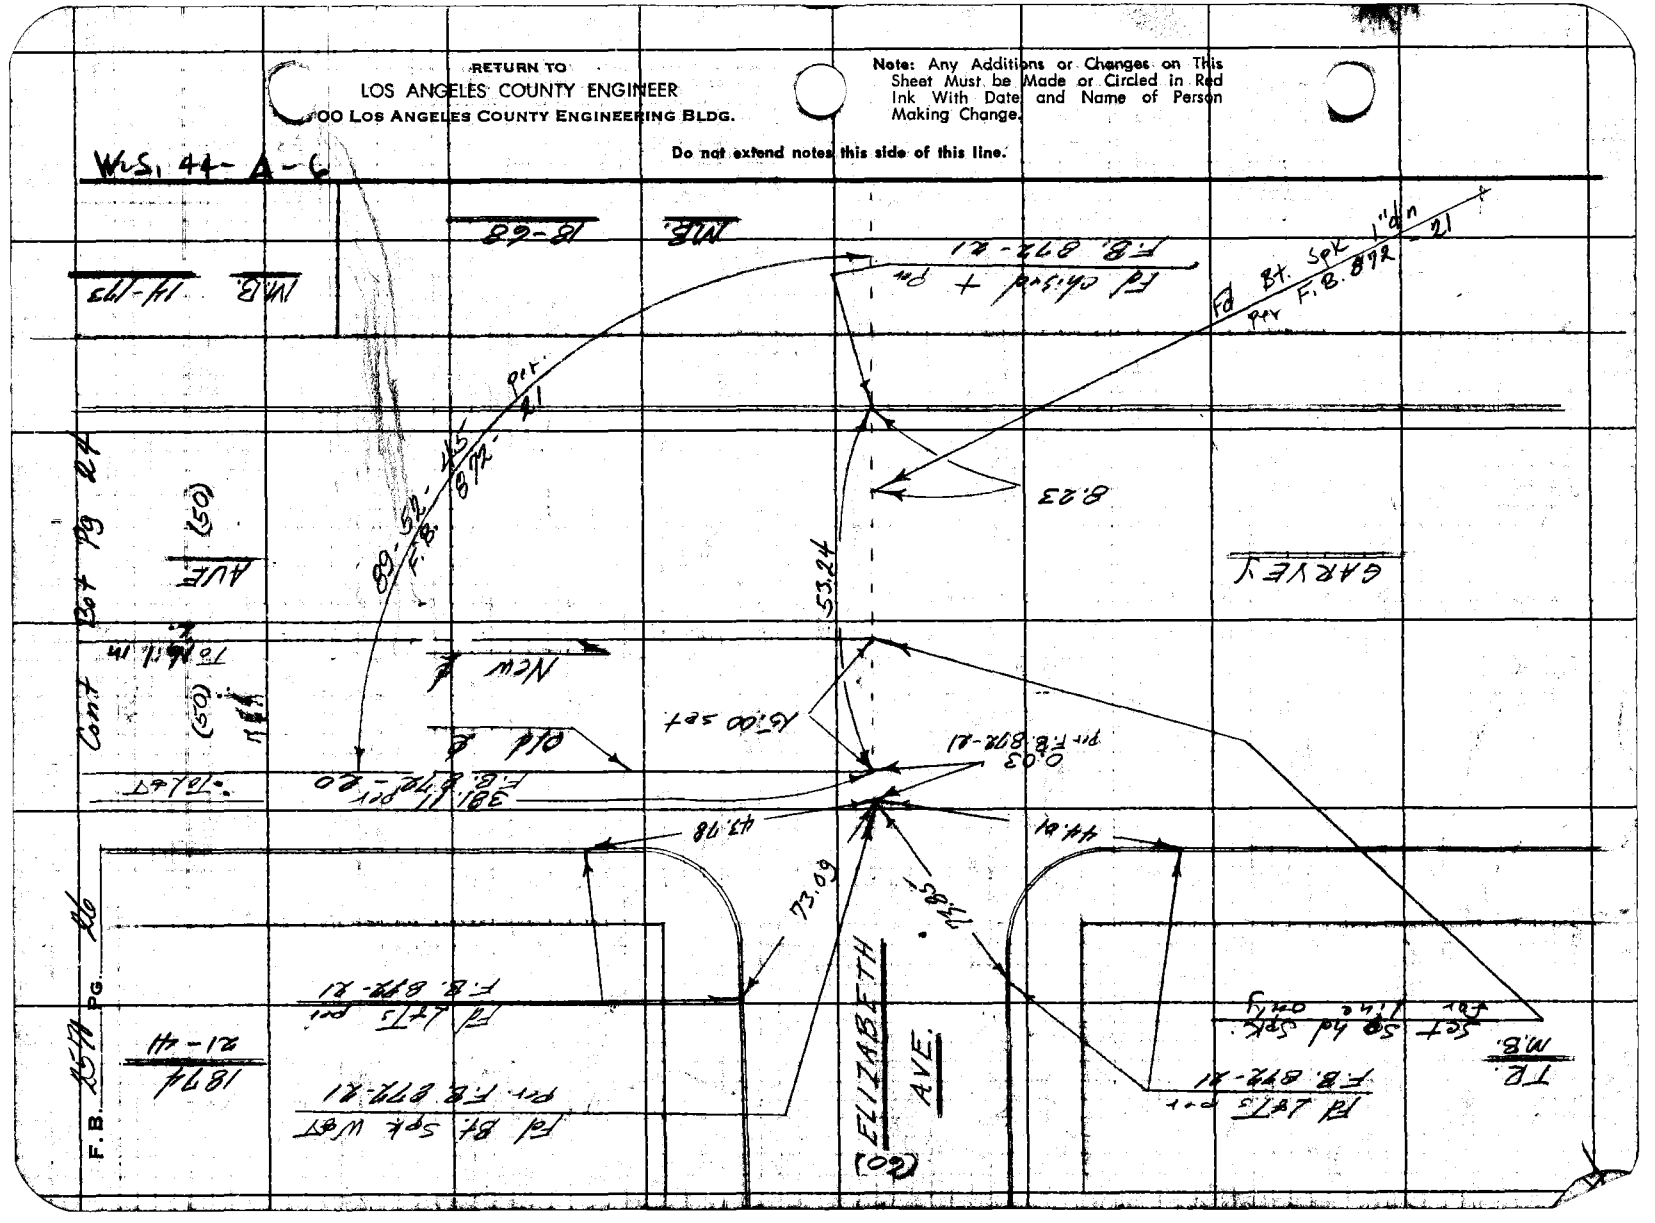

Notes Ck'd by	Survey of Potrero Grande S.D. B. 1540 Pg. 27
Map No.	IN 6252.90 Tape 070 Std. 68 °F
Office Work	Surveyed by F.E. Brooks
Checked	Notes F.E.B. Date 12 May 60
Date	Indexed C. Johnson 6-8-60

J.N. 6252.90

POTRERO GRANDE STORM DRAIN

Project #529

Location and elevations of storm drain and stub at Emerson Pl & Del Mar Ave.

Brooks
LeGault
Thrill
Siemann
Bicksler

Note: Any Additions or Changes on this Sheet Must be Made or Circled in Red Ink With Date and Name of Person Making Change.

Do not extend notes this side of this line.

RETURN TO
LOS ANGELES COUNTY ENGINEER
900 LOS ANGELES COUNTY ENGINEERING BLDG.

768095 CE #247—7-58

F. B. 2570 PG. 28

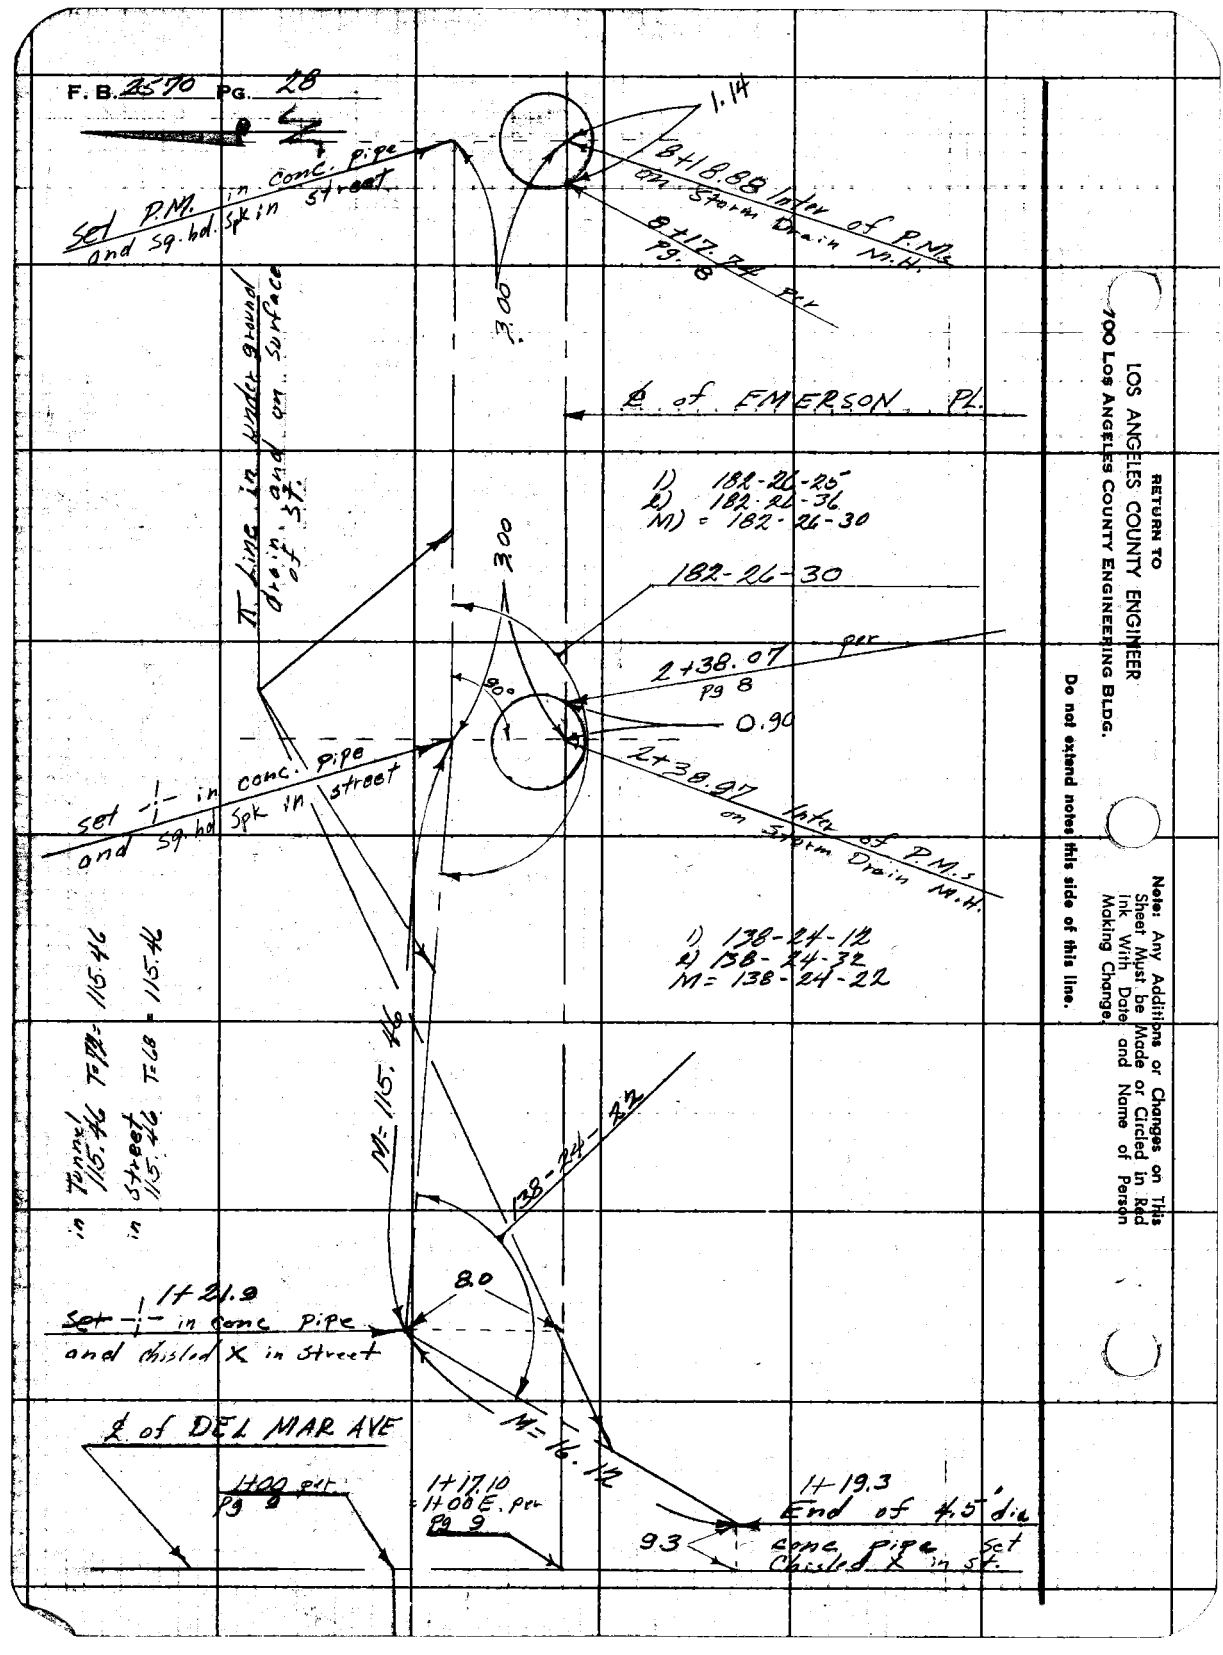

RETURN TO
LOS ANGELES COUNTY ENGINEER
700 LOS ANGELES COUNTY ENGINEERING BLDG.

Do not extend notes this side of this line.

Note: Any Additions or Changes on This Sheet Must be Made or Circled in Red Ink With Date and Name of Person Making Change.

Notes Ck'd by	Survey of Policeo Tract M.B. 65/10 Pg. 22
Map No.	IN 6252 Page 170 Std 68 of
Office Work	Surveyed by F.E. Brooks
Checked	Notes F.E.B. Date 10 May 60
Date	Indexed C. Johnson

Note: Any Additions or Changes on This Sheet Must be Made or Circled in Red Ink With Date and Name of Person Making Change.

Do not extend notes this side of this line.

RETURN TO
LOS ANGELES COUNTY ENGINEER
900 LOS ANGELES COUNTY ENGINEERING BLDG.

7680GS CE #247—7-55

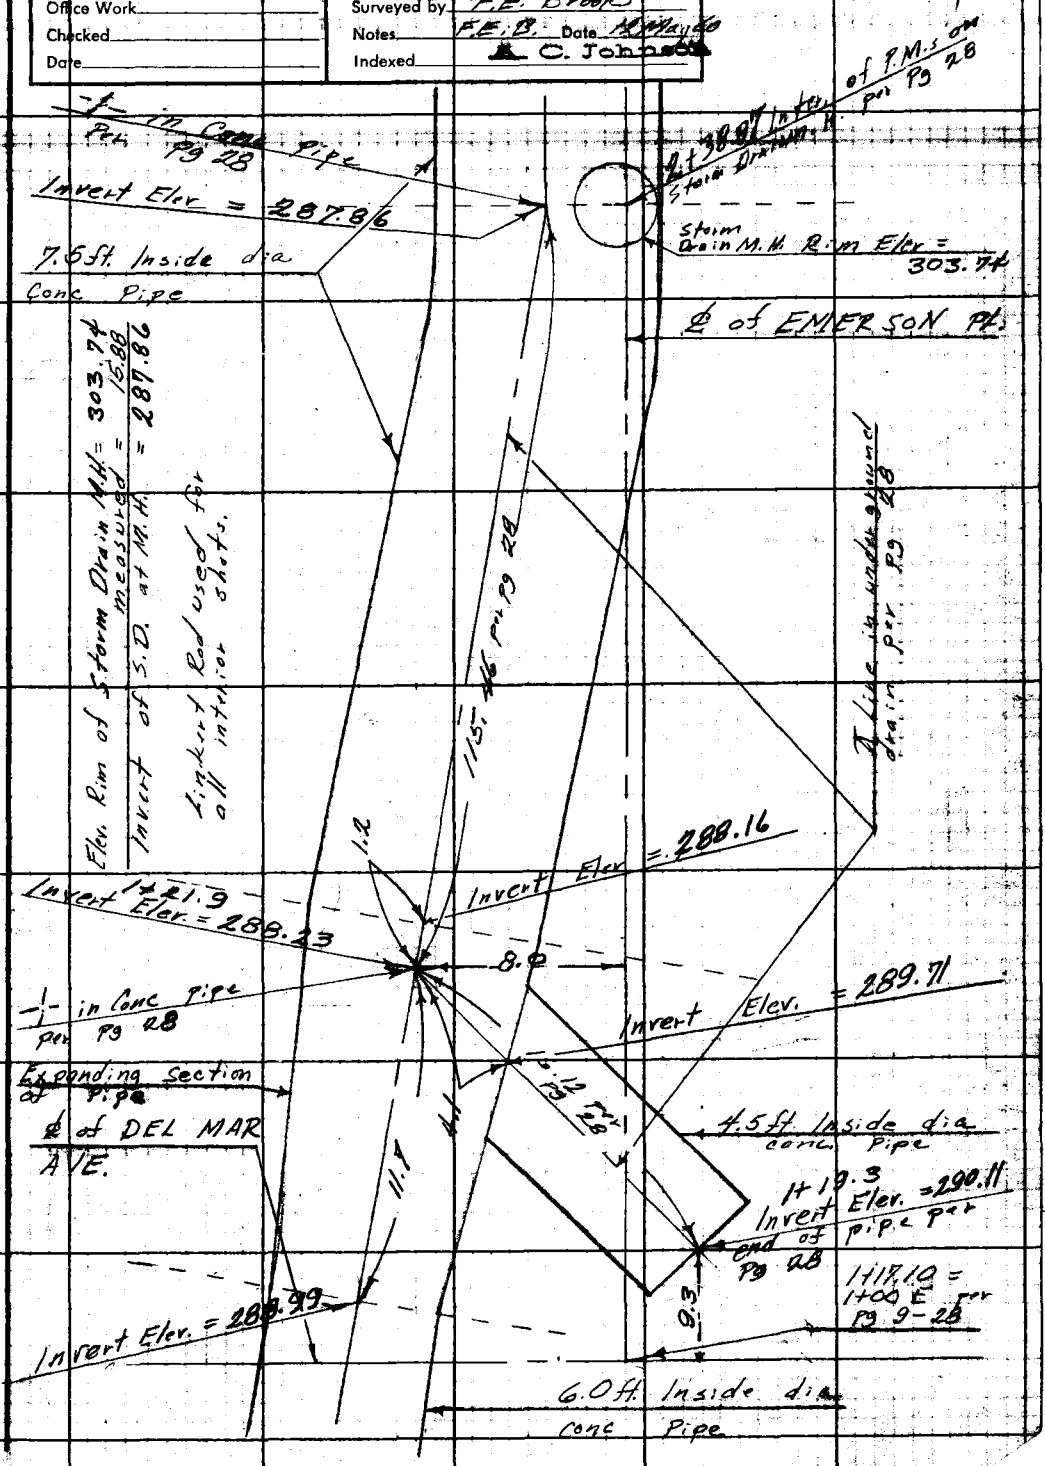

Notes Ck'd by	Survey of
Map No.	IN Tape Std °F
Office Work	Surveyed by
Checked	Notes Date
Date	Indexed

F. B. Pg.

Pgs 21-36 Blanks

Note: Any Additions or Changes on This Sheet Must be Made or Circled in Red Ink With Date and Name of Person Making Change.

Do not extend notes this side of this line.

RETURN TO
LOS ANGELES COUNTY ENGINEER
700 Los Angeles County Engineering Bldg.

76309S CE #247—7-53

Notes Ck'd by
Map No.
Office Work
Checked
Date

Survey of Potrero Grande Storm Drain Bk. 357 Pg. 29
In 6252-90 Sht. of
Surveyed by BROOKS
Notes Levels Pgs. 536 & C. Fulmor
Indexed
6-3-60

T.M. 6252-90

POTRERO GRANDE STORM DRAIN

PROJECT #529

TOPOG

QH

LINE "C"

PARTY
BROOKS
LEGAULT
TURRILL
SIEMAN
BICKSTER
5-60

Note: Any Additions or Changes on This Sheet Must Be Made or Circled in Red Ink With Date and Name of Person Making Change.

Do not extend notes this side of this line.

RETURN TO
LOS ANGELES COUNTY ENGINEER
900 LOS ANGELES COUNTY ENGINEERING BLDG.

763095 CE #247—7-58

RETURN TO
LOS ANGELES COUNTY ENGINEER
700 LOS ANGELES COUNTY ENGINEERING BLDG.

Note: Any Additions or Changes on This Sheet Must be Made or Circled in Red Ink With Date and Name of Person Making Change.

Do not extend notes this side of this line.

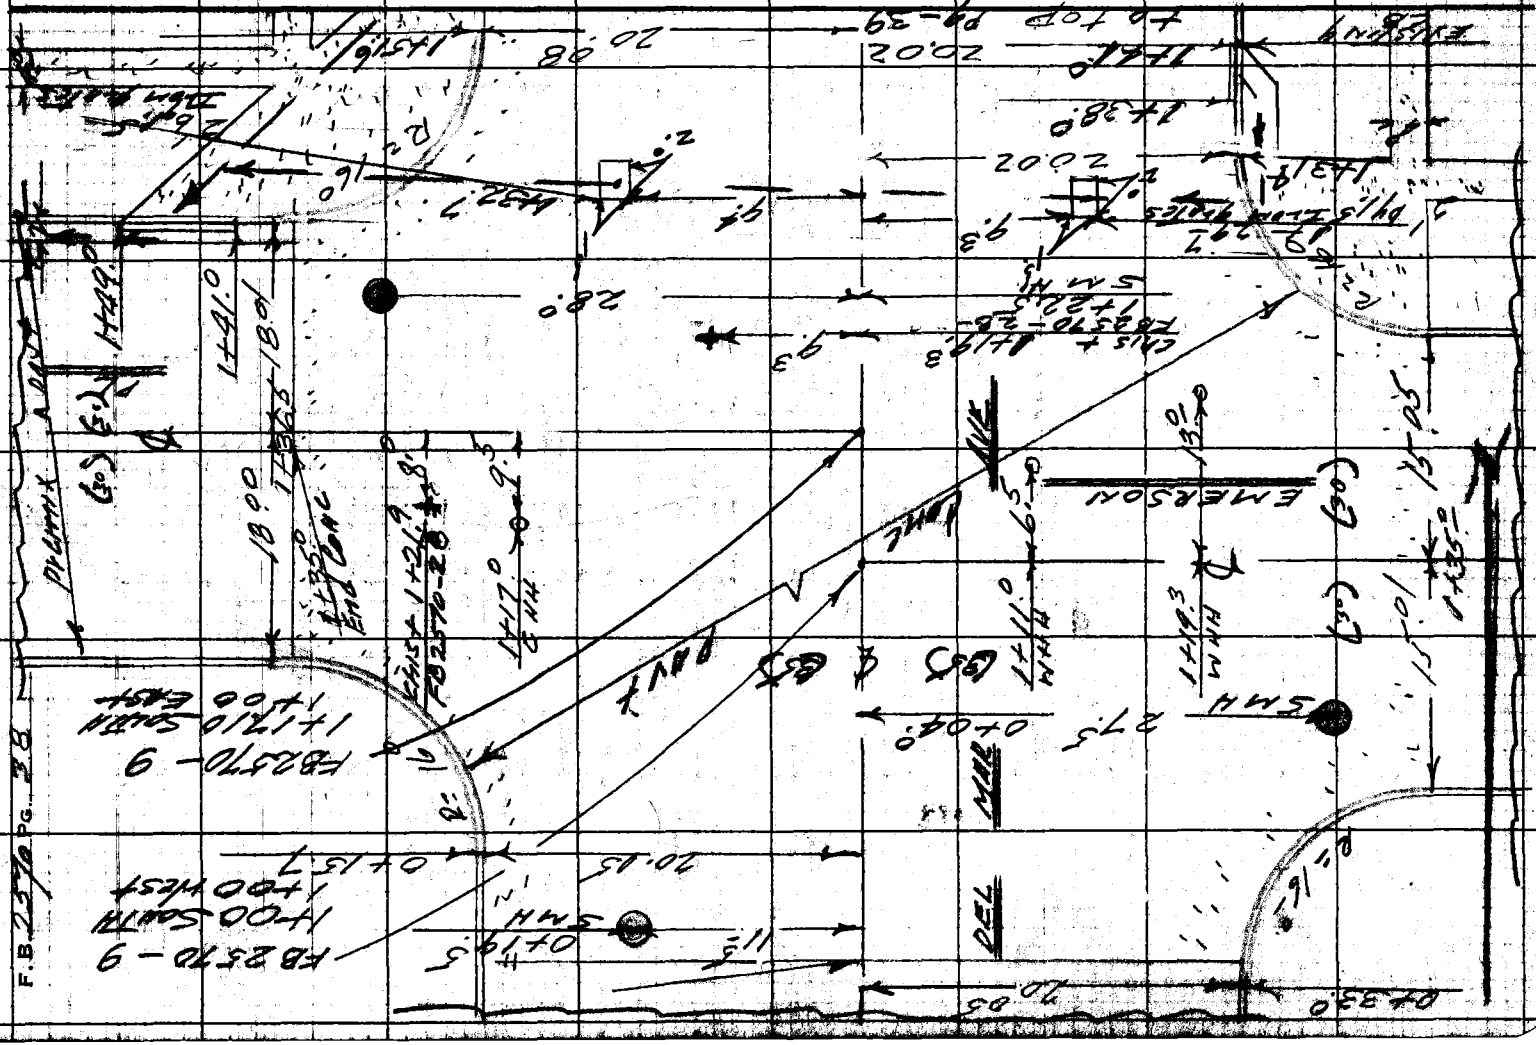

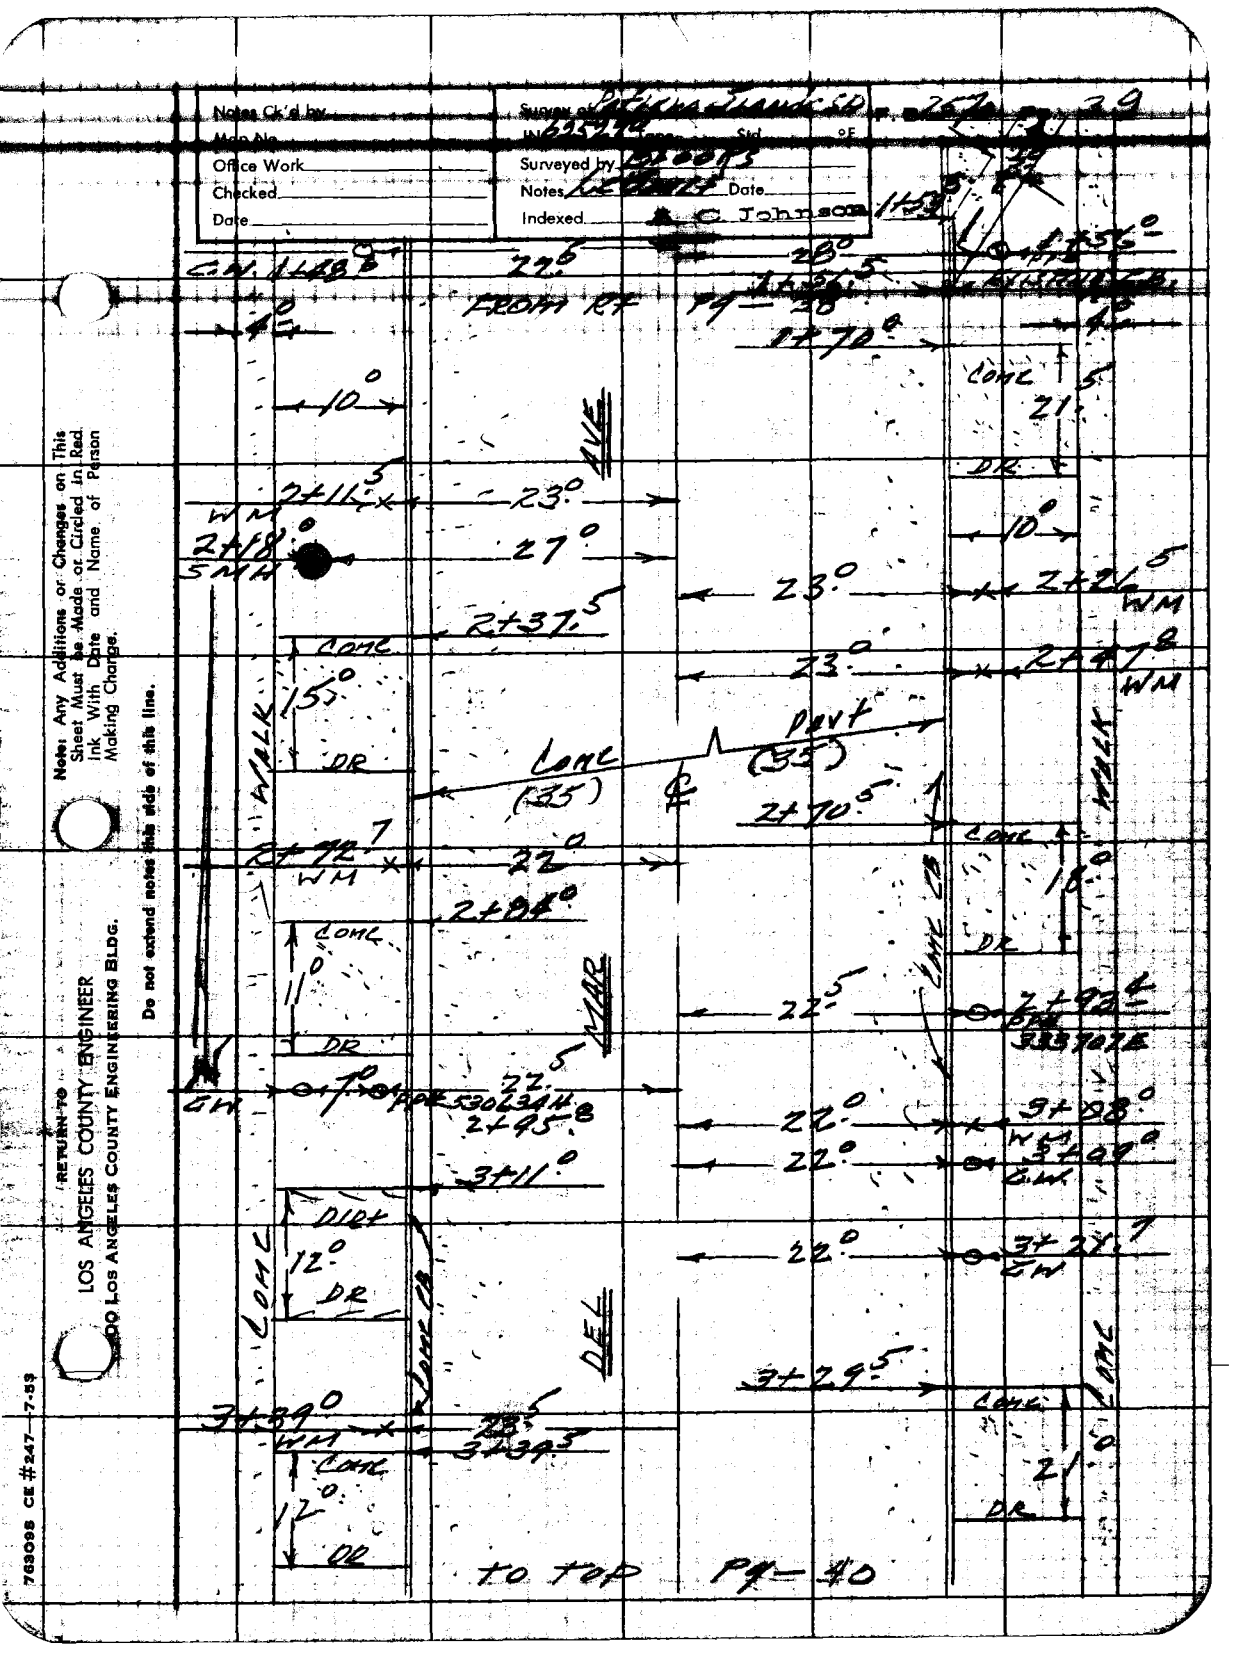
Notes Ck'd by
Map No.
Office Work
Checked
Date
Surveyed by
Notes
Date
Indexed
C. Johnson
Note: Any Additions or Changes on This Sheet Must be Made or Circled in Red Ink With Date and Name of Person Making Changes.
Do not extend notes this side of this line.
RETURN TO
LOS ANGELES COUNTY ENGINEER
900 LOS ANGELES COUNTY ENGINEERING BLDG.
763098 CE #247—7-58
to top
Pg—40

F. B 2570 PG. 40

FROM BOT Pg—39

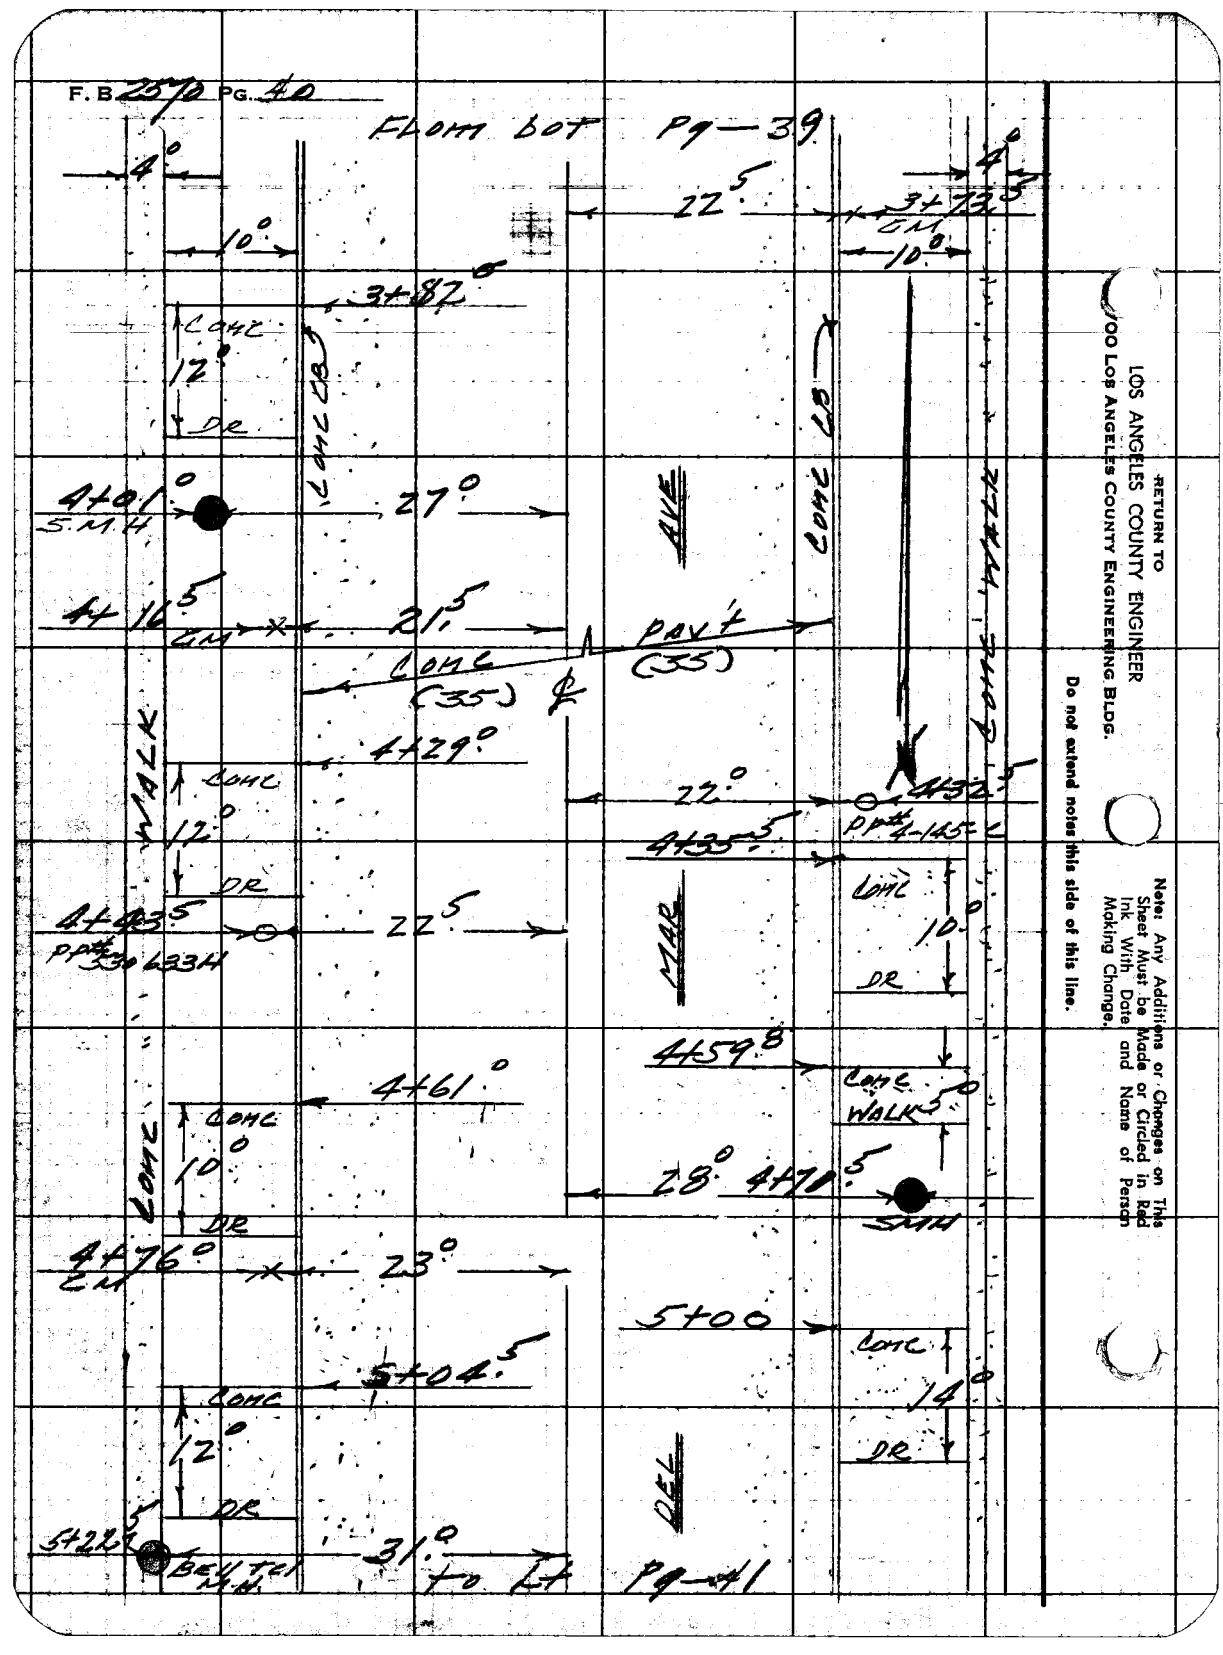

RETURN TO
LOS ANGELES COUNTY ENGINEER
900 Los Angeles County Engineering Bldg.

Do not extend notes this side of this line.

Note: Any Additions or Changes on This Sheet Must be Made or Circled in Red Ink With Date and Name of Person Making Change.

763098 CE #247—7-53

RETURN TO
LOS ANGELES COUNTY ENGINEER
900 LOS ANGELES COUNTY ENGINEERING BLDG.

Note: Any Additions or Changes on This Sheet Must be Made or Circled in Red Ink With Date and Name of Person Making Change.

Do not extend notes this side of this line.

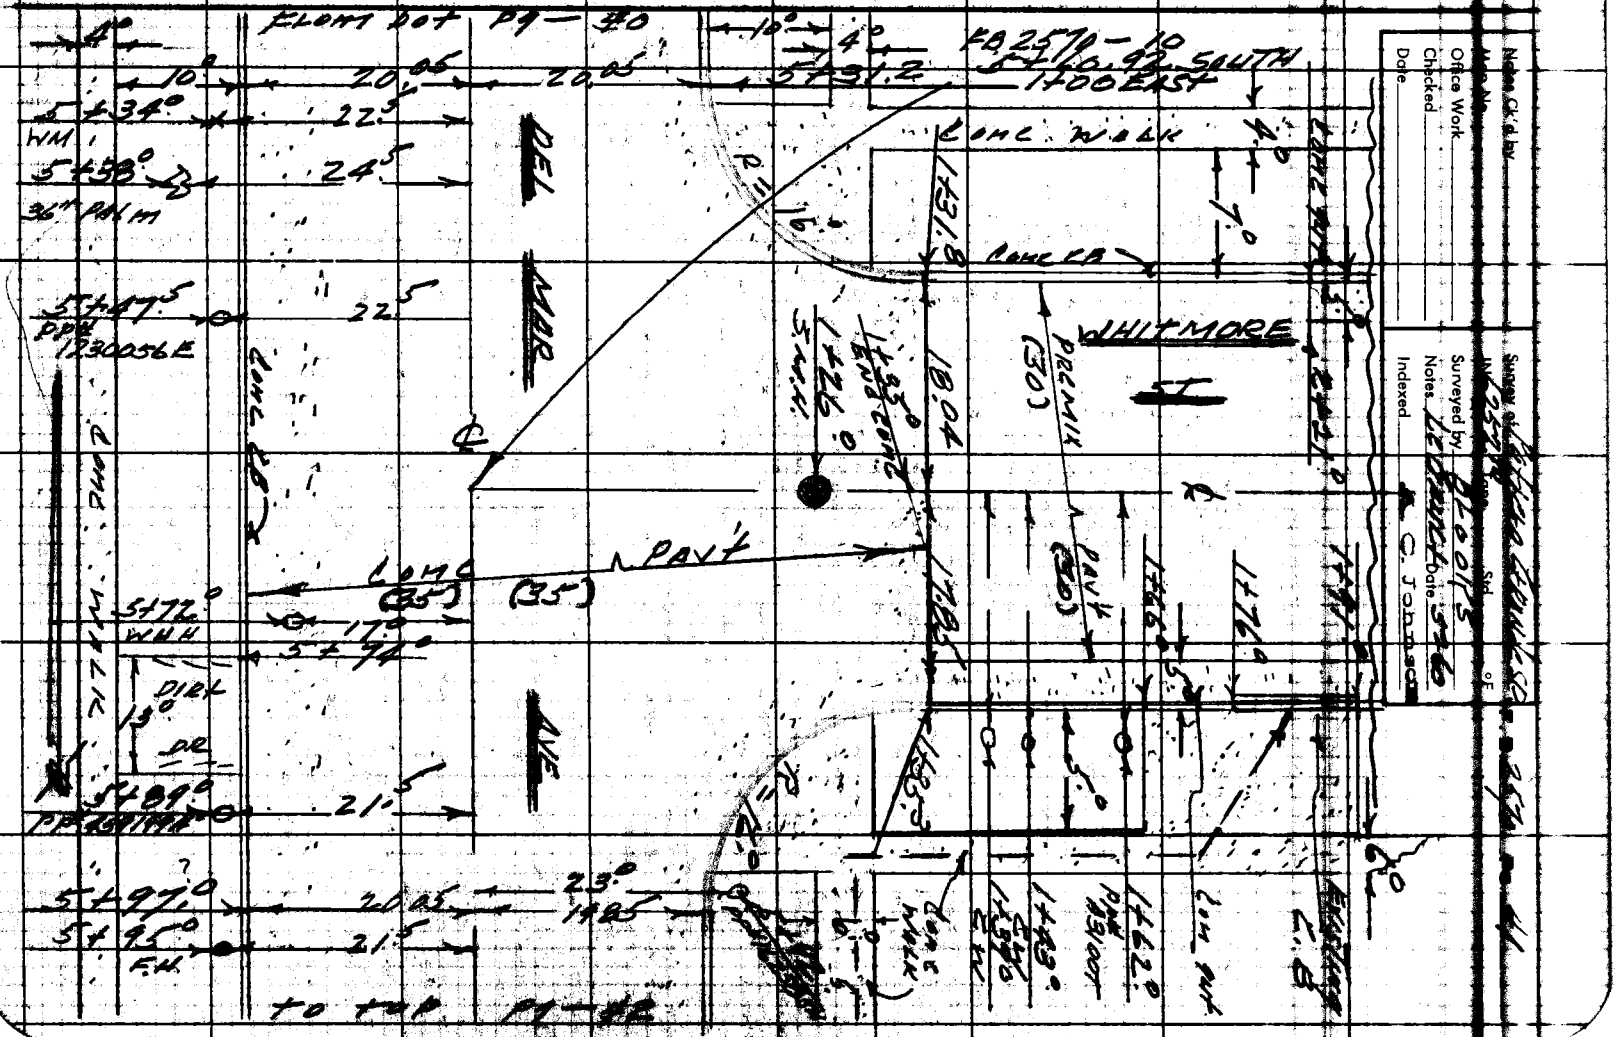
FLOW LINE
DEL MAR
AVE
WHITMORE
ST
PREMIX (30)
CONC. WALK
CONC. CB
PAVT
(35)
(30)
PAVT
CONC. WALK
CONC. PAVT
CONC. CB
DIRT
DR
WHH
FH
PP
PP
PP

RETURN TO
LOS ANGELES COUNTY ENGINEER
700 LOS ANGELES COUNTY ENGINEERING BLDG.

Note: Any Additions or Changes on This Sheet Must be Made or Circled in Red Ink With Date and Name of Person Making Change.

Do not extend notes this side of this line.

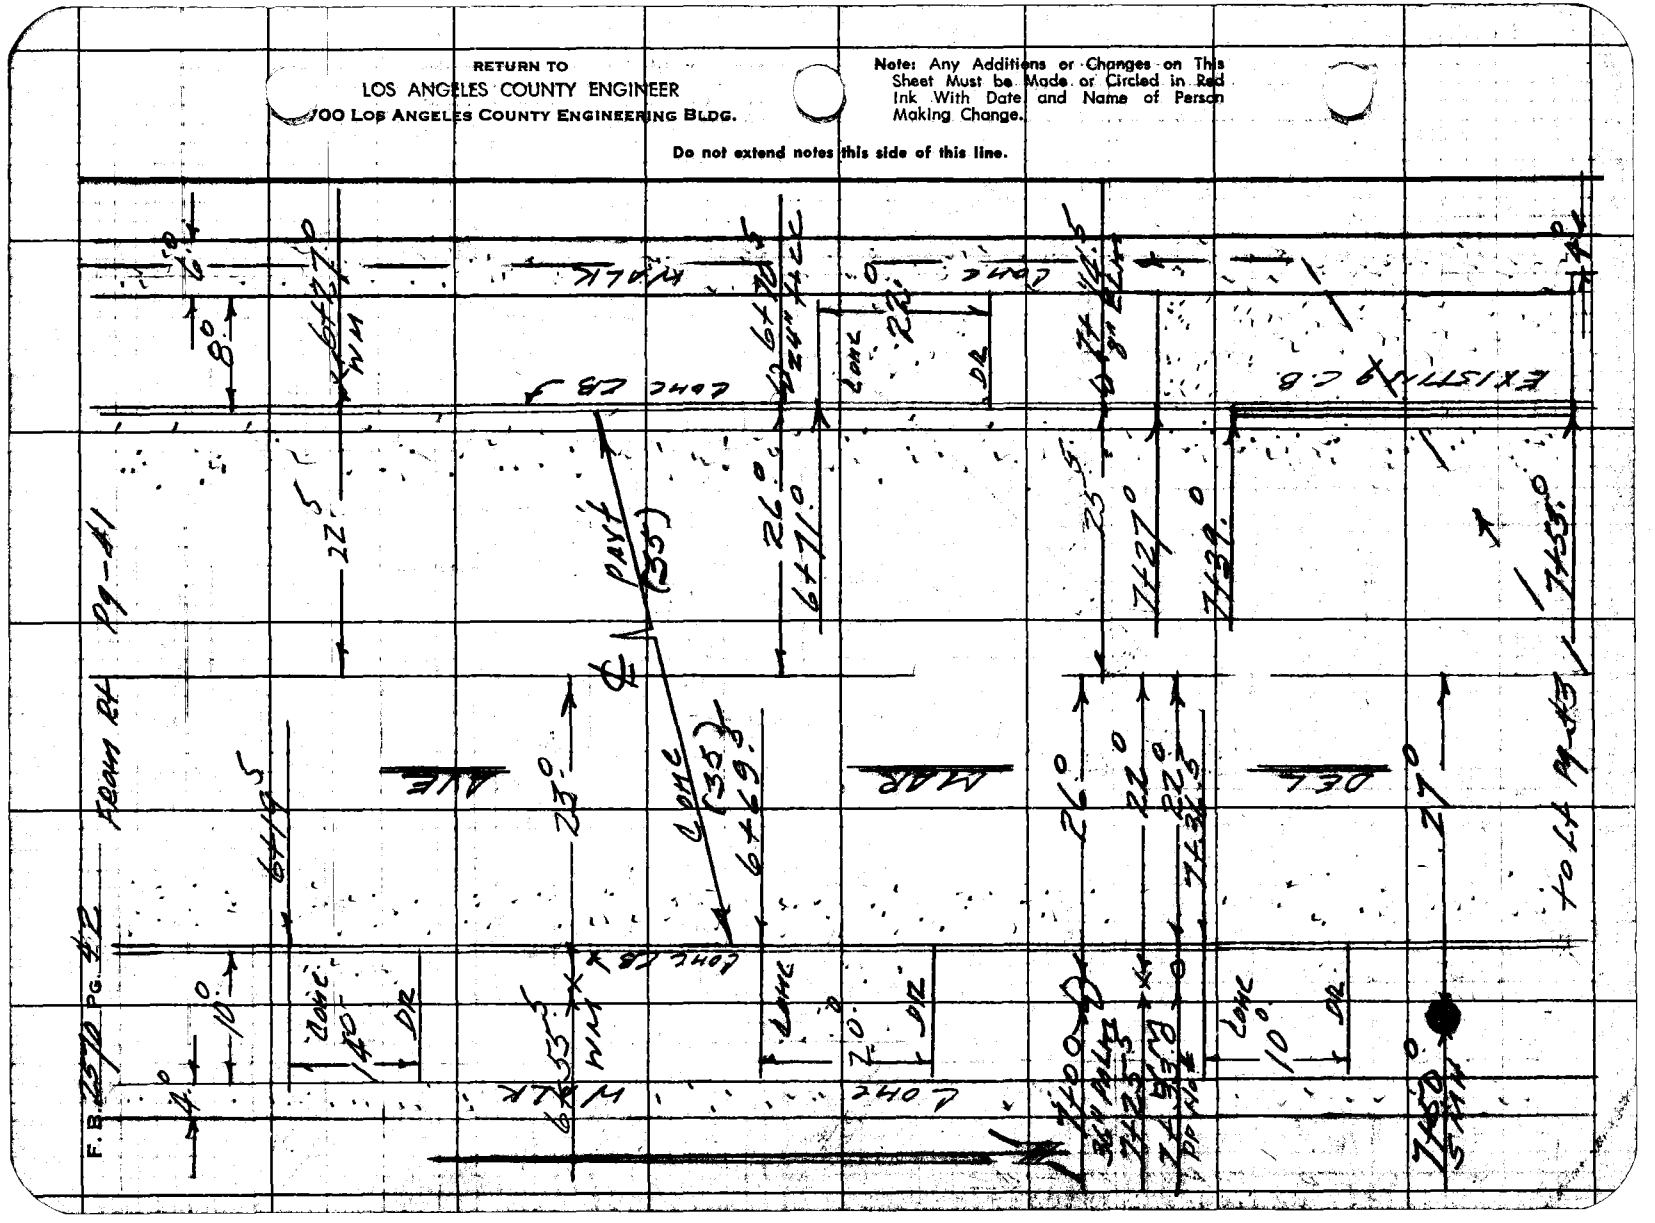

768098 CE #247—7-53

RETURN TO
LOS ANGELES COUNTY ENGINEER
2100 LOS ANGELES COUNTY ENGINEERING BLDG.

Note: Any Additions or Changes on This Sheet Must be Made or Circled in Red Ink With Date and Name of Person Making Change.

Do not extend notes this side of this line.

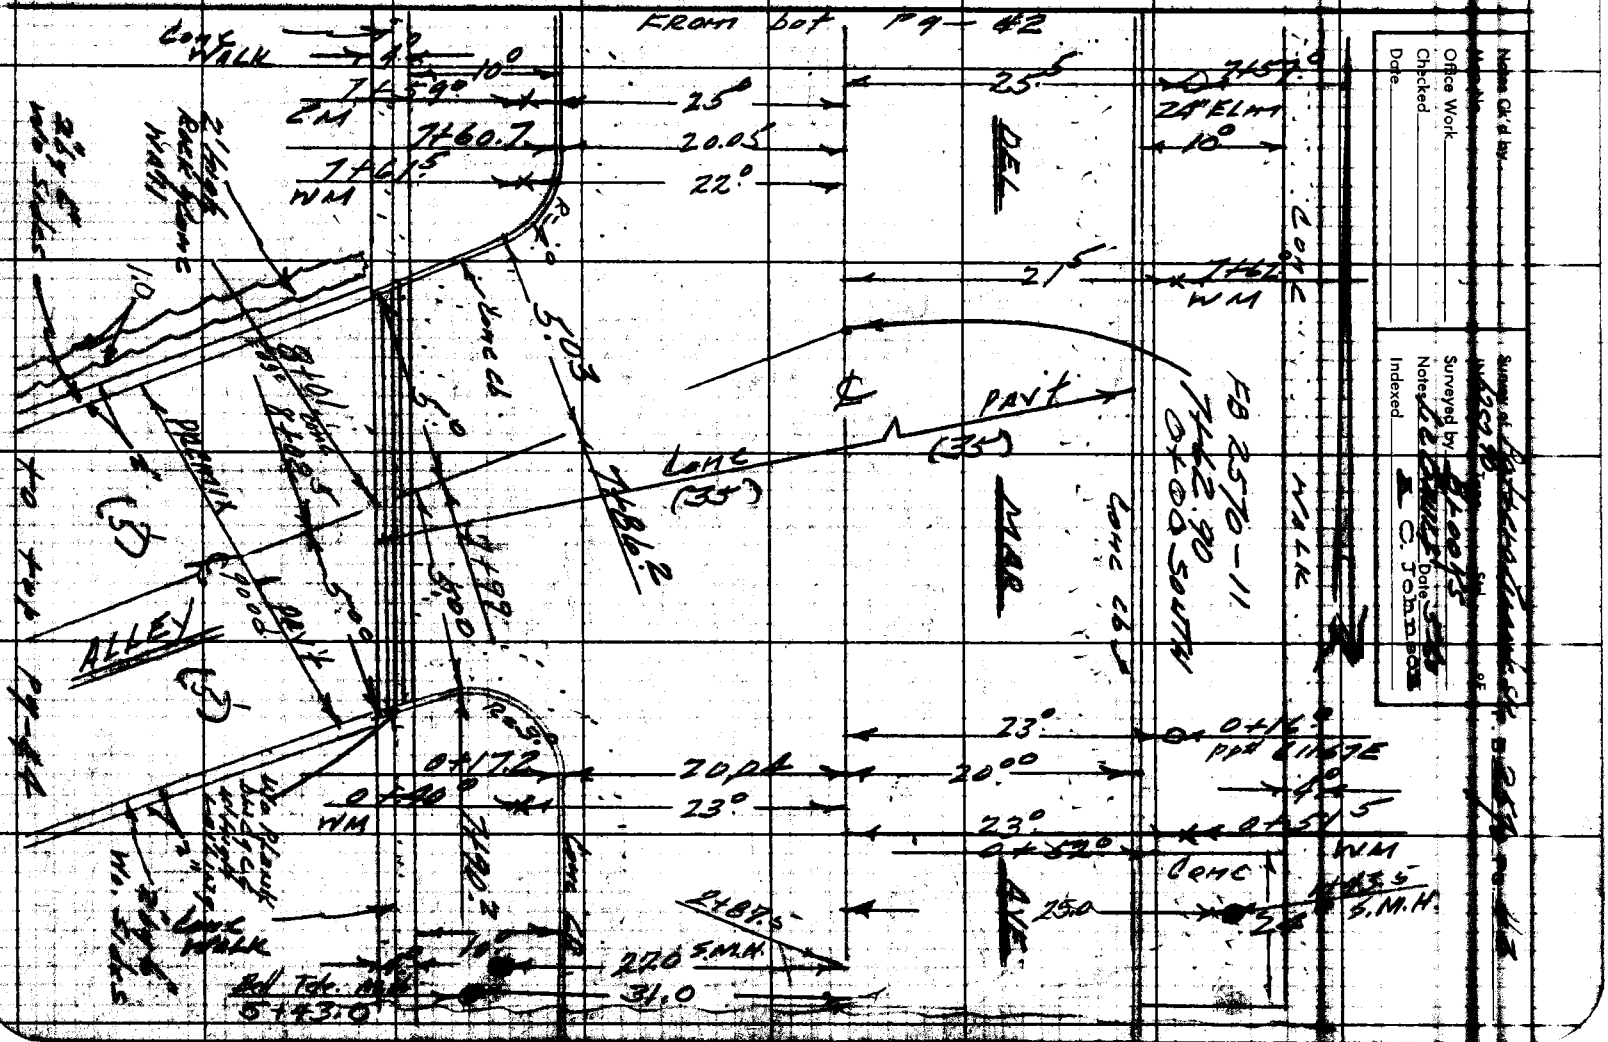

Office Work
Checked
Date

Surveyed by
Notes
Date
Indexed
C. Johnson

Notes Ck'd by
Map Ck'd by

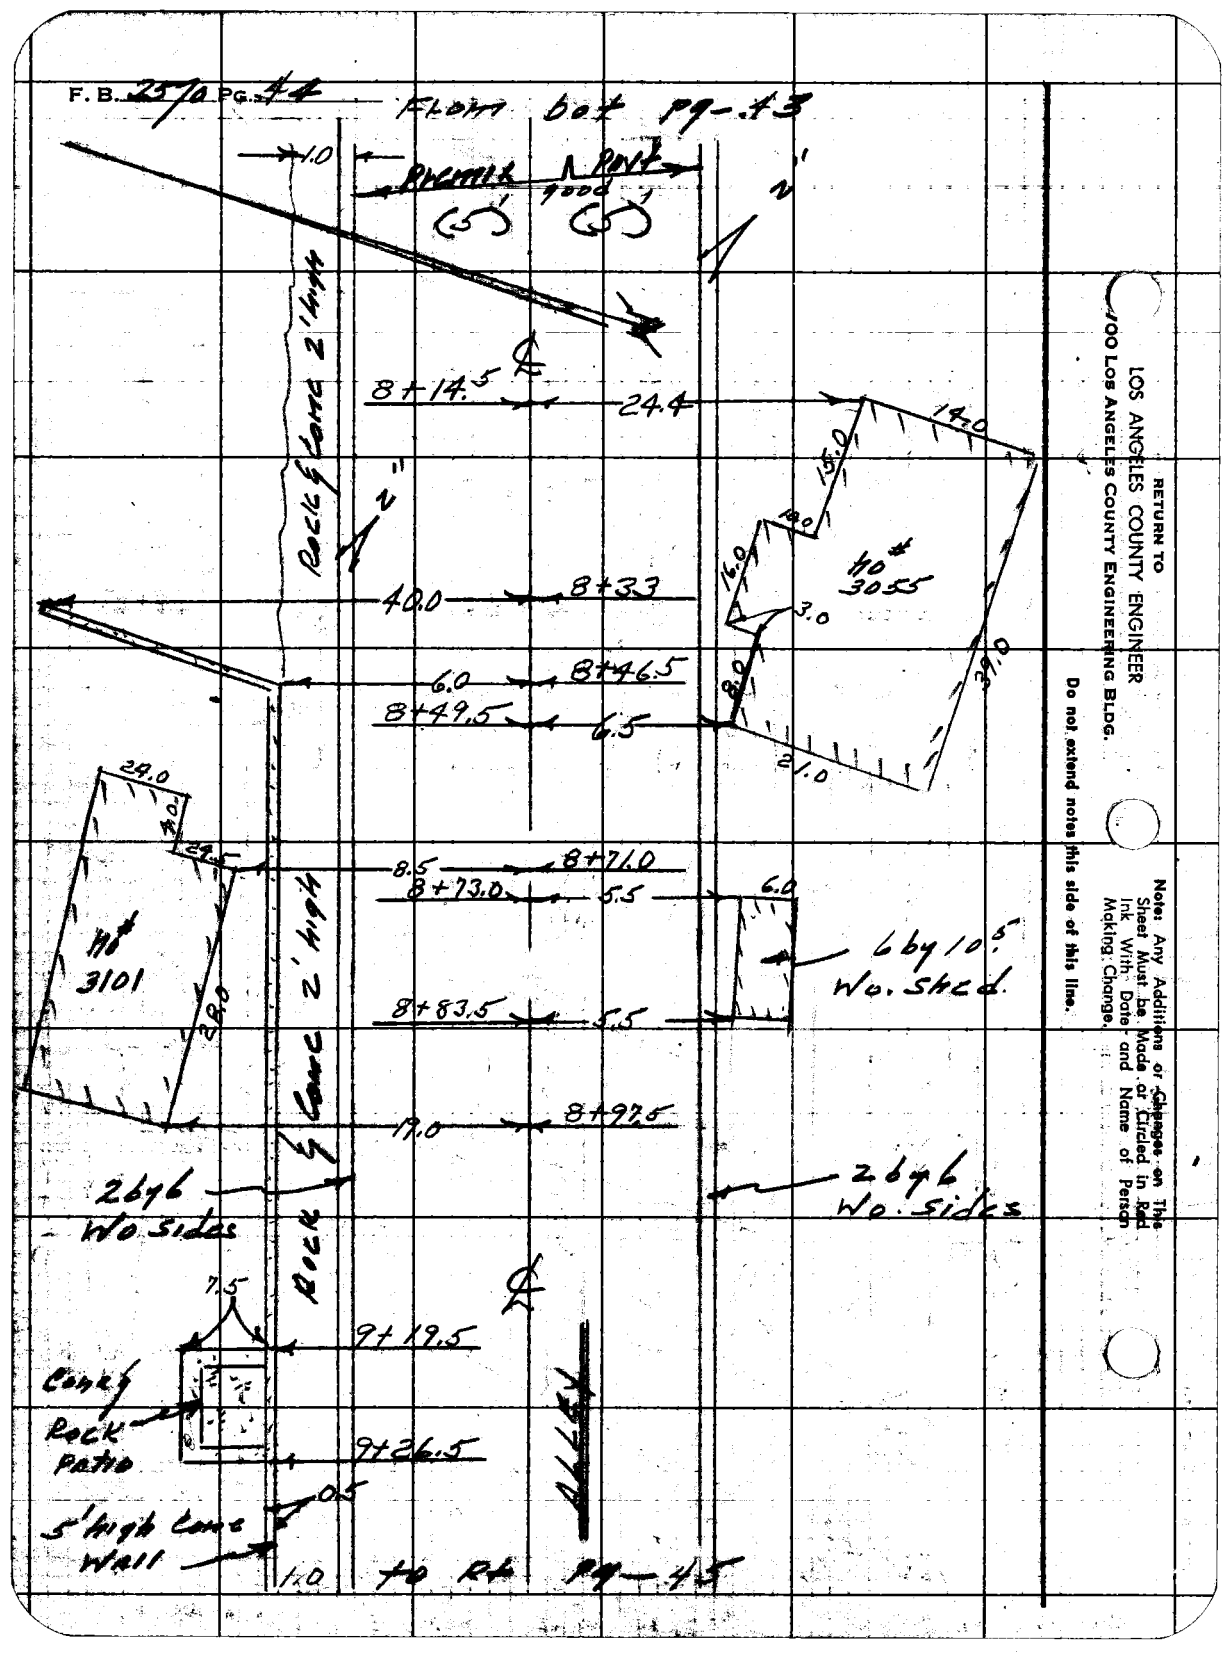
F. B. 2570 PG. 44
FROM Bk pg-43
1.0
Rock & Conc 2' High
8+14.5
24.4
14.0
15.0
18.0
16.0
3.0
8.0
39.0
40'
3055
40.0
8+33
6.0
8+46.5
8+49.5
6.5
1.0
29.0
30.0
29.0
116'
3101
30.0
8.5
8+71.0
8+73.0
5.5
6.0
6 by 10.5
Wo. Shed
8+83.5
5.5
19.0
8+92.5
2646
W/o Sides
2646
W/o Sides
Rock & Conc 2' High
7.5
9+19.5
Conc
Rock
Patio
9+26.5
0.5
5' High Conc
Wall
1.0
To Bk Pg-45
RETURN TO
LOS ANGELES COUNTY ENGINEER
1100 Los Angeles County Engineering Bldg.
Do not extend notes this side of this line.
Note: Any Additions or Changes on This Sheet Must be Made or Circled in Red Ink With Date and Name of Person Making Change.

Notes Ck'd by _____
Map No. _____
Office Work _____
Checked _____
Date _____

Survey of Pacific Electric R.R. P. B. 257 Pg. 46
W.O. 62918 Scale 1" = 5'
Surveyed by Brooks
Notes L.C. Date 3-26
Indexed C. Johnson

Note: Any Additions or Changes on This Sheet Must be Made or Circled in Red Ink With Date and Name of Person Making Change.

Do not extend notes this side of this line.

RETURN TO
LOS ANGELES COUNTY ENGINEER
900 LOS ANGELES COUNTY ENGINEERING BLDG.

78B09S CE #247—7-58


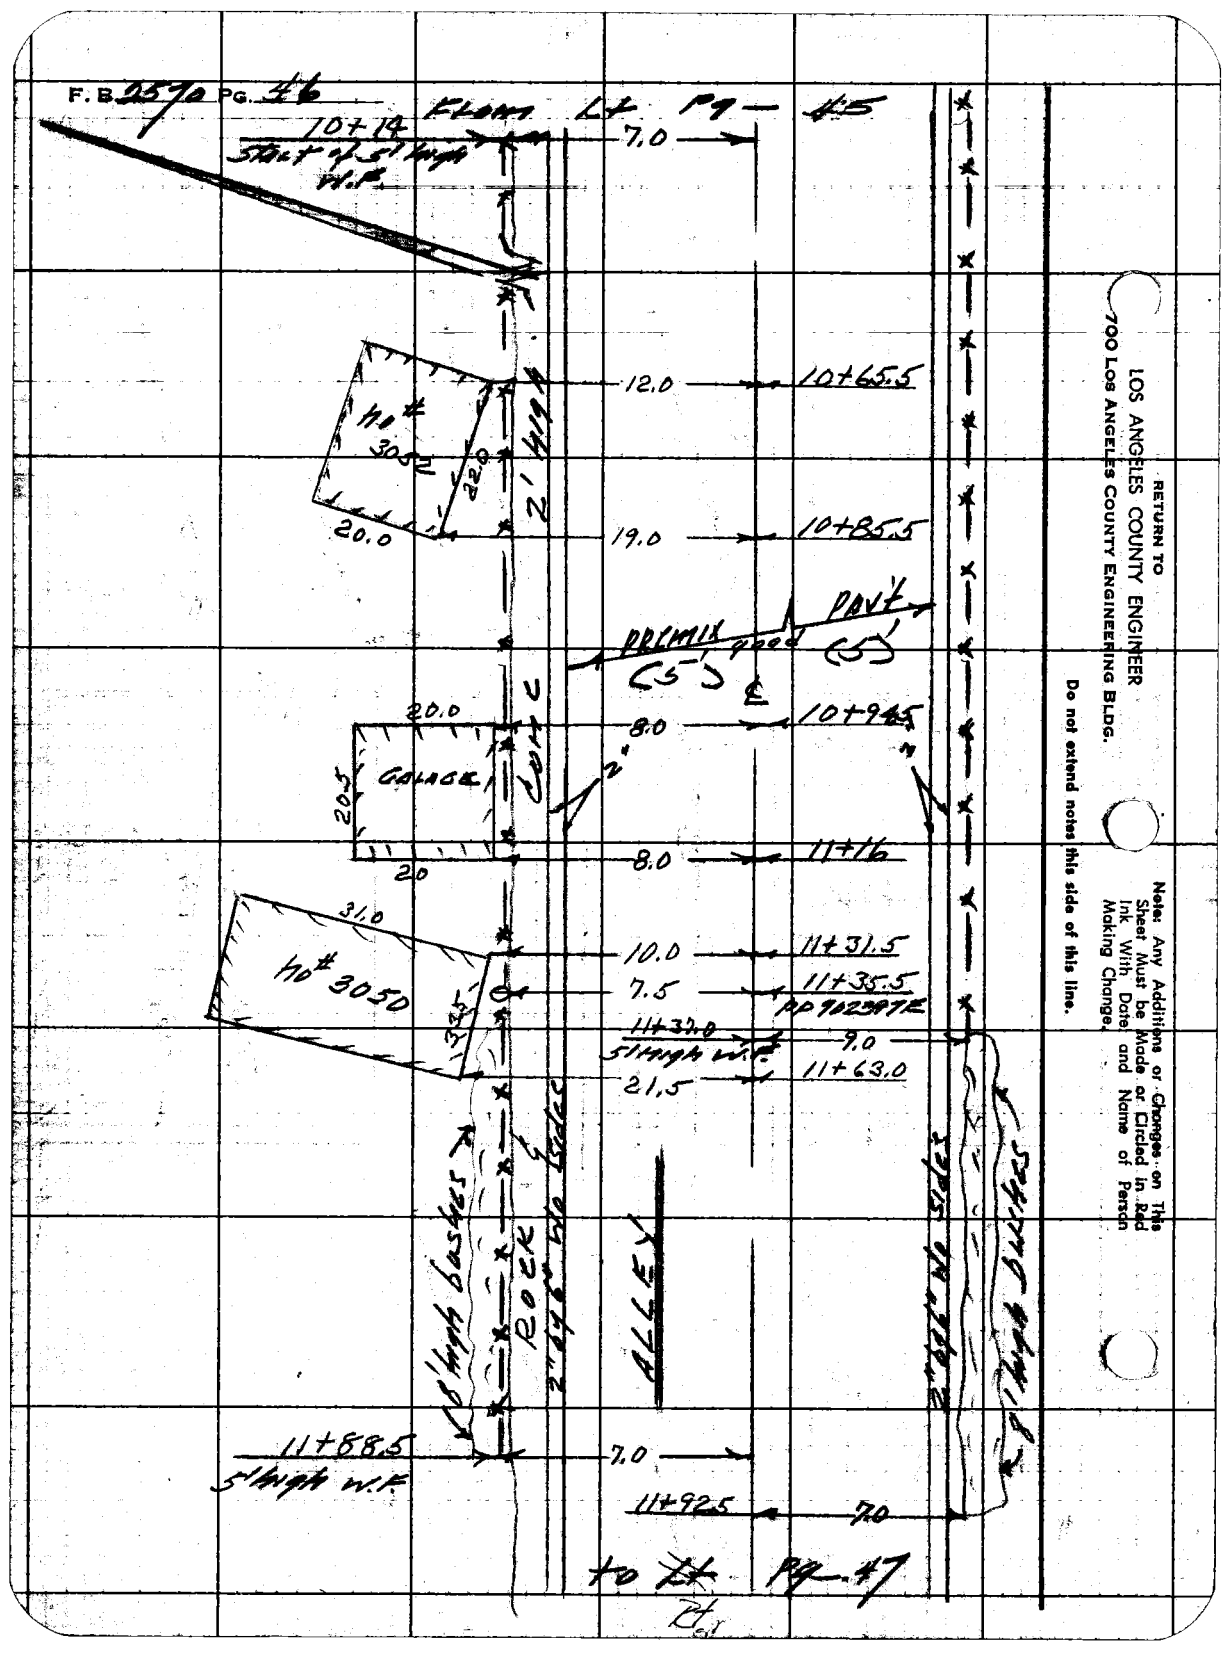
F. B. 2570 PG. #6
FLOW LF PG — #5
10+19
Start of 5' high W.F.
7.0
12.0
10+65.5
H0 # 3050
22.0
21' high
20.0
19.0
10+85.5
PREMIX
PAVT
6'
20.0
8.0
10+94.5
GUTTER
20.5
20
8.0
11+16
31.0
H0 # 3050
10.0
11+31.5
7.5
11+35.5
RP 902397E
11+32.0
5' high W.F.
9.0
11+63.0
21.5
ALLEY
2'x2'x6" Rock Gutter
6' high basket
6' high basket
11+68.5
5' high W.F.
7.0
11+92.5
7.0
to #7 PG. #7
RETURN TO
LOS ANGELES COUNTY ENGINEER
700 Los Angeles County Engineering Bldg.
Do not extend notes this side of this line.
Note: Any Additions or Changes on This Sheet Must be Made or Circled in Red Ink With Date and Name of Person Making Change.

763098 CE #247—7-53

RETURN TO
LOS ANGELES COUNTY ENGINEER
700 LOS ANGELES COUNTY ENGINEERING BLDG.

Note: Any Additions or Changes on This Sheet Must be Made or Circled in Red Ink With Date and Name of Person Making Change.

Do not extend notes this side of this line.

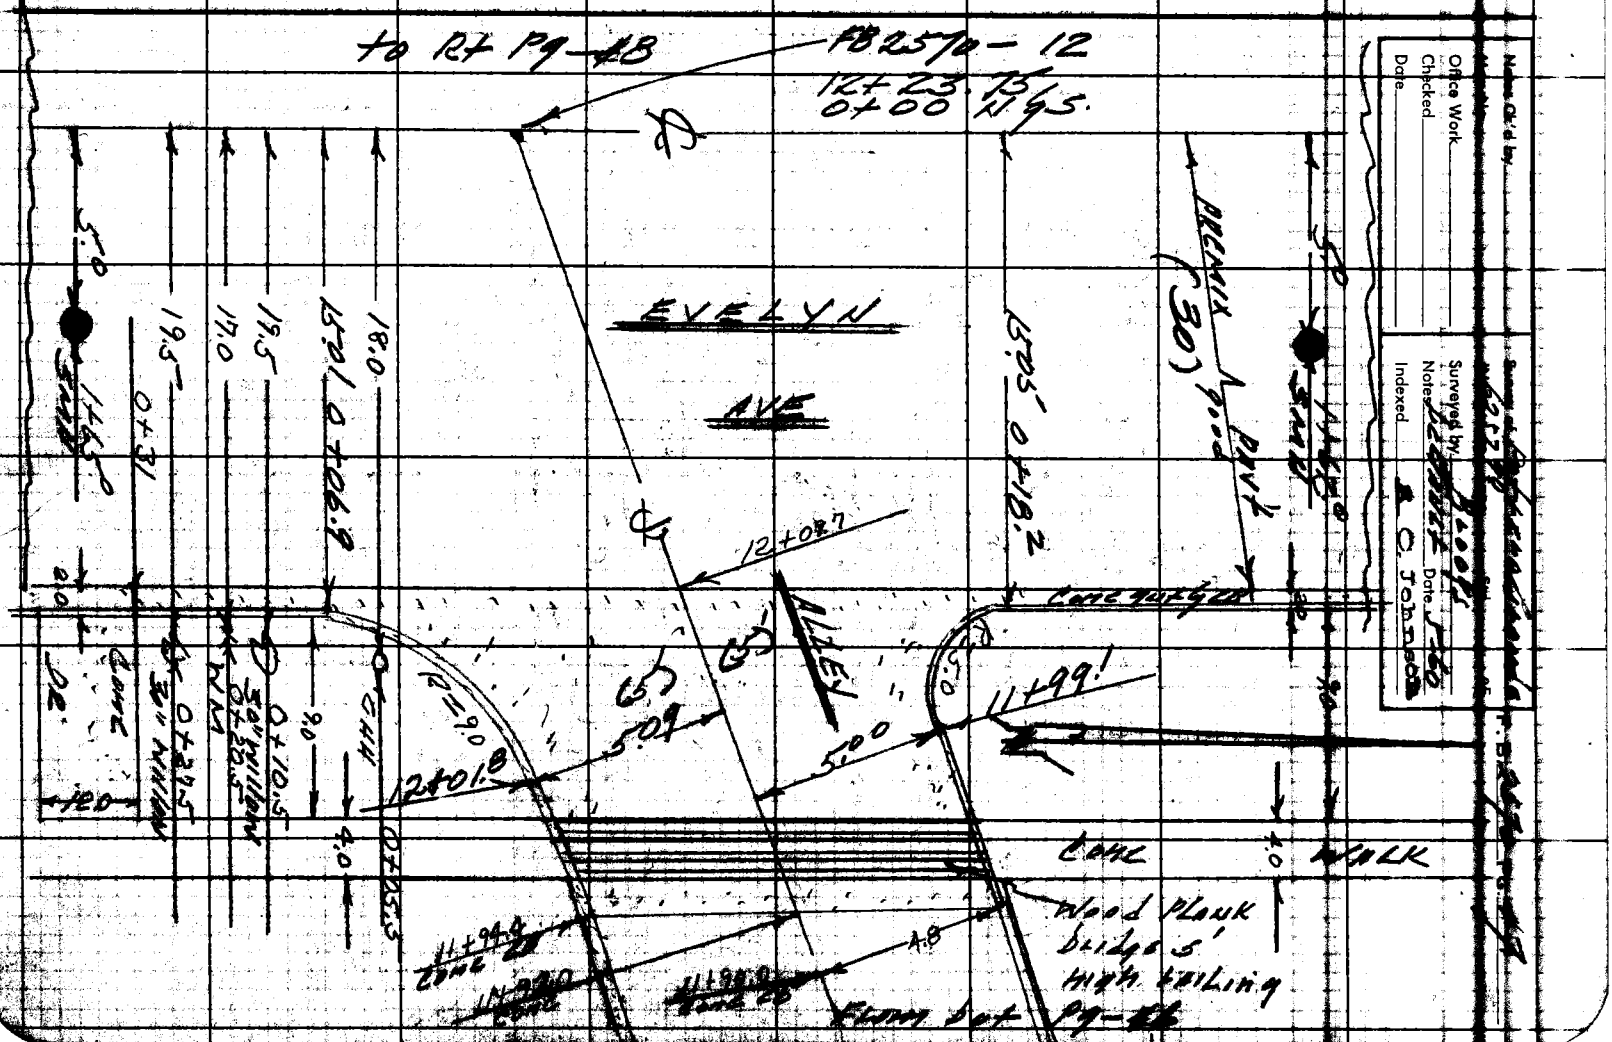

RETURN TO
LOS ANGELES COUNTY ENGINEER
700 LOS ANGELES COUNTY ENGINEERING BLDG.

Note: Any Additions or Changes on This Sheet Must be Made or Circled in Red Ink With Date and Name of Person Making Change.

Do not extend notes this side of this line.

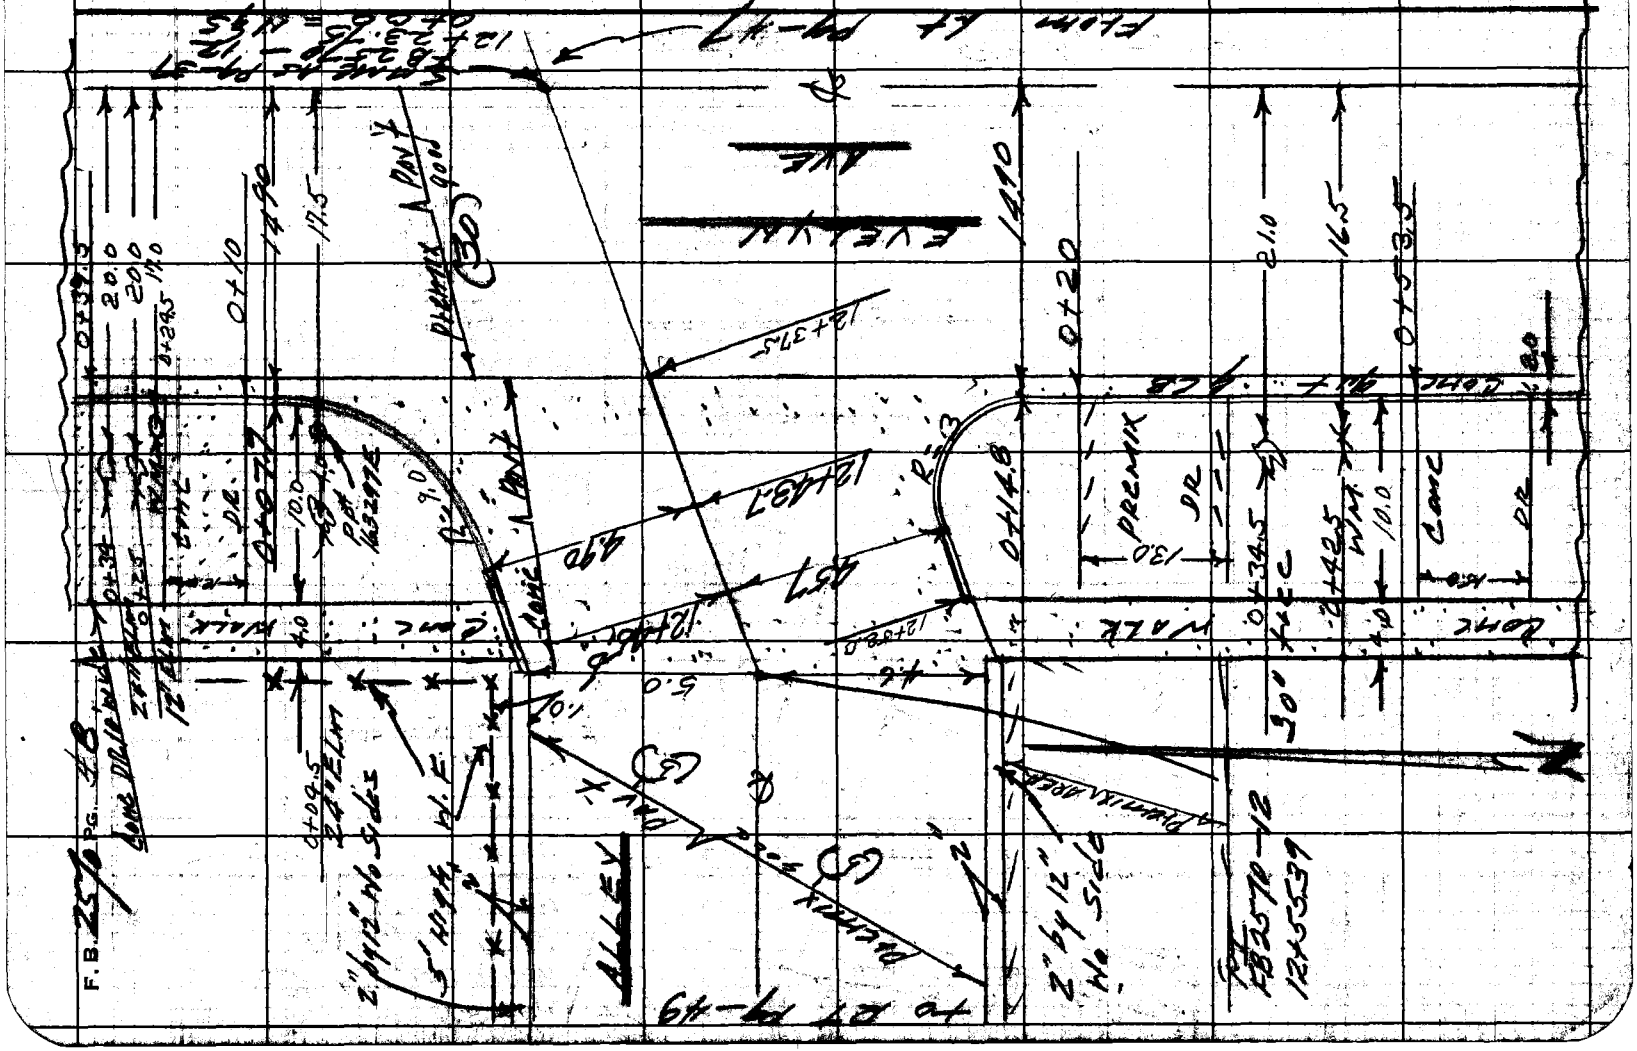
PREMIX
CONC
WALK

763098 CE #247—7-53

RETURN TO
LOS ANGELES COUNTY ENGINEER
900 LOS ANGELES COUNTY ENGINEERING BLDG.

Note: Any Additions or Changes on This Sheet Must Be Made or Circled in Red Ink With Date and Name of Person Making Change.

Do not extend notes this side of this line.

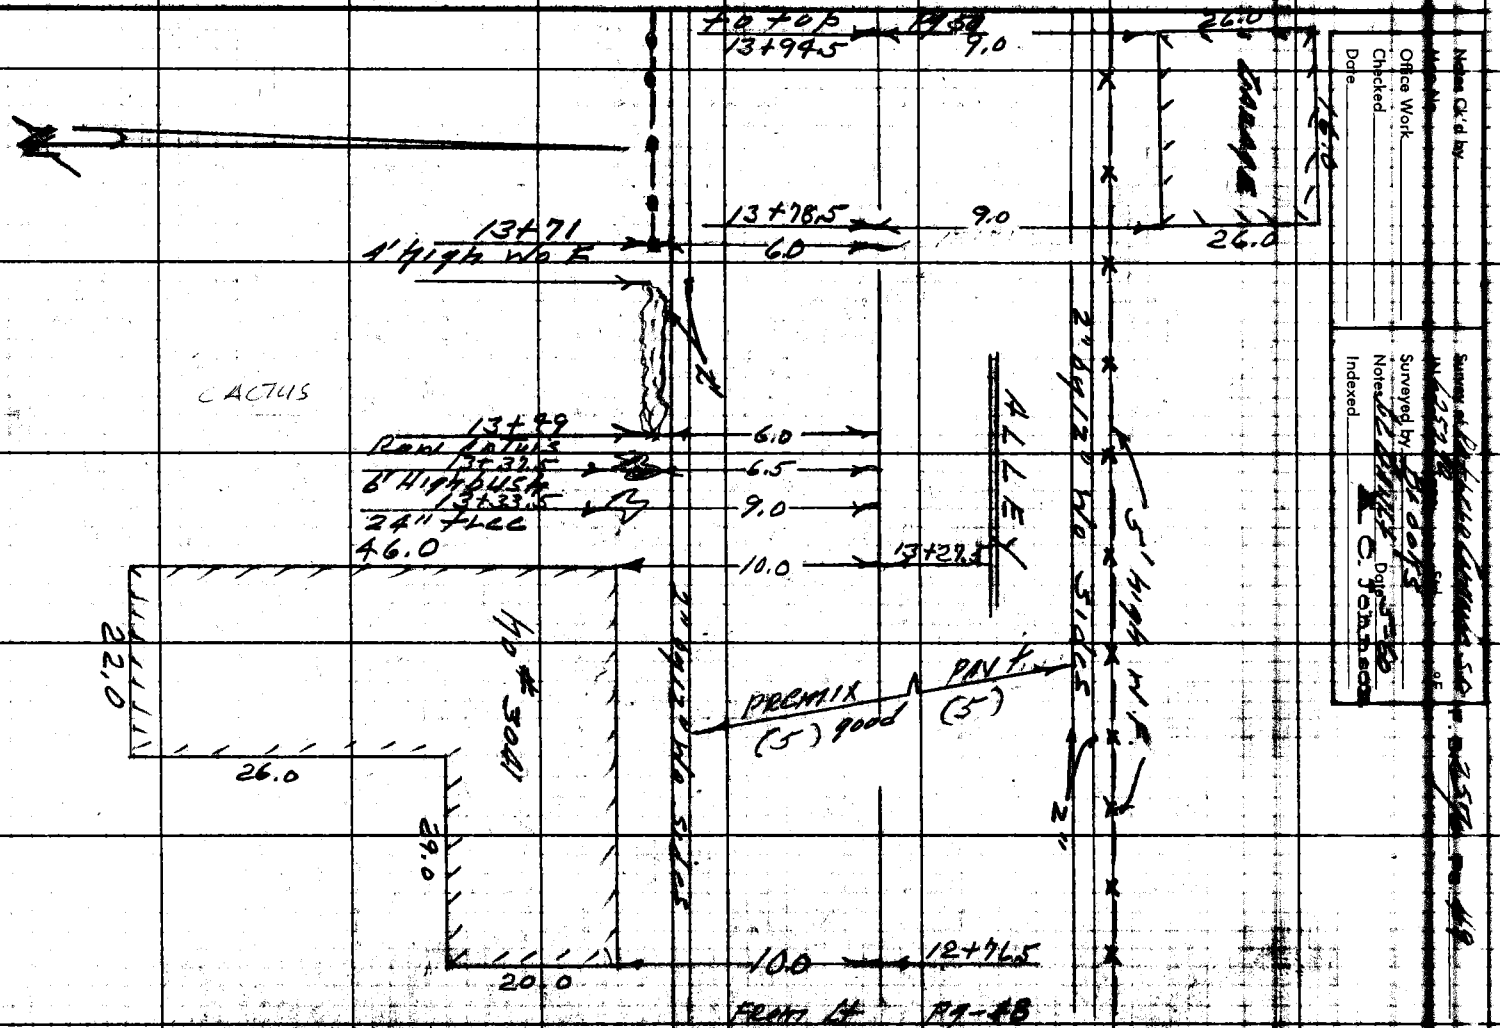

Office Work
Checked
Date

Notes Ck'd by
Indexed

Surveyed by
Notes
Date

RETURN TO
LOS ANGELES COUNTY ENGINEER
700 LOS ANGELES COUNTY ENGINEERING BLDG.

Note: Any Additions or Changes on This Sheet Must be Made or Circled in Red Ink With Date and Name of Person Making Change.

Do not extend notes this side of this line.

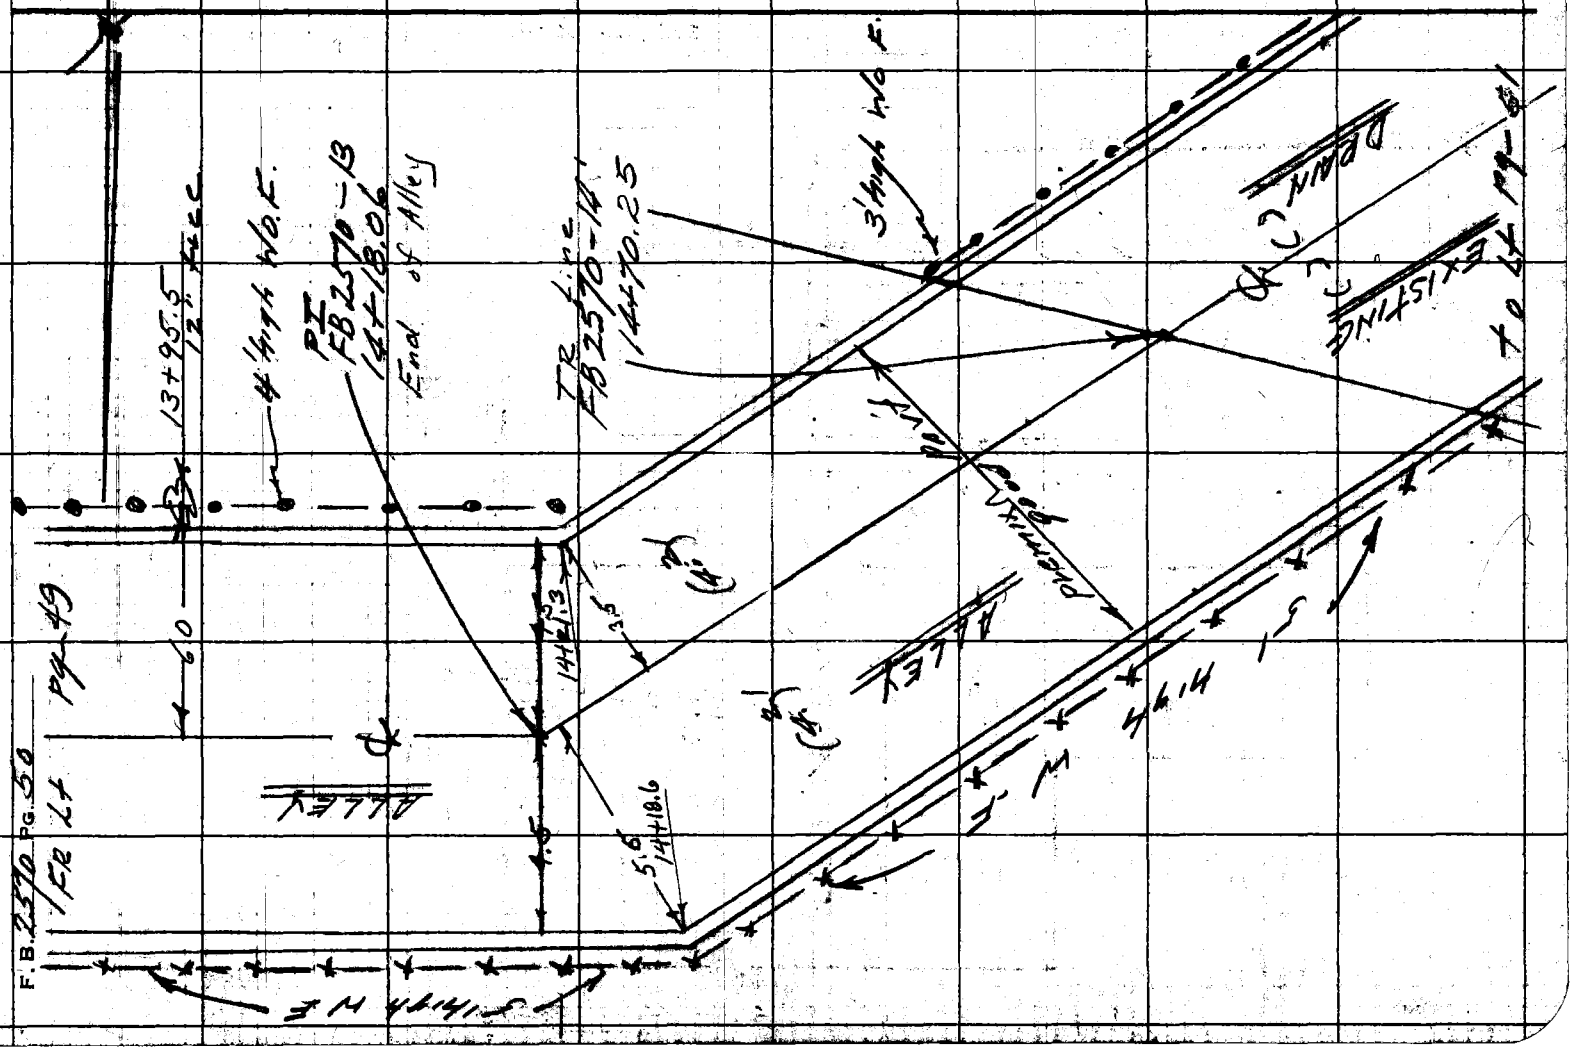

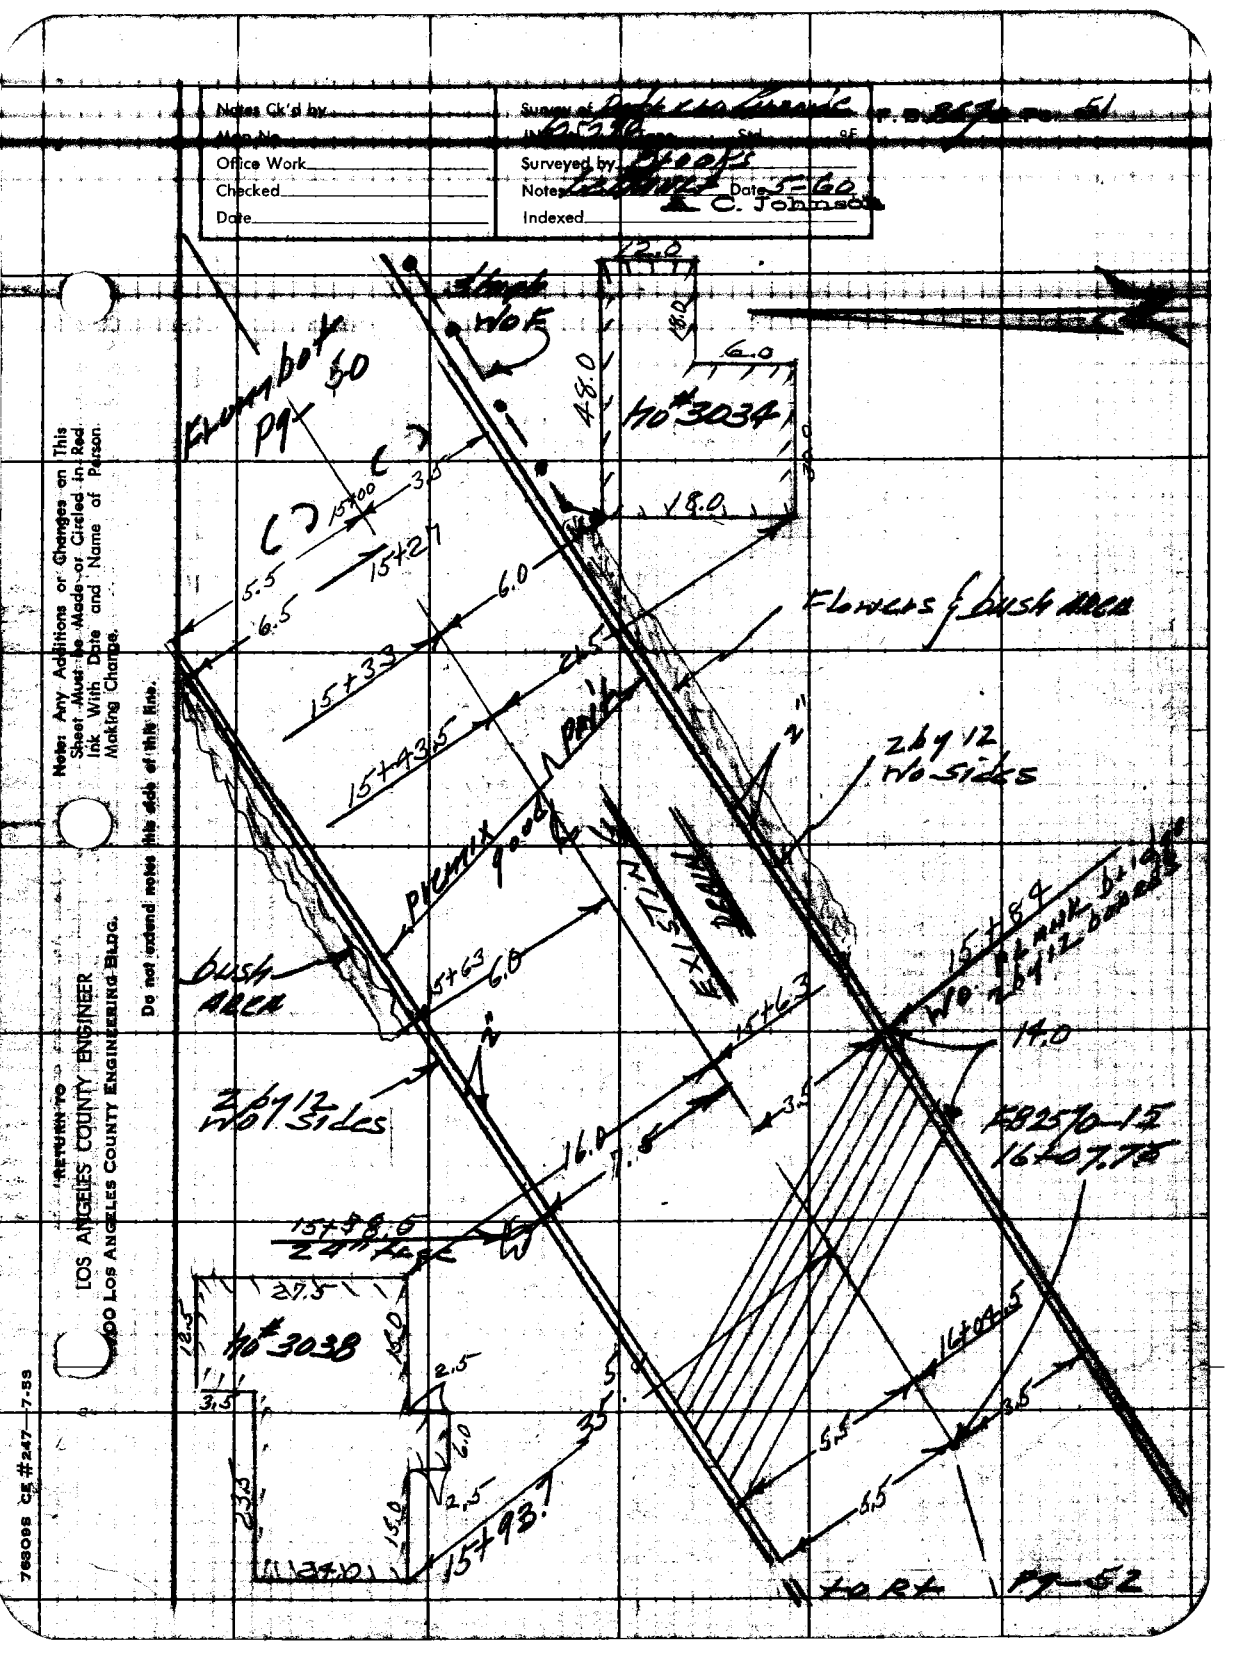
Notes Ck'd by
Map No.
Office Work
Checked
Date
Surveyed by
Notes
Date 5-60
C. Johnson
Indexed
Flowline
W of E
Flowline
P9+
50
48.0
23.0
6.0
H/O #3034
18.0
15+00
3.5
15+27
5.5
6.5
6.0
15+33
15+43.5
Flowers & Bush Area
2 by 12
H/O Sides
Pavement
9.0
Pavement
Bush
Area
5+63
6.0
15+89
H/O 2 by 12 Sides
14.0
3.5
2 by 12
H/O Sides
16.0
17.0
15+98.0
F825(0)-15
16+07.78
27.5
12.5
15.0
H/O #3038
3.5
2.5
6.0
2.5
15.0
23.5
15+93.7
16+04.5
3.5
5.5
5.5
to Rt
Pt-52
RETURN TO
LOS ANGELES COUNTY ENGINEER
900 LOS ANGELES COUNTY ENGINEERING BLDG.
Note: Any Additions or Changes on This Sheet Must be Made or Circled in Red Ink With Date and Name of Person Making Change.
Do not extend notes into this area of this line.
763098 CE #247—7-59

RETURN TO
LOS ANGELES COUNTY ENGINEER
700 LOS ANGELES COUNTY ENGINEERING BLDG.

Note: Any Additions or Changes on This Sheet Must be Made or Circled in Red Ink With Date and Name of Person Making Change.

Do not extend notes this side of this line.

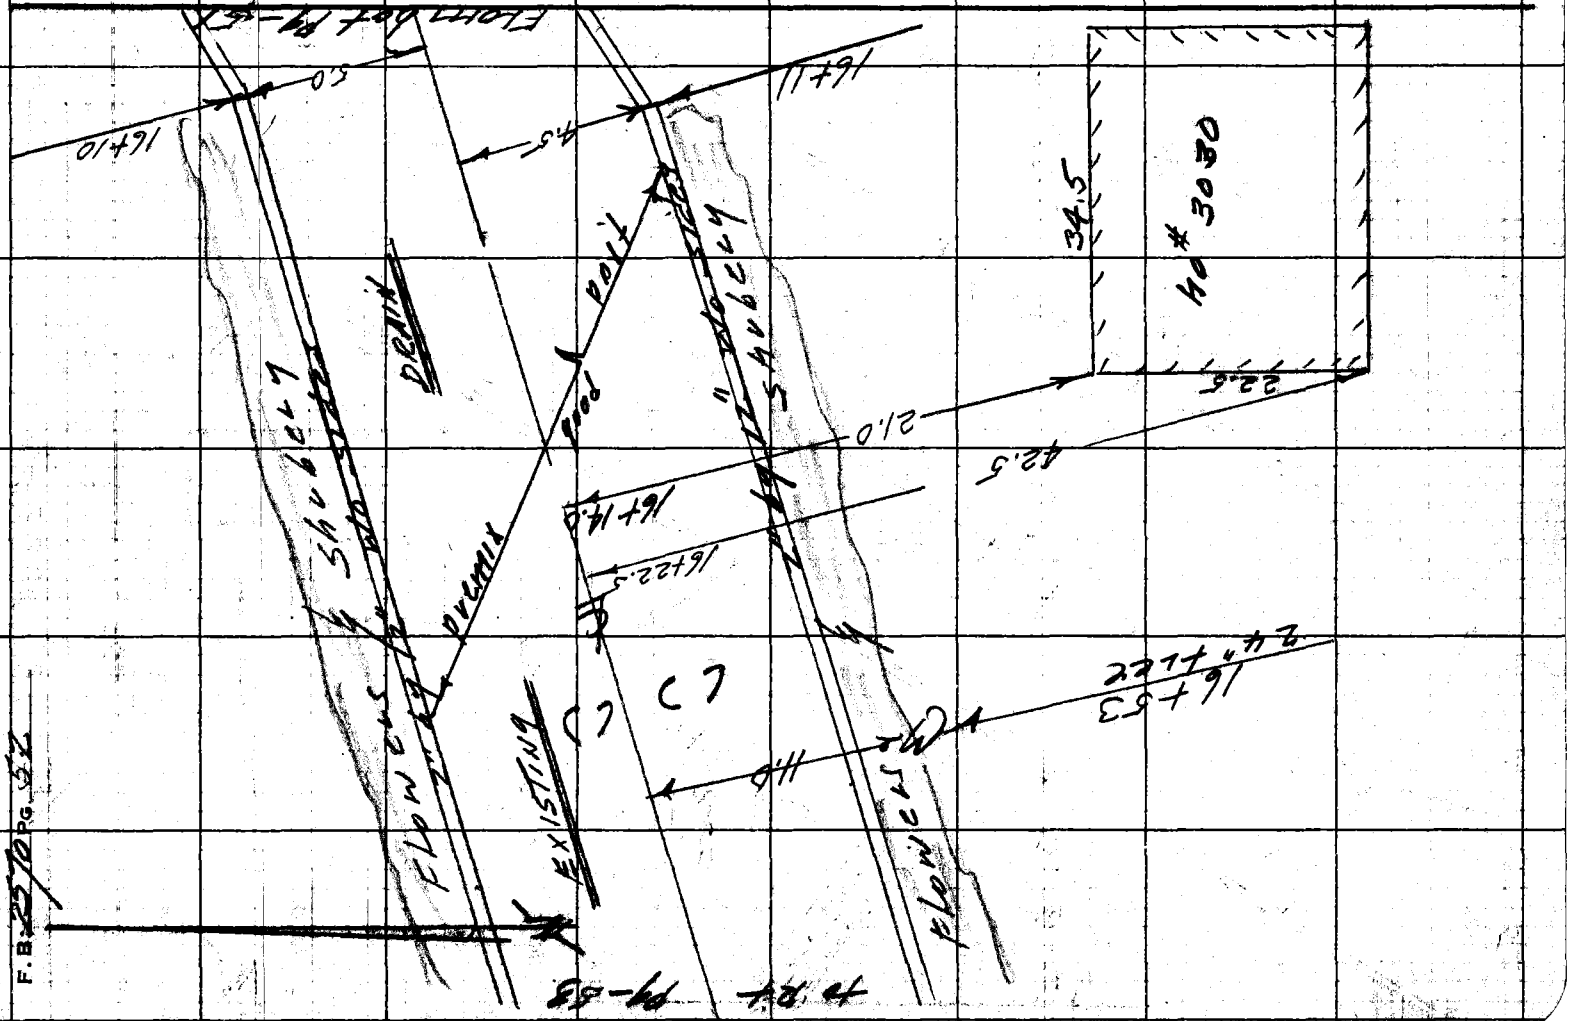

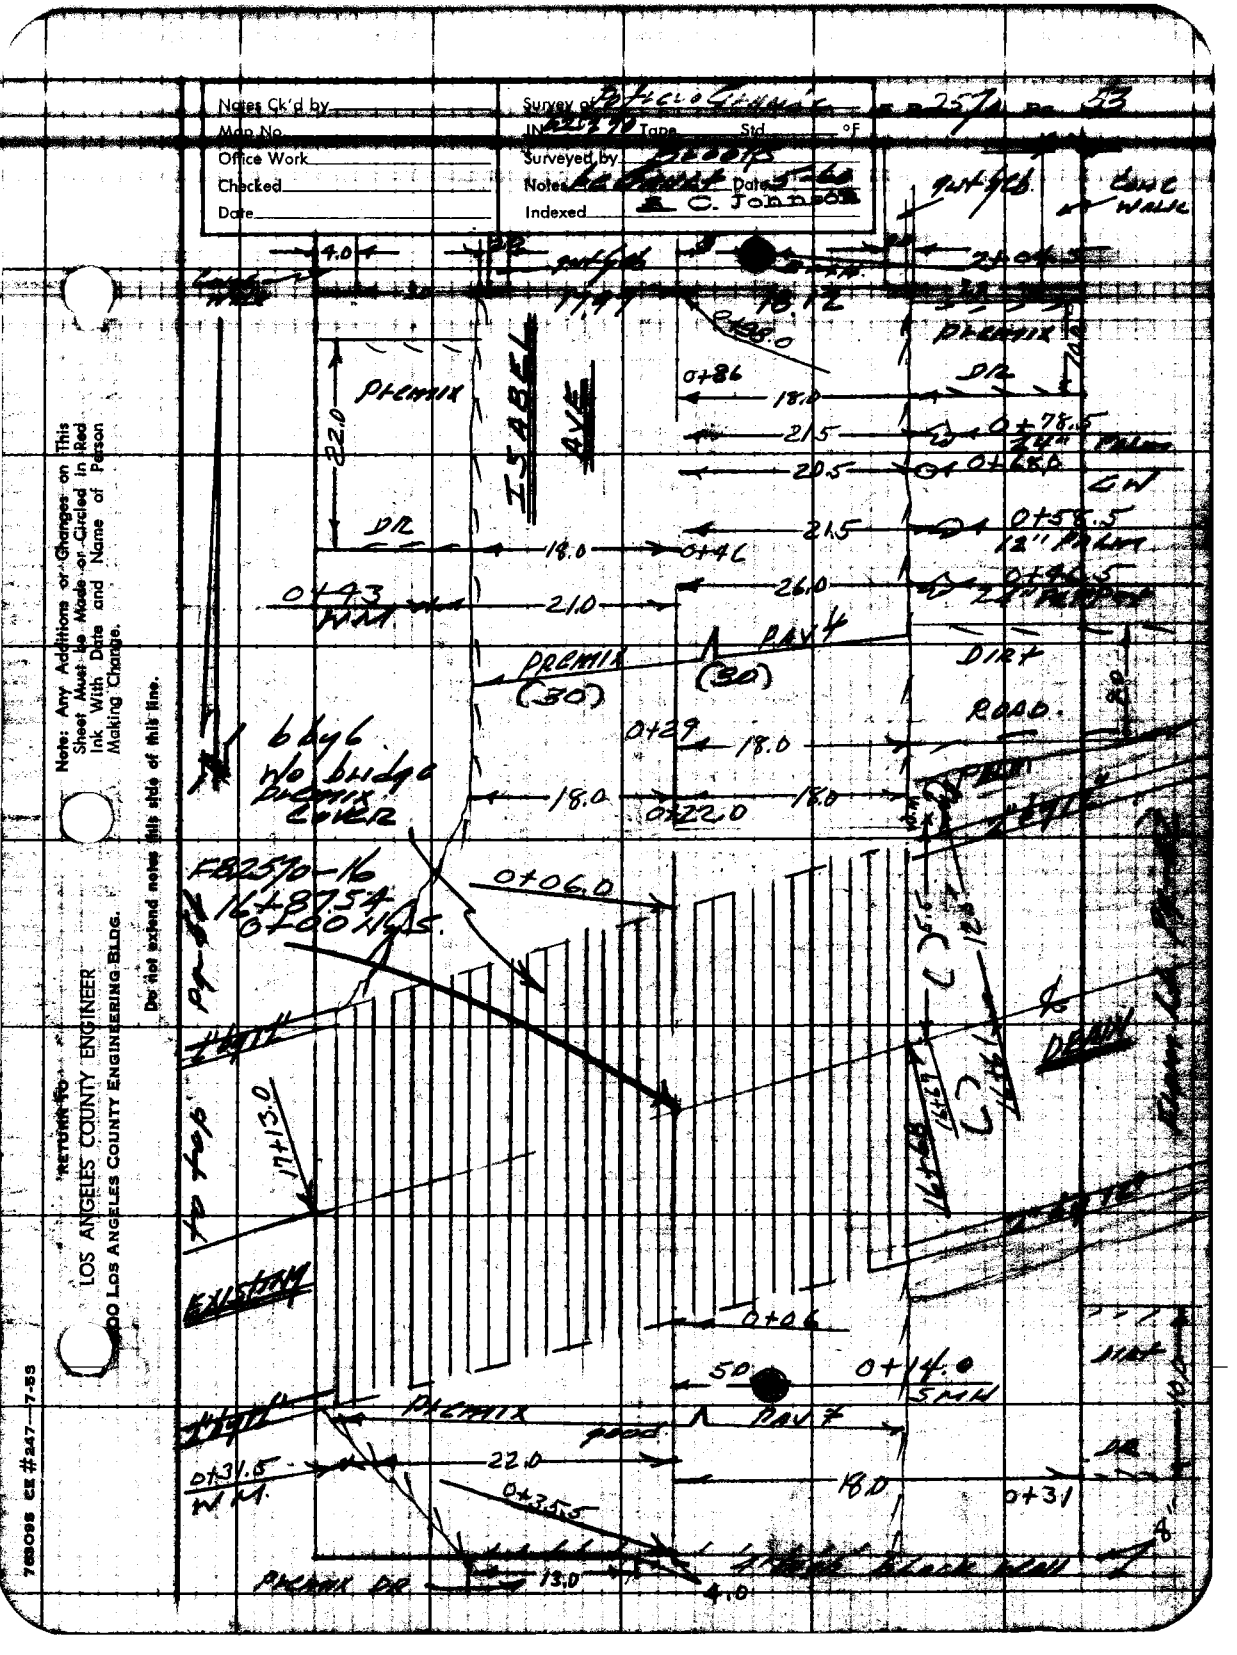
Notes Ck'd by
Map No.
Office Work
Checked
Date
Survey of
Tape Std °F
Surveyed by
Notes
Date
Indexed
C. Johnson
Note: Any Additions or Changes on This Sheet Must be Made or Circled in Red Ink With Date and Name of Person Making Change.
Do not extend notes this side of this line.
RETURN TO
LOS ANGELES COUNTY ENGINEER
900 LOS ANGELES COUNTY ENGINEERING BLDG.
7-55 CE #247
4.0
22.0
PREMIX
ISABEL AVE
DR
18.0
0+43
21.0
0+86
21.5
20.5
0+46
26.0
PAVT
(30)
DIRT
ROAD.
0+29
0+22.0
6x6
No bridge
FB2570-16
14+87.54
6 Loc Nuts.
0+06.0
0+06
0+14.0
50
22.0
0+31.5
0+31
0+35.5
13.0
4.0
CMP
DEAD END
EXISTING
To Top
17+13.0

F. B 2570 PG. 54

From 64 Pg-53

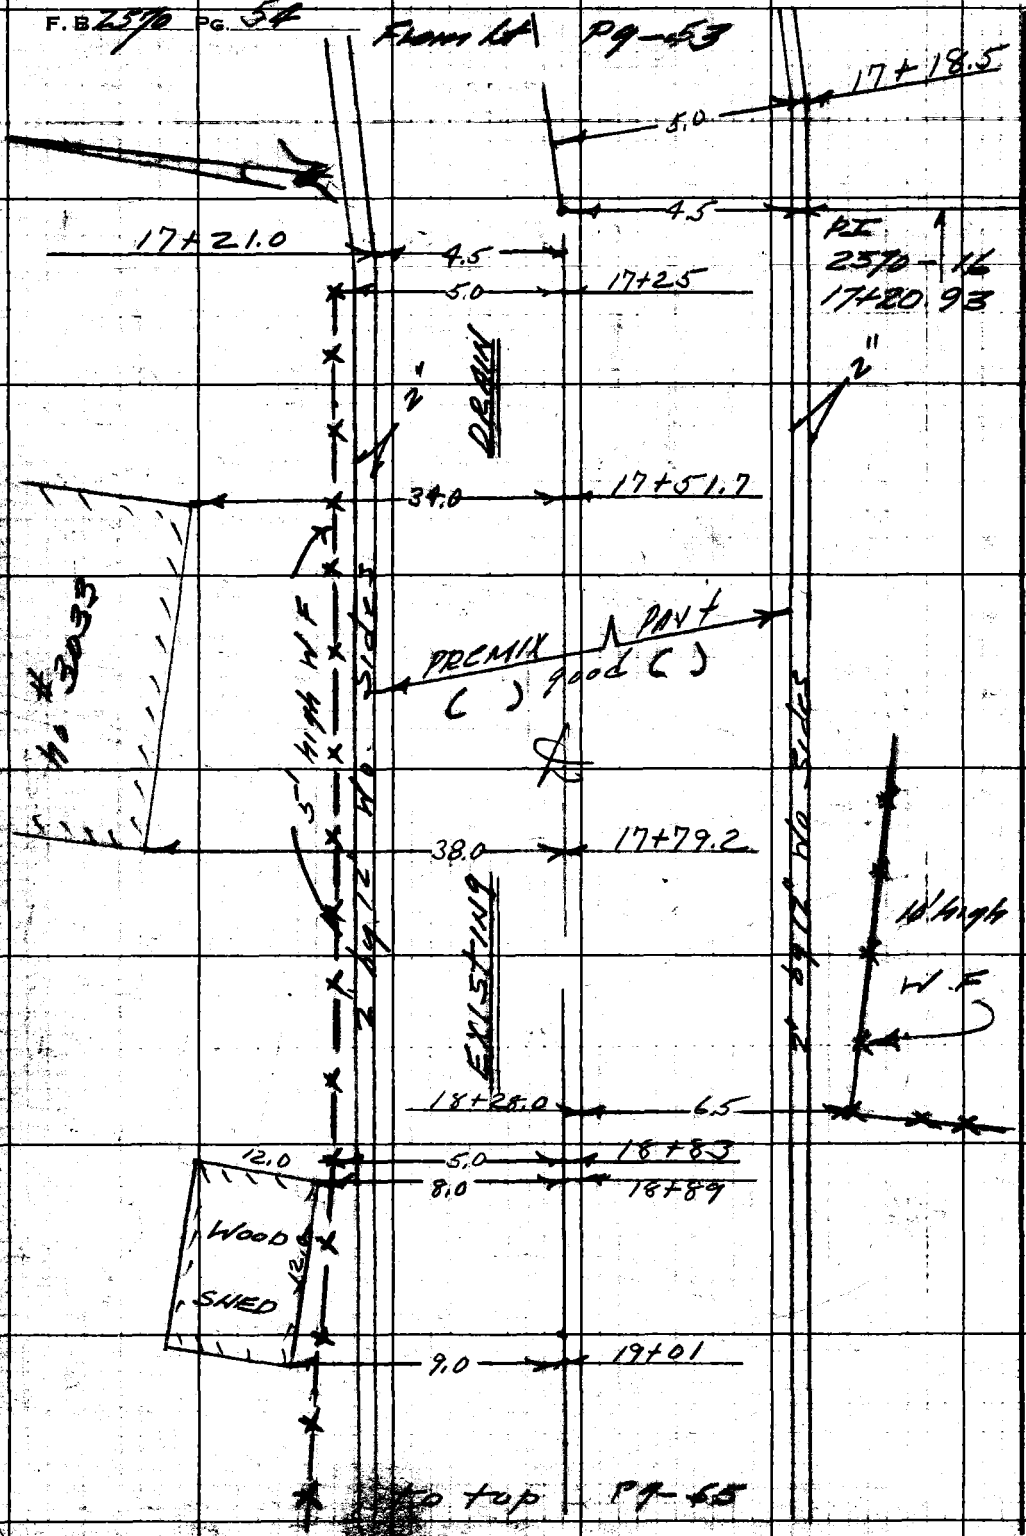

RETURN TO
LOS ANGELES COUNTY ENGINEER
900 LOS ANGELES COUNTY ENGINEERING BLDG.

Do not extend notes this side of this line.

Note: Any Additions or Changes on This Sheet Must be Made or Circled in Red Ink With Date and Name of Person Making Change.


Office Work _____
Checked _____
Date _____

Surveyed by Brooks
Notes Lehnhart Date 5-60
C. Johnson
Indexed _____

Flow bal pg 54

PE
FB 2570-17
19+51.50

DRAIN

5.0

19+51

5.0

19+52

4.5

5' High
W F

5.3

19+58

14.0

19+62
10" FREE
Pepper

11.5

10.0

19+71

9.5

5.0

10" FREE

20+15.0
36" Pepper

6.0

20+00

20+23
36" OAK

8.5

DRIVE

PAVT

9.0

20+33.5

18.0

8.0

8.0

4/0 3021

20+52

7.0

4.5

20+57.3

30" mahog

4.5

5.0

PE
FB 2570-18
20+57.93

20+80
30" OAK

20.5

20+57.9

20+69

8.5

EXIST 24" RCP

24" RCP

to P+

pg 56

"RETURN TO
LOS ANGELES COUNTY ENGINEER
AND LOS ANGELES COUNTY ENGINEERING-BLDG."

Note: Any Additions or Changes on This Sheet Must be Made or Circled in Red Ink With Date and Name of Person Making Change.

Do not extend notes this side of this line.

763095 CE #247—7-59

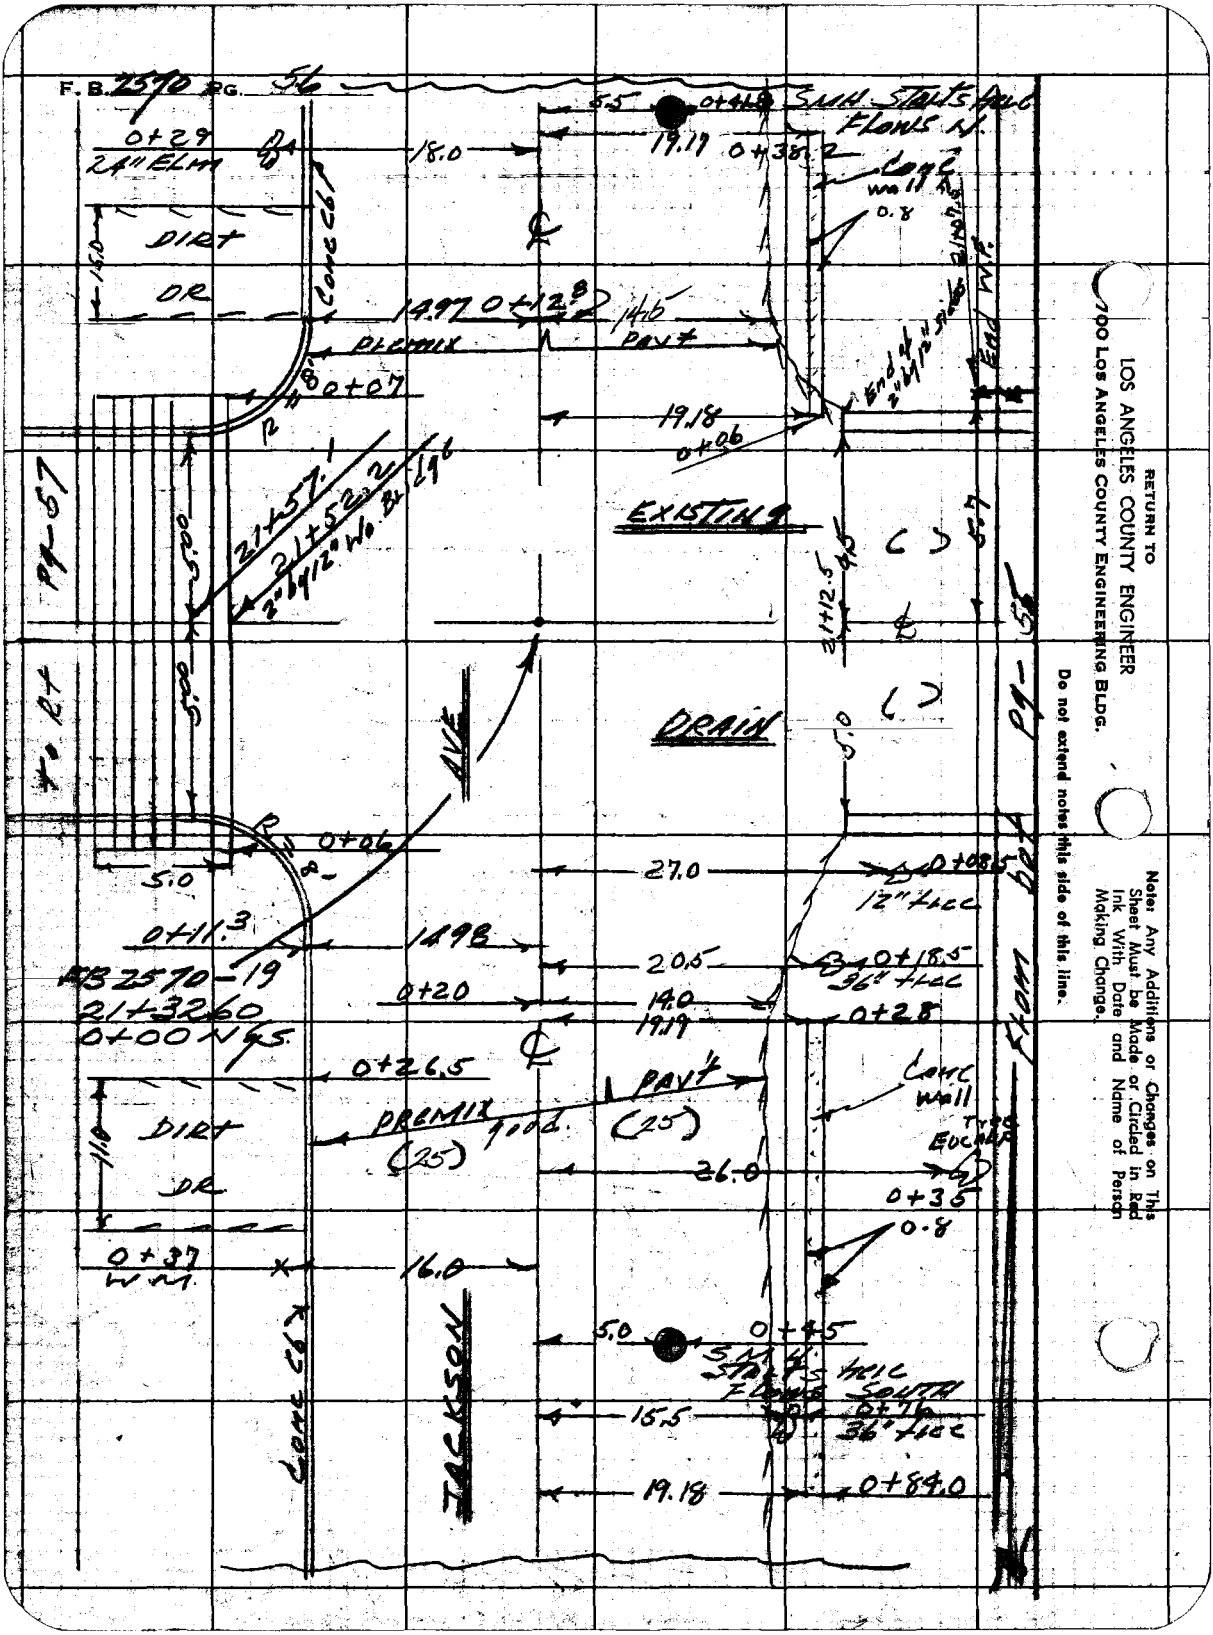
F.B. 2570 PG. 56
0+29
24" ELM
18.0
DIRT
OR
16.0
CONC.
14.97
0+12.8
14.6
PAVT
PREMIX
0+07
19.18
0+06
EXISTING
21+57.1
21+52.2
2" Ø 1/2" W.O. BY
PL-57
21+12.5
DRAIN
5.0
0+08.5
12" RCC
27.0
0+04
5.0
0+11.3
14.98
AB 2570-19
21+32.60
0+00 N 45°
20.5
0+18.5
36" RCC
0+20
14.0
19.19
0+28
0+26.5
PAVT
PREMIX
(25)
CONC WALL
TYP.
EXCEPT
26.0
0+35
0.8
DIRT
OR
11.0
0+37
W.M.
16.0
5.0
0+45
SMH
STORM
FLOWS
RCC
SOUTH
0+79
36" RCC
15.5
19.18
0+84.0
JACKSON
CONC.
LOS ANGELES COUNTY ENGINEER
900 LOS ANGELES COUNTY ENGINEERING BLDG.
RETURN TO
Do not extend notes this side of this line.
Notes Any Additions or Changes on This Sheet Must be Made or Circled in Red Ink With Date and Name of Person Making Change.

763098 CE #247—7-53

RETURN TO
LOS ANGELES COUNTY ENGINEER
900 LOS ANGELES COUNTY ENGINEERING BLDG.

Note: Any Additions or Changes on This Sheet Must be Made or Circled in Red Ink With Date and Name of Person Making Change.

Do not extend notes this side of this line.

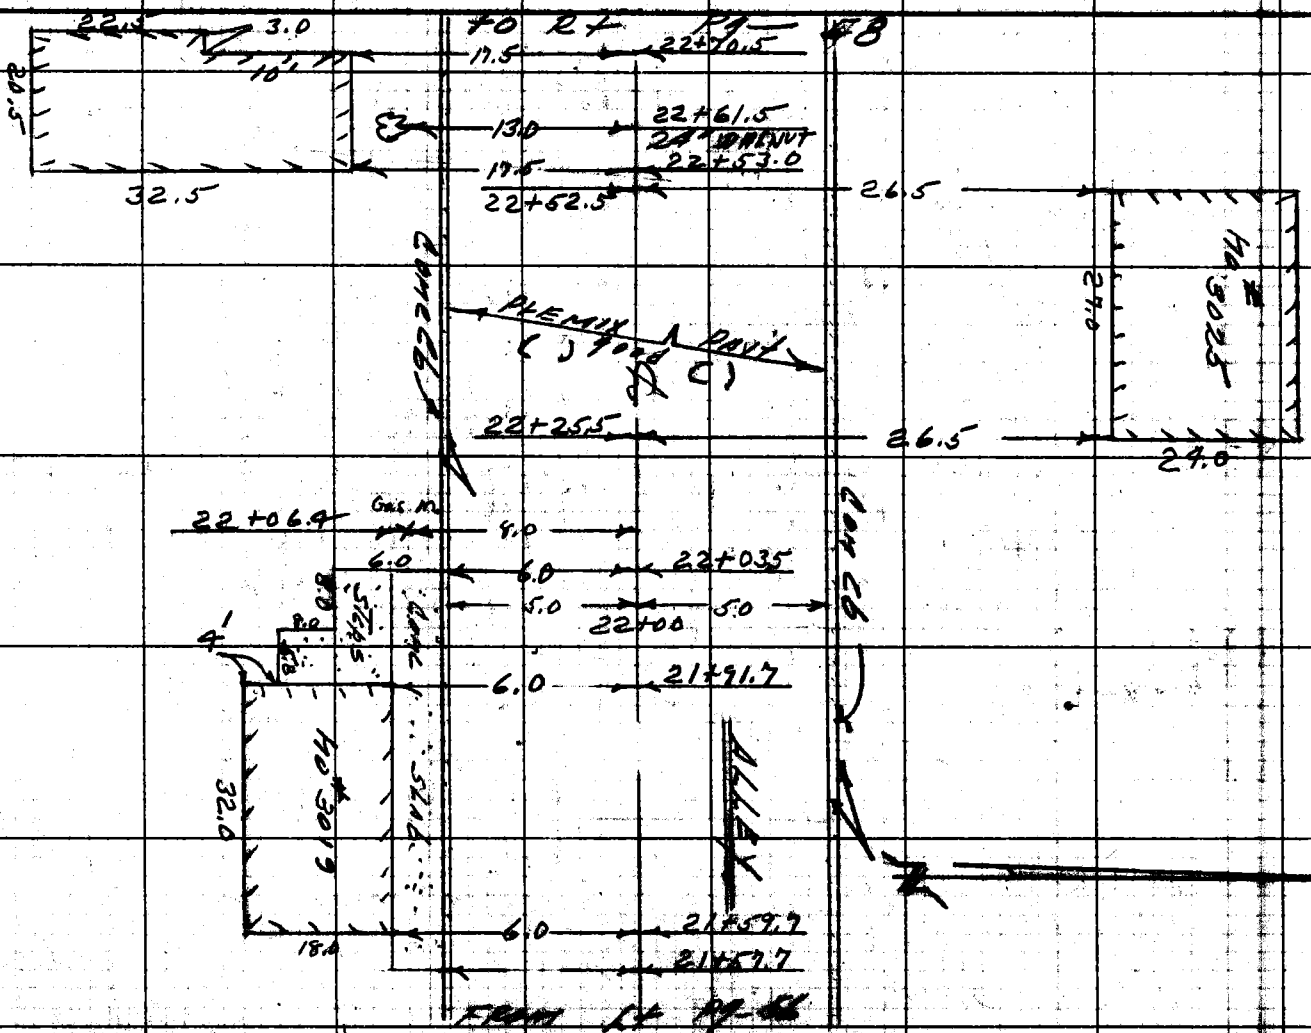

Office Work
Checked
Date

Notes Ck'd by
Surveyed by
Notes
Indexed
Date

F. B. 251 PG. 58

RETURN TO
LOS ANGELES COUNTY ENGINEER
700 Los Angeles County Engineering Bldg.

Note: Any Additions or Changes on This Sheet Must be Made or Circled in Red Ink With Date and Name of Person Making Change.

Do not extend notes this side of this line.

22+83
ALLEY
6.0
Py-59

763095 CE #247—7-53

RETURN TO
LOS ANGELES COUNTY ENGINEER
900 LOS ANGELES COUNTY ENGINEERING BLDG.

Note: Any Additions or Changes on This Sheet Must Be Made or Circled in Red Ink With Date and Name of Person Making Change.

Do not extend notes this side of this line.

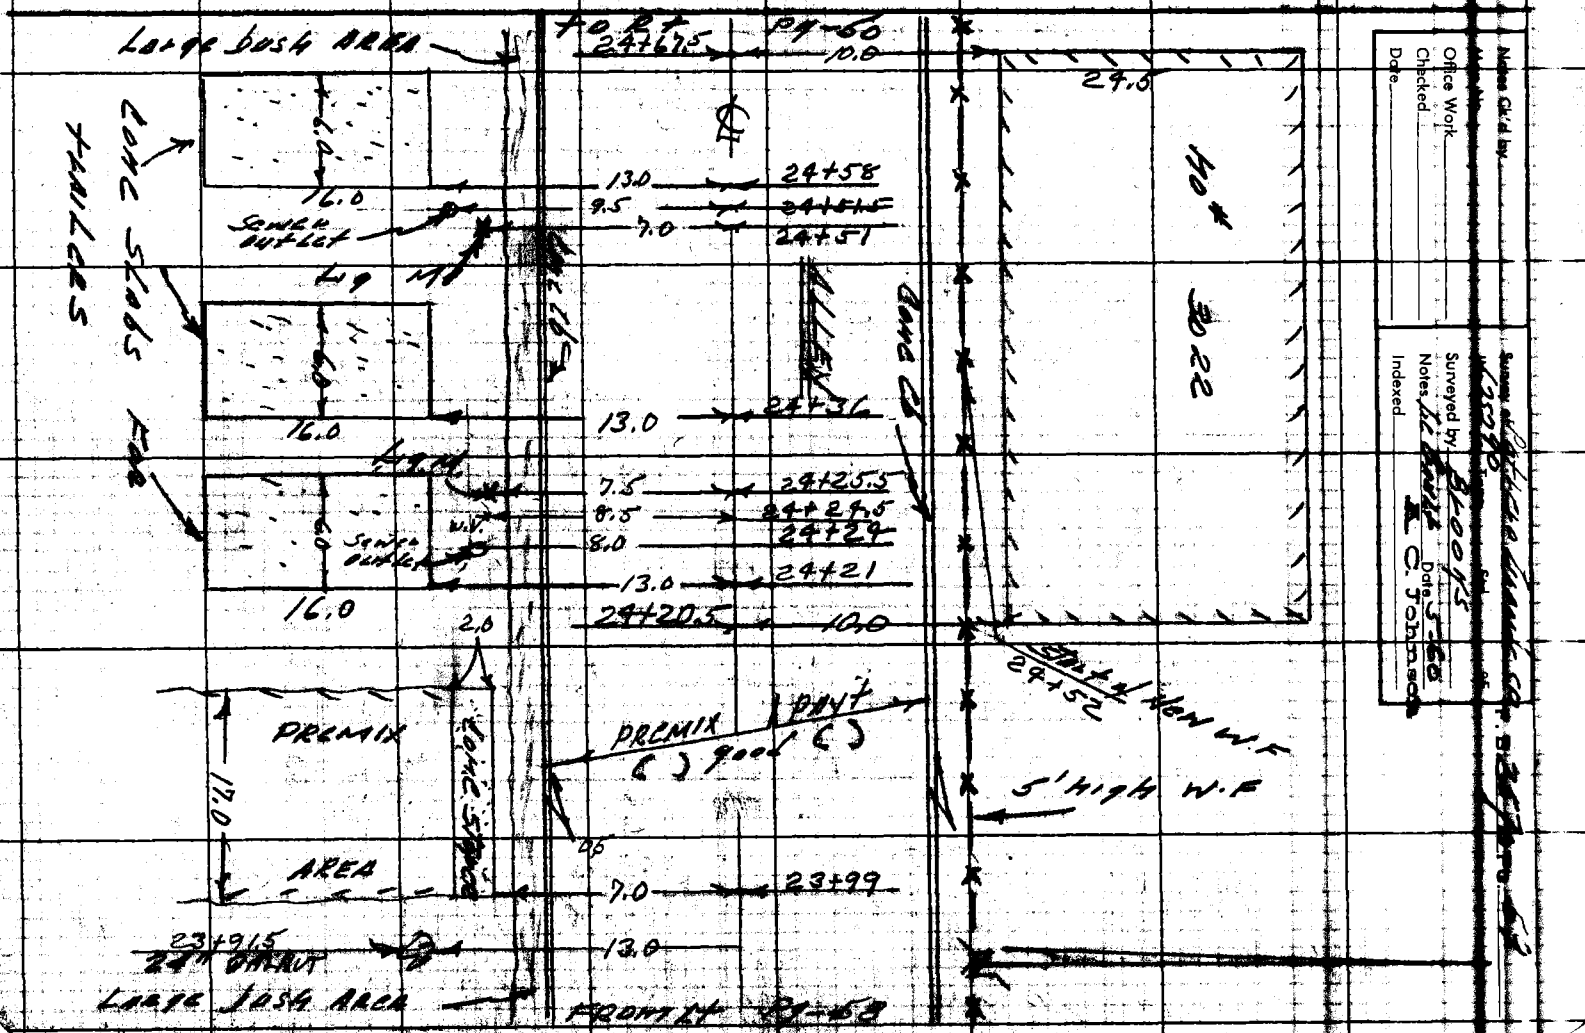

Office Work
Checked
Date

Surveyed by
Notes
Indexed

Notes Ck'd by
Date

F. B 2570 Pg. 60

RETURN TO
LOS ANGELES COUNTY ENGINEER
900 Los Angeles County Engineering Bldg.

Note: Any Additions or Changes on This Sheet Must be Made or Circled in Red Ink With Date and Name of Person Making Change.

Do not extend notes this side of this line.

NEW W.L.

Conc Cb

ALLEY

Pg-57

To ex

Pg-58

From ex

Pavement

Conc Cb

11.0

5.0

25+00

11.0

10.5

9.0

9.5

10.5

24+60

18.5

11.0

10.0

Large Sycamore

25+13.5

10" Palm

2.5±D

4.1m

16.0

29+91

12" Sec

29+90.8

Lt M.

29+90.5

W Val

29+89

Sewer outlet

6.0

16.0

24+73

Sewer outlet

24+69

Large Sycamore

Conc SLABS

For

TRAILERS

Notes Ck'd by
Map No.
Office Work
Checked
Date

Indexed C. Johnson

Note: Any Additions or Changes on This Sheet Must be Made or Circled in Red Ink With Date and Name of Person Making Change.

Do not indent notes this side of this line.

LOS ANGELES COUNTY ENGINEER
AND LOS ANGELES COUNTY ENGINEERING BASIS.

7-SGS-8 CE #47—7-55

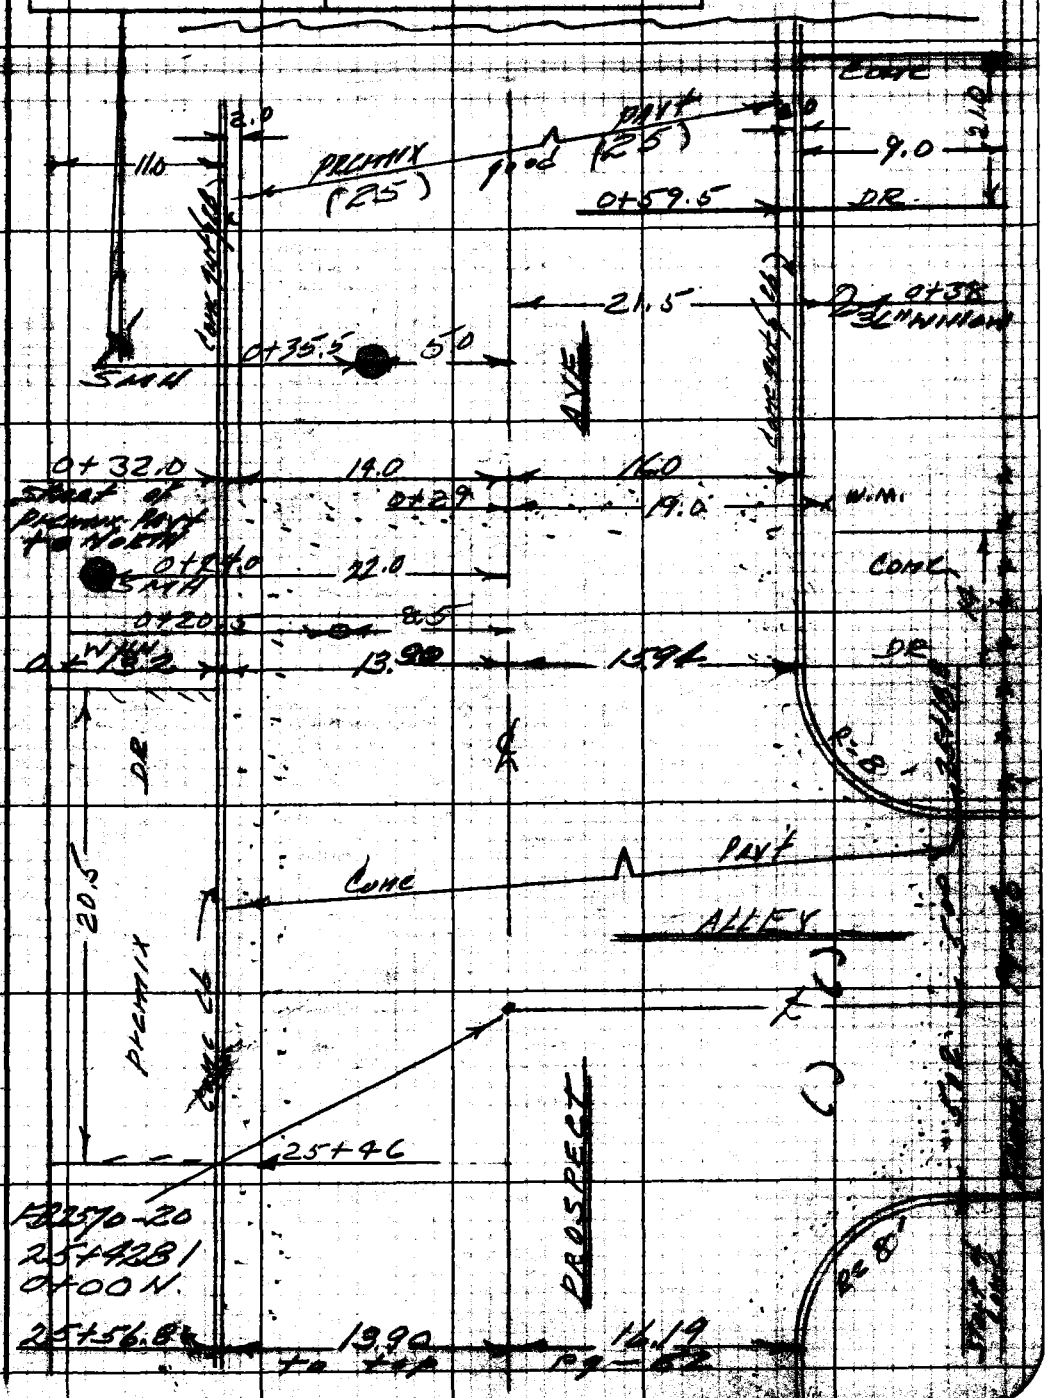

F.B. 2570 PG. 62 — FROM DOT P.9-61




















RETURN TO
LOS ANGELES COUNTY ENGINEER
900 LOS ANGELES COUNTY ENGINEERING BLDG.

Do not extend notes this side of this line.

Note: Any Additions or Changes on This Sheet Must be Made or Circled in Red Ink With Date and Name of Person Making Change.

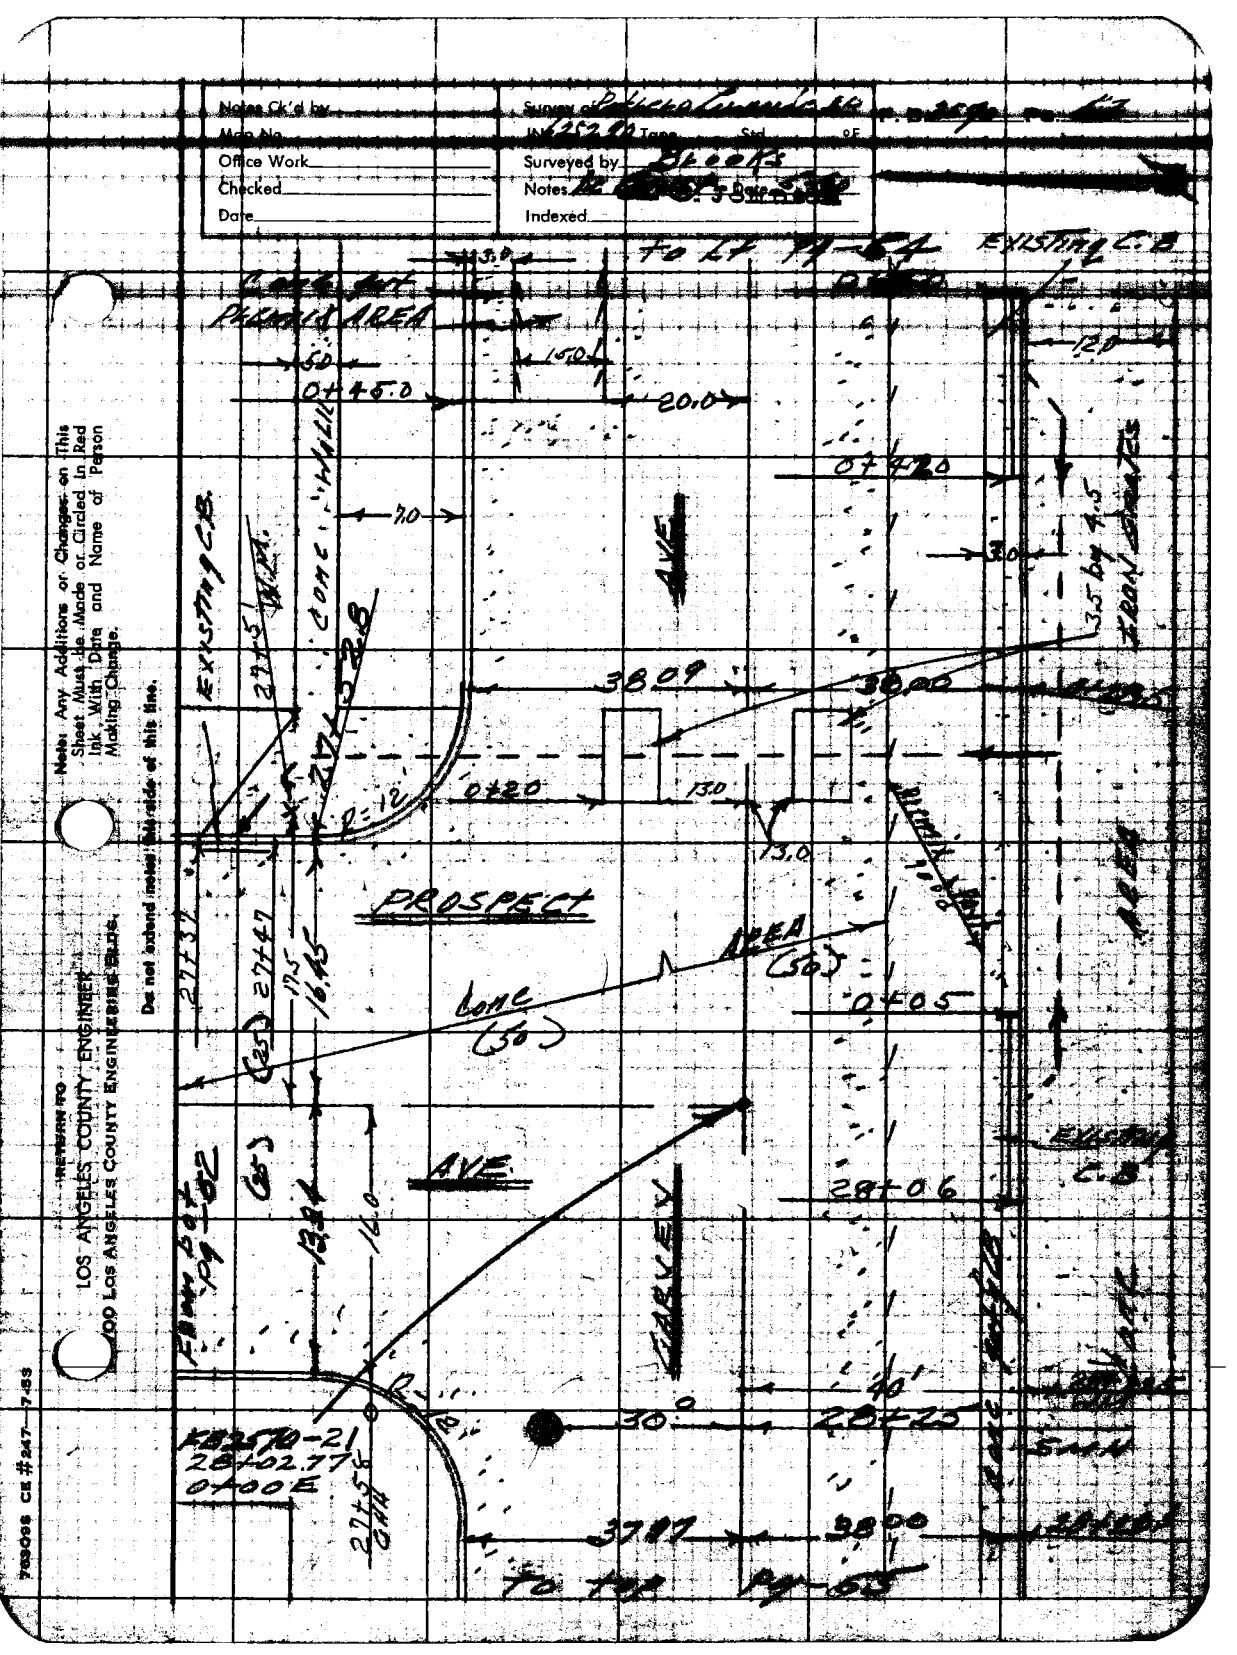
Notes Ck'd by
Mdp No.
Office Work
Checked
Date
Surveyed by
Notes
Indexed
EXISTING C.B.
PROSPECT AREA
EXISTING C.B.
PROSPECT
AVE.
CURVE
Note: Any Additions or Changes on This Sheet Must be Made or Circled in Red Ink With Date and Name of Person Making Change.
LOS ANGELES COUNTY ENGINEER
900 Los Angeles County Engineering Bldg.

RETURN TO
LOS ANGELES COUNTY ENGINEER
700 LOS ANGELES COUNTY ENGINEERING BLDG.

Note: Any Additions or Changes on This Sheet Must be Made or Circled In Red Ink With Date and Name of Person Making Change.

Do not extend notes this side of this line.

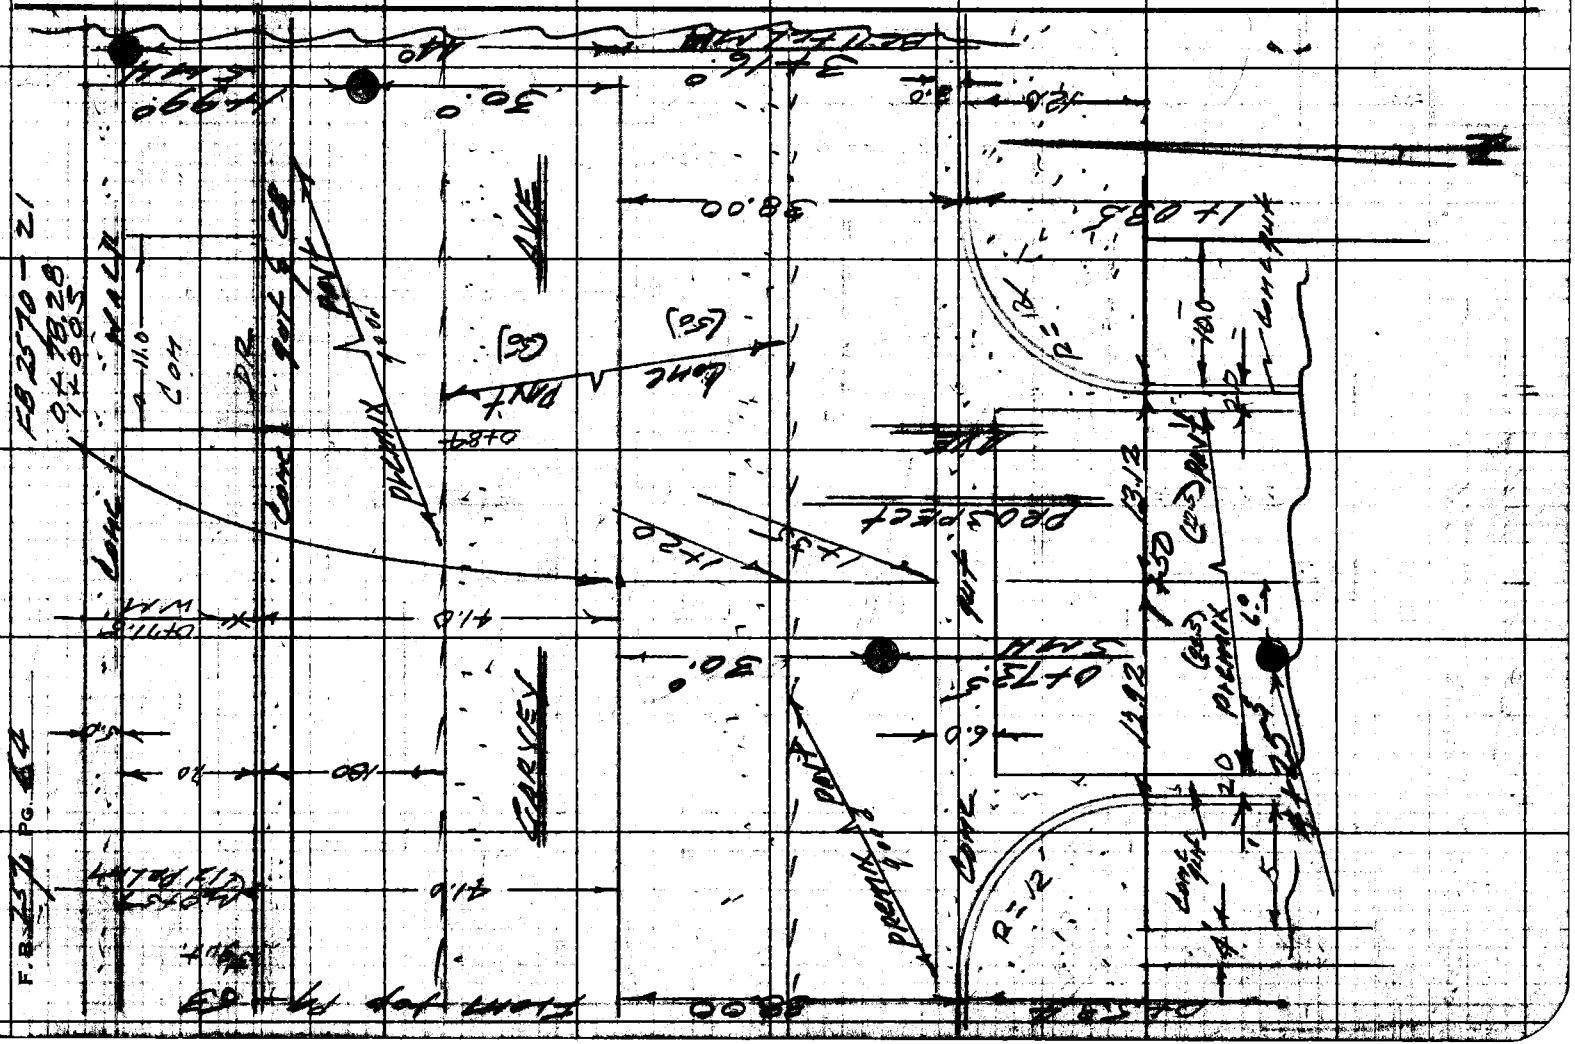

Name Ck'd by
Map No.
Office Work
Checked
Date

Surveyed by Brooks
Notes DC Date 3-58
Indexed C. Johnson

Front bot Pg. 63

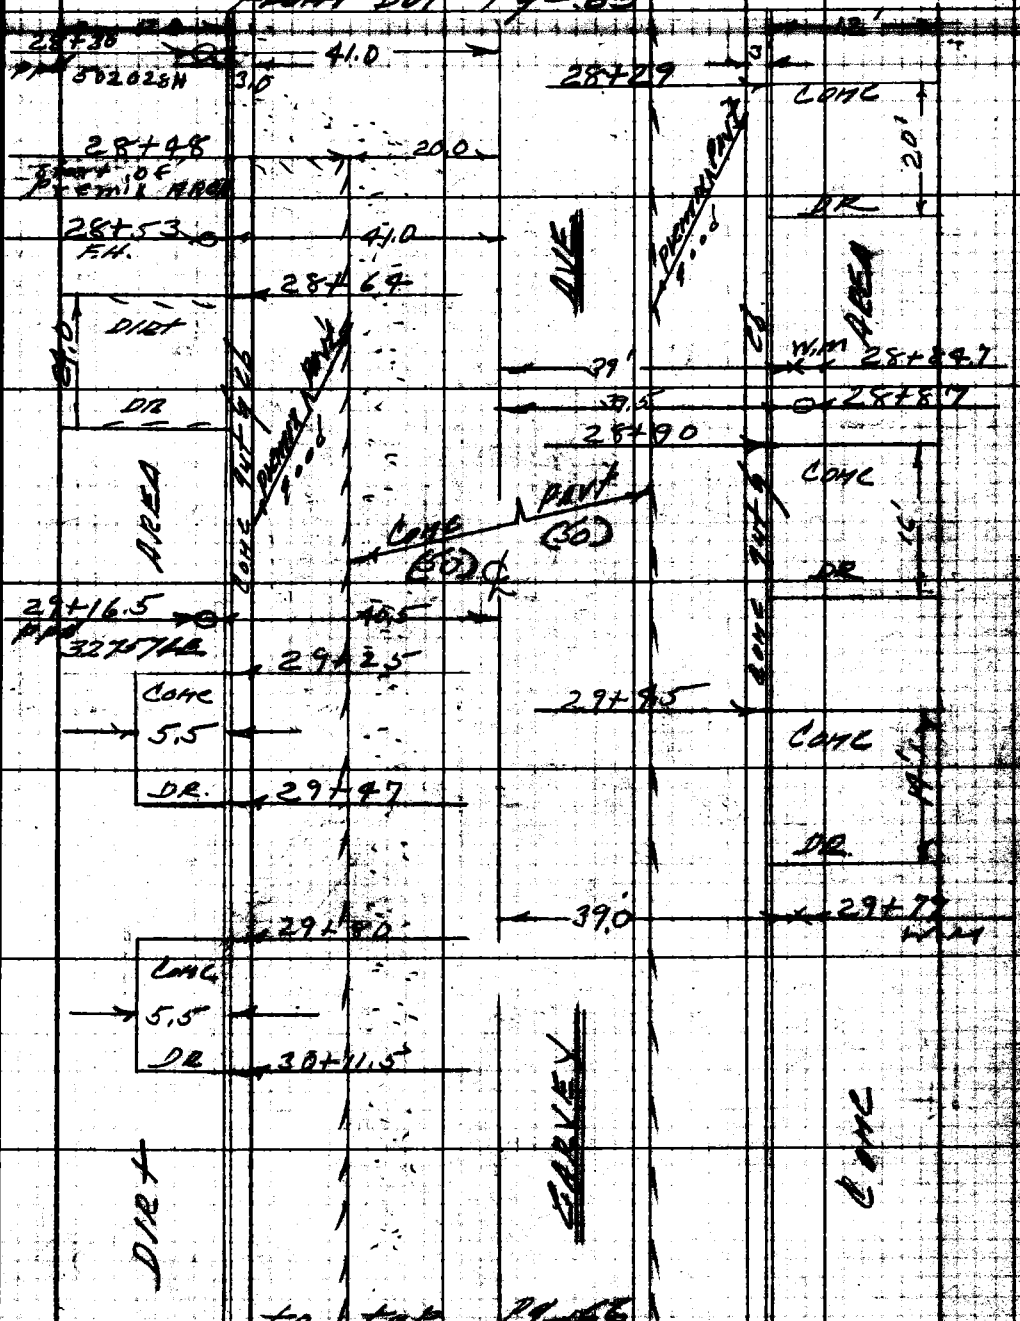

Note: Any Additions or Changes on This Sheet Must be Made or Circled in Red Ink With Date and Name of Person Making Change.

Do not extend notes this side of this line.

RETURN TO
LOS ANGELES COUNTY ENGINEER
900 LOS ANGELES COUNTY ENGINEERING BLDG.

763095 CE #247 7-58

RETURN TO
LOS ANGELES COUNTY ENGINEER
700 LOS ANGELES COUNTY ENGINEERING BLDG.

Note: Any Additions or Changes on This Sheet Must be Made or Circled in Red Ink With Date and Name of Person Making Change.

Do not extend notes this side of this line.

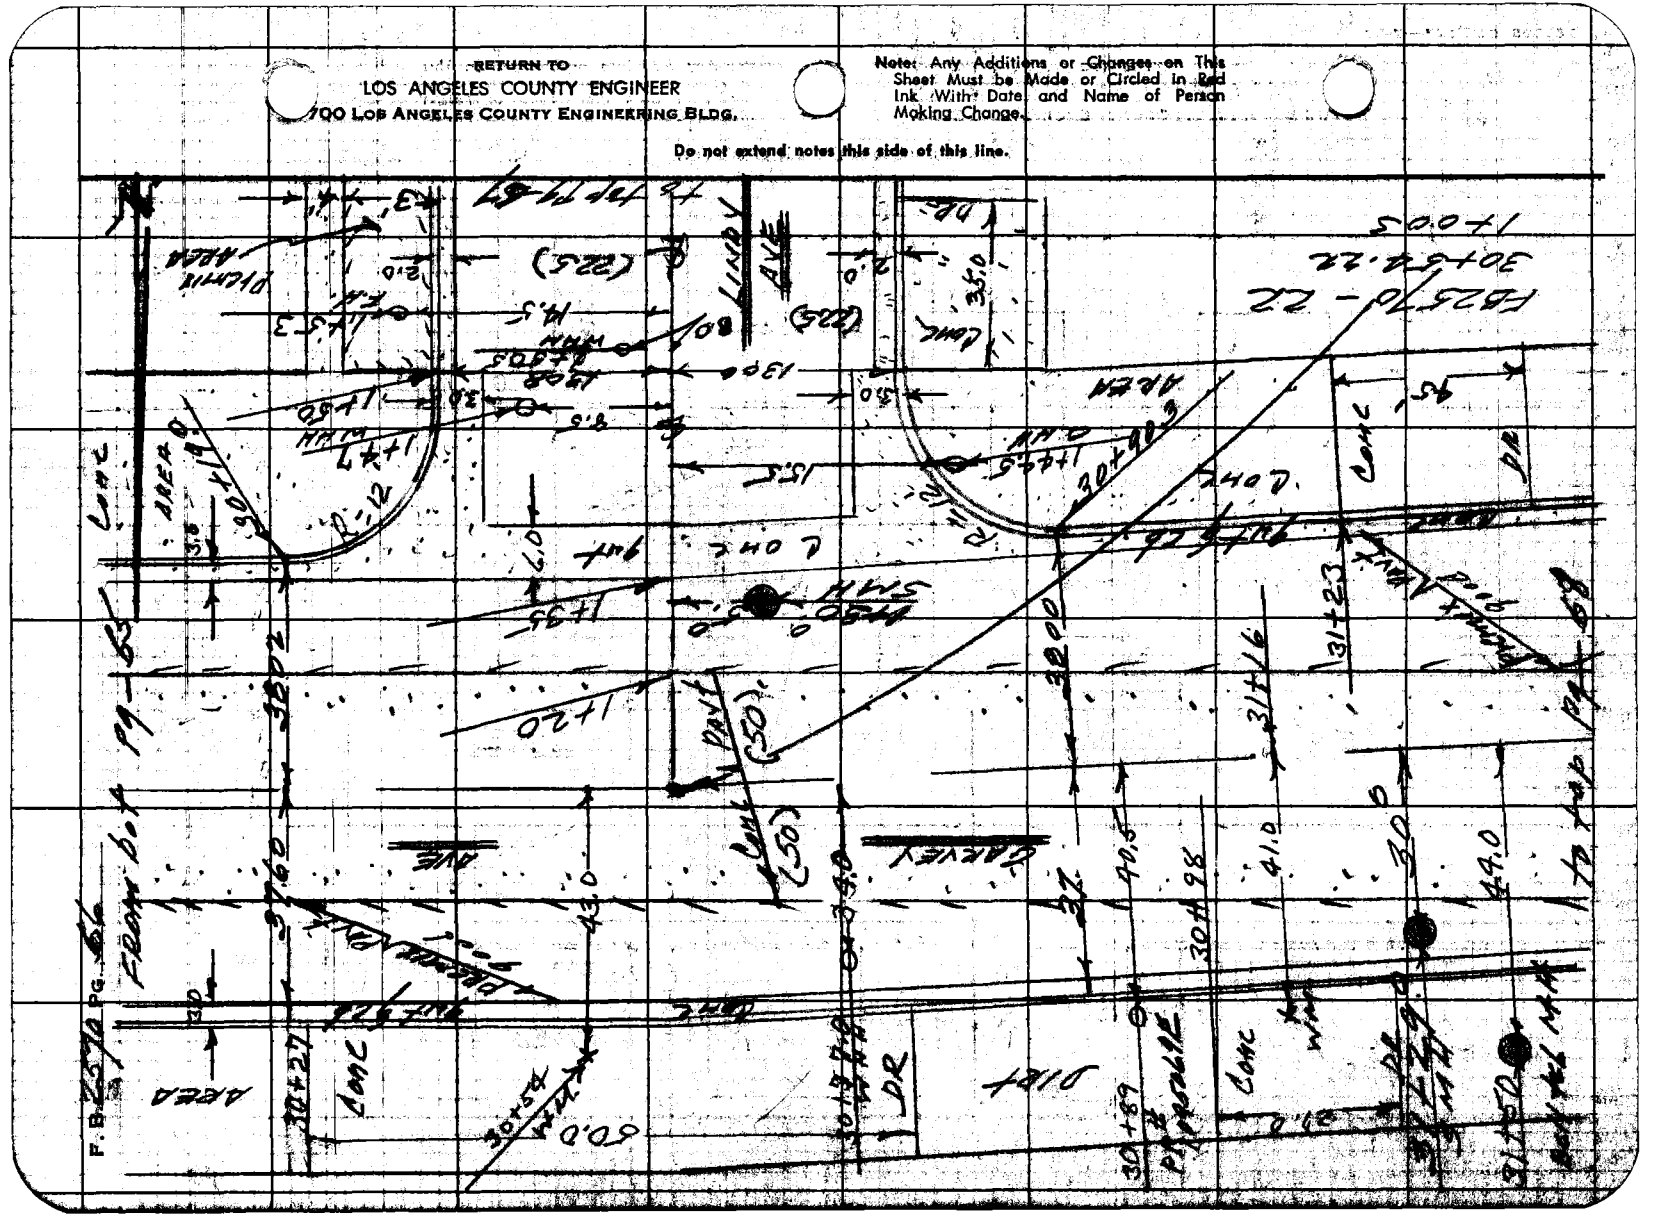
F.B. 2370 PG. 56


Office Work _____ Surveyed by Brooks
Checked _____ Notes _____ Date 5-8
Date _____ Indexed _____






























Note: Any Additions or Changes on This Sheet Must be Made or Circled in Red Ink With Date and Name of Person Making Change.

Do not extend notes this side of this line.

"RETURN TO"
LOS ANGELES COUNTY ENGINEER
900 LOS ANGELES COUNTY ENGINEERING BLDG.

783098 CE #247—7-53

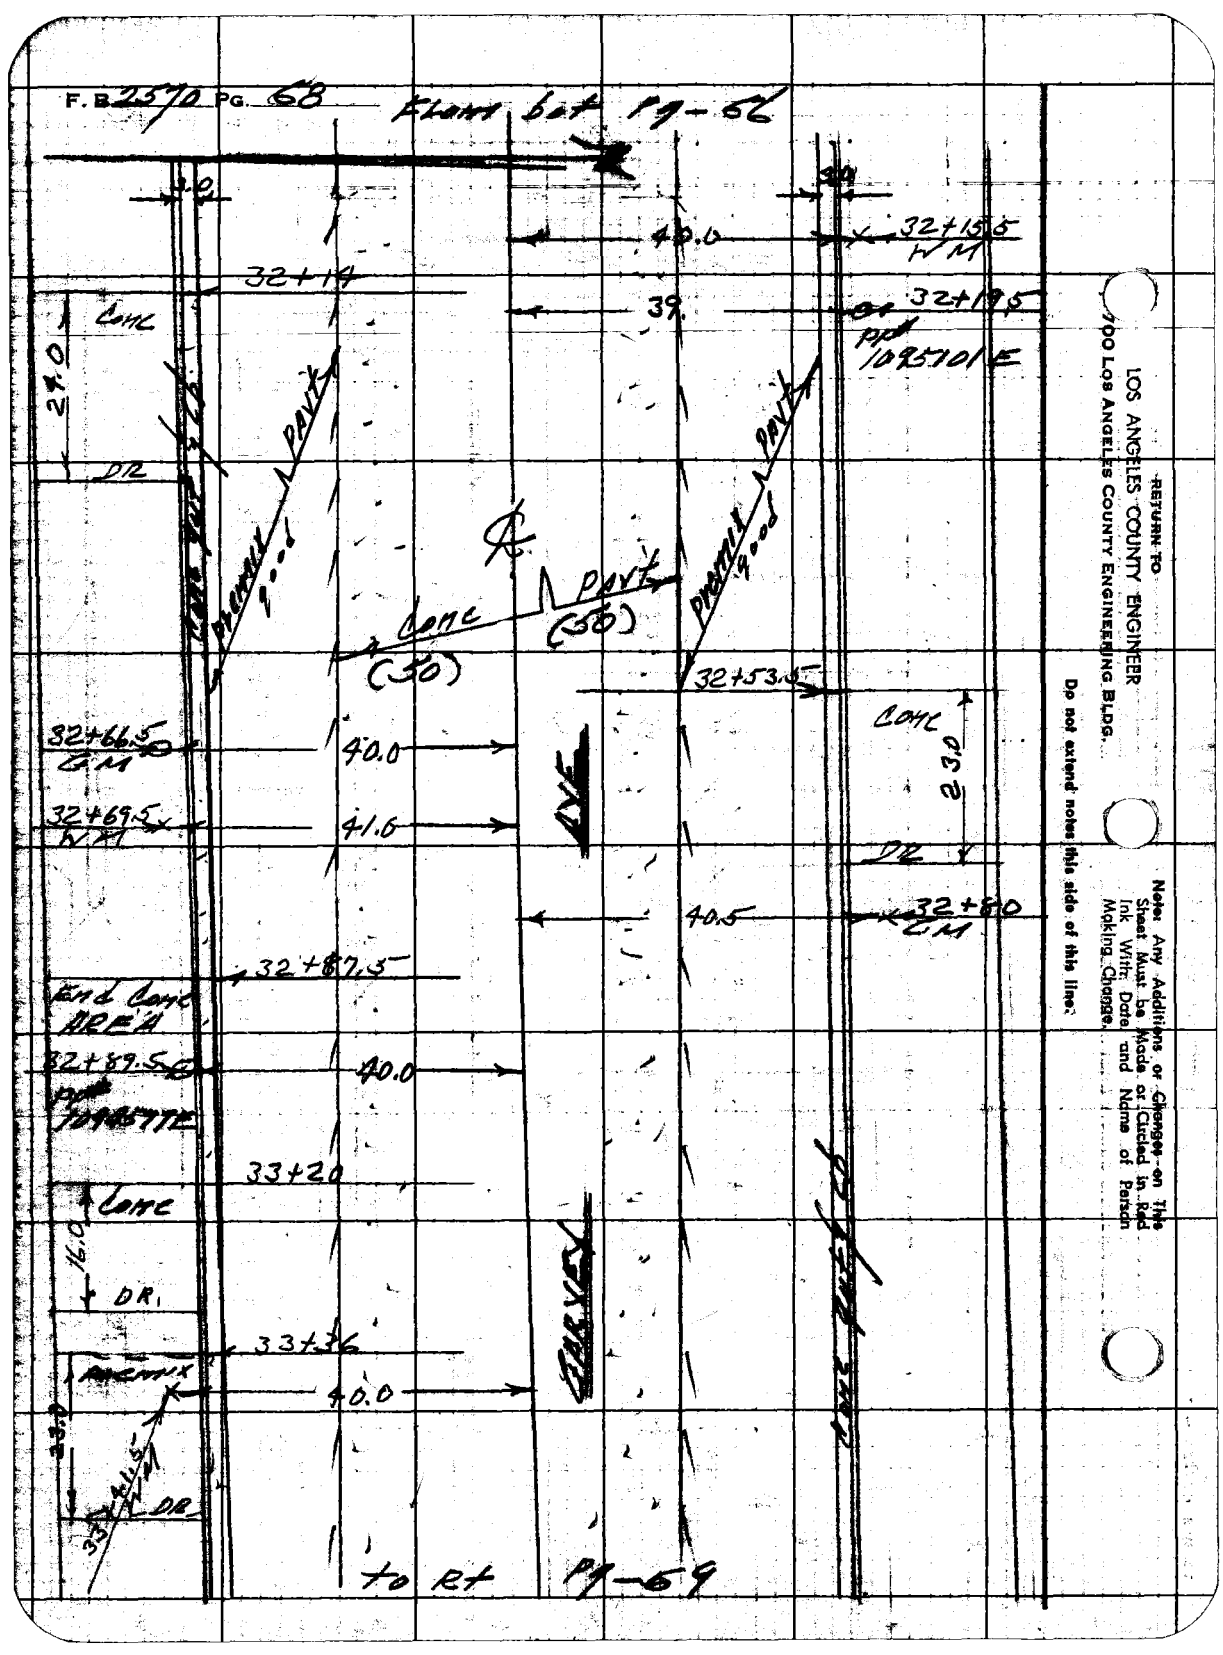

RETURN TO
LOS ANGELES COUNTY ENGINEER
900 Los Angeles County Engineering Bldg.

Do not extend notes this side of this line.

Note: Any Additions or Changes on This Sheet Must be Made or Circled in Red Ink With Date and Name of Person Making Change.





Note: Any Additions or Changes on This Sheet Must Be Made or Circled in Red Ink With Date and Name of Person Making Change.

Do not extend notes this side of this line.

RETURN TO
LOS ANGELES COUNTY ENGINEER
900 LOS ANGELES COUNTY ENGINEERING BLDG.

765098 CE #2417—7-55

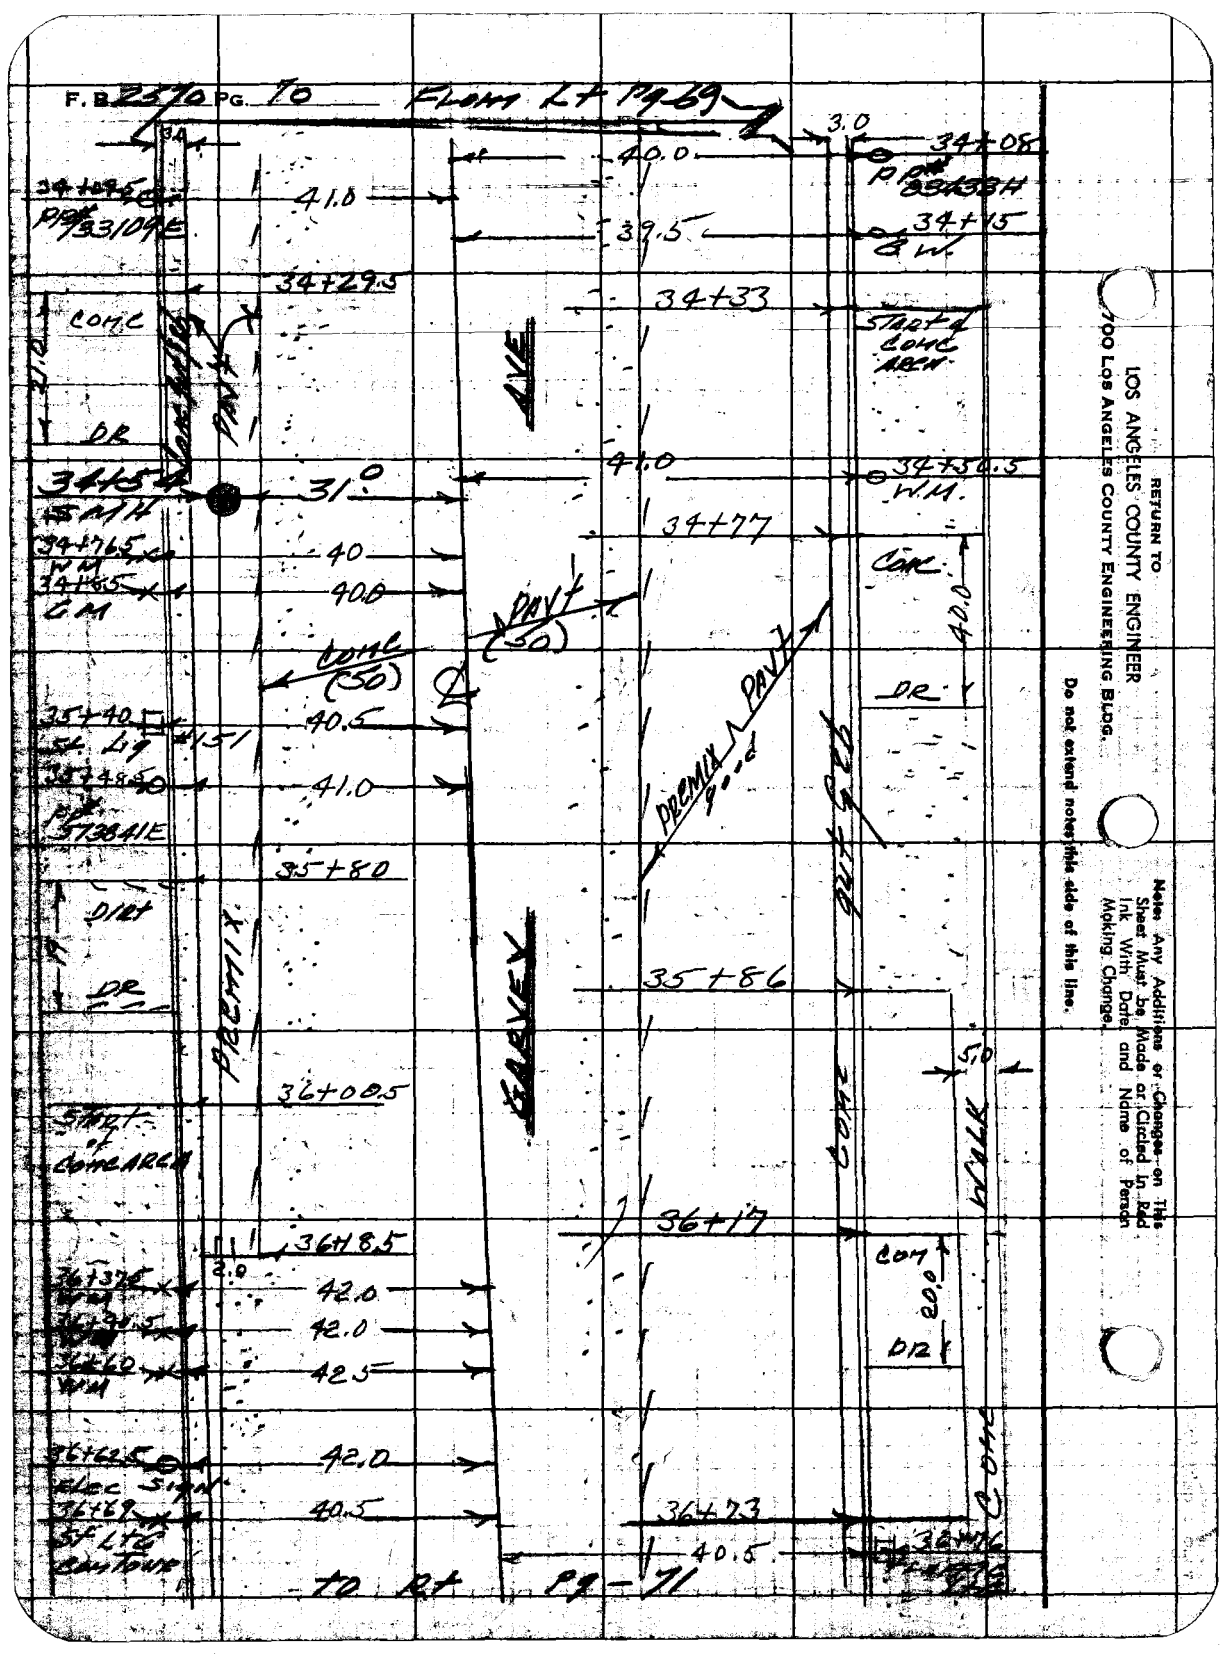
F.B. 2370 PG. 70 FLOW LINE PG 69
RETURN TO
LOS ANGELES COUNTY ENGINEER
900 LOS ANGELES COUNTY ENGINEERING BLDG.
Do not extend notes this side of this line.
Notes Any Additions or Changes on This Sheet Must be Made or Circled in Red Ink With Date and Name of Person Making Change.
ALLEY
SURVEY
PAVT
CONC
DR
CURB
DRIVEWAY
34+08
34+13
34+33
34+50.5
34+77
35+80
35+86
36+00.5
36+17
36+48.5
36+73.5
36+92.5
36+23
36+46
TO PAGE 71





Notes: Any Additions or Changes on This Sheet Must Be Made or Circled in Red Ink With Date and Name of Person Making Change.

Do not extend notes into this area of this line.

RETURN TO
LOS ANGELES COUNTY ENGINEER
900 LOS ANGELES COUNTY ENGINEERING BLDG.

CE #247—7-53

4.0 10.0 to bot Pg 72

20.0 20.0

Curb

(35)

(23)

AVE

Curb

R=12

Conc. to prem. Approx. location of edge of prem. 900.0 W of ℄

0.2

0+19.7 S.M.H.

10.0

0+19. S.M.H.

Conc. to prem. over to fence

FARNEY AVE

(60)

(60)

0+10.5

0+33

Curb

Pavt

0+41

Prem. x

Pavt

(35)

AVE

Curb

R=12

Curb

3.0

0+50

3.0

to bot Pg 72

40.0

19.0

38.0

100

R=12

Curb

F. B. 2370 PG. 72

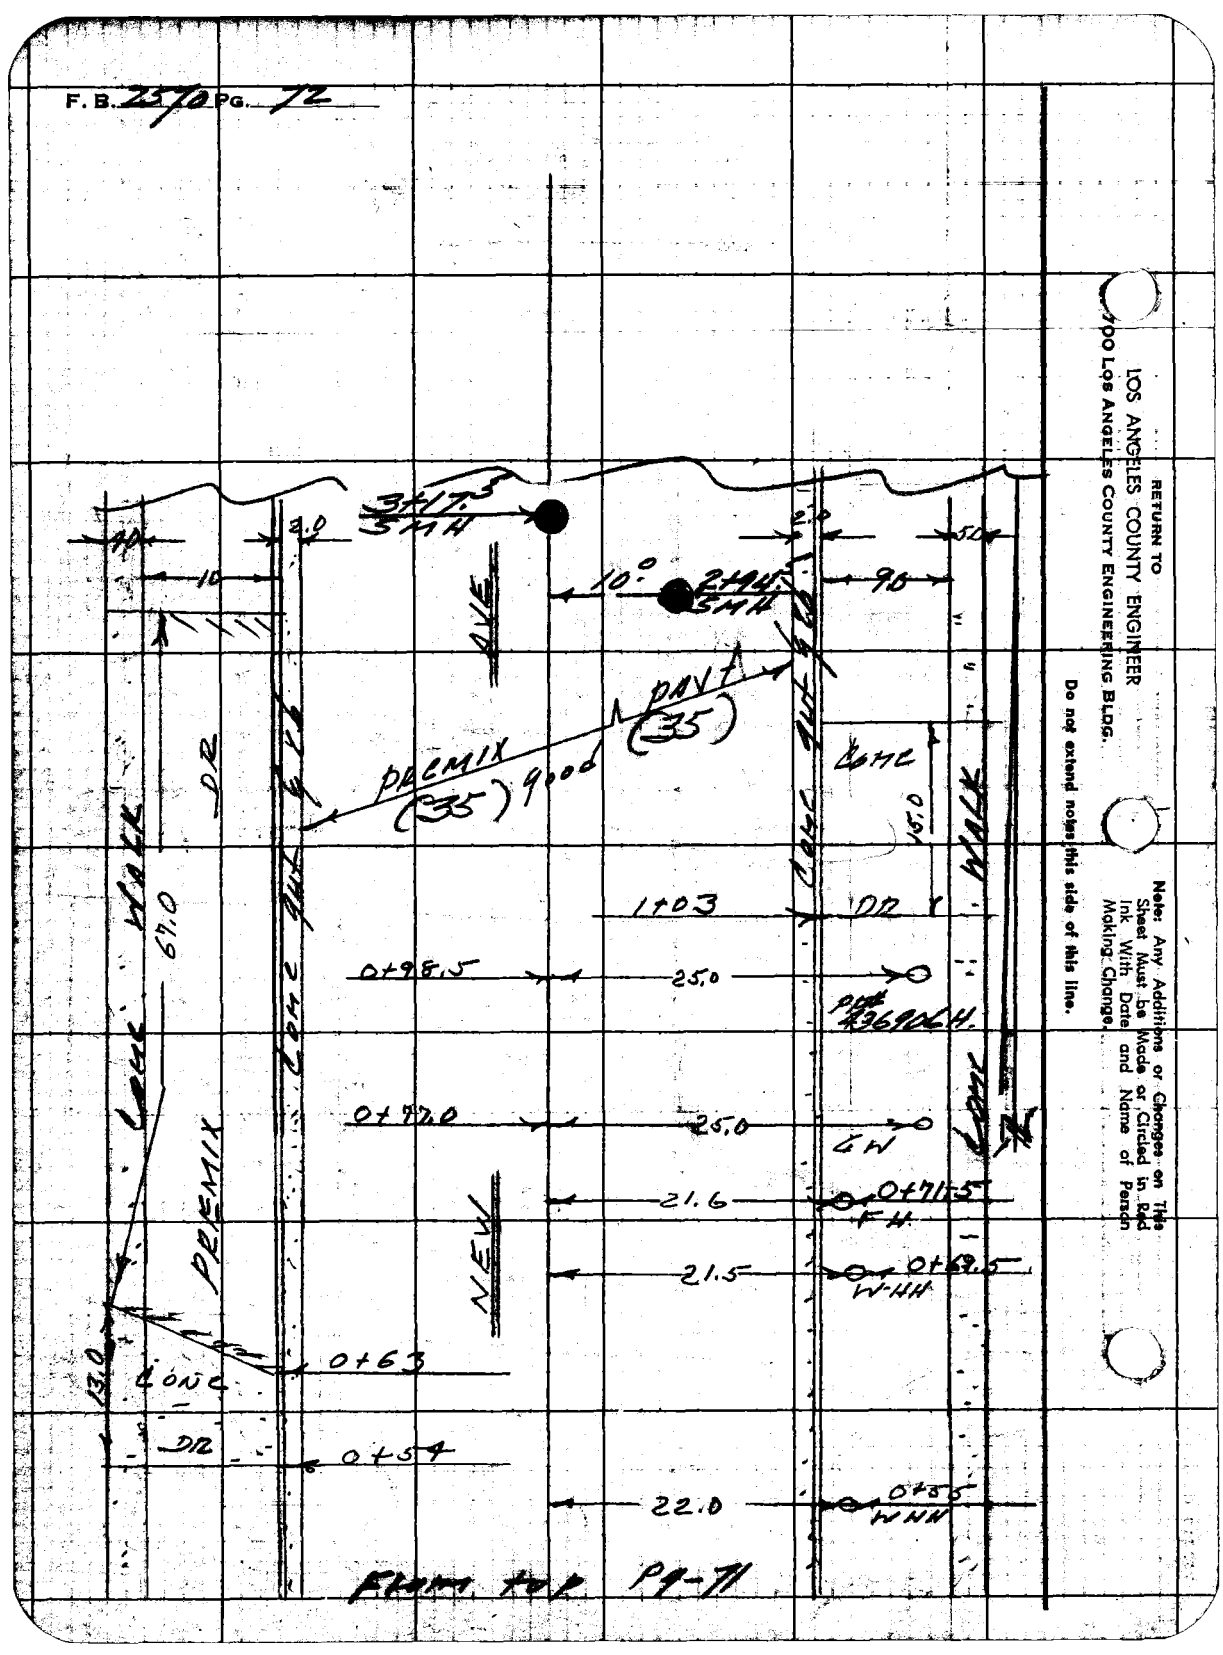
RETURN TO
LOS ANGELES COUNTY ENGINEER
900 Los Angeles County Engineering Bldg.
Do not extend notes this side of this line.
Note: Any Additions or Changes on This Sheet Must be Made or Circled in Red Ink With Date and Name of Person Making Change.
3+47.5
3 WH
AP
3.0
10
10.0
2+94.5
SMH
9.0
5.0
AVE
PAVT
(35)
PREMIX
(35) 9.00
DR
CONC
15.0
WALK
1+03
DR
0+98.5
25.0
PVC
#3692 LH.
CONC
67.0
0+72.0
25.0
GW
0+71.5
FH
21.6
PREMIX
NEW
21.5
0+69.5
W-HH
13.0
CONC
0+63
DR
0+54
22.0
0+35
WNH
FROM 10+2 Pg-11

Notes Ck'd by _____ Survey of _____ F. B. _____ Pg. 15

Map No. _____ Jn. _____ Tape _____ Std. _____

Checked _____ Notes _____

Date _____ Indexed _____

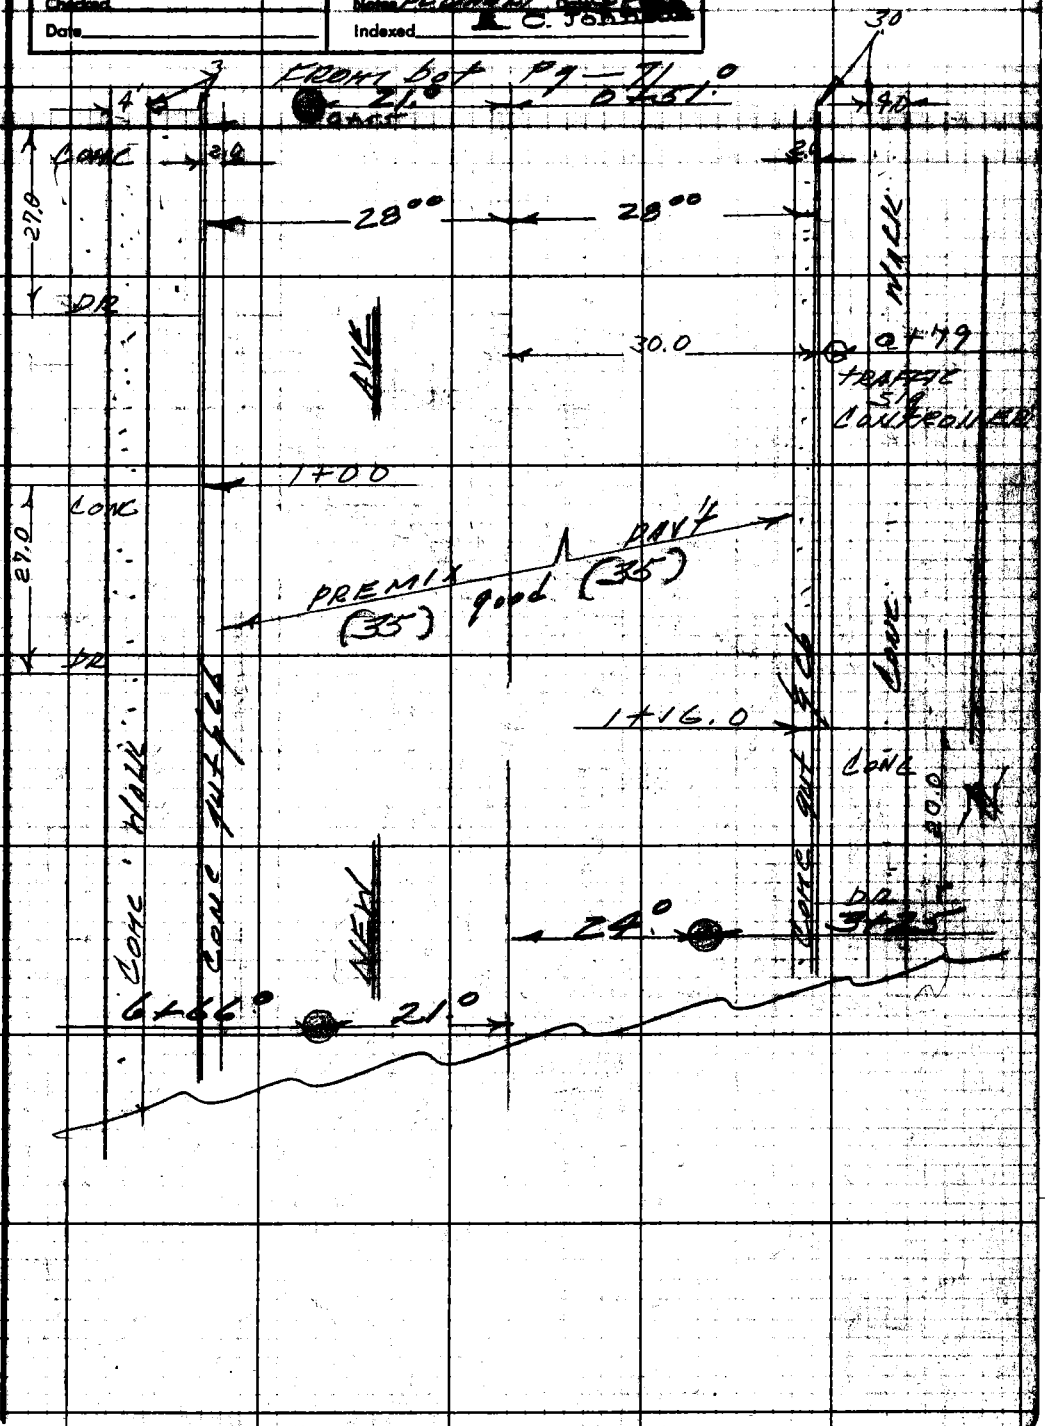

Note: Any Additions or Changes on This Sheet Must Be Made or Circled In Red Ink With Date and Name of Person Making Change.

Do not extend notes this side of this line.

RETURN TO
LOS ANGELES COUNTY ENGINEER
700 Los Angeles County Engineering Bldg.

7673088 CE #247—8-57

F. B. 270 Pg. 74

From Lt Pg-71

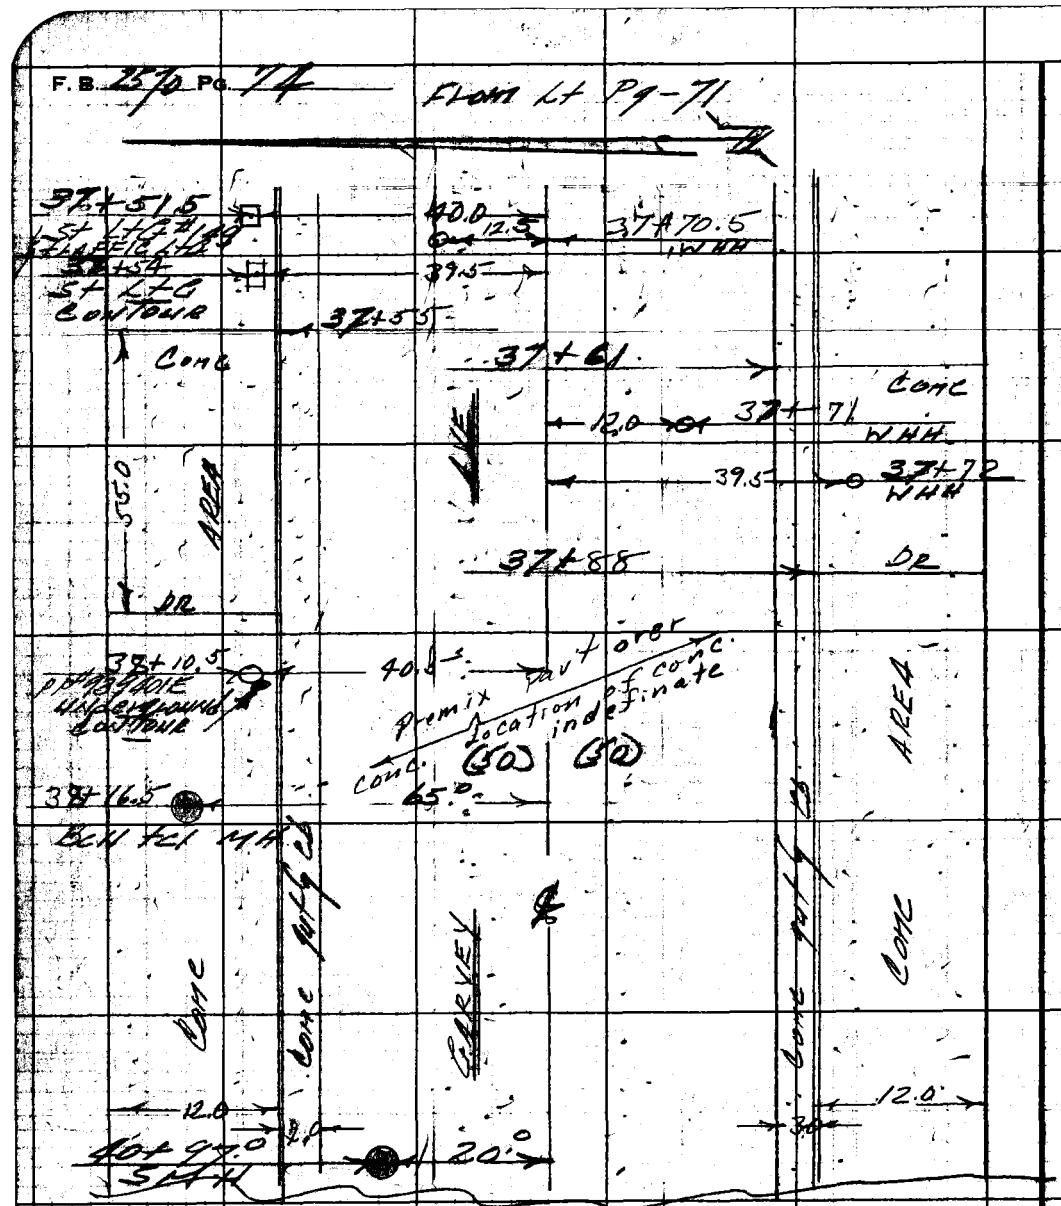

RETURN TO
LOS ANGELES COUNTY ENGINEER
700 Los Angeles County Engineering Bldg.

Do not extend noted this side of this line.

Note: Any Additions or Changes on This Sheet Must be Made or Circled in Red Ink With Date and Name of Person Making Change.

Profile No. | Notes Red. Date | Notes Chkd. | Plotted Date | Chec'd | Job No. 6252-90 | Division No. 10 | Survey of [illegible] | 2570 85

T.H. 6252.90

PLAT 90 [illegible]

PROJECT #329

X SECTIONS

ON

LINE "C"

PARTY
BROOKS
LeGAULT
HURRIII
SICHMAN
BATCHELOR
5-60

NOTE: ANY ADDITIONS OR CHANGES ON THIS SHEET MUST BE MADE OR CIRCLED IN RED INK, WITH DATE AND NAME OF PERSON MAKING CHANGE.

PLEASE RETURN TO
LOS ANGELES COUNTY ENGINEER
700 Los Angeles County Engineering Bldg.

Do not extend notes this side of this line.

STATION	B.S.	H.I.	F.S.	ELEV.

761-298 CE 307 11-58

76L-298 CE 307 11-58

PLEASE RETURN TO
LOS ANGELES COUNTY ENGINEER
700 LOS ANGELES COUNTY ENGINEERING BLDG.

NOTE: ANY ADDITIONS OR CHANGES ON THIS SHEET MUST BE MADE OR CIRCLED IN RED INK, WITH DATE AND NAME OF PERSON MAKING CHANGE.

Do not extend notes this side of this line.

Profile ____ Plotted ____ Notes Red ____ Date ____ No. ____ X-Sec. ____ Notes Chkd. ____ Checked ____ Date ____ No. ____ Date ____

P.B. 295 Pg. 86 Job No. 6294 Division No. 10 Date 5-5-59
Survey of Florence Avenue Storm Drain
Survey by Blank Notes by Blank
Indexed by C. Johnson Date

STATION	B. S.	H. I.	F. S.	ELEV		
BM A-59				305 19	BM A-59 ELEV 305.19 FB 2515-34 EMERSON PL & DEL MAR AVE N.E. COR. BT. SPK IN CB 2 FT N of N end CR.	
Going NORTH on DEL MAR AVE					Left & West & Right & East	
1+00 S = 1+00 West				305 66	& Int of DEL MAR AVE & EMERSON PL (H)	
1+04.0 S.M.H.					27.5 S.M.H.	
		N. Rim	306.12		RIM 3.06.12	
Flooded M.H.		S. Rim	306.13		MEAS	
Inverts not meas.					Top P	
					DIA	
					INVERT	
1+15.7				304 36		20 out
				305 14		" top CB.
1+19.5 S.M.H.						11.5 S.M.H.
		N rim	304.99			
		S. rim	305.04		RIM 305.01	
Sealed Trunk M.H.					MEAS	
not opened					Top P.	
					DIA	
					INVERT.	

76L-298 CE 307 11-58

PLEASE RETURN TO
LOS ANGELES COUNTY ENGINEER
700 LOS ANGELES COUNTY ENGINEERING BLDG.

NOTE: ANY ADDITIONS OR CHANGES ON THIS SHEET MUST BE MADE OR CIRCLED IN RED INK, WITH DATE AND NAME OF PERSON MAKING CHANGE.

Do not extend notes this side of this line.

STATION	B. S.	H. I.	F. S.	ELEV.	Left ℄ West	℄	Right ℄ East
1+33				305 12	20 / gut		
				305 73	" top cb.		
2+00				305 71		℄	
					Left ℄ South ℄		Right ℄ North
Going West on Emerson PL							
1+35				305 88			15 gut
				06 42			" top cb
				06 18	15 gut		
				06 71	" top cb		
2+00				11 30		℄	
					Left ℄ North ℄		Right ℄ South
Going East on Emerson PL							
1+17.2 ± 1+00 East				305 83	℄ Int. Emerson PL (East) ℄ Delmare Ave		
1+21.9				05 22	8.0 top chis+ (FB 2570-29-38)		
1+44.0				05 19		℄	
				05 20			9 pav+
				04 63			16 gut ext
				04 45			18 " "
				05 44			" top cb

Profile Notes Red ____ Plotted ____
No. Assoc. ____ Date ____ Date ____
Notes Chkd. ____ Date ____ Checked ____
Survey of ____ Division No. ____
Survey By ____ Date ____ Notes ____ Date ____
Map No. ____ Date ____

76L-298 CE 307 11-58

PLEASE RETURN TO
LOS ANGELES COUNTY ENGINEER
700 LOS ANGELES COUNTY ENGINEERING BLDG.

NOTE: ANY ADDITIONS OR CHANGES ON THIS SHEET MUST BE MADE OR CIRCLED IN RED INK, WITH DATE AND NAME OF PERSON MAKING CHANGE.

Do not extend notes this side of this line.

Profile No. ____ Plotted ____ Notes Red ____ Date ____
X-Sec. No. ____ Date ____ Notes Chkd. ____ Date ____
Job No. 62528 Division No. 10 Notes ____ Date ____
Survey & Plotted by Brandt Notes by ____ Checked ____ Date ____
Survey by Brandt Notes by C. Johnson Indexed ____ Date ____
F.B. 2528 Pg. 88

STATION	B. S.	H. I.	F. S.	ELEV	Left & North	Right & South
1+42				3057		P/L
				0453	9 pave	
				no gut out	16 gut out	
				04 06	18" RM	
				04 75	11 top EB	
				05 05	P/L	
2+00				04 07		
2+38.97		W. rim 303.04 E. rim 303.96		303 74	top Storm Drain M.H. (EB 25 70-28-38.	
Comp South on Del Mar Ave					Left & East	& Right & West
1+19.3				305 73	9.3 top Chis + (EB 25 70-28-38	

76L-298 CE 307 11-58

PLEASE RETURN TO
LOS ANGELES COUNTY ENGINEER
700 LOS ANGELES COUNTY ENGINEERING BLDG.

NOTE: ANY ADDITIONS OR CHANGES ON THIS SHEET MUST BE MADE OR CIRCLED IN RED INK, WITH DATE AND NAME OF PERSON MAKING CHANGE.

Do not extend notes this side of this line.

Profile Notes Red. Date Plotted Date
No. A Sec. Notes Chkd. Date Checked Date Survey of Survey By Map No. Division No. 42
Job No. 6252.00 F.B. 2598 p. 34

STATION	B. S.	H. I.	F. S.	ELEV.	LEFT & EAST	& RIGHT & WEST.	
1+22.5 SM.H.					28.0 SM.H.		
		N-RIM	305.48		8" INLET N	8" INLET S	8" INLET E
		S- "	305.48		RIM 305.48	305.48	305.48
					MEAS 8.12	9.77	10.09
INVERT	8"	INLET	N	296.69	TOP P. 297.36	295.71	295.39
"	"	"	S	295.04	DIA .67	.67	.67
"	"	OUTLET	E.	294.72	INVERT 296.69	295.04	294.72
1+29.7				305.99		9.3 TOP ILON CLEANOUT GLATES	
				304.89		" F.L.	
1+32.7				305.88	9.4 TOP ILON CLEAN OUT GLATES		
				304.77	" F.L.		
1+41.4				06.20			
				06.03		10 PAVT	
				05.86		18 CUT OUT	
				05.69		20 " "	
				06.67		" TOP OF	
				071		35 FIL	

76L-296 CE 307 11-58

PLEASE RETURN TO
LOS ANGELES COUNTY ENGINEER
700 LOS ANGELES COUNTY ENGINEERING BLDG.

NOTE: ANY ADDITIONS OR CHANGES ON THIS SHEET MUST BE MADE OR CIRCLED IN RED INK, WITH DATE AND NAME OF PERSON MAKING CHANGE.

Do not extend notes this side of this line.

Profile No. ____ Plotted ____ Notes Red ____ Division No. 10 Job No. 6252
X-Sec. No. ____ Date ____ Date ____ Date ____
Checked ____ Notes Chkd. ____ Notes
Date ____ Date ____ Date ____
P.B. 254 Pg. 60
Survey of Potrero Canyon Sta 0 to 5+00
Survey by Shook & Johnson
Indexed C. Johnson

STATION	B. S.	H. I.	F. S.	ELEV	Left ℄ EAST	℄ Right ℄ West
1+56.5				305 15	20 gut in	
1+61.6				06 82		℄
				06 13	10 PAVT	
				05 60	18 gut out	
				05 39	20 " IN	
				06 31	" top CB	
				06 6	35 PIL	
1+81.4				07 45		℄
				07 37		10 PAVT
				07 36		18 gut out
				07 10		20 " IN
				07 71		" top CB
				08 0		35 PIL
2+01.6				08 05		℄
				07 55	10 PAVT	
				07 09	18 gut out	
				06 94	20 " IN	
				07 57	" top CB	
				07 8	35 PIL	

76L-298 CE 307 11-58

PLEASE RETURN TO
LOS ANGELES COUNTY ENGINEER
700 LOS ANGELES COUNTY ENGINEERING BLDG.

NOTE: ANY ADDITIONS OR CHANGES ON THIS SHEET MUST BE MADE OR CIRCLED IN RED INK, WITH DATE AND NAME OF PERSON MAKING CHANGE.

Do not extend notes this side of this line.

Profile Notes Red____ Plotted____ Job No. 62520
No. A Sec. Date Date Survey of Division No. 6
Notes Ckkd. Date Checked Survey by Map No.
No. Date Date Date
F.B. 1570 P.6

STATION	B.S.	H.I.	F.S.	ELEV.	LEFT & EAST	&	RIGHT & WEST
2+18.0	S.M.H.						27.0 S.M.H.
	N. RIM =		308.95		8" INLETS		8" INLET N
	S " =		308.98		RIM 308.96		308.96
					MEAS 8.33		8.39
INVERT	8"	INLET S		299.96	Top P. 300.63		300.57
"	"	OUTLET N		299.90	Dia .67		.67
					INVERT 299.96		299.90
2+81.4				310.41		℄	
				10.33			10 PAVT
				10.16			18 GUTTER
				09.99			20 " "
				10.74			11 TOP CB
				11.1			35 PIL
				09.99	10 PAVT		
				09.60	18 GUTTER		
				09.45	20 " "		
				10.07	11 TOP CB		
				10.3	35 PIL		
3+00				10.73		℄	

76L-298 CE 307 11-58

PLEASE RETURN TO
LOS ANGELES COUNTY ENGINEER
700 Los Angeles County Engineering Bldg.

NOTE: ANY ADDITIONS OR CHANGES ON THIS SHEET MUST BE MADE OR CIRCLED IN RED INK, WITH DATE AND NAME OF PERSON MAKING CHANGE.

Do not extend notes this side of this line.

F.B. 2570 Pg. 93 Job No. 62543 Division No. 10 Notes Red ____ Plotted ____ Profile
Survey of Potrero Grade Notes Date ____ No. ____ X-Sec.
Survey by Crews Notes Checked ____ No.
Indexed K. Johnson Date Notes Chkd. ____ Date ____

STATION	B. S.	H. I.	F. S.	ELEV	Left ℄ East	℄	Right ℄ West
4+00				311 67		℄	
				11 68			10 Pav't
				11 54			18 gut out
				11 35			20 " in
				12 02			11 top Cb
				12 4			35 P/L
				11 16	10 Pav't		
				10 93	18 gut out		
				1053	20 " in		
				11 10	11 top Cb		
				11 3	35 P/L		
4+01.0	5 M.H.						25.5 5-M.H.
		N. Rim =	312.14		8" Inlet 5		8" outlet N.
		5. " =	312.14		Rim 312.14		312.14
					Meas 9.28		9.40
Inv Out	8" Inlet		5	302 19	Up P. 302.86		302.94
"	" outlet		N	302 07	Dif .67		.67
					Inv Out 302.19		302.07

76L-298 CE 307 11-58

PLEASE RETURN TO
LOS ANGELES COUNTY ENGINEER
700 LOS ANGELES COUNTY ENGINEERING BLDG.

NOTE: ANY ADDITIONS OR CHANGES ON THIS SHEET MUST BE MADE OR CIRCLED IN RED INK, WITH DATE AND NAME OF PERSON MAKING CHANGE.

Do not extend notes this side of this line.

Profile No. ____ Notes Red. Date ____ Plotted Date ____
X-Sec. No. ____ Notes Chkd. Date ____ Checked Date ____
Job No. 2210 Survey of Division No. 10
Survey By Brown Notes Date 8-29-60
Map No. ____ Traced ____ F.B. 2570 Pg. 13

STATION	B. S.	H. I.	F. S.	ELEV.	LEFT ℄ EAST	&	RIGHT ℄ WEST
4+70.5	SMH.				28.0 SMH		
	N-RIM = 311.63				8" OUT LCT N.		
	S " = 311.63				RIM 311.63		
					MEAS 10.06		
	INVCLT 8" OUT LCT N			300.90	top P 301.57		
					DIA .67		
					INVCLT 300.90		
5+00				312.39		&	
				12.47			10 PAVT
				12.44			18 gut out
				12.25			20 " "
				12.89			" top CB
				13.2			35 P/L
				11.79	10 PAVT		
				11.24	18 gut out		
				10.99	20 " "		
				11.60	" top CB		
				11.9	35 P/L		
5+22.5				313.35			31.0 top BUILT CB M.H.

76L-298 CE 307 11-58

PLEASE RETURN TO
LOS ANGELES COUNTY ENGINEER
700 LOS ANGELES COUNTY ENGINEERING BLDG.

NOTE: ANY ADDITIONS OR CHANGES ON THIS SHEET MUST BE MADE OR CIRCLED IN RED INK, WITH DATE AND NAME OF PERSON MAKING CHANGE.

Do not extend notes this side of this line.

F.B. 3570 Pg. 94 Job No. 4252.10 Division No. 10 Notes Red Plotted Profile
Survey of Flatiro Storm Drain Date Date No. X-Sec.
Survey by Crosby Notes Chkd. Checked
Indexed A. Gaskamp Date Date Date No.

STATION	B. S.	H. I.	F. S.	ELEV	Left of EAST ℄	℄ Right of West
5+21.2				312 52		℄
				12 62		10 Pav't
				12 51		18 gut out
				12 37		20 " IM
				13 11		" top CB
				13 4		35 DIL
				12 05	10 Pav't	
				11 52	18 gut out	
				11 20	20 " IM	
				11 63	" top CB	
				11 9	35 DIL	
5+22.5				313 35		31° top Bell tel M H
5+60.92 = HARVEST				12 81	℄ Int Del Mar Ave & WHITMORE St.	
					Left of NORTH	℄ Right of SOUTH
Going EAST on WHITMORE St						
1+26.0	S. M. H.					℄ S. M. H.
	E RIM = 311.76				8" INLETS	8" OUTLETS
	W " = 311.84				RIM 311 80	311 80
					MEAS 10 54	10.65
INVCLT	8" INLETS			300 59	top P. 301 26	301 15
"	" OUTLETS			300 49	DIA .67	.67
					INVCLT 300.59	300.49

76L-286 CE 307 11-58

PLEASE RETURN TO
LOS ANGELES COUNTY ENGINEER
700 LOS ANGELES COUNTY ENGINEERING BLDG.

NOTE: ANY ADDITIONS OR CHANGES ON THIS SHEET MUST BE MADE OR CIRCLED IN RED INK, WITH DATE AND NAME OF PERSON MAKING CHANGE.

Do not extend notes this side of this line.

Profile Notes Red Plotted Job No. 2210 Division No. 10
No. Date Date Survey of Notes Taken Date
Notes Chkd. Checked Survey by Notes Date

F.B. 2772 Pg. 23

STATION	B. S.	H. I.	F. S.	ELEV.	Left ℄ North		℄	Right ℄ South	
1+35.0				311 49			℄	Edge	Conc
1+41.8				11 21			℄		
				10 91	9	Pav't			
				10 49	16	"			
				10 47	18	gut			
				11 11	"	top cb			
				11 4	30	P/L			
1+45.8				11 08			℄		
				10 98				9	Pav't
				10 82				13	gut
				10 42				18	"
				11 71				11	top cb
				123				30	P/L
1+83.5				0897				13	gut
				0873				18	"
				10 04				"	Top
									cb.
2+00				08 65					
3+00				04 30					

76L-298 CE 307 11-58

PLEASE RETURN TO
LOS ANGELES COUNTY ENGINEER
700 Los Angeles County Engineering Bldg.

NOTE: ANY ADDITIONS OR CHANGES ON THIS SHEET MUST BE MADE OR CIRCLED IN RED INK, WITH DATE AND NAME OF PERSON MAKING CHANGE.

Do not extend notes this side of this line.

F.B. 7510 Pg. 96 Job No. 5252.10 Division No. 10 Profile
Survey of Potrero Canyon Storm Drain No. X-Sec.
Survey by Biggs Notes Red Plotted
Notes C. Johnson Date Date
Indexed Notes Chkd. Checked
Date Date No.

STATION	B. S.	H. I.	F. S.	ELEV				
BM. 501404		T.P.		312 80	BM 501404 ELEV 312.803 FB 2515-35 DCL MAR AVE & WHITMORE ST, SE COR CUT SPK IN CB, AT M100LC of CR.			
Going South on DCL MAR AVE.					Left & East	&	Right & West	
6+07.0				313 03		&		
				13 04			10	Pav't
				12 89			18	gut-out
				12 77			20	" in
				13 75			11	top CB
				14 1			35	P/L
				1262	10	Pav't		
				1216	16	gut-out		
				11 69	20			
				1316	11			
				1280	35			
6+47.0				1325		&		
				1326			10	Pav't
				1306			18	gut-out
				1299			20	" in

76L-298 CE 307 11-58

PLEASE RETURN TO
LOS ANGELES COUNTY ENGINEER
700 LOS ANGELES COUNTY ENGINEERING BLDG.

NOTE: ANY ADDITIONS OR CHANGES ON THIS SHEET MUST BE MADE OR CIRCLED IN RED INK, WITH DATE AND NAME OF PERSON MAKING CHANGE.

Do not extend notes this side of this line.

STATION	B. S.	H. I.	F. S.	ELEV.	Left ℄ EAST	℄ Right ℄ West
6+47				313.90		20 top CB
				14.2		35 PIL
				12.81	10 PAVT	
				12.35	16 gut-out	
				11.87	20 gut-in	
				13.37	11 top CB	
				13.1	35 PIL	
7+46	0			13.14	℄	
				13.49		10 PAVT
				13.57		16 gut-out
				13.42		20 " in
				14.23		11 top CB
				14.5		35 PIL
				12.97	10 PAVT	
				12.84	16 gut-out	
				12.36	20 F.L. EXISTING CB (FB 250-42)	
				14.00	11 top "	"
				14.31	35 PIL	

Profile Notes Red _____ Plotted _____ Job No. 6-1220 Division No. 12
No. X-Sec. Date _____ Date _____ Survey of Parcels 5-11-12 F.B. 350 Pg. 97
Notes Chkd. _____ Checked _____ Survey by Weeks Notes 5-11-12 Date 5-30
No. _____ Date _____ Date _____ Map No. _____ Indexed _____ Date _____

76L-298 CE 307 11-58

PLEASE RETURN TO
LOS ANGELES COUNTY ENGINEER
700 Los Angeles County Engineering Bldg.

NOTE: ANY ADDITIONS OR CHANGES ON THIS SHEET MUST BE MADE OR CIRCLED IN RED INK, WITH DATE AND NAME OF PERSON MAKING CHANGE.

Do not extend notes this side of this line.

Profile ____ Plotted ____ No. ____ X-Sec. ____ Notes Red ____ Date ____ Notes Chkd. ____ Date ____ Checked ____ Date ____ No. ____

F.B. 2570-H Job No. 6251.80 Division No. 10 S.D. 5

Survey of Storm Drain Notes Levels & Profile

Surveyed by Brooks & Jones Date ____ Indexed ____ Date ____

STATION	B.S.	H.I.	F.S.	ELEV	Left ℄ East	℄	Right ℄ West
7+50 SMH							27° SMH
		N. Rim = 314.45			8" Inlets		8" Outlet N.
		S " = 314.47			Rim 314.46		314.46
					Meas 8.70		8.70
Invert	8" Inlets			305.09	Top P 305.76		305.76
"	8" Outlet N			305.09	Dia .67		.67
					Invert 305.09		305.09
7+62.90 = 0+00 South				313.10	℄ Int. Del Mar Ave ℄ Alley (N)		
					Left ℄ East	℄	Right ℄ West
Going South on Del Mar Ave							
0+27.0				313.50		℄	
				13.61			10 Pavt
				13.65			18 gut out
				13.59			20 " in
				14.33			11 top CB
				14.7			35 P/L
				13.45	10 Pavt		
				13.25	18 gut out		
				13.08	20 " in		

76L-298 CE 307 11-58

PLEASE RETURN TO
LOS ANGELES COUNTY ENGINEER
700 LOS ANGELES COUNTY ENGINEERING BLDG.

NOTE: ANY ADDITIONS OR CHANGES ON THIS SHEET MUST BE MADE OR CIRCLED IN RED INK, WITH DATE AND NAME OF PERSON MAKING CHANGE.

Do not extend notes this side of this line.

Profile Notes Red ____ Plotted ____ Job No. 4221.20
No. Asst. ____ Date ____ Date ____ Survey of ____ Division No. 6
Notes Chkd. ____ Checked ____ Survey by L.C. Lyon Notes Accept Date ____ F.B. 1579 Pg. 99
No. ____ Date ____ Map No. ____

STATION	B. S.	H. I.	F. S.	ELEV.	LEFT & EAST	&	RIGHT & WEST
0+27.0				314.18	20 top ch		
				14.5	30 P/L		
0+67.0				14.66		&	
				14.53			10 Pavt
				14.21			18 gut out
				14.05			20 " in
				14.73			11 Top ch
				15.0			35 P/L
				14.41	10 Pavt		
				14.02	18 gut out		
				13.89	20 " in		
				14.61	11 Top ch		
				14.9	35		
1+43.5 S.M.H.					25.0 S.M.H		
	N. Rim = 315.51					8" Inlet S.	8" Inlet N.
	S. Rim = 315.51				Rim	315.51	315.51
					Meas	9.79	9.90
	Invert 8" Inlet S.			305.05	Top P.	305.72	305.61
	" " Outlet N.			304.94	Dia	67	67
					Invert	305.05	304.94

76L-298 CE 307 11-58

PLEASE RETURN TO
LOS ANGELES COUNTY ENGINEER
700 Los Angeles County Engineering Bldg.

NOTE: ANY ADDITIONS OR CHANGES ON THIS SHEET MUST BE MADE OR CIRCLED IN RED INK, WITH DATE AND NAME OF PERSON MAKING CHANGE.

Do not extend notes this side of this line.

F.B. 2570 Pg. 100 Job No. 6252.90 Division No. 10 Profile
Survey of Potrero Grande S.D. Notes Red Plotted
Survey by E.E. Brooks Notes F.E.B. Date Date No. X-Sec.
Indexed C. Peterson Date Notes Chkd. Checked No.
Date Date

STATION	B. S.	H. I.	F. S.	ELEV	Left ℄ East	℄ Right ℄ West
1+67.0				315.87		℄
				15.74		10 par't
				15.44		18 gut out
				15.18		20 " in
				15.77		" Top ℄
				16.1		35 P/L
				15.56	10 par't	
				15.20	18 gut out	
				15.01	20 " in	
				15.52	" Top ℄	
				15.9	35 P/L	
2+87.5	S.M.H.					27.0 S.M.H.
						8" outlet N.
		N. rim	317.60		Rim	317.40
		S. rim	317.60		meas	8.53
					Top pipe	309.07
		Invert 8" outlet N.		308.40	dia	.67
					invert	308.40

76L-298 CE 307 11-58

PLEASE RETURN TO
LOS ANGELES COUNTY ENGINEER
700 Los Angeles County Engineering Bldg.

NOTE: ANY ADDITIONS OR CHANGES ON THIS SHEET MUST BE MADE OR CIRCLED IN RED INK, WITH DATE AND NAME OF PERSON MAKING CHANGE.

Do not extend notes this side of this line.

STATION	B. S.	H. I.	F. S.	ELEV.	Left & East	&	Right & West
5+43.0				320.18			31.0 Bell Tele M.H.
BM S.D.1405				314.15	BM S.D. 1405 Elev. 314.147 per F.B. 2515-36 Del Mar Ave 220 ft. S. of Whitmore St. Bt. spk in E. curb in front of House #3056		
	Going West in Alley				Left & South	&	Right & North
7+72				313.22		&	
7+82				13.23		&	
7+99				13.57		&	
				13.94			5 gut in end of cb.
				14.58			" Top " " "
				15.62			6 " Rock Conc wall
				1.50			10 ground

Profile Notes Red
No. 2-58C Date Notes Chkd. Date
Plotted Date Checked Date
Job No. C2258.20 Division No. 10
Survey of Pt Loma Notes Date
Survey by L. Davis Notes Date
Map No. Tracked Date
F.B. 2515 Pg. 101

76L-298 CE 307 11-58

PLEASE RETURN TO
LOS ANGELES COUNTY ENGINEER
700 LOS ANGELES COUNTY ENGINEERING BLDG.

NOTE: ANY ADDITIONS OR CHANGES ON THIS SHEET MUST BE MADE OR CIRCLED IN RED INK, WITH DATE AND NAME OF PERSON MAKING CHANGE.

Do not extend notes this side of this line.

F.B. 2570 Pg. 102 Job No. 6251.90 Division No. 10 Notes Red Plotted Profile
Survey of Potrero Grande S.D. Date Date No. X-Sec.
Survey by T.E. Bragg Notes E.E.B. Notes Chkd. Checked No.
Indexed L. O. Johnson Date Date Date

STATION	B. S.	H. I.	F. S.	ELEV	Left ℄ South	℄ Right ℄ North
8+01				313 58		℄ edge conc.
8+02.5				13 65		℄
				13 87	5.0 gut. in end of curb	
				14 46	" Top " " "	
				151	6 ground	
				148	10 "	
9+00 ✓		T. P.		314 85		℄
				14 90		4 bot of alley
				15 59		" Top wood side
				16 79		5 Rock wall
				162		10 "
				14 89	4 bot. of alley	
				15 62	" Top wood side	
				16 58	6 ground	
				170	10 ground	
10+00				1596		℄
				16 13		4 bot of alley
				16 90		" Top wood side
				1929		5.5 rock wall
				197		10 "

76L-298 CE 307 11-58

PLEASE RETURN TO
LOS ANGELES COUNTY ENGINEER
700 Los Angeles County Engineering Bldg.

NOTE: ANY ADDITIONS OR CHANGES ON THIS SHEET MUST BE MADE OR CIRCLED IN RED INK, WITH DATE AND NAME OF PERSON MAKING CHANGE.

Do not extend notes this side of this line.

Profile Notes Red ____ Plotted ____
No. ____ X-Sec. ____ Date ____ Date ____
Notes Chkd. ____ Checked ____
No. ____ Date ____ Date ____
Map No. ____ Inclined ____ Survey of ____
Survey by ____ Notes ____ Date ____
Job No. 62-52.9e Division No. ____
F.B. ____ Pg. ____

STATION	B. S.	H. I.	F. S.	ELEV.	Left ℄ South	℄	Right ℄ North
10+00				316 11	℄ bot. of alley		
				16 94	" Top wood side		
				184	7 ground		
				188	10 "		
11+00				1759		℄	
				1757			℄ bot of alley
				1843			" Top wood side
				2120			6 rock wall
				212			8 back of garage
	T.P.	320.75		1776	℄ bot of alley		
				1854	" Top wood side		
				205	7 ground		
				207	10 "		
11+90				2132		℄	
				2168			4.8 gut in start c/b
				2244			" Top " "
				224			6 ground
				224			10 "

76L-298 CE 307 11-58

PLEASE RETURN TO
LOS ANGELES COUNTY ENGINEER
700 LOS ANGELES COUNTY ENGINEERING BLDG.

NOTE: ANY ADDITIONS OR CHANGES ON THIS SHEET MUST BE MADE OR CIRCLED IN RED INK, WITH DATE AND NAME OF PERSON MAKING CHANGE.

Do not extend notes this side of this line.

F. B. 2570 Pg. 104 | Job No. 6237.90 | Division No. 10 | Notes Red | Plotted | Profile No.
Survey of Potrero Grande | Date | Date | X-Sec. No.
Survey by E. Ferris & Notes | Notes Chkd. | Checked
Indexed | Date | Date | Date

STATION	B. S.	H. I.	F. S.	ELEV	Left ℄ South	℄	Right ℄ North
11+92				32130		℄	edge conc.
11+94.4				21 33		℄	
				21 79	5 Gut in start ch		
				22 59	" Top " "		
				229	7 ground		
				229	10 ground		
12+09.7				21 54		℄	edge conc.
12+16				21 90		℄	
12+23.75	= 0+00 N&S			21 99	℄ inter. Evelyn Ave and Alley		
	Going N. on Evelyn Ave				Left ℄ West	℄	Right ℄ East.
0+17.7				22 35		℄	
				22 54	7 part		
				22 55	12.9 gut out		
				22 40	14.9 " in		

76L-298 CE 307 11-58

PLEASE RETURN TO
LOS ANGELES COUNTY ENGINEER
700 Los Angeles County Engineering Bldg.

NOTE: ANY ADDITIONS OR CHANGES ON THIS SHEET MUST BE MADE OR CIRCLED IN RED INK, WITH DATE AND NAME OF PERSON MAKING CHANGE.

Do not extend notes this side of this line.

STATION	B. S.	H. I.	F. S.	ELEV.	Left ℄ West	℄ Right ℄ East
0+17.7				323 07	14.9 Top cb	
				233	30.0 P/L	
0+28.2				2259		℄
				2236		7 par't
				2210		13.0 gut out
				2195		15.0 " in
				2256		" Top cb
				227		30 P/L
0+57.7				2320		℄
				2282		7 par't
				2241		13.0 gut out
				2224		15.0 " in
				2297		" Top cb
				232		30 P/L
				2322	7 par't	
				2300	12.9 gut out	
				2285	14.9 " in	
				2349	" Top cb	
				238	30 P/L	

Profile Notes Red ____ Plotted ____
No. ____ Date ____ Date ____ Job No. 6250 90
X-Sec. ____ Notes Chkd. ____ Checked ____ Division No. 16
No. ____ Date ____ Date ____ Survey of ____ F.B. 2513 Pg. 123
Survey by ____ Notes ____ Date ____
Map No. ____ Inked ____ Date ____

76L-298 CE 307 11-58

PLEASE RETURN TO
LOS ANGELES COUNTY ENGINEER
700 Los Angeles County Engineering Bldg.

NOTE: ANY ADDITIONS OR CHANGES ON THIS SHEET MUST BE MADE OR CIRCLED IN RED INK, WITH DATE AND NAME OF PERSON MAKING CHANGE.

Do not extend notes this side of this line.

F.B. 1670 Pg. 106 Job No. 6252.90 Division No. 10 Notes Red Plotted Profile
Survey of Flat Iron Grande S.D. Date No. X-Sec.
Survey by F.E. Brooks Notes F.E.B. Notes Chkd. Checked
Indexed C. Johnson Date Date Date No.

STATION	B.S.	H.I.	F.S.	ELEV	Left & West ℄	Right & East ℄
457.7				325.22		℄
				24.98		7 part
				24.69		13.0 gut out
				24.55		15.0 " in
				25.19		" Top ob
				25.3		30 P/L
				25.35	7 part	
				25.33	12.9 gut out	
				25.19	14.9 " in	
				25.71	" Top ob	
				26.1	30 P/L	
462.0	S.M.H.					5 S.M.H.
					8" Inlet S.	
		N. rim 325.20			Rim 325.19	
		S. rim 325.19			Mvas 9.64	
					Top pipe 315.55	
					dia 67	
		Invert 8" Inlet S.		314.88	Invert 314.88	

76L-298 CE 307 11-58

PLEASE RETURN TO
LOS ANGELES COUNTY ENGINEER
700 Los Angeles County Engineering Bldg.

NOTE: ANY ADDITIONS OR CHANGES ON THIS SHEET MUST BE MADE OR CIRCLED IN RED INK, WITH DATE AND NAME OF PERSON MAKING CHANGE.

Do not extend notes this side of this line.

STATION	B. S.	H. I.	F. S.	ELEV.		
BM A-73				322.66	BM A-73 Elev. 322.660 per F.B. 2513-36 Evelyn Ave 535 N. of Garvey Ave. Bt. Spk in E. curb in front of house # 3050	
	Going	South	on	Evelyn Ave	Left & East ℄	Right & West
0+16.9				32230	℄	
				2220	7 pav't	
				2196	13.0 gut out	
				2187	15.0 " in	
				2250	" Top cb	
				228	30 P/L	
0+24.8				2247	℄	
				2251		7 pav't
				2251		12.9 gut out
				2246		14.9 " in
				2295		" Top cb
				233		30 P/L

Profile Notes Red. Plotted Job No. 6666.91 Division No. 4
No. X-Sec. Date Date Survey of
Notes Chkd. Checked Survey by F.E. Brown Notes F.B. Date
No. Date Date Map No. July 61 C. Tabb
F.B. 2513 Pg. 14

76L-298 CE 307 11-58

PLEASE RETURN TO
LOS ANGELES COUNTY ENGINEER
700 Los Angeles County Engineering Bldg.

NOTE: ANY ADDITIONS OR CHANGES ON THIS SHEET MUST BE MADE OR CIRCLED IN RED INK, WITH DATE AND NAME OF PERSON MAKING CHANGE.

Do not extend notes this side of this line.

F.B. 2570 Pg. 100 | Job No. 62527.90 | Division No. 10 | Notes Red | Plotted | Profile
Survey of Potrero Grande S.D. | Date | Date | No.
Survey by E.E. Brady Notes E.E.B. | Notes Chkd. | Checked | X-Sec.
Indexed C. Johnson | Date | Date | No.

STATION	B. S.	H. I.	F. S.	ELEV	Left ℄ East	℄ Right ℄ West
0+56.9				32291		℄
				2292		7 pav't
				2281		12.9 gut out
				2273		14.9 " in
				2327		" Top cb
				236		30 P/L
				2266	7 pav't	
				2235	13 gut out	
				2225	15 " in	
				2281	" Top cb	
				231	30 P/L.	
1+56.9				32355		℄
				2362		7 pav't
				2349		12.9 gut out
				2345		14.9 " in
				2400		" Top cb
				244		30 P/L
				2332	7 pav't	
				2324	13 gut out	
				2311	15 " in	

76L-296 CE 307 11-58

PLEASE RETURN TO
LOS ANGELES COUNTY ENGINEER
700 LOS ANGELES COUNTY ENGINEERING BLDG.

NOTE: ANY ADDITIONS OR CHANGES ON THIS SHEET MUST BE MADE OR CIRCLED IN RED INK, WITH DATE AND NAME OF PERSON MAKING CHANGE.

Do not extend notes this side of this line.

Profile Notes Red. Plotted
No. Sec. Date Date
Notes Chkd. Checked Survey of
Date Date Survey by
Job No. Division No.
Notes Date
F.B. Pg.
Map No.

STATION	B.S.	H.I.	F.S.	ELEV.	Left ℄ East	℄	Right ℄ West
1+56.9				323.53	15 Top cb		
				23.8	30 P/L		
1+65.5	S.M.H.				6 S.M.H.		
		323.47				8" outlet N.	
		323.48			Rim	323.47	
					Meas	7.23	
	Invert 8" outlet N			315.57	Top pipe	316.24	
					dia	.67	
					invert	315.57	
	Going West in Alley				Left ℄ South	℄	Right ℄ North
12+30				32.06		℄	
12+37.5				22.02		℄ edge conc	
12+51.0				22.34		℄	
				22.57	4.6 gut in end of cb.		
				23.05	" Top " " "		
				23.0	10 ground		

76L-298 CE 307 11-58

PLEASE RETURN TO
LOS ANGELES COUNTY ENGINEER
700 LOS ANGELES COUNTY ENGINEERING BLDG.

NOTE: ANY ADDITIONS OR CHANGES ON THIS SHEET MUST BE MADE OR CIRCLED IN RED INK, WITH DATE AND NAME OF PERSON MAKING CHANGE.

Do not extend notes this side of this line.

F.B. 2570 Pg. 110 Job No. 6252.90 Division No. 10 Notes Red Plotted Profile
Survey of Potrero Grande S.D. Date Date No. X-Sec.
Survey by E.E. Banks Notes E.E.B. Notes Chkd. Checked No.
Indexed C. Johnson Date Date Date

STATION	B.S.	H.I.	F.S.	ELEV.	Left of South	℄	Right of North
12+55.39				322 46		℄ P.I.	
				22 78		5 got in end cb	rt & To line ahead
				23 28		" Top "	" "
				234		6 ground	
				234		10 "	
				2273	4.6 Bot. alley	rt & To line ahead	
				2417	" Top wood side		
				233	5.1 ground		
				234	10 "		
13+00				2319		℄	
				2316		4.5 Bot alley	
				2479		" Top wood side	
				253		5.5 ground	
				256		10 "	
				2326	4.3 Bot. alley		
				2502	" Top wood side		
				261	5.3 ground		
				286	10 ground side of house		

76L-296 CE 307 11-58

PLEASE RETURN TO
LOS ANGELES COUNTY ENGINEER
700 LOS ANGELES COUNTY ENGINEERING BLDG.

NOTE: ANY ADDITIONS OR CHANGES OR THIS SHEET MUST BE MADE OR CIRCLED IN RED INK. WITH DATE AND NAME OF PERSON MAKING CHANGE.

Do not extend notes this side of this line.

Profile Notes Red____ Plotted____ Job No. 4277-99 Division No. 12
No.____ Date____ Date____ Survey of Gardena Ave Paving Notes F.B. 4570 Pg. 111
Sec. Notes Chkd. Checked Survey by [redacted] Date July 30

STATION	B.S.	H.I.	F.S.	ELEV.	Left ℄ South	℄	Right ℄ North
14+00				325.19		℄	
				25.13			4.5 Bot alley
				26.94			" Top wood side
				26.8			5 ground
				27.3			10 "
				25.25	4.5 Bot. alley		
				26.91	" Top wood side		
				27.7	5. ground		
				27.9	10 "		
14+18.06		T.P.		325.57		℄	P.I.
14+18.6				25.65		℄	
				25.68			5.5 Bot. drain
				27.47			" Top wood side
				28.0			6.5 ground
				28.0			10 "
14+21.3				25.56		℄	
				25.58	3.5 bot drain		
				27.36	" Top wood side		
				28.7	4.5 ground		
				29.0	10 "		

76L-295 CE 307 11-58

PLEASE RETURN TO
LOS ANGELES COUNTY ENGINEER
700 LOS ANGELES COUNTY ENGINEERING BLDG.

NOTE: ANY ADDITIONS OR CHANGES ON THIS SHEET MUST BE MADE OR CIRCLED IN RED INK, WITH DATE AND NAME OF PERSON MAKING CHANGE.

Do not extend notes this side of this line.

F.B. 4570 Pg. 114 | Job No. 4198.30 | Division No. 10 | Notes Red | Plotted | Profile
Survey of Potrero Grande S.D. | Date | Date | No. | X-Sec.
Survey by F.E.B. and Notes F.E.B. | Notes Chkd. | Checked | No.
Indexed C. Jonathan | Date | Date | Date

STATION	B.S.	H.I.	F.S.	ELEV.	Left ℄ South	℄	Right ℄ North
16+87.54 = 0+00 N 85				333.74	℄ Inter. of drain ℄ bridge		Isabel Ave on
	Going N. on	Isabel Ave			Left ℄ West	℄	Right ℄ East
0+06				333.72		℄	edge of Bridge
0+10				333.65		℄	
				333.45			9 pav't
				333.34			18 edge pav't
				not taken			30 P/L
				333.79	11 pav't		
				333.81	22.5		
				333.37	25.5 lot ditch		
				333.81	27.5 edge pav't		
				333.47	30.0		
0+22				333.63		℄	
				333.73	9 pav't		
				333.56	18 edge pav't		
				333.49	30 P/L		

76L-296 CE 307 11-58

PLEASE RETURN TO
LOS ANGELES COUNTY ENGINEER
700 LOS ANGELES COUNTY ENGINEERING BLDG.

NOTE: ANY ADDITIONS OR CHANGES ON THIS SHEET MUST BE MADE OR CIRCLED IN RED INK, WITH DATE AND NAME OF PERSON MAKING CHANGE.

Do not extend notes this side of this line.

STATION	B.S.	H.I.	F.S.	ELEV.	Left ℄ West	℄	Right ℄ East
0+60				334.41		℄	
				34.21			9 Pav't
				33.85			18 edge pav't
				34.3			30 P/L
				34.33	9 Pav't		
				34.14	18 edge pav't		
				35.5	30 P/L		
0+98.0				35.32			18.1 Gut in start cb
				35.93			" Top " "
				35.30	18.0 Gut in start cb		
				35.94	" Top "		"
1+60				37.82		℄	
				37.73			9 pav't
				37.41			16.1 Gut out
				37.27			18.1 " in
				37.93			" Top cb
				38.1			30 P/L
				37.67	9 pav't		
				37.50	16.0 Gut out		

Profile Notes Red
No. X-Sec. Notes Chkd. Date
No. Date
Plotted Date Checked Date
Job No. 62-E-90 Division No. 10
Survey of Survey by Notes Date
Map No. Traced Date
F.B.

76L-296 CE 307 11-58

PLEASE RETURN TO
LOS ANGELES COUNTY ENGINEER
700 Los Angeles County Engineering Bldg.

NOTE: ANY ADDITIONS OR CHANGES ON THIS SHEET MUST BE MADE OR CIRCLED IN RED INK, WITH DATE AND NAME OF PERSON MAKING CHANGE.

Do not extend notes this side of this line.

F.B. 4570 Pg. 116 Job No. 4232.90 Division No. 10 Notes Red ____ Plotted ____ Profile ____
Survey of Potrero Grande J.D. Date ____ Date ____ No. ____ X-Sec. ____
Survey by FEB+dark Notes F.E.B. Notes Chkd. ____ Checked ____ No. ____
Indexed C. Johnson Date ____ Date ____ Date ____

STATION	B.S.	H.I.	F.S.	ELEV.	Left & West	& Right & East
1+60				337.37	18.0 Cut in	
				37.99	" Top cb	
				38.2	30 P/L	
2+04.5	S.M.H.					5.0 S.M.H.
		N. rim	338.25		8" Inlet S	
		S. rim	338.25		Rim 338.25	
					Meas 12.00	
	Invert 8" Inlet S.			325.58	Top pipe 326.25	
					dia .67	
					invert 325.58	
BM A-72				336.23	BM A-72 Elev. 336.230 per F.B. 2515-36 Isabel Ave S. end, S. of Emerson Pl. Bt. spk in E. cb. 8 ft. N. of S end in front of house #3044	
	Going S. on Isabel Ave				Left & East & Right & West	
0+06				333.70		Ridge bridge

76L-296 CE 307 11-58

PLEASE RETURN TO
LOS ANGELES COUNTY ENGINEER
700 Los Angeles County Engineering Bldg.

NOTE: ANY ADDITIONS OR CHANGES ON THIS SHEET MUST BE MADE OR CIRCLED IN RED INK, WITH DATE AND NAME OF PERSON MAKING CHANGE.

Do not extend notes this side of this line.

STATION	B. S.	H. I.	F. S.	ELEV.	Left & East	Right & West
0+10				333.64		℄
				3390		9 part
				3398		18 edge part
				not taken		30 P/L
				3359	12 part	
				3381	25 edge part	
				340	30 P/L	
0+14.0	S.M.H				5.0 S.M.H.	
						8" outlet N.
		N rim 333.90			Rim	333.99
		S. rim 334.09			mean	7.28
					Top pipe	326.71
		Invert 8" Outlet N.		326.04	dia	.68
					invert	326.04
0+35.5		bot. conc. block wall		335.91		℄ S. edge part
				3683		4.0 cor part & above
				3696		17.0 edge part & above
				372		30.0 P/L
				3560	9.0 S. edge Part.	

Profile Notes Red Plotted Job No. 6455.99
No. X-Sec. Date Date Division No. 6
No. Notes Chkd. Date Checked Date Survey of Notes F.B. 5170 Pg. 117
Date Map No. Inked Date Survey by EE Proctor Date May 89

76L-296 CE 307 11-58

PLEASE RETURN TO
LOS ANGELES COUNTY ENGINEER
700 Los Angeles County Engineering Bldg.

NOTE: ANY ADDITIONS OR CHANGES ON THIS SHEET MUST BE MADE OR CIRCLED IN RED INK, WITH DATE AND NAME OF PERSON MAKING CHANGE.

Do not extend notes this side of this line.

F. B. 2570 Pg. 118 | Job No. 6252.30 | Division No. 10 | Notes Red | Plotted | Profile
Survey of Petrelo Grader S.D. | Date | Date | No.
Survey by E.R. Notes FEB | Notes Chkd. | Checked | X-Sec.
Index C. Johnson | Date | Date | No.

STATION	B.S.	H.I.	F.S.	ELEV.	Left ℄ East	℄	Right ℄ West
0+35.5	bot	conc. block wall		335 15	18 S.E. Cor. pavt		
				342	30 P/L		
0+35.5	Top	conc block wall		3816		℄	
				3817			4.0
				3814	18		
				3815	30		
0+60				392		℄	proof ground
				3869			4.0 Edge drive
				3887			17.0 " "
				3891			30 Premix lot
				401	15 ground		
				414	30 "		
1+60				407		℄	proof ground
				4170			4.0 edge drive
				4185			17 " "
				4199			30 premix lot
				411	15 ground		

76L-298 CE 307 11-58

PLEASE RETURN TO
LOS ANGELES COUNTY ENGINEER
700 LOS ANGELES COUNTY ENGINEERING BLDG.

NOTE: ANY ADDITIONS OR CHANGES ON THIS SHEET MUST BE MADE OR CIRCLED IN RED INK, WITH DATE AND NAME OF PERSON MAKING CHANGE.

Do not extend notes this side of this line.

Profile Notes Red Plotted
No. Date Checked
X-Sec. Date Checked
No. Notes Chkd. Date Checked
Date Checked
Survey of Job No. 5336 Div. No. 10
Survey by EE Brock Notes EE Date 11-29
Map No. Indexed Date
F. B. 4518 Pg. 119

STATION	B. S.	H. I.	F. S.	ELEV.	Left & East	& Right & West
1+60				341 8	30 ground	
		T.P.		336 14		
		Going West in drain			Left & South	& Right & North
17+13.0				330 99		& drain at edge bridge
				30 98		4.0 bot. of drain
				33 33		" Top wood side
				33 3		5 ground
				33 4		10 "
				30 96	5.0 bot of drain	
				33 33	" Top wood side	
				33 4	6 ground	
				34 2	10 "	
17+20.93	P.I.			31 19		& P.I.
				31 14		4.5 bot drain 1ft + to 1ft above
				32 87		" Top wood side
				33 5		5.5 ground "
				34 3		10 " "

76L-298 CE 307 11-58

PLEASE RETURN TO
LOS ANGELES COUNTY ENGINEER
700 Los Angeles County Engineering Bldg.

NOTE: ANY ADDITIONS OR CHANGES ON THIS SHEET MUST BE MADE OR CIRCLED IN RED INK, WITH DATE AND NAME OF PERSON MAKING CHANGE.

Do not extend notes this side of this line.

F.B. 1570 Pg. 110
Survey of Potrero Grande
Survey by E.E. Brink Notes FEB
Indexed C. Johnson Date
Job No. 1252.90 Division No. 10 Notes Red Plotted Profile
S.P. Date Date No. X-Sec.
Notes Chkd. Checked
Date Date No.

STATION	B.S.	H.I.	F.S.	ELEV.	Left ℄ South	℄	Right ℄ North
17+20.98	P.I.			3312	4.5 Bot drain		
				3296	" Top Wood side		
				331	5.5 ground		
				341	10 "		
18+00		T.P.		3248		℄	
				5240			4.5 Bot drain
				3400			" Top Wood side
				359			5.5 ground
				370			10 "
				3252	4.5 Bot drain		
				3434	" Top Wood side		
				353	5.5 ground		
				367	10 "		
19+00				3453		℄	
				3452			4.2 Bot drain
				3637			" Top Wood side
				363			4.7 ground
				368			10 "
				3455	4.7 Bot drain		

76L-298 CE 307 11-58

L-298

PLEASE RETURN TO
LOS ANGELES COUNTY ENGINEER
700 Los Angeles County Engineering Bldg.

NOTE: ANY ADDITIONS OR CHANGES ON THIS SHEET MUST BE MADE OR CIRCLED IN RED INK, WITH DATE AND NAME OF PERSON MAKING CHANGE.

Do not extend notes this side of this line.

Profile Notes Red — Plotted — Job No. — Division No. — F.B. — Pg.
No. — Date — Date — Date — Survey of — Survey by — Notes — Date
No. — Date — Checked — Date — M&P No. — Date

Notes Chkd.

STATION	B. S.	H. I.	F. S.	ELEV.	℄ Left & South	℄	℄ Right & North
19+00				3363.5	4.7 Top wood side		
				3648	5.2 ground		
				378	10 "		
19+51.50	P.I.			3548		℄	P.I.
				3559	5.0 Bot drain Ht & To line ahead		
				3746	" Top wood side "		
				374	5.5 ground "		
				376	10 " "		
19+52.0				3549		℄	
				3546			4.5 bot drain
				3716			" Top wood side
				373			5. ground
				397			10 "
20+00				3621		℄	
				3616			4.5 bot drain
				3793			" Top wood side
				378			5.0 ground
				385			10 "

76L-298 CE 307 11-58

PLEASE RETURN TO
LOS ANGELES COUNTY ENGINEER
700 LOS ANGELES COUNTY ENGINEERING BLDG.

NOTE: ANY ADDITIONS OR CHANGES ON THIS SHEET MUST BE MADE OR CIRCLED IN RED INK, WITH DATE AND NAME OF PERSON MAKING CHANGE.

Do not extend notes this side of this line.

F.B. 2570 Pg. 184 | Job No. 6252.90 | Division No. 10 | Notes Red | Plotted | Profile
Survey of Potrero Grande S.D. | Date | Date | No.
Survey by F.E. Brooks Notes F.E.B. | Notes Chkd. | Checked | X-Sec.
Index C. Johnson | Date | Date | No.

STATION	B.S.	H.I.	F.S.	ELEV.	Left ℄ West	℄ Right ℄ East.
0+22.8				3399		25 P/L
				3923	7 pav't	
				3908	15 gut in	
				3973	" Top cb.	
				401	25 P/L	
0+38.2				3974		19.2 Top Conc. Wall Flush with surface apprx 30" deep.
0+62.8				3975		℄
				3950		7 pav't
				3929		14.5 edge pav't
				402		17.5 ground
				402		25 P/L
				3974	7 pav't	
				3937	15 gut in	
				4000	" Top cb	
				407	25 P/L	
1+62.8				4052		℄
				4029		7 pav't

76L-298 CE 307 11-58

PLEASE RETURN TO
LOS ANGELES COUNTY ENGINEER
700 LOS ANGELES COUNTY ENGINEERING BLDG.

NOTE: ANY ADDITIONS OR CHANGES ON THIS SHEET MUST BE MADE OR CIRCLED IN RED INK, WITH DATE AND NAME OF PERSON MAKING CHANGE.

Do not extend notes this side of this line.

Profile Notes Red Plotted Job No. 6259.90
No. X-Sec. Date Date Survey of Division No. 10
No. Notes Chkd. Date Checked Survey by E. Brooks Notes E.B. 3570 Pg. 127
No. Date Map No. Date

STATION	B. S.	H. I.	F. S.	ELEV.	Left & West	&	Right & East
1462.8				34 09			14.5 edge pavt
				40 6			17.5 ground
				41 2.			25 P/L
				40 54	7 pavt		
				4034	15 gut in		
				4107	" Top cb		
				414	25 P/L		
	Going South on Jackson Ave.				Left & East	&	Right & West.
0421.3				33884		&	
				3867			7 pavt
				3873			15 Gut in
				3929			" Top cb
				393			25 P/L
				3863	7 pavt		
				3845	14 edge pavt		
				389	17 ground		
				384	25 P/L		

76L-298 CE 307 11-58

PLEASE RETURN TO
LOS ANGELES COUNTY ENGINEER
700 Los Angeles County Engineering Bldg.

NOTE: ANY ADDITIONS OR CHANGES ON THIS SHEET MUST BE MADE OR CIRCLED IN RED INK, WITH DATE AND NAME OF PERSON MAK.NG CHANGE.

Do not extend notes this side of this line.

F.B. 2570 Pg. 116 Job No. 4252.20 Division No. 10 Notes Red Plotted Profile
Survey of Potters Grande S.D. Date No. X-Sec.
Survey by F.E. Brooks Notes F.E.B. Notes Chkd. Checked
Indexed ~~E. C. Johnson~~ Date Date Date No.

STATION	B. S.	H. I.	F. S.	ELEV.	Left ℄ East	℄	Right ℄ West
0+28				339 23	19.2 Top Conc. wall flush with surface aprox 30" dep.		
0+61.3				3941		℄	
				3931			7 pav't
				3898			15 Gut in
				3940			" Top ob.
				397			25 P/L
				3924	7 pav't		
				3901	14 edge pav't		
					~~19.2 bot Conc. ob.~~		
				3934	19.2 Top Conc wall		
				399	25 P/L		
0+84.0				3955	19.2 Top conc. wall flush with surface aprox 30" dn.		
1+61.3				4097		℄	
				4065			7 pav't
				4063			15 Gut. in
				4121			" Top ob

76L-298 CE 307 11-58

PLEASE RETURN TO
LOS ANGELES COUNTY ENGINEER
700 LOS ANGELES COUNTY ENGINEERING BLDG.

NOTE: ANY ADDITIONS OR CHANGES ON THIS SHEET MUST BE MADE OR CIRCLED IN RED INK, WITH DATE AND NAME OF PERSON MAKING CHANGE.

Do not extend notes this side of this line.

STATION	B. S.	H. I.	F. S.	ELEV.	Left & East ℄	Right & West
1461.3				3414		25 P/L
				4088	7 pav't	
				4069	14 edge pav't	
				4115	17 ground	
				4222	25 P/L	
	Going West on Alley				Left & South ℄	Right & North
21+58				33863	℄	
				3875		5.0 Cut in
				3941		" Top cb
				397		7 ground
				399		10 "
				3859	5.0 Cut in	
				3940	" Top cb	
				395	10 ground	
22+00				3876	℄	
				3881		5.0 Cut in
				3959		" Top cb

Profile No. ____ Date ____ Notes Chkd. ____ Date ____
Notes Rod ____ Date ____ Checked ____ Date ____
Plotted ____ Date ____ Map No. ____ Indexed ____ Date ____
Job No. 4232.90 Division No. 10
Survey of [illegible] Co. Grading Proj. No. [illegible]
Survey by R.E. Brinks Notes [illegible] Date May 69
F.B. 1570 Pg. 42
X-Sec. No. ____

76L-298 CE 307 11-58

PLEASE RETURN TO
LOS ANGELES COUNTY ENGINEER
700 LOS ANGELES COUNTY ENGINEERING BLDG.

NOTE: ANY ADDITIONS OR CHANGES ON THIS SHEET MUST BE MADE OR CIRCLED IN RED INK, WITH DATE AND NAME OF PERSON MAKING CHANGE.

Do not extend notes this side of this line.

F.B. 2570 Pg. 128 Job No. 6252.90 Division No. 4 Notes Red Plotted Profile
Survey of Potrero Grande S.D. Date No.
Survey by FE Brooks Notes FEB Date X-Sec.
Index C. Johnson Notes Chkd. Checked No.
Date Date

STATION	B.S.	H.I.	F.S.	ELEV.	Left ℄ South	℄	Right ℄ North
22+00				3405			8 ground
				408			10 "
				3879	5.0 Gut in		
				3959	" Top cb		
				398	6.0 Cone slab		
				399	10 ground		
23+00				3914		℄	
				3925			5.0 Gut in
				3991			" Top cb.
				4091			5.5 Cone
				409			10 ground
				3916	5.0 Gut in		
			T.P.	33995	" Top cb.		
				407	7.0 ground		
				407	10 "		
24+00				396		℄	
				3975			5.0 Gut in
				4039			" Top cb
				407			5.5 ground

76L-298 CE 307 11-58

PLEASE RETURN TO
LOS ANGELES COUNTY ENGINEER
700 LOS ANGELES COUNTY ENGINEERING BLDG.

NOTE: ANY ADDITIONS OR CHANGES ON THIS SHEET MUST BE MADE OR CIRCLED IN RED INK, WITH DATE AND NAME OF PERSON MAKING CHANGE.

Do not extend notes this side of this line.

Profile Notes Red ____ Plotted ____ Job No. 4277.90 Division No. 10
No. ____ Date ____ Date ____ Survey of ____ F.B. 2570 Pg. 49
Notes Chkd. ____ Checked ____ Survey by ____ Notes ____ Date ____

STATION	B.S.	H.I.	F.S.	ELEV.	Left ℄ South	℄	Right ℄ North
24+00				3911			10 ground
				3973	5.0 Gut in		
				4033	" Top cb		
				410	6.0 ground		
				410	10 "		
25+00				3997		℄	
				3999			5.0 Gut in
				4083			" Top cb
				419			6.0 ground
				420			10 "
				4025	5.0 Gut in		
				4081	" Top cb.		
				413	6.0 ground		
				413	10 "		
25+18.8				4006		℄	edge of conc.
25+42.81				4053	℄ intr. Alley and Prospect Ave.		

76L-298 CE 307 11-58

PLEASE RETURN TO
LOS ANGELES COUNTY ENGINEER
700 Los Angeles County Engineering Bldg.

NOTE: ANY ADDITIONS OR CHANGES ON THIS SHEET MUST BE MADE OR CIRCLED IN RED INK, WITH DATE AND NAME OF PERSON MAKING CHANGE.

Do not extend notes this side of this line.

F.B. 2570 Pg. 130 | Job No. 6854.90 | Division No. 10 | Notes Red | Plotted | Profile
Survey of Petrol Grande S.D. | Date | Date | No.
Survey by E.E. Brock | Notes F.B. | Notes Chkd. | Checked | X-Sec.
Indexed [illegible] | Date | Date | Date | No.

STATION	B. S.	H. I.	F. S.	ELEV.		
B.M. W.M. 279				341.17	B.M. W.M. 279 Elev. 341.174 per F.B. 2515-39 Prospect Ave 243 ft N. of Garvey Ave Bt Spk in E. C6. 4 ft. S of C.L. of drive	
Going North on Prospect Ave					Left & West	& Right & East.
0+23.2				340.88		℄
				40.55		7.0 p.o.t
				not taken		15.9 Gut. in
				41.16		" Top of C6
				41.4		25 P/L
				40.84	6.0 p.o.t	
				40.76	17.9 Gut in	
				41.25	" Top of C6	
				41.8	25 P/L	

76L-296 CE 307 11-58

PLEASE RETURN TO
LOS ANGELES COUNTY ENGINEER
700 LOS ANGELES COUNTY ENGINEERING BLDG.

NOTE: ANY ADDITIONS OR CHANGES ON THIS SHEET MUST BE MADE OR CIRCLED IN RED INK, WITH DATE AND NAME OF PERSON MAKING CHANGE.

Do not extend notes this side of this line.

Profile Notes Red ____ Plotted ____
No. ____ Date ____ Date ____
X-Sec. Notes Chkd. ____ Checked ____
No. ____ Date ____ Date ____
Job No. 6250.90
Survey of [illegible] Division No. 2
Survey by [illegible] Notes [illegible]
Map No. ____ Date ____
F.B. 1570 Pg. 131

STATION	B.S.	H.I.	F.S.	ELEV.	Left ℄ West	℄	Right ℄ East
0+24.0	S.M.H.				22.0 S.M.H.		
					8"Inlet N.E.		8"Outlet S.
		N rim	341.35		Rim	341.37	341.37
		S. rim	341.39		Meas	7.33	7.40
	Invert 8"Inlet N.E.			333.37	Top pipe	334.04	333.97
	" " Outlet S			333.30	dia	.67	.67
					invert	333.37	333.30
0+32.						℄ end of conc.	
0+35.5	S.M.H.				5.0 S.M.H.		
		N rim	341.05			8"outlet S.W.	
		S rim	341.02		Rim	341.03	
					Meas	6.86	
	Invert 8"Outlet S.W.			333.50	Top pipe	334.17	
					dia	.67	
					invert	333.50	
0+63.2				341.37		℄	
				41.13		7" Pvc	
				40.74		14" RCP out	

76L-296 CE 307 11-58

PLEASE RETURN TO
LOS ANGELES COUNTY ENGINEER
700 Los Angeles County Engineering Bldg.

NOTE: ANY ADDITIONS OR CHANGES ON THIS SHEET MUST BE MADE OR CIRCLED IN RED INK, WITH DATE AND NAME OF PERSON MAKING CHANGE.

Do not extend notes this side of this line.

F.B. 1570 Pg. 132 Job No. 6452.90 Division No. 10 Notes Red Plotted Profile
Survey of Potrero Grande S.D. Date No. X-Sec.
Survey by F.E. Brock Notes F.E.B. Date No.
Indexed C.C. Johnson Date Notes Chkd. Checked Date

STATION	B.S.	H.I.	F.S.	ELEV.	Left ℄ West	℄	Right ℄ East
0+63.2				340 59			16.0 Gut in
				41 20			" Top cb
				41 5			25 P/L
				41 22	6.0 pav't		
				40 84	12.0 Gut out		
				40 75	14.0 " in		
				41 30	" Top cb		
				41 7	25 P/L		
1+63.2				41 51		℄	
				41 32			7.0 pav't
				40 85			14.0 Gut out
				40 73			16.0 " in
				41 36			" Top cb
				41 6			25 P/L
				41 25	6.0 pav't		
				40 94	12.0 Gut out		
				40 83	14.0 " in		
				41 30	" Top cb		
				41 6	25 P/L		
		T.P.	341.13				

76L-298 CE 307 11-58

PLEASE RETURN TO
LOS ANGELES COUNTY ENGINEER
700 LOS ANGELES COUNTY ENGINEERING BLDG.

NOTE: ANY ADDITIONS OR CHANGES ON THIS SHEET MUST BE MADE OR CIRCLED IN RED INK, WITH DATE AND NAME OF PERSON MAKING CHANGE.

Do not extend notes this side of this line.

STATION	B. S.	H. I.	F. S.	ELEV.	Left & East ℄	℄ Right & West.
	Going South on Prospect Ave.					
25+66.8				3+0.91		℄
				4+0.91		7.0 par't
				4+0.91		13.9 Gut in
				4+1.30		" Top cb
				4+2.0		25.0 P/L
				4+0.72	8.0 par't	
				4+0.65	16.2 Gut in	
				4+1.20	" Top cb	
				4+1.3	25.0 P/L	
26+06.8				4+1.19		℄
				4+1.28		7.0 par't
				4+1.35		13.9 Gut in
				4+1.61		" Top cb
				4+2.2		25.0 P/L
				4+1.05	8.0 par't	
				4+1.03	16.2 Gut in	
				4+1.54	" Top cb.	
				4+1.7	25.0 P/L	

Profile Notes Rod Plotted Job No. 6252.10
No. 2-Sec. Date Date Survey of Division No.
No. Notes Chkd. Date Checked Survey by Notes Date
No. Date Date Map No. Notes Date
F.B. 16-72 Pg. 133

76L-298 CE 507 11-58

PLEASE RETURN TO
LOS ANGELES COUNTY ENGINEER
700 Los Angeles County Engineering Bldg.

NOTE: ANY ADDITIONS OR CHANGES ON THIS SHEET MUST BE MADE OR CIRCLED IN RED INK, WITH DATE AND NAME OF PERSON MAKING CHANGE.

Do not extend notes this side of this line.

F.B. 4570 Pg. 114 — Job No. 6352-2 — Division No. 10 — Notes Red — Plotted — Profile
Survey of Prospect Ave Improvements — Date — No. — X-Sec.
Survey by Boots — Notes Chkd. — Checked — No.
Indexed — Notes — Date — Date — Date

STATION	B.S.	H.I.	F.S.	ELEV.	Left of East	℄	Right of West
27+06.8				4206		℄	
				4215			7 Pavt
				4215			13.3 gutter
				4260			11 top CB
				427			25 P/L
				4205	8 Pavt		
				4203	16.4 gutter		
				4257	11 top CB		
				427	25 P/L		
27+42.0				4253		℄	
				4255			7 Pavt
				4254			13.3 gutter
				4212			11 top CB
				431			25 P/L
				4254	8 Pavt		
				4252	16.4 gutter		
				4390	11 top CB		
				439	25 P/L		
27+67.8				4375			
28+02.77 = 0+00 E			T.P.	3441	℄ Int. Prospect Ave & Garvey Ave		

76L-298 CE 307 11-56

PLEASE RETURN TO
LOS ANGELES COUNTY ENGINEER
700 LOS ANGELES COUNTY ENGINEERING BLDG.

NOTE: ANY ADDITIONS OR CHANGES ON THIS SHEET MUST BE MADE OR CIRCLED IN RED INK, WITH DATE AND NAME OF PERSON MAKING CHANGE.

Do not extend notes this side of this line.

Profile Notes Red. Plotted
No. X-Sec. Date Date. Date.
Notes Chkd. Checked Survey of
No. Date Date Map No. Traced Survey by Notes Date Date
Job No. 6257-D Division No. 16
F.B. 2577-D Pg. 25

STATION	B.S.	H.I.	F.S.	ELEV.	LEFT ℄ NORTH	℄	RIGHT ℄ SOUTH
Going East on Garvey Ave							
0+01				34416		℄	
				4411			20 Edge conc Pav't
				4307			35 gutter out
				4292			38 " in
				4425			" top Cb
				445			50 P/L
0+22				4403			15 top drain
				4266			" F.L. "
				4399	15 top drain		
				4256	" F.L. "		
0+38.5				4397		℄	
				4391	20 Pav't		
				4382	35 gutter out		
				4369	38 " in		
				4395	" top Cb		
				441	50 P/L		

76L-298 CE 307 11-58

PLEASE RETURN TO
LOS ANGELES COUNTY ENGINEER
700 LOS ANGELES COUNTY ENGINEERING BLDG.

NOTE: ANY ADDITIONS OR CHANGES ON THIS SHEET MUST BE MADE OR CIRCLED IN RED INK, WITH DATE AND NAME OF PERSON MAKING CHANGE.

Do not extend notes this side of this line.

Profile No. ____ Plotted ____ Notes Red ____
X-Sec. No. ____ Date ____ Date ____
Checked ____ Notes Chkd. ____
No. ____ Date ____ Date ____
Division No. 10 Job No. 43520
Survey of Bellflow Quincy St
Survey by Brooks Notes by Brooks
Indexed by S. Tajima Date ____
F.B. 2578 Pg. 13

STATION	B. S.	H. I.	F. S.	ELEV	LEFT ℄ NORTH	℄	RIGHT ℄ SOUTH
0+46 ℄				343 91		℄	
				43 91			20 Edge Conc
				42 99			35 gut out
				42 77			38 " in
				43 99			11 top CB
				44 4			50 PIL
0+73.5	5 MH						30 5 MH
		E. RIM =	34 3.35		8" INLET W		8" INLET S 8" INLET E.
		W " =	34 3.36		RIM 343.35		343.35 343.35
					MEAS 7.16		6.98 7.40
INVERT	8"	INLET	W	335 52	top P 336.19		336.37 336.95
"	8"	"	S	335 70	DIA .67		.67 .67
"	8"	OUTLET	E	335 28	INVERT 335.52		335.70 335.28
0+78.28 = 1400 SOUTH				343 80	℄ INT HARVEY AVE		℄ PROSPECT AVE (S)
0+78.5				43 80		℄	
				43 68	20 Edge Conc		
				43 22	35 gut out		
				43 08	38 " in		
				43 72	" top CB		
				439	50 PIL		

76L-298 CE 307 11-58

PLEASE RETURN TO
LOS ANGELES COUNTY ENGINEER
700 Los Angeles County Engineering Bldg.

NOTE: ANY ADDITIONS OR CHANGES ON THIS SHEET MUST BE MADE OR CIRCLED IN RED INK, WITH DATE AND NAME OF PERSON MAKING CHANGE.

Do not extend notes this side of this line.

Profile No. Notes Red. Plotted
X-Sec. No. Date Notes Chkd. Date Checked
No. Date Date Map No.
Job No. 62-13 Division No. 10
Survey of [illegible] Survey by [illegible] Notes [illegible] Date 5-28
F. B. 2570 Pg. 157

STATION	B. S.	H. I.	F. S.	ELEV.	LEFT ℄ NORTH			℄	RIGHT ℄ SOUTH		
1+13.5				34375				℄			
				4351					20	Edge	Conc
				4396					35	gut	out
				4382					38	"	in
				4365					"	top	cb
				440					50	PIL	
1+78.5				4370				℄			
				4340					20	Edge	Conc
				4300					35	gut	out
				4286					38	"	in
				4363					"	top	cb
				439					50	PIL	
				4336	20	Edge	Conc				
				4303	35	gut	out				
				4285	38	"	in				
				4365	"	top	cb				
				438	50	PIL					

76L-298 CE 307 11-58

PLEASE RETURN TO
LOS ANGELES COUNTY ENGINEER
700 LOS ANGELES COUNTY ENGINEERING BLDG.

NOTE: ANY ADDITIONS OR CHANGES ON THIS SHEET MUST BE MADE OR CIRCLED IN RED INK, WITH DATE AND NAME OF PERSON MAKING CHANGE.

Do not extend notes this side of this line.

F.B. 2317 Pg. 138 Profile
Survey of Pomona Notes Red Plotted
Survey by Brooks Notes Chkd. Checked
Indexed C. Johnson Date Date
Job No. 62C10 Division No. 10 Date Date
Notes Date No. X-Sec.
No.

STATION	B.S.	H.I.	F.S.	ELEV	Left of North & Right of South
1+99.0	SMH.				30.0 SMH.
	E	Rim = 343.11			8" INLet W
	W	" = 343.09			Rim 343.10
					Meas 1086
INVERT	8"	INLet	W	331.57	Top P. 332.24
					Dia .67
					INVERT 331.57
3+16.0				343.60	44.0 Top Bell tel. MH.
					Left of East & Right of West
Going South on Prospect Ave					
1+20				343.65	& Edge Conc
1+35				43.00	& " "
1+38				42.84	& F.L.
1+41				42.97	& Edge Conc
1+60				43.81	&
				43.54	6 Pavt
				43.23	11 gutter
				43.07	13 " in
				43.49	" to p.c.

76L-298 CE 307 11-58

PLEASE RETURN TO
LOS ANGELES COUNTY ENGINEER
700 LOS ANGELES COUNTY ENGINEERING BLDG.

NOTE: ANY ADDITIONS OR CHANGES ON THIS SHEET MUST BE MADE OR CIRCLED IN RED INK. WITH DATE AND NAME OF PERSON MAKING CHANGE.

Do not extend notes this side of this line.

STATION	B.S.	H.I.	F.S.	ELEV.	Left & East	℄	Right & West
1+60				34.38			22.5 P/L
				43.85	6 PAVT		
				43.65	11 gut out		
				43.55	13 " 14		
				43.96	" top cb		
				44.2	22.5 P/L		
2+00				44.60		℄	
				44.32			6 PAVT
				43.95			11 gut out
				43.80			13 " 14
				44.21			" top cb
				44.4			22.5 P/L
				44.55	6 PAVT		
				44.34	11 gut out		
				44.20	13 " 14		
				44.73	" top cb.		
				44.9	22.5 P/L		
3+00			T.P.	3+46.50		℄	
				46.16			6 PAVT
				45.75			11 gut out
				45.66			13 " 14

Profile Notes Pad Plotted
No. X-Sec. Date Date Date
Notes Chkd. Checked Survey of Division No. 10
Date Date Survey by Notes Date
Map No. Inst. No. C.E. Job No.
F.B. 3+00 PG.

76L-298 CE 307 11-58

PLEASE RETURN TO
LOS ANGELES COUNTY ENGINEER
700 LOS ANGELES COUNTY ENGINEERING BLDG.

NOTE: ANY ADDITIONS OR CHANGES ON THIS SHEET MUST BE MADE OR CIRCLED IN RED INK, WITH DATE AND NAME OF PERSON MAKING CHANGE.

Do not extend notes this side of this line.

Profile No. ____ Plotted ____ Date ____
X-Sec. No. ____ Checked ____ Date ____
Notes Red ____ Date ____
Notes Chkd. ____ Date ____
Job No. [illegible] Division No. [illegible]
Survey of Potrero Grande Drive
Survey by Engrs. Notes [illegible]
Inked C. Johnson Date ____
F. B. 257 Pg. 40

STATION	B. S.	H. I.	F. S.	ELEV	LEFT & EAST	&	RIGHT & WEST
3+00				346 12			13 Top cb
				46 2			22.5 P/L
				46 50	6 Pavt		
				46 25	11 gut out		
				46 11	13 " in		
				46 53	11 top cb		
				46 7	22.5 P/L		
4+25.5	S M.H.						6°. S M.H.
	N	RIM =	348.60		8" Outlet N		
	S	" =	348.60		RIM 348.60		
					Meas 7.04		
INVERT	8" Outlet	N		340 89	top P. 341.56		
					Dia .67		
					INVERT 340.89		
		T.P.	343.96				
BM SD 1406				344 25	BM SD 1406 ELEV 344.250 FB 2515-37 Harvey Ave & Prospect Ave, S. side B. Spk in curb 6 Ft N. of ℄ Prod.		

76L-298 CE 307 11-58

PLEASE RETURN TO
LOS ANGELES COUNTY ENGINEER
700 LOS ANGELES COUNTY ENGINEERING BLDG.

NOTE: ANY ADDITIONS OR CHANGES ON THIS SHEET MUST BE MADE OR CIRCLED IN RED INK, WITH DATE AND NAME OF PERSON MAKING CHANGE.

Do not extend notes this side of this line.

Profile Notes Red. Date Plotted Date
No. Notes Cmkd. Date Checked Date
Survey of Survey by Notes Date
Job No. 6252.30 Division No. 19
F.B. 2-77 Pg. 111

STATION	B. S.	H. I.	F. S.	ELEV.	Left of South		& Right of North	
Going West on Garvey Ave								
							30° SMH	
28+25.0	S.M.H.					8" Inlet N	8" Inlet W	8" Outlet E
	E. Rim = 343.70				Rim	343.70	343.70	343.70
	W. Rim = 343.71				Meas	10.40	10.55	10.77
	Invert 8" Inlet N			332 63	Top pipe	333.30	333.15	332.93
	" " " W			332 48	Dia	.67	.67	.67
	" " Outlet E			332 26	Invert	332.63	332.48	332.26
28+38.5				344 28			2	
				44 12			20 edge conc	
				43 48			35 gut out	
				43 34			38 " in	
				44 14			" Top cb	
				43 8			50 P/L	
				44 21	20 edge conc			
				43 48	35 gut out			
				43 33	38 " in			
				44 35	" Top cb			
				44 6	50 P/L			

76L-298 CE 307 11-58

PLEASE RETURN TO
LOS ANGELES COUNTY ENGINEER
700 Los Angeles County Engineering Bldg.

NOTE: ANY ADDITIONS OR CHANGES ON THIS SHEET MUST BE MADE OR CIRCLED IN RED INK, WITH DATE AND NAME OF PERSON MAKING CHANGE.

Do not extend notes this side of this line.

F.B. 2570 Pg. 142 Job No. 6252.90 Division No. 10 Notes Red Plotted Profile
Survey of Potrero Grande S.D. Date Date No. X-Sec.
Survey by Brooks Notes E.E.B. Notes Chkd. Checked No.
Indexed C. Jamison Date Date Date

STATION	B. S.	H. I.	F. S.	ELEV	Left of South ℄	Right of North
28+78.5				344 52		℄
				44 39		20 edge conc
				43 84		35 gut out
				43 71		38 " in
				43 57		" Top cb
				44 4		50 P/L
				43 97	20 edge conc.	
				43 86	35 gut out	
				43 72	38 " in	
				44 58	" Top cb	
				44 9	50 P/L	
29+78.5				45 79		℄
				45 49		20 edge conc
				45 09		35 gut out
				44 88		38 " in
				45 69		" Top cb
				45 6		50 P/L
				45 51	20 edge conc	
				45 14	35 gut out	

76L-298 CE 307 11-58

PLEASE RETURN TO
LOS ANGELES COUNTY ENGINEER
700 Los Angeles County Engineering Bldg.

NOTE: ANY ADDITIONS OR CHANGES ON THIS SHEET MUST BE MADE OR CIRCLED IN RED INK, WITH DATE AND NAME OF PERSON MAKING CHANGE.

Do not extend notes this side of this line.

Profile No. Noted Rod No. X-Sec. Notes Chkd. Date Date Checked Date Map No. Date

Plotted Job No. 62290 Division No. 16 Survey of Date Noted Date

F.B. 2570 Pg. 43

STATION	B.S.	H.I.	F.S.	ELEV.	LEFT & SOUTH	&	RIGHT & NORTH
29+78.5				34496	38 gut out		
				45 76	" top cb		
				46 1	50 PIL		
30+09.0				46 10		&	
				46 08			20 Edge Conc
				45 69			35 gut out
				45 66			38 " in
				46 38			" top cb
				46 5			50 PIL
				46 14	20 Edge Conc		
				45 84	35 gut out		
				45 73	38 " in		
				46 49	" top cb		
				46 7	50 PIL		
		T.P. 347.02					
30+54.22		= 140 SOUTH		46 93	& Tan. CALVEY AVE & LINDY AVE		
BM WM 268		Note B.M. destroyed by drive way const.			BM BM 268 ELEV 347.216 FB 2515-37 CALVEY AVE & LINDY AVE N. 51.0 B. Spk in curb 19.4 W. of & Rad		

76L-298 CE 307 11-58

PLEASE RETURN TO
LOS ANGELES COUNTY ENGINEER
700 LOS ANGELES COUNTY ENGINEERING BLDG.

NOTE: ANY ADDITIONS OR CHANGES ON THIS SHEET MUST BE MADE OR CIRCLED IN RED INK, WITH DATE AND NAME OF PERSON MAKING CHANGE.

Do not extend notes this side of this line.

F.B. 251 Pg. 42 Job No. 4321.0 Division No. 10 Profile
Survey of Bonita Canyon Storm Drain No. X-Sec.
Survey by Blanks Notes Kennedy Plotted
Inked C. Johnson Date Notes Red Date Checked Date Notes Chkd. Date

STATION	B. S.	H. I.	F. S.	ELEV	Left / East	℄	Right / West
Going South on Lindy Ave							
1+20				346.66		℄	Edge conc
1+30	SMH.						5° SMH
		N Rim = 346.66			8" Inlet W		8" Inlet S 8" Outlet E
		S " 346.59			Rim 346.62		346.62 346.62
					Meas 7.78		7.68 7.96
Invert	8"	Inlet	W	338.17	Top 338.84		338.94 338.66
"	8"	"	S	338.27	Dia .67		.67 .67
"	8"	Outlet	E	337.99	Invert 338.17		338.27 337.99
1+35				346.36		℄	Edge conc
1+38				46.13		℄	F.L.
1+41				46.30		℄	Edge conc
1+60				47.38		℄	
				47.37			6 Pvt
				47.14			11 gutter
				47.03			18 " in
				47.57			11 top cb
				47.7			22.5 P/L
				47.20	6 Pvt		

76L-298 CE 307 11-58

PLEASE RETURN TO
LOS ANGELES COUNTY ENGINEER
700 LOS ANGELES COUNTY ENGINEERING BLDG.

NOTE: ANY ADDITIONS OR CHANGES ON THIS SHEET MUST BE MADE OR CIRCLED IN RED INK, WITH DATE AND NAME OF PERSON MAKING CHANGE.

Do not extend notes this side of this line.

Profile Notes Red. Plotted Job No. 55-90 Division No. 16
No. X-Sec. Date Date Date Survey of Notes 22 Date
No. Notes Chkd. Date Checked Date Survey by Notes Date
No. Date Date Map No. Inspected Date

F.B. 2570 Pg 145

STATION	B.S.	H.I.	F.S.	ELEV.	LEFT ℄ EAST	℄	RIGHT ℄ WEST
1+60				346 71	11 gut out		
				46 58	13 11 14		
				47 03	11 top CB		
				47 2	22.5 P/L		
2+00				47 77		℄	
				47 76			6 PAVT
				47 44			11 gut out
				47 34			13 11 14
				47 80			11 top CB
				48 0			22.5 P/L
				47 46	6 PAVT		
				46 98	11 gut out		
				46 84	13 11 14		
				47 28	11 top CB		
				47 4	22.5 P/L		
3+00				48 33		℄	
				48 31			6 PAVT
				48 14			11 gut out
				48 08			13 11 14
				48 52			11 top CB
				48 8			22.5 P/L

76L-298 CE 307 11-58

PLEASE RETURN TO
LOS ANGELES COUNTY ENGINEER
700 LOS ANGELES COUNTY ENGINEERING BLDG.

NOTE: ANY ADDITIONS OR CHANGES ON THIS SHEET MUST BE MADE OR CIRCLED IN RED INK, WITH DATE AND NAME OF PERSON MAKING CHANGE.

Do not extend notes this side of this line.

F.B. 2 Pg. 146 Job No. 6325 Division No. 10 Profile
Survey of Catalina Avenue No. X-Sec.
Survey by Blanks Notes Lt Chance Plotted Date
Indexed C. J. Schmidt Date Notes Chkd. Date Checked Date Notes Red Date No.

STATION	B. S.	H. I.	F. S.	ELEV	LEFT ℄ EAST	℄ RIGHT ℄ WEST
3+00				348 06	6 PAVT	
				47 68	11 gut out	
				47 53	13 " IN	
				47 99	11 top C6	
				48 1	22.5 P/L	
4+00 S. M. H.						5.0 S M H
		N RIM =	349.25		8" OUT LCT N	
		S " =	349.27		RIM 349.26	
					MEAS 7.33	
INVERT 8" OUT LCT N.				341 26	top P. 341 93	
					DIA .67	
					INVERT 341.26	
					LEFT ℄ SOUTH	℄ RIGHT ℄ NORTH
Going West on Valencia Ave						
3+00				347 52	℄	
					same as ℄	Center Conc Pave
				47 17		20 Edge Conc
				46 93		35 gut out
				46 71		38 " IN

76L-298 CE 307 11-58

PLEASE RETURN TO
LOS ANGELES COUNTY ENGINEER
700 LOS ANGELES COUNTY ENGINEERING BLDG.

NOTE: ANY ADDITIONS OR CHANGES ON THIS SHEET MUST BE MADE OR CIRCLED IN RED INK, WITH DATE AND NAME OF PERSON MAKING CHANGE.

Do not extend notes this side of this line.

Profile Notes Red ____ Plotted ____
No. X-Sec. Notes Date ____ Survey of ____
No. ____ Notes Chkd. Date ____ Checked Date ____ Survey by ____ Notes ____ Date ____
Map No. ____ Index ____ Job No. 62-90 Division No. 18 F.B. 2570 Pg. 47

STATION	B.S.	H.I.	F.S.	ELEV.	Left & South	&	Right & North
31+00				347.54			38 top CB
				47.9			50 P/L
				47.22	19.5 Edge Conc		
				46.88	35 gut Inl		
				46.71	38 " Inl		
				47.51	" top CB		
				47.8	50 P/L		
31+29	SMH						30° SMH
	E Rim =		347.56		8" Inlet W		8" Inlet E
	W " =		347.57		Rim 347.56		347.58
					Meas 10.43		10.59
Invert	8" Inlet	W		336.46	Top P. 337.13		336.97
"	8" Outlet	E		336.30	Dia .67		.67
					Invert 336.46		336.30
31+40				348.11		&	
				48.10			1.8 Center Conc Pvt
				47.80			2.8 Edge Conc
				47.46			35 gut Inl
				47.26			38 " "
				48.02			" top CB

76L-298 CE 307 11-56

PLEASE RETURN TO
LOS ANGELES COUNTY ENGINEER
700 Los Angeles County Engineering Bldg.

NOTE: ANY ADDITIONS OR CHANGES ON THIS SHEET MUST BE MADE OR CIRCLED IN RED INK, WITH DATE AND NAME OF PERSON MAKING CHANGE.

Do not extend notes this side of this line.

F. B. 238 Pg. 40 Job No. 4352 Division No. 10 Profile
Survey of Pellem Avenue Notes Red Plotted
Survey by Hanson Notes Chkd. Checked
Indexed C. Johnson Date Date Date

STATION	B. S.	H. I.	F. S.	ELEV	LEFT & SOUTH	&	RIGHT & NORTH
31+40				348 4			50 P/L
				47 80	19. Edge conc		
				47 53	35 gut out		
				47 25	38 " in		
				48 01	" top cb		
				48 4	50 P/L		
31+50				348 49			44.° top Bell tel. M.H.
32+40				49 59		℄	
				49 61			4 Centel conc Pad
				49 25			24. Edge conc
				48 92			35 gut out
				48 80			38 " in
				49 56			" top cb
				49 7			50 P/L
				49 27	175 Edge conc		
				48 93	25 gut out		
				48 77	38 " in		
				49 55	" top cb		
				49 8	50 P/L		

76L-298 CE 307 11-58

PLEASE RETURN TO
LOS ANGELES COUNTY ENGINEER
700 LOS ANGELES COUNTY ENGINEERING BLDG.

NOTE: ANY ADDITIONS OR CHANGES ON THIS SHEET MUST BE MADE OR CIRCLED IN RED INK. WITH DATE AND NAME OF PERSON MAKING CHANGE.

Do not extend notes this side of this line.

STATION	B.S.	H.I.	F.S.	ELEV.	LEFT OF SOUTH	℄ RIGHT OF NORTH
33+00				350 45		℄
				50 49		6 Center Conc Pavt
		T.P.		350 13		26 Edge Conc
				49 79		35 gut out
				49 67		38 " in
				50 47		" top CB
				50 5		50 P/L
				50 14	17.2 Edge Conc	
				49 84	35 gut out	
				49 70	38 " in	
				50 48	" top CB	
				50 7	50 P/L	
33+43.50				50 87		℄
				50 92		6.5 Center of Conc Pavt
				50 56		26.5 Edge Pavt
				50 19		35 gut out
				49 98		38 " in
				50 77		" top CB
				50 9		50 P/L
				50 61	15.5 Edge Conc	
				50 31	35 gut out	

Profile Noted Red Plotted
Date Date Date
X-Sec. Noted Chkd. Checked Survey of Survey by Noted Date
No. Date Date Map No. Index Checked

F.B. PG.

76L-298 CE 307 11-58

PLEASE RETURN TO
LOS ANGELES COUNTY ENGINEER
700 LOS ANGELES COUNTY ENGINEERING BLDG.

NOTE: ANY ADDITIONS OR CHANGES ON THIS SHEET MUST BE MADE OR CIRCLED IN RED INK, WITH DATE AND NAME OF PERSON MAKING CHANGE.

Do not extend notes this side of this line.

F.B. 2520 Pg. 150 Job No. 4252.10 Division No. 10 Notes Red Plotted Profile
Survey of Patterson Avenue SD Date Date No. X-Sec.
Survey by Elliott Notes Checked No.
Indexed C. Johnson Date Notes Chkd. Date Date

STATION	B.S.	H.I.	F.S.	ELEV	LEFT ℄ SOUTH	℄ RIGHT ℄ NORTH
33+45.0				350 12	38 gut. in	
				50 92	" top CB	
				51 2	50 P/L	
33+79.12 = 1400 SOUTH				51 21	Int. GARVEY AVE & DEBUNNE AVE	
					LEFT ℄ EAST	℄ RIGHT ℄ WEST
FROM ℄ SOUTH ON DEBUNNE AVE						
1+15.5				350 91		℄ Edge Lane
1+30 SMH						3.0 SMH.
	E RIM =		350.73		8" INLET W	8" INLET S 8" OUTLET E
	W " =		350.78		RIM 350.75	350.75 350.75
					MEAS 644	634 663
	8" INLET		W	343 64	TOP P. 344.31	344.41 344.12
	" "		S	343 74	DIA .67	.67 .67
	" OUTLET		E	343 45	INVERT 343.64	343.74 343.45
1+36				350 59		℄ Edge Lane
1+39				50 43		℄ P.L.
1+42				50 52		℄ Edge Lane

76L-298 CE 307 11-58

PLEASE RETURN TO
LOS ANGELES COUNTY ENGINEER
700 Los Angeles County Engineering Bldg.

NOTE: ANY ADDITIONS OR CHANGES ON THIS SHEET MUST BE MADE OR CIRCLED IN RED INK, WITH DATE AND NAME OF PERSON MAKING CHANGE.

Do not extend notes this side of this line.

Profile Notes Red ____ Date ____ Plotted ____ Date ____
No. ____ Cross Sec. ____ Notes Chkd. ____ Date ____ Checked ____ Date ____
No. ____ Date ____ Map No. ____ Survey of ____ Survey by ____ Notes ____ Date ____
Job No. 6257-90 Division No. 16 F.B. 2570 Pg. 51

STATION	B.S.	H.I.	F.S.	ELEV.	LEFT ℄ EAST	℄	RIGHT ℄ WEST
1+60				35137		℄	
				5132			6 PAVT
				5104			11 gut out
				5092			13 " lip
				5139			11 top CB
				516			22.5 P/L
				5130	6 PAVT		
				5103	11 gut out		
				5088	13 " lip		
				5139	11 top CB		
				516	22.5 P/L		
2+00				5192		℄	
				5179			6 PAVT
				5161			11 gut out
				5134			13 " lip
				5183			11 top CB
				520			22.5 P/L
				5179	6 PAVT		
				5147	11 gut out		
				5134	13 " lip		
				5184	11 top CB		

76L-298 CE 307 11-58

PLEASE RETURN TO
LOS ANGELES COUNTY ENGINEER
700 Los Angeles County Engineering Bldg.

NOTE: ANY ADDITIONS OR CHANGES ON THIS SHEET MUST BE MADE OR CIRCLED IN RED INK, WITH DATE AND NAME OF PERSON MAKING CHANGE.

Do not extend notes this side of this line.

F.B. 258 Pg. 42 Job No. 1252.90 Division No. 10
Survey of Bellflo Bloom St. Notes Dec 1957
Survey by Brooks Notes Extension
Indexed M. C. Tabulated Date
Profile Plotted Date Notes Red Date
No. X-Sec. Checked Date Notes Chkd. Date
No.

STATION	B. S.	H. I.	F. S.	ELEV	Left ℄ East	℄	Right ℄ West
2+00				351 9	22.5 PIL		
				52 91		℄	
3+00				52 82			6 Pav't
				52 57			11 gut out
				52 47			13 " lip
				52.94			11 top CB
				53 2			22.5 PIL
				52 80	6 Pav't		
				52 49	11 gut out		
				52 39	13 " lip		
				52 87	11 top CB		
				53 0	22.5 PIL		
4+24.5 MH							3.0 SMH
	N	RIM =	354.23		8" out Let N.		
	S	" =	"		RIM 354.23		
					MHS 6.76		
INVERT	8" out Let N			346.80	top P. 347.47		
					Dia .67		
					INVERT 346.80		
BM WM 269				351.21	BM WM 269 Elev 351.205 FB 2515-38		
					Gallery Ave & Delmine Ave. N. side		
					B. SDH in Conc 1.5 FT W. of R Rod		

76L-298 CE 307 11-58

PLEASE RETURN TO
LOS ANGELES COUNTY ENGINEER
700 LOS ANGELES COUNTY ENGINEERING BLDG.

NOTE: ANY ADDITIONS OR CHANGES ON THIS SHEET MUST BE MADE OR CIRCLED IN RED INK, WITH DATE AND NAME OF PERSON MAKING CHANGE.

Do not extend notes this side of this line.

Profile Notes Rod. Plotted
No. X-Sec. Notes Chkd. Date Checked Date
No. Date Map No. Index Notes Date

Survey of 1957-90 Division No. 68
Survey by Streets Notes [illegible] Date 3-28
F.B. 253 Pg. 53

STATION	B.S.	H.I.	F.S.	ELEV.	Left & South	&	Right & North
Going West on HARVEY AVE							
34+15				351.50		℄	
				51.58		8	Center of Conc Pavt
				51.17		28	Edge Conc
				50.82		35	gut out
				50.72		38	" IM
				51.50		"	top CB
				51.4		50	PIL
				51.24	14.5 Edge Conc		
				50.95	35 gut out		
				50.80	38 " IM		
				51.57	" top CB		
				51.6	50 PIL		
34+54	S.M.H.					31	S.M.H.
		E Rim =	351.41		8" Int Lat E.		
		W " =	351.43		Rim 351.42		
					Mins 1020		
Invert	8" out Lat E			340.55	Top 341.22		
					Dia .67		
					Invert 340.55		

76L-298 CE 307 11-58

PLEASE RETURN TO
LOS ANGELES COUNTY ENGINEER
700 Los Angeles County Engineering Bldg.

NOTE: ANY ADDITIONS OR CHANGES ON THIS SHEET MUST BE MADE OR CIRCLED IN RED INK, WITH DATE AND NAME OF PERSON MAKING CHANGE.

Do not extend notes this side of this line.

F.B. 257 Pg. 154 Profile
Survey of Alleys Easterly of Garfield Ave. between Garvey Ave. & Live Oak Ave. No. X-Sec.
Survey by Beals Notes Checked No.
Indexed A. C. Jensen Date Date Date
Job No. 1321 Division No. 10 Notes Red Plotted
Date Notes Chkd. Date

STATION	B. S.	H. I.	F. S.	ELEV.	Left & South	℄	Right & North
34+55				351.81		℄	
				51.86		8	Center of Conc Pavt
				51.51		29	Edge Conc
				51.25		35	gut out
				51.13		38	" "
				51.93		"	top CB
				520		50	PIL
				51.61	14 Edge Pavt		
				51.25	35 gut out		
				51.10	38 " "		
				51.89	" top CB		
				522	50 PIL		
35+55				52.67		℄	
				52.81		11.5	Center of Conc Pavt
				52.37		31.5	Edge Conc
				52.22		35	gut out
				52.09		38	" "
				52.89		"	top CB
				53.2 52.49	12.5 Edge Conc	50	PIL
				52.00	35 gut out		
				51.86	38 " "		

76L-298 CE 307 11-58

PLEASE RETURN TO
LOS ANGELES COUNTY ENGINEER
700 LOS ANGELES COUNTY ENGINEERING BLDG.

NOTE: ANY ADDITIONS OR CHANGES ON THIS SHEET MUST BE MADE OR CIRCLED IN RED INK, WITH DATE AND NAME OF PERSON MAKING CHANGE.

Do not extend notes this side of this line.

STATION	B.S.	H.I.	F.S.	ELEV.	LEFT of SOUTH	&	RIGHT of SOUTH
35+55				352 66	38 top cb		
				530	50 P/L		
36+00				5311		℄	
				5324			12.5 Cen Tel of Conc Pav't
				5281			32.5 Edge Conc
				5260			35 gut out
				5248			38 " in
				5331			" top cb
				538			50 P/L
				5286	12.0 Edge Conc		
				5239	35 gut out		
				5225	38 " in		
				5305	" top cb		
				533	50 P/L		
36+67.4				5340		℄	
				5323	11.0 Edge Conc		
				5295	35 gut out		
				5281	38 " in		
				5362	" top cb		
				539	50 P/L		

Profile Notes Red. Plotted
No. Date Date
Notes Chkd. Checked
No. Date Date

Job No. 5232.10 Division No. 2
Survey of
Survey by
Map No.
Notes

F.B. 2572 Pg. 53

76L-296 CE 307 11-58

PLEASE RETURN TO
LOS ANGELES COUNTY ENGINEER
700 LOS ANGELES COUNTY ENGINEERING BLDG.

NOTE: ANY ADDITIONS OR CHANGES ON THIS SHEET MUST BE MADE OR CIRCLED IN RED INK, WITH DATE AND NAME OF PERSON MAKING CHANGE.

Do not extend notes this side of this line.

F.B. 2358 Pg. 156 Job No. 4252 Division No. 20 Notes Red ____ Plotted ____ Profile ____
Survey of Gallery Ave Date ____ No. ____ X-Sec. ____
Survey by Engineers Notes Chkd. ____ Checked ____ No. ____
Indexed by C. Johnson Date ____ Date ____ Date ____

STATION	B. S.	H. I.	F. S.	ELEV	LEFT & SOUTH	℄	RIGHT & NORTH
36+73.3				353 50		℄	14 PAVT
				53 86			24 PAVT
				53 71			35 PAVT OUT
				53 30			38 " IN
				53 12			11 TOP CB
				53 92			50 BL
				543			
36+92.5	SMH.				31.0 SMH		
		E RIM =	35 3.27		8" INLET S		8" OUTLET E
		W " =	35 3.29		RIM 353.28		353.28
					MEAS 6.86		7.06
INVERT	8" INLET	S		345 75	TOP P 346.42		345.22
"	8" OUTLET	E		344 55	DIA .67		.67
					INVERT 345.75		345.55 RCM 5-3-62
37+16.14	= 0+00 N & S.			353 99	℄ INT GALLEY AVE & NEW AVE		
					LEFT & SOUTH	℄	RIGHT & NORTH
GOING WEST ON GALLEY AVE							
37+56.6				354 73		℄	
				354 91			15
				54 23			38 PAVT OUT

76L-298 CE 307 11-58

PLEASE RETURN TO
LOS ANGELES COUNTY ENGINEER
700 LOS ANGELES COUNTY ENGINEERING BLDG.

NOTE: ANY ADDITIONS OR CHANGES ON THIS SHEET MUST BE MADE OR CIRCLED IN RED INK, WITH DATE AND NAME OF PERSON MAKING CHANGE.

Do not extend notes this side of this line.

Profile Notes Red. Date Plotted
No. Sec. Notes Chkd. Date Checked Survey of
No. Date Map No. Date Date

Job No. 6352.40 Division No. 10
F.B. 2578 Pg. 157

STATION	B.S.	H.I.	F.S.	ELEV.	LEFT ℄ SOUTH	℄	RIGHT ℄ NORTH
37+56.6				354.16			40 gut 54
		T.P. 354.72		54.71			11 top 66
				54.9			50 P/L
37+65.8				54.81		℄	
				54.34	19		
				53.71	25 gut nut		
				53.68	38 " "		
				54.23	11 top 66		
				54.4	50 P/L		
38+16.5				355.19			40.5 top Bell to M.H.
37+96.0				54.99		℄	
				55.17			15
				54.43			38 gut 04
				54.37			40 " "
				55.01			11 top 66
				55.2			50 P/L
				54.51	19		
				53.90	25 gut nut		
				53.77	38 " "		

76L-298 CE 307 11-58

PLEASE RETURN TO
LOS ANGELES COUNTY ENGINEER
700 LOS ANGELES COUNTY ENGINEERING BLDG.

NOTE: ANY ADDITIONS OR CHANGES ON THIS SHEET MUST BE MADE OR CIRCLED IN RED INK, WITH DATE AND NAME OF PERSON MAKING CHANGE.

Do not extend notes this side of this line.

Profile No. ____ Plotted ____ Date ____ Notes Red ____ Date ____ Notes Chkd. ____ Date ____
X-Sec. No. ____ Checked ____ Date ____

Job No. 6252 Division No. 10 Notes Date
Survey of Rosecrans Ave. Lynwood to Compton
Survey by C. Hobbs Notes C. Hobbs Date
Indexed Date
F.B. 258 Pg. 58

STATION	B. S.	H. I.	F. S.	ELEV	LEFT & SOUTH	℄	RIGHT & NORTH
37+96				354 42	38 top cb		
				546	50 P/L		
38+96				5546		℄	
				5559			15
				5486			38 gut out
				5482			40 " in
				5554			11 top cb
				556			50 P/L
				5501	19		
				5437	35 gut out		
				5420	38 " in		
				5494	11 top cb		
				551	50 P/L		
40+97.0	SM.H.						20.0 SM H
	E. RIM =		356.53		15" outlet E		
	W " =		356.55		RIM 356.54		
					Meas 6.96		
INVERT	15" outlet E			348 33	Top P. 349.58		
					DIA 1.25		
					INVERT 348.33		

76L-298 CE 307 11-58

PLEASE RETURN TO
LOS ANGELES COUNTY ENGINEER
700 LOS ANGELES COUNTY ENGINEERING BLDG.

NOTE: ANY ADDITIONS OR CHANGES ON THIS SHEET MUST BE MADE OR CIRCLED IN RED INK, WITH DATE AND NAME OF PERSON MAKING CHANGE.

Do not extend notes this side of this line.

Profile Notes Red. Date Notes Chkd. Date Checked

Plotted Date Map No.

Job No. 62578 Division No. 10 Survey of Survey by Notes Date

F.B. 2578 P. 61

STATION	B.S.	H.I.	F.S.	ELEV.	LEFT / WEST	℄	RIGHT / EAST
1+00				355.1	35 P/L		
2+00				54.84		℄	
				54.60			10 Pav't
				54.20			18 gut out
				54.00			20 " "
				54.70			11 top cb
				55.0			35 P/L
				54.95	10 Pav't		
				54.56	18 gut out		
				54.36	20 " "		
				55.11	11 top cb		
				55.4	35 P/L		
2+94.5	SMH						10.0 SMH
	N RIM = 354.84				12" Outlets		
	S " = 354.83				RIM 354.83		
					MEAS 11.58		
INVERT	12" Outlets			342.25	Top P. 343.25		
					DIA 1.00		
					INVERT 342.25		

76L-298 CE 307 11-58

PLEASE RETURN TO
LOS ANGELES COUNTY ENGINEER
700 Los Angeles County Engineering Bldg.

NOTE: ANY ADDITIONS OR CHANGES ON THIS SHEET MUST BE MADE OR CIRCLED IN RED INK, WITH DATE AND NAME OF PERSON MAKING CHANGE.

Do not extend notes this side of this line.

F.B. Pg. 162 Job No. 62127 Division No. 12 Profile
Survey of Pollard Heights Notes Red Plotted
Survey by Sheets Notes Dated No. X-Sec.
Indexed C. Jones Notes Chkd. Checked
Date Date Date No.

STATION	B.S.	H.I.	F.S.	ELEV	Left ℄ West	℄	Right ℄ East
3+17.5	S.M.H.					℄	S.M.H.
	N	Rim =	355.16		8" outlet S.		
	S	" =	355.14		Rim 355.15		
					Meas 12.71		
	Invert	8" outlet S.			Hpp 342.44		
		T.P. 354.35			Dia .67		
					Invert 341.77		
					Left ℄ East	℄	Right ℄ West
Going South on Nth Ave							
0+20				353.69		℄	
0+35				53.32		℄	Edge Conc
0+38				53.17		℄	F.L.
0+41				53.29		℄	Edge Conc
0+57.0	S.M.H.						21.0 S.M.H.
	N	Rim =	353.60		12" Inlet NE		12" outlets
	S	" =	353.63		Rim 353.61		353.61
					Meas 11.85		11.87
	Invert	12" Inlet NE		340.76	Hpp 341.76		341.76 4
	"	12" outlet S		340.76	Dia 1.00		1.00
					Invert 340.76		340.76 4 KCM 5-3-62

76L-298 CE 307 11-58

PLEASE RETURN TO
LOS ANGELES COUNTY ENGINEER
700 LOS ANGELES COUNTY ENGINEERING BLDG.

NOTE: ANY ADDITIONS OR CHANGES ON THIS SHEET MUST BE MADE OR CIRCLED IN RED INK, WITH DATE AND NAME OF PERSON MAKING CHANGE.

Do not extend notes this side of this line.

Profile No. _____ Notes Red _____ Plotted _____ Job No. 2252.10
Date _____ Date _____ Division No. 6
Notes Chkd. _____ Checked _____ Survey of _____ Notes _____ F.B. 2570 pg 43

STATION	B.S.	H.I.	F.S.	ELEV.	LEFT ℄ EAST	℄ RIGHT ℄ WEST
0+60				353 76		℄
				53 81		14 PAVT
				53 72		26 gut out
				53 55		28 " "
				54 14		" top CG
				54 30		35 P/L
				53 66	14 PAVT	
				53 35	26 gut out	
				53 19	28 " "	
				53 86	" top CG	
				54 0	35 P/L	
1+00				54 34		℄
				54 31		14 PAVT
				54 07		26 gut out
				53 93		28 " "
				54 54		" top CG
				54 7		35 P/L
				54 19	14 PAVT	
				53 74	26 gut out	
				53 60	28 " "	
				54 19	" top CG	

76L-298 CE 307 11-58

PLEASE RETURN TO
LOS ANGELES COUNTY ENGINEER
700 LOS ANGELES COUNTY ENGINEERING BLDG.

NOTE: ANY ADDITIONS OR CHANGES ON THIS SHEET MUST BE MADE OR CIRCLED IN RED INK, WITH DATE AND NAME OF PERSON MAKING CHANGE.

Do not extend notes this side of this line.

P.B. 28 Pg 62 Job No. 5312.12 Division No. 10 Profile
Surveyed Jan 1958 Notes Red Plotted
Surveyed by Knapp Notes Date Date No. X-Sec.
Indexed C. Johnson Date Notes Chkd. Checked
Date Date No.

STATION	B. S.	H. I.	F. S.	ELEV	LEFT ℄ EAST	℄	RIGHT ℄ WEST
1+00				3543	35 P/L		
2+00				5545		℄	
				5539			14 Pav't
				5515			26 gut out
				5501			28 " in
				5560			11 top CB
				557			35 P/L
				5530	14 Pav't		
				5477	26 gut out		
				5464	28 " in		
				5527	11 top CB		
				555	35 P/L		
3+25.0	S M H				24.0 S M H		
	N. RIM =	356.39			8" Out Let N.		
	S " =	"			RIM 356.39		
					MEAS 6.54		
INVert	8" Out Let N			349.18	Top P. 349.85		
					DIA .67		
					INVert 349.18		

76L-298 CE 307 11-58

PLEASE RETURN TO
LOS ANGELES COUNTY ENGINEER
700 LOS ANGELES COUNTY ENGINEERING BLDG.

NOTE: ANY ADDITIONS OR CHANGES ON THIS SHEET MUST BE MADE OR CIRCLED IN RED INK, WITH DATE AND NAME OF PERSON MAKING CHANGE.

Do not extend notes this side of this line.

Profile No. ____ Notes Red ____ Plotted ____
Date ____ Date ____
Notes Chkd. ____ Checked ____ Job No. 42520
Survey of Los Angeles County Engineers Division No. 12

STATION	B. S.	H. I.	F. S.	ELEV.	LEFT & EAST	& RIGHT & WEST
6+66.0 S.M.H.						21.0 West
		N. rim = 360.30			12" IN Lot N	
		S. rim = "			RIM 360.30	
					MHS 20.05	
		Invert 12" Inlet N		33925	Top P 340.25	
					DIA 1.00	
					INVERT 339.25	
BM WM 124				354.07	BM WM 124 ELEV. 354.088 FD 2515-38 HARVEY AVE & NEW AVE S.E. COR. B. SPK IN CURB 36 FT S. of end CR.	
		End	Line		"C"	

Notes Ck'd by	Survey of Potrero Grande B.P. B.95 70 Pg. 167
Map No.	IN 6252.90 Page 0161 Sht 68 of
Office Work	Surveyed by C.V. Crowe
Checked	Notes Crowe / Carrasco Date Aug '62
Date	Indexed C. J. GALLI AUG 29 62

POTRERO GRANDE
LINE B
C.I. #6252.90

August 1962

Topography along realignment of line "B"

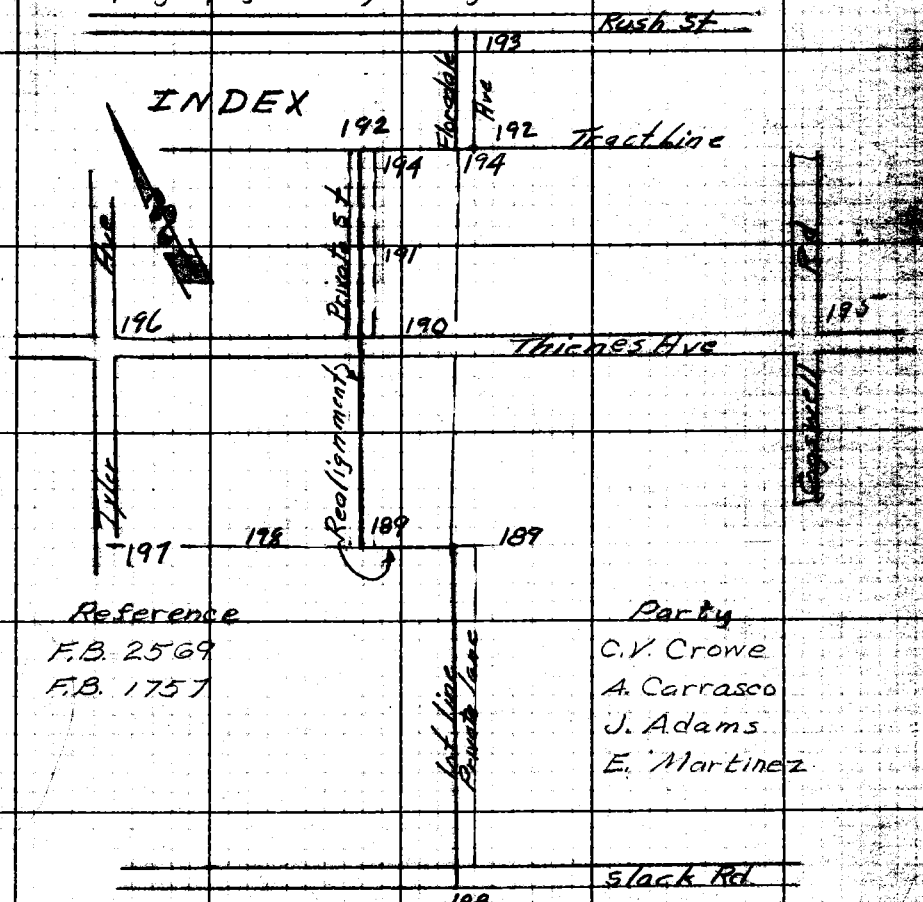

Reference
F.B. 2569
F.B. 1757

Party
C.V. Crowe
A. Carrasco
J. Adams
E. Martinez

RETURN TO
LOS ANGELES COUNTY ENGINEER
900 LOS ANGELES COUNTY ENGINEERING BLDG.

Notes: Any Additions or Changes on This Sheet Must be Made or Circled in Red Ink With Date and Name of Person Making Change.

Do not extend notes this side of this line.

763088 CE #247—7-58

RETURN TO
LOS ANGELES COUNTY ENGINEER
100 LOS ANGELES COUNTY ENGINEERING BLDG.

Note: Any Additions or Changes on This Sheet Must be Made or Circled in Red Ink With Date and Name of Person Making Change.

Do not extend notes this side of this line.

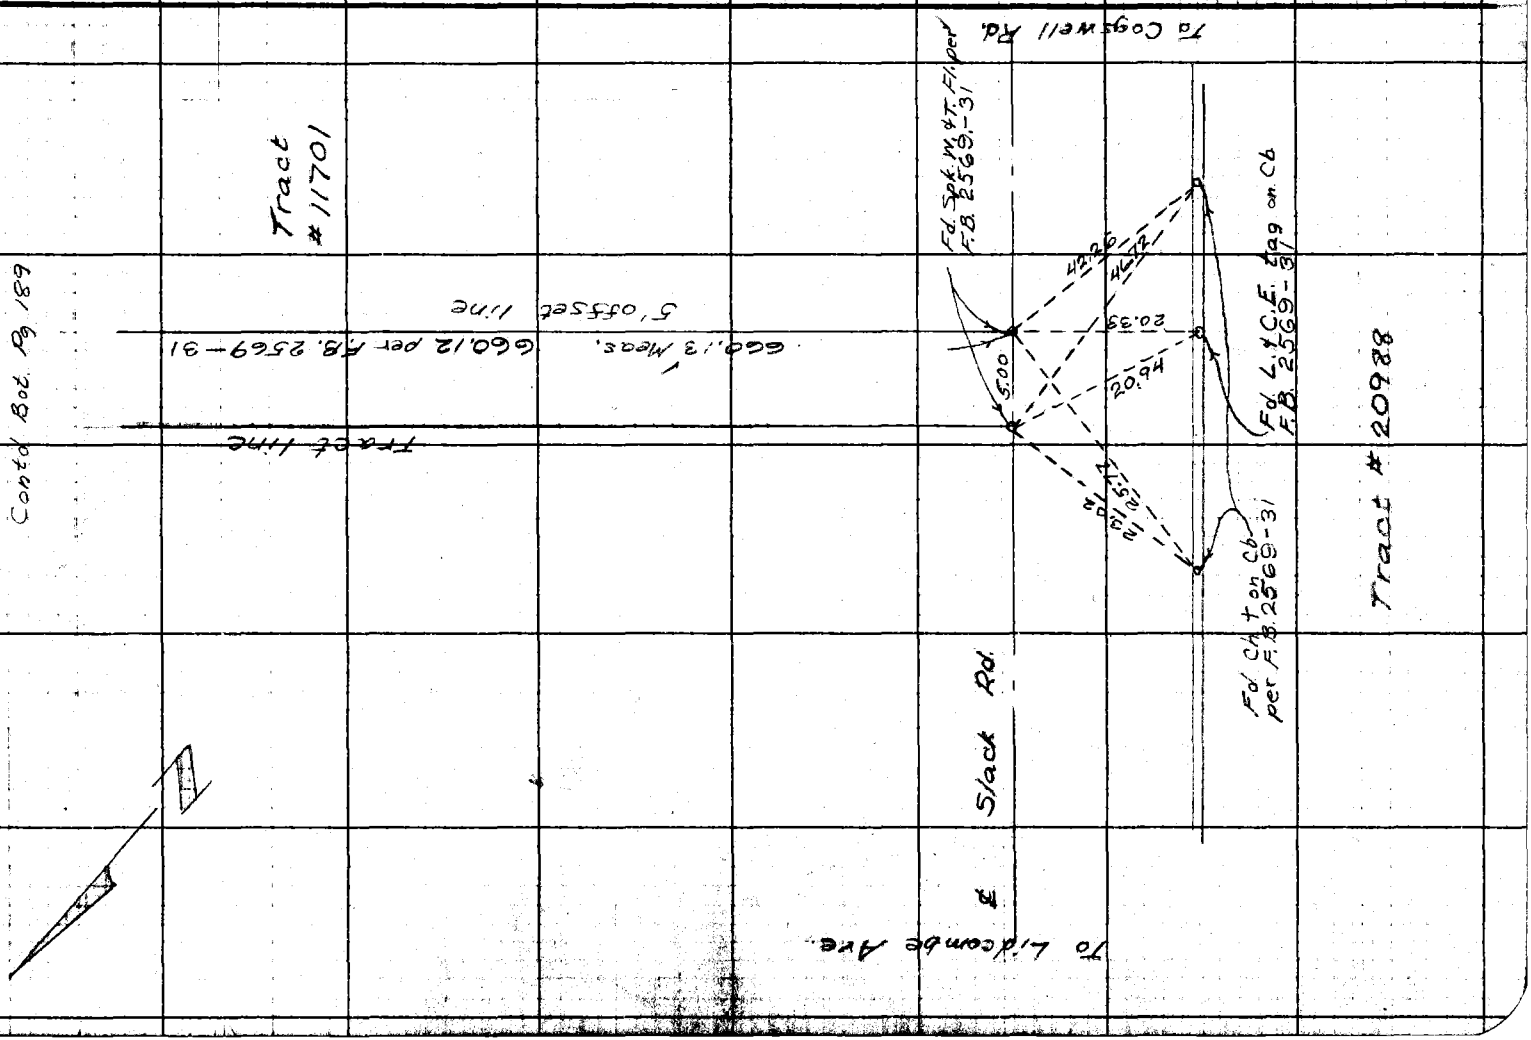

Notes Ck'd by
Map No.
Office Work
Checked
Date

Survey of Crowe & Carrara Tract
IN 6252.96 Tape 9/61 Std 66 of
Surveyed by C. V. Crowe
Notes Crowe & Carrara Date Aug. 62
Indexed C. J. GALLI
AUG 29 62

Contd. Bot Pg. 190

D	89	58	00
Ø	359	52	15
Ø	179	48	45
	89	58	08
	T @ 13A		
	90	02	15
Ø	360	09	00
Ø	180	14	00
	90	02	15

Contd. Bot. Pg. 194

601.33'

T Line F.B. 2569-33

B-13
= 1+61.42
Set 1X2 & N

90° 02' 15"

B-13A
= 1+13.97
Set 1X2 & N
by Inter

47.45'

Set 1X2 & N
on line Prod
from So.

Contd. Bot Pg 198

257.33'

T Line

65.37'

5.01'

9.99'

10.00'

13.97'

90°

5.00'

Fd 1X2 & N PK
per F.B. 2569-33

35.19'

B-14
= 1+00
Set 1X2 & N Fl.
on line Prod.
from B through B-7

Fd. Tin in
18" Willow
F.B. 2569-33

Catholic

School

Fd 2" I.P. Conc.
& tag R.E. 617
Dn 12" pet
F.B. 2569-33
M.B. 211-41

Tract
#11701

Set N & T.
PP # 1366838E

Prop. Line

5' offset line 660.13'

660.06' @ Ler. T 84° = 660.13'
10.00' @ Ler. T 84° = 10.00
65.36 @ Ler. T 84° = 65.37

Contd. top Pg. 188

Note: Any Additions or Changes on This Sheet Must Be Made or Circled in Red Ink With Date and Name of Person Making Change.

Do not extend notes this side of this line.

RETURN TO
LOS ANGELES COUNTY ENGINEER
900 Los Angeles County Engineering Bldg.

783098 CE #247—7-63

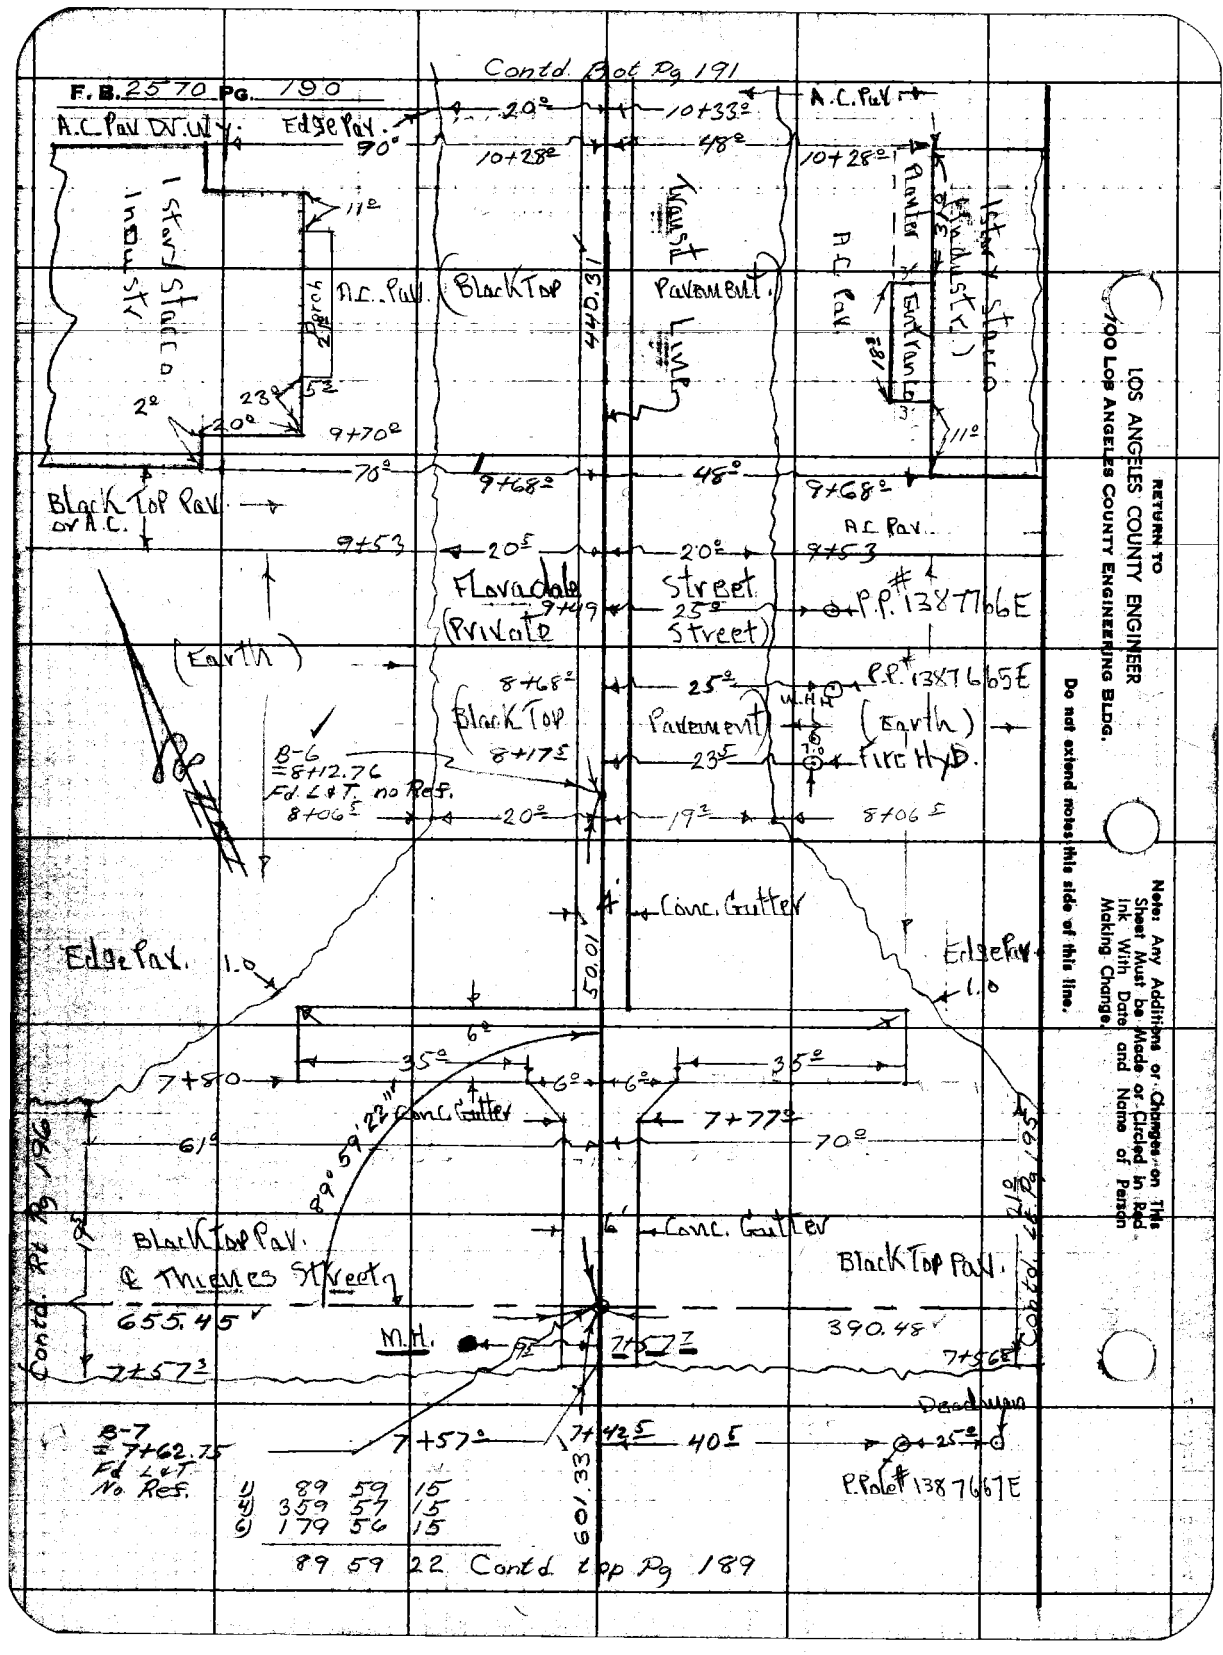
F. B. 2570 Pg. 190
Contd. Bot Pg 191
A.C. Pav Drive Way
Edge Pav.
1 Story Stucco Industry
Block Wall
A.C. Pav.
Black Top Pav. or A.C.
Earth
Flavadale (Private Street)
Black Top Pavement
Lamp
Planter
Earth Planter
1 Story Stucco
A.C. Pav.
P.P. # 1387766E
P.P. # 1387765E
W.H.
Fire Hyd.
B-6 = 8+12.76 Fd. L & T. no Ref.
Conc. Gutter
Edge Pav.
Black Top Pav. & Thieves Street
655.45
M.H.
Black Top Pav.
390.48
Contd. Pg 196
Contd. Pg 197
B-7 = 7+62.75 Fd. L & T. No Ref.
1) 89 59 15
4) 359 57 15
6) 179 56 15
89 59 22 Contd. Top Pg 189
Dead Man
P.P. # 1387767E
RETURN TO LOS ANGELES COUNTY ENGINEER 1100 Los Angeles County Engineering Bldg.
Do not extend notes this side of this line.
Note: Any Additions or Changes on This Sheet Must be Made or Circled in Red Ink With Date and Name of Person Making Change.

Notes Ck'd by
Map No.
Office Work
Checked
Date

Survey of Carrasco Terrace Unit B, M.B. 106 Pg. 191
IN 6252 90 Tape 6116 Std. Cat. of F
Surveyed by C. V. Crowe
Notes A. Carrasco Date Aug 9, '62
Indexed C. J. GALLI AUG 29 62

Fd Bat Page 192)

Note: Any Additions or Changes on This Sheet Must Be Made or Circled In Red Ink With Date and Name of Person Making Change.

Do not extend notes this side of this line.

RETURN TO
LOS ANGELES COUNTY ENGINEER
900 Los Angeles County Engineering Bldg.

763098 CE #247—7-58

13+47.2 45°
13+36.2 65°
50.02
Black Top Pad
Chain Link Fence
Transit Line
Floradale Street
B-3 = 13+03.07 Fd L&T No Ref.
12+73.3
20°
30'
50.00
12+97.2
47°
22'
Conc. Pad
1 Story Stucco (Industrial)
20'
50'
20'
Chain Fence
49°
12+75.2
12+67.3
25'
29°
P.P.# 1387662E
Conc. Curb
Gutter
Fire Hyd
W.C.H.H
B-4 = 12+53.07 Fd L&T No Ref.
11+87.2
24°
11+12.2
20'
11+07.2
25'
11+07.2
45°
Dr.Wy.
5' Black Top
(Black Top Pad)
P. Pole # 1387663E
34.2
440.31
m.H.
10°
10+52.2
(Black Top Pad)
25'
Planter
3'
10+48.2
47'
1 Story Stucco Industrial Bldg
Black Top Pad. Dr.Wy
Edge Pav.
Edge Pav.
From Top Page 190

F. B. 2570 Pg. 192

Contd Bot Pg 193

RETURN TO
LOS ANGELES COUNTY ENGINEER
900 Los Angeles County Engineering Bldg.

Do not extend notes this side of this line.

Note: Any Additions or Changes on This Sheet Must be Made or Circled in Red Ink With Date and Name of Person Making Change.

Notes Ck'd by	Survey of Eagle Subdivision
Map No.	IN 6252.90 Tape 0/61 Std. 68 °F
Office Work	Surveyed by C.V. Crowe
Checked	Notes Crowe Date Aug. 6, 67
Date - -	Indexed C. J. GALLI AUG 2 9 62

M. B. 10 Pg. 198

Fd. 3/4" I.P. Conc. plug & Cop. wire Do. 30" on line Prod. per F.B. 2569-38

Fd. Spk. & T. PP# 777280E per F.B. 2569-38

N 3.25 E

28.72

Fd. Spk. W. & T. Do. 2" per F.B. 2569-38

℄ Rush St.

S 2.23 E

50.98

45.31

59.17

23.05

Fd. Bt. Spk. & T. PP# 777279E per F.B. 2569-38

Fd L. & T. per F.B. 2569-38

Curb

Cur

Florada St.

660.13 per F.B. 2569-38

Tract Line

Tract #14320

Contd. top Pg 199

Note: Any Additions or Changes on This Sheet Must Be Made or Circled In Red Ink With Date and Name of Person Making Change.

Do not extend notes this side of this line.

RETURN TO LOS ANGELES COUNTY ENGINEER 900 Los Angeles County Engineering Bldg.

783098 CE #247—7-53

F.B. 2570 PG. 194

Contd. Bot. Pg 193

Tract #14320

	T @ B-1		
	89	55	45
	359	42	45
	179	34	30
	89°	55'	45"

U	89	55	15
U	359	41	00
Ø	179	31	00
	89	55	10

U	89	56	00
U	359	44	15
Ø	179	36	15
	89	56	03

Florable St.

660.13' per F.B. 2569-37

10"

89° 55'

58.56'

38.83'

26.72'

18.96'

Fd. L & T Curb Aer F.B. 2569-37

B = 14+23.10
Fd. ½" I.P.
Conc. & tag
L.S. 2760 Dn 10"
No Ref.
(See Pg 192)

03"

72.48'

18.29'

Fd. 4.0' N Ref.

29° 56'

15.00'

15.00'

Fd. 2" I.P. Conc. plug & N. Dn 25" per F.B. 2569-37

B-1
= 14+08.10
Set 1X2 & N on line between B & B-7
(See Pg 192)

72.51'

Set 1X2 & N on line Prod.

55.45'

89°

55.01'

L.T. Line F.B. 2569-37

Contd. top Pg 189

Contd. Mid. Pg 192

RETURN TO
LOS ANGELES COUNTY ENGINEER
900 LOS ANGELES COUNTY ENGINEERING BLDG.

Do not extend notes this side of this line.

Note: Any Additions or Changes on This Sheet Must be Made or Circled in Red Ink With Date and Name of Person Making Change.

Notes Ck'd by
Map No.
Office Work
Checked
Date

Survey of Potrero Grande
IN 6252 90 Tape 2/61 Std. 68 °F
Surveyed by C.V. Crowe
Notes CVC Date Aug. 62
Indexed C. J. GALLI AUG 2 c 62

F.B. 2570 Pg. 195

Note: Any Additions or Changes on This Sheet Must be Made or Circled in Red Ink With Date and Name of Person Making Change.

Do not extend notes this side of this line.

RETURN TO
LOS ANGELES COUNTY ENGINEER
900 LOS ANGELES COUNTY ENGINEERING BLDG.

763098 CE #247—7-58

F. B. 2570 PG. 196

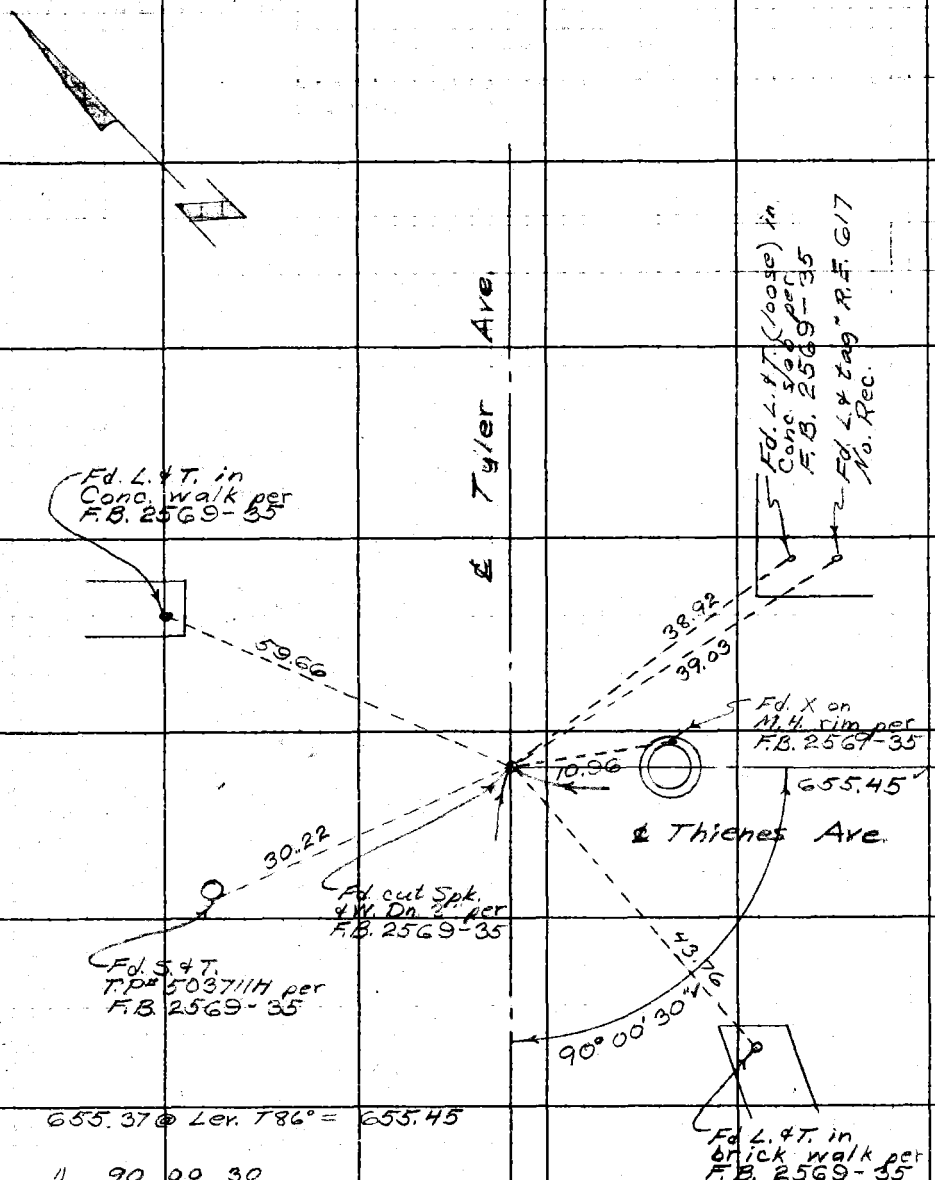

Cont'd Pg. 197

655.37 @ Ler. T86° = 655.45

℄	90	00	30
℄	360	02	00
℄	180	03	00
	90°	00	30"

RETURN TO
LOS ANGELES COUNTY ENGINEER
700 LOS ANGELES COUNTY ENGINEERING BLDG.

Do not extend notes this side of this line.

Note: Any Additions or Changes on This Sheet Must be Made or Circled in Red Ink With Date and Name of Person Making Change.

Cont'd Pg. 190

Notes Ck'd by
Map No.
Office Work
Checked
Date

Survey of Torrance Garage Tract B. 2570 Pg. 181
IN Tape 0/61 Std. 68° °F
Surveyed by C.V. Crowe
Notes Crowe Date Aug 9 62
Indexed C. J. GALLI AUG 2 9 '62

Contd. Bot Pg 196

649.15 @ Lev. T=90° = 649.24

649.24'

Tyler St.

	89	56	15
	359	46	45
	179	40	00
	89	56	40

89° 56' 40" =

Set N in Pvmt. on line to N.

T line

200.33'

Contd. Top Pg. 198

0.02'

1.000'

Fd Bt. Spk. & T Dn. 3" No Ref.

Hoyt St.

393.27'

393.21 @ Lev. T=90° = 393.27

Fd. Sq. Spk in Dvmt. No Ref. Cont.

46.99

Fd L & T in Pvmt. Dn. 3" No Ref.

51.03

Fd Spk & T in PP (no No.) No Ref.

RETURN TO
LOS ANGELES COUNTY ENGINEER
900 Los Angeles County Engineering Bldg.

Note: Any Additions or Changes on This Sheet Must be Made or Circled in Red Ink, With Date and Name of Person Making Change.

Do not extend notes this side of this line.

763098

F.B. 2570 Pg. 198

Contd Rt. Pg 197

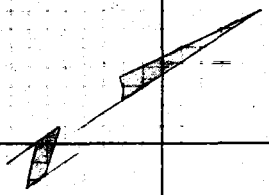

200.30' @ Ler. T 94° = 200.33

200.33'

Set N. Prmt.

0.50

Fd 2" I.P. Conc. & Tag RE G17 up 2" No Refs.

10.25

197.95' @ Ler. T 94° = 197.98

198.61'

T 2111

Fd 2" I.P. up 2" No Refs.

10.7

129.21'

Set 2X2 ⊥ N

257.31' @ Ler. T 80° = 257.33

257.33'

Contd left Pg 199

RETURN TO
LOS ANGELES COUNTY ENGINEER
700 Los Angeles County Engineering Bldg.

Do not extend notes this side of this line.

Note: Any Additions or Changes on This Sheet Must be Made or Circled in Red Ink With Date and Name of Person Making Change.

F.B. 2570 Pg. 99

Profile No. ____ X-Sec. No. ____ | Notes Red ____ Date ____ Notes Ckkd ____ Date ____ | Plotted ____ Date ____ Checked ____ Date ____ | Job No. ____ Division No. ____ | Survey of Potrero Grande – Line B | Survey by Crowe Notes by ____ Date Aug. 62 | Map No. ____ Indexed C. J. GALLI Date AUG 2 9 '62

POTRERO GRANDE
LINE B
C.I. # 6252.90

August 1962

STATION	B.S.	H.I.	F.S.	ELEV.
		Reference FB 2515		

Party
Crowe
Carrasco
Adams

NOTE: ANY ADDITIONS OR CHANGES ON THIS SHEET MUST BE MADE OR CIRCLED IN RED INK, WITH DATE AND NAME OF PERSON MAKING CHANGE.

Do not extend notes this side of this line.

PLEASE RETURN TO:
LOS ANGELES COUNTY ENGINEER
403 LOS ANGELES COUNTY ENGINEERING BLDG.

76-1298 CE 307 3-61

76-L298 CE 307 3-61

PLEASE RETURN TO
LOS ANGELES COUNTY ENGINEER
403 Los Angeles County Engineering Bldg.

NOTE: ANY ADDITIONS OR CHANGES ON THIS SHEET MUST BE MADE OR CIRCLED IN RED INK. WITH DATE AND NAME OF PERSON MAKING CHANGE

Do not extend notes this side of this line.

F.B. 2570 Pg. 200
Survey of Potrero Grande - Line B Division No. Job No 6252.98 Notes Red Plotted Profile
Survey by Crowe Notes Crowe Notes Chkd. Date Checked No. X-Sec.
Indexed C. J. GALLI Date Date Date

STATION	B. S.	H. I.	F. S.	ELEV.		
BM-SD1416				239.52	BM-SD1416 Elev. 239.520 F.B. 2515-23 Fd. Bt. Spk. in Cb, 5' SE. of SE end of C.R.	
TP				242.07	1X1	
TP				242.86	Pt. of rock	
BM-SD1417				243.09	BM-SD1417 Elev. 243.073 F.B. 2515-23 Fd Bt. Spk. in Conc. driveway @ center of sheet metal gate on S.E. side of private Rd.	
0+00 ℄				242.5	DIRT	
40'R				242.5	"	
90'R				243.7	edge of corregated tin wall	
60'L				241.8	DIRT	
100'L				243.2	"	
1+00 ℄				243.1	1X24N	
40'R				243.2	Dirt	
90'R				243.3	edge corregated tin wall	
60'L				243.5	Dirt	
100'L				243.9	"	
2+00 ℄				243.5	"	
40'R				243.4	"	
100'R				243.7	"	

76-L298 CE 307 3-61

PLEASE RETURN TO
LOS ANGELES COUNTY ENGINEER
403 LOS ANGELES COUNTY ENGINEERING BLDG.

NOTE: ANY ADDITIONS OR CHANGES ON THIS SHEET MUST BE MADE OR CIRCLED IN RED INK, WITH DATE AND NAME OF PERSON MAKING CHANGE.

Do not extend notes this side of this line.

STATION	B.S.	H.I.	F.S.	ELEV.		
2+00					DIRT	
60' L				2438	"	
100' L				2440	"	
2+61.72	TP			2438.2	IX24N	
3+00 &				2439	DIRT	
40' R				2438		
100' R				2439		
60' L				2441		
100' L				2443		
4+00 &				2442		
40' R				2441		
100' R				2443		
60' L				2444		
100' L				2442		
5+00 &				2445		
40' R				2443		
100' R				2447		
60' L				2450		
100' L				2454		

Profile Notes Red ____ Plotted ____ Job No. 2555 Division No. ____
No. X-Sec. Date ____ Date ____ Survey of Herrero Grange - Line 6
Notes Cked. Date ____ Checked ____ Survey by Crane Notes Clerk Date 4/10/62
Map No. ____ Date ____ Inked ____ Traced ____ Date ____

F.B. 2570 Pg. 201

76-L298 CE 307 3-61

PLEASE RETURN TO
LOS ANGELES COUNTY ENGINEER
403 Los Angeles County Engineering Bldg.

NOTE: ANY ADDITIONS OR CHANGES ON THIS SHEET MUST BE MADE OR CIRCLED IN RED INK, WITH DATE AND NAME OF PERSON MAKING CHANGE

Do not extend notes this side of this line.

F.B. 2570 Pg. 202 | Job No 6252.90 | Division No. | Notes Red | Plotted | Profile
Survey of Potrero Grande - Line B | Date | Date | No.
Survey by Crowe | Notes Crowe | Notes Chkd | Checked | X-Sec.
Indexed C. J. GALL | Date | Date | Date | No.

STATION	B. S.	H. I.	F. S.	ELEV.		
5+62.26 ℄				244.70	1×2 ⊀ N	
6+00 ℄				2449	DIRT	
40' R				2449		
100' R				2452		
60' L				2456		
100' L				2458		
7+00 ℄				2457		
40' R				2454		
100' R				2455		
60' L				2461		
100' L				2462		
7+43 ℄				2463	Top Brk.	Dirt
40' R				2462	" "	
100' R				2466	" "	
60' L				2469	" "	
100' L				2475	" "	
7+48.7 ℄				2459	Bot Brk.	
40' R				2460	" "	
100' R				2466	" "	
60' L				2467	" "	
100' L				2474	" "	

76-L298 CE 307 3-61

PLEASE RETURN TO
LOS ANGELES COUNTY ENGINEER
403 LOS ANGELES COUNTY ENGINEERING BLDG.

NOTE: ANY ADDITIONS OR CHANGES ON THIS SHEET MUST BE MADE OR CIRCLED IN RED INK, WITH DATE AND NAME OF PERSON MAKING CHANGE.

Do not extend notes this side of this line.

STATION	B. S.	H. I.	F. S.	ELEV.		
TP				247.52	Spk. Prmt.	
BM-ME-492				247.57	BM-ME-492 Elev. 247.571 F.B. 2515-1 Fd. Bt. Spk. in Cb, Cogswell Rd & Thienes Ave., N. Cor., 5' NLy of N.E. end C.R.	
TP				247.52	Spk. Prmt.	
7+56.7 ℄				245.92	Edge Conc. Prmt.	
50' R				246.54	Edge Prmt. top Brk.	
100' R				247.20	" " " "	
50' L				247.13	" " " "	
100' L				248.22	" " " "	
7+65.9 ℄				246.08	Center Prmt.	
50' R				246.60	" "	
100' R				247.32	" "	
50' L				247.10	" "	
100' L				248.12	" "	
7+77.3 ℄				246.16		
69.5 R				246.75	4 Pt. Edge Prmt	
100' R				247.08	Edge Prmt	
7+77.3 61.5 122 L				247.15	4 Pt. Edge Prmt.	
				248.03	Edge Prmt.	

Profile Notes Red Plotted Job No. Division No.
No. X-Sec. Date Date Survey of Partridge Grande Line B
Notes Chkd. Checked Survey by Crews Notes Chkd. Date
Map No. Drawn Traced Checked Date

F.B. 2515 Pg. 203

76-L298 CE 307 3-61

PLEASE RETURN TO
LOS ANGELES COUNTY ENGINEER
403 LOS ANGELES COUNTY ENGINEERING BLDG.

NOTE: ANY ADDITIONS OR CHANGES ON THIS SHEET MUST BE MADE OR CIRCLED IN RED INK, WITH DATE AND NAME OF PERSON MAKING CHANGE

Do not extend notes this side of this line.

F.B. 2570 Pg. 204 | Job No 6252.98 | Division No. | Notes Red | Date | Plotted | Profile
Survey of Potrero Grande - Line B | Date | Notes Chkd. | Date | Checked | Date | No. | X-Sec. | No.
Survey by Crowe | Notes CVC
Indexed C. J. GALLI | Date

STATION	B. S.	H. I.	F. S.	ELEV.		
7+83 ℄						
40.5 R				24638	Center of end of Conc. gutter	
100' R				2465	Bot. Brk	
40.5 L				24654	Center end of Conc. Gut.	
100 L				2476	Bot. Brk	
8+06.5 ℄				24608	℄ Conc. Gut	
19.5 R				24640	Edge Pvmt	
30.5 R				2471	Top Brk	
100' R				2476	Dirt	
20.5 L				24652	Edge Pvmt.	
100 L				2481	Dirt	
TP=B-5=8+62.75 ℄				24630	L & T	
9+00 ℄				24642	℄	
20' R				24670	Edge Pvmt	
40' R				2474	Top Brk.	
70' R				2467	Dirt	
20' L				24675	Edge Pvmt	
40' L				2478	Top Brk	
70' L				2481	Dirt	

76-L298 CE 307 3-61

PLEASE RETURN TO
LOS ANGELES COUNTY ENGINEER
403 LOS ANGELES COUNTY ENGINEERING BLDG.

NOTE: ANY ADDITIONS OR CHANGES ON THIS SHEET MUST BE MADE OR CIRCLED IN RED INK, WITH DATE AND NAME OF PERSON MAKING CHANGE.

Do not extend notes this side of this line.

STATION	B. S.	H. I.	F. S.	ELEV.		
10+00 ℄				24674	℄ Conc. Gutter	
20' R				24693	Bot Brk. Pvmt.	
45' R				24795	Bot Bldg	
20' L				24707	Bot. Brk Pvmt.	
45' L				24851	Bot Bldg.	
11+00 ℄				24707	℄ Conc. Gut.	
20' R				24746	Edge Pvmt	
45° R				24855	Bot. Edge Bldg.	
20' L				24754	Edge Pvmt.	
35' L				2483	top Brk.	
70' L				2489	Dirt	
TP				24728	Cor. Conc. Gut.	
12+00 ℄				24745	℄ Conc. Gut	
20' R				24784	Edge Pvmt	
70' R				2485	Dirt	
20' L				24791	Edge Pvmt.	
50' L				2493	Top Brk., Dirt	
70' L				2495	Dirt	

Profile Notes Red Plotted Job No. Division No.
No. R-Sec. Date Date Survey of Dykstra Crowe Line H
No. Notes Ckd. Checked Survey by Crowe Notes Crowe Date Aug. 9, 62
Date Date Map No. Traced C. L. GALL Date
F. B. 2570 Pg. 28

76-L298 CE 307 3-61

PLEASE RETURN TO
LOS ANGELES COUNTY ENGINEER
403 LOS ANGELES COUNTY ENGINEERING BLDG.

NOTE: ANY ADDITIONS OR CHANGES ON THIS SHEET MUST BE MADE OR CIRCLED IN RED INK, WITH DATE AND NAME OF PERSON MAKING CHANGE

Do not extend notes this side of this line.

F.B. 2570 Pg. 206 | Job No 6252.99 | Division No. | Notes Red | Plotted | Profile
Survey of Potrero Grande - Line B | Date | Date | No.
Survey by Crowe | Notes Crowe | Notes Chkd. | Checked | X-Sec.
Indexed C. J. GALLI | Date | Date | Date | No.

STATION	B. S.	H. I.	F. S.	ELEV.		
13700 ℄				24781	℄ Conc. Gut	
22' R				24805	Edge Prmt, begging of Conc.	
69± R				24956	Bot. Bldg	
22' L				24811	Bot. Brk. Prmt.	
50± L				24907	Bot. Fence	
B-2 =13+53.09	TP			24801	2.47, 4 Pt. in ℄ Conc. Gut.	
13+98° ℄				24846	Edge Prmt.	
13+91° 23' R				24825	4 Pt. ℄ Conc. Gutter & beg. of ℄ asphalt Gut	
55 R				24944	Top Brk., dirt	
90' R				2500	Dirt	
13+98° 20° L				24833	Cor. of Prmt.	
50± L				24956	Bot. Fence	
14+23± ℄				2496	Dirt Bot. Fence	
42± R				2496	Bot. Cor. of Fence	
58° R				2500	Top Brk.	
60° R				2490	Bot Brk.	
73° R				24855	Cor. Prmt.	
90± R				24844	W. edge Gut.	
91± R				24842	Bot Cb.	
91± R				24903	Top Cb.	

76-L296 CE 307 3-61

PLEASE RETURN TO
LOS ANGELES COUNTY ENGINEER
403 LOS ANGELES COUNTY ENGINEERING BLDG.

NOTE: ANY ADDITIONS OR CHANGES ON THIS SHEET MUST BE MADE OR CIRCLED IN RED INK, WITH DATE AND NAME OF PERSON MAKING CHANGE.

Do not extend notes this side of this line.

STATION	B. S.	H. I.	F. S.	ELEV.	
14+08 20'L				24.62	Bot Fence, Cor. Prmt.
50'L				24.85	Bot. Fence Cor.
14+50					
73 R				24.90	W. edge Prmt.
91 R				24.88	W. edge Cut
91 R				24.82	Bot. Cb.
91 R				24.98	Top Cb.
42 R				25.00	P/L, Bot gate, top Brk.
BM-ME 490				24.97	BM-ME 490 Elev. 249.201 F.B. 2515-24 Floradale Ave. & Swly of Rush St., Bt. Spk in SEly Cb. in front of house #1902 12.5' NEly from NEly edge driveway.

Profile Notes Red Plotted Job No. 2[illegible] Division No.
No. X-Sec. Date Date Survey of Durfee Grande - Line B
Notes Ch'kd. Checked Survey by C.V.C. Notes C.V.C. Date 7 Aug. 68
Date Date Map No. Traverse Ch'kd. Date

F.B. 2570 Pg. 207

F. B. 2570 Pg. 209

Profile No. ____ X-Sec. No. ____ Notes Red ____ Date ____ Notes Chkd ____ Date ____ Plotted ____ Date ____ Checked ____ Date ____ Job No. 6252.90 Division No. ____ Survey of Potrero Grande Line B Survey by C.V. Crowe Notes CVC Date 20 Sept 62 Map No. ____ Indexed C. J. GALLI Date 10-2-62

POTRERO GRANDE
LINE B
INVERT ELEVATIONS OF M.H.s

C.I.# 6252.90

Sept. 1962

STATION	B.S.	H.I.	F.S.	ELEV.	Reference	Party
						Crowe Jones Giedeman Yamamoto

NOTE: ANY ADDITIONS OR CHANGES ON THIS SHEET MUST BE MADE OR CIRCLED IN RED INK, WITH DATE AND NAME OF PERSON MAKING CHANGE.

PLEASE RETURN TO
LOS ANGELES COUNTY SURVEYOR
726 LOS ANGELES COUNTY ENGINEERING BLDG.

Do not extend notes this side of this line.

761298 S & E #307 9-54

76L295 S & E #307 9-54

PLEASE RETURN TO
LOS ANGELES COUNTY SURVEYOR
726 Los Angeles County Engineering Bldg.

NOTE: ANY ADDITIONS OR CHANGES ON THIS SHEET MUST BE MADE OR CIRCLED IN RED INK, WITH DATE AND NAME OF PERSON MAKING CHANGE.

Do not extend notes this side of this line.

F. B. 2570 Pg. 210 | Job No. 6252.8 | Division No. | Notes Red | Plotted | No. | Profile
Survey of Potrero Grande – Line B | Date | Date | X-Sec.
Survey by C.K. Crowe | Notes Chkd. | Checked | No.
Indexed C. J. GALLI | Date | Date | Date

STATION	B. S.	H. I.	F. S.	ELEV.		
B.M.-SD 1417				243.07	BM-SD1417 Elev. 243.07 F.B. 2515-23 Fd. Bt. Spk. in Conc. driveway @ center of sheet metal gate on S.E. side of private Rd.	
T.P.				243.76	1X1	
T.P.				244.63	1X1	
TBM				247.54	TBM Elev. 247.52 F.B. 2570-203 Fd. Sq. Spk. edge Pvmt.	
N. edge rim M.H. 7+57.2				246.18	Elev. N. edge rim M.H.	= 246.18
					Dist. M.H. rim over N. inlet to top inside pipe	= - 5.25
					Elev. top inside pipe	240.93
					Diam. pipe	= - 0.67
				240.26	Invert Elev. inlet	240.26 -0.09
E. edge rim M.H. 7+57.2				246.17	Elev. E. edge rim M.H.	= 246.17
					Dist M.H. rim over E. outlet to top inside pipe	= - 5.24
						240.93
					Inside Diam pipe	= - 0.67
				240.26	Invert Elev. outlet	240.26

76L298 S & E #307 9-54

PLEASE RETURN TO
LOS ANGELES COUNTY SURVEYOR
726 LOS ANGELES COUNTY ENGINEERING BLDG.

NOTE: ANY ADDITIONS OR CHANGES ON THIS SHEET MUST BE MADE OR CIRCLED IN RED INK, WITH DATE AND NAME OF PERSON MAKING CHANGE.

Do not extend notes this side of this line.

STATION	B. S.	H. I.	F. S.	ELEV.		
W. edge rim M. H. 7+57.2				246 18	Elev. W. edge rim M. H.	= 246.18
					Dist. M. H. rim over W. inlet to top inside pipe	= - 5.19
						240.99
					Inside Diam pipe	= - 0.67
				240 32	Invert Elev. inlet	= 240.32
T. P. N. edge rim M. H 10+57				246 75	Sq. Spk.	
				247 21	Elev. N. edge rim M. H.	= 247.21
					Dist. M. H. rim over N. inlet to top inside pipe	= - 5.58
						241.63
					Inside Diam. pipe	= 0.67
				240 96	Invert Elev. inlet	= 240.96
S. edge rim M. H. 10+57				247.20	Elev. S. edge rim M. H.	= 247.20
					Dist M. H. rim over S. outlet to top inside pipe	= - 5.62
						241.58
					Inside Diam. pipe	= - 0.67
				240 91	Invert Elev. outlet	240.91
T. P.				247.81	Sq. Spk.	

Profile Notes Red. Plotted Job No. Division No.
No. Date Survey of Potrero Grande - Line B
Notes Chkd. Date Survey by C. K. Crane Map Chkd. C. J. GALLI Date
F. B. 9570 PG. 211

F. B. 2570 Pg. 212

Survey of Potrero Grande - Line 8 Job No. 6252 Division No. Notes Red. Plotted Profile

Survey by C.V.C. Crews Notes C.V.C. Date Notes Chkd. Date Checked

Indexed C.J. GALLI Date Date

LOS ANGELES COUNTY SURVEYOR

726 Los Angeles County Engineering Bldg.

NOTE: ANY ADDITIONS OR CHANGES ON THIS SHEET MUST BE MADE OR CIRCLED IN RED INK, WITH DATE AND NAME OF PERSON MAKING CHANGE.

STATION	B. S.	H. I.	F. S.	ELEV.	
S. edge rim M.H. 13+82				248.37	Elev. S. edge rim M.H. = 248.37
					Dist M.H. rim over outlet South to top inside pipe = - 6.05
					242.32
					Inside Diam pipe = - 0.67
N. edge rim M.H. 13+82				241.65	Invert Elev. outlet South 241.65
				248.37	Elev. N. edge rim. M.H. = 248.37
					Dist. M.H. rim to F.L. N. end M.H. (No inlet) = - 6.62
				241.75	F.L. N. end M.H. 241.75
BM-ME 490				249.21	BM-ME 490 Elev. 249.201 F.B. 2515-24 Floradale Ave. SWly of Rush St., Bt. Spk. in SEly Cb. in front of house # 1902 12.5' N.Ely from NEly edge driveway.