Notes Ck'd by
No.
Office Work
Checked
Date

Survey of
JN Tape Std °F
Surveyed by
Notes Date
Indexed

F.B. 2609 Pg

Page	Job	Description
		AVENUE O - J.N. 007585
5-9	Index.	
10-194	C.L.	Survey on Ave. "O" from 30th St. E. to S.B. Co. Line & all intersecting streets from Avenue N to Ave. P.
195-196	Sec. Lines	Replacing 2" x 2" stake with C.S. Mon. at center of Sec. 11, T6N R11W.
201-256	Topog.	Loc. Imp. on Ave. O from 30th St. E. to 260th St. E.

Monumented July '85

CSB-2763-1-10

Notes Ck'd by W. D. WAGNER	Survey of AVE O	F. B. 2602 Pg. 5	
Map No. C. SB2763-1-10	JN 007585 Tape 101 Std 89 °F		
Office Work T. M. PALMER	Surveyed by J S COATES		
Checked W. D. WAGNER	Notes J.S.C. Date 6/60		
Date JAN 12 1962	Indexed H. E. OD JAN 27		

JN. 007585

AVE. O

FROM

30TH ST. E. TO { SAN BERNARDINO COUNTY LINE = 260TH ST. E.

COATES
BEERS
KING
VAN NESS
HUBBARD

Note: Any Additions or Changes on This Sheet, Must be Made or Circled in Red Ink With Date and Name of Person Making Change.

Do not extend notes this side of this line.

RETURN TO
LOS ANGELES COUNTY ENGINEER
ATTN: LOS ANGELES COUNTY ENGINEERING BLDG.

763085 CE #247 7-61

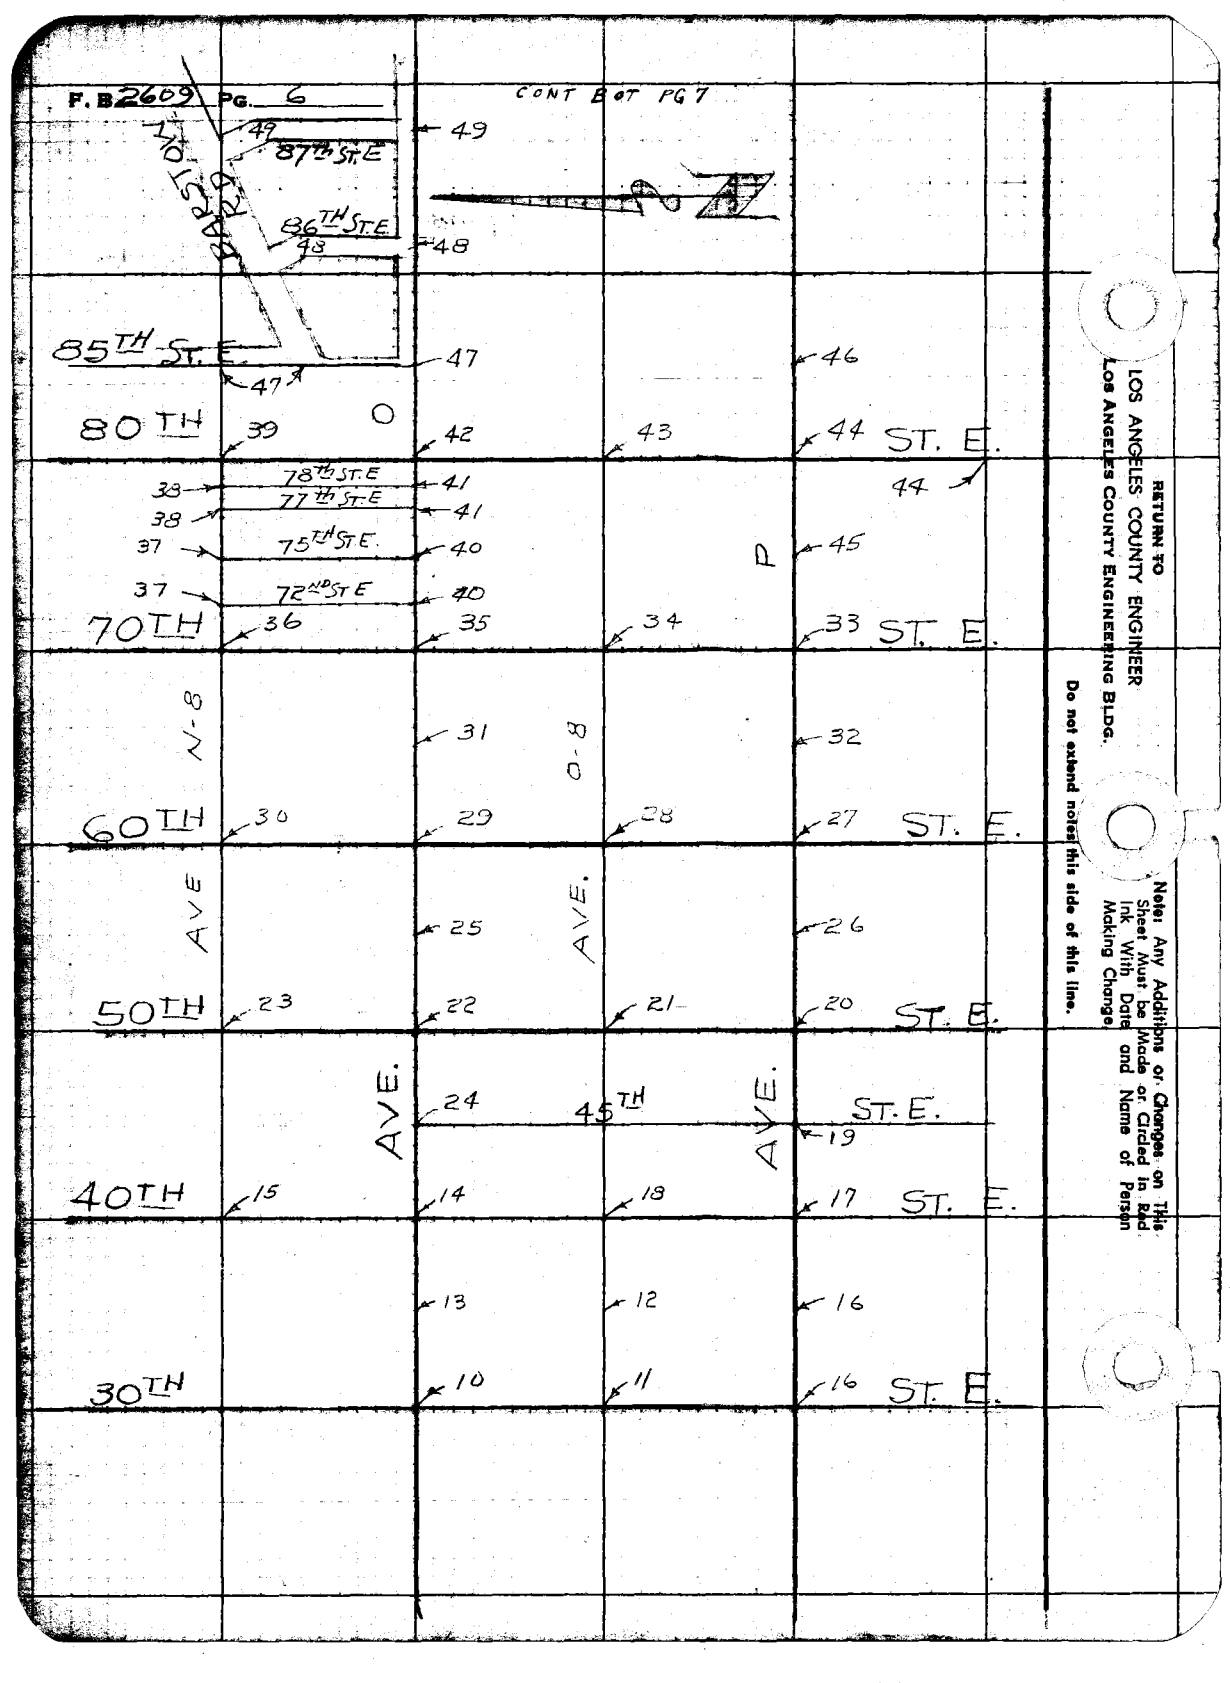
F. B 2609 PG. 6
CONT BOT PG 7
87TH ST E
86TH ST E
85TH ST E
80TH
78TH ST E
77TH ST E
75TH ST E
72ND ST E
70TH
60TH
50TH
40TH
30TH
45TH
AVE.
ST. E.
RETURN TO
LOS ANGELES COUNTY ENGINEER
LOS ANGELES COUNTY ENGINEERING BLDG.
Do not extend notes this side of this line.
Note: Any Additions or Changes on This Sheet Must be Made or Circled in Red Ink With Date and Name of Person Making Change.

Notes Ck'd by W. D. WAGNER
Map No. C.S.B. 2763 1-10
Office Work T.M. PALMERI
Checked W. D. WAGNER
Date JAN 1 2 1962

Survey of AVE O
JN 0075 85 Tape 101 Std 84 °F
Surveyed by T.S. COATES
Notes T.S.C. Date 6/60
Indexed A. E. ON

F. B 2609 Pg. 7

Note: Any Additions or Changes on This Sheet Must Be Made or Circled in Red Ink With Date and Name of Person Making Change.

Do not extend notes this side of this line.

RETURN TO
LOS ANGELES COUNTY ENGINEER
900 Los Angeles County Engineering Bldg.

120 TH
110 TH
100 TH
98 TH
97 TH
96 TH
95 TH
93 RD
92 ND
91 ST
90 TH
88 TH STR
AVE N-8
AVE N-12
AVE O
AVE O-4
AVE O-8
HWY.
ANTELOPE
BARSTOW RD
CONT'D FROM PG 8
FRAMED PG 6
88 ST. E.
87
86 ST. E.
85
ST. E.
59
58
57
56
91
90
89
83
81
84
82
80
72
64
63
79
71
78
77
76
75
74
73
69
68
67
66
65
62
61
60
55
54
53
52
51
50

783098 CE #247—7-53

F. B 2609 Pg. 8

CONT'D ON PG 9

143 148

190TH 142 141 139 140 ST. E.

132 134 AVE N-4 182ND ST E 135 AVE N-12 ST E 138 137 136 128

180TH 133 131 181ST ST E 130 129 127 ST. E.

N 121 N-8 O 126 O-8 P

170TH 120 122 124 125 ST. E.

119 123

160TH 118 116 114 115 ST. E.

AVE. 117 AVE. 113 AVE. 112 ST E AVE.

150TH 109 110 111

108 104

AVE. AVE. 106 105 AVE.

140TH 107 98 97 99 ST. E.

103

96 102

130TH 94 93 95 ST. E.

101

92 100

FROM TOP PG 7.

RETURN TO
LOS ANGELES COUNTY ENGINEER
900 Los Angeles County Engineering Bldg.

Do not extend notes this side of this line.

Note: Any Additions or Changes on This Sheet Must be Made or Circled in Red Ink With Date and Name of Person Making Change

Notes Ck'd by W. D. WAGNER
Map No. C.S.B. 2703-1-10
Office Work T. M. PALMER
Checked W. D. WAGNER
Date JAN 12 1962

Survey of AVE. O
JN 0075.85 Tape 101 Std. 84 °F
Surveyed by J. S. COATES
Notes J. S. C. Date 6/60
Indexed B. E. OH

F. B. 2609 Pg. 9

Note: Any Additions or Changes on This Sheet Must Be Made or Circled in Red Ink With Date and Name of Person Making Change.

Do not extend notes this side of this line.

RETURN TO LOS ANGELES COUNTY ENGINEER
900 Los Angeles County Engineering Bldg.

763098 CE #247

260TH 192 187 183 186 ST. E.

179 178 185

250TH 191 190 188 182 181 TRANSITION 184 177 ST. E.

240TH Z 189 I 170 N-8 180 O 194 O-8 171 172 176 P ST. E.

230TH 169 167 166 AVE. 173 162 174 174 175 AVE. ST. E.

220TH 168 157 158 159 160 ST. E. AVE. AVE. AVE. 227TH N-12 ST E 165 164 225TH AVE ST E N-14 161 161 163

210TH 156 155 154 152 151 153 ST. E.

200TH 149 144 145 150 146 147 ST. E.

FROM TOP PG. 8

RETURN TO
LOS ANGELES COUNTY ENGINEER
900 LOS ANGELES COUNTY ENGINEERING BLDG.

Note: Any Additions or Changes on This Sheet Must be Made or Circled in Red Ink With Date and Name of Person Making Change.

Do not extend notes this side of this line.

W.S. 65-B-1

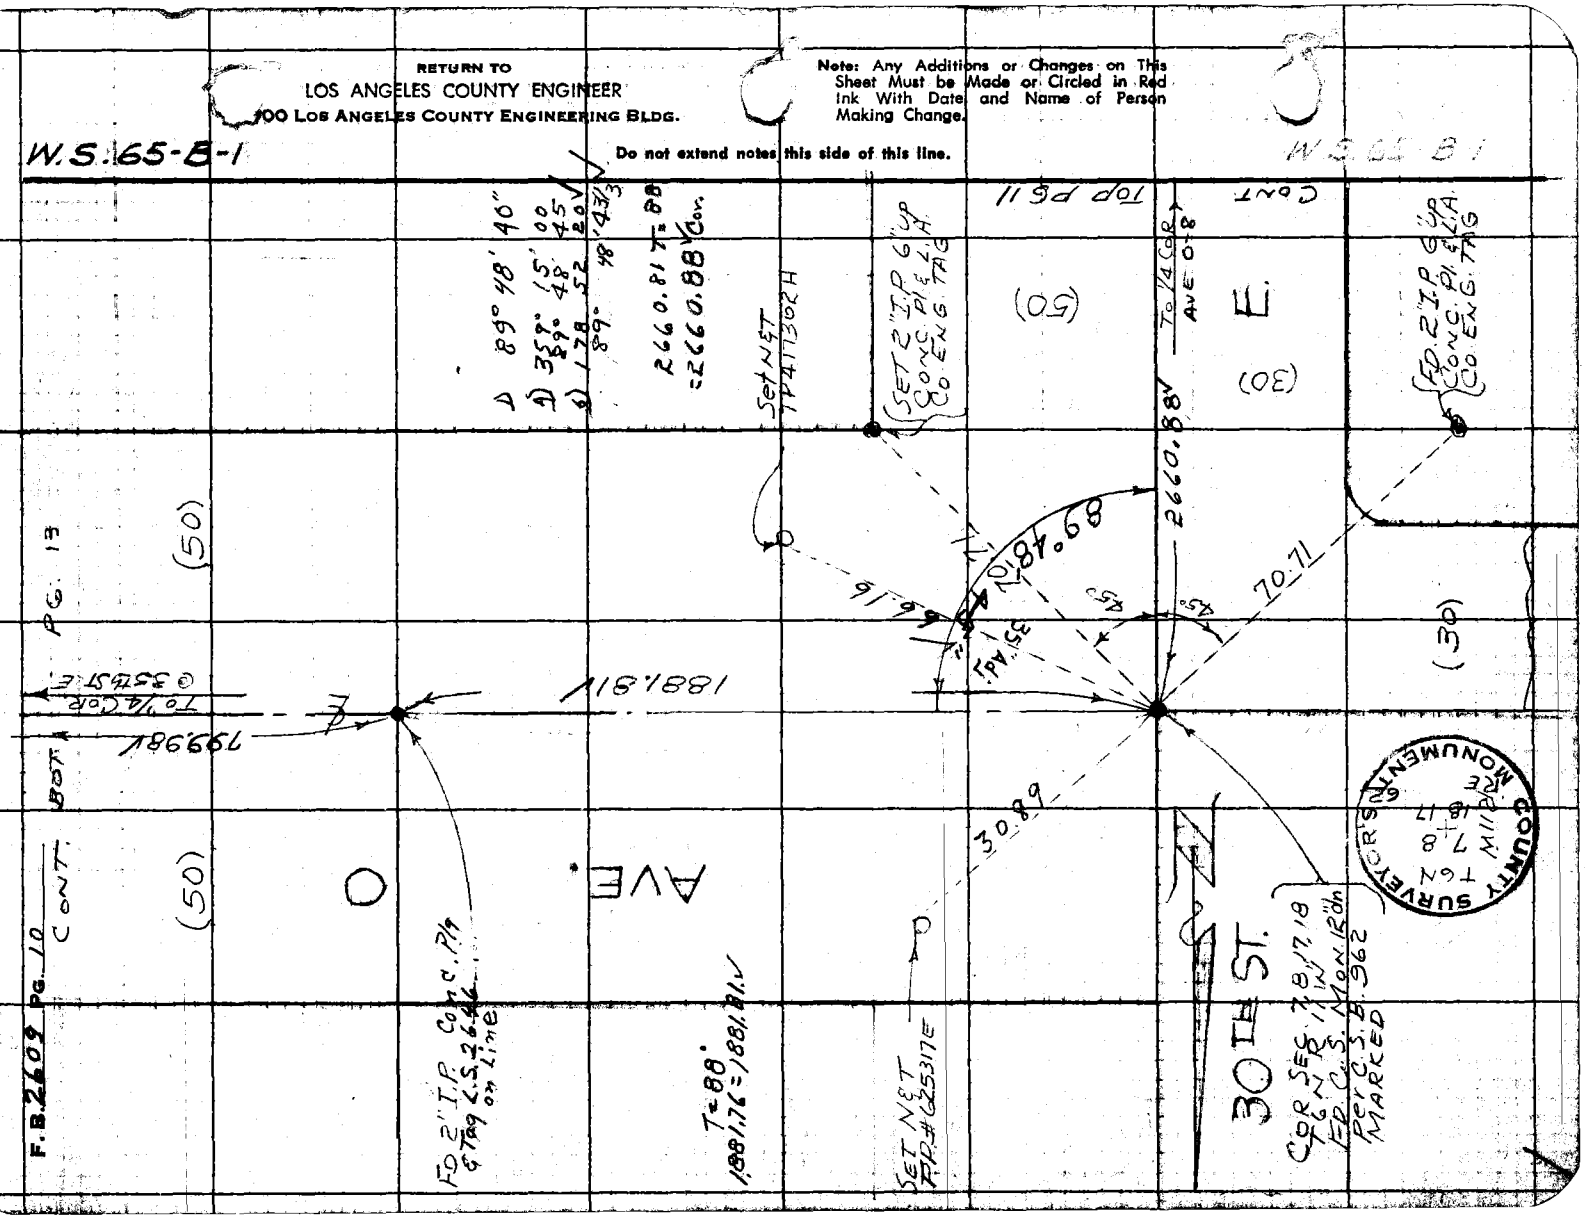

W.S.65-B-1

Notes Ck'd by W. D. WAGNER
Map No. C.S.B. 2962 1-10
Office Work T. M. PALMER
Checked W. D. WAGNER
Date JAN 12 1962

Survey of AVE O
JN 007585 Tape 101 Std 84 °F
Surveyed by J. S. COATES
Notes J. S. C. 6/60
Indexed

F. B. 2609 PG. 11

FROM RT. SIDE PG 10

(30) (50)

30TH ST. E.

℄ TO AVE O SECT. COR

2660.88'

R.P. SET 2" I.P. 6" UP CONC. P.L. L.A. CO. ENG. TAG

10.11

AVE.

2684.24 TO ctr. SEC. 17

CONT. LEFT SIDE PG 12

O-8 (39)

40.00

40.00

90°

45°

1.50

179° 59' 50"

FD. 2" I.P. C" up Wood Pl. & Spk

1/4 COR 17, 18 T6N. R11W FD. C.S. Mon. 12" dn per C.S.B 962 MARKED

FD. 2" I.P. 6" up Wood Pl. & Spk

① 89° 42' 30"
② 358° 49' 40"
③ 89° 42' 25"
④ 178° 14' 40"
89° 42' 26"

179° 59' 25"

89° 42'

2660.80'

COUNTY SURVEYOR'S MONUMENT T6N R11W 18+17 1/4 SEC. COR

R.P. SET 2" I.P. 6" UP CONC. P.L. L.A. CO. ENG. TAG

2660.73 T=89=2660.80'

TO SEC. COR AVE P

① 179° 59' 50"
② 359° 59' 20"
179° 59' 50"
③ 359° 59' 00" ✓
179° 59' 50" ✓

CONT. LEFT SIDE PG 16

Note: Any Additions or Changes on This Sheet Must Be Made or Circled in Red Ink With Date and Name of Person Making Change.

Do not extend notes this side of this line.

RETURN TO LOS ANGELES COUNTY ENGINEER 900 Los Angeles County Engineering Bldg.

783098 CE #247—7-63

F.B. 2609 PG. 12

CONT RT. SIDE PG. 13

W.S.66-Q-2

RETURN TO
LOS ANGELES COUNTY ENGINEER
900 Los Angeles County Engineering Bldg.

Do not extend notes this side of this line.

Note: Any Additions or Changes on This Sheet Must be Made or Circled in Red Ink With Date and Name of Person Making Change.

35TH ST. E.

2665.57 ✓ TO 1/4 COR. & AVE. O

1) 89° 39' 50"
4) 358° 39' 40"
3) 89° 39' 55" ✓
2) 177° 59' 20" ✓
Hub 89° 39' 53 1/2" ✓

Set NET TP #3185 J.B. 67

Set NET PP #3187

T = 88°
2684.17 =
2684.24 ✓

89° 39' 50" ✓

1329 ✓

To 1/4 COR @ 30th St. E.

2684.24 ✓

To 1/4 COR @ 40th St. E.

FROM RT. SIDE PG. 11

AVE.

O-8

6937

P/C #3188 O 58

SET NET TP #3188 JB 68

CENTER SECT. 17 T6N R11W SET C.E MON. 12"dn. BY INT. OF THE (N. & S.) & (E. & W.) 1/4 Sec CORNERS MARKED

COUNTY ENGINEER T6N R11W CTR SEC. 17 R.E. 5809

To 1/4 COR @ AVE P

Notes Ck'd by W. D. WAGNER
Map No. CSB 2263-1-10
Office Work T. M. PALMER
Checked W. D. WAGNER
Date JAN 12 1962

Survey of AVE. O
JN 007585 Tape 101 Std 84 °F
Surveyed by J. S. COATES
Notes J. S. C. Date 6/60
Indexed H. E. OTT

F. B. 2609 PG. 13

W.S. 65-C-1

CONT. BOT. | PG 14

(50) (50)

To Sect. Cor 40.45 ST E

R.P. SET 2" I.P. FL. CONC. PLUG L.A. CO. ENG. TAG

2683.21 V

1/4 COR. SEC. 8.17 T6N R11W FD. C.S. MON 12" dm per C.S.B. 962 MARKED

SURVEYOR'S MONUMENT 2006 LOS ANGELES COUNTY

T 6N + 17 R 11W 1/4 SEC.

FD. NET TP 417307 H

35TH ST. E.

70.71

1.85 1.57 0.60

2665.57 V To Ctr. Sect PG 12

22.57

26.10

FD NET PP 625199 E

FD NET 625200 E

45°

T = 90°

2665.47 = 2665.57 V

FROM TOP

T = 88°

799.96 = 799.98 V

799.98 V

R.P. SET 2" I.P. 6" UP CONC. PLUG L.A. CO. ENG. TAG

T = 90

AVE. E

To 2" IP

D 89° 45' 30"

4) 359° 03' 10"
89° 45' 47 1/2"

D 178° 33' 00" V

AVG = 89° 45' 50" V

(50) (50)

FROM TOP PG. 10

Note: Any Additions or Changes on This Sheet Must Be Made or Circled in Red Ink With Date and Name of Person Making Change.

Do not extend notes this side of this line.

RETURN TO
LOS ANGELES COUNTY ENGINEER
900 Los Angeles County Engineering Bldg.

783095 CE #247 7-59

RETURN TO
LOS ANGELES COUNTY ENGINEER
900 LOS ANGELES COUNTY ENGINEERING BLDG.

Note: Any Additions or Changes on This Sheet Must be Made or Circled in Red Ink With Date and Name of Person Making Change.

W.S. 65-C-1

Do not extend notes this side of this line.

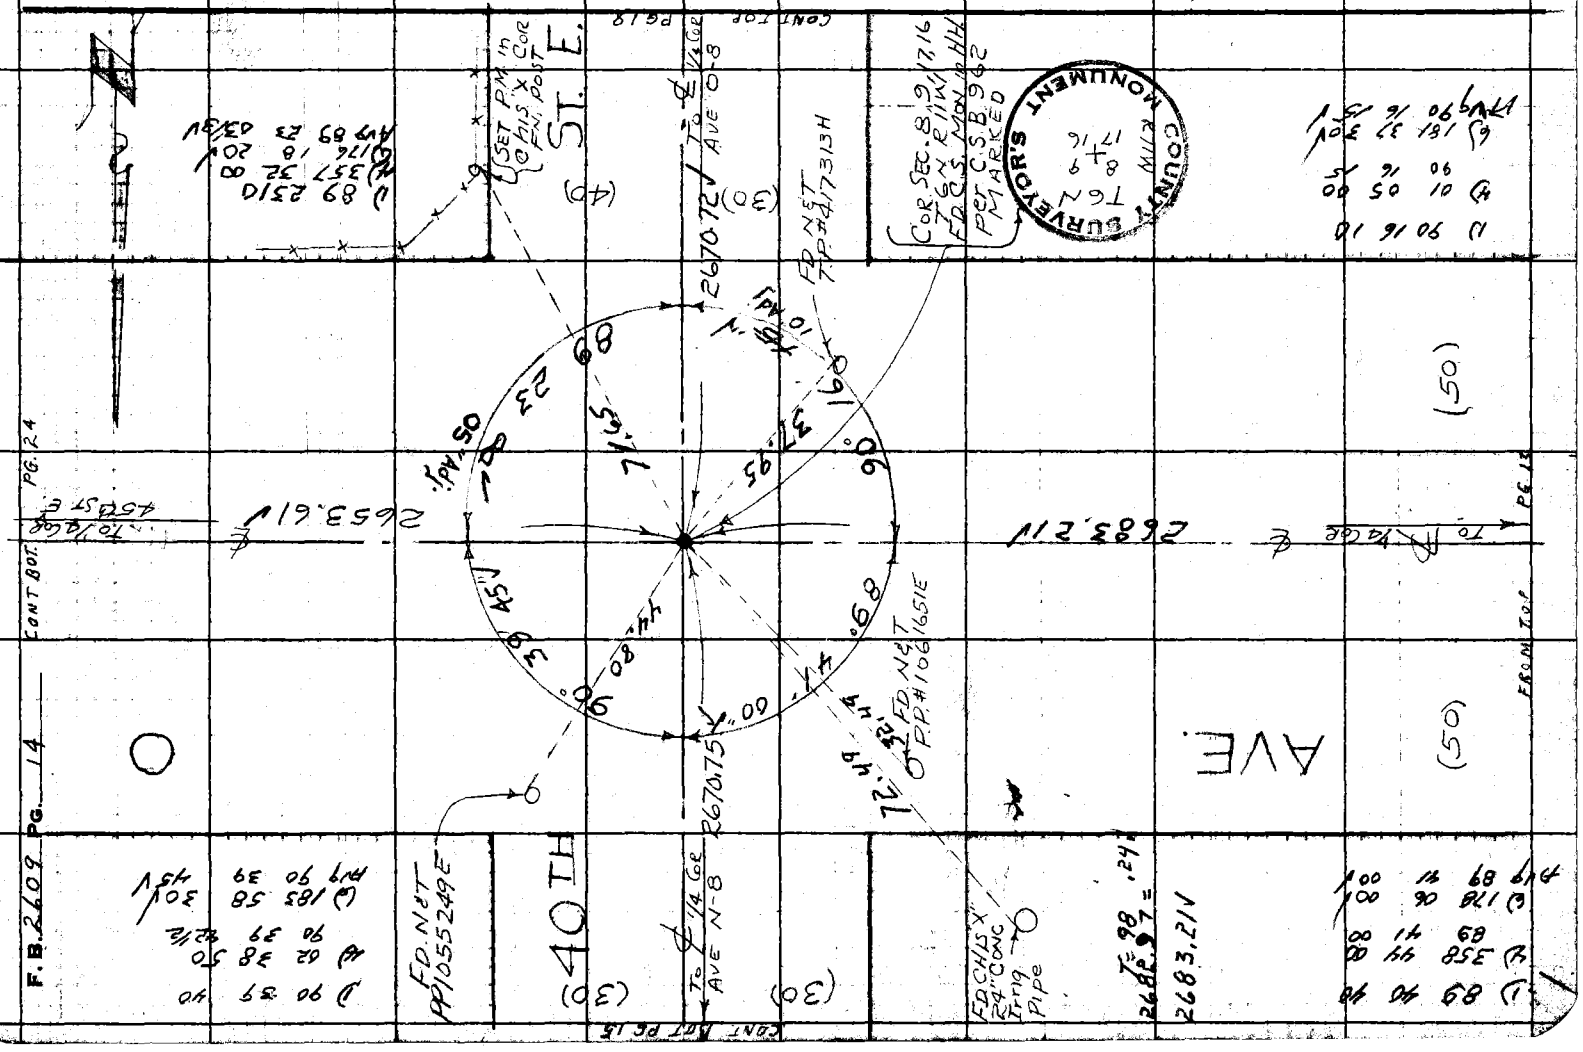

F.B. 2609 PG. 14

Notes Ck'd by W. D. WAGNER
Map No. C.S.B. 2763-1-10
Office Work T. M. PALMIERI
Checked W. D. WAGNER
Date JAN 12 1962

Survey of AVE O
JN 007585 Tape 101 Std 82 °F
Surveyed by J.S. COATES
Notes J.S.C. Date 6/60
Indexed M. E. OTT

F. B. 2609 Pg. 15

W.S. 65-C-1

Note: Any Additions or Changes on This Sheet Must be Made or Circled in Red Ink With Date and Name of Person Making Change.

Do not extend notes past this line.

RETURN TO
LOS ANGELES COUNTY ENGINEER
900 Los Angeles County Engineering Bldg.

(30) (30)

Set N&T PP #1055238E

Set N&T PP #1062250E

59.52

43.47

Set N&T PP #702101H

32.63

AVE. N-8

1/4 COR 8,9
T 6N R 11W
FD. C.S. MON. 20"dn
FB 106-40
MARKED AS SHOWN
SET Well & Cover
± 2-3 SQ. Spk & Tin

COUNTY SURVEYORS MONUMENT
T 6N
R 11W
8+9
1/4 SEC. COR.

40TH ST.

T=90°
2670.65 = 2670.75 V

152.04 92.

To Sect. Cor
E AVE O

FROM LEFT

SIDE PG. 14

763098 CE #247—7-53

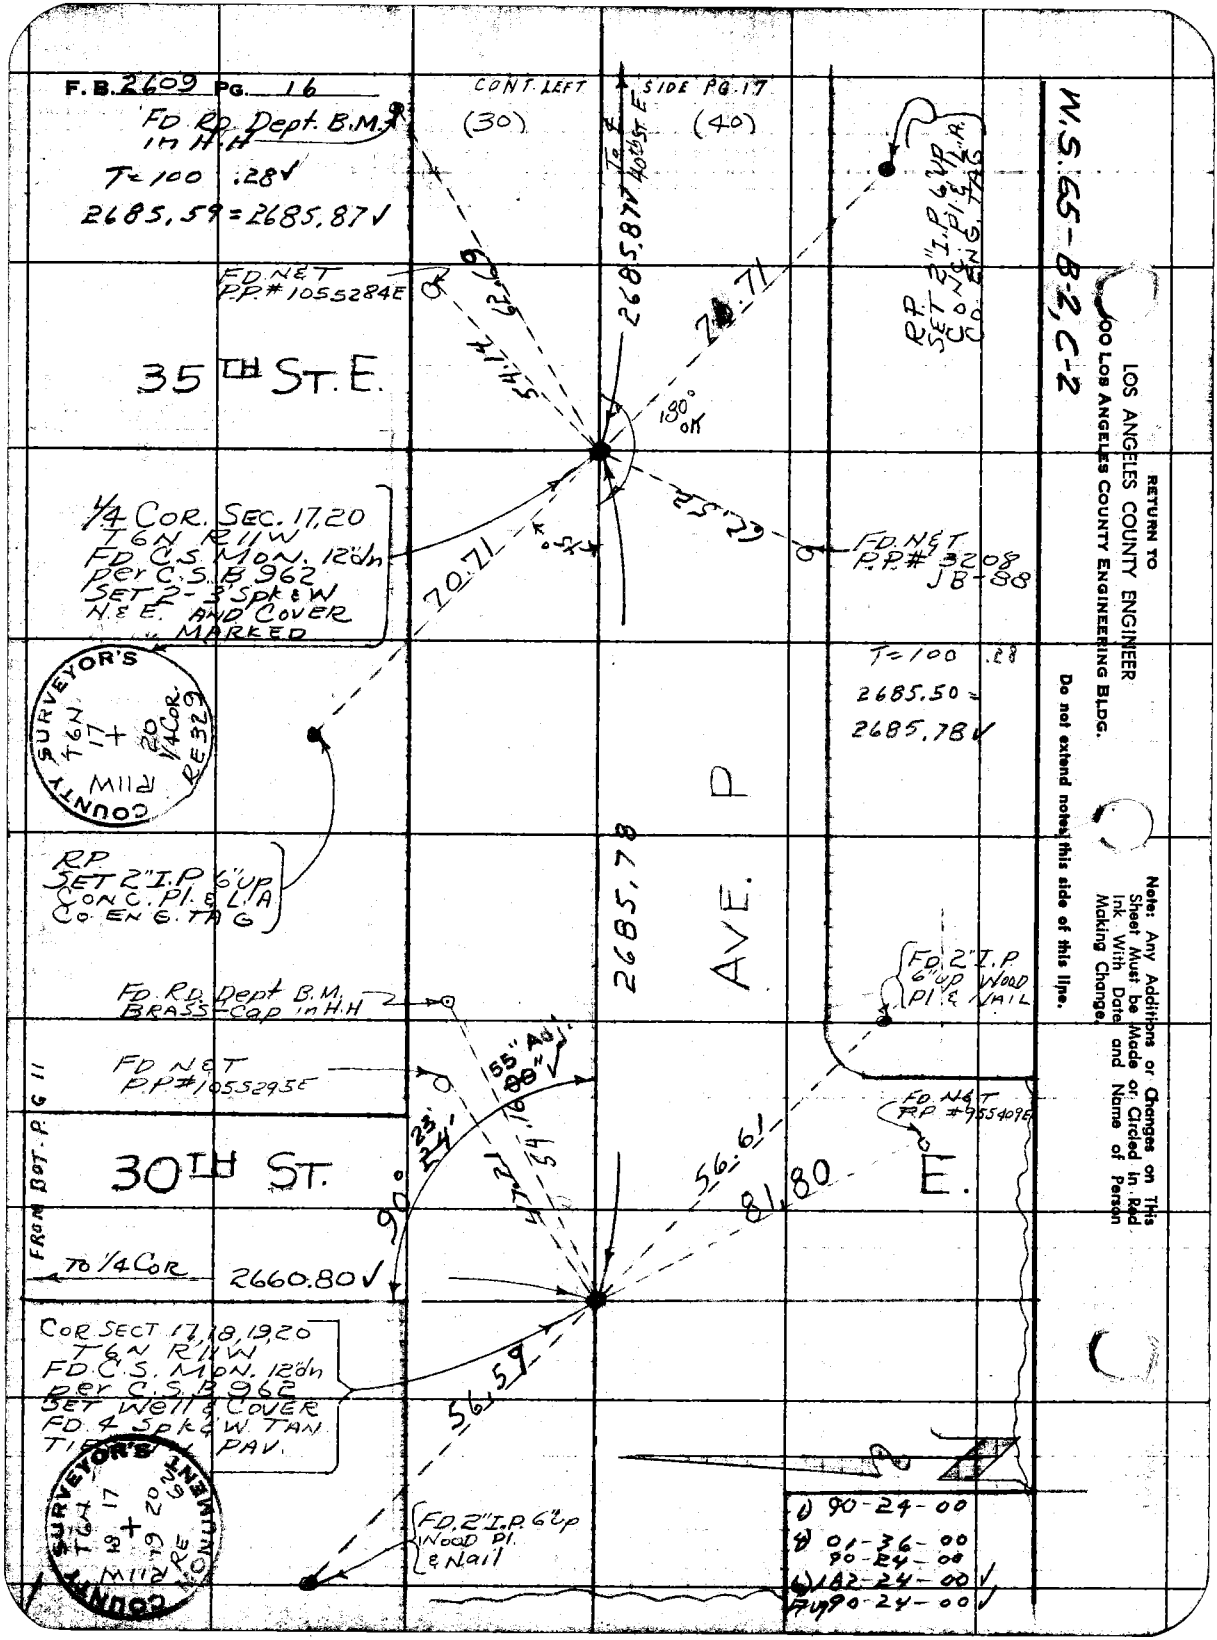
F.B. 2609 Pg. 16
CONT. LEFT (30)
SIDE PG. 17 (40)
FD Rd. Dept. B.M. in H.H
T=100 .28
2685.59=2685.87
FD NET P.P.# 1055284E
35TH ST. E.
2685.87 To E
402.71
RP SET 2" I.P 6" UP CONC. PI. & L.A. CO. ENG. TAG
W.S. 65-B-2, C-2
RETURN TO LOS ANGELES COUNTY ENGINEER 900 Los Angeles County Engineering Bldg.
Note: Any Additions or Changes on This Sheet Must be Made or Circled in Red Ink With Date and Name of Person Making Change.
Do not extend notes this side of this line.
1/4 COR. SEC. 17,20 T6N R11W FD C.S. MON. 12"dn Per C.S.B. 962 SET 2-3 Spk & W N & E. AND COVER MARKED
180° OR
402.71
FD NET P.P.# 3208 JB-88
T=100 .28
2685.50
2685.78
COUNTY SURVEYOR'S T6N R11W 17 + 20 1/4 COR. RE 329
RP SET 2" I.P 6" UP CONC. PI. & L.A. CO. ENG. TAG
2685.78
AVE. P
FD Rd. Dept B.M. BRASS-Cap in H.H
FD 2" I.P 6" UP WOOD PI. & NAIL
FD NET P.P.#1055295E
55" Adj. 80=2660.80
FD NET P.P.#1055409E
30TH ST.
E.
FROM BOT. P.G. 11
90° 23' 24"
54.10
56.61
81.80
TO 1/4 COR 2660.80
COR SECT 17,18,19,20 T6N R11W FD C.S. MON. 12"dn Per C.S.B. 962 SET WELL & COVER FD 4 Spk's W TAN T[illegible] PAV.
56.59
COUNTY SURVEYOR'S T6N 17 + 18 19 20 R11W RE 1012
FD 2" I.P 6" UP WOOD PI. & NAIL
D 90-24-00
D 01-36-00
90-24-00
D 182-24-00
Fig 90-24-00

Notes Ck'd by W. D. WAGNER Survey of AVE O F. B 2609 Pg. 17
Map No. C.S.B. 2743-1-10 JN 0075.8 5 Tape 101 Std. 8A °F
Office Work T. M. PALMERI Surveyed by J. S. COATES
Checked W. D. WAGNER Notes J. S. C. Date 9/60
Date JAN 12 1962 Indexed N. E. OTT

W.S. 65-C-2

COUNTY SURVEY T6N R11W 17 16 + R20 21 1926 MONUMENT

CONT ROT PG 18

(30) (40)

To 1/4 Cor AVE O-8

COR SEC 16,17 20,21 T6 N C.S. R11W MON. IN H.H. PER C.S.B. 87388 1962 MARKED

ST. E.

2670.46

45° Adj 50'

90

31 38

89

FD. NET PP # 1055272E

FD. BH. Dept. Brass-Cap MON in H.H.

57.09

52.19

55' Adj

15.03

To 1/4 Cor 35TH ST 2685.87

2665.00

To 1/4 Cor 45TH ST

Set P.M. in "X" on S.S.M.H. rim on Line

41.81

59.20

FROM ROT PG 16

(30) (30) (40) (40)

AVE.

P

CONT ROT PG 19

SET NET T.P. # 702111H

D 89-32-00
4) 358-07-20
89-31-50
6) 177-11-00
Avg 89-31-50

40TH

FD. BH. SPIKE IN 20" JOSHUA

1) 90-39-00
4) 02-35-20
90-38-50
6) 183-53-00
Avg 90-38-50

T = 82.03
2665.03 = 2665.00

RETURN TO
LOS ANGELES COUNTY ENGINEER
900 LOS ANGELES COUNTY ENGINEERING BLDG.

Note: Any Additions or Changes on This Sheet Must be Made as Circled in Red Ink With Date and Name of Person Making Change.

Do not extend notes this side of this line.

763095 CE #247 7-53

F.B. 2609 PG. 18

D 179 59 50

W 359 59 00
179 59 45

G 359 58 30 ✓
Proj 179 59 45 ✓

FROM RT SIDE PG. 14

(30) (40)

To Sec Cor. AVE O

W.S. 65-C-2

T-90
2670.62 =
2670.72 ✓

RETURN TO
LOS ANGELES COUNTY ENGINEER
900 LOS ANGELES COUNTY ENGINEERING BLDG.

Do not extend notes this side of this line.

Note: Any Additions or Changes on This Sheet Must be Made or Circled in Red Ink With Date and Name of Person Making Change.

E.

2670.72 ✓

SET NAIL
TP 3166
J.B/47

SET NAIL
PP #1055 260 E

46.63

45 ✓

51.58

FD 4"X4" RWD
POST & N

To ctr. Sec. 17
Pg. 12

0.72

26.91

AVE O-8

90°

26.91

59

58.76

SET NAIL
PP #419169 H

0.21

22

85.44 ✓

Set P.M. @
this Arrow
Fn. Post

¼ COR. SEC 16, 17
T 6 N R 11 W
FD. C.S. MON in H.H.
per C.S. 8962
C.S. 8966
MARKED

COUNTY SURVEYOR'S
T6N
R11W
17+16
¼ Sec Cor
MONUMENT

① 90° 22' 00"
④ 361° 28' 30"
90° 22' 07½" ✓
⑥ 182° 12' 40"
90° 22' 06½" ✓

40TH ST.

2670.46 ✓

T = 90°
2670.36 = 2670.46 ✓

(30) (40)

To Sec Cor AVE P

FROM TOP PG 17

Notes Ck'd by W. D. WAGNER | Survey of AVE O | F. B. 2609 Pg. 19
Map No. C.S.B. 2763-1-10 | JN 007586 Tape 101 Std 84 °F
Office Work T.M. PALMERI | Surveyed by J.S. COATES
Checked W. D. WAGNER | Notes J. S. C. Date 6/60
Date JAN 12 1962 | Indexed H. E. ON

W.S. 65-C-2

Note: Any Additions or Changes on This Sheet Must Be Made or Circled In Red. Ink With Date and Name of Person Making Change.

Do not extend notes this side of this line.

RETURN TO LOS ANGELES COUNTY ENGINEER 900 Los Angeles County Engineering Bldg.

CONT. LEFT SIDE PG 20

(30) To Sect. Cor. 50th St. E. (40)

1335.49 @ 94° = 1335.58
2671.35 @ 94° = 2671.52

P

2664.56 per F.B. 1880-117

(FD. 2" I.P. F/ CONC. PL. & SHELL - CASE)

SIDE PG. 24

45TH

CONT. RT. SIDE PG. 24

(20) To 2671.52 ✓

1335.58 ✓

40.00

90°

40.00

89° 13' 55" ✓ 80.41 L.

(20)

FD. 2" X 2" "M" 24' dn per San. Dist. S.E. Cor. Sewer disposal Area

2665.00

To Sect. Cor. 40th St. E.

(40)

AVE

(30)

FROM RT. SIDE PG. 17

1/4 COR. SEC. 16, 21 FD. S. MON. 24' dn per F.B. 1880-117 C.S. 8738 C.S.B. 2542-2 MARKED 2-3" NET N&E

SURVEYOR'S MONUMENT COUNTY T 6 N 1/4 SEC. COR. R 11 W 16 21

ST. E.

FD. 2" I.P. F/ CONC. PL. & SHELL CASE F.B. 1880-117

⑧ 89° 13' 50"
④ 356° 55' 40"
⑥ 89° 13' 55" ✓
175° 23' 40"
85° 13' 56½" ✓

783098 CE #247—7-53

F.B. 2609 PG. 20

CONT BOT

PG. 21

W.S. 65-C-2

RETURN TO
LOS ANGELES COUNTY ENGINEER
900 LOS ANGELES COUNTY ENGINEERING BLDG.

Do not extend notes this side of this line.

Note: Any Additions or Changes on This Sheet Must be Made or Circled in Red Ink With Date and Name of Person Making Changes

1) 89-06-50

4) 356-36-40
89-06-40

6) 174-90-00 V
89-06-40 V

(50)

To 1/4 Cor
AVE 0-8

(50)

1) 90-56-50

4) 03-47-10
90-56-47 1/2

6) 185-40-50 V
90-56-48 1/2 V

℄ ST. E.

2672.32
per F.B. 1880-91

COUNTY SURVEY MONUMENT
T6N
R11W
16, 15
21 + 22

Cor. Sec. 15, 16, 21, 22
T6N R11W
F.D.C.S. Mon in HH.
per F.B. 1880-91
C.S.B. 2542-2
C.S. 8738
Set 2-3" Spk & W
Ties N & E

R.P.
FD. 2" I.P.
Gut Conc
Pl & Shell
case

45° Adj
40' V

89° 06'

90° 57'

70.71

00" Adj
50' V

(30)

AVE.

(50)

P

From 2 of PG 19

To 1/4 Cor
45TH ST. E.

2664.56
per F.B. 1880-91

2690.66
per F.B. 1880-91

To 1/4 Cor
55th St. E.

(40)

70.71

(50)

R.P.
FD. 2" I.P. Fl.
Conc. Plug
& Shell Case

50TH

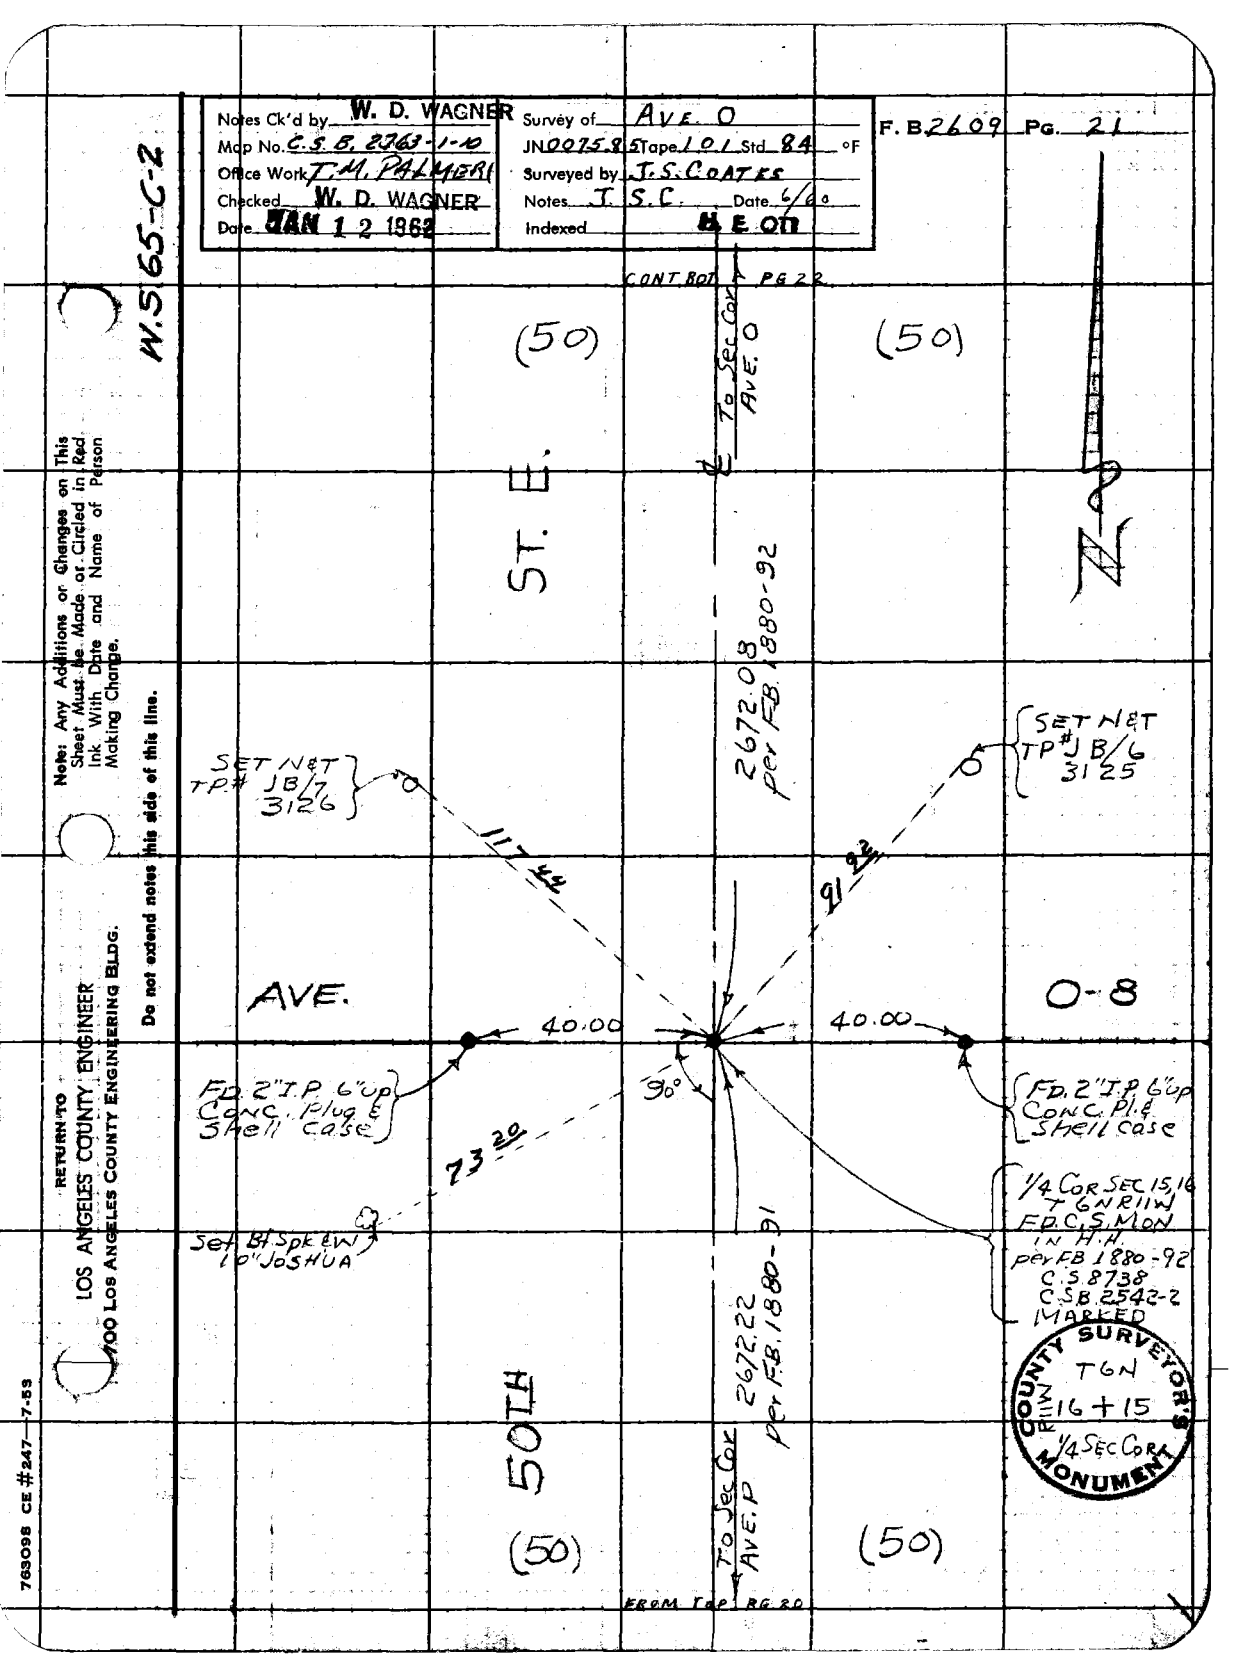
Notes Ck'd by W. D. WAGNER
Map No. C.S.B. 2763-1-10
Office Work T.M. PALMIERI
Checked W. D. WAGNER
Date JAN 12 1962
Survey of AVE. O
JN 007585 Tape 101 Std 84 °F
Surveyed by J.S. COATES
Notes J.S.C. Date 6/60
Indexed
F. B. 2609 Pg. 21
W.S 65-C-2
CONT. FROM PG 22
(50)
(50)
To Sec Cor AVE. O
ST. E.
2672.08 per F.B. 1880-92
SET N&T TP# JB/7 3126
SET N&T TP# JB/6 3125
117.44
91.92
AVE.
O-8
40.00
40.00
90°
FD. 2" I.P. 6" up Conc. Plug & Shell case
FD. 2" I.P. 6" up Conc. Pl. & Shell case
73.20
Set B" Spk & W/ 10" JOSHUA
1/4 Cor Sec 15, 16 T 6N R 11W FD C.S. MON IN H.H. per F.B. 1880-92 C.S. 8738 C.S.B. 2542-2 MARKED
COUNTY SURVEYOR'S MONUMENT
T 6N
R 11W 16+15
1/4 Sec Cor
50TH
2672.22 per F.B. 1880-91
To Sec Cor AVE. P
(50)
(50)
FROM TOP PG 20
Note: Any Additions or Changes on This Sheet Must Be Made or Circled in Red Ink With Date and Name of Person Making Change.
Do not extend notes this side of this line.
RETURN TO
LOS ANGELES COUNTY ENGINEER
900 Los Angeles County Engineering Bldg.
763098 CE #247 7-53

RETURN TO
LOS ANGELES COUNTY ENGINEER
900 LOS ANGELES COUNTY ENGINEERING BLDG.

Note: Any Additions or Changes on This Sheet Must be Made or Circled in Red Ink With Date and Name of Person Making Change.

Do not extend notes this side of this line.

W.S.65-C-1

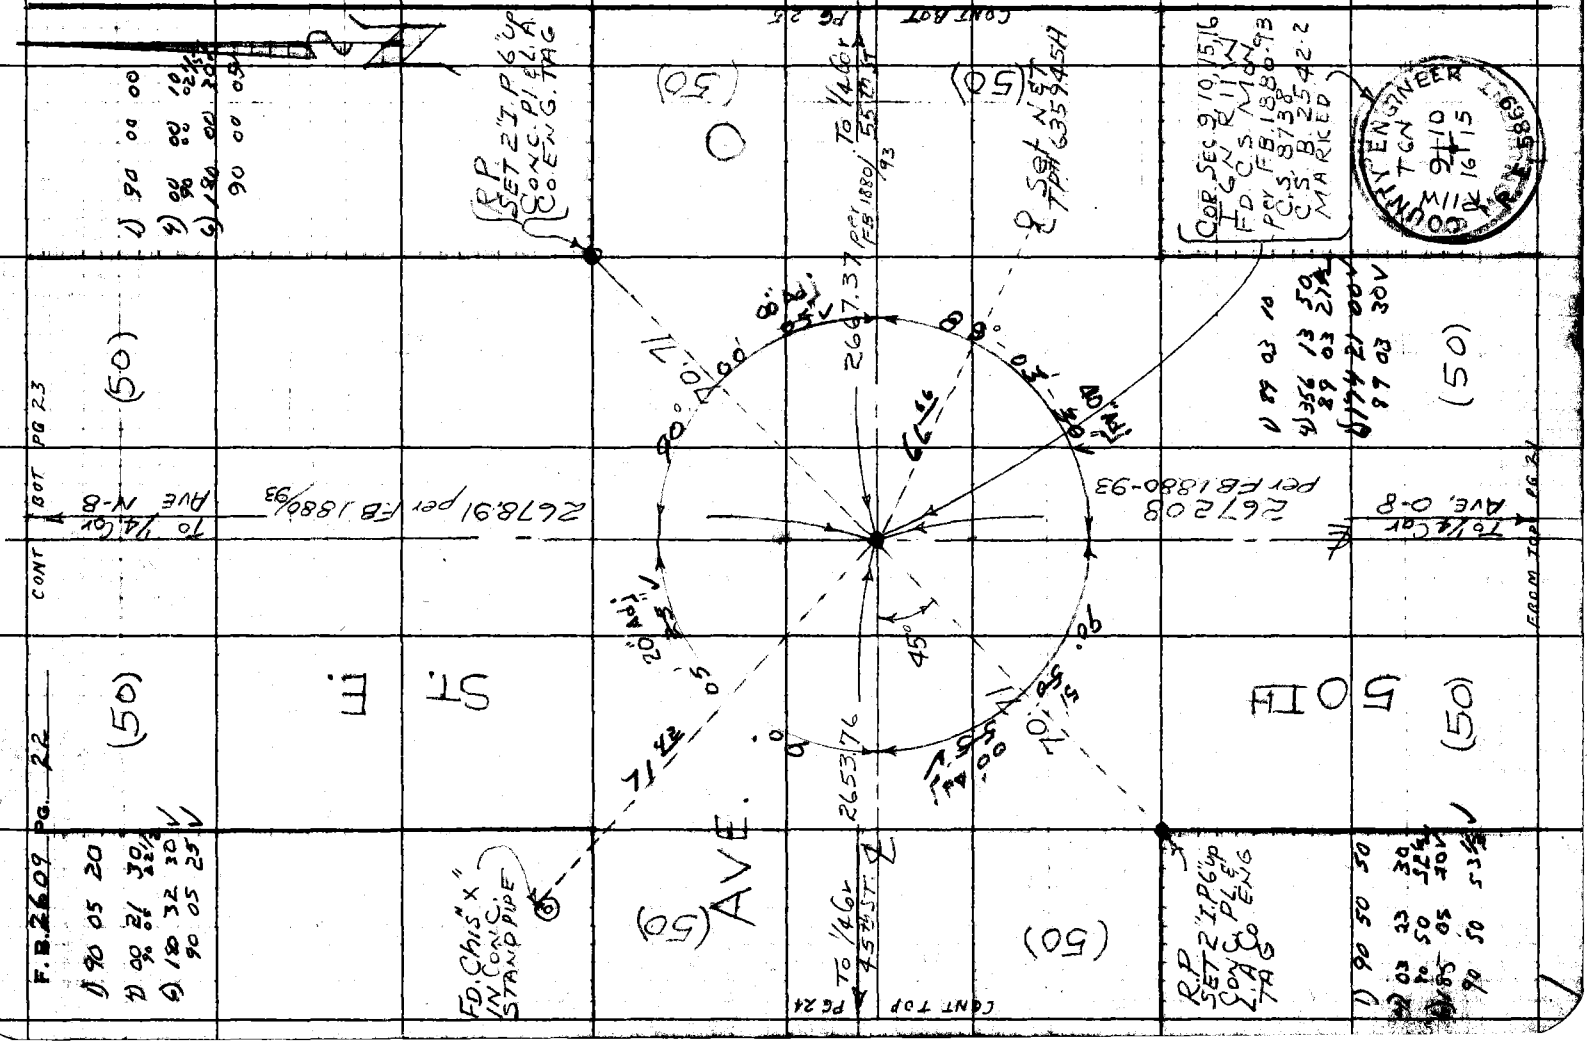

769098 CE #247—7-53

RETURN TO
LOS ANGELES COUNTY ENGINEER
700 LOS ANGELES COUNTY ENGINEERING BLDG.

Note: Any Additions or Changes on This Sheet Must be Made or Circled In Red Ink With Date and Name of Person Making Change.

Do not extend notes this side of this line.

W.S. 65-C-1

Notes Ck'd by W. D. WAGNER
Map No. C.S. 8762-1-10
Office Work T.M. PALMER
Checked W. D. WAGNER
Date JAN 12 1952

Survey of AVE O
JN 007188 Tape 1/01 Std. 84 OF
Surveyed by T. S. COATES
Notes T. S. C. Date 6/52
Indexed E. E. Off

F. B. 2609 PG. 23

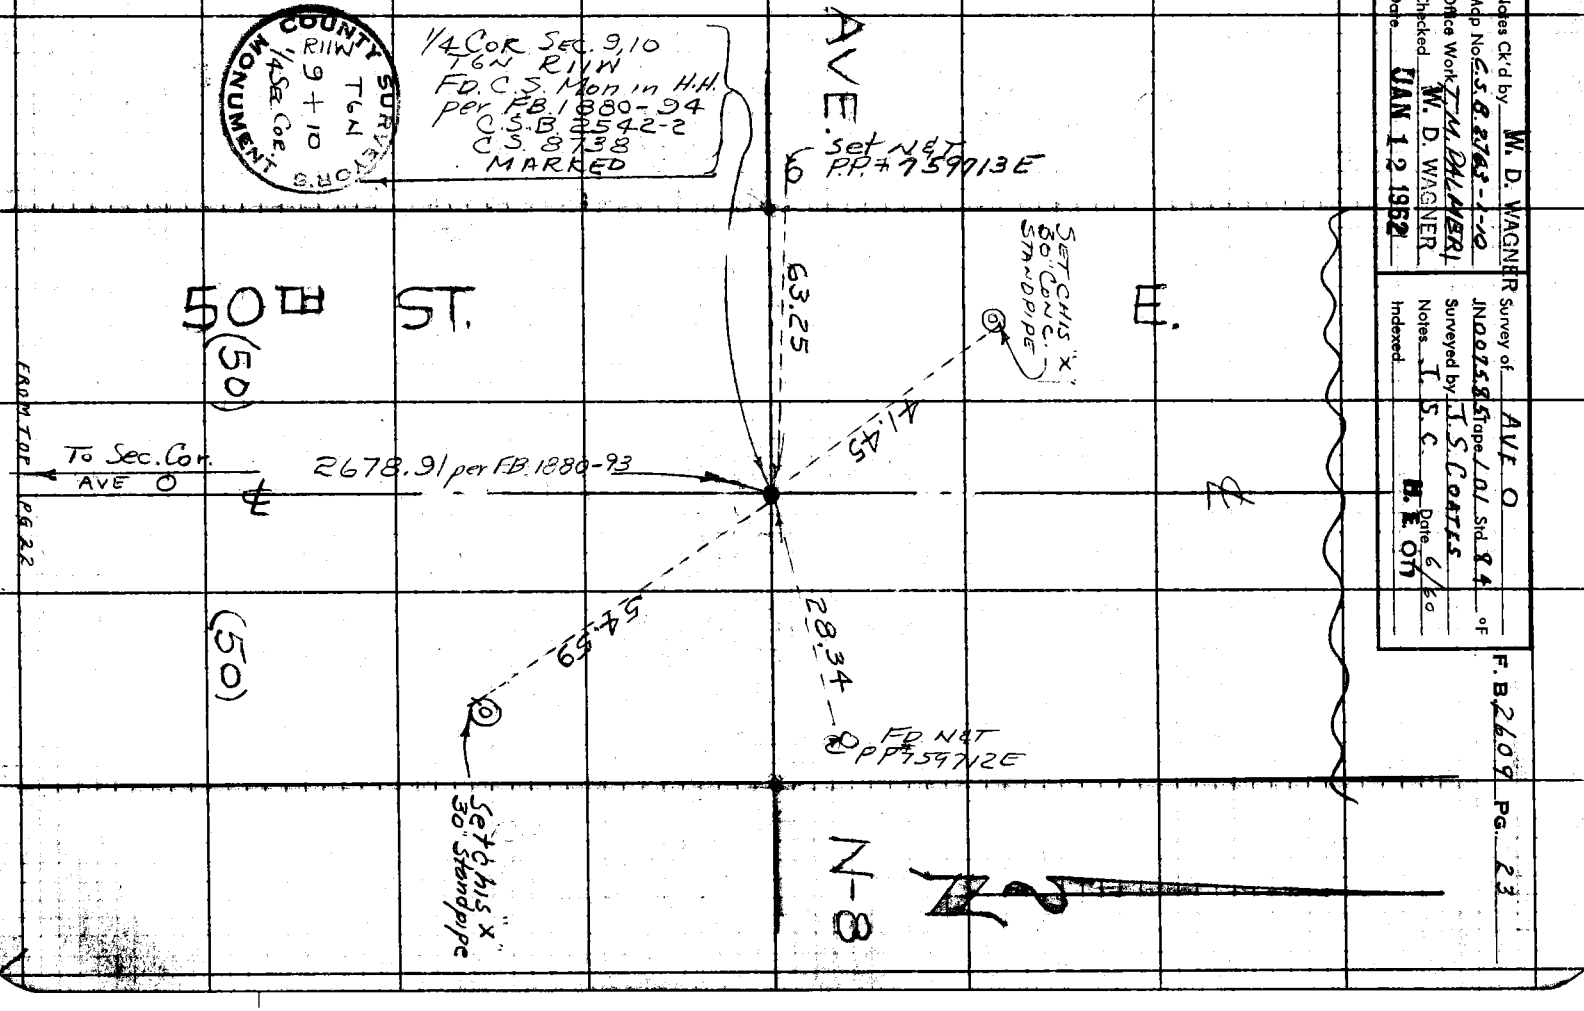

RETURN TO
LOS ANGELES COUNTY ENGINEER
900 LOS ANGELES COUNTY ENGINEERING BLDG.

Note: Any Additions or Changes on This Sheet Must be Made or Circled in Red Ink With Date and Name of Person Making Change.

Do not extend notes this side of this line.

W.S. 65-C-1

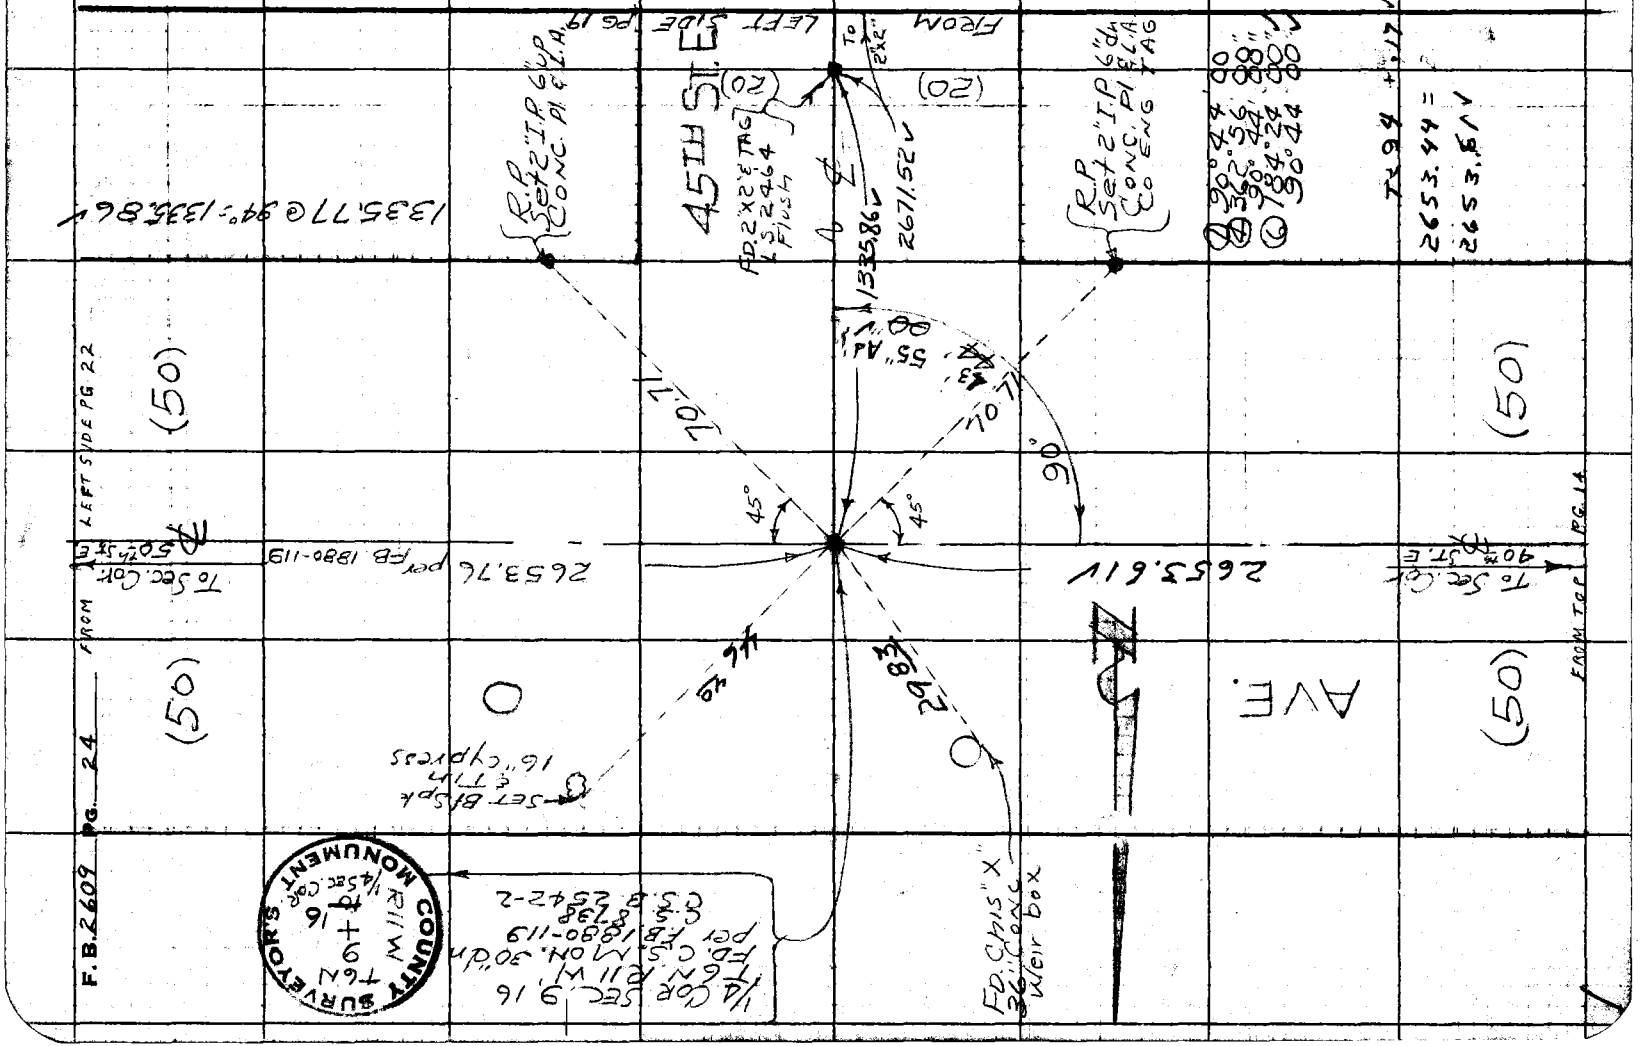

763098 CE #247—7-53

RETURN TO
LOS ANGELES COUNTY ENGINEER
700 LOS ANGELES COUNTY ENGINEERING BLDG.

Note: Any Additions or Changes on This Sheet Must be Made or Circled in Red Ink, With Date and Name of Person Making Change.

Do not extend notes this side of this line.

W.5.65-D-1

Notes Ck'd by W. D. WAGNER
Map No. C.S.B. 2765-1-10
Office Work T.M. PALMER
Checked W. D. WAGNER
Date JAN 12 1962

Survey of AVE O
JN 007585 Tape 101 Std. 8.4 of
Surveyed by J.S.C. GATES
Notes J.S.C. Date 6/62
Indexed H.E.ON

F.B. 2609 PG. 25

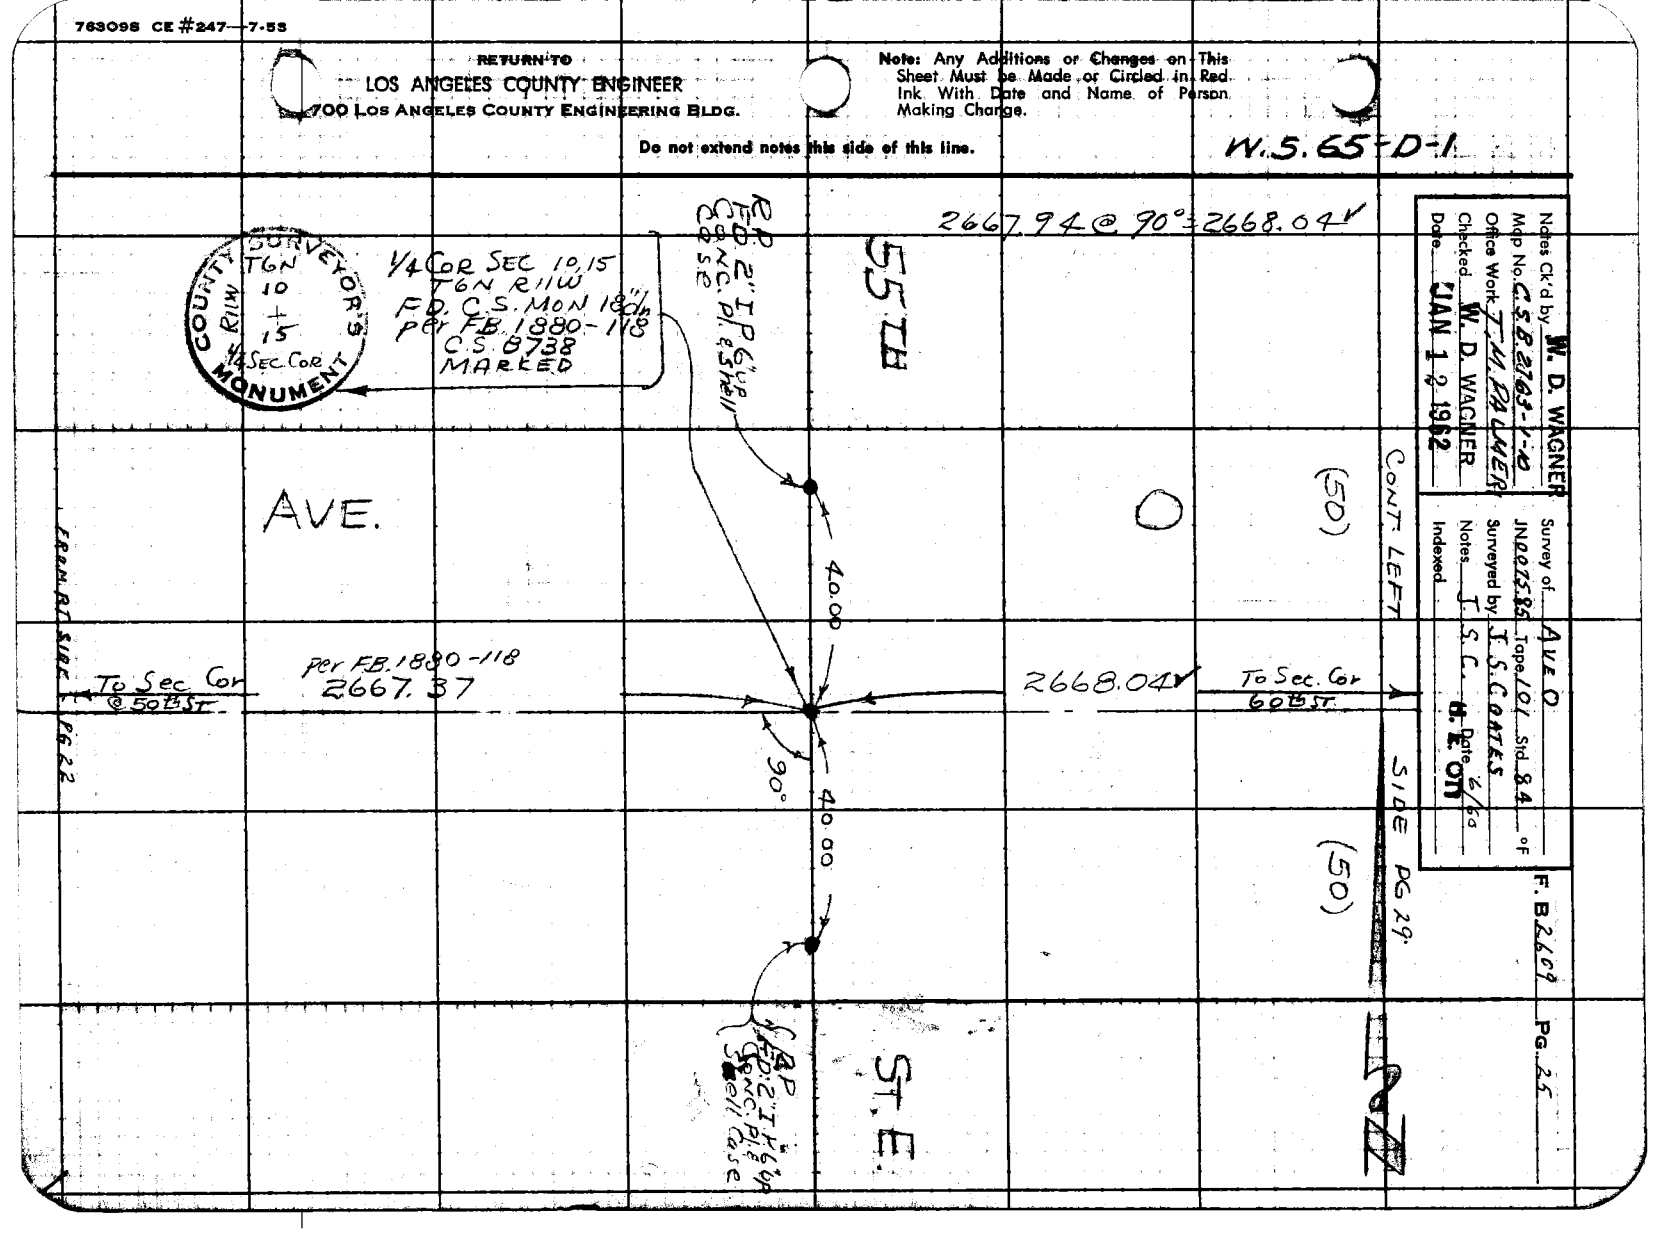

RETURN TO
LOS ANGELES COUNTY ENGINEER
700 LOS ANGELES COUNTY ENGINEERING BLDG.

Note: Any Additions or Changes on This Sheet Must be Made or Circled in Red Ink With Date and Name of Person Making Change.

W.S. 65-D-2

Do not extend notes this side of this line.

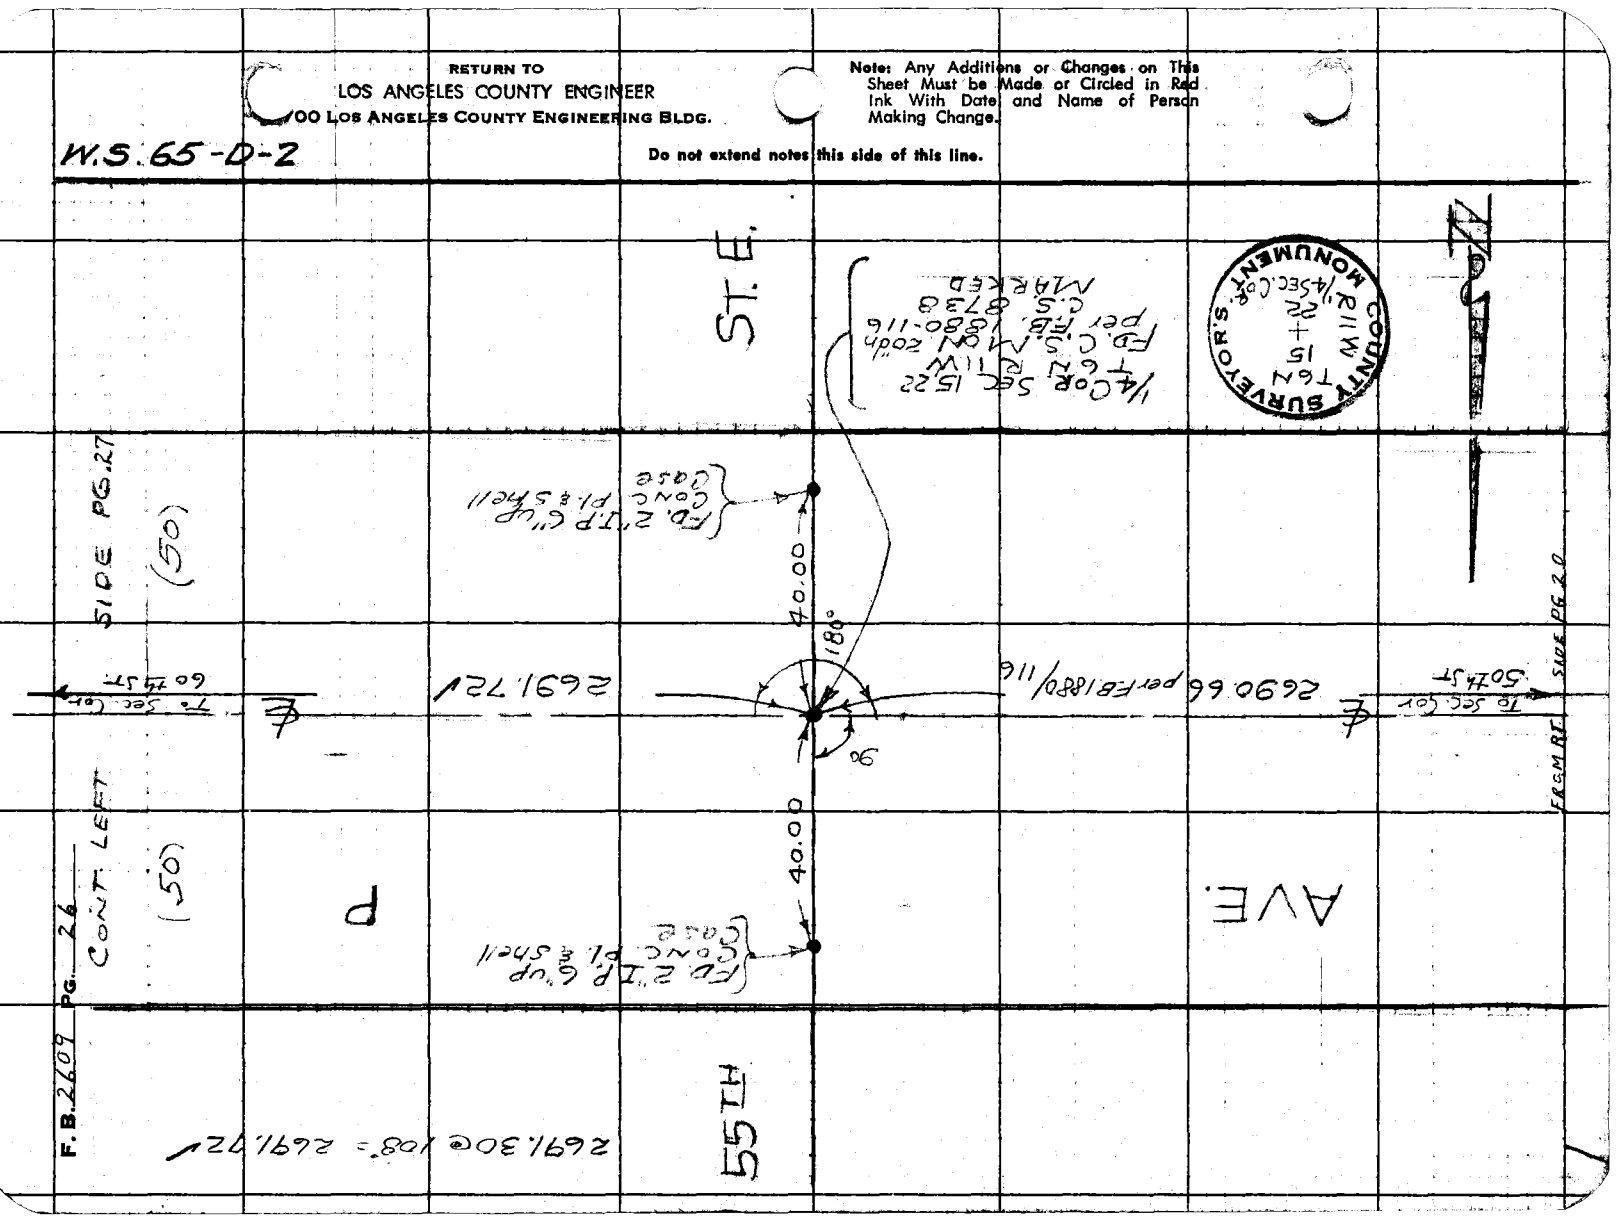

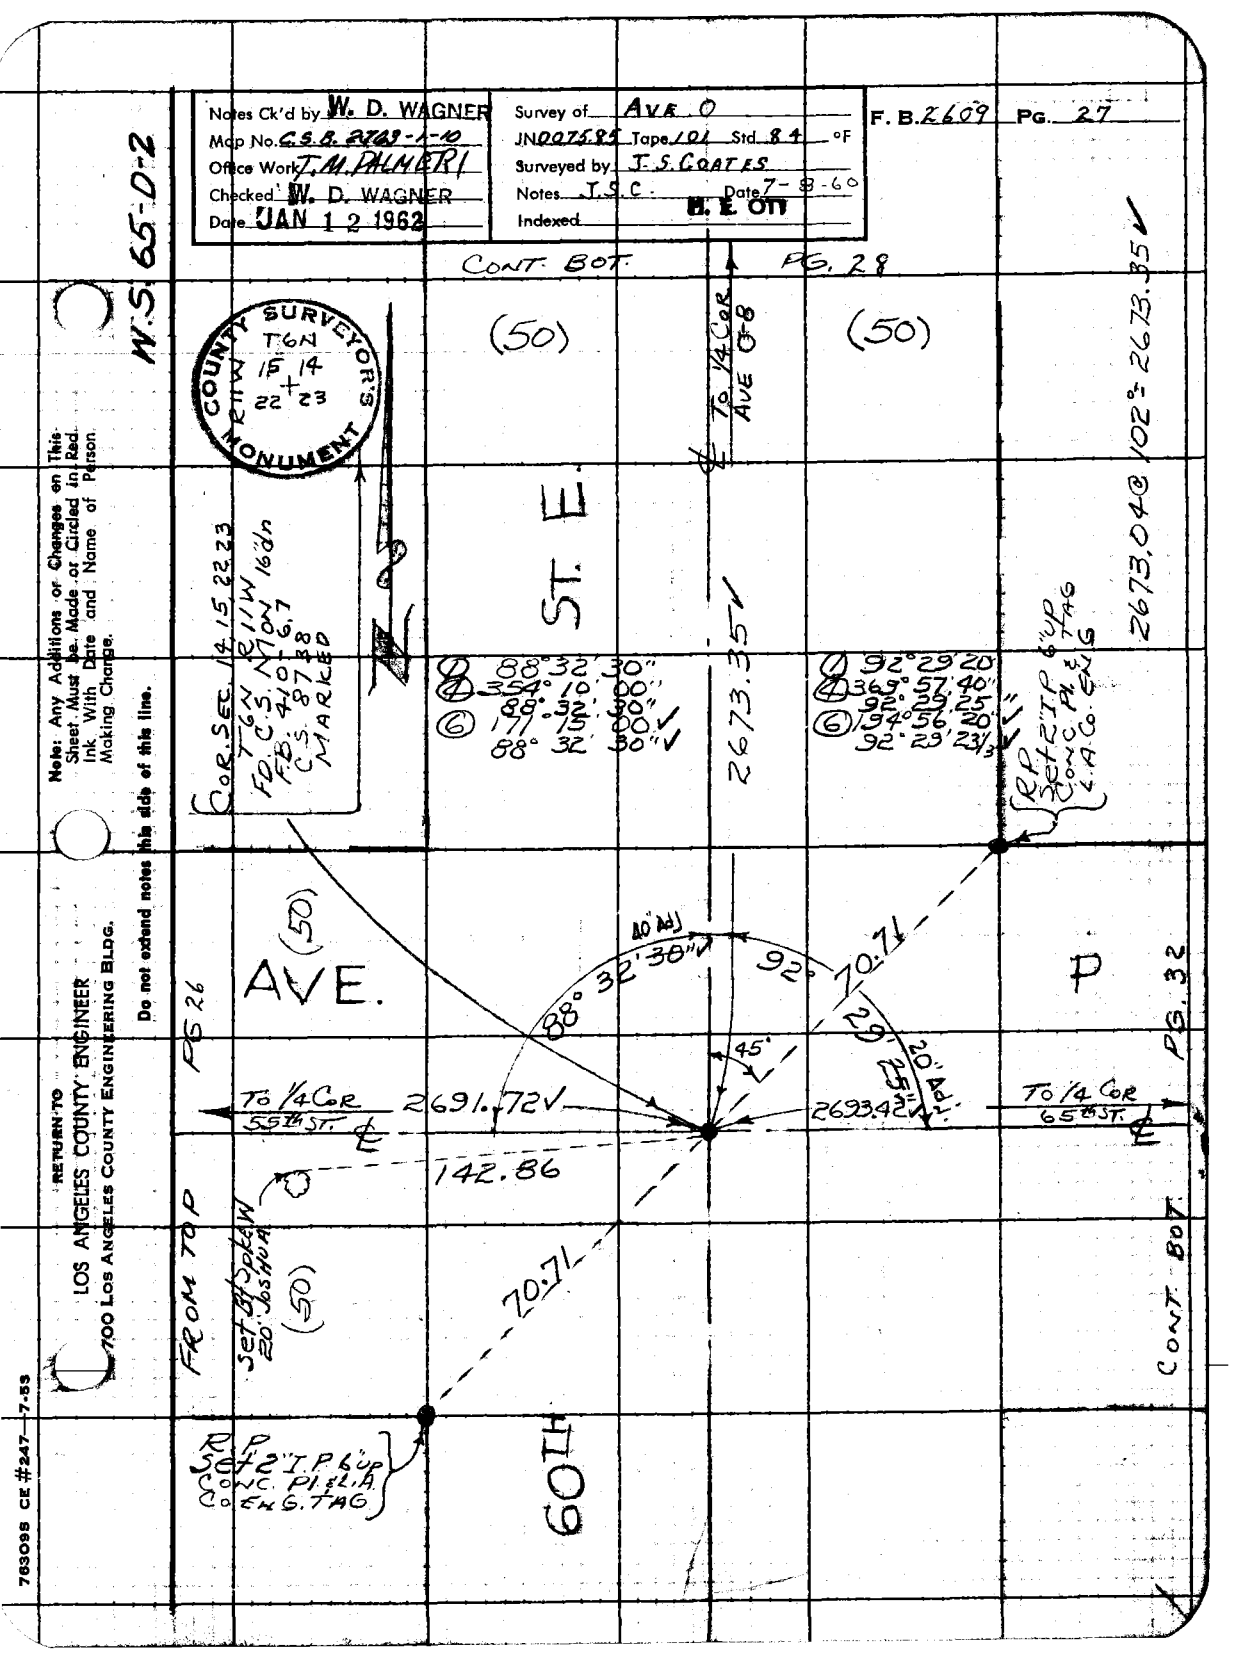
W.S. 65-D-2
Notes Ck'd by W. D. WAGNER
Map No. C.S.B. 2769-1-10
Office Work T. M. PALMER
Checked W. D. WAGNER
Date JAN 12 1962
Survey of AVE. O
JN 007585 Tape 101 Std. 84 °F
Surveyed by J. S. COATES
Notes J.S.C. Date 7-8-60
Indexed H. E. OTT
F. B. 2609 PG. 27
CONT. BOT. PG. 28
COUNTY SURVEYOR'S MONUMENT
T6N R11W
15 14
22 23
(50)
(50)
ST. E
℄ To 1/4 Cor AVE O-8
2673.35
2673.04@ 102°-26 73.85
COR. SEC. 14, 15, 22, 23
T6N R11W
FD C.S. MON 16"ø
FB 4.10.6.7
C.S. 487.38
MARKED
⊙ 88° 32' 30"
Ⓐ 354° 10' 00"
88° 32' 00"
Ⓑ 177° 15' 00"
88° 32' 30"
⊙ 92° 29' 20
Ⓐ 369° 57' 40"
92° 28' 25
Ⓑ 194° 56' 20
92° 29' 23 1/3
RP SET 2" I.P. 6" UP CONC. PL. & L.A. CO. ENG. TAG
AVE. (50)
PG 26
40' Adj
88° 32' 30"
92°
70.71
45°
29° 25' 20"
20' Adj.
P
PG. 32
To 1/4 Cor 55TH ST.
2691.72
2693.42
To 1/4 Cor 65TH ST.
142.86
FROM TOP
Set B/Spike & W 20' Joshua
(50)
70.71
RP SET 2" I.P. 6" UP CONC. PL. & L.A. CO. ENG. TAG
60TH
CONT. BOT.
RETURN TO
LOS ANGELES COUNTY ENGINEER
700 Los Angeles County Engineering Bldg.
Note: Any Additions or Changes on This Sheet Must be Made or Circled in Red. Ink With Date and Name of Person Making Change.
Do not extend notes this side of this line.
763098 CE #247—7-53

RETURN TO
LOS ANGELES COUNTY ENGINEER
900 LOS ANGELES COUNTY ENGINEERING BLDG.

Note: Any Additions or Changes on This Sheet Must be Made or Circled In Red Ink With Date and Name of Person Making Change.

Do not extend notes this side of this line.

W.S. 65-D-2

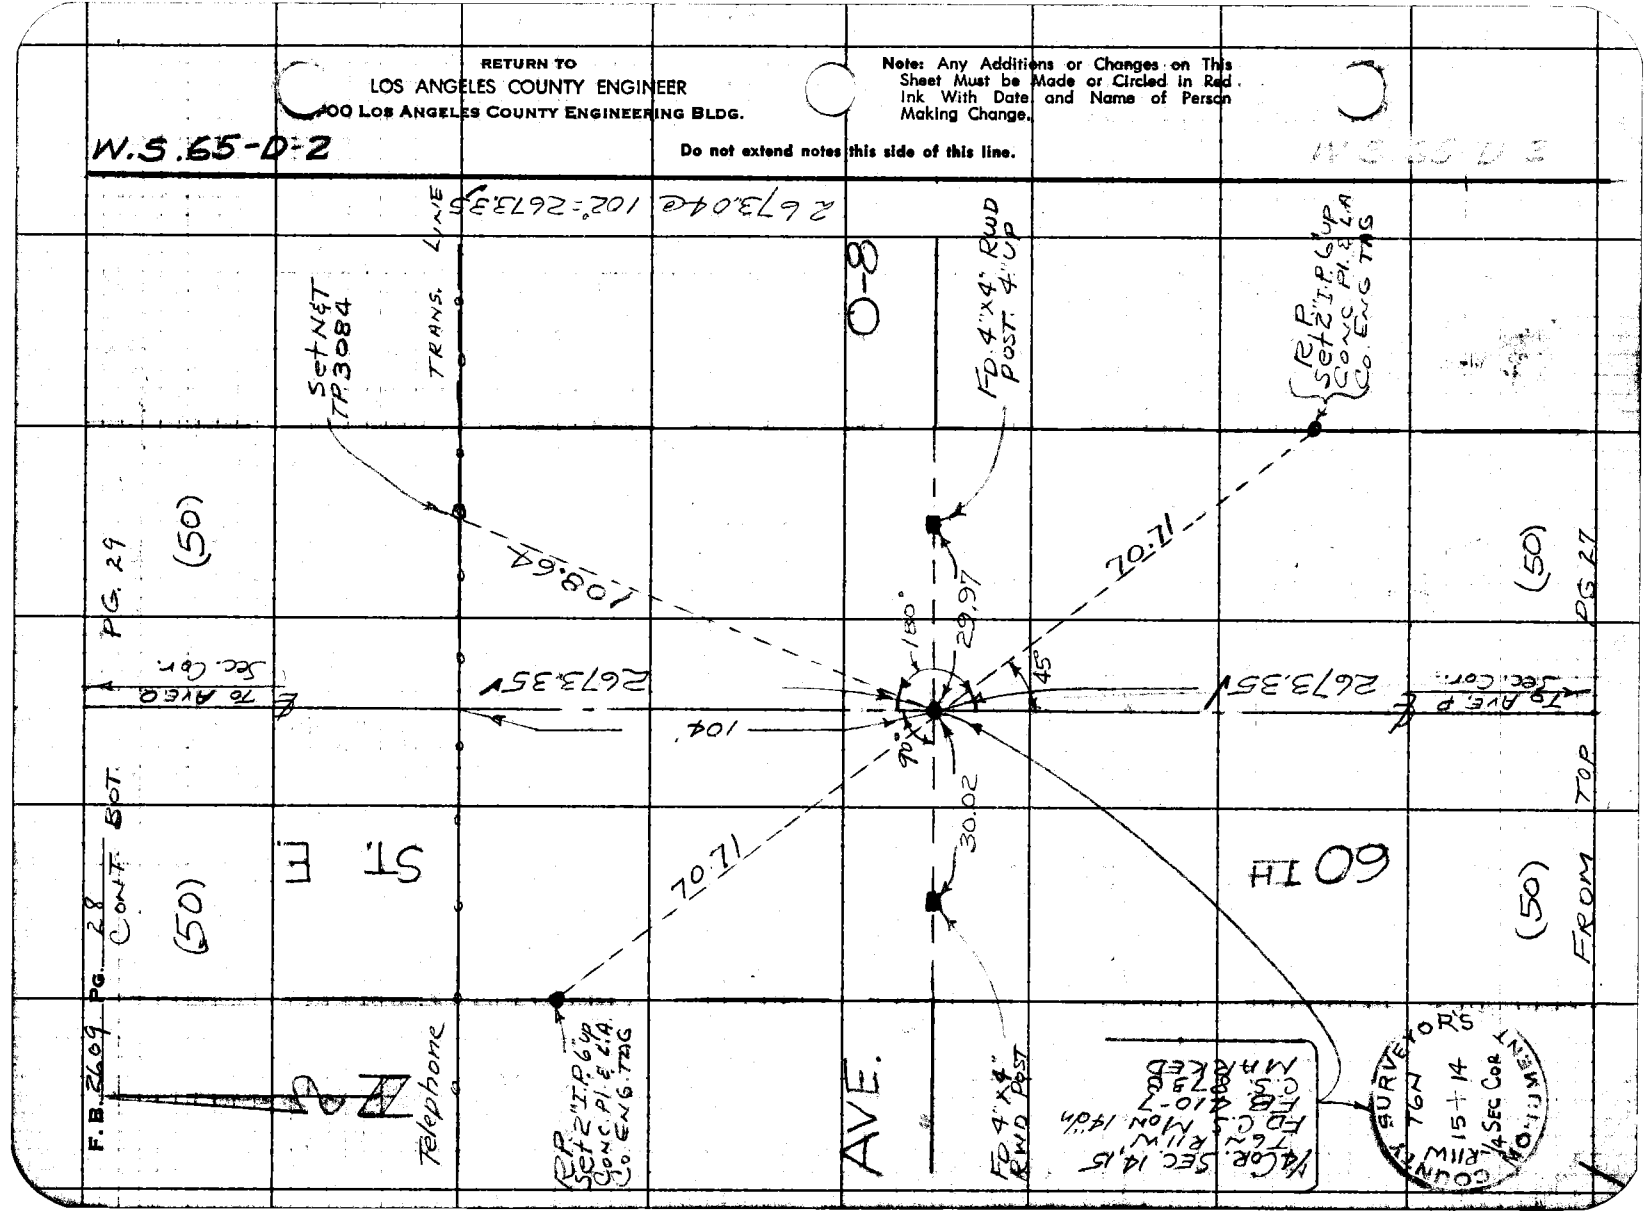

W.S. 65-D-1

Notes Ck'd by W. D. WAGNER
Map No. C.S.B. B763-1-10
Office Work J.M. PALMIERI
Checked W. D. WAGNER
Date JAN 12 1962

Survey of AVE O
JN 007585 Tape 101 Std 84 °F
Surveyed by J.S. COATES
Notes J.S.C. Date 7-1-60
Indexed H. E. OTT

F. B. 2609 PG. 29

CONT- BOT PG 30

Note: Any Additions or Changes on This Sheet Must Be Made or Circled in Red Ink With Date and Name of Person Making Change.

Do not extend notes this side of this line.

RETURN TO
LOS ANGELES COUNTY ENGINEER
900 LOS ANGELES COUNTY ENGINEERING BLDG.

783098 CE #247—7-58

(50) ST. E.

(50) AVE.

60TH

(50) AVE O

(50) AVE O

(50) FROM TOP

PG 25

PG 31

PG 28

FROM TOP

CONT BOT

To ¼ Cor AVE N-8

To ¼ Cor 55TH ST

To ¼ Cor 65TH ST

To ¼ Cor AVE O-8

2691.66

2668.04

2708.55

2673.35

89°16'50"
357°07'30"
88°16'30"
175°41'10"
89°16'51½"

R.P. Set 2" I.P. 6' dn Conc. Pl & L.A. Co Eng TAG

91°17'30"
365°17'30"
87°45'20"
91°17'53½"

Set B.S. & I.W. 15' Jos Mkd

T.G.N.C. R11W

COUNTY SURVEY MONUMENT T6N R11W 10 11 15 14

91°26'20"
365°46'00"
91°26'30"
188°39'00"
91°26'30"

R.P. Set 2" I.P. & Tag Conc. Pl. & L.A. Co Eng TAG

87°59'10"
351°56'20"
87°59'05"
167°54'30"
87°59'03"

70.71
45° Adj 50'
45°
159.45
91°
89°
16'
17'
116.43.4
26'
38'
40' Adj
87°
70.71
N 44°59'05" W

FD. Remains of 4"x4" Rwd Post 4" up

RETURN TO
LOS ANGELES COUNTY ENGINEER
900 LOS ANGELES COUNTY ENGINEERING BLDG.

Note: Any Additions or Changes on This Sheet Must be Made or Circled in Red Ink With Date and Name of Person Making Change.

Do not extend notes this side of this line.

W.S. 65-D-1

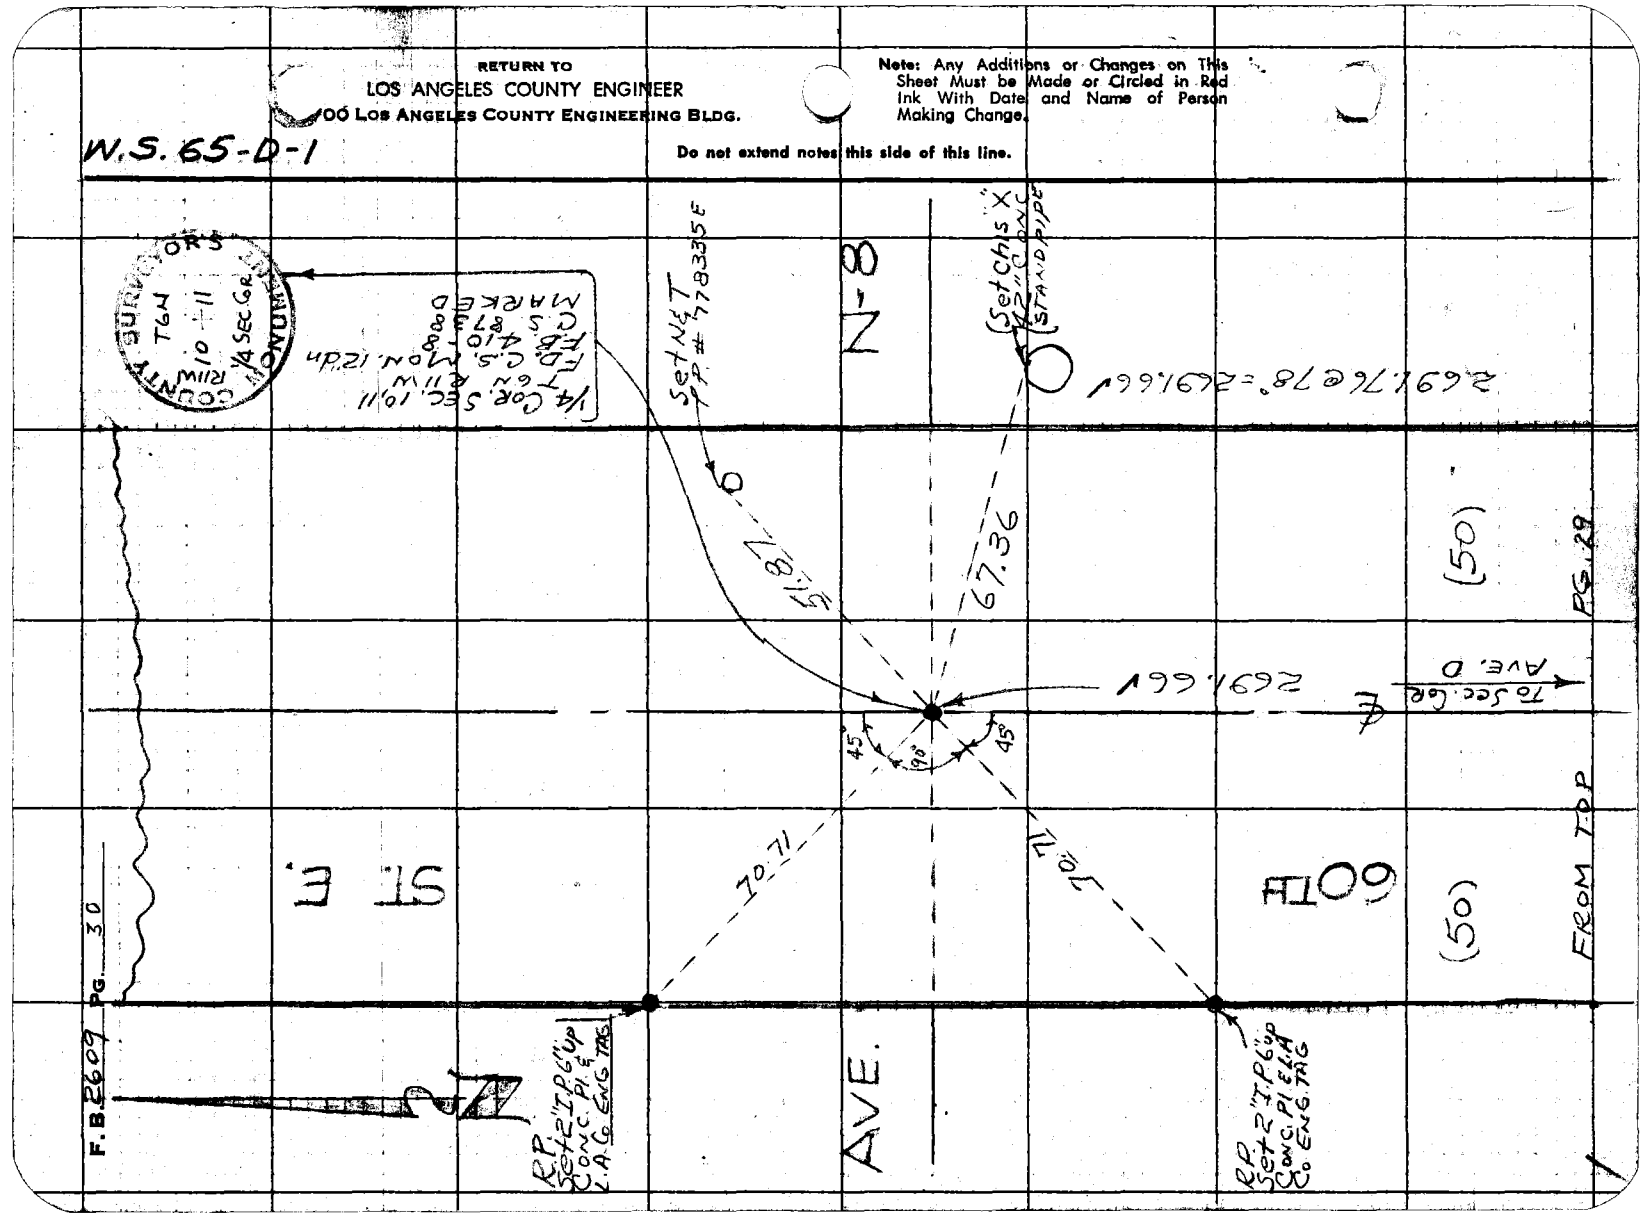

763095 CE #247—7-55

RETURN TO
LOS ANGELES COUNTY ENGINEER
700 LOS ANGELES COUNTY ENGINEERING BLDG.

Note: Any Additions or Changes on This Sheet Must Be Made or Circled in Red Ink With Date and Name of Person Making Change.

Do not extend notes this side of this line.

W.S. 65-D-2

Notes Ck'd by W. D. WAGNER
Map No. C.S.A. 2743 1-12
Office Work T.M. PALMERI
Checked W. D. WAGNER
Date JAN 12 1962

Survey of AVE. O
JN 6075 & Tape 101 Std. 84 OF
Surveyed by J.S. COATES
Notes J.S.C. Date 6-60
Indexed H. E. OTT

F.B. 2609 PG. 33

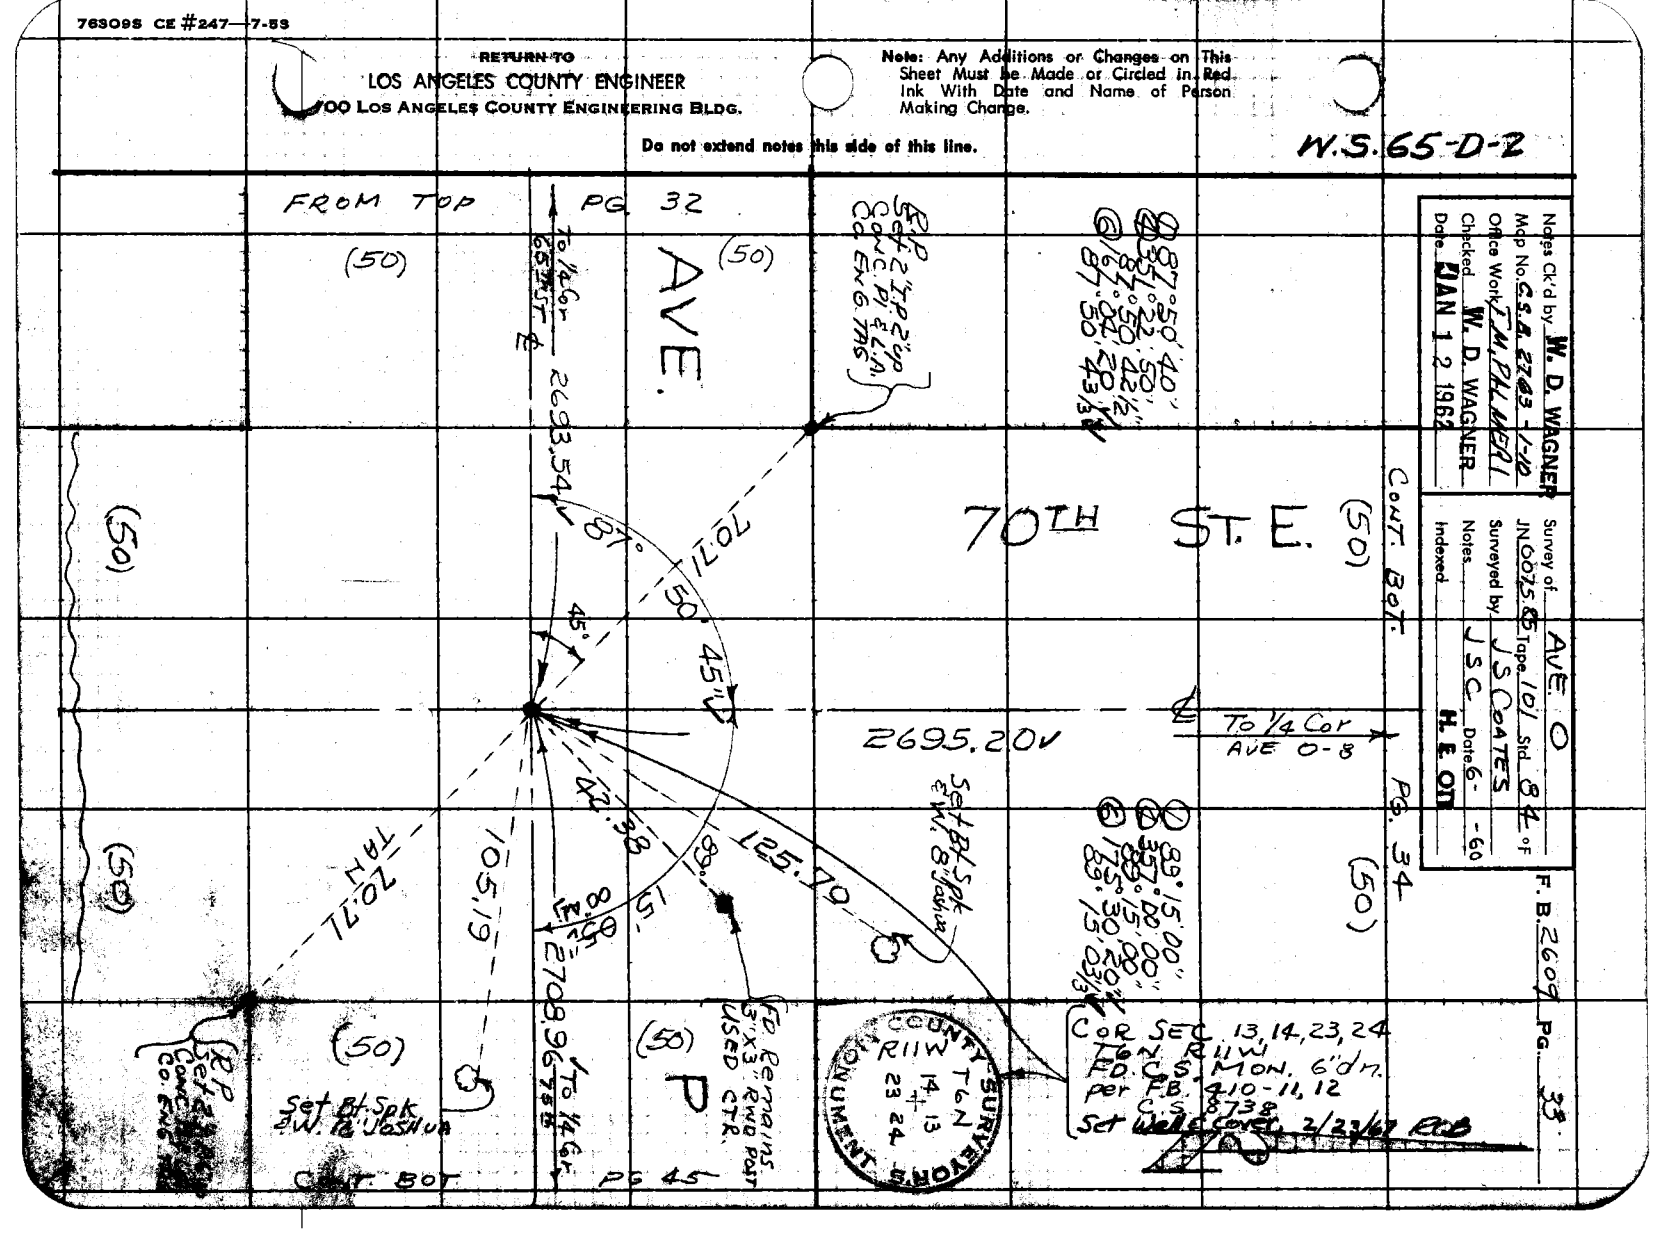

RETURN TO
LOS ANGELES COUNTY ENGINEER
900 LOS ANGELES COUNTY ENGINEERING BLDG.

Note: Any Additions or Changes on This Sheet Must be Made or Circled in Red Ink With Date and Name of Person Making Change.

Do not extend notes this side of this line.

W.S.65-D-2

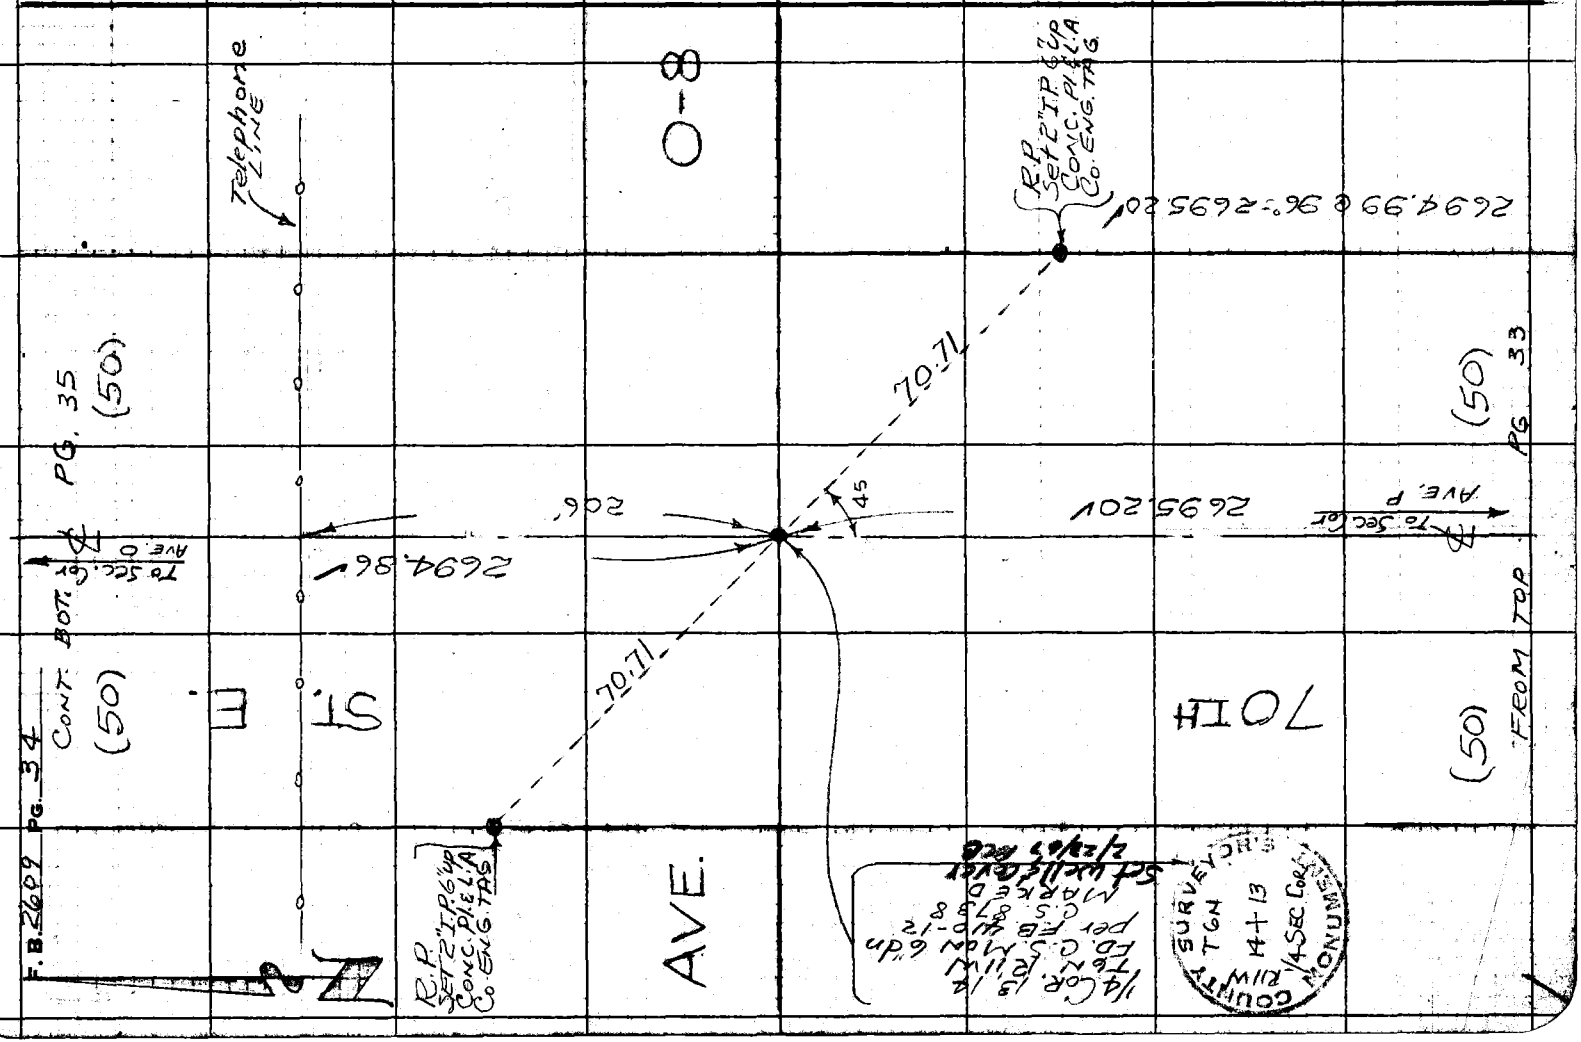

763098 CE #247—7-53

RETURN TO
LOS ANGELES COUNTY ENGINEER
700 LOS ANGELES COUNTY ENGINEERING BLDG.

Note: Any Additions or Changes on This Sheet Must be Made or Circled in Red Ink With Date and Name of Person Making Change.

Do not extend notes this side of this line.

W.S. 65-D-2

2708.55 @ 84° = 2708.55 ✓
2708.39 @ 86° = 2708.43 ✓

65TH

AVE.

AVE O

(50)

(50)

(50)

(50)

CONT LEFT

FROM ET.

SIDE PG 29

SIDE PG 35

70.71

70.71

180°

45°

℄ To Sec. Cor 60th St. E

2708.55 ✓

℄ To Sec. Cor 70th St.

2708.43 ✓

R.P. SET 2" I.P. 6" DP CONC. ENG. THS

R.P. SET 2" I.P. 6" DP CONC. ENG. THS

1/4 Cor. SEC. 11, 14
T6N R11W
FD. C.S. MON 1.2' D/n
FD. 410-37
FD. S 8738
MARKED

SURVEYOR'S MONUMENT
T6N
11 + 14
1/4 SEC. COR.

Notes Ck'd by W. D. WAGNER
Map No. C.S.M. 8265-1-42
Office Work TM. PALMER
Checked W. D. WAGNER
Date JAN 12 1962

Survey of AVE O
JN 007518 Tape 101 Std. 84 OF
Surveyed by T.S.C. - H. & D.H. 7/60
Notes T.S.C.
Indexed

F. B. 2409 PG. 37

RETURN TO
LOS ANGELES COUNTY ENGINEER
900 LOS ANGELES COUNTY ENGINEERING BLDG.

Note: Any Additions or Changes on This Sheet Must be Made or Circled In Red Ink With Date and Name of Person Making Change.

Do not extend notes this side of this line.

W.S. 65-D-2

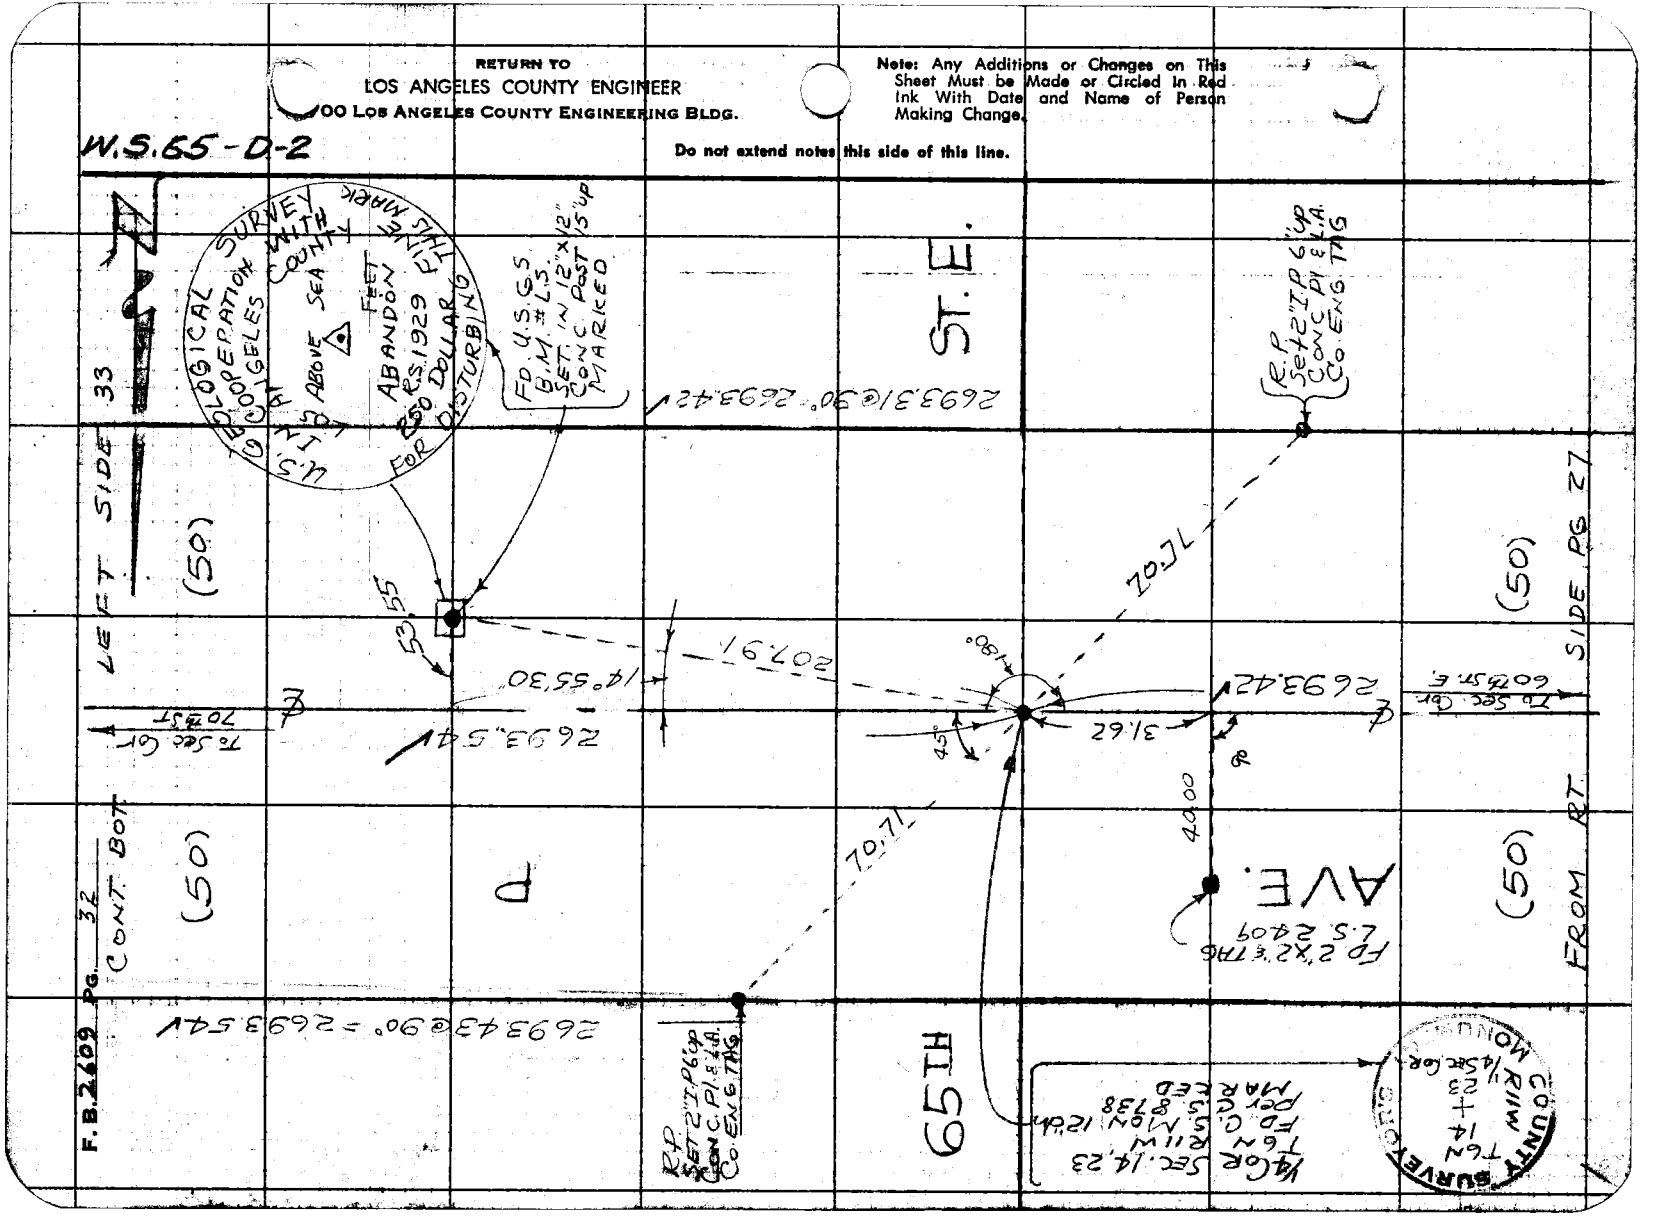

763098 CE #247—7-53

RETURN TO
LOS ANGELES COUNTY ENGINEER
900 LOS ANGELES COUNTY ENGINEERING BLDG.

Note: Any Additions or Changes on This Sheet Must Be Made or Circled in Red Ink With Date and Name of Person Making Change.

Do not extend notes this side of this line.

W.S. 65-D-2

Notes Ck'd by W. D. WAGNER
Map No. C.S.B. 2763-1-2
Office Work T. M. PALMER
Checked W. D. WAGNER
Date JAN 12 1962

Survey of AVE. O
JN 0025 P.S. Tape 10' Std. 84 °F
Surveyed by J.S. COATES
Notes, Indexed. Date 6-60
H. E. OTT

FROM TOP PG. 31

91° 40' 50"
346° 43' 20"
91° 40' 50" ✓
190° 05' 10" ✓
91° 40' 51½" ✓

(50) (50) AVE. (50)

2694.68@94°=2694.86 ✓

88° 44' 00"
354° 56' 40"
88° 44' 10" ✓
172° 25' 00" ✓
88° 44' 10" ✓

S.P. 2" I.P. L.S. Conc. Plug E.S. Tag R.E. Bdy. found 2/23/62 RCB

E.P. Set a 2" I.P. Conc. Plug f.C.E. Tag, up 6"

70.71

2708.43 ✓

88° 44' 20" Adj.

42"

90° 00' 00"

91° 40' 50" ✓

88° 44' 10" Adj.

25" Adj.

23" Adj.

70.71

70.71

70 ⊞

(50) (50) ST. E. (50)

CONT. BOT. PG. 36

FROM TOP PG. 34

℄ To ¼ Cor Ave. O-8

2694.86 ✓

℄ To ¼ Cor Ave N-B

2693.12 ✓

(50) (50) (50)

E.P. destroyed 2/23/62 RCB

E.P. Set 2" I.P. & Plug Conc. E.S. Tag

90° 23' 30"
361° 34' 23"
90° 21' 23"
180° 00' 00"

S.P. Set 2" I.P. Conc. Plug f.C.E. Tag up 6" 3/9/61 RCB

℄ To 1/4 Cor 1354.60 ✓

℄ To 1/4 Cor 2722.57

COR. SEC 11, 12, 13, 14 T6N R11W F.D.C.S. MON. 6" dh per C.S. 8738 MARKED Set well & Cover, 2/23/62 RCB

COUNTY SURVEYOR'S MONUMENT R11W T6N 11 12 13 14

88° 11' 20"
359° 45' 40"
89° 11' 25"
179° 08' 20"
89° 11' 23"

(50) (50) CONT. BOT. PG. 40

F. B. 2402 PG. 15

RETURN TO
LOS ANGELES COUNTY ENGINEER
900 LOS ANGELES COUNTY ENGINEERING BLDG.

Note: Any Additions or Changes on This Sheet Must be Made or Circled in Red Ink With Date and Name of Person Making Change.

Do not extend notes this side of this line.

W.S. 65-D-1

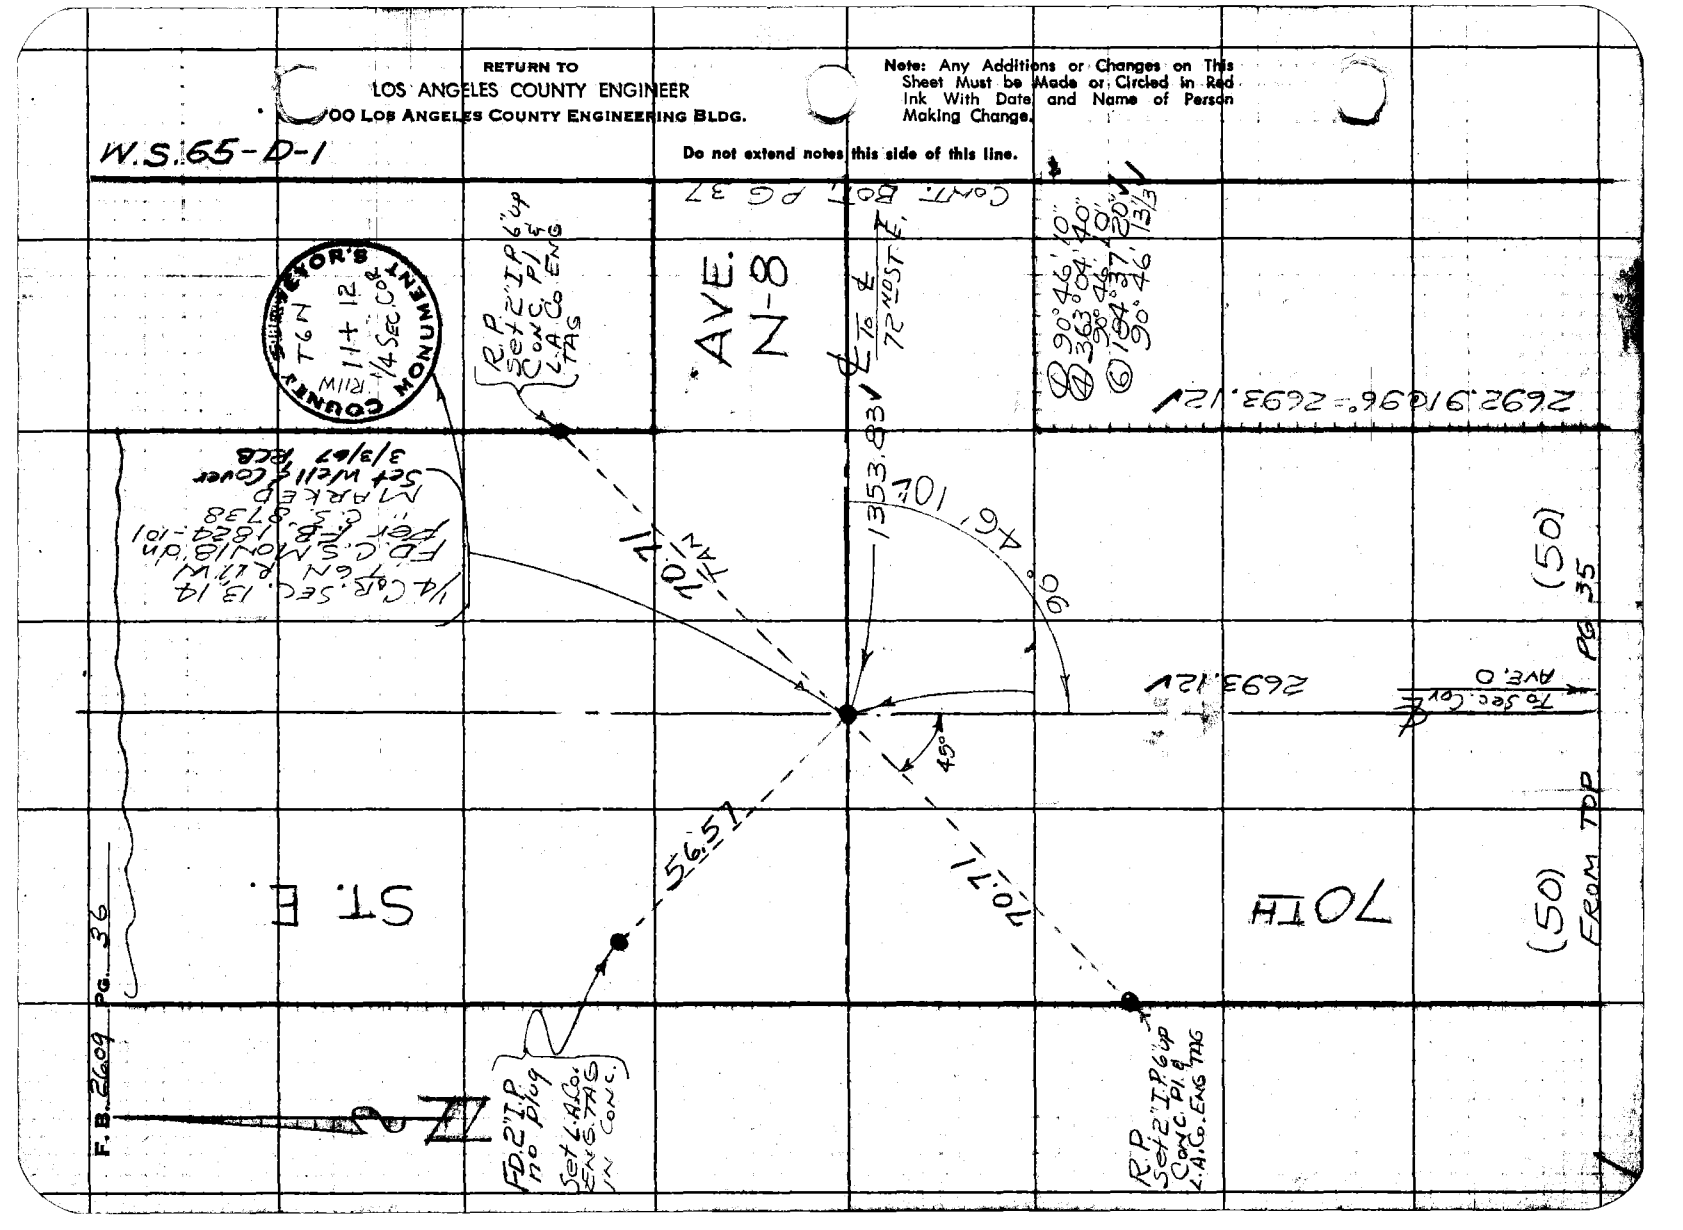

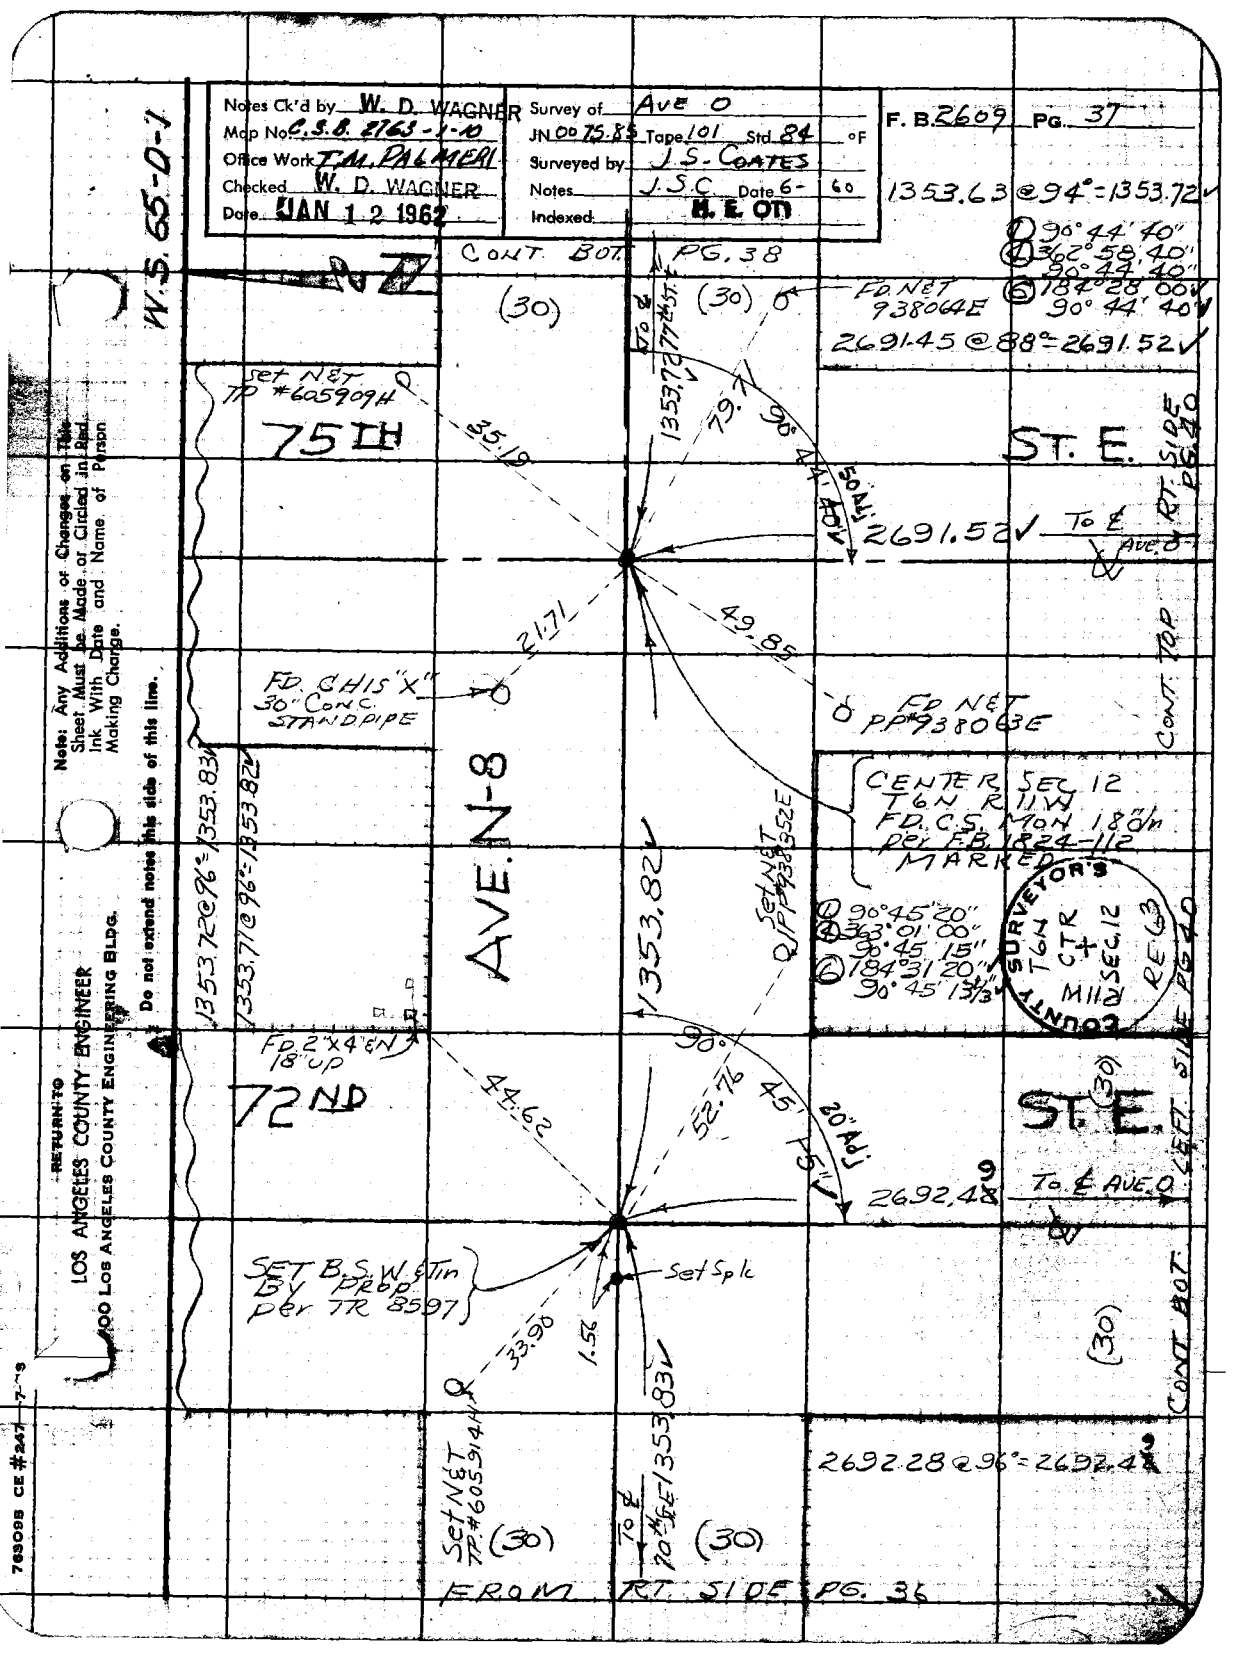
Notes Ck'd by W. D. WAGNER
Map No C.S.B. 2763-1-10
Office Work T.M. PALMIERI
Checked W. D. WAGNER
Date JAN 12 1962
Survey of AVE O
JN 00 75-85 Tape 101 Std 84 °F
Surveyed by J.S. COATES
Notes J.S.C. Date 6-60
Indexed H. E. OTT
F. B. 2609 PG. 37
W.S. 65-D-1
CONT. BOT. PG. 38
(30)
FD NET 938064E
1353.63 @ 94° = 1353.72
90° 44' 40"
362° 58' 40"
90° 44' 40"
184° 28' 00"
90° 44' 40"
2691.45 @ 88° = 2691.52
SET NET TP #605909H
75TH
1353.72
79.7
90°
50' ADJ
ST. E.
2691.52
To ℄ AVE. O
RT. SIDE PG. 40
215.19
21.71
49.89
FD. CHIS "X" 30" CONC. STANDPIPE
FD NET PP 938063E
CONT. TOP
CENTER SEC 12 T6N R11W FD. C.S. MON 180" DEP. FB 1824-112 MARKED
1353.71 @ 96° = 1353.82
1353.82
AVE. N-8
SET NET PP 938052E
90° 45' 20"
363° 01' 00"
90° 45' 15"
184° 31' 20"
90° 45' 13 1/3"
SURVEYOR'S COUNTY T6N CTR M11 SEC 12 RE 63
FD 2" X 4" 6'N 18" UP
72ND
44.62
90°
52.76
45
75'
20' ADJ
ST. E.
(30)
2692.48
To ℄ AVE. O
LEFT SIDE PG 40
SET B.S. W/TIN BY PROP PER TR 8597
Set Spk
33.90
1.52
1353.83
(30)
(30)
2692.28 @ 96° = 2692.43
CONT. BOT.
SET NET TP #605914H
To ℄ 20' ADJ ℄ 1353.83
FROM RT. SIDE PG. 36
Note: Any Additions or Changes on This Sheet Must be Made or Circled in Red Ink With Date and Name of Person Making Change.
Do not extend notes this side of this line.
RETURN TO
LOS ANGELES COUNTY ENGINEER
900 LOS ANGELES COUNTY ENGINEERING BLDG.
763098 CE #247 7-63

F.B. 2609, Pg. 38

CONT. BOT. (30)

PG 39

(30)

676.82 @ 94° = 676.86

676.86

Established by Tie as Prop. Intersection Set

5.00'

3.73

78TH

Set NET PP#938073E

Set NET PP#938074E

18.05

ST. E.

(30)

LOT LINE

Set B.S. W ETIN By Prop Per TR#8597

2.95

Set Spk

To ℄ AVE.

2689.77 @ 98° = 2689.97

90.01

8" Adj.

Set NET TP#605903H

36.03

89° 17'

AVE. N-8

676.82 @ 94° = 676.86

676.86

89° 17' 00"
357° 08' 20"
89° 17' 05"
175° 42' 40"
89° 17' 06.3"

FD NET PP#938070E

63.00

Set NET 4"x4" ST. SIGN POST 77TH

42.28

ST. E.

(30)

2690.84

To ℄ AVE.

SET BY Spk W. S. T. IN By Prop Per TR 8597

34.31

6.85

Set Spk

25" Adj.

89° 16' 30"

353.72

FD. NET T.P. # 605905H

2690.63 @ 96° = 2690.84

89° 16' 40"
357° 06' 00"
89° 16' 30"
175° 39' 00"
89° 16' 30"

(30)

To 75th St. Ctr. Sec.

(30)

FROM TOP PG 37

CONT. LEFT SIDE BOT. PG 41

CONT. TOP LEFT SIDE PG 41

Revised by HJA 9-11-68

S. 65-E-1

RETURN TO LOS ANGELES COUNTY ENGINEER 900 Los Angeles County Engineering Bldg.

Do not extend notes this side of this line.

Note: Any Additions or Changes on This Sheet Must be Made or Circled in Red Ink With Date and Name of Person Making Change.

763098 CE #247—7-53

RETURN TO
LOS ANGELES COUNTY ENGINEER
700 LOS ANGELES COUNTY ENGINEERING BLDG.

Note: Any Additions or Changes on This Sheet Must be Made or Circled in Red Ink With Date and Name of Person Making Change.

Do not extend notes this side of this line.

W.S. 66 - A-1

Notes Ck'd by W. D. WAGNER
Map No. 63-2-27 Sht. 1-10
Office Work TM. PALMER
Checked W. D. WAGNER
Date JAN 12 1962

Survey of AVE O
JN 2075.85 Tape ☐ / Std 84 ☐ OF
Surveyed by J.S.C. COATES
Notes J.S.C. Date 6-60
Indexed H. E. ORT

F. B. 2609 PG. 39

SURVEYOR'S MONUMENT
T6N R11W
12+7
1927

1/4 COR. Sec. 7, T6N R10, 11 W
1/4 SEC. COR.
FD. C.S. Mon. 12 dn
per F.B. 1824-102
C.S. 8738
C.S. 8733

FD 2" I.P. F.N.
F.B. 1824-102

FD. 2"x2" E.N.
No Ref

80TH ST.

AVE. N-8

(30)
FROM TM PG 38
(30)

To ℄ 79th St E
HJA 9-11-68

676.86'

56.68'

64.31'

89° 03' 17"

55'

56.59'

69.83'

2689.69'

2689.59 @ 90° = 2689.69

Set Chis "X" & PM IN 4" Chis COR FN BRT

(50)

Set B&T Spk & Tin Washer

To Sec Cor Y & AVE O

(50)

FD 2" I.P. F.N. & Nail
F.B. 1824-102

AVE O

89° 8' 00" E 355.11'
89° 11' 30" E 89.11'
89° 47' 30" E 55'

CONT. LEFT SIDE PAGE

RETURN TO
LOS ANGELES COUNTY ENGINEER
900 LOS ANGELES COUNTY ENGINEERING BLDG.

Note: Any Additions or Changes on This Sheet Must be Made or Circled in Red Ink With Date and Name of Person Making Change.

Do not extend notes this side of this line.

W.S. 65-D-2

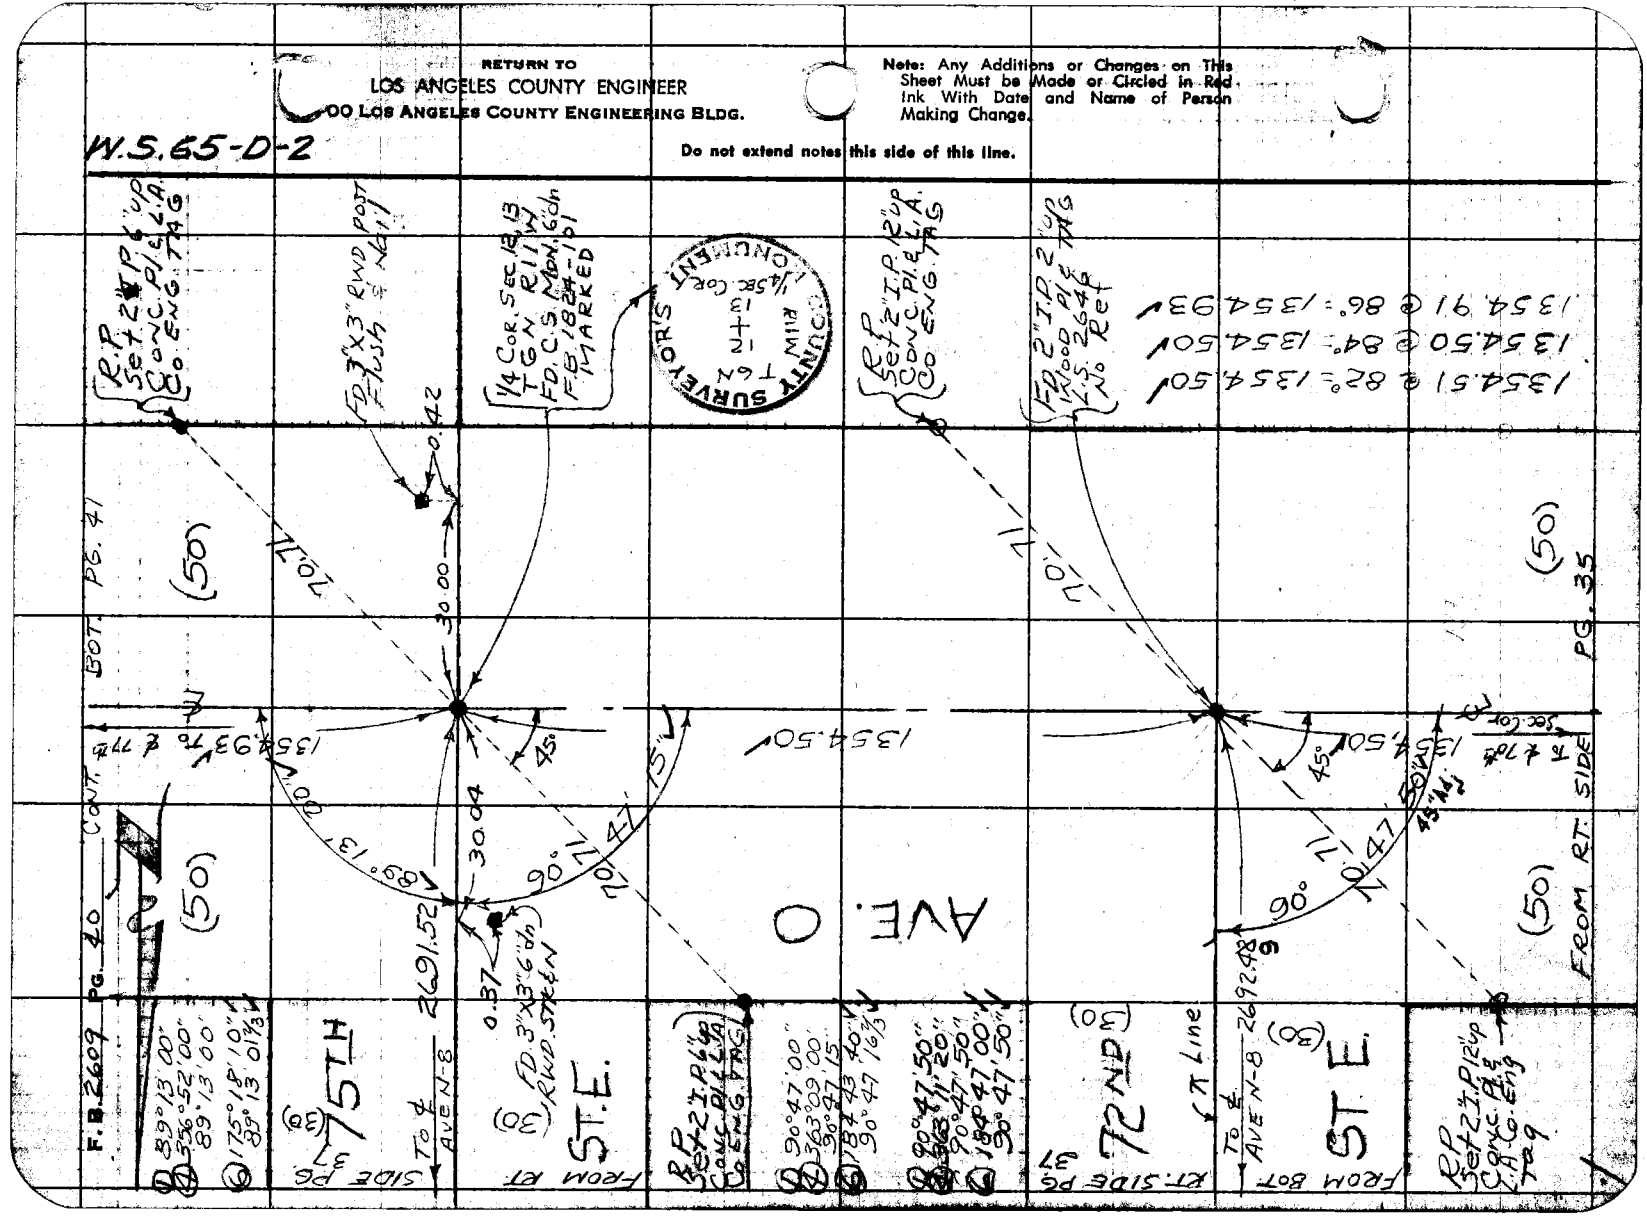

W.S. 66-A-2

Notes Ck'd by W. D. WAGNER
Map No C.S.B. 2765 1-10
Office Work T.M. PALMER
Checked W. D. WAGNER
Date JAN 12 1962

Survey of AVE O
JN 0075 85 Tape 101 Std. 84 °F
Surveyed by J.S. COATES
Notes J.S.C. 11-2-61 Date 60
Indexed

F.B. 2609 PG. 41

Revised by HJA 9-11-68

CONT. BOT. PG 42

Note: Any Additions or Changes on This Sheet Must Be Made or Circled in Red Ink With Date and Name of Person Making Change.

Do not extend notes this side of this line.

RETURN TO
LOS ANGELES COUNTY ENGINEER
900 LOS ANGELES COUNTY ENGINEERING BLDG.

763098 CE #247—7-59

89° 15' 00"
356° 59' 20"
89° 14' 50"
175° 29' 10"
89° 14' 51 1/2"

SET N&T PP#938090E

78TH

(30)

LOT LINE

5.00

To ℄ AVE N-8 2688.97 90.01

FROM TOP RT. SIDE PG. 38

ST. E.

(30)

Set N&T PP# 605342H

41.25

To ℄ 677.47

Set 1/2" I.P. 12" in Conc. Pl. & L.H. CO. ENG. TAG By RP&P per TR 8597

Established by Proportion per T.R. B597 Nothing Set

89° 14' 50"

175

1.00

1.75

67.47

40.46

O

677.46

89° 14' 20"
356° 57' 00"
89° 14' 15"
175° 25' 20"
89° 14' 13 1/2"

Set N&T PP#605841H

677.46

RP Set 1" I.P. 2" up Conc. Pl. & L.H. CO. ENG. TAG

Set 2" I.P. 12" in Conc. Pl. & L.H. CO. ENG. TAG By RP&P per TR 8597

FD. 2 X 4 EN 18" h. ga

77TH

(30)

89° 14' 15"

40

70.71

AVE.

50.00

FROM BOT. RT. SIDE PG 38

To ℄ AVE N-8 2690.84

45°

24.44

Set 1" I.P.F.I. Conc. Pl. & L.H. CO. ENG. TAG & prod

ST. E.

(30)

70.71

Set 1" x 1" EN

To ℄ 1354.93

Set 1" I.P.R. up Conc. Pl. & L.H. CO. ENG. TAG

FROM TOP PG. 40

RETURN TO
LOS ANGELES COUNTY ENGINEER
900 LOS ANGELES COUNTY ENGINEERING BLDG.

Note: Any Additions or Changes on This Sheet Must be Made or Circled in Red Ink With Date and Name of Person Making Change.

Do not extend notes this side of this line.

W.S. 66-A-2

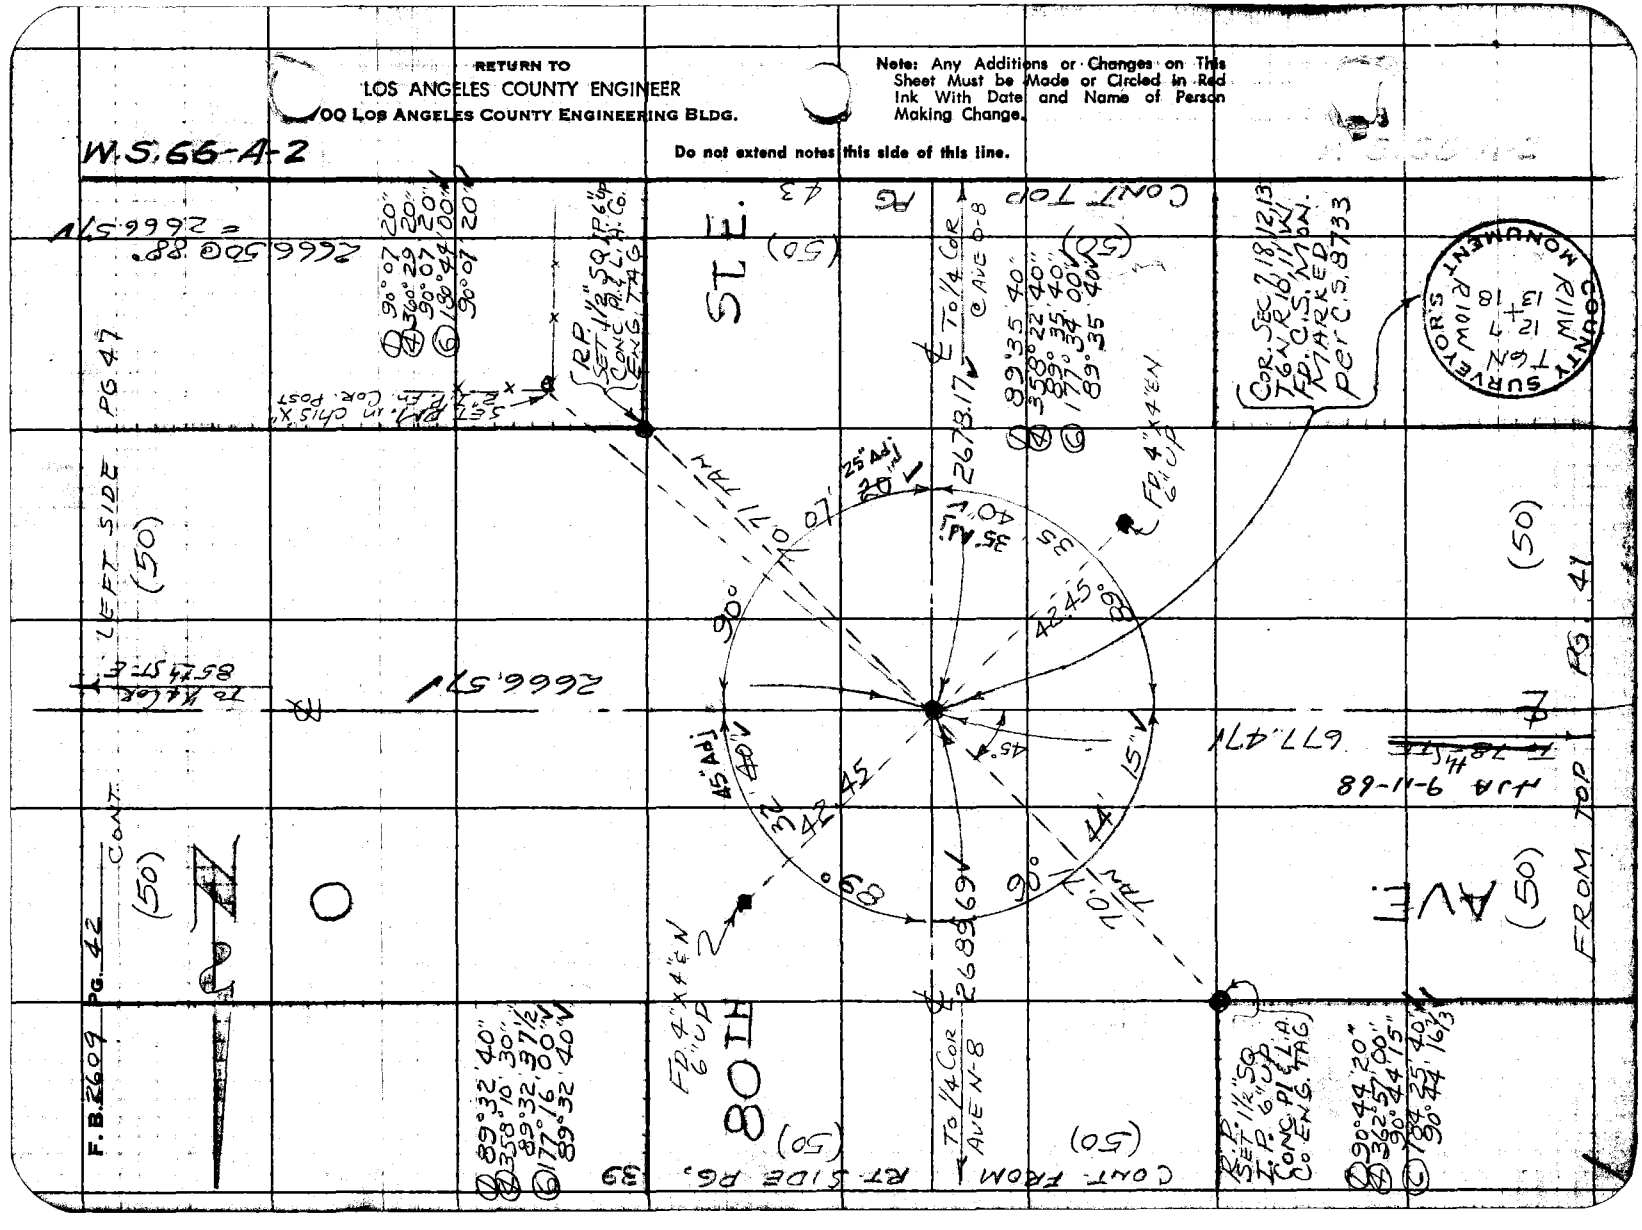

763098 CE #247—7-53

RETURN TO
LOS ANGELES COUNTY ENGINEER
700 LOS ANGELES COUNTY ENGINEERING BLDG.

Note: Any Additions or Changes on This Sheet Must be Made or Circled In Red Ink With Date and Name of Person Making Change.

Do not extend notes this side of this line.

W.S. 65-A-2

Notes Ck'd by W. D. WAGNER
Map No. C.S. B 2763-1-10
Office Work T.M. PALMIERI
Checked W. D. WAGNER
Date JAN 12 1962

Survey of AVE. O
JN 00765 Tape 101 Std. 84 °F.
Surveyed by J.S. COATES
Notes Date 6-60
Indexed H.E. OTT

F.B. 2609 Pg. 43

AVE. O

80TH ST. E (50)

FROM RT SIDE

(50) CONF. TOP

(50) PG 44

(50) PG 42

1/4 SEC. COR 13, 18
T 6N R 10W S.B.B.&M.
FD C.S. MON. FI
LOWERED TO 12 in
PGR C.S. 8738
NO MARKED

COUNTY SURVEYOR'S MONUMENT
1/4 SEC. COR
T6N
13+18
R10W

RP
Set 2" I.P. 6' UP
CONC. PLUG
CO. ENG. TAG

RP
Set 2" I.P. 6' UP
CONC. PLUG
CO. ENG. TAG

FD 4" x 4" K.M.
POST. ENDS

To Sec. Cor AVE. P

2677.60 V

To Sec. Cor AVE. O

2678.17 V

45°

70.71

70.71

179° 59' 20"

.08

2677.50 @ 90° = 2677.50

2678.03 @ 92° = 2678.17 V

① 179° 59' 20"
② 359° 59' 50"
③ 179° 59' 20"
④ 359° 56' 00" V
179° 59' 20" V

RETURN TO
LOS ANGELES COUNTY ENGINEER
900 LOS ANGELES COUNTY ENGINEERING BLDG.

Note: Any Additions or Changes on This Sheet Must be Made or Circled in Red Ink With Date and Name of Person Making Change.

Do not extend notes this side of this line.

W.S. 66-A-2

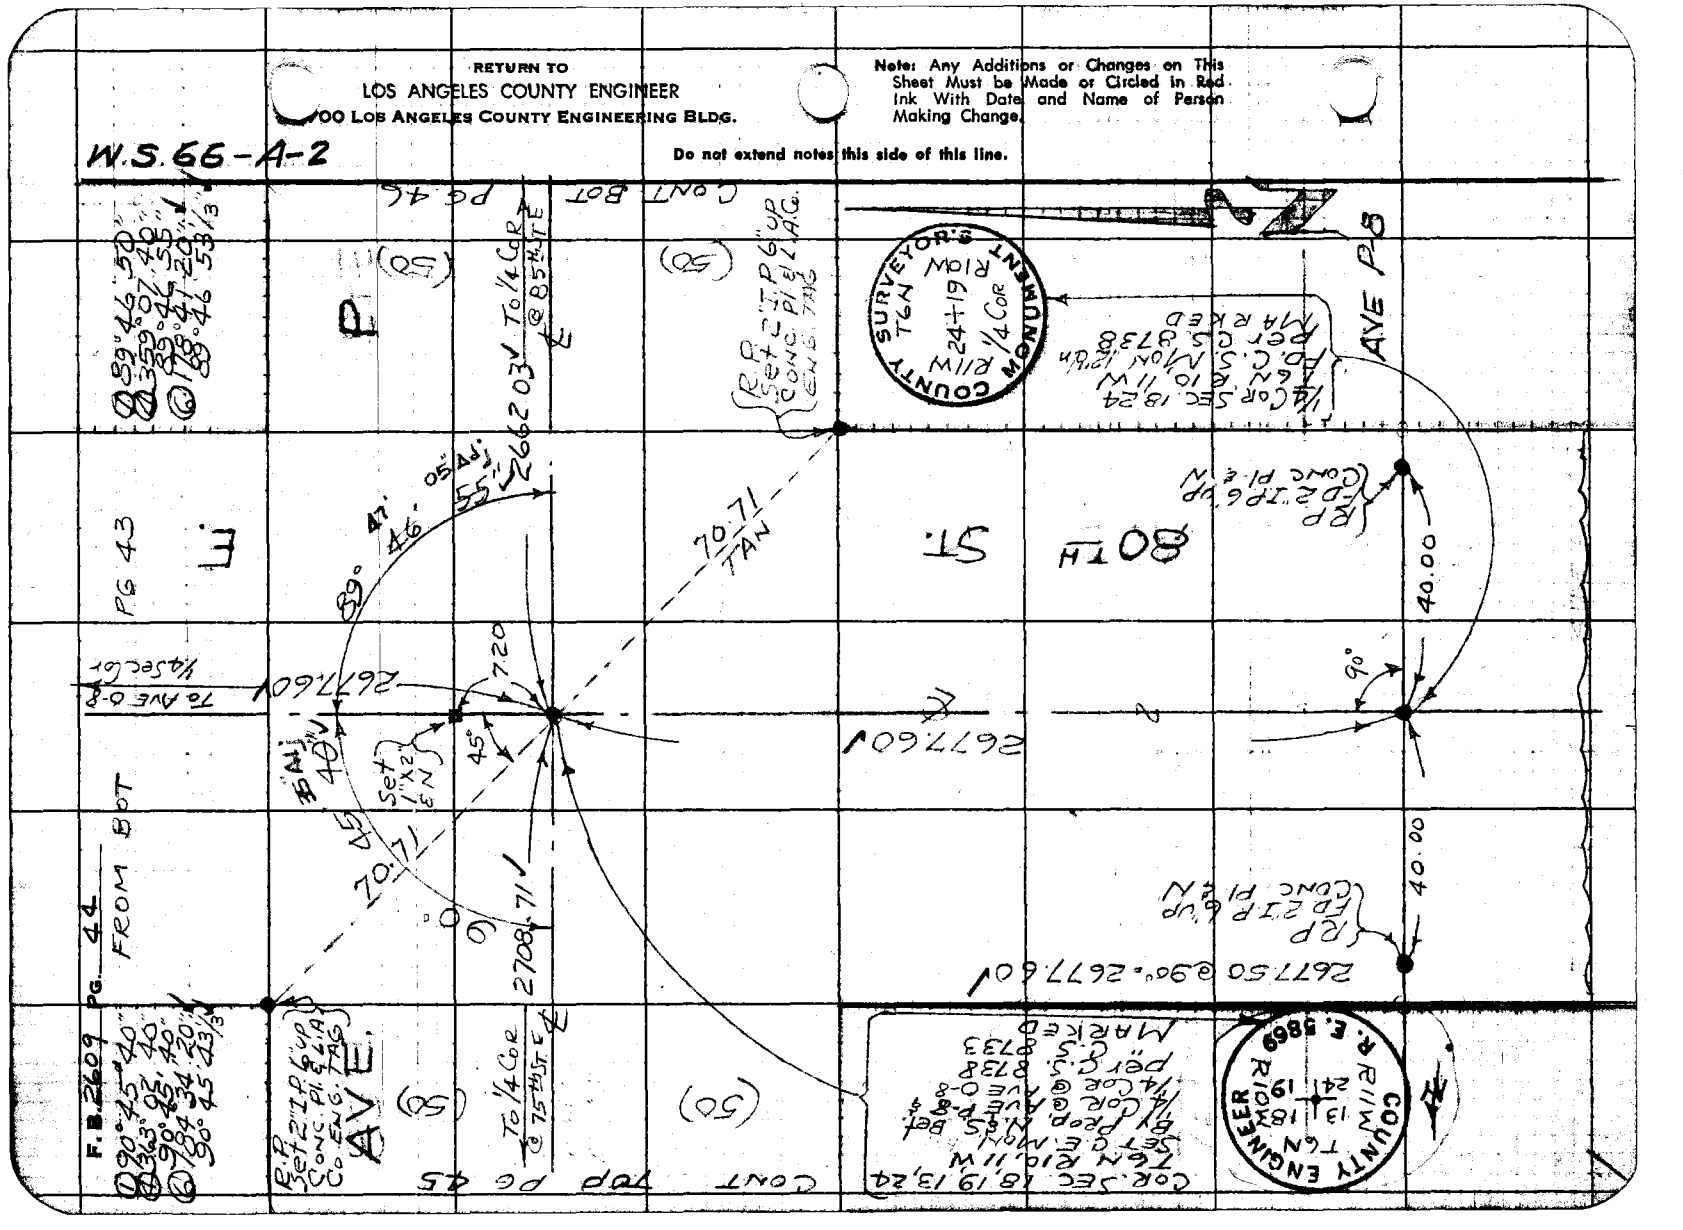

76F3095 S&E #247 11-58

PLEASE RETURN TO
LOS ANGELES COUNTY ENGINEER
700 LOS ANGELES COUNTY ENGINEERING BLDG.

Note: Any Additions or Changes on This Sheet Must be Made or Circled in Red Ink With Date and Name of Person Making Change.

Do not extend this side of this line.

W.S. 65-D-2

Notes Ck'd by W. D. WAGNER
Map No. C.S. 8783-1-20
Office Work T.H. PALMER
Checked W. D. WAGNER
Date JAN 12 1952

Survey of AVE. O
JN 0075.86 Tape 101 Std. 84 °F
Surveyed by J.S.C. COATES
Notes J.S.C. Date 7-28-49
Indexed H. E. ON

2708.67 @ 100° = 2708.96 ✓

75TH

R.P. SET 2" I.P. 6" UP CONC. FD. & L.A.C. ENG. TAG

AVE. O

AVE.

(50)

(50)

(50)

FROM LEFT SIDE PG 44

FROM RT. SIDE PG. 33

To Sec. Cor. 70th ST. E.

2708.96 ✓

℄

2708.71 ✓

To ℄ 80th ST E @ Sec. Cor.

℄

70.71

70.71

45°

R.P. SET 2" I.P. 6" UP CONC. FD. & L.A.C. ENG. TAG

1/4 COR SEC 13, 24
T 6 N R 11 W
FD. C.S. MON. 12"6M
PER C.S. 8738
MARKED

ST. E.

2708.43 @ 100° = 2708.71 ✓

COUNTY SURVEYORS T 6 N R 11 W 13 24 1/4 SEC. COR MONUMENT

F. B. 2609 Pg. 46

PLEASE RETURN TO
LOS ANGELES COUNTY ENGINEER
700 LOS ANGELES COUNTY ENGINEERING BLDG.

Note: Any Additions or Changes on This Sheet Must be Made or Circled in Red Ink With Date and Name of Person Making Change.

Do not extend this side of this line.

W.S. 66-A-2

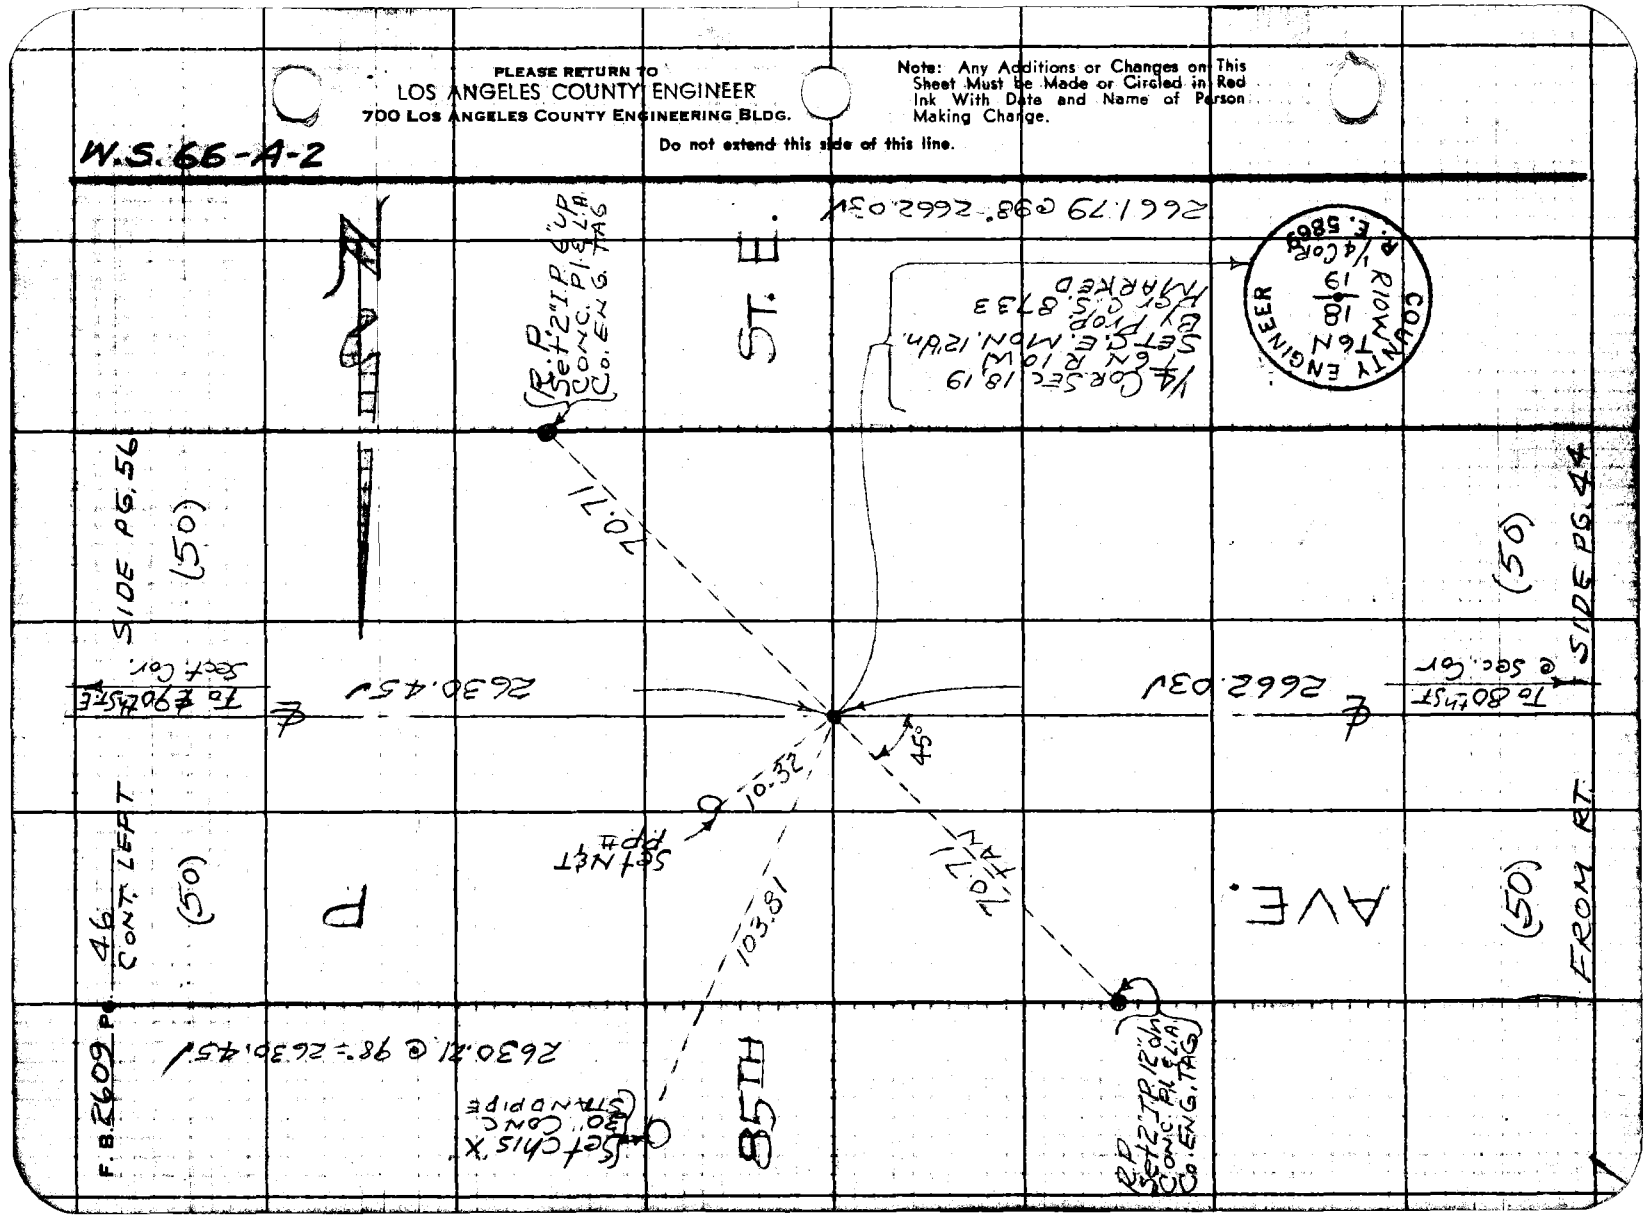

W.S.66-4-2

Notes Ck'd by W. D. WAGNER
Map No. C.S.B. 2763 - 1-10
Office Work I. M. PALMIERI
Checked W. D. WAGNER
Date JAN 12 1962

Survey of AVE O
JN 0075.85 Tape 101 Std 84 °F
Surveyed by J.S. COATES
Notes JS 8-10-60 D.O.H.
Indexed

F. B. 2609 Pg. 47

Note: Any Additions or Changes on This Sheet Must be Made or Circled in Red Ink With Date and Name of Person Making Change.

Do not extend this side of this line.

PLEASE RETURN TO
LOS ANGELES COUNTY ENGINEER
700 LOS ANGELES COUNTY ENGINEERING BLDG.

N.W. COR R.S. 75-25

FD. 2" I.P. CONC. PLUG PER R.S. 75-25

FD. NAIL & TAG #2772 J.A.56

Set N&T T.P. #2772

BARSTOW RD

R.S. #75-25

522.84 @ 96° = 522.88
816.00 @ 96° = 816.12

816.12

134.95

71.10

FD. 2"X2" Nail

48.11

68.21

FD. 2"X2" & Nail

R.P. Set 2" I.P. 6" up Conc. Pl. & L.A. Co. ENG TAG

Set N&T T.P. #7015 H

522.88

(40)

85TH ST E

1/4 COR SEC 7, 8
T6N R10W
FD. C.S. NAIL 12" dn
per C.S. 8733
MARKED

COUNTY SURVEYOR
T6N
R10W
7
18
1/4 SEC. COR.
MONUMENT

90° 14' 00"
360° 56' 10"
90° 14' 02 1/2"
179° 34' 10"
90° 14' 01 2/3"

89° 46' 20"
359° 05' 20"
89° 46' 20"
178° 38' 00"
89° 46' 20"

AVE. O

(82)

SIDE LINE

673.35

To ℄ 86TH ST E

℄

90° 14' 00"

89° 46' 20"

138.82

To Sec Cor 80TH ST E

45°

2666.57

TAN

40.71

FROM TOP DG. 4E

R.S. Set 2" I.P. 6" up Conc. Pl. & L.A. Co. ENG. TAG

(50)

CONT. LEFT

SIDE LINE

28F3066 SAE #242 11-58

PLEASE RETURN TO
LOS ANGELES COUNTY ENGINEER
700 LOS ANGELES COUNTY ENGINEERING BLDG.

Note: Any Additions or Changes on This Sheet Must be Made or Circled in Red Ink With Date and Name of Person Making Change.

Do not extend this side of this line.

W.S. 66-A-2

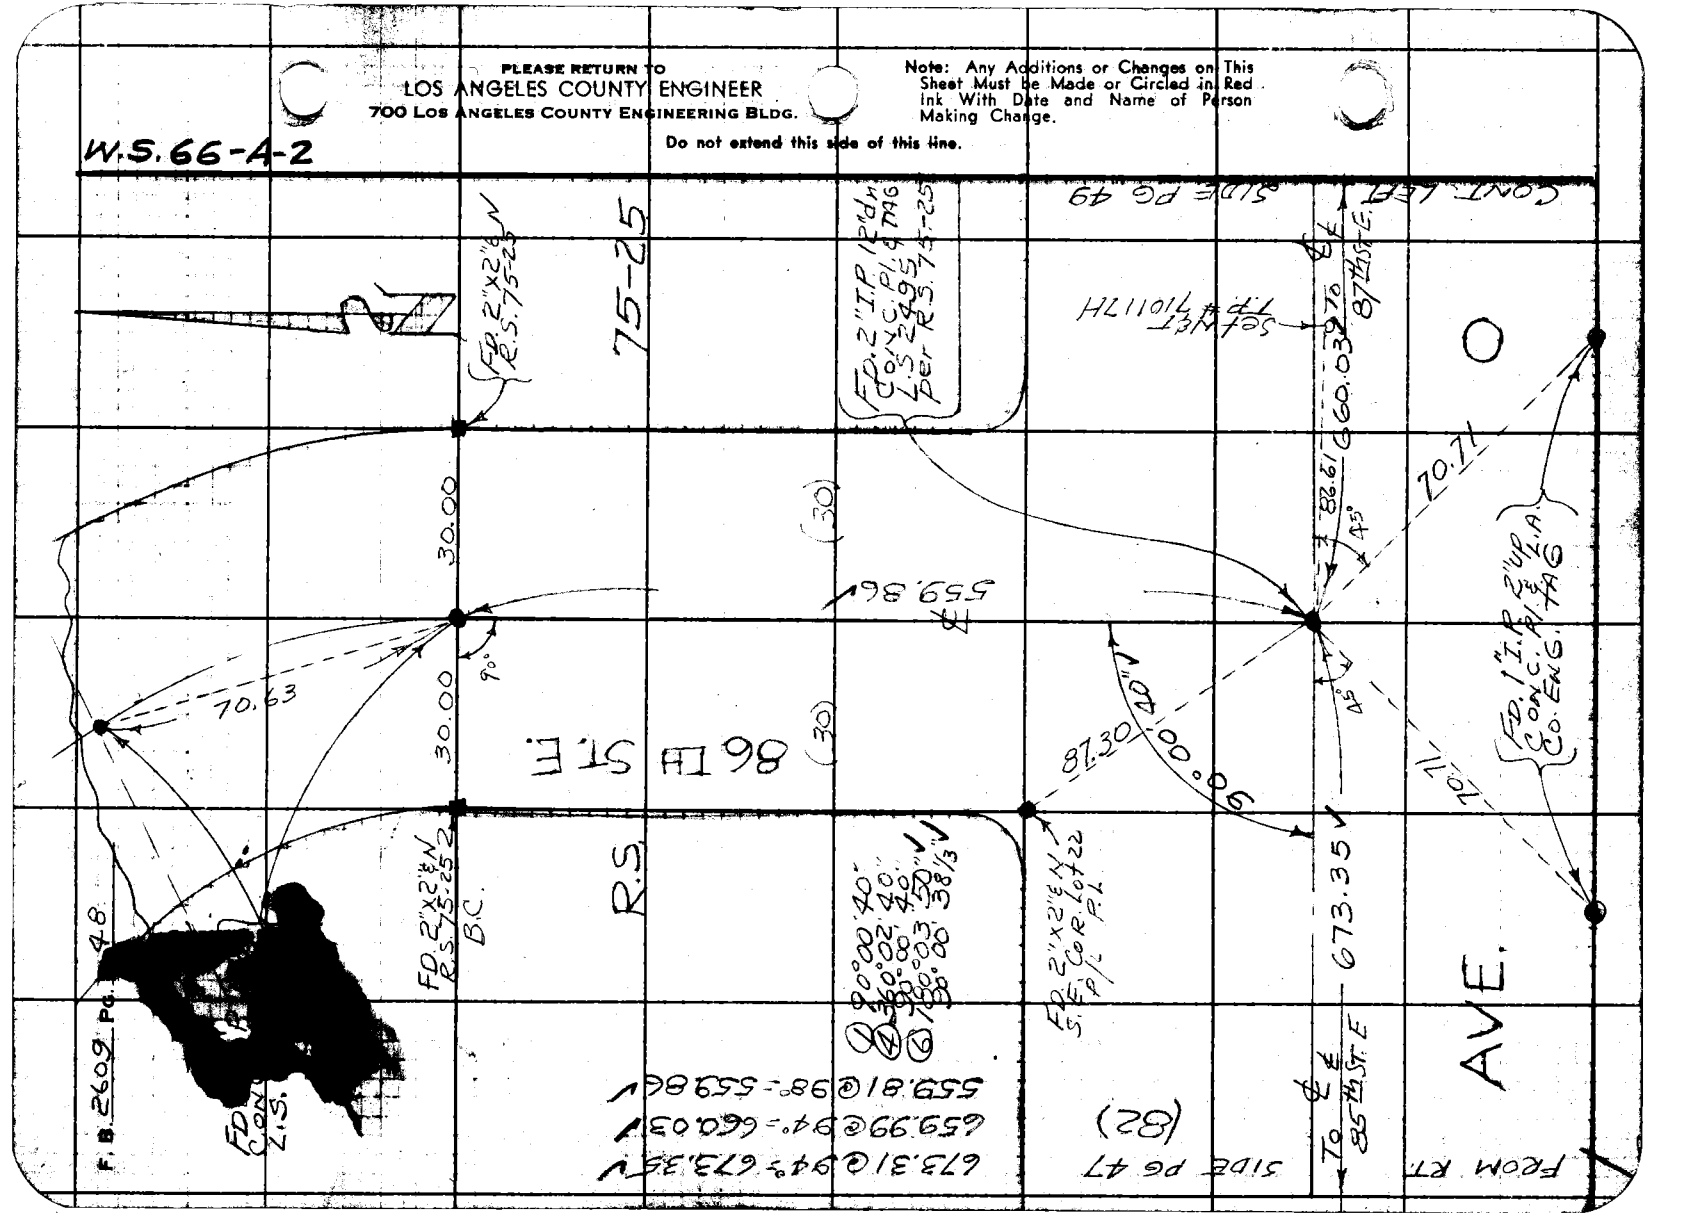

Notes Ck'd by W. D. WAGNER
Map No. C.S.B.2263-1-10
Office Work T.M. PALMERI
Checked W. D. WAGNER
Date JAN 12 1962

Survey of AVE. O
JN 0075.85 Tape 101 Std 84 °F
Surveyed by JS COATES
Notes J.S.C. Date 8-12-60
Indexed H. L. Orr

F. B. 2609 Pg. 49

W.S. 66-A-2

Note: Any Additions or Changes on this Sheet Must be Made or Circled in Red Ink With Date and Name of Person Making Change.

Do not extend this side of this line.

PLEASE RETURN TO
LOS ANGELES COUNTY ENGINEER
700 Los Angeles County Engineering Bldg.

E.C.

FD. 2" I.P. 12" in C. P. & Tag R.S. 75-25

29.07

30.00

30.01

FD. 2" X 2" & N R.S. 75-25

FD. 2" X 2" & N R.S. 75-25

RS

97TH ST. E.

612.01 @ 94°

612.05

828.99

828.91 @ 98°

828.99

75-25

FD. 2" I.P. 12" in C. P. & Tag R.S. 75-25 per R.S. 75-25

FD. 2" X 2" & N P.K. Nail

FD. 2" X 2" & N P.K. Nail

90° 01' 00"
90° 04' 00"
90° 01' 00"
90° 01' 00"

87.19

87.22

90° 01' 00"

(82) AVE.

(82) O

SIDE PG 48

SIDE PG 50

FROM RT

(50)

(50)

CONT. NEXT

To ℄ 86th ST

660.03

45°

45°

612.05

To ℄ 88th ST

70.71

70.71

SET 1" I.P. 2" UP CONC. P. L. A. CO. ENG. TAG

76F3095 SAE #247 11-58

PLEASE RETURN TO
LOS ANGELES COUNTY ENGINEER
700 LOS ANGELES COUNTY ENGINEERING BLDG.

Note: Any Additions or Changes on This Sheet Must be Made or Circled in Red Ink With Date and Name of Person Making Change.

Do not extend this side of this line.

W.S. 66-A-2

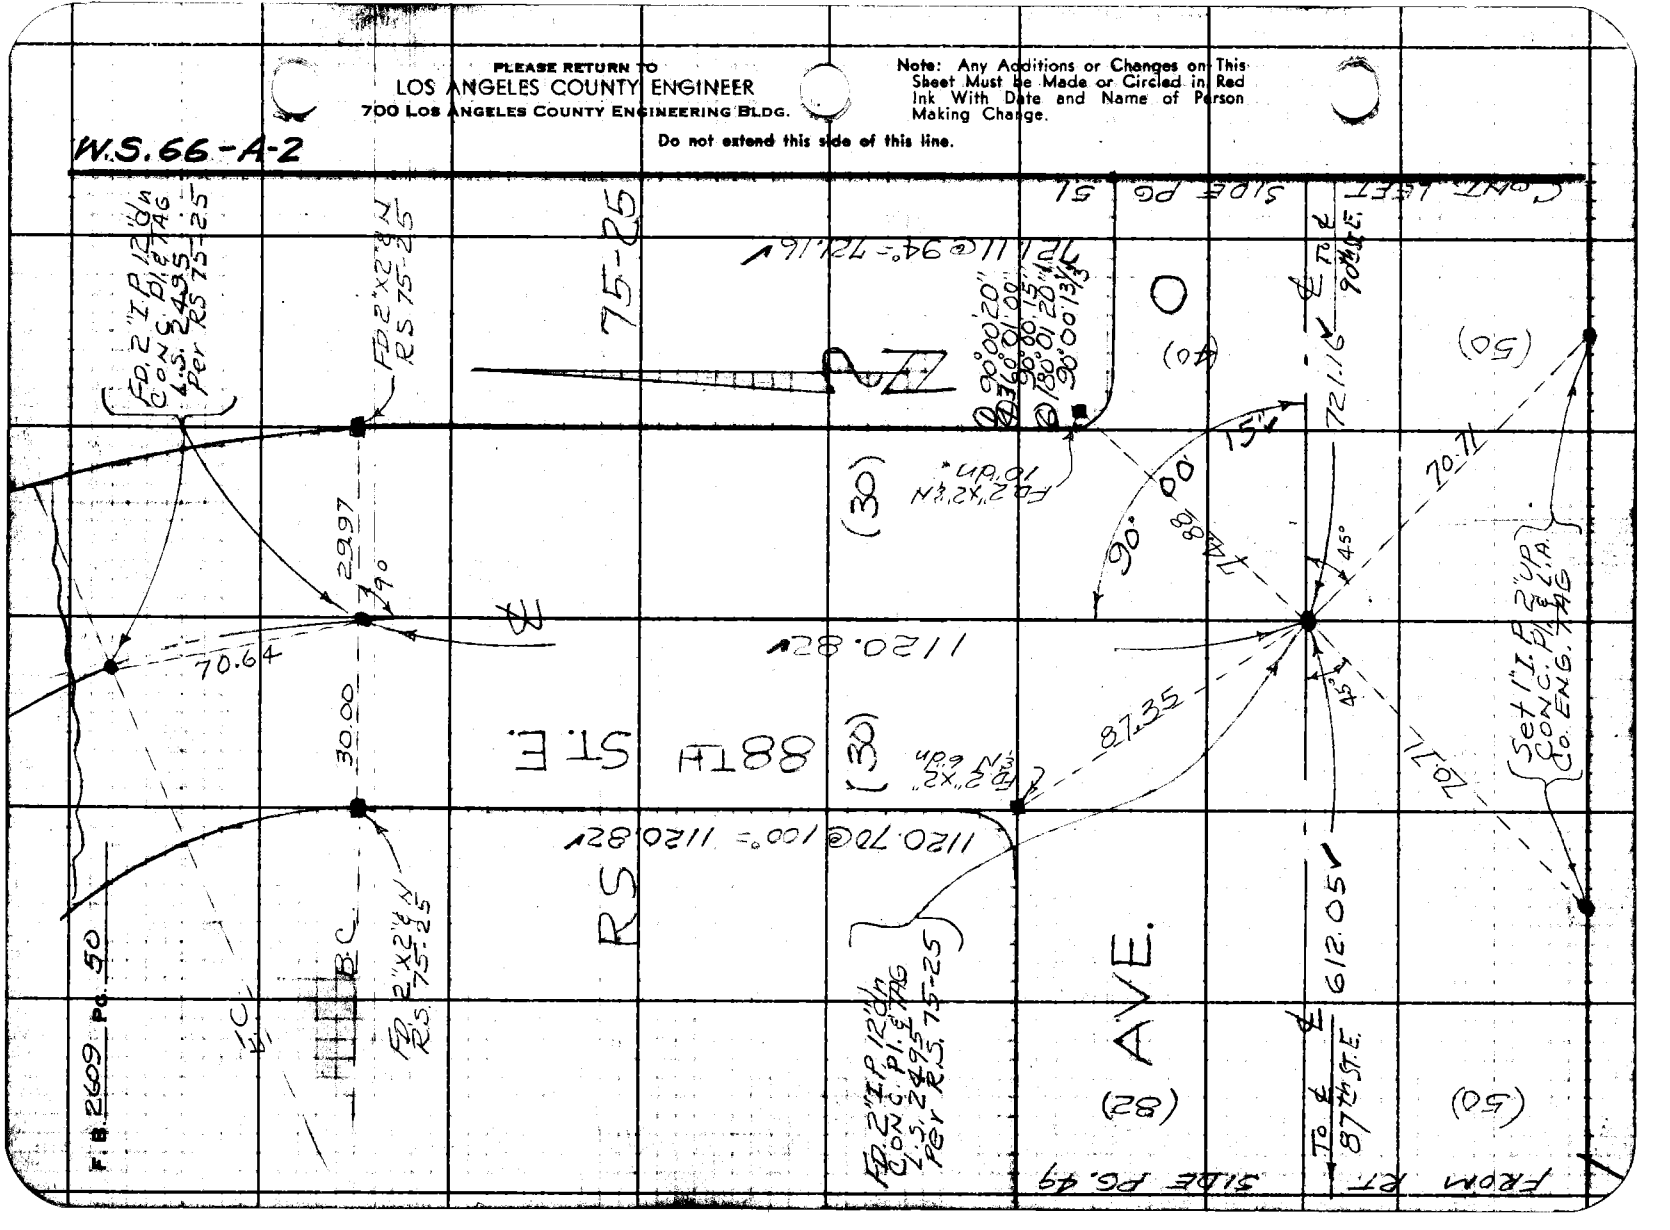

Notes Ck'd by W. D. WAGNER	Survey of AVE. O	F. B. 2609	PG. 51
Map No. C.S.A. 2263-1-10	JN 0075.85 Tape 101 Std 84 °F		
Office Work T.M. PALMERI	Surveyed by J.S. COATES		
Checked W. D. WAGNER	Notes J S C Date 8/10-60 H. E. OH		
Date JAN 12 1962	Indexed		

W.S. 66-A-2

CONT. BOT. PG 52

90TH ST. E.

1334.87 @ 86°-1334.89

1334.89

℄ TO ℄ AVE N-12

COUNTY SURVEYOR MONUMENT

T6N R10W 7 8 18 17

COR SEC 7,8,17,18 T6N R10W SAN BERNARDINO, in M.H. FD. C.S. 8733 PUNCH MARKED

90°36'40"
362°26'20"
98°36'35"
183°39'20"
90°36'33"

90°05'20"
360°20'40"
90°05'10"
180°31'00"
90°05'10"

FD. 2" I.P. 4' up CONC. PI. & TK

FD. 2" I.P. 4' up CONC. PI. & TK

70.71

40' Adj 35"

77.79 TAN

90° 36' 51"

45° 45°

R 8.

669.02 TO ℄ 91ST ST

336.11 TO 2ND

721.16

℄ TO ℄ 88TH ST E

FROM ℄ AVE.

(40) SIDE RD.

(50)

(92) 1334.89

(50) BOT

O

77.79

89° 26' 40"

45 Adj

1336.42

℄ TO AVE O-4 ℄

FD. 4" L.A. RD. DEPT BM TAG IN CONC FOOTING OF Fn. COR. POST

99°51'20"
359°26'00"
89°51'30"
179°09'00"
89°51'30"

89°26'40"
357°46'40"
89°26'40"
176°40'00"
89°26'40"

(30) (30)

CONT. TOP PG. 54

Note: Any Additions or Changes on This Sheet Must be Made or Circled in Red Ink With Date and Name of Person Making Change.

Do not extend this side of this line.

PLEASE RETURN TO LOS ANGELES COUNTY ENGINEER 700 Los Angeles County Engineering Bldg.

78F3098 SSE #247 11-56

PLEASE RETURN TO
LOS ANGELES COUNTY ENGINEER
700 LOS ANGELES COUNTY ENGINEERING BLDG.

Note: Any Additions or Changes on This Sheet Must Be Made or Circled in Red Ink With Date and Name of Person Making Change.

Do not extend this side of this line.

W.S.66-A-1

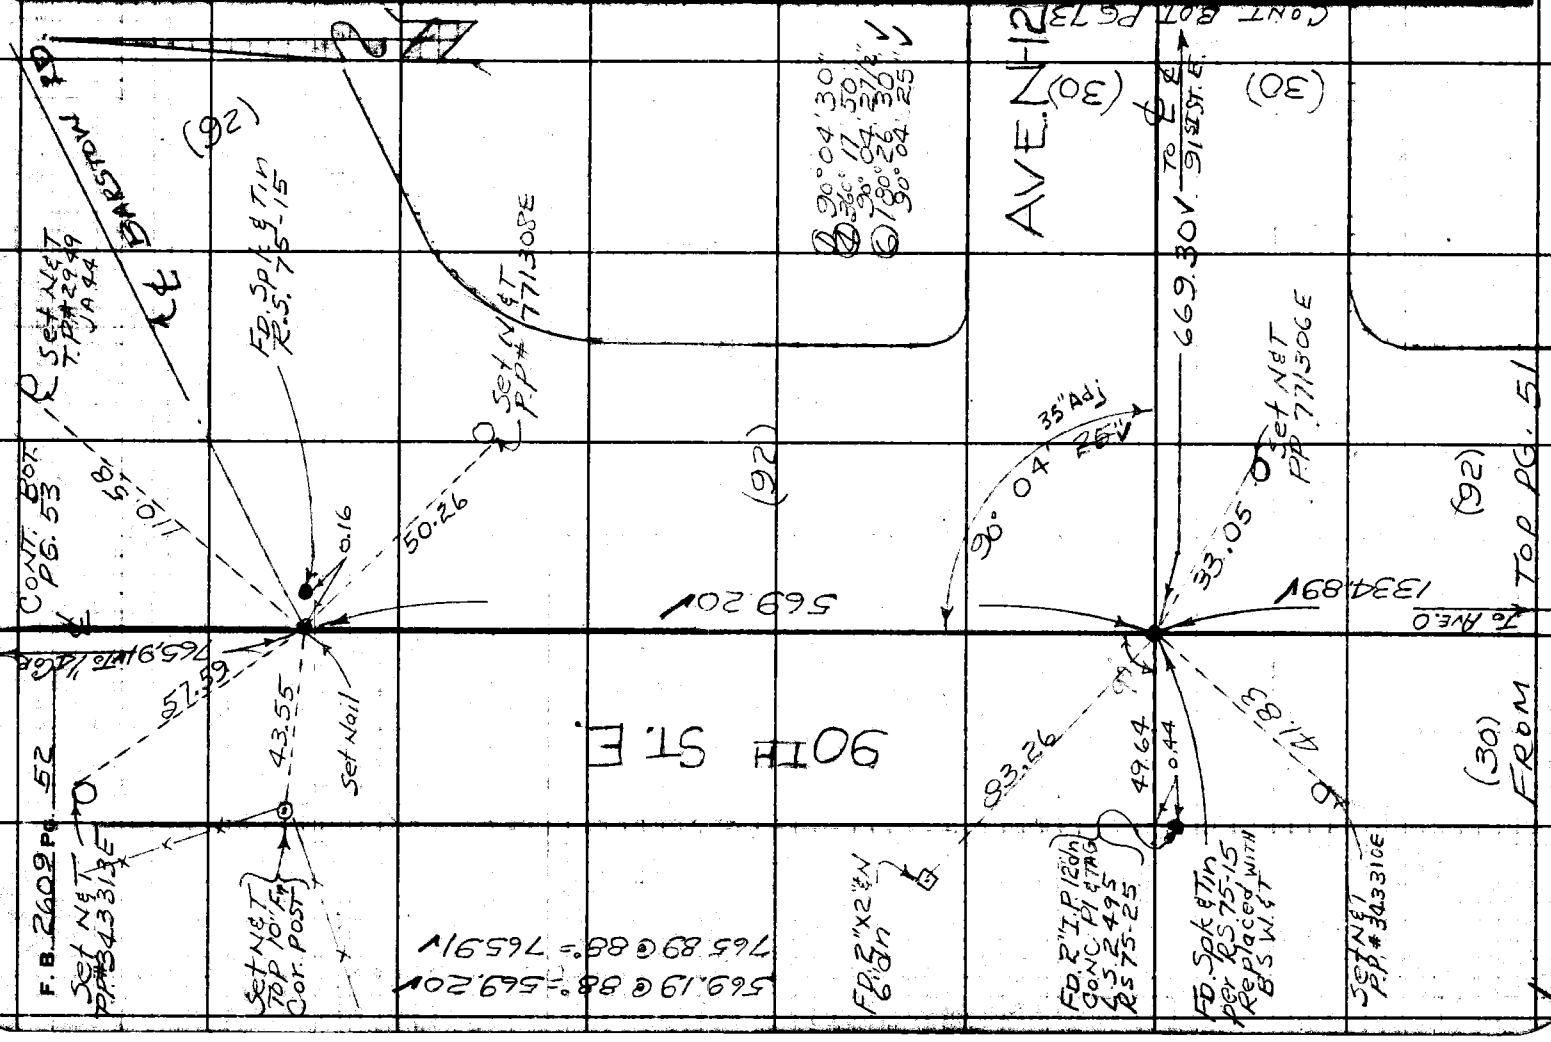

76F3095 S&E #247 11-56

PLEASE RETURN TO
LOS ANGELES COUNTY ENGINEER
700 LOS ANGELES COUNTY ENGINEERING BLDG.

Note: Any Additions or Changes on This Sheet Must be Made or Circled in Red Ink With Date and Name of Person Making Change.

Do not extend this side of this line.

W.S.66-A-1

Notes Ck'd by W. D. WAGNER
Map No. C.S.A. 47 63 1-10
Office Work TM. PALMER
Checked W. D. WAGNER
Date JAN 12 1962

Survey of AVE. O
JN0075.85 Tap 101 Std. 84 °F
Surveyed by J.S. COATES
Notes Date 8-4-60
Indexed H. E. OH

F.B. 2609 Pg. 52

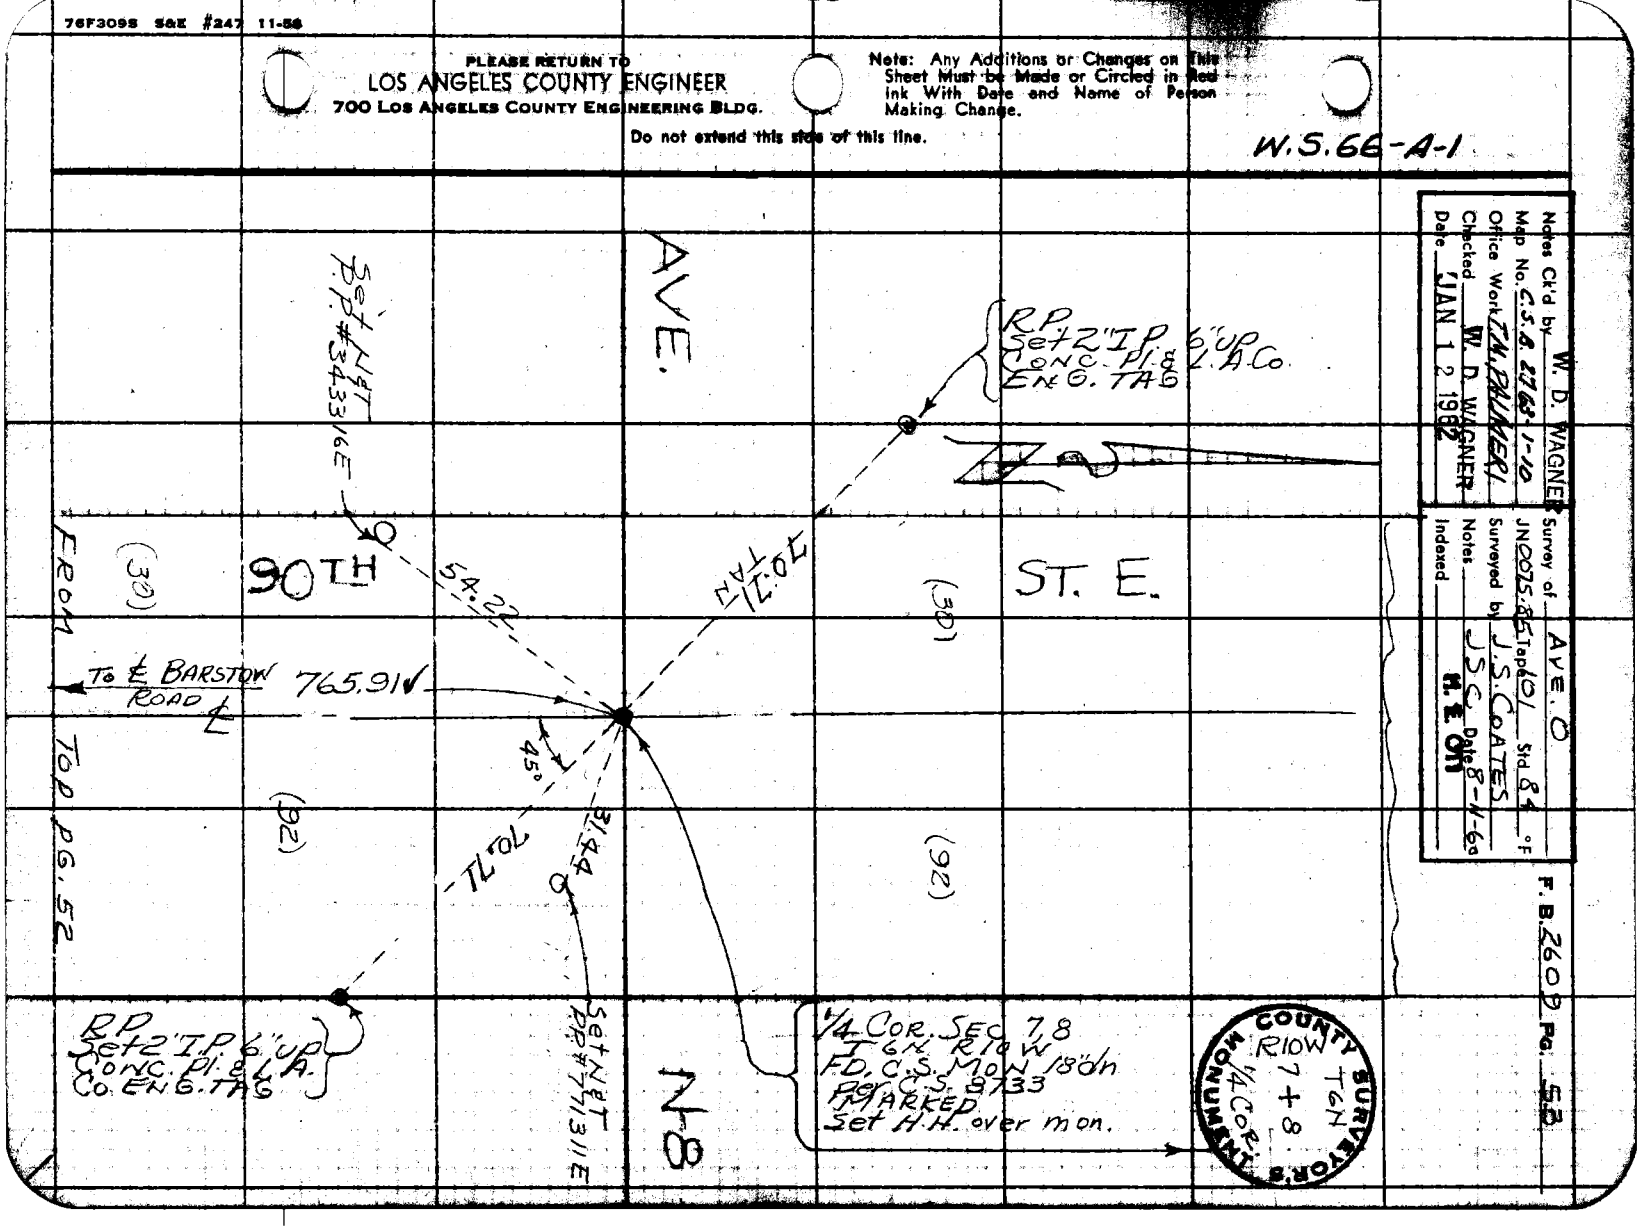

F.B. 2609 PG. 54

W.S. 66-4-2

FROM (30) ... Bot PG. 51 (92)

To ℄ AVE. O

ST. E

1336.42 @ 84° = 1336.42

1336.42

Set NAIL & TAG PP

FD 2" X 2" ℄ N 12" in FB 2074-107

73.40

61° 17'

AVE. (30)

0.98

SET SQ. Spk

90°

75.02

O-4

(30)

FD Spk & Tin FB 2074-107 R.S. 74-34

FD 2" X 2" ℄ N 18" in FB 2074-107

90TH

1336.42

(30) (92)

To ℄ AVE. O-8

CONT. TOP PG. 55

LOS ANGELES COUNTY ENGINEER
700 Los Angeles County Engineering Bldg.

PLEASE RETURN TO

Do not extend this side of this line.

Note: Any Additions or Changes on This Sheet Must be Made or Circled in Red Ink With Date and Name of Person Making Change.

Notes Ck'd by W. D. WAGNER
Map No. C.S.B. 2763-1-10
Office Work T. M. PALMERI
Checked W. D. WAGNER
Date JAN 12 1962

Survey of AVE. O
JN 0075.85 Tape 101 Std 84 °F
Surveyed by J.S. COATES
Notes J.S.C. Date 8-18-60
Indexed B. E. OTT

F. B. 2609 Pg. 55

W.S. 66-A-2

CONT. FROM BOT. PG. 54

(30) (92)

ST. E.

To ℄ AVE O-4

1336.42 ✓

Ⓓ 90° 08' 00"
Ⓐ 360° 31' 40"
Ⓒ 90° 07' 55"
Ⓑ 180° 47' 30" ✓
90° 07' 54" ✓

COUNTY SURVEYOR'S MONUMENT
T6N
18 + 17
1/4 COR

1/4 COR. SEC. 17/18 T6N R10W FD. C.S. MON in H.H. per C.S. 2733 MARKED

R.P. 2" I.P. 2" up L.S.A.Co. TAG 1.46

Set NET Pk 373162E

1336.62 @ 60° 00' / 1336.59 ✓
1336.44 @ 82° 52' / 1336.42 ✓
668.13 @ 68° 08' 00" 668.06 ✓

70.71 TAN

90°

88.37

89° 07' 55" Adj

70.71 TAN

668.06 ✓ To ℄ 91ST ST. E

AVE O-8

(40)

BOT. PG. 56

89° 52' 05" Adj

89° 52' 05"

(40)

COUNTY

Ⓓ 89° 52' 00"
Ⓐ 359° 28' 20" ✓
89° 52' 05"
Ⓒ 179° 12' 20" ✓
89° 52' 05" Adj

90TH

1336.59 ✓

R.P. 2" I.P. 6" up O.N.C. Pl. 8.2' L.A. ENG. TAG

668.30 ✓

Fd. Spk & Tin RS 15-42

℄ AVE O-12

(30) To ℄ 91ST

(92)

CONT. TOP PG. 56

Note: Any Additions or Changes on This Sheet Must be Made or Circled in Red Ink With Date and Name of Person Making Change.

Do not extend this side of this line.

PLEASE RETURN TO
LOS ANGELES COUNTY ENGINEER
700 LOS ANGELES COUNTY ENGINEERING BLDG.

76F3095 SSE #242 11-58

PLEASE RETURN TO
LOS ANGELES COUNTY ENGINEER
700 LOS ANGELES COUNTY ENGINEERING BLDG.

Note: Any Additions or Changes on This Sheet Must be Made or Circled in Red Ink With Date and Name of Person Making Change.

Do not extend this side of this line.

W.S. 66-A-2

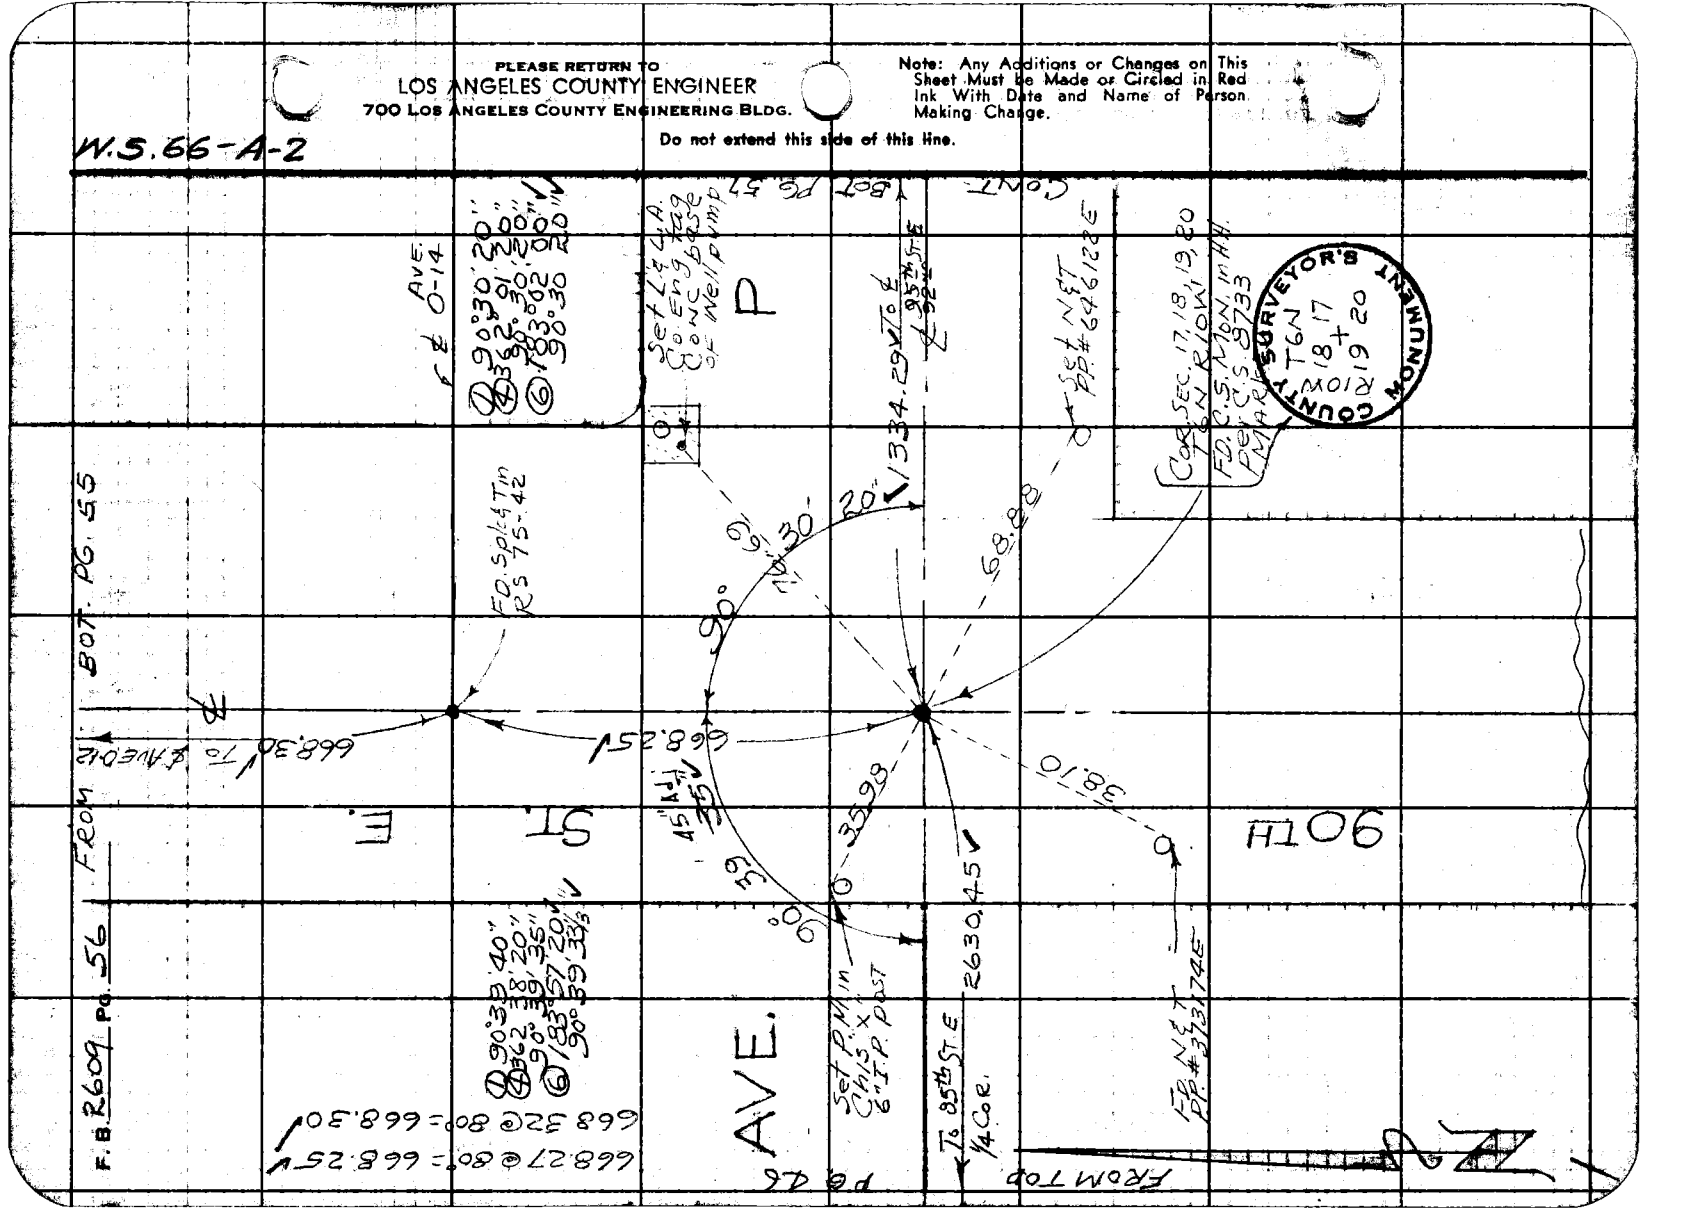

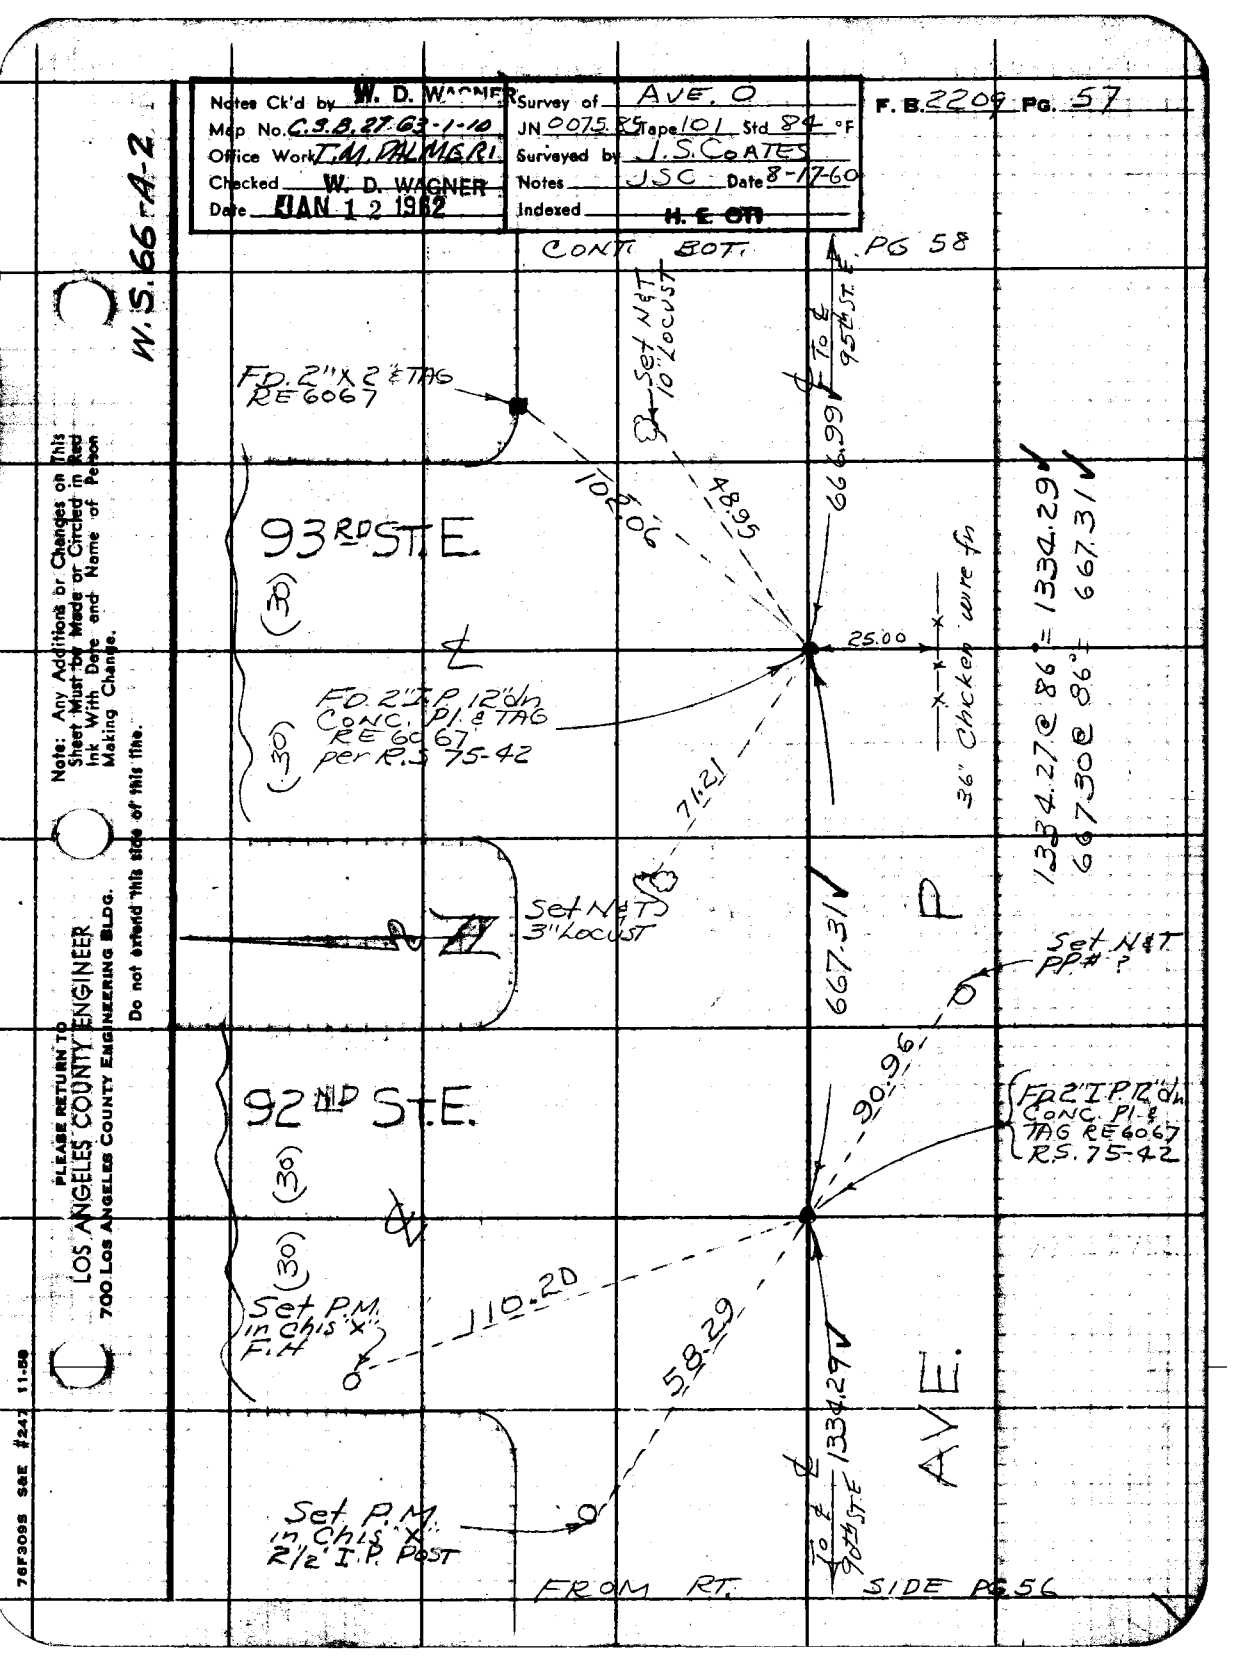
Notes Ck'd by W. D. WAGNER
Map No. C.S.B. 27 G3-1-10
Office Work T.M. PALMERI
Checked W. D. WAGNER
Date JAN 12 1962
Survey of AVE. O
JN 0075.25 Tape 101 Std 84 °F
Surveyed by J.S. COATES
Notes JSC Date 8-17-60
Indexed H. E. OTT
F. B. 2209 Pg. 57
W.S. 66-A-2
CONT. BOT. PG 58
FD. 2" X 2" TAG RE 6067
Set N&T 10" Locust
93RD ST. E.
(30)
FD. 2" I.P. 12" dn CONC. PL. & TAG RE 6067 per R.S. 75-42
Set N&T 3" Locust
92ND ST. E.
Set P.M. in Chis. "X" F.H.
Set P.M. in Chis. "X" 2 1/2" I.P. Post
AVE. E.
FROM RT. SIDE PG 56
Fd 2" I.P. 12" dn CONC. Pl. & TAG RE 6067 RS. 75-42
Set N&T PP# ?
25.00
36" Chicken wire fn
666.99
667.31
1334.27 @ 86° = 1334.29
667.30 @ 86° = 667.31
71.21
90.96
110.20
58.29
1334.29
To ℄ 95TH ST. E.
To ℄ 90TH ST. E.
Note: Any Additions or Changes on This Sheet Must be Made or Circled in Red Ink With Date and Name of Person Making Change.
PLEASE RETURN TO LOS ANGELES COUNTY ENGINEER 700 Los Angeles County Engineering Bldg.
Do not detach this side of this file.
76F3095 S&E #247 11-58

F. B. 2609 PG. 58

CONT. BOT. PG 59

W.S. 66-4-2

(30) (30)

To Sec. Cor @ 100' S.E.

2679.18

P

Ⓐ 179°43'20"
Ⓑ 358°53'00"
179°43'15"
Ⓒ 358°19'40" ✓
179°43'16⅔" ✓

R.P. Set 2" I.P. 6" up Conc. Plug L.A. Co. Eng. Tag

R.P. Set 2" I.P. 6" up Conc. Plug L.A. Co. Eng. Tag

95TH ST. E.

(82)

42' 10" Calc ✓

115.96

90°

70.71

179°

43'

To Ctr. Sect. Pg. 61

135° T

135°

31.09

Set N&T P.P. # 765382

45" ✓

(82)

89°

120.56

34'

35" ✓

Set P.M. in Conc. "X" on F.H.

Ⓐ 89°34'40"
Ⓑ 358°18'20"
89°34'35"
Ⓒ 177°27'20" ✓
89°34'33⅓" ✓

666.99 ✓

666.98 @ 86 = 666.99 ✓

1/4 COR. SEC. 17 T2O R10W F.D. C.S. MON 12" dn. per C.S. 8733 MARKED

AVE.

COUNTY SURVEYOR'S T2N R10W 17 20 1/4 COR. 1927 MONUMENT

(92)

To 95th St. E.

(30)

FROM TOP PG 57

LOS ANGELES COUNTY ENGINEER
700 Los Angeles County Engineering Bldg.

PLEASE RETURN TO

Do not extend this side of this line.

Note: Any Additions or Changes on This Sheet Must be Made or Circled in Red Ink With Date and Name of Person Making Change.

76F3098 S&E #247 11-58

PLEASE RETURN TO
LOS ANGELES COUNTY ENGINEER
700 LOS ANGELES COUNTY ENGINEERING BLDG.

Note: Any Additions or Changes on This Sheet Must be Made or Circled in Red Ink With Date and Name of Person Making Change.

Do not extend this side of this line.

W.S. 66-A-2

Notes Ck'd by W. D. WAGNER
Map No. CSB 2743-1-W
Office Work T.M. BALLARD
Checked W. D. WAGNER
Date JAN 1 2 1962

Survey of JN 0025 85 Tape 101 Std. 84 °F
Surveyed by J.S.C. COATES
Notes Indexed J.S.C. Date 8-18-60
H. & OT

F. B. 2604 PG. 59

CONT. RT. SIDE PG 63

THIS MON. IS FACED AS SHOWN (TOP to EAST)

COUNTY SURVEYOR'S MONUMENT 1925

COR. SEC. 16, 17, 20, 21 T6N R10W F.D.C.S. MON 10" dn per C.C.S. 8733 MARKED Reset top T. North

89°02'00" 356°08'30" 177°42'50" 89°02'08" 2721.05 @ 80° 2720.98

89°33'00" 358°11'50" 89°42'50" 177°42'50" 89°33'00" 2721.05 @ 80° 2720.98

R.P. Set 2" I.P. 6" up L.A. Co. Eng. Tag

100TH ST. E.

AVE O

CONT. BOT.

68° 89° 02' 10"

70.71 TAN 45°

EW-1"=50'

FROM TOP PG. 58

℄ To 1/4 Cor 95th St. 2679.18

AVE.

2657.24 2656.38 To 1/4 Cor 105th St E

P

PG. 85

70.71

2679.07 @ 90° = 2679.18

2657.08 @ 94° = 2657.24

Rechained 2-14-61 J.S.C.
2657.00 @ 48° = 2656.38

R.P. Set 2" I.P. 6" up L.A. Co. Eng. Tag

PLEASE RETURN TO
LOS ANGELES COUNTY ENGINEER
700 LOS ANGELES COUNTY ENGINEERING BLDG.

Note: Any Additions or Changes on This Sheet Must be Made or Circled in Red Ink With Date and Name of Person Making Change.

Do not extend this side of this line.

W.S. 66-A-2

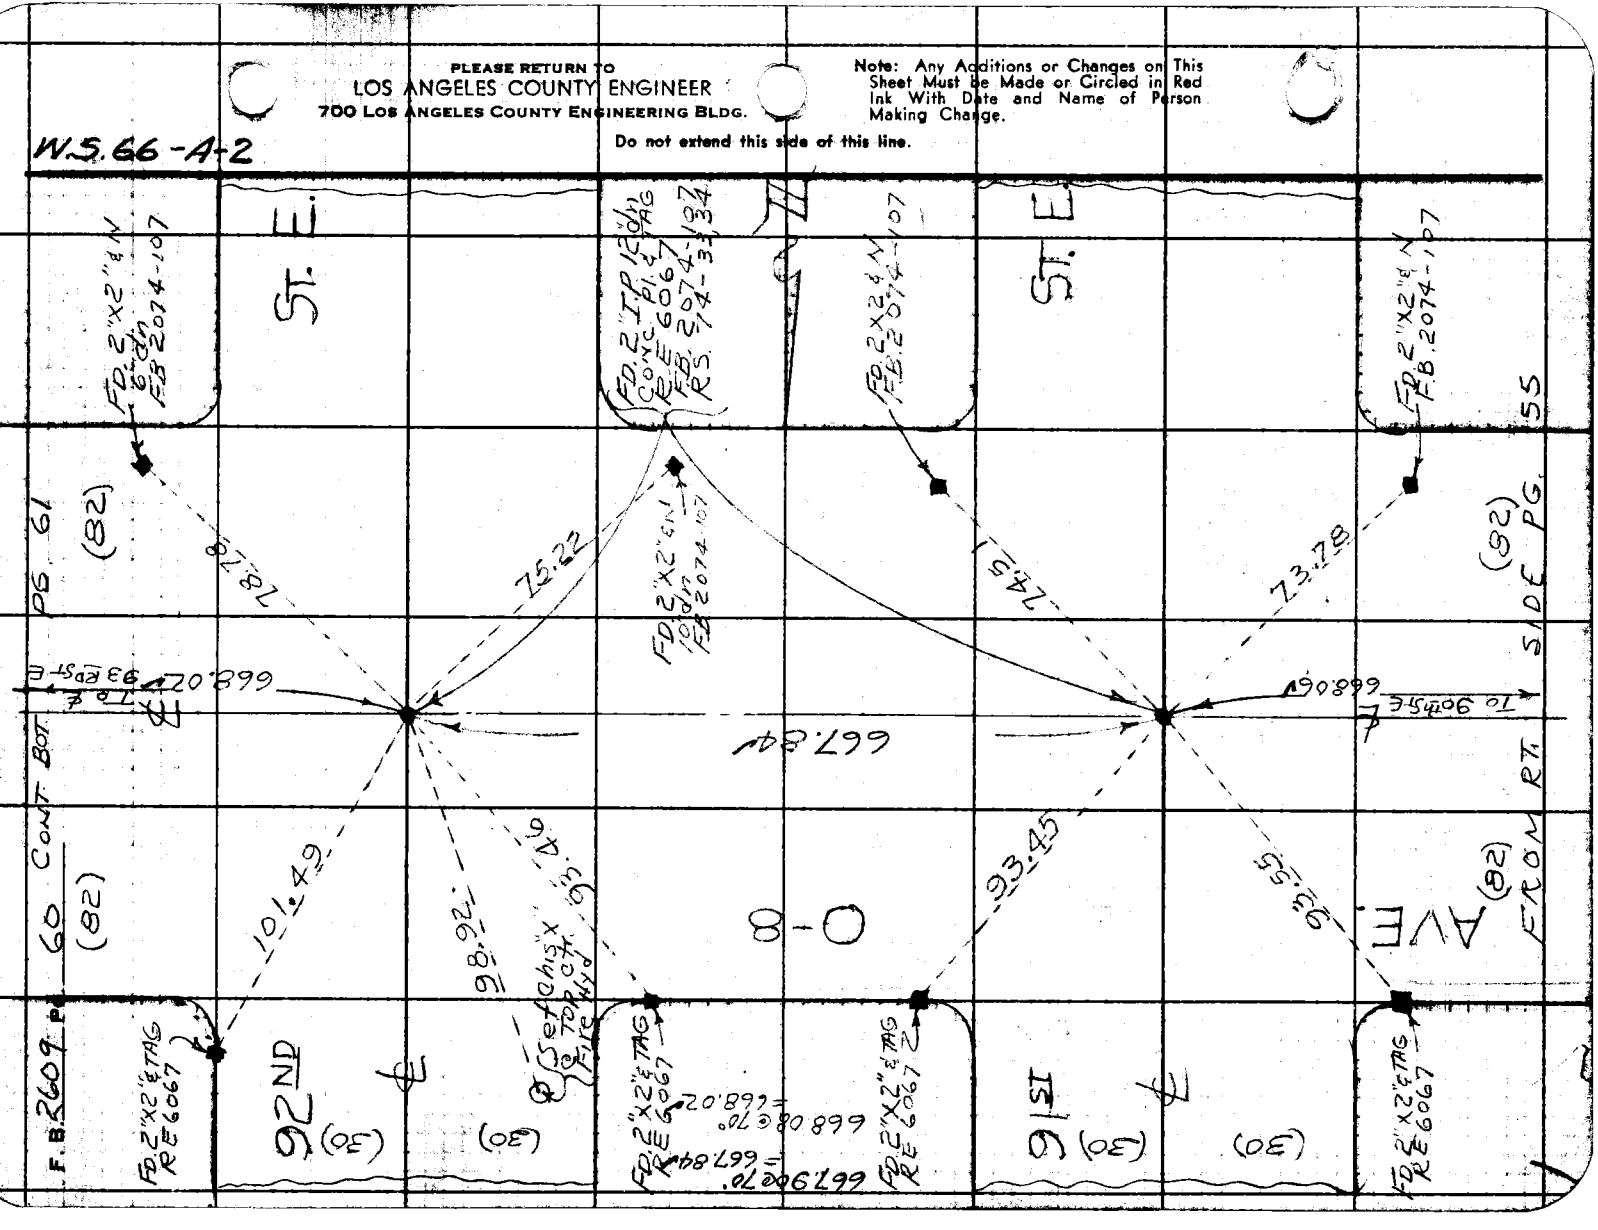

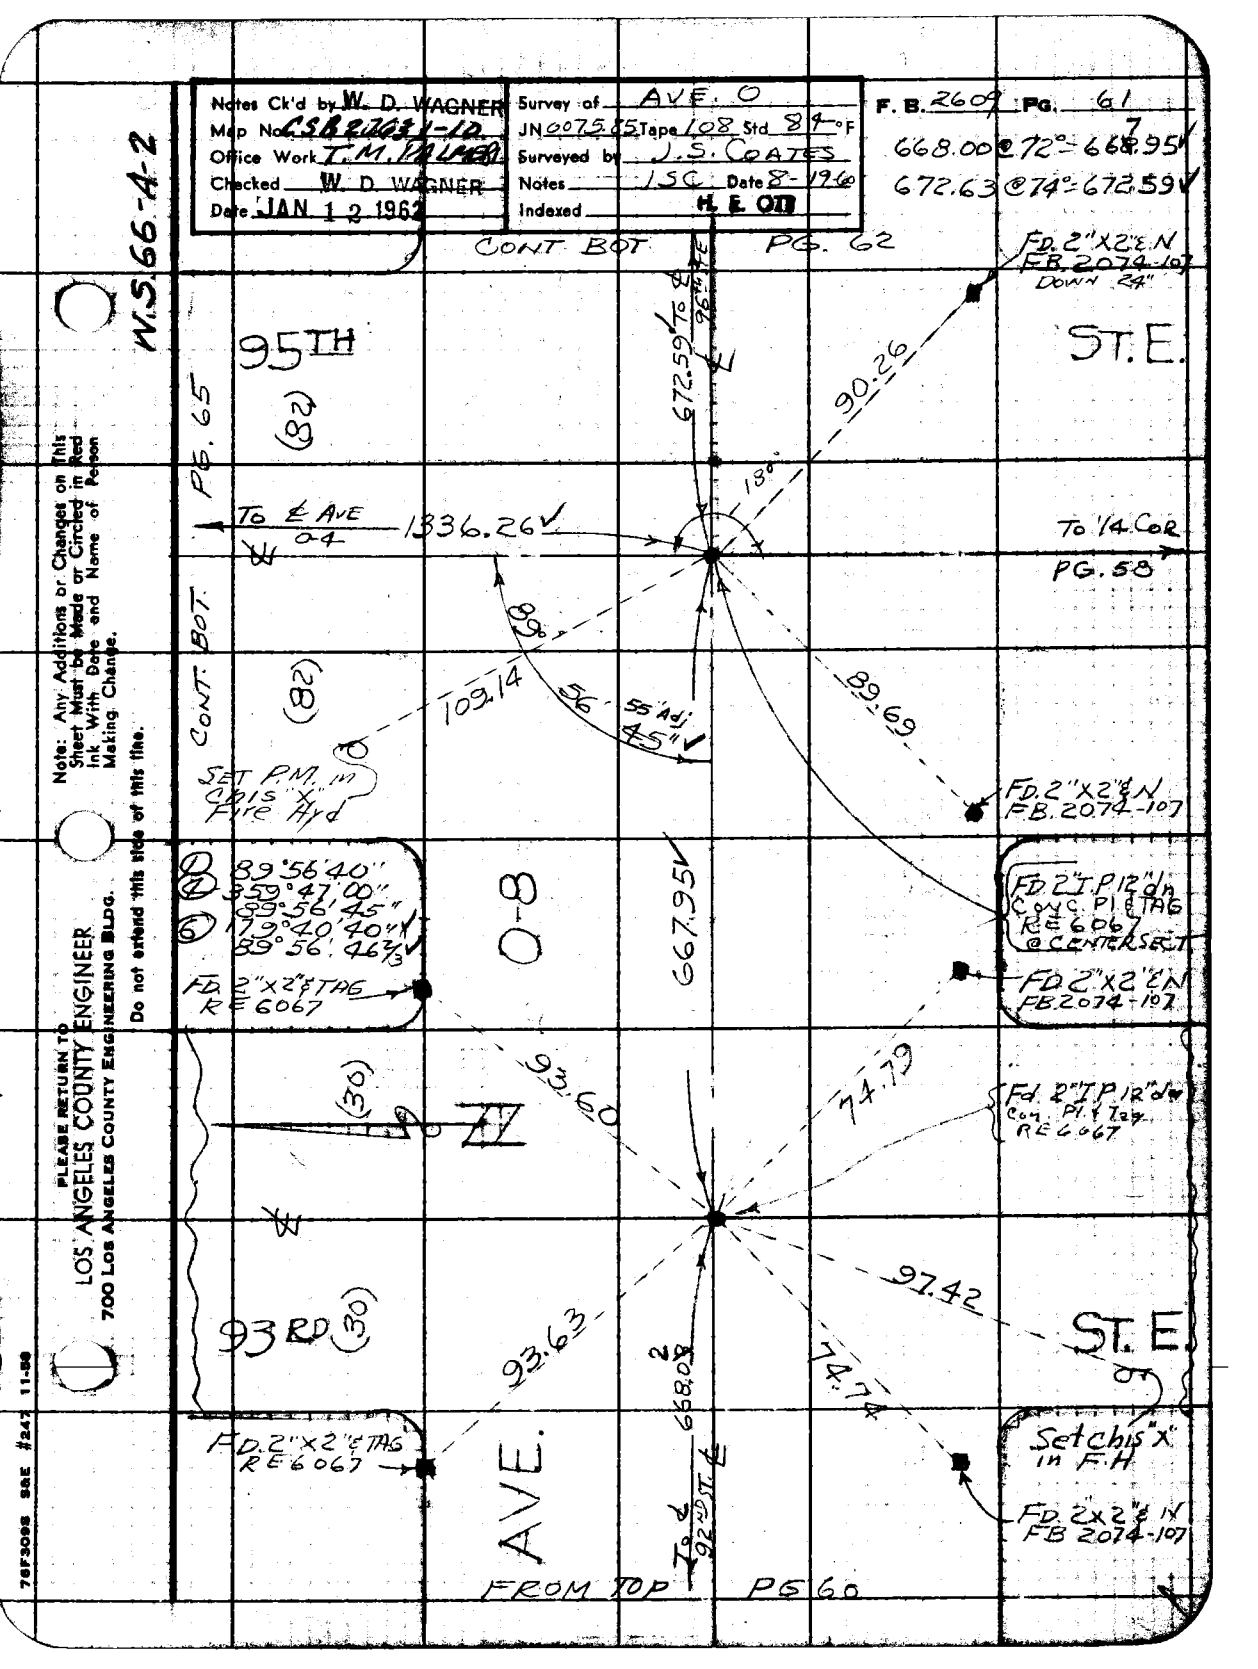
Notes Ck'd by W. D. WAGNER
Map No. CSB 2074-12
Office Work T.M. PALMER
Checked W. D. WAGNER
Date JAN 12 1962
Survey of AVE. O
JN 007565 Tape 108 Std 84 °F
Surveyed by J.S. COATES
Notes ISC Date 8-1960
Indexed H. E. OH
F. B. 2609 Pg. 61
668.00 @ 72° = 668.95
672.63 @ 74° = 672.59
W.S. 66-4-2
CONT. BOT PG. 62
95TH (82)
PG. 65
672.59 To ℄ 95TH ST. E.
90.26
FD. 2" X 2" E N FB. 2074-107 DOWN 24"
13°
To ℄ AVE 04
1336.26
To 1/4 COR PG. 58
CONT. BOT.
89°
109.14
56
55' Adj 45'
89.69
SET P.M. IN CRIS "X" Fire Hyd
FD 2" X 2" E N FB. 2074-107
89°56'40"
359°47'00"
89°56'45"
179°40'40"
89°56'46 1/3
O-8
667.95
FD 2" I.P 12" dn CONC. PI & TAG RE 6067 @ CENTERSET
FD 2" X 2" E N FB 2074-107
FD 2" X 2" & TAG RE 6067
(30)
93.60
74.79
Fd. 2" I.P 12" d/w Conc. Pl. & Tag RE 6067
93RD (30)
97.42
93.63
74.74
668.08
To ℄ 92ND ST. E.
ST. E.
Set chis "X" in F.H
FD 2" X 2" E N FB 2074-107
AVE. O
FD. 2" X 2" & TAG RE 6067
FROM TOP PG 60
LOS ANGELES COUNTY ENGINEER
700 LOS ANGELES COUNTY ENGINEERING BLDG.
PLEASE RETURN TO
Note: Any Additions or Changes on This Sheet Must be Made or Circled in Red Ink With Date and Name of Person Making Change.
Do not extend this side of this file.
76F3098 SAE #247 11-59

F.B. 2609 PG. 62

CONT. BOT. PG 63

W.S. 66-4-2

(82) (82)

FD 2"X2" & TAG RE 6067

FD 2"X2" & N F.B. 2074-106

672.80 M

672.77 M

672.83 M

97TH

93.39

76.46

FD 2" I.P. 18"d/n CONC. PL & TAG RE 6067 per R.S. 74-33,34

SET P.M. in CHIS. X" ON F.H.

98.00

93.80

75.09

672.81 @ 74° - 672.77

672.83 @ 76° - 672.80

ST. E. 6

FD 2"X2" & TAG RE 6067

O-8

672.77 M

FD 2"X2" & N F.B. 2074-108

FD 2"X2" & TAG RE. 6067

93.50

75.93

FD 2" I.P. 18"d/n CONC. PL & TAG RE 6067 F.B. 2074-108 R.S. 74-33,34

96TH

(30)

℄

(30)

ST. E.

93.71

74.98

672.59 M

672.56 M

FD 2"X2" & TAG FL. RE. 6067

AVE.

FD 2"X2" & N. F.B. 2074-108

FROM TOP PG. 61

PLEASE RETURN TO LOS ANGELES COUNTY ENGINEER 700 Los Angeles County Engineering Bldg.

Do not extend this side of this line.

Note: Any Additions or Changes on This Sheet Must be Made or Circled in Red Ink With Date and Name of Person Making Change.

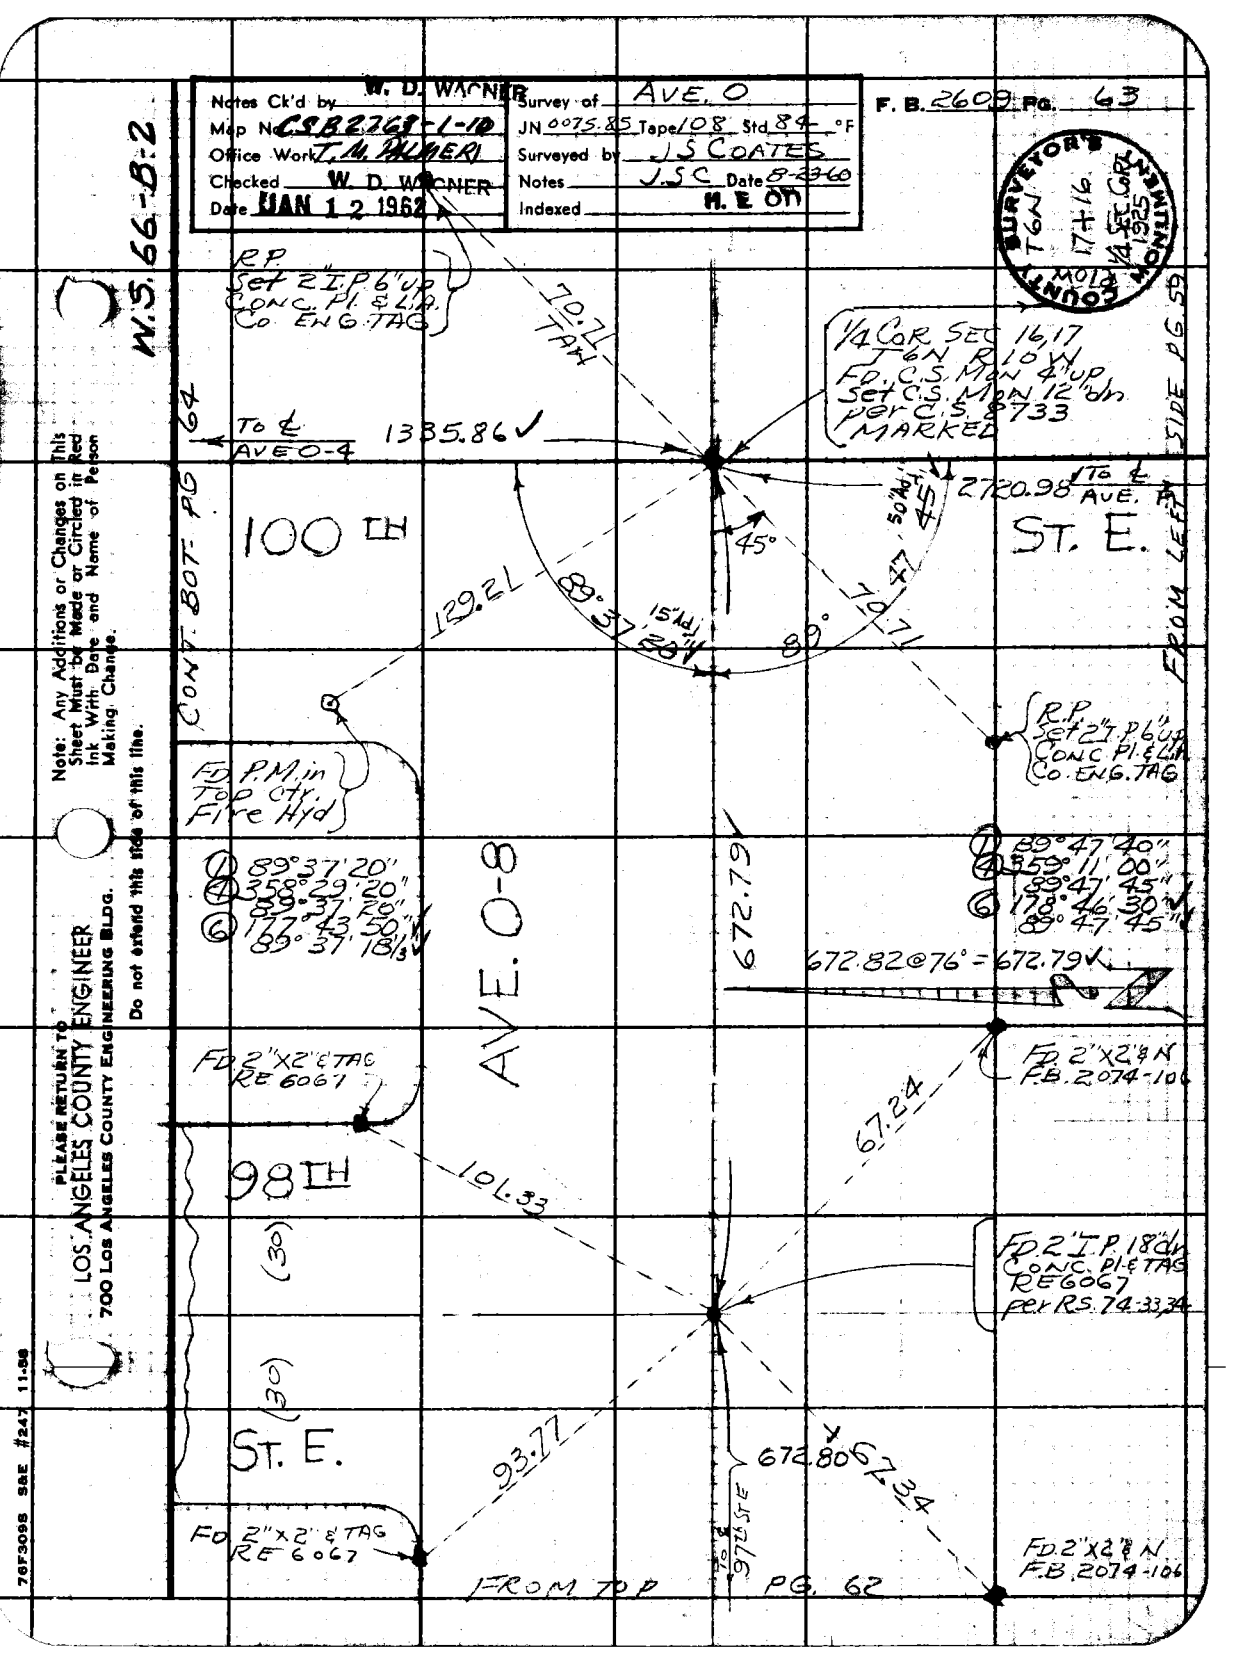
Notes Ck'd by W. D. WAGNER
Map No CSB2268-1-10
Office Work T. M. WAGNER
Checked W. D. WAGNER
Date JAN 1 2 1962
Survey of AVE. O
JN 0075.85 Tape 108 Std 84 °F
Surveyed by J.S COATES
Notes J.S.C. Date 8-2-60
Indexed H. E. OH
F. B. 2609 Pg. 63
W.S. 66-B-2
RP Set 2 I.P 6" up Conc. Pl. & Lid. Co. Eng. Tag
70.71' TAN
1/4 COR SEC 16, 17 T6N R10W FD. C.S. MON 4" up Set C.S. MON 12" dn. per C.S. 8733 MARKED
To ℄ AVE O-4
1335.86
2720.98 To ℄ AVE. P
ST. E.
FROM LEFT SIDE PG 59
CONT. BOT. PG. 64
100 IH
45°
129.21
89° 37' 20"
15" IN
70.71
89°
FD. P.M. in Top of Cir. Fire Hyd
R.P. Set 2" I.P 6" up Conc. Pl. & Lid Co. Eng. Tag
① 89° 37' 20"
② 358° 29' 20"
③ 89° 37' 20"
④ 87° 43' 50"
⑤ 89° 37' 18"
AVE. O-8
672.79
① 89° 47' 40"
② 359° 11' 00"
③ 89° 47' 45"
⑥ 178° 46' 30"
⑤ 89° 47' 45"
672.82 @ 76° = 672.79
FD 2" X 2" & TAG RE 6067
98 IH
(30)
101.33
67.24
FD. 2" X 2" & N F.B. 2074-106
FD. 2" I.P. 18" dn Conc. Pl. & TAG RE 6067 per R.S. 74-33, 34
(30)
ST. E.
93.77
672.80
67.34
FD 2" X 2" & TAG RE 6067
FROM TOP PG. 62
FD. 2" X 2" & N F.B. 2074-106
PLEASE RETURN TO LOS ANGELES COUNTY ENGINEER 700 Los Angeles County Engineering Bldg.
Note: Any Additions or Changes on This Sheet Must be Made or Circled in Red Ink With Date and Name of Person Making Change.
Do not extend this ride of this file.
SURVEYOR'S MONUMENT COUNTY OF LOS ANGELES T6N R10W 17+16. 1925 1/4 SEC. COR.
76F3098 SAE #247 11-58

PLEASE RETURN TO
LOS ANGELES COUNTY ENGINEER
700 LOS ANGELES COUNTY ENGINEERING BLDG.

Note: Any Additions or Changes on This Sheet Must be Made or Circled in Red Ink With Date and Name of Person Making Change.

Do not extend this side of this line.

W.S.66-B-2

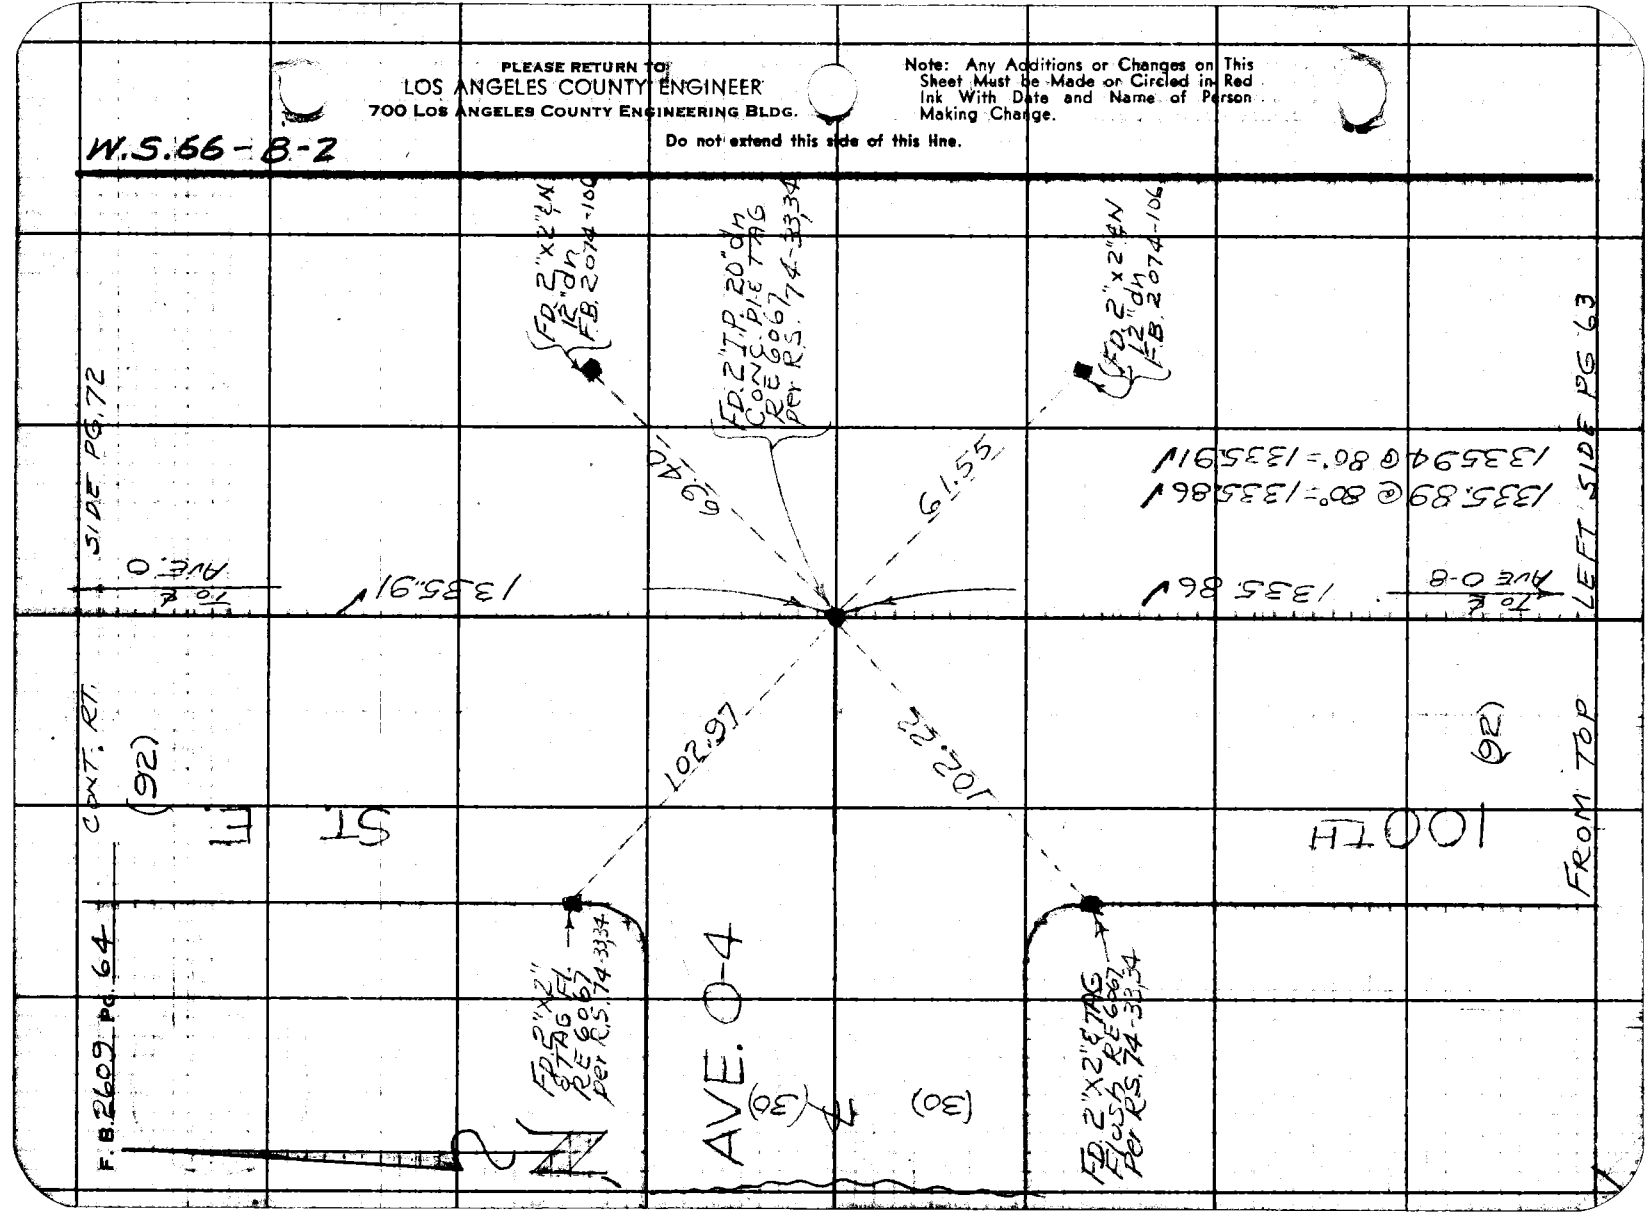

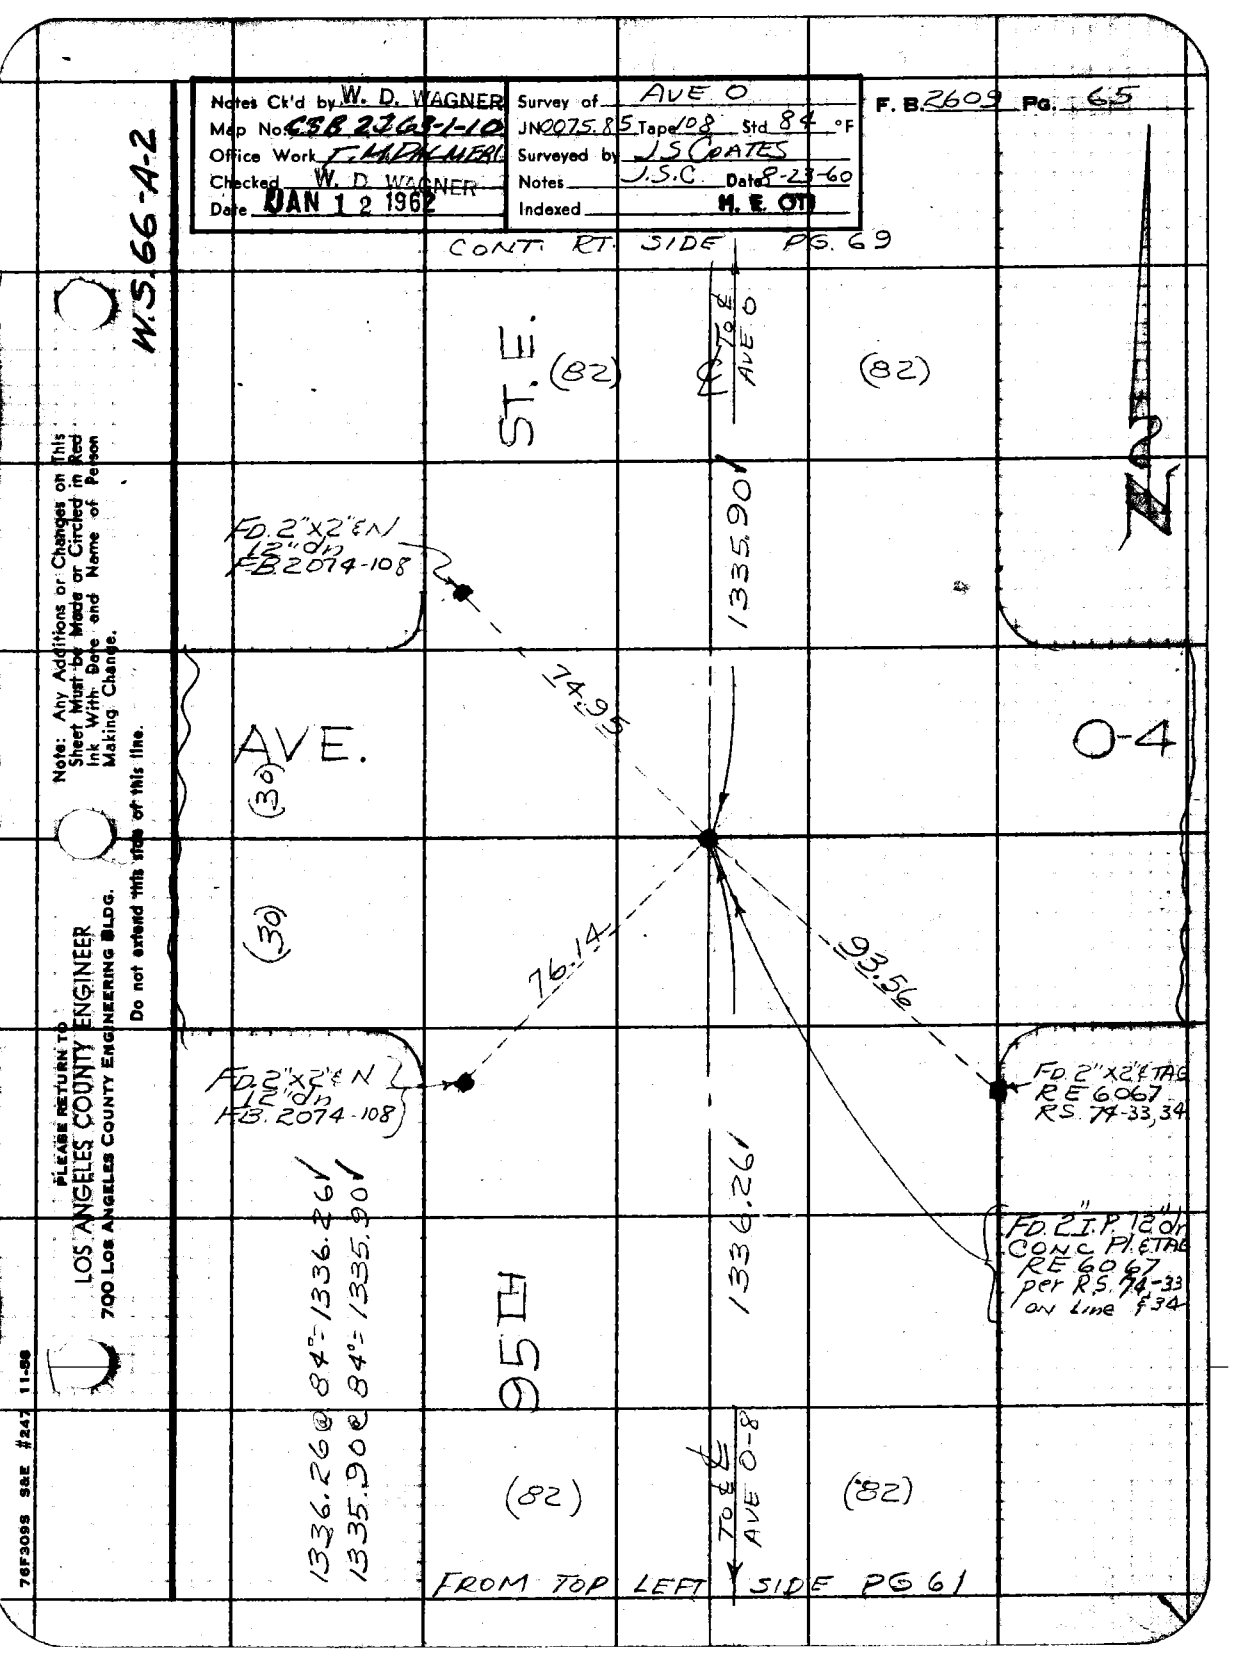
Notes Ck'd by W. D. WAGNER
Map No. CSB 2363-1-10
Office Work F. LADEMUERA
Checked W. D. WAGNER
Date JAN 12 1962
Survey of AVE O
JN 0075.85 Tape 108 Std 84 °F
Surveyed by J.S. COATES
Notes J.S.C. Date 8-23-60
Indexed M. E. OTT
F. B. 2609 Pg. 65
W.S. 66-A-2
CONT. RT. SIDE PG. 69
ST. E
(82)
℄ 70 & E AVE O
(82)
FD. 2"X2" E N L 12" dn FB. 2074-108
1335.90'
AVE.
(30)
O-4
(30)
76.14
93.56
FD. 2"X2" E N L 12" dn FB. 2074-108
FD. 2" X 2" E TAG RE 6067 RS. 74-33, 34
FD. 2 I.P. 12" dn CONC PI. E TAG RE 6067 per R.S. 74-33 on line E 34
1336.26' @ 84°-1336.26'
1335.90' @ 84°-1335.90'
95TH
1336.26'
(82)
70 & E AVE O-8
(82)
FROM TOP LEFT SIDE PG 61
Note: Any Additions or Changes on This Sheet Must be Made or Circled in Red Ink With Date and Name of Person Making Change.
Do not extend this side of this line.
PLEASE RETURN TO
LOS ANGELES COUNTY ENGINEER
700 LOS ANGELES COUNTY ENGINEERING BLDG.
76F3095 S&E #247 11-58

PLEASE RETURN TO
LOS ANGELES COUNTY ENGINEER
700 LOS ANGELES COUNTY ENGINEERING BLDG.

Note: Any Additions or Changes on This Sheet Must Be Made or Circled in Red Ink With Date and Name of Person Making Change.

Do not extend this side of this line.

W.S. 66-A-2

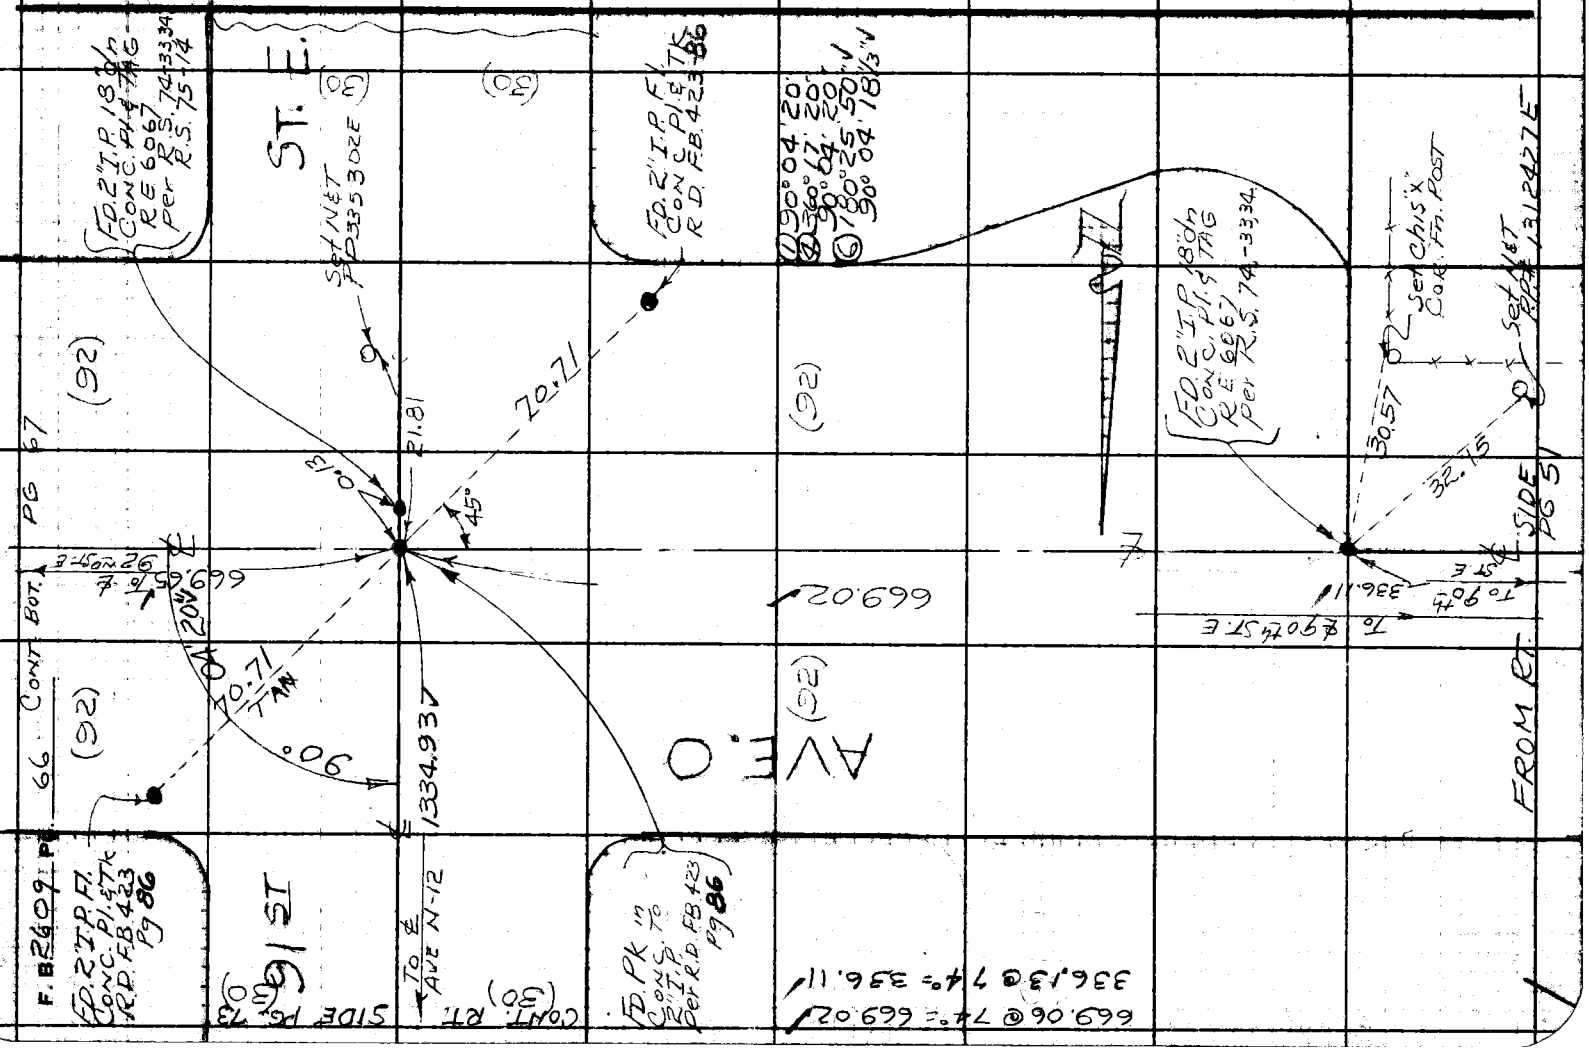

W.S. 66-A-2

Notes Ck'd by W. D. WAGNER | Survey of AVE O | F. B. 2609 Pg. 67
Map No. C.S.B. 2269-1-10 | JN 0675.85 Tape 108 Std. 84 °F
Office Work T.M. PALMIERI | Surveyed by J.S. COATES
Checked W. D. WAGNER | Notes J.S.C. Date 8-23-66
Date JAN 12 1962 | Indexed H. E. OTT

Note: Any Additions or Changes on This Sheet Must be Made or Circled in Red Ink With Date and Name of Person Making Change.

PLEASE RETURN TO
LOS ANGELES COUNTY ENGINEER
700 LOS ANGELES COUNTY ENGINEERING BLDG.
Do not extend this side of this line.

CONT. BOT. PG. 68

(92) (92)

To ℄ 93RD ST. E

Δ ① 90°06'10"
Δ ② 36°24'50"
90°06'12½"
Δ ③ 180°37'20" ✓
90°06'13⅓ ✓

669.69 @ 74° = 669.65 ✓
667.86 @ 74° = 667.82 ✓
1335.07 @ 74° = 1335.02 ✓

667.82 ✓

(SET 2" I.P. 6' UP
CONC. PI. L.S.
CO. ENG TAG

92ND

15" ✓

90°06'

70.71

45°

ST. E

℄

CONT. BOT. PG (30)

(30)

To ℄ AVE N-12

1335.02 ✓

22.14

108.73

FD NET P.P. # 583142 E

70.71 TAN

FD P.M. Top Ctr. F.H.

SET 2" I.P. 6' UP
CONC. PI. L.S.
CO. ENG TAG

AVE.

669.65 ✓

FD 2" I.P. 18" CONC. PI. L.S. RE 6067 RS 74-33 PS

To ℄ 91ST ST E

FROM TOP PG. 66

76F3098 SAE #242 11-66

W.S. 66-A-2

F.B. 2609 Pg. 68 CONT. BOT. PG 69

92.00 TAN

50.00

FD. 2"I.P. F.I. CONC. PI. & TK R.D. EB. 428, 5.89

FD. 2"I.P. 1 3/4"O/D CONC. PI. & TAG RE 7217 PER R.S. 75-15

FD. 2"x2" BR S.E. Cor. Lot 45 R.S. 75-15

334.49

334.50 @ 78° = 334.49

1335.26 @ 52° = 1335.24

To ℄ 95TH ST E

334.49

668.94

RP Set 2"I.P. 6"UP CONC. PI. & L.A. Co. ENG. TAG

70.71

ST. E.

PG. 75

93RD

To ℄ AVE. N-12

(30)

133524

℄

CONT. BOT

(30)

89°

45°

70.71

26.46

FD. NET P.P. # 335308 E

45°44'

55"

Set 2"I.P. 6"UP CONC. PI. & L.A. Co. ENG. TAG

FD. 2"I.P. 6"UP CONC. PI. & TAG RE 7217 R.S. 75-14, 15

89°55'00"

359°39'20"

89°54'50"

179°29'20"

89°54'53"

AVE

667.82

To ℄ 92ND ST E

(92)

(92)

FROM TOP PG. 67

PLEASE RETURN TO
LOS ANGELES COUNTY ENGINEER
700 Los Angeles County Engineering Bldg.

Do not extend this side of this line.

Note: Any Additions or Changes on This Sheet Must be Made on Circled in Red Ink With Date and Name of Person Making Change.

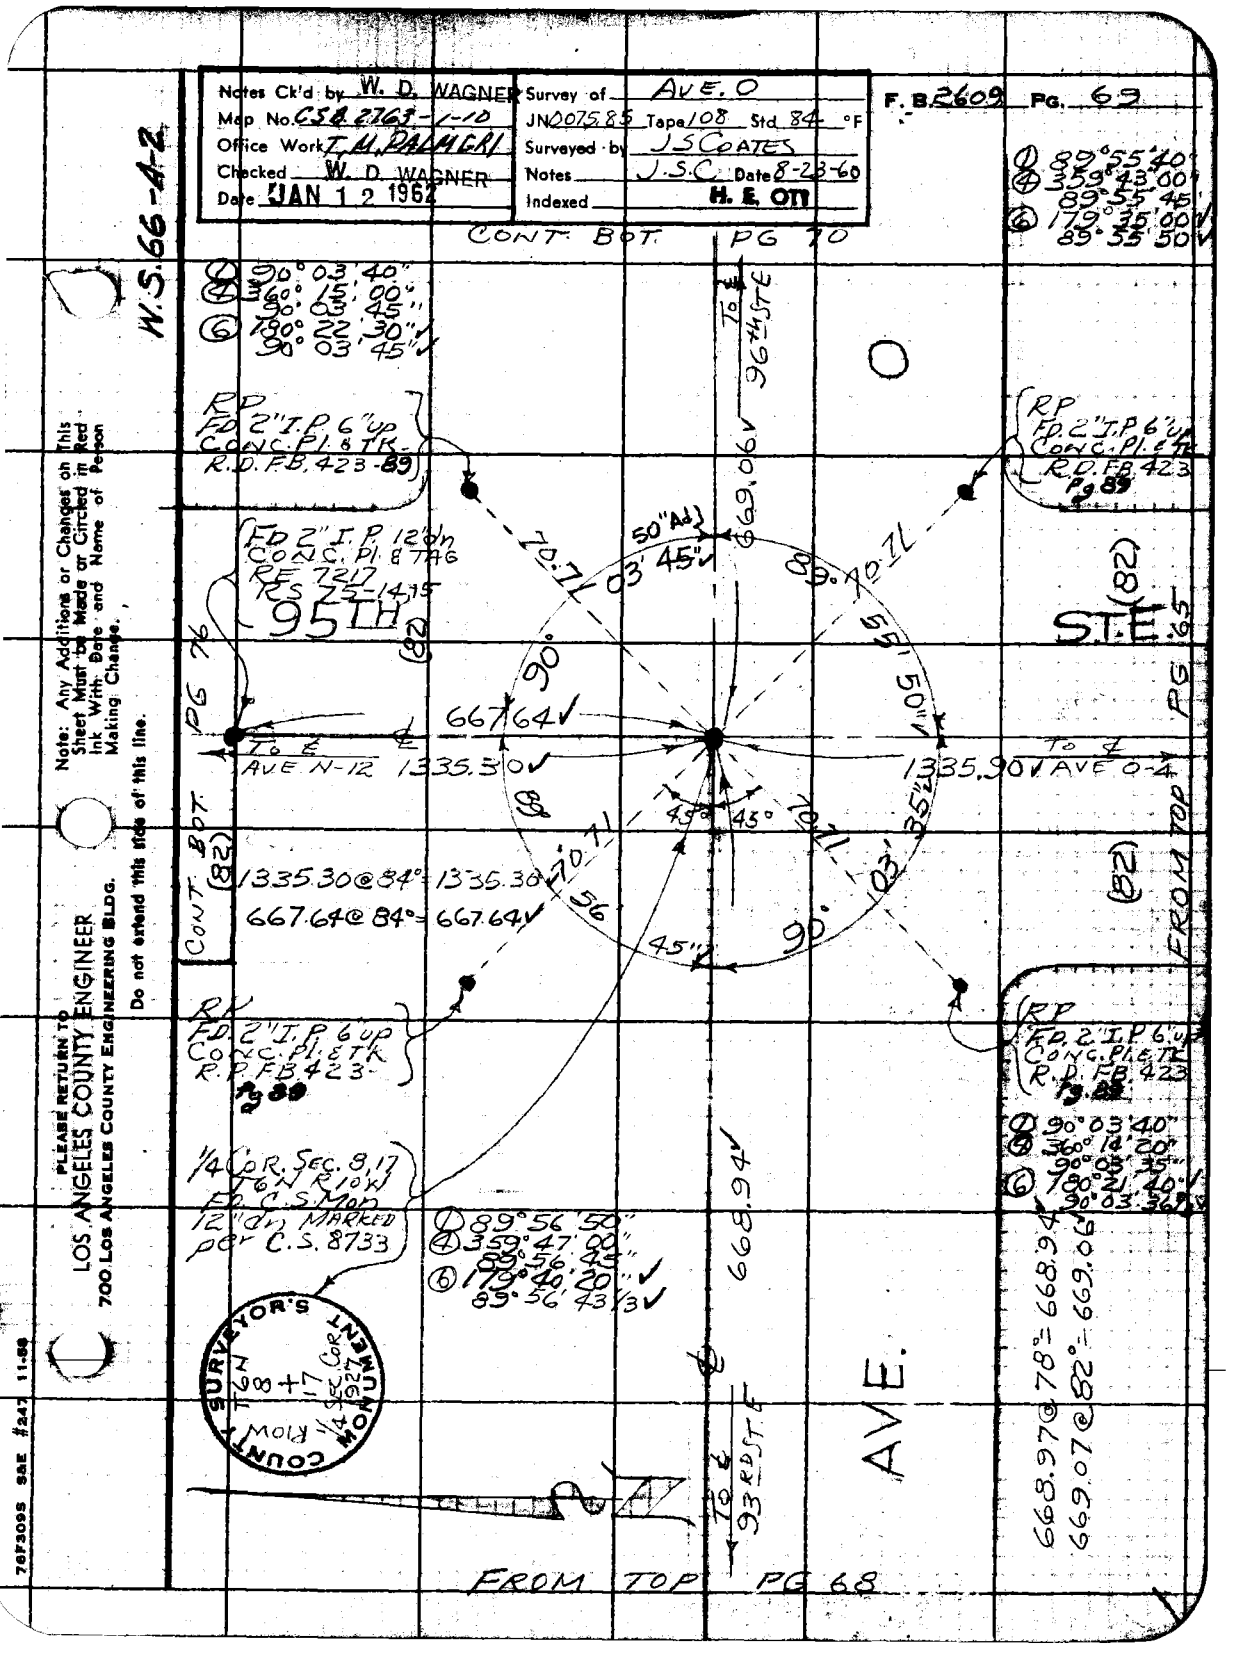
Notes Ck'd by W. D. WAGNER
Map No. C58 2769 - 1-10
Office Work I. M. PALMERI
Checked W. D. WAGNER
Date JAN 12 1962
Survey of AVE. O
JN 0075.85 Tape 108 Std. 84 °F
Surveyed by J.S. COATES
Notes J.S.C. Date 8-28-60
Indexed H. E. ON
F. B. 2609 Pg. 69
W.S. 66-42
CONT. BOT. PG 70
RP FD 2" I.P 6" up CONC. PL. & TK. R.D. F.B. 423-89
FD 2" I.P 12" dn CONC. PL. & TK. RE 7217 RS 25-14,15
95TH
(82)
PG 76
To ℄ AVE N-12 1335.50
1335.90 To ℄ AVE O-4
669.06
To ℄ 96TH ST E
S.T.E.
PG 65
FROM TOP
CONT. BOT.
1335.30@84°=1335.30
667.64@84°=667.64
1/4 COR. SEC. 8, 17 T6N R10W FD C.S. MON 12" dn MARKED per C.S. 8733
89°56'50"
359°47'00"
89°56'45"
179°46'20"
89°56'43"
668.94
℄ AVE.
To ℄ 93RD ST E
SURVEYOR'S MONUMENT
COUNTY
T6N R10W
8+17
1/4 SEC. COR.
1927
FROM TOP PG 68
89°55'40"
359°43'00"
89°55'45"
179°35'00"
89°55'50"
90°03'40"
360°14'20"
90°03'35"
180°21'40"
90°03'36"
668.97@78°=668.94
669.07@82°=669.06
Note: Any Additions or Changes on This Sheet Must Be Made or Circled in Red Ink With Date and Name of Person Making Change.
Do not extend this side of this line.
PLEASE RETURN TO
LOS ANGELES COUNTY ENGINEER
700 LOS ANGELES COUNTY ENGINEERING BLDG.
76F3095 SAE #247 11-58

PLEASE RETURN TO
LOS ANGELES COUNTY ENGINEER
700 LOS ANGELES COUNTY ENGINEERING BLDG.

Note: Any Additions or Changes on This Sheet Must Be Made or Circled in Red Ink With Date and Name of Person Making Change.

Do not extend this side of this line.

W.S. 66 A-2

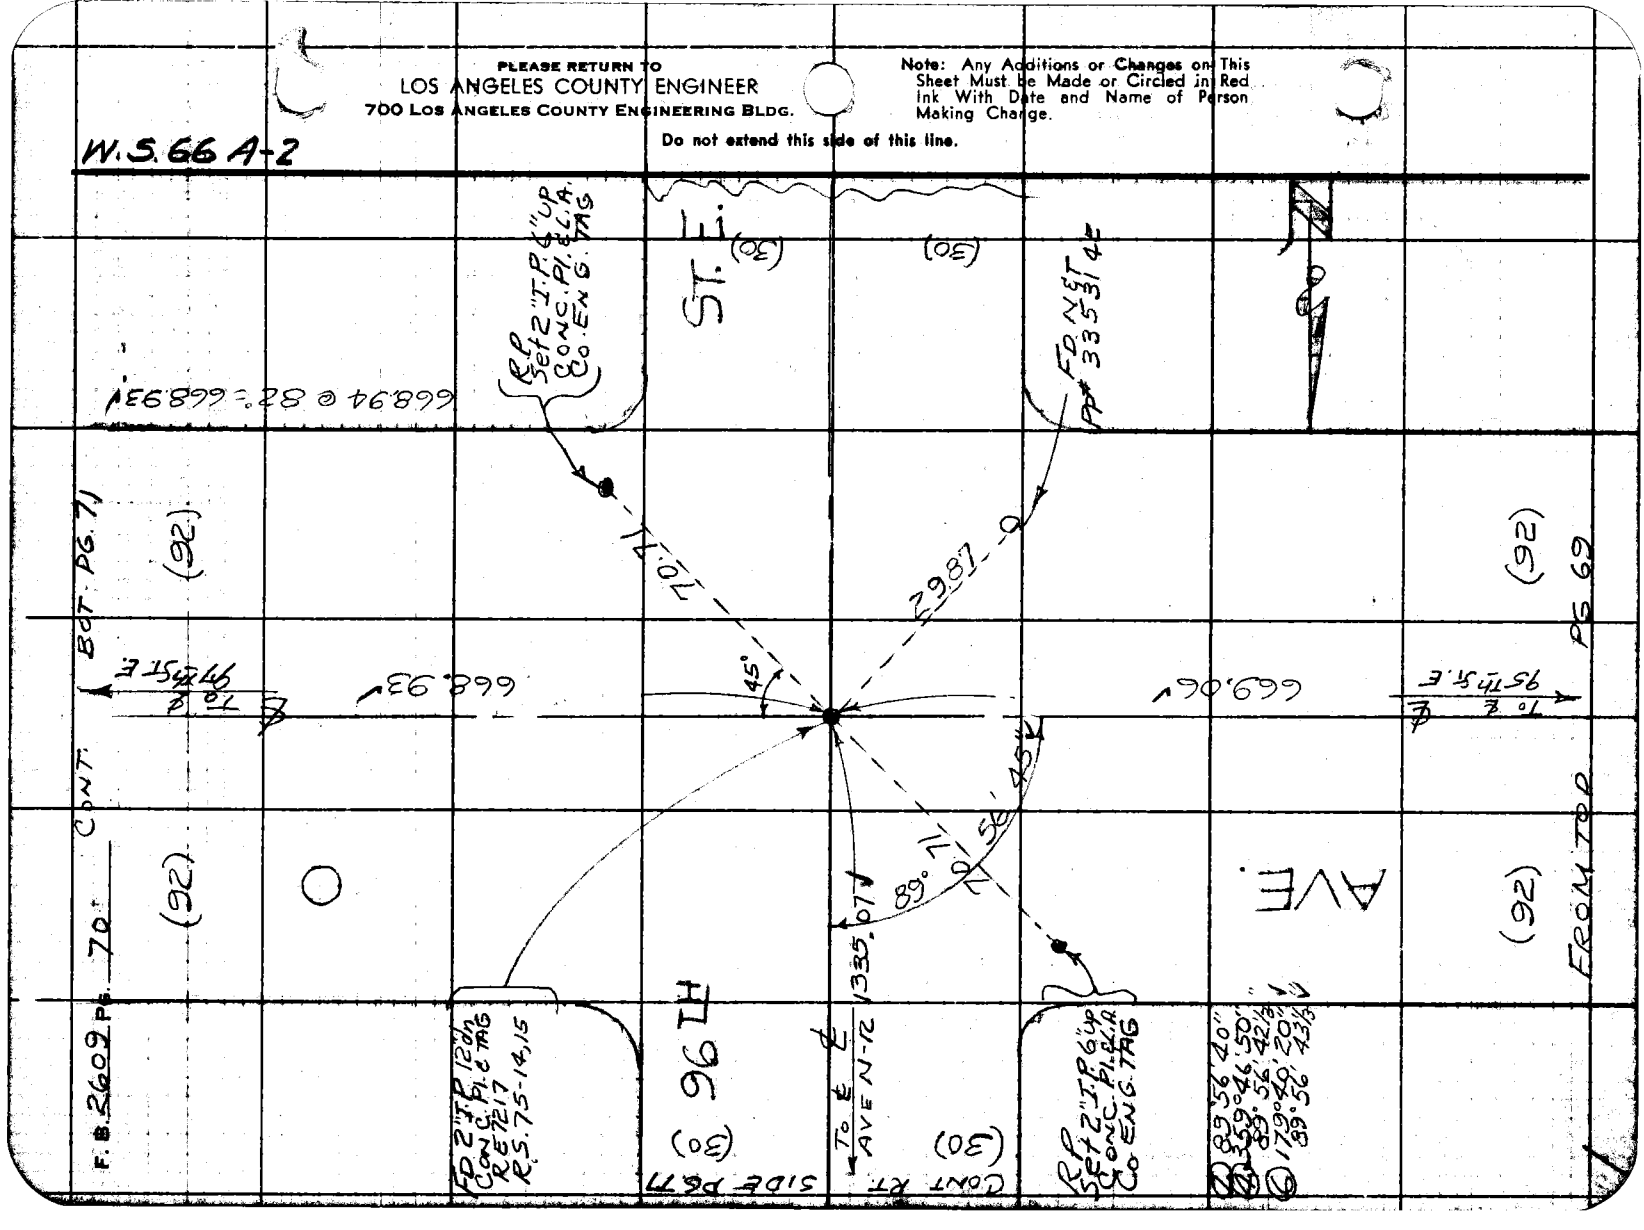

F.B. 2609 Pg.

Notes Ck'd by W. D. WAGNER | Survey of AVE O | F. B. 2609 PG. 71
Map No. C.S.B 2165-1-10 | JN 007585 Tape 108 Std 84 °F
Office Work T.M. PALMER | Surveyed by J.S. COATES
Checked W. D. WAGNER | Notes J.S.C. Date 8-25-60
Date JAN 12 1962 | Indexed H. & OR

W.S. 66 A2, B-2

CONT. BOT. PG. 72

(50) (92)

To 100TH ST. E.

668.88

RP Set 2" I.P. 6" up Conc. Pl. & L.A. Co. ENG TAG

98TH

70.71

FD 2" I.P. 12" dn Conc. Pl. & TAG RE 6067 RS 71-33, 34

668.87 @ 82° = 668.86
668.89 @ 82° = 668.88
90° 02' 20"
360° 09' 03"
180° 05' 13"
90° 02' 20" 13/3

Set 2" I.P. 6" up Conc. Pl. & L.A. Co. ENG. TAG

70.71 TAN

45°

ST. E.

57.03

SET N&T PP# 335320E

AVE. E.

668.86

RP Set 2" I.P. 6" up Conc. Pl. & L.A. Co. ENG. TAG

FD 2" I.P. 12" dn Conc. Pl. & TAG RE 6067 RS 71-33, 34 RS 75-14, 15

90° 02' 15"

70.71 TAN

PG. 78

CONT. BOT. ← C/L AVE N-12 1334.94

(30) 97TH

45°

106.04

70.71

ST. E.

RP Set 2" I.P. 6" up Conc. Pl. & L.A. Co. ENG. TAG

To C/L 668.93 STE

FD. P.M. TOP CTR. FIRE HYD

(92)

FD. N&T PP# 335317E

FROM TOP PG. 70

Note: Any Additions or Changes on This Sheet Must be Made or Circled in Red Ink With Date and Name of Person Making Change.

Do not extend this side of this line.

PLEASE RETURN TO
LOS ANGELES COUNTY ENGINEER
200 LOS ANGELES COUNTY ENGINEERING BLDG.

76F3098 SAE #247 11-58

PLEASE RETURN TO
LOS ANGELES COUNTY ENGINEER
700 LOS ANGELES COUNTY ENGINEERING BLDG.

Note: Any Additions or Changes on This Sheet Must be Made or Circled in Red Ink With Date and Name of Person Making Change.

Do not extend this side of this line.

W.S. 66-B-2

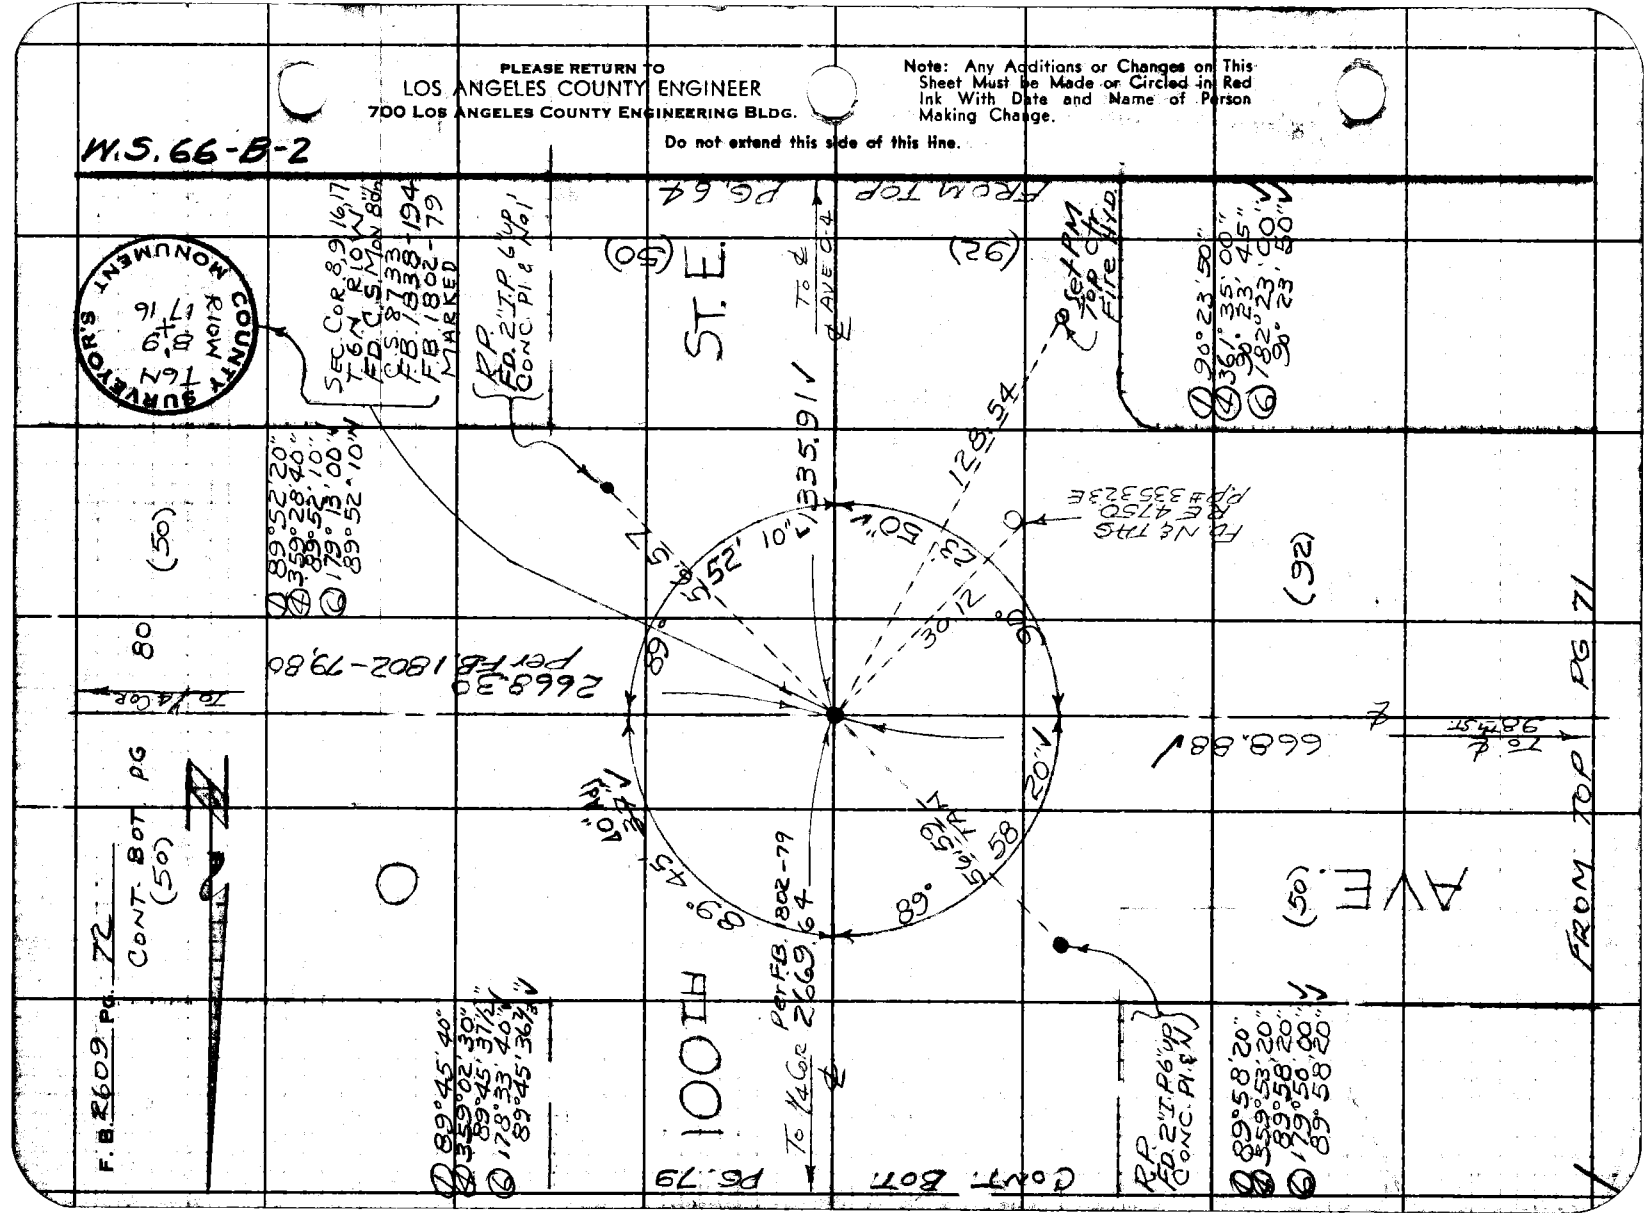

Notes Ck'd by W. D. WAGNER | Survey of AVE O | F. B. 2609 Pg. 73
Map No. C.S.A. 2763-4-10 | JN 0075.85 Tape 108 Std 84 °F
Office Work T. M. PALMERI | Surveyed by J.S.COATES
Checked W. D. WAGNER | Notes J.S.C. Date 8-24-60
Date JAN 12 1962 | Indexed H. E. OTT

W.S. 66-A-1

CONT LEFT SIDE PG. 74

(30) N-12 (30)

℄ to ℄ 91ST

668.71

FD. 2" X 2" ℄ N RS 75-15

FD. 2" X 2" ℄ N RS. 75-15

FD. 2" I.P. 1.50' N CONC. PL. & TAG RE 7217 R.S. 75-15

55.45

54.07

1334.93 ℄ to ℄ AVE O

(30) SIDE PG. 66

91ST

52.61

54.00

50' R/W

90° 03' 45"

ST. E. (30)

FROM LEFT

FD. 2" X 2" ℄ N RS 75-15

FD. 2" X 2" ℄ N R.S. 75-15

669.30

AVE.

669.30

① 90° 03' 40"
④ 360° 15' 00"
90° 03' 45"
⑥ 180° 22' 20"
90° 03' 43 1/3"

669.30 @ 84° = 669.30
668.71 @ 84° = 668.71
1335.00 @ 90° = 1334.93

℄ to ℄ 90TH E

(30) (30)

FROM RT SIDE PG. 52

PLEASE RETURN TO LOS ANGELES COUNTY ENGINEER
700 Los Angeles County Engineering Bldg.

Note: Any Additions or Changes on This Sheet Must be Made or Circled in Red Ink With Date and Name of Person Making Change.

Do not extend this line.

76F3093 SAE #247 11-59

PLEASE RETURN TO
LOS ANGELES COUNTY ENGINEER
700 LOS ANGELES COUNTY ENGINEERING BLDG.

Note: Any Additions or Changes on This Sheet Must be Made or Circled in Red Ink With Date and Name of Person Making Change.

Do not extend this side of this line.

W.S. 66-A-1

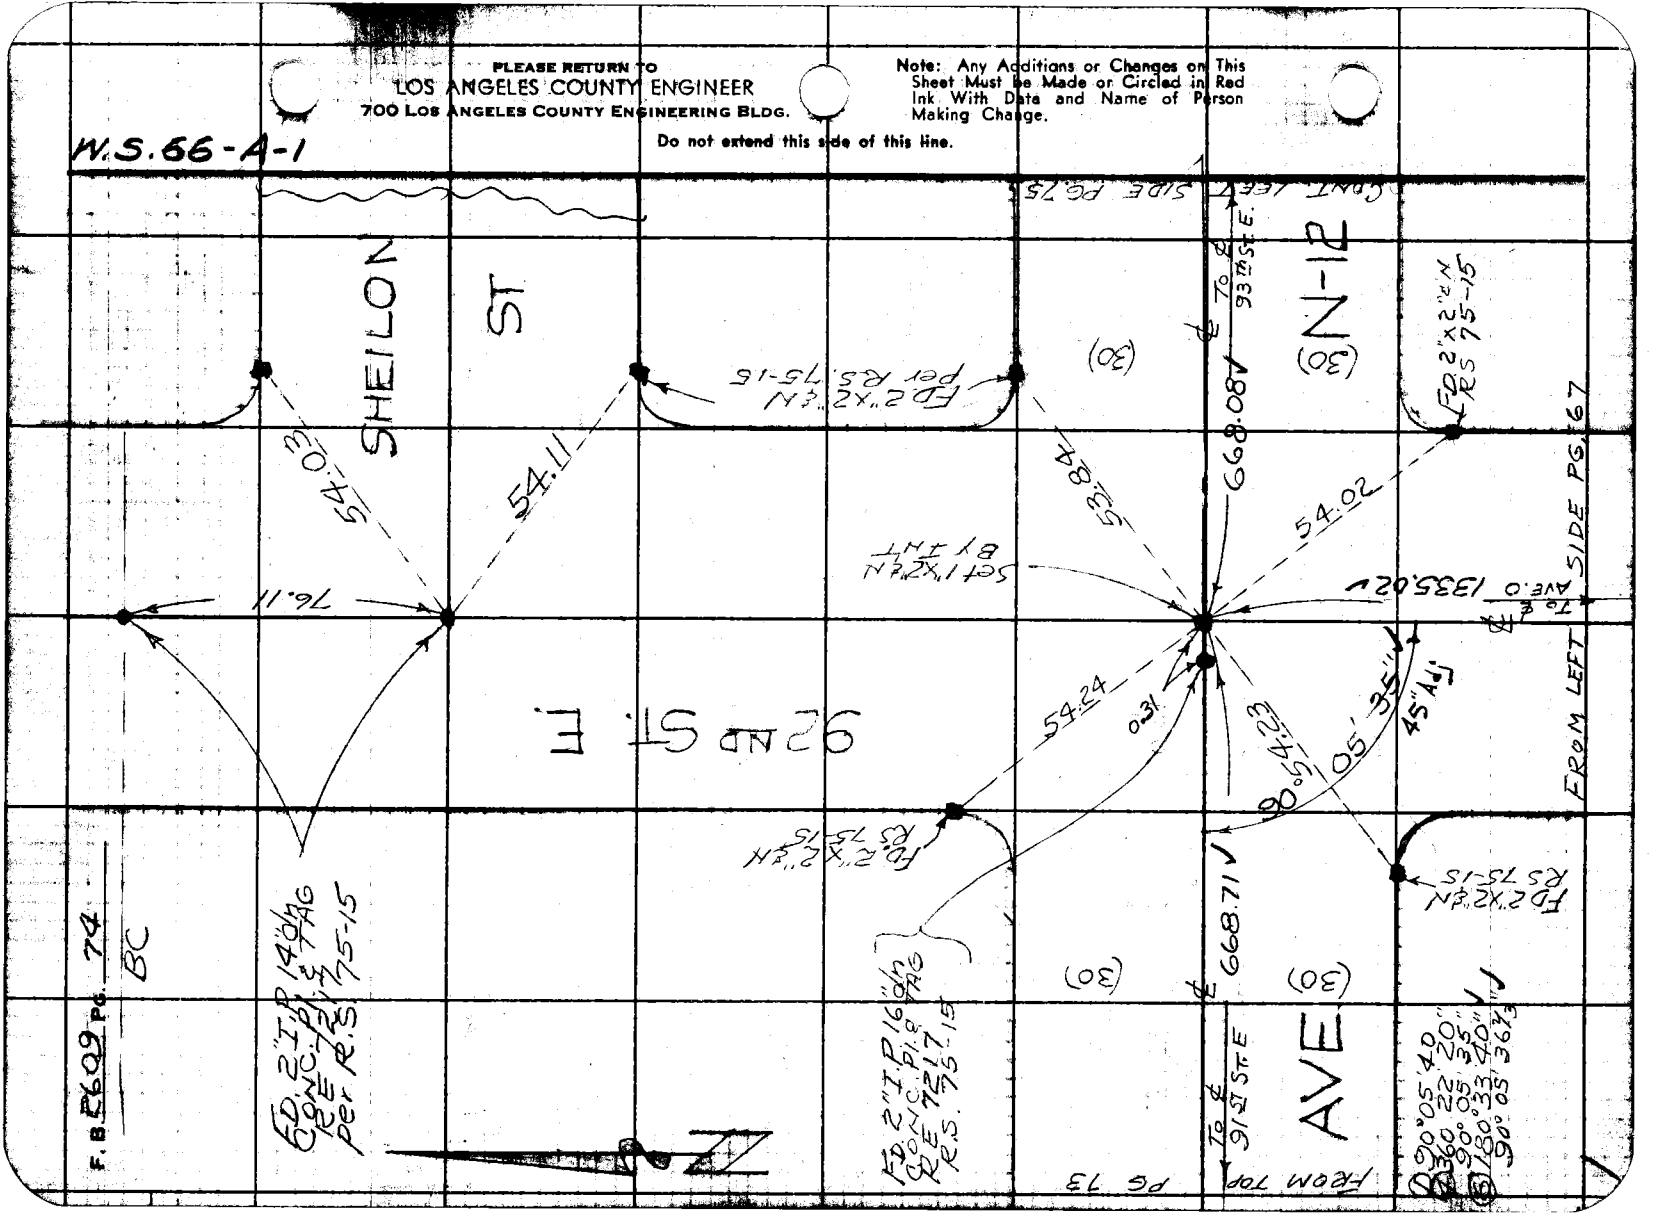

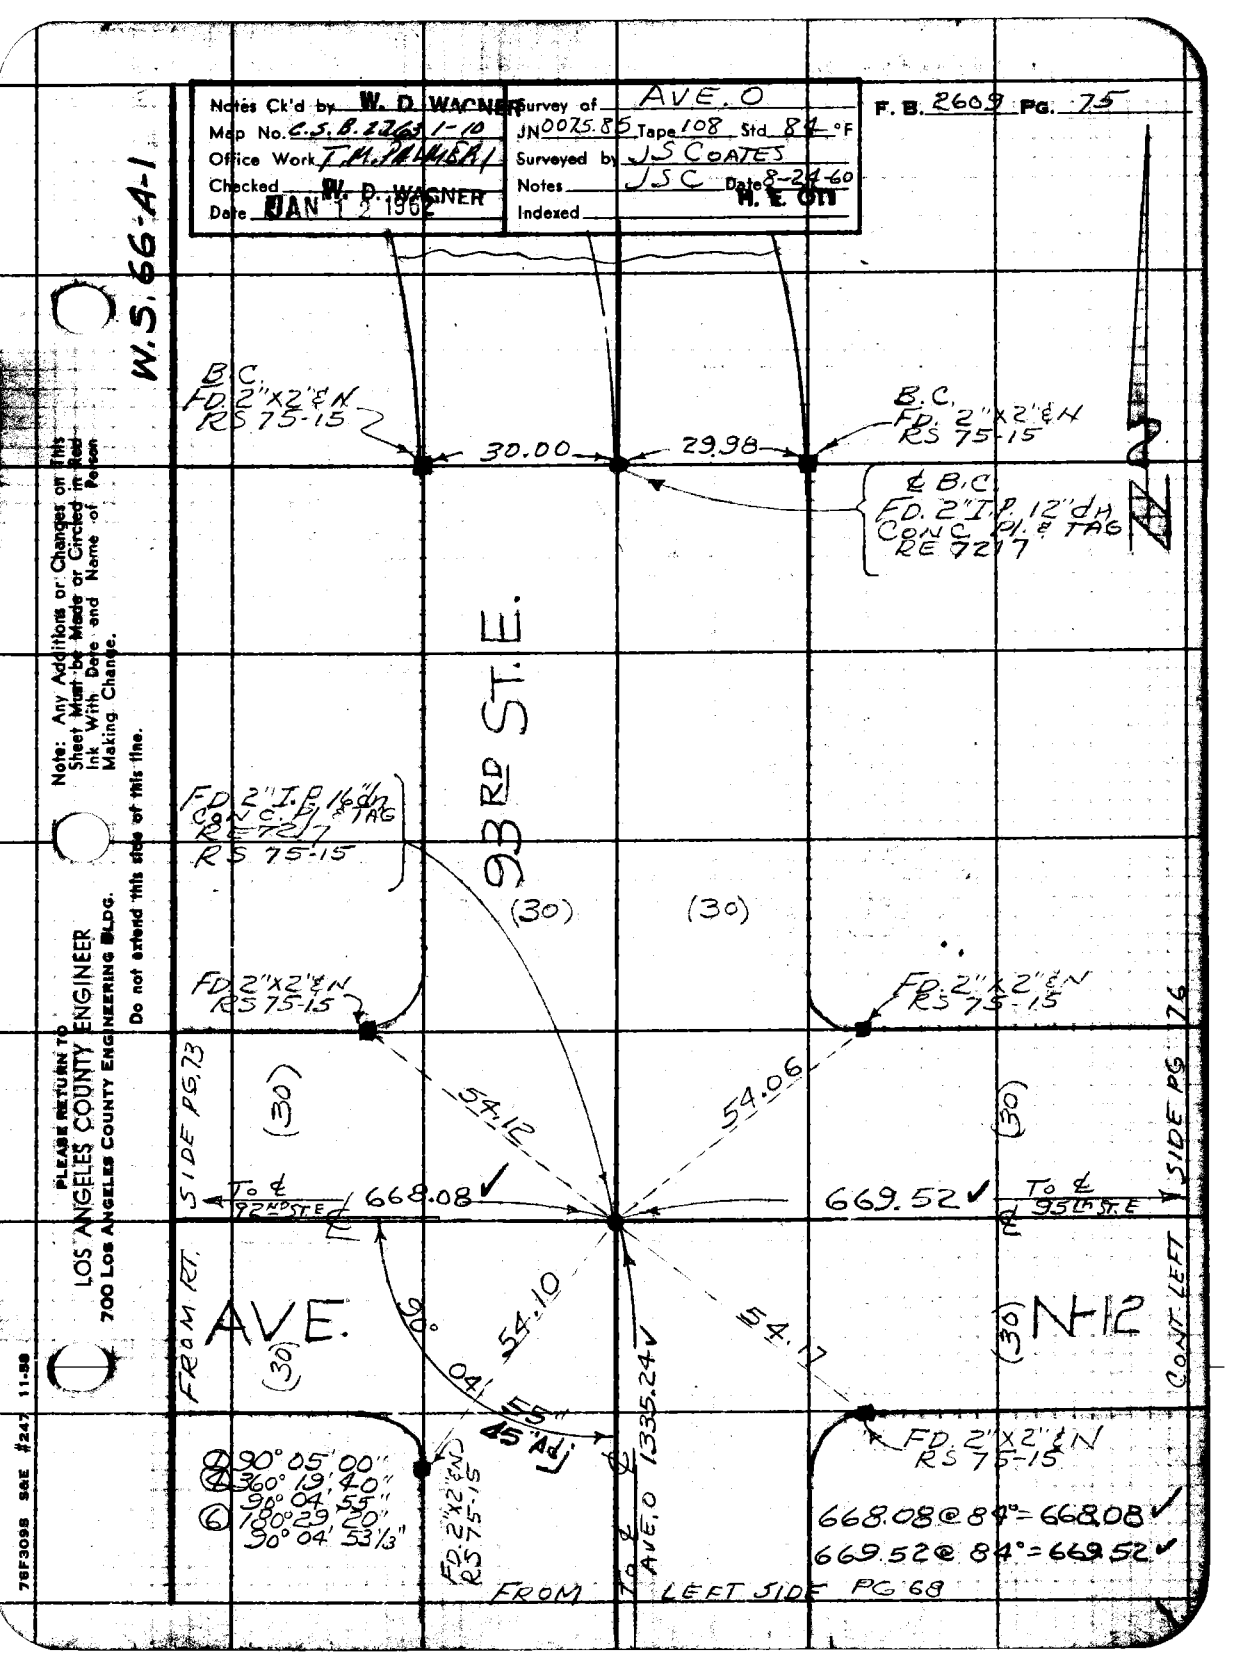
Notes Ck'd by W. D. WAGNER
Map No. C.S.B. 2263 1-10
Office Work T.M. PALMER
Checked W. D. WAGNER
Date JAN 12 1962
Survey of AVE. O
JN 0025.86 Tape 108 Std 84 °F
Surveyed by J.S. COATES
Notes J.S.C. Date 8-24-60
Indexed H. E. OTT
F. B. 2609 PG. 75
W.S. 66-A-1
Note: Any Additions or Changes on This Sheet Must be Made or Circled in Red Ink With Date and Name of Person Making Change.
Do not extend this side of this line.
PLEASE RETURN TO
LOS ANGELES COUNTY ENGINEER
700 Los Angeles County Engineering Bldg.
B.C. FD 2"X2" E N RS 75-15
30.00
29.98
B.C. FD 2"X2" E N RS 75-15
℄ B.C. FD 2" I.P. 12" DM CONC. PL. & TAG RE 7217
FD 2" I.P. 16" DM CONC. PL. & TAG RE 7217 RS 75-15
93RD ST. E.
(30)
(30)
FD 2"X2" E N RS 75-15
FD 2"X2" E N RS 75-15
SIDE PG 73
(30)
54.12
54.06
(30)
SIDE PG 76
To ℄ 92ND ST. E
668.08 ✓
669.52 ✓
To ℄ 95TH ST. E
FROM RT.
AVE.
(30)
90°
54.10
04'
45' Rad.
54.17
(30)
N 12
CONT. LEFT
℄ 90° 05' 00"
℄ 360° 19' 40"
90° 04' 55"
℄ 180° 29' 20"
90° 04' 53 1/3"
FD 2"X2" E N RS 75-15
℄ AVE. O 1335.24 ✓
FD 2"X2" E N RS 75-15
668.08 @ 84° = 668.08 ✓
669.52 @ 84° = 669.52 ✓
FROM LEFT SIDE PG 68
78F3098 SAE #247 11-59

PLEASE RETURN TO
LOS ANGELES COUNTY ENGINEER
700 LOS ANGELES COUNTY ENGINEERING BLDG.

Note: Any Additions or Changes on This Sheet Must be Made or Circled in Red Ink With Date and Name of Person Making Change.

Do not extend this side of this line.

W.S.66-A-1

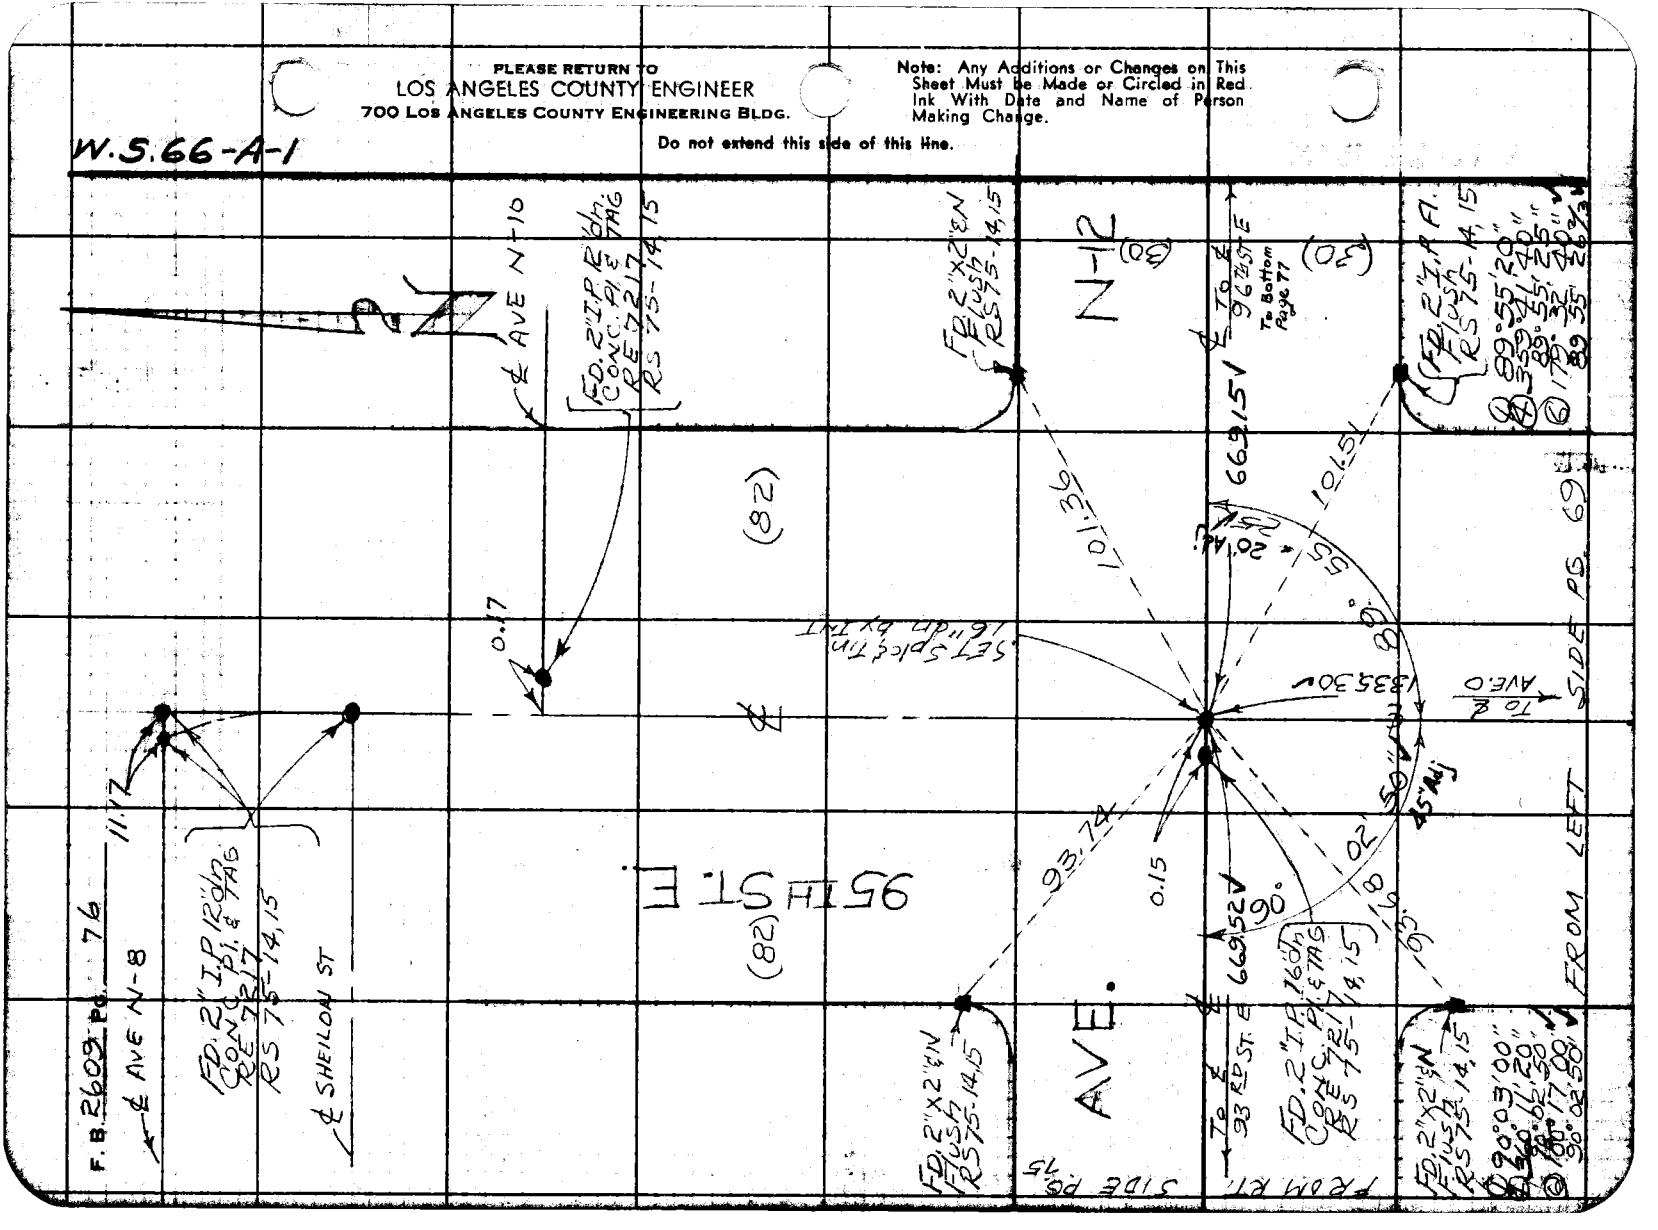
AVE N-10
FD. 2" I.P. & Tag RE 7-21-7 RS 75-14, 15
FD. 2" X 2" CONC. PLUG & TAG RS 75-14, 15
AVE N-12
(82)
95TH ST E.
SET Spiked Tin 16" deep by Tin
0.17
0.15
101.36
101.51
669.51
669.52
20' Adj
45' Adj
50' Adj
90°
90°
90°
93.74

W.S. 66-A-1

Notes Ck'd by W. D. WAGNER	Survey of AVE O	F. B 2609	PG. 77
Map No. C.S.B. 27 92-1-10	JN 007585 Tape 108 Std 84 °F		
Office Work T. M. PALMERI	Surveyed by J.S. COATES		
Checked W. D. WAGNER	Notes J.S.C Date 8-25-66		
Date JAN 12 1962	Indexed H. E. OTT		

CONT. LEFT SIDE PG 78

Note: Any Additions or Changes on This Sheet Must be Made or Circled in Red Ink With Date and Name of Person Making Change.

PLEASE RETURN TO
LOS ANGELES COUNTY ENGINEER
700 LOS ANGELES COUNTY ENGINEERING BLDG.
Do not extend this side of this line.

(30) N-12 (30)

℄ To ℄ 97TH ST. E

669.21

669.15 @ 84° = 669.15
669.21 @ 84° = 669.21

Set Spk & Tin 4, "Joshua"

FD. 2"X2" & N FLUSH

89°56'00"
360°43'40"
89°55'55"
179°35'20"
89°55'53"

PG. 20

89°

53°55'55"

18.92

96TH ST. E.

(30)

LEFT SIDE

℄ To ℄ AVE. O

1335.07

FROM

FD. 2" I.P. 14" in CONC. PI. & TAG RE 7217 RS 75-14,15

31.14

54°01'

FD. 2"X2" & N FLUSH RS 75-14,15

1335.10 @ 80° = 1335.07

Set P.M. in X 3" Pipe Line

AVE.

669.15

℄ To ℄ 95TH ST.

(30) (30)

FROM RT. SIDE PG 76

76F3095 SAE #247 11-58

F. B 2609 Pg. 78

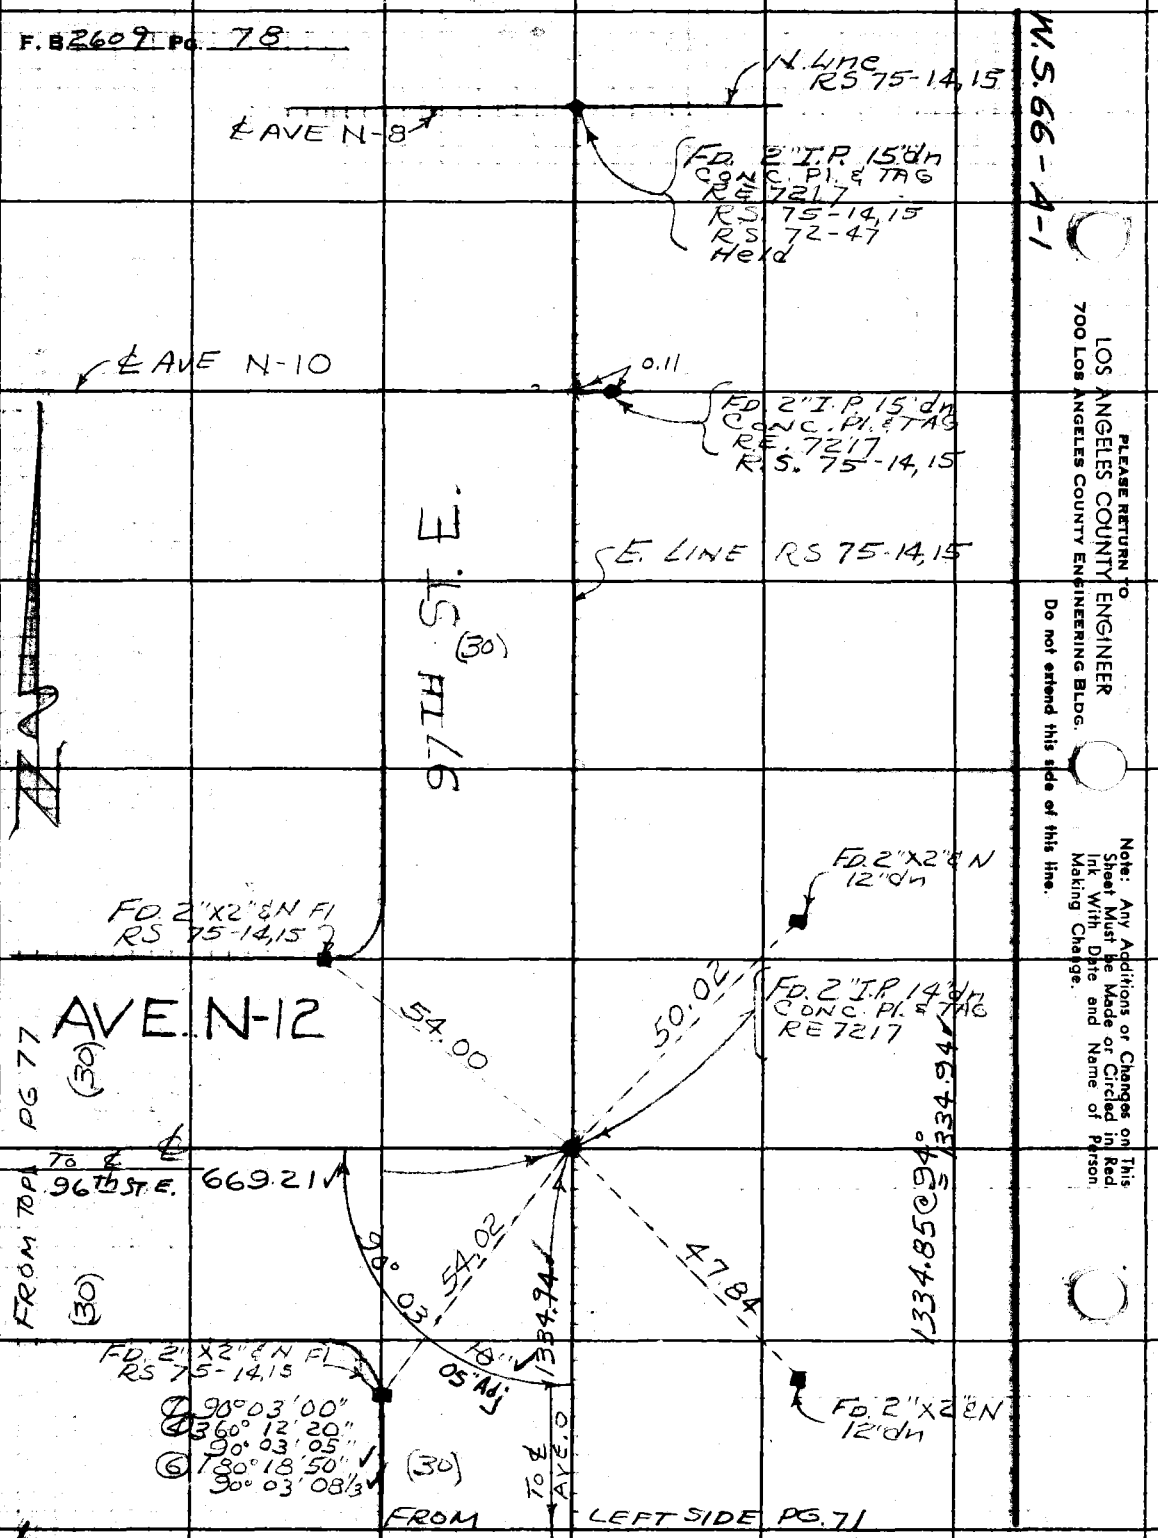

LOS ANGELES COUNTY ENGINEER
700 Los Angeles County Engineering Bldg.

PLEASE RETURN TO

Do not extend this side of this line.

Note: Any Additions or Changes on This Sheet Must be Made or Circled in Red Ink With Date and Name of Person Making Change.

Notes Ck'd by W. D. WAGNER	Survey of AVE. O	F. B. 2609 Pg. 79
Map No. C.S.B. 276 3-1-10	JN 0075.85 Tape 108 Std 84 °F	
Office Work T. M. PALMERI	Surveyed by J. S. COATES	
Checked W. D. WAGNER	Notes JSC Date 9-1-60	
Date JAN 12 1962	Indexed H. E. ON	

W.S. 66-8-1

Note: Any Additions or Changes on This Sheet Must be Made or Circled in Red Ink With Date and Name of Person Making Change.

Do not extend this side of this line.

PLEASE RETURN TO
LOS ANGELES COUNTY ENGINEER
700 LOS ANGELES COUNTY ENGINEERING BLDG.

76F3098 S&E #247 11-58

RP
FD. 2" I.P. C/W
CONC. PL. & Nail
F.B. 1838-45

56.57

45°

AVE.

37.88

Set this "X"
30" CONC.
STANDPIPE

N-8

1/4 COR SEC 8,9
T6N R10W
U.S. MON 16"D/F
PER F.B. 1838-94
MARKED

COUNTY SURVEYOR'S
T6N
R10W 8+9
1/4 SEC COR
1925
MONUMENT

93.75

SET N&T
PK#11616 20E

66.15

RP
FD. 2" I.P. FL.
CONC. PL. & L.A.
CO ENG. TAG

100TH ST. E.

PER F.B. 1802-79
2669.64

TO E. AVE. O

FROM LEFT SIDE PG. 72

PLEASE RETURN TO
LOS ANGELES COUNTY ENGINEER
700 LOS ANGELES COUNTY ENGINEERING BLDG.

Note: Any Additions or Changes on This Sheet Must be Made or Circled in Red Ink With Date and Name of Person Making Change.

Do not extend this side of this line.

W.S. 66-B-2

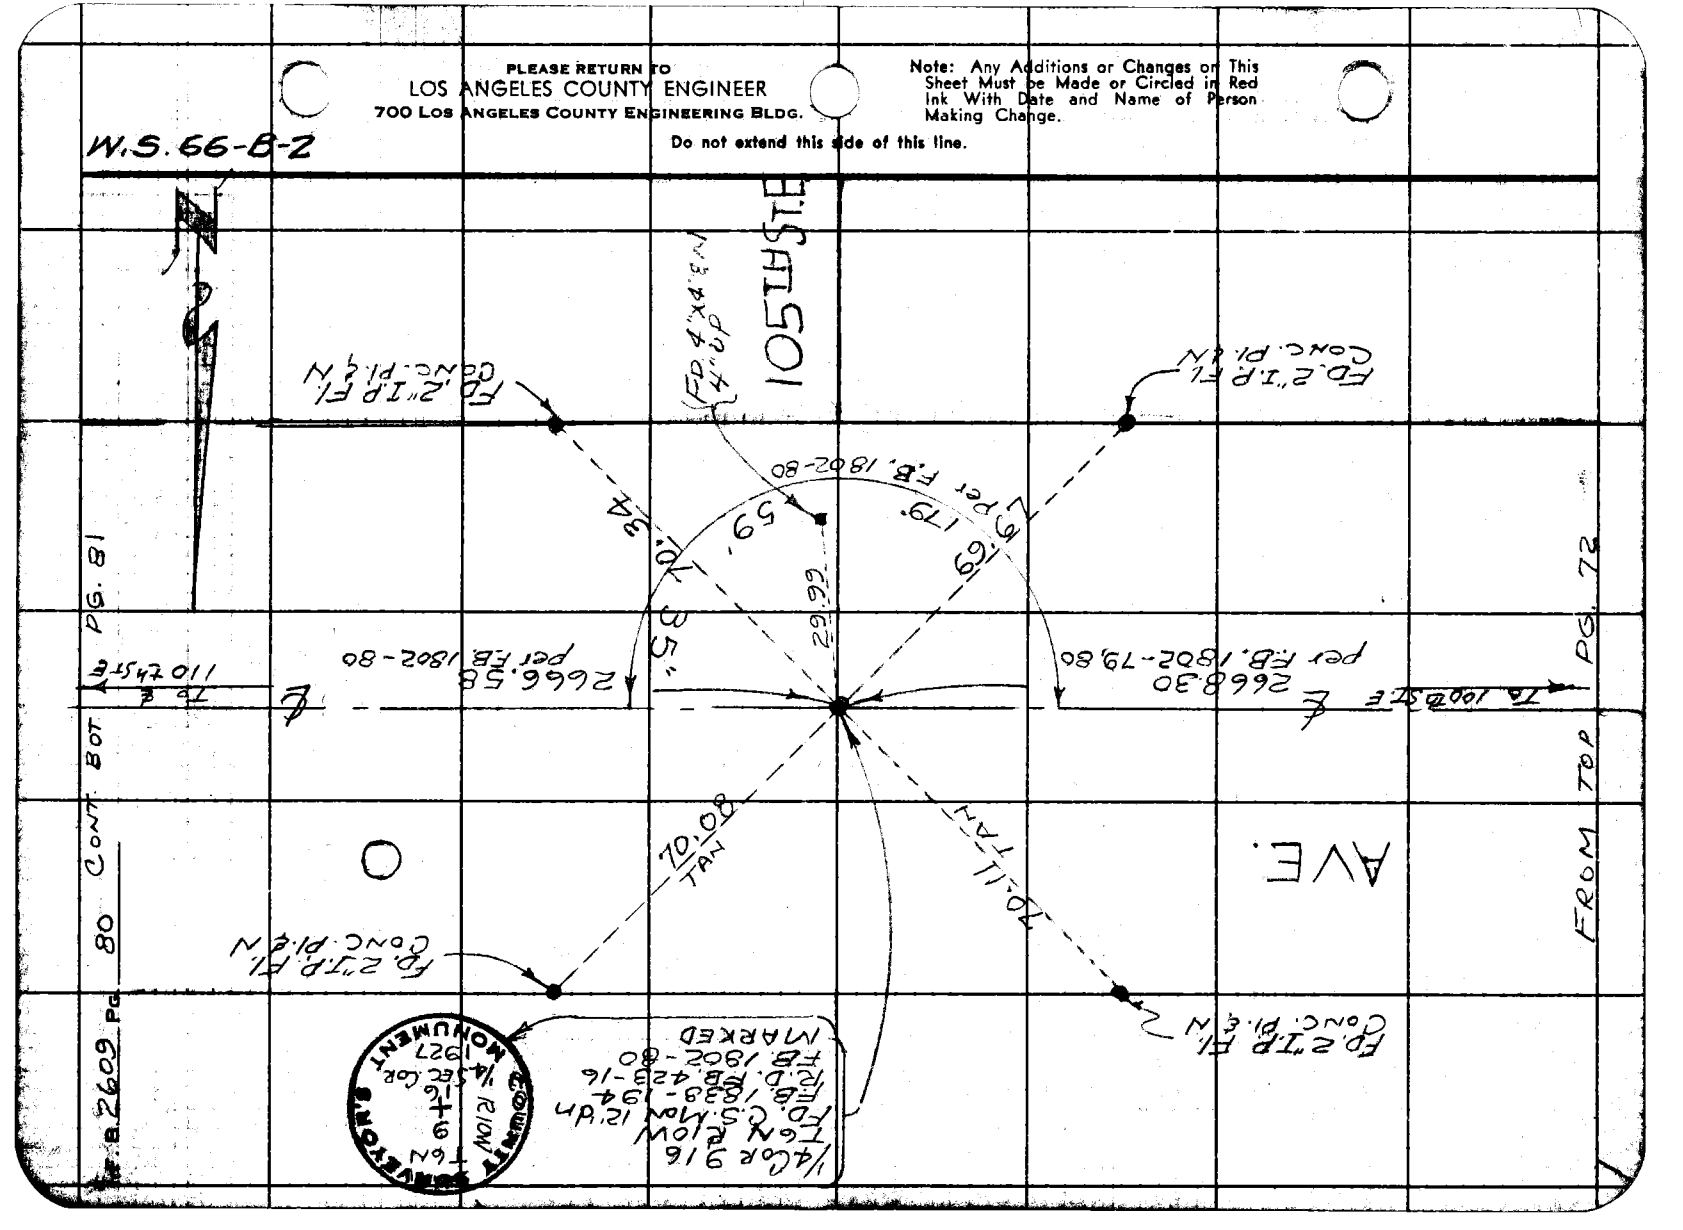

Notes Ck'd by W. D. WAGNER | Survey of AVE O | F. B. 2609 Pg. 81
Map No. C.S.B. 2265 1-10 | JN 007585 Tape 108 Std. 84 °F
Office Work I. M. PALMER | Surveyed by J. S. COATES
Checked W. D. WAGNER | Notes JSC Date 9-2-60
Date JAN 12 1962 | Indexed H. E. OD

W.S. 66-B-2

Note: Any Additions or Changes on This Sheet Must be Made or Circled in Red Ink With Date and Name of Person Making Change.

PLEASE RETURN TO LOS ANGELES COUNTY ENGINEER 700 LOS ANGELES COUNTY ENGINEERING BLDG. Do not extend this side of this line.

CONT. BOT. PG 83

89° 59' 00"
359° 56' 20"
89° 53' 05"
179° 54' 40"
89° 59' 06⅔"

90° 37' 20"
362° 28' 30"
90° 37' 01⅔"
183° 43' 00"
90° 37' 10"

(50) (50)

FD. 2" I.P. FI. CONC. PL. & N

FD. 2" I.P. FI. CONC. PL. & N

110 TH

FD. N&T P.P. #1062411E

FD. N&T P.P. #1062/18E

ST. E

PG. 82

PG. 84

(50) (50)

To ℄ ANTELOPE AVE

Per F.B. 1802/58

1627.21

2665.00 per F.B. 1802-50

To ℄ 116TH ST.

10" Adj

69.55

69.76

33.39

40.87

89° 59' 15"

90° 00' 02"

89° 21' 15"

89° 21' 15"

89° 21' 15

PLEASE RETURN TO
LOS ANGELES COUNTY ENGINEER
700 LOS ANGELES COUNTY ENGINEERING BLDG.

Note: Any Additions or Changes on This Sheet Must be Made or Circled in Red Ink With Date and Name of Person Making Change.

Do not extend this side of this line.

W.S. 66-8-1

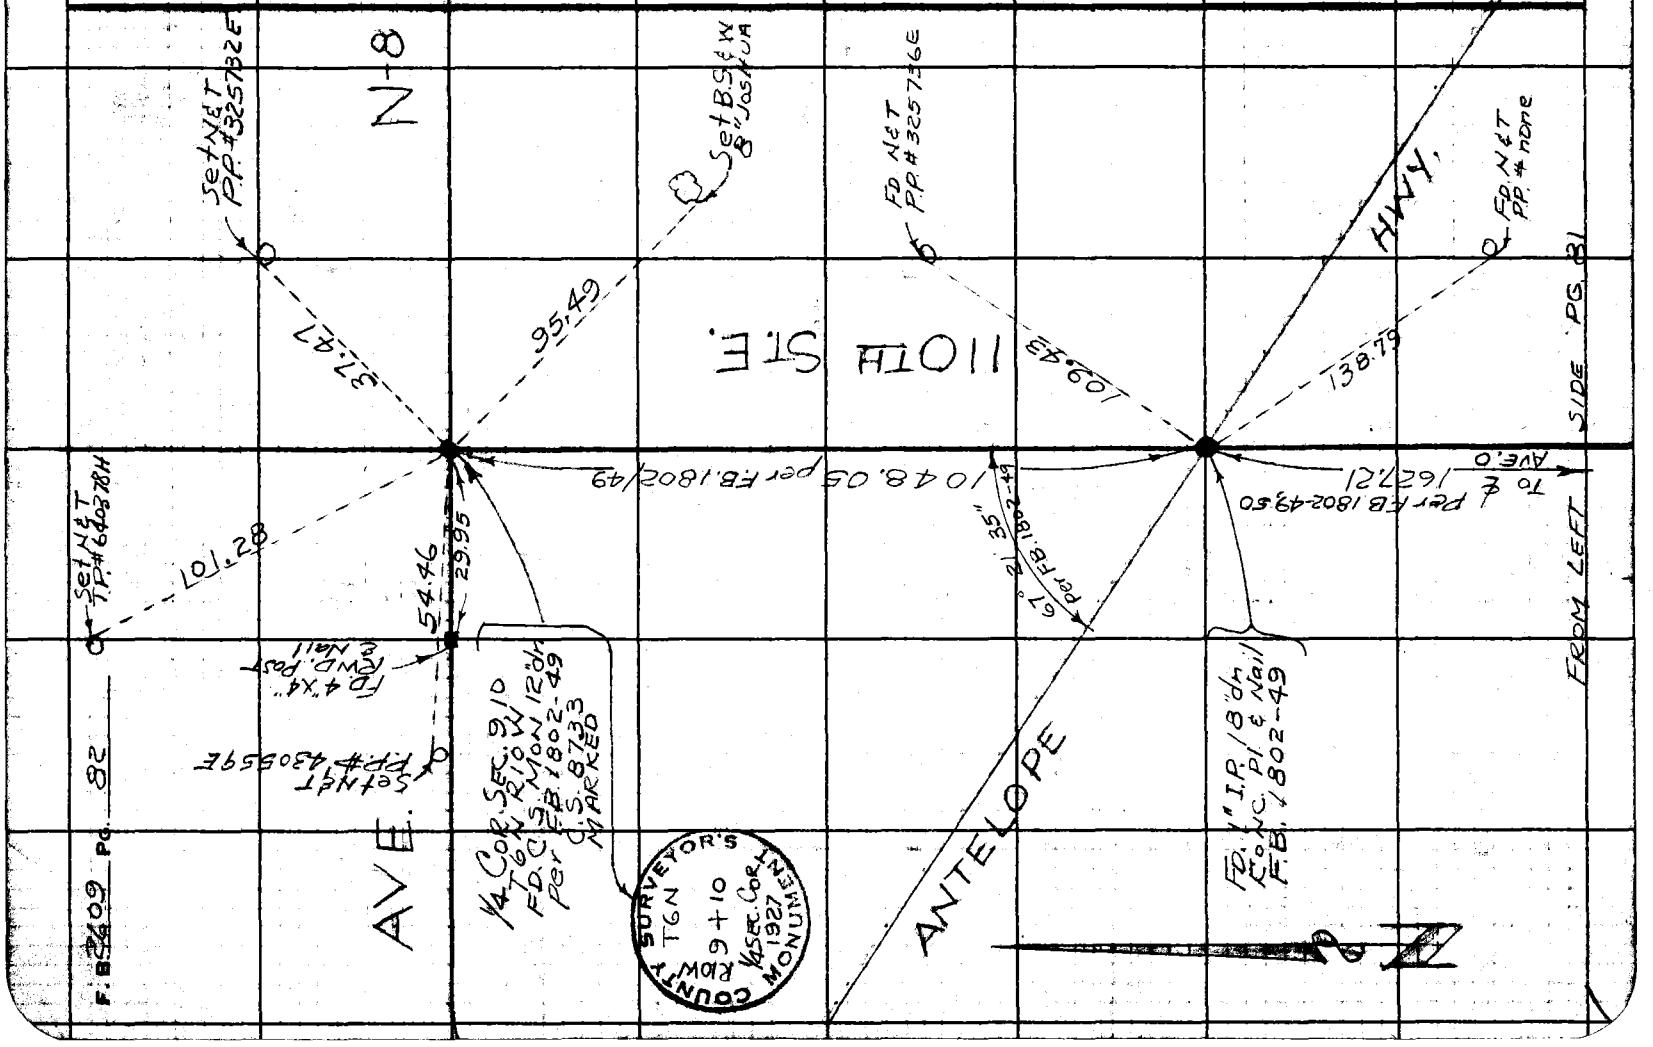

F: B5409 Pg. 82

76F3098 S&E #247 1-56

PLEASE RETURN TO
LOS ANGELES COUNTY ENGINEER
700 LOS ANGELES COUNTY ENGINEERING BLDG.

Note: Any Additions or Changes on This Sheet Must be Made or Circled in Red Ink With Date and Name of Person Making Change.

Do not extend this side of this line.

W.S.66-B-2

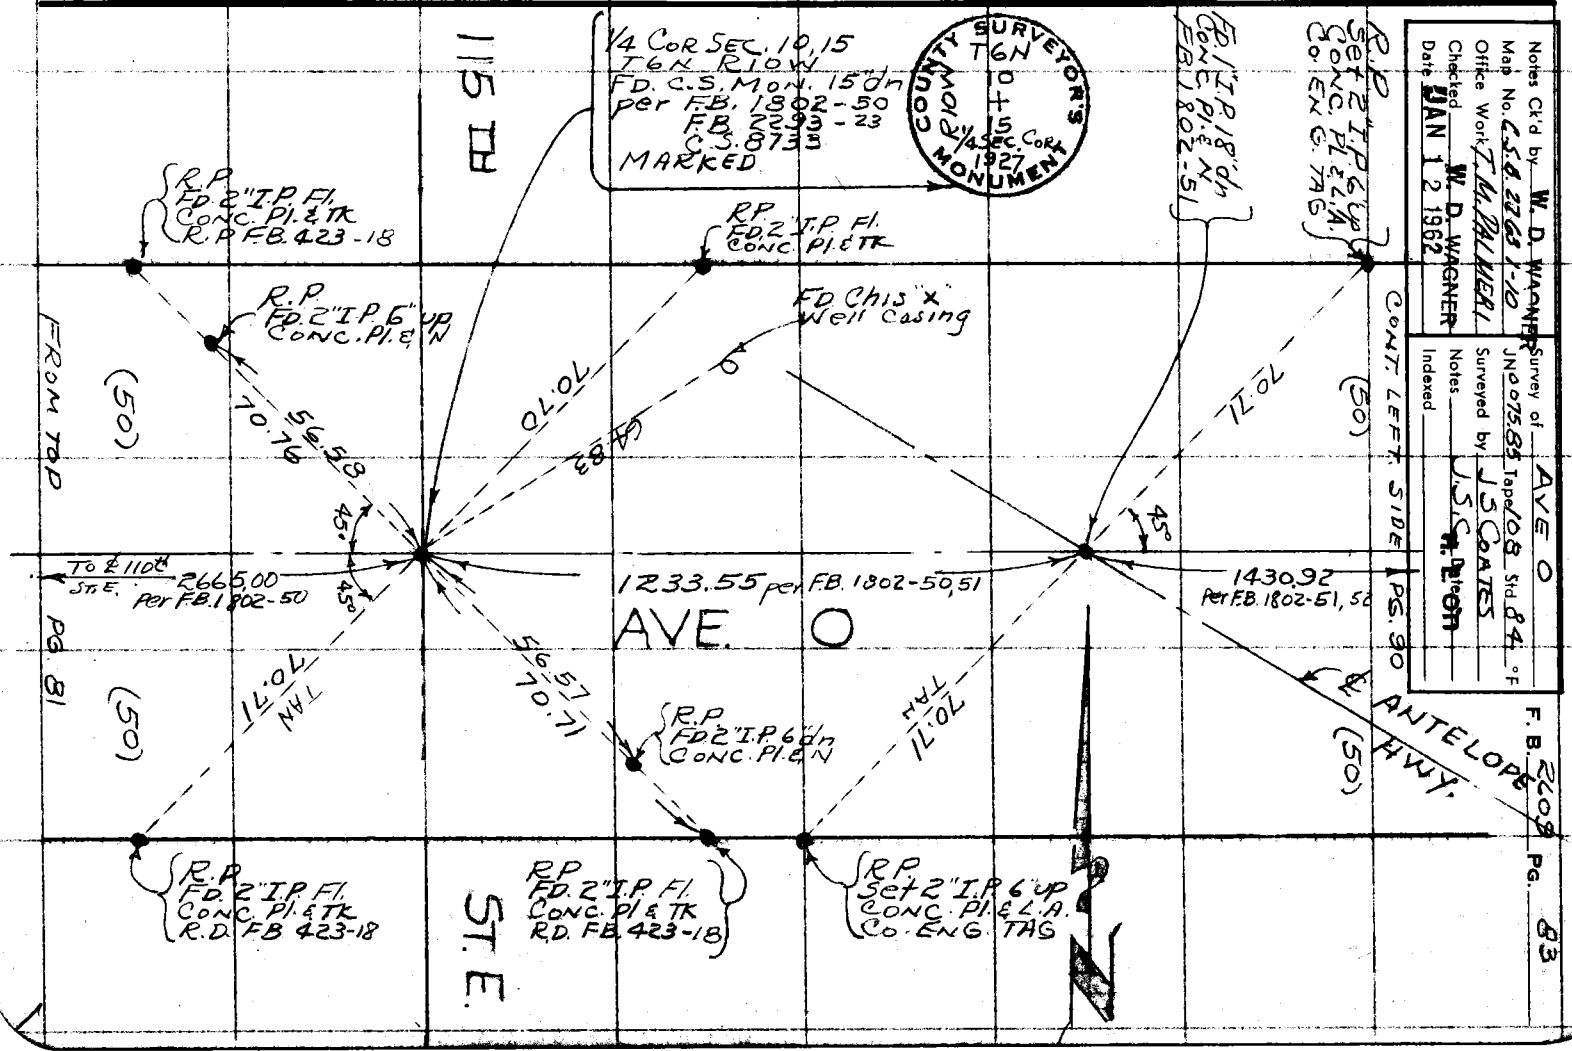

Notes Ck'd by W. D. WAGNER
Map No. C.S. 8763 1-10
Office Work T. M. PALMIERI
Checked W. D. WAGNER
Date JAN 12 1962

Survey of AVE O
JNo 0758.85 Tape/OS Std. 84 °F
Surveyed by J.S. COATES
Notes
Indexed

F.B. 2608 PG. 83

PLEASE RETURN TO
LOS ANGELES COUNTY ENGINEER
700 LOS ANGELES COUNTY ENGINEERING BLDG.

Note: Any Additions or Changes on This Sheet Must be Made or Circled in Red Ink With Date and Name of Person Making Change.

Do not extend this side of this line.

W.S. 66 B-2

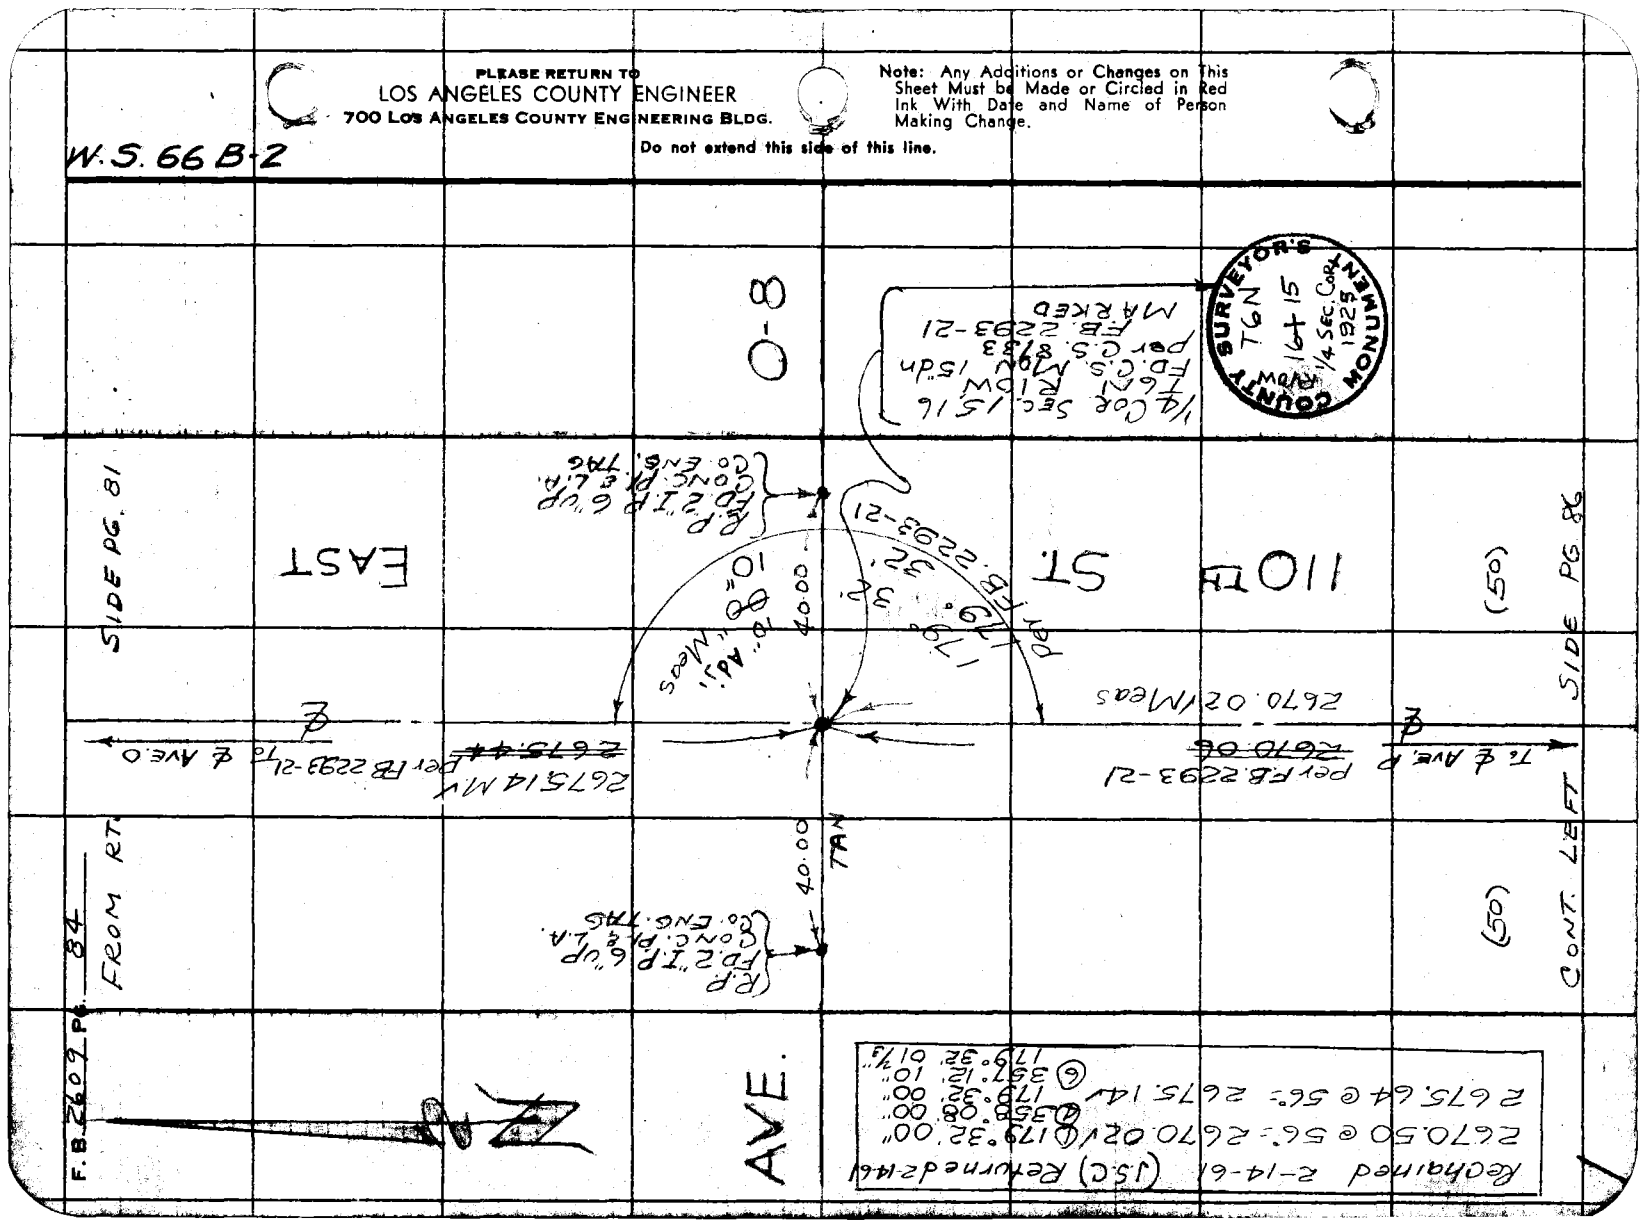

76F3095 S&E #247 1-56

PLEASE RETURN TO
LOS ANGELES COUNTY ENGINEER
700 LOS ANGELES COUNTY ENGINEERING BLDG.

Note: Any Additions or Changes on This Sheet Must be Made or Circled in Red Ink With Date and Name of Person Making Change.

Do not extend this side of this line.

W.S. 66-B-2

Notes Ck'd by W. D. WAGNER
Map No. C.S.S. 8733-10
Office Work T. MAPLEHEAD
Checked W. D. WAGNER
Date JAN 12 1962

Survey of AVE. O
JN 0075.85 Tape 108 Std 84 °F
Surveyed by J.S.C. COATES
Notes
Indexed J.S.C. Date H.E.O.

F. B. 2609 Pg. 85

COUNTY SURVEYOR'S MONUMENT
T6N R10W
16 + 21
1/4 SEC. COR. 1927

1/4 COR. SEC. 16, 21
T6N R10W
FD. C.S. MON. 16" DM.
per C.S. 8733
MARKED

105TH ST. E

AVE. P

RP SET 2" IP 6" UP CONC. P.I. E.L.A. CO. ENG. TAGS

70.71

45°

(50)

CENT. BOT.

FROM TOP P6.59

(50)

To ℄ 100TH ST. E

℄

~~2657.24~~ V
2656.38

~~2656.81~~ V
2656.72 ✓

To ℄ 110TH ST. E.

P6.86

(50)

RP SET 2" IP 6" UP CONC. P.I. E.L.A. CO. ENG. TAGS

2656.64 @ 94° = 2656.81 V

2657.27 @ 52° = 2656.72 ✓
Rechained 2-14-61 J.S.C.

PLEASE RETURN TO
LOS ANGELES COUNTY ENGINEER
700 LOS ANGELES COUNTY ENGINEERING BLDG.

Note: Any Additions or Changes on This Sheet Must be Made or Circled in Red Ink With Date and Name of Person Making Change.

Do not extend this side of this line.

W.S. 66-B-2

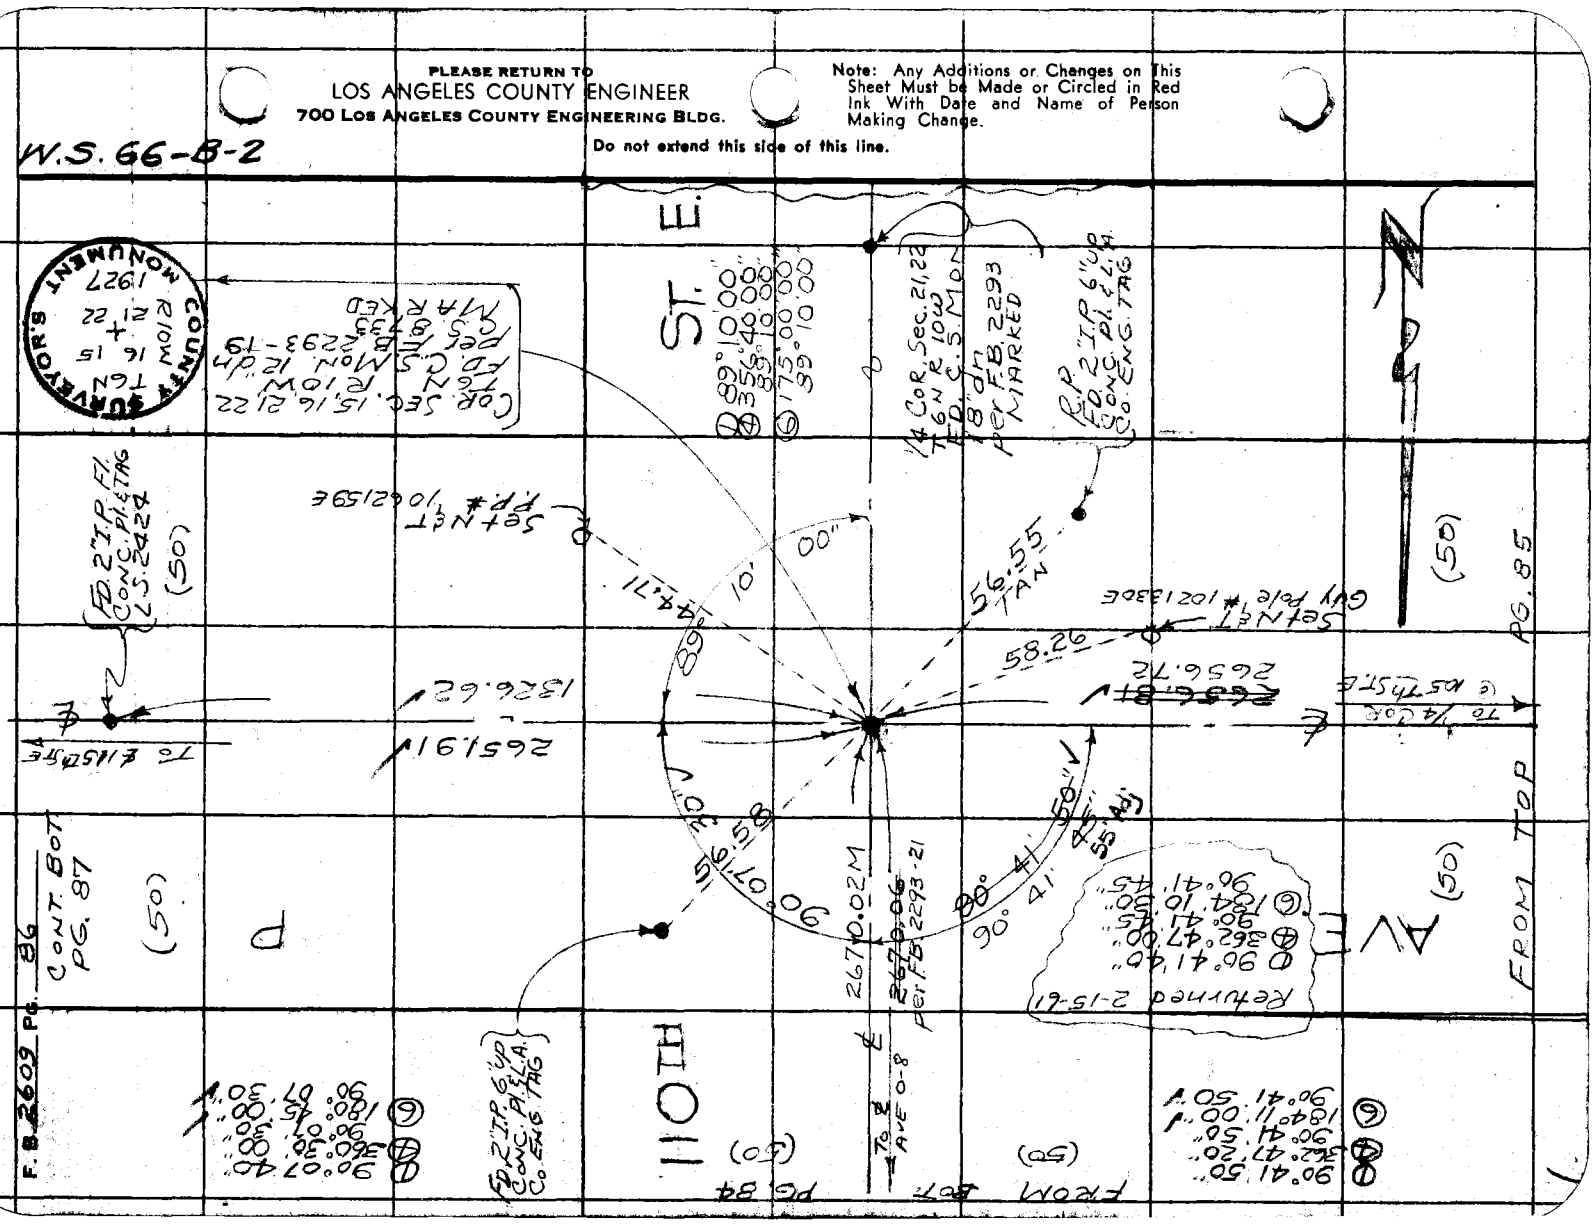

76F3095 S&E #247 1-56

PLEASE RETURN TO
LOS ANGELES COUNTY ENGINEER
700 LOS ANGELES COUNTY ENGINEERING BLDG.

Note: Any Additions or Changes on This Sheet Must be Made or Circled in Red Ink With Date and Name of Person Making Change.

Do not extend this side of this line.

W.S.66-B-2

Notes Ck'd by W. D. WAGNER
Map No. C.S. 8733 Sht 2 of 2
Office Work T.M. PALMER
Checked W. D. WAGNER
Date JAN 12 1962

Survey of AVE O
JN2075.83 Tape/08 Std. 84 °F
Surveyed by J.S. COATES
Notes
Indexed M. E. ON
Date 9-14-60

2651.70 @ 96° = 2651.91 ✓
1326.52 @ 96° = 1326.62 ✓

2650.96 @ 96° = 2651.17 ✓
1325.48 @ 96° = 1325.58 ✓

115TH

AVE.

(50)

FROM 70 PG. 86

(50)

CONT. EOT PG. 88

P

RP FD 2" I.P. 6' UP CONC. PI & L.A. CO. ENG. TAG

40.01

Set B.S & W 24" JOSHUA

99.09

To ℄ 110TH ST. E

2651.91 ✓

2651.17 ✓

1325.58 ✓

To ℄ 120TH ST. E

FD. 2" I.P. FI. CONC. PI & TAG L.S. 2424

40.00

49.97

179°

57'

20"

Set N ℄ PP 110453

RP FD. 2" I.P. 6" UP CONC. PI & L.A. CO. ENG TAG

1/4 COR. SEC. 15 22 T 6N R 10W FD. C.S. MON. 12 dm. PER C.S. 8733 F.B. 2293-24 MARKED

ST. E

① 179°57'20"
② 359°44'20"
179°57'20"
③ 359°44'00"
179°57'20" ✓

COUNTY SURVEYOR'S MONUMENT T6N 15 22 1/4 SEC. COR 1927

F. B. 2609 PG. 87

PLEASE RETURN TO
LOS ANGELES COUNTY ENGINEER
700 LOS ANGELES COUNTY ENGINEERING BLDG.

Note: Any Additions or Changes on This Sheet Must be Made or Circled in Red Ink With Date and Name of Person Making Change.

Do not extend this side of this line.

W.S. 66-B-2

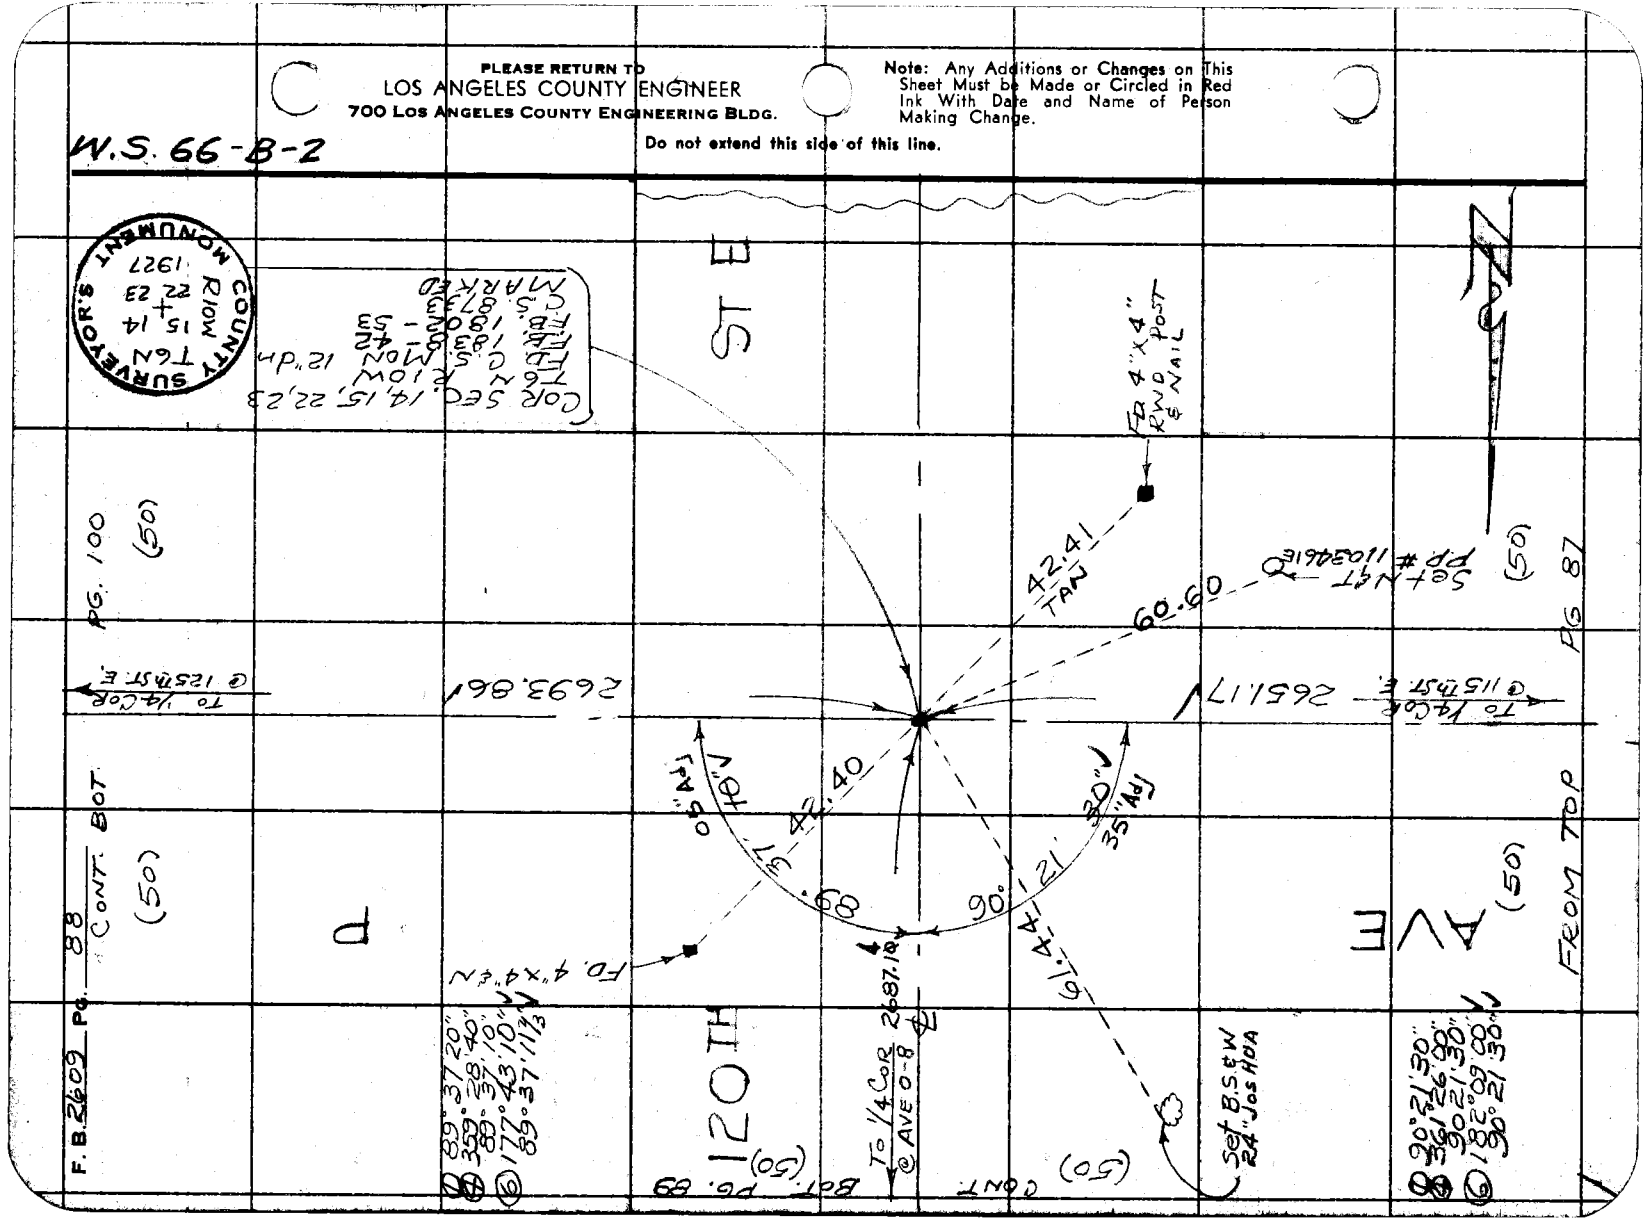

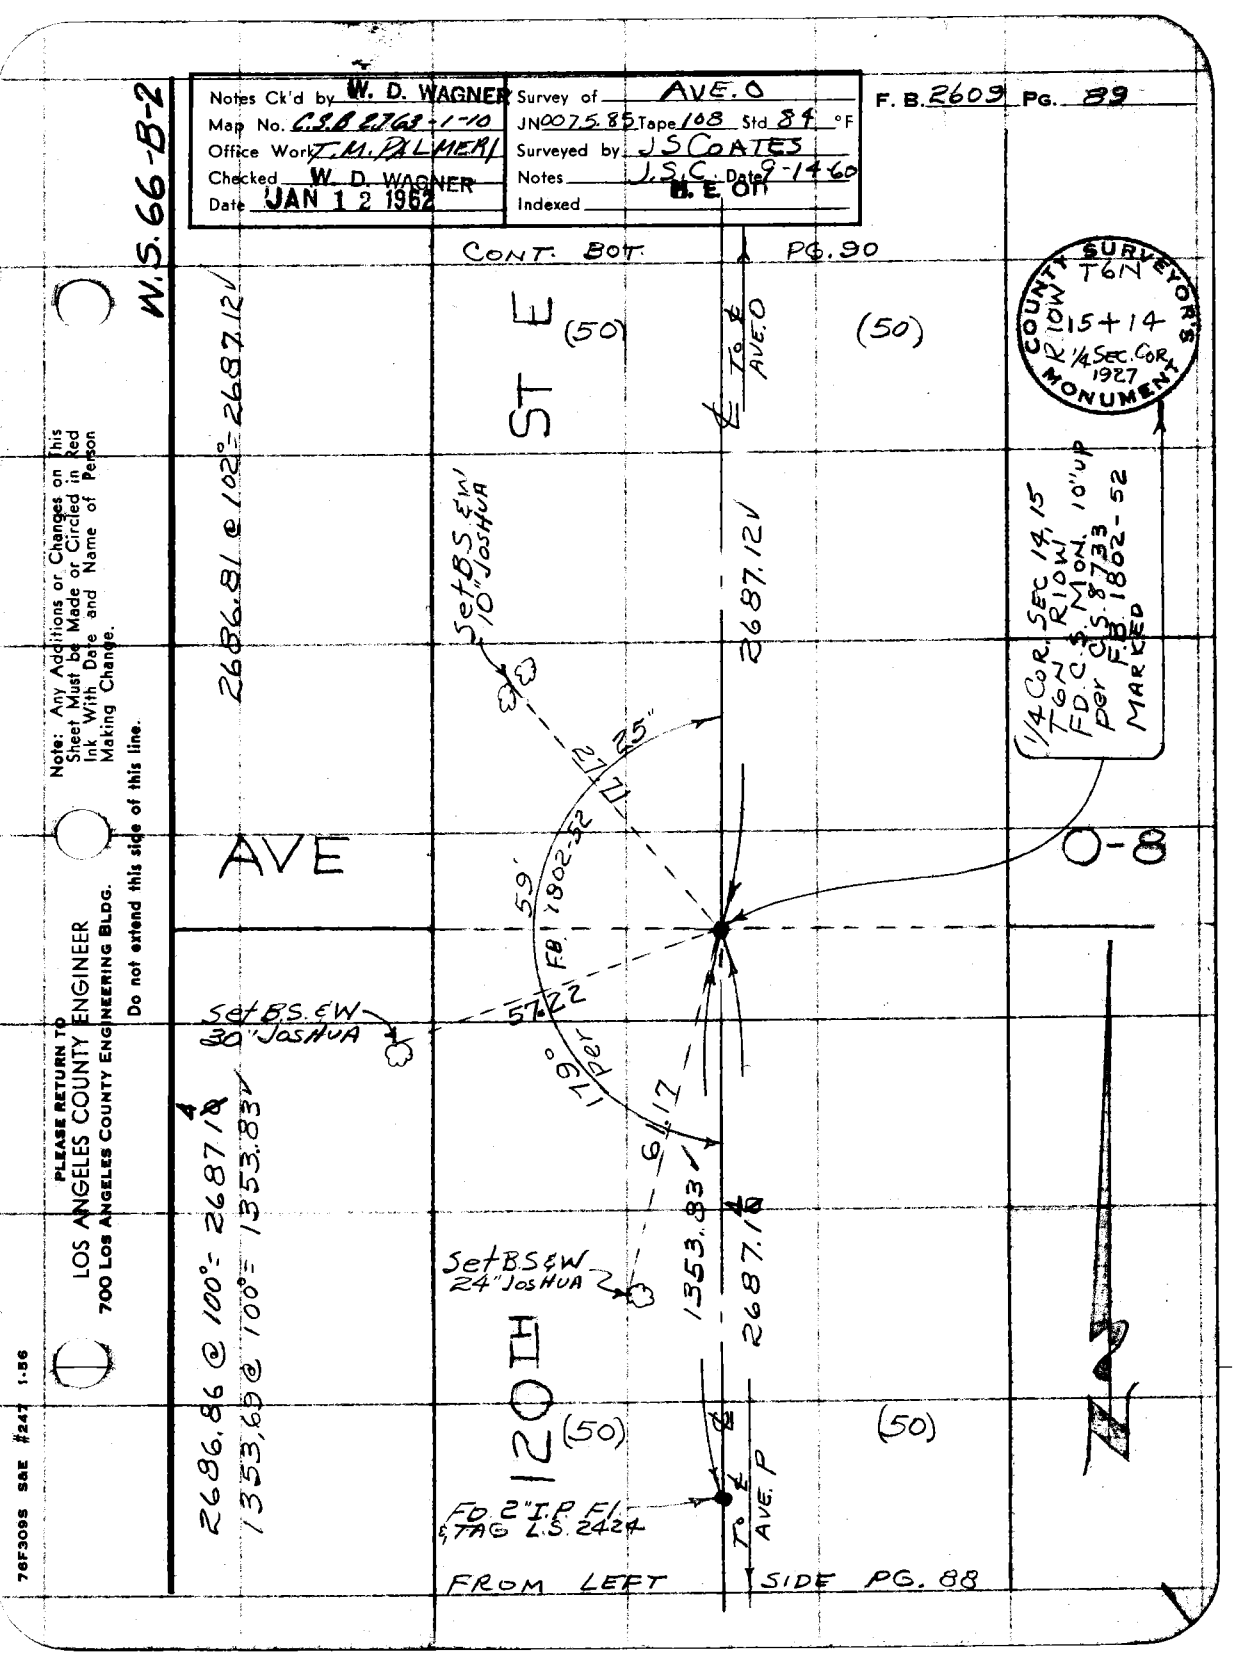
W.S.66-B-2
Notes Ck'd by W. D. WAGNER
Map No. C.S.B 2763 +1-10
Office Work T.M. PALMER
Checked W. D. WAGNER
Date JAN 12 1962
Survey of AVE. O
JN 007.5.85 Tape 108 Std 84 °F
Surveyed by J.S. COATES
Notes J.S.C. Date 9-1460
Indexed
F. B. 2609 Pg. 89
CONT. BOT. PG. 90
ST E
AVE
120TH
(50)
℄ TO ℄ AVE. O
℄ TO ℄ AVE. P
2686.81 @ 102°= 2687.12'
2687.12'
2686.86 @ 100°= 2687.12'
1353.69 @ 100°= 1353.83'
1353.83'
2687.12'
Set B.S. & W. 10" JOSHUA
Set B.S. & W. 30" JOSHUA
Set B.S. & W. 24" JOSHUA
27° 25'
59.71'
57.22'
17° 9' per F.B. 1802-52
6.17'
FD. 2" I.P. F/ & TAG L.S. 2424
COUNTY SURVEY T6N R10W 15+14 1/4 SEC. COR. 1927 MONUMENT
1/4 COR. SEC. 14, 15 T6N R10W FD. C.S. 8733 10" UP per F.B. 1802-52 MARKED
O-8
FROM LEFT SIDE PG. 88
Note: Any Additions or Changes on This Sheet Must be Made or Circled in Red Ink With Date and Name of Person Making Change.
Do not extend this side of this line.
PLEASE RETURN TO
LOS ANGELES COUNTY ENGINEER
700 LOS ANGELES COUNTY ENGINEERING BLDG.
78F309S SAE #247 1-56

F. B. 2609 Pg. 90

W.S. 66-B-2

CONT. BOT. PG 91

(50) (50)

To ¼ Cor

COUNTY SURVEYOR'S MONUMENT
T6N
R10W
10 11
15 14
1927

Cor. Sec. 10, 11, 14, 15
T6N R10W
FD. C.S. Mon. Fl.
per C.S. 8733
FB 1802-52
MARKED

① 89°26'10"
② 357°44'20"
③ 89°26'05"
④ 176°36'40" ✓
89°26'06½" ✓

① 91°26'20"
② 365°45'40"
③ 91°26'25"
④ 188°38'30" ✓
91°26'25" ✓

2067.76

R.P.
FD. 2" I.P. Fl.
Conc. Pl. & Tk
R.D. F.B. 423-19

R.P.
FD. 2" I.P. Fl.
Conc. Pl. & Tk
R.D. F.B. 423-19

ST E

AVE

70.71

70.67 TAN

10" N.

89° 26'05" ✓

91° 26'25" ✓

PG 83 (50)

PG 92 (50)

To ¼ Cor 115th St E. 1430.92 per F.B. 1802-52

1444.22 ✓

To ¼ Post 1"x2" ± N

89°

92°

F.B. 1802-52

119°30"

87°55"

89°

70.71

70.71 TAN

FROM Top

(50)

(50)

CONT. BOT.

R.P.
FD. 2" I.P. Fl.
Conc. Pl. & Tk
R.D. F.B. 423-19

R.P.
FD. 2" I.P. Fl.
Conc. Pl. & Tk
R.D. F.B. 423-19

594.51 per

2687.12 ✓

120 TH

(50) (50)

① 89°19'30"
② 357°18'00"
③ 89°19'30"
④ 175°57'00" ✓
89°19'30" ✓

① 89°47'50"
② 359°11'40"
③ 89°47'55"
④ 178°47'20" ✓
89°47'53½" ✓

To ¼ Cor

ANTELOPE HWY

FD. 1" I.P. 18" dn
Conc. Pl. & N
F.B. 1802-52
FROM TOP

PG. 89

PLEASE RETURN TO
LOS ANGELES COUNTY ENGINEER
700 Los Angeles County Engineering Bldg.

Do not extend this side of this line.

Note: Any Additions or Changes on This Sheet Must be Made or Circled in Red Ink With Date and Name of Person Making Change.

Notes Ck'd by W. D. WAGNER	Survey of AVE O
Map No. C.S.B. 2763-1-10	JN 00758 Tape 108 Std 84 °F
Office Work T. M. PALMIERI	Surveyed by J. S. COATES
Checked W. D. WAGNER	Notes J.S.C. Date 7-15-60
Date JAN 1 2 1962	Indexed M. E. OTT

F. B. 2609 PG. 91

W.S. 66-8-1

COUNTY SURVEYOR'S MONUMENT 1927 1/4 Sec. Cor. R10W T6N 10+11

1/4 COR. SEC. 10, 11 T6N R10W, 6" UP FD. C.S.S. 8733 DUG REED MARKED

STE

AVE

613.72 @ 80° = 613.70

N-8

300.17 @ 2°38' = 299.85 ✓
300.11 @ 2°23' = 299.85 ✓

247.07 @ 3°38' = 246.57 ✓
247.16 @ 3°56' = 246.58 ✓

300.43 @ 2°58' = 300.03 ✓
300.40 @ 2°45' = 300.05 ✓

300.58 @ 2°35' = 300.27 ✓
300.65 @ 2°49' = 300.29 ✓

300.19 @ 3°10' = 299.73 ✓
300.12 @ 2°51' = 299.75 ✓

300.38 @ 1°40' = 300.20 ✓
300.36 @ 1°53' = 300.20 ✓

286.43 @ 2°20' = 286.19 ✓
286.40 @ 2°02' = 286.22 ✓

29.85 @ Level = 29.85 ✓
2062.73 ✓
T 86° + .03 = 2062.76 ✓

613.7 ✓

Set 1X2" EN W/GGLE PT CROWN OF HILL

20TH

(50) (50)

To ℄ 2062.76
2062.73

FROM TOP PG 90

PLEASE RETURN TO
LOS ANGELES COUNTY ENGINEER
700 Los Angeles County Engineering Bldg.

Note: Any Additions or Changes on This Sheet Must be Made or Circled in Red Ink With Date and Name of Person Making Change.

Do not extend this side of this line.

76F3085 S&E #247 1-56

PLEASE RETURN TO
LOS ANGELES COUNTY ENGINEER
700 LOS ANGELES COUNTY ENGINEERING BLDG.

Note: Any Additions or Changes on This Sheet Must be Made or Circled in Red Ink With Date and Name of Person Making Change.

Do not extend this side of this line.

W.S. 66-C-2

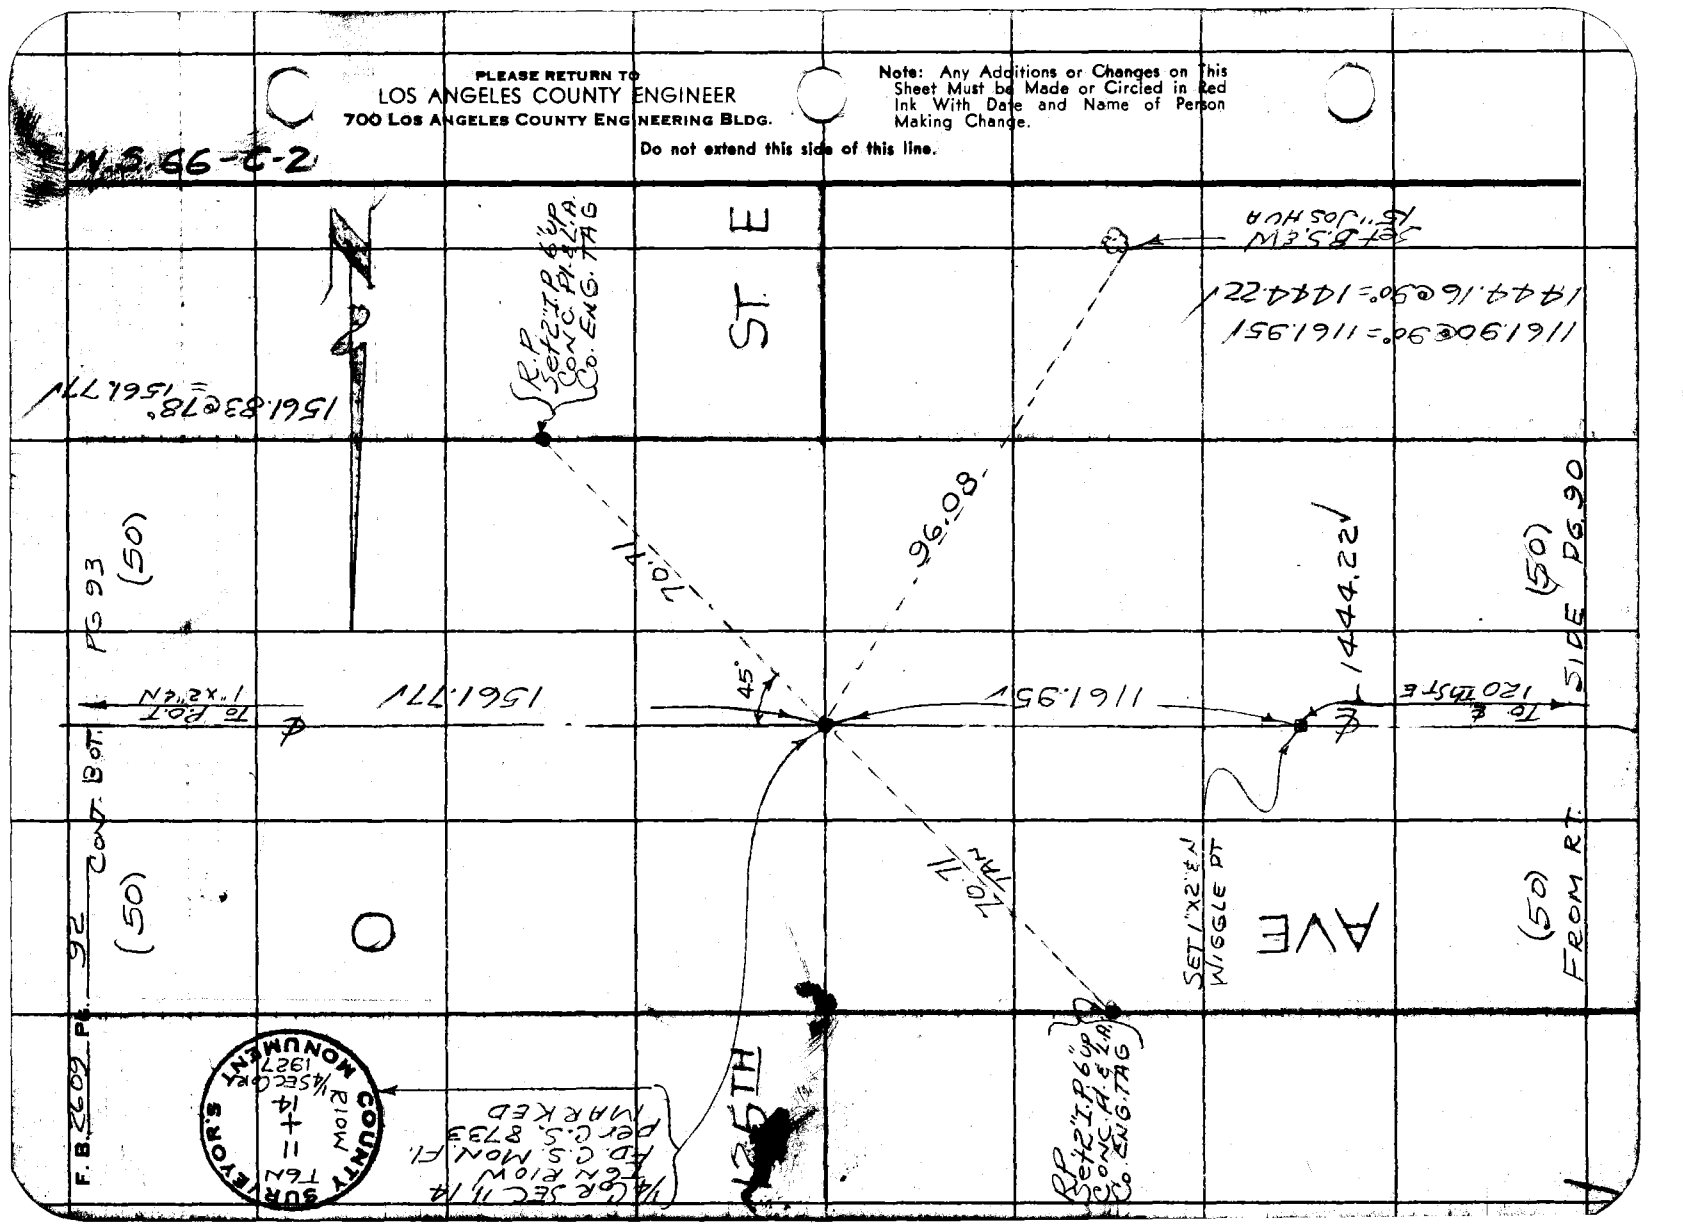

W.S 66-C-1

Notes Ck'd by W. D. WAGNER
Map No. C.S.B. 2769 1-10
Office Work T. M. PALMEAI
Checked W. D. WAGNER
Date JAN 12 1962

Survey of AVE. O
JN 007585 Tape 108 Std 89 °F
Surveyed by J.S. COATES
Notes J.S.C. Date
Indexed H. E. ON

F. B. 2609 Pg. 33

Ⓓ 89°22'50"
Ⓐ 357°31'40"
89°22'55"
Ⓒ 176°17'20" V
89°22'53½" V

CONT. BOT. PG. 96

(50) (50)

F.D. B.S.&W. 10" JOSHUA

R.P. Set 2" I.P. 6' UP CONC. FILL & CO. ENG. TAG

To 2" I.P. 1372.67 Per F.B. 2607-119, 120

111.89

70.71

130TH

F.D. B.S.E.W. 10" JOSHUA

30" Adj 55" V

89° 22' 55" V

89° 37' 14" V

ST. E

(50)

CONT. TOP PG 95

CONT. BOT. PG 94

To P.O.T 428.26 V

Per F.B. 2607-117, 118 1330.79 To 2" I.P.

Ⓓ 89°15'00"
Ⓐ 356°59'40"
89°14'55"
Ⓒ 175°29'20" V
89°14'53½" V

89° 14' 55" V

91° 58' 00" V

R.P. Set 2" I.P. 6" UP CONC. FILL & CO. ENG. TAG

70.71 TAN

55" V

1044.48 V

COR. SEC. 11, 12, 13, 14 T6N R10W S.B.M. FD. C.S. MON. FL. PER C.S. B 733 F.B. 2607-118

MARKED 1044.45 @ 88° = 1044.48

AVE

P.O.T. SET 1" X 2" ℄ N.

Ⓓ 91°58'00"
Ⓐ 367°51'
91°57'
Ⓒ 791°47'
91°57'58"

1561.77 V

(50) (50)

FROM TOP To ℄ 125TH PG 92

COUNTY SURVEYOR'S MONUMENT

T6N 11 12 14 13 R10W

Note: Any Additions or Changes on This Sheet Must be Made or Circled in Red Ink With Date and Name of Person Making Change.

Do not extend this side of this line.

PLEASE RETURN TO
LOS ANGELES COUNTY ENGINEER
700 LOS ANGELES COUNTY ENGINEERING BLDG.

76FB006 SEE B247 1-58

PLEASE RETURN TO
LOS ANGELES COUNTY ENGINEER
700 LOS ANGELES COUNTY ENGINEERING BLDG.

Note: Any Additions or Changes on This Sheet Must be Made or Circled in Red Ink With Date and Name of Person Making Change.

Do not extend this side of this line.

W.S 66-C-1

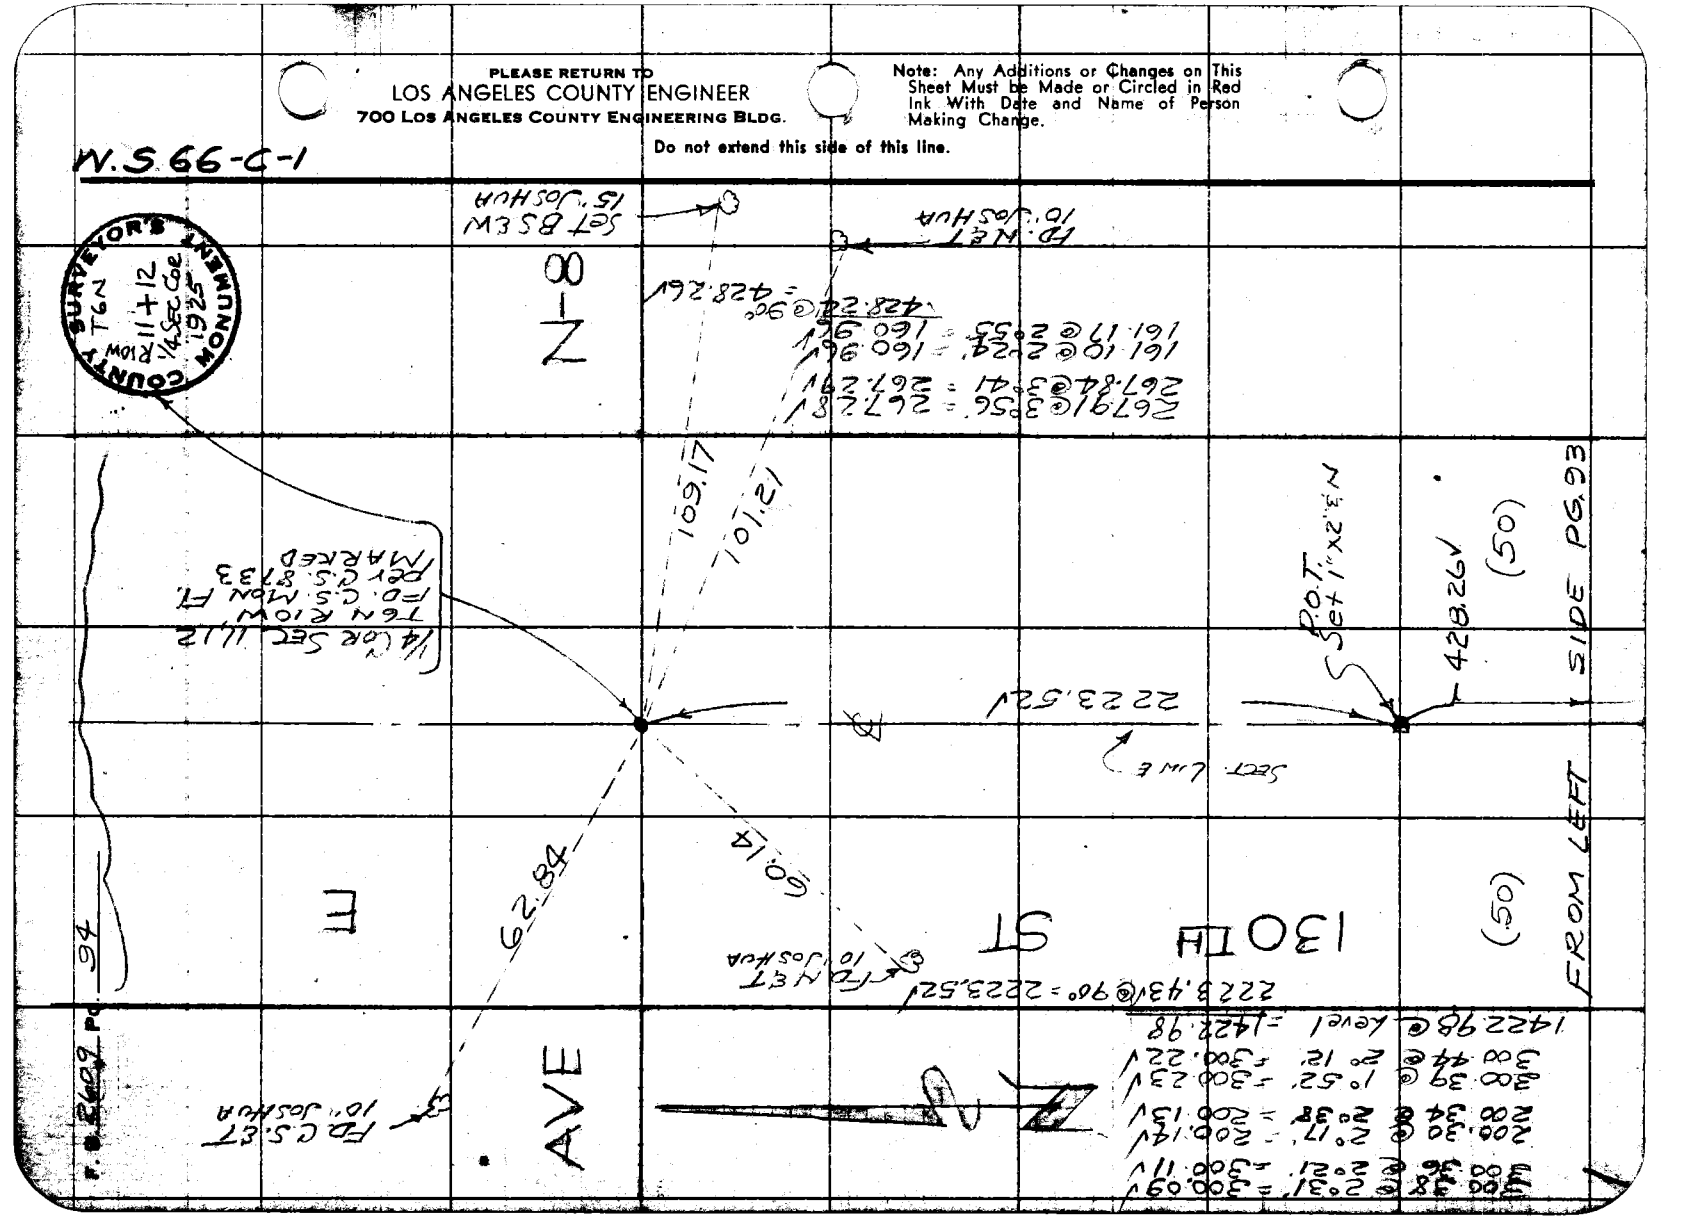

W.S. 66-C-2

Notes Ck'd by W. D. WAGNER
Map No. C.S.B. 2762-1-10
Office Work T.M. PALMERI
Checked W. D. WAGNER
Date JAN 12 1962

Survey of AVE. O
JN 007585 Tape 108 Std 84 °F
Surveyed by J.S. COATES
Notes J.S.C. Date 9-21-60
Indexed H. E. OTT

F. B. 2609 Pg. 93

FROM RT. SIDE PG. 93

FD 2" I.P. 6" UP CONC. PL. & TAG F.B. 2607-117

(50)

1330.79 per F.B. 2607 Pg 117, 118

(50)

FD 2" I.P. 6" UP CONC. PL. & TAG F.B. 2607-117

40.00 90° 40.00

FD 2" I.P. 4" UP CONC. PL. & L.A. CO. ENG. TAG F.B. 2607-117

1330.79 Per F.B. 2607-115, 116, 117

R.P. FD 2" I.P. 6" UP CONC. PL. & CO. ENG. TAG

56.57

R 50

AVE

O-8

130 TH ST.

56.5

1330.69 Per F.B. 2607-114, 115

1/4 COR 13 KK T6N R10W N. FI. FD. C.S.S. 87B3-54 PER C.S. 18802-42 F.B. 1838-42 F.B. 2607-115 MARKED

COUNTY SURVEYOR'S MONUMENT T6N R10W 14+13 1/4 SEC COR 1925

R.P. FD 2" I.P. 6" UP PL. & L.A. CO. ENG. TAG

R.P. FD 2" I.P. 6" UP CONC. PL. & L.A. CO. ENG. TAG

40.00 40.00

90°

FD 2" I.P. 3" UP CONC. PL. & L.A. CO. ENG. TAG F.B. 2607-113

1330.69 Per F.B. 2607-112, 113

(50) (50)

CONT. TO P PG 101

Note: Any Additions or Changes on This Sheet Must be Made or Circled in Red Ink With Date and Name of Person Making Change.

Do not extend this side of this line.

PLEASE RETURN TO
LOS ANGELES COUNTY ENGINEER
700 LOS ANGELES COUNTY ENGINEERING BLDG.

76F3095 SAE #247 1-58

PLEASE RETURN TO
LOS ANGELES COUNTY ENGINEER
700 LOS ANGELES COUNTY ENGINEERING BLDG.

Note: Any Additions or Changes on This Sheet Must be Made or Circled in Red Ink With Date and Name of Person Making Change.

Do not extend this side of this line.

W.S. 66-C-1

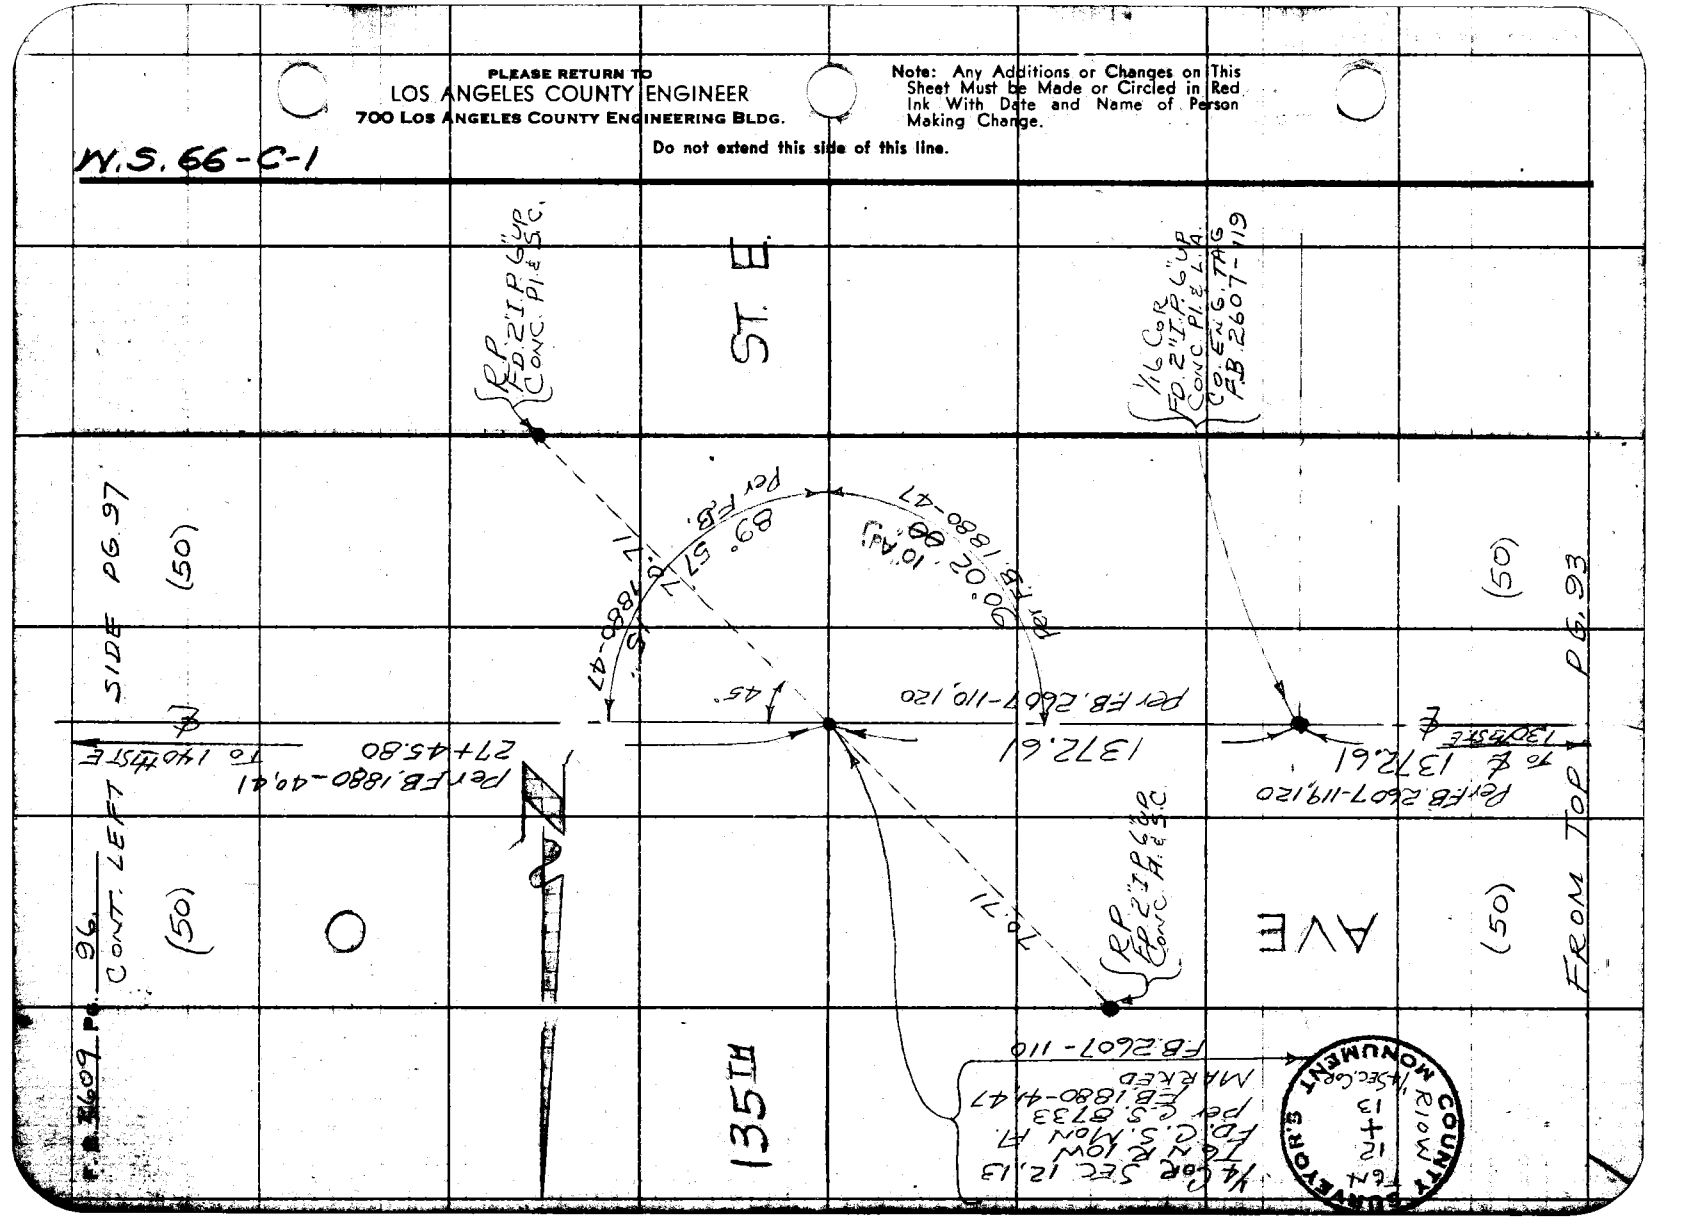

Notes Ck'd by W. D. WAGNER	Survey of AVE O	F. B. 2609	PG. 97
Map No. C.S.A. 276-1-18	JN 0075.85 Tape 108 Std 84 °F		
Office Work T. M. PACHERI	Surveyed by J S COATES		
Checked W. D. WAGNER	Notes JSC Date 9-22-60		
Date JAN 12 1962	Indexed H. E. Oh		

W.S. 66-C-1

CONT. BOT. PG. 98

COUNTY SURVEY T6N R10W 12 7 13 18 R9W Sec. Cor. MONUMENT

Note: Any Additions or Changes on This Sheet Must be Made or Circled in Red Ink With Date and Name of Person Making Change.

PLEASE RETURN TO LOS ANGELES COUNTY ENGINEER 700 Los Angeles County Engineering Bldg.

Do not extend this side of this line.

FROM TOP PG. 96

CONT. LEFT PG. 100

CONT. TOP PG. 99

(50) AVE (50) ST. E (50) 140 TH (50)

To ℄ AVE N-8

To ℄ AVE O-8

To ℄ 135th ST. E 2745.30 per F.B. 1880-40

To ℄ 145th ST. E 2761.88

2644.35 per F.B. 1880-40

2670.69 per F.B. 1880-39 40

R.P. FD. 2" I.P. & TK CONC. PL & N

R.P. FD. 2" I.P. FL CONC. PL & TK

R.P. FD. 2" I.P. 6" UP CONC. PL & N

R.P. FD. 2" I.P. FL CONC. PL & TK

R.P. FD. 2" I.P. FL CONC. PL & TK

R.P. FD. 2" I.P. 6" UP CONC. PL & SC

SEC. COR. T6N R9W R10W 7 12 13 18 FD. C.S.S. MONUMENT 6" UP per C.S.S. 1880-40 1423-20 R.P. 2" I.P. MARKED

① 91-05-40"
② 364°22'30"
③ 91-05-37½"
④ 186°33'40"
⑤ 91-05-32½"

① 89°01'20"
② 356°05'20"
③ 89°01'20"
④ 174°08'00"
⑤ 89°01'20"

90° 70.24 20" Adj 10" 70.67 91°05'37½" 70.69 N 45° E 45° 89°01'20" 70.71 89°57'40" 70.78

1880-40 per F.B. 1880-40 per F.B. 1880-40

40.41

76F3098 SAE #247 1-56

PLEASE RETURN TO
LOS ANGELES COUNTY ENGINEER
700 LOS ANGELES COUNTY ENGINEERING BLDG.

Note: Any Additions or Changes on This Sheet Must be Made or Circled in Red Ink With Date and Name of Person Making Change.

Do not extend this side of this line.

W.S.66-C-1

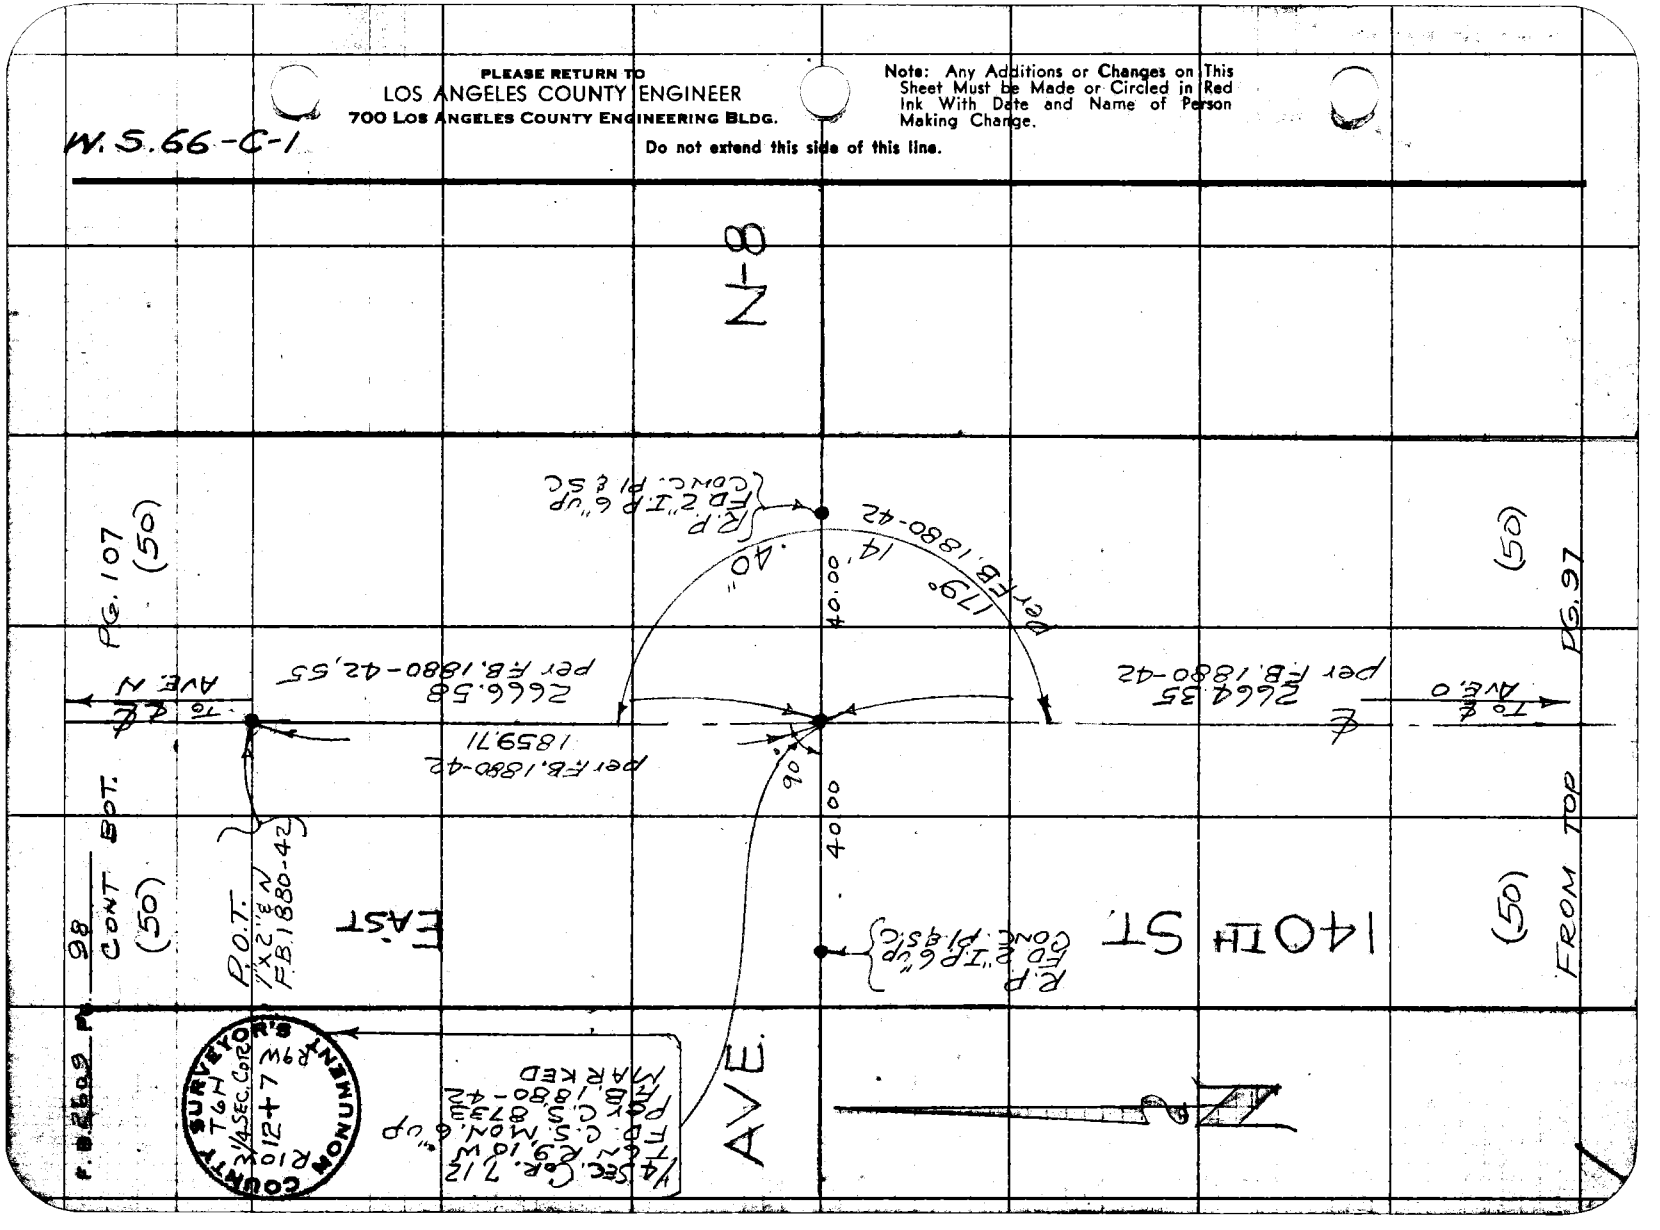

W 565-C-2

Notes Ck'd by W. D. WAGNER	Survey of AVE O		
Map No. C.S.B. 2769-1-10	JN 007535 Tape 108 Std 84 °F		
Office Work T.M. PALMERI	Surveyed by J.S. COATES		
Checked W. D. WAGNER	Notes J.S.C. Date 9-22-60 H.E. OH		
Date JAN 12 1962	Indexed		

F. B. 2609 PG. 99

FROM BOT. PG. 97

(50) (50)

To ℄ AVE O

℄

Per F.B. 1880-39, 40
2670.69

R.P.
FD. 2" I.P. FL.
CONC. PL. & S.C.
No Ref

AVE

90°

180°

30.00

40.00

40.00

O-8

FD 2" I.P. FL.
CONC. PL. & S.C.
F.B. 1880-39

R.P.
FD. 2" I.P. FL.
CONC. PL. & S.C.
F.B. 1880-39

1/4 COR. SEC. 13, T 6 N, R 10 W, FD. C.S. MON. W/ FL. PER F.B. 1902-55, F.B. 1938-48, F.B. 1880-39. MARKED

140TH ST.

Per F.B. 1880-38, 39
2670.98

659.12
Per F.B. 1880-39

P.O.T.
FD 1X2 & N
F.B. 1880-39

SURVEYOR'S MONUMENT
T 6N
R 10W
1/4 SEC COR M6
13+18

To Ave P ℄

(50) (50)

CONT LEFT SIDE PG. 103

PLEASE RETURN To
LOS ANGELES COUNTY ENGINEER
700 Los Angeles County Engineering Bldg.

Note: Any Additions or Changes on This Sheet Must be Made or Circled in Red Ink With Date and Name of Person Making Change.

Do not extend this side of this time.

78F3095 SSE #247 1:30

PLEASE RETURN TO
LOS ANGELES COUNTY ENGINEER
700 LOS ANGELES COUNTY ENGINEERING BLDG.

Note: Any Additions or Changes on This Sheet Must be Made or Circled in Red Ink With Date and Name of Person Making Change.

Do not extend this side of this line.

W.S. 66-C-2

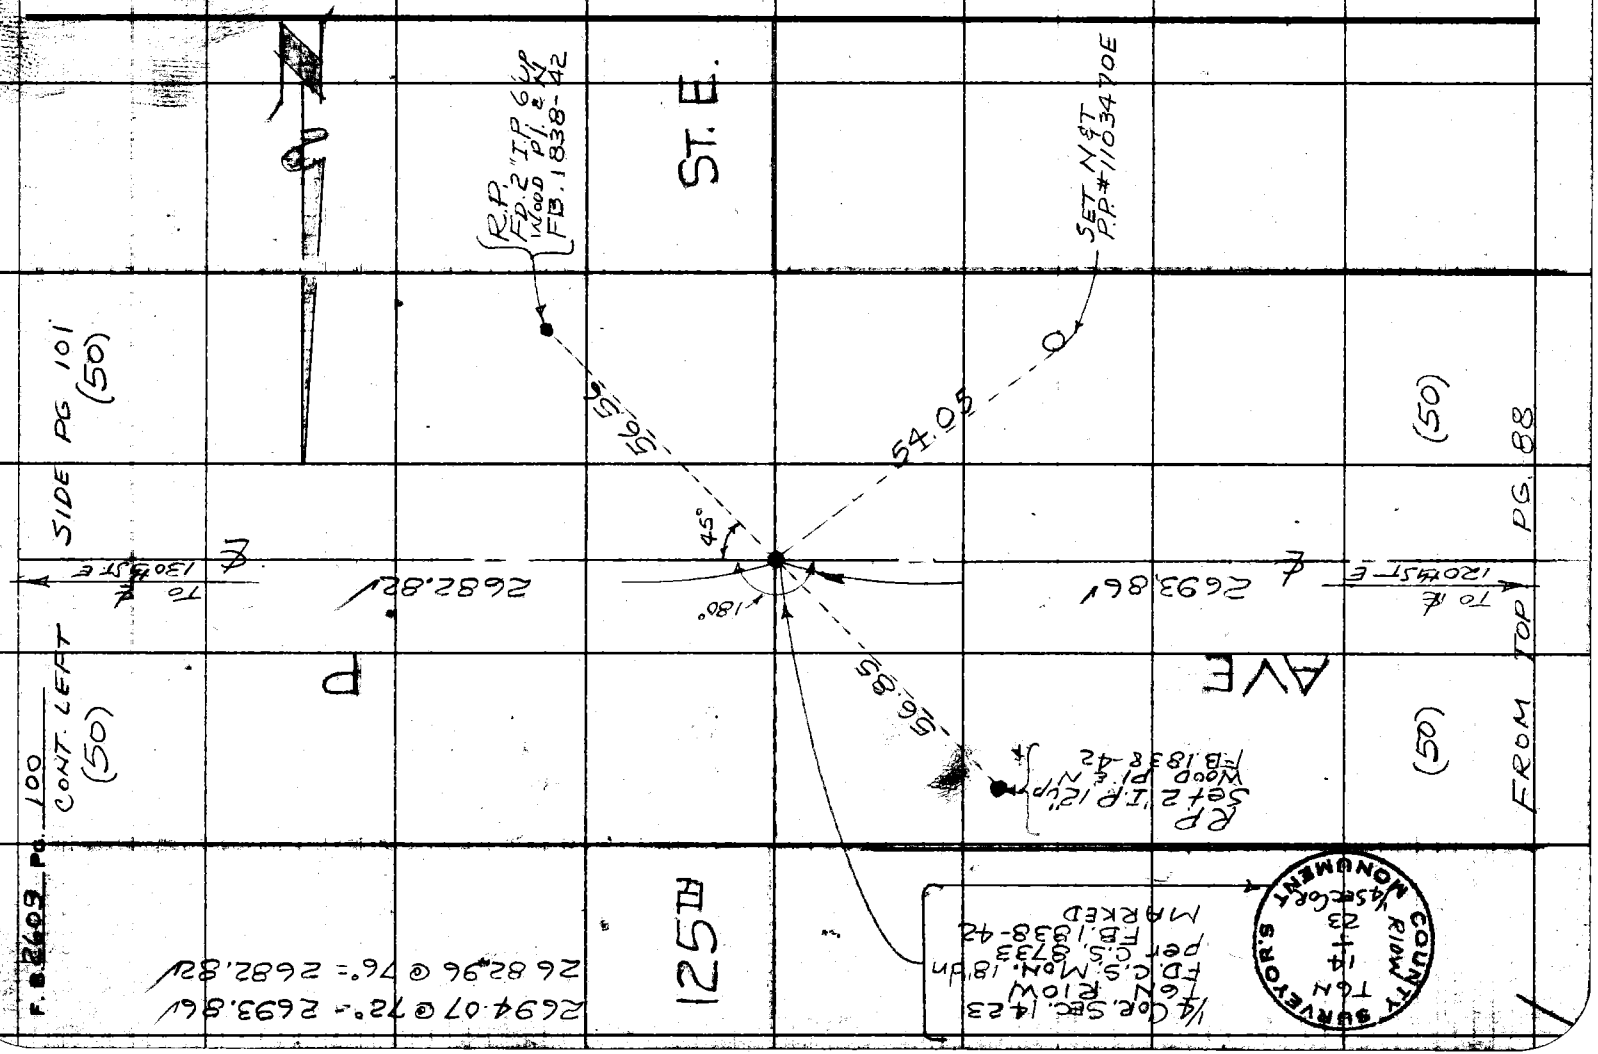

F.B. 2403 Pg. 100

2694.07 @ 72° = 2693.86'
2682.96 @ 76° = 2682.82'

W.S. 66-C-2

Notes Ck'd by W. D. WAGNER	Survey of AVE O	F. B. 2609 Pg. 101	
Map No. C.S.B. 2768 1-10	JN 007585 Tape 108 Std 84 °F		
Office Work T. M. PALMEAL	Surveyed by J.S. COATES		
Checked W. D. WAGNER	Notes J.S.C. Date 9-21-60		
Date JAN 12 1962	Indexed H. E. OH		

CONT. BOT PG 95

(50) (50)

ST E

℄ 76 2" I.P 1/4 Cor

① 88°36'20"
④ 354°25'30" 88°36'22½" ✓
⑥ 171°38'20" 88°36'23⅓" ✓

FD. N&T 24" JOSHUA

FD. C.E.MON. 6" UP BM# A-1

85.41

1330.69

56.55

36

25" ✓

90°

88°

56.57

47

35" ✓

AVE.

100

P

(50)

PG. (50)

To ℄ 125th St. 1/4 Cor 2682.82 ✓

℄

45°

51.56

56.54 TR ✓

SET N&T P.P. # 110347 8 E

FROM TOP

(50)

R.P. FD. 2" I.P. 8" UP WOOD PL. & N

130 TH

① 90°47'20"
④ 363°10'30" 90°47'30"
⑥ 184°45'20" 90°47'33½" ✓

R.P. FD. 2" I.P. 6" UP WOOD PL. & N

Per F.B. 2607-103, 121
2693.90 To ℄ 131st St. E@ 1/4 Cor

1346.95 per F.B. 2607 pg 103, 121 To 2" I.P. 1/4 1/4 Cor

(50)

CONT. BOT PG. 102

COR. SEC. 13 14 23 24 T6N R10W. 18" dn. FD. C.S.M. ON 87332 PER 1338-42 MARKED M.B. 2607-112

COUNTY SURVEYOR T6N R10W 14 13 23 24 1925 MONUMENT

Note: Any Additions or Changes on This Sheet Must be Made or Circled in Red Ink With Date and Name of Person Making Change.

Do not extend this side of this line.

PLEASE RETURN TO LOS ANGELES COUNTY ENGINEER 700 Los Angeles County Engineering Bldg.

76F3098 SAE #247 1-56

PLEASE RETURN TO
LOS ANGELES COUNTY ENGINEER
700 LOS ANGELES COUNTY ENGINEERING BLDG.

Note: Any Additions or Changes on This Sheet Must be Made or Circled in Red Ink With Date and Name of Person Making Change.

Do not extend this side of this line.

W.S. 66-C:2

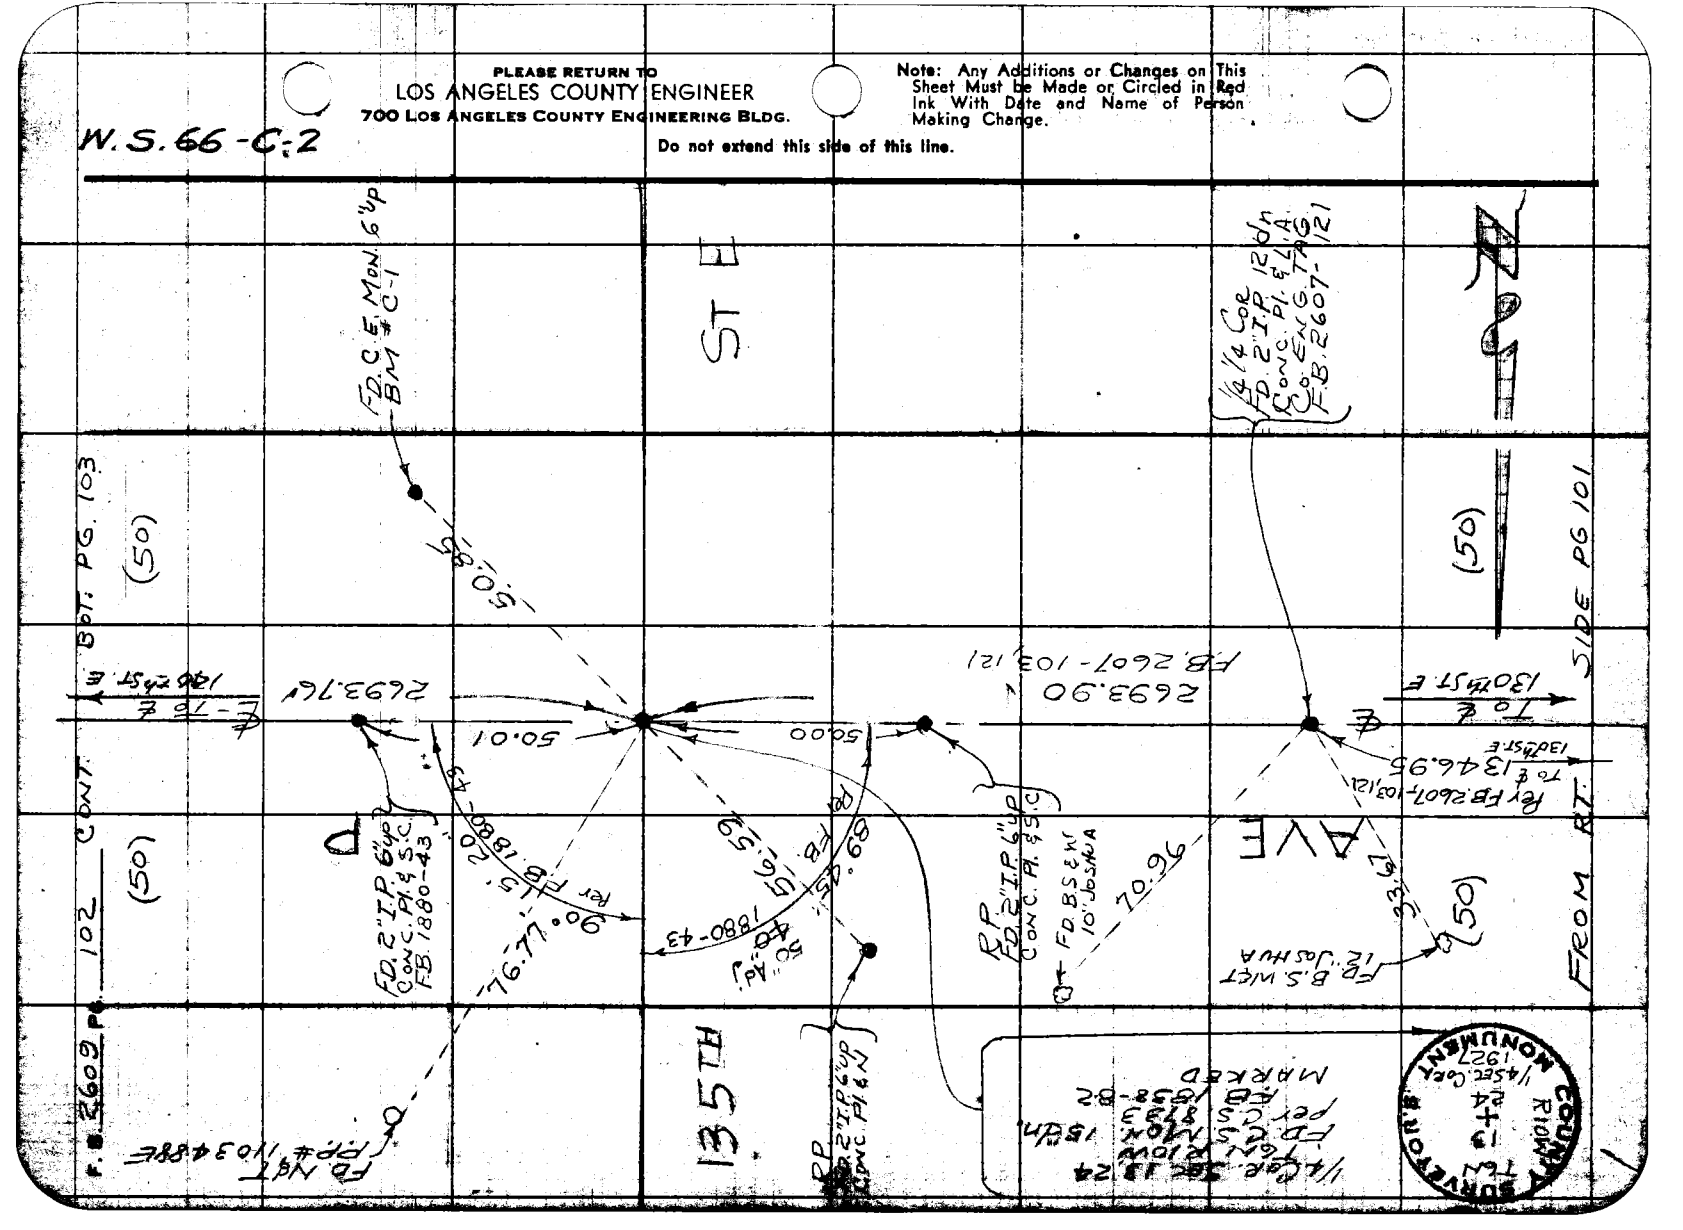

Notes Ck'd by W. D. WAGNER
Map No. C.S.A. 2768 1-10
Office Work F. M. PALMER
Checked W. D. WAGNER
Date JAN 12 1962

Survey of AVE. O
JN 007585 Tape 101 Std 84 °F
Surveyed by J.S. COATES
Notes J.S.C. Date 9-26-60
Indexed H. E. OH

F. B. 2609 Pg. 103

W.S. 66-C-2

(A) 89°24'00"
(B) 267°36'00"
(C) 89°24'00"
(D) 176°24'00"
(E) 89°24'00"

CONT BOT PG 104

(50) (50)

To Antelope Hwy

732.12

FD. 2" IR 6" UP CONC. PL & L.A. CO. ENG. TAG

(COR. SEC. 13, 24, 18, 19 T6N, R9, 10 W.
FD. C.E. MON. IN WELL 2607-187 FEET
PER MARKED

140TH ST. E.

23° 50' Adj
24° 00'
42.45'
42.45'
89°
45°

FD. 2" I.P. FLUSH WOOD PL & L.A. F.B. 1824-30

PG 99

(50)

To ℄ AVE O-8
2670.98
F.B. 1880-38

90° 18' 35"
Per F.B. 1880-38

40.16'
42.44'

FD. NET P.P.# 116/1326

FROM BOT

(50)

R.P. FD. 2" I.P. 6" UP CONC. PL & L.A. CO. ENG. TAG

2693.76

AVE O

2693.76 @ 80 = 2693.76

To VAC @ 135TH ST. E

(50) (50)

FROM TOP PG 102

PLEASE RETURN TO
LOS ANGELES COUNTY ENGINEER
700 Los Angeles County Engineering Bldg.

Note: Any Additions or Changes on this Sheet Must be Made or Circled in Red Ink With Date and Name of Person Making Change.

Do not extend this side of this line.

76F2008 SAE #247 1-58

PLEASE RETURN TO
LOS ANGELES COUNTY ENGINEER
700 LOS ANGELES COUNTY ENGINEERING BLDG.

Note: Any Additions or Changes on This Sheet Must be Made or Circled in Red Ink With Date and Name of Person Making Change.

Do not extend this side of this line.

W.S. 66-D-2

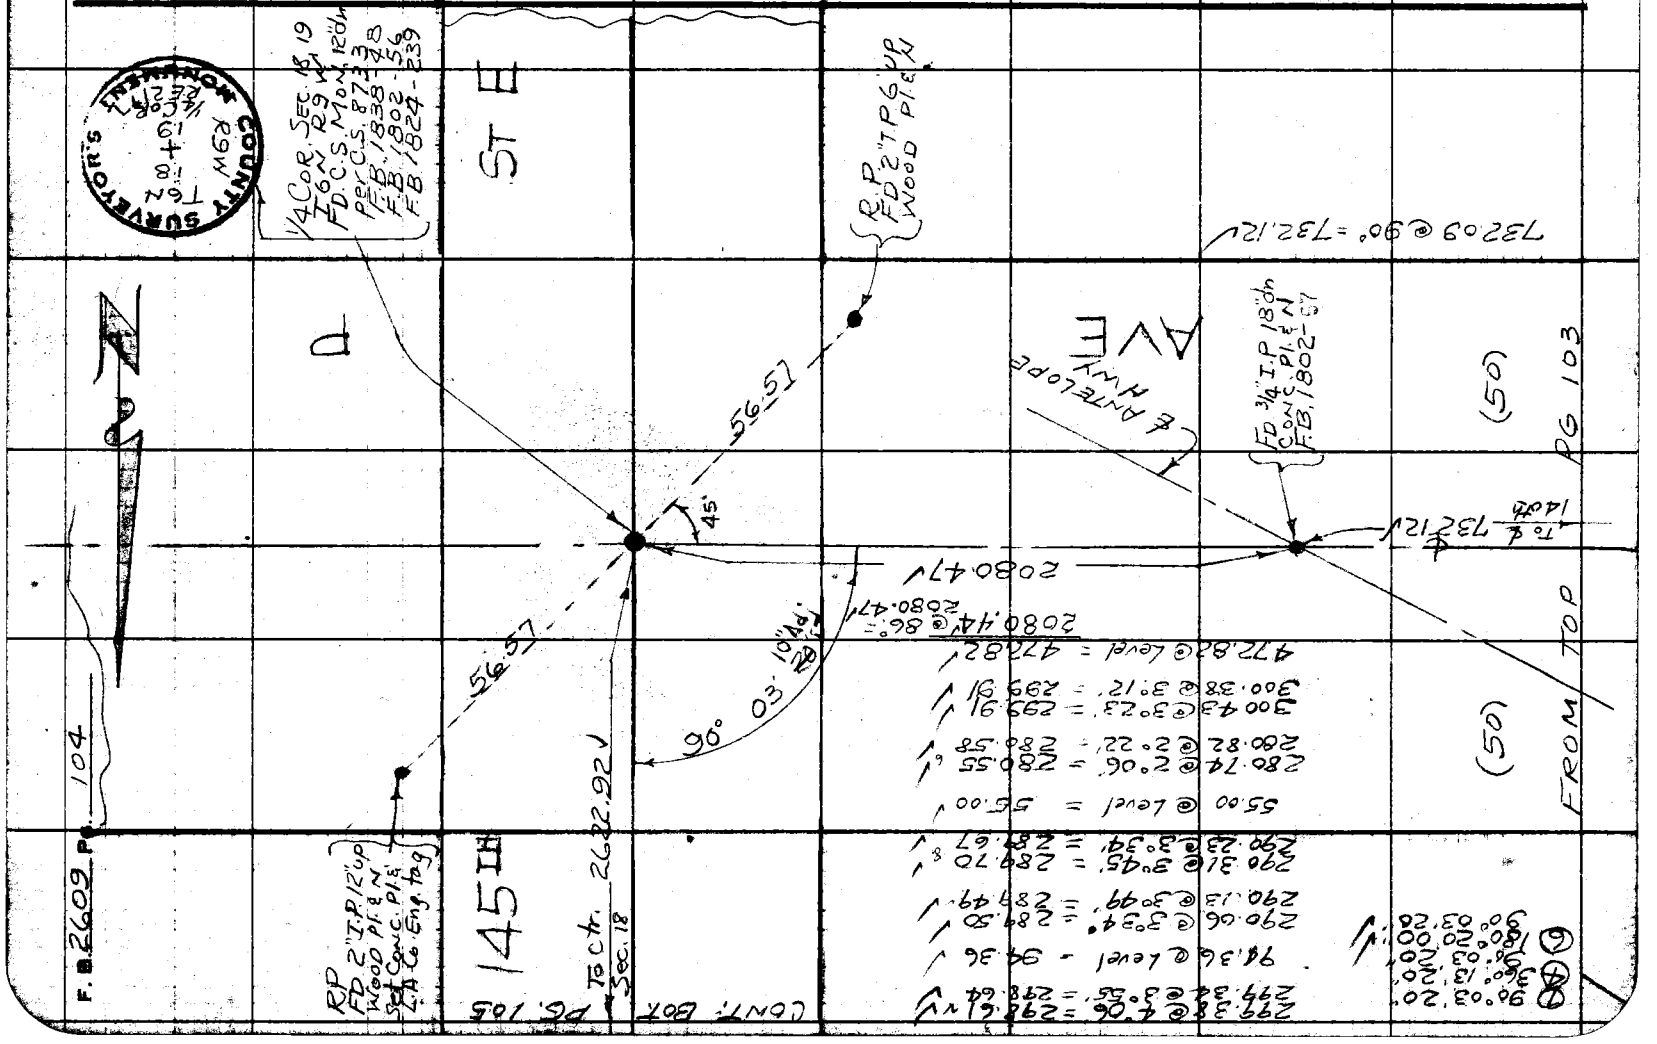

W.S.66-D-2

Notes Ck'd by W. D. WAGNER | Survey of AVE O | F. B. 2609 PG. 105
Map No. C.S.B. 2767-1-10 | JN 007585 Tape 101 Std 84 °F
Office Work T.M. PALMER | Surveyed by JSC
Checked W. D. WAGNER | Notes JSC Date 9-27-60
Date JAN 12 1962 | Indexed H. E. OTT

CONT. BOT. PG 105

(40) ST. E. (40)

To ℄ AVE O

2643.46

2643.46

2643.19 @ 100° 2643.46

R.P. FD 2" I.P. F.I. CONC. PL. E.N. F.B. 1838-49

40.00 0.69 0.00 0.65

R.P. FD 2" I.P. 6" U.S. CONC. PL. E.N. F.B. 1838-49

CENTER SEC. 18 T6N R9W FD. C.S. MON 18" DN F.B. 1838-49 MARKED

SURVEY TGN CTR SEC. 18 R9W

RE 63

145 TH

2622.92

2622.92

2622.65 @ 100° 2622.92

To ¼ Cor ℄ AVE P

(40) (40)

FROM LEFT SIDE PG. 104

Note: Any Additions or Changes on this Sheet Must be Made or Circled in Red Ink With Date and Name of Person Making Change.

Do not extend this side of this line.

PLEASE RETURN TO LOS ANGELES COUNTY ENGINEER 700 Los Angeles County Engineering Bldg.

76F3095 S&E #247 1-56

PLEASE RETURN TO
LOS ANGELES COUNTY ENGINEER
700 LOS ANGELES COUNTY ENGINEERING BLDG.

Note: Any Additions or Changes on This Sheet Must be Made or Circled in Red Ink With Date and Name of Person Making Change.

Do not extend this side of this line.

W.S.66-D-1

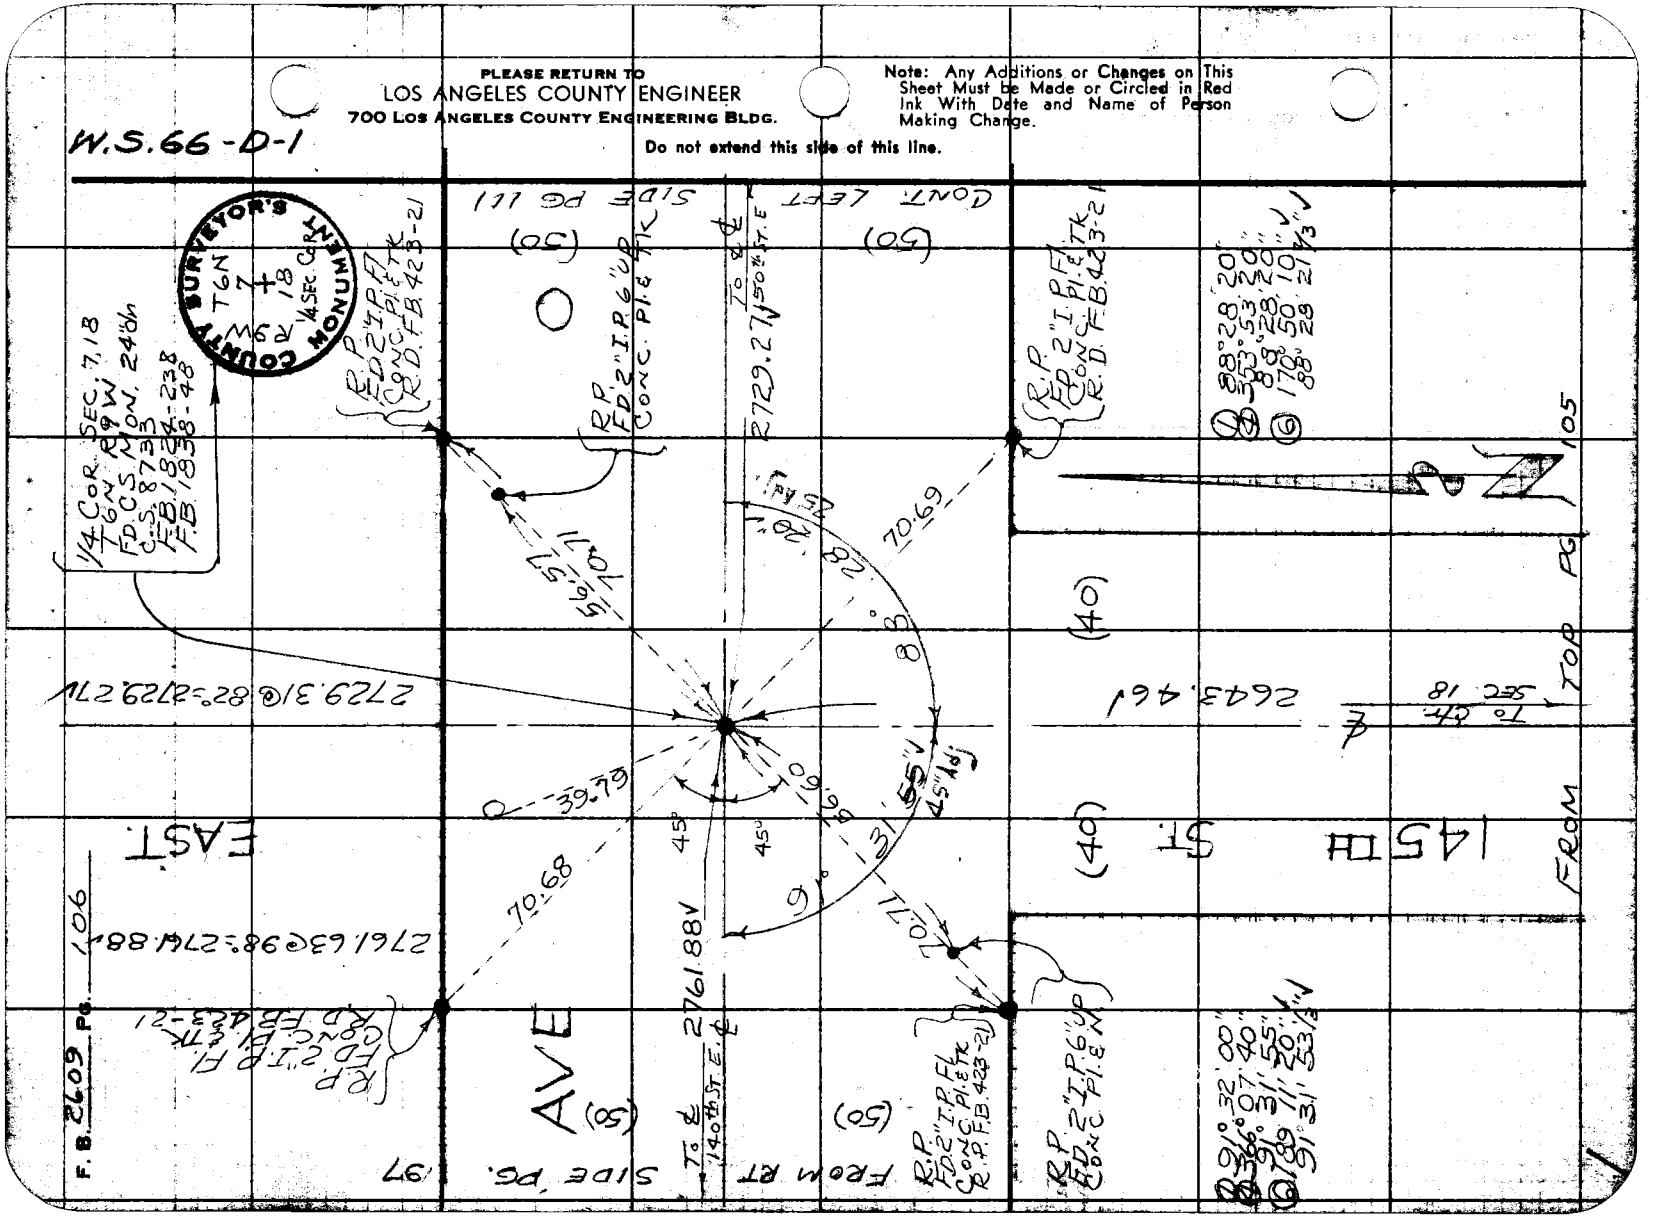

W.S 66-C-1

Notes Ck'd by	W. D. WAGNER	Survey of	AVE. O
Map No	C.S. B.2763-1-10	JN	0075.85
Office Work	T.M. PALMERI	Tape	101 Std 89 °F
Checked	W. D. WAGNER	Surveyed by	J.S COATES
Date	JAN 12 1962	Notes	J.S.C. Date 8-27-60
		Indexed	H. E. OH

F. B. 2609 PG. 107

Note: Any Additions or Changes on this Sheet Must be Made or Circled in Red Ink With Date and Name of Person Making Change.

PLEASE RETURN TO LOS ANGELES COUNTY ENGINEER 700 Los Angeles County Engineering Bldg.

Do not extend this side of this line.

SET Spk. W. & T. 12" JOSHUA

AVE

59.71

RP FD. 2" I.P. 6" UP CONC. P. & S.C.

(50)

N

PG 108

40.00

PIPES ARE TAN

40.00

0.52

TO ℄ COR.

2696.01

5.97

FD. 2" I.P. 6" UP CONC. P. & S.C. R.B. 1880-55 ON LINE

89° 43' 15" Adj 20.00

119.09

COUNTY RD.

(50)

SET Spk. W. & T. 12" JOSHUA

COR. SEC 16, 17, 20, 21 T6N, R9W, S.B.M. ON 4" UP FD. C.S. 8733 PER C.S. 1880-55 F.B. 180 MARKED

2666.58

140 TH

℄

①	89° 43' 00"
②	358° 53' 20"
	89° 43' 20"
③	178° 20' 00"
	89° 43' 20"

COUNTY SURVEYOR'S MONUMENT T6N R10W 1 12 6 7 R9W

(50)

TO ℄ AVE. N-8

(50)

FROM TOP PG. 98

76F3088 S&E #247 1-56

PLEASE RETURN TO
LOS ANGELES COUNTY ENGINEER
700 LOS ANGELES COUNTY ENGINEERING BLDG.

Note: Any Additions or Changes on This Sheet Must Be Made or Circled in Red Ink With Date and Name of Person Making Change.

Do not extend this side of this line.

W.S. 66-D-1

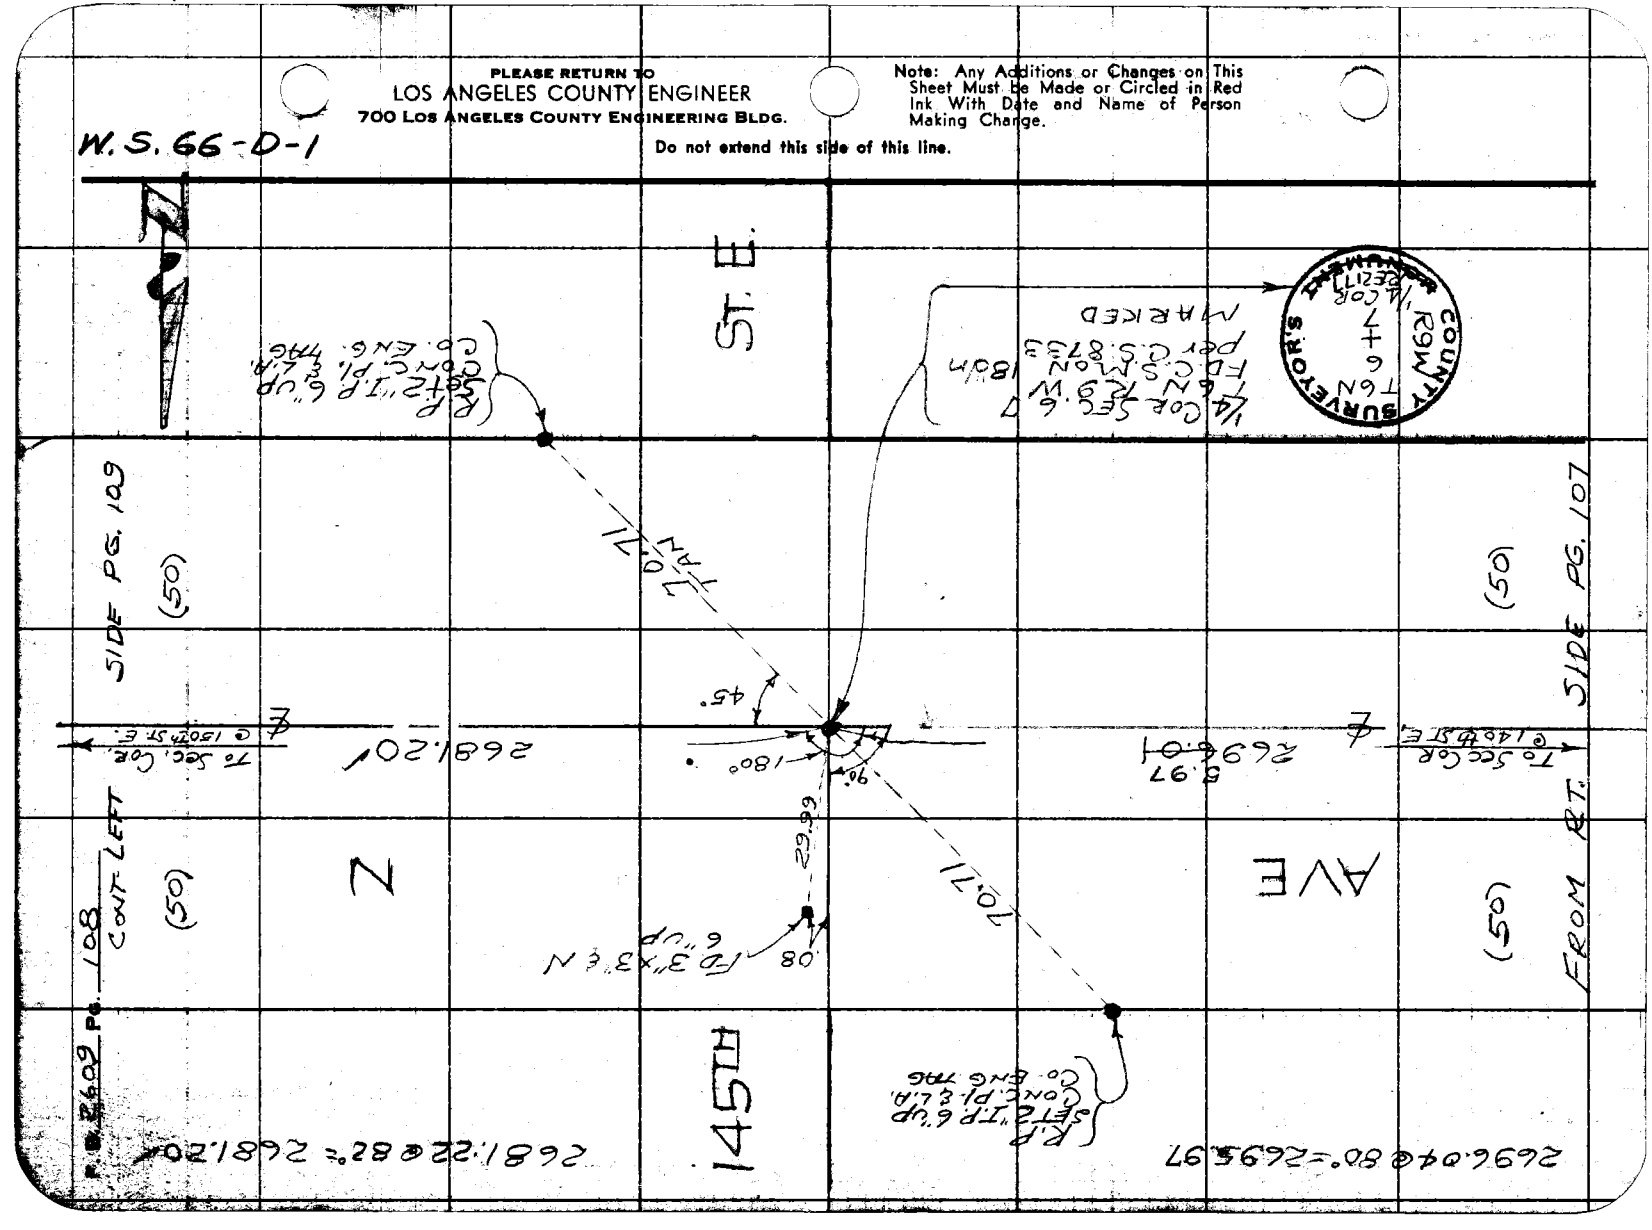

Notes Ck'd by W. D. WAGNER
Map No. C.S. 8 27 A 1-10
Office Work T.M. PALMERI
Checked W. D. WAGNER
Date JAN 12 1962

Survey of AVE. O
JN 007565 Tape 101 Std 84 °F
Surveyed by J.S. CORTES
Notes J.S.C. Date 9-28-66
Indexed H. E. OTT

F. B. 2609 Pg. 109

W.S. 66-D-1

COUNTY SURVEYOR'S MONUMENT
T6N R9W
6 5
7 8

SEC. COR. 5,6,7,8
T6N R9W
FD. C.S. MON
IN H.H.
C.S. 8733
F.B. 1824-226
F.B. 2264-
MARKED

ST. E

R.P. Set 2"IP 6" Conc. P.L. & Co. ENG TAG

FD NAIL & DISK (illegible)

38.44
70.71 TAN

N.

PG. 108

AVE (50)

PG. 117

To 1/4 Cor 2681.20 ℄

per F.B. 2264-94 2698.10

To 1/4 Cor ℄

FROM TOP

(50)

CONT. TOP

91° 56' 50" 71
51.10
52.25 Adj 35"
89° 06' 40" 35.44 Adj

R.P. FD 2"I.P. 14" up Conc. P.L. & L.A. Co ENG TAG

R.P. Set 2"IP 6" up Conc. P.L. & L.A. Co ENG TAG

2669.29 ℄

150TH

To 1/4 Cor

(50) (50)

CONT. TOP PG 110

CONT. BOT.

91° 52' 40"
367° 30' 20"
91° 52' 35"
191° 15' 30" ✓
91° 52' 35" ✓

89° 06' 40"
356° 26' 40"
89° 06' 40"
174° 40' 80" ✓
89° 06' 40" ✓

PLEASE RETURN TO
LOS ANGELES COUNTY ENGINEER
700 Los Angeles County Engineering Bldg.

Note: Any Additions or Changes on This Sheet Must be Made or Circled in Red Ink With Date and Name of Person Making Change.

Do not extend this side of this line.

76F3095 SEE #247 1-56

PLEASE RETURN TO
LOS ANGELES COUNTY ENGINEER
700 LOS ANGELES COUNTY ENGINEERING BLDG.

Note: Any Additions or Changes on This Sheet Must Be Made or Circled in Red Ink With Date and Name of Person Making Change.

Do not extend this side of this line.

W.S.66-D-1

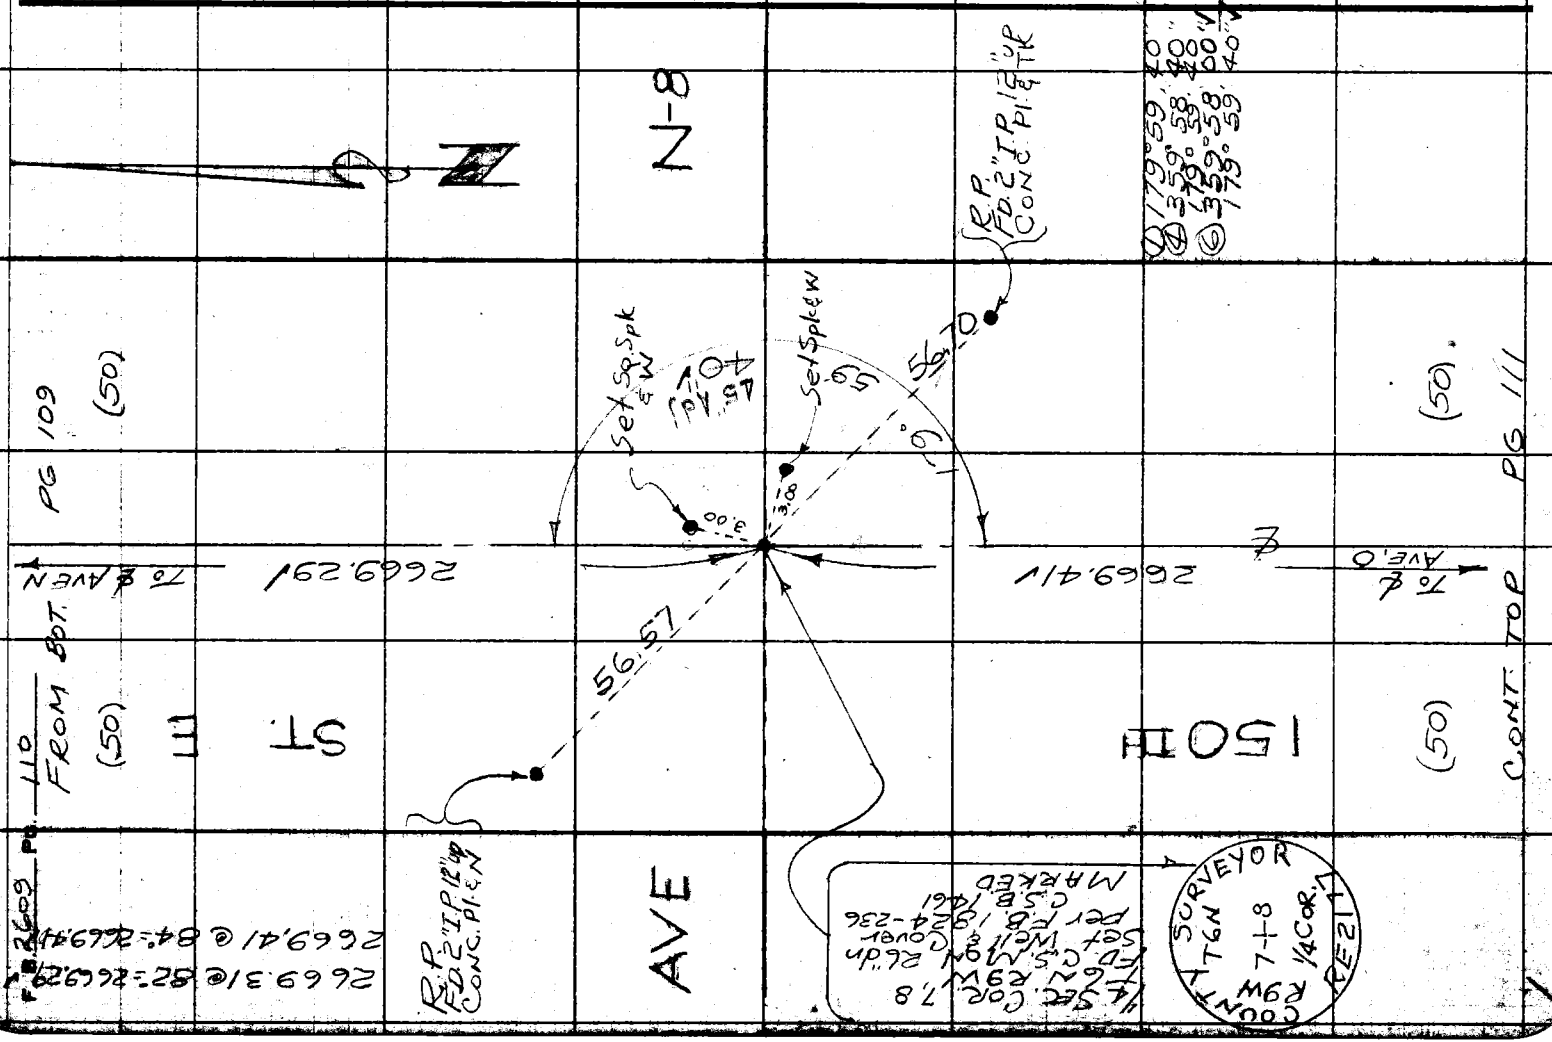

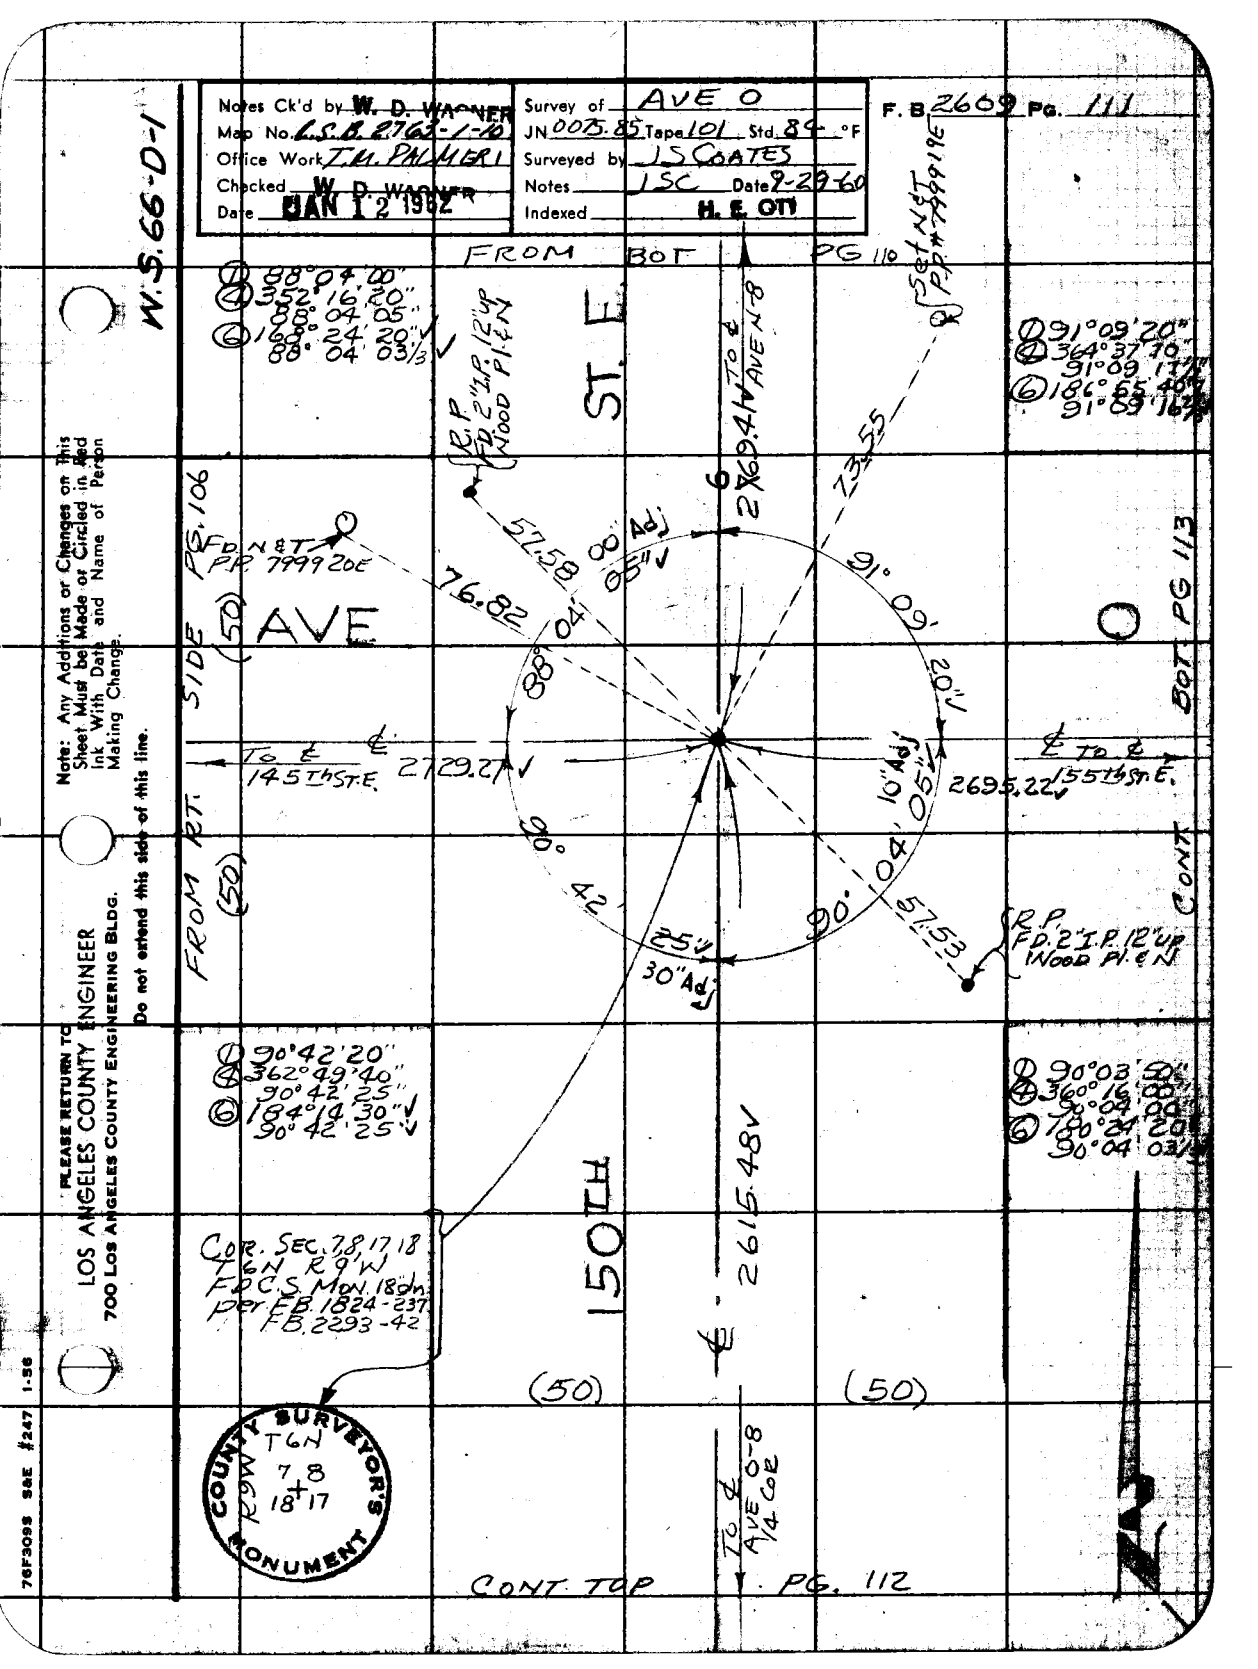
Notes Ck'd by W. D. WAGNER
Map No. L.S.B. 2762-1-10
Office Work T.M. PALMERI
Checked W. D. WAGNER
Date JAN 12 1962
Survey of AVE O
JN 0035.85 Tape 101 Std. 89 °F
Surveyed by J.S. COATES
Notes J.S.C. Date 9-29-60
Indexed H. E. OTT
F. B. 2669 PG. 111
W.S. 66-D-1
FROM BOT PG 110
88°04'00"
352°16'20"
88°04'05"
168°24'20"
88°04'03"
SET NAIL & TAG
91°09'20"
364°37'10"
91°09'17"
180°55'40"
91°09'16"
R.P. FD 2" I.P. 12" UP WOOD P.L.&N.
57.58
73.55
2609.44 To ℄ AVE N 18
ST. E
PG. 106
FD N & T PP 7999 20E
76.82
AVE
SIDE (50)
88°04'05" Adj
91°09'20"
℄ To ℄ 145TH ST. E. 2729.27
℄ To ℄ 155TH ST. E. 2695.22
10" Adj
05"
90°42'25"
30" Adj
90°04'05"
57.53
R.P. FD 2" I.P. 12" UP WOOD P.L.&N.
FROM RT. (50)
CONT
BOT PG 113
90°42'20"
362°49'40"
90°42'25"
184°14'30"
90°42'25"
90°03'50"
360°16'00"
90°04'08"
180°24'20"
90°04'03"
150TH
2615.48
COR. SEC. 7, 8, 17, 18
T6N R9W
FD C.S. MON. 18 dn.
per F.B. 1824-237
F.B. 2293-42
(50)
(50)
COUNTY SURVEYOR'S MONUMENT
T6N
R9W
7 8
18 17
℄ To ℄ AVE O-8 1/4 COR
CONT TOP PG. 112
PLEASE RETURN TO
LOS ANGELES COUNTY ENGINEER
700 Los Angeles County Engineering Bldg.
Note: Any Additions or Changes on this Sheet Must be Made or Circled in Red Ink With Date and Name of Person Making Change.
Do not extend this side of this line.
76F3098 SAE #247 1-58

PLEASE RETURN TO
LOS ANGELES COUNTY ENGINEER
700 LOS ANGELES COUNTY ENGINEERING BLDG.

Note: Any Additions or Changes on This Sheet Must Be Made or Circled in Red Ink With Date and Name of Person Making Change.

Do not extend this side of this line.

W.S. 66-D-2

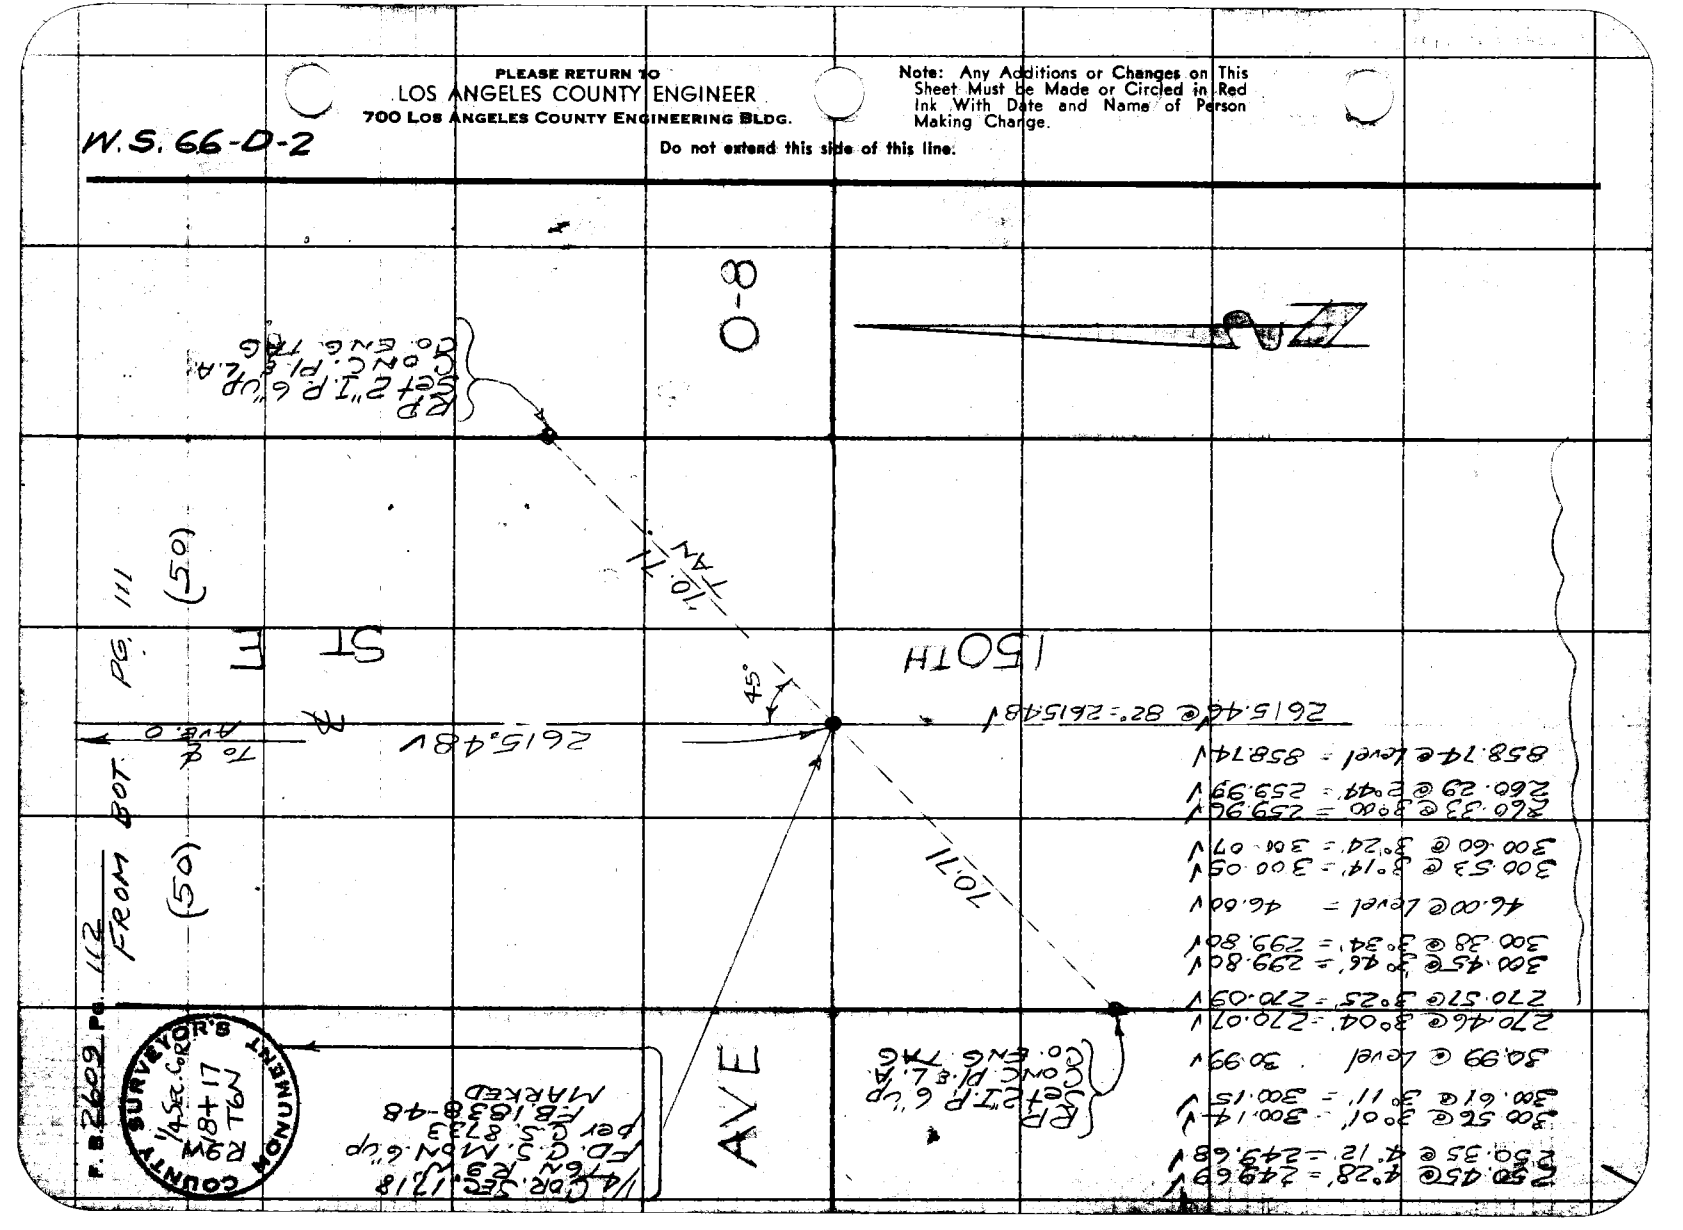

76F3095 S&E #247 1-56

PLEASE RETURN TO
LOS ANGELES COUNTY ENGINEER
700 LOS ANGELES COUNTY ENGINEERING BLDG.

Note: Any Additions or Changes on This Sheet Must be Made or Circled in Red Ink With Date and Name of Person Making Change.

Do not extend this side of this line.

W. S. 66-D-1

Notes Ck'd by W. D. WAGNER
Map No. C.S. 2243-V-12
Office Work T.M. P.M. M.M.
Checked W. D. WAGNER
Date JAN 12 1962

Survey of AVE. O
JN 0075 85 Tape 1 ch. Std. 84 °F
Surveyed by J.S.C. COATES
Notes
Indexed
Date 9-29-60
M. E. ON

F. B. 2609 Pg. 114

1/4 SEC. COR. B.17
T 6 N R 9 W
F.D.C.E. MON in H.H.
F.B. 2237-204
F.B. 2293-204
MARKED

COUNTY ENGINEER
T 6 N
R 9 W
X 8
7817
1/4 COR
R. E. 5869

R.P.
FD 2" I.P. 6" UP
CONC PI & N.

55TH

56.57

AVE

(50)
FROM RT.

To 150th ST. E

2695.22 ✓

1505.69 ✓

P.O.T.
Set B.S.W
& TIN
CROWN OF HUB

(50)
CONT. LEFT

To Set
COR
@ 160 STE

45°

1189.75 ✓

(50)
SIDE PG. 114

56.59
K.A.N.

RP
FD 2" I.P. 6" OP
CONC PI & N

(50)
SIDE PG. 111

STE

1505.65 @ 88° = 1505.69 ✓
2695.15 @ 88° = 2695.22 ✓
1189.71 @ 82° = 1189.75 ✓

PLEASE RETURN TO
LOS ANGELES COUNTY ENGINEER
700 LOS ANGELES COUNTY ENGINEERING BLDG.

Note: Any Additions or Changes on This Sheet Must be Made or Circled in Red Ink With Date and Name of Person Making Change.

Do not extend this side of this line.

W.S.66-D-1

COUNTY ENGINEER T6N R9W 8 9 16 17 R.E. 5869

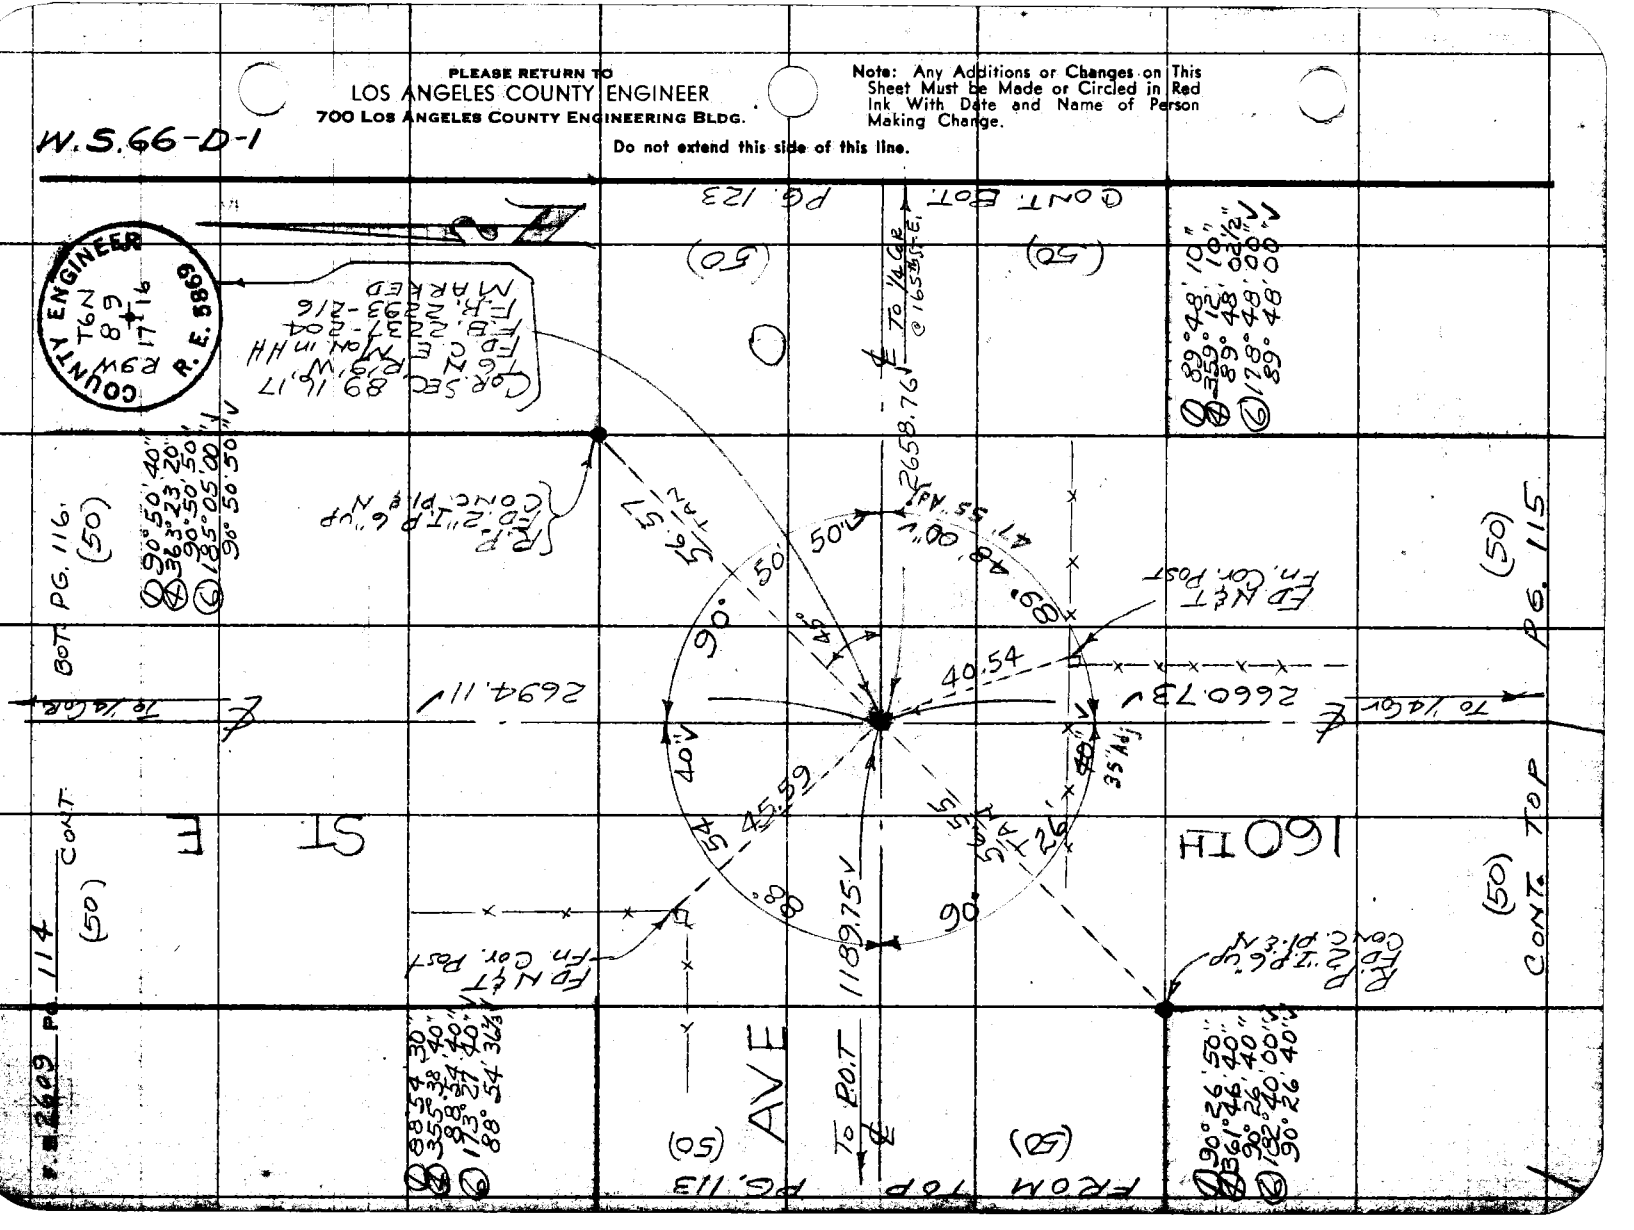

76F3095 S&E #247 1-56

PLEASE RETURN TO
LOS ANGELES COUNTY ENGINEER
700 LOS ANGELES COUNTY ENGINEERING BLDG.

Note: Any Additions or Changes on This Sheet Must be Made or Circled in Red Ink With Date and Name of Person Making Change.

Do not extend this side of this line.

W.S. 66-D-2

¼ Cor. Sec. 16, 17
T6N R9W
F.D.C.S. Mon. 4A
per C.S. 8733
MARKED

COUNTY SURVEYOR'S
17+16
1/4 Cor.
RE2177

300.11 @ 16°14' = 288.14 ✓
300.44 @ 16°28' = 288.12 ✓

300.39 @ 3°51' = 299.71 ✓
300.47 @ 4°02' = 299.72 ✓

300.37 @ 3°45' = 299.73 ✓
300.33 @ 3°34' = 299.75 ✓

1773.18 @ Level = 1773.18 ✓
2660.76 @ 82° = 2660.73 ✓

Notes Ck'd by W. D. WAGNER
Map No. C.S. 8733-V-10
Office Work T.H. PALMER
Checked W. D. WAGNER
Date JAN 12 1962

Survey of JN0075 85 Tape/101 Std. 84 °F
Surveyed by J.S. COATES
Notes
Indexed H. E. Om
Date 2-30-60

AVE

160TH

ST E

300'±

2660.73 ✓

℄ To ℄ AVE

(50) CONT. FROM BOT. (50) PG. 114

Bathe

O-8

F. B. 2609 Pg. 11

PLEASE RETURN TO
LOS ANGELES COUNTY ENGINEER
700 LOS ANGELES COUNTY ENGINEERING BLDG.

Note: Any Additions or Changes on This Sheet Must be Made or Circled in Red Ink With Date and Name of Person Making Change.

Do not extend this side of this line.

W.S. 66-D-1

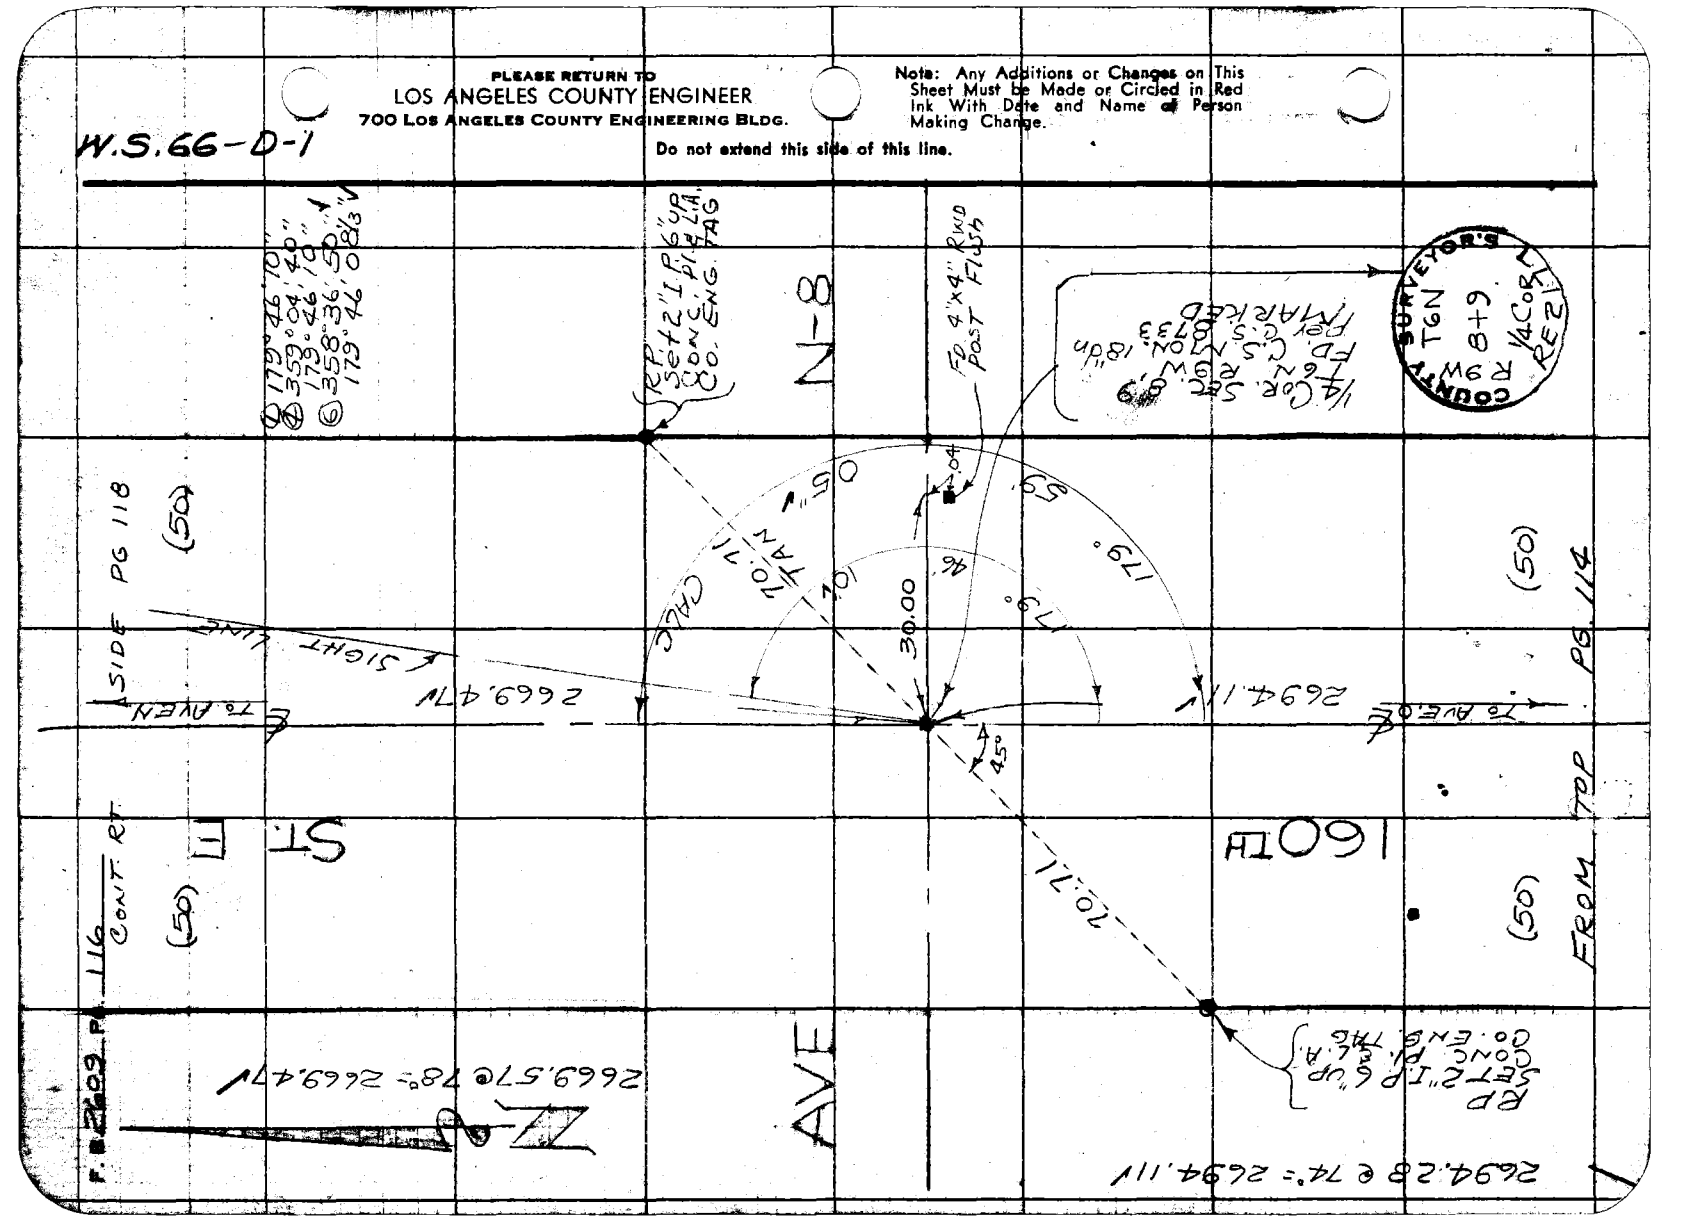

76F3098 S&E #247 1-56

PLEASE RETURN TO
LOS ANGELES COUNTY ENGINEER
700 LOS ANGELES COUNTY ENGINEERING BLDG.

Note: Any Additions or Changes on This Sheet Must be Made or Circled in Red Ink With Date and Name of Person Making Change.

Do not extend this side of this line.

W.S.66-D-1

COUNTY SURVEYOR'S MONUMENT
T6N
5
+8
R9W
1/4 SEC. COR.

1/4 COR SEC. 5, 8
T6N, R9W
FD. C.S. MON. 20dm
per C.S. 8733
F.B. 2264-93
MARKED

55TH

AVE

FD. N&T
P.P.# 734482E

R.P.
FD. 2" I.P. 6" UP
CONC. PL. & L.A.
CO. ENG. TAG

39.98

180°

90°

40.00

R.P.
FD. 2" I.P. 6" UP
CONC. PL. & L.A.
CO. ENG. TAG

To ℄ 150th ST E

2698.10
per F.B. 2264-93

2698.11
per F.B. 2264-92, 93

To ℄ 160th St. E.

(50) FROM RT.

(50) SIDE PG. 109

(50) CONT. SOT. PG. 118

ST. E

Notes Ck'd by W. D. WAGNER
Map No. C.S. 8733-1-12
Office Work F. M. PALMER
Checked W. D. WAGNER
Date JAN 12 1962

Survey of AVE. O
JN 06785 Tape 101 Std. 84 °F
Surveyed by J.S. COATES
Notes J.S.C. Date 10-6-60
Indexed H. E. OTT

F.B. 2609 Pg. 117

PLEASE RETURN TO
LOS ANGELES COUNTY ENGINEER
700 LOS ANGELES COUNTY ENGINEERING BLDG.

Note: Any Additions or Changes on This Sheet Must be Made or Circled in Red Ink With Date and Name of Person Making Change.

Do not extend this side of this line.

W.S. 66-D-1

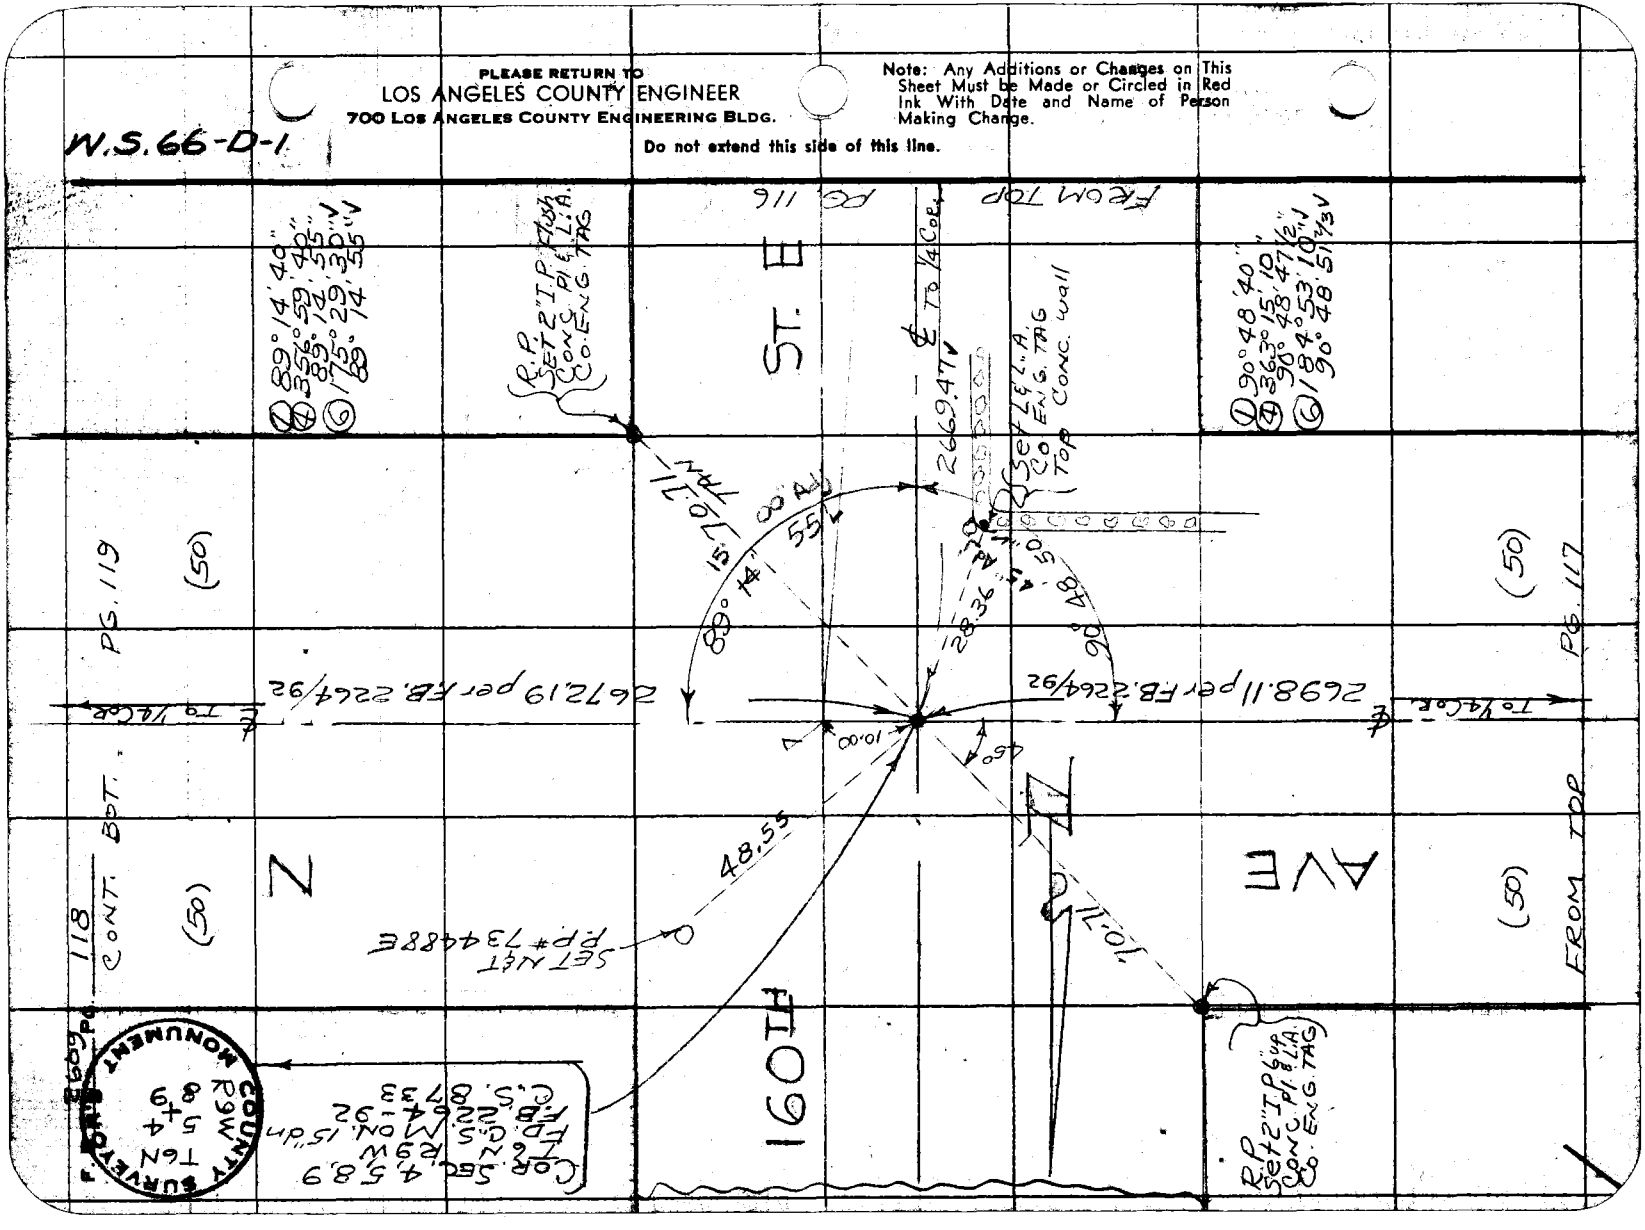

76F3098 S&E #247 1-56

PLEASE RETURN TO
LOS ANGELES COUNTY ENGINEER
700 LOS ANGELES COUNTY ENGINEERING BLDG.

Note: Any Additions or Changes on This Sheet Must be Made or Circled in Red Ink With Date and Name of Person Making Change.

Do not extend this side of this line.

W.S.66-D-1

Notes Ck'd by W. D. WAGNER
Map No. CS8276-1-10
Office Work Completed 1-81
Checked W. D. WAGNER
Date JAN 12 1962

Survey of AVE. O
JN 0025 85 Tape/101 Std. 84 °F
Surveyed by J.S.C. COATES
Notes J.S.C. Date 10-2-60
Indexed H.E.OTT

F.B. 2602 Pg. 119

165TH

(50) FROM TOP PG. 118

(50) CONT. BOT. PG. 120

AVE N

R.P. FD. 2" I.P. 6" UP CONC. PI. & L.A. CO. ENG. TAG

59° 19' per F.B. 2264

39.97 TAN

50" pg. 91

To ℄ 160TH ST. E

Per F.B. 2264-91
2672.19

Per F.B. 2264-91
2672.56

To ℄ 170TH ST. E

90°

39.99

R.P. FD. 2" I.P. 6" UP CONC. PI. & L.A. CO. ENG. TAG

1/4 Cor. SEC 4,9 T6N R9W
FD. C.S. MON. 15" dn.
Per C.S. 8733
F.B. 2264-91
MARKED

COUNTY SURVEYOR'S MONUMENT
T6N
R9W
4
9
1/4 SEC. COR.

PLEASE RETURN TO
LOS ANGELES COUNTY ENGINEER
700 LOS ANGELES COUNTY ENGINEERING BLDG.

Note: Any Additions or Changes on This Sheet Must be Made or Circled in Red Ink With Date and Name of Person Making Change.

Do not extend this side of this line.

W.S. 67-A-1

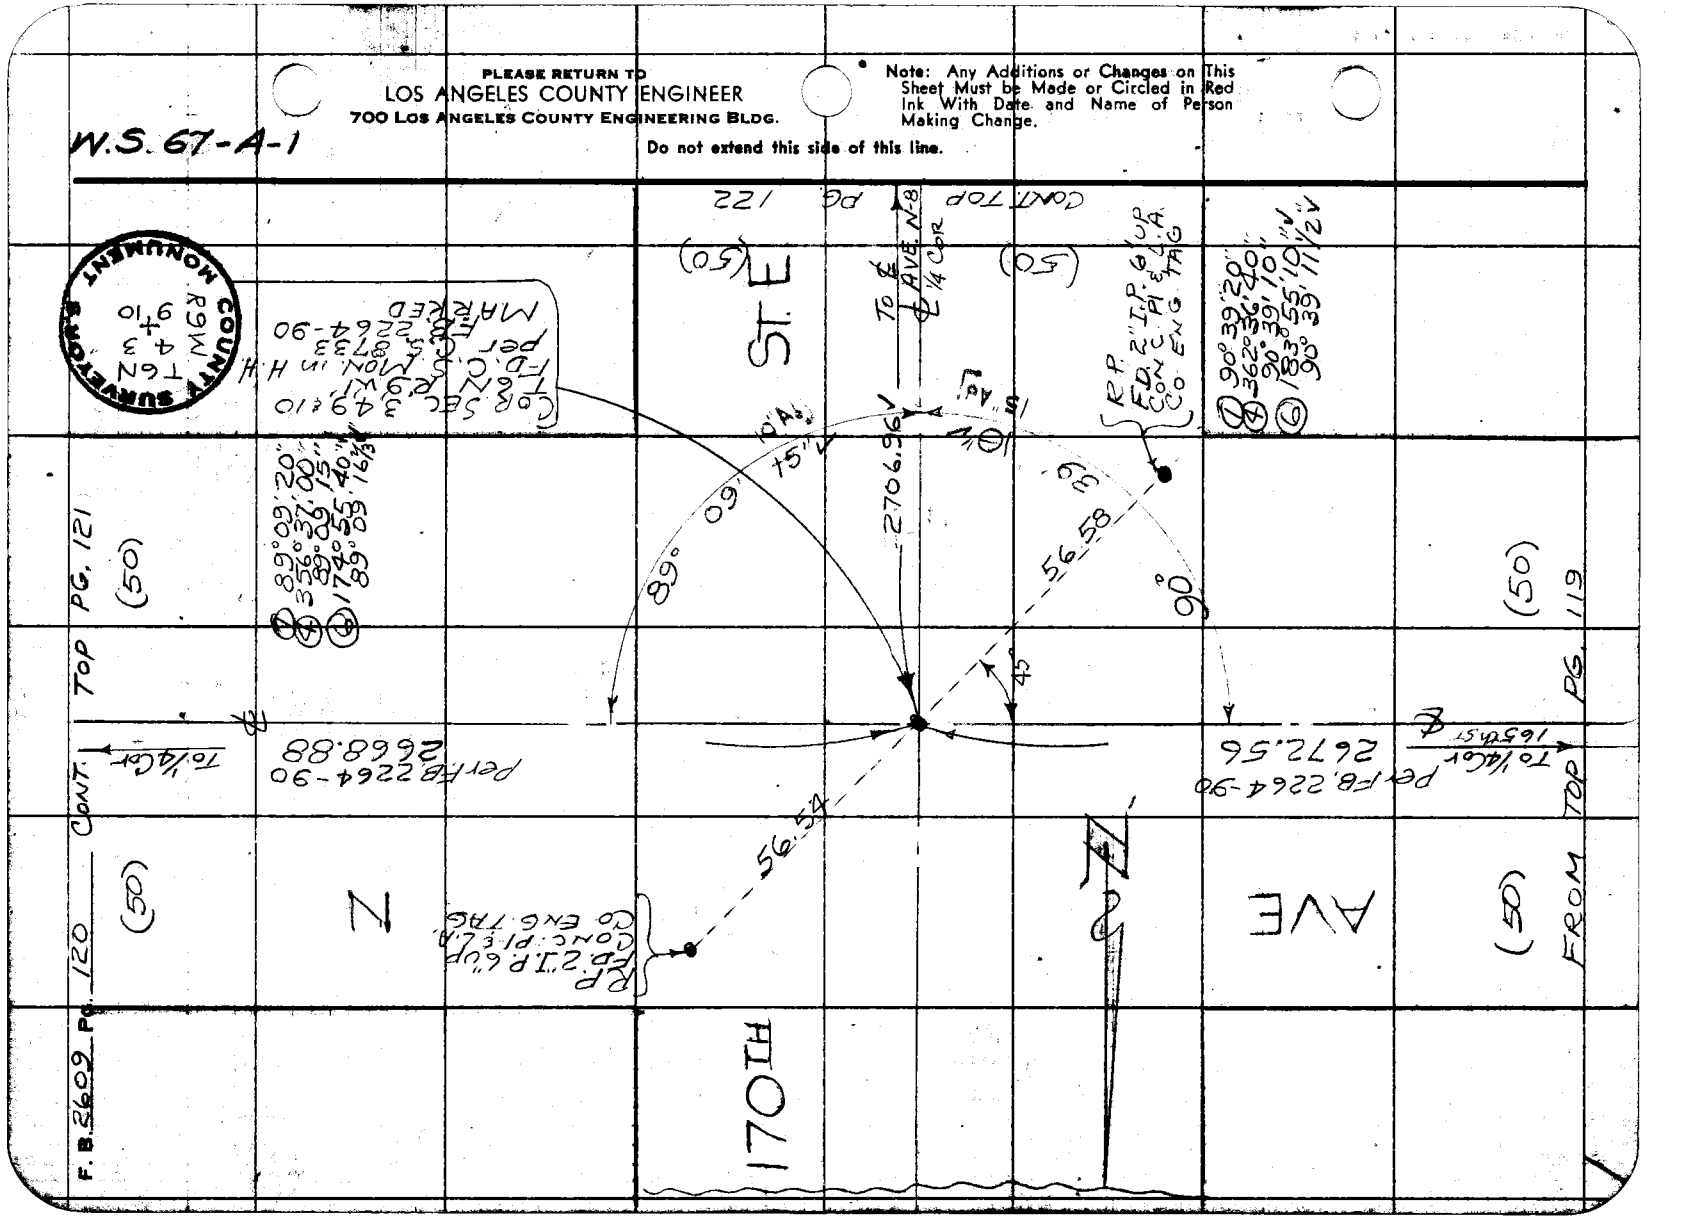

76F3098 S&E #247 1-56

PLEASE RETURN TO
LOS ANGELES COUNTY ENGINEER
700 LOS ANGELES COUNTY ENGINEERING BLDG.

Note: Any Additions or Changes on This Sheet Must be Made or Circled in Red Ink With Date and Name of Person Making Change.

Do not extend this side of this line.

W.S. 67-A-1

Notes Ck'd by W. D. WAGNER
Map No. C.S. 8733 Tape 10/ Std. 84 °F
Office Work Tape Plotted
Checked W. D. WAGNER
Date JAN 1 2 1962

Survey of AVE O
JN 2075.85 Tape 10/ Std. 84 °F
Surveyed by J.S.C. COATES
Notes
Indexed H. E. OTT Date 10-31-62

F. B. 2609 Pg. 121

175TH ST E

RP
FD 2" I.P. 6" UP
CONC. PI. & L.A.
CO. ENG. TAG

179° 58' 40"
Per F.B. 2264-89
45° Adj.

56.57

AVE. N

(50)

FROM TOP
PG. 120

To ℄ 170th ST. E
℄

per F.B. 2264-89
2668.88

Per F.B. 2264-89
2672.05

To ℄ 180th ST. E
℄

CONT. LEFT & SIDE PG. 131

45°

56.57
TAN

1/4 COR. SEC. 8 & 10
T6N R9W
FD 2" I.P. & Nail
Set 12" Conc. 12" dn
Per F.B. 2264-89
C.S. 8733

R.P.
FD 2" I.P. 6" UP
CONC. PI. & L.A.
CO. ENG. TAG

STE

PLEASE RETURN TO
LOS ANGELES COUNTY ENGINEER
700 LOS ANGELES COUNTY ENGINEERING BLDG.

Note: Any Additions or Changes on This Sheet Must be Made or Circled in Red Ink With Date and Name of Person Making Change.

Do not extend this side of this line.

W.S.67-A-1

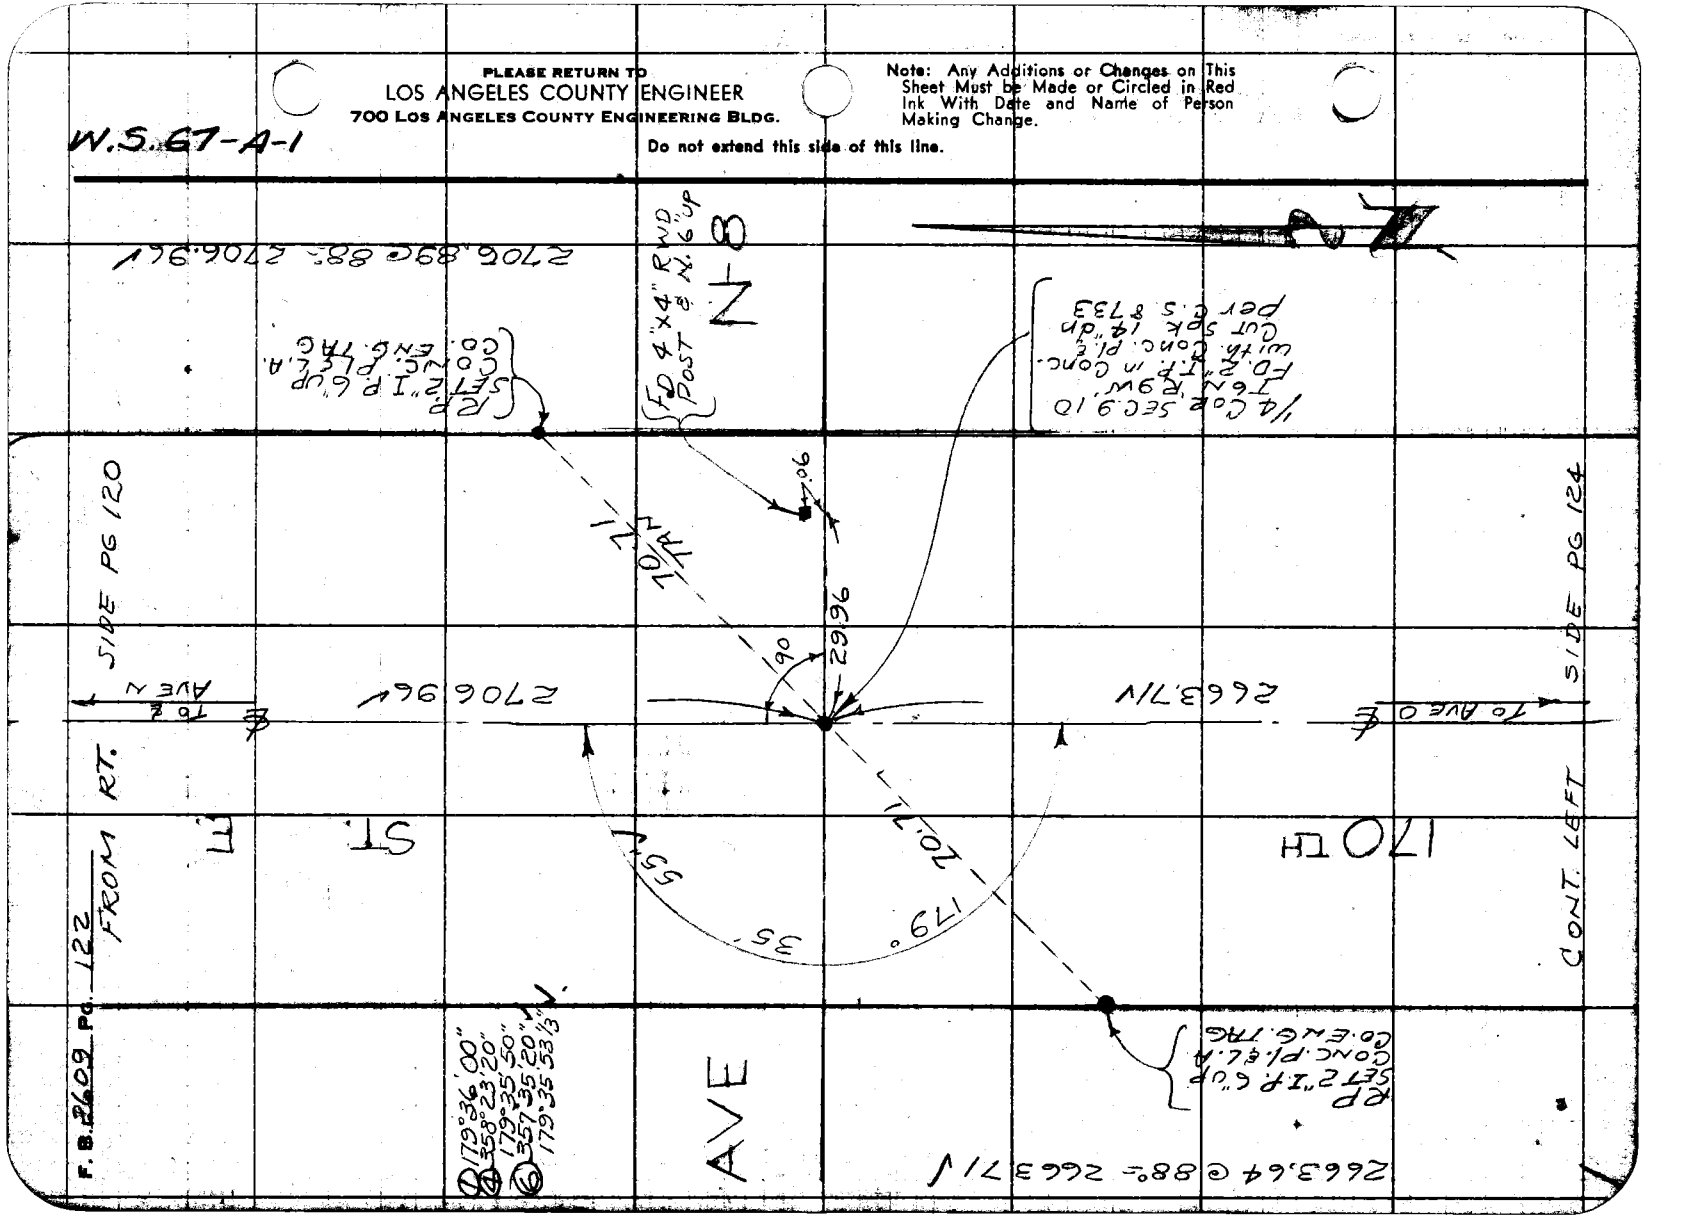

76F3095 S&E #247 1-56

PLEASE RETURN TO
LOS ANGELES COUNTY ENGINEER
700 LOS ANGELES COUNTY ENGINEERING BLDG.

Note: Any Additions or Changes on This Sheet Must be Made or Circled in Red Ink With Date and Name of Person Making Change.

Do not extend this side of this line.

W.S. 67-A-1

Notes Ck'd by W. D. WAGNER
Map No. C.S.B. 67-1-12
Office Work by T.H. PULLEN-RI
Checked W. D. WAGNER
Date JAN 12 1962

Survey of AVE. O
JNO 75.85 Tape 101 Std. 84 °F
Surveyed by J.S. COATES
Notes J.S.C. Date
Indexed M.E.ON

F. B. 2609 Pg. 123

SURVEYOR'S MONUMENT
16N 9 16 W
1/4 COR RE 2177

1/4 COR SEC. 9 16
T 6 N R 9 W
ED. C.S. MON. IN H.H.
PER F.B. 2237-205
F.B. 2293-218
MARKED

16.5 TH

AVE

(50) FROM RT.

(50) SIDE PG 114

CONT. SOUTH (50) PG 124

R.P. ED. 2" I.P. 6" UP CONC. PI & TK

56.57

180°

45°

56.58

R.P. ED. 2" I.P. 6" UP CONC. PI & TK







STE

PLEASE RETURN TO
LOS ANGELES COUNTY ENGINEER
700 LOS ANGELES COUNTY ENGINEERING BLDG.

Note: Any Additions or Changes on This Sheet Must be Made or Circled in Red Ink With Date and Name of Person Making Change.

Do not extend this side of this line.

W.S. 67-A-1

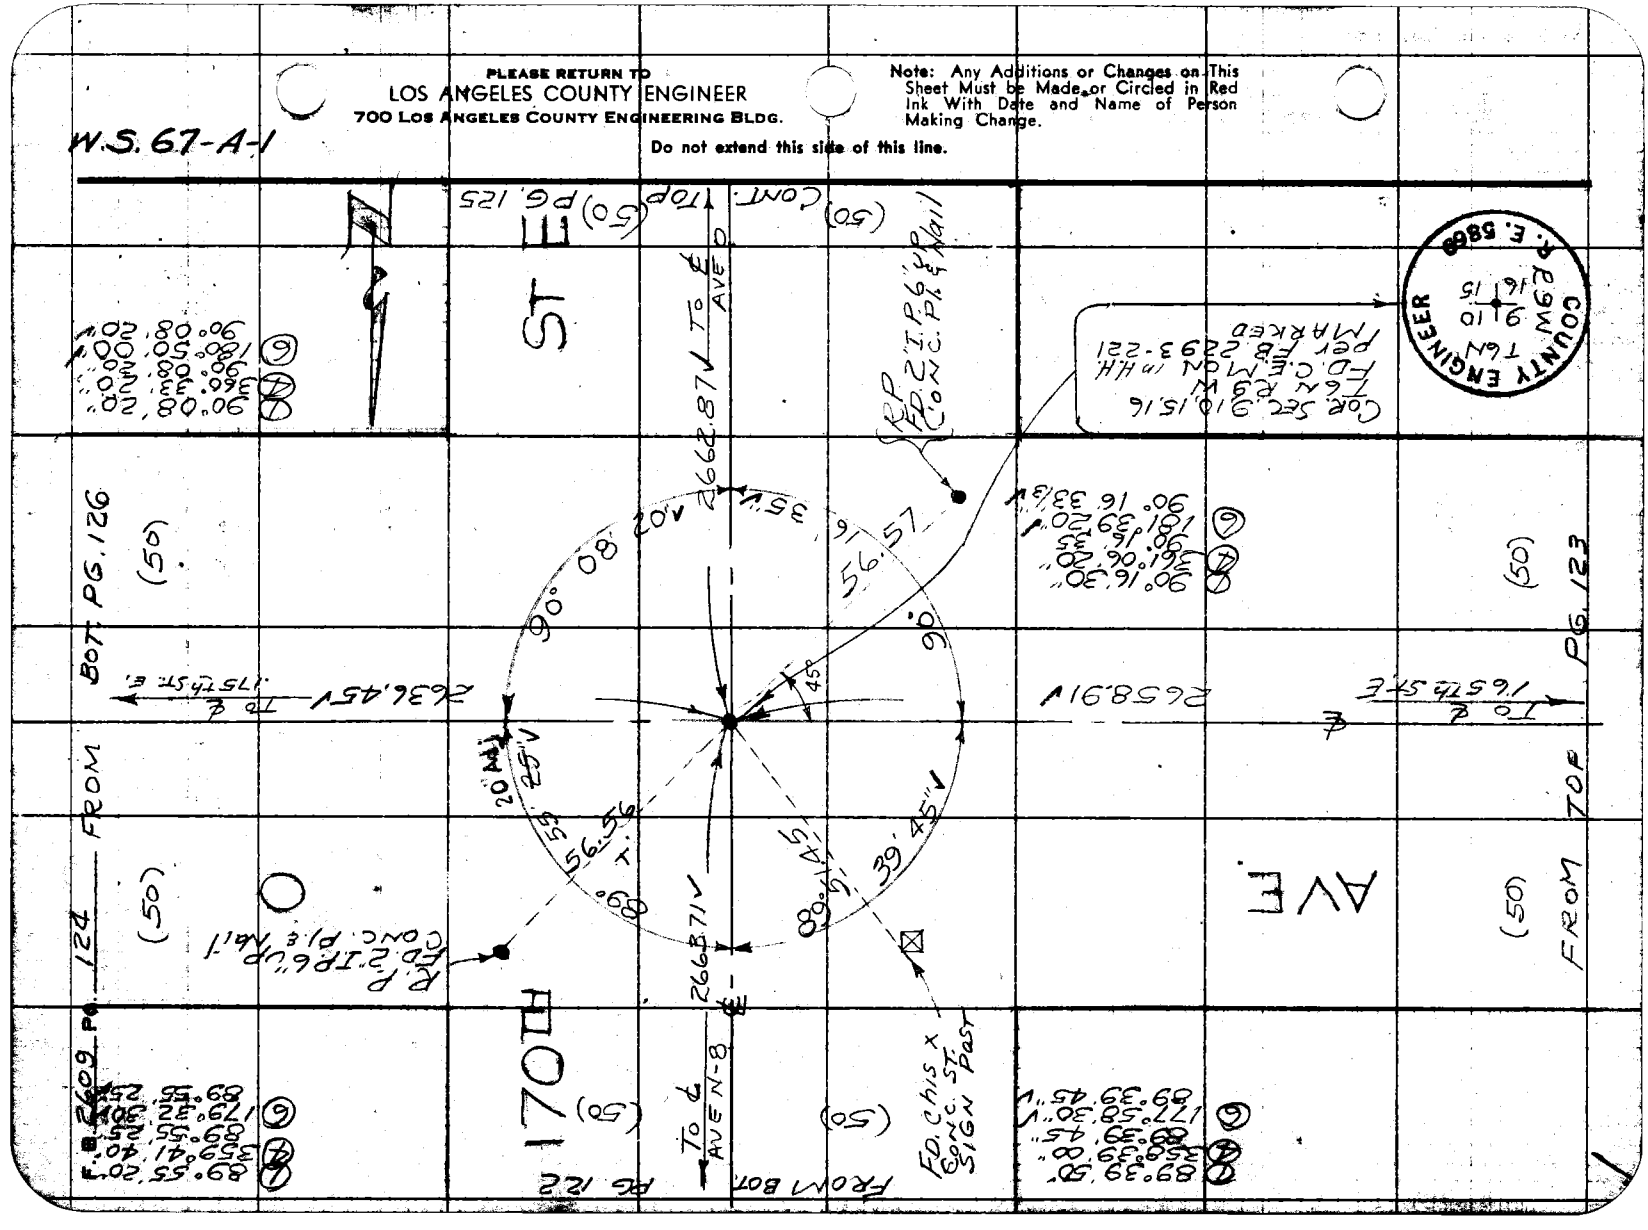

76F3095 S&E #247 1-56

PLEASE RETURN TO
LOS ANGELES COUNTY ENGINEER
700 LOS ANGELES COUNTY ENGINEERING BLDG.

Do not extend this side of this line.

Note: Any Additions or Changes on This Sheet Must be Made or Circled in Red Ink With Date and Name of Person Making Change.

W.S. 67-A-2

Notes Ck'd by W. D. WARNER
Map No. C.S.A. 2762 1-10
Office Work T.M. PALMER
Checked W. D. WARNER
Date JAN 12 1962

Survey of AVE. O
JN 00255 Tape 10.1 Std. 84 °F
Surveyed by J.S.C. COATES
Notes J.S.C. Date 11-1-60
Indexed H. E. OTT

1/4 COR. SEC. 15, 16
T 6 N. R 9 W.
F.D. 2" I.P. Set in Conc.
12" dm. With cut spk
per C.S. 8733

Set Bt. Spk. & W.
16" JOSHUA

R.P.
Set 2" I.P. 6" up
Conc. P.L. & L.A.
Co. Eng. TAG

170TH

AVE

ST. E.

(50)

FROM RT. 1 SIDE PG. 124

(50)

70.71

95.24

2662.87 V

TO ℄ AVE. O

45°

70.71

R.P.
Set 2" I.P. 6" up
Conc. P.L. & L.A.
Co. Eng. TAG

O-8

2662.77 @ 90° = 2662.87 V

F. B. 2609 Pg. 125

PLEASE RETURN TO
LOS ANGELES COUNTY ENGINEER
700 LOS ANGELES COUNTY ENGINEERING BLDG.

Note: Any Additions or Changes on This Sheet Must be Made or Circled in Red Ink With Date and Name of Person Making Change.

Do not extend this side of this line.

W.S. 67-A-1

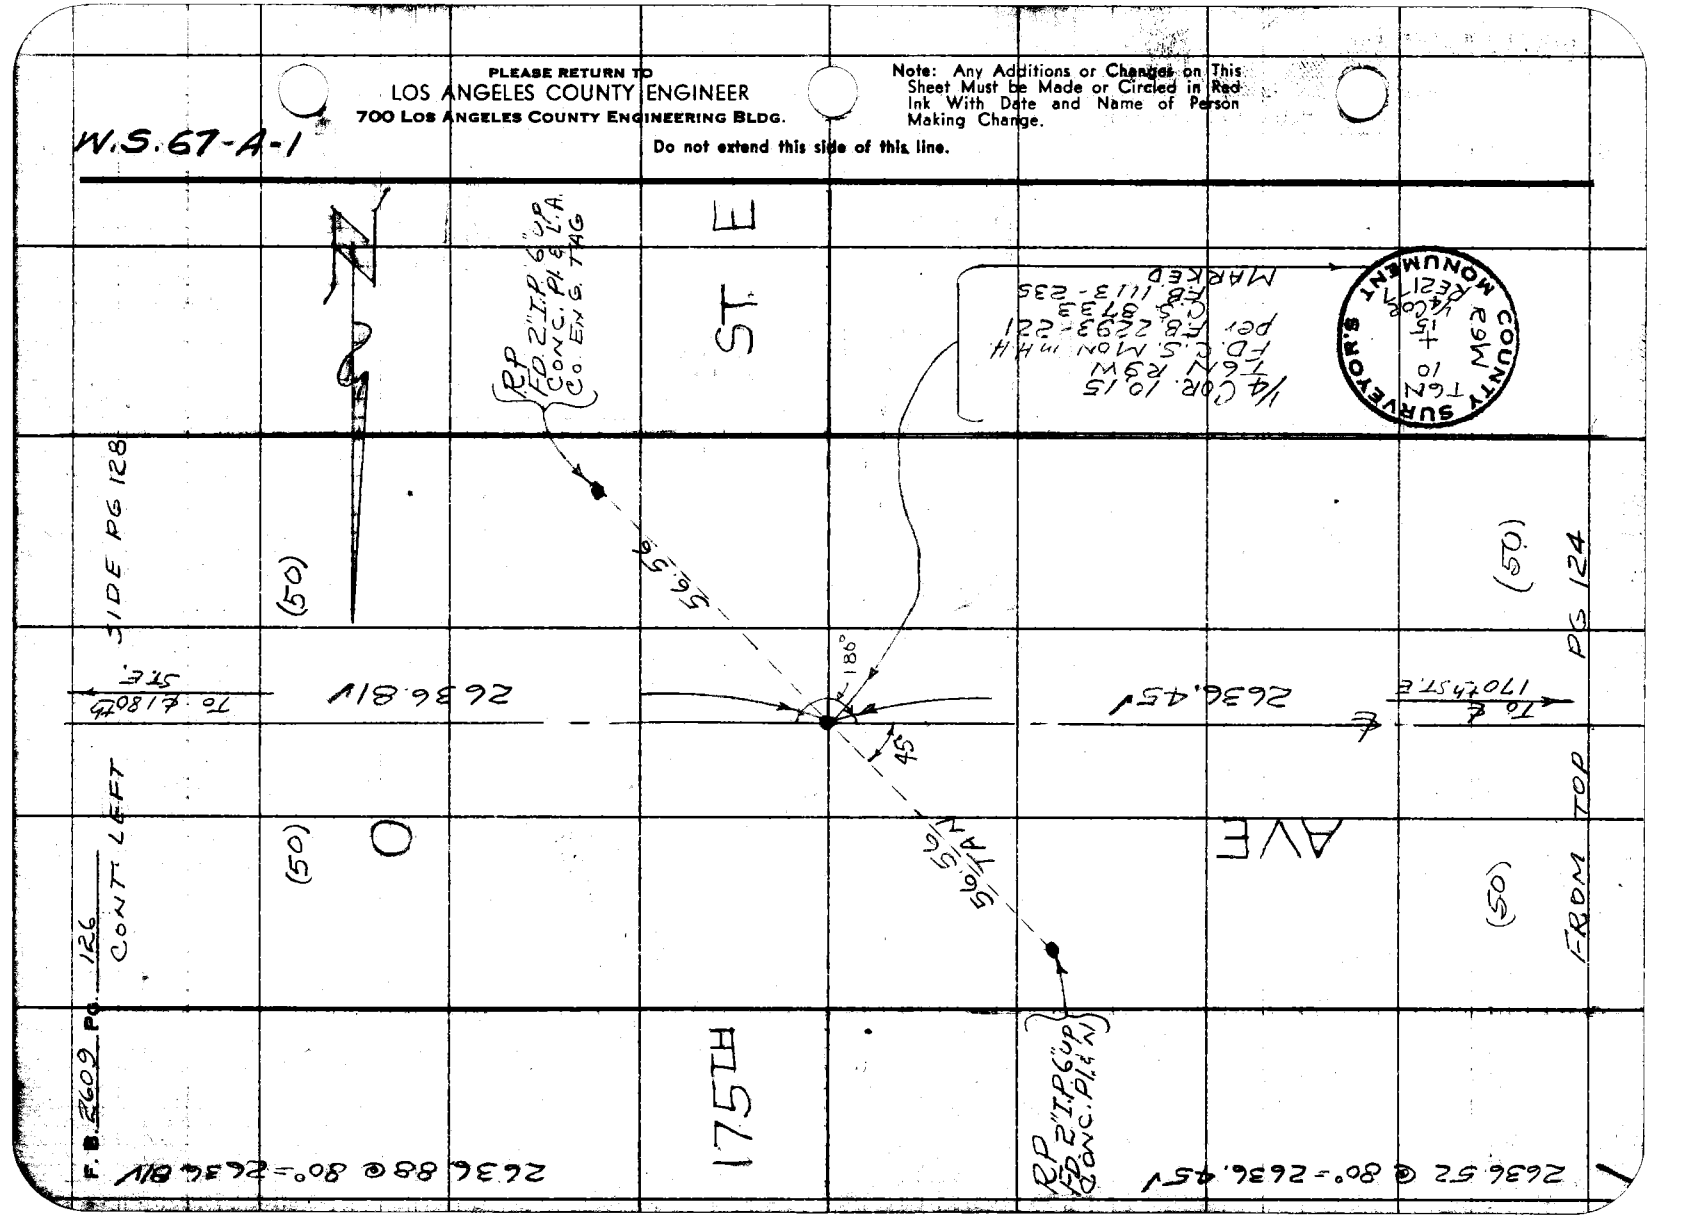

76F3093 S&E #247 1-56

PLEASE RETURN TO
LOS ANGELES COUNTY ENGINEER
700 LOS ANGELES COUNTY ENGINEERING BLDG.

Note: Any Additions or Changes on This Sheet Must be Made or Circled in Red Ink With Date and Name of Person Making Change.

Do not extend this side of this line.

W.S. 67-A-2

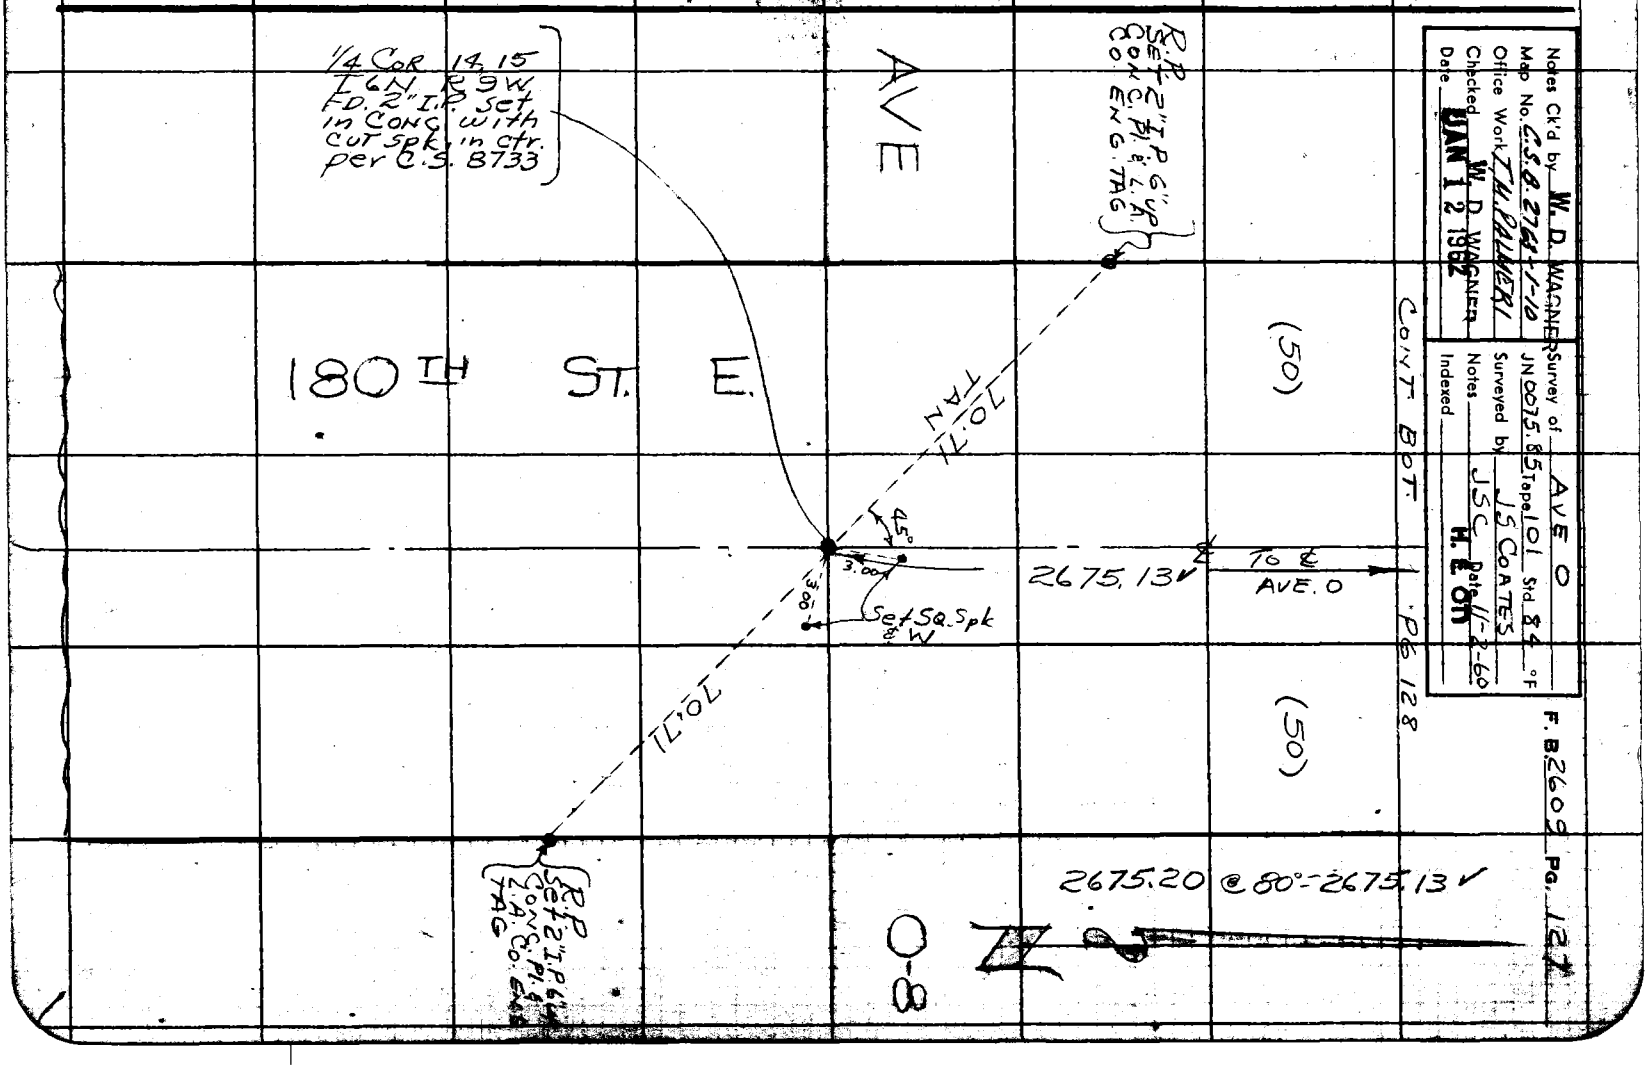

Notes Ck'd by W. D. WAGNER
Map No. C.S.B. 2764-1-10
Office Work TH. PALMER
Checked JAN 12 1962 W. D. WAGNER
Date

Survey of AVE O
JN 0075.85 Topo 101 Std. 84 °F
Surveyed by J.S.C. & COATES 11-2-60
Notes
Indexed H. L. Ott

F. B. 2609 PG. 127

PLEASE RETURN TO
LOS ANGELES COUNTY ENGINEER
700 LOS ANGELES COUNTY ENGINEERING BLDG.

Note: Any Additions or Changes on This Sheet Must be Made or Circled in Red Ink With Date and Name of Person Making Change.

Do not extend this side of this line.

W.S. 67-A-1

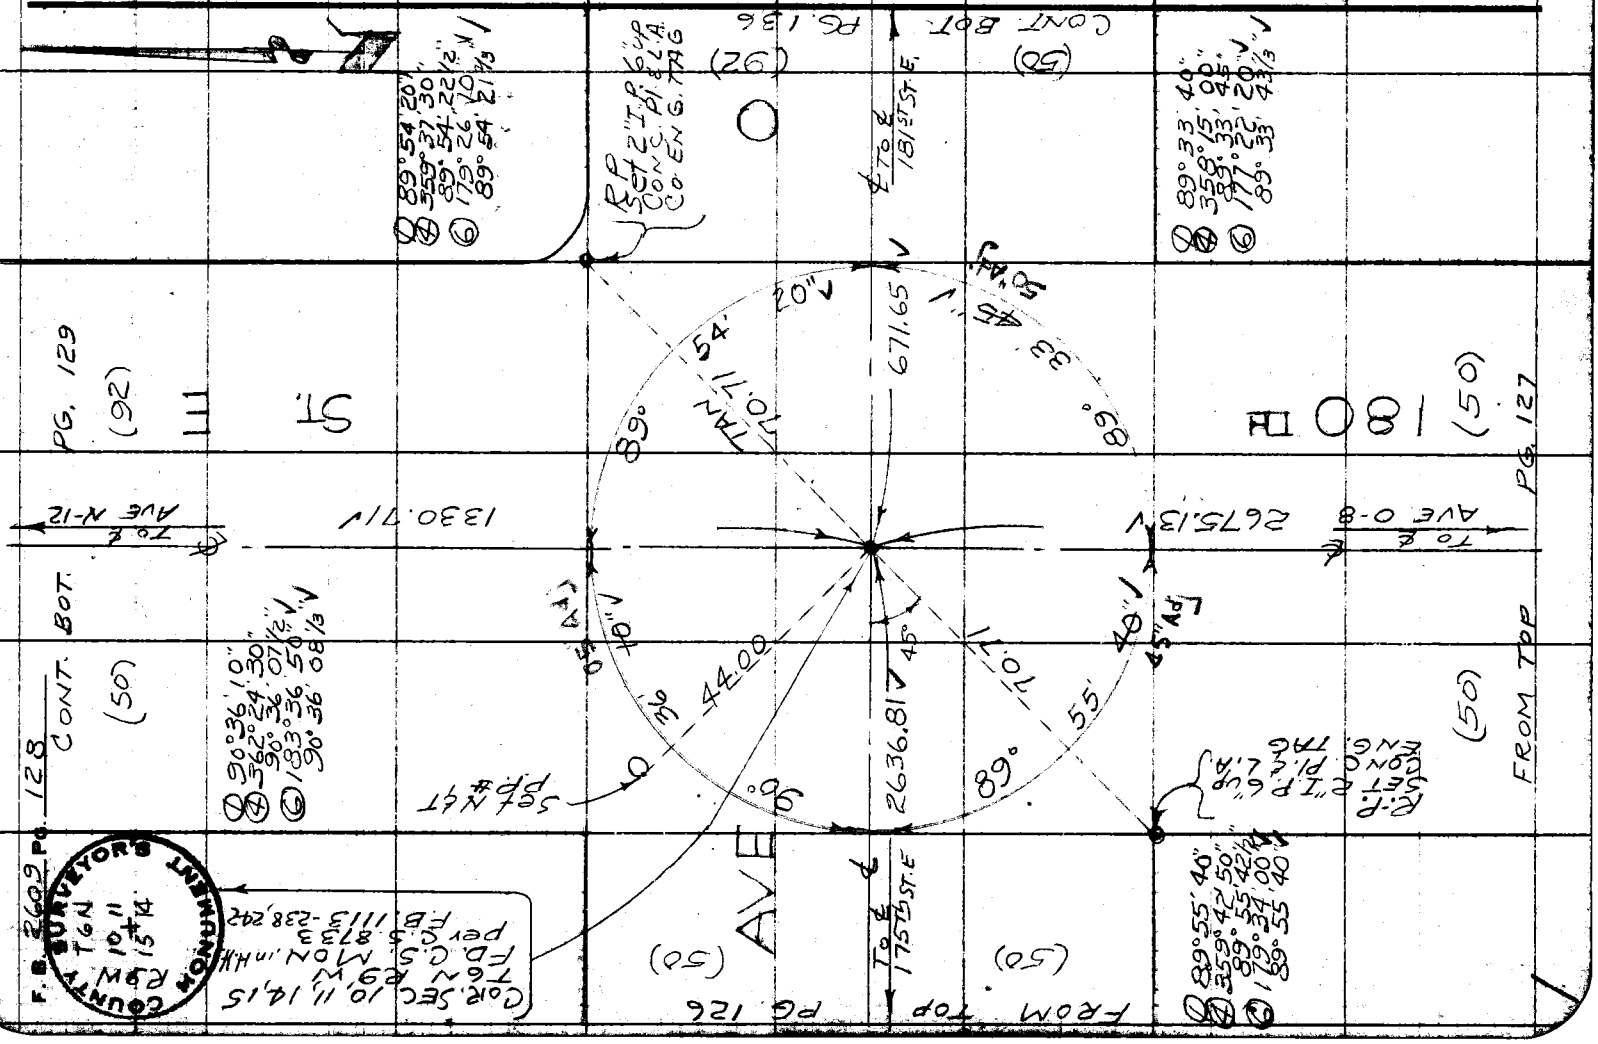
89° 54' 20"
359° 54' 30"
89° 54' 22 1/2"
179° 26' 10"
89° 54' 21 1/3
R&P SET 2" I.P. & L.A. CO. ENG. TAG
(92)
CONT BOT
PG. 136
℄ TO ℄ 18TH ST. E.
89° 33' 40"
358° 33' 20"
89° 33' 40"
177° 22' 53"
89° 33' 20"
44 1/3
PG. 129
(92)
ST
E
St
(50)
180 DR
PG. 127
℄ TO ℄ AVE N-12
1330.71
2675.13
℄ TO ℄ AVE O-8
90° 36' 10"
362° 24' 30"
90° 36' 07 1/2"
90° 36' 50"
180° 00' 08 1/3
CONT. BOT.
128
(50)
(50)
FROM TOP
R&P SET 2" I.P. & L.A. CO. ENG. TAG
89° 55' 40"
359° 55' 42 1/2"
89° 55' 40"
179° 34' 00"
89° 55' 40"
44 1/3
671.65
89° 33' 40"
89° 54' 20"
89° 54' 30"
89° 54' 10"

Notes Ck'd by W. D.	Survey of AVE. O		F. B. 2609 Pg. 129
Map No. C.S.B. 2768-1-12	JN 007555 Tape 101 Std 84 °F		
Office Work T. M. PALMERI	Surveyed by J S COATES		
Checked W. D.	Notes JSC Date 1-3-60		
Date JAN 12 1962	Indexed H. E. OH		

W.S. 67-A-1

CONT. BOT. PG. 130

(50) (92)

TO ℄ AVE 8

E. ST.

1330.88 @ 60° 1330.67

1330.67

FD. 2"X2" & NAIL

FD. 2"X2" & NAIL

FD. 2" I.P 12" dn CONC. PL & TAG L.S. 2646 per R.S. 74-34 PB. 2072-90

48.63

47.17

45°

45°

49.25

48.96

74-34

AVE

℄

(30)

(30)

Z-12

FD. 2"X2" & NAIL

FD. 2"X2" & NAIL

1330.92 @ 60° 1330.71

1330.71

180 FT

R.S.

(50) (92)

TO ℄ AVE O

FROM TOP PG 128

Note: Any Additions or Changes on This Sheet Must be Made or Circled in Red Ink With Date and Name of Person Making Change.

Do not extend this side of this line.

PLEASE RETURN TO
LOS ANGELES COUNTY ENGINEER
700 Los Angeles County Engineering Bldg.

76F3098 SBE 1247 1-58

PLEASE RETURN TO
LOS ANGELES COUNTY ENGINEER
700 LOS ANGELES COUNTY ENGINEERING BLDG.

Note: Any Additions or Changes on This Sheet Must be Made or Circled in Red Ink With Date and Name of Person Making Change.

Do not extend this side of this line.

W.S. 67-A-1

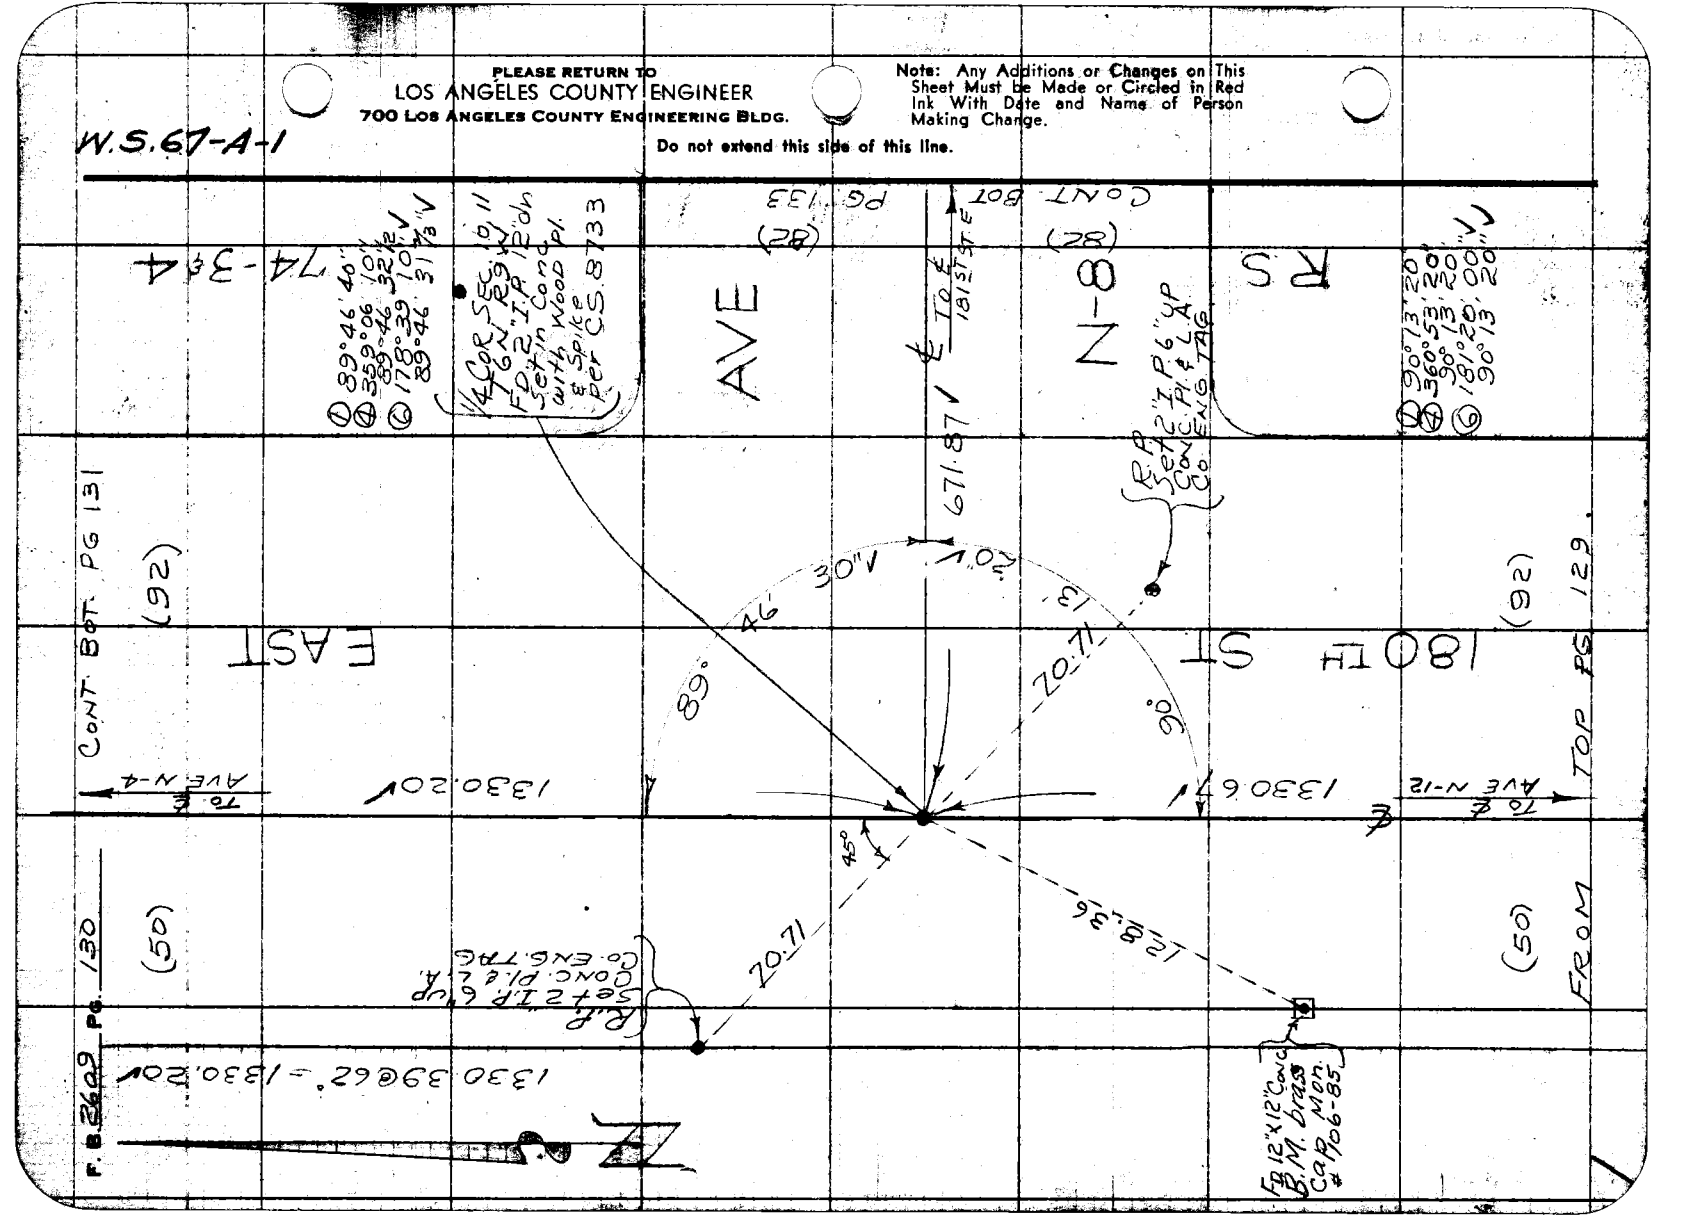

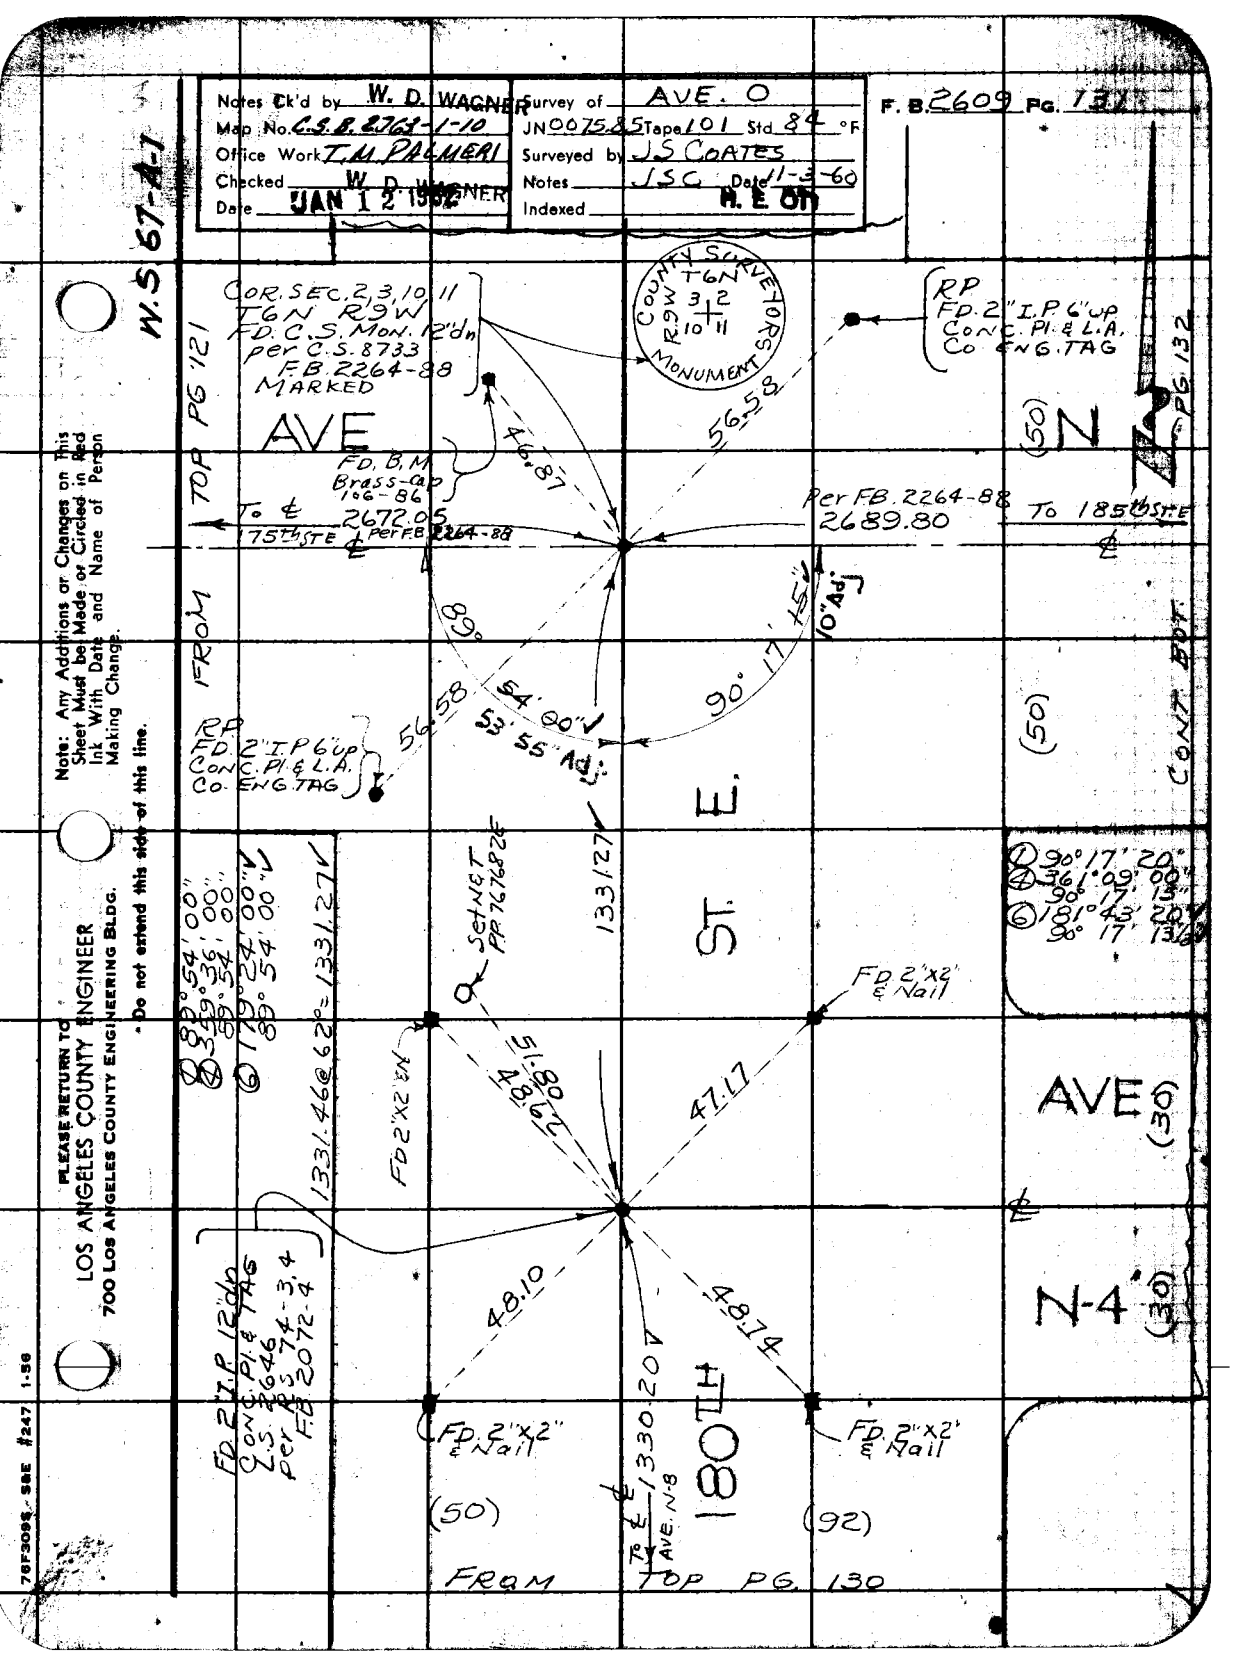
Notes Ck'd by W. D. WAGNER
Map No. C.S.B. 2763-1-10
Office Work T. M. PALMERI
Checked W. D. WAGNER
Date JAN 12 1962
Survey of AVE. O
JN 00758 Tape 101 Std 84 °F
Surveyed by J.S COATES
Notes J.S.C. Date 11-3-60
Indexed H. E. Ott
F. B. 2609 Pg. 131
W.S 67-A-1
COR. SEC. 2,3,10 11 T6N R9W FD. C.S. MON. 12"dp per C.S. 8733 F.B. 2264-88 MARKED
AVE
COUNTY SURVEYORS MONUMENT T6N R9W 3 2 10 11
RP FD. 2" I.P. 6" UP CONC. PI. & L.A. Co. ENG. TAG
FD. B.M. Brass Cap 106-86
To ℄ 175TH STE per FB 2264-88 2672.05
Per FB. 2264-88 2689.80 To 185TH STE ℄
TOP PG 121
FROM
CONT. TOP PG 132
(50)
N
46.87
56.58
89°
54' 00" V
53' 55" Adj.
90° 17' 45" V
10" Adj
RP FD. 2" I.P. 6" UP CONC. PI. & L.A. Co. ENG. TAG
56.58
SET NAIL & TAG PP 76782
133.27
ST.
E.
(50)
① 90° 17' 20"
② 361° 09' 00"
③ 90° 17' 13"
④ 181° 43' 20"
⑤ 90° 17' 13"
① 89° 54' 00" V
② 359° 36' 00" "
③ 89° 54' 00" "
④ 179° 24' 00" V
⑤ 89° 54' 00" "
1331.46 @ 62° = 1331.27 V
FD 2"X2" & Nail
FD 2"X2" & Nail
48.10
47.17
AVE
(30)
FD 2" I.P. 12" dp CONC. PI. & TAG L.S. 4646 PER R.S. 74-3,4 F.B. 2072-4
48.10
48.74
N-4
(30)
FD. 2"X2" & Nail
(50)
℄ 180TH
1330.20 V
℄ AVE. N-8
FD. 2"X2" & Nail
(92)
FROM TOP PG. 130
Note: Any Additions or Changes on this Sheet Must be Made or Circled in Red Ink With Date and Name of Person Making Change.
Do not extend this plat at this time.
PLEASE RETURN TO LOS ANGELES COUNTY ENGINEER 700 Los Angeles County Engineering Bldg.
76F3095 SBE #247 1-56

F.B. 2609 Pg. 132 CONT. LEFT SIDE PG 142

W.S. 67-A-1

(50) (50)

To ℄ 190TH ST. E.

N

2692.22
per F.B. 2264-86,87

1/4 COR SEC. 2, 11
T6N, R9W, SBM
FD 2" I.P. 12"DN
Set in Co. NC with
Conc. PL & NAIL
per C.S. 8733
F.B. 2264-87

185TH ST.

180°

90°

40.00 TAN

40.00 TAN

FD 2" I.P. 6"UP
CONC. PI. & L.A.
CO. ENG. TAG

FD. 2" I.P. 6"UP
CONC. PI. & L.A.
CO. ENG. TAG

CONT. TOP PG 195

2689.80
per F.B. 2264-87,88

AVE

To ℄ 180TH ST. E.

(50) (50)

FROM TOP RT SIDE PG. 131

PLEASE RETURN TO
LOS ANGELES COUNTY ENGINEER
700 Los Angeles County Engineering Bldg.

Do not extend this side of this line.

Note: Any Additions or Changes on This Sheet Must be Made or Circled in Red Ink With Date and Name of Person Making Change.

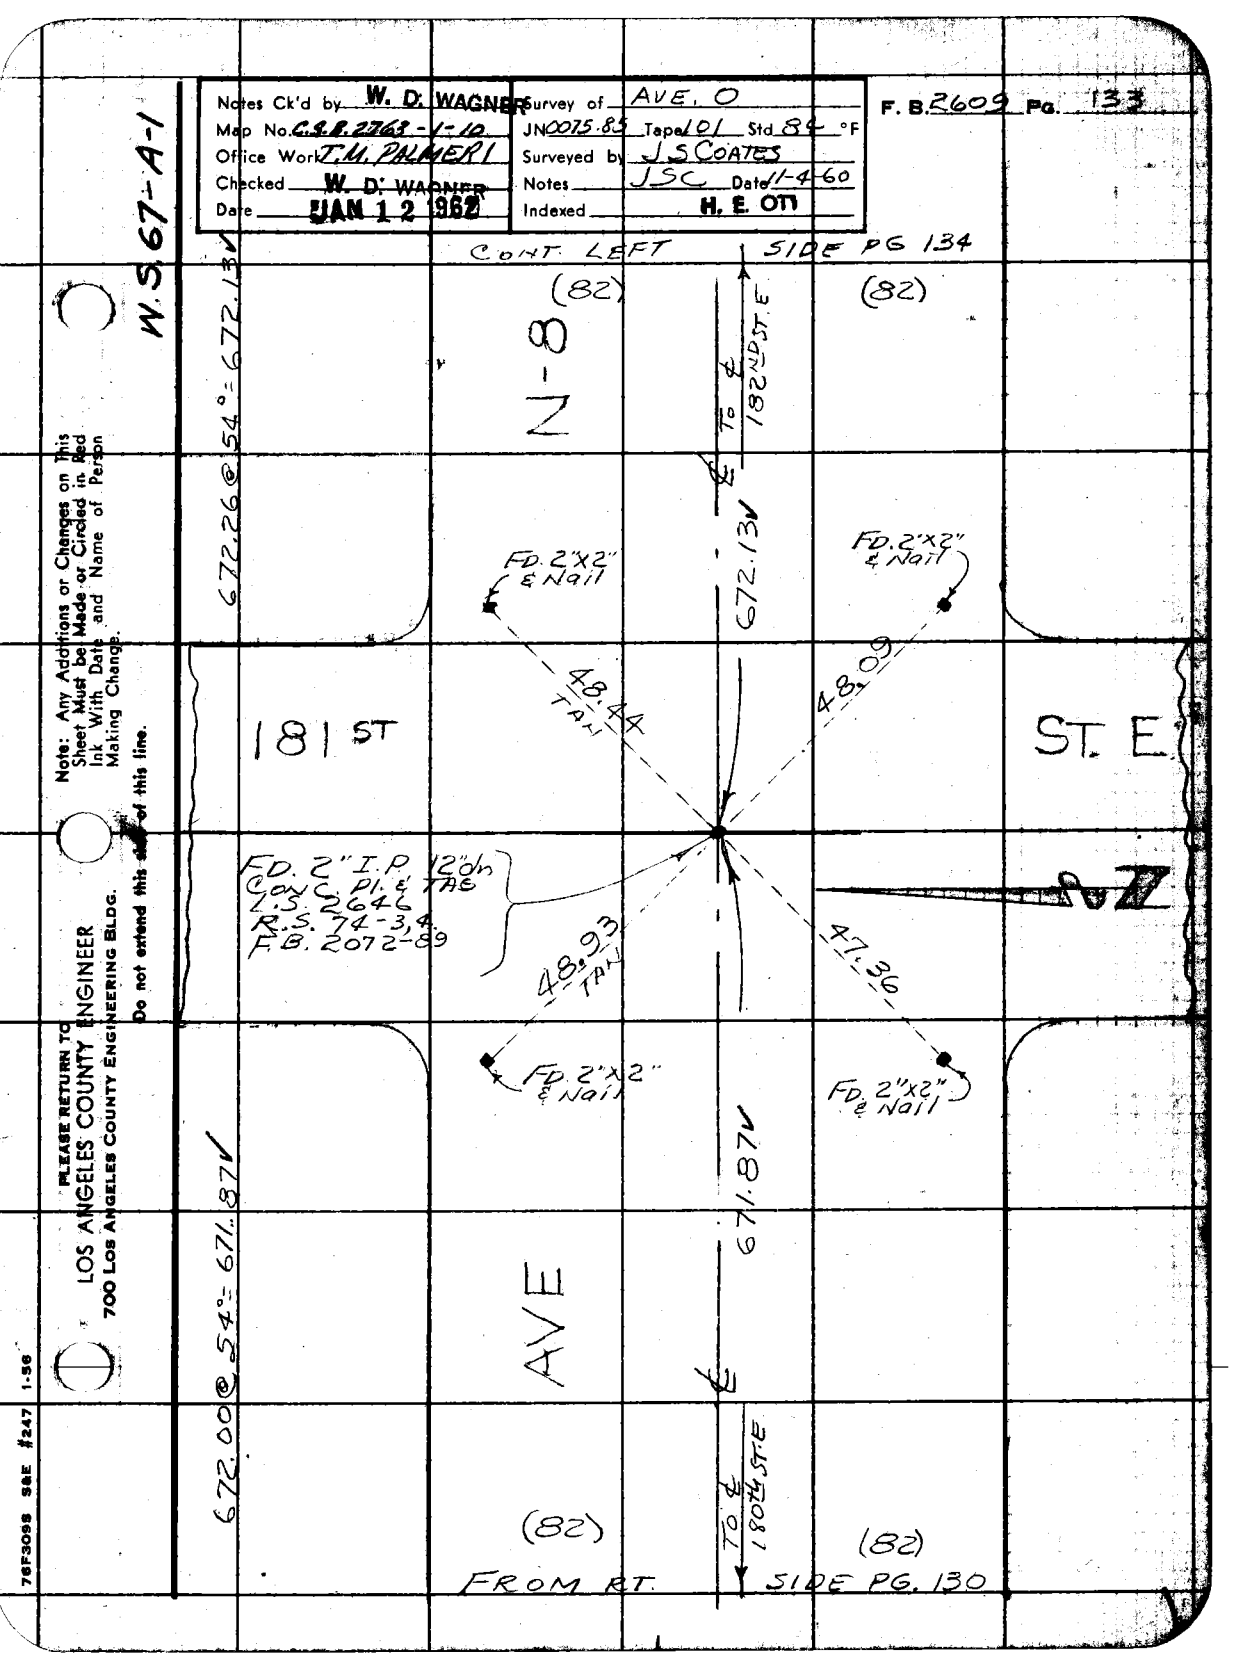
Notes Ck'd by W. D. WAGNER
Map No. C.S.B. 2763 - 1 - 10
Office Work T. M. PALMER I
Checked W. D. WAGNER
Date JAN 12 1962
Survey of AVE. O
JN 0075.85 Tape 101 Std 84 °F
Surveyed by J. S. COATES
Notes JSC Date 11-4-60
Indexed H. E. OTT
F. B. 2609 Pg. 133
W.S. 67-A-1
CONT. LEFT SIDE PG 134
(82)
(82)
8-Z
To ℄ 182ND ST. E
672.26 @ S 54° E = 672.13'
672.13'
FD. 2"X2" & Nail
FD. 2"X2" & Nail
48.44 TAN
48.09
181 ST
ST. E
FD. 2" I.P. 12"/n CONC. Pl. & TAE L.S. 2646 R.S. 74-3,4 F.B. 2072-89
48.93 TAN
47.36
FD. 2"X2" & Nail
FD. 2"X2" & Nail
672.00 @ S 54° E = 671.87'
671.87'
AVE
To ℄ 180TH ST. E
(82)
(82)
FROM RT. SIDE PG. 130
Note: Any Additions or Changes on This Sheet Must be Made or Circled in Red Ink With Date and Name of Person Making Change.
Do not extend this side of this line.
PLEASE RETURN TO
LOS ANGELES COUNTY ENGINEER
700 LOS ANGELES COUNTY ENGINEERING BLDG.
76F3098 S&E #247 1-56

F.B. 2609 Pg. 134

W.S. 67-4-1

N. LINE RS 74-3,4

40

Per RS 74-3,4 359.96 Rec.

FD. 2" I.P. 12"dn CONC. PI. & TAG L.S. 2646 per RS. 74-3.4 F.B. 2072-88

AVE N-4

℄

(30)

(30)

74-3 & 4

FD. 2" I.P. 12"dn CONC. PI. & TAG L.S. 2646 per RS. 74-3.4 F.B. 2072-87

ST. E

1331.72 Rec. per RS 74-3,4

FD. 2"X2" & NAIL FLUSH

FD. 2"X2" & NAIL FLUSH

47.86

48.08

LEFT SIDE PG.

PG. 133

(82)

AVE N-8

To ℄ 181ST ST ℄

672.13

1344.18

℄ CTR SEC

89°

47.65

47.65

CONT.

FROM TOP

(82)

45'

45'

FD. 2"X2" & NAIL FLUSH

FD. 2"X2" & NAIL FLUSH

RS

182ND

1332.32

1332.32

1332.58 @ 54°

① 89°45'40"
④ 359°03'00"
89°45'45"
⑥ 178°34'20"
89°45'43"

(40)

To ℄ AVE N-12

CONT. TOP

PG. 135

PLEASE RETURN TO
LOS ANGELES COUNTY ENGINEER
700 Los Angeles County Engineering Bldg.

Do not extend this side of this line.

Note: Any Additions or Changes on This Sheet Must be Made or Circled in Red Ink With Date and Name of Person Making Change.

Notes Ckd by W. D. WAGNER
Map No. C.S.B. 2763 1-10
Office Work T.M. PALMER
Checked W. D. WAGNER
Date JAN 12 1962

Survey of AVE. O
JN 0075.65 Tape 101 Std. 84 °F
Surveyed by J.S. GATES
Notes J.S.C. Date 11-4-60
Indexed H. E. OTT

F.B. 2609 Pg. 135

FROM BAT. PG 134.

W.S. 67-A-1

74-3:4

ST. E (40)

Sta. 2 AVE N-8

1332.32'

FD. 2"X2" & NAIL FLUSH

AVE N-12

(30)

49.19

FD. 2" I.P. 1/2" DP CONC. PIER THS L.S. 2646 PER RS 74-34 F.B. 2072-93

(30)

49.27

FD. 2"X2" & NAIL FLUSH

RS

182 ND

E. LINE R.S. 74-3, 4)

1332.20'

(40)

Sta. E AVE. O

CONT LEFT SIDE

PG 137

1332.46 @ S 5° E = 1332.20'

Note: Any Additions or Changes on this Sheet Must Be Made or Circled in Red Ink With Date and Name of Person Making Change.

Do not extend this plat off this file.

PLEASE RETURN TO
LOS ANGELES COUNTY ENGINEER
700 LOS ANGELES COUNTY ENGINEERING BLDG.

26PSDOS SAS #842 11-68

F.B. 2609 Pg. 136

CONT. BOT.

PG. 137

N.S. 67+41

LOS ANGELES COUNTY ENGINEER
700 Los Angeles County Engineering Bldg.

PLEASE RETURN TO

Do not extend this side of this line.

Note: Any Additions or Changes on This Sheet Must be Made or Circled in Red Ink With Date and Name of Person Making Change.

(92)

(50)

182ND ST E

671.62

B.C. FD 2"x2" & TAG P.S. 22646

FD 2"x2" & NAIL FLUSH

102.5

47.72

A 29°11'26" @ 47.76

S 59°11'26" @ 47.76

181ST ST. E.

(30)

(30)

48.23

56.72

FD 2"x2" & NAIL FLUSH

S 59° 671.57

Set N&T PP 1185557E

AVE

180TH ST E

FD 2" IP 12.0N & 0.8E T.G. PS 5747-3.4 Per R.S. 20722-91

FROM RT. SIDE PG. 128

Notes Ck'd by W. D. WAGNER | Survey of AVE O | F. B. 2688 Pg. 137
Map No C.S.B. 2763-1-10 | JN0075 85 Tape 101 Std 84 °F
Office Work I. M. PALMERI | Surveyed by J.S COATES
Checked W. D. WAGNER | Notes J.S.C Date 11-4-60
Date JAN 12 1962 | Indexed H. E. OTT

W.S.67-A-1

CONT. BOT. PG. 138

(2) 89°53'20"
(4) 359°33'40"
(6) 89°53'25" ✓
179°20'30" ✓
89°53'25" ✓

(50) (50)

To ℄ 185TH ST. E

℄ O

89°53'25" ✓

1343.26

1343.49 @ S 58°-13'45.26" W

FD. 2"x2" & Nail Flush

46.90

50.00

Set 1"I.P. 10" Conc. Pl. L.S. Co Eng Tag & prod

48.18

65.22

FD. 2"x2" & Nail Flush

BOT PG. 135

To ℄ AVE N-12 1332.20 ✓

E. Line R.S. 74-3,4

CONT. FROM 182ND ST. E.

Note: Any Additions or Changes on This Sheet Must be Made or Circled in Red Ink With Date and Name of Person Making Change.

Do not extend this side of this line.

PLEASE RETURN TO LOS ANGELES COUNTY ENGINEER
700 LOS ANGELES COUNTY ENGINEERING BLDG.

Set ℄ I.P. #1185560E

671.62

AVE

To ℄ 181ST ST. E

Fd. 2" I.P. 12" D/G Conc. Pl. & Tag L.S. 2646 74-3, ℄4 Per R.S. 2072-94 F.B.

(92) (50)

FROM TOP PG 136

78F3098 SBE #247 11-58

PLEASE RETURN TO
LOS ANGELES COUNTY ENGINEER
700 LOS ANGELES COUNTY ENGINEERING BLDG.

Note: Any Additions or Changes on This Sheet Must Be Made or Circled in Red Ink With Date and Name of Person Making Change.

Do not extend this side of this line.

W.S. 67-A-1

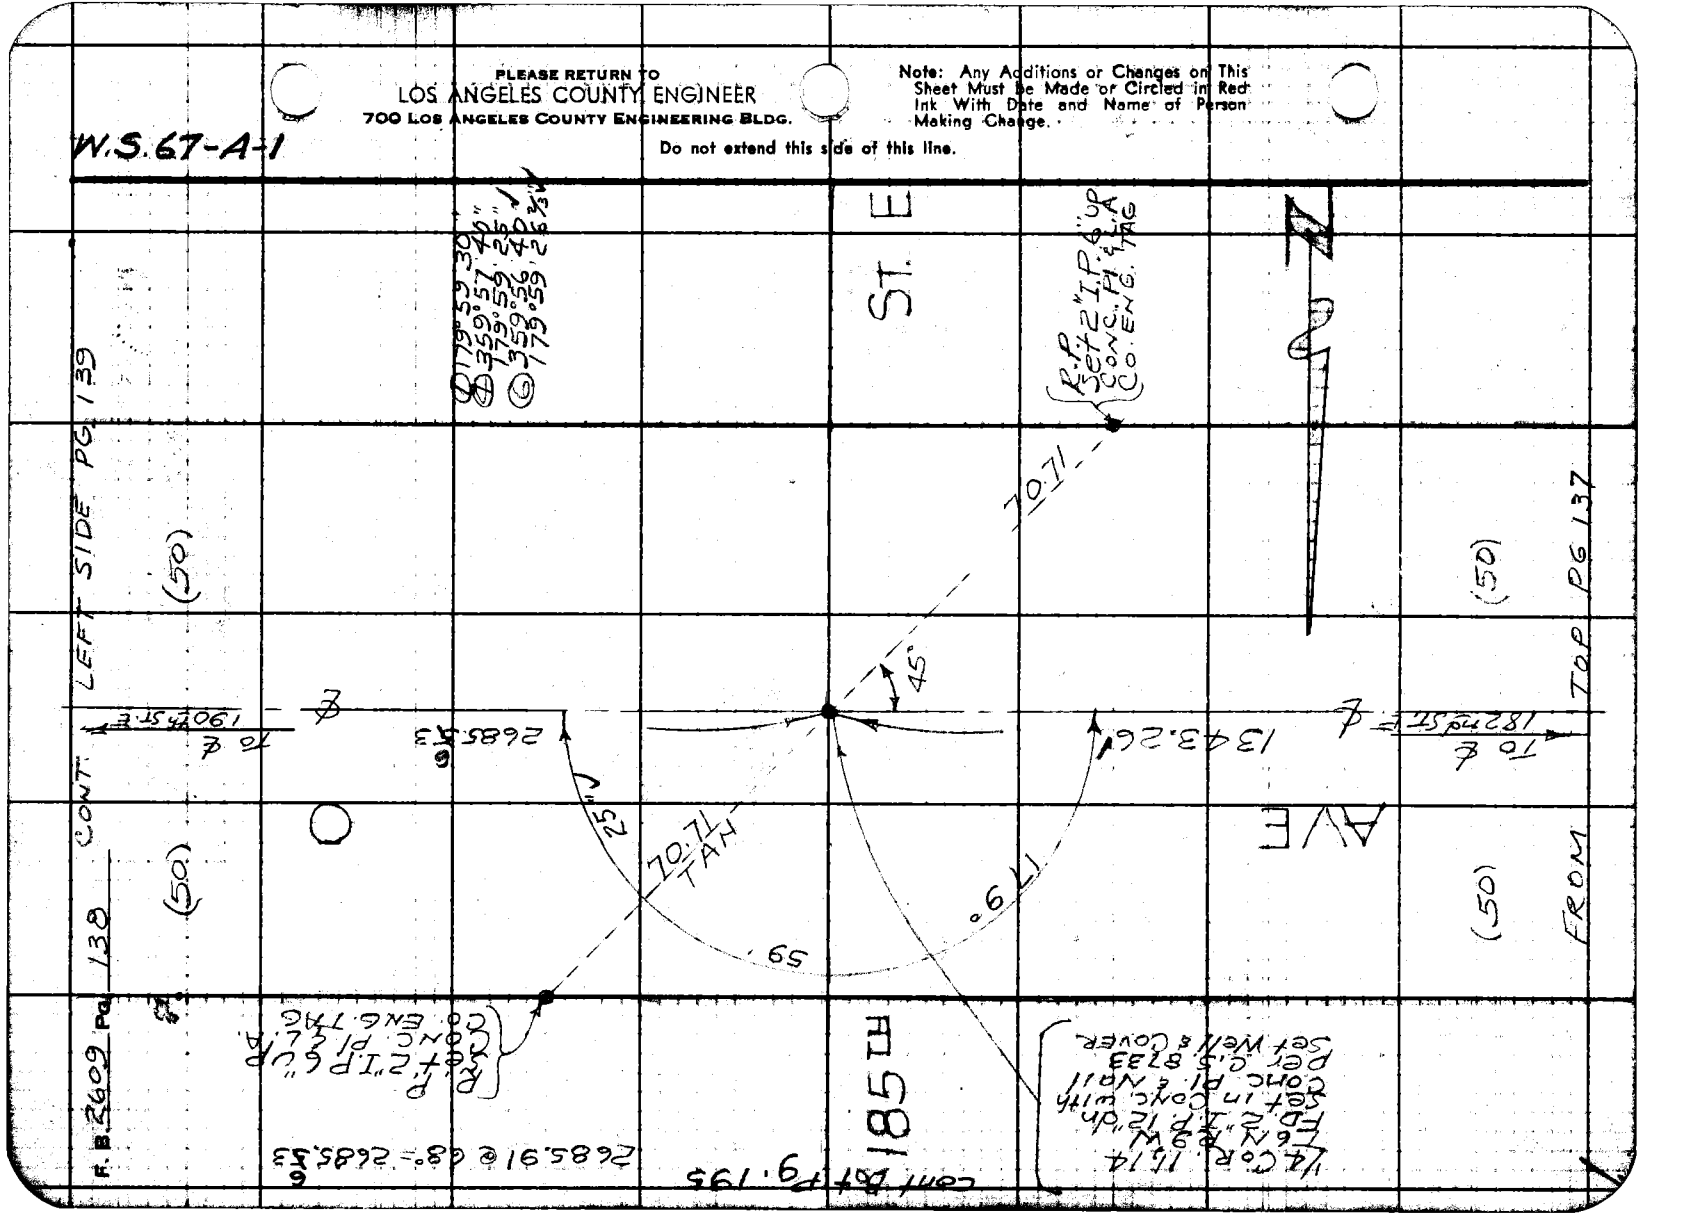

W.S 67-B-1

Notes Ck'd by W. D. WAGNER — Survey of AVE. O — F.B. 2609 Pg. 139
Map No. C.S.B. 2767-1-10 — JN 007585 Tape 101 Std 84 °F
Office Work T.M. PALMER — Surveyed by J.S. COATES
Checked W. D. WAGNER — Notes J.S.C. Date 11-14-60
Date JAN 1 2 1962 — Indexed M. E. OTT

CONT. SOT PG. 141

(50) ST. E (50)

To 2"x2"

90°12'50"
360°50'30"
90°12'37½"
181°15'40"
90°12'36½"

RP SET 2"I.P. 6"up CONC PI. L.A. CO ENG. TAG

1336.42
1336.38

89°26'20"
357°45'00"
89°26'15"
176°37'40"
89°26'14"

FD. Precise B.M. Brass-Cap MON 12"N2"C CONC POST 106-82

(50) AVE. (50)

PG. 138

70.71
90°
35" 30" Adj.
89° 26'
75.91
45°
15"
40"
11

TO ¼ COR ℄ 2685.53 — 2667.68 ✓ ℄ TO ¼ COR.

FROM TOP

90°09'20"
360°38'00"
90°09'30"
180°57'00"
90°09'30"

90°09'30"
90°
70.71
A ¼

R.P. SET 2"I.P.C.W. CONC. PI. L.A. CO. ENG. TAG

90°11'40"
360°46'40"
90°11'40"
181°09'50"
90°11'38"

SECTION COR. 11, 12, 13, 14 T6N R9W FD. C.S. MON PER C.S. 8733 F.B. 1113-233 MARKED

SURVEYOR'S MONUMENT COUNTY T6N R9W 11+12 14+13

190TH

2670.74
2706.74

TO AVE O ½ Cor ℄

(50) (50)

CONT. TOP PG. 140

Note: Any Additions or Changes on This Sheet Must Be Made or Circled in Red Ink With Date and Name of Person Making Change.

PLEASE RETURN TO
LOS ANGELES COUNTY ENGINEER
700 Los Angeles County Engineering Bldg.
Do not extend this side of this line.

76FS099 SBE #242 11-58

PLEASE RETURN TO
LOS ANGELES COUNTY ENGINEER
700 LOS ANGELES COUNTY ENGINEERING BLDG.

Note: Any Additions or Changes on This Sheet Must be Made or Circled in Red Ink With Date and Name of Person Making Change.

Do not extend this side of this line.

W.S. 67-B-2

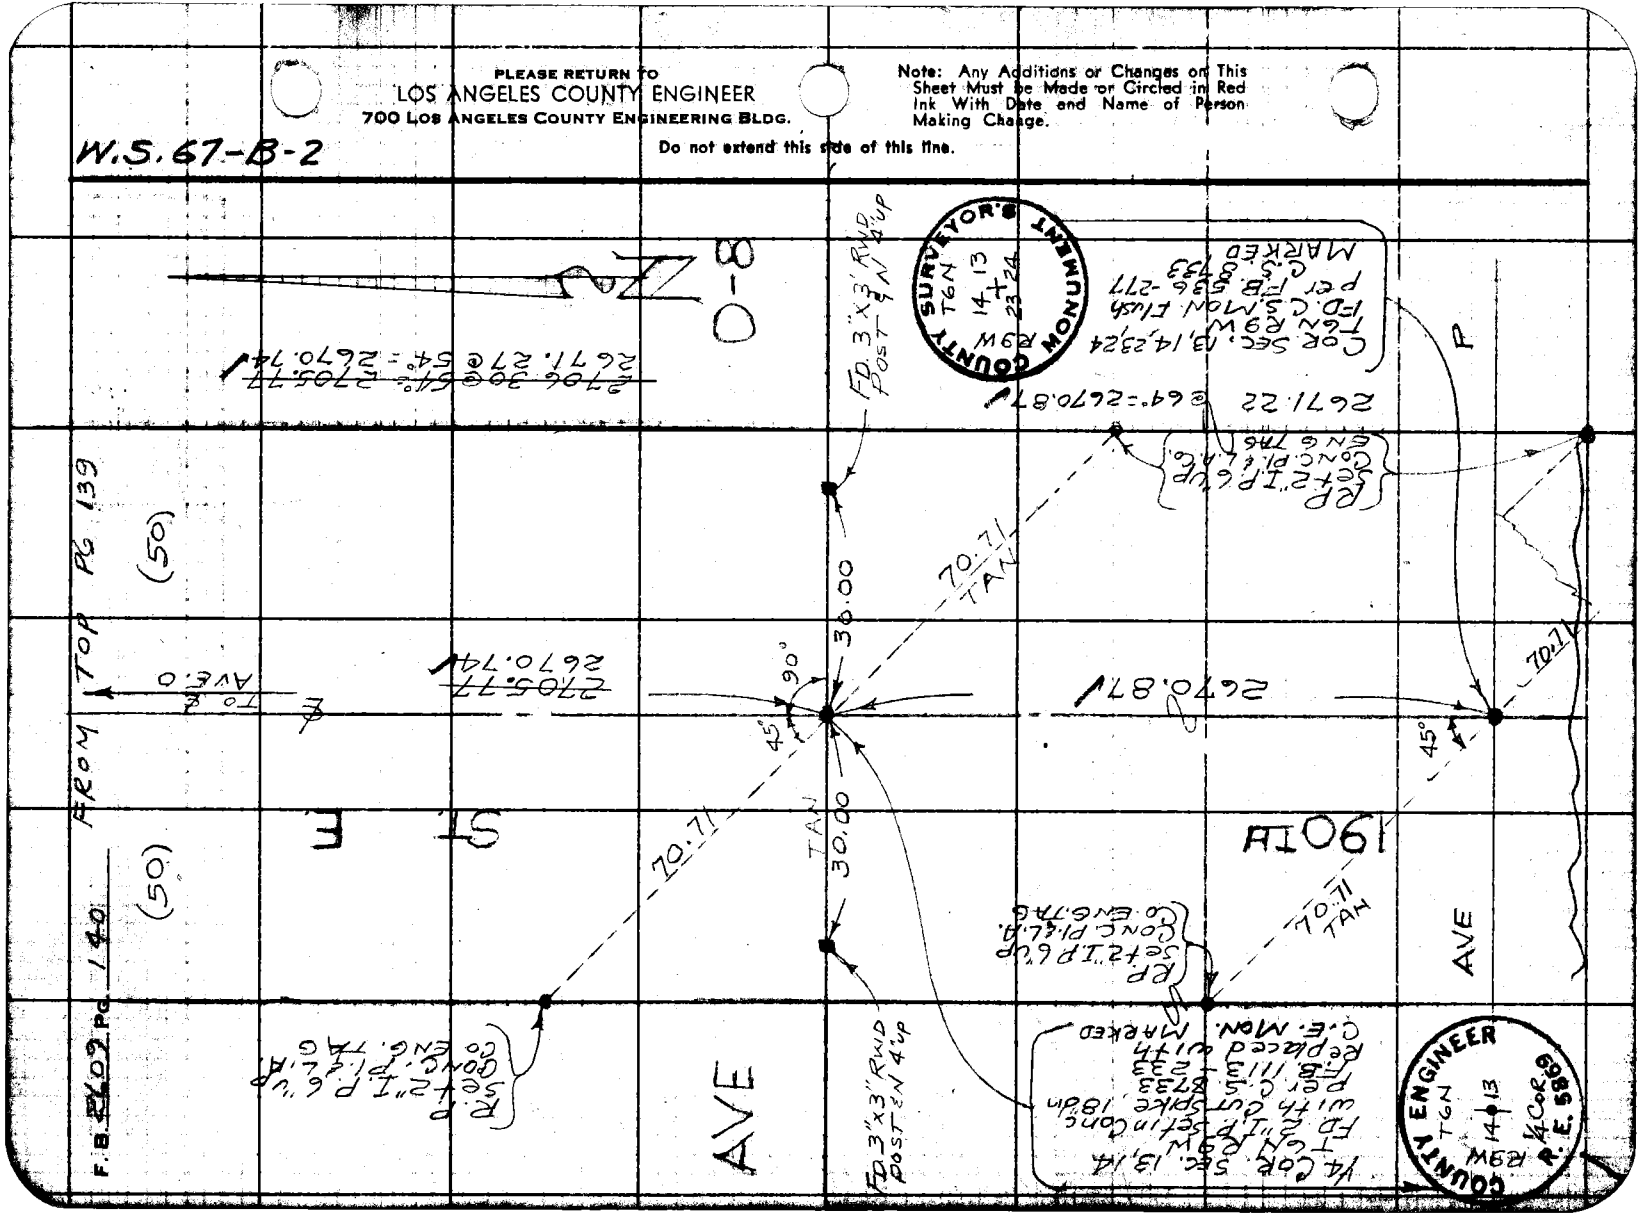

76F3098 SAE #247 11-66

PLEASE RETURN TO
LOS ANGELES COUNTY ENGINEER
700 LOS ANGELES COUNTY ENGINEERING BLDG.

Note: Any Additions or Changes on This Sheet Must be Made or Circled in Red Ink With Date and Name of Person Making Change.

Do not extend this side of this line.

W.S.67-B-1



TO RT. SIDE PG.

R.P. Set 2" "TPG" "UP" Conc. Pl. & L.A. Co. Eng. TAG

AVE

190 TH

ST

(50)

CONT. BOT.

PG. 142

FROM TOP PG. 139

To ℄ AVE. O

To ℄ AVE. N
























Rechained 3-10-61 JHC

Z-8

Notes Ck'd by W. D. WAGNER

Map No. 6.5.8 2667 1-1-10

Office Work TAB. W. D. WAGNER

Checked W. D. WAGNER

Date JAN 12 1962

Survey of AVE. O

JN 00752 Tape 101 3rd B4 LFF

Surveyed by J.S.C. COATES

Notes

Indexed W. E. OTT Date 1/-

F. B. 2609 Pg. 44

PLEASE RETURN TO
LOS ANGELES COUNTY ENGINEER
700 LOS ANGELES COUNTY ENGINEERING BLDG.

Note: Any Additions or Changes on This Sheet Must be Made or Circled in Red Ink With Date and Name of Person Making Change.

Do not extend this side of this line.

W.S. 67-B-1

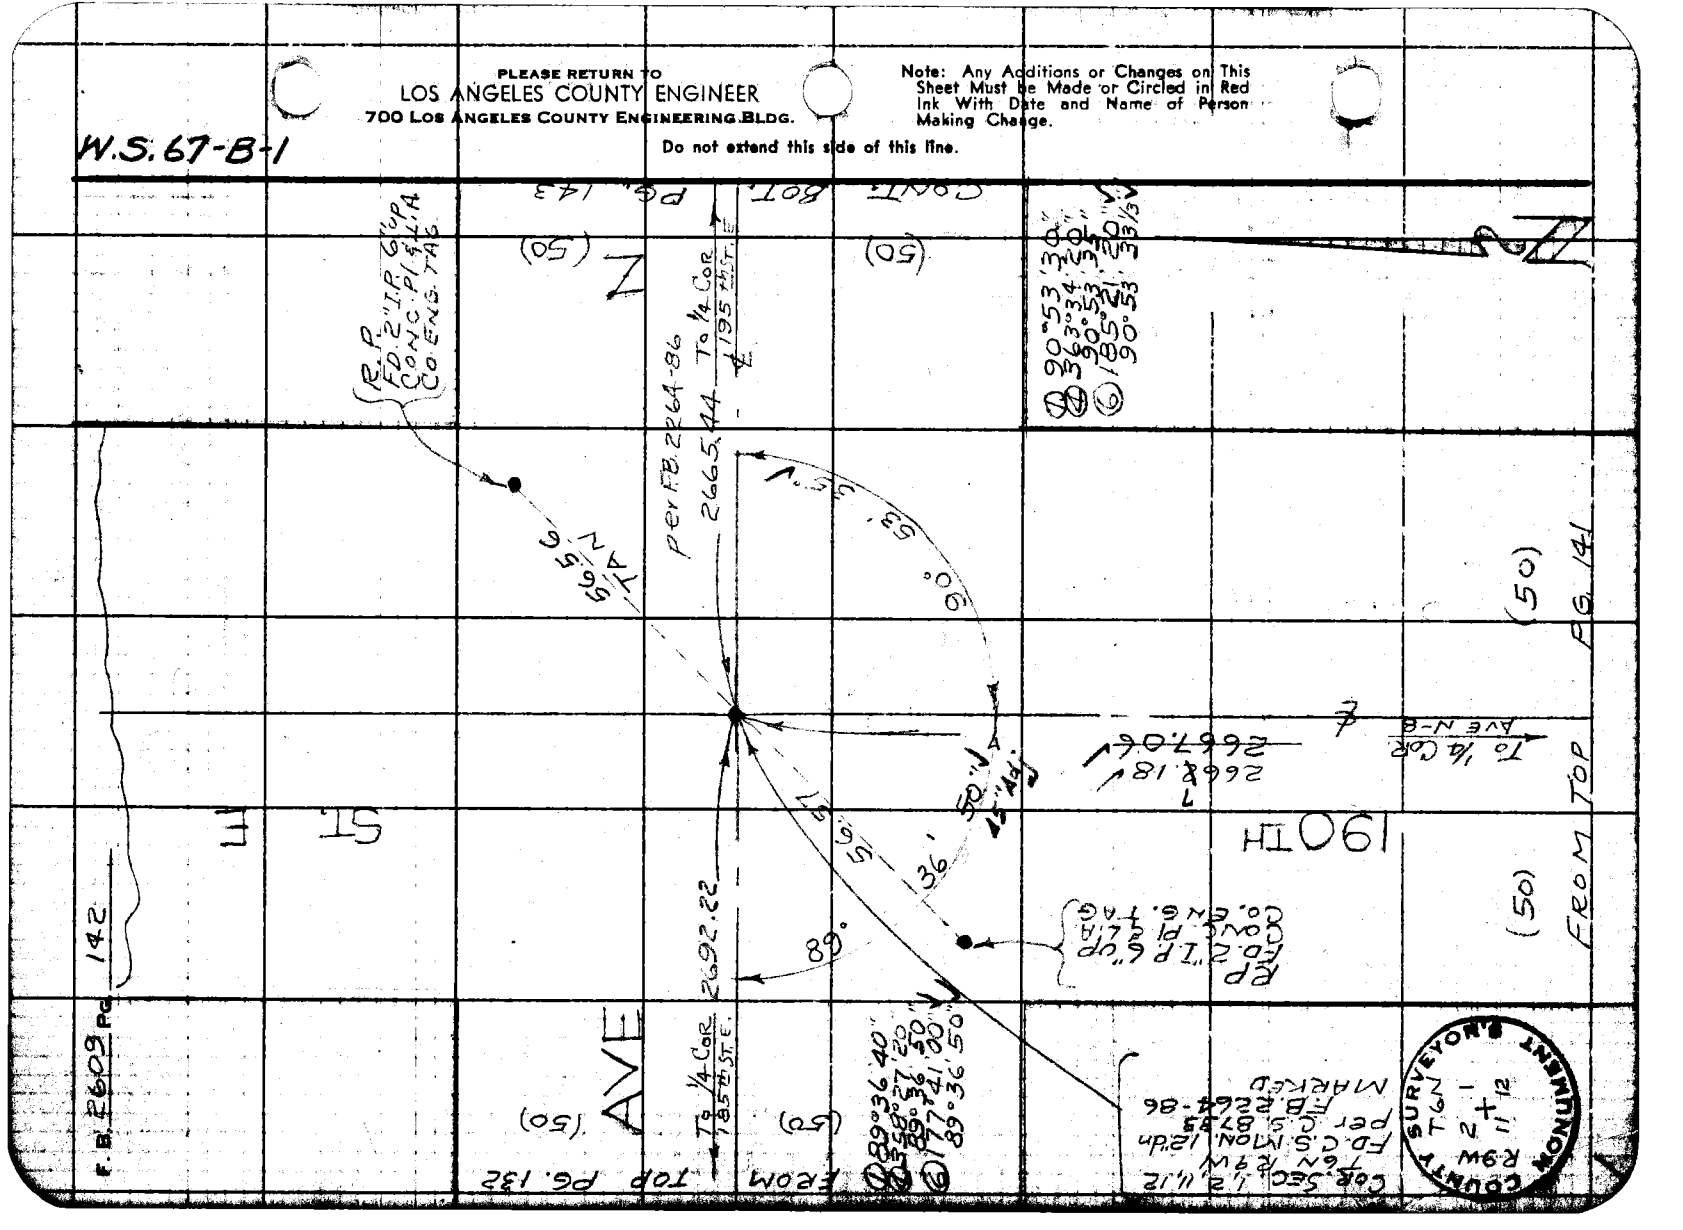

76F3088 SBE #247 11-68

PLEASE RETURN TO
LOS ANGELES COUNTY ENGINEER
700 LOS ANGELES COUNTY ENGINEERING BLDG.

Note: Any Additions or Changes on This Sheet Must be Made or Circled in Red Ink With Date and Name of Person Making Change.

Do not extend this side of this line.

W.S. 67-B-1

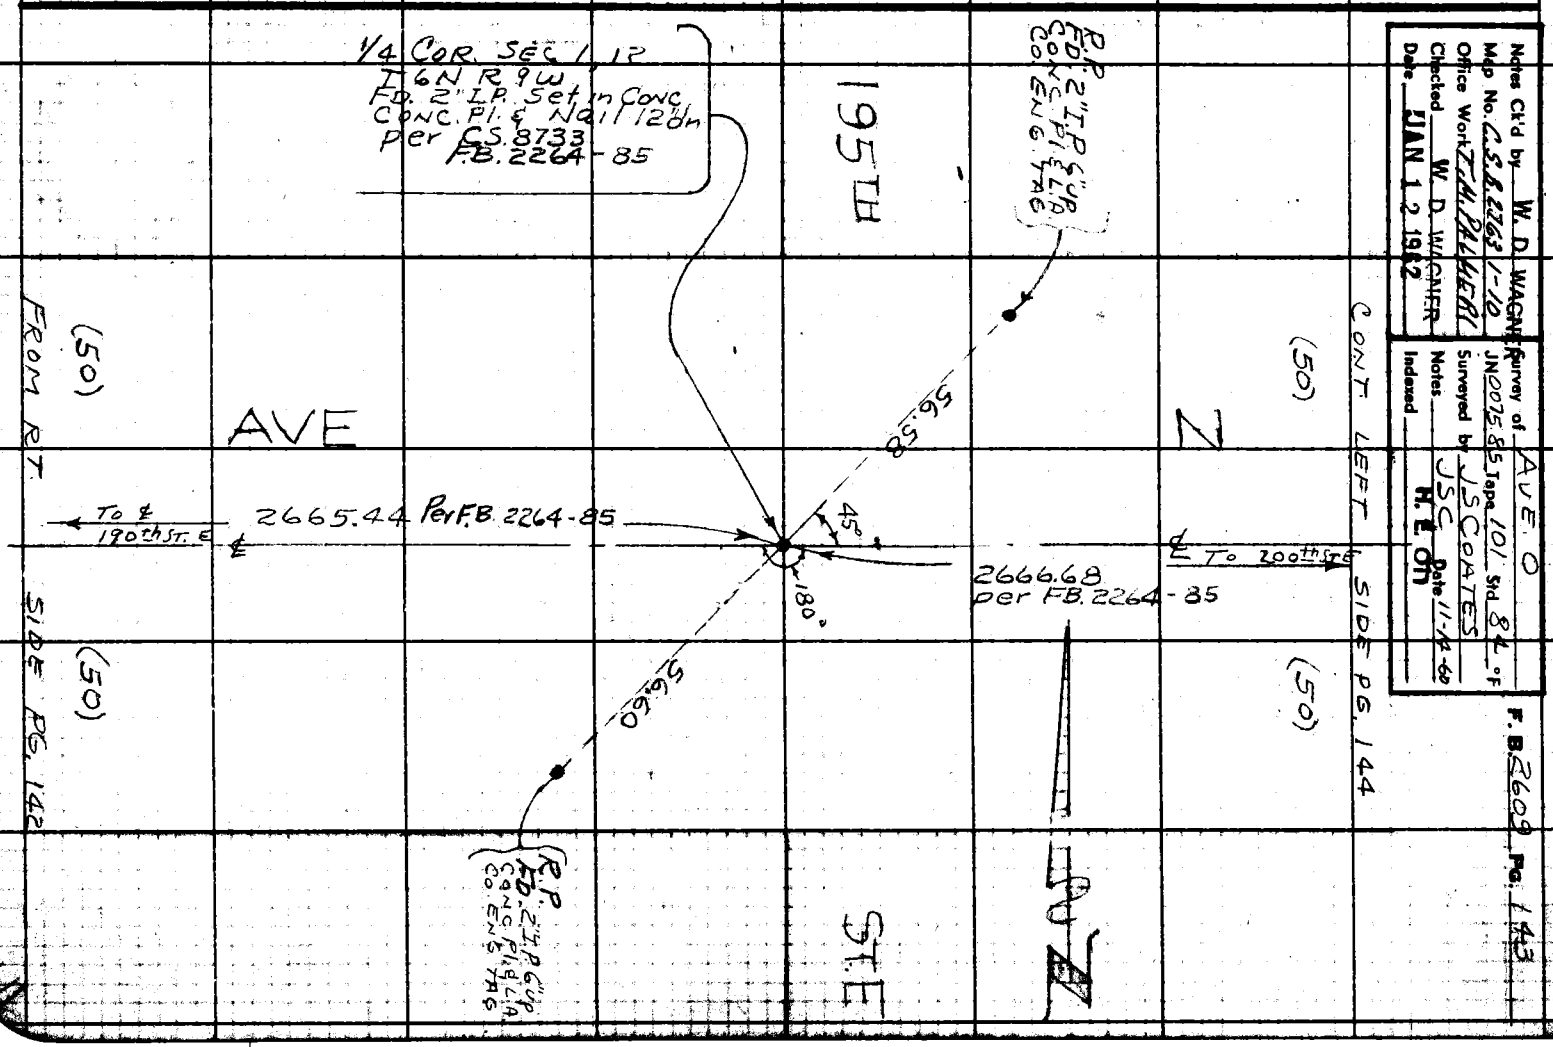

Notes Ck'd by W. D. WAGNER
Map No. C.S.S. 2763 1-10
Office Work ZIMMERMAN
Checked W. D. WAGNER
Date JAN 12 1962

Survey of AVE. O
JN 0075.85 Tape 101 Std. 84 °F
Surveyed by JSC COATES
Notes
Indexed H. E. OH Date 11-14-62

F. B. 2609 Pg. 143

PLEASE RETURN TO
LOS ANGELES COUNTY ENGINEER
700 LOS ANGELES COUNTY ENGINEERING BLDG.

Note: Any Additions or Changes on This Sheet Must be Made or Circled in Red Ink With Date and Name of Person Making Change.

Do not extend this side of this line.

W.S. 67-B-1

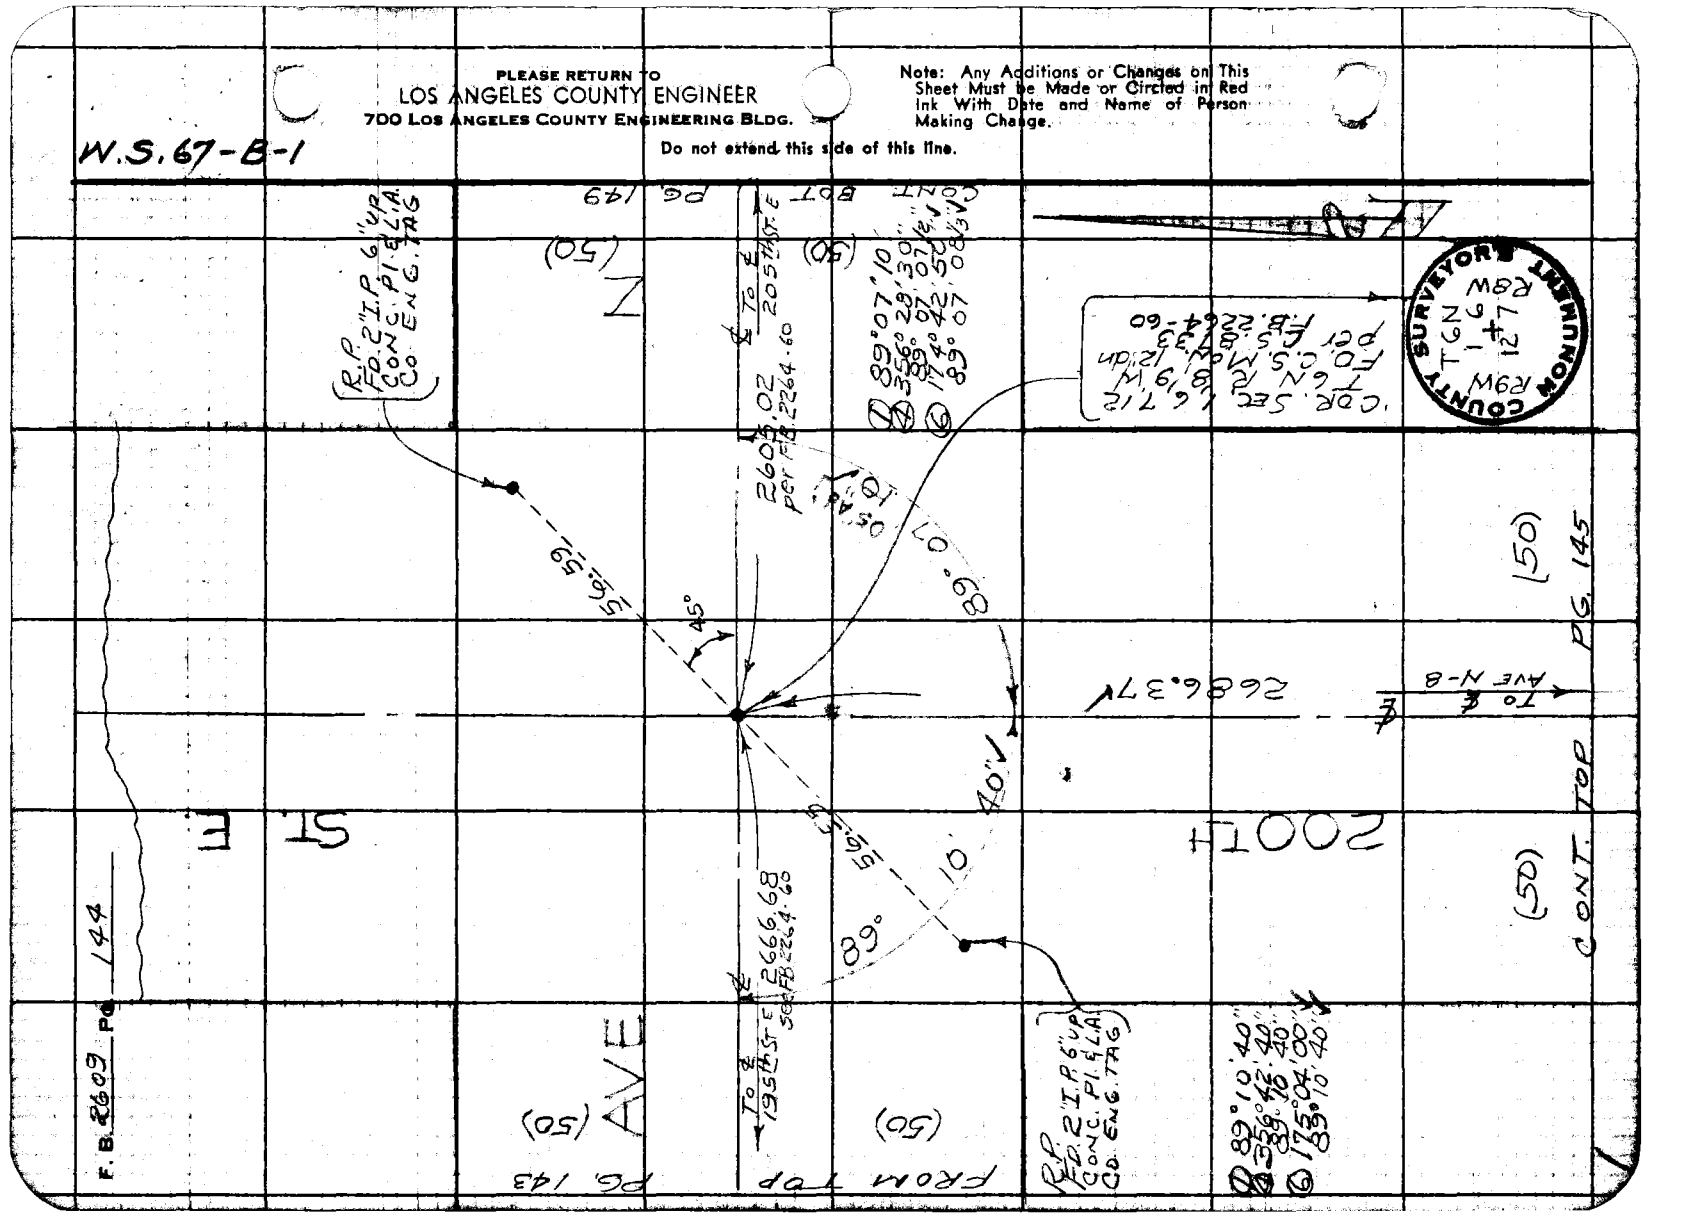

7673098 SBE #247 11-66

PLEASE RETURN TO
LOS ANGELES COUNTY ENGINEER
700 LOS ANGELES COUNTY ENGINEERING BLDG.

Note: Any Additions or Changes on This Sheet Must be Made or Circled in Red Ink With Date and Name of Person Making Change.

Do not extend this side of this line.

W.S. 67-B-1

COUNTY ENGINEER
L.A. CO. SURV.
1/4 COR. 12
T6N
R8W

1/4 COR. 7,12
T6N R8W
FD. 2" I.P. Set
IN CONC. FLUSH
WITH CUT SPK.
per C.S. 8733
Replaced with
C.E. MON 12'4n
MARKED

R.P. Set 2" I.P. 6" up
Cor. P.L. & L.A.
CO. ENG. TAG

AVE

200TH

ST. E.

(50) CONT. TOP

(50)

(50)

(50)

FROM SOT. PG. 144

TO PG. 146

TO ℄ AVE. O

℄ 2683.50

45°

180°

70.71

70.71

℄ TO ℄ AVE N

2686.37

2684.06 @ 52° = 2683.50

2686.89 @ 54° = 2686.37

R.P. Set 2½" I.P. L.S. Cor. P.L. & L.A. CO. ENG. TAG

N-8

Notes Ck'd by W. D. WAGNER
Map No. C.S. 67-1-6
Office Work T. M. DAMIGO
Checked W. D. WAGNER
Date JAN 1 9 1968

Survey of AVE O
JN 00 25 85 Tape 101 Std. 84 °F
Surveyed by J. S. COATES
Notes
Indexed M. E. ON
Date 11-15-67

F.B. 2609 Pg. 145

PLEASE RETURN TO
LOS ANGELES COUNTY ENGINEER
700 LOS ANGELES COUNTY ENGINEERING BLDG.

Note: Any Additions or Changes on This Sheet Must be Made or Circled in Red Ink With Date and Name of Person Making Change.

Do not extend this side of this line.

W.S. 67-B-1

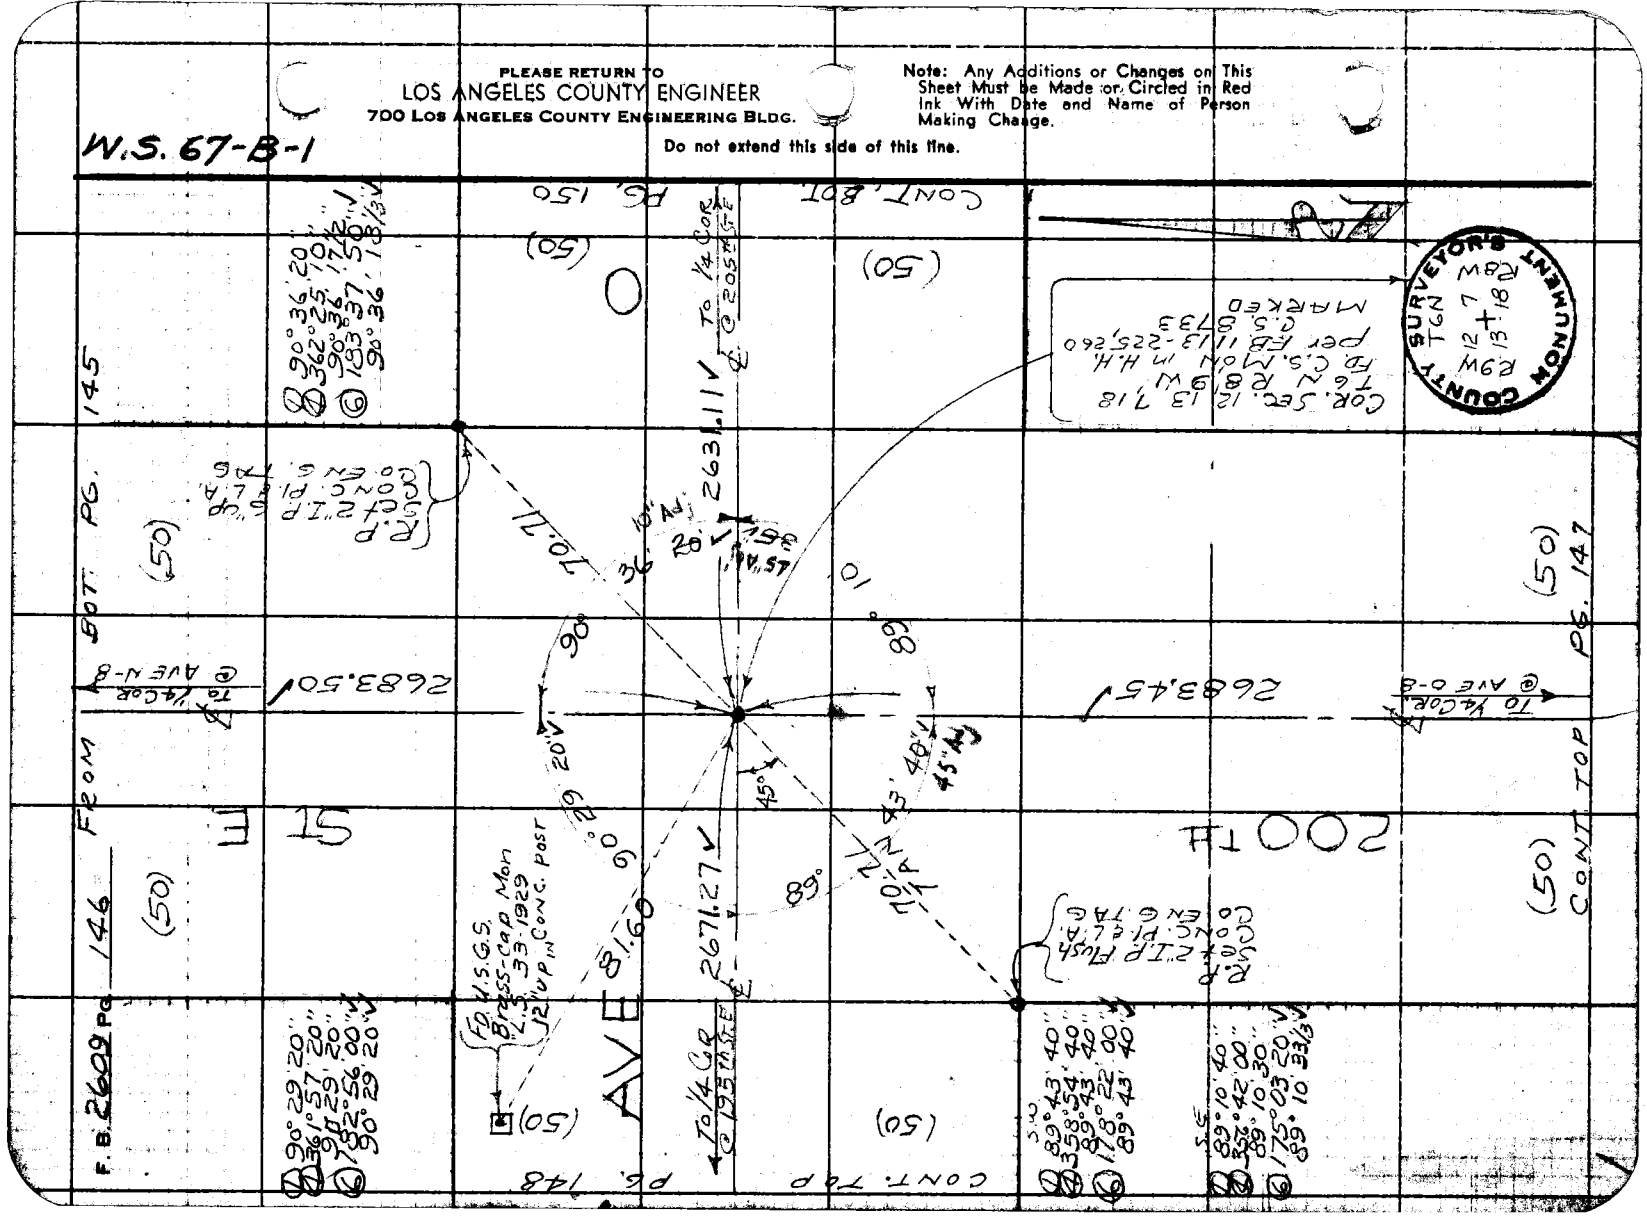

76F3095 S&E #247 11-58

PLEASE RETURN TO
LOS ANGELES COUNTY ENGINEER
700 LOS ANGELES COUNTY ENGINEERING BLDG.

Note: Any Additions or Changes on This Sheet Must be Made or Circled in Red Ink With Date and Name of Person Making Change.

Do not extend this side of this line.

W.S. 67-B-2

Notes Ck'd by W. D. WAGNER
Map No. C.S.B. 2863-1-10
Office Work T.M. PALMER
Checked W. D. WAGNER
Date JAN 12 1962

Survey of AVE. O
JN 0075.85 Tape 101 Std. 84 °F
Surveyed by J.S. COATES
Notes
Indexed N.E. ON
Date 11-15-60

F. B. 2602 Pg. 147

FROM BPT. Pg. 146

2684.01 @ 50° - 2683.45

AVE

200TH

ST.

E

(50)

(50)

70.71

70.71

45°

2683.45

To ℄ AVE. O

℄

R.P. Set 2" I.P. 6" up Conc. Pl. & L.A. Co. ENG. TAG

R.P. Set 2" I.P. 6" up Conc. Pl. & L.A. Co. ENG. TAG

1/4 COR. 13, 18
T6N R8W
FD. C.S. MON. 15" up
PER C.S. 8733
RB. 1113-226, 260
MARKED

Reset MON. 12" dn

COUNTY SURVEY MONUMENT
R9W 1/4 SEC. COR
13 18
T6N
R8W

O-8

PLEASE RETURN TO
LOS ANGELES COUNTY ENGINEER
700 LOS ANGELES COUNTY ENGINEERING BLDG.

Note: Any Additions or Changes on This Sheet Must be Made or Circled in Red Ink With Date and Name of Person Making Change.

Do not extend this side of this line.

W.S. 67-B-1

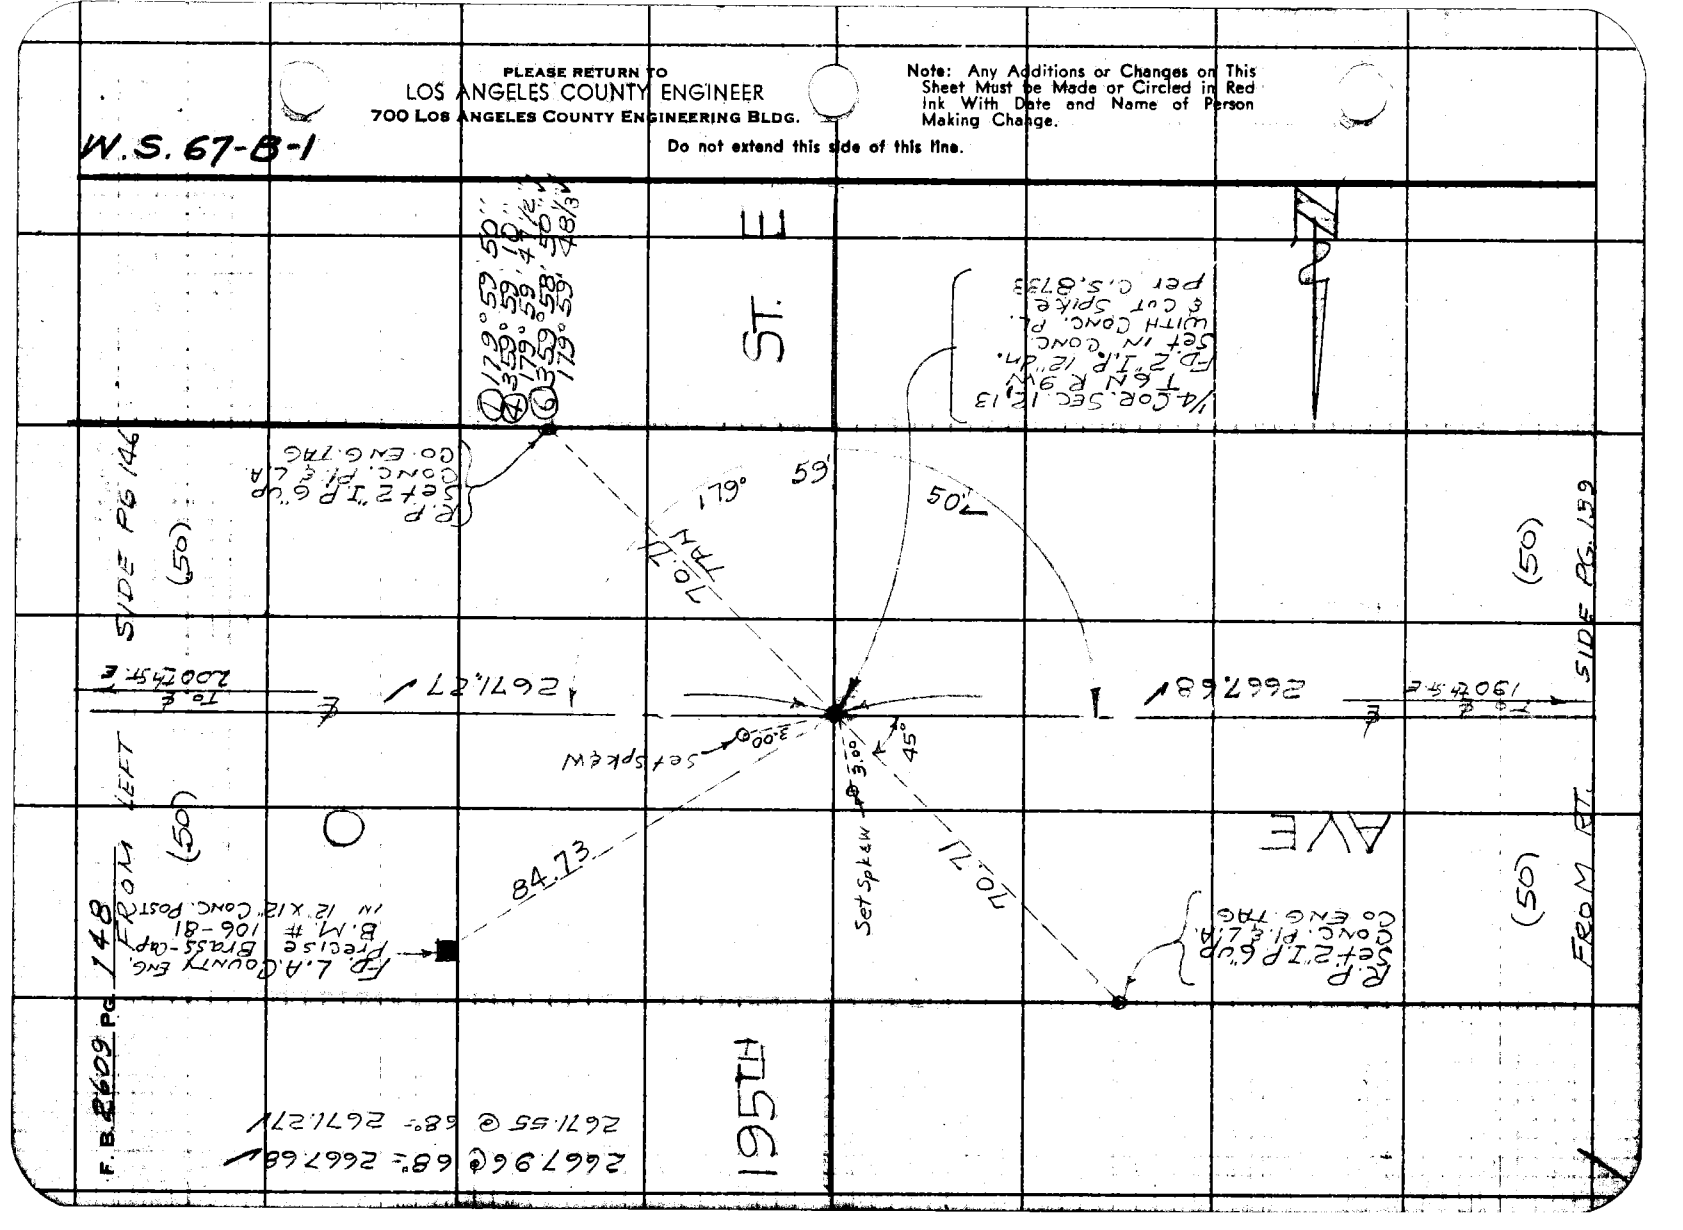

76F3095 SAE #247 11-58

PLEASE RETURN TO
LOS ANGELES COUNTY ENGINEER
700 LOS ANGELES COUNTY ENGINEERING BLDG.

Do not extend this side of this line.

Note: Any Additions or Changes on This Sheet Must be Made or Circled in Red Ink With Date and Name of Person Making Change.

W.S. 67-B-1

Notes Ck'd by W. D. WATTERS Date JAN 12 1962
Map No. C.S.G. 2967-1-10
Office Work T.M. PALMER
Checked W. D. WATTERS
Date JAN 12 1962

Survey of JN0075. 85 tape 101 Std. 84 °F
Surveyed by J.S.C. COATES Date 11-17-60
Notes
Indexed H. E. OH

ENGINEER COUNTY
T 6N
6
R 8W
7
1/4 COR 9
RE 5869

1/4 COR. SEC. 6, 7
T 6 N R 8 W
FD. C.E. MON. 12" dn
PER F.B. 2264-59
MARKED

205TH

RP
FD. 2" I.P. 6" UP
CONC. PI. & L.A.
CO. ENG. TAG

AVE

Z

(50)

FROM RT SIDE PG. 144

(50)

(50)

CONT. LEFT SIDE PG. 155

To ℄ 200TH ST. E.

Per F.B. 2264-60
2605.02

℄

Per F.B. 2264-59
2610.72

To ℄ 210TH ST. E.

90° 00'

40.00

40.00

179° 59' 30"
Per F.B. 2264 - Pg. 59

RP
FD. 2" I.P. 6" UP
CONC. PI. & L.A.
CO. ENG. TAG

ST. E

AVE. O

F.B. 2609 PG. 149

PLEASE RETURN TO
LOS ANGELES COUNTY ENGINEER
700 LOS ANGELES COUNTY ENGINEERING BLDG.

Note: Any Additions or Changes on This Sheet Must be Made or Circled in Red Ink With Date and Name of Person Making Change.

Do not extend this side of this line.

W.S. 67-B-1

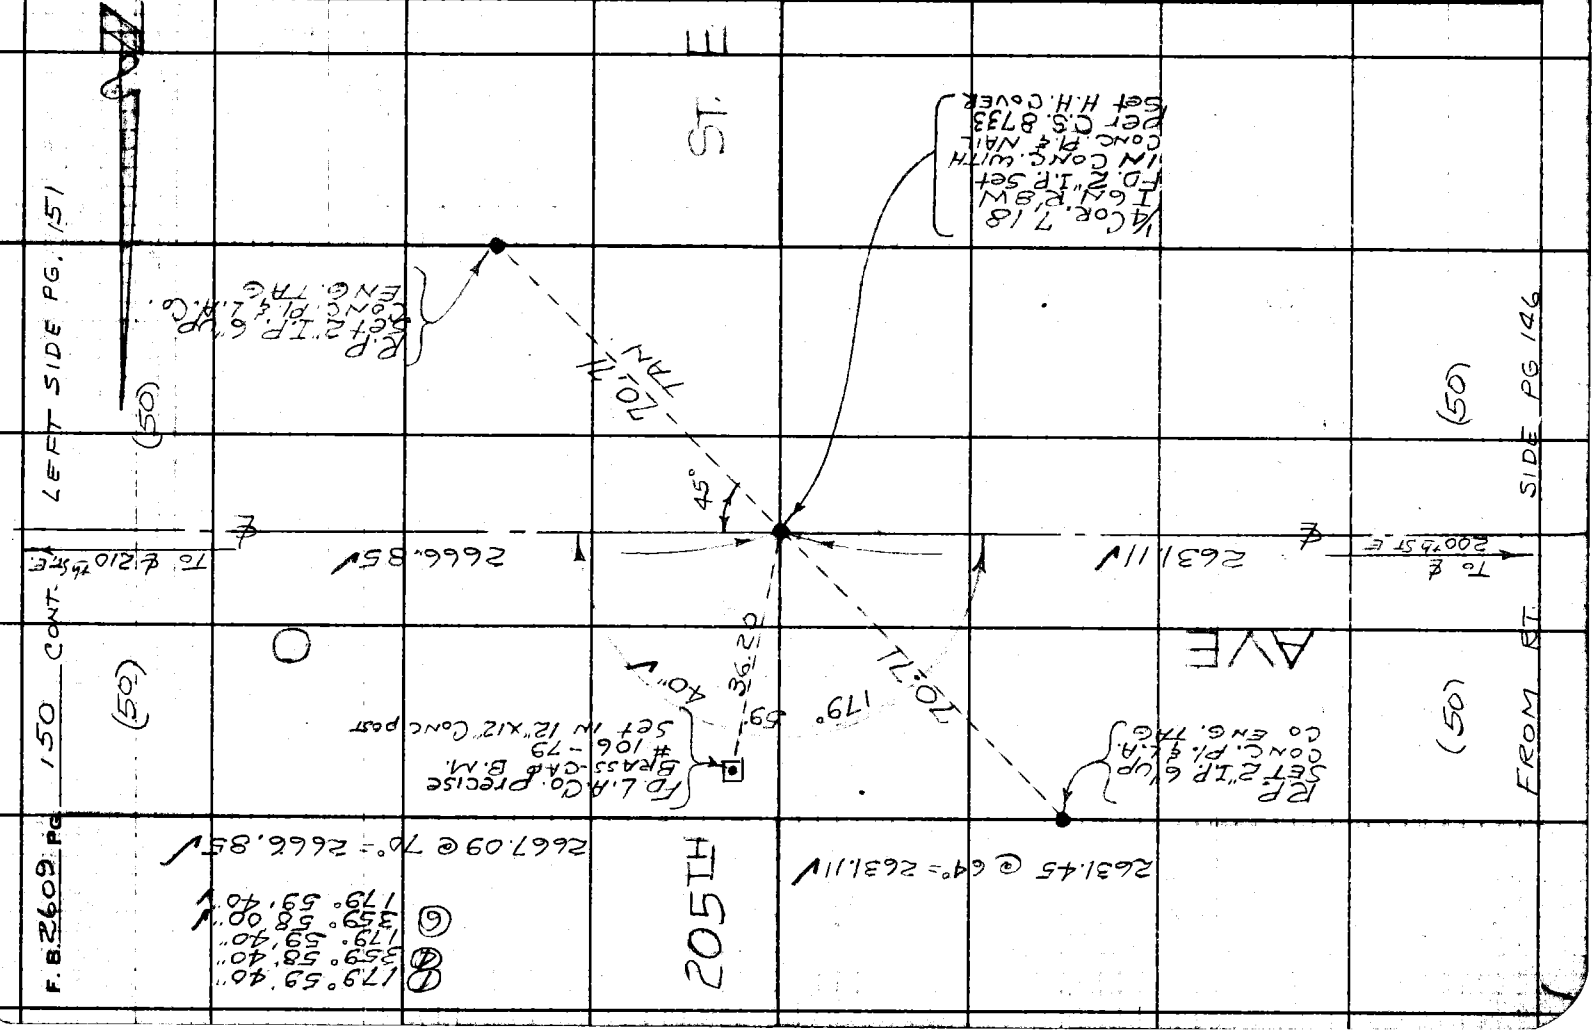

76F3095 S&E #247 11-66

PLEASE RETURN TO
LOS ANGELES COUNTY ENGINEER
700 LOS ANGELES COUNTY ENGINEERING BLDG.

Note: Any Additions or Changes on This Sheet Must be Made or Circled in Red Ink With Date and Name of Person Making Change.

Do not extend this side of this line.

W.S. 67-C-1

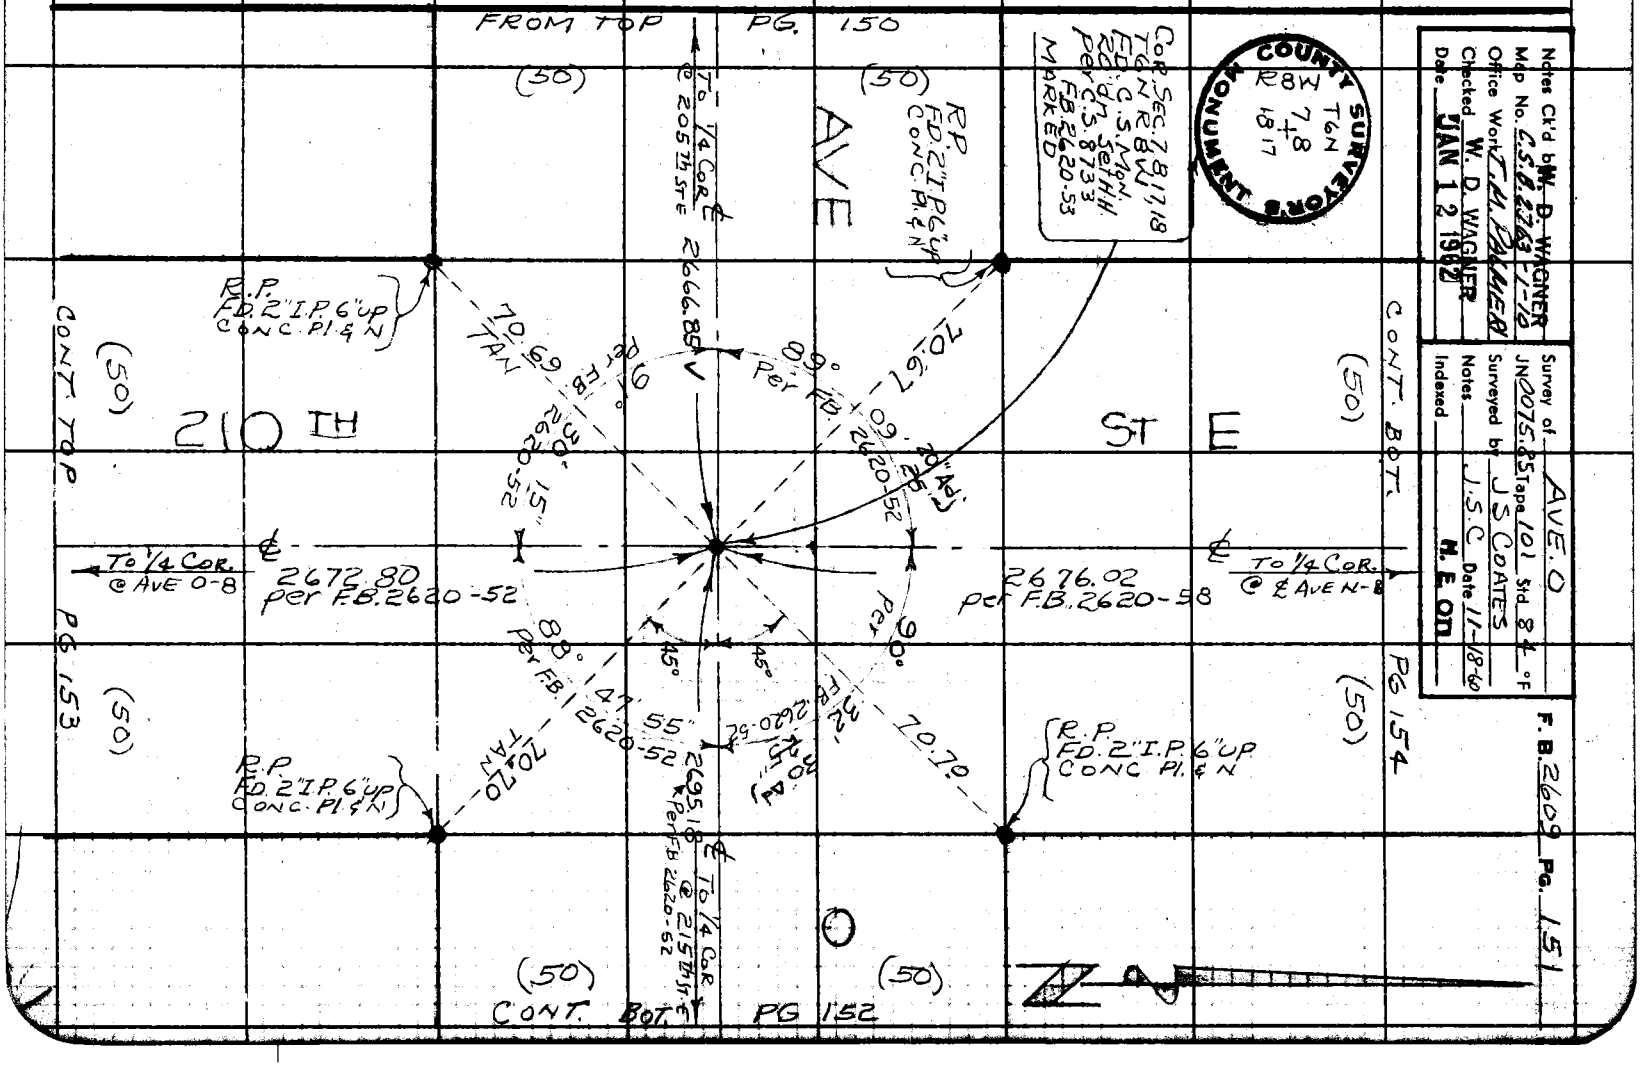

Notes Ck'd by W. D. WAGNER
Map No. C.S.B. 2763 11-70
Office Work C.M. PALMER
Checked W. D. WAGNER
Date JAN 12 1982

Survey of AVE. O
JN 0075.25 Tape 101 Std. & 4 °F
Surveyed by J.S. COATES
Notes J.S.C. Date 11-18-80
Indexed M. E. ON

F. B. 2609 Pg. 151

PLEASE RETURN TO
LOS ANGELES COUNTY ENGINEER
700 LOS ANGELES COUNTY ENGINEERING BLDG.

Note: Any Additions or Changes on This Sheet Must be Made or Circled in Red Ink With Date and Name of Person Making Change.

Do not extend this side of this line.

W.S. 67-C-1

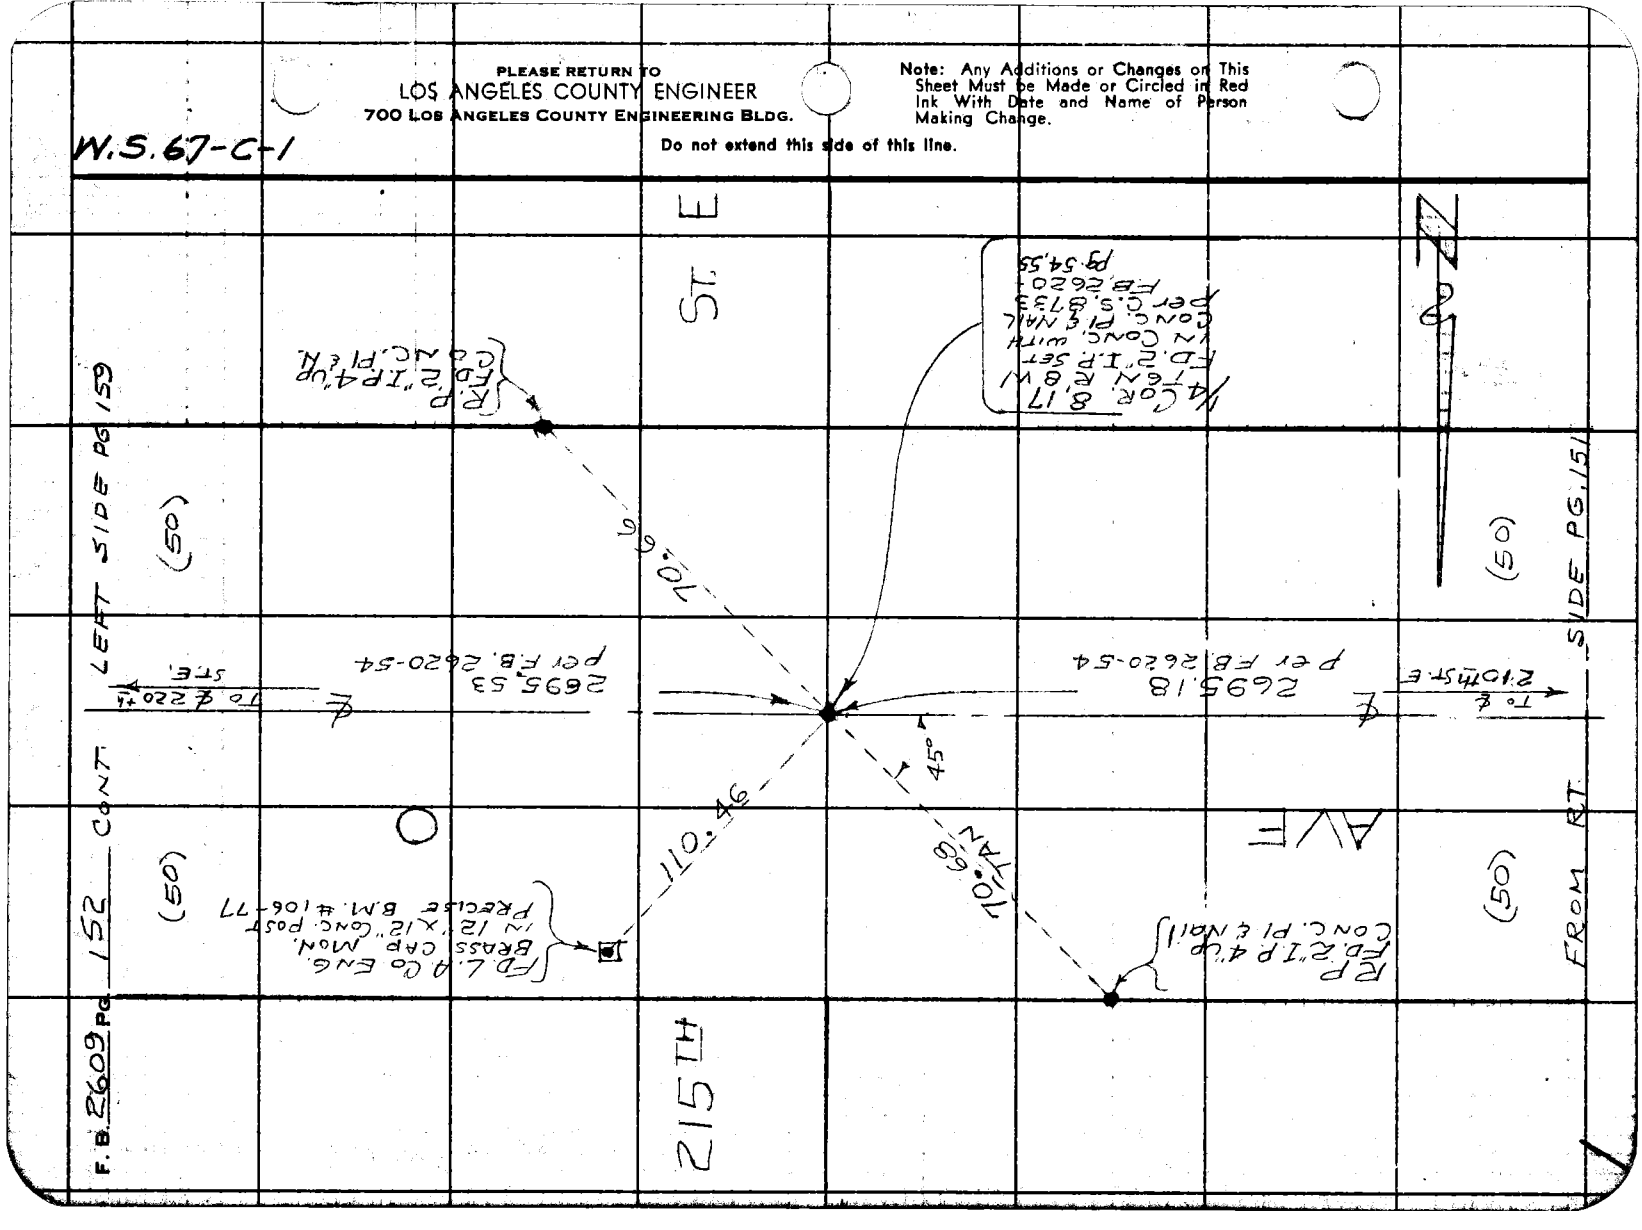

76F3095 SSE #247 11-58

PLEASE RETURN TO
LOS ANGELES COUNTY ENGINEER
700 LOS ANGELES COUNTY ENGINEERING BLDG.

Note: Any Additions or Changes on this Sheet Must be Made or Circled in Red Ink With Date and Name of Person Making Change.

Do not extend this side of this line.

W.S. 67-C-2

Notes Ck'd by W. D. WAGNER
Map No. C.S.B. 2763 1-10
Office Work T. M. PALMER
Checked W. D. WARNER
Date JAN 12 1962

Survey of AVE. O
JN0025. 85 Tape 101 Std. 84 °F
Surveyed by J.S. COATES
Notes
Indexed
Date 11-21-60
R. E. ON

F.B. 2609 Pg. 153

COUNTY ENGINEER
R.E. 5869

1/4 COR. SEC. 17, 18
T6N R8W
F.D. C.E. MON. 16"dp
per F.B. 2620-53
MARKED

T6N
R8W
18 17
1/4 COR

AVE

210TH

ST.

E

(50)

FROM BDY.

PG. 151

(50)

R.P.
FD. 2"I.P. 3"UP
CONC. PI. & N

FD. 1"I.P. 2"UP
CONC. PI. & N

30.10

70.71

45°

2672.80
per F.B. 2620-52

℄ To ℄ AVE. O

30.02

70.71

FD 1"I.P. 1"UP
CONC. PI. & N

R.P.
FD. 2"I.P. 3"UP
CONC. PI. & N

O-8

PLEASE RETURN TO
LOS ANGELES COUNTY ENGINEER
700 LOS ANGELES COUNTY ENGINEERING BLDG.

Note: Any Additions or Changes on This Sheet Must be Made or Circled in Red Ink With Date and Name of Person Making Change.

Do not extend this side of this line.

W.S.67-C-1

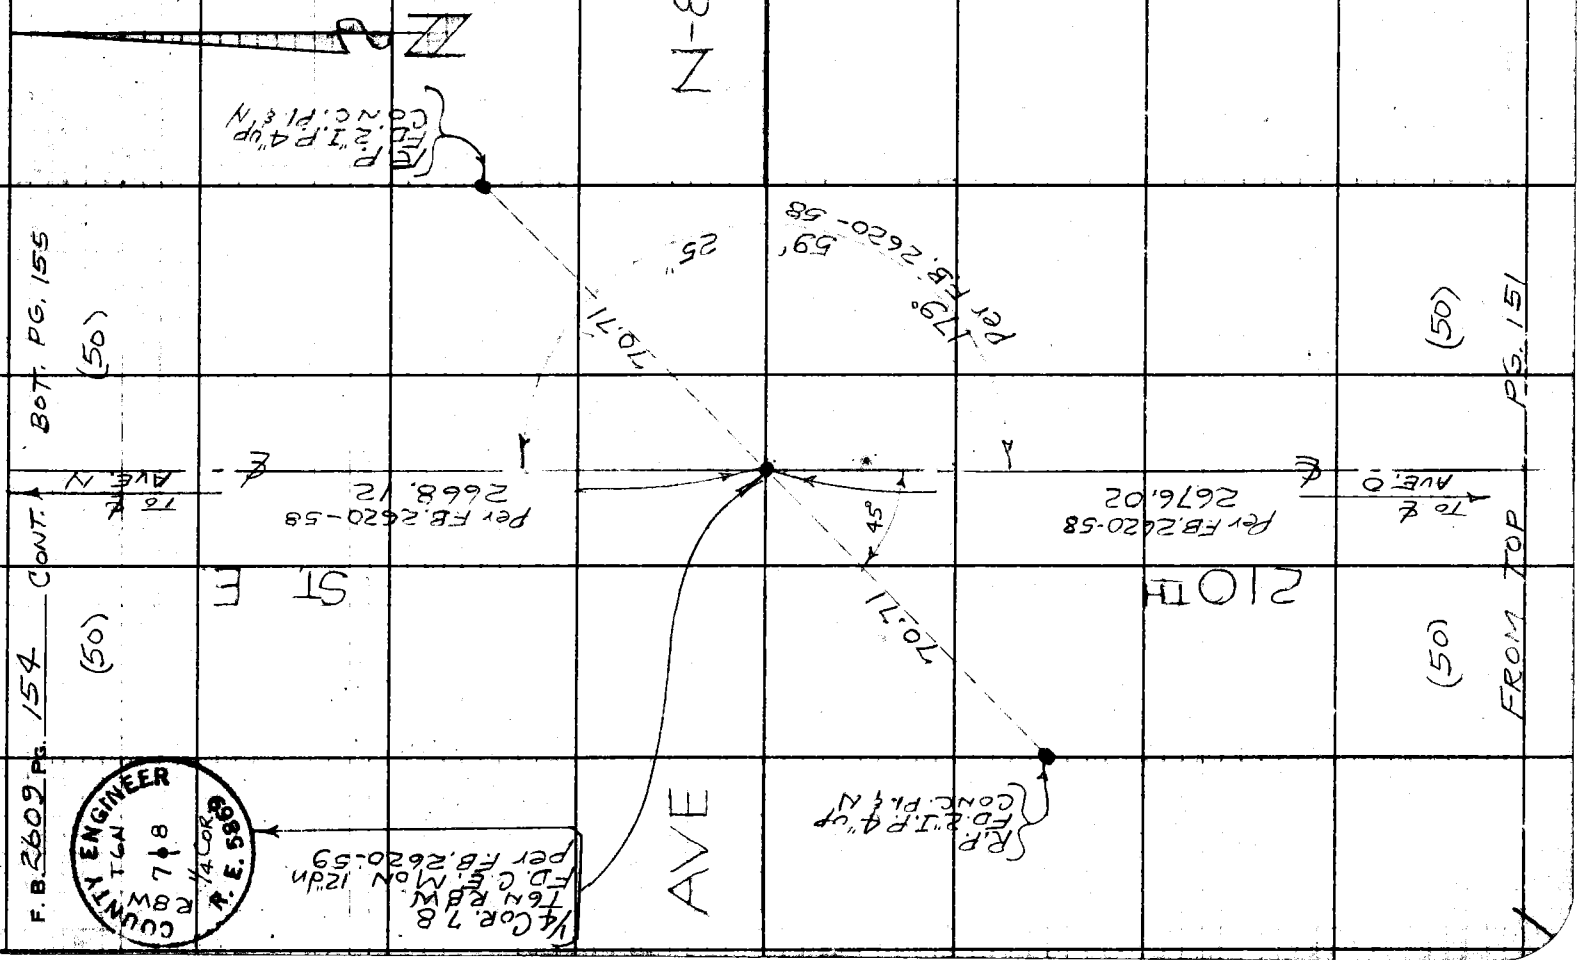

76F3095 S&E #247 11-58

PLEASE RETURN TO
LOS ANGELES COUNTY ENGINEER
700 LOS ANGELES COUNTY ENGINEERING BLDG.

Note: Any Additions or Changes on This Sheet Must be Made or Circled in Red Ink With Date and Name of Person Making Change.

Do not extend this side of this line.

W.S. 67-C-1

Notes Ck'd by W. D. WAGNER
Map No. C.S. 22837-1-10
Office Work T.M. DALHEIM
Checked W. D. WAGNER
Date JAN 12 1962

Survey of JN 0075.85 Topo 01 Std. 84 of
Surveyed by J.S. COATES
Notes
Indexed

F.B. 2602 PG. 155

CONT. TOP PG 149

AVE. O

AVE. N

210TH ST. E

(50)

FD. 2" I.P. 4" up CONC. P.L. & N.

R&P FD. 2" I.P. FLUSH CONC. P.L. & L.A. CO. ENG. TAG

To ¼ Cor. 2670.72 per F.B. 2264 Pg 58

205th St. E

S. 6.50 E. 70.71

45°

48.01

SET NET P.P. #766926

To ¼ Cor. © AVE N-8 2668.12 per F.B. 2620-58

N. 89° 41' 30" E. 70.72

89° 41' 35" Per F.B. 2620-58

2694.74 per F.B. 2264 Pg. 58

To ¼ Cor. 215th St. E


MONUMENT

COUNTY SURVEY T6N R13W 6 5 7 8

R&P FD. 2" I.P. FLUSH CONC. P.L. & L.A. CO. ENG. TAG

CONT. BOT. PG. 156

FROM TOP PG. 154

PLEASE RETURN TO
LOS ANGELES COUNTY ENGINEER
700 LOS ANGELES COUNTY ENGINEERING BLDG.

Note: Any Additions or Changes on This Sheet Must be Made or Circled in Red Ink With Date and Name of Person Making Change.

Do not extend this side of this line.

W.S.67-C-1

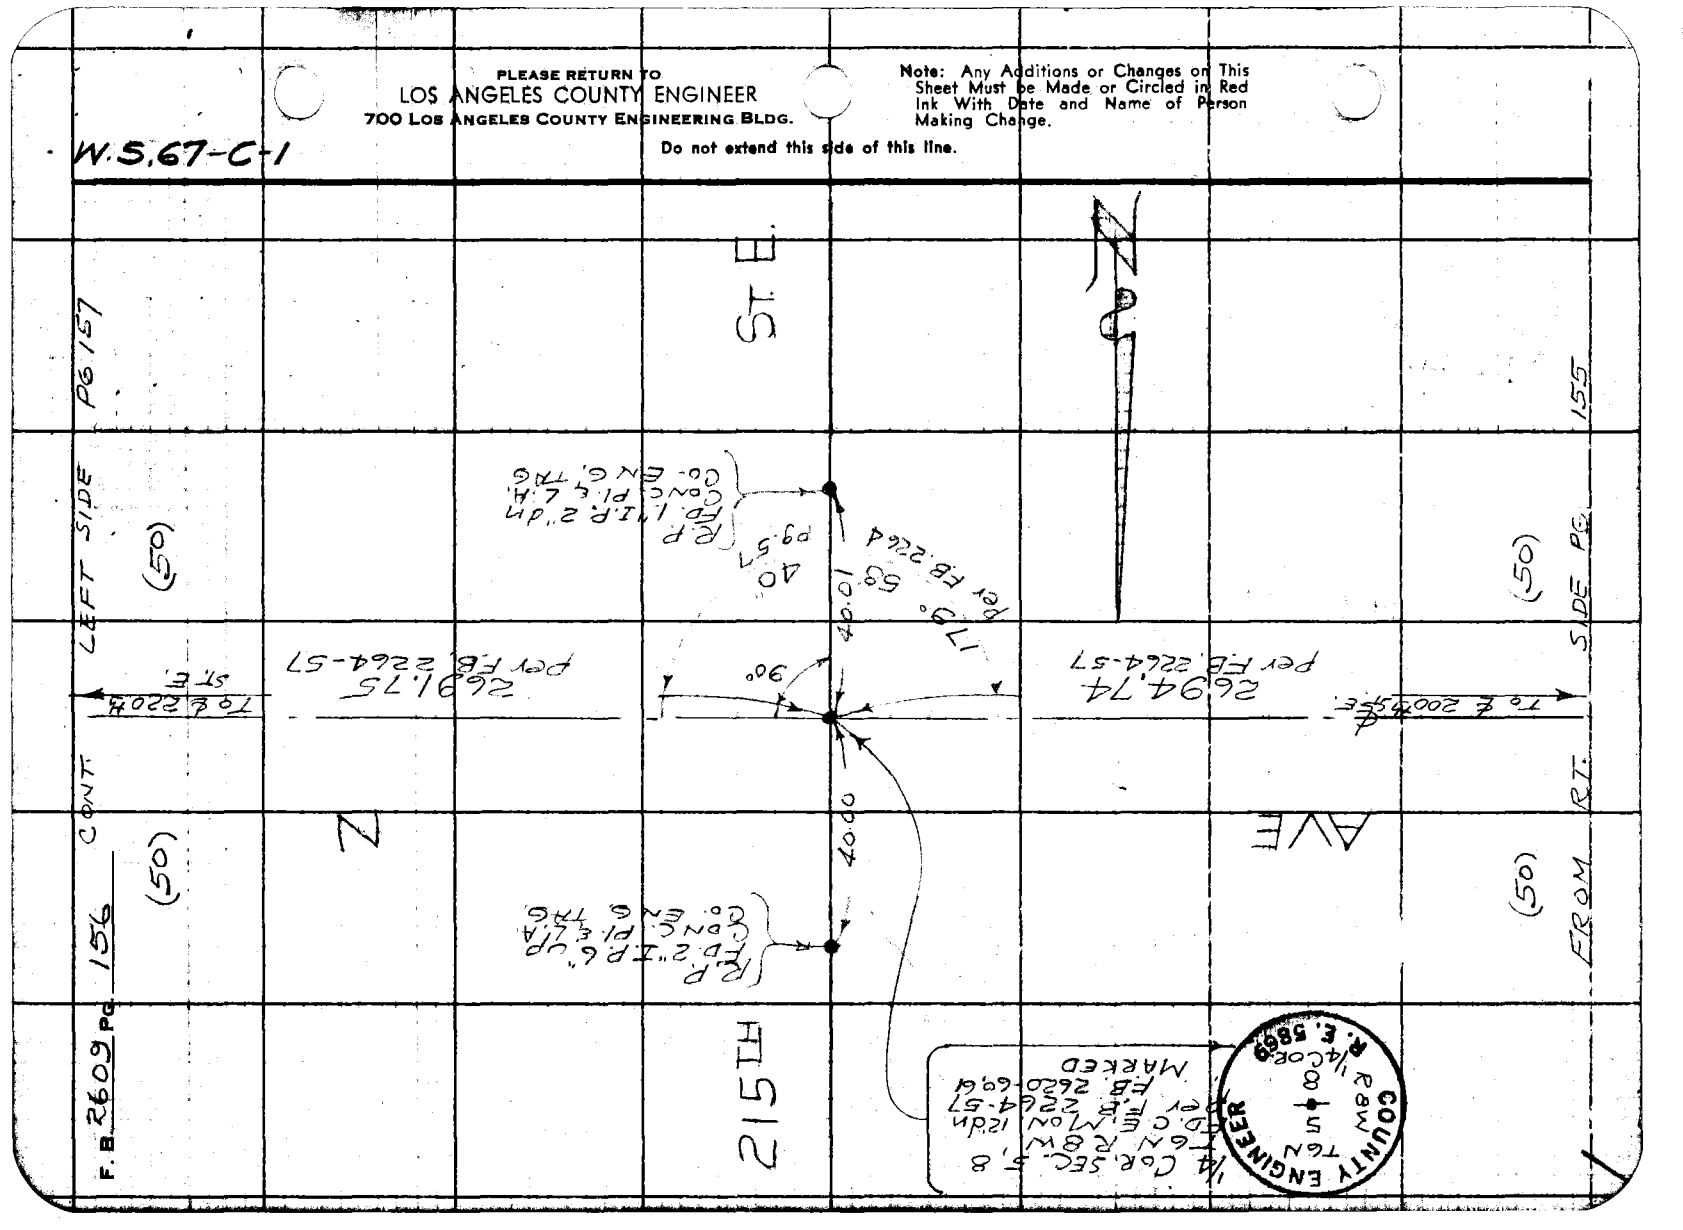

W.S. 67-C-1

Notes Ck'd by W. D. WAGNER | Survey of AVE. O | F.B. 2608 PG. 157
Map No. C.S. A 2764-1-10 | JN 0075-86 Tape 101 Std 84 °F
Office Work T. M. PALMIERI | Surveyed by J.S. COATES
Checked W. D. WAGNER | Notes J.S.C. Date 11-22-60
Date JAN 12 1962 | Indexed H. E. OD

Note: Any Additions or Changes on this Sheet Must be Made or Circled in Red Ink With Date and Name of Person Making Change.

Do not extend this side of this line.

PLEASE RETURN TO
LOS ANGELES COUNTY ENGINEER
700 LOS ANGELES COUNTY ENGINEERING BLDG.

76F3098 SEE #247 11-58

ST. E

RP FD. 2" I.P. 6" UP CONC. P.I. & L.A. CO. ENG. TAG

56.57 TAN

48.84

FD. NAIL & TAG #735837E

AVE Z

(50)

PG 156

PG. 168

FROM TOP

(50)

℄ To ℄ 215th ST. E 2691.75 per F.B. 2264-56

2694.9 per F.B. 2264-55 ℄ To ¼ Cor @ 225th ST. E

90° 22' 10"

89° 50' 00"

56.57

RP FD. 2" I.P. 6" UP CONC. P.I. & L.A. CO. ENG. TAG

(50)

CONT. TOP PG. 159

Ⓓ 90°22'00"
Ⓐ 361°28'30"
90°22'01½"
Ⓒ 182°13'00"
90°22'10" ✓

Ⓓ 89°50'00"
Ⓐ 359°20'10"
89°50'02½"
Ⓒ 179°00'20"
89°50'08" ✓

COR. SECTION 5, 8, 9
T 6 N R 8 W
FD. C.S. MON.
per F.B. 2264-56
C.S. 8733
MARKED

220TH

Per F.B. 2620-62
2681.79

1469.64 per F.B. 2620-62

P.O.T
FD 1"X2" &N
F.B. 2620-62

COUNTY SURVEYOR'S MONUMENT
T 6 N
R 8 W
5 4
8 9

(50)

℄ To ¼ Cor @ AVE N-8

(50)

CONT. TOP PG. 158

PLEASE RETURN TO
LOS ANGELES COUNTY ENGINEER
700 LOS ANGELES COUNTY ENGINEERING BLDG.

Note: Any Additions or Changes on This Sheet Must be Made or Circled in Red Ink With Date and Name of Person Making Change.

Do not extend this side of this line.

W.S.67-C-1

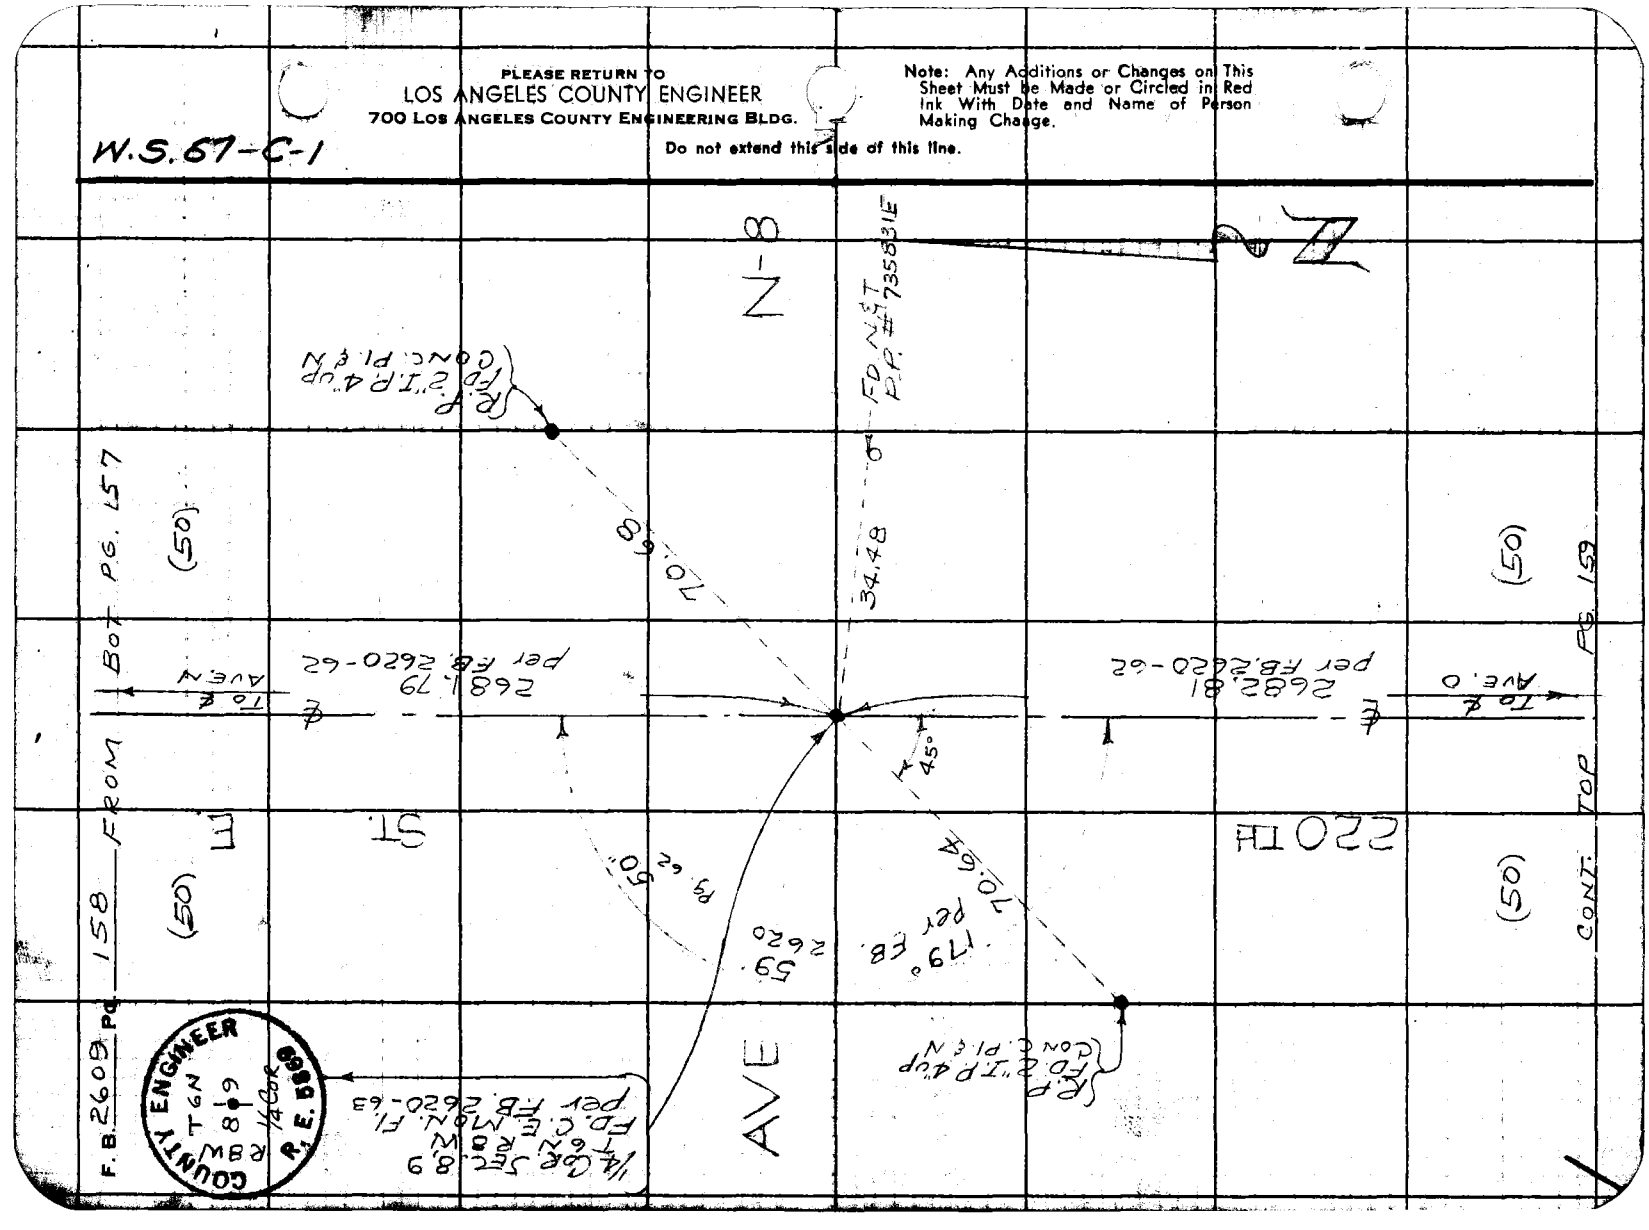

Notes Ck'd by W. D. [illegible]
Map No. C.S.B. 2763-1-10
Office Work T.M. PALMIERI
Checked W. D. [illegible]
Date JAN 12 1962

Survey of AVE. O
JN 0075.86 Tape 101 Std 84 °F
Surveyed by J.S. COATES
Notes J.S.C. Date 11-28-60
Indexed H.E.OD

F. B. 2609 Pg. 159

W.S.67-C-1

FROM BOT. PG. 158

(50) (50)

ST. E

To 1/4 Cor AVE N-8

Per F.B. 2620-62
2682.81

R.P. FD. 2" I.P. 4" UP CONC. PL. & N

89°25'50"
357°42'50"
89°25'42½"
176°34'30"
89°25'45"

89°53'40"
359°34'40"
89°53'40"
179°22'00"
89°53'40"

Cor Sec. 89, 16, 17
T6N R8W, M.D.M.
Per C.S. 8733
F.B. 2620-55
MARKED

COUNTY SURVEYOR'S MONUMENT
T6N
R8W 8 9
17 16

FD. L.A. Co. Eng. Brass-Cap. in 12" X 12" Conc. pad Precise B.M. # 106-76

PG 152

(50)

AVE

89° 25' 70.69

50" (M) 45°

89° 53' 53.66 40"

45°

To 1/4 Cor @ 215th St. E

2095.53
Per F.B. 2620-54

2685.06

To 1/4 Cor 225th St. E

BOT. PG 161

(50)

FROM TOP

(50)

91° 42' 56

50" (M) 45°

70.79 02'

FD. 2" I.P. Fl. Wood Plug

37' 40"

89°

R.P. FD. 2" I.P. L.C.U. Conc. Pl. & N

(50)

CONT.

91°37'40"
366°30'30"
91°37'37½"
189°46'00"
91°37'40"

220TH

2686.34
Per F.B. 2620-55

89°03'00"
359°10'40"
89°02'40"
174°16'20"
89°02'43½"

To 1/4 Cor @ AVE O-8

(50) (50)

CONT. TOP PG 160

Note: Any Additions or Changes on this Sheet Must be Made or Circled in Red Ink With Date and Name of Person Making Change.

Do not extend this side of this line.

PLEASE RETURN TO
LOS ANGELES COUNTY ENGINEER
700 Los Angeles County Engineering Bldg.

76F3098 SAE #247 11-

F.B. 2609 PG. 160

FROM BOT. PG 159

W.S. 67-C-2

PLEASE RETURN TO
LOS ANGELES COUNTY ENGINEER
700 Los Angeles County Engineering Bldg.

Do not extend this side of this line.

Note: Any Additions or Changes on This Sheet Must be Made or Circled in Red Ink With Date and Name of Person Making Change.

(50)

E

ST

(50)

To ℄ Ave. 0

℄

Per F.B. 2620-56
2686.34

N

AVE

220TH

R.P. FD. 2" I.P. 6" UP CONC. PL. & N

P.P. #N 1/4 T 7358.20 E

1/4 COR. SEC. 16, 17
T 6 N R 8 W I.P. SET IN CONC.
WITH C. PL. & CUT SPK
PER C.S. 8733
F.B. 2620-56, 57

70.68

45°

38.87

90°

30.00

FD. 3" X 3" ℄ N 3" UP

70.69

R.P. FD. 2" I.P. 6" UP CONC. PL. ℄ N

76F3098 S&E #247 11-58

PLEASE RETURN TO
LOS ANGELES COUNTY ENGINEER
700 LOS ANGELES COUNTY ENGINEERING BLDG.

Note: Any Additions or Changes on This Sheet Must be Made or Circled in Red Ink With Date and Name of Person Making Change.

Do not extend this side of this line.

W.S. 67-C-1

Notes Ck'd by W. D. WAGNER
Map No. C.S. 8733-1-12
Office Work Tpy. PALMER
Checked W. D. WAGNER
Date JAN 12 1952

Survey of AVE. O
JN 0075 85 Tape 101 Std. 84°F
Surveyed by J.S. COATES
Notes
Indexed R. E. ON 11-27-60

F.B. 2602 PG. 161

CONT. BOT. PG. 164

CONT. BOT. PG. 165

CONT. LEFT SIDE PG. 162

SIDE PG. 159

(30) 225TH STE

(30) 227TH STE

AVE O

AVE N-14 ℄

AVE N ℄

89°46'10"
359°46'05"
89°46'37"
89°46'15"

89°47'33"20
358°53'40"25
89°43'25"
88°20'30"25

89°50'12"30
360°50'30"
90°12'30"
90°15'00"
90°12'30"

R.S. 66-47

Set N&T PP# 734982E

668.98

668.15

74.39

31.00

(50) 70.71

(40)

(50)

(50)

(50)

80.00 R

15"

45°

℄ to 220 M.S.E.

℄ to 230 St.E.

1342.69

1342.70

2685.06

R.P. Set 2" I.P. 6" up Conc. P.L. & L.A. Co. Eng. Tag

Set N&T RR Tie F.N. Post

Set 2" I.P. 6" up Conc. P.L. & L.A. Co. Eng. Tag

¼ Cor. Sec. 9, 16 T 6N R 8W F.D. 2" I.P. in Conc. with Conc. P.L.S. Per C.S. 8733 F.B. 1113-187

¼ ¼ Cor. Set 2" I.P. 12" in Conc. P.L. & L.A. Co. Eng. Tag. By Prop. Per R.S. 66-47

2685.20@ 76°=2685.06
1342.76@ 76°=1342.69
1342.77@ 76°=1342.70

PLEASE RETURN TO
LOS ANGELES COUNTY ENGINEER
700 LOS ANGELES COUNTY ENGINEERING BLDG.

Note: Any Additions or Changes on This Sheet Must be Made or Circled in Red Ink With Date and Name of Person Making Change.

Do not extend this side of this line.

W.S. 67-C-1

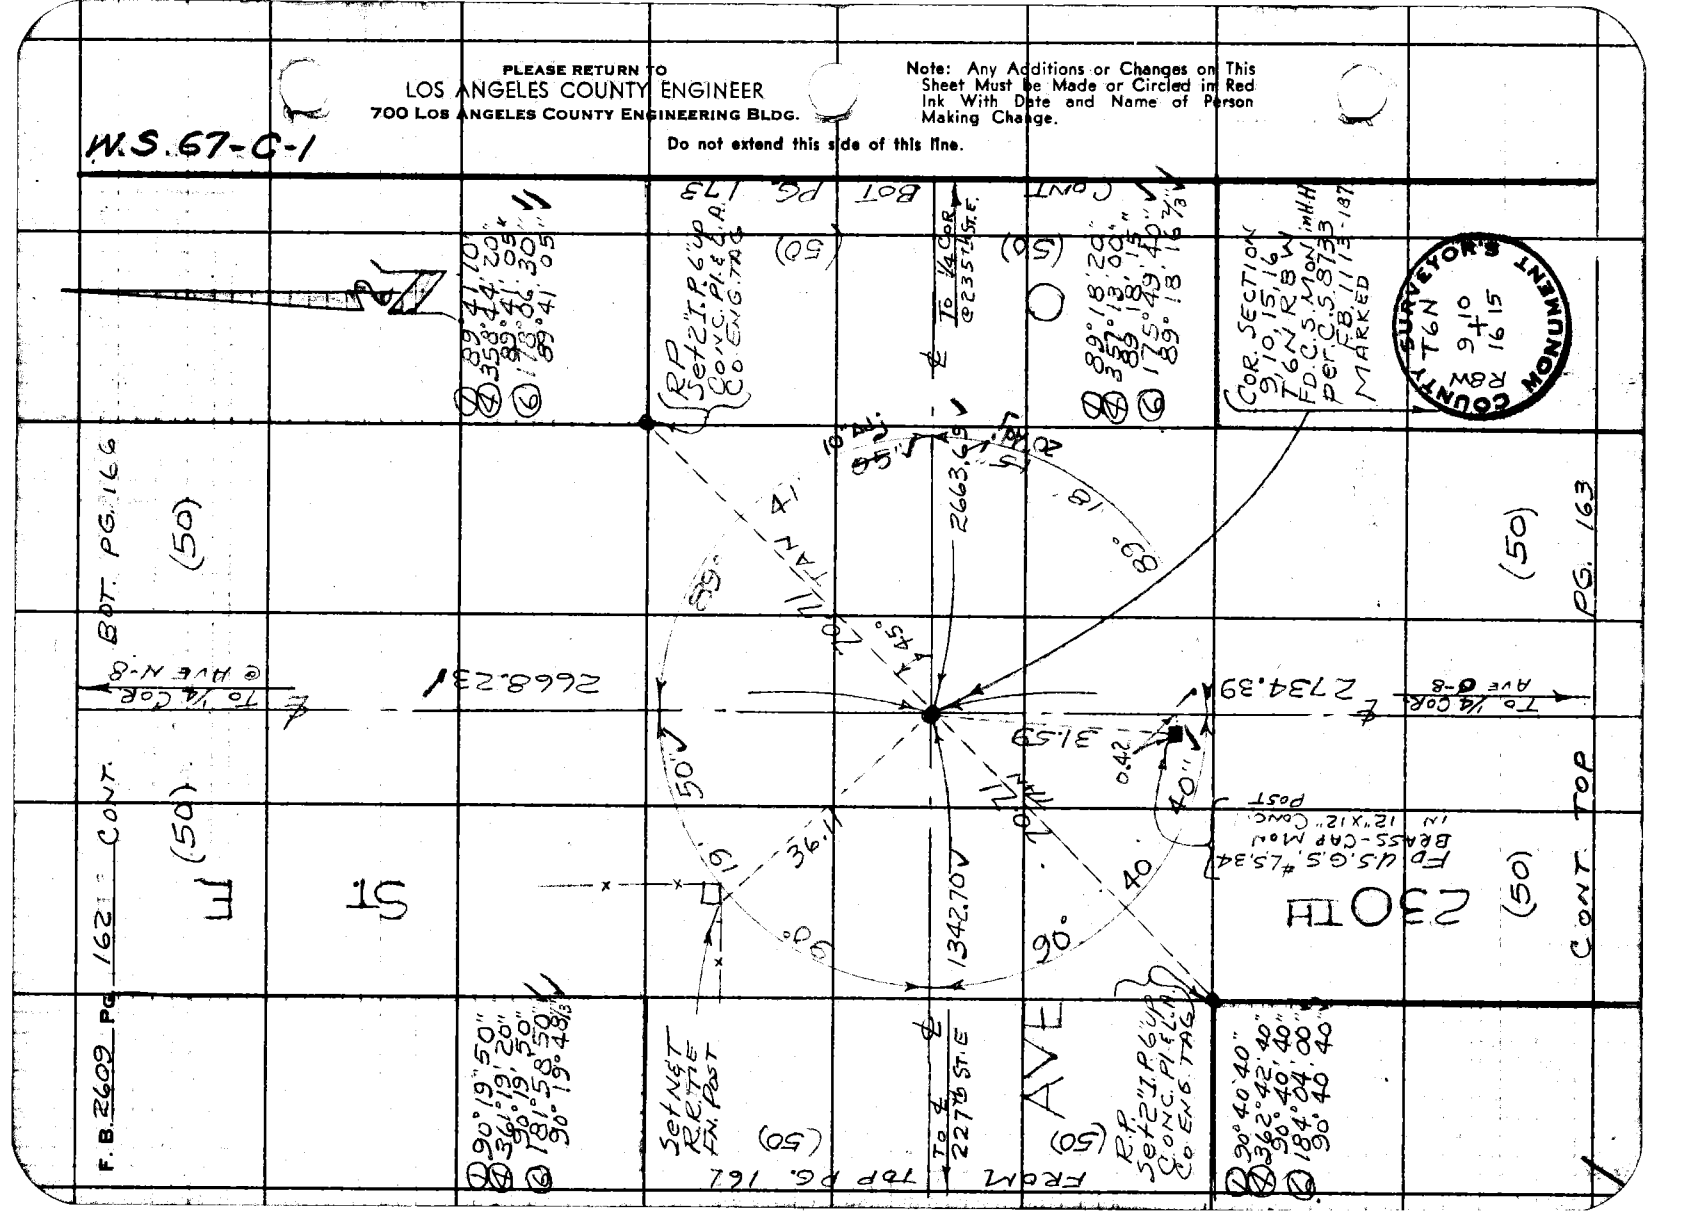

76F3095 S&E #247 11-58

PLEASE RETURN TO
LOS ANGELES COUNTY ENGINEER
700 LOS ANGELES COUNTY ENGINEERING BLDG.

Note: Any Additions or Changes on This Sheet Must be Made or Circled in Red Ink With Date and Name of Person Making Change.

Do not extend this side of this line.

W.S. 67-C-2

Notes Ck'd by W. D. WAGNER
Map No. C.S.B. 2683-1-12
Office Work TM. PALLEGA
Checked W. D. WAGNER
Date JAN 12 1962

Survey of AVE. O
JN 0075.85 Tape 101 Std. 84 °F
Surveyed by JSC COATES
Notes
Indexed N. E. ON Date 1-27-60

F.B. 2609 Pg. 163

1/4 COR. SEC 15, 16
T 6 N, R 8 W
FD. 2" I.P. in CONC.
WITH CONC. PL. &
CUT SPK & WASHER
STAMPER RE 2177
12" DOWN
Per F.B. 1113-184

2735.14 @ 42° = 2734.39 ✓

AVE

230TH ST. E

RP
FD. 2" I.P. 6" UP
WOOD PL & N

29.98

40°

2734.39 ✓

To ℄
AVE. O

(50)

FROM BOT. PG. 162

30.00

RP
FD. 2" I.P. 6" UP
WOOD PL. & N

(50)

PLEASE RETURN TO
LOS ANGELES COUNTY ENGINEER
700 LOS ANGELES COUNTY ENGINEERING BLDG.

Note: Any Additions or Changes on This Sheet Must be Made or Circled in Red Ink With Date and Name of Person Making Change.

Do not extend this side of this line.

W.S. 67-C-1

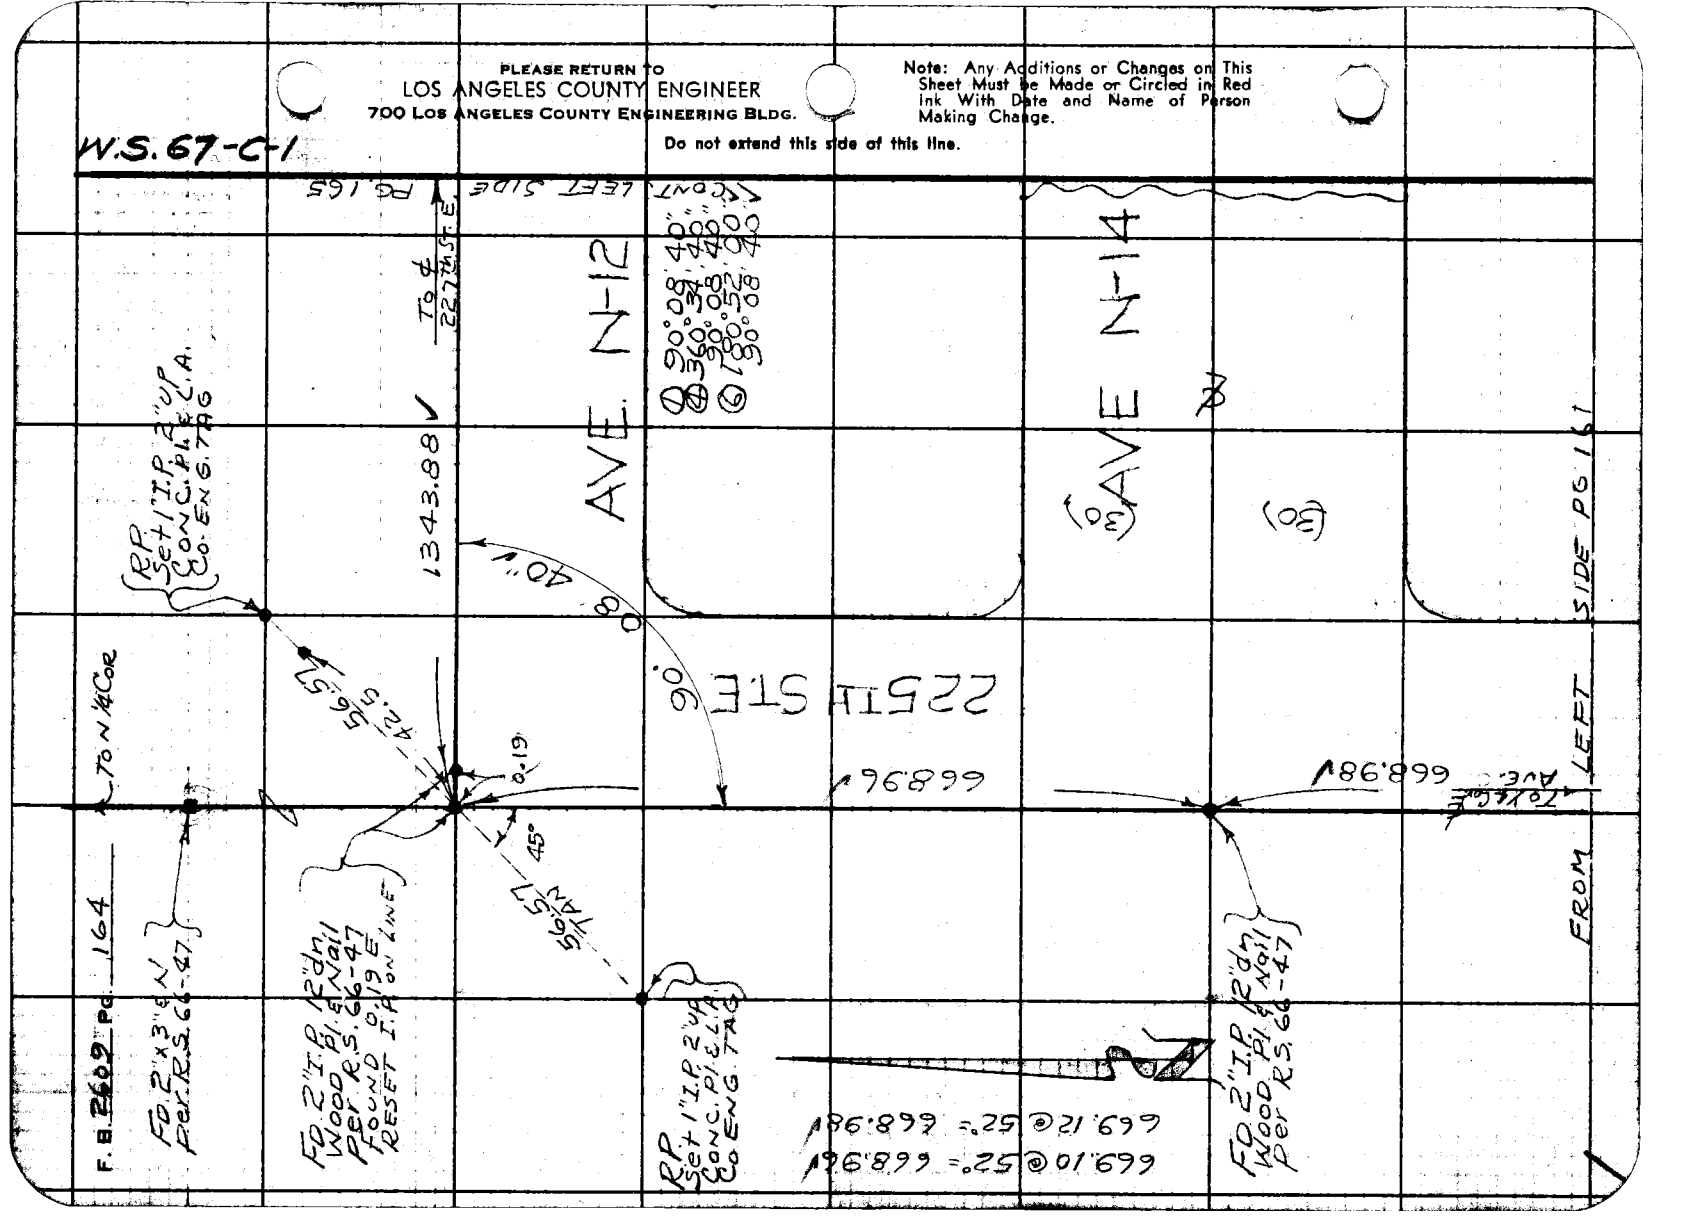

W.S. 67-C-1

Notes Ck'd by W. D. WAGNER
Map No. C.S.B. 2769 1-10
Office Work T. M. PALMERI
Checked W. D. WAGNER
Date JAN 12 1962

Survey of AVE. O
JN 0075-85 Tape 101 Std 84 °F
Surveyed by J.S COATES
Notes J.S.C. H. E. Oth Date 11-28-60
Indexed

F. B. 2609 PG. 165

Note: Any Additions or Changes on This Sheet Must be Made or Circled in Red Ink With Date and Name of Person Making Change.

Do not extend this side of this line.

PLEASE RETURN TO
LOS ANGELES COUNTY ENGINEER
700 LOS ANGELES COUNTY ENGINEERING BLDG.

L344.19 @ 48° = 1343.88 ✓

Fd 2" I.P. 6"dm Wood Pl. & Nail per R.S. 66-47

Set Net R.R. Tie Fn Post

To ℄ 225th St. E. 1343.88 ✓

25.00

AVE N-12 (30)

FROM RT. SIDE PG. 164

68°

42.50

25.00

Fd. 2"x2" ℄ N per R.S. 66-47

48.

Set 1"x2" ℄ Nail

89°48'20"
353°13'10"
89°48'17½" ✓
178°49'40"
89°48'16⅜" ✓

(30)

ST E

667.85 ✓

667.99 @ 52° = 667.85 ✓

668.29 @ 52° = 668.15 ✓

Fd. 2"x2" ℄ Nail per R.S. 66-47

Set Net R.R. Tie Fn Post

AVE N-14 (30)

42.33

13.84

(30)

227TH (30)

Fd 2" I.P. 12"dm Wood Pl. & Nail per R.S. 66-47

668.15 ✓

℄ 225th St. E. & Ave. O

FROM LEFT SIDE PG 161

76F3095 SAE #247 11-59

F.B. 2609 Pg. 166 CONT. BOT. PG. 167

W.S. 67-C-1

PLEASE RETURN TO
LOS ANGELES COUNTY ENGINEER
700 LOS ANGELES COUNTY ENGINEERING BLDG.

Do not extend this side of this line.

Note: Any Additions or Changes on This Sheet Must be Made or Circled in Red Ink With Date and Name of Person Making Change.

(50) (50)

ST. E.

AVE

230TH ST.

AVE. N

AVE. O

N 00° 10' E 2669.38 @ 56.2 = 2668.89'

2668.89'

2668.23'

2668.68 @ 58.0 = 2668.23'

FROM TOP PG. 162

R.P. Set 2" I.P. 6" L.P. & L.A. CO. ENG. TAG

R.P. Set 2" I.P. 6" L.P. & L.A. CO. ENG. TAG

70.71' TAN

70.71'

180°

45°

1/4 COR. 9 10 T6N R8W FD. 2" I.P. in conc. PIL WITH SPIKE & REPLACED BY MON. MARKED FLUSH WITH 12" conc.

COUNTY ENGINEER T6N R8W 9 10 1/4 COR R.E. 5868

W.S. 67-C-1

Notes Ck'd by W. D. WAGNER	Survey of AVE. O	F. B. 2609 Pg. 167
Map No C.S.B. 2763 - 1-10	JN 0075.85 Tape 101 Std 84 °F	
Office Work T.M. PALMERI	Surveyed by J.S. COATES	
Checked W. D. WAGNER	Notes J.S.C. Date 11-28-60	
Date JAN 12 1962	Indexed H. E. OTT	

COUNTY SURVEYOR'S MONUMENT
T6N
R8W 4 3
9 10

Note: Any Additions or Changes on This Sheet Must be Made or Circled in Red Ink With Date and Name of Person Making Change.

Do not extend this side of this line.

PLEASE RETURN TO
LOS ANGELES COUNTY ENGINEER
700 Los Angeles County Engineering Bldg.

76F3095 SSE #247 11-59

2ND ST. E.

AVE (50)

R.P. FD. 2" I.P. 6" UP CONC. P.& L.A. CO. ENG. TAG

COR. SECTION N. 3, 4, 9, 10
T6N R8W, 12" dn
Per C.S. 8733
FB. 2264-54
MARKED

PG. 168

CONT. TOP

(50)

Per F.B. 2264-54
To ¼ Cor 225th St. E
2694.92

56.57' TAN

45°

Per F.B. 2264-54
2664.91
To ℄ 235th St. E

PG. 169

CONT. BOT

(50)

89° 58' 20"

90° 28' 00"

50' RAD

45.71'

R.P. FD. 2" I.P. 6" UP CONC. P.L. & L.A. CO. ENG. TAG

Ⓐ 89°58'20"
Ⓑ 359°53'20"
Ⓒ 89°58'20"
Ⓓ 179°50'00"
89°58'20"

Ⓐ 90°29'00"
Ⓑ 361°55'00"
Ⓒ 90°28'45"
Ⓓ 182°52'40"
90°28'46½"

230TH

(50)

FROM TOP

2668.89

To ¼ Cor @ AVE N-8

(50)

PG. 166

F. B. 2609 Pg. 168 FROM LEFT SIDE PG. 167

W.S. 67-9-1

(50) (50)

To E 2305 ST. E.

N

℄ 2694.92 per F.B. 2264-55

225TH

R.P. 2" I.P. & 6" DP FD. CONC. PIPE & L.A. Co. ENGS TAG

R.P. 2" I.P. & 2" DP FD. CONC. PIPE & L.A. Co. ENG TAG

ST. E

90°

40.00

40.01

10

179° 59 per F.B. 2264-55

1/4 COR. 4-9 T6N R8W MON. 12" dn FD. C.I.E. PER F.B. 2264-55 MARKED

COUNTY ENGINEER T6N 4-9 1/4 COR R8W

AVE

℄ 2694.91 per F.B. 2264-55

To E 2210 ST. E.

(50) (50)

FROM RT. SIDE PG 157

PLEASE RETURN TO
LOS ANGELES COUNTY ENGINEER
700 LOS ANGELES COUNTY ENGINEERING BLDG.

Do not extend this side of this line.

Note: Any Additions or Changes on This Sheet Must be Made or Circled in Red Ink With Date and Name of Person Making Change.

76F309S S&E #247 11-59

PLEASE RETURN TO
LOS ANGELES COUNTY ENGINEER
700 LOS ANGELES COUNTY ENGINEERING BLDG.

Note: Any Additions or Changes on This Sheet Must be Made or Circled in Red Ink With Date and Name of Person Making Change.

Do not extend this side of this line.

W.S. 67-D-1

Notes Ck'd by W. D. WAGNER
Map No. C.S.B. 6/16/62 1-1-62
Office Work T.M. PALMER
Checked W. D. WAGNER
Date JAN 12 1962

Survey of AVE. O
JN 0075 85 Tape 101 Std. 84 °F
Surveyed by J.S. COATES Date 11-29-60
Notes
Indexed W. E. OH

F. B. 2609 Pg. 169

235TH ST. E

AVE Z

(50) FROM R.T. SIDE PG. 167

(50) CONT. LEFT SIDE PG. 170

R.P. FD. 2" I.P. 6" UP CONC. P.L. & L.A. CO. ENG. TAG

39.99

90°

40.01

R.P. FD. 2" I.P. 6" UP CONC. P.L. & L.A. CO. ENG. TAG

℄ To ℄ 230th ST. E

2664.91 per F.B. 2264-53

2665.99 per F.B. 2264-53

℄ To ℄ 240th ST. E

COUNTY ENGINEER T6N R8W 3 10 1/4 Cor. S.E. 1962

1/4 COR. SEC. 3, 10 T6N R8W F.D.C.E. MON. 12"dn per F.B. 2264-53 MARKED

F.B. 2609 Pg. 170

COUNTY ENGINEER
3 2
10 11

W.S. 67-D-1

LOS ANGELES COUNTY ENGINEER
700 Los Angeles County Engineering Bldg.

PLEASE RETURN TO

Do not extend this side of this line.

Note: Any Additions or Changes on This Sheet Must be Made or Circled in Red Ink With Date and Name of Person Making Change.

COR. SECTION 2, 3, 10, 11
T 6 N
R 11 W
FD. C.E. MON. 12" dm.
Per F.B. 2264-52
MARKED

R.P.
FD. 2" I.P. 6" UP
CONC. PI. & L.A.
CO. ENG. TAG

R.P.
FD. 2" I.P. 6" UP
CONC. PI. & L.A.
CO. ENG. TAG

ST. E

AVE (50)

240TH

N (50)

Pg 169

Pg 189

FROM TOP

CONT BOT.

(50)

(50)

(50)

P.O.T.
FD. 1" X 2" E.N.
F.B. 2264-51

56.58

44°02'

466.56 Per F.B. 2264-51

To ℄ 245th St. E

To ℄ CoR @ 235th St E

2665.99
Per F.B. 2264-52

2687.47
Per F.B. 2264-52

89° 56' 56"

90° 38' 27½"
30 Adj

89° 29' 00"
LA

90° 38' 20"
362° 33' 50"
90° 38' 27½"
183° 50' 40"
90° 38' 26⅜"

2676.20

To ℄ Cor AVE N-8

89° 29' 00"
357° 55' 50"
89° 28' 57½"
176° 54' 00"
89° 29' 00"

CONT. TOP PG. 171

76F3095 S&E #247 11-58

PLEASE RETURN TO
LOS ANGELES COUNTY ENGINEER
700 LOS ANGELES COUNTY ENGINEERING BLDG.

Note: Any Additions or Changes on This Sheet Must be Made or Circled in Red Ink With Date and Name of Person Making Change.

Do not extend this side of this line.

W.S. 67-D-1

Notes Ck'd by W. D. WAGNER
Map No. C.S.A. 2367-1-W
Office Work T.H. PALMIERI
Checked W. D. WAGNER
Date JAN 12 1962

Survey of JN 0075 85 Tape 101 Std 84 °F
Surveyed by J.S.C. COATES
Notes M.E. on
Indexed
Date 11-30-60

F. B. 2602 PG. 171

AVE. O

FROM BOT. PG. 170

14 COR. SEC. 10, 11
T 6N R 8W
FD. 12" I.P. IN CONC. 6" up
WITH CONC. PLUG
PER C.S. 8733
REPLACED WITH
C.E. MON. 12" dn
MARKED

COUNTY ENGINEER
RBW
T 6 N
10 11
14 COR. 9
RE 586

240TH

ST.

E.

(50)

(50)

(50)

(50)

CONT. TOP PG. 172

R.P. SET 2" I.P. 6" up CONC. PLUG & TAG

R.P. SET 1" X 2" N

R.P. SET 2" I.P. 6" up CONC. PLUG & TAG

18.0°

70.71

70.71

45°

℄ TO ℄ AVE O

2676.79 ✓

1192.29 ✓

2676.20 ✓

℄ TO ℄ AVE N

340.60 @ Level = 340.60
1484.78 @ Level = 1484.78

300.81 @ 2°26° = 300.53 ✓
300.79 @ 2°19° = 300.53 ✓

299.67 @ 1°13° = 299.60 ✓
299.74 @ 1°43° = 299.63 ✓

251.93 @ 2°05° = 251.76 ✓
251.91 @ 1°47° = 251.76 ✓

2676.69 @ 56 = 2676.20 ✓

7 8

PLEASE RETURN TO
LOS ANGELES COUNTY ENGINEER
700 LOS ANGELES COUNTY ENGINEERING BLDG.

Note: Any Additions or Changes on This Sheet Must be Made or Circled in Red Ink With Date and Name of Person Making Change.

Do not extend this side of this line.

W.S. 67-D-1

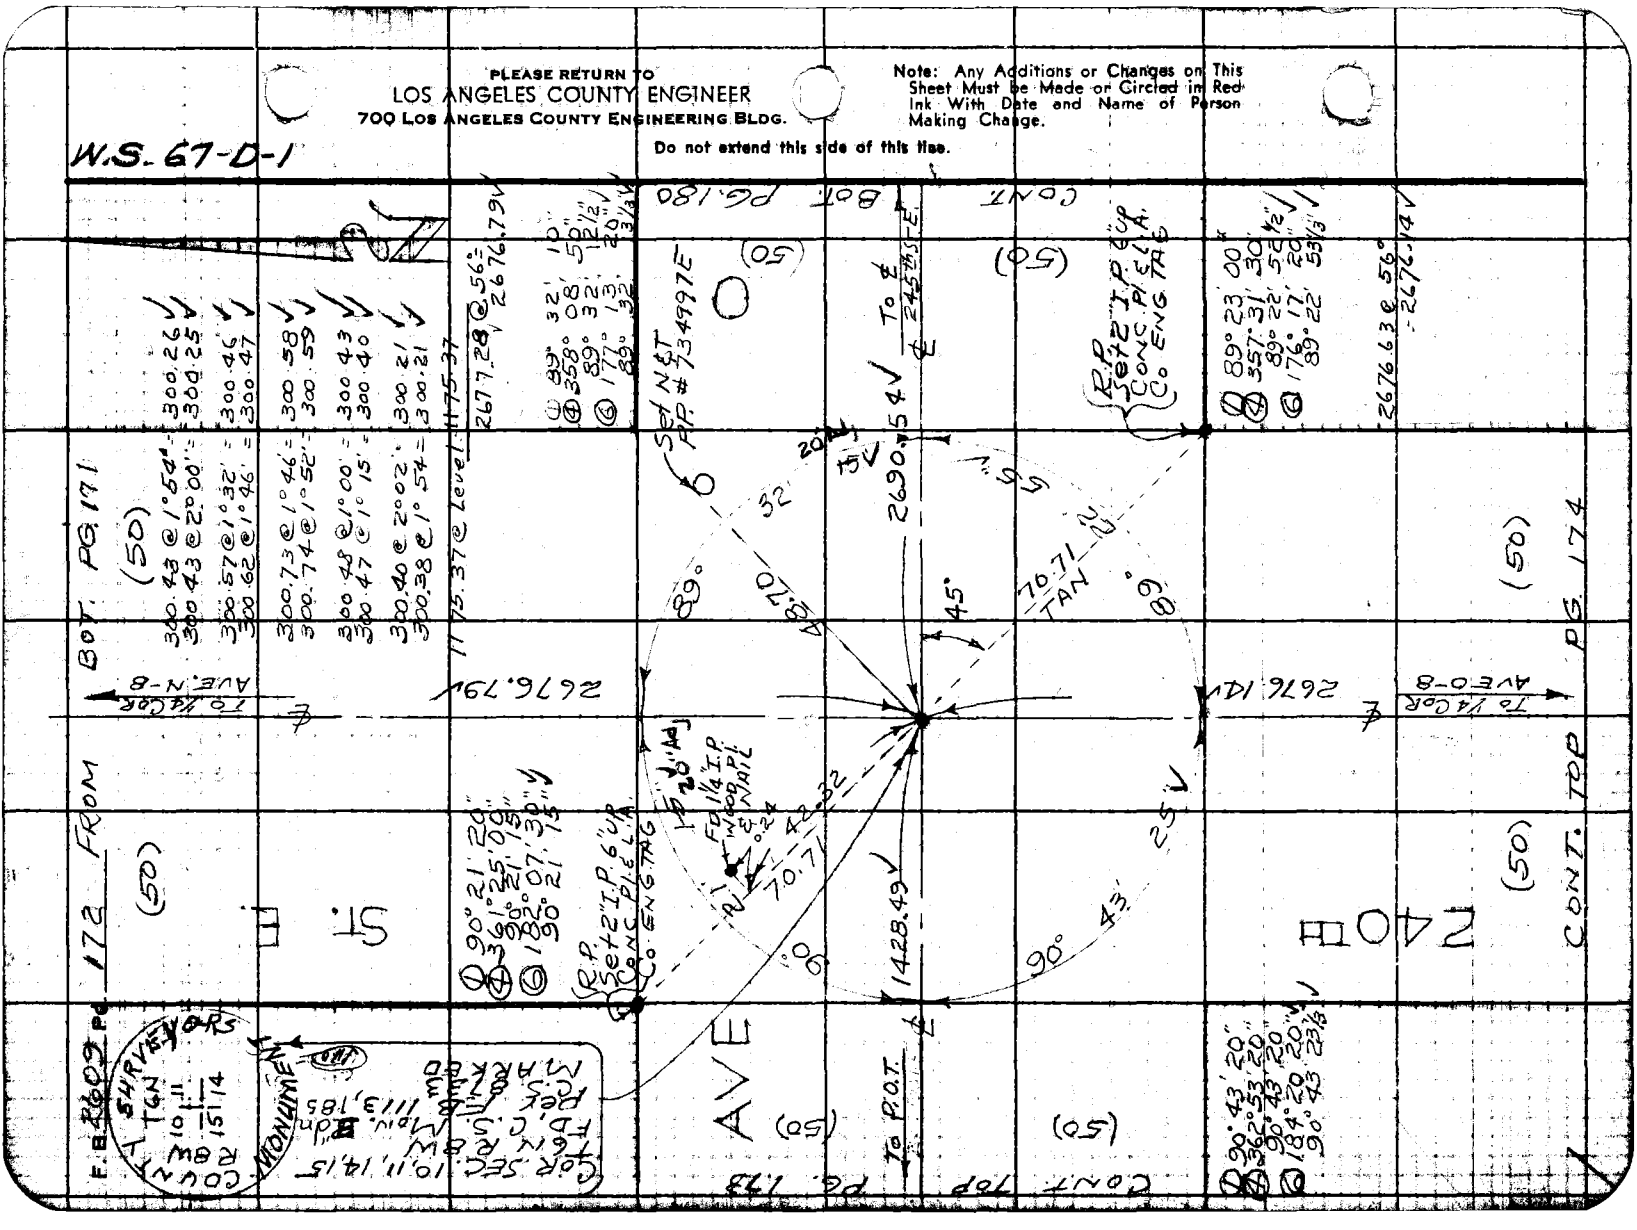

W.S.67-D-1

Notes Ck'd by W. D. WAGNER
Map No. C.S. B.2163-1-10
Office Work T. M. PALMORE
Checked W. D. WAGNER
Date JAN 12 1962

Survey of AVE. O
JN 0075.35 Tape 101 Std. 84 °F
Surveyed by J. S. COATES
Notes J S C Date 12-1-60
Indexed H. E. On

F. B. 2609 PG. 173

FROM LEFT SIDE PG. 172

Set N&T Cor. Fn. post

(50)

(50)

102.65

To ℄ 2401 St. E.

1428.49

Set N&T P.P. #734894E

45.56

P.O.T Set Spk. W & T/T Top of rise

FD N&T F.B. 1113-185

0.13

42.94

Set P.M. in "X" Top W. Gate Fence post

1235.38

R.P. Set 2" I.P. 6" Up CONC. PL. & L.A. CO. ENG. TAG

35"

179°59'40"
359°58'20"
179°59'35"
359°57'20"
179°59'33½"

70.71

59°

45°

0.19

Set N&T P.P. #734791E

34.89

235 IH

179°

AVE

FD N&T F.B. 1113-185

2663.69

70.71 TAN

To ℄ 2301 St. E.

(50)

(50)

FROM RT. SIDE PG. 162

R.P. Set 2" I.P. C/W CONC. PL. & L.A. CO. ENG. TAG

1428.71 @ 60° = 1428.49
1235.58 @ 60° = 1235.38
2664.17 @ 56° = 2663.69


ST E

Note: Any Additions or Changes on This Sheet Must be Made or Circled in Red Ink With Date and Name of Person Making Change.

Do not extend this side of this line.

PLEASE RETURN TO
LOS ANGELES COUNTY ENGINEER
700 LOS ANGELES COUNTY ENGINEERING BLDG.

70F3095 SAE #247 11-59

PLEASE RETURN TO
LOS ANGELES COUNTY ENGINEER
700 LOS ANGELES COUNTY ENGINEERING BLDG.

Note: Any Additions or Changes on This Sheet Must be Made or Circled in Red Ink With Date and Name of Person Making Change.

Do not extend this side of this line.

W.S. 67-D-2

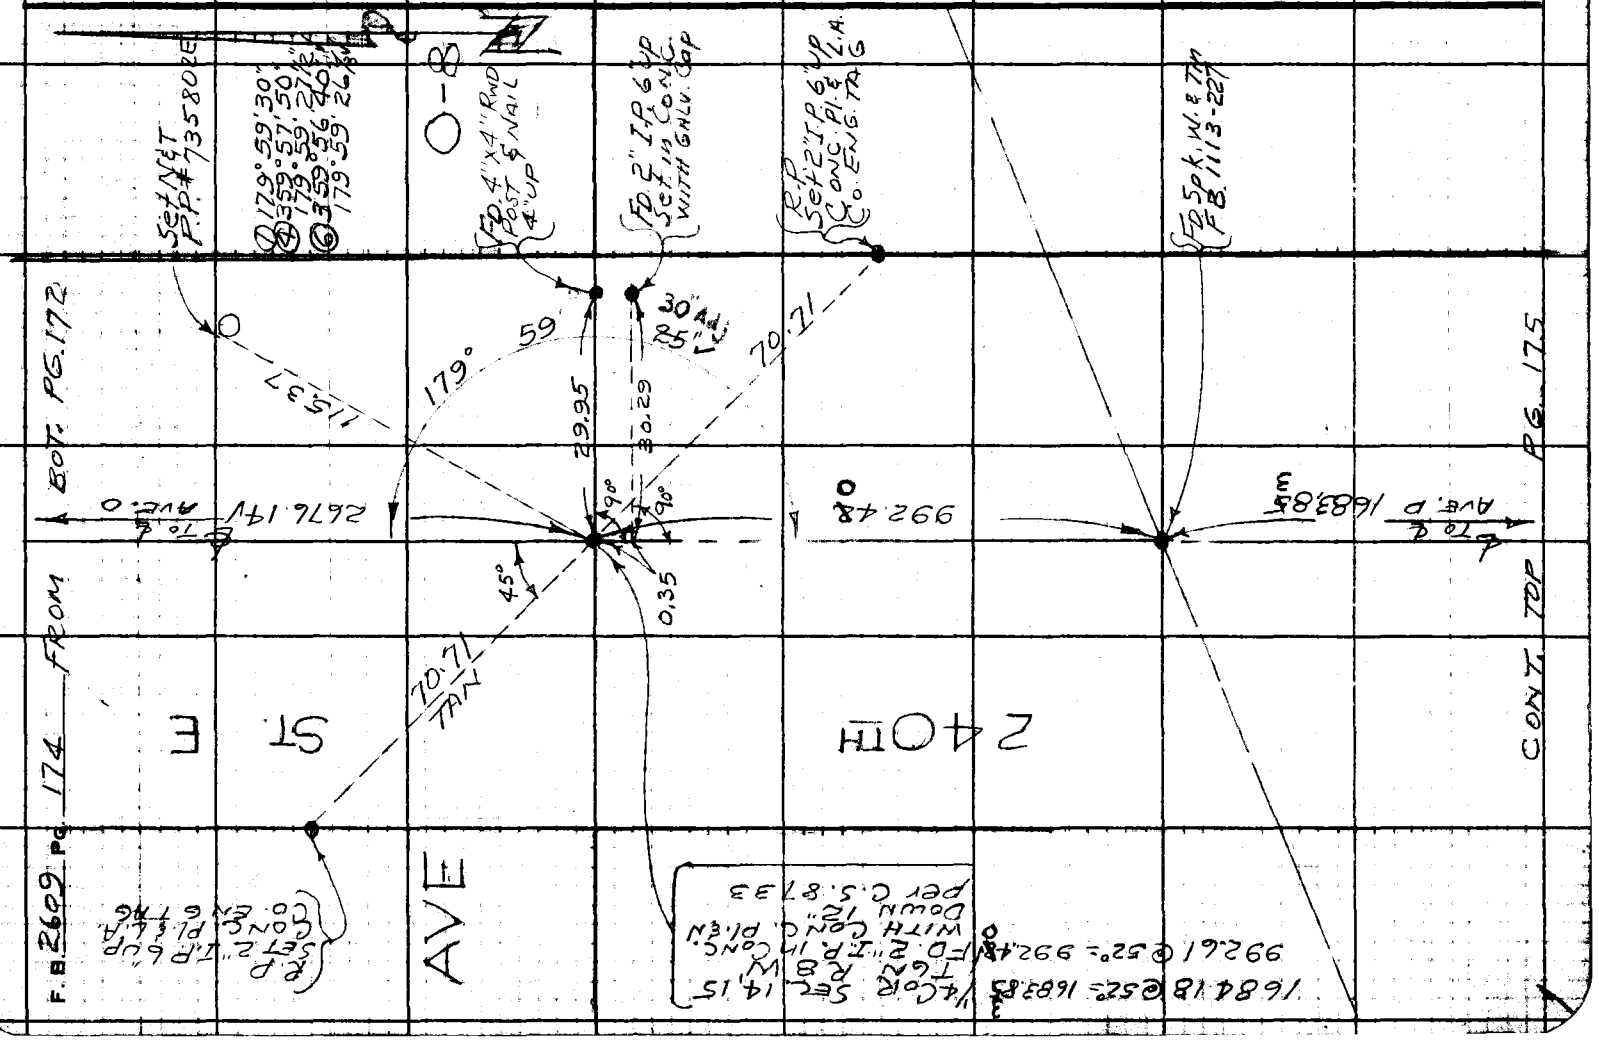

W.S. 67-D-2

Notes Ck'd by W. D. WAGNER
Map No. C.S.B. 2703-1-10
Office Work T. M. PALMIERI
Checked W. D. WAGNER
Date JAN 12 1962

Survey of AVE. O
JN 007585 Tape 101 Std 84 °F
Surveyed by J.S. COATES
Notes J.S.C. Date 12-1-66
Indexed H.E.OD.

F. B. 2609 Pg. 175

FROM BOT. PG. 174

(50) ST. E (50)

℄ To Spk LW

FD. L.A.Co. precise B.M. Brass-Cap mon. in 12"x12" Conc. Post #106-69

1683.85

191.66

① 90° 49' 20"
② 363° 17' 10"
③ 90° 49' 17"
④ 184° 55' 30"
⑤ 90° 49' 18"

RP Set 2"IP 6"up Conc. Pl. & L.A. Co. Eng. Tag

70.71 TAN

45°

Set Spk & W

90° 49' 20"

AVE

P (50) PG. 174

3'

Set Spk & W

3'

℄ To ¼ Cor

2667.03 ℄ 245th St

70.71

CONT. BOT. (50)

240TH

Cor Sec. 14, 15, 22, 23 T1N R8W Fd. C.S. Mon. Down 24" Per C.S. 8733 F.B. 1113-216 Marked

COUNTY SURVEYOR'S MONUMENT T6N R8W 15 14 22 23

R.P. Set 2"I.P. 6"up Conc. Pl. & L.A. Co. Eng. Tag

PLEASE RETURN TO
LOS ANGELES COUNTY ENGINEER
700 Los Angeles County Engineering Bldg.

Note: Any Additions or Changes on This Sheet Must be Made or Circled in Red Ink With Date and Name of Person Making Change.

Do not extend this side of this line.

76F3095 SEE #247 11-58

PLEASE RETURN TO
LOS ANGELES COUNTY ENGINEER
700 LOS ANGELES COUNTY ENGINEERING BLDG.

Note: Any Additions or Changes on This Sheet Must be Made or Circled in Red Ink With Date and Name of Person Making Change.

Do not extend this side of this line.

W.S.67-D-2

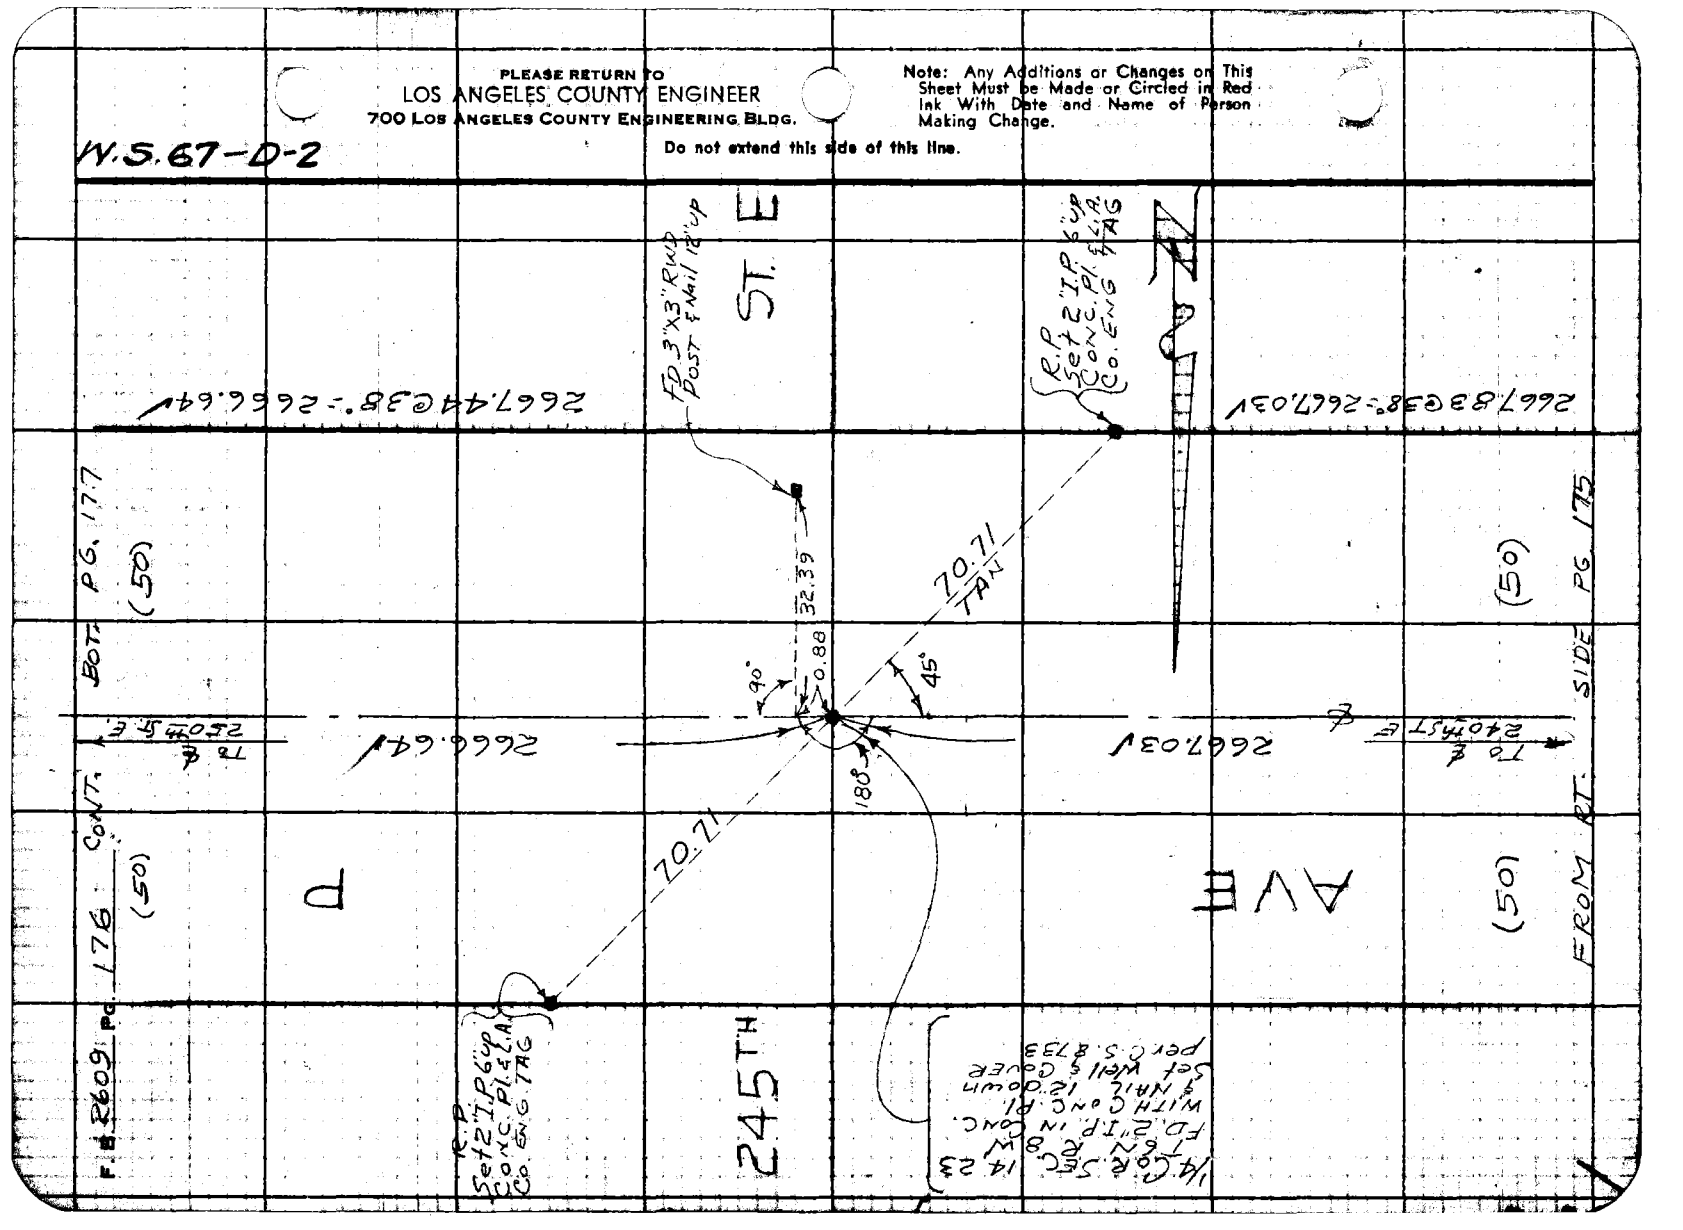

W.S.67-D-2

Notes Ck'd by W. D. WAGNER | Survey of AVE. O
Map No. C.S.B. 2768 1-10 | JN 007505 Tape 101 Std 84 °F
Office Work T.M. PALMERI | Surveyed by J.S. COATES
Checked W. D. WAGNER | Notes JSC Date 12-5-60
Date JAN 12 1962 | Indexed H.E. OTT

F. B. 2602 PG. 179

CONT. BOT. PG. 178

SURVEYOR'S MONUMENT
14 + 23 24

(50) (50)

To 1/4 Cor. @ 2557 ft ±

89°30'50"
358°03'50"
89°30'57½"
177°05'40"
89°30'56⅓"

FD. C.S. #8733
PER C.S. #8733
FD. MKD. #D
FB 1113-214

RP SET 2" I.P. 6" UP CONC. PL. & L.A. CO. ENG. TAG

2661.44

FD. U.S.G.S. BRASS-CAP MON. 12" UP IN 6"x6" CONC. POST MARKED L.S.35 1929

250TH

89° 31' 28" 30.55

70.71 TAN

ST E

184

PG.

(50)

4.45

20.96

To 1/4 COR AVE O-8 = AVE. O Transition

2685.92

CONT. BOT.

25°33'30"

89°

45°

40.88

40'

50"

70.71 TAN

(50)

To ⊕ MOODY

RP SET 2" I.P. 6" UP CONC. PL. & L.A. CO. ENG. TAG

25°33'20"
102°14'20"
25°33'35"
153°21'10"
25°33'31⅓"

89°40'50"
358°43'00"
89°40'45"
178°04'50"
89°40'48⅓"

AVE

2666.64

SET NET (none)

To 1/4 Cor @ 2457 ft ±

(50) (50)

FROM TOP PG. 176

Note: Any Additions or Changes on This Sheet Must be Made or Circled in Red Ink With Date and Name of Person Making Change.

Do not extend this side of this line.

PLEASE RETURN TO
LOS ANGELES COUNTY ENGINEER
700 Los Angeles County Engineering Bldg.

76F3095 SEE #247 11-59

PLEASE RETURN TO
LOS ANGELES COUNTY ENGINEER
700 LOS ANGELES COUNTY ENGINEERING BLDG.

Note: Any Additions or Changes on This Sheet Must be Made or Circled in Red Ink With Date and Name of Person Making Change.

Do not extend this side of this line.

W.S. 67-E-2

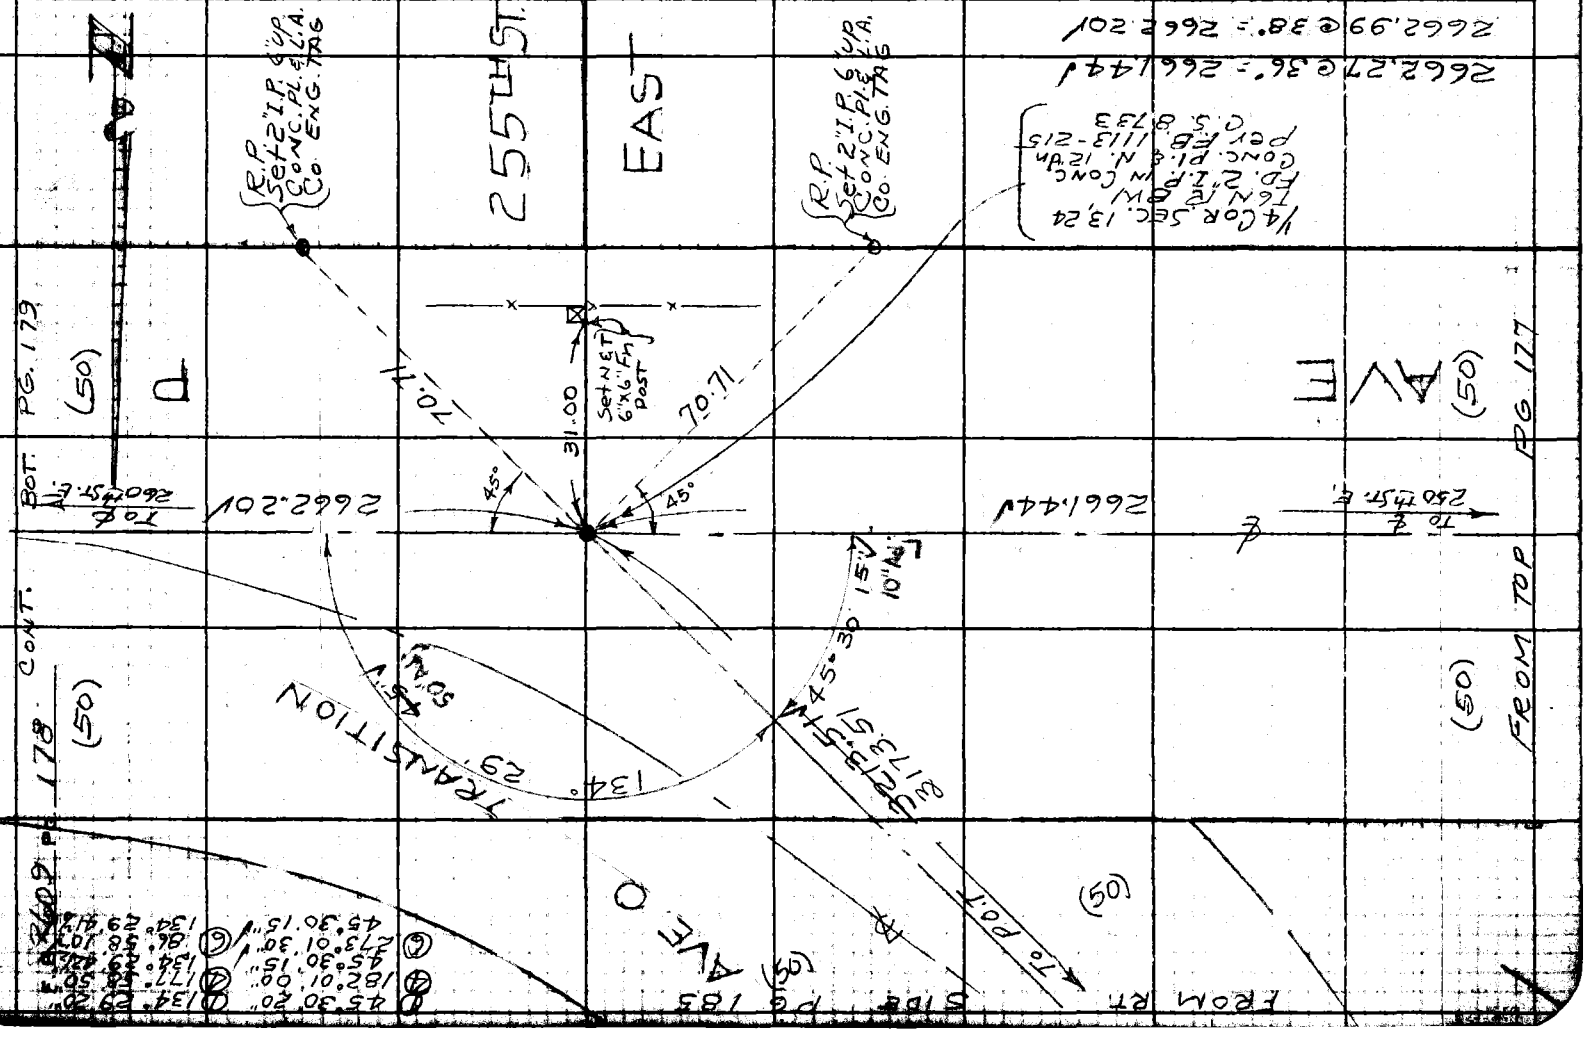

W.S. 67-E-2

Notes Ck'd by W. D. WAGNER
Map No. C.S.B. 2763-1-10
Office Work T. M. PALMIERI
Checked W. D. WAGNER
Date JAN 12 1962

Survey of AVE. Q Transition
JN 0075.96 Tape 84 Std 101 °F
Surveyed by J.S. COATES
Notes J.S.C. Date 12-1-60
Indexed H. E. OTT

F. B. 2609 Pg. 179

CS 9368

Note: Any Additions or Changes on This Sheet Must be Made or Circled in Red Ink With Date and Name of Person Making Change.

Do not extend this line.

PLEASE RETURN TO
LOS ANGELES COUNTY ENGINEER
700 LOS ANGELES COUNTY ENGINEERING BLDG.

76F3098 SBE #247 11-58

260TH ST E

(50) PG. 186

SAN BERNARDINO COUNTY

F.D.G.L.O. Brass-Cap Mon. 12"dn. No Ref. MARKED CS 9368

LAND OFFICE SURVEY
T6N R8W SBM
S13 S18 S19 S24
U.S. GEN'L LAND OFFICE 1924
SET NAIL PP 6821946

To 1/4 Cor 2665.46

0.36

49.98

45° 45°

LOS ANGELES COUNTY

CONT. BDY.

(50)

91° 00'

70.71

70.71

20' Alley

R.P. Set 2" I.P. Flush Conc. Pl. & L.A. Co. Eng. Tag

R.P. Set 2" I.P. & Up Conc. Pl. & L.A. Co. Eng. Tag

91°00'00"
364°00'10"
91°00'02½"
186°00'20"
91°00'03⅓"

2662.20

AVE P

(50) (50)

Cor. Sec. 13, 18, 19, 24
F.D.C.S. Mon. 12"dn.
Per C.S. 8773, 215, 257
MARKED

SURVEYOR'S MONUMENT
COUNTY OF L.A.
S.B. COUNTY
T6N
13 18 19
24

E.C.

To 1/4 Cor Ave. 25th St. E = P1. Ave. Q Transition

FROM TOP PG. 178

PLEASE RETURN TO
LOS ANGELES COUNTY ENGINEER
700 LOS ANGELES COUNTY ENGINEERING BLDG.

Note: Any Additions or Changes on This Sheet Must be Made or Circled in Red Ink With Date and Name of Person Making Change.

Do not extend this side of this line.

W.S.67-D-1

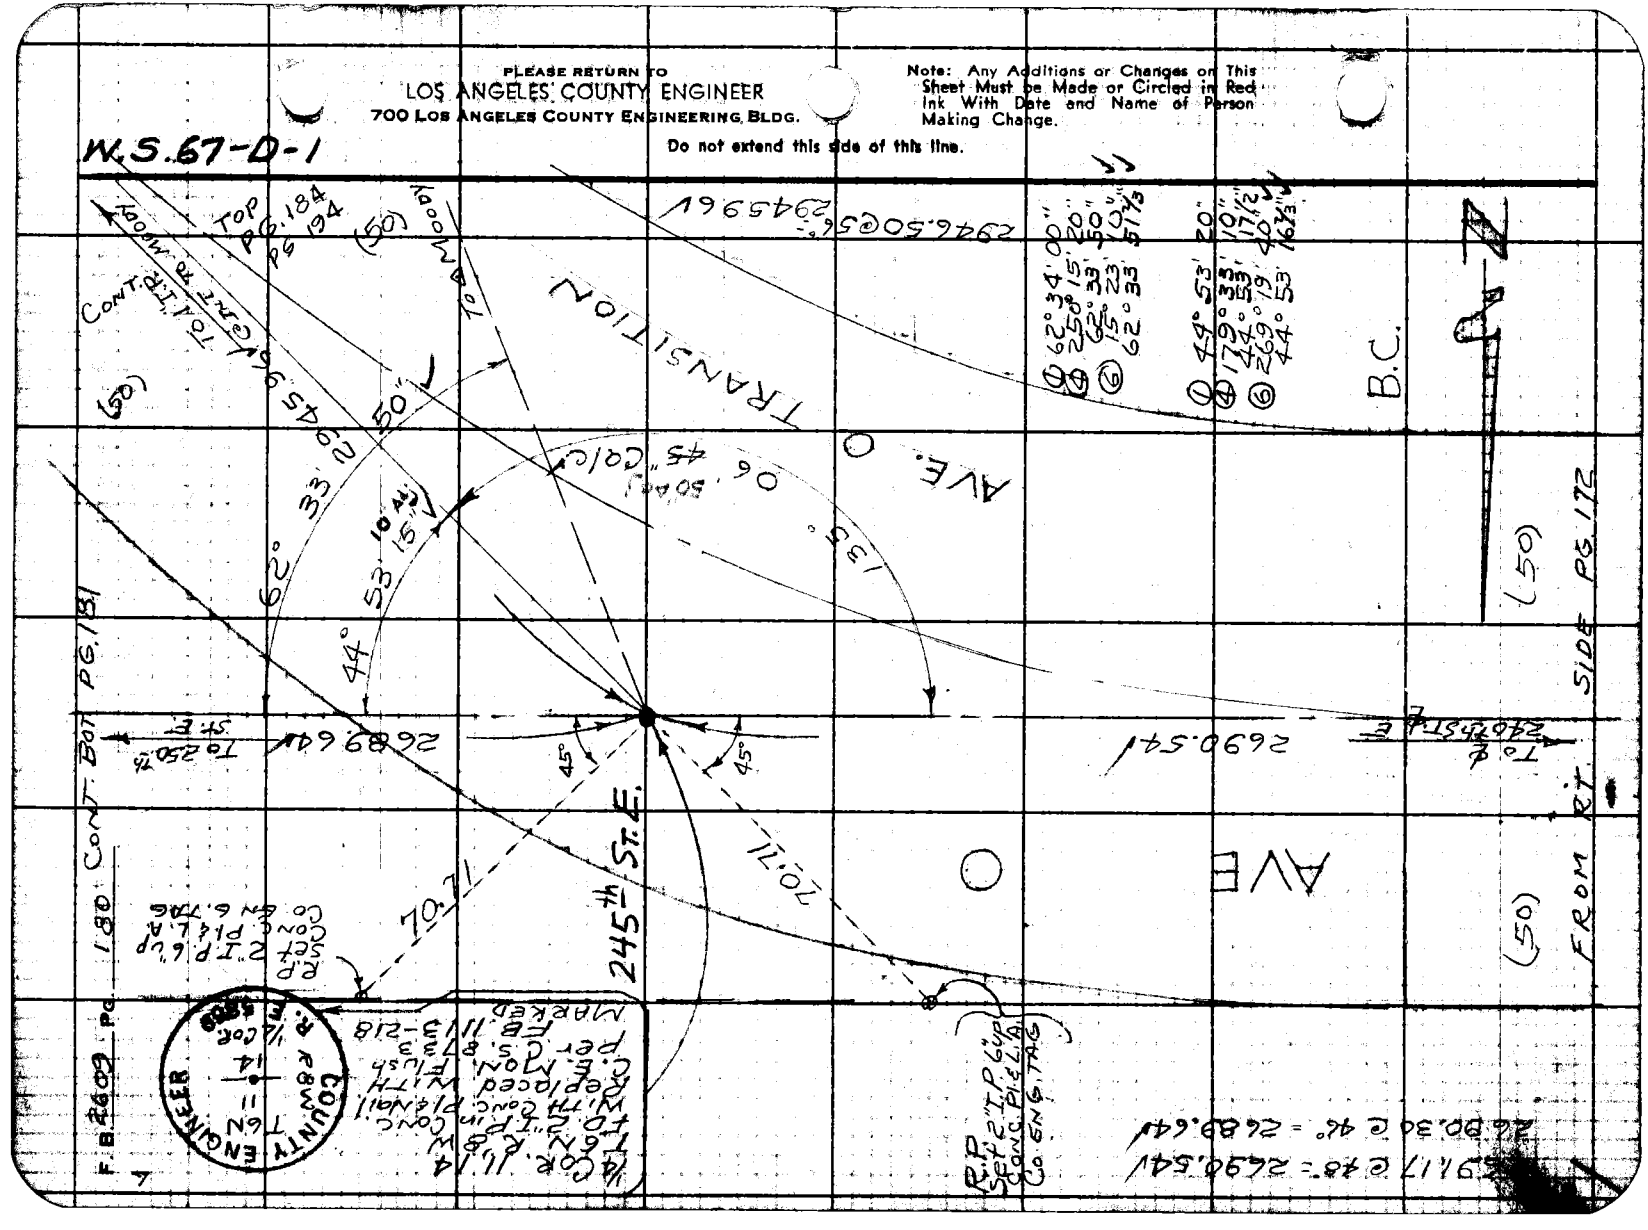

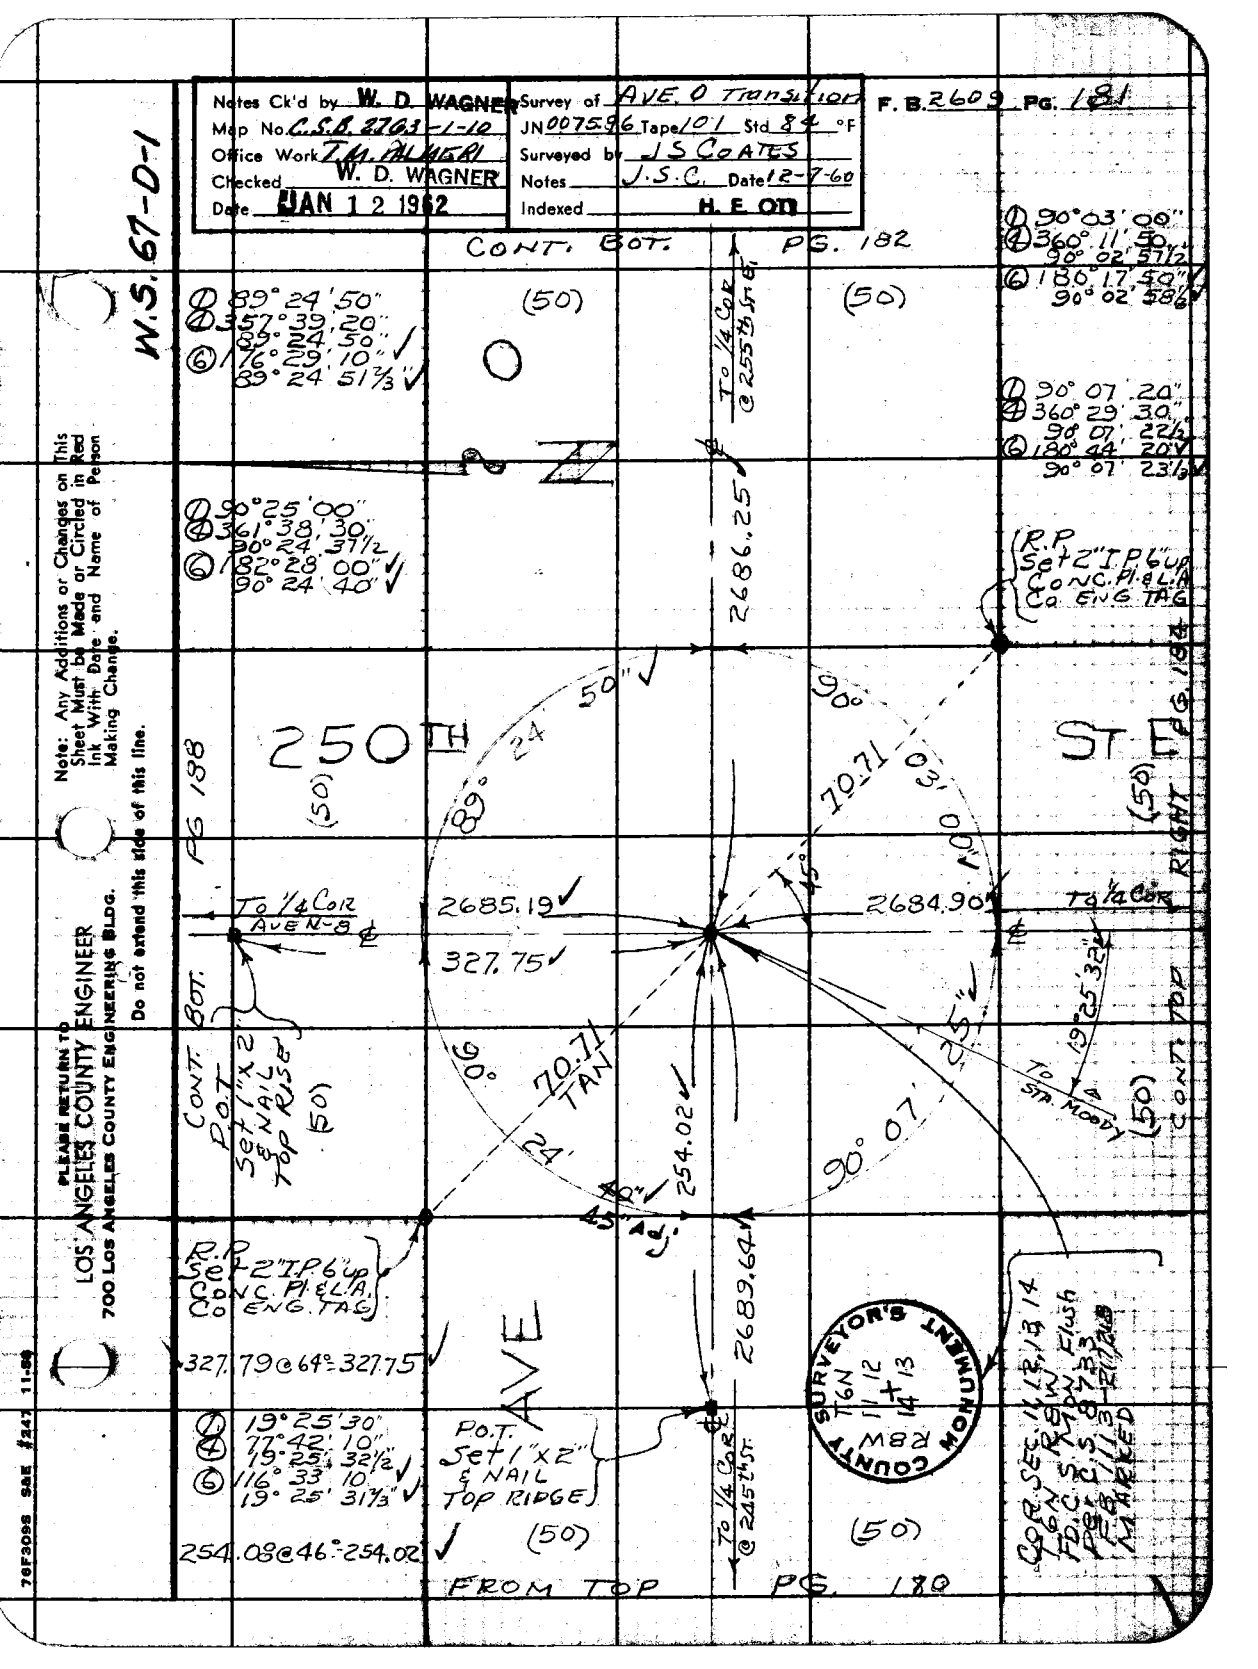
Notes Ck'd by W. D. WAGNER
Map No C.S.B. 2763 -1-10
Office Work T.M. PALMIERI
Checked W. D. WAGNER
Date JAN 12 1962
Survey of AVE. O TRANSITION
JN 007596 Tape 101 Std 84 °F
Surveyed by J.S COATES
Notes J.S.C. Date 12-7-60
Indexed H. E. OTT
F. B. 2609 PG. 181
W.S. 67-D-1
CONT. EOT. PG. 182
89° 24' 50"
357° 39' 20"
89° 24' 50"
176° 29' 10"
89° 24' 51 1/3"
90° 25' 00"
361° 38' 30"
90° 24' 37 1/2"
182° 28' 00"
90° 24' 40"
90° 03' 00"
360° 11' 50"
90° 02' 57 1/2"
180° 17' 40"
90° 02' 58 1/2"
90° 07' 20"
360° 29' 30"
90° 07' 22 1/2"
180° 44' 20"
90° 07' 23 1/2"
(50)
O
To 1/4 Cor @ 255TH ST.
2686.25
R.P. Set 2" I.P 6" up CONC. PI. L.A. Co ENG. TAG
250TH ST E
PG. 184
PG. 188
(50)
RIGHT
To 1/4 Cor AVE N-8
2685.19
327.75
2684.90
To 1/4 Cor
89° 24' 50"
70.71
90°
90° 03' 00"
15°
CONT. BOT.
P.O.T. Set 1"x 2" & NAIL TOP RISER
90° 07' 25"
19° 25' 32"
To STR MON
CONT. TOP
90°
70.71 TAN
24'
254.02
45° 00" Adj.
R.P. Set 2" I.P 6" up CONC. PI. L.A. Co ENG. TAG
327.79 @ 64° = 327.75
19° 25' 30"
77° 42' 10"
19° 25' 32 1/2"
116° 33' 10"
19° 25' 31 1/3"
254.08 @ 46° = 254.02
P.O.T. Set 1"x 2" & NAIL TOP RIDGE
AVE
2689.64
To 1/4 Cor @ 245TH ST.
SURVEYOR'S MONUMENT
T6N 12 11 13 14 R8W
COR. SEC. 11, 12, 13, 14
T6N, R8W, FLUSH
FROM TOP PG. 180
PLEASE RETURN TO
LOS ANGELES COUNTY ENGINEER
700 Los Angeles County Engineering Bldg.
Do not extend this side of this line.
Note: Any Additions or Changes on This Sheet Must be Made or Circled in Red Ink With Date and Name of Person Making Change.
78F3098 SAE #247 11-59

F. B. 2609 Pg. 182 CONT. LEFT SIDE PG. 183

W.S. 67-E-1

LOS ANGELES COUNTY ENGINEER
700 Los Angeles County Engineering Bldg.

PLEASE RETURN TO

Do not extend this side of this line.

Note: Any Additions or Changes on This Sheet Must be Made or Circled in Red Ink With Date and Name of Person Making Change.

(50) (50)

To E 260th St. E.

2686.25

Set B.T. Spk. & W. 24" Joshua

98.32

Set Spk. & W. Top Ridge

R.P. Set 2" I.P. 6" up Conc. Fl. & L.A. Co. Eng. Tag

70.71 N.W.

44.57

Set N&T P.P. 7358 RE

50.42

255TH

ST.

E

45°

70.71

2686.67 @ 60° = 2686.25

R.P. Set 2" I.P. 6" up Conc. Fl. & L.A. Co. Eng. Tag

AVE

2686.25

To E 250th St. E.

(50) (50)

FROM RT. SIDE PG. 181

1/4 Cor. Sec. 12, 13 T6N R8W
No Evidence of Ref. I.P. 8733 Conc. Ref. C.S. Mon. 12" dr. @ Mid. Point Bet. NW. & NE. Cor. Sec. 13 Marked

COUNTY ENGINEER
T6N 12 13 1/4 Cor.
R8W R.E. 3869

W.S.67-E-1

Notes Ck'd by W. D. WAGNER	Survey of AVE. O Transition
Map No. C.S.B. 27 G3 - 1-10	JN 0075.96 Tape 101 Std 84 °F
Office Work T. H. PALMER	Surveyed by J.S. COATES
Checked W. D. WAGNER	Notes J.S.C. Date 12-7-60
Date JAN 12 1962	Indexed H. E. OTT

F. B. 2609 Pg. 183

SURVEY OF T6N R7W SBB&M

COUNTY R.R.W. 12 7 13 18

R.E. 2177

CONT. BOT. PG. 187

(50) ST. E (50)

COUNTY COUNTY

℄ To 1/4 Cor @ AVE N-8

COR. SEC. 12/13/7/18 T6N R7W 1954 ON 15" DIA. FD. C.S.B. PER 1113-218 MARKED

① 90° 34' 50"
② 362° 19' 20"
③ 90° 34' 50"
④ 183° 29' 00"
⑤ 90° 34' 50"

R.P. Set 2" I.P. 6" Up Conc. Pl. & L.A. Co. ENG. TAG

AVE

(50)

PG. 182

FROM TOP

2666.14

34' 50"

70.71

90°

To 1/4 Cor 2686.25

℄ 255th ST. E

45°

45°

89°

70.71

25'

37.76

Set NAT PP #C82166E

578.69

2665.46

85 M

LOS ANGELES 260 IH

SAN BERNARDINO

Set 1" x 6" steel post IN 6" RM

45.62

To 1/4 Cor @ AVE. O-8

Set 5PK&N Top of Ridge

578.83 @ 48° = 578.69

(50) (50)

CONT. TOP PG 186

① 89° 25' 30"
② 357° 41' 40"
③ 89° 25' 25"
④ 176° 32' 30"
⑤ 89° 25' 25"

R.P. Set 2" I.P. 6" Up Conc. Pl. & L.A. Co. ENG. TAG

PLEASE RETURN TO LOS ANGELES COUNTY ENGINEER 700 LOS ANGELES COUNTY ENGINEERING BLDG.

Note: Any Additions or Changes on This Sheet Must be Made or Circled in Red Ink With Date and Name of Person Making Change.

Do not extend this side of this line.

76F3095 SOE #247 11-59

PLEASE RETURN TO
LOS ANGELES COUNTY ENGINEER
700 LOS ANGELES COUNTY ENGINEERING BLDG.

Note: Any Additions or Changes on This Sheet Must be Made or Circled in Red Ink With Date and Name of Person Making Change.

Do not extend this side of this line.

W.S. 67-D-2

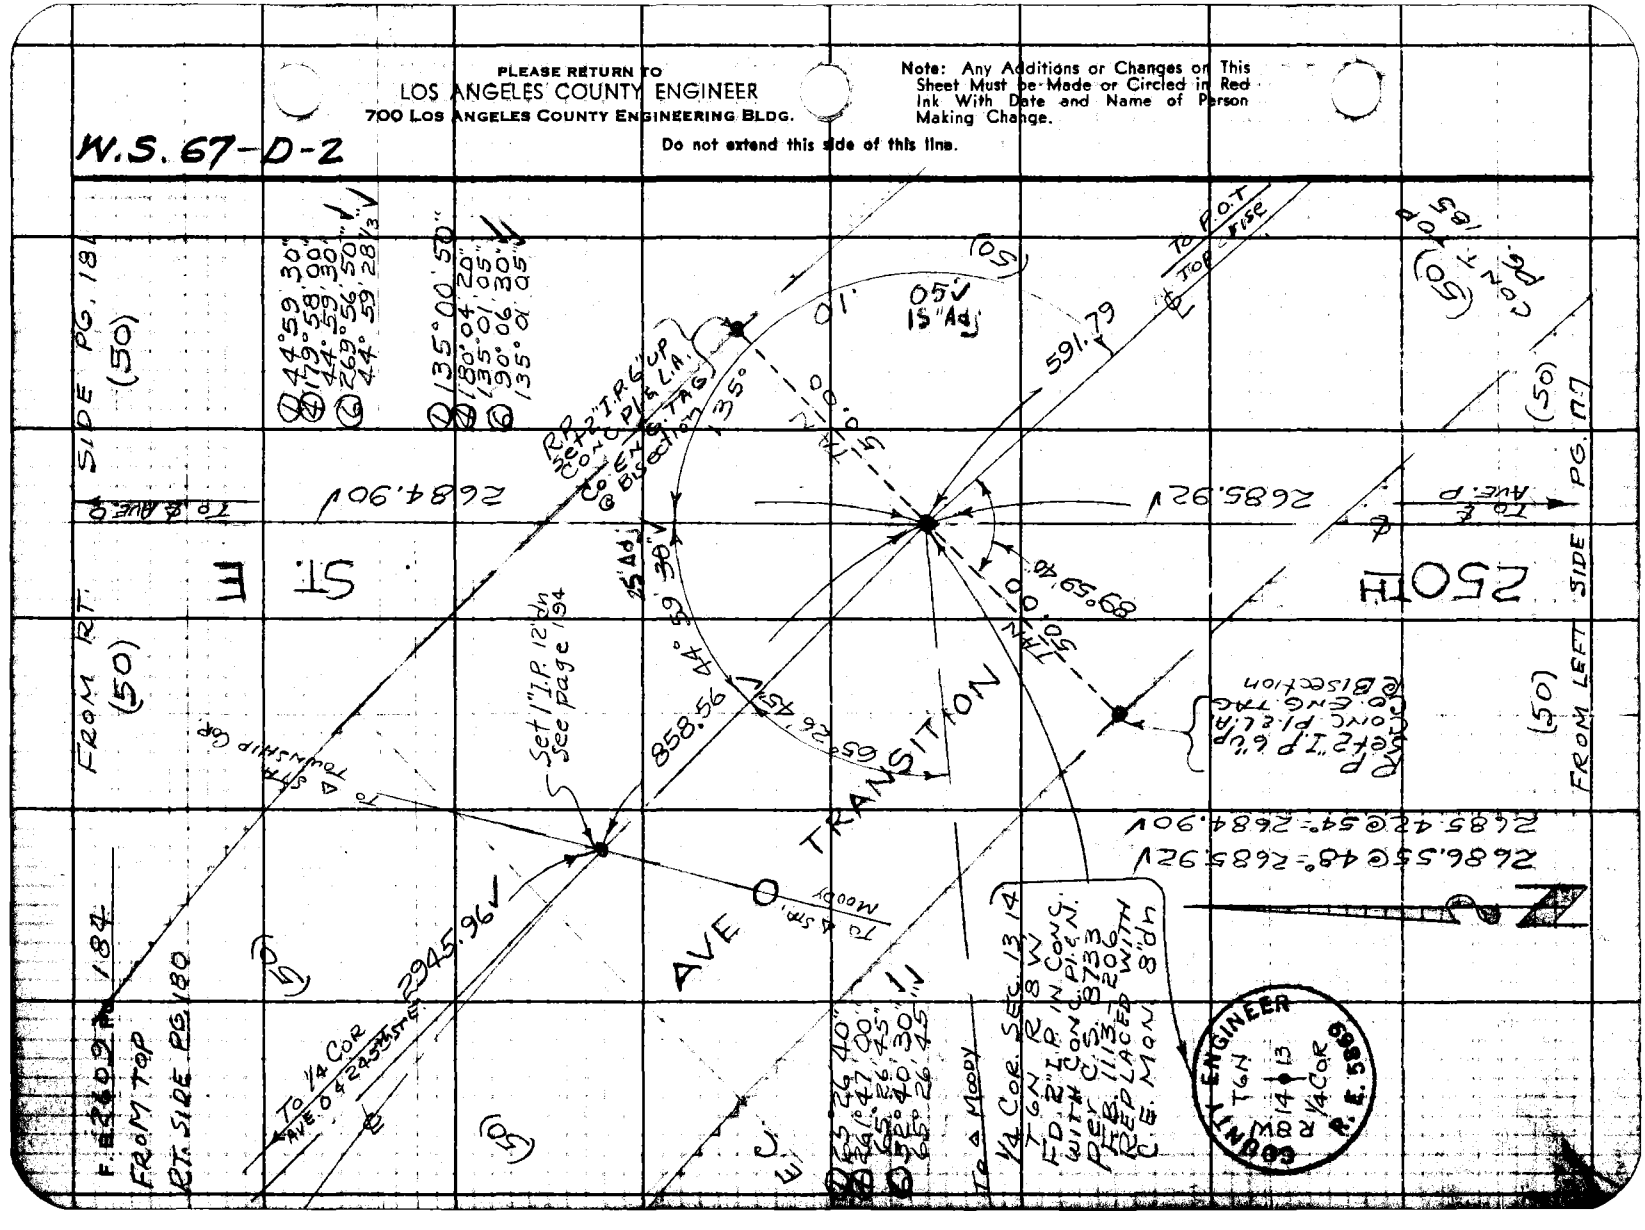
SIDE PG. 184
(50)
FROM RT.
(50)
ST
E
250TH
(50)
FROM LEFT SIDE PG. 184
(50)
AVE O
TRANSITION
591.79
2684.90'
2685.92'
858.56
2945.96'
Set 1" I.P. 12" dn See page 184
Set 2" I.P. & L.P. Conc. Plug & Tag Bo. Eng. Tac Bo. Section
Set 2" IP

Notes Ck'd by	W. D. WAGNER	Survey of	AVE. O Transition
Map No.	C.S.B. 2763-1-10	JN	007596 Tape 101 Std 84 °F
Office Work	T.M. PALMER	Surveyed by	J.S. COATES
Checked	W. D. WAGNER	Notes	J.S.C. Date 12-7-60
Date	JAN 12 1962	Indexed	H. E. OTT

F. B. 2609 Pg. 185

591.89@58° = 591.79 ✓

~~3214.05@58° = 3213.51 ✓~~

3174.05@58° = 3173.51

FROM BOT. RT. SIDE PG 184

(50)

B.C.

N 24° W

To 1/4 Cor. @ 250 ft S/E

℄

P.O.T. SET 1"x2" @ TOP RISE

(50)

59179

AVE. O

TRANSITION

3174.05 = 3173.51

(50)

To 1/4 Cor. Ave. O & 25th St. E.

FROM ℄ AHEAD SIDE PG. 178

Note: Any Additions or Changes on This Sheet Must be Made or Circled in Red Ink With Date and Name of Person Making Change.

Do not extend this side of this line.

PLEASE RETURN TO
LOS ANGELES COUNTY ENGINEER
700 LOS ANGELES COUNTY ENGINEERING BLDG.

76F3095 S&E #247 11-58

PLEASE RETURN TO
LOS ANGELES COUNTY ENGINEER
7100 LOS ANGELES COUNTY ENGINEERING BLDG.

Note: Any Additions or Changes on This Sheet Must be Made or Circled in Red Ink With Date and Name of Person Making Change.

Do not extend this side of this line.

W.S. 67-E-2

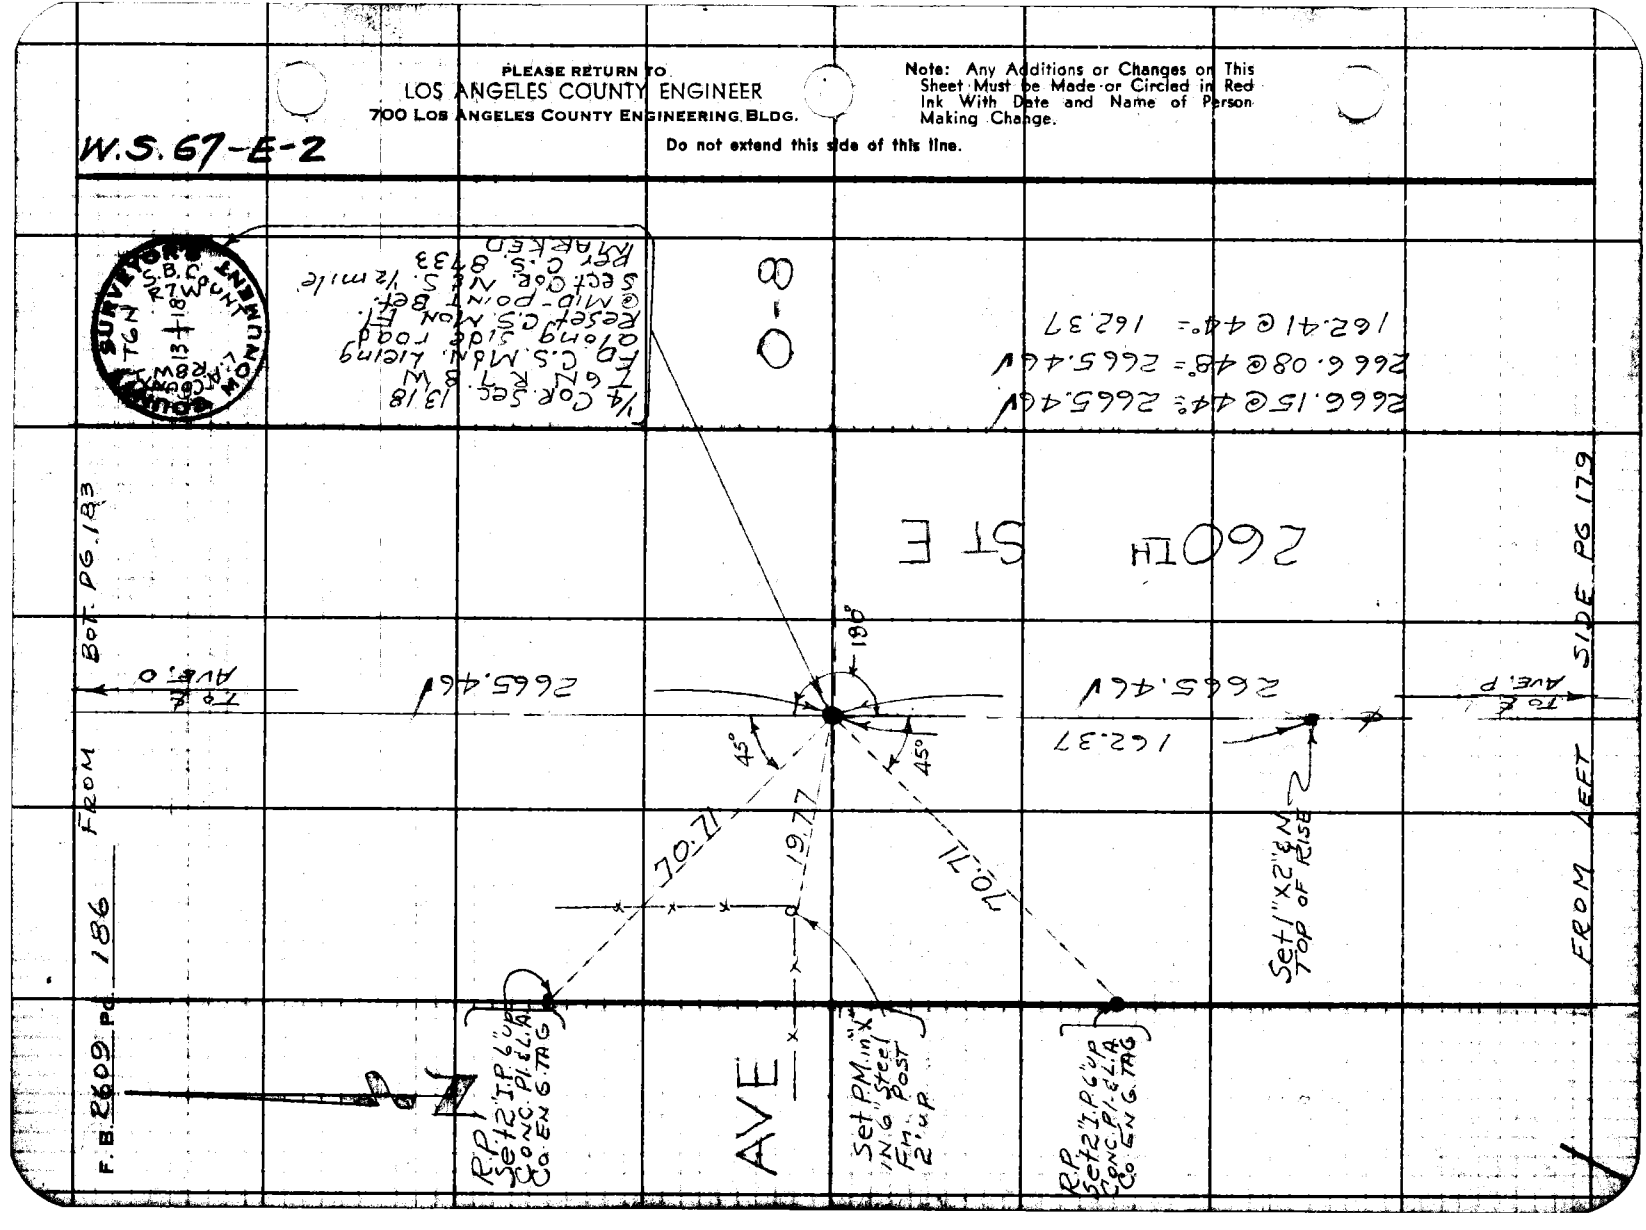

76F3095 S&E #247 11-58

PLEASE RETURN TO
LOS ANGELES COUNTY ENGINEER
700 LOS ANGELES COUNTY ENGINEERING BLDG.

Note: Any Additions or Changes on This Sheet Must be Made or Circled in Red Ink With Date and Name of Person Making Change.

Do not extend this side of this line.

W.S. 67-E-1

Notes Ck'd by W. D. WAGNER
Map No. 2563-1-10
Office Work T.M. PALMER
Checked
Date W. D. WAGNER

Survey of AVE. O Transit Pt.
JN 00795 96 Tape 101 Std. 84 °F
Surveyed by J.S.C. Date 12-7-60
Notes
Indexed H. E. OTT

F. B. 2609 PG. 197

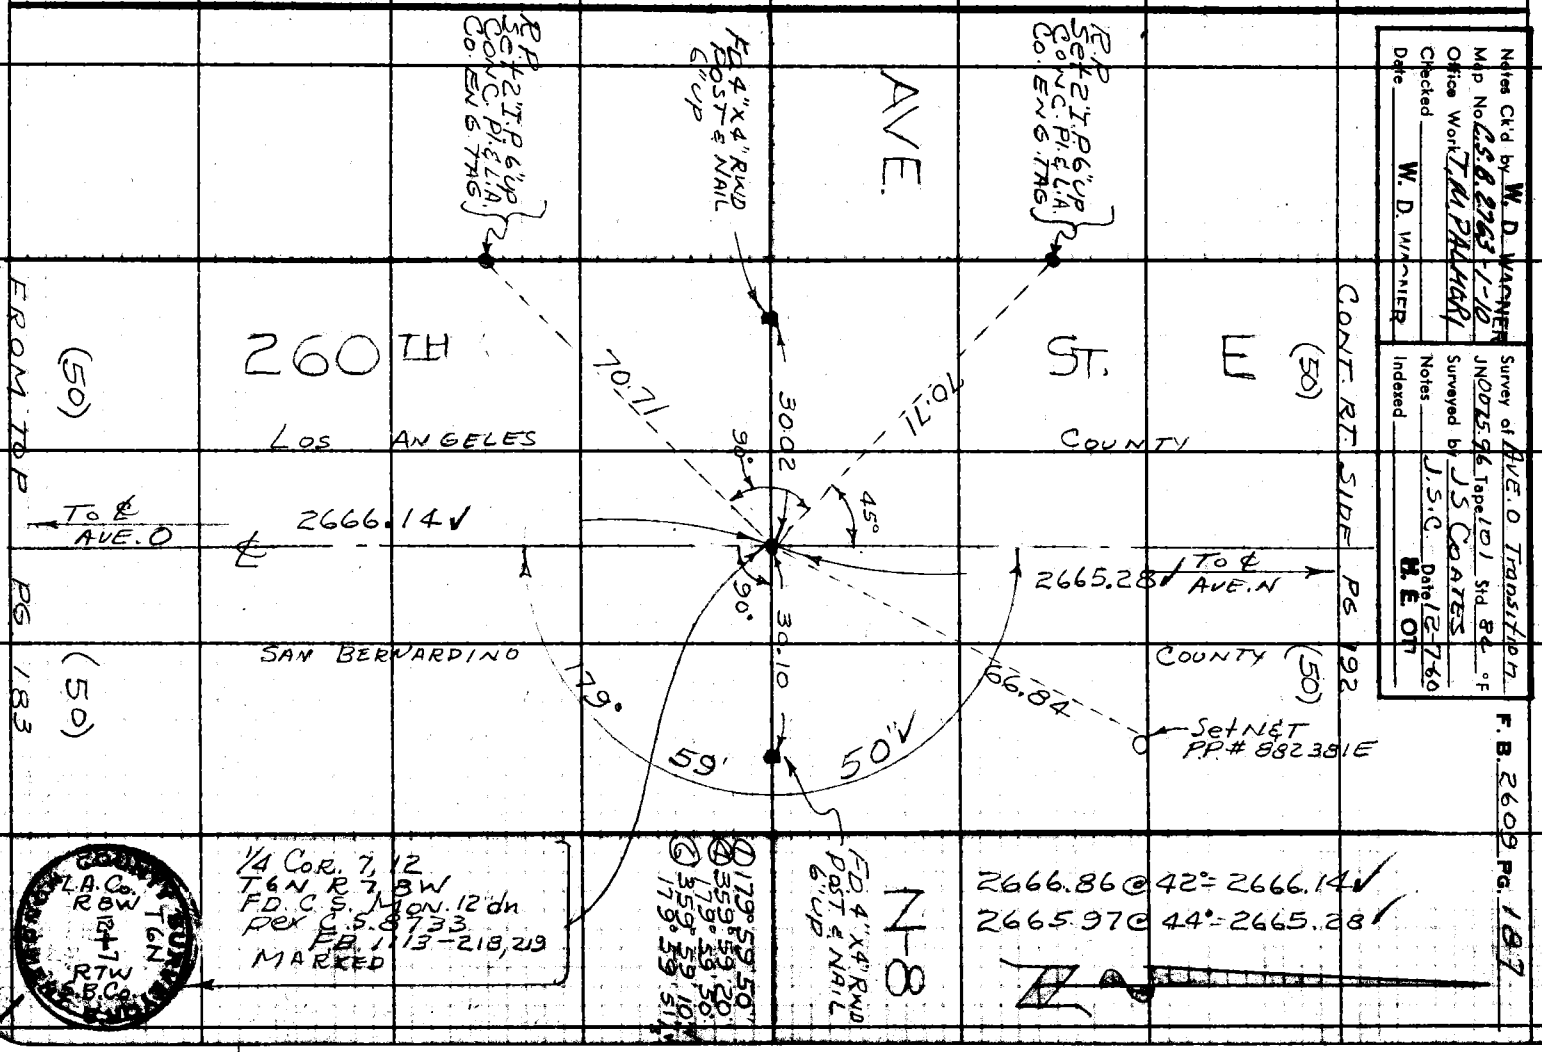

PLEASE RETURN TO
LOS ANGELES COUNTY ENGINEER
700 LOS ANGELES COUNTY ENGINEERING BLDG.

Note: Any Additions or Changes on This Sheet Must be Made or Circled in Red Ink With Date and Name of Person Making Change.

Do not extend this side of this line.

W.S.66-D-1

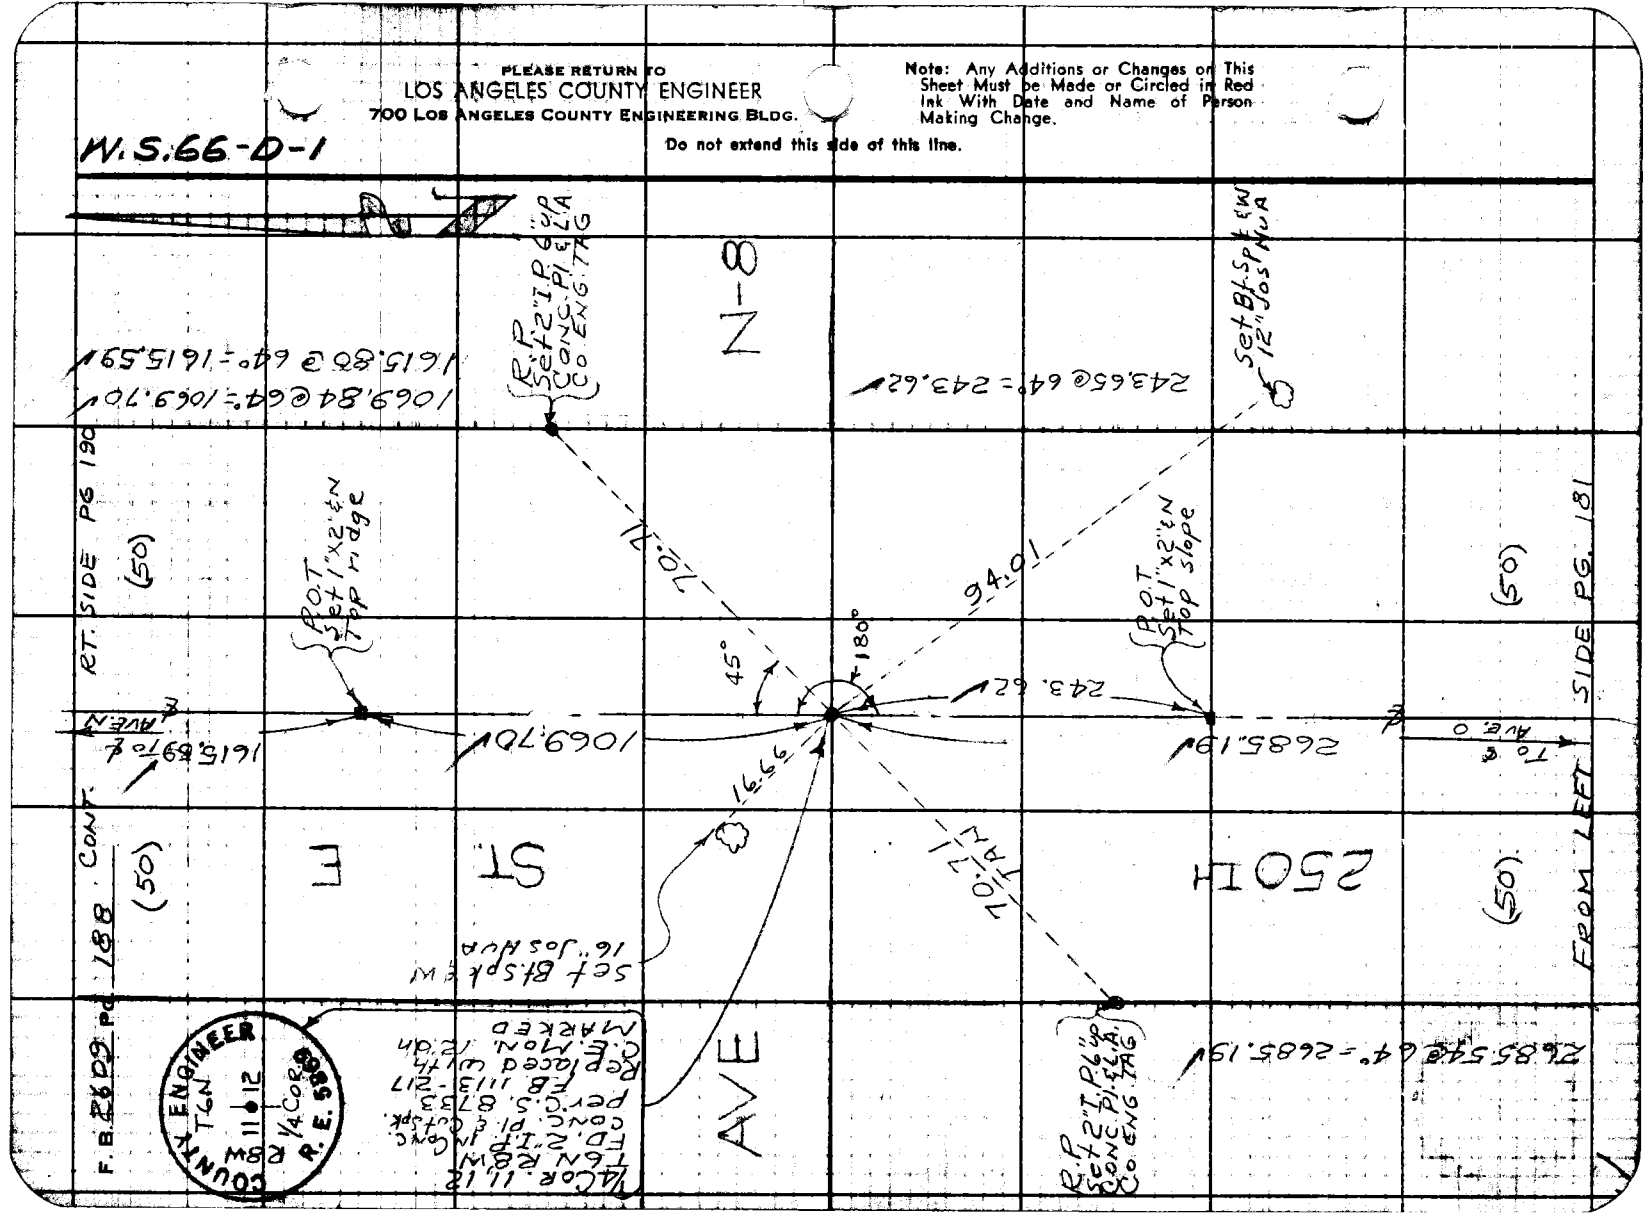

76F3098 S&E #247 11-58

PLEASE RETURN TO
LOS ANGELES COUNTY ENGINEER
700 LOS ANGELES COUNTY ENGINEERING BLDG.

Do not extend this side of this line.

Note: Any Additions or Changes on This Sheet Must be Made or Circled in Red Ink With Date and Name of Person Making Change.

W.5.67-D-1

Notes Ck'd by W. D. WAGNER
Map No. C.S.G. 1968 V-10
Office Work Tim Parker
Checked W. D. WAGNER
Date JAN 12 1962

Survey of AVE. O Transition
JN 007596 Tape 101 Std. 84 °F
Surveyed by J.S.C. & J.S. COATES
Notes
Indexed N. E. ON
Date 12-7-60

F. B. 2603 Pg. 133

AVE N

245 TH ST E

R.P. FD. 2" I.P. 6" UP CONC. P.L. & L.A. CO. ENG. TAG

40.00

per F.B. 2264-51
1042.76

FD. 1"x2" & N FLUSH F.B. 2264-51

(50) FROM RT. SIDE PG. 170

(50) CONT. BOT. PG. 190

To ℄ 240 ths ST E.

2687.47 per F.B. 2264-51

2687.79 per F.B. 2264-50,51

To ℄ 250 ths ST E

40.00

50° 4' 40" 179.59 per F.B. 2264-51

R.P. FD. 2" I.P. 6" UP CONC. P.L. & L.A. CO. ENG. TAG

1/4 COR. SEC 2, 11 T6N R8W FD. C.E. MON. 12dn Rer. F.B. 2264-51 MARKED

COUNTY ENGINEER T6N 2 11 R8W 1/4 Cor. A. E. 5868

STE

PLEASE RETURN TO
LOS ANGELES COUNTY ENGINEER
700 LOS ANGELES COUNTY ENGINEERING BLDG.

Note: Any Additions or Changes on This Sheet Must be Made or Circled in Red Ink With Date and Name of Person Making Change.

Do not extend this side of this line.

W.S. 67-D-1

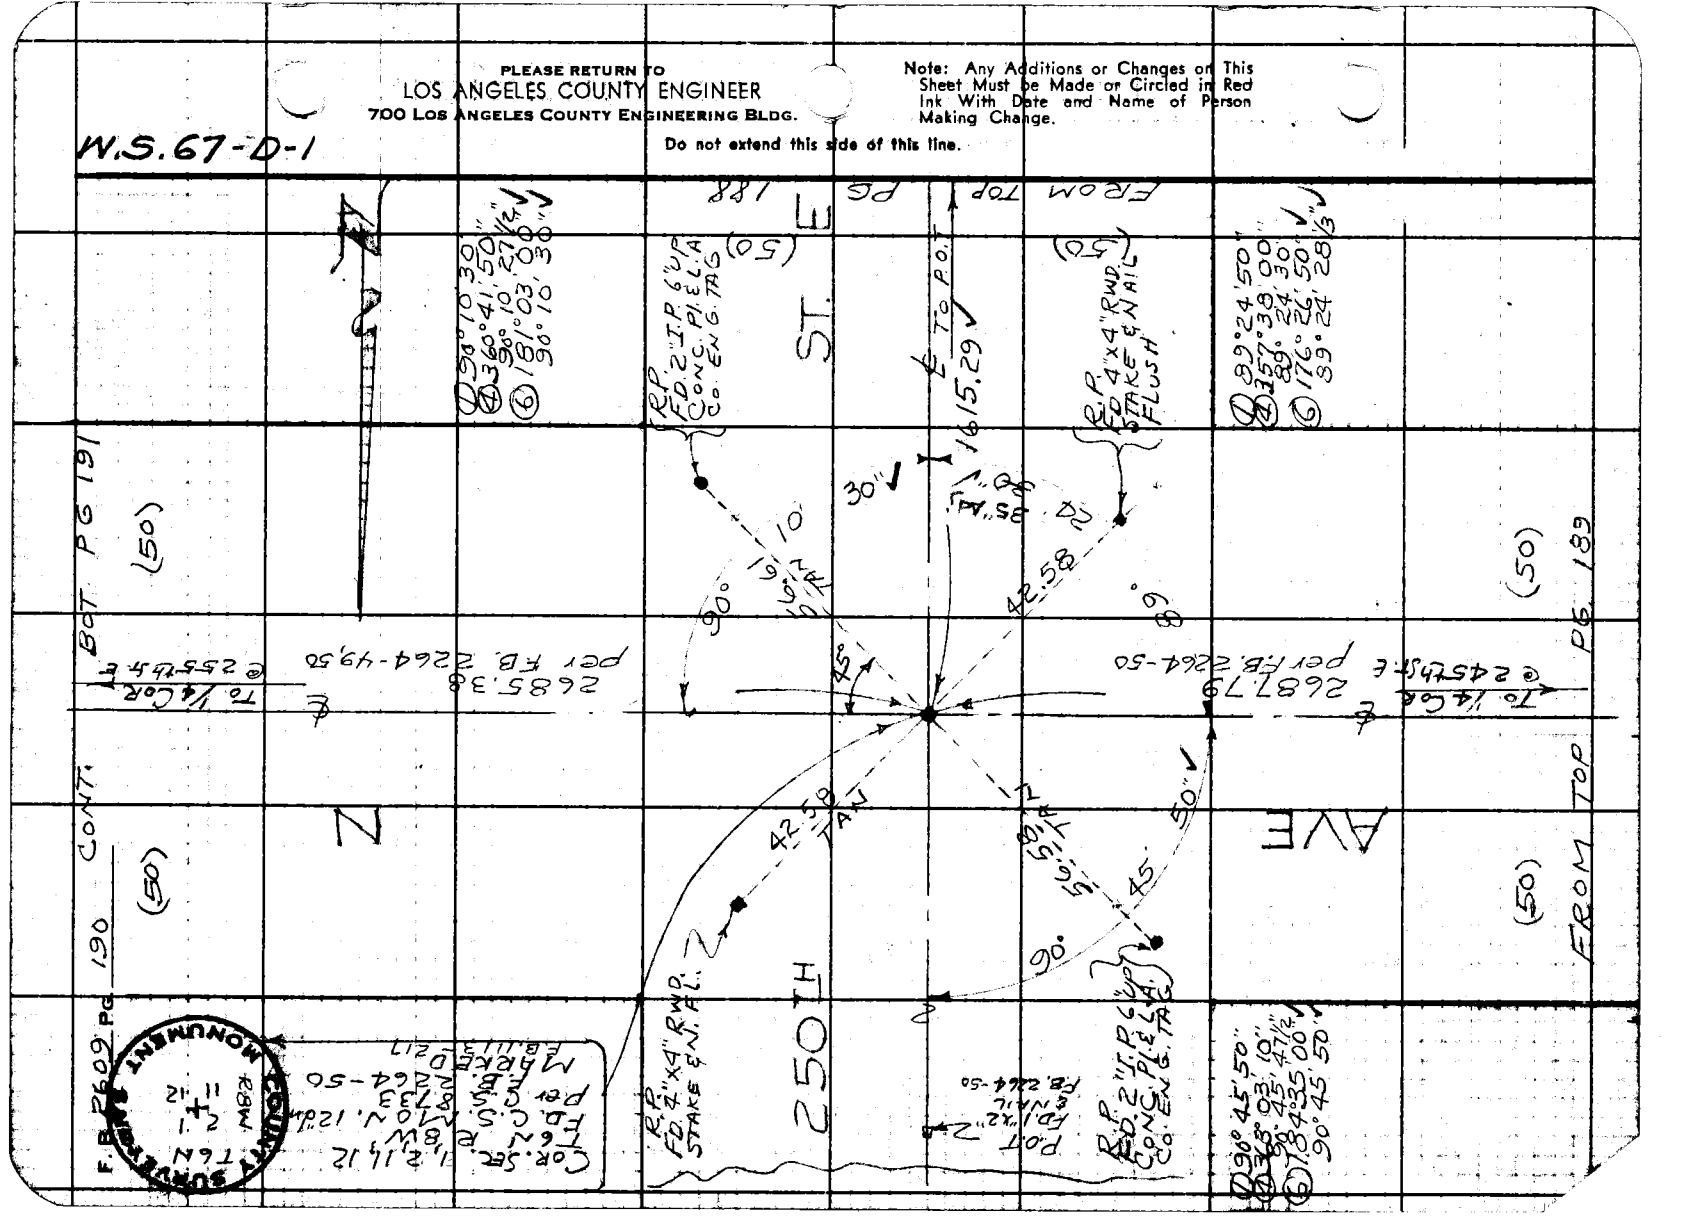

76F3095 S&E #247 11,58

PLEASE RETURN TO
LOS ANGELES COUNTY ENGINEER
700 LOS ANGELES COUNTY ENGINEERING BLDG.

Note: Any Additions or Changes on This Sheet Must be Made or Circled in Red Ink With Date and Name of Person Making Change.

Do not extend this side of this line.

W.S 67-E-1

Notes Ck'd by W. D. WAGNER
Map No. G.S.A. 2102-1-10
Office Work T.H. PALMIERI
Checked W. D. WAGNER
Date JAN 1, 1962

Survey of JN0075 & Topo LO1 Std. 84 °F
Surveyed by J.S.C. COATES
Notes 60
Indexed

























EAST

PLEASE RETURN TO
LOS ANGELES COUNTY ENGINEER
700 LOS ANGELES COUNTY ENGINEERING BLDG.

Note: Any Additions or Changes on This Sheet Must be Made or Circled in Red Ink With Date and Name of Person Making Change.

Do not extend this side of this line.

W.S. 67-E-1

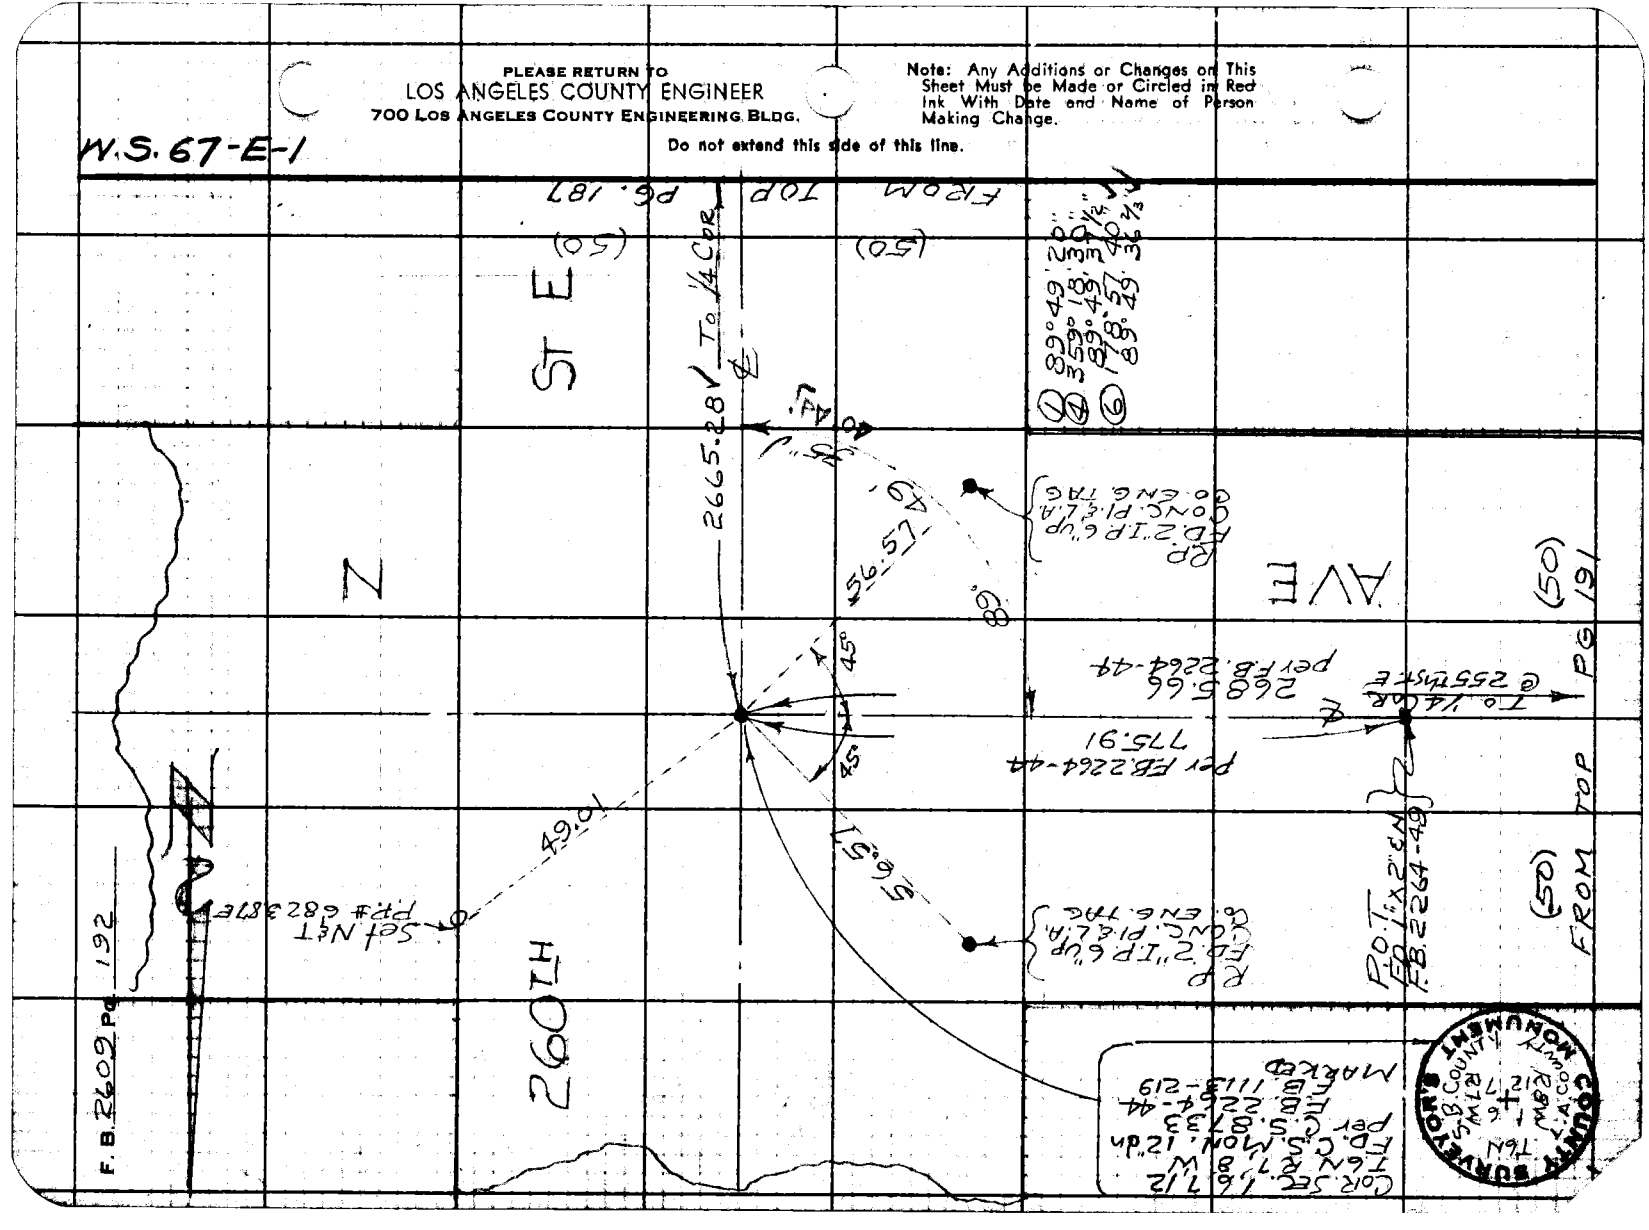

Notes Ck'd by W. D. WAGNER	Survey of AVE O Transition	F. B. 2609	PG. 193
Map No C.S.B. 2761 1-10	JN 0075.96 Tape 101 Std 84 °F		
Office Work T. M. PALMERI	Surveyed by J S COATES		
Checked W. D. WAGNER	Notes JSC Date 2-19-60		
Date JAN 1 2 1962	Indexed H. E. OH		

W.S 67-E-1

SAN BERNARDINO RD

260TH ST E

Triangulation Station
TOWNSHIP CORNER
COR. SEC. 30, 36, 1, 6
T6, 7 N R 7, 8 W
FD. C.S. MON. Flush
per C.S. 8733
FB 2264-
MARKED

64° 55' 40"

SURVEYOR'S MONUMENT
T7N R8W
S.B.B.&M.
T6N R7W
S.B.B.&M.
COUNTY

AVE M

① 64° 55' 50"
② 259° 42' 40"
64° 55' 40"
③ 29° 34' 00"
64° 55' 40"

To ⊕ STA. Moody

¼ Cor. Sec. 1, 36
T6, 7 N R 8W
FD. 2" I.P. in Conc.
6" UP
per C.S. 8733

Note: Any Additions or Changes on This Sheet Must be Made or Circled in Red Ink With Date and Name of Person Making Change.

Do not extend this side of this line.

PLEASE RETURN TO
LOS ANGELES COUNTY ENGINEER
700 LOS ANGELES COUNTY ENGINEERING BLDG.

76F3085 SAE #247 11-58

PLEASE RETURN TO
LOS ANGELES COUNTY ENGINEER
700 LOS ANGELES COUNTY ENGINEERING BLDG.

Note: Any Additions or Changes on This Sheet Must be Made or Circled in Red Ink With Date and Name of Person Making Change.

Do not extend this side of this line.

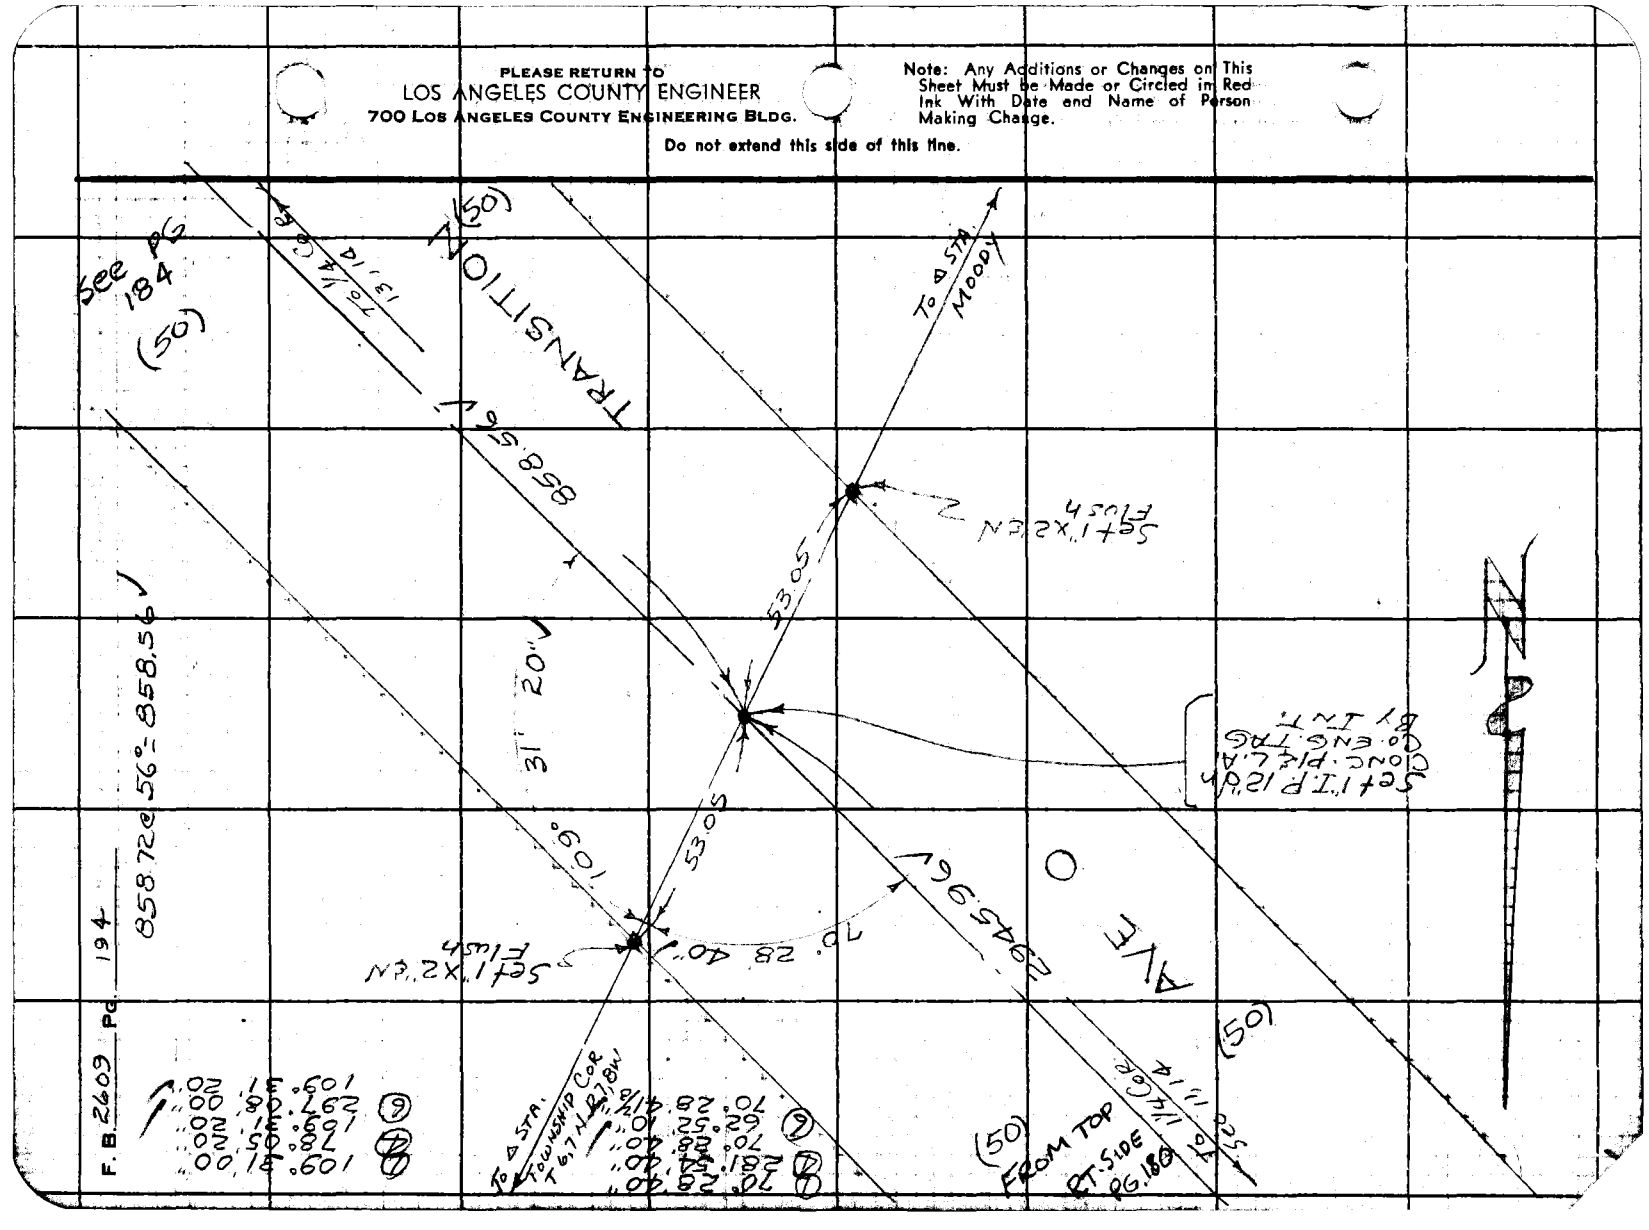

Notes Ck'd by W. D. WAGNER		Survey of AVE. O	F. B. 2609 Pg. 195
Map No. C.S.B. 276 - 1-10		JN 00075.85 Tape 168 Std 84 °F	
Office Work T. M. PALMIERI		Surveyed by J.S COATES	
Checked W. D. WAGNER		Notes J.S.C Date 4-17-61	
Date JAN 12 1962		Indexed H. E. OTT	

W.S. 65-D-1

90° 15' 20"
361° 01' 20"
90° 15' 20"
181° 32' 00"
90° 15' 20" ✓

To N1/4 Cor Sec. 11 See RT. SIDE PG. 132

90° 15' 20" ✓

To 1/4 1/4 Cor 1344.18 ✓

To W1/4 Cor Sec. 11 See RT. SIDE PG. 134

To E1/4 Cor Sec. 11. See LEFT SIDE PG. 141

CTR SEC. 11
T6N R11W
FD. 2" XC & TAG
L.S. 2646
PER R.S. 74-4
AT INTERSECTION
OF 1/4 CORNERS
REPLACED WITH
C.E. MON FLUSH

COUNTY ENGINEER
T6N
R11W
CTR
SEC. 11
R.E. 5869

1344.16 @ 86° = 1344.18 ✓

To S1/4 Cor Sec. 11 See LEFT SIDE PG 138

Note: Any Additions or Changes on This Sheet Must be Made or Circled in Red Ink With Date and Name of Person Making Change.

Do not extend this side of this line.

PLEASE RETURN TO
LOS ANGELES COUNTY ENGINEER
700 LOS ANGELES COUNTY ENGINEERING BLDG.

78F308 SAF. 1247

Notes Ck'd by W. D. WAGNER
Map No. C.S.B. 2263-1-10
Office Work T.M. PALMERI
Checked W. D. WAGNER
Date JAN 12 1962

Survey of AVE. O
JN 00785 Tape 101 Std 84 °F
Surveyed by J S COATES
Notes JSC Date 12-19-60
Indexed JAN 27 61 H. E. OTT

F. B. 2609 PG. 201

J.N 007.85

AVE. O

LOCATION OF IMPROVEMENTS

FROM

30TH ST. E TO 260TH ST. E

COATES
BEERS
HUBBARD
KING
VAN NESS

Note: Any Additions or Changes on This Sheet Must be Made or Circled in Red Ink With Date and Name of Person Making Change.

Do not extend this line off of this line.

PLEASE RETURN TO
LOS ANGELES COUNTY ENGINEER
700 LOS ANGELES COUNTY ENGINEERING BLDG.

76F3098 SAE #342 11-58

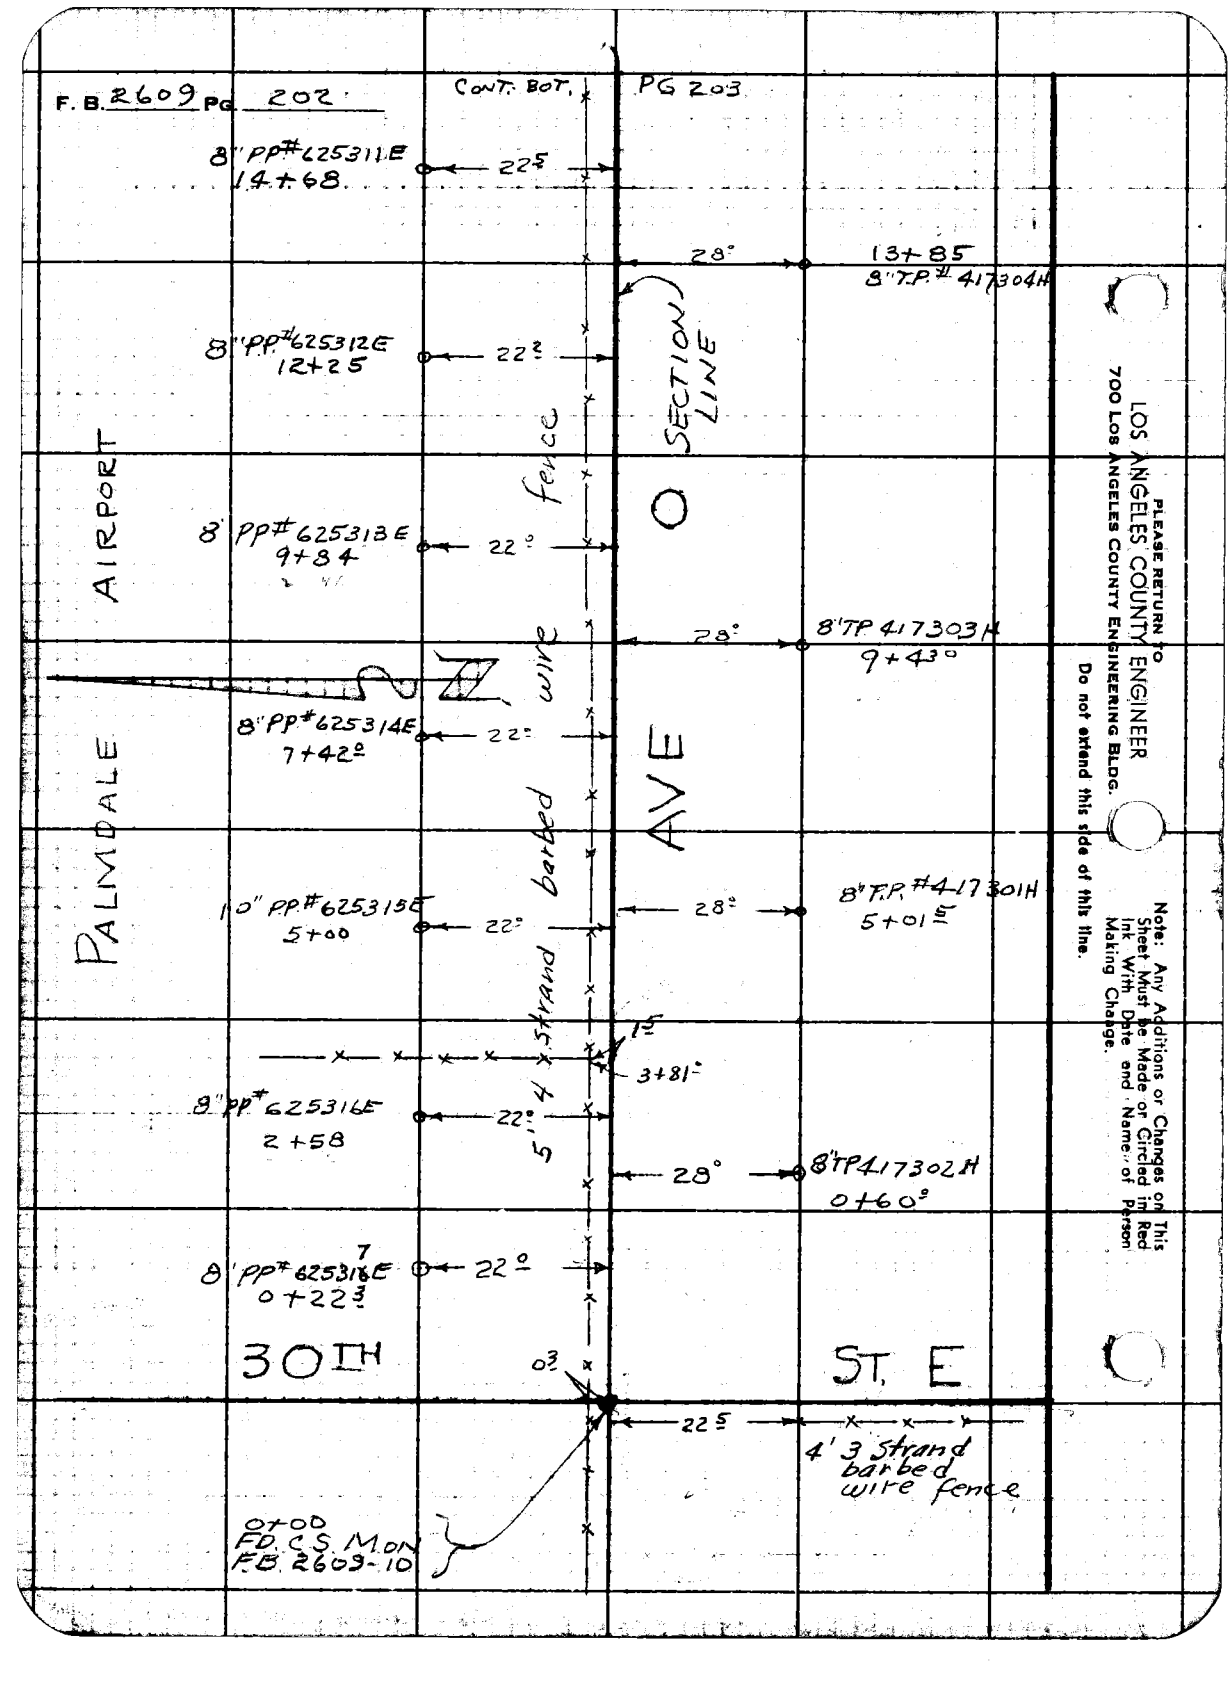
F. B. 2609 Pg 202
CONT. BOT.
PG 203
8" PP# 625311E
14+68
22.5
28'
13+85
8" T.P.# 417304H
8" PP# 625312E
12+25
22.5
SECTION LINE
fence
8' PP# 625313E
9+84
22'
28'
8" TP 417303H
9+43'
wire
8" PP# 625314E
7+42.
22'
AVE
barbed
PALMDALE
10" PP# 625315E
5+00
22'
28'
8" T.P. # 417301H
5+01.5
5 Strand
1.5
3+81'
8" PP# 625316E
2+58
22'
5'
28'
8" TP 417302H
0+60'
8" PP# 625316E
0+22.3
22'
30TH
0.3
ST. E
22.5
4' 3 strand barbed wire fence
0+00
FD. C.S. MON
FB. 2609-10
PLEASE RETURN TO
LOS ANGELES COUNTY ENGINEER
700 Los Angeles County Engineering Bldg.
Do not extend this side of this line.
Note: Any Additions or Changes on This Sheet Must be Made or Circled in Red Ink With Date and Name of Person Making Change.

Notes Ck'd by W. D. WAGNER | Survey of AVE. O | F. B. 2609 Pg. 203
Map No. C.S.B. 2703-1-10 | JN 0075 | Tape | Std | °F
Office Work T.M. PALMER | Surveyed by JSC
Checked W. D. WAGNER | Notes JSC Date 12-20-66
Date JAN 12 1962 | Indexed H. E. OTT

Note: Any Additions or Changes on This Sheet Must be Made or Circled in Red Ink With Date and Name of Person Making Change.

Do not extend this line of this line.

PLEASE RETURN TO
LOS ANGELES COUNTY ENGINEER
700 Los Angeles County Engineering Bldg.

28+83
10" Locust
37.5
10" PP# 625198E
28+71
22°
12" Locust
28+67
37.5
CONT. BOT. PG 204
4' 3 strand barbed wire fence
26+81.7
1/4 COR
F.D. C.S. MON
F.B. 2609-13
10" PP# 625199E
26+78
28°
6" TP# 417307H
27+06.3
19°
12'
26+82.5
35TH ST E
22°
26+59°
20
15°
3" Elm
6" Elm
6" Elm
33.5
26.4
32.4
26+78°
Anchor Pole
#625200E
deadman
26+71°
8" PP# 625307E
24+36.0
22°
SECTION LINE
28°
8" TP# 417306H
22+64.8
8" PP# 625308E
21+93.5
22
AVE O
8" PP# 625309
19+51.5
22.5
4' 3 Strand barbed wire fence
18+96.4
12" Conc. Irr. Standpipe
48°
7.5
18+81.8
FD. 2" I.P.
F.B. 2609-10
18+81.8
30.2
18+67.0
5' 4 Strand barbed Wire Fn
28°
6" TP# 417305H
18+22.5
8" PP# 625310
17+08
22.6
FROM TOP
PG. 202

76F3095 S&E #247 11-58

F. B. 2609 Pg. 204

CONT. BOT.

PG. 205

34+79 ± 39°
24" Locust

10" PP # 625196 E 33+46 ± 22°

18" Locust 39°
33+41 ±

SECTION LINE

18" Locust 35°
32+68 ±

24" Locust 40°
32+16 ±

12" Locust 39 ±
31+97 ±

16" Locust 39 ±
31+57 ±

16" Locust 40 ±
31+30 ±

28°

6" T.P. # 417308H
31+48 ±

wire fence

31+08 22°
12" PP # 625197E

AVE O

31°

12" Locust 40°
30+86 ±

12" Locust 41° 30+74

24" Locust 34 ± 30+54 ±

4" 3 Strand barbed

12" Locust 38 30+24 ±

6" Locusts 37 ± 30+11

2 ±

10" Locust 40 ± 29+91

35 ± 29+90

8" Locust 35 ± 29+85

40 ± 29+83

FROM TOP PG 203

PLEASE RETURN TO
LOS ANGELES COUNTY ENGINEER
700 Los Angeles County Engineering Bldg.
Do not extend this side of this line.

Note: Any Additions or Changes on This Sheet Must Be Made or Circled in Red Ink With Date and Name of Person Making Change.

Notes Ck'd by W. D. WAGNER
Map No. C.S.B. 2.76 1-1-10
Office Work T. M. PALMERI
Checked W. D. WAGNER
Date JAN 12 1962

Survey of AVE. O
JN 0075.8 S Tape ____ Std ____ °F
Surveyed by J S COATES
Notes JSC Date 12-20-60
Indexed W. E. OTT

F. B. 2609 PG. 205

CONT. BOT. PG. 206

Note: Any Additions or Changes on This Sheet Must be Made or Circled in Red Ink With Date and Name of Person Making Change.

Do not extend this side of this line.

PLEASE RETURN TO LOS ANGELES COUNTY ENGINEER 700 LOS ANGELES COUNTY ENGINEERING BLDG.

76F3095 SSE #247 11-60

38⁹ — 29° — 38+51.1

8" Locust — 36.8 — 38+28.5

10" P.P. #146526E — 24.2 — 38+17.2

4' 4 Strand barbed wire fn

4' Locust — 30° — 38+07.2

8" Locust — 35.3 — 38+02

12" Locust — 39.5 — 37+95.3

SECTION LINE

8" Locust — 38.2 — 37+54.2

3" Locust — 43.3 — 37+48.0

4' 4 Strand barbed wire fn

6" Locust — 37.8 — 37+23.0

3/4" Riser

5' board rail fence — 37+14 — 69.0 — 30° — 37+18.6

30.2 — 37+13.2 Steel water tank 18" high 10' Dia.

15" Locust — 36.8 — 37+08.2

3-6" Locust — 40.5 — 36+93.0

6" Locust — 33.2 — 36+87.5

10" Locusts — 31.2 — 36+74.5

39.2 — 36+69.5

4' 3 Strands barbed wire & board fence

65.0 — 30.3 — 36+44.0

38⁹ — 36+00

28.5 — 6" T.P. # 417309H 35+89.5

10" P.P. # 625195E 35+84 — 20.5

FROM TOP PG. 204

F. B. 2609 Pg. 206

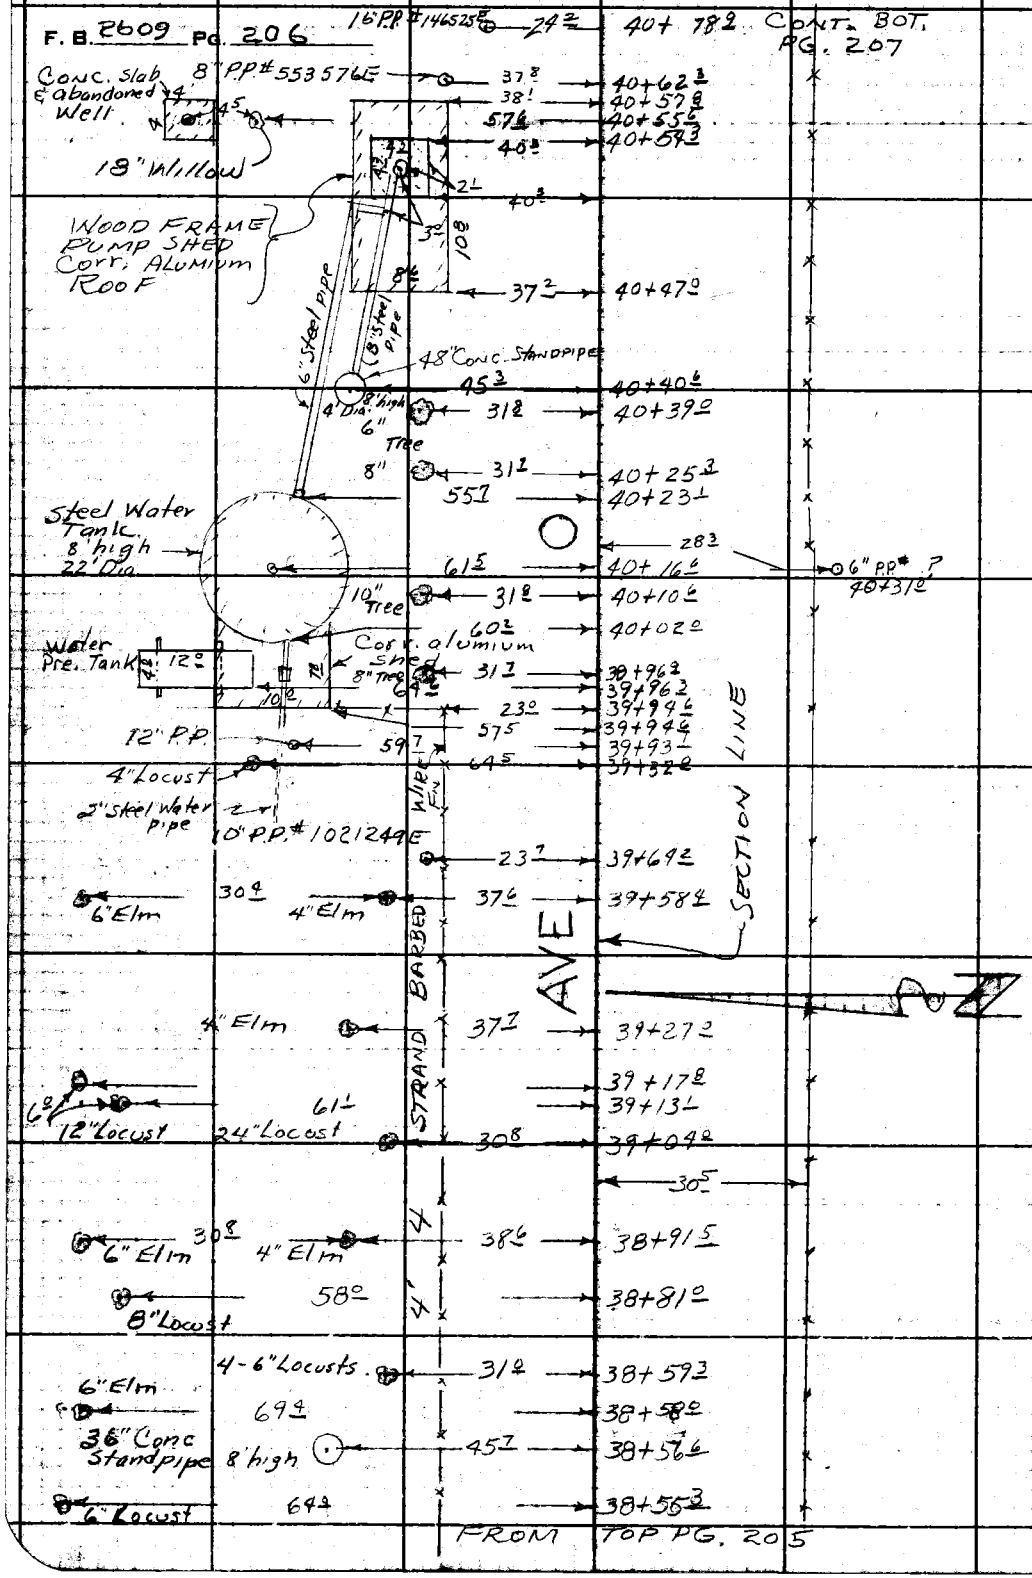

PLEASE RETURN TO
LOS ANGELES COUNTY ENGINEER
700 Los Angeles County Engineering Bldg.

Do not extend this side of this line.

Note: Any Additions or Changes on This Sheet Must be Made or Circled in Red Ink With Date and Name of Person Making Change.

Notes Ck'd by W. D. WAGNER | Survey of AVE. O | F. B. 2609 PG. 207
Map No. C.S.A. 2768-1-10 | JN 0075.55 Tape Std °F
Office Work T. M. PALMIERI | Surveyed by J.S. COATES
Checked W. D. WAGNER | Notes J.S.C. Date 12-21-60
Date JAN 12 1962 | Indexed M. E. ON.

edge pav'g | CONT. | BOT. PG. 208

40TH

53+77.6

53+65 | 12° | 10.3 | ℄ ST E

53+65.00 F.D. C.S. Mon F.B. 2609-14

edge pav't

53+59.7

16" PP# 1061661E
53+39.6 — 20.1 — 28.6 — 10" T.P.# 417813H 53+39.6 #0 Deal Man 2.3S

4' 4 strand barbed wire fn

53+38.8 — 30.1

Stand pipe 30" Dia 4' High — 45.8 — 53+08.6

O

10" PP. #826113E — 20.9 — 51+18.4

49+11.2 — 28.8 — TP# 417812H

8" PP# 146522E — 21.4 — 48+60.3

AVE O

SECTION LINE

ALFALFA HAY FIELD

4' 4 strand barbed wire fence

8" PP# 146523E — 21.4 — 46+00.6

44+74.0 — 28.4 — 6" T.P.# 417311H

8" PP# 146524E — 23.1 — 43+40.2

43+00 — 30.5

FROM TOP PG. 206

Note: Any Additions or Changes on this Sheet Must be Made or Circled in Red Ink With Date and Name of Person Making Change.

Do not extend this side of this line.

PLEASE RETURN TO
LOS ANGELES COUNTY ENGINEER
700 Los Angeles County Engineering Bldg.

F. B. 2609 Pg. 208

CONT. BOT. PG 209

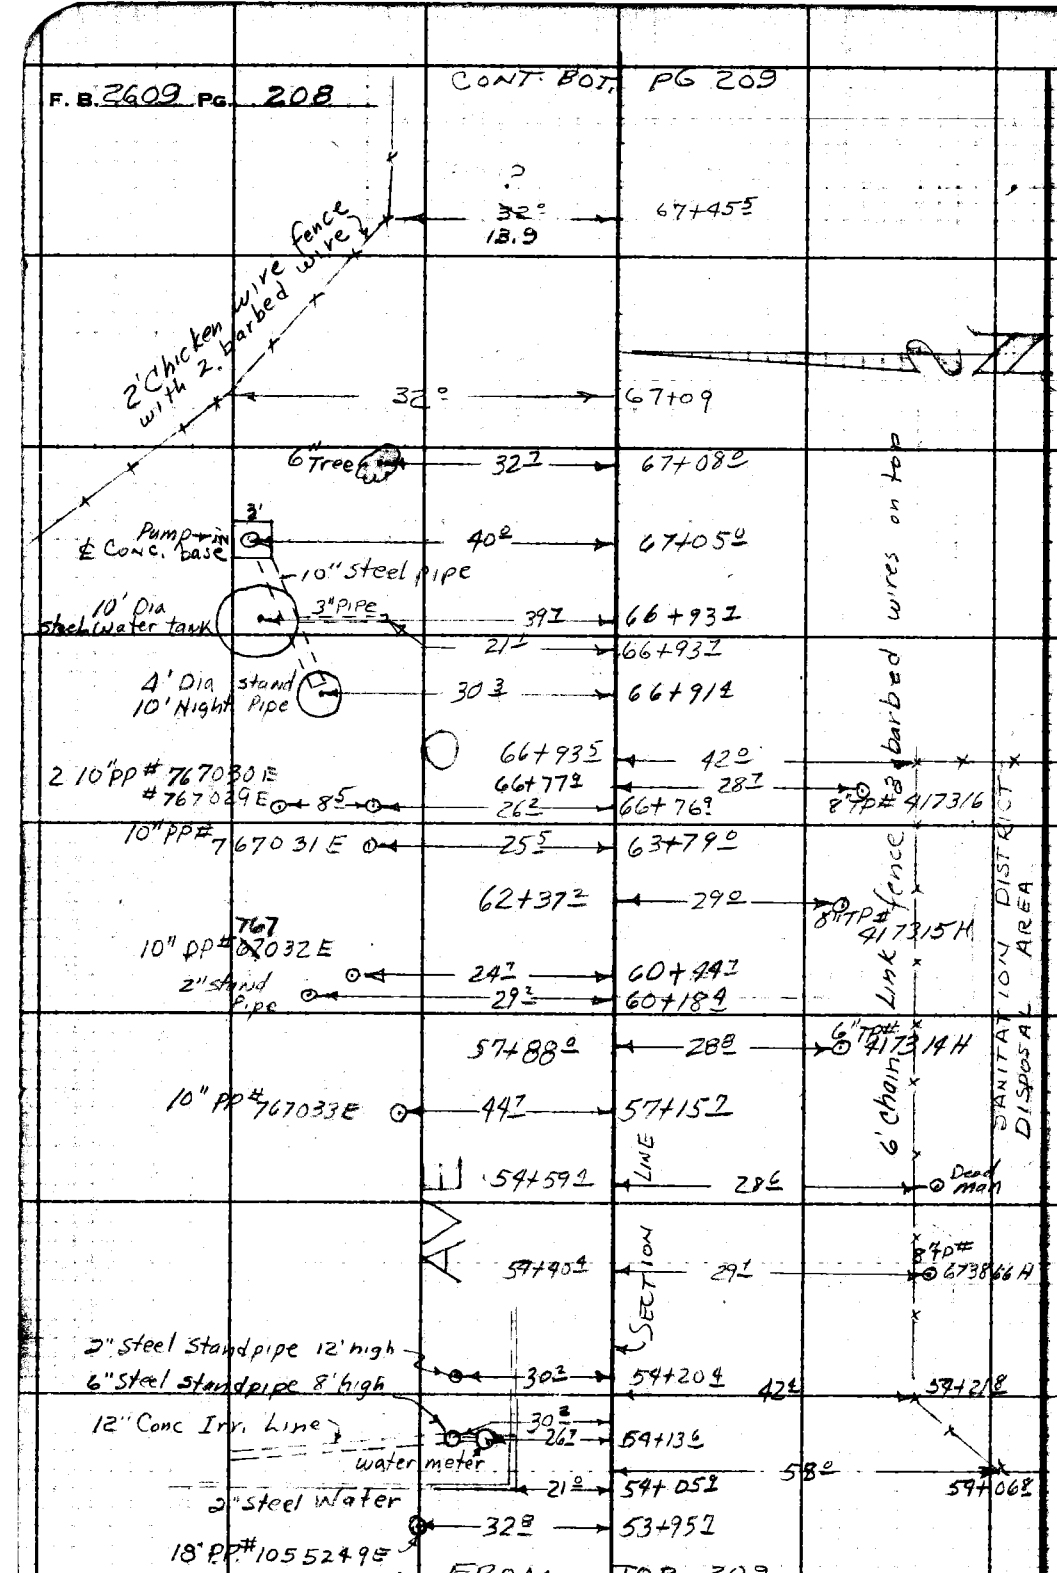

PLEASE RETURN TO
LOS ANGELES COUNTY ENGINEER
700 LOS ANGELES COUNTY ENGINEERING BLDG.

Do not extend this side of this line.

Note: Any Additions or Changes on This Sheet Must be Made or Circled in Red Ink With Date and Name of Person Making Change.

Notes Ck'd by W. D. WARNER
Map No. C.S.B. 274 -1-10
Office Work T. M. PULLIAM
Checked W. D. WARNER
Date JAN 12 1962

Survey of AVE. O
JN 2075.85 Tape Std °F
Surveyed by J.S. COATES
Notes JSC Date 12-21-60
Indexed

F. B. 2609 Pg. 209

CONT. BOT PG 210

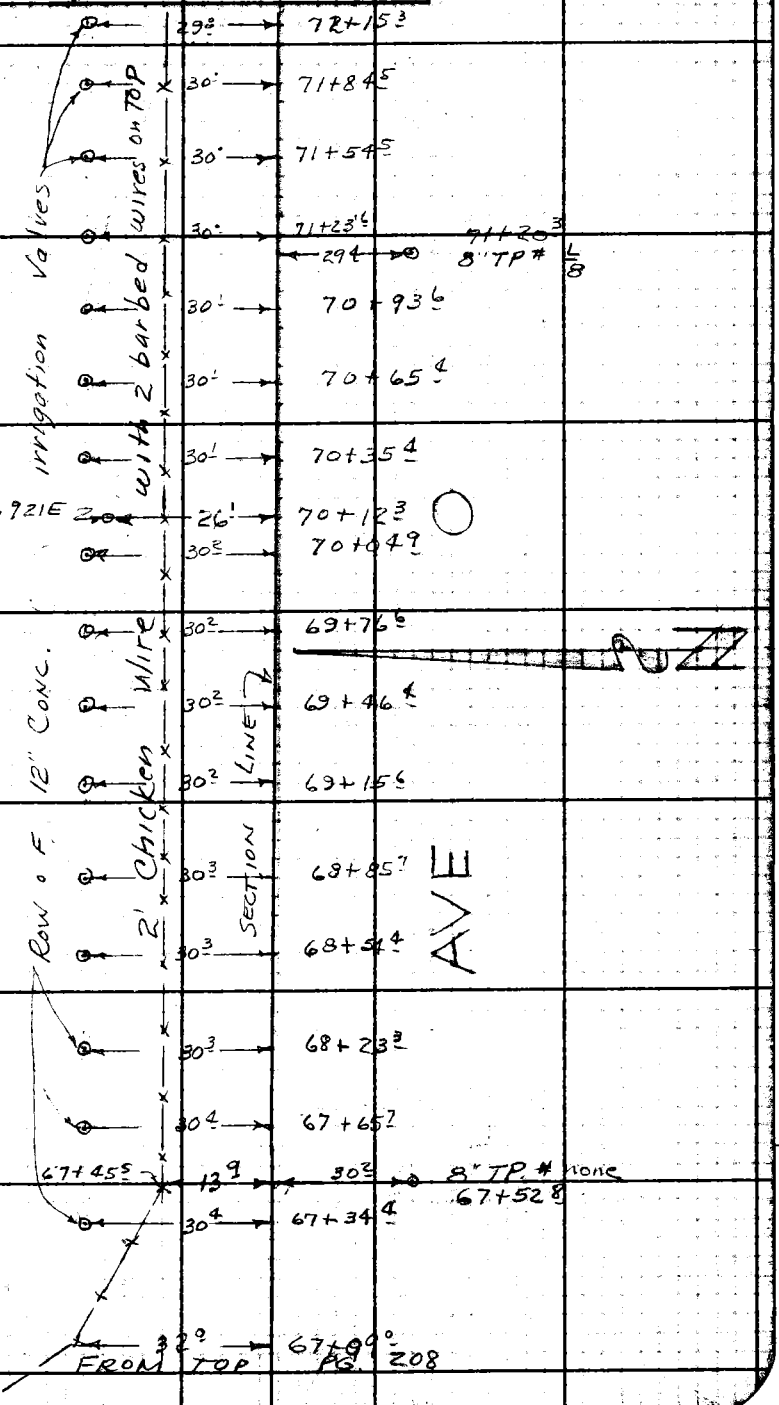

Note: Any Additions or Changes on This Sheet Must be Made or Circled in Red Ink With Date and Name of Person Making Change.

Do not extend this side of this line.

PLEASE RETURN TO
LOS ANGELES COUNTY ENGINEER
700 Los Angeles County Engineering Bldg.

76F3095 S&E #247 11-58

F. B 2609 Pg. 210

CONT. BOT. PG. 211

29.6 → 77+82.4

29.7 → 77+54.4

29.3 → 77+24.2

29.7 → 76+93.3

16" P.P. # 766923E → 26° → 76+80.3

29.7 → 76+65.8

29.8 → 76+35.4

29.8 → 76+01.7

29.8 → 75+74°

29.3 → 8" T.P. # 75+61.3

29.9 → 75+43.2

29.9 → 75+12.9

30° → 74+85°

30° → 74+54.6

30.1 → 74+23.7

30.1 → 73+93.3

2" I.P. Standpipe → 30.2 → 73+62.3 LT

30.1 → 73+47°

12" P.P. # 766922E → 26.7 → 73+41.4

30.3 → 73+31.4

30.2 → 73+01.3

30° → 72+73.5

30° → 72+43.4

FROM TOP PG 209

Row of 12" Irrigation Control Valves on top of 2' Chicken Wire fence with 2 barbed wires on top

SECTION LINE

LOS ANGELES COUNTY ENGINEER
700 Los Angeles County Engineering Bldg.

PLEASE RETURN TO

Do not extend this side of this line.

Note: Any Additions or Changes on This Sheet Must be Made or Circled in Red Ink With Date and Name of Person Making Change.

Notes Ck'd by W. D. WAGNER
Map No CSB. 2769 - 1-10
Office Work T. M. PALMER
Checked W. D. WAGNER
Date JAN 12 1962

Survey of AVE O
JN 0075.85 Tape Std °F
Surveyed by J.S. COATES
Notes J.S.C. Date 12-21-60
Indexed H.E.O.

F.B. 2609 Pg. 211

CONT. BOT PG. 212

Note: Any Additions or Changes on This Sheet Must be Made or Circled in Red Ink With Date and Name of Person Making Change.

Do not extend this side of this line.

PLEASE RETURN TO
LOS ANGELES COUNTY ENGINEER
700 Los Angeles County Engineering Bldg.

29⁶ → 82+98³
Valves
29⁶ → 82+68⁵
18" CYPRESS
25° → 82+38⁵
29⁶ → 82+38⁴
Irrig. wires on top
29⁶ → 82+08³
14" CYPRESS
25° → 81+78⁵
29⁵ → 81+73³
29⁵ → 81+43³
29⁵ → 81+13°
12" Conc. Barbed
29⁵ → 80+87⁸
16" Cypress
Valve
24⁶ → 80+58⁴
29⁴ → 80+57⁵
14" Elm 80+54⁹
22°
24³
10" Elm 80+48³
Row of
Fence with
16" PP # 766924E
45TH
21° → 80+29²
13⁷
SECTION LINE
ST E.
6" Steel Standpipe 9' high
29° → 80+14⁵
36" Conc. Standpipe 7' high
29² → 80+12⁵
80+18⁶¹
FD C.S. MON.
F.B. 2609-24
29³ → 8" TP # 417319H 79+99°
Wire
29⁵ → 79+62⁵
AVE N
Chicken
29⁵ → 79+34⁸
2'
29⁵ → 79+01⁵
Row of 12" Trv. Vales
29⁶ → 78+73⁵
29⁶ → 78+43²
29⁶ → 78+12⁴
FROM TOP
PG. 210

78F3098 SAE #247 11-58

DOES FENCE END HERE?

F. B. 2609 PG. 212

CONT BOT. PG. 213

36" CYPRESS

12" PP # 766926E

20" CYPRESS

20" CYPRESS

24" CYPRESS

24" CYPRESS

26" CYPRESS

4" STL. STANDPIPE

10" PP # 766920E

24" CYPRESS

16" CYPRESS

14" CYPRESS

12" CYPRESS

16" CYPRESS

12" PP # 766925E

Valves

Irri.

12" Barbed wire fence

2' OFF OF ROW

SECTION LINE

AVE

6" TP # 417320 H

FROM TOP PG. 211

LOS ANGELES COUNTY ENGINEER
700 LOS ANGELES COUNTY ENGINEERING BLDG.

PLEASE RETURN TO

Do not extend this side of this line.

Note: Any Additions or Changes on This Sheet Must be Made or Circled in Red Ink With Date and Name of Person Making Change.

Notes Ck'd by W. D. WAGNER
Map No. C.S.B. 2763-1-10
Office Work T.M. PALLIERI
Checked W. D. WAGNER
Date JAN 12 1962

Survey of AVE. O
JN 00758.85 Tape Std °F
Surveyed by J.S. COATES
Notes KING 12-21-60
Indexed

F.B. 2609 PG. 213

CONT. BOT. PG. 214

12" Irr. Valve 38° → 95+91

24" ELM 27.4 → 94+98.2
50.4
55° →

WOOD FLOOR SHED
FRAME CONCRETE PACKING
101°

12" Irr. Valve 5°
27.2 → 24" ELM 94+32.8

GUY WIRE
23.6 → 93+97.2
56° → 93+82.1

16" ELM 28.3 → 93+72.5
12" PP# 766929E 24° → 93+67.8
WATER HYD 42° → 93+58.1
24" ELM 64.9 → 93+56.9

SECTION LINE

5'x10' STEEL WATER TANK
53.4 → 93+27.0
50° → 93+25.0
6" Steel pipe
(10' high) 36" STANDPIPE 32° → 93+26.6
10" Steel pipe 93+20.7
20° 55.5 → 28.4 6" TP" none

Conc. floor of abandoned gas motor Conc. Mounts

CORRUGATED IRON PUMP HOUSE
24' 12' 10.4' 7.8' 7.8'
27.1 → 30" Cottonwood 93+18.5
42.7 → 93+13.8
Pump) 100 H.P. Elec. Motor
25° → 93+06.9
25° → 14" PP# 766928E
14" PP# 766927E 92+98.5
20° 55.7 → 92+97.4

AVE

18" Locusts 16.7
35.1 → 92+92.1
30.5 → 92+52.6
30.5 → 92+22.8
30" CYPRESS 25.5 → 91+94.0
30.5 → 91+93.8
30.5 → 91+63.5
30.5 → 91+34.7
30.5 → 91+05.5
12" Cypress 25.5 → 90+75.6
30.5 → 90+75.5
30.5 → 90+45.6

Row of 12" Conc. Irrigation Valves

FROM TOP PG. 212

Note: Any Additions or Changes on This Sheet Must be Made or Circled in Red Ink With Date and Name of Person Making Change.

Do not extend this side of this line.

PLEASE RETURN TO
LOS ANGELES COUNTY ENGINEER
700 LOS ANGELES COUNTY ENGINEERING BLDG.

76F309S S&E #247 11-59

F. B. 2609 Pg. 214 CONT. BOT. PG 215

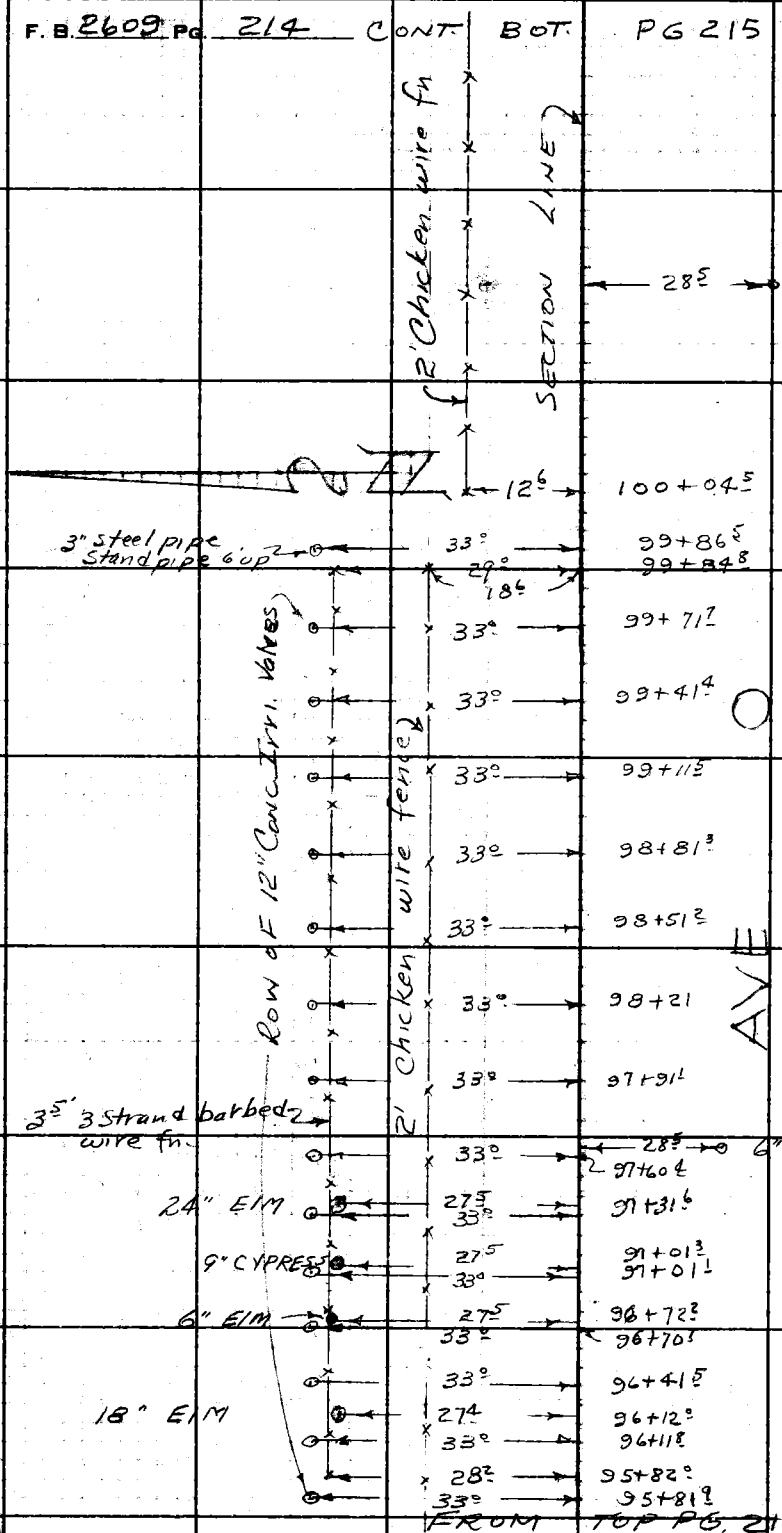

PLEASE RETURN TO
LOS ANGELES COUNTY ENGINEER
700 LOS ANGELES COUNTY ENGINEERING BLDG.

Do not extend this side of this line.

Note: Any Additions or Changes on This Sheet Must Be Made or Circled in Red Ink With Date and Name of Person Making Change.

Notes Ck'd by W. D. WAGNER
Map No. C.S.B. 2763 - 1-10
Office Work T. M. PALMER
Checked W. D. WAGNER
Date JAN 12 1962

Survey of AVE. O
JN 0075.85 Tape ____ Std ____ °F
Surveyed by J.S COATES
Notes JSC Date 12-21-60
Indexed M. E. OTT

F. B. 2609 PG. 215

CONT. BOT. PG. 216

133+39.74
1/4 COR.
FD. C.S. MON.
F.B. 2609-25

55TH ST E

SECTION LINE

O

deadman
107+56

28.5

8" T.P# 635945E

28.4

107+32.4

106+72.37
FD C.S. MON.
FB. 2609-22

106+84.7 edge pav

50TH

12.3

ST. E.

12.4

106+60.2 edge pav

106+44.9

2.3

8" T.P# 417325H

44.5

106+44.0
deadman

14.5

106+38.1

2' chicken wire fence

AVE

29.0

106+22.7

8' high
4" Steel Standpipe
106+09.0

34.0

18.0

106+08.8

FROM TOP PG. 214

Note: Any Additions or Changes on This Sheet Must be Made or Circled in Red Ink With Date and Name of Person Making Change.

Do not extend this side of this line.

PLEASE RETURN TO
LOS ANGELES COUNTY ENGINEER
700 LOS ANGELES COUNTY ENGINEERING BLDG.

76F3095 S&E #247 11-58

F. B. 2609 Pg. 216 CONT. BOT. PG 217

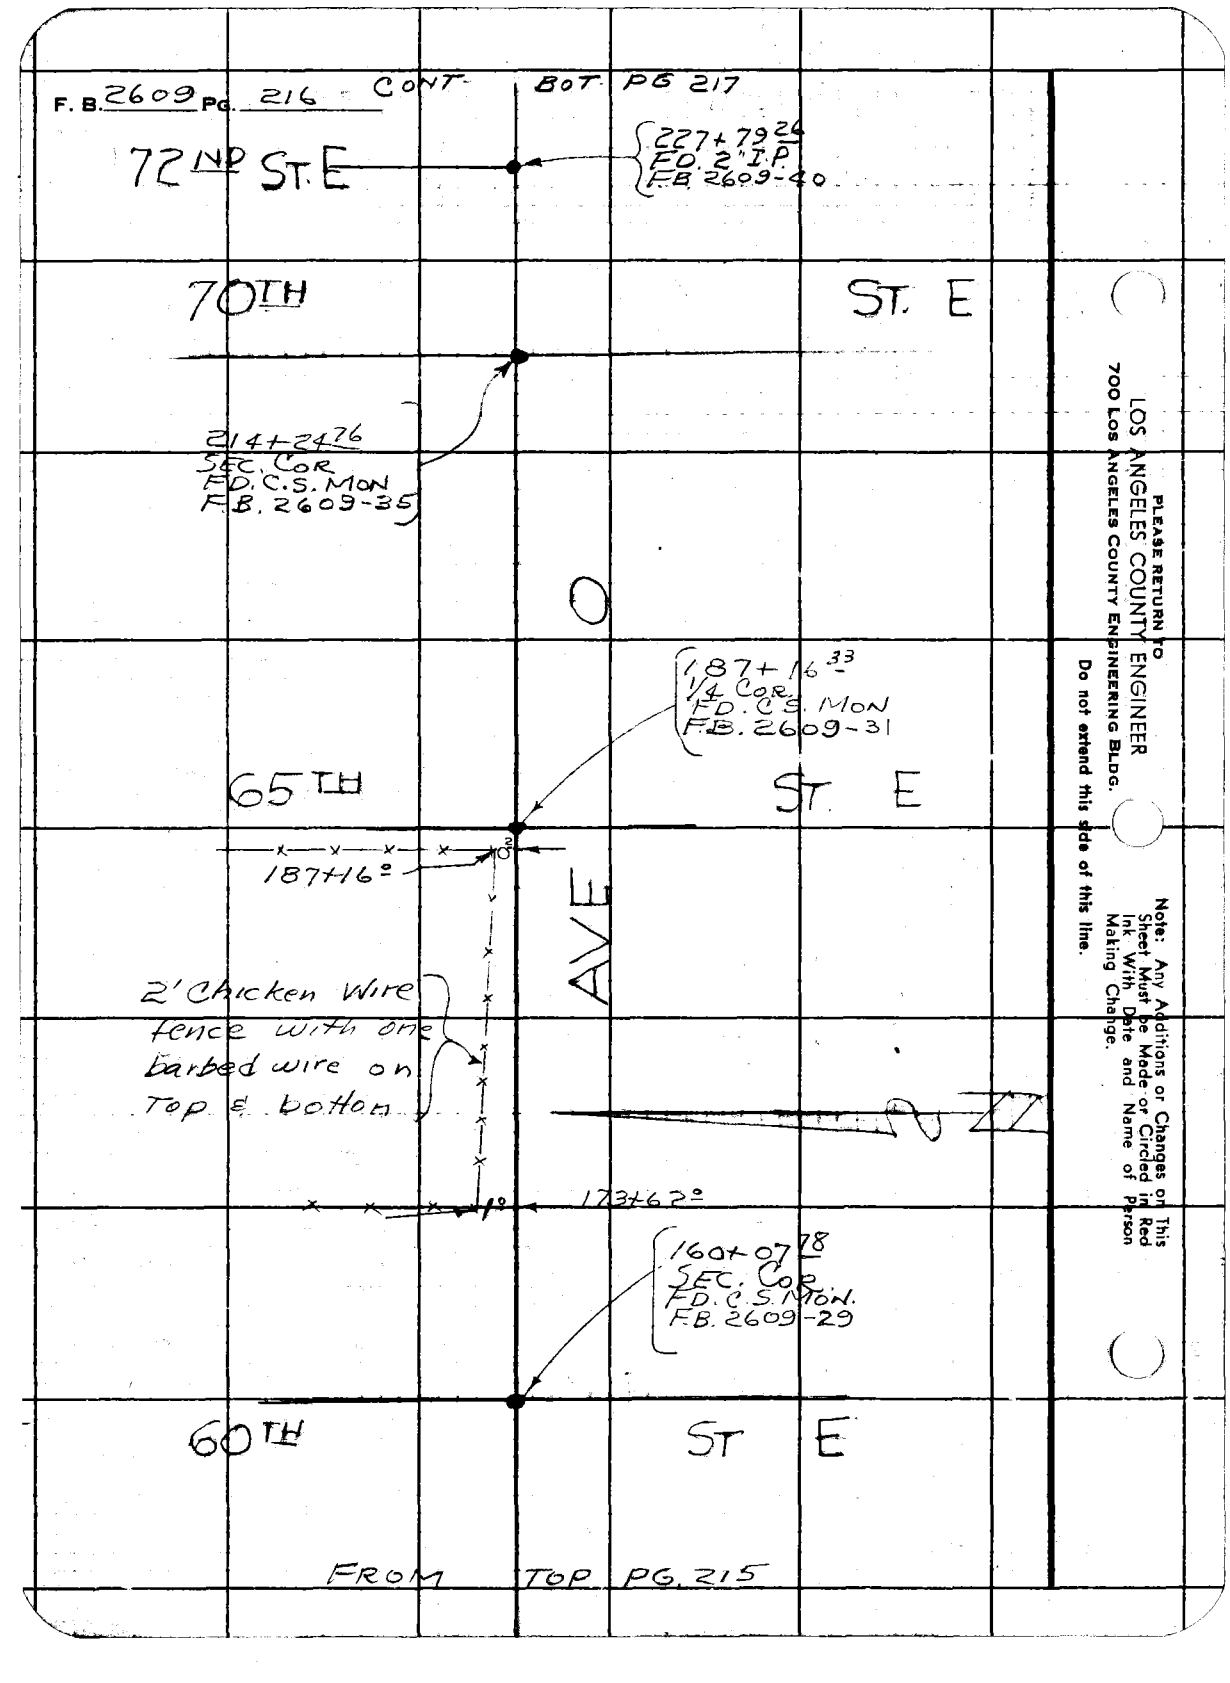

FROM TOP PG. 215

LOS ANGELES COUNTY ENGINEER
700 LOS ANGELES COUNTY ENGINEERING BLDG.

PLEASE RETURN TO

Do not extend this side of this line.

Note: Any Additions or Changes on This Sheet Must be Made or Circled in Red Ink With Date and Name of Person Making Change.

Notes Ck'd by W. D. WAGNER | Survey of AVE. O | F. B. 2609 Pg. 217
Map No. C.S.B. 2223-1-10 | JN 0075.85 Tape Std °F
Office Work T. M. PALMER | Surveyed by J.S. COATES
Checked W. D. WAGNER | Notes JSC Date 12-22-60
Date JAN 12 1962 | Indexed H. E OTT

CONT. BOT. PG 218

Deadman 21⁶ → 57³ → 261+99⁵
12" PP # 93809DE
2" water pipe riser → 50³ → 261+89²
6" T.P. # 605842H 261+41² → 34⁴ → 32⁷
8" T.P. # 605841H 261+22² → 25³ Dead man
Dead man → 40³ → 261+33⁸
5 pyracantha Bushs along fn. → 34⁰ → 261+21⁵
4' board & Chicken wire fence → 40³ → 261+23⁷
12" 2" Elm 12" → 45³ → 261+22⁴
7³ 5³⁸ → 261+21⁴
3" Cedar 66⁸ → 261+20⁹
Lilac 68 → 261+01⁸
29⁶ → 59⁷ → 260+99⁰
10" Elm → 49⁴ → 260+97⁹
Conc. Step → 59⁸ → 260+87⁵
11³
12" Elm. → 50¹ → 260+76⁸
135' ONE story FRAME House 35⁸ 33³ 24³
2" Elm → 61⁰ → 260+61⁵
8" Elm fence → 49⁶ → 260+57⁰
60¹ → 260+51⁰
Pyracantha Bush
21³ 8" Elm → 50⁶ → 260+36⁰
6' board fence
15" 22⁶ 15" → 60⁹ → 260+23⁷
41² → 260+13²
4' High board fence
2" Cotton wood TREES 16⁷ → 59⁸ → 260+01³

77 IH

254+88⁶⁹
F.D. 2" I.P.
F.B. 2609-41

75 IH

241+33⁷⁶
1/4 COR. S. MON
F.B. 2609-40

AVE O
ST E.
AVE O
ST E.

FROM TOP PG 216

Note: Any Additions or Changes on This Sheet Must be Made or Circled in Red Ink With Date and Name of Person Making Change.
Do not extend this side of this line.

PLEASE RETURN TO
LOS ANGELES COUNTY ENGINEER
700 LOS ANGELES COUNTY ENGINEERING BLDG.

76F3095 SAE #247 11-58

F. B. 2609 Pg. 218

CONT. BOT. PG. 219

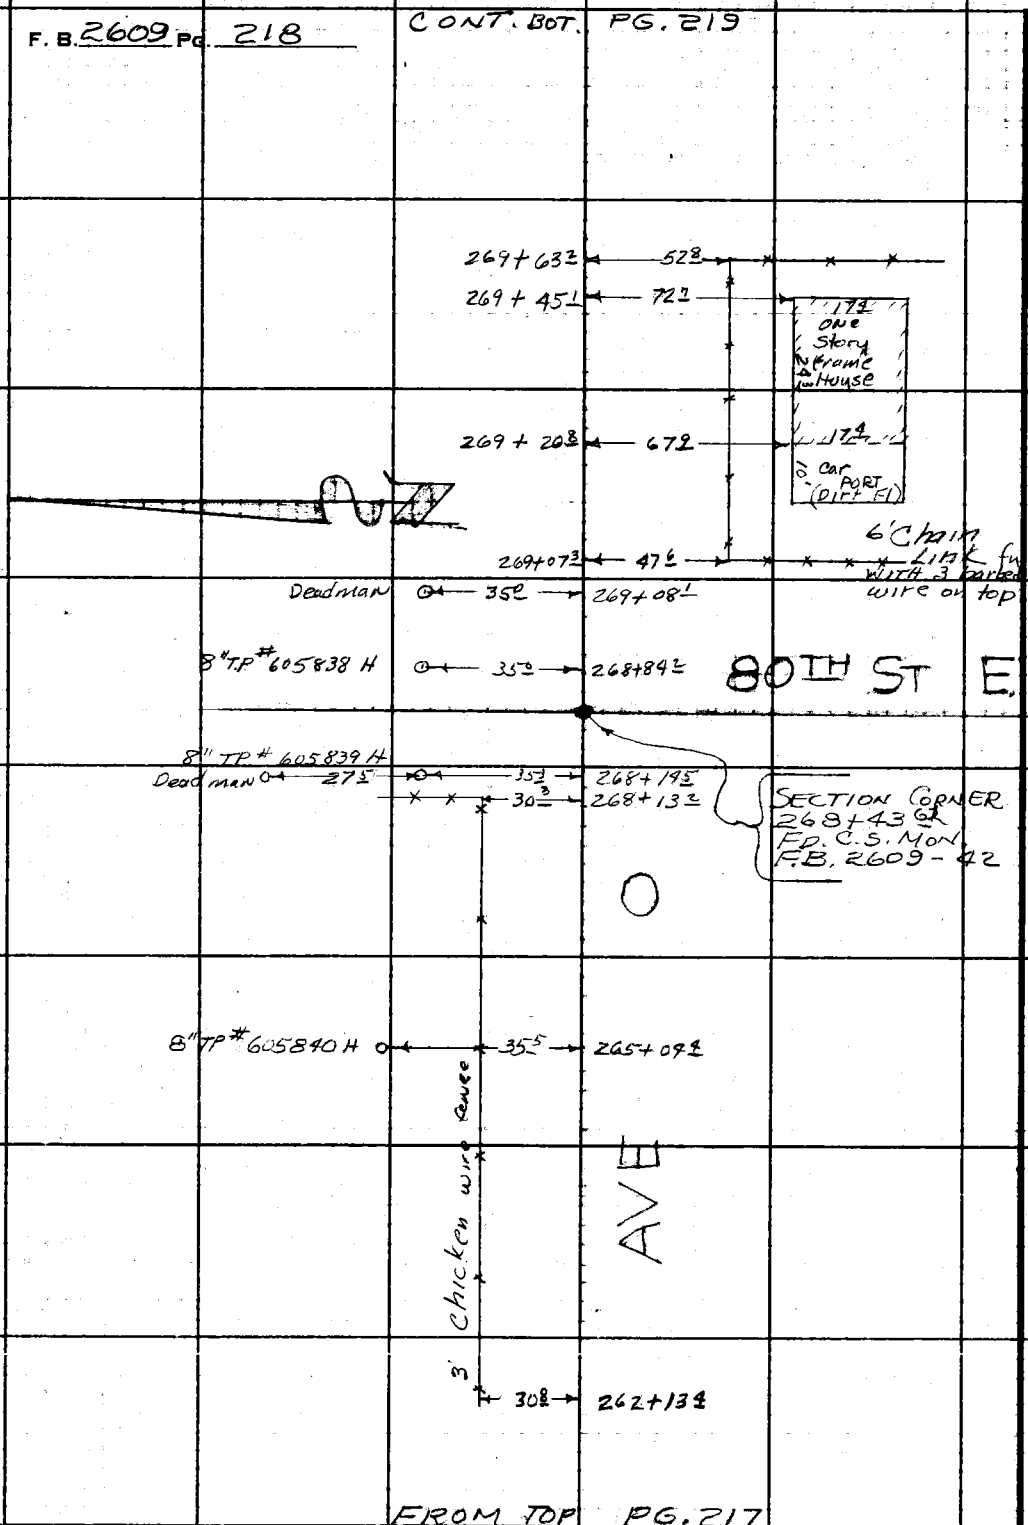

FROM TOP PG. 217

PLEASE RETURN TO
LOS ANGELES COUNTY ENGINEER
700 LOS ANGELES COUNTY ENGINEERING BLDG.

Do not extend this side of this line.

Note: Any Additions or Changes on This Sheet Must be Made or Circled in Red Ink With Date and Name of Person Making Change.

Notes Ck'd by	W. D. WAGNER	Survey of	AVE. O
Map No.	C.S.B. 2763 1-10	JN 0075-25 Tape	Std °F
Office Work	T.M. PALMIGRI	Surveyed by	J.S. COATES
Checked	W. D. WAGNER	Notes	JSC Date 12-22-60
Date	JAN 12 1962	Indexed	H. E. OTT

F. B. 2609 PG. 219

CONT. BOT PG. 220

85TH ST E

1/4 Cor
295+19.19
FD. C.S. MON
F.B. 2609-47

118

293+71?

8" T.P.# 710115H

BARSTOW DIAGONAL

8" T.P.# 710114H

18.5

289+37?

10" T.P. 710113H

26.3

284+73°

deadman

45°

284+72°

10" T.P.# 2982

43.5

284+26°

TEL. TRANSMISSION LINE

AVE O

8" T.P.# 2983

283+11°

16.7

283+02°

deadman

2°

20.6

282+95°

deadman

282+20

66°

deadmen

282+16.5

60.8

281+94.5

79.8

8" T.P.# 2984

281+91.5

73.8

8" T.P.# 2

281+70°

93.9

deadman

281+65°

87°

FROM TOP PG 218

Note: Any Additions or Changes on This Sheet Must be Made or Circled in Red Ink With Date and Name of Person Making Change.

PLEASE RETURN TO
LOS ANGELES COUNTY ENGINEER
700 Los Angeles County Engineering Bldg.
Do not extend this side of this line.

78F3095 SSE #247 11-58

F. B. 2609 Pg. 220 CONT. BOT. PG. 221

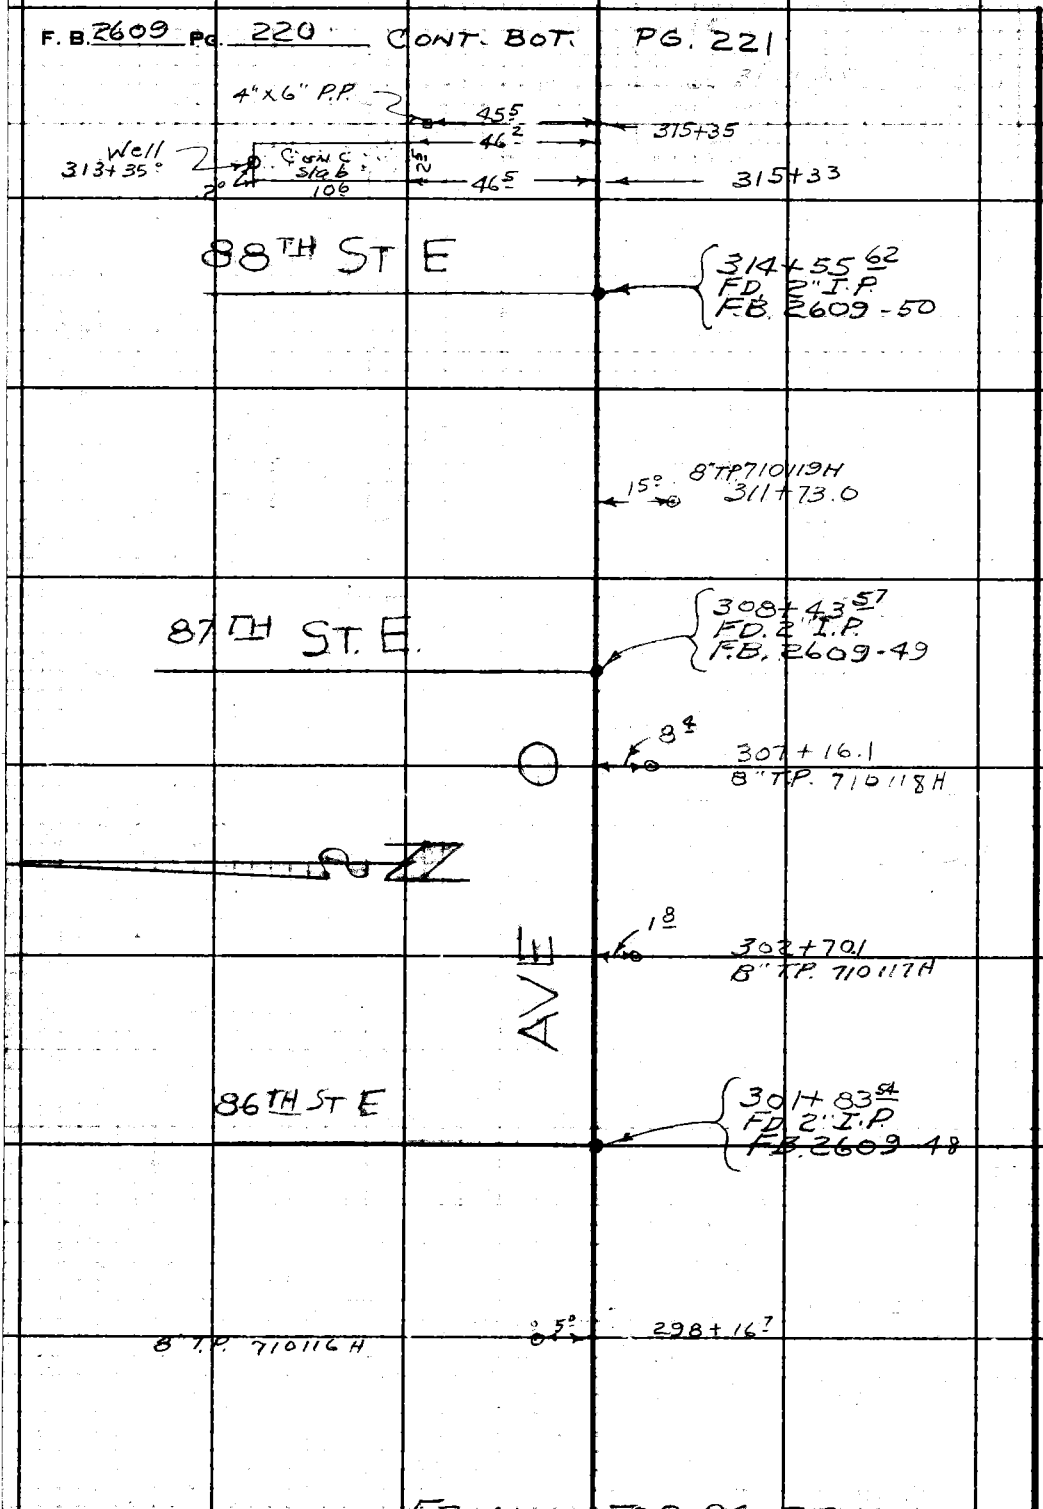

FROM TOP PG. 219

LOS ANGELES COUNTY ENGINEER
700 Los Angeles County Engineering Bldg.

PLEASE RETURN TO

Do not extend this side of this line.

Note: Any Additions or Changes on This Sheet Must be Made or Circled in Red Ink With Date and Name of Person Making Change.

Notes Ck'd by W. D. WAGNER | Survey of AVE. O | F. B. 2609 PG. 221
Map No. C.S.B. 2963-1-10 | JN 0075-85 Tape Std °F
Office Work I. M. PALMIERI | Surveyed by J.S. COATES
Checked W. D. WAGNER | Notes JSC Date 12-22-60
Date JAN 12 1962 | Indexed H. E. OTT

CONT BOT. PG. 222

6" Elm 79.5 → 318+73.0
59° → 318+69.5
2" Locust 31.4 → 318+58.4
Coadman
Conc. Porch 5.5
76.6
6" Elm 59.9 → 318+46.2
Wire fn
Chicken
2 STORY CONC BLOCK HOUSE 36.6
3" Elm 73.7 → 318+32.5
6" Elm 61.4 → 318+23.5
6" Cottonwood 75.8 → 318+18.5
4' Board Fn 63.4 → 318+15.3
0.5
WALK 3.0
6.8
3.5' CONC 64° → 318+11.8
77.9 → 318+11.0
8 62.4 → 318+09.2
12.3 62.8 → 318+05.0
Fence
63.3 → 316+98.4
3/4" Riser
67° → 316+94.3
4" Locust 64° → 316+91.5
1" Locus
HOG PEN Chicken Wire fn 6'
TURKEY PEN 6' Board
2" Locust 64° → 316+85.5
2" Locust 64° → 316+81.0
13.0
Frame shed 12.0 10.1
68° → 316+57.0
69.0 → 316+47.4
4"X6" Power Pole
76° → 316+47.0
AVE O
22.5 → 8" TP 316+20
Row of Small Cypress
77
316+13.5
4"X6" Power Pole 62° → 315+94
4" Cottonwood 71.7 → 315+65.0

FROM TOP PG. 220

Note: Any Additions or Changes on This Sheet Must be Made or Circled in Red Ink With Date and Name of Person Making Change.

PLEASE RETURN TO
LOS ANGELES COUNTY ENGINEER
700 LOS ANGELES COUNTY ENGINEERING BLDG.
Do not shade this side of this line.

76F309S SAE #247 11-58

F. B. 2609 PG. 222

CONT. BOT. PG. 223

322+76.3

72°

10.6

72.0

78°

EDISON LITTLE ROCK SUB-STATION

6"I" beam Frame for Transformers Set in 18' x 18" CONC. base

3.6

3.9

1.8

1.8

EDISON CO. M.H. IN CONC.

322+59.5

34.8

322+08.9

15.5

57.7

5.3 de

322+07.5

30.4

P.P.

8' Chain Link fn.

SECT. COR. 321+76.78 FD. C.S. MON. F.B. 2609-51

N 11° W

12.2

90 TH ST. E.

321+64.6

321+56.5

20.2

16" P.P. # 343334E

321+53.5

69.3

5.2

deadmen

20.6

deadman 321+20.5

20.6

deadman 321+03.°

deadman

30.°

321+02.°

20.6

deadman 320+99.°

10" PP # 734599E

30.8

320+74.4

320+28.3

10.3

deadman

28.2

6" TP 480309H

320+19.3

55'

319+37.°

2' Chicken wire fence

12" PP # 734600E

31.7

318+82.5

FROM TOP PG. 221

LOS ANGELES COUNTY ENGINEER
700 LOS ANGELES COUNTY ENGINEERING BLDG.

PLEASE RETURN TO

Do not extend this side of this line.

Note: Any Additions or Changes on This Sheet Must be Made or Circled in Red Ink With Date and Name of Person Making Change.

Notes Ck'd by W. D. WAGNER
Map No. C.S.B. 2763-1-10
Office Work T. M. PALMER
Checked W. D. WAGNER
Date JAN 12 1962

Survey of AVE. O
JN 007585 Tape Std °F
Surveyed by J.S. COATES
Notes JSC Date 12-22-60
Indexed H. E. OTT

F. B. 2609 PG. 223

CONT'D FROM PG. 224

3'26+29°

21.9 → ⊙ 16" P.P.# 335301E

325+05.3

30.5

325+10.3

Deadmen ← 35.2 → 37.3 ← 25.7 → 325+03

12" Guy Pole #735980E

325+03.5

23.9 → 325+03.4

16" P.P.# 883190E

324+91.3

324+88.6

23.5 →

18" P.P.# 1312427E

76.8

4°

6.8

Note: Any Additions or Changes on this Sheet Must be Made or Circled in Red Ink With Date and Name of Person Making Change.

Link fn

Towers with Steel Cross-ties & Conc. bases

SUB-STATION

LITTLE ROCK

324+62°

76.8

4°

6.8

8' Chain

324+13.7

76.8

4°

6.8

STEEL TOWER

EDISON

324+06

61.8

6" Steel posts Set in 18"x18" Conc. base

AVE

323+96°

61.8

323+87.1

323+85.5

76.8

4°

6.8

30.5

6' Chain link fn

20" P.P.# 343303E

323+51.8

323+50.2

23.4

23.4

0.9

6" Steel Conduits going underground to sub-sta.

323+20.4

23.6 → deadmen

323+14.5

23.8 → deadmen

65.1

3.4

3.4

Steel Tower IN Conc. base

323+08.8

65.1

FROM TOP PG. 222

PLEASE RETURN TO
LOS ANGELES COUNTY ENGINEER
700 LOS ANGELES COUNTY ENGINEERING BLDG.
Do not extend this side of this line.

76F3088 SAE #247 11-58

F. B. 2609 PG. 224

CONT. BOT. PG. 225

343+90[3]

21[5]

16" PP # 335309 E

93RD ST E

341+83[27]
FD. 2" I. P
F.B. 2609 - 68

341+68[6]

21[5]

16" P.P. # 335308 E

339+46[9]

22[0]

16" PP # 335307 E

O

337+29[8]

21[9]

16" PP # 335306 E

92ND ST E

335+19[45]
FD. 2" I. P
F.B. 2609 - 67

335+08[2]

20[9]

16" P.P. # 583142 E

AVE

332+86[5]

21[1]

16" P.P. # 335304 E

330+65[8]

21[3]

16" PP # 335303 E

328+47[4]

22[1]

16" P.P. # 335302 E

91ST ST. E.

328+45[80]
FD. Pk Spike
F.B. 2609 - 66

FROM TOP PG. 223

PLEASE RETURN TO
LOS ANGELES COUNTY ENGINEER
700 Los Angeles County Engineering Bldg.

Do not extend this side of this line.

Note: Any Additions or Changes on This Sheet Must be Made or Circled in Red Ink With Date and Name of Person Making Change.

Notes Ck'd by W. D. WAGNER
Map No. C.S.B. 270-1-10
Office Work T.M. PALMER
Checked W. D. WAGNER
Date JAN 12 1962

Survey of AVE. O
JN 007585 Tape Std 84 °F
Surveyed by J.S. COATES
Notes JSC Date 12-27-60
Indexed H.E. ON

F. B. 2609 Pg. 225

CONT.

BOT. PG. 226

357+02.6 — 21 — 16" PP # 335315E

96TH ST E

355+00.2 — 22 — 355+21.27 FD. 2" I.P. F.B. 2609-70

16" PP # 335314E

352+65.4 — 21.4 — 16" PP # 335313E

350+48.3 — 21.5 — 16" PP # 335312E

95TH ST E

348+28.8 — 21.5 — 1/4 COR 348+52.21 FD. C.S. MON F.B. 2609-69

16" PP # 335311E

LWA

346+06.3 — 21.5 — 16" PP # 335310E

FROM TOP PG 224

Note: Any Additions or Changes on This Sheet Must be Made or Circled in Red Ink With Date and Name of Person Making Change.

Do not extend this side of this line.

PLEASE RETURN TO
LOS ANGELES COUNTY ENGINEER
700 Los Angeles County Engineering Bldg.

76F309S SAE #247 11-59

F. B. 2609 Pg. 226

CONT. BOT. PG. 227

375+27.94
FD. C.S. Mon. 12"dn
F.B. 2609-72

100TH ST E

deadman 7° 31.6
14" Guy Pole # 1062410E

375+10.9
21.2
16" PP # 335323 E
375+06.3

372+49.2 21.3 16" PP # 335322 E

370+29.2 21.4 16" PP # 335321E

368+39.06
FD. 2" I.P.
F.B. 2609-71

98TH ST E

368+06.5 21.6 16" PP # 335320E

365+87.8 21.5 16" PP # 335319E

363+69.7 21.8 16" PP # 335318E

97TH ST E

AVE

361+90.20
FD. 2" I.P.
F.B. 2609-71

3611 47.9 22.2 16" PP 335317E

359+28.5 21.0 16" PP # 335316E

FROM TOP PG 225

PLEASE RETURN TO
LOS ANGELES COUNTY ENGINEER
700 Log Angeles County Engineering Bldg.

Do not extend this side of this line.

Note: Any Additions or Changes on This Sheet Must be Made or Circled in Red Ink With Date and Name of Person Making Change.

Notes Ck'd by W. D. WAGNER
Map No. C.S.B. 2763-1-10
Office Work T. M. PALMERI
Checked W. D. WAGNER
Date JAN 12 1962

Survey of AVE. O
JN 0075-95 Tape Std 84 °F
Surveyed by J.S. COATES
Notes J.S.C. Date 12-27-60
Indexed H. E. OTT

F. B. 2609 Pg. 227

14" Locust ⊗ ← 28⁹ → 393+13°
CONT. FROM PG 228

IRR. Valve ← 35² → 393+08⁵
30" Cottonwood ⊗ ← 28⁶ → 392+91°
IRR. Valve ← 35² → 392+85⁵
10" Locust ⊗ ← 28⁷ → 392+68⁵
IRR. Valve ← 35³ → 392+62⁸

8' high 12" CONC. Standpipe ⊗ ← 35² → 392+49⁴
12" Locust ⊗ ← 29⁵ → 392+44⁷
12" Locust ⊗ ← 29³ → 392+19²
12" Locust ⊗ ← 29³ → 391+95⁵

12" Locust ⊗ ← 30¹ → 391+72⁵
6" Locust ⊗ ← 30¹ → 391+00
390+69° ← 31⁶ → 16" PP# 1062195E

10" Locust ⊗ ← 31° → 390+20°
St. DIRT Road
18' ← 37⁶ → 388+59⁵
8" T.P.# 47621H Deadman
388+11 ← 31.9 → 16" PP# 1062196E

AVE O

385+49° ← 32⁴ → 16" PP# 1062197E

382+89⁷ ← 32³ → 16" PP# 1062198E

380+29⁵ ← 32³ → 16" PP# 1062199E

377+68⁵ ← 32¹ → 15⁷ → deadman
16" PP# 1062200E

FROM TOP PG. 226

Note: Any Additions or Changes on This Sheet Must be Made or Circled in Red Ink With Date and Name of Person Making Change.

PLEASE RETURN TO
LOS ANGELES COUNTY ENGINEER
700 LOS ANGELES COUNTY ENGINEERING BLDG.
Do not extend this side of this line.

76F3093 SAE #242 11-58

F. B. 2609 Pg. 228

Cont. on Bottom 229

35.2 → 397+38.8

10" Locust ← 29.6 → 397+26.5

36.2 → 397+15.2

5.5 ← 29.5 → 396+90.0

6" Ash

35.2 → 396+68.2

16" Cottonwood ← 29.9 → 396+50.5

396+43.5

Valves

8" Locust ← 29.4 → 396+23.3

12" Conc. Standpipe 8' High ← 34.5 → 396+20.5

35.2 → 395+95.8

14" Locust ← 29.2 → 395+92.5

32.2 → 395+89.3

16" P.P. # 106 2193E

Irrigation

12" Locust ← 35.2 → 395+72.7

← 29.2 → 395+70

35.2 → 395+47.3

3" Locust ← 29.2 → 395+46.2

8" Locust ← 29.3 → 395+25.5

Conc. ← 35.2 → 395+24.2

35.2 → 395+01

15" Locust ← 28.9 → 395+00

12"

35.2 → 394+75.5

12" Locust ← 28.7 → 394+55.2

35.2 → 394+50.8

10" Locust ← 28.6 → 394+31.8

Row

35.2 → 394+27

Clump of 3" Trees

35.3 → 394+04

35.2 → 394+03.4

55.9 ← 28.7 → 393+97.5

10" Locust ← 28.5 → 393+86.8

35.2 → 393+80.2

35.3 → 393+56.5

16" Locust ← 28.5 → 393+36.0

35.3 → 393+32.5

32.5 → 16" P.P. # 106 2194E 393+22.9

Cont. top Pg. 227

PLEASE RETURN TO
LOS ANGELES COUNTY ENGINEER
700 Los Angeles County Engineering Bldg.

Do not extend this side of this line.

Note: Any Additions or Changes on This Sheet Must be Made or Circled in Red Ink With Date and Name of Person Making Change.

Notes Ck'd by W. D. WAGNER
Map No. C.S.B. 2363-1-10
Office Work J. M. PALMIERI
Checked W. D. WAGNER
Date JAN 12 1962

Survey of AVE. O
JN 0095-85 Tape Std. 84 °F
Surveyed by J.S. COATES
Notes JSC Date 12-27-60
Indexed H. E. ON.

F. B. 2609 Pg. 229

Cont. on Bottom pg 230

4' hog wire fn

30.3

402+11.5

1/4 Cor
40 +96.24
FD. C.S. MON.
FB 2609-80

105 TH ST E

12" LOCUST — 30.5 → 401+21.5
← 31.1 → 401+09.4
16" PP # 1062191E

10" LOCUST — 30.1 → 400+27.5

12" LOCUST — 30.0 → 400+06.5

12" LOCUST

12"Conc. Standpipe 8' High

29.3 → 399+82.5
34.8 → 399+75.5

35.0 → 399+54.8

10" LOCUST — 29.5 → 399+35.8

12" Conc. Irrigation Valves

35.0 → 399+27.5

12" LOCUST — 35.0 → 399+07.5

29.7 → 398+89.5

35.0 → 398+83.0

AVE O

35.0 → 398+59.0
← 32.0 → 398+48.8
16" PP # 1062192E

12" LOCUST — 29.7 → 398+41.7

35.0 → 398+35.5

Row of

35.0 → 398+11.3

10" LOCUST — 29.2 → 398+07.8

35.0 → 397+85.5

35.0 → 397+59.7

10" LOCUST — 29.4 → 397+50

Cont. From top 228

PLEASE RETURN TO
LOS ANGELES COUNTY ENGINEER
700 Los Angeles County Engineering Bldg.

Note: Any Additions or Changes on this Sheet Must be Made or Circled in Red Ink With Date and Name of Person Making Change.

Do not extend this side of this line.

76F3098 S&E #242 11-58

F. B. 2609 Pg. 230

cont. on Bottom 231

406+17.5

31.8 → 16" PP #1062189E

12" ASA

28.4 → 405+70°

2" Gate Valve

34.8 → 405+09.5

28.8 → 405+07.5

16" Locusts

28° → 404+81.5

28° → 404+74°

4' hog wire fn.

34.9 → 404+66.5

35.2 → 404+51°

404+51°

28°

16" Elm

71.5 → 404+44°

28° → 404+44.4

14" Umbrella

40.3 → 404+36°

Chicken Wire fn.

30' 1 STORY FRAME House 42.4

8.5' conc steps

6" Elm

28° → 404+22.5

12" Irr. Valve

33.6 → 404+18.5

5.9'

12.3'

10.2'

12.5'

3°

3.5'

18.4'

3'

72.6 → 404+08.5

16' Umbrella

40.7 → 404+04.5

16" Elm

27.5 404+03°

28° → 403+93.3

35° → 403+85.5

AVE E

35° 403+70°

403+68.2

33° → 16" PP #1062190E

16° Headman 403+62.2

8" TP #632152H 403+67.5

28.8 → 21.6

403+62.5

4' hog wire fn.

2" TP riser

34.3 403+49.5

30" Conc. Standpipe 8' high

36° → 403+24.5

CONT. FROM TOP 229

LOS ANGELES COUNTY ENGINEER
700 LOS ANGELES COUNTY ENGINEERING BLDG.
PLEASE RETURN TO
Do not extend this side of this line.
Note: Any Additions or Changes on This Sheet Must be Made or Circled in Red Ink With Date and Name of Person Making Change.

Notes Ck'd by W. D. WAGNER | Survey of AVE. O | F. B. 2609 PG. 231
Map No. C.S.B. 2763 1-10 | JN 0075.85 Tape Std °F
Office Work T. M. PALMER | Surveyed by J. S. COATES
Checked W. D. WAGNER | Notes JSC | Date 12-28-60
Date JAN 12 1962 | Indexed H. E. Oh

CONT. BOT. PG 232

12" Locust — 29⁵ — 412+29²
12" Locust — 30⁰ — 412+12⁹
30⁰ — 411+30⁰
411+17¹ — 32⁵ — P.P. # 1062187E — 17² — deadman

Row of Locust trees 2" to 6" diam

410+28⁰ — 21⁰ — 6" T.P. # 632151H
30² — 409+79³
Row of Locust trees 2" to 4" diam
60⁰ — 409+67⁵
30' — 25⁵ — 409+38⁹
Clump of 2 Poplars
23² — 409+40¹
30" Conc STANDPIPE 4' high
38⁵ — 409+25²
33⁵ — 409+35⁴
28⁵ — 409+05⁷
14" Ash
408+66⁷ — 32² — 16" PP # 1062188E
16" Ash
28⁵ — 408+60²
28⁰ — 408+25⁸
12" Locust
6" Locust
38⁷ — 407+92²
12" Locust
29⁴ — 407+79²
AVE
29⁰ — 407+18⁵
34⁰ — 407+18⁰
29³ — 407+08⁵
3-3" Ashs
16" Ash
23⁰ — 407+05⁰
126'
16" Ash
29⁴ — 406+71⁰
12" Conc. Standpipe 8' high
34⁵ — 406+46²
FROM TOP
PG. 230

OUTSIDE SLOPE
TOP BERM
INSIDE SLOPE 1½:1
EMPTY RESERVOIR
DIRT
15'
3'
60'

Note: Any Additions or Changes on this Sheet Must be Made or Circled in Red Ink With Date and Name of Person Making Change.
Do not extend this side of this line.

PLEASE RETURN TO
LOS ANGELES COUNTY ENGINEER
700 LOS ANGELES COUNTY ENGINEERING BLDG.

76F309S SSE #247 11-59

F. B. 2609 Pg. 232

CONT. BOT. PG. 233

424+96 ← 32 → 16" P.P. #1062182E

422+21 ← 33 → 16" P.P. #1062183E

419+46 ← 34 → 16" P.P. #1062184E

416+68 ← 34 → 16" P.P. #1062185E

O

12" Locust — 28 → 415+18

8" I.P. Standpipe 8' high — 35 → 415+16

10" Locust — 29 → 414+91

8" Locust — 29 → 414+80

12" Locust — 29 → 414+69

12" Locust — 29 → 414+58

AVE

10" Locust — 29 → 414+20

8" Locust — 29 → 414+08

12" Locust — 29 → 413+97

8" Locust — 413+85 ← 32 → 16" P.P. #1062186E

30 → 413+73

14" Locust — 30 → 413+47

10" Locust — 29 → 413+29

14" Locust — 30 → 413+12

8" Locust — 29 → 413+00

6" Locust — 29 → 412+87

8" Locust — 30 → 412+73

8" Locust — 30 → 412+61

FROM TOP PG 231

PLEASE RETURN TO
LOS ANGELES COUNTY ENGINEER
700 Los Angeles County Engineering Bldg.

Do not extend this side of this line.

Note: Any Additions or Changes on This Sheet Must be Made or Circled in Red Ink With Date and Name of Person Making Change.

Notes Ck'd by W. D. WAGNER	Survey of AVE. O		F. B. 2609 PG. 233
Map No. C.S.B. 2263-1-10	JN 0075-85 Tape Std °F		
Office Work T. M. PALMERI	Surveyed by J S COATES		
Checked W. D. WAGNER	Notes JSC Date 12-28-60		
Date JAN 12 1961	Indexed H. E. OD		

Note: Any Additions or Changes on This Sheet Must be Made or Circled in Red Ink With Date and Name of Person Making Change.

Do not extend this side of this line.

PLEASE RETURN TO LOS ANGELES COUNTY ENGINEER 700 Los Angeles County Engineering Bldg.

76F3095 S&E #247 11-58

CONT. BOT. PG 234 455+79 E

Well 39 I

115TH ST. E.

1/4 COR 455+27.82 FD. C.S. MON F.B. 2609-83

3 — 454+29

5' 6 barbed wire fence R.R. Tie 2 Posts

30 E — 453+62

AVE O

429+35 E — 31 E

429+29 E — 31 E — deadmen

429+25 E — 31 I

14" P.P. # 1062411E

45 — 9 E — 30 E — 32 O — 428+87 E — 16" P.P. # 1062180 E

428+85 E — 32 O

deadmen

110TH ST. E

SEC. COR. 428+62.82 FD. C.S. MON F.B. 2609-81

428+25 I — 31 E

428+20 E — 30 E — deadmen

AVE N

427+72 E — 31 O — 16" P.P. # 1062181E

FROM TOP PG 232

F. B. 2609 Pg. 234

CONT. BOT. PAGE 235

135TH ST. E.

¼ Cor
561+49.93
FD. C.S. MON.
F.B. 2609-96

547+77.32
FD. 2" I.P.
F.B. 2609-96

130TH ST. E

534+04.71
FD. C.S. MON.
F.B. 2609-93

NO IMPROVEMENTS

125TH ST. E

507+98.46
FD. C.S. MON
F.B. 2609-92

AVE

481+92.29
FD. C.S. MON.
F.B. 2609-90

120TH ST. E.

℄ Antelope Hwy

467+61.37
FD. 1" I.P. 18"dn
F.B. 2609-83

FROM TOP PAGE 233

LOS ANGELES COUNTY ENGINEER
700 Los Angeles County Engineering Bldg.
PLEASE RETURN TO
Do not extend this side of this line.
Note: Any Additions or Changes on This Sheet Must be Made or Circled in Red Ink With Date and Name of Person Making Change.

Notes Ck'd by W. D. WAGNER | Survey of AVE. O | F. B. 2609 Pg. 235
Map No. C.S.B. 2763-1-10 | JN 0075-85 | Tape | Std | °F
Office Work T. M. PALMER | Surveyed by J S COATES
Checked W. D. WAGNER | Notes JSC | Date 12-28-60
Date JAN 12 1962 | Indexed H. E. OTT

Note: Any Additions or Changes on This Sheet Must be Made or Circled in Red Ink With Date and Name of Person Making Change.

Do not extend this side of this line.

PLEASE RETURN TO LOS ANGELES COUNTY ENGINEER 700 Los Angeles County Engineering Bldg.

2' Chicken wire fn CONT. FROM BOT. PG. 236

602+93 deadman

602+90 24 25 5 10 31 3 602+90 8" T.P.# 584216H

10" P.P.# 799936E deadman 12" Conc. standpipe 8' high

5' 2 barbed wire fn 602+35 97 26 5 14 5' 2 barbed wire fn

5' board rail fn

700+20 25 8" T.P.# 584215H

12" P.P.# 1001934E 27 699+72

699+50 25 8" T.P.# 584214H

12" P.P.# 1001935E 29 696+87

ELK Edge wash

Elk edge wash 694+91 8" T.P.# 584213H 25 694+72

693+75

12" P.P.# 1001936E 29 692+83

692+01 25 8" T.P.# 584212H

588+95.73 P.O.C.S. MON FB. 2609-97

689+28 25 8" T.P.# 584211H

689+27 5 deadmen

689+03 25

140TH ST. E.

688+66 31 deadman 12" P.P.# 1001938E 23

12" P.P.# 1001937E 29 688+65

deadman 29 688+38

FROM TOP PG. 234

78F3088 BRE #247 15

F. B. 2609 PG. 236

CONT. BOT. PAGE 237

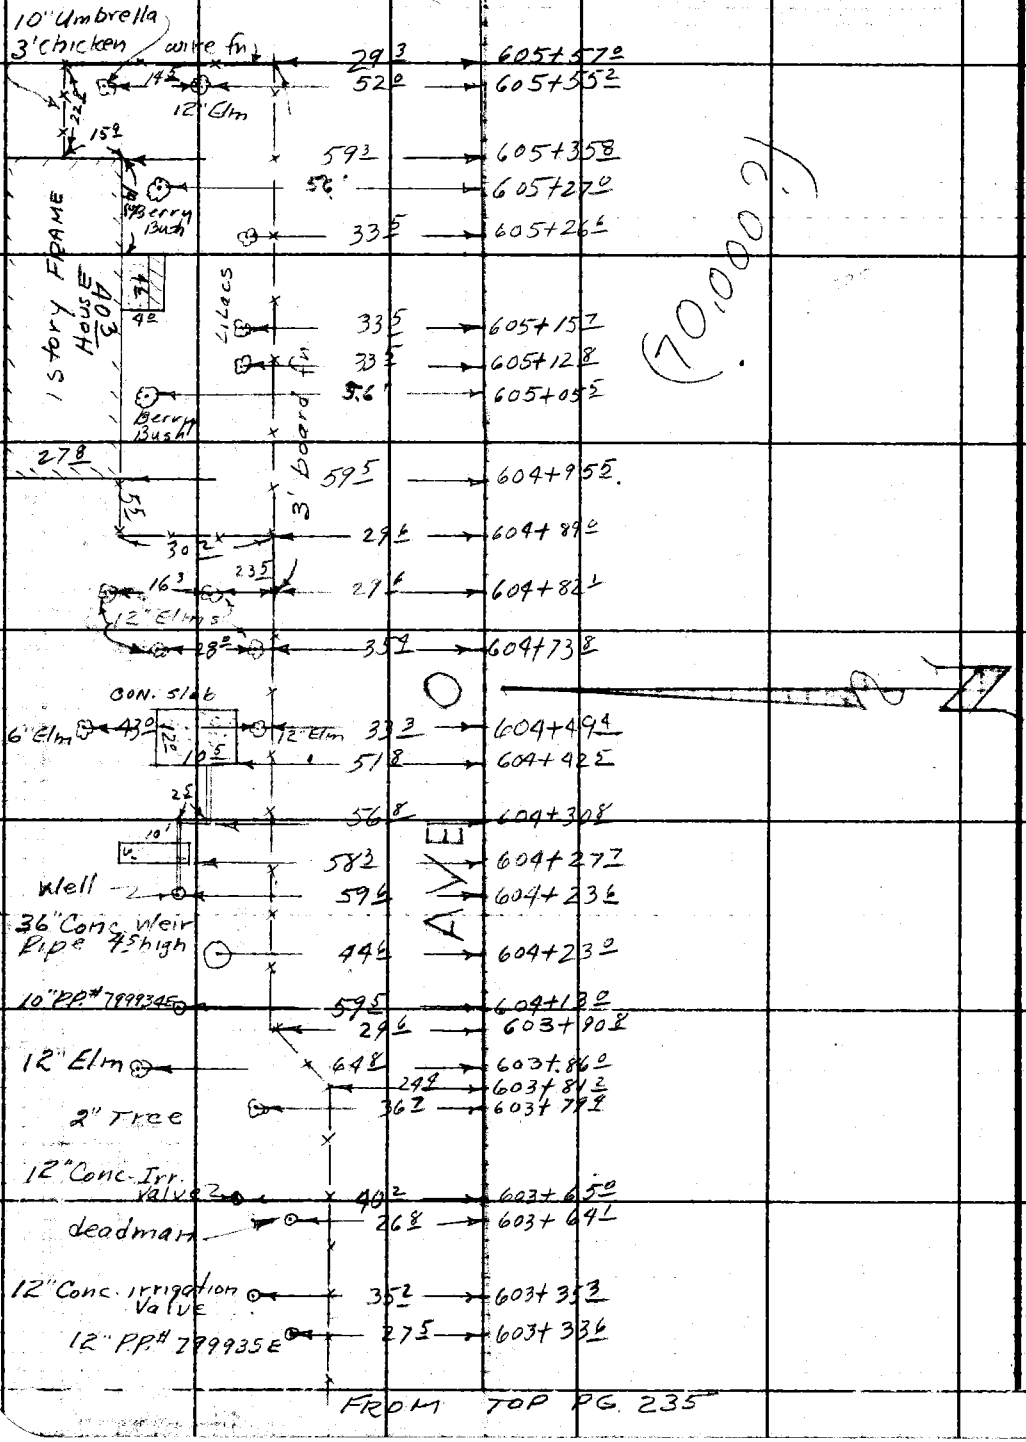

FROM TOP PG. 235

PLEASE RETURN TO
LOS ANGELES COUNTY ENGINEER
700 LOS ANGELES COUNTY ENGINEERING BLDG.
Do not extend this side of this line.
Note: Any Additions or Changes on This Sheet Must Be Made or Circled in Red Ink With Date and Name of Person Making Change.

Notes Ck'd by W. D. WAGNER
Map No. C.S.B. 2763-1-10
Office Work T. H. PALMER
Checked W. D. WAGNER
Date JAN 12 1962

Survey of AVE. O
JN 00758 Tape Std °F
Surveyed by J.S. COATES
Notes J.S.C. Date 1-28-60
Indexed H. E. OTT

F. B. 2609 PG. 237

CONT. BOT. PAGE 238

Note: Any Additions or Changes on This Sheet Must be Made or Circled in Red Ink With Date and Name of Person Making Change.

Do not extend this side of this line.

PLEASE RETURN TO
LOS ANGELES COUNTY ENGINEER
700 LOS ANGELES COUNTY ENGINEERING BLDG.

12" P.P.# 799930E 29.0 613+37.6

12" CONC IRR. Valve 7.8 28.4 610+24.2
12" P.P.# 799931E

12' Conc. Standpipe 8' High 21.2 609+84.5
34.2 609+80.0
34.5 609+64.8

609+39.3 Flowline 12" Conc. Pipe
609+05.2
608+75.5
608+44.2
608+14.6
607+83.9

4" Chicken Wire Fence

35.0 607+53.9
23.3 607+57.3
36" Conc. Pipe 4'± high 35.3 607+39.2
28.8 607+28.5

10" P.P.# 799932E 29.0 606+85.2
606+10.1 25.3 deadman

6" Peach 59.2 605+97.1
6" Apricot 75.4 605+86.0
605+89.8 25.2 8" T.P.# 5842171H
32.8 605+77.2
29.8 605+77.5
12" Elm 90 6.8 7.0 51.0 605+75.9
10" P.P.# 799933E

FROM TOP PAGE 236

76F3095 SAE #247 11-58

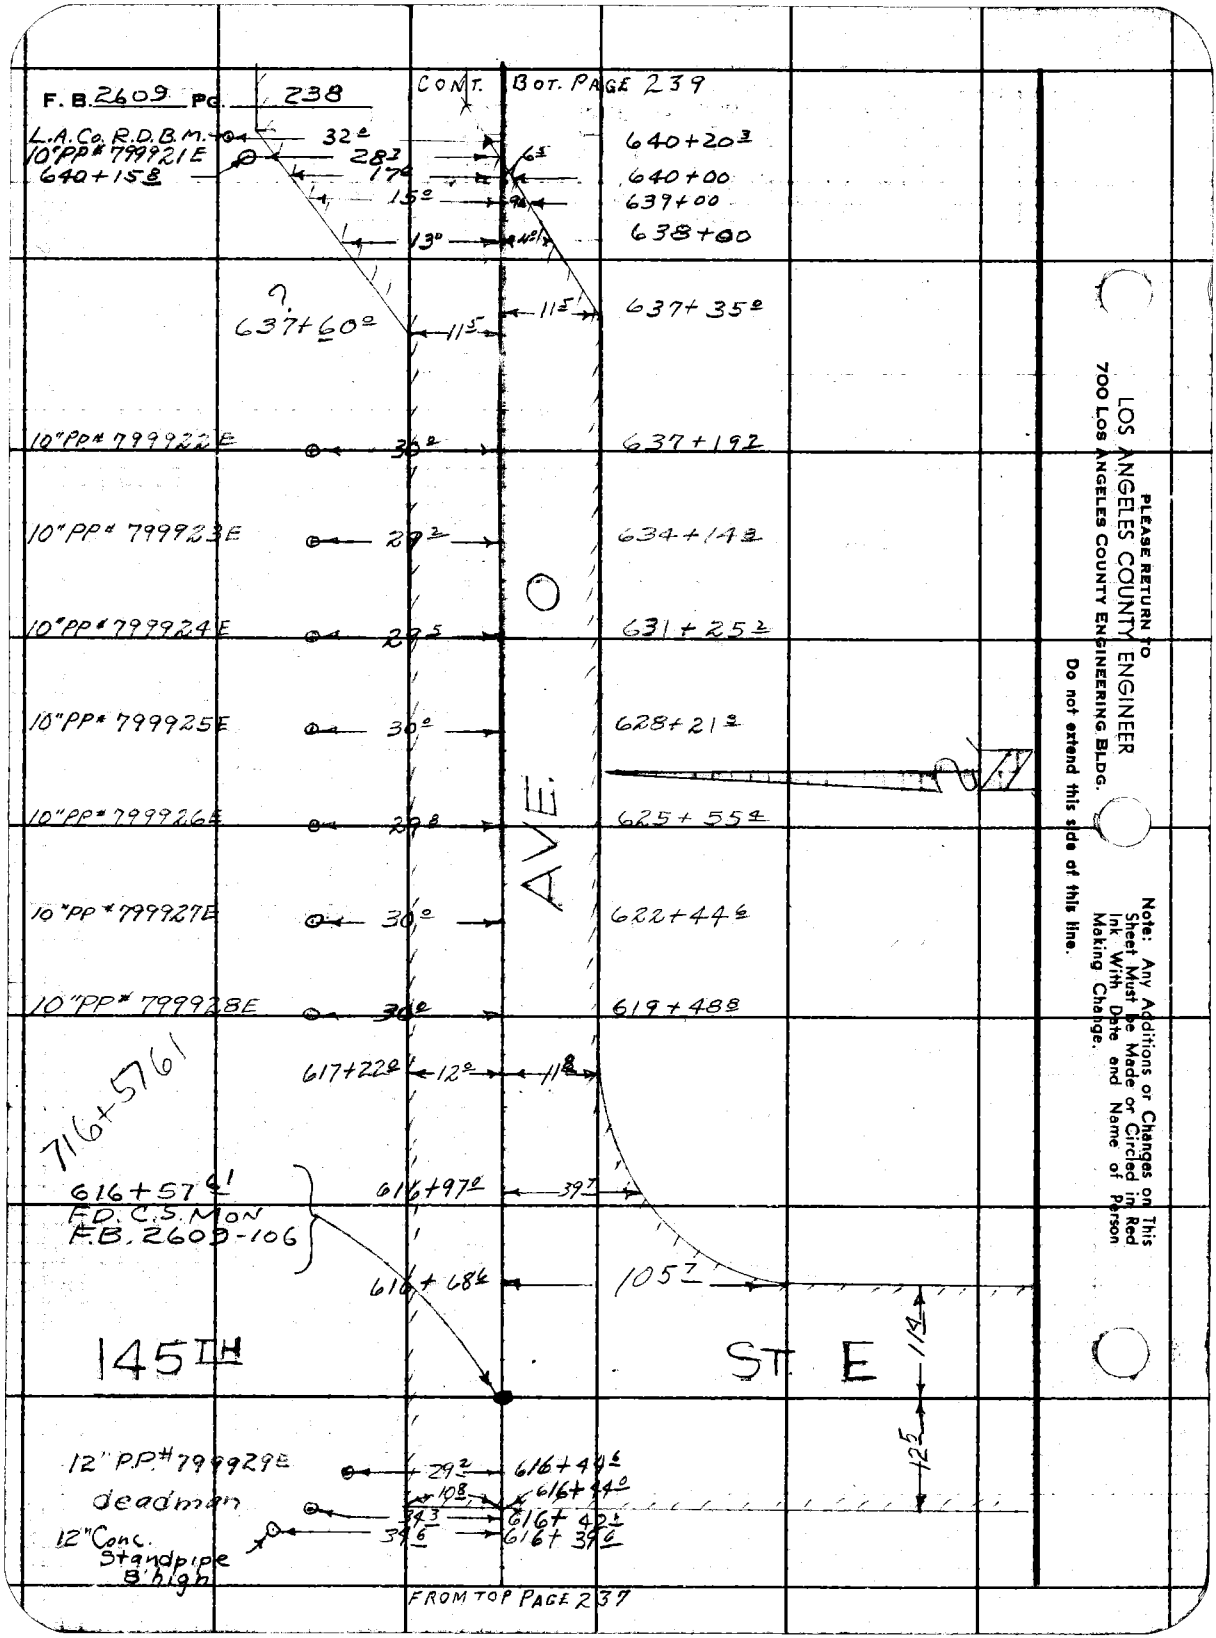
F.B. 2609 Pg. 238
CONT. BOT. PAGE 239
L.A.Co. R.D.B.M.
10"PP# 799921E
640+15
640+20
640+00
639+00
638+00
637+60
637+35
637+19
10"PP# 799922E
10"PP# 799923E
634+14
10"PP# 799924E
631+25
10"PP# 799925E
628+21
10"PP# 799926E
625+55
10"PP# 799927E
622+44
10"PP# 799928E
619+48
617+22
716+57.61
616+57
616+97
FD. C.S. MON
F.B. 2609-106
616+68
105
145TH
ST E
114
125
12" P.P. # 799929E
deadman
12" Conc.
Standpipe
8' high
616+49
616+44
616+42
616+39
FROM TOP PAGE 237
PLEASE RETURN TO
LOS ANGELES COUNTY ENGINEER
700 Los Angeles County Engineering Bldg.
Do not extend this side of this line.
Note: Any Additions or Changes on This Sheet Must be Made or Circled in Red Ink With Date and Name of Person Making Change.

Notes Ck'd by W. D. WAGNER
Map No. C.S.B. 276-140
Office Work T. M. PALMEAL
Checked W. D. WAGNER
Date JAN 12 1962

Survey of AVE. O
JN 0075.85 Tape Std °F
Surveyed by J.S. COATES
Notes JSC Date 1-9-61
Indexed H. E. OD

F. B. 2609 PG. 239

155TH

CONT. FROM PAGE 240

ST. E

670+82.10
½ Cor. Sec
Fd D.E. Mon in Handhole
per F.B. 2609 Pg 113

669+53

4' ± 3 Strand Barbwire Fence

669+52.5
3.5
1 Strand Barb wire fence

AVE O

edge pav't

edge pav't

663+00

662+00

661+00

660+00

659+90

658+70

658+65

658+00

653+00

650+00

647+00

644+21

644+14.5

643+96

150TH

ST. E.

643+75.2

643+49 Bear marker

643+33.2

10" PP
643+16

#799920 E
P. Pole

643+86.88
F.D. C.S. Mon.
per F.B. 2609-111

@ 643+00

642+00

FROM TOP PAGE 238

Note: Any Additions or Changes on This Sheet Must be Made or Circled in Red Ink With Date and Name of Person Making Change.

PLEASE RETURN TO
LOS ANGELES COUNTY ENGINEER
700 LOS ANGELES COUNTY ENGINEERING BLDG.

Do not extend this side of this line.

76 Forms SAE #247 11-60

F. B. 2609 Pg. 240

CONT. BOT. PAGE 241

4'-3 Strand barbed wire fn

40

12.4 11.5

697+77.54
FD. C.E. MON
F.B. 2609-114

40.7

160TH

41°

697+57°

ST. E.

685+87.79
P.O.T. Fd Spk & T
F.B. 2609 P. 113

12.6 11°

40.3 40.9

4'-3 Strand barbed wire fn

AVE

Edge pav

Edge pav

3'-1 strand barbed wire fn

12.2 11.5

40.

FROM TOP PAGE 239

LOS ANGELES COUNTY ENGINEER
700 Los Angeles County Engineering Bldg.

PLEASE RETURN TO

Do not extend this side of this line.

Note: Any Additions or Changes on This Sheet Must be Made or Circled in Red Ink With Date and Name of Person Making Change.

Notes Ck'd by W. D. WAGNER
Map No. C.S.D. 2769-1-10
Office Work T. M. PALMIERI
Checked W. D. WAGNER
Date JAN 12 1962

Survey of AVE. O
JN 0075.85 Tape Std °F
Surveyed by J S COATES
Notes J S C Date 1-9-61
Indexed B. E. OH

F. B. 2609 Pg. 241

CONT. FROM PAGE 241

40.5 → 752+11.5 end of fn
12.7 → 12°
12.7 → 751+40.9
23 → 751+15.5
58° → 751+06.6

170TH ST. E.

11.5
11°
12°
41.3 → 750+91.5
52.4 → 750+85°
48.7 → 750+70°
11.8 → 750+

750+95.21
ED. C.E. MON
F.B. 2609-124

AVE. O

edge pav
edge pav
4' shldr

165TH ST. E

724+36.30
FD. C.S. MON.
FB. 2609-123

12.2 → 11.5
40.3 →

FROM TOP PAGE 240

Note: Any Additions or Changes on This Sheet Must be Made or Circled in Red Ink With Date and Name of Person Making Change.

Do not extend this side of this line.

PLEASE RETURN TO
LOS ANGELES COUNTY ENGINEER
700 Los Angeles County Engineering Bldg.

76F3098 S&E #247 11-58

F. B. 2609 PG. 242

CONT. OT PAGE 243

805+05.3
14" PP# 1185555E

804+76.5
deadman

32.5

32.3

11.1

804+17.8

803+87°

29.8

803+88.5

803+80.2

54.5

180TH

OILED

95'

ST E

13°

DIRT

16" PP# 767672E

803+38.5
deadman

803+46°

69°

68.2

803+57°

32.7

34.9

803+38.8

803+44°

803+06.2

803+68.47
FD. C.S. MON.
F.B. 2609-128

deadman

32.7

803+27.3

AVE O

edge of pav.

edge of pav.

175TH

ST. E

11.5

13.5

777+31.96
FD. C.S. MON.
F.B. 2609-126

FROM TOP PAGE 241

PLEASE RETURN TO
LOS ANGELES COUNTY ENGINEER
700 LOS ANGELES COUNTY ENGINEERING BLDG.

Do not extend this side of this line.

Note: Any Additions or Changes on This Sheet Must Be Made or Circled in Red Ink With Date and Name of Person Making Change.

Notes Ck'd by W. D. WAGNER
Map No. C.S.B. 2763-1-10
Office Work T.M. PALMER
Checked W. D. WAGNER
Date JAN 12 1962

Survey of AVE. O
JN 0075-85 Tape Std °F
Surveyed by J.S. COATES
Notes JSC Date 1-9-61
Indexed R.E. Ott

F. B. 2609 Pg. 243

CONT. FROM PAGE 244

12" P.P. # 1185561E
32° → 819+75.7

182ND ST E
817+11.74
FD. 2" I.P. 12"dn
F.B. 2609-137

12" P.P. # 1185560E
32° → 816+54.7

AVE O

12" P.P. # 1185559E
32° → 813+75.0

12" P.P. # 1185558E
32° → 811+83.8

181ST ST E
810+40.12
FD. 2" I.P. 12"dn
F.B. 2609-136

12" PP 1185557E
32° → 809+94.5

12" P.P. # 1185556E
32° → 807+03.5

FROM TOP PAGE 242

Note: Any Additions or Changes on this Sheet Must be Made or Circled in Red Ink With Date and Name of Person Making Change.
Do not extend this side of this line.

PLEASE RETURN TO
LOS ANGELES COUNTY ENGINEER
700 Los Angeles County Engineering Bldg.

76F3098 SEE #247 11-60

F. B. 2609 PG 244

CONT. BOT. PAGE 245

Precise B.M. #106-81 Brass-Cap Mon. in 12" x 12" Conc Post

35[9] → 884+85[2]

12[3] 12[1]

195TH ST.

E.

884+08[21] F.D.C.S. Mon F.B. 2609-148

Precise BM Brass-Cap Mon. in 12" x 12" Conc Post

37[3] → 858+06[5]

12[5] 11[7]

190TH ST

E

857+40.53 F.D.C.S. Mon F.B. 2609-139

830+55[00] F.D.C.S. Mon F.B. 2609-138

telephone pole

AVE

telephone pole

11° 11[5]

185TH ST

E.

deadman

Precise BM #106-83 1959 BRASS-CAP IN 12"x12" Conc. Post

12" PP #1185563E

32[5] → 825+62[7]

32[9] → 825+59[2]

32[2] → 825+35[7]

12" PP #1185562E

32° → 822+41[2]

FROM TOP PAGE 243

LOS ANGELES COUNTY ENGINEER
700 Los Angeles County Engineering Bldg.

PLEASE RETURN TO

Do not extend this side of this line.

Note: Any Additions or Changes on This Sheet Must be Made or Circled in Red Ink With Date and Name of Person Making Change.

Notes Ck'd by W. D. WAGNER
Map No. C.S.B. 2763-1-10
Office Work T. M. DRAKE
Checked W. D. WAGNER
Date JAN 12 1962

Survey of AVE. O
JN 0076.85 Tape Std °F
Surveyed by J.S. COATES
Notes J.S.C. Date 1-10-61
Indexed H. E. OTT

F. B. 2609 Pg. 245

Precise B.M. #106-79
Brass-cap mon.
12"x12" Conc. post

CONT.

BOT. PG. 246

ST. E

205TH

937+69.2

12.2 — 13.2

36.2

15" P.P. #766976E — 36° — 937+04.9

937+10.59
FD. C.S. MON.
FB. 2609-150

10" P.P. #734956E — 36° — 933+19.2

10" P.P. #734955E — 36° — 928+68.5

924+52.9

89°
60.9

10" P.P. #734953E
deadman
924+50.6

12" P.P. #734954E — 36° — 924+44.9

deadman — 36° — 924+15.7

12" P.P. #1310180E — 36° — 921+68.7

12" P.P. #1310181E — 36° — 919+15.2

Edge of pav

AVE O

12" P.P. #1310182E — 36° — 916+63.7

12" P.P. #1310183E — 36° — 914+15.0

4" Steel post fn. — 44.4 — 913+08.7

15" P.P. #1310184E — 36° — 911+71.1

deadman — 36.2 — 911+44.4

200TH

ST. E

11.2 — 13.5

910+79.48
FD. C.S. MON.
FB. 2609-146

U.S.G.S. △ Sta
Brass-cap
in 6"x6" Post
L.S. 33 1928

40° — 910+08.0

FROM TOP PG 244

Note: Any Additions or Changes on This Sheet Must be Made or Circled in Red Ink With Date and Name of Person Making Change.

Do not erase this side of this line.

PLEASE RETURN TO
LOS ANGELES COUNTY ENGINEER
700 Los Angeles County Engineering Bldg.

FORM 2098 SEE #247 11-58

F. B. 2609 PG 246 — CONT — BOT. PG. 247

Precise B.M. #106-77
Brass-Cap Mon
in 12"x12" Conc. post

10" P.P. #734968E

215TH

10" P.P. #734967E

10" P.P. #734966E

12" P.P. 1190534E

10" P.P. #734965E

10" P.P. #734964E

10" P.P. #734963E

Precise B.M. #106-78
Brass-Cap Mon
12"x12" Conc. post

210TH

10" P.P. #734962E

10" P.P. #734961E

10" P.P. #734960E

10" P.P. #734959E

10" P.P. #734958E

34.6 → 991+77.2

34.6 → 991+73.1

11.0 → 12.5

ST E

990+72.62
FD C.S. MON
FB. 2609-152

34.6 → 983+18.9

57.9

34.6 → 980+79.3

977+50.5 ← 977+50.3 → 977+53.3

deadman
10" P.P. #1190527E

32.7

34.6 → 975+68.1

34.6 → 970+43.3

Precise B.M. #106-78
Brass-Cap Mon
12"x12" Conc. post

34.6 → 965+96.9
34.7 → 965+91.2

10.2 → 13.2

ST. E.

963+77.44
FD. C.S. MON
FB. 2609-151

34.7 → 960+69.2

35.0 → 956+36.2

35.2 → 953+10.2

AVE E

35.5 → 948+15.2

35.5 → 943+14.8

FROM TOP PG. 246

PLEASE RETURN TO
LOS ANGELES COUNTY ENGINEER
700 Los Angeles County Engineering Bldg.

Do not extend this side of this line.

Note: Any Additions or Changes on This Sheet Must be Made or Circled in Red Ink With Date and Name of Person Making Change.

Notes Ck'd by W. D. WAGNER
Map No. C.S.B. 2763 -1-10
Office Work T. M. PALLIERI
Checked W. D. WAGNER
Date JAN 12 1962

Survey of AVE. O
JN 0075 85 Tape Std °F
Surveyed by J. S. COATES
Notes JSC Date 1-10-61
Indexed H. E. OT

F. B. 2609 PG. 247

CONT. ; BOT. PG. ; 248

10" P.P. # 734975E ← 34.8 → 1023+40.3

10" P.P. # 734974E ← 34.8 → 1021+29.2

deadman ← 34.8 → 1021+12.2

52.5 — 32.7 — edge of pav

52.5 — 32.7 → 1019+83.9

Barb wire fence 49.2

Precise B.M. #106-76
Brass Cap Mon
12" X 12" Conc. Post.

10" P.P. # 734973E ← 34.9 → 1018+08.0
34.8 → 1018+03.2

1017+68.15
F.D.C.S. Mon
FB. 2609-159

12.9 — 11.9

220TH

ST E

10" P.P. # 734972E ← 34.8 → 1012+85.2

AVE

10" P.P. # 734971E ← 34.9 → 1006+88.3

86.3 → 10" P.P. # 134177E

1002+30.0 ←

12" P.P. # 134177E ← 34.8 → 1001+81.9

10" P.P. # 734969E ← 34.7 → 997+00.0

FROM TOP PG. 246

Note: Any Additions or Changes on this Sheet Must be Made or Circled in Red Ink With Date and Name of Person Making Change.

Do not extend this side of this line.

PLEASE RETURN TO
LOS ANGELES COUNTY ENGINEER
700 LOS ANGELES COUNTY ENGINEERING BLDG.

7BF3098 SEE F247 11-58

F. B. 2609 PG 248

CONT. BOT. PG. 249

10" P.P. # 734981E — 34.5 — 1052+06.3

10" P.P. # 734980E — 34.9 — 1046+81.5

225 TH ST. E

11.5 — 12.1

1044+53.2 FD 2" I.P. in Conc. F.B. 2609-16

34.9 — 1042+28.6

38.2

1 STORY FRAME STORE BLDG 38.5

24.4 — 4.5 — 1.3

36.2

37.1 — 1041+66.9

12" P.P. # 734978E — 34.9 — 1041+59.5

11.2

8" Elms? — 38.5 — 1041+58.2

1041+32.4

5' — 35.0 — 1041+19.5

3 strand hog wire fn

edge of Pav

56.5 — 12° — 38.5 — 14" CONC. FOOTING — 27.8 — CONC. SLAB 22.2

53.0 — 38.5

12" P.P. # 1185071E — 34.9 — 1039+95.5

deadman — 45.6 — 1039+94.4

12" P.P. # 1185072E — 66.0 — 1039+90.0

WEST AVE

12" P.P. # 734977E — 34.9 — 1036+32.3

12" P.P. # 734977E — 34.9 — 1031+09.3

deadman — 34.9 — 1026+11.2

10" P.P. # 734976E — 34.9 — 1025+86.1

FROM TOP PG 247

LOS ANGELES COUNTY ENGINEER
700 Los Angeles County Engineering Bldg.

PLEASE RETURN TO

Do not extend this side of this line.

Note: Any Additions or Changes on This Sheet Must be Made or Circled in Red Ink With Date and Name of Person Making Change.

Notes Ck'd by W. D. WAGNER
Map No. C.S.B. 2068-1-10
Office Work T.M. PALMIERI
Checked W. D. WAGNER
Date JAN 12 1962

Survey of AVE. O
JN 2075.85 Tape ___ Std ___ °F
Surveyed by J.S. COATES
Notes J.S.C. Date 1-10-61
Indexed H. E. Ott

F. B. 2609 Pg. 249

PG. 250

		CONT.	BOT.	
4" Apple	2" Peach		49	1064+49
	bush		33	1064+44
4" Apple			68	1064+33
	Bush		33	1064+26
4" Apple			44	1064+19
	bush		33	1064+08
10" Elm			74	1064+12
	6" Elm		54	1064+06
12" Elm			76	1063+92
10" Elm			58	1063+87
	ATHEL Bush		31	1063+63
2" Apple			45	1063+25
2" Apple			45	1063+58
4" Elm			42	1063+40
			31/4	1063+38
4' 3 Strand barbed wire fn		edge	OF	PAV'T
10" P.P. #734983E			34	1062+56
			31	1062+44
4' - 3 Strand barbed wire fence				AVE
			31	1057+95 P.O. F.D. 2" I.P. 12" dn F.B. 2609-161
227TH	1057+97			STE
10" PP #734982E			34	1057+30
10" PP #951698E			34	1054+60

FROM TOP PG 248

Note: Any Additions or Changes on this Sheet Must be Made or Circled in Red Ink With Date and Name of Person Making Change.

Do not extend this side of this line.

PLEASE RETURN TO
LOS ANGELES COUNTY ENGINEER
700 Los Angeles County Engineering Bldg.

76F3088 SOE #247 11-58

F. B. 2609 PG. 250

CONT. BOT. PG. 251

32° → 1083+35°

1083+28.5 39.5 → 9° 10.5

9° 10.5

1083+16.3 39.5 → 6-4" Locusts

10" PP #734987E 35.2 → 31° 1082+70°

1082+02.3

4' 2 Strand barbed wire fence

10" PP #734986E 35± 1077+54.8

4' 4 Strand barbed wire fence 32° → edge OF PAVT 1074+69.5

54.4 1074+24.2

16" Elms 54.2 → 1074+04.2

6" Apple 56± → 1073+59.2

10" PP #734985E 35.5 1073+07.2

31° 1071+57.8

230 CH

10.5 14.2 ST E

30.6 → 1071+30.2

1071+38.60

FD. C.S. MON.

F.B. 2609-162

4" 3 Strand barbed wire fence

12" PP #734984E 35± → 1067+65.2

31.2 → 1064+58.2

FROM TOP PG 249

PLEASE RETURN TO
LOS ANGELES COUNTY ENGINEER
700 Los Angeles County Engineering Bldg.

Do not extend this side of this fine.

Note: Any Additions or Changes on This Sheet Must be Made or Circled in Red Ink With Date and Name of Person Making Change.

Notes Ck'd by W. D. WAGNER | Survey of AVE O | F. B. 2609 Pg. 251
Map No. C.S.B. 226 - 1-10 | JN 00756 5 Tape Std °F
Office Work T. M. PALMIERI | Surveyed by J S COATES
Checked W. D. WAGNER | Notes J S C Date 1-10-61
Date JAN 12 1962 | Indexed H. E. OTT

Note: Any Additions or Changes on this Sheet Must be Made or Circled in Red Ink With Date and Name of Person Making Change.

PLEASE RETURN TO
LOS ANGELES COUNTY ENGINEER
700 Los Angeles County Engineering Bldg.
Do not extend this side of this line.

35 hog wire fn. I — CONT. BOT. — PG. 252

1093+72.7

10" P.P. #734996E — 35° — 1092+78.8
4' wire fn. 2

32.8 — 1090+78.7

35 2 Strand barbed wire fn
4' wire fence 2

10.4

23.3 — 1088+57.5

12" Locust — 27.8 — 1088+34.5

deadman 2 — 37.6 — 1086+85.8
Row of Arbol Shrubs

36.6 — 1086+69

23.5 — 1086+64

10' P.P. #734989E — 35° — 1086+56.1

4' wire fn 2

AVE

edge of Pav. 2 — 135° — 1084+07.5

10" P.P. #734988E

deadman — 35° — 1084+27.6

4' 2 Strand barbed wire fn

4' 3 Strand barbed wire fn. 2

31.5 — 1083+99.5

23.8 — 1083+74.0

17.7 — 1083+66.0

22.8 — 1083+65.7

24" Corr. Iron culvert

FROM TOP PG 251

76F3098 9&E #247 11-59

F. B. 2609 PG. 252 — CONT. PG. BOT 253

3' W. wire fn.

4' 2 Strand barbed wire fn.

10" P.P.# 734993E

10" P.P.# 734992E

12" P.P.# 734991E

1098+02.29
FD. 2" I.P. in Conc
F.B. 2609-173

deadman

3 Strand Hog wire fence

edge of PAV. 2

235 FWY

ATHEL TREES.

ST. E

4' wire fn with 3' Chicken wire

2-4" Poplars

4" Plum

3" Poplar

6" Elms

4" Elms

18'

6-6" Elms

4' 3 Strand barbed wire fn.

1110+31.6	33.8	
1109+53.8	34.8	
1108+02.1	35.4	
1105+84.2	30.5	
1105+62.0	34.8	
1103+27.0	30.5	
1103+16.2	34.8	
1103+15.5	30.6	
1102+89.0	35.2	
1102+82.9	39.1	
1102+67.3	34.8	
1102+58.5	38.8	
1101+34.2	25.3	
1101+29.2	30.0	
1100+46.6	30.0	
1098+04.5	12.8	
1098+02.5	12.4	
1098+01.0	30.0	
1098+02.8	29.8	

CONT. FROM TOP PG. 251

PLEASE RETURN TO
LOS ANGELES COUNTY ENGINEER
700 LOS ANGELES COUNTY ENGINEERING BLDG.
Do not extend this side of this line.
Note: Any Additions or Changes on This Sheet Must be Made or Circled in Red Ink With Date and Name of Person Making Change.

Notes Ck'd by W. D. WAGNER
Map No. C.S.B. 2723-1-10
Office Work T.M. PALMERI
Checked W. D. WAGNER
Date JAN 12 1962

Survey of AVE. O
JN 00758 Tape Std °F
Surveyed by J.S. COATES
Notes JSC Date 1-11-61
Indexed H. E. OTT

F. B. 2609 PG. 253

CONT. BOT. PG 254

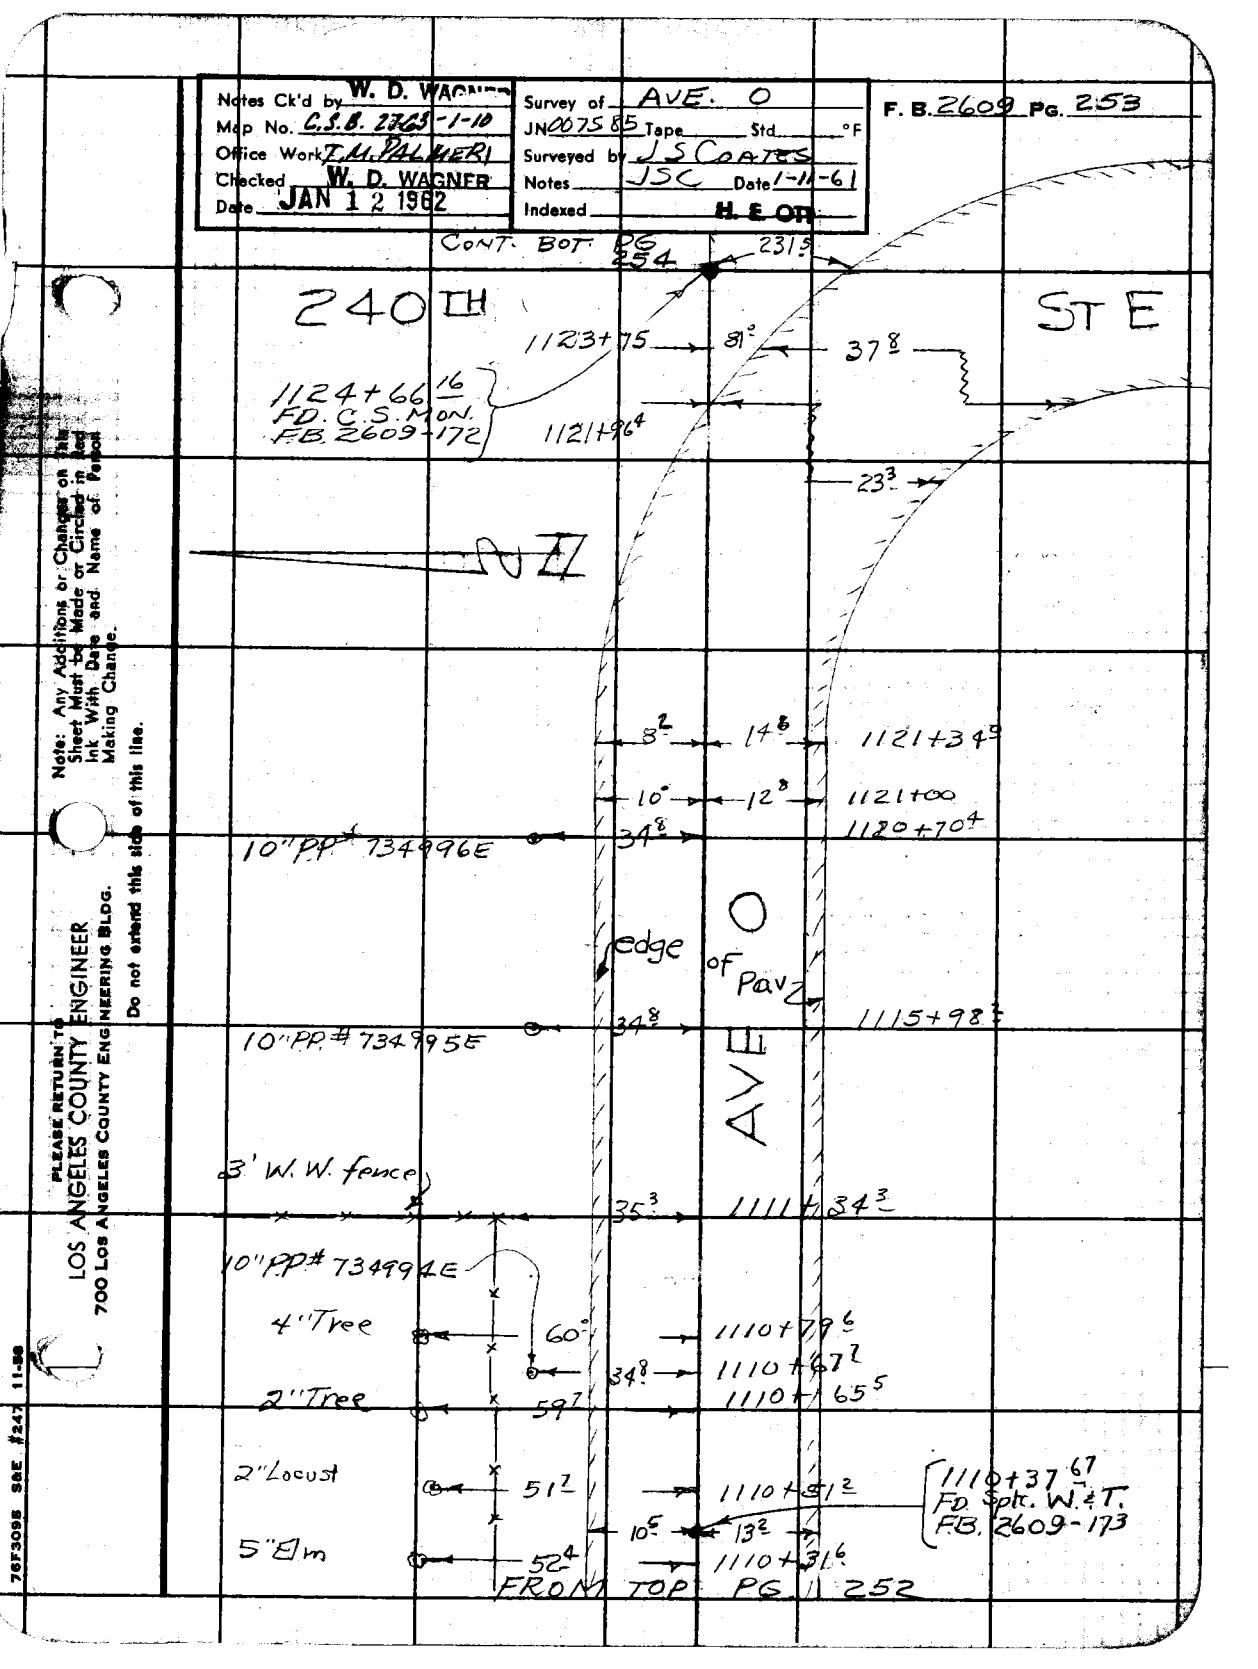

Note: Any Additions or Changes on this Sheet Must Be Made or Circled in Red Ink With Date and Name of Person Making Change.

Do not extend this side of this line.

PLEASE RETURN TO
LOS ANGELES COUNTY ENGINEER
700 Los Angeles County Engineering Bldg.

75F3095 SEE #247 11-58

F.B. 2609 Pg. 254

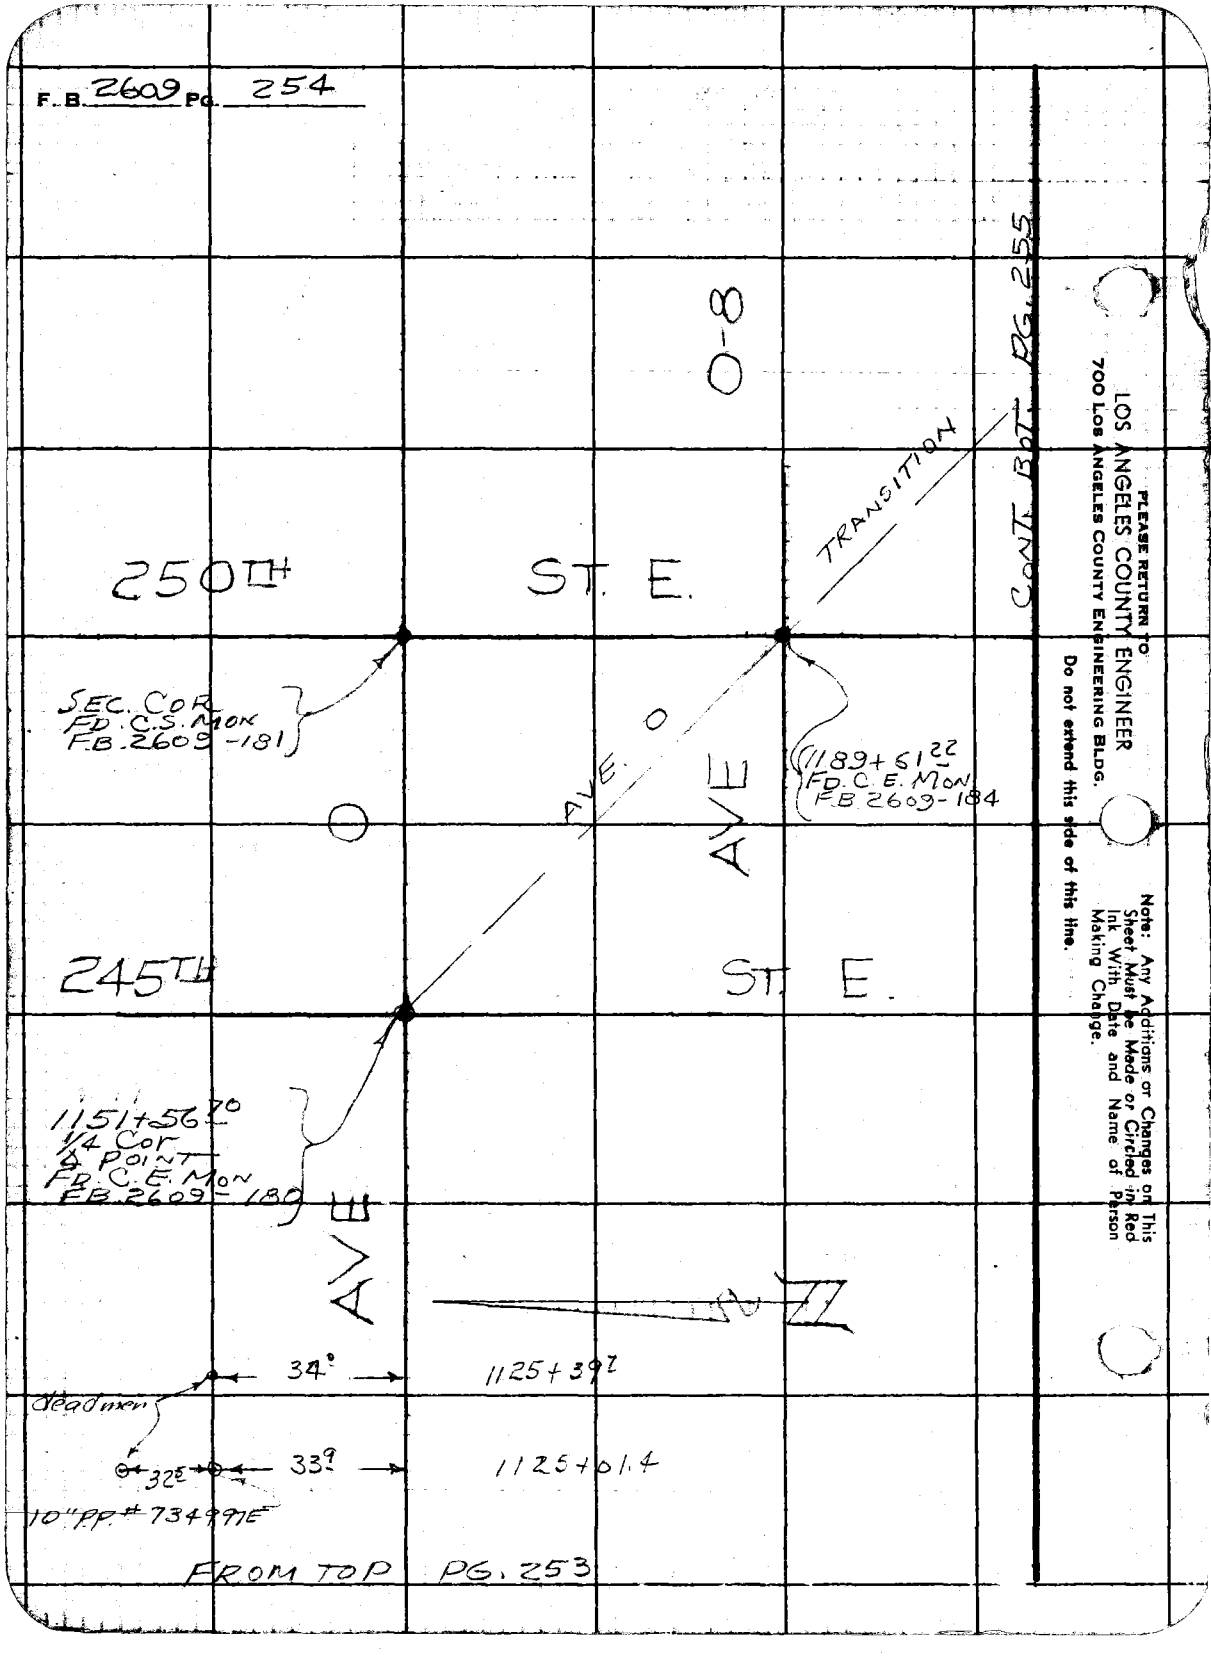

PLEASE RETURN TO
LOS ANGELES COUNTY ENGINEER
700 LOS ANGELES COUNTY ENGINEERING BLDG.

Do not extend this side of this line.

Note: Any Additions or Changes on This Sheet Must be Made or Circled in Red Ink With Date and Name of Person Making Change.

Notes Ck'd by W. D. WAGNER
Map No. G.S.B. 2763-1-10
Office Work T. M. PALMIERI
Checked W. D. WAGNER
Date JAN 1 2 1962

Survey of AVE. O
JN 0075.85 Tape Std °F
Surveyed by J.S. COATES
Notes J.S.C. Date 1-11-61
Indexed H. E. ON

F. B. 2609 Pg. 255

CONT. BOT. PG. 256

12+40+86.8 — 31°

12+39+72.5 — 36° — 12" P.P. #6821516

12+34+82.6 — 36° — 12" P.P. #6821506 — 4' 3strand barbed wire fn

12+29+86.3 — 36° — 12" P.P. #6821496

255 TH

12+27+86.52 — 12.3 — 12.8 — 30°

P.O.C. S.MON P.B. 2609-192 178

AVE O

UTE

FROM TOP / RT. SIDE PG. 254

LOS ANGELES COUNTY ENGINEER
700 Los Angeles County Engineering Bldg.

Zerposs BRK 7.5x7 11-58
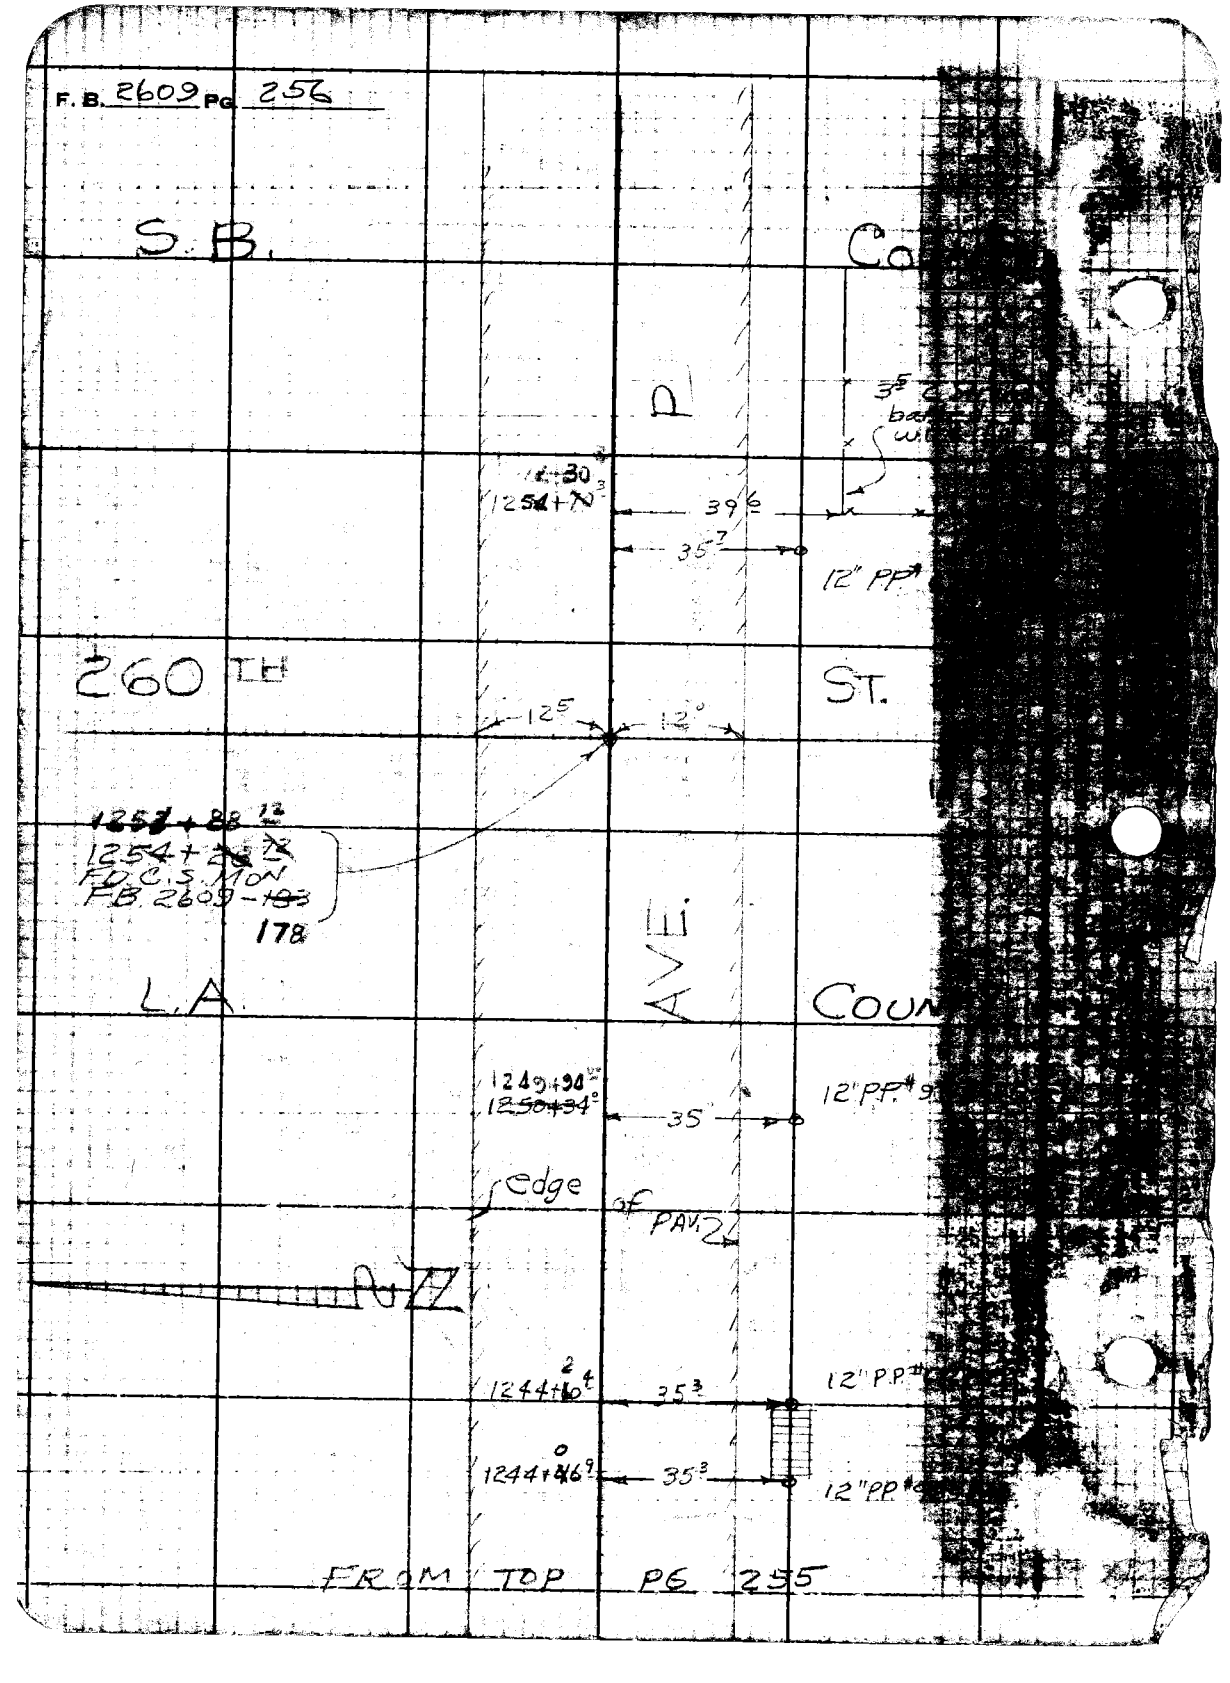
F. B. 2609 Pg 256