Survey of
JN Tape Std °F
Surveyed by
Notes Date
Indexed

F.B. 2640 Pg.

Job	Description
	DOHENY DRIVE 0075.91
	(continued from F.B. 2625:248)
Topog.	Loc. Imp. from Cynthia St. N'ly to Sunset Blvd.
	SAN VICENTE BLVD. 0095.52
C.L.	Realignment survey of San Vicente Blvd. between Santa Monica Blvd. & Beverly Blvd.
C.L.	New alignment Santa Monica Blvd. S'ly to Melrose Ave.
	W. HOLLYWOOD COUNTY BLDG. 0021.10
Index	
Bdry.	Prop line survey on El Tovar Pl, W'ly of San Vicente.
B.M.	Bench Levels.
	W. HOLLYWOOD ROAD DEPT. MAINT. YD. 301 0779.95
C.L.	Retracement.
Topog.	Location of telephone pull box.
	EL TOVAR PL. 0055.94
Vac.	Surv. for St. Vacation.
B.M.	Bench level control for P.T.Shts. H-100-A-1, H-90-1, H-90-2.
	Modified June 85
	W. HOLLYWOOD ROAD DEPT. MAINT. YD. #330 J.N. 0779.37
Index	On El Tover Pl. w'ly. of San Vicente

over

F.B. 2640 Pg.

157-158 Prop. Cor. Monutation

159-160 Bench levels for Const.

PLEASE RETURN TO
LOS ANGELES COUNTY ENGINEER
403 Los Angeles County Engineering Bldg.

Do not extend ink side of this line.

Note: Any Additions or Changes to this Sheet Must be Made or Checked in Red Ink With Date and Name of Person Making Change

Notes Ck'd by	Survey of DOHENY DR
Map No.	JN 0075.91 Tape 0135 Std 68 °F
Office Work R. L. GREEN	Surveyed by H. E. GRANDUIST
Checked	Notes H.E.G. Date 3/2/66
Date	Indexed A. C. Johnson

F.B. 2640 Pg. 5

JN. 0075.91

DOHENY DRIVE.

LOCATION OF IMPROVEMENTS

SELEVADO AVE W.S.
From 3/4 11.5 houses West Side of St. to end of Jo.
& From 3946 East Side to end of Jo.
N.E. Cor Cynthia St. & Doheny Dr. Impr. Pg. 6 To Pg.

FOR OTHER IMPR. SEE F.B. 2625 Pg. 246
FOR 4 NOTES SEE F.B. 2625 Pg. 5 to 9.

GRANDIST, Chief.
MALDONADO Instr.
E. MARTINEZ Head chain.
G.E. Look Rear chain.

Note: Any Additions or Changes on This Sheet Must Be Made or Circled in Red Ink With Date and Name of Person Making Change.

Do not extend notes this side of this line.

RETURN TO
LOS ANGELES COUNTY ENGINEER
1100 LOS ANGELES COUNTY ENGINEERING BLDG.

76F3095 CE #247—3-57

RETURN TO
LOS ANGELES COUNTY ENGINEER
700 LOS ANGELES COUNTY ENGINEERING BLDG.

Note: Any Additions or Changes on This Sheet Must be Made or Circled in Red Ink With Date and Name of Person Making Change.

Do not extend notes this side of this line.

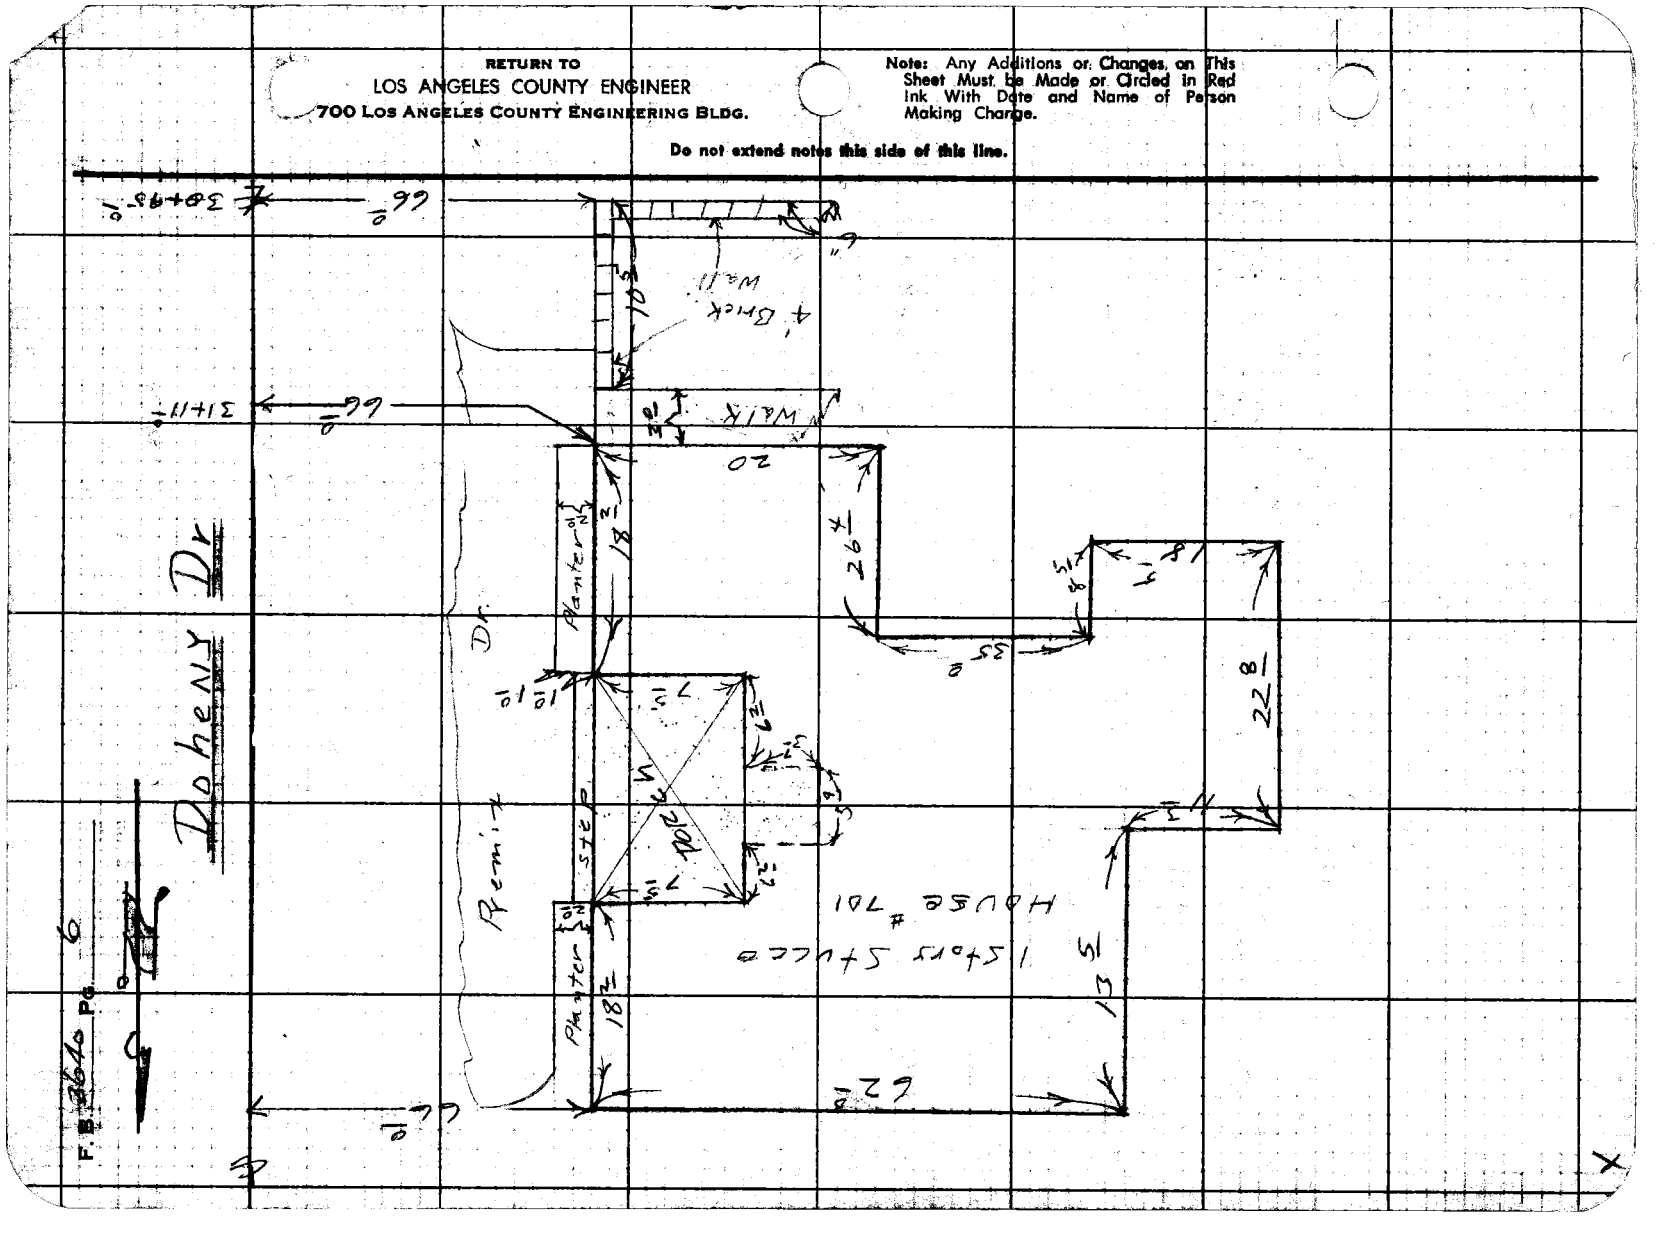

Notes Ck'd by
Map No.
Office Work R. L. GREEN
Checked
Date

Survey of DOHENY DR
JN 0075.71 Tape 0135 Std 68 °F
Surveyed by H.E. GRANDHUS
Notes H.E.G. Date 3/21/60
Indexed A. C. Johnson

F. B. 2640 Pg. 7

Note: Any Additions or Changes on This Sheet Must be Made or Circled in Red Ink With Date and Name of Person Making Change.

Do not extend notes this side of this line.

RETURN TO
LOS ANGELES COUNTY ENGINEER
700 Los Angeles County Engineering Bldg.

76F309S CE #247—3-57

DOHENY DR

66'

SEE WALK Notes

19.6'

8'

20'

Garage

17.6'

4'

DRIVE

1-Story
STUCCO
703

13.5'

14'

PORCH

5.0'

14'

28'

68'

26.2'

42.5'

9.8'

9'

13'

3175.5'

F.B. 2640 Pg. 8

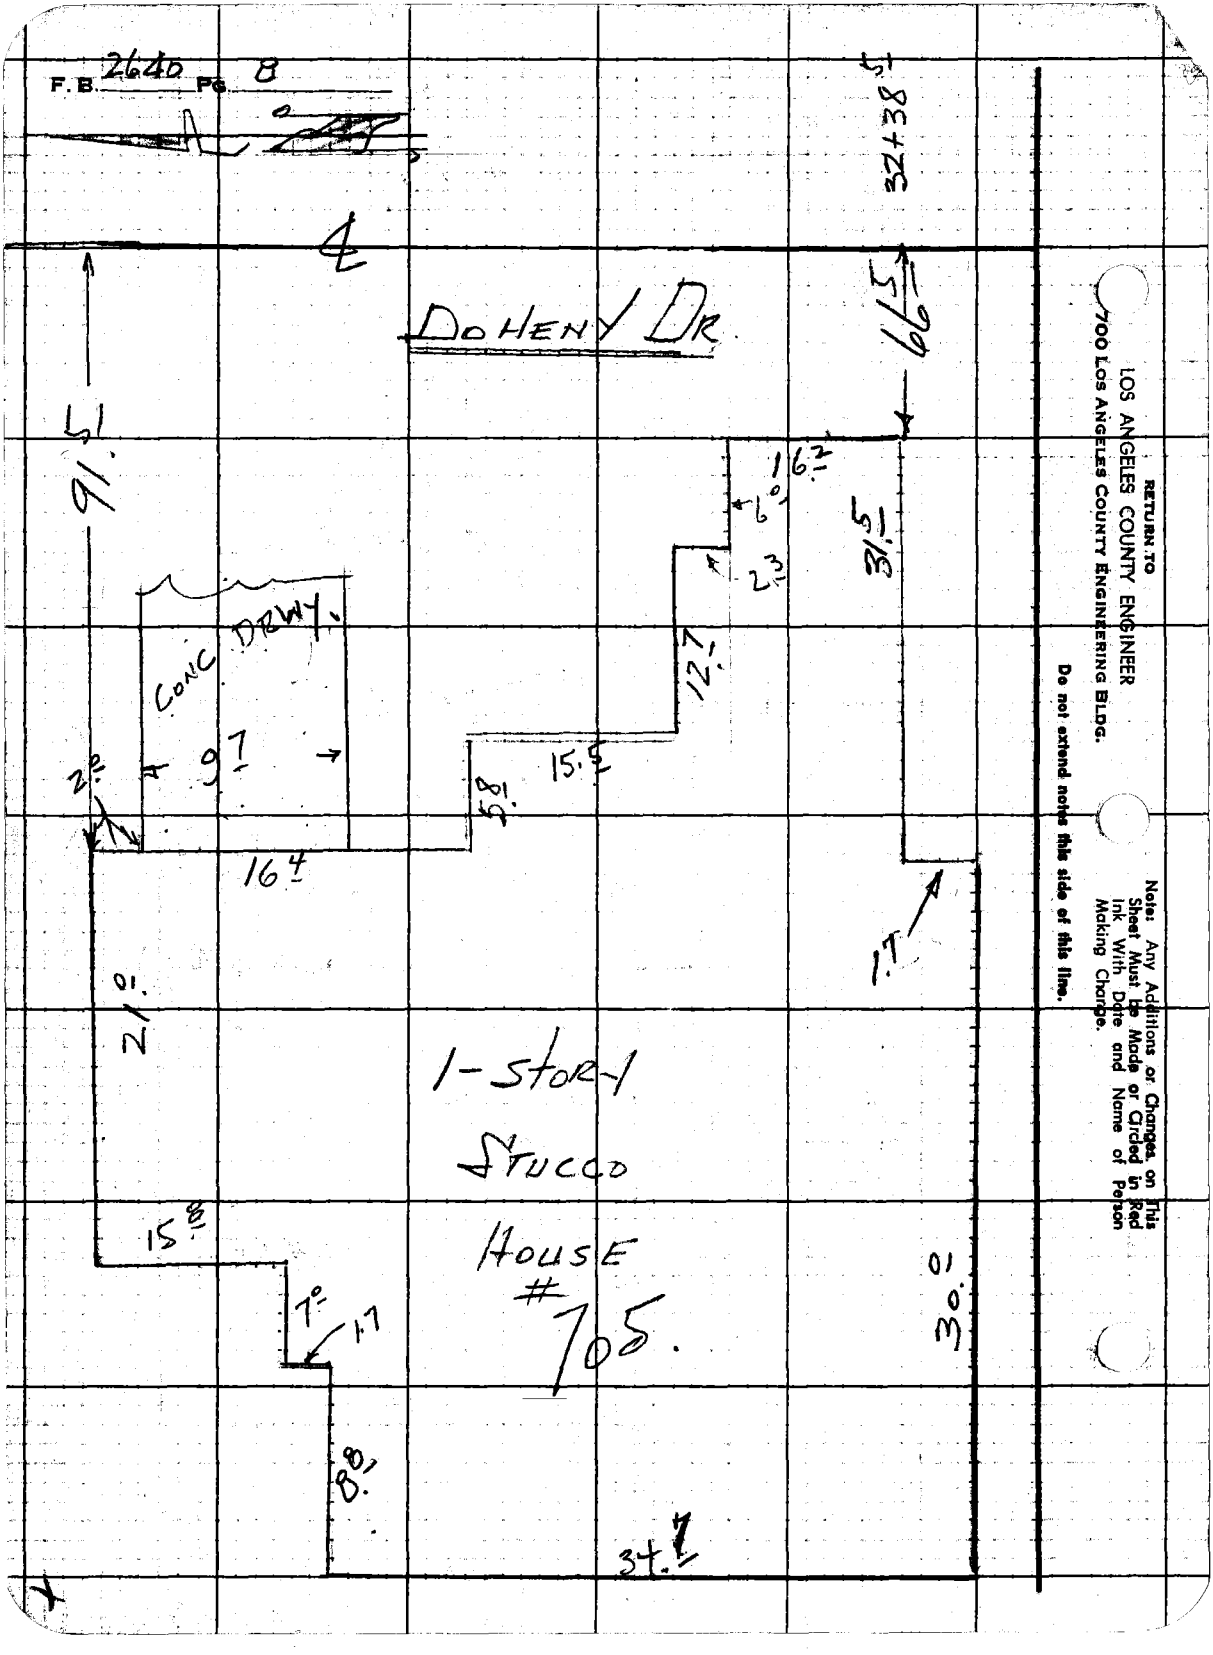

RETURN TO
LOS ANGELES COUNTY ENGINEER
700 LOS ANGELES COUNTY ENGINEERING BLDG.

Note: Any Additions or Changes on This Sheet Must be Made or Circled in Red Ink With Date and Name of Person Making Change.

Do not extend notes this side of this line.

Notes Ck'd by	Survey of DOHENY DR.
Map No.	JN 007591 Tape 0135 Std 68 PF
Office Work R. L. GREEN	Surveyed by H. E. GRANQUIST.
Checked	Notes H.E.G. Date 3/21/60
Date	Indexed C. Johnson

F. B. 2640 PG. 9

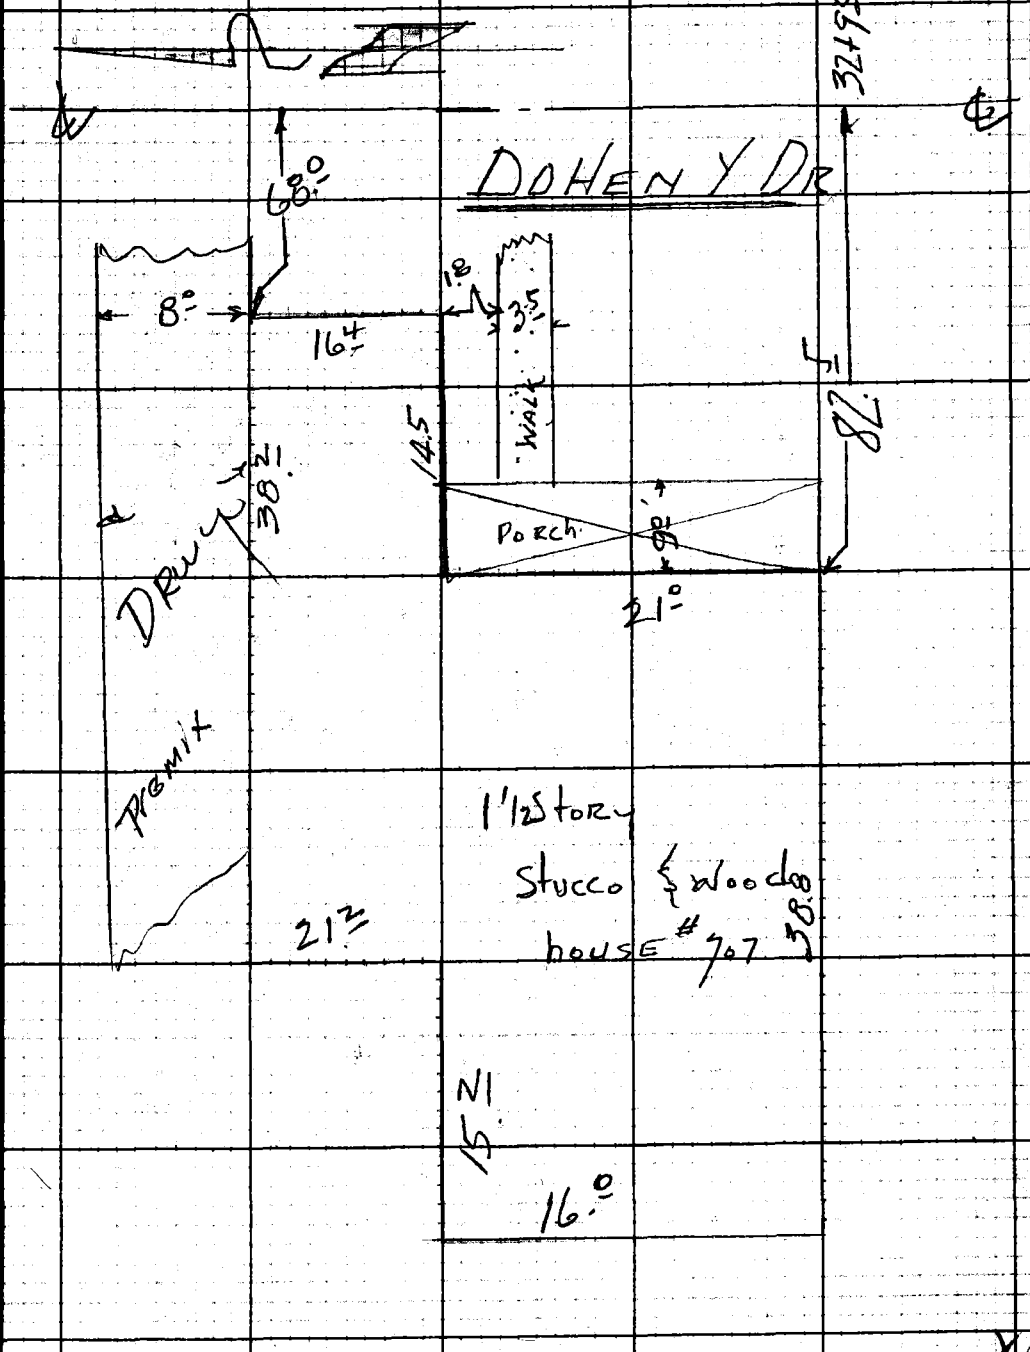

Note: Any Additions or Changes on This Sheet Must Be Made or Circled in Red Ink With Date and Name of Person Making Change.

Do not extend notes this side of this line.

RETURN TO
LOS ANGELES COUNTY ENGINEER
700 Los Angeles County Engineering Bldg.

76F3095 CE #247—3-57

F.B. 2640 PG. 10

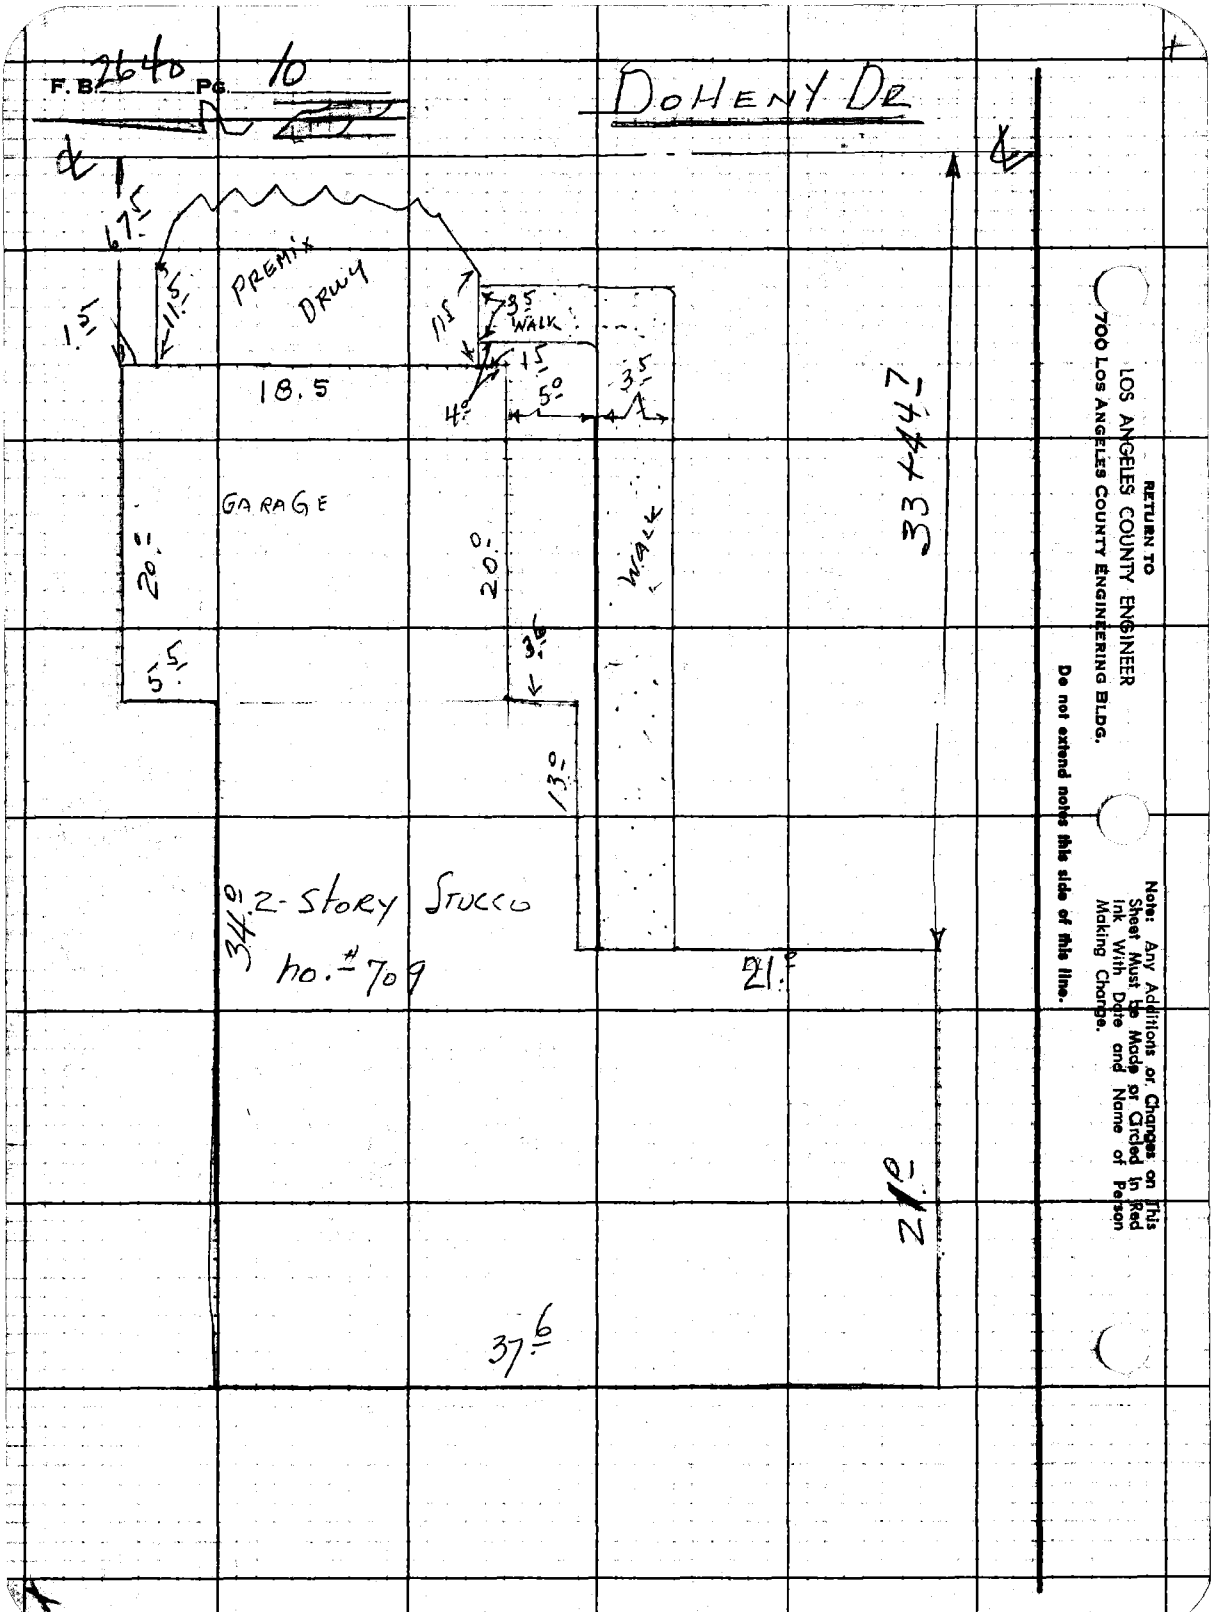

RETURN TO
LOS ANGELES COUNTY ENGINEER
700 LOS ANGELES COUNTY ENGINEERING BLDG.

Note: Any Additions or Changes on This Sheet Must be Made or Circled in Red Ink With Date and Name of Person Making Change.

Do not extend notes this side of this line.

Notes Ck'd by
Map No.
Office Work R. L. GREEN
Checked
Date

Survey of POHENTOR
JN 00 75.91 Tape 0135 Std 66' of
Surveyed by H. E. GRANQUIST
Notes H. E. G. Date 3/22/60
Indexed C. Johnson

F. B. 2640 Pg. 11

DOHENY DR

Note: Any Additions or Changes on This Sheet Must be Made or Circled in Red Ink With Date and Name of Person Making Change.

Do not extend notes this side of this line.

RETURN TO
LOS ANGELES COUNTY ENGINEER
700 LOS ANGELES COUNTY ENGINEERING BLDG.

76F309S CE #247—3-57

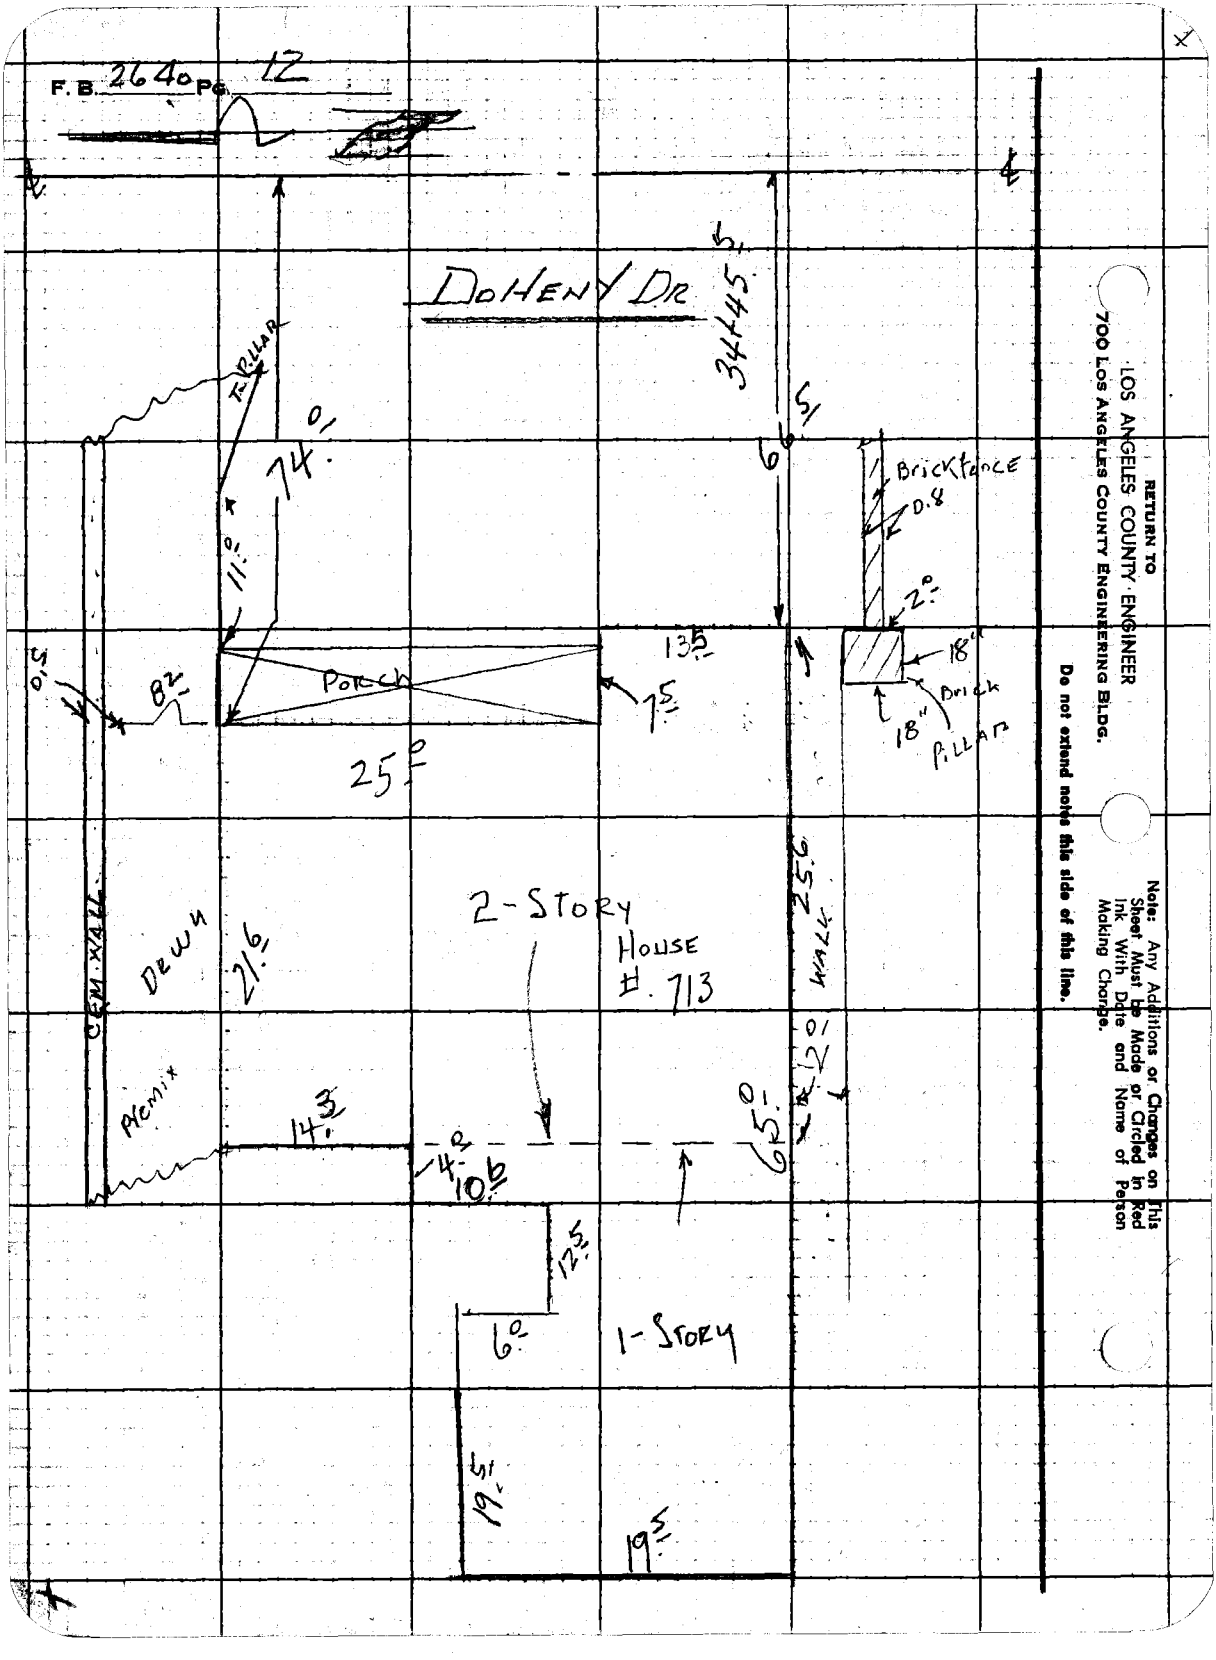

RETURN TO
LOS ANGELES COUNTY ENGINEER
700 LOS ANGELES COUNTY ENGINEERING BLDG.

Note: Any Additions or Changes on This Sheet Must be Made or Circled in Red Ink With Date and Name of Person Making Change.

Do not extend note this side of this line.

Notes Ck'd by
Map No.
Office Work R. L. GREEN
Checked
Date

Survey of DOHENY DR.
JN 007591 Tape 0735 Std. 66 of
Surveyed by H. E. GRANQUIST
Notes H. E. G. Date 3/22/60
Indexed ~~A. C. Johnson~~

F. B. 2640 Pg. 13

Notes: Any Additions or Changes on This Sheet Must be Made or Circled in Red Ink With Date and Name of Person Making Change.

Do not extend notes this side of this line.

RETURN TO
LOS ANGELES COUNTY ENGINEER
700 Los Angeles County Engineering Bldg.

76F3095 CE #247—3-57

DOHENY

35.73'

57.5

10" MAGNOLIA

10.8'

69.8'

PREMIX DRWY 8'

WALK

3'

2.5'

6.0'

3.0'

16.0'

9.0'

19.0'

House # 717 outof Limits

BREEZWAY

16.0'

34.49'

66.5'

22.6'

3.0'

1-STORY

STUCCO HOUSE

715

0.5'

CONC WALL

57.6'

40.0'

35.0'

F.B. 260 Pg. 14

DOHENY DR.

36+75

36+53

36+45.5

69.6

57.0

57.0

69.6

8" Shade Tr.

8" Shade Tr.

WALK 4.0

1.5

1.5

8.

2.

brick steps

PORCH 12.5

4.5

7.5

11.6

PREMIX DRWY

11.

31.6

31.6

38.1

2-STORY STUCCO HOUSE #721

38.

PATH OF FLOW

RETURN TO
LOS ANGELES COUNTY ENGINEER
700 LOS ANGELES COUNTY ENGINEERING BLDG.

Note: Any Additions or Changes on This Sheet Must be Made or Circled in Red Ink With Date and Name of Person Making Change.

Do not extend notes this side of this line.

76F309S CE #247—3-57

RETURN TO
LOS ANGELES COUNTY ENGINEER
700 LOS ANGELES COUNTY ENGINEERING BLDG.

Note: Any Additions or Changes on This Sheet Must be Made or Circled in Red Ink With Date and Name of Person Making Change.

Do not extend notes this side of this line.

Notes Ck'd by
Map No.
Office Work R. L. GREEN
Checked
Date

Survey of DEHENY DR.
JN 07 75.91 Tape 0137 Std 68 OF
Surveyed by L.F.G. (GEARHOUSE)
Notes L.F.G. Date 3/22/60
Indexed C. Johnson

F. B. 2640 PG. 15

F.B. 2640 Pg. 16

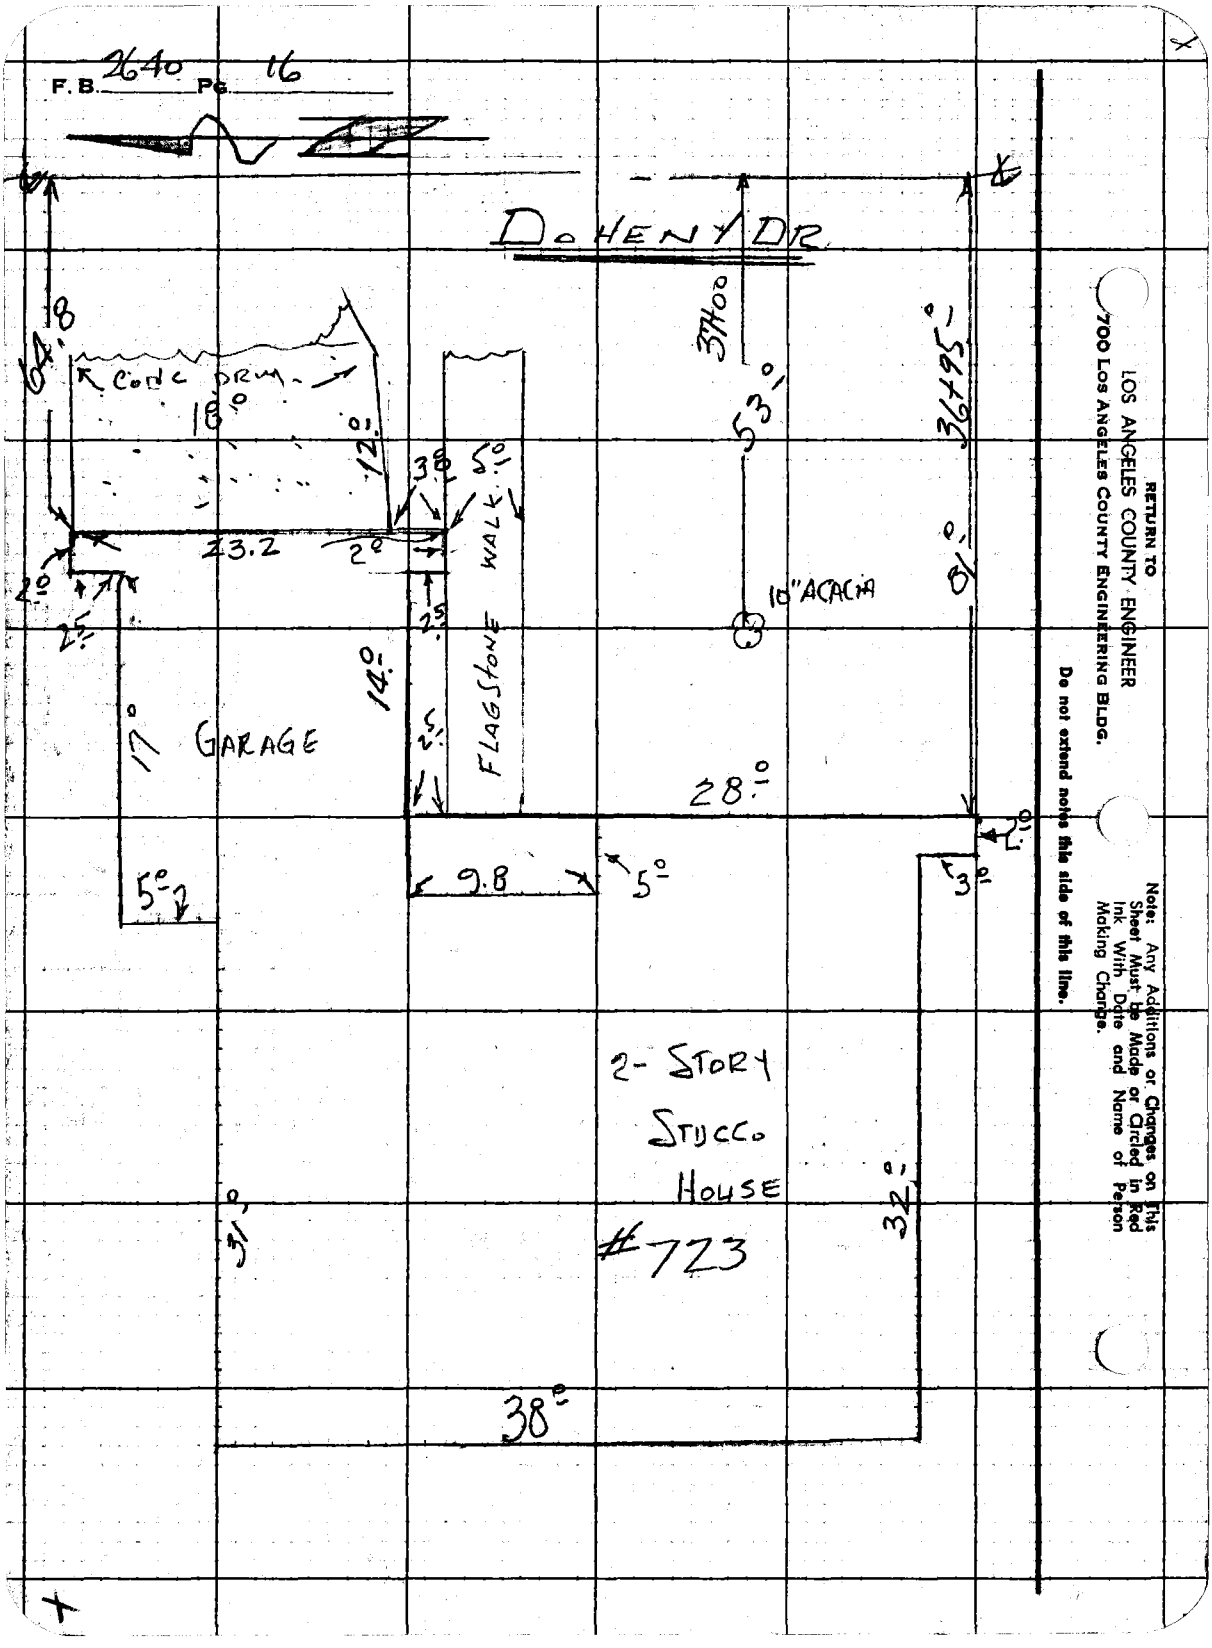

RETURN TO
LOS ANGELES COUNTY ENGINEER
700 LOS ANGELES COUNTY ENGINEERING BLDG.

Note: Any Additions or Changes on This Sheet Must be Made or Circled in Red Ink With Date and Name of Person Making Change.

Do not extend notes this side of this line.

Notes Ck'd by		Survey of DOHENY DR.	F. B. 2640 Pg. 17
Map No.		JN 00759.91 Tape 0135 Std 68 °F	
Office Work R. L. GREEN		Surveyed by H.E.GRANQUIST	
Checked		Notes H.E.G. Date 3/22/60	
Date		Indexed E. C. Johnson	

DOHENY DR.

66.0'

37+45 66.0'

CEM. BRICK WALK 4.9'

1.0' 1.3' 16.0' CEM. 6.0' 38.0'

85'

PREMIX DRWY

2- STORY

#725

30.2'

23.5'

14.5'

6.5'

4.5' 6.5'

6.5' 6.5' 12.5'

PORCH

5.5'

19.0'

Note: Any Additions or Changes on This Sheet Must be Made or Circled in Red Ink With Date and Name of Person Making Change.

Do not extend notes this side of this line.

RETURN TO
LOS ANGELES COUNTY ENGINEER
700 LOS ANGELES COUNTY ENGINEERING BLDG.

76F309S CE #247—3-57

F.B. 2640 PG. 18

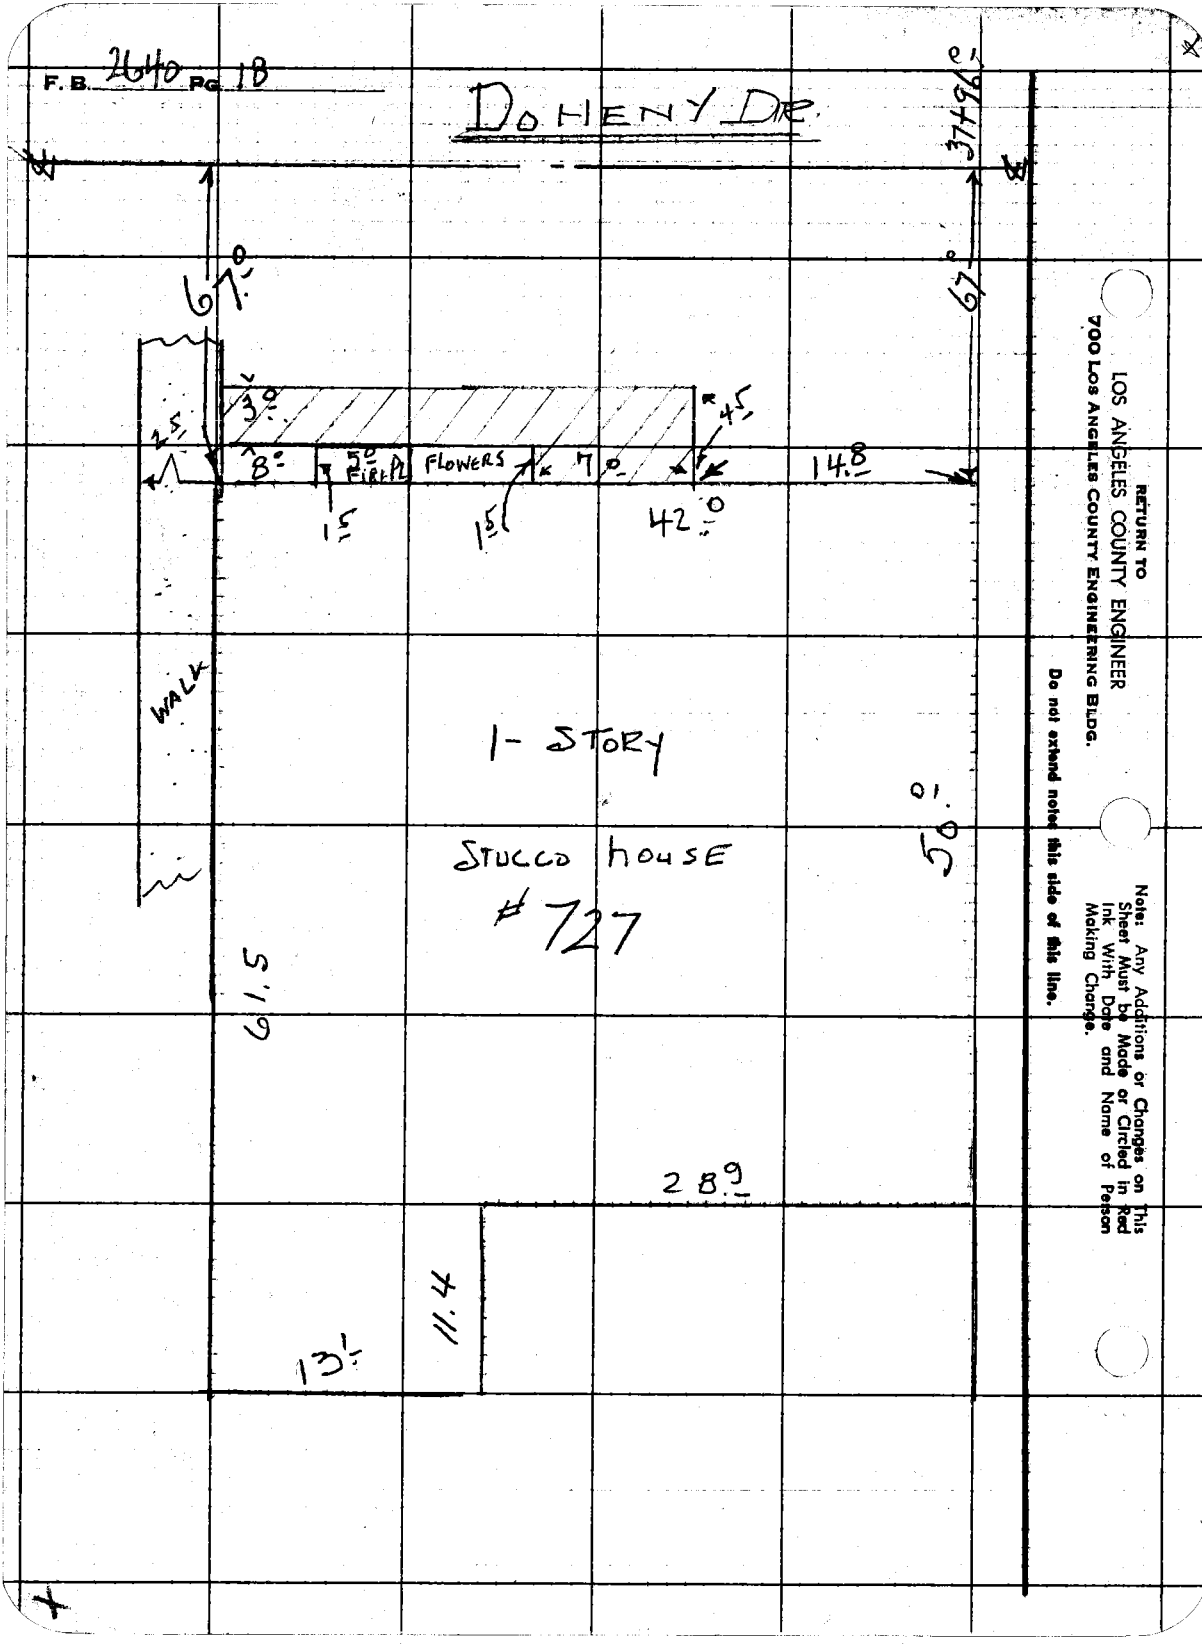

RETURN TO
LOS ANGELES COUNTY ENGINEER
700 LOS ANGELES COUNTY ENGINEERING BLDG.

Do not extend notes this side of this line.

Note: Any Additions or Changes on This Sheet Must be Made or Circled in Red Ink With Date and Name of Person Making Change.

Notes Ck'd by	Survey of DOHENY DR.
Map No.	JN 007591 Tape 0135 Std 68 of
Office Work R. L. GREEN	Surveyed by H E GUANIQUIST
Checked	Notes H.E.G. Date 3/22/60
Date	Indexed R. C. Johnson

F. B. 264 Pg. 19

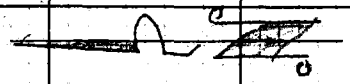

DOHENY DR

38.48'

71.3'

10.5'

2.0'

8.0'

WINDOW

39.5

11.5'

2-STORY WOOD FRAME HOUSE

#800 CINTHIA ST.

PORCH

5.8'

5.0'

17.0'

22.5'

6.5'

4.5'

PORCH

6.8'

CINTHIA ST.

FOR TRAP SEE FB 2625-247 5246

32.5'

27.0'

3.4'

3.0'

66.0'

DRWY.

15.0'

24'

GARAGE

25.6'

TIE LINE

22.0'

20.'

Note: Any Additions or Changes on This Sheet Must be Made or Circled in Red Ink With Date and Name of Person Making Change.

Do not extend notes this side of this line.

RETURN TO
LOS ANGELES COUNTY ENGINEER
700 LOS ANGELES COUNTY ENGINEERING BLDG.

76F3095 CE #247—3-57

F.B. 2640 Pg. 20

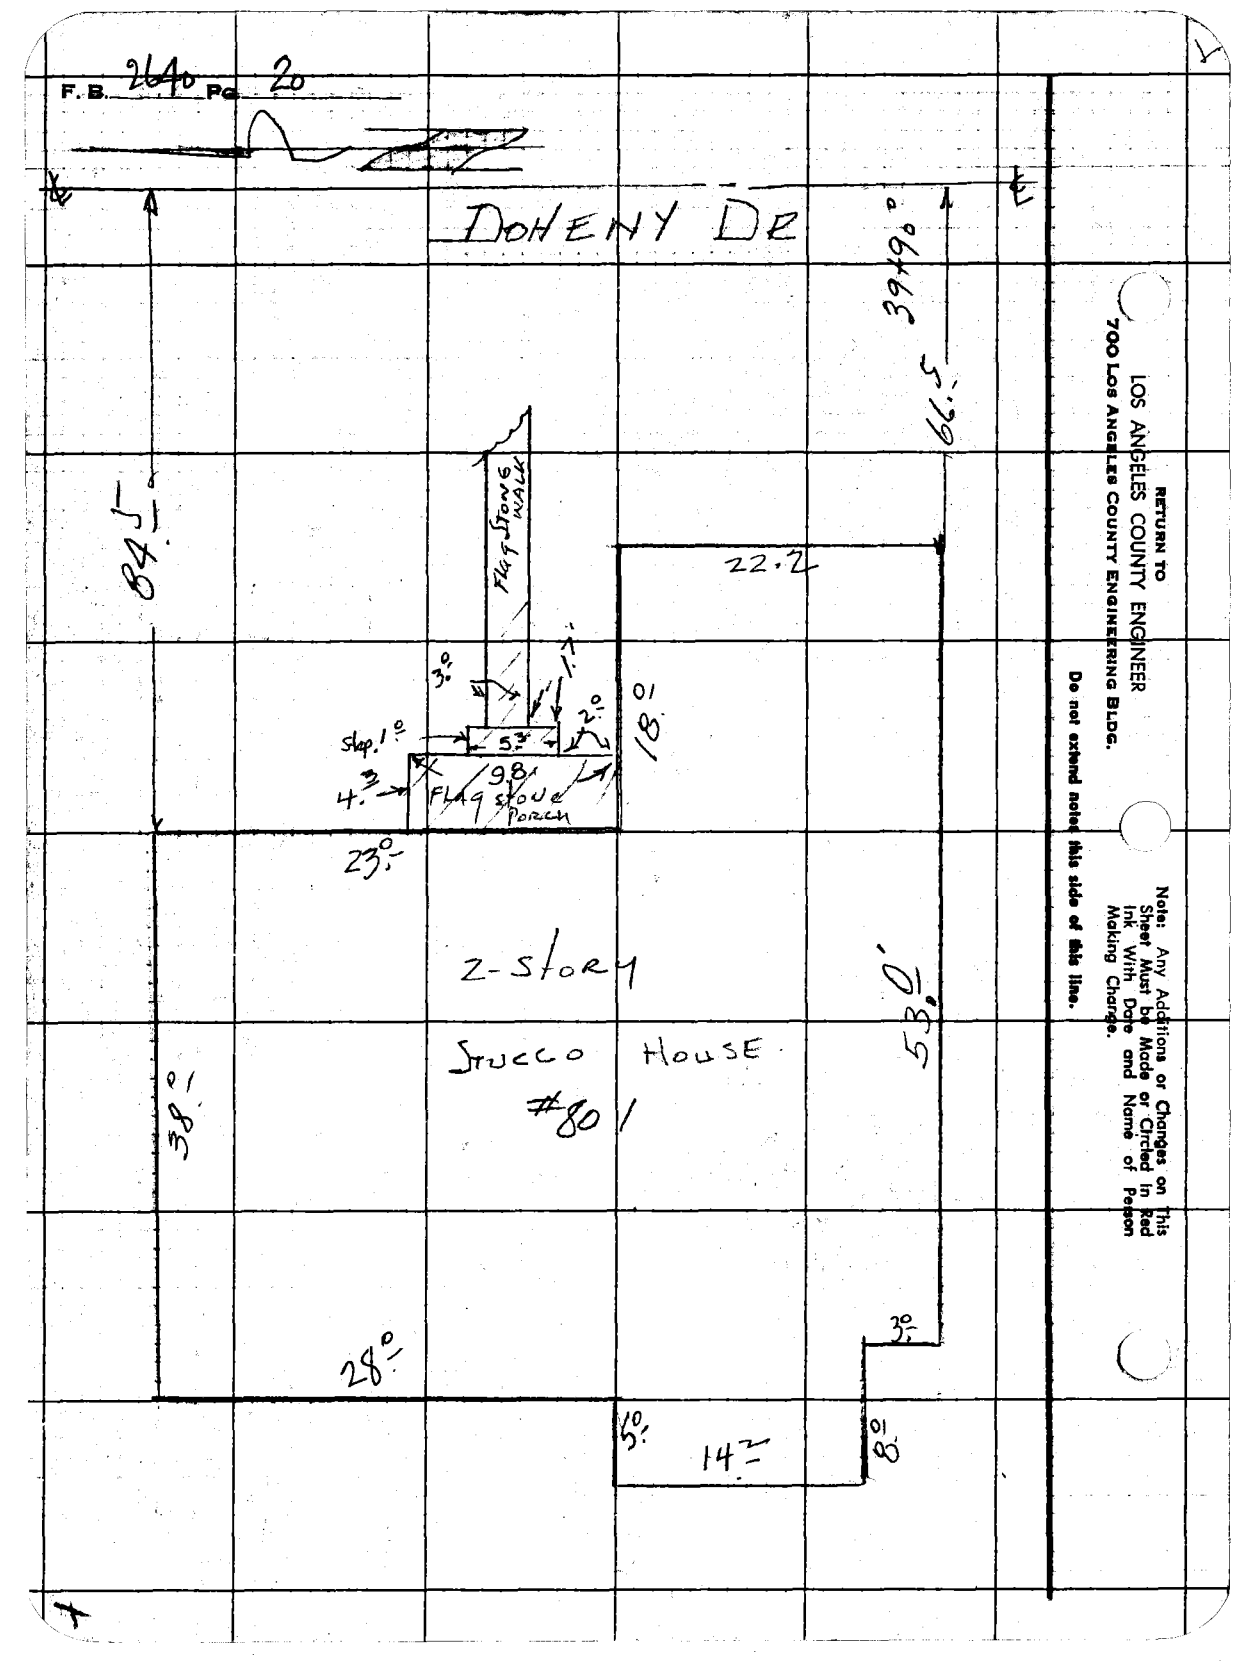

RETURN TO
LOS ANGELES COUNTY ENGINEER
700 LOS ANGELES COUNTY ENGINEERING BLDG.

Do not extend notes this side of this line.

Note: Any Additions or Changes on This Sheet Must be Made or Circled in Red Ink With Date and Name of Person Making Change.

Notes Ck'd by
Map No.
Office Work L. L. GREEN
Checked
Date

Survey of DOHENY DR
JN 00759 Tape 0 135 Std. 68 °F
Surveyed by H.E. GRANQUIST
Notes H.E.G. Date 3/23/60
Indexed L. C. Johnson

F. B. 2640 Pg. 21

Note: Any Additions or Changes on This Sheet Must be Made or Circled in Red Ink With Date and Name of Person Making Change.

Do not extend notes this side of this line.

RETURN TO
LOS ANGELES COUNTY ENGINEER
700 LOS ANGELES COUNTY ENGINEERING BLDG.

76F3095 CE #247 3-57

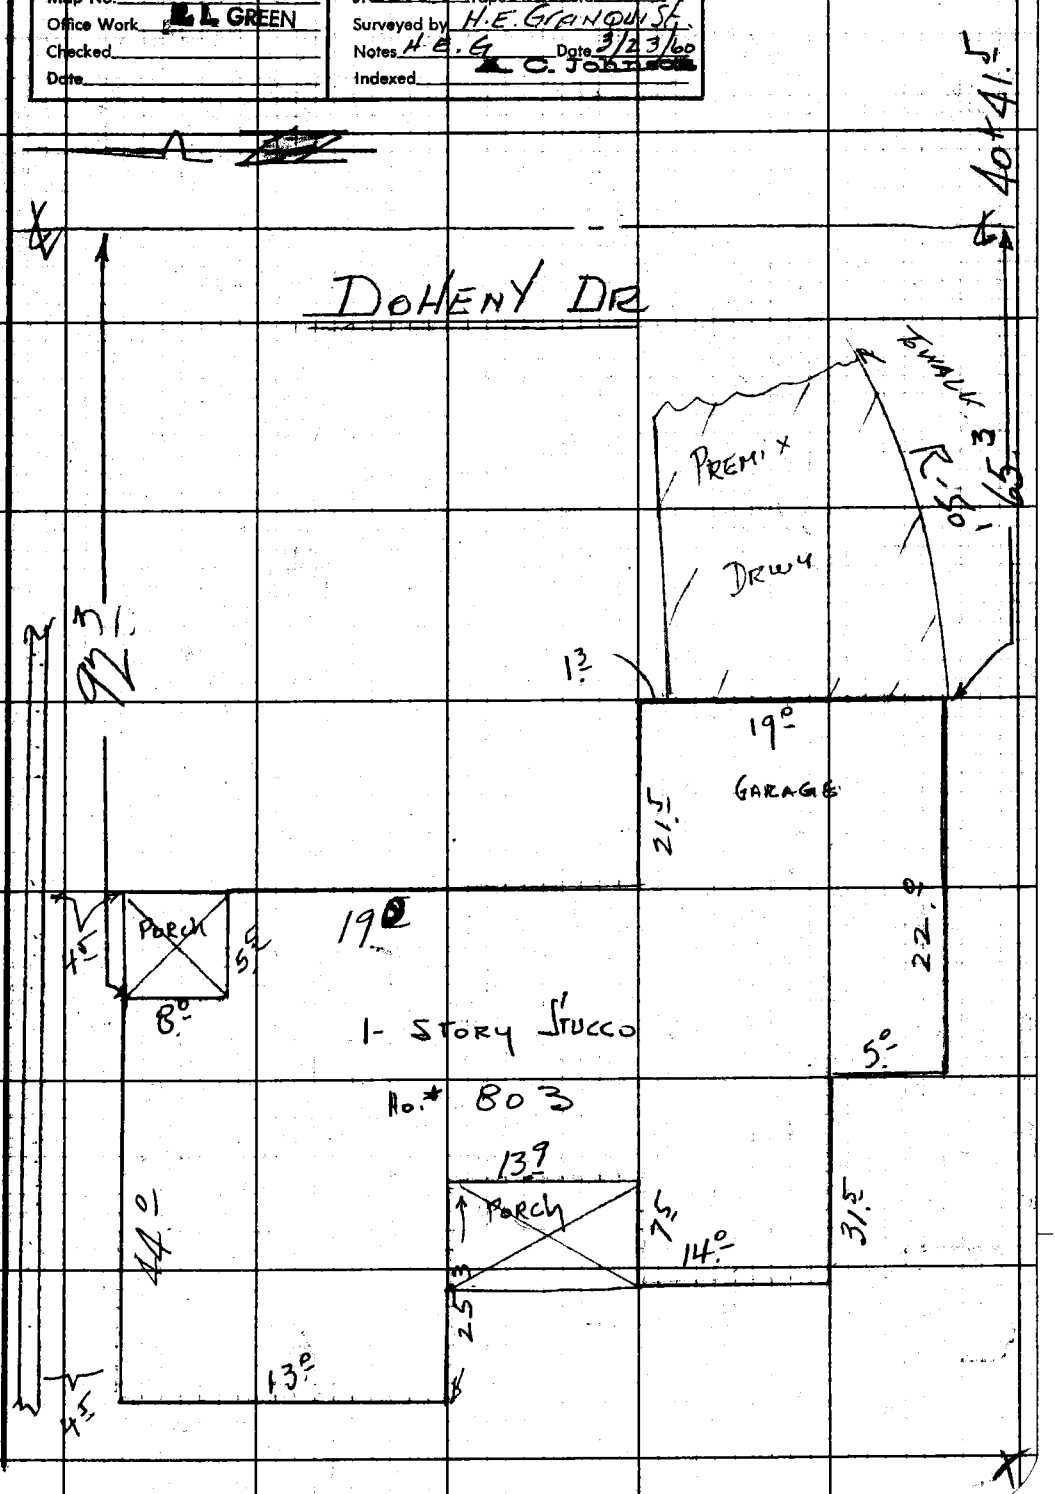

RETURN TO
LOS ANGELES COUNTY ENGINEER
700 LOS ANGELES COUNTY ENGINEERING BLDG.

Note: Any Additions or Changes on This Sheet Must be Made or Circled in Red Ink With Date and Name of Person Making Change.

Do not extend notes this side of this line.

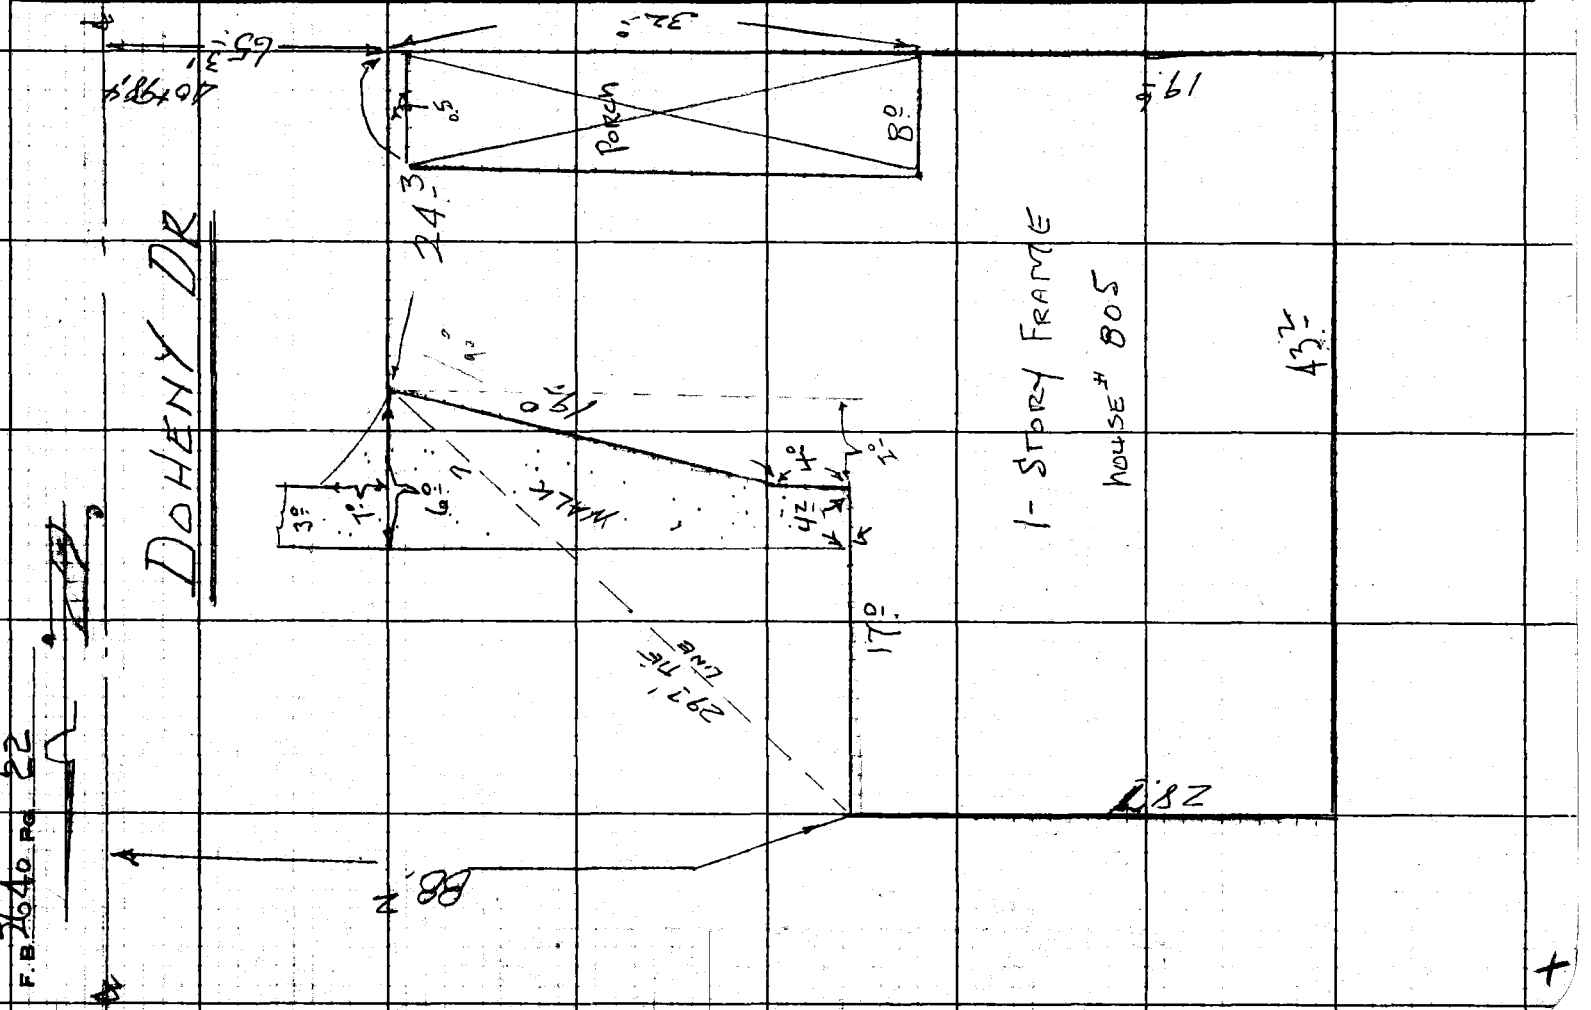

Notes Ck'd by
Map No.
Office Work R. L. GREEN
Checked
Date

Survey of DOHENY DR.
JN 00759 Tape 0/3 Std 68 °F
Surveyed by H.E. GRANQUIST
Notes H.E.G. Date 3/29/60
Indexed C. Johnson

F. B. 2640 Pg. 23

Note: Any Additions or Changes on This Sheet Must be Made or Circled in Red Ink With Date and Name of Person Making Change.

Do not extend notes this side of this line.

RETURN TO
LOS ANGELES COUNTY ENGINEER
700 LOS ANGELES COUNTY ENGINEERING BLDG.

76F309S CE #247—3-57

DOHENY DR

41453.01

65.01

6"

13.2

3"

4.0

WALK

7.5

3.5

PORCH

3"

6"

2'-12"

4.8

10.7

5.8

7.4

19.5

CEM. BLK. WALL

6"

15 FT STUCCO HOUSE #807

40.2

11.4

5.4

13.1

14.01

15.7

44.2

7.4

CEM. BLOCK WALL

RETURN TO
LOS ANGELES COUNTY ENGINEER
700 LOS ANGELES COUNTY ENGINEERING BLDG.

Note: Any Additions or Changes on This Sheet Must be Made or Circled in Red Ink With Date and Name of Person Making Change.

Do not extend notes this side of this line.

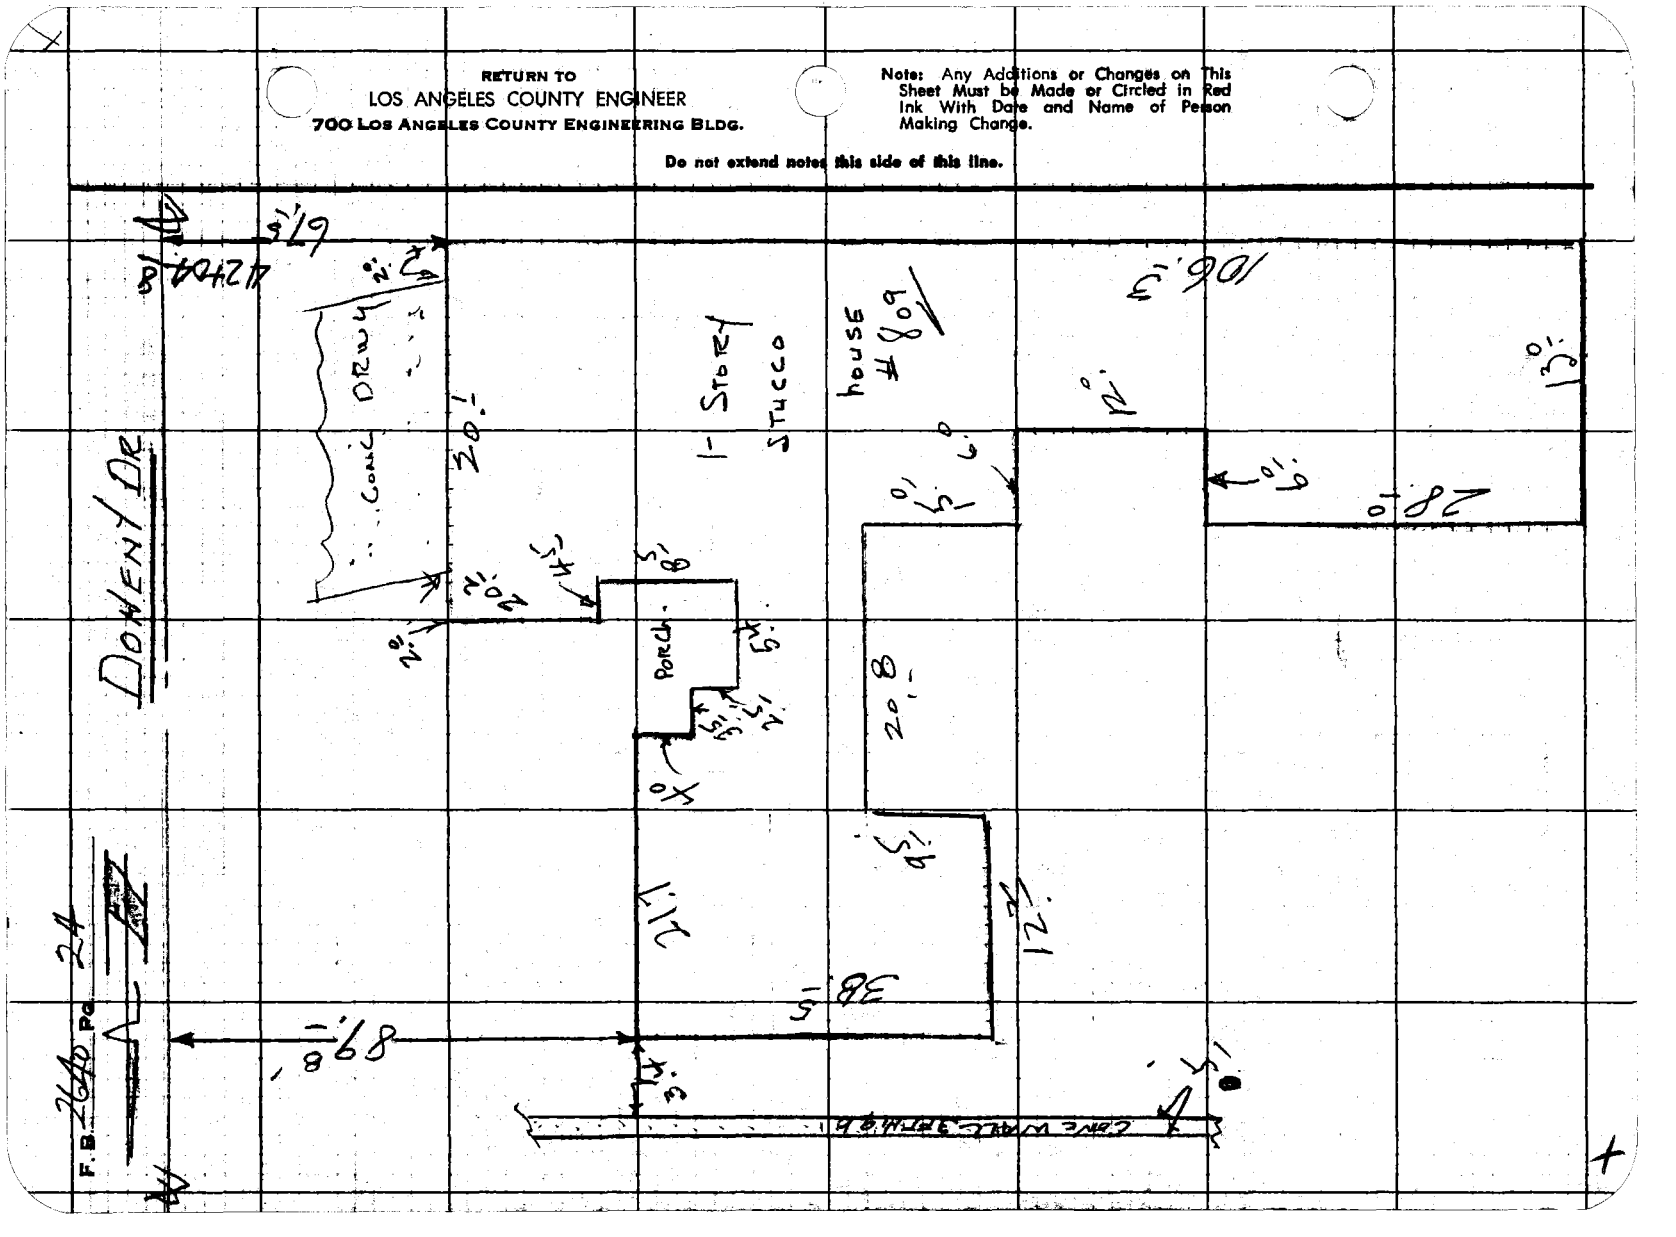

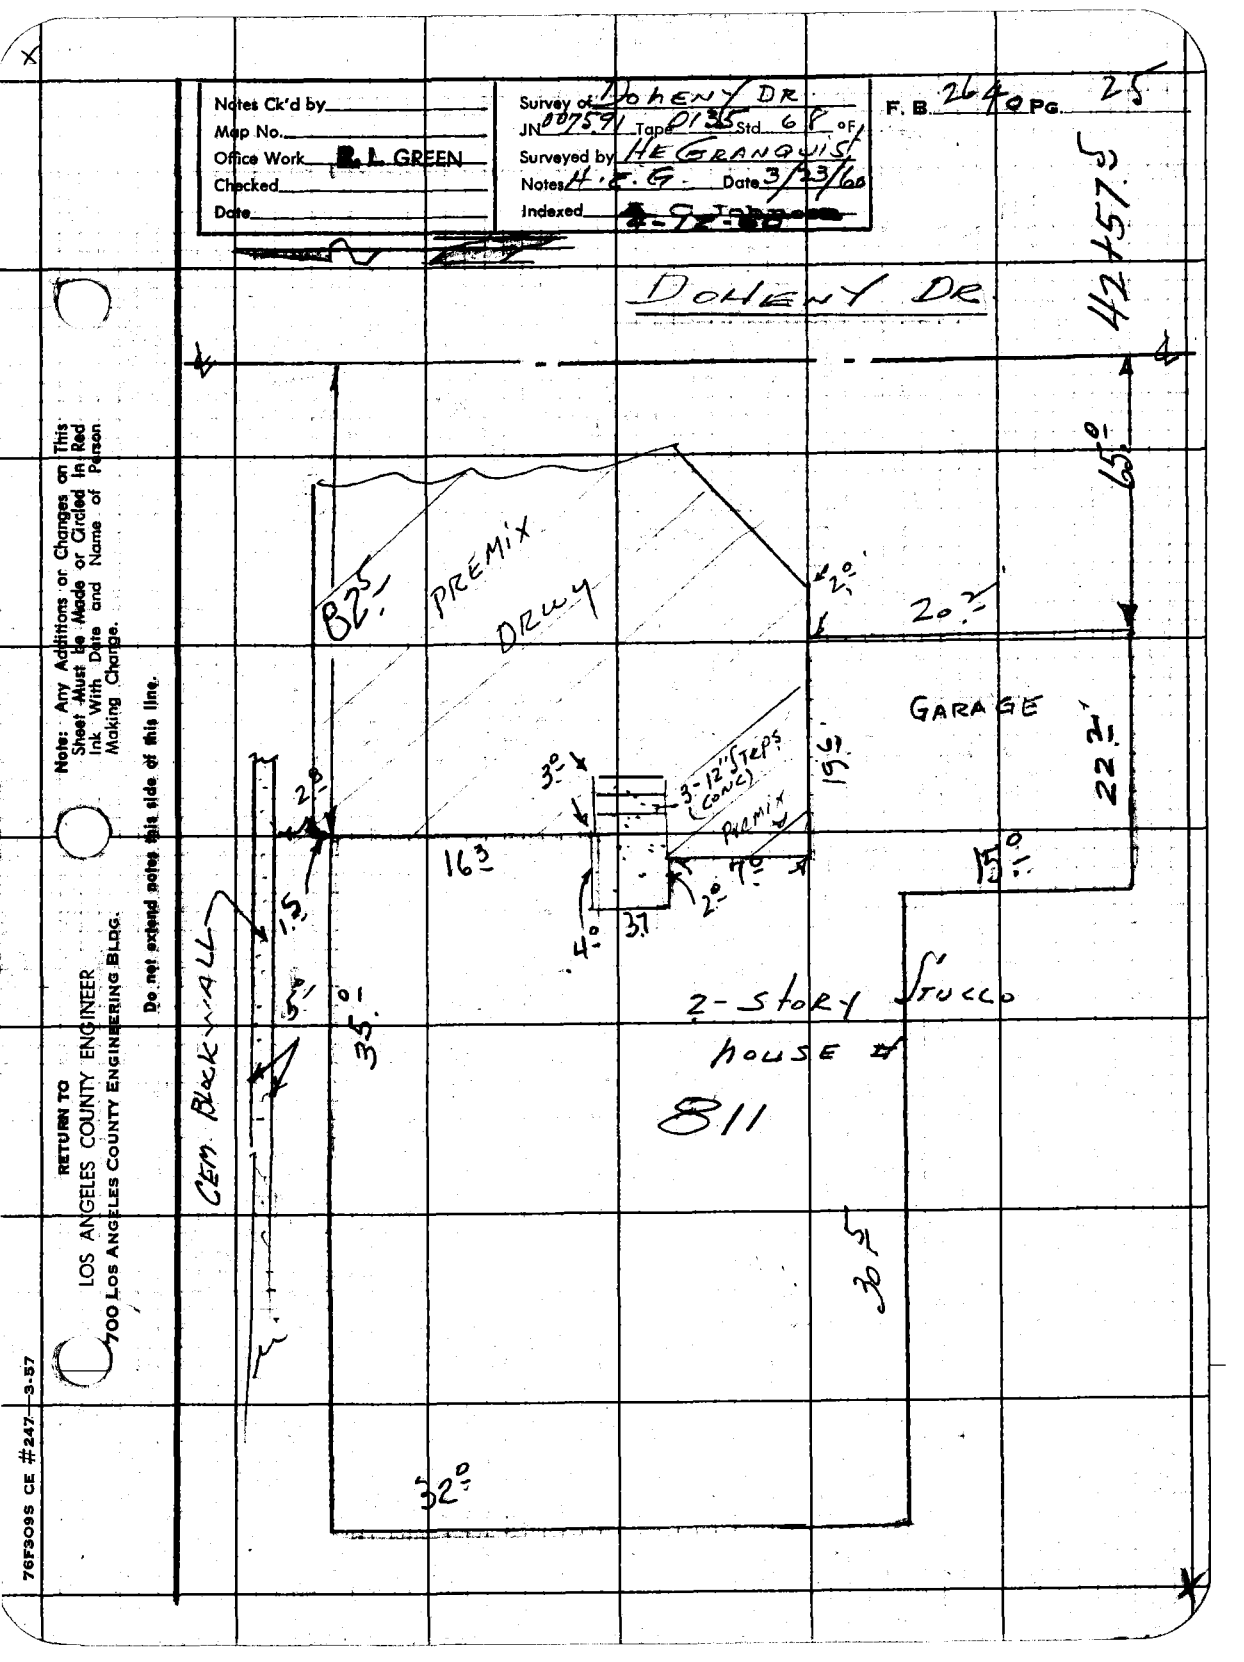
Notes Ck'd by
Map No.
Office Work R. L. GREEN
Checked
Date
Survey of DOHENY DR
JN 007591 Tape 0135 Std. 6 8 of F
Surveyed by HEGRANQUIST
Notes H. E. G. Date 3/23/60
Indexed
F. B. 264 PG. 25
DOHENY DR.
42 457.5
65.0
B25.
PREMIX
DRWY
20.
20.±
GARAGE
22.2'
3.0
3-12" STEPS (CONC)
PREMIX
19.6'
16.3
7.0
15.0±
2.0
4.0
3.7
2.0
1.5
5.0
35.0
CEM. BLK. WALL
2-STORY STUCCO
HOUSE #
811
30.5
32.0
Note: Any Additions or Changes on This Sheet Must be Made or Circled in Red Ink With Date and Name of Person Making Change.
Do not extend notes this side of this line.
RETURN TO
LOS ANGELES COUNTY ENGINEER
700 LOS ANGELES COUNTY ENGINEERING BLDG.
76F309S CE #247 3-57

F. B. 640 Pg. 26

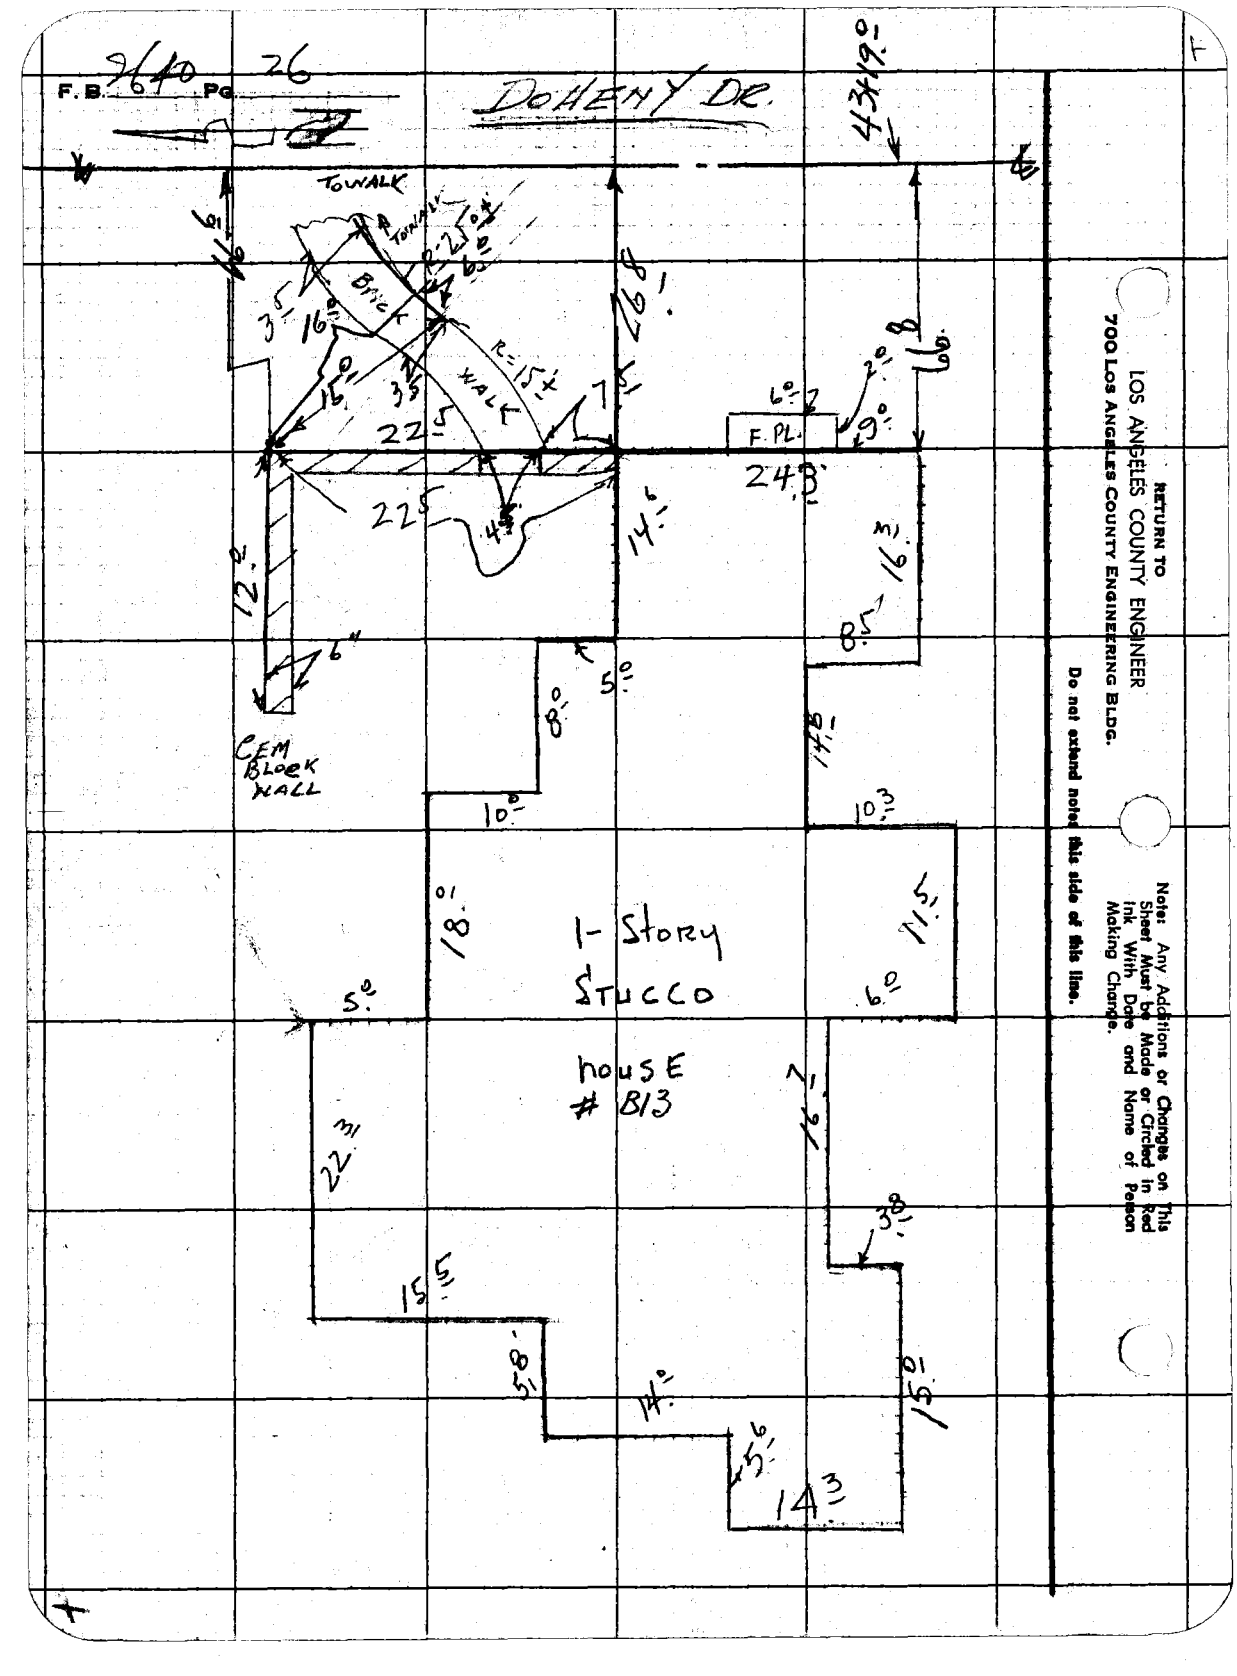
DOHENY DR.
43.49.0
TOWALK
TOWALK
BRICK
WALK
R=15'±
F. PL.
24.3'
22.5'
22.5'
CEM BLOCK WALL
1-Story
STUCCO
house
813
RETURN TO
LOS ANGELES COUNTY ENGINEER
700 LOS ANGELES COUNTY ENGINEERING BLDG.
Do not extend notes this side of this line.
Note: Any Additions or Changes on This Sheet Must be Made or Circled in Red Ink With Date and Name of Person Making Change.

Notes Ck'd by
Map No.
Office Work R. L. GREEN
Checked
Date

Survey of Doheny Dr.
JN 007591 Tape 0135 Std 68 °F
Surveyed by H.E. Granquist
Notes J. Maldonado Date 3-23-60
Indexed C. Johnson

F. B. 2640 Pg. 27

Note: Any Additions or Changes on This Sheet Must be Made or Circled in Red Ink With Date and Name of Person Making Change.

Do not extend notes this side of this line.

RETURN TO
LOS ANGELES COUNTY ENGINEER
700 Los Angeles County Engineering Bldg.

76F309S CE #247 3-57

44" Palm
31.5
41+10
5°
7°
28°
44+00
6" 18" Retaining Wall
40+92.5
Gutter
31.5 40" Palm
40+78°
40+63.3
40+63.5
40+61°
17.8
Premix Dr
40+51.3
40+51.5
31.5 40" Palm
40+48°
40+47.5
40+41.8
Flagstone Walk
3°
40+17.5
31.5 44" Palm
40+16.5
40+12.4
2.3
3° Catch Basin
2.5
Park Way
Walk
40+00
5°
7°
3°
1°
39+93.7

F.B. 2640 Pg.

Walk

Parkway

Gutter

℄

31 5 44" Palm 42+62 7

Drive

20" Conc. Retaining Wall

6"

42+54 4

36" Palm 31 5 42+33 0

42+27 6

42+28 0

42+28 0

Conc. Drive

Conc. Drive

42+19 0

Delaney

42+14 2

42+12 0

31 5 40" Palm 42+01 6

3' Hollow Brick Retaining Wall

6"

5 0

7 2

3 0

28 0

42+00

41+99 5

Walk 3 0

5x2+8

41+77 0

31 5 44" Palm 41+71 3

3' Hollow Brick Retaining Wall

6"

41+46 0

31 5 44" Palm 41+40 5

Walk 3 0

3 0

41+25 3

Walk

Parkway

Gutter

℄

RETURN TO
LOS ANGELES COUNTY ENGINEER
700 LOS ANGELES COUNTY ENGINEERING BLDG.

Do not extend notes this side of this line.

Note: Any Additions or Changes on This Sheet Must be Made or Circled in Red Ink With Date and Name of Person Making Change.

Notes Ck'd by	Survey of Doheny Dr.
Map No.	JN 0075-91 Tape 0135 Std. 65 °F
Office Work R. L. GREEN	Surveyed by H. E. Grammkist
Checked	Notes J. M. Donado Date 3-23-60
Date	Indexed C. Johnson

F. B. 2640 Pg. 29

Note: Any Additions or Changes on This Sheet Must be Made or Circled in Red Ink With Date and Name of Person Making Change.

Do not extend notes this side of this line.

RETURN TO
LOS ANGELES COUNTY ENGINEER
700 LOS ANGELES COUNTY ENGINEERING BLDG.

76F3095 CE #247—3-57

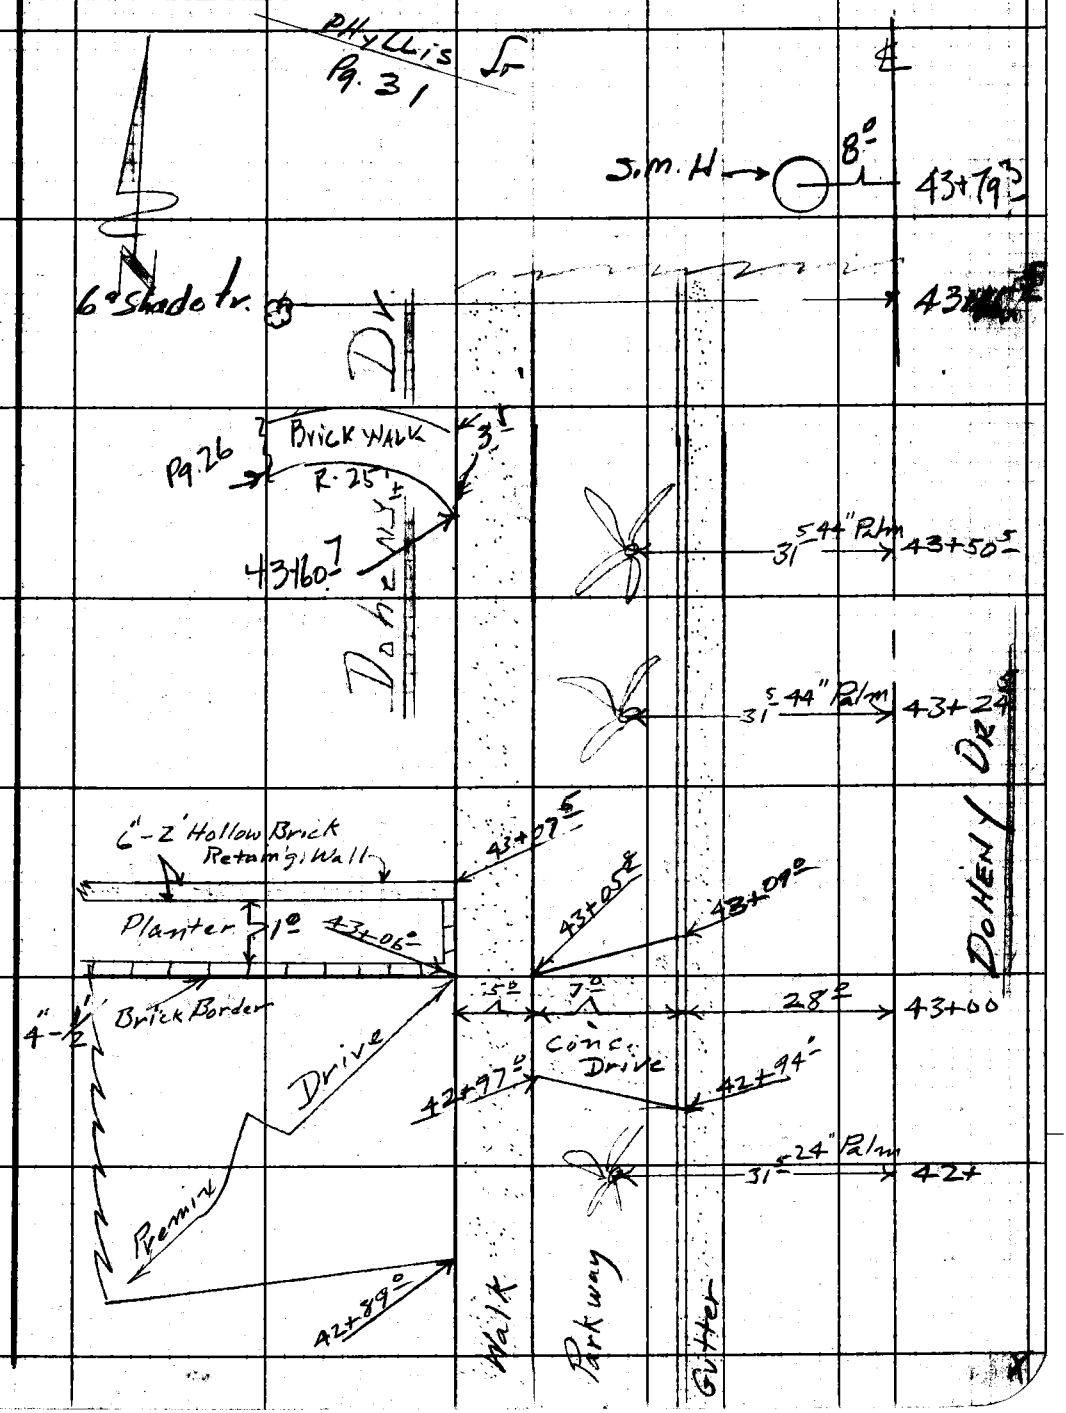

RETURN TO
LOS ANGELES COUNTY ENGINEER
700 LOS ANGELES COUNTY ENGINEERING BLDG.

Note: Any Additions or Changes on This Sheet Must be Made or Circled in Red Ink With Date and Name of Person Making Change.

Do not extend notes this side of this line.

F.B. 2610 Pg. 30

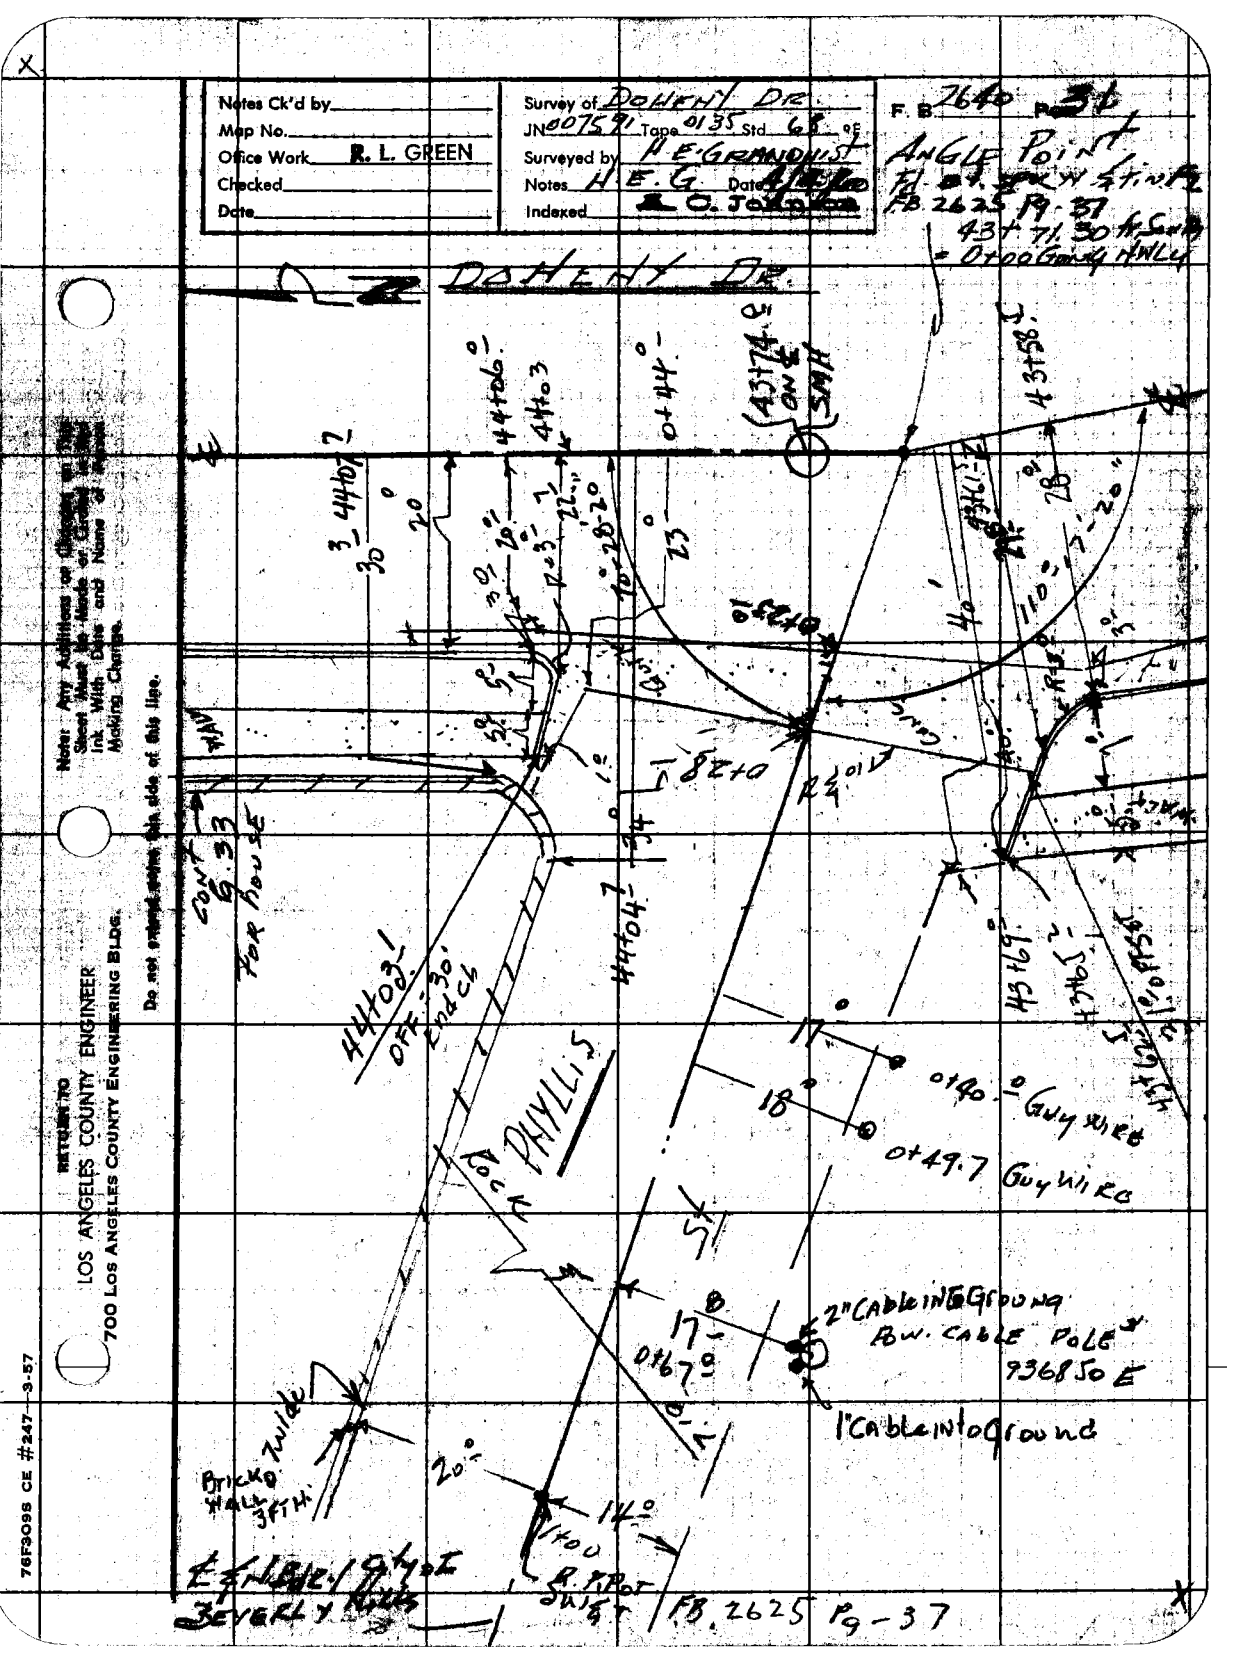
Notes Ck'd by
Map No.
Office Work R. L. GREEN
Checked
Date
Survey of DOHENY DR.
JN 007591 Tape 0135 Std 66 °F
Surveyed by H.E. GRANQUIST
Notes H.E.G. Dated 4/15/66
Indexed L.O. Johnson
ANGLE POINT
FD. 2" IPKW & TIN TAG
FB 2625 Pg. 37
43+71.30 N 66°49'W
= 0+00.00 on HWLY
DOHENY DR
43+74.2 ON ℄ SMH
43+58.1
44+06.0
44+03
0+44.0
3_44+06.7
30.0
20.0
10.0
22.0
10+28.20
23.0
0+52.0
40.0
110.0
28.0
43+17.5
R=30.0
R=25.0
CONC
1.8
0+82.0
R=40.0
HWY
CONC
G.33
FOR HOUSE
44+03.1
OFF 30.0
ENGR
44+04.7
43+69.2
43+76.5
0+45.4
17.0
18.0
0+40.0 GUY WIRE
0+49.7 GUY WIRE
N 60° PHYLLIS
17.8
0+67.9
2" CABLE IN GROUND
POW. CABLE POLE #
936850 E
1" CABLE IN GROUND
BRICK WALL 3FT. HI.
20.0
14.0
1+00
R.R.P.
SET
FB. 2625 Pg-37
ENGLE / DYKE
BEVERLY HILLS
RETURN TO
LOS ANGELES COUNTY ENGINEER
700 LOS ANGELES COUNTY ENGINEERING BLDG.
Note: Any Additions or Changes Will Be Shown on Sheet Must Be Made or Certified by Person Making Change.
Do not erase entries this side of this line.
76F3095 CE #247 3-57

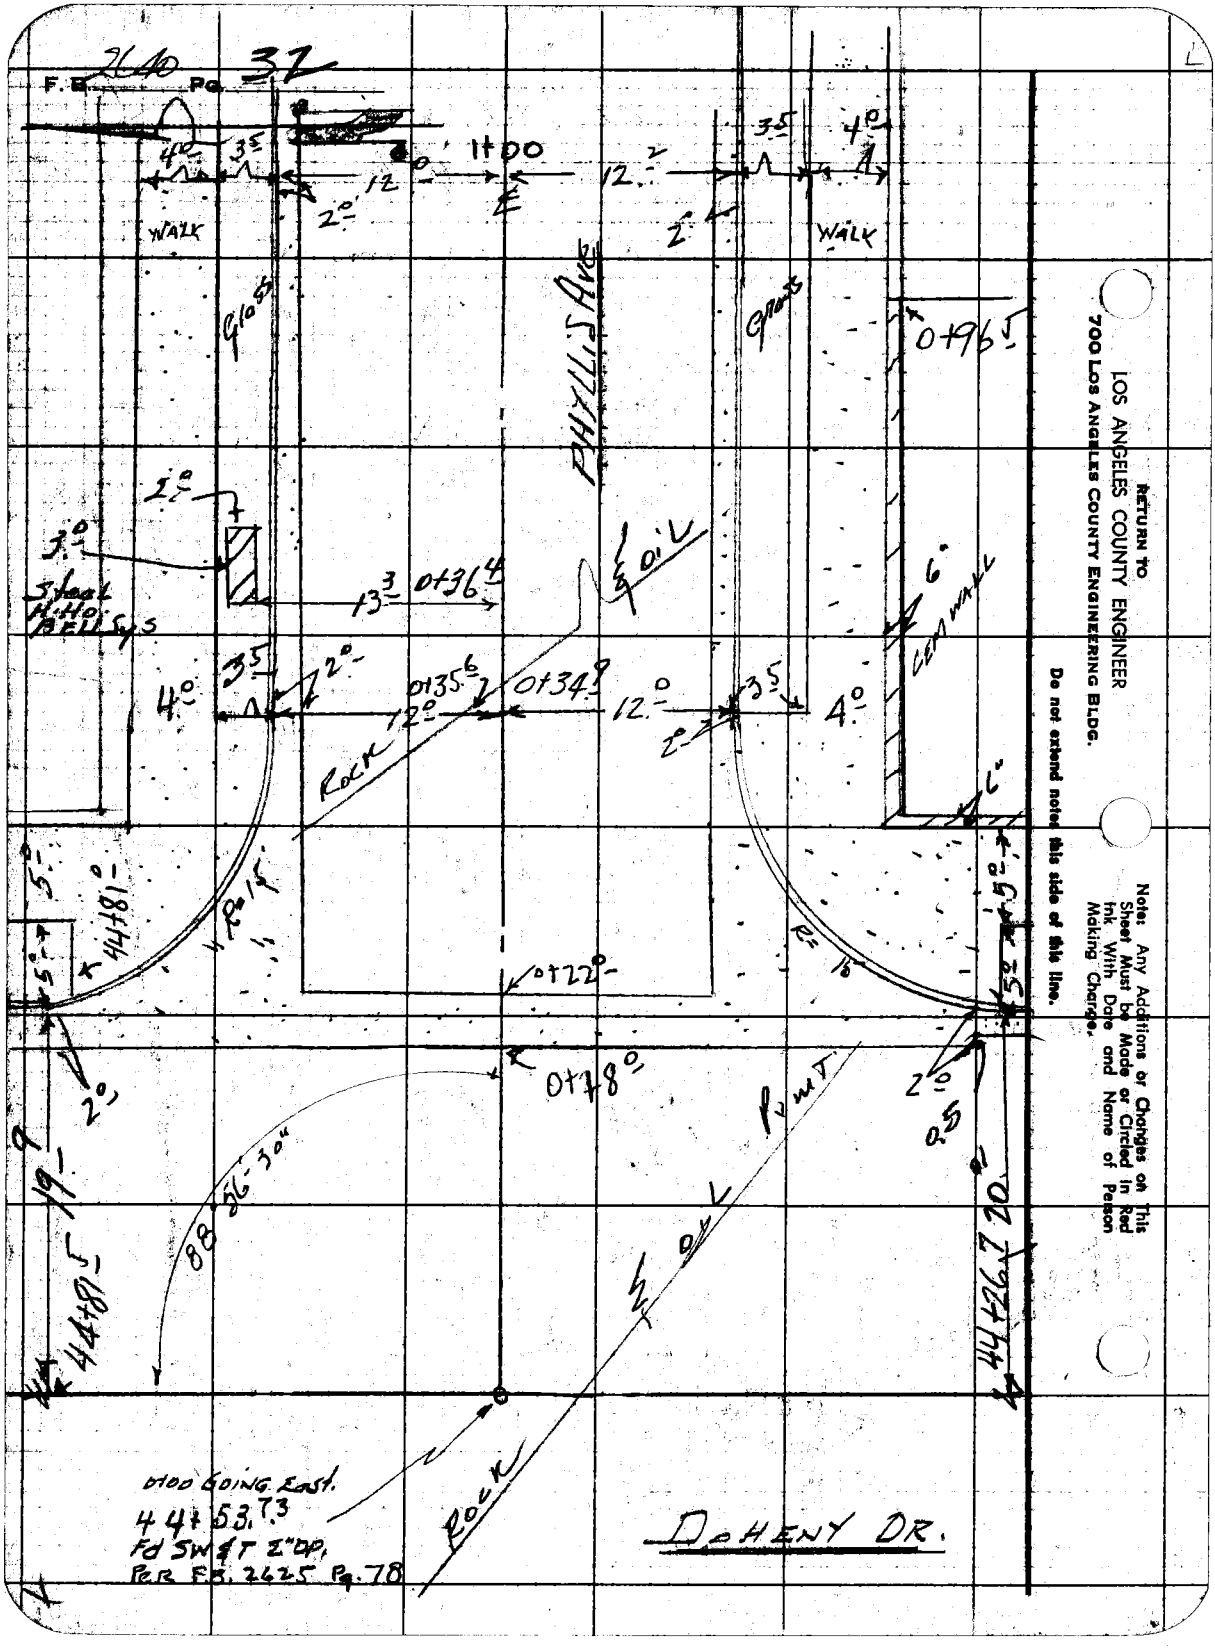
WALK
WALK
Grass
Grass
0+196.5
6" CEM WALK
Rock
R=15'
0+22
0+78
POINT
DOHENY DR.
0100 GOING EAST.
44+53.73
FD SW & T 2" DP.
PER F.B. 2625 Pg. 78
RETURN TO
LOS ANGELES COUNTY ENGINEER
700 LOS ANGELES COUNTY ENGINEERING BLDG.
Do not extend notes this side of this line.
Note: Any Additions or Changes on This Sheet Must be Made or Circled in Red Ink With Date and Name of Person Making Change.

Notes Ck'd by
Map No.
Office Work R.L. GREEN
Checked
Date

Survey of Doheny Dr.
JN 0075.91 Tape 0135 Std 68 °F
Indexed R.C. Johnson

F. B. 2640 Pg. 33

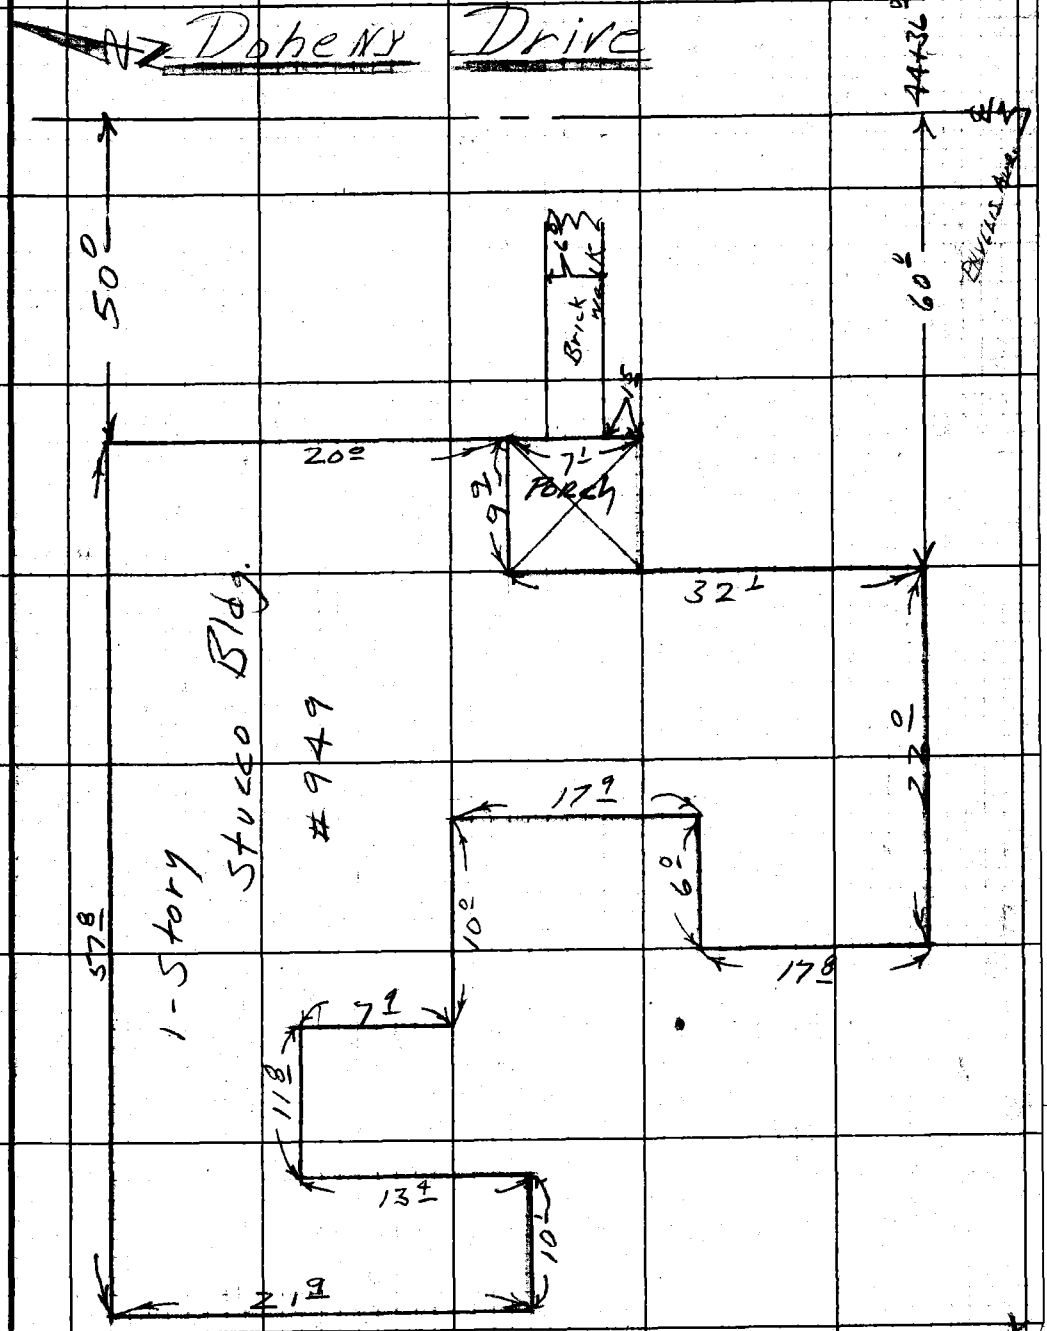

RETURN TO
LOS ANGELES COUNTY ENGINEER
700 LOS ANGELES COUNTY ENGINEERING BLDG.

Note: Any Additions or Changes on This Sheet Must be Made or Circled in Red Ink With Date and Name of Person Making Change.

Do not extend notes this side of this line.

76F3095 CE #247 9-57

RETURN TO
LOS ANGELES COUNTY ENGINEER
700 LOS ANGELES COUNTY ENGINEERING BLDG.

Note: Any Additions or Changes on This Sheet Must be Made or Circled In Red Ink With Date and Name of Person Making Change.

Do not extend notes this side of this line.

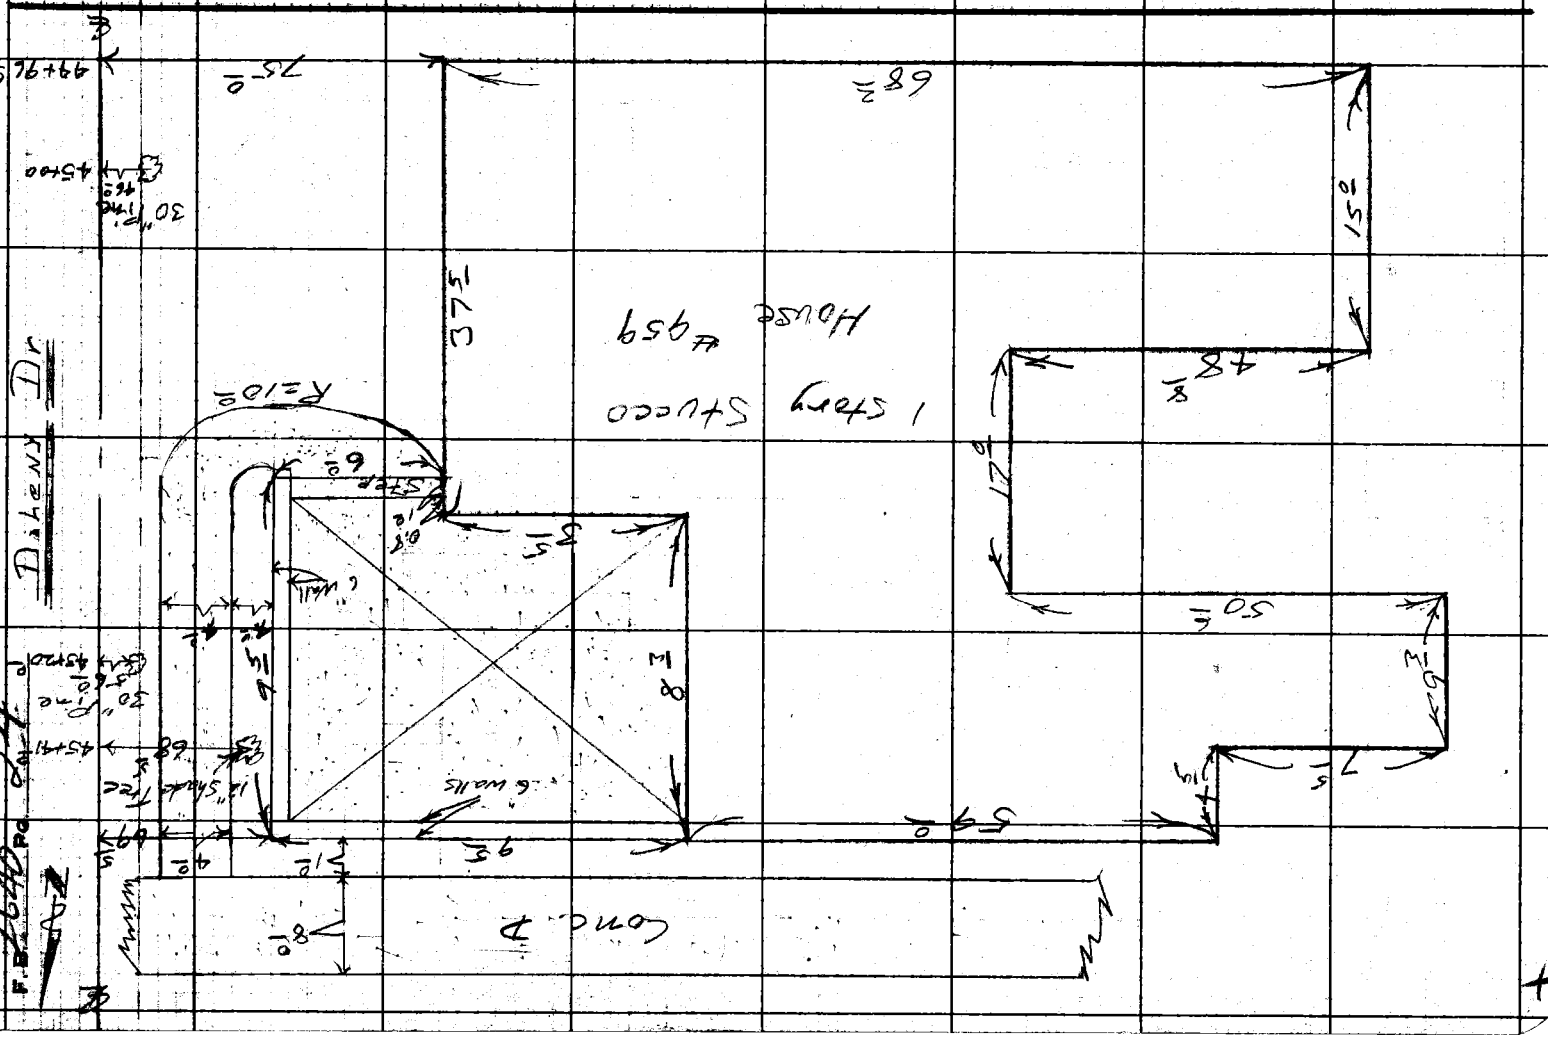

76F3095 CE #247—3-57

RETURN TO
LOS ANGELES COUNTY ENGINEER
700 LOS ANGELES COUNTY ENGINEERING BLDG.

Note: Any Additions or Changes on This Sheet Must be Made or Circled In Red Ink With Date and Name of Person Making Change.

Do not extend notes this side of this line.

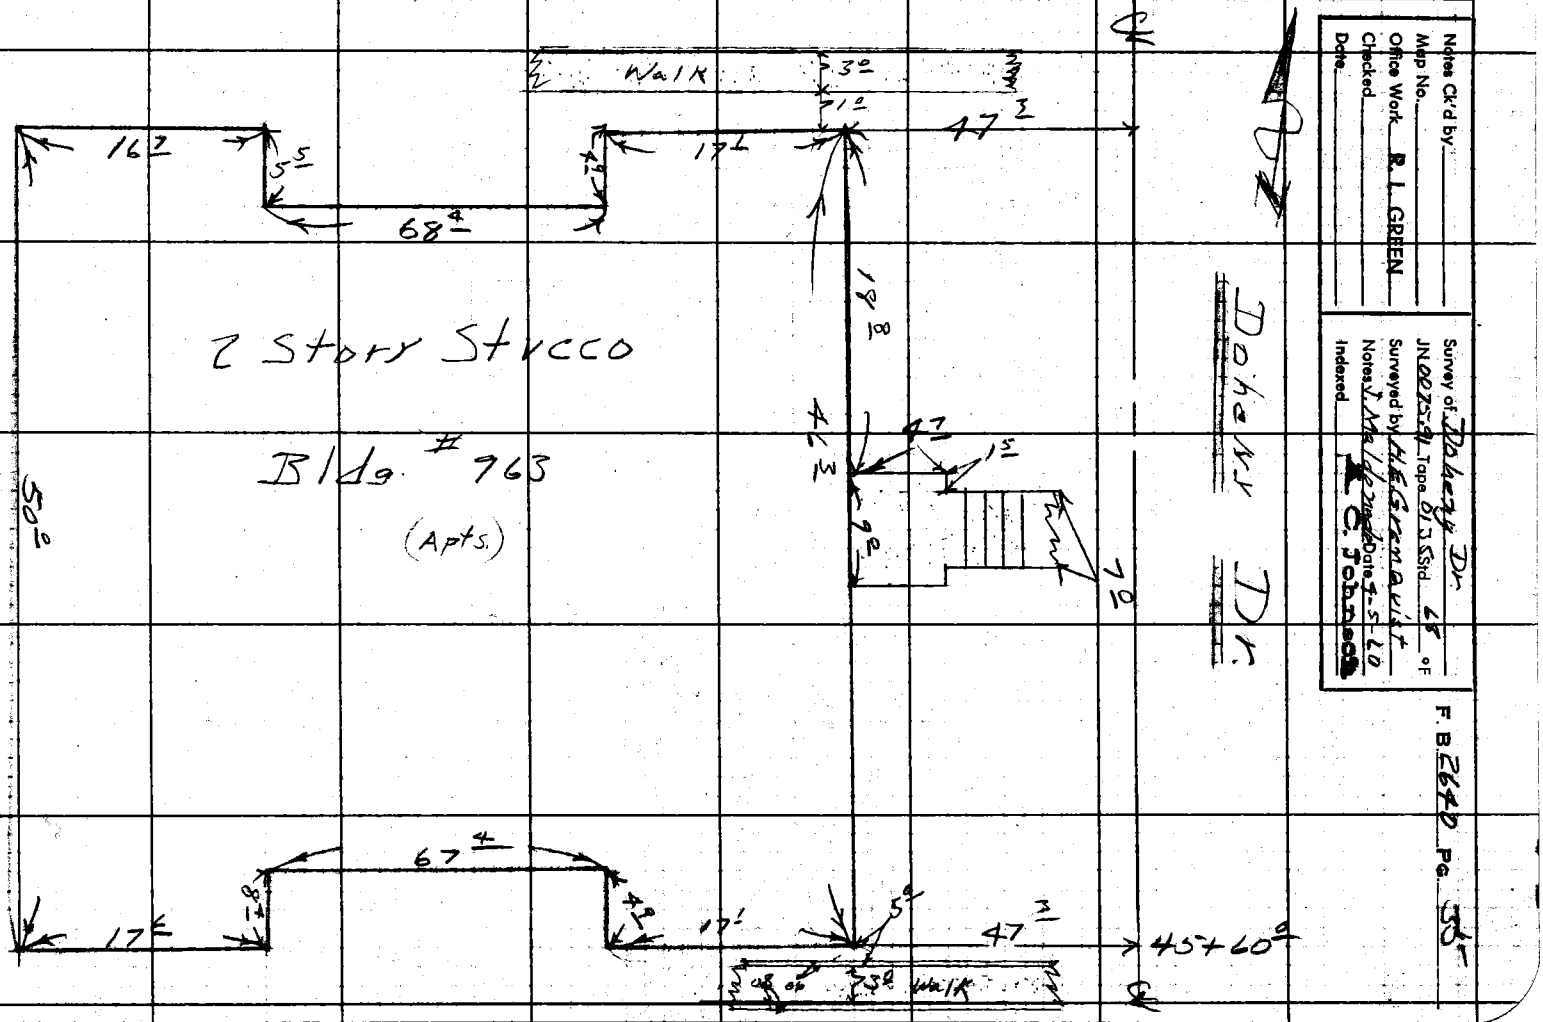

2 Story Stucco

Bldg # 765

(Apts.)

Notes Ck'd by
Map No.
Office Work R. L. GREEN
Checked
Date

Survey of Dohony Dr

F. B. 2640 Pg. 55

RETURN TO
LOS ANGELES COUNTY ENGINEER
700 LOS ANGELES COUNTY ENGINEERING BLDG.

Note: Any Additions or Changes on This Sheet Must be Made or Circled in Red Ink With Date and Name of Person Making Change.

Do not extend notes this side of this line.

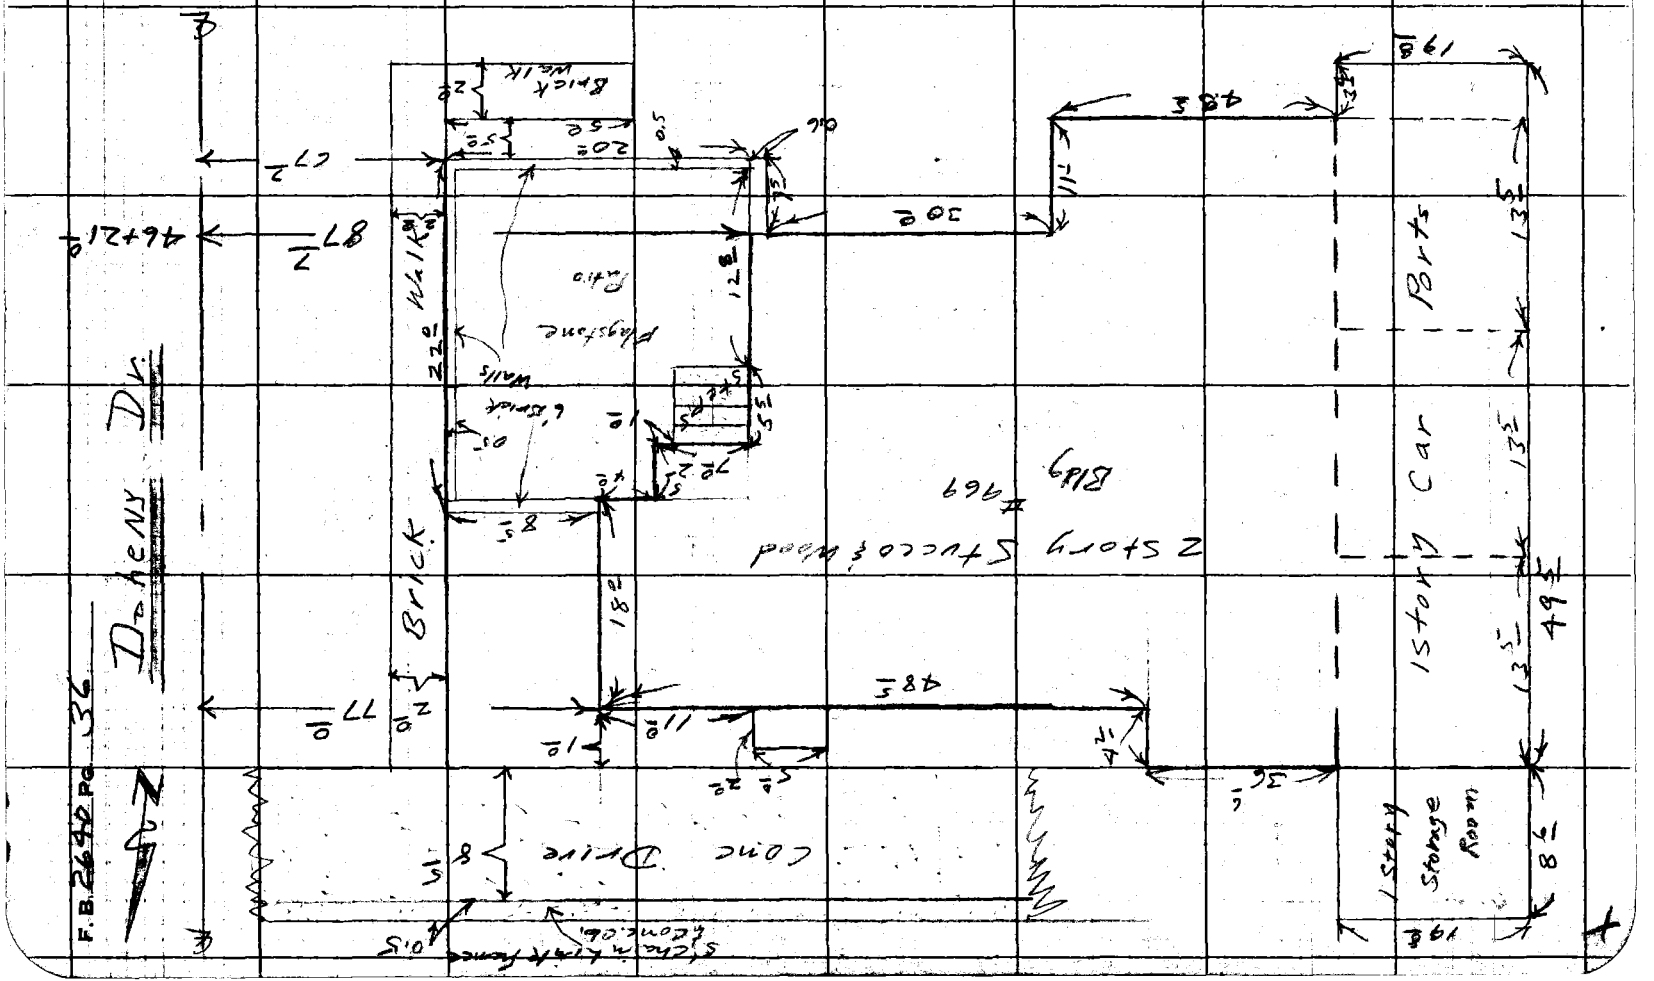

Notes Ck'd by
Map No.
Office Work R. L. GREEN
Checked
Date

Survey of Doheny Dr.
JN 007591 Tape 0135 Std 68 °F
Surveyed by H.E. Grandquist
Notes T. McDonald Date 4-5-60
Indexed C. Johnson

F. B. 2640 Pg. 57

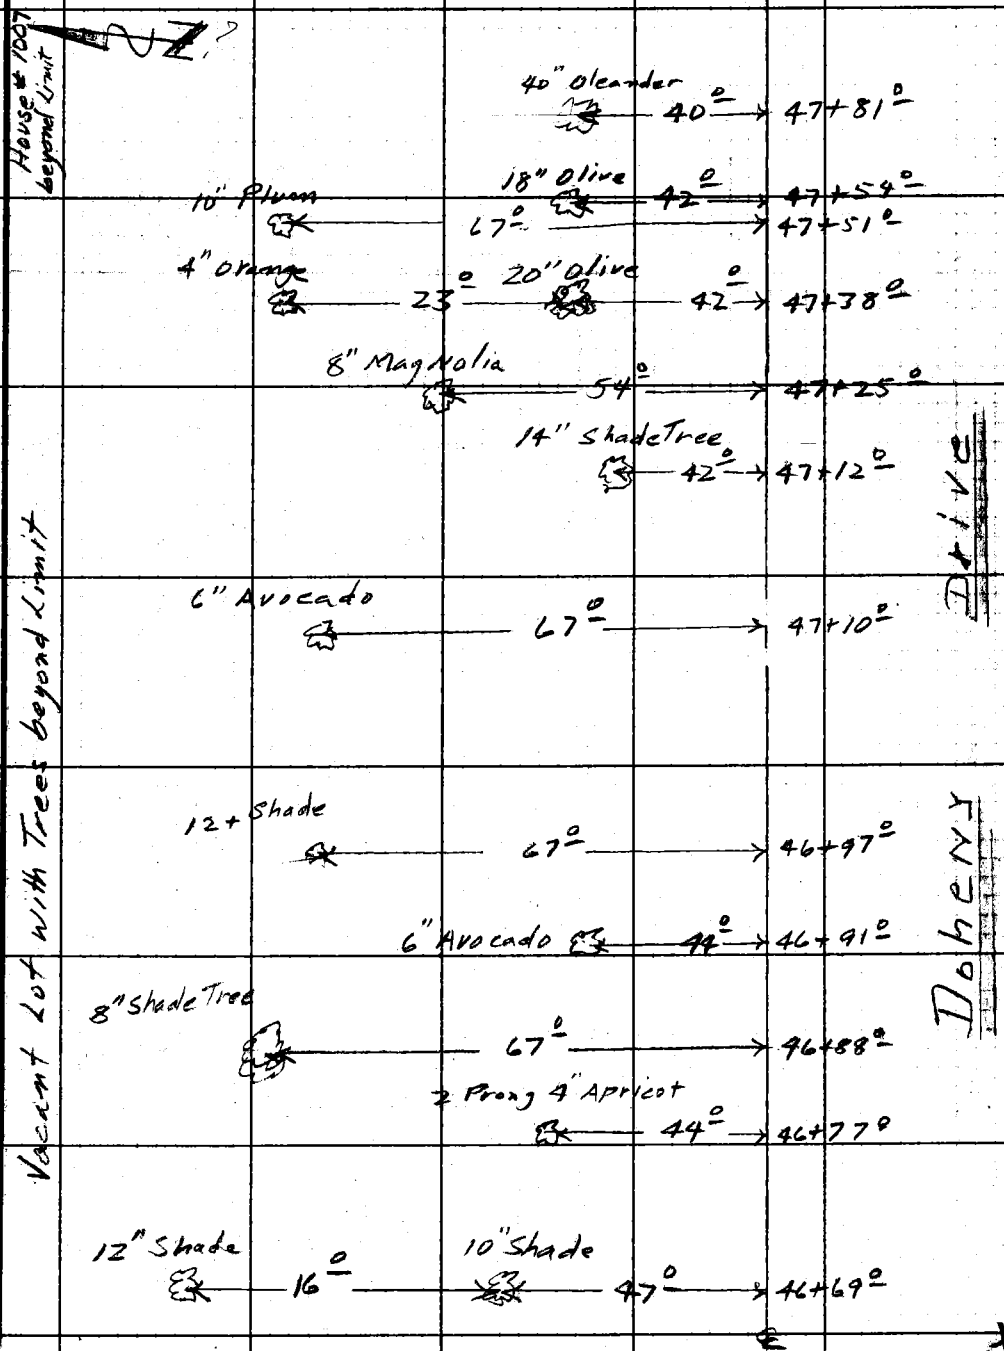

Note: Any Additions or Changes on This Sheet Must be Made or Circled in Red Ink With Date and Name of Person Making Change.

Do not extend notes this side of this line.

RETURN TO
LOS ANGELES COUNTY ENGINEER
900 Los Angeles County Engineering Bldg.

76F309S CE #247—3-57

RETURN TO
LOS ANGELES COUNTY ENGINEER
700 LOS ANGELES COUNTY ENGINEERING BLDG.

Note: Any Additions or Changes on This Sheet Must be Made or Circled in Red Ink With Date and Name of Person Making Change.

Do not extend notes this side of this line.

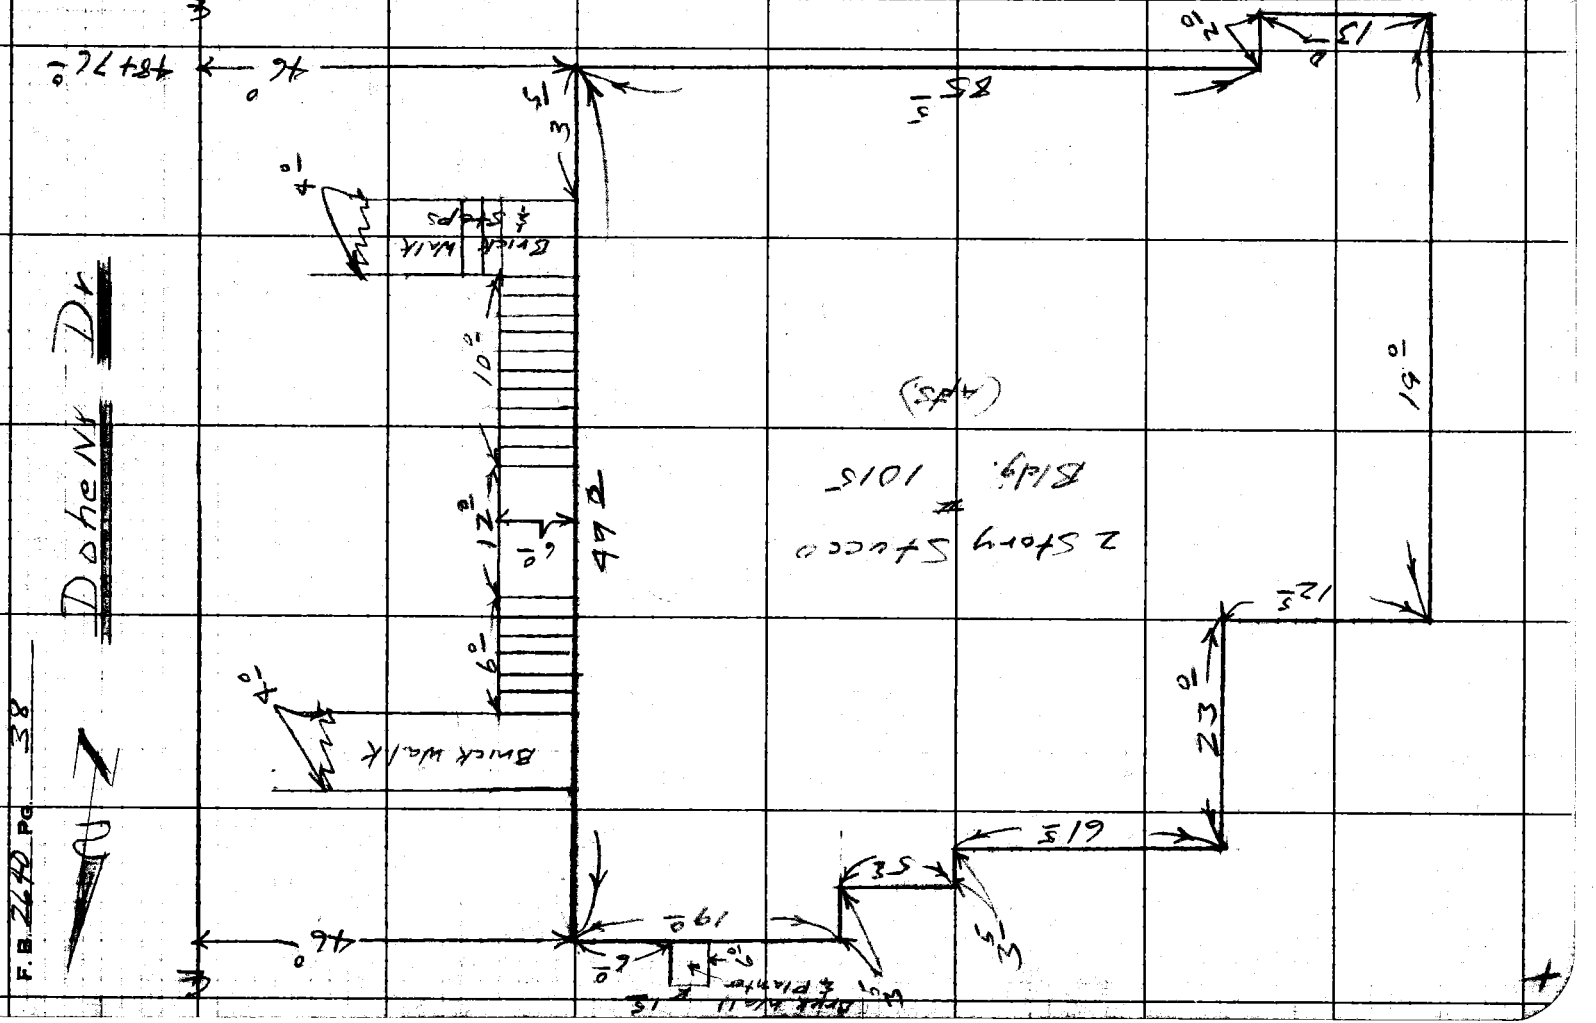

Notes Ck'd by
Map No.
Office Work R. L. GREEN
Checked
Date

Survey of DOHENY DR.
JN 007591 Tape 0135 Std 66 3F
Surveyed by H.E. GRANDY S.
Notes H.E.G. Date 11/6/60
Indexed C. Johnson

F. B. 264 Pg. 37

DOHENY DR































Note: Any Alterations or Changes on this Sheet Must be Made or Checked in Red Ink With Date and Name of Person Making Change.

Do not cancel this side of this line.

PLEASE RETURN TO
LOS ANGELES COUNTY ENGINEER
700 Los Angeles County Engineering Bldg.

76F3095 SAE 1247 11-58

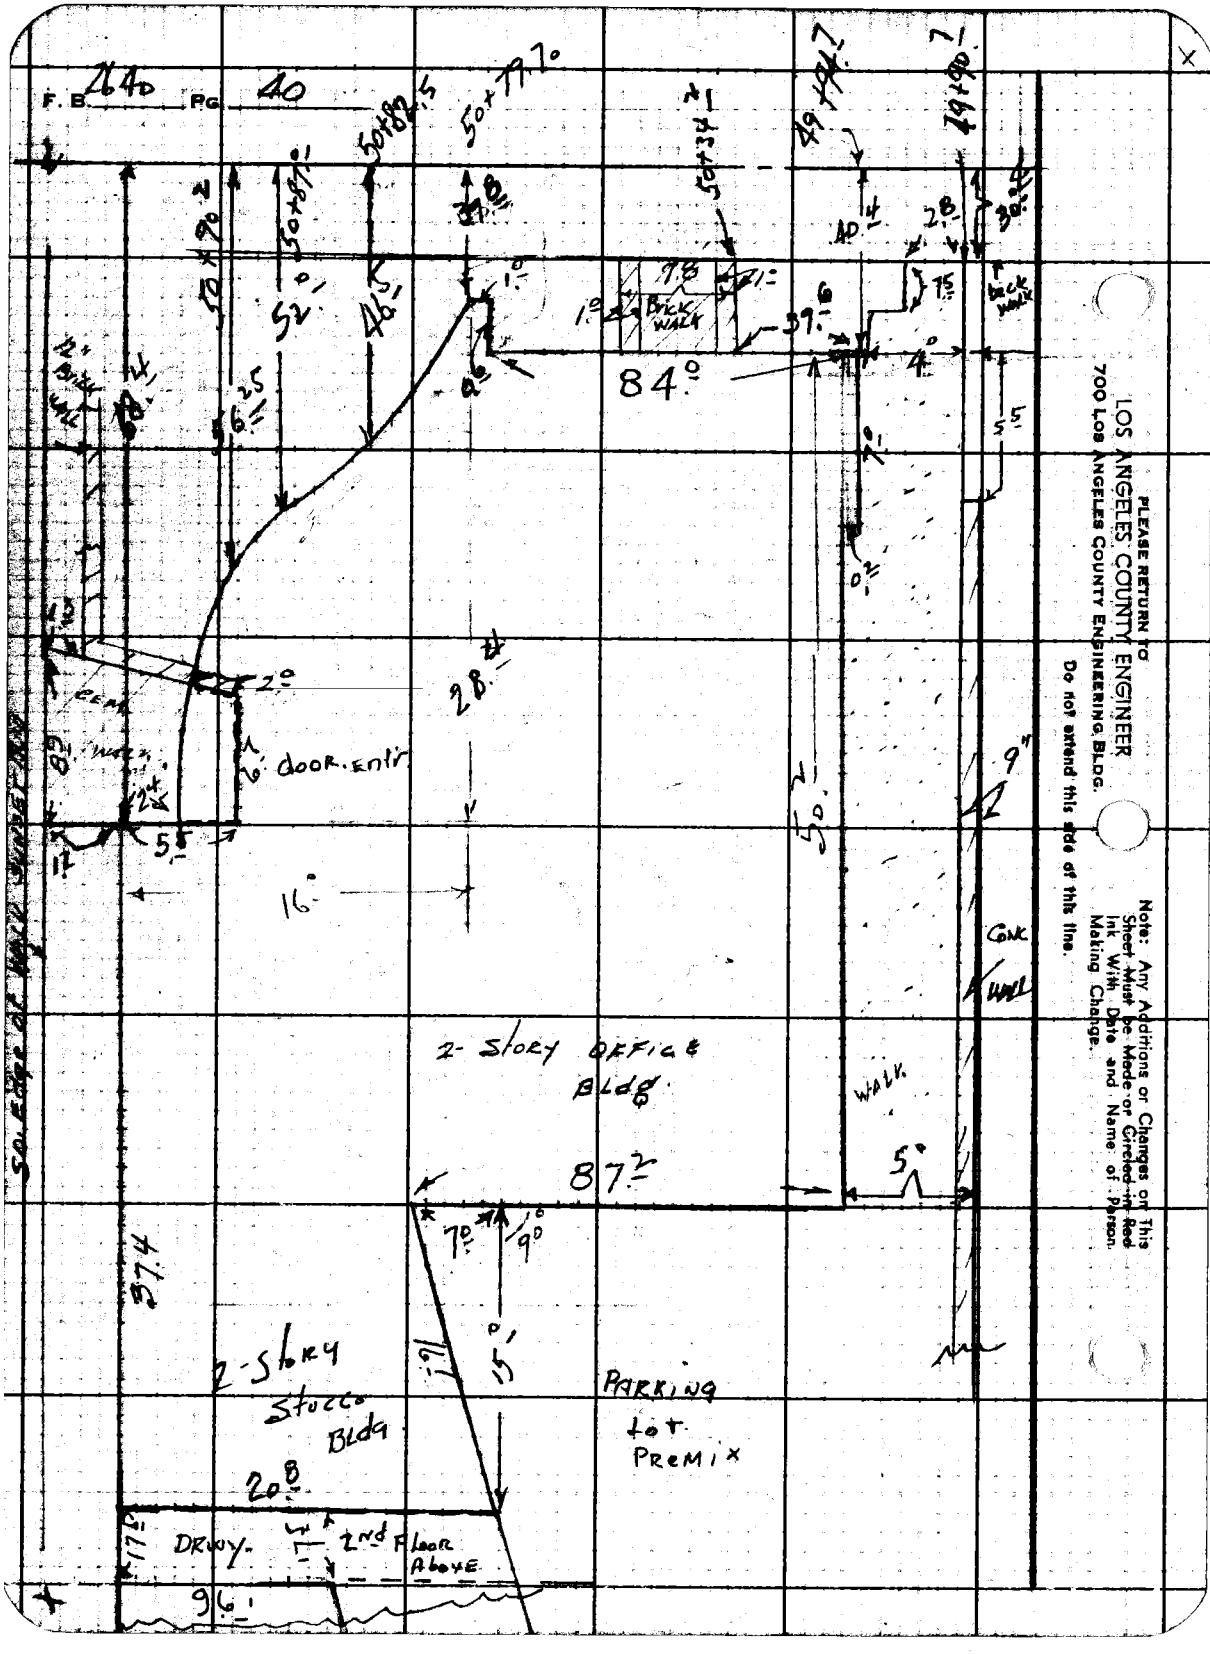
50.82
50'
19.7'
50'
52'
46.1'
84.0'
39.6'
49.4'
19.7'
30.4'
28'
75'
BRICK WALK
AD
5'
9"
CONC WALL
WALK
5'
2-Story OFFICE Bldg.
87.2'
7.0'
90°
15'
16.1'
PARKING lot PREMIX
2-Story Stucco Bldg
20.8'
DRWY.
2nd Floor Above
96'
41.75'
28'
16'
6' DOOR. ENTR
2'
5'
17'
12' BRICK WALL
CONC WALK
PLEASE RETURN TO
LOS ANGELES COUNTY ENGINEER
700 Los Angeles County Engineering Bldg.
Do not extend this side of this line.
Note: Any Additions or Changes on This Sheet Must be Made or Circled in Red Ink With Date and Name of Person Making Change.

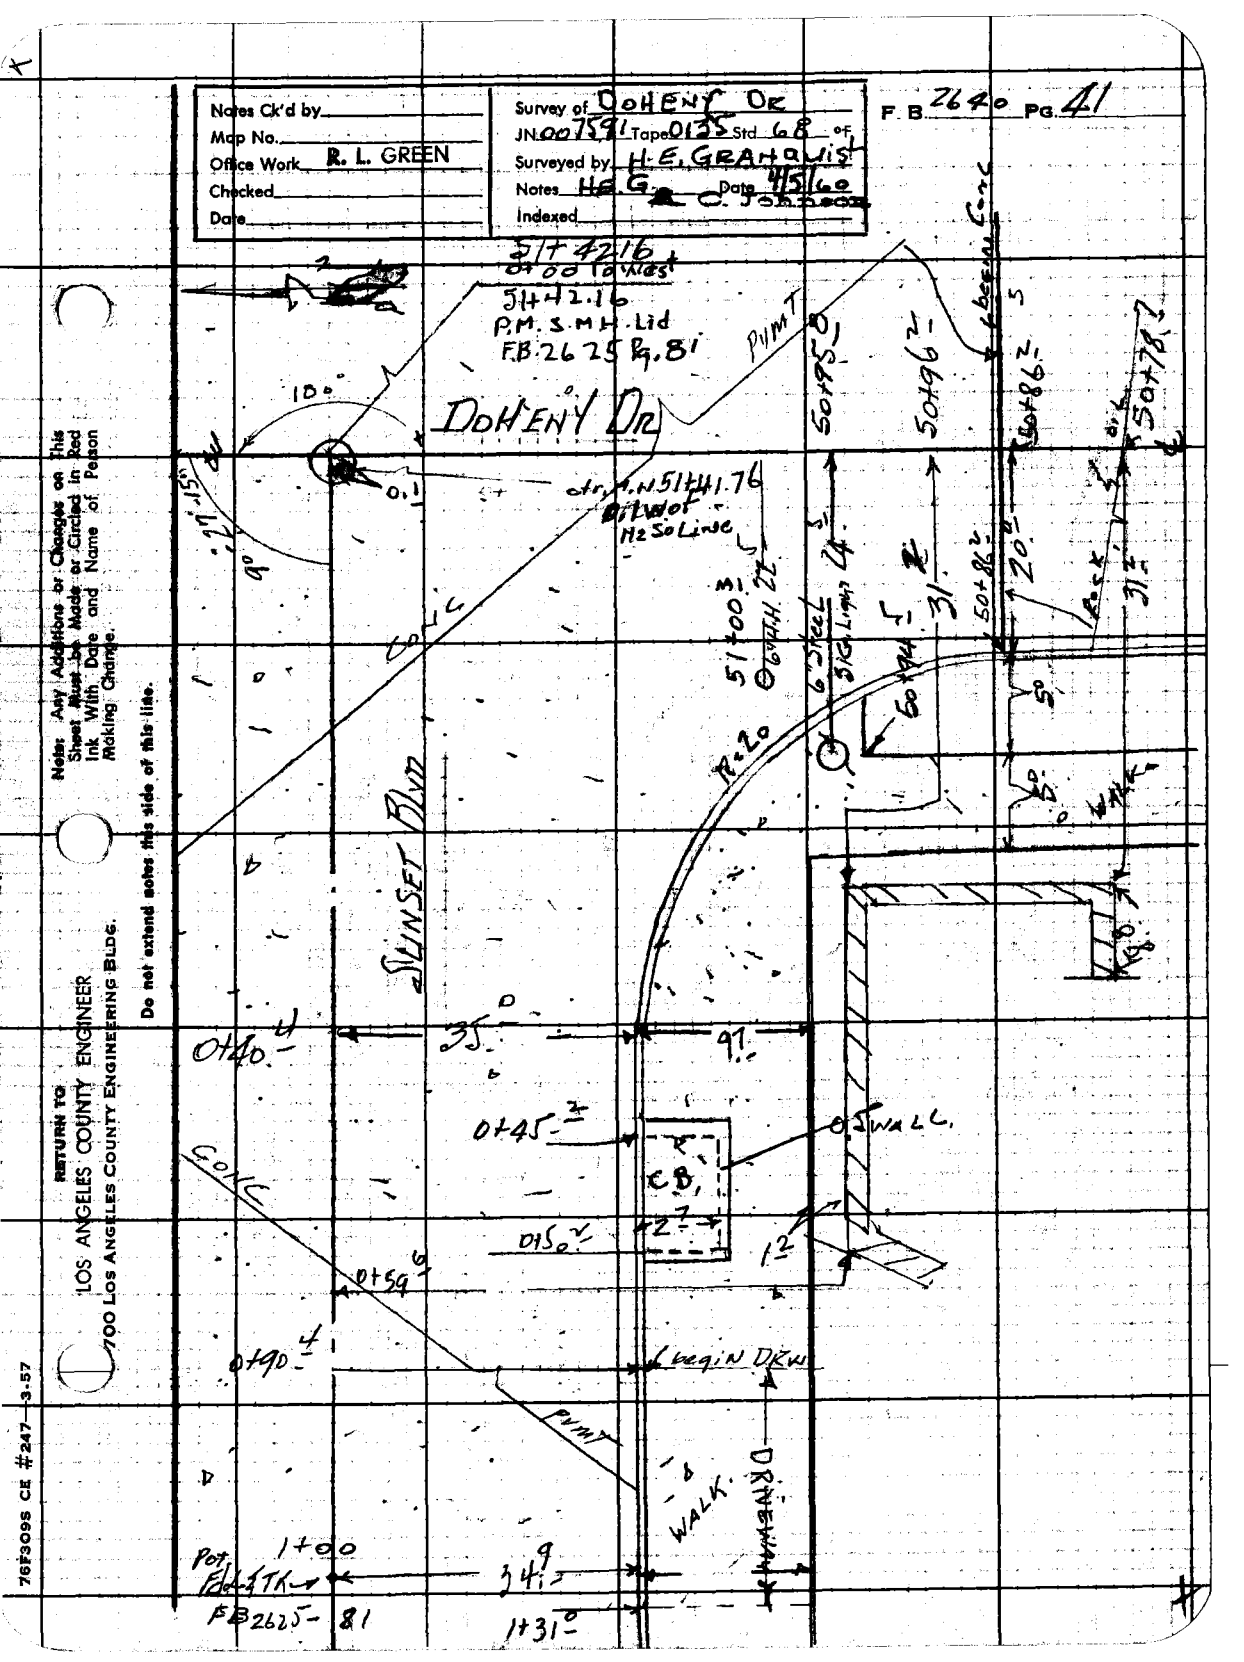
Notes Ck'd by
Map No.
Office Work R. L. GREEN
Checked
Date
Survey of DOHENY DR
JN 007591 Tape 0135 Std 68 of
Surveyed by H.E. GRAHAM Jr
Notes H.E.G. & C. Johnson Date 4/5/60
Indexed
F.B. 2640 PG. 41
51+42.16
0+00 to last
51+42.16
P.M. S.M.H. Lid
F.B. 2625 Pg. 81
DOHENY DR
P.I.M.T.
10.0'
90°
N51°41'15"E
Sta. 1+00 N 51+41.76
Bit. of H2So Line
50+96.2
50+86.2
20.0'
31.2'
50+78.7
6" Steel Sig. Light
Conc.
51+00 M.S.
6" M.H.
R=20
SUNSET BLVD.
0+40
35'
91'
0+45
C.B.
0.5' WALL
D15
42"
1.2'
0+59
0+90
Begin DKWY
P.I.M.T.
WALK
DRIVEWAY
Pot 1+00
FB 2625-81
34.9'
1+31
RETURN TO
LOS ANGELES COUNTY ENGINEER
Note: Any Additions or Changes on This Sheet Must be Made or Circled in Red Ink With Date and Name of Person Making Change.
Do not extend notes this side of this line.
76F3095 CE #247 3-57

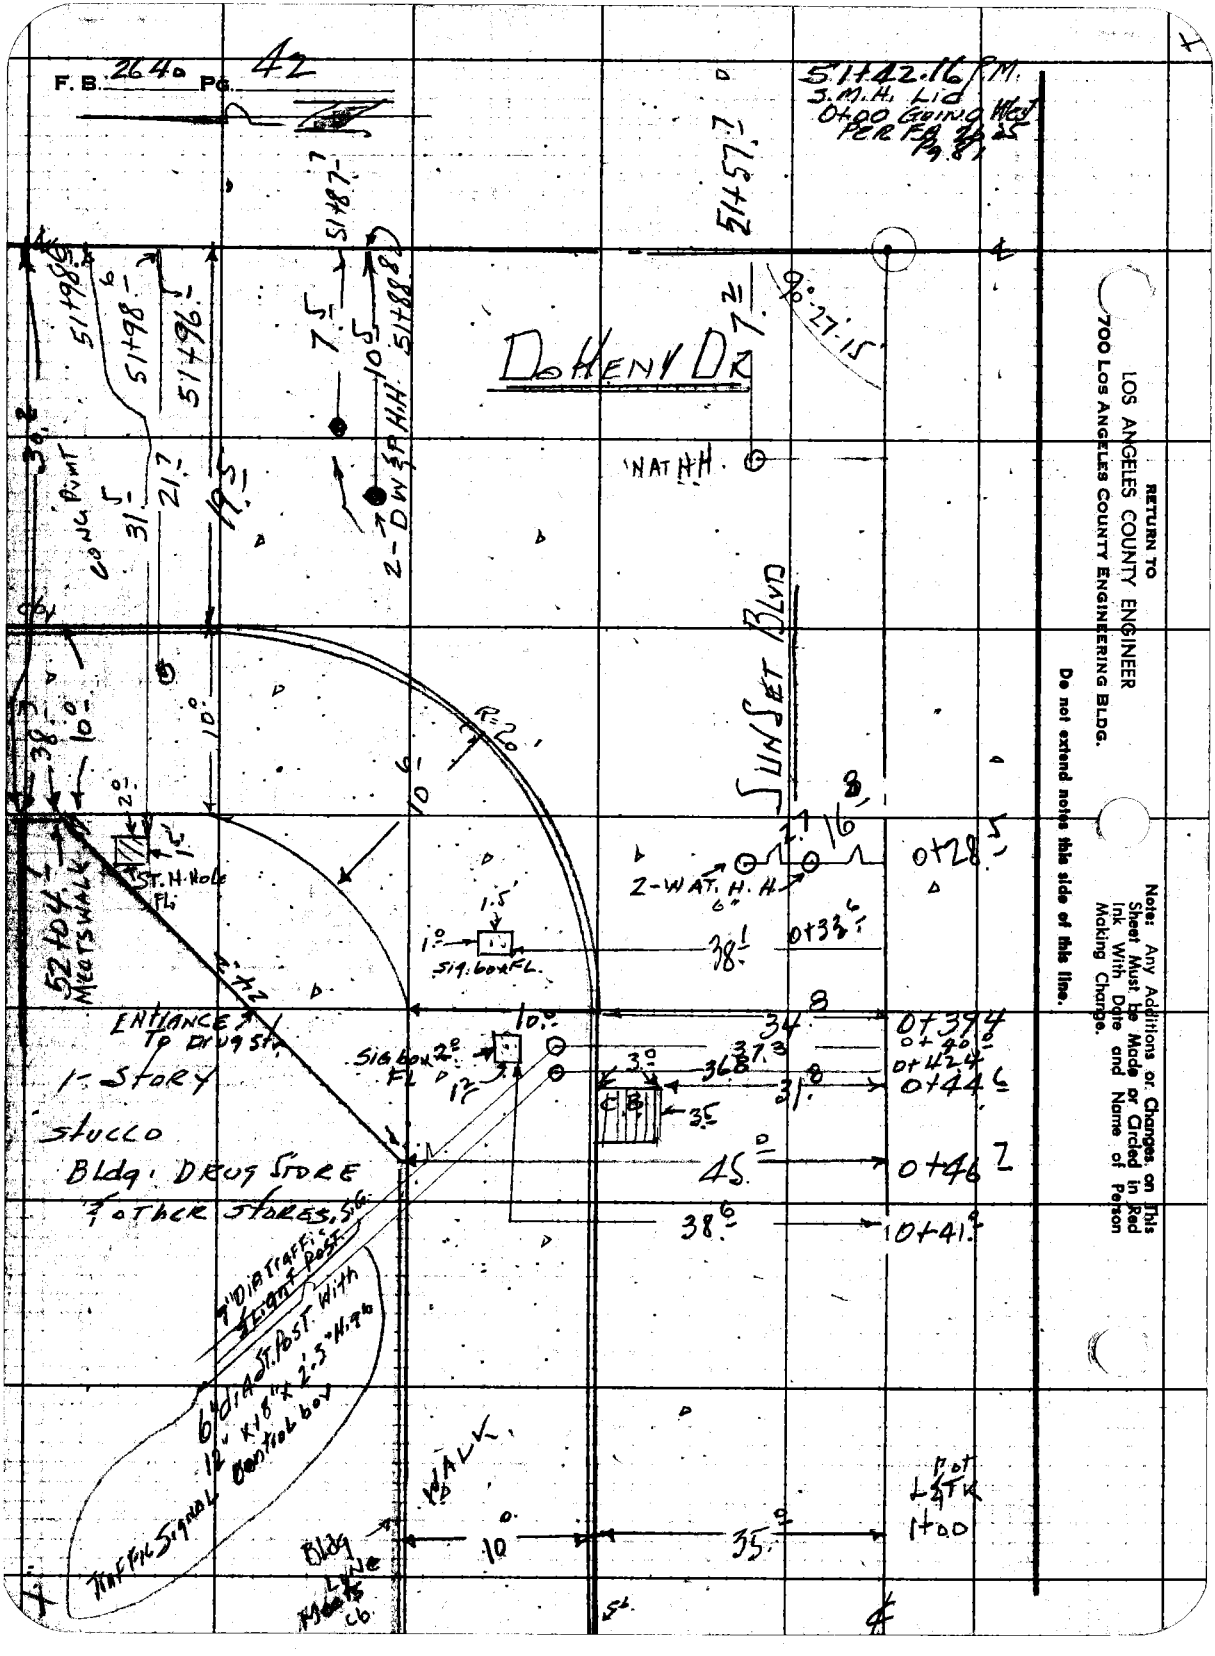
F.B. 2640 Pg. 42
5142.16 P.M.
3.M.H. Lid
0+00 Going West
Per F.B. 2640 Pg. 81
5145.7±
5148.7±
5148.8
5149.8
5149.8
DOHENY DR
7.5
10.5
Z-DWSP HH
NAT HH
90°27'15"
SUNSET BLVD
R=20'
Z-WAT. H. H.
0+28.5
0+33.6
0+39.4
0+44.6
0+46.7
10+41.9
1+00
52 Lin. Ft. Meets Walk
T. H. Hole FL
Sig. box FL
ENTRANCE TO DRUG ST.
1-STORY STUCCO BLDG. DRUG STORE & OTHER STORES, &c.
SIG. BOX FL
4" DIA. TRAFFIC SIGNAL POST
6" DIA. ST. POST WITH 12" x 18" x 2.5" M.T.C. BOX
TRAFFIC SIGNAL
WALK
BLDG LINE
PROP. LIGHT
RETURN TO
LOS ANGELES COUNTY ENGINEER
700 LOS ANGELES COUNTY ENGINEERING BLDG.
Do not extend notes this side of this line.
Notes: Any Additions or Changes on This Sheet Must be Made or Circled in Red Ink With Date and Name of Person Making Change.

76F3098 CE #247—3-57

RETURN TO
LOS ANGELES COUNTY ENGINEER
700 LOS ANGELES COUNTY ENGINEERING BLDG.

Note: Any Additions or Changes on This Sheet Must Be Made or Circled In Red Ink With Date and Name of Person Making Change.

Do not extend notes this side of this line.

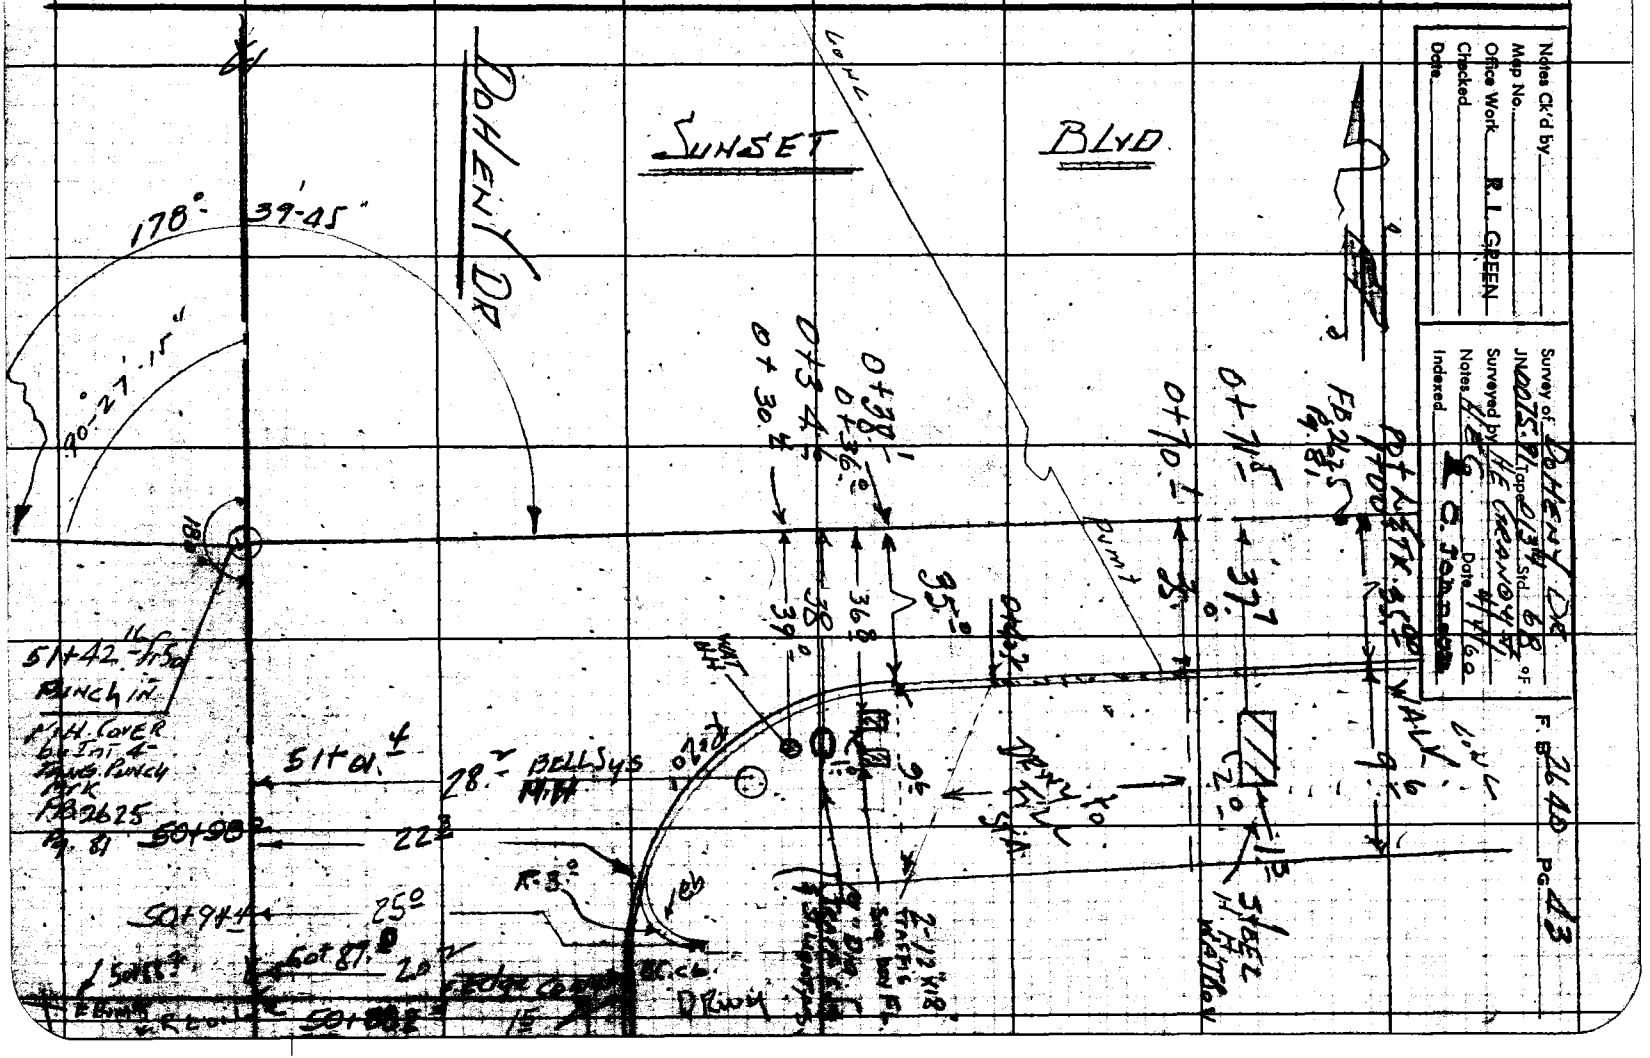

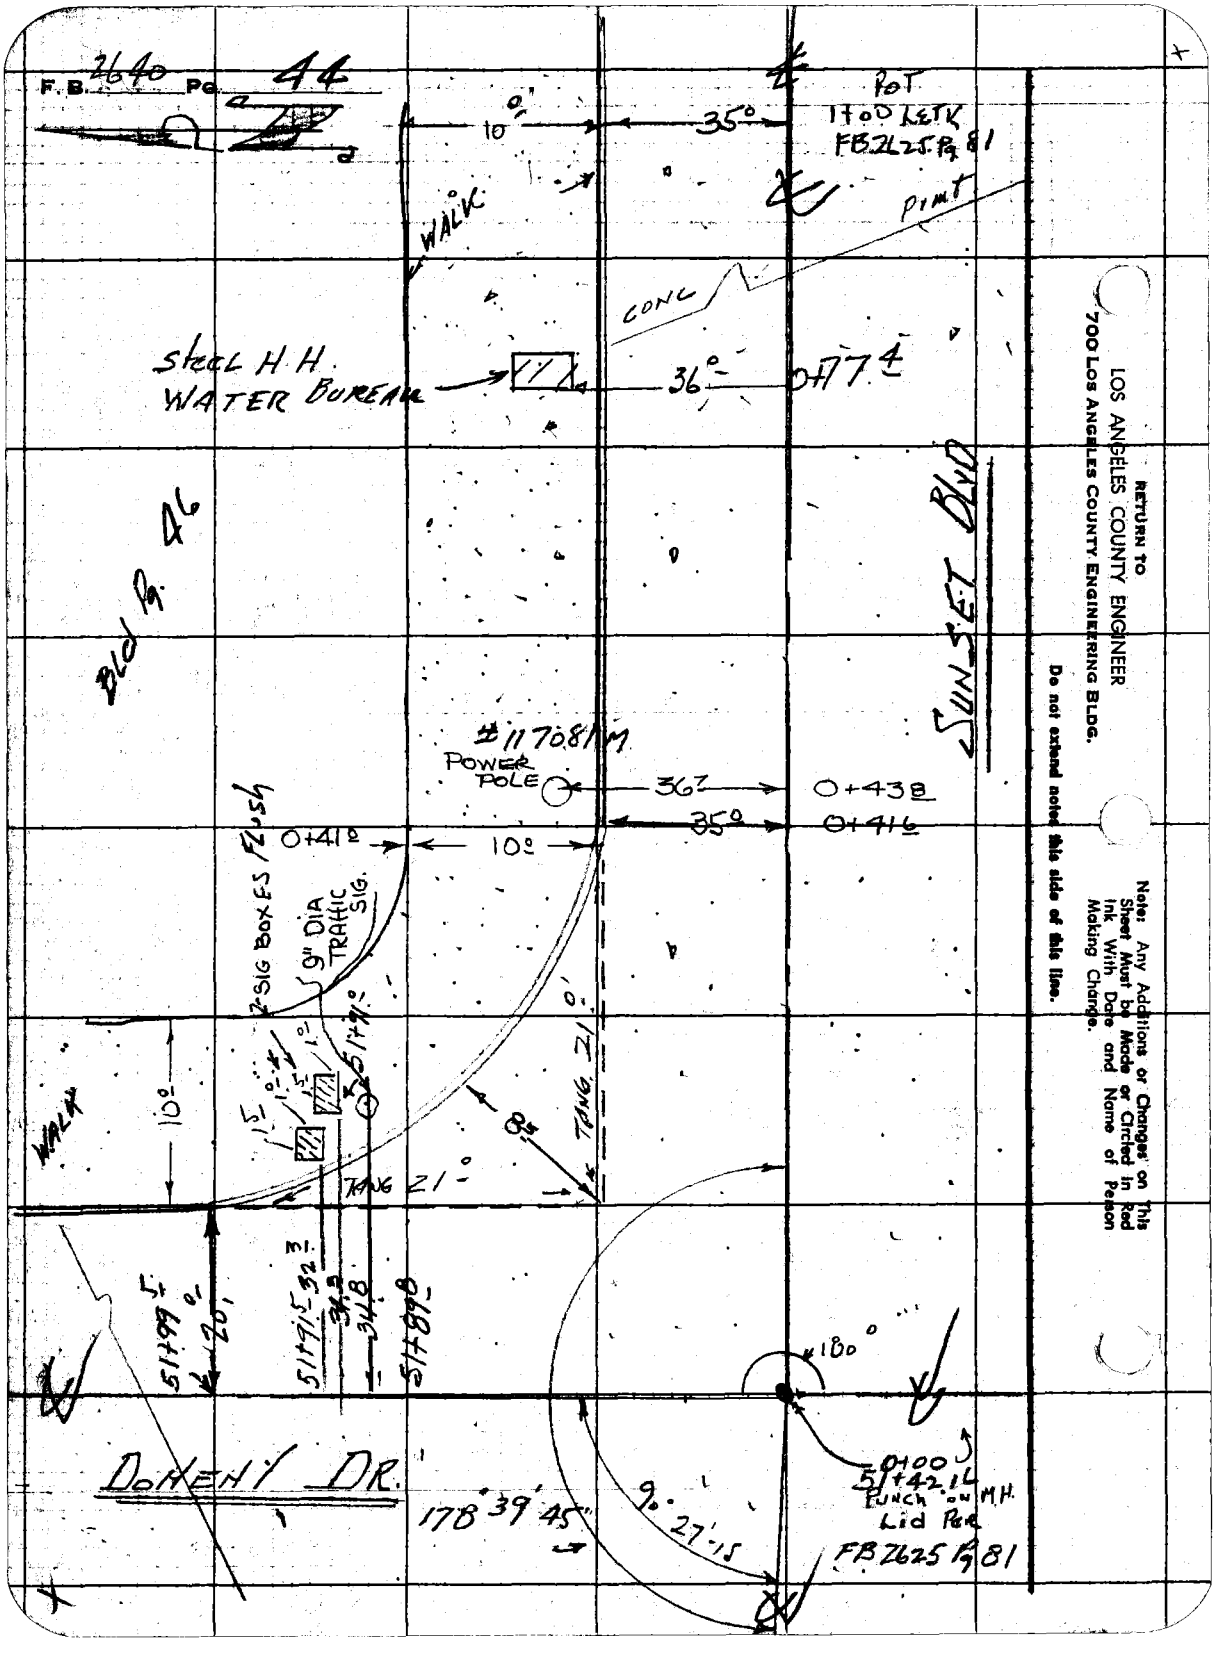
F.B. 2640 Pg. 44
10'
35°
POT
1700 LT K
FB 2625 Pg 81
WALK
PIMT
CONC
STEEL H.H.
WATER BUREAU
36°
0+774
BLD Pg. 46
SUNSET BLVD
#117081M
POWER POLE
36°
0+438
35°
0+416
0+411
10°
FLUSH
2 SIG BOXES
9" DIA TRAFFIC SIG.
WALK
10'
TANG 21°
TANG 21°

Notes Ck'd by	Survey of DOHENY DR.
Map No.	JN 007591 Tape 0135 Std 68 °F
Office Work R. L. GREEN	Surveyed by H. E. GRWOLL
Checked	Notes NEG Date 4/1/69
Date	Indexed A. C. Johnson


Note: Any Additions or Changes on this Sheet Must be Made or Circled in Red Ink With Date and Name of Person Making Change.

Do not extend this side of this line.

PLEASE RETURN TO
LOS ANGELES COUNTY ENGINEER
700 LOS ANGELES COUNTY ENGINEERING BLDG.

76F3095 SSE #247 11-68

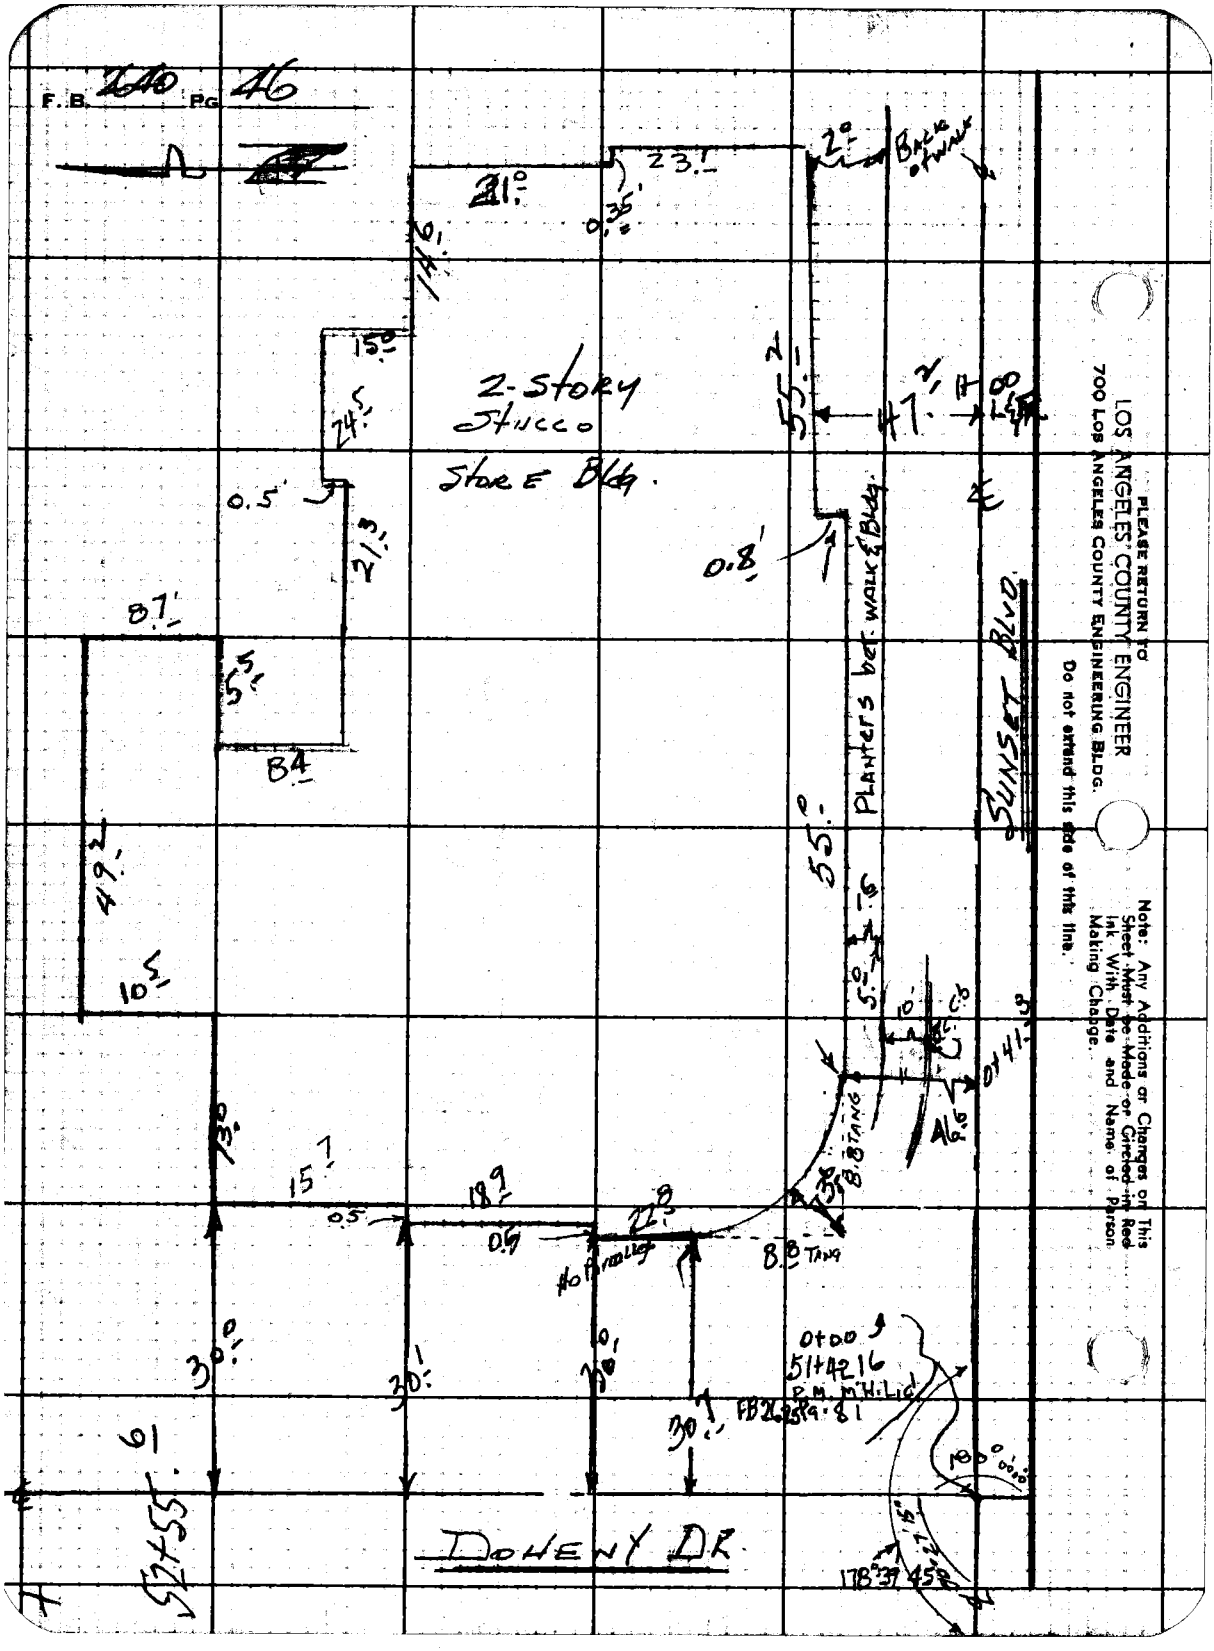
F.B. 240 Pg. 46
2-Story Stucco Store Bldg.
Planters bet walk & Bldg.
SUNSET BLVD.
DOHENY DR.
Bldg. Ofset
B.B. Tang

Notes Ck'd by
Map No.
Office Work R. L. GREEN
Checked
Date

Survey of Dahenq Dr
JN 00 75.91 Tape 01 35 Std 68 °F
Surveyed by H.E. Grunawitt
Notes J. Mallonado Date 3-23-60
Indexed A. C. Johnson

F. B. 264 Pg. 47

Note: Any Additions or Changes on This Sheet Must be Made or Circled in Red Ink With Date and Name of Person Making Change.

Do not extend notes this side of this line.

RETURN TO
LOS ANGELES COUNTY ENGINEER
700 LOS ANGELES COUNTY ENGINEERING BLDG.

76F309S CE #247—3-57

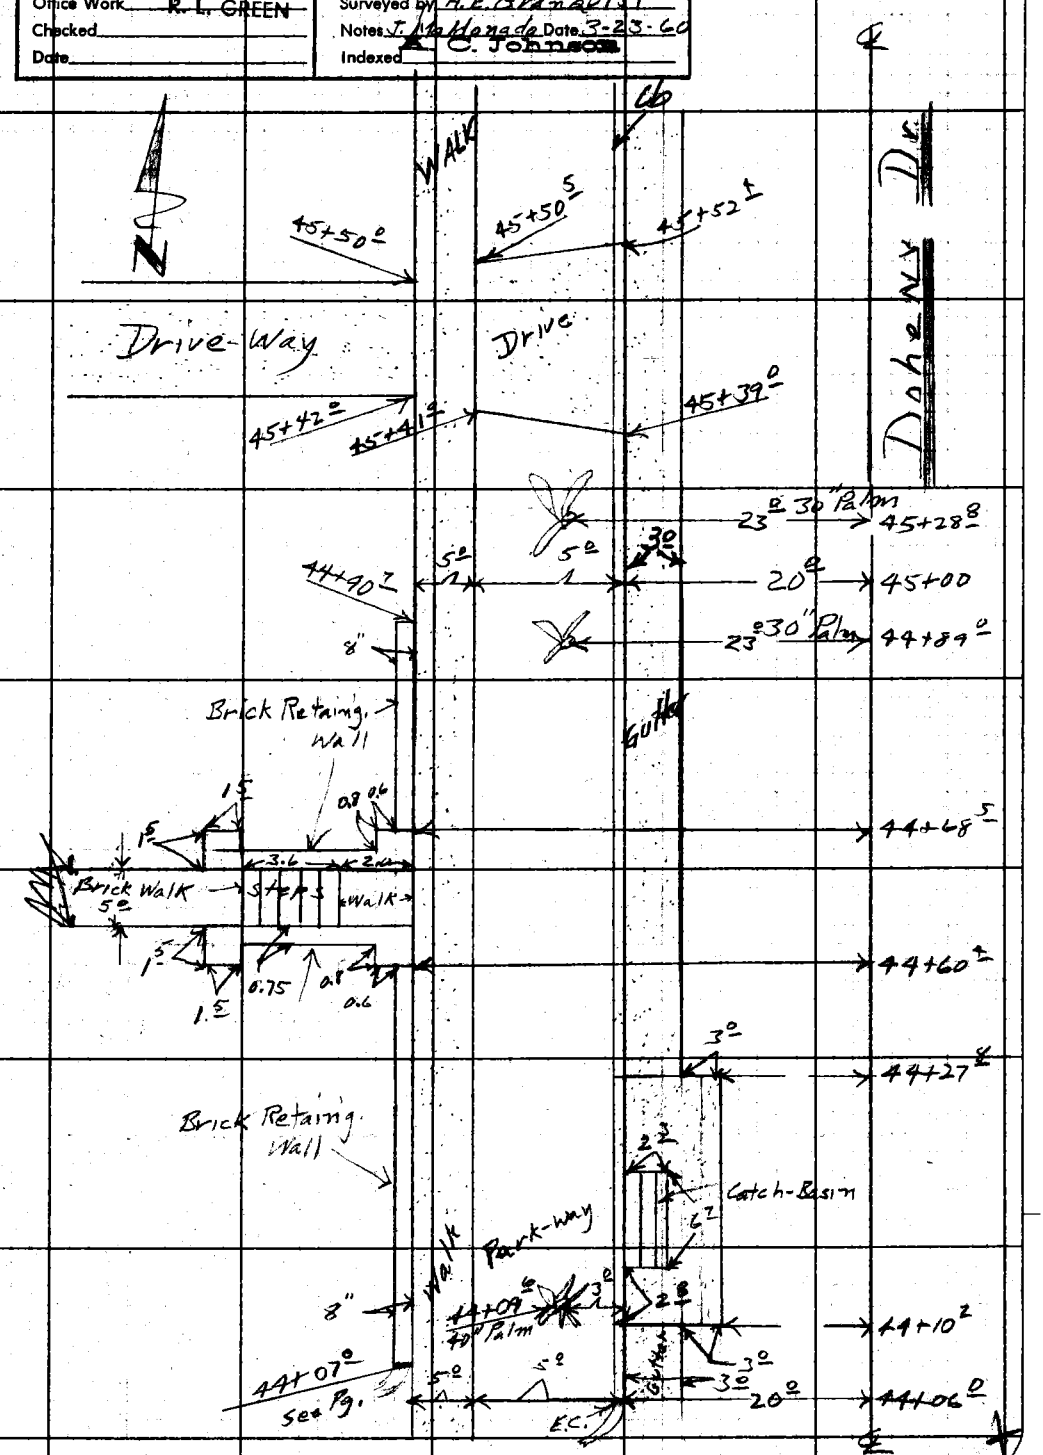

F.B. 2640 Pg. 48

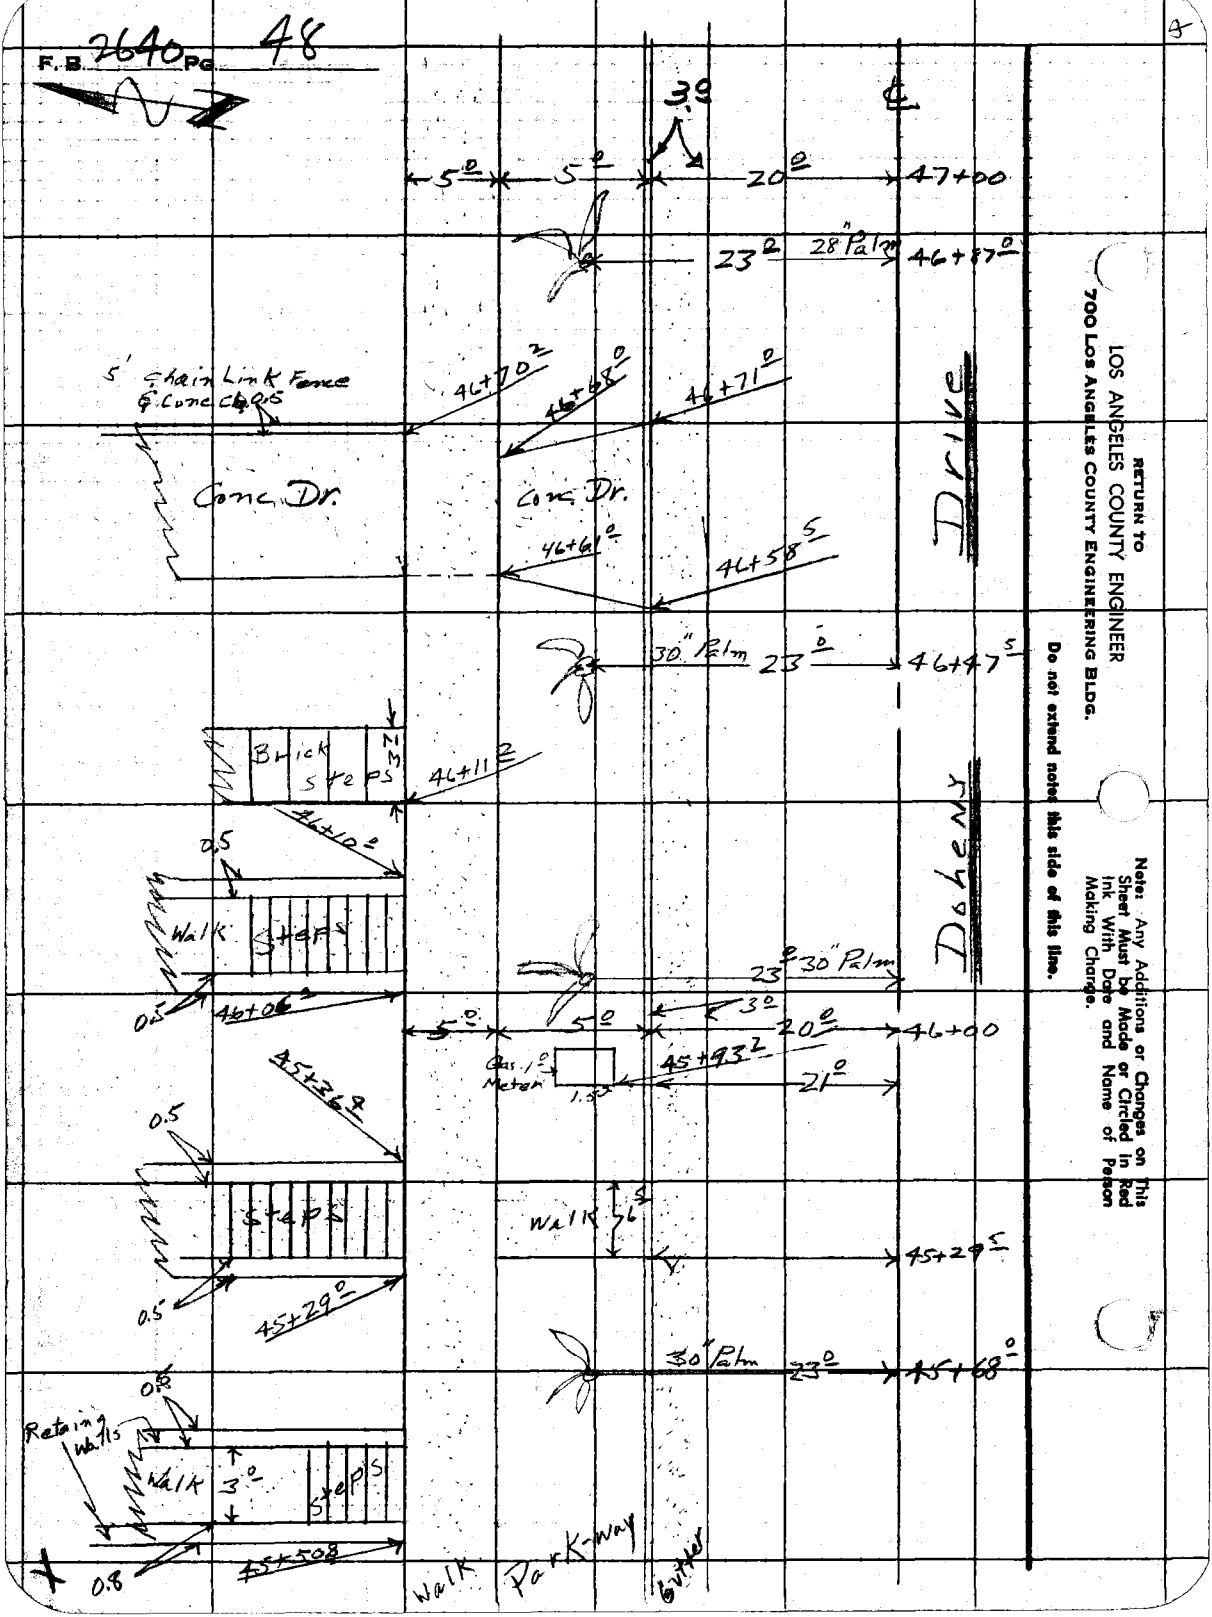

RETURN TO
LOS ANGELES COUNTY ENGINEER
700 Los Angeles County Engineering Bldg.

Do not extend notes this side of this line.

Note: Any Additions or Changes on This Sheet Must be Made or Circled in Red Ink With Date and Name of Person Making Change.

Notes Ck'd by
Map No.
Office Work R. L. GREEN
Checked
Date

Survey of Doheny Dr.
JN 007591 Tape 0125 Std. 68 °F
Surveyed by H.E. Granquist
Notes J. Maldonado Date 4-3-60
Indexed L. C. Johnson

F. B. 2640 PG. 49

Note: Any Additions or Changes on This Sheet Must be Made or Circled in Red Ink With Date and Name of Person Making Change.

Do not extend notes this side of this line.

RETURN TO
LOS ANGELES COUNTY ENGINEER
700 Los Angeles County Engineering Bldg.

76F3095 CE #247—3-57

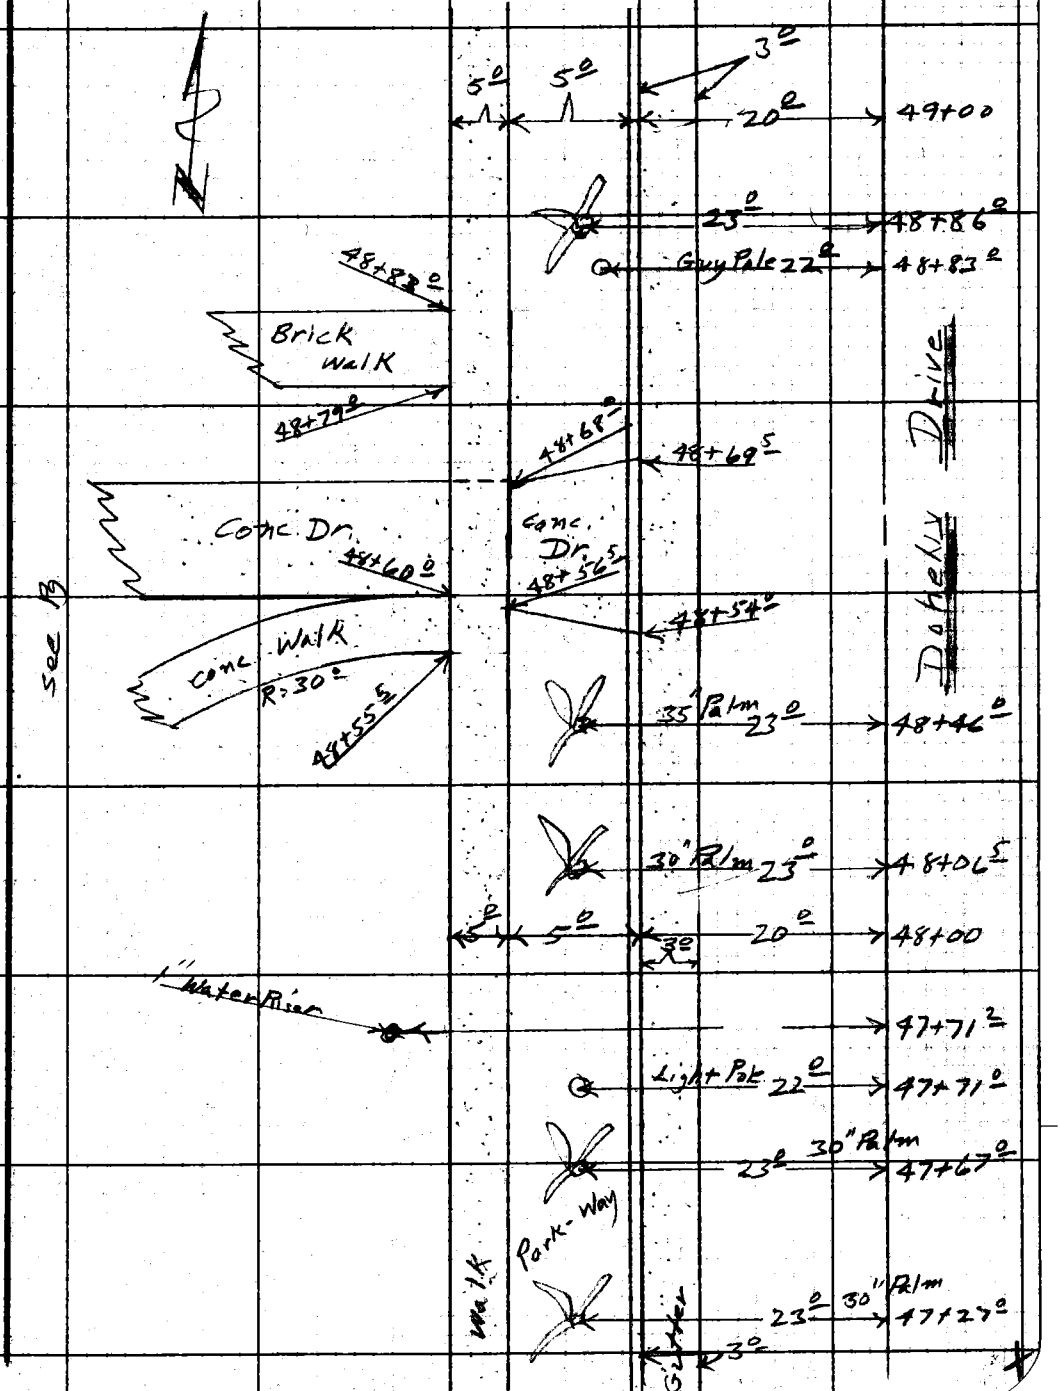

F. B. 2640 PG. 6

Fire Hyd. 22° → 50+87 R

30" Palm 23° R → 50+84 S

P. Pole 22° → 50+80 S

Guy Wire 22° → 50+51 S

30" Palm 23° L → 50+45°

50+34.3 Brick Walk

P. Meter 22° → 50+29 S

P. Meter 22° → 50+09°

30" Palm 23° L → 50+05 S

30" Palm 23° → 50+02 S

5° 5° 8° 20' → 50+00

Conc. Walk 4° M

49+90.7

Brick Walk 4°

22° Parking Meter → 49+75 S

49+72°

30" Palm 23° → 49+65 S

45+51°

Brick 4° Walk

45+47.5

Conc. Walk

49+45 S

30" Palm 23° → 49+26°

49+15°

Brick Walk

Conc. Walk

49+11°

Dohenny

Dohenny

RETURN TO
LOS ANGELES COUNTY ENGINEER
700 LOS ANGELES COUNTY ENGINEERING BLDG.

Do not extend notes this side of this line.

Note: Any Additions or Changes on This Sheet Must be Made or Circled in Red Ink With Date and Name of Person Making Change.

Notes Ck'd by
Map No.
Office Work R. L. GREEN
Checked
Date

Survey of Dohany Dr.
JN 0025.91 Tape 0135 Std. 68 °F
Surveyed by H.E. Granquist
Notes J. Maldonado Date 4-6-60
Indexed [illegible]

F. B. 2640 PG. 51

Note: Any Additions or Changes on This Sheet Must be Made or Circled in Red Ink With Date and Name of Person Making Change.

Do not extend notes this side of this line.

RETURN TO
LOS ANGELES COUNTY ENGINEER
700 LOS ANGELES COUNTY ENGINEERING BLDG.

76F3095 CE #247—3-57

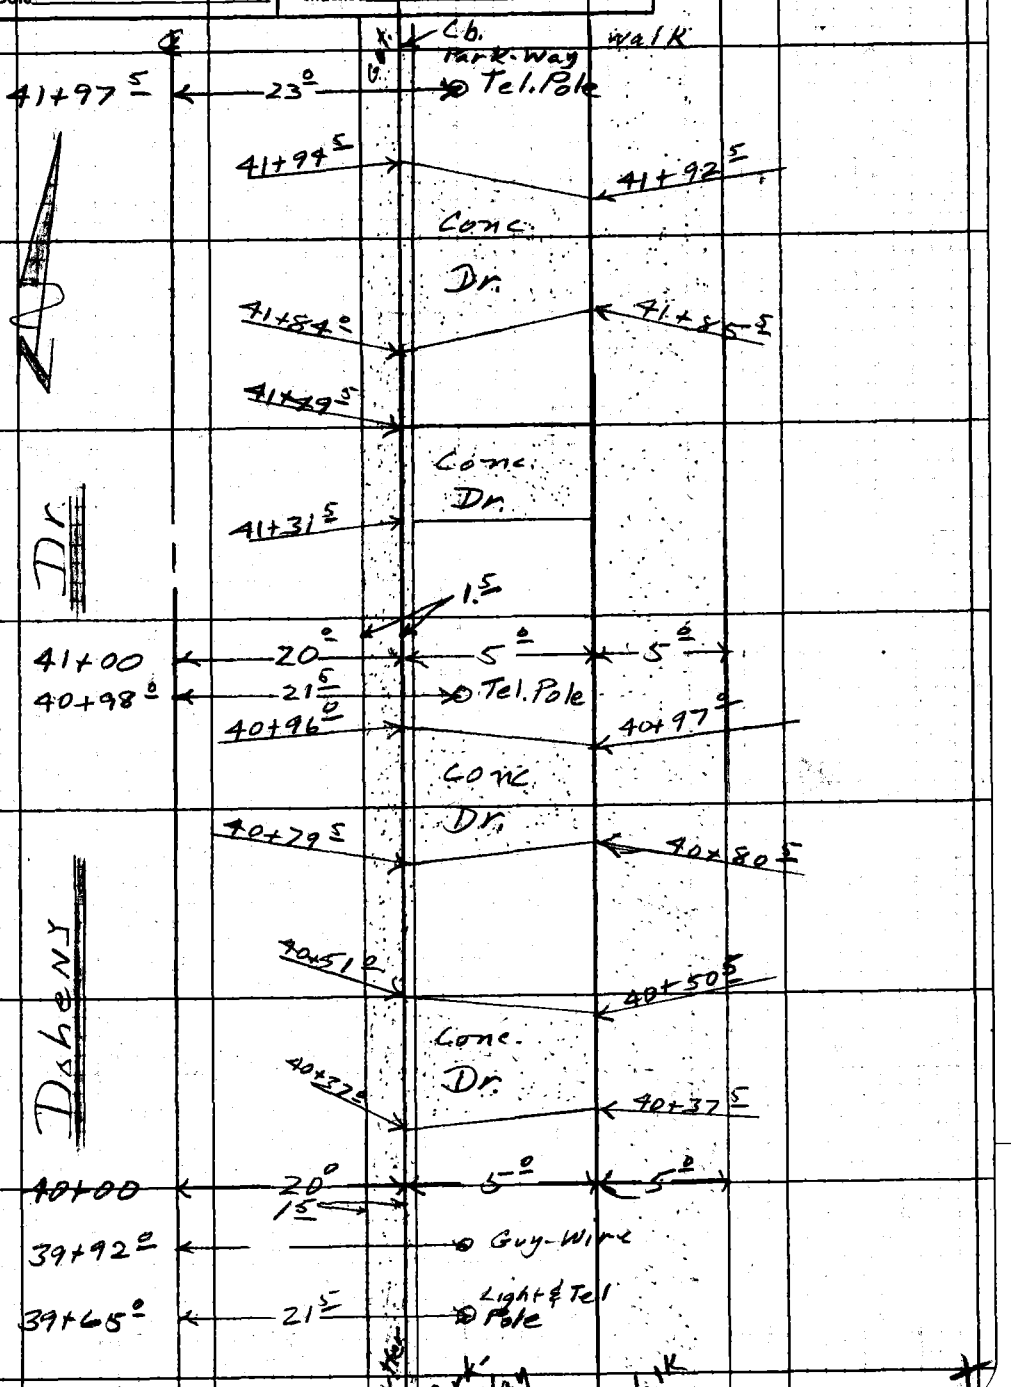

F. B. 2680 Pg. 52

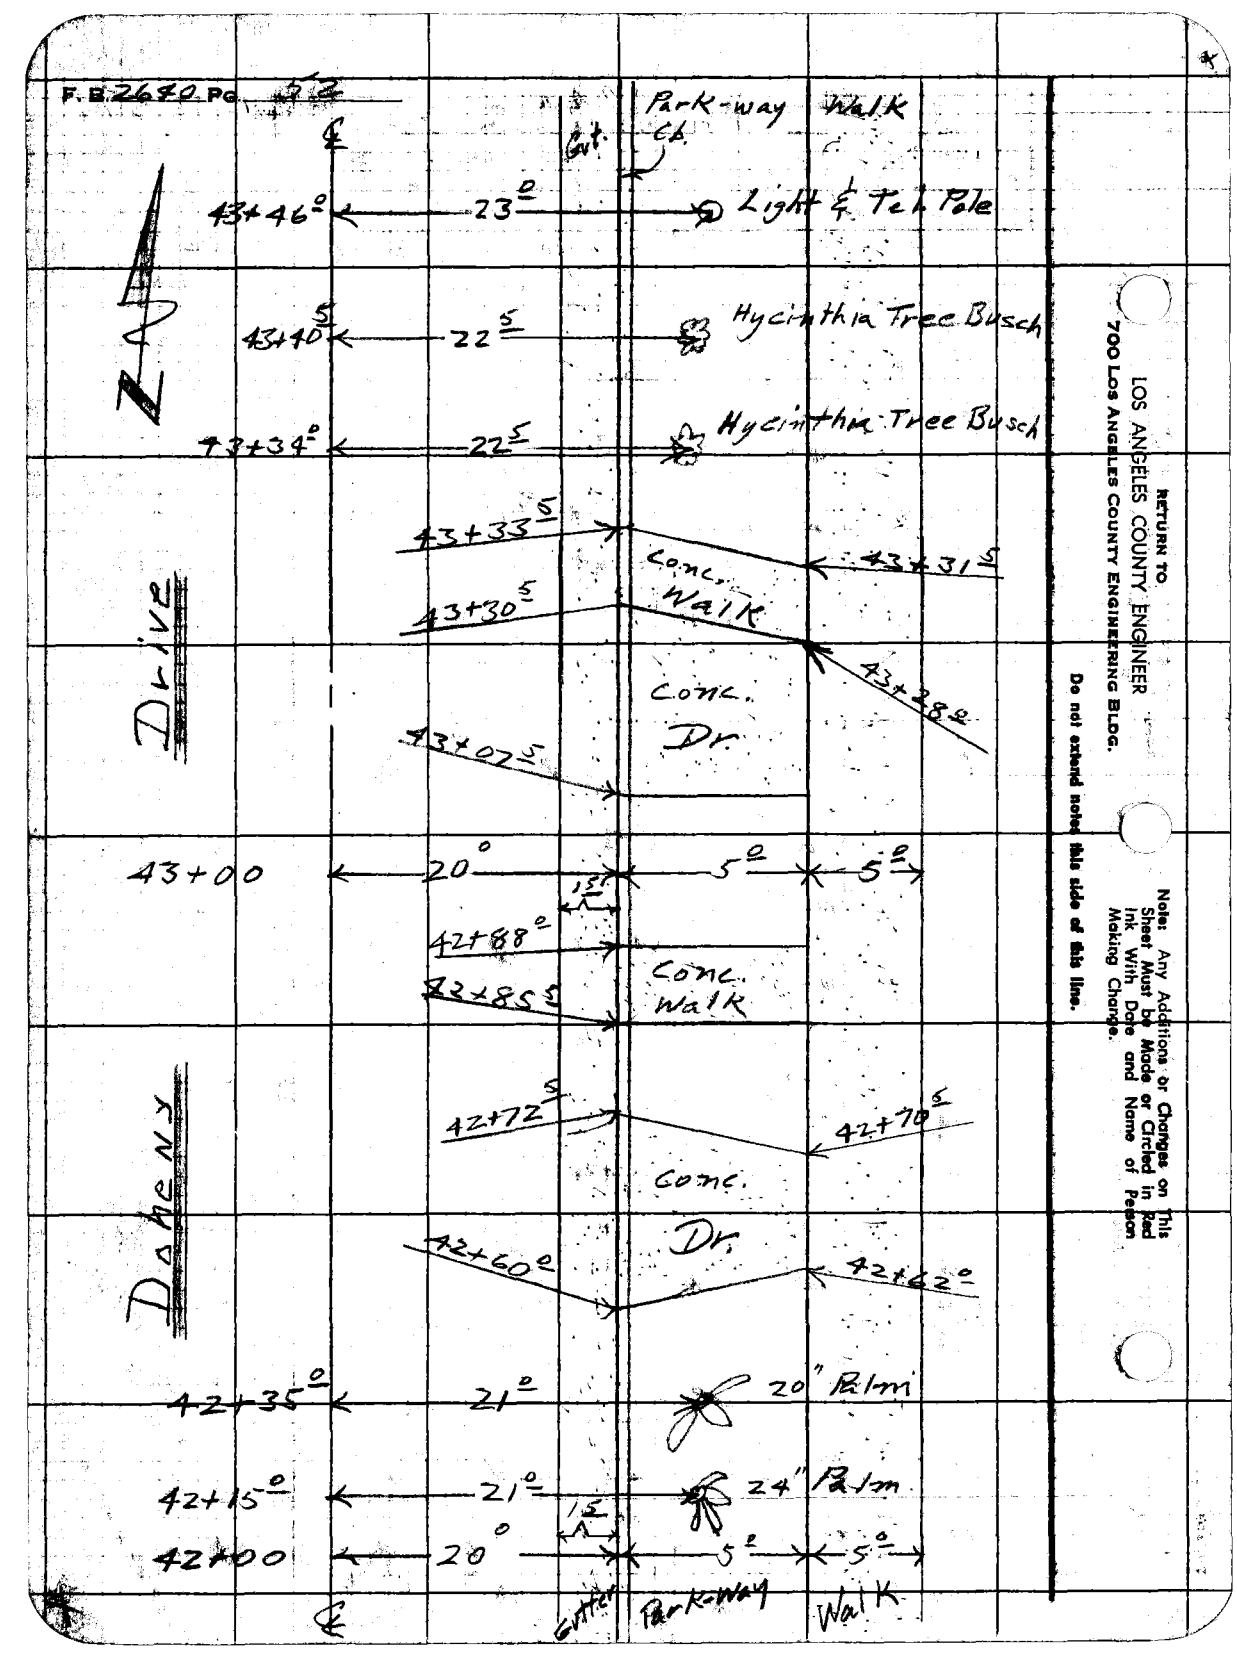

RETURN TO
LOS ANGELES COUNTY ENGINEER
700 Los Angeles County Engineering Bldg.

Do not extend notes this side of this line.

Note: Any Additions or Changes on This Sheet Must be Made or Circled in Red Ink With Date and Name of Person Making Change.

Notes Ck'd by
Map No.
Office Work R. L. GREEN
Checked
Date

Survey of Dakeny Dr
JN 1175-91 Tape 0135 Std. 68° F
Surveyed by H.L. Grannquist
Notes J. Maldonado Date 4-6-50
Indexed M. C. Johnson

F. B. 2540 Pg. 58

Note: Any Additions or Changes on this Sheet Must Be Made or Circled in Red Ink With Date and Name of Person Making Change.

PLEASE RETURN TO
LOS ANGELES COUNTY ENGINEER
700 LOS ANGELES COUNTY ENGINEERING BLDG.
Do not extend this side of this line.

78 3066 SBE 1247 11-48

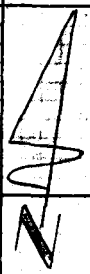

Park-way Walk
Gutter
℄
Water M.H.
47+25 ± 13° 9 ±
Fire Hydrant
Drive
44+00 20 ± 10 5° 5°
43+88° 22°
2" Magnolia Tree
Dakeny
43+61° 48+77°
Conc.
Dr.
43+59° 43+69 ±
43+51 9 23°
Hyacintha Tree Bush
43+46 8 27 2
Bell System M.H.
℄
Gutter
Park-way Walk

F. B. 2690 PG. 54

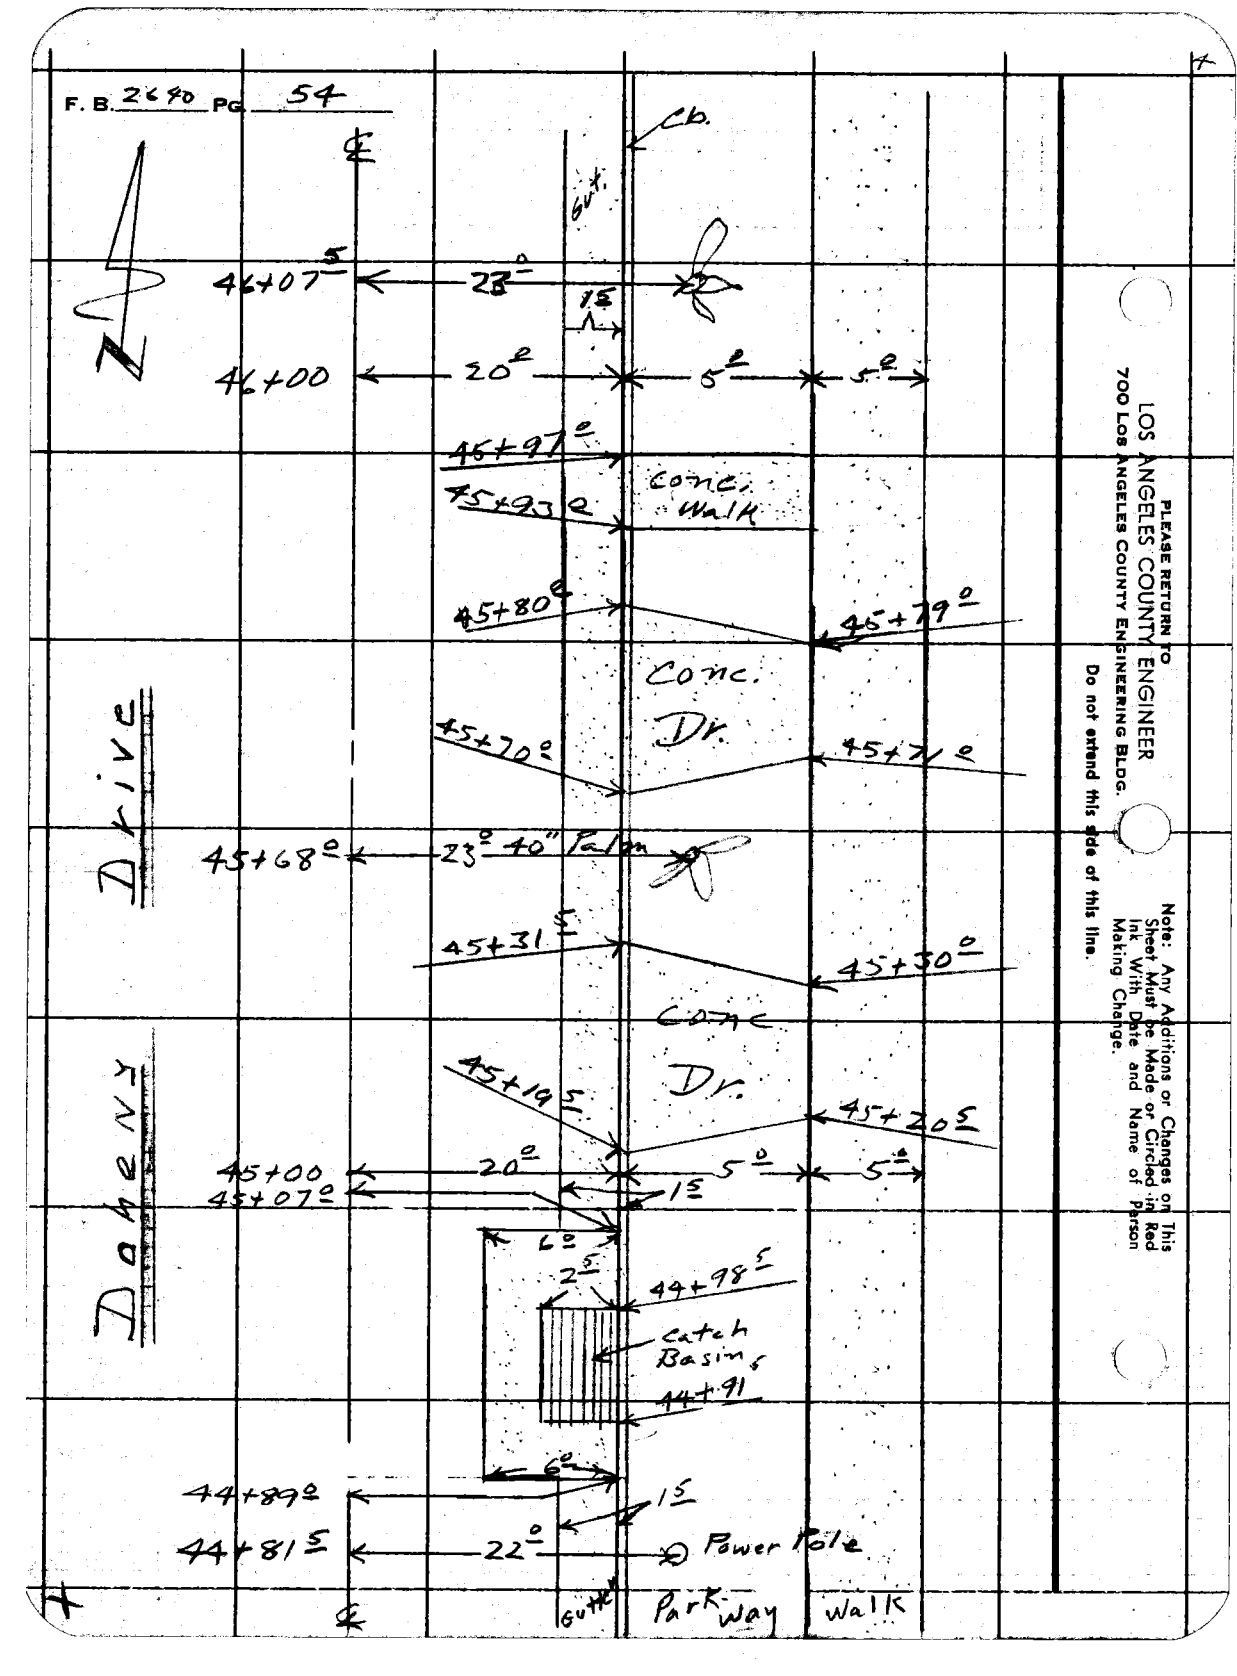

PLEASE RETURN TO
LOS ANGELES COUNTY ENGINEER
700 LOS ANGELES COUNTY ENGINEERING BLDG.

Do not extend this side of this line.

Note: Any Additions or Changes on This Sheet Must be Made or Circled in Red Ink With Date and Name of Person Making Change.

Notes Ck'd by	Survey of Doheny Dr.	F. B. 2640 PG. 55
Map No.	JN 00751 Tape 0135 Std. 68 °F	
Office Work R. L. GREEN	Surveyed by H.E. Granquist	
Checked	Notes J. Maldonado Date 4-6-60	
Date	Indexed C. Johnson	

Note: Any Additions or Changes on this Sheet Must be Made or Circled in Red Ink With Date and Name of Person Making Change.

Do not extend this side of this line.

PLEASE RETURN TO
LOS ANGELES COUNTY ENGINEER
700 Los Angeles County Engineering Bldg.

76F3098 SSE #247 11-58

47+71 5 ← 25° — 3° Bell System Steel Cover 2° Box (Flush)

47+70° ← 21° — Guide Pole

47+66° ← 23° — 50" Palm

47+62 5 ← 23° — 1" Water Riser

47+59 5 — 47+57° Conc. Dr

47+47 5 — 47+49 5

Drive

47+26 5 — 30" Palm

47+00 ← 20° — 15' R — 5° — 5°

46+87° ← 23° — 30" Palm

Doheny

46+47° ← 23° — 30" Palm

46+39° ← 22° — Guy-Wire

46+30 5 — 46+29° Conc Dr

46+19 5 — 46+21 2

46+17 5 ← 22° — P.P. & Tel. Pole

South Park-Way Walk

F. B. 2480 PG. 56

50+45 ← 23 → 30" Palm

50+43 → Conc Dr.

50+13 →

50+11 ← 21 → 10" Guy Pole

50+05 ← 23 → 30" Palm

50+00 ← 20 → 5 → 5

49+91 → 49+88 ←

Conc Dr.

49+78 → 49+80 ←

49+66 ← 23 → 30" Palm

49+56 ← 22 → Guy-Wire

49+40 ← 24 → Bell System M.H.

Drive

49+33 ← 21 → 10" Guy Pole

49+25 ← 23 → 30" Palm

49+00 ← 20 → 5 → 5

15' Curb Return

48+85 →

48+81 →

Brick Walk

Doheny

48+86 ← 23 → 30" Palm

48+61 → 48+59 ←

48+56 ← 23 → Conc Dr. Gas H.H.

48+48 → 48+50 ←

48+46 → 40" Palm

15' Curb Return

48+00 ← 20 → 5 → 5

Park-Way Walk

PLEASE RETURN TO
LOS ANGELES COUNTY ENGINEER
700 Los Angeles County Engineering Bldg.

Do not extend this side of this line.

Note: Any Additions or Changes on This Sheet Must be Made or Circled in Red Ink With Date and Name of Person Making Change.

Notes Ck'd by		Survey of Doheny Dr.	F. B. 2640 Pg. 57
Map No.		JN 007591 Tape 0135 Std 68 °F	
Office Work R. L. GREEN		Surveyed by N.E. Grandquist	
Checked		Notes J. Maldonado Date 4-6-60	
Date		Indexed C. Johnson	

Note: Any Additions or Changes on This Sheet Must be Made or Circled in Red Ink With Date and Name of Person Making Change.

PLEASE RETURN TO
LOS ANGELES COUNTY ENGINEER
700 LOS ANGELES COUNTY ENGINEERING BLDG.
Do not extend this side of this line.

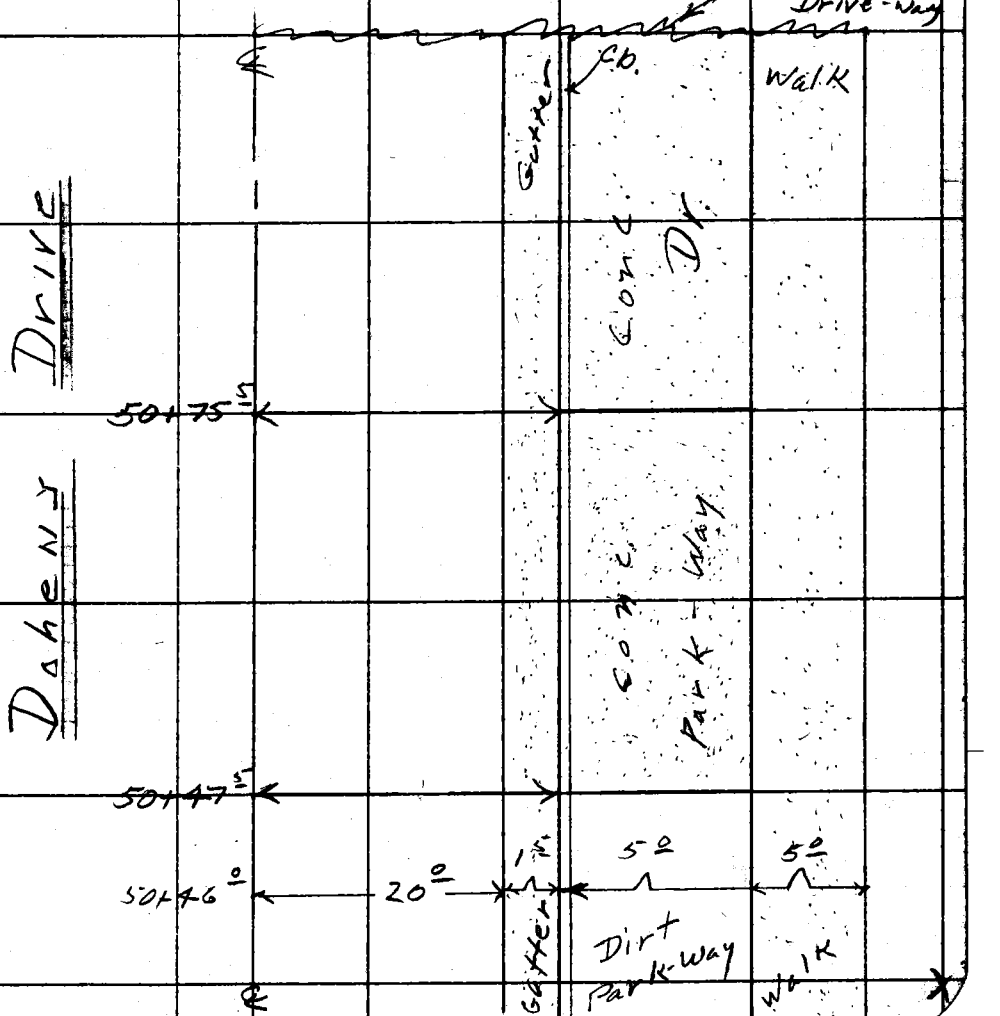

7SF309S SSE #247 11-58

PLEASE RETURN TO
LOS ANGELES COUNTY ENGINEER
700 LOS ANGELES COUNTY ENGINEERING BLDG.

Note: Any Additions or Changes on This Sheet Must be Made or Circled in Red Ink With Date and Name of Person Making Change.

Do not extend this side of this line.

F. B. 2640 PG. 58

Notes Ck'd by	Survey of DOHENY DR.
Map No.	JN 007591 Tape 0135 Std 68 °F
Office Work R. L. GREEN	Surveyed by R.E.GRAN 04/5/60
Checked	Notes H.E.G. Date 4/5/60
Date	Indexed C. Johnson

F. B. 264 Pg. 59

Note: Any Additions or Changes on this Sheet Must be Made or Circled in Red Ink With Date and Name of Person Making Change.
Do not extend this side of this line.

PLEASE RETURN TO
LOS ANGELES COUNTY ENGINEER
700 LOS ANGELES COUNTY ENGINEERING BLDG.

76F3098 SAE #247 11-58

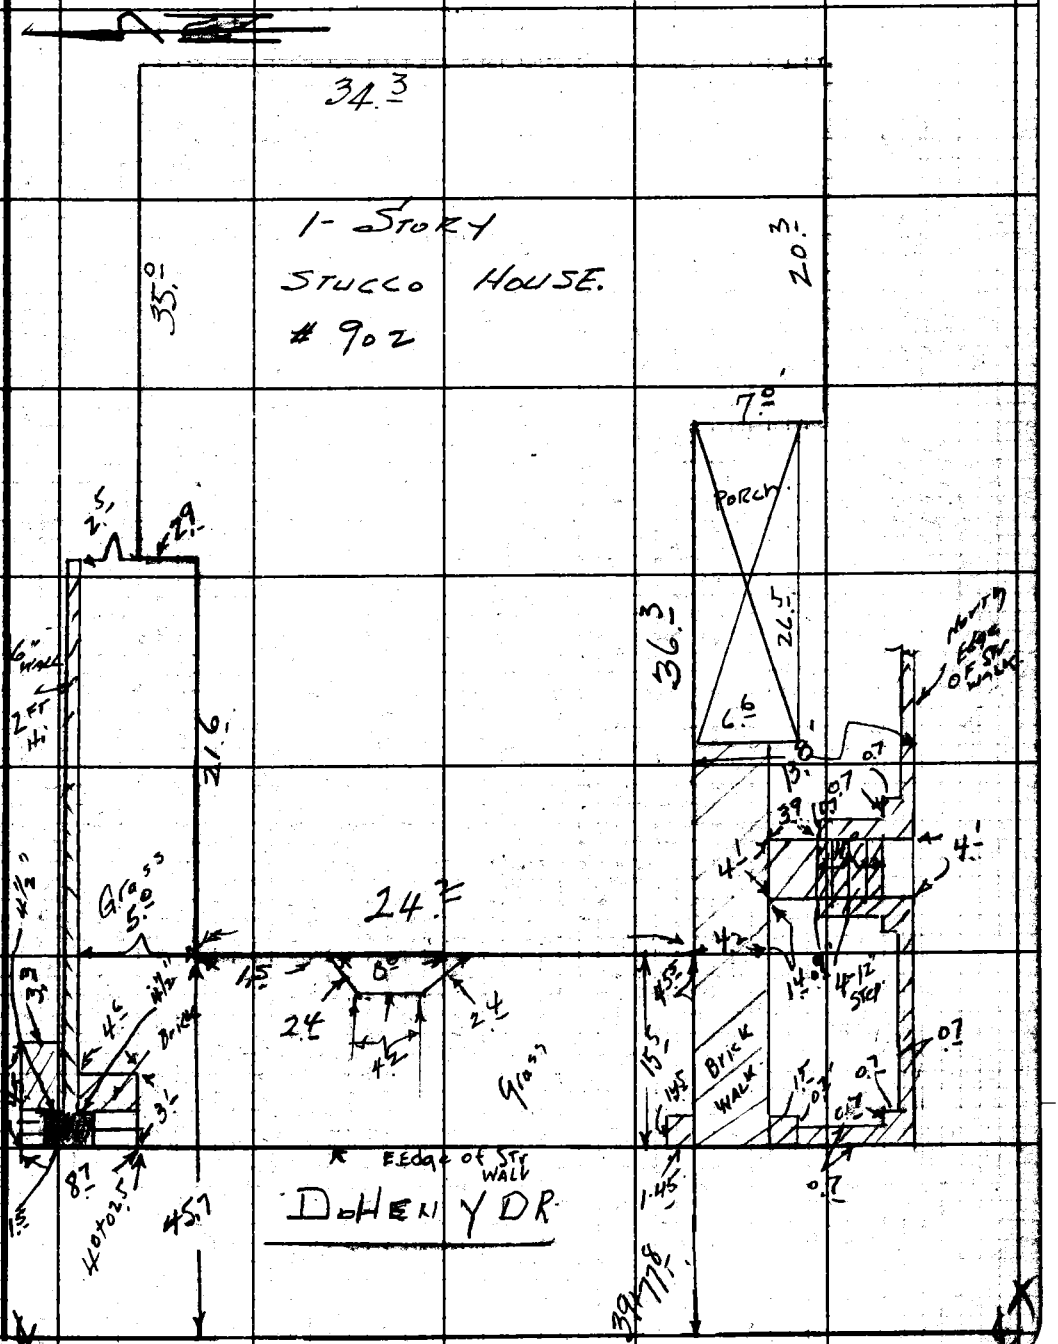

F. B. 264 Pg. 60

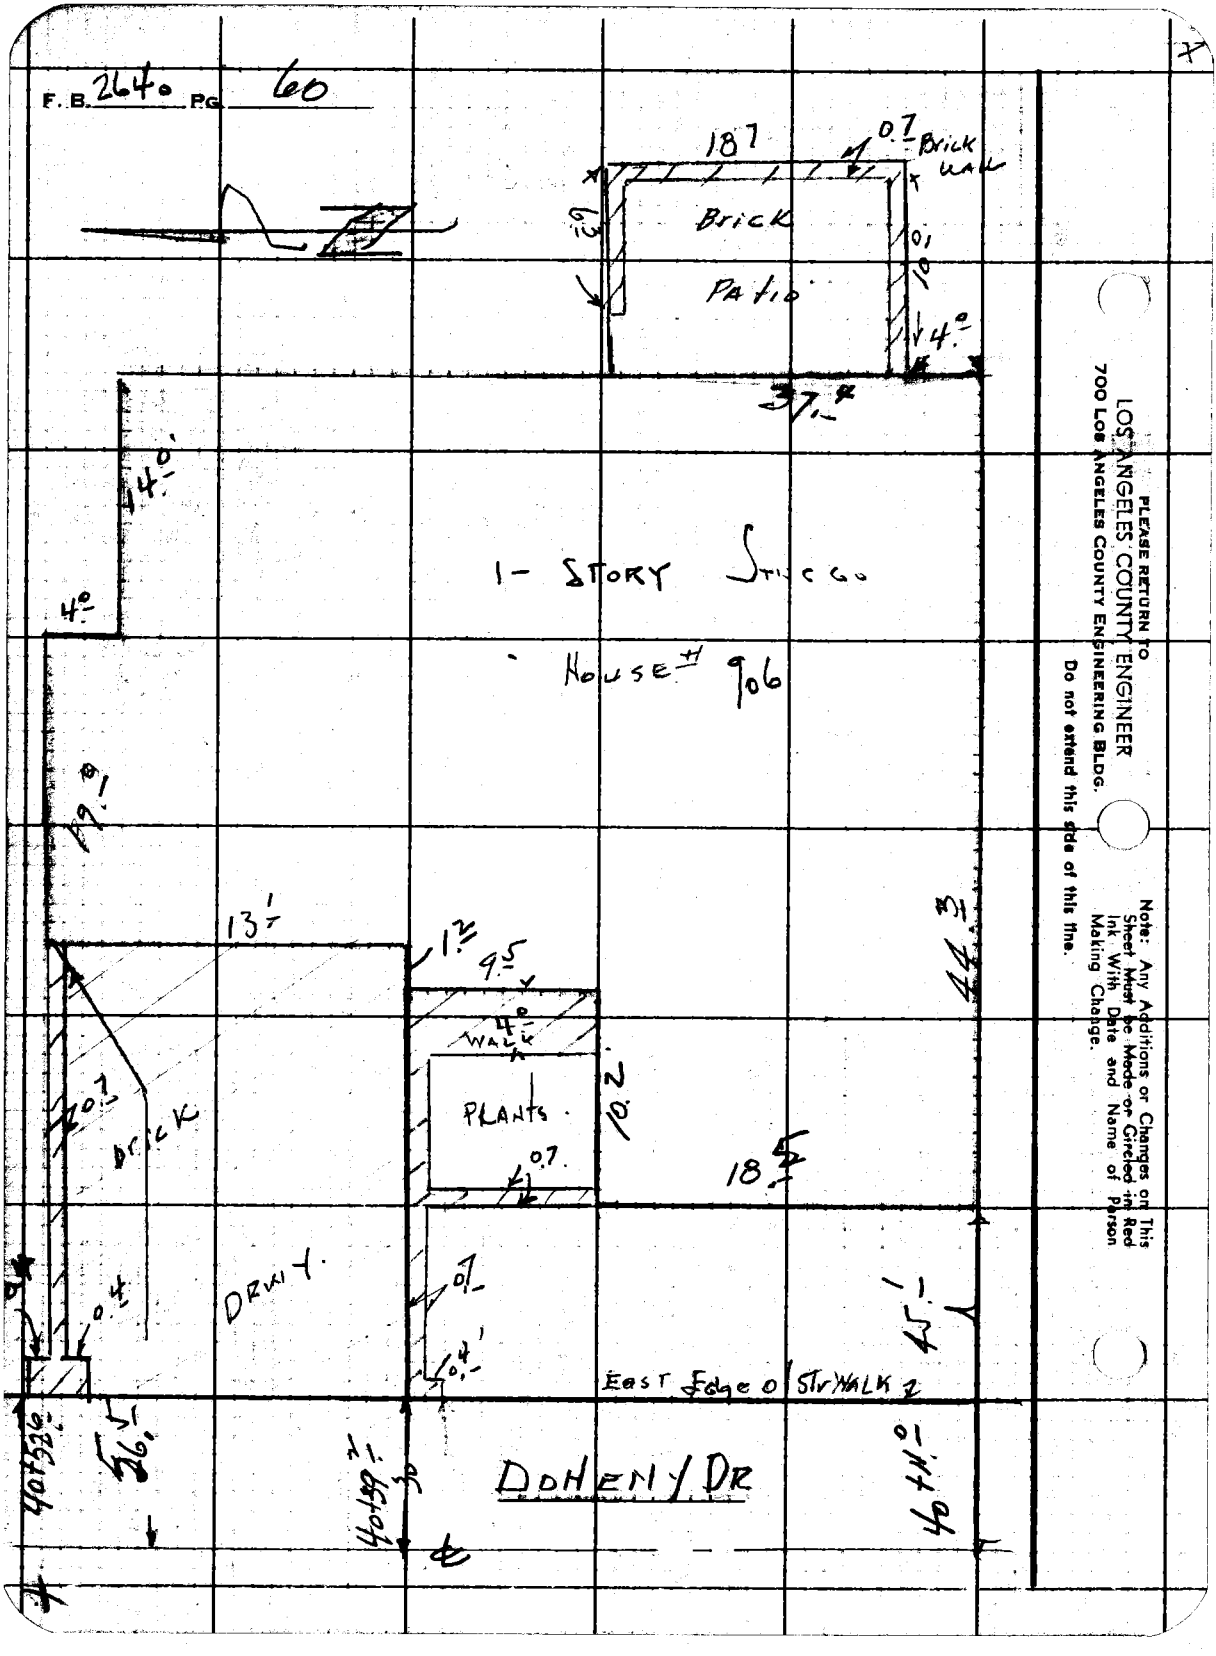

PLEASE RETURN TO
LOS ANGELES COUNTY ENGINEER
700 LOS ANGELES COUNTY ENGINEERING BLDG.

Do not extend this side of this line.

Note: Any Additions or Changes on This Sheet Must be Made or Circled in Red Ink With Date and Name of Person Making Change.

Notes Ck'd by	Survey of DOHENY DR.
Map No.	JN 00759 Tape 031 Std 6 8 °F
Office Work R. L. GREEN	Surveyed by H. E. Grangaard
Checked	Notes H. E. G. Date 1/6/60
Date	Indexed R. O. Johnson

F. B. 1640 PG. 61

Note: Any Additions or Changes on this Sheet Must be Made or Circled in Red Ink With Date and Name of Person Making Change.

Do not extend this side of this line.

PLEASE RETURN TO
LOS ANGELES COUNTY ENGINEER
700 Los Angeles County Engineering Bldg.

13.0±
15.2±
10.1
10.3
14.0
26.9
4.0
1-STORY STUCCO
HOUSE #908
13.1
40.
20.2
17.4±
10.2±
9.1
0.4
1.5
3.0±
17.1
13.8
6" Conc
6" WALL brick
CONC DRWY
BRICK WALK
GRASS
0.4
1.5
EAST EDGE OF STR. WALK
54.6
40.8
40.8
40.8

F. B. 2646 PG. 62

17.2

14.1

12.8

12.1

1-Story Wood FRAME House #914

16.

36.2

1.1

1.0

2.9

3.5

11.6

19.9

3.8

Brick Landing

2.1

7.0

57.6

Brick WALL

2 FT. Hi

3"Hi.

0.1

0.1

94.14

96.04

30

DOHENY DR.

44.27

PLEASE RETURN TO
LOS ANGELES COUNTY ENGINEER
700 Los Angeles County Engineering Bldg.

Do not extend this side of this line.

Note: Any Additions or Changes on This Sheet Must be Made or Circled in Red Ink With Date and Name of Person Making Change.

Notes Ck'd by	Survey of DOHENY DR.
Map No.	JN 00759 Tape 0131 Std GB °F
Office Work R. L. GREEN	Surveyed by H.E. GRANDY 1st
Checked	Notes H.E.G Date 4/16/60
Date	Indexed C. Johnson

F. B. 1640 PG. 63

Note: Any Additions or Changes on This Sheet Must be Made or Circled in Red Ink With Date and Name of Person Making Change.

Do not extend this side of this line.

PLEASE RETURN TO
LOS ANGELES COUNTY ENGINEER
700 LOS ANGELES COUNTY ENGINEERING BLDG.

76F3095 SAE #247 11-59

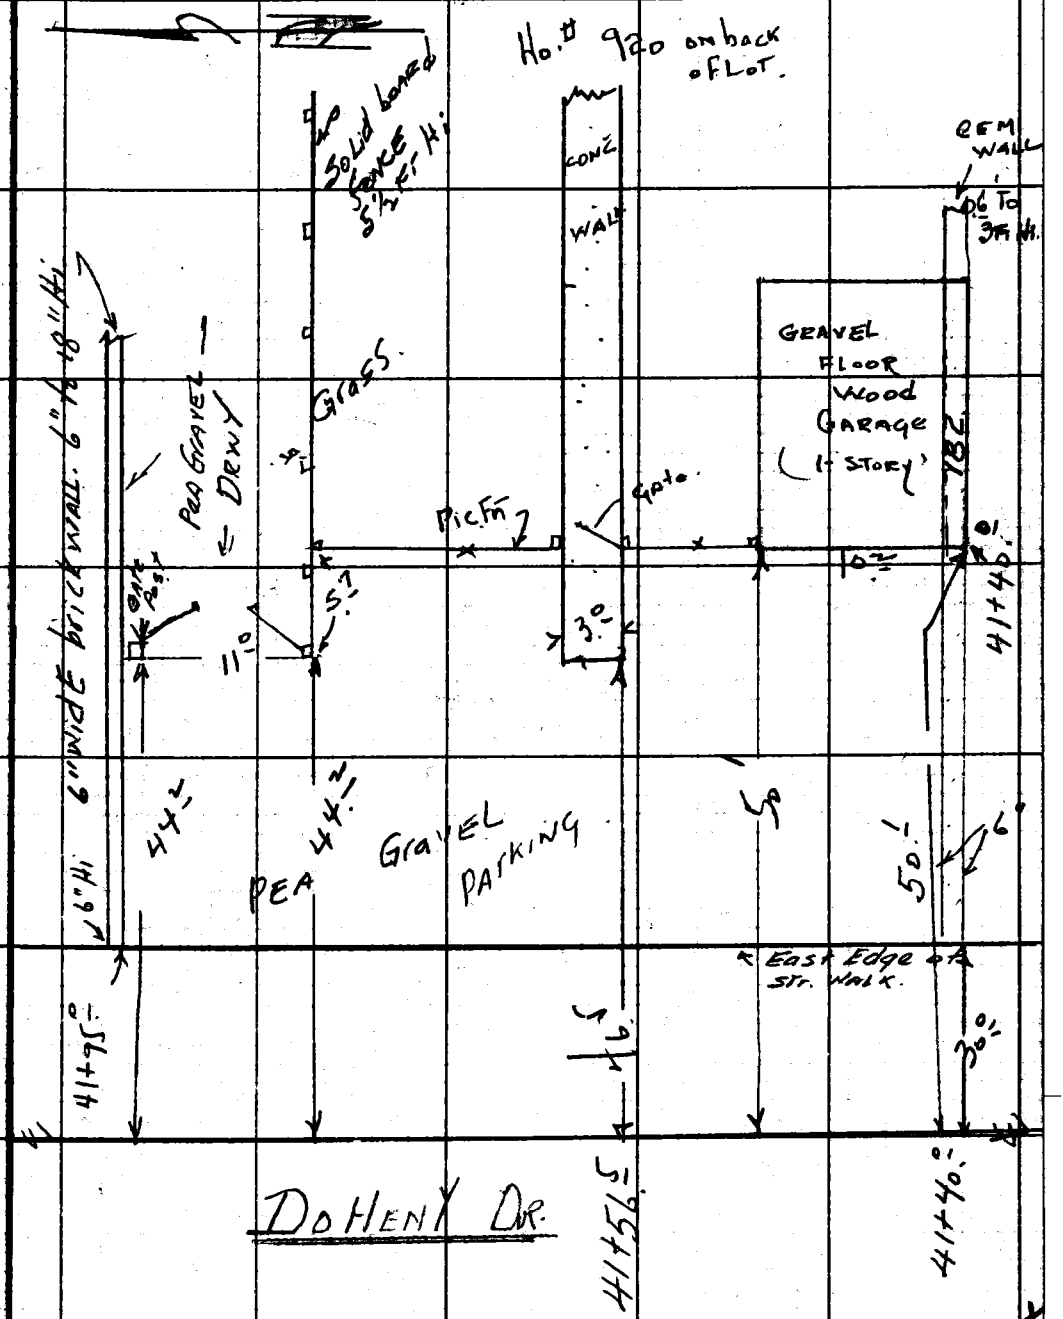

F. B. 264 PG. 64

PLEASE RETURN TO
LOS ANGELES COUNTY ENGINEER
700 Los Angeles County Engineering Bldg.

Do not extend this side of this line.

Note: Any Additions or Changes on This Sheet Must be Made or Circled in Red Ink With Date and Name of Person Making Change.

Notes Ck'd by
Map No.
Office Work R. L. GREEN
Checked
Date

Survey of DOHENY DR
JN 007591 Tape 0135 Std 68 °F.
Surveyed by H.E. GRANQUIST
Notes M. E. G. Date 11-16-60
Indexed L. A. Johnson

F. B. 2640 Pg. 65

Note: Any Additions or Changes on This Sheet Must be Made or Circled in Red Ink With Date and Name of Person Making Change.

Do not extend this side of this line.

PLEASE RETURN TO
LOS ANGELES COUNTY ENGINEER
700 Los Angeles County Engineering Bldg.

203

1- STORY Wood FR. house #936

35.5'

35.5'

67'

CONC DRWY

CONC CONT'G

CONC CONT'G

0.1

1.1

ENCLOSED PORCH

5.3

0.8

1.1

19'-

3-12"SQ

4'±

2.3'

4.3'

12"

55.0'

55.0'

0.6 RET WALL

#937

#936

30'-

EAST EDGE OF STY WALK

DOHENY DR

42+78'-

7SF3098 SEE #247 11-58

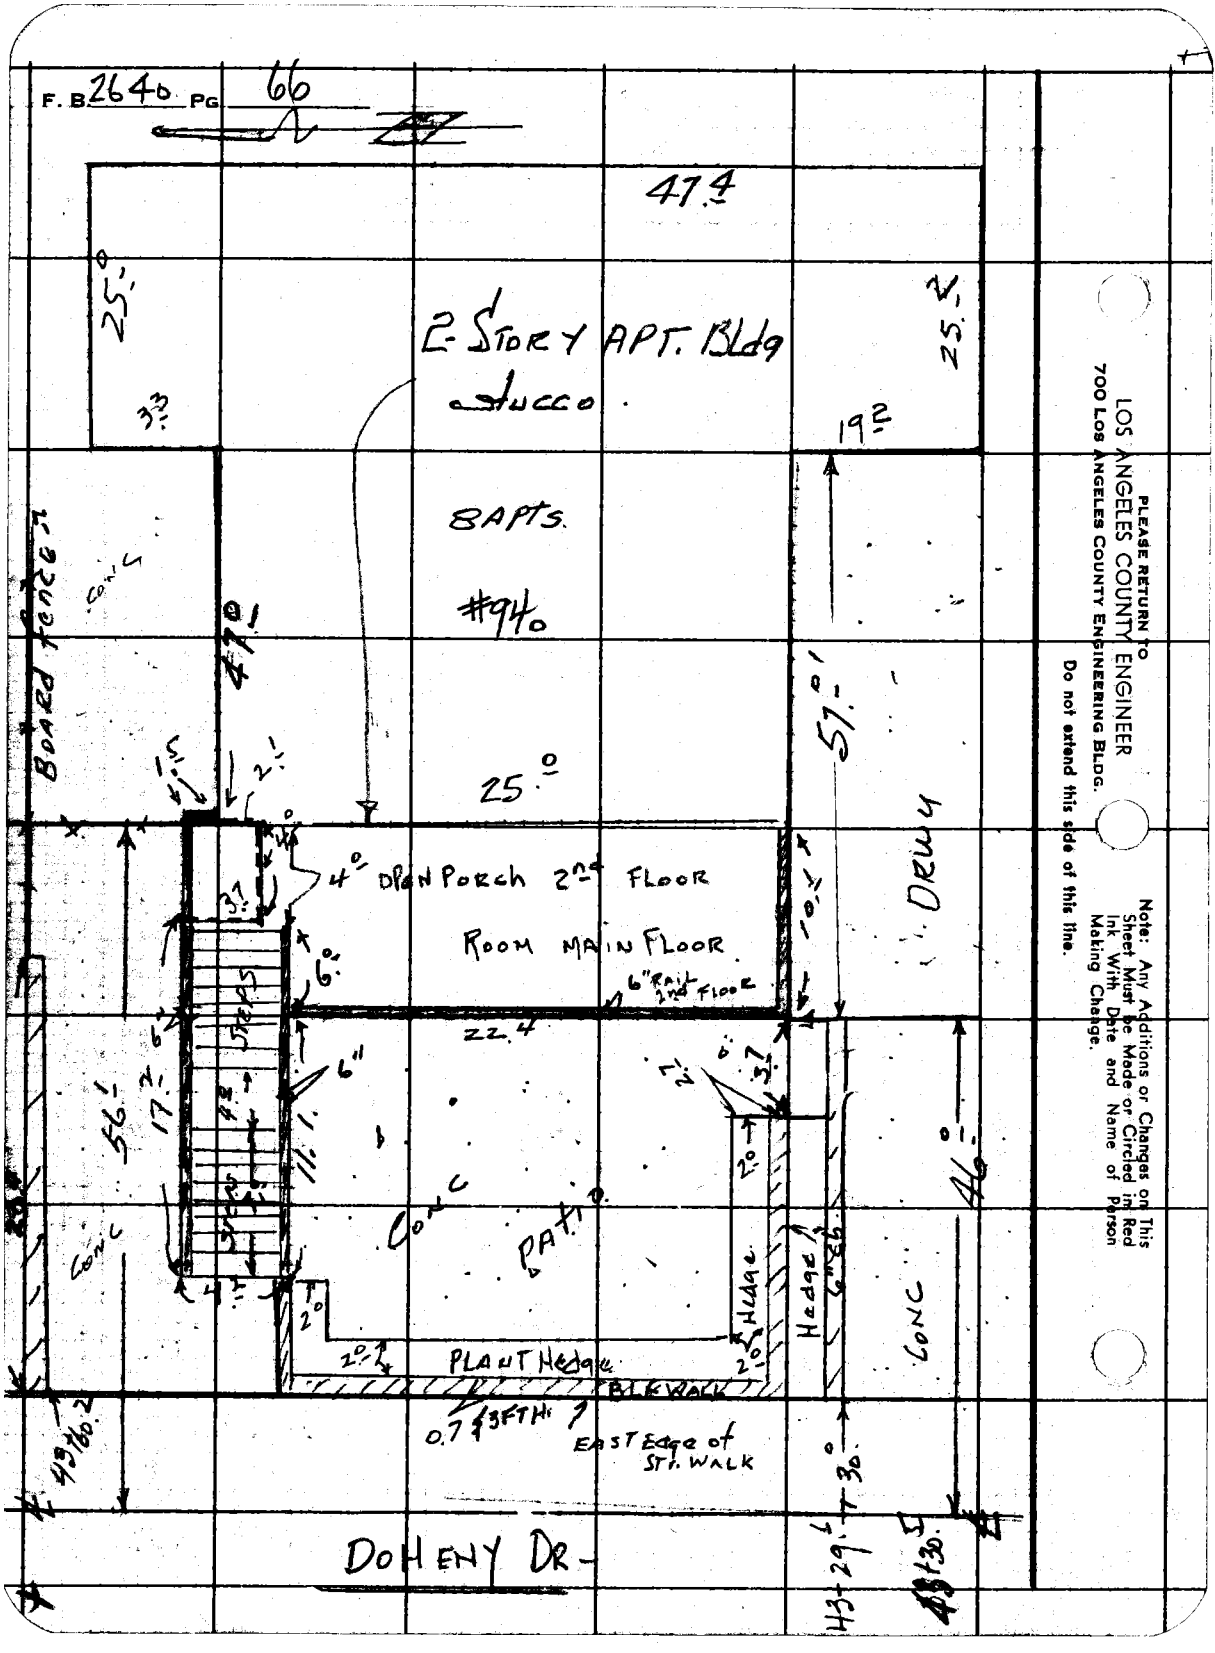
F. B. 2640 PG. 66
47.4
25.0
33.3
2-STORY APT. Bldg
Stucco
8 APTS.
#940
25.2
19.2
BOARD FENCE
CONC
4701
25.0
57.01
4'0" OPEN PORCH 2ND FLOOR
ROOM MAIN FLOOR
6" RAIL 2ND FLOOR
DRIVE
22.4
STEPS
56.1
17.2
11.1
CONC
CONC
PATIO
HEDGE
HEDGE
CONC
PLANT HEDGE
BLK WALK
0.7 (5FT)
EAST EDGE of ST. WALK
DOHENY DR.
43.29.2
43.29.4
30.0
PLEASE RETURN TO
LOS ANGELES COUNTY ENGINEER
700 LOS ANGELES COUNTY ENGINEERING BLDG.
Do not extend this side of this line.
Note: Any Additions or Changes on This Sheet Must be Made or Circled in Red Ink With Date and Name of Person Making Change.

Notes Ck'd by
Map No.
Office Work R. L. GREEN
Checked
Date

Survey of DOHENY DR.
JN 0075 91 Tape 0135 Std 68 °F
Surveyed by H.E. GRANQUIST
Notes H.E.G. Date 4/6/60
Indexed J. C. JOHNSON

F. B. 264 Pg. 67

Note: Any Additions or Changes on This Sheet Must be Made or Circled in Red Ink With Date and Name of Person Making Change.

PLEASE RETURN TO
LOS ANGELES COUNTY ENGINEER
700 Los Angeles County Engineering Bldg.

Do not extend this side of this line.

35'
21.9
6.6'
17°
4.8
1.6
4.6
11.9
5.0
1.7
1.5
FP
5°
5.4
1.5
16.7
6°
3.0
6'
55'
30°
WALK
44+10.
6" C. BLK WALL 4'Hi
44+07.0
44+04.5
GATE
6' CEM BLK WALL 4'Hi
30'
44+35.0
EDGE OF SIDEWALK
38.4
20.0
0.5 INV.
#946
1 & 2- STORY
STUCCO APT
BLD. 3 APTS
24.7
CONC. DRWY.
8°
5.0
43+60.7
43+77.0
DOHENY DR

76F3095 SRE #247 11-58

F. B. 2640 PG 68

LOS ANGELES COUNTY ENGINEER
700 Los Angeles County Engineering Bldg.

PLEASE RETURN TO

Do not extend this side of this line.

Note: Any Additions or Changes on This Sheet Must Be Made or Circled in Red Ink With Date and Name of Person Making Change.

2- Story Stucco.

Apt. bldg. 950

Brick

Brick Wall 5'-11"

Porch 2nd Floor

Breezway

Wall Main Floor 2nd Floor

12" Step

Grass

Cone Walk

Edge of Sidewalk

East Edge of Str. Walk

Doheny Dr.

76F3098 SAE #247 11.58

PLEASE RETURN TO
LOS ANGELES COUNTY ENGINEER
700 LOS ANGELES COUNTY ENGINEERING BLDG.

Note: Any Additions or Changes on This Sheet Must be Made or Circled in Red Ink With Date and Name of Person Making Change.

Do not extend this side of this line.

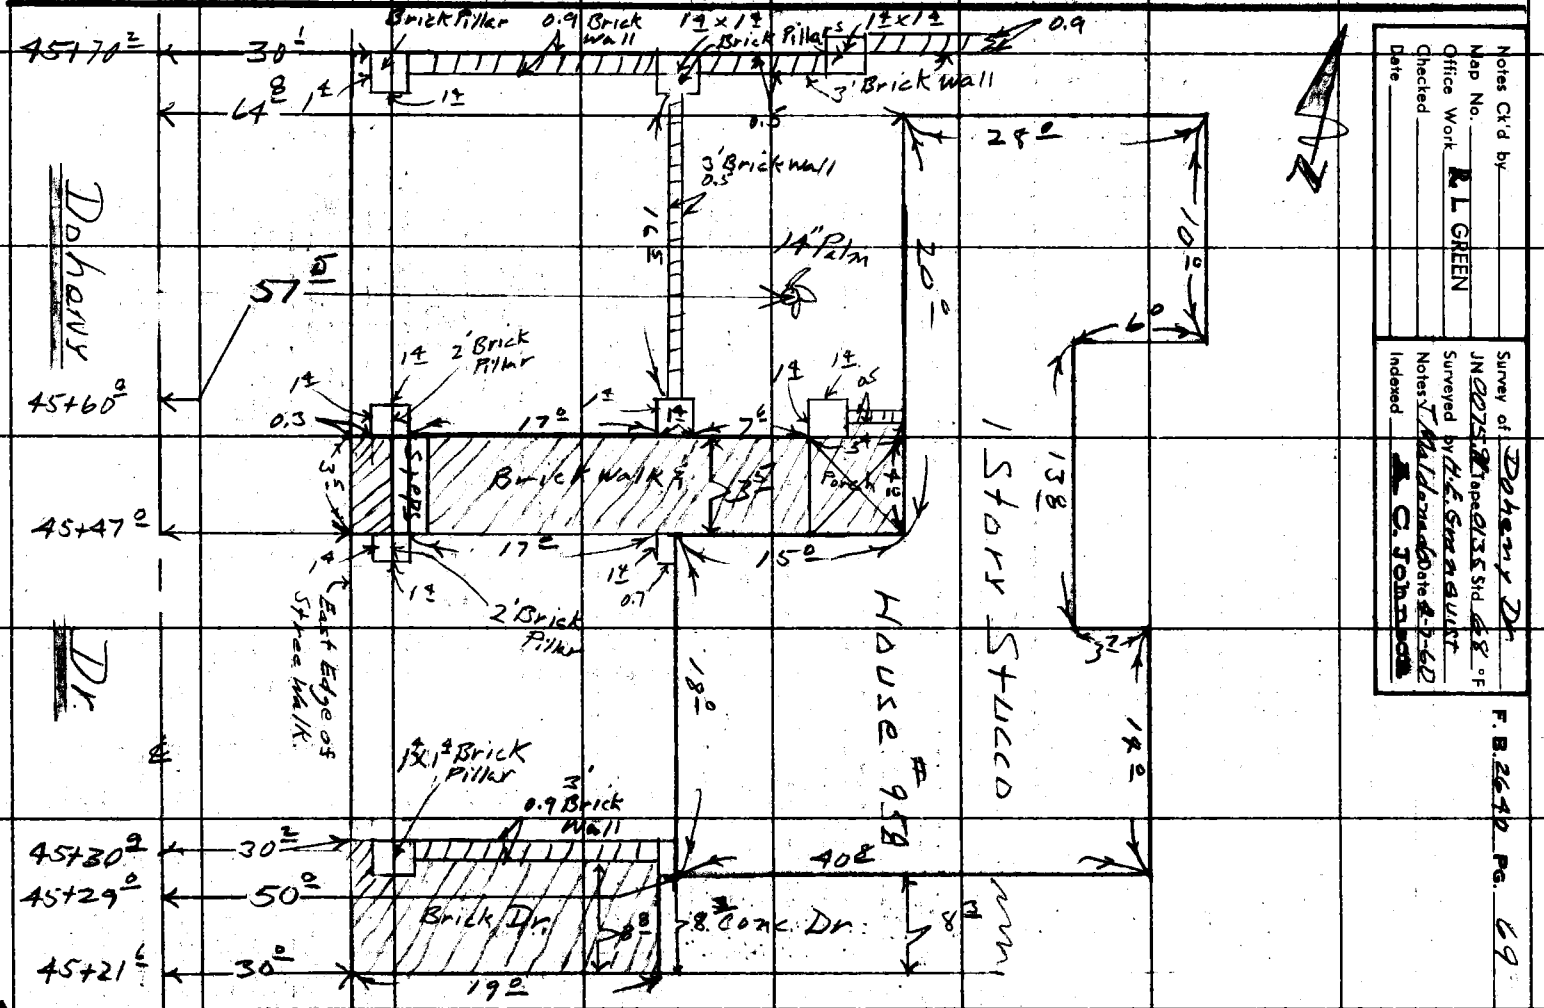

Notes Ck'd by _____
Map No. _____
Office Work R. L. GREEN
Checked _____
Date _____

Survey of Dohony Dr.
JN 007538 Tape 0.135 Std. 68° F
Surveyed by H. G. Smeaton
Notes T. Baldemar Date 8-2-60
Indexed R. C. Johnson

F. B. 2642 Pg. 69

PLEASE RETURN TO
LOS ANGELES COUNTY ENGINEER
700 LOS ANGELES COUNTY ENGINEERING BLDG.

Note: Any Additions or Changes on This Sheet Must be Made or Circled in Red Ink With Date and Name of Person Making Change.

Do not extend this side of this line.

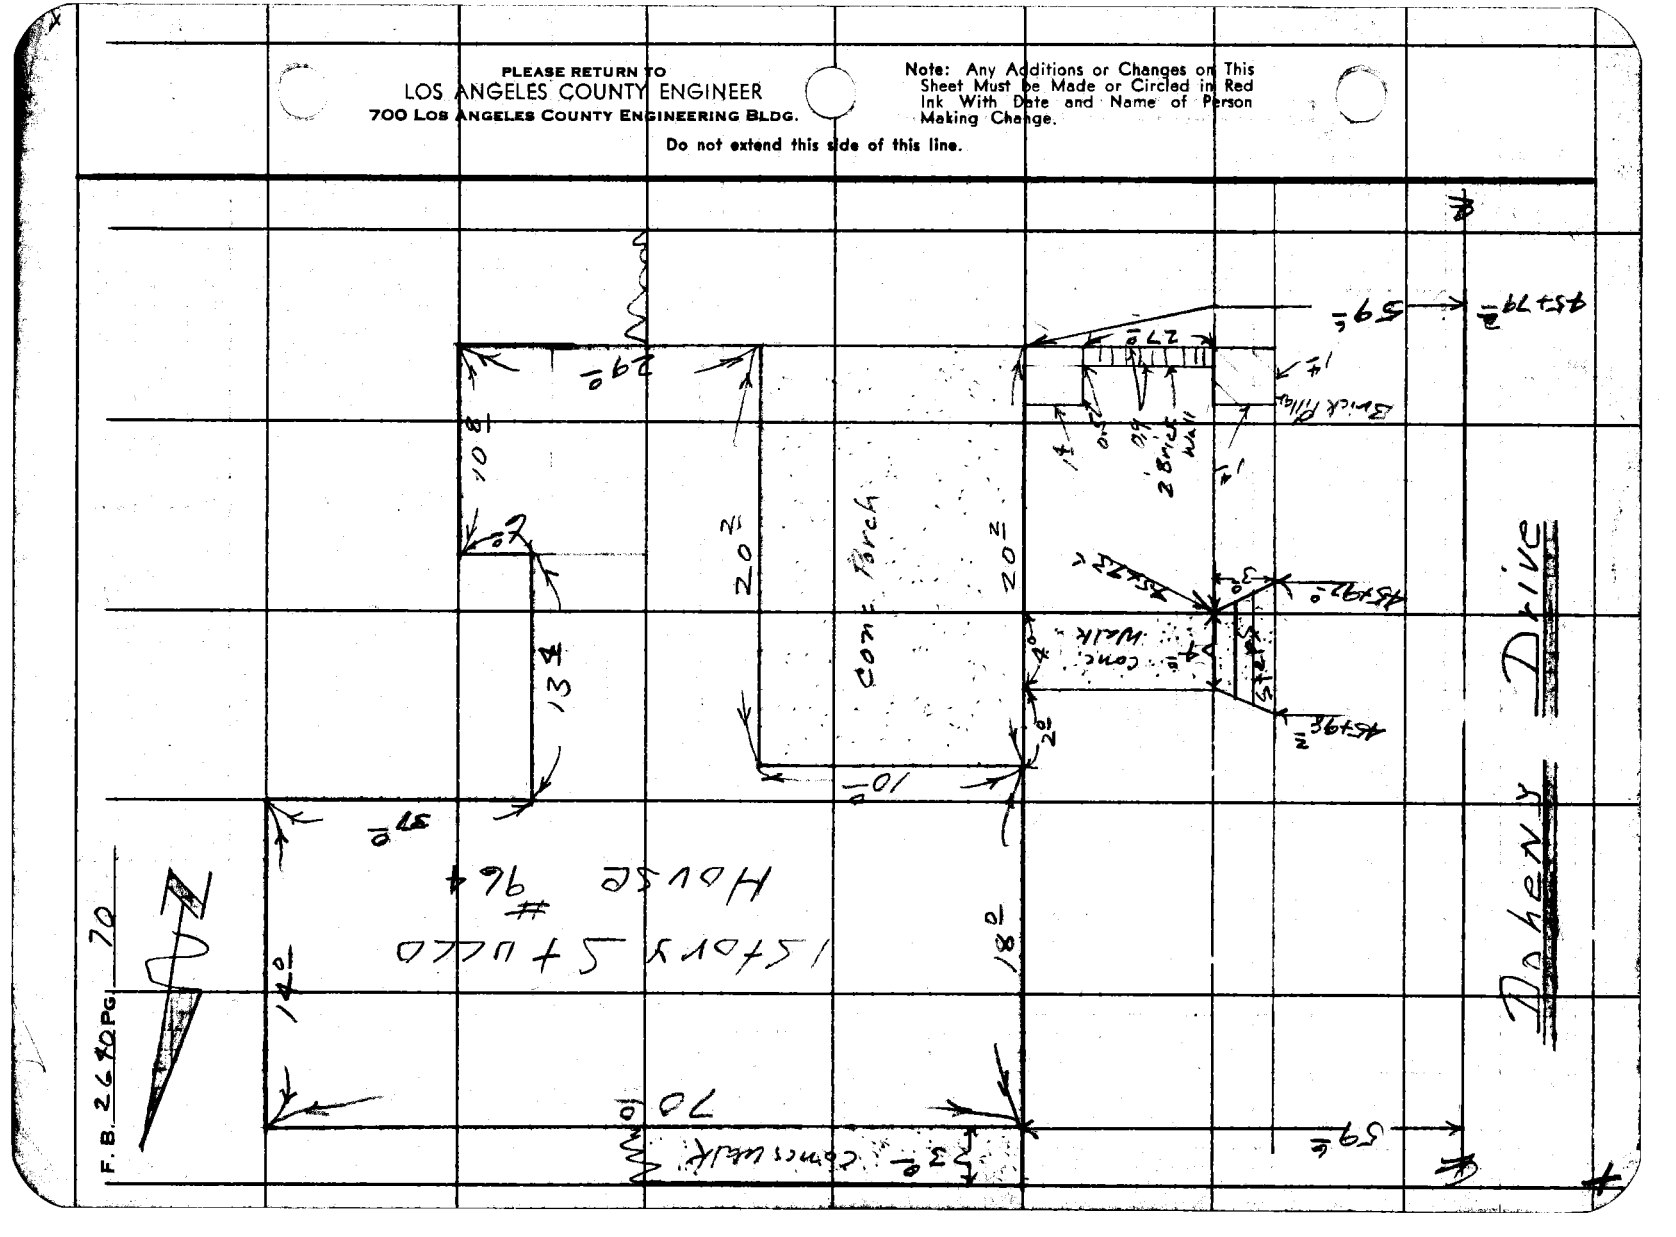
Conc. Walk
Conc. Porch
Brick
Brick Pillar
Conc. Walk
Conc. Walk
Conc. Walk

Notes Ck'd by	Survey of DOHENY DR.	F. B. 2640 Pg. 71
Map No.	JN 0075.91 Tape 43 Std 68 °F	
Office Work R. L. GREEN	Surveyed by H.E. GRANQUIST	
Checked	Notes H.E.G. Date 8/7/60	
Date	Indexed C. Johnson	

Note: Any Additions or Changes on This Sheet Must be Made or Circled in Red Ink With Date and Name of Person Making Change.

Do not extend this side of this line.

PLEASE RETURN TO
LOS ANGELES COUNTY ENGINEER
700 LOS ANGELES COUNTY ENGINEERING BLDG.

76F3098 SRE #247 11-58

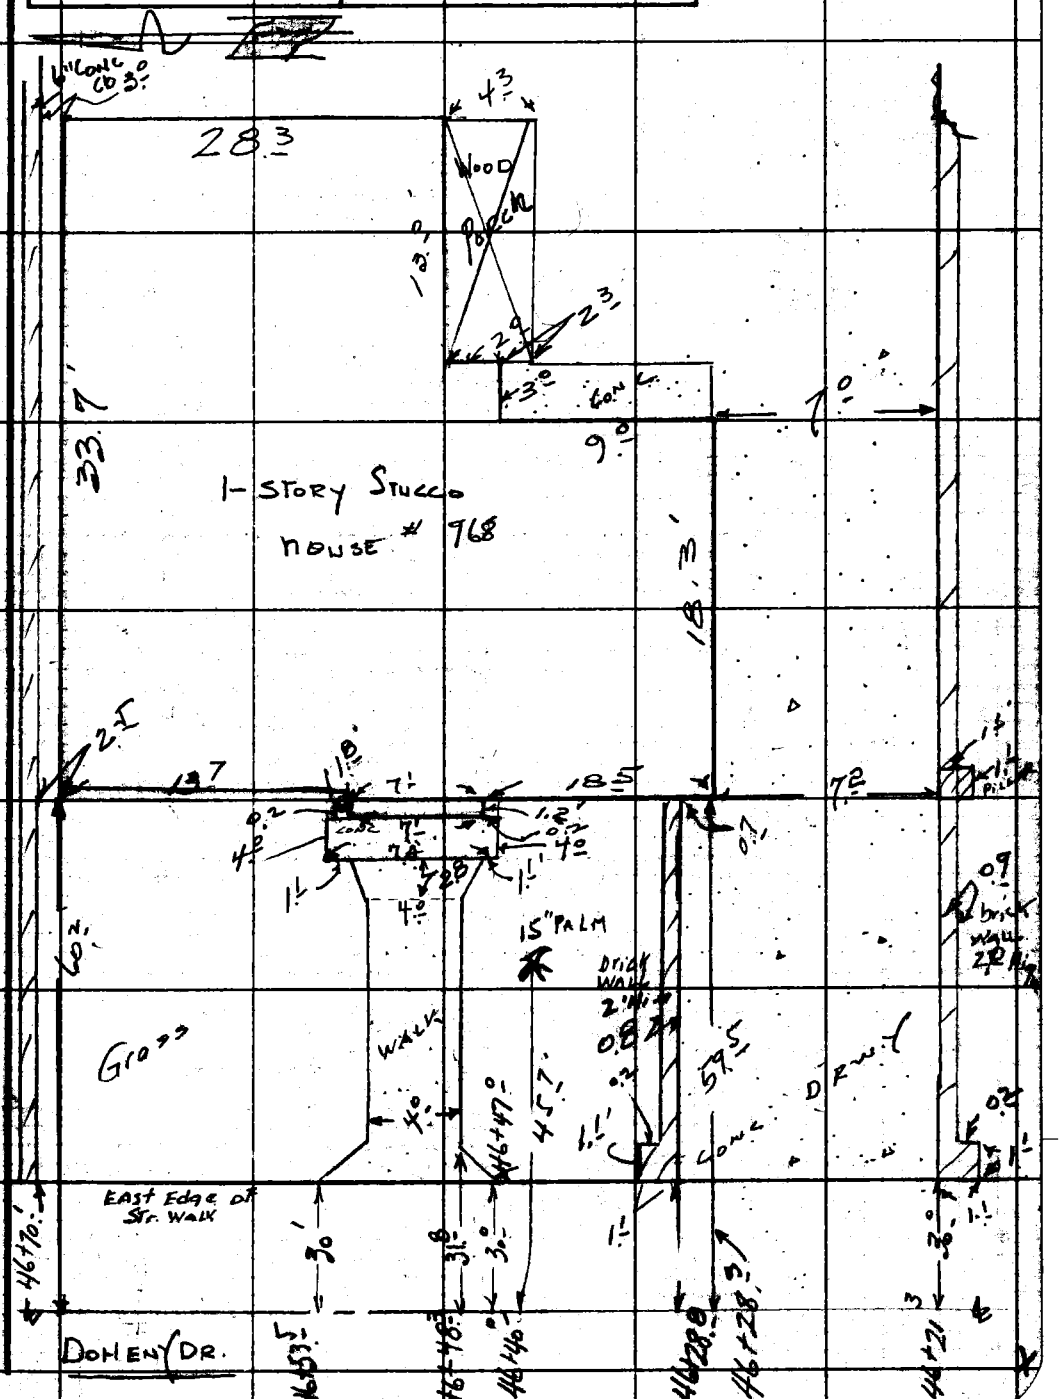

F. B. 2640 PG. 72

1-Story Stucco

Note: Any Additions or Changes on This Sheet Must be Made or Circled in Red Ink With Date and Name of Person Making Change.

PLEASE RETURN TO
LOS ANGELES COUNTY ENGINEER
700 Los Angeles County Engineering Bldg.

Do not extend this side of this line.

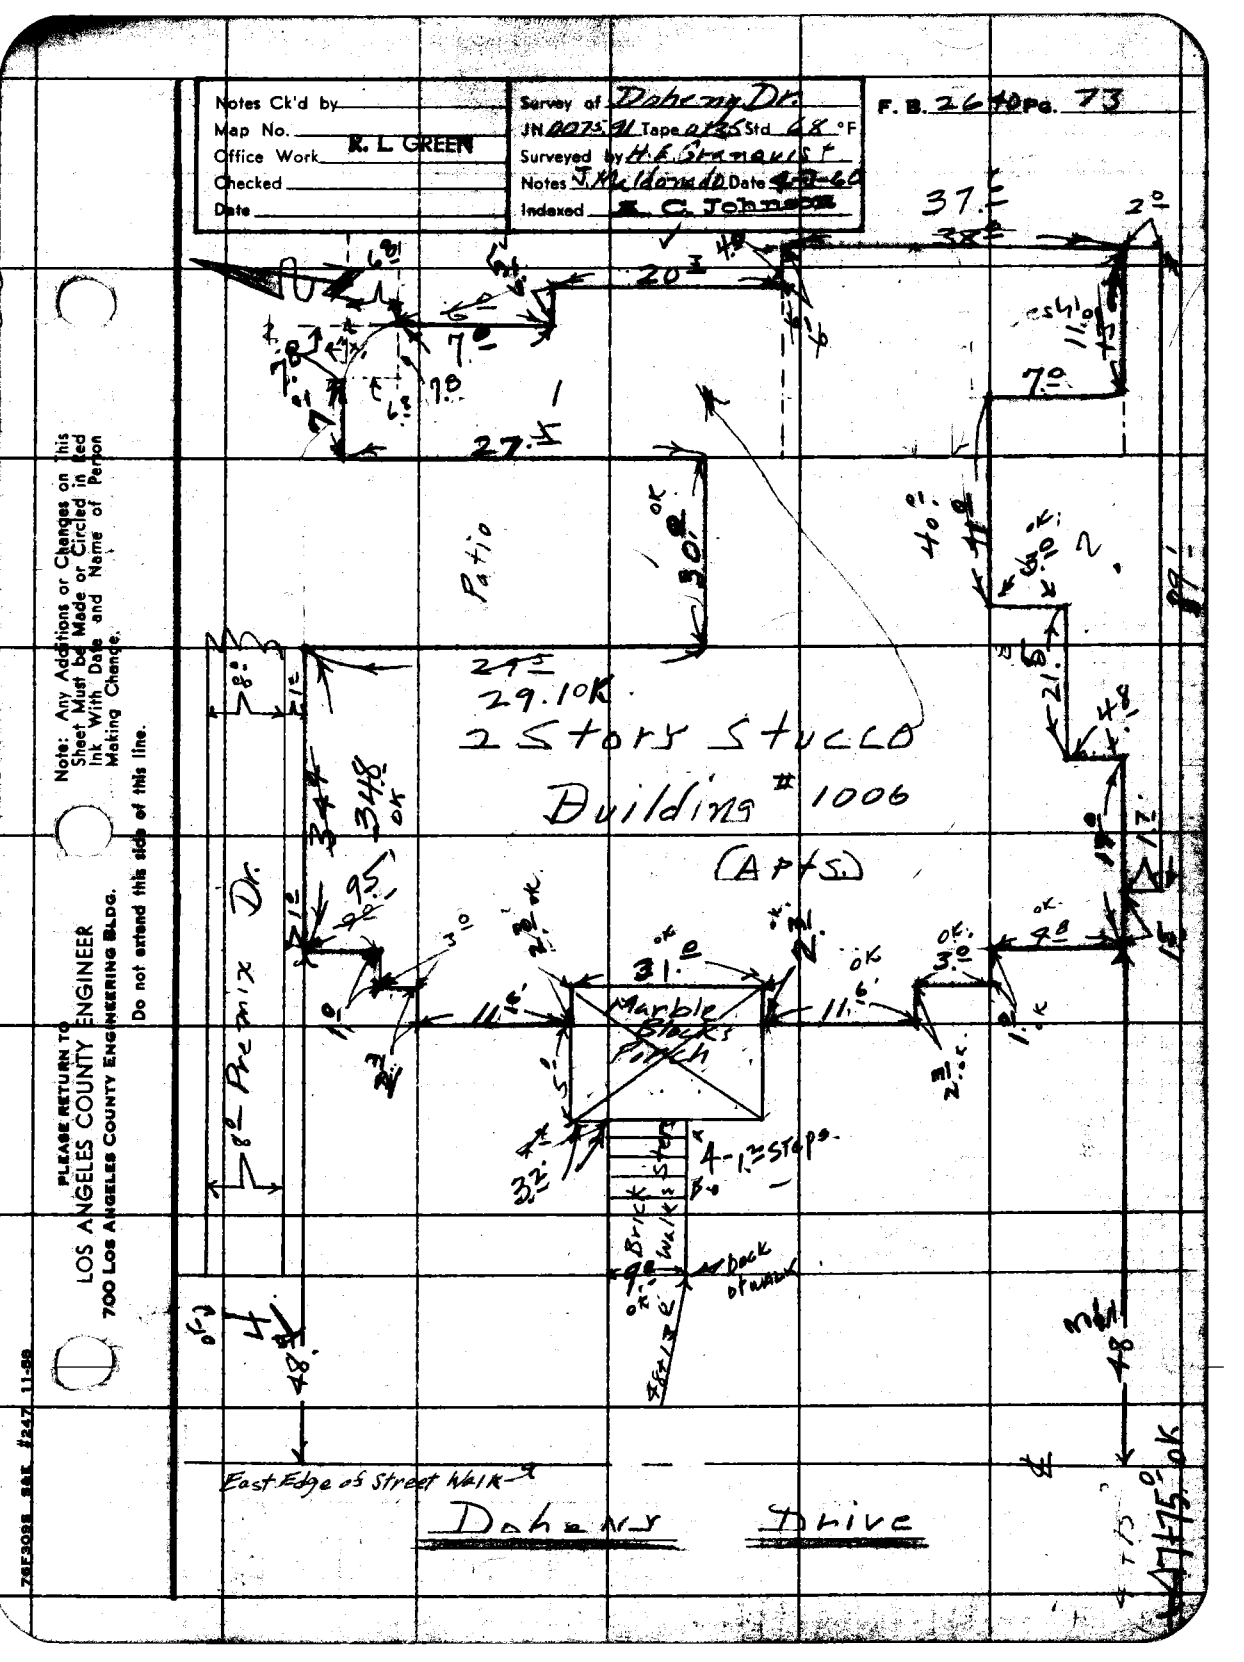
Notes Ck'd by
Map No.
R. L. GREEN
Office Work
Checked
Date
Survey of Dahemy Dr.
JN 0075 91 Tape 0.25 Std 68 °F
Surveyed by H.E. Stranquist
Notes J. Maldonado Date 4-27-60
Indexed K. C. Johnson
F. B. 2640 Pg. 73
Note: Any Additions or Changes on This Sheet Must be Made or Circled in Red Ink With Date and Name of Person Making Change.
Do not erase this side of this line.
PLEASE RETURN TO
LOS ANGELES COUNTY ENGINEER
700 Los Angeles County Engineering Bldg.
Patio
2 Story Stucco
Building # 1006
(Apts)
Marble Block Porch
4-12" Steps
Brick Walk
Back of Curb
East Edge of Street Walk
Dahemy Drive
37.5
20.1
27.4
29.10K
34.8
95.12
31.0
11.6
32.5
48.0
21.6
40.2
11.0
7.0
20.0
38.2
OK
ZEF3028 SAF #247 11-59

PLEASE RETURN TO
LOS ANGELES COUNTY ENGINEER
700 LOS ANGELES COUNTY ENGINEERING BLDG.

Note: Any Additions or Changes on This Sheet Must be Made or Circled in Red Ink With Date and Name of Person Making Change.

Do not extend this side of this line.

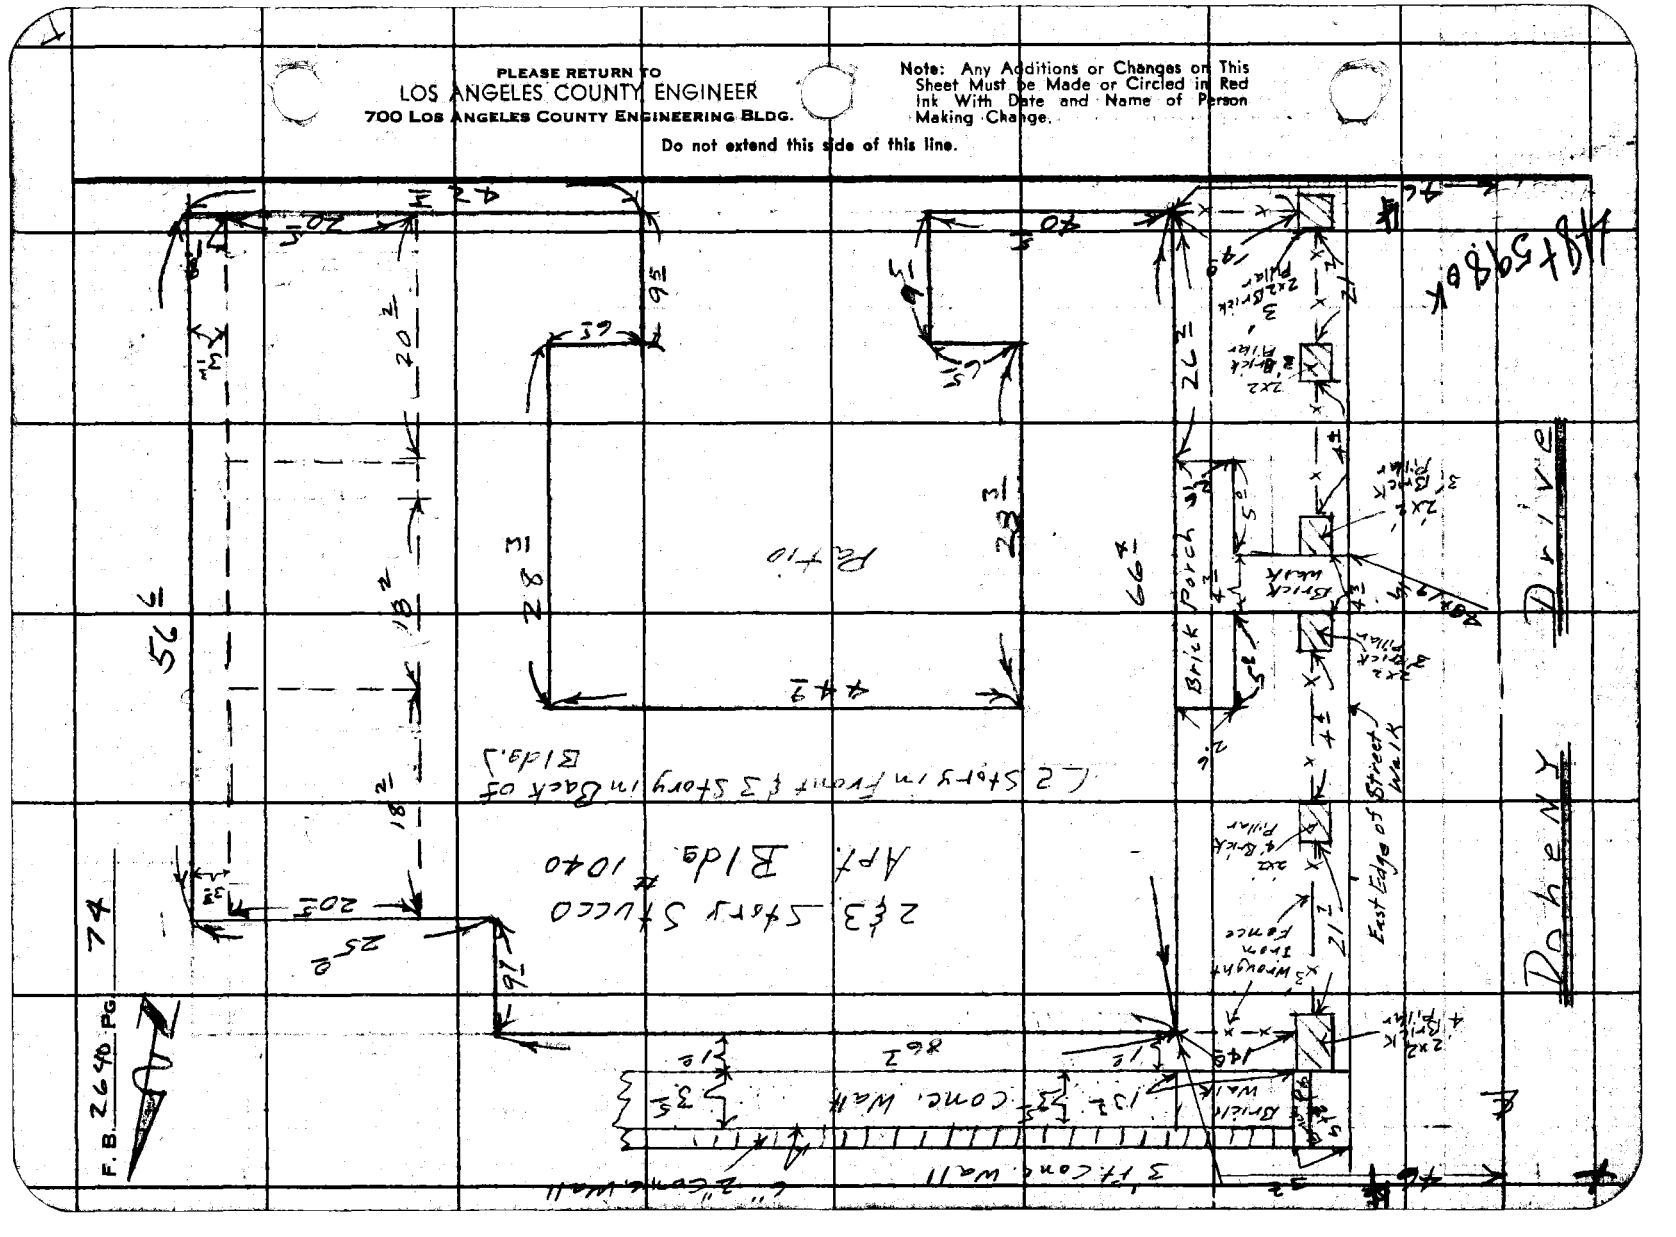

Notes Ck'd by
Map No. R. L. GREEN
Office Work
Checked
Date

Survey of DOHENY DR.
JN 0075.91 Tape 0135 Std 68 °F
Surveyed by H.E. GRANQUIST
Notes H.E.G Date 4/8/60
Indexed C. Johnson

F. B. 2640 Pg. 75

Note: Any Additions or Changes on This Sheet Must Be Made or Circled in Red Ink With Date and Name of Person Making Change.

Do not extend this side of this line.

PLEASE RETURN TO
LOS ANGELES COUNTY ENGINEER
700 Los Angeles County Engineering Bldg.

5 Steps
3.6'
4.3'
38.2'
11-Steps
Landing
Step
24.2'
1.0'
2.0'
1.25'
17.8'
2-Story Stucco
APT. BLVD.
#1020
3.0'
5.6'
23.0'
3.8'
10.0'
WALK
29.8'
41.6'
9.8'
14.2'
12.0'
1.0'
2-Brick Steps
& Brick Landing
PROMIX.
DRWY.
10.2'
46.0'
BRICK
WALK
5.0'
East Edge of Sidewalk
DOHENY DR
49.55'
49.37'
49.34'
49.91'
49.81'
2.30'
32.0'
46.0'
7.30'

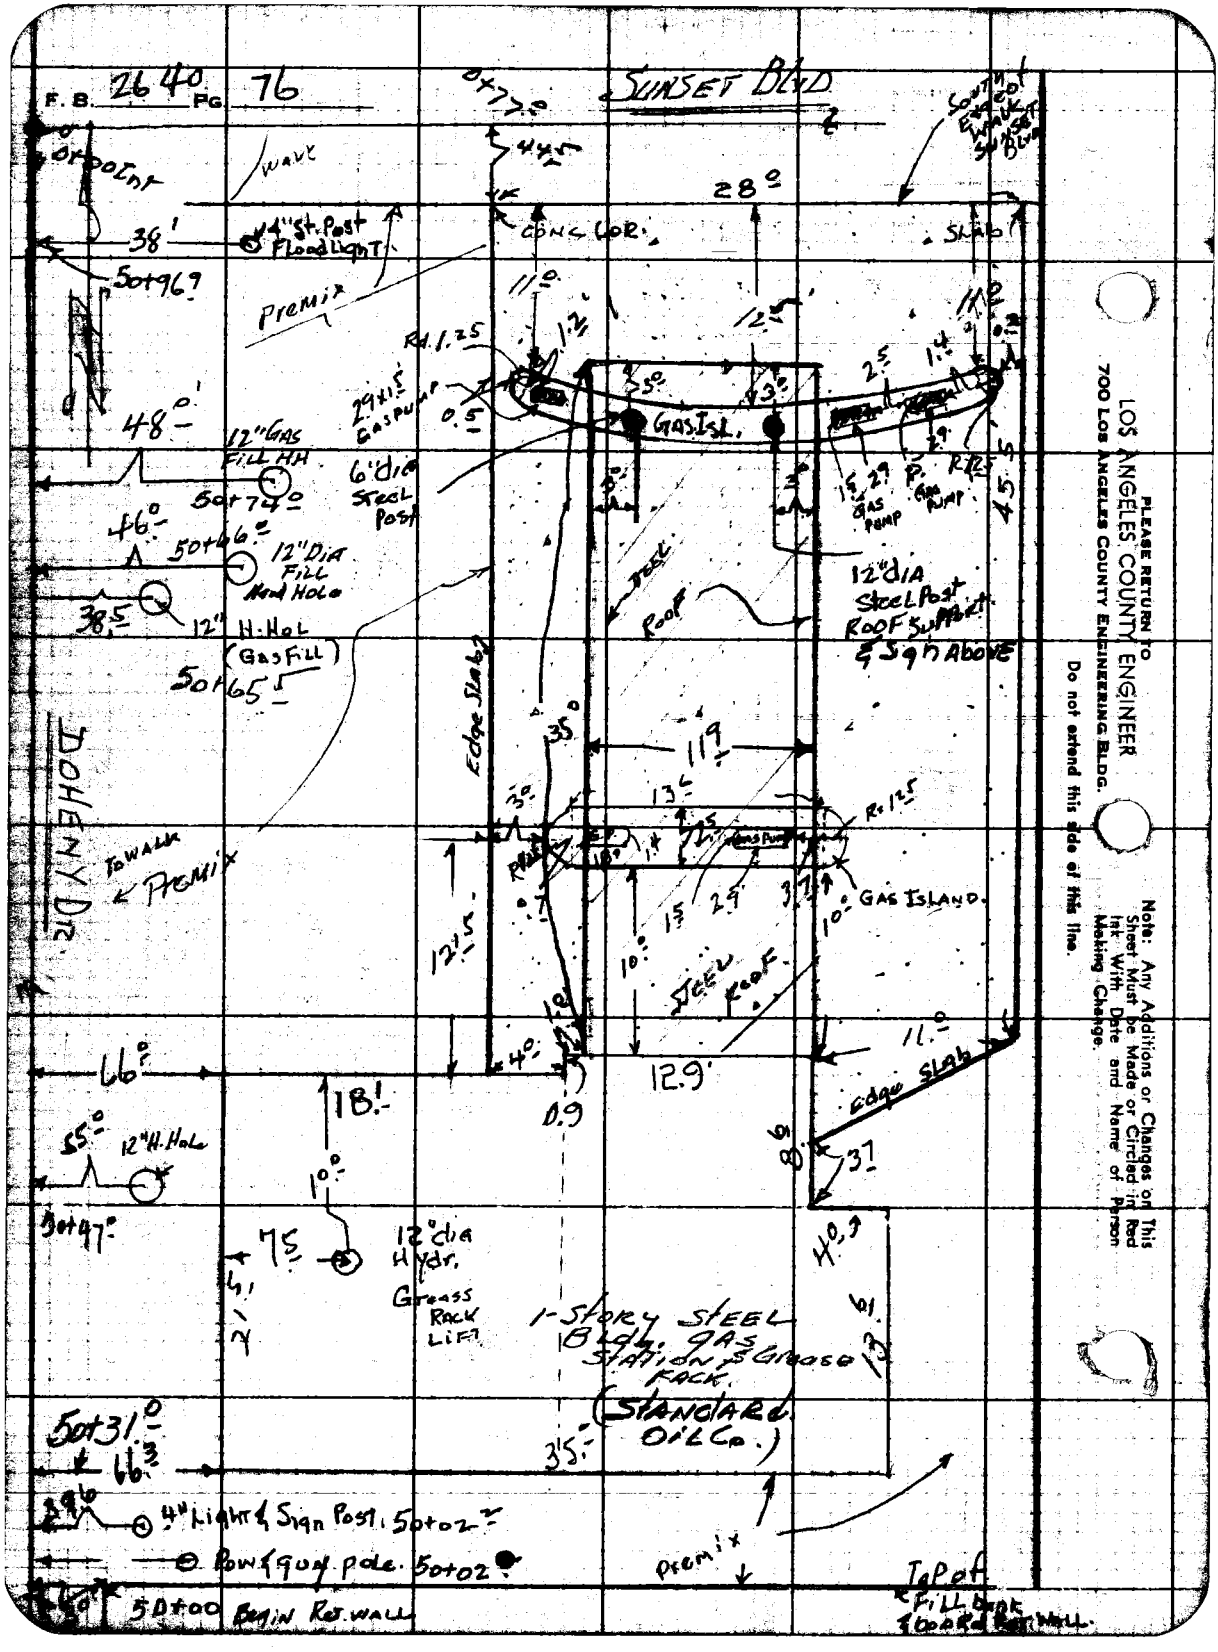
F.B. 2640 PG 76
SUNSET BLVD
DOHENY DR.
GAS ISL.
1-STORY STEEL
STATION & GREASE RACK
(STANDARD OIL CO.)
12"dia STEEL POST ROOF SUPPORT & SIGN ABOVE
12"dia HYDR.
GREASE RACK LIFT
4" LIGHT & SIGN POST
POWR & GUY POLE
BEGIN RET. WALL
PREMIX
CONC. WALK
EDGE SLAB
STEEL ROOF
GAS PUMP
12" GAS FILL HH
12" DIA FILL MONUMENT HOLE
12" H. HOL (GAS FILL)
12" H. HOL
6' DIA STEEL POST
4" ST. POST FLOODLIGHT
ORNAMENTAL
WALL
LOS ANGELES COUNTY ENGINEER
700 LOS ANGELES COUNTY ENGINEERING BLDG.
PLEASE RETURN TO
Do not extend this side of this line.
Note: Any Additions or Changes on This Sheet Must be Made or Circled in Red Ink With Date and Name of Person Making Change.

7673095 SBE #247 1-56

PLEASE RETURN TO
LOS ANGELES COUNTY ENGINEER
700 Los Angeles County Engineering Bldg.

Note: Any Additions or Changes on This Sheet Must be Made or Circled in Red Ink With Date and Name of Person Making Change.

Do not extend this side of this line.

Notes Ck'd by
Map No.
Office Work
Checked
Date

Survey of
JN Tape Std °F
Surveyed by
Notes Date
Indexed

F. B. PG.

PLEASE RETURN TO
LOS ANGELES COUNTY ENGINEER
700 LOS ANGELES COUNTY ENGINEERING BLDG.

Note: Any Additions or Changes on This Sheet Must be Made or Circled in Red Ink With Date and Name of Person Making Change.

Do not extend this side of this line.

F. B. _____ Pg. _____

Notes Ck'd by	Survey of San Vicente Blvd.
Map No.	JN 0095.52 Tape 0191 Std 68° °F
Office Work	Surveyed by A. S. Curtis
Checked	Notes Curtis Date 2-14-62
Date	Indexed J. GALLI

F. B. 2640 PG. 81

Note: Any Additions or Changes on This Sheet Must be Made or Circled in Red Ink With Date and Name of Person Making Change.

J.N. 0095.52

SAN VICENTE BLVD.

NEW ALIGNMENT

BETWEEN

SANTA MONICA BLVD

AND

BEVERLY BLVD.

To Conform to the latest Road Dept. Alignment.

Index Map on page 82

Ref.-
TRACT #5105
TRACT #5939
TRACT #3616
FB 2709
RD. FB. 453

CURTIS
CARRASCO
YASUI
GOSHOEN

PLEASE RETURN TO
LOS ANGELES COUNTY ENGINEER
700 Los Angeles County Engineering Bldg.
Do not extend this side of this line.

78F3095 SEE #247 1-56

4

PLEASE RETURN TO
LOS ANGELES COUNTY ENGINEER
700 LOS ANGELES COUNTY ENGINEERING BLDG.

Note: Any Additions or Changes on This Sheet Must be Made or Circled in Red Ink With Date and Name of Person Making Change.

Do not extend this side of this line.

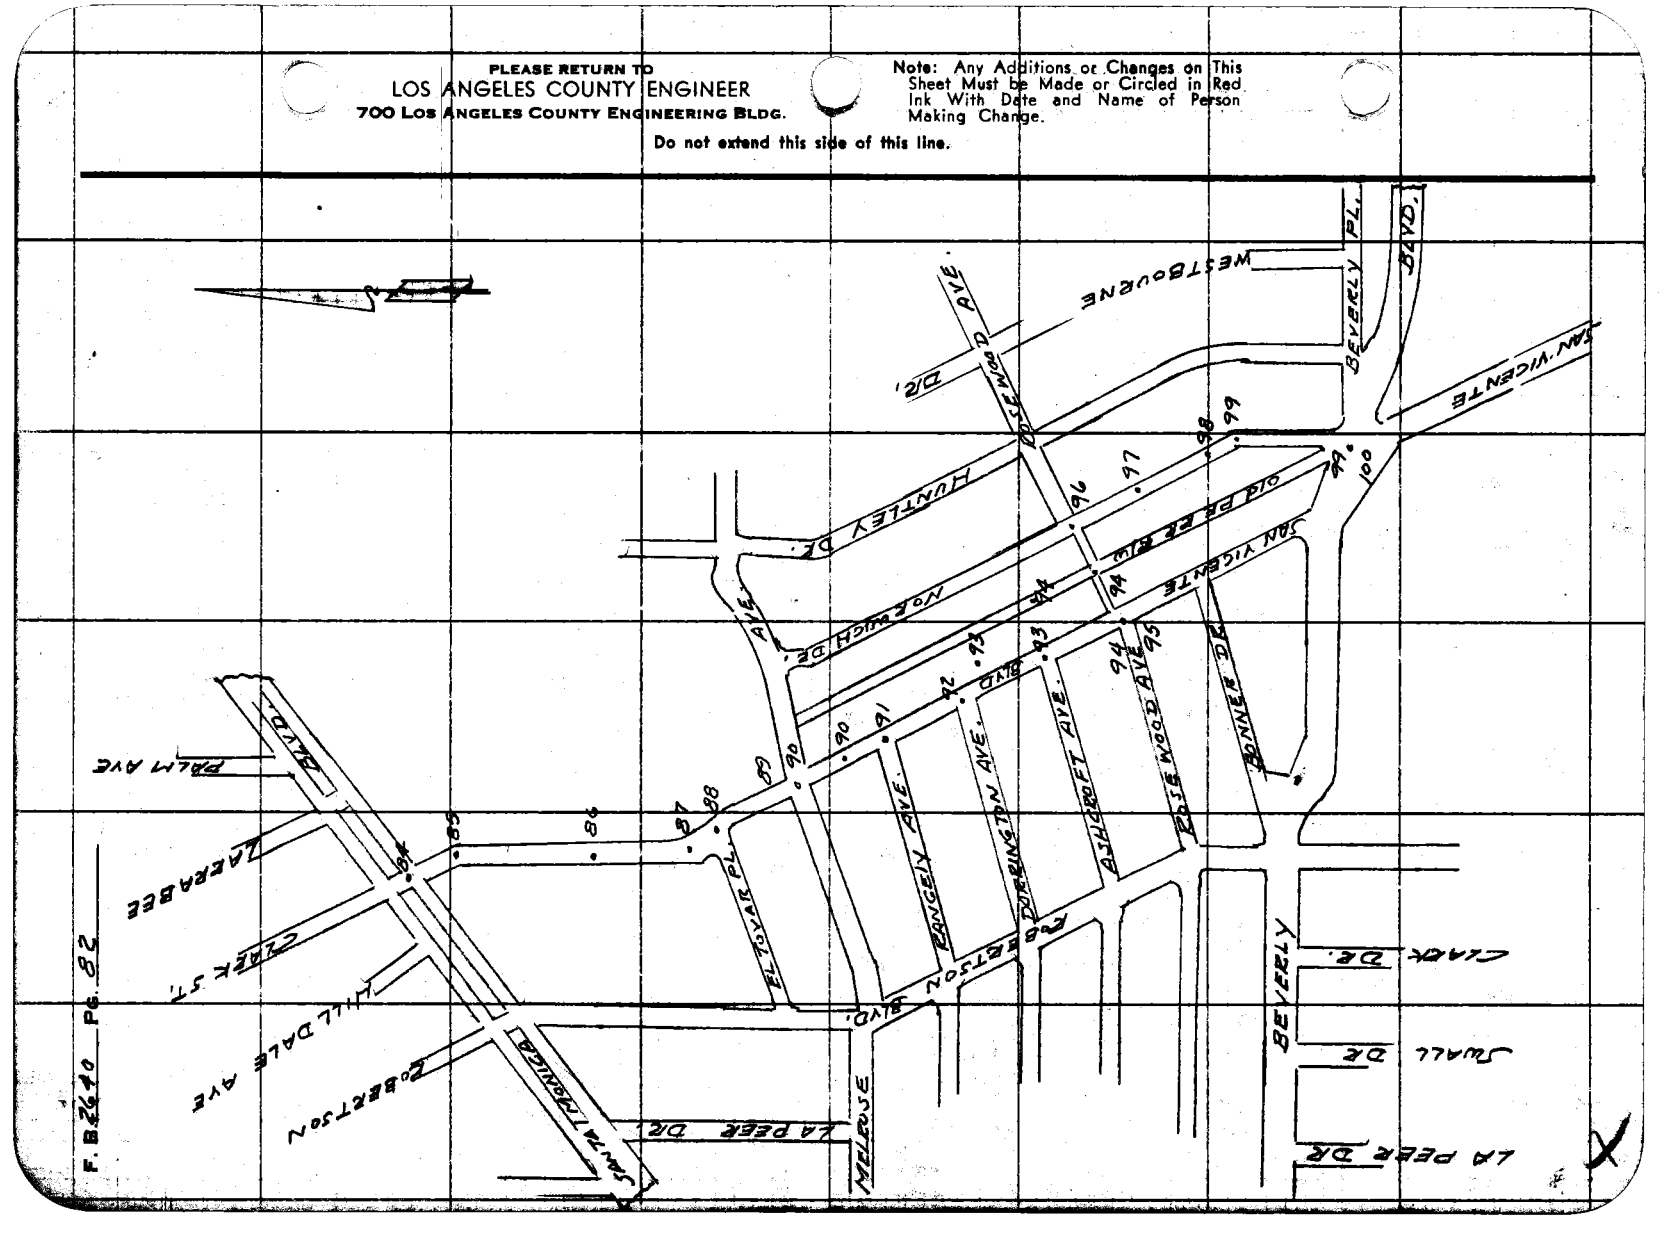

F. B. 2640 PG. 82

Notes Ck'd by D. SAPPELT	Survey of San Vicente Blvd.	F. B. 2640	PG. 83
Map No.	JN 0095.52 Tape 0191 Std 60 °F		
Office Work	Surveyed by A.S. Curtis		
Checked	Notes Curtis Date 9-13-62		
Date	Indexed K. J. GALLI JUL 3 '63		

Note: Any Additions or Changes on This Sheet Must be Made or Circled in Red Ink With Date and Name of Person Making Change.

J.N. 0095.52

SAN VICENTE BLVD.

New Location

Between Beverly Blvd

& Santa Monica Blvd.

to conform with the

latest Road Department

alignment.

Curtis

Carrasco

Yasui

Goshorn

PLEASE RETURN TO
LOS ANGELES COUNTY ENGINEER
403 LOS ANGELES COUNTY ENGINEERING BLDG.

Do not extend this side of this line.

76F309S CE # 310 3-61

PLEASE RETURN TO
LOS ANGELES COUNTY ENGINEER
403 LOS ANGELES COUNTY ENGINEERING BLDG.

Note: Any Additions or Changes on This Sheet Must be Made or Circled in Red Ink With Date and Name of Person Making Change.

Do not extend this side of this line.

4522, B-3

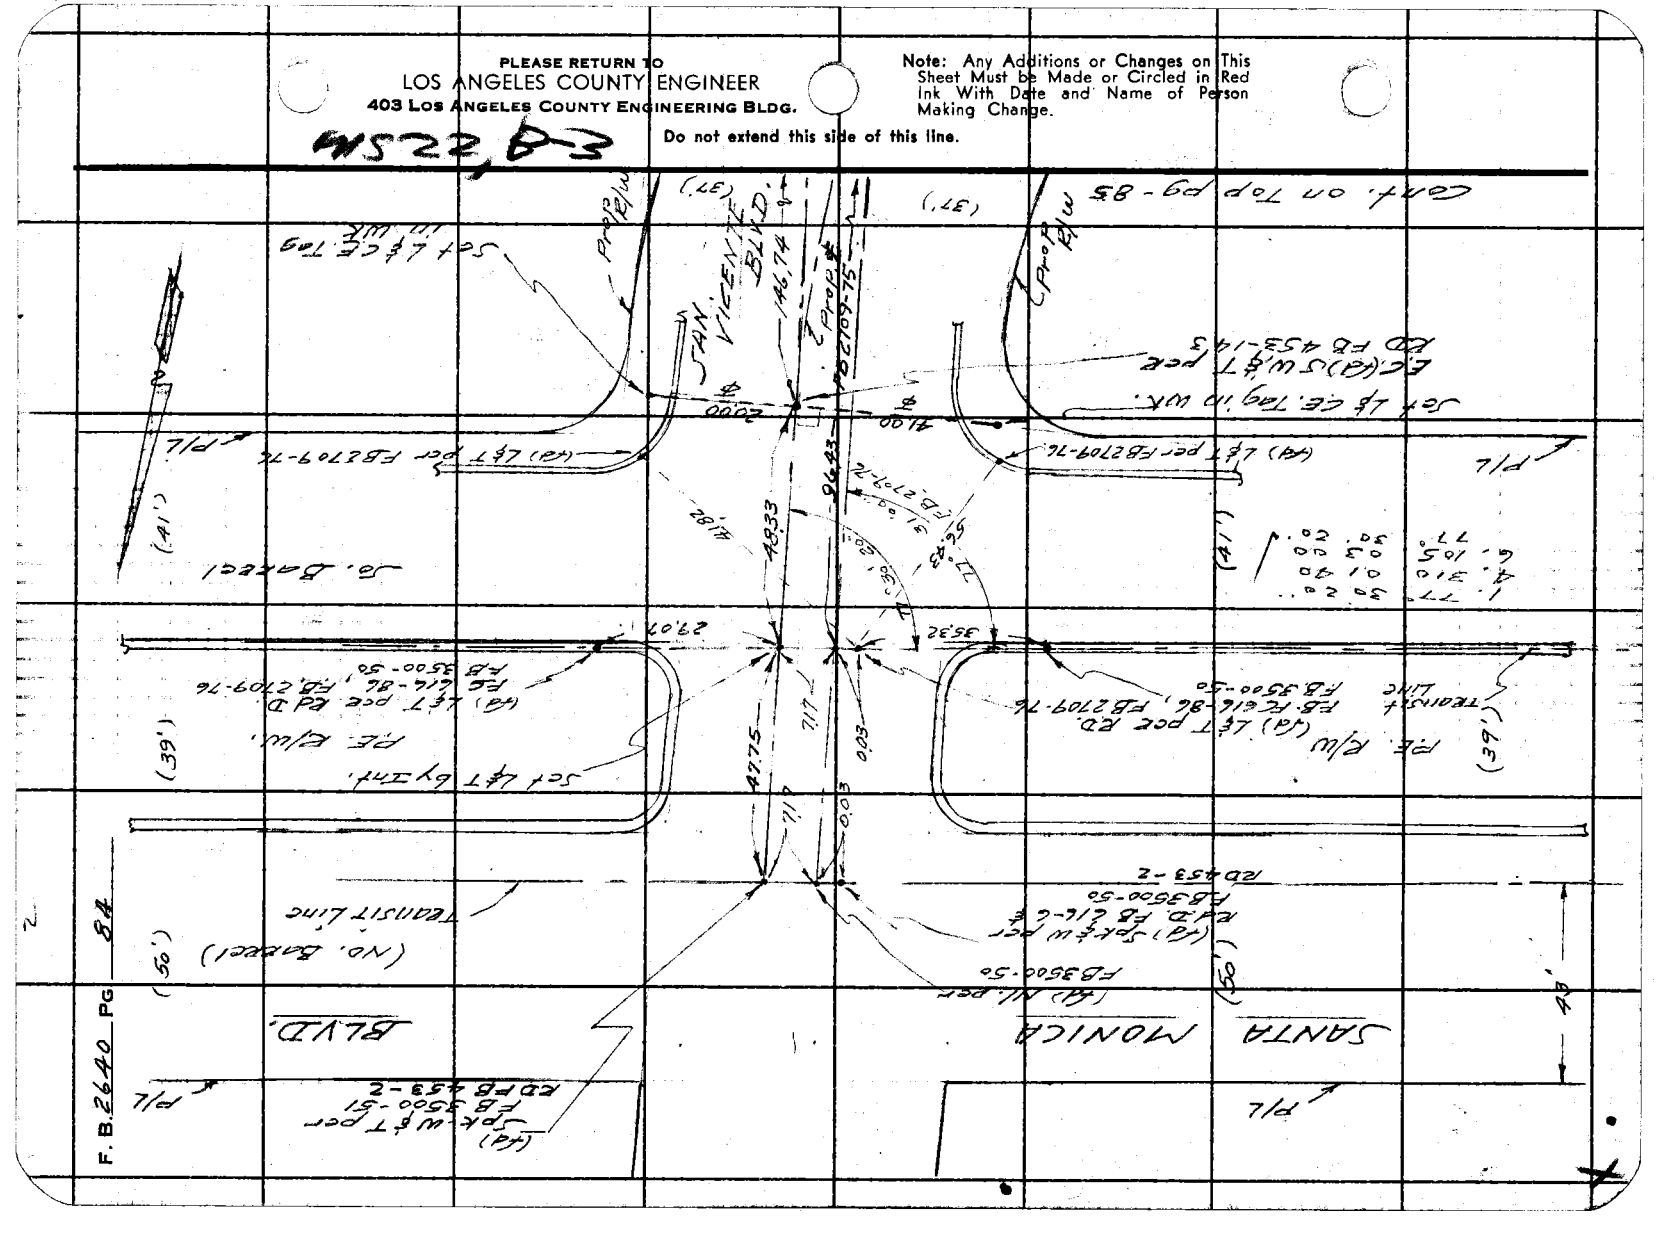
SANTA MONICA BLVD.
SAN VICENTE BLVD.
TRANSIT LINE
(No. Bound)
F.B. 2640 PG 84
P/L
(Ad) Spk. w & T per F.B. 3500-51 & R.D. F.B. 453-2
(Ad) Mk. per F.B. 3500-50
(Ad) Spk & w per R.D. F.B. 3500-50
R.D. 453-2
(Ad) & T per F.B. 2709-76
Sd. Bartel
Sd. Barrel
Sd. & T Bykirk
P.E. R/W
(Ad) & T per R.D. F.B. 2709-76
Sd. & T Tag in W.K.
Sd. & T Tag in W.K.
Sd. & T Tag in W.K.
Cont. on Top Pg - 85
(Ad) & T per F.B. 2709-76
E.C. (Ad) S.W. & T per R.D. F.B. 453-143
Pro. Bldg
Pro. Bldg
Pro. Bldg

Notes Ck'd by D. SAPPELL
Map No.
Office Work
Checked
Date

Survey of San Vicente Blvd.
JN 095592 Tape 9191 Std GB °F
Surveyed by G.S. Curtis
Notes Curtis Date 7-14-62
Indexed G. J. GALLI

F. B. 2640 PG. 85

Cont. from Rt. pg. - 84

WS 23B7

Note: Any Additions or Changes on This Sheet Must be Made or Circled in Red Ink With Date and Name of Person Making Change.

Do not extend this side of this line.

PLEASE RETURN TO
LOS ANGELES COUNTY ENGINEER
403 Los Angeles County Engineering Bldg.

78F3095 CE # 310 3-61

E.C.

Exist. & Prop R/W

(37')

Prop. E'

(37')

Prop R/W

E.C. (fd) S w&T per F.B. 2709-75

Set L&T C.E. Tag on Prod

Exist. Pl. (fd) S w&T per F.B. 2709-75

153°09'30" per F.B. 2709-75

146.74

26.07

(fd) Pl. Spk. w&T per RD F.B. 453-143

2. 306° 18' 40"
4. 252 37 20
6. 178 56 20
153° 09' 23" 1/3

BLVD.

SAN VICENTE

153° 09' 23"

fd L&T in Curb per F.B. 2709-75

682

B.C. (fd) S w&T per F.B. 2709-75

Set L&T C.E. Tag in Wall

B.C.

95.42 per F.B. 2709-75

146.74 ℄

Prop. R/W

Set L&T C.E. Tag on Prod.

30

B.C. (fd) Spk & W per RD F.B. 453-143

33.00

146.18

Exist. ℄

25.00

Set L&T C.E. Tag in Walk

146.74 Level @ 70° = 146.74

To El Tomo Pl.

172.43

Prop. ℄

Cont. on Top Pg. - 86

PLEASE RETURN TO
LOS ANGELES COUNTY ENGINEER
403 LOS ANGELES COUNTY ENGINEERING BLDG.

Note: Any Additions or Changes on This Sheet Must be Made or Circled in Red Ink With Date and Name of Person Making Change.

Do not extend this side of this line.

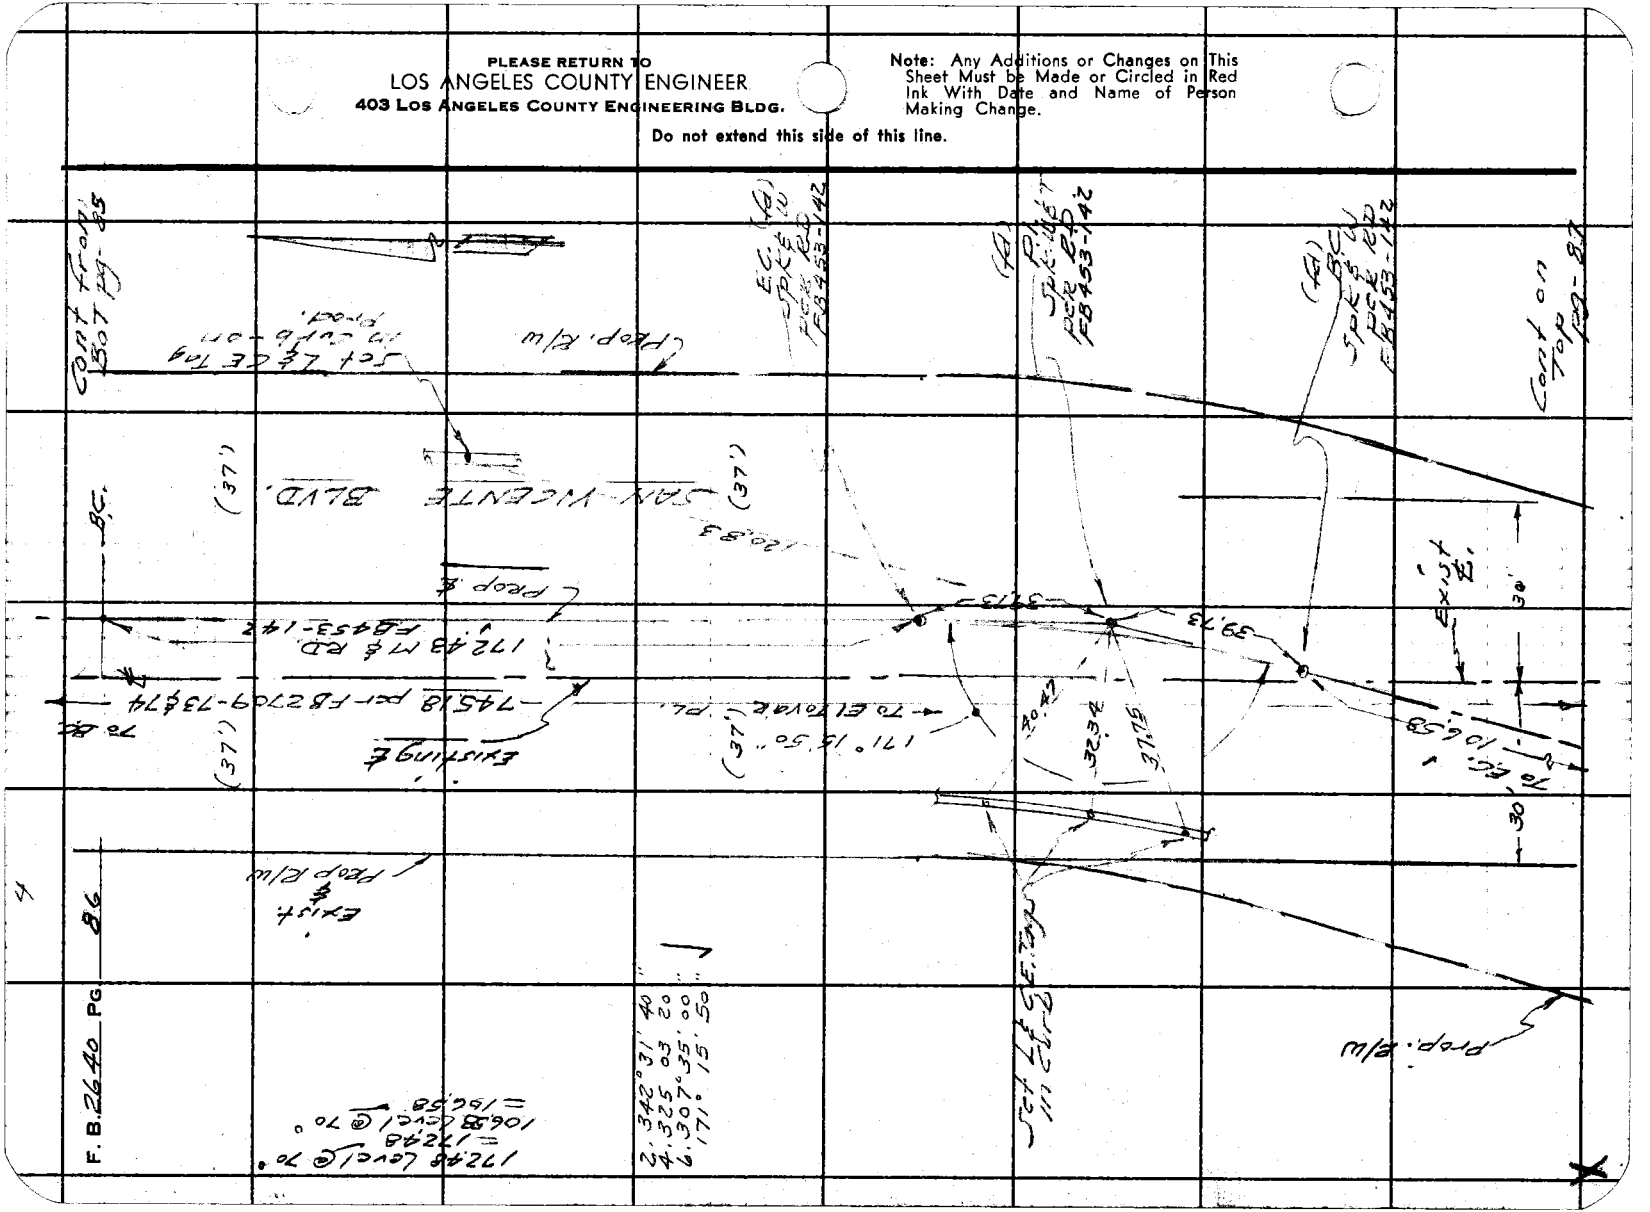
SAN VICENTE BLVD.
(37')
BC.
Prop. R/W
Existing ℄
172.48 M ℄ RD.
F8453-142
745.18 per F8709-73&74
To BC
To ELMWOOD (PL.)
171° 15' 50"
(37')
Prop. R/W
Exist ℄
Prop R/W
172.48 Curve @ 70°
= 172.48
106.58 Curve @ 70°
= 106.58
2,342° 31' 40"
4,325 03 20
6,307° 35' 00
171° 15' 50
Prop. R/W
Prop. R/W
Prop. R/W

Notes Ck'd by D. SAPPELL	Survey of San Vicente Blvd
Map No.	JN 009552 Tape 0191 Std 68 °F
Office Work	Surveyed by A.S. Curtis
Checked	Notes Curtis Date 9-14-67
Date	Indexed R. J. GALLI

F. B. 2640 Pg. 87

Cont from Bk T. pg. 86

Note: Any Additions or Changes on This Sheet Must Be Made or Circled in Red Ink With Date and Name of Person Making Change.

Do not extend this side of this line.

PLEASE RETURN TO
LOS ANGELES COUNTY ENGINEER
403 Los Angeles County Engineering Bldg.

76F309S CE # 310 3-61

EXIST. R/W.

PROP. R/W.

SAN VICENTE BLVD.

TO BC

GRADE TO BC

EXIST. R/W.

(Set) L & C.E. Tag

10.00 ℄

41.00 ℄

(37')

(37')

(Set) L & C.E. Tag

(Fd) E.C. of L & W. per RD FB 453-142

PROP R/W

2. 284° 18' 20"
4. 208 36 20
6. 132 54 20
142° 09' 06"

(Set) Large Bf. Spk. W & T on Prod in ac. permit.

150.86

29.06

PROP ℄

TO EXIST ℄

EXIST. ℄

(Fd) P.I. 2" x 2" Stk & Rd. Dept Tag (Flush) per RD F.B. 453-142

(Set) L & C.E. Tag in Curb @ Ear. Conc pillar

14.48

22.31

142° 09' 06"

(Old P.I.)

(Fd) L & Rd. D. Tag in 1st Step of L.A. Co. Bldg. on Prod per R.D. F.B. 453-142

15.00

30'

30'

150.86 Level @ 64° = 150.96

Cont on Top pg. 88

F. B. 2640 PG. 88

Cont'd. from B.T. pg. 87

P.I. (fd) 2"x2" & R.D. Tag "Hush" per R.D. FB 453-142

Sgt-L&CE Tag in curb

Prop. ℄

Exist. ℄

37'

37'

2269

150.86

To B.C.

Prop. E/W

Existing E/W

SAN VICENTE BLVD.

745.19

150.86 Curve @ 70°
= 1508.6 R
292.82 Curve @ 68°
= 294.82 R

TR #3616

Exist. E/W

(fd) P.I. 1/2 J.W.&T. per FB 2709-73

B.C. (fd) J.W.&T. per R.D. FB 453-141

TR # 5939

52.06 M

93.55 M

41.96 M

TR # 5939

EL TOVAR, PL.

110°58'10" FB 2709-73

(fd) J.W.&T. per R.D. FB 453-141

(fd) Ink of 4 PMS on M.H. rim with ties per FB 2709-73

557.27 FB 2709-73 To ℄ Robertson Blvd.

59.37 M

32.80 M.

7.46 M

98°16'37" FB 2709-73

(fd) J.P.&T. per FB 2709-73

(fd) P.I. #1 J.P.&T.W. per FB 2709-73

1. 98°16'40"
4. 33 06 20
6. 229°39'40"
98°16'37"

FB 2709-71

293.92

292.82

To Melrose

Prop E/W

Exist. E/W

TR # 5939

Cont. on Top pg. 89

PLEASE RETURN TO
LOS ANGELES COUNTY ENGINEER
403 Los Angeles County Engineering Bldg.

Do not extend this side of this line.

Note: Any Additions or Changes on This Sheet Must be Made or Circled in Red Ink With Date and Name of Person Making Change.

W 2 2 B 3

Notes Ck'd by D. SAPPELL	Survey of San Vicente Blvd
Map No.	W. O. 0095.52 Tape No. 0199 St'd. 68 °F
Office Work	Surveyed by D.S. Curtis
Checked	Notes Curtis Date 3/24/65
Date	Indexed J. GALLI

F.B. 2640 PG. 89

Cont. from Bot. pg. - 88

RETURN TO
LOS ANGELES COUNTY SURVEYOR
726 LOS ANGELES COUNTY
ENGINEERING BLDG.

Note: Any Additions or Changes on This Sheet Must be Made or Circled in Red Ink With Date and Name of Person Making Change.

Do not extend notes this side of this line

LWS 22 B 3

29283 Level @ 64°= 29282
Steel Level @ 64°= 56.01

TR. 5939

1. 81°44'20"
4. 826 57 00
6. 130°25'50"
81°44'20"

Prop. E/W

42'

(30')

(30')

℄ Exist. E/W

℄ Prop. ℄

℄ Exist. ℄

℄ Prop E/W

℄ Exist. E/W

To P.I. #1

29282

283.92

FB. 2709-71

SAN VICENTE BLVD.

TR. 5939

44'

MELROSE AVE.

(Fd) L & T per FB 2709-71

81°44'18"

0°42'05" FB 2709-71

10°42'30" FB 2709-71

(Fd) ✱ pt. Int. Chis'd N&S, & P.M.'s E&W on M.H. rim FB 2709-71

555.11 FB 2709-71

To L & T P.I.

100.00 FB 2709-71

20.98 M.

108.25 FB 2709-71

NOTE - See page 98 for TIES

(Fd) L & RD Tag per R.D. FB. 453-140

56.01

299.87

(Fd) L & T per FB. 2709-71

Cont on Top. pg. 96

76FS095 247 4-53

RETURN TO
LOS ANGELES COUNTY SURVEYOR
726 LOS ANGELES COUNTY
ENGINEERING BLDG.

Note: Any Additions or Changes on This Sheet Must be Made or Circled in Red Ink With Date and Name of Person Making Change.

Do not extend notes this side of this line.

W.S. 24 B3

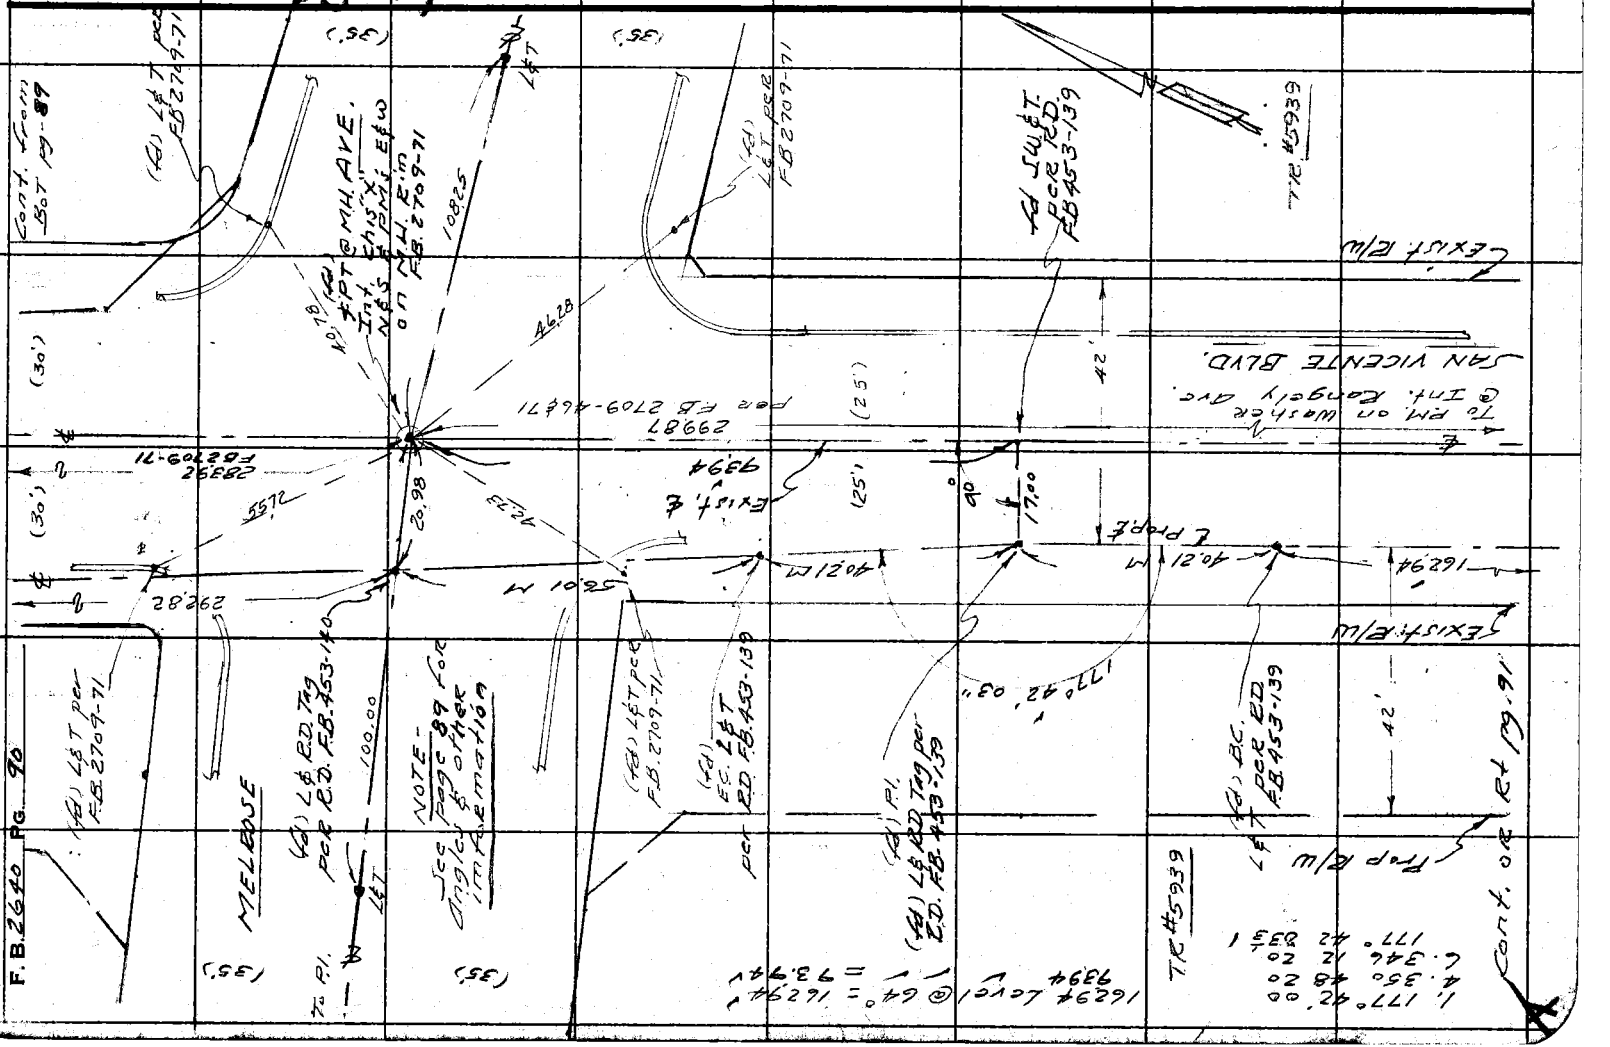
F.B. 2640 PG. 90
MELROSE
SAN VICENTE BLVD.
EXIST. R/W
PROP. R/W
EXIST. ℄
PROP. ℄
℄ EXIST.
℄ PROP.
CONT. FROM BOT PG-89
(FB) L&T PER FB 2709-71
(FB) L&T PCC FB 2709-71
(FB) L&T PER FB 2709-71
(FB) L&T PCC FB 2709-71

Notes Ck'd by D. SAPPELL
Map No.
Office Work
Checked
Date

Survey of San Vicente Blvd
JN 0095.52 Tape 0.99 Std 68° °F
Surveyed by A.S. Curtis
Notes Curtis Date 3-25-63
Indexed E. J. GALLI

F. B. 2640 PG. 97

LOS ANGELES COUNTY ENGINEER
700 Los Angeles County Engineering Bldg.

PLEASE RETURN TO

Note: Any Additions or Changes on This Sheet Must be Made or Circled in Red Ink With Date and Name of Person Making Change.

Do not extend this line of this line.

LS 22 B-3

Exist. R/W

SAN VICENTE AVE

Existing ℄

Prop ℄

162.94

(R4) L & T per FB 2709-46

Fol. L & Ts FEB 2709-46

1,80° 33' 50"
4 322° 15' 20"
6. 123° 23' 00"
80° 33' 50" ✓

F. J. & W. with R.M. on Washer per FB 2709-46

T.B.M. 5939

EC. Conf. on Top Pg-92

1977

1853 prod.

1373

283.72 pr. FB 2709-38

299.87

115.95

42'

(25')

R=1910.08'

Δ=8° 33' 50"

L=287.7

R=1910.08'

Δ=8° 33' 50"

L=287.7

1123.98

(R4) J. & W. & T. 3" CDP. PB 2-139 per R.D. F.B. 4253-139

100.08 FB 2709-46

(R4) L & T per FB. 2709-46

Exist. R/W

Prop. R/W

℄ Prop R/W

Conf. from Bot Pg-90

RANGLEY AVE.

640.15 FB 2709-46

3555 FB 2709-44

BERTSON BLVD.

T.B.M. 5939

E.C. (R4) L & T per FB 4253-138

E.D. FB. 4253-138

M.H. @ this ℄ Int. has been moved. Replaced Pt. by ties per FB. 2709-44. Set Lead & C.E. Tag.

7812008 SBE #247 11-58

PLEASE RETURN TO
LOS ANGELES COUNTY ENGINEER
700 LOS ANGELES COUNTY ENGINEERING BLDG.

Note: Any Additions or Changes on This Sheet Must be Made of Circled in Red Ink With Date and Name of Person Making Change.

Do not extend this side of this line.

M.S. 252 B - 3

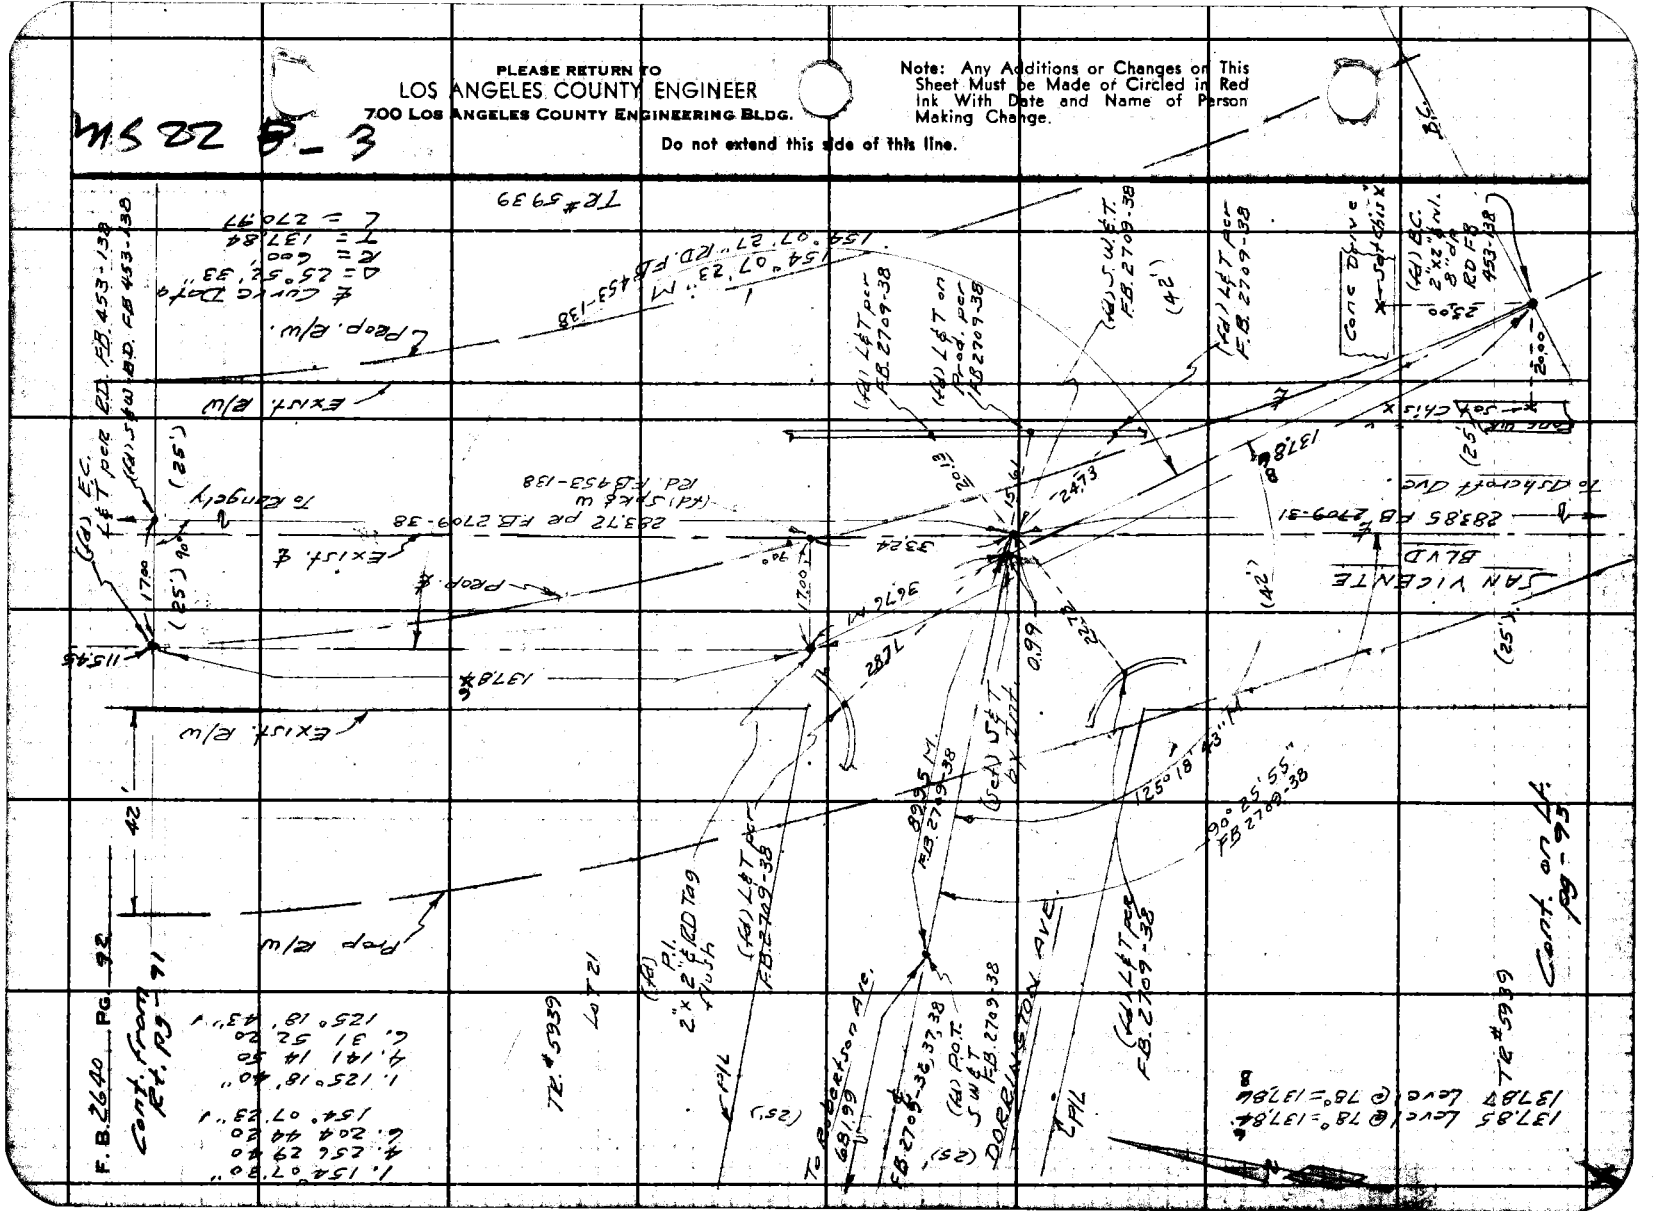

Notes Ck'd by D. SAPPELL
Map No.
Office Work
Checked
Date

Survey of San Vicente Blvd.
JN 0095.52 Tape Std °F
Surveyed by A.S. Curtis
Notes Curtis Date 6-5-63
Indexed E. J. GALLI

F. B. 2640 PG. 93

WT 221 B-3

Note: Any Additions or Changes on this Sheet Must be Made or Circled in Red Ink With Date and Name of Person Making Change.

Do not extend this side of this line.

PLEASE RETURN TO
LOS ANGELES COUNTY ENGINEER
403 Los Angeles County Engineering Bldg.

76F3095 C.E. #310 6-62

Cont. from Bot. Pg. 92

Set N&Ts in fence posts

Set 1" IP plug & Tk.

TE #5105

1.90° 00' 00"
4.36° 00 00
6.18° 00 00
90° 00' 00" /

212.03 Level @ 68°
= 212.03 +

102.84 Level @ 68°
= 102.84

Set 1" IP plug & Tk 10" dip.

Set chis'x' in conc. wk.

(Old) PE R.R. R/W

(42')

89.84 Calc. & C.

Cont. on Lt. Pg. 94

14.52

19.92

212.03 Calc. & M.

249.76

TE Line

BC

90° 00' 00"

BC (42) 2"x2" # N, 8' dp per Co. D. FB 453-138

SAN VICENTE BLVD.

Co. D. FB 453-138

102.84

PROP.

325.49 Calc. & Rd. D. FB 453-138

(40')

PROP. R/W

PROP. ℄

TE #5939

℄ 134.86

EXIST. R/W

Rd. L&TCE Tag in roadway per FB 2709-31

Rd. L&TCE Tag per FB 2709-31

4 Pins on Monuments FB 2709-31

Rd. L&TCE Tag per FB 2709-31

73.16 M

90° 00' 00"

198.05 M

SAN VICENTE BLVD.

(25')

283.89 pr. FB 2709-31

283.74

℄ Sherring Ton Ave.

54.44

(25)

Rd. L&TCE Tag per FB 2709-31

EXIST. R/W.

Rd. L&TCE Tag per FB 2709-31

EXIST. R/W.

(20')

ASHCROFT AVE.

(25')

EXIST. R/W.

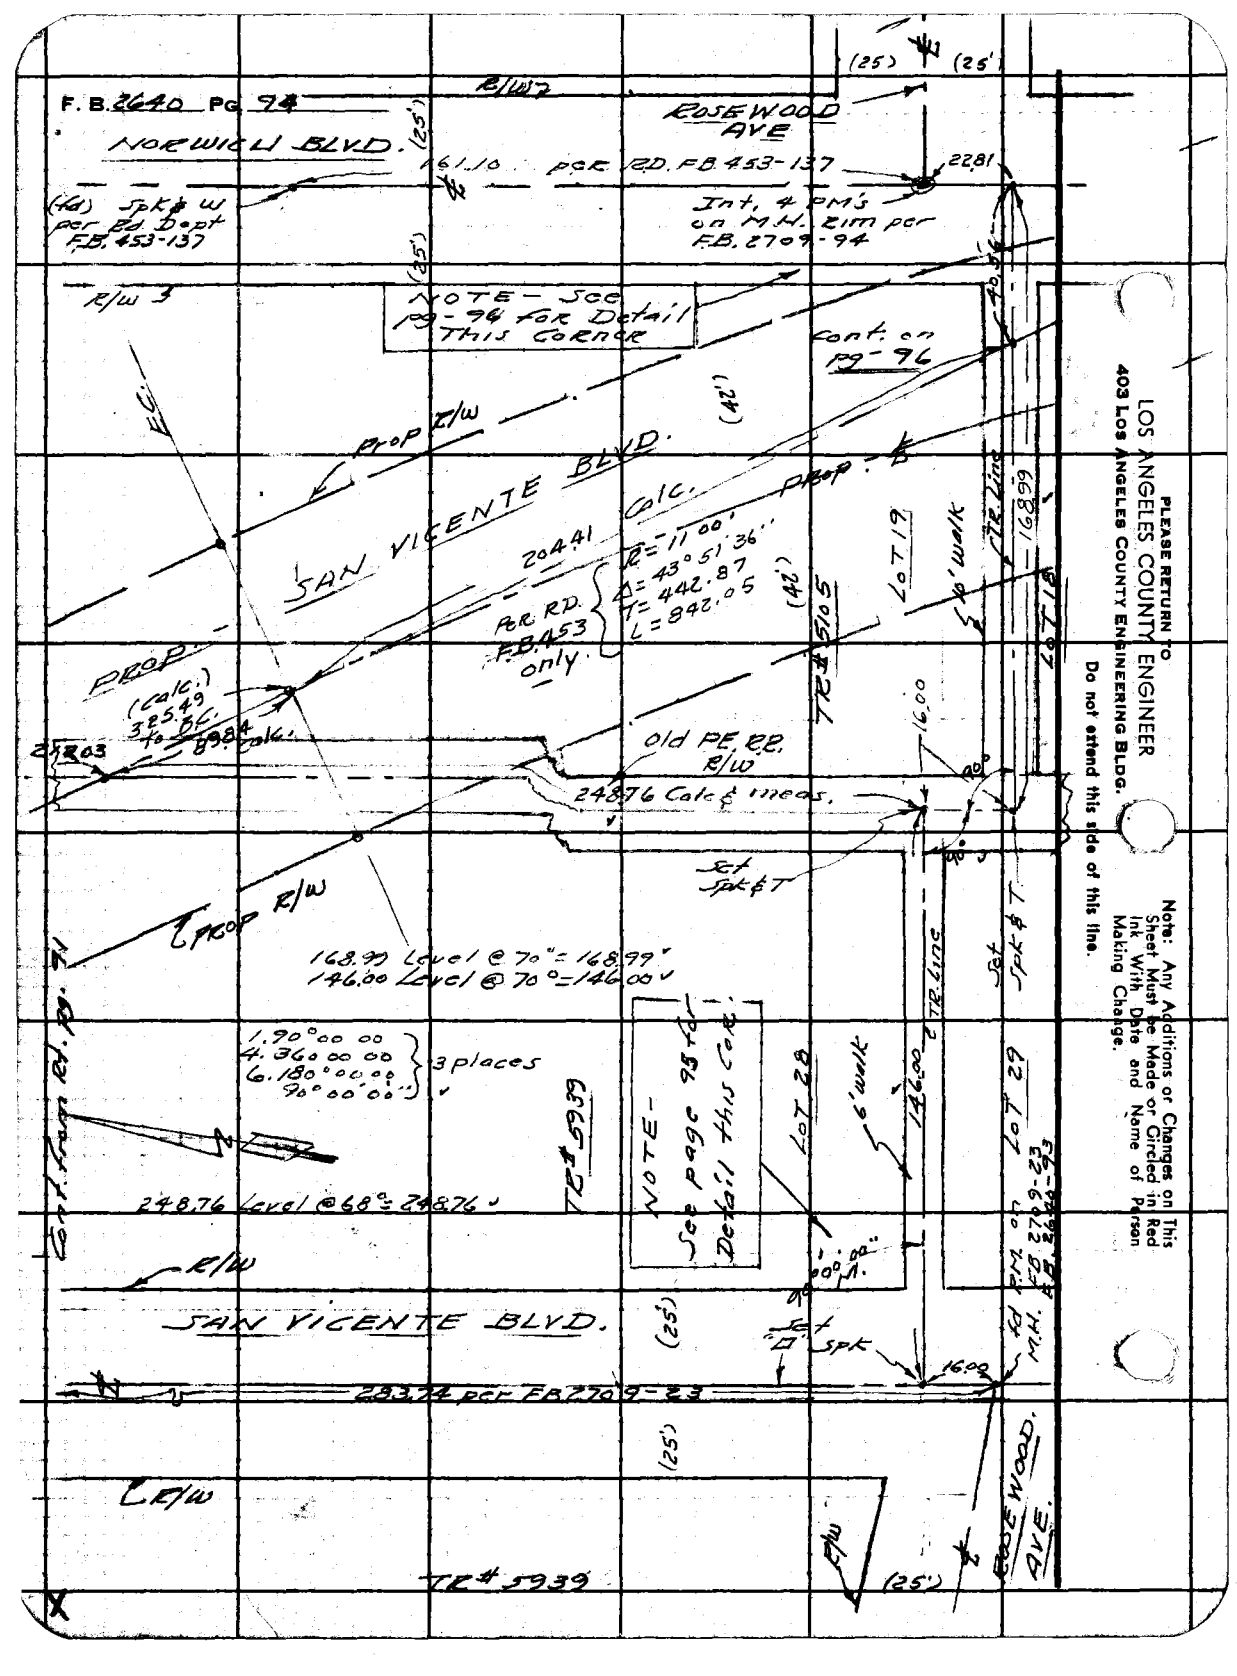

PLEASE RETURN TO
LOS ANGELES COUNTY ENGINEER
403 Los Angeles County Engineering Bldg.

Do not extend this side of this line.

Note: Any Additions or Changes on This Sheet Must be Made or Circled in Red Ink With Date and Name of Person Making Change.

76F3095 CE #310 6-62

PLEASE RETURN TO
LOS ANGELES COUNTY ENGINEER
403 Los Angeles County Engineering Bldg.

Note: Any Additions or Changes on This Sheet Must be Made or Circled in Red Ink With Date and Name of Person Making Change.

Do not extend this side of this line.

W522, B-3

8840 Land @ 72¢ = 88.90

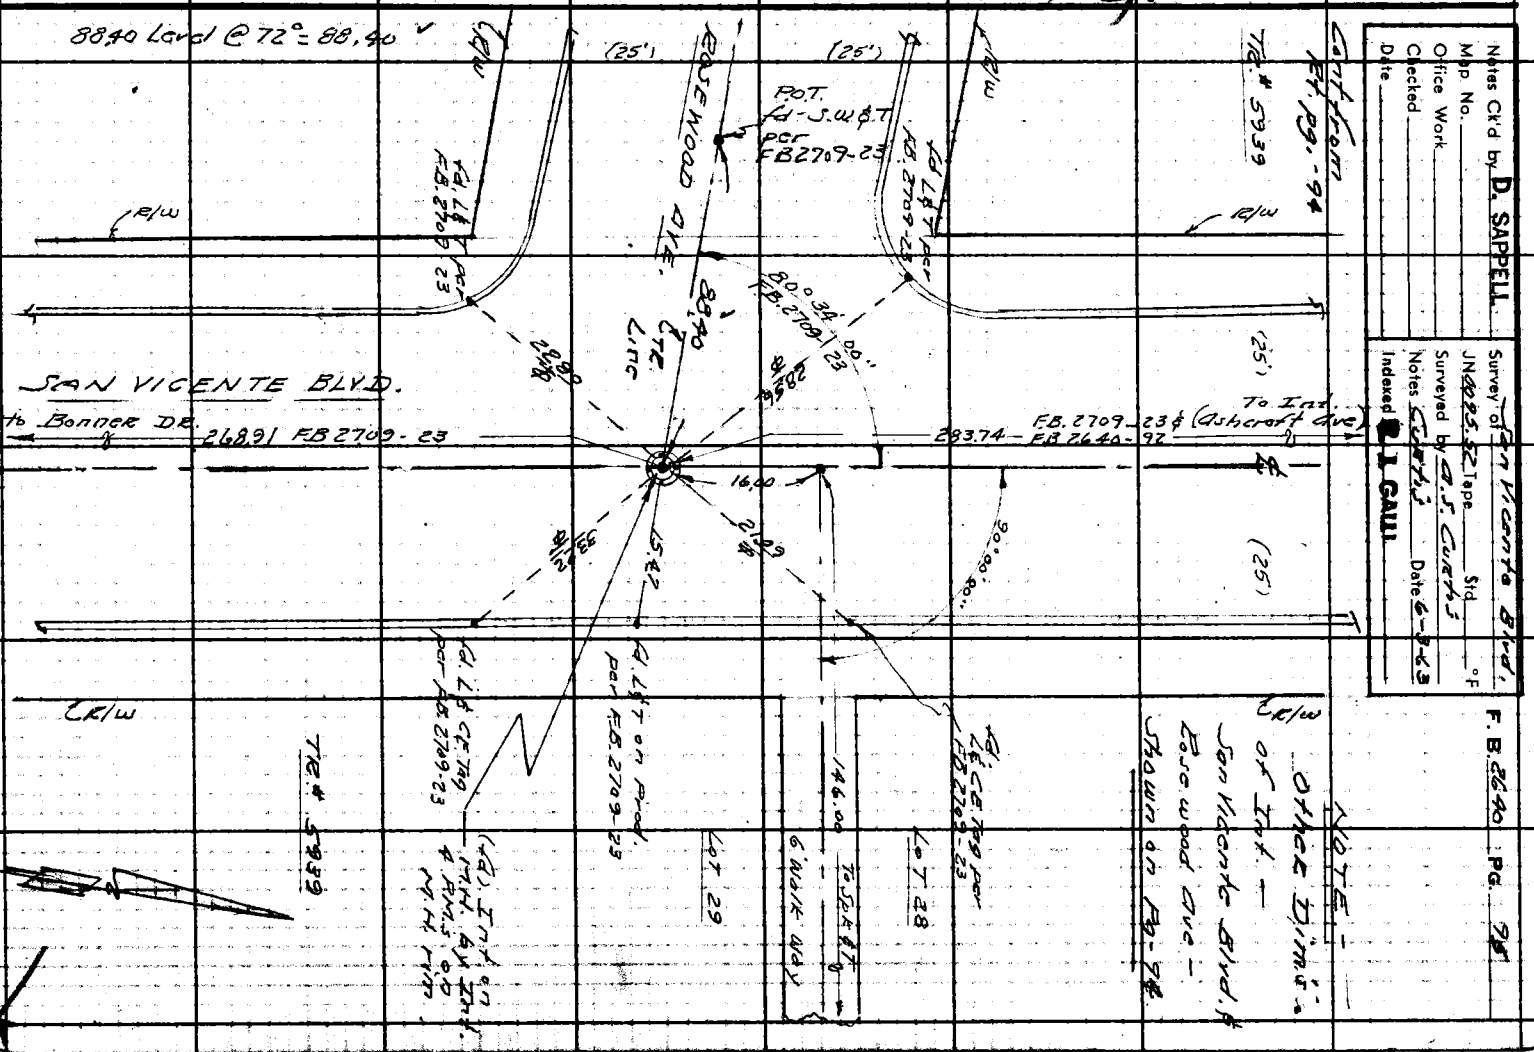

Notes Ck'd by D. SAPPELL
Map No.
Office Work
Checked
Date

Survey of San Vicente Blvd.
JN 4225.52 Tape Std °F
Surveyed by E.J.S. Curtis
Notes Curtis Date 6-8-62
Indexed by L. GALL

F. B. 2640 PG. 97

PLEASE RETURN TO
LOS ANGELES COUNTY ENGINEER
403 LOS ANGELES COUNTY ENGINEERING BLDG.

Note: Any Additions or Changes on This Sheet Must be Made or Circled in Red Ink With Date and Name of Person Making Change.

Do not extend this side of this line.

AIS 22, B-2

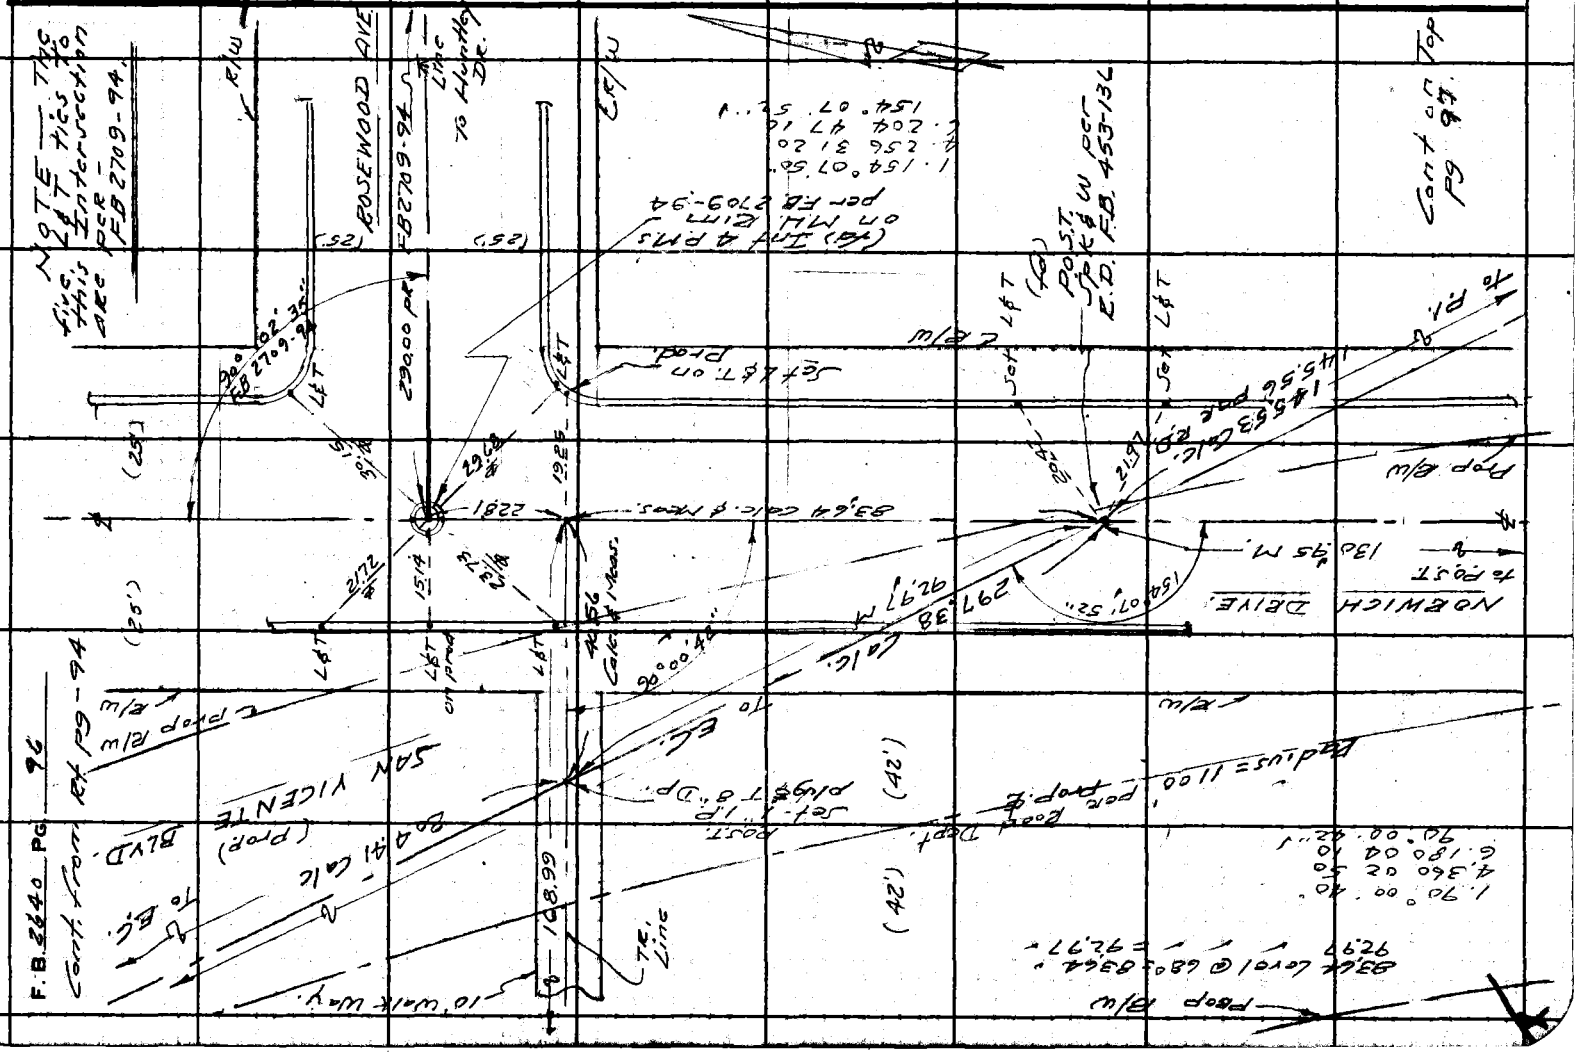

76F309S C.E. #310 6-62

PLEASE RETURN TO
LOS ANGELES COUNTY ENGINEER
403 Los Angeles County Engineering Bldg.

Note: Any Additions or Changes on This Sheet Must be Made or Circled in Red Ink With Date and Name of Person Making Change.

Do not extend this side of this line.

1, 161°59'40"
4. 287.58 30
6. 251.58 00
161° 59' 40"

TR. # 5105

Prop R/W

195.36 Local @ 70° = 195.36' (42')
130.95 " " " = 130.95' (42')

Proposed SAN VICENTE BLVD.

Prop. ℄

℄ R/W

Jt. & W per R.D. FB 453-136

P.O.T.

NORWICH DRIVE

161°59'40"

50'

127.47

195.36 M'sds
195.37 pr. R.D. FB 453-136

130.95 MEAS. To P.O.T.
130.98 pr. R.D. FB 453-136

(42')

(52')

90°

Q. Spk & W per R.D. FB 453-136

Prop E/W

Set L&T

Proposed
℄ Dr. TR. per R.D. FB 453-136
R = 1100
Δ = 43°51'36"
T = 442.87
L = 842.05

205.42 Calc
205.43 pr. R.D. FB 453-136

Tg. Spk & W per R.D. FB 453-136

145.53 Calc
145.56 pr. R.D. FB 453-136

Prop. R/W Intersection

Notes Ck'd by D. SAPPELL
Map No.
Office Work
Checked
Date

Survey of San Vicente Blvd.
JN 2095 Slope Std. °F
Surveyed by E.J. CURTIS
Notes CURTIS Date 6-63
Indexed R.J. GALLI

F.B. 6640 PG. 97
Cont. from Sht. 95

136

PLEASE RETURN TO
LOS ANGELES COUNTY ENGINEER
403 LOS ANGELES COUNTY ENGINEERING BLDG.

Note: Any Additions or Changes on This Sheet Must be Made or Circled in Red Ink With Date and Name of Person Making Change.

Do not extend this side of this line.

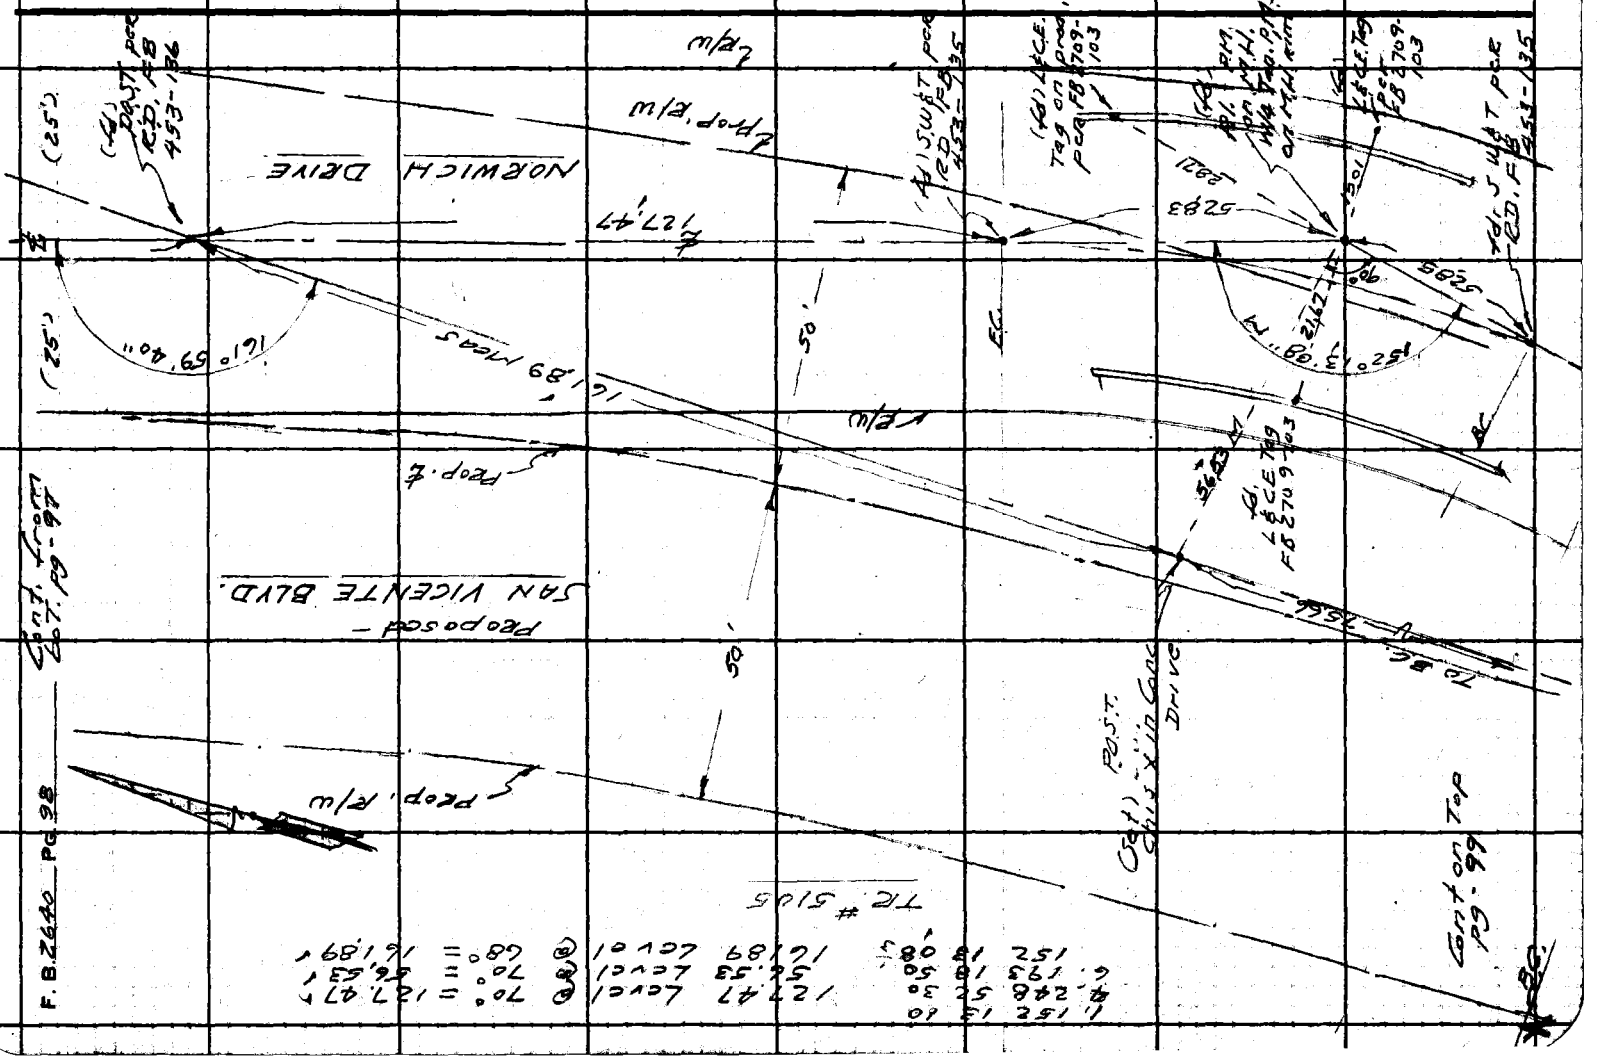
NORWICH DRIVE
SAN VICENTE BLVD.
Proposed
Prop. E/W
E/W
Prop. R/W
Prop. ℄
℄ 127.47
(25')
(25')
16° 59' 40"
15° 13' 09"
1.89 Meas
50'
50'
EG
BC
Cont. on Pg 99
Cont. on Pg 97
Cont. on Top Pg 99
(Post) Chain Link Fence
Drive
(4) 5 Wd T Pole FD. 453-135
(4) DWST Pole FD. 453-136
(4) LACE. 749 on prop. P.O.L. FB 4709-103
(4) Pole FD. 453-135
(4) Pole FD. 453-135
(4) LACE. 749 FB 4709-103
(4) Pole FD. 453-135
(4) Pole FD. 453-135
(4) Pole FD. 453-135

Notes Ck'd by D. SAPPELL
Map No.
Office Work
Checked
Date

Survey of San Vicente Blvd.
JN 0095.52 Tape Std °F
Surveyed by G.S. CURTIS
Notes Curtis Date 6-11-63
Indexed E. J. GALLI

F. B. 2640 Pg. 99

W 5733

Note: Any Additions or Changes on This Sheet Must be Made or Circled in Red Ink With Date and Name of Person Making Change.

Do not extend this side of this line.

PLEASE RETURN TO
LOS ANGELES COUNTY ENGINEER
700 LOS ANGELES COUNTY ENGINEERING BLDG.

75F3095 SSE #247 1-56

Cont. from BOT. pg-98

P.O.T. Set Ch. "X" in Conc. Dr

257.25 Level @ 66° = 257.25
56.53 Level @ 70° = 56.53
75.46 Level @ 66° = 75.46

Set L&T

Prop. E.

50'

56.53

22.31

N 52°83' E 38.71

(Fd) Pt. P.M. on MH. W/4 PMs on in M.H. rim. FB 2709-103 (See pg. -96)

E.C. per pg-96

(Fd) L&CE Tag on ℄ Prod. per FB 2709-103

90°

32.85

28.93

12 W/W

Prop. E/W

-Proposed-

SAN VICENTE BLVD.

43.68 Level @ 70° = 43.68

75.46 M

12 W/W

(25')

(Fd) L&CE Tag on ℄ Prod. per FB 2709-103

(25')

(Fd) B.C. SW ℄ PT per R.D. FB 453-62 FB 2709-103

B.C.

(Fd) 2"X2" ℄ M.L. flush

43.68

90°

21.70

257.25 M

275.23 M ℄ per FB 2709-103

NORWICH DR.

BEVERLY BLVD.

1. 56° 03' 40"
4. 224° 14' 30"
6. 336° 21' 50"
56° 03' 38"

56° 03' 38"

PROP.

(45') Cont. on pg. 100

PLEASE RETURN TO
LOS ANGELES COUNTY ENGINEER
700 LOS ANGELES COUNTY ENGINEERING BLDG.

Note: Any Additions or Changes on This Sheet Must be Made or Circled in Red Ink With Date and Name of Person Making Change.

Do not extend this side of this line.

WS 22, B-3

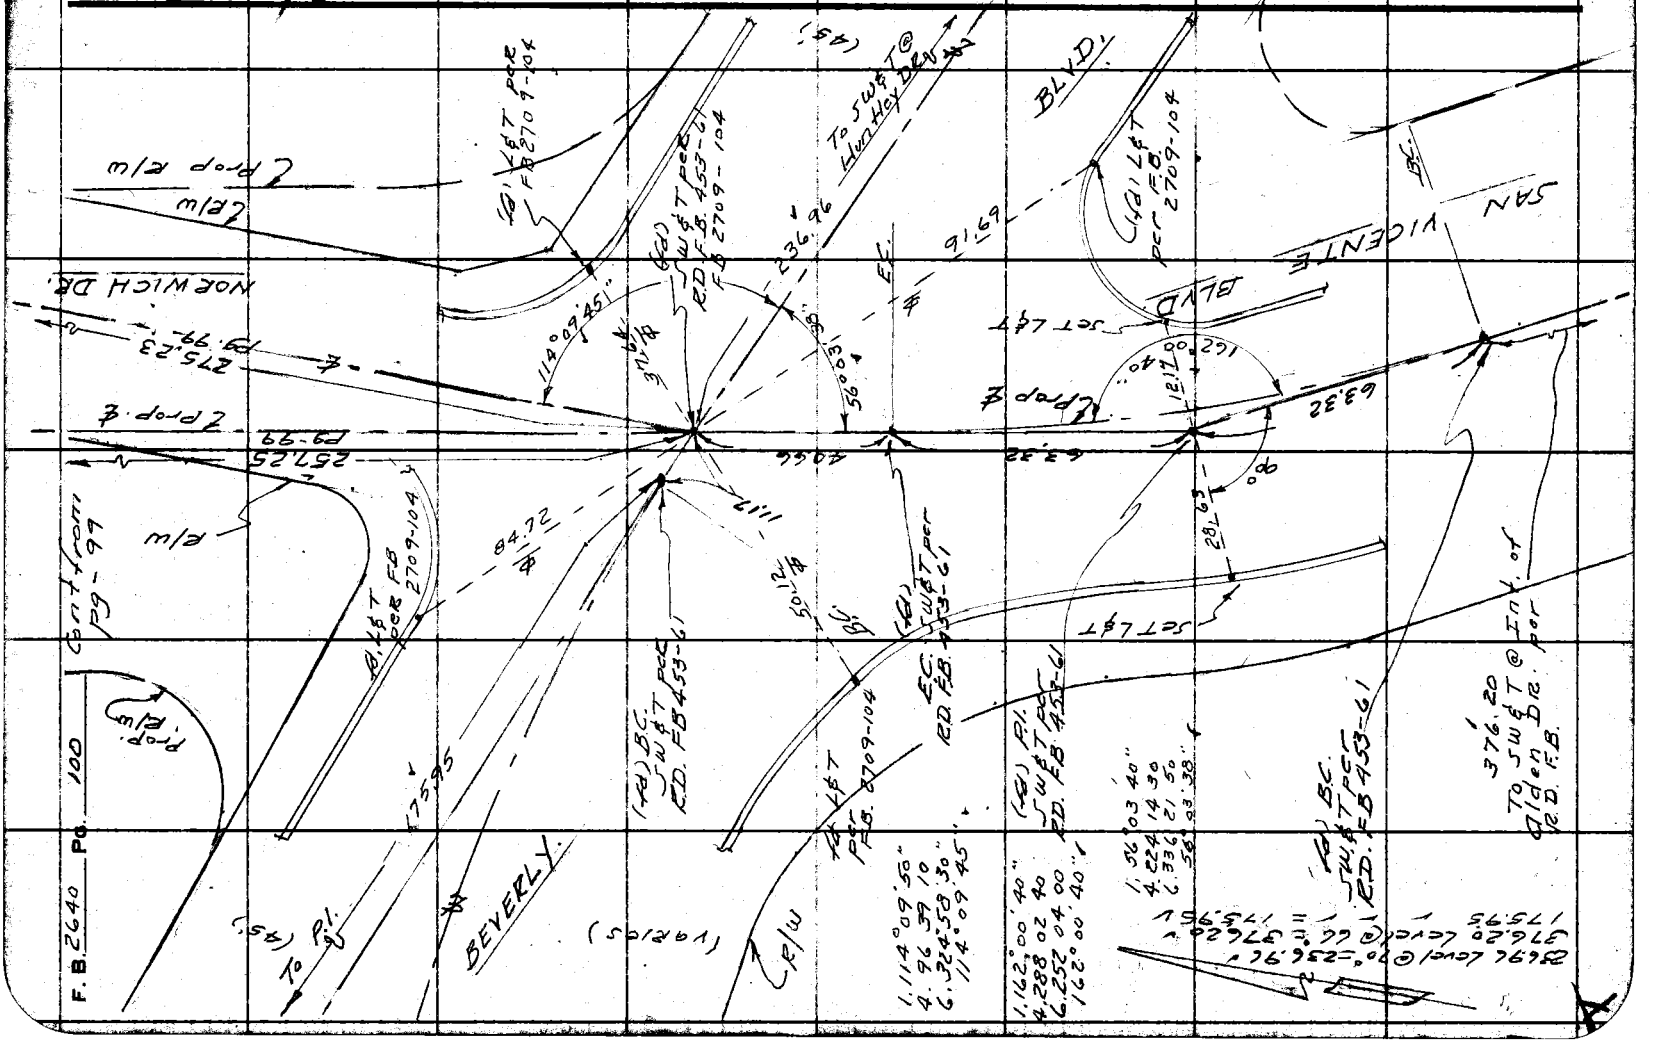
NORWICH DR.
SAN VICENTE BLVD.
BEVERLY
℄ Prop ℄ w
℄ Prop ℄
℄ Prop. ℄
PROP. R/W
℄ R/W
℄ Prop
PB 99
PB 99-99
PB 99-23
275.23
256.25
100
F.B. 2640 Pg.
To Pl.
To SW&T @ HUNTLEY DR.
To SW&T @ Alden Dr.
SET L&T
SET L&T per F.B. 2709-104
SET L&T per F.B. 2709-104
SET L&T per F.B. 2709-104

Notes Ck'd by ADONIHS 'S
Map No.
Office Work
Checked
Date

Survey of San Vicente Blvd.
JN 0095.50 Tape 024 / Std 68 °F
Surveyed by Mankey Jr.
Notes Extra Date 1-11-66
Indexed FEB 2 66 C. J. GALLI

F. B. 2640 PG. 105

0095.50

SAN VICENTE BLVD.

NEW ALIGNMENT

SANTA MONICA BLVD. STA 76 MELROSE AVE.

Mankey Jr.
Peterson
Caro
Clifford

Note: Any Additions or Changes on This Sheet Must be Made or Circled in Red Ink With Date and Name of Person Making Change.

PLEASE RETURN TO
LOS ANGELES COUNTY ENGINEER
403 LOS ANGELES COUNTY ENGINEERING BLDG.
Do not extend this side of this line.

76F3095 CE# 310 1-65

F. B. 264-9 Pg. 106

INDEX MAP

PLEASE RETURN TO
LOS ANGELES COUNTY ENGINEER
403 Los Angeles County Engineering Bldg.

Do not extend this side of this line.

Note: Any Additions or Changes on This Sheet Must Be Made or Circled in Red Ink With Date and Name of Person Making Change.

76F309S CE#310 1-65

PLEASE RETURN TO
LOS ANGELES COUNTY ENGINEER
403 LOS ANGELES COUNTY ENGINEERING BLDG.

Note: Any Additions or Changes on This Sheet Must be Made or Circled in Red Ink With Date and Name of Person Making Change.

Do not extend this side of this line.

W.S. 22, B-3

Notes Ck'd by S. SHINODA
Map No.
Office Work
Checked
Date

Survey of San Vicente Blvd
JN 009552 Tape 0241 Std. 60 °F
Surveyed by Mapkey C.E. 66
Notes Early A.M. Date
Indexed C. J. Gall

F. B. 2640 PG. 107

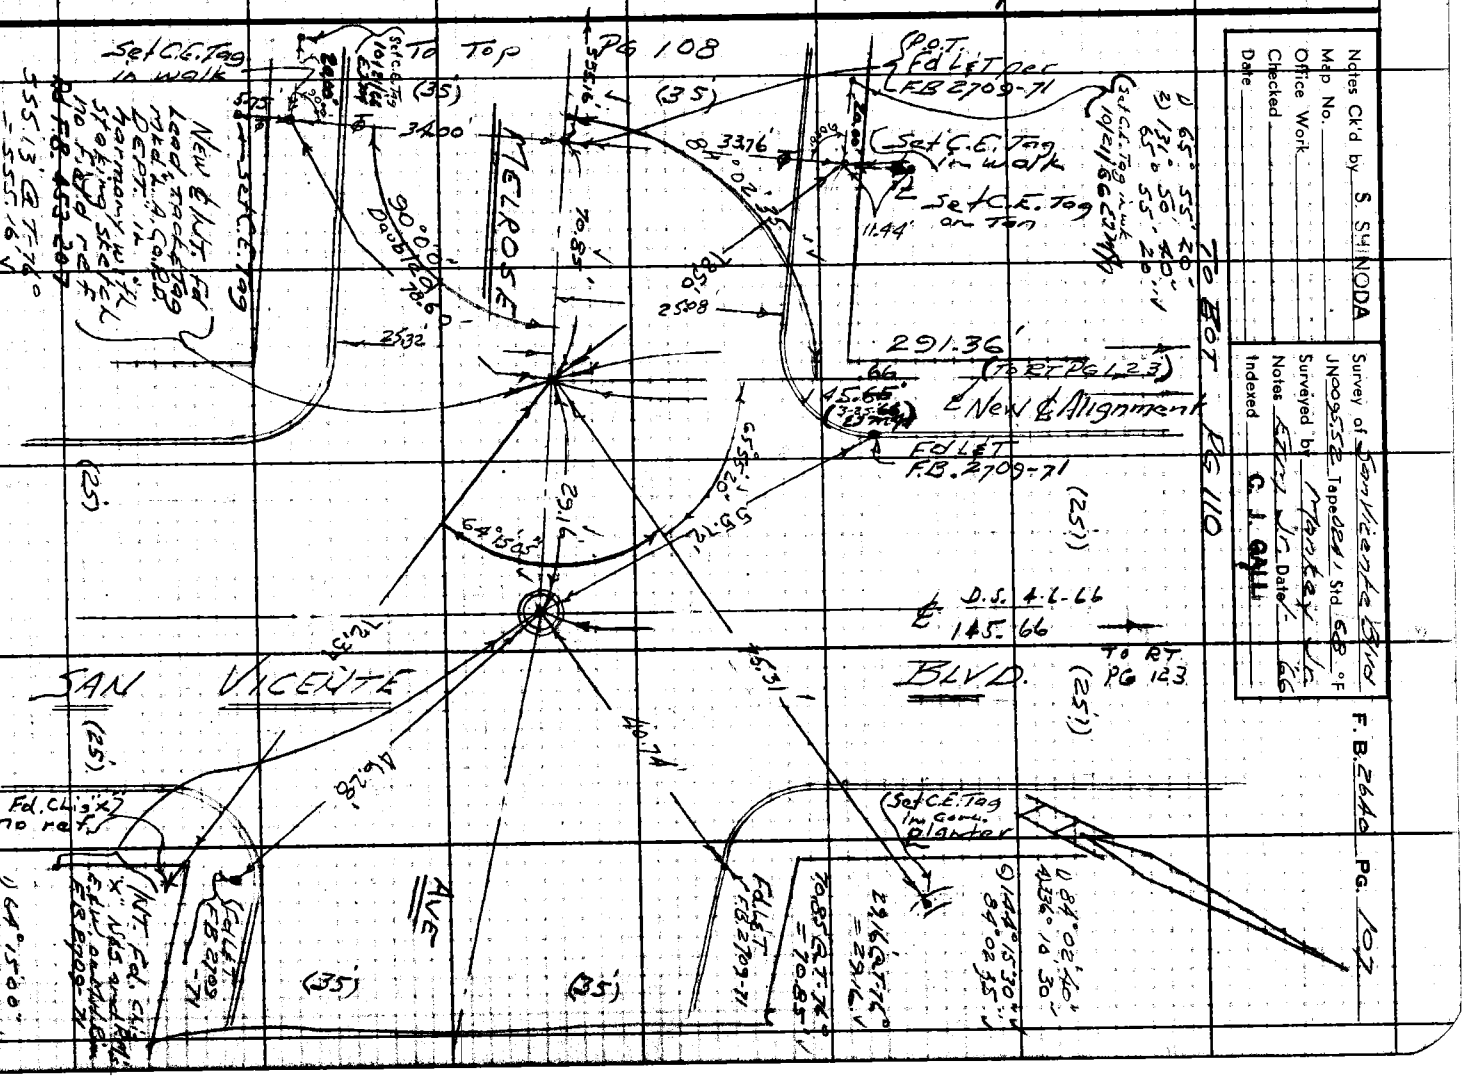

F. B. 2640 PG. 108

To Rt. PG. 109

PLEASE RETURN TO
LOS ANGELES COUNTY ENGINEER
403 Los Angeles County Engineering Bldg.
Do not extend this side of this line.

Note: Any Additions or Changes of This Sheet Must Be Made or Circled in Red Ink With Date and Name of Person Making Change.

Notes Ck'd by S. SHINODA
Map No.
Office Work
Checked
Date

Survey of San Vicente Blvd
JN 0085.52 Tape 0241 Std 68 °F
Surveyed by Mankey Jr.
Notes [illegible] Date 1-17-66
Indexed C. J. GALM

F. B. 2640 PG. 109

W.S. 22, B-3

Note: Any Additions or Changes on This Sheet Must be Made or Circled in Red Ink With Date and Name of Person Making Change.

Do not extend this side of this line.

PLEASE RETURN TO
LOS ANGELES COUNTY ENGINEER
403 LOS ANGELES COUNTY ENGINEERING BLDG.

36F3095 CE#310 1-65

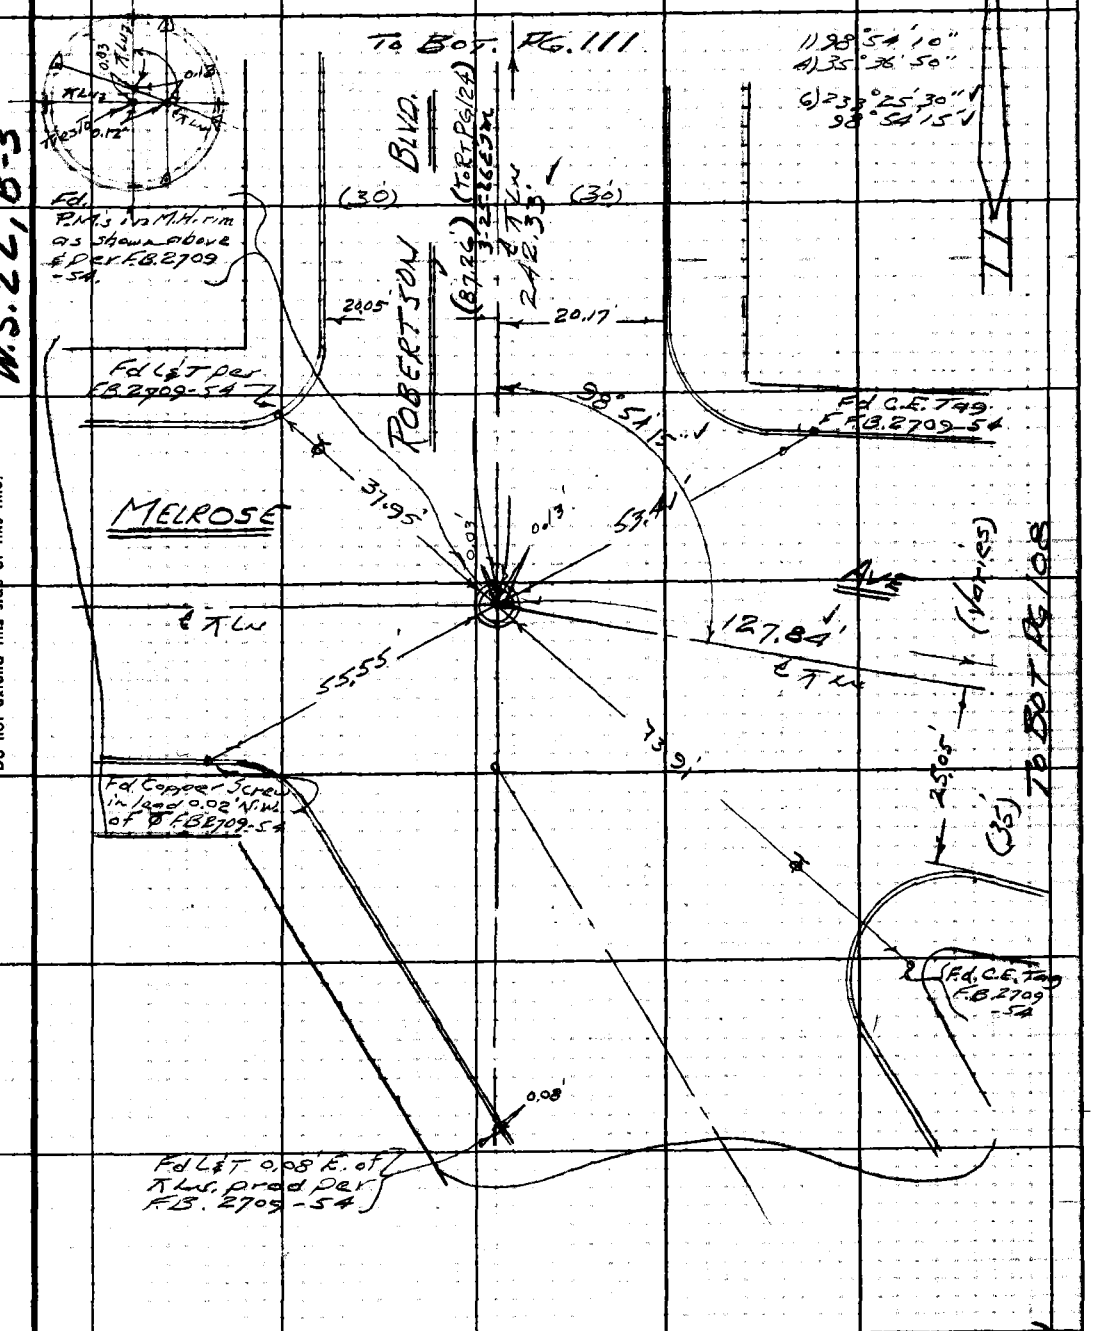

F. B. 2640 Pg 110

To Bot Pg 112

W.S. 22, B-3

51.65' QT. 72° = 51.65'

51.65' New ℄ Alignment

identical

PLEASE RETURN TO
LOS ANGELES COUNTY ENGINEER
403 Los Angeles County Engineering Bldg.

Do not extend this side of this line.

Note: Any Additions or Changes on This Sheet Must be Made or Circled in Red Ink With Date and Name of Person Making Change.

Fd. C.E. Tag in wall

Fd. C.E. Tag or prod F.B. 2709-73

I.N.T. Fd 4 P.K.'s on M.H. Rim F.B. 2709-73 which ties R.O. F.B. 453-6

Fd. C.E. Tag F.B. 2709-73

Fd. L&T 0.02' N. of ℄ Prod F.B. 2709-73

TOVAR

Pl.

83.32'

63.21'

55°35' ℄

16°43'30" Doubled

1.52'

89°50'

15.14'

29.16'

19.56'

19.44'

53.50'

107.29'

Fd. L&T on old ℄ Prod F.B. 2709-73

To ℄ Pl. (25')

Set C.E. Tag in wall

Fd. 3/4 Hd. Spk. old & Prod. per F.B. 2709-73

95° 58' 30" Doubled

63.21' QT. 80° = 63.21'

New ℄ I.N.T. Fd Lg. B.H. Spk. W. (Mkd. "L.A. Co. Rd. Dept.") ℄ at 90° to old ret Rd. F.B. 453-208

Set C.E. Tag in wall on ℄ prod

P.I. #1 Fd Skw per F.B. 2709-73

45°00' Doubled

Set C.E. Tag top Conc. Cb.

291.36'

291.36' QT. 70° = 291.36'

Fd. C.E. Tag F.B. 2709-73

New ℄ Alignment

VICENTE

SAN

(25')

(25')

1) 95° 58' 30" ✓
2) 23° 53' 30" ✓
3) 215° 50' 00" ✓
95° 58' 20" ✓

To Top Pg 107

Notes Ck'd by S. SHINODA
Map No.
Office Work
Checked
Date

Survey of San Vicente Blvd
JN 009532 Tape 0201 Std 68 °F
Surveyed by Manley Jr.
Notes EFM Jr. Date 6-66
Indexed C. J. CALLI

F. B. 2640 Pg. 111

TO RT PG 116

NOTE: DIST'S IN (-) FT'S SHOWN AS FD. ARE PER FB 2709-55

777.82' @ T = 777.83'
101.69' @ T = 101.68'

10.168

0.02'

(30')

BLVD.

20.01'

777.83'

Fd L&T

69°

11'

Fd L&T Per FB. 2709-67, S. Im. of Alley Prod W. 0.02' E. of ℄
1) 69° 11' 10"
4) 276° 44' 50"
6) 55° 07' 10" ✓
69° 11' 12" ✓

Fd L&T

39.16'
(39.18')

TOVAR

PL.

EL

557.35' ✓

(25')

TO LT

Fd L&T Temporary

21.85'
(21.70')

30.44'
(30.44')

27.81'
(27.82')

110° 51' 25"

15.11'

INT. Fd'g Cut Spk. FB 769-11

Fd L&T

20.16'
(30')

20.10'
(30')

Fd L&T

557.31' @ T 480'
= 557.35' ✓

1) 110° 51' 20"
4) 83° 25' 40"
6) 305° 08' 30"
110° 51' 25"

242.33' @ T 68°
= 252.33' ✓

ROBERTSON

242.33' ✓

ETL

TO TOP PG 109

W.S. 22, B-3

Note: Any Additions or Changes on This Sheet Must be Made or Circled in Red Ink With Date and Name of Person Making Change.

Do not extend this side of this line.

PLEASE RETURN TO
LOS ANGELES COUNTY ENGINEER
403 LOS ANGELES COUNTY ENGINEERING BLDG.

76F3095 CE#310 1-65

F. B. 2640 Pg. 112

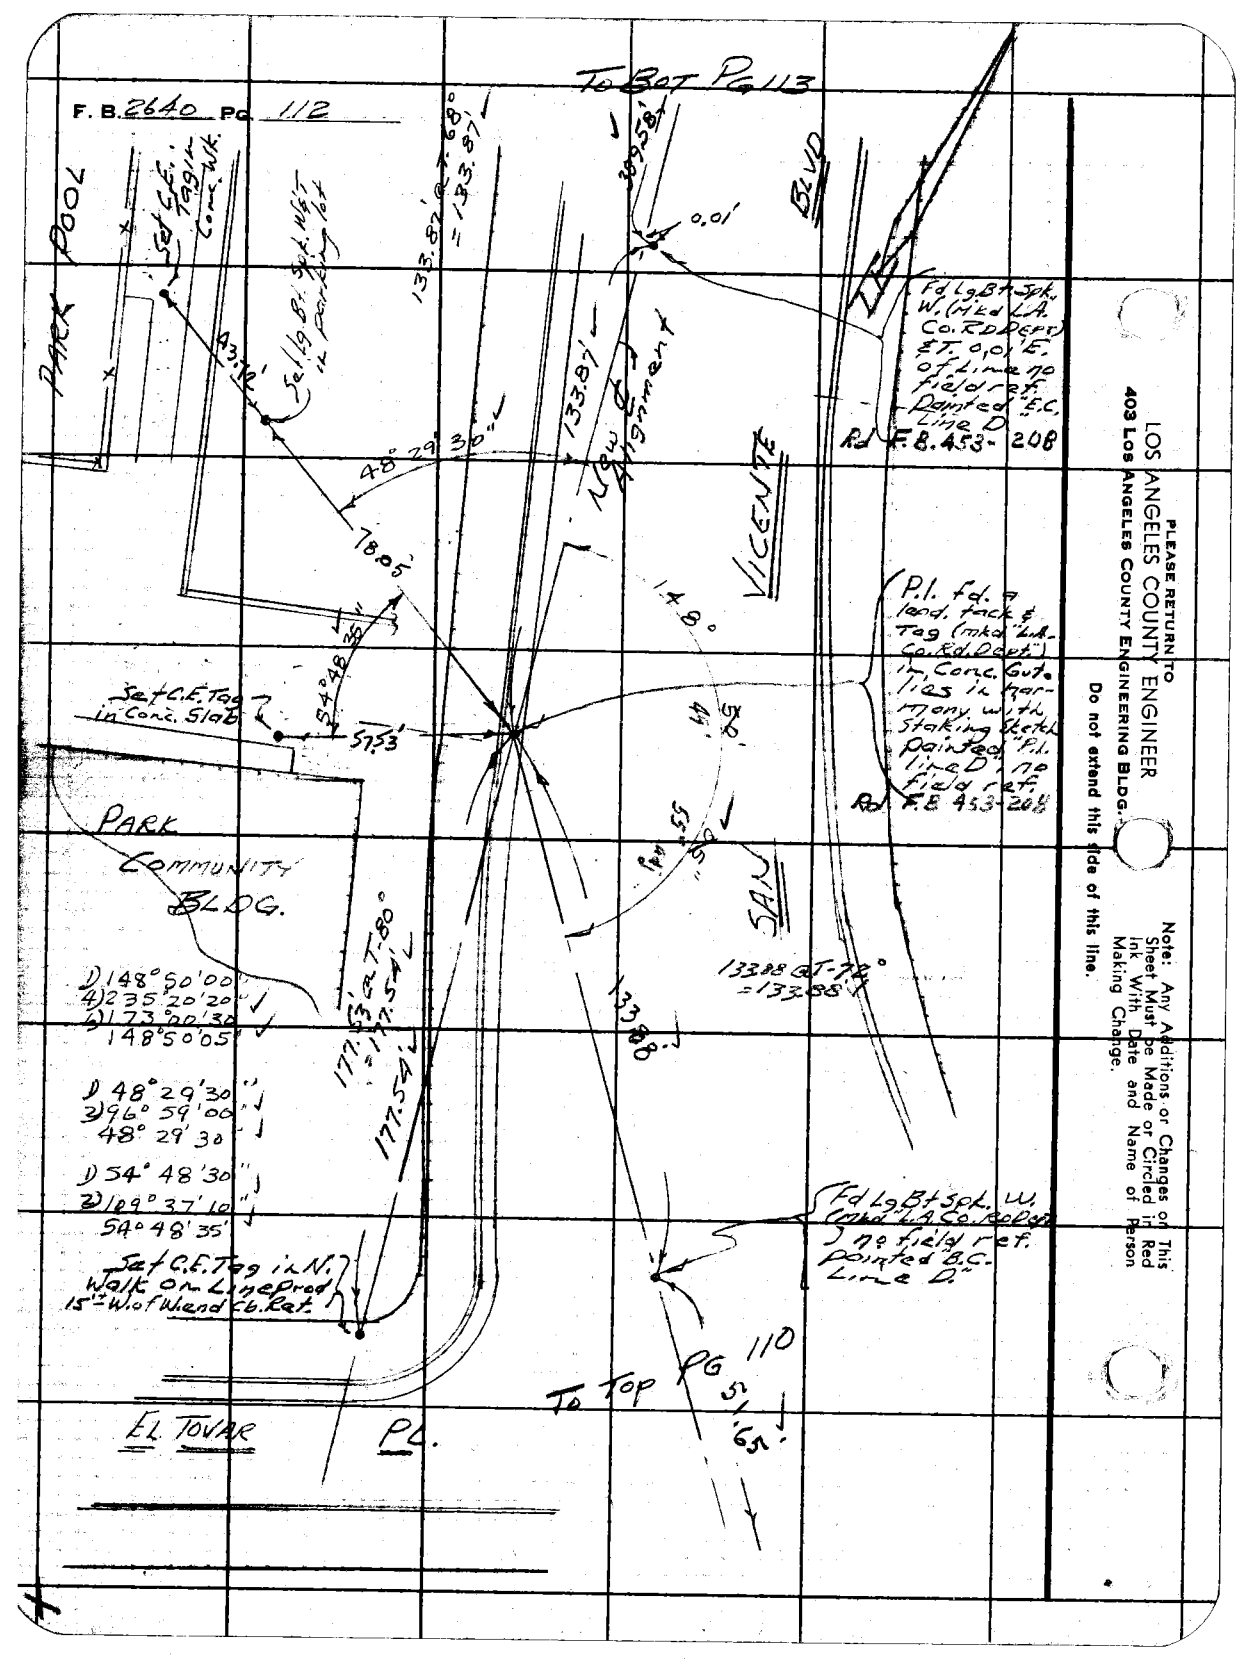

LOS ANGELES COUNTY ENGINEER
403 Los Angeles County Engineering Bldg.

PLEASE RETURN TO

Do not extend this side of this line.

Note: Any Additions or Changes on This Sheet Must be Made or Circled in Red Ink With Date and Name of Person Making Change.

Notes Ck'd by S. SHINODA
Map No.
Office Work
Checked
Date

Survey of San Vicente Blvd
JN P035.52 Tape 0241 Std 68 °F
Surveyed by Monkay Jr.
Notes Ezmon Date 6-86
Indexed C. J. GALLI

F. B. 264C PG. 113

W.S. 22, B-3

Note: Any Additions or Changes on this Sheet Must be Made or Circled in red Ink With Date and Name of Person Making Change.

PLEASE RETURN TO
LOS ANGELES COUNTY ENGINEER
403 Los Angeles County Engineering Bldg.
Do not extend this side of this line.

26F3098 CE#310 1-65

To RT. Pg. 114

(30')

(30')

24.00'

New ℄ Alignment

Old E.C. Fd 7 S.W.ET per F.B. 2709-75 held for Control

Set C.E. Tag in Walk to Bldg. #43

125.19'

Fd. L & C.E. Tag 0.01' E. of Line Prod. F.B. 2709-75

125.19' Δ=68° = 125.19' ✓

BLVD.

83.70'

43°34'20" Doubled

(P.I. Fd. 2"x2" Stke Tagged by ties in F.B. 2709-75 held for control

48.89

Set Nail

58°05'10" Doubled

Set Lg. Bk. Spk. W. ET.

6.20'

8.84'

52°12'20" Doubled

140°48'05" Δ1 11°56' adj.

30.00'

24.00'

14.01'

ALLEY

New P.I. Fd Lg. Bk. Spk. W. ET. No ref. ties in harmony with Staking Sketch. P.I. pointed Line "D" Washer mk'd R.C.E. 6464 Rec'd F.B. 453-209

86.91'

VICENTE

46.75'

Fd. L & T F.B. 2709-75

Fd. L & Tack on Line Prod. per F.B. 2709-75

129.78'

Set C.E. Tag in Conc. Wall

PARK

Set C.E. Tag in Conc. Wall

134.05' ∠ 70°

= 134.05' ✓

389.57' ET 70°

= 389.58' ✓

1) 148°48'00"

4) 235°12'10"

6) 172°48'30"

148°48'05" ✓

(30')

SAN

℄ New ℄ Alignment

(30')

389.58'

Fd. Lg. Bk. Spk. W. (Mkd L.A. Co. R.D. Dept.) E. Tie pointed P.C. Line D no field ties Rec'd F.B. 453-209

To Top Pg 112

PLEASE RETURN TO
LOS ANGELES COUNTY ENGINEER
403 LOS ANGELES COUNTY ENGINEERING BLDG.

Note: Any Additions or Changes on This Sheet Must be Made or Circled in Red Ink With Date and Name of Person Making Change.

Do not extend this side of this line.

W.S.22, B-3

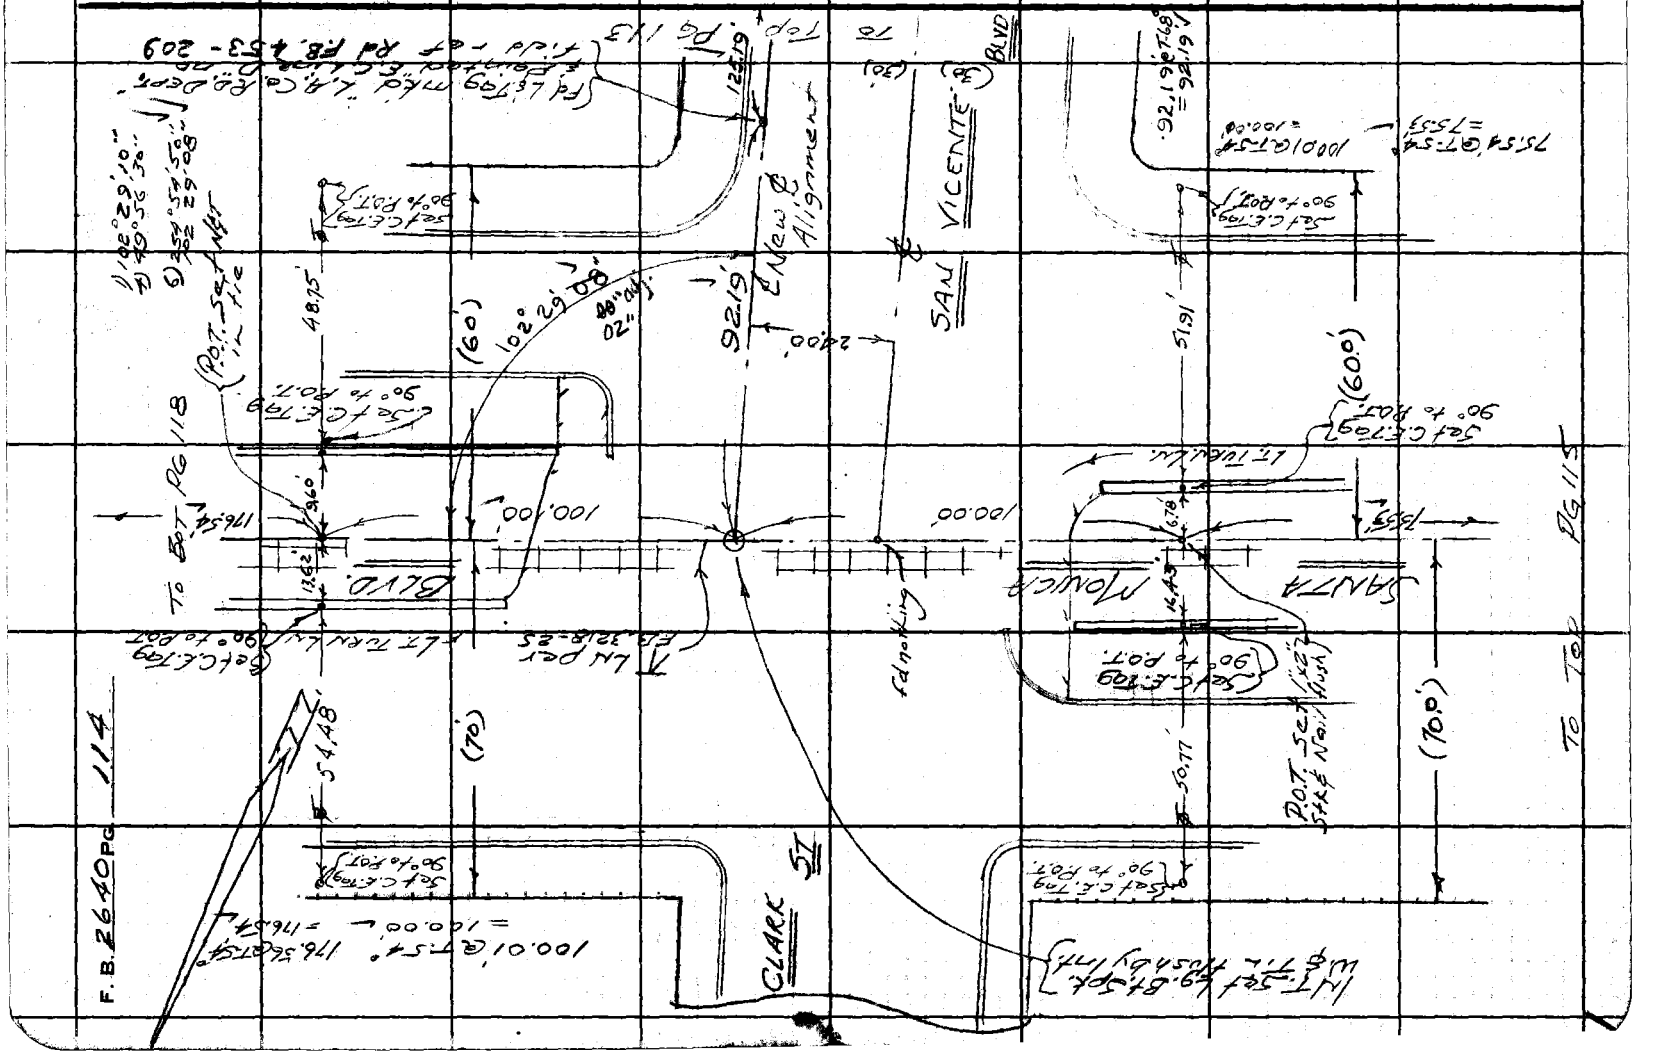
SAN VICENTE BLVD
CLARK ST
BLVD.
SANTA MONICA
New ℄ Alignment
F.B. 2640 PG. 114
TO F.B. PG 118
TO F.B. PG 115
Top PG 113
To
(30)
(60')
(70)
(70.0')
(60.00')
100.00'
92.19'
24.00'
48.25'
51.91'
50.77'
54.48'
39.00'
13.62'
6.78'
14.43'
7.59'
Lt. Turn Lane
Lt. Turn Lane
Lt. Turn Lane

76F309S CE#310 1-65

PLEASE RETURN TO
LOS ANGELES COUNTY ENGINEER
403 LOS ANGELES COUNTY ENGINEERING BLDG.

Note: Any Additions or Changes on This Sheet Must be Made or Circled in Red Ink With Date and Name of Person Making Change.

Do not extend this side of this line.

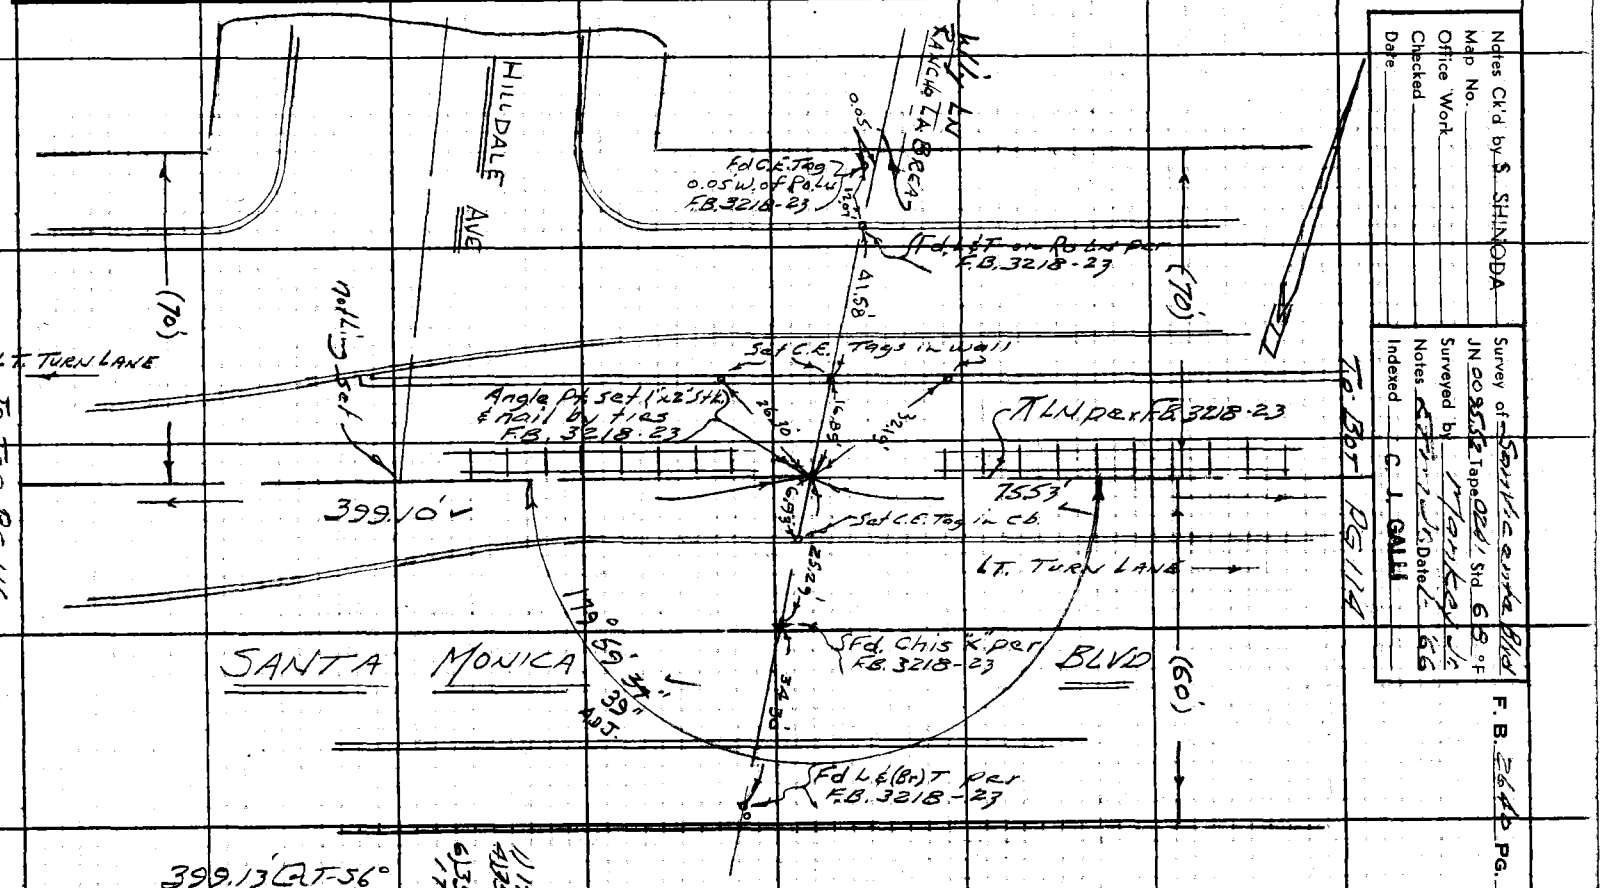

Notes Ck'd by S. SHINODA
Map No.
Office Work
Checked
Date

Notes
Indexed C. J. GALLI

F. B. 3640 PG. 115

PLEASE RETURN TO
LOS ANGELES COUNTY ENGINEER
403 LOS ANGELES COUNTY ENGINEERING BLDG.

Note: Any Additions or Changes on This Sheet Must be Made or Circled in Red Ink With Date and Name of Person Making Change.

Do not extend this side of this line.

W.S. 22, B-3

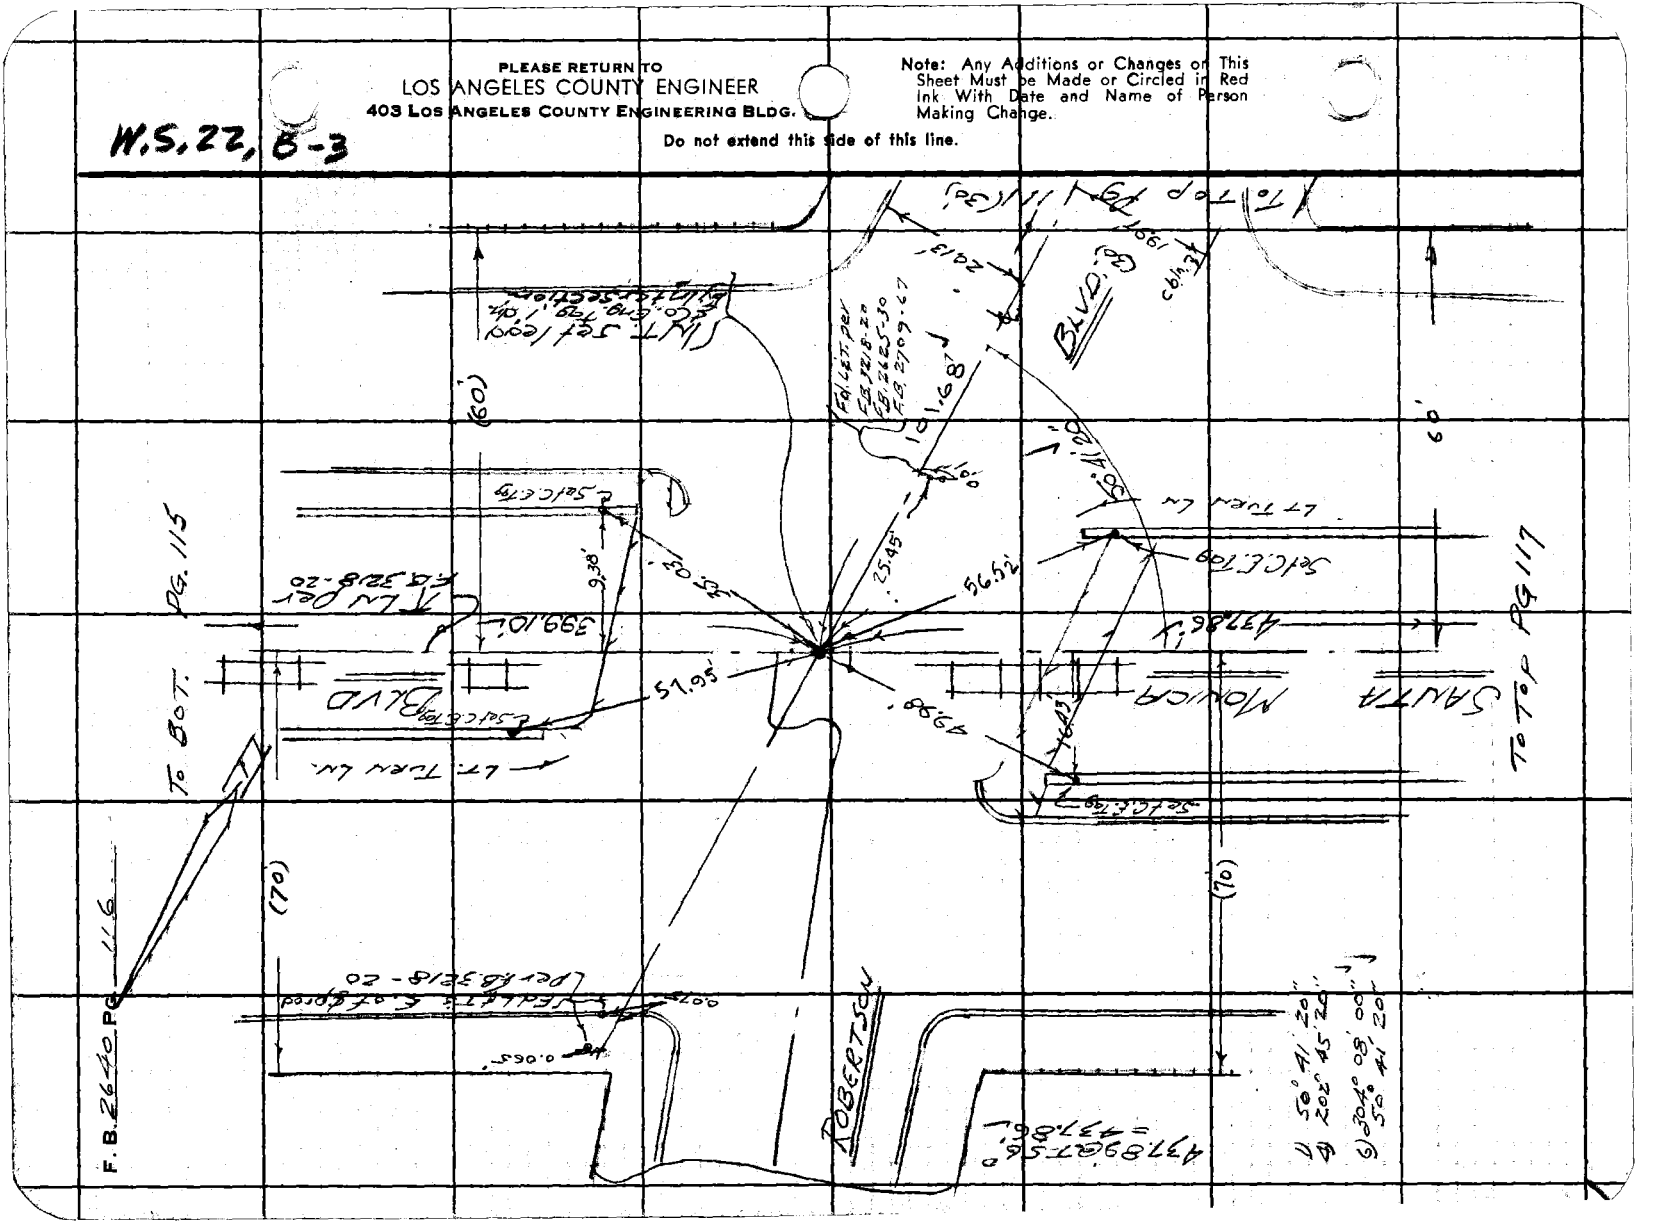
To Top Pg 117
To Bot. Pg. 115
F.B. 2640 Pg. 116
Santa Monica Blvd
Lt. Turn Ln.
(60')
(70')
399.10'
473.86'
51.95'
56.5'
49.88'
30.41'
30.52'
9.38'
0.07'
0.06'

76F309S CE#310 1-65

PLEASE RETURN TO
LOS ANGELES COUNTY ENGINEER
403 LOS ANGELES COUNTY ENGINEERING BLDG.

Note: Any Additions or Changes on This Sheet Must be Made or Circled in Red Ink With Date and Name of Person Making Change.

Do not extend this side of this line.

W.S. 22, 8-3

Notes Ck'd by S. SHINODA
Map No.
Office Work
Checked
Date

Survey of San Vicente Blvd
JN00955 Tape 0241 Std. 68 °F
Surveyed by Franke, Davis
Notes
Indexed C. J. GALLI Date 1-66

F.B. 2640 PG. 117

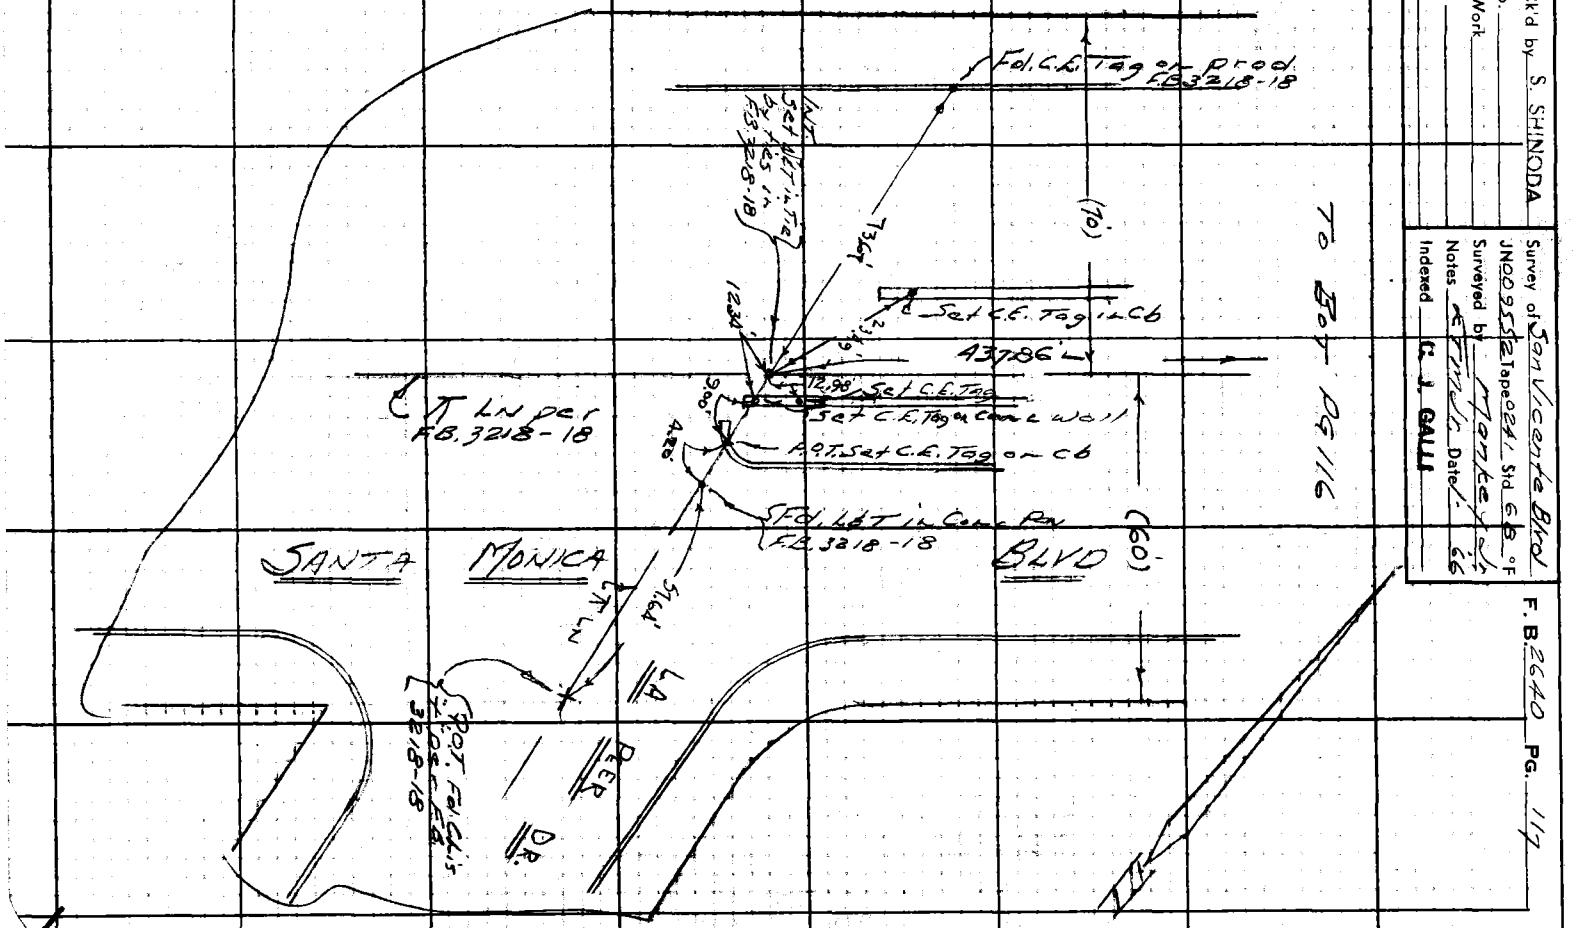

PLEASE RETURN TO
LOS ANGELES COUNTY ENGINEER
403 LOS ANGELES COUNTY ENGINEERING BLDG.

Note: Any Additions or Changes on This Sheet Must be Made or Circled in Red Ink With Date and Name of Person Making Change.

Do not extend this side of this line.

W.S. 22, B-3

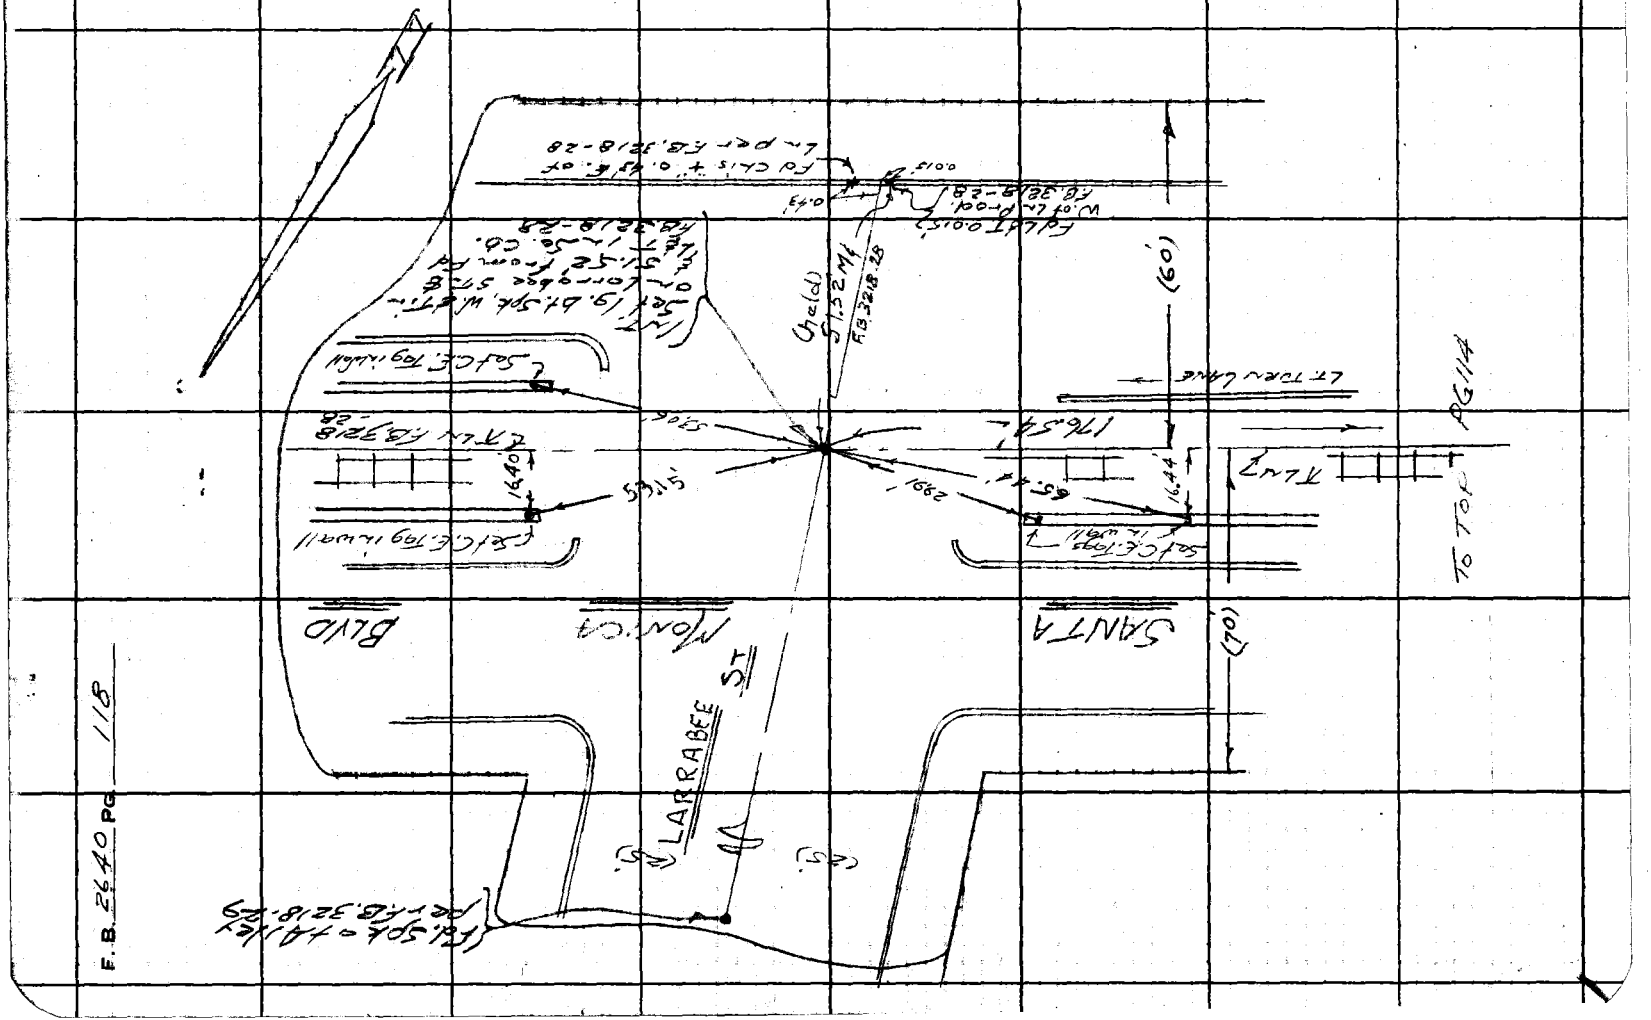

Notes Ck'd by D. SAPPELL	Survey of W. Holly Co. Bldg.
Map No. C.S.B-2996	JN 0021.10 Tape 0241 Std 68 °F
Office Work I. H. BURNS	Surveyed by Monkey Jr.
Checked D. SAPPELL	Notes EPM Jr Date 2-23-66
Date MAR 1966	Indexed C. J. GALLE

F. B 2640 PG. 119

JN 0021.10

WEST HOLLYWOOD COUNTY BLDG.

ALLEY SURVEY

LOT "E", BLOCK 4, TRACT # 5939

and

LOTS 15, 16, 17 of Said BLOCK & TRACT

Monkey Jr.
Peterson
Caro
Clifford

Note: Any Additions or Changes on this Sheet Must be Made or Circled in Red Ink With Date and Name of Person Making Change.

Do not extend this side of this line.

PLEASE RETURN TO
LOS ANGELES COUNTY ENGINEER
403 Los Angeles County Engineering Bldg.

76F309S CE#310 1-65

PLEASE RETURN TO
LOS ANGELES COUNTY ENGINEER
403 LOS ANGELES COUNTY ENGINEERING BLDG.

Note: Any Additions or Changes on This Sheet Must be Made or Circled in Red Ink With Date and Name of Person Making Change.

Do not extend this side of this line.

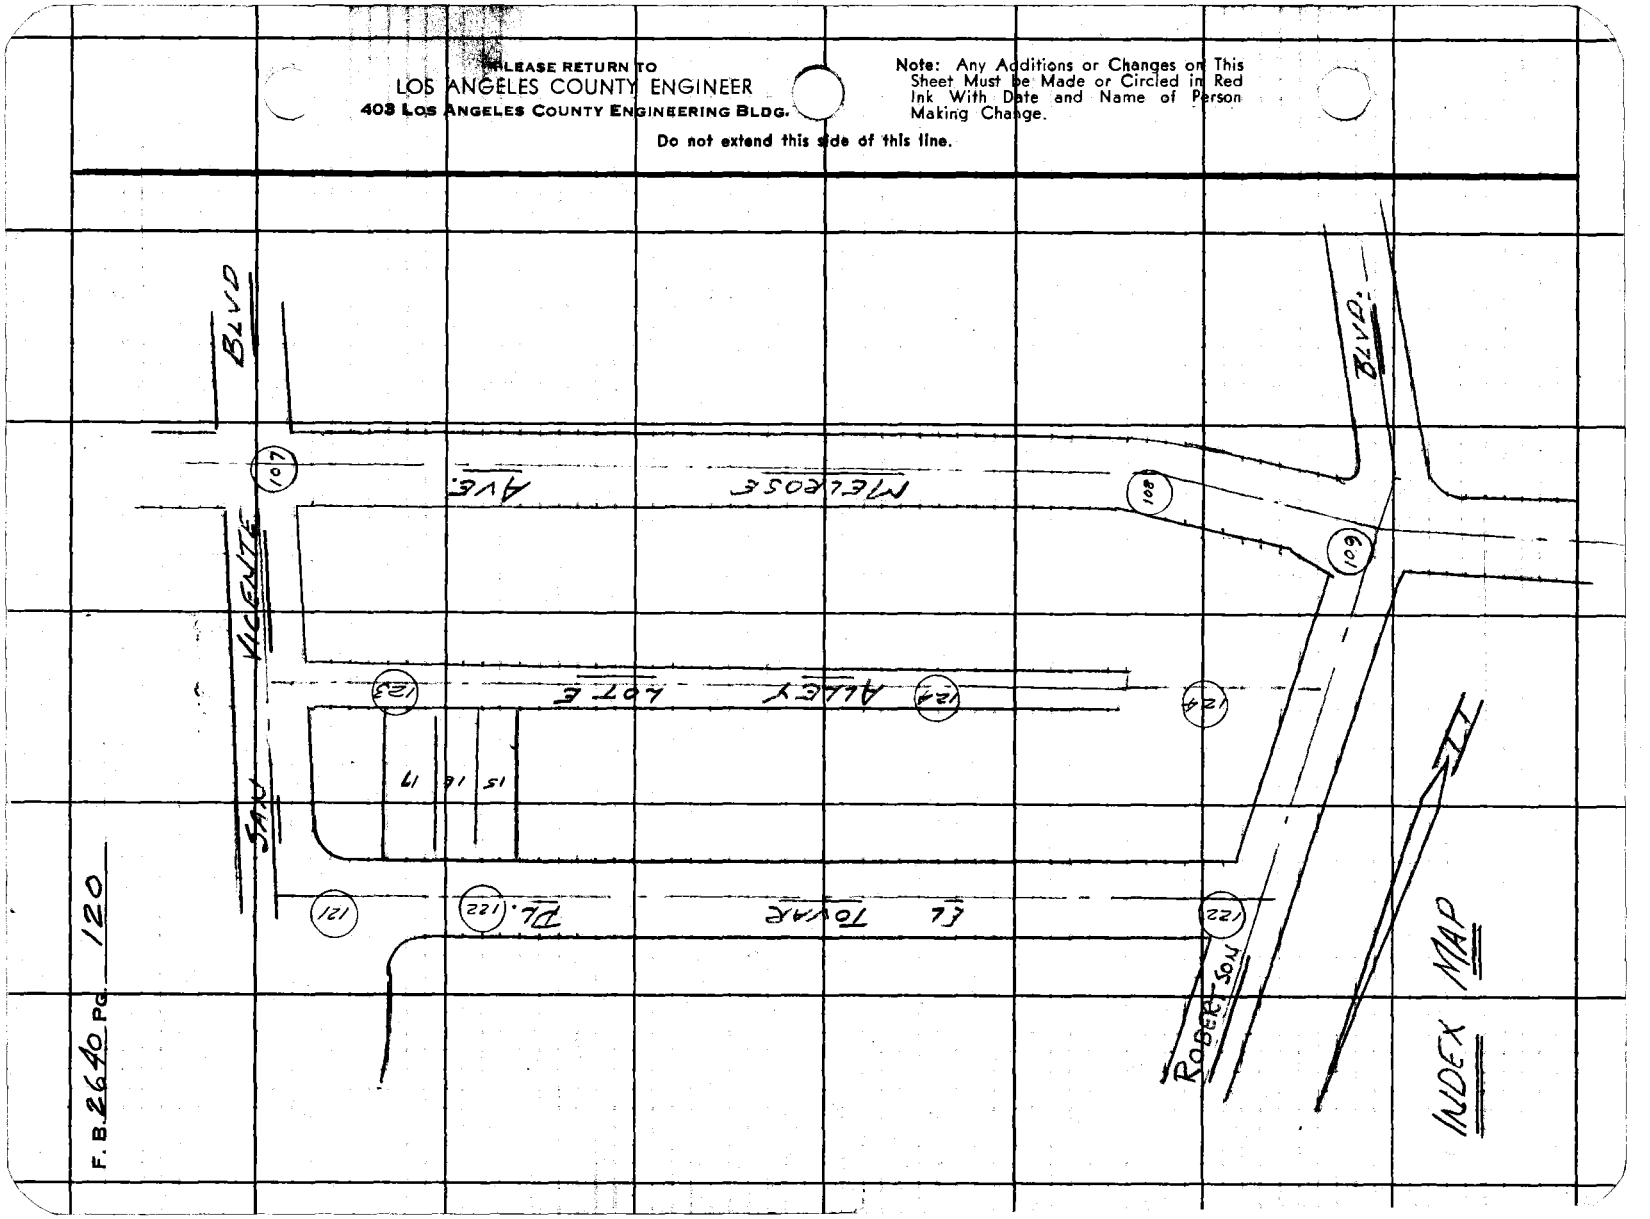

F. B. 2640 PG. 120

Notes Ck'd by D. SAPPELL
Map No. C.S.B-2996
Office Work T. H. BURNS
Checked D. SAPPELL
Date 10 A R 1966

Survey of W. Holly. Co. Bldg.
JN 0021.10 Tape 0241 Std 68 °F
Surveyed by Monkey Jr
Notes E Tm Jr. Date 3-23-66
Indexed C. J. GALLI

F. B. 2640 PG. 121

W.S. 22, B-3

Note: Any Additions or Changes for this Sheet Must be Made or Circled in Red Ink With Date and Name of Person Making Change.

PLEASE RETURN TO
LOS ANGELES COUNTY ENGINEER
403 Los Angeles County Engineering Bldg.
Do not extend this side of this line.

NOTE: Pts. "Fd." & D/ST's Shown in (.) are per F.B. 2640-110

To Top Pg 122

New E/L Alignment

Fd. C.E. Tag 1/2 walk

Fd. 4" Sq. Mon. w/ Tack in C. & G. (Old Ref. Mon.)

Fd. C.E. Tag one foot

Fd. C.E. Tag

Fd. 1/2" I.P. 0.02' N. of E. Prop.

Fd. C.E. Tag on E. Prop.

Fd. C.E. Tag 1/2 walk

Set C.E. Tag in new wk. over C.E. Mon. 10-21-66 E.T.

Set C.E. Mon. flush with S.E. of walk mkd. + as shown

N.E. Prop. Cor.

Set Sq. Hd. Spk. & Tin Flush By Prop. Cor. Between Alhambra Ave. & San Vicente Blvd. per M.B. 62-43

Set C.E. Tag 1/2 wk.

Fd. C.E. Tag

Fd. C.E. Tag

Fd. C.E. Tag

PLEASE RETURN TO
LOS ANGELES COUNTY ENGINEER
403 LOS ANGELES COUNTY ENGINEERING BLDG.

Note: Any Additions or Changes on This Sheet Must be Made or Circled in Red Ink With Date and Name of Person Making Change.

Do not extend this side of this line.

W.S. 22, B-3

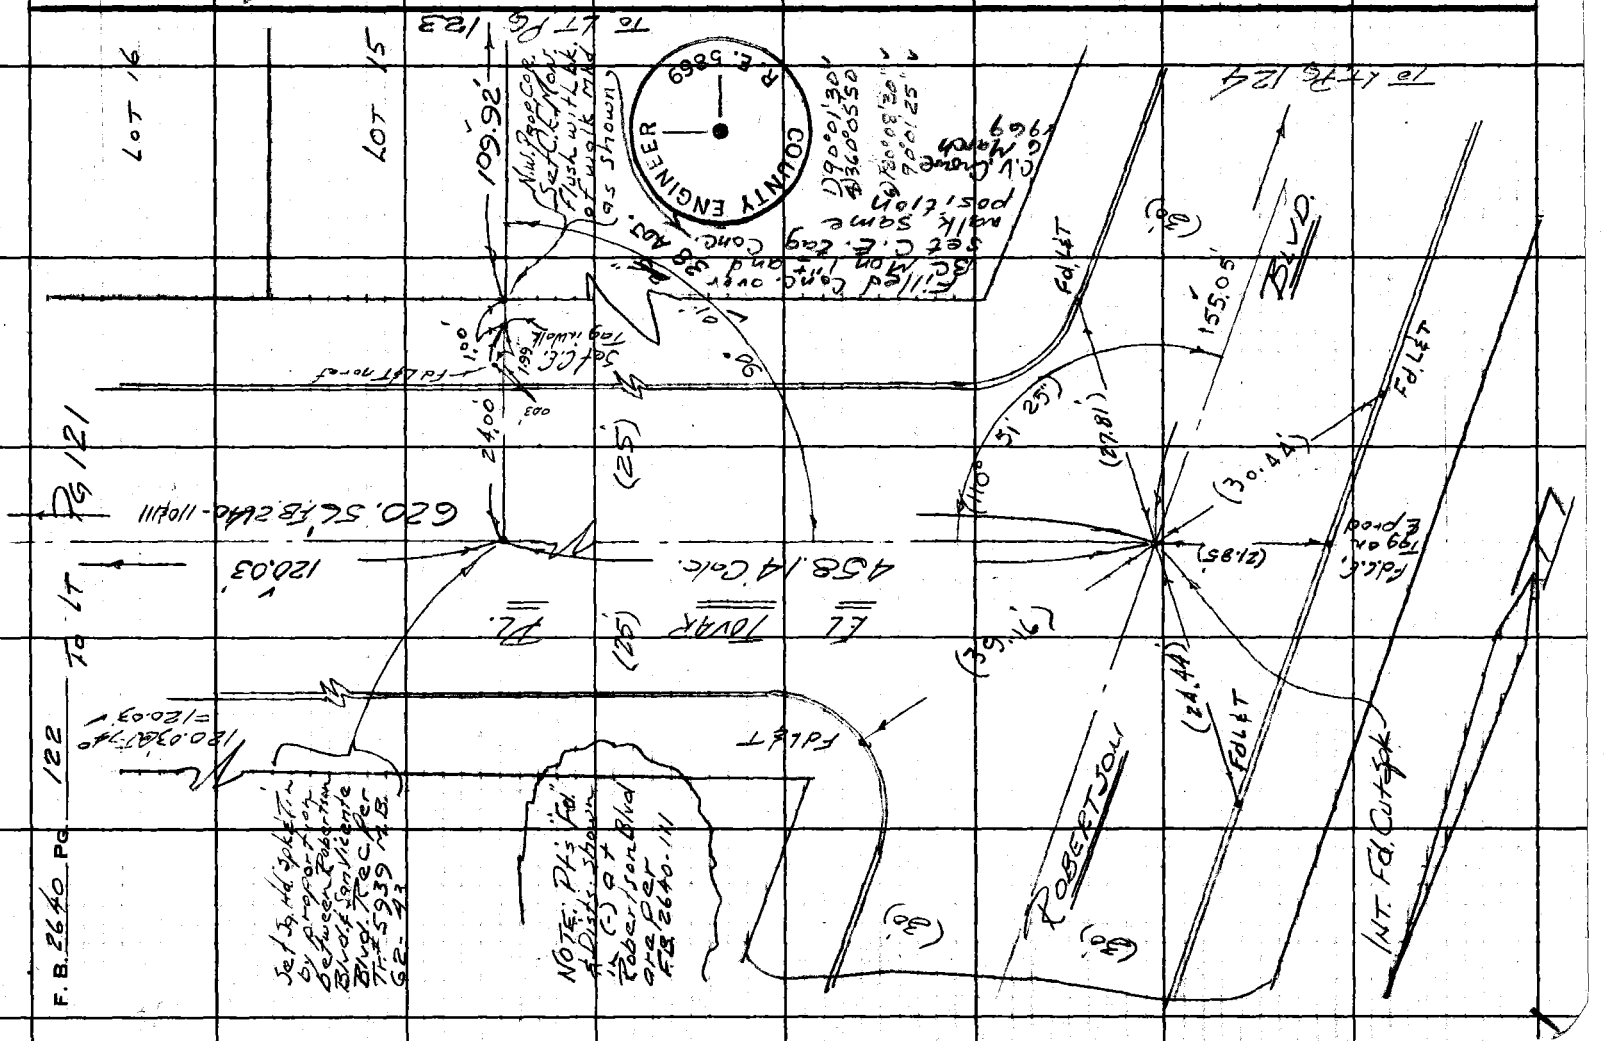

Notes Ck'd by D. SAPPELL	Survey of W. Holly Co. Bldg.
Map No. C.58-2996	JN 0021-10 Tape 0241 Std 68 °F
Office Work T. H. BURNS	Surveyed by Monkey Jr.
Checked D. SAPPELL	Notes Sty Jr. Date 3-24-66
Date MAR 1968	Indexed C. J. GALLI

F. B. 2640 Pg. 123

Note: Any Additions or Changes on This Sheet Must be Made or Circled in Red Ink With Date and Name of Person Making Change.

W, S, 22, B-3

PLEASE RETURN TO
LOS ANGELES COUNTY ENGINEER
403 Los Angeles County Engineering Bldg.
Do not extend this side of this line.

145.64' @ T 84° = 145.66' ✓

Set C.E. Tag in walk

Fd. Chis. "X" in Conc. Slab Bldg. #616

Set C.E. Tag in walk of & Prod

Set nothing

35°58'40" Doubled

Estab. by prop. between El Tovar Pl. & Melrose Ave. per TR #5939 M.B. 62-43 Set Nothing

75.5'

Calc. 145.70

43°00'20" Doubled

D.S. 4-6-66

28.62

29.16 Calc.

145.66 Calc.

SAN VICENTE BLVD.

To Top Pg 107

145.66

145.94' .70

New Alignment

Set nothing

2.01

To Bot Pg 121

J.C.P. Prop. Cor. Set C.E. Mon. dn. 12" mkd as shown

84° 01' 30" 339.72' 57.74'

Set C.E. Tag by ~~Proportion between Pl. Tovar Pl. & Melrose Ave. Rec. for TR #5939 M.B. 62-43~~

109.91' 109.92 Adj. D.S.

2.00 1000

Set 1"x2" Stk. & tail by Proportion between Robertson Blvd & San Vicente Blvd per Record TR 5939 M.B. 62-43 Flush

57.73' @ T 84° = 57.74' ✓

LOT 17

1) 84°01'30" 4) 336°06'10" 1) 89°58'00" 4) 359°55'50"

89°58'30"

Set 1" I.P. Conc. Plug, & C.E. Tag 6" dn

6) 144°09'10" ✓ 84°01'32" ✓ 6) 179°53'50" ✓ 89°58'58" ✓

LOT 16

ALLEY (10') (LOT E) (10')

129.01 @ T 80° = 129.09' ✓

1290.2

2.00 ± off set Ln

109.91 @ T 80° = 109.92' ✓

LOT 15

109.92'

2.00 10.00

Set 1"x2" Stk. & nail flush by proportion between Robertson Blvd & San Vicente Blvd per Record TR 5939 M.S. 62-43

S.W. Prop. Cor. Set 1" I.P. Conc. Plug, & C.E. Tag in concrete 6" above alley Grade

Set 1" I.P. Conc. Plug & C.E. Tag 6" dn

89°58'30" 240.08' ADJ.

1) 89°58'30" ✓ 4) 359°53'30" 6) 179°59'30" ✓ 89°58'25" ✓

To Top Pg 124

COUNTY ENGINEER R.E. 5698

76F3095 CE#3101-65

PLEASE RETURN TO
LOS ANGELES COUNTY ENGINEER
403 LOS ANGELES COUNTY ENGINEERING BLDG.

Note: Any Additions or Changes on This Sheet Must be Made or Circled in Red Ink With Date and Name of Person Making Change.

Do not extend this side of this line.

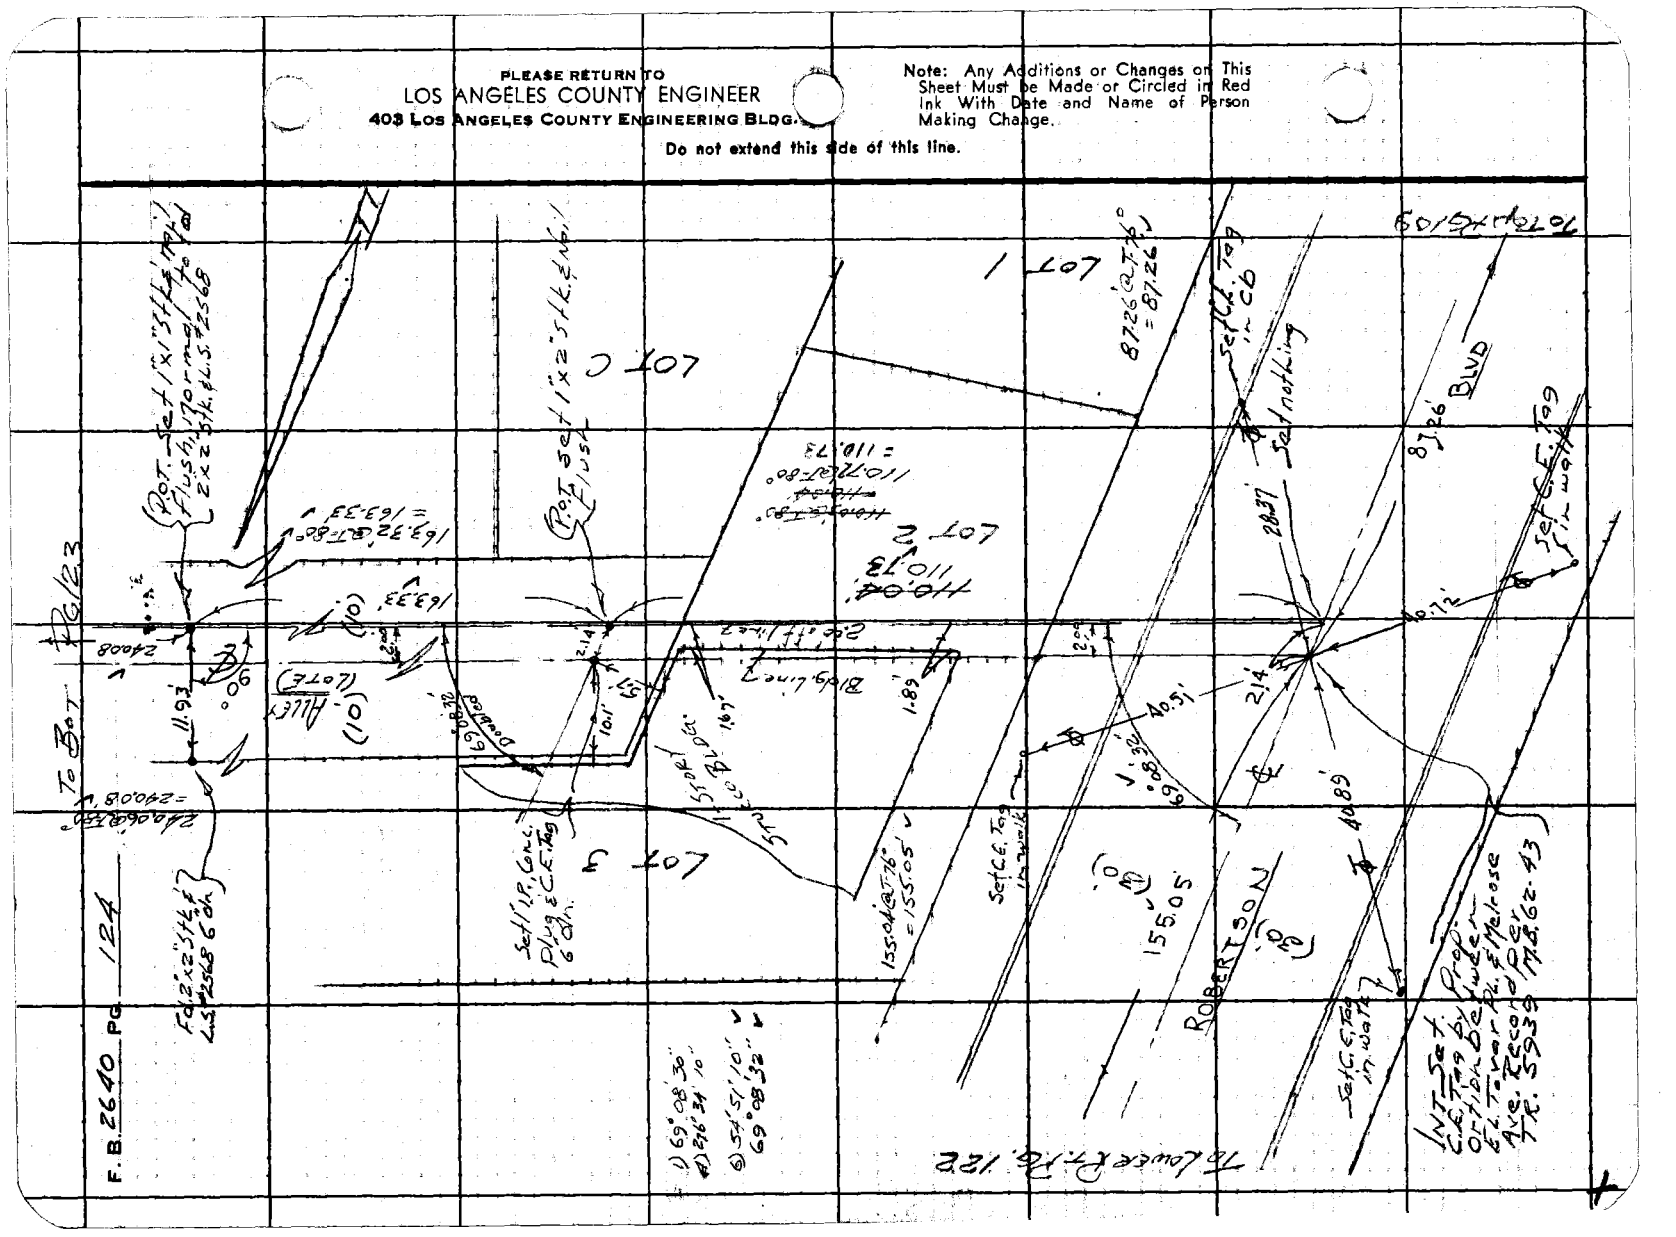

F. B. 2640 PG. 125

NOTES RED. _____ JOB NO. 0021.10 SURVEY OF W. HOLLYWOOD CO. BLDG.
DATE _____ SURVEY BY Mankey
NOTES CHKD. _____ NOTES BY ETM Jr. DATE 3-25-66
DATE _____ INDEXED C. J. CALL DATE MAR 31 '66

NOTE: ANY ADDITIONS OR CHANGES ON THIS SHEET MUST BE MADE OR CIRCLED IN RED INK, WITH DATE AND NAME OF PERSON MAKING CHANGE.

PLEASE RETURN TO
LOS ANGELES COUNTY SURVEYOR
725 LOS ANGELES COUNTY ENGINEERING BLDG.

Do not extend notes this side of this line

DESCRIPTION	ADJ. ELEV.	3RD RUN	2ND RUN	DIFF.	1ST RUN	B.M.
J/N 0021.10 WEST HOLLYWOOD CO. BLDG. BENCH's Mankey Jr Peterson Caro Clifford						

765420 353 3-51

765420 353 3-51

PLEASE RETURN TO
LOS ANGELES COUNTY SURVEYOR
725 LOS ANGELES COUNTY ENGINEERING BLDG.

NOTE: ANY ADDITIONS OR CHANGES ON THIS SHEET MUST BE MADE OR CIRCLED IN RED INK, WITH DATE AND NAME OF PERSON MAKING CHANGE.

JOB NO. 00221.10 SURVEY OF W. Holly Co. Bldg. NOTES RED.
SURVEY BY Manley & Co. DATE NOTES CK'D R. SAPPELL
NOTES BY E. J. GALLI DATE 3-25-66 DATE
INDEXED DATE DATE

F.B. 2640 Pg. 126

Do not extend notes this side of this line

B.M.	1ST RUN	DIFF.	2ND RUN	3RD RUN	ADJ. ELEV.	DESCRIPTION
B.M. MW-83 (Fd)	215.981				215.981	B.M. M.W. 83 EL. 215.981 FB 2197-44 SAN VICENTE BLVd & SAN MONICA BLVd. S.E. COR BT. SPK IN CRUb 2.0 E OF END S.E. CRUb RET.
+	1.035					
π	217.016					
−	11.995					
B.M. #1 (Fd)	205.021	✓				B.M. #1 EL 205.088 FB 2197-44 San Vicente Blvd., W. Cb., Bt. Spk. in Cb 50' N. of S. Ln. of existing tennis Courts
+	0.693					
π	205.714					
−	9.382					
T.P.	196.332	✓				
+	4.002					
π	200.334					
−	6.623					
B.M. #2 (Fd)	193.711	✓				B.M. #2 EL 193.885' FB 2197-43 San Vicente Blvd., W. side, Bt. Spk. in Cb. 105' N. of ℄ Conc. Steps to Rec. Bldg. (West Hollywood Park)
+	1.252					
π	194.963					
−	10.123					
T.P.	184.840	✓				
+	4.538					
π	189.378					
−	5.565					
B.M. N.E. Cor (Set)	183.813	✓				B.M. N.E. Cor. EL FB 2640-126 San Vicente Blvd ℄ El Tovar PL. S.W. Cor. C.E. Mon. at N.E. Cor. Co. Bldg. Site (Location Pg. 121
+	3.727					
π	187.540					
−	6.582					
B.M. S.E. Cor (Set)	180.958	✓				B.M. S.E. Cor. EL. FB 2640-126 C.E. Mon. (12" dn) S.E. Cor. Co. Bldg Site Pg 123 for location (FB 2640)
+	6.987					
π	187.945					
−	3.830					
B.M. S.W. Cor (Set)	184.115	✓				B.M. S.W. Cor. EL FB. 2640-126 C.E. Tag, conc. plug, & 1" I.P. set in conc. at S.W. Cor Co. Bldg Site Location FB 2640-123

769420 353 3-51

PLEASE RETURN TO
LOS ANGELES COUNTY SURVEYOR
725 LOS ANGELES COUNTY ENGINEERING BLDG.

NOTE: ANY ADDITIONS OR CHANGES ON THIS SHEET MUST BE MADE OR CIRCLED IN RED INK, WITH DATE AND NAME OF PERSON MAKING CHANGE.

Do not extend notes this side of this line

NOTES RED. DATE
NOTES CHKD. SAPPELL DATE
DATE INDEXED C. J. GALLI DATE


F. B. 2640 PG. 127

B.M.	1ST RUN	DIFF.	2ND RUN	3RD RUN	ADJ. ELEV.	DESCRIPTION
						B.M. S.W. Cor. E.L. FB 2640-126
B.M. S.W. Cor (Set)	184.115 ✓					C.E. Tag, Conc. Plug, & ½" I.P. set in Conc.
+	4.926					+ S.W. Prop. Cor. Co. Bldg. Site (Located 3E) FB 2640-123
∧	189.041					
- (Set)	2.811					
B.M. N.W. Cor.	186.230 ✓					B.M. N.W. Cor. E.L. FB 2640-127
+	5.794					E.L. Tower P.L. (50 Rw.) & 190± W. of
∧	192.024					San Vicente Blvd, New Alignment, &
-	3.962					C.E. Mon. at N.W. Cor. Co. Bldg. Site
T.P.	188.062 ✓					
+	9.378					
∧	197.440					
-	1.114					
T.P.	196.326 ✓					
+	9.415					
∧	205.741					
-	0.722					
T.P.	205.019 ✓					
+	11.925					
∧	216.944					
-	0.970					
B.M. M.W.-83 (Fd)	215.974 ✓					B.M. M.W. 83 El. 215.981 FB. 2197-11
						San Vicente Blvd & Santa Monica Blvd
						S.E. Cor. Bk. Spk. in Cb. 2.0 E. of
						E. end S.E. Cb. Ref.

F.B. 2640 Pg. 125

JOB NO. _____ SURVEY OF _____ NOTES RED. _____

SURVEY BY _____ DATE _____

NOTES BY _____ DATE _____ NOTES CHKD. _____

INDEXED _____ DATE _____ DATE _____

B.M.	1ST RUN	DIFF.	2ND RUN	3RD RUN	ADJ. ELEV.	DESCRIPTION

Do not extend notes this side of this line

NOTE: ANY ADDITIONS OR CHANGES ON THIS SHEET MUST BE MADE OR CIRCLED IN RED INK, WITH DATE AND NAME OF PERSON MAKING CHANGE.

PLEASE RETURN TO

LOS ANGELES COUNTY SURVEYOR

725 LOS ANGELES COUNTY ENGINEERING BLDG.

765420 353 3-51

Notes Ck'd by D. SAPPELL	Survey of W.H. RD. DEPT/YARD #301	F. B. 2640	PG. 129
Map No. B-2996	JN 0779.95 Tape 0203 Std 68 °F		
Office Work I. H. BURNS	Surveyed by J. TERRANOVA		
Checked D. SAPPELL	Notes J.T. Date 6-10-66		
Date JUN 1966	Indexed H. E. OTT JUN 17 '66		

Note: Any Additions or Changes on This Sheet Must be Made or Circled in Red Ink With Date and Name of Person Making Change.

Do not extend this tide of this line.

PLEASE RETURN TO
LOS ANGELES COUNTY ENGINEER
403 LOS ANGELES COUNTY ENGINEERING BLDG.

WEST HOLLYWOOD ROAD DEPARTMENT MAINTENANCE YARD 301

CENTERLINE RETRACEMENT & PROP. CORNERS. - W'LY. LINE OF LOT 6 & E'LY LINE OF LOT 10 - TRACT NO. 5939.

J.N. 0779.95

JUNE 1966

REF: F.B. 2640 -

PARTY
J. TERRANOVA
C. YASUI
G. MASUDA
H. DIETZ

76F309S CE#310 1-65

PLEASE RETURN TO
LOS ANGELES COUNTY ENGINEER
403 LOS ANGELES COUNTY ENGINEERING BLDG.

Note: Any Additions or Changes on This Sheet Must be Made or Circled in Red Ink With Date and Name of Person Making Change.

Do not extend this side of this line.

F. B. 2640 PG. 130

INDEX

SAN VICENTE BLVD.

(131)

(132)

(133)

(134)

EL TOVAR PL.

LOT E

RAGLEY

LOT 11

LOT 10

PRO. RD. DEPT. YARD # 301

LOT 6

LOT 3

LOT 4

LOT 5

ROBERTSON BLVD.

76F309S CE#310 1-65

PLEASE RETURN TO
LOS ANGELES COUNTY ENGINEER
403 LOS ANGELES COUNTY ENGINEERING BLDG.

Note: Any Additions or Changes on This Sheet Must be Made or Circled in Red Ink With Date and Name of Person Making Change.

Do not extend this side of this line.

W.S. 22, B-3

Notes Ck'd by D. SAPPELL
Map No. B-2996
Office Work T. H. BURNS
Checked D. SAPPELL
Date JUN 1966

Survey of W.H. CO. DEPT. ROAD "32"
JN 377995 Tape 0203 Std. 66 °F
Surveyed by J. TERRANOVA
Notes
Indexed H. E. OTT Date 6-7-66

F. B. 2640 PG. 131

TP RG. 132

EL TOVAR PL.

FD. SQ SPK. & T. NO REF.

T = 78 19.45 @ 0-00 = 19.45
42.59 @ 0-00 = 42.59
19.56 @ 0-00 = 19.56

T = 74 92.34 @ 0-00 = 92.34
99.22 @ 0-00 = 99.22

96.32 21 ADJ. TO ROBERTSON

91.56 ADJ. 92.34 ADJ.

(25) 649.68(M) 649.68(R) (25)

FD. C.E. TAG & NL IN CB. F.B. 2640-121

SAN VICENTE BLVD.

42.59

℄

19.56

19.45

FD. C.E. TAG & NL IN CB. F.B. 2640 - 121

FD. L&T IN CURB F.B. 2640 - 121

.02

INT. FD 4 TAN P.M.'S ON MAN HOLE RIM F.B. 2640-121

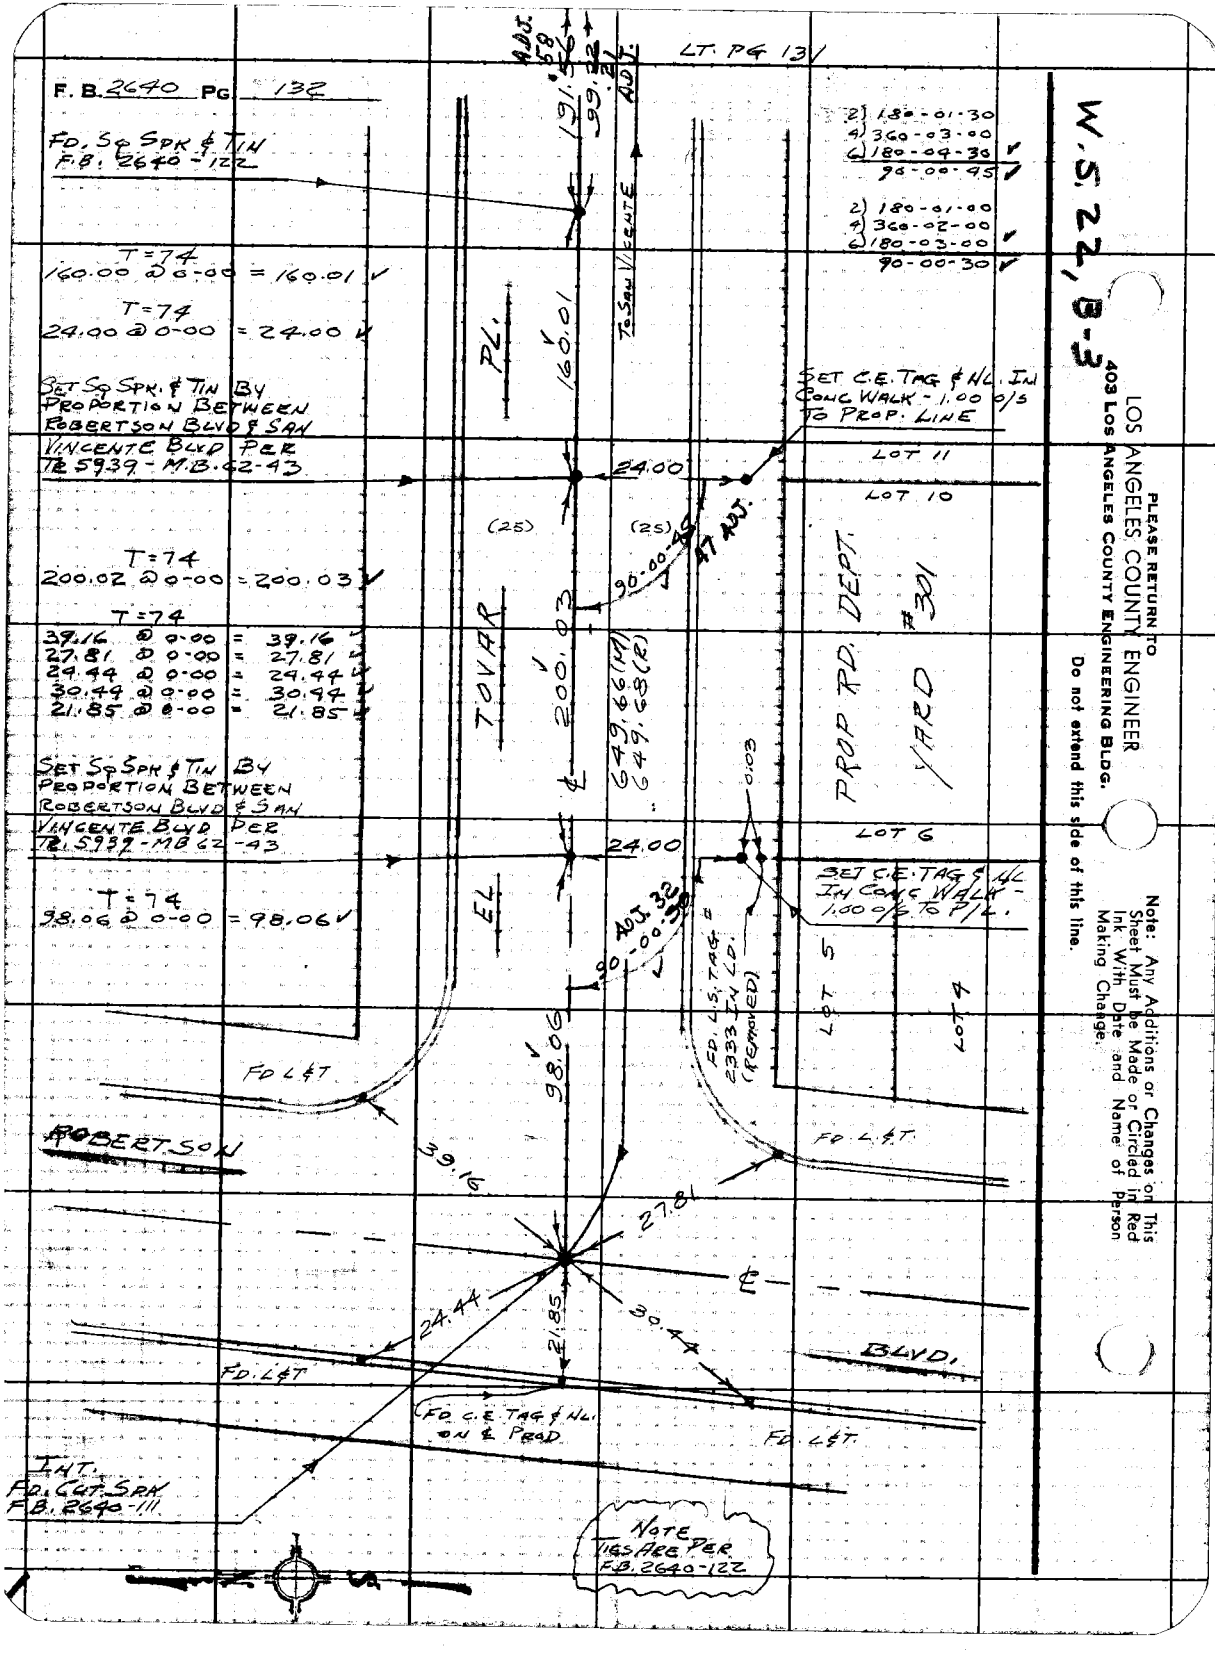
F. B. 2640 PG 132
FD. SQ SPK & TIN
F.B. 2640 - 122
T=74
160.00 @ 0-00 = 160.01
T=74
24.00 @ 0-00 = 24.00
SET SQ SPK & TIN BY PROPORTION BETWEEN ROBERTSON BLVD & SAN VINCENTE BLVD PER TR 5939 - M.B. 62-43
T=74
200.02 @ 0-00 = 200.03
T=74
39.16 @ 0-00 = 39.16
27.81 @ 0-00 = 27.81
24.44 @ 0-00 = 24.44
30.44 @ 0-00 = 30.44
21.85 @ 0-00 = 21.85
SET SQ SPK & TIN BY PROPORTION BETWEEN ROBERTSON BLVD & SAN VINCENTE BLVD PER TR 5939 - MB 62 - 43
T=74
98.06 @ 0-00 = 98.06
FD L & T
ROBERTSON
I.H.T.
FD. CUT SPK
F.B. 2640 - 111
ADJ. 58
99.32
LT. PG 131
191.32
TO SAN VICENTE
PL.
160.01
2) 180-01-30
4) 360-03-00
6) 180-04-30
90-00-45
2) 180-01-00
4) 360-02-00
6) 180-03-00
90-00-30
SET C.E. TAG & N/L IN CONC WALK - 1.00 O/S TO PROP. LINE
24.00
LOT 11
LOT 10
(25)
(25)
90-00-45
47 ADJ.
TOVAR
200.03
649.66 (M)
649.68 (E)
PROP. DEPT. #301
1/1200
LOT 6
0.03
SET C.E. TAG & N/L IN CONC WALK - 1.00 O/S TO P/L.
24.00
EL
ADJ. 32
90-00-30
FD. 4.5" TAG & 2333 IN L.D. (REMOVED)
LOT 5
LOT 4
98.06
39.16
27.81
24.44
30.44
21.85
FD L & T
FD L & T
BLVD.
FD. L & T
FD. C.E. TAG & N/L ON E PROD.
NOTE TIES HERE PER F.B. 2640-122
W.S. 22, B-3
LOS ANGELES COUNTY ENGINEER
403 Los Angeles County Engineering Bldg.
PLEASE RETURN TO
Do not extend this side of this line.
Note: Any Additions or Changes on This Sheet Must be Made or Circled in Red Ink With Date and Name of Person Making Change.

Notes Ck'd by D. SAPPELL	Survey of W.H.B. DEPT. YARD #301
Map No. B-2996	JN 07795 Tape 0203 Std 68 °F
Office Work T. H. BURNS	Surveyed by J. TERRANOVA
Checked D. SAPPELL	Notes J.T. Date 6-9-66
Date JUN 1966	Indexed H. E. OTT

F. B. 2640 PG. 133

Note: Any Additions or Changes on This Sheet Must be Made or Circled in Red Ink With Date and Name of Person Making Change.

PLEASE RETURN TO LOS ANGELES COUNTY ENGINEER 403 Los Angeles County Engineering Bldg.

Do not extend this side of this line.

NOTHING SET F.B. 2640-123

SAN VICENTE BLVD.

FD. C.E.TAG & NL. IN DRIVE F.B. 2640-123

FD. 1" I.P. W/ CONC. PLUG & C.E.TAG & NL. DH. 6" F.B. 2640-123

FD. 1" I.P. W/ CONC. PLUG & C.E.TAG & NL. DH. 6" F.B. 2640-123

PROP. COR. SET 2" I.P. W/ CONC. PL. C.E.TAG & NL. FLUSH

SET 1" I.P. W/ CONC. PL. C.E. TAG & NL. BY PROPORTION BETWEEN ROBERTSON BLVD. & SAN VICENTE BLVD. TR. 5939 M.B. 62-93 DH. 6"

57.53 @ 0-00 T=80 = 57.53
119.99 @ 0-00 T=80 = 120.00
160.03 @ 0-00 T=80 = 160.04
200.02 @ 0-00 T=82 = 200.04

2) 180-01-30
4) 360-03-00
5) 180-04-30
90-00-45

LOT 11

LOT 10

PROP. ED. DEPT. YARD #301

LOT E

ALLEY

23.76(E)

57.53

120.00

140.04

200.04

720; 0

720; 0

90-00-00

(10)

T(10)

10.00

TO ROBERTSON

TP. DG. 134

F6F309S CE#310 1-65

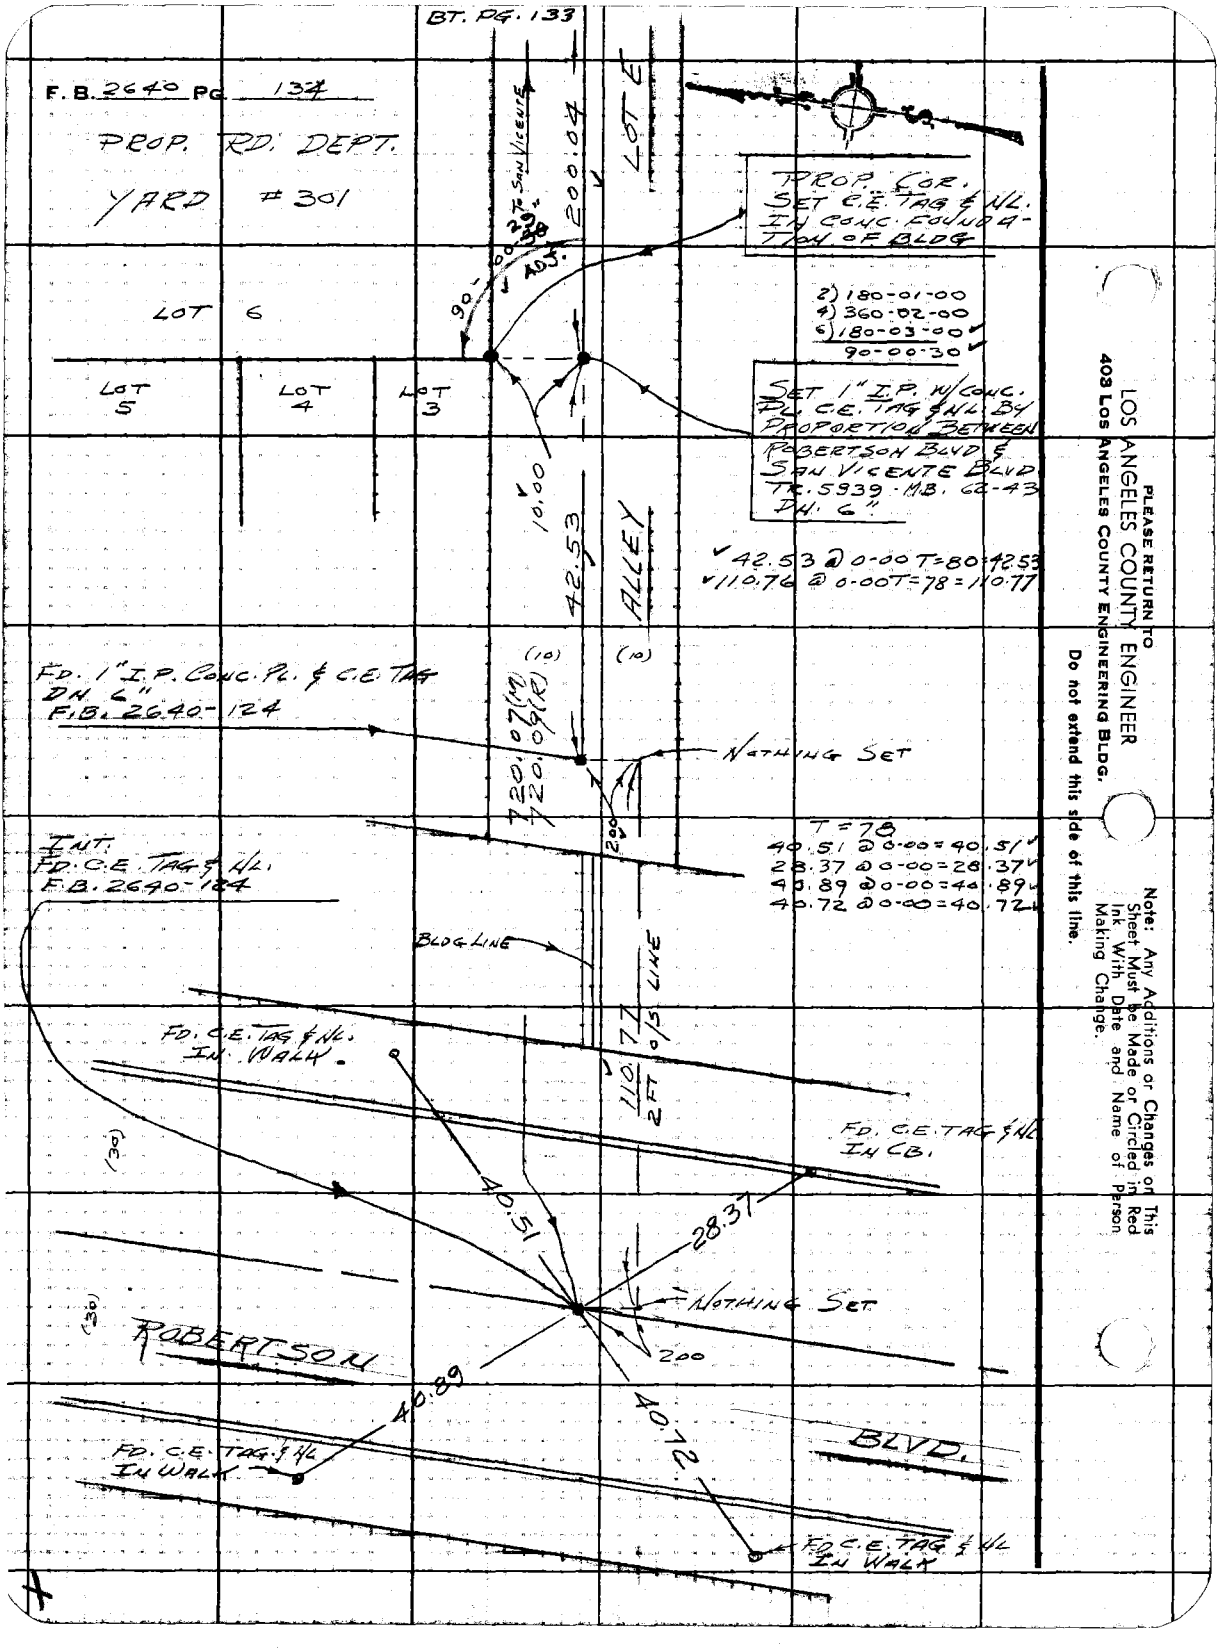
BT. PG. 133
F.B. 2640 PG. 134
PROP. RD. DEPT.
YARD # 301
LOT E
SAN VICENTE
200.04
PROP. COR. SET C.E. TAG & NL. IN CONC. FOUNDATION OF BLDG
2) 180-01-00
4) 360-02-00
6) 180-03-00
90-00-30
LOT 6
LOT 5
LOT 4
LOT 3
SET 1" I.P. W/CONC. PL. C.E. TAG & NL. BY PROPORTION BETWEEN ROBERTSON BLVD. & SAN VICENTE BLVD. TR. 5939 · MB. 62-43 DH. 6"
10.00
42.53
ALLEY
42.53 @ 0-00 T=80=42.53
110.76 @ 0-00 T=78=110.77
FD. 1" I.P. CONC. PL. & C.E. TAG DH 6" F.B. 2640-124
(10)
(10)
NOTHING SET
200
INT. FD. C.E. TAG & NL. F.B. 2640-124
T=78
40.51 @ 0-00 = 40.51
28.37 @ 0-00 = 28.37
40.89 @ 0-00 = 40.89
40.72 @ 0-00 = 40.72
BLDG LINE
110.77
0/S LINE
2 FT
FD. C.E. TAG & NL. IN WALK.
FD. C.E. TAG & NL. IN CB.
(30)
40.51
28.37
NOTHING SET
200
(30)
ROBERTSON
BLVD.
40.89
40.72
FD. C.E. TAG & NL. IN WALK
FD. C.E. TAG & NL. IN WALK
PLEASE RETURN TO
LOS ANGELES COUNTY ENGINEER
403 Los Angeles County Engineering Bldg.
Do not extend this side of this line.
Note: Any Additions or Changes on This Sheet Must be Made or Circled in Red Ink With Date and Name of Person Making Change.

Notes Ck'd by D. SAPPELL	Survey of W.H. Co. Dept. Yard # 301
Map No.	JN 0779.95 Tape Std °F
Office Work	Surveyed by J. TERRANOVA
Checked JUN 1966	Notes C.Y. Date 6-10-66
Date	Indexed

F. B. 2640 PG. 135

WEST HOLLYWOOD ROAD DEPARTMENT
MAINTENANCE YARD 301

BENCH MARKS AT JOB SITE
P.T. SH. - H-100

J.N. 0779.95

JUNE 1966

REF: F.B. 2640-125

PARTY
J. TERRANOVA
C. YASUI
G. MASUDA
W. DIETZ

Note: Any Additions or Changes on This Sheet Must be Made or Circled in Red Ink With Date and Name of Person Making Change.

Do not extend this side of this line.

PLEASE RETURN TO
LOS ANGELES COUNTY ENGINEER
403 LOS ANGELES COUNTY ENGINEERING BLDG.

76F309S CE#310 1-65

F. B. 2640 PG 136

INDEX

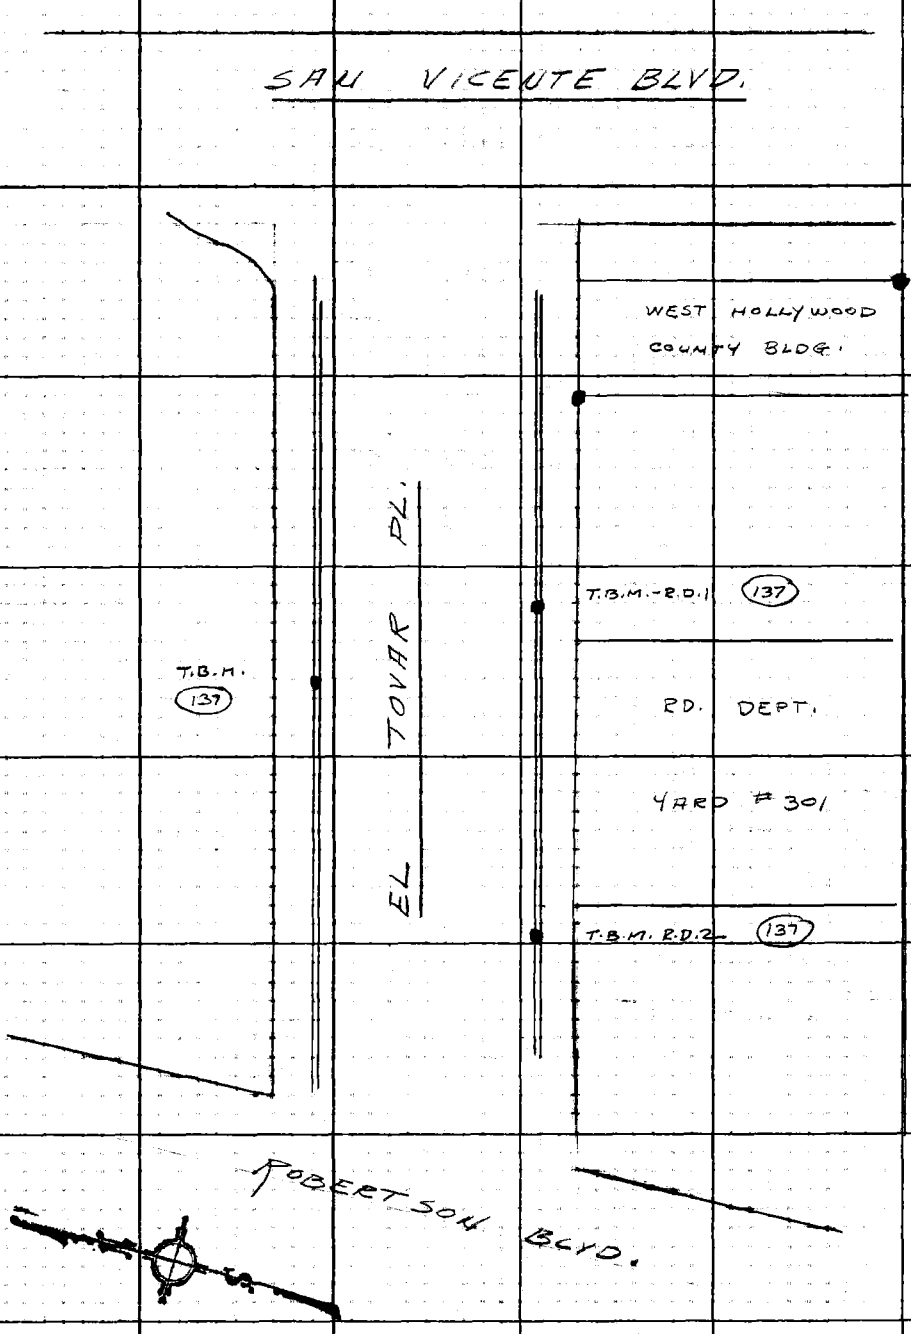

PLEASE RETURN TO
LOS ANGELES COUNTY ENGINEER
403 Los Angeles County Engineering Bldg.

Do not extend this side of this line.

Note: Any Additions or Changes on This Sheet Must be Made or Circled in Red Ink With Date and Name of Person Making Change.

768420 S & E-353 4-54

PLEASE RETURN TO
LOS ANGELES COUNTY SURVEYOR
725 LOS ANGELES COUNTY ENGINEERING BLDG.

NOTE: ANY ADDITIONS OR CHANGES ON THIS SHEET MUST BE MADE OR CIRCLED IN RED INK, WITH DATE AND NAME OF PERSON MAKING CHANGE.

Do not extend notes this side of this line

NOTES RED. JOB NO. 0772.25 SURVEY OF W.H.WY. RD. DEPT YARD # 301
DATE SURVEY BY J. TERRANOVA
NOTES CHK'D. NOTES BY C.Y. DATE 6-10-66
DATE INDEXED H.E.O.T. DATE

F.B. 2640 PG. 137

B.M.	1ST RUN	DIFF.	2ND RUN	3RD RUN	ADJ. ELEV.	DESCRIPTION
B.M. S.E Cor.	180.958					B.M. S.E. COR. EL. = 180.958 FD. C.S. MON DN. 12" S.E. COR. CO. BLDG SITE F.B. 2640-123, 126
+	9.337		9278			
⊼	190.295	+5.268	+5.268			
−	4.069		4.010			
B.M. N.W. Cor	186.226	✓				B.M. N.W. COR. EL. = 186.280 - EL TOVAR PL. (SLY R/W) & 190± W OF SAN VICENTE BLVD. NEW ALIGNMENT FD. C.S. MON. @ N.W. COR. CO. BLDG SITE F.B. 2640-127
+	6.932		6.841			
⊼	193.158	+3.359	+3.359			
−	3.573		3.482			
T.B.M.-R.D.1	189.585	✓				T.B.M.-R.D.1 EL. = EL TOVAR PL. 299± E. OF ROBERTSON BLVD. 1FT ELY OF ELY P/L OF PROPOSED RD. DEPT. YARD # 301, SET BT. SPK IN LD, TOP OF CURB, S. SIDE OF EL TOVAR PL.
+	7.085		7.032			
⊼	196.670	+2.071	+2.070			OUT 12/70 J.T.
−	5.014		4.962			
T.B.M.-	191.656	✓				T.B.M. EL. = EL TOVAR PL. 230± E. OF ROBERTSON BLVD. FD. BT. SPK IN LD. TOP OF CURB, N. SIDE OF EL TOVAR PL. NO. REF.
+	7.409		7.278			
⊼	199.065	+1.807	+1.806			OUT 12/70 J.T.
−	5.602		5.472			
T.B.M.-R.D.2	193.463	✓				T.B.M.-R.D.2 EL. = EL TOVAR PL. 96± E. OF ROBERTSON BLVD. 2 FT. WLY OF WLY P/L OF PROPOSED RD. DEPT. YARD # 301, SET BT. SPK. IN LD, TOP OF CURB, S. SIDE OF EL TOVAR PL.
+	4.902		4.803			
⊼	198.365	-2.655	-2.656			OUT 12/70 J.T.
−	7.557		7.459			
T.P.	190.808	✓				
+	3.714		3.591			
⊼	194.522	-3.842	-3.844			
−	7.556		7.435			
T.P.	186.966	✓				
+	3.382		3.479			
⊼	190.348	-6.000	6.000			
−	9.382		9.479			
B.M. S.E. Cor.	180.966	✓				SEE DISC. AT BEGIN. OF CIRCUIT

F. B. 2640 Pg. 138

JOB NO. _____ SURVEY OF _____ NOTES RED. _____

SURVEY BY _____ DATE _____

NOTES BY _____ DATE _____ NOTES CHKD. _____

INDEXED _____ DATE _____ DATE _____

765420 S & E-333 4-54

PLEASE RETURN TO

LOS ANGELES COUNTY SURVEYOR

723 LOS ANGELES COUNTY ENGINEERING BLDG.

NOTE: ANY ADDITIONS OR CHANGES ON THIS SHEET MUST BE MADE OR CIRCLED IN RED INK, WITH DATE AND NAME OF PERSON MAKING CHANGE.

Do not extend notes this side of this line

B.M.	1ST RUN	DIFF.	2ND RUN	3RD RUN	ADJ. ELEV.	DESCRIPTION

Notes Ck'd by	
Map No.	
Office Work	
Checked	
Date	

Survey of W. Hollywood Bldg.
Sht. No. Tape Sta. °F
Surveyed by Monkey Jr.
Notes by Monkey Jr. Rodman
Indexed by C. J. GALLI

F. B. 2640 Pg. 139

JN 7265.02

WEST HOLLYWOOD COUNTY BUILDING

AS BUILT LOCATION
OF
NEW TELEPHONE PULLBOX

Monkey Jr.
Peterson
Clifford
Cano

Note: Any Additions or Changes on This Sheet Must be Made or Circled in Red Ink With Date and Name of Person Making Change.

RETURN TO
LOS ANGELES COUNTY ENGINEER
Los Angeles County Engineering Bldg.
Do not extend this side of this Map.

7265.02 CE #340 8-68

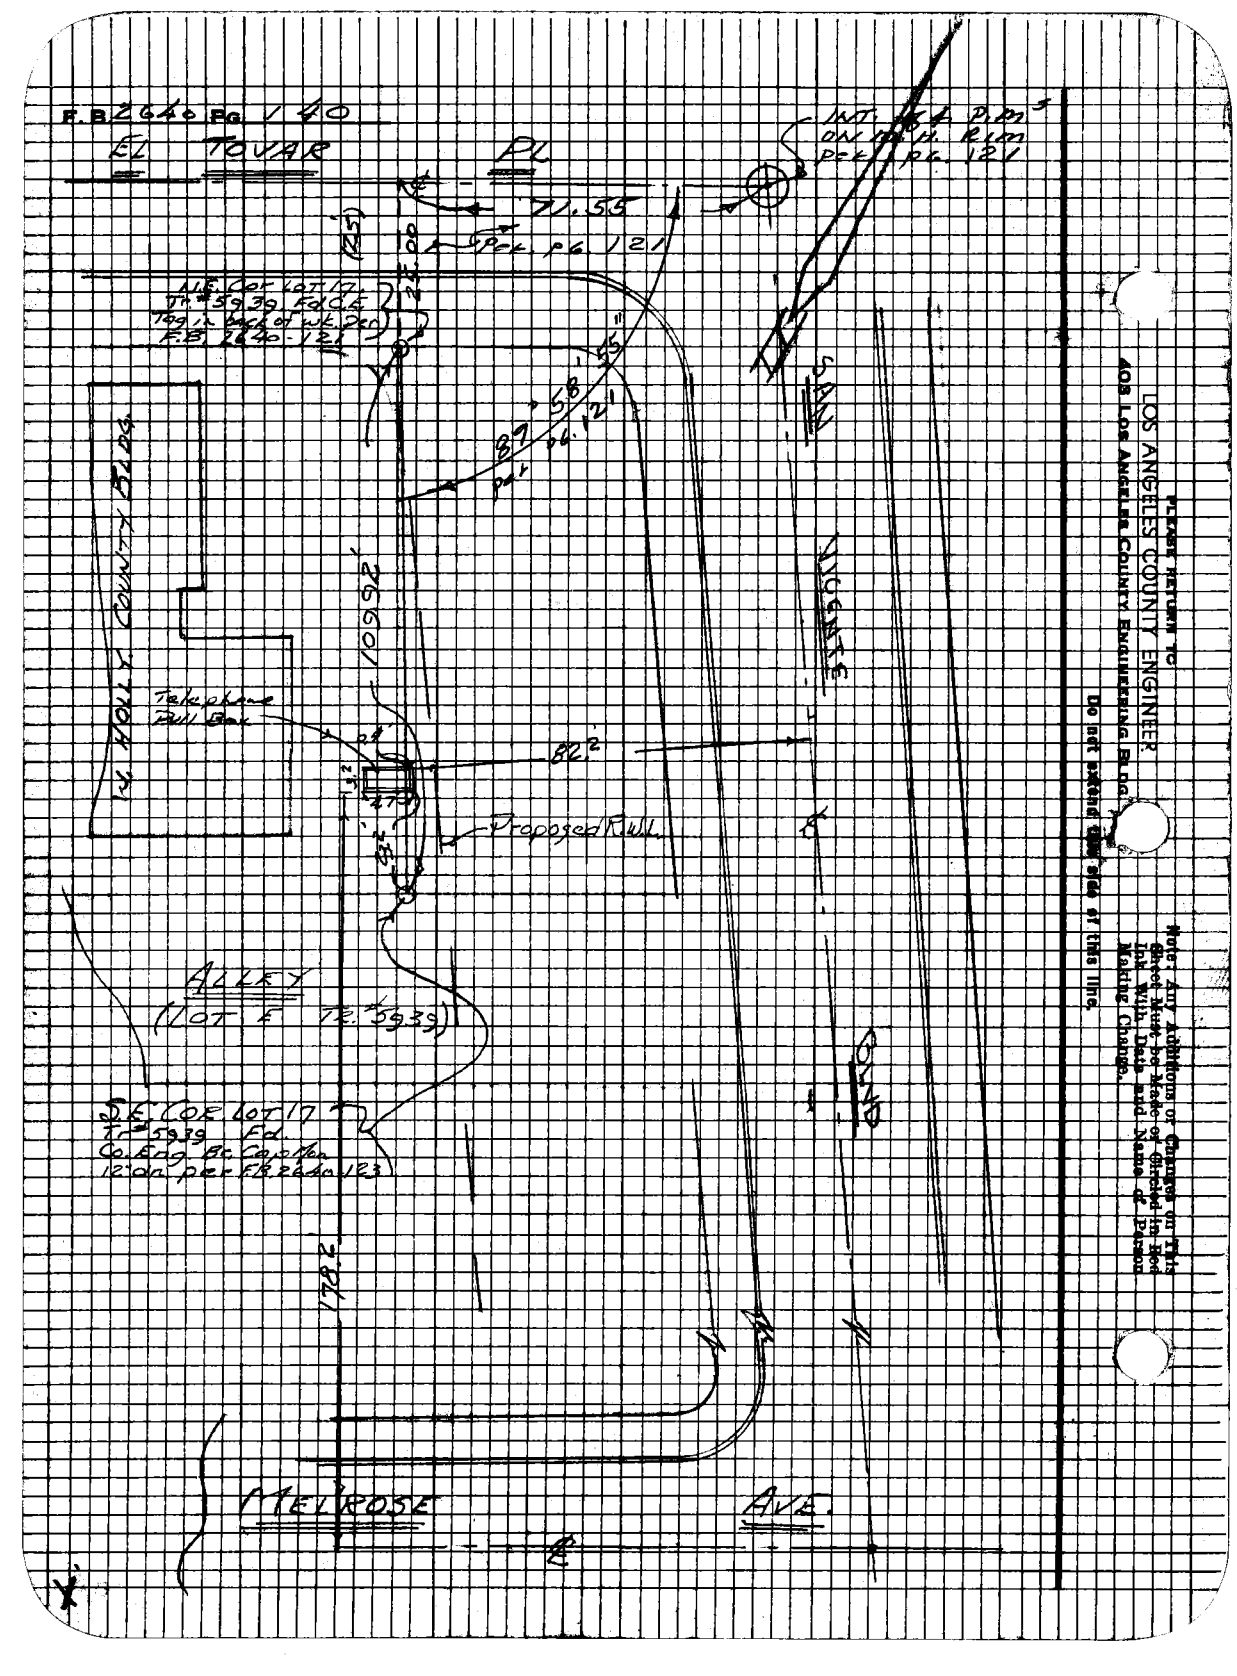
EL
TOVAR
PL
71.55
(TYP)
10
S.B.K. pg. 121
N.E. Cor. Lot 17
Tr. #5939, Fd C.E.
Tag in back of walk per
F.B. 2640-121
10998'
Telephone
Pull Box
82.2
Proposed Rwll.
ALLEY
(Lot E Tr. #5939)
S.E. Cor. Lot 17
Tr. #5939, Fd
Co. Brass Cap in
12" dia. per F.B. 2640-123
178.2'
ROSE
AVE.
N. HOLLYWOOD
Int. of C.L. of Rwy
per S.B.K. pg. 121
PLEASE RETURN TO
LOS ANGELES COUNTY ENGINEER
408 Los Angeles County Engineering Bldg.
Do not extend over this line.
Note: Any Additions or Changes on this Sheet Must be Made or Ordered in Ink With Date and Name of Person Making Change.

Notes Ck'd by _____
Map No. _____
Office Work _____
Checked _____
Date _____

Survey of El Tovar Pl. (Vacation) F.B. 2640 Pg. 141
JN 005594 Tape 0254 Std 68 °F
Surveyed by Monkey Jr.
Notes Tm Jr. Date 10. 68
Indexed C.J. CA 11 OCT 13 68

JN 005594

EL TOVAR PLACE (VACATION)

Monkey Jr
Cano
Tollison
A.L. Fisher

Note: Any Additions or Changes on this Sheet Must be Made or Circled in Red Ink With Date and Name of Person Making Change.

Do not extend this side of this line.

PLEASE RETURN TO
LOS ANGELES COUNTY ENGINEER
403 LOS ANGELES COUNTY ENGINEERING BLDG.

168308 CE#310 8.67

PLEASE RETURN TO
LOS ANGELES COUNTY ENGINEER
403 LOS ANGELES COUNTY ENGINEERING BLDG.

Note: Any Additions or Changes on this Sheet Must be Made or Circled in Red Ink With Date and Name of Person Making Change.

Do not extend this side of this line.

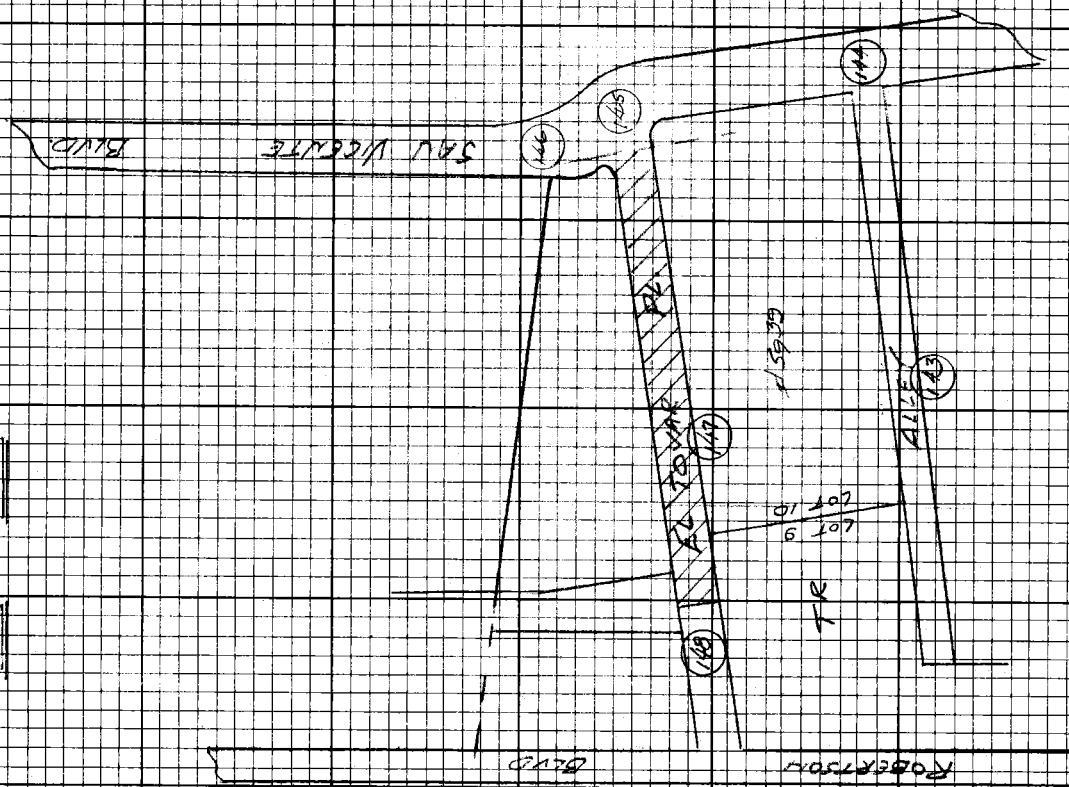

Notes Ck'd by D. SAPPELL
Map No. B-1996
Office Work M. HAMASU
Checked D. SAPPELL

JN 00 55 24 Tape 100' Std 68 °F
Surveyed by Hankey Jr.
Notes Fair Date 11 '68
Indexed C. Sec. Ck'd

F.B. 2640 Pg. 143

Note: Any Additions or Changes on this Sheet Must be Made or Circled in Red Ink With Date and Name of Person Making Change.

PLEASE RETURN TO
LOS ANGELES COUNTY ENGINEER
403 LOS ANGELES COUNTY ENGINEERING BLDG.

Do not extend this side of this line.

16F3098 CE#310 9-67

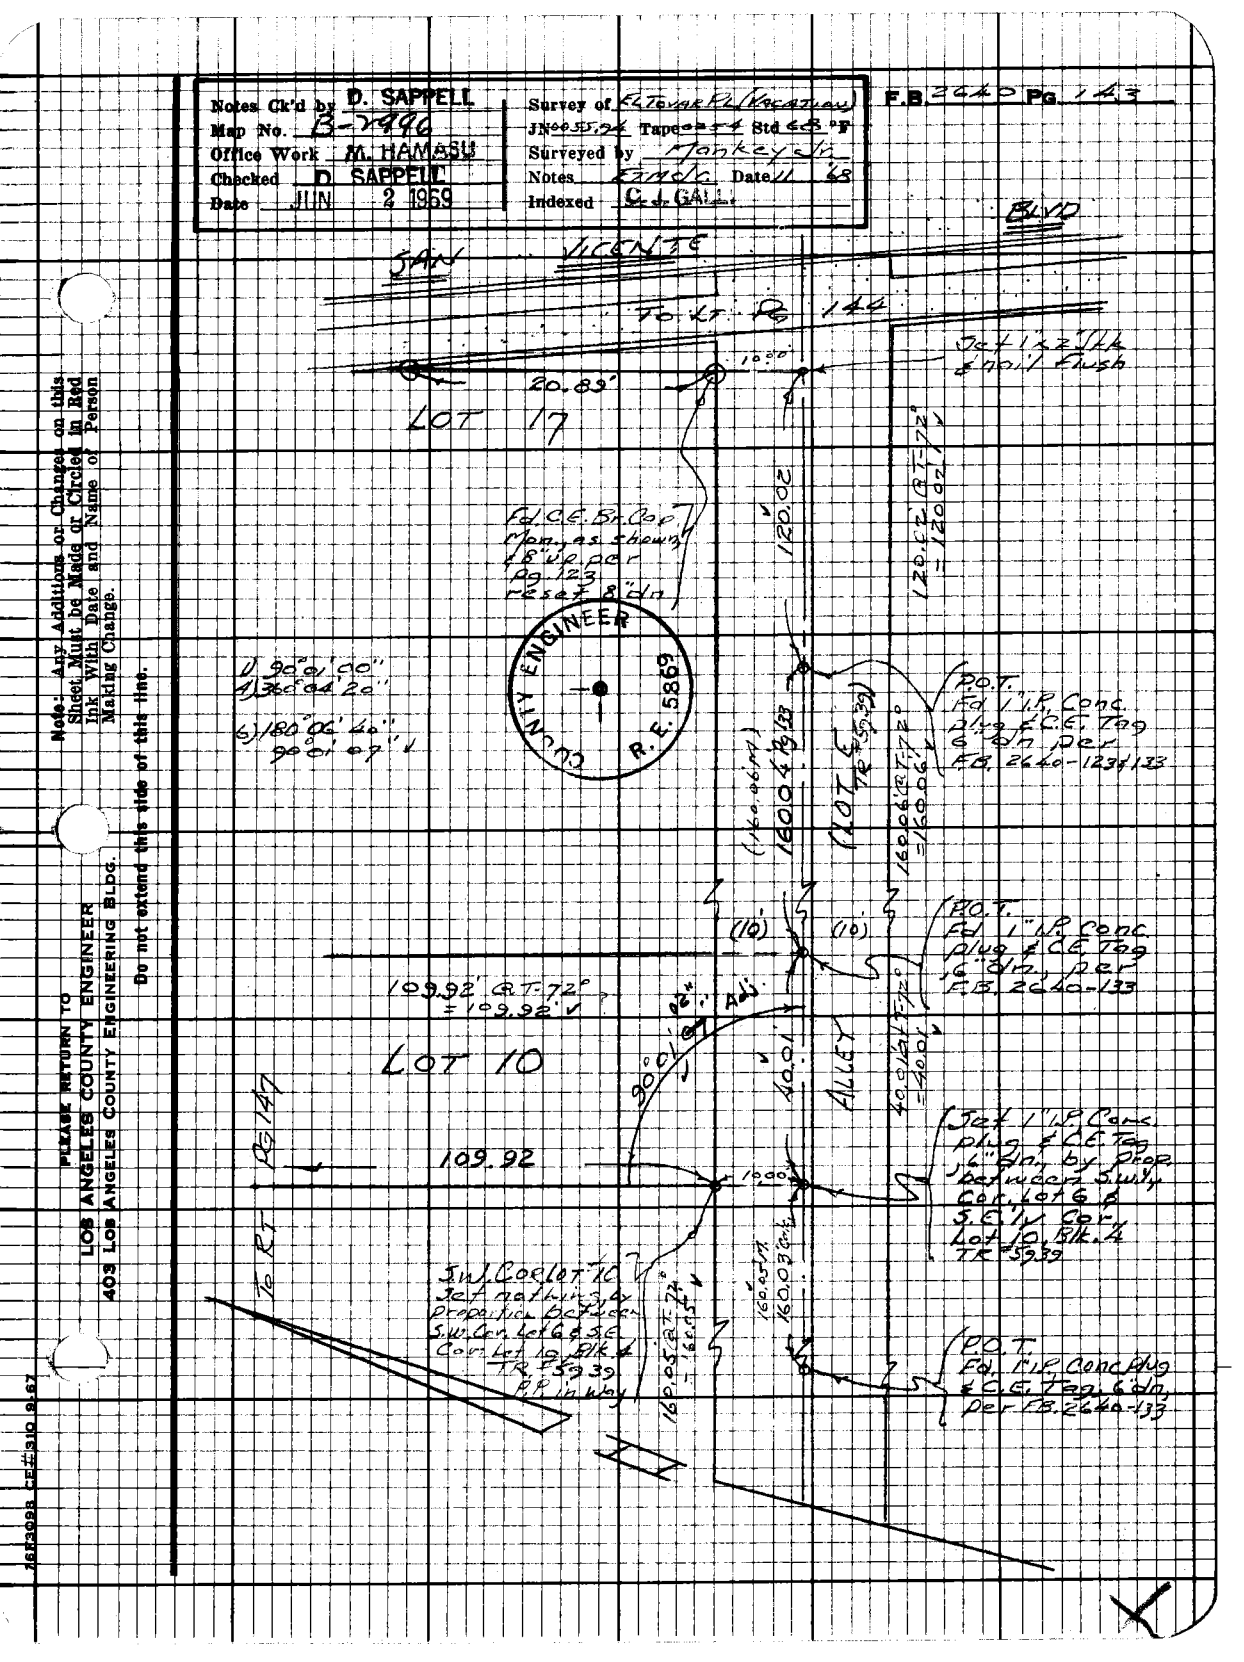

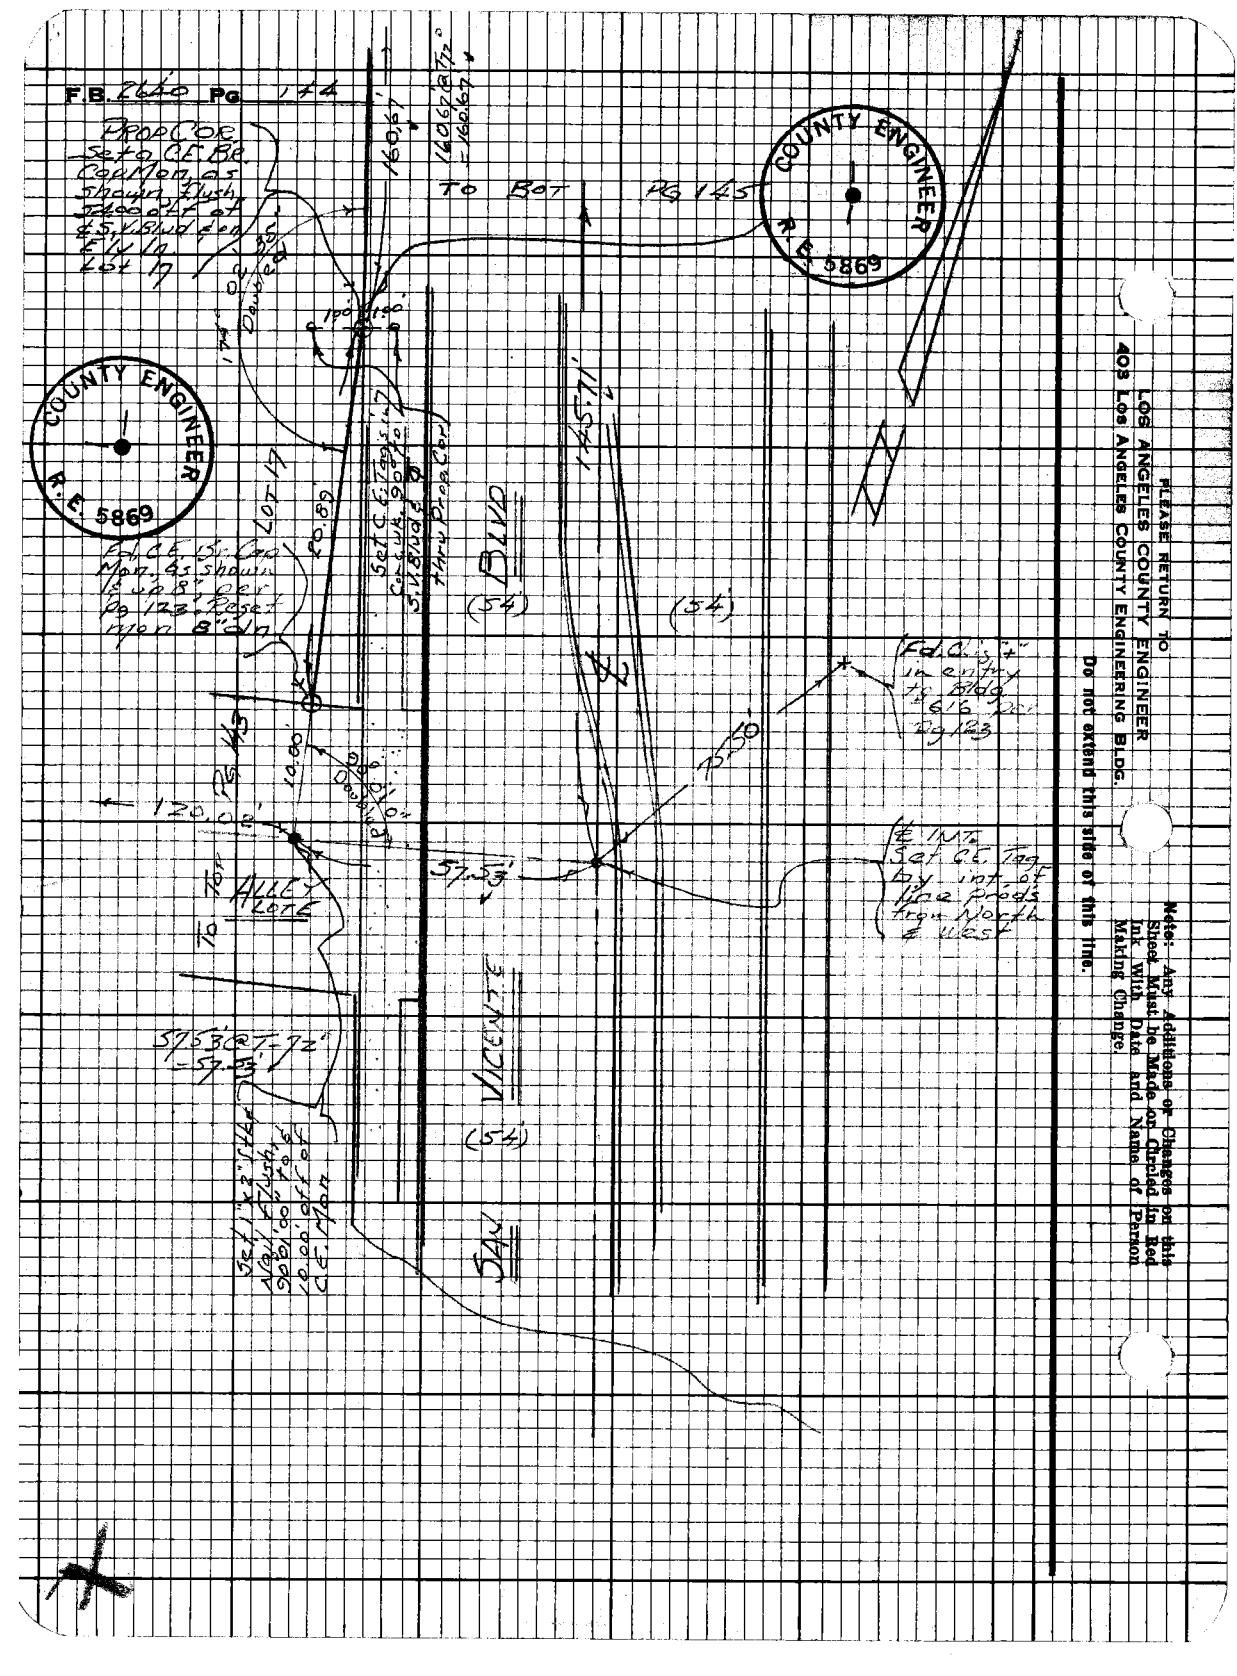
Prop Cor Set to CE Bc Common as shown, flush w/ sidewalk at ℄ & S'ly side of ℄ Alley in Lot 17
Lot 17
Lot 18
COUNTY ENGINEER
R.E. 5869
To Bot
Pg 145
Fd C.S. Cap Mon. as shown 1.4' Below Gr. Pg 123
Set C.S. Cap Mon. as shown flush w/ Gr.
Fd C.S. Cap Mon. as shown 1.8' Below Gr. Pg 123, Reset 1/10 of 8" Dia

Checked D. SAPPELL	Notes C.S. Date 10 45
Date JUN 2 1969	Indexed

F.B. 2640 Pg. 145

1322.52

Note: Any Additions or Changes on this Sheet Must be Made or Circled in Red Ink With Date and Name of Person Making Change.

PLEASE RETURN TO
LOS ANGELES COUNTY ENGINEER
403 LOS ANGELES COUNTY ENGINEERING BLDG.
Do not extend this side of this line.

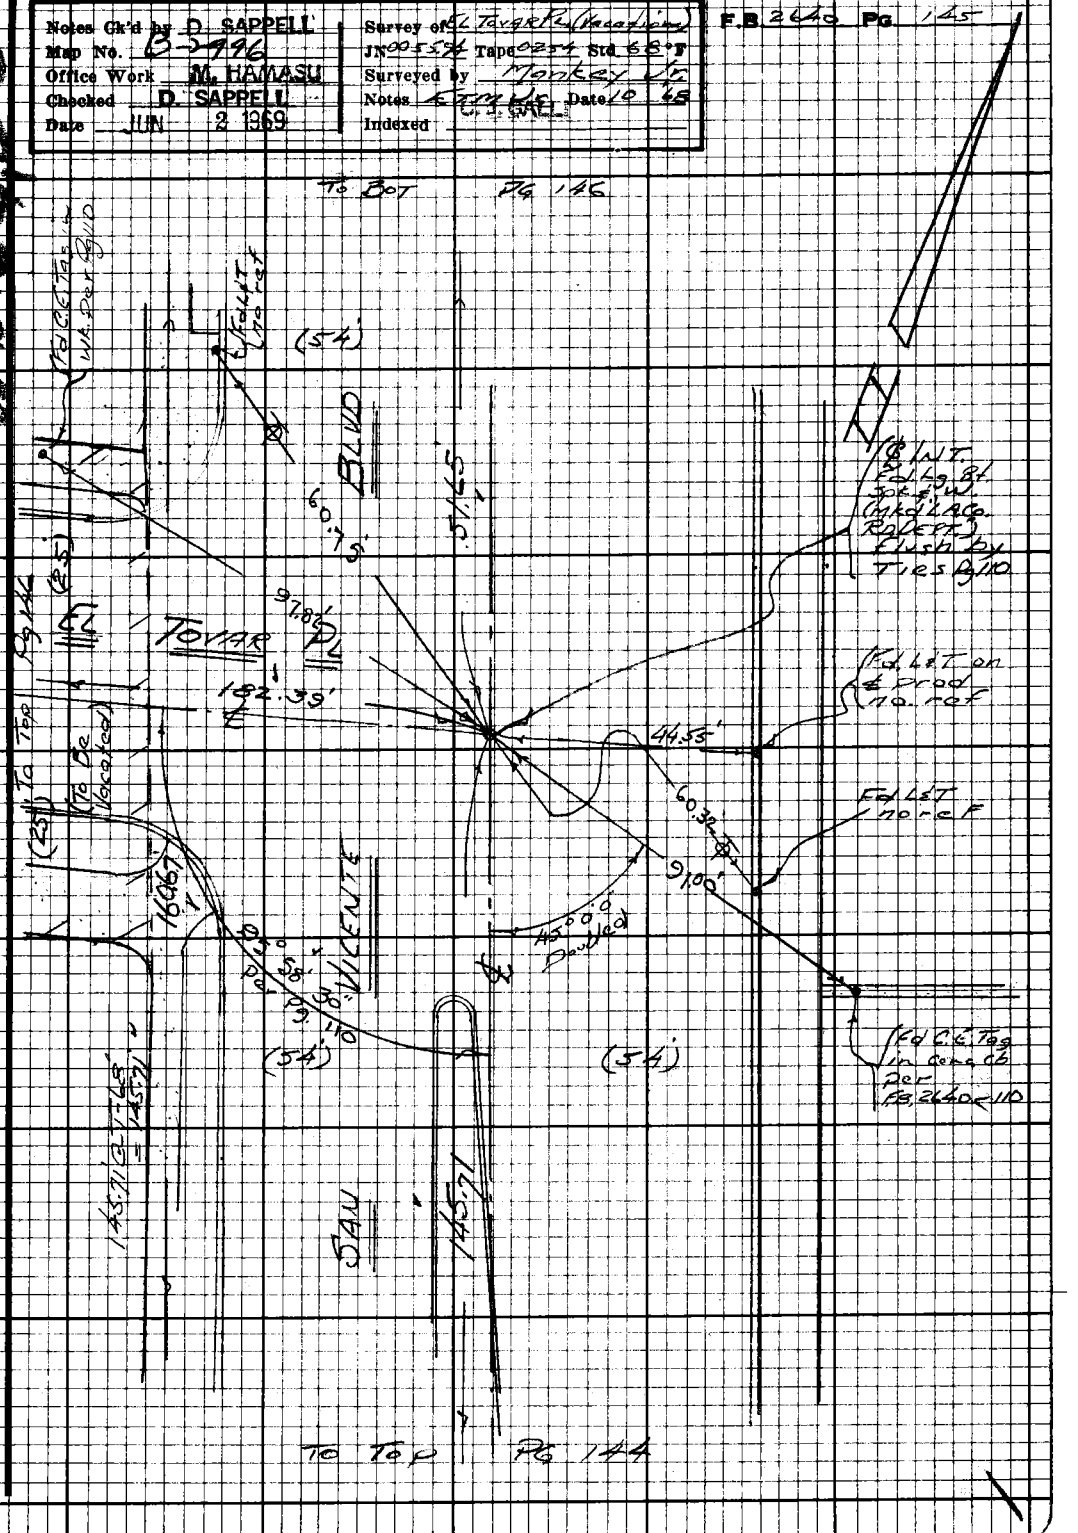

AB3098 CE#310 8-67

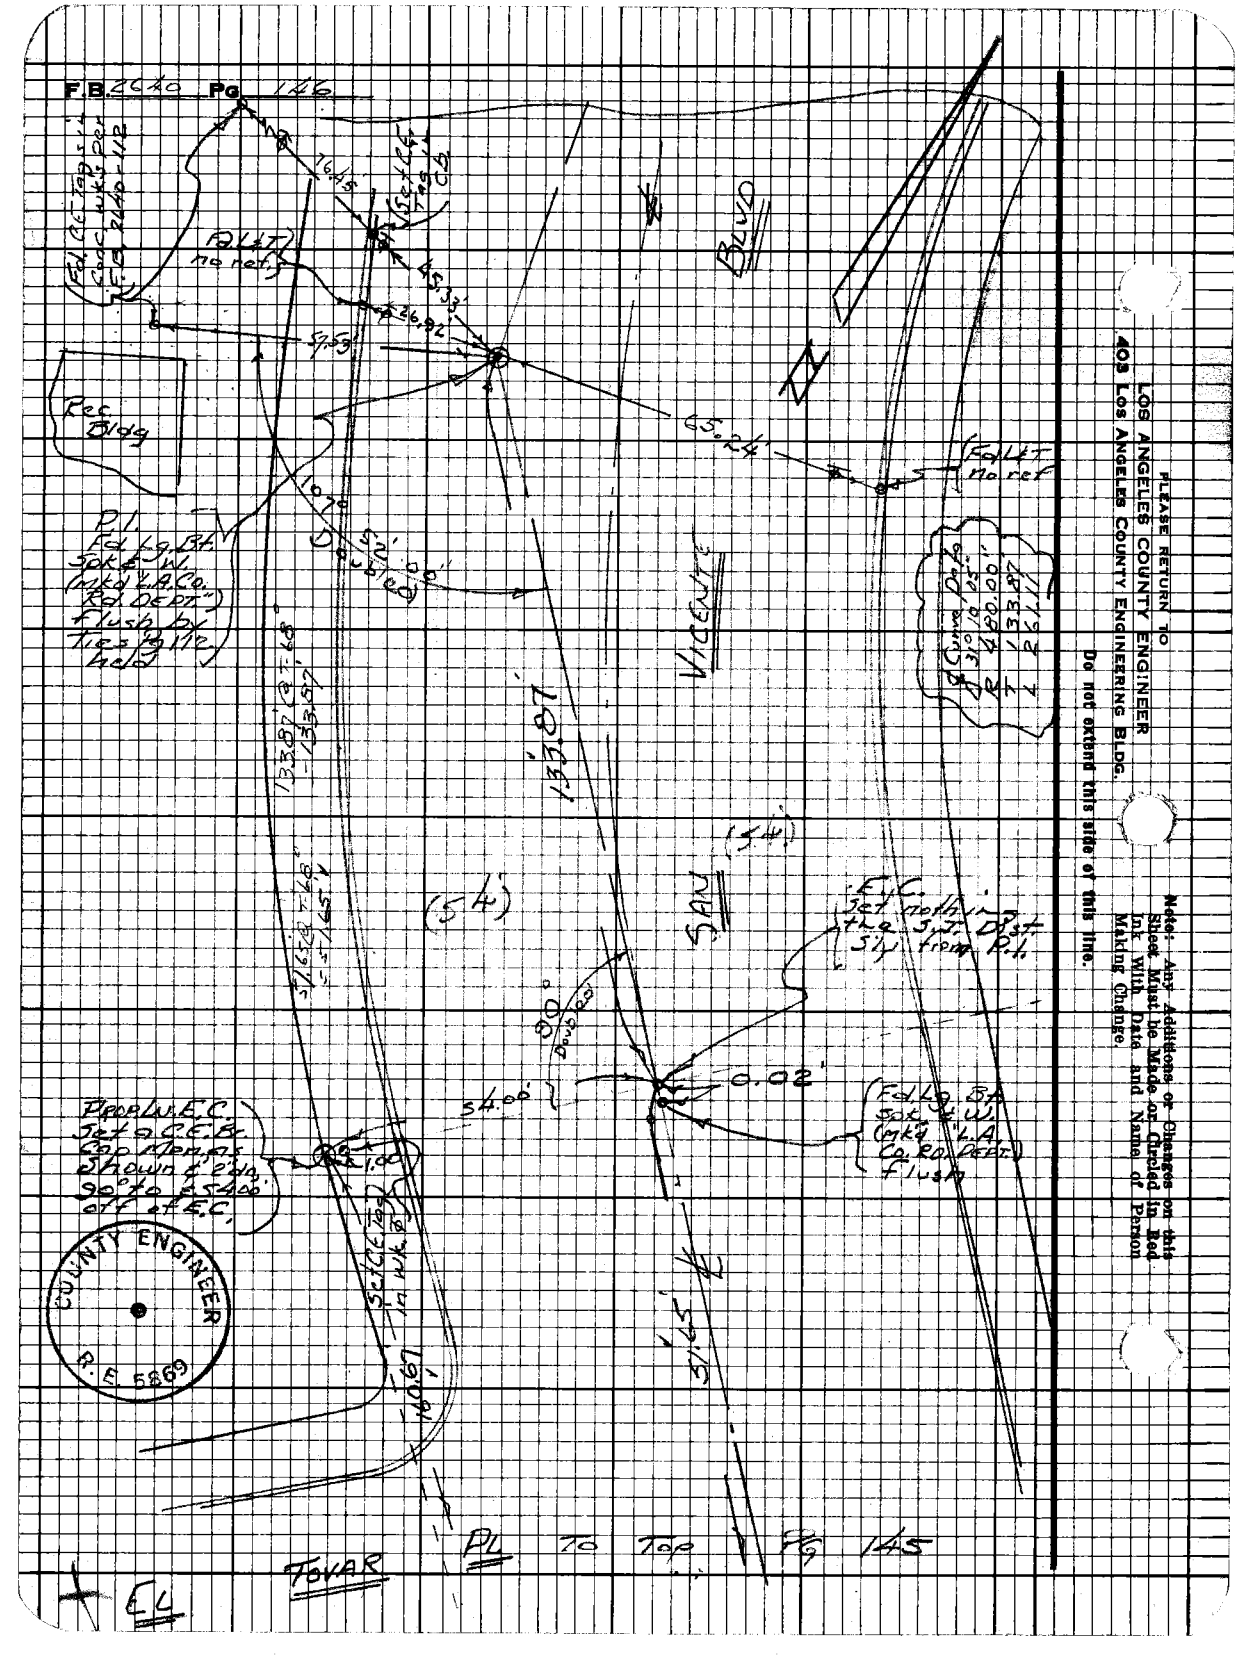
F.B. 2640 Pg 146
PLEASE RETURN TO
LOS ANGELES COUNTY ENGINEER
403 Los Angeles County Engineering Bldg.
Do not extend this side of this line.
Note: Any Additions or Changes on this Sheet Must be Made or Circled in Red Ink With Date and Name of Person Making Change.
Rec Bldg
P.I. Ed Lg. Str. Sorg. W. (aka L.A. Co. Rd. Dept.) flush by tree 9 1/2 ago
Ed. Lg. Str. Sorg. W. (aka L.A. Co. Rd. Dept.) flush

Notes Ck'd by D. SAPPELL
Map No. B-1996
Office Work M. HAMASU
Checked D. SAPPELL
Date JUN 2 1969

Survey of ET Tract #1 (Vacation)
JN 0057.94 Tape 0254 Std. 68 °F
Surveyed by Monkey Jr.
Notes ETANK Date 10-68
Indexed C. J. GALLI

F.B. 2640 Pg. 147

Note: Any Additions or Changes on this Sheet Must be Made or Circled in Red Ink, With Date and Name of Person Making Change.

Do not extend this side of this line.

PLEASE RETURN TO
LOS ANGELES COUNTY ENGINEER
403 LOS ANGELES COUNTY ENGINEERING BLDG.

To LT PG 145

P.O.T. Fd. Lead Plug & Tack in Mk. (Mk. Lot Cor. Radial) Flush No. ret.

182.39' R.T. 72°

182.39' = 182.39'

PLACE

Fd. C.C. Tag in Walk per Pg 132

Lot Cor. Fd. Mk. Flush per Pg 132

1.90'

24.00'

Fd. Sq. Hd. Spike Flush. Per CS 2640-132

40.01' (ATTA) = 40.01'

TOWAR (To Be Vacated)

LOT 10

Set Sq. Hd. Spike & Tin Cap Flush.

10.01'

25.00'

109.92'

PG 143

Fd. C.C. Tags in Walk per CS 769-142

PG 149

LOT #7

12.43' (ATTA) = 12.43'

EL

30.00' (Meas.) 30.00' (Rad.)

12.43'

Nail & Tin. Cap Lot 10 Set 1" I.P. Cont. Plug & C.C. Tag 2.00' Ft. of proportion between W.M. Cor. Lot 6 & N.E. Cor. Lot 10 Blk 4 Tr. 5939

24.00'

50.85' (ATTA) = 50.85'

To P.O.T.

Set Sq. Hd. Spike & Tin Cap Flush in No. 1 Walk

1) 90°01' 00"
2) 360°00' 00"
6) 180°00' 00"
90°01' 00"

To To PG 148

2639-98 CE #310 9-67

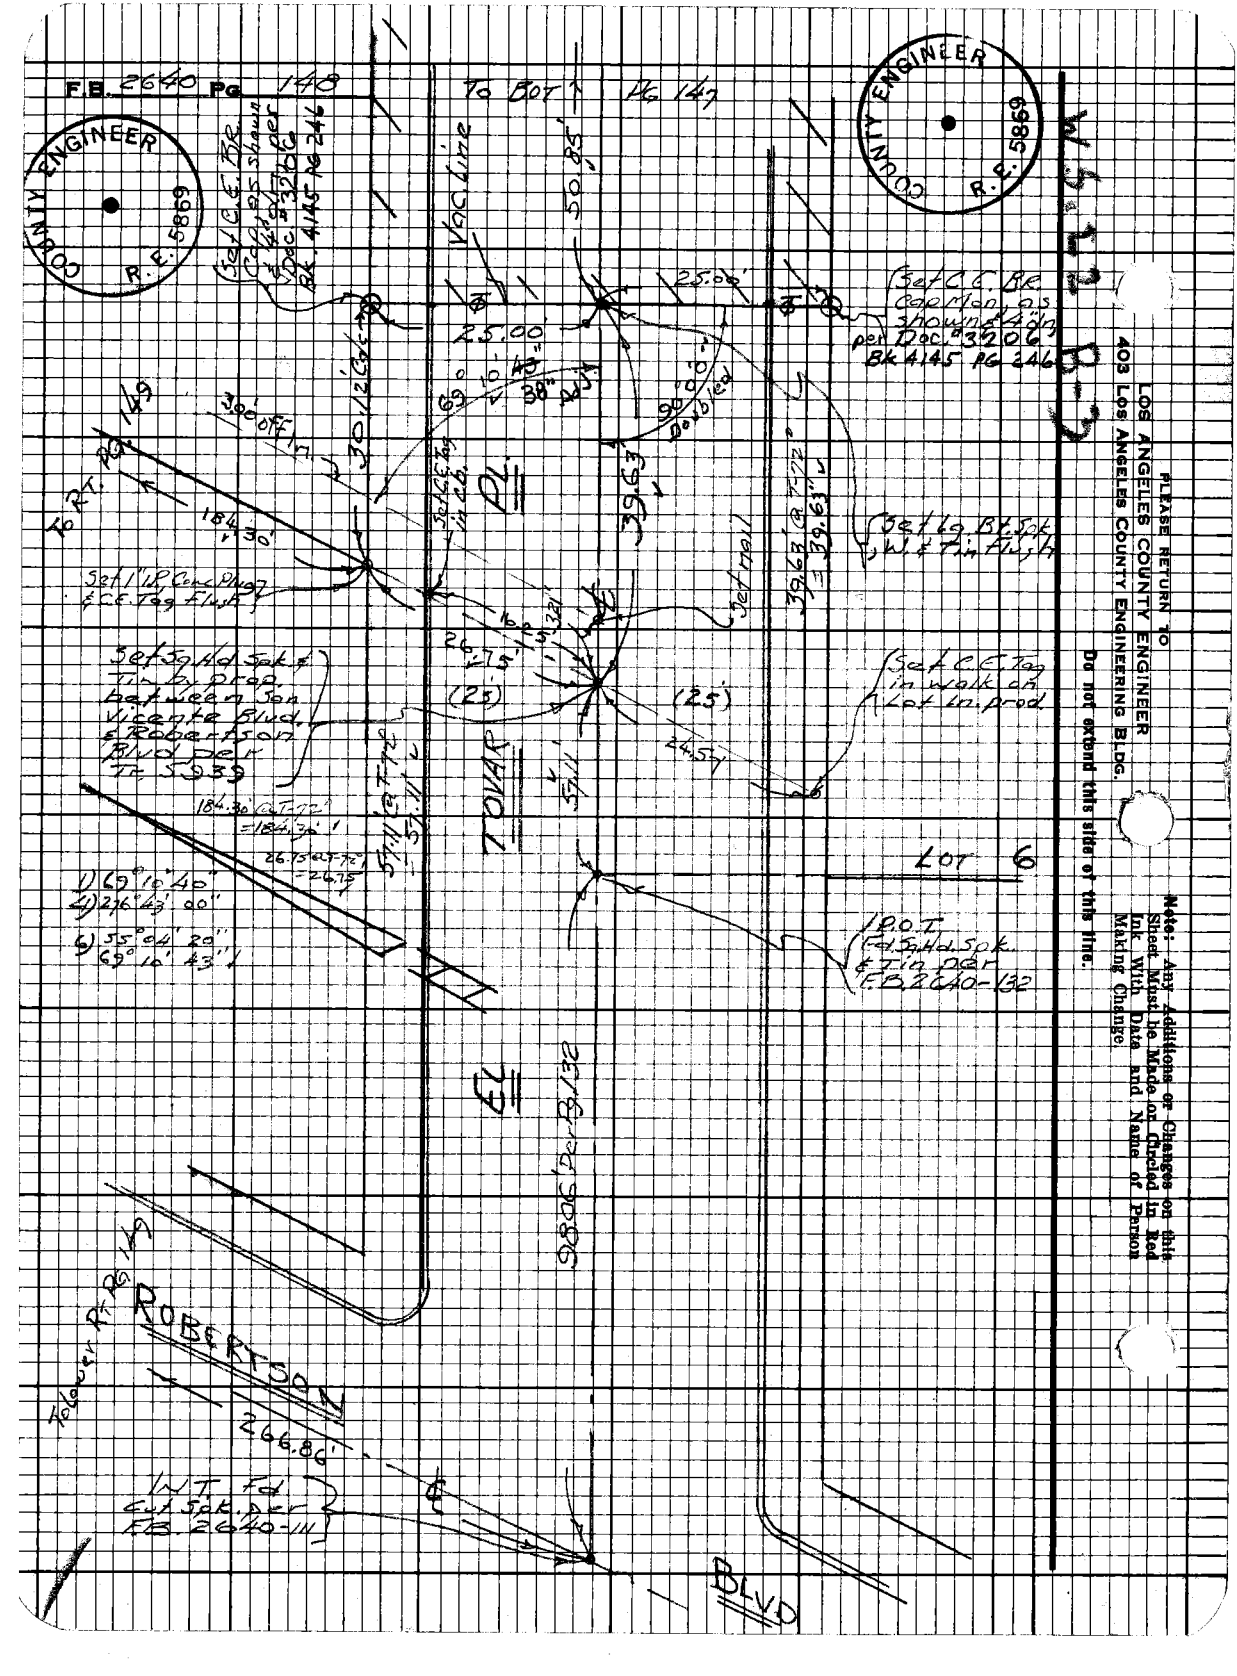
F.B. 2640 Pg. 148
To Bot. Pg. 147
COUNTY ENGINEER R.E. 5869
Set C.C. Tag Collinear as shown per Doc. #3206 Bk. 4145 Pg. 246
Set C.C. Tag Collinear as shown per Doc. #3206 Bk. 4145 Pg. 246
403 Los Angeles County Engineering Bldg.
PLEASE RETURN TO LOS ANGELES COUNTY ENGINEER
Note: Any Additions or Changes on this Sheet Must Be Made or Checked in Red Ink With Date and Name of Person Making Change.
Do not extend this side of this line.
Set 1" I.P. Cone Mag & C.C. Tag Flush
Set Lg. Bolt & Tin Flush
Set C.C. Tag in walk at Lot Line Prod.
Lot 6
TOVAR PL.
ROBERTSON BLVD.
25.00'
50.25'
39.63'
39.63' (R)
266.86'
184.30' (R)
26.75' (R)
1) 69° 18' 40"
2) 216° 43' 00"
3) 55° 04' 20"
69° 16' 43"

Notes Ck'd by D. SAPPELL
Map No. B-2996
Office Work M. HAMASU
Checked D. SAPPELL
Date JUN 2 1969

Survey of El Tovar Rd. (Recon.)
JN 005594 Tape 0.254 Std 58.°F
Surveyed by Mankey/Jr
Notes ETTI Date 6 '68
Indexed C. J. (JA!!)

F.B. 2640 Pg. 149

Note: Any Additions or Changes on this Sheet Must be Made or Circled in Red Ink With Date and Name of Person Making Change.

Do not extend this side of this line.

PLEASE RETURN TO
LOS ANGELES COUNTY ENGINEER
403 Los Angeles County Engineering Bldg.

Fd. nothing
104.29' at 72°
= 104.27'
12° 05'
90°
104.29'
Fd. 2 pcs Nail & Dsc. F.B. 769-146
17.50' off Tan. Ln. per F.B. 769-146
(Fd. C.E. 769-14 1/2 per F.B. 769-145)
899.72'
F.B. 769-146
1) 90°17'05"
2) 361°08'10"
3) 181°42'30"
90°17'05"
Tan. Ln. 75.00' off Ln. 7.00
Set 1"x2" Stk & Tack thru F.B. 769-146
Rec. Dist. 104.29' from the North
1) 89°43'30"
2) 358°54'00"
3) 178°21'10"
89°43'32"
Tan. Ln. 75.00' off Ln.
358°16'30" E
358°16'
75.00'
358°16'
75.00' at 72°
= 75.00'
220.03' at 72°
= 220.03'
Wly Ln. Lot #21
Tr. 3916
Fd nothing
89°
43'
30"
LOT 7
To Lot 6 F.B. 147
Fd. nothing
Set 1"x2" Stks
22.03'
113°25'30" Calculated
3.00' off Ly Ln.
To Lot 8 Pg. 148
Set 1" I.P. Cork Plug & Tag "Flush by Intersection between Sawtelle Blvd. & Robertson Blvd. per Tr. 5939"
7.63'
184.30'
1450.08 C/L
To Lot 47 Pg. 148
ROBERTSON
BLVD
Fd. 1" I.P. per F.B. 769-116 & 145
266.86'
F.B. 769-145
To Lot 47 Pg. 148

PLEASE RETURN TO
LOS ANGELES COUNTY ENGINEER
403 LOS ANGELES COUNTY ENGINEERING BLDG.

Note: Any Additions or Changes on this Sheet Must be Made or Circled in Red Ink With Date and Name of Person Making Change.

Do not extend this side of this line.

F.B. 2240 PG 150

F. B. 2640 Pg. 151

Profile No. ____ Notes Red ____ Plotted ____ Job No. 005594 Division No. 11
Date ____ Date ____ Survey of WEST HOLLYWOOD PARK
X-Sec. No. ____ Notes Checked J. Cavataio Checked ____ Survey by J.T. Notes T.P. Date 12-29-70
Date JAN 19 '71 Date ____ Map No. ____ Indexed G. J. GALLI Date JAN 18 '71

NOTE: ANY ADDITIONS OR CHANGES ON THIS SHEET MUST BE MADE OR CIRCLED IN RED INK, WITH DATE AND NAME OF PERSON MAKING CHANGE.

PLEASE RETURN TO
LOS ANGELES COUNTY ENGINEER
403 Los Angeles County Engineering Bldg.

Do not extend notes this side of this line.

WEST HOLLYWOOD PARK

BENCH LEVEL CONTROL FOR R.T. SHTS. H-100 A-1, H 90-1, H 90-2

J.N. 0055.94

DEC. 1970

STATION	B.S.	H.I.	F.S.	ELEV.

REF:
F.B. 2197

PARTY
J. TERRANOVA
T.C. PETERSON
J. ZBYSENSKI

76-L-298 CE 307 2-63

76-L-296 CE 307 2-63

PLEASE RETURN TO
LOS ANGELES COUNTY ENGINEER
403 LOS ANGELES COUNTY ENGINEERING BLDG.

NOTE: ANY ADDITIONS OR CHANGES ON THIS SHEET MUST BE MADE OR CIRCLED IN RED INK, WITH DATE AND NAME OF PERSON MAKING CHANGE

Do not extend notes this side of this line.

F.B. 2640 Pg. 152 Job No. 005594 Division No. Notes Red Plotted Profile
Survey of WEST HOLLYWOOD PARK Date No. X-Sec.
Survey by J.F. Notes T.P. Date Checked
Indexed B.H. GALLI Date JUN 19 71 Date No.

STATION	B.S.	H.I.	F.S.	ELEV.	
B.M. M.W. 85	5.959	217.350		211.391	FD B.M. H.W. 85 ELEV. 211.391 FB. 2197-44 SANTA MONICA BLVD & PALM AVE. N.E. COR BT. SPK. IN CURB AT EAST END C.R.
B.M. M.W. 84	5.279	219.265	3.369	213.991	FD B.M. H.W. 84 ELEV. 213.991 FB. 2197-44 SANTA MONICA BLVD & CARRABEE ST. N.E. COR WIRE SPK IN CURB 5' E OF EAST END C.R.
T.P.	6.138	221.468	3.935	215.330	
T.P.	3.023	219.051	5.440	216.028	
T.B.M. # 1	2.325	215.671	5.705	213.346	SET T.B.M. # 1 ELEV. 213.350 SANTA MONICA BLVD & SAN VICENTE BLVD S.W. COR 163 ± S OF ℄ SANTA MONICA BLVD & 11' W. OF WEST CURB SAN VICENTE BLVD A LEAD & TK IN CONC. AT SIDE ENTRANCE TO COMMERCIAL BLDG.
T.P.	1.089	209.745	7.015	208.656	
T.P.	2.175	205.070	6.850	202.895	
T.B.M. # 2			6.434	198.645	SET T.B.M. # 2 ELEV. 198.645 SAN VICENTE BLVD. W'LY SIDE 603' ± S OF SANTA MONICA BLVD. BT. SPK IN CURB AT S.E. COR. LIBRARY PARKING LOT.

76-L-298 CE 307 2-63

PLEASE RETURN TO
LOS ANGELES COUNTY ENGINEER
403 LOS ANGELES COUNTY ENGINEERING BLDG.

NOTE: ANY ADDITIONS OR CHANGES ON THIS SHEET MUST BE MADE OR CIRCLED IN RED INK, WITH DATE AND NAME OF PERSON MAKING CHANGE.

Do not extend notes this side of this line.

STATION	B. S.	H. I.	F. S.	ELEV.		
T.B.M.#2	1520	200156		198636		
T.P.	0116	192719	7553	192603		
T.B.M.#3	7623	192233	8109	184~~610~~622	SET T.B.M. #3 ELEV. 184.622 SAN VICENTE BLVD & EL TOVAR PL N.W. COR BT. SPK IN CURB 5' W. OF WEST END C.R.	
T.B.M.#4	7625	198826	1032	191~~801~~214	SET T.B.M. #4 ELEV. 191.214 EL TOVAR PL SO. SIDE 360' W OF ℄ SAN VICENTE BLVD BT. SPK IN CURB 3' N'WLY OF N.W. COR TENNIS COURT.	
T.P.	3196	198717	3305	19552		
B.M.M.W.75			5998	192~~774~~735	FD B.M. M.W. 75 ELEV. 192.735 F.B. 2197-39 ROBERTSON BLVD & MELROSE AVE N.W. COR BT. SPK IN CURB 6' W OF WEST END C.R.	

Profile Notes Rel. Plotted Job No 005534 Division No.
No. X-Sec. Date Checked Survey of WEST HOLLYWOOD PARK
No. Notes Circled Date Checked Survey by J.T. Notes T.P. Date 12-29-70
No. Date JM 1 9 71 Date Map No. Indexed L. D. GALLI Date JM 1 8 71

F. B. 2640 Pg. 153

F.B. 2640 Pg. 154

Job No. Division No. Notes Red Plotted Profile

Survey of Date Date No.

Survey by Notes Notes Chkd. Checked X-Sec.

Indexed Date Date Date No.

STATION	B.S.	H.I.	F.S.	ELEV.

Do not extend notes this side of this line.

NOTE: ANY ADDITIONS OR CHANGES ON THIS SHEET MUST BE MADE OR CIRCLED IN RED INK, WITH DATE AND NAME OF PERSON MAKING CHANGE

PLEASE RETURN TO

LOS ANGELES COUNTY ENGINEER

403 Los Angeles County Engineering Bldg.

76-L-296 CE 307 2-63

Notes Ck'd by	Survey of Rd. Dept. Main. Yard 331
Map No.	JN 0779 37/36 Tape Std 68 °F
Office Work	Surveyed by Tom Mankey
Checked	Notes Tom M. Date 7-11-73
Date	Indexed G. D. BAILEY JUL 23 1973

F. B. 2640 PG. 155

J.N. 0779. 37/36

ROAD DEPT. MAINTENANCE YARD

8752 EL TOVAR PL. W. HOLLYWOOD

PROPERTY CORNERS

FOR CONSTRUCTION USE ONLY

Mankey
Dover
Derby
H. Jackson

FOR CONSTRUCTION USE ONLY

Note: Any Additions or Changes on This Sheet Must be Made or Circled in Red Ink With Date and Name of Person Making Change.

Do not extend this side of this line.

PLEASE RETURN TO
COUNTY OF LOS ANGELES
DEPARTMENT OF COUNTY ENGINEER
403 LOS ANGELES COUNTY ENGINEERING BLDG.

76F309S CE#310 3-68

F. B. 2640 PG 156

INDEX MAP

SAN VICENTE BLVD.

PL.

EL TOVAR

LOT "E"

ALLEY

LOTS 6, 7, 8, & 9
OF
TRACT Nº 5939

ROBERTSON BLVD.

157 157 157 158 158 158

PLEASE RETURN TO
COUNTY OF LOS ANGELES
DEPARTMENT OF COUNTY ENGINEER
403 LOS ANGELES COUNTY ENGINEERING BLDG.

Do not extend this side of this line.

Note: Any Additions or Changes on This Sheet Must be Made or Circled in Red Ink With Date and Name of Person Making Change.

Notes Ck'd by	Survey of Rd Dept. Maint Yard #331
Map No.	JN 0779 Tape Std 68 °F
Office Work	Surveyed by Tom Mankey
Checked	Notes Tom M. Date 7-1-73
Date	Indexed G. D. BAILEY JUL 23 1973

F. B. 2640 PG. 157

Note: Any Additions or Changes on this Sheet Must be Made or Circled in red Ink With Date and Name of Person Making Change.

Do not extend this side of this line

PLEASE RETURN TO
COUNTY OF LOS ANGELES
DEPARTMENT OF COUNTY ENGINEER
403 LOS ANGELES COUNTY ENGINEERING BLDG.

Set a nail 90° to & 25' off of N.W. Cor. Lot 15

0.01' Cal

200.01 @ T-72° = 200.02

25.00

90°00'

200.02'

N.W. COR. LOT 15 Fd. a C.E. Tag in conc. patch & conc. walk, per F.B. 2640-122

1) 90°00'35"
4) 360°02'20"
90°00'35"

℄

INT. ℄ & lot line prod set a Sq. Hd. Spk. & Tin, flush

25.00

N.E. PROP. COR. Set a 2" I.P. Conc. Plug & C.E. Tag, Fl. 2' by proportion E & W

109.94

RD. DEPT. YARD #331

160.01 @ T-72° = 160.01

(25')

160.01'

(25')

90°00'

160.01'

35'

Set a nail

INT. of F & ℄ Lot Ln Prod. Fd. nothing to dtr. Set a Sq. Hd. Spk. & Tin, Fl.

144.92'

18.71' off set line

18.71'

24.00'

1.00'

109.92'

℄ INT. Fd. a cut spk. per F.B. 2640-111

98.05 @ T-72° = 98.05

℄ TOVAR

N.W. Prop Cor. set nothing by proportion E. & W.

R.P. to N.W. Prop. Cor. Set a C.E. Tag in wk., 1.00' No. of Cor.

90°00'30"

℄

98.05'

Double 90°00' per F.B. 2640

1) 90°00'30"
4) 360°02'00"
90°00'30"

ROBERTSON

℄

BLVD

21.85'

Fd. C.E. Tag in cb. on ℄ prod per F.B. 2640-111

LT. 10 & PG 158

16F309s CE#3103-69

F. B. 2640 PG. 158

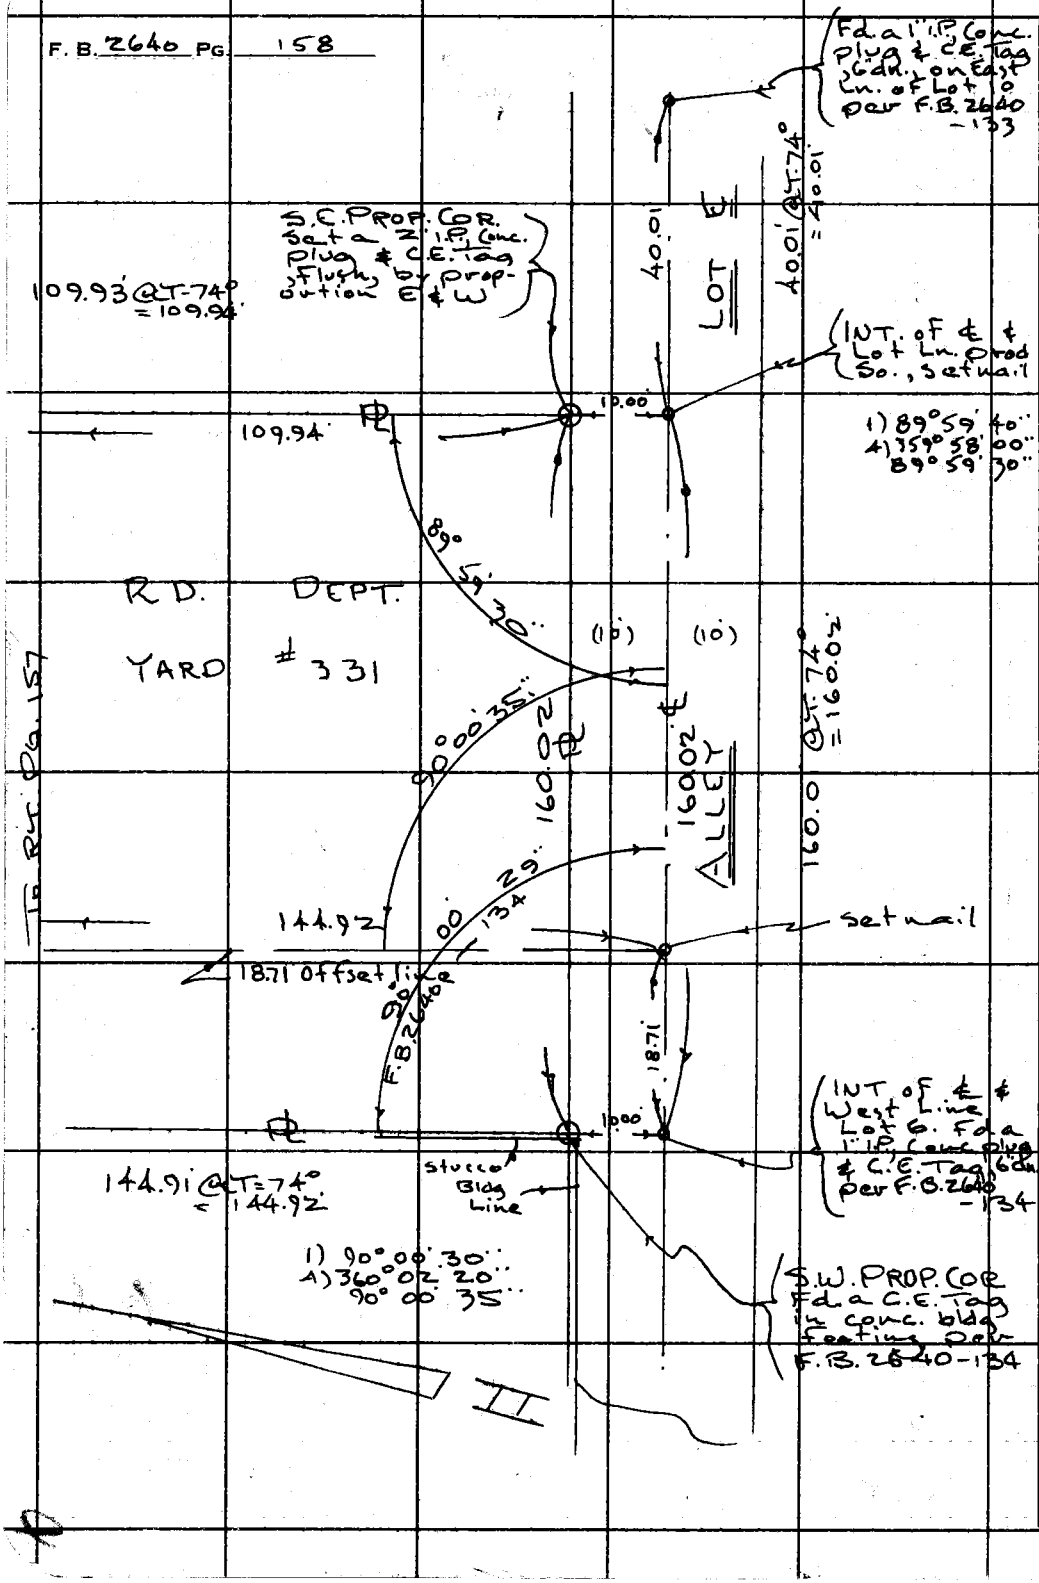

To R.S. Pg. 157

PLEASE RETURN TO
COUNTY OF LOS ANGELES
DEPARTMENT OF COUNTY ENGINEER
403 LOS ANGELES COUNTY ENGINEERING BLDG.

Do not extend this side of this line.

Note: Any Additions or Changes on This Sheet Must Be Made or Circled in Red Ink With Date and Name of Person Making Change.

NOTES RED. JOB NO. 0779.37/36 SURVEY OF Rd. Dept. Yard 331 | F. B. 2640 PG. 159

DATE SURVEY BY Tom Mankey

NOTES CHKD. NOTES BY J.M. & R. Dover DATE 7-11-73

DATE INDEXED G.D. BAILEY DATE JUL 23 1973

NOTE: ANY ADDITIONS OR CHANGES ON THIS SHEET MUST BE MADE OR CIRCLED IN RED INK, WITH DATE AND NAME OF PERSON MAKING CHANGE.

Do not extend notes this side of this line

DESCRIPTION	ADJ. ELEV.	3RD RUN	2ND RUN	DIFF.	1ST RUN	B.M.

J.N. 0779 37/36

ROAD DEPT. MAINTENANCE YARD.

8752 EL TOUAR PL. W. HOLLYWOOD

CONSTRUCTION BENCHS

Mankey
Dover
Darby
H. Jackson

PLEASE RETURN TO
LOS ANGELES COUNTY ENGINEER
900 LOS ANGELES COUNTY ENGINEERING BLDG.

768420 S & E-333 9-55

JOB NO. 0779.32 SURVEY OF ROAD DEPT YARD 331 NOTES
SURVEY BY E.T. Mankey Jr. DATE
NOTES BY R. Daley DATE 7-4-73 NOTES CHKD
INDEXED G.D. BAILEY DATE JUL 23 1973

F.B. 2640 Pg. 160

		4.799	
+	5.044		
X	197.055	195973	
−	7.840	7.840	
T.B.M. S.E. cor.	188.133	188.133	
+	7.661		
X	195.794		
−	2.609		
T.P.	193.185		
+	5.397		
X	198.582		
−	4.606		
T.B.M. N.W. cor.	193.976		
+	6.740		
X	200.716		
−	8.047		
BM MW 75	192.669		
T.B.M. #4	191.214		
+	3.346		
X	194.560		
−	8.111		
T.P.	186.449		
+	3.806		
X	190.255		
−	5.630		
TBM # 3	184.625		

Vicente Blvd. Bt. Spk. in curb 3' N/Ly of N.W. Cor. Tennis Court.
Set T.B.M. S.E. Cor. EL =
Set A 2" I.P. Cem Plug & L.A. Co Engr's Tag flush @ S.E. Prop. Cor. W edge of Iron Pipe

TBM N.W. COR EL =
A C.E. Tag in Sidewalk 24' So. & EL Tovar (N.W. Cor 1' Off)
BM MW 75 EL = 192.735 FB. 2197-39
Robertson Blvd & Melrose Ave N.W. Cor Bt. Spk in curb 6' W of West End C.R.
"See Above"

T.B.M. #3 EL = 184.622 F.B. 2640-153
San Vicente Blvd. & El Tovar Pl. N.W. Cor. Bt. Spk. in curb 5' W of West End C.R.