Ck'd by

Survey of
JN Tape Std °F
Surveyed by
Notes Date
Indexed

F.B. 2663 Pg.

	Job	Description
		120th STREET - J.N. 00/5.84
4	C.L.	Final C.L. from Vermont Ave. to Wilton Place along 120th Street.
2	C.L.	Realign. of final C.L. of 120th St. from Western Ave. to Wilton Pl.
5	C.L.	Alignment check on Budlong Ave. between 120th St. & El Segundo Blvd.

Microfilmed July '85

Notes Ck'd by
Map No. B-2722
Office Work
Checked
Date

Survey of 120th Street
JN 0075.84 Tape 2187 Std. 68 °F.
Surveyed by R.J. Mitchell
Notes Mitchell Date 9/60
Indexed H.E.O.W. MS

F. B. 2663 PG. 5

SURVEY OF FINAL CENTERLINE OF 120TH STREET FROM VERMONT AVENUE TO WILTON PLACE

J.N. 0075.84

Mitchell
Stanley
Bustrum
Marino

Sept. 1960

1. Final centerline is based on centerline survey shown in FB 1485 and on staking sheets (2) furnished by office. Note that offset from

F. B. 1663 PG. 6

centerline to Restaurant Bldg at 120 ft E Western (pg 19) is less than minimum specified on staking sheet. Note that revised offset to bldg. cor. is 0.3 greater than shown on orig. Topog.

2. No Ref. other than FB 1485 available in field.

Index

LOS ANGELES COUNTY ENGINEER
PLEASE RETURN TO
700 Los Angeles County Engineering Bldg.
Do not extend this date at this time.

Note: Any Additions or Changes on This Sheet Must be Made or Circled in Red Ink With Date and Name of Person Making Change.

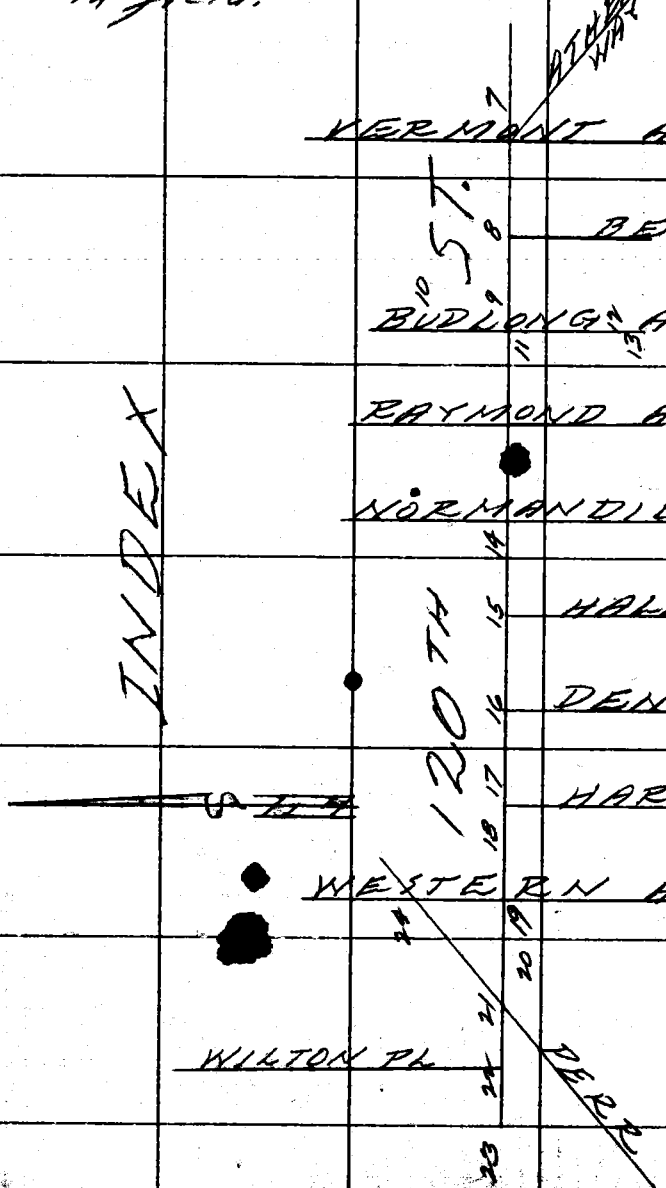

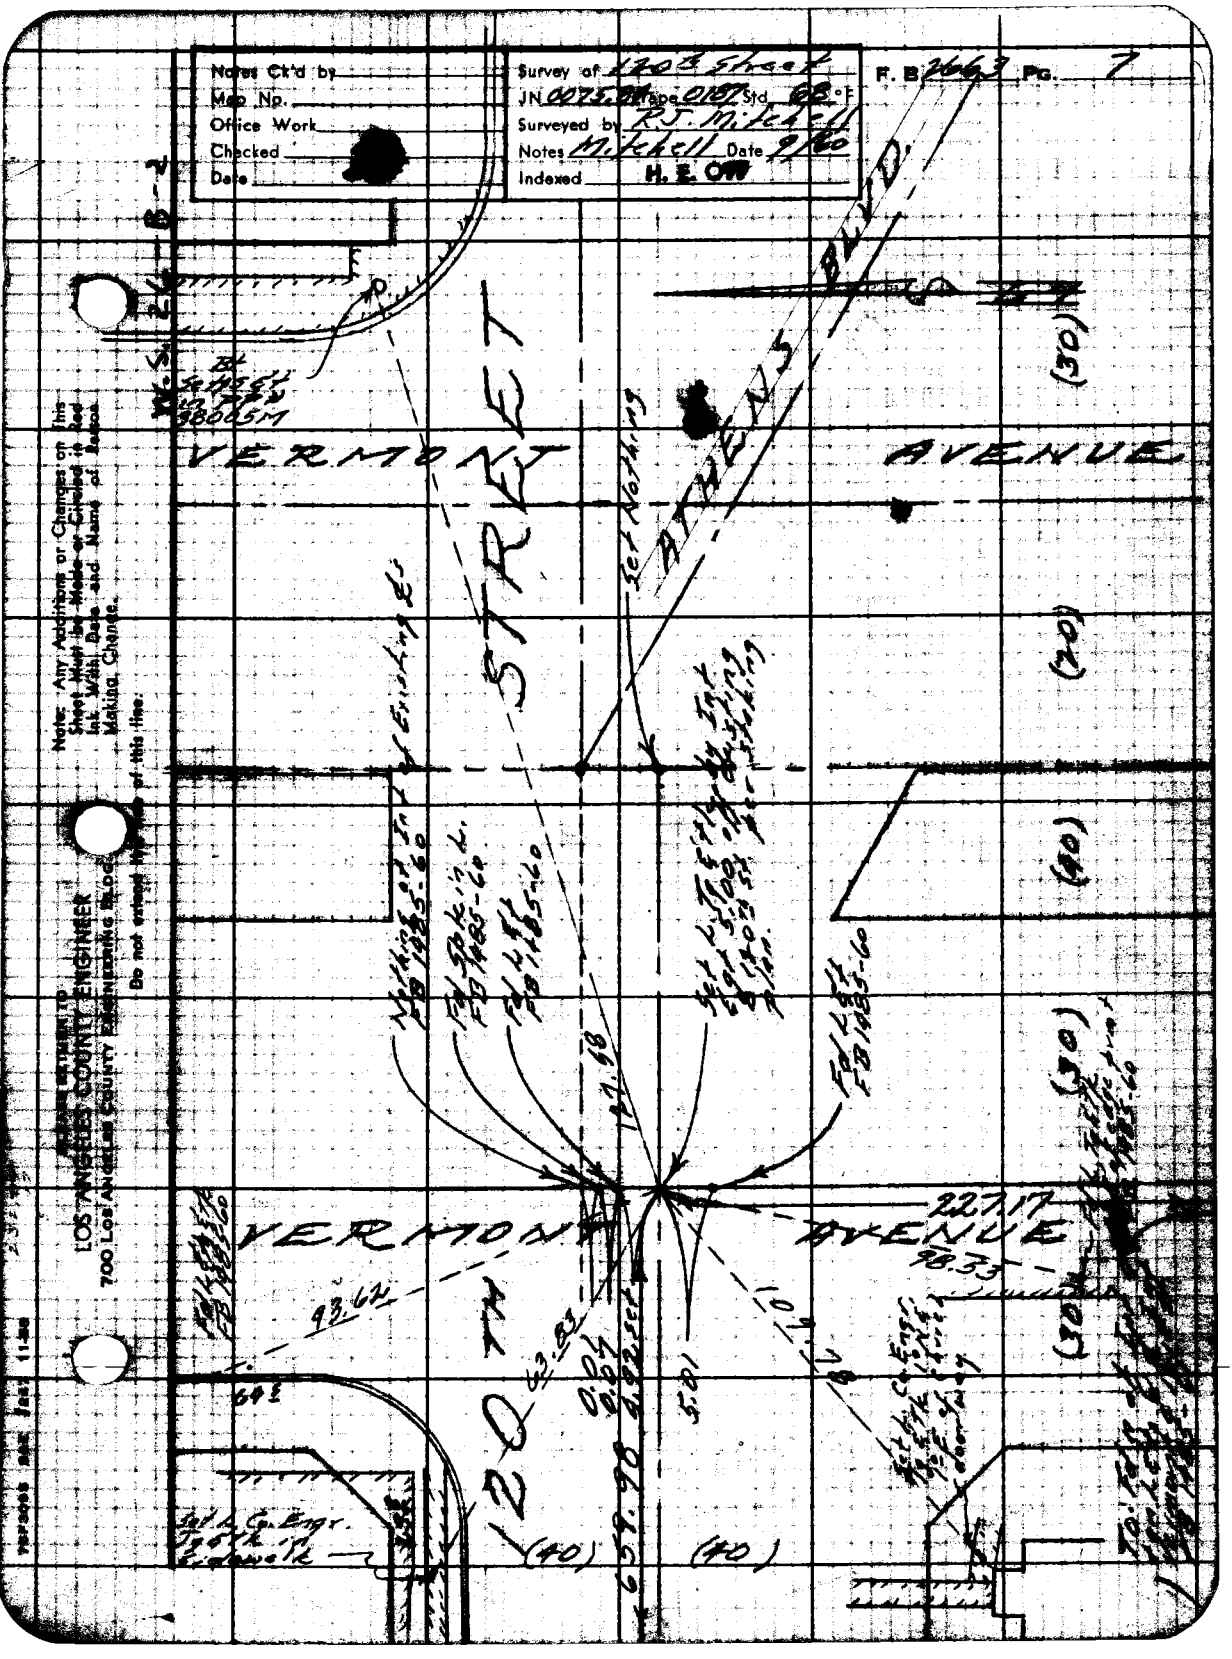
Notes Ck'd by
Map No.
Office Work
Checked
Date
Survey of 1903 Sheet
JN 0075.01 Tape 0.01 Std. 68° F
Surveyed by R.J. Mitchell
Notes M. Ickell Date 9/60
Indexed H. E. OW
F. B. 2663 Pg. 7
VERMONT AVENUE
120TH STREET
VERMONT AVENUE
(30)
(40)
(70)
(40)
(30)
(40)
(40)
(30)
147.68
93.62
43.83
0.04
0.04
50.01
101.17
98.33
227.17
649
Set A.C. Engr.
Set Tack
Sidewalk

PLEASE RETURN TO
LOS ANGELES COUNTY ENGINEER
700 LOS ANGELES COUNTY ENGINEERING BLDG.

Note: Any Additions or Changes on This Sheet Must be Made or Circled in Red Ink With Date and Name of Person Making Change.

Do not extend this side of this line.

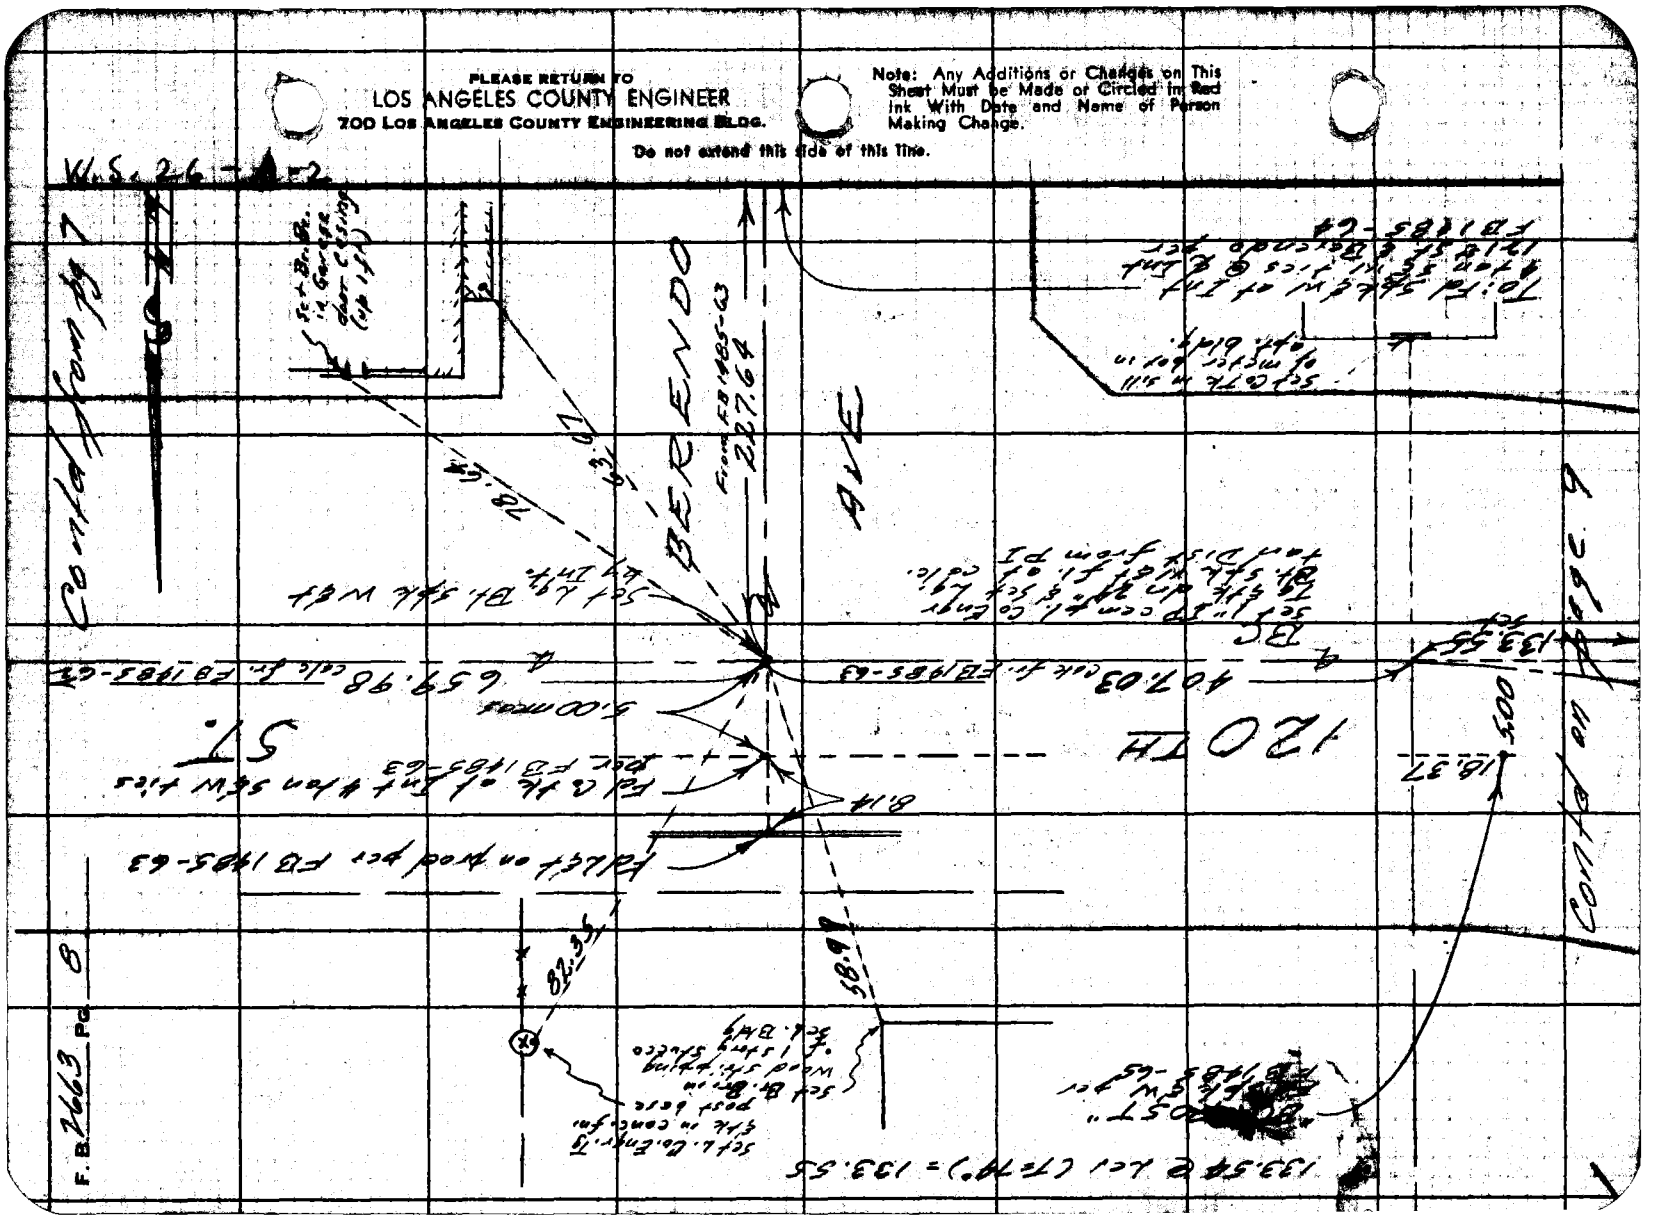

PLEASE RETURN TO
LOS ANGELES COUNTY ENGINEER
700 LOS ANGELES COUNTY ENGINEERING BLDG.

Do not extend this line of this line.

Note: Any Additions or Changes on This Sheet Must be Made or Checked in Red Ink With Date and Name of Person Making Change.

20.85
9.52
25.40

W.S. 24 & M-2

1) 26 55 15
2) 107 33 15
3) 161 19 45
4) 26 53 17E

Contd on Page 10

Set 5/8" I.P. & 814483E

66.05

Set Sm. Bk. Sh. in P.P. 814483E

15.32

Set Sm. Bk. Sh. in P.P. 814483E

60.81

60.81

NOTE: All Pts. on This Sh. shown as "Set" are per FB 1485-65

Removed Bk. Curve Data Pg. 10

Set Lg. Bk. Spk. W 6± Fl. 120 ft. S'ly from R 110 Pl. per Office Staking Sheet

BC Removed Set Lg. Bk. Spk. W 6± Fl. or c (set) 1" Pipe Pl. Co. Engr. Tag & 18" al. cak Fd. Dist. S'ly on calc. Δ from P.I.

Contd on Page 9

Removed See Pg 45

Off BC Fd n. 0.03 E

23.03

Set

Set

Set

PLEASE RETURN TO
LOS ANGELES COUNTY ENGINEER
700 LOS ANGELES COUNTY ENGINEERING BLDG.

Note: Any Additions or Changes on This Sheet Must be Made or Circled in Red Ink With Date and Name of Person Making Change.

Do not extend this side of this line.

W.S. 26-A-2

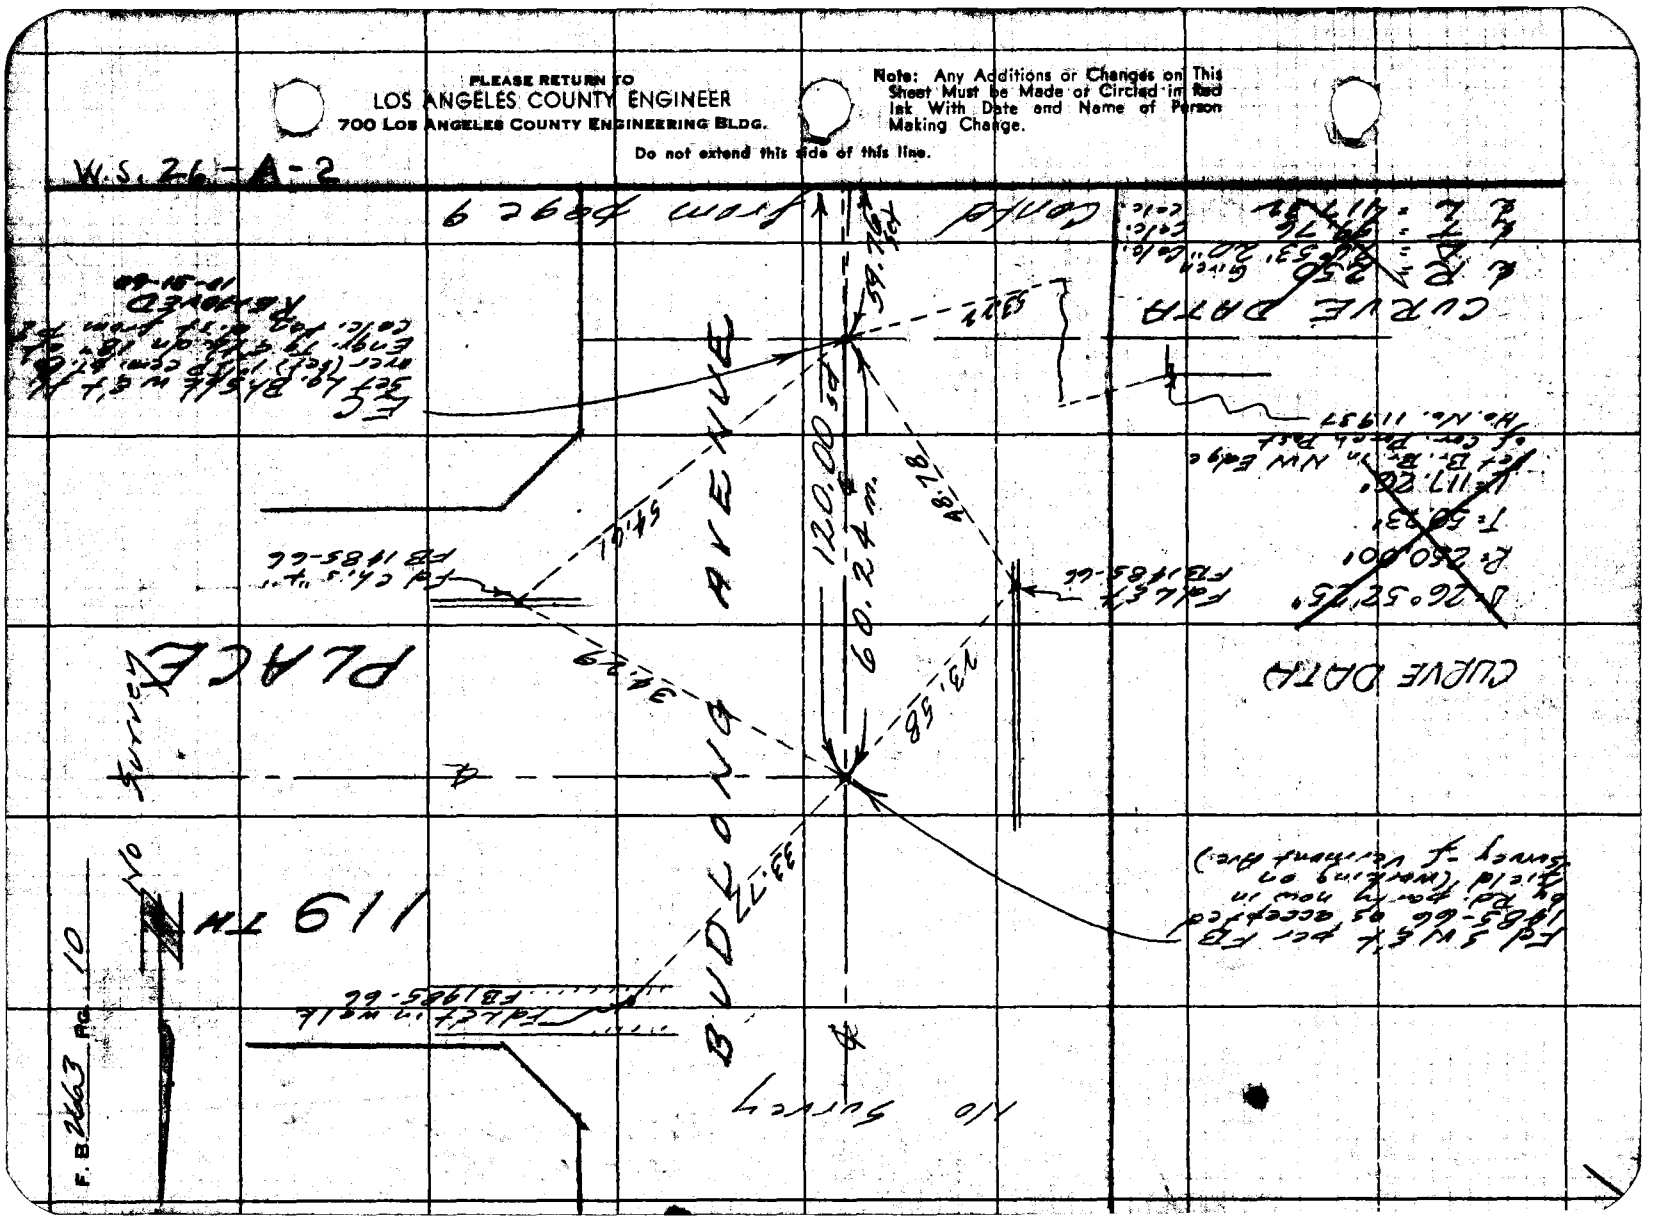
PLACE
Loring
AVENUE
BUDLONG
No Survey
119 TW
F.B. 2663 Pg. 10
CURVE DATA
CURVE DATA
33.73
23.58
32.29
48.87
120.00' M.
60.22'
55.45'
93.42'

Notes Ck'd by	Survey of 120 St
Map No.	JN 0075.84 Tape 2187 Stg 68 °F
Office Work	Surveyed by R.S. Mitchell
Checked	Notes Mitchell Date Aug 60
Date	Indexed H. E. Ott

F. B. 2663 Pg. 11

Note: Any Additions or Changes on this Sheet Must be Made or Circled in Red Ink With Date and Name of Person Making Change.

Do not extend this line beyond ends of this line.

PLEASE RETURN TO
LOS ANGELES COUNTY ENGINEER
700 Los Angeles County Engineering Bldg.

7673005 SBE 1247 11-58

Contd from page 9

S. 23.03

134.60

FB 5566 & 65 M-C

BUDLONG AVE

37.66 — 41.13 — 233.01 To Curve — 195.01

120 TH

78.59

FB 1485-68

FB 1485-65

(40)

(40)

0.45

133.98

Contd in FB 1485 on page 68.

PLEASE RETURN TO
LOS ANGELES COUNTY ENGINEER
700 LOS ANGELES COUNTY ENGINEERING BLDG.

Note: Any Additions or Changes on This Sheet Must be Made or Circled in Red Ink With Date and Name of Person Making Change.

Do not extend this side of this line.

W.S. 26 - A-2

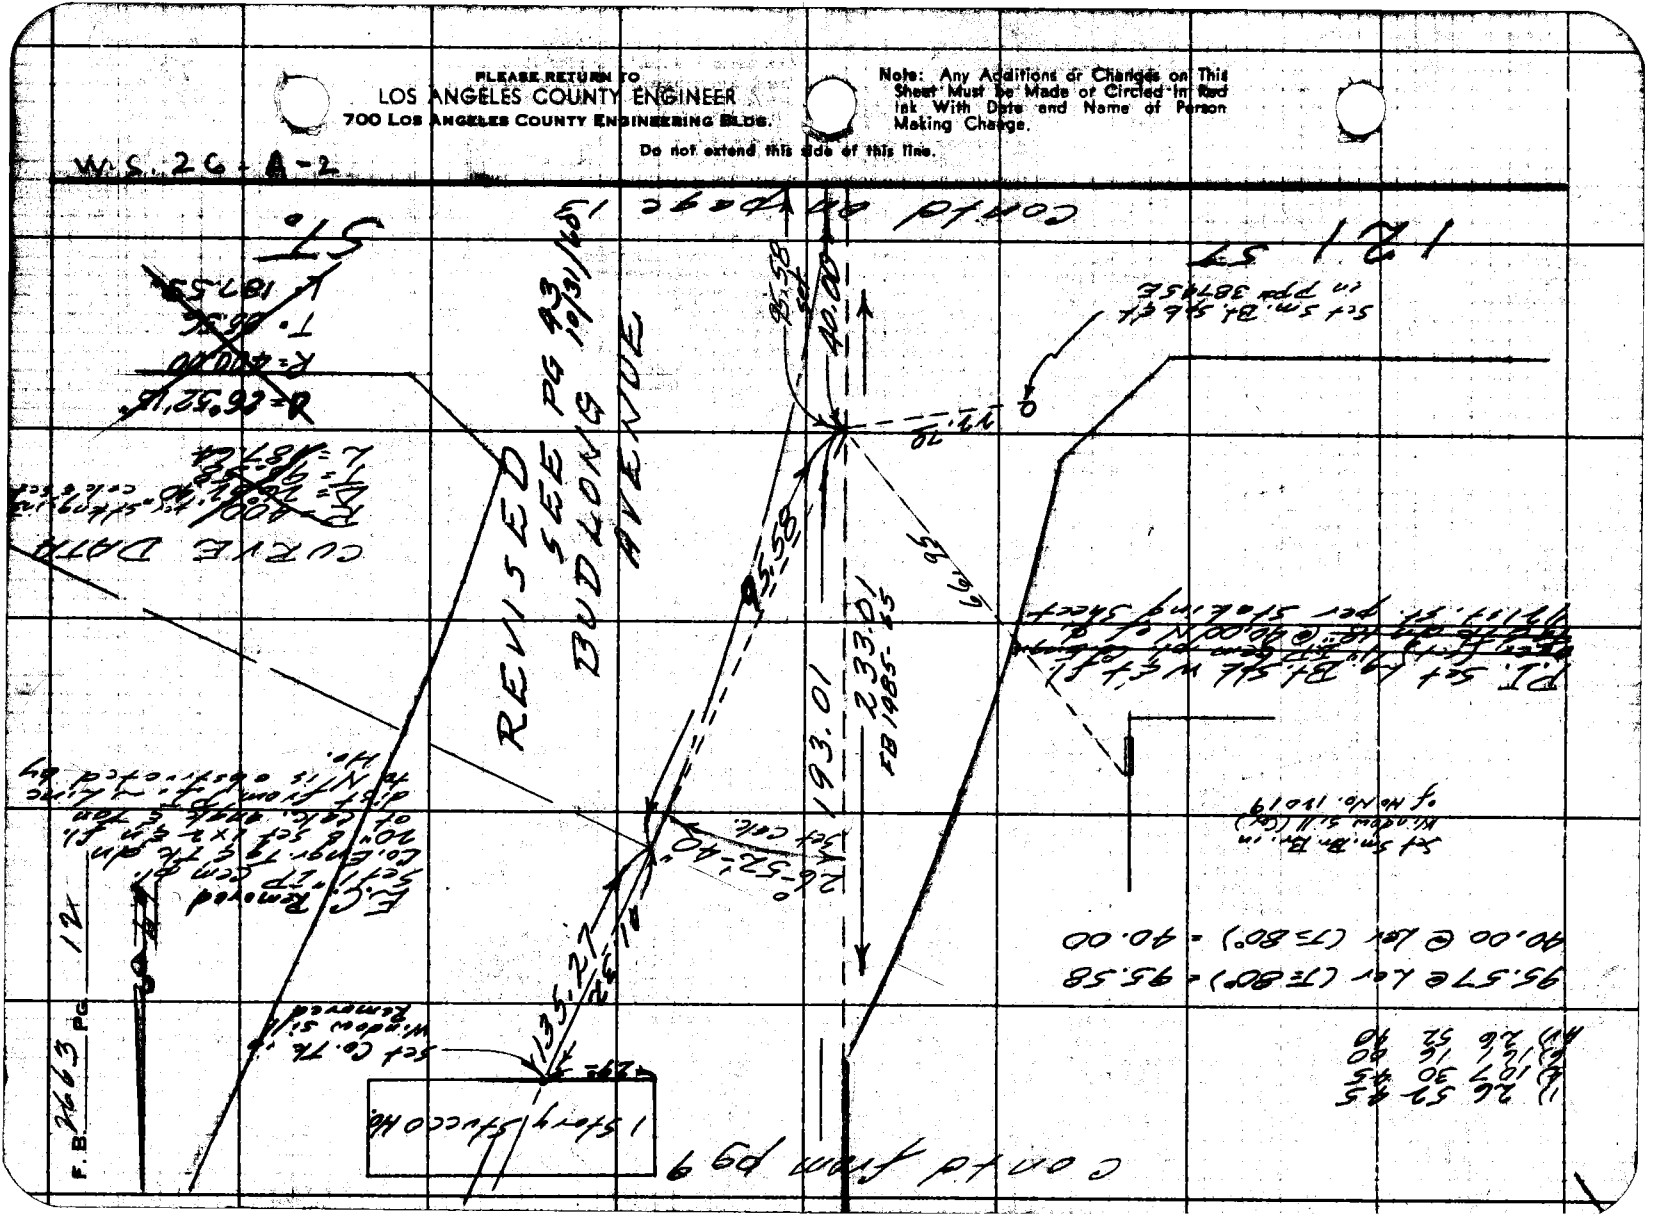
REVISED
SEE PG 193.01
BULLONS AVENUE
193.01
FB 1985-45
Cont'd from pg 99
Cont'd from pg 99
1 Story Stucco Hse.

76F3095 S&E #247 11-68

PLEASE RETURN TO
LOS ANGELES COUNTY ENGINEER
700 LOS ANGELES COUNTY ENGINEERING BLDG.

Note: Any Additions or Changes on This Sheet Must be Made or Circled in Red Ink With Date and Name of Person Making Change.

Do not extend this line of this line.

W 6 36-A2

Notes Ck'd by
Map No.
Office Work
Checked
Date

Survey of
Surveyed by
Notes
Indexed

F. B.

55.58 @ Ler (Rad) = 55.58 L

Cont'd from page 12

Fd nail in PP #3879 E
FB 1983-67

Fd nail in PP #3879 W
FB 1983-67

Fd nail in Guy Pole #6184 N

Set 10,00 233.01

Bell Point

12 1 ST

STREET

(30)

61.33

87.28

Fd Chis "+" in Hyd.

Fd Chis "+" in Hyd.

33.25

Fd nail & W of int Bell Point & 55 W per FB 1983-67

Fd Chis "+" in Rim MH

55.58

49.91

Bell Avenue

(30)

(30)

No Survey

Fd nail in driveway NE Corner of Bldg

Set nail & tag "LS 6184" in top of curb at PT in line with prop. line

PLEASE RETURN TO
LOS ANGELES COUNTY ENGINEER
700 LOS ANGELES COUNTY ENGINEERING BLDG.

Note: Any Additions or Changes on This Sheet Must be Made or Circled in Red Ink With Date and Name of Person Making Change.

Do not extend this side of this line.

W.S. 26 - A 2

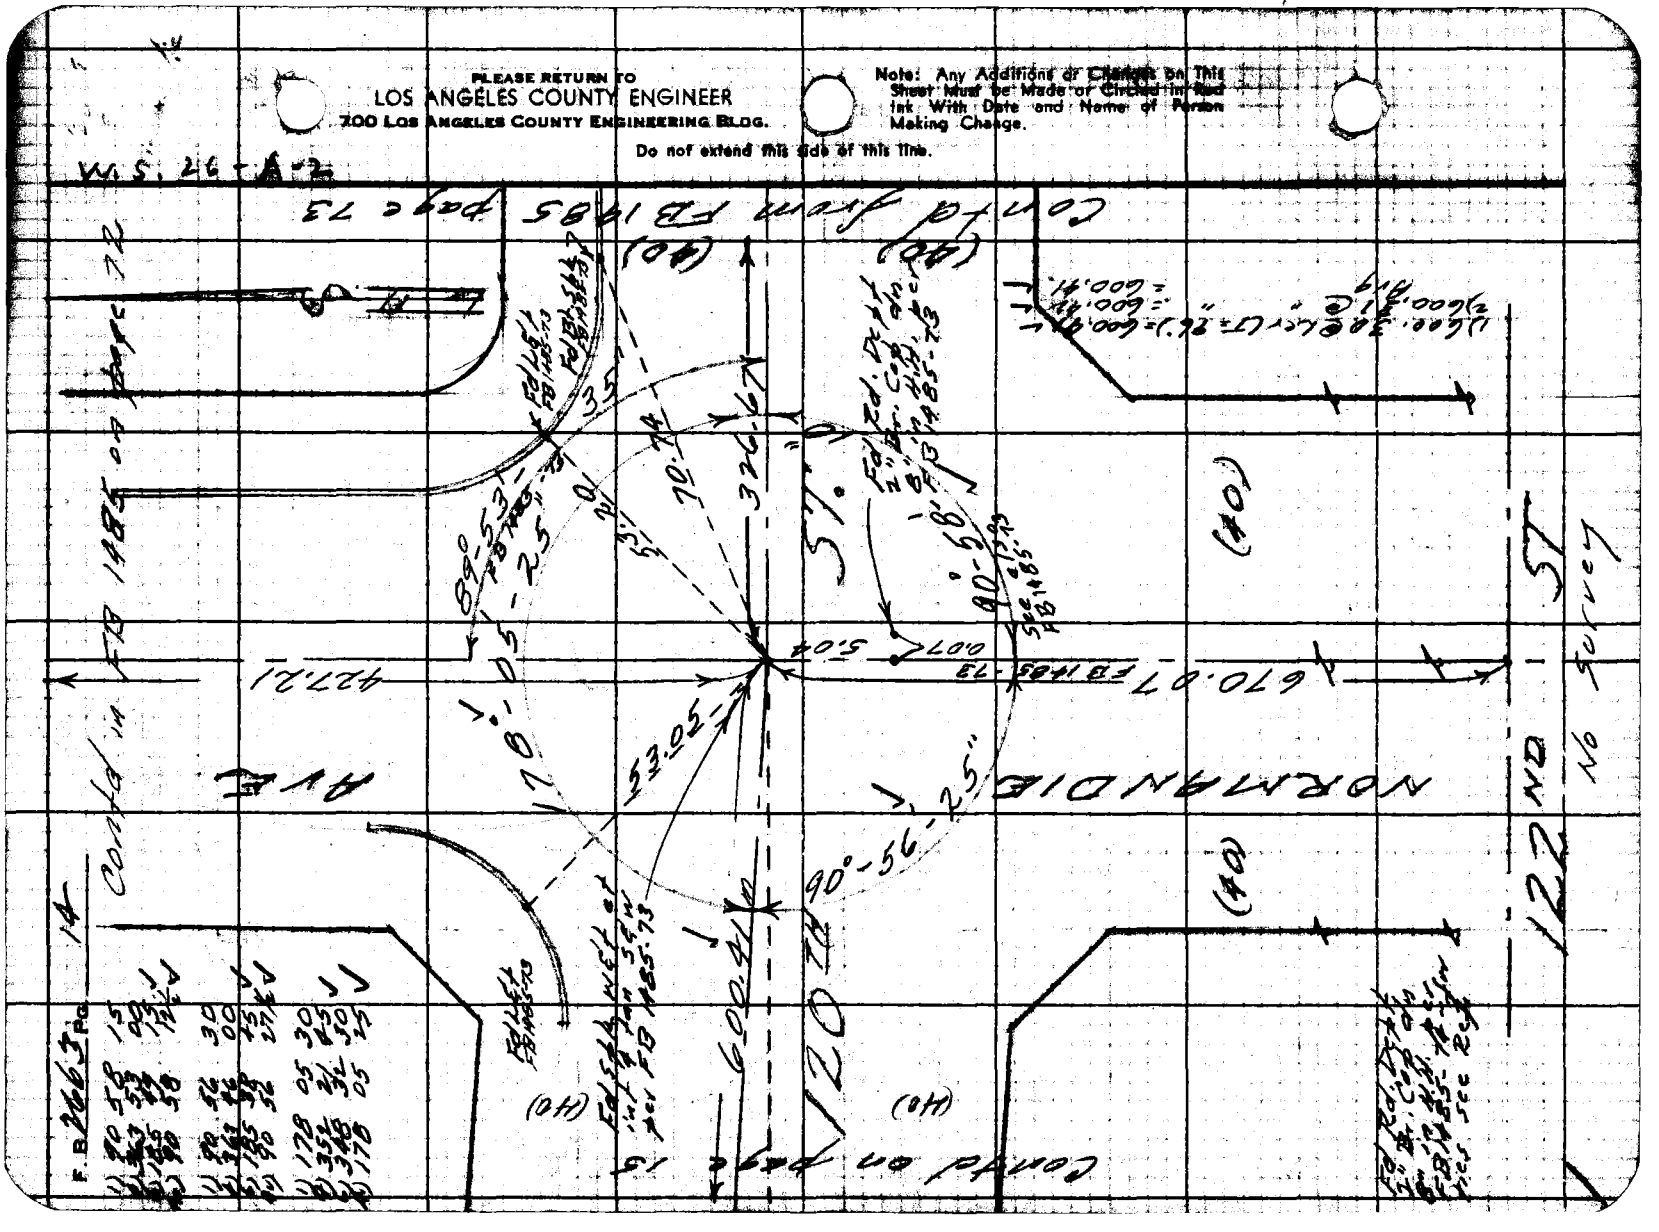

Notes Ck'd by Miller
Map No. 8282
Office Work Manasu
Checked Miller
Date Dec. 1960

Survey of 120th St.
J.N. 0075.84 Tape 0187 Std. 68 °F
Surveyed by R.J. Mitchell
Notes Mitchell Date 9/60
Indexed H. E. Ott

F. B. 2663 Pg. 15

Set 1" I.P. cem. w/ L.A. Co. Engr. Tag flr.
in 18" dia. set 1'x2'x2' in Pl. conc. 20.00
N. of G.S. Mon. per Stirling
Sheet.

Fd L.A. Co. Rd. Dept. Br. Cap in 1" IP dg
Pr. and on line of Holldale Ave — Acc
FB 1885-75

Fd 1" I.P. in PP "Rancho" FB 1885-75

Fd Std. Conc. Mon. Well with BB, Std. Cap, 1.0' PPd 12.4 S30E

Fd Std. C.S. Br. Cap Mon dn 10" in FB 1885-75 M.M. per

Fd 1" I.P. in conc. and U.S.C.M.M. FB 1885-75

Fd 1" I.P. in Conc. drive FB 1885-75

1) 88 12 15
2) 274 10 45
3) 268 13 00
4) 88 12 10

1) 89 53 30
2) 357 53 30
3) 177 30 30
4) 89 53 25

1) 181 54 30
2) 357 37 45
3) 177 54 45
4) 181 54 35

Fd P.K. at int. of 4 Ave. S. of W. — No Ref. — Mon. as now permanently established by L.A. Co. Rd. — Tie shown in FB 1885-75 — acc. from C.L. of Holldale Ave.

Fd 4 pcs Lead in Conc. of C.G. 3 No Ref. — Prof. set by L.A. Co. Rd.

Fd 4 Chis in "X" grids E — No Ref. Prof. L.A. Co. Rd.

No Survey

HOLLDALE AVENUE

120TH ST.

121ST ST.

670.11

600.41

28.77

38.23

47.60

89°-62'

83°-53'-42"

88°-10'-10"

39.84

39.00

18.06

18.13

39.11

39.52

(40)

Note: Any Additions or Changes on This Sheet Must be Made or Circled in Red Ink With Date and Name of Person Making Change.

Do not extend notations beyond this line.

LOS ANGELES COUNTY ENGINEER
700 Los Angeles County Engineering Bldg.

P.I. 1.5 MI. TO SEPULVEDA BLVD.

78F3088 SEE F24 11-68

F. B. 7663 Pg. 16

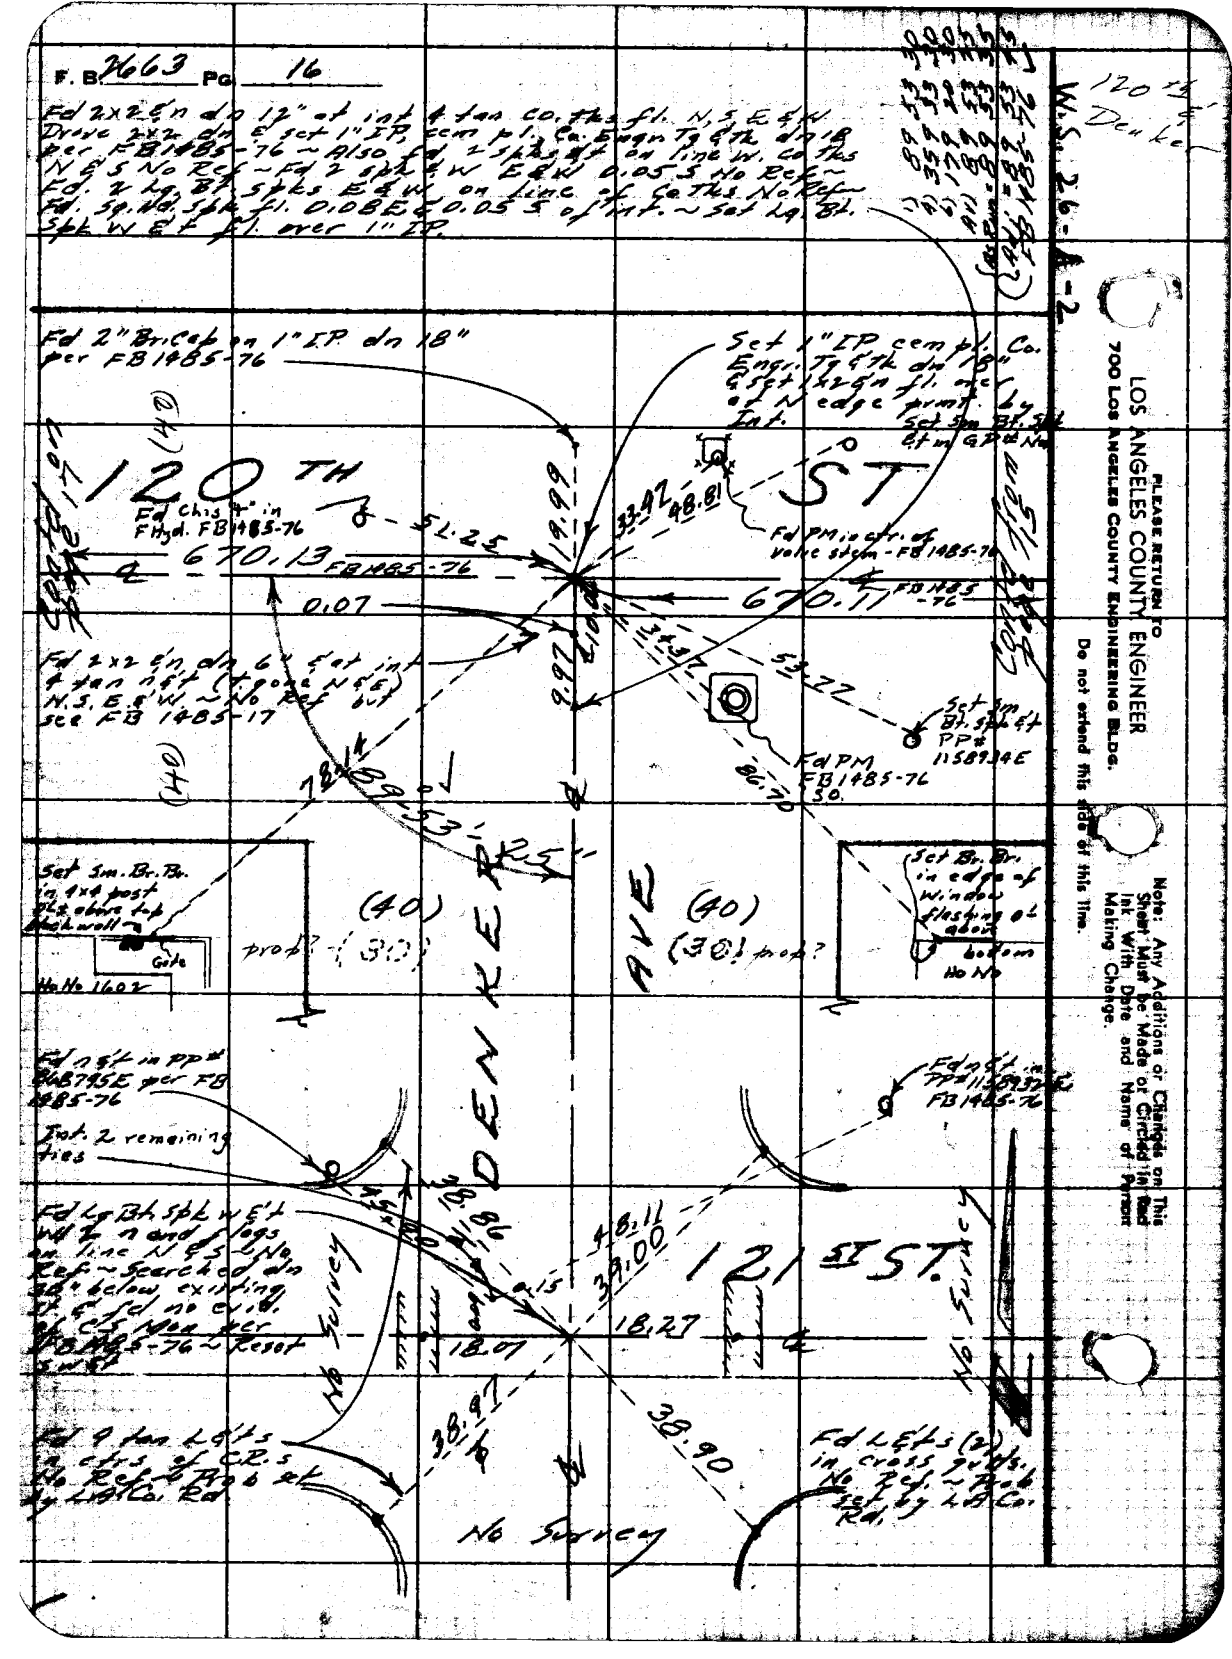
Fd 2x2 E'n d'd 12" at int 4 tan co. fks fl. N, S, E & W
Drive 2x2 E'n E set 1" IP, cem pl. Co. Engr. Tg 4th d'd 18 per FB 1485-76 ~ Also fd 2 spks 4ft on line W. Co fks N & S No Ref ~ Fd 2 spks E & W E&W 0.05 S No Ref ~ Fd. 2 Lg. Bk. spks E & W on line of Co fks. No Ref ~ Fd. Sq. Nail 5ft fl. 0.10 E & 0.05 S of Int. ~ Set Lg. Bl. Spk W & E ft fl. over 1" IP.
W. S. 26-A-2
120 TH
Dead
LOS ANGELES COUNTY ENGINEER
700 Los Angeles County Engineering Bldg.
Please Return To
Do not extend this side of this line.
Note: Any Additions or Changes on This Sheet Must be Made or Circled in Red Ink With Date and Name of Person Making Change.
Fd 2" Br. Cap on 1" IP dn 18" per FB 1485-76
Set 1" IP cem pl. Co. Engr. Tg 4th dn 18" & set Lazy N ft. on E edge prmt. by Int.
Set 3m Br. Spk 6ft W of Gate No
120 TH
ST
Fd Chis'd "+" in Flgd. FB 1485-76
S 2.25
670.13 FB 1485-76
670.11 FB 1485-76
19.99
33.97
48.81
Fd PM in ctr. of Valve stem - FB 1485-76
0.07
Fd 2x2 E'n, dn 6" S at int 4 tan ast (Tgoe N & S) N, S, E & W ~ No Ref but see FB 1485-17
53.27
Set 3m Br. Spk 1ft PP# 1158914E
Fd PM FB 1485-76
50.70
78.14
89.53
Set 3m. Br. Bs. in 4x4 post 0.5 ohm 1ft Blackwall ~ Gate No No 1602
(40)
prod? (30)
DENKER
AVE
(40)
(30.1 prod?)
Set Br. Br. in edge of window flashing of door bottom No No
Fd nail & Tack in PP# 1158795E per FB 1485-76
Tack 2 remaining ties
Fd nail & tack in PP# 1158937E FB 1485-76
Fd Lg Bk. Spk W & E ft W ft N and S legs on line N & S ~ No Ref ~ Searched dn 24" below existing gr. & fd no evid. of C.S. Mon per FB 1485-76 ~ Reset same
45.00
38.86
4.81
39.00
0.15
121 ST
ST
18.07
18.27
No Survey
Fd 4 tan Ls & 1 ctrs of C.R.s No Ref ~ Rob at Ly Light Co. Rd
38.91
38.90
Fd L & Ts (2) in cross gutts. No Ref. ~ Rob set by Ly Co. Rd.
No Survey

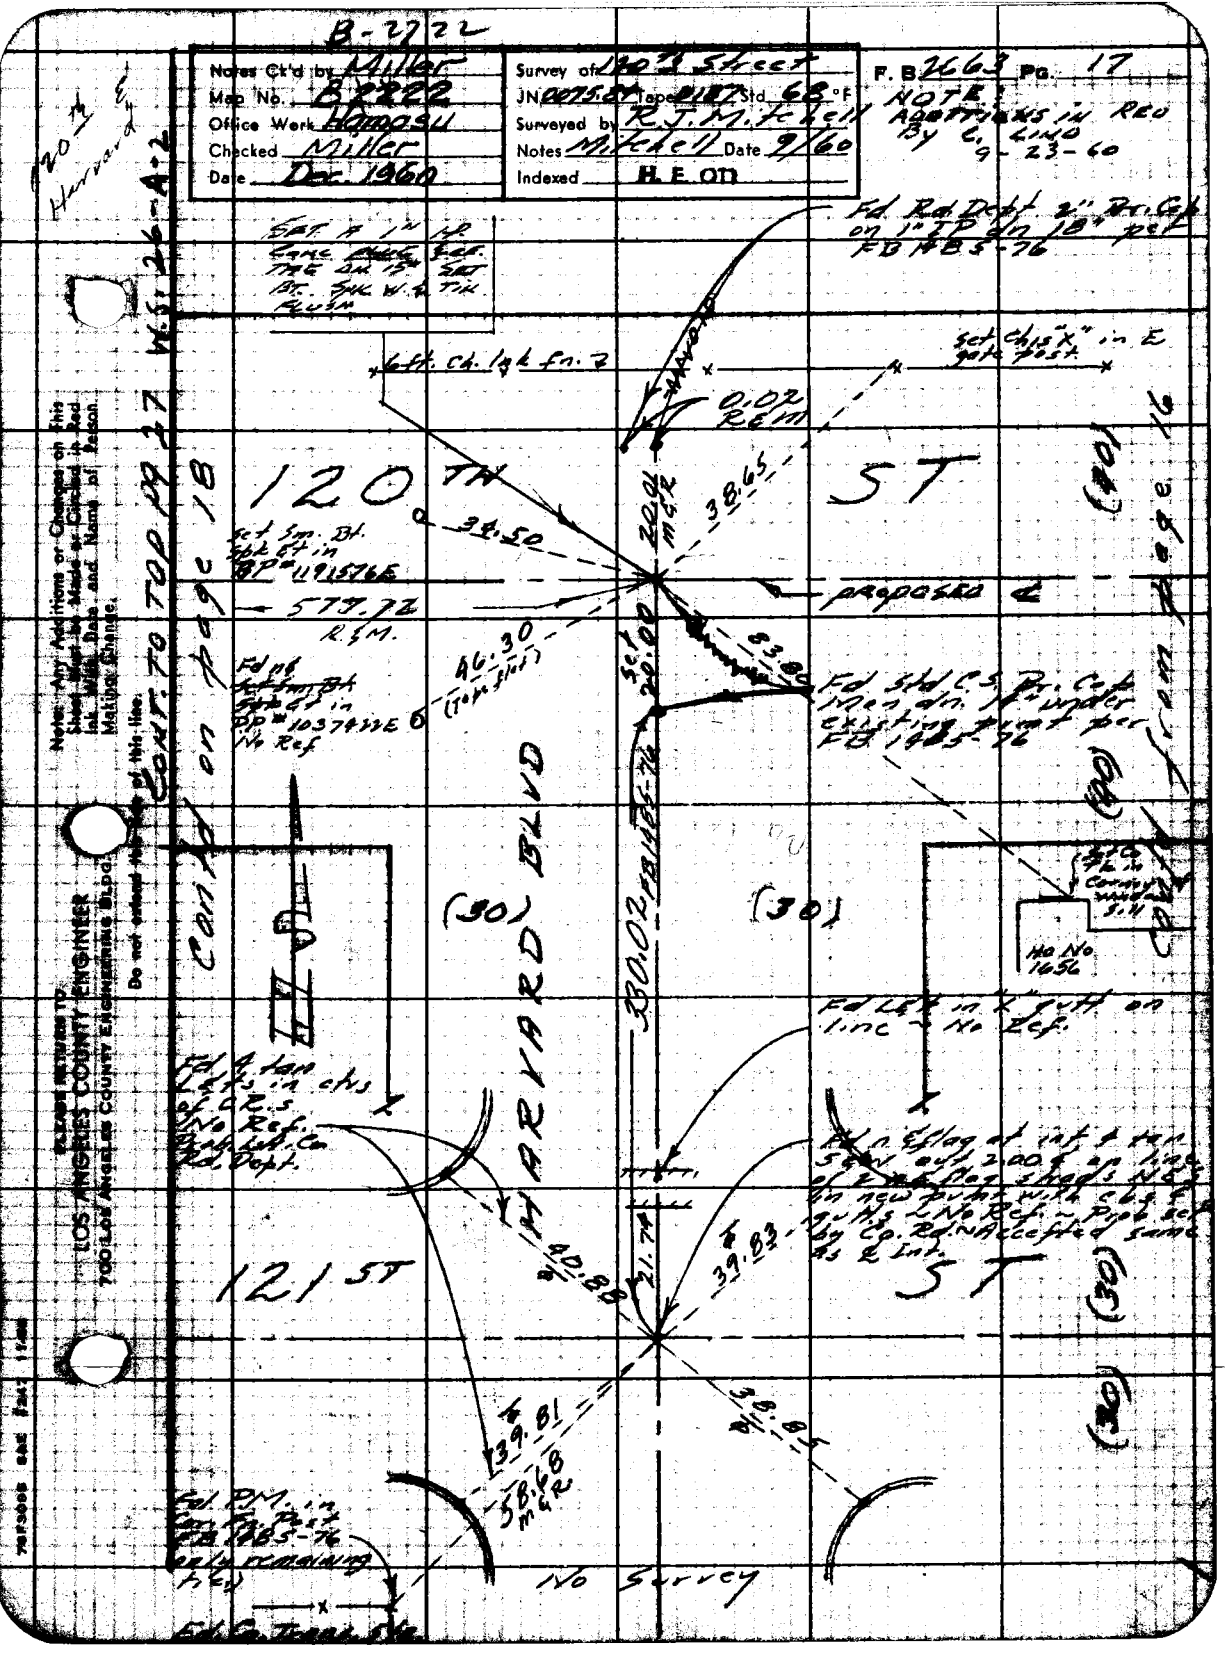
B-2722
Notes Ck'd by Miller
Map No. B-2722
Office Work Hamasu
Checked Miller
Date Dec. 1960
Survey of 120th Street
JN 0075.01 Maps PLAT Std. 68 °F
Surveyed by R.J.M. Ickell
Notes Mickell Date 9/60
Indexed H.E.ON
F. B. 2663 Pg. 17
NOTE: ADDITIONS IN RED BY C. LINO 9-23-60
Harvard
Set 1" IP
Fd Rad Dot 2" Br. Ck on 1" IPDen 18" pcf FD NBS-76
Left Ck. 1/2 Fn. 2
Set Chis "X" in E gate post
0.02 Rein
120 TH
Set Sm. Bl. Spk & Tag in BP "1915766"
S 77° 22 E R&M
Fd NB Nail & Tag in DP "1037432E" IN Ref
Cont. to Page 18
Cont. from Page 16
PROPOSED
Fd Std Cs Br. Ck Indent. 1" under existing pvmt per FD 1985-76
379 Ft. to Conway Water S.M.
Ho No 1656
(30)
HARVARD BLVD
Fd Lead in X cut on line - No Ref.
Fd 2 Nail & Tags in chs of CRS No Ref. Both Left Co Rd. Dept.
121 ST
Fd Nail & Tag in Conc Post FD 1985-76 No Ref
No Survey
LOS ANGELES COUNTY ENGINEER
700 Los Angeles County Engineering Bldg.
Do not extend notes past this line.
Notes: Any Additions or Changes on this Sheet Must be Made or Checked in Red Ink. Wilful Data and Name of Person Making Change.

PLEASE RETURN TO
LOS ANGELES COUNTY ENGINEER
700 LOS ANGELES COUNTY ENGINEERING BLDG.

Note: Any Additions or Changes on This Sheet Must be Made or Circled in Red Ink With Date and Name of Person Making Change.

Do not extend this side of this line.

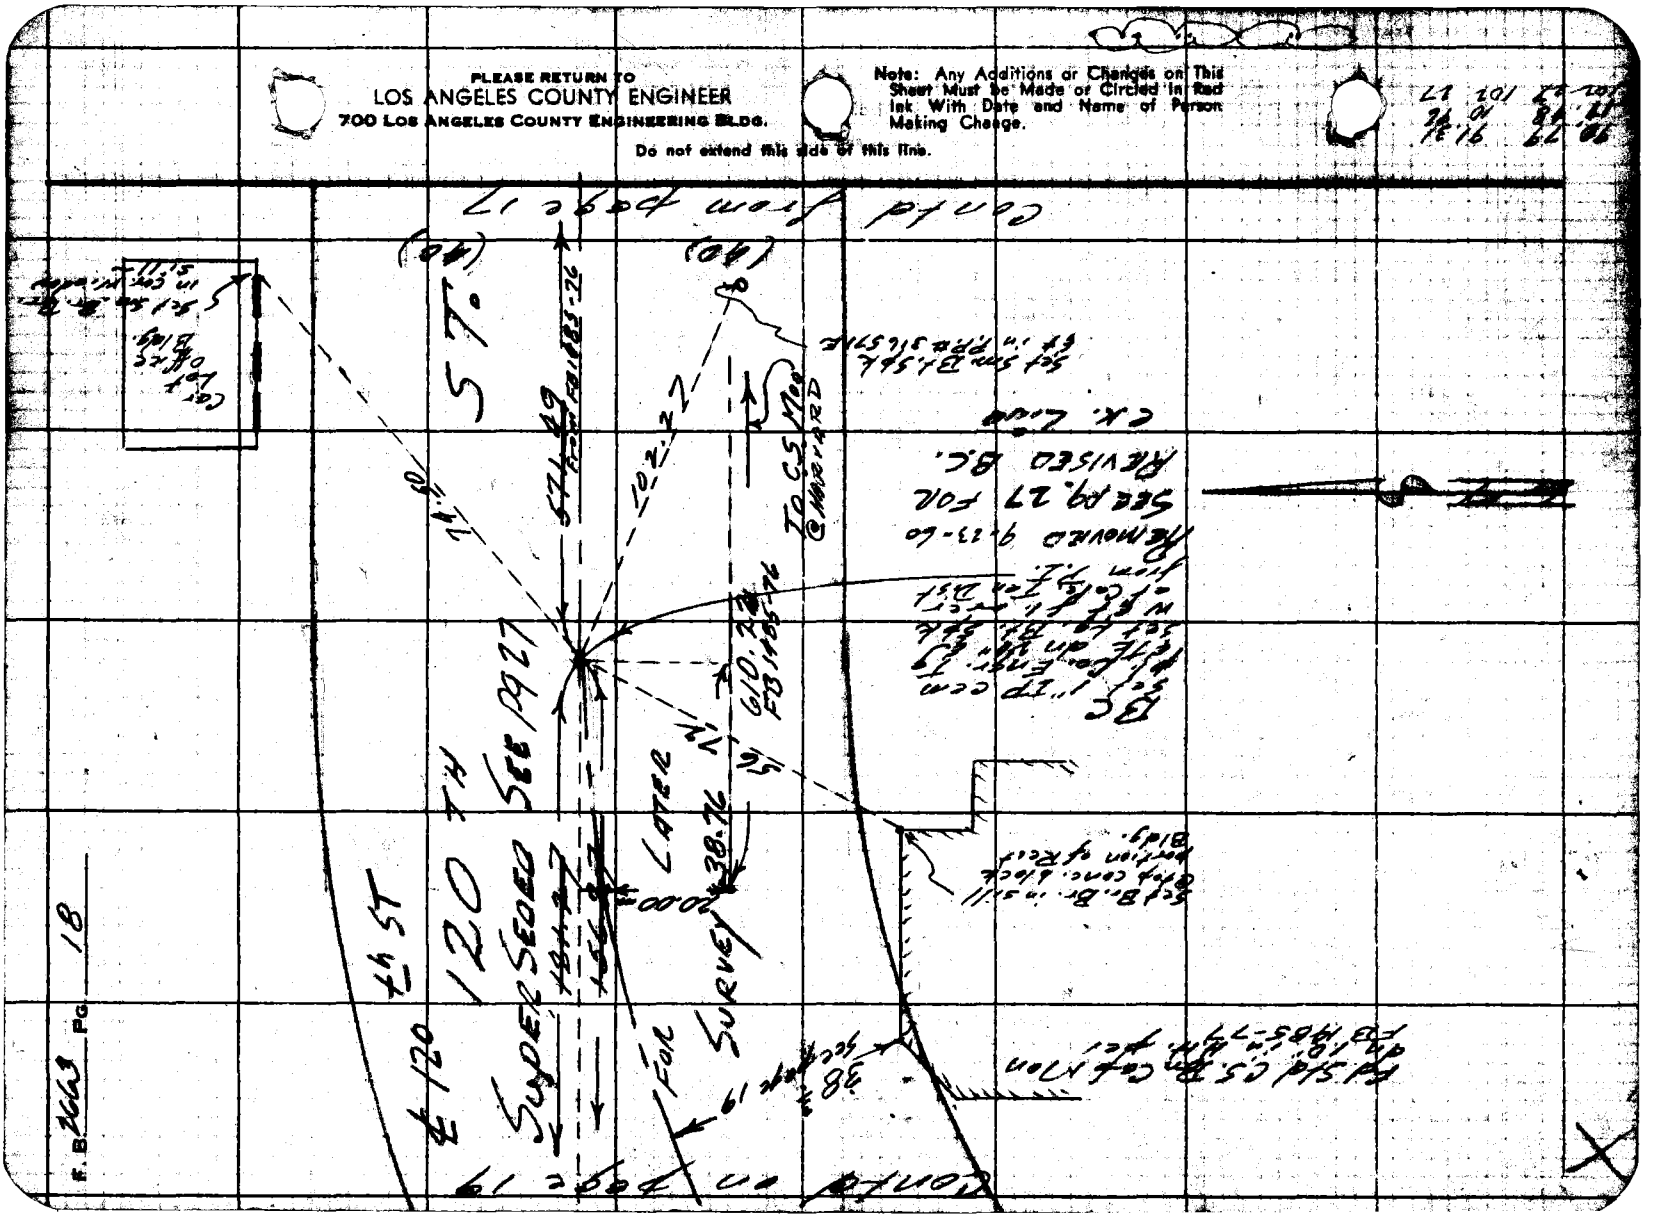

Notes Ck'd by Miller
Map No. B2222
Office Work Homasu
Checked Miller
Date Dec. 1960

Survey of 120th Street
Tract No. [illegible] Maps 0087 Sht. 68 of
Surveyed by RJ Mitchell
Notes [illegible] Date 9/60
Indexed [illegible]

F. B 266 Pg 12

























F. B. 2063 Pg. 20

Continued from page 19

Note: Sep. Tap and Tap are back of sidewalk in all courts for location of cable for traffic signals. Locate on N. side of E-W streets & on E. side of N-S streets.

PLEASE RETURN TO
LOS ANGELES COUNTY ENGINEER
700 Los Angeles County Engineering Bldg.

Note: Any Additions or Changes on This Sheet Must be Made or Circled in Red Ink With Date and Name of Person Making Change.

Do not extend this side of this line.

DEPARTMENT OF PUBLIC WORKS

(40)

(40)

Curve Data
R = 100.00'
Δ = 23°32'39" Lt.
T = 20.90'
L = 41.09'
Rad. Brg. N 66°27'21" E

Δ = 12°29'09"
Ref. Sta. Pcr
FD 1485-94

Ref. Bk Mkmt
Sta. 7+00 Pcr
FD 1485-94

Sta. 13+80 @ Back
Sta. 12+77.27 Ahead

Back
Ahead

Continued on page 21

Notes Ck'd by Miller
Map No. B 2822
Office Work Homosu
Checked Miller
Date Dec. 1960

Survey of 120th St.
JN 077584 Tape 0.997 Std. 68 °F
Surveyed by R.F. Mitchell
Notes M. Kidell Date 2/60
Indexed H.E. Ott

F. B. 2663 Pg. 21

cont pg. 20

Fd ⊥ & ⊥ FB 1485-95
FB 2663-24

Fd ch. X in sidewalk
FB 1485-95
FB 2663-
See o/s° page 24

0.06

10' off set FB 1485-95

PB 1485-95
1224.

15 00
19
32° 19 54
1) 32° 19 16
2) 129
3) 193

Avg 32° 19 00

℄ 120 x 54

Super Sed to See pg. 31

320.33 Lcv (T-80) = 320.36
320.33 Lcv (T-80) = 320.36
Avg = 320.36

Fd 3/4" hd spk 2 in FB 1485-95

0.16

Fd bt spk in R.R. Tie
(11+25.00 per FB. 1485-95)

32° 19 00

1 meas.

Set large bl spk in tie Wash & tie by Mtrs

NOTES on this page are by

(40)

Meas 7234

(40)

℄ 120 ft

Meas 7234

℄ 120 ft

cont pg 22

98.50 Lcv (T-80) = 98.51

Avg = 72.34

72.33 +
72.34 +

Kidell Line
PB 1485-95

Note: Any Additions or Changes on This Sheet Must be Made or Circled in Red Ink With Date and Name of Person Making Change.

Do not extend the life of this film.

PLEASE RETURN TO
LOS ANGELES COUNTY ENGINEER
900 Los Angeles County Engineering Bldg.

No Survey

Fd 3/4" G.P.
FD 1985-96

117TH ST

Nothing

Fd 3/4" G.P.
FD 1985-96

WILTON PLACE

N11°55'58"E 1185.58

R.P.B.T.
Set 1" IP
@90° off line
to Engr. TP

Fd L.S. tag
FD 1985-96

Fd L.S. tag
FD 1985-96

Fd L.S. tag
FD 1985-96

Fd L.S. tag
FD 1985-96

68.75

E OF 120TH ST
SUPERSEDED
SEE PG 32
FOR REVISED
SURVEY

No Survey

Fd 3/4" G.P.
FD 1985-96

Set 1" IP cem'd
TP L.S. 6421
in 24" R.C.P.
1.22' W. & 0.21'
S. of Fd Nail

Fd 1" IP cem'd
Engr. TP L.S.
6421 in 24"
R.C.P. 1.22'
W. & 0.21' S.
of Fd Nail

Set 1" IP cem'd
TP L.S. 6421
in 24" R.C.P.
1.22' W. & 0.21'
S. of Fd Nail
FD 1985-96

PT
Set 1" IP cem'd
Co. Engr. TP L.S.
6421 in 24" R.C.P.
1.22' W. & 0.21'
S. of Fd Nail
Office Set 1.22'
W. & 50.00'
N. of Wilton Pl

30.10

120TH ST

281.79

Fd Nail
FD 1985-96

63.83

48.21

Set 1" IP cem'd
TP L.S. 6421
in 24" R.C.P.
1.22' W. & 0.21'
S. of Fd Nail
FD 1985-96

Notes Ck'd by Miller
Map No. B2822
Office Work Homasu
Checked Miller
Date Dec. 1960

Survey of 120th Street
JN 007582 Tape 087 Sfd 68 °F
Surveyed by R.F. Mitchell
Notes M. Itchell Date 9/60
Indexed H. E. OTT

F. B. 2663 PG. 23

1) 174 07 15
2) 336 53 00
3) 324 07 45
4) 174 07 15 L
174 07 27 Calc'd & held

Note: Any Additions or Changes on This Sheet Must Be Made or Circled in Red Ink With Date and Name of Person Making Change.

Do not extend this line of this line.

RECORD RETURN TO
LOS ANGELES COUNTY ENGINEER
700 Los Angeles County Engineering Bldg.

Continued on Page

Set Tack 1.1 Ft. Left to Line

Tree in Plant

Set L. Tack in C.L.

Removed 9-23-60 C.L.

Set L. Tack in C.L.

Set L. Tack @ 90° off P.T.

95.10

29 FOOT OFFSET LINE

281.79 Calc.

30.05

15.91

120TH ST

~~1582.82~~ Calc.
261.11
A Calc. - FB 1485-96

To ℄ Int Tarron Ave. ℄ 120th St.

174° 07' 27"

℄ 120 th St. Superseded

See 09 32 for Revised Survey

℄ & Line
9-23-60

F.B. 2663 Pg. 24

DETAIL

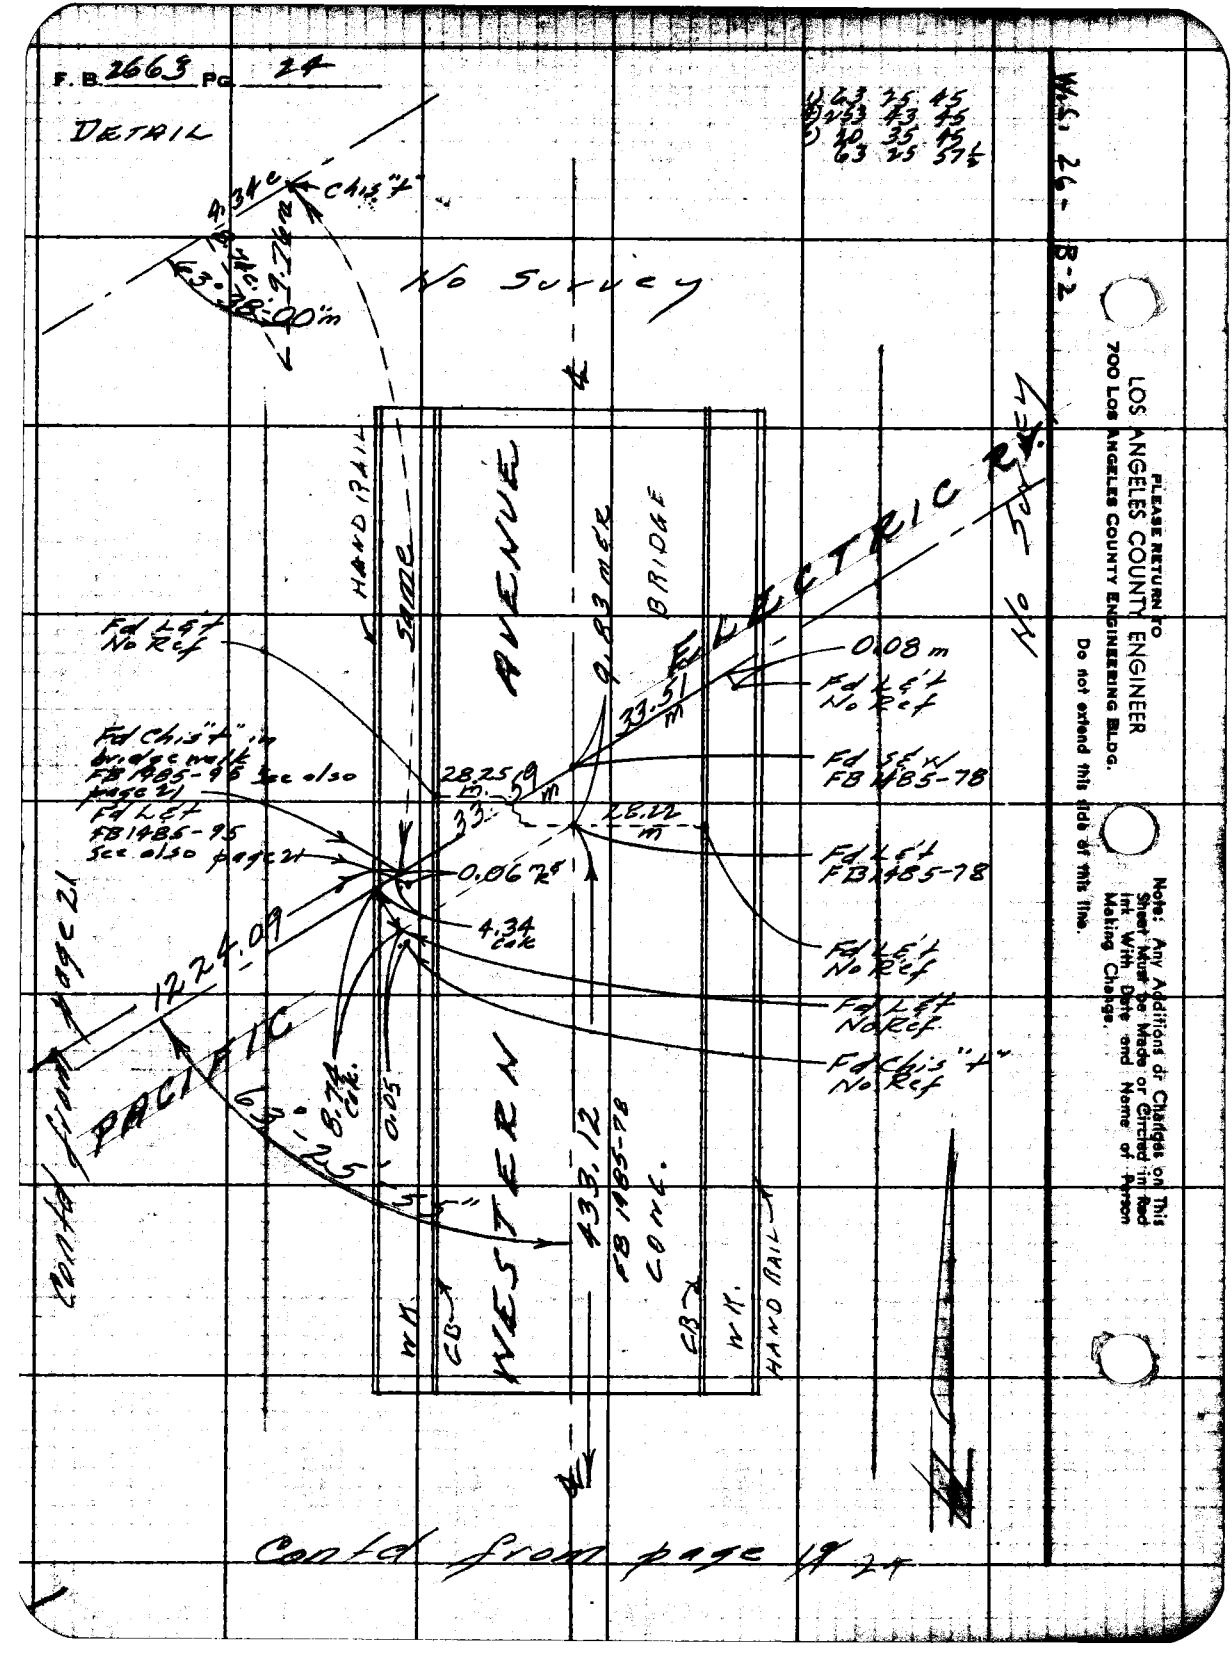

W.O. 26-B-2

LOS ANGELES COUNTY ENGINEER
700 Los Angeles County Engineering Bldg.

PLEASE RETURN TO

Do not extend this data on this line.

Note: Any Additions or Changes on This Sheet Must be Made or Circled in Red Ink With Date and Name of Person Making Change.

Notes Ck'd by Miller	Survey of 120 th Street	F. B. 2663	Pg. 25
Map No. B 2822	JN 0075.84 Tape 0/92 Std 68 °F		
Office Work Masuda	Surveyed by C.L. Lind		
Checked Miller	Notes Lind Date 9-23-60		
Date Dec. 1960	Indexed H. E. OTT NOV 1 '60		

J.N. 0075.84

REALIGNMENT OF THE

FINAL CENTER LINE

OF

120 TH STREET

FROM

WESTERN AVE

TO

WILTON PLACE

9-23-60

LIND

WILKS

CARO

OHASHI

MASUDA

Note: Any Additions or Changes on This Sheet Must Be Made or Circled in Red Ink With Date and Name of Person Making Change.

Do not extend notes this side of this line.

RETURN TO
LOS ANGELES COUNTY ENGINEER
900 LOS ANGELES COUNTY ENGINEERING BLDG.

78S09S CE #247—7-53

RETURN TO
LOS ANGELES COUNTY ENGINEER
700 LOS ANGELES COUNTY ENGINEERING BLDG.

Note: Any Additions or Changes on This Sheet Must be Made or Circled in Red Ink With Date and Name of Person Making Change.

Do not extend notes this side of this line.

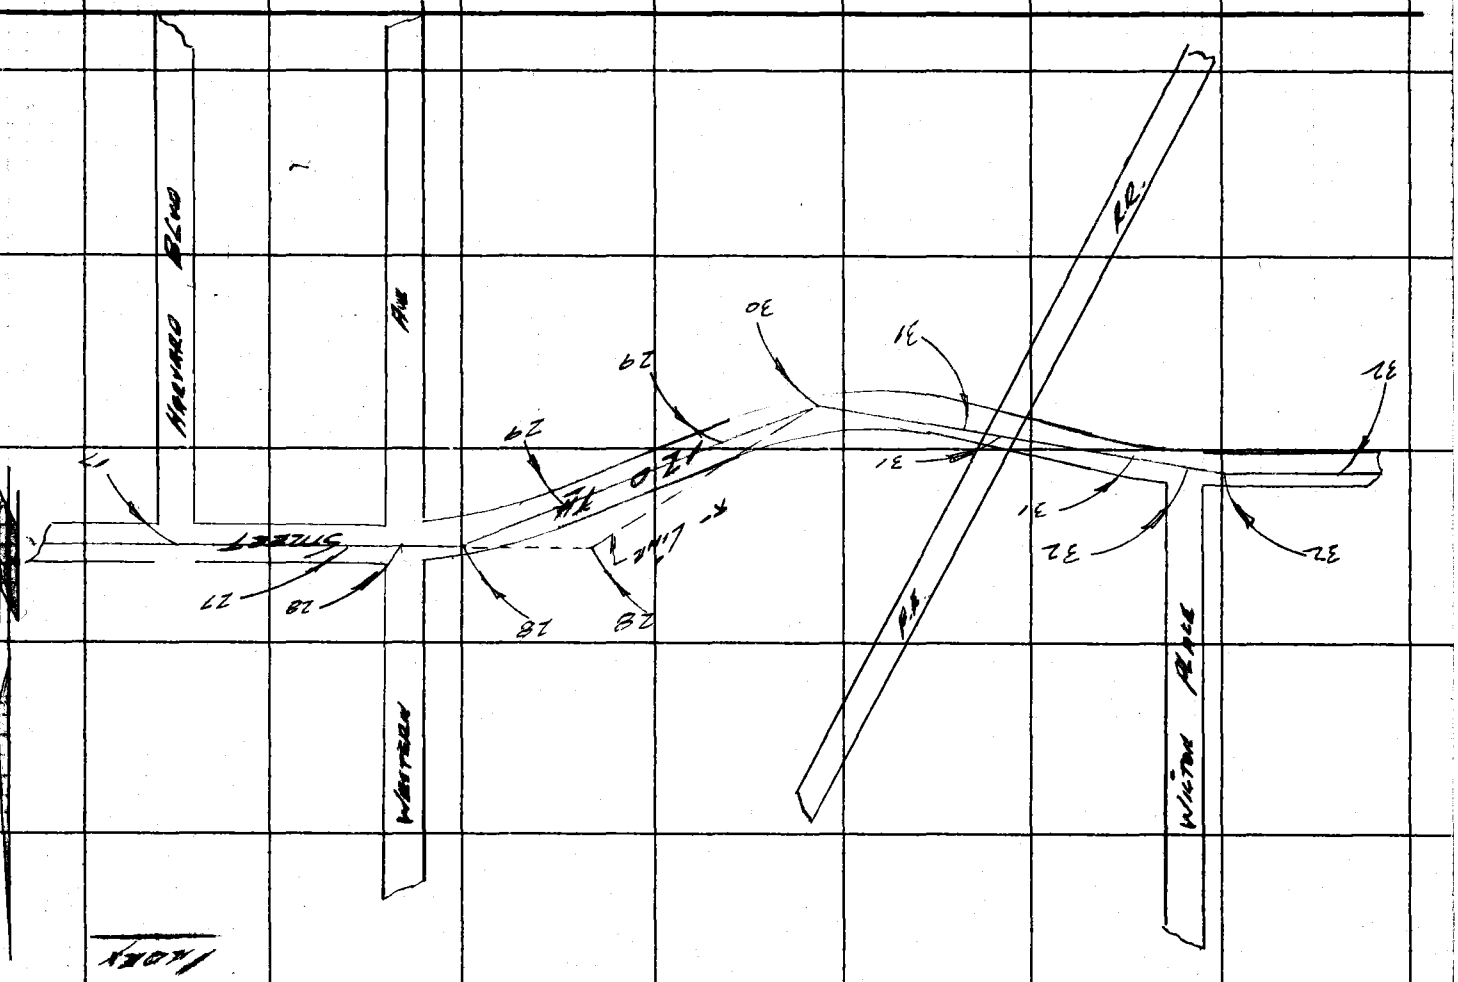

768098 CE #247—7-53

RETURN TO
LOS ANGELES COUNTY ENGINEER
900 LOS ANGELES COUNTY ENGINEERING BLDG.

Note: Any Additions or Changes on This Sheet Must Be Made or Circled in Red Ink With Date and Name of Person Making Change.

Do not extend notes this side of this line.

W.S. 26 - B-2

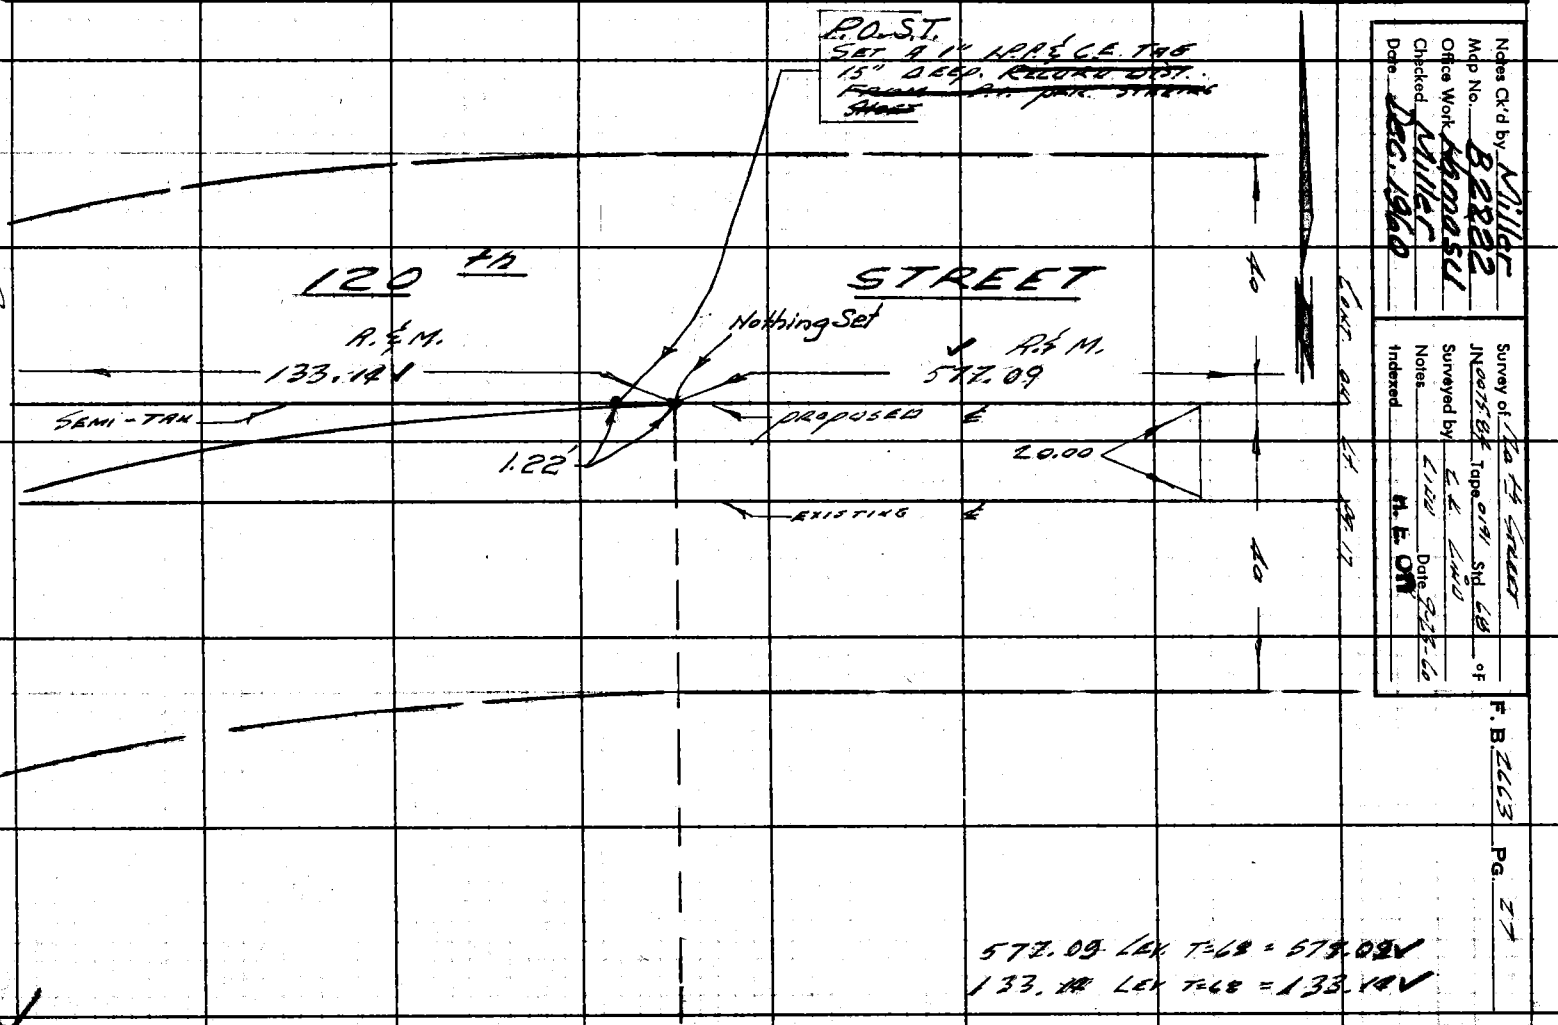

Notes Ck'd by Miller
Map No. B2222
Office Work Komasu
Checked Miller
Date DEC. 1960


F. B. 2663 PG. 27

RETURN TO
LOS ANGELES COUNTY ENGINEER
700 LOS ANGELES COUNTY ENGINEERING BLDG.

Note: Any Additions or Changes on This Sheet Must be Made or Circled in Red Ink With Date and Name of Person Making Change.

Do not extend notes this side of this line.

WS. 26-B-2

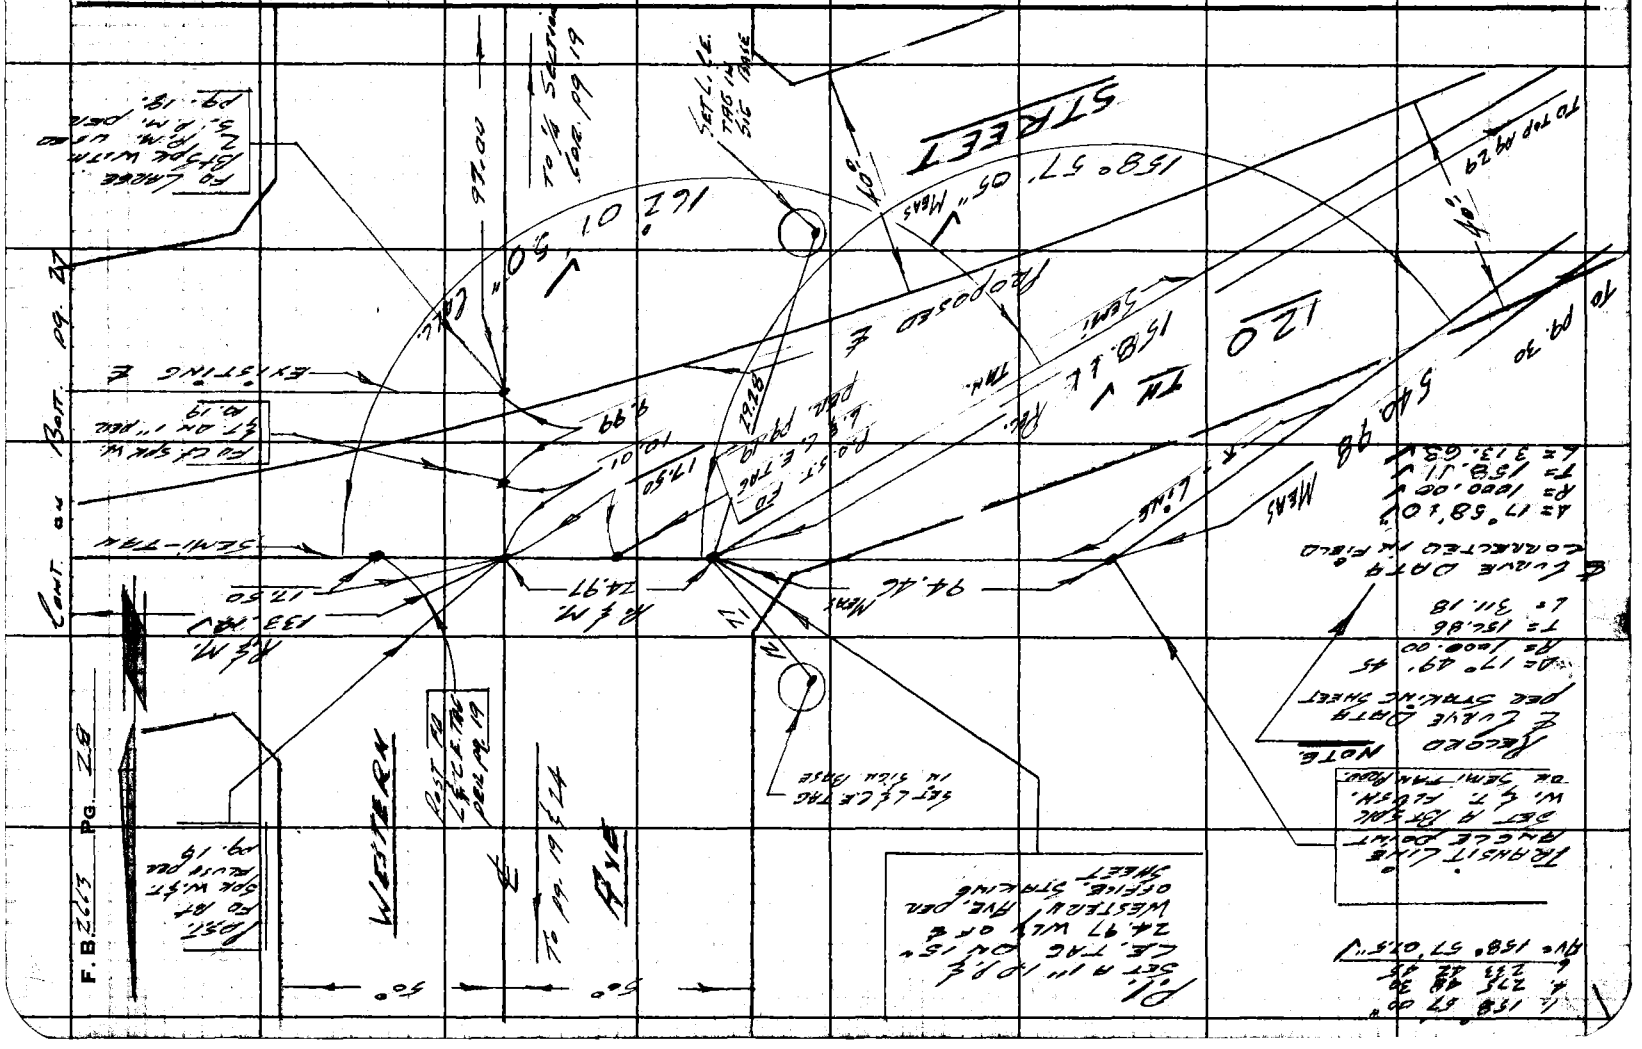

768098 CE #247—7-53

RETURN TO
LOS ANGELES COUNTY ENGINEER
700 LOS ANGELES COUNTY ENGINEERING BLDG.

Note: Any Additions or Changes on This Sheet Must Be Made or Circled in Red Ink With Date and Name of Person Making Change.

Do not extend notes this side of this line.

B-2712

Notes Ck'd by Miller
Map No. B-2822
Office Work Hopkins
Checked Miller
Date DEC. 1960

Survey of 120 TH STREET
JN 00777 64 Tape 0.01 Std. 68 °F
Surveyed by C.E. Cline
Notes Date 9-2764
Indexed H.E. OR

F. B. 2663 PG. 27

B.C. NOTHING SET

120 FT

STREET

EAST ON

TO PI.

264.44 CALC.

260.98 REC.

PROPOSED ℄

158.21 REC.

EAST ON 120

TO PI.

210.45 REC.

210.38

TO PI.

EAST ON 120

TO PI.

133.14
17.50
115.64
1.22
114.42

E.C. NOTHING SET

NOTE:
THIS PORTION
OF PROPOSED
℄ IS BLOCKED
BY HOUSE TRAILERS
NO CHAINING OR
ANGLES BETWEEN
PI. SEE PAGE 28220
FOR TRANSIT LINE TIE

RETURN TO
LOS ANGELES COUNTY ENGINEER
900 LOS ANGELES COUNTY ENGINEERING BLDG.

Note: Any Additions or Changes on This Sheet Must be Made or Circled in Red Ink With Date and Name of Person Making Change.

Do not extend notes this side of this line.

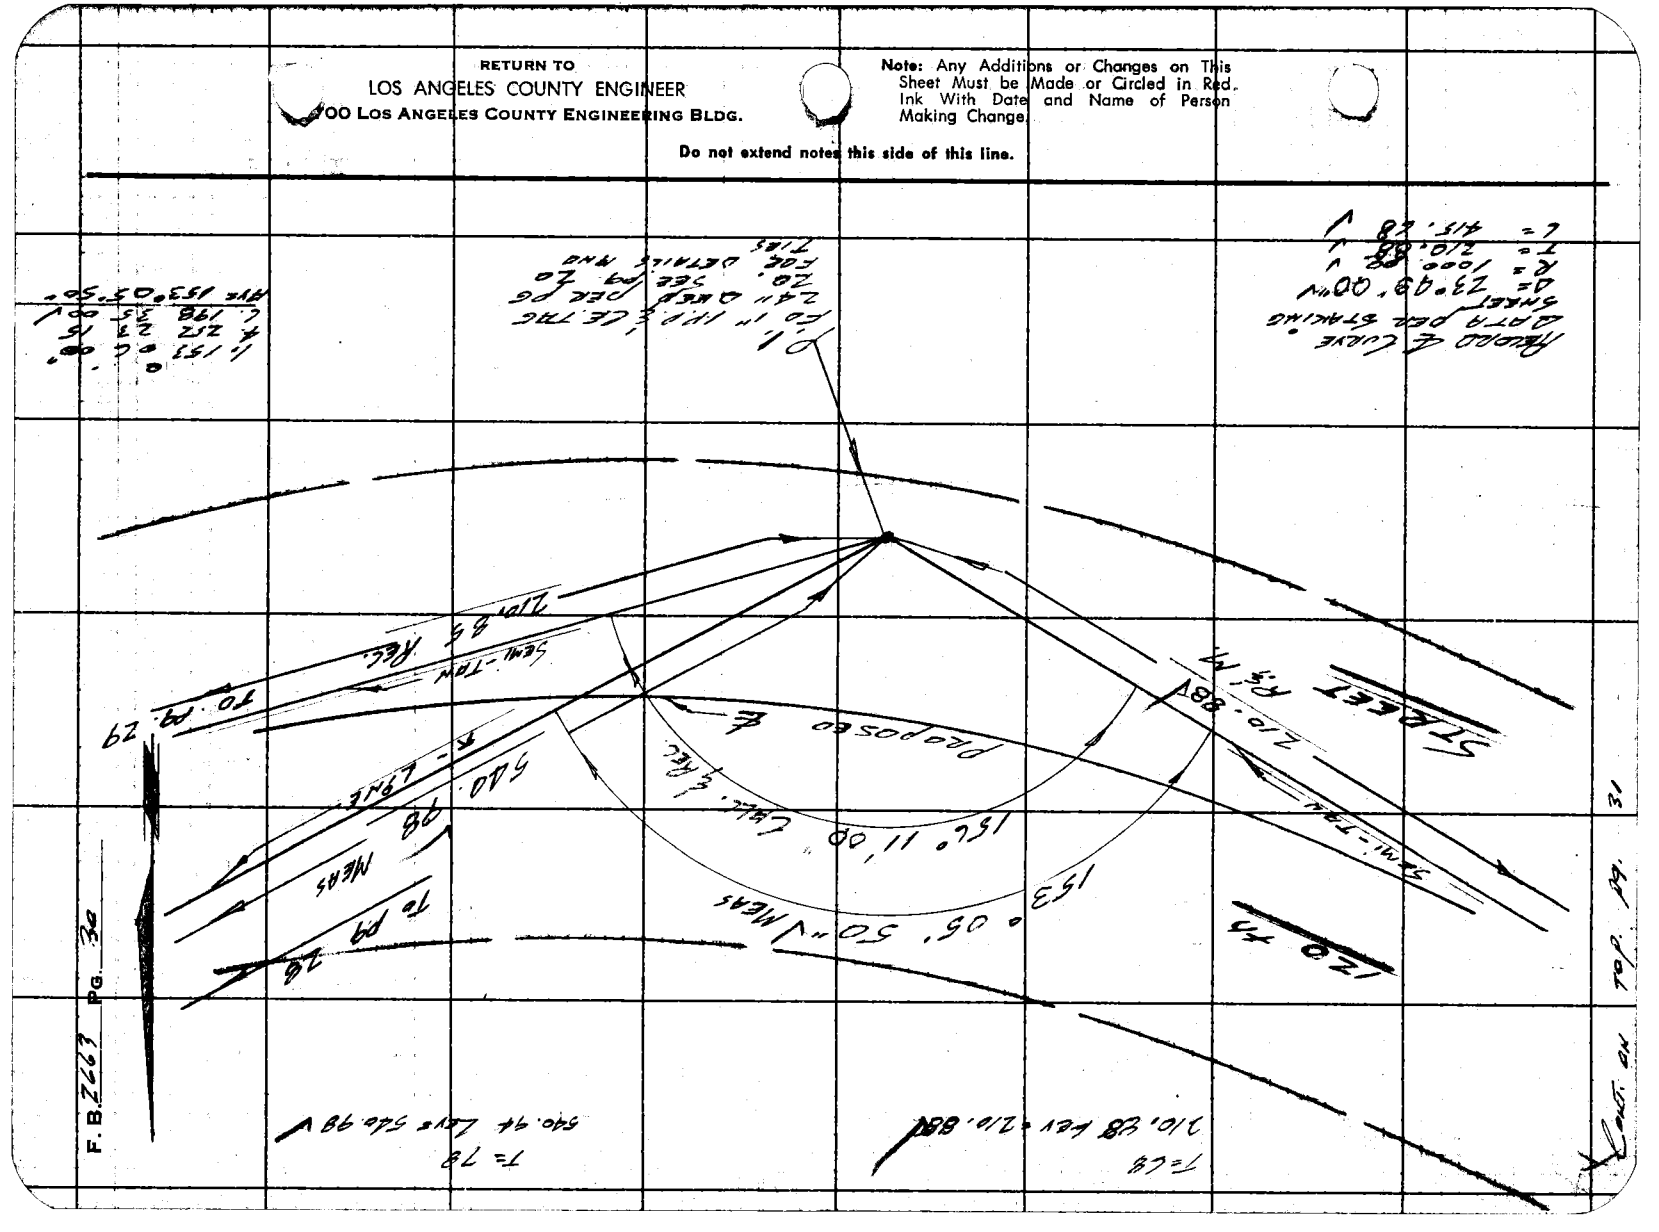
Proposed ℄ Street
Semi-Tan
Semi-Tan
Ac. Pave
Ac. Pave
Meas
Meas
Curb
Curb
Curb

768098 CE #247—7-55

RETURN TO
LOS ANGELES COUNTY ENGINEER
700 LOS ANGELES COUNTY ENGINEERING BLDG.

Note: Any Additions or Changes on This Sheet Must Be Made or Circled in Red Ink With Date and Name of Person Making Change.

Do not extend notes this side of this line.

W.O. 5, 26 - A-2

123.25 Lev. T=68 = 123.25 ✓

BC. SET A 1" I.P. & CENTRE ON 15" RECORD DIST. FROM P.I. PER STAKING SHEET.

P.E. P.I.

120 FT. STREET

EAST FROM

R.& M.

123.25 ✓

78.92 CALC

09.22

PROPOSED ℄

417.54 REC ✓

417.54 MEAS. ✓

710.98 ✓ R.& M.

EAST ON 30

Ave

COAST ON 70 PG. 32

40

FD A LARGE PK SOK. W. & TIN IN R.R. TIE SEE PAGE 21 FOR DETAILS

E.C. SET A 1" I.P. CONC. PLUG & C.E. TAG. 15" DEEP RECORD DISTANCE FROM P.I. PER. STAKING SHEET.

CENTER OF TRACKS

417.54 Lev. T=68 = 417.54 ✓

Notes Ck'd by Miller
Map No. B 2222
Office Work Homes
Checked Miller
Date Dec. 1960

Survey of JN 0775 Tape 4.11 Std. 68 °F
Surveyed by E.K. Cano Date 9-17-60
Notes
Indexed B.E. OTT

120 FT STREET

F. B. 2663 PG. 31

RETURN TO
LOS ANGELES COUNTY ENGINEER
700 LOS ANGELES COUNTY ENGINEERING BLDG.

Note: Any Additions or Changes on This Sheet Must be Made or Circled in Red Ink With Date and Name of Person Making Change.

Do not extend notes this side of this line.

W.S. 26 - A-2

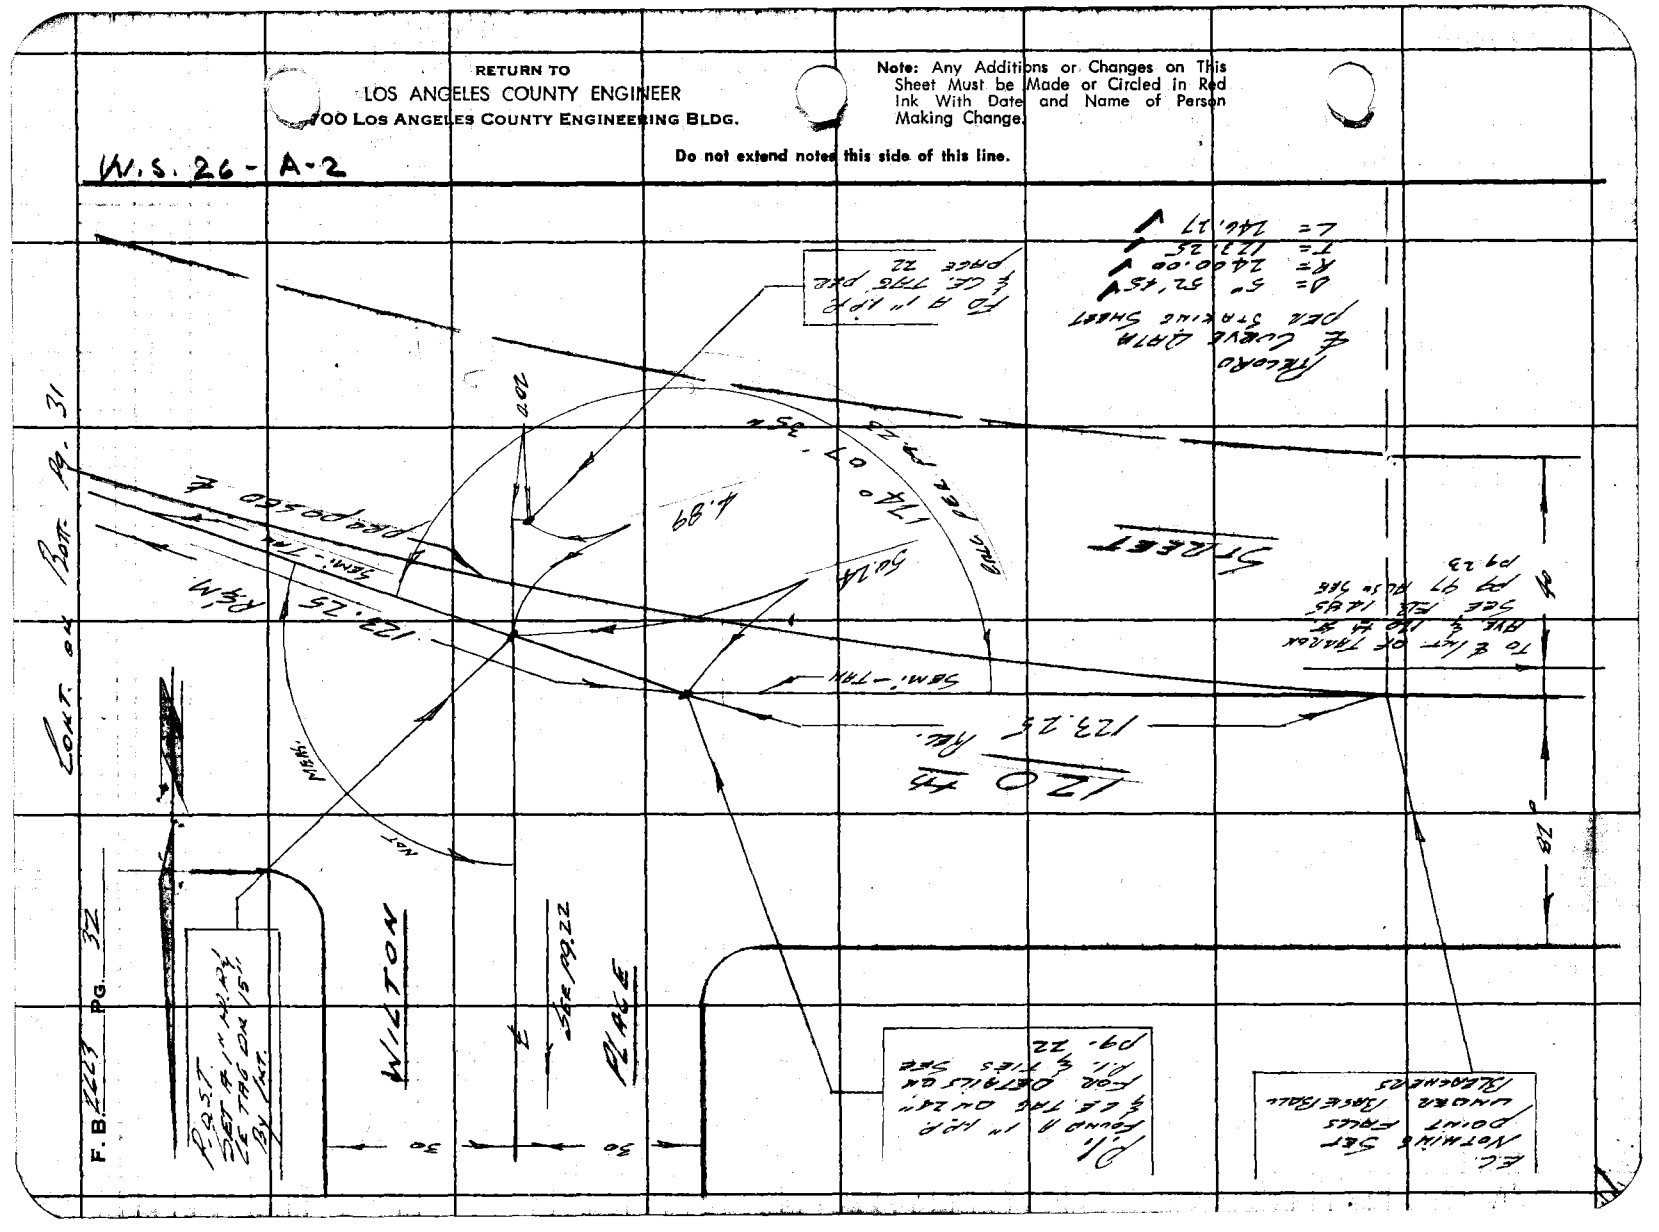
WILTON
PLACE
SEMI-TAN
123.25 Rem.
123.25 Rec.
120 45
Cont. on Bk. Pg. 31
F.B. 2213 Pg. 32

Notes Ck'd by Miller
Map No. B 2222
Office Work Hamasu
Checked Miller
Date Dec 1960

Survey of 120TH ST. & BUDLONG AVE.
JN 0075.84 Tape 0171 Std 68 °F
Surveyed by W.A. RICHARDS
Notes W.A.R. Date 10-14-60
Indexed H.E. OTT

F. B. 2663 PG. 33

J.N. 0075.84

CENTER LINE ALIGNMENT CHECK SURVEY ON BUDLONG AVE. BETWEEN 120TH ST. & EL SEG - - UNDO BLVD.; AND ADJUSTMENT OF MISC. SURVEY POINTS TO CONFORM WITH OFFICE STAKING SHEET NO. 56 - 31 - 1*

* NOTE: THIS RESURVEY OF BUDLONG AVE. INDICATES SOME CHANGES OF THE CALCULATED CURVE DATA ON PROPOSED BUDLONG AVE. FROM 121ST ST. NELY TO 119TH ST. THEREFORE THIS SURVEY IS INTERRUPTED UNTIL THE FIELD CALCULATIONS ARE CHECKED BY THE OFFICE. 10-21-60 - OWR.

PRELIMINARY SURVEYS REF. -- FB. 2663: 5-32
" " " " " 1970: 14, 102-145
" " " " " 1784: 49-51

10-14
RICHARD
OCHSNER
TURRILL
CROWDER

Note: Any Additions or Changes on this Sheet Must be Made or Circled in Red Ink With Date and Name of Person Making Change.

Do not extend this side of this line.

PLEASE RETURN TO
LOS ANGELES COUNTY ENGINEER
700 Los Angeles County Engineering Bldg.

7BP3098 SAE #247 11-58

F. B 2663 PG. 34

INDEX MAP

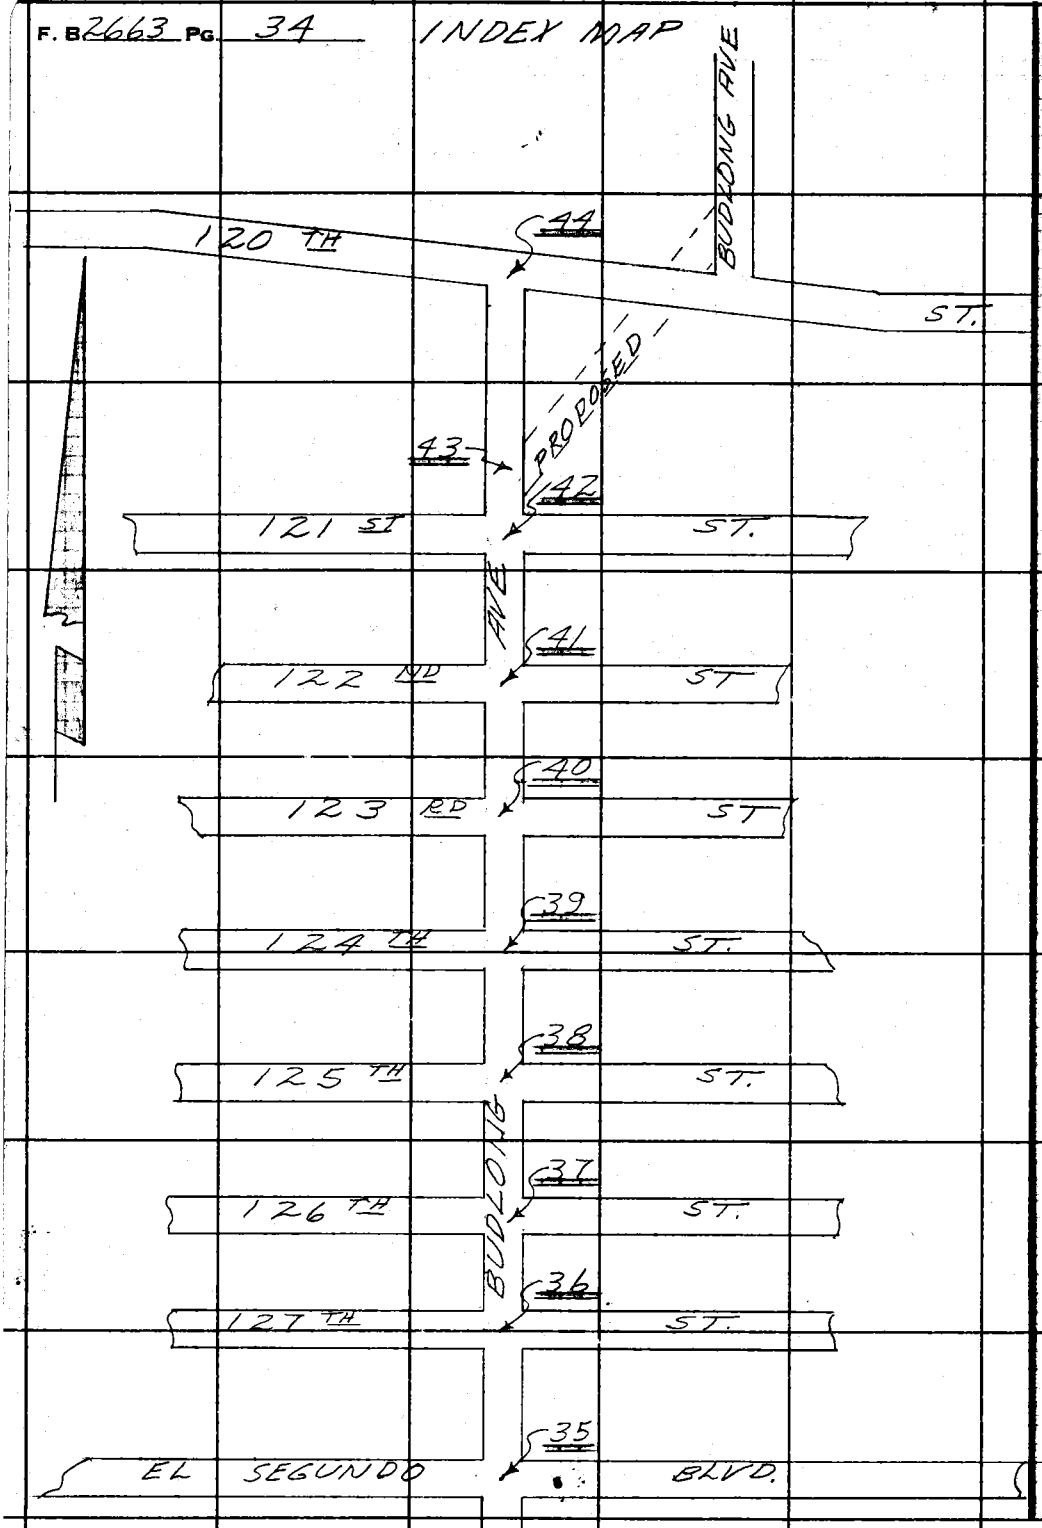

PLEASE RETURN TO
LOS ANGELES COUNTY ENGINEER
700 Los Angeles County Engineering Bldg.

Do not extend this side of this line.

Note: Any Additions or Changes on This Sheet Must Be Made or Circled in Red Ink With Date and Name of Person Making Change.

Notes Ck'd by Miller
Map No. B-2222
Office Work Yamasu
Checked Miller
Date Dec. 1960

Survey of 120th ST. & BUDLONG AVE.
JN 007584 Tape 0171 Std 68 °F
Surveyed by W. A. RICHARDS
Notes W. A. R. Date 10-60
Indexed H. E. OTT

F. B. 2663 Pg. 35

W.S. 26-A-2

CONT. BOT PG. 36

COUNTY SURVEYOR
CHESTNUT 120TH ST.

(30) (30)

INT.

FD. P.K. SPK. FLUSH
FD. STD. C.S. MON.
DN. 24" MARKED
F.B. 1970-102
" 1784-49
" 2560-181
SET S. & W. FLUSH OVER
MON. & USED FOR LINE NORTH

AVE

MEAS. 350.12
350.03 REC.
F.B. 1970-102

0.12

F.B. L.&T.

FD. L.&T.

0.12

15 R 1.9 18

6 1.51 18

EL SEGUNDO BLVD.

℄ NO SURVEY NO SURVEY ℄

58.34 18

62.50 R

68.53

74.58

FD. L.&T. FD. L.&T.

FD. L.&T. FD. L.&T.

BUDLONG

℄ NO SURVEY ℄

(30) (30)

Note: Any Additions or Changes on This Sheet Must be Made or Circled in Red Ink, With Date and Name of Person Making Change.

Do not extend this tick of this line.

PLEASE RETURN TO
LOS ANGELES COUNTY ENGINEER
700 Los Angeles County Engineering Bldg.

76F3098 S&E #247 11-58

PLEASE RETURN TO
LOS ANGELES COUNTY ENGINEER
700 LOS ANGELES COUNTY ENGINEERING BLDG.

Note: Any Additions or Changes on This Sheet Must Be Made or Circled in Red Ink With Date and Name of Person Making Change.

Do not extend this side of this line.

W.S. 26 - A-2

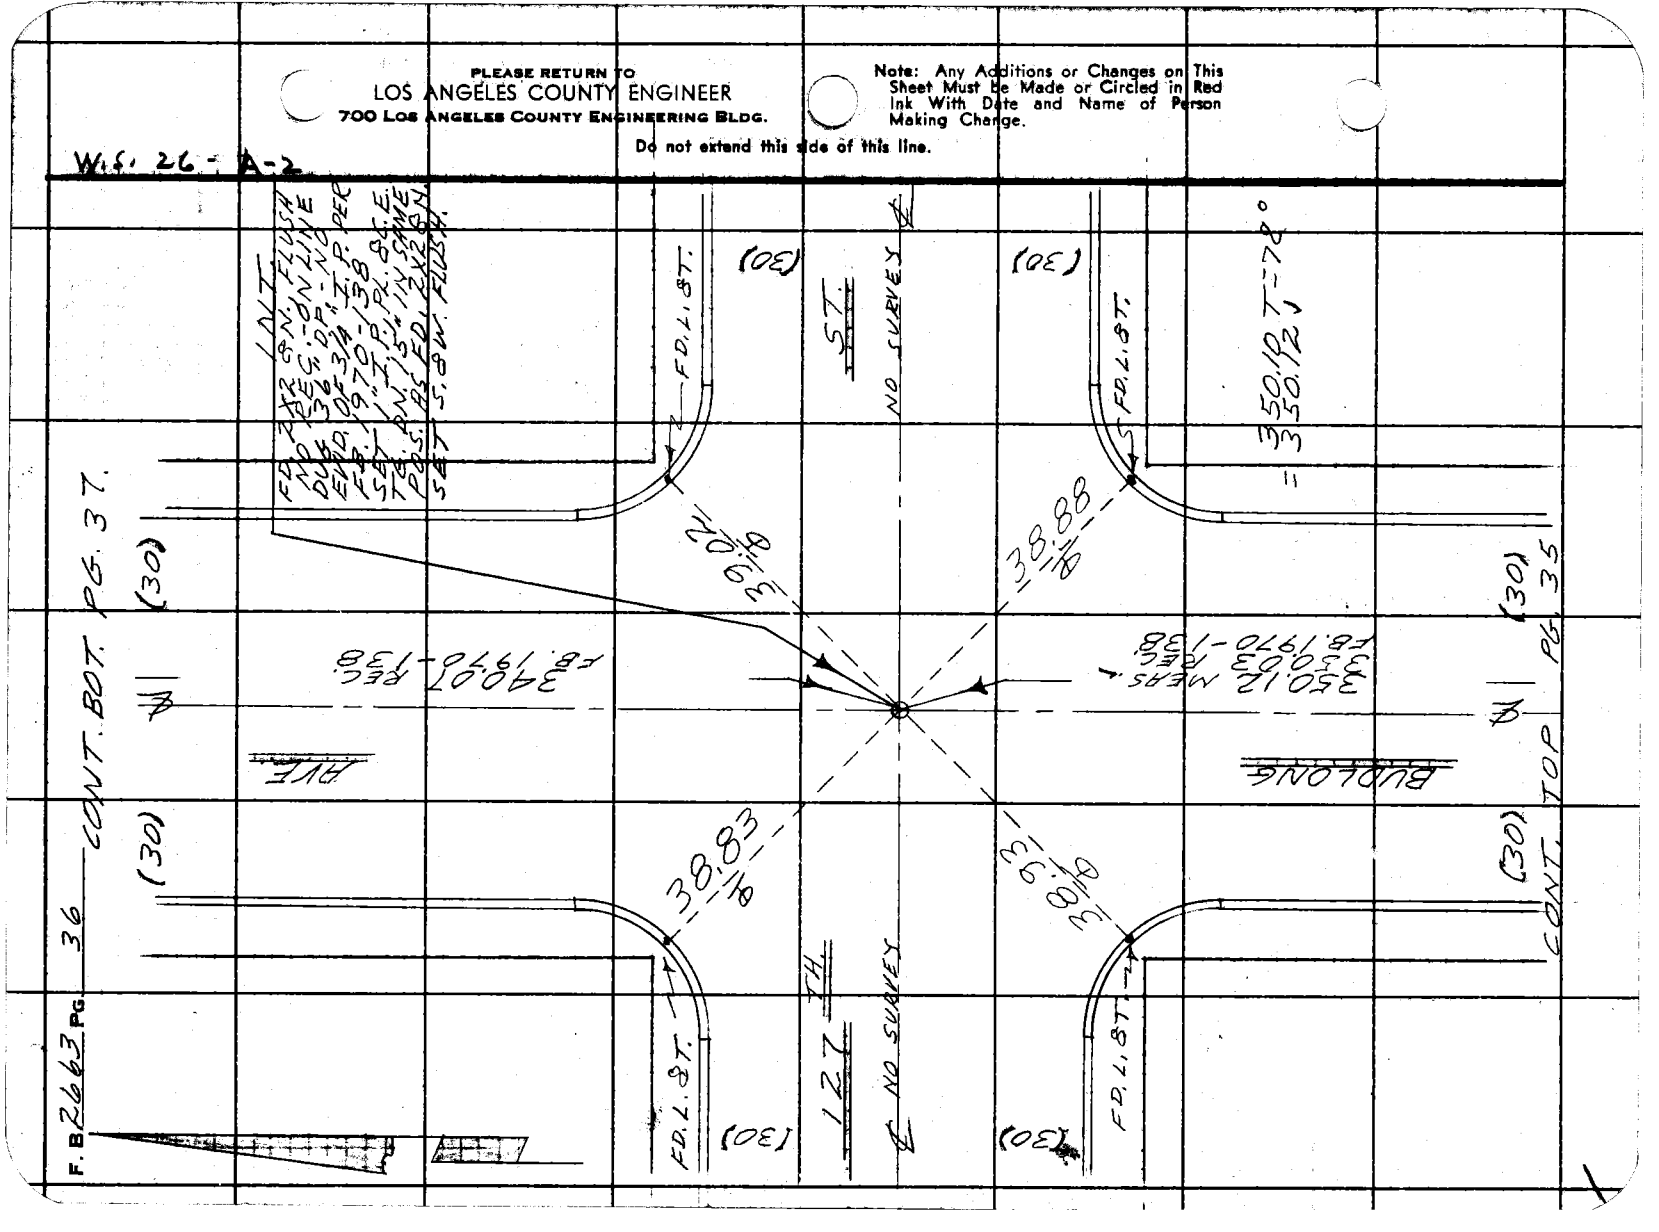

Notes Ck'd by Miller
Map No. 2222
Office Work Hamasu
Checked Miller
Date Dec. 1960

Survey of BUDLONG AVE.
JN 0075.84 Tape 0171 Std 68 °F
Surveyed by W. A. RICHARDS
Notes W.A.R. Date 10-60
Indexed H. E. ON

F. B. 2663 Pg. 37

W.S. 24-A-2

CONT. BOT. PG. 38

I.N.T. FD. S. & W. FLUSH PER EB. 1970-139 DUG 36" - NO EVID. OF 3/4" I.P. PER SAME REF. SET 1" I.P. PL. & C.E.T.G. DK. 15" RESET S. & W. ON SUR. IN SAME PDS.

(30) (30)

AVE.

℄

340.02 EB. 1970-139 REC.

FD. L. & T.

38.18 M

39.18 M

FD. L. & T.

(30)

126 TH.

ST.

℄ NO SURVEY

NO SURVEY ℄

(30)

39.03 M

38.18 M

(30)

FD. L. & T.

FD. L. & T.

BUDLONG

340.07 EB. 1970-139 REC.

℄

(30) (30)

CONT. TOP PG. 36

Note: Any Additions or Changes on This Sheet Must be Made or Circled in Red Ink With Date and Name of Person Making Change.

Do not extend this side of this line.

PLEASE RETURN TO
LOS ANGELES COUNTY ENGINEER
700 Los Angeles County Engineering Bldg.

78F3098 S&E #247 11-55

PLEASE RETURN TO
LOS ANGELES COUNTY ENGINEER
700 LOS ANGELES COUNTY ENGINEERING BLDG.

Note: Any Additions or Changes on This Sheet Must Be Made or Circled in Red Ink With Date and Name of Person Making Change.

Do not extend this side of this line.

W.S. 26 - A - 2

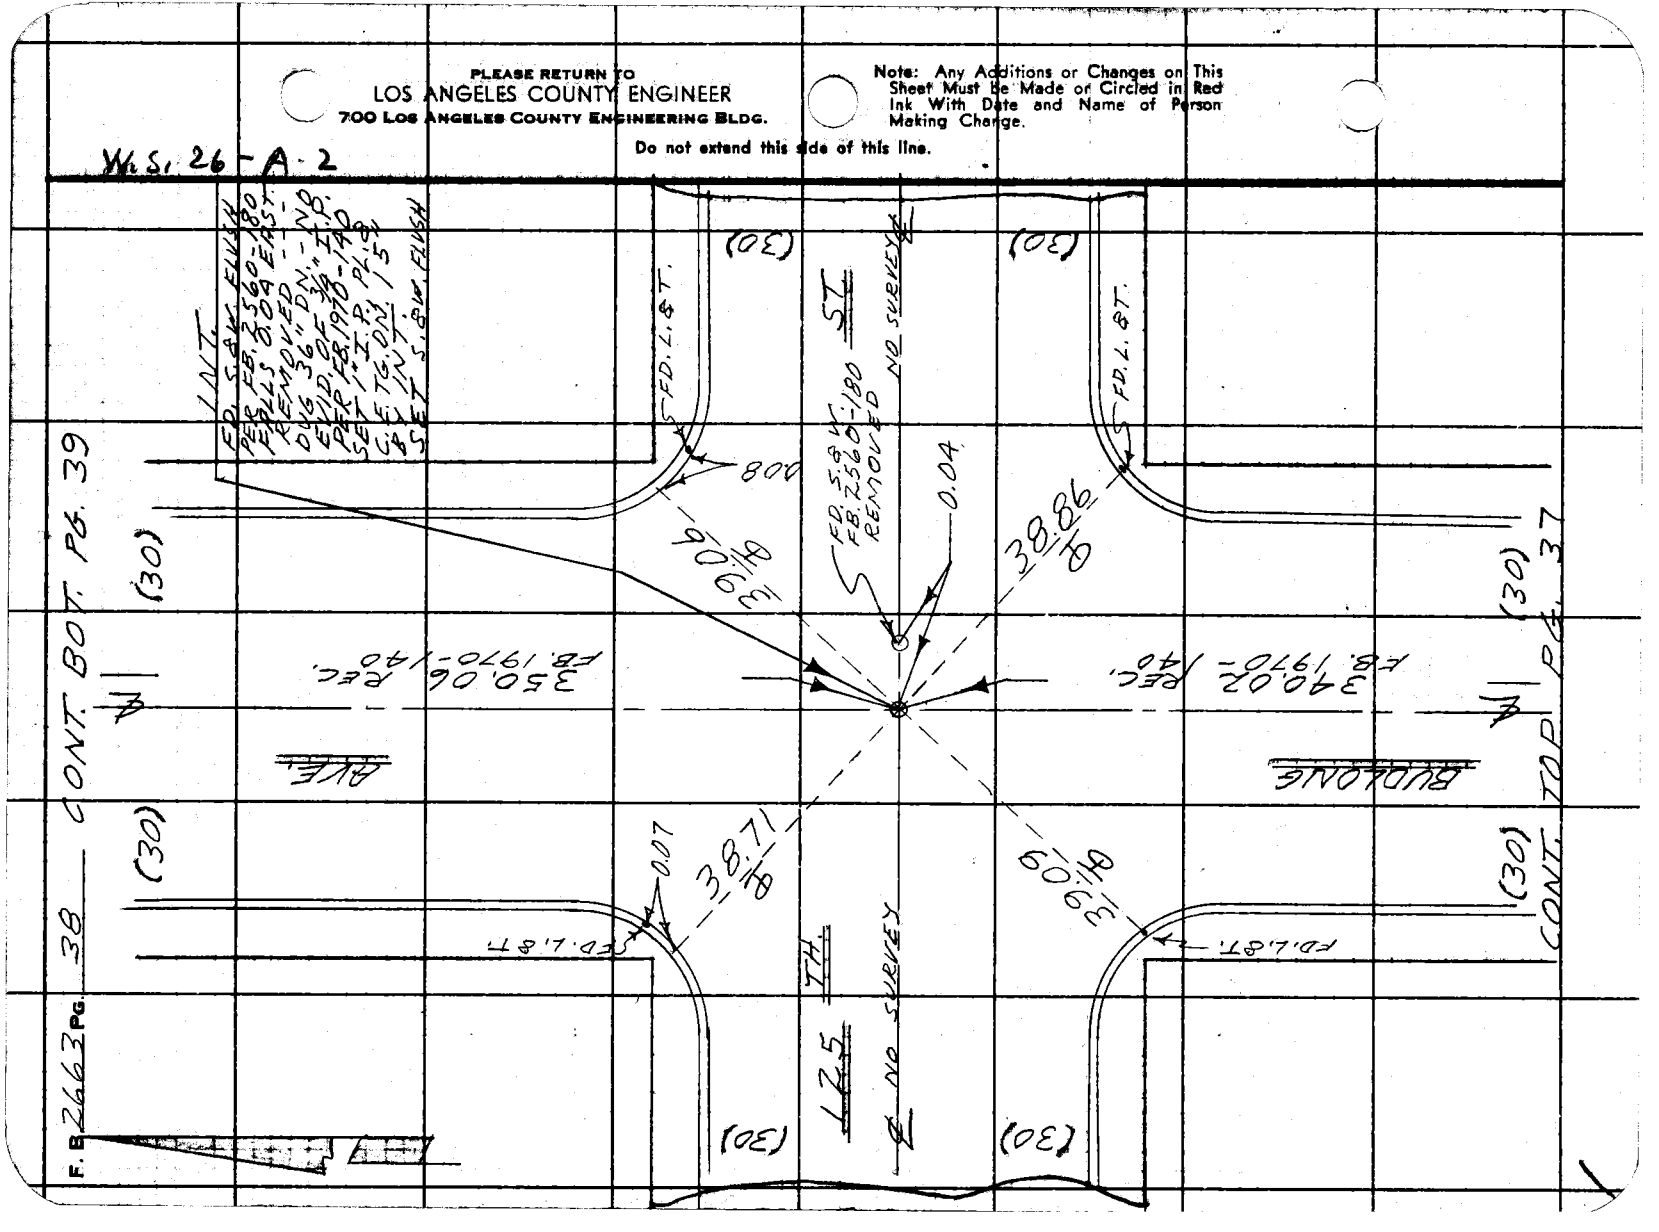

Notes Ck'd by Miller
Map No. B2722
Office Work Hamasu
Checked Miller
Date Dec. 1960

Survey of BUDLONG AVE.
JN 07584 Tape 011 Std 68 °F.
Surveyed by W.H.A. RICHARDS
Notes W.R.R. Date 10-60
Indexed H. E. ~~OTT~~

F. B. 2663 PG. 39

W.S. 26-A-2

CONT. BOT. PG. 40

L.N.T.
FD. S. & W. FLUSH
PER F.B. 1970-141
FD. PT. 0.04 E. &
REMOVED -
DUG 36" - NO EVID.
OF 3/4 I.P. PL. S.T.
PER F.B. 1970-141
SET 1" I.P. PL. &
C.E. FG. DN. 15"
SET S. & W. FLUSH
BY L.N.T.

BUDLONG AVE.

350.10 F.B. 1970-141 REC.

0.04

FD. L. & T.

(40)

N 08° 14' 10" E 39.55

0.07

FD. L. & T.

(40)

L 24 I.H.

℄ NO SURVEY

FD. S. & W. REMOVED ST.

NO SURVEY ℄

0.04

N 08° 10' 17" E 39.42

(40)

(40)

BUDLONG

350.06 F.B. 1970-141 REC.

FD. L. & T.

(30)

(30)

CONT. TOP PG. 38

Note: Any Additions or Changes on this Sheet Must be Made or Circled in Red Ink With Date and Name of Person Making Change.

Do not extend this tick of this line.

PLEASE RETURN TO
LOS ANGELES COUNTY ENGINEER
700 Los Angeles County Engineering Bldg.

76F3085 S&E #247 11-58

PLEASE RETURN TO
LOS ANGELES COUNTY ENGINEER
700 LOS ANGELES COUNTY ENGINEERING BLDG.

Note: Any Additions or Changes on This Sheet Must be Made or Circled in Red Ink With Date and Name of Person Making Change.

Do not extend this side of this line.

W.S. 26 - A-2

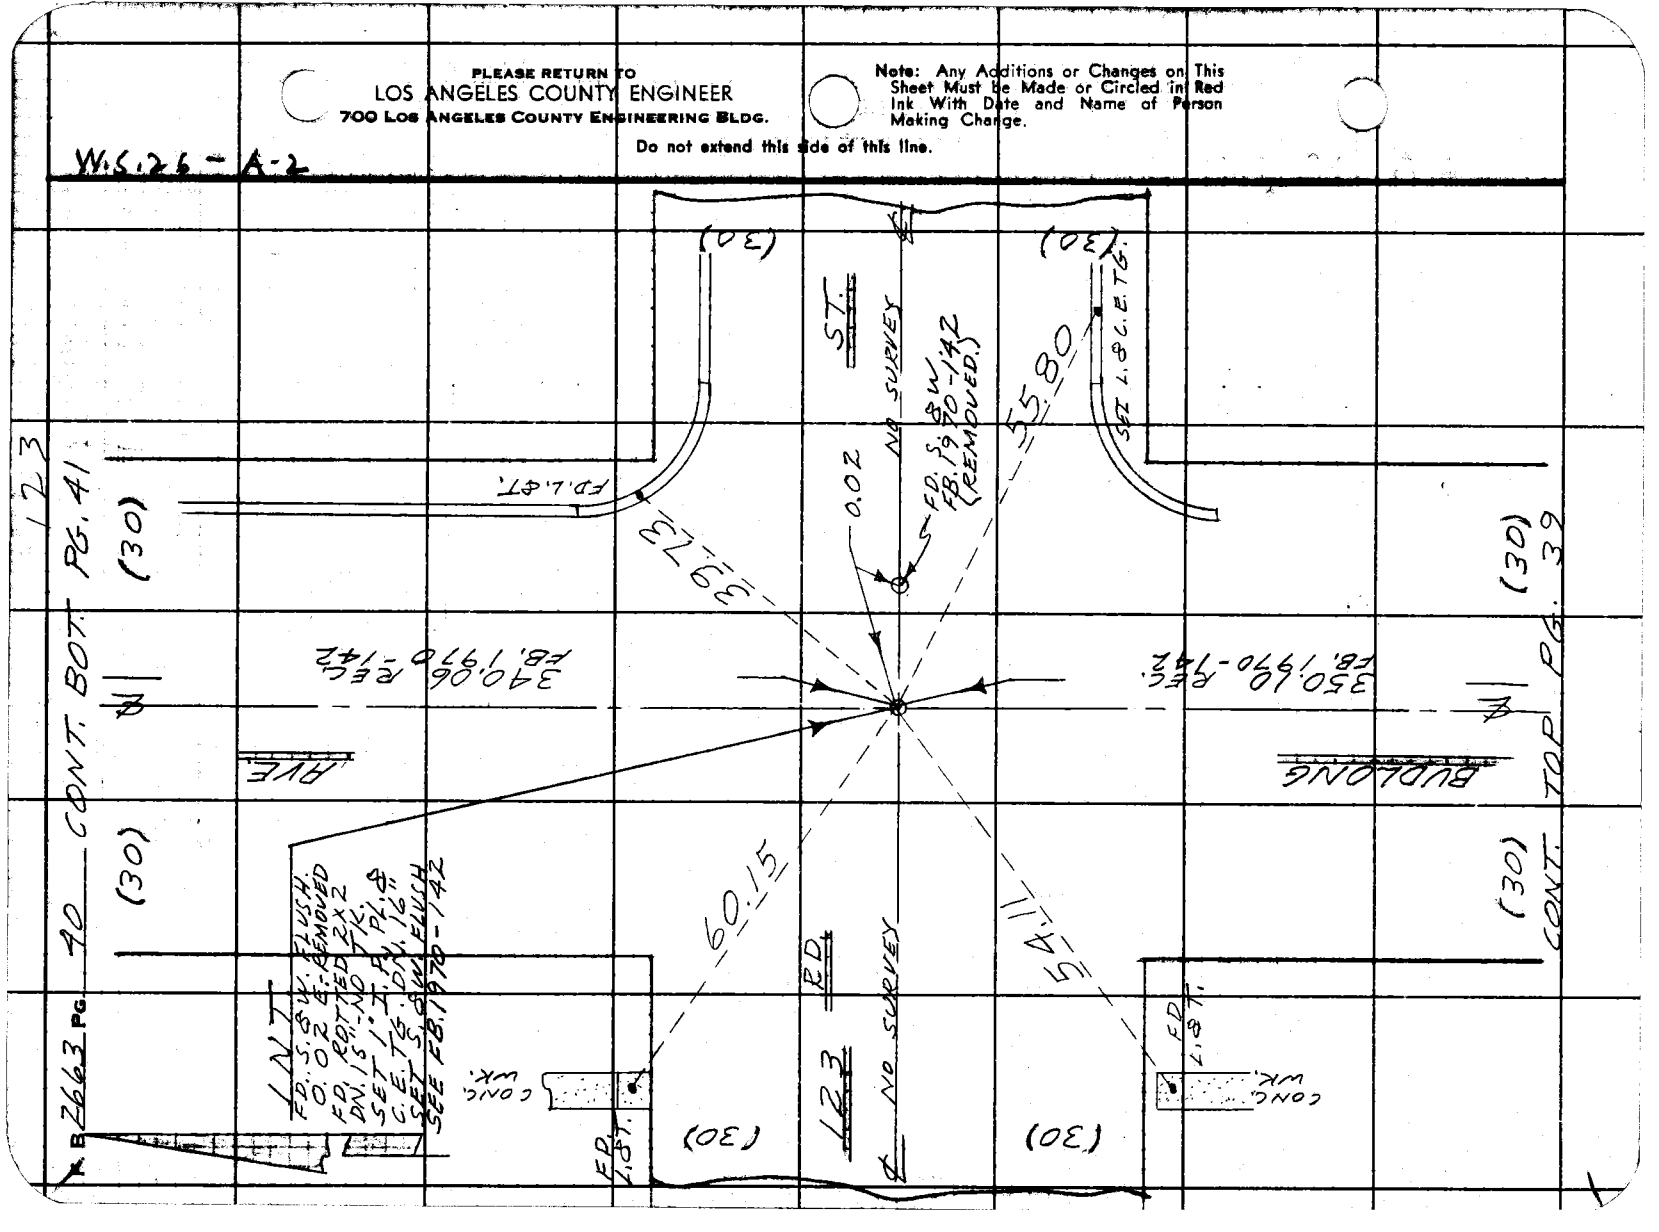

Notes Ck'd by Miller
Map No. B-2222
Office Work Hamasu
Checked Miller
Date Dec. 1960

Survey of BUDLONG AVE
JN 0075.84 Tape 0175 Std 68 °F
Surveyed by W. A. RICHARDS
Notes W. A. R Date 10-60
Indexed H. E. ON

F. B. 2663 PG. 41

W.S. 46-A-2

CONT. BOT. PG. 42

(30) (30)

SET L.N.T. P.N. BY L.N.T.

AVE

340.04 RAD. FB. 1970-143

FD. 3/4" I.P. PT. B.T. DN 1.5' FB. 1970-143 SET S.&W. FLUSH OVER THIS PT.

0.06

CFD. L.&T.

0.03

FD. L.&T.

FD. S.&W. FLUSH FB. 1970-143 REMOVED

(30)

41.10 Δ

39.10 Δ

0.03

122 ND.

ST.

℄ NO SURVEY

NO SURVEY ℄

0.02

39.09 Δ

41.09 Δ

(30)

FD. L.&T.

(30)

BUDLONG

340.06 RAD. FB. 1970-143

FD. L.&T.

(30) (30)

CONT. TOP PG. 40

Note: Any Additions or Changes on This Sheet Must Be Made or Circled in Red Ink With Date and Name of Person Making Change.

Do not extend this side of this line.

PLEASE RETURN TO
LOS ANGELES COUNTY ENGINEER
700 LOS ANGELES COUNTY ENGINEERING BLDG.

76F3085 SSE #247 11-58

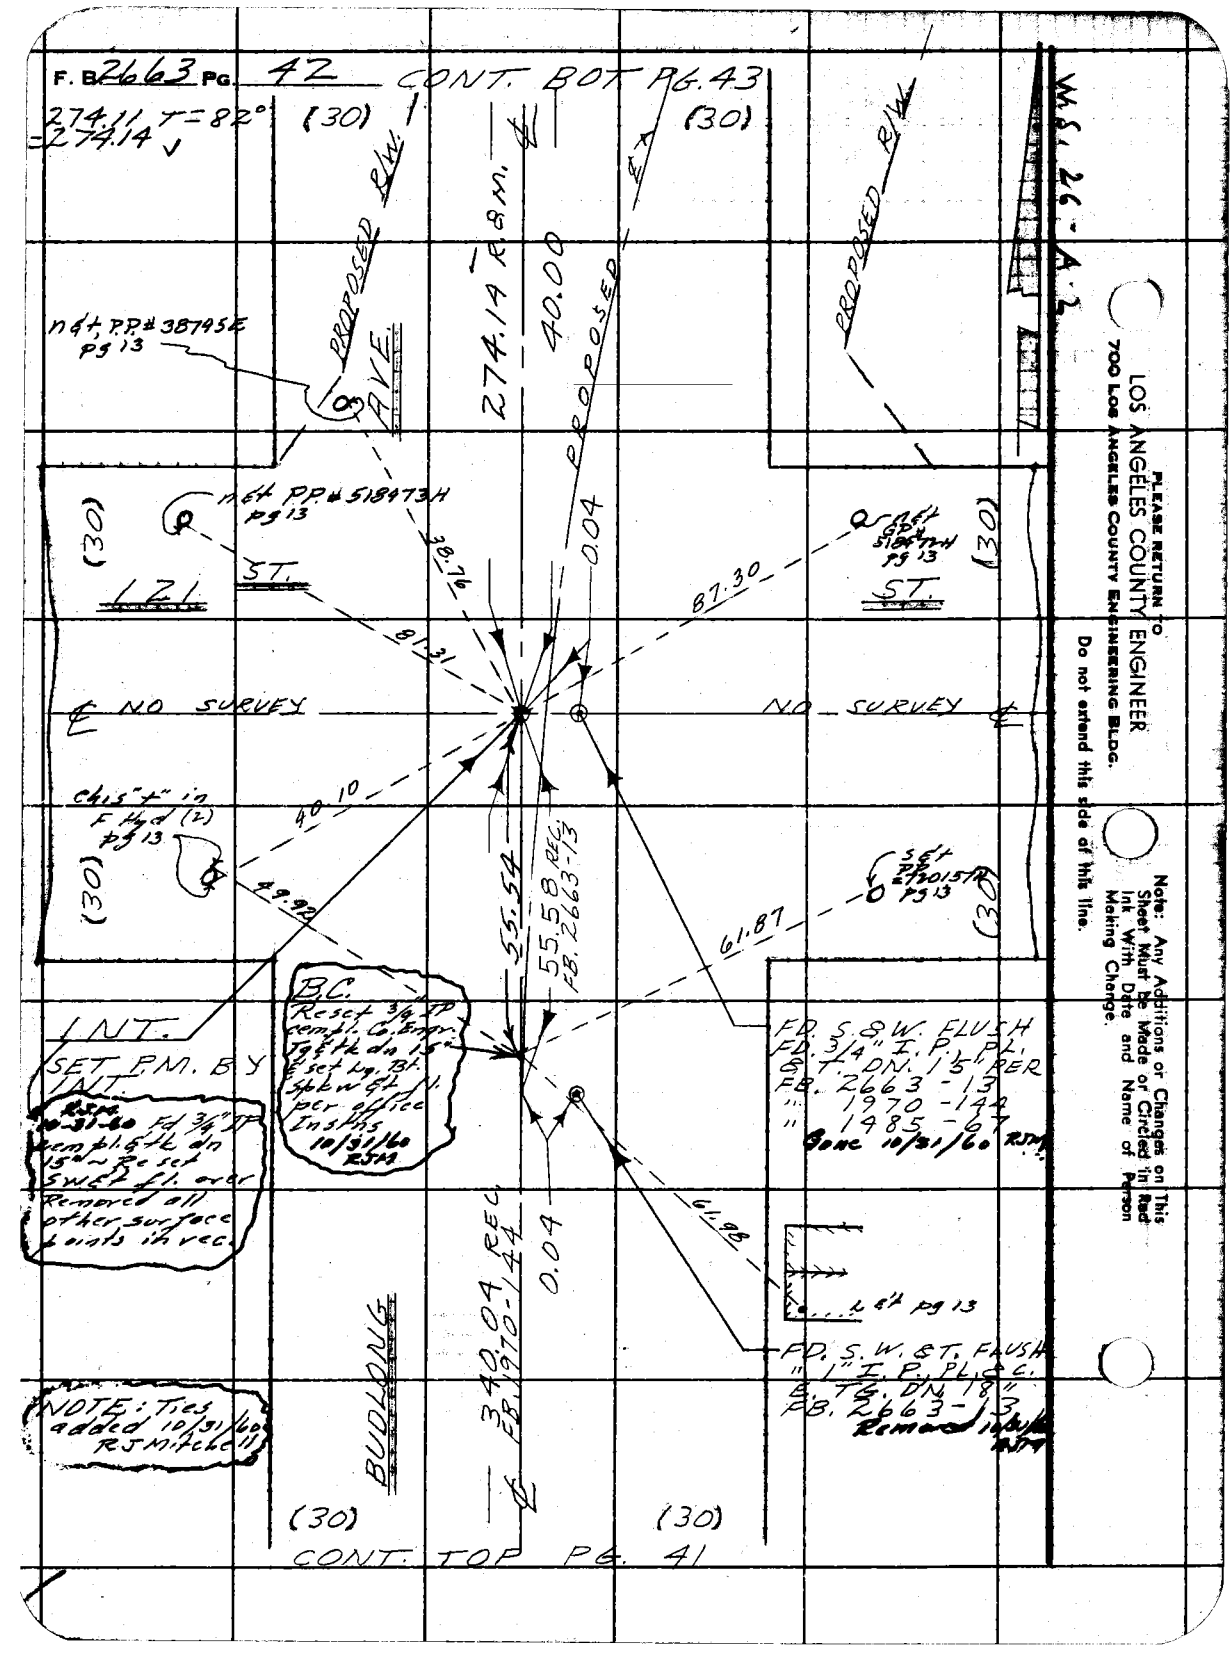
F. B. 2663 PG. 42
CONT. BOT PG. 43
274.11 T=82° (30) (30)
=274.14 V
PROPOSED R/W
274.14 R&M.
40.00
PROPOSED
W.S. 26 - A.2
n6+ P.P.# 3B795E pg 13
AVE.
n6+ P.P.# 5189731H pg 13
ST.
LOT
(30)
38.76
87.30
81.31
NO SURVEY
Chis"+" in F Hyd (2) pg 13
40.10
49.92
55.54
55.58 REC. F.B. 2663-13
61.87
B.C. Reset 3/4" IP compl. Co. Engr. Tgt thd in 1/2" E set Lg. Bl. stkd w/ Gt. N. per office Instrs 10/31/60 RJMA
INT. SET P.M. BY JAT
Ref. 10-31-60 Fd 3/4" IP compl. Gt. thd in 15" Reset SWEP fl. over Removed all other surface points in vec.
NOTE: Ties added 10/31/60 RJM. Field
0.04
340.04 REC. F.B. 1970-144
61.98
(30) (30)
CONT. TOP PG. 41
FD. S.W. FLUSH
FD. 3/4" I.P. PLUG
S.T. DN. 1.5' LR
F.B. 2663-13
" 1970-144
" 1985-67
Gone 10/31/60 RJM
FD. S.W. GT. FLUSH
" 1" I.P. PLUG
G. TG. DN. 1.8'
F.B. 2663-13
Remarked 10/31/60 RJM
LOS ANGELES COUNTY ENGINEER
700 Los Angeles County Engineering Bldg.
PLEASE RETURN TO
Do not extend this side of this line.
Note: Any Additions or Changes on This Sheet Must be Made or Circled in Red Ink With Date and Name of Person Making Change.

Contd on page 45 1/

Notes Ck'd by Miller
Map No. B-2222
Office Work Hamasu
Checked Miller
Date Dec. 1960

Survey of BUDLONG AVE
JN 2075.24 Tape 0171 Std 68 °F
Surveyed by W.A. RICHARDS
Notes W.F.R. Date 10-60
Indexed

F. B. 2663 Pg. 43

CONT. BOT. PG. 44

(30)

(30)

24°-52'-00"

1353.35

E.C. - STATION 5+11.11 ON BUDLONG AVE. PER O.R. 10181 PAGE 125

RESET CONTROL WITNESS STA. 5+11.11 BUDLONG AVE.

(30)

(30)

P.T.

F.D. S.&W. FLUSH PER F.B. 2663-12 RESET ON LINE 0.03 E. OF

274.14

95.54

PROPOSED R/W

F.D. S.&W. FLUSH F.B. 2663-12 REMOVED

0.03

Δ = 22°42'

SEE PP# 3B7 & 5E Pg 12

PROPOSED R/W

BUDLONG AVE.

40.00

(30)

(30)

CONT. TOP PG. 42

REVISED CURVE DATA - FIELD CALC.

Δ = 24° 52' 00"
R = 3600.00
T = 795.54
L = 1564.56

1) 24 52 00
2) 107 28 00
3) 166 17 54
4) 24 52 00
10-31-68 R.T.H.

NOTE: ITS Added

W.S. 26 = A-2

Notes: Any Addition or Changes on this Sheet Must be Made or Circled in Red Ink With Date and Name of Person Making Change.

Do not extend this line of this time.

PLEASE RETURN TO
LOS ANGELES COUNTY ENGINEER
700 Los Angeles County Engineering Bldg.

76F3088 SAE (247) 11-68

PLEASE RETURN TO
LOS ANGELES COUNTY ENGINEER
700 LOS ANGELES COUNTY ENGINEERING BLDG.

Note: Any Additions or Changes on This Sheet Must be Made or Circled in Red Ink With Date and Name of Person Making Change.

Do not extend this side of this line.

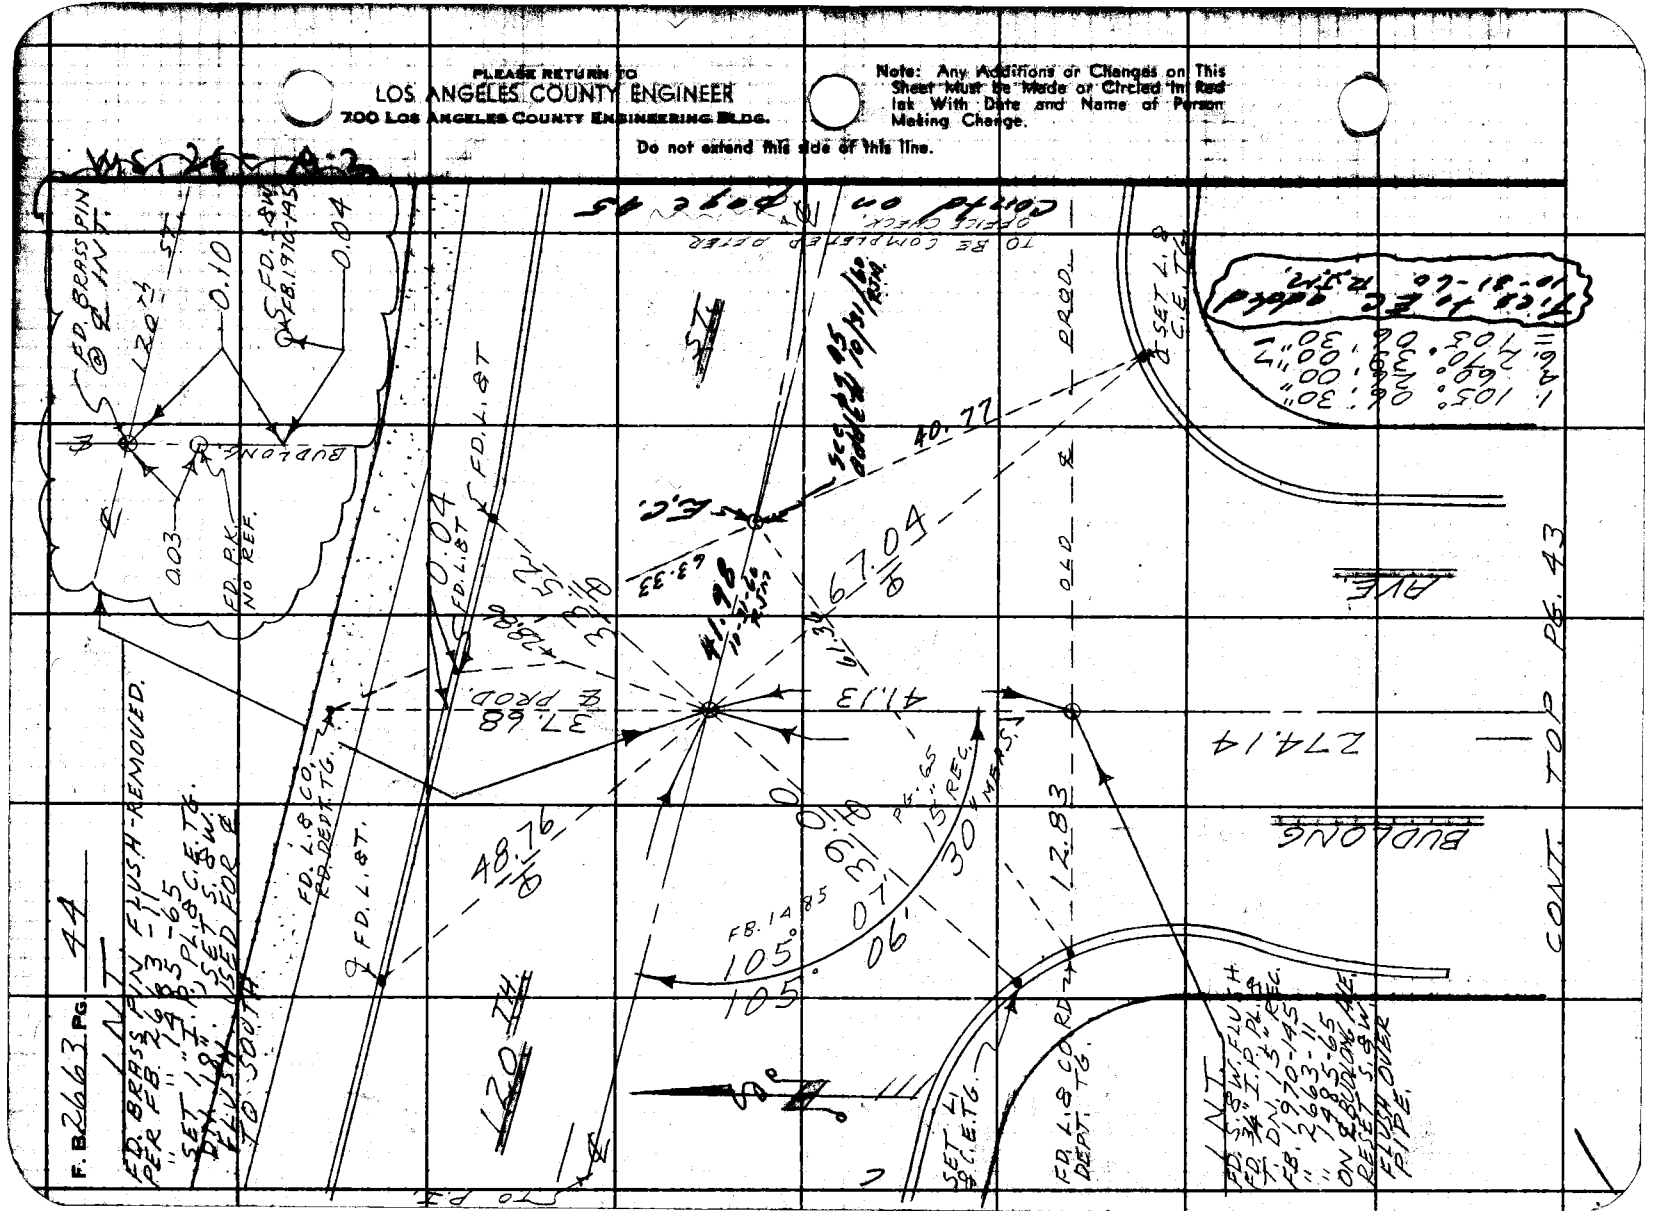
F. B2663 PG 44
ED. BRASS PIN IN LT.
PER F.B. 19703-65
SET 1" I.P. P.L.S. 6663 IN E.T.G.
FD. 3/4" I.P. FLUSH-REMOVED.
FD. SPIKE
0.10
0.04
0.03
ED. P.K. NO REF.
BUDLONG
FD. L.&T. CO. DEPT. T.G.
FD. L.&T.
FD. L.&T.
0.04
37.68 ℄ PROD.
48.76
120 TH
℄ PROD.
67.04
41.13
℄ PROD.
40.77
℄ C.
43.33
#1.96
10-21-65
FB. 1485
105°
105°
07'
06'
30' MEAS.
15' REC.
12.83
SET L.&T. C.E.T.G.
FD. L.&T. CO. DEPT. T.G.
SET L.&T. C.E.T.G.
TO BE COMPLETED AFTER OFFICE CHECK.

Notes Ck'd by Miller
Map No. B 2722
Office Work Homasu
Checked Miller
Date Dec. 1960

Survey of 120TH St.
JN 0075.84 Tape 0187 Std 68° F
Surveyed by R. J. MITCHELL
Notes R. J. MITCHELL Date 10/31/60
Indexed H. E. on

F. B 2663 PG. 45

This Page Added 10-31-60

119TH PL

SW'ly ⊥ pg 10

Lt ⊥ pg 10

Ch. ⊥ pg 10

BUDLONG AVE.

60.27

54.63

53.25

EC set 1" IP, corn Pt. Co. Engr. Tg ⊥ to ⊥ dig 18" ⊥ Set Lg. Bl. Sph w ⊥ ⊥ per Inst. ⊥ over

59.75

RT. set Lg. Bl. Sph w ⊥ per Office Inst.

66.05

15.22

S ⊥ (2) pg 9

58.27

set ⊥ in Pt.

50.14

59.75

120 TH

BC Set 1" IP corn Pt. Co. engr Tg ⊥ to ⊥ dig 18" ⊥ Set Lg. Bl. Sph w ⊥ ⊥ per Inst.

66.02

57.

7.06

S 52° 55' E

SW'ly ⊥ pg 9

31.29

36.25

NLY ⊥ pg 9

35.35

29.40

Office calc.

25.40

L. T ⊥ T ⊥ (Co. Engr) pg 9

L. T ⊥ T ⊥ (Rd) pg 9

cont'd from page 43