SAPPELL
5419
E FONG
R. HILARIO
10-17-83

Survey of WEST HOLLY-SHER
JN. 0303.00 Tape Std °F
Surveyed by A.N. HELLSTROM
Notes A.N.H. Date 3-1961
Indexed C. J. GAMES
JUL 1 0 '82

F. B. 2710 Pg. 5

J.N. #0303.00
EST HOLLYWOOD-SHERMAN
WER MAINTENANCE DIST.
(DIVISION #3)

PAGE 3

DEX MAP

A.N.H.

Microfilmed June 83

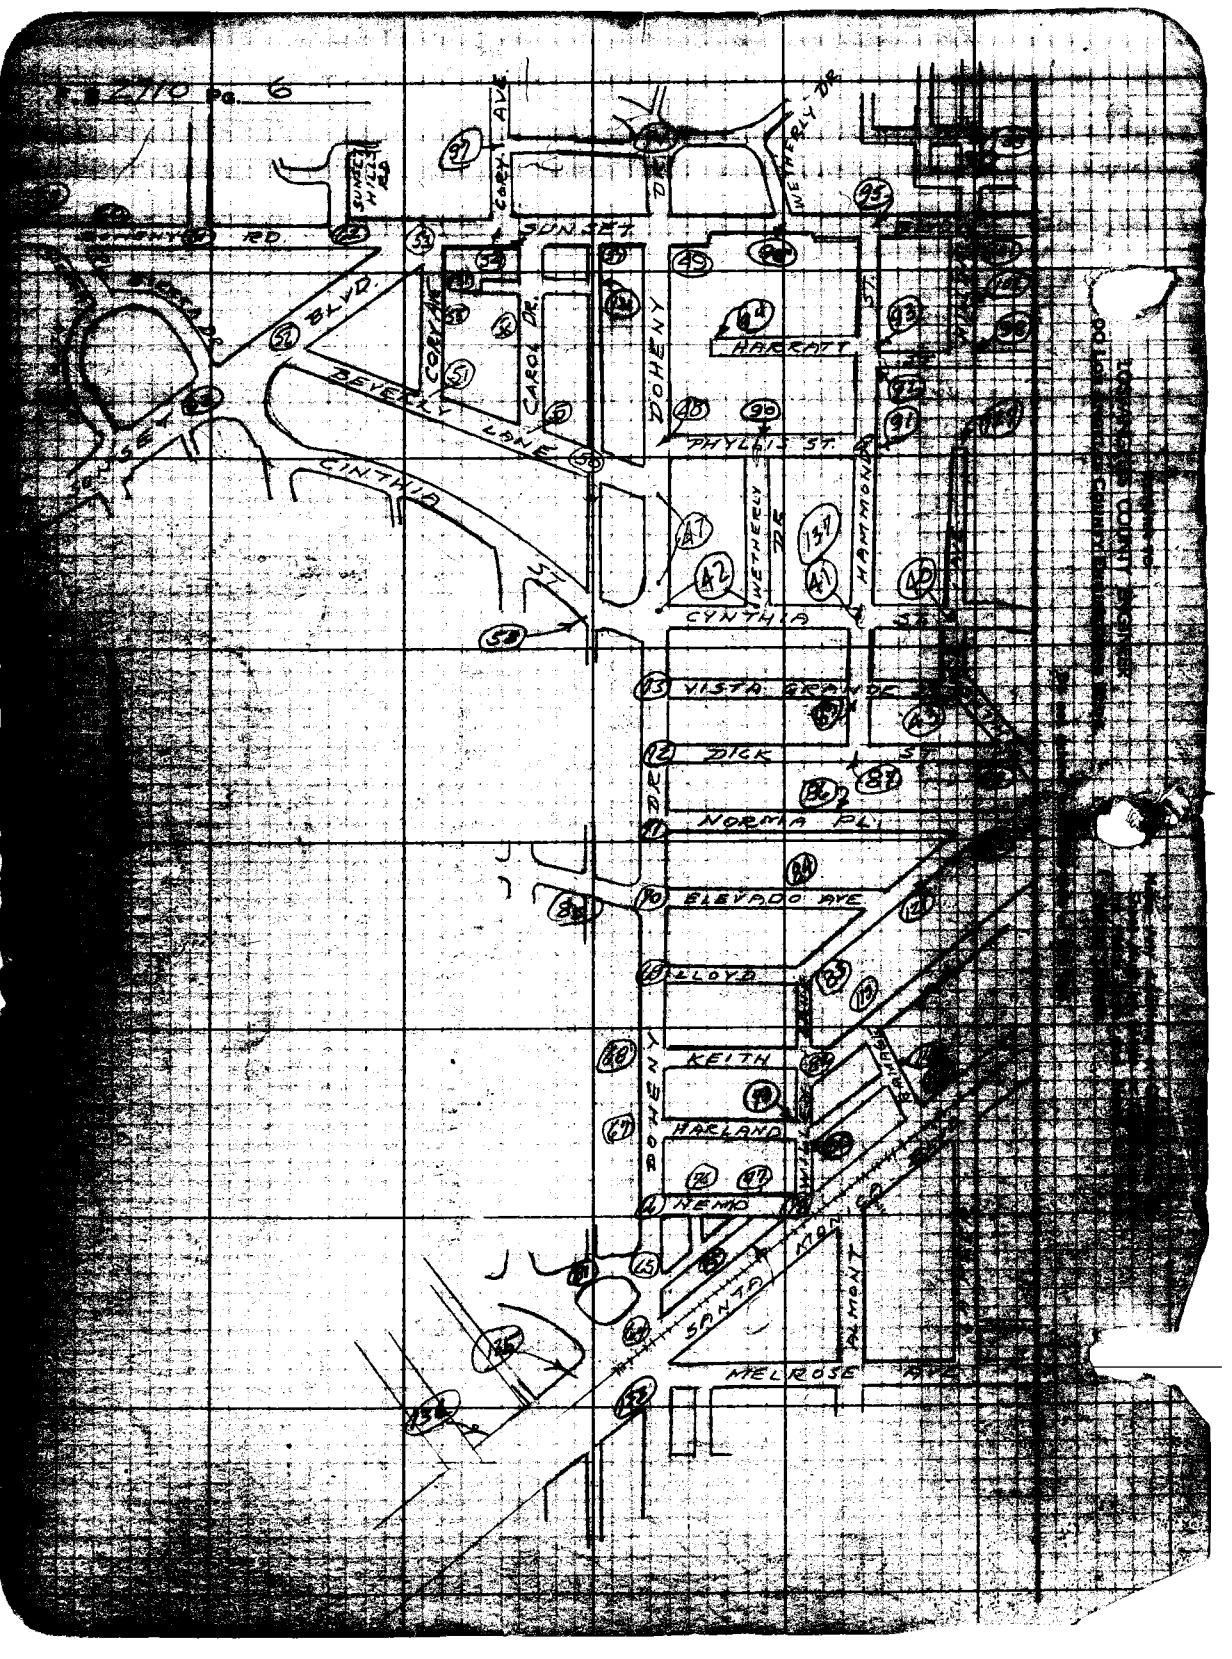
SUNSET HILLS RD.
CORY AVE.
WETHERLY DR.
SUNSET
RD.
BLVD.
CORVAN
CAROL DR.
DOHENY
HARRATT
BEVERLY LANE
PHYLLIS ST.
CINTHIA
WETHERLY DR.
HAMMOND
CYNTHIA
VISTA GRANDE
DICK
NORMA PL.
ELEVADO AVE.
LLOYD
KEITH
HARLAND
NEMO
SANTA MONICA
ALMONT
MELROSE AVE.

SAPPEL

Notes Ck'd by R. HILARIO	Survey of WEST HOLLY-SHER
Map No. 5418	JN 0303.00 Tape Std °F
Office Work E. FONG	Surveyed by A.N. HELLSTROM
Checked R HILARIO	Notes A.N.H. Date 3-1961
Date 10-17-83	Indexed C. J. GALL

F. B. 2710 Pg. 7

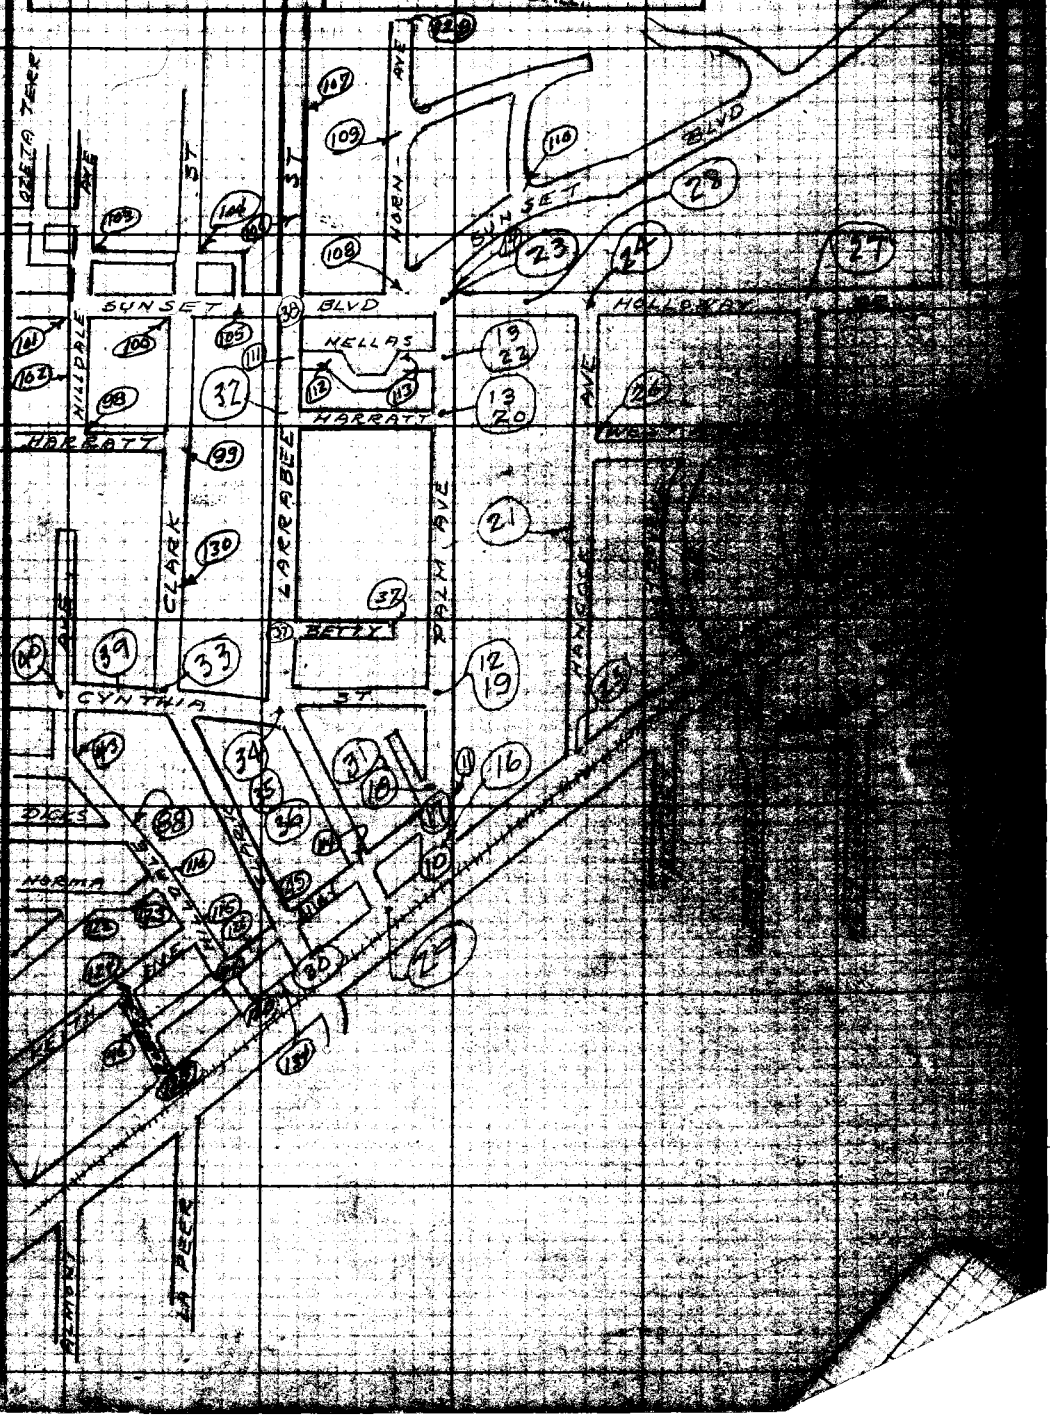

Note: Any Additions or Changes on This Sheet Must be Made or Circled in Red Ink With Date and Name of Person Making Change.

RETURN TO
LOS ANGELES COUNTY ENGINEER
00 LOS ANGELES COUNTY ENGINEERING BLDG.

Note: Any Additions or Changes on This Sheet Must be Made or Circled in Red Ink With Date and Name of Person Making Change.

Do not extend notes this side of this line.

F.B. 2770 Pg. 8

Notes Ck'd by SAPPELL	Survey of WEST HOLLY & SHER.
Map No. 5418	JN 0303.00 Tape Std °F
Office Work E FONG	Surveyed by A.N. Hellstrom
Checked R HILARIO	Notes A.N.H. Date 3-1961
Date 10-17-83	Indexed JUL 10 '62

F. B. 2710 Pg. 9

J.N. #0303.00

WEST HOLLYWOOD - SHERMAN
SEWER MAINTENANCE DIST.
(DIVISION 3)

LOCATION OF SURVEY PTS FOR PROPERTY
LINES ON PALM AVE. Pages 10-14

℄ OF STREETS — — — " 25-32

Pts Shown by Number only
L.S. or R.E. are Lead & Tags!

A.N. Hellstrom
J.C. Rice
H.H. Spriggs
R.J. Rodriguez

Notes: Any Additions or Changes on This Sheet Must Be Made or Circled In Red Ink With Date and Name of Person Making Change.
Do not extend notes into this side of this line.
RETURN TO
LOS ANGELES COUNTY ENGINEER
90 LOS ANGELES COUNTY ENGINEERING BLDG.
76008 CE #247—7-55

Cont. on BHM Pg. 11

F. B. 2910 Pg. 10

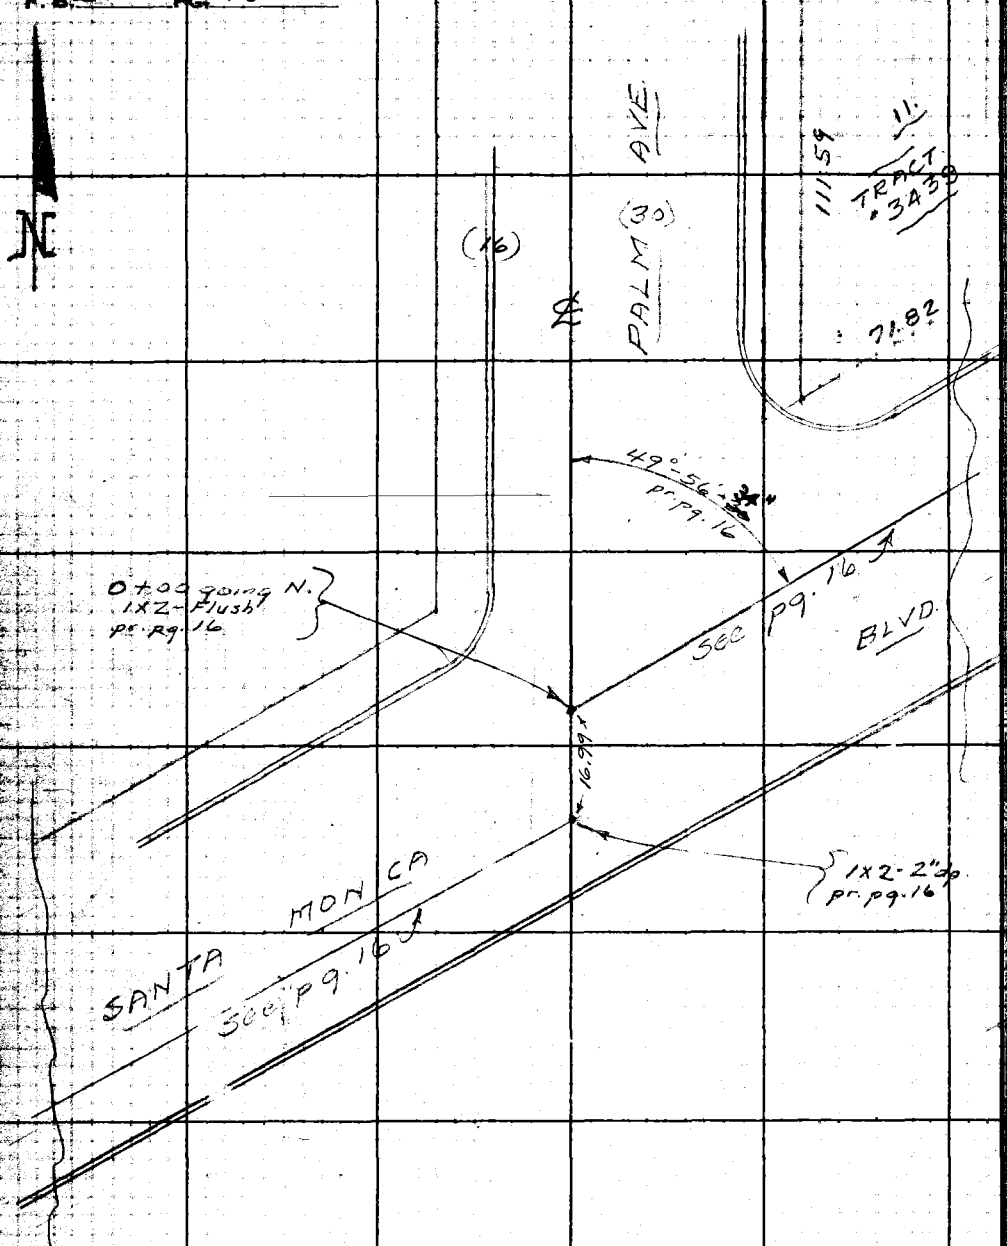

W.S. 22, B-3

RETURN TO
LOS ANGELES COUNTY ENGINEER
700 LOS ANGELES COUNTY ENGINEERING BLDG.

Do not extend notes this side of this line.

Note: Any Additions or Changes on This Sheet Must be Made or Circled in Red Ink With Date and Name of Person Making Change.

Notes Ck'd by D. SAPPELL	Survey of WEST HOLLY - SHERM
Map No. 5418	JN 0303.00 Tape 0188 Std 68 °F
Office Work E FONG	Surveyed by A.N. Heilstrom
Checked R HILARIO	Notes A.N.H. Date 3-1961
Date 10-17-83	Indexed C. J. GALLI

F. B. 2710 Pg. 11

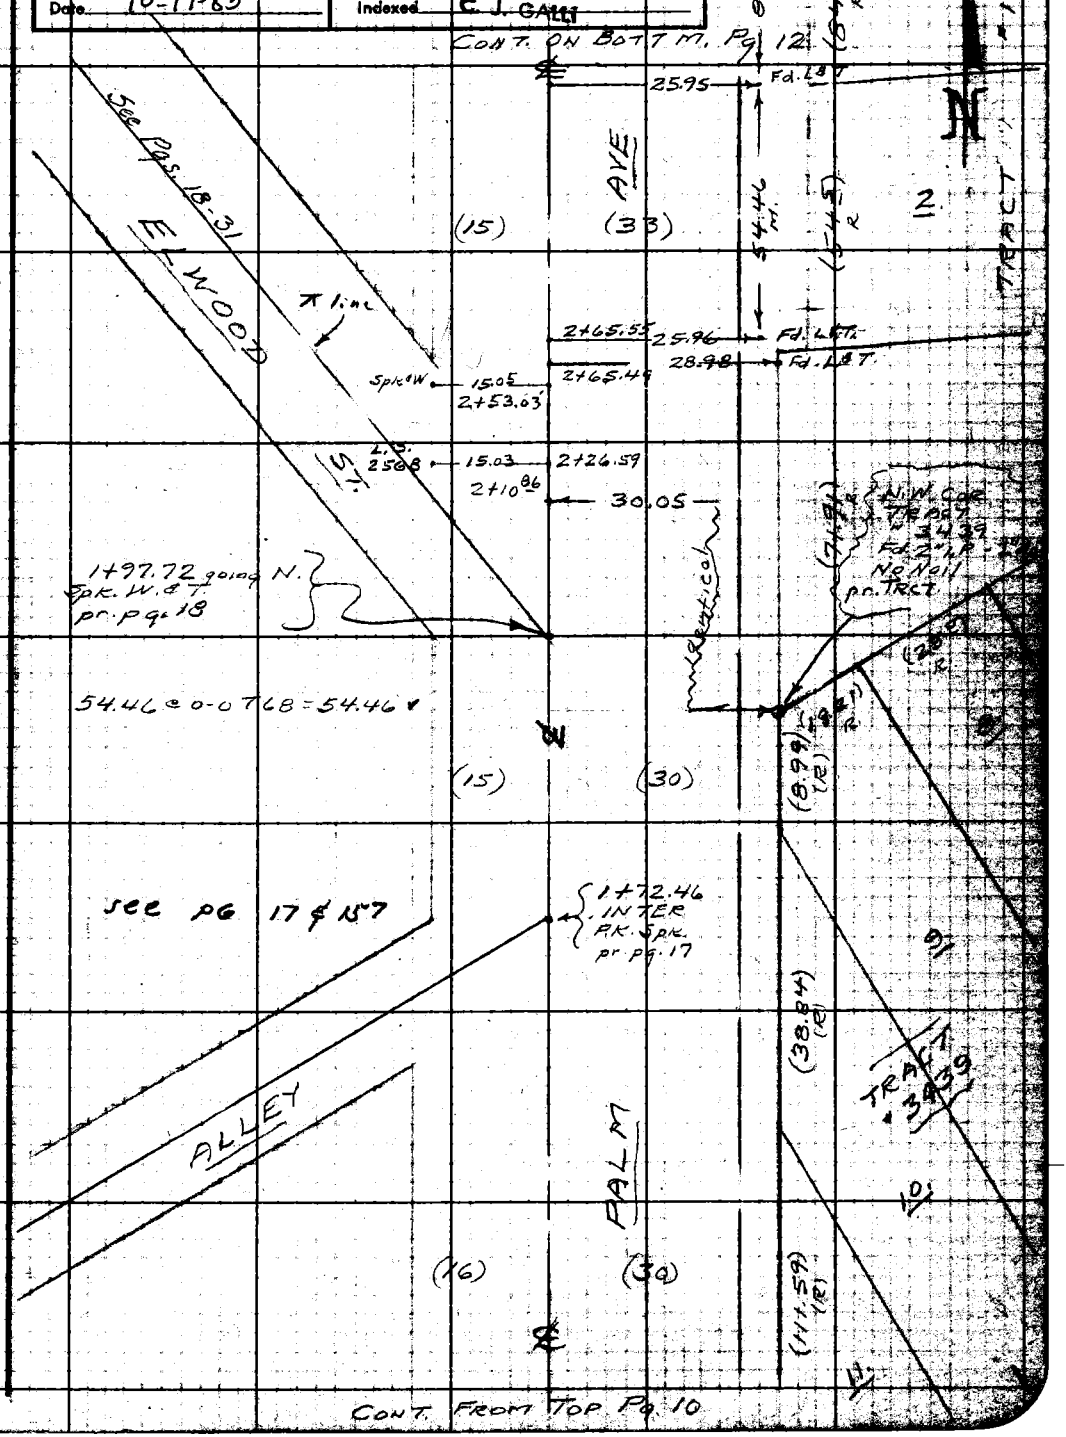

W.S. 22, B-3

Note: Any Additions or Changes on This Sheet Must be Made or Circled in Red Ink With Date and Name of Person Making Change.

Do not extend notes this side of this line.

RETURN TO
LOS ANGELES COUNTY ENGINEER
00 LOS ANGELES COUNTY ENGINEERING BLDG.

763098 CE #247—7-53

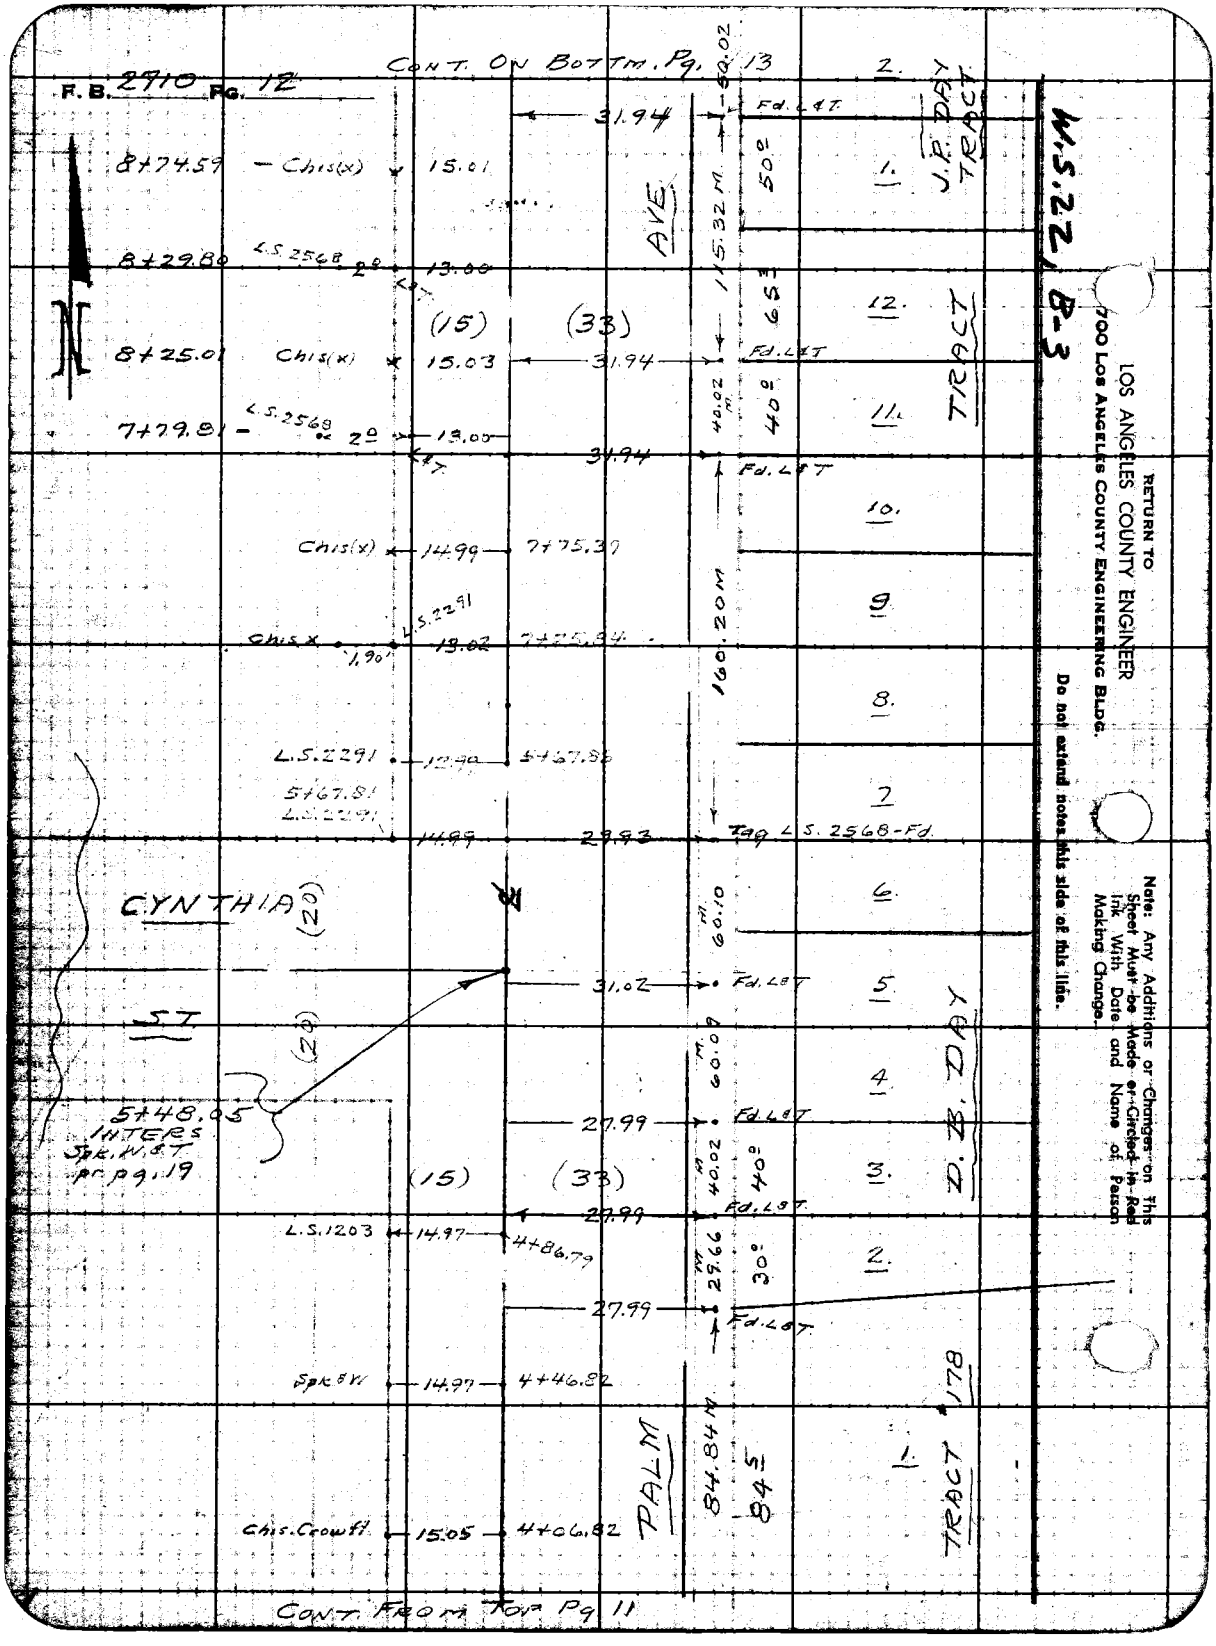

F.B. 2710 Pg. 12
CONT. ON BOTTM. Pg. 13
W.S. 22, B-3
RETURN TO
LOS ANGELES COUNTY ENGINEER
700 LOS ANGELES COUNTY ENGINEERING BLDG.
Do not extend notes this side of this line.
Note: Any Additions or Changes on This Sheet Must be Made or Circled in Red Ink With Date and Name of Person Making Change.
8+74.59 — Chis(x) 15.01
8+29.80 L.S. 2568 2° 13.00
8+25.01 Chis(x) 15.03
7+79.81 — L.S. 2568 2° 13.00
Chis(x) 14.99 7+75.39
Chis x 1.90' L.S. 2291 13.02 7+75.84
L.S. 2291 12.90 5+67.86
5+67.81 L.S. 2291
14.99 29.93 Tag L.S. 2568-Fd.
CYNTHIA (20)
ST. (20)
5+48.05 INTERS Spk. W.&T. pr. pg. 19
L.S. 1203 14.97 4+86.79
Spk & W 14.97 4+46.82
Chis. Crow ft. 15.05 4+06.82
(15) (33)
(15) (33)
31.94
31.94
31.94
31.02
27.99
27.99
27.99
AVE
PALM
115.32 M.
160.20 M
60.10 M
60.09 M
40.02 M
29.66 M
84.84 M
50.02
50°
65°
40°
40°
30°
84.5
Fd. L&T
Fd. L&T
Fd. L&T
Fd. L&T
Fd. L&T
Fd. L&T
Fd. L&T
J.P. DAY TRACT
TRACT
D.B. DAY
TRACT #178
2.
1.
12.
11.
10.
9.
8.
7
6.
5
4
3.
2.
1.
CONT. FROM TOP Pg 11

Notes Ck'd by D. SAPPELL	Survey of WEST HOLLY SHERM.
Map No. 5418	JN 0303.00 Tape 0188 Std 68 °F
Office Work E FONG	Surveyed by A.N. Hellstrom
Checked R HILARIO	Notes A.N.H. Date 3-1961
Date 10-17-83	Indexed C. I. GALLI

F. B. 2710 Pg. 13

CONT. ON BTTM Pg. 14

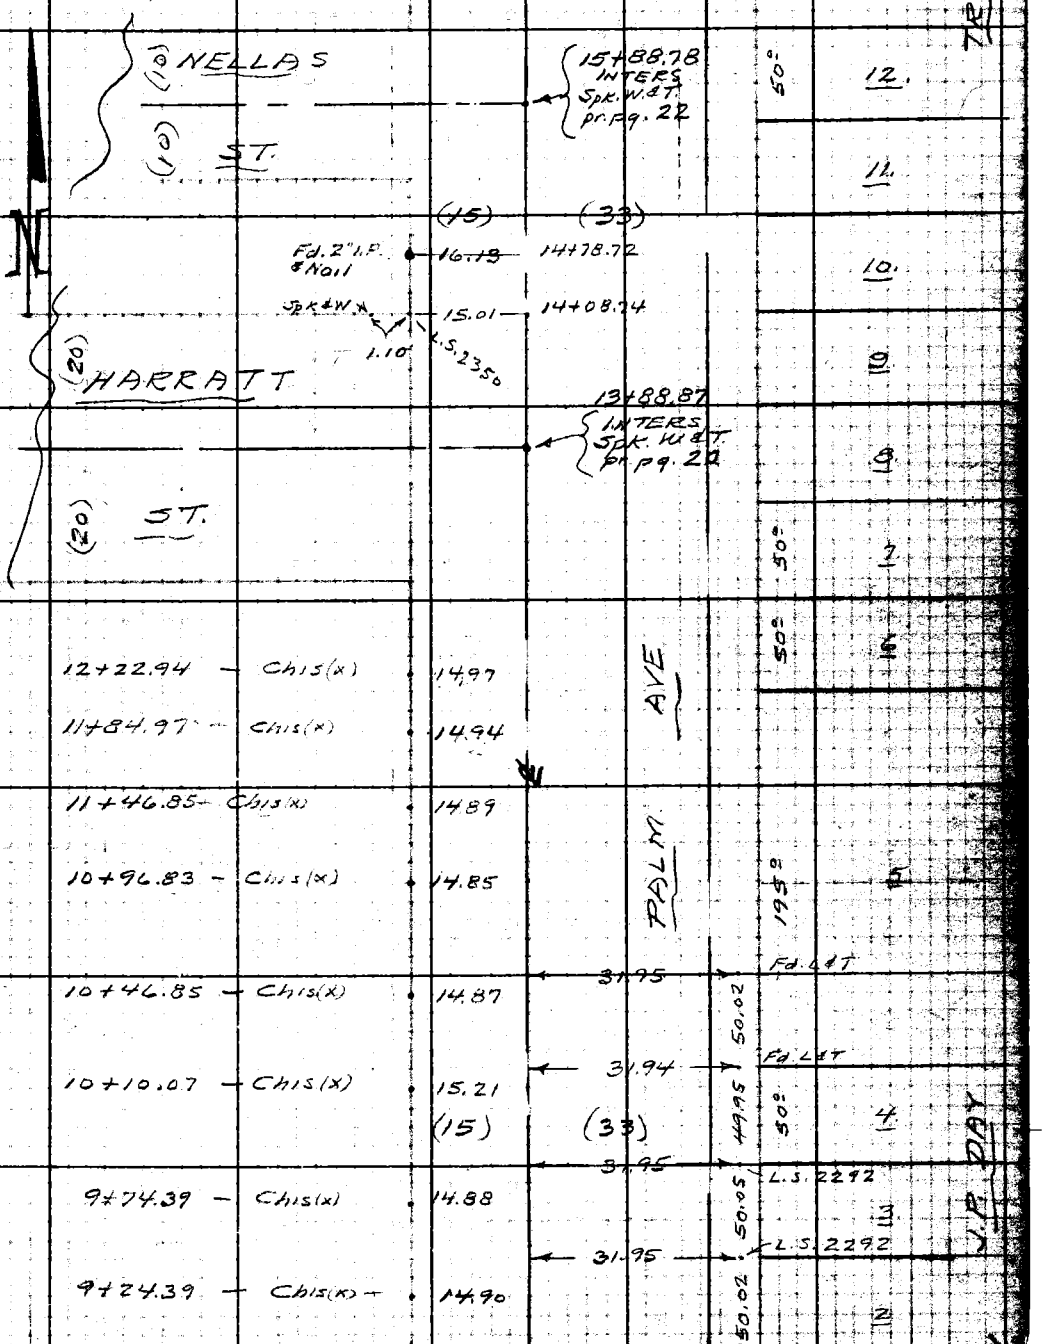

CONT. FROM TOP Pg. 12

W.S. 22, B-3

Note: Any Additions or Changes on This Sheet Must be Made or Circled in Red Ink With Date and Name of Person Making Change.

Do not extend notes this side of this line.

RETURN TO LOS ANGELES COUNTY ENGINEER
00 LOS ANGELES COUNTY ENGINEERING BLDG.

763095 CE #247—7-58

F. B. 2710 Pg. 14

W.S. 22, B-2

RETURN TO
LOS ANGELES COUNTY ENGINEER
700 LOS ANGELES COUNTY ENGINEERING BLDG.

Do not extend notes this side of this line.

Note: Any Additions or Changes on This Sheet Must be Made or Circled in Red Ink With Date and Name of Person Making Change.

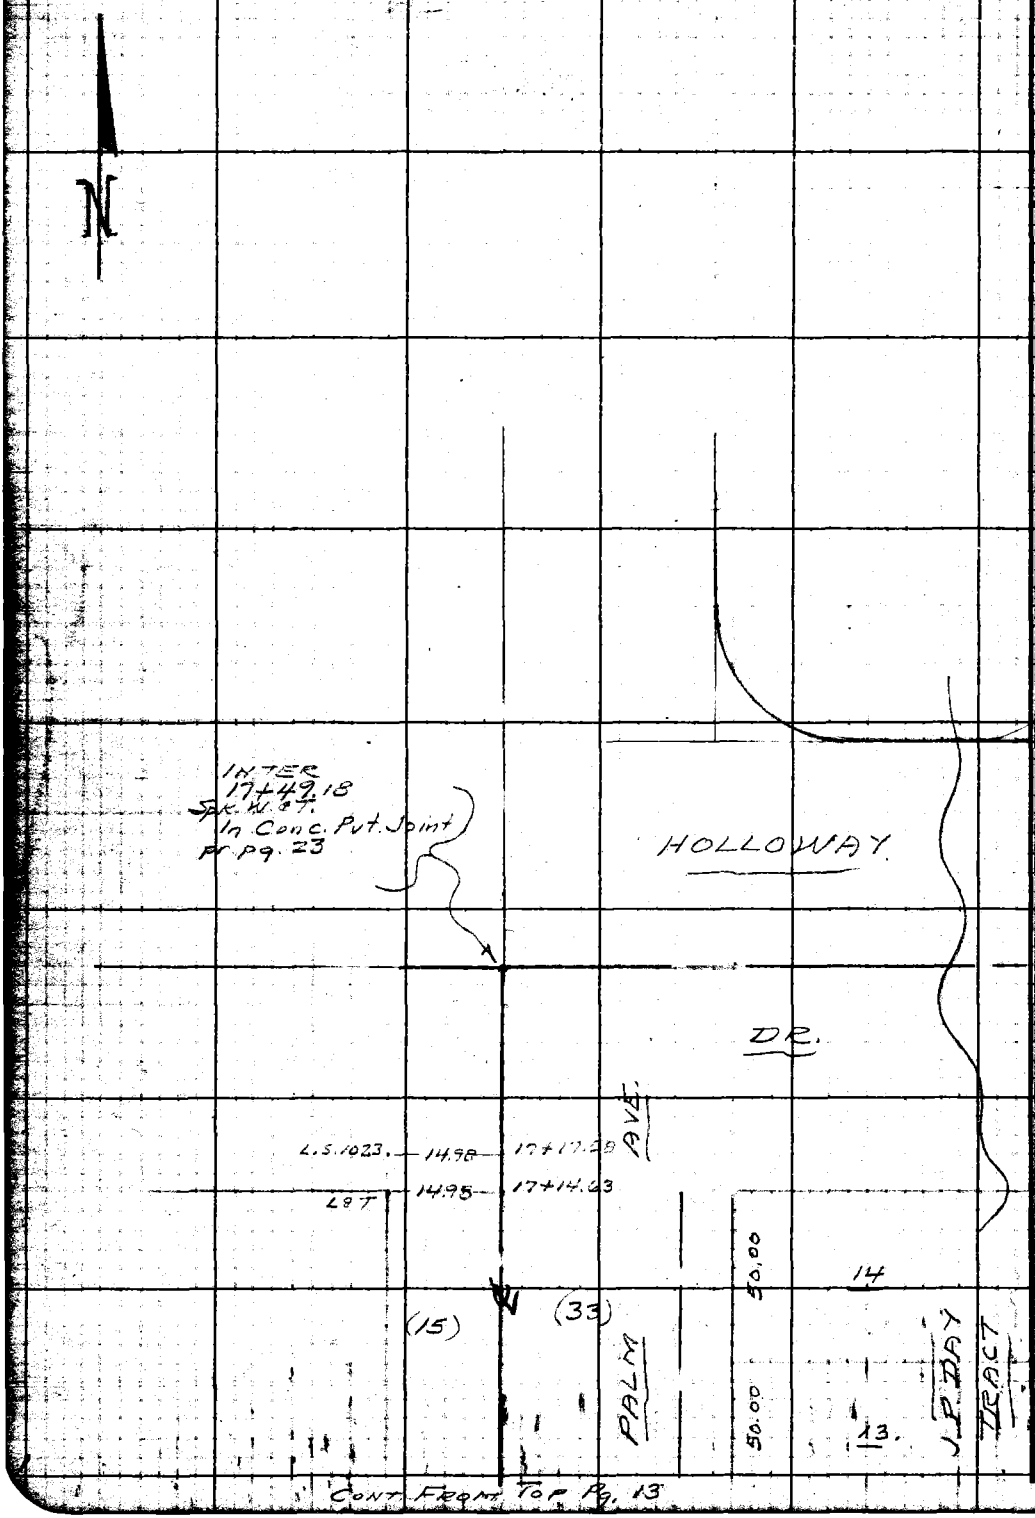

CONT. FROM TOP Pg. 13

Notes Ck'd by D SAPPELL	Survey of WEST HOLLY-SHER.
Map No. 5418	JN 0303.00 Tape 0188 Std 68 °F
Office Work E FONG	Surveyed by A.N. Hellstrom
Checked R HILARIO	Notes A.N.H. Date 3-1961
Date 10-17-83	Indexed C. J. GALLI JUL 1 0 '82

F. B. 2710 PG. 15

J.N. #0303.00
WEST HOLLYWOOD - SHERMAN
SEWER MAINTENANCE DIST.
(DIVISION #3)

PAGES

℄ OF STREETS — — —

15 — 136

A.N. HELLSTROM
J.C. RIKE
H.H. SPRIGGS
R.J. RODRIGUEZ

Note: Any Additions or Changes on This Sheet Must Be Made or Circled in Red Ink With Date and Name of Person Making Change.

Do not extend notes this side of this line.

RETURN TO
LOS ANGELES COUNTY ENGINEER
900 LOS ANGELES COUNTY ENGINEERING BLDG.

763098 CE #247—7-59

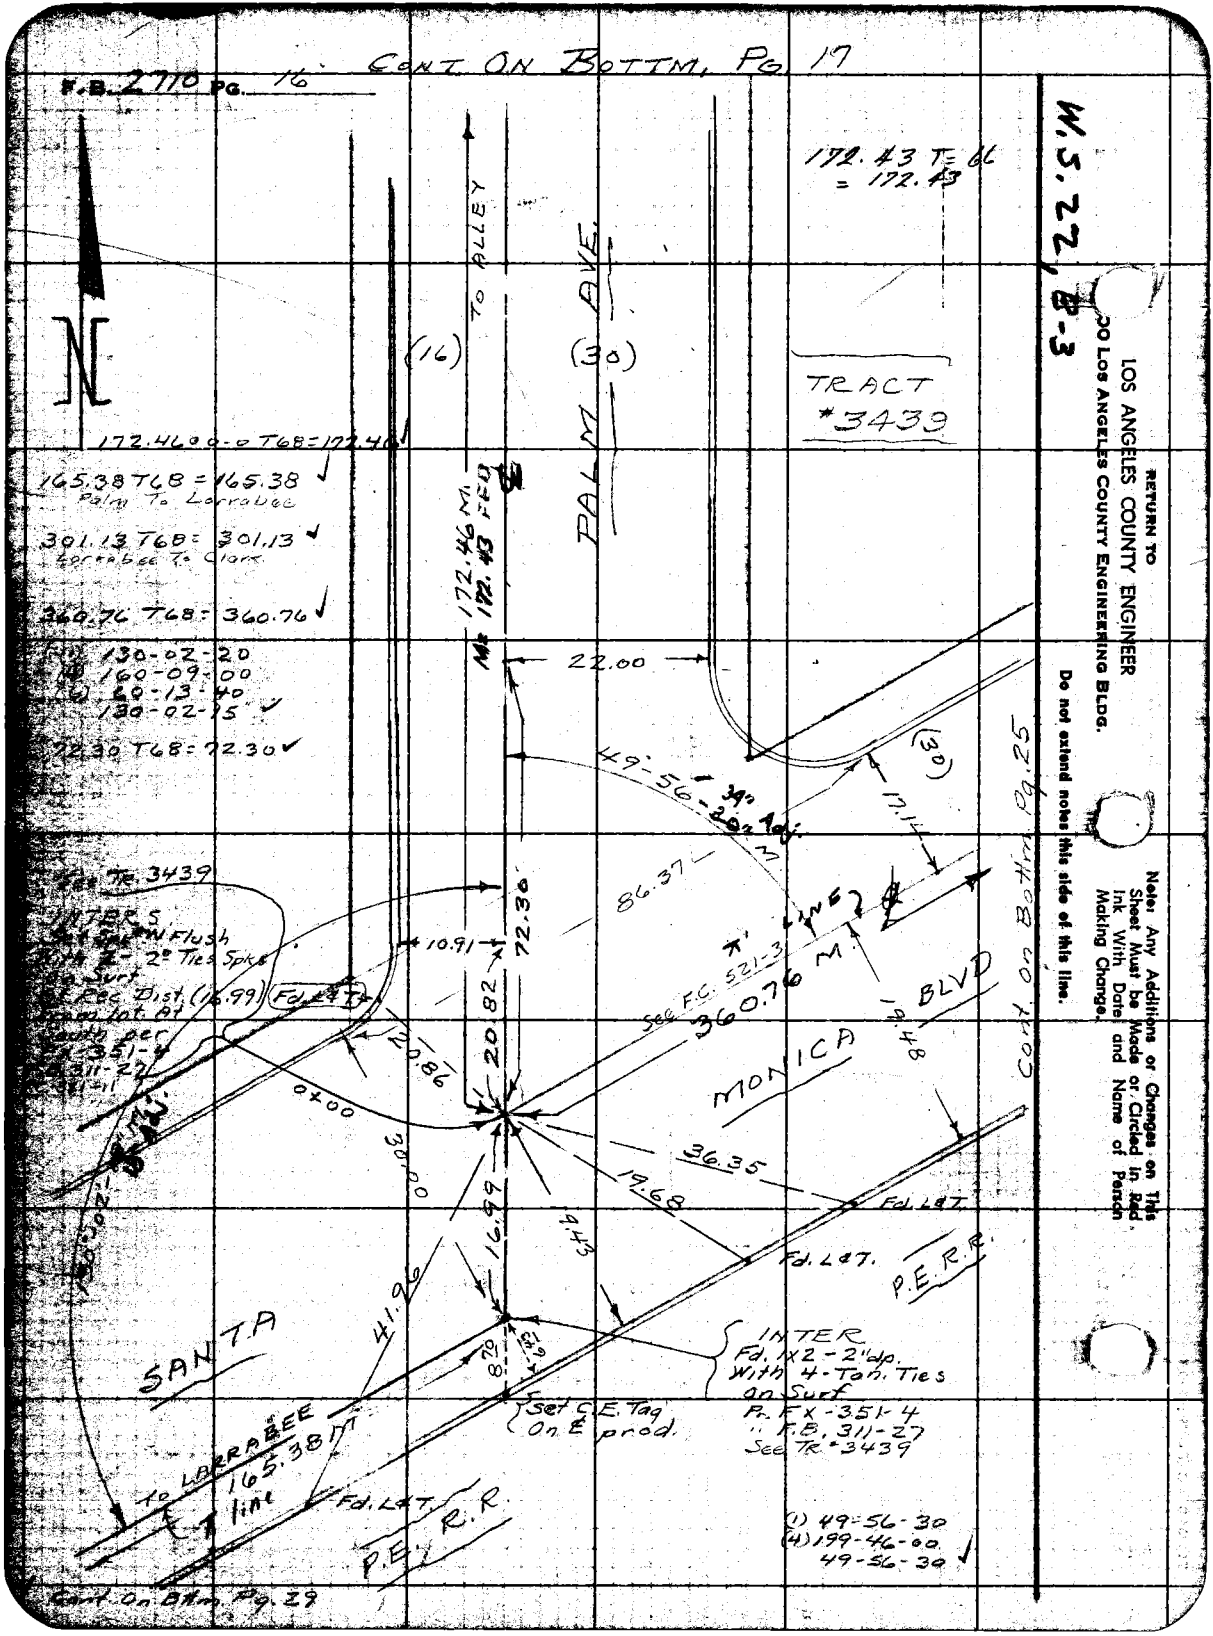

RETURN TO
LOS ANGELES COUNTY ENGINEER
00 LOS ANGELES COUNTY ENGINEERING BLDG.

Do not extend notes this side of this line.

Note: Any Additions or Changes on This Sheet Must be Made or Circled in Red Ink With Date and Name of Person Making Change.

Notes Ck'd by D. SAPPELL	Survey of WEST HOLLY - SHER.
Map No. 5418	JN #303.00 Tape 0188 Std 68 °F
Office Work E FONG	Surveyed by A.N. Hellstrom
Checked R HILARIO	Notes A.N.H. Date 4-1961
Date 10-17-83	Indexed C. J. GALLI

F. B. 2710 Pg. 17

Cont. on Bottm. Pg 18

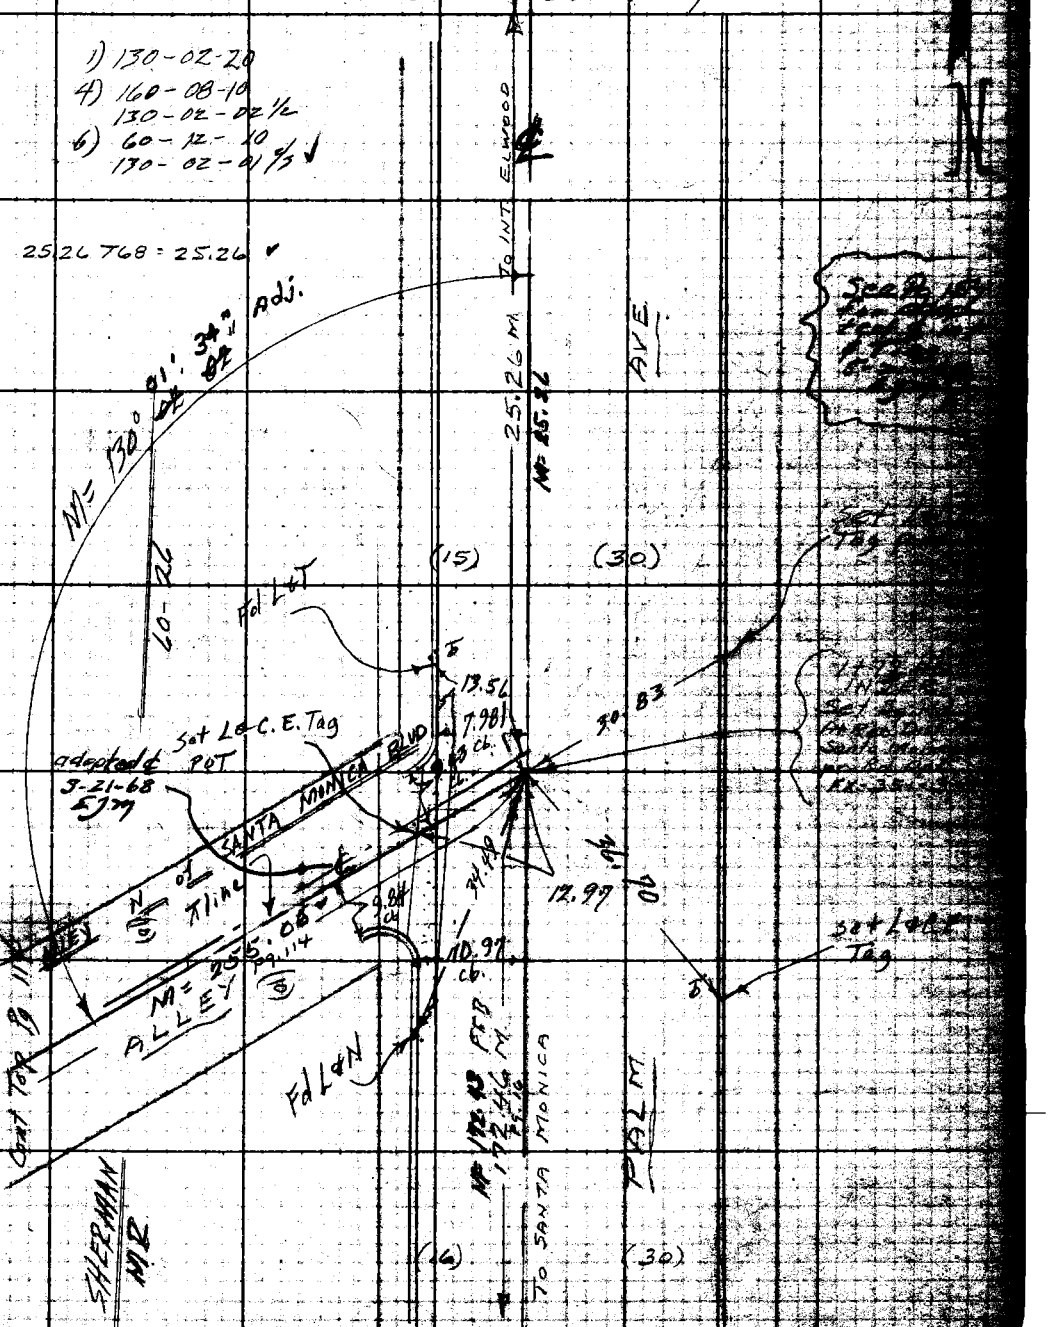

Cont From Top Pg 16

Note: Any Additions or Changes on This Sheet Must be Made or Circled in Red Ink With Date and Name of Person Making Change.

Do not extend notes this side of this line.

LOS ANGELES COUNTY ENGINEER
900 LOS ANGELES COUNTY ENGINEERING BLDG.

762098 CK #247—7-53

Cont. On Bottm. Pg. 19

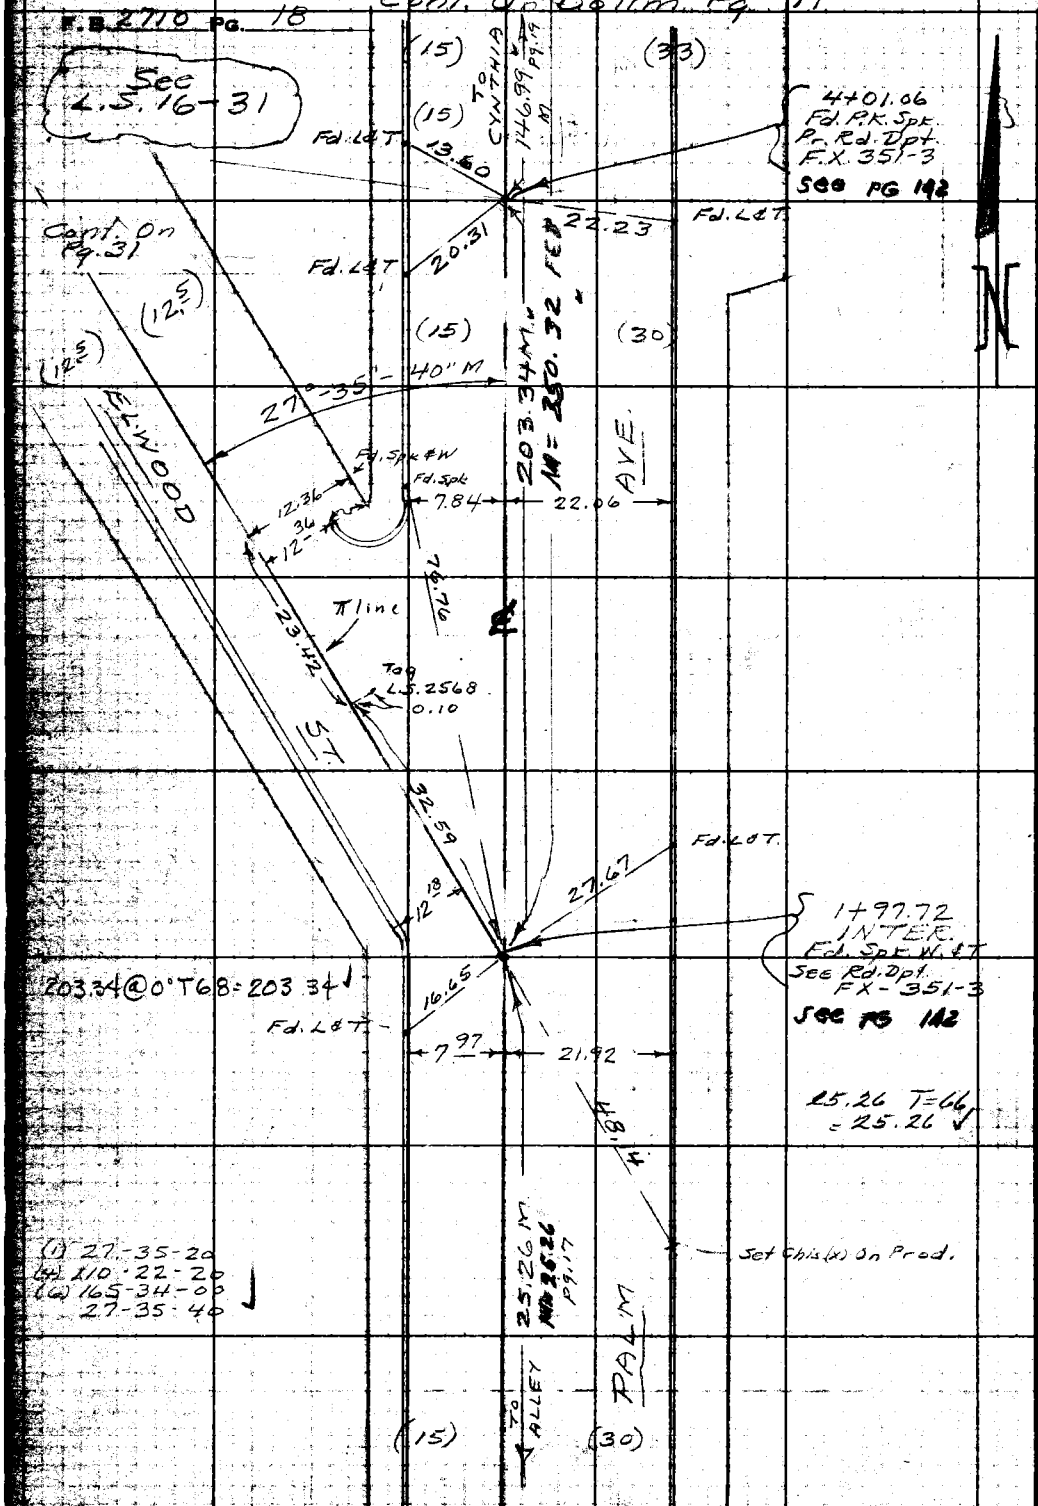

W.S. 22, B-3

RETURN TO
LOS ANGELES COUNTY ENGINEER
100 LOS ANGELES COUNTY ENGINEERING BLDG.

Do not extend notes this side of this line.

Note: Any Additions or Changes on This Sheet Must be Made or Circled in Red Ink With Date and Name of Person Making Change.

Cont. From Top Pg 17 & 157

Notes Ck'd by D. SAPPELL	Survey of WEST HOLLY - SHER.
Map No. 5418	JN 0303.0 Tape 0188 Std 68 °F
Office Work E FONG	Surveyed by A.N. Hellstrom
Checked R. HILARIO	Notes A.N.H. Date 4-1961
Date 10-17-83	Indexed C. J. GALLI

F. B. 2710 Pg. 21

Cont. On Bottom Pg. 26

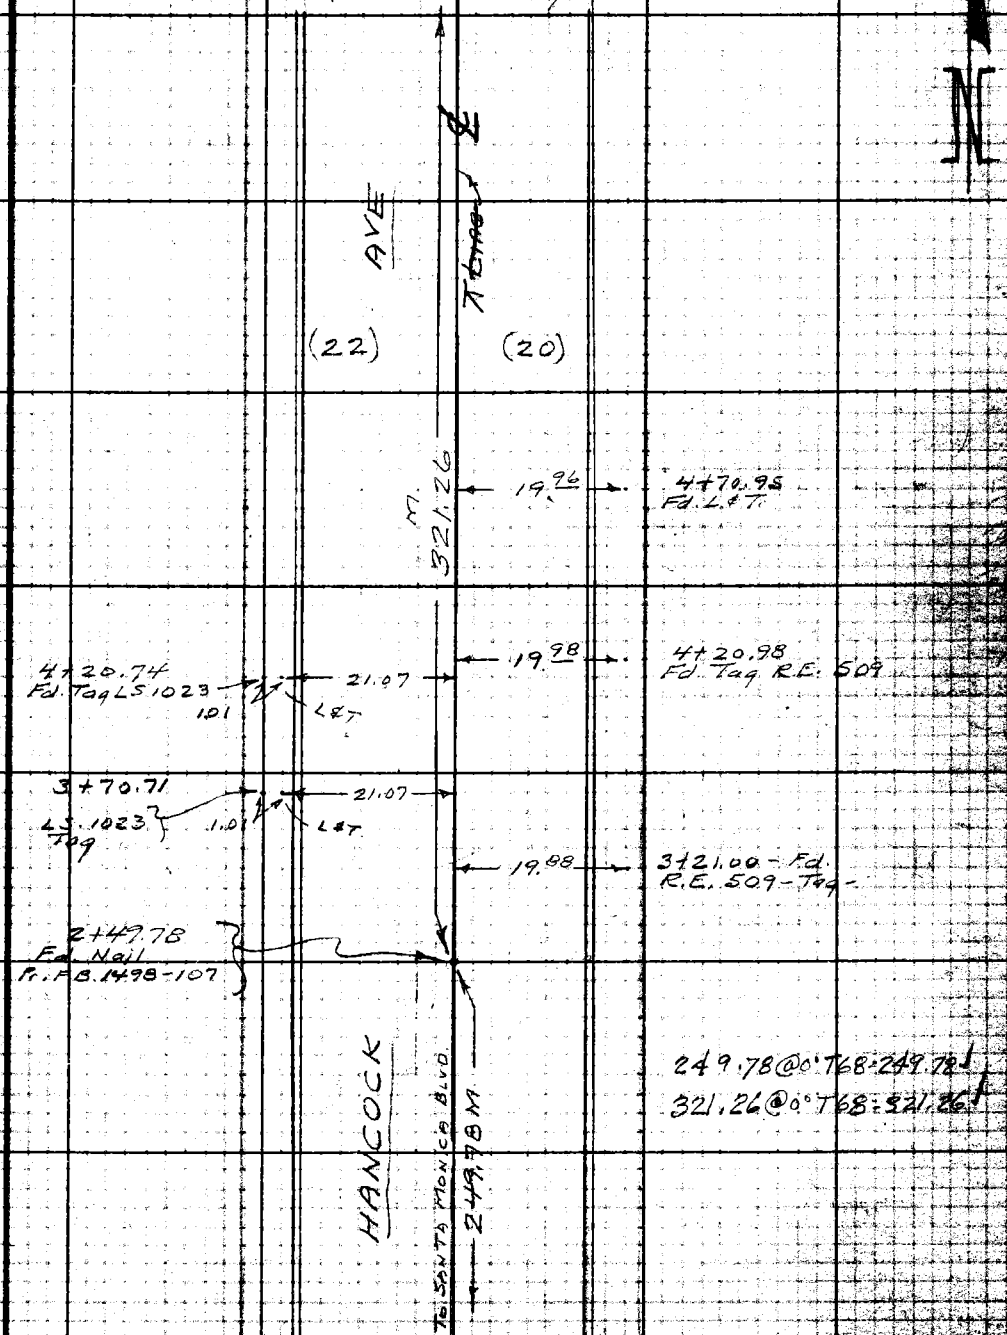

Cont. From Left Sd. Pg. 25

Note: Any Additions or Changes on This Sheet Must be Made or Circled in Red Ink With Date and Name of Person Making Change.

Do not extend notes this side of this line.

RETURN TO
LOS ANGELES COUNTY ENGINEER
20 LOS ANGELES COUNTY ENGINEERING BLDG.

763098 CE #247—7-53

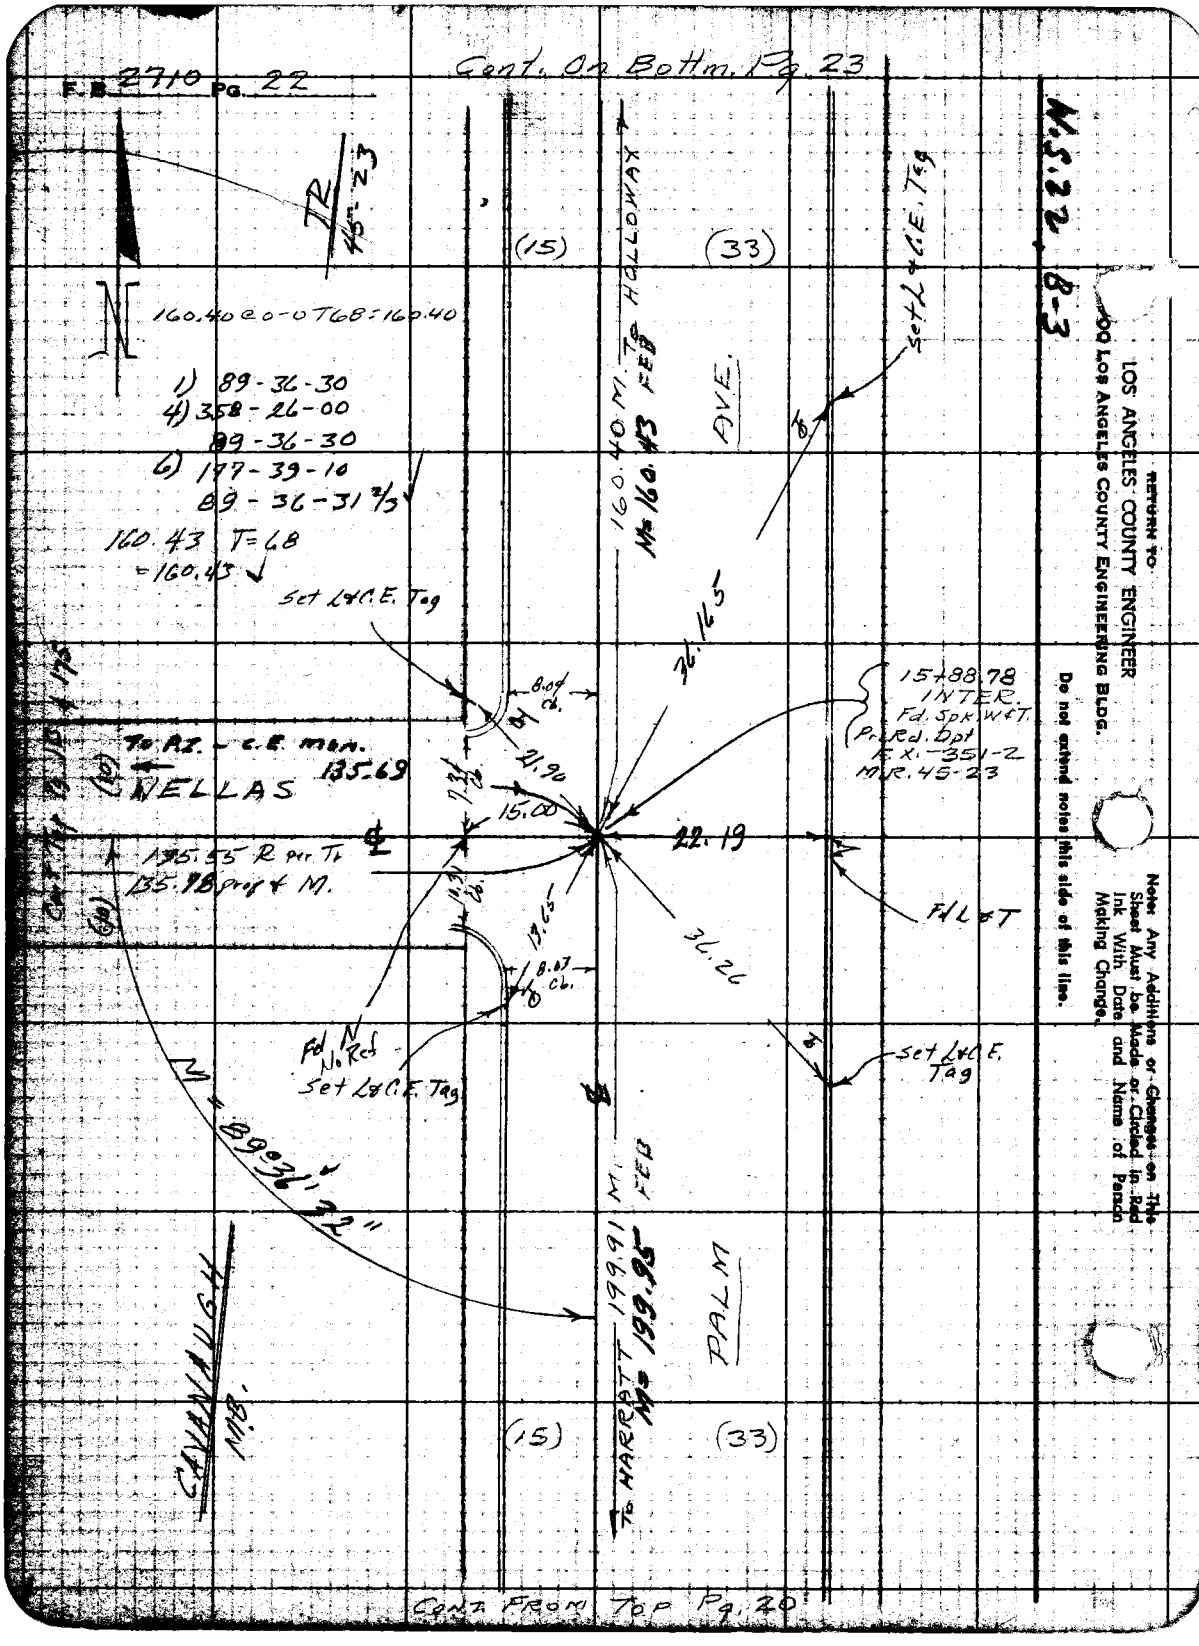
F.B. 2710 Pg. 22
Cont. On Bottm. Pg. 23
TR 45-23
N
160.40 @ 0-0 T68 = 160.40
1) 89-36-30
4) 358-26-00
89-36-30
6) 177-39-10
89-36-31 2/3
160.43 T=68
=160.43
Set L&C.E. Tag
(15)
(33)
160.40 M. To HOLLOWAY
M=160.43 FEB
AVE.
Set L&C.E. Tag
36.165
8.04 Cb.
21.90
15.00
15+88.78
INTER.
Fd. Spk. W&T.
Pr. Rd. Dpt
F.X.-351-2
M.R. 45-23
To P.I. - C.E. Mon.
135.69
WELLAS
135.55 R per Tr
135.98 prop & M.
22.19
Fd L&T
13.65
8.07 Cb.
36.26
Fd N
No Ref
Set L&C.E. Tag
Set L&C.E. Tag
M = 89°36'32"
CAVANAUGH
M.B.
199.91 M.
M=199.95 FEB
To HARRATT
PALM
(15)
(33)
Cont. From Top Pg. 20
N.S.22, B-3
RETURN TO
LOS ANGELES COUNTY ENGINEER
100 LOS ANGELES COUNTY ENGINEERING BLDG.
Do not extend notes this side of this line.
Note: Any Additions or Changes on This Sheet Must be Made or Circled in Red Ink With Date and Name of Person Making Change.

Notes Ck'd by D. SAPPELL	Survey of WEST HOLLY-SHERM
Map No. 5418	JN 0303.00 Tape 0188 Std 68 °F
Office Work E FONG	Surveyed by A.N. Hellstrom
Checked R HILARIO	Notes A.N.H Date 4-1961
Date 10-17-83	Indexed C. J. GALLI

F. B. 2710 Pg. 19

Cont. On Bottm. Pg. 20

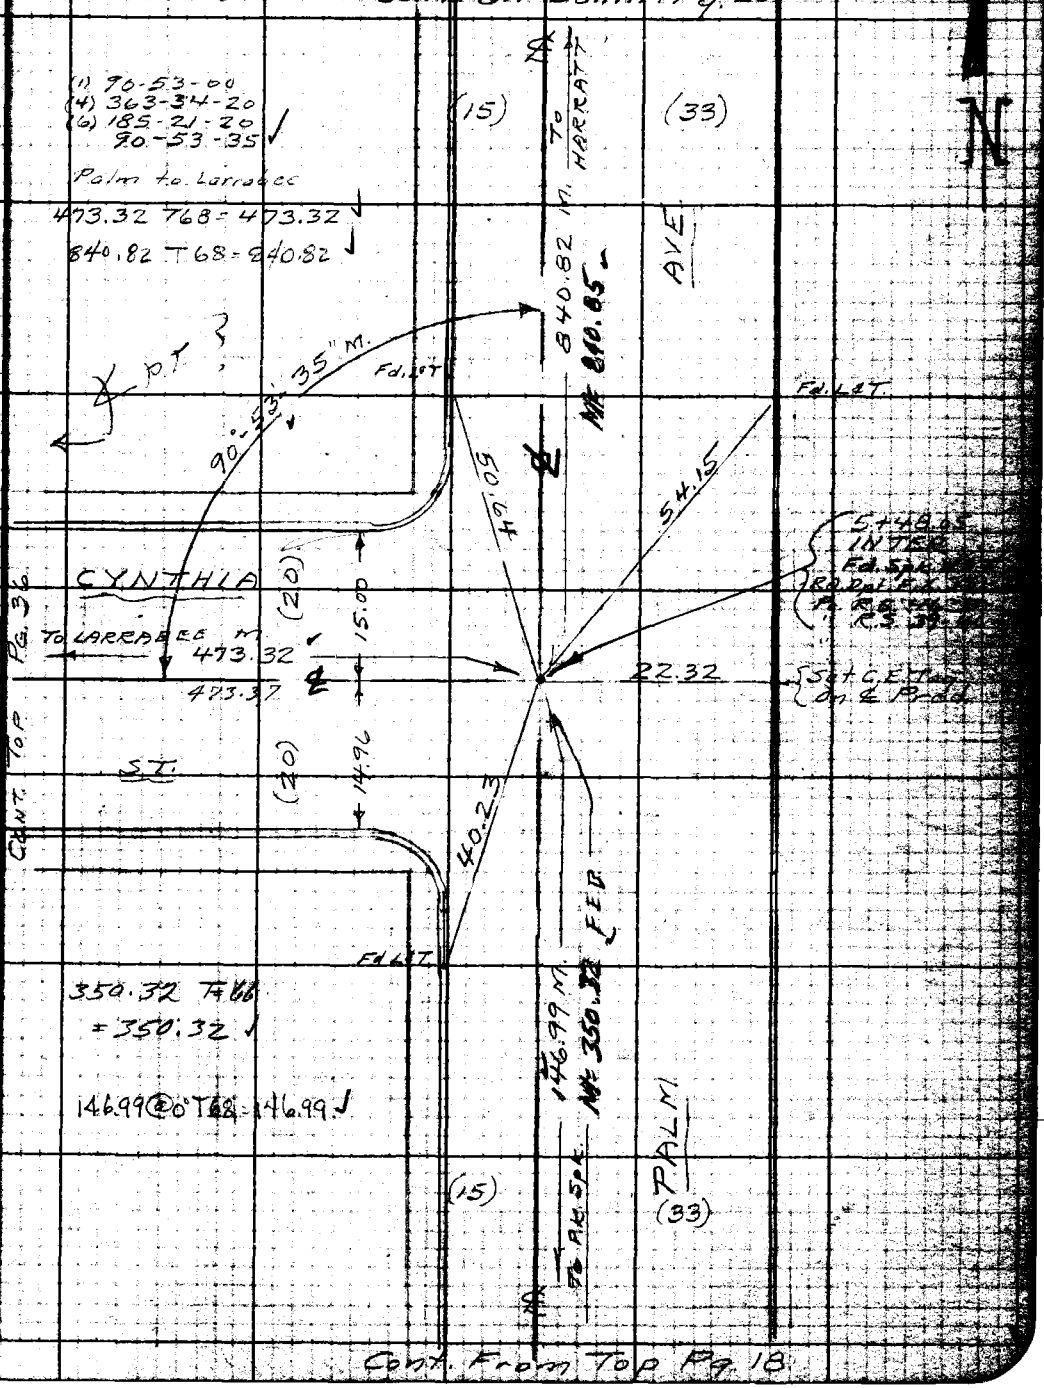

Cont. From Top Pg. 18

W.S. 22, B-3

Note: Any Additions or Changes on This Sheet Must be Made or Circled in Red Ink With Date and Name of Person Making Change.

Do not extend notes this side of this line.

RETURN TO LOS ANGELES COUNTY ENGINEER
900 LOS ANGELES COUNTY ENGINEERING BLDG.

76809B CE #247—7-58

Cont. On Bttm. Pg. 22

F.B. 2710 Pg. 20

W.S. 22, B-3

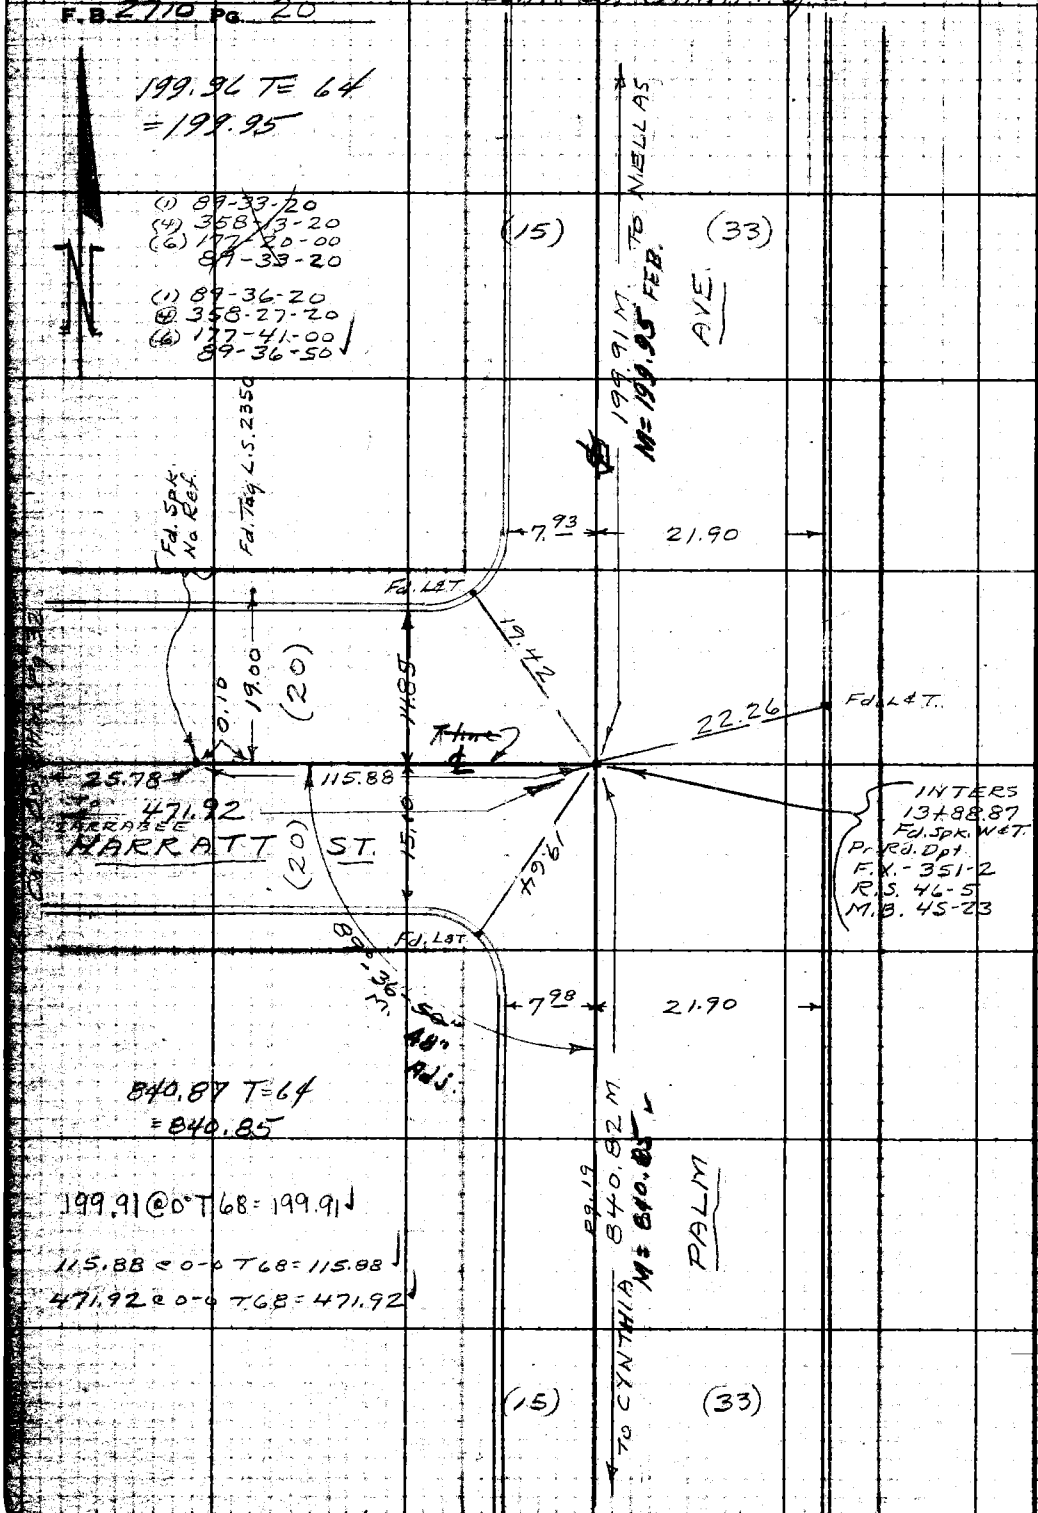

Cont. From Top Pg. 19

RETURN TO
LOS ANGELES COUNTY ENGINEER
900 LOS ANGELES COUNTY ENGINEERING BLDG.

Do not extend notes this side of this line.

Note: Any Additions or Changes on This Sheet Must be Made or Circled in Red Ink With Date and Name of Person Making Change.

Notes Ck'd by D. SAPPELL	Survey of WEST HOLLY-SHER
Map No. 5418	IN 0303.0 Tape 0188 Std 68 °F
Office Work E FONG	Surveyed by A.N. Hellstrom
Checked R. HEARIO	Notes A.N.H. Date 4-1961
Date 10-17-83	Indexed C. J. GALLI

F.B. 2710 Pg. 23

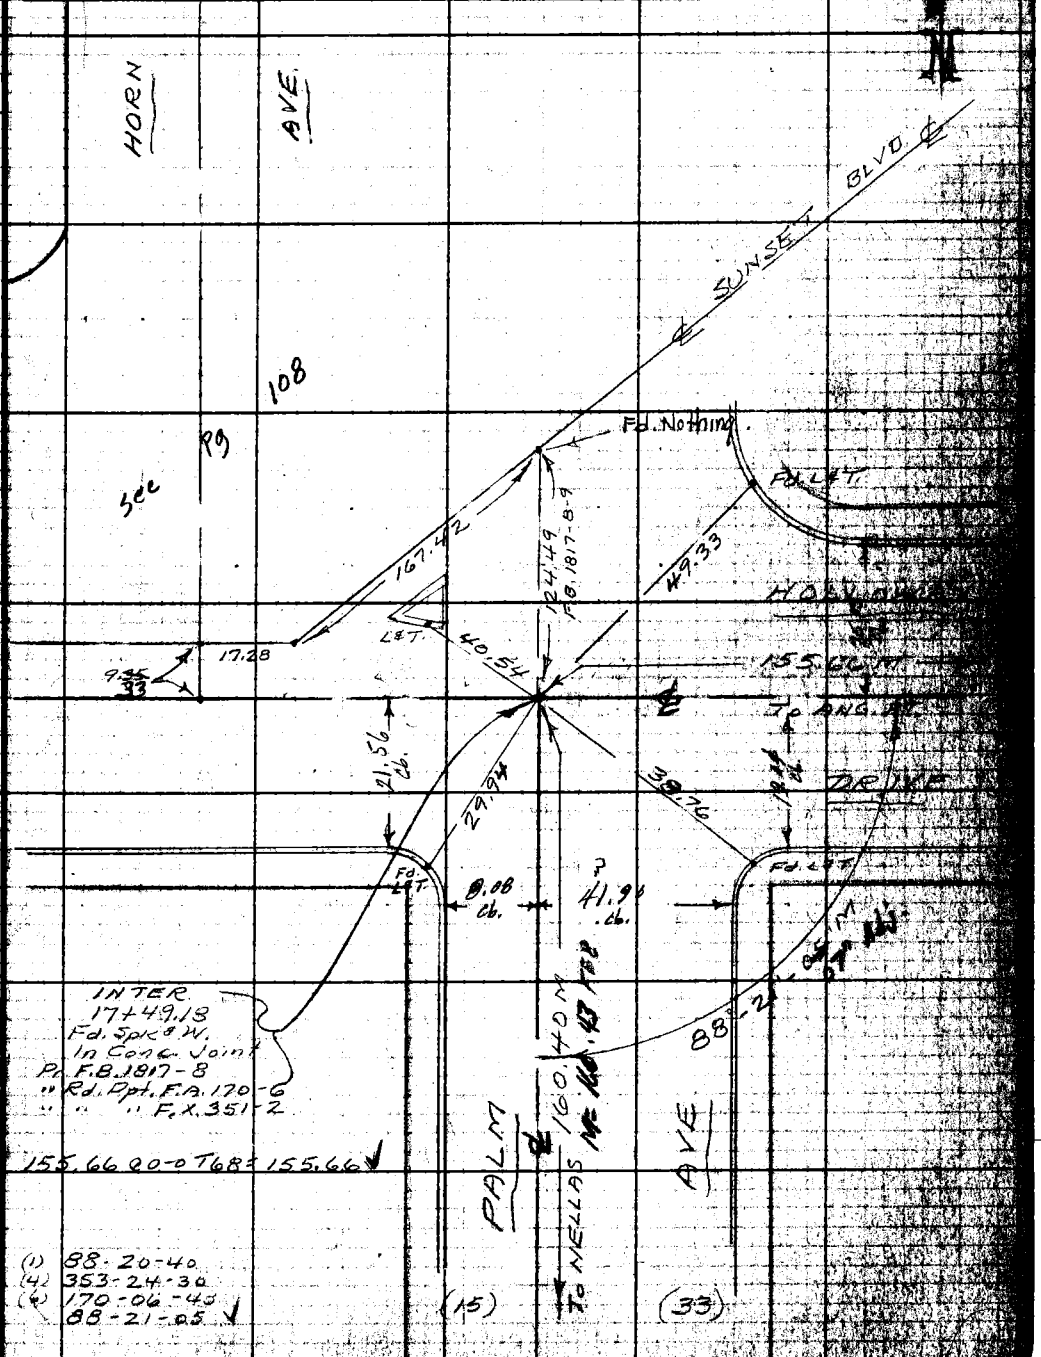

W.S. 22, B-2

Note: Any Additions or Changes on This Sheet Must Be Made or Circled In Red Ink With Date and Name of Person Making Change.

Do not extend notes this side of this line.

RETURN TO
LOS ANGELES COUNTY ENGINEER
TO LOS ANGELES COUNTY ENGINEERING BLDG.

76F3095 CE #247—3-57

Cont. From Top Pg. 22

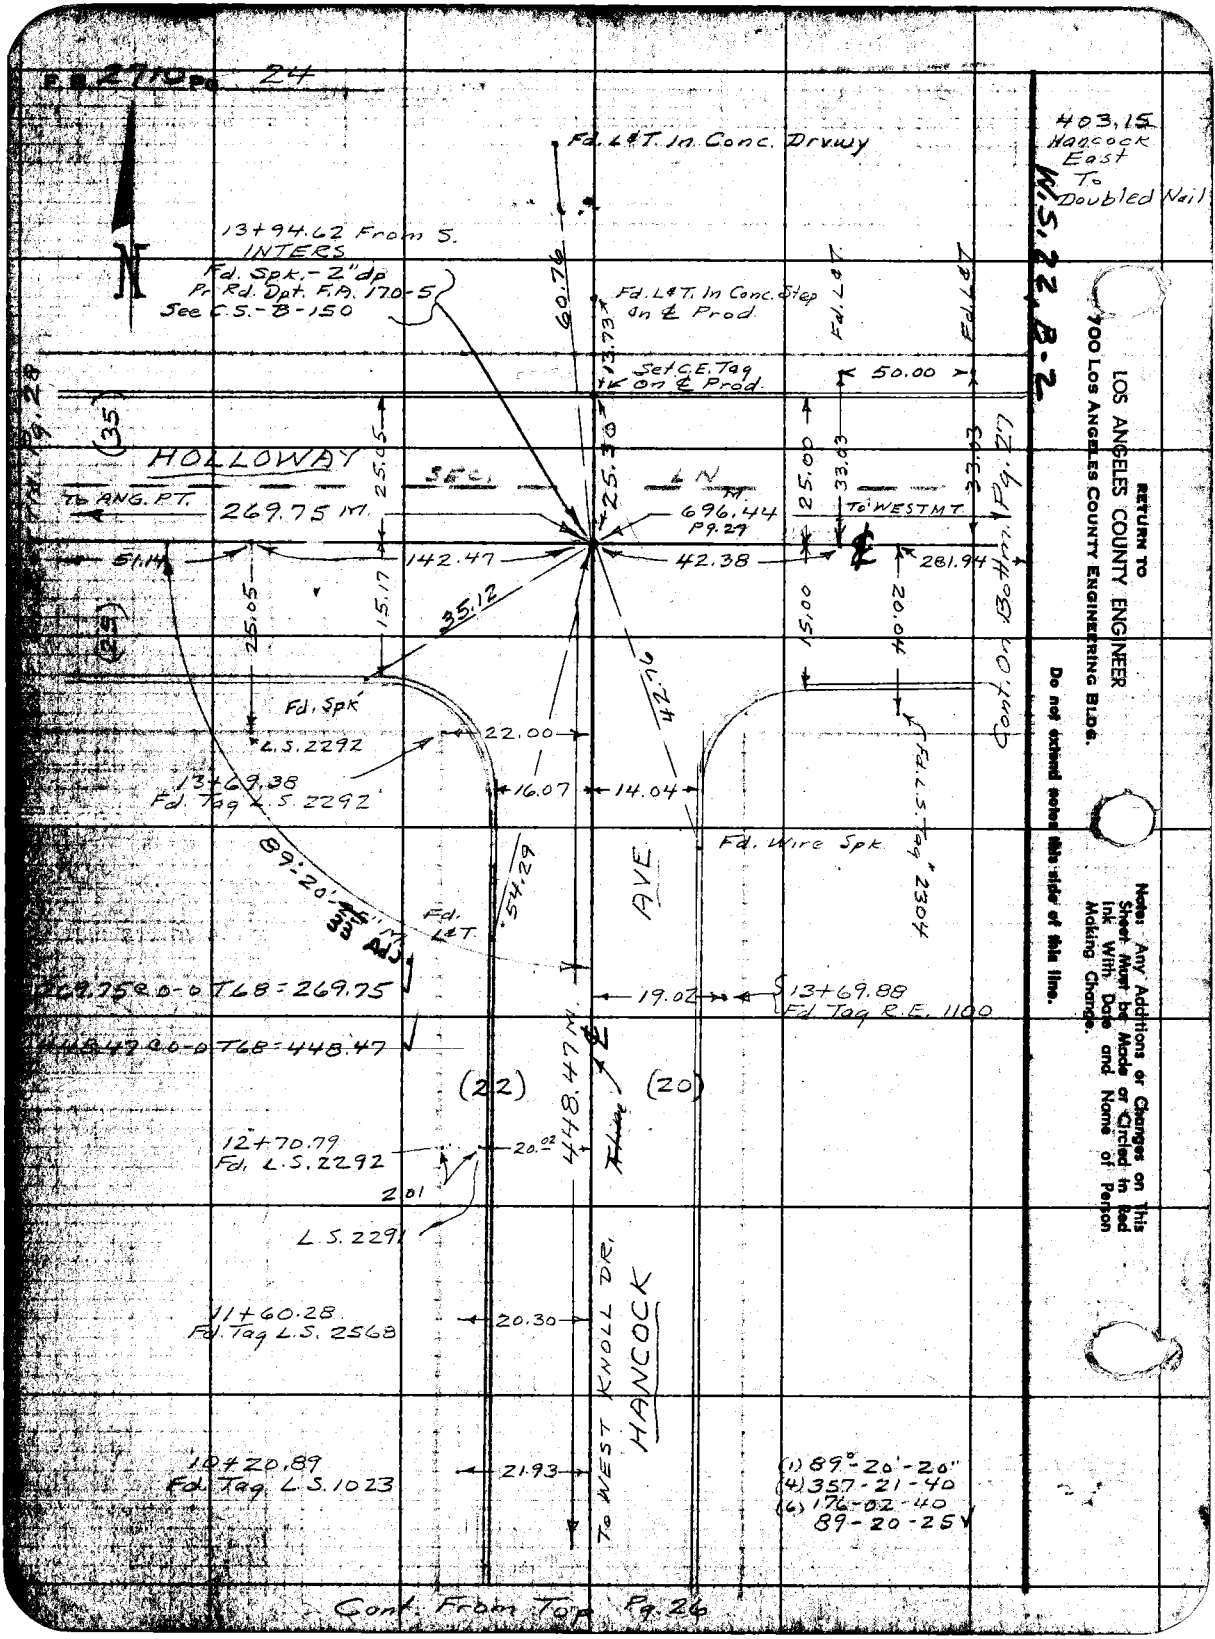

RETURN TO
LOS ANGELES COUNTY ENGINEER
700 LOS ANGELES COUNTY ENGINEERING BLDG.

Do not extend notes this side of this line.

Note: Any Additions or Changes on This Sheet Must be Made or Circled in Red Ink With Date and Name of Person Making Change.

Notes Ck'd by D. SAPPELL	Survey of WEST HOLLY-SHERM
Map No. 5418	JN 0303.00 Tape 125 Std 84 °F
Office Work E. PONG	Surveyed by A. N. Hellstrom
Checked R. HILARIO	Notes A.N.H. Date 4-1961
Date 10-17-83	Indexed C. A. GALLI

F. B. 2710 Pg. 28

(1) 130-20-10
(4) 141-21-00
(6) 62-01-00
130-20-10

RE-509

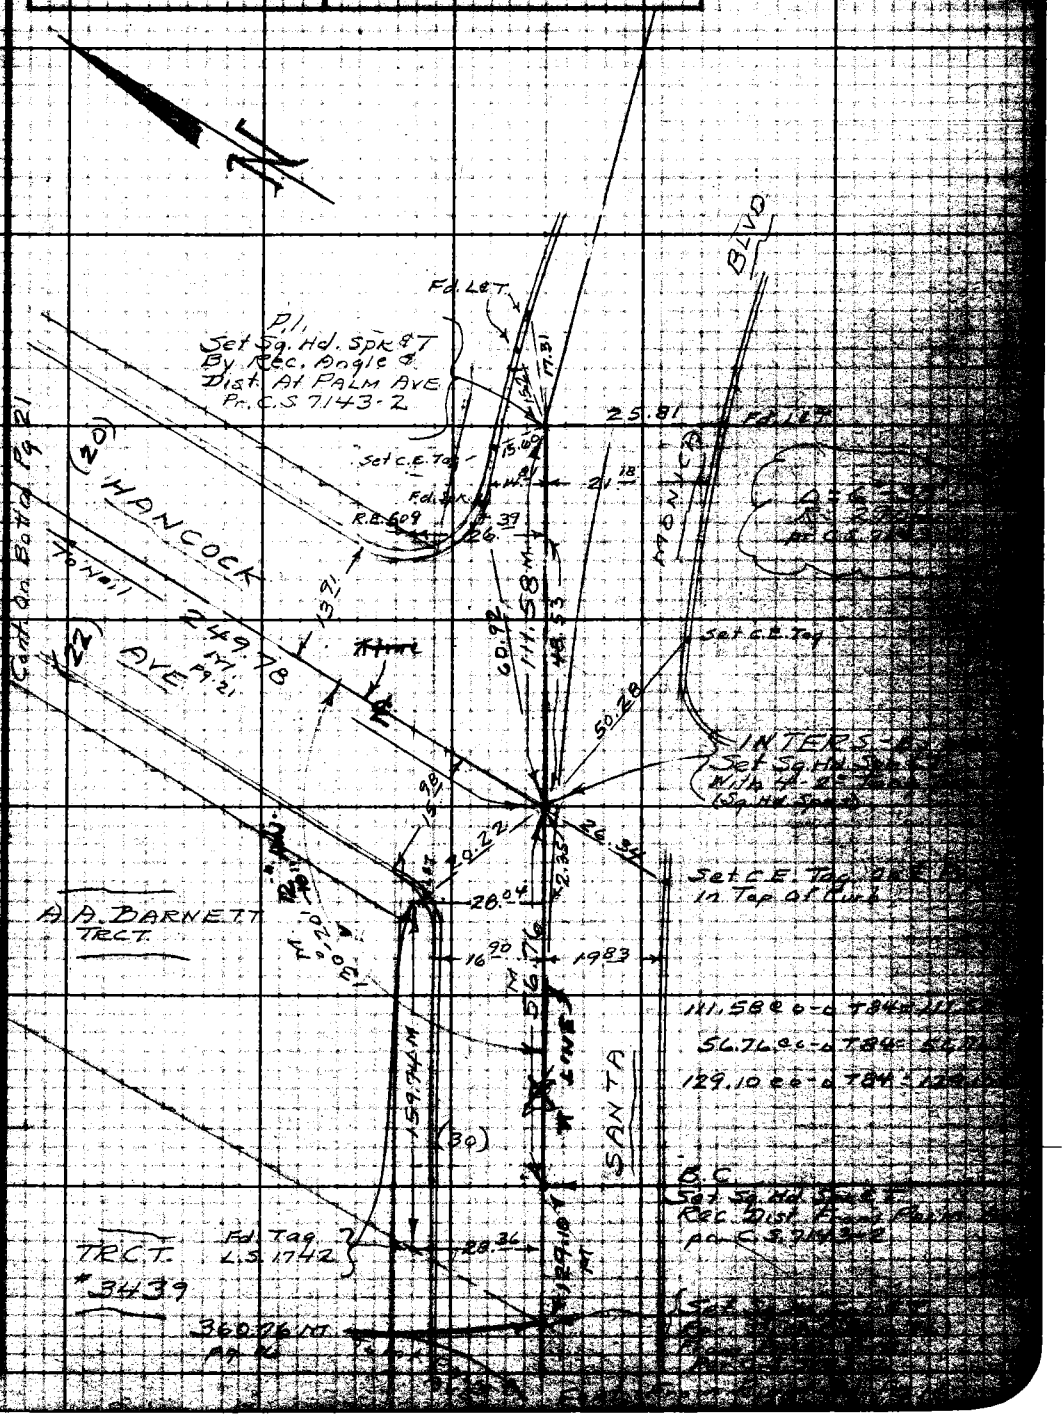

Note: Any Additions or Changes on This Sheet Must be Made or Circled in Red Ink With Date and Name of Person Making Change.


W.S. 22, B-3

REQUIRED TO
LOS ANGELES COUNTY ENGINEER
TO LOS ANGELES COUNTY ENGINEERING BLDG.

743096 CE #247—7-58

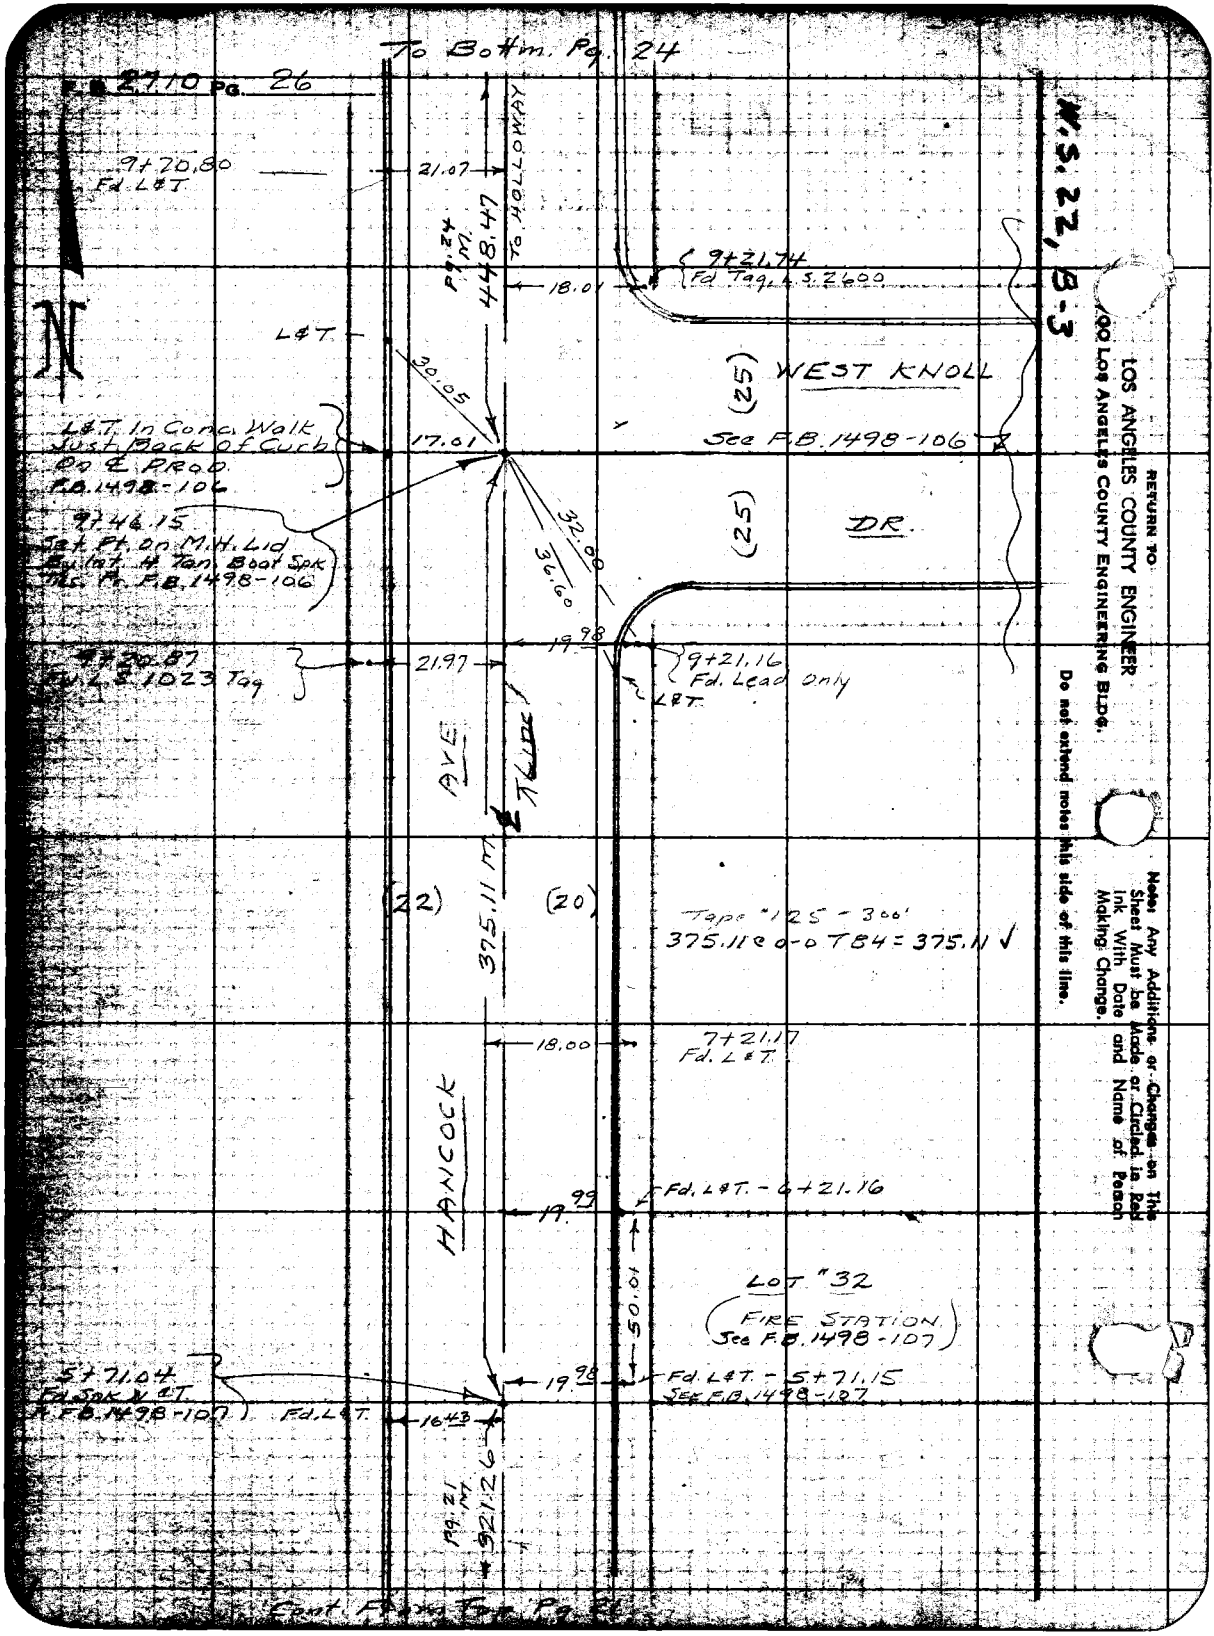
To Bottm. Pg. 24
F.B. 2710 Pg. 26
9+70.80
Fd. L&T
21.07
To HOLLOWAY
Pg. 24 M.
448.47
9+21.74
Fd Tag, L.S. 2600
18.01
L&T
30.05
(25)
WEST KNOLL
L&T. In Conc. Walk
Just Back of Curb
On ℄ PROD.
F.B. 1498-106
17.01
See F.B. 1498-106
9+46.15
Set Pt. on M.H. Lid
By Int. 4 Tan. Boat Spk
Ths. Pr. F.B. 1498-106
32.00
36.60
(25)
DR.
19.98
9+20.87
Fd. L.S. 1023 Tag
21.97
9+21.16
Fd. Lead Only
L&T
AVE
℄ Line
(22)
375.11 M
(20)
Tape "125 - 300'
375.11 @ 0-0 T84 = 375.11 ✓
18.00
7+21.17
Fd. L&T
HANCOCK
Fd. L&T. - 6+21.16
19.99
50.01
LOT "32
(FIRE STATION)
See F.B. 1498-107
5+71.04
Fd. Spk. N ℄ T.
F.B. 1498-107
Fd. L&T.
19.98
Fd. L&T. - 5+71.15
See F.B. 1498-107
16.43
Pg. 21 M.
321.26
Cont. From Top Pg. 21
N
W.S. 22, B-3
RETURN TO
LOS ANGELES COUNTY ENGINEER
100 LOS ANGELES COUNTY ENGINEERING BLDG.
Do not extend notes this side of this line.
Note: Any Additions or Changes on This Sheet Must be Made or Circled in Red Ink With Date and Name of Person Making Change.

Notes Ck'd by D. SAPPELL	Survey of WEST HOLLY-SHER
Map No. 5418	IN 0303.00 Tape 0188 Std 68 °F
Office Work E FONG	Surveyed by A. N. Hellstrom
Checked R HILARIO	Notes A.N.H. Date 4-1961
Date 10-17-83	Indexed C. J. GALLI

F.B. 2710 Pg. 27

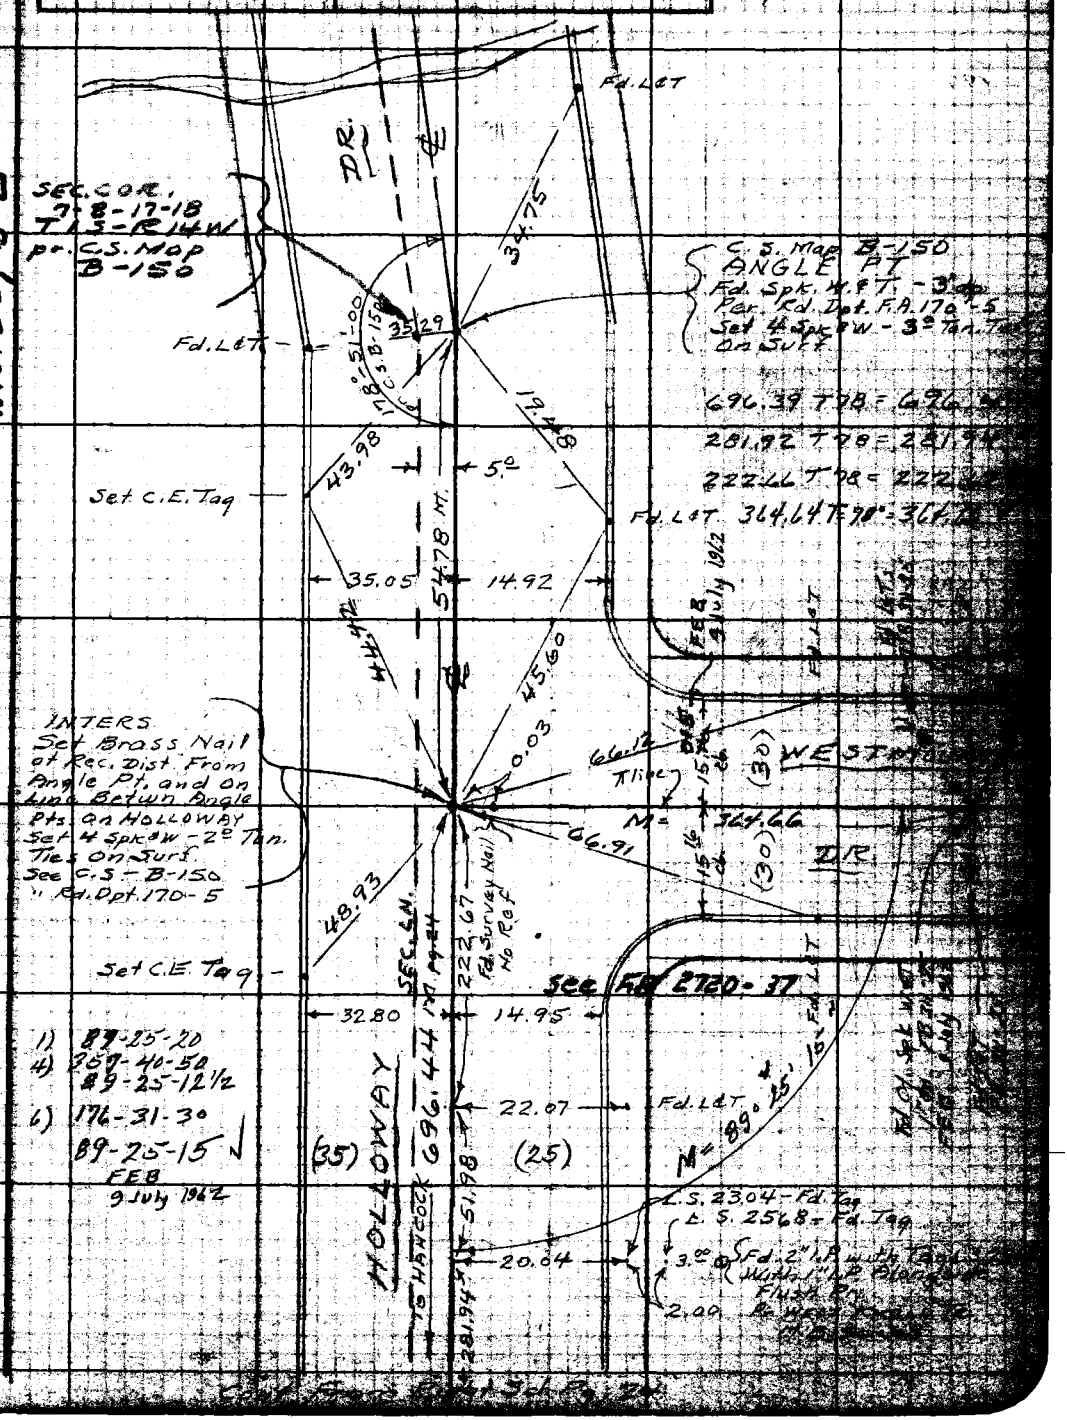

Note: Any Additions or Changes on This Sheet Must be Made or Circled in Red Ink With Date and Name of Person Making Change.

Do not extend notes this side of this line.

N.S. 22, B-2

RETURN TO LOS ANGELES COUNTY ENGINEER
DO LOS ANGELES COUNTY ENGINEERING BLDG.

Copy From Sheet 3d Pg. 24

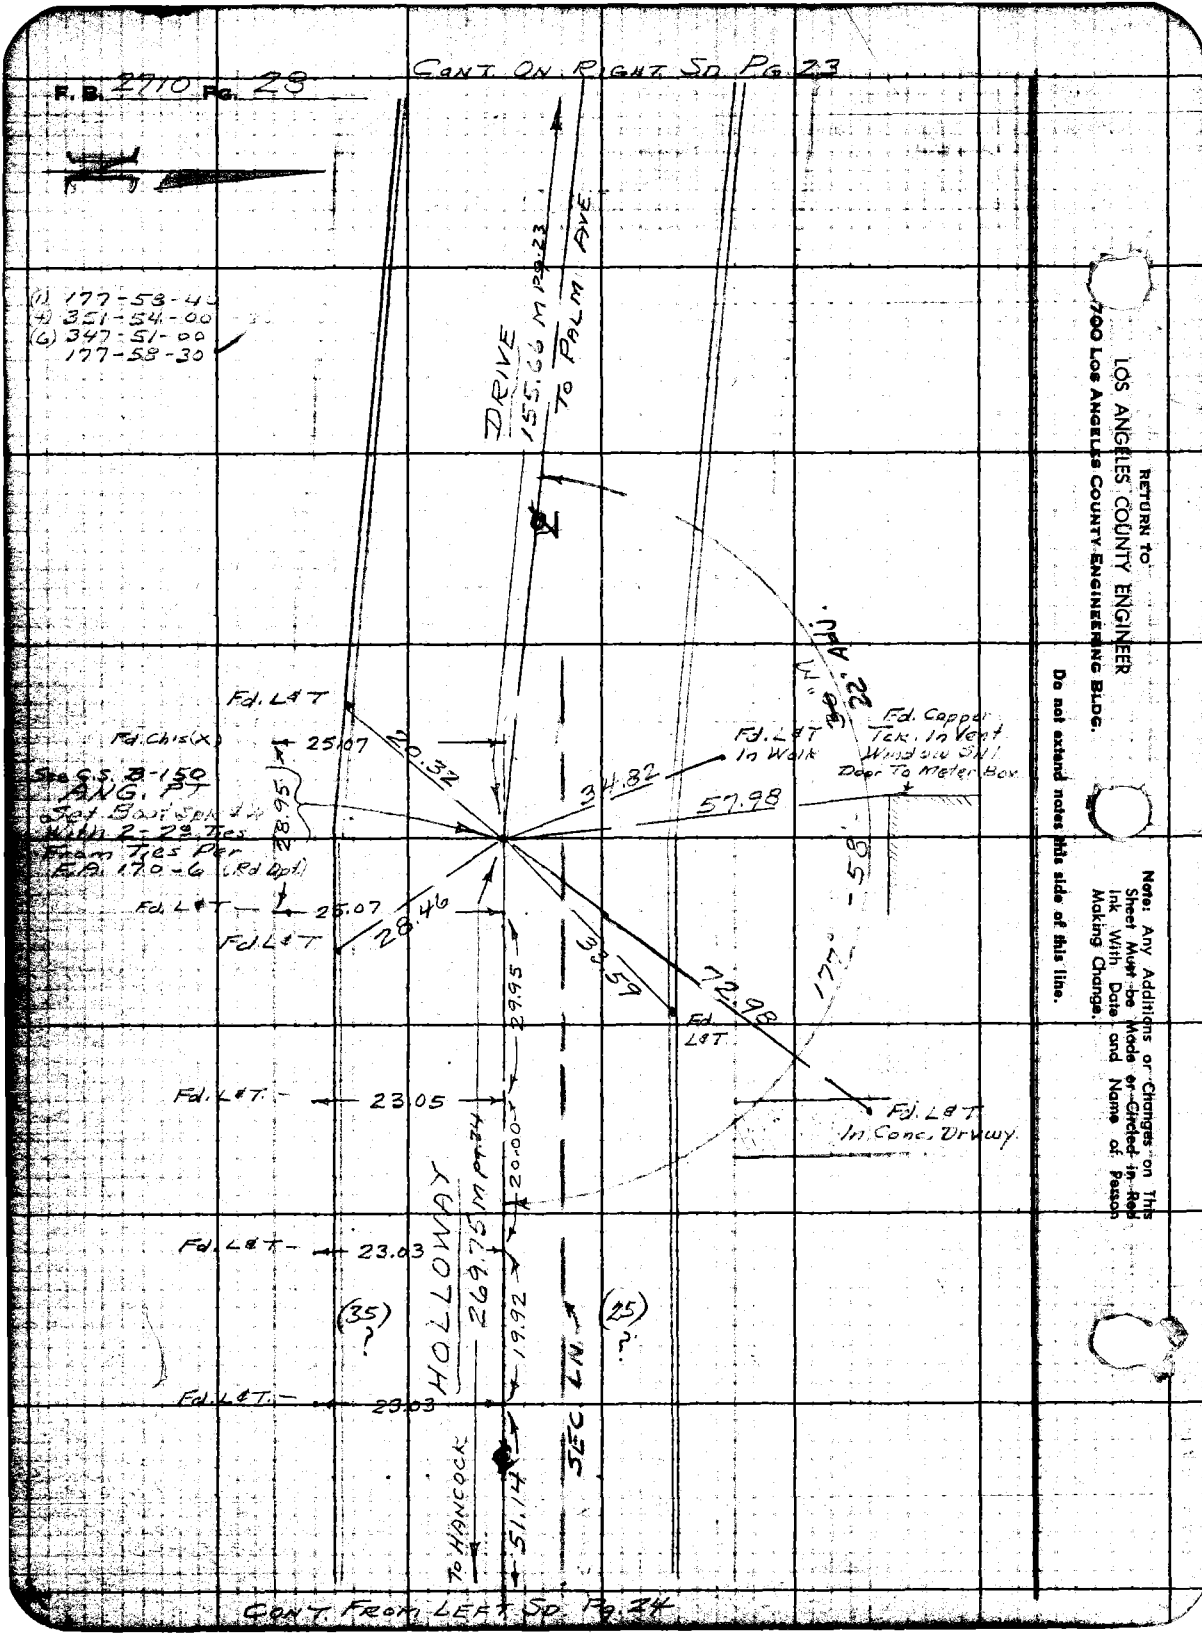

RETURN TO
LOS ANGELES COUNTY ENGINEER
700 LOS ANGELES COUNTY ENGINEERING BLDG.

Do not extend notes this side of this line.

Note: Any Additions or Changes on This Sheet Must be Made or Circled in Red Ink With Date and Name of Person Making Change.

30.78

Notes Ck'd by D. SAPPELL	Survey of WEST HOLLY-SHERM.
Map No. 5418	JN 0303.00 Tape 0188 Std 68 °F
Office Work E FONG	Surveyed by A.N. Hellstrom
Checked R. HILARIO	Notes B.N.H. Date 4-1961
Date 10-17-83	Indexed C. J. GAIN

F.B. 2710 Pg. 29

Cont. On Bttm. Pg. 30

W.S. 22, B-3

Note: Any Additions or Changes on This Sheet Must be Made or Circled in Red Ink With Date and Name of Person Making Change.

Do not extend notes this side of this line.

RETURN TO
LOS ANGELES COUNTY ENGINEER
DO LOS ANGELES COUNTY ENGINEERING BLDG.

(P.E.R.R.)

L&T

Fd. L&T

6.48

SANTA MONICA BLVD.

301.03 M 26 April 1962

301.13 M

To CLARK

34.01

30.00

36.21

16.98

LARRABEE ST.

M = 148.57

353.82

686.77 M

49.98

To INTERS OF CYNTHIA (To West)

22.96

16.98

55.93

51.84

6.42

Fd. L&T

INTERS. (P.E.R.R.)

Set 1x2 by Ties Pr. F.B. 433-64 2-2' Ties Spks

Cut X in S. Curb-S. Barrel

30.10

Fd. L & Spk

165.38 M

To PALM

S.M. To 1st & Pt

686.77 T68 = 686.77

(1) 102-30-00
(4) 50-01-00
(6) 255-02-00
102-30-00

Cont. From Bttm. Left Pg. 16

301.13 @ 0-6 T68 = 301.13

102°-30'-22" Adj

Fd. Tags L.S. 2350

Fd. L&T.

Fd. L&T.

Fd. L&T

Fd. L & Spk

Cut X in S. Curb-S. Barrel

Set 1x2 by Ties Pr. F.B. 433-64 2-2' Ties Spks

763095 CE #247—7-58

RETURN TO
LOS ANGELES COUNTY ENGINEER
700 LOS ANGELES COUNTY ENGINEERING BLDG.

Note: Any Additions or Changes on This Sheet Must be Made or Circled in Red Ink With Date and Name of Person Making Change.

W.S. 22, 8-3

Do not extend notes this side of this line.

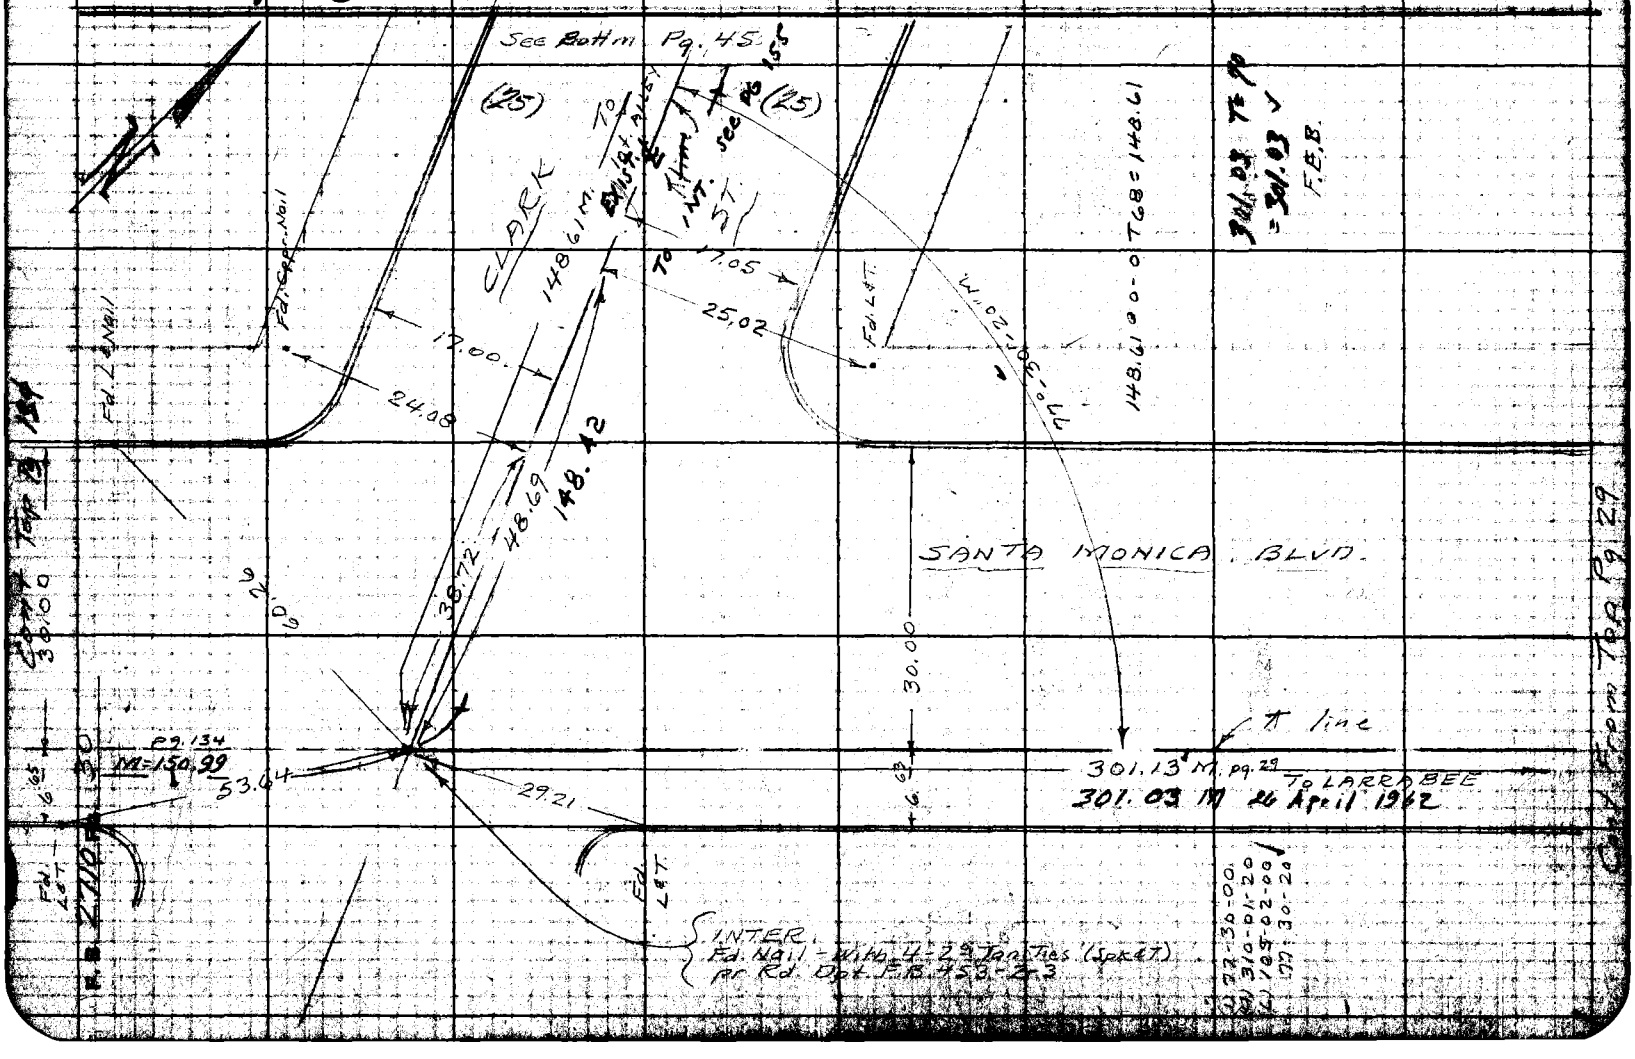

Notes Ck'd by D. SAPPELT	Survey of WEST HOLLY SHERM.
Map No. 5918	IN 0303.00 Tape 0188 Std. 68 °F
Office Work E. FONG	Surveyed by A.N. Hellstrom
Checked R. HILARIO	Notes [illegible] Date [illegible]
Date 10-17-83	Indexed C. J. GALLI

F. B. 2710 Pg. 34

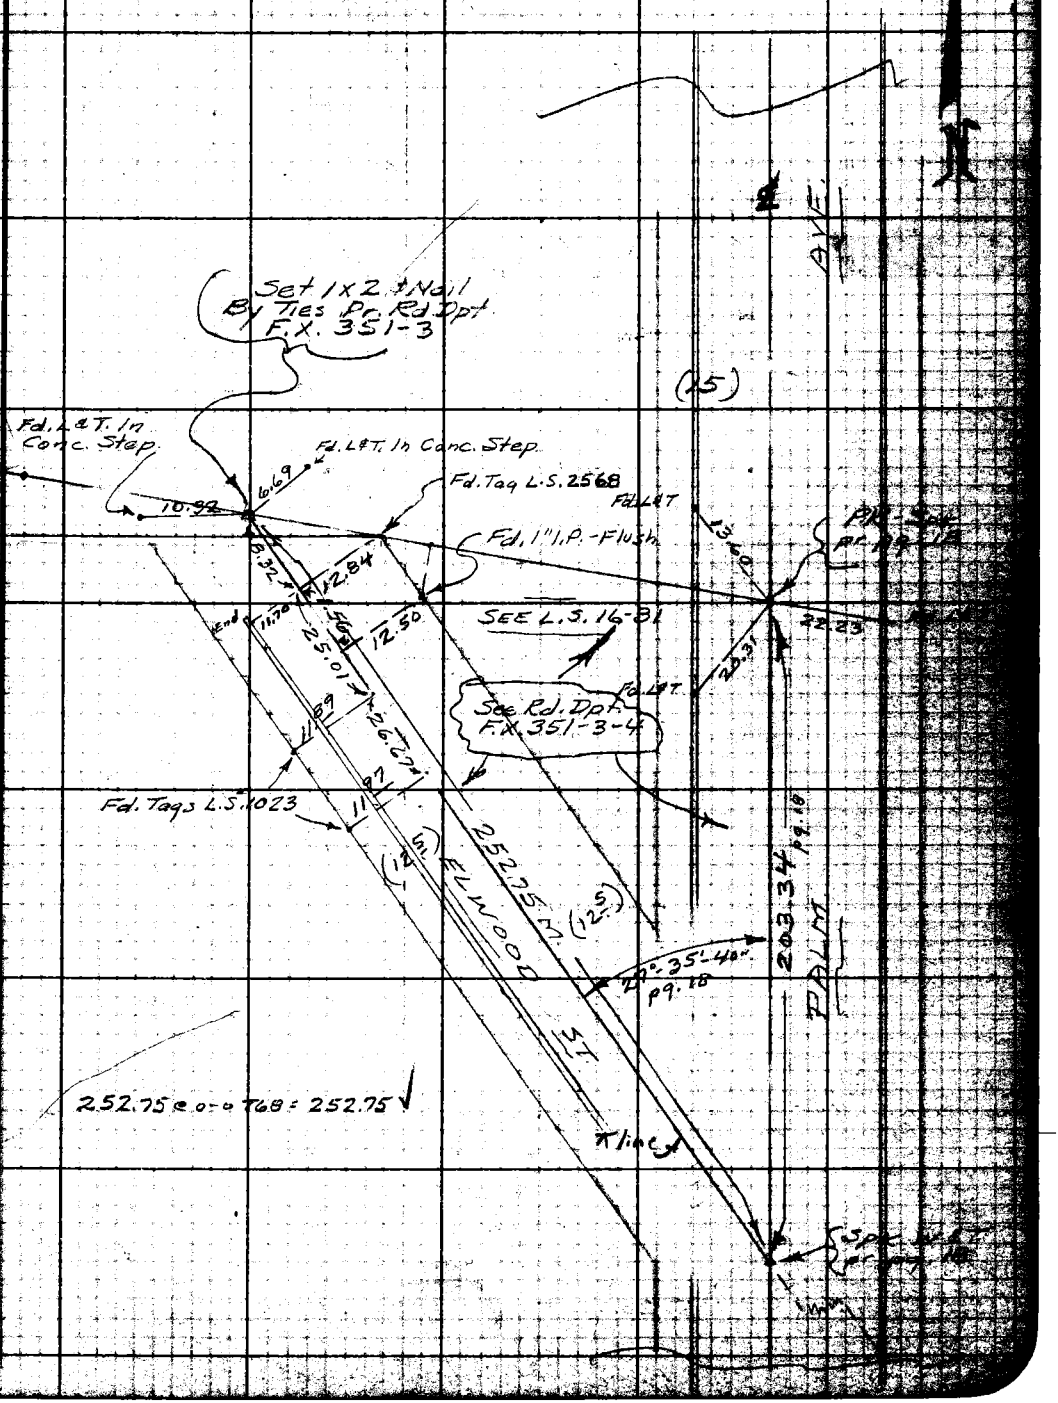

Notes: Any Additions or Changes on This Sheet Must Be Made or Circled in Red Ink With Date and Name of Person Making Change.

Do not extend notes this side of this line.

RETURN TO LOS ANGELES COUNTY ENGINEER 900 Los Angeles County Engineering Bldg.

765098 CE #247—7-85

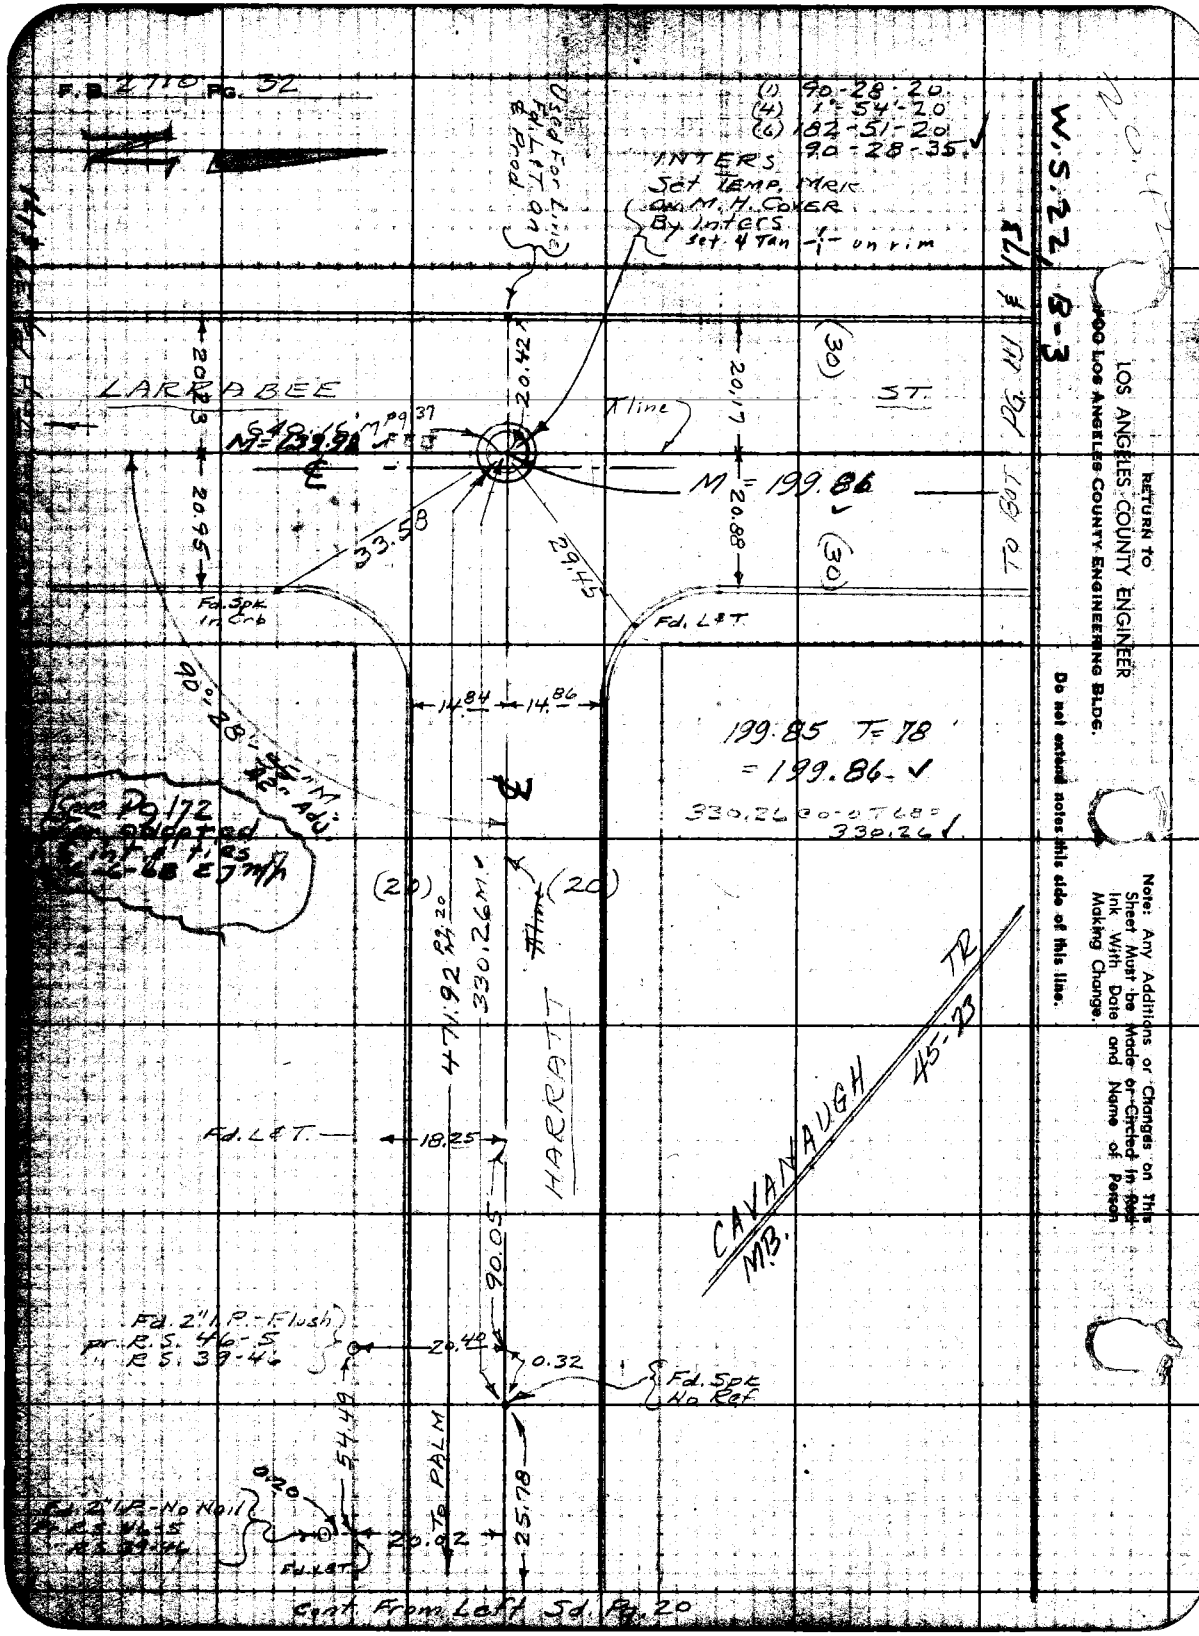
F.B. 2710 Pg. 32
(1) 90-28-20
(4) 1°-54-20
(6) 182-51-20
90-28-35
INTERS
Set Temp. Mrk
on M.H. Cover
By Inters
Set 4 Tan -/- on rim
Used For Line
Fd. L&T. on
℄ Prod
LARRABEE
ST.
M = 199.86
20.23
20.95
20.42
20.17
20.88
33.58
29.45
(30)
(30)
Fd. Spk
In Crb
Fd. L&T.
14.84
14.86
199.85 T=78
= 199.86
330.26 @ 0-0 T 68 = 330.26
See Pg 172
For adopted
Fin. Ties
(20)
(20)
471.92
330.26 M
HARRATT
CAVANAUGH
TR
45-23
MB.
Fd. L&T.
18.25
90.05
Fd. 2" I.P. - Flush
pr. R.S. 46-5
" R.S. 39-46
20.40
0.32
Fd. Spk
No Ref
54.49
To PALM
25.78
0.20
Fd. 2" I.P. - No Nail
20.02
Fd. L&T.
Cont. From Left Sd. Pg. 20
W.S. 22, B-3
RETURN TO
LOS ANGELES COUNTY ENGINEER
900 LOS ANGELES COUNTY ENGINEERING BLDG.
Do not extend notes this side of this line.
Note: Any Additions or Changes on This Sheet Must be Made or Circled in Red Ink With Date and Name of Person Making Change.

Notes Ck'd by D. SAPPELL	Survey of WEST HOLLY-SHER.		F. B. 2710 Pg. 33
Map No. 5418	IN 0503.00 Tape 0188 Std. 68 °F		
Office Work E. FONG	Surveyed by A.N. Hellstrom		
Checked R. HILARIO	Notes A.N.H. Date 5-1961		
Date 10-17-83	Indexed C. J. GALLI		

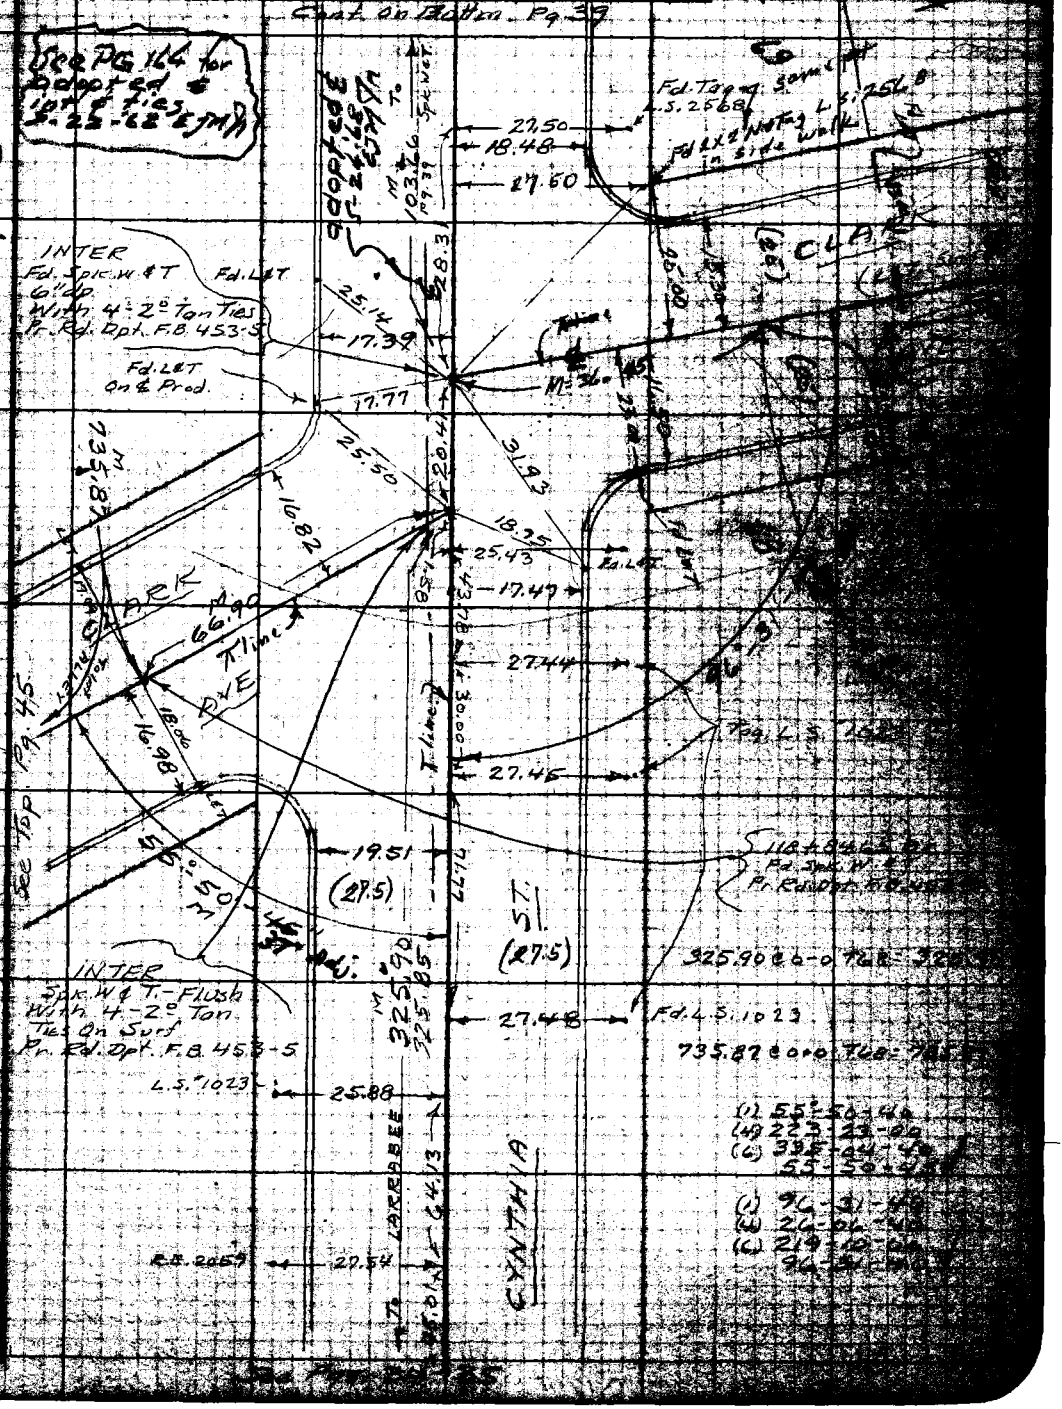

RETURN TO
LOS ANGELES COUNTY ENGINEER
700 LOS ANGELES COUNTY ENGINEERING BLDG.

Note: Any Additions or Changes on This Sheet Must be Made or Circled in Red Ink With Date and Name of Person Making Change.

W.S. 22, B-3

Do not extend notes this side of this line.

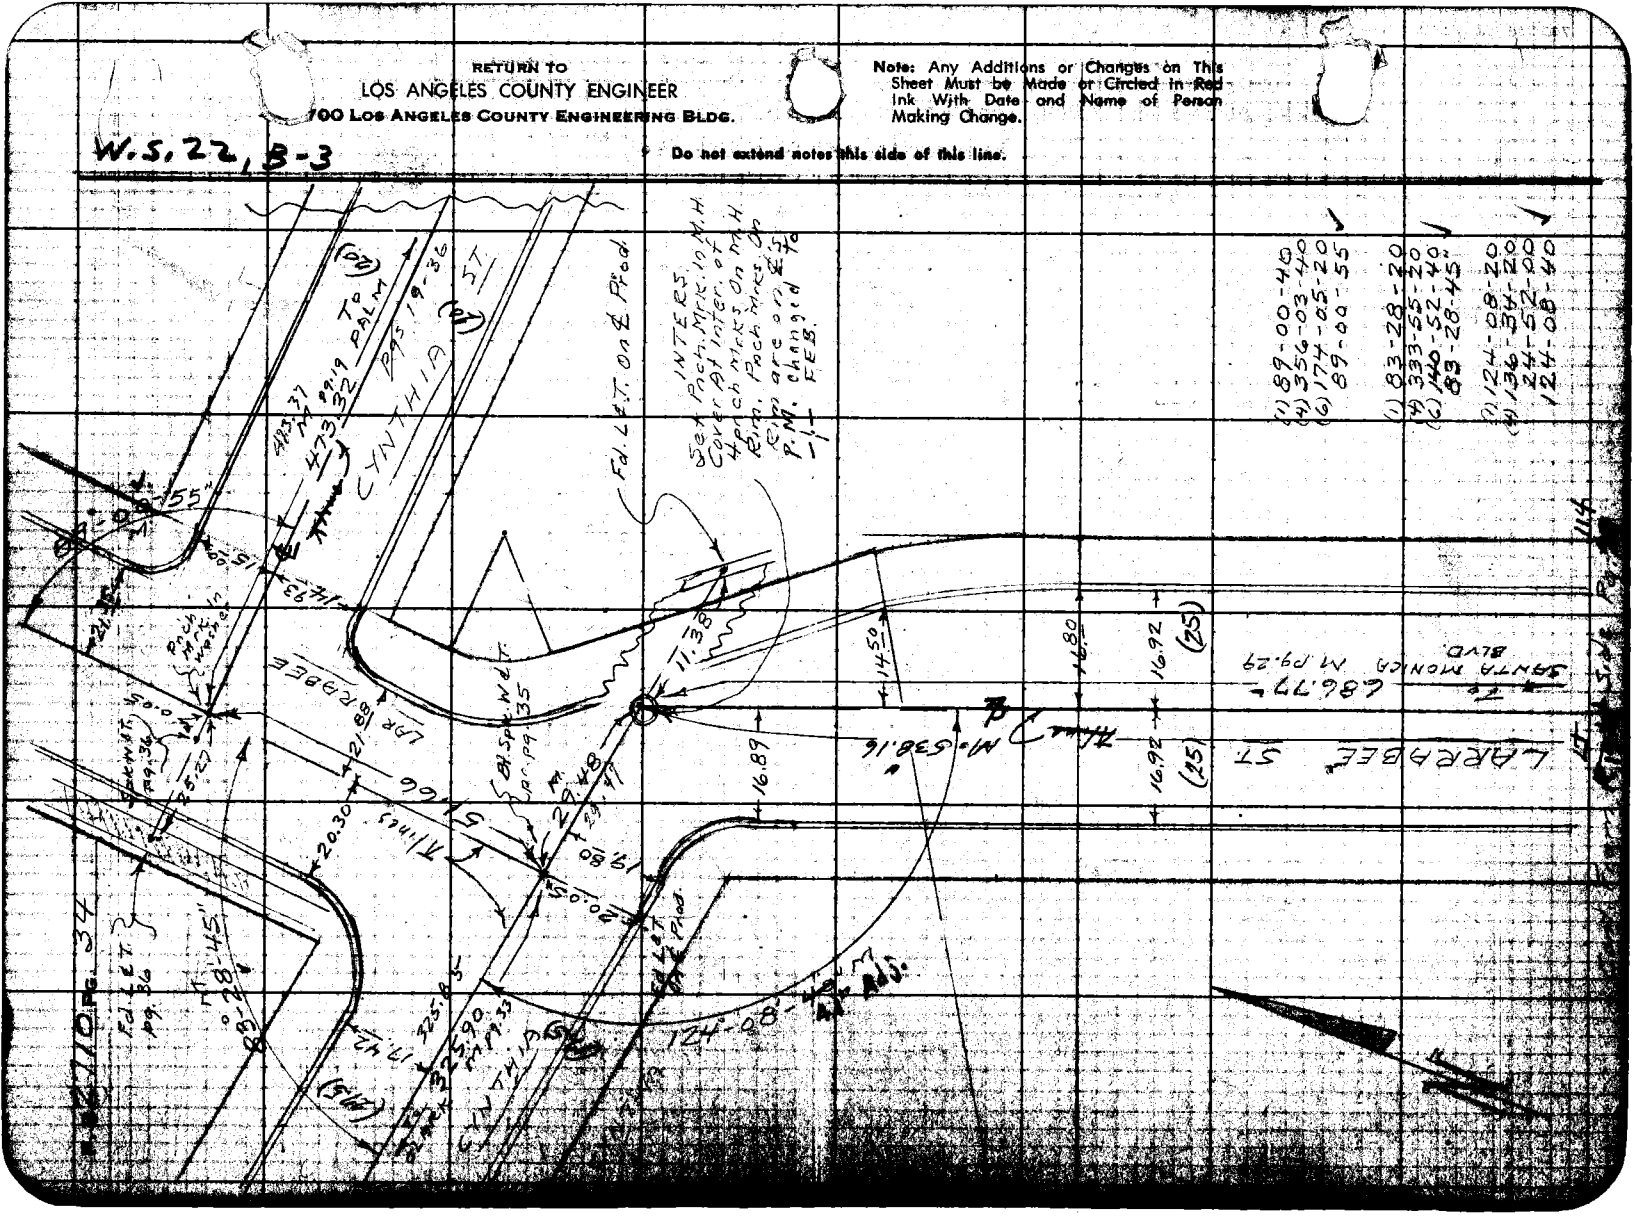
CYNTHIA ST.
LARRABEE ST.
SANTA MONICA BLVD.
Fd. L.E.T. on ℄ Prod.
Set Pack. Mrk. in M.H. Cover at Inter. of Pack Mrks. on M.H. Rim. Pack Mrks. on R.P.M. are on ℄ to R.P.M. changed 7-1-1 FEB.
(1) 89-00-40
(4) 356-03-40
(6) 174-05-20
89-00-55
(1) 83-28-20
(4) 333-55-20
(6) 140-52-40
83-28-45
(1) 124-08-20
(4) 136-34-20
124-52-00
124-08-40
N 89°19'36" W
473.37
N 89°19'36" W
325.85
N 0°28'45" E
124°08'40"
N 0°28'45" E
N 0°28'45" E
N 0°28'45" E

Notes Ck'd by D. SAPPELL	Survey of WEST HOLLY-SHERM
Map No. 5418	IN 0303.00 Tape 0188 Std 68 °F
Office Work E FONG	Surveyed by D.N. Hellstrom
Checked R HILARIO	Notes A.N.H. Date 5-1961
Date 10-17-83	Indexed C. J. GALLI

F.B. 2710 Pg. 35

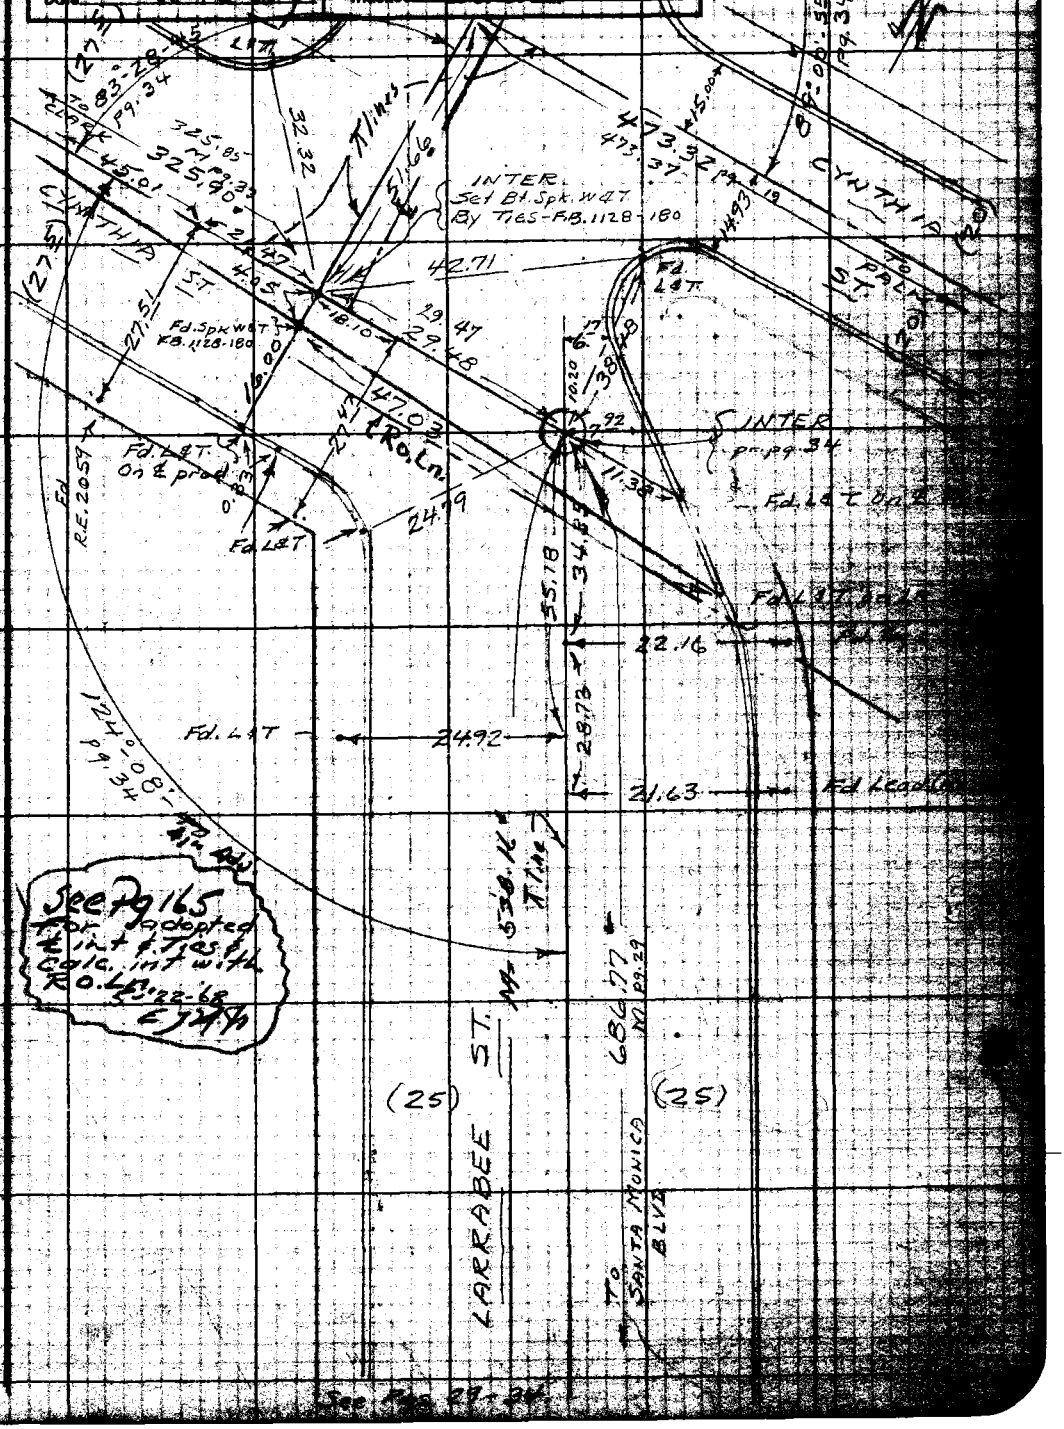

Note: Any Additions or Changes on This Sheet Must be Made or Circled in Red Ink With Date and Name of Person Making Change.

Do not extend notes this side of this line.

W.S. 22, B-3

LOS ANGELES COUNTY ENGINEER
DO LOS ANGELES COUNTY ENGINEERING BLDG.

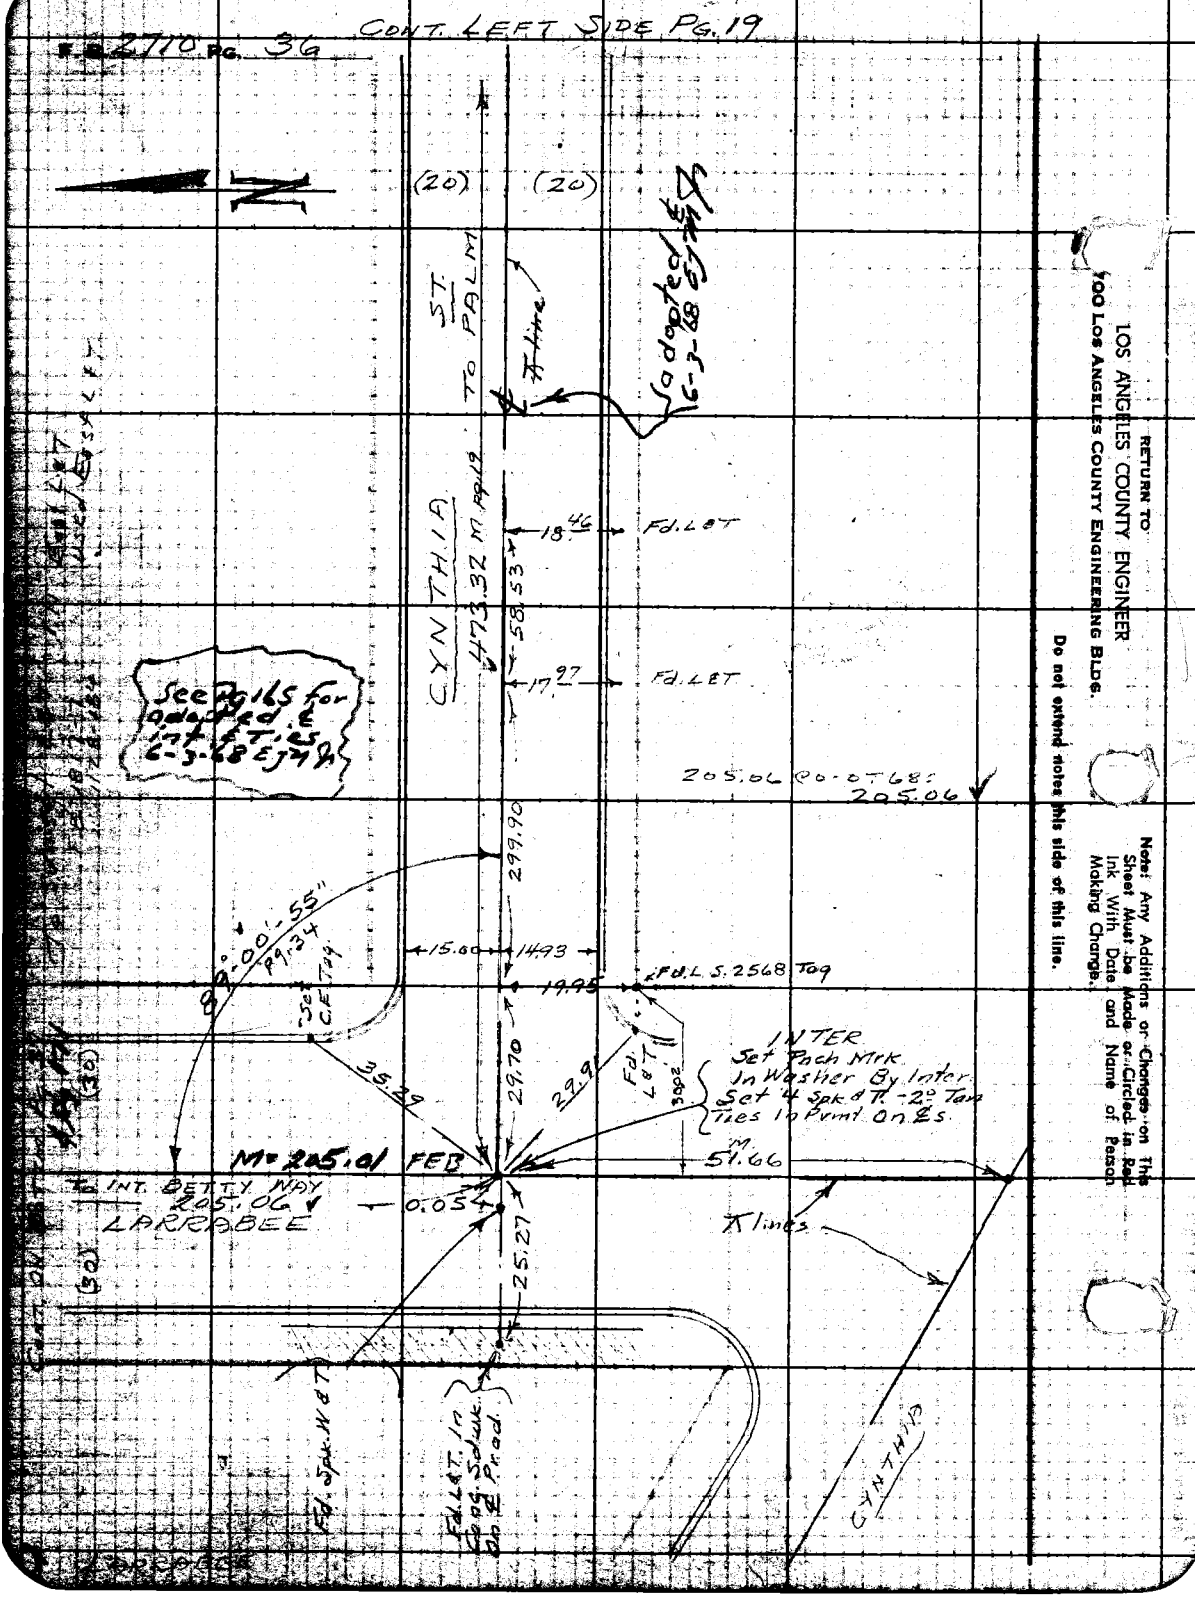

CONT. LEFT SIDE PG. 19
F.B. 2710 PG. 36
(20)
(20)
ST. TO PALM
CYNTHIA
473.32 M pg 19
Adopted 6-3-68 EJM
18.46
Fd. L&T
58.53
17.97
Fd. L&T
See Pg 165 for adopted ℄ int. & Ties 6-3-68 EJM
205.06 @ 0-0T68: 205.06
299.90
89°-00'-55" Pg. 34
15.00
14.93
19.95
Fd. L.S. 2568 Tag
Set C.F. Tag
35.29
29.70
29.9
Fd. L&T
INTER
Set Pach Mrk In Washer By Inter
Set 4 Spk & T. -2° Tan Ties In Pvmt On ℄s
M 51.66
M=205.01 FEB
TO INT. BETTY WAY 205.06
LARRABEE
0.05
25.27
Fd. Spk. W&T
Fd. L&T. In Conc. Sdwk. On ℄ Prod.
CYNTHIA
RETURN TO
LOS ANGELES COUNTY ENGINEER
900 LOS ANGELES COUNTY ENGINEERING BLDG.
Do not extend notes this side of this line.
Note: Any Additions or Changes on This Sheet Must be Made or Circled in Red Ink With Date and Name of Person Making Change.

Notes Ck'd by D. SAPPELL	Survey of WEST HOLLY SHERM.
Map No. 5418	JN 0303.00 Tape 193 Std 68 of
Office Work E FONG	Surveyed by A.N. Hellstrom
Checked R HILARIO	Notes A.N.H. Date 5-1961
Date 10-17-83	Indexed R. J. GALL

F. B. 2710 Pg. 37

Cont. Top Left Pg. 32 & Bot Pg. 172

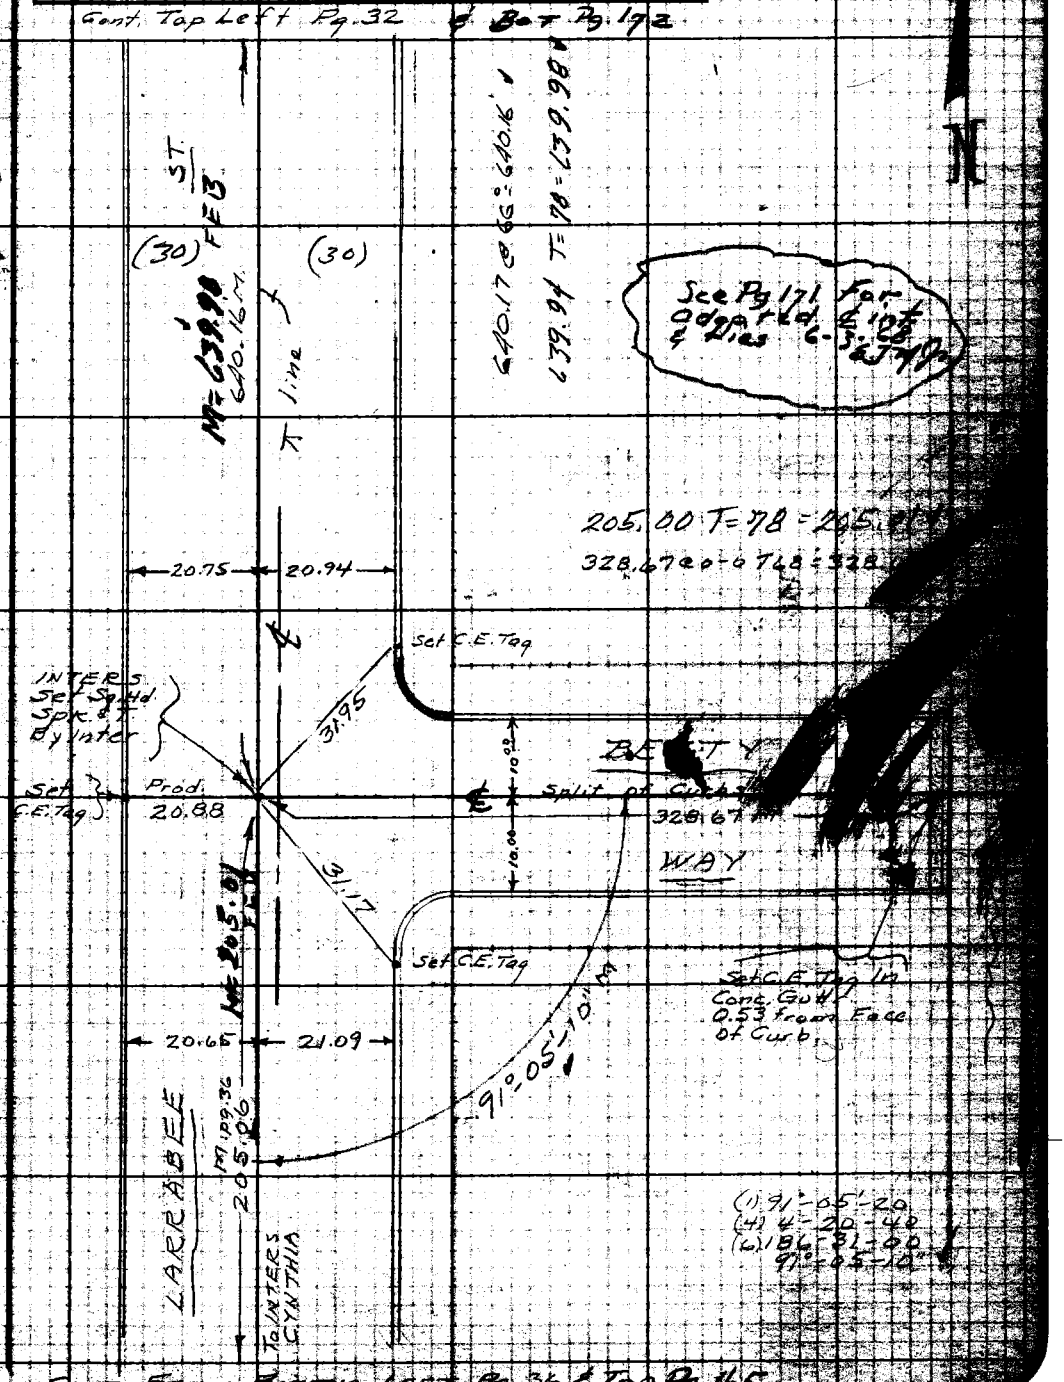

CONT. FROM BOTTM. LEFT Pg. 36 & Top Pg. 165

Notes: Any Additions or Changes on This Sheet Must be Made or Circled in Red Ink With Date and Name of Person Making Change.

W.S. 22, B-3

RETURN TO LOS ANGELES COUNTY ENGINEER
90 LOS ANGELES COUNTY ENGINEERING BLDG.

Do not extend notes this side of this line.

7580 08 CE #247—7-58

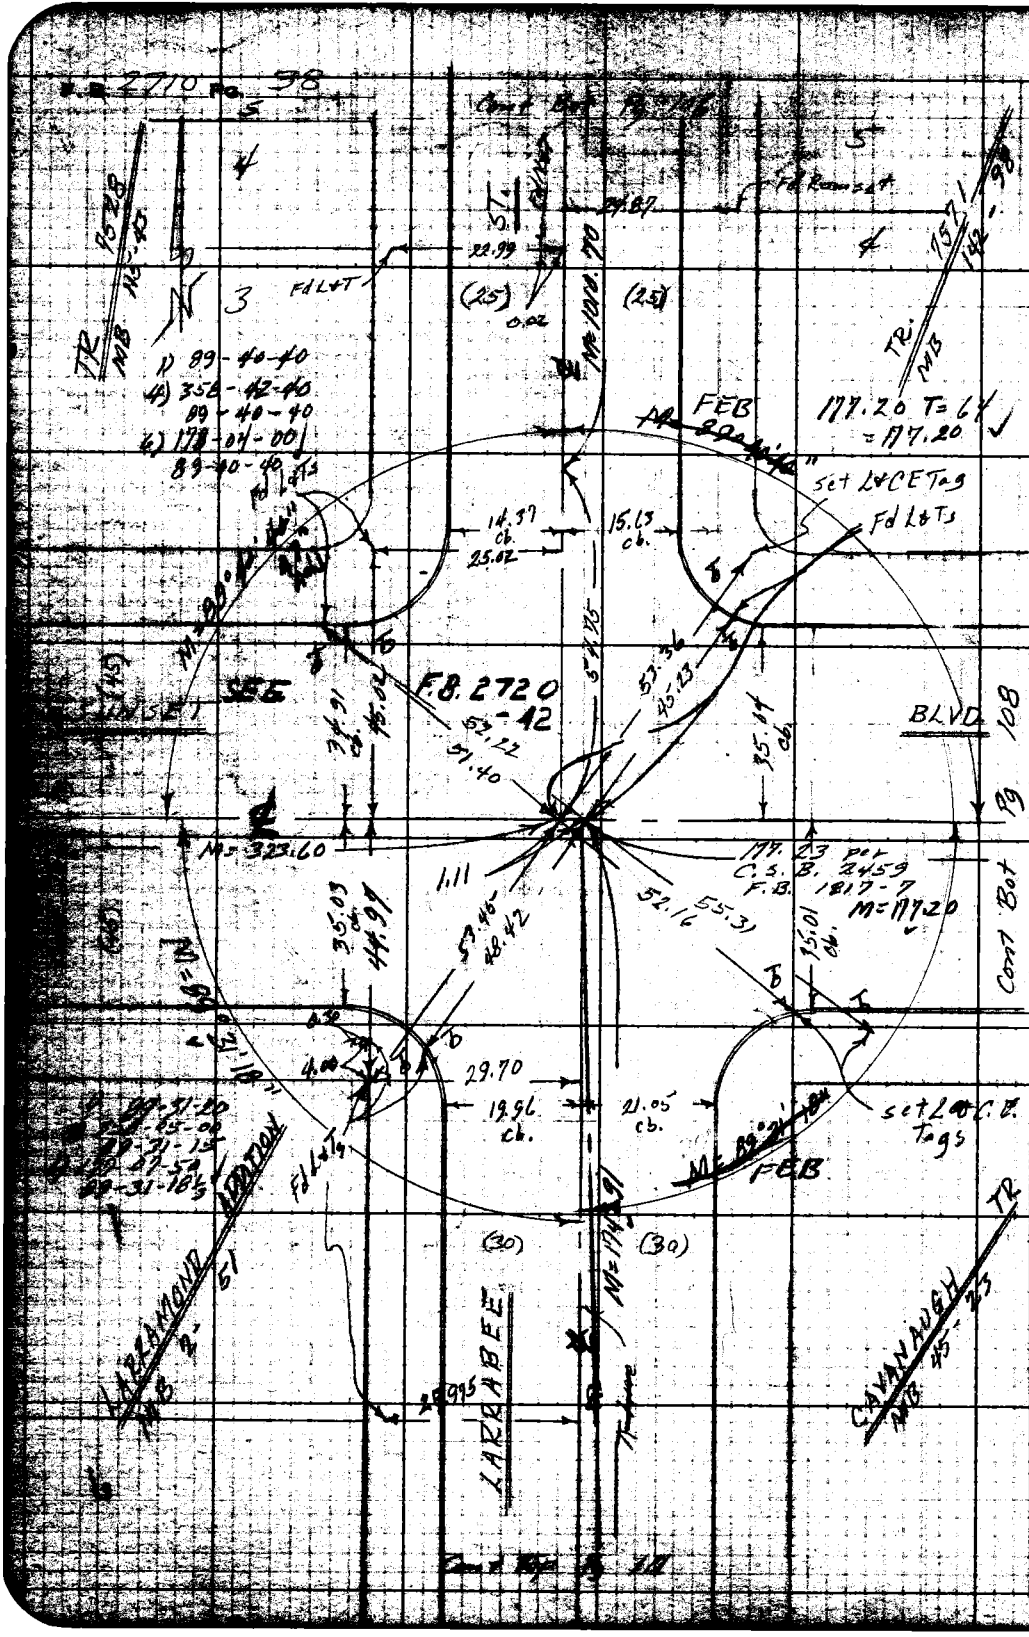

W.S. 22, B-2

RETURN TO
LOS ANGELES COUNTY ENGINEER
700 LOS ANGELES COUNTY ENGINEERING BLDG.

Do not extend notes this side of this line.

Note: Any Additions or Changes on This Sheet Must be Made or Circled in Red Ink With Date and Name of Person Making Change.

Notes Ck'd by D. SAPPELL	Survey [illegible] HOLLY SHERM.	F. B. 2910	Pg. 39
Map No. 5417	[illegible] Std. °F		
Office Work E FONG	Surveyed by A.H. Hellstrom		
Checked R HILARIO	Notes [illegible] Date [illegible]		
Date 10-17-83	Indexed C. J. GALLI		

Cont. on Right S.d. pg. 40

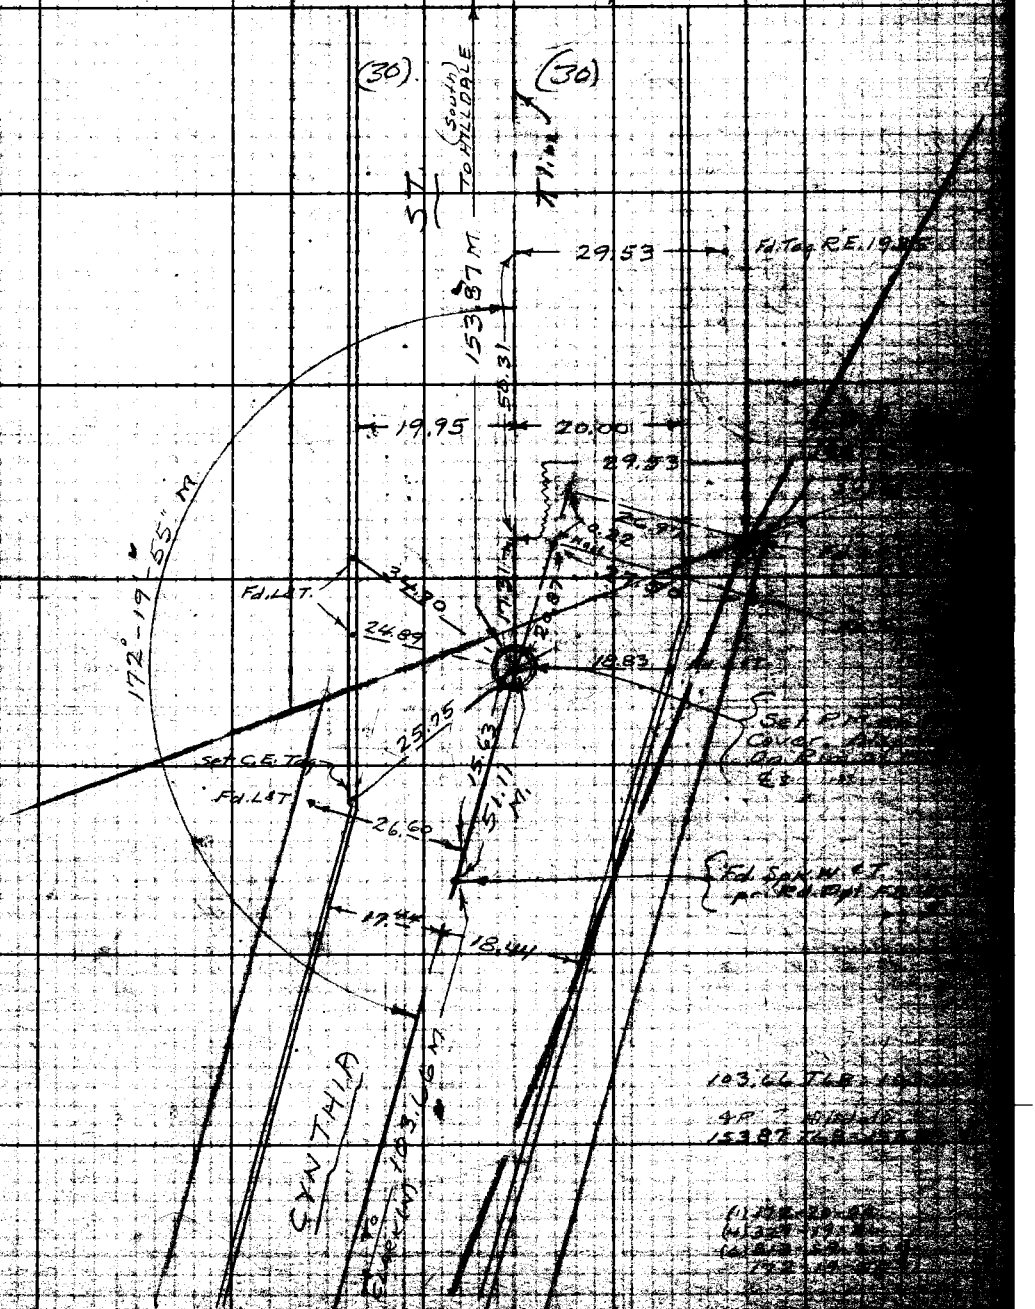

Cont. From Pg. 33

Note: Any Additions or Changes on this Sheet Must be Made or Circled in Ink With Date and Name of Person Making Change.
LOS ANGELES COUNTY ENGINEER
100 Los Angeles County Engineering Bldg.
On the second [illegible] of this line.
FORMOSE CE #247—7-8

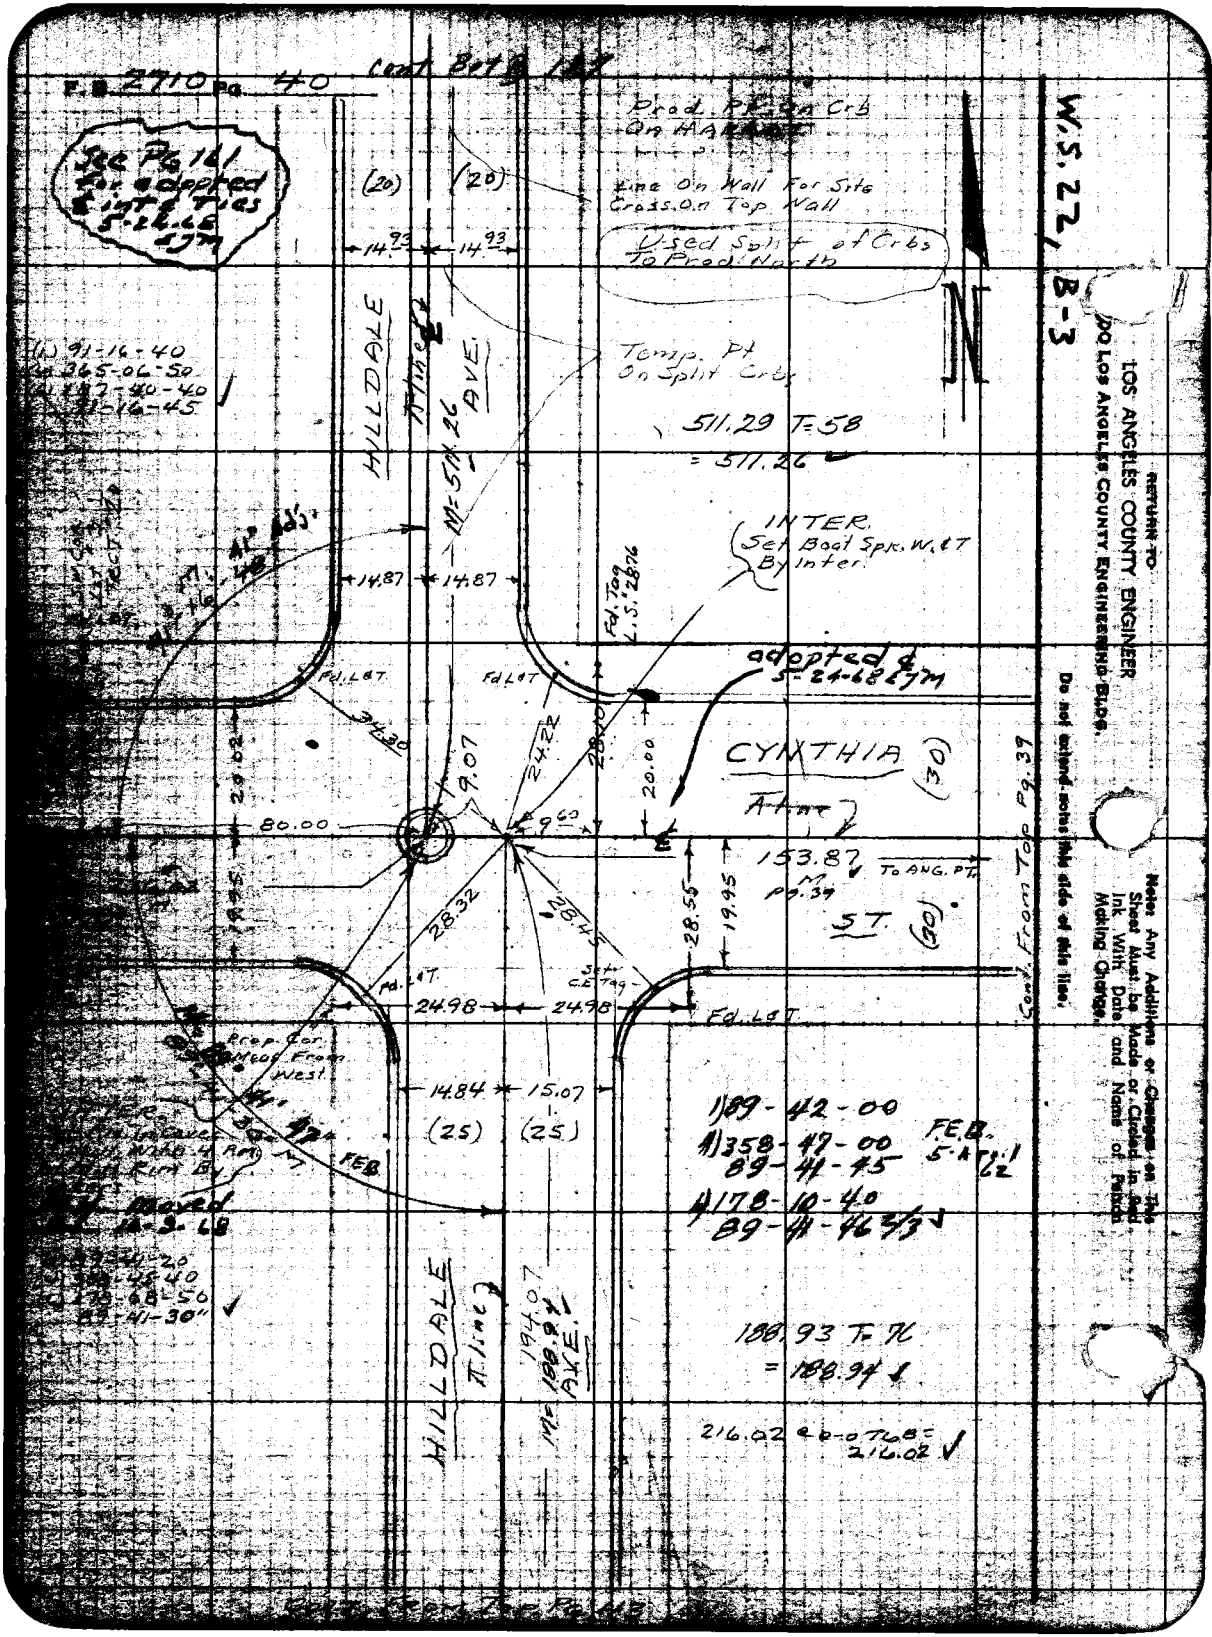
F.B. 2710 Pg. 40
Cont. Bot. Pg. 147
See Pg 161 for adopted ℄ int & Ties 5-24-68 EJM
Prod. Pt. On Crb On HARRIET
Line On Wall For Site Cross On Top Wall
Used Split of Crbs To Prod. North
(20)
(20)
14.93
14.93
HILLDALE
AVE.
M=511.26
Temp. Pt On Split Crb
511.29 T=58
= 511.26
INTER. Set Boat Spk. W. & T By Inter.
14.87
14.87
Fd. Tag L.S. 2876
adopted ℄ 5-24-68 EJM
Fd. L&T
Fd. L&T
34.30
24.22
28.10
20.00
20.02
9.07
CYNTHIA
(30)
80.00
9.60
153.87
To ANG. PT.
M Pg. 39
ST.
(30)
28.32
28.45
28.55
19.95
Fd. L&T
Set C.E. Tag
24.98
24.98
Fd. L&T
Prop. Cor. Meas. From West
14.84
15.07
(25)
(25)
FEB
1) 89-42-00
4) 358-47-00
89-41-45
4) 178-10-40
89-41-46 2/3
F.E.B. 5-Apr-62
Moved 10-9-68
89-41-30"
HILLDALE
AVE.
194.07
M=188.94
188.93 T=76
= 188.94
216.02 @ 0-0 T68 = 216.02
Cont. From Top Pg. 39
W.S. 22, B-3
RETURN TO
LOS ANGELES COUNTY ENGINEER
DO LOS ANGELES COUNTY ENGINEERING BLDG.
Do not extend notes this side of this line.
Note: Any Additions or Changes on This Sheet Must be Made or Circled in Red Ink With Date and Name of Person Making Change.

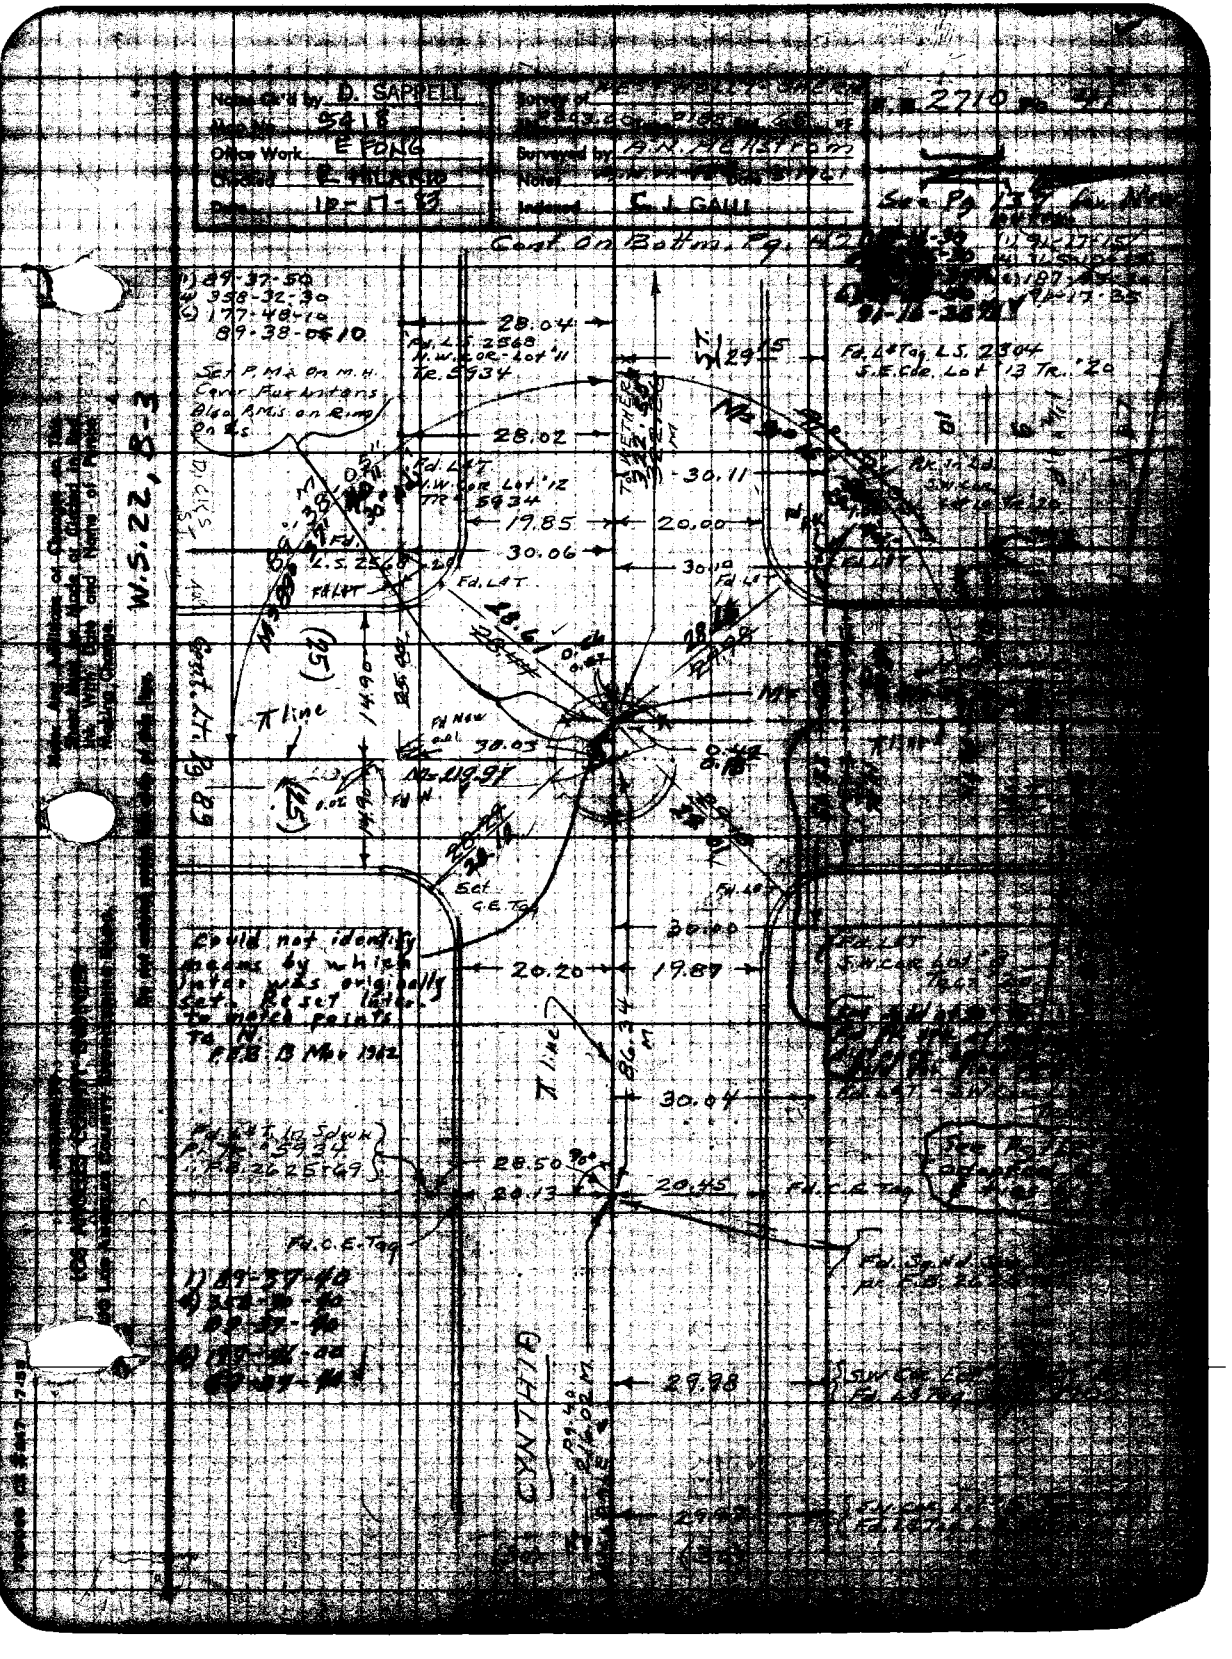

Notes Ck'd by D. SAPPELL
Map No. 5418
Office Work E FONG
Checked E. HILARIO
Date 10-17-83
Surveyed by A.N. Hellstrom
Notes
Indexed C. J. GALLI
2710
See Pg 137 for New
Cont. On Bottm. Pg. 42
(1) 89-37-50
(4) 358-32-30
(5) 177-48-10
89-38-0510
28.04
Fd. L.S. 2568 N.W. Cor. Lot 11 Tr. 5934
Set P.M.s on M.H. Cover Fur Intens. Also P.M.s on Rim On L.S.
28.02
Fd. L&T N.W. Cor. Lot 12 Tr. 5934
19.85
30.06
Fd. L&T
Fd. L&T
30.11
20.00
30.10
Fd. L&T
Fd. L&T Tag L.S. 2304 S.E. Cor. Lot 13 Tr. 20
Cont. Lt. Pg. 89
π line
14.90
30.03
Fd. New
Set C.E. Tag
Could not identify means by which Inter. was originally set. Reset Inter. to match points to N.
F.E.B. 13 Mar 1962
20.20
19.87
30.00
π line
86.34 M
30.04
Fd. L&T in Sdwk Pt. Tr. 5934 F.B. 2625-69
28.50
20.13
20.45
Fd. C.E. Tag
Fd. C.E. Tag
29.98
CYNTHIA
W.S. 22, B-3

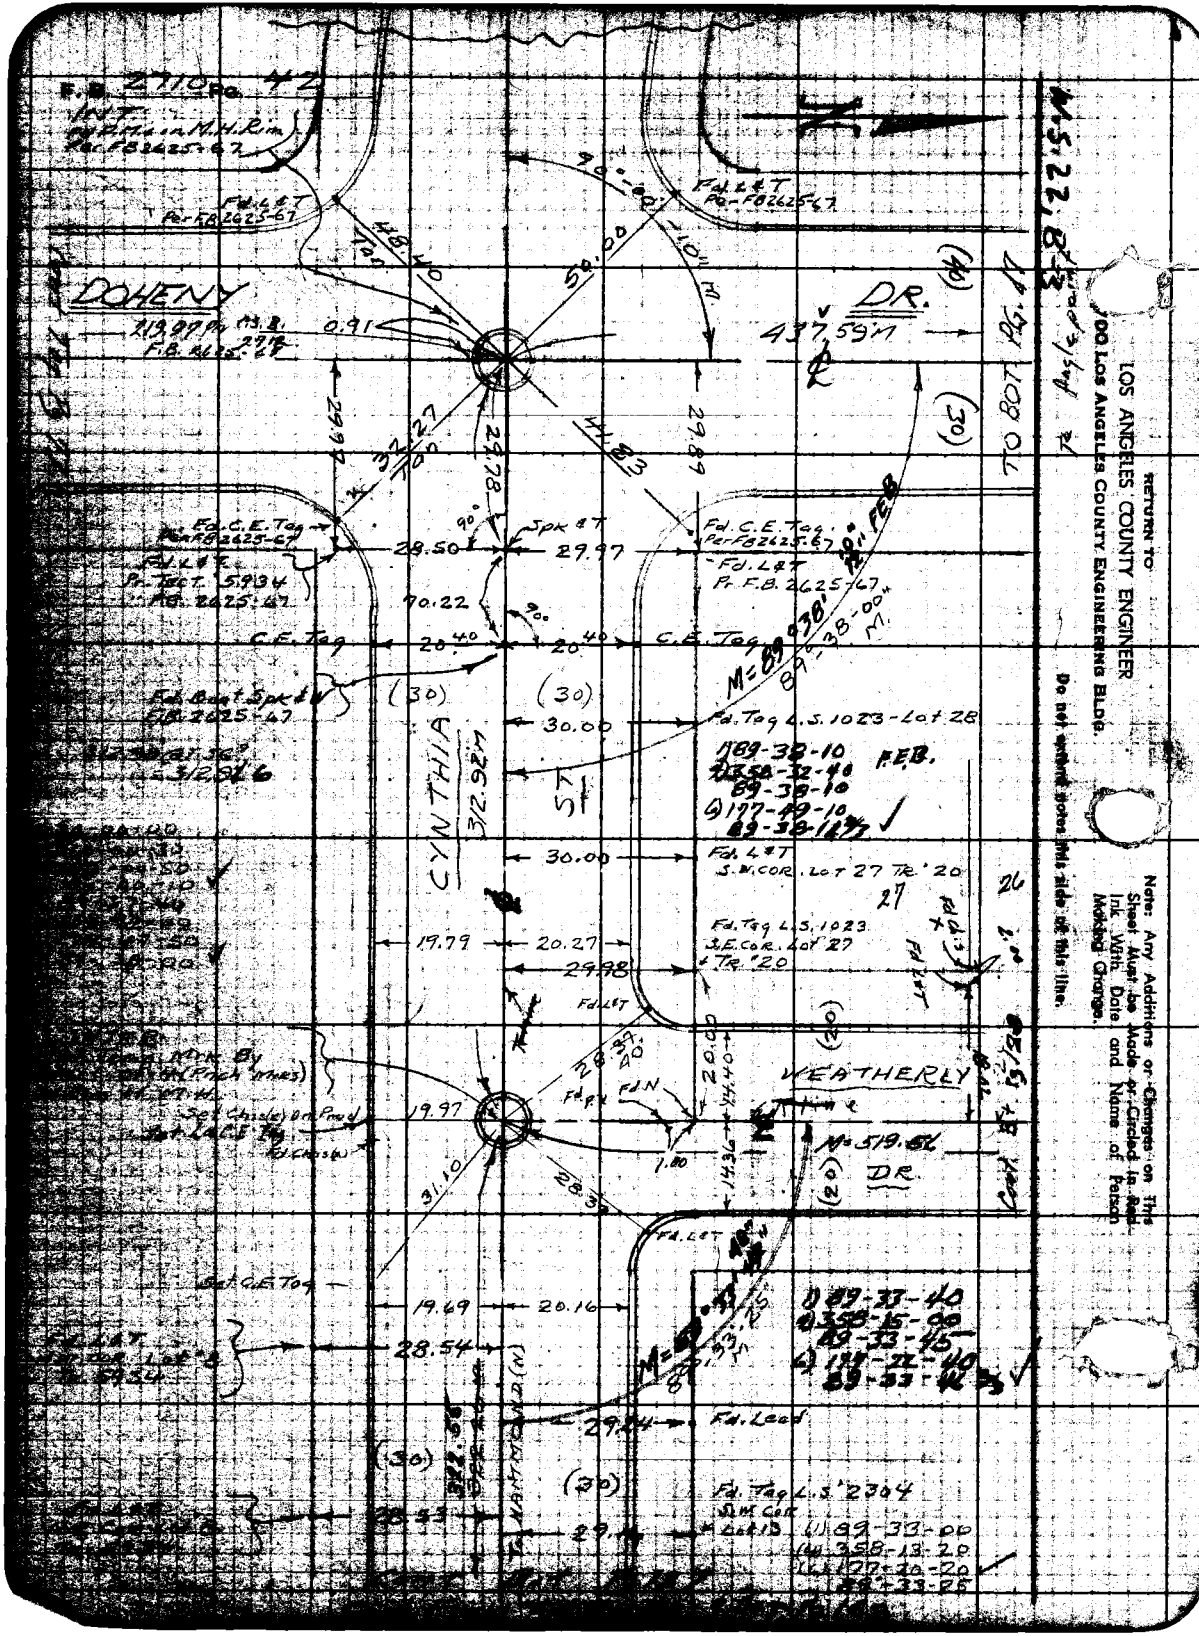
F.B. 2710 Pg. 42
DOHENY
DR.
437.59M
CYNTHIA
ST
WEATHERLY
DR.
M=519.56
Fd. L&T Pr. F.B. 2625-67
Fd. C.E. Tag Pr. F.B. 2625-67
Fd. L&T Pr. Tract 5934 F.B. 2625-67
Fd. Tag L.S. 1023-Lot 28
Fd. L&T S.W. Cor. Lot 27 Tr. 20
Fd. Tag L.S. 1023 S.E. Cor. Lot 27 Tr. 20
Fd. Lead
Fd. Tag L.S. 2304
TO BOH Pg. 17
RETURN TO
LOS ANGELES COUNTY ENGINEER
900 LOS ANGELES COUNTY ENGINEERING BLDG.
Do not extend notes this side of this line.
Note: Any Additions or Changes on This Sheet Must be Made or Circled in Red Ink With Date and Name of Person Making Change.

Notes Ck'd by D. SAPPELL	Survey of WEST HOLLY-SHERM
Map No. 5418	IN 0363.00 Tape 0188 Std 68 °F
Office Work E FONG	Surveyed by B.N. Hellstrom
Checked R HILARIO	Notes [illegible] Date 5-1-61
Date 10-17-83	Indexed C. J. GALLI

F.B. 2710 Pg. 43

1) 140-01-10
4) 200-04-20
140-01-05
6) 120-06-30
140-01-05 ✓

Cont. on Btm. Pg. 40 & 161

1) 90-18-10
4) 361-13-00
90-18-10
6) 181-49-20
90-18-13 1/3 ✓

W.S. 22, B-3

Note: Any Additions or Changes on This Sheet Must be Made or Circled in Red Ink With Date and Name of Person Making Change.

Do not extend notes into side of this line.

RETURN TO
LOS ANGELES COUNTY ENGINEER
TO LOS ANGELES COUNTY ENGINEERING BLDG.

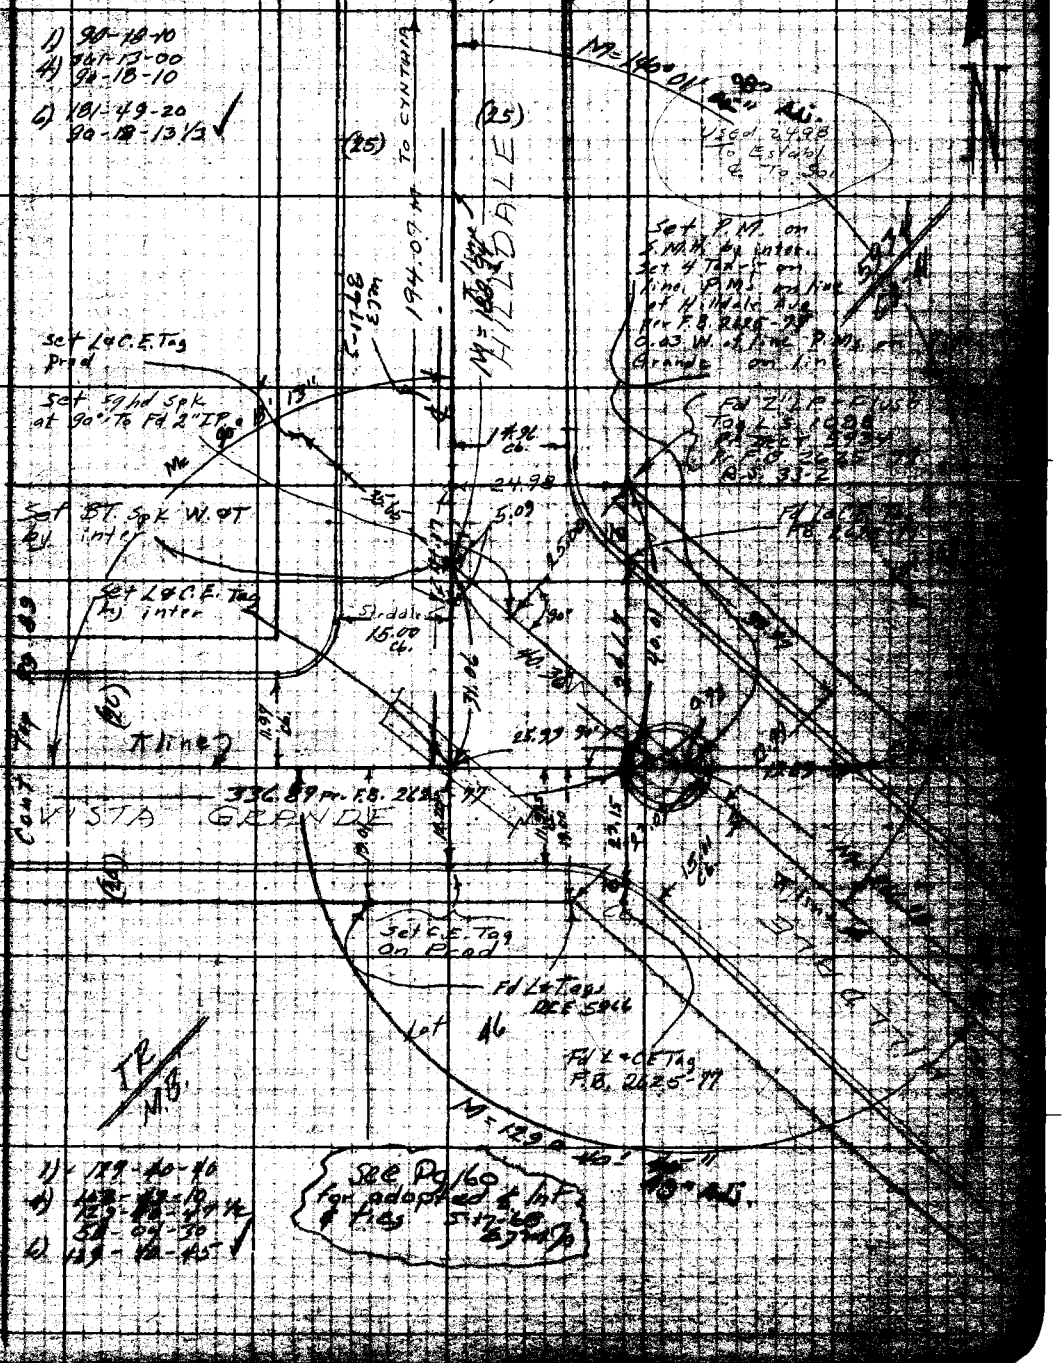

1) 129-40-40
4) 129-40-10
129-40-47 1/2
58-04-30
6) 129-40-45 ✓

See Pg. 160 for adopted ℄ Int. & Ties 5-17-68 67 m/p

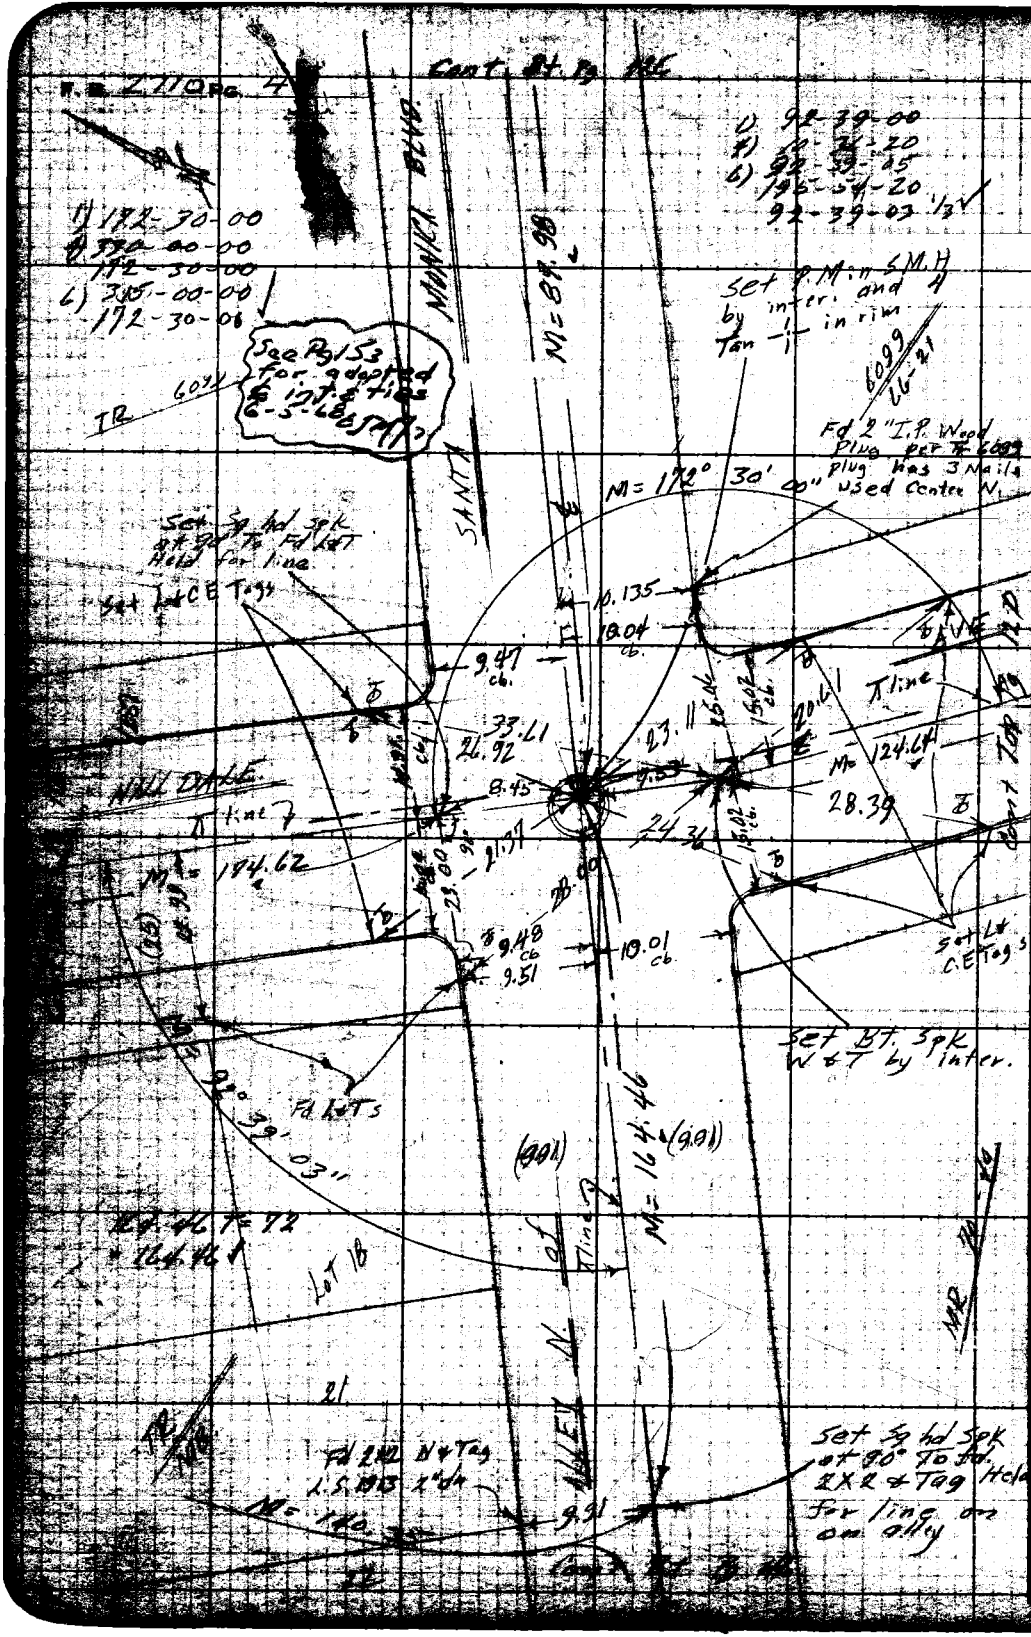

RETURN TO
LOS ANGELES COUNTY ENGINEER
900 LOS ANGELES COUNTY ENGINEERING BLDG.

Do not extend notes this side of this line.

Note: Any Additions or Changes on This Sheet Must be Made or Circled in Red Ink With Date and Name of Person Making Change.

Notes Ck'd by D. SAPPELL	Survey of N. HOLLY-SHERM.
Map No. 534 18	JN 2303.00 Tape 0188 Std 68 °F
Office Work E FONG	Surveyed by A.N. Hellstrom
Checked B [illegible]	Notes [illegible] Date 6-9-61
Date 10-17-83	Indexed E. J. GALLI

F. B. 2710 Pg. 45

Note: Any Additions or Changes on This Sheet Must be Made or Circled in Red Ink With Date and Name of Person Making Change.

Do not extend notes this side of this line.

RETURN TO LOS ANGELES COUNTY ENGINEER 100 LOS ANGELES COUNTY ENGINEERING BLDG.

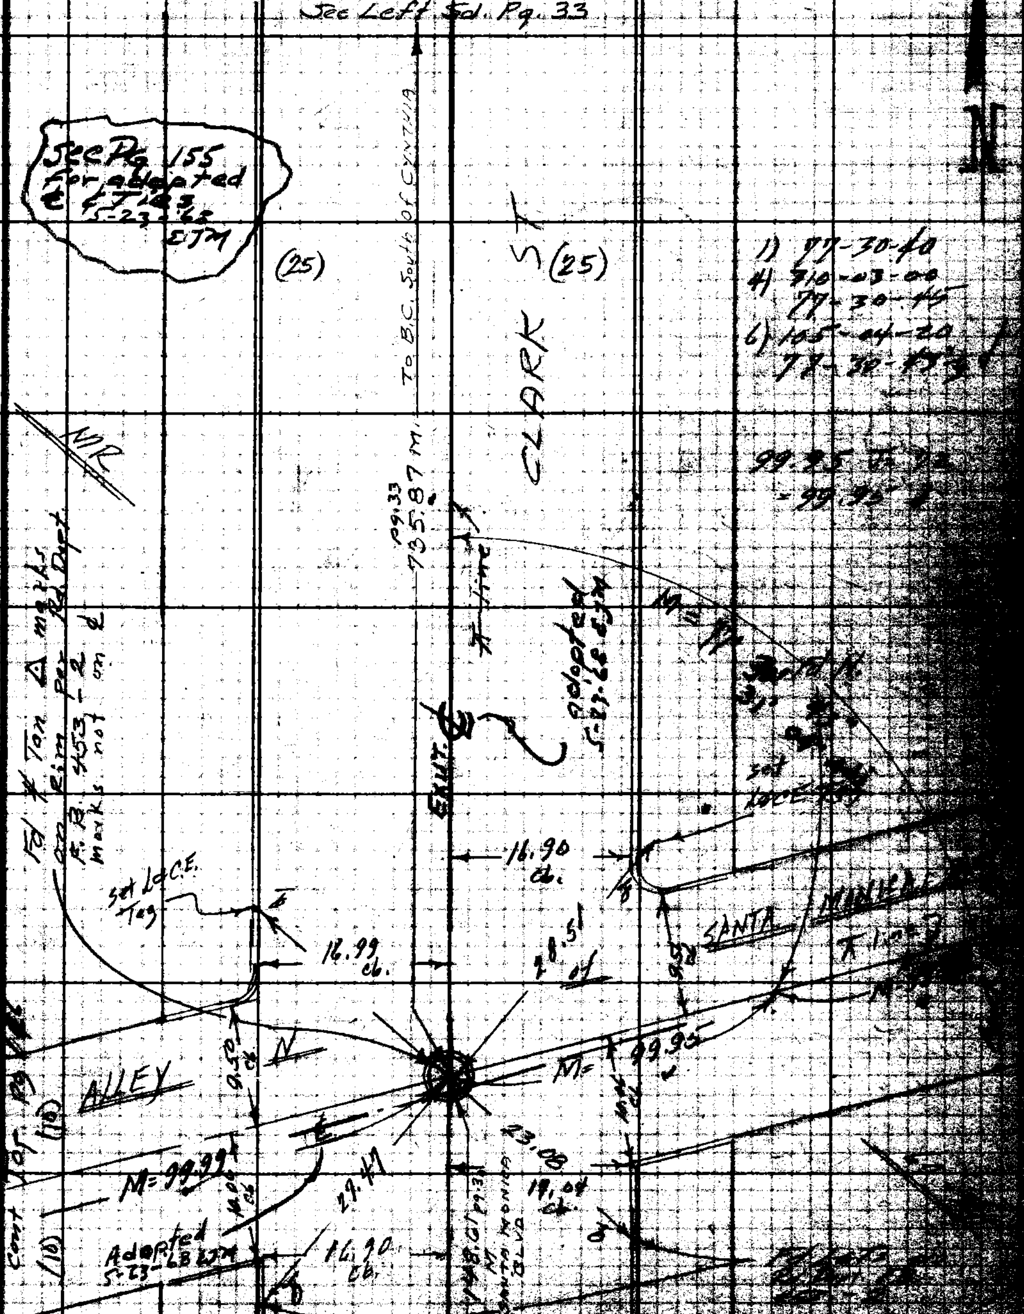

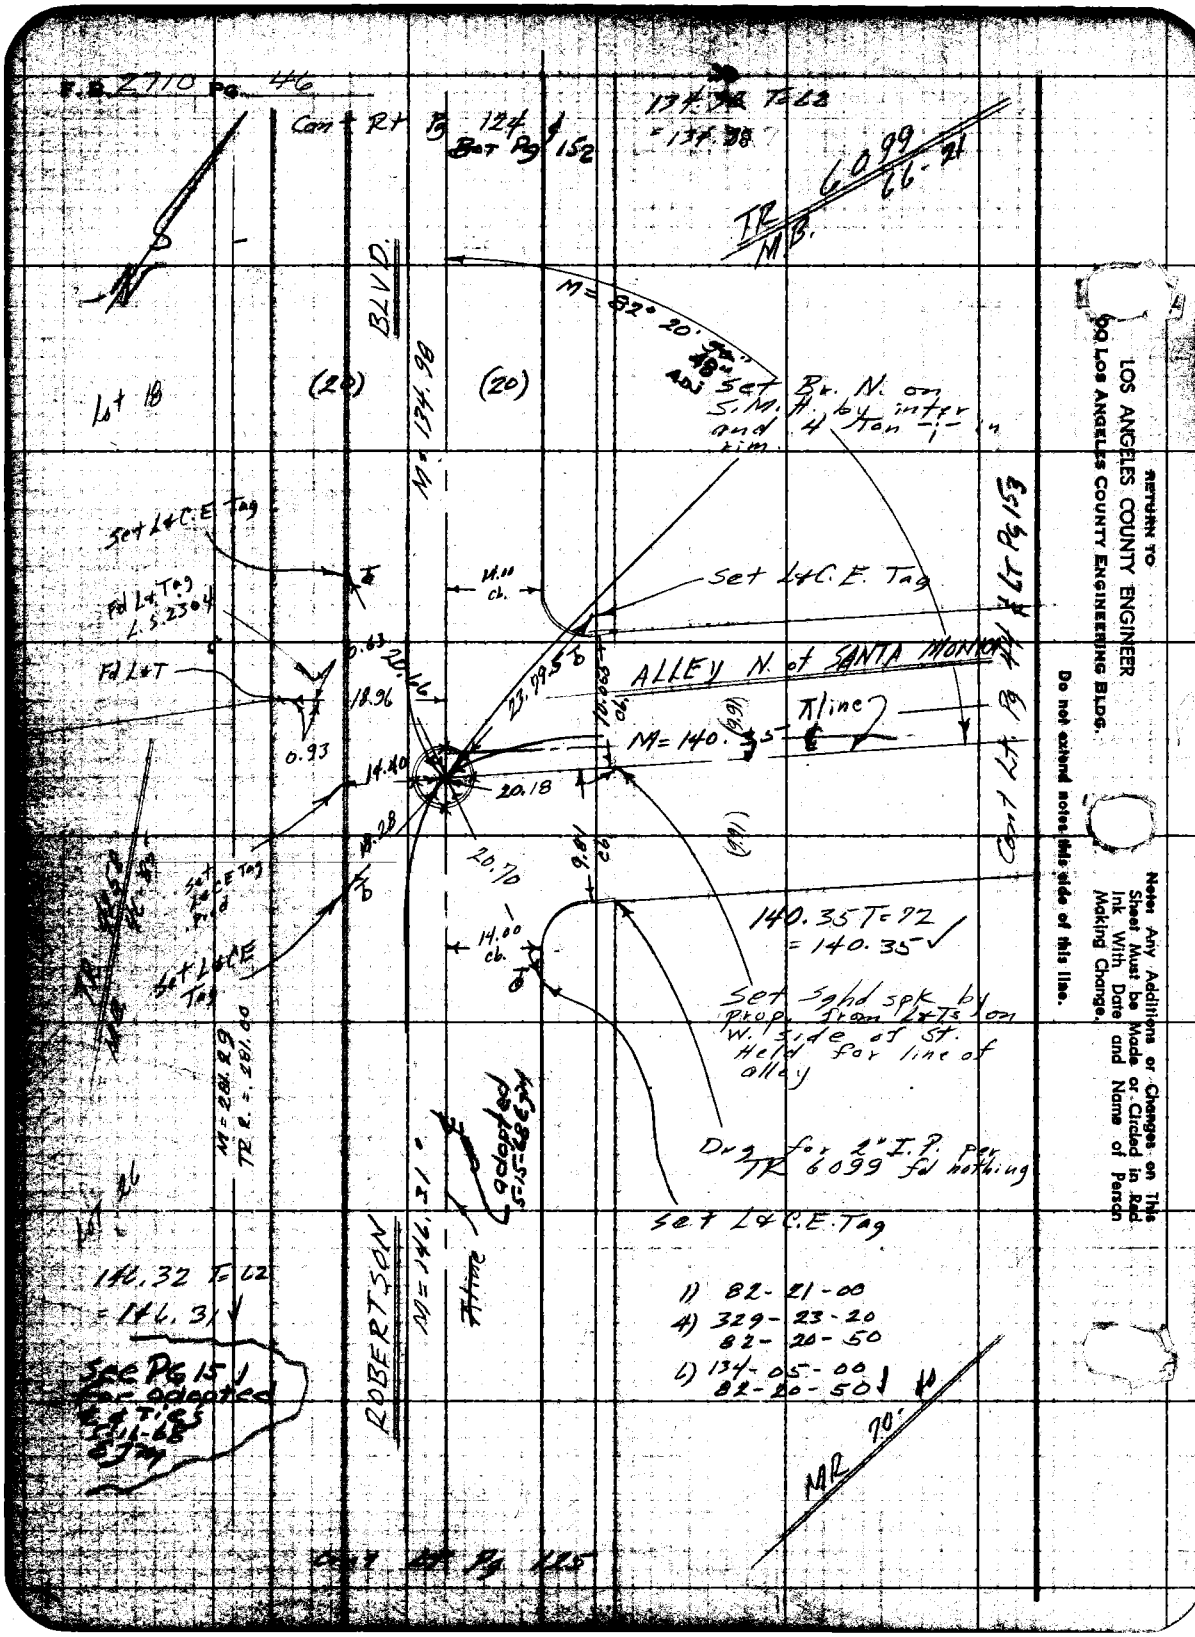

RETURN TO
LOS ANGELES COUNTY ENGINEER
90 LOS ANGELES COUNTY ENGINEERING BLDG.

Do not extend notes this side of this line.

Note: Any Additions or Changes on This Sheet Must be Made or Circled in Red Ink With Date and Name of Person Making Change.

Notes Ck'd by D. SAPPELL	Survey of W. HOLLY-SHERM SM.
Map No. 5A18	IN 0303.00 Tape 0188 Std. 68 °F
Office Work E. PONG	Surveyed by A.N. Hellstrom
Checked R. HILARIO	Notes D.B. Date 12-1961
Date 10-17-83	Indexed C. J. GALLI

F. B. 2710 Pg. 47

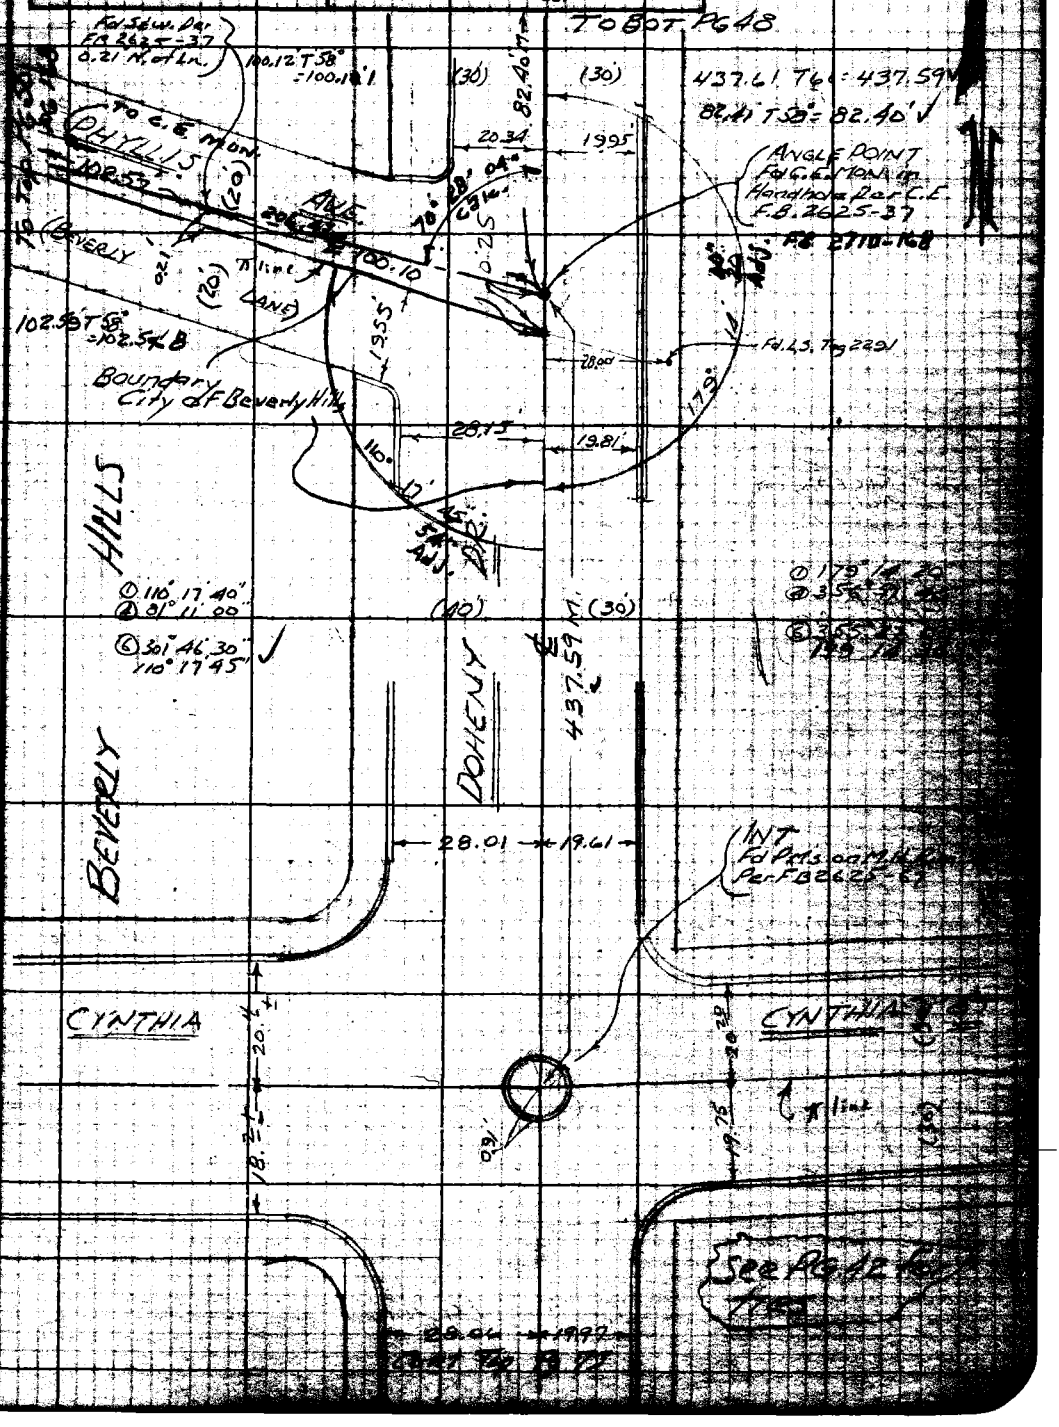

Note: Any Additions or Changes on This Sheet Must be Made or Circled in Red Ink With Date and Name of Person Making Change.

W.S. 22, B-3

Do not extend under this side of this line.

RETURN TO LOS ANGELES COUNTY ENGINEER
TO Los Angeles County Engineering Bldg.

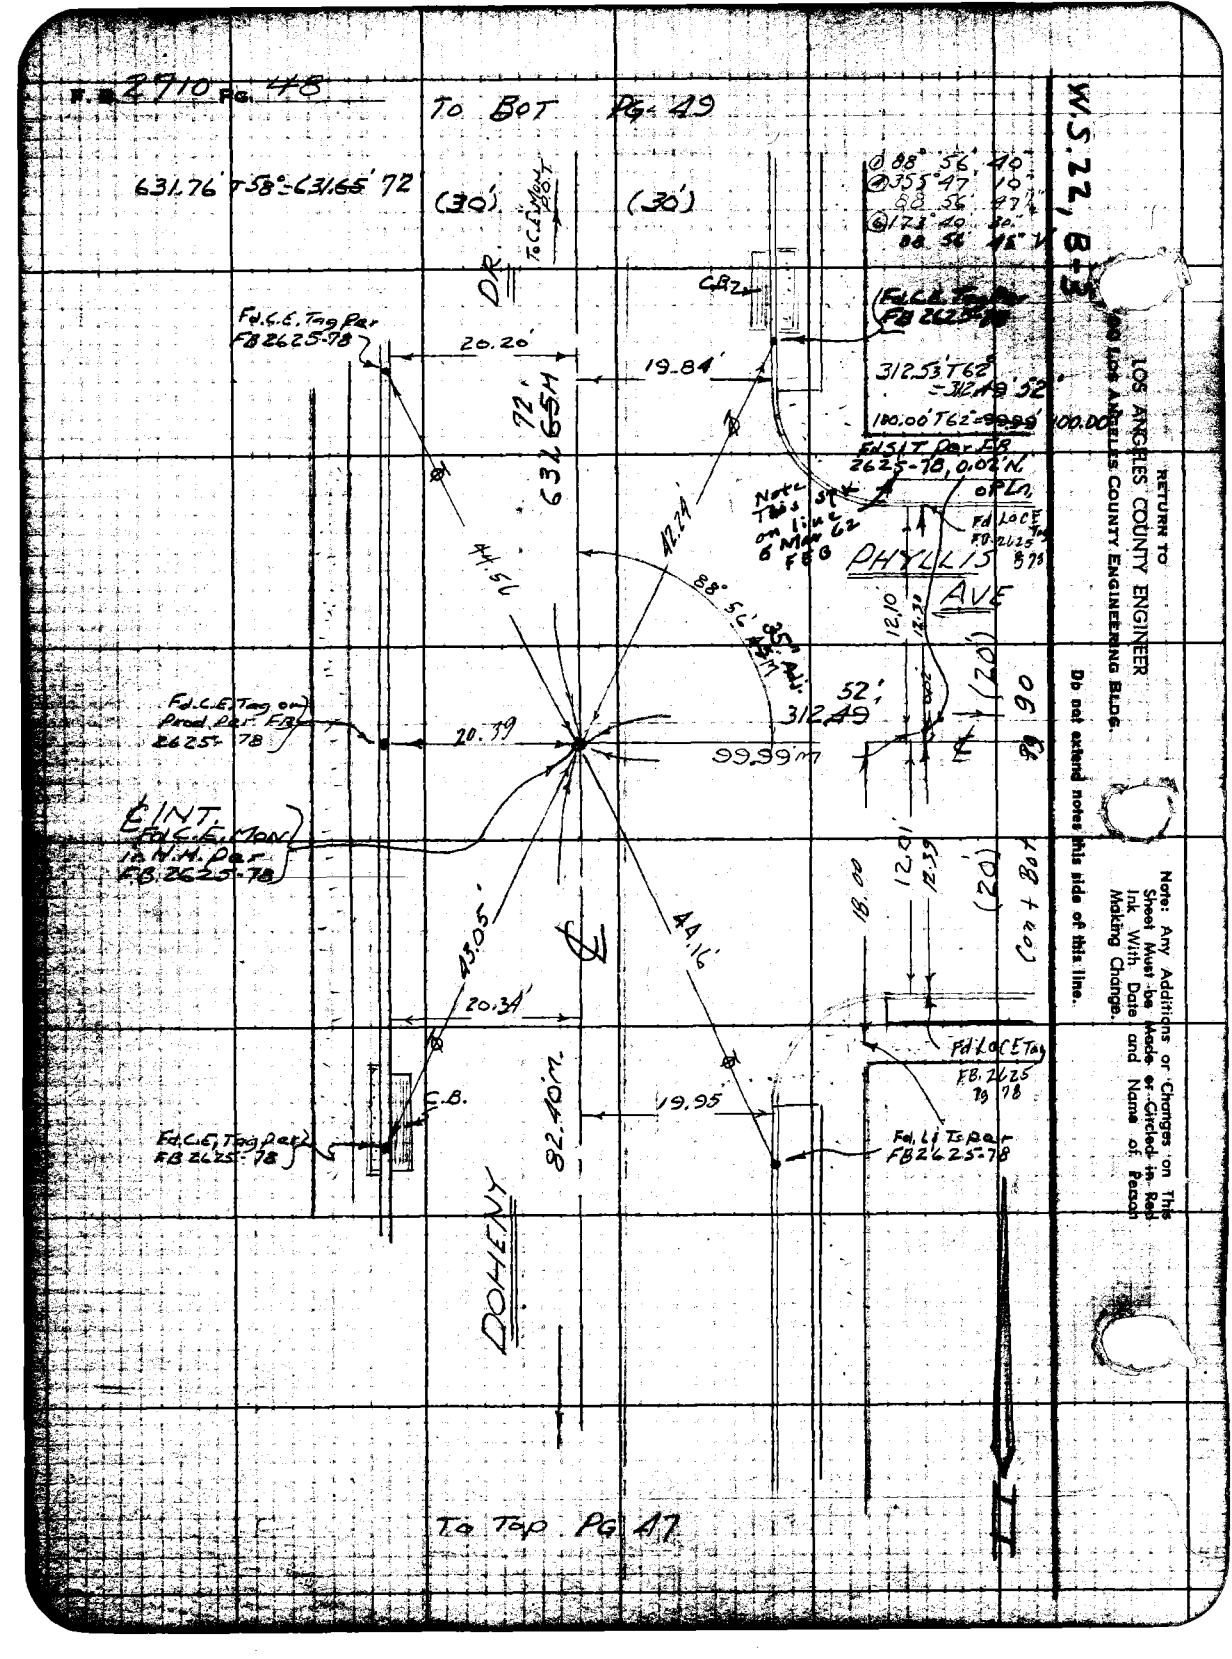
F.B. 2710 PG. 48
To BOT PG. 49
631.76' T58° = 631.65' 72
(30')
(30')
To C.E. Mon P.O.T.
DR.
C.B.
Fd. C.E. Tag Per FB 2625-78
20.20'
19.84'
72'
631.65 M
312.53' T62° = 312.49' 52'
100.00' T62° = 99.99' 100.00
Fd. SIT Per FB 2625-78, 0.02' N. of Ln.
Note This Sta on line 6 Mar 62 FEB
PHYLLIS AVE
44.56
42.24
88° 56' 35" Adj.
12.10
12.30
(20')
52'
312.49
99.99 m
Fd. C.E. Tag on Prod. Per FB 2625-78
20.39
℄ INT. Fd. C.E. Mon in H.H. Per FB 2625-78
43.05'
44.16'
18.00
12.01
12.39
(20')
Con + Bot
20.34'
Fd. LOCE Tag FB 2625 Pg 78
C.B.
19.95
82.40 m
Fd. C.E. Tag Per FB 2625-78
Fd. LI Ts Per FB 2625-78
DOHENY
To Top PG 47
W.S. 22, B-3
RETURN TO
LOS ANGELES COUNTY ENGINEER
900 LOS ANGELES COUNTY ENGINEERING BLDG.
Do not extend notes this side of this line.
Note: Any Additions or Changes on This Sheet Must be Made or Circled in Red Ink With Date and Name of Person Making Change.

763095 CE #247—7-58

RETURN TO
LOS ANGELES COUNTY ENGINEER
90 LOS ANGELES COUNTY ENGINEERING BLDG.

Name any Additions or Changes on This Sheet Must be Made or Circled in Red Ink With Date and Name of Person Making Change.

Do not extend notes this side of this line.

W.S. 22, B-2

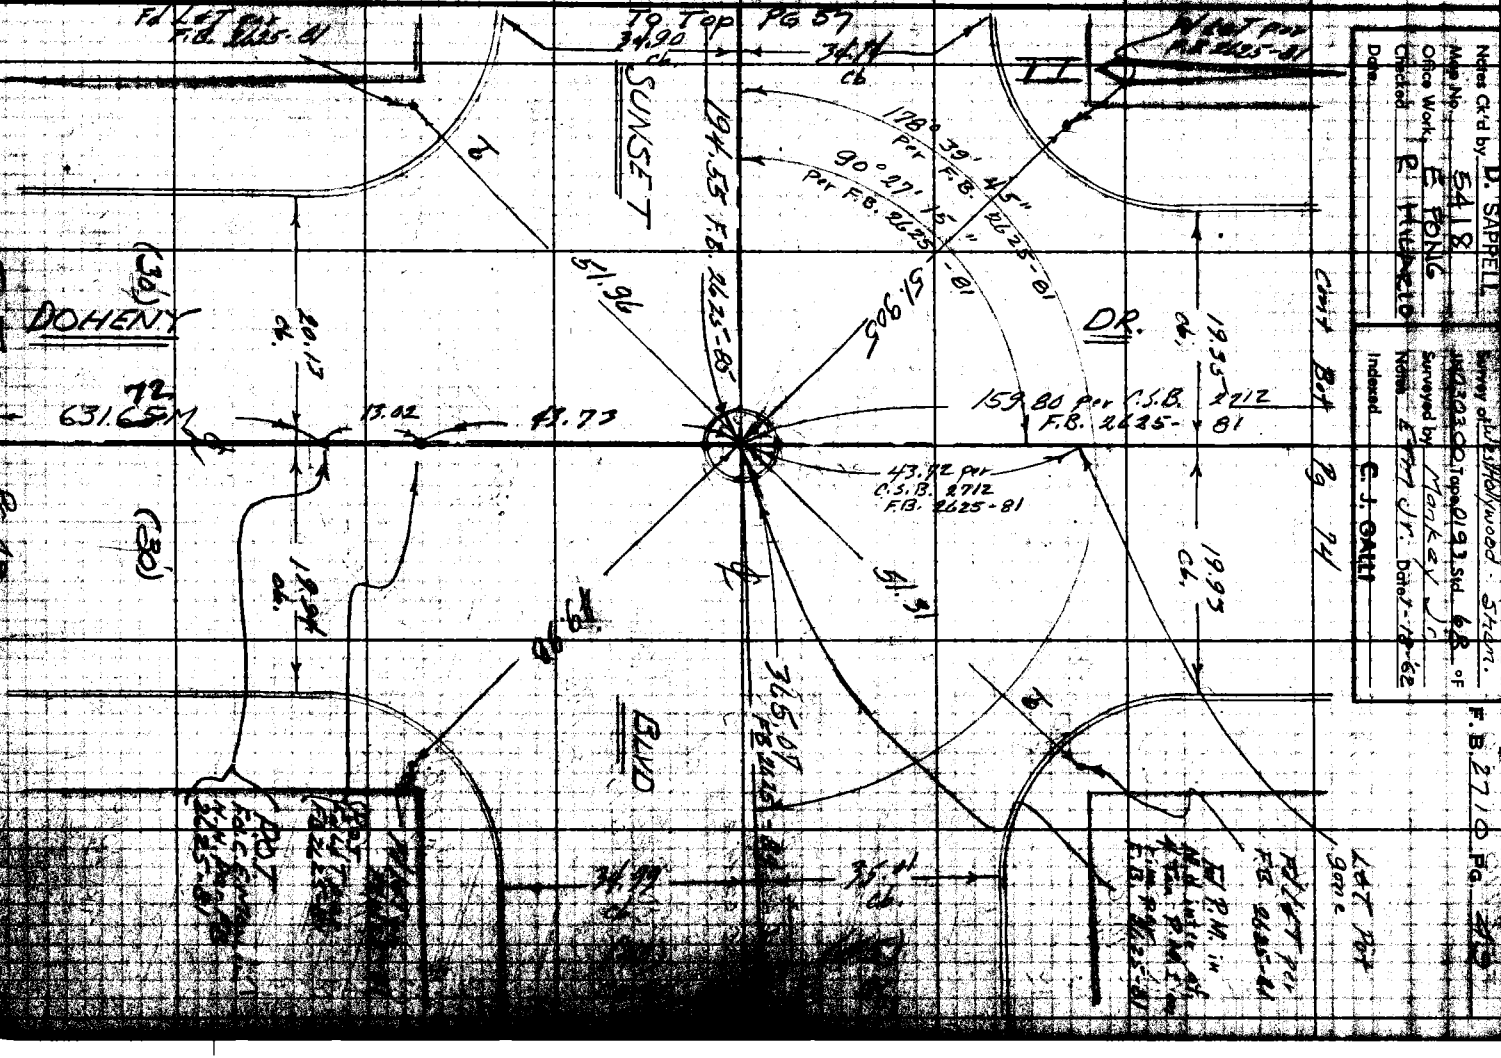

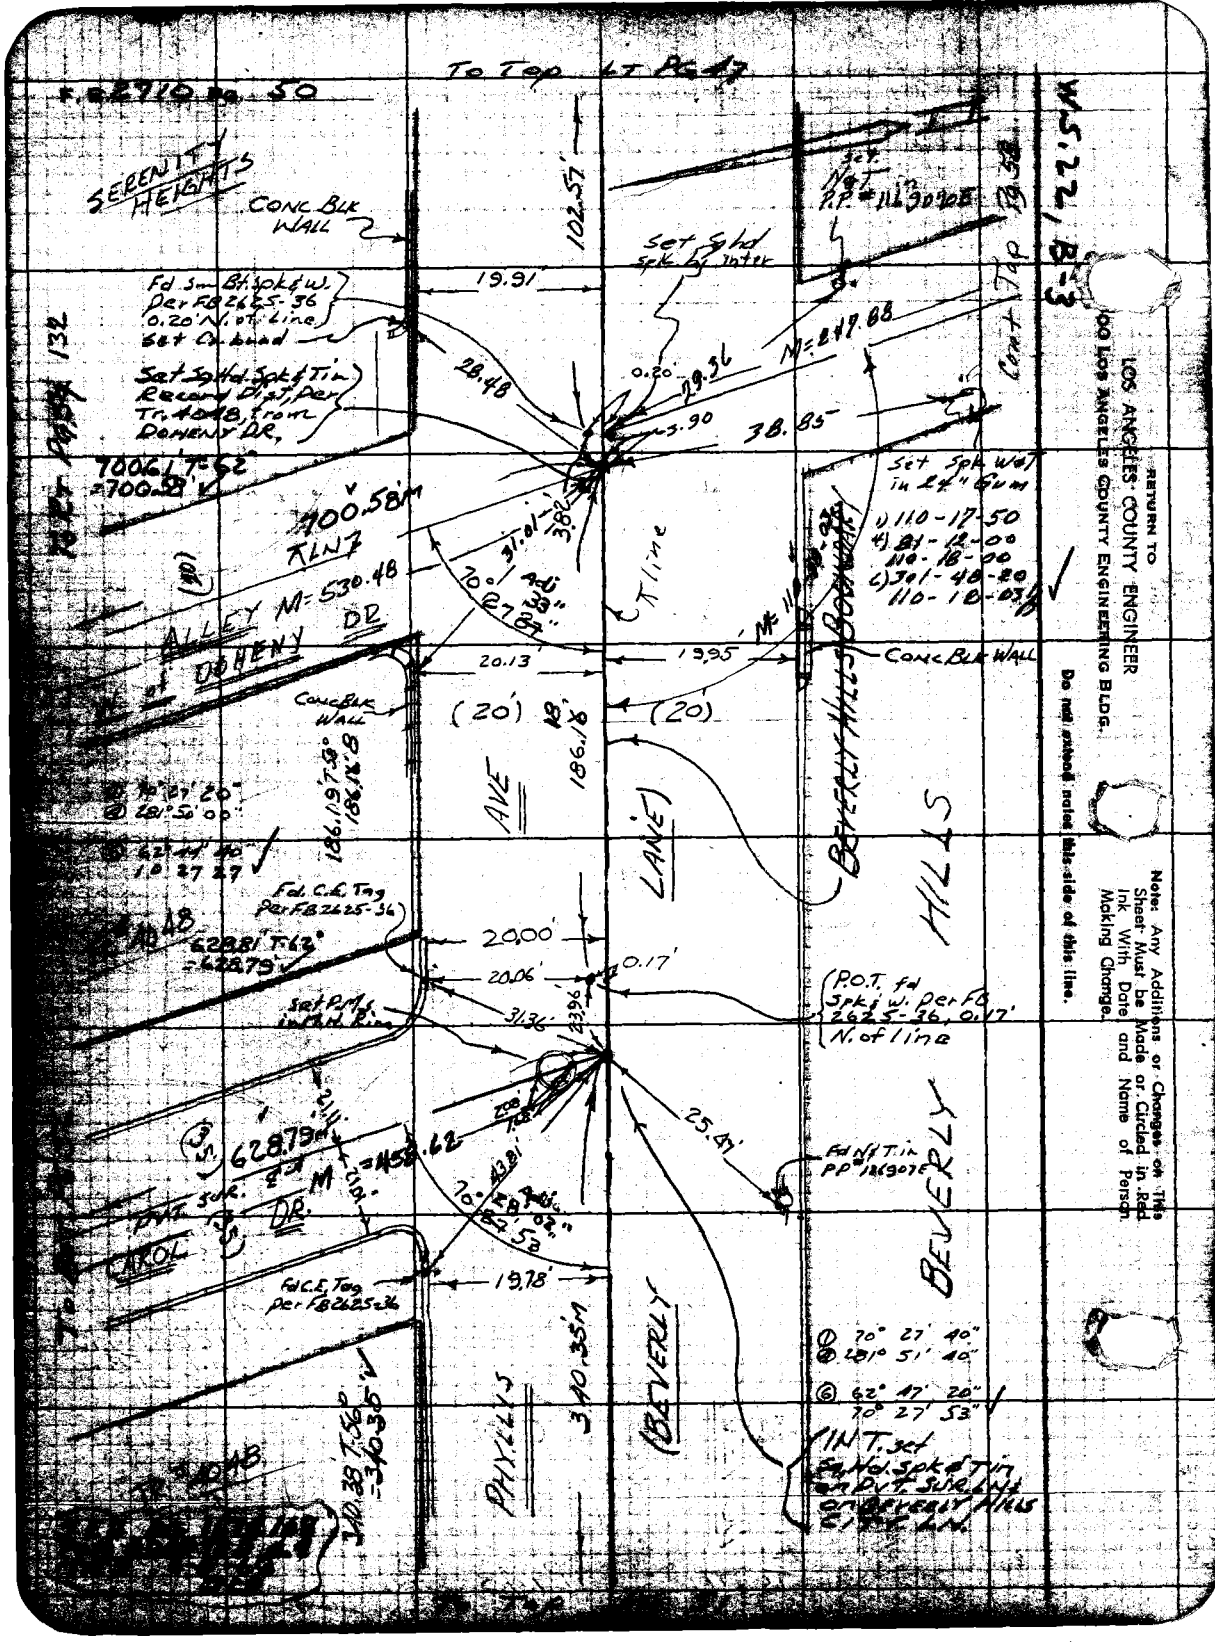

RETURN TO
LOS ANGELES COUNTY ENGINEER
100 LOS ANGELES COUNTY ENGINEERING BLDG.

Do not extend notes this side of this line.

Note: Any Additions or Changes on This Sheet Must be Made or Circled in Red Ink With Date and Name of Person Making Change.

Notes Ck'd by D. SAPPELL	Survey of West Holly. - Sherm
Map No. 5418	1st 030380 Tape 0193 Std. 68 °F
Office Work E PONG	Surveyed by Mankey Jr.
Checked R HILARIO	Notes E TTT Jr. Date 7-23-62
Date 10-17-83	Indexed C. J. GALLI

F. B. 2210 Pg. 57

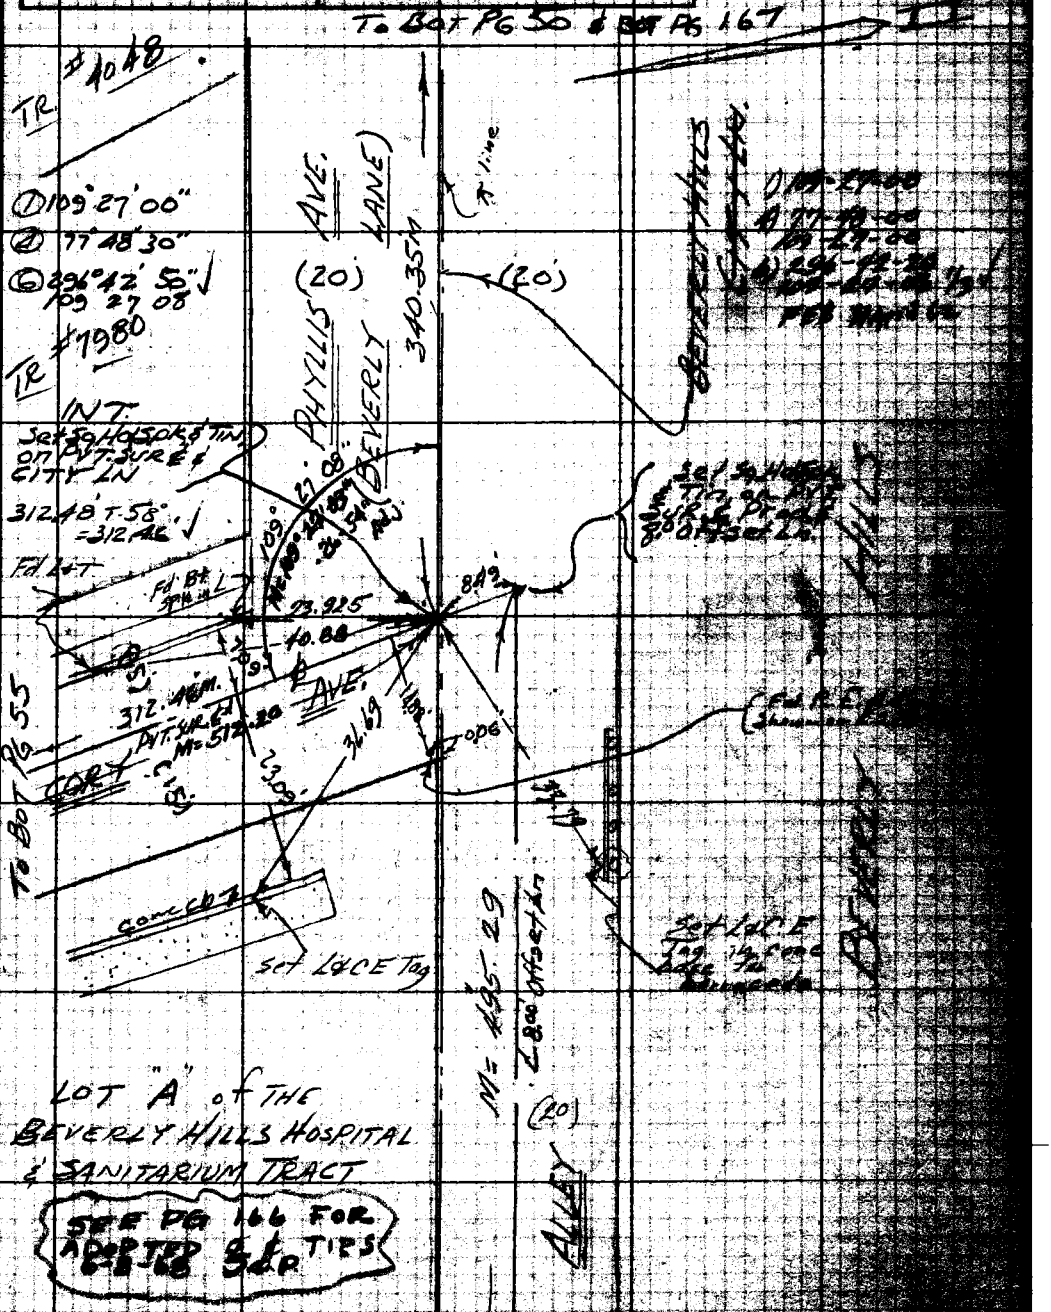

LOT "A" of THE BEVERLY HILLS HOSPITAL & SANITARIUM TRACT

SEE PG 166 FOR ADOPTED ℄ & TIES 6-8-68 SCP

W.S. 22, B-3

Note: Any Additions or Changes on this Sheet Must be Made or Circled in Red Ink With Date and Name of Person Making Change.

Do not extend notes this side of this line.

RETURN TO LOS ANGELES COUNTY ENGINEER
DO LOS ANGELES COUNTY ENGINEERING BLDG.

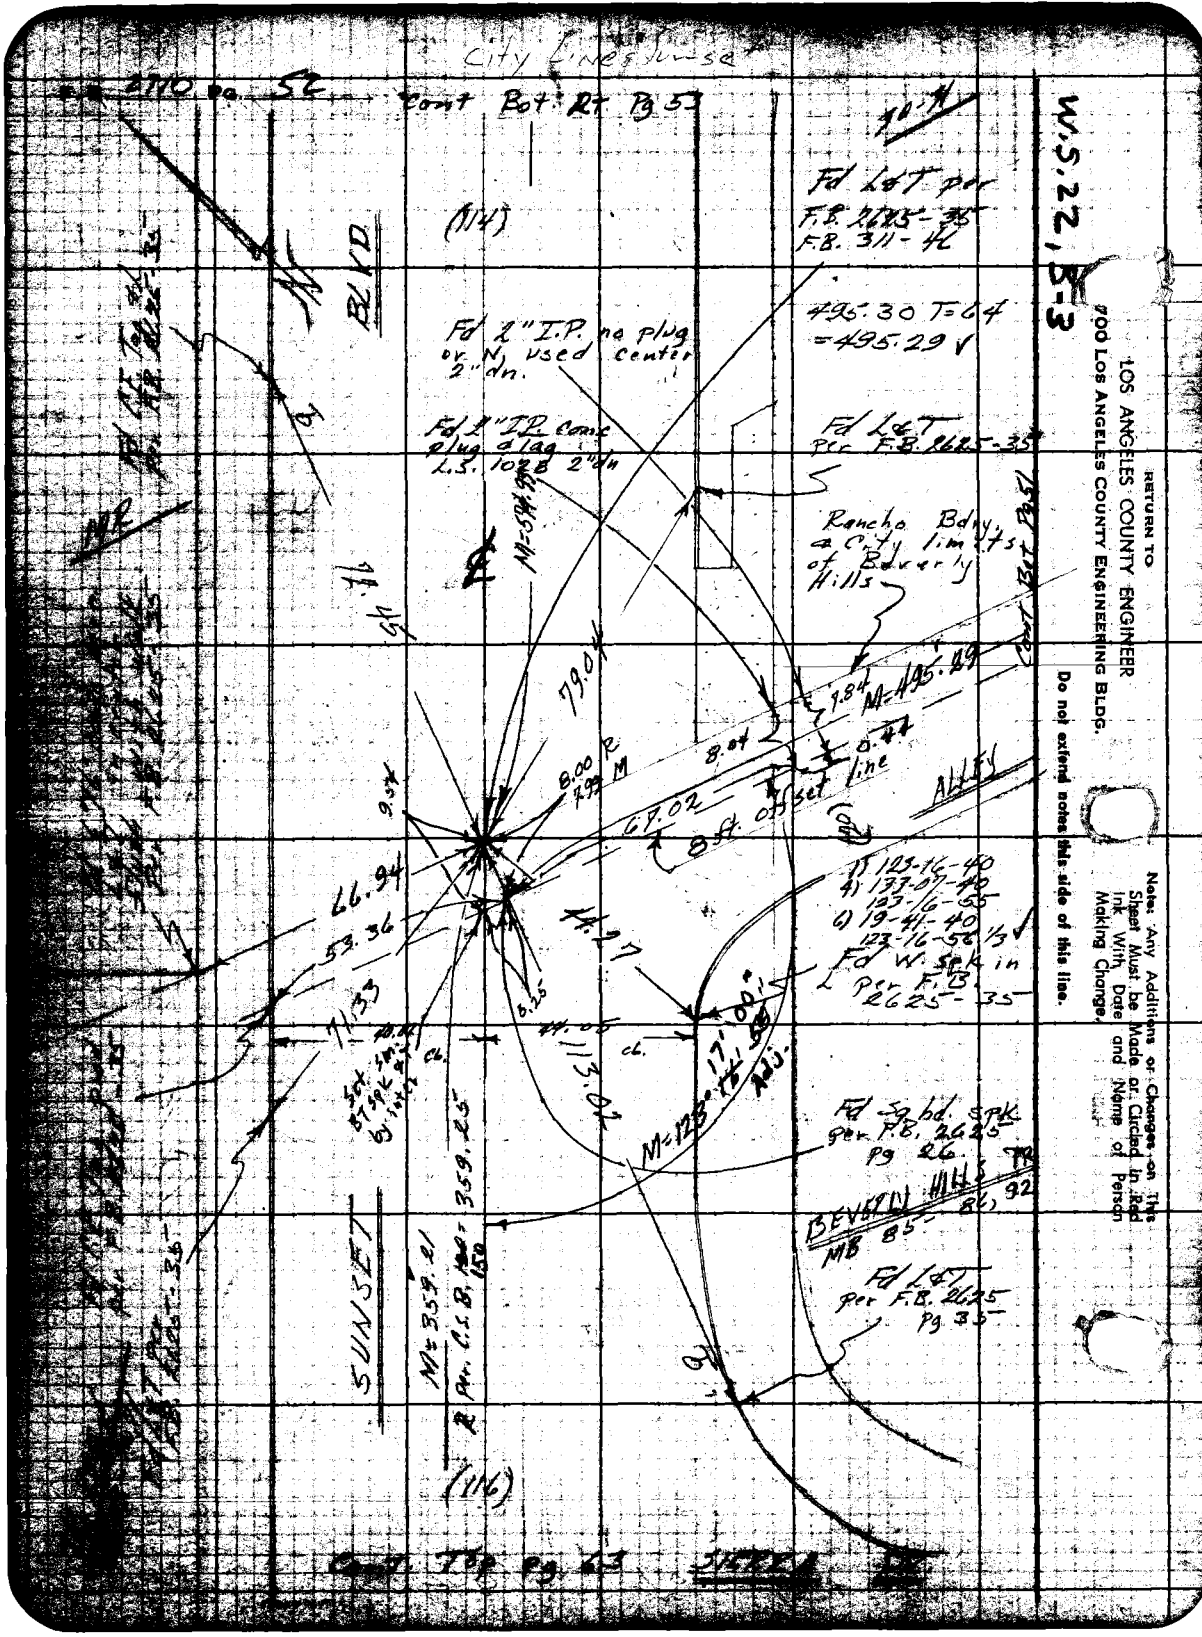
City Lines Sunset
Cont Bot Rt Pg 53
W.S. 22, B-3
Fd L&T per F.B. 2625-35 F.B. 311-46
495.30 T=64 =495.29
Fd 2" I.P. no plug or N, used center 2" dn.
Fd 2" I.P. conc plug & lag L.S. 1028 2" dn
Fd L&T per F.B. 2625-35
Rancho Bdry. & City limits of Beverly Hills
Cont Bot Pg 51
M=495.29
79.04
8.00 R
7.99 M
8.04
0.44
67.02
8 ft. offset line
ALLEY
66.94
53.36
71.33
44.27
113.02
1) 123-16-40
4) 133-07-40
123-16-55
6) 19-41-40
123-16-56 1/3
Fd W. spk in L per F.B. 2625-35
Fd Sq hd. spk per F.B. 2625 Pg 26
BEVERLY HILLS TR
MB 85-86, 92
Fd L&T per F.B. 2625 Pg 35
M=123°17'00" Adj.
M=359.21
SUNSET
BLVD
(114)
(116)
Cont Top Pg 63
RETURN TO
LOS ANGELES COUNTY ENGINEER
700 LOS ANGELES COUNTY ENGINEERING BLDG.
Do not extend notes this side of this line.
Note: Any Additions or Changes on This Sheet Must be Made or Circled in Red Ink With Date and Name of Person Making Change.

Notes Ck'd by D. SAPPELT	Survey of [illegible]
Map No. 5416	JN 0303.00 Tape 0135 Std. 60
Office Work E. FONG	Surveyed by [illegible]
Checked R. HILARIO	Notes [illegible] Date [illegible]
Date 10-17-83	Indexed C. J. GALLI

F. B. [illegible]

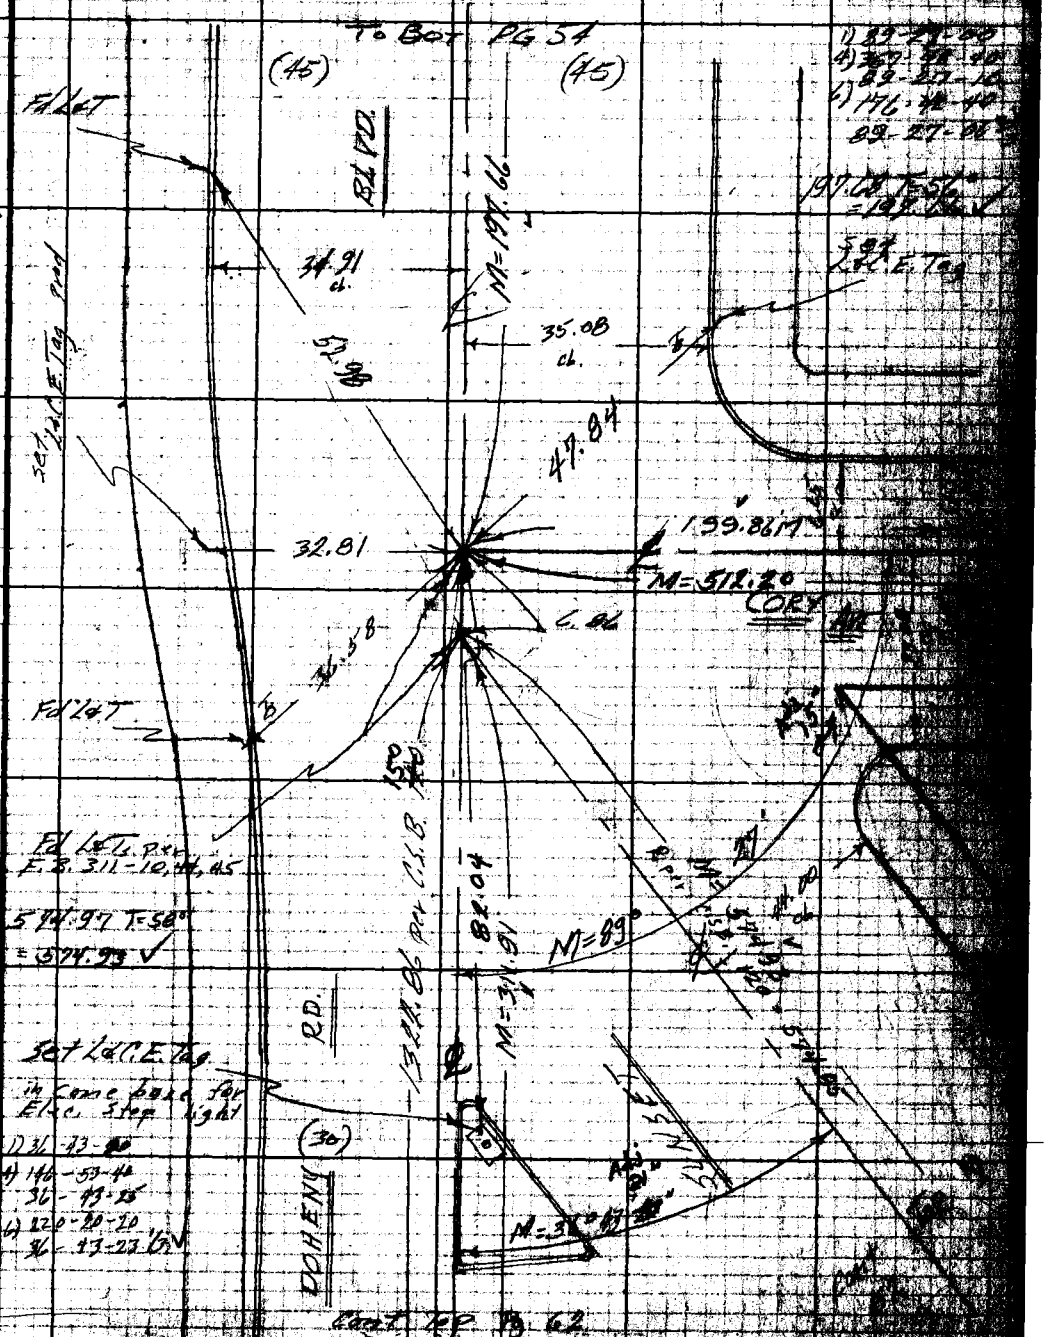

Note: Any Additions or Changes on This Sheet Must Be Made or Circled in Red Ink With Date and Name of Person Making Change.

W.S. 22, 8-2

Do not extend notes this side of this line.

RETURN TO
LOS ANGELES COUNTY ENGINEER
900 LOS ANGELES COUNTY ENGINEERING BLDG.

76P303 CK #247 3-77

F.B. 2710 Pg. 54

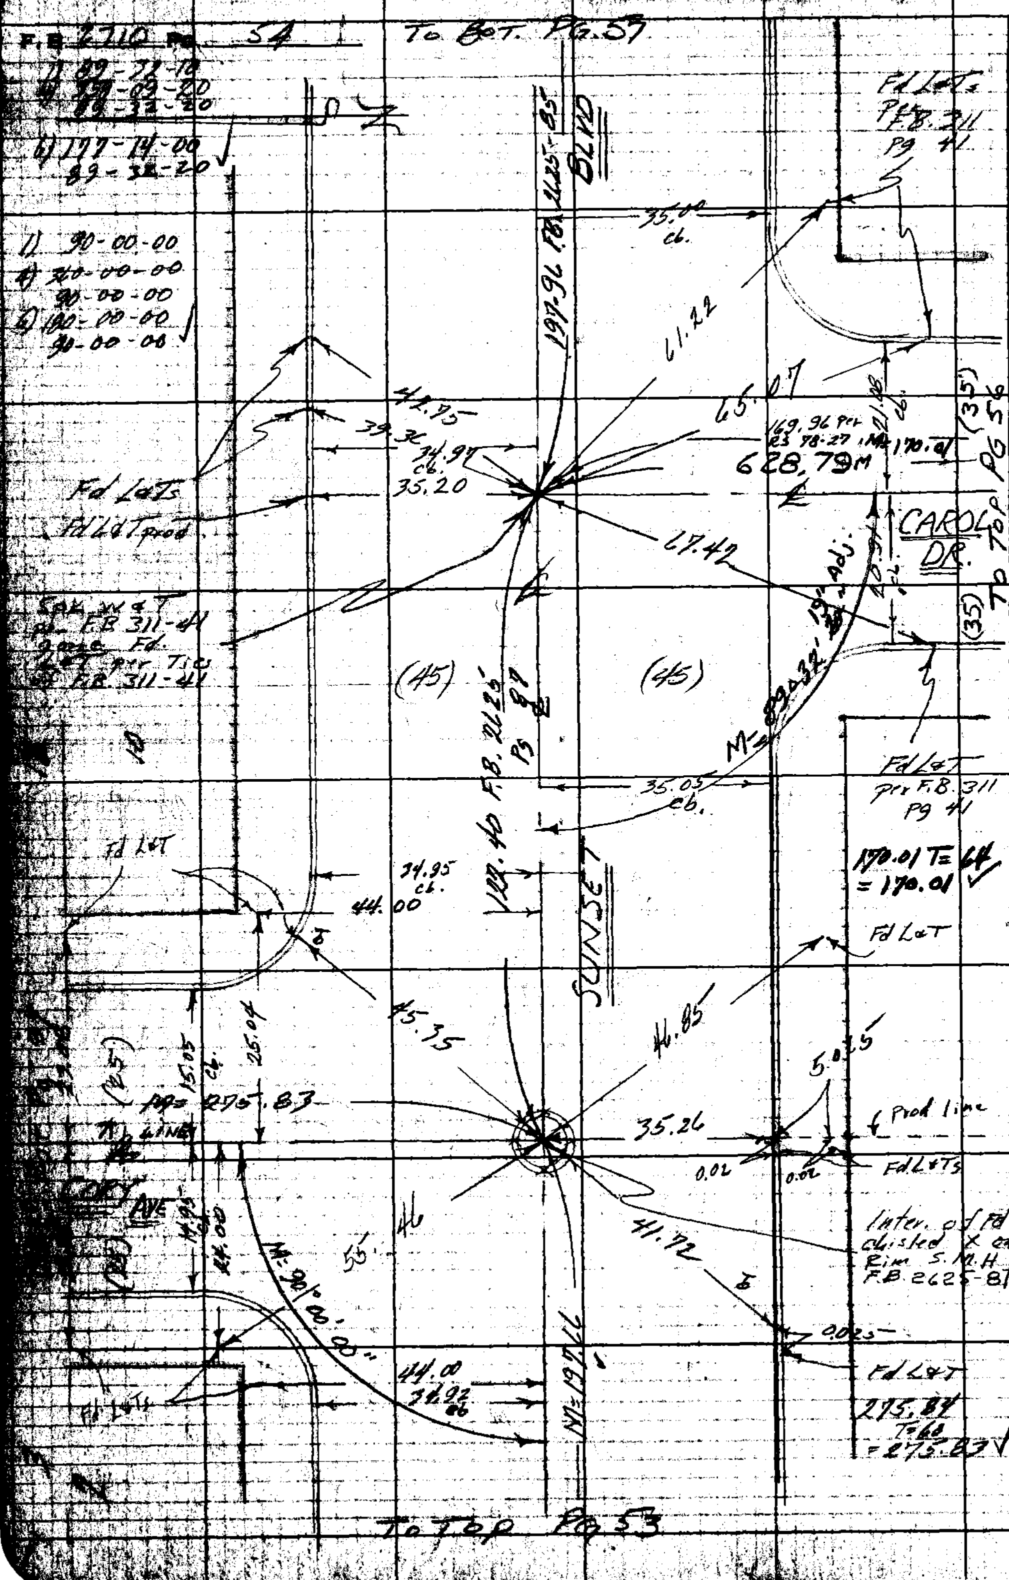

RETURN TO
LOS ANGELES COUNTY ENGINEER
700 LOS ANGELES COUNTY ENGINEERING BLDG.

Do not extend notes this side of this line.

Note: Any Additions or Changes on This Sheet Must be Made or Circled in Red Ink With Date and Name of Person Making Change.

Notes Ck'd by D. SAPPELL	Survey of Wilhelm-Sherman S.S. Dist
Map No. 5418	JN 030200 Tape 0193 Std 68 °F
Office Work E FONG	Surveyed by Monkey Jr.
Checked R. HILARIO	Notes [illegible] Date 1-23-'62
Date 10-17-83	Indexed C. J. GALLI

F.B. 2710 Pg. 58

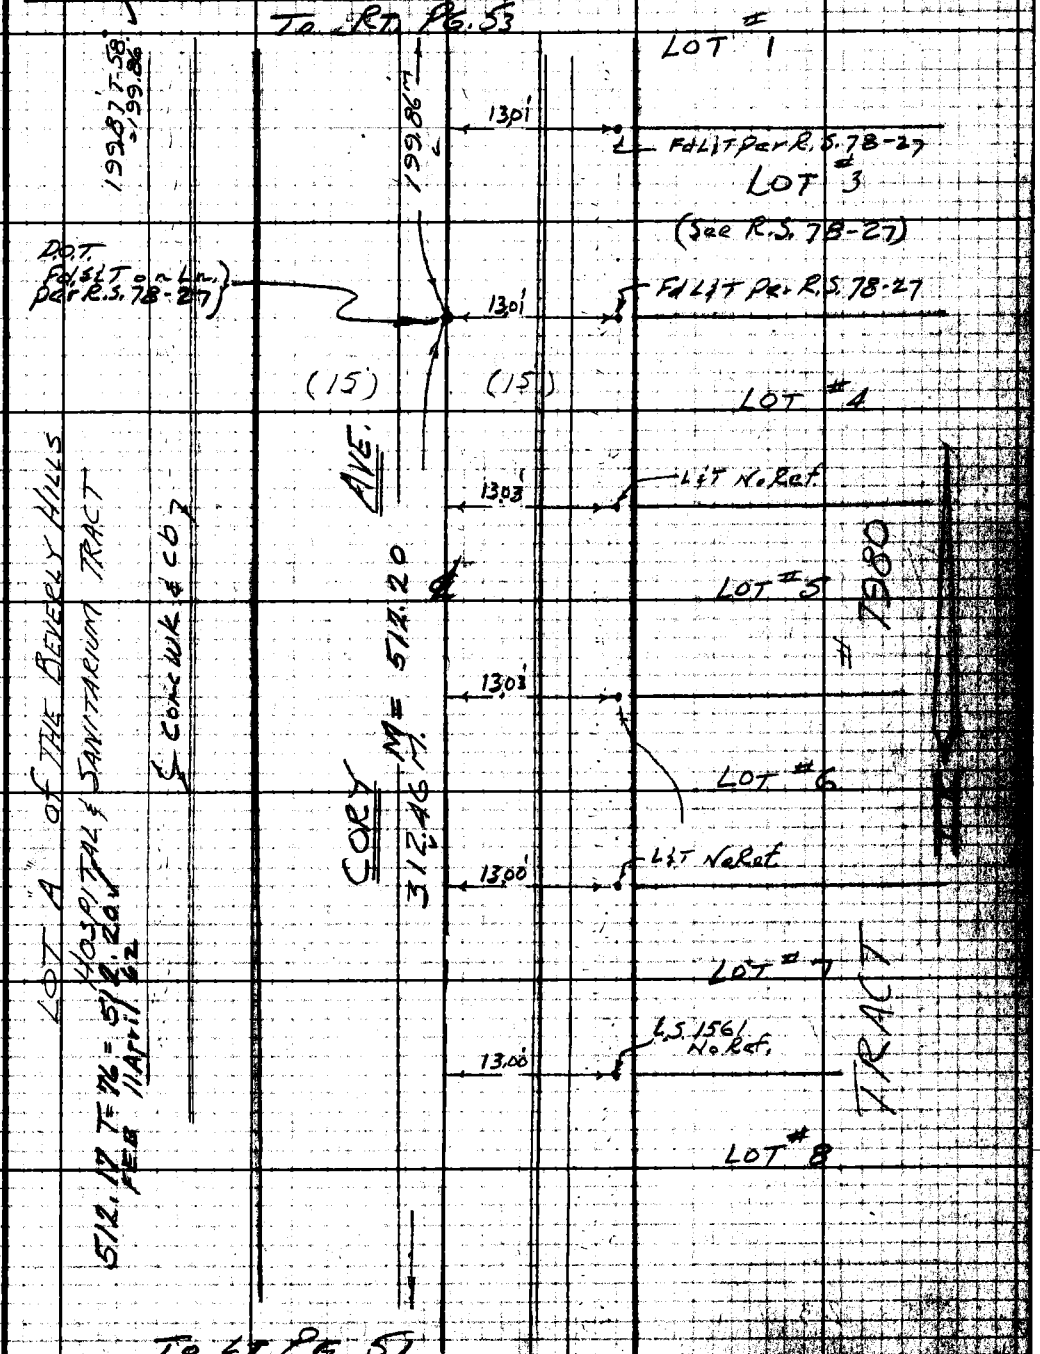

Note: Any Additions or Changes on This Sheet Must be Made or Circled in Red Ink With Date and Name of Person Making Change.

Do not extend notes this side of this line.

RETURN TO
LOS ANGELES COUNTY ENGINEER
700 LOS ANGELES COUNTY ENGINEERING BLDG.

76F3098 CE #247—3-57

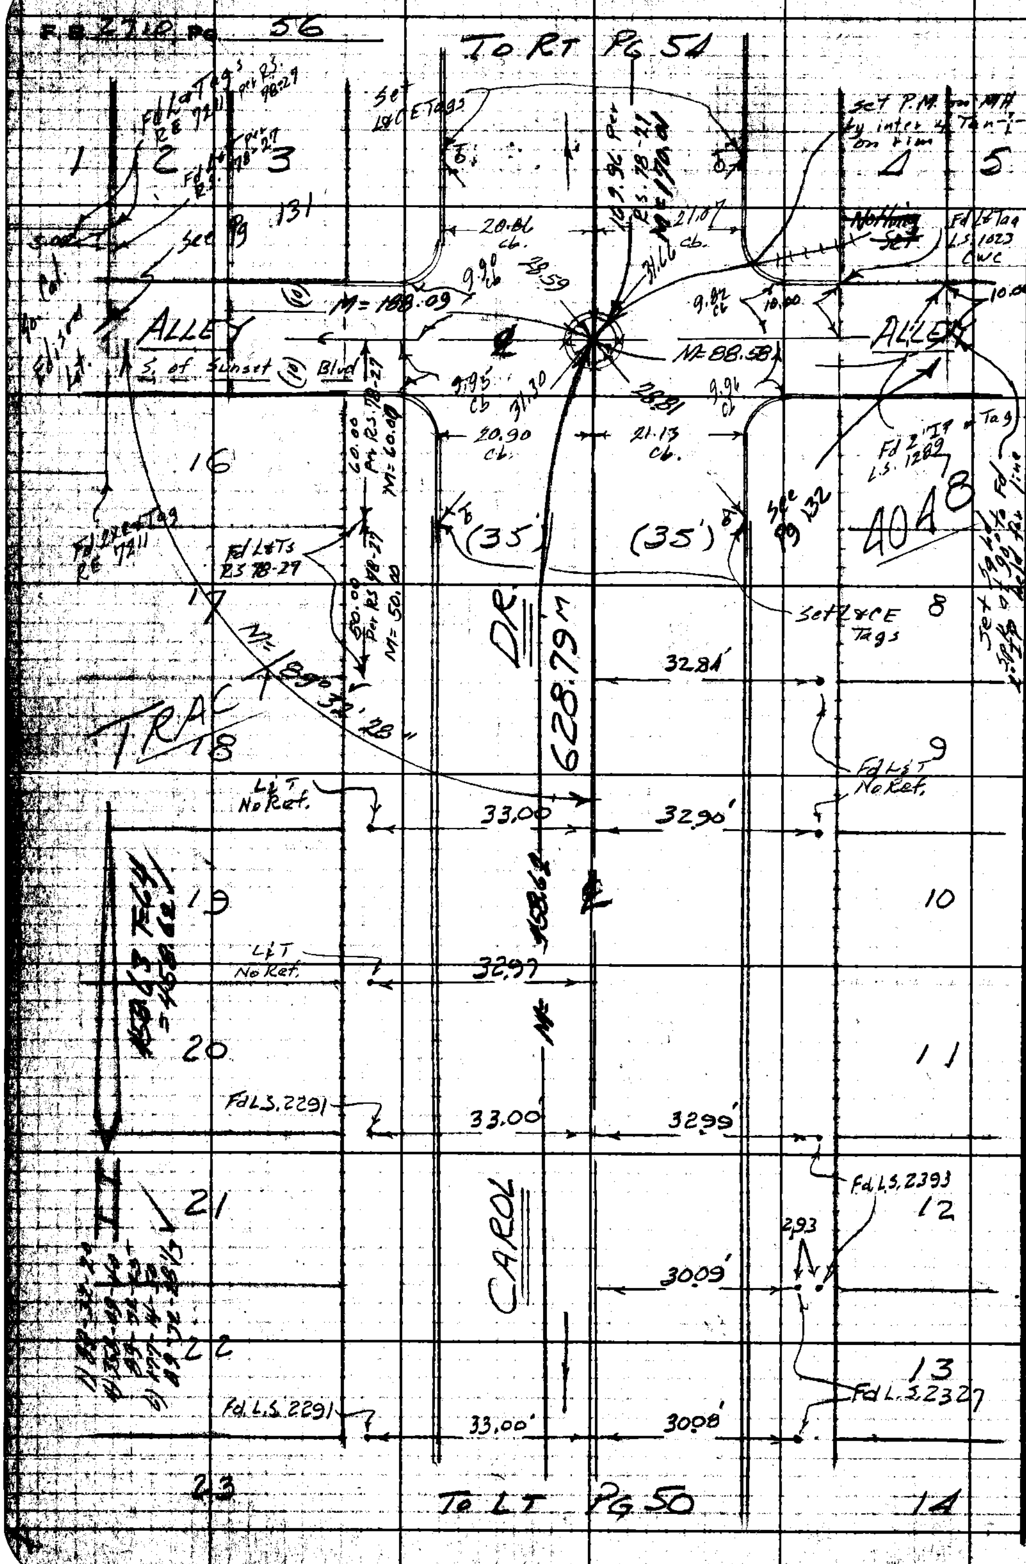

RETURN TO
LOS ANGELES COUNTY ENGINEER
700 LOS ANGELES COUNTY ENGINEERING BLDG.

Do not extend notes this side of this line.

Note: Any Additions or Changes on This Sheet Must be Made or Circled in Red Ink With Date and Name of Person Making Change.

Notes Ck'd by D. SAPPELL	Survey of W. Holy Shermans Dist
Map No. 5418	JN 0303.00 Tape 0135 Std 68 °F
Office Work E FONG	Surveyed by Monkey Jr.
Checked R. HILARIO	Notes ETM Jr. Date 1-29-62
Date 10-6-17-83	Indexed C. J. GALLI

F. B. 2710 Pg. 57

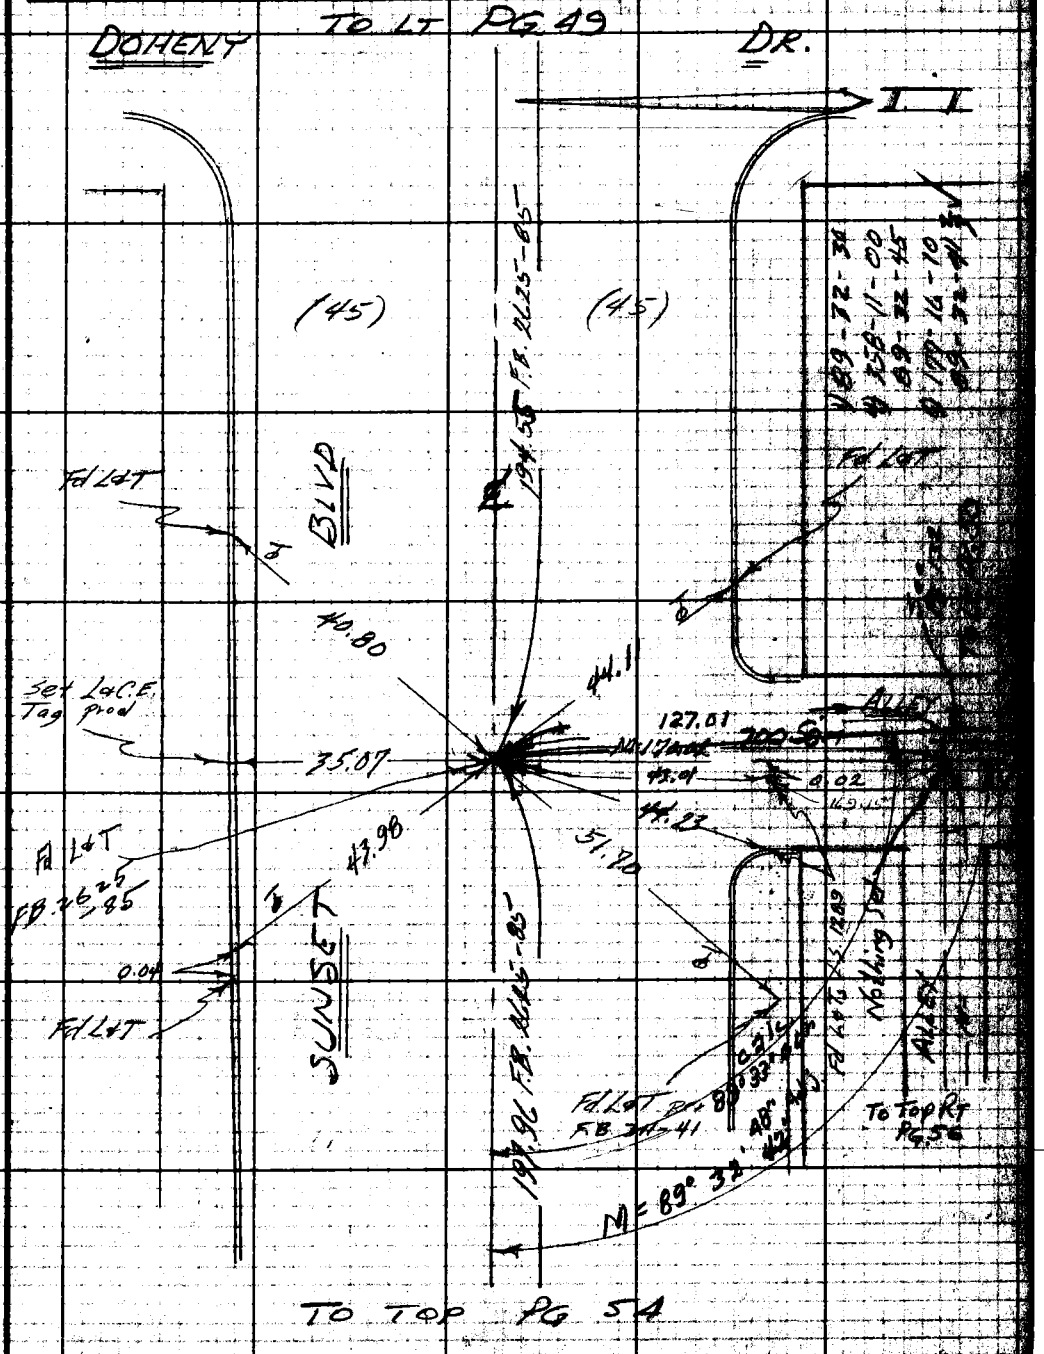

Note: Any Additions or Changes on This Sheet Must be Made or Circled in Red Ink With Date and Name of Person Making Change.

W.S. 22, B-2

Do not extend notes this side of this line.

RETURN TO
LOS ANGELES COUNTY ENGINEER
700 LOS ANGELES COUNTY ENGINEERING BLDG.

76F309S CE #247—3-77

F.B. 2710 PG. 58

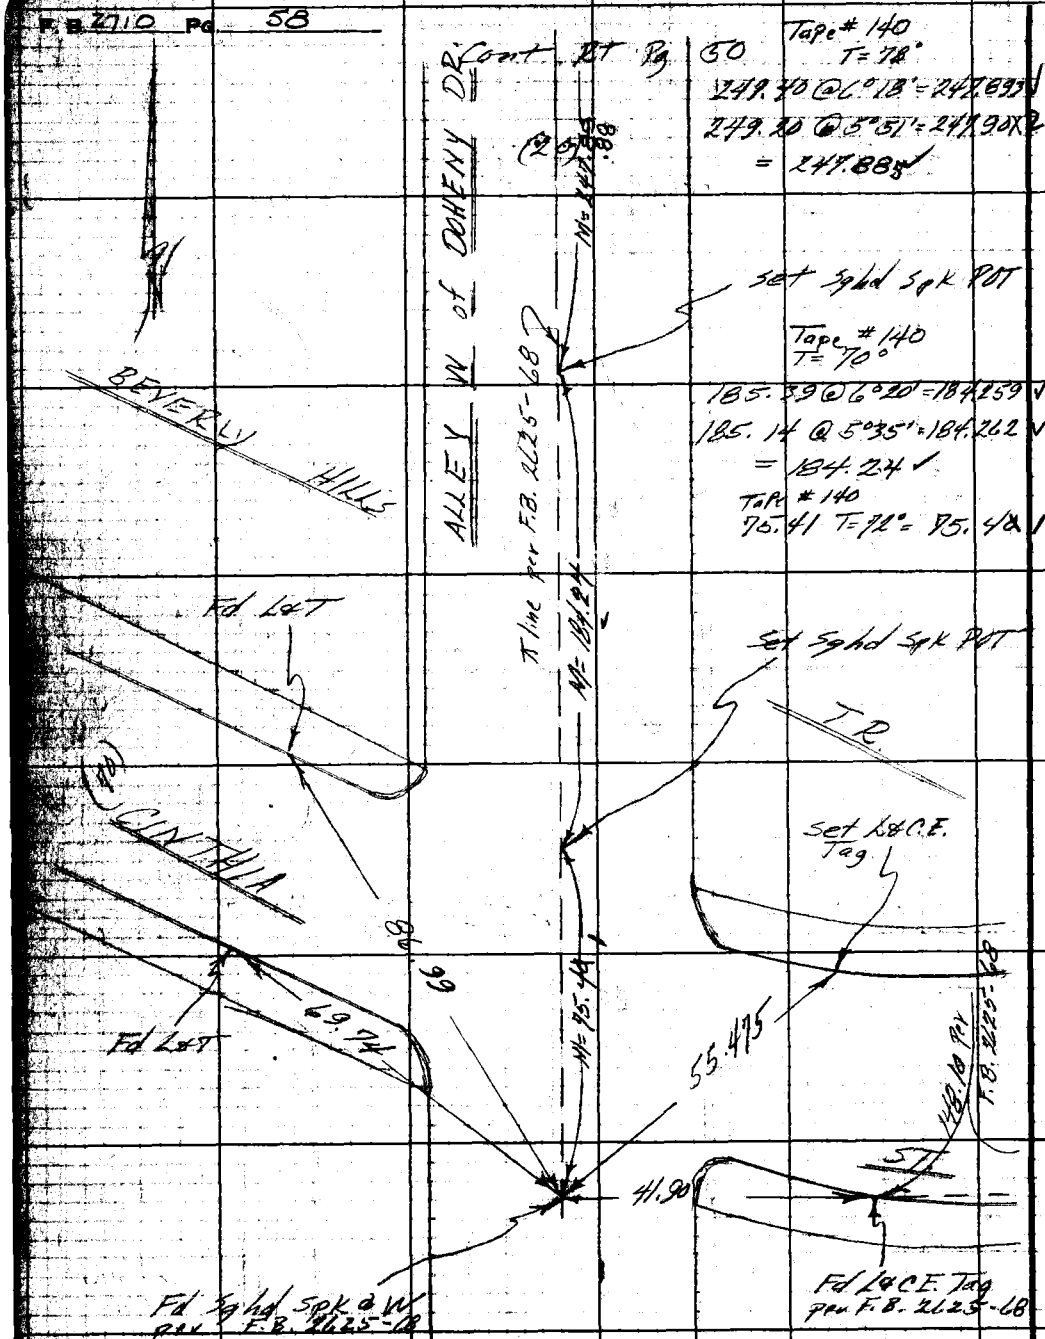

W.S. 22, B-3

RETURN TO
LOS ANGELES COUNTY ENGINEER
700 LOS ANGELES COUNTY ENGINEERING BLDG.

Do not extend notes this side of this line.

Note: Any Additions or Changes on This Sheet Must be Made or Circled in Red Ink With Date and Name of Person Making Change.

Notes Ck'd by D. SAPPELL	Survey of W. Hollywood & Sherman
Map No. 5418	IN 0303.00 Tape 0201 Std 68 °F
Office Work E FONG	Surveyed by F. E. Brooks
Checked R HILARIO	Notes F. E. Brooks Date 6 Feb 1962
Date 10-17-83	Indexed C. J. GALLI

S. Maint Dist. F. B. 2710 Pg. 59

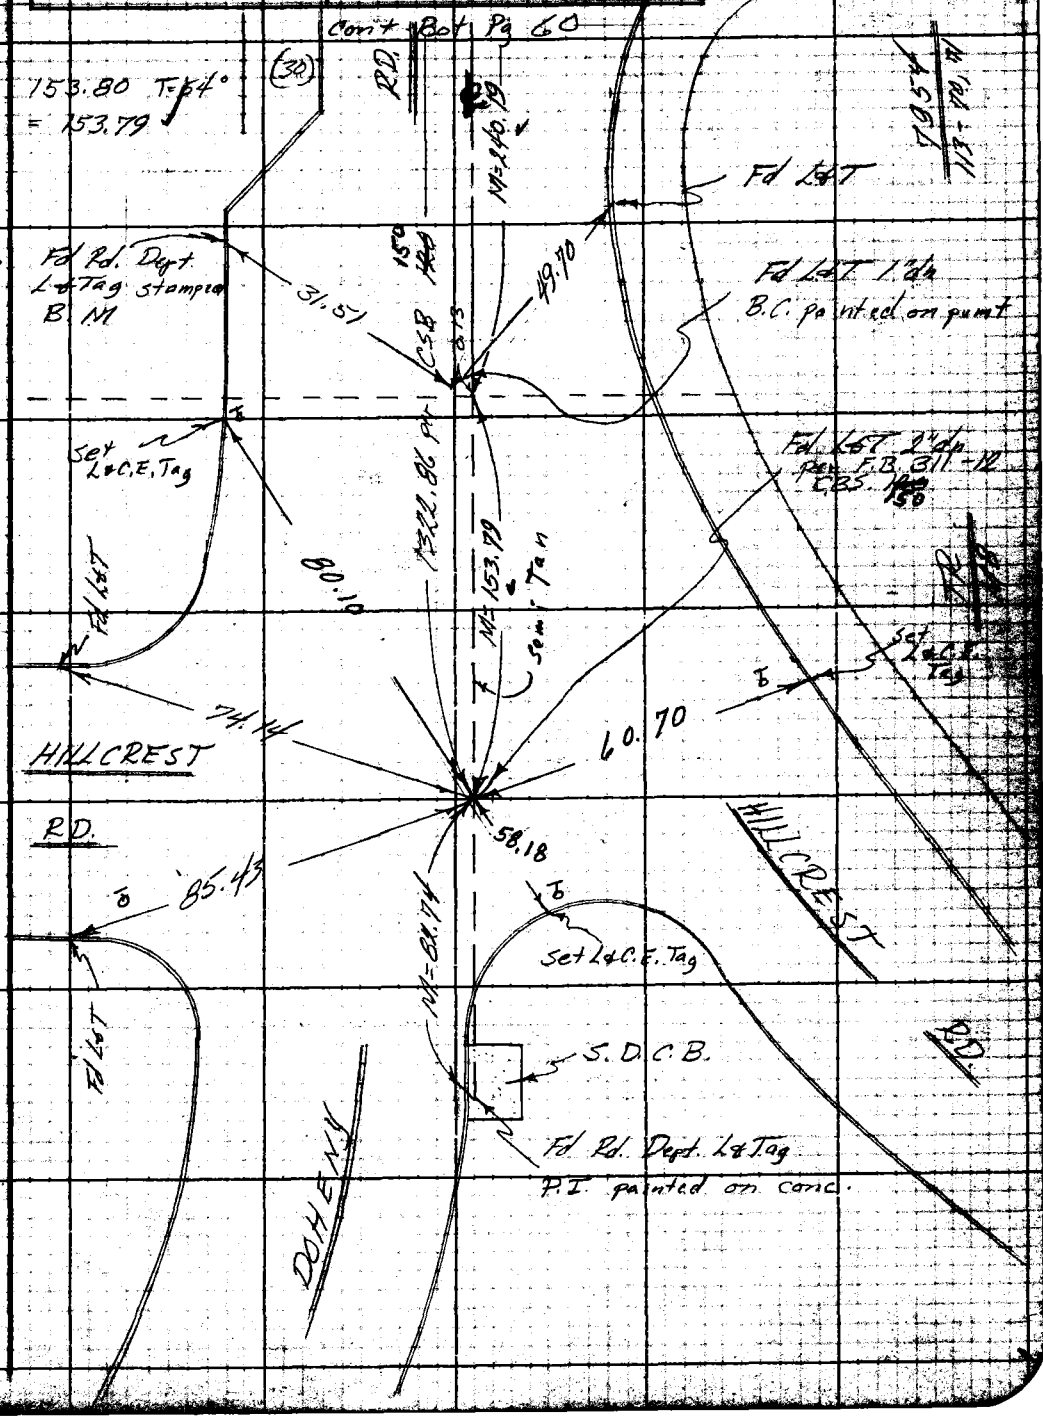

Note: Any Additions or Changes on This Sheet Must be Made or Circled in Red Ink With Data and Name of Person Making Change.

Do not extend notes this side of this line.

W.S. 22, B-2

RETURN TO
LOS ANGELES COUNTY ENGINEER
100 LOS ANGELES COUNTY ENGINEERING BLDG.

763098 CE #247—7-53

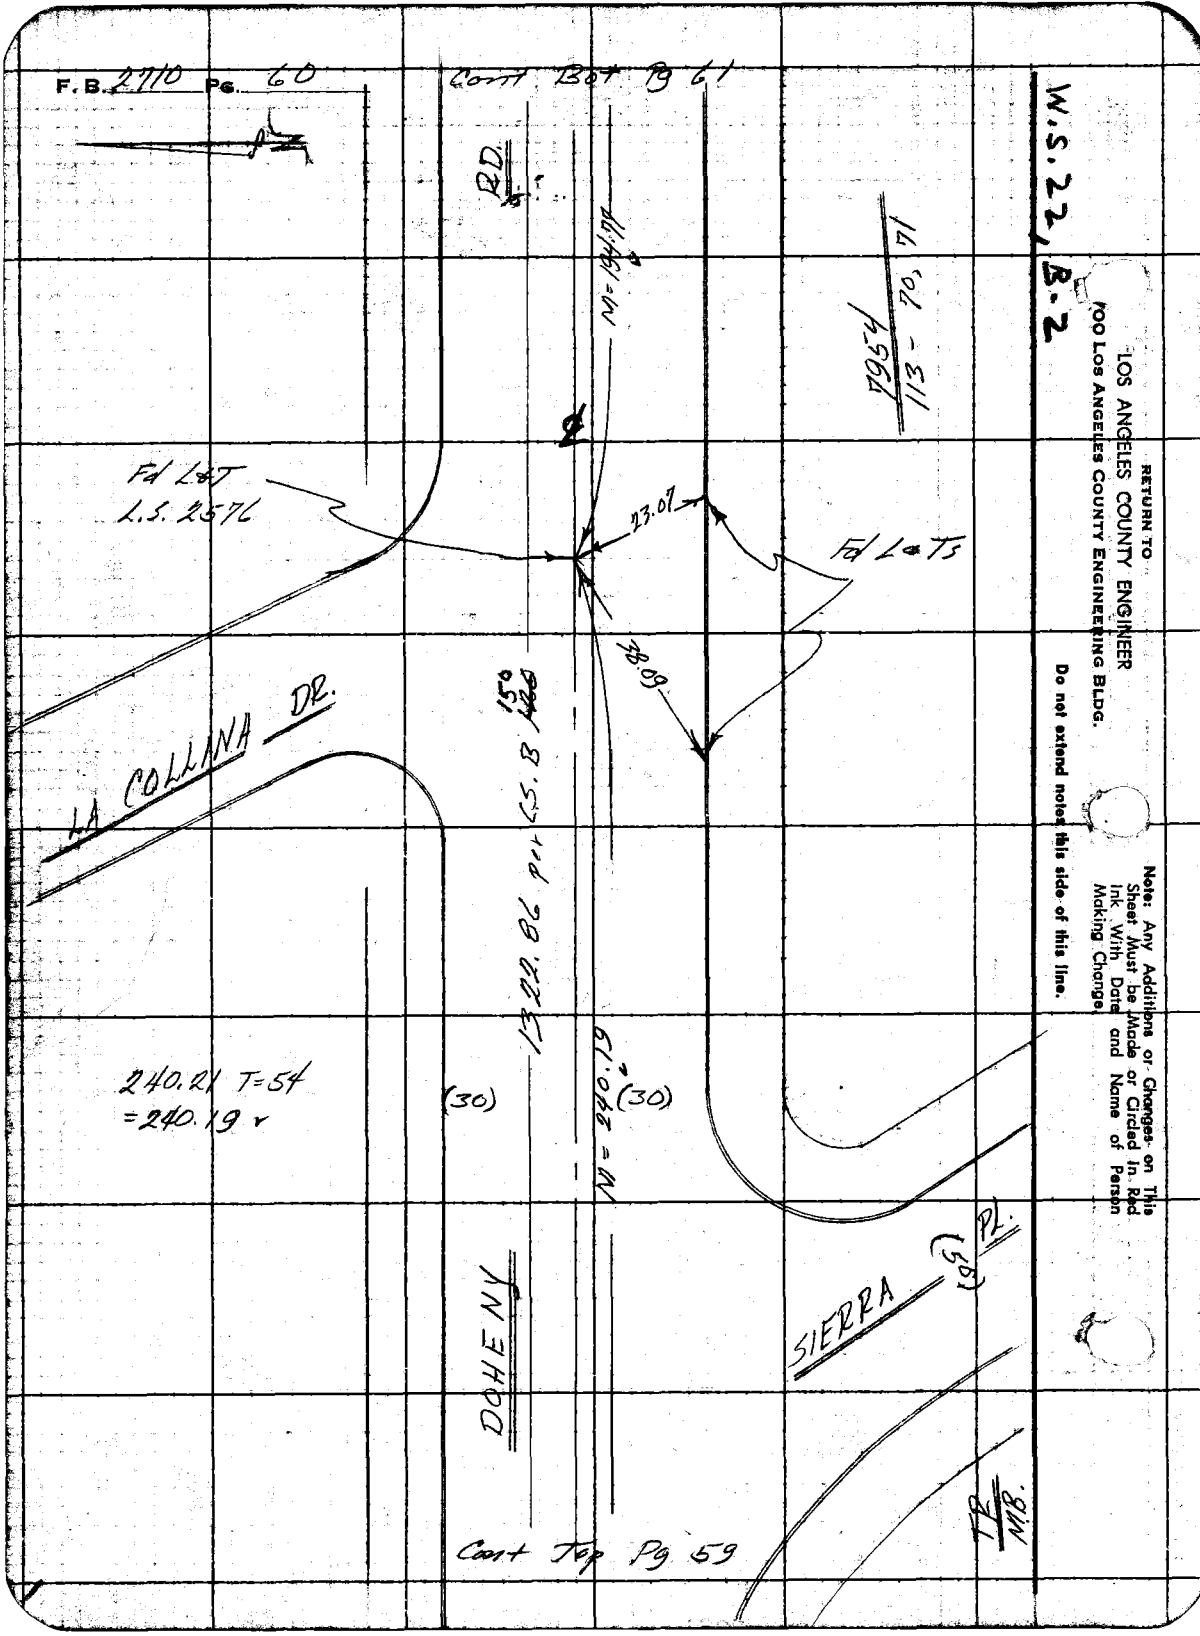
F.B. 2710 Pg. 60
Cont Bot Pg 61
RD.
M=194.77
7954
113-70, 71
Fd L&T
L.S. 2576
23.07
Fd L&Ts
38.09
150
1322.86 per C.S.B
LA COLLINA DR.
240.21 T=54
=240.19 r
(30)
(30)
M=240.19
DOHENY
SIERRA PL.
(50)
TR
MB.
Cont Top Pg 59
W.S. 22, B-2
RETURN TO
LOS ANGELES COUNTY ENGINEER
100 LOS ANGELES COUNTY ENGINEERING BLDG.
Do not extend notes this side of this line.
Note: Any Additions or Changes on This Sheet Must be Made or Circled in Red Ink With Date and Name of Person Making Change.

Notes Ck'd by D. SAPOLLE	Survey of W. Hollywood + Sherman S. Maint. Dist.
Map No. 5418	JN 0309.00 Tape 0201 Std 68 °F
Office Work E FONG	Surveyed by F. E. Brooks
Checked R. HILARIO	Notes F. E. Brooks Date 6 Feb 1962
Date 10-17-83	Indexed C. J. GALLI

F. B. 2710 PG. 61

Cont. Bot Pg 62

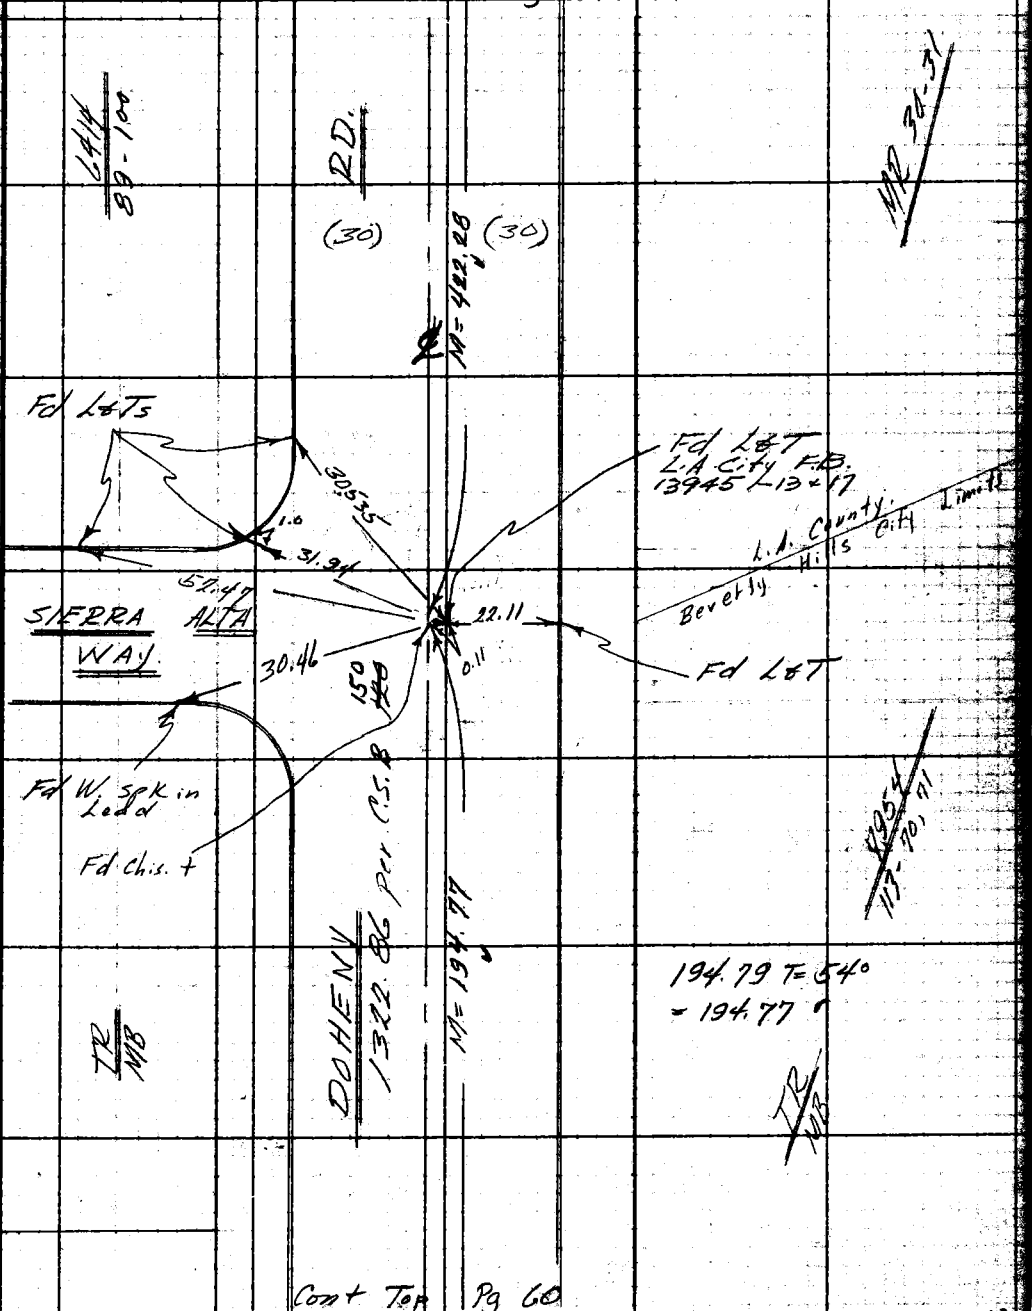

Cont Top Pg 60

Note: Any Additions or Changes on This Sheet Must be Made or Circled in Red Ink With Date and Name of Person Making Change.

W. S. 22, B-2

Do not extend notes this side of this line.

RETURN TO
LOS ANGELES COUNTY ENGINEER
700 LOS ANGELES COUNTY ENGINEERING BLDG.

763098 CE #247—7-53

F.B. 2710 PG. 62

Cont. Bot Pg 53

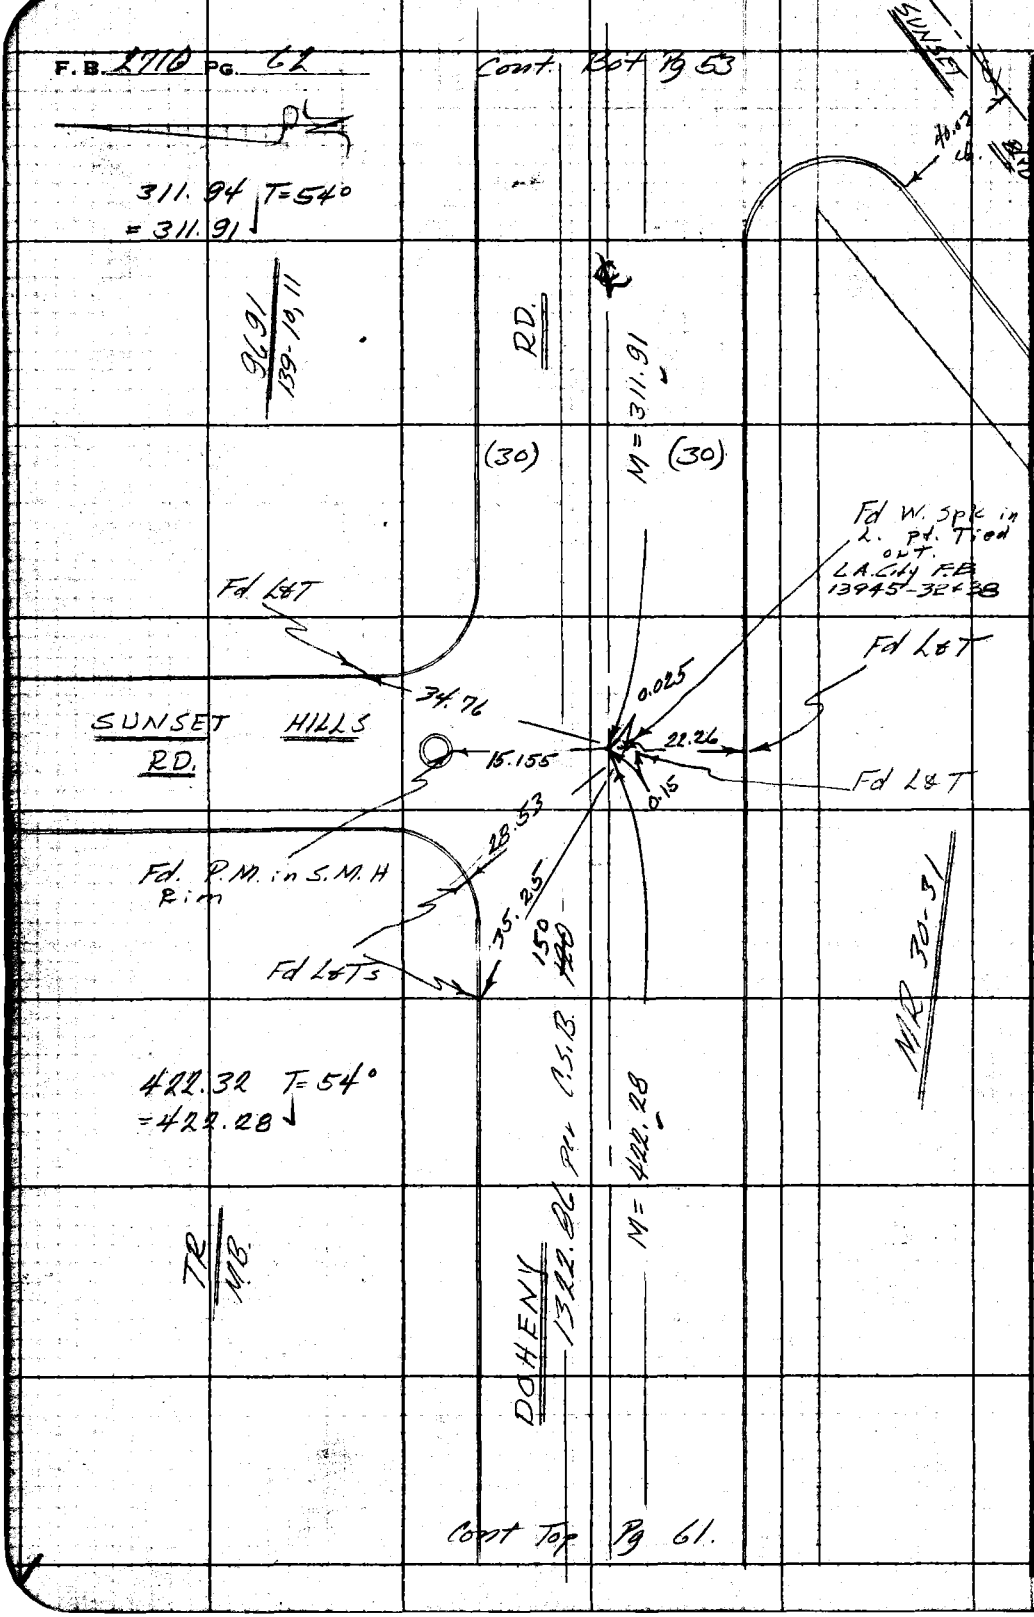

W.S. 22, B-2

RETURN TO
LOS ANGELES COUNTY ENGINEER
700 LOS ANGELES COUNTY ENGINEERING BLDG.

Do not extend notes this side of this line.

Note: Any Additions or Changes on This Sheet Must be Made or Circled in Red Ink With Date and Name of Person Making Change.

Cont Top Pg 61.

Notes Ck'd by D. SAPPELL	Survey of W. Hollywood & Sherman S. Maint Dist
Map No. 5418	IN 0303.08 Tape 0201 Std 68 °F
Office Work E FONG	Surveyed by F. E. Brooks
Checked R HILA 210	Notes F. E. Brooks Date 6 Feb 1962
Date 10-17-83	Indexed C. J. GALLI

F. B. 2710 PG. 63

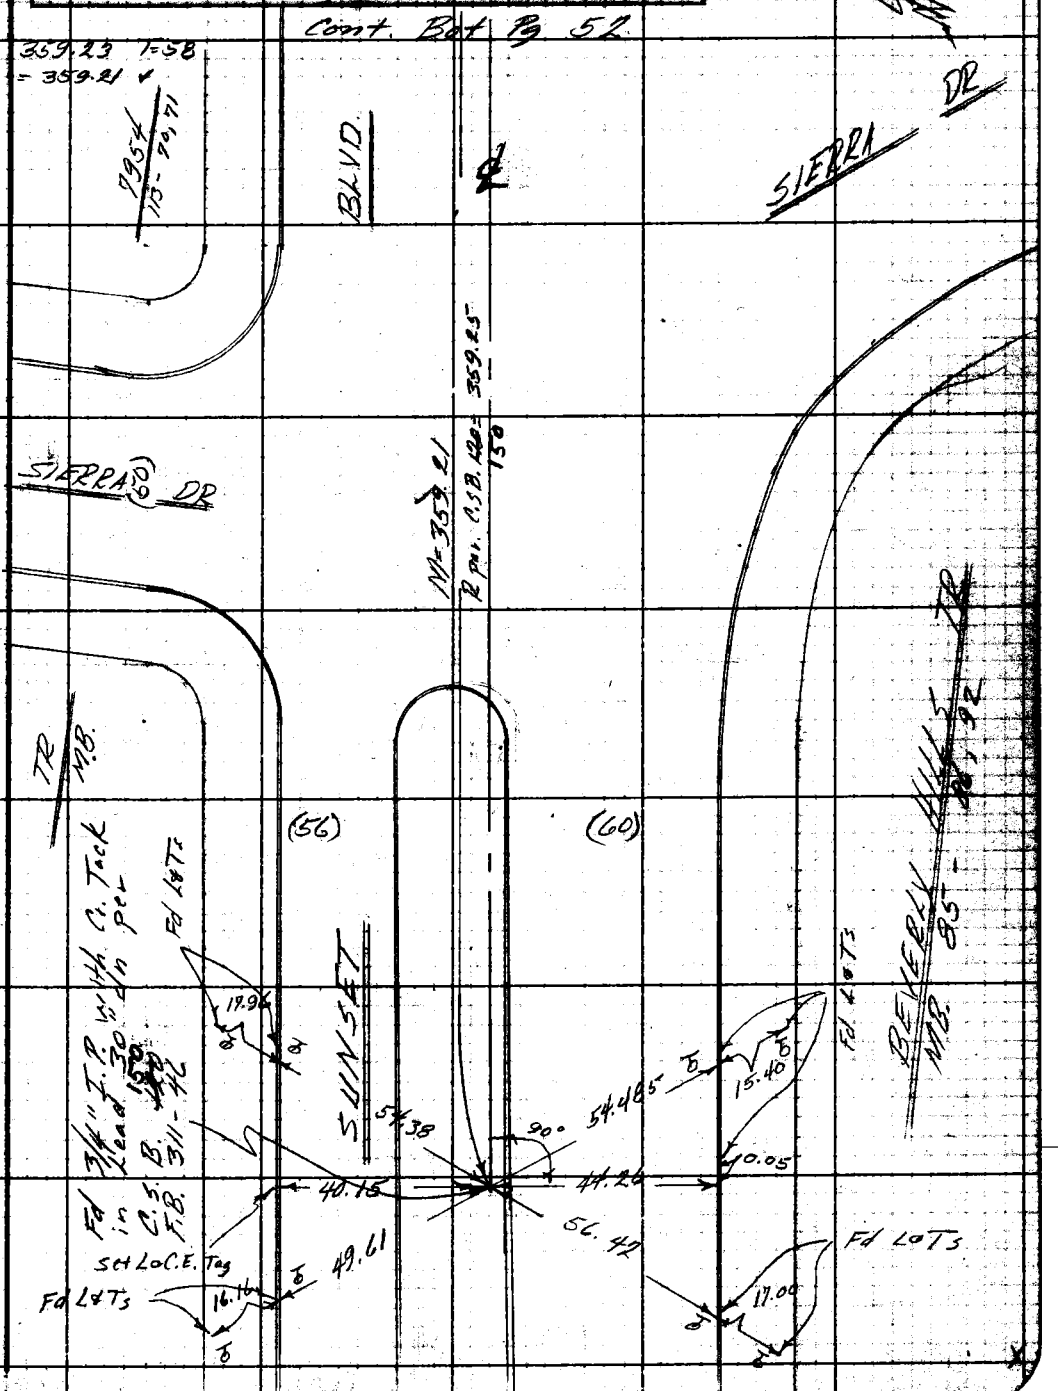

Note: Any Additions or Changes on This Sheet Must be Made or Circled in Red Ink With Date and Name of Person Making Change.

Do not extend notes this side of this line.

RETURN TO
LOS ANGELES COUNTY ENGINEER
700 LOS ANGELES COUNTY ENGINEERING BLDG.

763098 CE #247—7-53

RETURN TO
LOS ANGELES COUNTY ENGINEER
700 LOS ANGELES COUNTY ENGINEERING BLDG.

Note: Any Additions or Changes on This Sheet Must be Made or Circled in Red Ink With Date and Name of Person Making Change.

Do not extend notes this side of this line.

W.S. 22, B-3

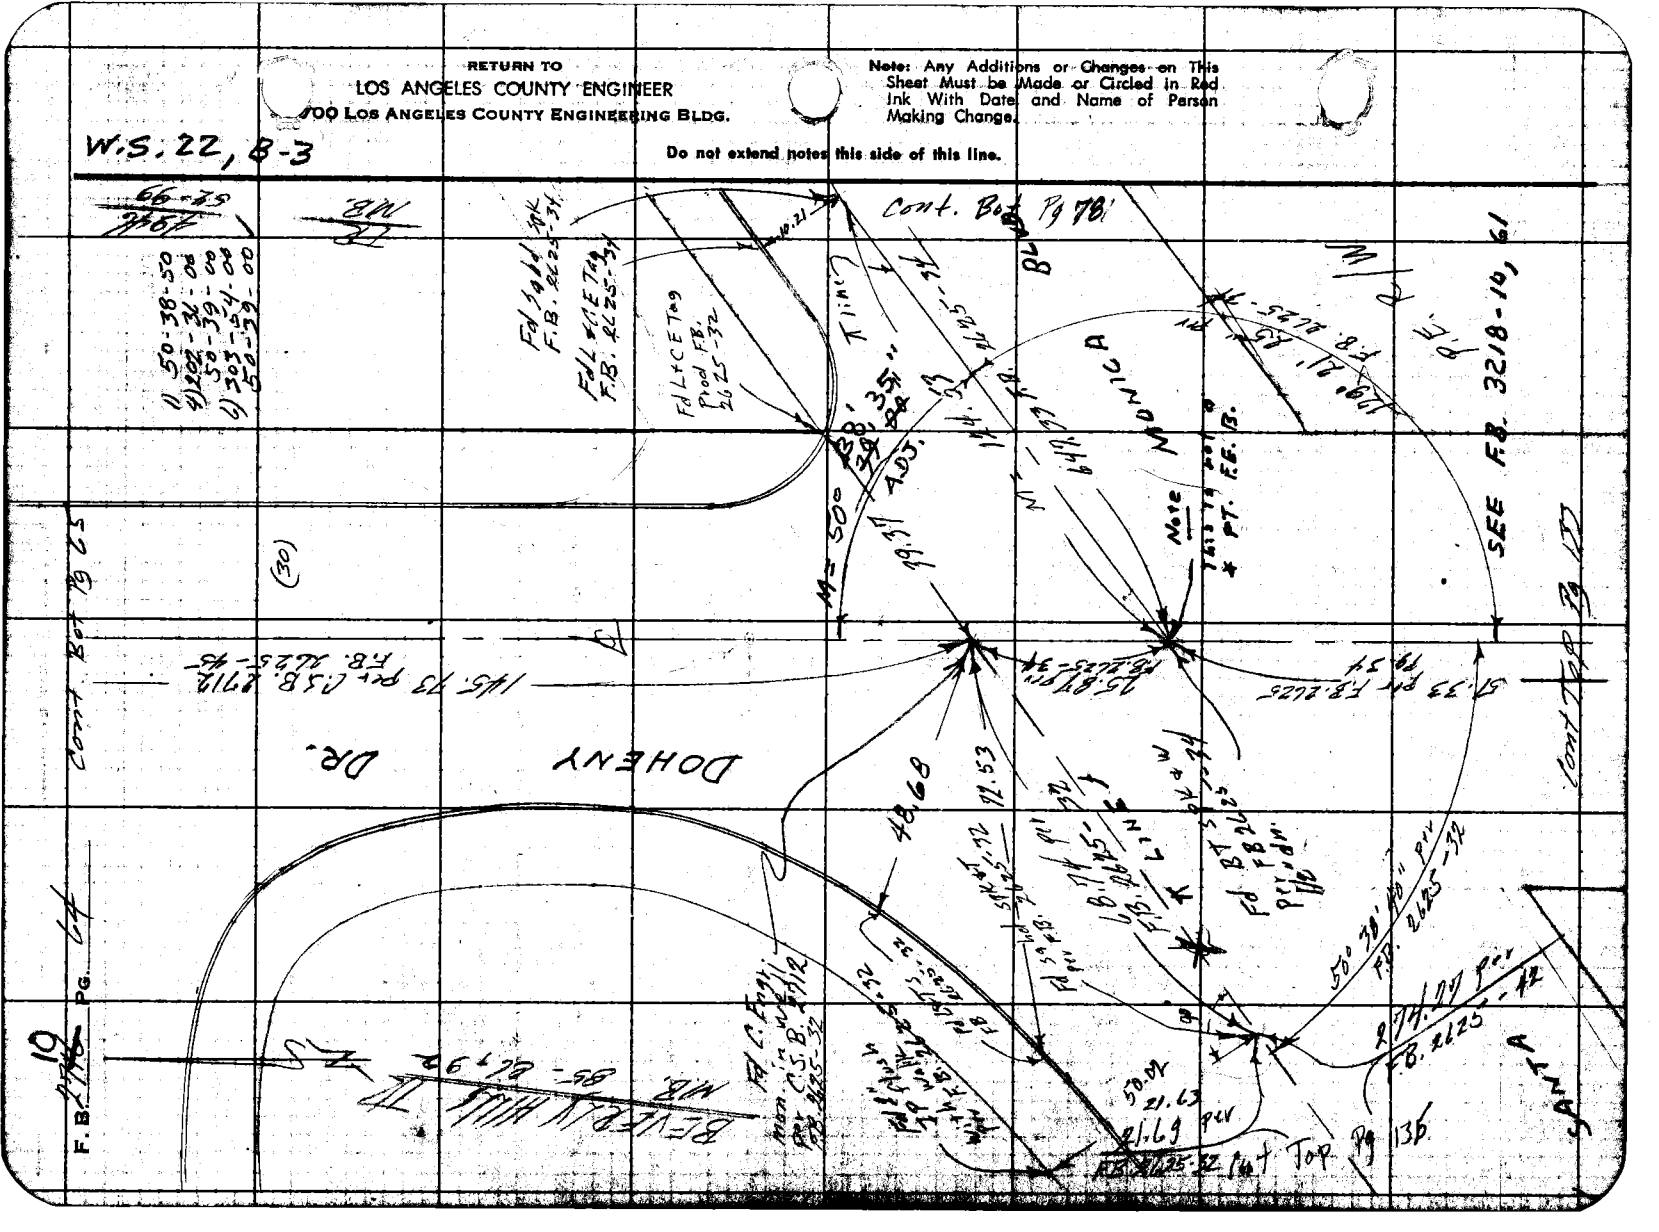

Notes Ck'd by D. SAPPELL	Survey of W. Hollywood & Sherman S. Maint. Dist
Map No. 5418	JN 0303.00 Tape 0201 Std 68 °F
Office Work E FONG	Surveyed by E. E. Brooks
Checked R HILARIO	Notes E. E. Brooks Date 7 Feb 19[illegible]
Date 10-17-83	Indexed C. J. GALLI

F. B. 2710 PG. 65

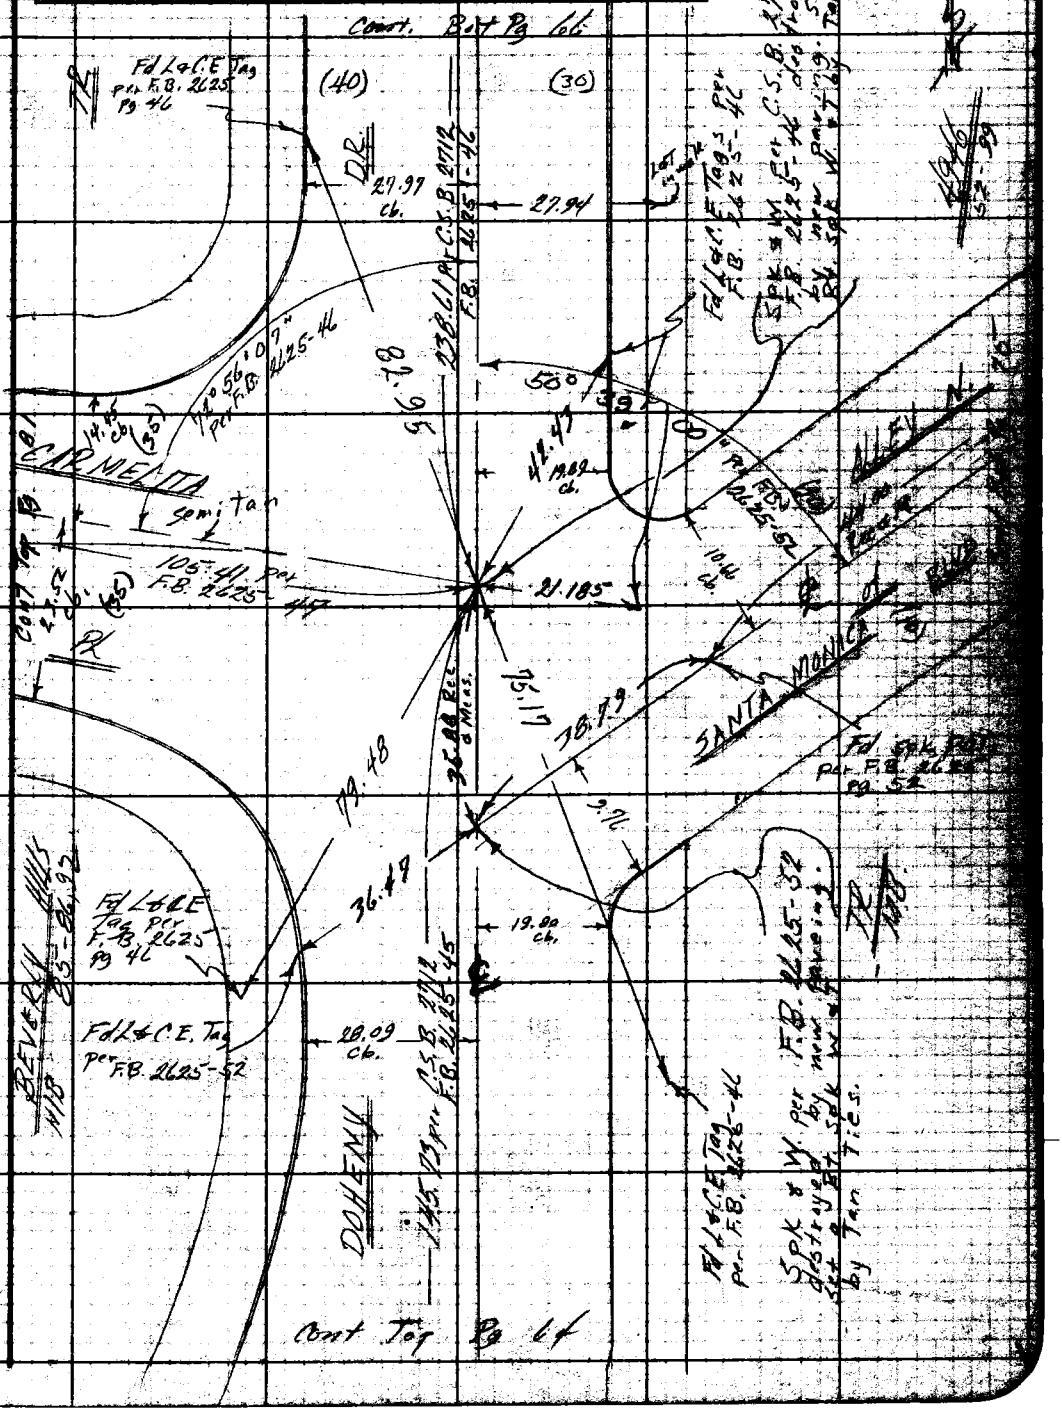

Note: Any Additions or Changes on This Sheet Must be Made or Circled in Red Ink With Date and Name of Person Making Change.

W.S. 22, B-3

Do not extend notes this side of this line.

RETURN TO
LOS ANGELES COUNTY ENGINEER
900 LOS ANGELES COUNTY ENGINEERING BLDG.

763098 CE #247—7-53

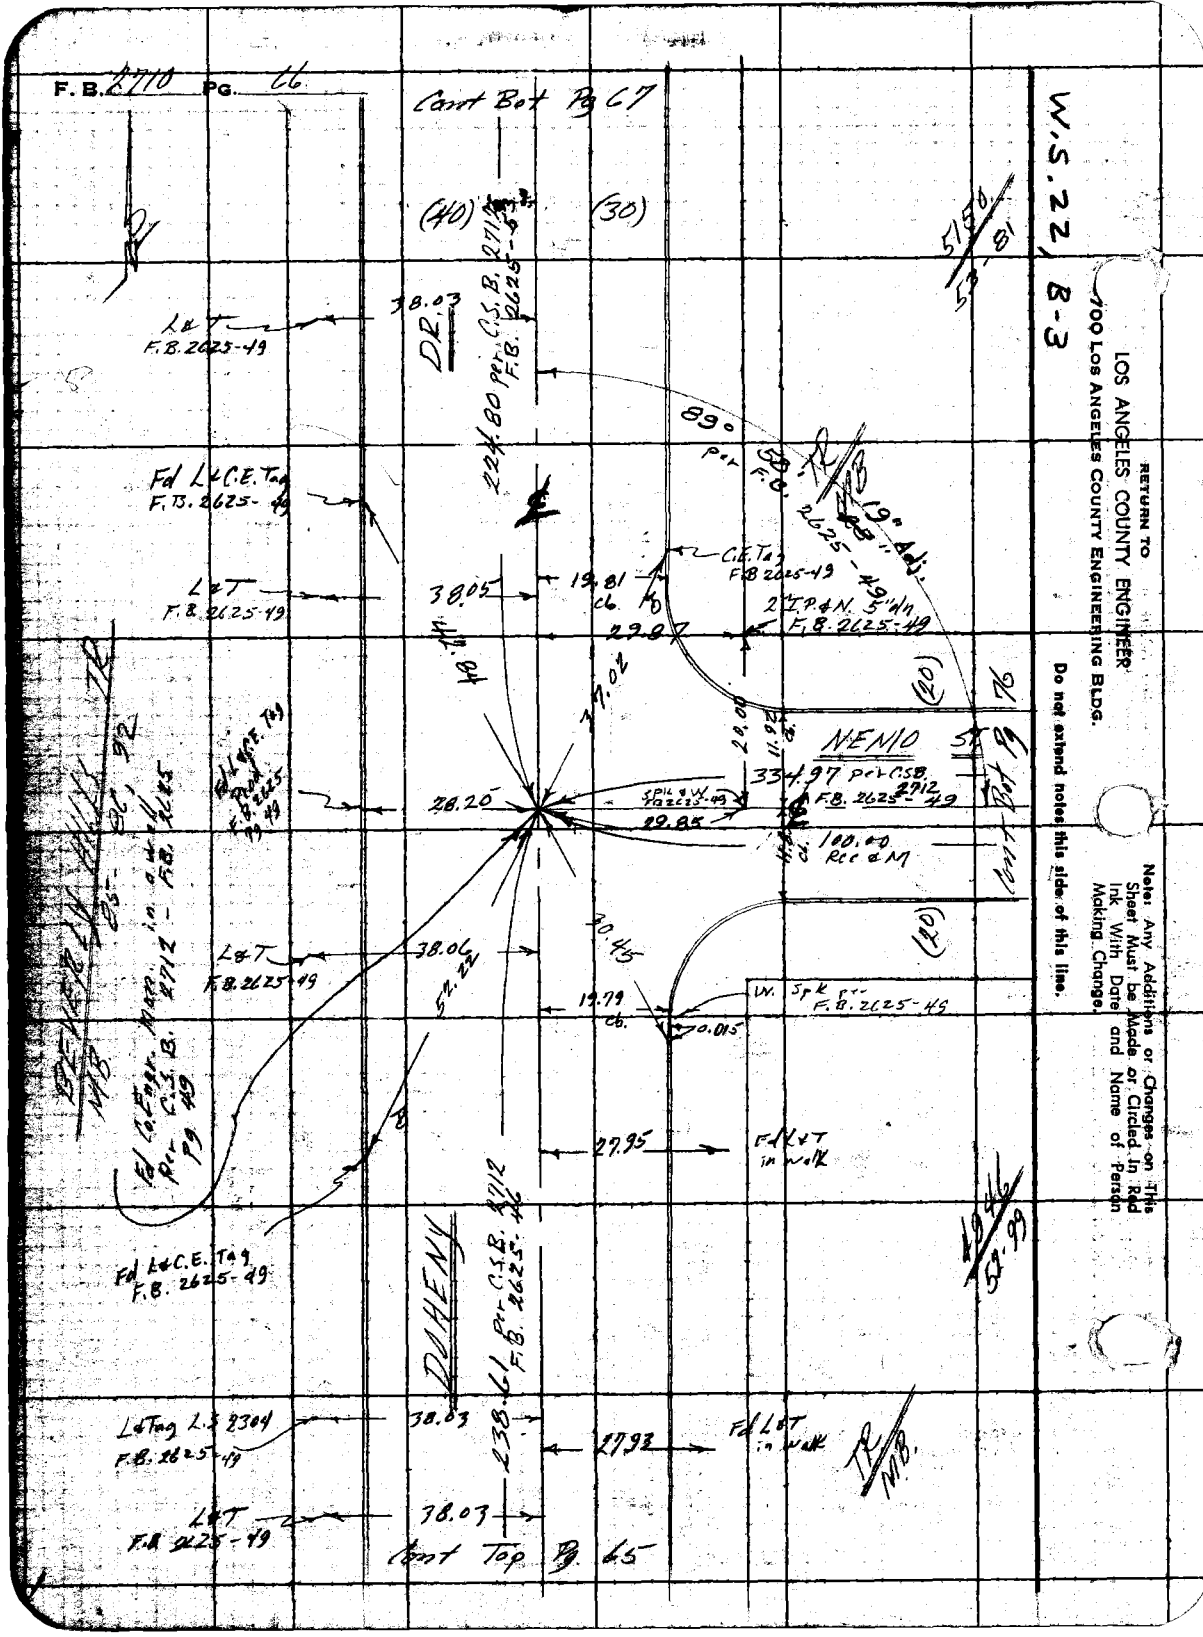
F.B. 2710 PG. 66
Cont Bot Pg 67
(40)
(30)
5150
53-81
L&T
F.B. 2625-49
38.03
DR.
224.80 per C.S.B. 2712
F.B. 2625-49
89°
per F.B. 2625-49
19" Adj.
Fd L&C.E. Tag
F.B. 2625-49
C.E. Tag
F.B. 2625-49
L&T
F.B. 2625-49
38.05
19.81
cb.
2" I.P. & N. 5" d/n
F.B. 2625-49
29.87
(20)
76
NEMO ST.
334.97 per C.S.B. 2712
F.B. 2625-49
28.20
29.85
100.00
Rec & M
Cont Bot Pg 76
L&T
F.B. 2625-49
38.06
30.45
(20)
19.79
cb.
W. Spk per
F.B. 2625-49
0.015
27.95
Fd L&T
in walk
Fd L&C.E. Tag
F.B. 2625-49
DOHENY
238.61 per C.S.B. 2712
F.B. 2625-49
L&Tag L.S. 2304
F.B. 2625-49
38.03
27.93
Fd L&T
in walk
L&T
F.B. 2625-49
38.03
Cont Top Pg 65
BEVERLY HILLS
MB
Fd Co. Engr. Mon. in a wall
per C.S.B. 2712 - F.B. 2625
Pg 49
W.S. 22, B-3
RETURN TO
LOS ANGELES COUNTY ENGINEER
100 LOS ANGELES COUNTY ENGINEERING BLDG.
Do not extend notes this side of this line.
Note: Any Additions or Changes on This Sheet Must be Made or Circled in Red Ink With Date and Name of Person Making Change.

Sewer Maint Dist #3

Notes Ck'd by D. SAPPELL	Survey of W. Hollywood & Sherman
Map No. 5418	IN 0303.00 Tape 0201 Std 60 °F
Office Work E FONG	Surveyed by F. E. Brooks
Checked R HILARIO	Notes F. E. Brooks Date 7 Feb 1962
Date 10-17-83	Indexed C. J. GALLI

F. B. 2710 PG. 67

Cont Bot Pg 68

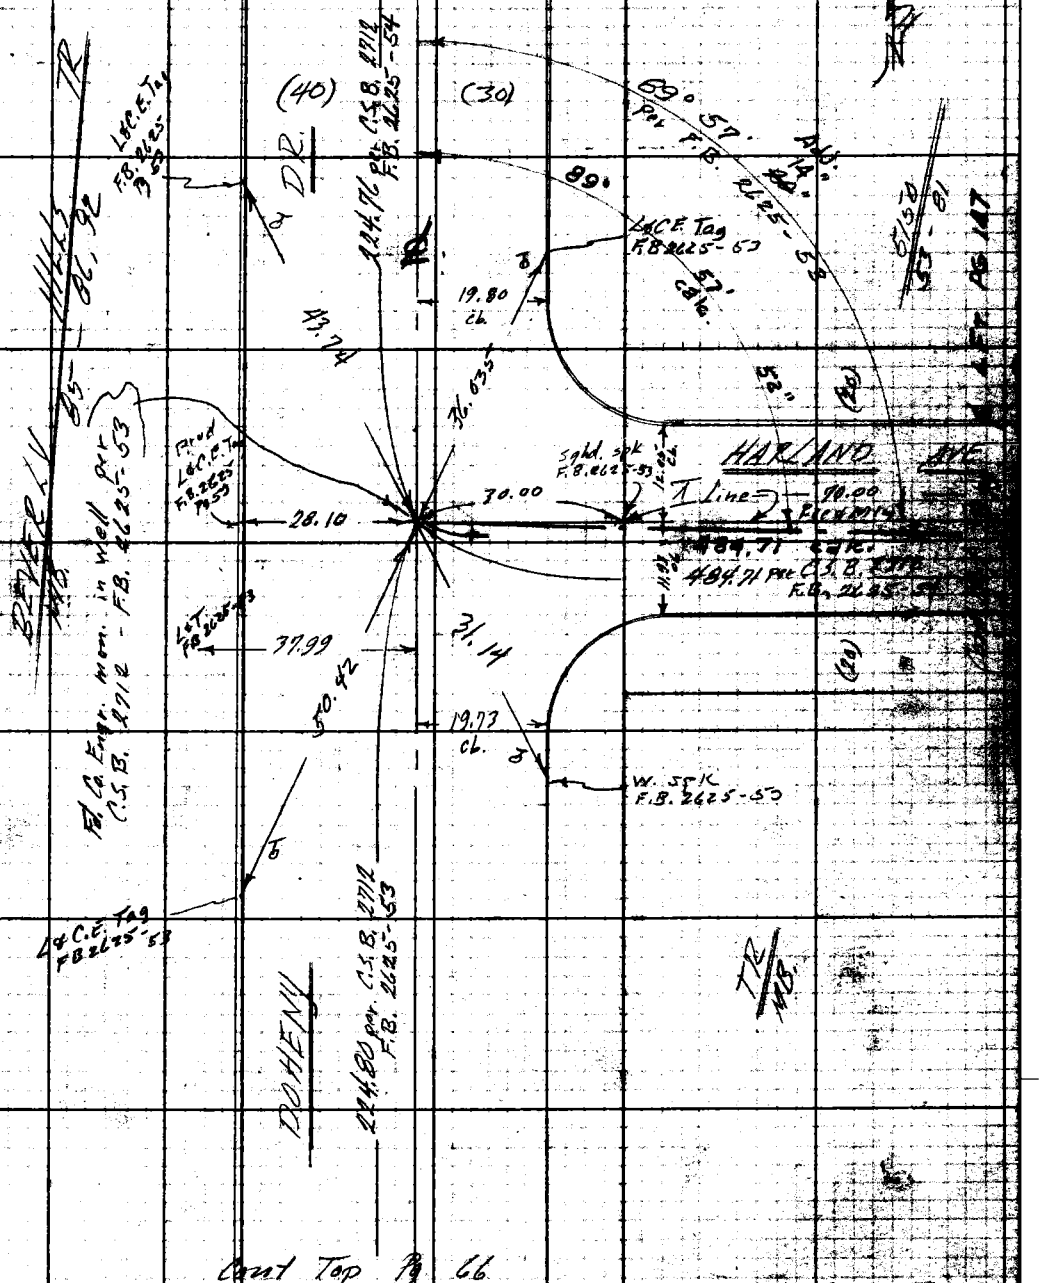

Cont Top Pg 66

W.S. 22, B-3

Note: Any Additions or Changes on This Sheet Must be Made or Circled in Red Ink With Date and Name of Person Making Change.

Do not extend notes this side of this line.

RETURN TO
LOS ANGELES COUNTY ENGINEER
100 LOS ANGELES COUNTY ENGINEERING BLDG.

763098 CE #247—7-53

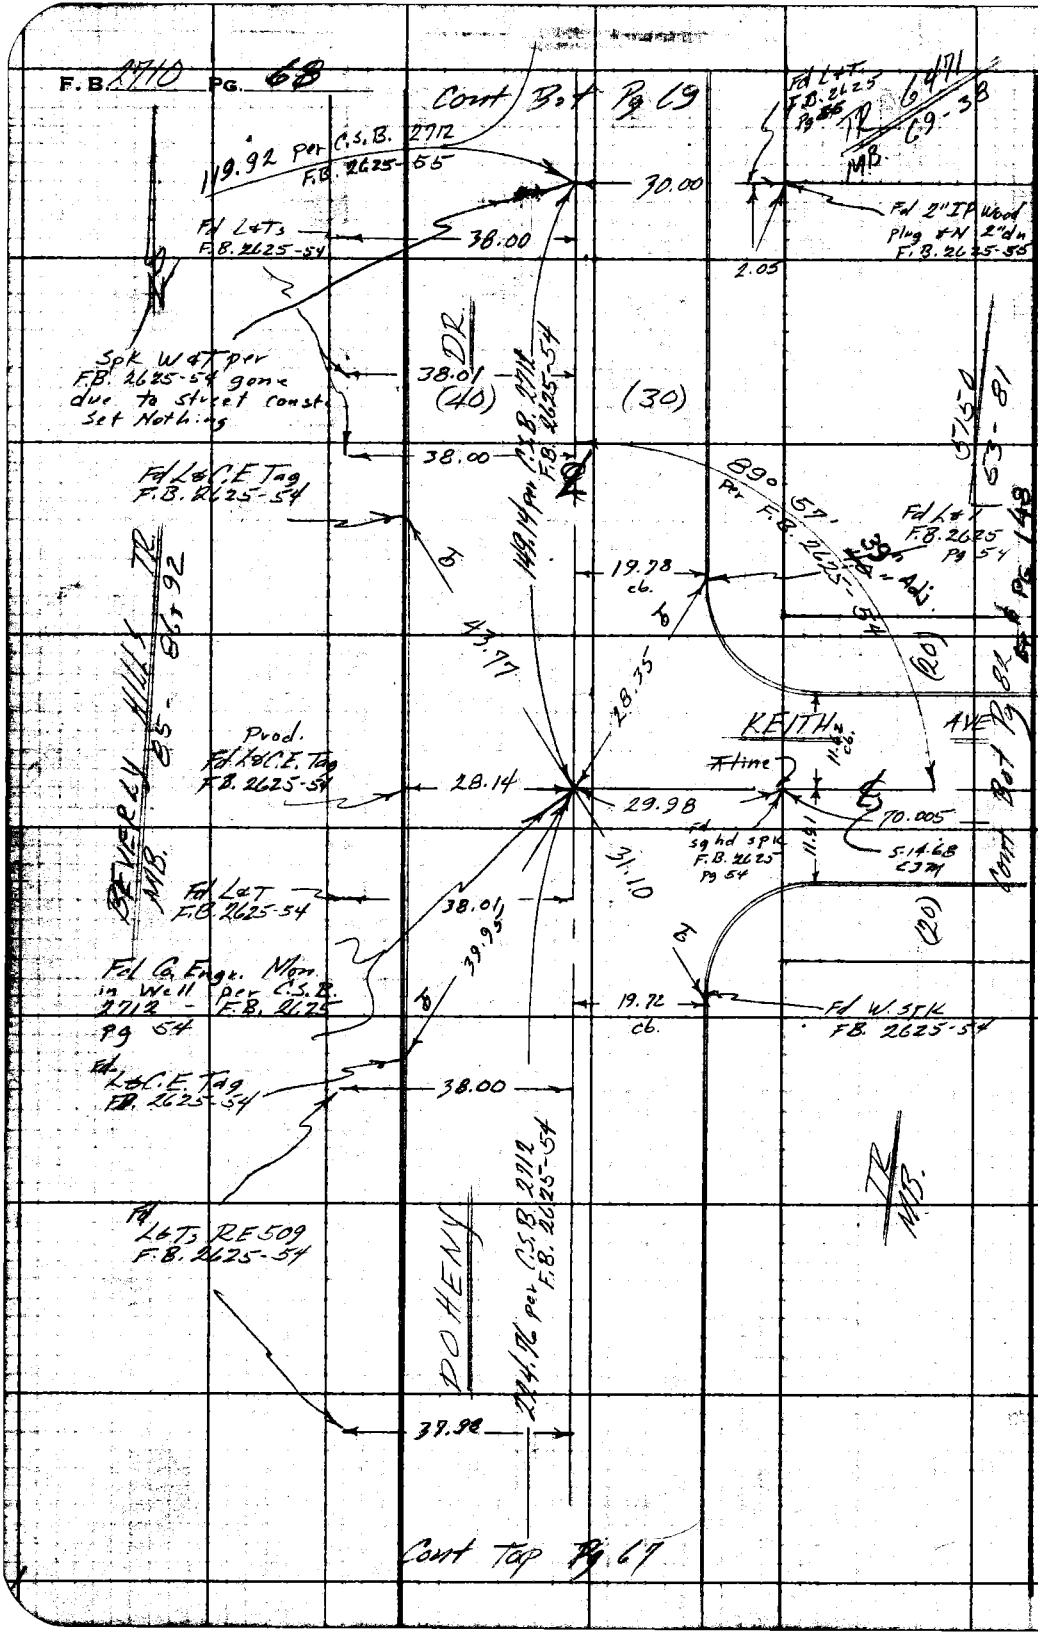

W.S. 22, B-3

RETURN TO
LOS ANGELES COUNTY ENGINEER
100 LOS ANGELES COUNTY ENGINEERING BLDG.

Do not extend notes this side of this line.

Note: Any Additions or Changes on This Sheet Must be Made or Circled in Red Ink With Date and Name of Person Making Change.

W. Hollywood &

Notes Ck'd by D. SAPPELL	Survey of Sherman Sewer Maint Dist
Map No. 5418	IN 0303.00 Tape 0201 Std 68 °F
Office Work E FONG	Surveyed by F. E. Brooks
Date 10-17-83	Indexed C. J. GALLI

F. B. 2710 PG. 69

Cont Bot Pg 70

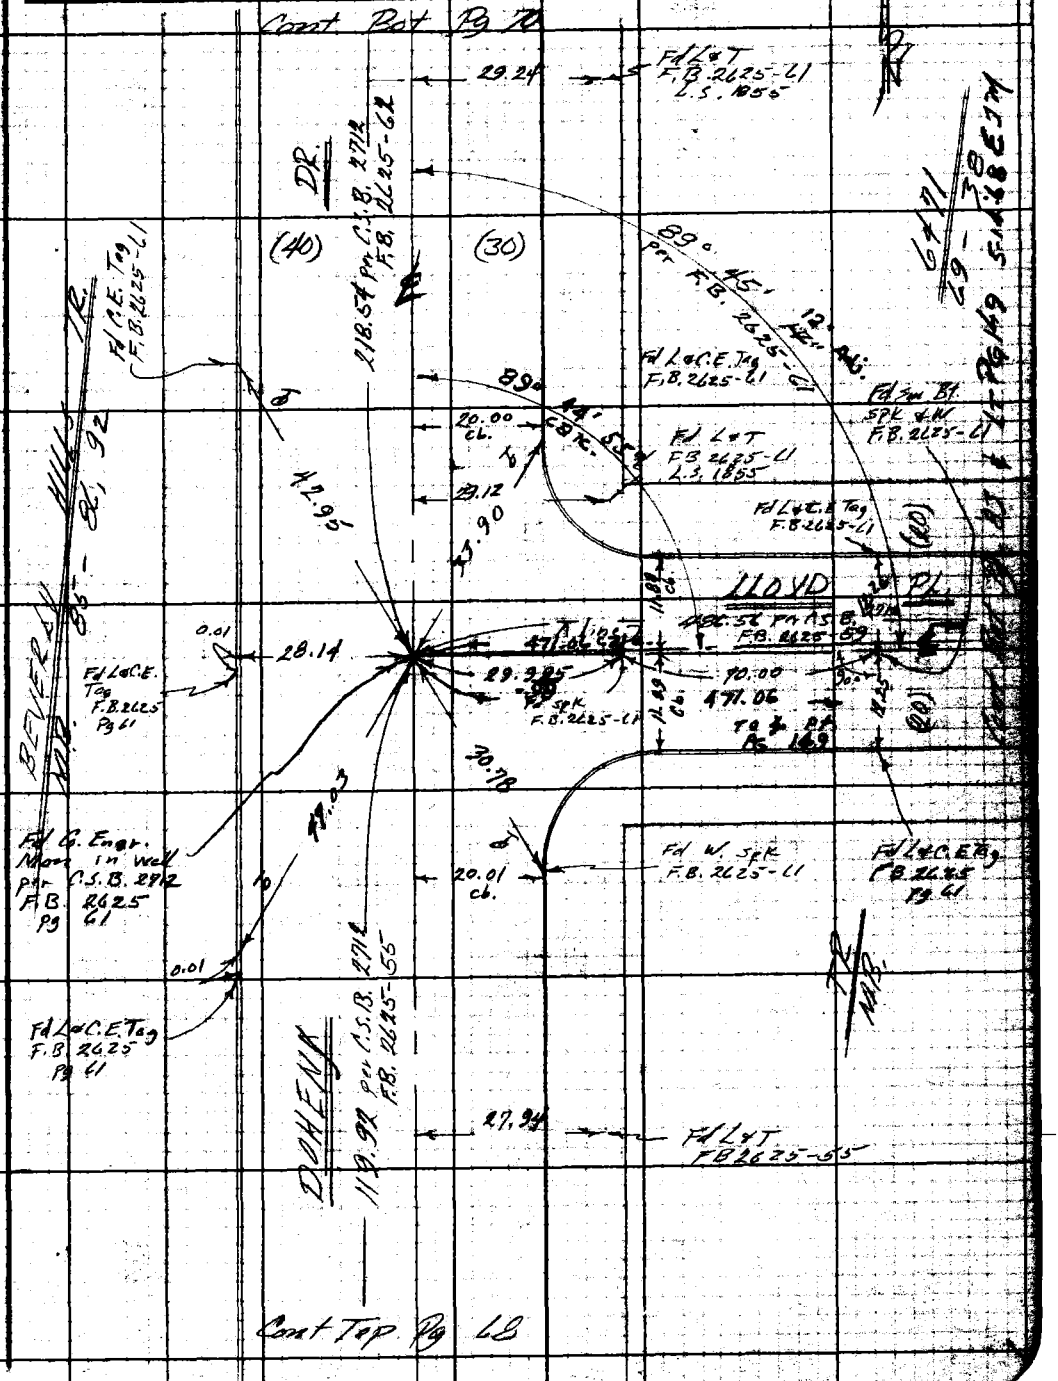

Cont Top Pg 68

W.S. 22, B-3

Notes: Any Additions or Changes on This Sheet Must be Made or Circled in Red Ink With Date and Name of Person Making Change.

Do not extend notes this side of this line.

RETURN TO
LOS ANGELES COUNTY ENGINEER
100 LOS ANGELES COUNTY ENGINEERING BLDG.

763098 CE #247—7-53

F.B. 2710 PG. 70

Cont Bot Pg 71

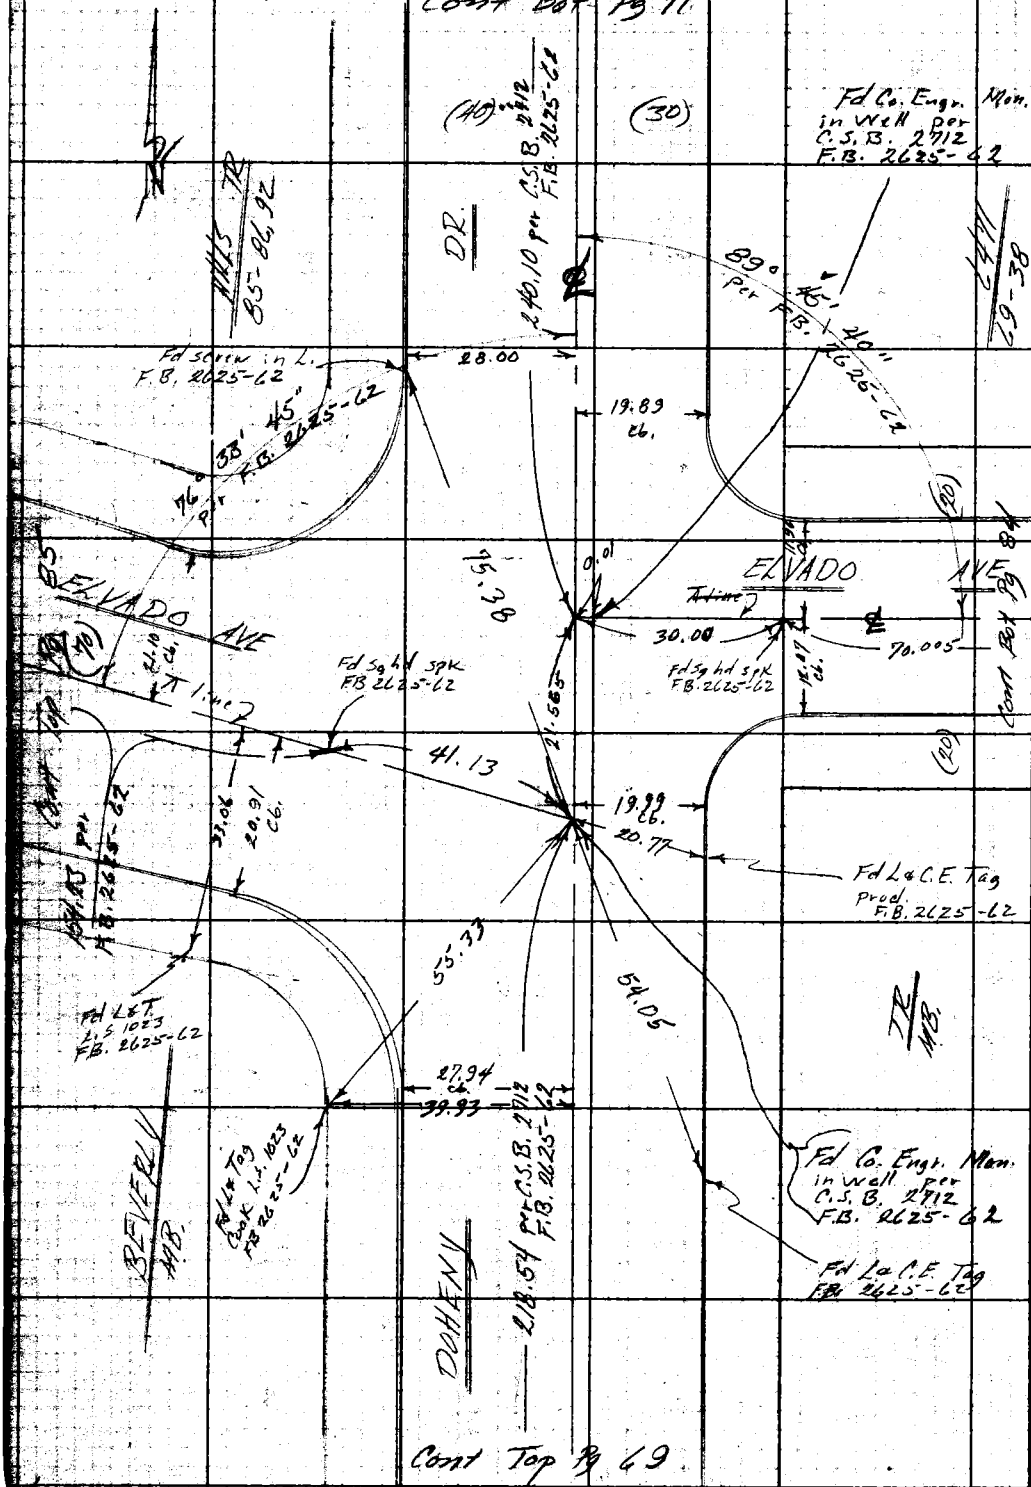

Cont Top Pg 69

W.S. 22, B-3

RETURN TO
LOS ANGELES COUNTY ENGINEER
100 LOS ANGELES COUNTY ENGINEERING BLDG.

Do not extend notes this side of this line.

Note: Any Additions or Changes on This Sheet Must be Made or Circled in Red Ink With Date and Name of Person Making Change.

W. Hollywood & Sherman

Notes Ck'd by D. SAPPELL	Survey of Sewer Maint. Dist #3
Map No. 5418	IN 0303.04 Tape 0201 Std 68 °F
Office Work E FONG	Surveyed by F. E. Brooks
Checked R HILARIO	Notes F. E. Brooks Date 13 Feb 1962
Date 10-17-83	Indexed C. J. GALLI

F. B 2710 PG. 71

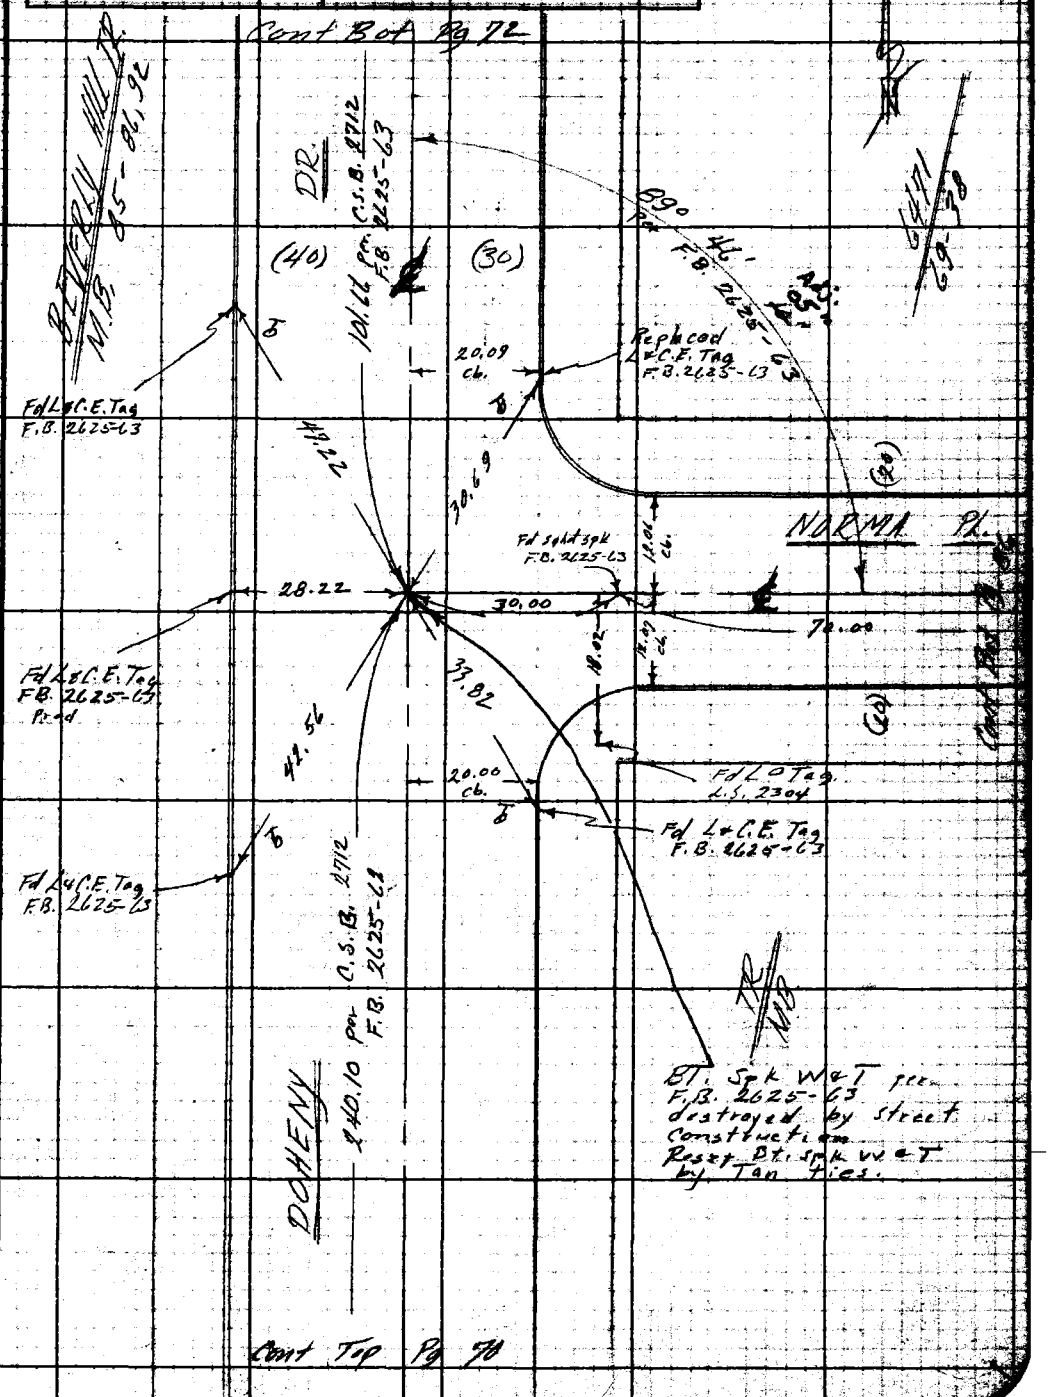

Note: Any Additions or Changes on This Sheet Must be Made or Circled in Red Ink With Date and Name of Person Making Change.

W.S. 71, B-3

Do not extend notes this side of this line.

RETURN TO
LOS ANGELES COUNTY ENGINEER
100 LOS ANGELES COUNTY ENGINEERING BLDG.

763098 CE #247—7-53

F.B. 2710 PG. 72

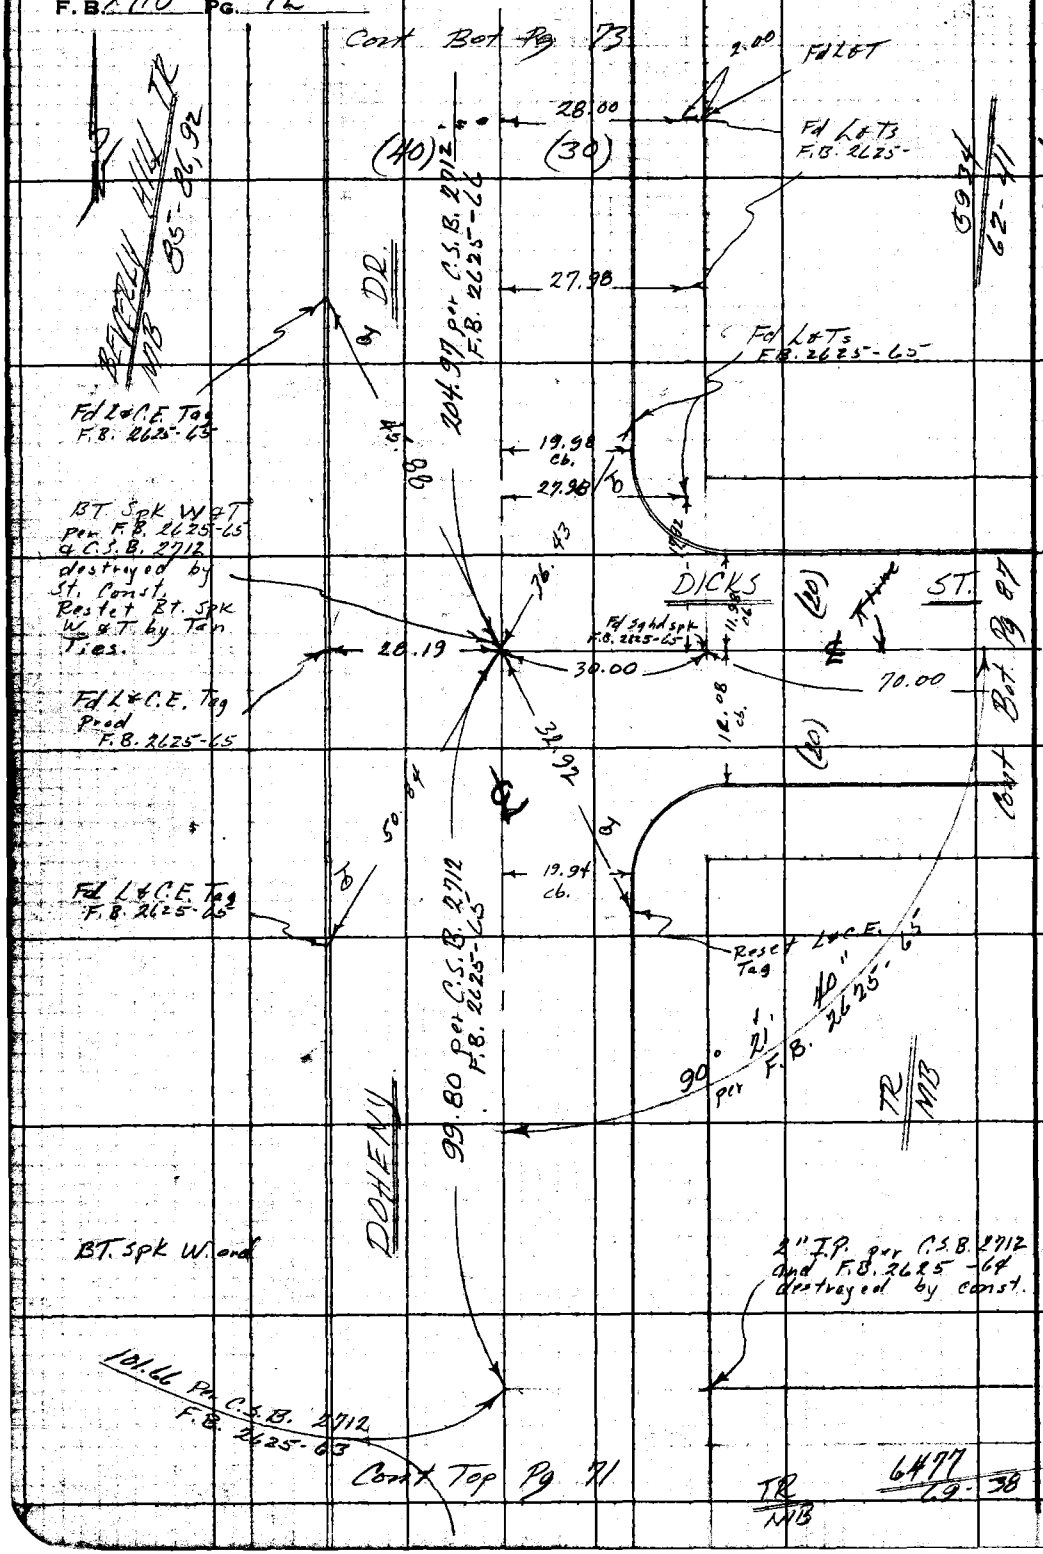

W.S. 22, B-3

RETURN TO
LOS ANGELES COUNTY ENGINEER
100 LOS ANGELES COUNTY ENGINEERING BLDG.

Do not extend notes this side of this line.

Note: Any Additions or Changes on This Sheet Must be Made or Circled in Red Ink With Date and Name of Person Making Change.

W. Hollywood & Sherman

Notes Ck'd by D. SAPPELL	Survey of Sewer Maint. Dist #3
Map No. 5418	IN 0303.00 Tape 6201 Std LB °F
Office Work E FONG	Surveyed by F. E. Brooks
Checked R HILARIO	Notes E. E. Brooks Date 14 Feb 1962
Date 10-17-83	Indexed C. J. GALLI

F. B. 2710 PG. 79

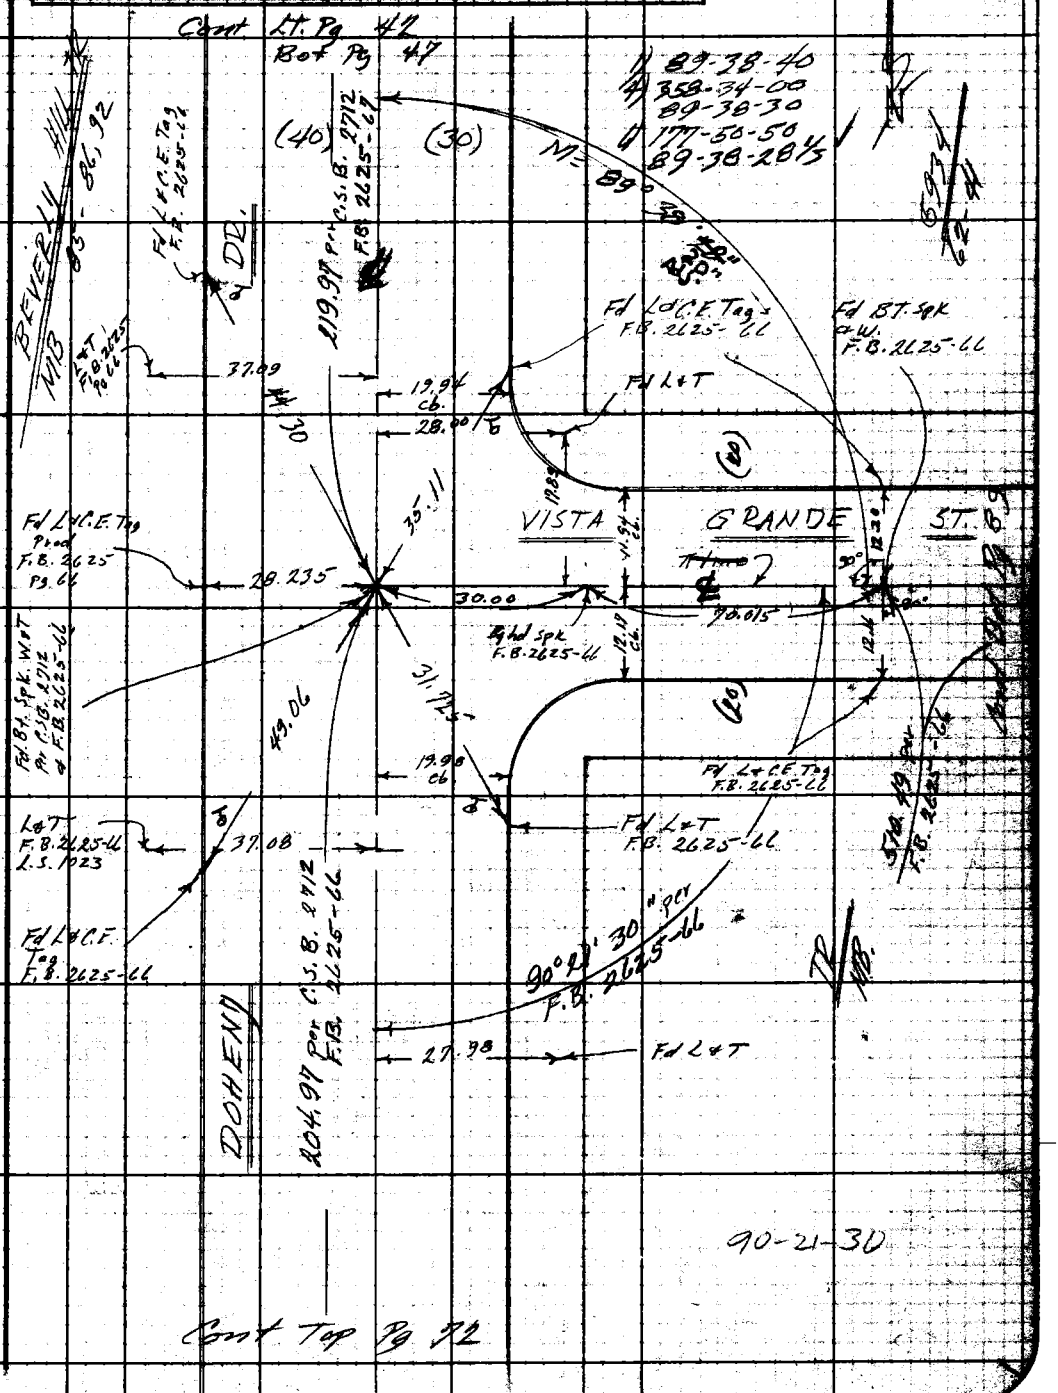

Note: Any Additions or Changes on This Sheet Must be Made or Circled in Red Ink With Date and Name of Person Making Change.

W.S. 22, B-3

Do not extend notes this side of this line.

RETURN TO
LOS ANGELES COUNTY ENGINEER
900 LOS ANGELES COUNTY ENGINEERING BLDG.

763095 CE #247—7-53

F.B. 2710 PG. 74

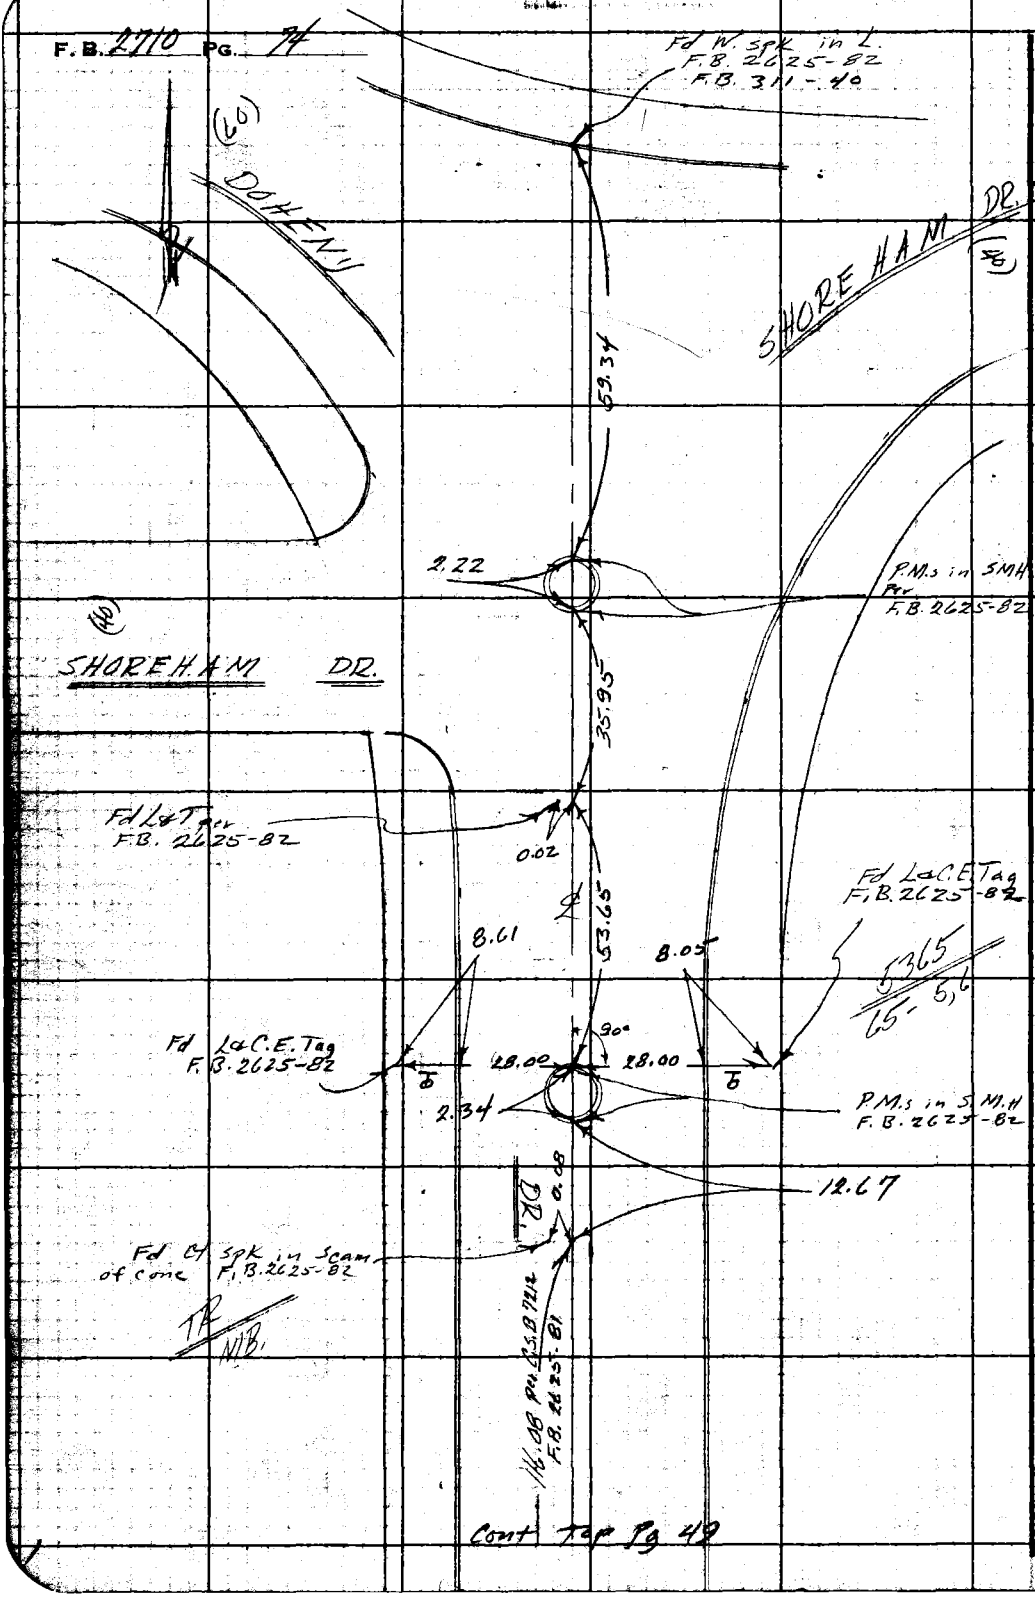

W.S. 22, B-2

RETURN TO
LOS ANGELES COUNTY ENGINEER
700 LOS ANGELES COUNTY ENGINEERING BLDG.

Do not extend notes this side of this line.

Note: Any Additions or Changes on This Sheet Must be Made or Circled in Red Ink With Date and Name of Person Making Change.

W. Hollywood & Sherman

Notes Ck'd by D. SAPPELL	Survey of Sewer Maint. Dist #3
Map No. 5418	IN 0303.00 Tape 0201 Std 68 °F
Office Work E. FONG	Surveyed by F. E. Brooks
Checked R. HILARIO	Notes F. E. Brooks Date 14 Feb 1962
Date 10-17-83	Indexed E. J. GALLI

F. B. 2710 PG. 75

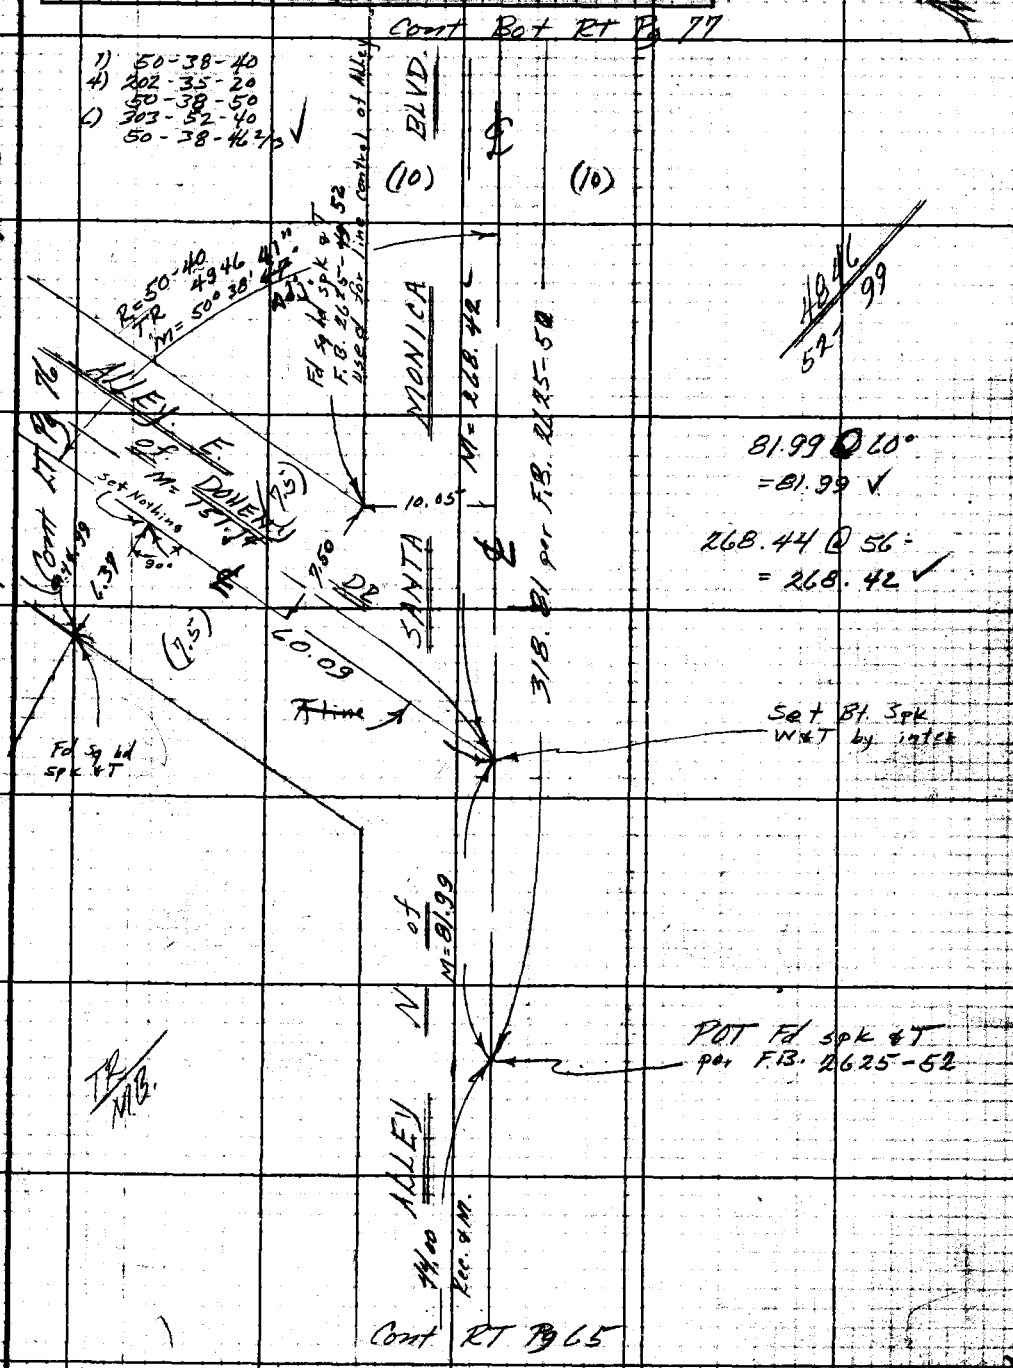

W.S. 22, B-3

Note: Any Additions or Changes on this Sheet Must be Made or Circled in Red Ink With Date and Name of Person Making Change.

Do not extend notes this side of this line.

RETURN TO
LOS ANGELES COUNTY ENGINEER
100 LOS ANGELES COUNTY ENGINEERING BLDG.

763098 CE #247—7-53

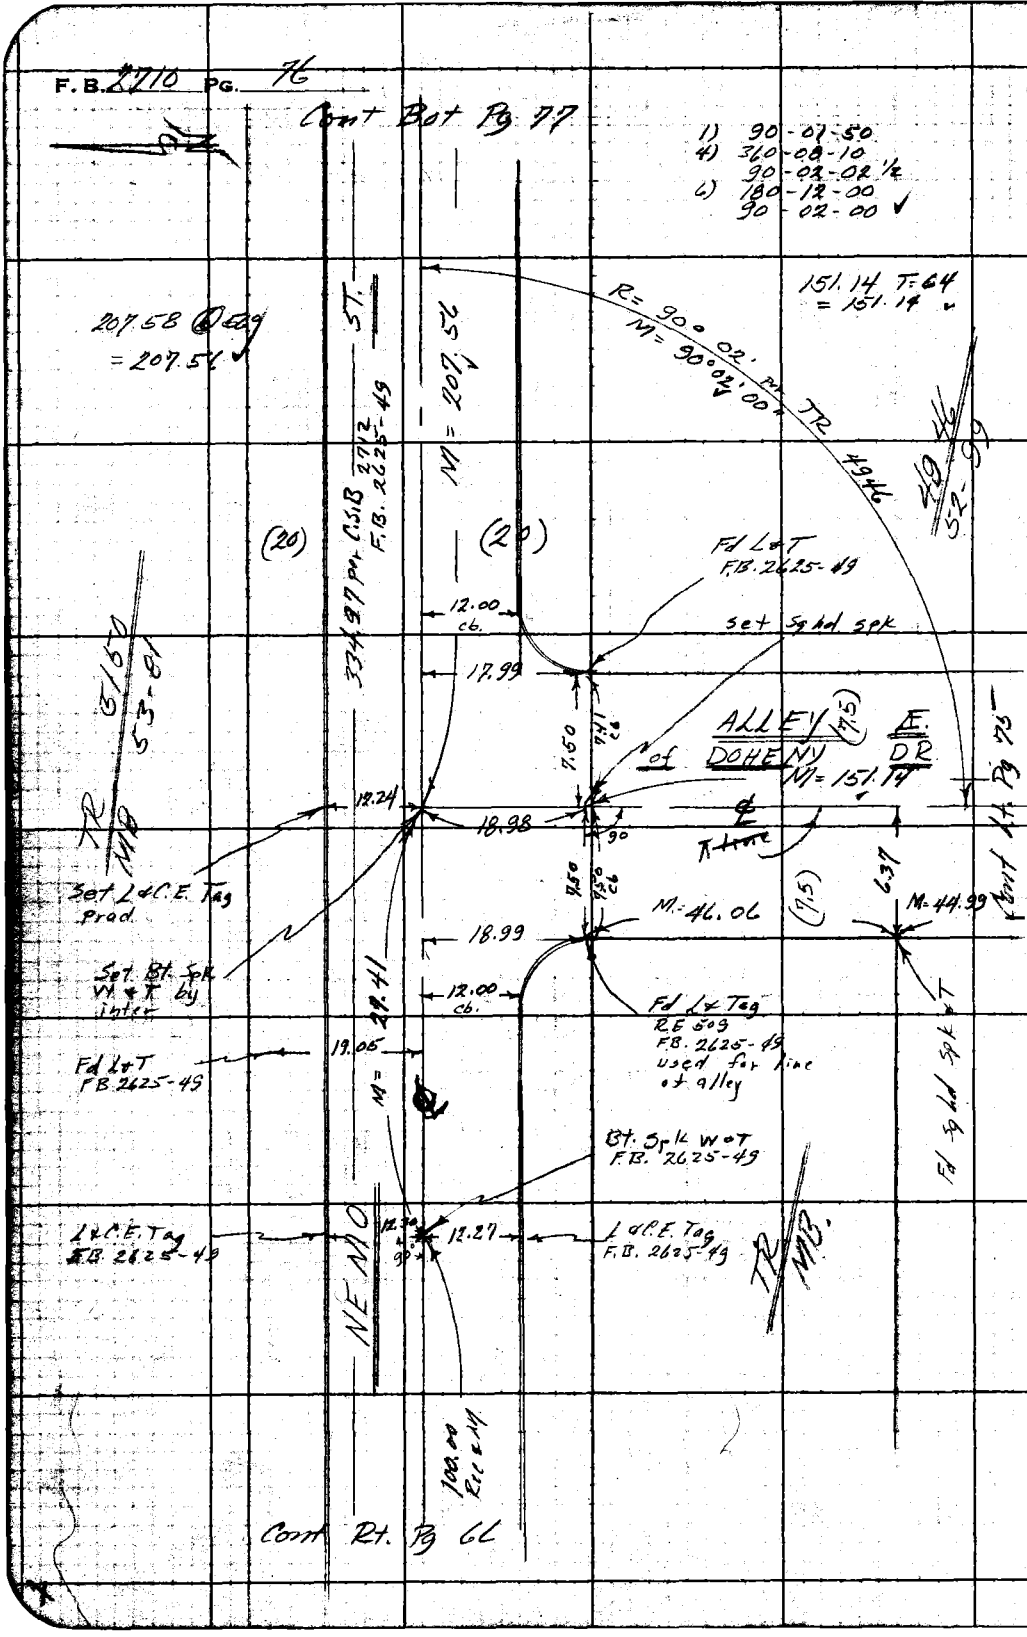

RETURN TO
LOS ANGELES COUNTY ENGINEER
900 LOS ANGELES COUNTY ENGINEERING BLDG.

Do not extend notes this side of this line.

Note: Any Additions or Changes on This Sheet Must be Made or Circled in Red Ink With Date and Name of Person Making Change.

W. Hollywood & Sherman

Notes Ck'd by D. SAPPELL	Survey of Sewer Maint Dist #3	F. B. 2710	Pg. 77
Map No. 5418	JN 0303.00 Tape 0201 Std 68 °F		
Office Work E FONG	Surveyed by F. E. Brooks		
Checked R HILARIO	Notes F. E. Brooks Date 14 Feb 1962		
Date 10-17-83	Indexed C. J. GALLI		

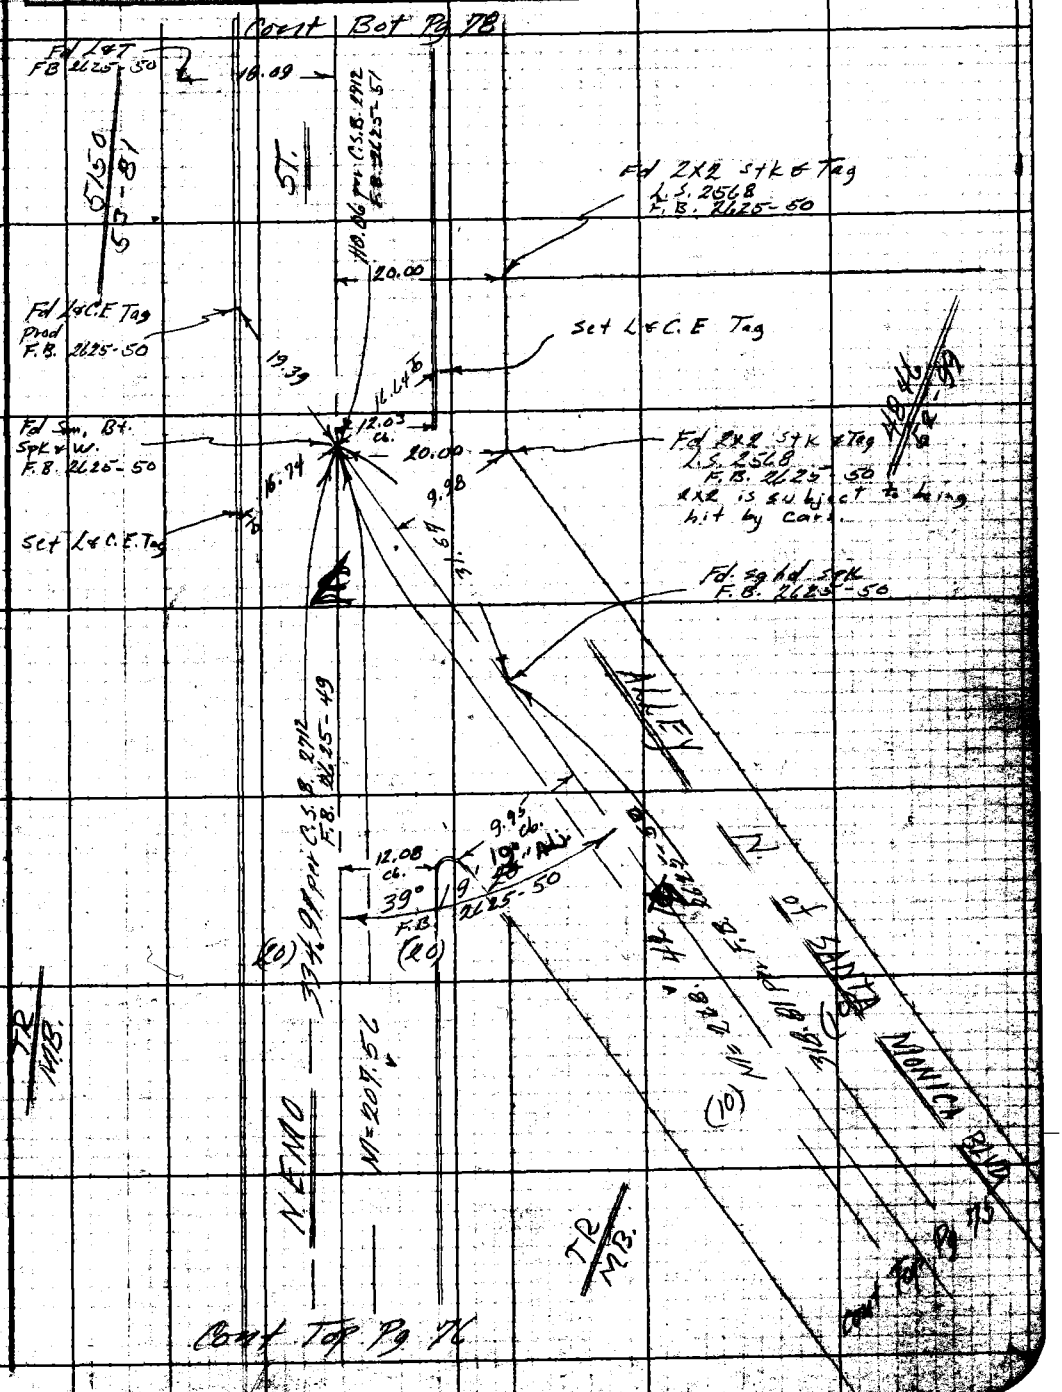

Note: Any Additions or Changes on This Sheet Must be Made or Circled in Red Ink. With Date and Name of Person Making Change.

W.S. 22, B-3

Do not extend notes this side of this line.

RETURN TO
LOS ANGELES COUNTY ENGINEER
900 LOS ANGELES COUNTY ENGINEERING BLDG.

763098 CE #247—7-53

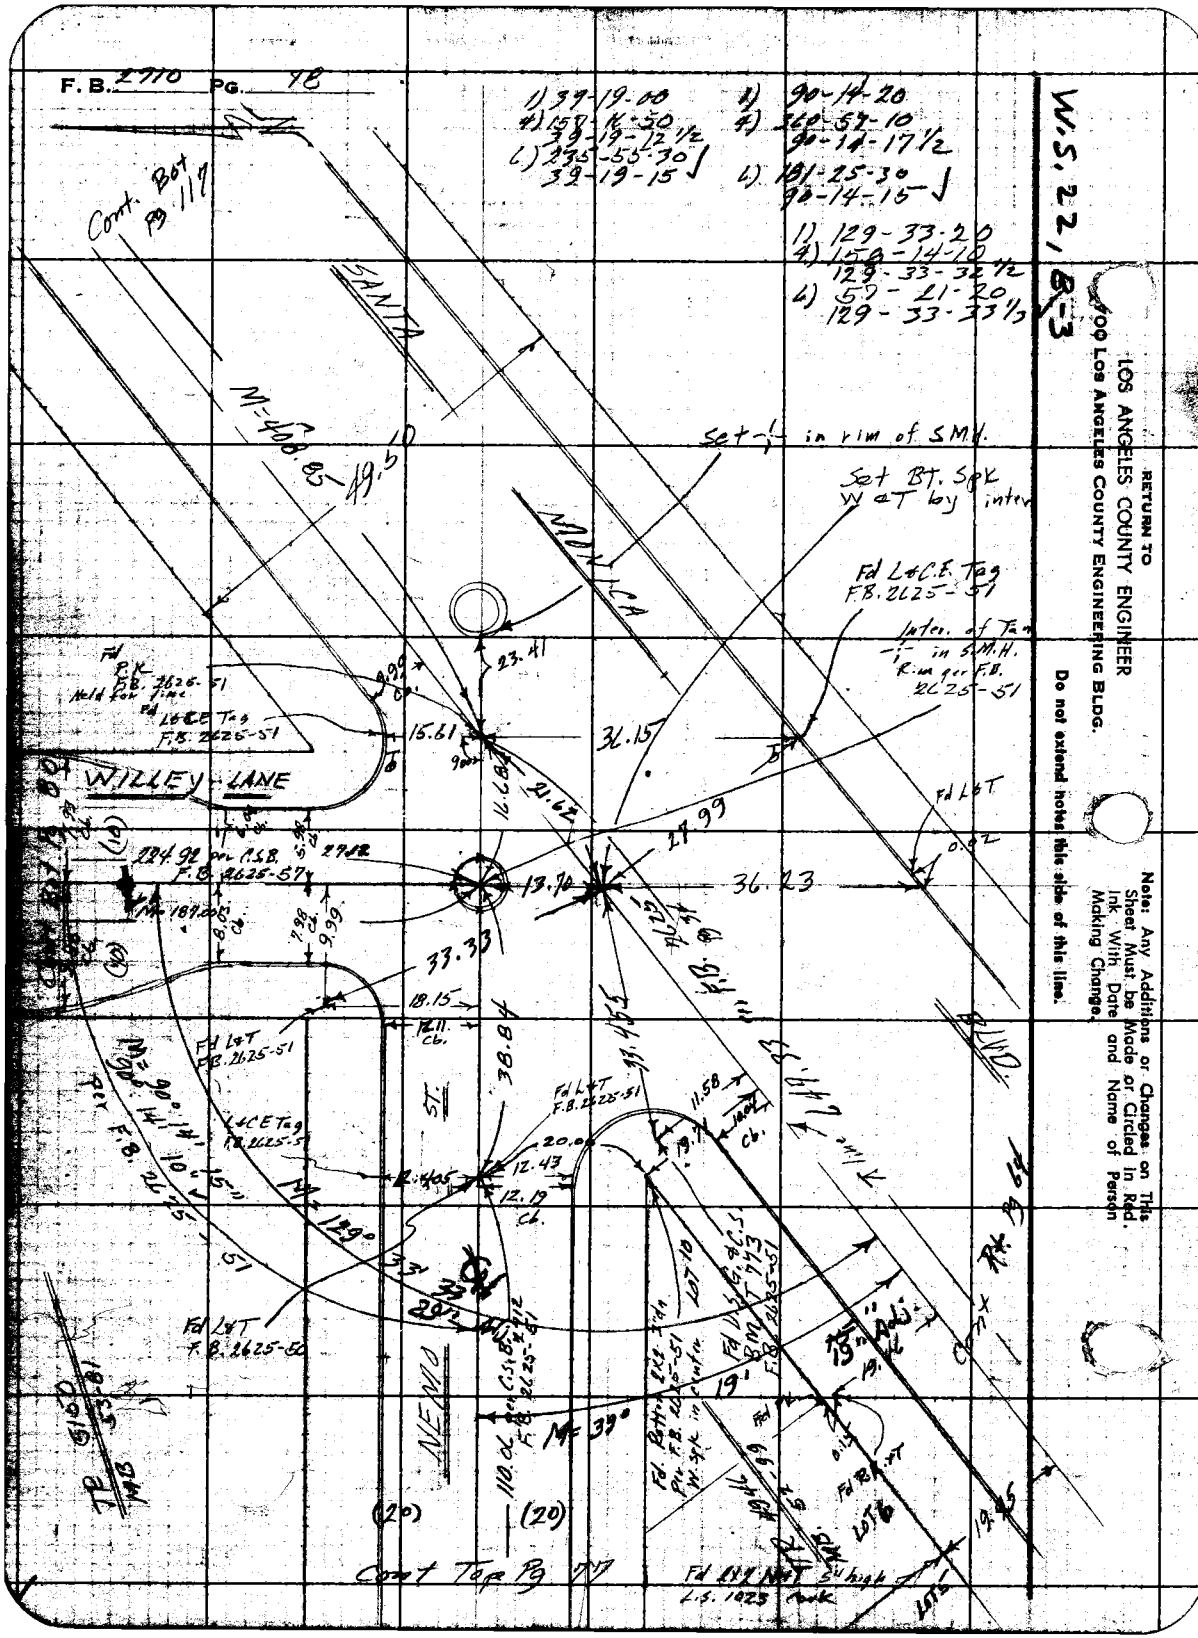
F. B. 2710 PG. 48
W.S. 22, B-3
RETURN TO
LOS ANGELES COUNTY ENGINEER
900 LOS ANGELES COUNTY ENGINEERING BLDG.
Do not extend notes this side of this line.
Note: Any Additions or Changes on This Sheet Must be Made or Circled in Red, Ink With Date and Name of Person Making Change.
1) 39-19-00
4) 158-16-50
39-19-12 1/2
6) 235-55-30
39-19-15
1) 90-14-20
4) 360-57-10
90-14-17 1/2
6) 181-25-30
90-14-15
1) 129-33-20
4) 158-14-10
129-33-32 1/2
6) 57-21-20
129-33-33 1/3
Cont. Bot Pg 117
SANTA
MONICA
WILLEY LANE
NEMO
Set -1/- in rim of S.M.H.
Set BT. Spk W & T by inter
Fd L&C.E. Tag F.B. 2625-51
Inter. of Tan -1/- in S.M.H. Rim per F.B. 2625-51
Fd P.K. F.B. 2625-51 Held for line
Fd L&CE Tag F.B. 2625-51
224.92 per C.S.B. F.B. 2625-57
Fd L&T F.B. 2625-51
L&CE Tag F.B. 2625-51
Fd L&T F.B. 2625-50
Fd L&T
Fd L&T F.B. 2625-51
Fd L&T F.B. 2625-51
Fd L&T F.B. 2625-51
Fd Bottom 2x2 3 dn Per F.B. 2625-51 W. Spk in center
Fd U.S.G.&C.S. BM T 773 F.B. 2625-51
Fd L&T 5" high L.S. 1023 rock
Cont Top Pg 77
Cont Rt. Pg 64
M=408.85
49.50
23.41
15.61
36.15
21.62
27.99
13.70
36.23
33.33
18.15
38.84
33.455
11.58
20.00
12.43
12.19
M=129°
M=39°
(20)
(20)
LOT 10
LOT 6
LOT 5
19.45
19.46
19.41
19.71
19.71
0.02
0.02
TP 5150 MB 53-81

W. Hollywood & Sherman

Notes Ck'd by D. SAPPELL	Survey of Sewer Maint. Dist #3
Map No. 5418	IN 0303.00 Tape 0201 Std 68 °F
Office Work E FONG	Surveyed by E. E. Brooks
Checked R HILARIO	Notes F. E. Brooks Date 12 Feb 62
Date 10-17-83	Indexed C. J. GALLI

F. B. 2710 PG. 79

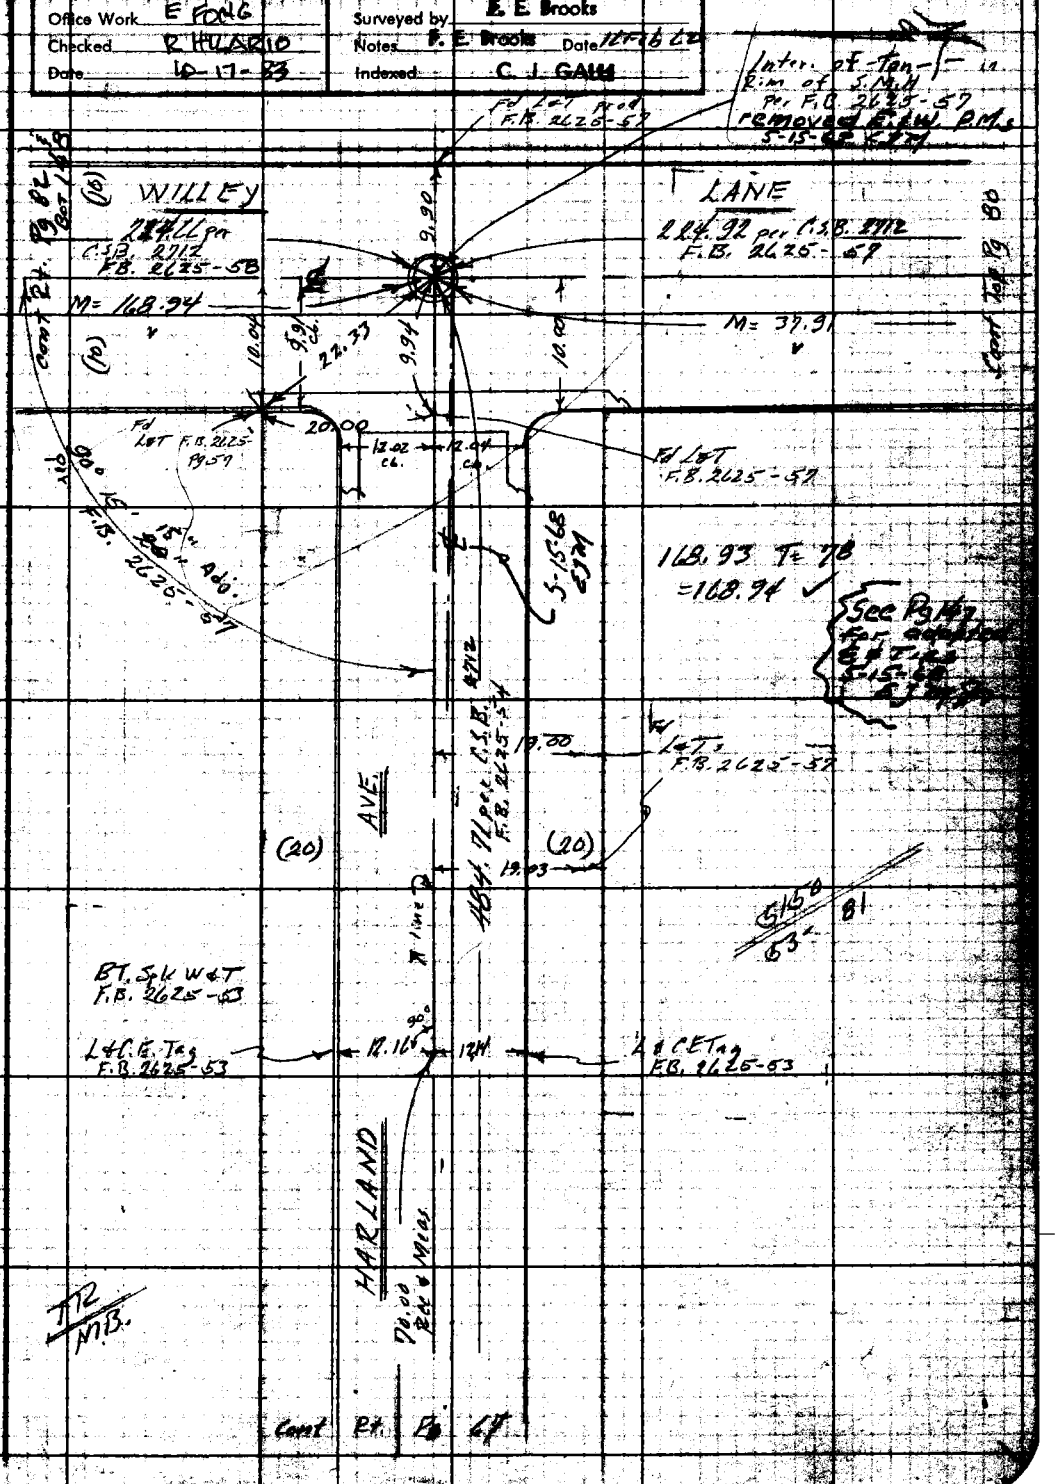

Note: Any Additions or Changes on This Sheet Must be Made or Circled in Red Ink With Date and Name of Person Making Change.

W.S. 22, B-3

Do not extend notes this side of this line.

RETURN TO
LOS ANGELES COUNTY ENGINEER
900 LOS ANGELES COUNTY ENGINEERING BLDG.

763098 CE #247—7-53

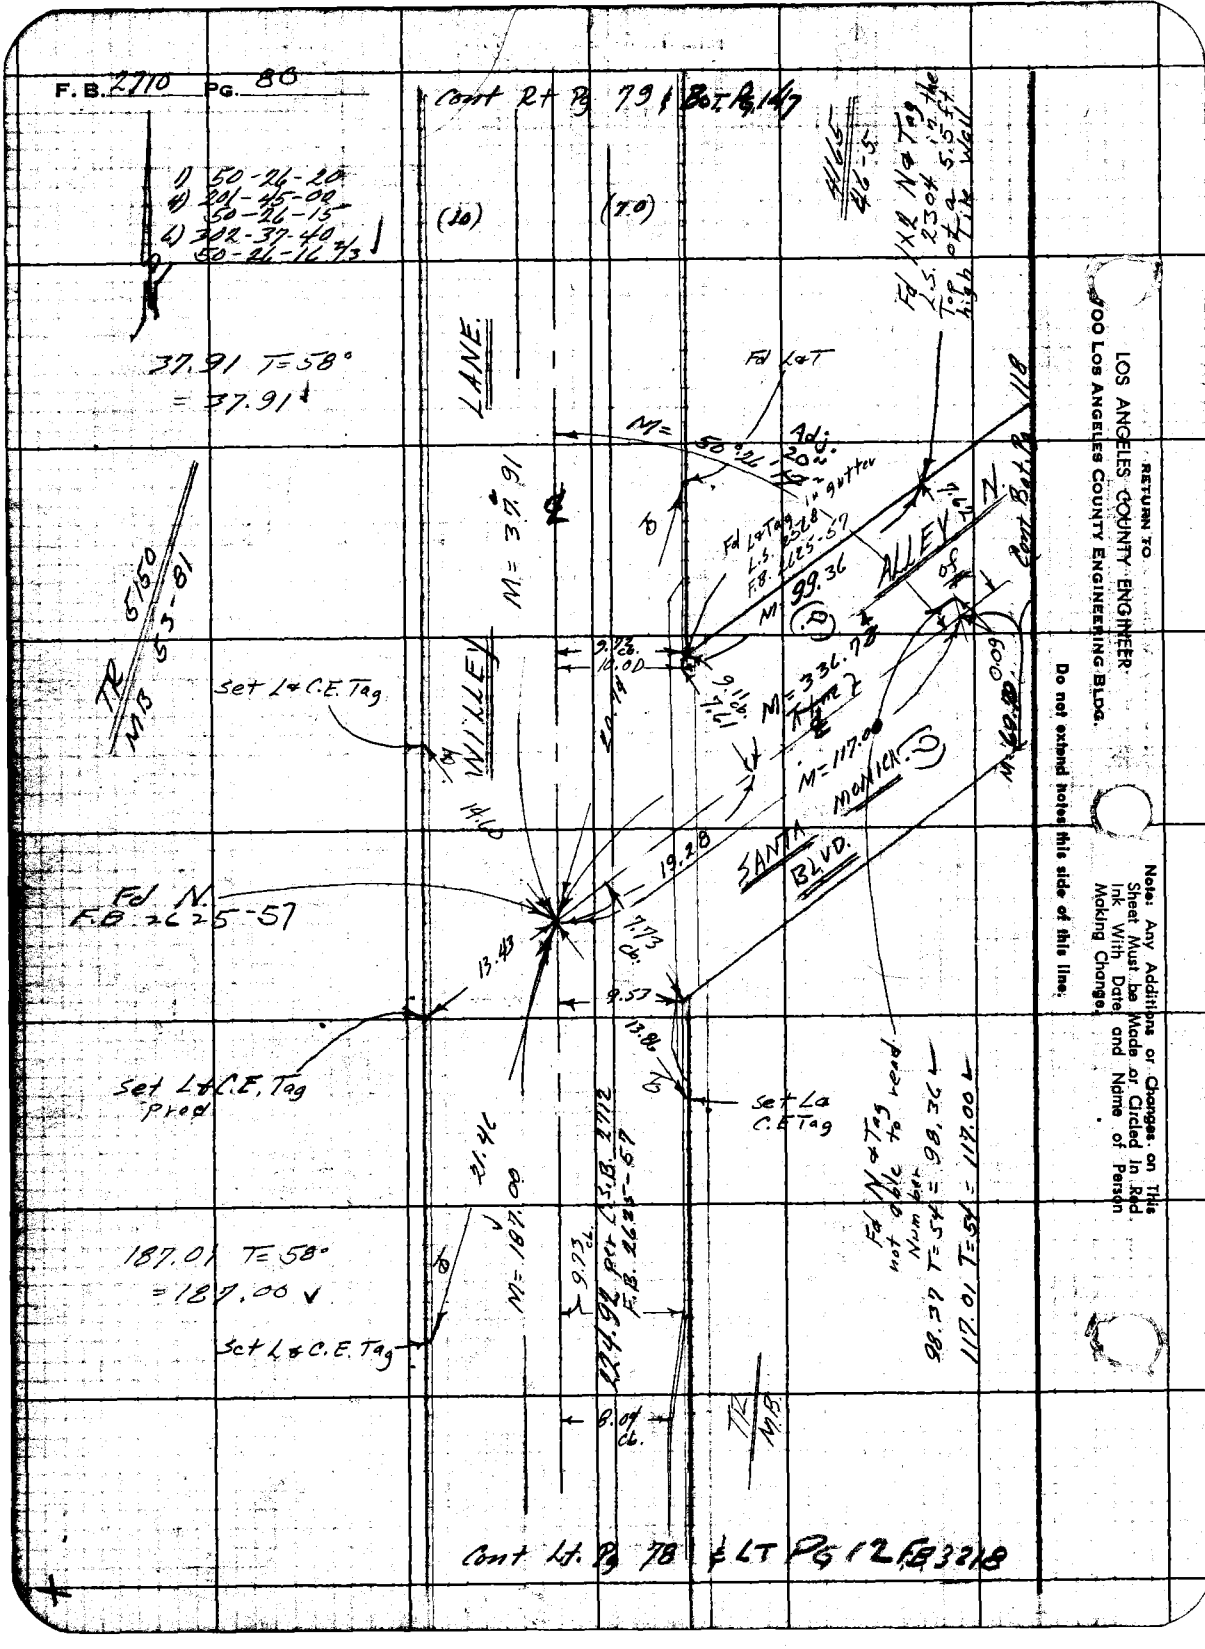
F.B. 2710 PG. 80
Cont Rt Pg 79 & Bot Pg 147
1) 50-26-20
4) 201-45-00
50-26-15
6) 302-37-40
50-26-16 2/3
(10)
(7.0)
4165
46-5
Fd 1X2 N & Tag
L.S. 2304 in the
Top of a 5.5 ft
high Tile Wall
37.91 T=58°
= 37.91
LANE
Fd L&T
M= 50°26'20"
Adj. 20"
in gutter
M= 37.91
Fd L&Tag
L.S. 2528
F.B. 2625-57
M= 99.36
ALLEY N.
Cont Bot Pg 118
TR 5150
MB 53-81
Set L&C.E. Tag
WILLEY
M= 336.78
M= 117.00
MONICA
SANTA
BLVD.
Fd N.
F.B. 2625-57
19.28
13.43
7.73 cb.
9.57
13.86
Set L&C.E. Tag
Prod
Set L&
C.E. Tag
Fd N & Tag
not able to read
Number
98.37 T=54 = 98.36
117.01 T=54 = 117.00
21.46
M= 187.00
9.73 cb.
224.92 per L.S.B. 2712
F.B. 2625-57
187.01 T=58°
= 187.00
Set L&C.E. Tag
8.04 cb.
TR
MB
Cont Lt. Pg 78 & LT Pg 12 F.B. 3218
RETURN TO
LOS ANGELES COUNTY ENGINEER
900 LOS ANGELES COUNTY ENGINEERING BLDG.
Do not extend notes this side of this line.
Note: Any Additions or Changes on This Sheet Must be Made or Circled in Red Ink With Date and Name of Person Making Change.

W. Hollywood & Sherman

Notes Ck'd by D. SAPPELL	Survey of Sewer Maint. Dist #3	F. B. 2710	Pg. 87
Map No. 5418	IN 0303.00 Tape 0201 Std 68 °F		
Office Work E. FONG	Surveyed by E. E. Brooks		
Checked R. HILARIO	Notes E. E. Brooks Date 1-6-82		
Date 10-17-83	Indexed C. J. GALLI		

Cont L+ Pg 65

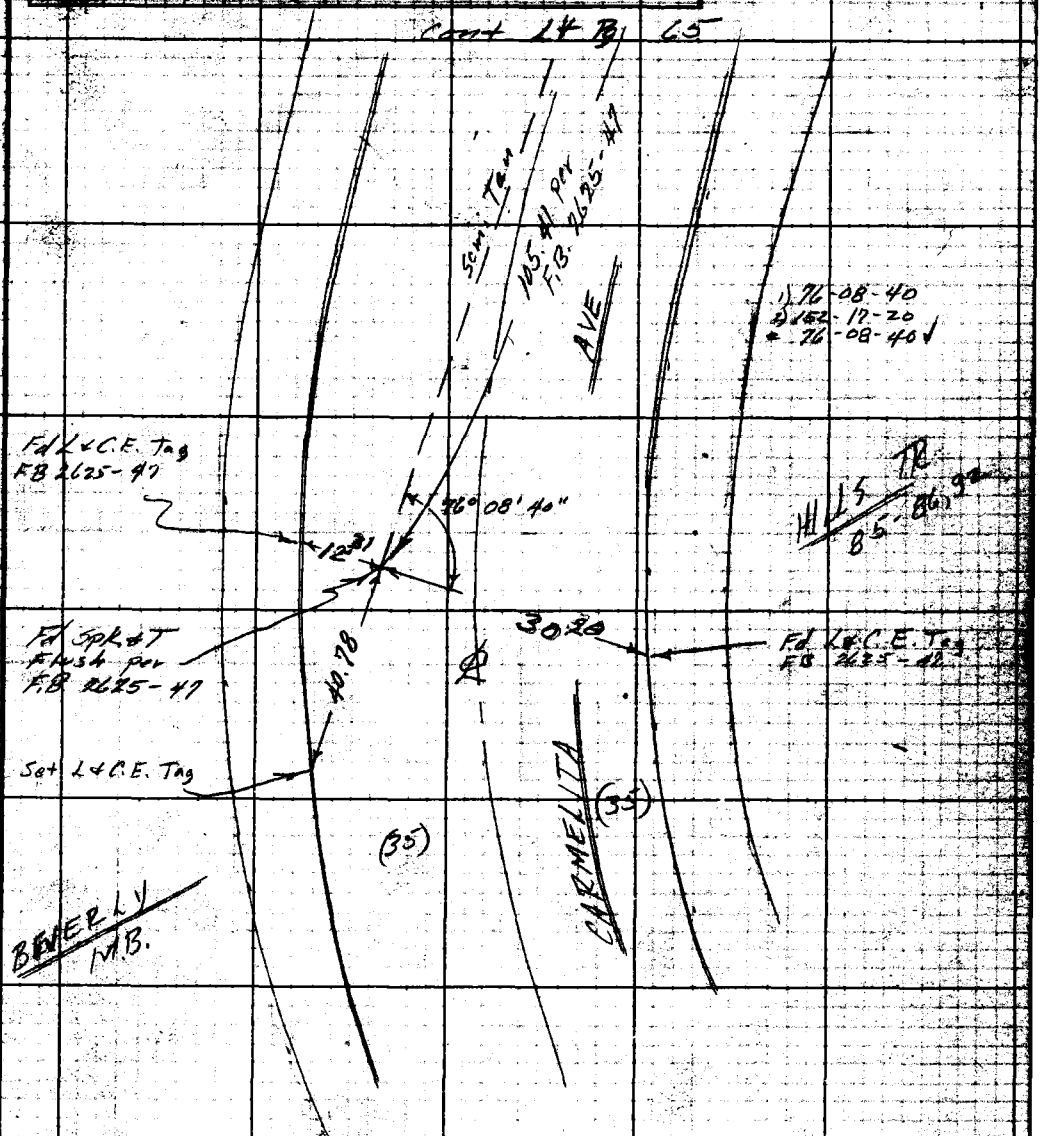

Note: Any Additions or Changes on This Sheet Must Be Made or Circled in Red Ink With Date and Name of Person Making Change.

Do not extend notes this side of this line.

RETURN TO
LOS ANGELES COUNTY ENGINEER
DO LOS ANGELES COUNTY ENGINEERING BLDG.

768098 CE #247—7-83

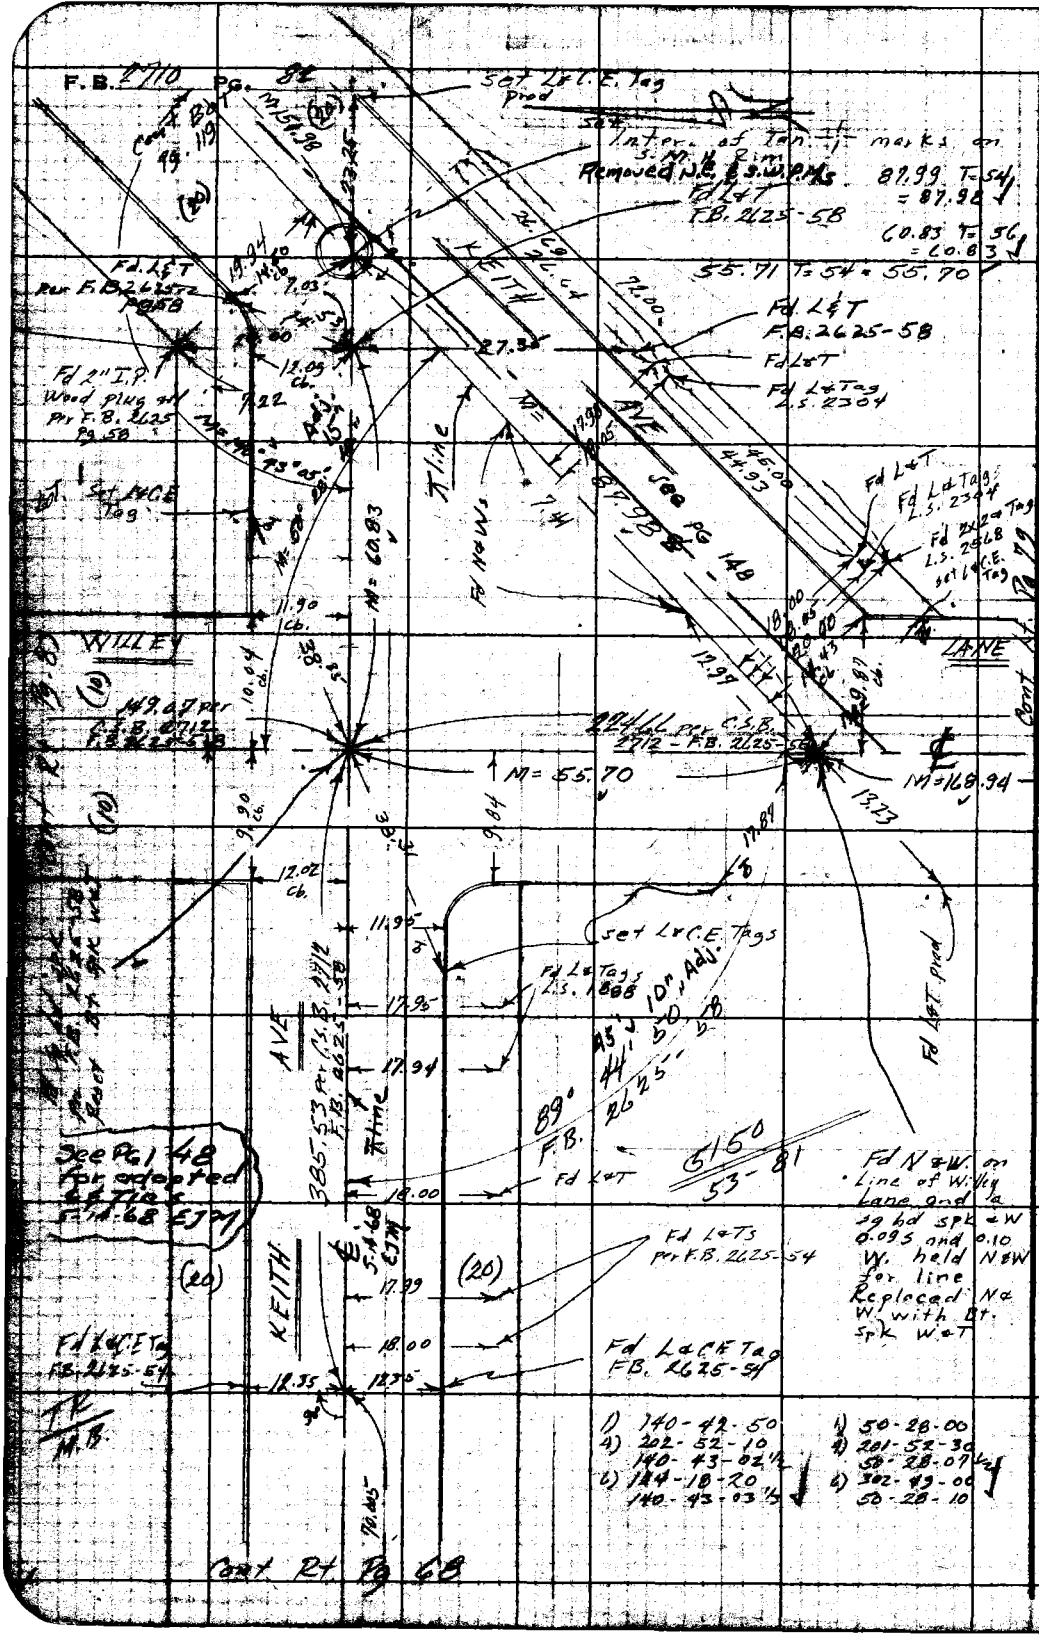
F.B. 2710 Pg. 82
Set L&C.E. Tag Prod
Inter. of Tan. ⅟₁ marks on S.M.H. Rim
Removed N.E. & S.W. P.M.s
87.99 T=54 = 87.98
60.83 T=56 = 60.83
55.71 T=54 = 55.70
Fd L&T F.B. 2625-58
Fd L&T
Fd L&Tag L.S. 2304
Fd L&T per F.B. 2625-72 Pg 58
Fd 2" I.P. Wood plug & Pr F.B. 2625 Pg 58
Set L&C.E. Tag
KEITH AVE
See Pg 148
Fd N&W
WILLEY LANE
149.07 per C.S.B. 2712 F.B. 2625-58
224.66 per C.S.B. 2712 - F.B. 2625-58
M = 55.70
M = 168.94
M = 60.83
Cont Rt Pg 79
Cont Rt Pg 68
Set L&C.E. Tags
Fd L&Tags L.S. 1888
Fd L&T prod
385.53 per C.S.B. 2712 F.B. 2625-58
89° 44' 50" 10" Adj.
F.B. 2625
5150
53-81
Fd L&T
Fd L&Ts per F.B. 2625-54
Fd L&C.E. Tag F.B. 2625-54
Fd N&W on Line of Willey Lane and a sq hd spk & W 0.09 S and 0.10 W. held N&W for line Replaced N&W with Bt. Spk W&T
See Pg 148 for adopted 6 & Tie 5-14-68 EJM
1) 140-42-50
4) 202-52-10
140-43-02½
6) 144-18-20
140-43-03½
1) 50-28-00
4) 201-52-30
50-28-07½
6) 302-49-00
50-28-10
W.S. 22, B-3
RETURN TO
LOS ANGELES COUNTY ENGINEER
100 LOS ANGELES COUNTY ENGINEERING BLDG.
Do not extend notes this side of this line.
Note: Any Additions or Changes on This Sheet Must be Made or Circled in Red Ink With Date and Name of Person Making Change.

W. Hollywood & Sherman

Notes Ck'd by D. SAPPELL	Survey of Sewer Maint Dist #3
Map No. 5418	JN 0303.00 Tape 02-1 Std 68 °F
Office Work E FONG	Surveyed by F. E. Brooks
Checked R HILARIO	Notes F. E. Brooks Date 16 Feb 1962
Date 10-17-83	Indexed C. J. GALLI

F. B. 2710 PG. 83

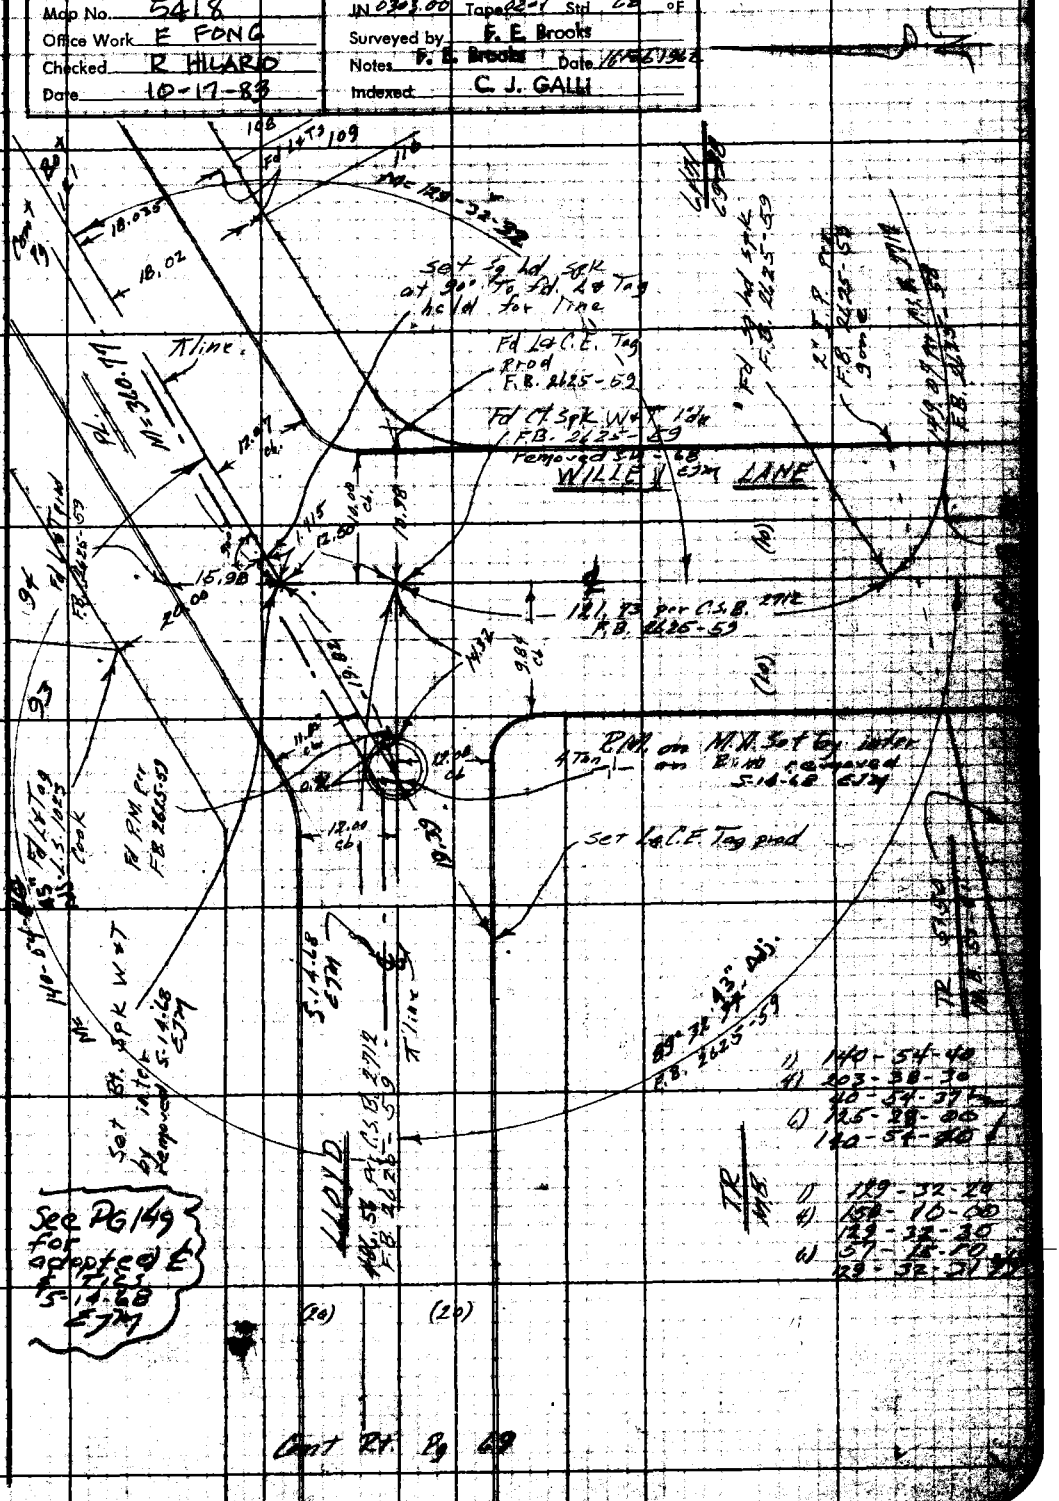

Note: Any Additions or Changes on This Sheet Must be Made or Circled in Red Ink With Date and Name of Person Making Change.

W.S. 22, B-3

Do not extend notes this side of this line.

RETURN TO
LOS ANGELES COUNTY ENGINEER
100 LOS ANGELES COUNTY ENGINEERING BLDG.

763095 CE #247—7-53

F. B. 2710 PG. 84 Cont Lt Pg 121 & Lt 150

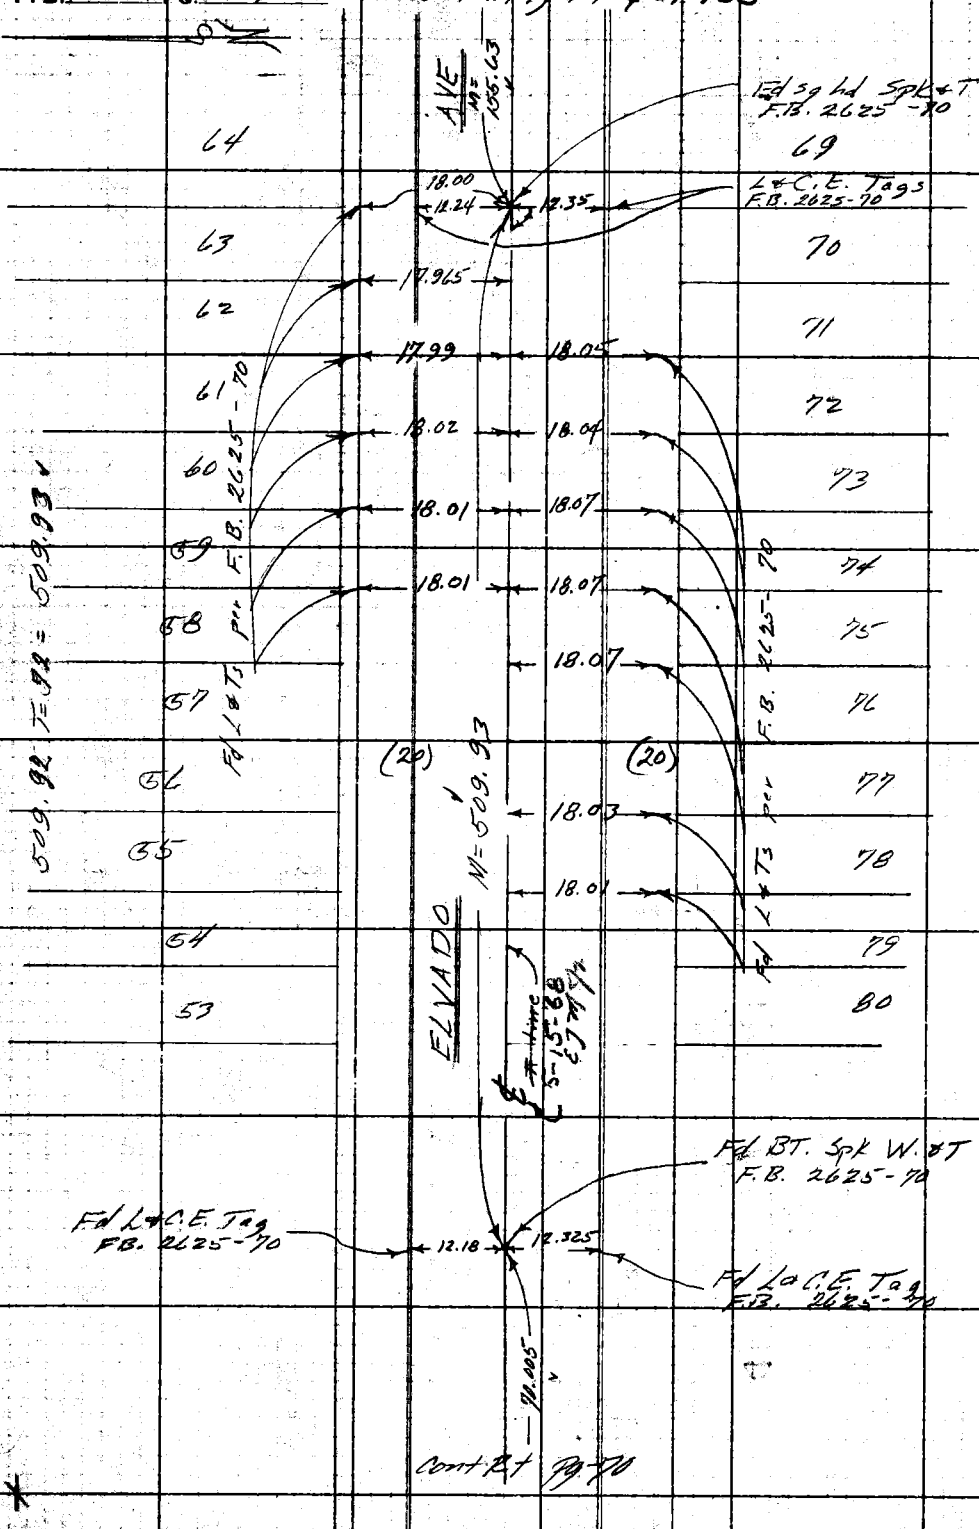

RETURN TO
LOS ANGELES COUNTY ENGINEER
00 LOS ANGELES COUNTY ENGINEERING BLDG.

Do not extend notes this side of this line.

Note: Any Additions or Changes on This Sheet Must be Made or Circled in Red Ink With Date and Name of Person Making Change.

W. Hollywood & Sherman

Notes Ck'd by D. SAPPELL	Survey of Sewer Maint Dist #3	F. B. 2710	Pg. 85
Map No. 5218	IN #303.00 Tape 6291 Std 68 °F		
Office Work E FONG	Surveyed by F. E. Brooks		
Checked R HILARIO	Notes F. E. Brooks Date 11-7-1962		
Date 10-17-83	Indexed C. J. GALLI		

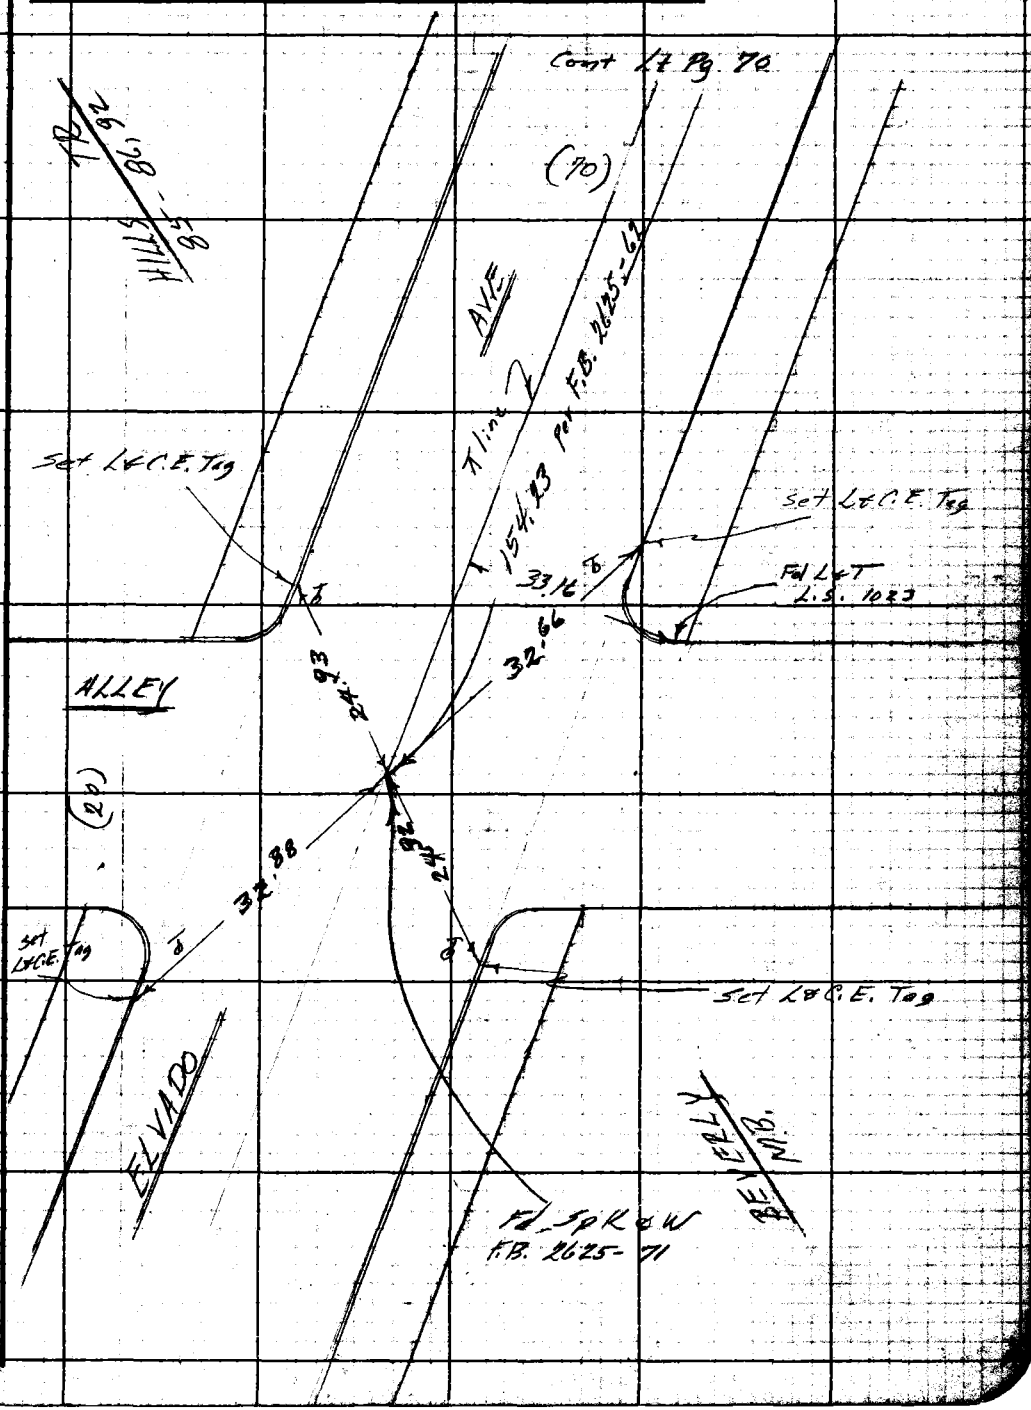

Note: Any Additions or Changes on This Sheet Must Be Made or Circled in Red Ink With Date and Name of Person Making Change.

Do not extend notes this side of this line.

RETURN TO
LOS ANGELES COUNTY ENGINEER
900 Los Angeles County Engineering Bldg.

763098 CE #247—7-53

F.B. 2710 PG. 86

Cont Lt Pg 122

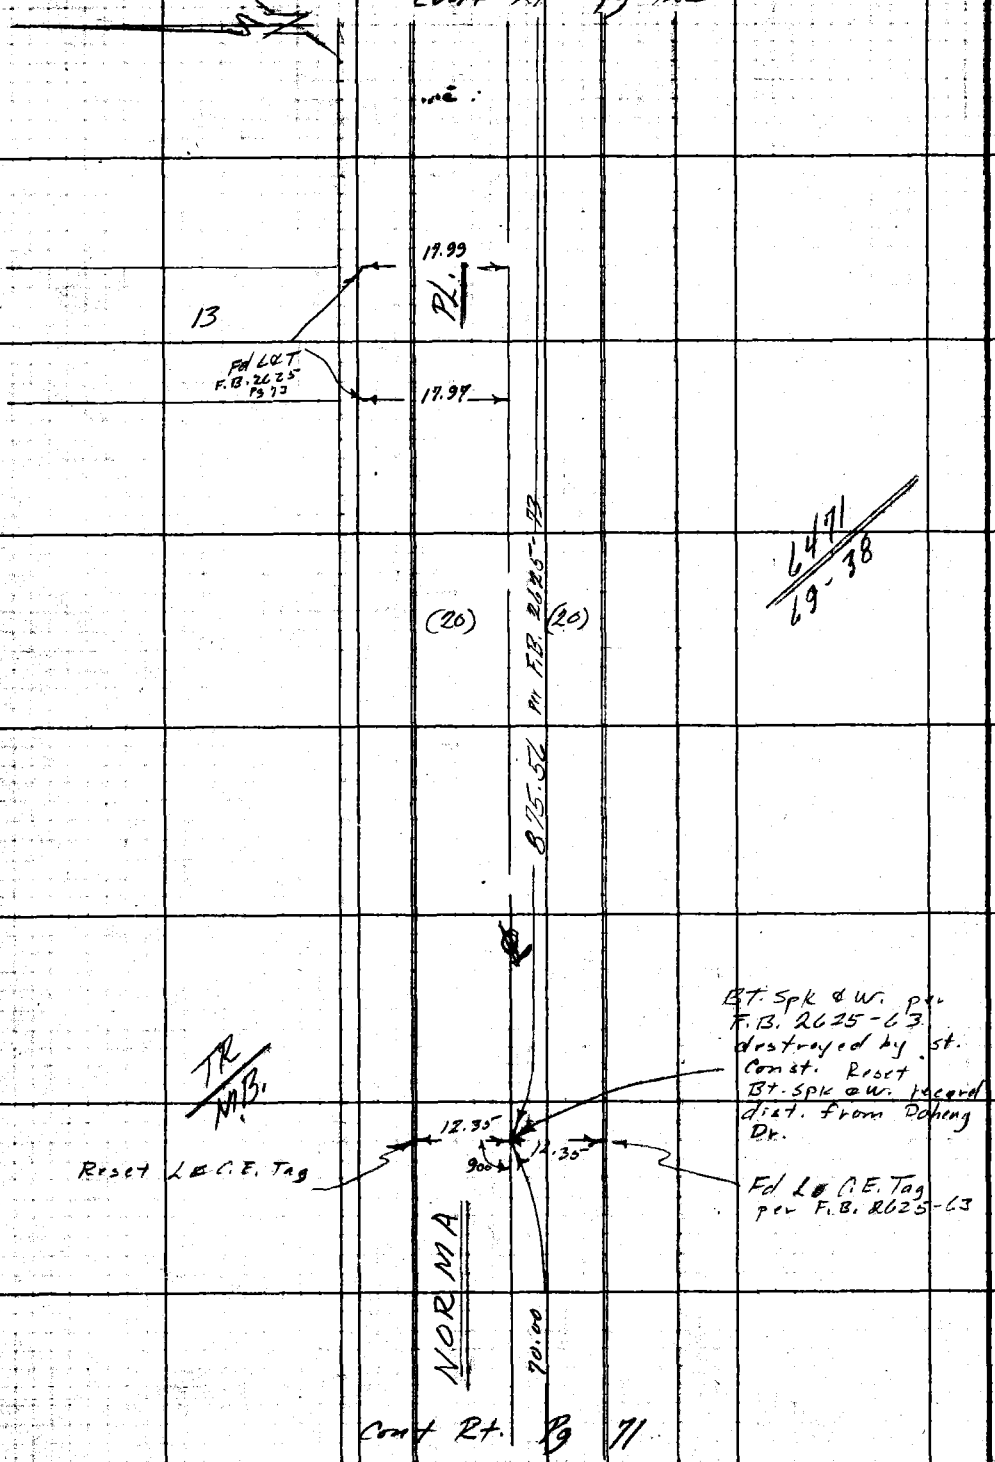

Cont Rt. Pg 71

RETURN TO
LOS ANGELES COUNTY ENGINEER
700 LOS ANGELES COUNTY ENGINEERING BLDG.

Note: Any Additions or Changes on This Sheet Must be Made or Circled in Red Ink With Date and Name of Person Making Change.

Do not extend notes this side of this line.

W. Hollywood & Sherman

Notes Ck'd by D. SAPPELL	Survey of Sewer Maint Dist #3
Map No. 5418	JN 0307.00 Tape 0201 Std 68 °F
Office Work E PONG	Surveyed by F. E. Brooks
Checked R. HILARIO	Notes F. E. Brooks Date 27 Feb 1962
Date 10-17-83	Indexed C. J. GALLI

F. B. 2710 PG. 87

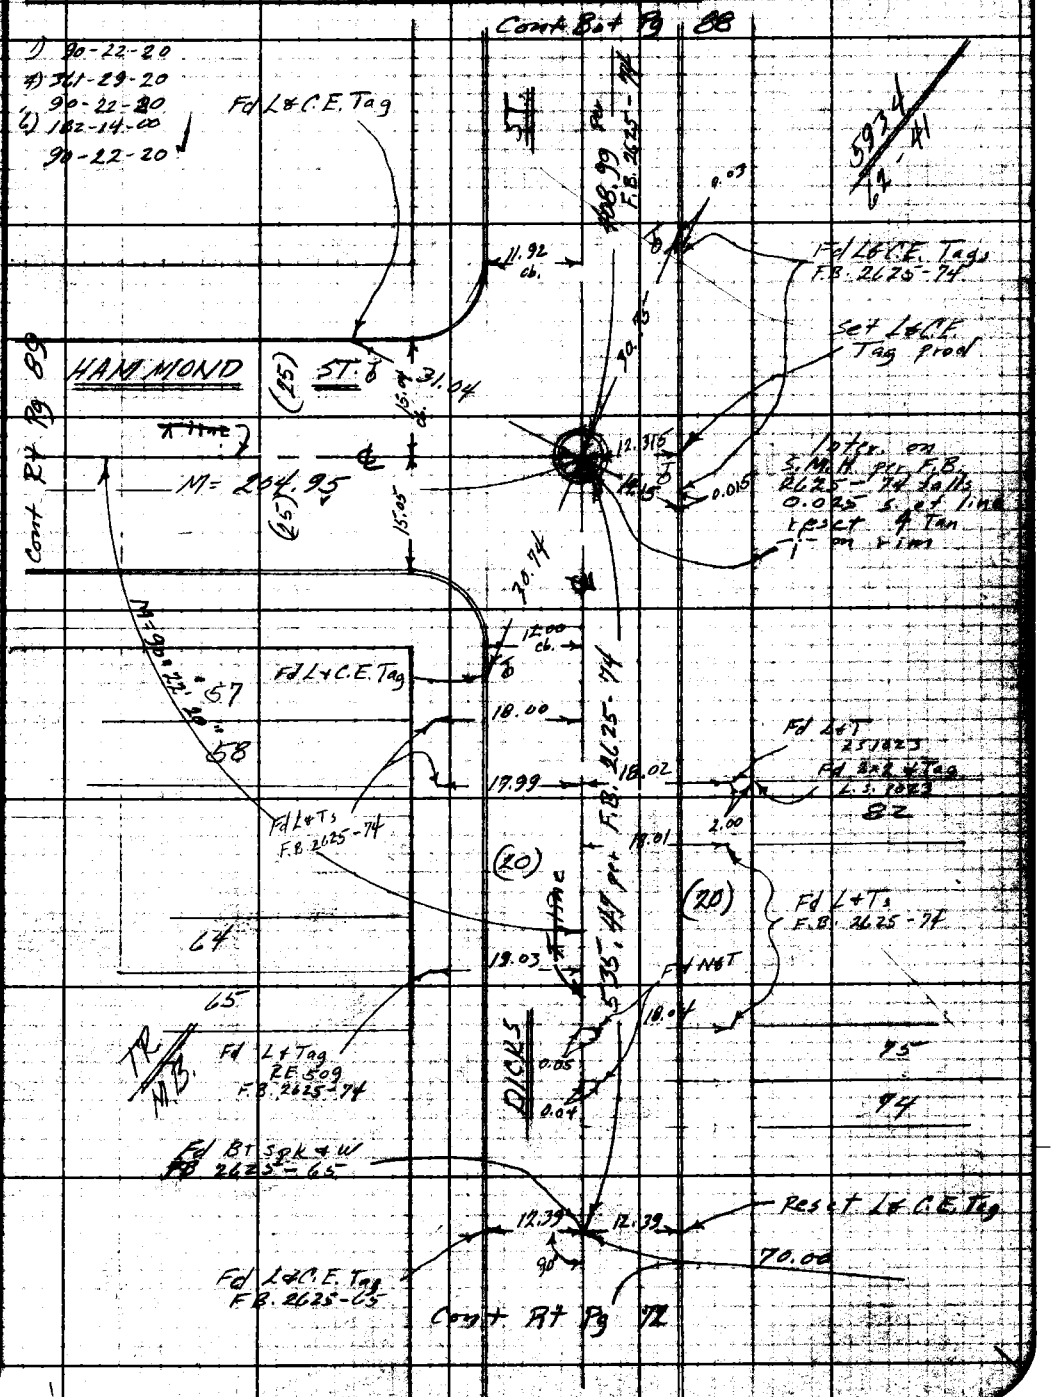

Note: Any Additions or Changes on This Sheet Must be Made or Circled in Red Ink With Date and Name of Person Making Change.

W.S. 22, B-3

Do not extend notes this side of this line.

RETURN TO
LOS ANGELES COUNTY ENGINEER
1700 LOS ANGELES COUNTY ENGINEERING BLDG.

763098 CE #247—7-58

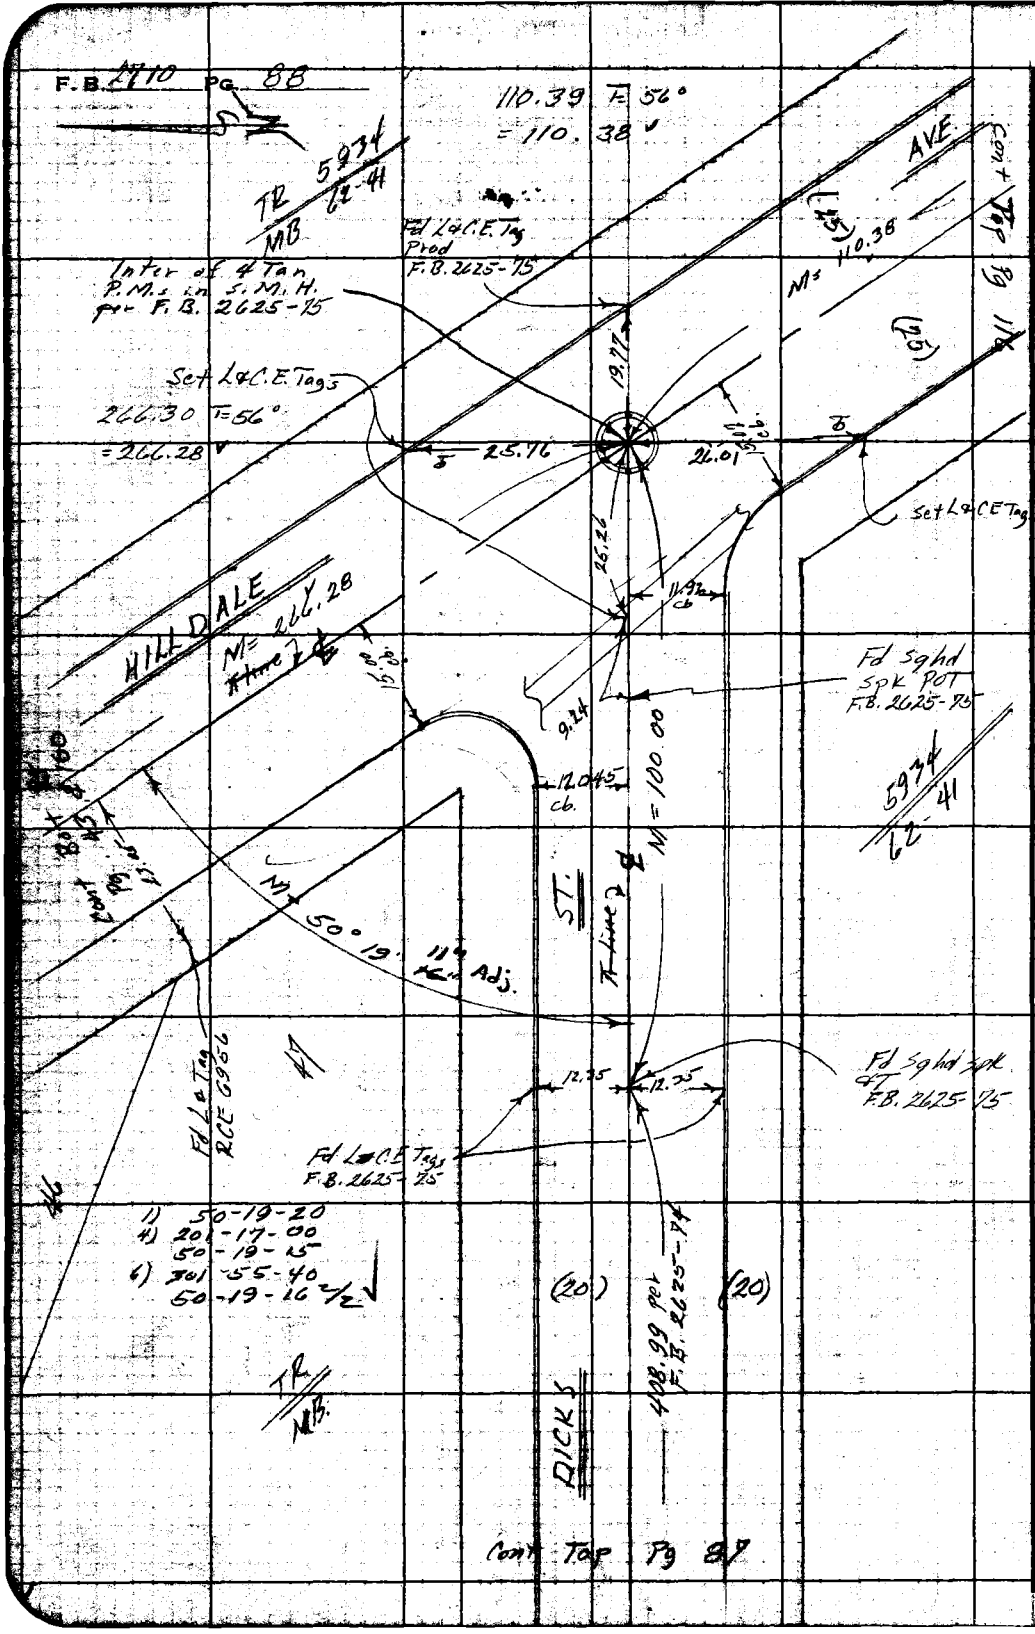

W.S. 22 B-3

RETURN TO
LOS ANGELES COUNTY ENGINEER
100 LOS ANGELES COUNTY ENGINEERING BLDG.

Do not extend notes this side of this line.

Note: Any Additions or Changes on This Sheet Must be Made or Circled in Red Ink With Date and Name of Person Making Change.

W. Hollywood & Sherman

Notes Ck'd by D. SAPPELL	Survey of Sewer Maint. Dist #3	F.B. 2710 Pg. 89
Map No. 5418	IN 0303.00 Tape 0207 Std 68 °F	
Office Work B FONG	Surveyed by F. E. Brooks	
Checked R HILARIO	Notes F. E. Brooks Date 1 Mar 1962	
Date 10-17-83	Indexed C. J. GALLI	

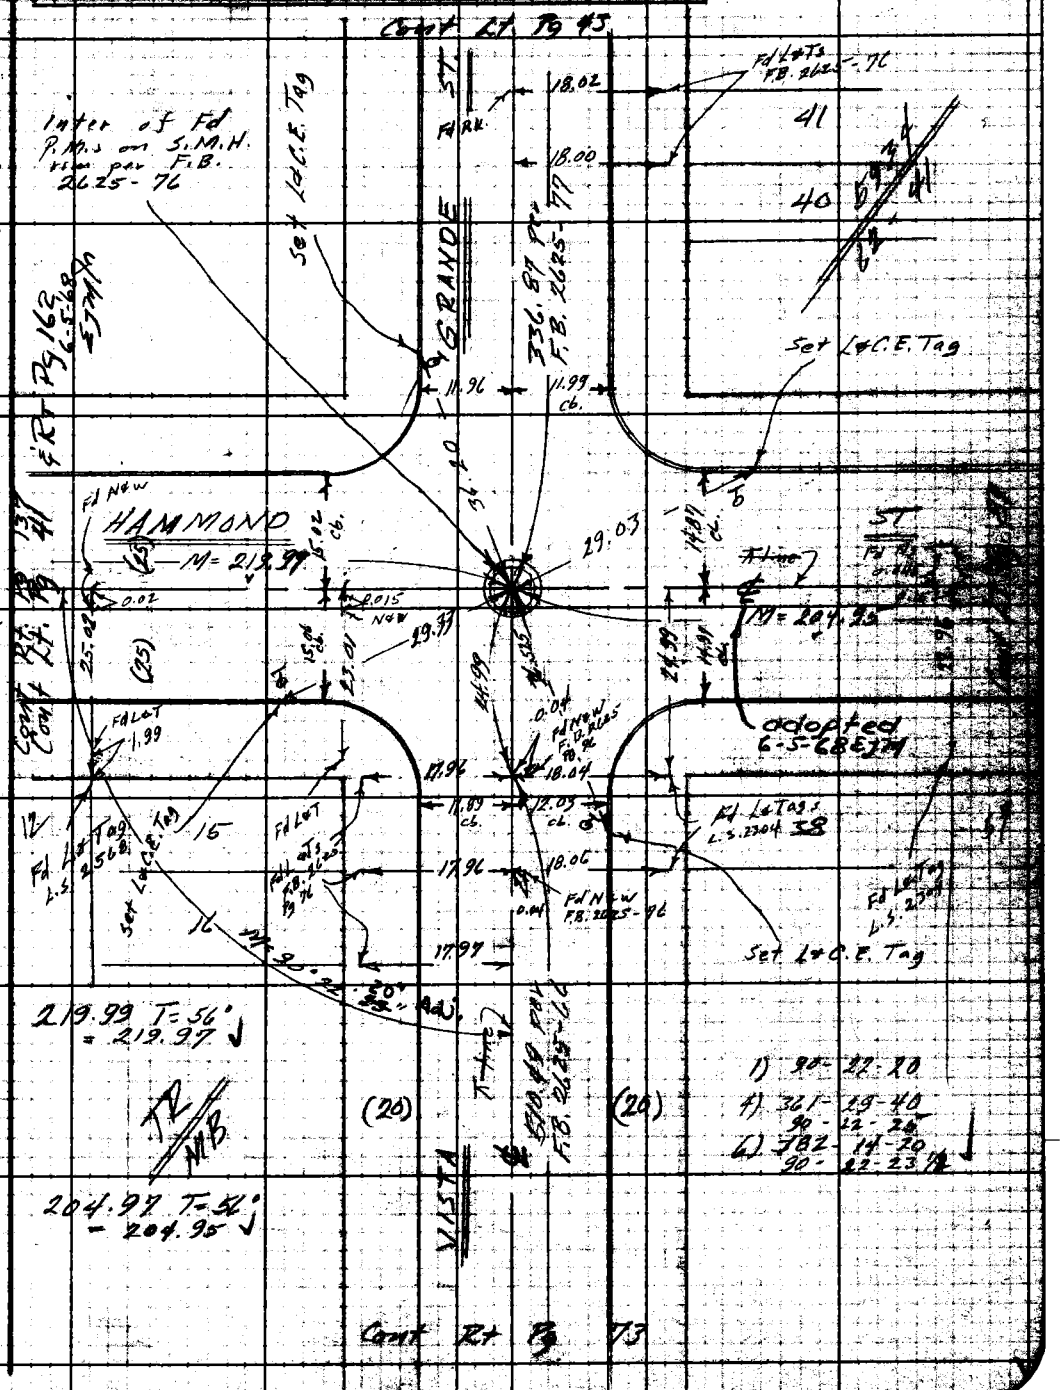

1) 90-22-20
4) 361-29-40
90-22-20
6) 382-14-20
90-22-23

Note: Any Additions or Changes on This Sheet Must Be Made or Circled in Red Ink With Date and Name of Person Making Change.

Do not extend notes this side of this line.

RETURN TO LOS ANGELES COUNTY ENGINEER
100 LOS ANGELES COUNTY ENGINEERING BLDG.

W.S.22, B-3

76309S CE #247—7-53

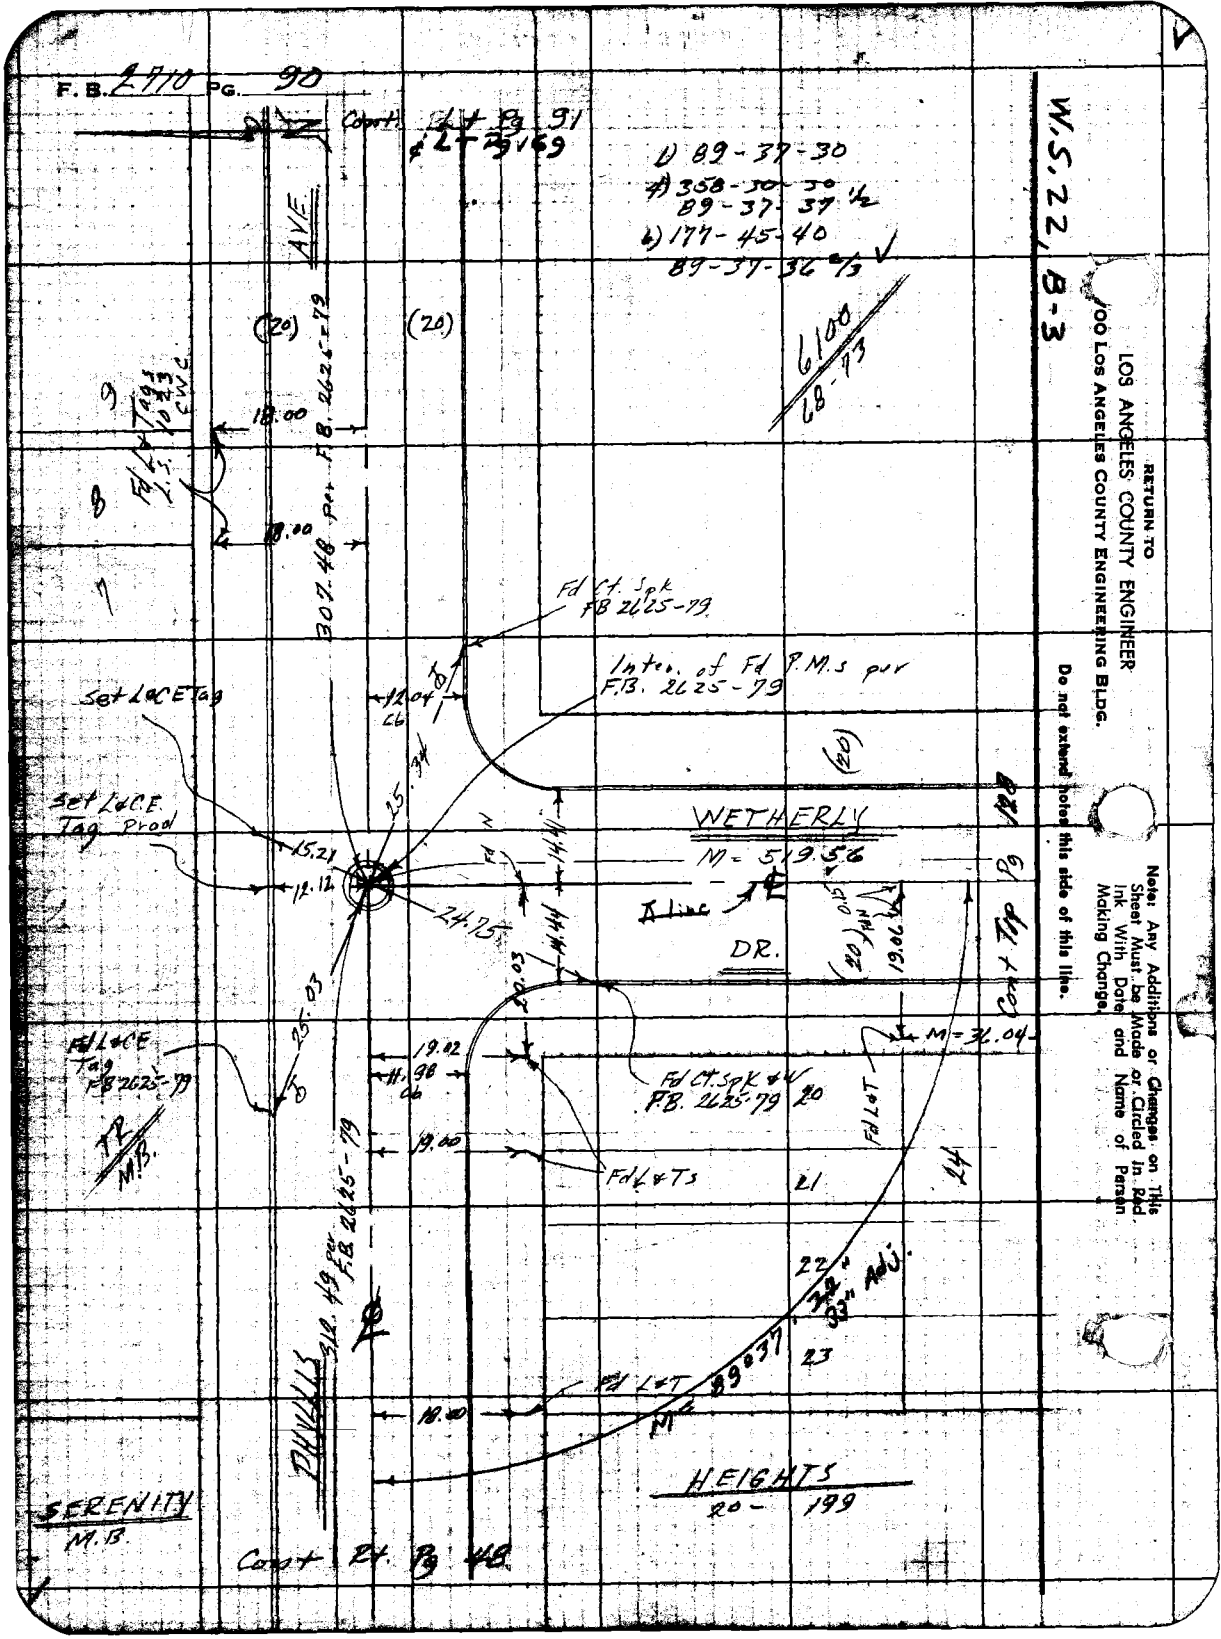
F.B. 2710 PG. 90
Const. Rt. Pg 91
℄ L-Pg 169
1) 89-37-30
4) 358-30-30
89-37-37 1/2
6) 177-45-40
89-37-36 2/3
6100
68-73
W.S. 22, B-3
AVE.
(20)
(20)
9
8
7
Fd L & Tags L.S. 1023 CWC
18.00
18.00
307.48 per F.B. 2625-79
Fd Ct. Spk F.B. 2625-79
Inter. of Fd P.M.s per F.B. 2625-79
Set L&CE Tag
12.04 Cb
25.34
Set L&CE Tag Prod
15.21
12.12
24.75
WETHERLY
M = 519.56
℄ Line
DR.
14.41
14.44
20.03
(20) 0.15 FAN
19.06
Cont Top Pg 128
M = 36.04
25.03
Fd L&CE Tag F.B. 2625-79
TR
M.B.
19.02
11.98 Cb
Fd Ct. Spk & W F.B. 2625-79
20
Fd L&T
19.00
Fd L & Ts
21
24
22
33" Adj.
23
Fd L&T
M = 89°37'
18.00
PHYLLIS
312.49 per F.B. 2625-79
℄
HEIGHTS
20 - 199
SERENITY
M.B.
Const Rt. Pg 48
RETURN TO
LOS ANGELES COUNTY ENGINEER
700 LOS ANGELES COUNTY ENGINEERING BLDG.
Do not extend notes this side of this line.
Note: Any Additions or Changes on This Sheet Must be Made or Circled in Red Ink With Date and Name of Person Making Change.

W. Hollywood and Sherman

Notes Ck'd by D. SAPPELL	Survey of Sewer Maint Dist #3
Map No. 5418	IN 0307.00 Tape 0201 Std 68 °F
Office Work E FONG	Surveyed by F. E. Brooks
Checked R HICARDO	Notes F. E. Brooks Date 13 Mar 62
Date 10-17-83	Indexed C. J. GALLI

F. B. 2710 PG. 91

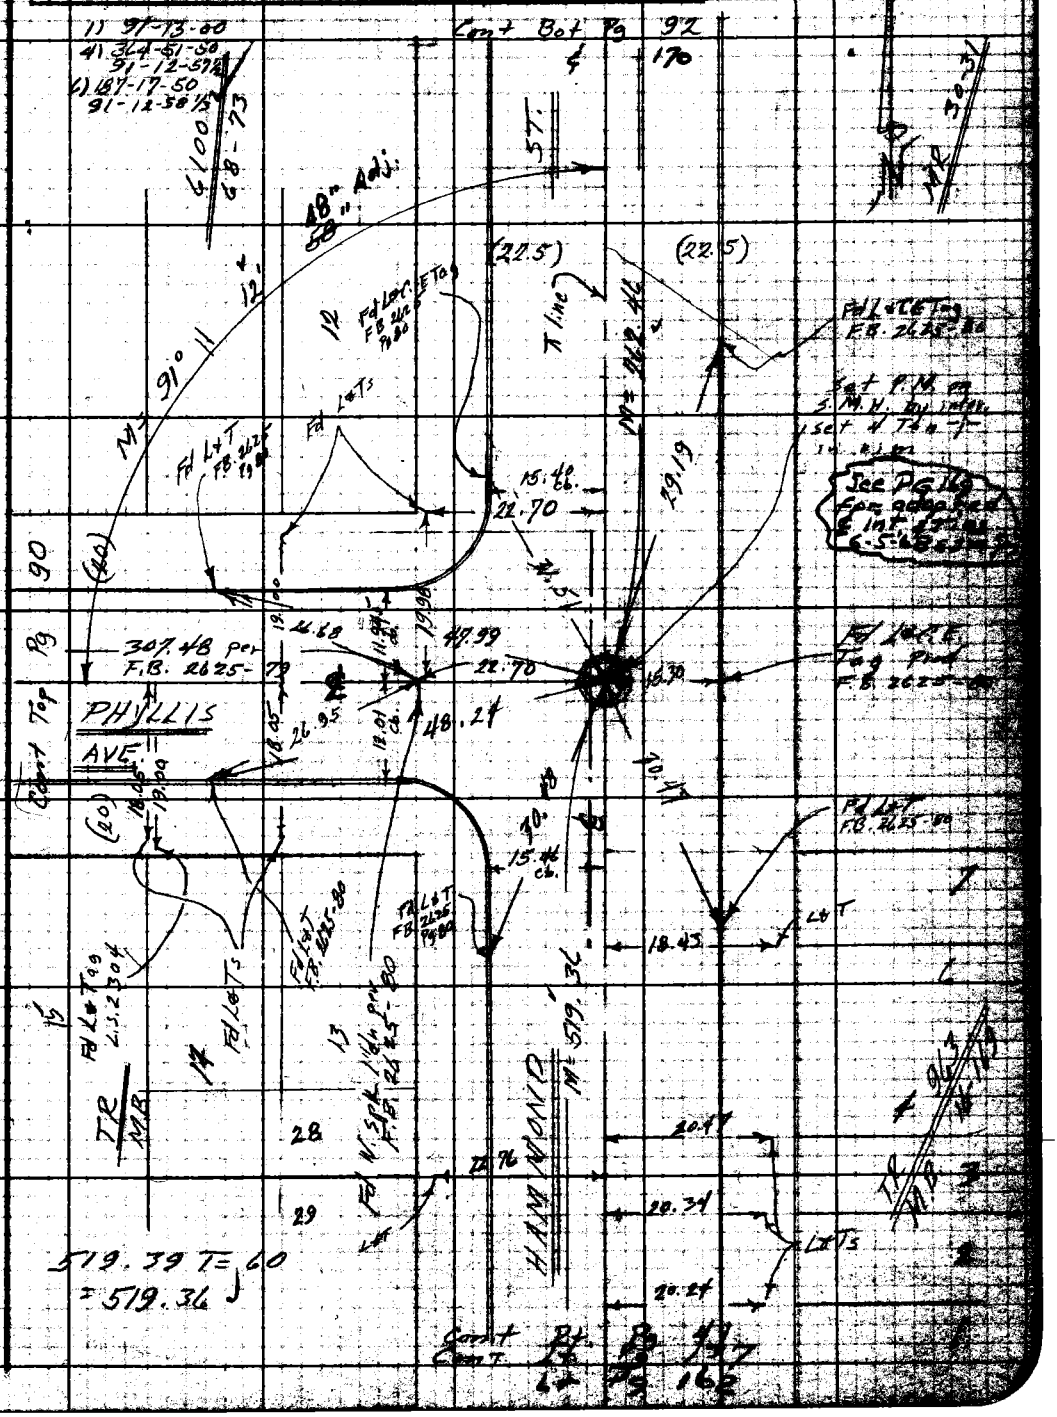

W.S. 22, B-3

Note: Any Additions or Changes on This Sheet Must be Made or Circled in Red Ink With Date and Name of Person Making Change.

Do not extend notes this side of this line.

REFERENCE TO
LOS ANGELES COUNTY ENGINEER
400 LOS ANGELES COUNTY ENGINEERING BLDG.

763098 CE #247—7-58

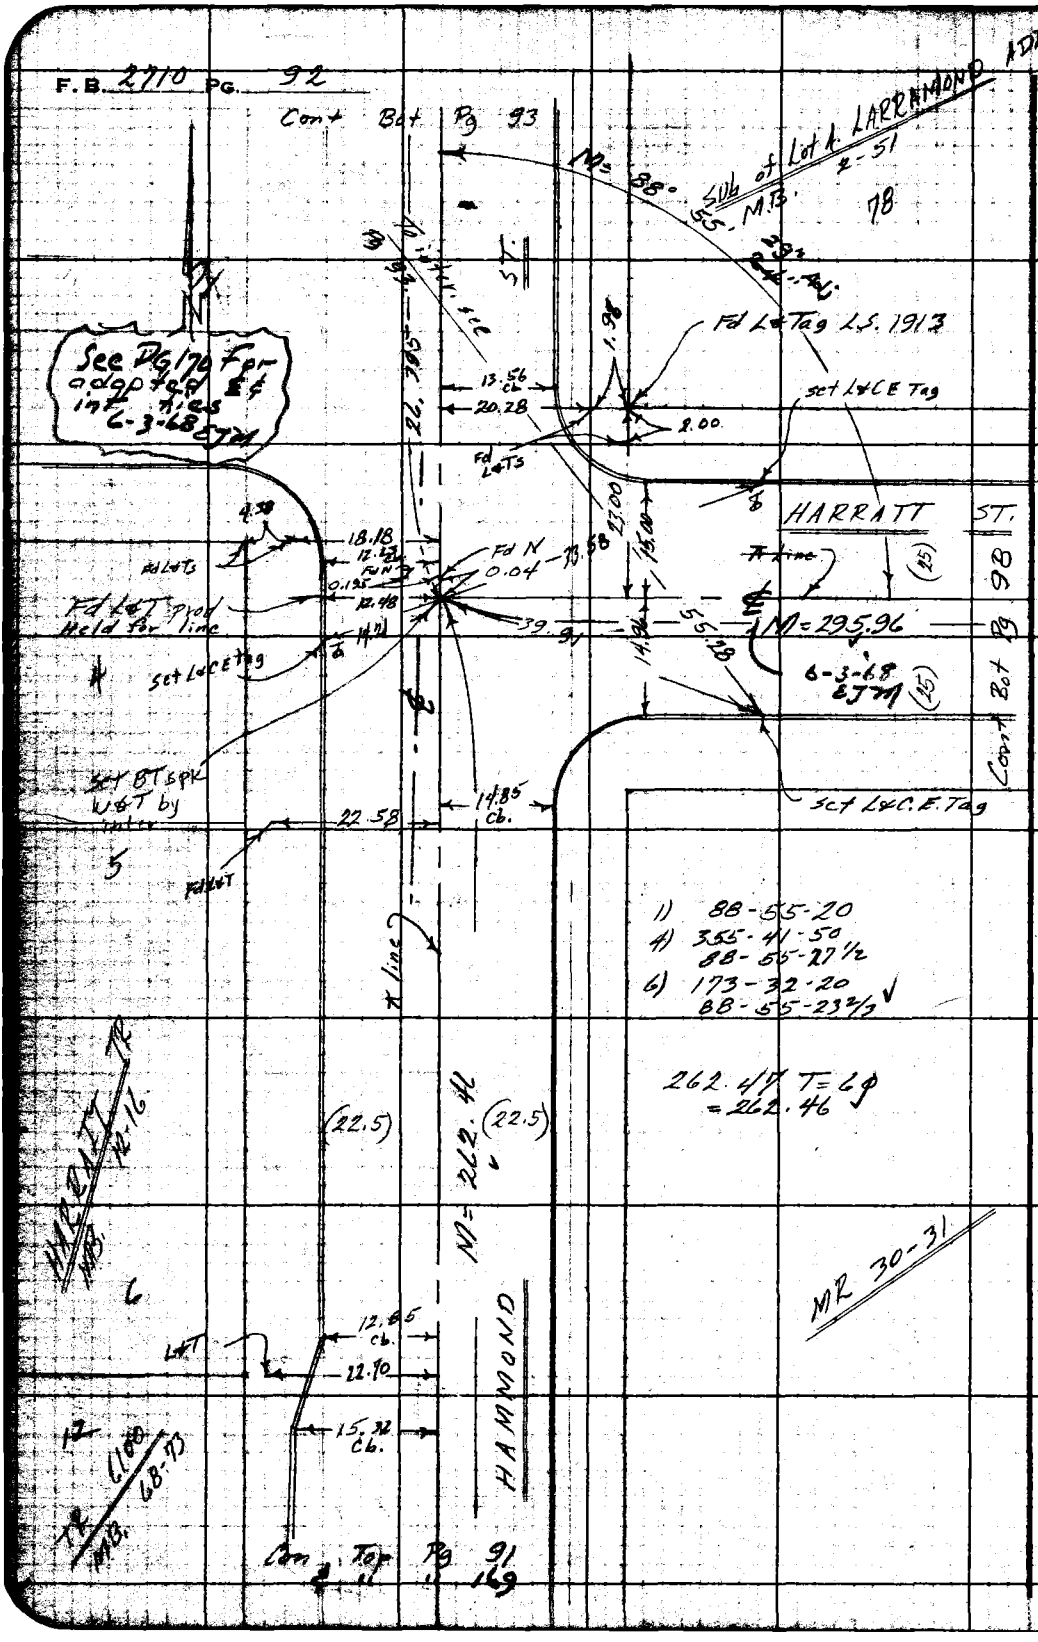

W.S. 22, B-3

RETURN TO
LOS ANGELES COUNTY ENGINEER
100 LOS ANGELES COUNTY ENGINEERING BLDG.

Do not extend notes this side of this line.

Note: Any Additions or Changes on This Sheet Must be Made or Circled in Red Ink With Date and Name of Person Making Change.

W. Hollywood & Sherman

Notes Ck'd by D. SAPPELL	Survey of Sewer Maint. Dist #3
Map No. 5418	JN 0707.00 Tape 0201 Std. 68 °F
Office Work E FONG	Surveyed by F. E. Brooks
Checked R HILARIO	Notes F. E. Brooks Date 13 Mar 82
Date 10-17-83	Indexed C. J. GALLI

F. B. 2710 PG. 93

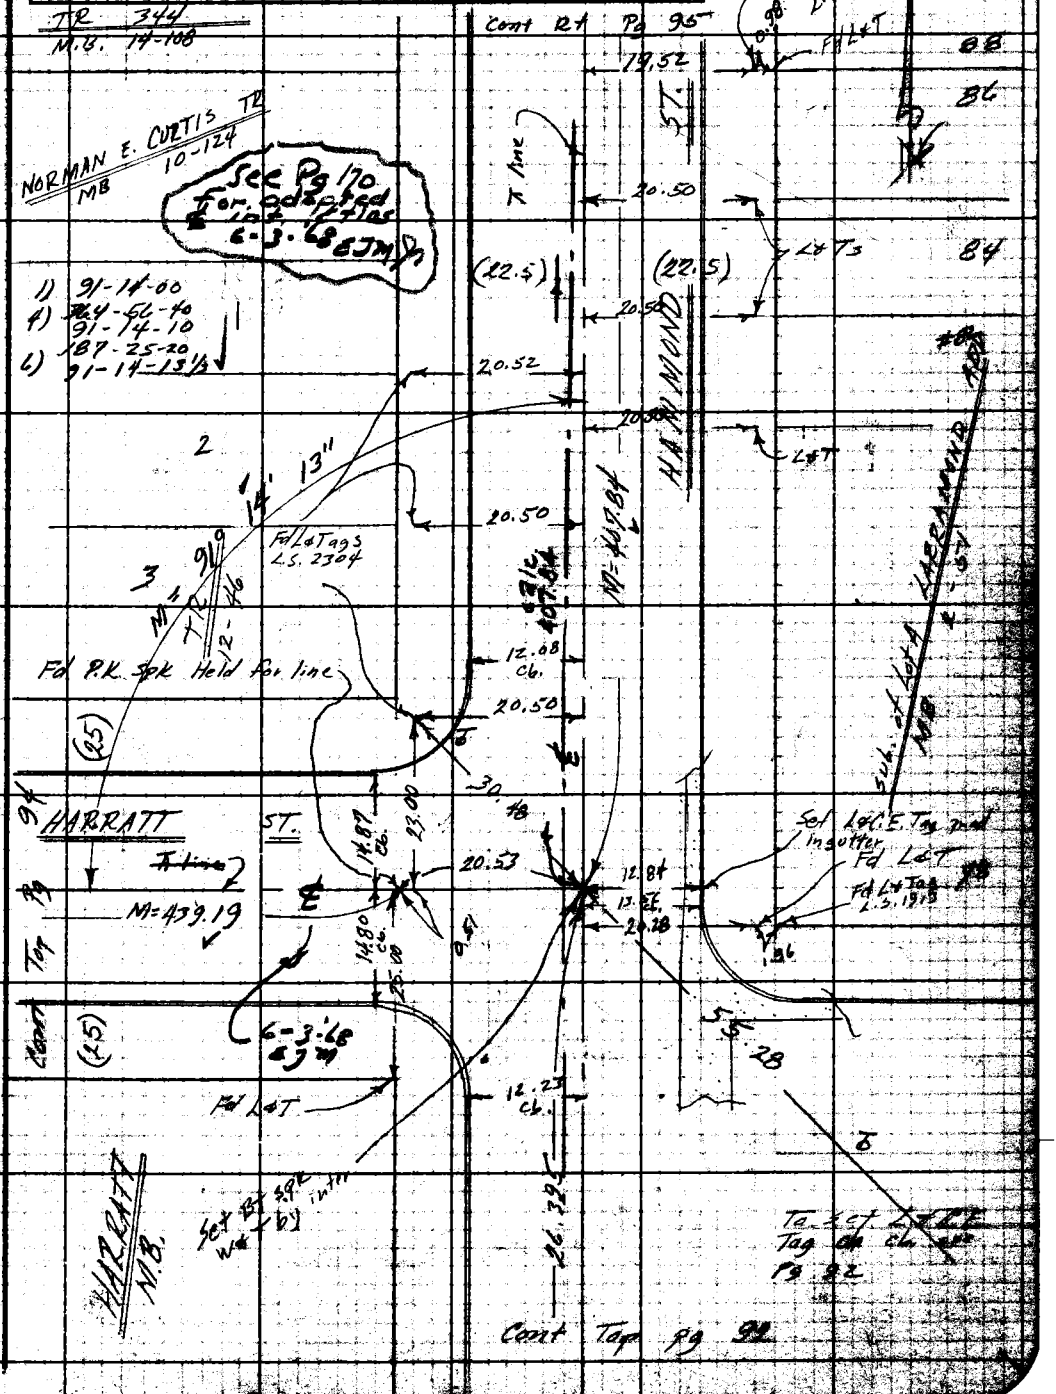

Note: Any Additions or Changes on This Sheet Must be Made or Graded in Red Ink With Date and Name of Person Making Change.

W.S. 22, B-3

Do not extend notes this side of this line.

RETURN TO
LOS ANGELES COUNTY ENGINEER
100 LOS ANGELES COUNTY ENGINEERING BLDG.

763098 CE #247—7-55

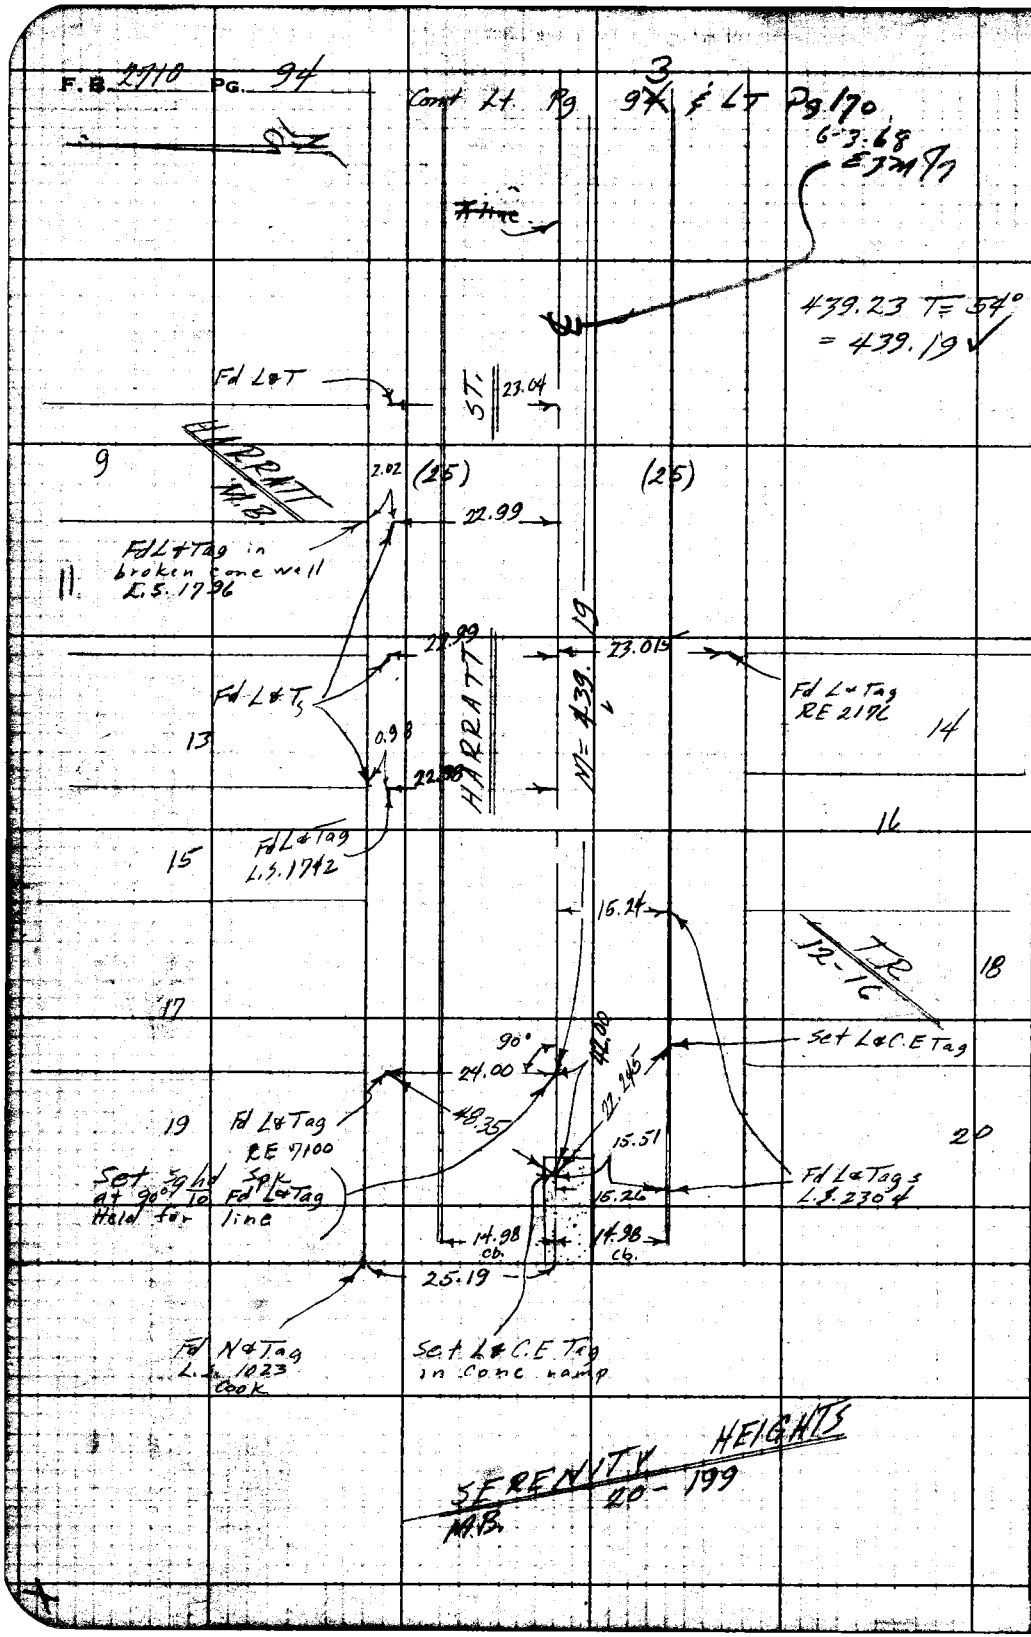

RETURN TO
LOS ANGELES COUNTY ENGINEER
700 LOS ANGELES COUNTY ENGINEERING BLDG.
Do not extend notes this side of this line.
Note: Any Additions or Changes on This Sheet Must be Made or Circled in Red Ink With Date and Name of Person Making Change.

W. Hollywood & Sherman

Notes Ck'd by D. SAPPELL	Survey of Sewer Maint Dist #3	F. B. 2710 Pg. 95
Map No. 5418	JN 0303.00 Tape 2201 Std 68 °F	
Office Work E FONG	Surveyed by F. E. Brooks	
Checked R. HILARIO	Notes F. E. Brooks Date 14 Mar 62	
Date 10-17-83	Indexed C. J. GALLI	

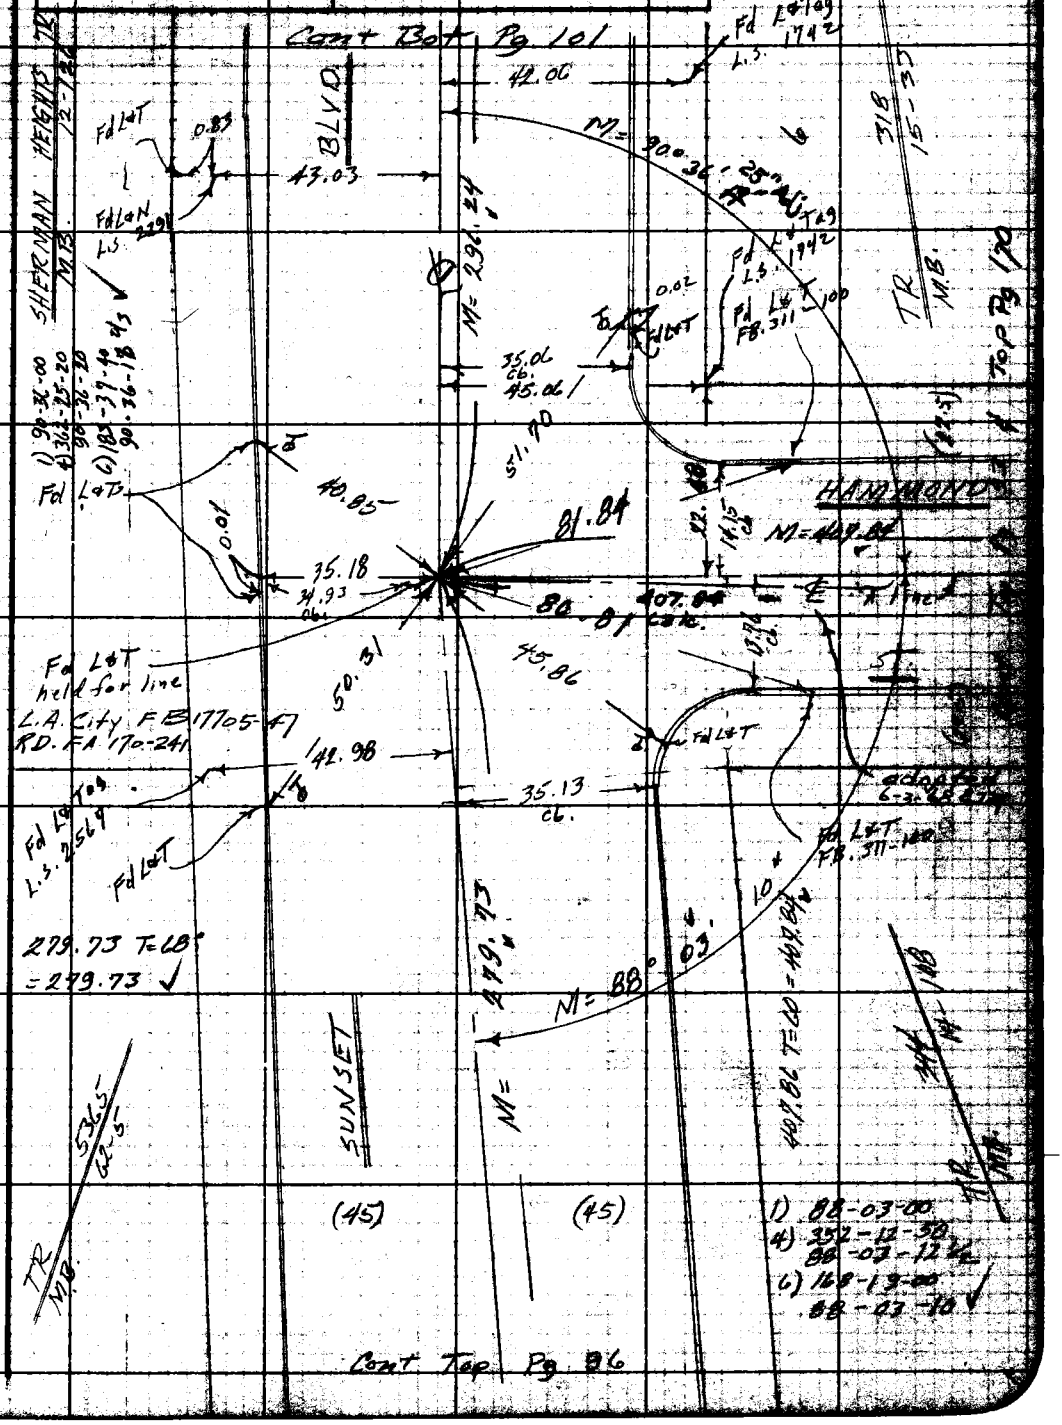

Note: Any Additions or Changes on This Sheet Must be Made or Circled in Red Ink With Date and Name of Person Making Change.

Do not extend notes this side of this line.

RETURN TO
LOS ANGELES COUNTY ENGINEER
900 LOS ANGELES COUNTY ENGINEERING BLDG.

W.S. 22, B-2

763098 CE #247—7-53

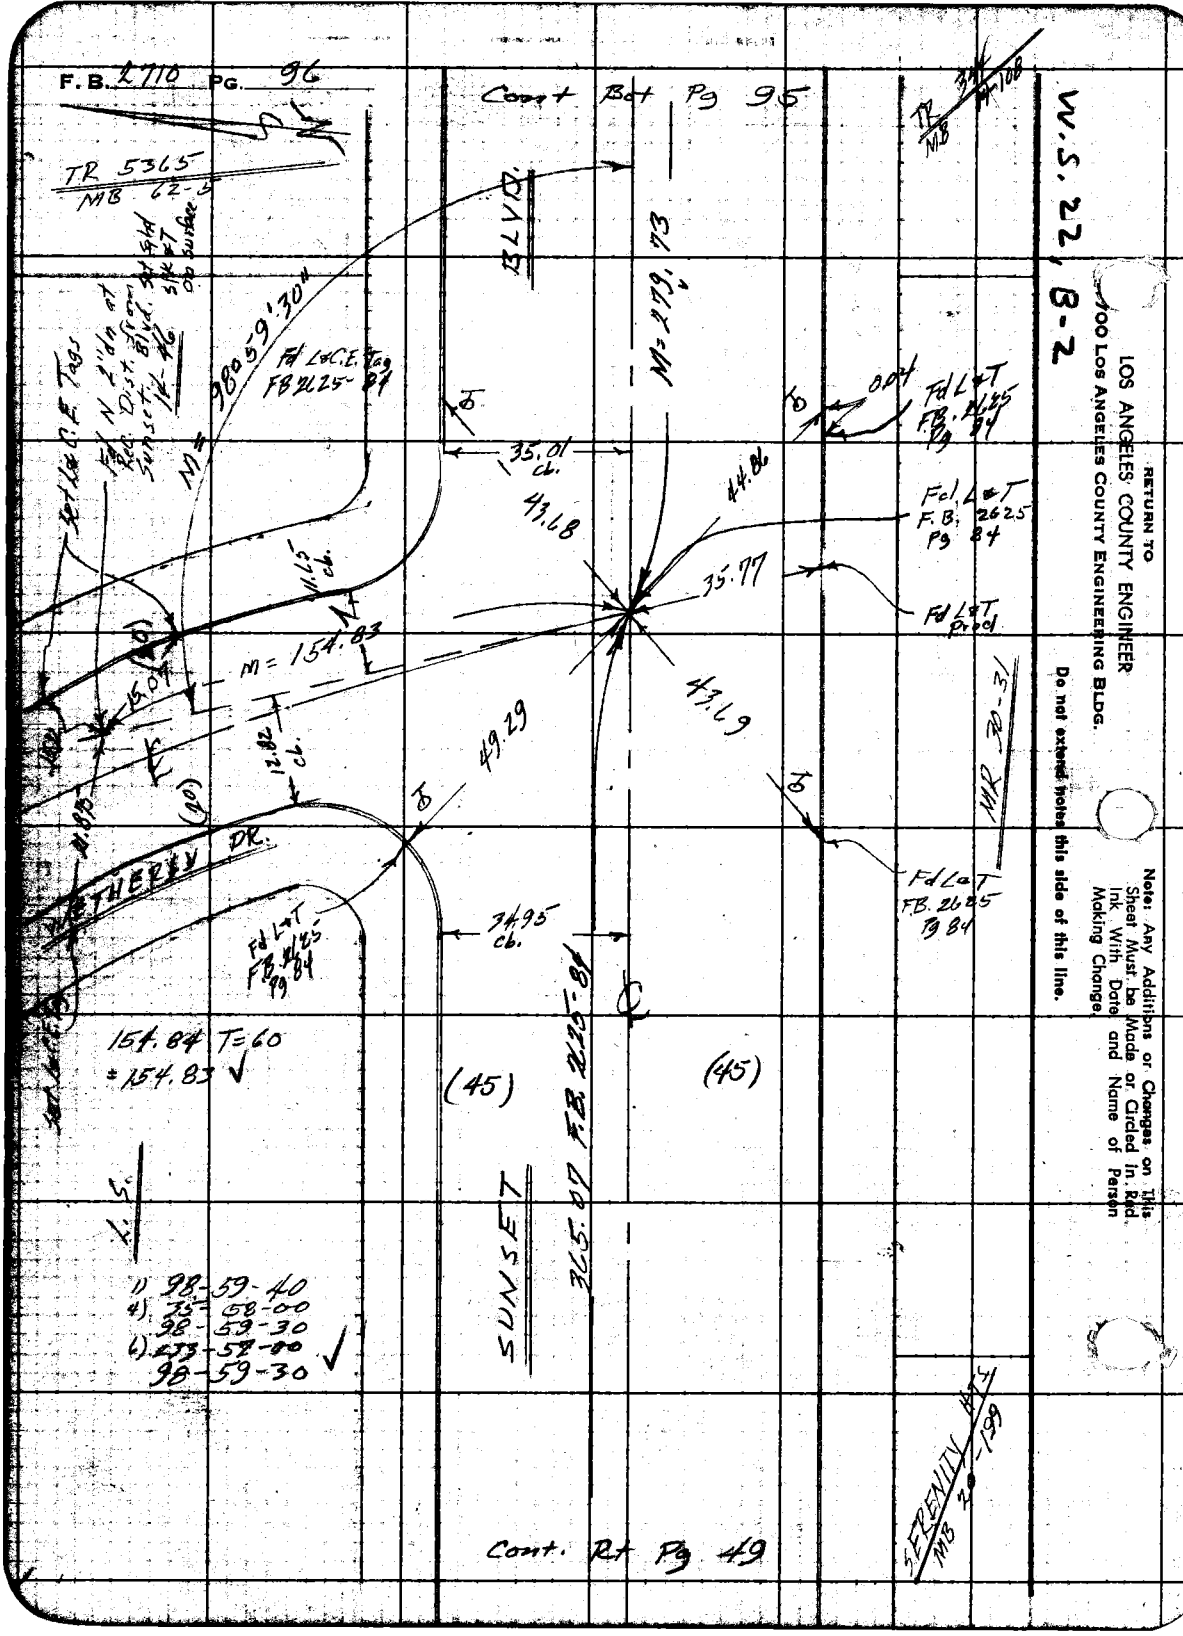
F.B. 2710 PG. 96
Cont Bot Pg 95
TR 5365
MB 62-5
BLVD.
M = 279.73
M = 98059'30"
Fd L&C.E. Tag
FB 2625-84
Set L&C.E. Tags
Fd N 2"dn at Rec. Dist. Blvd. Sunset
Set Sgd Sink & T on Surface
14-46
35.01 cb.
43.68
44.86
35.77
43.69
0.04
Fd L&T
F.B. 2625
Pg 84
Fd L&T Prod
M = 154.83
15.07
11.65 cb.
12.82 cb.
49.29
34.95 cb.
WETHERLY DR.
Fd L&T
F.B. 2625
Pg 84
MR 30-31
154.84 T=60
= 154.83
(45)
(45)
SUNSET
365.07 F.B. 2625-84
L.S.
1) 98-59-40
4) 35-58-00
98-59-30
6) 33-58-00
98-59-30
SERENITY HTS
MB 20-199
Cont. Rt Pg 49
W.S. 22, B-2
RETURN TO
LOS ANGELES COUNTY ENGINEER
100 LOS ANGELES COUNTY ENGINEERING BLDG.
Do not extend notes this side of this line.
Note: Any Additions or Changes on This Sheet Must be Made or Circled in Red Ink With Date and Name of Person Making Change.

W. Hollywood & Sherman

Notes Ck'd by D. SAPPELL	Survey of Sewer Maint Dist #3	F. B. 2710	Pg. 97
Map No. 5418	JN 0303.00 Tape 0201 Std 68 °F		
Office Work E FONG	Surveyed by F. E. Brooks		
Checked R HILARIO	Notes F. E. Brooks Date 9 Mar 1962		
Date 10-17-83	Indexed C. J. GALLI		

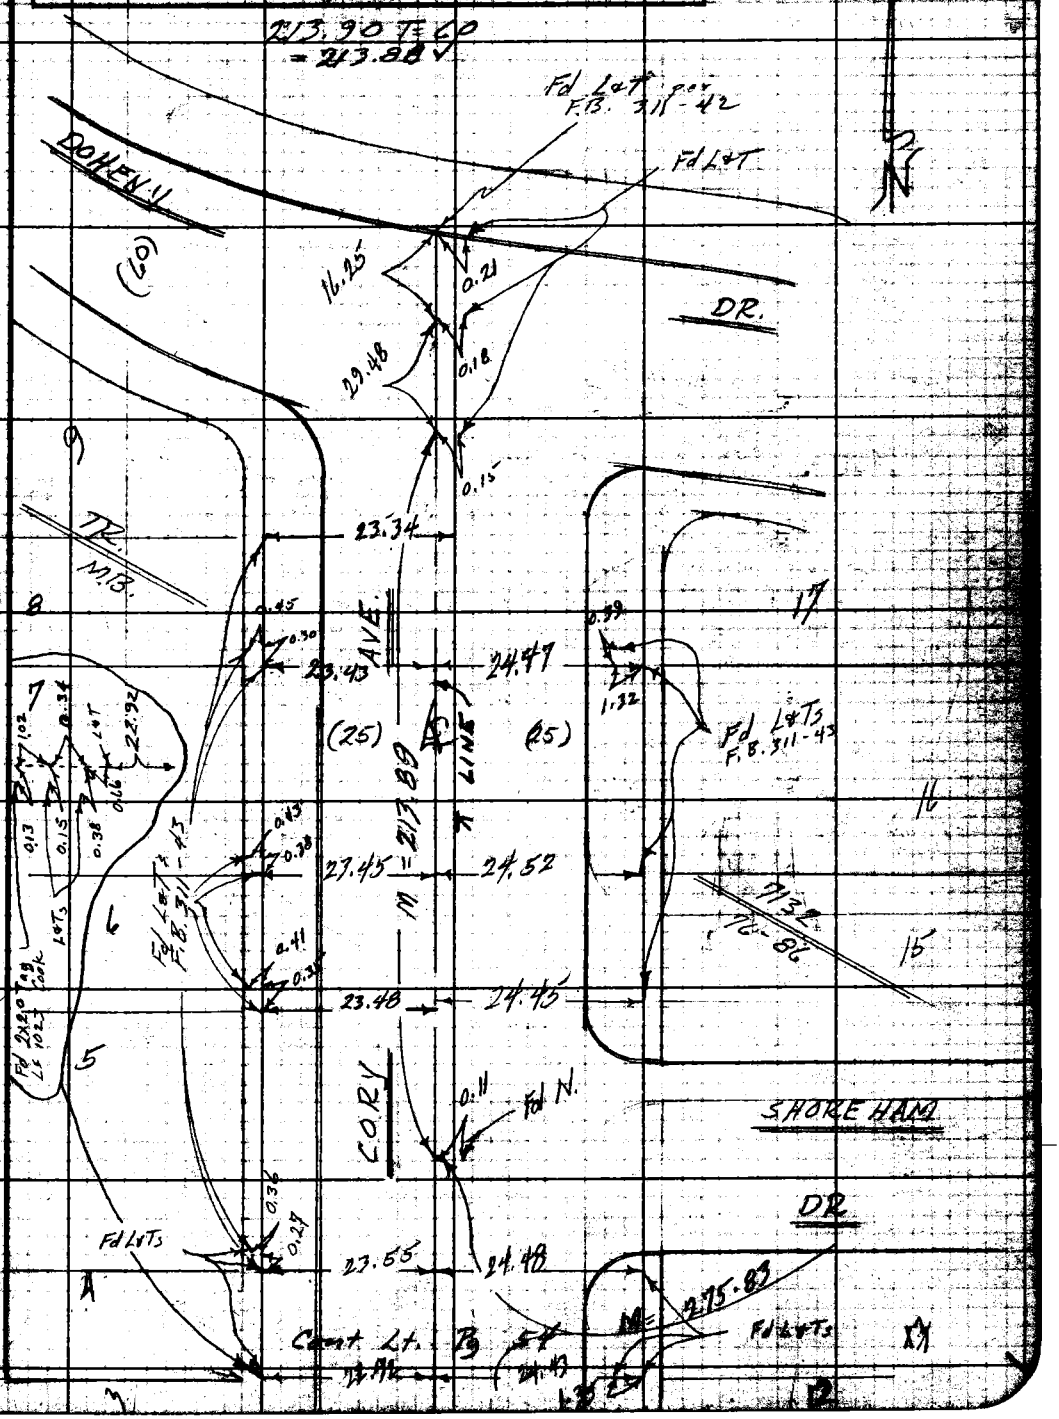

W.S. 22, B-2

Note: Any Additions or Changes on This Sheet Must be Made or Circled in Red Ink With Date and Name of Person Making Change.

Do not extend notes this side of this line.

RETURN TO
LOS ANGELES COUNTY ENGINEER
900 LOS ANGELES COUNTY ENGINEERING BLDG.

763098 CE #247—7-53

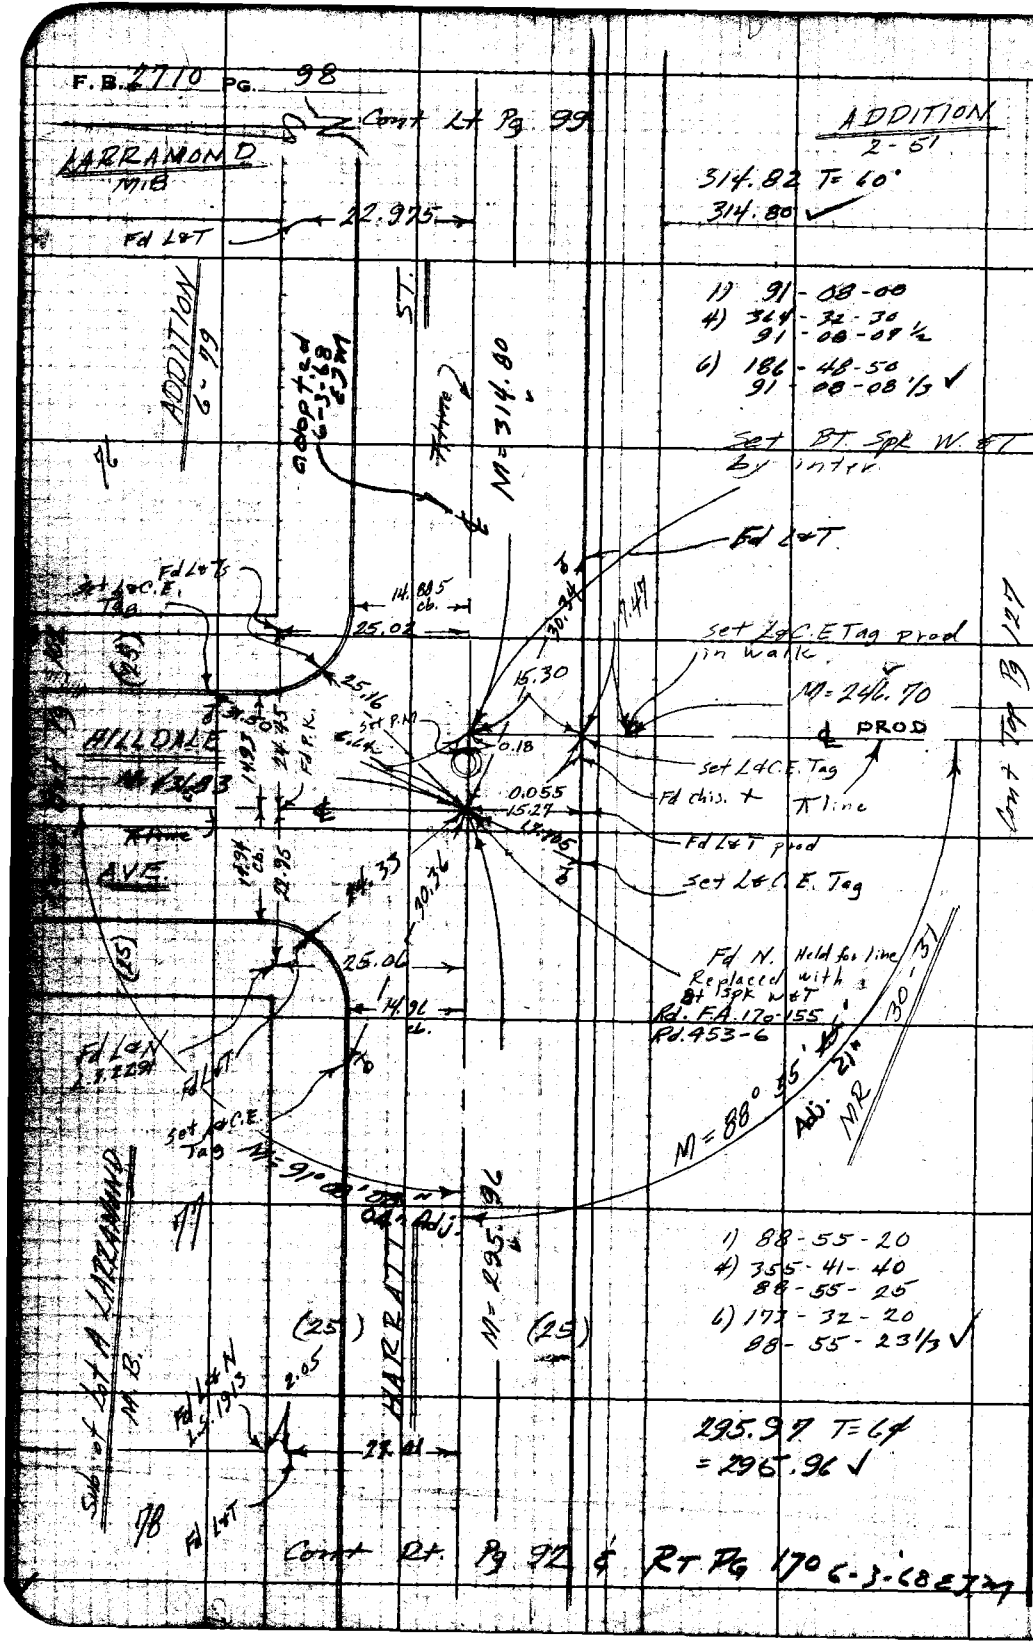

W.S. 22, B-3

RETURN TO
LOS ANGELES COUNTY ENGINEER
900 Los Angeles County Engineering Bldg.

Do not extend notes this side of this line.

Note: Any Additions or Changes on This Sheet Must be Made or Circled in Red Ink With Date and Name of Person Making Change.

W. Hollywood & Sherman

Notes Ck'd by D. SAPPELL	Survey of Sewer Mount Dist #3	F. B. 2710	PG. 99
Map No. 5418	JN 0303.00 Tape 6201 Std 68 °F	193.57 T=62°	
Office Work E FONG	Surveyed by F. E. Brooks	193.56 ✓	
Checked E HILARIO	Notes F. E. Brooks Date 16 Mar 62		
Date 10-17-33	Indexed C. J. GALLI		

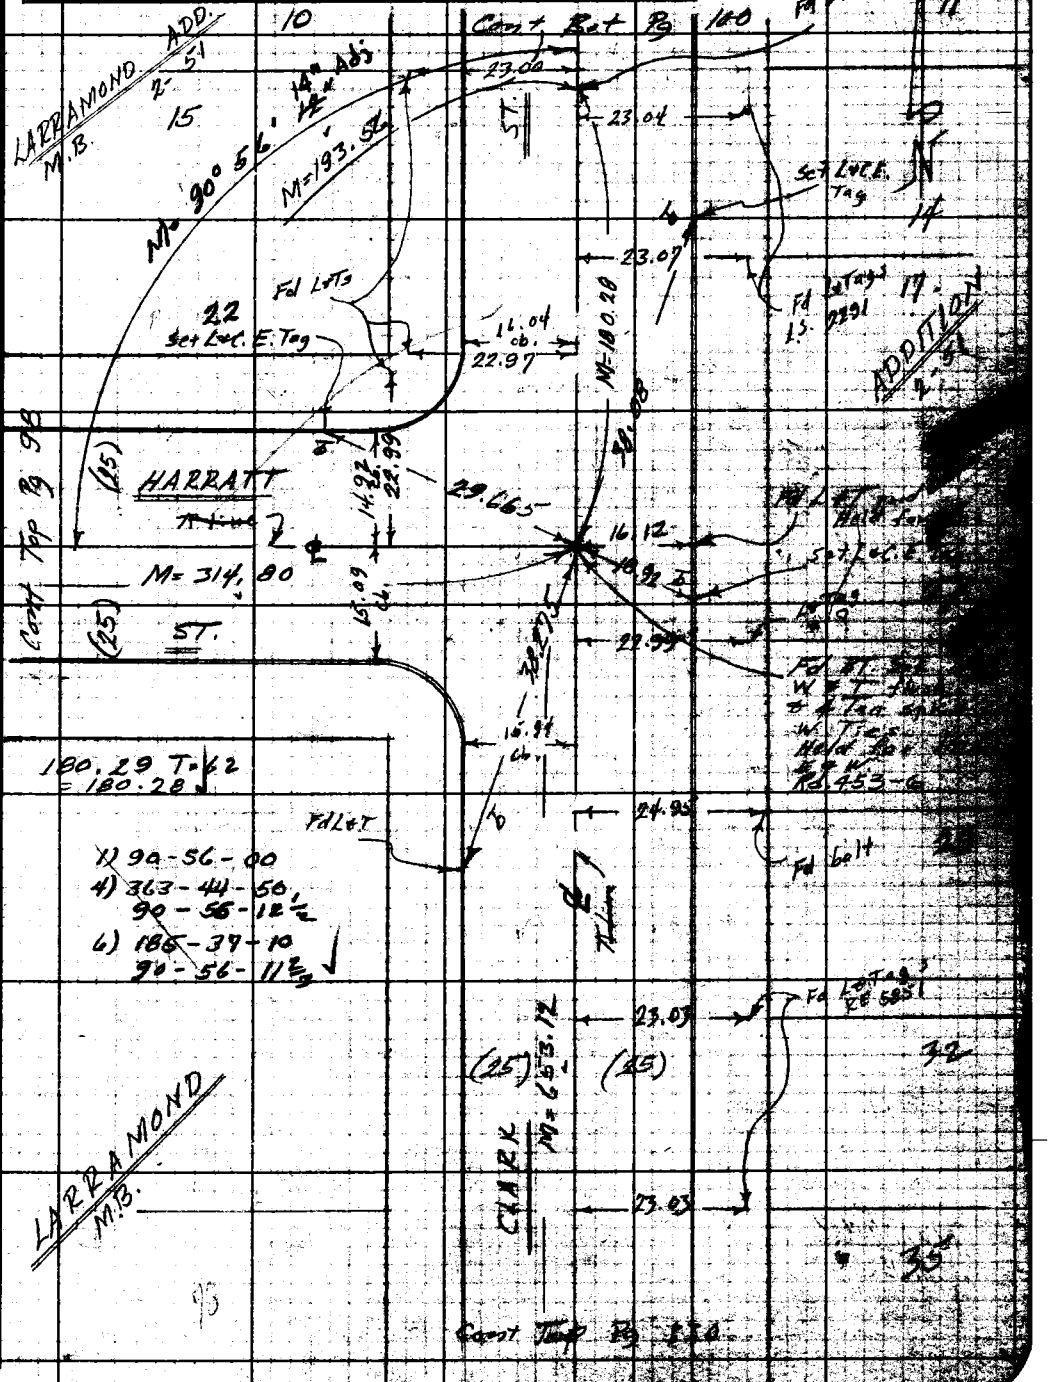

Note: Any Additions or Changes on This Sheet Must be Made or Circled in Red Ink With Date and Name of Person Making Change.

Do not extend notes this side of this line.

W.S.22, B-3

RETURN TO
LOS ANGELES COUNTY ENGINEER
DO LOS ANGELES COUNTY ENGINEERING BLDG.

763098 CE #247—7-53

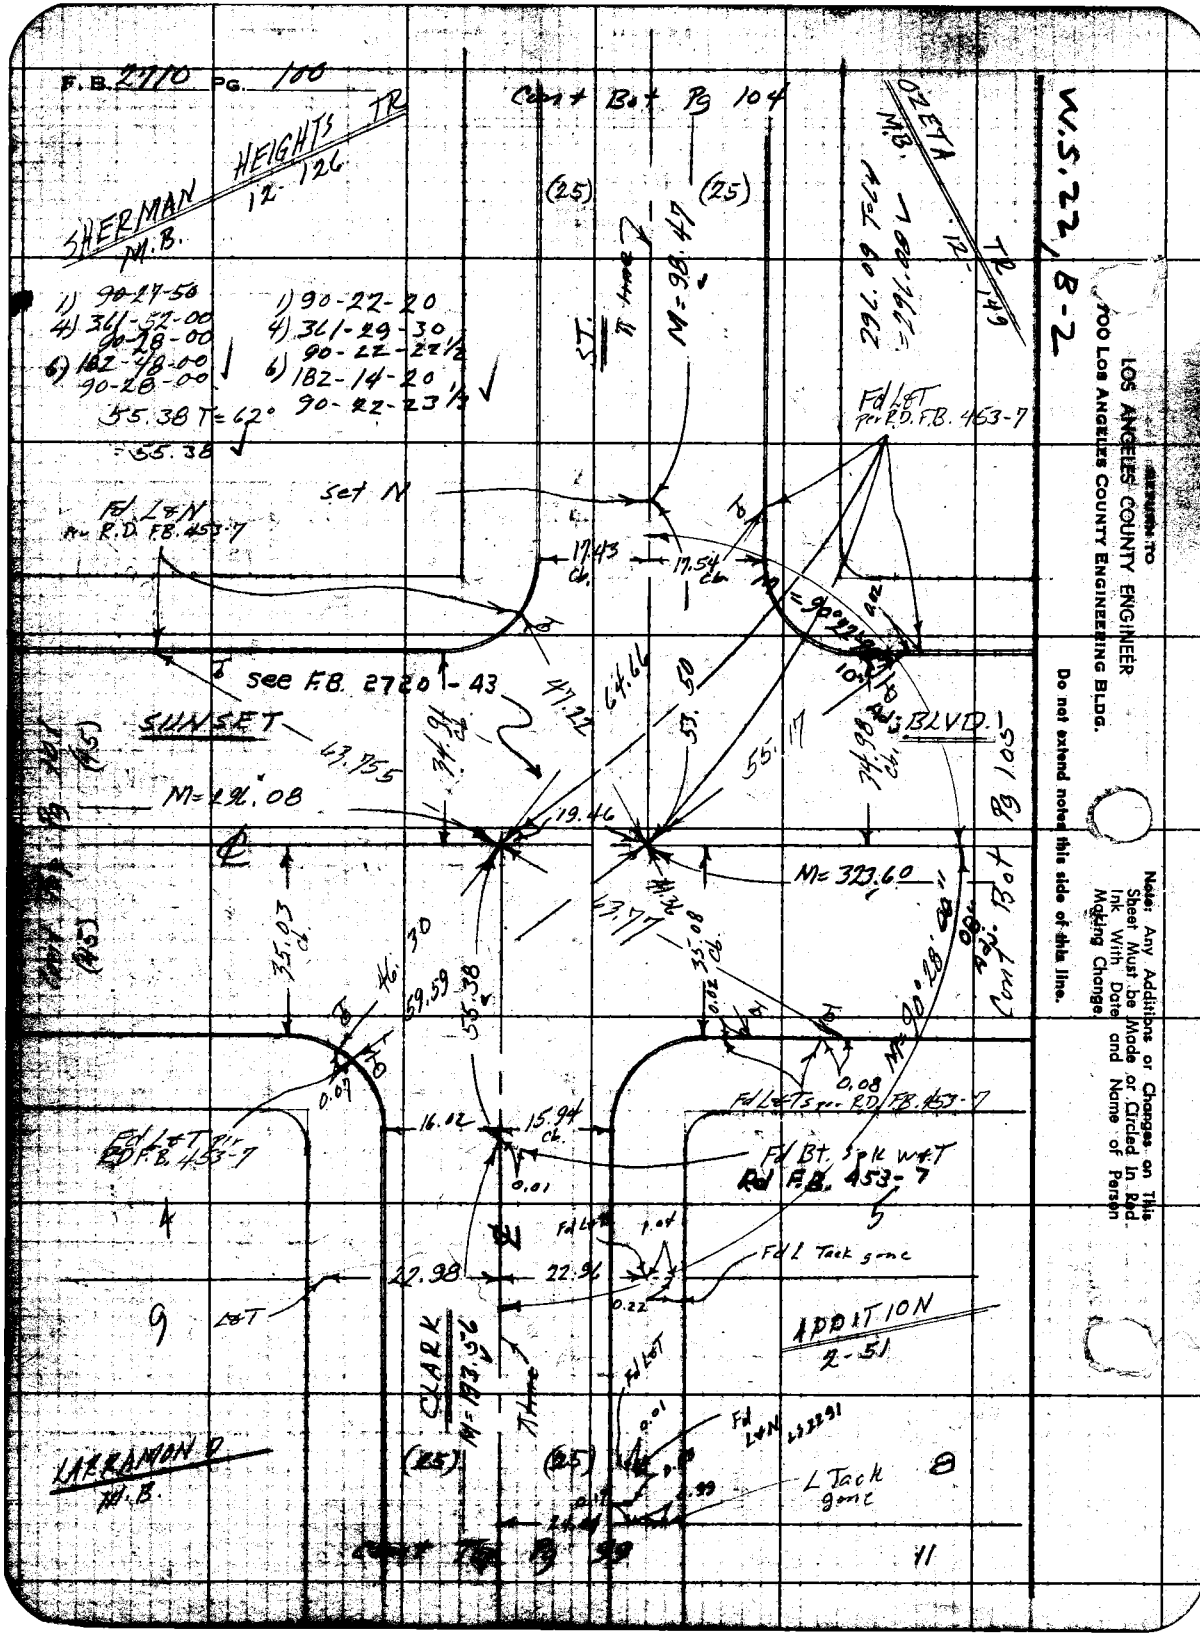

LOS ANGELES COUNTY ENGINEER
700 Los Angeles County Engineering Bldg.

Do not extend noted this side of this line.

Note: Any Additions or Changes on This Sheet Must be Made or Circled In Red Ink With Date and Name of Person Making Change.

W. Hollywood & Sherman

Notes Ck'd by D. SAPPELL	Survey of Sewer Maint. Dist.
Map No. 5418	JN 0303.00 Tape 0201 Std 68 °F
Office Work E FONG	Surveyed by F. E. Brooks
Checked R HILARIO	Notes F. E. Brooks Date 15 Mar 62
Date 10-17-80	Indexed C. J. GALLI

F. B. 2710 Pg. 101

LARRAMOND ADDITION
M.B. 2-51

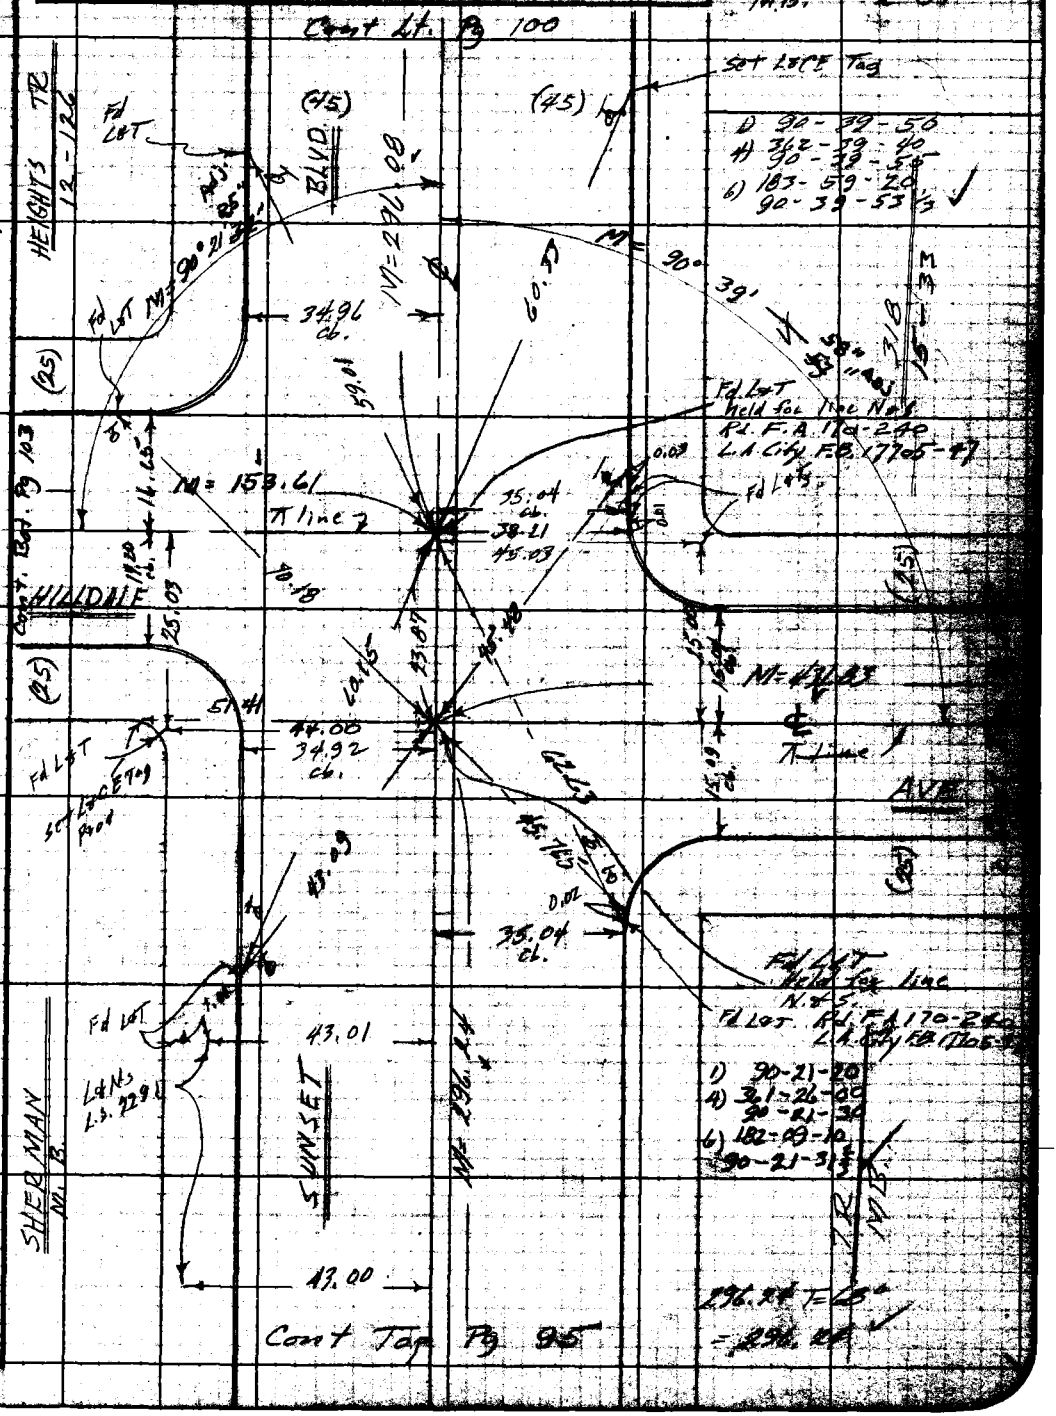

W.S. 22, B-2

Note: Any Additions or Changes on This Sheet Must be Made or Circled in Red Ink With Date and Name of Person Making Change.

Do not extend notes this side of this line.

RETURN TO
LOS ANGELES COUNTY ENGINEER
100 Los Angeles County Engineering Bldg.

763098 CE #247—7-53

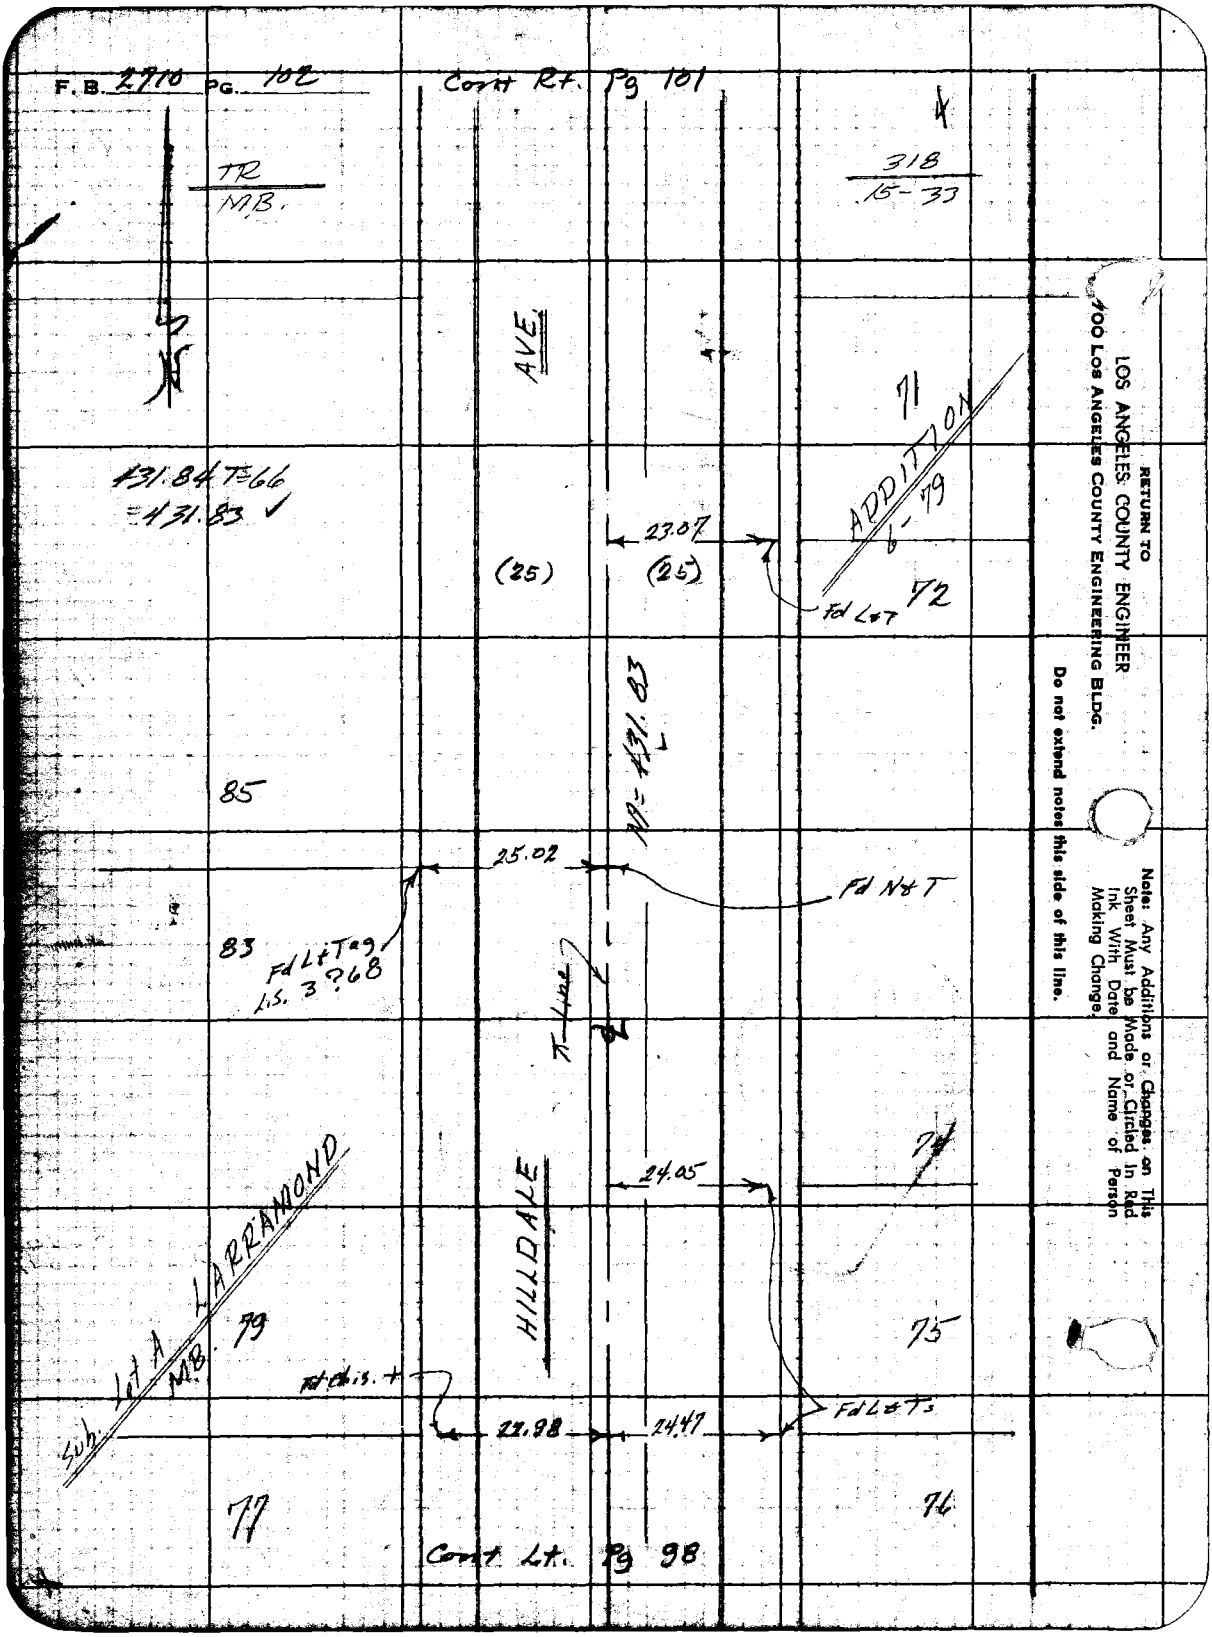
F.B. 2710 PG. 102
Cont Rt. Pg 101
TR
MB.
318
15-33
AVE.
71
ADDITION
6-79
431.84 T=66
=431.83 ✓
23.07
(25)
(25)
Fd L&T
72
NP=431.83
85
25.02
Fd N&T
83
Fd L&T Tag
L.S. 3 ?68
π Line
74
24.05
HILLDALE
Sub. Lot A LARRAMOND
MB.
79
75
Fd Chis. +
22.98
24.47
Fd L&Ts
77
76
Cont Lt. Pg 98
RETURN TO
LOS ANGELES COUNTY ENGINEER
100 LOS ANGELES COUNTY ENGINEERING BLDG.
Do not extend notes this side of this line.
Note: Any Additions or Changes on This Sheet Must be Made or Circled In Red Ink With Date and Name of Person Making Change.

N. Hollywood & Sherman

Notes Ck'd by D. SAPPELL	Survey of Sewer Maint. Dist #3
Map No. 5418	JN 8303.00 Tape 0201 Std 68 °F
Office Work E FONG	Surveyed by F. E. Brooks
Checked R. HILARIO	Notes F. E. Brooks Date 15 Mar 62
Date 10-17-83	Indexed C. J. GALLI

F. B. 2710 PG. 103

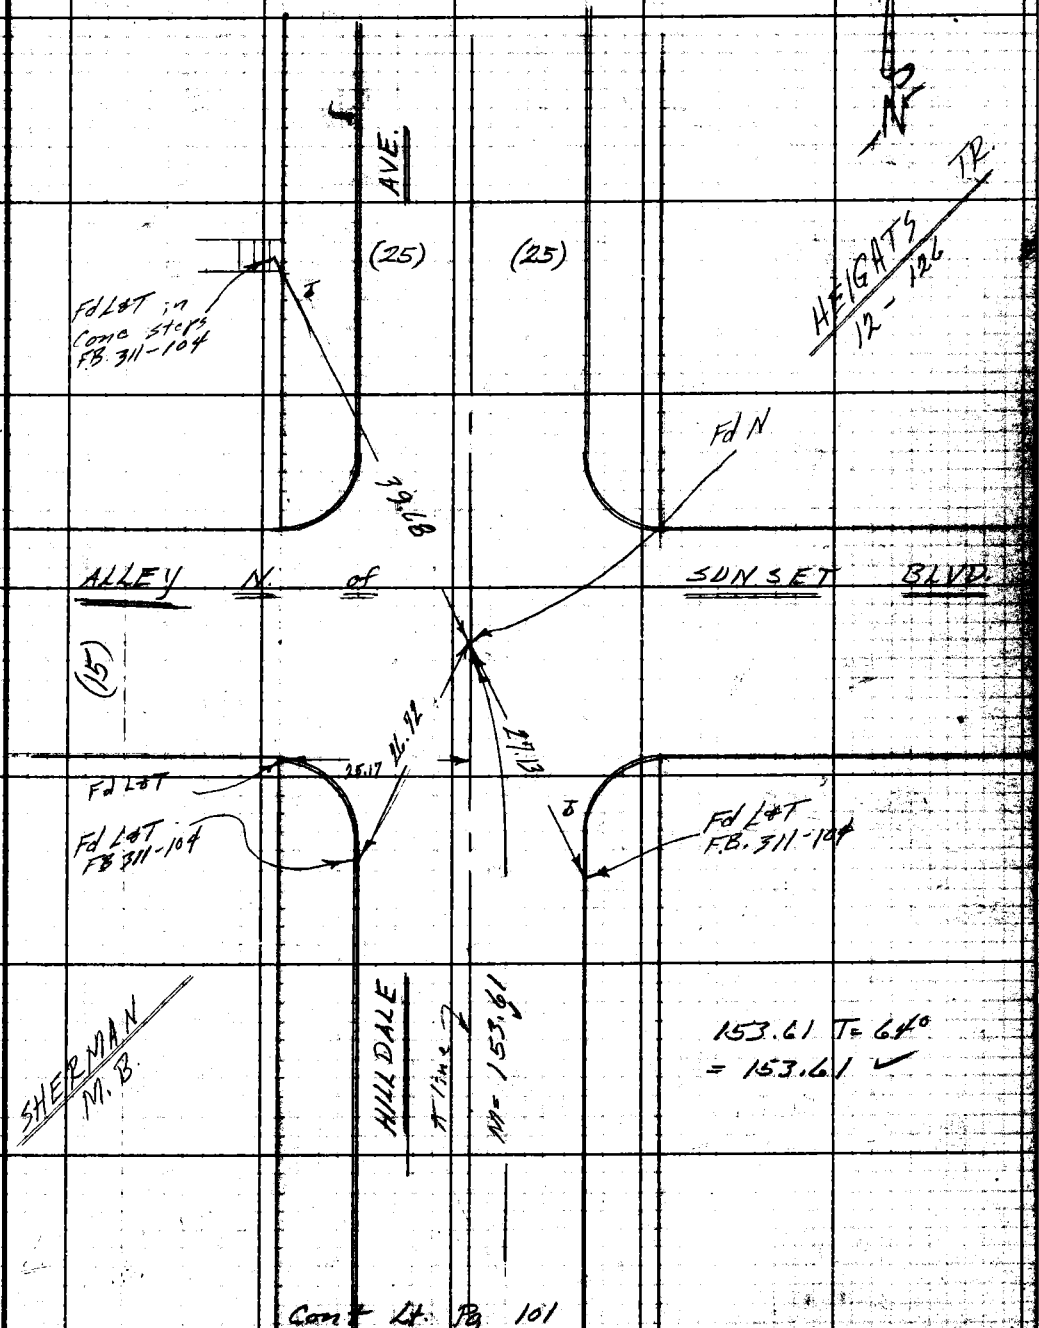

Note: Any Additions or Changes on This Sheet Must Be Made or Graded in Red Ink With Date and Name of Person Making Change.

W.S. 22, B-2

Do not extend notes this side of this line.

RETURN TO
LOS ANGELES COUNTY ENGINEER
DO Los Angeles County Engineering Bldg.

763098 CE #247—7-53

F. B. 2710 Pg. 104

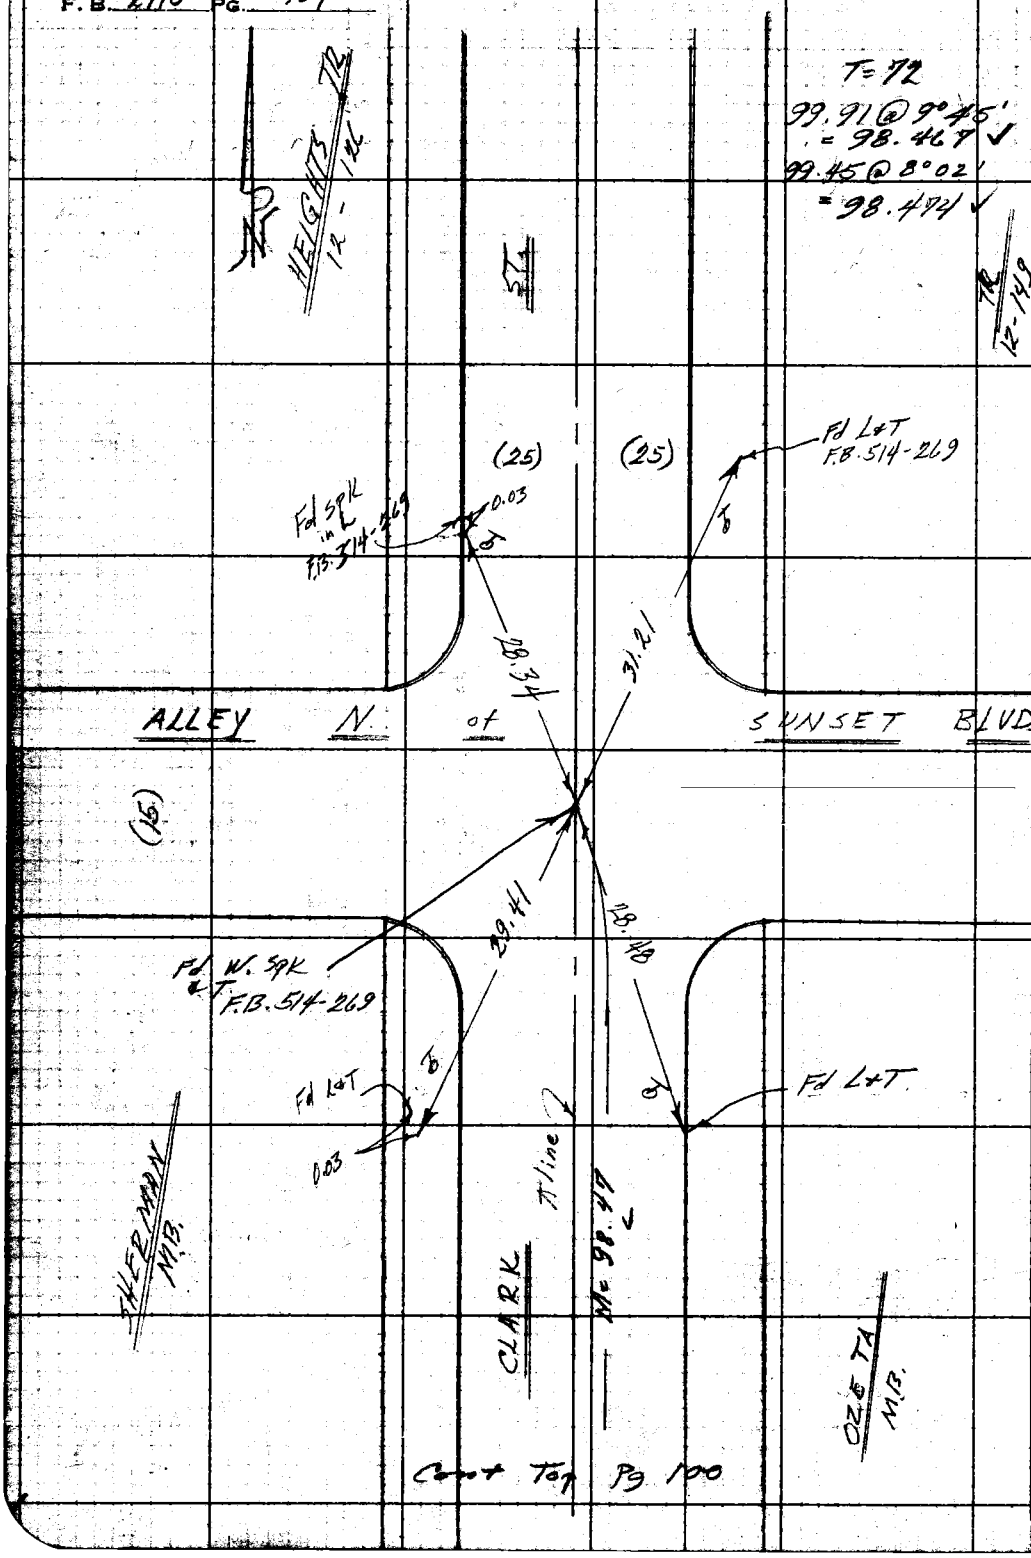

Cont Top Pg 100

W.S. 22, B-2

RETURN TO
LOS ANGELES COUNTY ENGINEER
700 Los Angeles County Engineering Bldg.

Do not extend notes this side of this line.

Note: Any Additions or Changes on This Sheet Must be Made or Circled In Red Ink With Date and Name of Person Making Change.

W. Hollywood & Sherman

Notes Ck'd by D. SAPPELL	Survey of Sewer Maint. Dist #3
Map No. 5418	A 0303.00 Tape 0001 Std 68 °F
Office Work E FONG	Surveyed by F. E. Brooks
Checked R. HILARIO	Notes F. E. Brooks Date 11 Mar 62
Date 10-17-83	Indexed C. J. GALLI

F. B. 2710 PG. 105

Cont Lt Pg 38

(45) (45)

BLVD.

℄

34.87 cb

ALLEY W. of LARRABEE

This Alley is Terraced as a parking lot for Apt houses on Larrabee and is not usable as a alley.

#01

40.97

Fd L+Ts

34.80 Cb.

323.61
T=64
=323.60 ✓

M = 323.60

SUNSET

Cont RT Pg 100

W.S.22, B-2

Note: Any Additions or Changes on This Sheet Must Be Made or Circled in Red Ink With Date and Name of Person Making Change.

Do not extend notes this side of this line.

RETURN TO
LOS ANGELES COUNTY ENGINEER
900 LOS ANGELES COUNTY ENGINEERING BLDG.

763095 CE #247—7-59

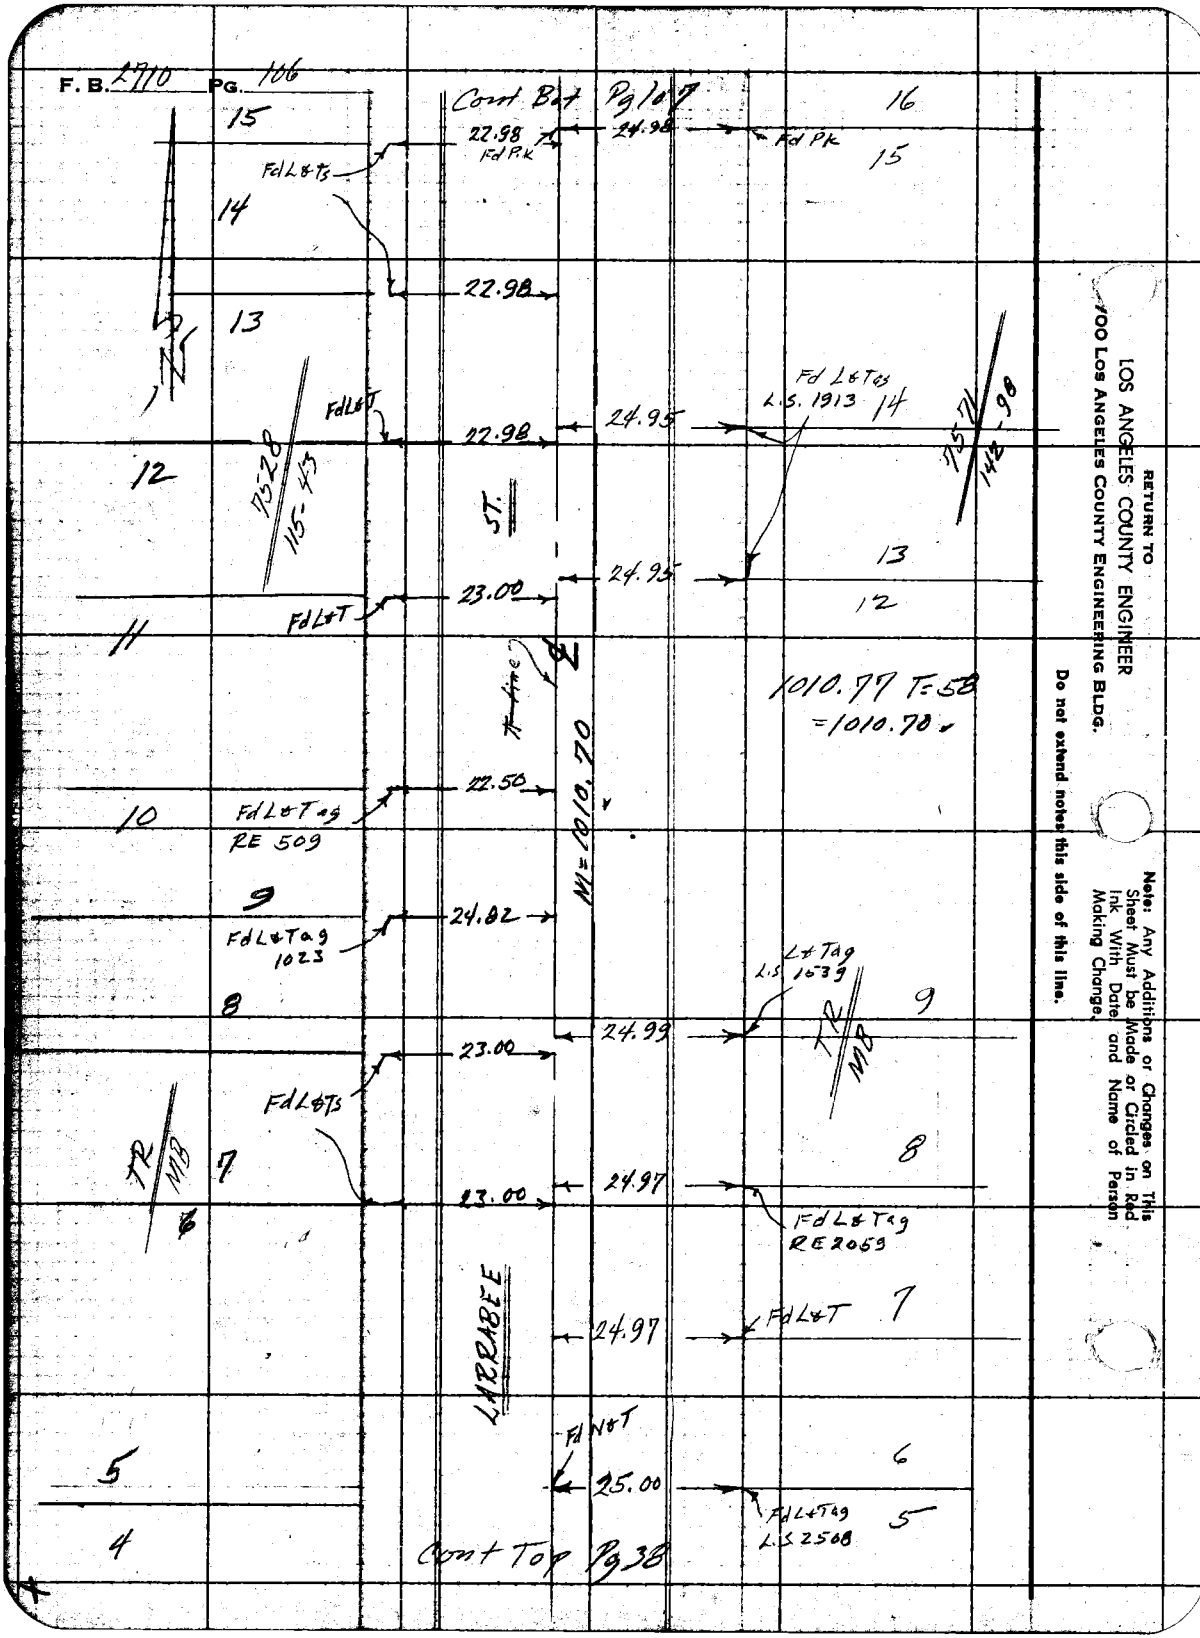

RETURN TO
LOS ANGELES COUNTY ENGINEER
100 LOS ANGELES COUNTY ENGINEERING BLDG.

Do not extend notes this side of this line.

Note: Any Additions or Changes on This Sheet Must be Made or Circled in Red Ink With Date and Name of Person Making Change.

W. Hollywood & Sherman

Notes Ck'd by D. SAPPELL	Survey of Sewer Maint Dist 03
Map No. 5418	JN 0303.00 Tape 0201 Std 68 °F
Office Work E FONG	Surveyed by F. E. Brooks
Checked R. HILARIO	Notes F. E. Brooks Date 22 Mar 62
Date 10-17-83	Indexed C. J. GALLI

F. B. 2910 PG. 107

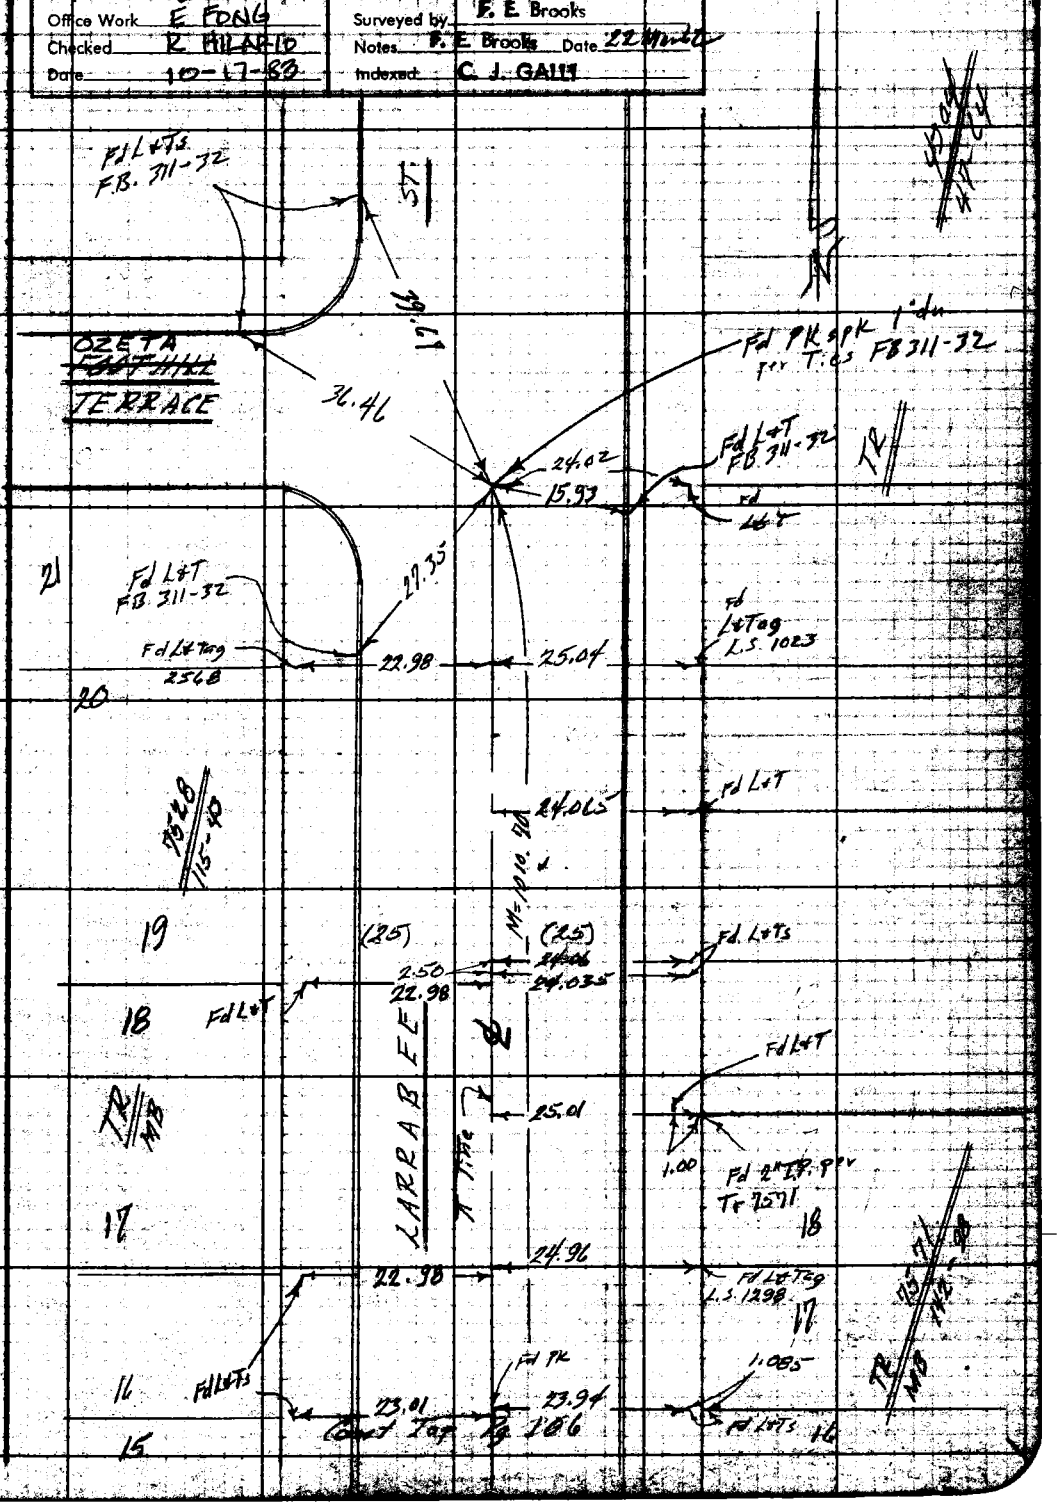

W.S. 22, B-2

Notes: Any Additions or Changes on This Sheet Must be Made or Graded in Red Ink With Date and Name of Person Making Change.

Do not extend notes this side of this line.

RETURN TO
LOS ANGELES COUNTY ENGINEER
900 LOS ANGELES COUNTY ENGINEERING BLDG.

763098 CE #247—7-83

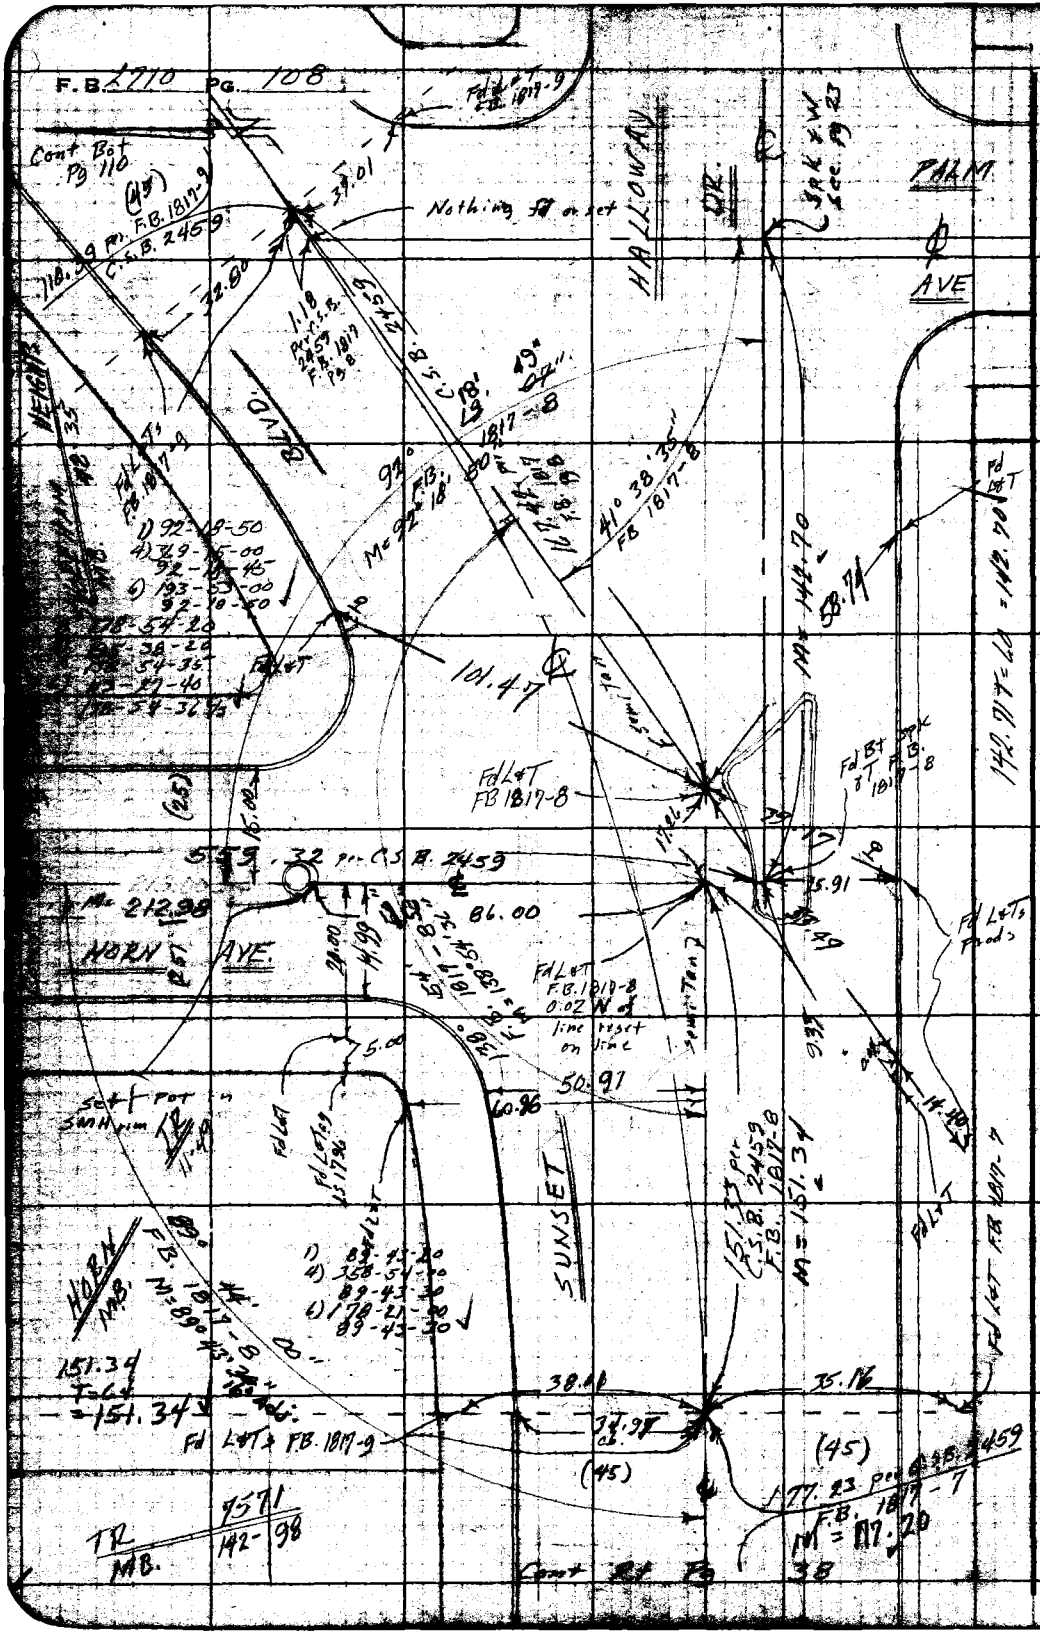

RETURN TO
LOS ANGELES COUNTY ENGINEER
700 LOS ANGELES COUNTY ENGINEERING BLDG.

Do not extend notes this side of this line.

Note: Any Additions or Changes on This Sheet Must be Made or Circled in Red Ink With Date and Name of Person Making Change.

W. Hollywood & Sherman

Notes Ck'd by D. SAPPELL	Survey of Sewer Maint Dist #3 F.B. 2710 Pg. 109
Map No. 5418	IN 0303-00 Tape 0201 Std 68 °F
Office Work E FONG	Surveyed by F. E. Brooks
Checked R HILARIO	Notes F. E. Brooks Date 23 March 62
Date 10-17-83	Indexed C. J. GALLI

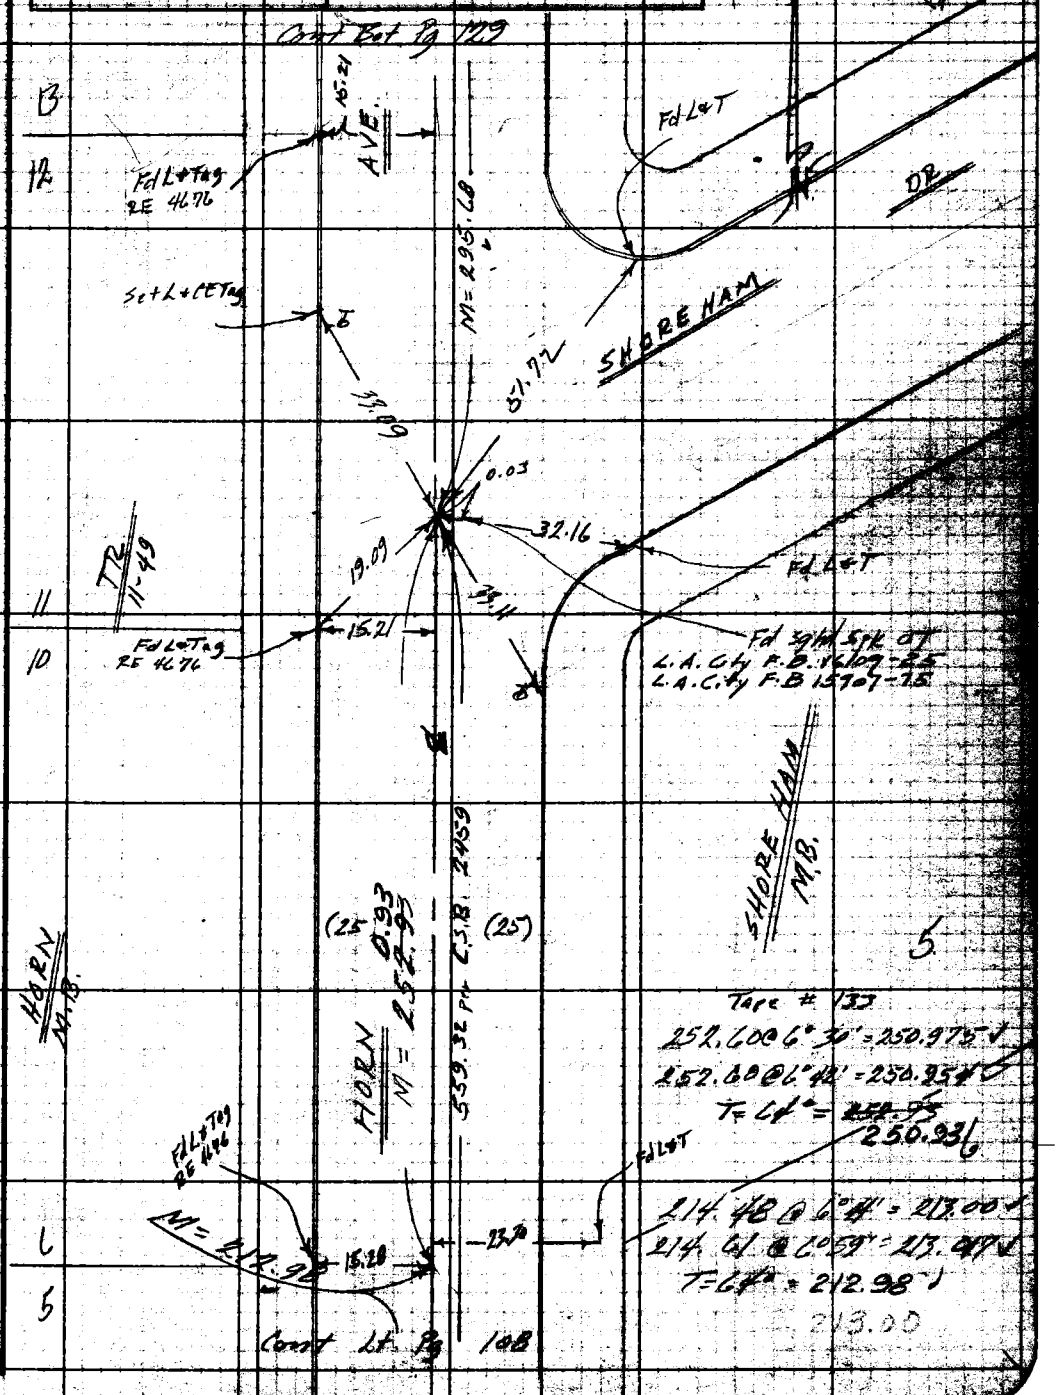

Note: Any Additions or Changes on This Sheet Must be Made or Circled in Red Ink With Date and Name of Person Making Change.

W.S. 22, B-2

Do not extend notes this side of this line.

RETURN TO
LOS ANGELES COUNTY ENGINEER
100 LOS ANGELES COUNTY ENGINEERING BLDG.

763098 CE #247—7-53

F. B. 2710 PG. 110

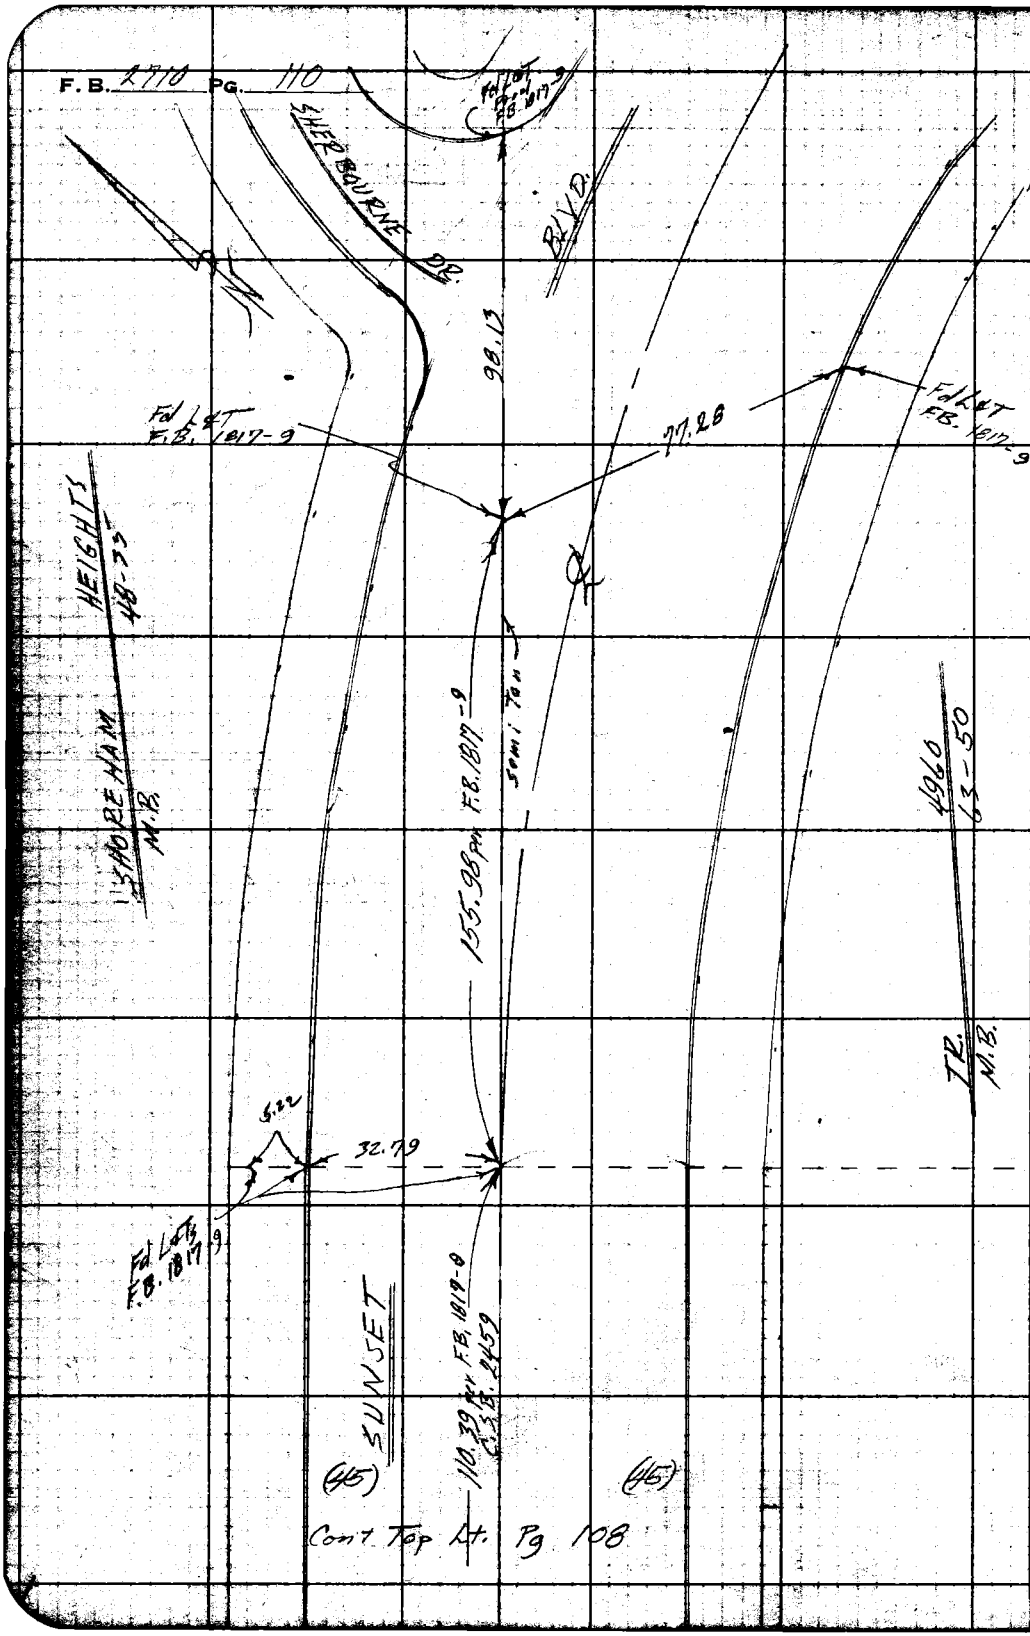

Cont Top Lt. Pg 108

W.S. 22, B-2

RETURN TO
LOS ANGELES COUNTY ENGINEER
900 LOS ANGELES COUNTY ENGINEERING BLDG.

Do not extend notes this side of this line.

Note: Any Additions or Changes on This Sheet Must be Made or Circled In Red Ink With Date and Name of Person Making Change.

W. Hollywood & Sherman

Notes Ck'd by D. SAPPELL	Survey of Sewer Maint Dist #3	F. B. 2710	Pg. 111
Map No. 5418	IN 0303.04 Tape 0201 Std 08 °F		
Office Work E FONG	Surveyed by E. E. Brooks		
Checked D. HILARIO	Notes E. E. Brooks Date 20 Mar 62		
Date 10-17-83	Indexed C. J. GALLI		

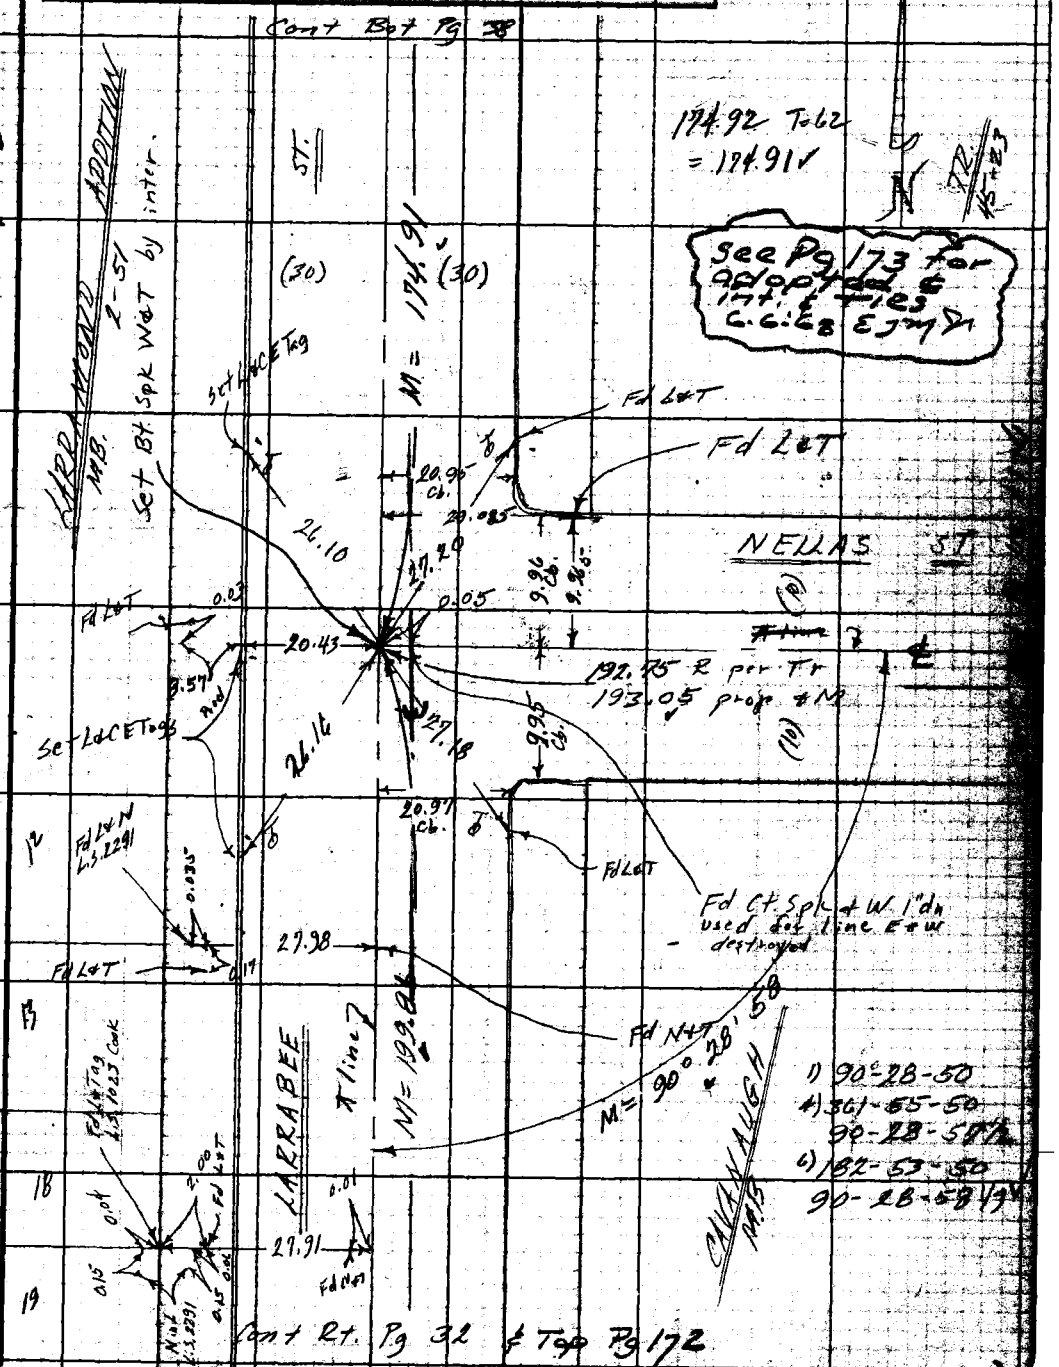

Note: Any Additions or Changes on This Sheet Must be Made or Circled in Red Ink With Date and Name of Person Making Change.

W.S. 22, B-3

Do not extend notes this side of this line.

RETURN TO
LOS ANGELES COUNTY ENGINEER
1100 LOS ANGELES COUNTY ENGINEERING BLDG.

763098 CE #247—7-58

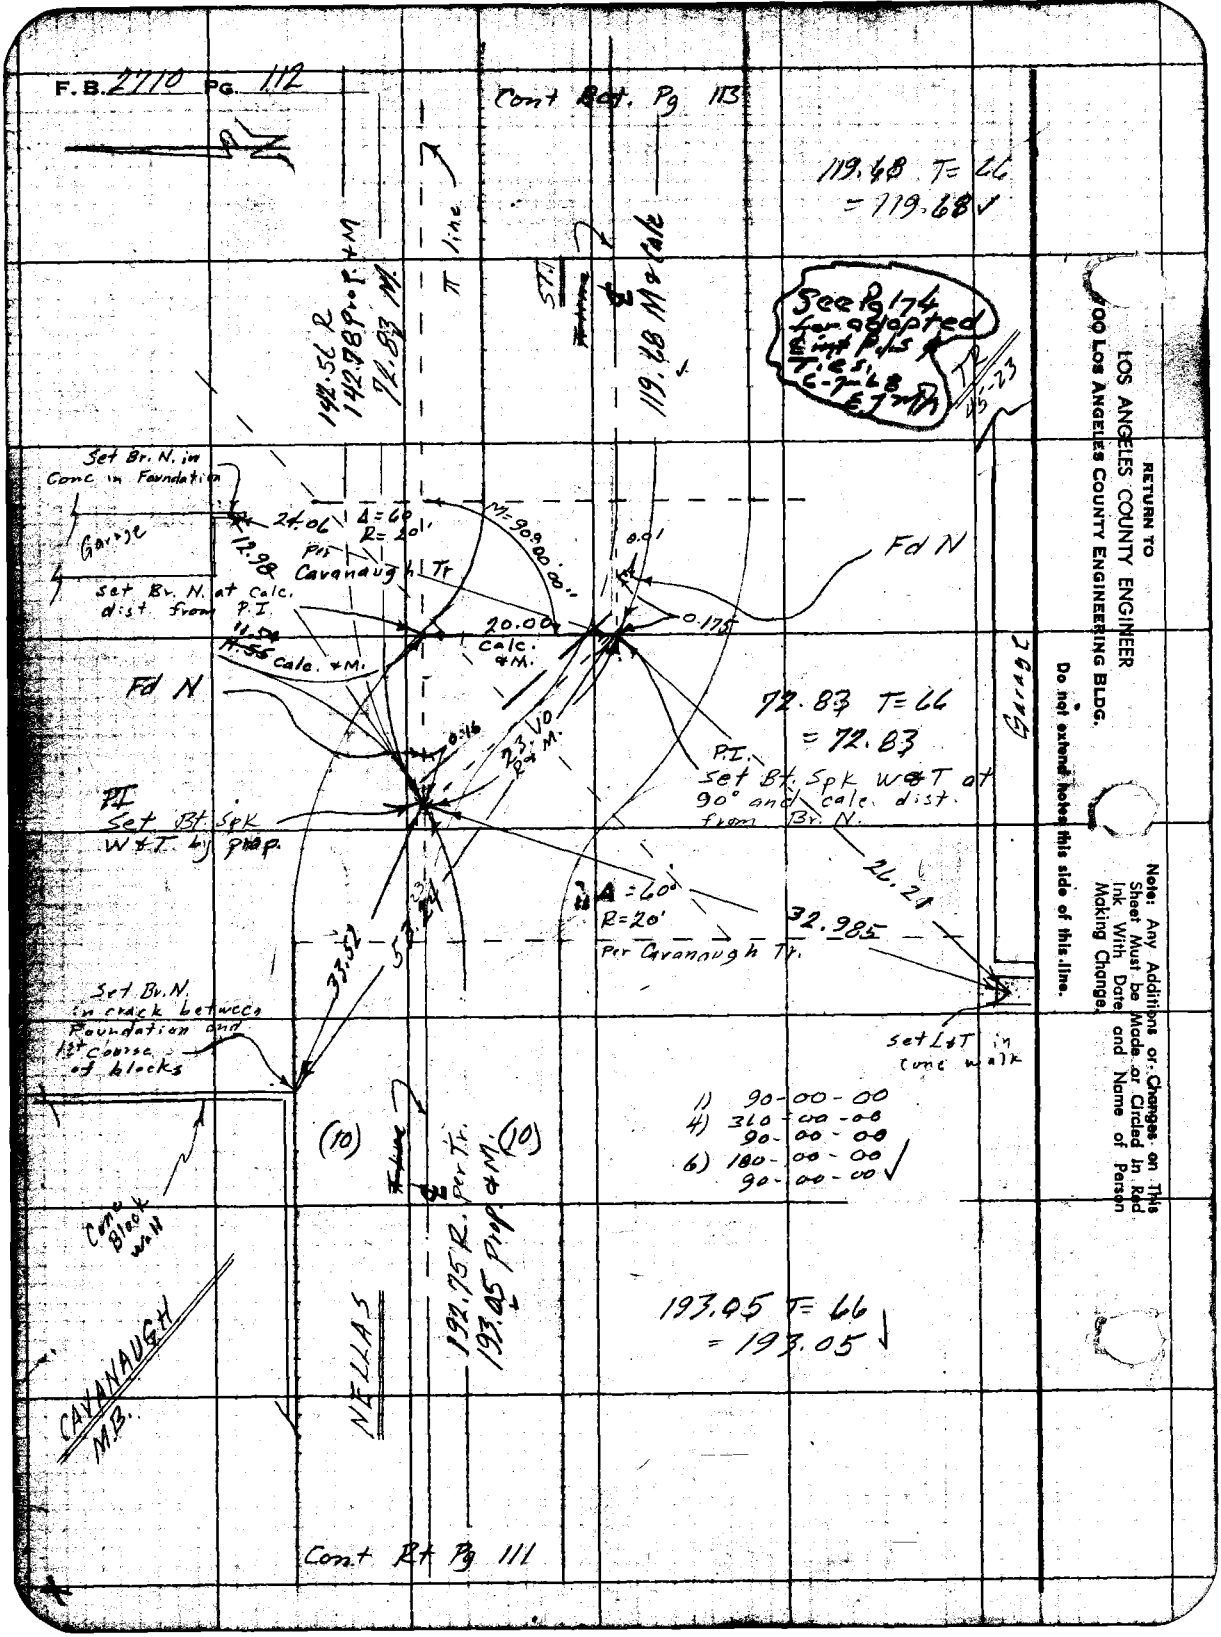

RETURN TO
LOS ANGELES COUNTY ENGINEER
900 LOS ANGELES COUNTY ENGINEERING BLDG.

Do not extend notes this side of this line.

Note: Any Additions or Changes on This Sheet Must be Made or Circled in Red Ink With Date and Name of Person Making Change.

W. Hollywood & Sherman

Notes Ck'd by D. SAPPELL	Survey of Sewer Maint Dist #3
Map No. 5418	IN 0703.00 Tape 0201 Std 68 °F
Office Work E FONG	Surveyed by F. E. Brooks
Checked R HILARIO	Notes F. E. Brooks Date 20 Mar 62
Date 10-17-83	Indexed C. J. GALLI

F. B. 2710 Pg. 113

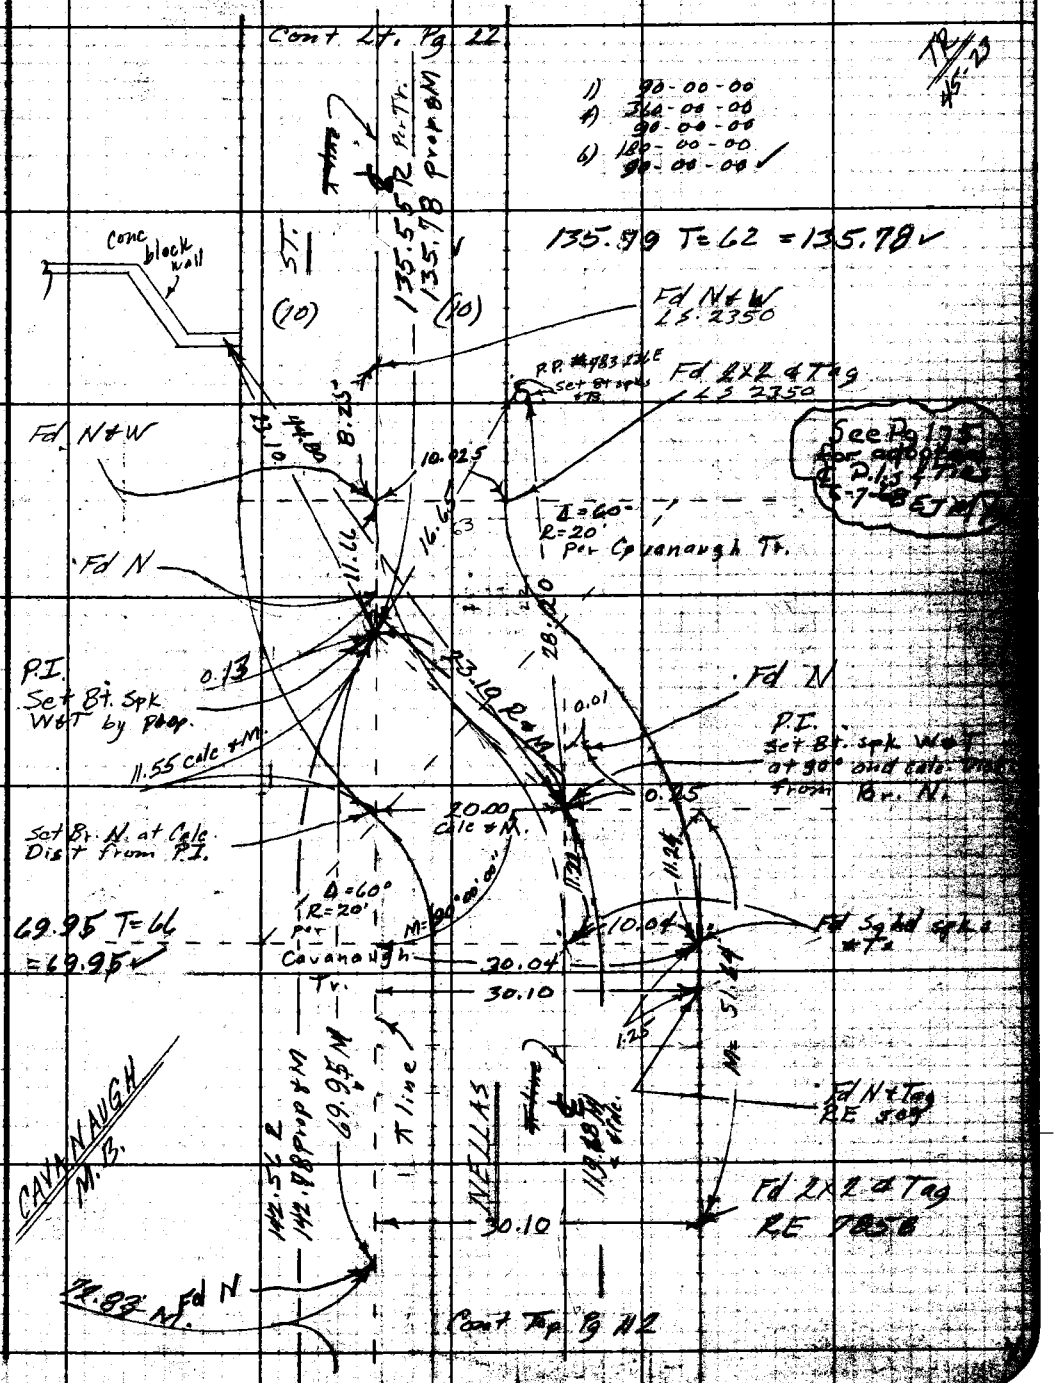

Note: Any Additions or Changes on this Sheet Must be Made or Circled in Red Ink With Date and Name of Person Making Change.

Do not extend notes this side of this line.

RETURN TO
LOS ANGELES COUNTY ENGINEER
100 LOS ANGELES COUNTY ENGINEERING BLDG.

763098 CE #247—7-83

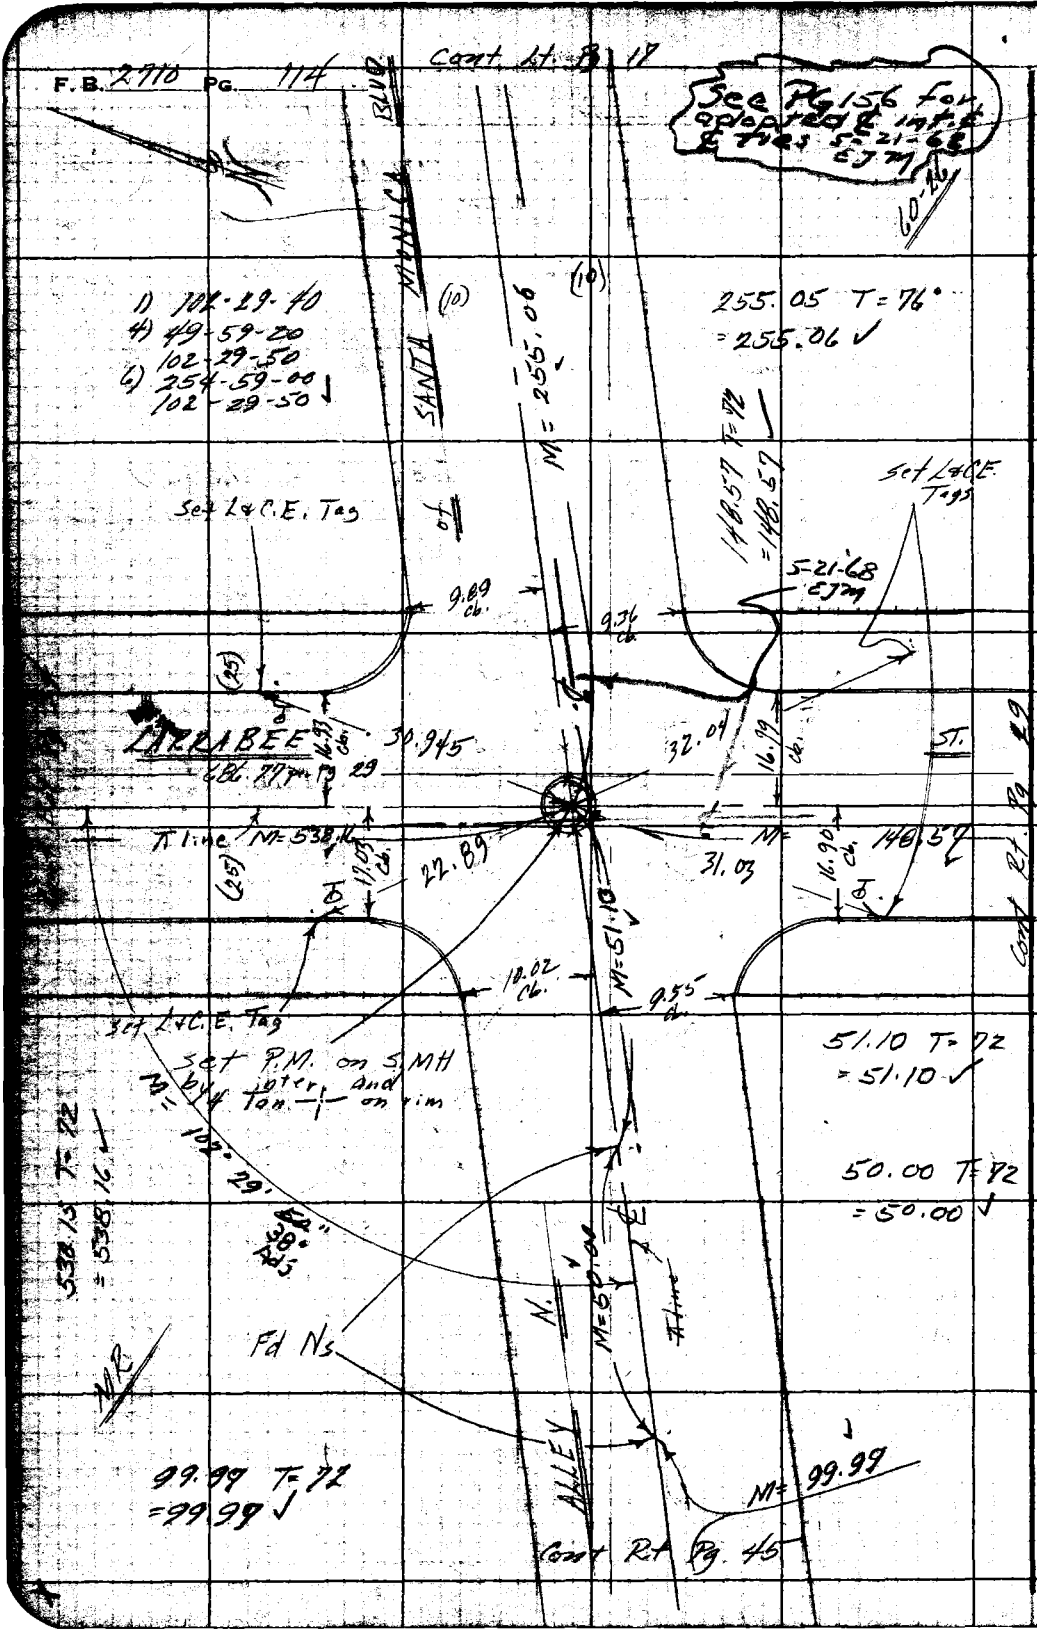

RETURN TO
LOS ANGELES COUNTY ENGINEER
700 LOS ANGELES COUNTY ENGINEERING BLDG.

Do not extend notes this side of this line.

Note: Any Additions or Changes on This Sheet Must be Made or Circled In Red Ink With Date and Name of Person Making Change.

W. Hollywood & Sherman

Notes Ck'd by D. SAPPELL	Survey of Sewer Maint. Dist. #3
Map No. 5418	IN 0343.00 Tape 0201 Std 68 °F
Office Work E FONG	Surveyed by F. E. Brooks
Checked R HUARIO	Notes F. E. Brooks Date 27 Feb 1968
Date 10-17-83	Indexed C. J. GALLI

F. B. 2710 PG. 115

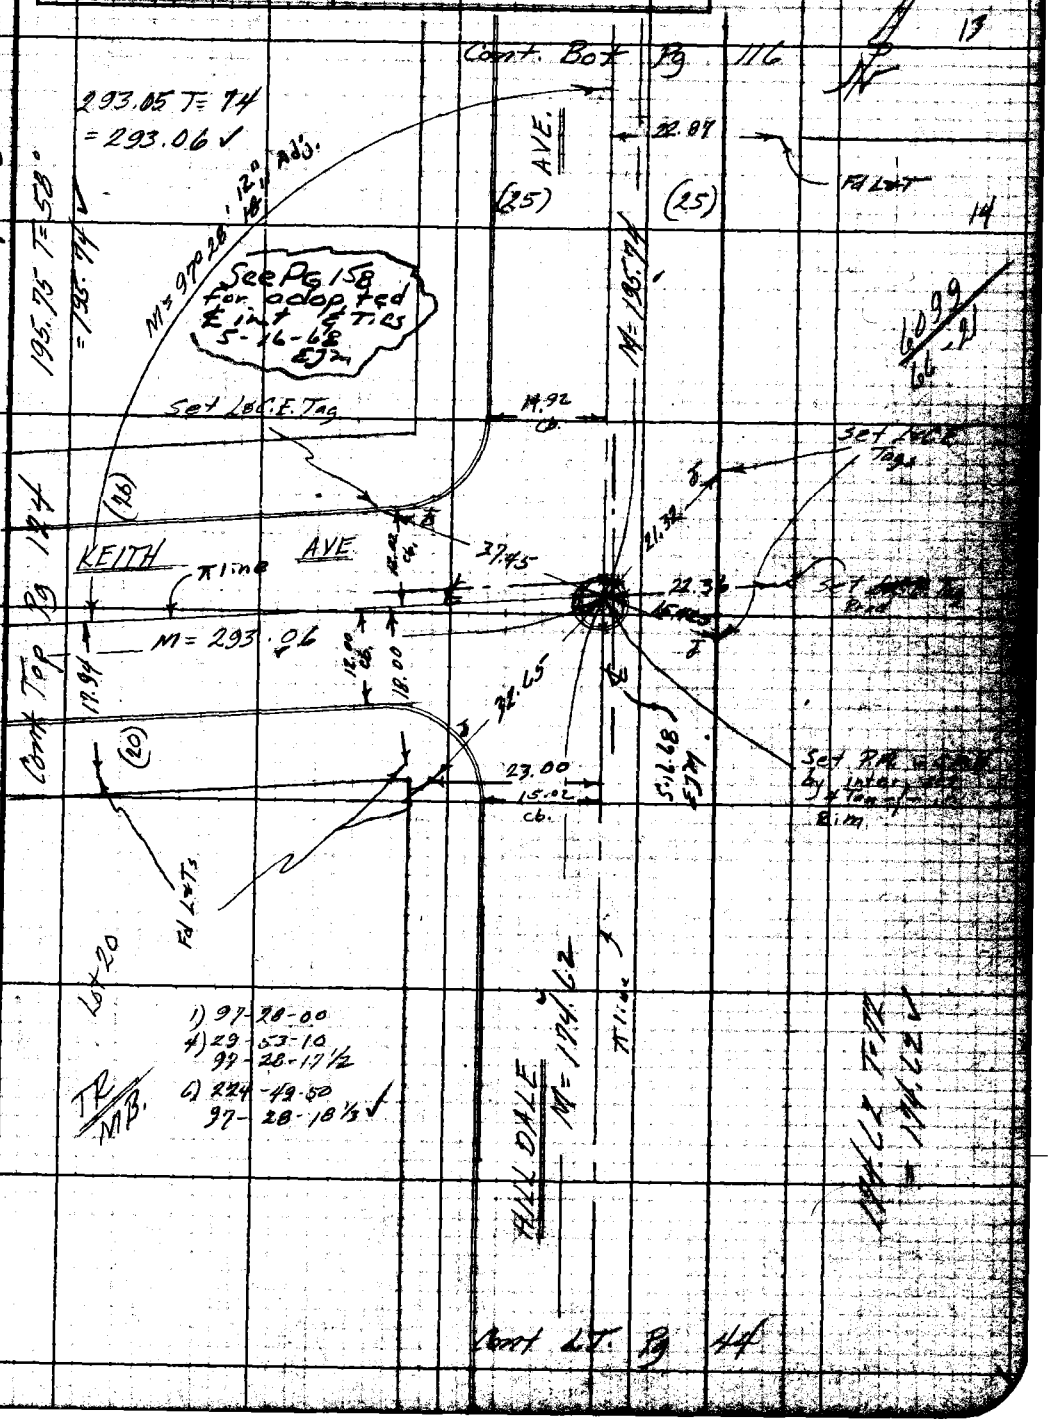

Note: Any Additions or Changes on This Sheet Must be Made or Circled in Red Ink With Date and Name of Person Making Change.

Do not extend notes this side of this line.

W.S. 22, B-3

RETURN TO
LOS ANGELES COUNTY ENGINEER
DO LOS ANGELES COUNTY ENGINEERING BLDG.

763098 CE #247—7-55

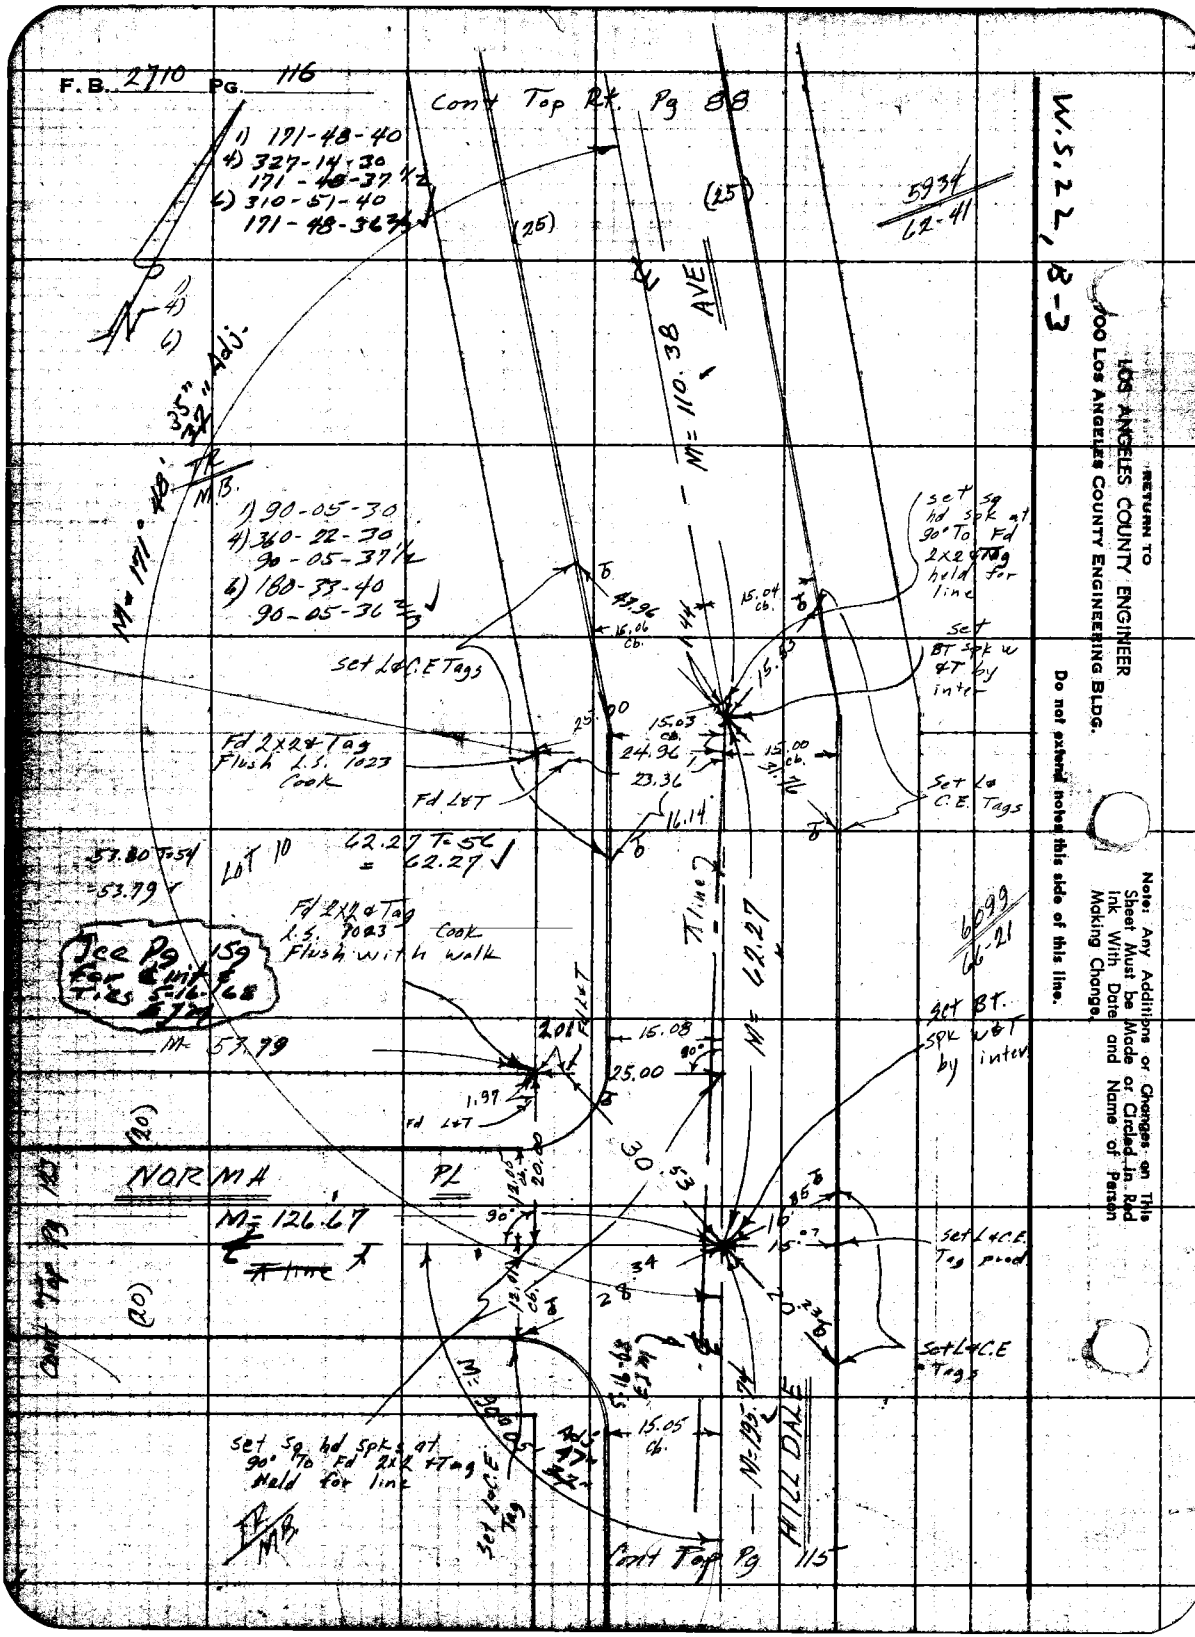
F.B. 2710 PG. 116
Cont Top Rt. Pg 88
1) 171-48-40
4) 327-14-30
171-48-37 1/2
6) 310-51-40
171-48-36 2/3
5934
62-41
(25)
(25)
M = 110.38
AVE
M = 171° 48' 35" 32" Adj.
TR
M.B.
1) 90-05-30
4) 360-22-30
90-05-37 1/2
6) 180-33-40
90-05-36 2/3
set Sq hd spk at 90° To Fd 2x2 & Tag held for line
Set BT spk w & T by inter
Set L & C.E Tags
Fd 2x2 & Tag Flush L.S. 1023 Cook
Fd L & T
Set L & C.E. Tags
LOT 10
62.27 T-56 = 62.27
Fd 2x2 & Tag L.S. 1023 Cook Flush with walk
Ice Pg 159 For Unit 5-16-68
M = 57.79
M = 62.27
6099
66-21
Set BT. spk w & T by inter
NORMA
PL
M = 126.67
Set L & C.E. Tag prod
Set L & C.E Tags
Set Sq hd spks at 90° To Fd 2x2 & Tag Held for line
Set L & C.E Tag
HILL DALE
Cont Top Pg 115
Cont Top Pg 183
W.S. 22, B-3
RETURN TO
LOS ANGELES COUNTY ENGINEER
100 LOS ANGELES COUNTY ENGINEERING BLDG.
Do not extend notes this side of this line.
Note: Any Additions or Changes on This Sheet Must be Made or Circled in Red Ink With Date and Name of Person Making Change.

W. Hollywood & Sherman

Notes Ck'd by D. SAPPELL	Survey of Sewer Maint Dist #3
Map No. 5418	IN 0303.01 Tape 0201 Std CB °F
Office Work E FONG	Surveyed by F. E. Brooks
Checked R HILARIO	Notes E. E. Brooks Date 9 Apr 162
Date 10-17-83	Indexed C. J. GALLI

F. B. 2710 Pg. 117

Cont Bot Pg 125

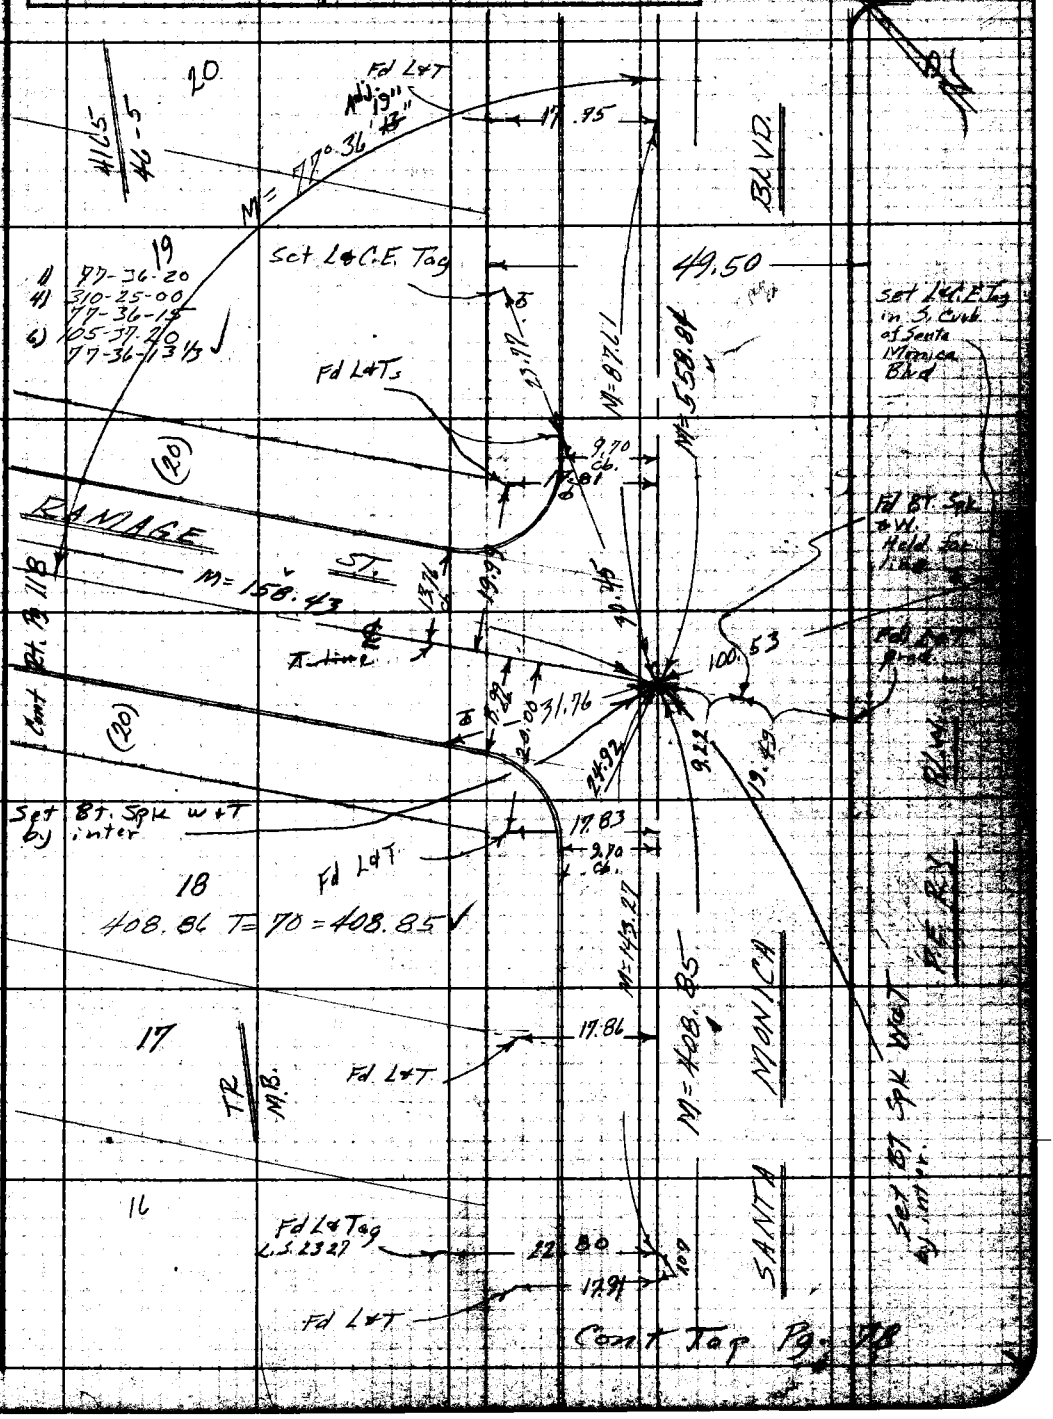

Note: Any Additions or Changes on This Sheet Must be Made or Circled in Red Ink With Date and Name of Person Making Change.

W.S. 22, B-3

Be not extend notes this side of this line.

REVISED TO
LOS ANGELES COUNTY ENGINEER
400 LOS ANGELES COUNTY ENGINEERING BLDG.

769095 CE #247—7-53

F.B. 2710 PG. 118

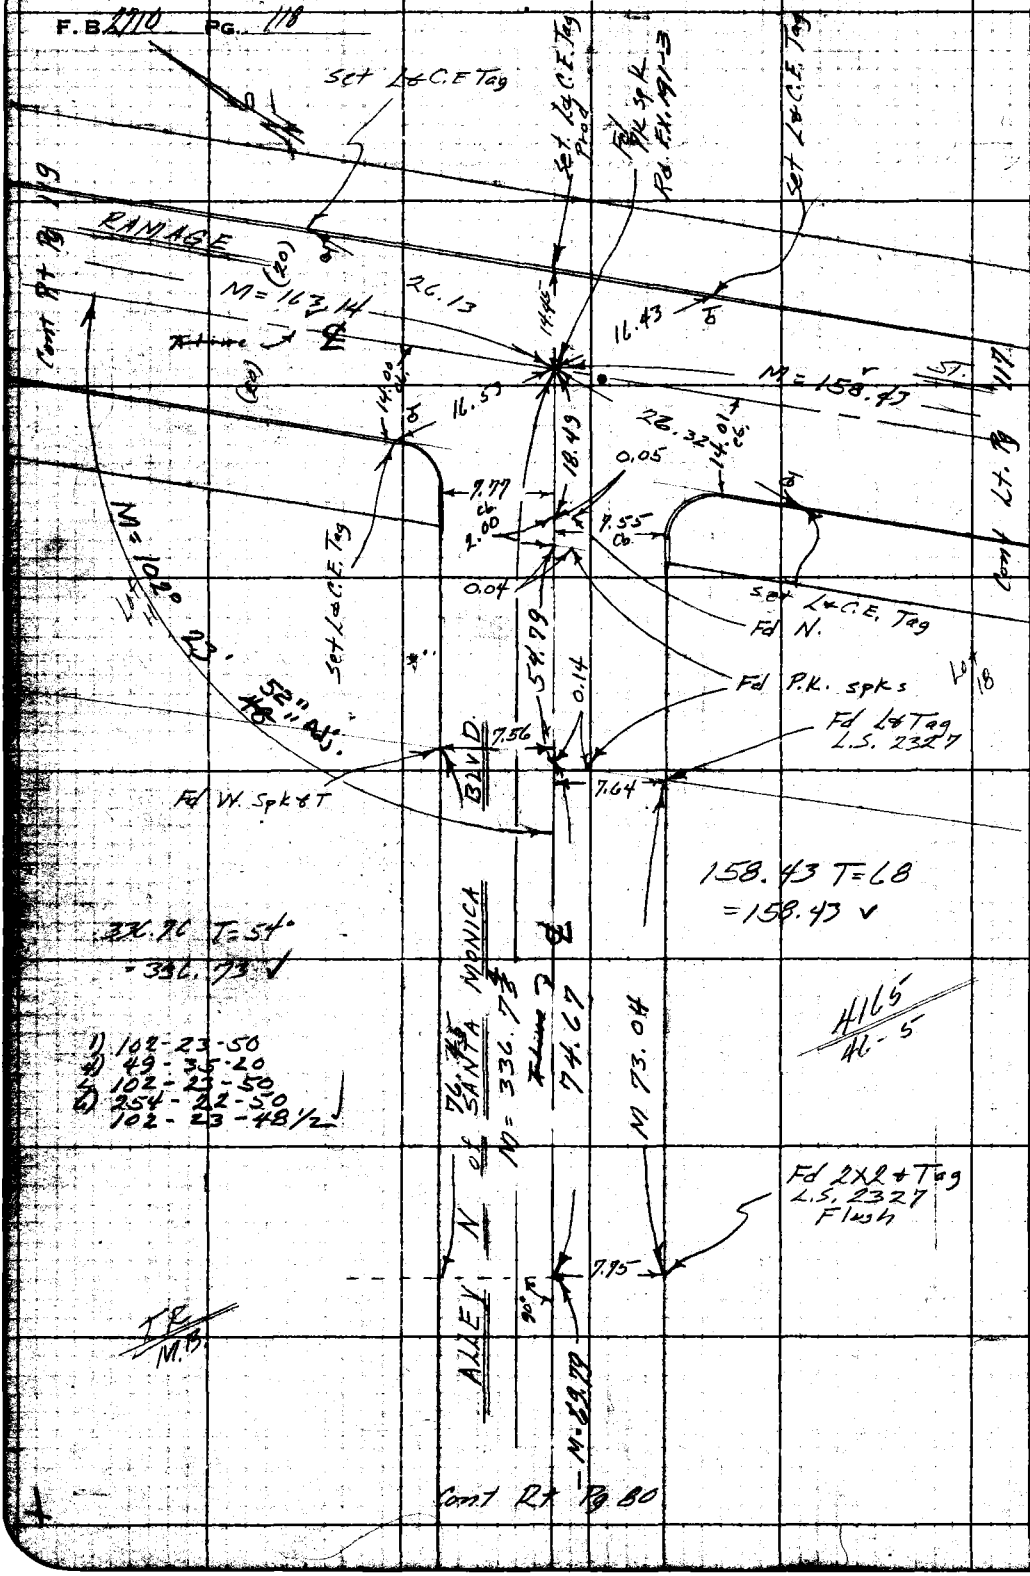

RETURN TO
LOS ANGELES COUNTY ENGINEER
100 LOS ANGELES COUNTY ENGINEERING BLDG.

Do not extend notes this side of this line.

Note: Any Additions or Changes on This Sheet Must be Made or Circled in Red Ink With Date and Name of Person Making Change.

W. Hollywood & Sherman

Notes Ck'd by D. SAPPELL	Survey of Sewer Maint Dist #3
Map No. 5418	IN 0363.69 Tape 0201 Std 68 °F
Office Work E FONG	Surveyed by F. E. Brooks
Checked R HILARIO	Notes F. E. Brooks Date 21 Feb 1962
Date 10-17-83	Indexed C. J. GALLI

F. B. 2710 PG. 119

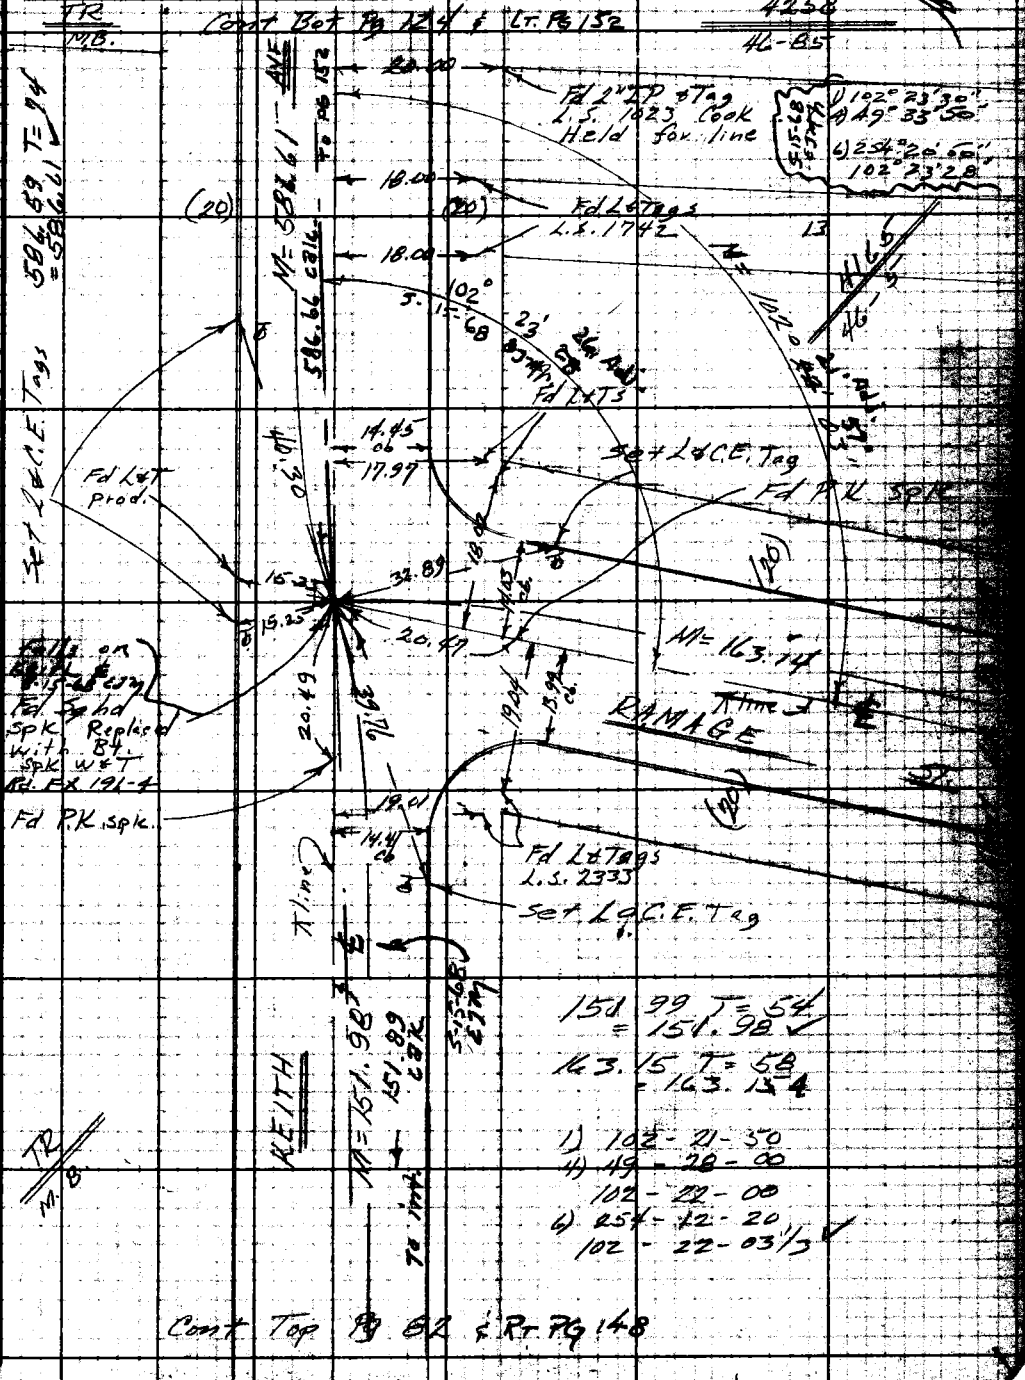

Note: Any Additions or Changes on This Sheet Must be Made or Circled in Red Ink With Date and Name of Person Making Change.

W.S. 22, B-3

Do not extend notes this side of this line.

RETURN TO
LOS ANGELES COUNTY ENGINEER
200 LOS ANGELES COUNTY ENGINEERING BLDG.

763098 CE #247—7-53


Cont Rt Pg 44
& Bot Pg 153

W.S. 22, B-3

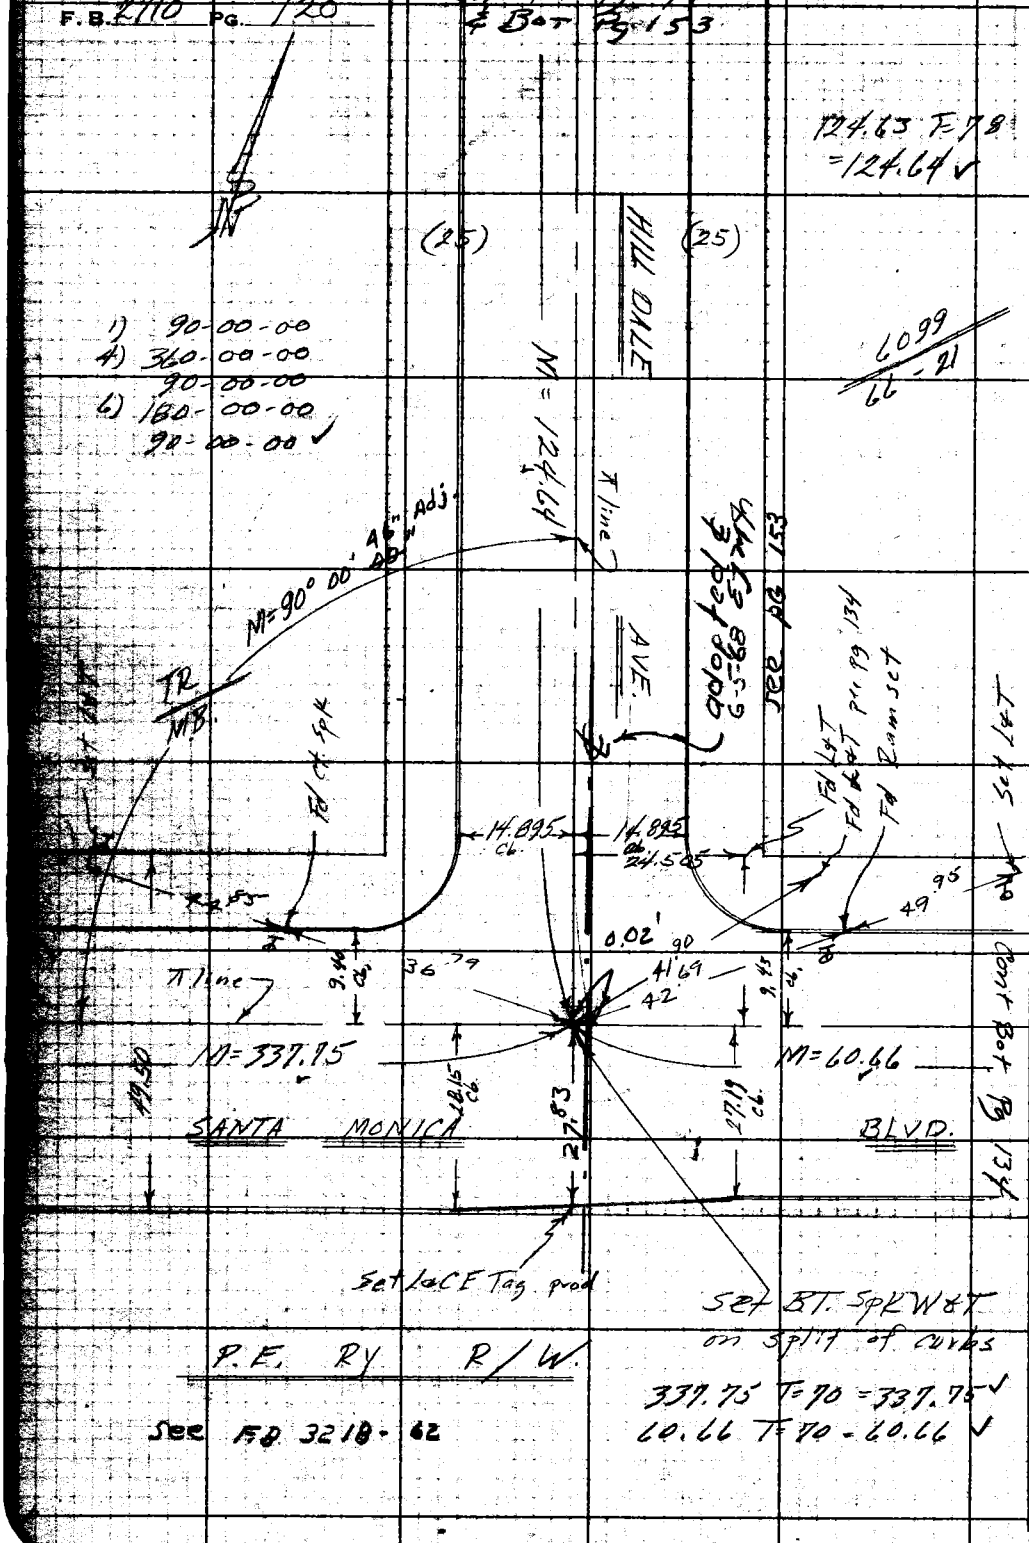

RETURN TO
LOS ANGELES COUNTY ENGINEER
900 LOS ANGELES COUNTY ENGINEERING BLDG.

Do not extend notes this side of this line.

Note: Any Additions or Changes on This Sheet Must be Made or Circled in Red Ink With Date and Name of Person Making Change.

W. Hollywood — Sherman

Notes Ck'd by D. SAPPELL	Survey of Sewer Maint. Dist #3
Map No. 5418	IN 0308.00 Tape 0201 Std 68 °F
Office Work E FONG	Surveyed by F. E. Brooks
Checked R. HILARIO	Notes F. E. Brooks Date 23 Feb 1962
Date 10-17-83	Indexed C. J. GALLI

F. B. 2710 Pg. 121

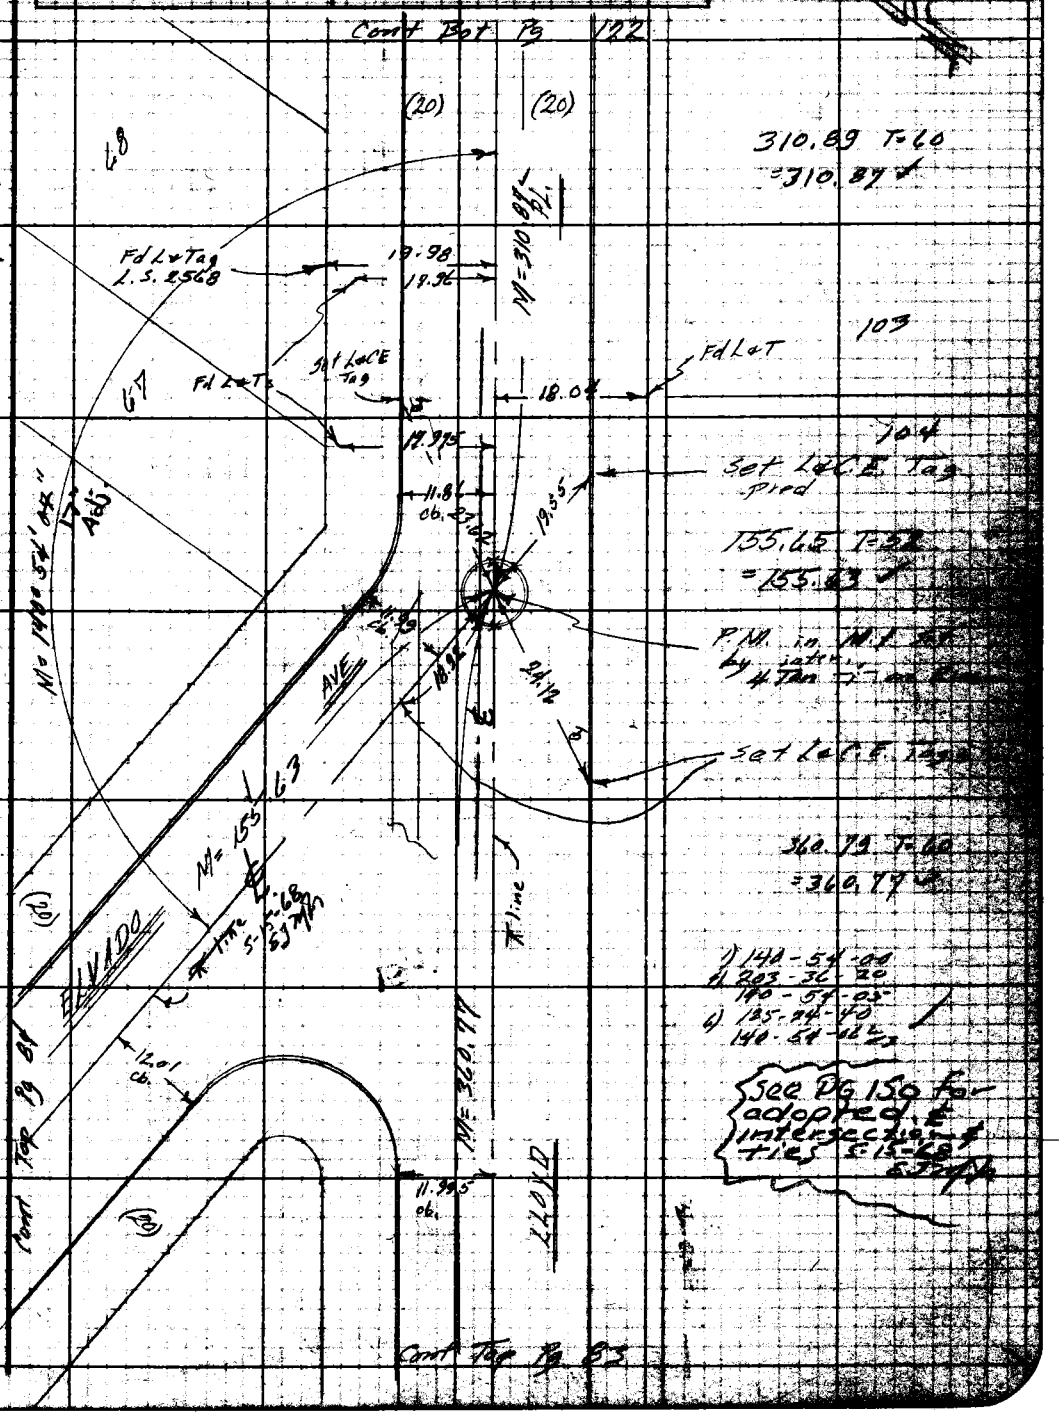

Note: Any Additions or Changes on This Sheet Must be Made or Circled in Red Ink With Date and Name of Person Making Change.

Do not extend notes this side of this line.

W.S. 22, B-3

RETURN TO
LOS ANGELES COUNTY ENGINEER
DO LOS ANGELES COUNTY ENGINEERING BLDG.

763098 CE #247—7-83

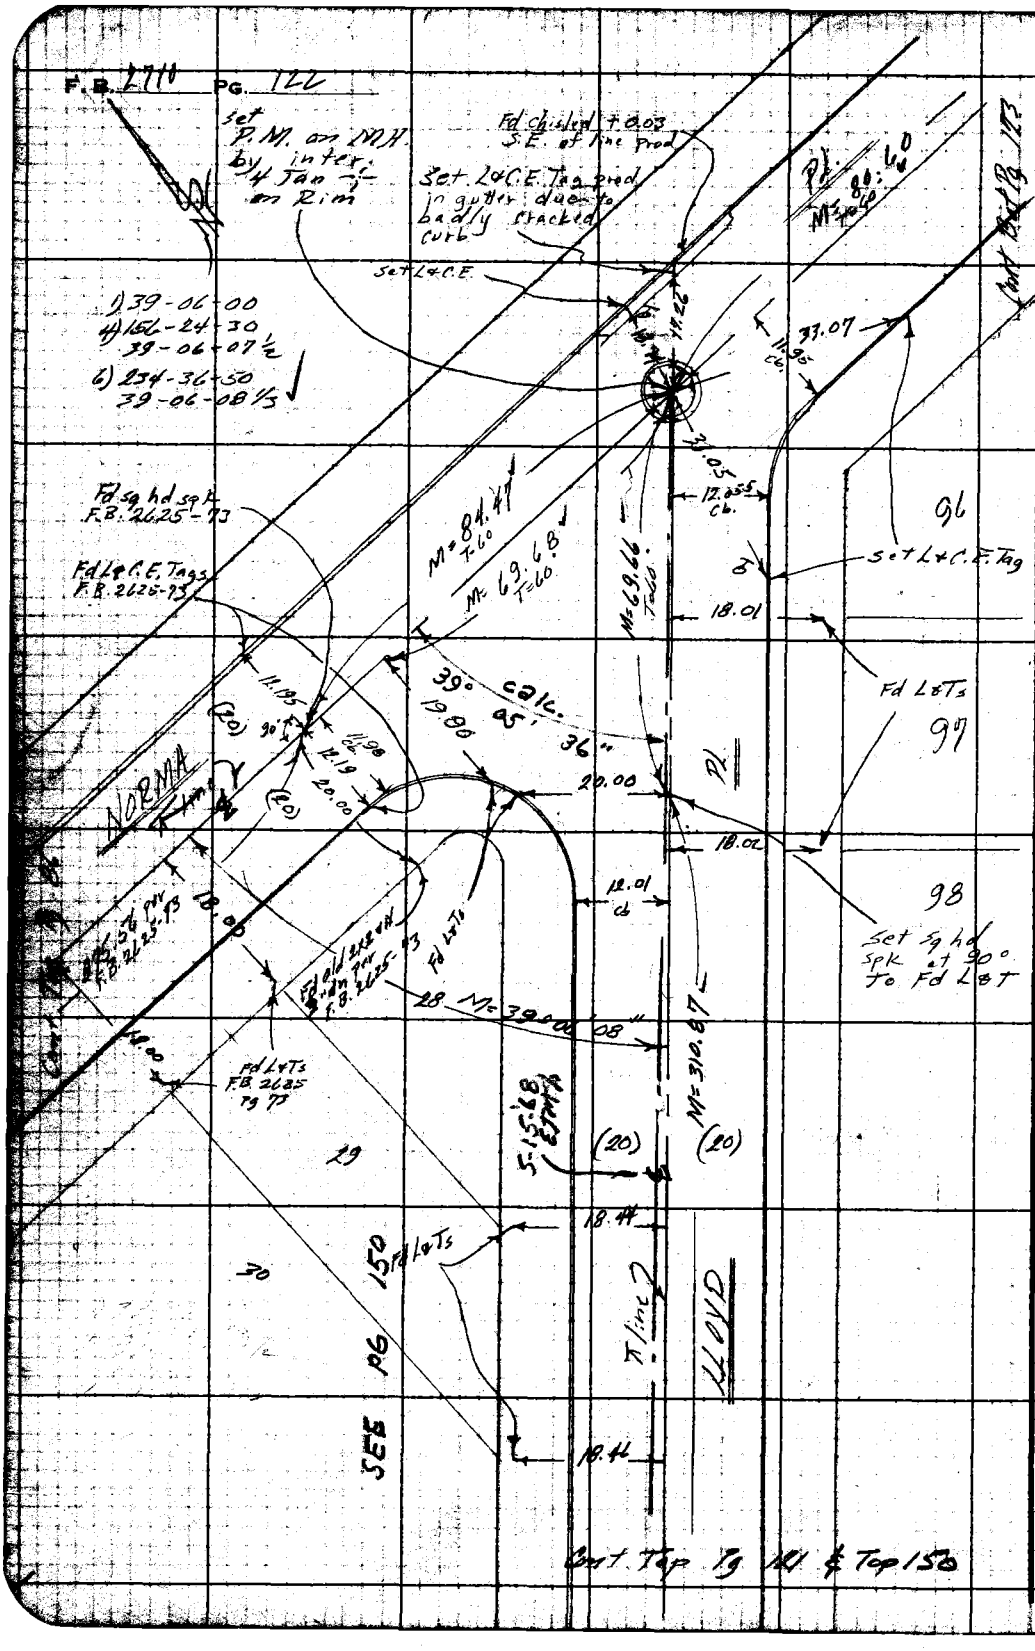

W.S. 22, 8-3

RETURN TO
LOS ANGELES COUNTY ENGINEER
100 LOS ANGELES COUNTY ENGINEERING BLDG.

Do not extend notes this side of this line.

Note: Any Additions or Changes on This Sheet Must be Made or Circled in Red Ink With Date and Name of Person Making Change.

W. Hollywood & Sherman

Notes Ck'd by D. SAPPELL	Survey of Sewer Maint Dist #3
Map No. 5418	IN 1303.00 Tape 6201 Std 68 °F
Office Work E FONG	Surveyed by F. E. Brooks
Checked R HILARIO	Notes F. E. Brooks Date 26 Feb 1962
Date 10-17-83	Indexed C. J. GALLI

F. B. 2710 PG. 123

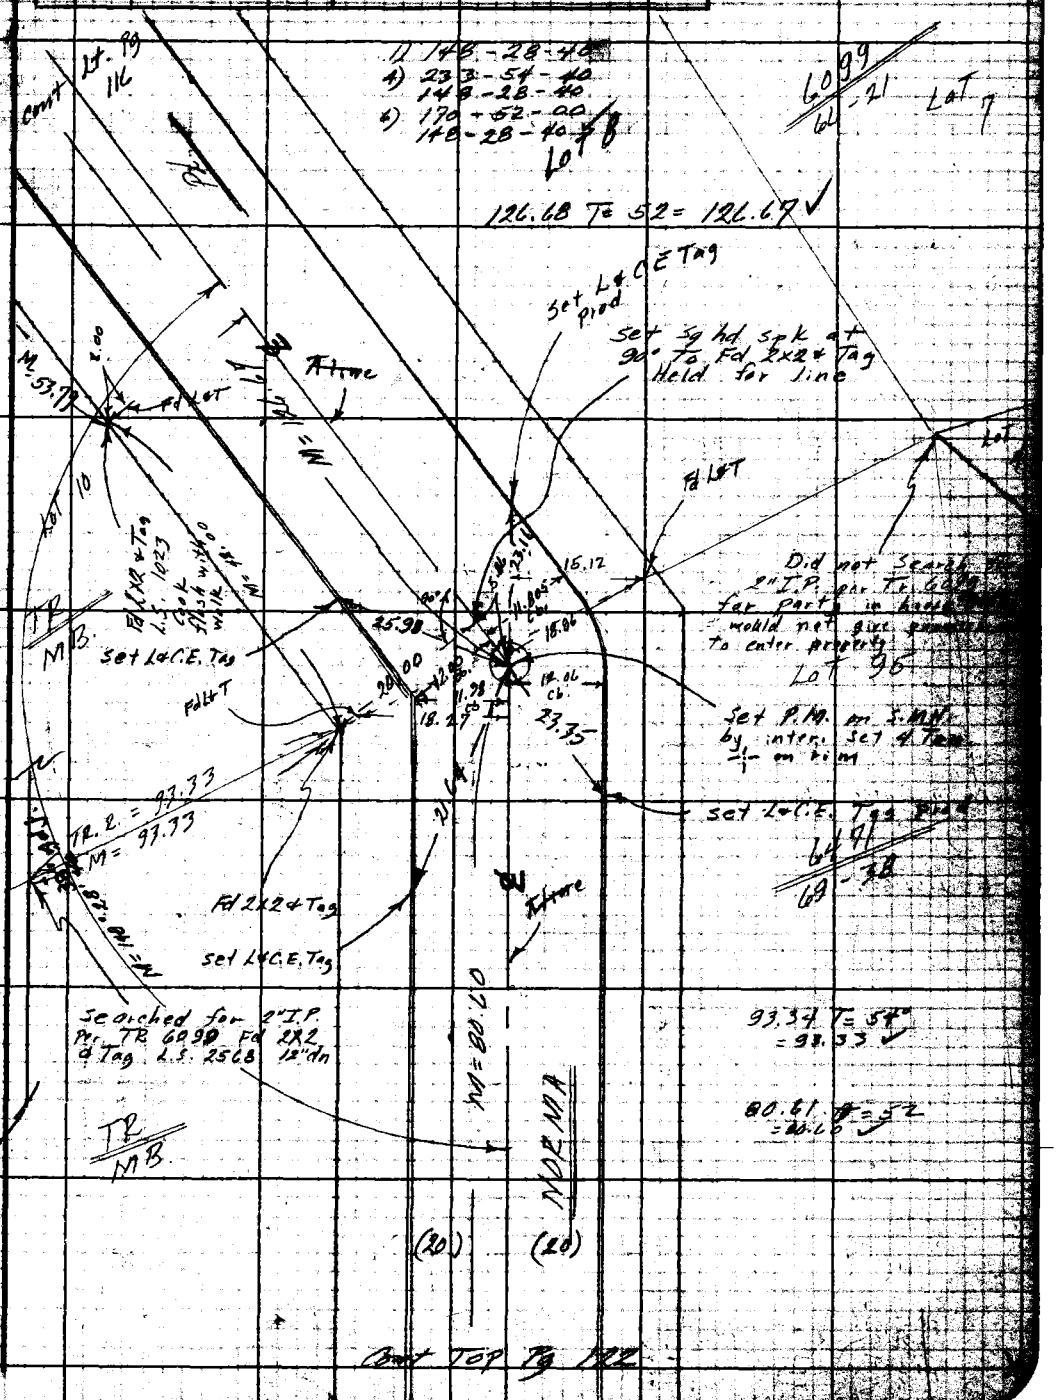

Note: Any Additions or Changes on This Sheet Must be Made or Circled in Red Ink With Date and Name of Person Making Change.

Do not extend notes this side of this line.

RETURN TO
LOS ANGELES COUNTY ENGINEER
DO LOS ANGELES COUNTY ENGINEERING BLDG.

763098 CE #247—7-53

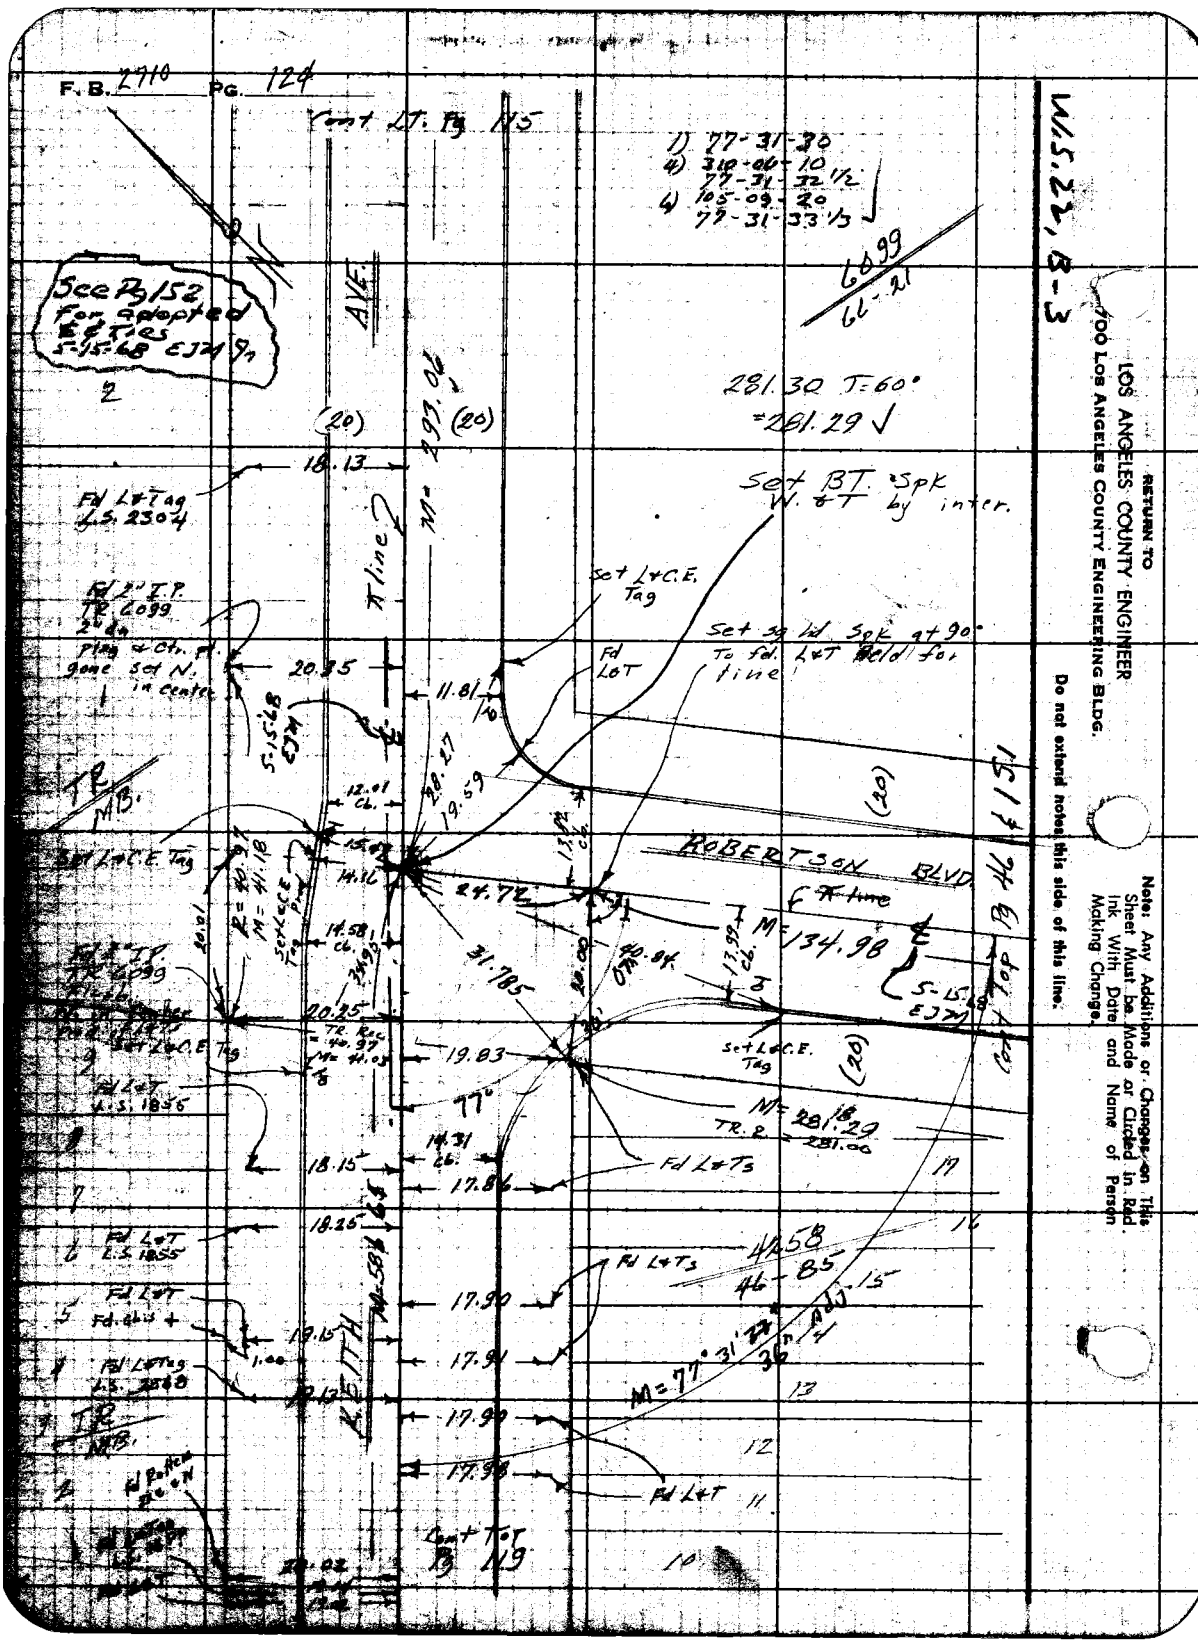
F.B. 2710 PG. 124
Cont Lt. Pg 115
1) 77-31-30
4) 310-06-10
77-31-32 1/2
6) 105-09-20
77-31-33 1/3
6099
66-21
See Pg 152 for adopted ℄ & Ties 5-15-68 EJM
AVE.
281.30 T=60°
=281.29 ✓
(20)
(20)
18.13
Fd L&T Tag L.S. 2304
M=297.06
Set BT. Spk W. & T by inter.
Set L&C.E. Tag
Set sq hd Spk at 90° To fd. L&T Held for line
Fd L&T
Fd 2" I.P. TR 6099 2" dia Plug & Ctr. pt. gone set N. in center
20.35
11.81
5-15-68 EJM
TR MB.
12.01 Cb.
28.27
19.59
(20)
ROBERTSON BLVD.
Set L&C.E. Tag
R=40.97 M=41.18
Set L&C.E. Tag
14.16
24.72
M=134.98
14.58 Cb.
31.785
40.84
13.99 Cb.
5-15-68 EJM
Cont Top Pg 46 & 151
20.25
TR. Rec. =40.97 M=41.03
Set L&C.E. Tag
19.83
Set L&C.E. Tag
(20)
Fd L&T L.S. 1855
77°
M=281.29
TR. R. = 281.00
14.31 Cb.
18.15
17.86
Fd L&Ts
17
18.25
Fd L&T L.S. 1855
16
Fd L&Ts
4258
46-85
15
Fd L&T
Fd. Cb. +
17.90
19.15
17.91
M=77° 31' 22" 36" Adj.
Fd L&T Tag L.S. 2548
KEITH
17.90
13
TR MB.
17.98
12
Fd L&T
11
Cont Top Pg 119
10
W.S. 22, B-3
RETURN TO
LOS ANGELES COUNTY ENGINEER
700 LOS ANGELES COUNTY ENGINEERING BLDG.
Do not extend notes this side of this line.
Note: Any Additions or Changes on This Sheet Must be Made or Circled in Red Ink With Date and Name of Person Making Change.

W. Hollywood & Sherman

Notes Ck'd by D. SAPPELL	Survey of Sewer Maint Dist #3	F. B. 2710 Pg. 125
Map No. 5418	IN 0303.00 Tape 0207 Std 68 °F	
Office Work E FDNG	Surveyed by F. E. Brooks	
Checked L HILARIO	Notes F. E. Brooks Date 9 April 62	
Date 10-17-83	Indexed C. J. GALLI	

Cont Bot Pg 120

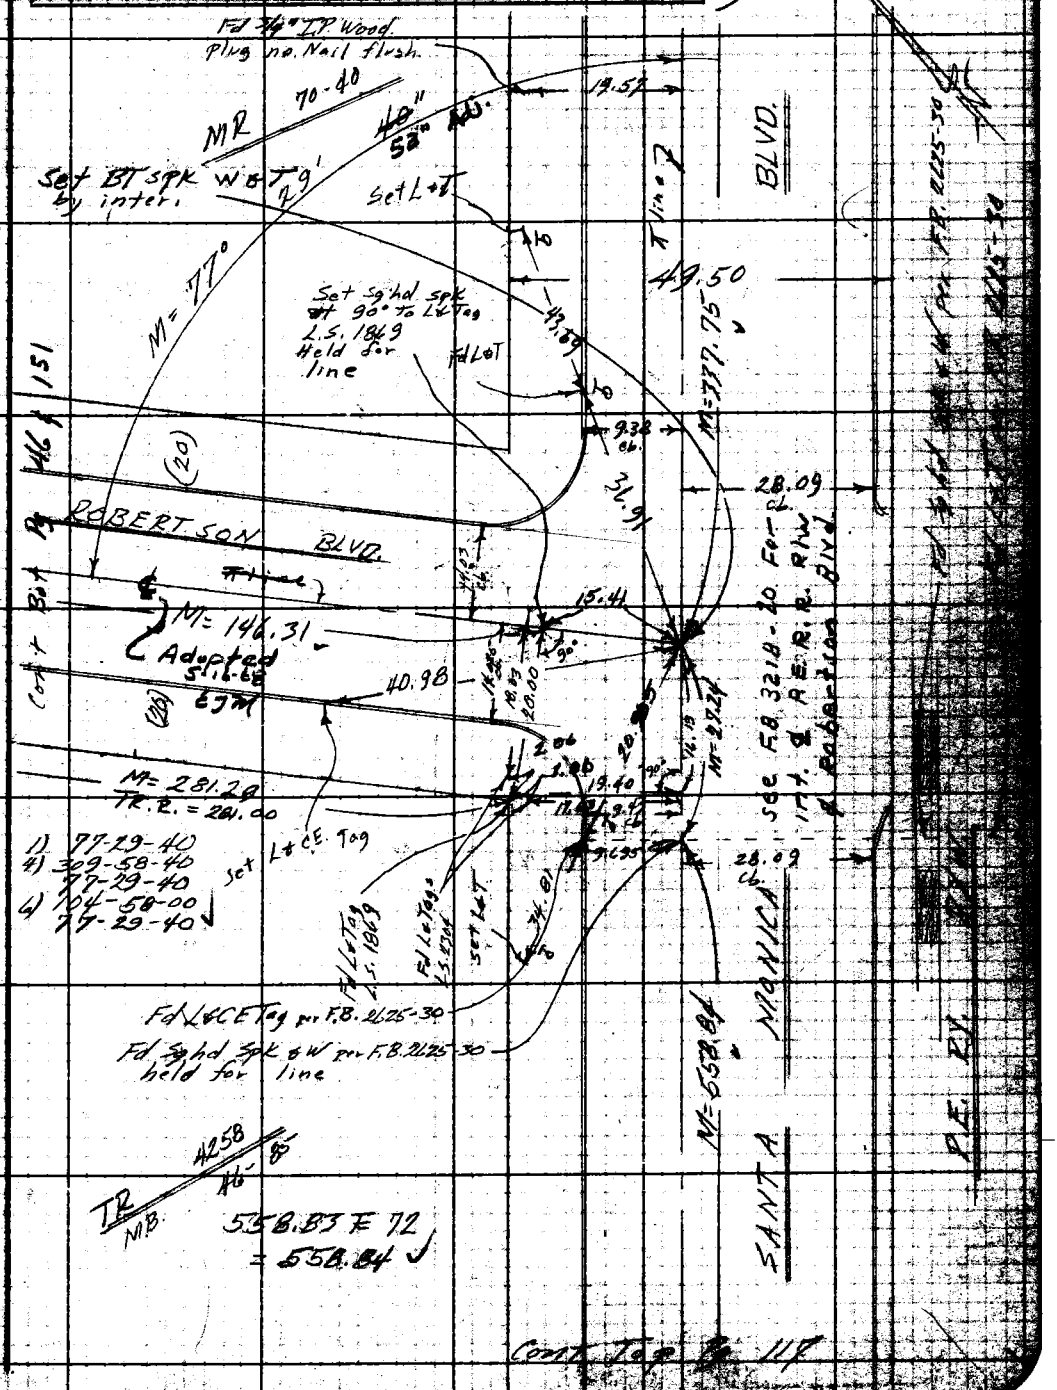

Cont Top Pg 117

Note: Any Additions or Changes on This Sheet Must be Made or Circled in Red Ink With Date and Name of Person Making Change.

W.S. 22, B-3

Do not extend notes this side of this line.

RETURN TO
LOS ANGELES COUNTY ENGINEER
DO LOS ANGELES COUNTY ENGINEERING BLDG.

763098 CE #247—7-55

F.B. 1710 PG. 126 Cont Lt Pg 45

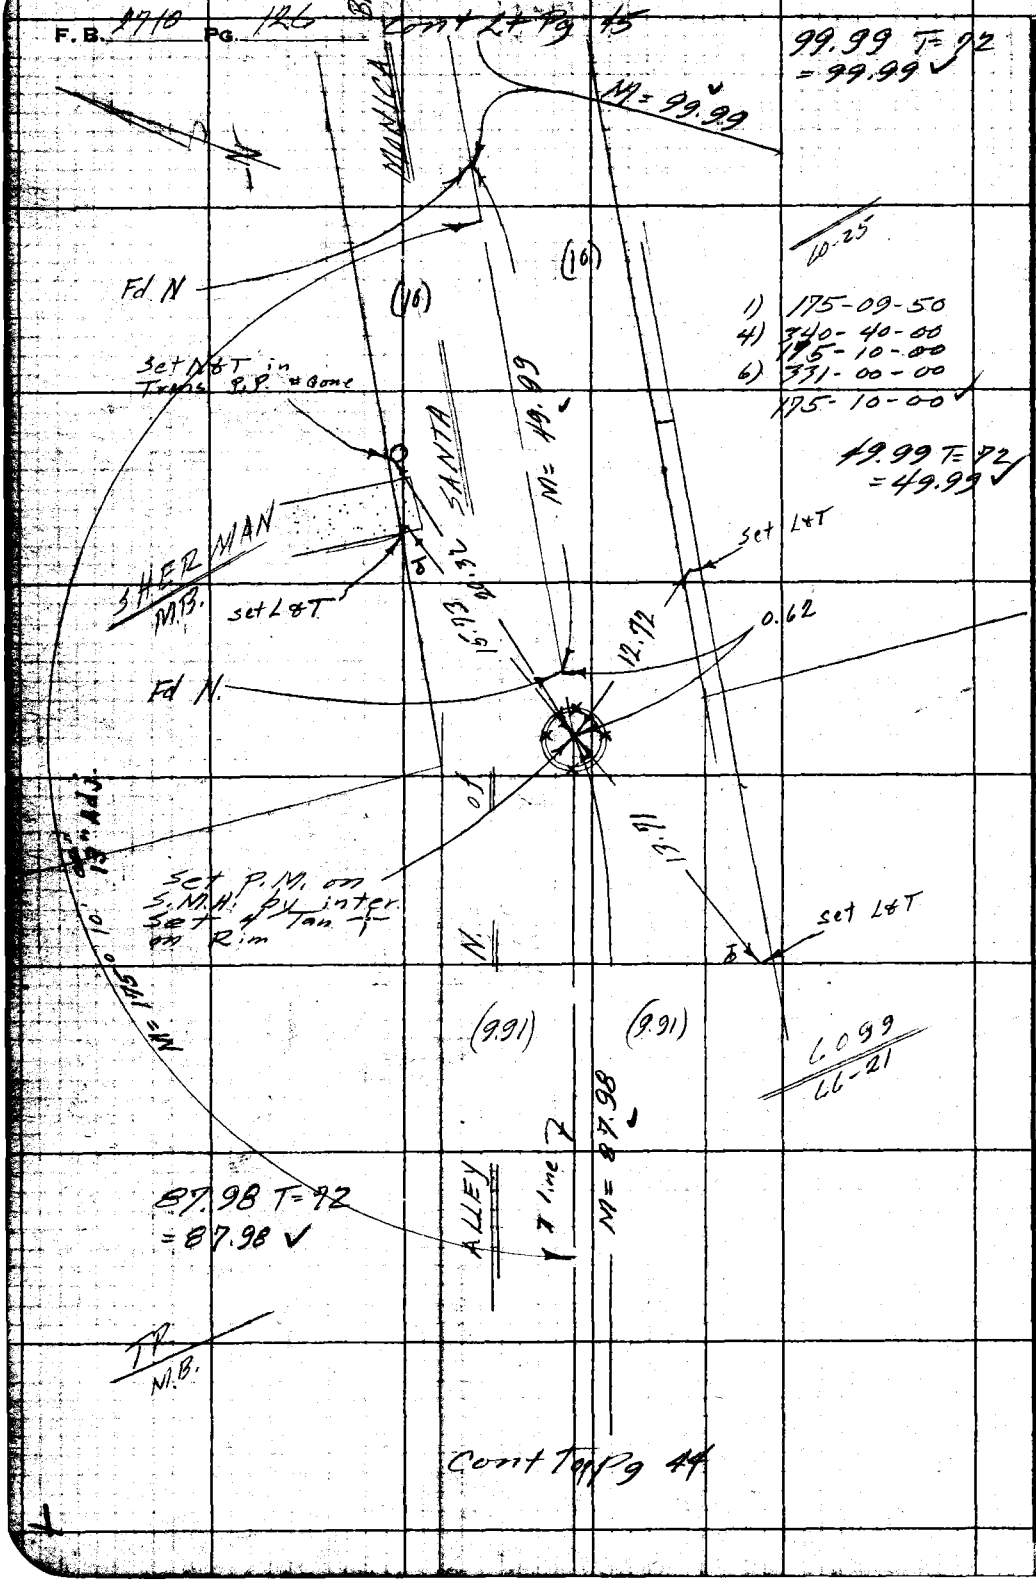

Cont Top Pg 44

RETURN TO
LOS ANGELES COUNTY ENGINEER
700 LOS ANGELES COUNTY ENGINEERING BLDG.

Do not extend notes this side of this line.

Note: Any Additions or Changes on This Sheet Must be Made or Circled In Red Ink With Date and Name of Person Making Change.

W. Hollywood & Sherman

Notes Ck'd by D. SAPPELL	Survey of Sewer Maint Dist #3	F. B. 2710 Pg. 127
Map No. 5418	IN 030300 Tape 1201 Std 68 °F	
Office Work E. FONG	Surveyed by F. E. Brooks	
Checked R. HILARIO	Notes F. E. Brooks Date 5 Mar 62	
Date 10-17-83	Indexed C. J. GALLI	

Cont Rt. Pg 98

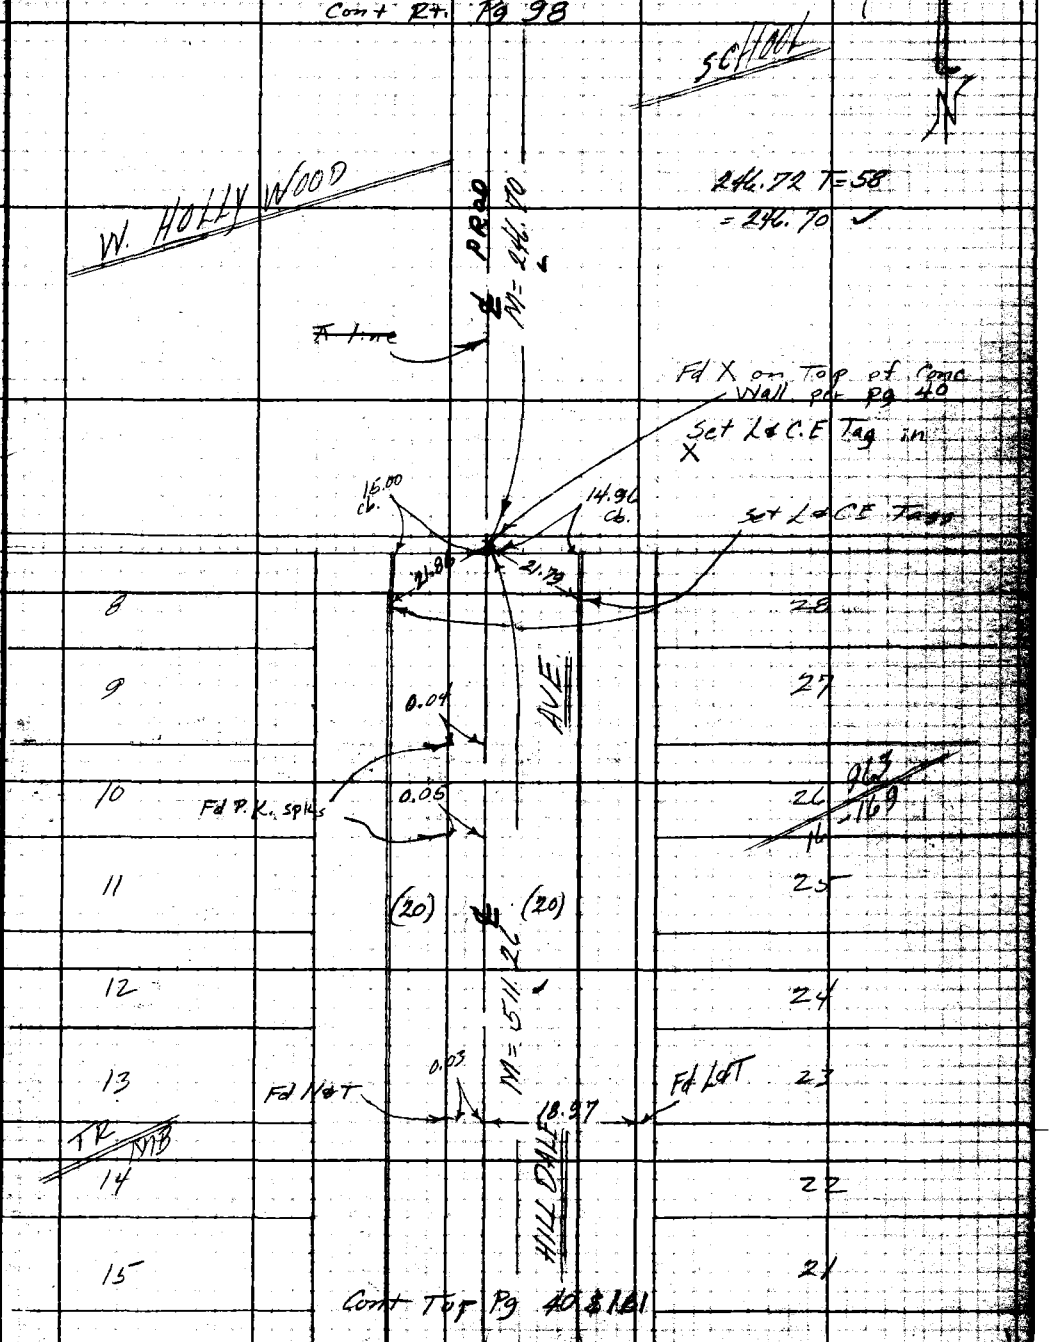

Note: Any Additions or Changes on This Sheet Must be Made or Circled in Red Ink With Date and Name of Person Making Change.

Do not extend notes this side of this line.

RETURN TO
LOS ANGELES COUNTY ENGINEER
400 LOS ANGELES COUNTY ENGINEERING BLDG.

763098 CE #247—7-63

F. B. 2710 PG. 128 Cont. Rt. Pg 90

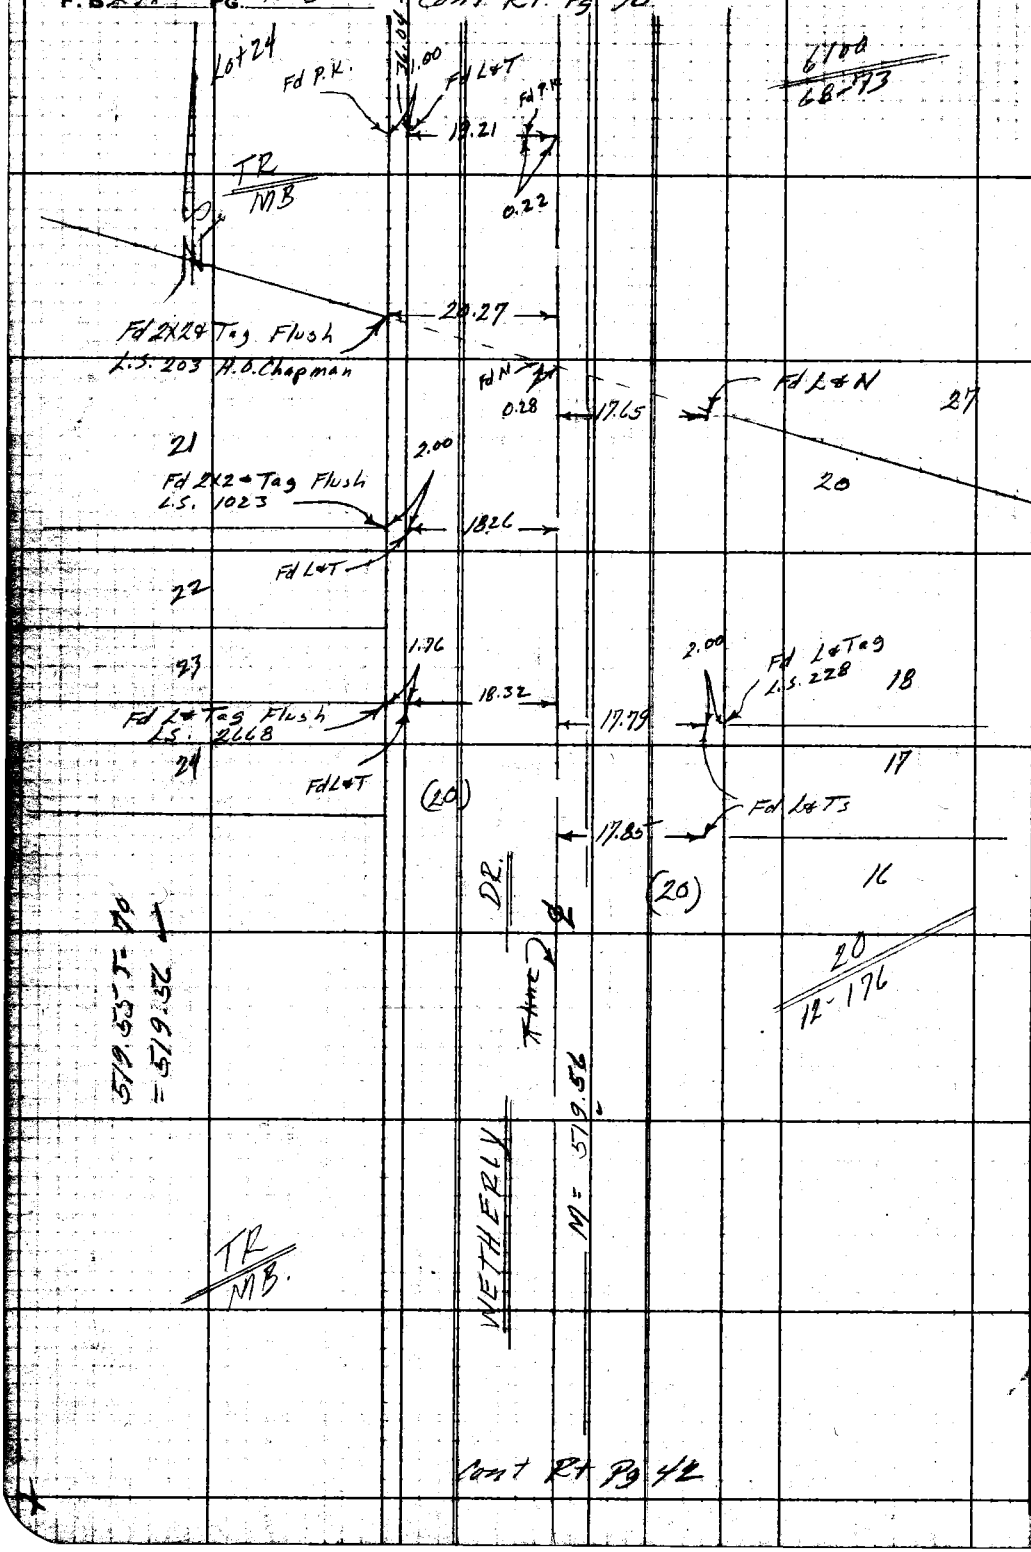

RETURN TO
LOS ANGELES COUNTY ENGINEER
700 LOS ANGELES COUNTY ENGINEERING BLDG.

Do not extend notes this side of this line.

Note: Any Additions or Changes on This Sheet Must be Made or Circled in Red Ink With Date and Name of Person Making Change.

W. Hollywood & Sherman

Notes Ck'd by D. SAPPELL	Survey of Sewer Maint Dist #3
Map No. 5418	JN 0303.00 Tape 0201 Std. 68 °F
Office Work E FONG	Surveyed by E. E. Brooks
Checked R. HILARIO	Notes E. E. Brooks Date 22 Mar 62
Date 10-17-89	Indexed C. J. GALLI

F. B. 2710 PG. 129

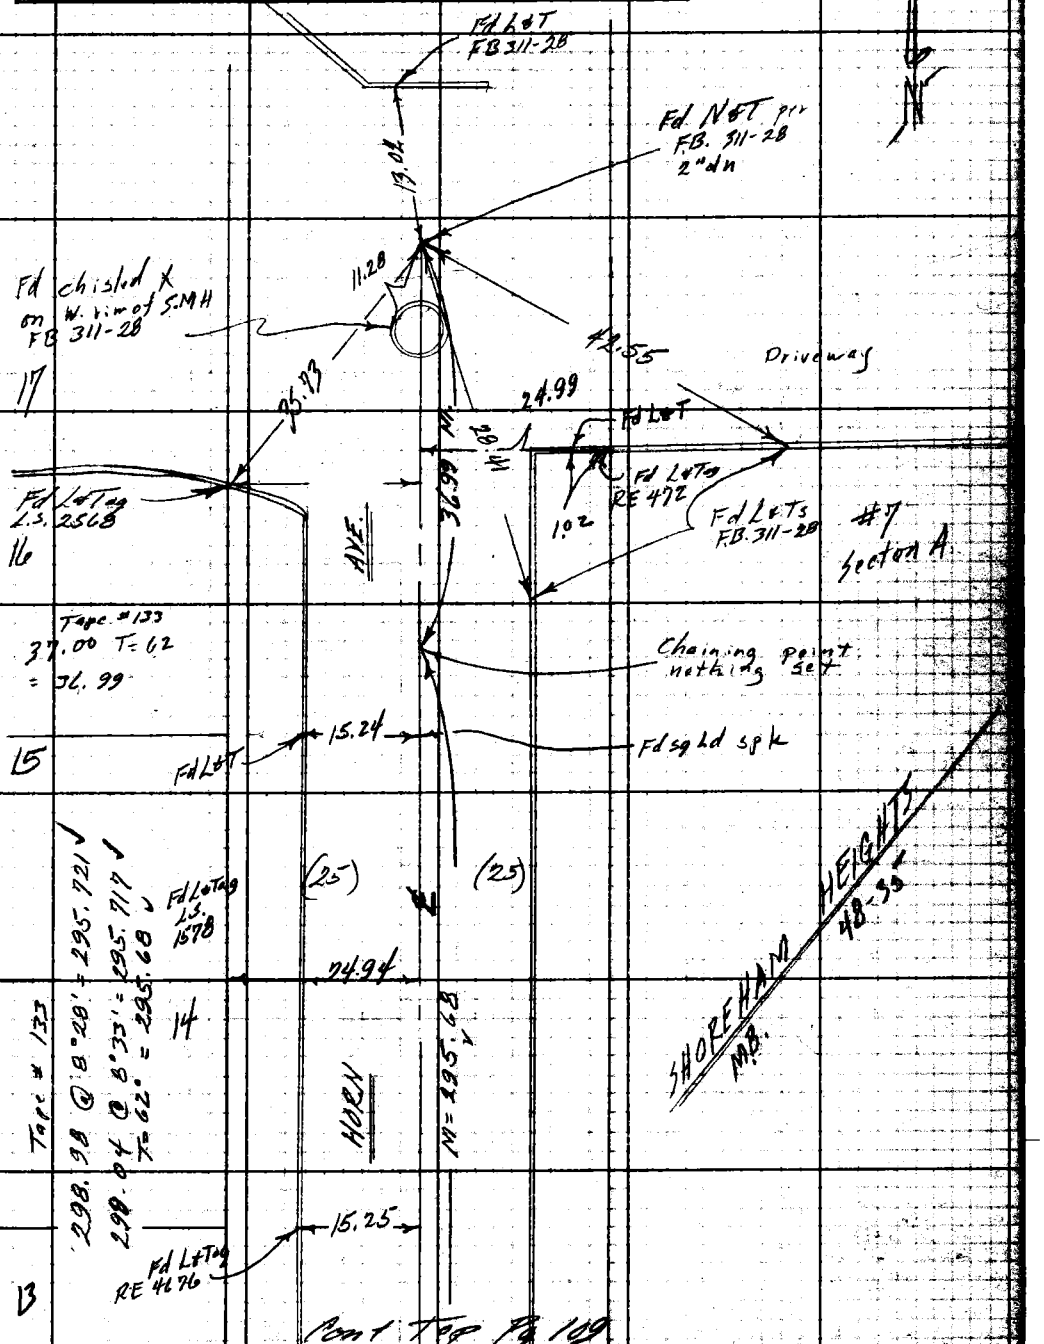

Notes: Any Additions or Changes on This Sheet Must Be Made or Circled in Red Ink With Date and Name of Person Making Change.

Do not extend notes this side of this line.

RETURN TO
LOS ANGELES COUNTY ENGINEER
900 Los Angeles County Engineering Bldg.

768098 CE #247—7-59

F.B. 2710 PG. 130

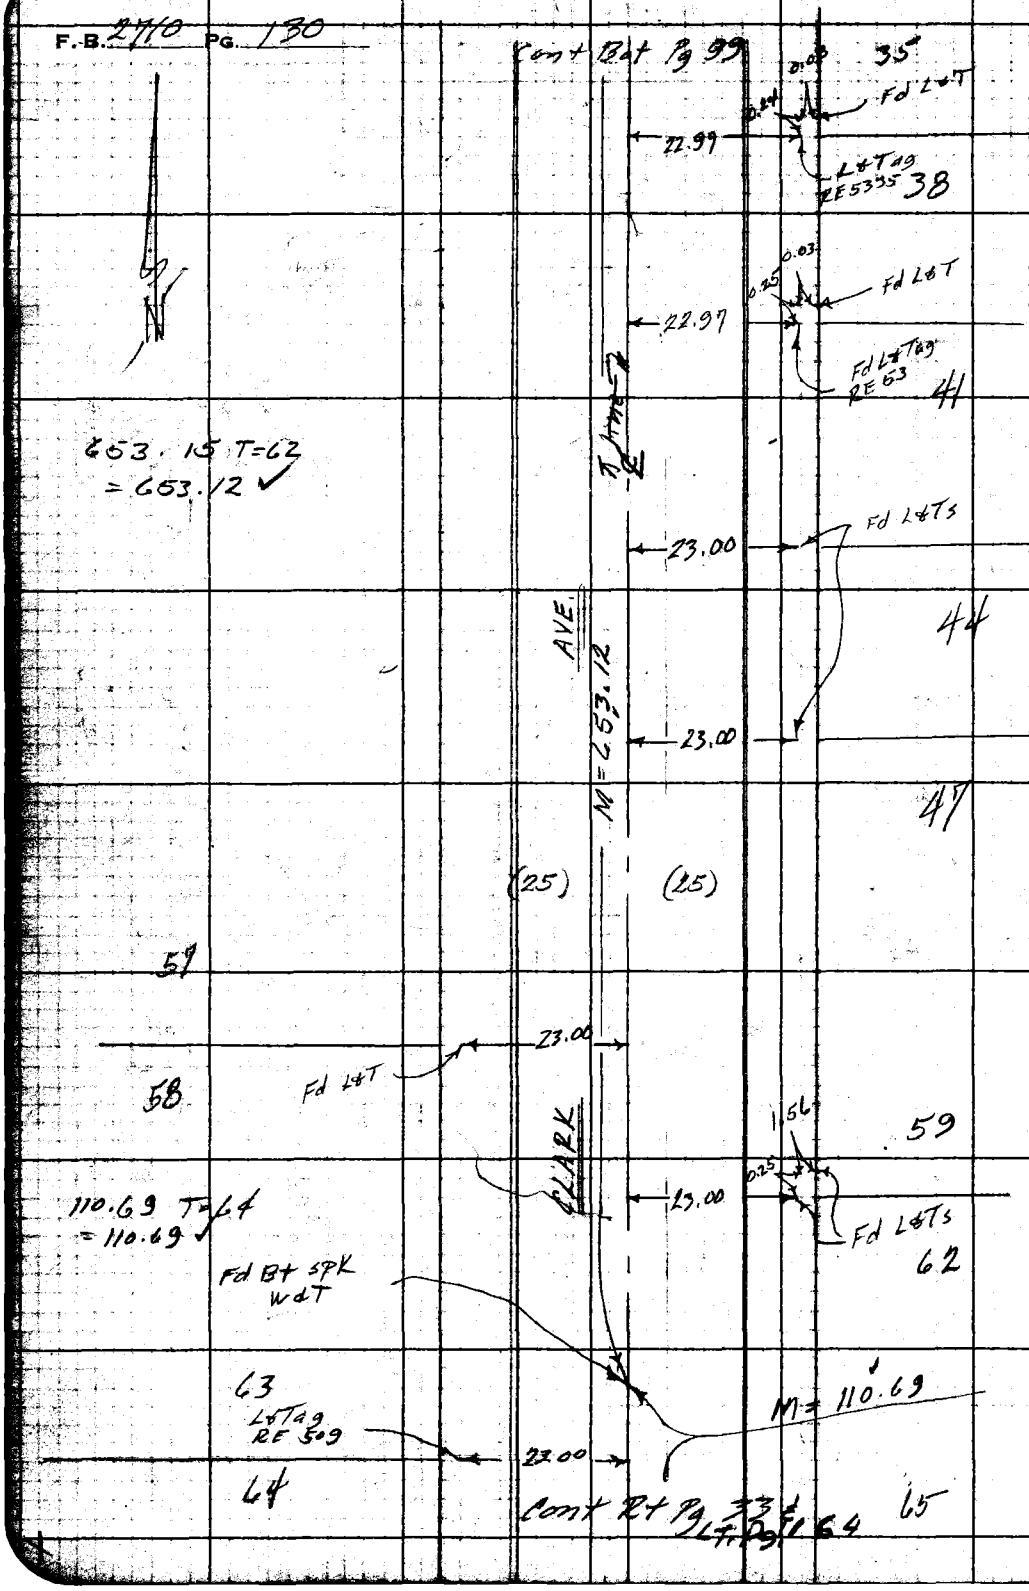

RETURN TO
LOS ANGELES COUNTY ENGINEER
700 LOS ANGELES COUNTY ENGINEERING BLDG.

Do not extend notes this side of this line.

Note: Any Additions or Changes on This Sheet Must be Made or Circled In Red Ink With Date and Name of Person Making Change.

W. Hollywood & Sherman

Notes Ck'd by D. SAPPELL	Survey of Sewer Maint Dist #3
Map No. 5418	IN 0303.00 Tape 0201 Std 68 °F
Office Work E FONG	Surveyed by F. E. Brooks
Checked R HILARIO	Notes F. E. Brooks Date 16 Mar 62
Date 10-17-83	Indexed C. J. GALLI

F. B. 2710 PG. 131

Cont Lt Pg 56

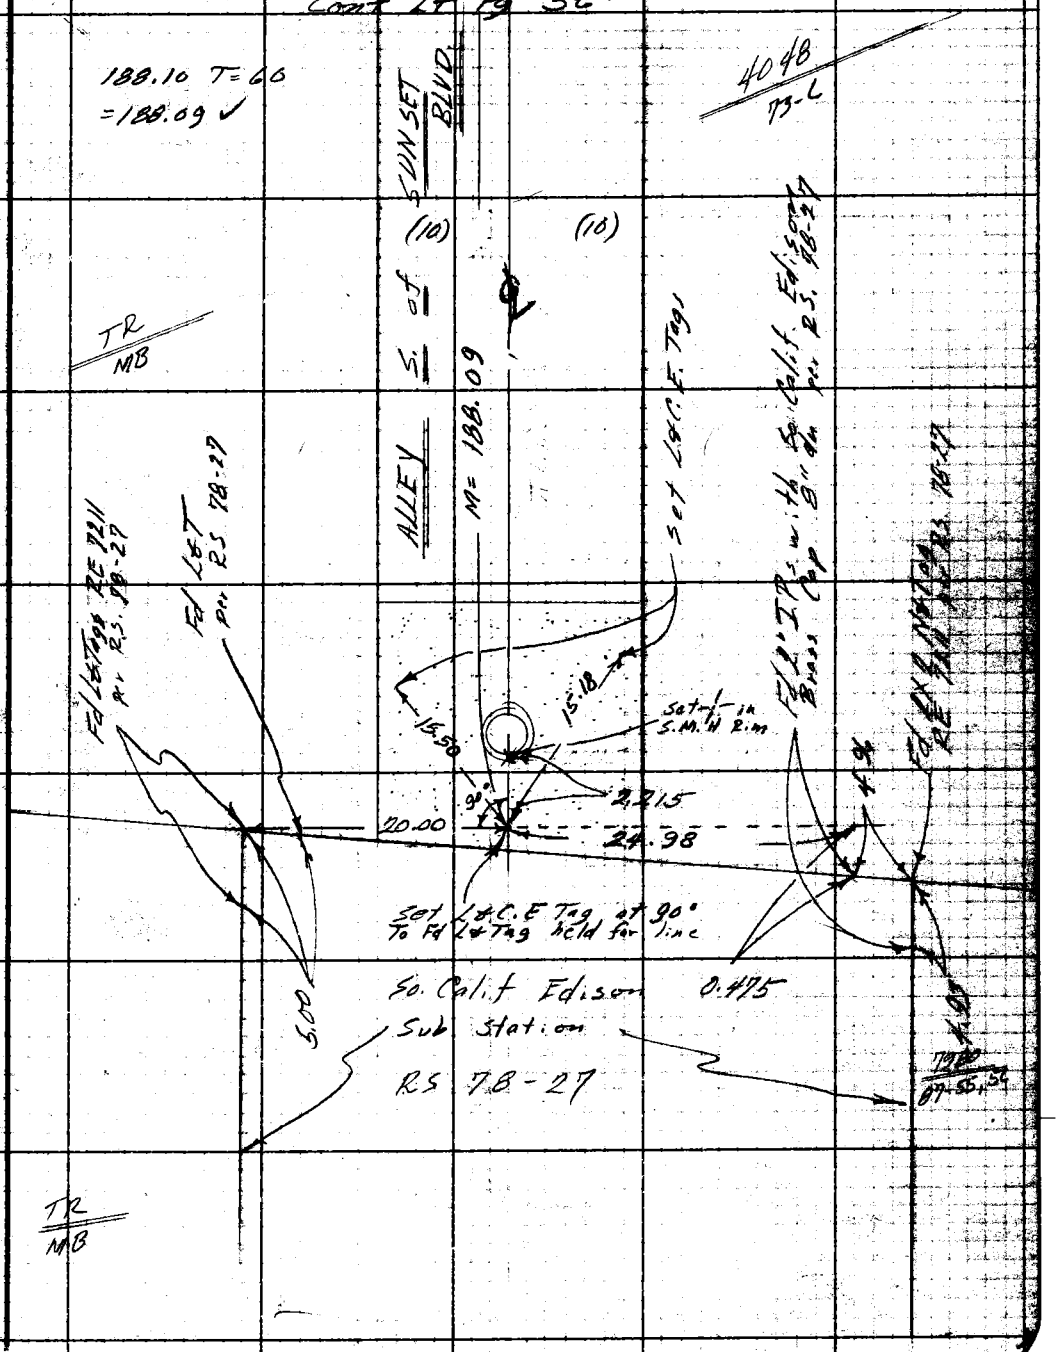

Note: Any Additions or Changes on This Sheet Must be Made or Circled in Red Ink With Date and Name of Person Making Change.

Do not extend notes this side of this line.

RETURN TO
LOS ANGELES COUNTY ENGINEER
700 LOS ANGELES COUNTY ENGINEERING BLDG.

763098 CE #247—7-53

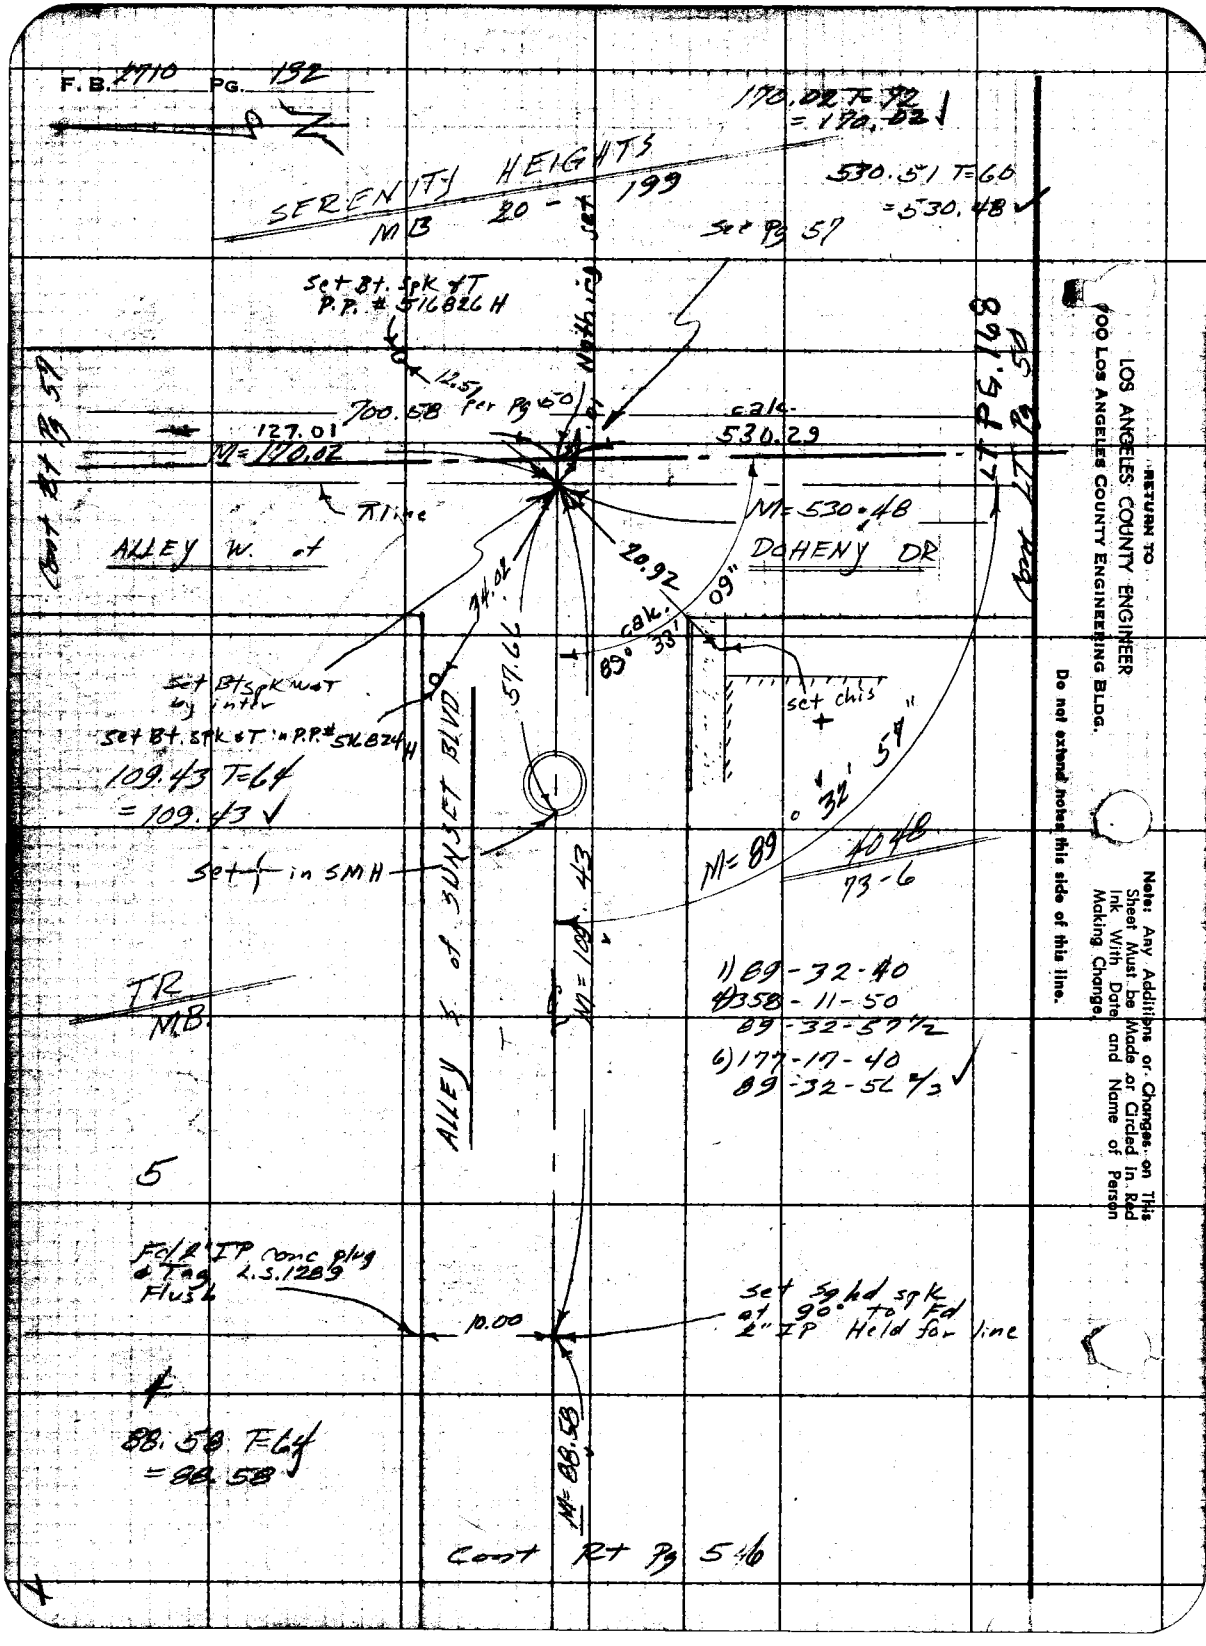
F. B. 2710 PG. 192
170.02 T=72
= 170.02
SERENITY HEIGHTS
MB 20 - 199
530.51 T=60
= 530.48
Set Pg 57
Set Bt. Spk & T
P.P. # 516826 H
12.51 per Pg 50
Nothing set
700.58
127.01
M=170.02
calc.
530.29
T line
M=530.48
ALLEY W. of
DOHENY DR
20.92
74.02
57.66
89° 33' 09"
calc.
set chis
Set Bt Spk W & T
by inter
Set Bt. Spk & T in P.P. # 516824 H
109.43 T=64
= 109.43
Set ⊥ in SMH
ALLEY ℄ of SUNSET BLVD
M=109.43
M=89° 32' 57"
40.48
73-6
1) 89-32-40
4) 358-11-50
89-32-57½
6) 177-17-40
89-32-56⅔
TR
MB
5
Fd 2" IP conc plug
& Tag L.S. 1289
Flush
10.00
Set Sq hd spk
at 90° to Fd
2" IP Held for line
88.58 T=64
= 88.58
M=88.58
Cont Rt Pg 546
Cont Rt Pg 57
Cont LT Pg 50
LT PG. 168
RETURN TO
LOS ANGELES COUNTY ENGINEER
700 LOS ANGELES COUNTY ENGINEERING BLDG.
Do not extend notes this side of this line.
Note: Any Additions or Changes on This Sheet Must be Made or Circled in Red Ink With Date and Name of Person Making Change.

W. Hollywood & Sherman

Notes Ck'd by D. SAPPELL	Survey of Sewer Maint Dist
Map No. 5418	JN 1303.00 Tape 0201 Std 68 °F
Office Work E FONG	Surveyed by E. E. Brooks
Checked R MILARIO	Notes E. E. Brooks Date
Date 10-17-83	Indexed C. J. GALLI

F. B. 2710 Pg. 133

Cont Bot Pg 64

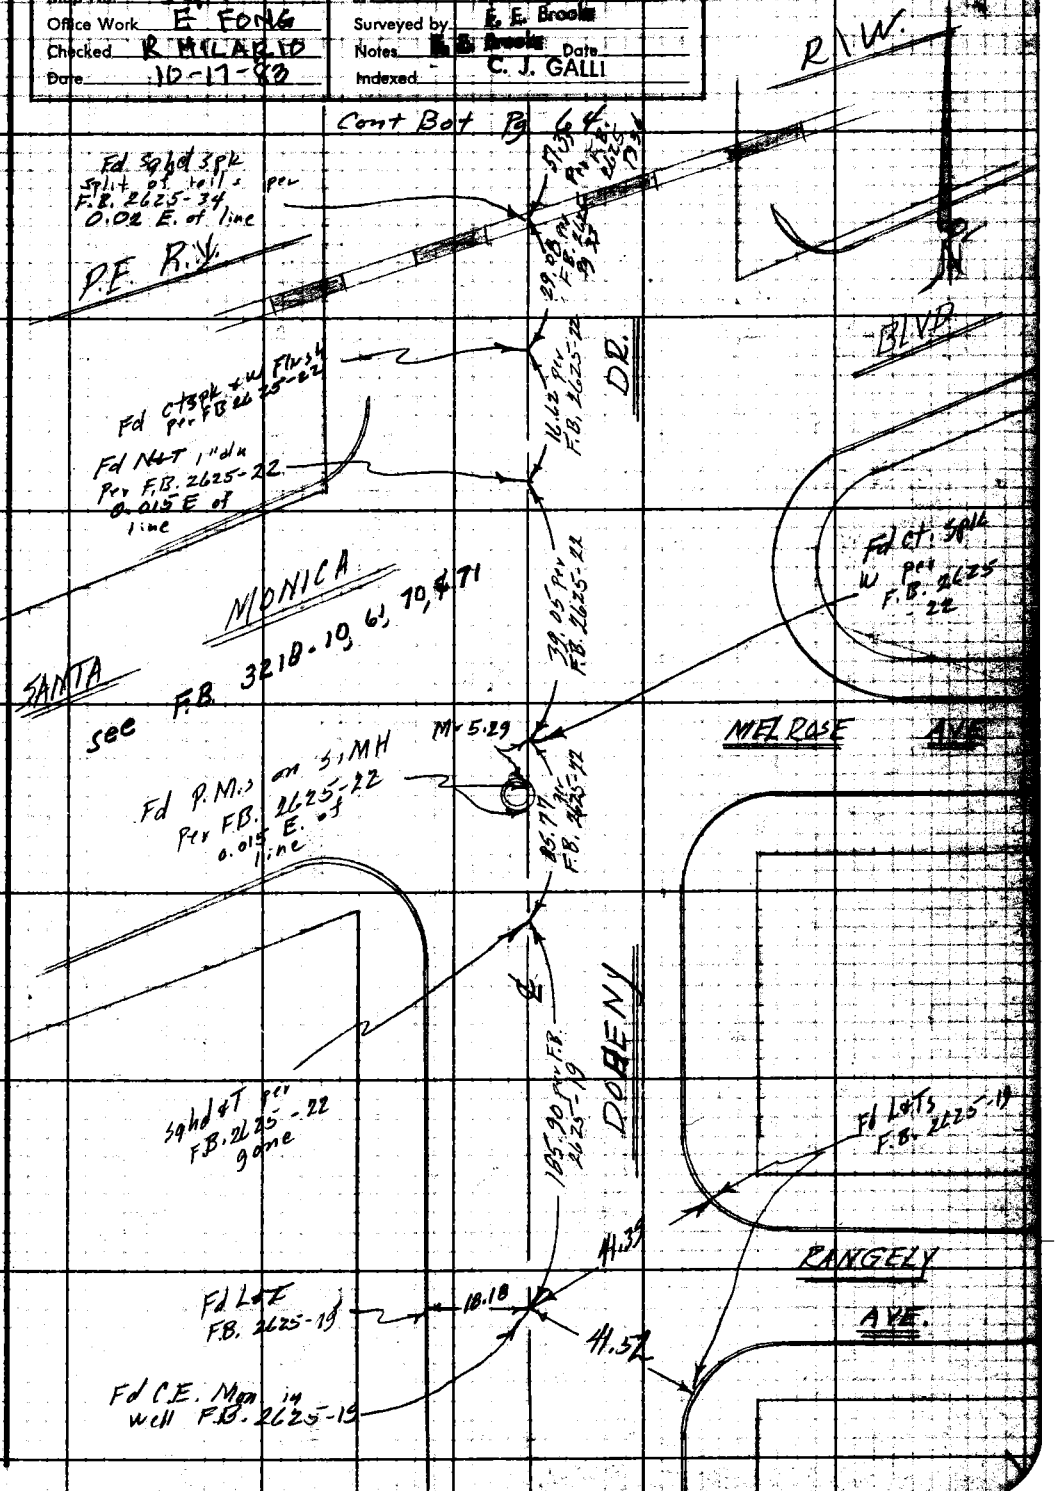

Note: Any Additions or Changes on This Sheet Must Be Made or Circled in Red Ink With Date and Name of Person Making Change.

W.S. 22, B-3

Do not extend notes this side of this line.

RETURN TO
LOS ANGELES COUNTY ENGINEER
700 LOS ANGELES COUNTY ENGINEERING BLDG.

763098 CE #247—7-59

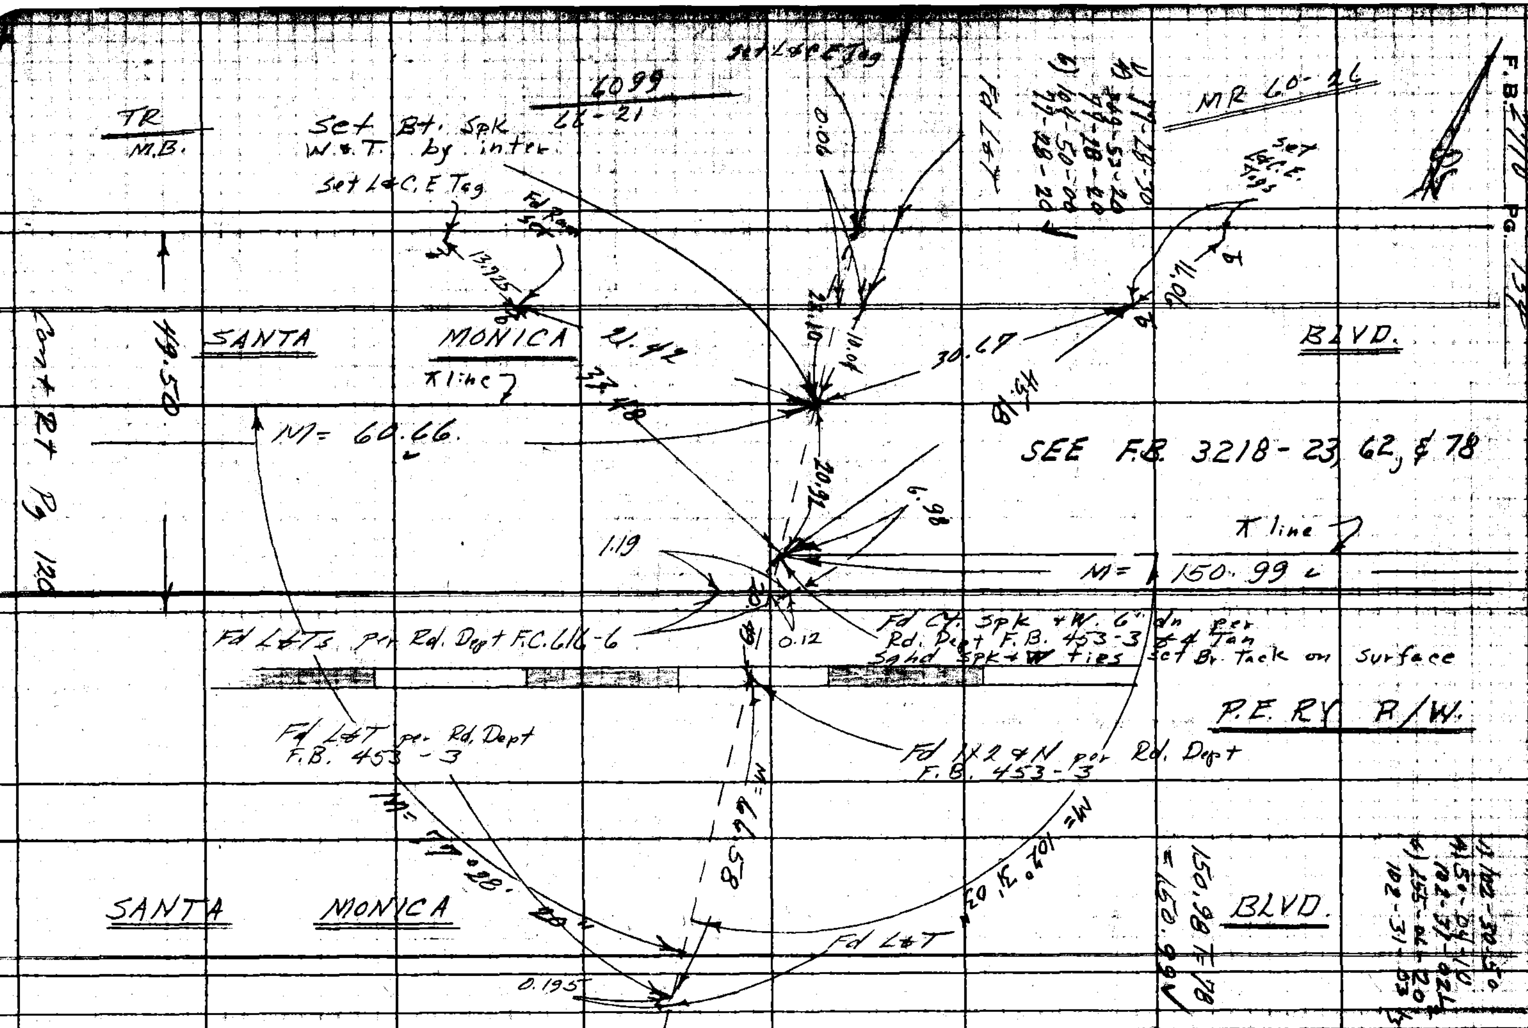

RETURN TO
LOS ANGELES COUNTY ENGINEER
700 LOS ANGELES COUNTY ENGINEERING BLDG.

Note: Any Additions or Changes on This Sheet Must be Made or Circled in Red Ink With Date and Name of Person Making Change.

Do not extend notes this side of this line.

W Hollywood & Sherman

Notes Ck'd by D. SAPPELL	Survey of Sewer Maint Dist #3
Map No. 5418	JN 0303.00 Tape 0201 Std 68 °F
Office Work E FONG	Surveyed by FE Brooks
Checked R HILARIO	Notes FEB Date 29 Apr. 162
Date 10-17-84	Indexed C. J. GALLI

F. B. 2710 PG. 135

Cont Bot Lt Pg 64

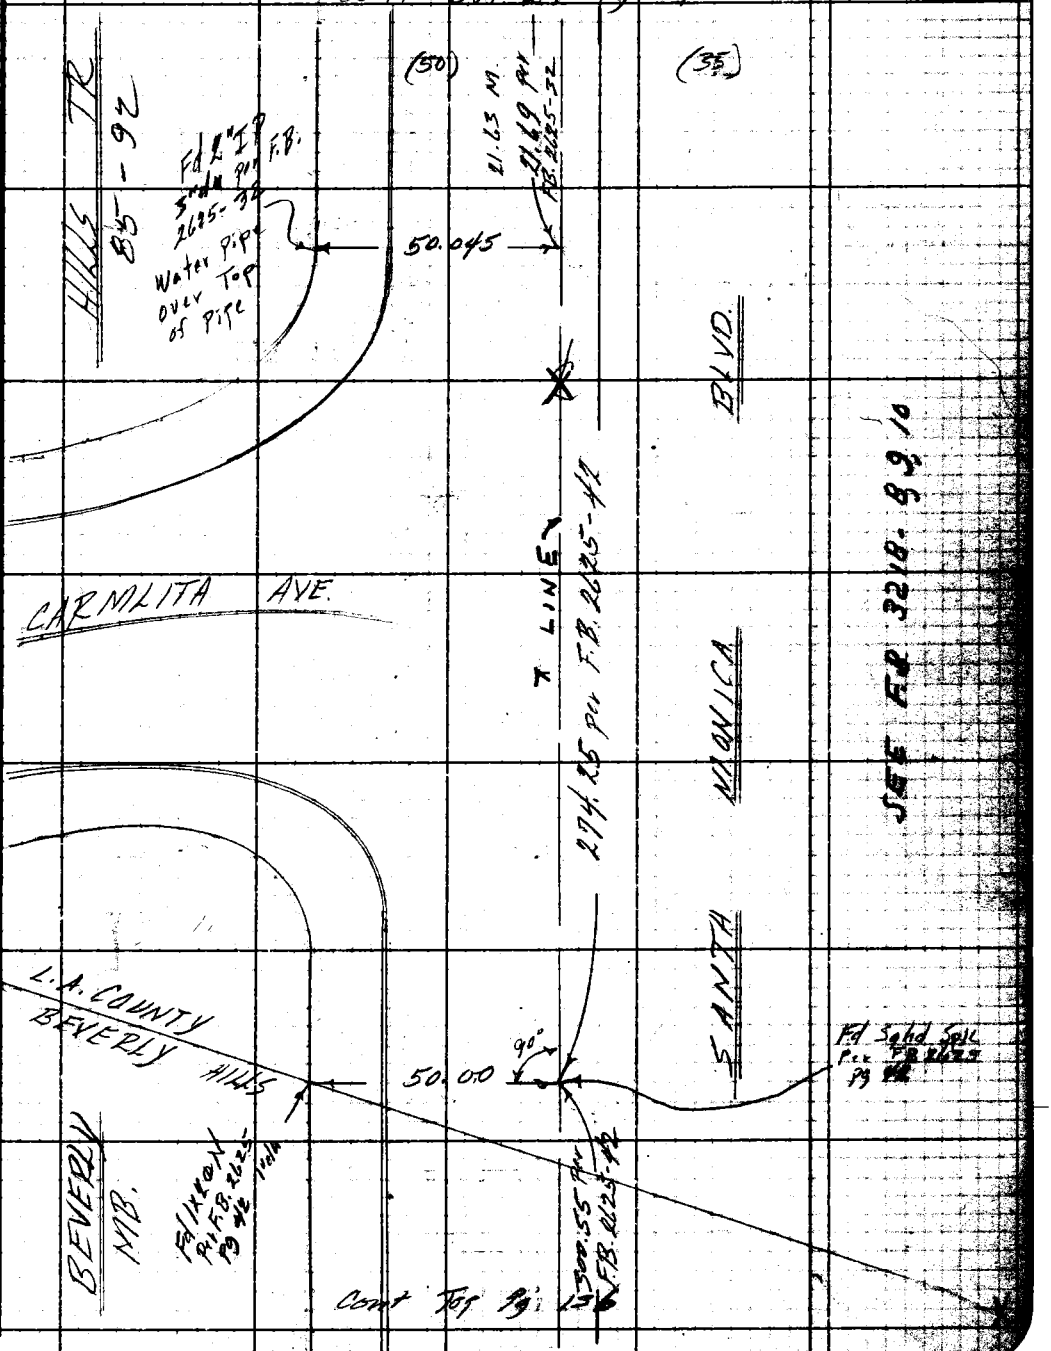

Cont Top Pg 136

Note: Any Additions or Changes on This Sheet Must be Made or Circled in Red Ink With Date and Name of Person Making Change.

Do not extend notes this side of this line.

RETURN TO
LOS ANGELES COUNTY ENGINEER
700 LOS ANGELES COUNTY ENGINEERING BLDG.

763098 CE #247—7-83

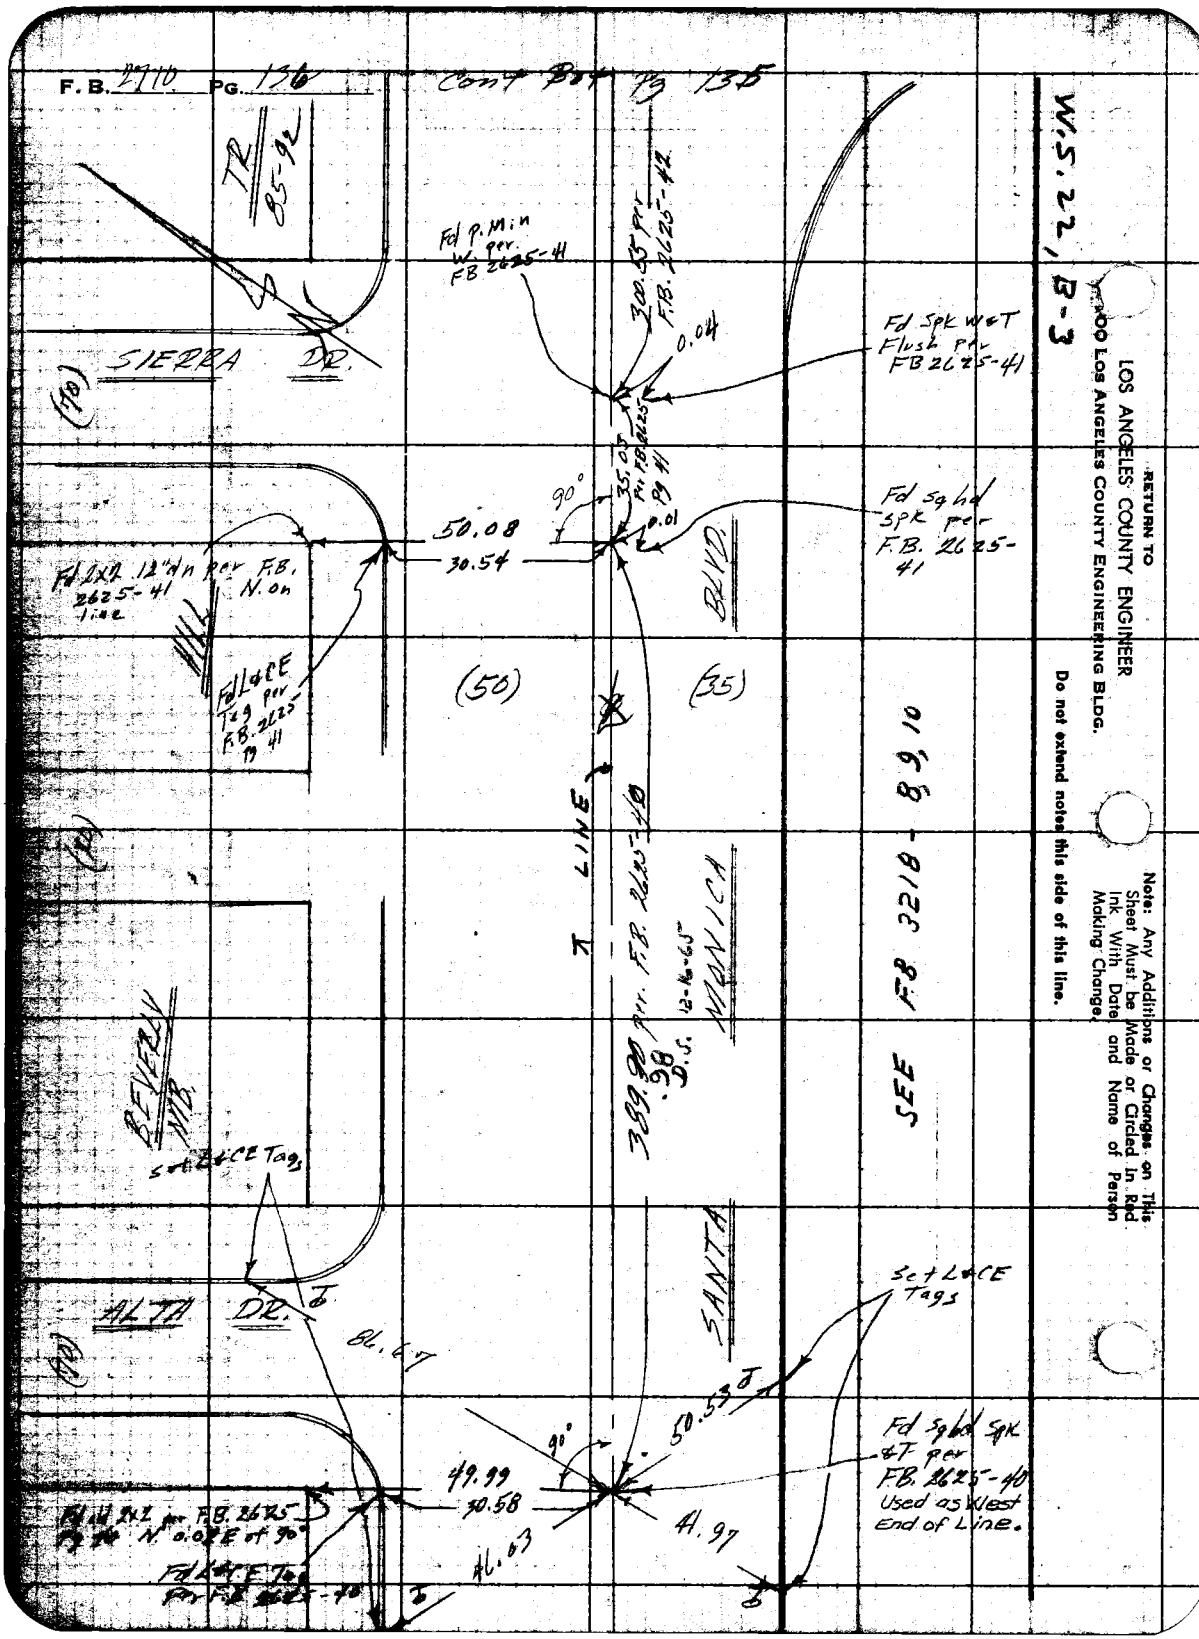
F. B. 2710 PG. 136
Cont Bot Pg 135
TR 85-92
SIERRA DR.
(70)
Fd p. Min W. per FB 2625-41
300.55 per F.B. 2625-42
0.04
Fd Spk W&T Flush per FB 2625-41
90°
35.05 per F.B. 2625 Pg 41
0.01
50.08
30.54
Fd sq hd spk per F.B. 2625-41
Fd 2x2 12" dn per F.B. 2625-41 N. on line
Fd L&CE Tag per F.B. 2625 Pg 41
(50)
(35)
BLVD.
LINE
389.90 per F.B. 2625-40
.98
D.S. 12-16-65
MONICA
SEE FB 3218 - 8, 9, 10
BEVERLY MB.
Set L&CE Tags
ALTA DR.
86.67
SANTA
Set L&CE Tags
50.53
90°
49.99
30.58
41.97
46.63
Fd sq hd spk &T per F.B. 2625-40 Used as West End of Line.
Fd 2x2 per F.B. 2625 Pg 40 N. 0.02E of 90°
Fd L&CE Tag per F.B. 2625-40
W.S. 22, B-3
RETURN TO
LOS ANGELES COUNTY ENGINEER
900 LOS ANGELES COUNTY ENGINEERING BLDG.
Do not extend notes this side of this line.
Note: Any Additions or Changes on This Sheet Must be Made or Circled in Red Ink With Date and Name of Person Making Change.

W. Hollywood & Sherman

Notes Ck'd by L. SAPPELL	Survey of Sewer Maint Dist #3
Map No. 5418	JN 0303.06 Tape 0201 Std 68° °F
Office Work E FONG	Surveyed by F. E. Brooks
Checked R HILARIO	Notes F. E. Brooks Date 30 June 1962
Date 10-17-83	Indexed C. J. GALLI

F. B. 2710 Pg. 137

See Pg 41

Lot 5 Cont Lt.: Pg 40

29.97

Lot 6

29.98

N = 216.02

Fd Sq hd spk & T. F.B. 2625-69

See Pg 162 for adopted 6 Int & T.'s 6-5-68 LSMH

Fd L&CE Tag F.B. 2625-69

20.45

20.13

28.50

90°

Fd L&C.E. Tag F.B. 2625-69

Fd L&T in sidewalk per TR 5934 F.B. 2625-69

(30)

(30)

Lot 7

30.04

L&Ts per Pg 41

Lot 8

ST.

N = 86.34

P.M on S. MH per Pg 41

Set sq hd at 90° To Fd Pk spk at mid point of dist between Pk & Fd L&T. Hold for line

20.20 cb.

19.87 cb.

30.00

L&C.E Tag per Pg 41

L&T per Pg 41

0.13

29.01

29.12

HAMMOND

(22.5)

20.35

14.84

22.83

Cont Bot Pg 41

N = 219.97

ST.

(25)

14.90 cb.

30.03

0.01

FdN

9.02 FdN

N = 519.36

Tline

28.61

0.56

28.16

21.10

(22.5)

Fd L&T 2.01

Fd L.S. 2568

Adopted 6-5-68 LSMH

L&T per Pg 41

Fd L&Ts

Fd Pk.

30.06

30.10

19.85 cb.

28.00 cb.

Fd Pks

1.00

Set P.M. on S.M.H by inter of 4 Tan X on cb

Tline

Lot 9

30.11

N = 89°34'

1) 89-37-40
4) 358-[illegible]-40
89-37-40
6) 179-[illegible]-40
89-37-40

28.22

Fd L&T per Pg 41

Lot 12

TR

Fd L&T Tag L.S. 2304 per Pg 41

Lot 13

29.15

N = 322.65

Fd L&T Tag L.S. 2568 per Pg 41

28.04

1) 91-16-30
4) 365-06-30
91-16-37½
6) 187-39-50
91-16-38⅓

CYNTHIA

Lot 11

Cont Bot Pg 42

W.S. 22, B-3

Notes: Any Additions or Changes on This Sheet Must Be Made or Circled In Red Ink With Date and Name of Person Making Change.

Do not extend notes this side of this line.

RETURN TO
LOS ANGELES COUNTY ENGINEER
900 Los Angeles County Engineering Bldg.

763095 CE #247—7-58

RETURN TO
LOS ANGELES COUNTY ENGINEER
700 LOS ANGELES COUNTY ENGINEERING BLDG.

Note: Any Additions or Changes on This Sheet Must be Made or Circled in Red Ink With Date and Name of Person Making Change.

Do not extend notes this side of this line.

F.B. 2710 PG. 138

Notes Ck'd by D. SAPPELL	Survey of CYNTHIA ST.
Map No. 5418	JN 030300 Tape 0122 Std 68 °F
Office Work E FONG	Surveyed by J. TERRANOVA
Checked R HILARIO	Notes J.T. Date 3-22-66
Date 10-17-83	Indexed [redacted] GALLO

F. B. 2710 PG. 141

Note: Any Additions or Changes on This Sheet Must be Made or Circled in Red Ink With Date and Name of Person Making Change.

W.S. 22, B-3

Do not extend this side of this line.

PLEASE RETURN TO
LOS ANGELES COUNTY ENGINEER
403 LOS ANGELES COUNTY ENGINEERING BLDG.

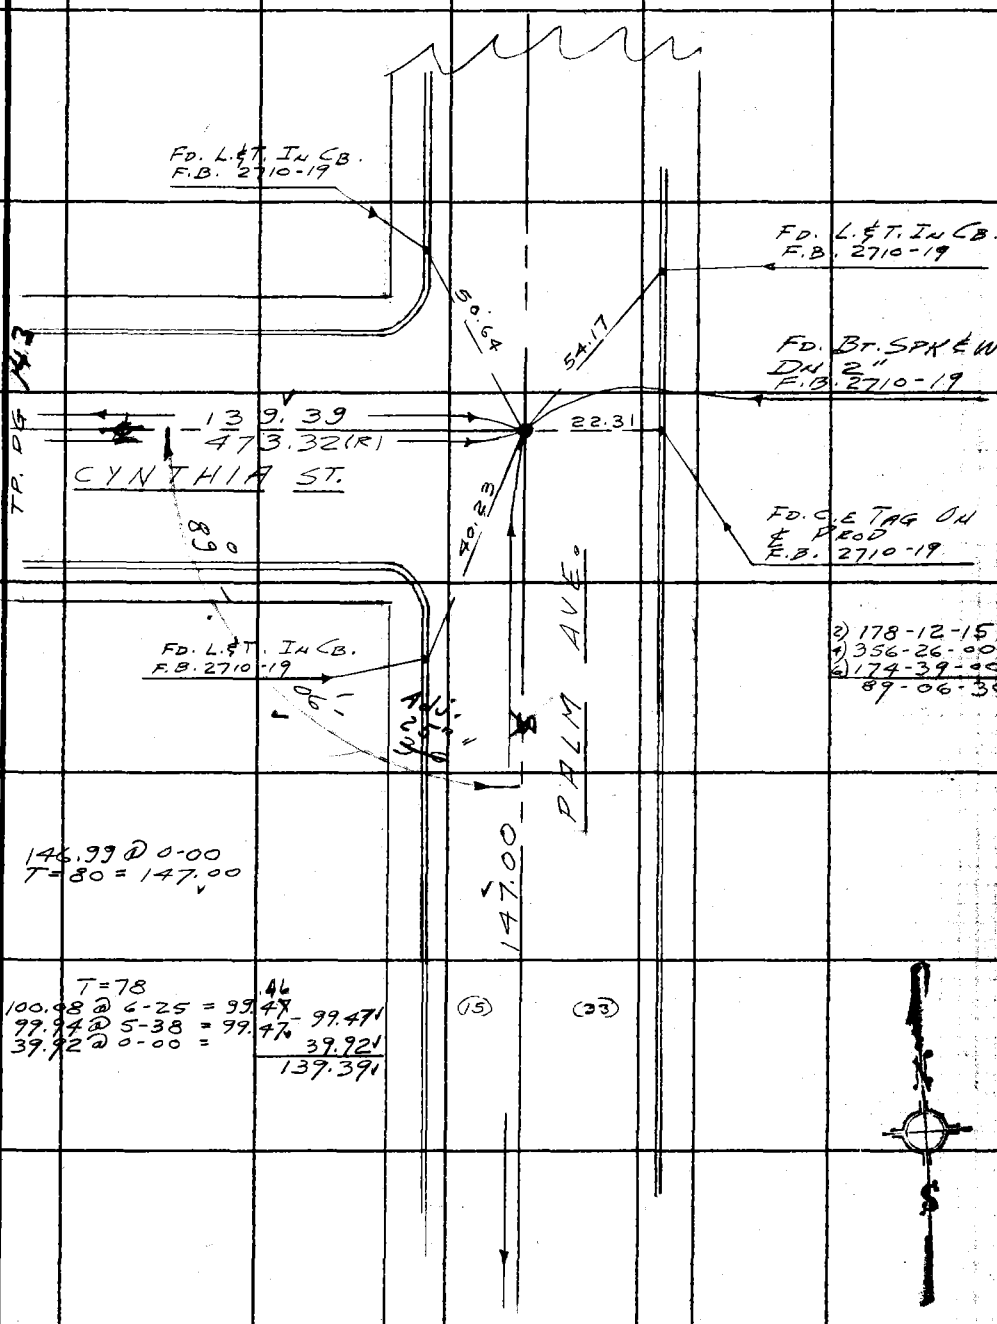

76F3095 CE # 310 3-61

F. B. 2710 PG. 142

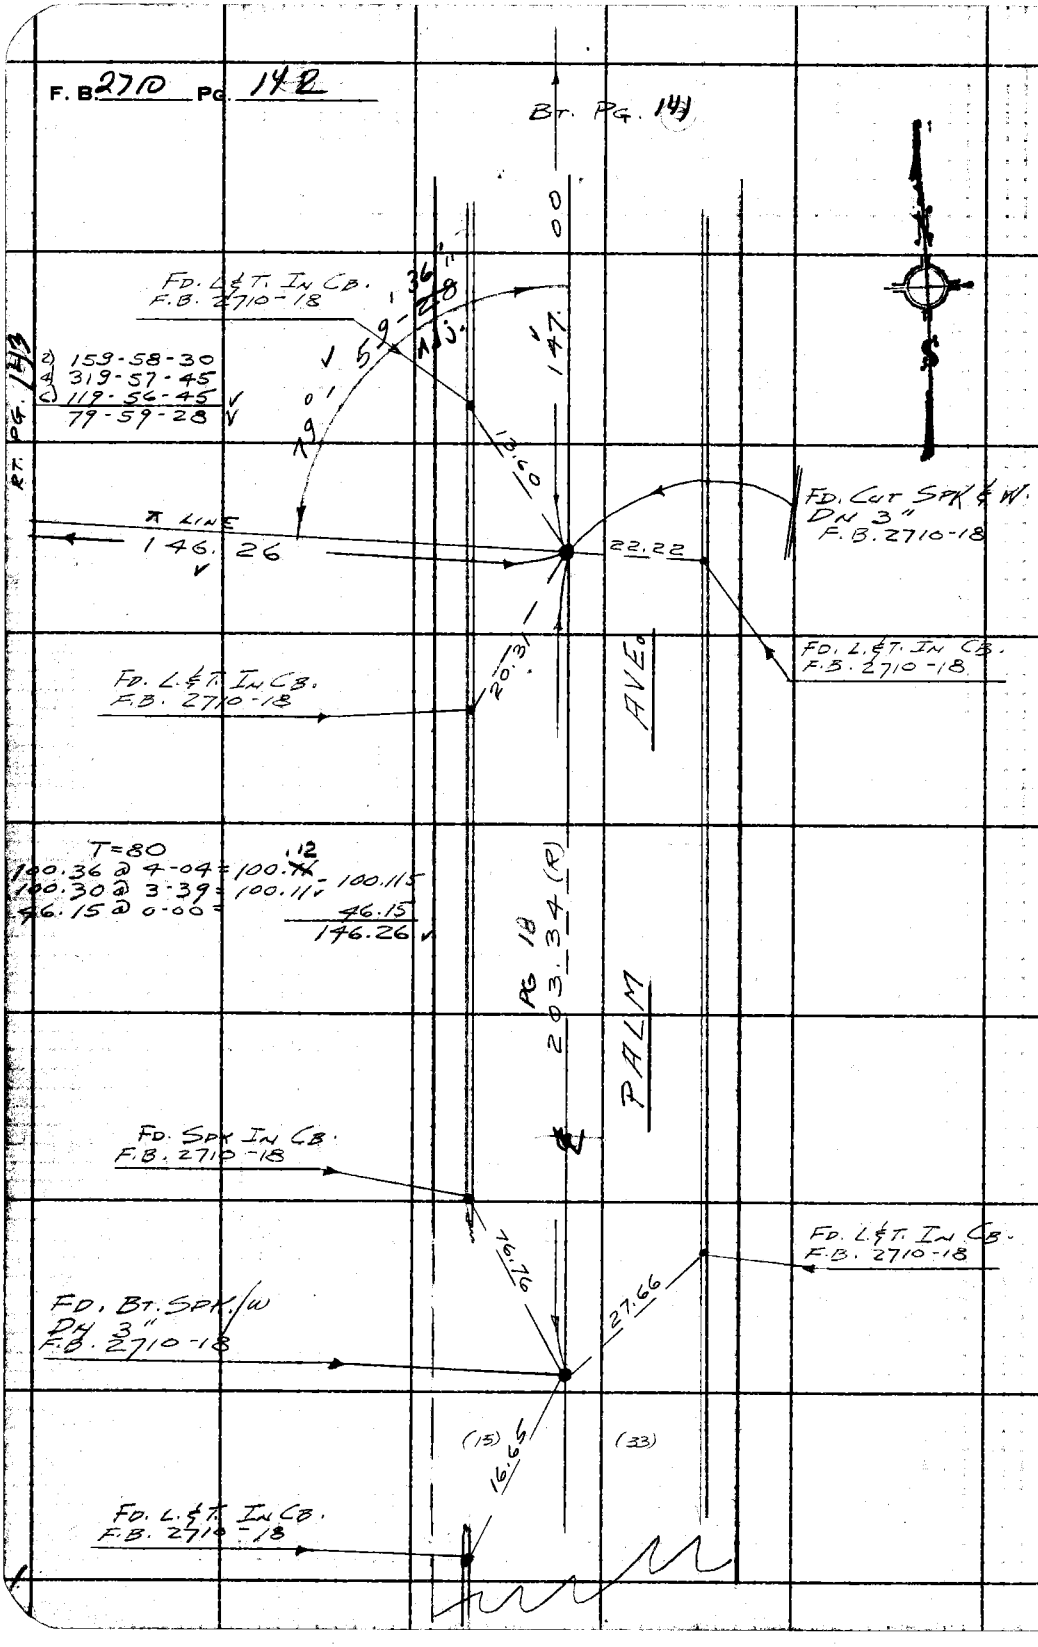

PLEASE RETURN TO
LOS ANGELES COUNTY ENGINEER
403 Los Angeles County Engineering Bldg.

Do not extend this side of this line.

Note: Any Additions or Changes on This Sheet Must be Made or Circled in Red Ink With Date and Name of Person Making Change.

Notes Ck'd by SAPPELL	Survey of CYNTHIA ST.
Map No. 5418	JN 0303.00 Tape 0122 Std 68 °F
Office Work E FONG	Surveyed by J. TERRANOVA
Checked R HILARIO	Notes J.T. Date 3-22-66
Date 10-17-83	Indexed C. J. GALLP MAR 2 1 '88

F. B. 2710 PG. 139

CYNTHIA ST. ℄

~~RETRACEMENT OF CYNTHIA ST & PALM AVE. TO MAPS &~~ TIE TO EXISTING RANCHO MOH. L.B. #5, WHICH WILL BE LOST DUE TO CONST. WORK

J.N. 0303.00

MAR. 1966

REF.

F.B. 2710
RD. DEPT-FX-351

PARTY

J. TERRANOVA
C. YASUI
G. MASUDA
W. DIETZ

Note: Any Additions or Changes on this Sheet Must be Made or Circled in Red Ink With Date and Name of Person Making Change.

Do not extend this area of this line.

PLEASE RETURN TO
LOS ANGELES COUNTY ENGINEER
403 Los Angeles County Engineering Bldg.

70F3095 CE #3 0 6-82

R. B. 2710 PG. 140

INDEX

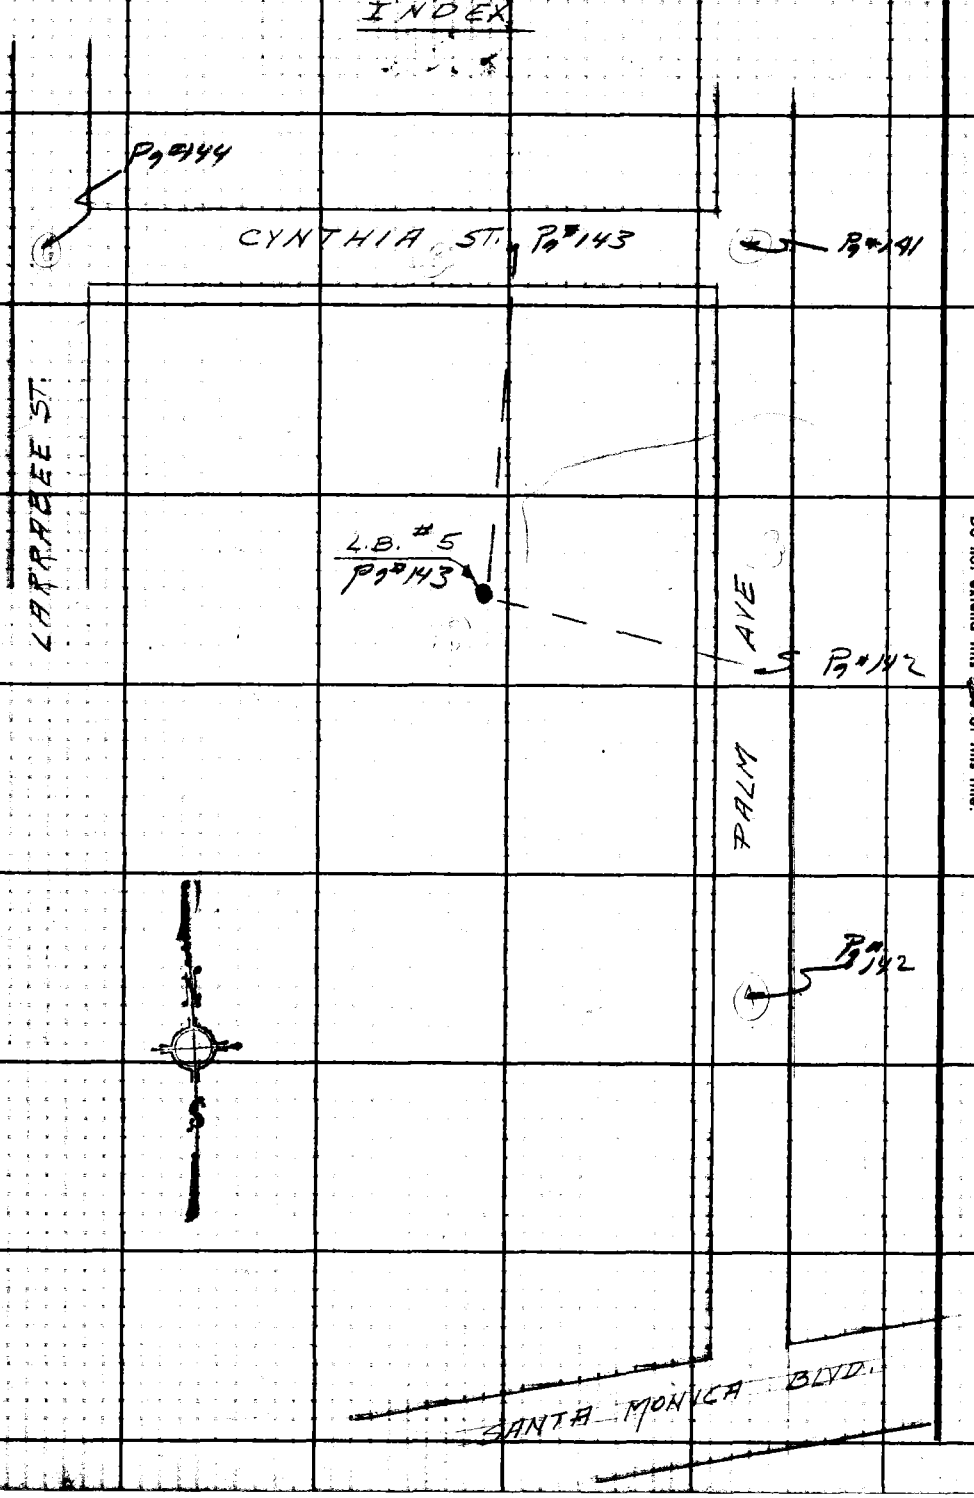

PLEASE RETURN TO
LOS ANGELES COUNTY ENGINEER
403 LOS ANGELES COUNTY ENGINEERING BLDG.

Do not extend this side of this line.

Note: Any Additions or Changes on This Sheet Must be Made or Circled in Red Ink With Date and Name of Person Making Change.

Notes Ck'd by	Survey of CYNTHIA ST.	F. B. 2710 PG. 143
Map No. 5418	JN 0303.00 Tape 0122 Std 68 °F	
Office Work E FONG	Surveyed by J. TERRANOVA	
Checked R. HILARIO	Notes J.T. Date 3-22-66	
Date 10-17-83	Indexed C. J. GALLI	

LT. PG. 141

Note: Any Additions or Changes on This Sheet Must be Made or Circled in Red Ink With Date and Name of Person Making Change.

Do not extend this side of this line.

PLEASE RETURN TO
LOS ANGELES COUNTY ENGINEER
403 LOS ANGELES COUNTY ENGINEERING BLDG.

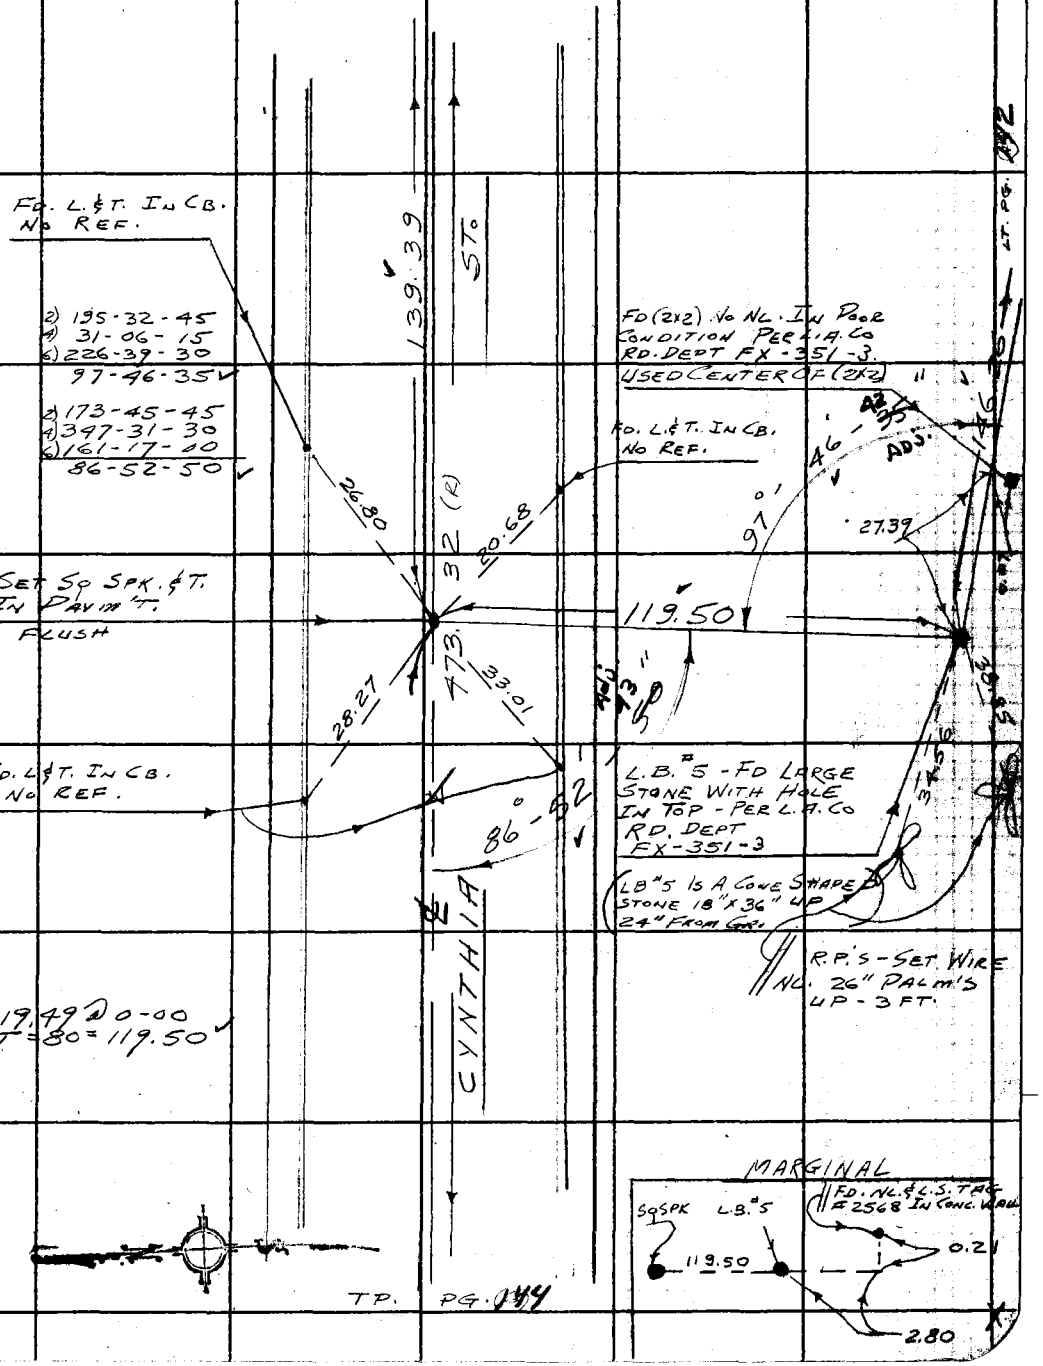

TP. PG. 144

76F309S CE # 310 3-81

F. B. 2210 PG. 144

BT. P.G. 143

W.S. 22, B-3

LOS ANGELES COUNTY ENGINEER
403 LOS ANGELES COUNTY ENGINEERING BLDG.

PLEASE RETURN TO

Do not extend this side of this line.

Note: Any Additions or Changes on This Sheet Must be Made or Circled in Red Ink With Date and Name of Person Making Change.

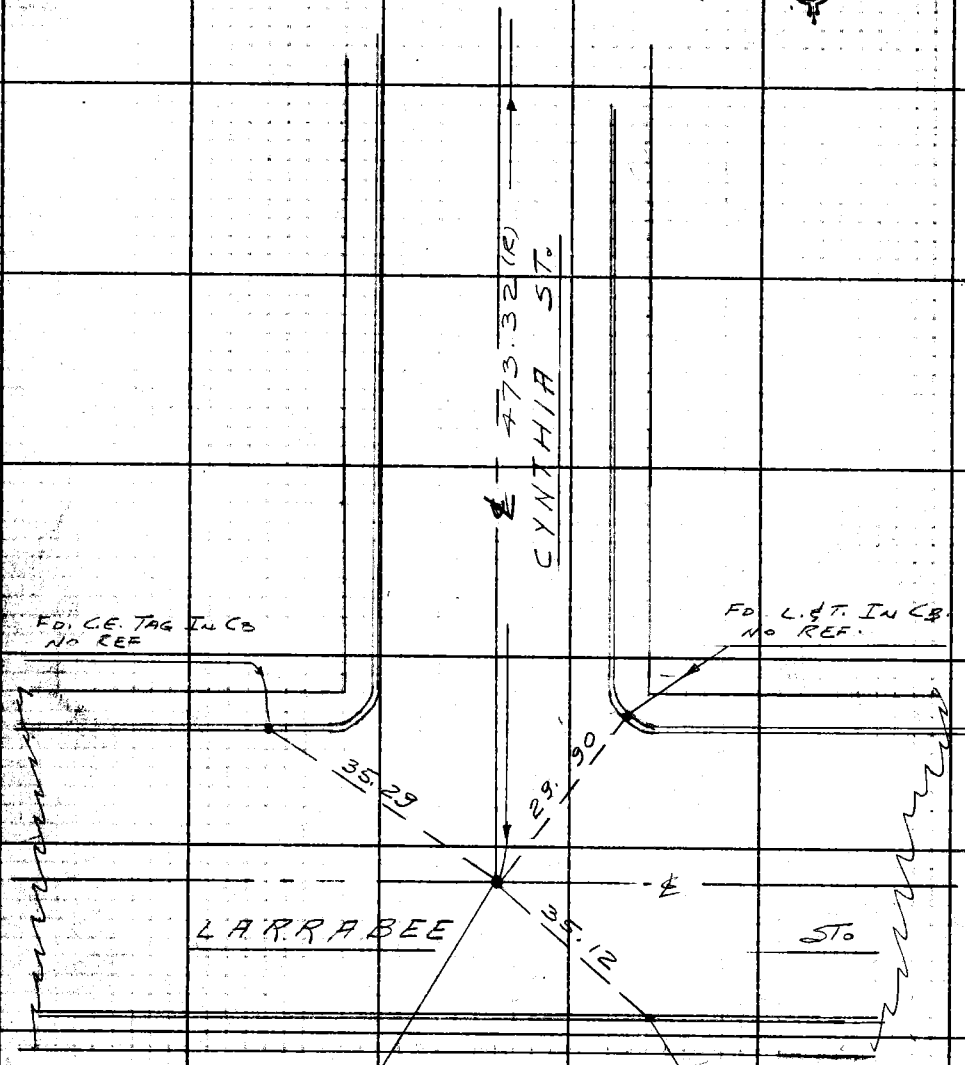

SEE PG 165

Notes Ck'd by	D SAPPELL	Survey of	W. Holly ℄ Sur. Div #3
Map No.	5418	JN	030300 Tape 0254 Std 68 °F
Office Work	E PONG	Surveyed by	Mankey Jr.
Checked	R HILARIO	Notes	Etry Jr. Date 5-68
Date	10-17-83	Indexed	C.J. GALLI 59 12 68

F.B. 2710 PG. 145

JN 030300

WEST HOLLYWOOD

DIV. #3 ℄

Mankey Jr.
Peterson
Caro
Tollison

Note: Any Additions or Changes on this Sheet Must be Made or Circled in Red Ink With Date and Name of Person Making Change.

Do not extend this side of this line.

PLEASE RETURN TO
LOS ANGELES COUNTY ENGINEER
403 LOS ANGELES COUNTY ENGINEERING BLDG.

76F3098 CE#310 9-67

F.B. 2710 Pg. 146

Notes Ck'd by	[illegible]	Survey of	W. Holly & Sur. Div. 3
Map No.	5418	JN	030300 Tape 0254 Std 68 °F
Office Work	E FONG	Surveyed by	Mankey Jr.
Checked	R. HILARIO	Notes	[illegible] Jr. Date 5 68
Date	10-17-83	Indexed	[illegible] GALLI SEP 12 [illegible]

F.B. 2710 PG 147

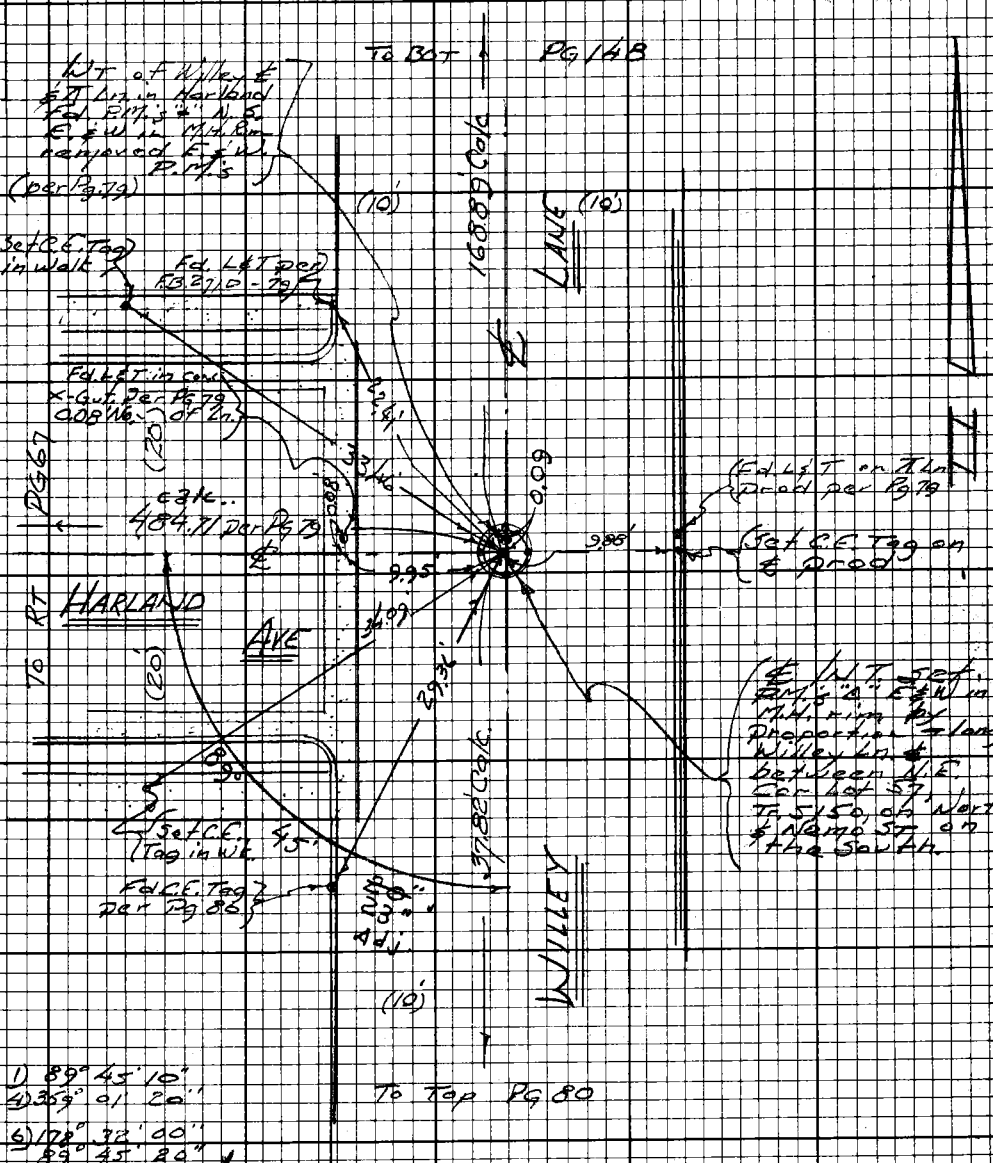

Note: Any Additions or Changes on this Sheet Must be Made or Circled in Red Ink With Date and Name of Person Making Change.

W.S. 22, 8-3

Do not extend this side of this line.

PLEASE RETURN TO
LOS ANGELES COUNTY ENGINEER
403 LOS ANGELES COUNTY ENGINEERING BLDG.

76F3098 CE#310 9-67

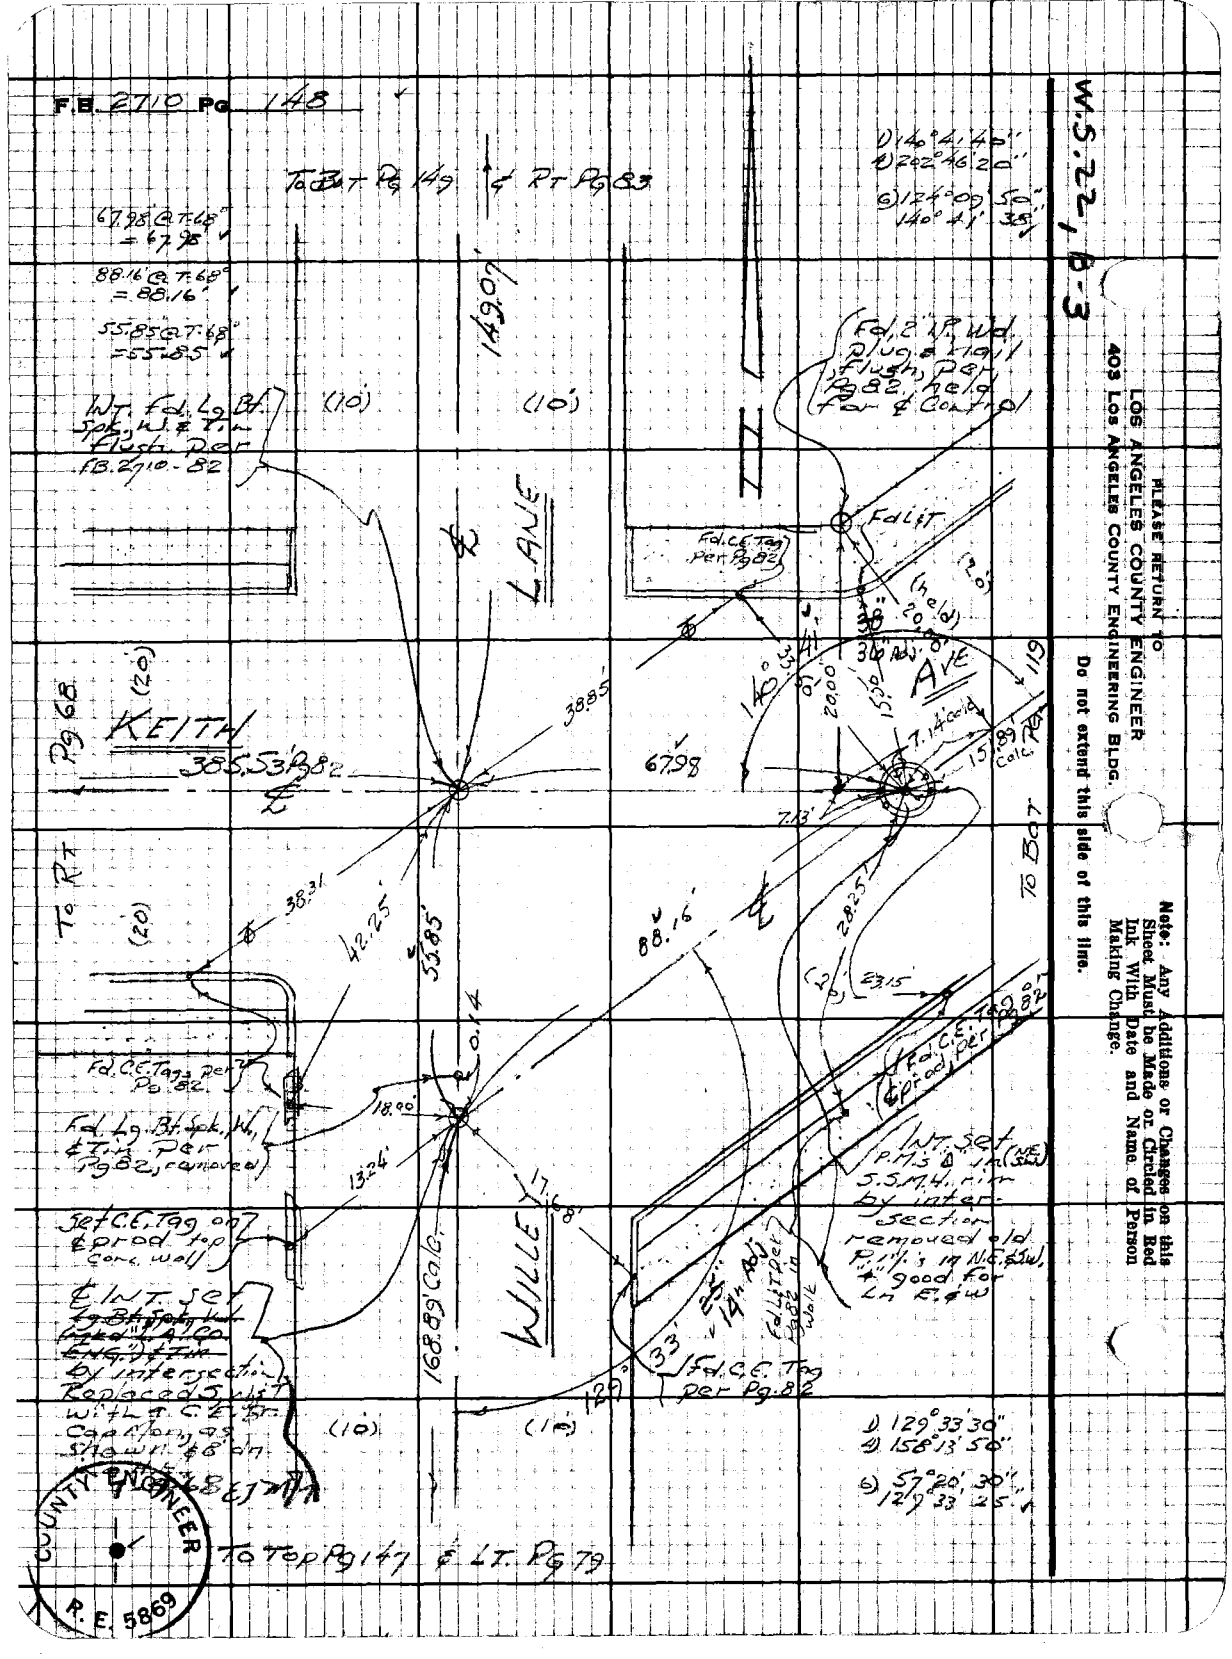
F.B. 2710 Pg 148
To Bot Pg 149 & Rt Pg 83
67.98 @ T-68° = 67.98
88.16 @ T-68° = 88.16
55.85 @ T-68° = 55.85
Wt. Fd. Lg. Bt. Spk. W. & Tin Flush. Per FB. 2710-82
(10)
(10)
149.07
LANE
Fd. C.E. Tag Per Pg 82
Fd. 2" I.P. Wd. Plug & Nail Flush, Per Pg 82, held for ℄ Control
Fd. L.T.
(20)
(held)
AVE
KEITH
385.53' Pg 82
38.85
67.98
140°
33.41
20.00
15.50
7.14 calc.
15.89 Calc.
7.13
119
To Bot
To Rt
Pg 68
(20)
38.31
42.25
55.85
88.16
28.25
23.15
Fd. C.E. Tag Per Pg 82
Fd. Lg. Bt. Spk. W. & Tin Per Pg 82, removed
18.00
13.24
17.68
Set C.E. Tag on ℄ prod top conc. wall
℄ Int. Set ~~Lg. Bt. Spk. W. (Mkd. "A. Co. Eng.") & Tin~~ by intersection Replaced 5 W.S.T. with a C.E. Br. Cap Mon. as shown, 8' on
168.89 Calc.
WILLEY
Fd. C.E. Tag Per Pg 82
Fd. L.T. Per Pg 82 in Walk
Int. Set P.M.'s 4" in (NE SW) S.S.M.H. rim by intersection removed old P.M.'s in N.E. & S.W. "4" good for Ln E. & W.
129°
33'
25'
14" Adj
(10)
(10)
1) 129°33'30"
4) 158°13'50"
6) 57°20'30"
129°33'25"
To Top Pg 147 & Lt. Pg 79
COUNTY ENGINEER
R.E. 5869
W.S. 22, B-3
1) 140°41'40"
4) 202°46'20"
6) 124°09'50"
140°41'38"
PLEASE RETURN TO
LOS ANGELES COUNTY ENGINEER
403 LOS ANGELES COUNTY ENGINEERING BLDG.
Do not extend this side of this line.
Note: Any Additions or Changes on this Sheet Must be Made or Circled in Red Ink With Date and Name of Person Making Change.

Notes Ck'd by D. SAPPELL
Map No. 5418
Office Work E FONG
Checked R HILARIO
Date 10-17-83

Survey of W. Holly & Sur. Div. #3
JN 430.00 Tape 0254 Std 68 °F
Surveyed by Mankey Jr
Notes ETM Jr. Date 5-58
Indexed E. J. GALL

F.B. 2710 Pg. 149

COUNTY ENGINEER R.E. 5869

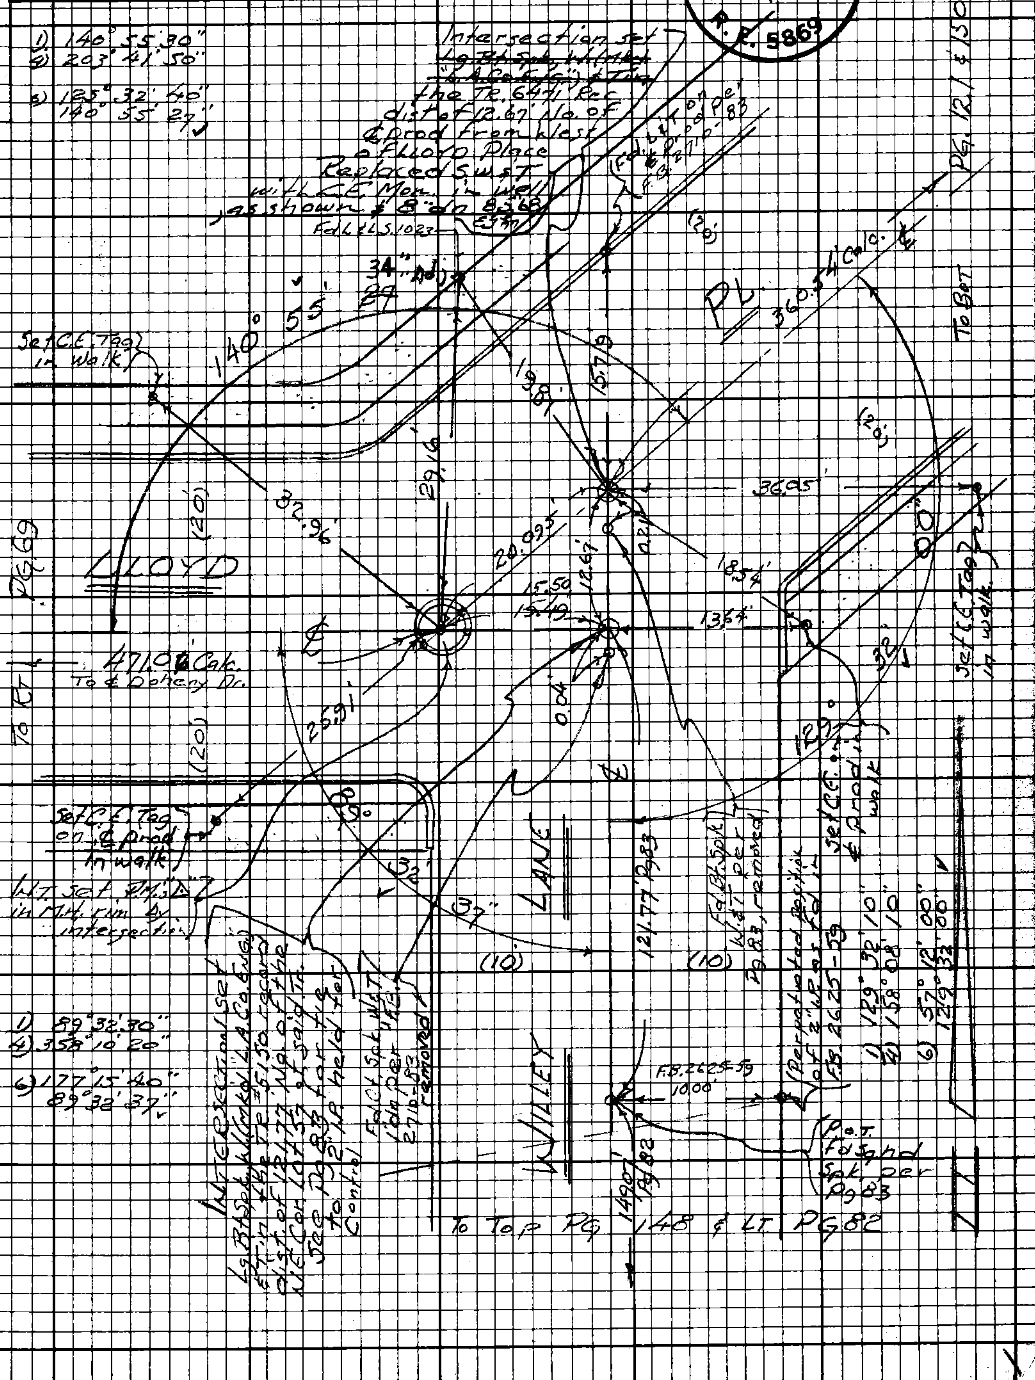

Note: Any Additions or Changes on this Sheet Must be Made or Circled in Red Ink With Date and Name of Person Making Change.

W.S. 22, B-3

Do not extend this side of this line.

PLEASE RETURN TO
LOS ANGELES COUNTY ENGINEER
403 LOS ANGELES COUNTY ENGINEERING BLDG.

76F3098 CE#31D 9-67

F.B. 2710 Pg 150

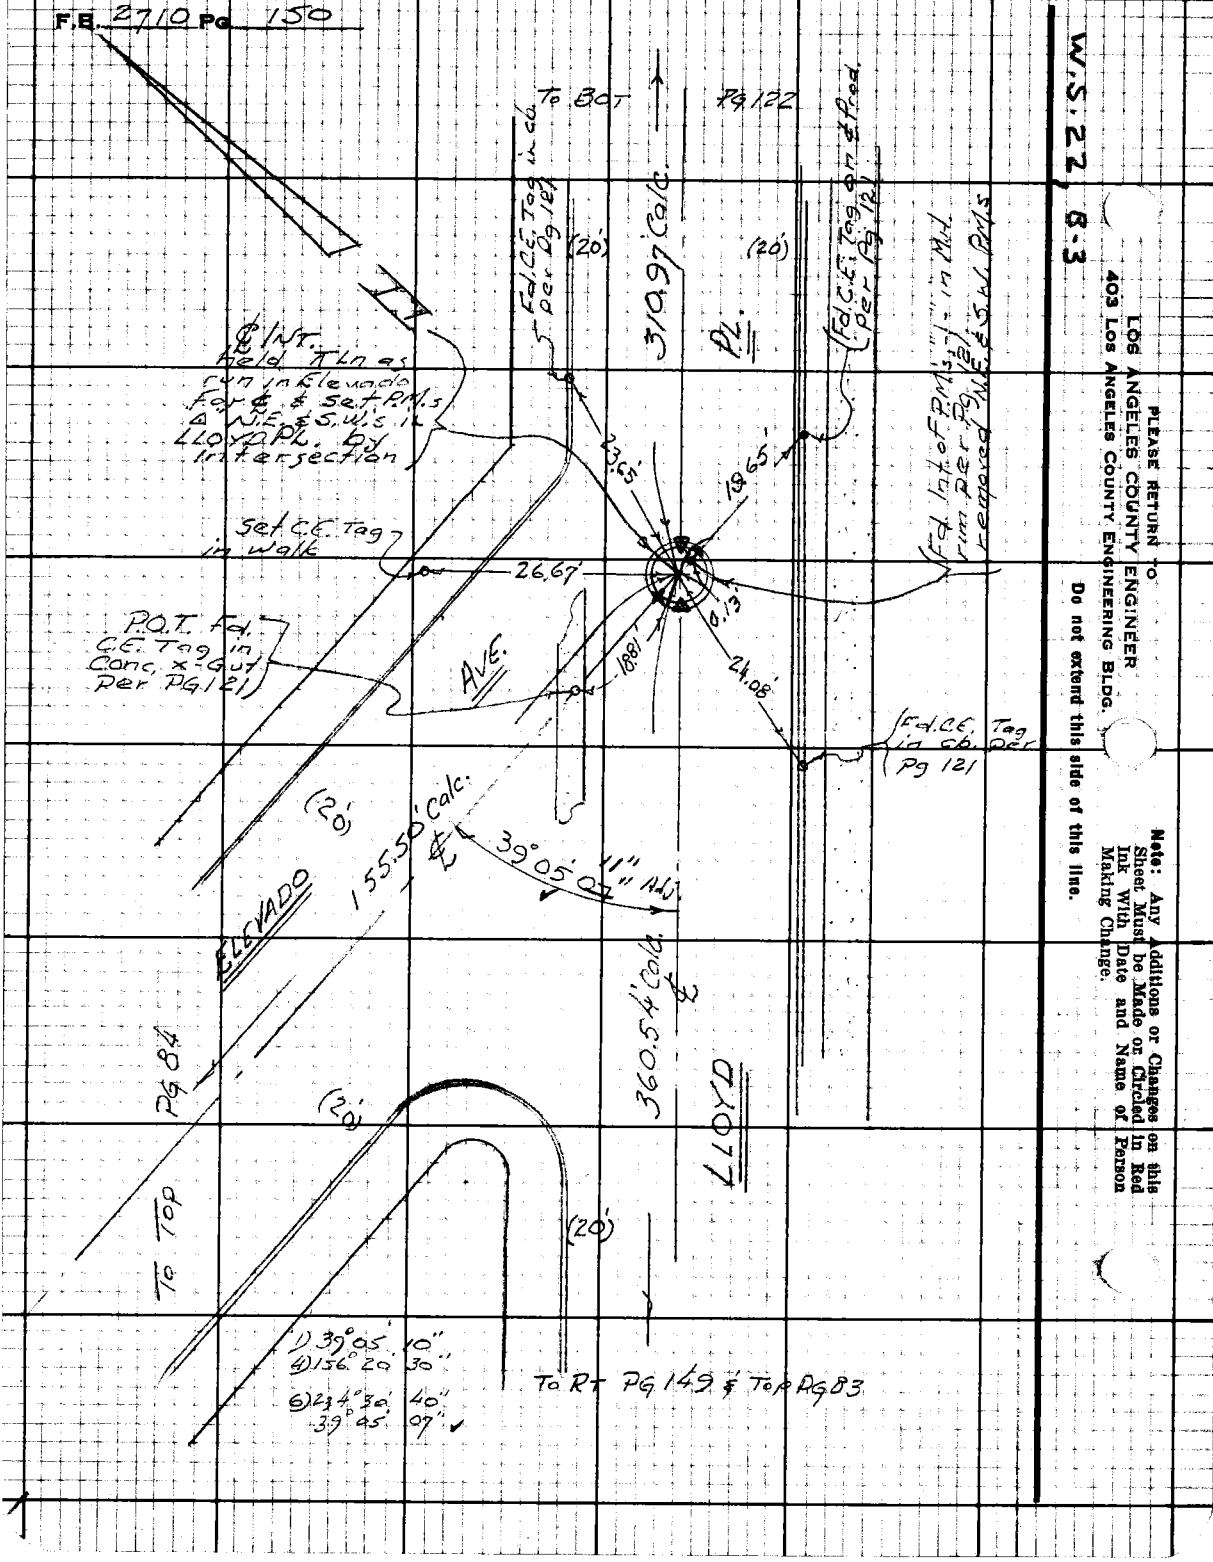

W.S. 22, 8-3

PLEASE RETURN TO
LOS ANGELES COUNTY ENGINEER
403 Los Angeles County Engineering Bldg.

Do not extend this side of this line.

Note: Any Additions or Changes on this Sheet Must be Made or Circled in Red Ink With Date and Name of Person Making Change.

Notes Ck'd by D. SAPPELL	Survey of W. Holly & Sun. Div #3
Map No. 5418	JN 4303.00 Tape 0254 Std 65 °F
Office Work E PONG	Surveyed by Mankey Jr.
Checked R HILARIO	Notes ETM Jr. Date 5 '68
Date 10-17-83	Indexed [illegible]

F.B. 2710 PG. 151

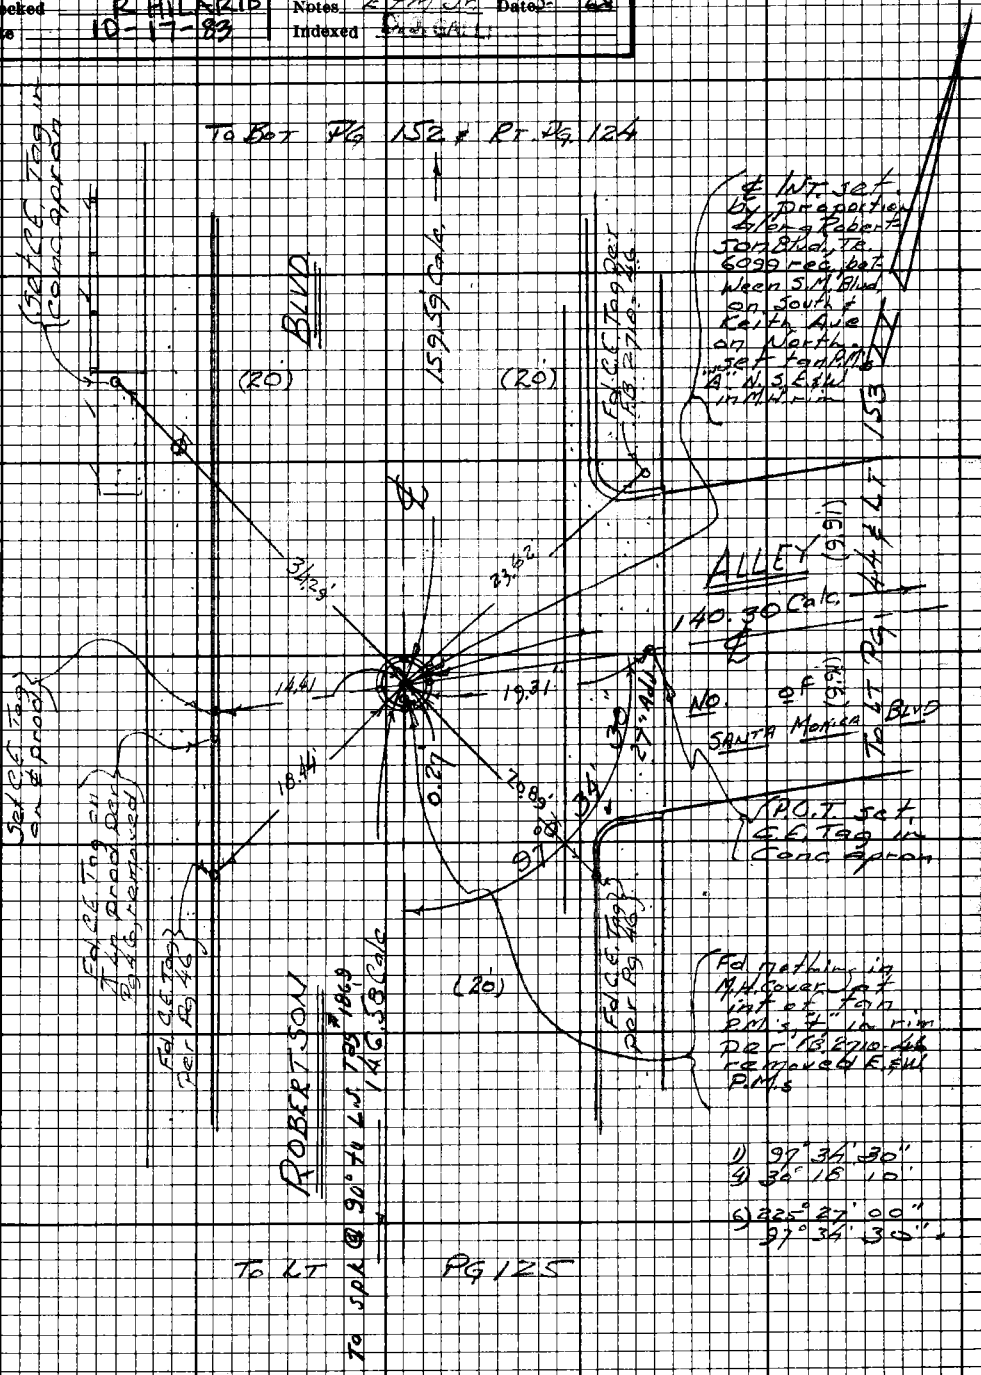

Note: Any Additions or Changes on this Sheet Must be Made or Circled in Red Ink With Date and Name of Person Making Change.

Do not extend this side of this line.

PLEASE RETURN TO
LOS ANGELES COUNTY ENGINEER
403 LOS ANGELES COUNTY ENGINEERING BLDG.

76F3098 CE#310 9-67

F.B. 2710 Pg 152

COUNTY ENGINEER
R.E. 5869

W.S. 22, B-3

PLEASE RETURN TO
LOS ANGELES COUNTY ENGINEER
403 LOS ANGELES COUNTY ENGINEERING BLDG.

Do not extend this side of this line.

Note: Any Additions or Changes on this Sheet Must be Made or Circled in Red Ink With Date and Name of Person Making Change.

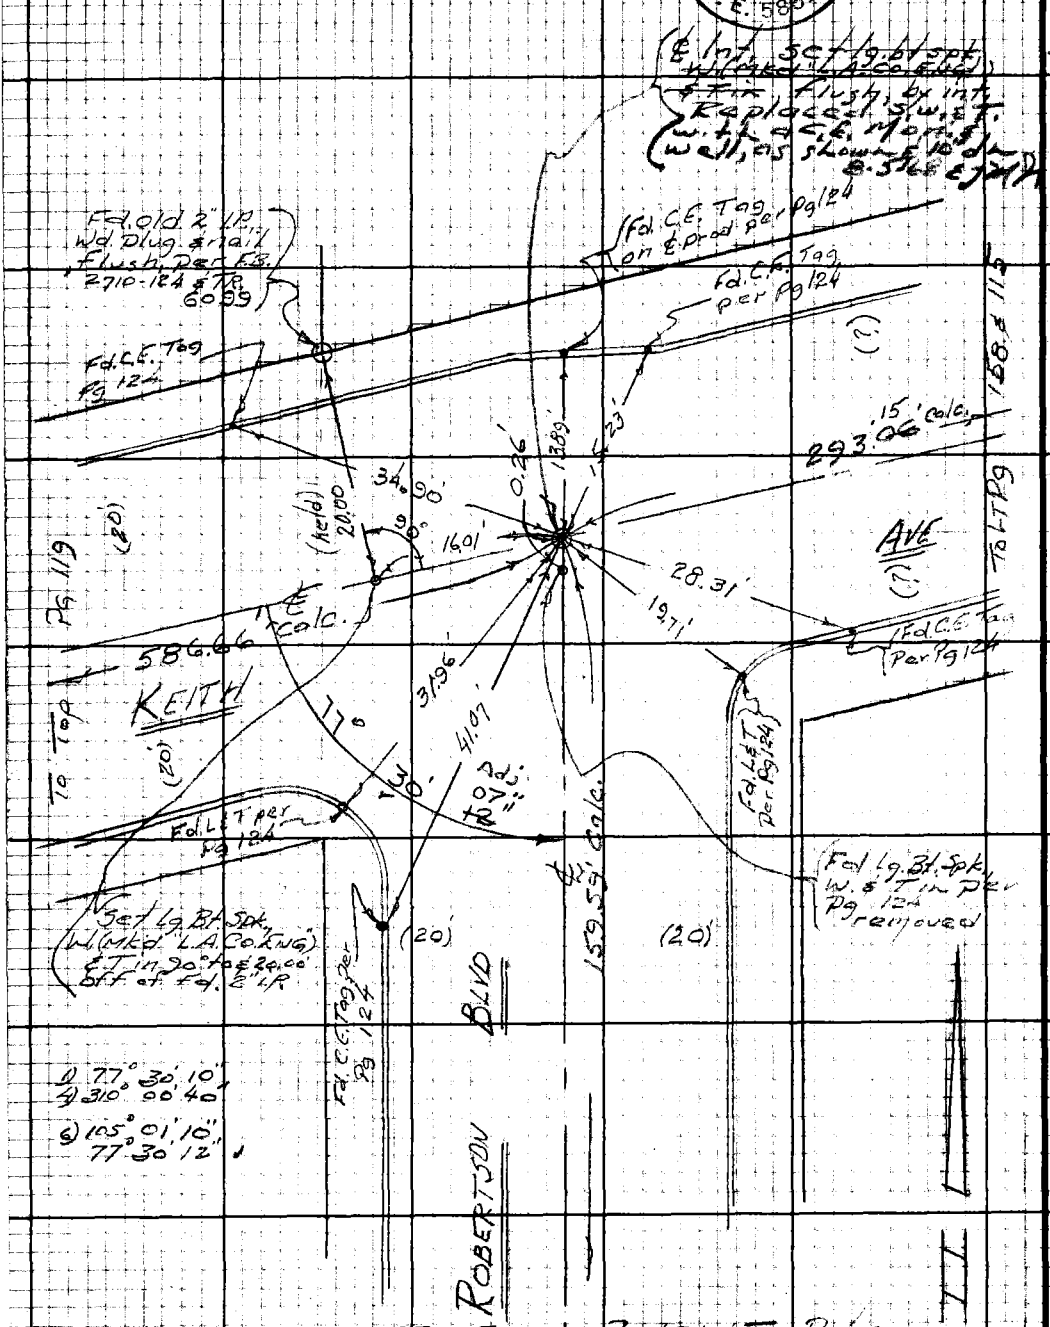

Notes Ck'd by	D. SAPPELL	Survey of	W. Holly & Sur. Div #3
Map No.	5418		Tape 0254 Std 68 °F
Office Work	E. FONG	Surveyed by	Mankey Jr.
Checked	R. HILARIO	Notes	E.T.M. Jr. Date 5-16-68
Date	10-17-83	Indexed	C. J. GALLI

F.B. 2710 PG. 153

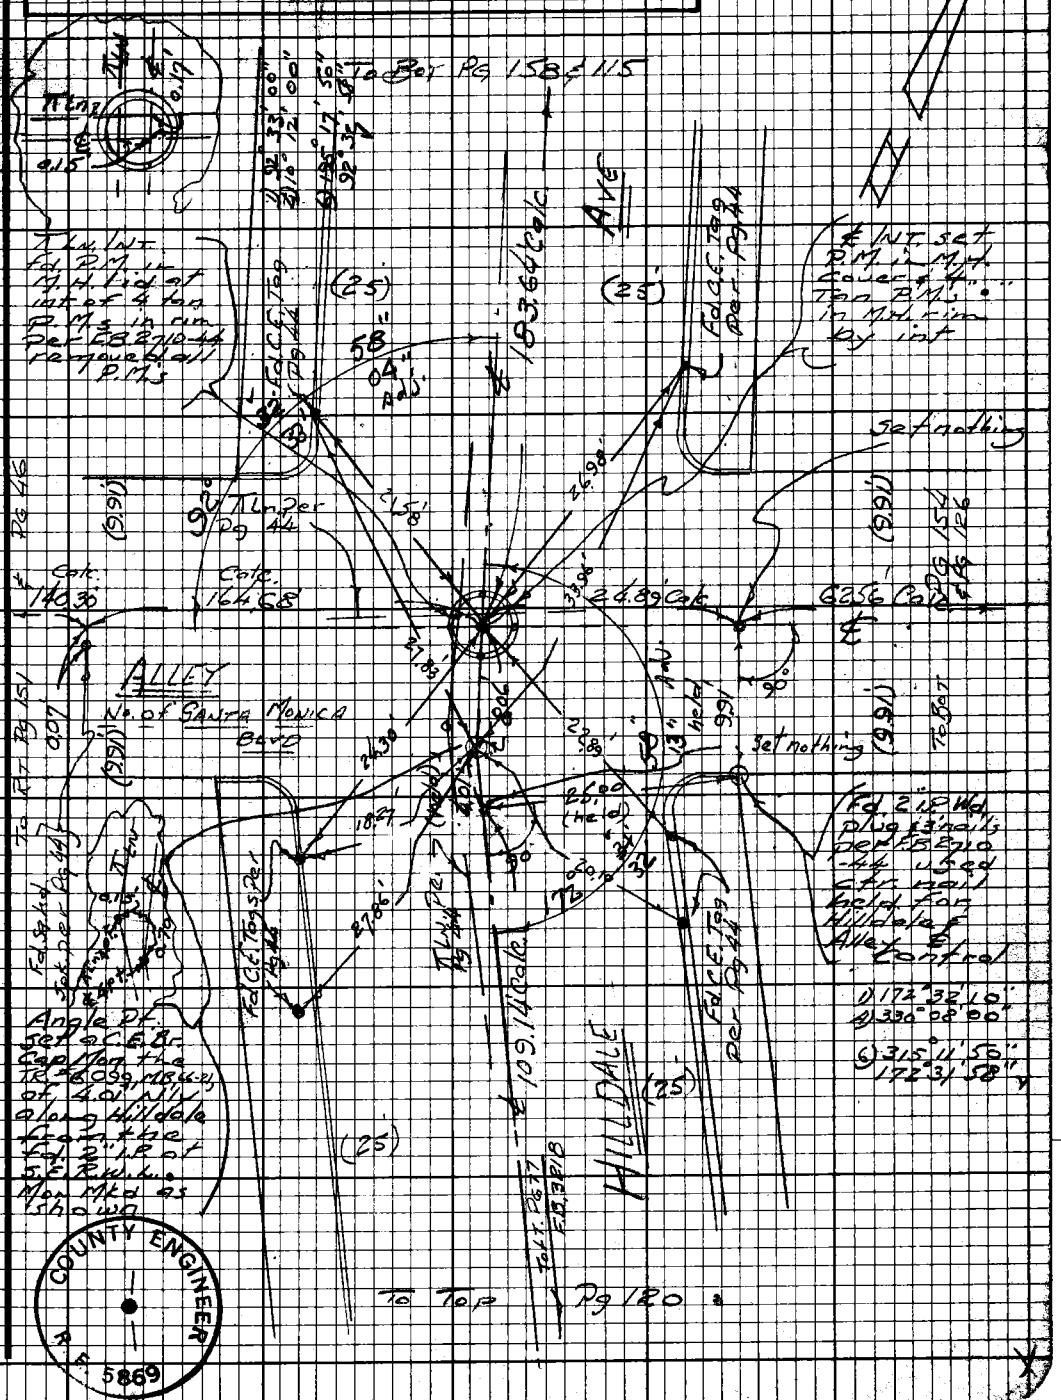

Note: Any Additions or Changes on this Sheet Must be Made or Circled in Red Ink With Date and Name of Person Making Change.

Do not extend this side of this line.

PLEASE RETURN TO
LOS ANGELES COUNTY ENGINEER
403 LOS ANGELES COUNTY ENGINEERING BLDG.

COUNTY ENGINEER
R.E. 5869

76F3098 CE#310 9-67

F.B. 2710 Pg 154

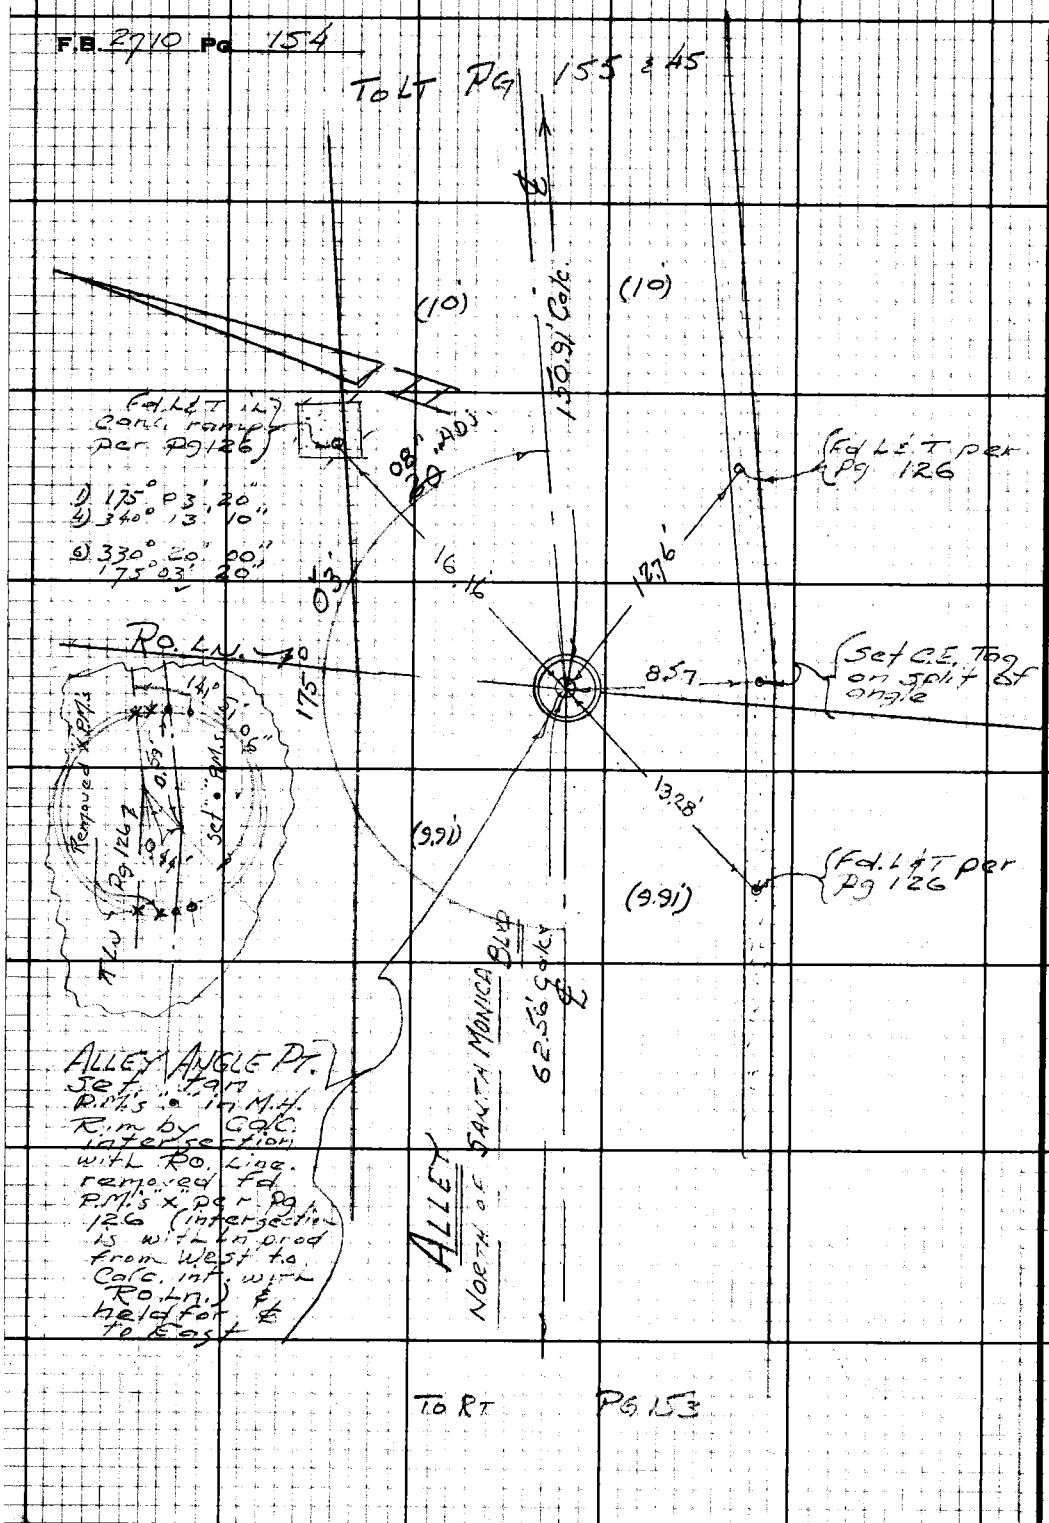

PLEASE RETURN TO
LOS ANGELES COUNTY ENGINEER
403 LOS ANGELES COUNTY ENGINEERING BLDG.

Do not extend this side of this line.

Note: Any Additions or Changes on this Sheet Must be Made or Circled in Red Ink With Date and Name of Person Making Change.

Notes Ck'd by	D. SAPPELL	Survey of	W. Holly & Sur. Div. #3
Map No.	5418	JN	0303.00 Tape 0254 Std 68°F
Office Work	E FONG	Surveyed by	Monkey Jr.
Checked	R HILARIO	Notes	E.F.M. Jr. Date 5-22-68
Date	10-17-83	Indexed	C.J. GALLI

F.B. 2710 PG. 155

1) 77° 29' 10"
4) 309° 56' 30"
6) 104° 54' 50"
77° 29' 08" ✓

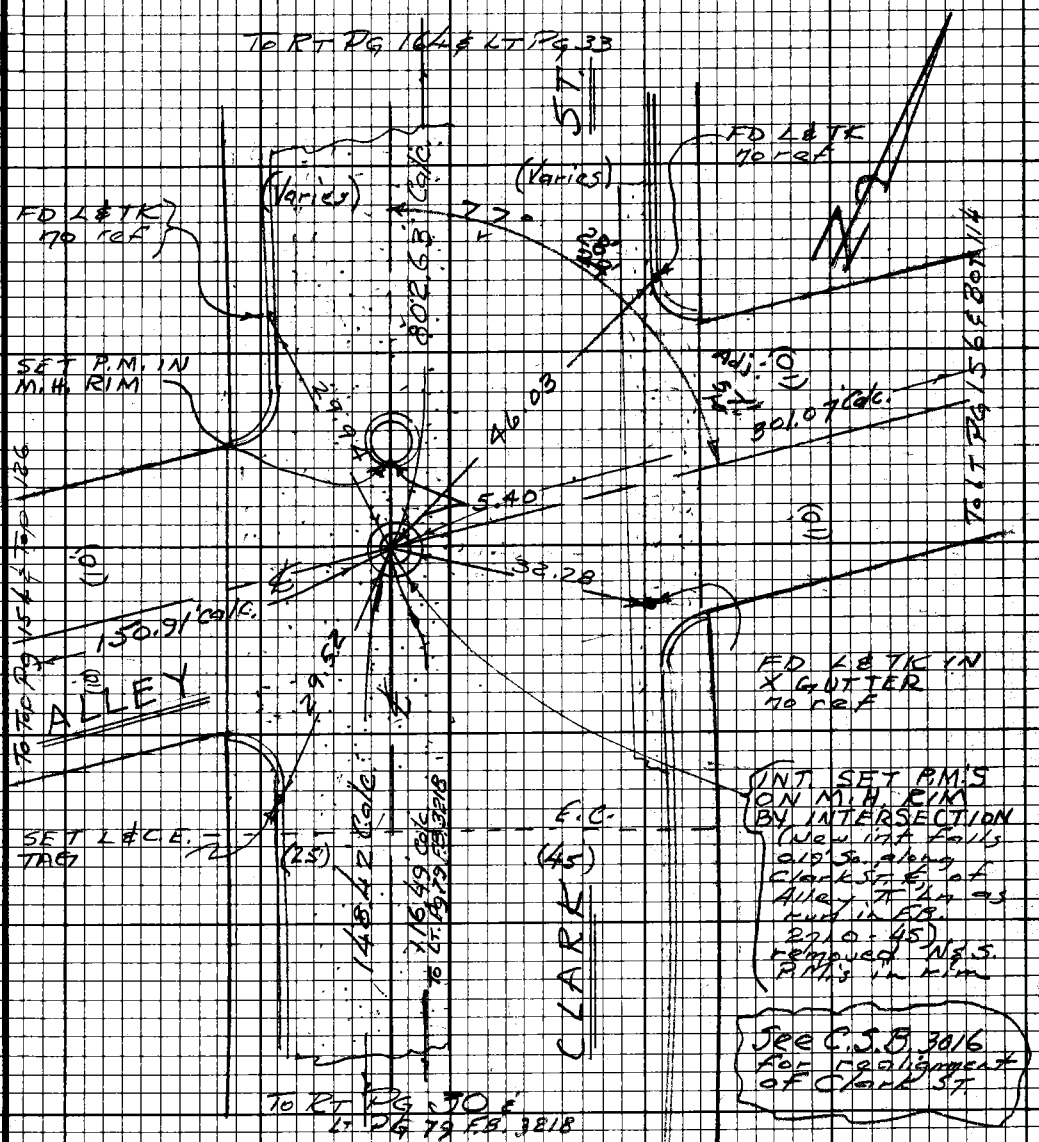

Note: Any Additions or Changes on this Sheet Must be Made or Circled in Red Ink With Date and Name of Person Making Change.

Do not extend this side of this line.

PLEASE RETURN TO
LOS ANGELES COUNTY ENGINEER
403 LOS ANGELES COUNTY ENGINEERING BLDG.

76F3098 CE#310 9-67

F.B. 2710 PG 156

1) 102° 31' 50"
4) 50° 07' 50"
6) 255° 11' 50"
102° 31' 58"

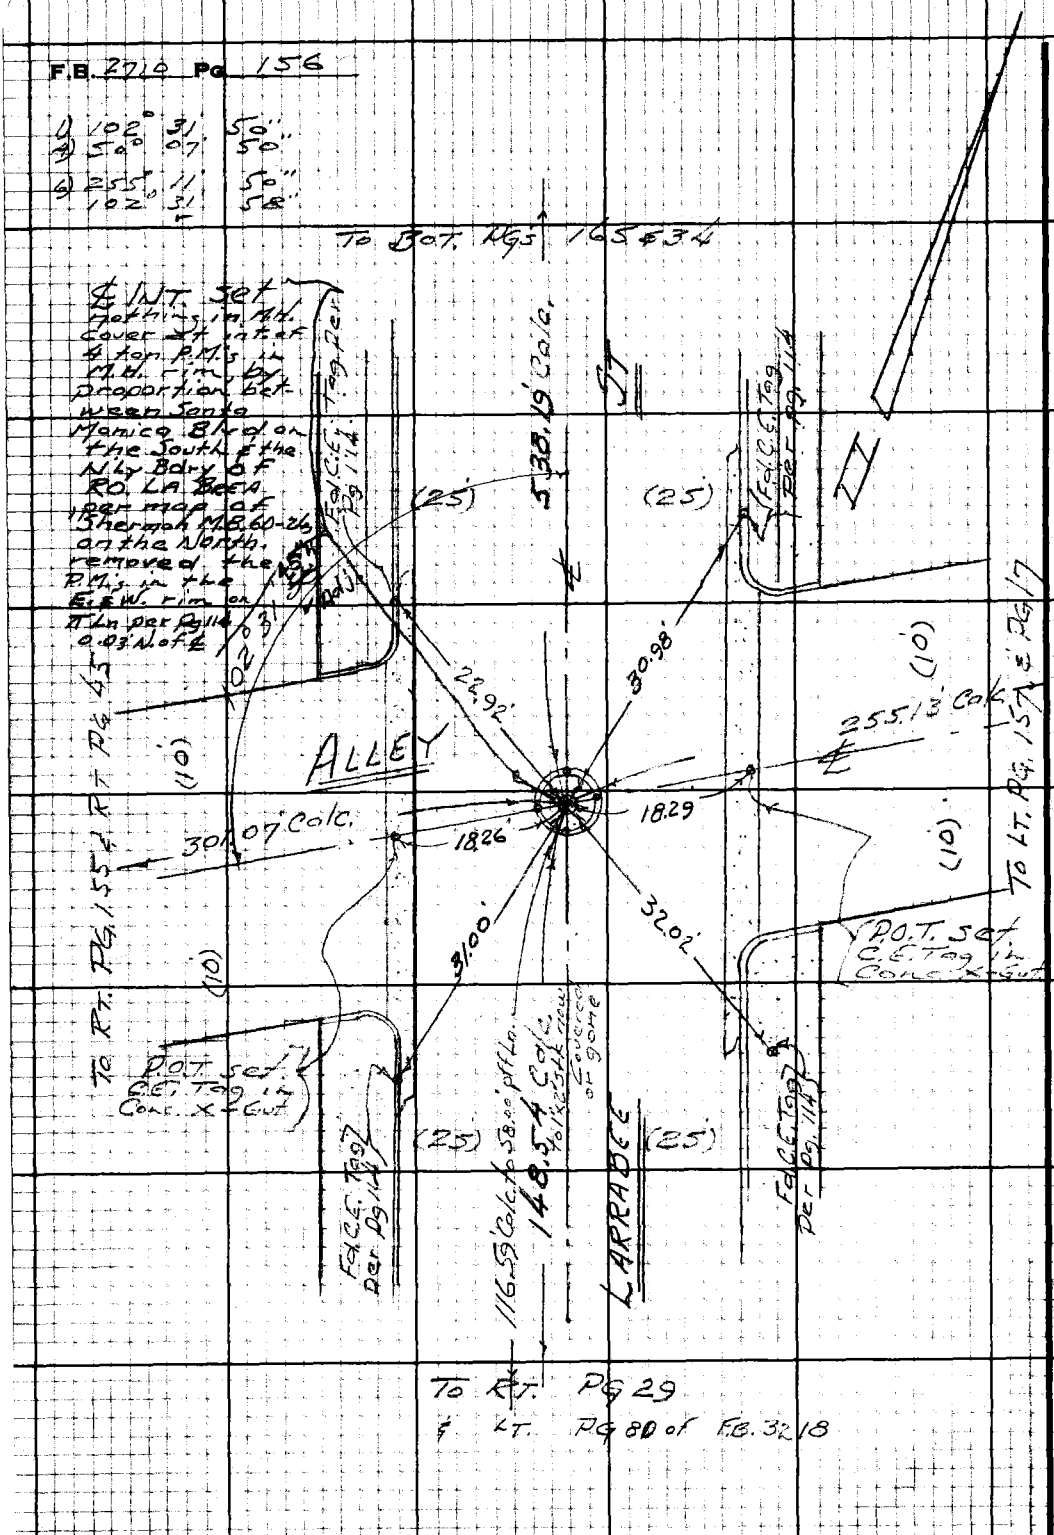

PLEASE RETURN TO
LOS ANGELES COUNTY ENGINEER
403 LOS ANGELES COUNTY ENGINEERING BLDG.

Do not extend this side of this line.

Note: Any Additions or Changes on this Sheet Must be Made or Circled in Red Ink With Date and Name of Person Making Change.

Notes Ck'd by	
Map No.	5418
Office Work	E FONG
Checked	R HILARIO
Date	10-17-83

Survey of	W. Holly. & Sur. Dist.
JN	630300 Tape 9254 Std 68 °F
Surveyed by	Monkey Jr.
Notes	[illegible] Date 5 63
Indexed	[illegible]

F.B. 2710 Pg 157

Note: Any Additions or Changes on this Sheet Must be Made or Circled in Red Ink With Date and Name of Person Making Change.

W.S. 22, B-3

PLEASE RETURN TO LOS ANGELES COUNTY ENGINEER 405 LOS ANGELES COUNTY ENGINEERING BLDG.

Do not extend this side of this line.

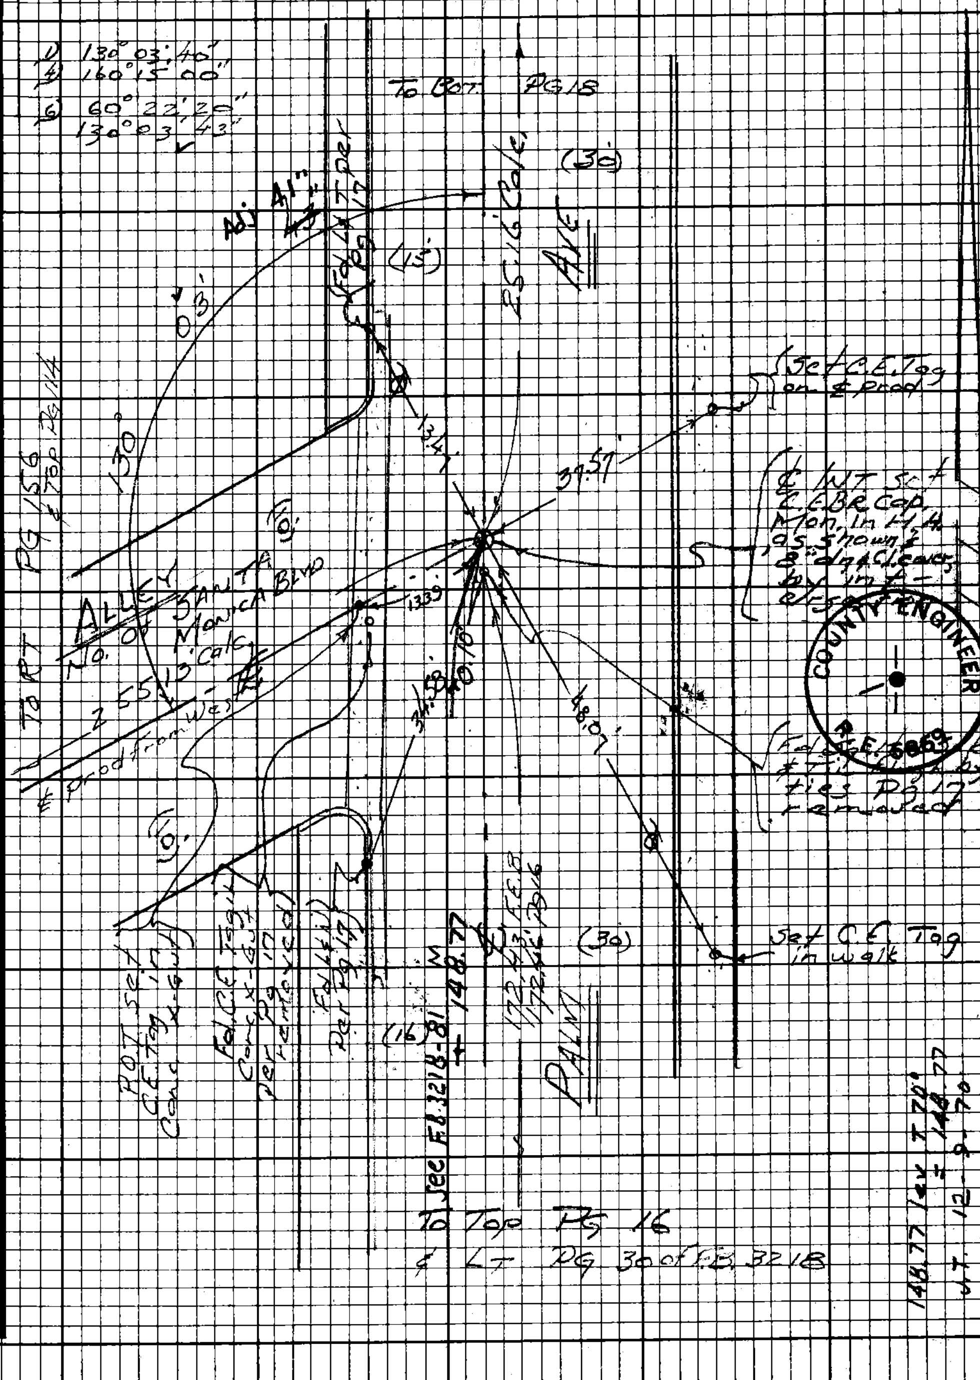

COUNTY ENGINEER R.E. 6869

76F3093 CE#310 9-67

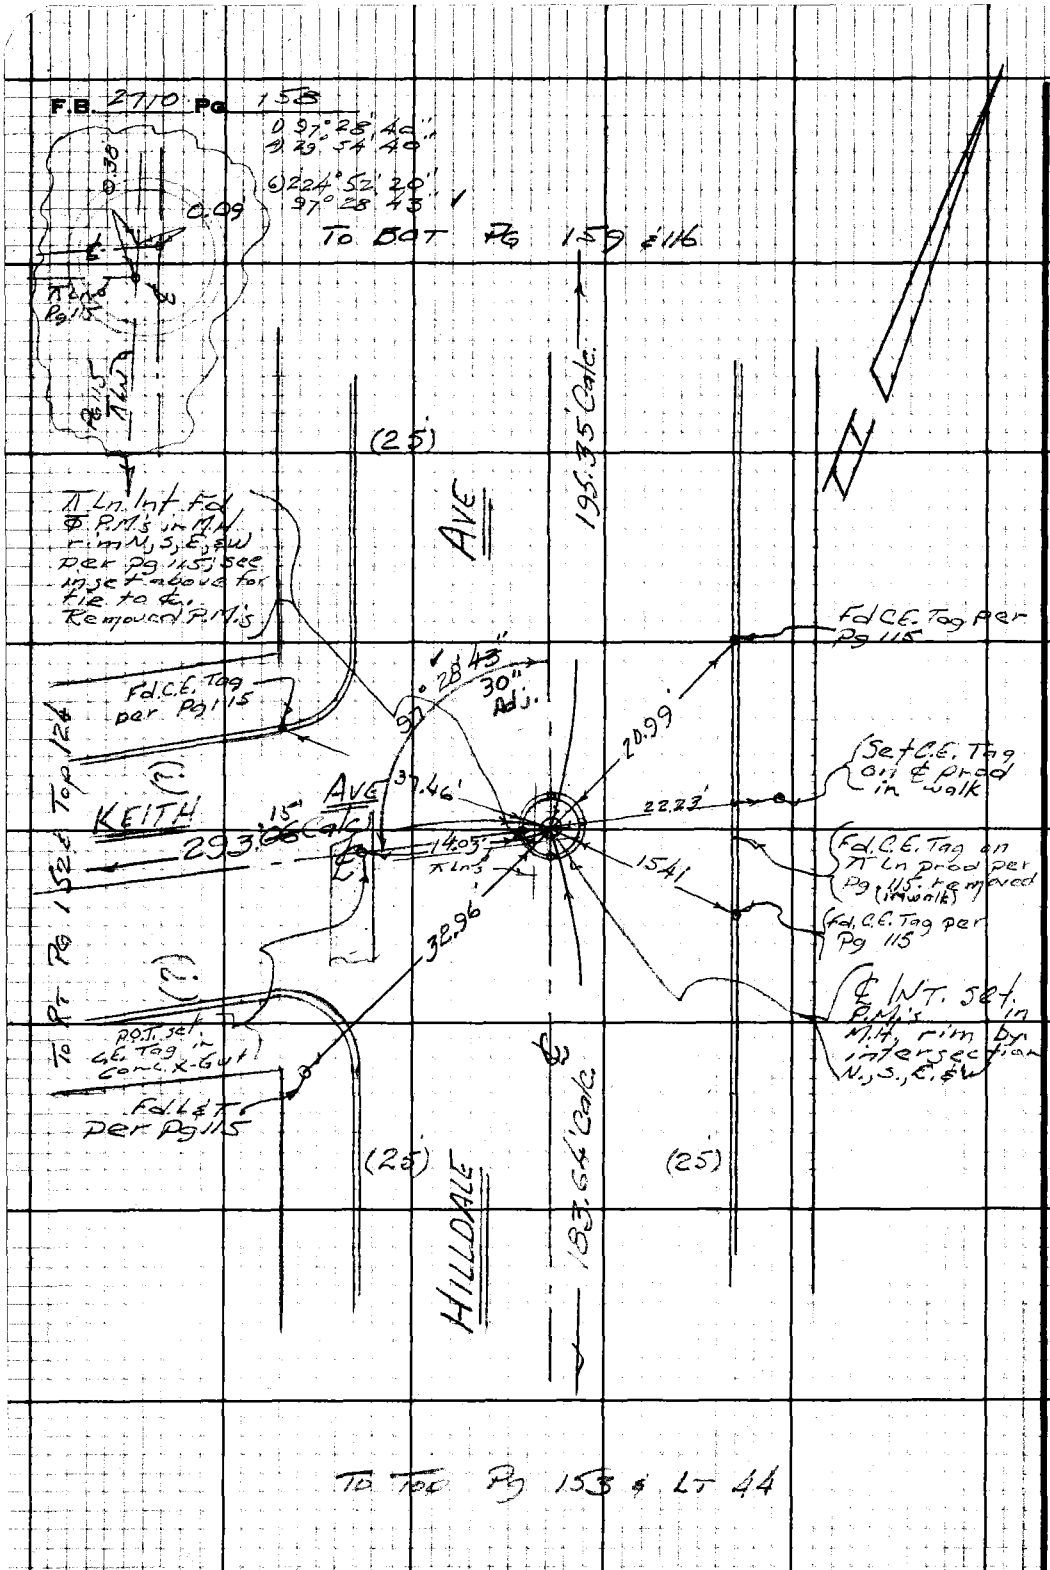

W.S. 22, B-3

PLEASE RETURN TO
LOS ANGELES COUNTY ENGINEER
403 LOS ANGELES COUNTY ENGINEERING BLDG.

Do not extend this side of this line.

Note: Any Additions or Changes on this Sheet Must be Made or Circled in Red Ink With Date and Name of Person Making Change.

Notes Ck'd by	D. SARRELL	Survey of	W. Holly & Sur. Dist. #3
Map No.	5418	JN	0303.00 Tape 0254 Std 68°F
Office Work	E FONG	Surveyed by	Mankey Jr.
Checked	R. HILARIO	Notes	E.T.M. Jr. Date 5 68
Date	10-17-83	Indexed	[illegible] GALLI

F.B. 2710 Pg. 159

Note: Any Additions or Changes on this Sheet Must be Made or Circled in Red Ink With Date and Name of Person Making Change.

Do not extend this side of this line.

W.S. 22, B-3

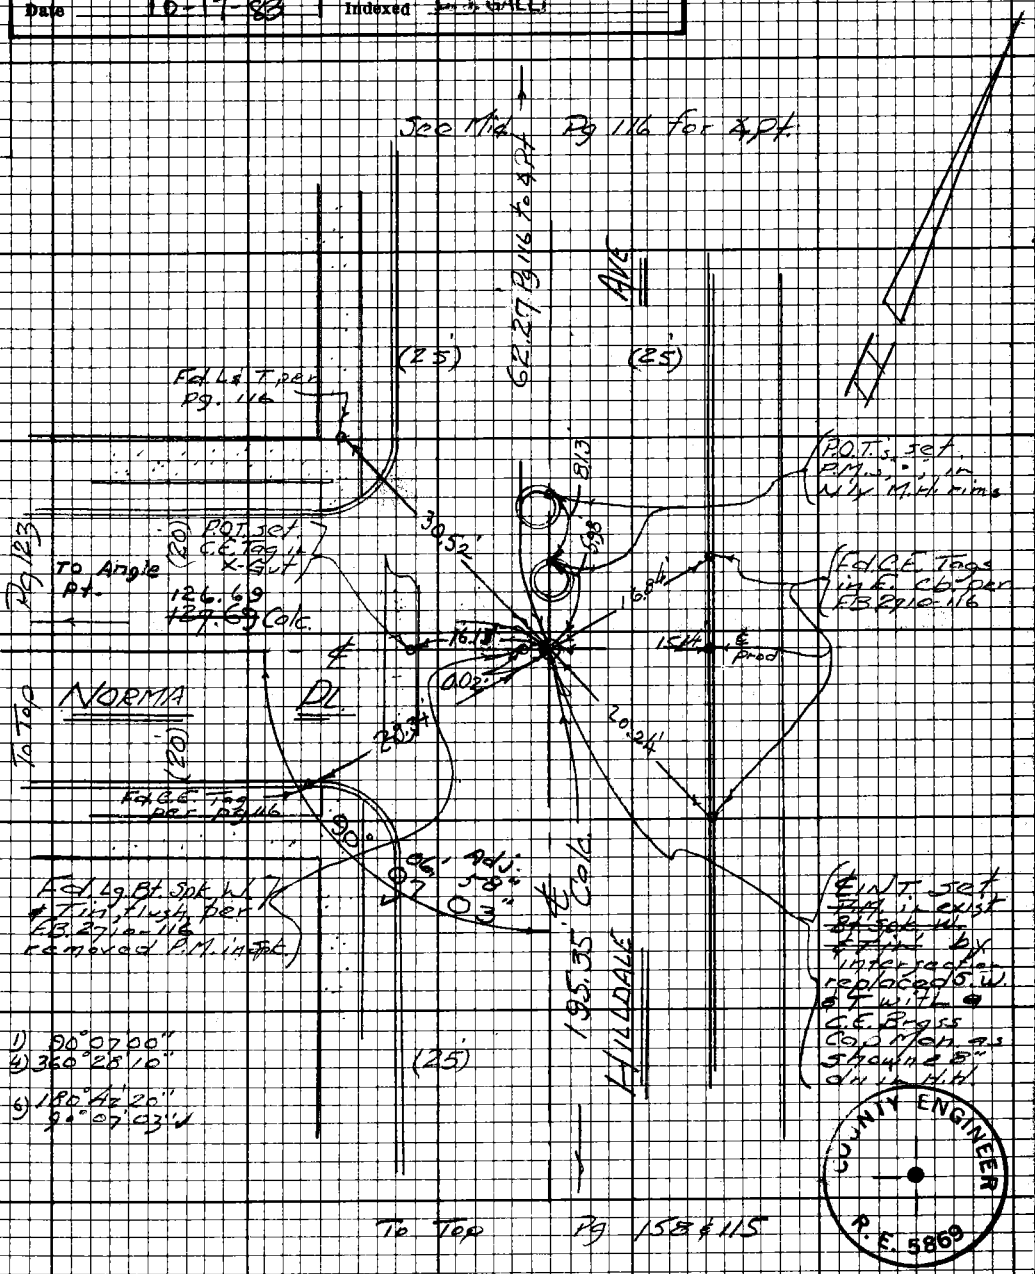

PLEASE RETURN TO
LOS ANGELES COUNTY ENGINEER
403 Los Angeles County Engineering Bldg.

76F3098 CE#31D 9-67

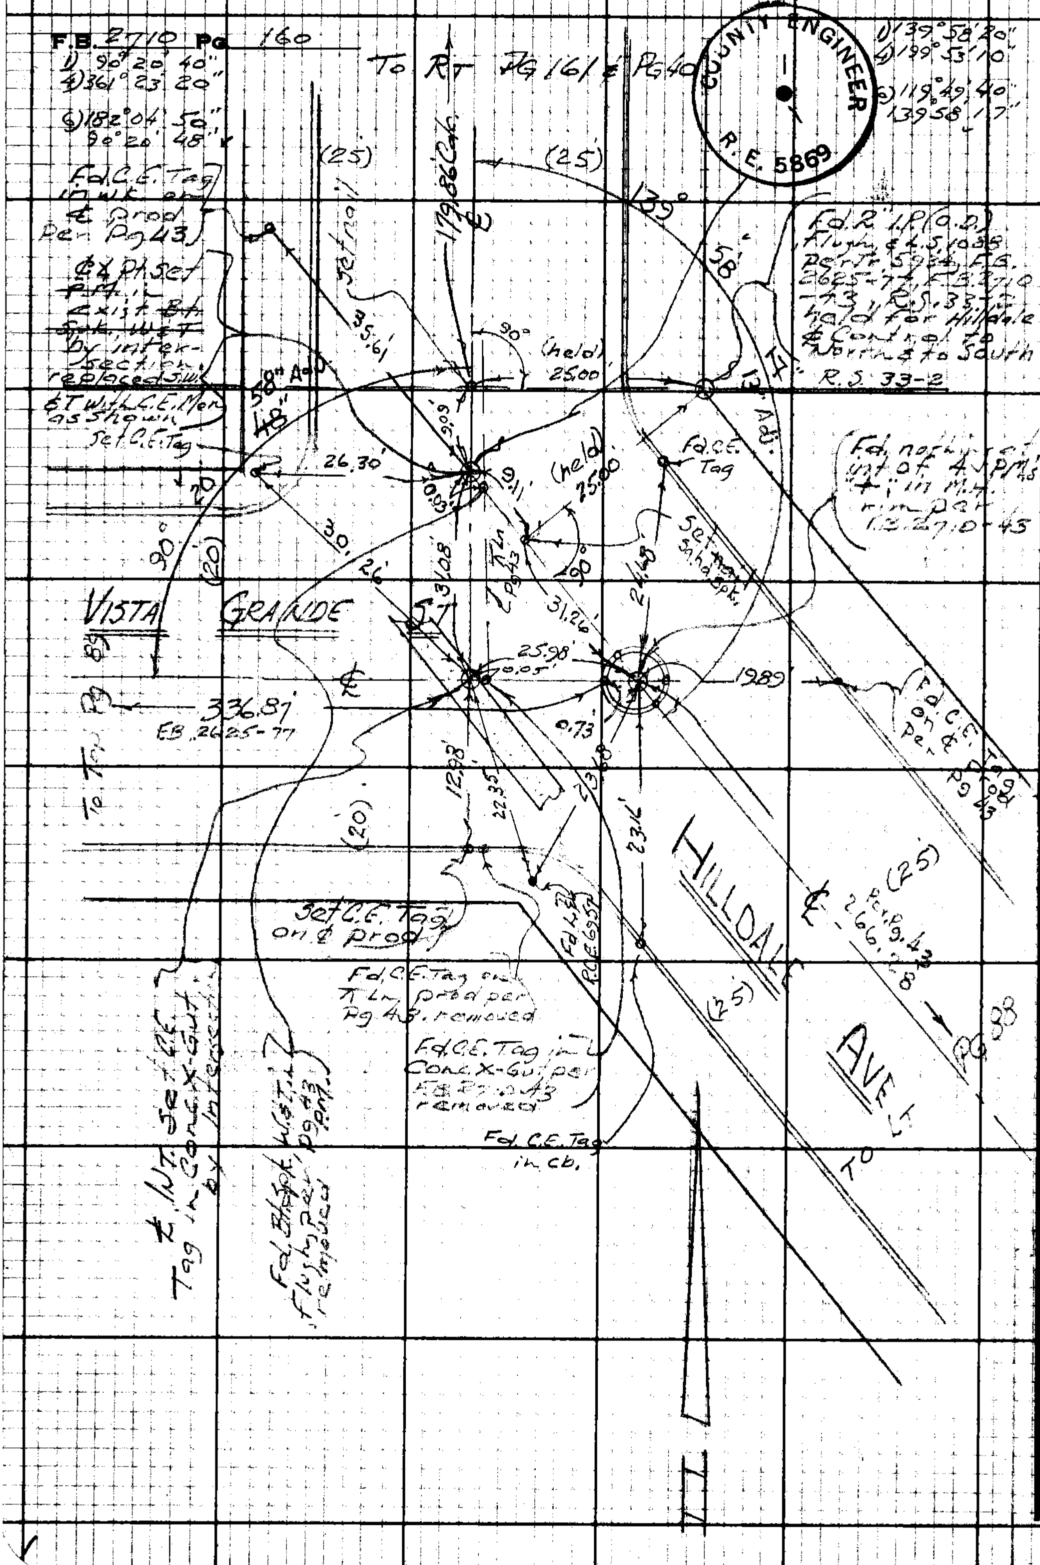

PLEASE RETURN TO
LOS ANGELES COUNTY ENGINEER
403 LOS ANGELES COUNTY ENGINEERING BLDG.

Do not extend this side of this line.

Note: Any Additions or Changes on this Sheet Must be Made or Circled in Red Ink With Date and Name of Person Making Change.

Notes Ck'd by	D. SAPPELL	Survey of	W. Holly & Sunlin #3
Map No.	5418	JN	0303.00 Tape 0254 Std 68 °F
Office Work	E. FONG	Surveyed by	Markey Jr.
Checked	E. HILARIO	Notes	E.T.M. Jr. Date 5-69
Date	10-17-89	Indexed	C. J. GAELL

F.B. 2710 Pg 161

COUNTY ENGINEER R.E. 5869

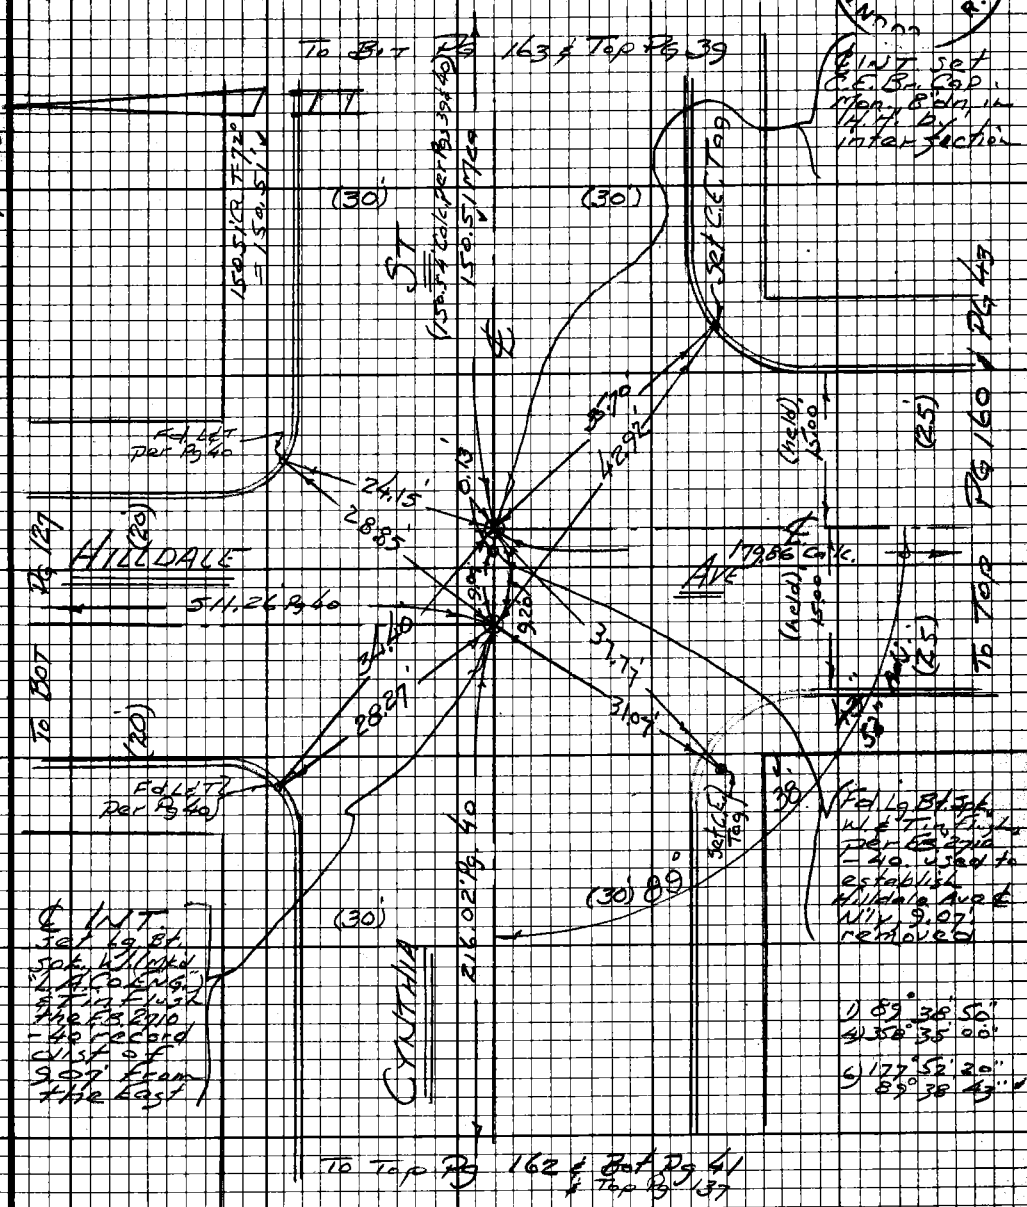

Note: Any Additions or Changes on this Sheet Must be Made or Circled in Red Ink With Date and Name of Person Making Change.

Do not extend this side of this line.

W.S. 22, B-3

PLEASE RETURN TO
LOS ANGELES COUNTY ENGINEER
403 LOS ANGELES COUNTY ENGINEERING BLDG.

76F3098 CE#310 9-67

F.B. 2710 Pg 162

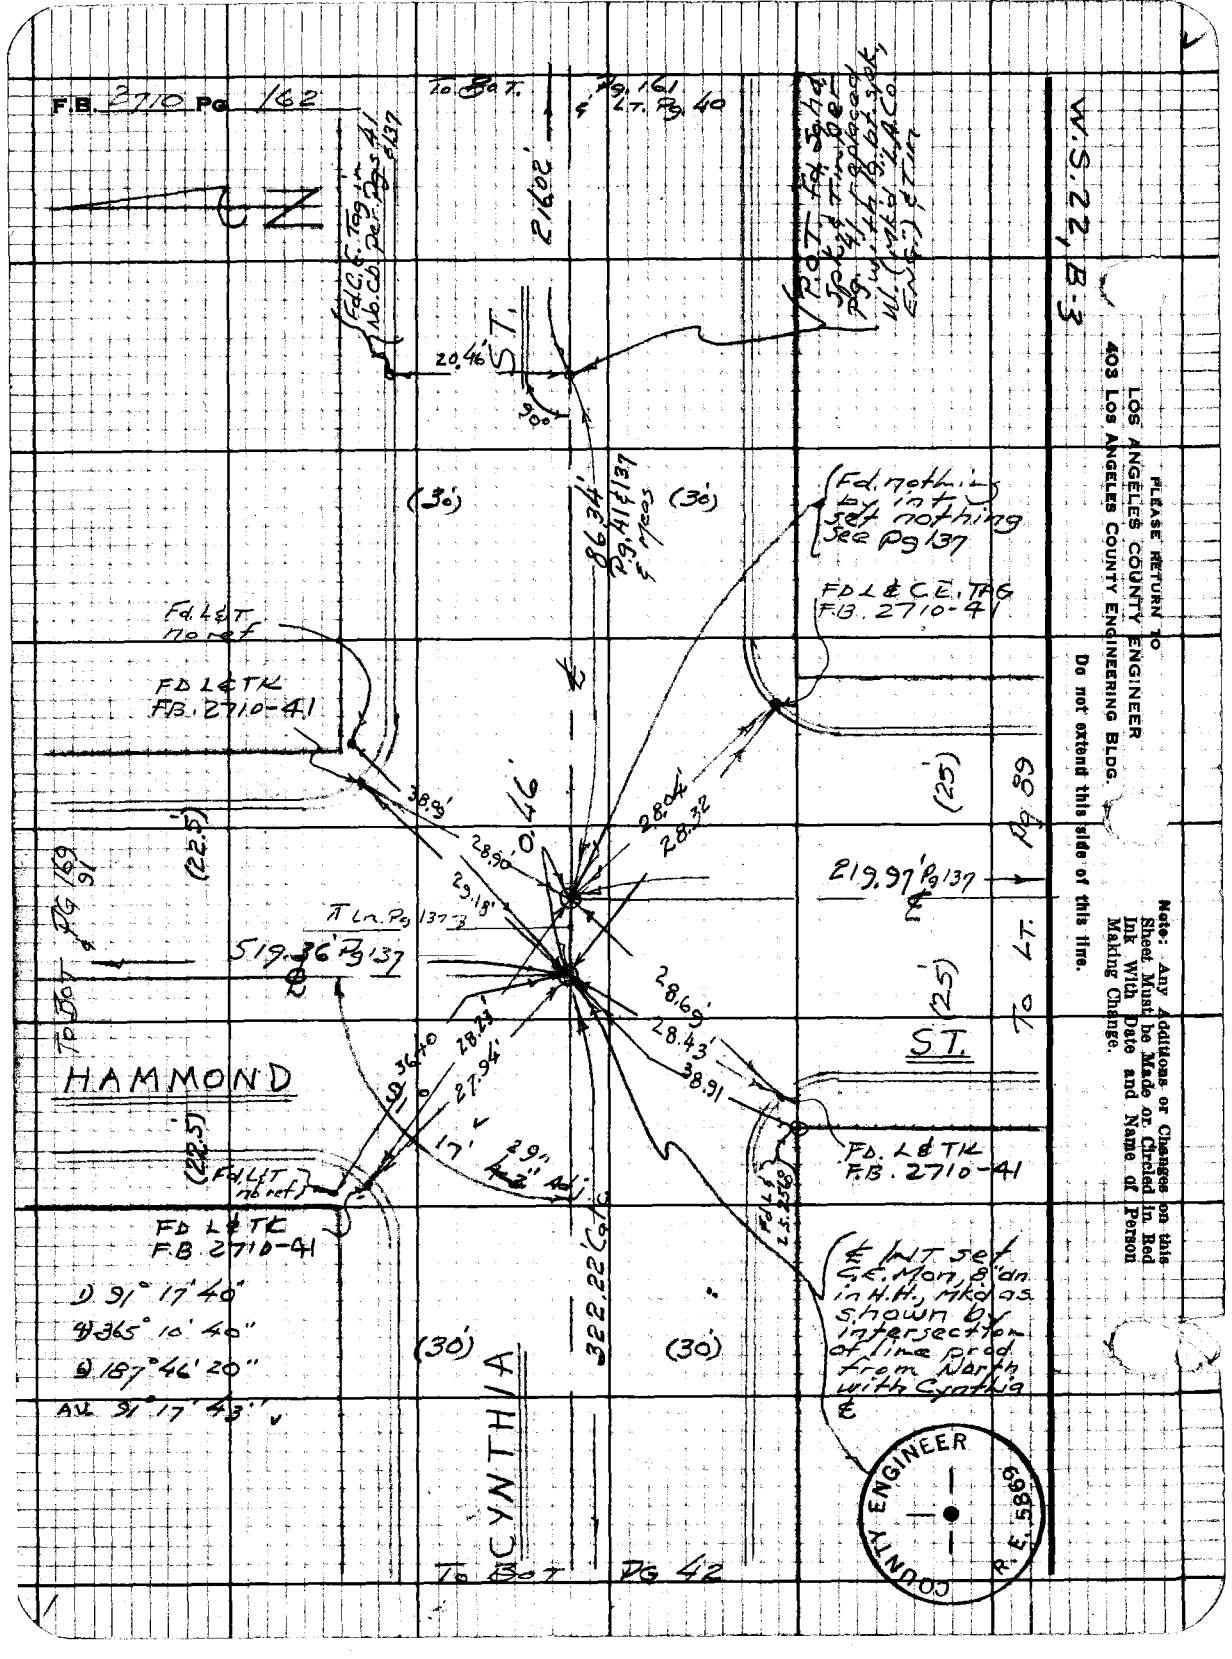

PLEASE RETURN TO
LOS ANGELES COUNTY ENGINEER
403 Los Angeles County Engineering Bldg.

Do not extend this side of this line.

Note: Any Additions or Changes on this Sheet Must be Made or Circled in Red Ink With Date and Name of Person Making Change.

Notes Ck'd by	D. SAPPELL	Survey of	W. Holly & Sur. Div. #3
Map No.	5418	JN	930300 Tape 0254 Std 68°F
Office Work	E FONG	Surveyed by	Mankey Jr.
Checked	R HILARIO	Notes	[illegible] Date 5-68
Date	10-17-83	Indexed	[illegible]

F.B. 2710 PG. 163

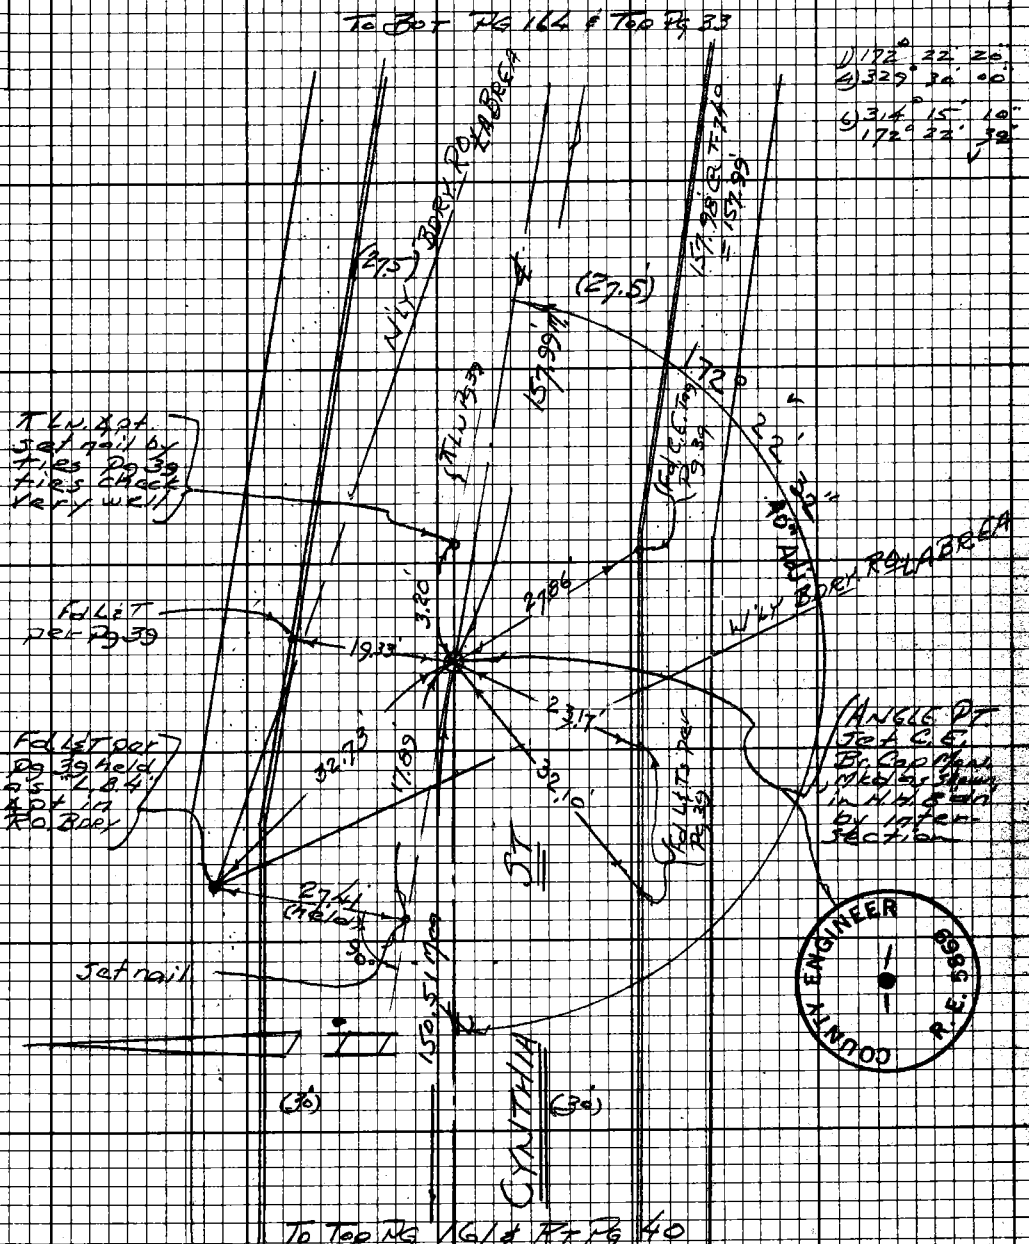

Note: Any Additions or Changes on this Sheet Must be Made or Circled in Red Ink With Date and Name of Person Making Change.

Do not extend this side of this line.

PLEASE RETURN TO
LOS ANGELES COUNTY ENGINEER
403 LOS ANGELES COUNTY ENGINEERING BLDG.

76F3098 CE#310 9-67

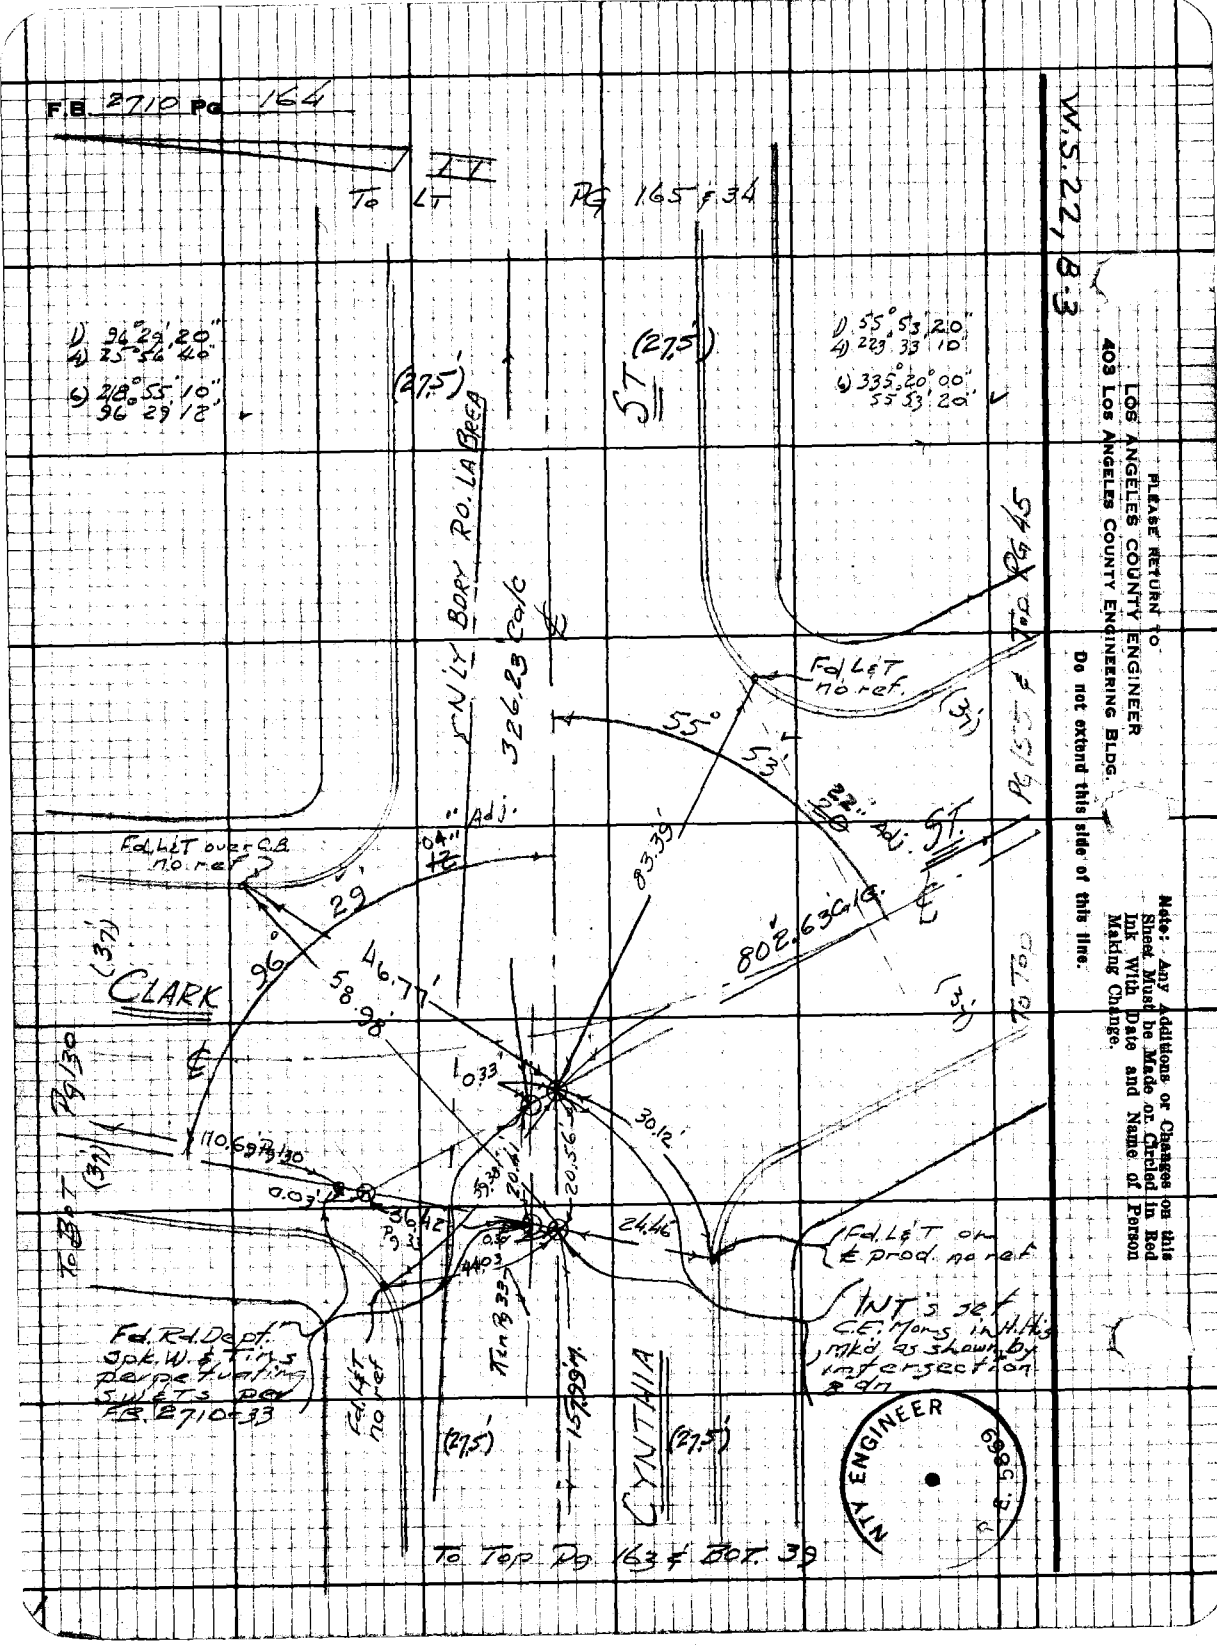

PLEASE RETURN TO
LOS ANGELES COUNTY ENGINEER
403 LOS ANGELES COUNTY ENGINEERING BLDG.

Do not extend this side of this line.

Note: Any Additions or Changes on this Sheet Must be Made or Circled in Red Ink With Date and Name of Person Making Change.

Notes Ck'd by D. SAPPELL
Map No. 5418
Office Work E. FONG
Checked R. HILARIO
Date 10-17-83

Survey of
JN Tape Std 68 °F
Surveyed by
Notes Date
Indexed

F.B. 2710 Pg 165

W.S. 22, B-3

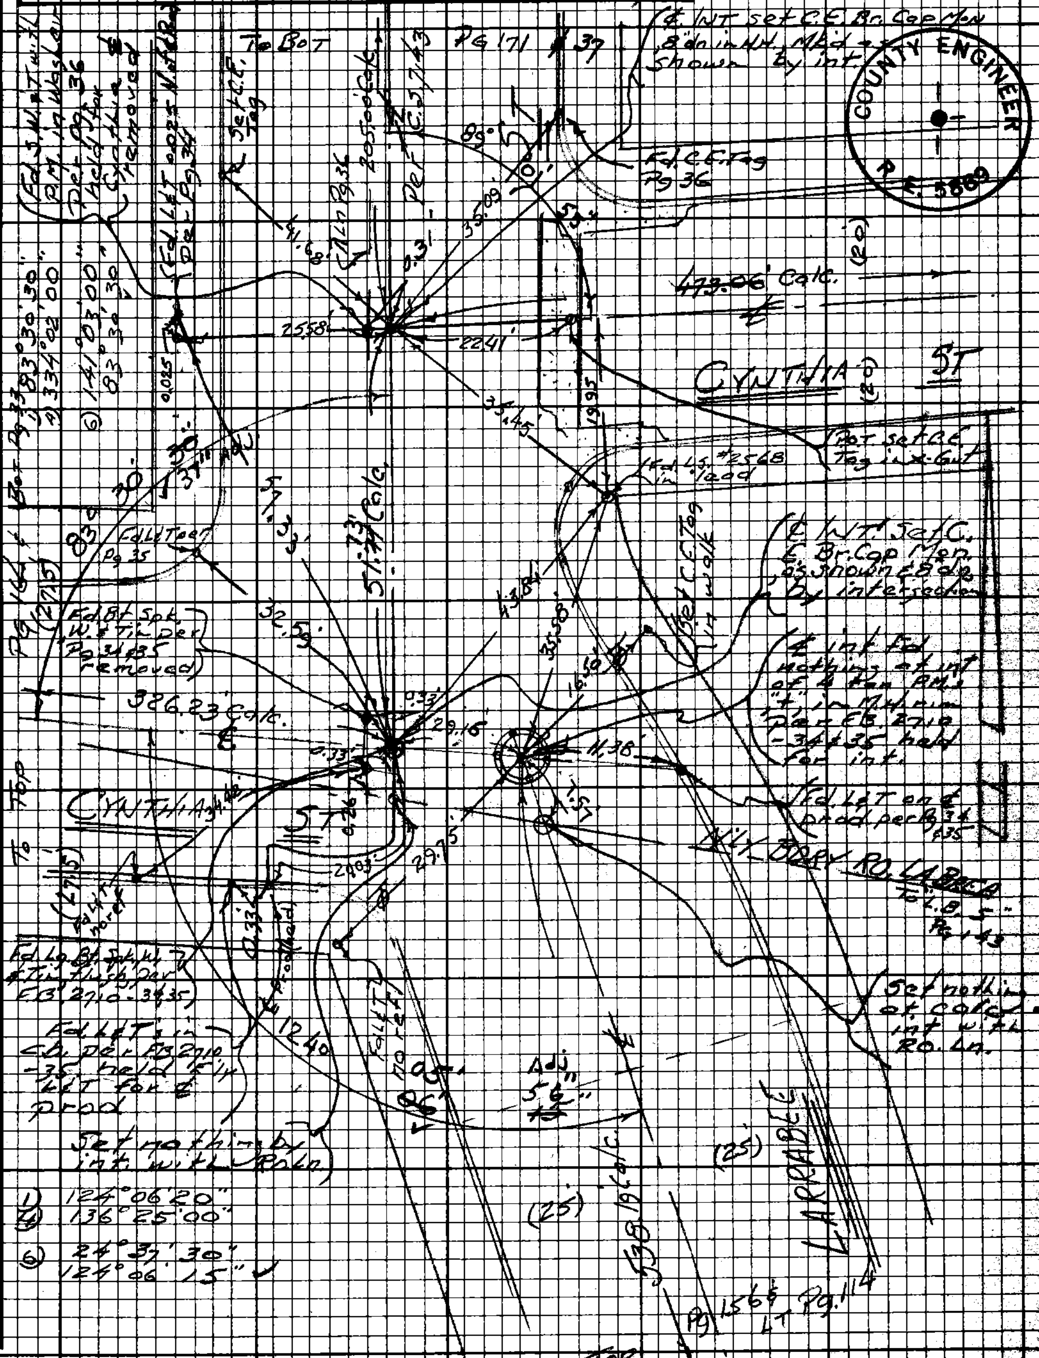

Note: Any Additions or Changes on this Sheet Must be Made or Circled in Red Ink With Date and Name of Person Making Change.

Do not extend this side of this line.

PLEASE RETURN TO
LOS ANGELES COUNTY ENGINEER
403 LOS ANGELES COUNTY ENGINEERING BLDG.

76F309B CE#310 9-67

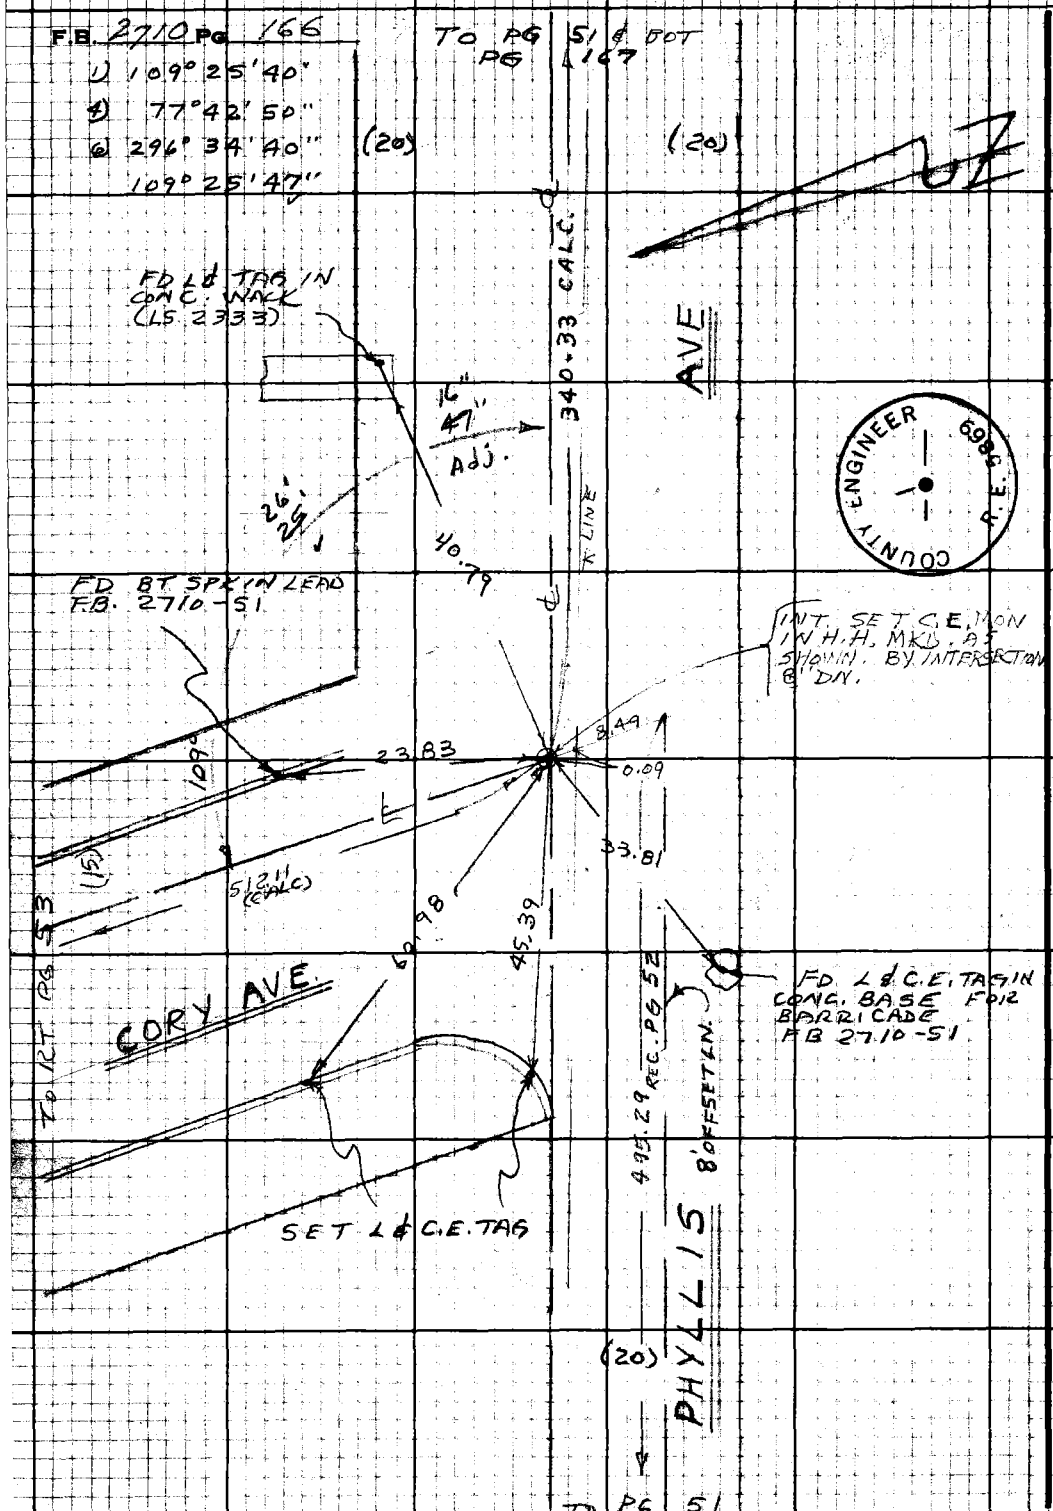

W.S. 22, B-3

PLEASE RETURN TO
LOS ANGELES COUNTY ENGINEER
403 LOS ANGELES COUNTY ENGINEERING BLDG.

Do not extend this side of this line.

Note: Any Additions or Changes on this Sheet Must be Made or Circled in Red Ink With Date and Name of Person Making Change.

Notes Ck'd by D. SAPPELL		Survey of W. HOLLYWOOD & SUR. DIV. #3	F.B. 2710 PG 167
Map No. 5418		JN 0203.00 Tape 0254 Std 68 °F	
Office Work E. FONG		Surveyed by MANKEY JR	
Checked R. HILARIO		Notes T.C.P. JR. Date 5-68	
Date 10-17-83		Indexed	

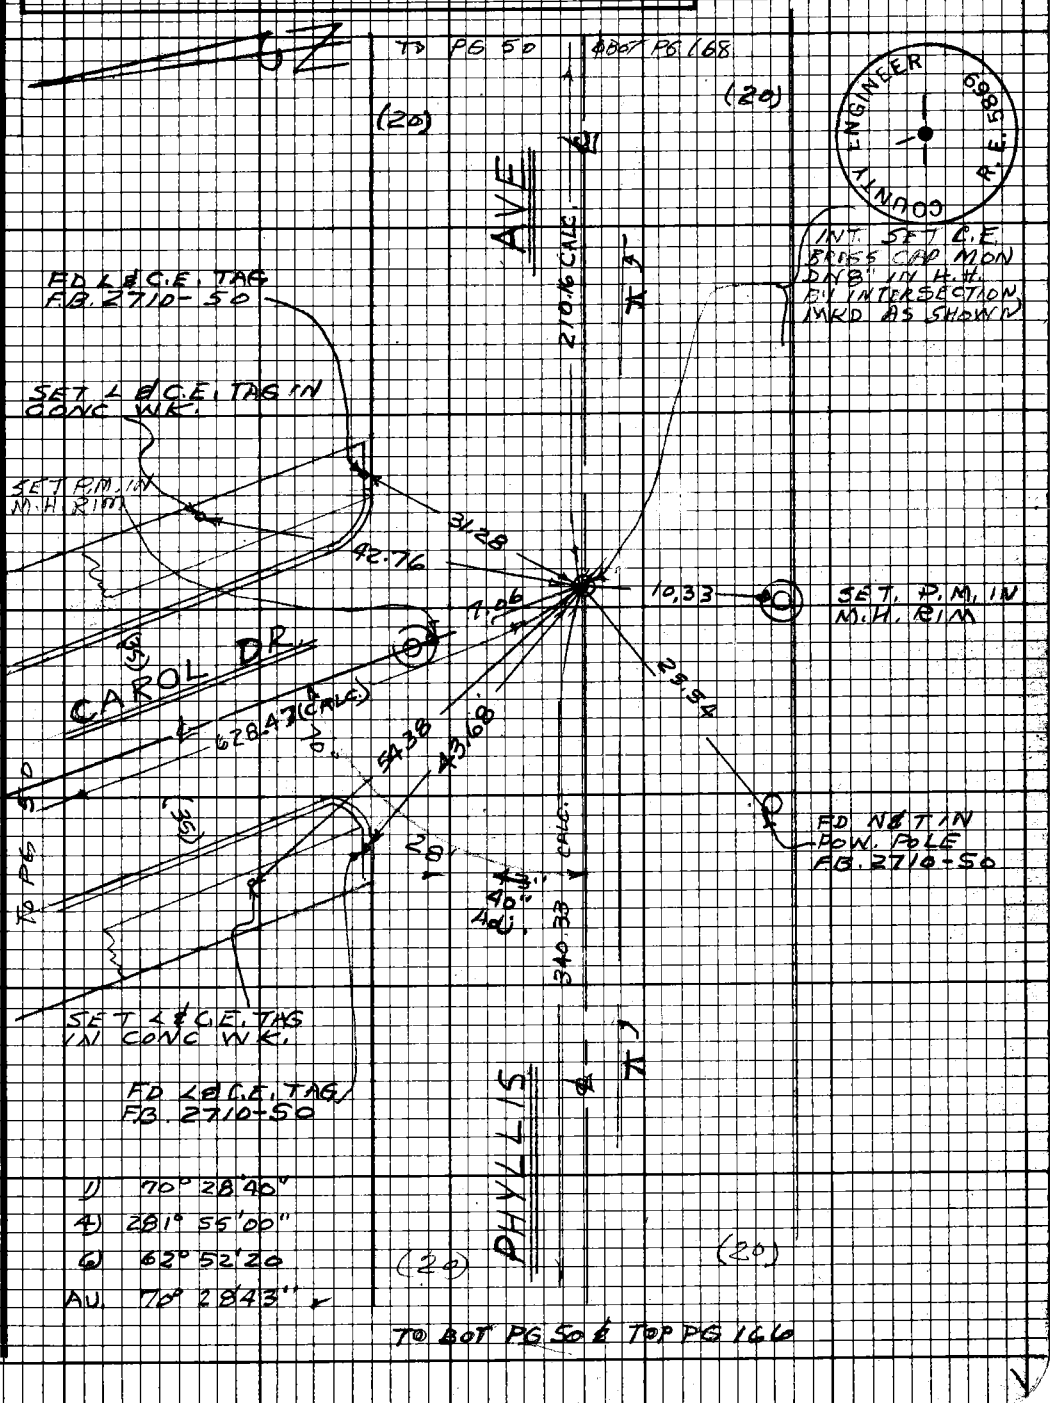

Note: Any Additions or Changes on this Sheet Must be Made or Circled in Red Ink With Date and Name of Person Making Change.

W.S. 22, B-3

Do not extend this side of this line.

PLEASE RETURN TO
LOS ANGELES COUNTY ENGINEER
403 LOS ANGELES COUNTY ENGINEERING BLDG.

76F3098 CE#310 9-6

F.B. 2710 PG 168

TO TOP PG 47

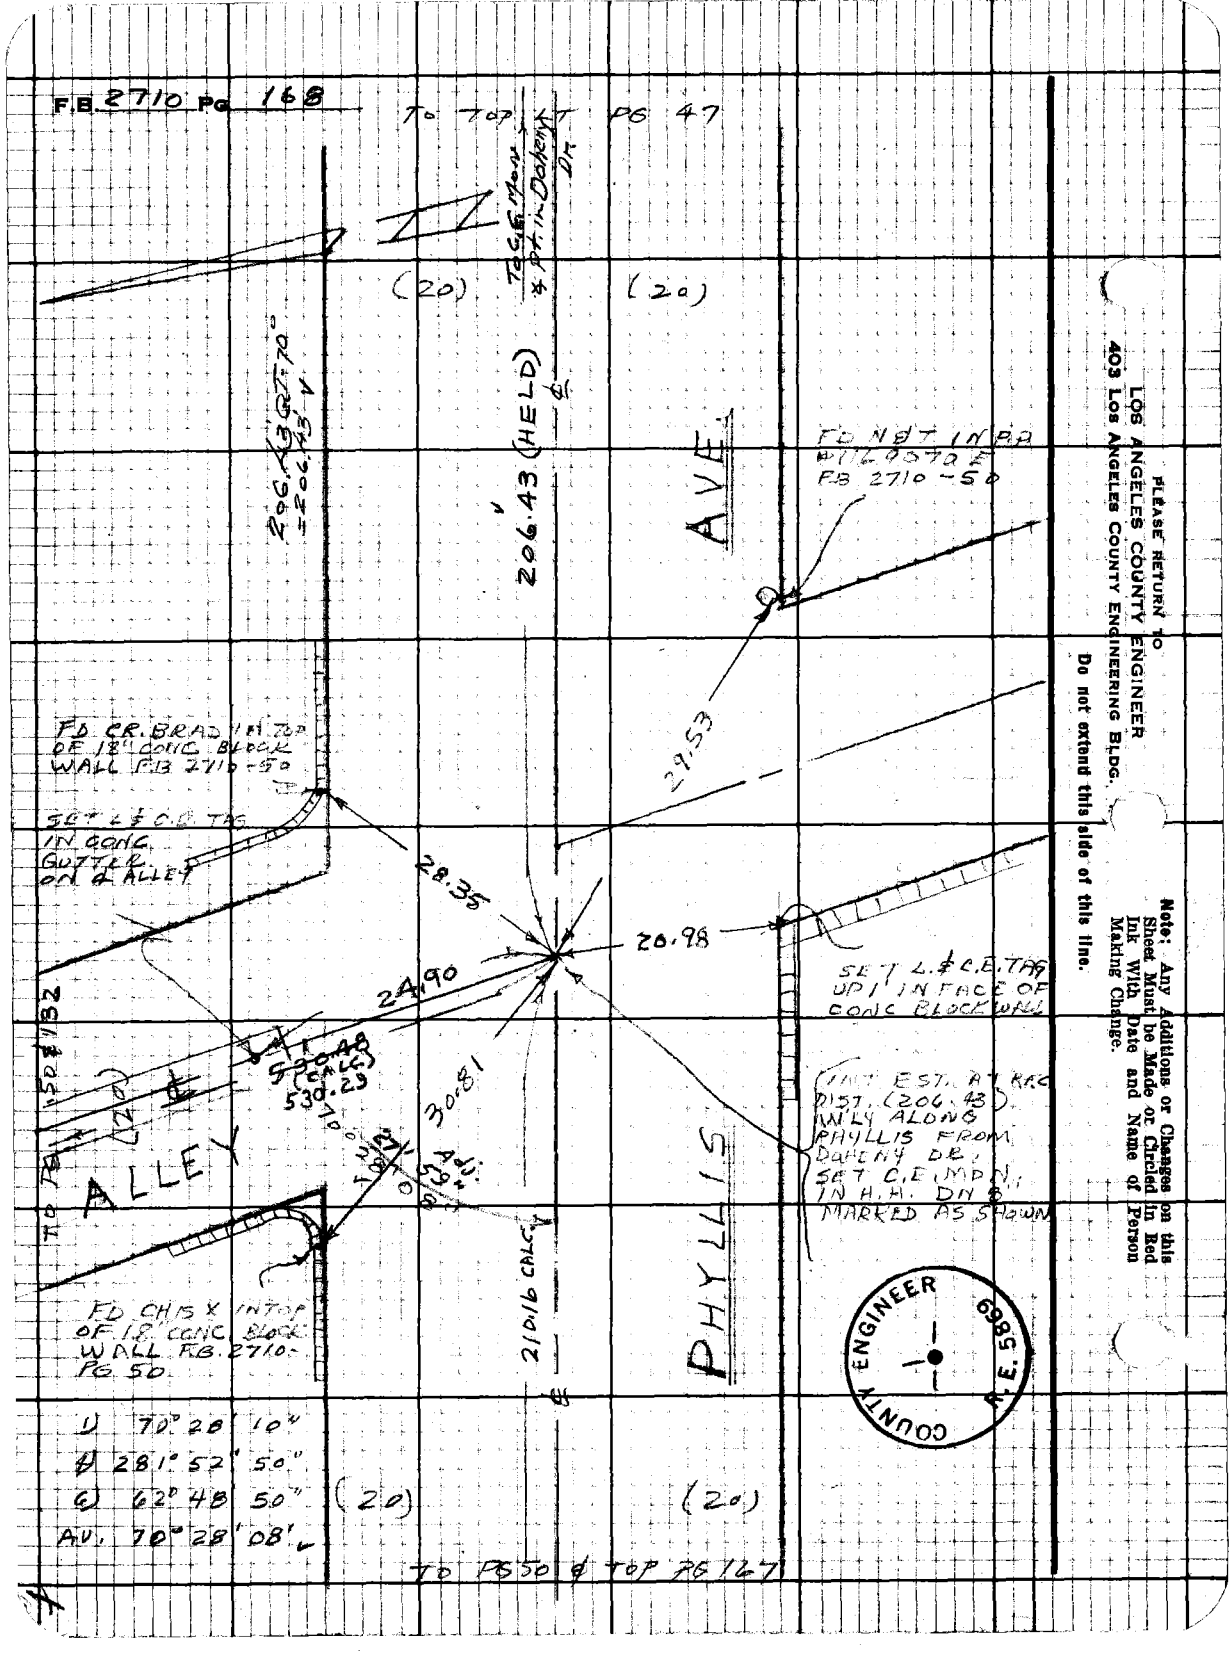

1) 70° 28' 10"
2) 281° 52' 50"
3) 62° 48' 50"
AV. 70° 28' 08"

(20) (20)

TO PG 50 & TOP PG 167

PLEASE RETURN TO
LOS ANGELES COUNTY ENGINEER
403 Los Angeles County Engineering Bldg.

Do not extend this side of this line.

Note: Any Additions or Changes on this Sheet Must be Made or Circled in Red Ink With Date and Name of Person Making Change.

Notes Ck'd by	D. SAPPELL	Survey of	W. Holly & Sur. Div #3
Map No.	5418	JN	0303.00 Tape 0254 Std 68 °F
Office Work	E FONG	Surveyed by	Mankey Jr.
Checked	R HILARIO	Notes	E.T.M. Jr. Date
Date	10-17-83	Indexed	

F.B. 2710 PG. 169

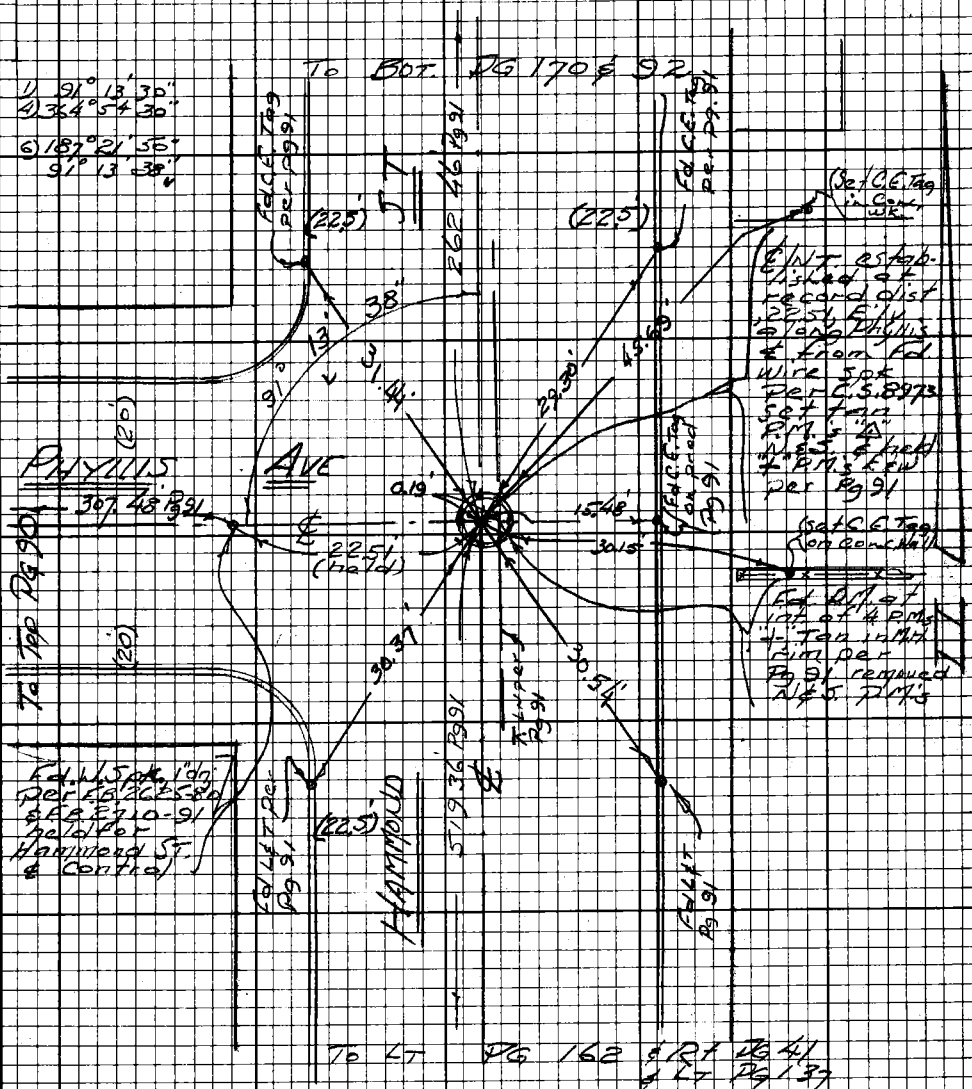

Note: Any Additions or Changes on this Sheet Must be Made or Circled in Red Ink With Date and Name of Person Making Change.

W.S. 22, B-3

Do not extend this side of this line.

PLEASE RETURN TO
LOS ANGELES COUNTY ENGINEER
403 LOS ANGELES COUNTY ENGINEERING BLDG.

76F3098 CE#310 9-67

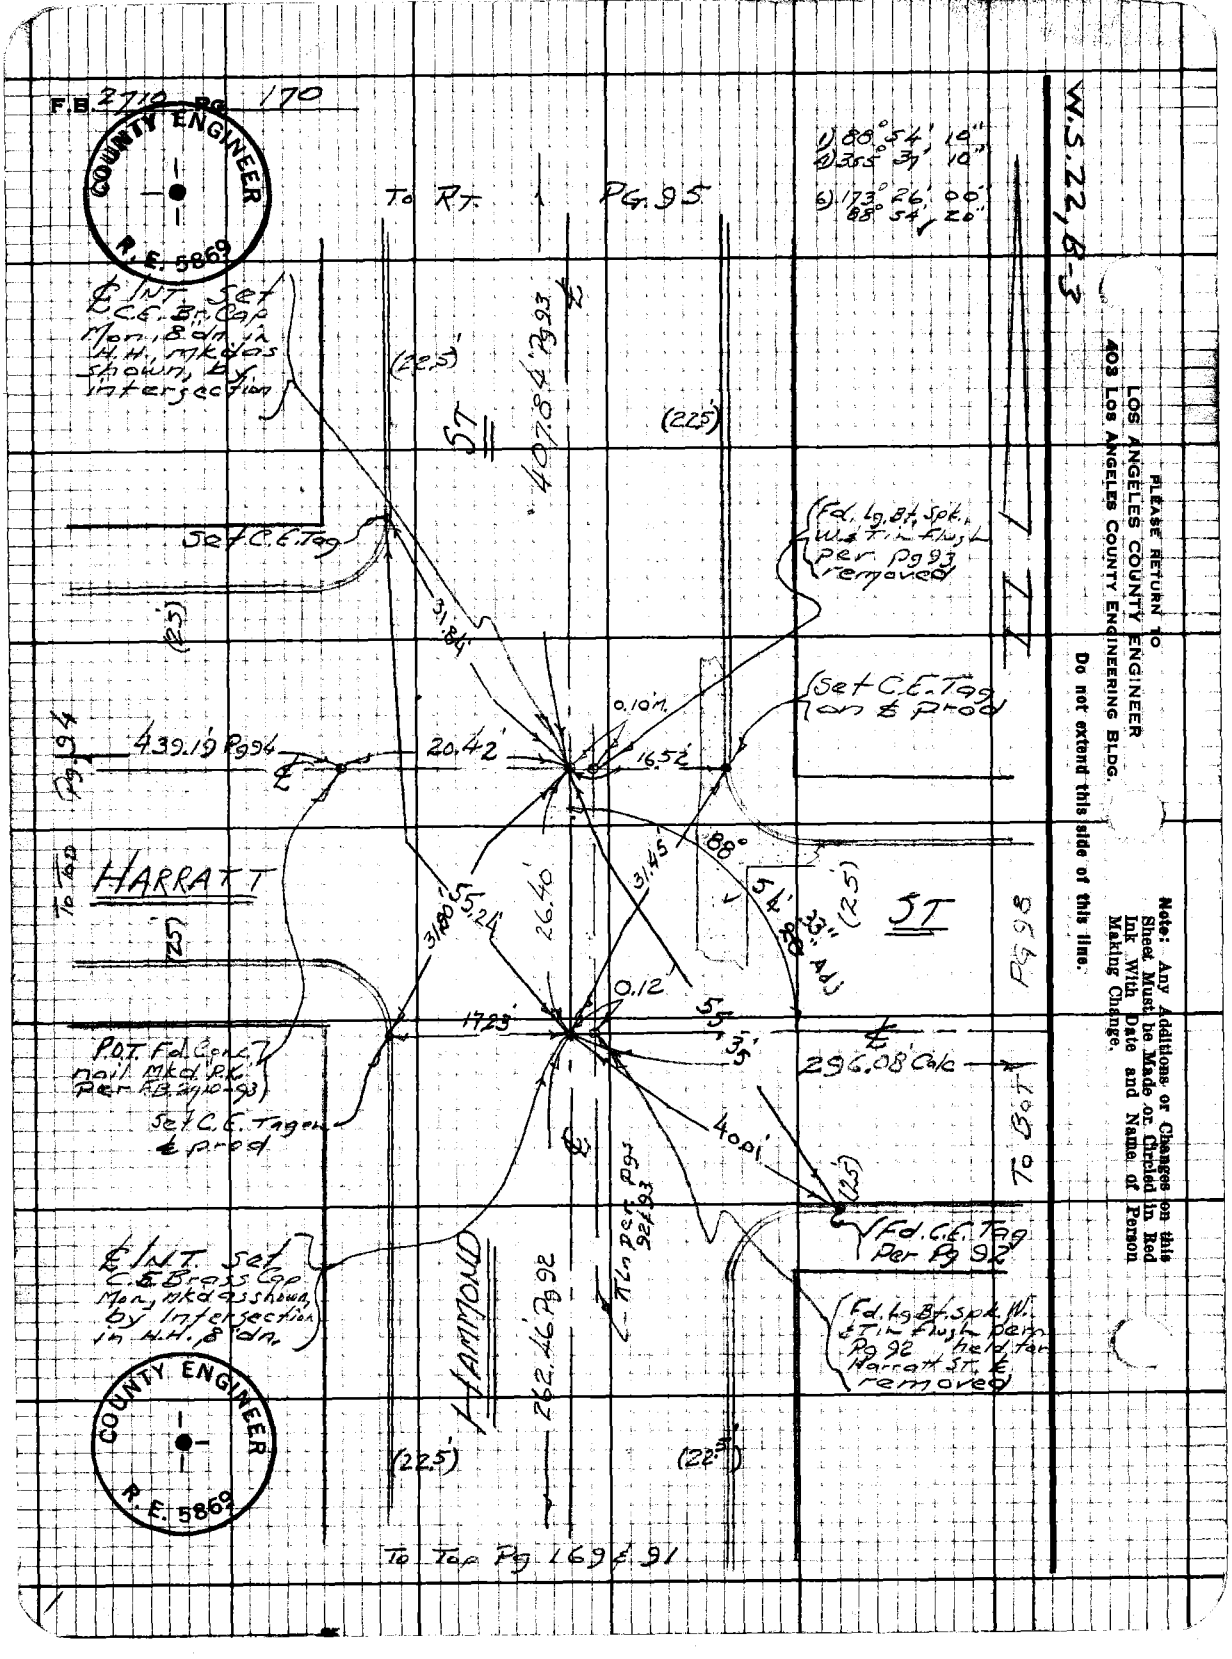
F.B. 2710 PG 170
COUNTY ENGINEER
R.E. 5869
To Rt. PG. 95
1) 88° 54' 10"
4) 355° 37' 10"
6) 173° 26' 00"
88° 54' 20"
W.S. 22, B-3
℄ INT. Set C.E. Br. Cap Mon. 8" dn. in H.H. mkd as shown, by intersection
(22.5')
ST
407.84' Pg 93
(22.5')
Set C.E. Tag
Fd. Lg. Bt. Spk. W. & Tin Flush per Pg 93 removed
(25')
31.84'
Set C.E. Tag on ℄ Prod
0.10'
Pg. 94
439.19' Pg 94
20.42'
16.52'
To Top
HARRATT
88°
31.45'
54'
33" Adj
(25')
ST
Pg 98
31.80'
55.24'
26.40'
0.12'
17.23'
55.35'
296.08' Calc
P.O.T. Fd. Conc. nail Mkd P.K. Per F.B. 2710-93
Set C.E. Tag on ℄ prod
40.01'
To Bot
(25')
Fd. C.E. Tag Per Pg 92
℄ INT. Set C.E. Brass Cap Mon. mkd as shown, by Intersection in H.H. 8" dn.
HAMMOND
262.46' Pg 92
Fd. Lg. Bt. Spk. W. & Tin Flush per Pg 92 held for Harratt St. ℄ removed
(22.5')
(22.5')
To Top Pg 169 & 91
PLEASE RETURN TO
LOS ANGELES COUNTY ENGINEER
403 LOS ANGELES COUNTY ENGINEERING BLDG.
Do not extend this side of this line.
Note: Any Additions or Changes on this Sheet Must be Made or Circled in Red Ink With Date and Name of Person Making Change.

76F3098 CE#31D 9-67

PLEASE RETURN TO
LOS ANGELES COUNTY ENGINEER
403 LOS ANGELES COUNTY ENGINEERING BLDG.

Do not extend this side of this line.

Note: Any Additions or Changes on this Sheet Must be Made or Circled in Red Ink With Date and Name of Person Making Change.

W.S. 22, B-3

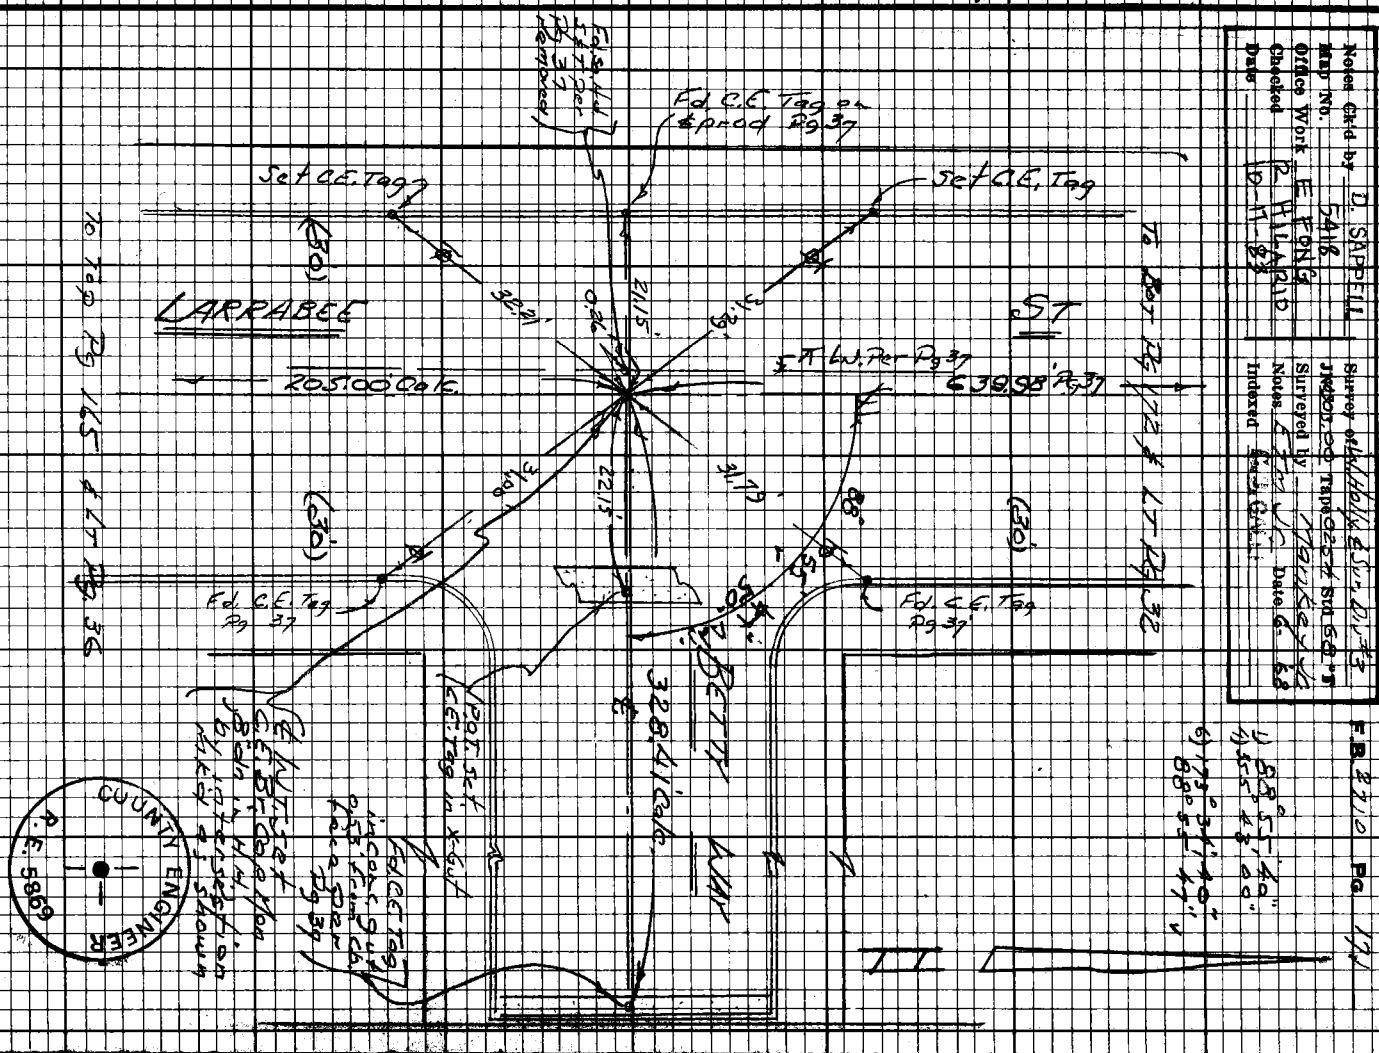

F.B. 2710 Pg. 172

W.S. 22, B-3

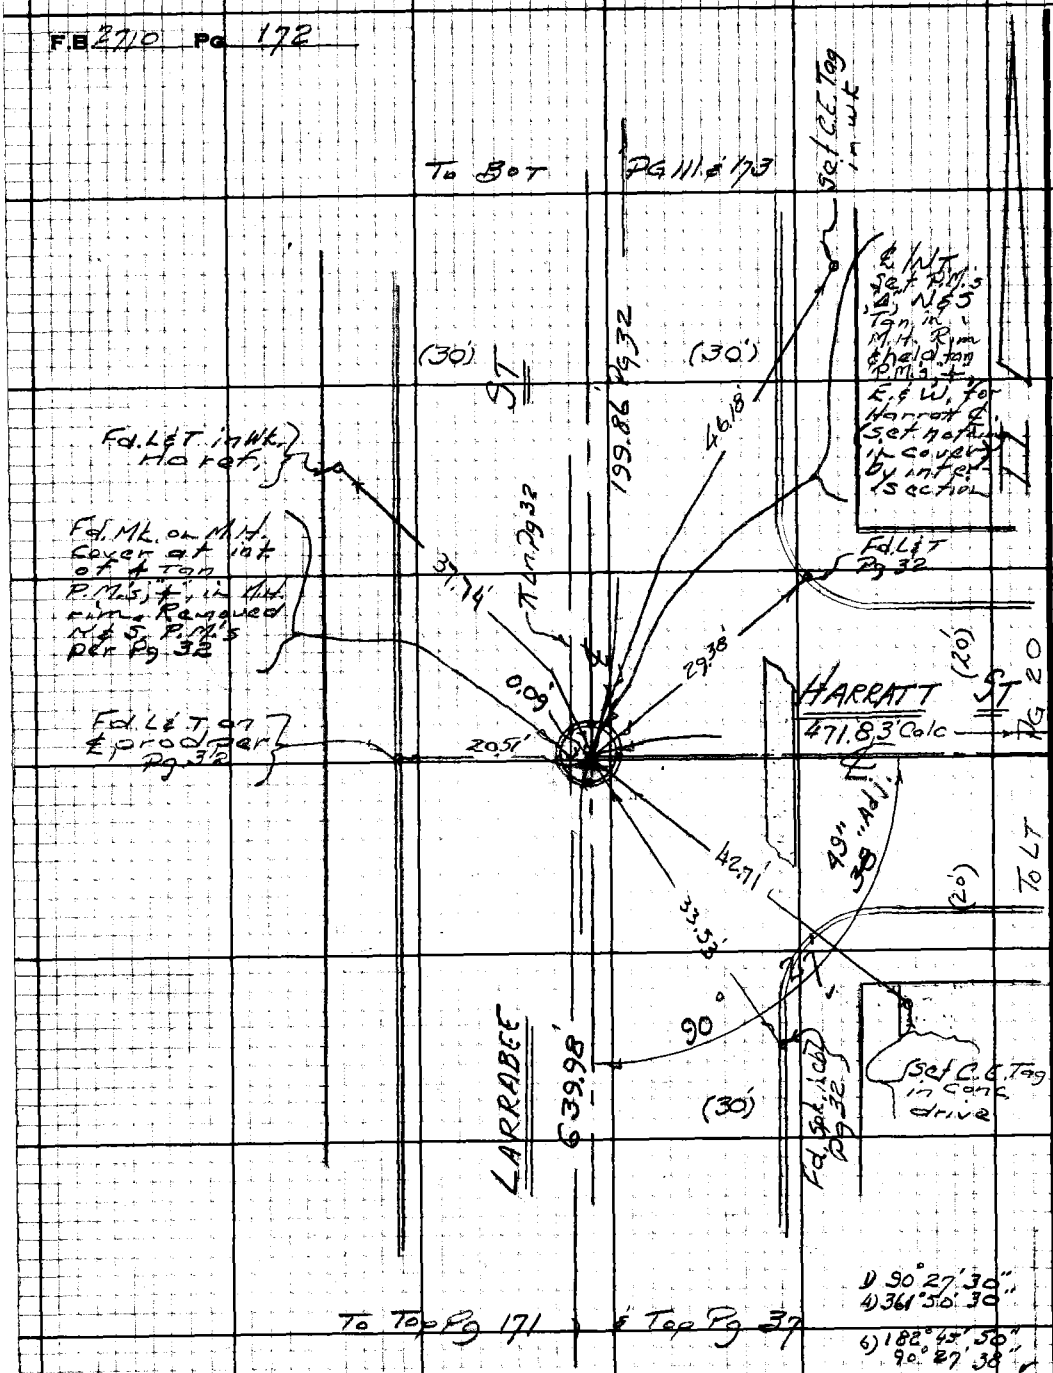

PLEASE RETURN TO
LOS ANGELES COUNTY ENGINEER
403 LOS ANGELES COUNTY ENGINEERING BLDG.

Do not extend this side of this line.

Note: Any Additions or Changes on this Sheet Must be Made or Circled in Red Ink With Date and Name of Person Making Change.

Notes Ck'd by	D. SAPPELL	Survey of	W. Holly & Sur. Div #3
Map No.	5418	JN	030300 Tape 0254 Std 68 °F
Office Work	E FONG	Surveyed by	Mankey Jr.
Checked	R HILARIO	Notes	ETM Jr. Date
Date	10-17-83	Indexed	[illegible]

F.B. 2710 Pg 173

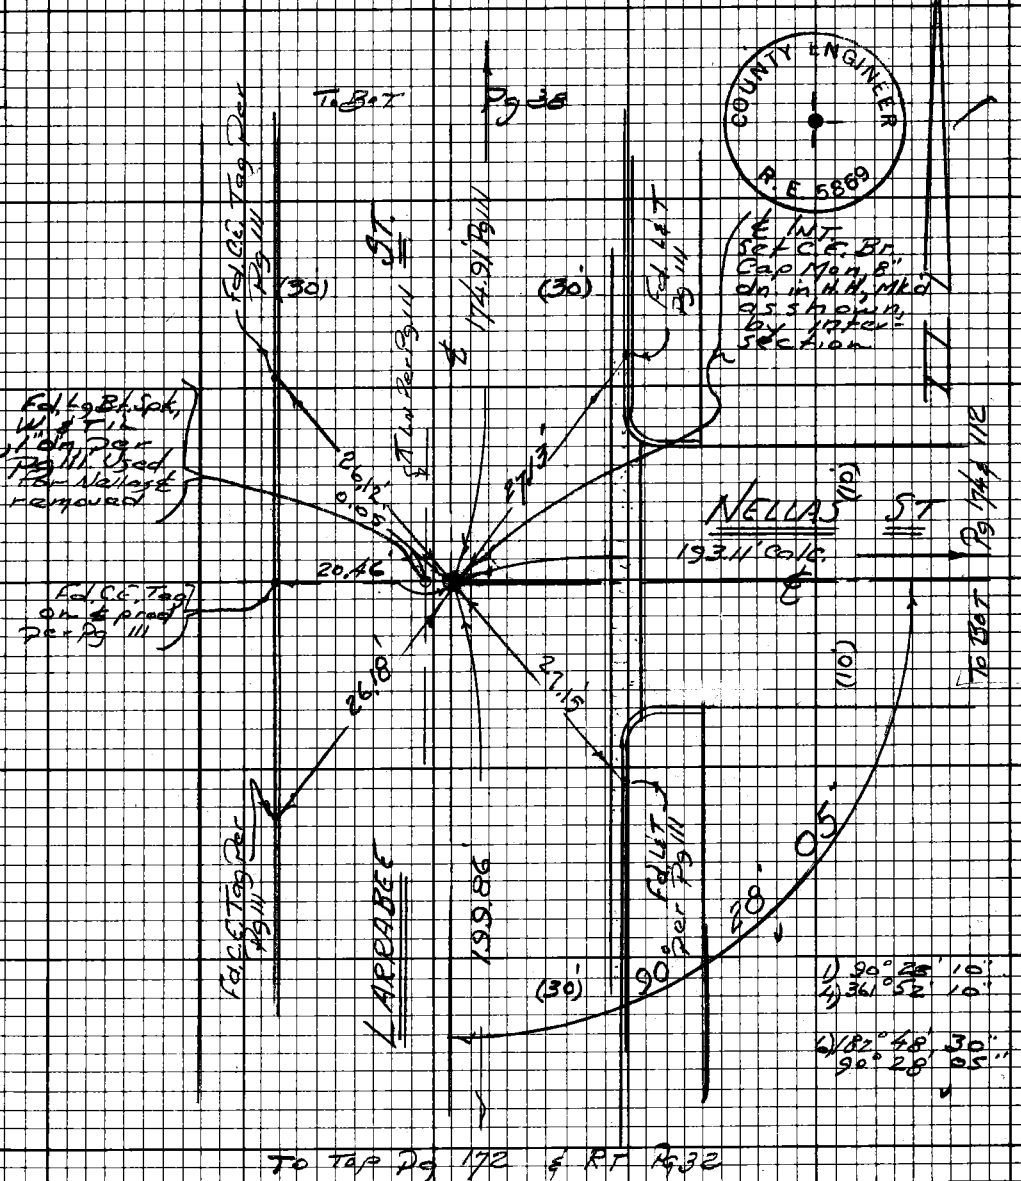

W.S. 22, B-3

Note: Any Additions or Changes on this Sheet Must be Made or Circled in Red Ink With Date and Name of Person Making Change.

Do not extend this side of this line.

PLEASE RETURN TO
LOS ANGELES COUNTY ENGINEER
403 LOS ANGELES COUNTY ENGINEERING BLDG.

76F3098 CE#310 9-67

F.B. 2710 PG. 174

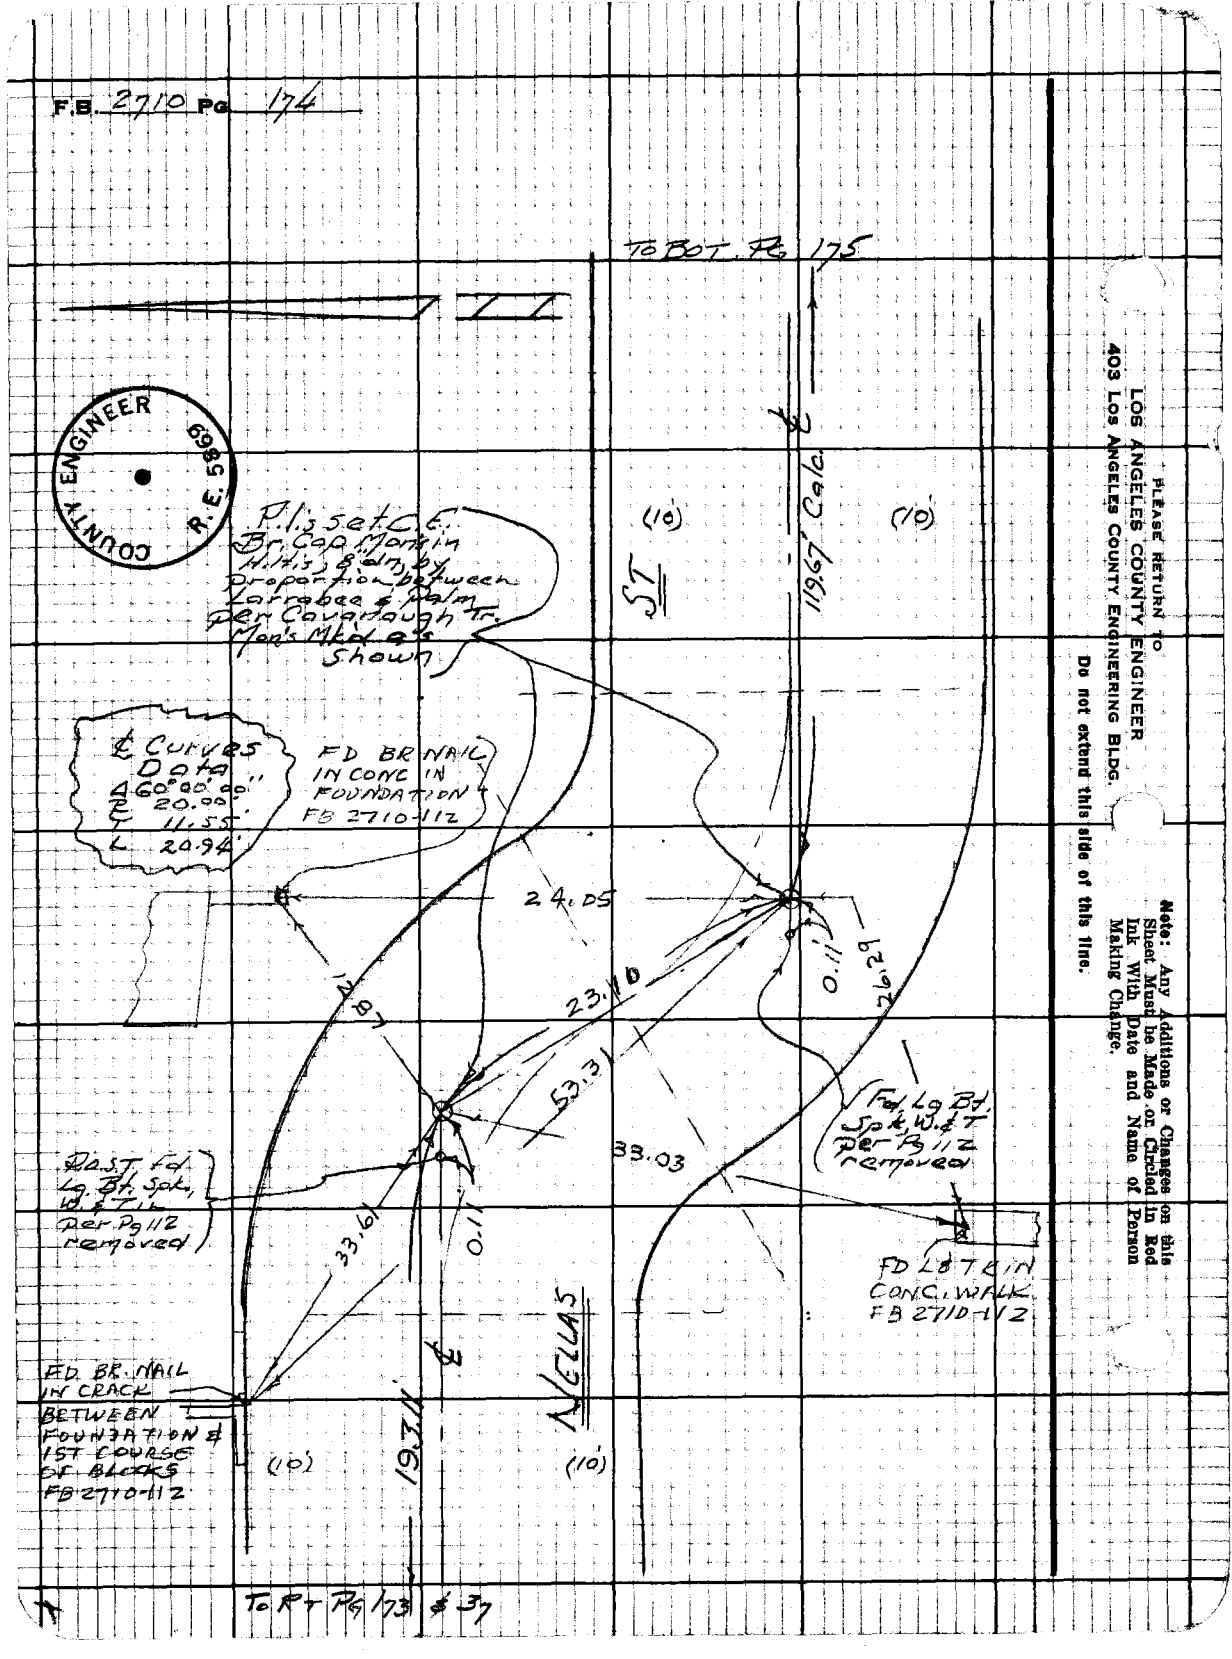

PLEASE RETURN TO
LOS ANGELES COUNTY ENGINEER
403 Los Angeles County Engineering Bldg.

Do not extend this side of this line.

Note: Any Additions or Changes on this Sheet Must be Made on Checked in Red Ink With Date and Name of Person Making Change.

Notes Ck'd by D. SAPPELL	Survey of W Holly & Sur. Div #3
Map No. 5418	JN 0303.00 Tape 0254 Std 68 °F
Office Work E FONG	Surveyed by Mankey Jr.
Checked R HILARIO	Notes ETM Jr. Date 6-68
Date 10-17-83	Indexed

F.B. 2710 PG. 175

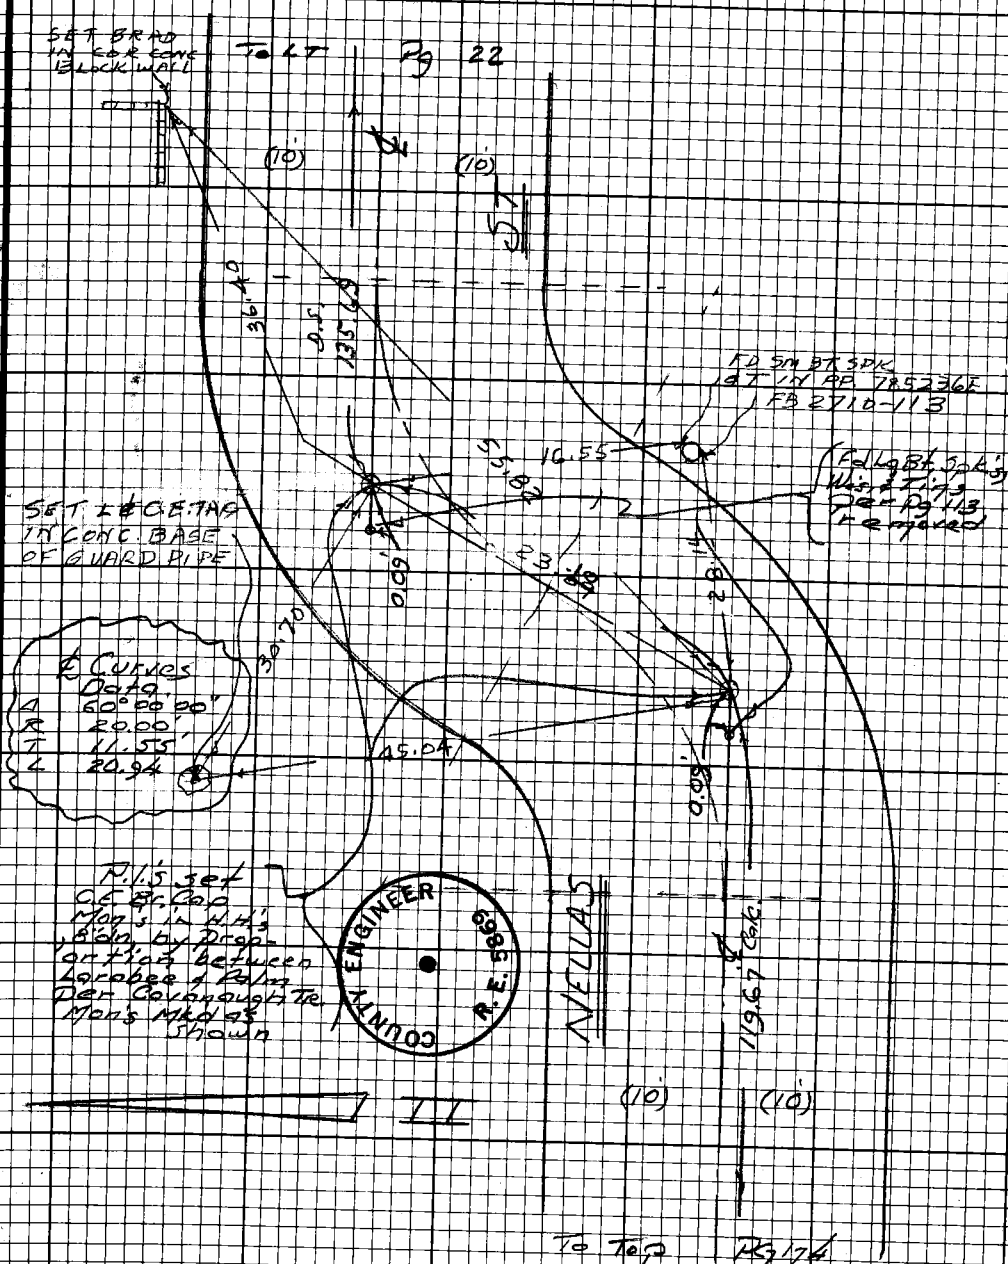

Note: Any Additions or Changes on this Sheet Must be Made or Circled in Red Ink With Date and Name of Person Making Change.

Do not extend this side of this line.

PLEASE RETURN TO
LOS ANGELES COUNTY ENGINEER
403 LOS ANGELES COUNTY ENGINEERING BLDG.

76F3098 CE#310 9-67

PLEASE RETURN TO
LOS ANGELES COUNTY ENGINEER
403 Los Angeles County Engineering Bldg.

Note: Any Additions or Changes on this Sheet Must be Made or Circled in Red Ink With Date and Name of Person Making Change.

Do not [illegible] this side of this line.

2110

PG