Notes Ck'd by _____ Survey of _____ E.B. 2905 Pg. _____
Map No. _____ JN _____ Tape _____ Std. _____ "F"
Office Work _____ Surveyed by _____
Checked _____ Notes _____ Date _____
Date _____ Indexed _____

Page	Jct.	Description
		CENTURY BLVD. J.N. 0074.82
6+94	C.L.	Proposed C.L. from Grape St. E'ly to Alameda St.
25+80	Trans. Line	For angular closure only, along C/L St. between Grape St. & Alameda St.
31+32	C.L. Mon.	Monumenting of the proposed C.L. of Century Blvd. from Grape St. to Alameda St.

Microfilmed April 85

Notes Ck'd by _____
Map No. B-2789
Office Work E. D. FASOLINS
Checked _____
Date _____

Survey of CENTURY BLVD
J.N. 00783 Tape 6146 Sta. 00 + 00
Surveyed by W. H. BROWN
Notes 1 of 2 Date 8-61
Inceved H. E. OTT 10 1 61

F. B. 2905 Pg. 5

CENTURY BLVD

PROPOSED CENTER LINE

from GRAPE ST

to ALAMEDA ST (EAST)

J. N. 00783

Aug., Sept., Oct., 1961

PARTY:

W. H. Brown
K. M. Kapp
B. Nunez
R. E. Siebram
S. R. Esquer
E. P. Rodrigues

Note: Any Additions or Changes on this Sheet Must be Made or Circled in Red Ink With Date and Name of Person Making Change.

Do not extend this line past this point.

PLEASE RETURN TO
LOS ANGELES COUNTY ENGINEER
ENGINEERING BLDG.
108 Los Angeles County Engineering Bldg.

PLEASE RETURN TO
LOS ANGELES COUNTY ENGINEER
405 Los Angeles County Engineering Bldg.

Note: Any Additions or Changes to This Sheet Must be Made or Circled in Red Ink With Date and Name of Person Making Change.

Do not extend this side of this line.

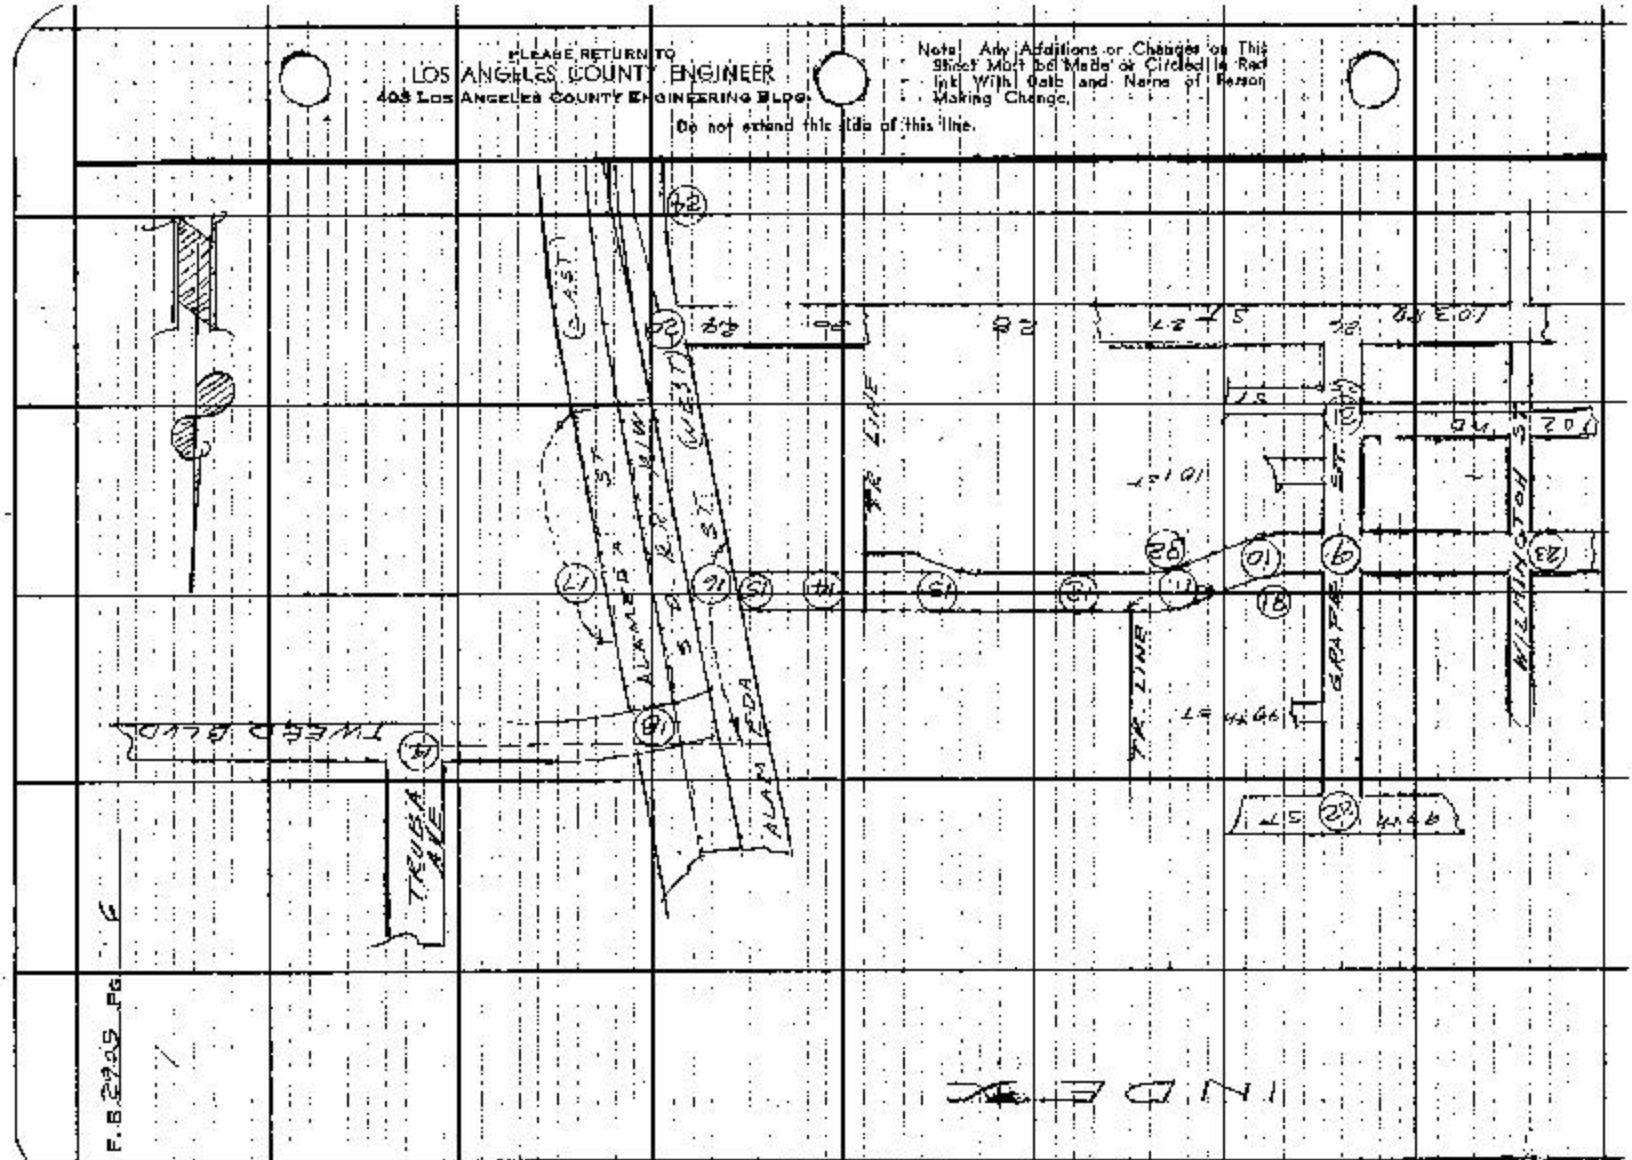

Notes Ck'd by
Map No. B-2789
Office Work E. D. FASOLINE
Checked
Date

Survey of CENTURY Blvd
JN 0074.03 Tape 0.1% Sta 67 + 00
Surveyed by T.H.B.
Notes T.H.B. Date 8-61
Indexed M. E. Ott NOV 1 '61

F. B. 290 S Pg. 7

INDEX

Note: Any Additions or Changes on This Sheet Must be Made by Original Party Making Change, and Noted in This Line.

PLEASE RETURN TO LOS ANGELES COUNTY ENGINEER
108 Hall of Records
Los Angeles County Engineering Bldg.
Do not extend this side of this line.

F. B. 2905 Pg. 8

PLEASE RETURN TO
LOS ANGELES COUNTY ENGINEER
403 Los Angeles County Engineering Bldg.

Do not detach this side of this slip.

Note: Any Additions or Changes of This Sheet Must Be Made in Circled in Red Ink. With Date and Name of Person Making Change.

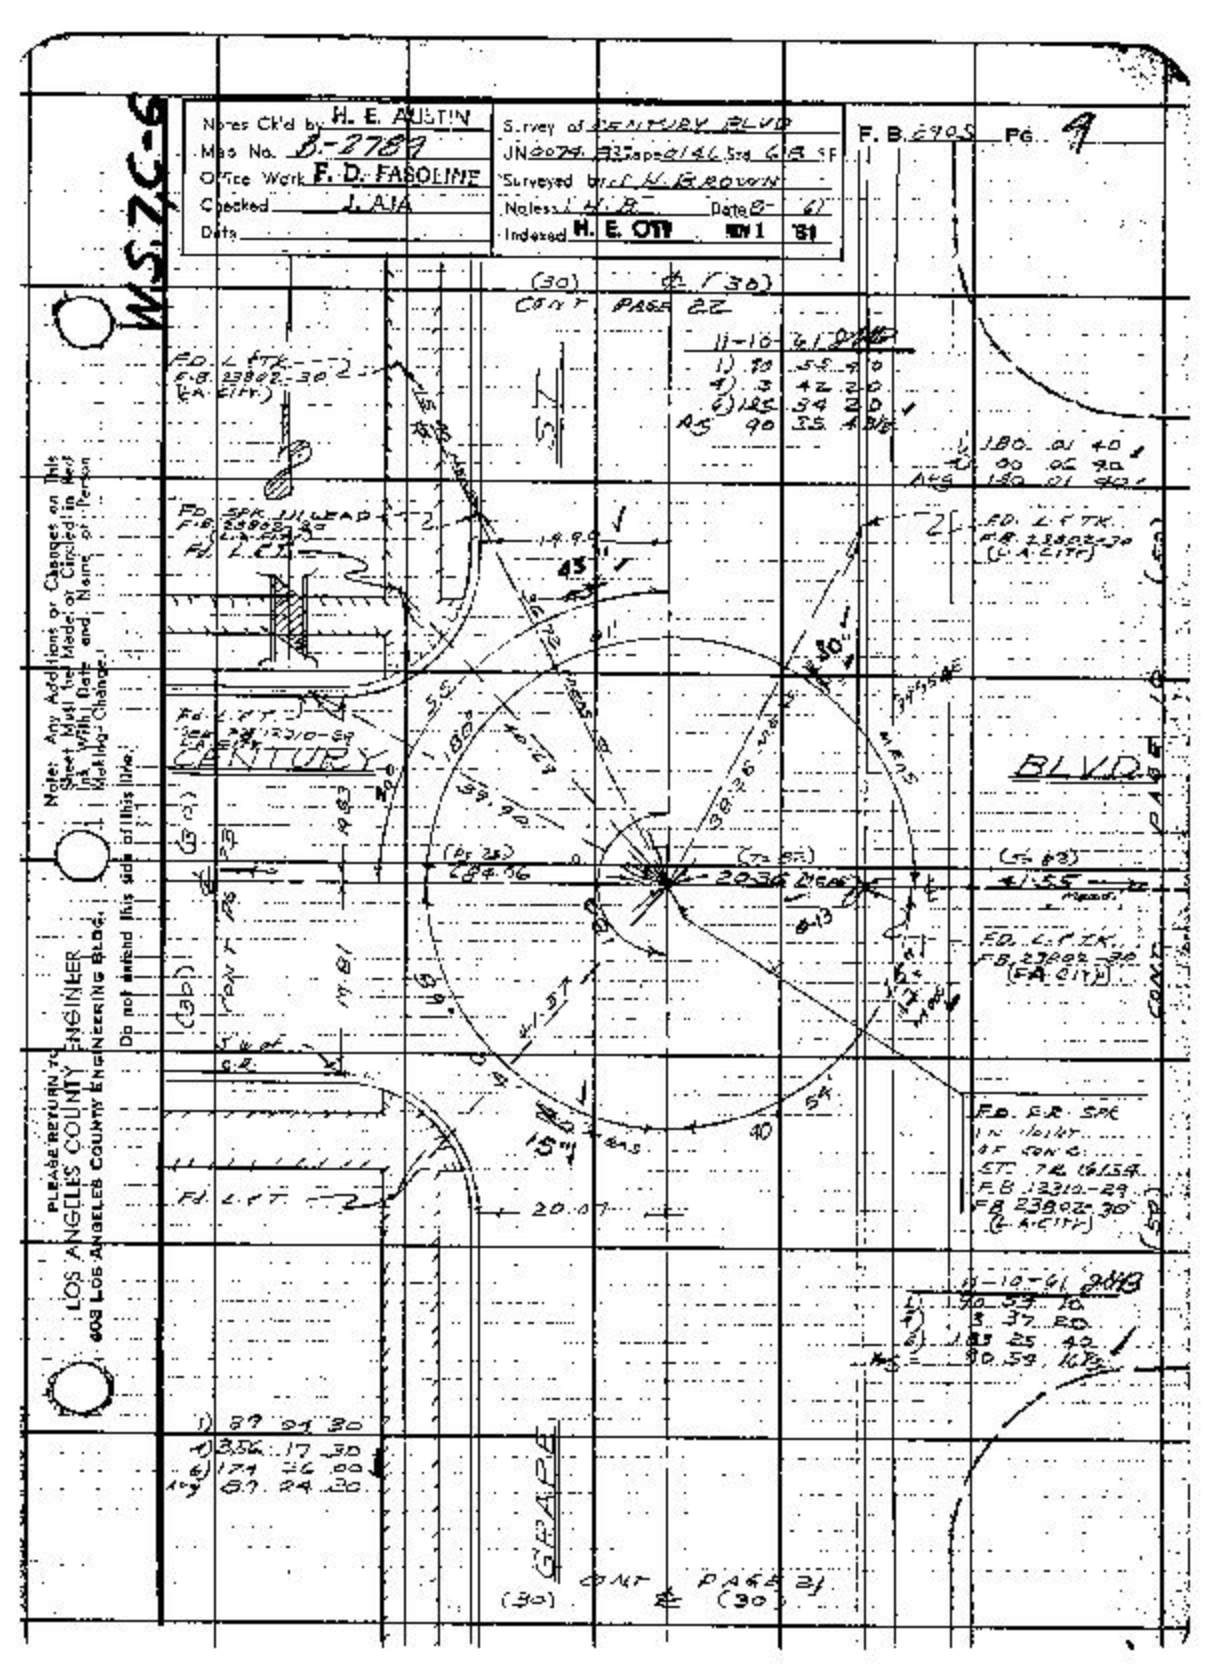
W.S.7C-6
Notes Ck'd by H. E. AUSTIN
Map No. B-2782
Office Work F. D. FASOLINE
Checked L. AIA
Date
Survey of CENTURY BLVD
JN 0079 Maps 214 Sht 6 & SF
Surveyed by C. V. BROWN
Notes J. K. B. Date 8-61
Indexed H. E. OTT NOV 1 '61
F. B. 2905 PG. 9
(30) CONT PAGE 22
11-10-61 DMB
1) 70 55 40
4) 3 42 20
6) 125 34 20
Avg 90 35 40
1) 180 01 40
4) 00 02 20
Avg 180 01 40
FD. L.F.TK.
F.B. 23802-30
(L.A.CITY)
FD. SPK. IN LEAD
F.B. 23802-30
(L.A. CITY)
FD. L.F.TK.
149.99
45°
30°
CENTURY
BLVD.
PAGE
CONT
FD. L.F.TK.
F.B. 23802-30
(L.A. CITY)
FD. L.F.TK.
F.B. 23802-30
(L.A. CITY)
FD. B.B. SPK
IN LEAD
OF CONC.
STR. 7.2L 1.6 IS R.
F.B. 12310-29
F.B. 23802-30
(L.A. CITY)
FD. L.F.TK.
20.00
10-10-61 DMB
1) 90 59 10
4) 5 37 50
6) 185 25 40
Avg 90 59 10
1) 89 24 30
4) 356 17 30
6) 179 36 00
Avg 89 24 30
GRADE
CONT PAGE 21
(30)
PLEASE RETURN TO
LOS ANGELES COUNTY ENGINEER
603 LOS ANGELES COUNTY ENGINEERING BLDG.
Do not extend this side of this line.
Note: Any Additions or Changes on This Sheet Must be Made or Circled in Red With Date and Name of Person Making Change.

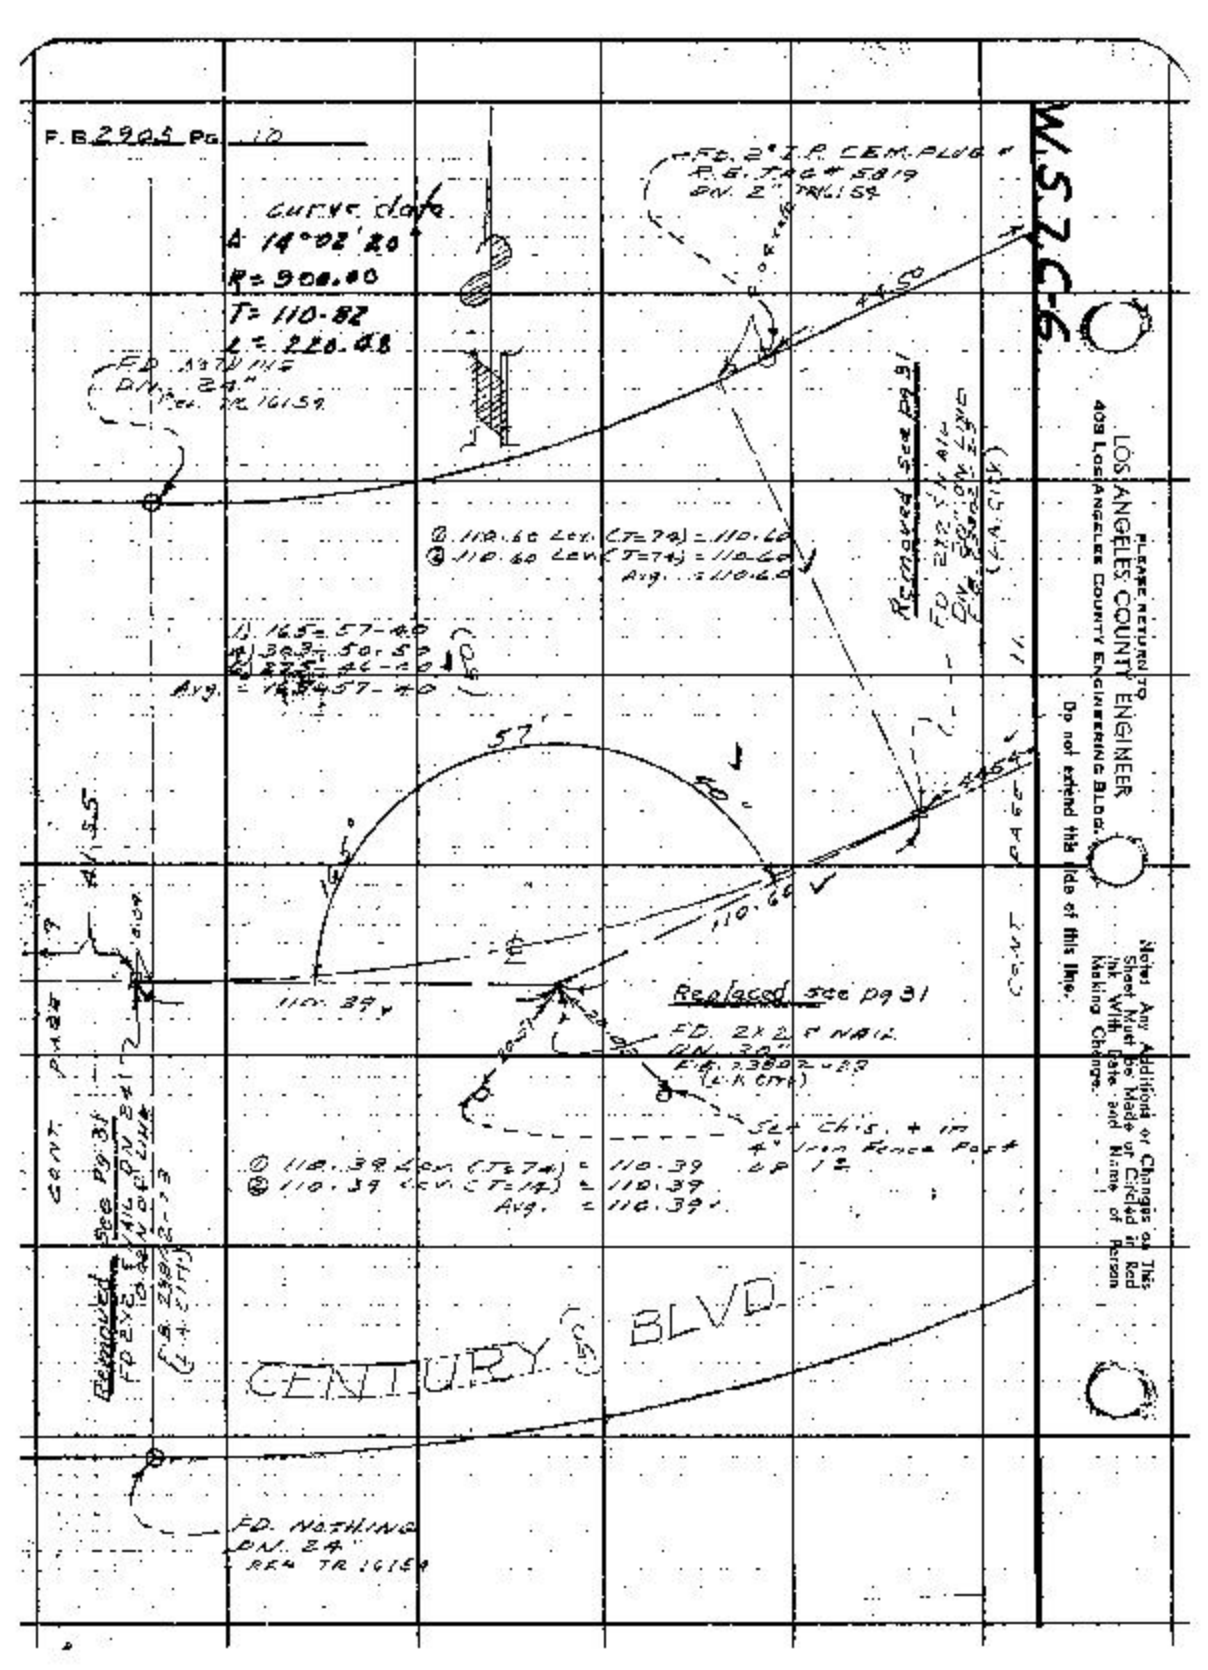
W.S.7.C-6
F.B. 2905 Pg. 10
Curve data
Δ 14°02'20"
R = 900.00
T = 110.82
L = 220.48
FD. 2" I.P. CEM. PLUG
P.G. TRACT 5819
ON 2' TRI. LIS
FD. NAIL IN LINE
ON 24"
REF. TR. 16159
Removed See pg 31
FD. 2" x 2" P NAIL
ON 30"
E.W. 2.38 S 0.29 E
(L.A. City)
52± Ch's. + in
4" Iron Fence Post
CENTURY (S) BLVD.
FD. NOTHING
ON 24"
REF. TR. 16159
Cont. Page 41
See Pg. 31
Removed
FD 2" x 2" P NAIL
ON 30"
E.W. 2.38 S 0.29 E
(L.A. City)
FD. NOTHING
ON 24"
REF. TR. 16159
LOS ANGELES COUNTY ENGINEER
409 Los Angeles County Engineering Bldg.
Please Return To
Do not extend this line beyond this line.
Notice Any Additions or Changes on This Sheet Must Be Made or Circled in Red Ink With Date and Name of Person Making Changes.

W.S.7C-6

Notes Chkd by J. F. AUSTIN
Map No. A-2789
Office Work E. D. FASOLINE
Checked J. AJA
Date May 2 1962

Survey of CENTURY BLVD
JN 0024 33 Tape 0146 Sta 6.8 °F
Surveyed By H. H. BROWN
Notes H. H. B. Date 8-61
Indexed H. E. OTT NOV 1 '61

F. B. 290 5 Pg. 11

FD 4" CONC MON
CITY ENGR'S TAG
MARKED C.E. 3344
PER F.B. 1091-100
F.B. 23802-31 (L.A. CITY)
TR. 16134-213

120.12 Rec (T=82) = 120.13
120.12 Rec (T=82) = 120.13
AVG = 120.13

120.01 Rec (T=90) = 120.07
120.06 Rec (T=90) = 120.07
AVG = 120.07

44.50

FI FD 2X2 6" NAIL
DN. 2.4' PER
F.B. 23802-31
(L.A. CITY)

BLVD

CENTURY

Removed See Pg 32

FD 2X2 6" NAIL
DN. 2.4' 0.03 N.
OF LINE
PER F.B. 23802-31
(L.A. CITY)

SET CHISELED X
UP 16" IN
4" IRON POST
FILLED WITH
CEMENT

Replaced

120.13 MEAS
120.32 MEAS
120.07 MEAS
120.98 MEAS

44.54 MEAS

Set Chis. + in.
4" Fence Post
NE 12"

Set Chiseled
UP 16" IN
CEMENT

FILLED IRON
EBELLE POST

FD
5/8" I.P.
0.70 Pur.
F.B. 23802
-31 (L.A. CITY)

N 71° 05' 00" E 169.47 OC
S 71° 05' 00" W 299.30 OC
149.47 OC

51.98 MEAS

FD 3/4" I.P. & CEM. PLUG
IZAAC MEE 3517
PLUGS PER
TR 16154-213

FD L&TK
IN CONC. WALK
F.B. 23802-31 (L.A. CITY)

(50)

PAGE 10

CONT. PART 12

Note: Any Additions or Changes on This Sheet Must Be Made or Ordered by the Party Making Changes. Do not extend this side of this title.

PLEASE RETURN TO
LOS ANGELES COUNTY ENGINEER
400 Los Angeles County Engineering Bldg.

PLEASE RETURN TO
LOS ANGELES COUNTY ENGINEER
409 LOS ANGELES COUNTY ENGINEERING BLDG.

Do not extend this side of this line.

Notes: Any Additions or Changes on This Sheet Must Be Made & Circled In Red Ink With Date and Name of Person Making Change.

W.S.Z.C-6

F.B. 2705 PG. 12

CENTURY BLVD.

100.74 NEAS

50 CM AMEAS

FD 6" CASING FILLED WITH CONC. MARKED LS 14944-103 PER F.B. 181-52

FD L.A.C.F.C.D. BRASS CAP IN WELL

FD 3/4" IP

FD 3/4" IP BENT

FD 3/4" IP BENT 0.3' ON LINE



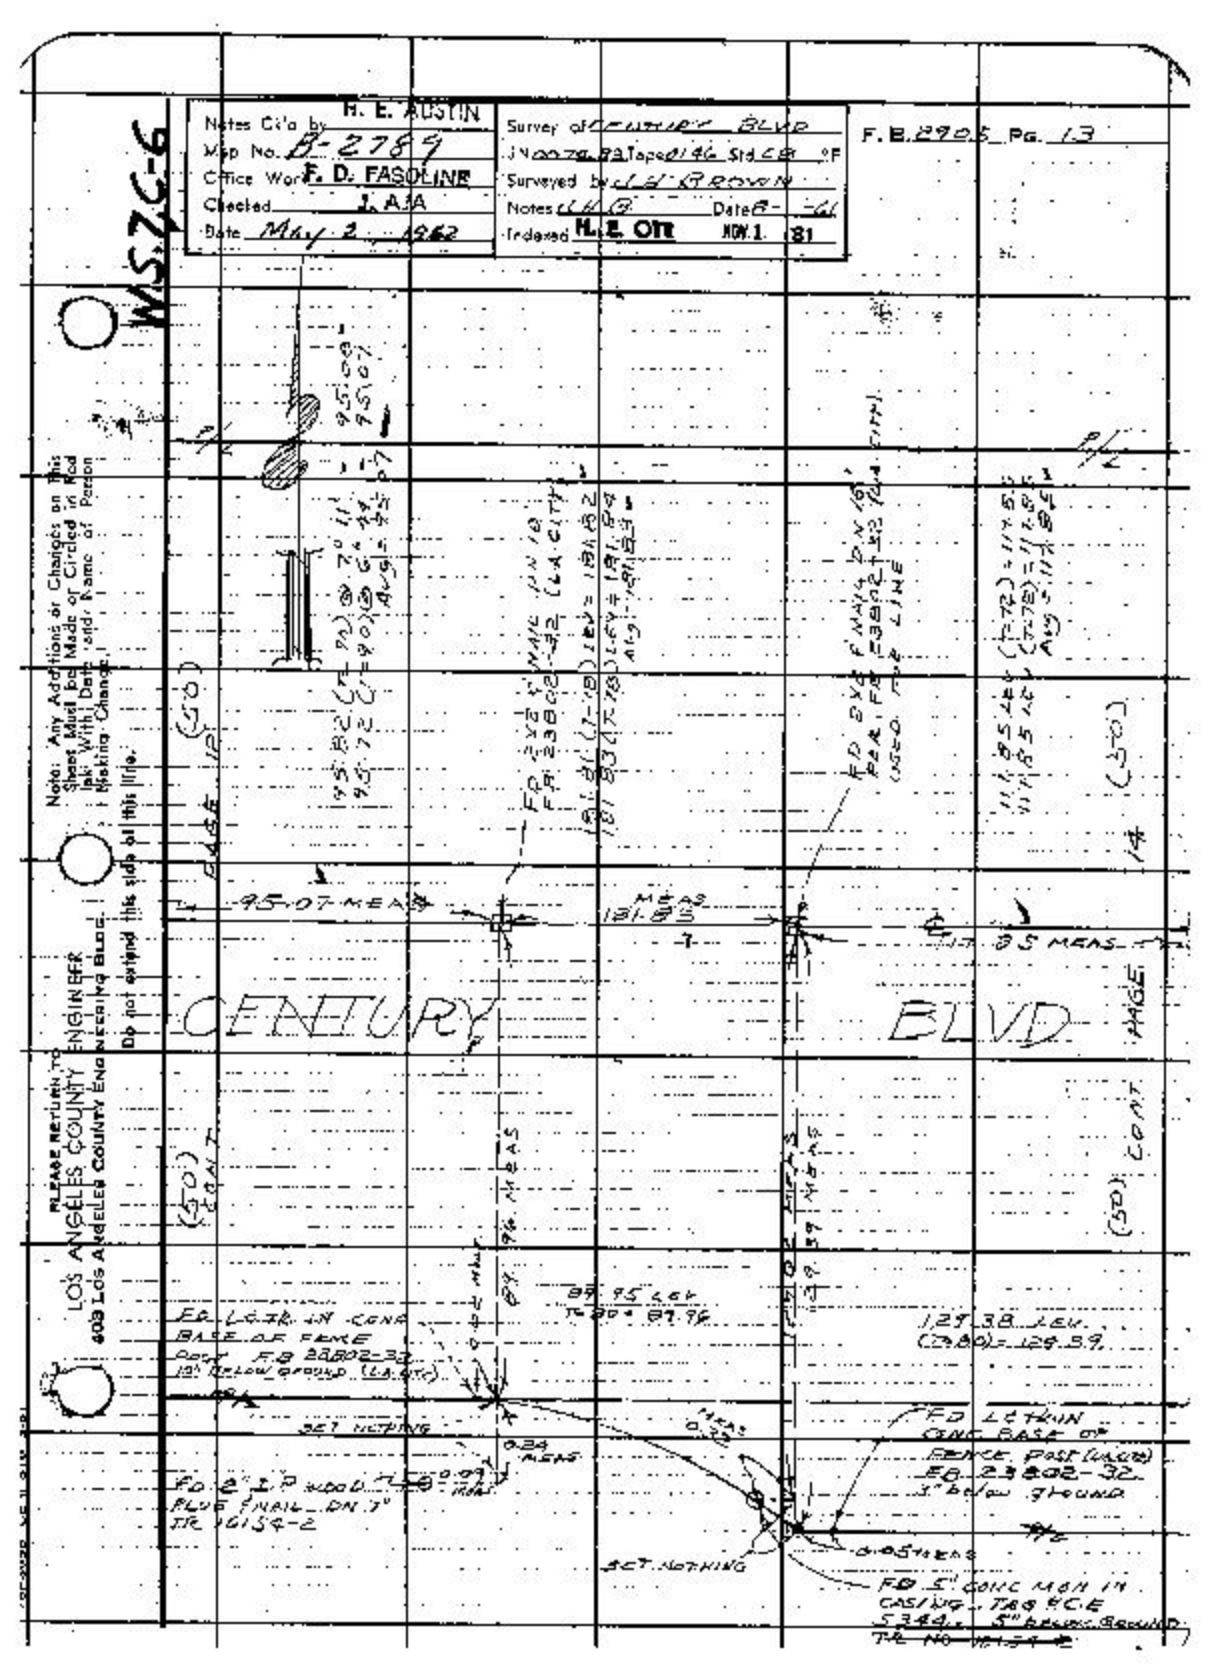
WS 26-6
Notes C'd'a by H. E. AUSTIN
Map No. B-2789
Office Work F. D. FASOLINE
Checked J. AJA
Date May 2, 1962
Survey of CENTURY BLVD
Surveyed by L. J. BROWN
Notes L.J.B. Date 8-
Indexed H. E. OTT NOV. 1 81
F. B. 2905 Pg. 13
Note: Any Additions or Changes on this Sheet Must be Made or Circled in Red Ink With Date and Name of Person Making Change.
Do not extend this side of this title.
PLEASE RETURN TO LOS ANGELES COUNTY ENGINEER 603 Los Angeles County Engineering Bldg.
CENTURY
BLVD
(50') CONT.
95.07 MEAS
181.85
FD 2" I.P. WOOD PLG 0.07' HIGH FLUE SNAIL DN 7" IR VOI54-2
SET NOTHING
FD LEAD IN CONC BASE OF FENCE POST FB 23802-32 12" BELOW GROUND (L.A. CITY)
FD LEAD IN CONC BASE OF FENCE POST (L.A.C.E.) FB 23802-32 1" below ground
FD 5" CONC MON IN CASING. TAG 4 C.E. 5344. 5" below ground TIE NO MARK

F.B. 2705 Pg. 14

FD 4" CAPPED PIPE FILLED WITH CONC. & TAG "LS 5868"
PB 1694 : 102
FB 23902 - 32 (LA CITY)
TR 10154

FD 1½" I.P. CBIA PLUG & TAG "LS 2568" FLUSH

FD NOTHING PER: F.B. 1694 : 102 DH 2

P/L

CENTURY BLVD

50.00 Lev (T=80) = 50.00'

1) 179° 49' 40"
2) 359° 18' 50"
3) 258° 58' 00"
Δ = 179° 49' 30"

R = 40'

179.90 MEAS

50.00 MEAS

50.00 MEAS

SET NOTHING

(50)

(50)

(80)

(80)

13

T

EAST 21ST PLACE

EAST 20TH PLACE

E. DAK CAPITA FB 23902

117.55 MEAS

PROP. ℄

27.09 MEAS

27.09 (T=80) LEV. = 27.09

CB 0.5 MEAS

SET CHISELED "X" IN CONC. GUTTER FLOW LINE

SET NAIL & TAG "LS 5868" FLUSH WITH CURB

SET CHISELED "X" IN CONC. GUTTER FLOW LINE

SET POINT MARKED BY IRR.

DH "A" BY INTERSECTION OF EXTENDED CURB LINE AND WEST TO EAST 4' SPLIT OF ANGLE AT 14' I.P.

TO NORTH WITH SAID PERIMETER WITH NAIL ON CO. MONUMENT AS SHOWN ON 2-27-62 SURVEY

SET CHISELED "X" IN CONC. GUTTER FLOW LINE

SET NAIL & TAG "LS 5868" FLUSH

129.30 MEAS

129.30 Lev (T=70) = 129.30

SET NOTHING

3.79 MEAS

0.08 MEAS

3.70 MEAS

SET NOTHING

FD 6" I.P. WOOD PLUG & NAIL ON 3" FENCE POST

TR 10154

FD 1X2 NAIL & BRASS CAP IN CONC. BASE FB 23902 - 32 (LA CITY)

LOS ANGELES COUNTY ENGINEER
408 LOS ANGELES COUNTY ENGINEERING BLDG.

PLEASE RETURN TO

Do not extend this title of this line.

Note: Any Additions or Changes to This Sheet Must Be Made or Circled In Ink With Date and Name of Person Making Changes.

COUNTY ENGINEER
P.E. 5869

W.S.7.5

W.S.7.C-6

Notes Ckd by R. E. AUSTIN
Map No. B-2789
Office Work by P. D. FASOLINO
Checked J. A. A.
Date May 2, 1962

Survey of CENTURY BLVD
JN [illegible] Sta [illegible] to [illegible]
Surveyed by W. H. CROWN
Notes W. H. C. Date 8-61
Indexed H. E. OTT NOV 1 '61

F. B. 2905 PG. 15

FD I&T P. COM. PLUG & TAG L.S. 89 '0 ON B/L FD 1697 - 10'D

B/L

(50)

CENTURY

BLVD

ALAMEDA ST (WEST)

PROP.

PAGE

LOS ANGELES COUNTY ENGINEER
PLEASE RETURN TO 403 LOS ANGELES COUNTY ENGINEERING BLDG.

Note: Any Additions or Changes on this Sheet Must Be Made or Circled in Red Ink With Date and Name of Person Making Change.

Do not extend this title on this file.

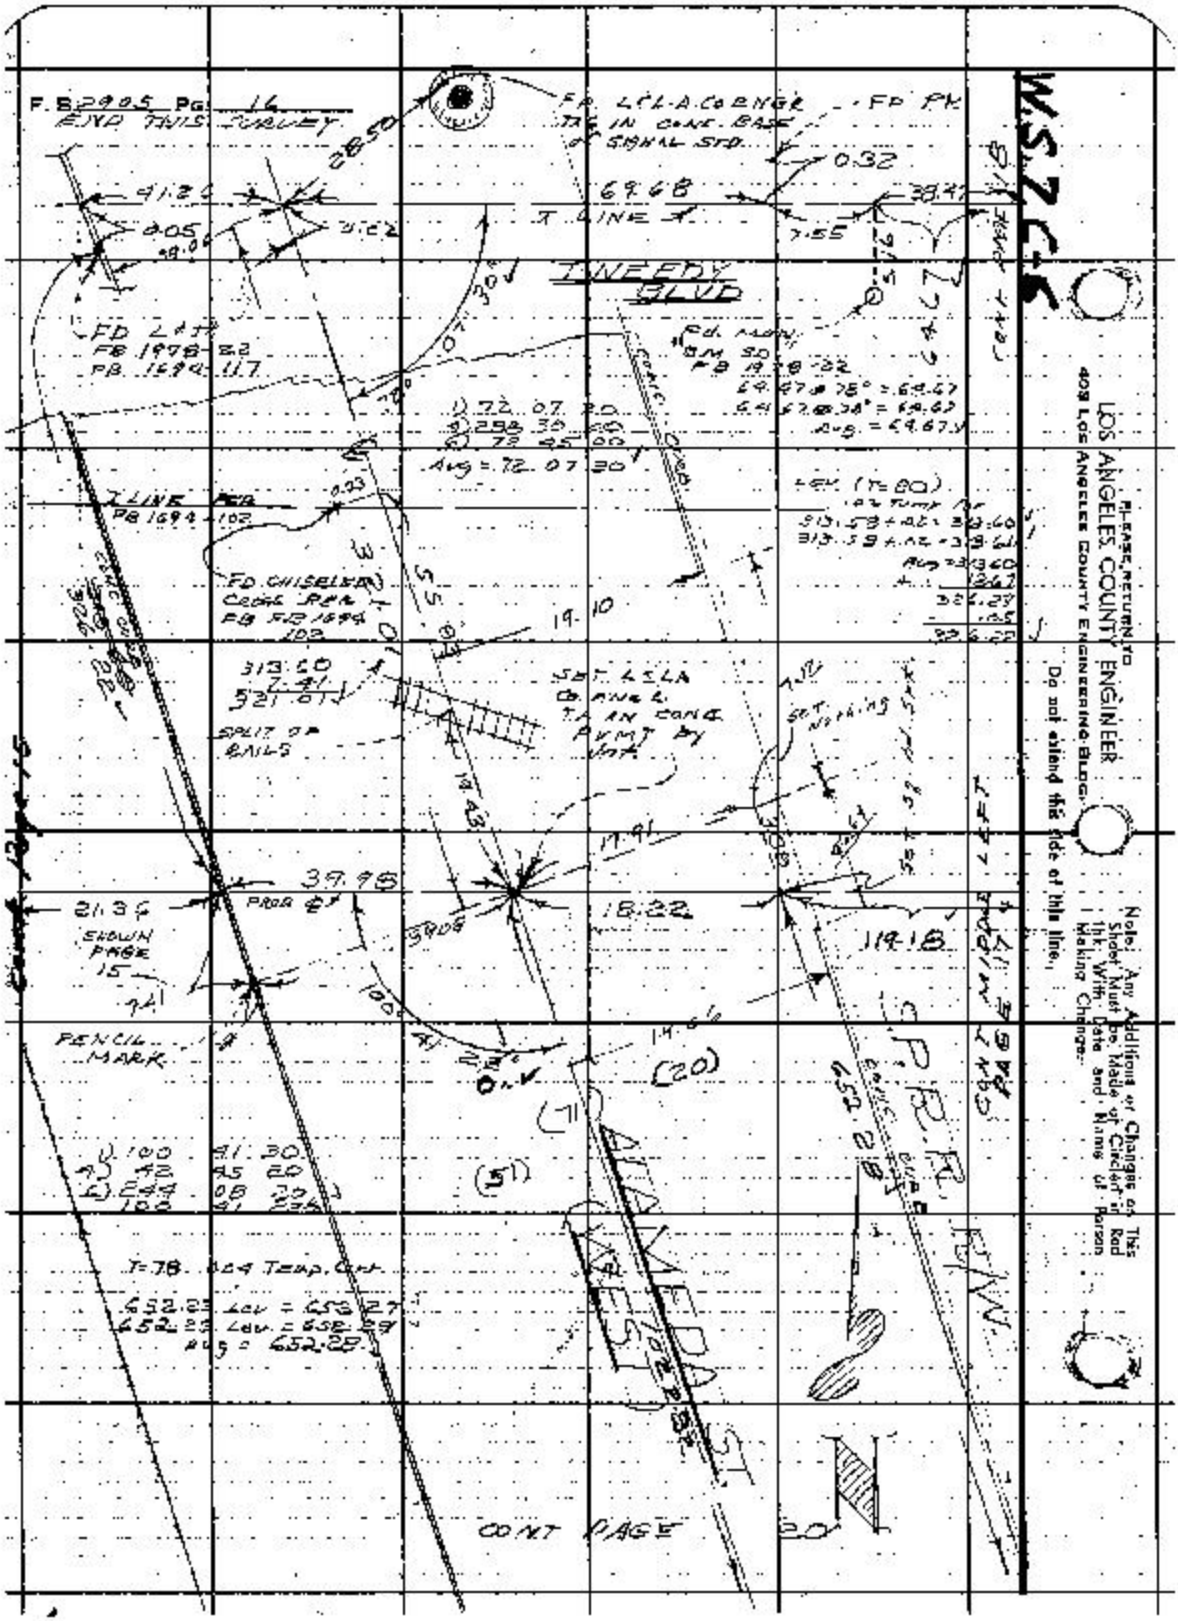
W.S.Z.C.S.
LOS ANGELES COUNTY ENGINEER
PLEASE RETURN TO
409 LOS ANGELES COUNTY ENGINEERING BLDG.
Do not extend this side of this line.
Note: Any Additions or Changes on This Sheet Must be Made at Circle and Ink With Date and Name of Person Making Change.
F.B. 2905 Pg. 14
END THIS SURVEY
FD L&T.C. & ENGR. IN CONC. BASE & SIGNAL STD.
FD PK
0.32
69.68
38.47
7.55
LINE FDY BLVD
FD L&T.C.
FB 1978 82
PB 1694 117
(Rd. Mon.)
BM 30
PB 19 28-32
Avg = 72.07 30"
LINE PCA
PB 1694 102
FD CHISELED CROSS REF
PB FB 1694 102
19.10
313.50
521.01
SPLIT OF RAILS
SET L&T.C. & ANG. IN CONC. PVMT BY HUB
SET NOTHING
39.96
21.36
SHOWN PAGE 15
PENCIL MARK
18.22
11.18
SPIKE
(20)
(51)
C.P.R.R.
652.28
T=78.164 Temp. Corr.
652.23 Elev = 652.27
652.23 Elev = 652.29
Avg = 652.28
CONT PAGE 20

W.S. 76-6

Notes Okd by H. E. Allen
Map No. B-2789
Office Work E. D. FASOLINE
Checked J. AJA
Date May 2 1962

Survey of Century Blvd
J.N. 0074.33 Tape 0.9996 Std 68 °F
Surveyed by J. H. Brown
Notes J. K. R. Date 7-61
Indexed H. E. Ott NOV 1 61

F. B. 2905 Pg. 17

Note: Any Additions or Changes on This Sheet Must be Made or Circled in Red Ink With Date and Name of Person Making Change.

Do not extend this tide off this line.

PLEASE RETURN TO
LOS ANGELES COUNTY ENGINEER
409 Los Angeles County Engineering Bldg.

CONT PAGE 18

25.00

FD. 2" I.P.
DN. 2'±

SET NAIL IN
CTR.
EB 807-13.26
TB 6717-3

X LINE PER TR 6717-163/117

LINE EXTENDED EAST
ACROSS WEST THROUGH
N.A. 60.00 SOUTH OF
A.C.S.P. PASS 15±

119.18'

PEDD

CONT PAGE
16

SET LARGE B
SPK. WASH. 2 IN
FLUSH BY IRIS

630.09 Lev To BC
= 630.15'
630.08 Lev To BC
= 630.15
Avg = 630.15'

(25)

(S) 90° 00' 00"
Avg = 90° 00' 00"

SET NOTHING
SPLIT OF RAILS
119.60'

FD. 2" I.P. SET NAIL & 0.10
IN CTR. DN. 2.4
FD NOTHING ON
SURFACE. CS. B HARRIS
set by TR 6717-3 EB 807.20

115.01'
CONT PAGE 20

SET SQUARE
SPK. & TIN

103.58 Lev To BC
= 103.59'
103.58 Lev To BC
= 103.59'
Avg = 103.59'

FD NOTHING
UNDER NEW PVMT
SET NAIL
IN ASPH. AT INTS
OF LINE
& TANGENT
PER PB 1699-117

55.91 Lev To BC
= 55.92'
55.91 Lev To BC
= 55.92'

119.17 Lev
To BC = 119.18'

119.17 Lev
To BC = 119.18
Avg = 119.18'

SET L.S.L.A. Co.
ENGR. TAG IN CURB
ON LINE PROD.
L 100 41 10
D 46 49 50
R 137 07 00
Avg = 100 41 10'

119.59 Lev
To BC = 119.60'
119.59 Lev
To BC = 119.60
Avg = 119.60'

FD 60° SPK
& TIN FLUSH
MARKED "C"
BC 49+30.98

115.01 Lev
To BC = 115.01'
115.00 Lev
To BC = 115.01
Avg = 115.01'

END THIS SURVEY

CALAMEDA

CEDAR

7/62 5005 CE 1-310 3-61

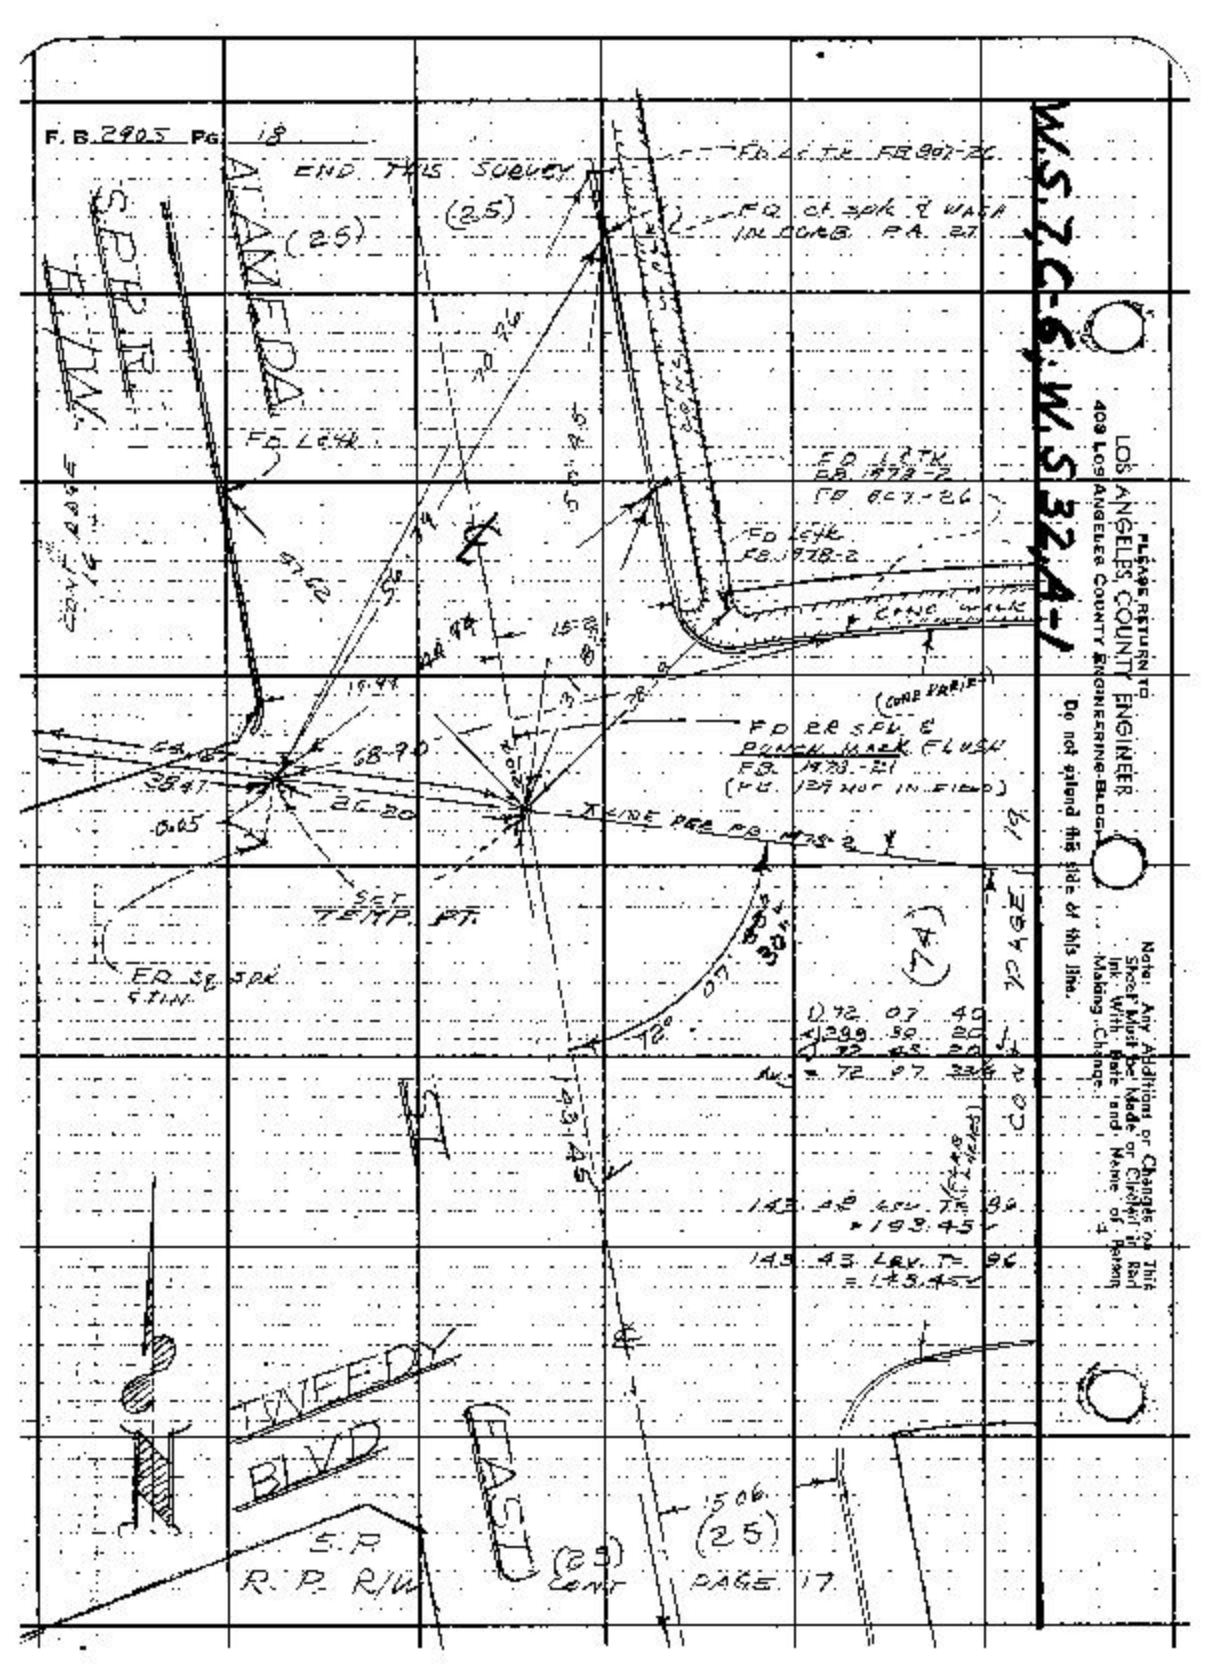
F. B. 2905 PG. 18
END THIS SURVEY
(25)
ALAMEDA
(26)
SPPR R/W
FD L&TK
FD L&TK FB 907-26
FD cr spk & WASH IN CONC. P.A. 27
FD L&TK FB 1978-2
FD 907-26
FD L&TK FB 1978-2
CONC WALK
(CORE DRILL)
FD BR SPK & PUNCH MARK FLUSH FB 1978-21 (PT. 129 NOT IN FIELD)
LINE PER FD MTS 2
SET TEMP. PT.
FD BR SPK & TIN
(74)
TWEEDY BLVD
EAST
S.P. R.R. R/W
(25)
PAGE 17
W.S. 7C-6, W.S. 32A-1
LOS ANGELES COUNTY ENGINEER
409 LOS ANGELES COUNTY ENGINEERING BLDG.
PLEASE RETURN TO
Do not extend this side of this line.
Note: Any Additions or Changes on This Sheet Must be Made or Checked in Ink With Date and Name of Person Making Change.

W.S.32A-1

Notes Okd by H. E. AUSTIN
Map No. B-2789
Office Work F. D. GASOLINE
Checked I. A. A
Date May 1, 1962

Survey of CENTINELA BLVD
LIN 0274.87 Tap 2146 Sta 62 °F.
Surveyed by C. H. BROWN
Notes L. & A. Date 9-61
Indexed H. E. OH NOV 1 - 61

F. B. 290 - Pg. 19

END THIS ½ SURVEY

(25)

CENTINELA AVE

ED. L. & BEAD.

ED. L. & GTR.

29.88

WEEDY

29.95

BLVD (80)

POINTS OF ℄ TAN. L. F. REAS. 0.05 N. OF CHISELED CROSS. PER. FB. 1978-20

30.02

ED. L. & BEAD. FB. 1978-53

ED. L. & GTR. FB. 1978-53

ED. L. & TAG. L.S. 2805

Note: Any Additions or Changes on this Sheet, Must be Made or Circled in Red Ink with Date and Name of Person Making Change.

Do not extend this file of this life.

PLEASE RETURN TO LOS ANGELES COUNTY ENGINEER
Los Angeles County Engineering Bldg.

F.B. 2905 PG. 20

CONT. FROM PAGE 16

W.S. 32, A-1

3.38 PB 16
65.28 PB 16 TO
567.16 PB 20
1022.82 ℄

ALAMEDA ST. (WEST)

FD. C.S. MON. MK. I.D. P.E. 2177 FLUSH PB 84-26

(71) (20)

252.28

0.64

PROJ. OF CURB

115.01

BC

10.22

2.09

SET CHISELED CROSS IN CURB ON ℄ LINE @ 90° TO MIN.

SET CHISELED CROSS IN CURB ON ℄ LINE PROJ. FROM PE to PE

FD L & L.A. CO. ENGR. TAG IN CURB

17.85

17.70

41.68

1.45

1022.80

17.91

SET PUNCH MARK IN SE. RAIL OF RD. FENCE

FD L & L.A. CO. ON ℄ ON LINE (LA CITY) PB 23 PG 36

4.33

8.00

41°

614.31 Lev. T. 72. = 614.33 ✓
614.35 Lev. T. 72. = 614.37 ✓
Avg. = 614.35 ✓

FD. L.A.C.F.C.D. Co. Eng'r. Tag

CONT. PAGE 24

PLEASE RETURN TO
LOS ANGELES COUNTY ENGINEER
403 Los Angeles County Engineering Bldg.
Do not extend this side of this line.

Note: Any Additions or Changes on This Sheet Must be Made or Circled in Red Ink With Date and Name of Person Making Change.

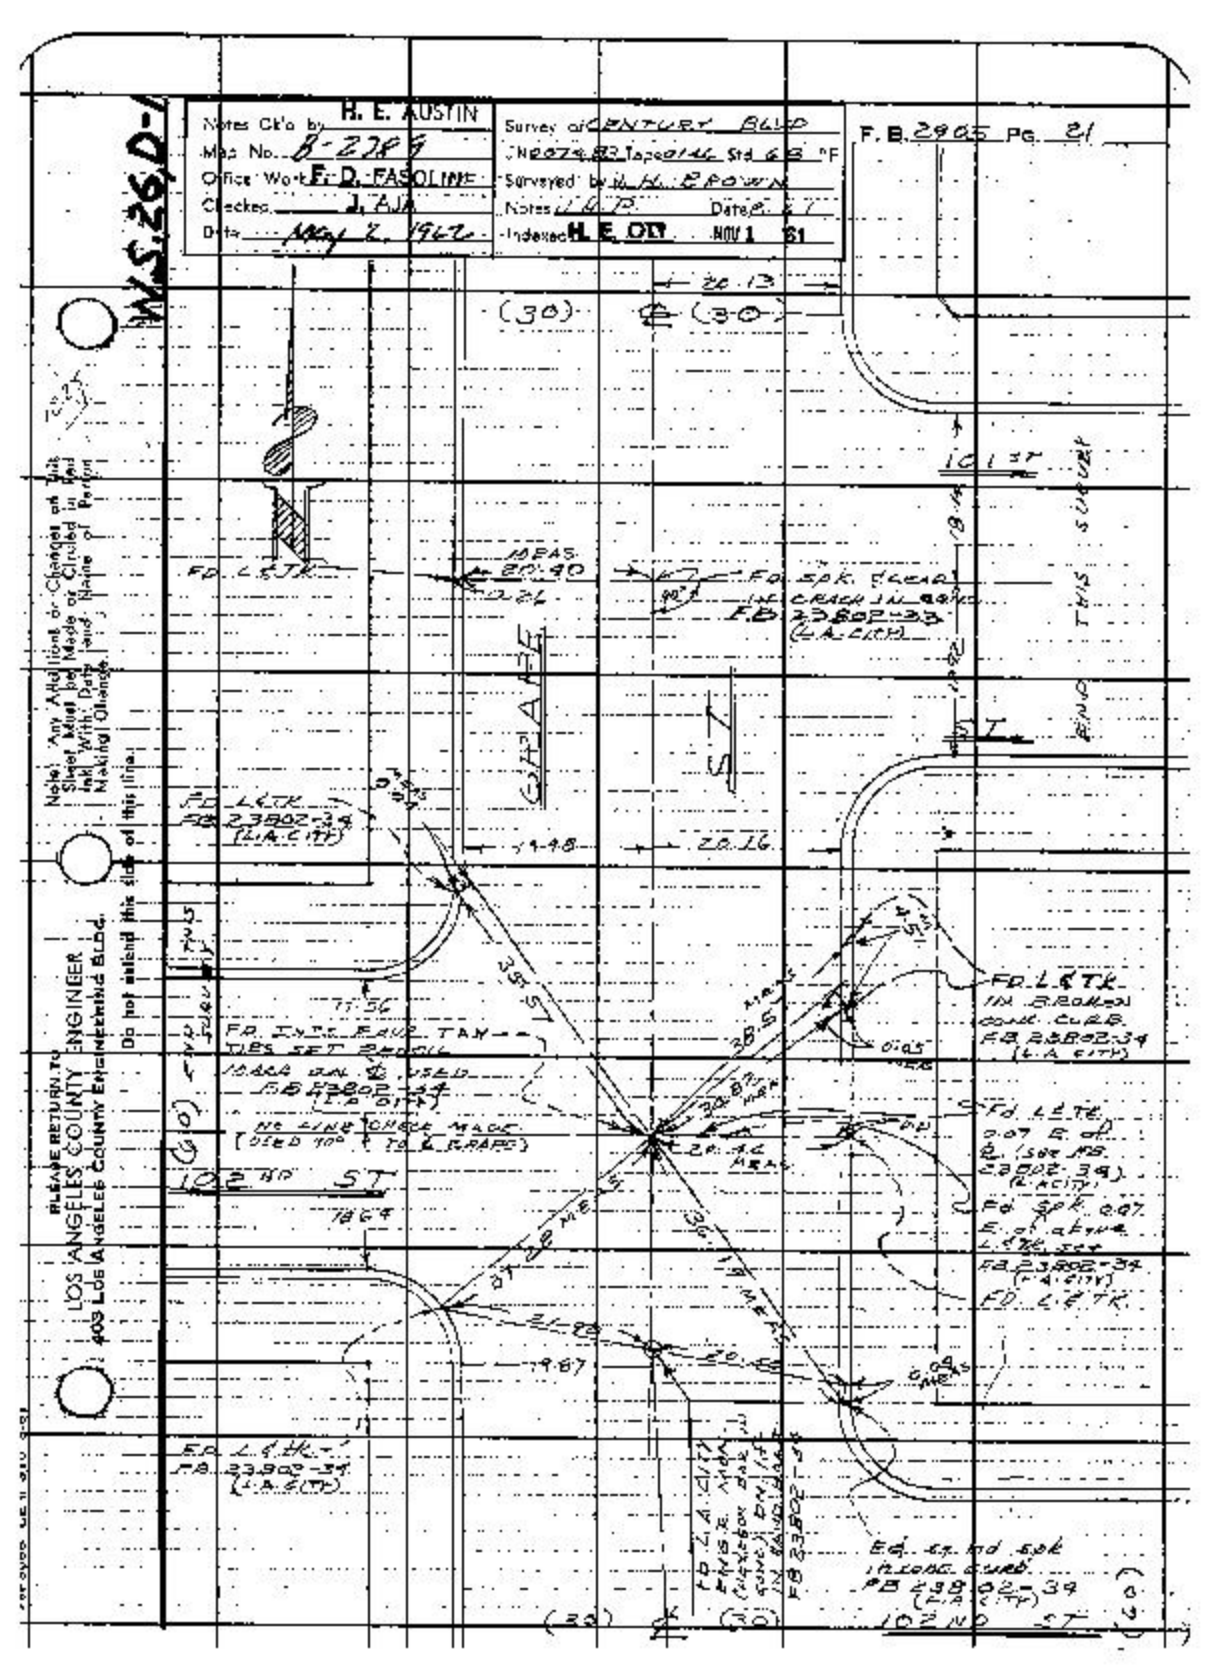
W.S. 26 D-1
Notes C'd'o by H. E. AUSTIN
Map No. B-2289
Office Work F. D. FASOLINE
Checked J. AJA
Date May 2, 1962
Survey of CENTURY BLVD
Tape 0144 Std. 68 °F
Surveyed by H. K. BROWN
Notes L.C.P. Date 8-61
Indexed H. E. OLT NOV 1 61
F.B. 2905 Pg. 21
(30)
(3-0)
20.13
10.13
FD. L & TK.
10 PAS. 20.90
2.21
FD. SPK. SHEAR IN CRACK IN CONC. F.B. 23802-33 (L.A.C.(TY.)
90°
19.46
19.92
THIS SURVEY
FD. L & TK. F.B. 23802-34 (L.A.C.(TY.)
20.16
FD. IN TK. FOUND TACK & TIES SET BROKE
10 ARA. DIA. USED F.B. 23802-34 (L.A.C.(TY.)
NO LINE CHISEL MARK (USED 10° TO L. FURNISH)
102 ND ST
18.64
FD. L & TK. IN BROKEN CONC. CURB F.B. 23802-34 (L.A.C.(TY.)
FD. L & TK. 0.07 E. OF ℄ F.B. 23802-34 (L.A.C.(TY.)
FD. SPK. 0.07 E. OF ABOVE L & TK. F.B. 23802-34 (L.A.C.(TY.)
FD. L & TK.
9.87
FD. L & TK. F.B. 23802-34 (L.A.C.(TY.)
FD. L.A.C.(TY.) ENGR. MON. (ALIGNMENT ONLY) IN RANGE F.B. 23802-34
Ed. cr. nd. SPK IN CONC. CURB F.B. 23802-34 (L.A.C.(TY.)
102 ND ST
(30)
(40)
Note: Any Additions or Changes on This Sheet Must Be Made or Circled in Red Ink With Party and Name of Person Making Change.
Do not extend this side of this line.
PLEASE RETURN TO LOS ANGELES COUNTY ENGINEER 403 LOS ANGELES COUNTY ENGINEERING BLDG.

F. B. 2905 Pg. 22

W.S. 7C-6

LOS ANGELES COUNTY ENGINEER
409 Los Angeles County Engineering Bldg.

Please Return To

Do not extend this side of this line.

Note: Any Additions or Changes on This Sheet Must be Made & Circled In With Date and Name of Person Making Changes.

(L.A. City)
Ed. L.S.T.R. per SD 12310-39
FD. 12510-47

Alameda St.

97th Place

97th

(SD)

Ed. L.A. City Mon. (Hexagon Bar in Conc.) on L.S. F.B. 12310-47 (L.A. City)

15.38

30.07

Meas 30.00 20.04

Set Nothing

(30)

(30)

Ed. Pt. on Tangent

Grape

St.

20.03

Ed. L.C. R.R. Spike in Top of N.W. Cor. of Mk. Punch Mark.

20.11

99

11.61

St.

Cont. Page 9

(30)

30.02

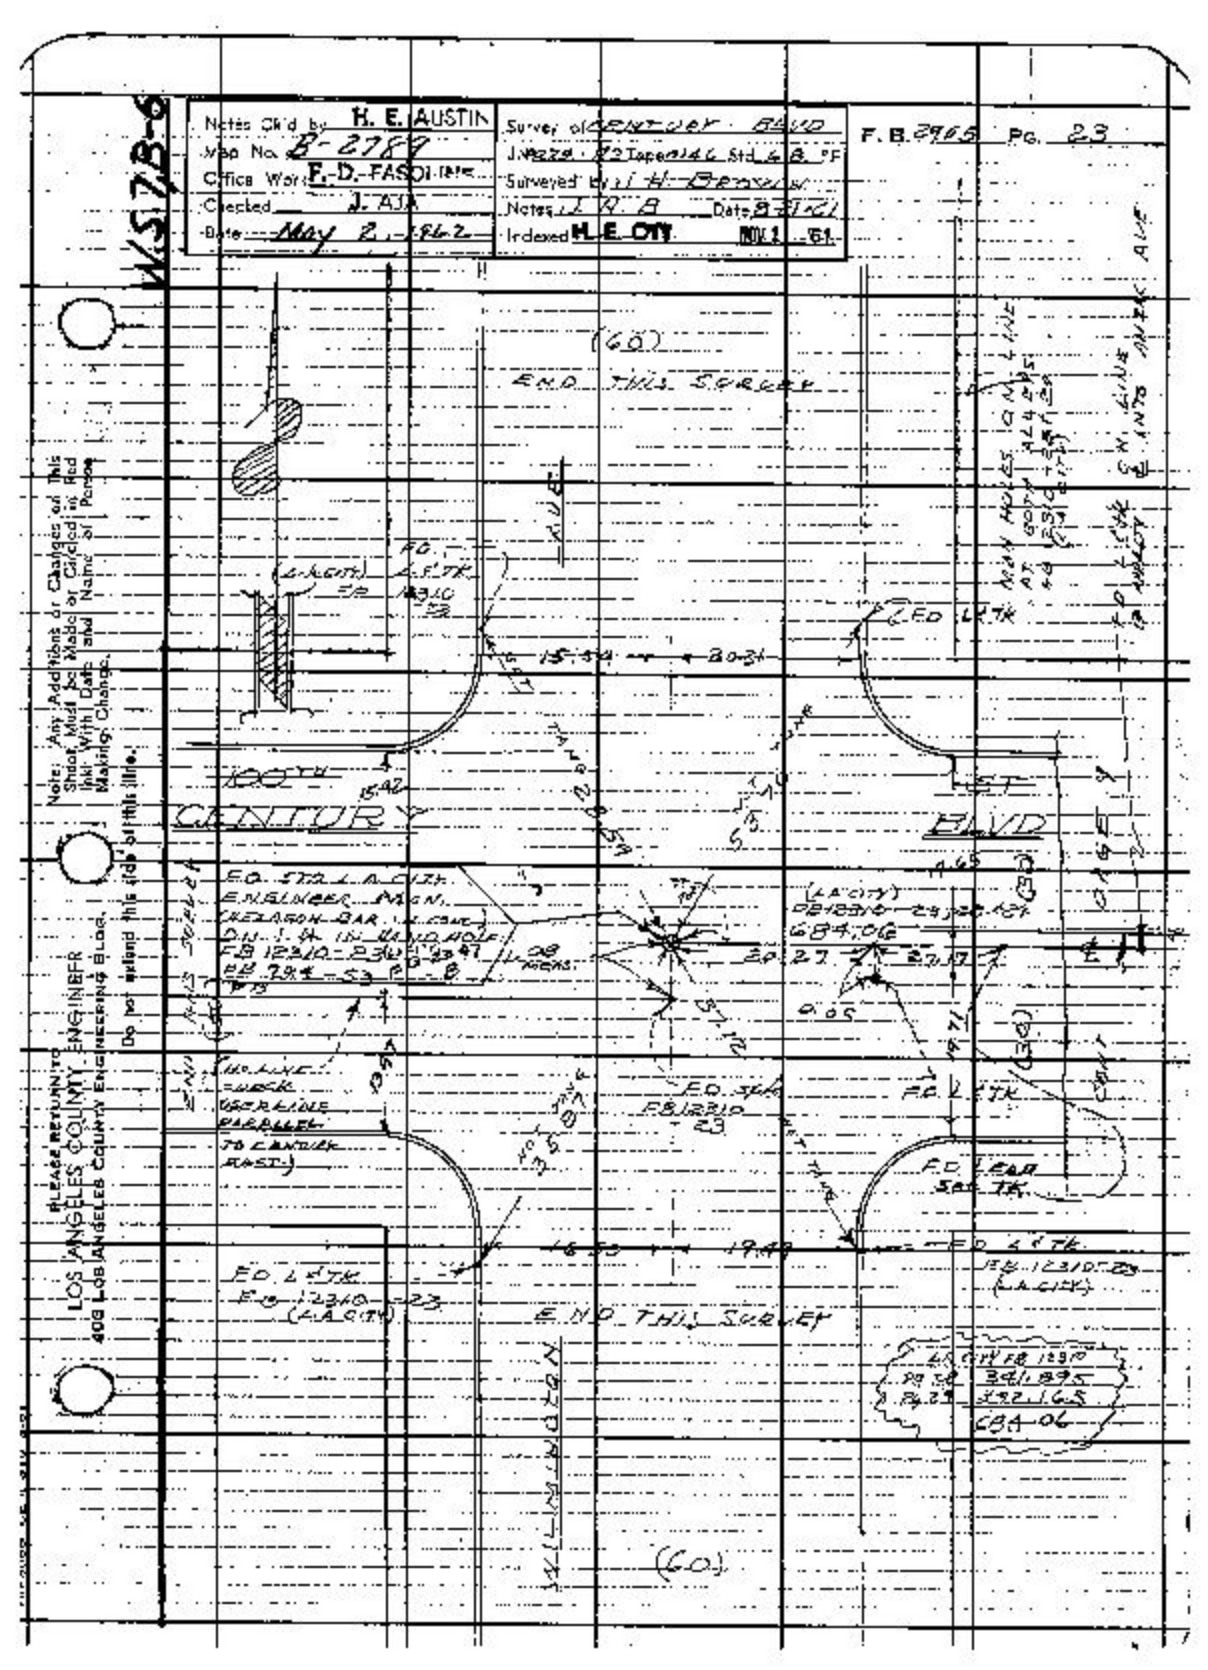
W 57 B-6
Notes Cl'd by H. E. AUSTIN
Map No. B-2789
Office Work F. D. FASOLINES
Checked J. AJA
Date May 2, 1962
Survey of CENTURY BLVD
Notes J. A. B Date 8-31-61
Indexed H. E. CITY NOV 1 '61
F. B. 2965 Pg. 23
Note: Any Additions or Changes of This Sheet Must be Made by Calcd'd and Red Ink With Date and Name of Person Making Change.
Do not extend this data on this line.
PLEASE RETURN TO
LOS ANGELES COUNTY ENGINEER
406 LOS ANGELES COUNTY ENGINEERING BLDG.
(60)
END THIS SURVEY
MUELLER
FD. L & TK
(L.A.CITY)
FD 12310 23
15.54
80.31
100TH
15.42
CENTURY
BLVD
FD. STA. L & TK
ENGINEER MON.
REFERENCE BAR (L.A.CO.)
DIA. IN. IN WATER METER BOX
FB 12310-23 P 97
FB 794-53 P 8
0.08 MEAS.
57.12
(L.A.CITY)
FB 12310-23 P 97
684.06
27.17
0.05
19.71
(30)
CENTER LINE
FD. L & TK
FD. L & TK
FB 12310-23
(L.A.CITY)
FD. L & TK
FB 12310-23
(L.A.CITY)
END THIS SURVEY
(60)
L & TK FB 12310 P 23
FD 12 BY 12 P 23
CBA 06

F.B. 2905 Pg. 24

CONT. PAGE 20

ALAMEDA STREET

(90)

(51)

20

6.14

35

U.S. SEARCH
P.R. R.E.
3 IS 4.03 OS
P.R.L. ER 807-12

FD. L.E.T.R.
1½ ROUND CUP
SEE ER 807-12

SET NAIL & TAG
IN L.R.R. TIE

FD. L.E.T.R.
IN CONC.
CURB

P.R.L. FOR
ER 807-12
FD. L.E.T.R. IN CONC.
P.R.M.T.
USED FOR LINE

END TAIS SURVEY

RETURN TO
LOS ANGELES COUNTY ENGINEER
Los Angeles County Engineering Bldg.

Do not extend this date of this line.

Note: Any Additions or Changes on This Sheet Must Be Made in Red Ink With Date and Name of Person Making Change.

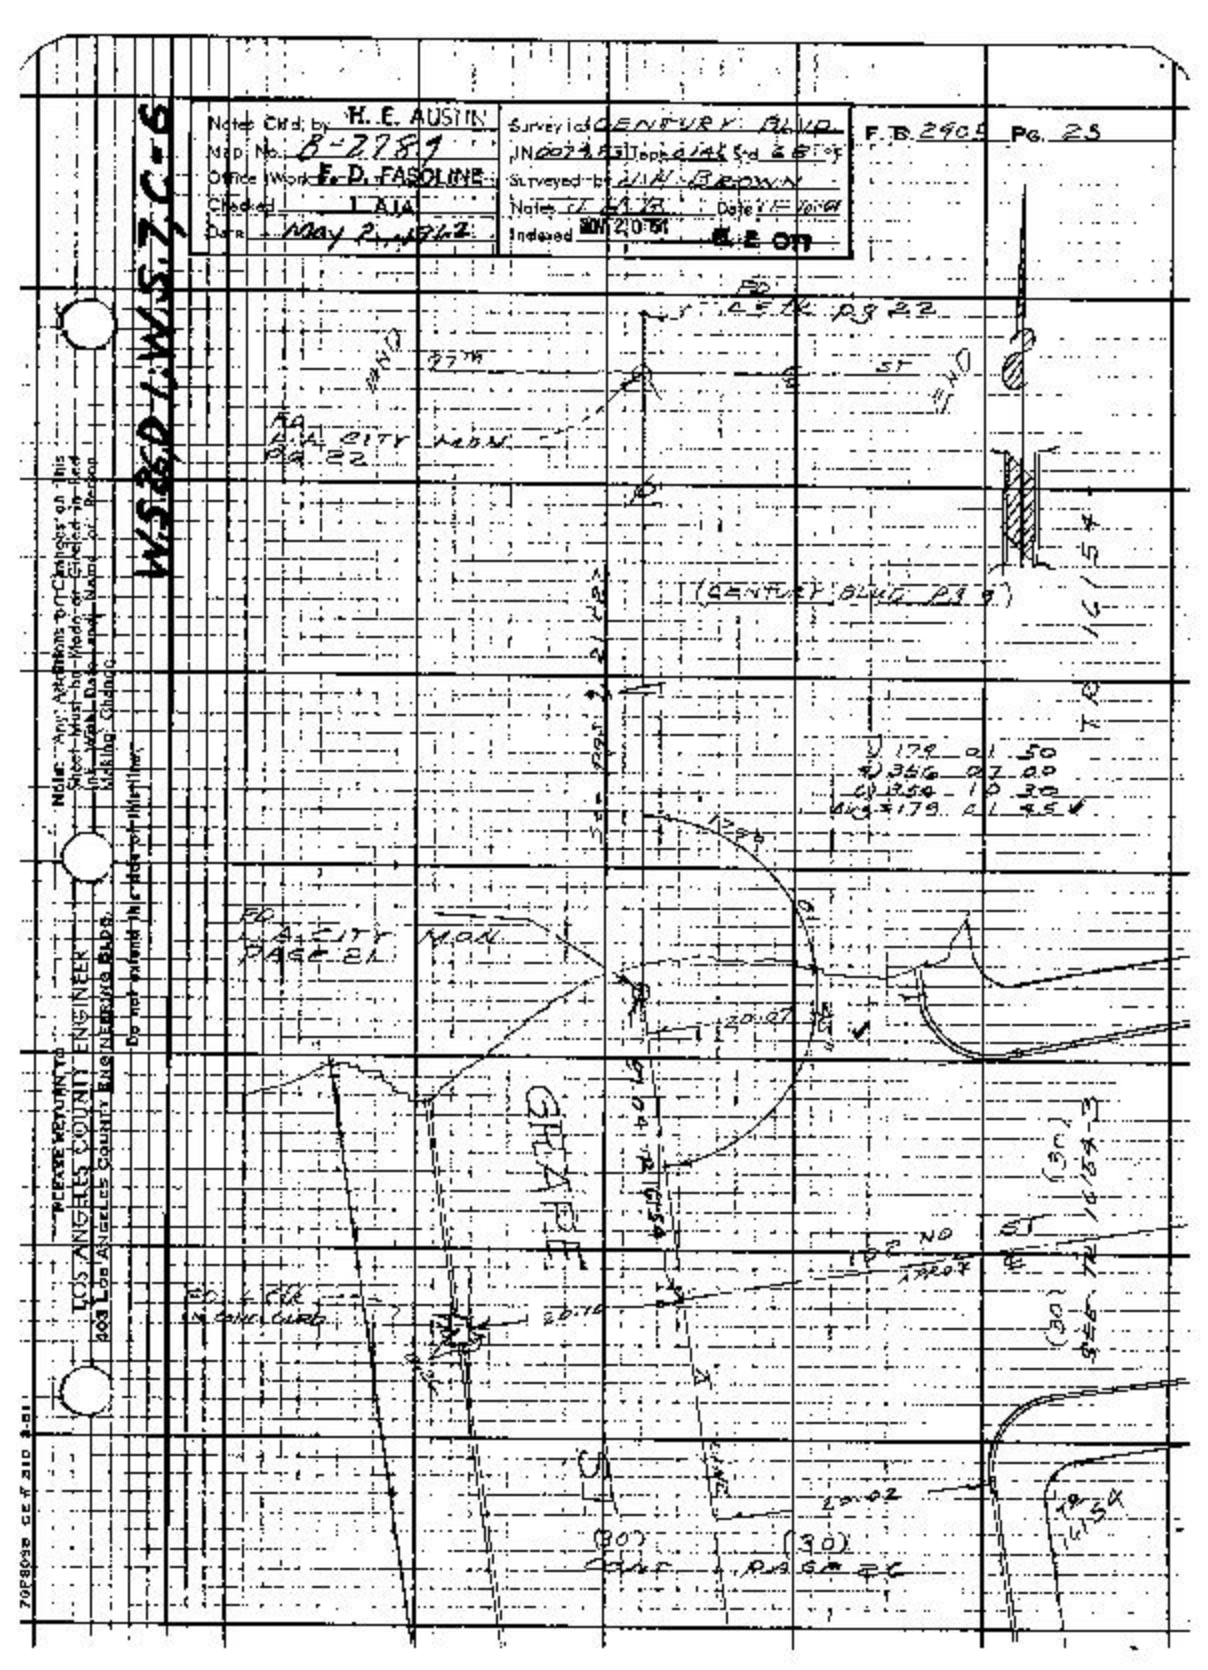
W.S.&D. 1-W.S.T.C-6
Notes Chkd. by H. E. AUSTIN
Map No. B-2781
Office Work F. D. FASOLINE
Checked L. AJA
Date May 2, 1962
Surveyed CENTURY BLVD
JN 0074 Topo 6141 Sht 2 of
Surveyed by W. M. BROWN
Notes T. A. 75 Date 1" = 10'
Indexed MAY 20 '61 E. E. ON
F. B. 2905 Pg. 25
Note: Any Additions or Changes on this Sheet must be Made or Checked in Red Ink. Work Based upon Name of Person Making Changes.
Do not submit this sheet for Microfilm
RETURN TO
LOS ANGELES COUNTY ENGINEER
Los Angeles County Engineering Bldg.
(CENTURY BLVD P.S.)
(30)
(80)

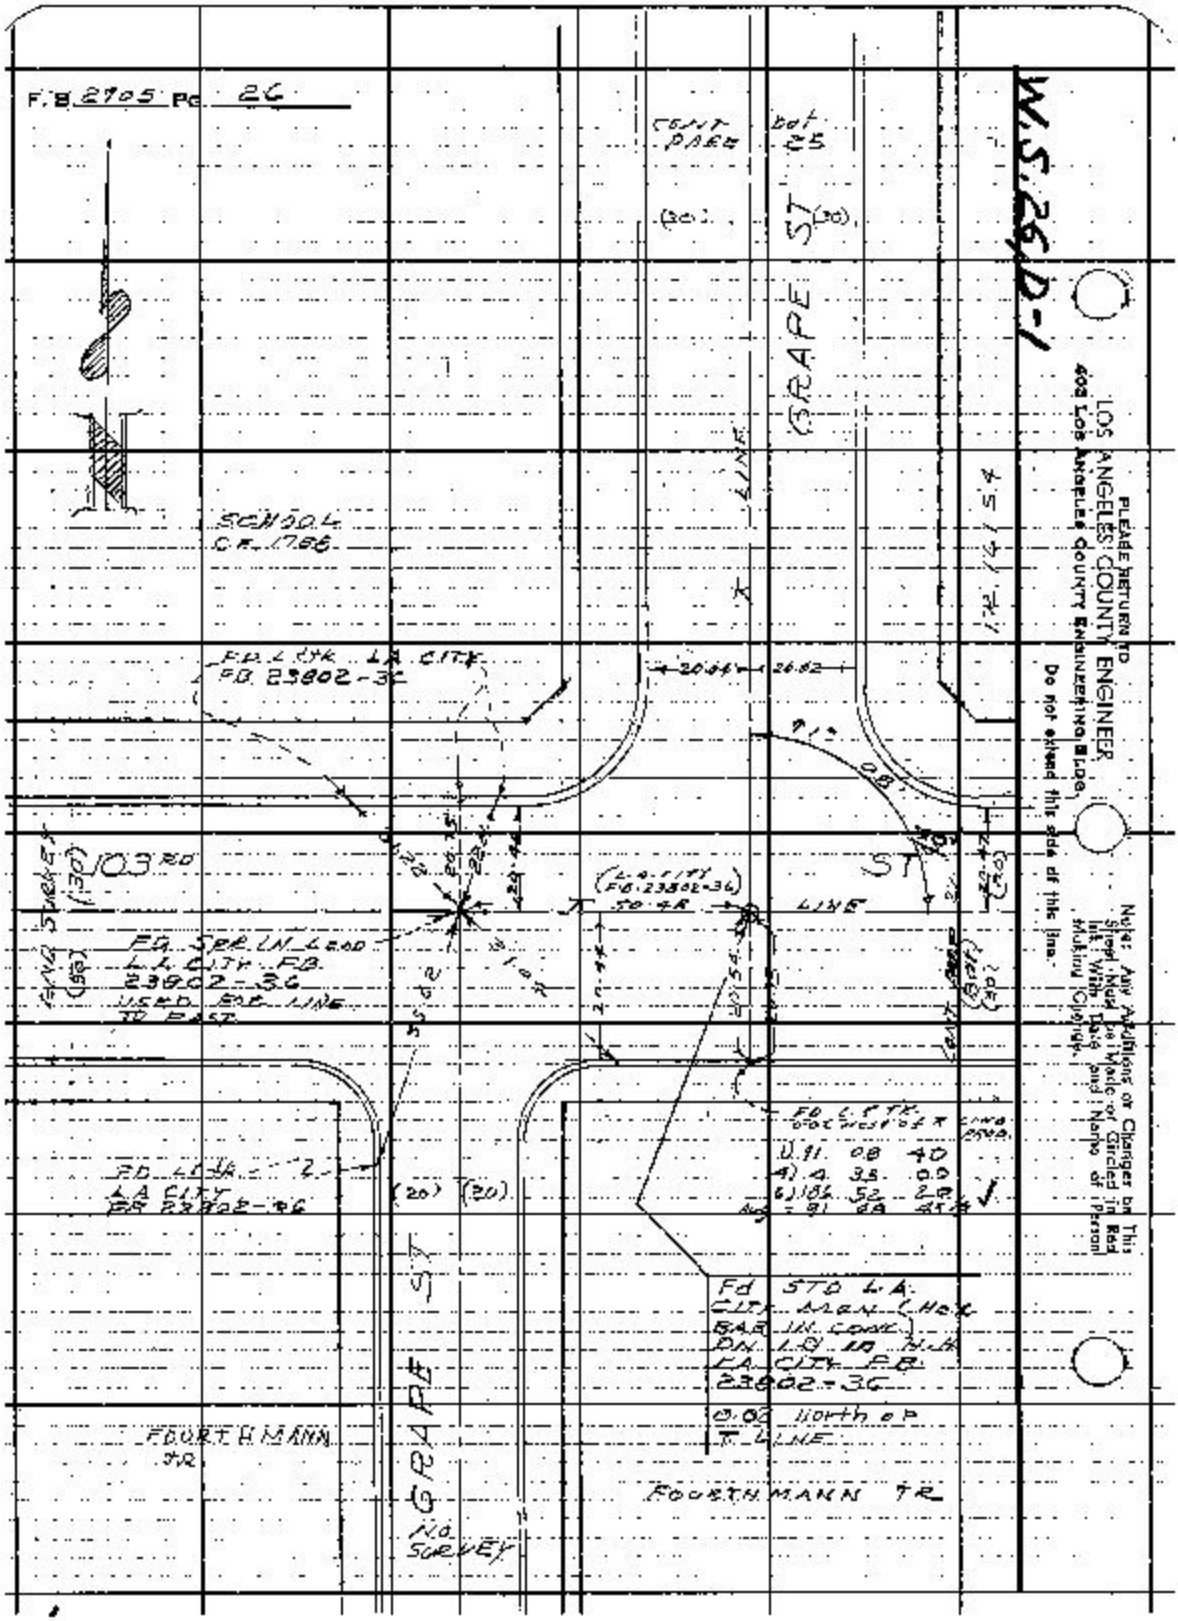
W.S. 26 D-1
F.B. 2705 Pg. 26
LOS ANGELES COUNTY ENGINEER
403 Los Angeles County Engineering Bldg.
PLEASE RETURN TO
Do not shred this side of this line.
Notice: Any Additions or Changes on This Sheet Must Be Made or Circled in Red Ink With Date and Name of Person Making Change.
COUNTY PARCEL
Bdy
25
GRAPE ST
(30)

Name Chkd By H. E. AUSTIN
Map No. B-2789
Office Work F. D. FASOLINI
Checked J. PUA
Date 1 May 2, 1962

Survey of CENTURY BLVD. JUNCTION Tp. 2 S., R. 5 W.
Surveyed by C. A. BROWN
Notes C. A. B. Date 4/10/62
Indexed H. E. ON

F. B. 220 Pg. 27

Notes: Any Additions or Changes on this Sheet Must be Made on Sheet Used in Field Ink Work Only Used Above Must Be Erased Making Changes

Please Return To
Los Angeles County Engineer
Room 603 Los Angeles County Engineering Bldg.

Do not extend this side of this line

CONC. BOX
PIPE 2 IN
(30) (30)

FOURTH MAN DR.

LOU DILLON
APPROX.
ST

NO SCALE

20.66
20.66
20.66

F.B. 2905 Pg. 25

W.S. 26 D-4

KALMIA APPROX ℄ ST.

JUNIPER APPROX ℄ ST.

CROESUS APPROX ℄ ST.

FOURTH AVENUE

CENT. PAGE (40)

L.T. NO 8607

FD. L. TAG R.E. S81°E (WORN OFF)

FD. 3/8 I.P. L.A. CITY MON. IN H.H. PNT. 1.5' ±

LOS ANGELES COUNTY ENGINEER
403 Hall of Records Los Angeles County Engineering Bldg.

PLEASE RETURN TO

Do not extend this data beyond this line.

Note: Any Additions or Changes on This Sheet Must be Made in Red Ink With Date and Name of Person Making Change.

W.S. 26, D-4

Notes Chd. by H. E. AUSTIN
Map No. B-2789
Office Work E. D. GASOLINE
Checked J. AJA
Date May 7, 1962

Survey of CENTURY BLVD.
Notes & Tape 0.46 S.A. E.B. "F"
Surveyed by W. H. BROWN
Notes C.N.B. Date 11-16-61
Indexed H. E. OTT

F. B. 2905 PG. 29

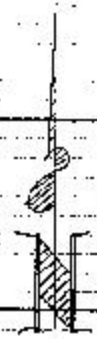

1)	34	14	10
2)	316	37	20 V
3)	115	25	40
	79	24	1639 V

ALAMEDA AVE.

CENTURY BLVD.

RAMP

Tool Hit 3 Arrows Mark

5" Alum. Cap

17.63

Ed. Lg. Ill
Pipe 20
See Page
20 Ed. Ea.
Side

N LINE

S LINE

40.00

Please Return To
LOS ANGELES COUNTY ENGINEER
Los Angeles County Engineering Bldg.
Do not extend information out of this area.

Note—Any Additions or Changes on this Sheet Must Be Made by Grantee in Red Ink With Date and Name of Person Making Change.

Form 3088 (6/59) 210 3-61

F.B. 2905 PG. 30

W.S. 26 B-7

LOS ANGELES COUNTY ENGINEER
405 Los Angeles County Engineering Bldg.

PLEASE RETURN TO

Do not spread this dot of this line.

Notice: Any Additions or Changes on This Sheet Must Be Made or Cancelled in Red Ink With Date and Name of Person Making Change.

CONT LEFT PAGE 29

(30) (30)

RANCHO SAN ANTONIO

FENCE LINE

FENCE LINE 1.50 SOUTHERLY

FENCE LINE

WEIGAND AVE

APPROX ℄ ST

(60)

FD NO 2366

FD NO 2366

FD NO 2366

FENCE LINE

FENCE LINE

FENCE LINE

W.S. 26 D 1

Notes Ckd by J. AIA
Map No. B-2789
Office Work E. D. FASOLINO
Checked J. AIA
Date May 2, 1962

Survey of CENTURY BLVD.
JN 2029 B3 Tape 0146 Sta 64 to F
Surveyed by J. W. Brown
Notes J. W. B. Date FEB '62
Indexed H. E. CITY MAR 2 '62

F. B. 2905 Pg. 21

41.12 Lau (T=62) = 41.12
110.82 Lek (T=60) = 110.82
110.82 Low (T=60) = 110.82
93.20 Lev (T=60) = 93.20
67.21 Lev (T=60) = 67.21

FIELD HOUSE

PLAYGROUND "JORDAN DOWNS"

Δ=14°02'20"
R=900.00'
T=110.82 L=220.48

Sd L.L.A.Co. Eng. tag in conc. walk

Fd 2x2 nail DN 30" pk-pg 10 Removed

Fd 2x2 nail DN 20" Removed

Sd L.L.A.Co. Eng. tag in conc. walk

CENTURY BLVD

Sd L.L.A.Co. Eng. tag Stub in conc. walk

COUNTY ENGINEER R.E. 5869

COUNTY ENGINEER R.E. 5869

COUNTY ENGINEER R.E. 5869

BC Sec. S.D. L.A. Co. Corner Mon. DN .22' by Line & Dist. per map.

PC Fd 2x2 & nail DN 30" pk-pg 10 replaced with Std. Corner Capped Mon. Cut X Marked as shown

EC Sd Std. L.A. Co. Corner Brass Capped Mon. DN .22' by Line & Dist. per map.

Please Return to Los Angeles County Engineer Engineering Section, Room 1, Hall of Records, Los Angeles 12, Calif.

Do not extend this title of this date.

Note: Any Additions or Changes on this Sheet Must be Made or Checked in Red Ink with Date and Name of Person Making Change.

F. B. 2905 Pg. 32

WS 29-D-1

105 A.M.
402 Los Angeles County Engineering Bldg.

COUNTY ENGINEER

Do not extend this side of this line.

Note: Any Additions or Changes on This Sheet Must Be Made & Initialed in Red Ink With Date and Name of Person Making Change.

RT
To Exc Road
Im 84" RCP
Page 11
Replaced With
STD CO ENGR
Rings Capped
MSN OA 84"
Manhole as Shown

Fd Mill in
Conc Mon per
Page 11

BLVD

CENTURY

Fd Exc Nail
in 84" RCP
Remain

Fd Mill in
Conc Mon per
Page 11

Fd 1/2" I.P. Sand Plug
Flush per CE 5919
Page 11

Std STD CO ENGR
MAN CL 84" DY
LINE & DIST per
M.B.D. Modified
as Shown

RC

Δ = 15°12'55"
R = 900.00'
T = 120.21'
L = 239.00'

63.55 Page 11
14
63.14 calc.

77.19 Lic (T=60) = 44.18'
120.27 Rad (T=60) = 120.21'
120.22 Lic (T=60) = 120.21'