| | | | |
|---|---|---|---|
| Notes Ck'd by | | Survey of | |
| Map No. | | JN | Tape Std °F |
| Office Work | | Surveyed by | |
| Checked | | Notes | Date |
| Date | | Indexed | |

F.B. 2910 Pg.

| Page | Job | Description |
|---|---|---|
| | | OLIVE VIEW HOSPITAL J.N. 0022.08 |
| 5-75 | Loc.Imp | Water lines. |
| 76-125 | Loc.Imp | Electrical Lines. |
| 126-169 | Loc.Imp | Sewer lines. |
| 170-175 | Loc.Imp | Drains. |
| 176-185 | Loc.Imp | Gas lines. |
| 186-249 | Loc.Imp | Water lines. |

Note: Any Additions or Changes on this Sheet Must be Made or Circled in Red Ink With Date and Name of Person Making Change

Do not extend this side of this line.

PLEASE RETURN TO
LOS ANGELES COUNTY ENGINEER
403 Los Angeles County Engineering Bldg.

[redacted] microfilmed April '85

7623093 CE #310 8-68

Notes Cal'd by
Draw No.
Office Work
Checked
Date

Survey of OLIVE VIEW HOSPITAL
Job 0022-06 Tape Std. 1F
Surveyed by
Notes Date
Indexed 4-25-68

F. B. 2910 Pg. 3

# INDEX

| | | |
|---|---|---|
| PAGES | 5 - 75 | INCL. WATER |
| " | 76 - 125 | " ELECTRICAL |
| | 126 - 169 | " SEWERS |
| | 170 - 175 | " DRAINS |
| | 176 - 185 | " GAS |
| | 186 - 230 | " WATER |

Note: Any additions or changes on this sheet must be made or signed by the Chief Engineer. Do not attach this slip to this like.

COUNTY OF LOS ANGELES
DEPARTMENT OF PUBLIC WORKS
COUNTY ENGINEER

Notes Ck'd by
Map No.
Office Work S.S.
Checked
Date 9/24/41

Survey of Olive View Hosp.
JN 0077.06 Tape Std °F.
Surveyed by Sotro
Notes Bowles Date 5-24-61
Indexed E. J. GALLI

F.B. 2910 Pg. 7

REST ROOMS
1 Story frame Bldg
Co. No 3016.1
conc. walk
2.7
4.8
conc. walk
Traffic Island & Planter
3/4" Hose bib.
18.6
3/4" water
2.4
23.3
4" conc. curb
33.5
29.4
conc. Walk
Valve
9.2
conc. walk
WARD No 401 & 402
Power Panel

Notes: Any Additions or Changes on This Sheet Must be Made or Circled in Red Ink With Date and Name of Person Making Change.
Do not Erase this Line

PLEASE RETURN TO
LOS ANGELES COUNTY ENGINEER
7007 Los Angeles County Engineering Bldg.

7552088 SAS Mar 11-58

F. B. 2910 Pg. 8

PLEASE RETURN TO
LOS ANGELES COUNTY ENGINEER
700 Los Angeles County Engineering Bldg.

Do not extend this date of this Print.

Note: Any Additions or Changes on This Sheet Must Be Made or Circled in Red Ink With Date and Name of Person Making Change.

3/4" Hose Bibs

3/4" Water

204' of 10"

3/4" H.B.

Valve

3/4" Water

3/4" Hose

Valve

3/4" H.B.

3/4" Water

Traffic Island

Traffic Island

Curb Face

Curb Face

7GF3096 SAK #247 1-58

PLEASE RETURN TO
LOS ANGELES COUNTY ENGINEER
700 LOS ANGELES COUNTY ENGINEERING BLDG.

Note: Any Additions or Changes on This Sheet Must be Made or Circled in Red Ink With Date and Name of Person Making Change.

Do not extend this side of this line

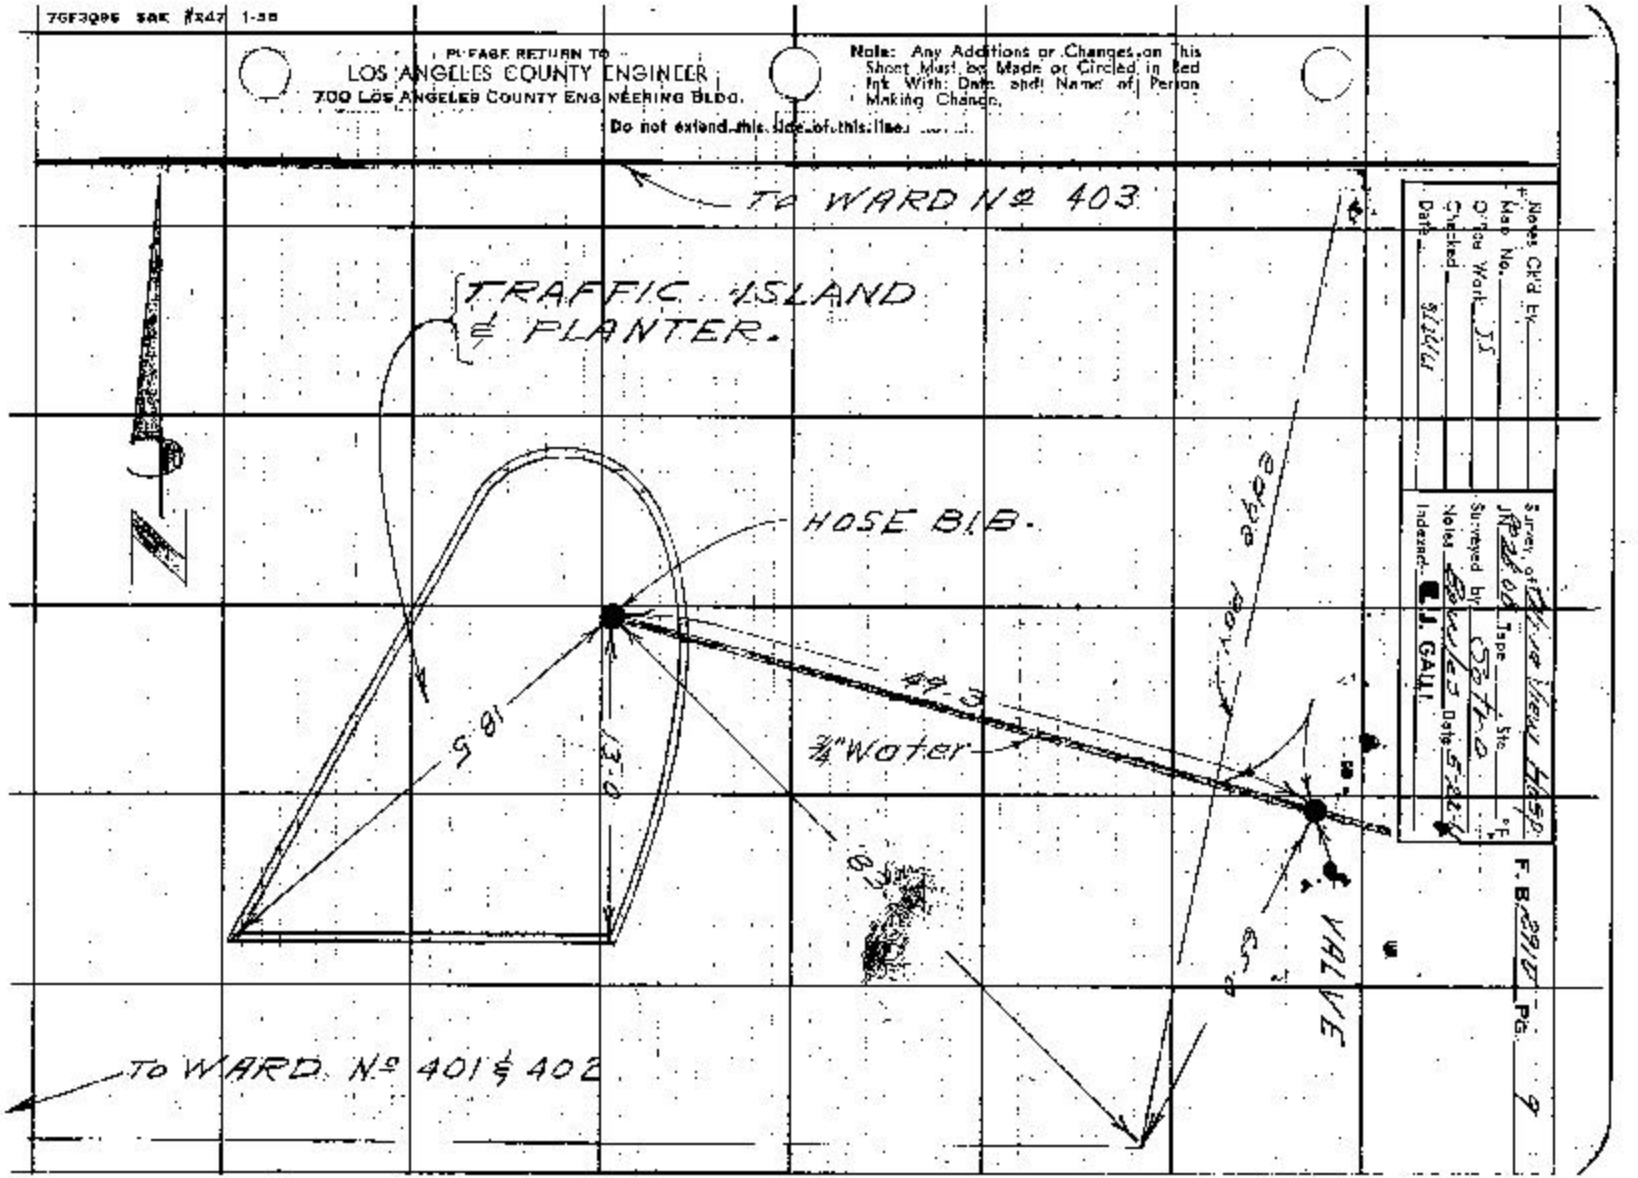


Notes Ckd by
Map No.
Office Work JS
Checked
Date 5/24/61

Tape Sta. to
Surveyed by Bowles Date 5-22-61
Notes
Indexed E.J. GALL

F. B. 2912 Pg. 9

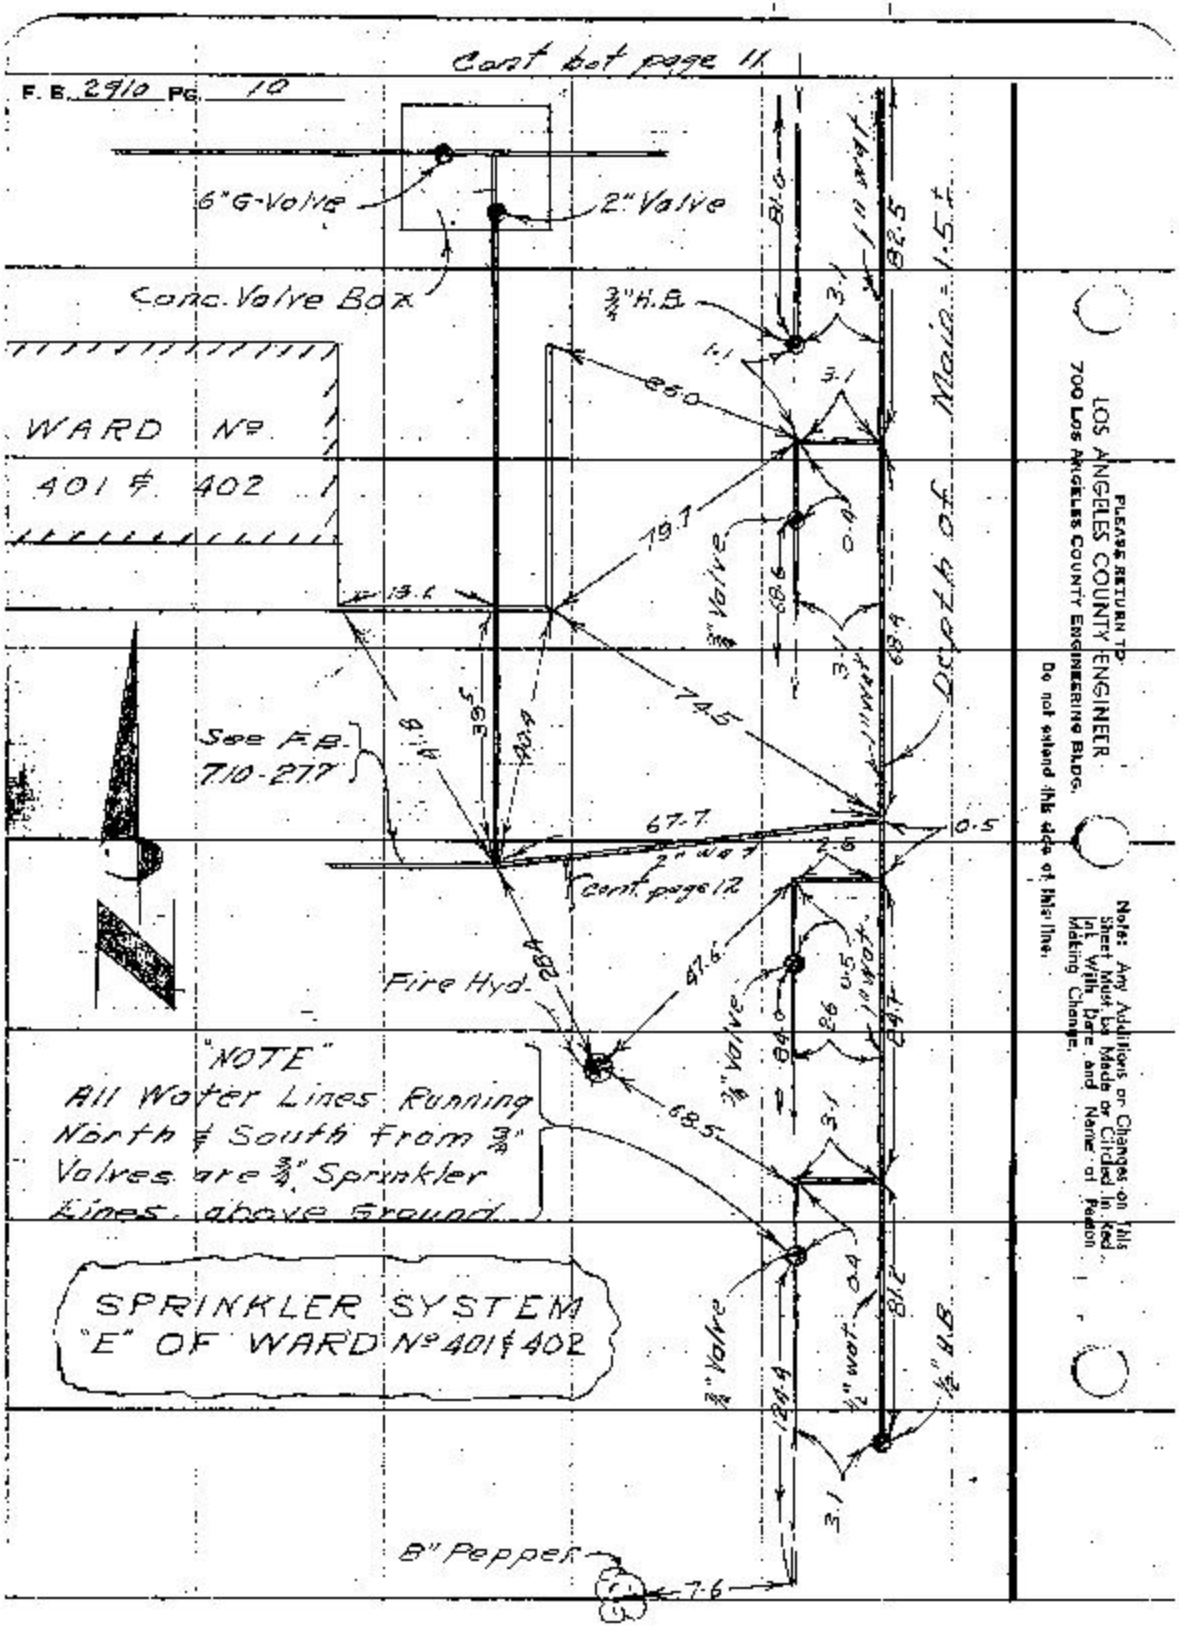
Cont bot page 11
F. B. 2910 PG. 10
6"G-Valve
2" Valve
Conc. Valve Box
3/4" H.B.
WARD No.
401 & 402
See F.B. 710-277
Fire Hyd.
"NOTE"
All Water Lines Running North & South from 3/4" Valves are 3/4" Sprinkler Lines above Ground.
SPRINKLER SYSTEM "E" OF WARD No 401 & 402
8" Pepper
Cont. page 12
Dist'd of Main = 1.5 ft.
LOS ANGELES COUNTY ENGINEER
700 LOS ANGELES COUNTY ENGINEERING BLDG.
PLEASE RETURN TO
Do not extend this side of this line.
Notes: Any Additions or Changes on this Sheet Must be Made or Circled in Red Ink with Date and Name of Person Making Change.

75F2058 S&E #247 1-66

PLEASE RETURN TO
LOS ANGELES COUNTY ENGINEER
7100 LOS ANGELES COUNTY ENGINEERING BLDG.

Note: Any Additions or Changes on this Sheet Must be Made or Circled in Red Ink With Date and Name of Person Making Change.

Do not extend this line of this line.

Traffic Island & Planter.

For detail of this Line see Pg

SPRINKLER SYSTEM "E" OF WARD No 401 & 402

1 Story Frame Garage.

¾" H.B.

¾" Valves

¾" H.B.

¾" Water

¾" H.B.

1" Water

Valve

Valve

Water

Depth of this Pipe 1-5±

Note ¾" Sprinkler System approx 1-5 above ground.

8" Flowering Euc.

Fire Hyd.

Notes Ck'd by _____
Map No. _____
Office Work SS
Checked _____
Date 8/16/61

Surveyed by Sterns Date 6-8-61
Notes Sprinklers
Indexed C. J. GAILL

F. B. 291 PG. 11

PLEASE RETURN TO
LOS ANGELES COUNTY ENGINEER
700 LOS ANGELES COUNTY ENGINEERING BLDG.

Note: Any Additions or Changes on This Sheet Must be Made or Circled in Red Ink With Date and Name of Person Making Change.

Do not extend this side of this line

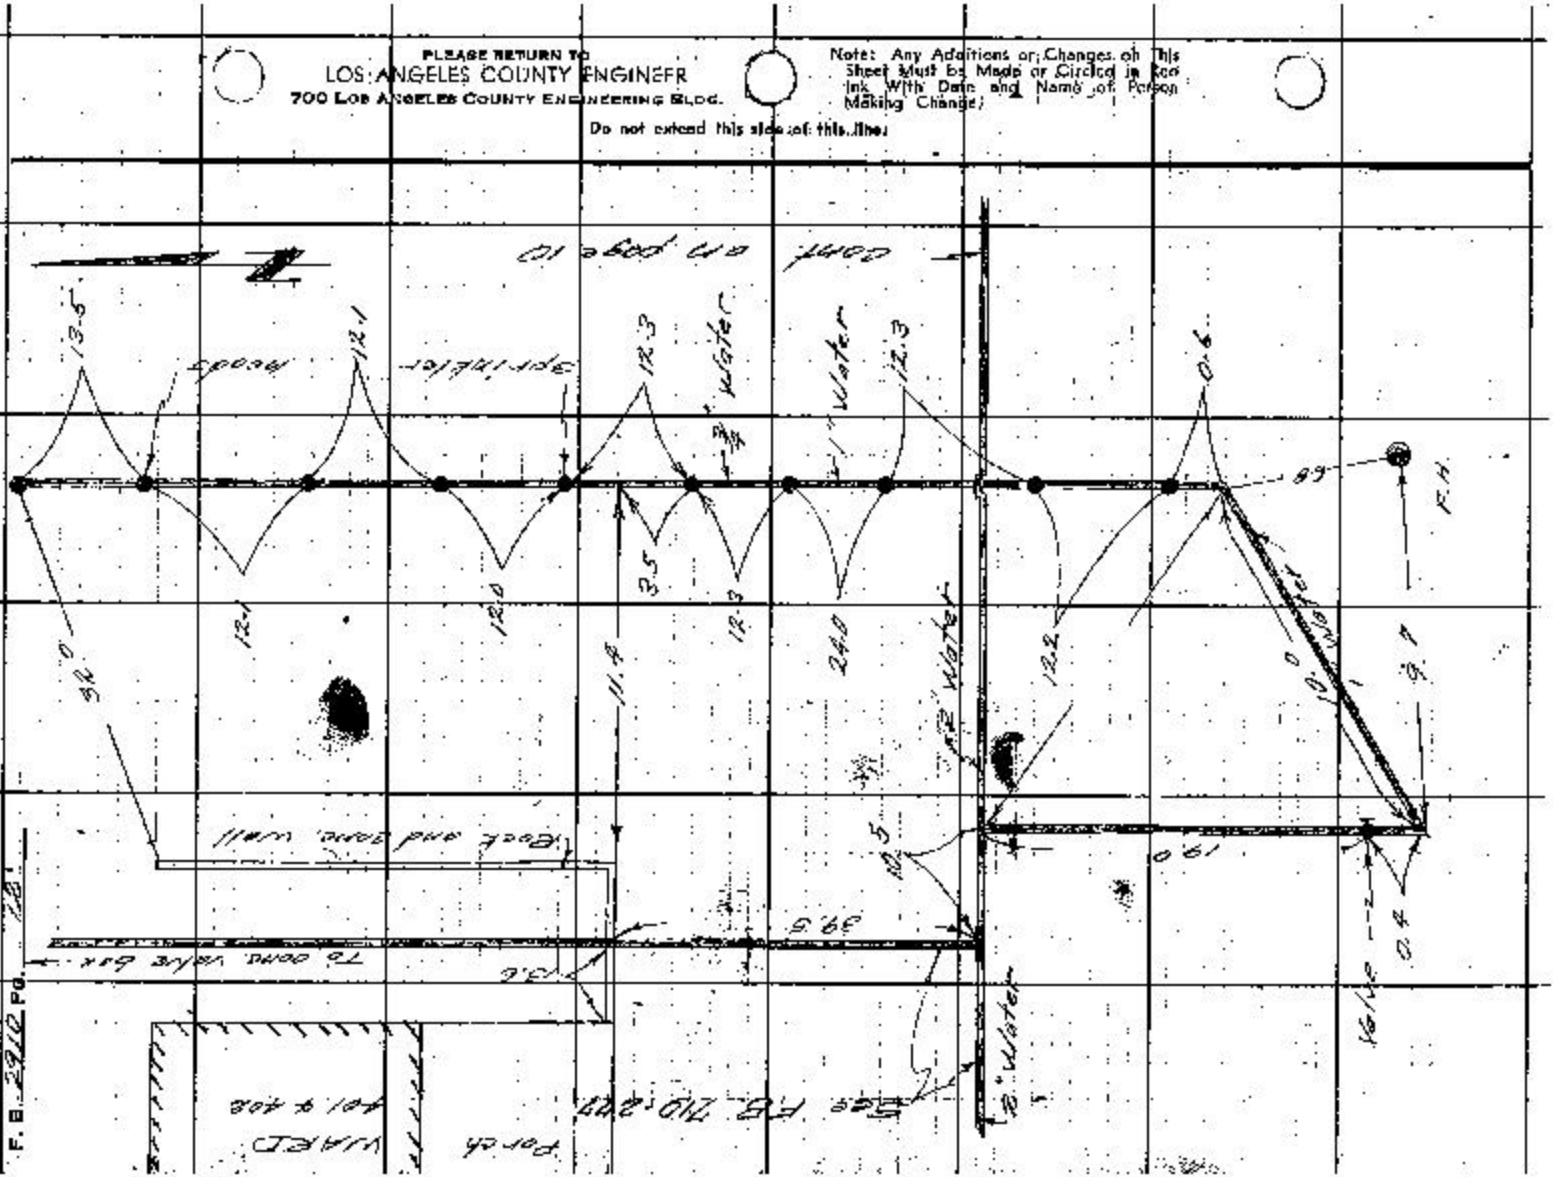

76F3098 882 #247 11-58

—PLEASE RETURN TO—
LOS ANGELES COUNTY ENGINEER
700 LOS ANGELES COUNTY ENGINEERING BLDG.
Do not extend this side of this line

Note: Any Additions or Changes on This Sheet Must be Made or Circled in Red Ink With Date and Name of Person Making Change.

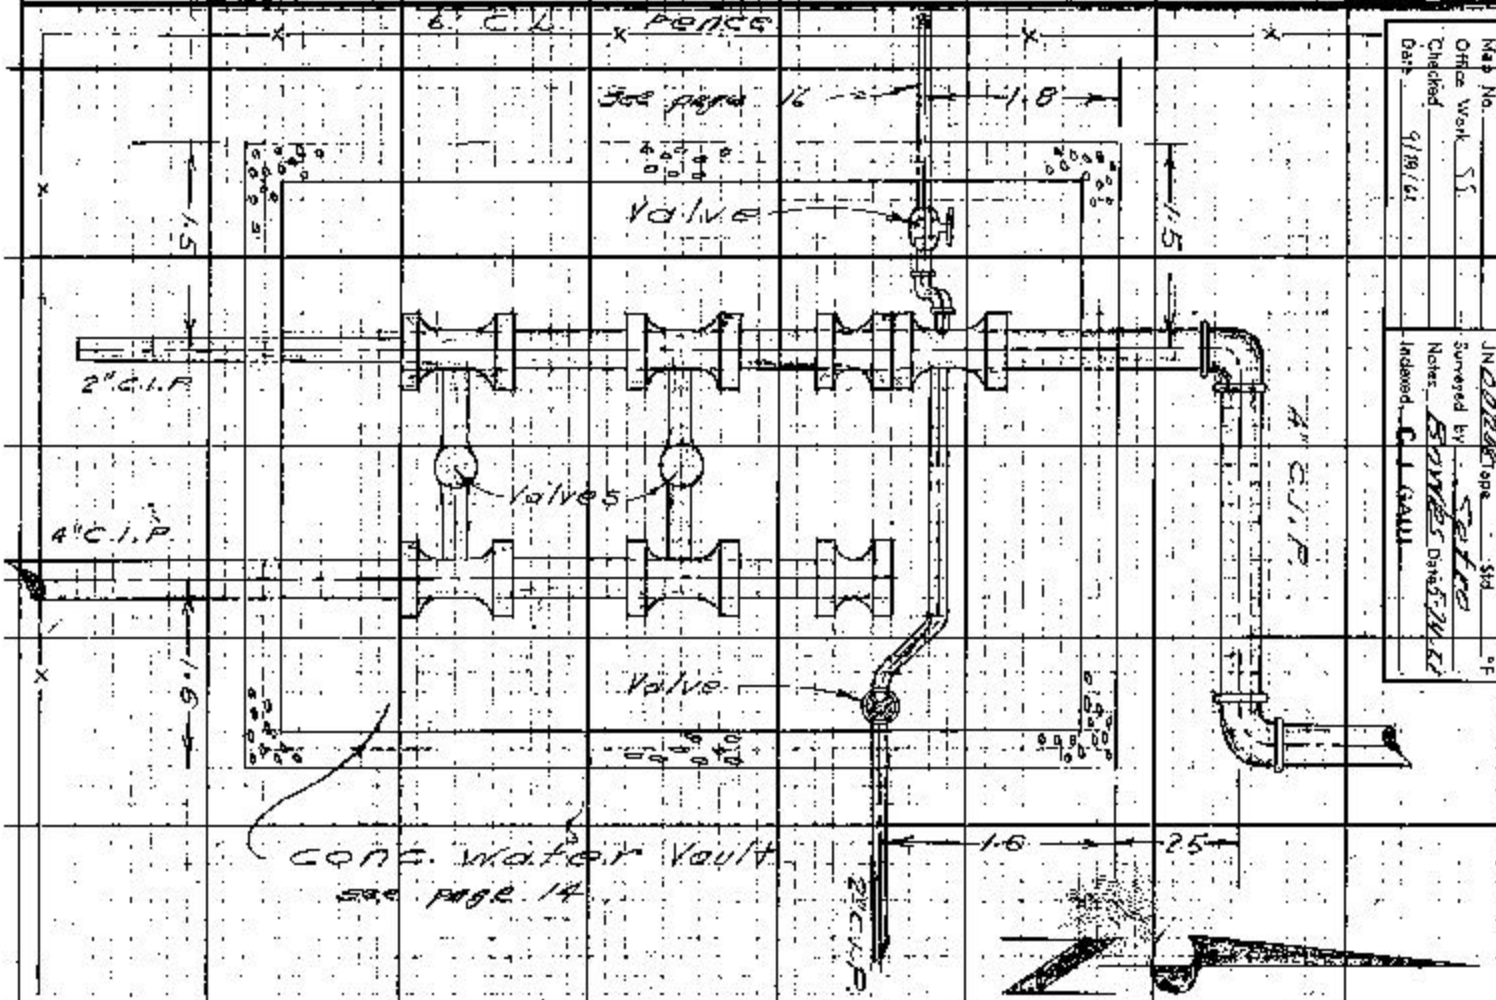


Notes: Ck'd. by
Map No.
Office Work
Checked 9/18/61
Date

Survey of Olive View Hosp
JN 0228 Tape Std °F
Surveyed by Soltes
Notes
Indexed C.J. Gau

F. B. 2918 Pg. 13

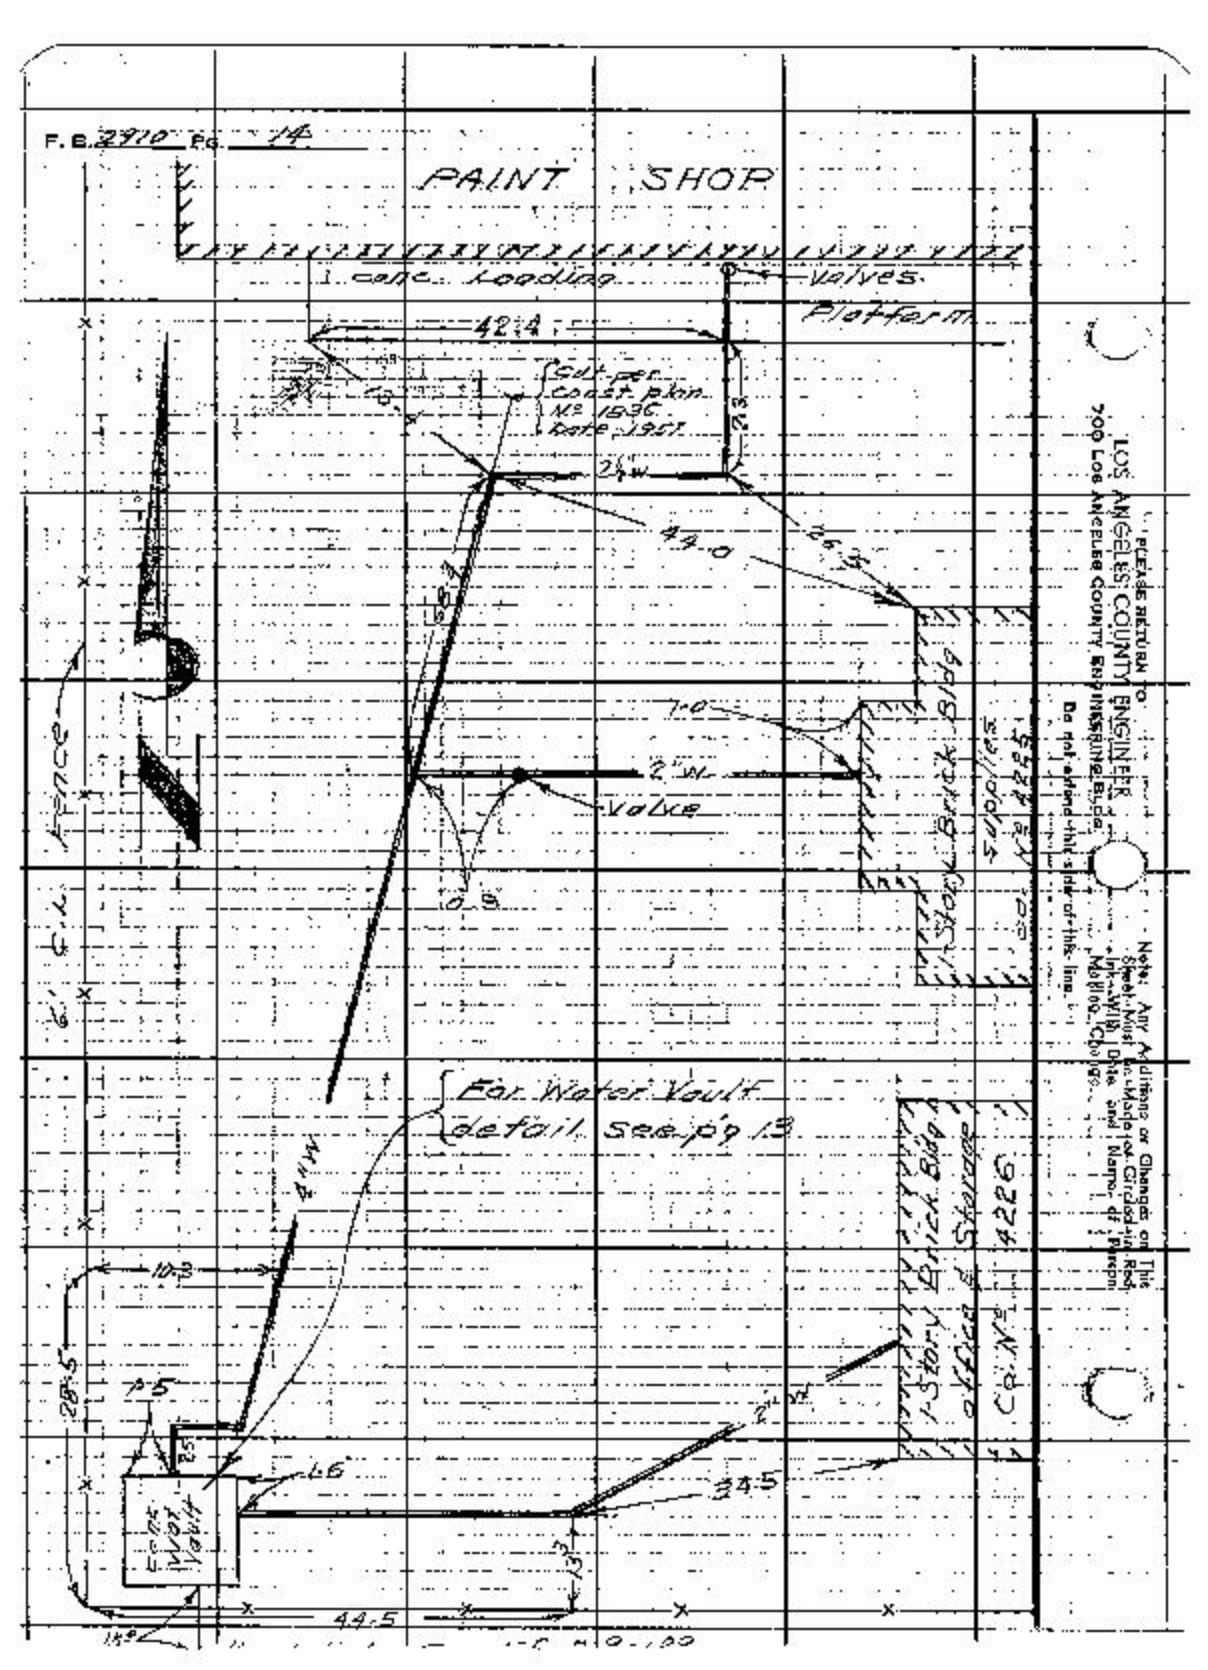
F. B. 2910 Pg. 14
PAINT SHOP
1 conc. loading
Valves
Platform
42.4
Std. Det. Const. Plan No. 1936 Date 1951
2½"W
49.0
26.9
7.0
2"W
Valve
0.9

Notes Ck'd by
Map No.
Office Work SS
Checked
Date 9/14/61

Survey of Olive View Hosp. F.B. 2910 Pg. 15
JN 202208 Tape Std °F
Surveyed by Setco
Notes Bowles Date 8-2-61
Indexed C. J. GALLI

Note: Any Additions or Changes on This Sheet Must be Made on Circled Jn. Nbd. Info With Date and Name of Person Making Change

Do not extend this side of this line.

PLEASE RETURN TO
LOS ANGELES COUNTY ENGINEER
700 LOS ANGELES COUNTY ENGINEERING BLDG.

1-STORY BRICK BLDG
PLUMBING SHOP

County Bldg No 4227

22.3

0.9

0.2

3/4" W

3/4 H.B.

Note
This Water Line Serviced from inside Bldg

PREVIOUS BOE #227 (11-58)

PLEASE RETURN TO
LOS ANGELES COUNTY ENGINEER
700 Los Angeles County Engineering Bldg.

Notes: Any Additions or Changes on This Sheet Must be Made or Circled in Red Ink With Date and Name of Person Making Change.

Do not extend this side of this line. →

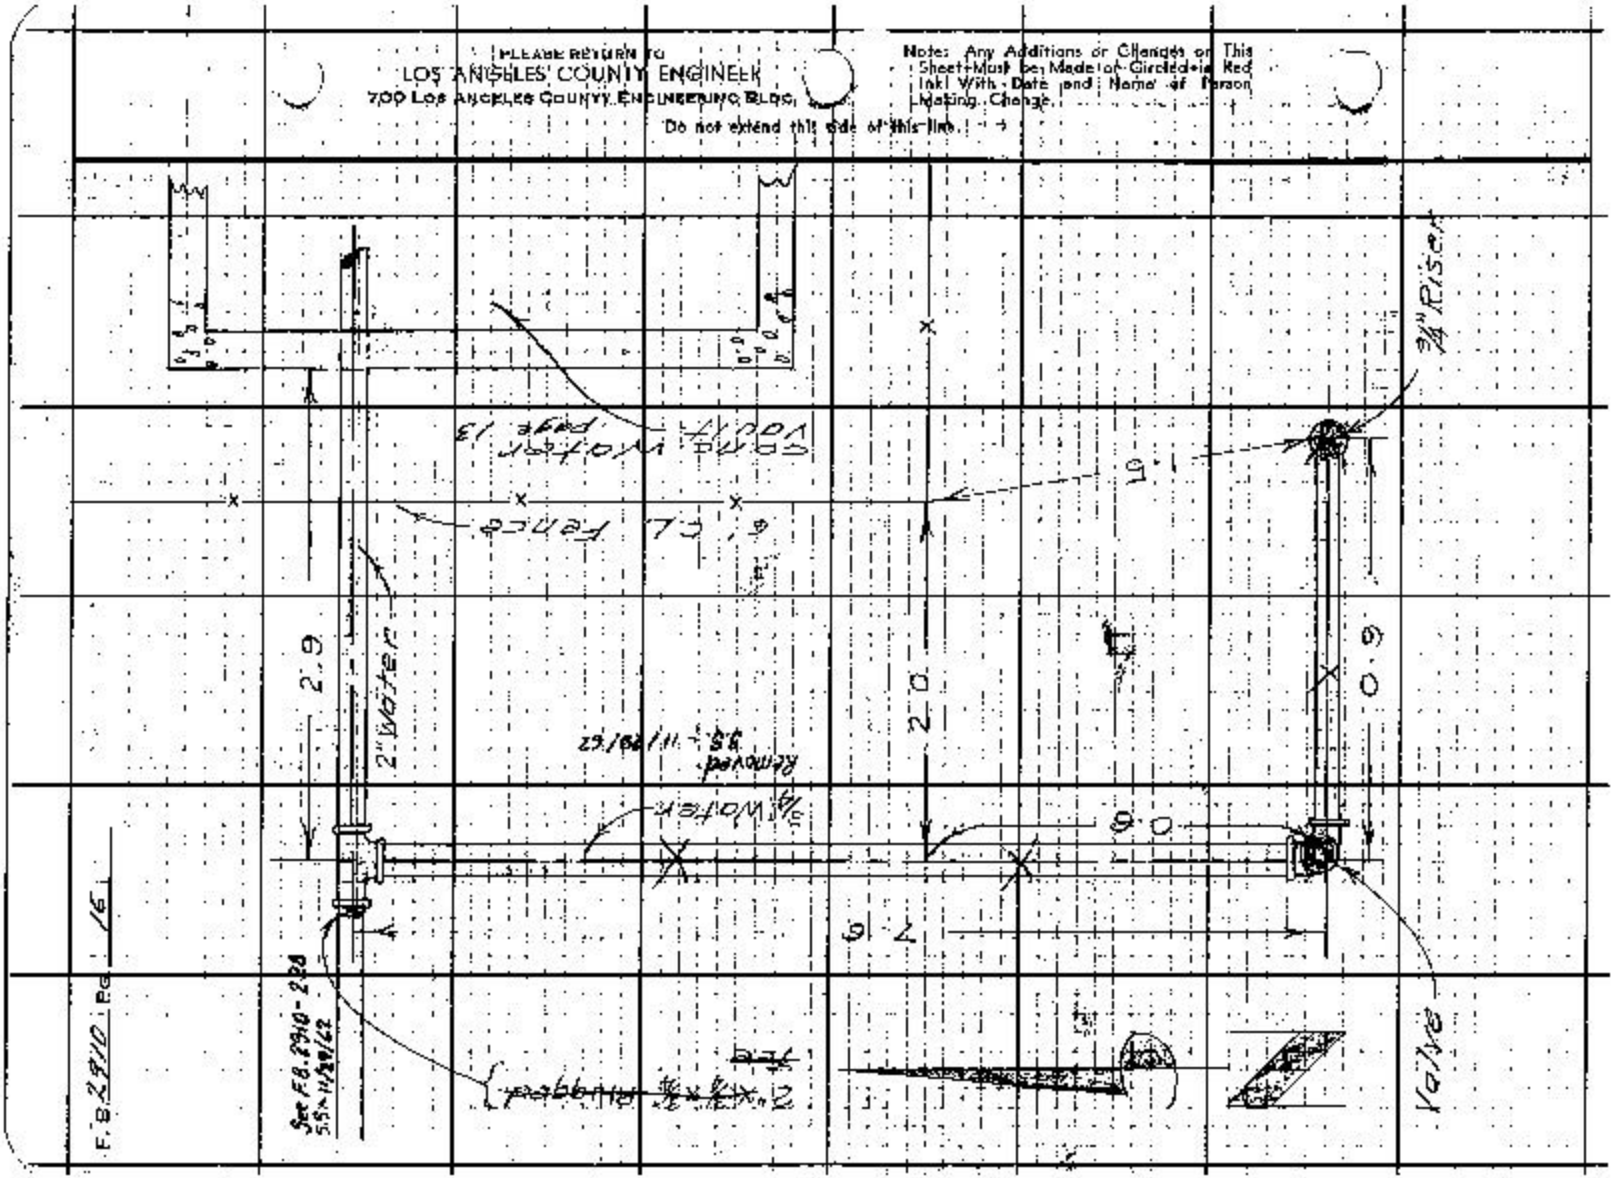

76F8098 SAE #247 1-66

PLEASE RETURN TO
LOS ANGELES COUNTY ENGINEER
700 LOS ANGELES COUNTY ENGINEERING BLDG.

Note: Any Additions or Changes on This Sheet Must be Made or Circled in Red Ink With Date and Name of Person Making Change.

Do not extend this side of this line.

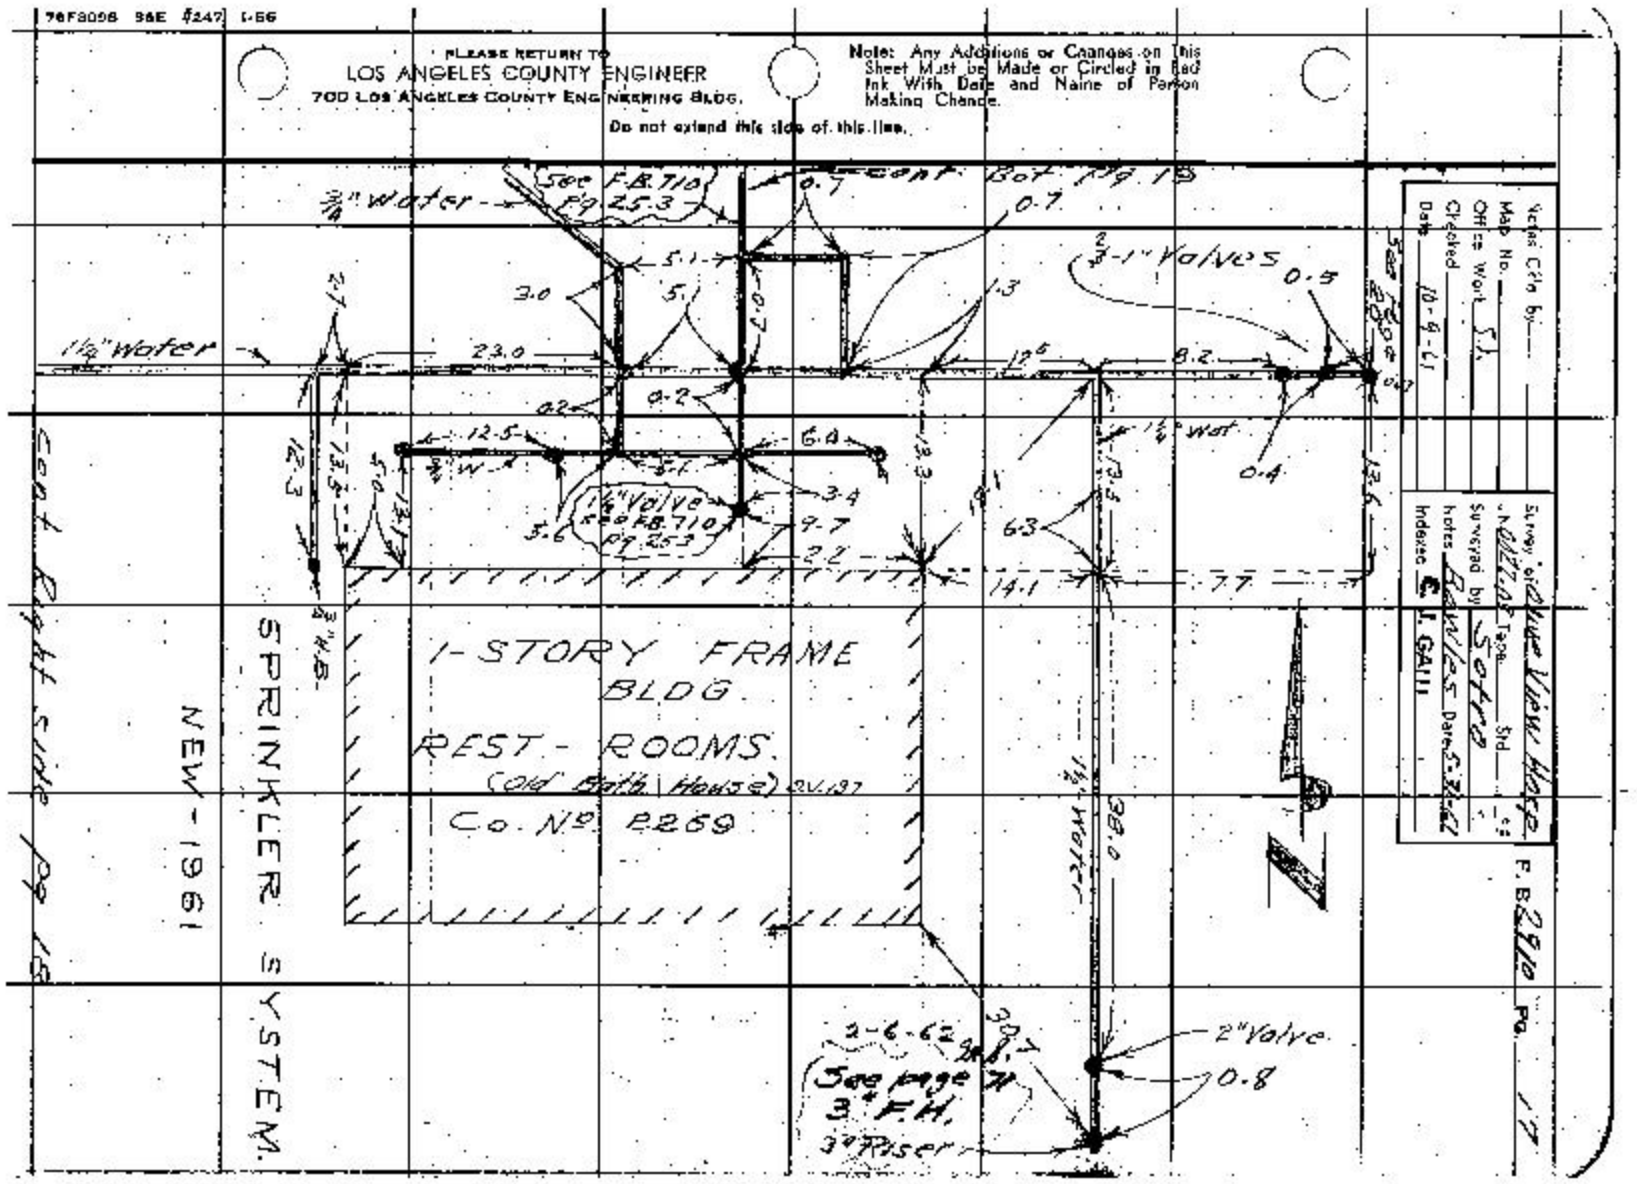


Victor Cty by
Map No.
Office Work S.J.
Checked
Date 10-9-61

Map Tract Std
Surveyed by Sohre
Notes Rawlins Dated 5-22-62
Indexed E. J. GALLI

F.B. 2910 Pg. 17

PLEASE RETURN TO
LOS ANGELES COUNTY ENGINEER
700 LOS ANGELES COUNTY ENGINEERING BLDG.

Note: Any Additions or Changes on This Sheet Must be Made or Circled in Red Ink With Date and Name of Person Making Change.

Do not extend this side of this line.

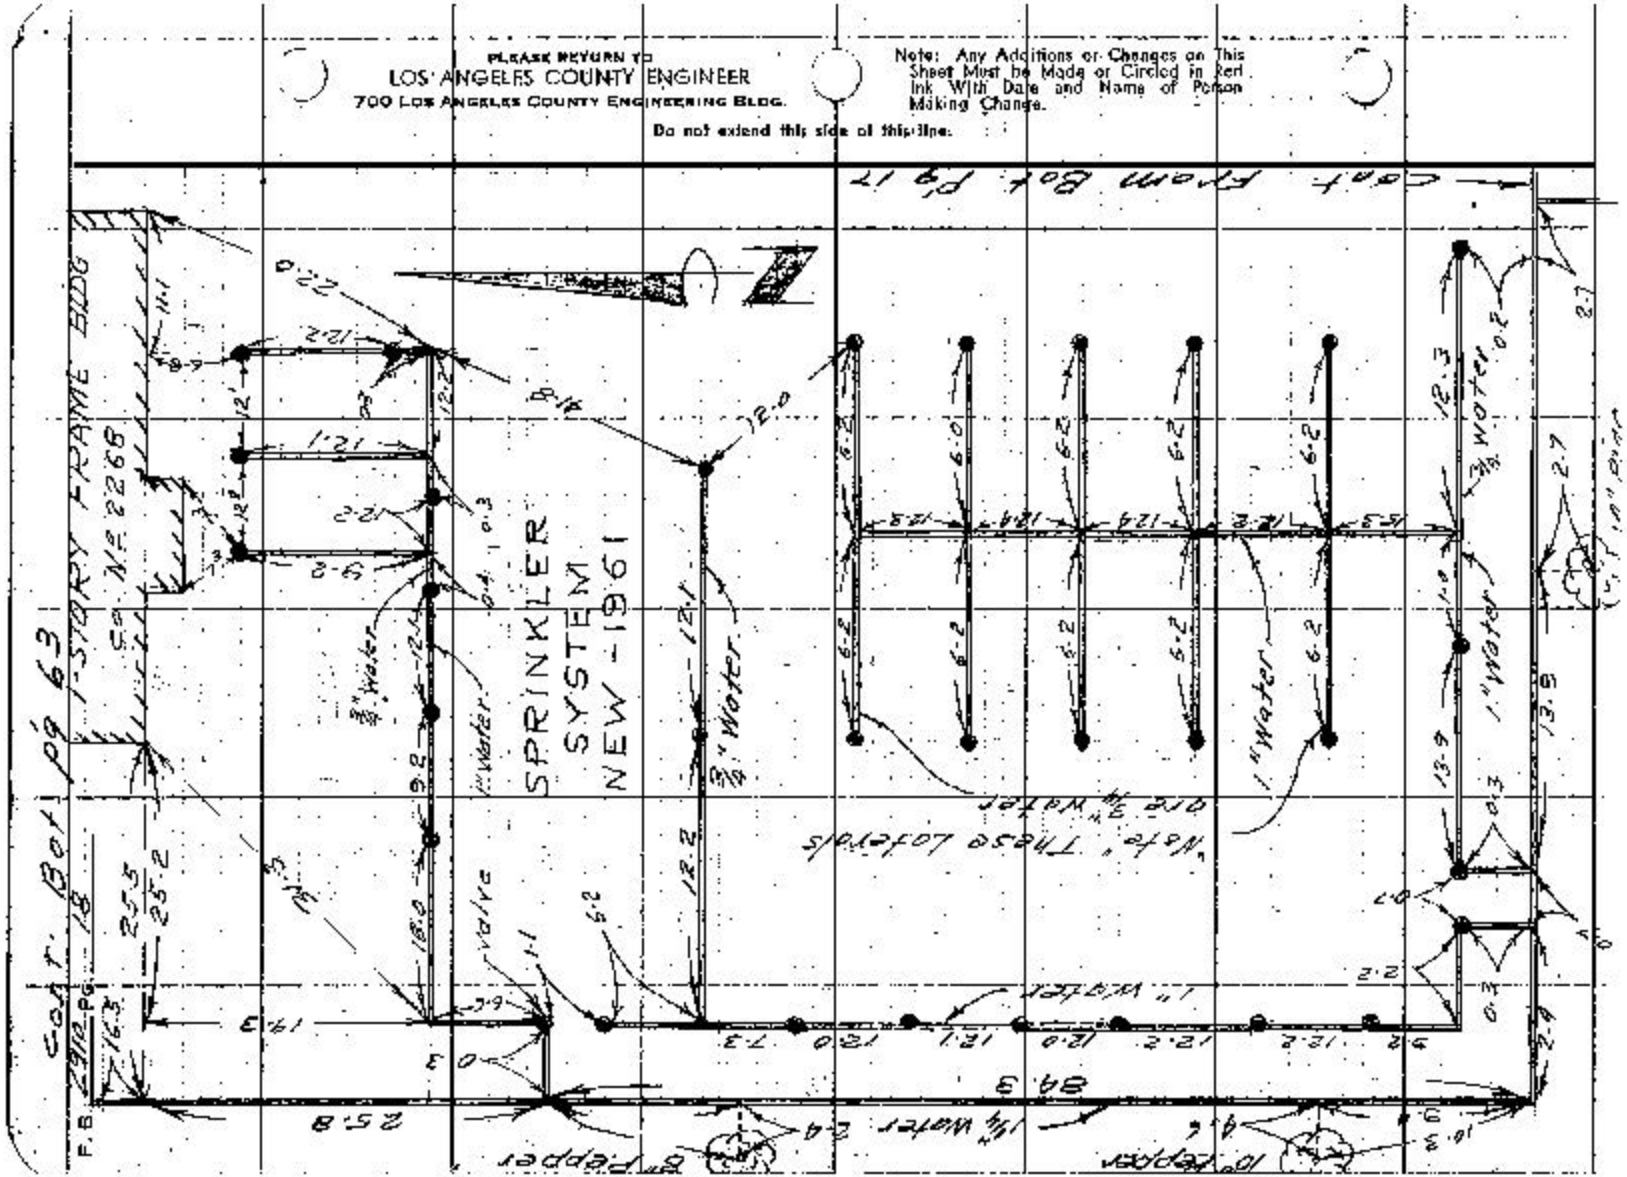

Notes Ck'd by
Map No.
Office Work SJ
Checked
Date 10/9/61

Survey of Olive View Hosp. F. B. 2910 Pg. 19
JN 0022 Tape Sta PF
Surveyed by Sotvo
Notes Raw Data Date 6-1-61
Indexed C. I. GALLI

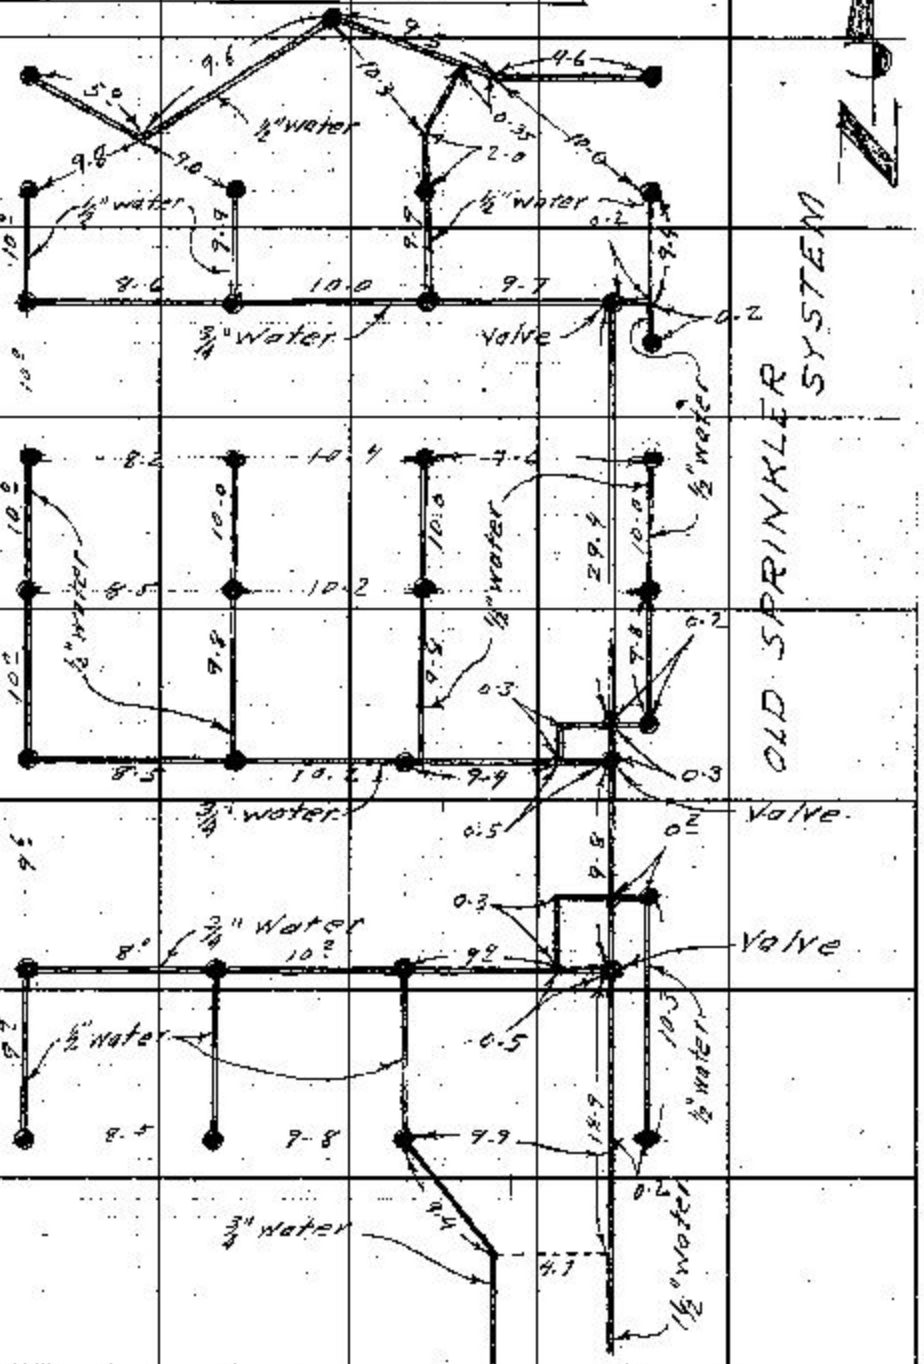


Note: Any Additions or Changes on This Sheet Must be Made or Circled in Red Ink, With Date and Name of Person Making Change.
Do not extend this data beyond this line.

PLEASE RETURN TO
LOS ANGELES COUNTY ENGINEER
700 LOS ANGELES COUNTY ENGINEERING BLDG.

78F3085 SAK 8247 1-56

cont. from left

PLEASE RETURN TO
LOS ANGELES COUNTY ENGINEER
700 LOS ANGELES COUNTY ENGINEERING BLDG.

Note: Any Additions or Changes on This Sheet Must be Made or Circled in Red Ink With Date and Name of Person Making Change.

Do not extend this side of this line.

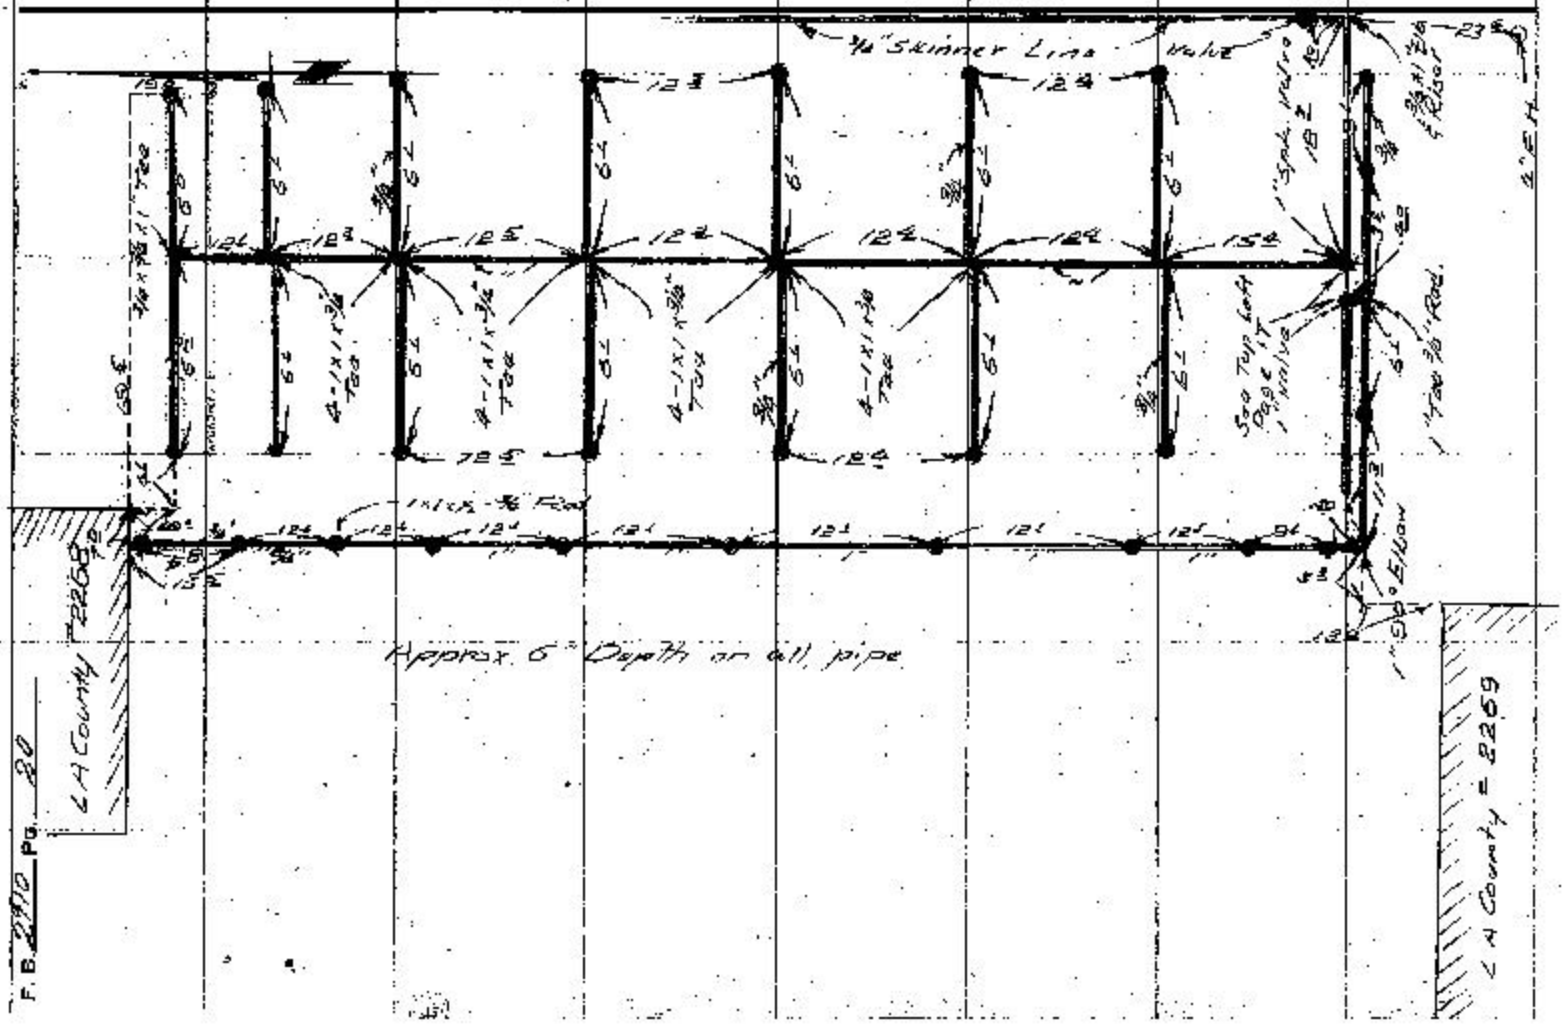

Notes Ch'd by
Map No.
Office Work SS
Checked
Date 10/9/61

Survey of OLIVE VIEW HOSPITAL F. B. 2915 Pg. 21
JN 5022.09 Tape S-a °F
Surveyed by M. Sotro
Notes Bailey Date 5-1-61
Indexed C. J. Gatti

Note: Any Additions or Changes on this Sheet Must be Made, or Circled in Red Ink With Date and Name of Person Making Change.
Do not extend this side of this line.

PLEASE RETURN TO
LOS ANGELES COUNTY ENGINEER
700 LOS ANGELES COUNTY ENGINEERING BLDG.




MORGUE
Bldg - 2175

70F3068 SAE R&A 11-58

F. B. 2910 Pg. 22

Incinerator Bldg.

Conc. Platform

Com House

38.0'

20.0'

3/4" HB

To Top of Post Pg

3/4" W

Premix

27.0'

BC. of Point

3/4" W

16" EUC

Pvmt

15'

4-20" OAK

14" OAK

3/4" HB

3/4" HB

3/4" W

12.0'

3/4" HB

Pvmt

3/4" HB

0+00

0+20.0

0+31.0

3/4" W

3/4" HB

Exposed

0+50

11.0

3/4" W

End = 1+03.0

3/4" HB

A

LOS ANGELES COUNTY ENGINEER

700 Los Angeles County Engineering Bldg.

Please Return To

Do not extend this date of this line.

Note: Any Additions or Changes on Sheet Must Be Made in Red Ink With Date and Name of Person Making Change.

Notes Ck'd by
Map No.
Office Work S.J.
Checked
Date 9/9/16

Survey of OLIVE VIEW HOSP
JN 22.09 Tape Sta + F
Surveyed by M Sotro
Notes Sotro Date 7-21-0
Indexed L. GAU

F. B. 2910 Pg. 23

OLIVE VIEW AVE.

conc.

Paved

coupling

2.2 — 2.2

Existing 6" Q.I.P. Main (See F.B. 709 - 182)

coupling

1.2

3" Valve

Hyd

3" Valve

4"x4"x3" Tee

Existing 6" Q.I.P. Main

VERTICAL DRG.

15 FIRE RISER & SPRINKLER

WARD 308
ONE STORY
STUCCO BLDG.
L.A. Co. No. 22.53

3" Riser & Valves

0.8

HALL WAY

Note: Any Additions or Changes on this Sheet, Must be Made or Circled in Red Ink With Date and Name of Person Making Change.

Do not extend this side of this title

PLEASE RETURN TO LOS ANGELES COUNTY ENGINEER
900 LOS ANGELES COUNTY ENGINEERING BLDG.

76R308 SEC. PG47) 11-08

F. B. 2910 Pg. 24

LOS ANGELES COUNTY ENGINEER
700 Los Angeles County Engineering Bldg.

PLEASE RETURN TO

Do not attend this side of this line.

Note: Any Additions or Changes on This Sheet Must be Made or Circled in Red Ink With Date and Name of Person Making Change.

EUCALYPTUS AVE. (Private Property)

BUCHER ST. (Dirt Road)

6' Chain Link Fence

Baseball Backstop

Redwood Box

Wood Box

Concrete Box

Wood Box

Wood Box

Redwood Box

Redwood Box

Redw

Notes Ck'd by _____
Map No. _____
Office Work SS
Checked _____
Date 9/27/61

Survey of Olive View Hosp. F. B. 290 Pg. 25
Jn 0822.8 Tape _____ S-d _____ °F
Surveyed by Sotro
Notes Bowles Date 6/
Indexed E. J. GALLI

6" & 8" A.C. WATER MAINS and PUMPING PLANT. (FIRE LINES)

CONSTRUCTED 1960
Per Specs. No. C-FS-135

SOTRO
BOWLES
MOODYMAN
LATTERY

Notes: Any Additions or Changes on this Sheet Must be Made or Circled in Red Ink With Date and Name of Person Making Change.

Do not extend this line beyond this point.

PLEASE RETURN TO
LOS ANGELES COUNTY ENGINEER
ENGINEERING SECTION
900 LOS ANGELES COUNTY ENG. BLDG.

76F3095 SAS/ R47 11-60

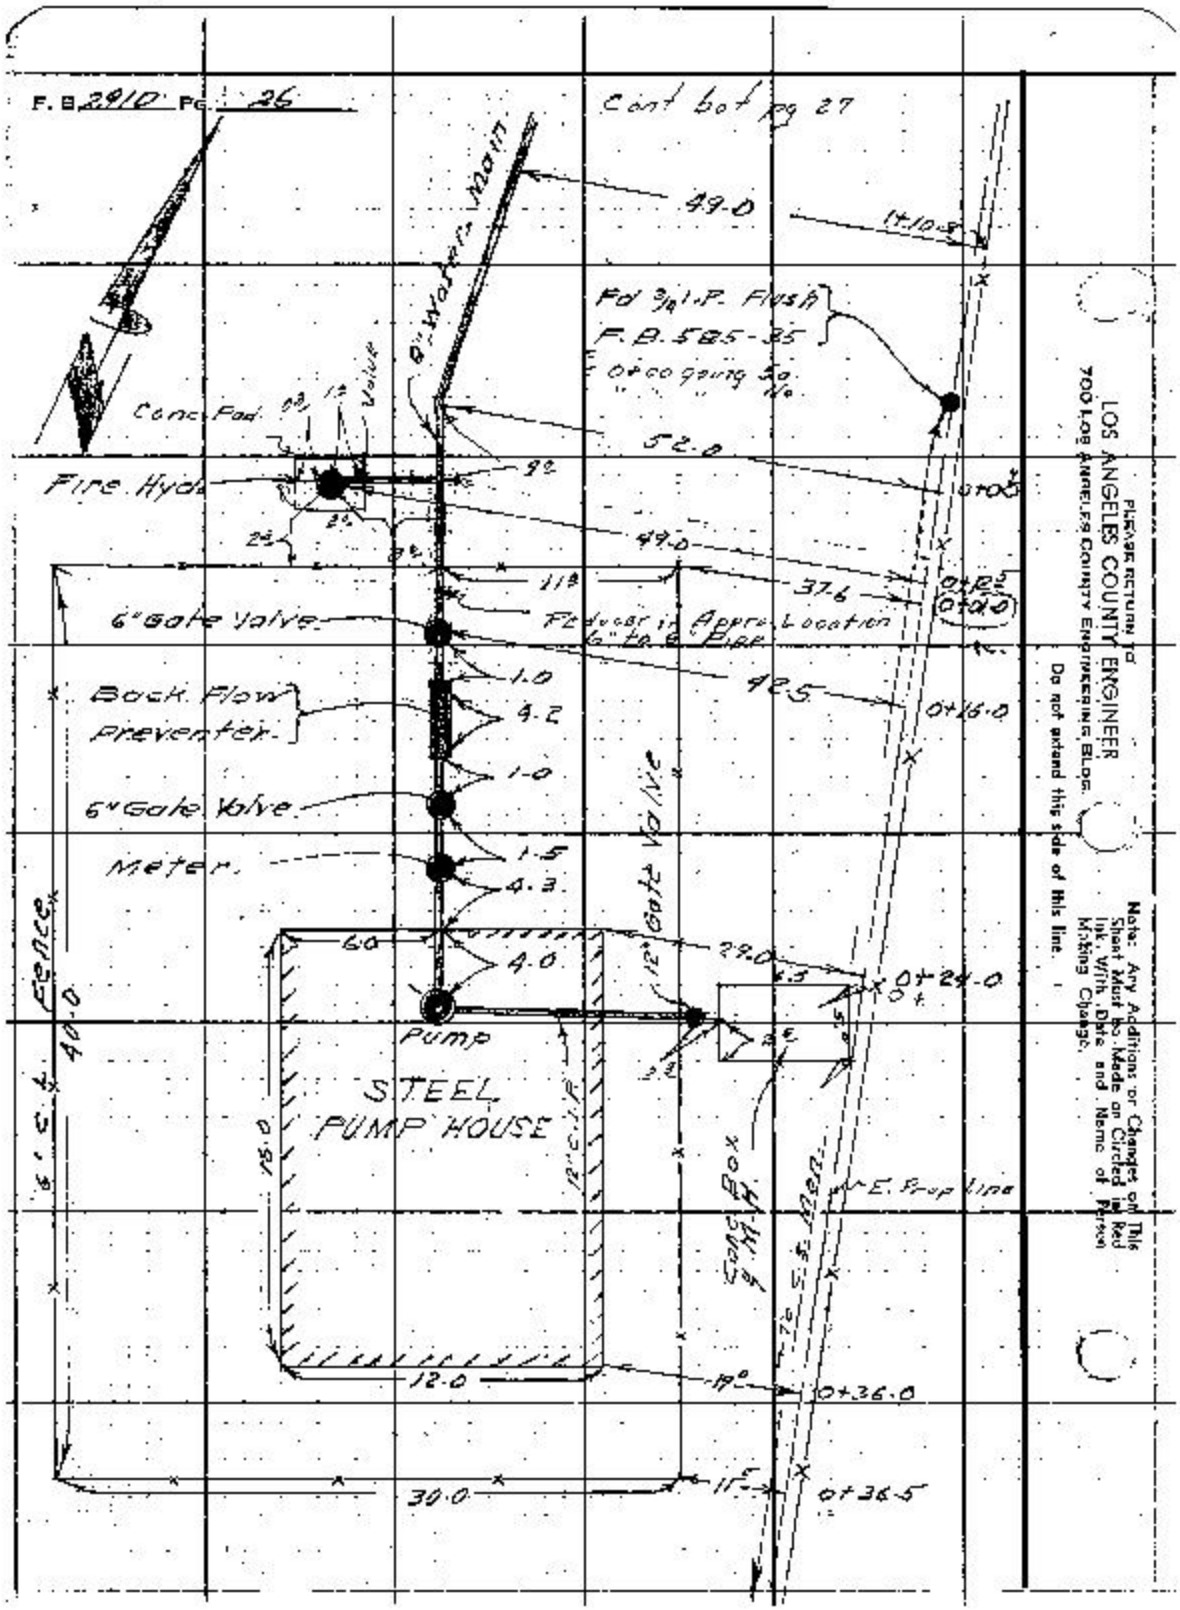
F. B. 2910 Pg. 26
Cont bot pg 27
49.0
14.10.5
8" Water Main
Fd 3/4" I.P. Flush
F.B. 585-35
Conc. Pad
Valve
52.0
Fire Hyd
49.0
37.6
6" Gate Valve
Fd Hydr in Approx. Location
Back Flow Preventer
42.5
1.0
9.2
1.0
6" Gate Valve
Meter
1.5
4.3
6.0
4.0
29.0
Pump
STEEL PUMP HOUSE
12.0
30.0
11°
19°
0+24.0
0+26.0
0+36.5
E. Prop Line
Fence
Please Return to
LOS ANGELES COUNTY ENGINEER
700 Los Angeles County Engineering Bldg.
Do not extend this side of this line.
Note: Any Additions or Changes on This Sheet Must Be Made in Circled Ink, With Date and Name of Person Making Change.

Notes Okd by
Mat No.
Office Work SS
Checked
Date 9/27/61

Survey of Olive View Hosp F.B. 2910 Pg. 27
J.N. 0022-06 Tape Std °F
Surveyed by Sotra
Notes Bowles Date 6-1-61
Indexed C. J. GALLI

cont. Bot. Pg 28

6" WATER
Valve Box
See F.B. 709 Pg 248
9.1
2-2
Valve & Hand Hole
15.5
A1 3
59-0
76.0
Main is approx. 30' deep (Per Pipe Locator)
WARD No 401, 402
57.2
57.4
7.0
E.C.
30.0
8" WATER
8.20
0.7
FIRE HYD. & VALVE
B.C.
19.3
187.0
8" WATER MAIN FROM NEW WELL "N" TO WARDS Nos 401, 402 & 403
8" Pepper Tr.
8.0
Water Well
Cont from top pg 26

Note: Any Additions or Changes on This Sheet Must be Made or Circled in Red Ink With Date and Name of Person Making Change.
Do not extend this side of this file.

PLEASE RETURN TO
LOS ANGELES COUNTY ENGINEER
700 Los Angeles County Engineering Bldg.

75F3099 SAE #247 1-58

PLEASE RETURN TO
LOS ANGELES COUNTY ENGINEER
700 LOS ANGELES COUNTY ENGINEERING BLDG.

Note: Any Additions or Changes on This Sheet Must Be Made or Circled in Red Ink With Date and Name of Person Making Change.

Do not extend this side of this line.

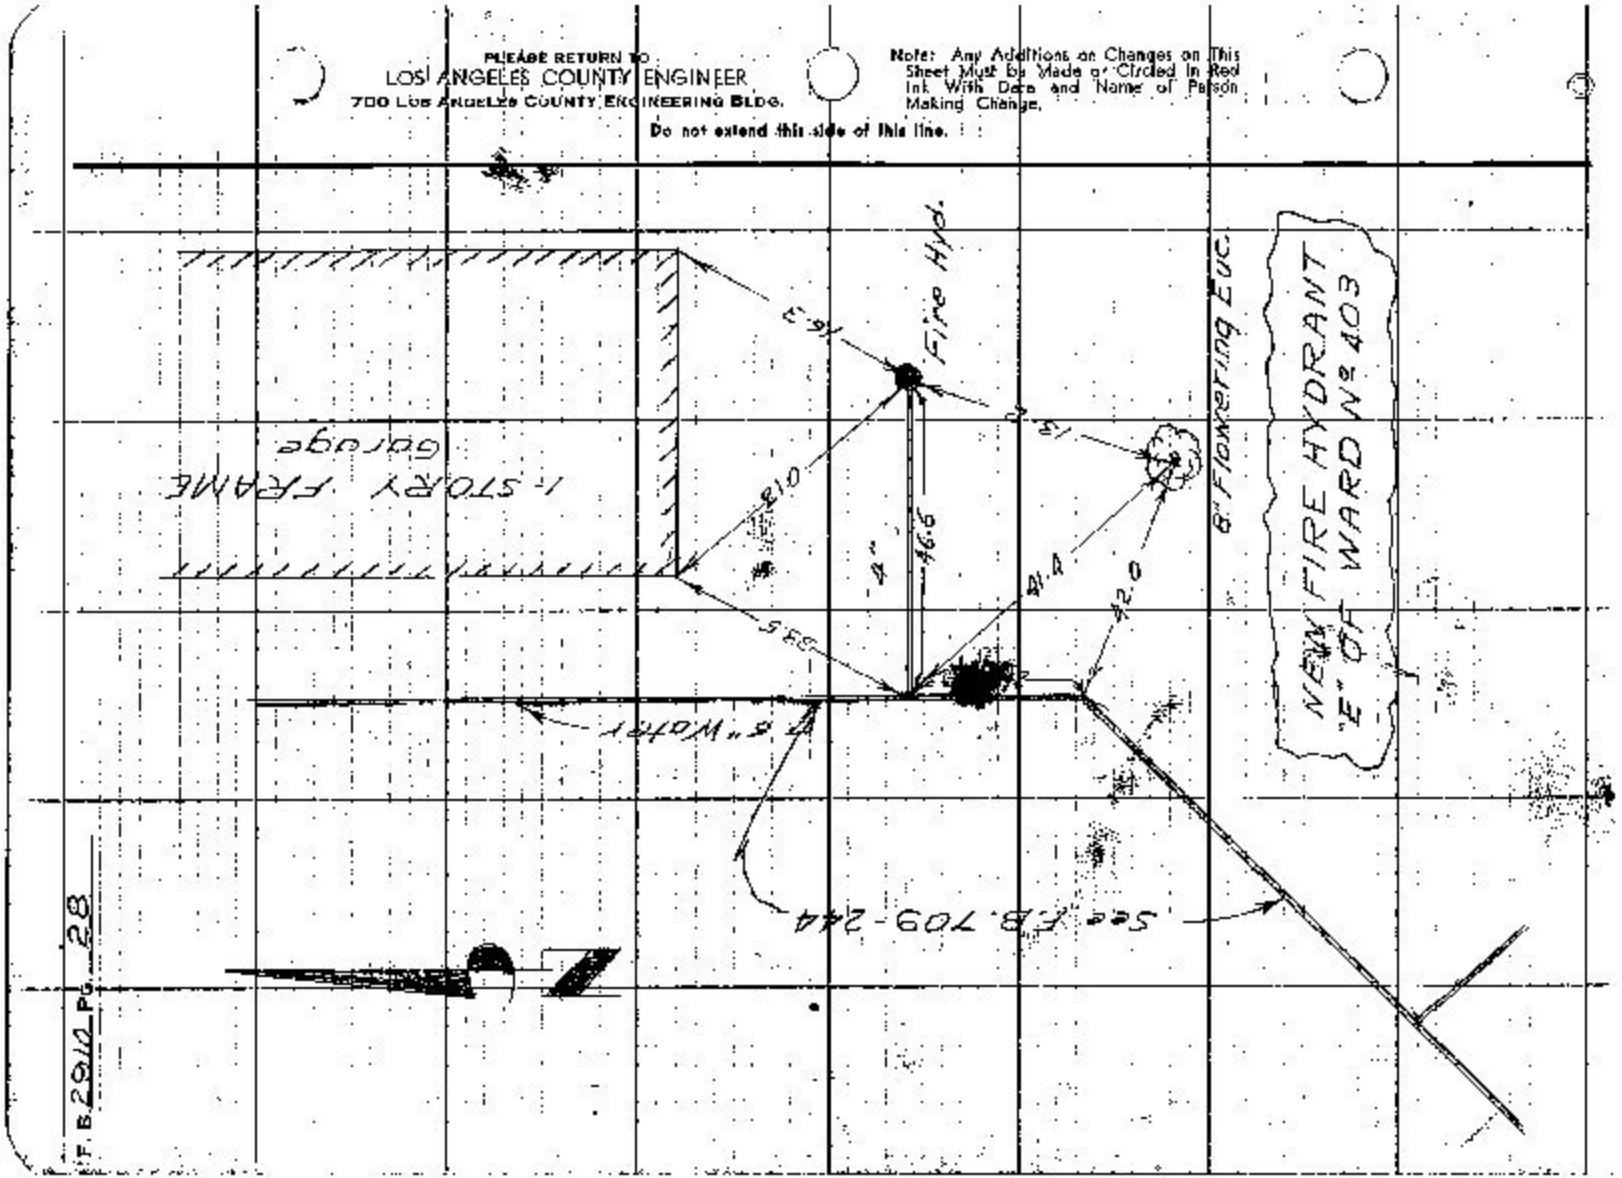

Notes Ck'd by
Map No.
Office Work S.S.
Checked
Date 9/27/61

Survey of Olive View Hosp
JN 022.08 Topo Std "F"
Surveyed by Sofre
Notes Bowles Date 8-20-61
Indexed C. J. CALLI

F.B. 2910 Pg. 29

Cont. Sof Pg 30

SAN ANAC AVE.

LAWN AREA

PARKING

1+50 ±5°

+10.5

8" Water

NOTE
Unable To Verify Main
In This Area (See Staking
Notes F.B. 2349-50.

Valve

old 6" Water

4.3 Pol
F.B. 709-242

Note: Any Additions or Changes on this Sheet Must Be Made or Circled in Red Ink With Date and Name of Person Making Change.

Do not extend this side of this line

PLEASE RETURN TO
LOS ANGELES COUNTY ENGINEER
7007 LOS ANGELES COUNTY ENGINEER BLDG.

76F3068 8&L R847 11-60

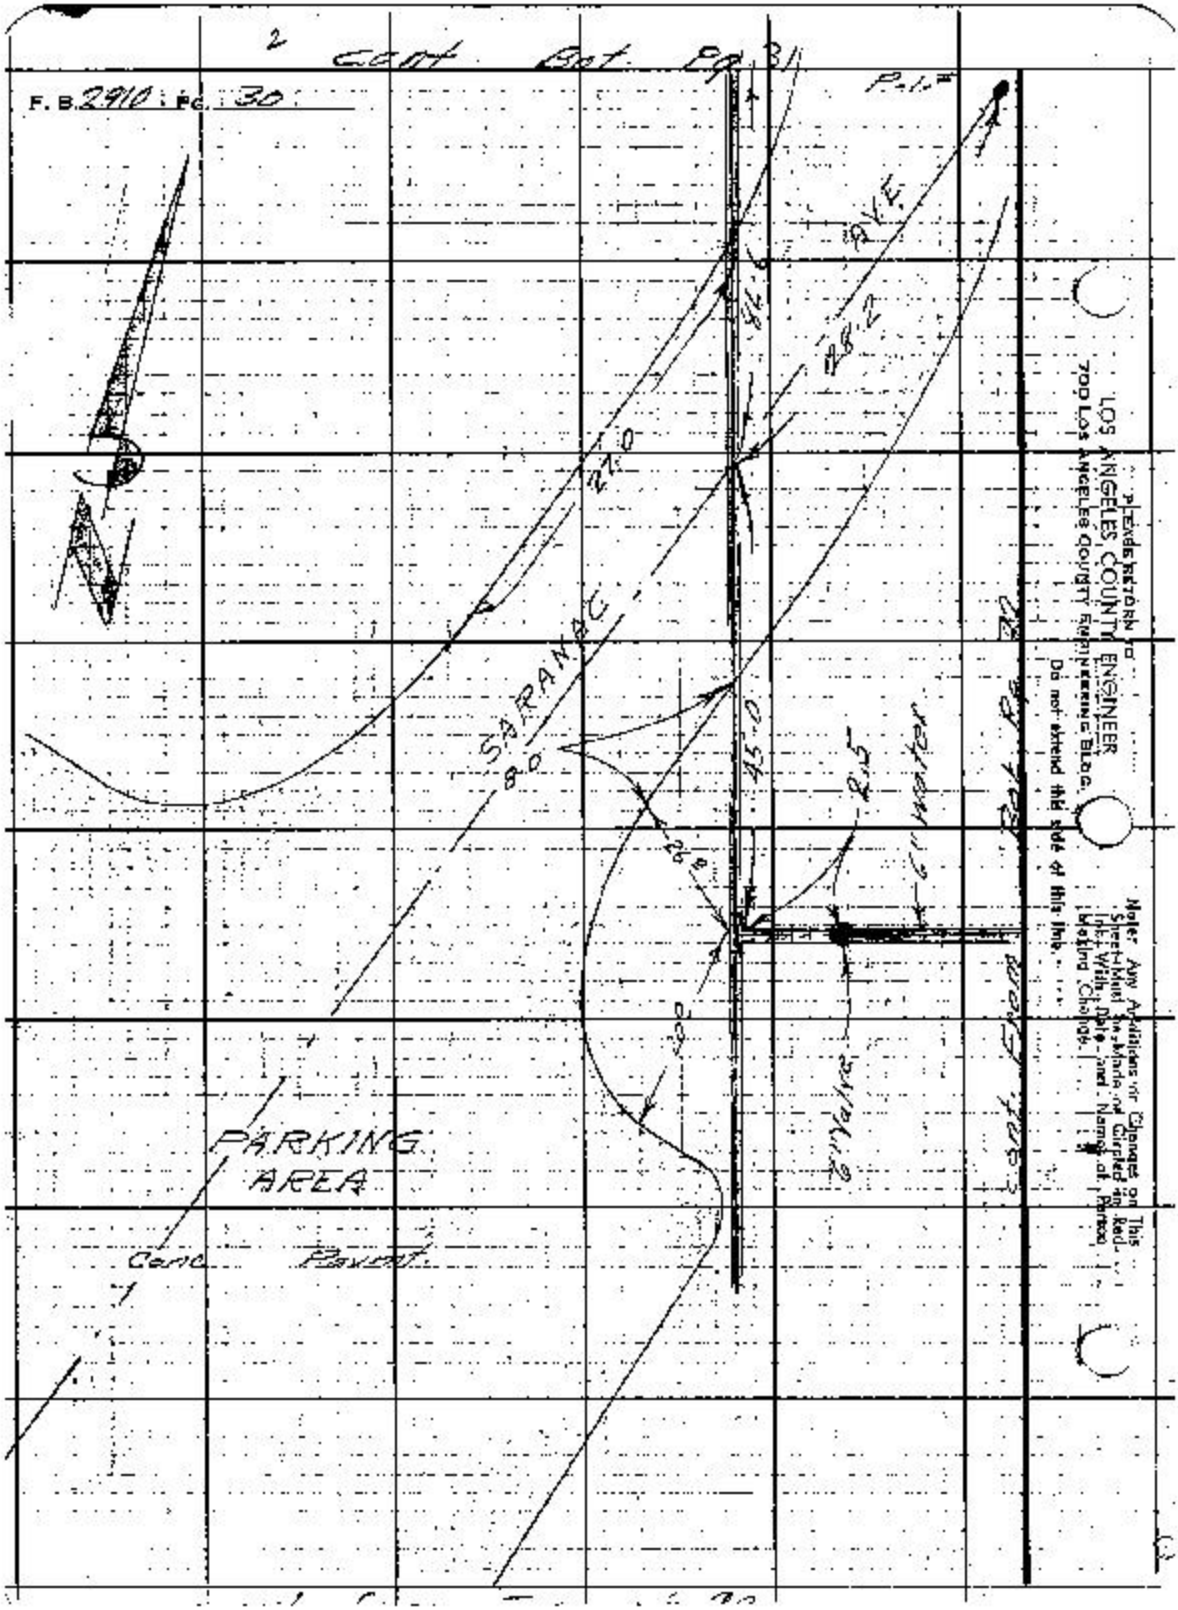
2 Cont Sht Eq 31
F. B. 2910 : Pg. 30
P.L.E.
P.L.E.
SARANAC
PARKING AREA
Conc Pavement
LOS ANGELES COUNTY ENGINEER
700 Los Angeles County Engineering Bldg.
Do not extend this side of this Map
Refer Any Additions or Changes on This Sheet-Must be Made on Corrected or Red-Inked Print With Date and Name of Person Making Change

Notes Ck'd by
Map No.
Office Work
Checked
Date 9/27/61

Survey of Olive View Hosp.
3N 66E-C Tape Std °F
Surveyed by Sofro
Notes Services Date 6-21-61
Indexed C. J. GALLI

F. B. 2910 Pg. 31

SARANAC AVE

Cor.

42.5

77.0

Pavmt

8" Gate Valve

45.5

20" Pine

Ent. Bldg. No. 33

8" A.C. Water Main Approx. Depth 4'-0"

9-Prong 18" Tree

29.5

36.5

15-0

8.0

10 Pl. 4

5-Prong 14" Tree

Notes: Any Additions or Changes on this Sheet, Must be Made, or Circled in Red Ink. With Date and Name of Person Making Changes.

Do not extend this side of this line

PLEASE RETURN TO
LOS ANGELES COUNTY ENGINEER
700 LOS ANGELES COUNTY ENGINEERING BLDG.

76F-2005 8247 11-MM

PLEASE RETURN TO
LOS ANGELES COUNTY ENGINEER
700 LOS ANGELES COUNTY ENGINEERING BLDG.

Do not extend this side of this line.

Note: Any Additions or Changes on This Sheet Must be Made or Circled in Red Ink With Date and Name of Person Making Change.

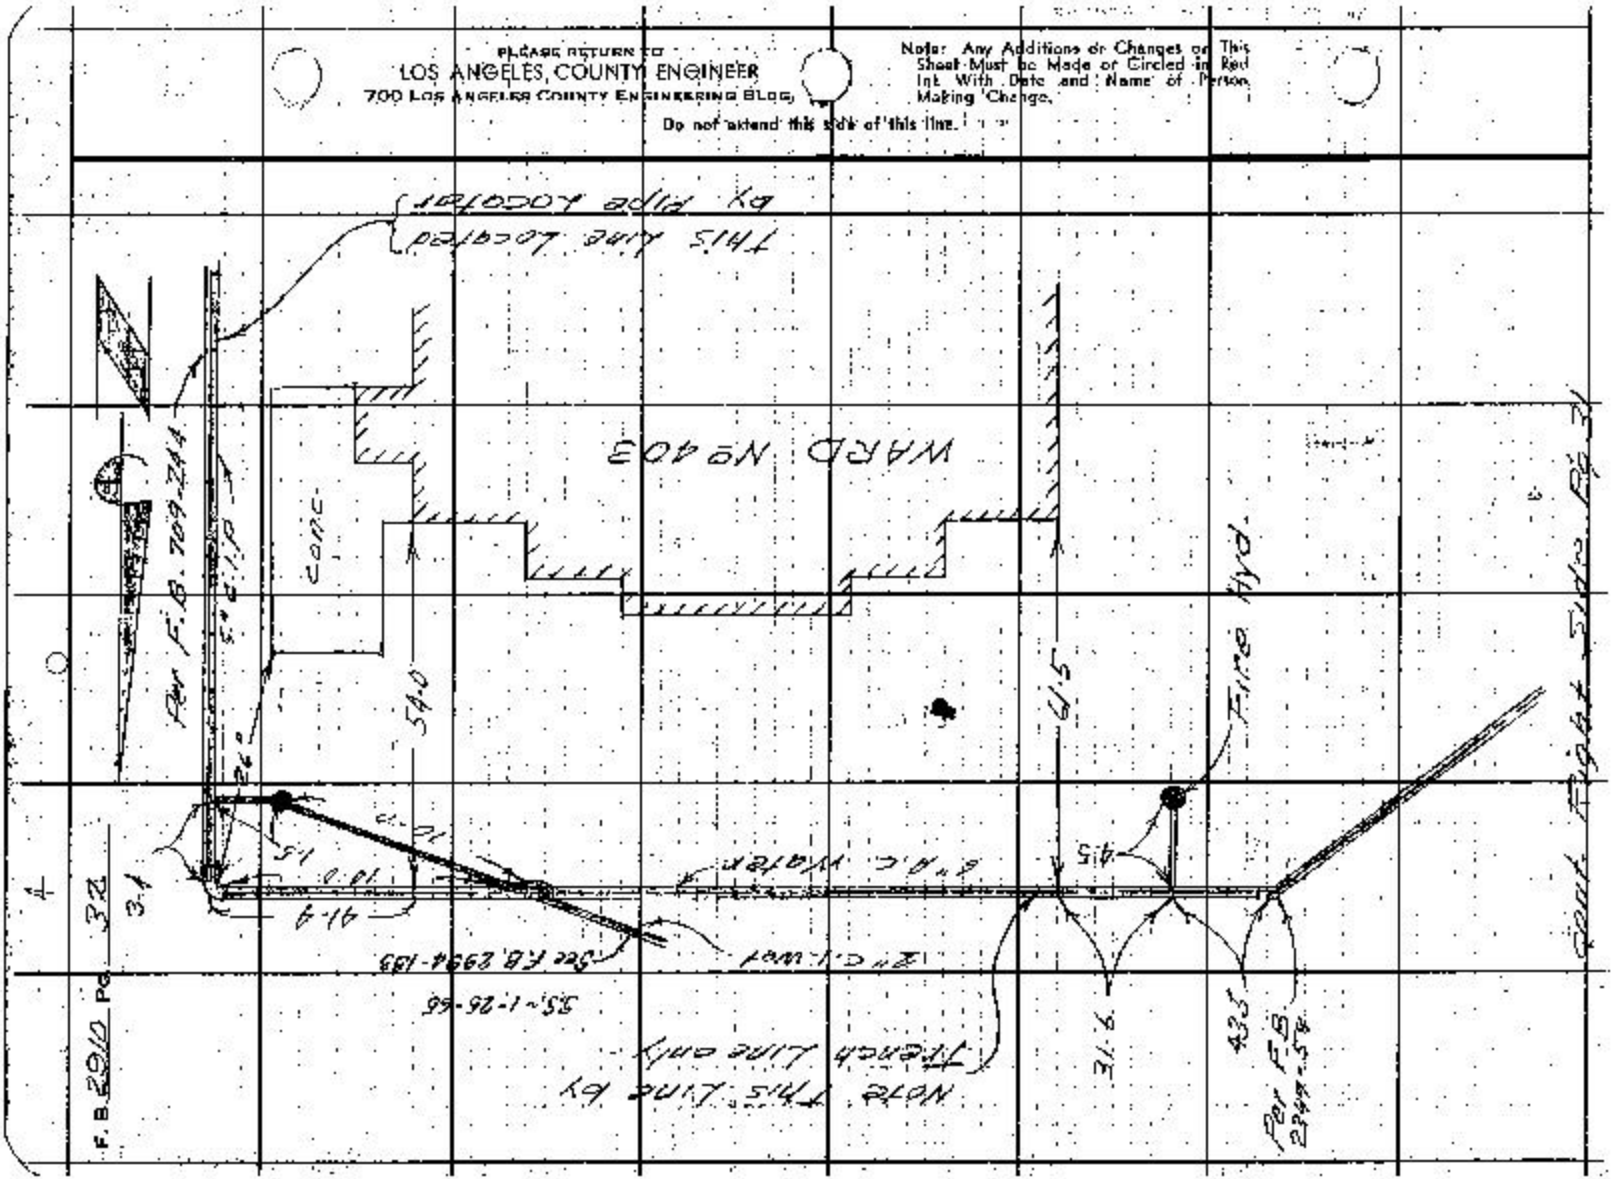

PLEASE RETURN TO
LOS ANGELES COUNTY ENGINEER
700 Los Angeles County Engineering Bldg.
Do not extend this side of this line.

Note! Any Additions or Changes on This Sheet Must Be Made or Circled in Red Ink With Date and Name of Person Making Change.

Top Bank Cont Top pg 34

Fire Hyd

1.0

Valve

6"CI-W

8"S

Fire Hyd

1.0

Valve

8.6

Cont. Bot pg 32

8" A.C.Mat'l

3.0

4.2.2

1.5

1.5

1.5

10.0

4.0

9.5

Cont. From Left

Side pg 31

SARANAC

Conc.

P.I. For Ld & Stock

Pavmt.

A.V.E.

Conc. Drain

Notes Cld on
Map No.
Office Work
Checked
Date 9/28/61

Survey of Olive View Area
JN 2232-33 Tops Srd of
Surveyed by Sparks
Notes Bowles Date 8-21-61
Indexed F. & Mail

F. B. 2810 Pg. 33

PLEASE RETURN TO
LOS ANGELES COUNTY ENGINEER
700 LOS ANGELES COUNTY ENGINEERING BLDG.

Note: Any Additions or Changes on This Sheet Must be Made on Circled in Red Ink With Date and Name of Person Making Change.

Do not extend this side of this line.

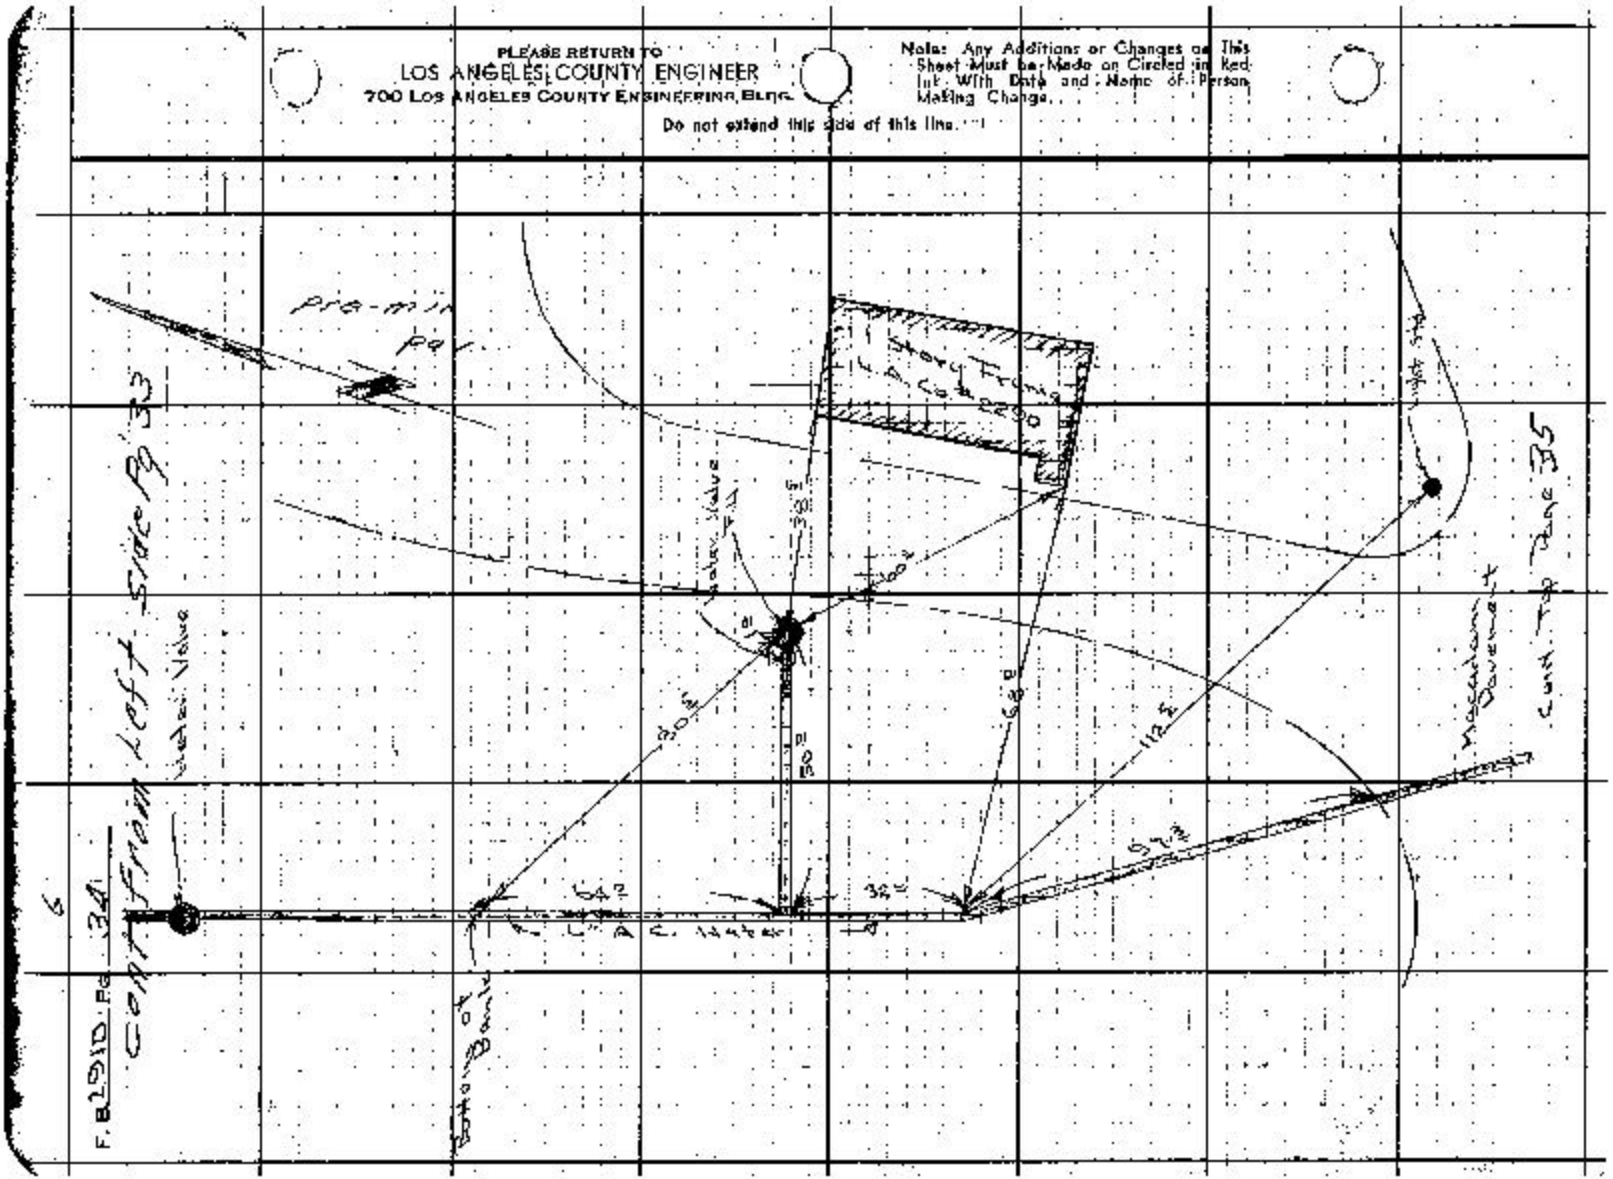
pro-min
pg
Intersection
Valve
Valve
Valve

Notes Ck'd by
Map No.
Office Work SS
Checked
Date 9/27/61

Survey of Olive View Zone
JN 5612.08 Tape Std °F
Surveyed by Sorber
Notes P.L. Sorber Date 6-21-61
Indexed C. J. GAITI

F.B. 2910 Pg. 25

Cont. from Bottom Page 24

OLIVE VIEW

Elec.

Water Valve

Water Valve

Re Mix Pavement

AVE

Notes: Any Additions or Changes on this Sheet Must be Made on Circled in Red Ink With Date and Name of Person Making Change.

Do not offend this side of this line.

PLEASE RETURN TO
LOS ANGELES COUNTY ENGINEER
700 Los Angeles County Engineering Bldg.

7875005 SEE 8247 11-58

F. B. 1910 Pg. 36

Cont. Bot pg 37

AVE

1.5

ROCK & CONC. BRIDGE

STARWAY

Conc

Air Pressure

PLEASE RETURN TO
LOS ANGELES COUNTY ENGINEER
700 Los Angeles County Engineering Bldg.

Notes: Any Additions or Changes on This Sheet Must Be Made or Circled in Red Ink With Date and Name of Person Making Change.

Do not extend title side of this line.

PLEASE RETURN TO
LOS ANGELES COUNTY ENGINEER
700 LOS ANGELES COUNTY ENGINEERING BLDG.

Note! Any Additions or Changes on This Sheet Must be Made or Circled in Red Ink With Date and Name of Person Making Change.

Do not extend this side of title line.

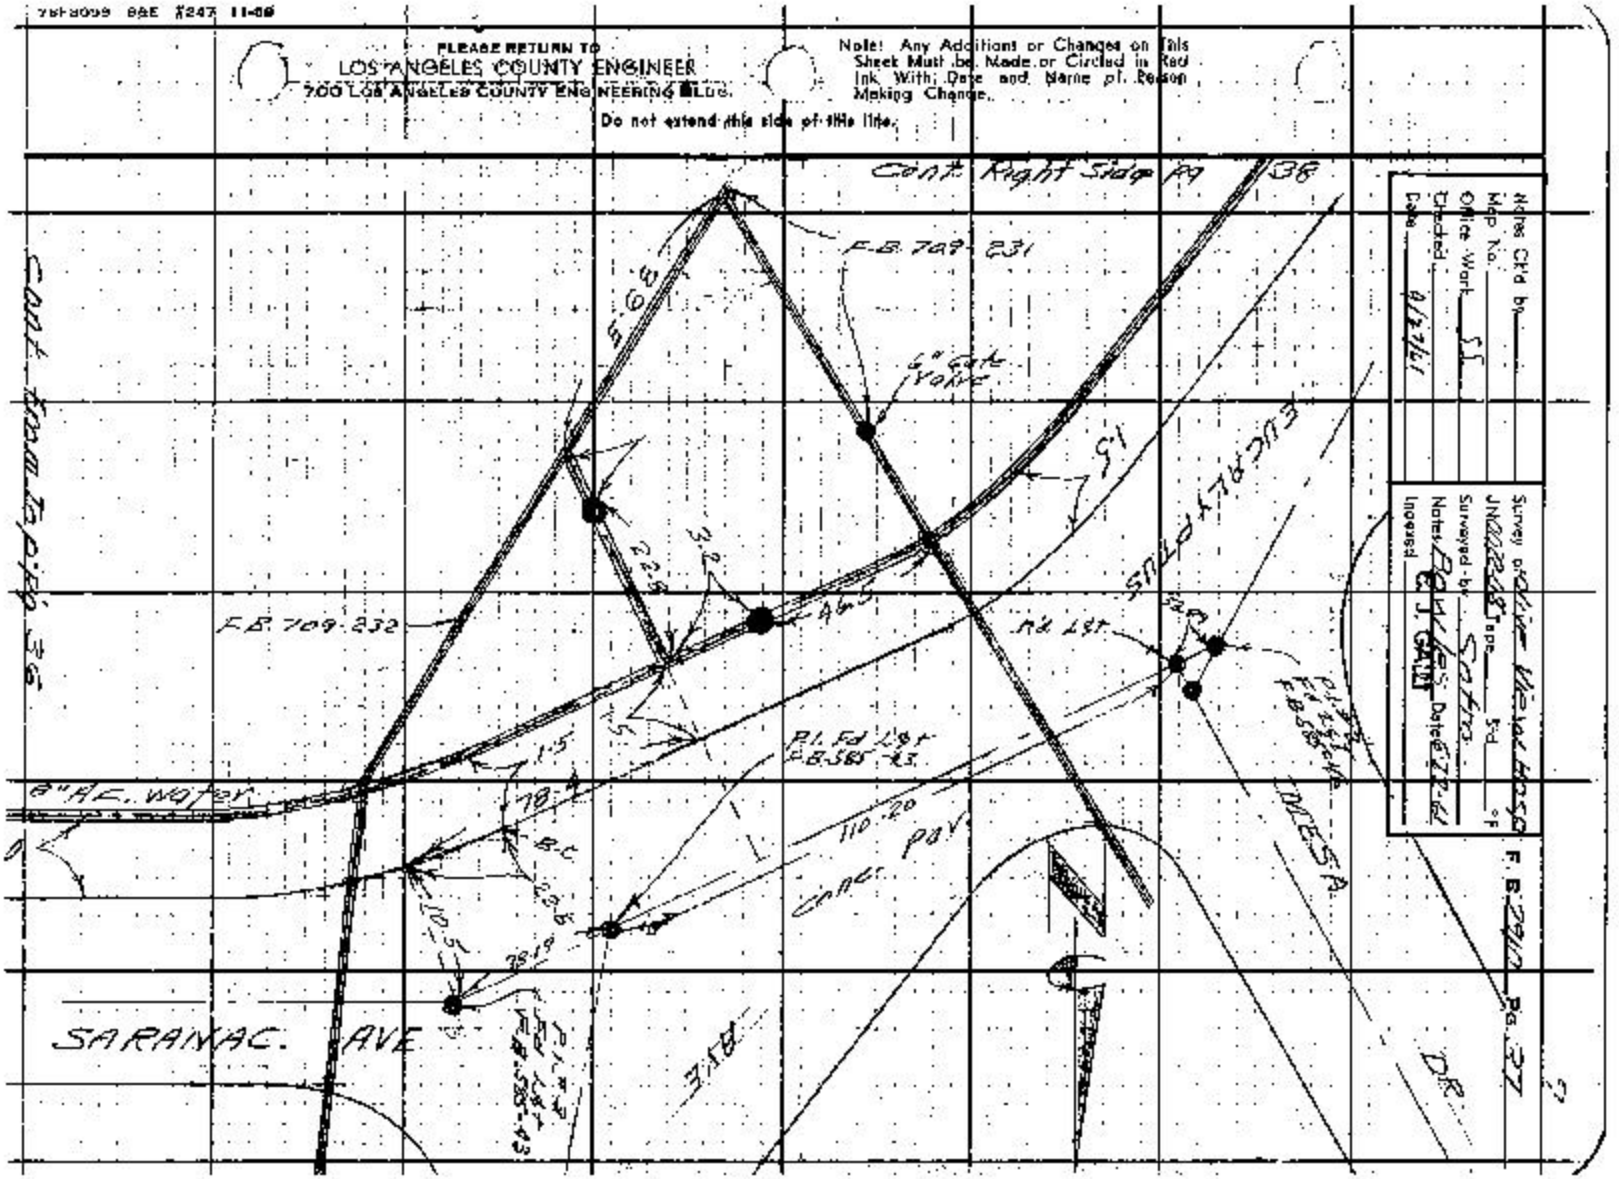


Notes Ck'd by _____
Map No. _____
Office Work SS
Checked _____
Date 8/24/61



PLEASE RETURN TO
LOS ANGELES COUNTY ENGINEER
700 LOS ANGELES COUNTY ENGINEERING BLDG.

Note: Any Additions or Changes on This Sheet Must be Made or Circled in Red Ink With Date and Name of Person Making Change.

Do not extend title field of this line.

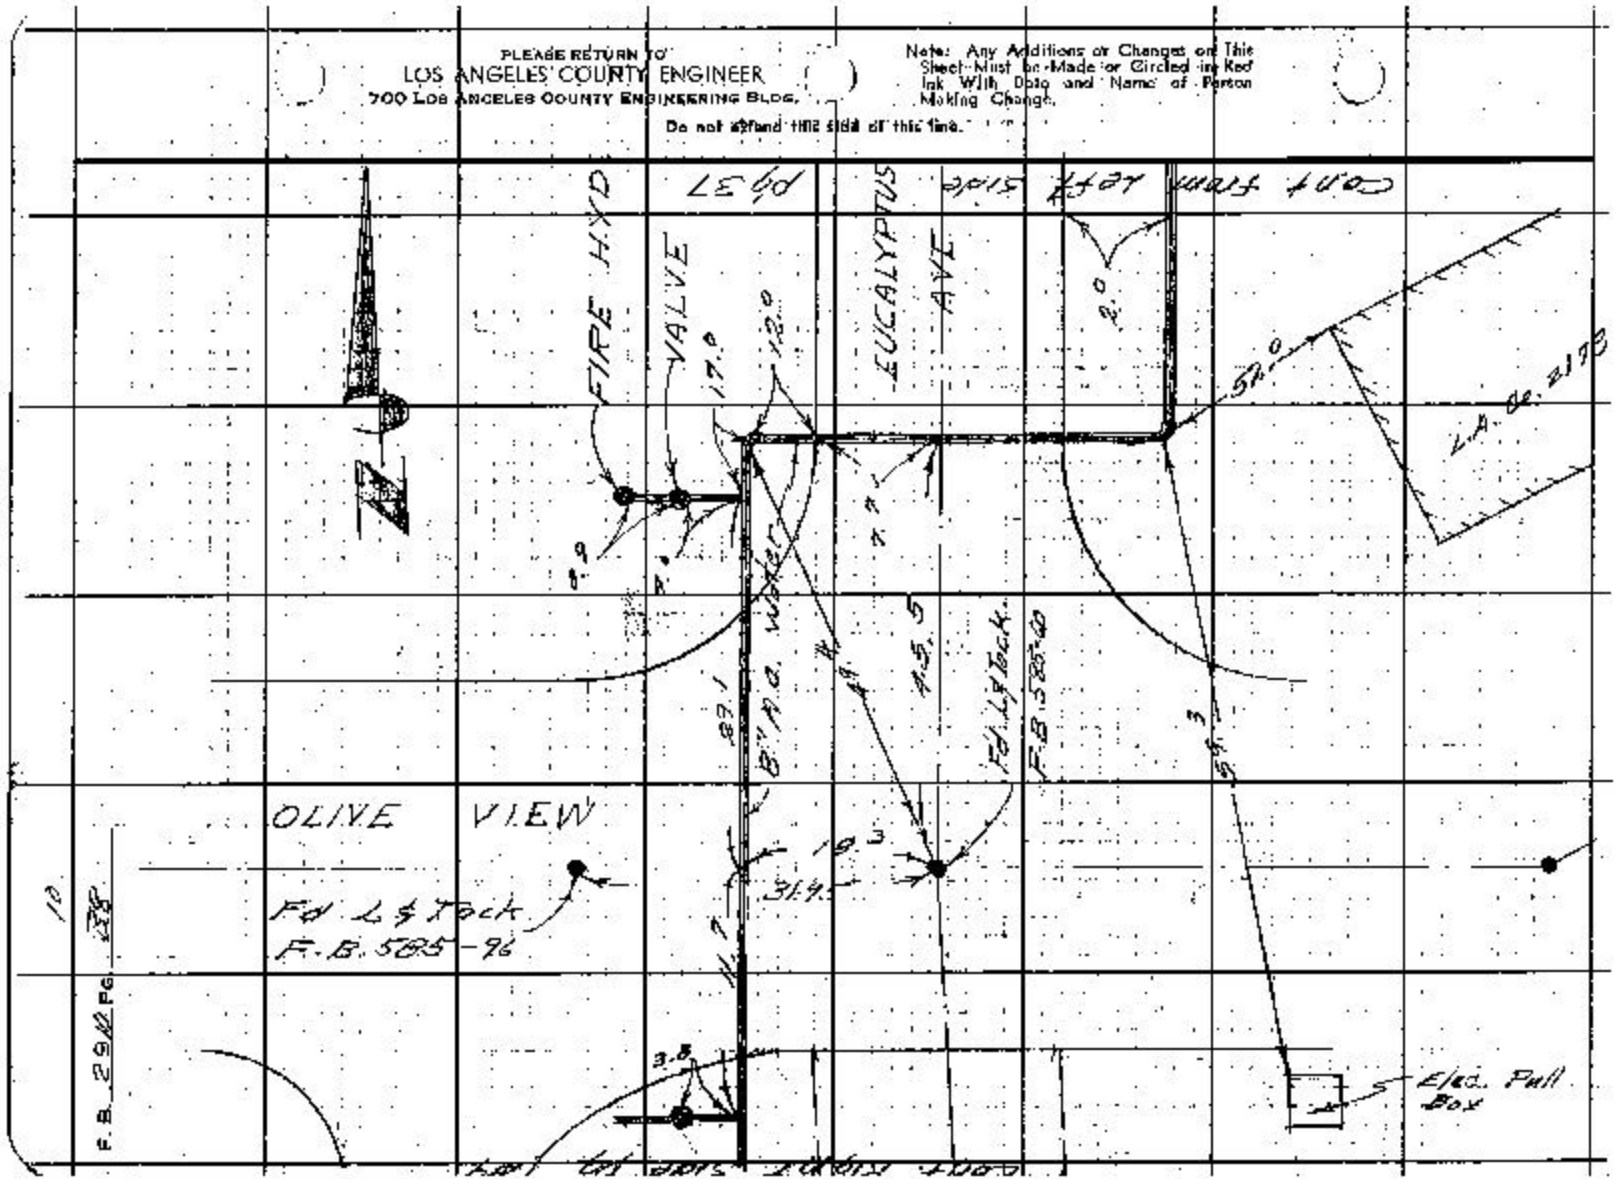

Notes Ck'd by
Map No.
Office Work S.J.
Checked
Date 9/27/61

Survey of Olive View Hosp.
JN 022-061 Tape Sta °E
Surveyed by Satre
Notes Bowles Date 6-24-61
Indexed C. J. CALL

F. B. 2910 Pg. 39

Cont. bot. pg. 20

See F.B. 709-184

Water

8" A.C.

DRIVE

OLIVE VIEW AVE

Conc.

Conc. Curb & Gutter Side Pg. 35

Valve

Valve

3-8

11.7

21-5

8" A.C.

6" A.C.

15

Fd. Lgt.

F.B. 585-60

EUCALYPTUS

AVE

Pre-mix pav.

Conc. pav

F.B. 709-184

PLEASE RETURN TO
LOS ANGELES COUNTY ENGINEER
700 LOS ANGELES COUNTY ENGINEERING BLDG.

Notes: Any Additions or Changes on this Sheet, Must be Made, or Circled in Red Ink, With Date and Name of Person Making Change.
Do not extend this slab at this line.

70F3085 STK (RAY) 11-58

cont. Bot pg 43

F. B. 2910 PG. 40

6" Gate Valve

197.0

211.6

VI. 5

211.67

Inlet

pre-mix par

Catch Basin

cont. Top pg 41

LOS ANGELES COUNTY ENGINEER
700 Los Angeles County Engineering Bldg.

PLEASE RETURN TO

Note: Any Additions or Changes on This Sheet Must Be Made on Contract in Red Ink With Date and Name of Person Making Change.

Do not extend this side of this line.

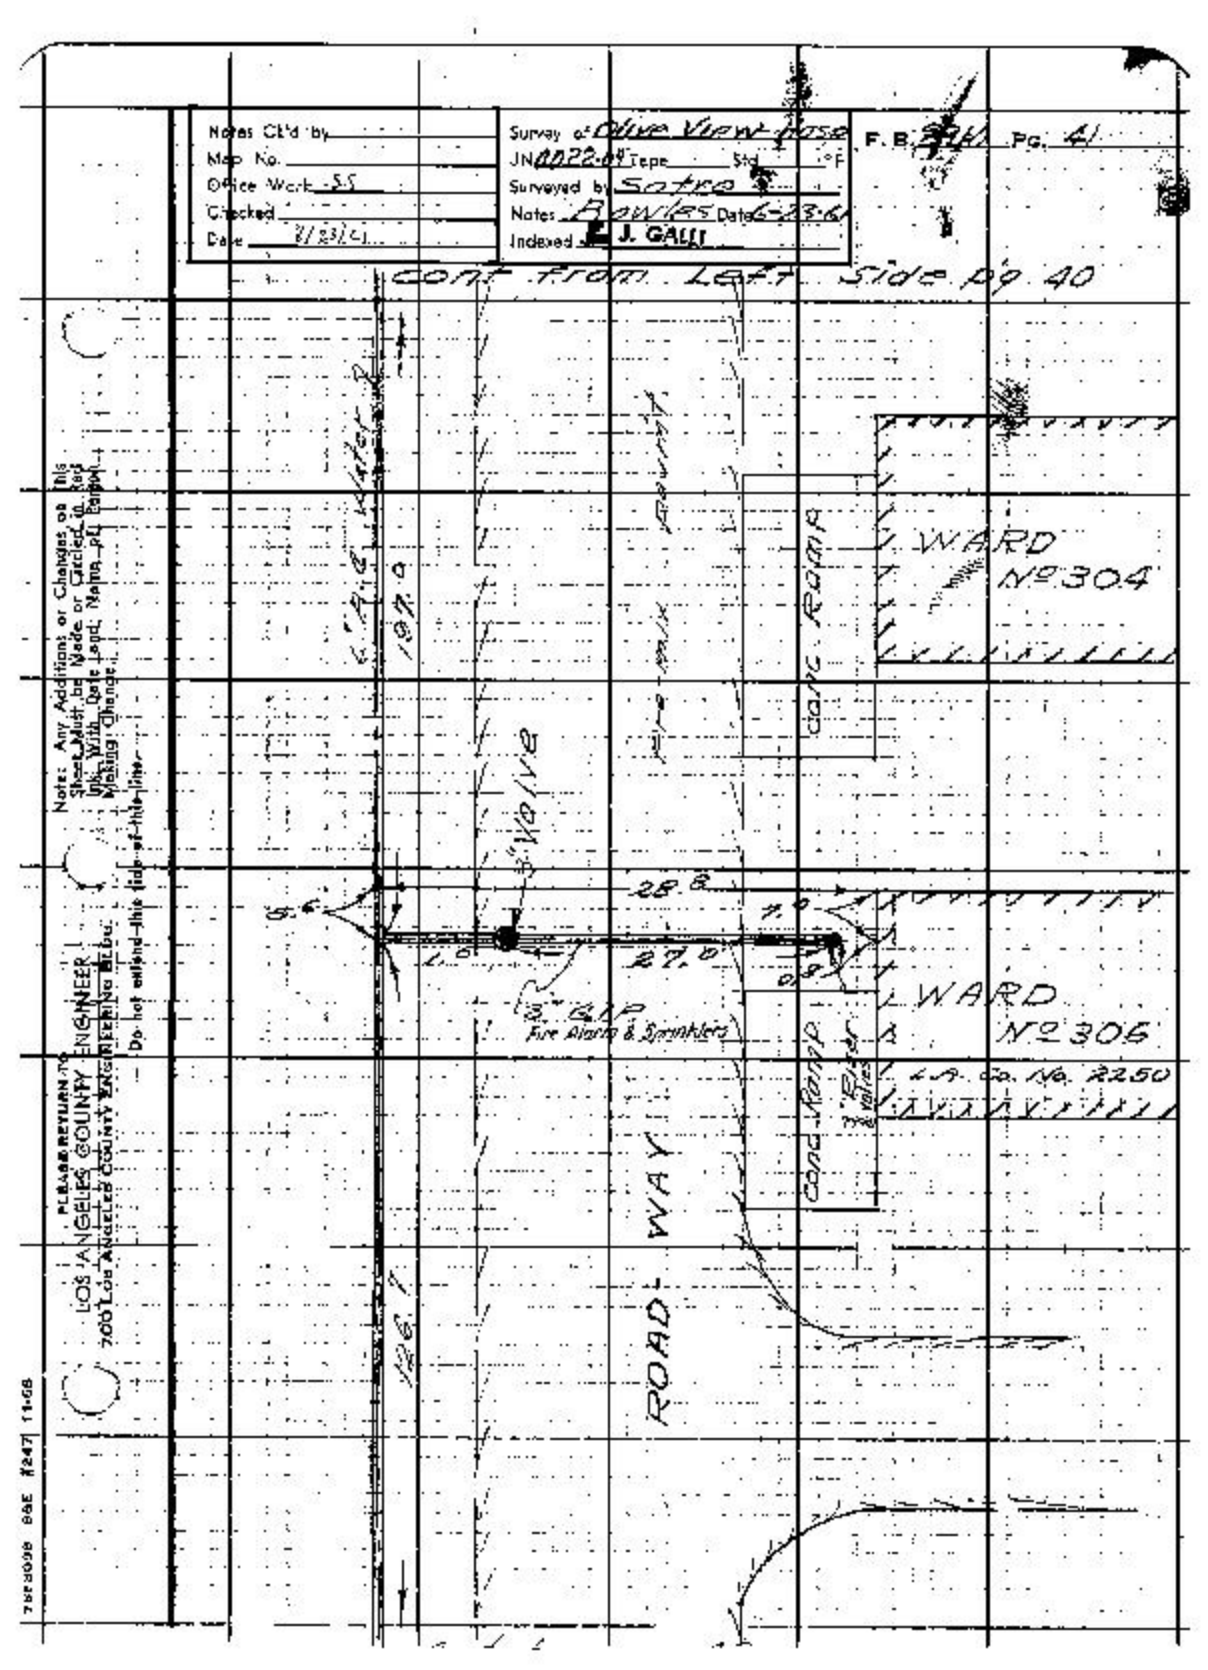
Notes Ck'd by
Map No.
Office Work S.S
Checked
Date 8/23/61
Survey of Olive View Hose F.B. 394 Pg. 41
JN 0022-09 Tape Std °F
Surveyed by Sotre
Notes Bowles Date 6-28-61
Indexed J. GALLI
cont from Left Side pg 40
WARD Nº304
WARD Nº306
Cond. Ramp
Cond. Ramp
197.9
28.8
27.6
Fire Alarm & Sprinklers
Fire Alarm & Sprinklers
L.A. Co. No. 2250
ROAD WAY
Notes: Any Additions or Changes on this Sheet Must be Made or Circled in Red Ink With Date Legd: Name of Person Making Changes
Do not extend this side of this line
PLEASE RETURN TO
LOS ANGELES COUNTY ENGINEER
7000 Los Angeles County Engineering Bldg.

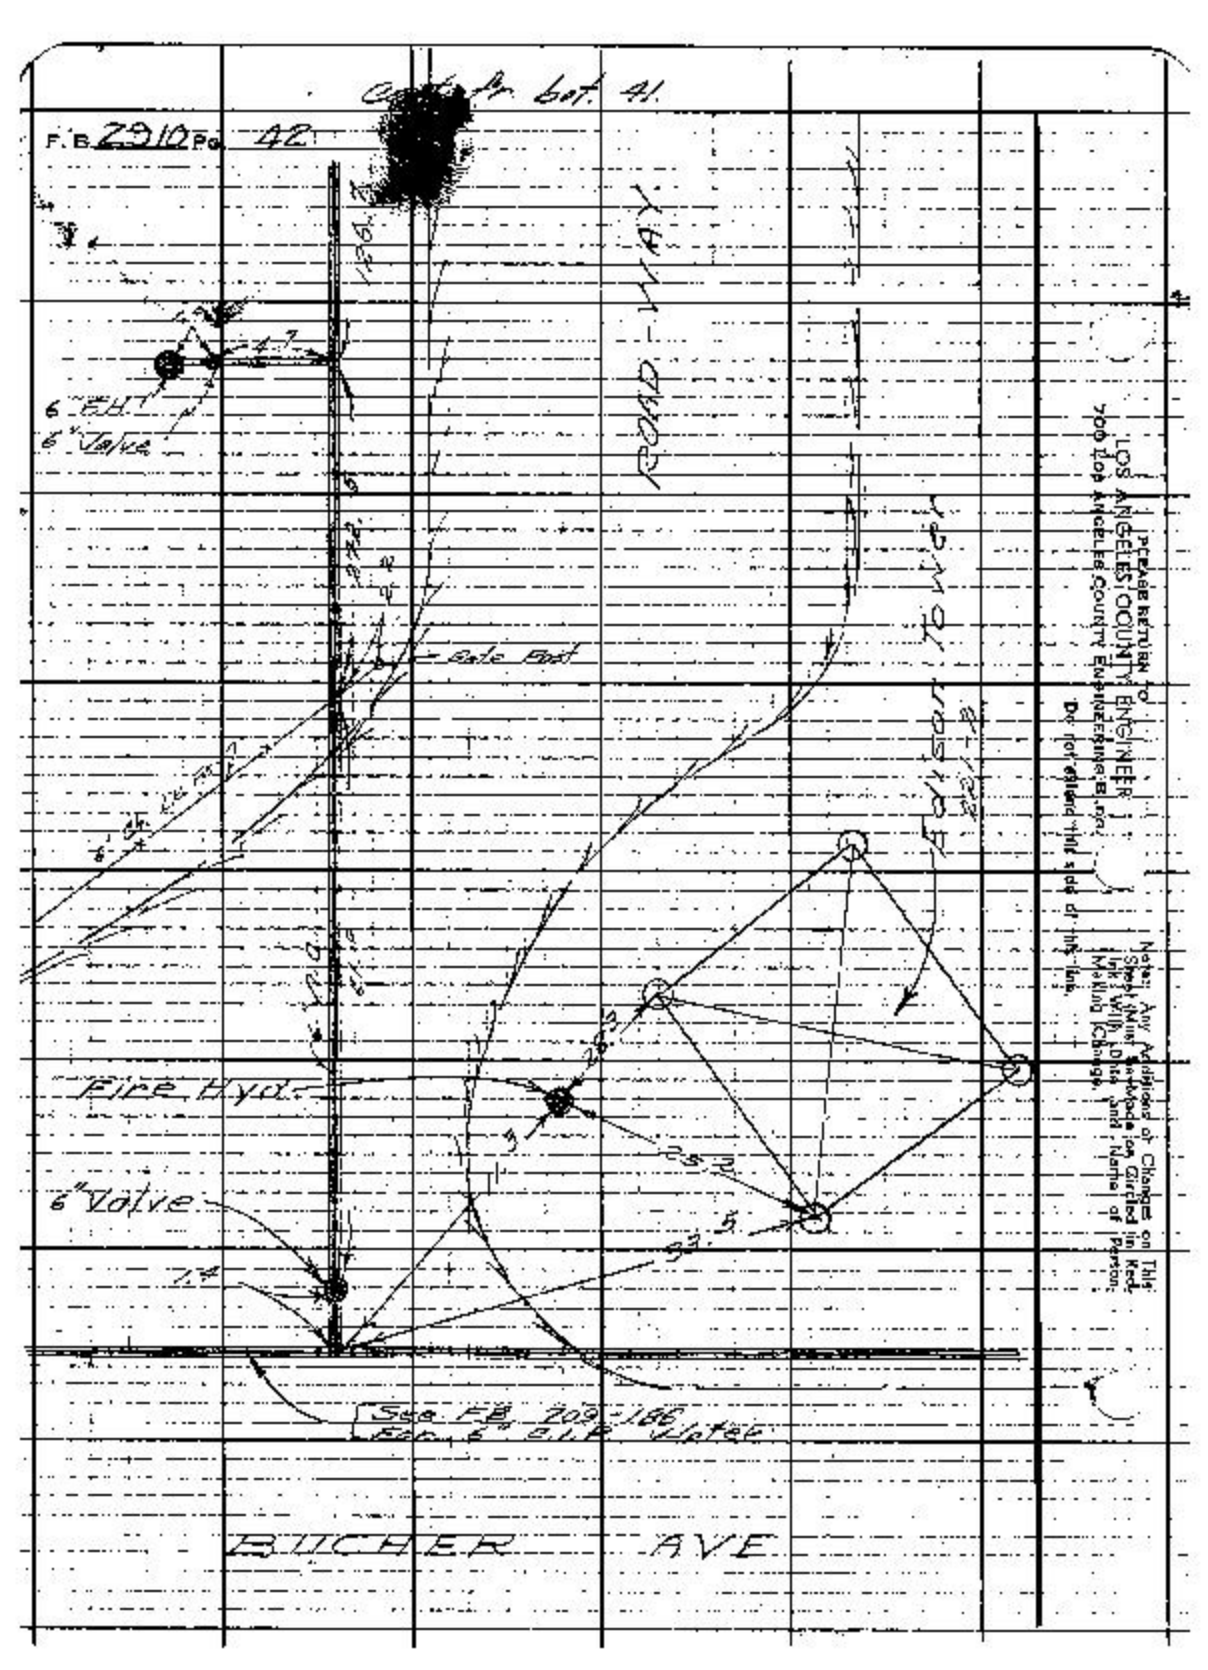
F.B. 2910 Pg. 42
Cont. for Sht. 41.
ROAD - WAY
6" Valve
Fire Hyd.
6" Valve
See F.B. 209-166 for 6" Gate Valve
BUCHER AVE
Gate End
PLEASE RETURN TO
LOS ANGELES COUNTY ENGINEER
700 Flor ANGELES COUNTY ENGINEERING BLDG.
Do not detach this side of this Map
Note: Any Additions or Changes on This Sheet Must be Initialed or Circled in Red, Ink With Date and Name of Person Making Change.

Notes C'k'd by
Map No.
Office Work
Checked
Date 8/26/61

Survey of Olive View Hosp
JN 0013 Tape Std
Surveyed by M Soto
Notes Date
Indexed C. J. GAU

F. B. 2910 Pg. 43

cont to Bottom Pg 44

Note: Any Additions or Changes on This Sheet Must be Made or Circled in Red Ink With Date and Name of Person Making Change.

PLEASE RETURN TO
LOS ANGELES COUNTY ENGINEER
900 Los Angeles County Engineering Bldg.
Do not extend title block off this line

OLIVE VIEW AVE

SYCAMORE AVE

Cont to Easement

Cont to Easement

Cont to Easement

79F3049 BAE #247 11-59

F. B. 2910 Pg. 44 Cont. to Bottom Pg. 45

PLEASE RETURN TO
LOS ANGELES COUNTY ENGINEER
700 Los Angeles County Engineering Bldg.

Do not extend this side of this line.

Note: Any Additions or Changes on This Sheet Must Be Made Or Circled In Red Ink With Date and Name of Person Making Change.

GRADEM GROVE

Ex. Pavement

Ex. Curb & Gutter

Ex. Pavement

Ex. Curb & Gutter

OLIVE VIEW AVE

LABORATORY

Cont. From Top Pg 43

76F9095 SKE 0247 11-68

PLEASE RETURN TO
LOS ANGELES COUNTY ENGINEER
700 LOS ANGELES COUNTY ENGINEERING BLDG.

Note: Any Additions or Changes on This Sheet Must Be Made or Circled in Red Ink With Date and Name of Person Making Change.

Do not extend this side of this line.

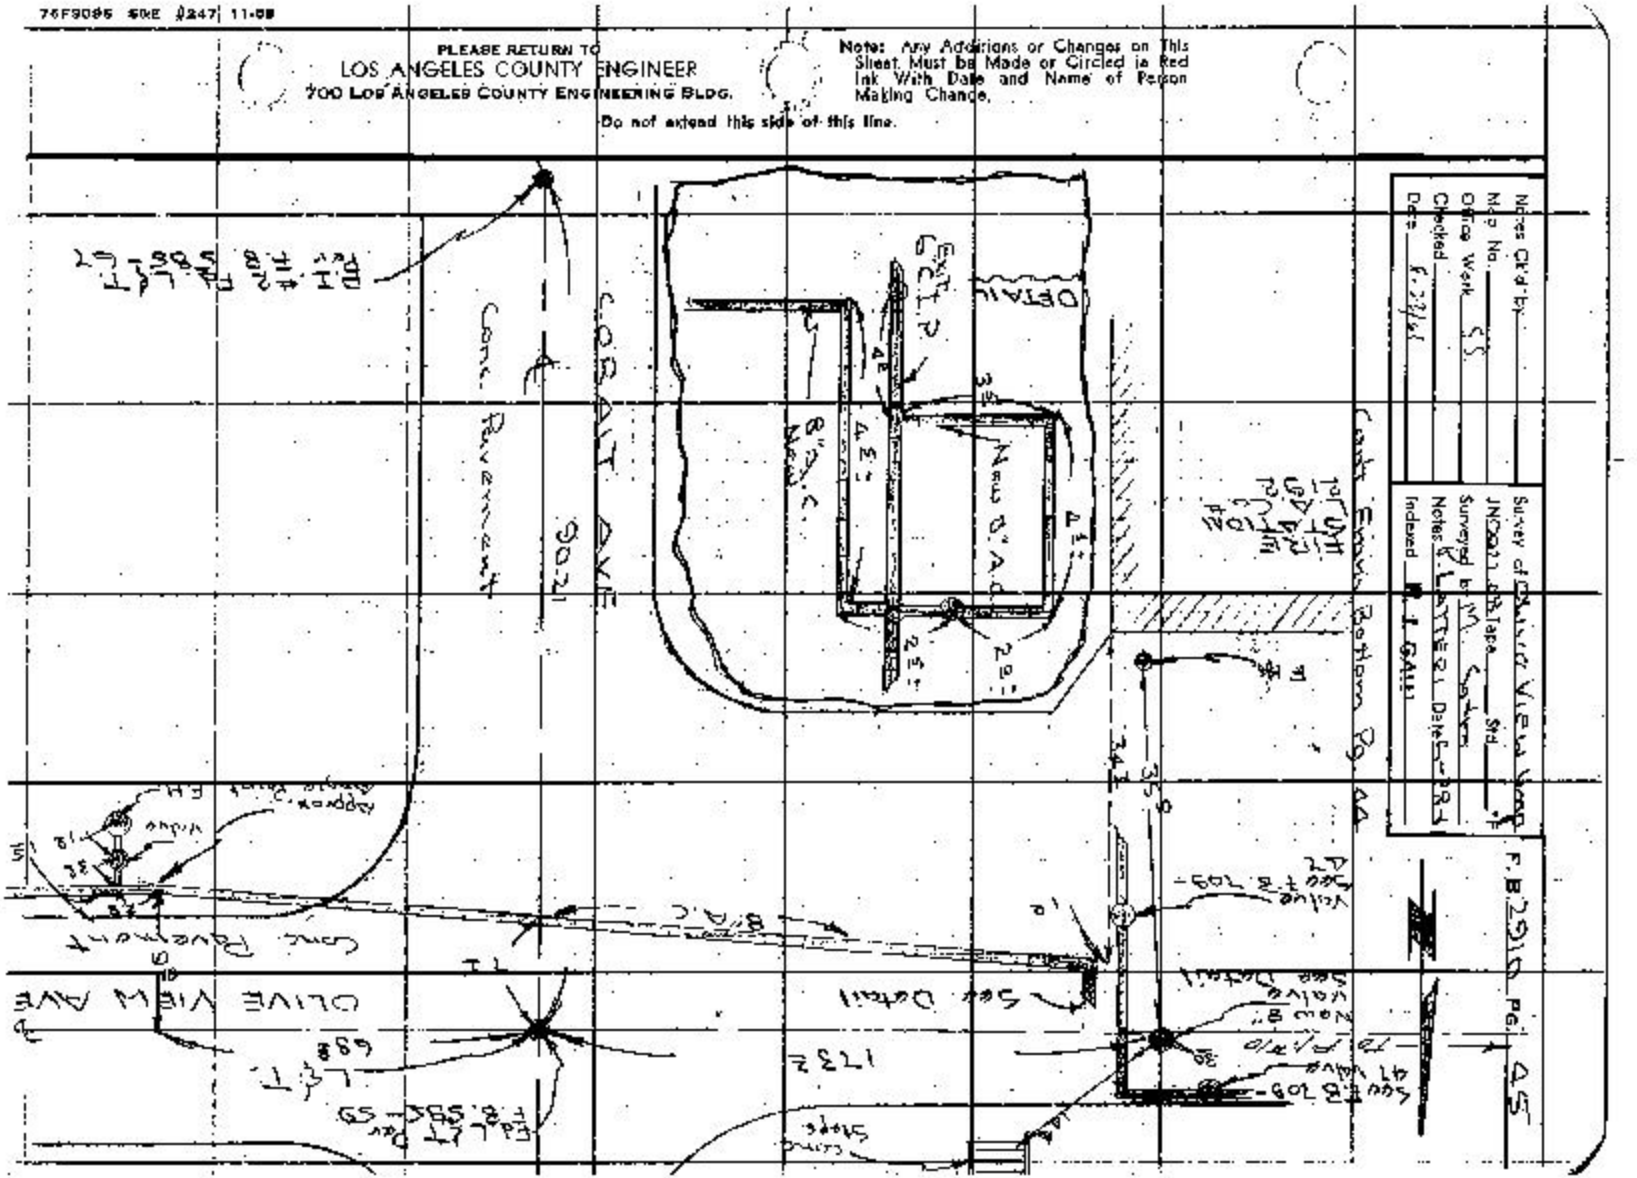

PLEASE RETURN TO
LOS ANGELES COUNTY ENGINEER
900 Los Angeles County Engineering, El. 09.

Note: Any Additions or Changes on This Sheet Must Be Marked or Circled in Red Ink With Date and Name of Person Making Change.

Do not extend this side of this line.

F. B. 2010 Pg. 46

Notes Ck'd by
Map No.
Office Work 55
Checked
Date 8/15/61

Survey of Olive View Hosp
JN 077.12 Topo Sht F
Surveyed by Soto
Notes Davies Date 7-12-61
Inclosed R. L. Gatti

F. B. 2910 Pg. 47

Note: Any Additions or Changes on this Sheet Must be Made or Circled in Red Ink With Date and Name of Person Making Changes.

Do not extend title of this line.

PLEASE RETURN TO LOS ANGELES COUNTY ENGINEER
and to Los Angeles County Engineering Bldg.

JACARANDA

CONC. P.G.V.

TO R/S

TERR.

21" Fd

L&T

F.B.

F.B. 385-11

CONC.

PAV.

F.B. 709-109

WEST

WAY

VALVE

5.2

5.5

1.3

13'

2'

1.5'

18.8

11.1

33.0

17.5

29.3

10463.6

11.4

9.7

0.59 ft

PLEASE RETURN TO
LOS ANGELES COUNTY ENGINEER
403 LOS ANGELES COUNTY ENGINEERING BLDG.

Note: Any Additions or Changes on This Sheet Must be Made or Circled in Red Ink With Date and Name of Person Making Change.

Do not extend this side of this line.

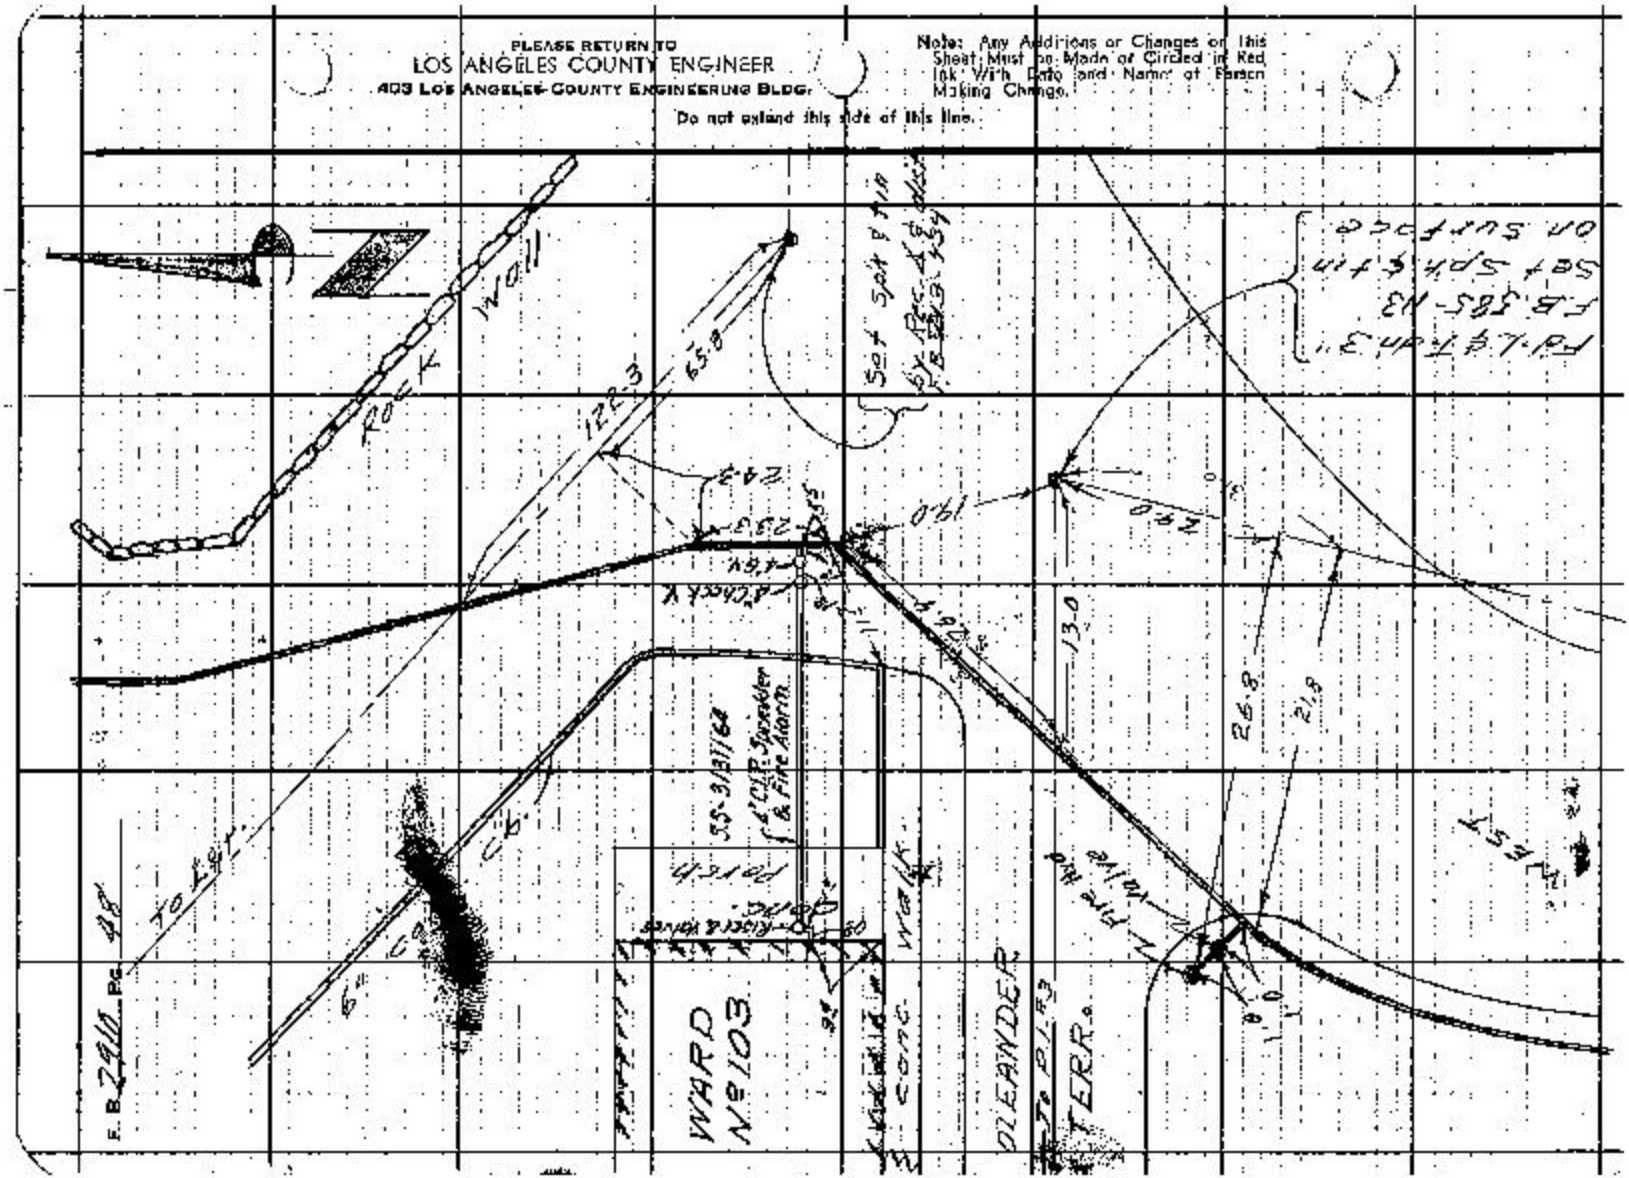
WARD No 103
DLEANDER
TERR.
F.B. 2910 Pg.
To Left
Rock
Wall
Set Spk & Tin
Set Spk & Tin on Survey
F.B. 585-N3
F.B. 743-N3

Notes Ck'd by
Map No.
Office Work SS
Checked
Date 5/15/61

Survey of Olive View Hosp
JN 022268 Tape Sta °F
Surveyed by Sotro
Notes Brooks Date 7-11-61
Indexed C. J. GALLI

F. B. 2912 PG. 49

CANTEEN BLDG

conc. porch

conc. Ramp.

Water Valve

F.B. 709-51
to P. 7

OLIVE VIEW AVE

Rock Wall

conc.

Note: Any Additions or Changes on This Sheet Must be Made or Circled in Red Ink With Date and Name of Person Making Change.

Do not extend this data off this line.

PLEASE RETURN TO
LOS ANGELES COUNTY ENGINEER
Los Angeles County Engineering Bldg.

F. B. 290 Pg. 32

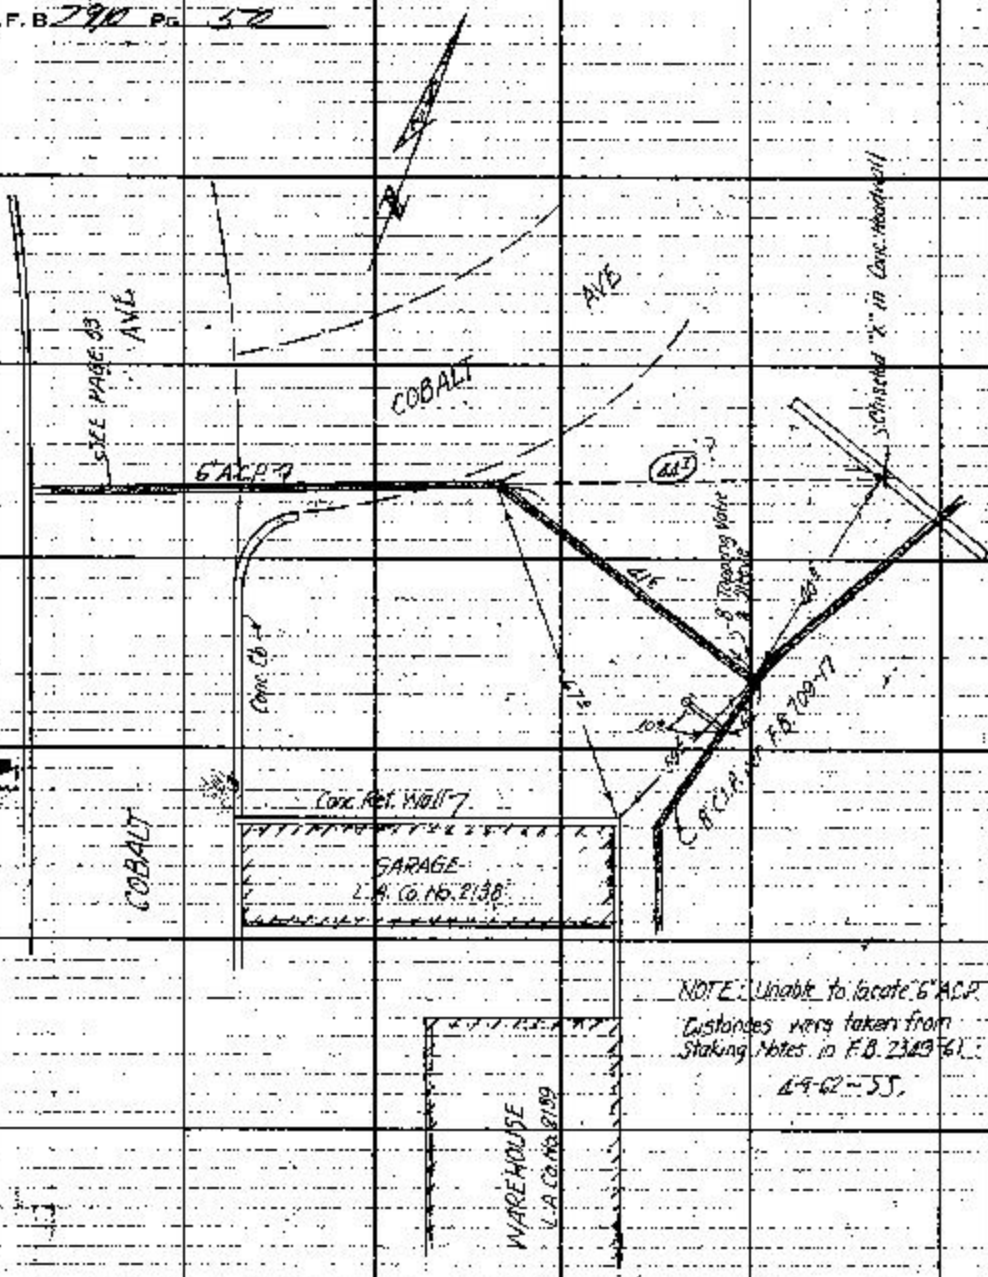


PLEASE RETURN TO
LOS ANGELES COUNTY ENGINEER
403 Los Angeles County Engineering Bldg.

Do not extend this side of this line.

Note: Any Additions or Changes of This Sheet Must Be Made or Circled in Red Ink With Date and Name or Person Making Change.

Notes Ck'd by
Map No.
Office Work
Checked
Date 8/15/62

Survey of Olive View Hosp
JN 00228 Tabs Sht of
Surveyed by Bowles
Notes Bowles Date 7-19-62
Indexed J. GALLI

F. B 2915 Pg 57

cont. Sht

09 32

Pre-Mix Walk

JACARANDA TERR.

P.I.T 3 Ft
L.F.
F.B 585-110

4.0

1220

P.I.T 4 Ft
F.B 585-110

10.0

Parking Lot

Time house

walk

9.3

16.5

17.0

Valve

DETAIL "A"

30

Step in Turn M.H.

Valve

DETAIL

Note: Any Additions or Changes on this Sheet Must Be Made or Circled in Red With Date and Name of Person Making Change.

Do not extend this line off this sheet

PLEASE RETURN TO
LOS ANGELES COUNTY ENGINEER
403 LOS ANGELES COUNTY ENGINEERING BLDG.

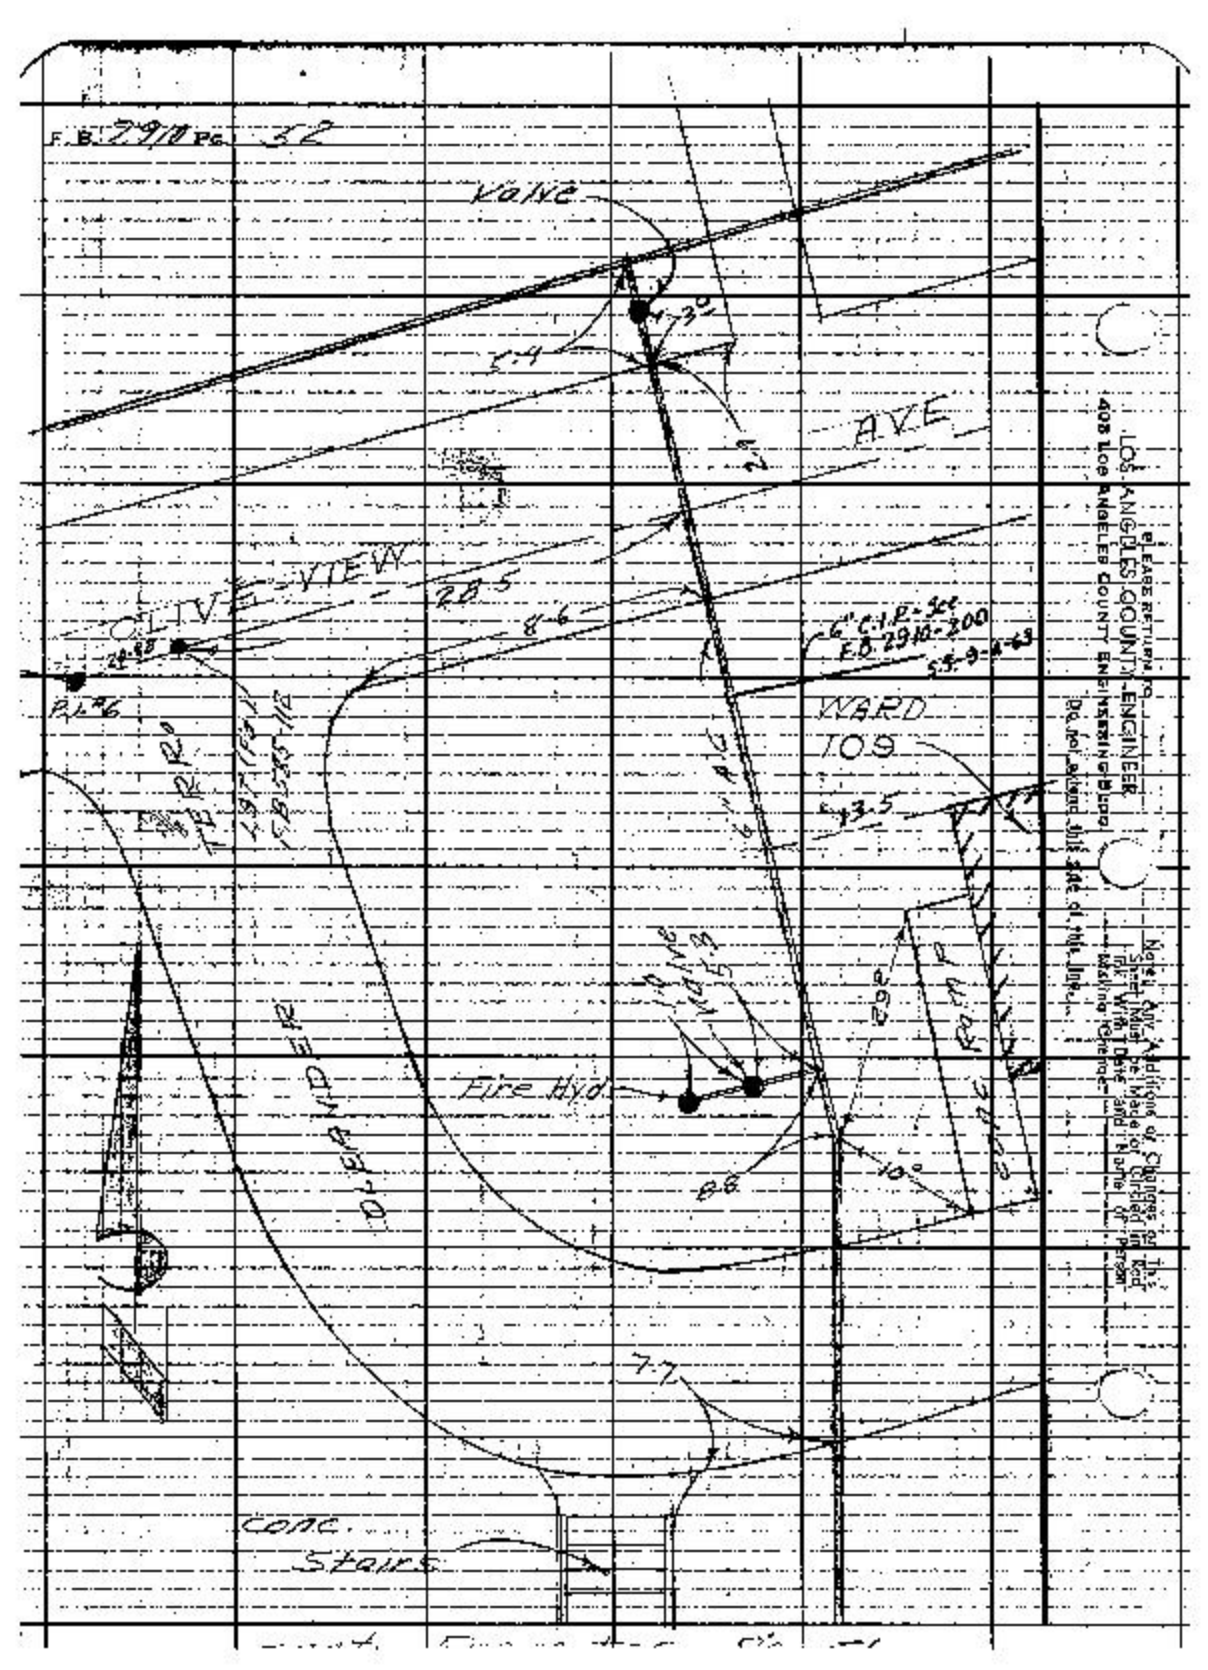
F.B. 2910 Pg. 32
Valve
AVE
VIEW
WARD
109
Fire Hyd
Cone
Stairs
LOS ANGELES COUNTY ENGINEER
408 Hoe ANGELES COUNTY ENGINEERING BLDG

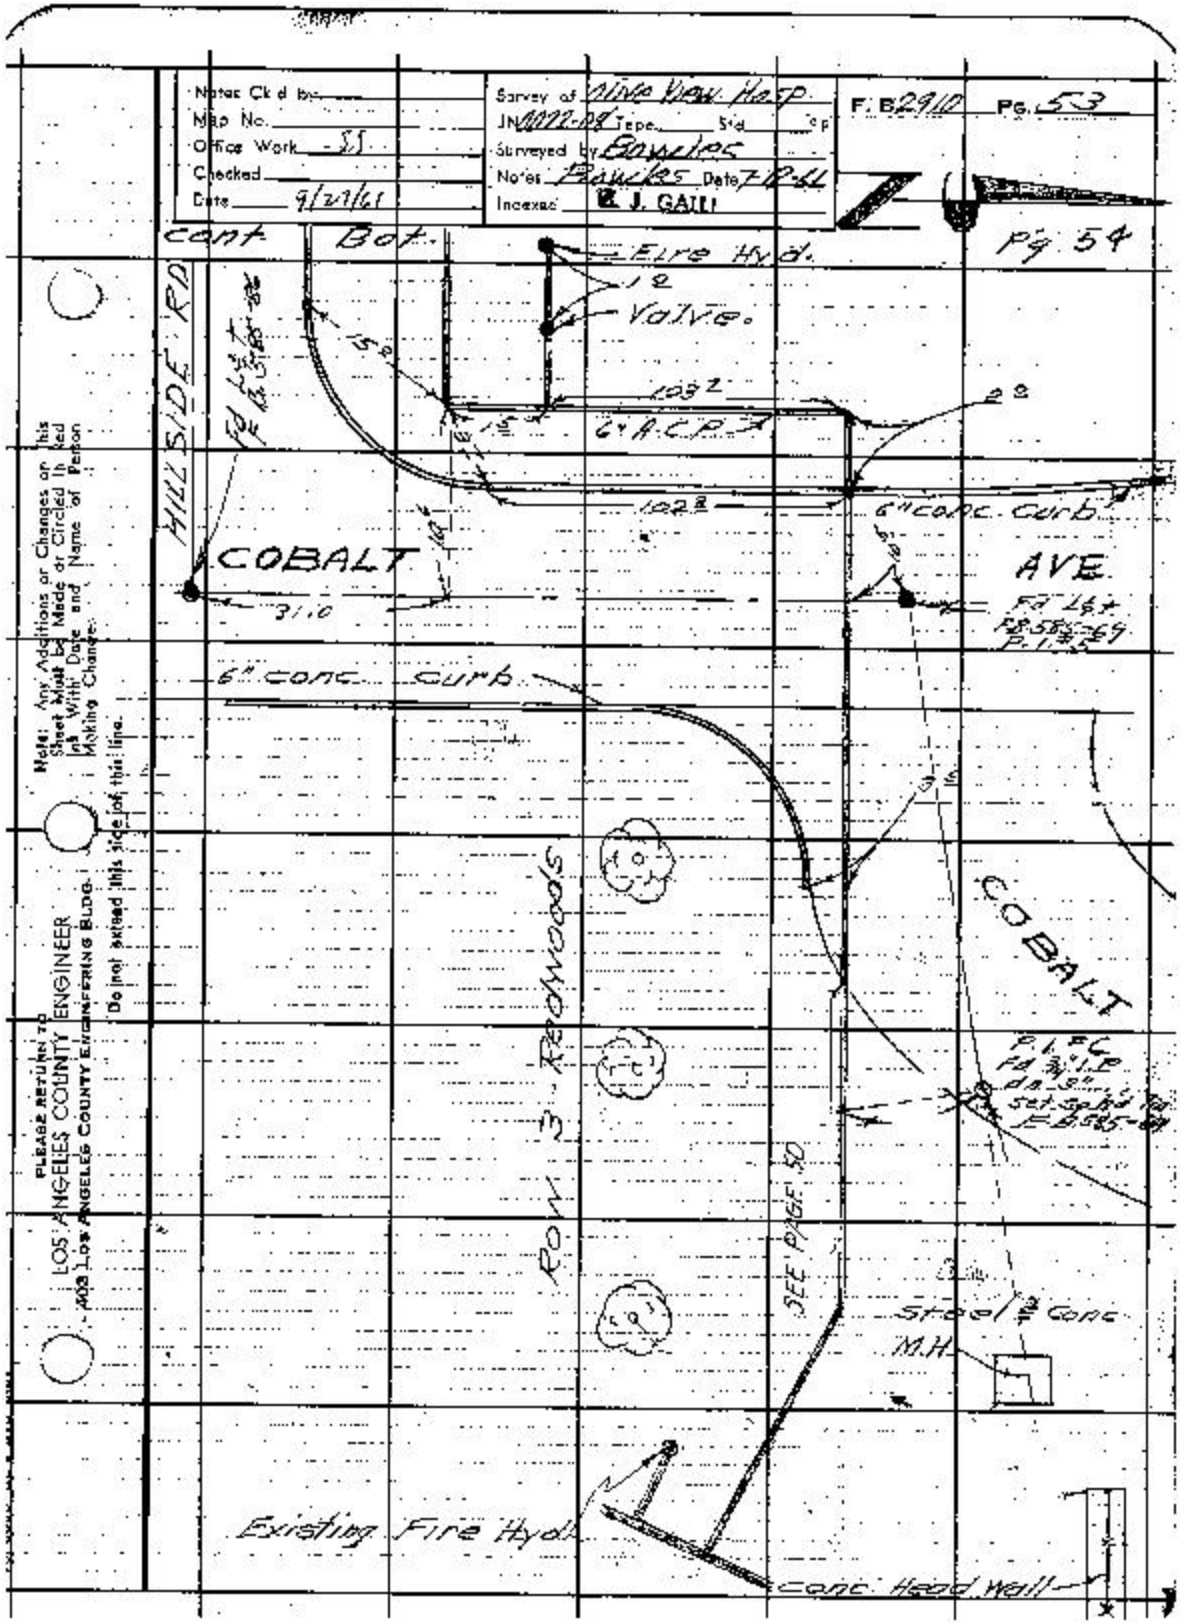
Notes Ck'd by
Map No.
Office Work SS
Checked
Date 9/21/61
Survey of Olive View Hosp.
JN 0072-09 Tape Sta Tp
Surveyed by Bowles
Notes Bowles Date 7-12-61
Indexed E. J. GALLI
F. B. 2910 Pg. 53
Pg 54
cont Bot.
Fire Hyd.
12" Valve.
HILLSIDE RD
103'
6" A.C.P.
2"
102'
6" conc. curb
COBALT
AVE.
310
6" conc. curb
Fd 1½" I.P.
Fd 5/8" I.P.
COBALT
Fd 1½" I.P.
Fd 3/4" I.P.
Set Spike
P.E. 585-69
ROW 3 Redwoods
SEE PAGE 50
Steel & Conc
M.H.
Existing Fire Hyd.
Conc. Head Wall
Note: Any Additions or Changes on this Sheet Must be Made or Circled in Red ink With Date and Name of Person Making Change.
Do not retrace this side of this line.
PLEASE RETURN TO
LOS ANGELES COUNTY ENGINEER
A-103 Los Angeles County Engineering Bldg.

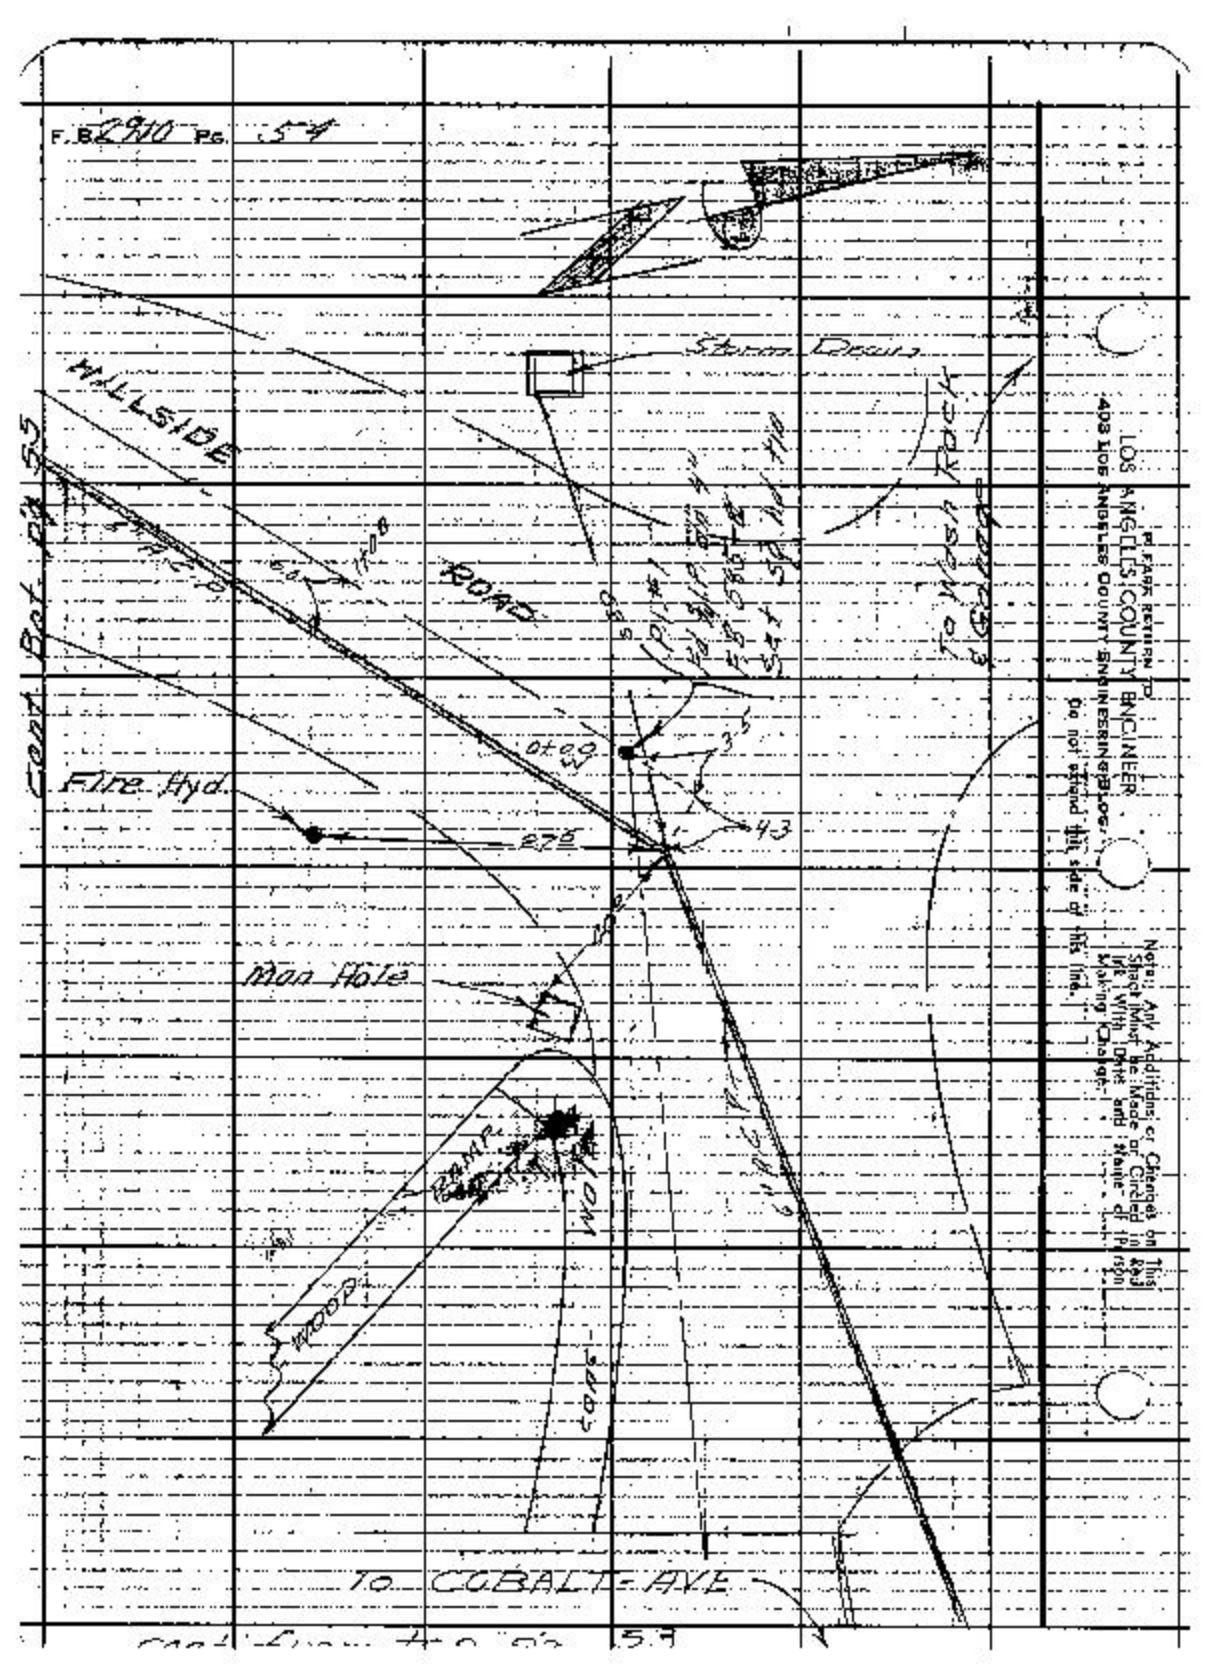
F.B. 2910 PG. 54
Storm Drain
HILLSIDE
ROAD
Fire Hyd.
Man Hole
WOOD
TO COBALT AVE
Cont. Bot. pg 55
Cont. from pg 53
LOS ANGELES COUNTY ENGINEER
Notice: Any Additions or Changes on This Sheet Must Be Made or Circled in Red Ink With Date and Name of Person Making Change.
Do not extend this side of this line.

Notes Ck'd by
Nom. No.
Office Work SS
Checked
Date 9/27/61

Survey of Olive View Hosp.
JN 11218 Tape S-a
Surveyed by Soto
Notes Bowles Date
Indexed R. J. GALLI

F.B. 2910 Pg. 55

Fire Hyd
Valve
For this Area
See F.B. 309-70

Valve

4" C.I.P.

Down 30°

Valve

Valve

HILLSIDE ROAD

WARD AVE

P#2
Set Sq. hd
& Tin Rec.
& dist
F.B. 585-87

21.0
19.0
3.6
8.7
3.6
2193.1
2188.1
2+00

6" R.C.P.

Notes: Any Additions or Changes on This Sheet Must Be Made in Red Ink With Dates and Name of Person Making Change.
Do not extend this title of this line.

PLEASE RETURN TO
LOS ANGELES COUNTY ENGINEER
408 Los Angeles County Engineering Bldg.

PLEASE RETURN TO
LOS ANGELES COUNTY ENGINEER
403 Los Angeles County Engineering Bldg.

Do not extend this side of this line.

Note: Any Additions or Changes on This Sheet Must Be Made or Circled in Red Ink With Date and Name of Person Making Change.

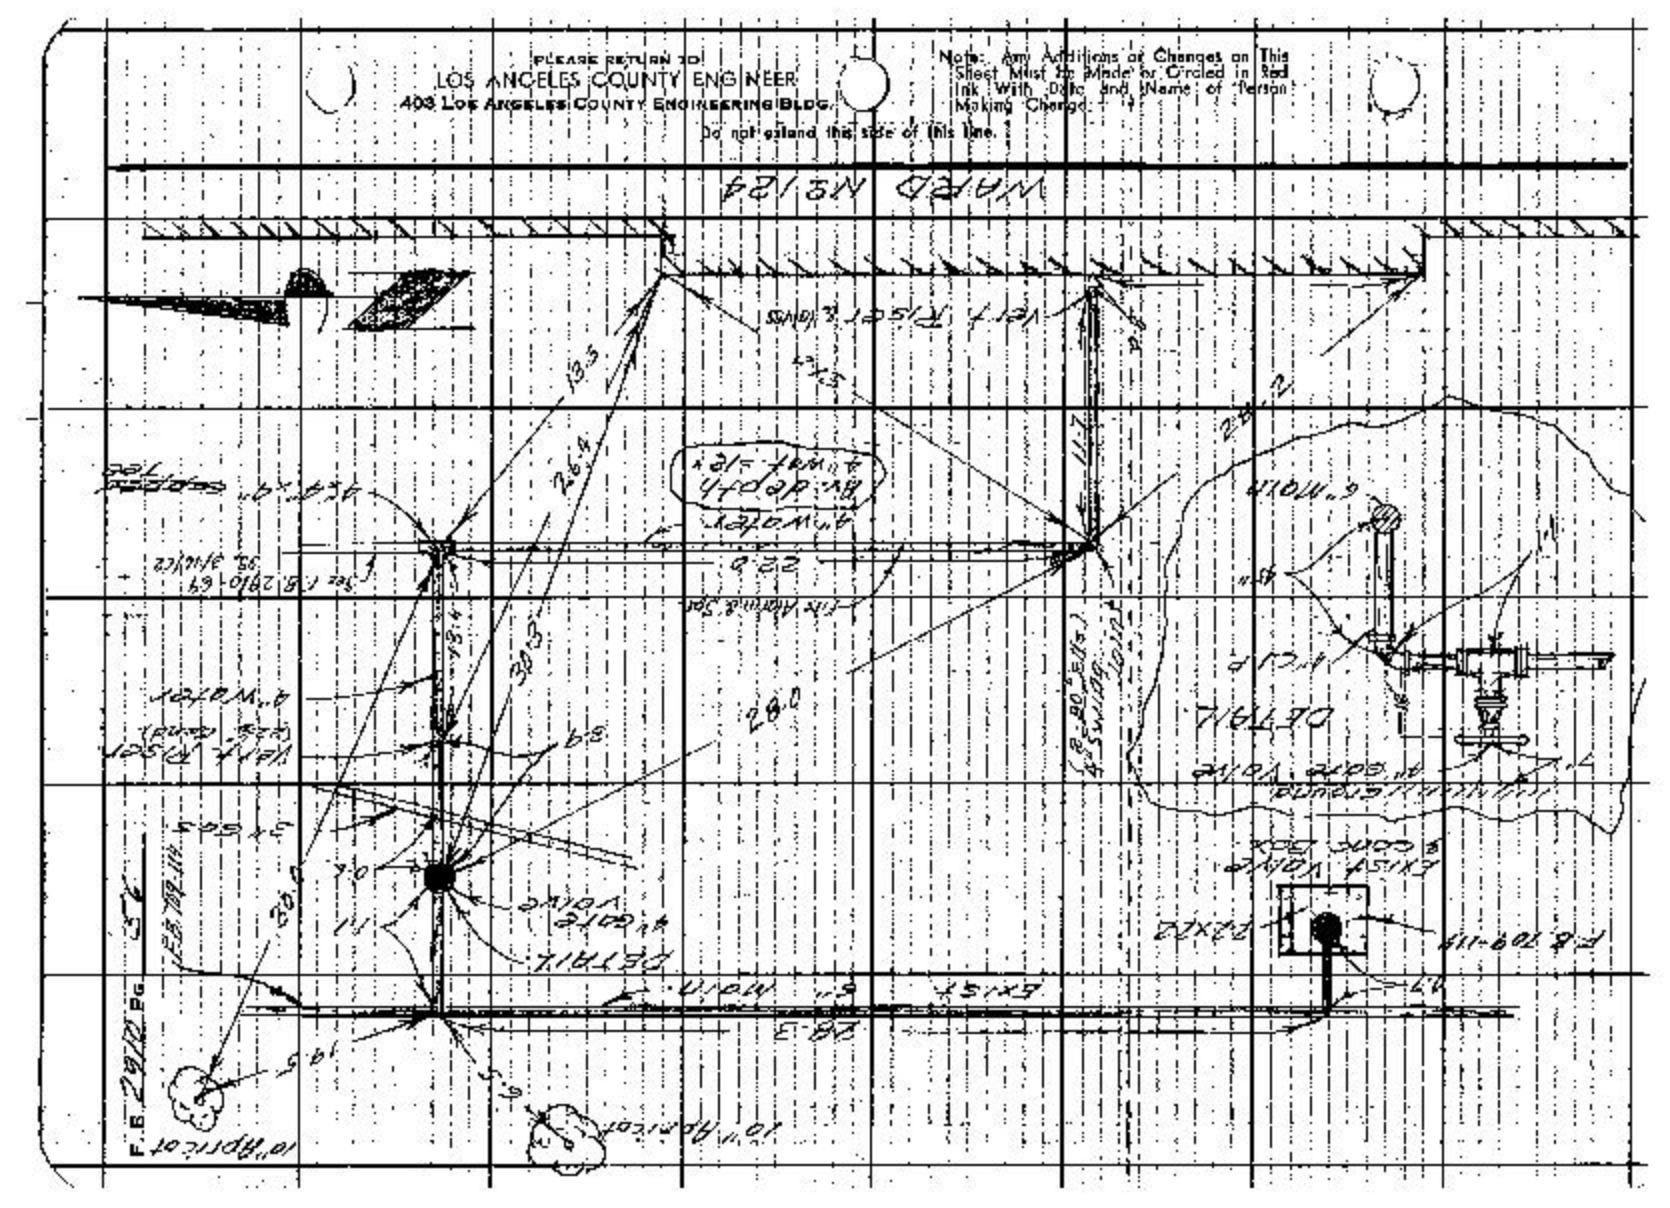

783098 CE #247 7-68

RETURN TO
LOS ANGELES COUNTY ENGINEER
700 LOS ANGELES COUNTY ENGINEERING BLDG.

Note: Any Additions or Changes on This Sheet Must Be Made for, Circled in Red Ink, With Date and Name of Person Making Change

Do not extend notes this side of this line.

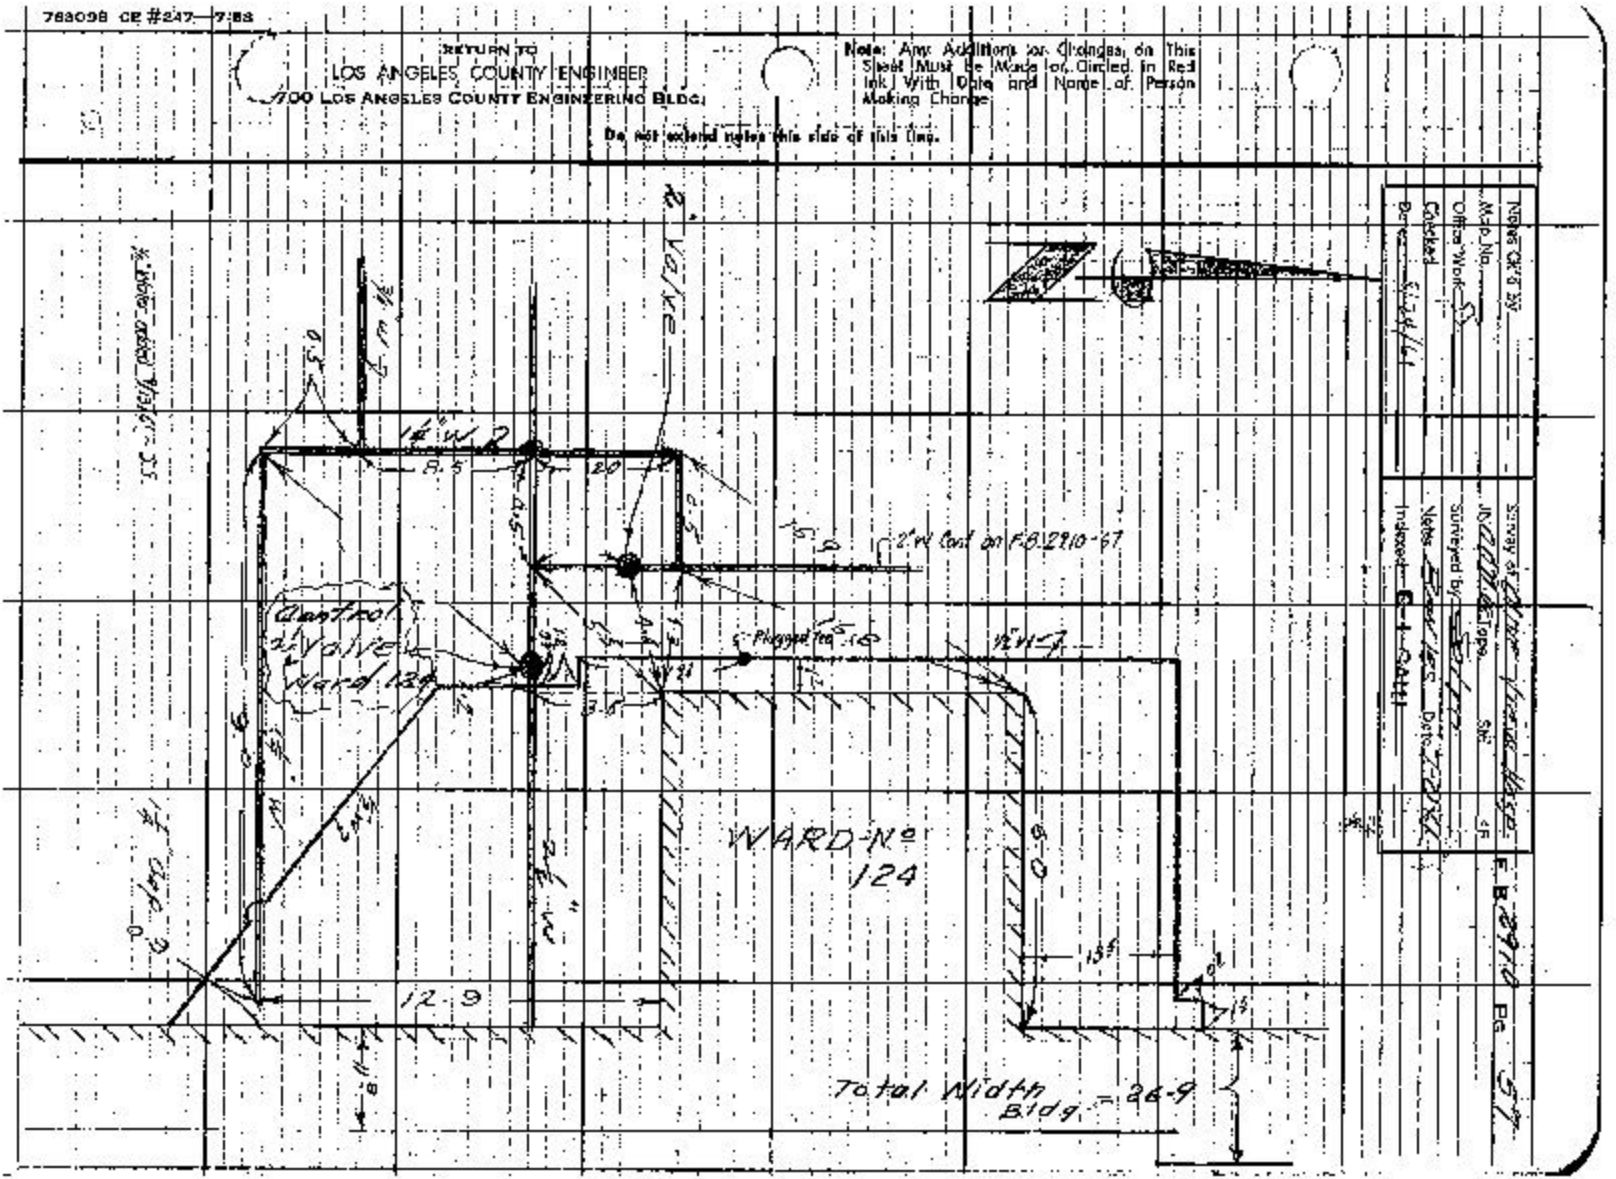

RETURN TO
LOS ANGELES COUNTY ENGINEER
900 Los Angeles County Engineering Bldg.

Note: Any Additions or Changes on This Sheet Must be Made or Circled in Red Ink With Date and Name of Person Making Change

Do not extend notes this side of this line.

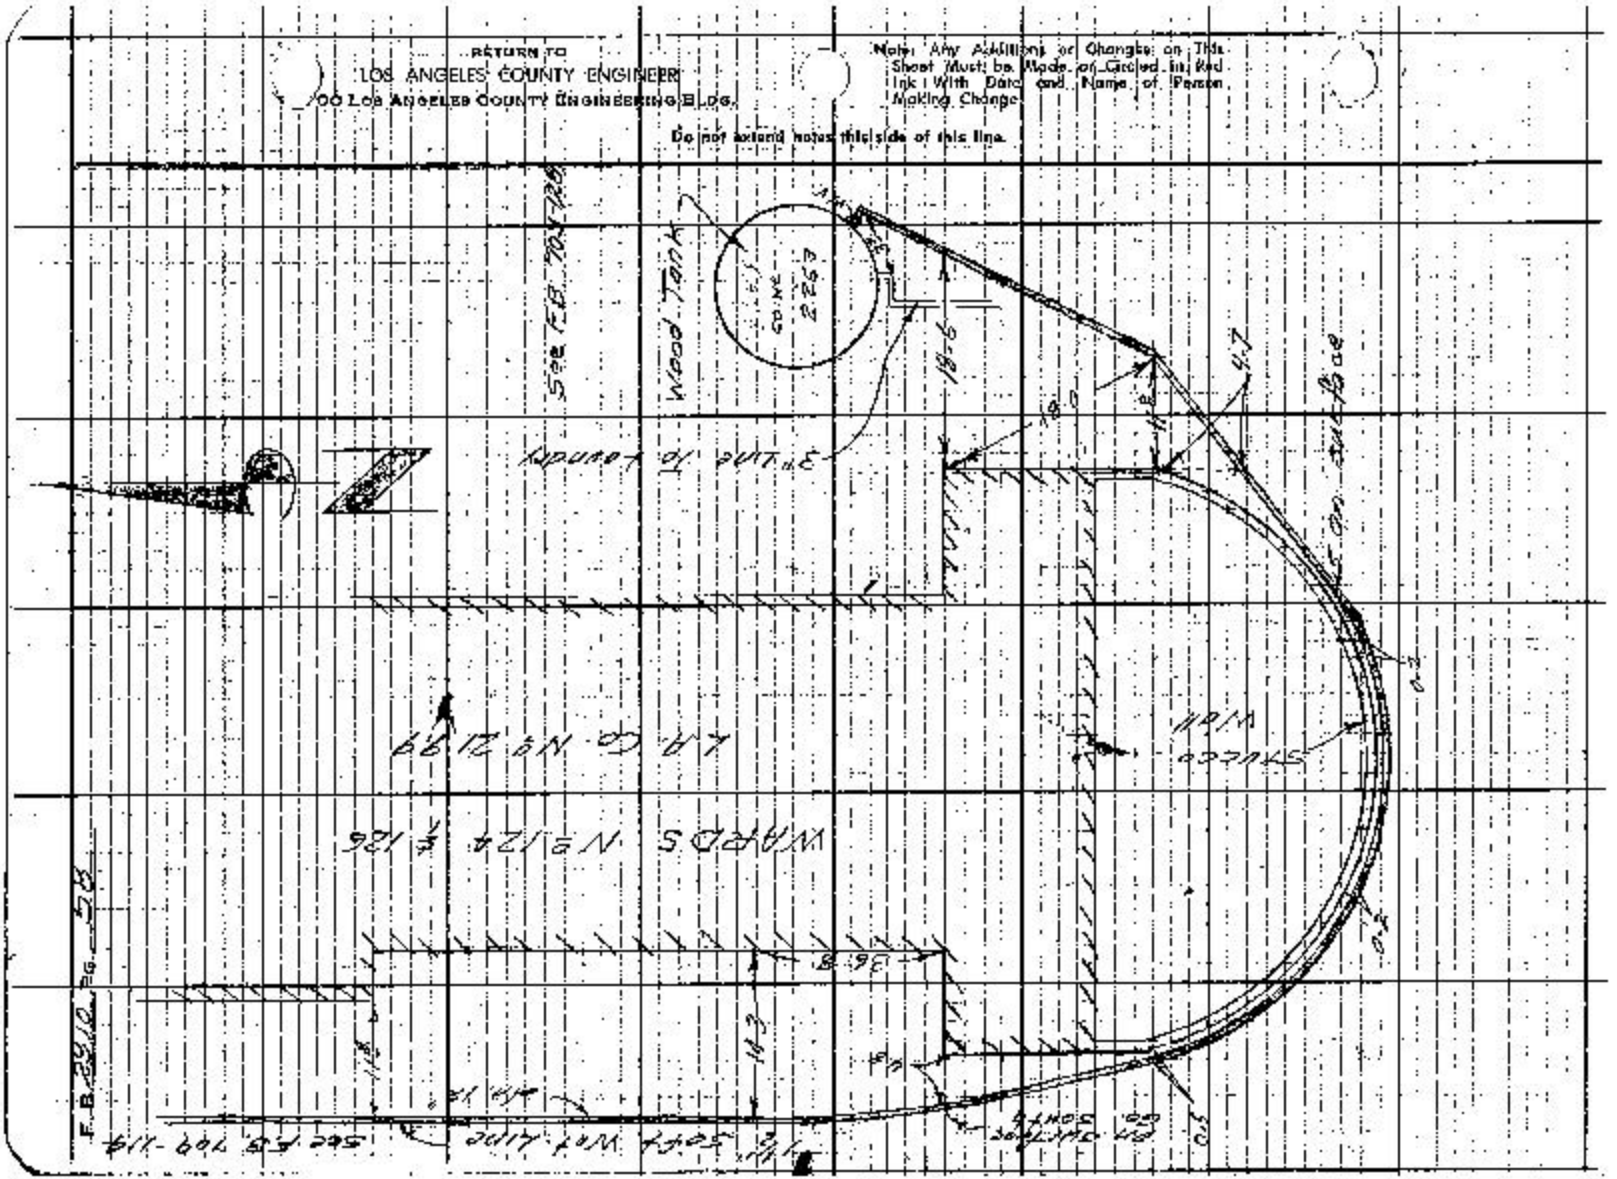

PLEASE RETURN TO
LOS ANGELES COUNTY ENGINEER
403 LOS ANGELES COUNTY ENGINEERING BLDG.

Note: Any Additions or Changes on This Sheet Must Be Made or Circled in Red Ink With Date and Name of Person Making Change.

Do not extend this side of this line.

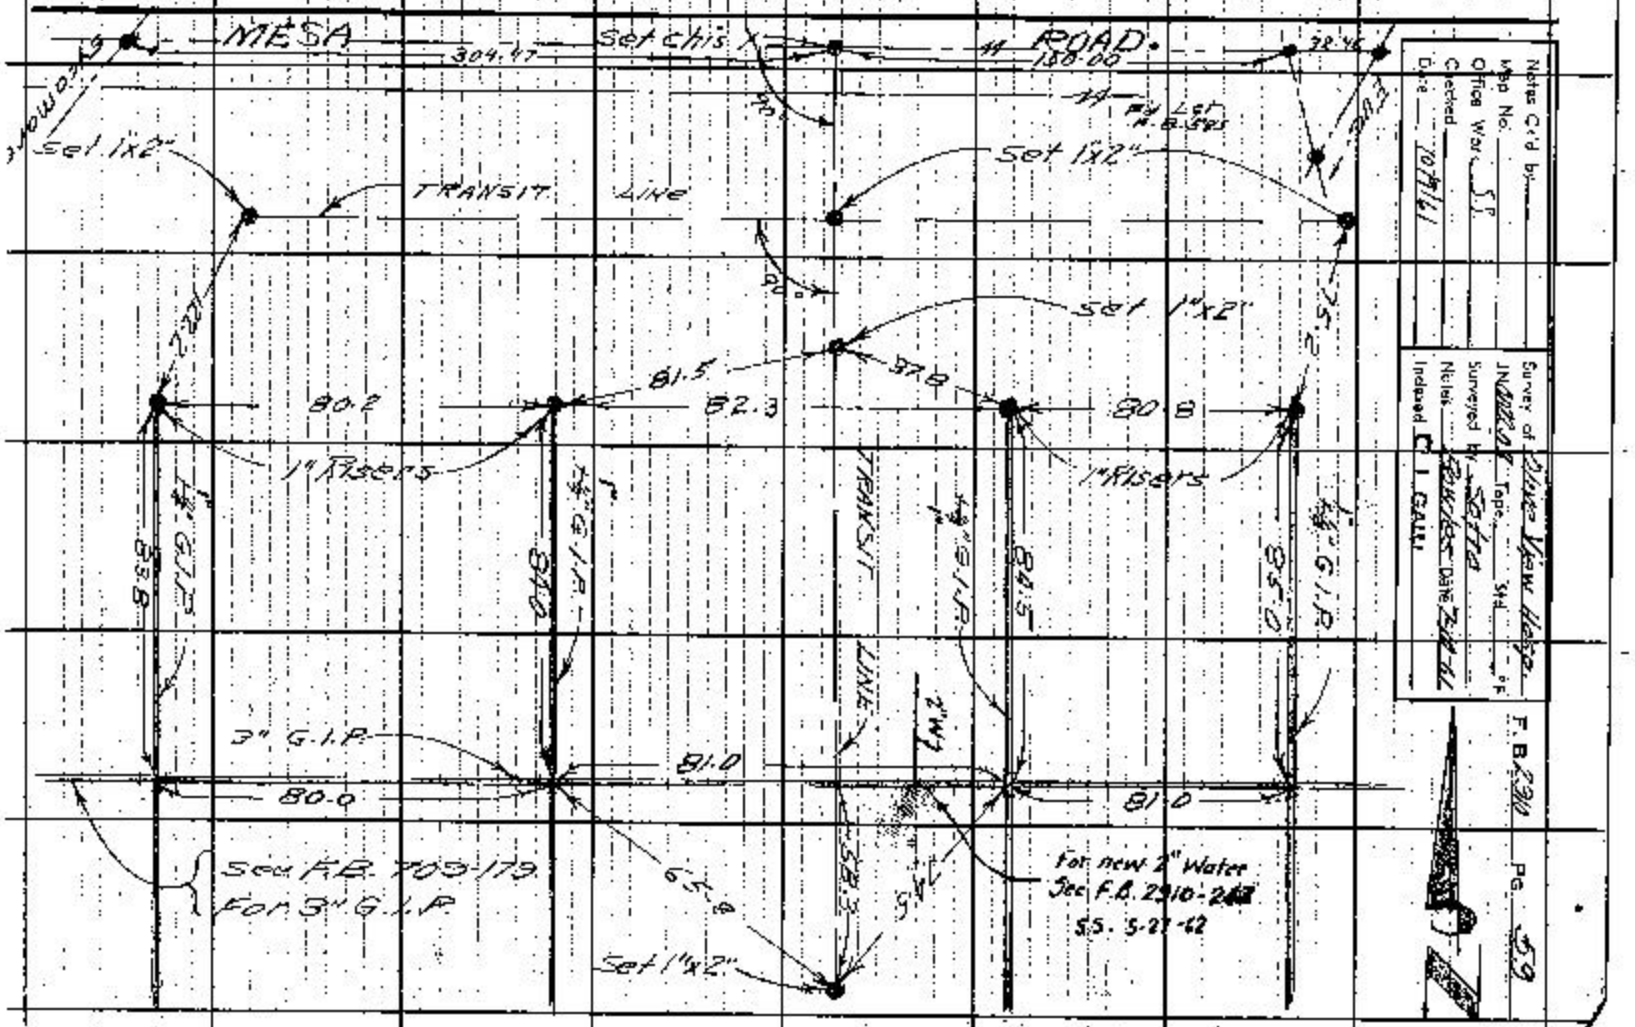


Notes C'd by
Map No.
Office Wat
Checked
Date 10/14/61

Notes
Indexed C. I. GALLI


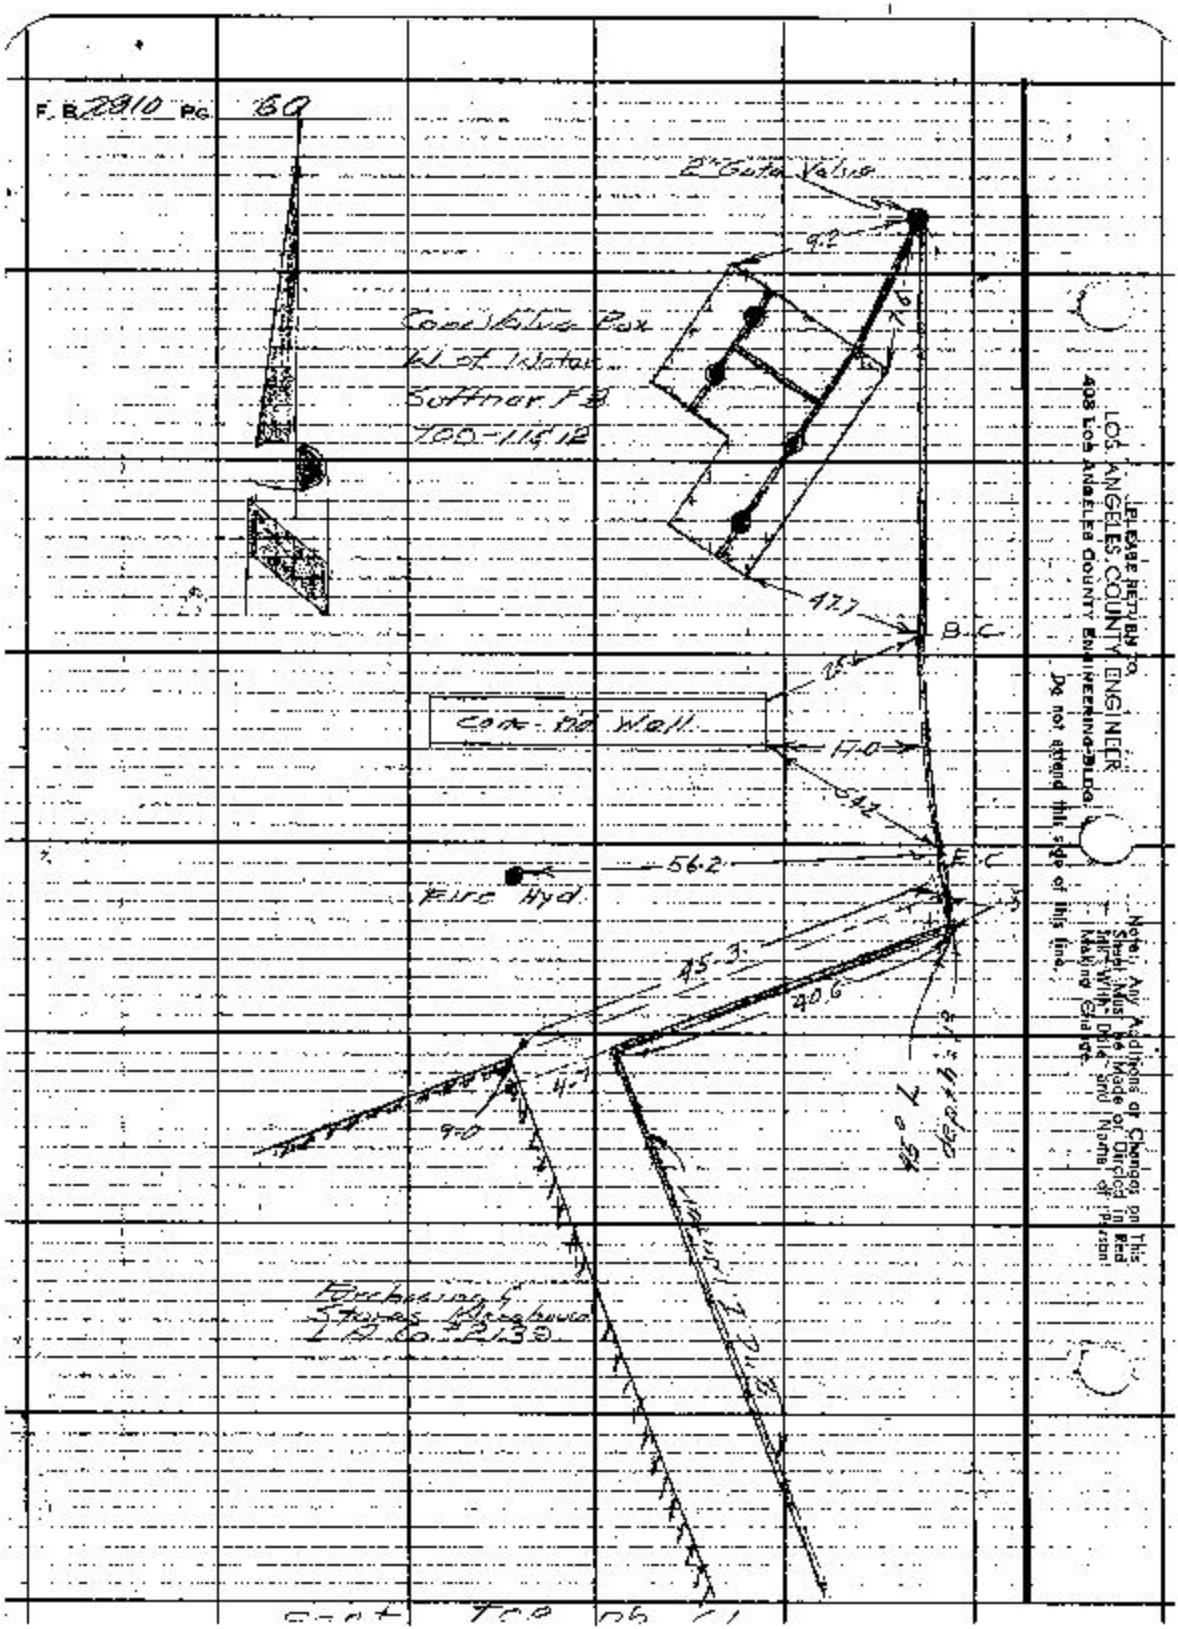
F. B. 2910 PG. 60
2" Gate Valve
9.2
Gate Valve Box
W.L. of Water
Soffmor F.B.
100-115 12
47.7
B.C.
Conc. Rd Wall
17.0
56.2
E.C.
Fire Hyd
45.3
40.6
41.7
90
Cont. to Rt. of Line
JEL BASE RETURN TO
LOS ANGELES COUNTY ENGINEER
408 Los Angeles County Engineering Bldg.
Do not extend this side of this line.
Note: Any Additions or Changes on This Sheet Must Be Made or Directed by Thos. Who Sign Same. Failure to Comply May Result in Delay in Making Final Payment.

Notes Ck'd by:
Map No.
O.T.W. Work: SI
Checked
Date: 10/9/61

Survey of: Olive View Hosp.
IN 0022-05 Topo Std °F
surveyed by: Gotro
Notes: Bowles Date 6-1961
Indexed: E. J. GALLI

F.B. 2910 Pg. 61

Cont From Bk pg 60

Purchasing & Stores
Warehouse
L.A. Co. #130

9'

30'

2" Cast Iron Meter

64'

64'

64'

2" Cast Iron Meter

RETURN TO
LOS ANGELES COUNTY ENGINEER
700 Los Angeles County Engineering Bldg.

Note: Any Additions or Changes on This Sheet Must be Made in Red Ink, With Date and Name of Person Making Change.

Do not extend notes this side of this line.

763058 SE #247—7-65

F.B. 2910 Pg. 62

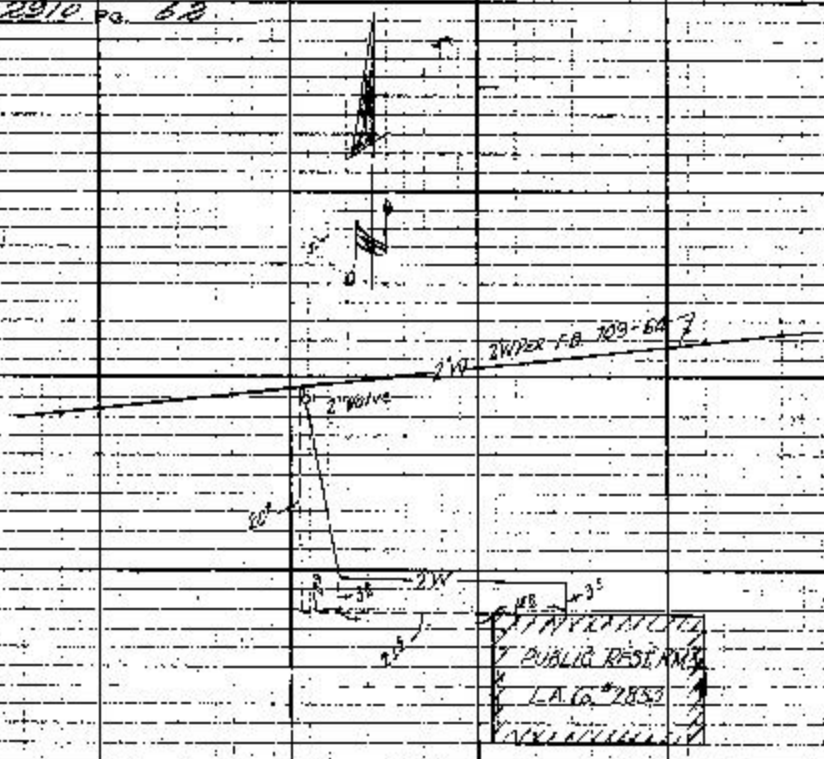
2"WPER F.B. 709-64
2"W
2"Water
20'
2W
3"
3"
3"

Notes Ck'd by
Map No.
Office Work
Checked
Date 10/9/61

Survey of Olive View Hosp. F.B. 2910 Pg. 63
Dwg. No. Tape Std. of F
Surveyed by Sedia
Notes Bradley Date 7-7-61
Indexed C. J. CALLI

Note: Any Additions or Changes on this Sheet Must be Made or Circled in Red Ink With Date and Name of Person Making Them.

Do not extend notes this side of this line.

RETURN TO
LOS ANGELES COUNTY ENGINEER
200 HOA ARGUELLO STREET, LOS ANGELES 12, CALIF.

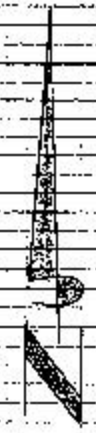

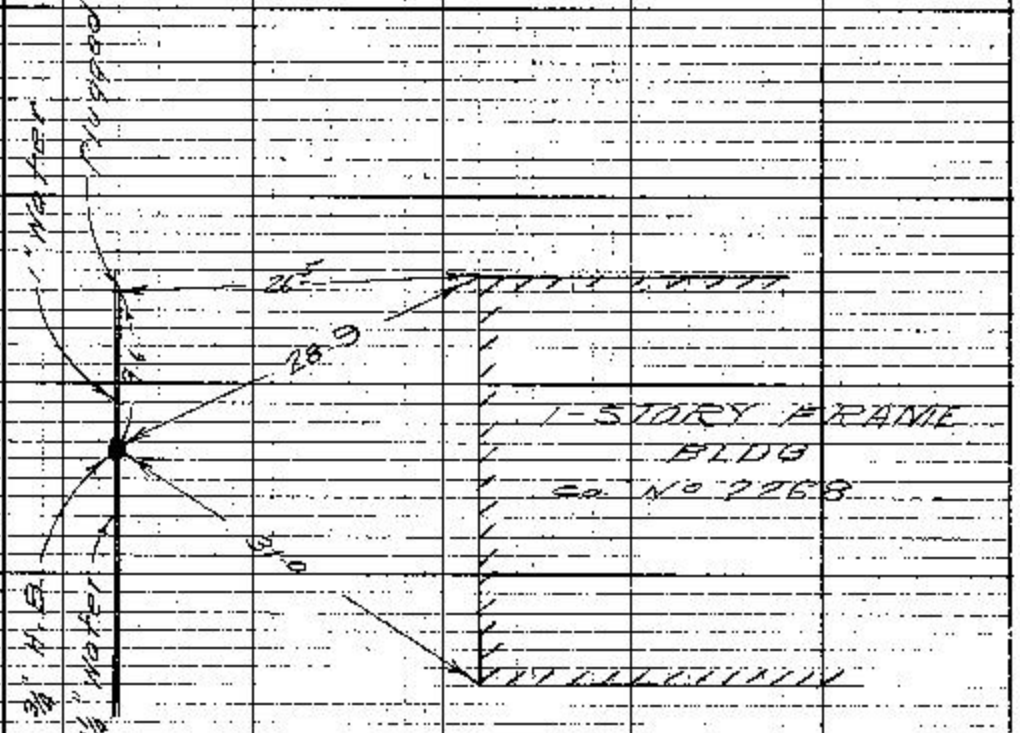


7-61 OS #2477—7-61

F.B. 2910 Pg. 64

Note: These ties are scaled distances from P.T. F-350-18 - 55 10/16/61

LOS ANGELES COUNTY ENGINEER
Los Angeles County Engineering Bldg.

Do not extend into this side of this line.

Road Improvement Agreements or Changes on This Sheet Must Be Made by Check-In and Initialed With Date and Name of Person Making Changes

Notes Ck'd by
Map No.
Office Work CJ
Checked
Date 10/11/61

Survey of OLIVE VIEW HOSPITAL
JN 00 22 38 Tape Std °F
Surveyed by
Notes J. SHINODA Date 10-10-61
Indexed C. J. GALLI

F. B. 2910 Pg. 65

PHARMACY
E.A.G. # 3217

Note: These distances were scaled from P.T.E-550-14

Cont. on Sht. 66

Note: Any Additions or Changes on this Sheet Must be Made at Office Issued With Date and Name of Person Making Change. Do not extend this side of this line.

RELEASE-RETURN TO
LOS ANGELES COUNTY ENGINEER
7500 LOS ANGELES COUNTY ENGINEERING BLDG.

76F3095 SAE #247 11-58

F. B. 2910 Pg. 66

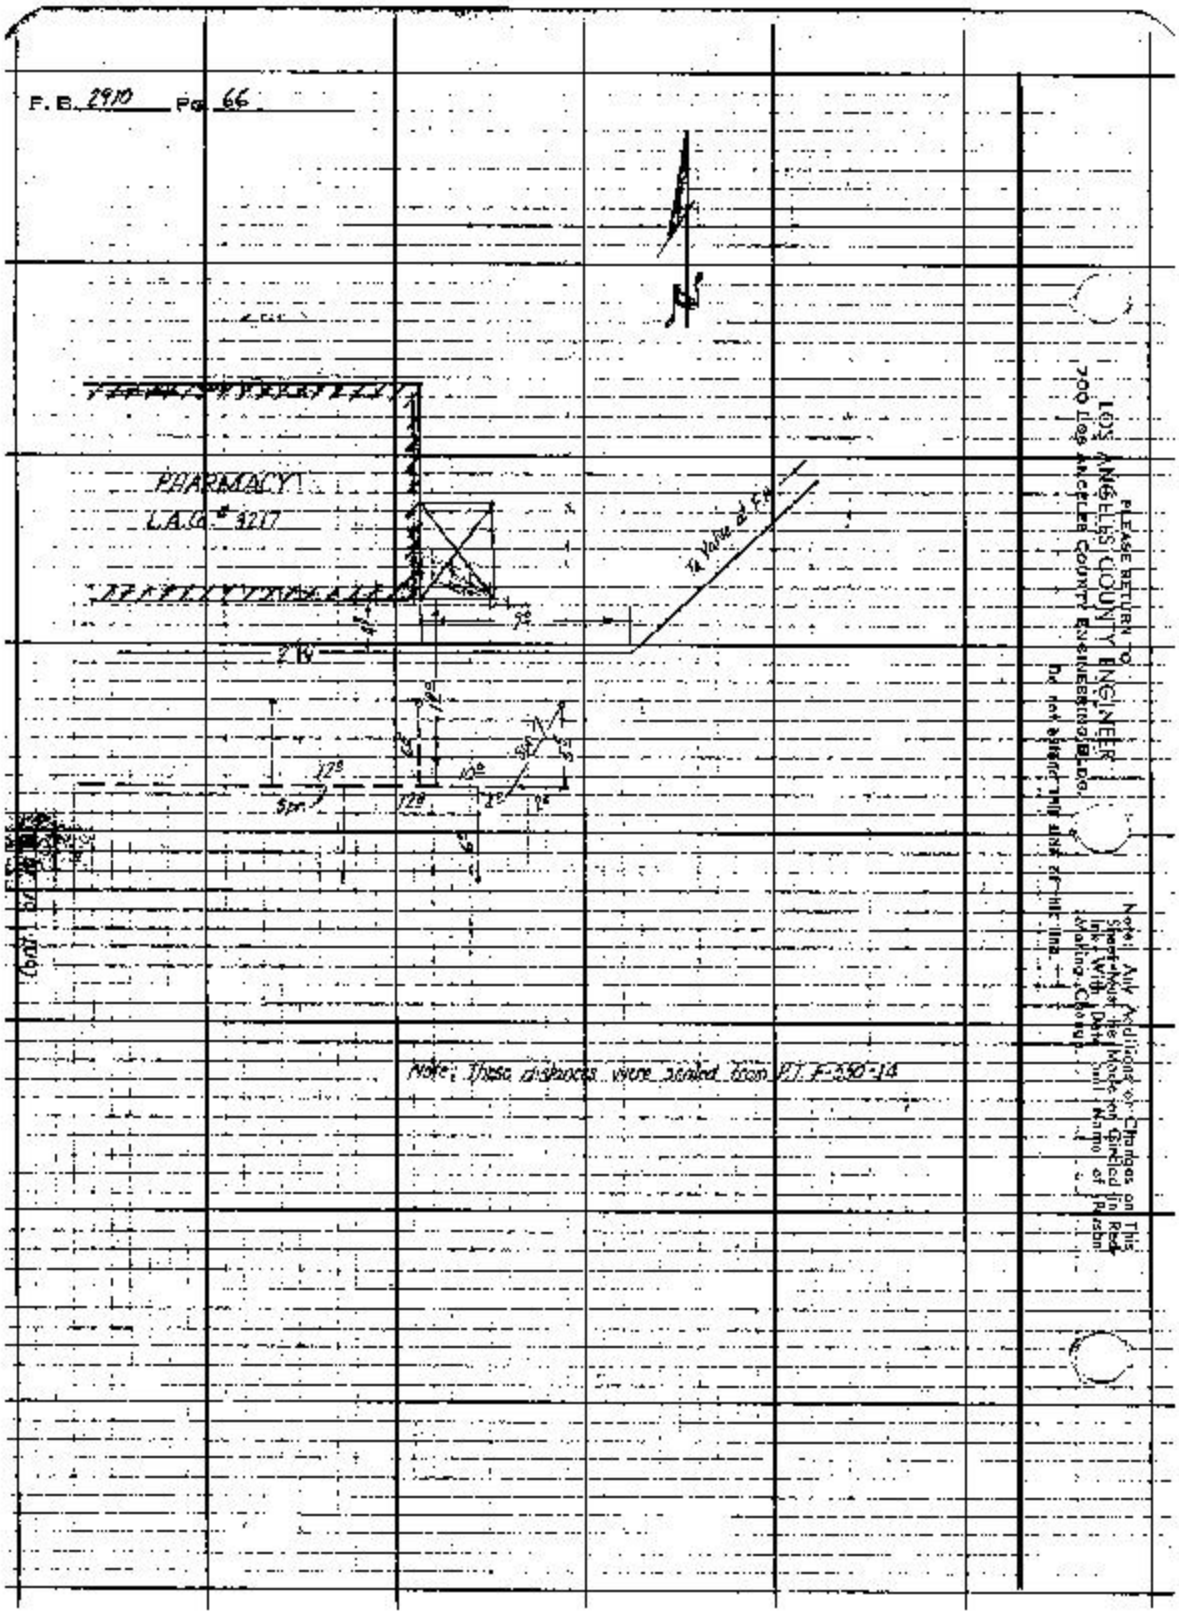


PLEASE RETURN TO
LOS ANGELES COUNTY ENGINEER
700 Los Angeles County Engineering Bldg.

Do not destroy this area of this line

Note: Any Additions or Changes on Sheet Must be Made in Ink With Date and Name of Person Making Change

This Red

Notes Ck'd by
Map No.
Office Work
Checked
Date 4-6-62

Survey of OLIVE VIEW HOSPITAL
JN 0022.08 Tape Std
Surveyed by
Notes S. Shimada Date 4-6-62
Indexed J. GALLI

F. B. 2910 Pg. 67

X-RAY

WATER

WARD 12A

WARD 12A

L.A. CO. NO. 2178

12" W.L.P.

4" W.L.P.

Fire Alarm & Sprinkler

4" W.L.P.

4" valve per I.B. 2910-57

Note: Any Additions or Changes on this Sheet Must be Made or Circled in Red Ink With Date and Name of Person Making Change

Do not extend this side of title line

PLEASE RETURN TO
LOS ANGELES COUNTY ENGINEER
Room 603, Los Angeles County Engineering Bldg.

F. B. 2910 Pg. 68

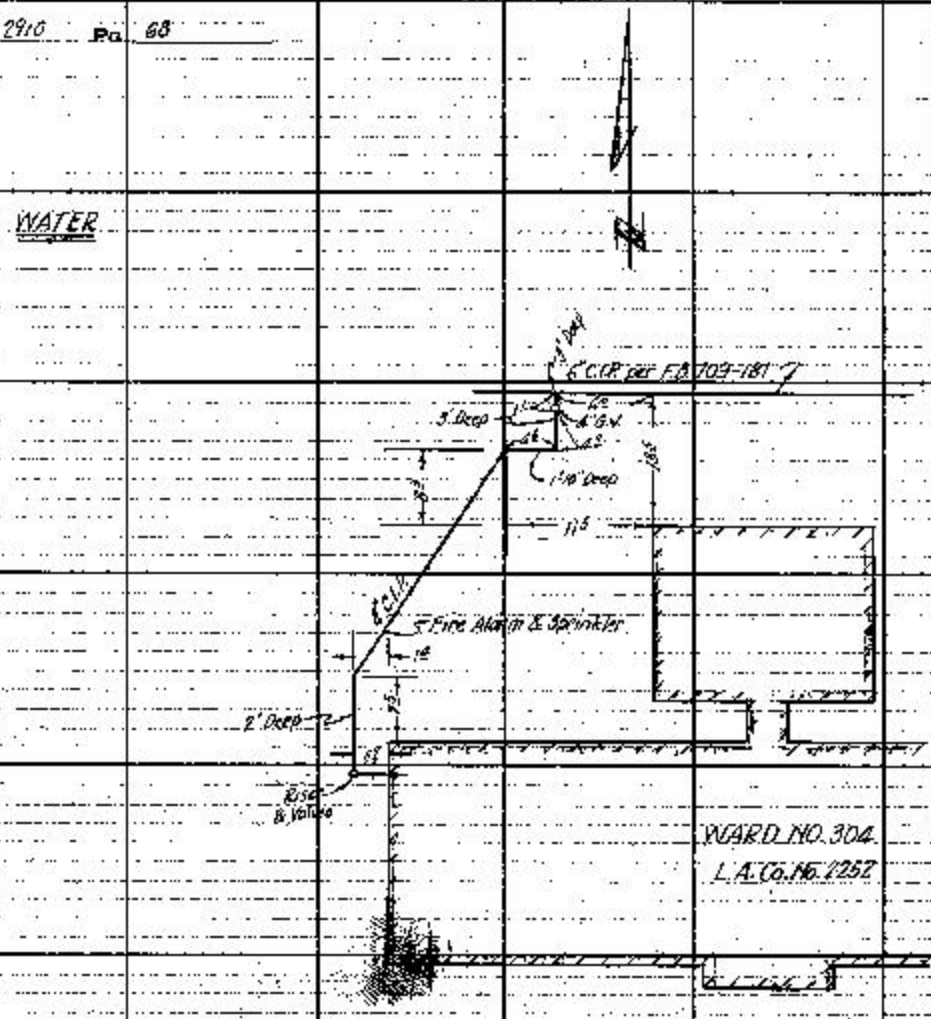


PLEASE RETURN TO
LOS ANGELES COUNTY ENGINEER
408 Los Angeles County Engineering Bldg.

Do not extend this side of this line.

Note: Any Additions or Changes on This Sheet Must Be Made or Checked in Red Ink With Date and Name of Person Making Change.

76F3085 SBE #247 11-88

PLEASE RETURN TO
LOS ANGELES COUNTY ENGINEER
900 Los Angeles County Engineering Bldg.
Do not extend this side of this line.

Note: Any Additions or Changes on This Sheet Must be Made or Checked in Red Ink With Date and Name of Person Making Change.



WATER

FIRE STATION

TOILET ADDITION

PLANO NO. 724

L.A.C.A. 1999

F. B. 2910 PG. 29

F. B. 2310 Pg. 70

LOS ANGELES COUNTY ENGINEER
700 Los Angeles County Engineering Bldg.

Interim Return of Engineer

Do not erase this sheet. Interim

Note: Any Additions or Changes on This Sheet Must Be Made in Green Ink. Write Date and Name of Person Making Change.

1½ G.I.P. on F.B. 209-118-7

1½ G.I.P.

5/8" Rebar

5/8" Rebar

5/8" Rebar

Notes Cked by
Map No.
Office Work JS
Checked
Date 4-1-62

Survey of Olive View Hosp
JR 22.08 Tape Std °F
Surveyed by M. Satro
Notes Satro Date 2-5-62
Indexed C. J. GALLI

F.B. 2910 Pg. 71

Notes: Any Additions or Changes on This Sheet Must Be Made or Circled in Red Ink With Date and Name of Person Making Changes.

Do not detach this sheet from file.

PLEASE RETURN TO
LOS ANGELES COUNTY ENGINEER
700 LOS ANGELES COUNTY ENGINEERING BLDG.

6" Valve

3" F.H.
See page 17

ONE STORY
FRAME RESIDENCE
L.A. Co. No. 2269

Entry

40.0

3" Galv. Water

10" Parked
Cork Oak

Line

ONE STORY
PUMP HOUSE
L.A. Co. No. 2272

Bottom of bank

Vertical Rise

Swing Joint
I = 90° Rt.
(On Surface)

Top Bank

3" F.H.
3" Valve

See F.B. 710-25

7AF9098 BSE (247) 11-58

F. B. 3910 PG. 22

LOS ANGELES COUNTY ENGINEER
700 LOS ANGELES COUNTY ENGINEERING BLDG.

PLEASE RETURN TO

Do not remove this sheet from this file.

Note: Any Additions or Changes on This Sheet Must Be Made on Red Ink With Date and Name of Person Making Change.

COBALT AVE.

WARD AVE.

1" = 100'

Notes Ck'd by
Map No.
Office Work SS
Checked
Date 4-2-62

Survey of OLIVE VIEW HOSPITAL
JN 0022.00 Tape S-2 EE
Surveyed by
Notes S. SWINDAH Date 3/15/62
Indexed C. L. GAILI

F. B. 2910 Pg. 73

WATER

Existing 6 C.I.P. per F.B. 709-20

4" C.I.P.

6" C.I.P.

4" C.I.P. changes to 3"

5/8" Fire Alarm & Sprinkler

3/4" Riser

3 Valves

WARD NO 303

L.A. Co. No 7167

Note: Any Additions or Changes on this Sheet Must be Made or Circled in Red Ink With Date and Name of Person Making Changes

PLEASE RETURN TO LOS ANGELES COUNTY ENGINEER
Los Angeles County Engineering Bldg.
Los Angeles, California

Do not attend this side of this line

ZEF 3082 OC 7-10 3-61

F. B. 2910 Pg. 74

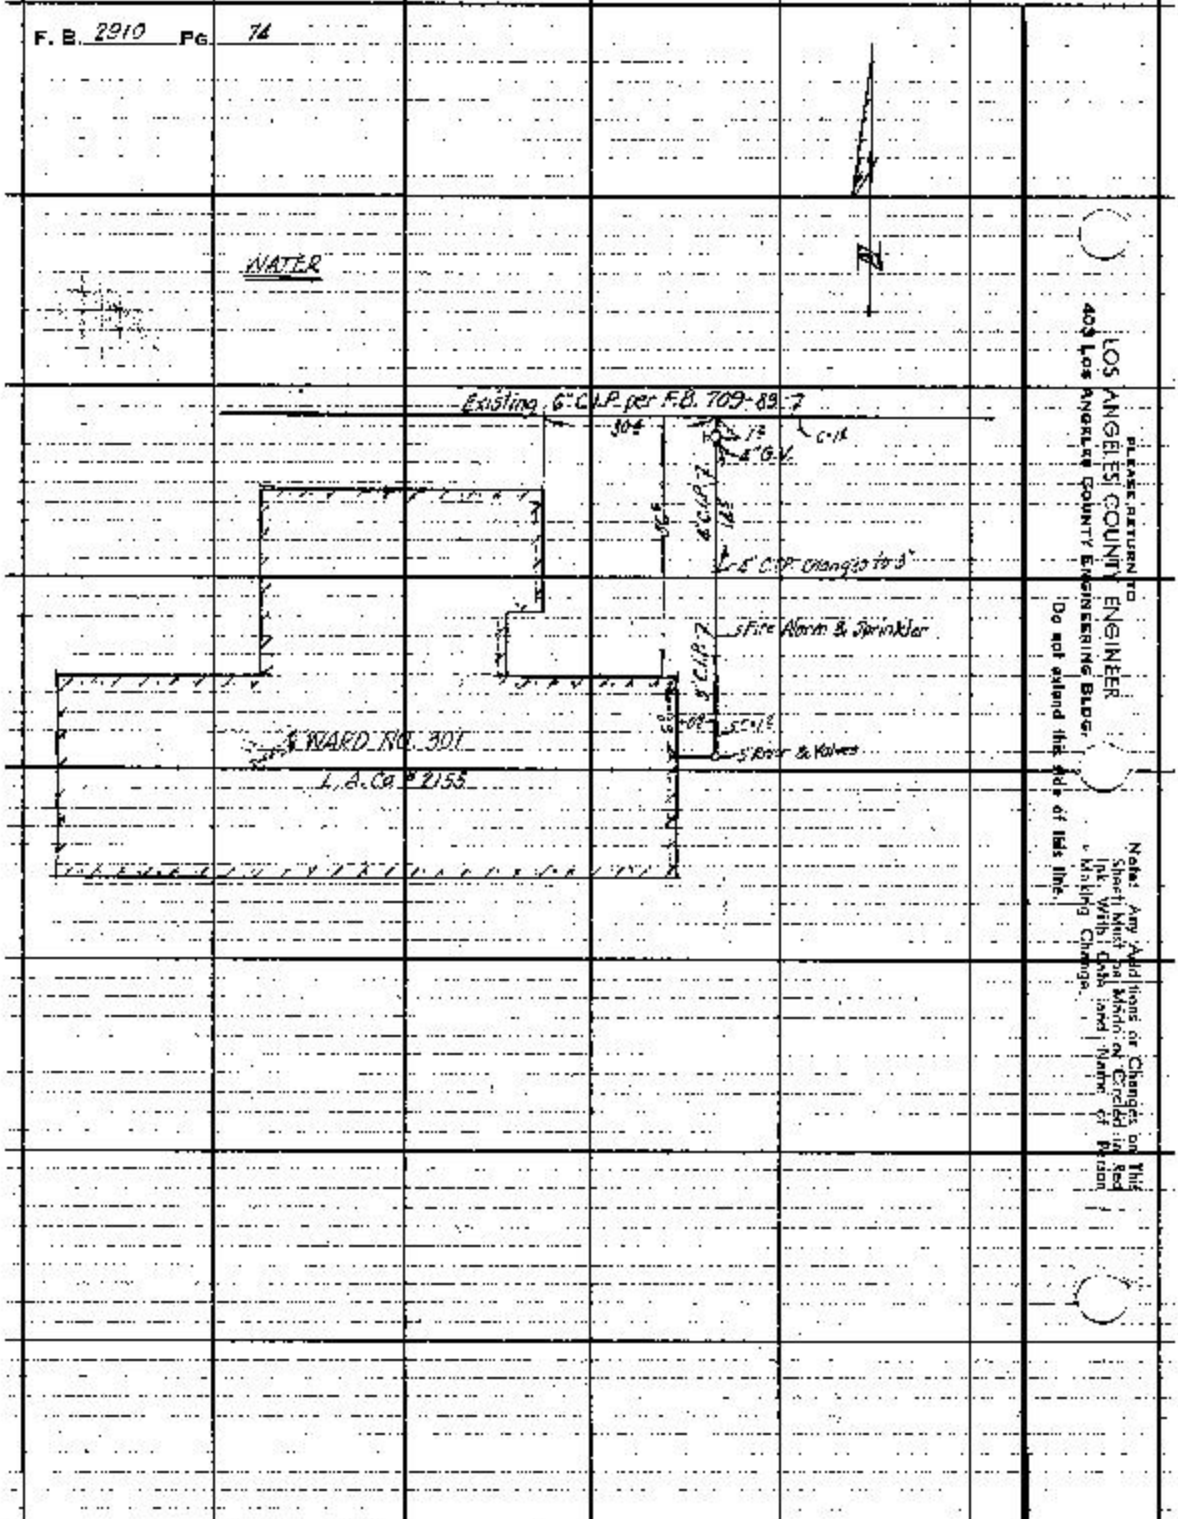


LOS ANGELES COUNTY ENGINEER
ANGELES COUNTY ENGINEERING BLDG.
Do not extend this side of this line.

Note: Any Additions or Changes on This Sheet Must Be Made in Red Ink With Date and Name of Person Making Change.

Notes, C'ks by
Maps by
Office Work
Checked
Date 2/16/62

Survey of OLIVE VIEW HOSPITAL
J.N. 702208 Tape Sta EE
Surveyed by
Notes S. Johnson Date 2/15/62
Indexed G. J. GALLI

F. B. 2910 Pg. 75

WATER

Existing 6" W per F.B. 709-182-7

3"G.W.

4"W.P.

Fire Alarm & Sprinkler

4" Riser
& Valves

VIARD NO. 302
L.A.Co. No 7254

Note: Any Alterations or Changes on this Sheet Must be Noted or Changed in Ink—With Date and Name of Person Making Changes

Do not detach this side of this filer

LOS ANGELES COUNTY ENGINEER
PLEASE RETURN TO
COUNTY ENGINEERING BLDG.
LOS ANGELES COUNTY ENGINEER

Notes Ck'd by
Map No.
Office Work
Checked
Date

Survey of
JN Tape Sta °F
Surveyed by
Notes Date JUL 2 5 '60
Indexed C. J. KAUL

F. B. 2910 Pg. 76

# OLIVE VIEW HOSPITAL

JN 0022.08

## ELECTRICAL LINES

Notes: Any Additions or Changes on this Sheet Must Be Made or Checked in Red Ink With Date and Name of Person Making Change.

Do not extend this line beyond limits of this sheet.

PLEASE RETURN TO
LOS ANGELES COUNTY ENGINEER
7660 Los Angeles County Engineering Bldg.

76F3033 SEC #247 11-58

Notes Ck'd by
Map No.
Office Work SS
Checked
Date 11/8/61

Survey of Office Visual Sanitation
W. O. 00 2208 Tape No. Std. °F.
Surveyed by M. Soto
Notes H.E.E. Date 8-27-61
Indexed E. GALLI

F. B. 2910 Pg. 78

Note: Any Additions or Changes on This Sheet Must be Made in Red Ink With Date and Name of Person Making Change.

Do not railroad notes this side of this line.

RETURN TO
LOS ANGELES COUNTY SURVEYOR
720 LOS ANGELES COUNTY
ENGINEERING BLDG.

City of L.A. High Voltage Transmission Easement

Power Pole

COBALT

Conc.

Conc. Patch

8.2'

11.5'

LAUNDRY

Brown L.A. Dealer

Electric Power Pole (Underground)

NORMAN

Lane

AVE

Pvm't

6' Conc. Curb

8.8'

Conc. Driveway

Conc. Patch

3.0'

ROAD

Pvm't

75F3089 SEE Sht. 1-54

RETURN TO
LOS ANGELES COUNTY SURVEYOR
720 LOS ANGELES COUNTY
ENGINEERING BLDG.
Do not extend notes this side of this line.

Note: Any Additions or Changes on This Sheet Must be Made or Circled in Red Ink With Date and Name of Person Making Change.

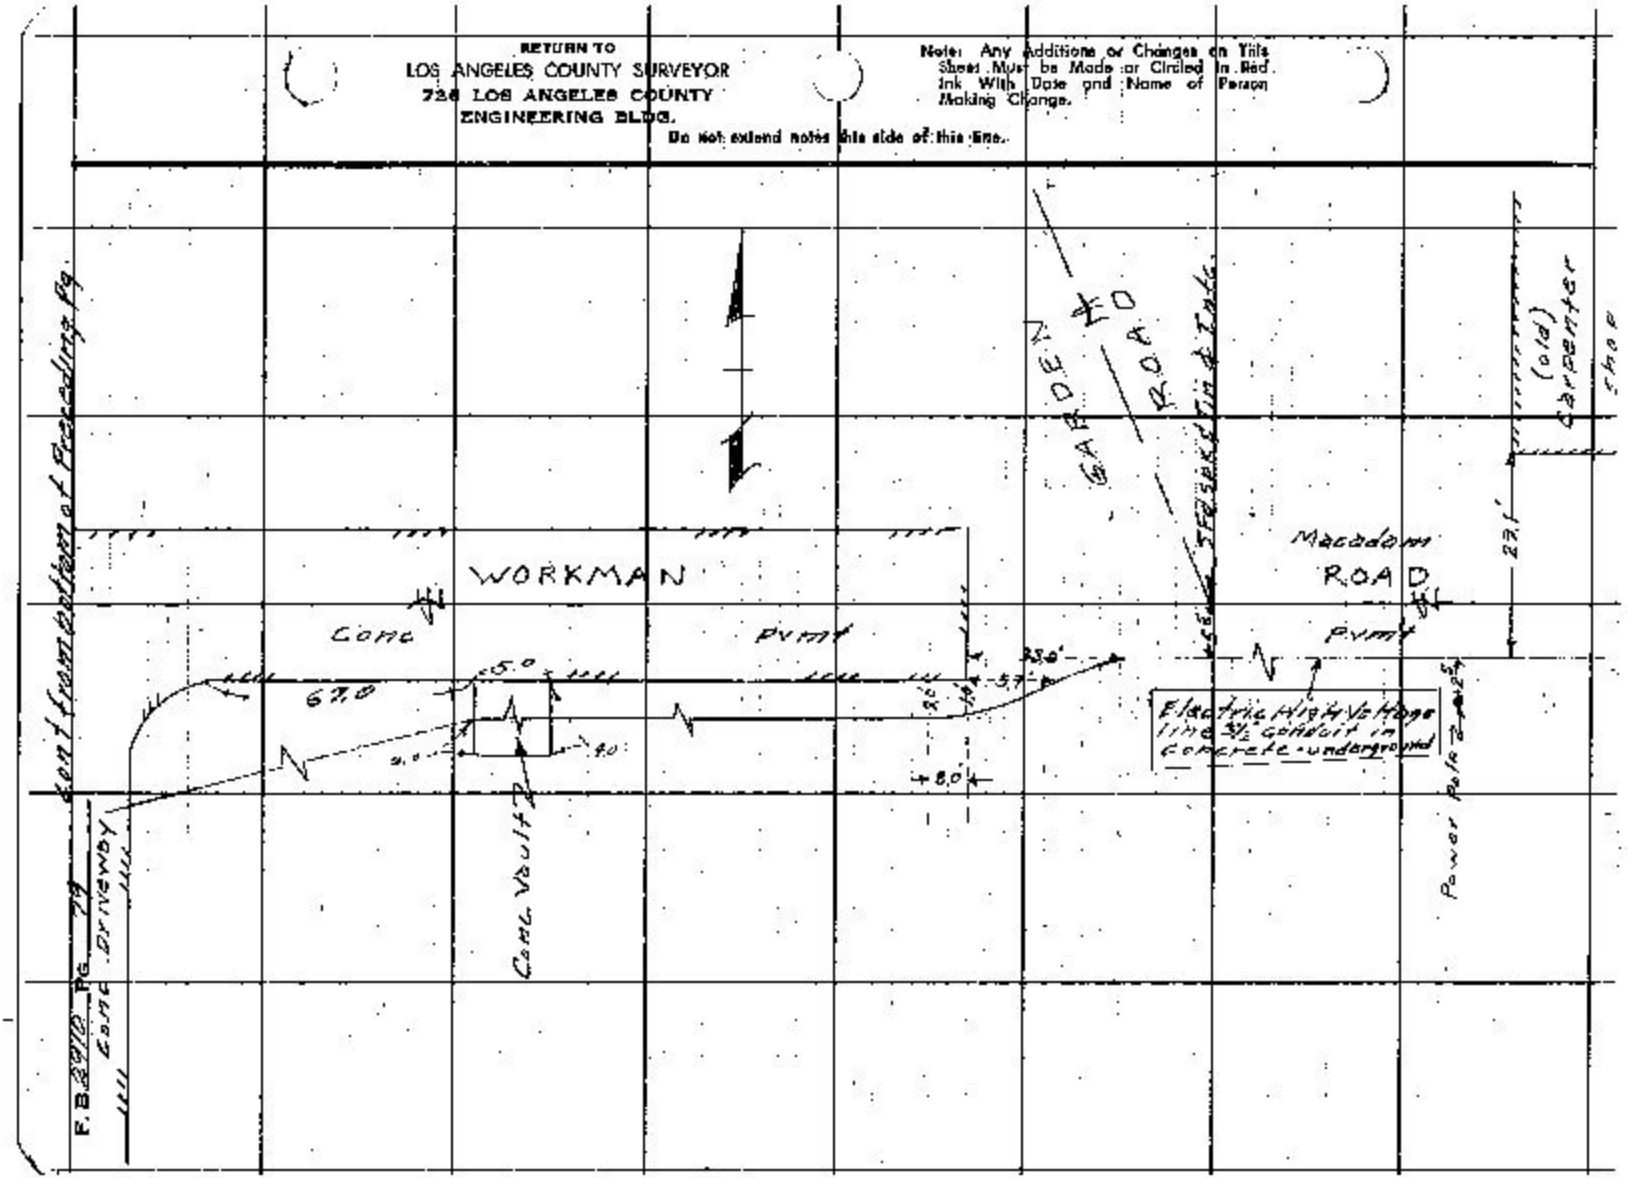

Notes Ck'd by
Map No.
Office Work SS
Checked
Date 11/8/60

Survey of Olympic Sanitarium
C.O. 8828-AB Tape No. Std. °F
Surveyed by M. Satro
Notes H.F.E. Date 4-21-61
Indexed C. F. CALL

F. B. 2910 Pg. 50

Cont from bottom of Preceding pg.

29.1'

Carpenter (oiled)

Iron pipe

Stake

WORKMAN

Iron pipe

237'

6' chain link Fence

(Gate)

Electric High Voltage line

24½" concrete curb & gutter

ROAD

Macadam

Iron pipe

100'

A4225

1 Story Brick Supply Bldg.

Note: Any Additions or Changes on This Sheet Must Be Made or Circled In Red Ink With Date and Name of Person Making Change.

Do not write on this side of this link.

RETURNED TO
LOS ANGELES COUNTY SURVEYOR
720 LOS ANGELES COUNTY
ENGINEERING BLDG.

FORM 308 #1-57, B-64

F.B. 390 Pg. 31

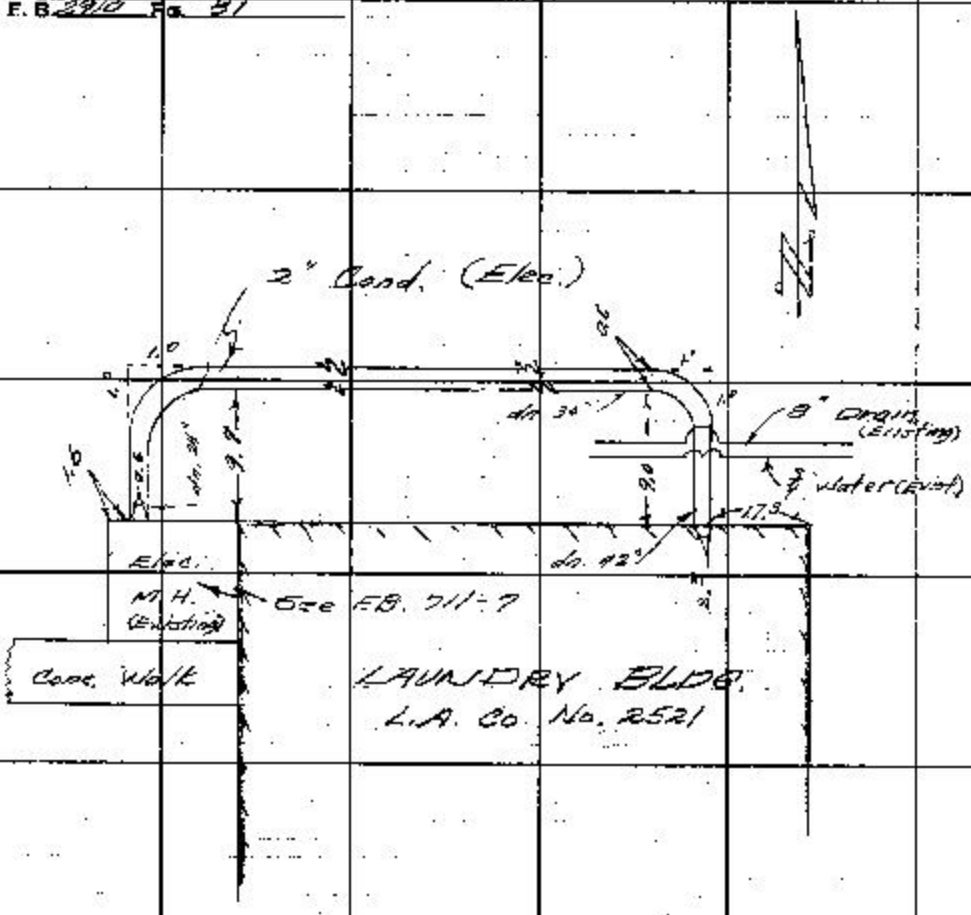


RETURN TO
LOS ANGELES COUNTY SURVEYOR
726 LOS ANGELES COUNTY
ENGINEERING BLDG.

Do not extend notes this side of this line.

Notice: Any Additions or Changes on This Sheet Must be Made or Circled in Red Ink With Date and Name of Person Making Change.

70F3098 SDE #247 11-68

PLEASE RETURN TO
LOS ANGELES COUNTY ENGINEER
700 Los Angeles County Engineering Bldg.

Do not extend this side of this line.

Note: Any Additions or Changes on This Sheet Must be Made or Circled in Red Ink With Date and Name of Person Making Change.

WARD 124 & 126

Co. # 2199

0+00

1+02.3

0+93.3

0+85.0

0+82.8

39.3

18.5

15.4

10.0

L.A. Co. No. 2873

Transformer Vault.

1-Story Stucco Bldg.

H2

9.1

9.1

To Cabot Drive

To Alice View Ave

Cont. Text on next page.

Notes Child of
Map No.
Office Mark SS
Checked
Date 11/2/61

Survey of Boundary Section
JN 68226 Date Sept. 1968
Surveyed by Bowles & Sayre
Noted E. J. Gallo
Indexed E. J. Gallo

F. B. 2910 Pg. 82

F. B. 2910 Pg. 83

P.I. #2
Lead & tack

COBALT AVE.

6" Conc. Curb

Conc. Curb

Conc. Curb

Notes Ck'd by
Map No.
Office Work SS
Checked
Date 11/66

Survey of Olive View Sanitarium
W. O. 8228.08 Tape No. Std. °F
Surveyed by M. Sotelo
Notes Sotelo Date 4-1966
Indexed C. J. GALLI

F. B. 2770 Pg. 82

Note: Any Additions or Changes on This Sheet Must be Made or Circled in Red Ink With Date and Name of Person Making Change.

Do not extend notes this side of this line.

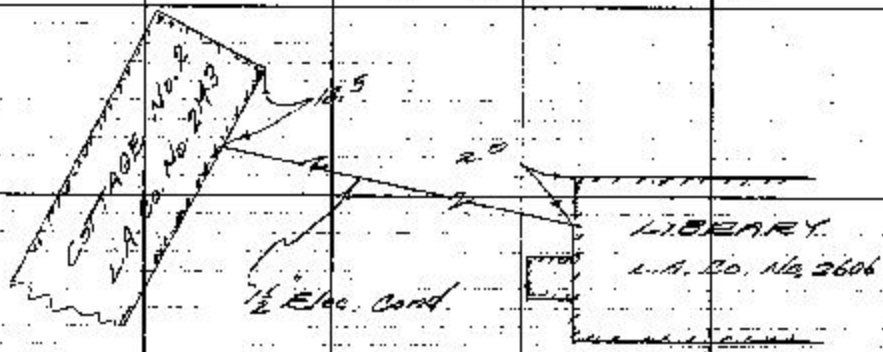


RETURN TO
LOS ANGELES COUNTY SURVEYOR
726 LOS ANGELES COUNTY
ENGINEERING BLDG.

76F8099 Stat. 8-64

RETURN TO
LOS ANGELES COUNTY SURVEYOR
720 LOS ANGELES COUNTY
ENGINEERING BLDG.

Notes: Any Additions or Changes on This Sheet Must be Made or Circled in Red Ink With Date and Name of Person Making Change.

Do not extend notes this side of this line.

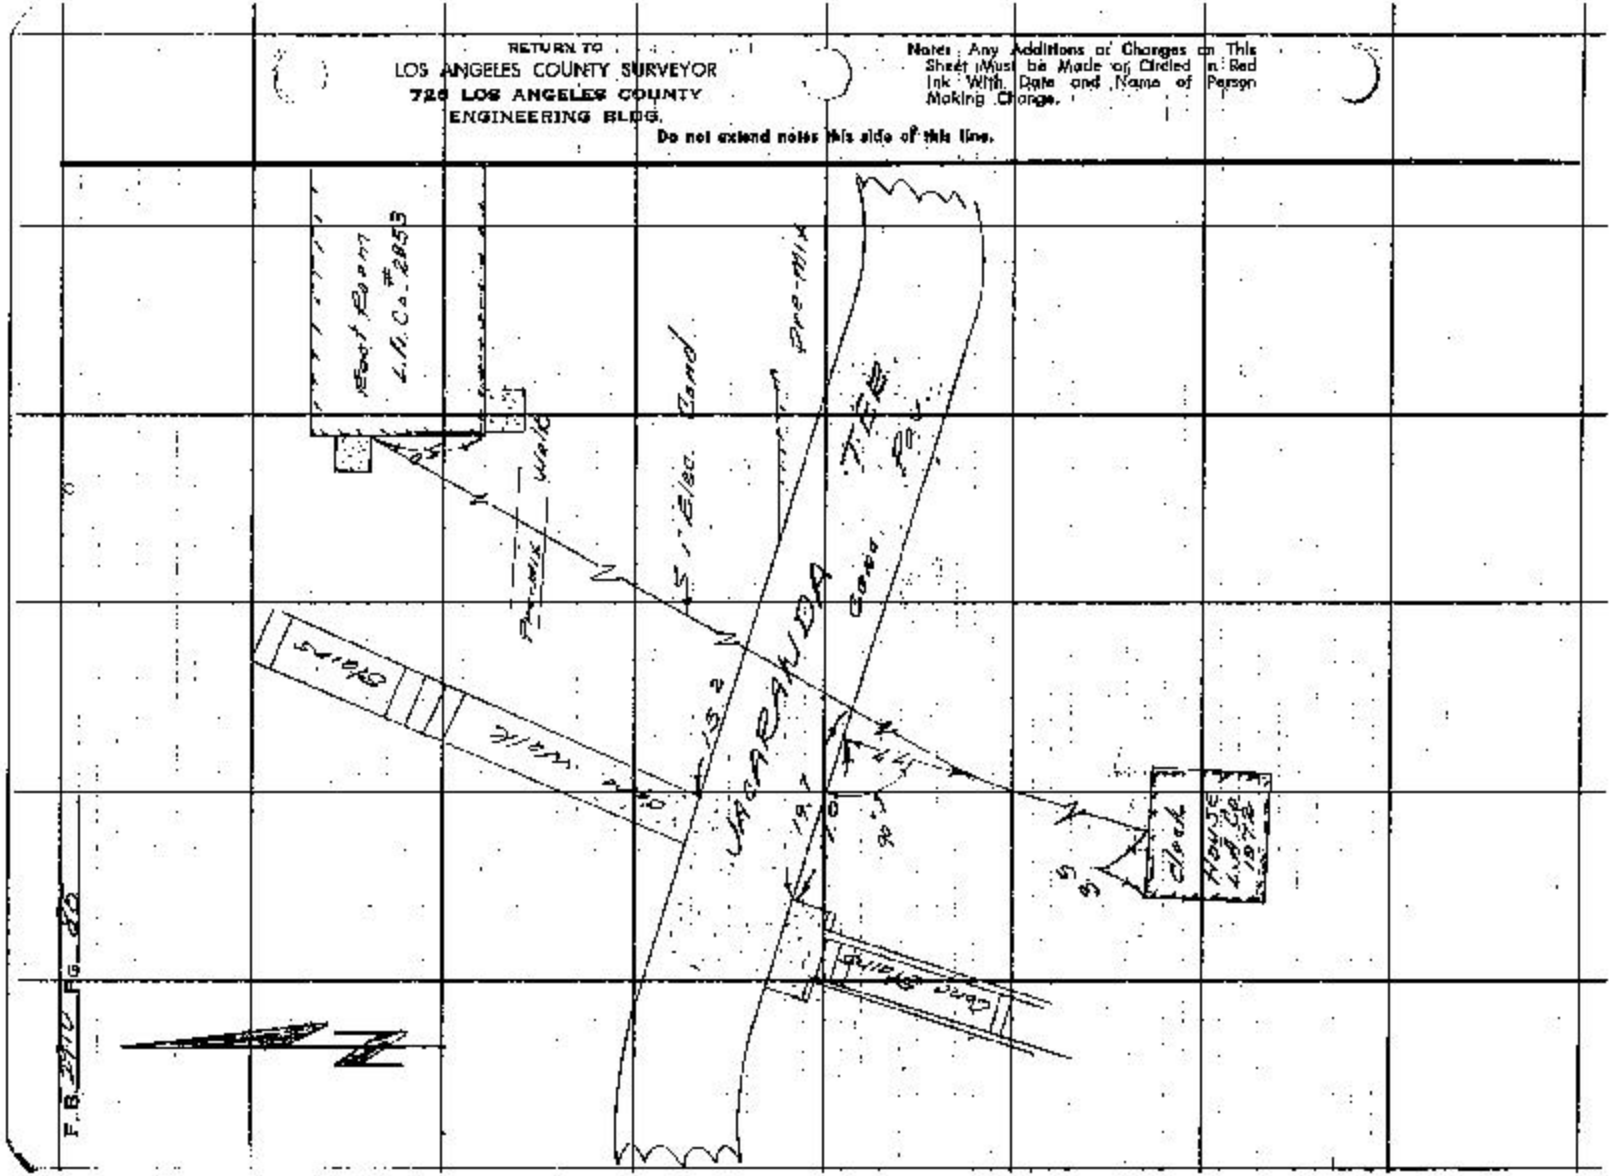

7573085 SSE #247 11-66

PLEASE RETURN TO
LOS ANGELES COUNTY ENGINEER
700 LOS ANGELES COUNTY ENGINEERING BLDG.

Do not extend this side of this line

Note: Any Additions or Changes on This Sheet Must be Made or Circled in Red Ink With Date and Name of Person Making Change.

Notes Ck'd by
Map No.
Office Work
Checked
Date 11/61

Surveyed by Sopko Tapes Std °F
Notes Bowles Datum
Indexed J. GALLI

F.B. 2910 Pg. 85

Tel conduit enters Steam Tunnel here

c.l.L. Fence

3/4" conduit

Conduit Between Light Poles Per Plan 1836 Date 1957

3/4" conduit

Note Pipe & conduit sizes Taken from Plans

1" Elec 1 1/2" Elec 1 1/2" Tel

Conc. Gut. Pg. 84

Tel & Elec conduit appears to be in same trench

W.H.

Steam Tunnel

x Tel conduit

29.7

29.5

4.3

0.9

21.5

85.4

4.5

1-Story Brick Bldg Office & Storage Co. Bldg No. 4226

East Side Pg. 88

PLEASE RETURN TO
LOS ANGELES COUNTY ENGINEER
700 LOS ANGELES COUNTY ENGINEERING BLDG.

Do not extend this side of this line.

Note: Any Additions or Changes on This Sheet Must be Made or Checked in Red Ink With Date and Name of Person Making Change.

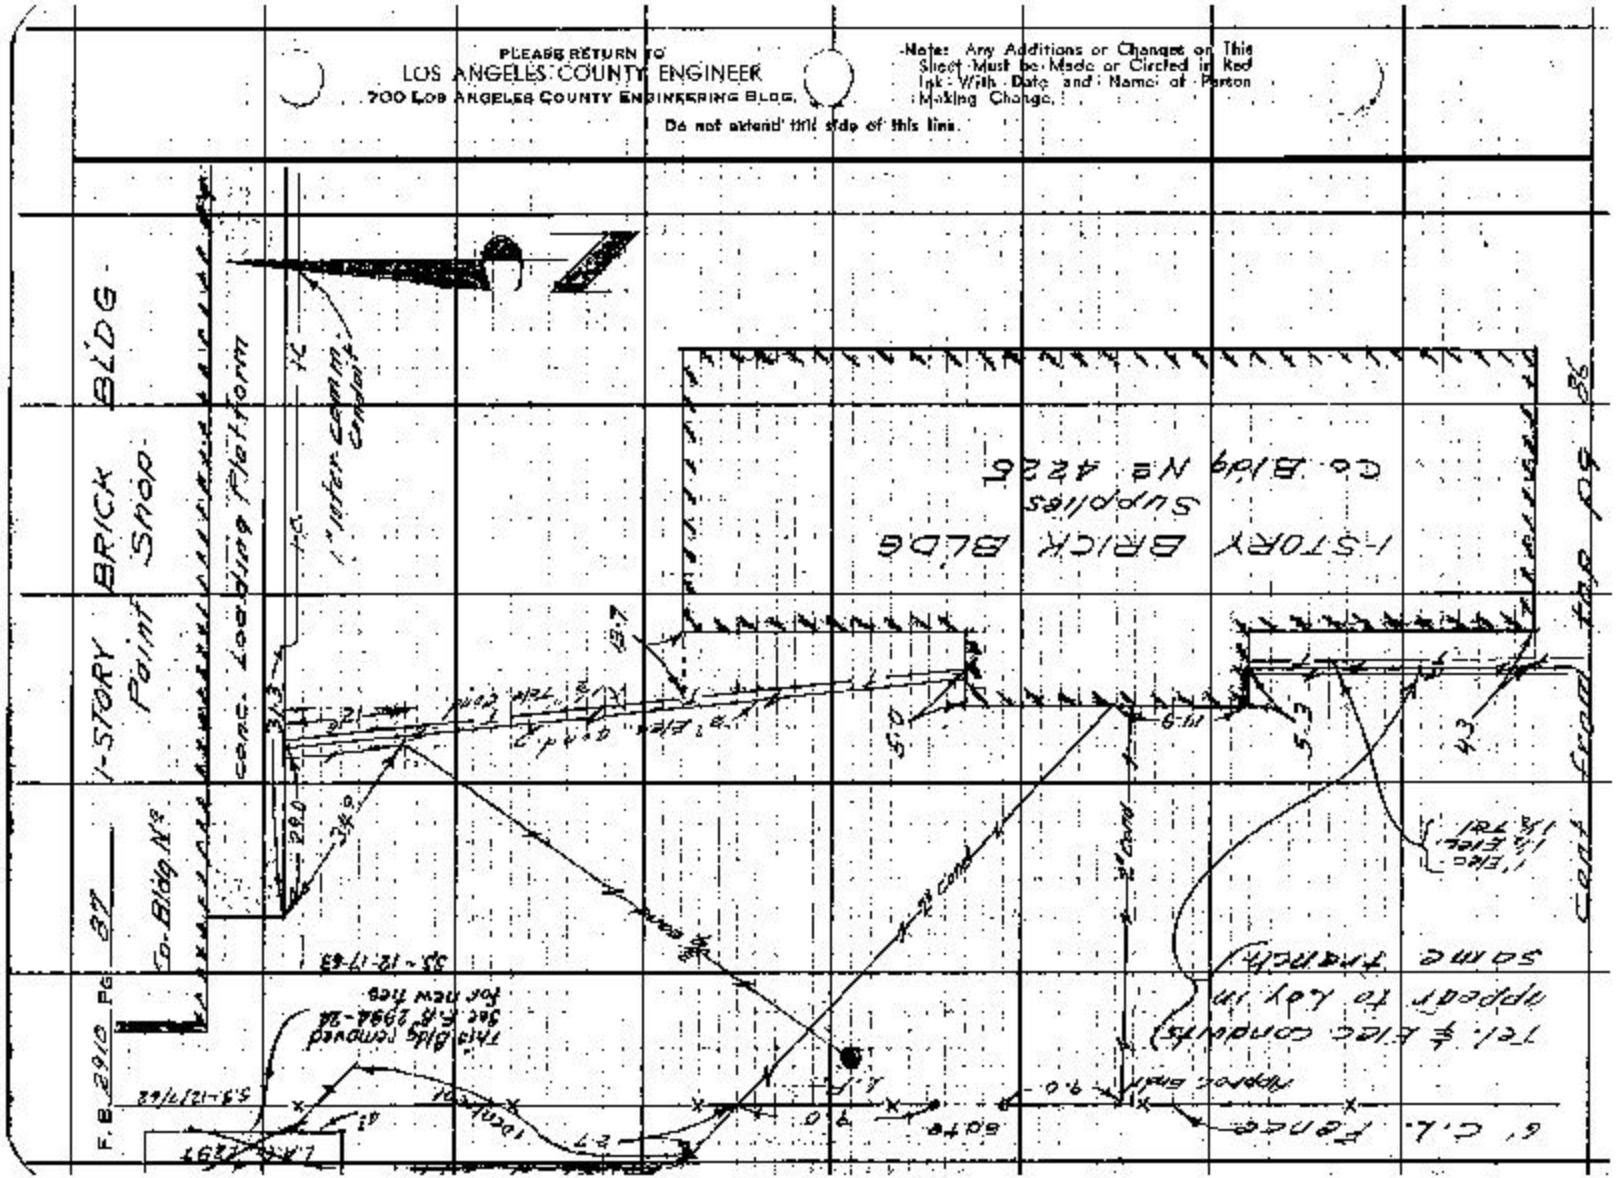

75F3099 S&2 #247. 8-54

RETURN TO
LOS ANGELES COUNTY SURVEYOR
720 LOS ANGELES COUNTY
ENGINEERING BLDG.

Note: Any Additions or Changes on This Sheet Must be Made or Circled in Red Ink With Date and Name of Person Making Change.

Do not extend notes this side of this line.

Notes Ck'd by
Map No.
Office Work
Checked
Date 11/18/61

Surveyed by Sattao
Notes Bowles Date 5-17-61
Indexed E. J. GALLI

F.B. 2910 PG. 26

1-STORY BRICK BLDG
Office & Storage
Co. Bldg No 92

conc. loading platform

Curb, Gutter & Sidewalk

6' C.L. Fence

2" Elec. Underground

Sand, Mortar-Comm.

1½" conc.

1-STORY BRICK BLDG
Plumbing Shop.
Co. Bldg No 4227

F.B. 2912 Pg. 89

1-STORY BRICK BLDG
Paint Shop.
Co. Bldg No.

conc. Loading Platform.

Approx. Location
Inter-com. System

1-STORY BRICK BLDG
Co. Bldg No. 4225
Supplies.

1-STORY BRICK BLDG
Plumbing Shop.
Co. Bldg No. 4227

cont. from top Pg 88

RETURN TO
LOS ANGELES COUNTY SURVEYOR
726 LOS ANGELES COUNTY
ENGINEERING BLDG.

Do not extend notes this side of this line.

Note: Any Additions or Changes on This Sheet Must be Made or Circled in Red Ink With Date and Name of Person Making Change.

Notes Ck'd by
Map No.
Office Work
Checked
Date 12/6/61

Survey of Olive View Hosp.
W.O. Tape No. Std.
Surveyed by Sotro
Notes Rowlo S. Date 5-24-61
Indexed E. J. GALLI

F. B. 2910 Pg. 70

Traffic Island & Planter.

Light Pole

6.0

12.0

6" Conc. curb

30.6

22.5

16.5

24

10.6

6" conc. curb

4" conduit

conc. walk

9.8

1.5

1.3

conc. walks

WARD No. 401 & 402

wood enclosure for Power Panel

Notes: Any Additions or Changes on This Sheet Must be Made or Circled in Red Ink With Date and Name of Person Making Change.

Do not extend notes this side of this line.

RETURN TO
LOS ANGELES COUNTY SURVEYOR
ENGINEERING BLDG.
7261 LOS ANGELES COUNTY

Lost Pk.

Sand

- 78F2038 247 12-31

F.B. 2918 PG. 91

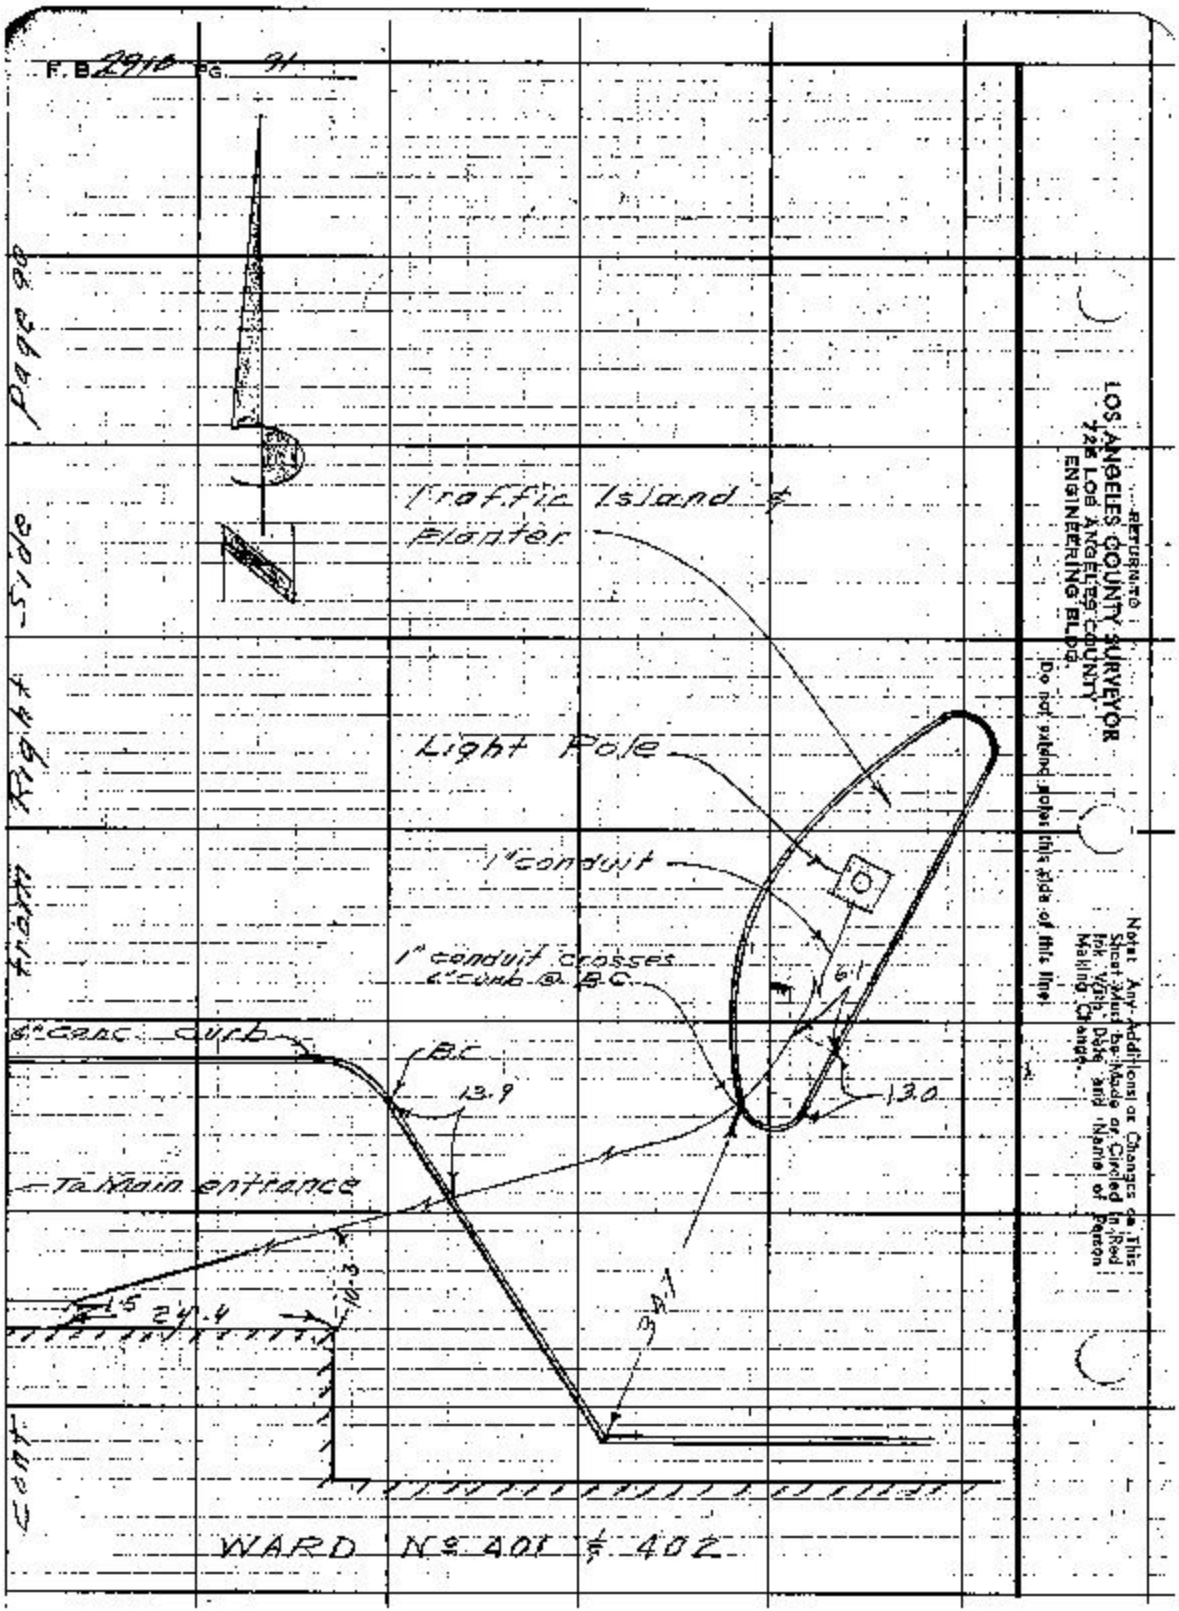


RETURN TO
LOS ANGELES COUNTY SURVEYOR
725 LOS ANGELES COUNTY
ENGINEERING BLDG.

Do not extend notes this side of this line

Note: Any Additions or Changes on This Sheet Must be Made or Circled in Red Ink With Date and Name of Person Making Change.

Notes Ck'd by
Map No.
Office Work S.S.
Checked
Date 12/8/61

Survey of Olive View Hosp
JN 0112-08 Tape Std °F
Surveyed by Setco
Notes Baxter Date 6-1911
Indexed R. J. GALLI

F. B. 2910 Pg. 92

REST ROOMS
1-Story Frame Bldg.
Co. No. 3016

Pipe & Cable Gaurd Fence

conc. walk

3.7

49.9

43.5

Traffic-Island Planter.

1" Elec conduit

Rock & conc curb

39.2

37.5

34.2

43.5

48.2

L.P.

0.7

Conc. Roadway.

Man Hole over Steam Tunnel.

conc. walk

conc. walk

WARD Nº 401 & 402

Note: Any Additions or Cautions on this Sheet Must be Made or Circled in Red Ink, With Date and Name of Person Making Change.

Do not extend this line of this line.

PLEASE RETURN TO LOS ANGELES COUNTY ENGINEER 700 Los Angeles County Engineering Bldg.

7673095 S&E #247 1-58

PLEASE RETURN TO
LOS ANGELES COUNTY ENGINEER
700 LOS ANGELES COUNTY ENGINEERING BLDG.

Note: Any Additions or Changes on This Sheet Must be Made or Circled in Red Ink With Date and Name of Person Making Change.

Do not extend this side of this line.

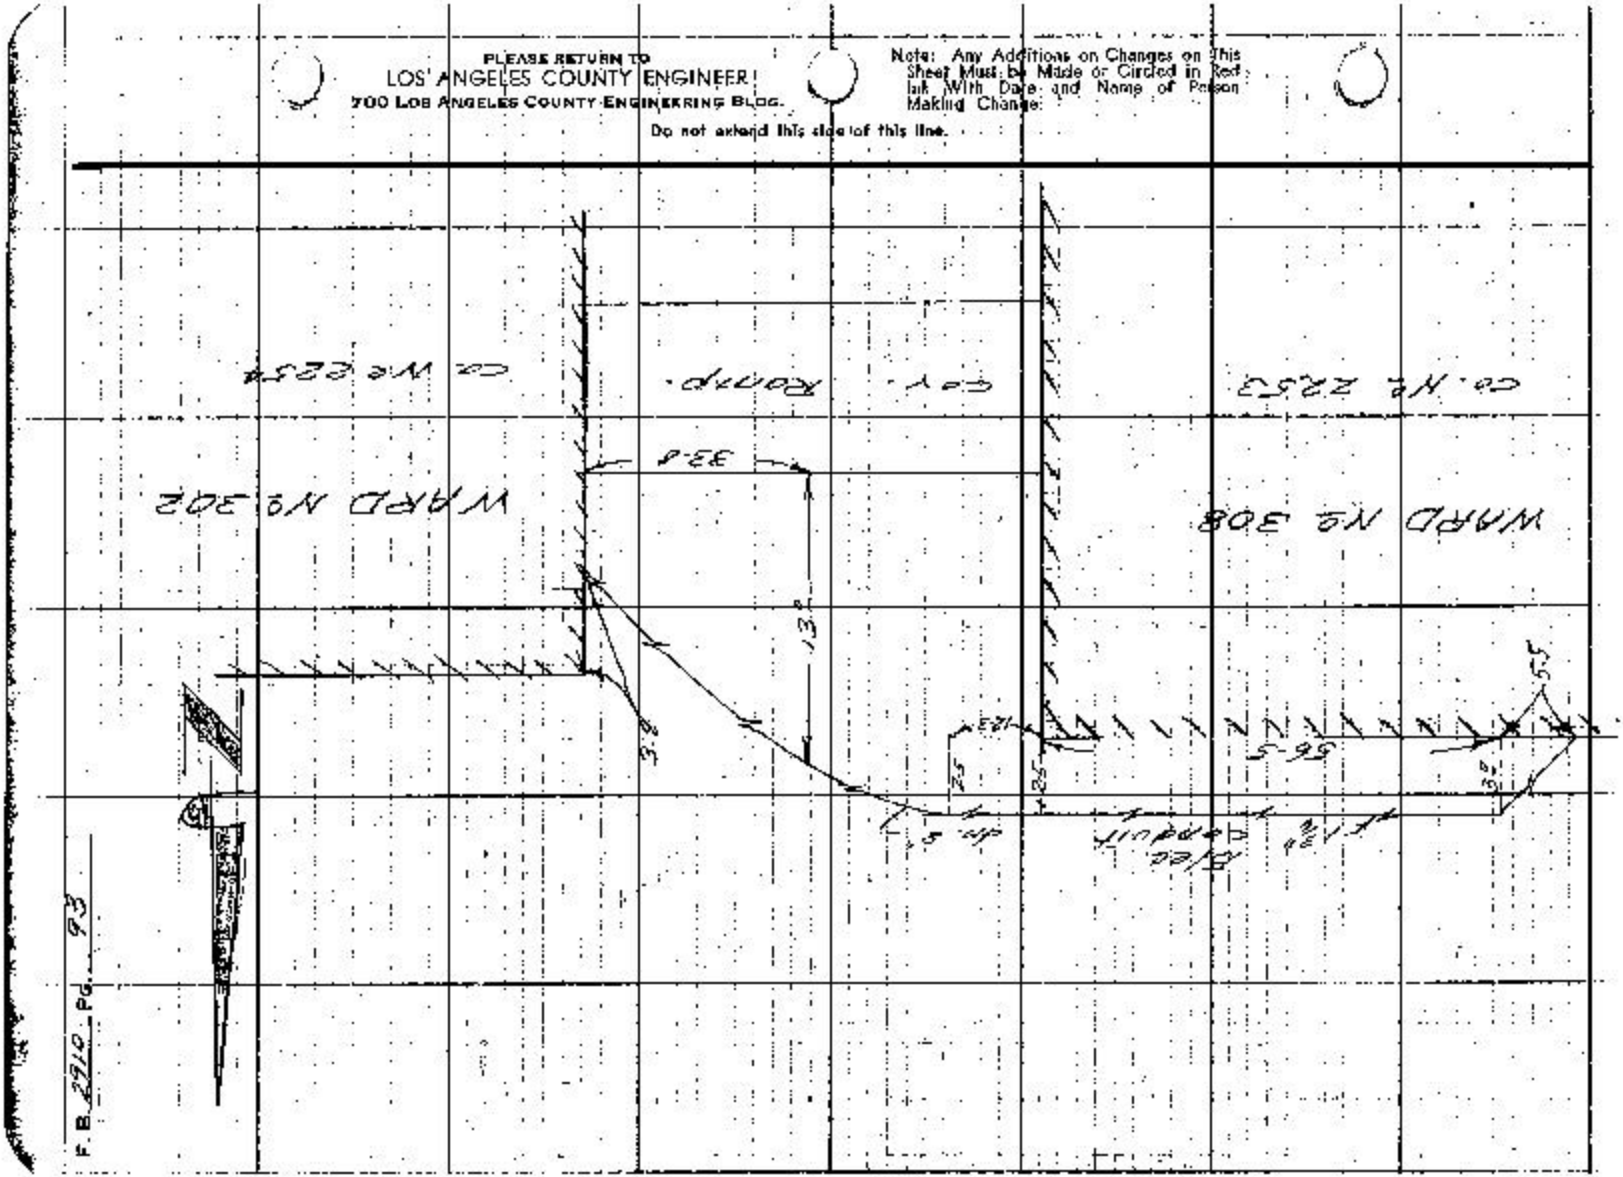

75F3099 9&E F247. 6-84

RETURN TO
LOS ANGELES COUNTY SURVEYOR
726 LOS ANGELES COUNTY
ENGINEERING BLDG.

Notes: Any Additions or Changes on This Sheet Must be Made or Circled in Red Ink With Date and Name of Person Making Change.

Do not extend notes this side of this line.

Notes Ckd by
Map No.
Office Work
Checked
Date

Survey of
W.O.
Map No. Bk.
Surveyed by
Notes
Indexed

F.B. 2777 Pg. 77

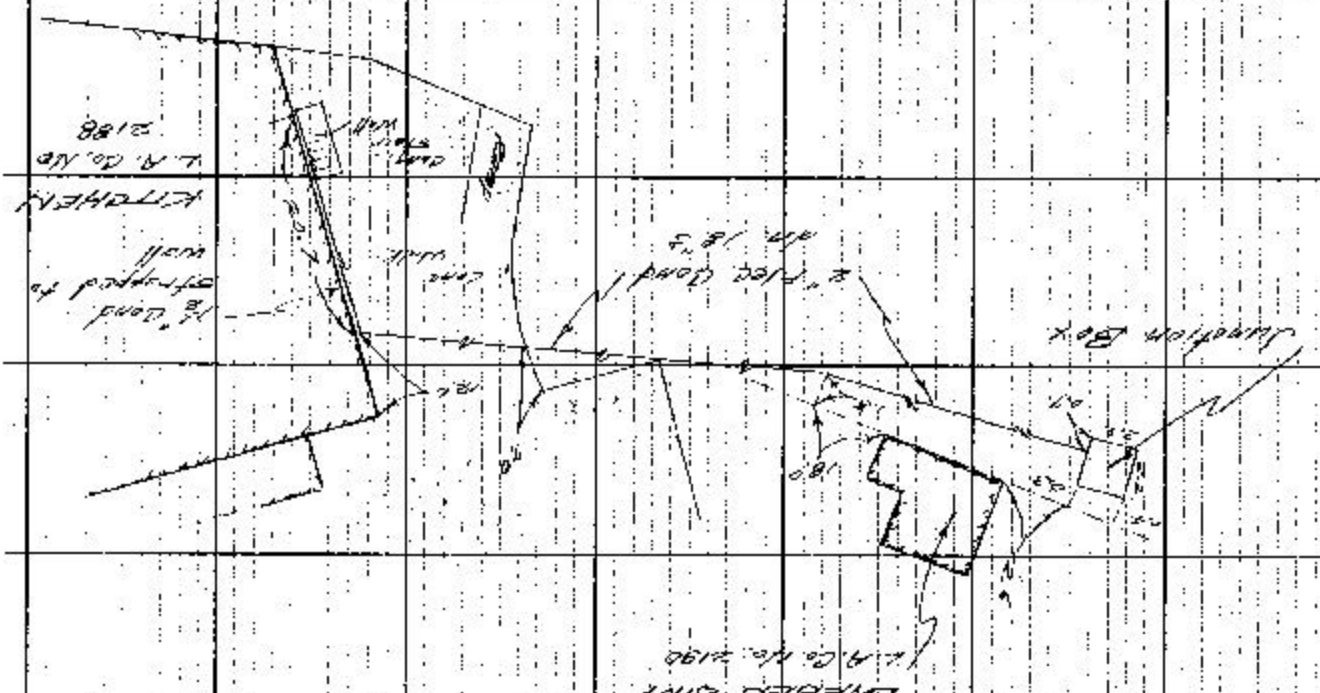

RETURN TO
LOS ANGELES COUNTY SURVEYOR
726 LOS ANGELES COUNTY
ENGINEERING BLDG.

Do not extend notes this side of this line.

Note: Any Additions or Changes on This Sheet Must be Made or Circled in Red Ink With Date and Name of Person Making Change.

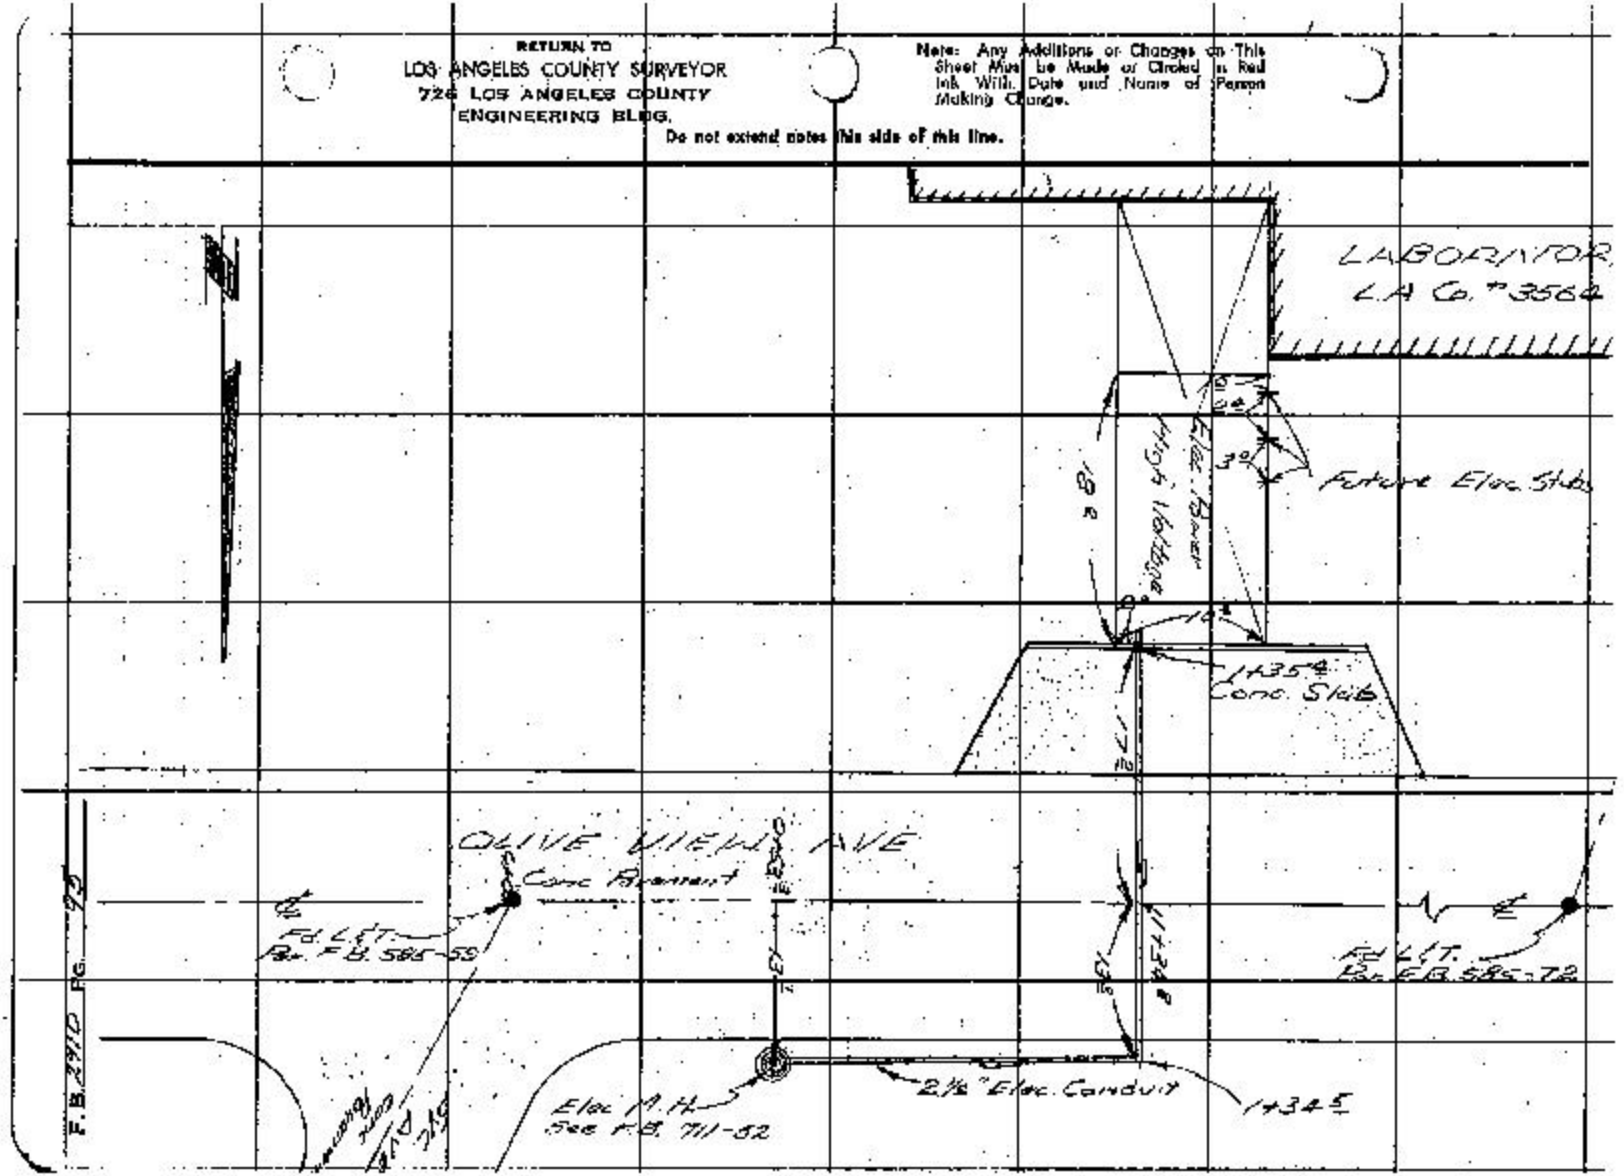

Notes Ckd by _____
Map No. _____
Office Work 55
Checked _____
Date 12/4/61

Survey of Olive View Hospital
JN 20220 Tape _____ Std _____ °F
Surveyed by M Sotro
Notes P Lichau Date 5-15-61
Indexed C. J. GALLI

F. B. 2910 PG. 96

Los Angeles County
# 2268

Light Standard

1" Conduit

Light Standard

Light Standard

1/2" Conduit

Note: Elec. Conduit above Sprk. Line approx. 6" deep.

Los Angeles Co.
# 2269

To Elec. Fill Box

Note: Any Additions or Changes on this Sheet Must be Made or Checked in Red Ink With Date and Name of Person Making Changes.

Do not extend this line off this sheet.

PLEASE RETURN TO
LOS ANGELES COUNTY ENGINEER
700 LOS ANGELES COUNTY ENGINEERING BLDG.

1-56

PLEASE RETURN TO
LOS ANGELES COUNTY ENGINEER
700 LOS ANGELES COUNTY ENGINEERING BLDG.

Note: Any Additions or Changes on This Sheet Must be Made or Circled in Red Ink With Date and Name of Person Making Change.

Do not extend this side of this line.

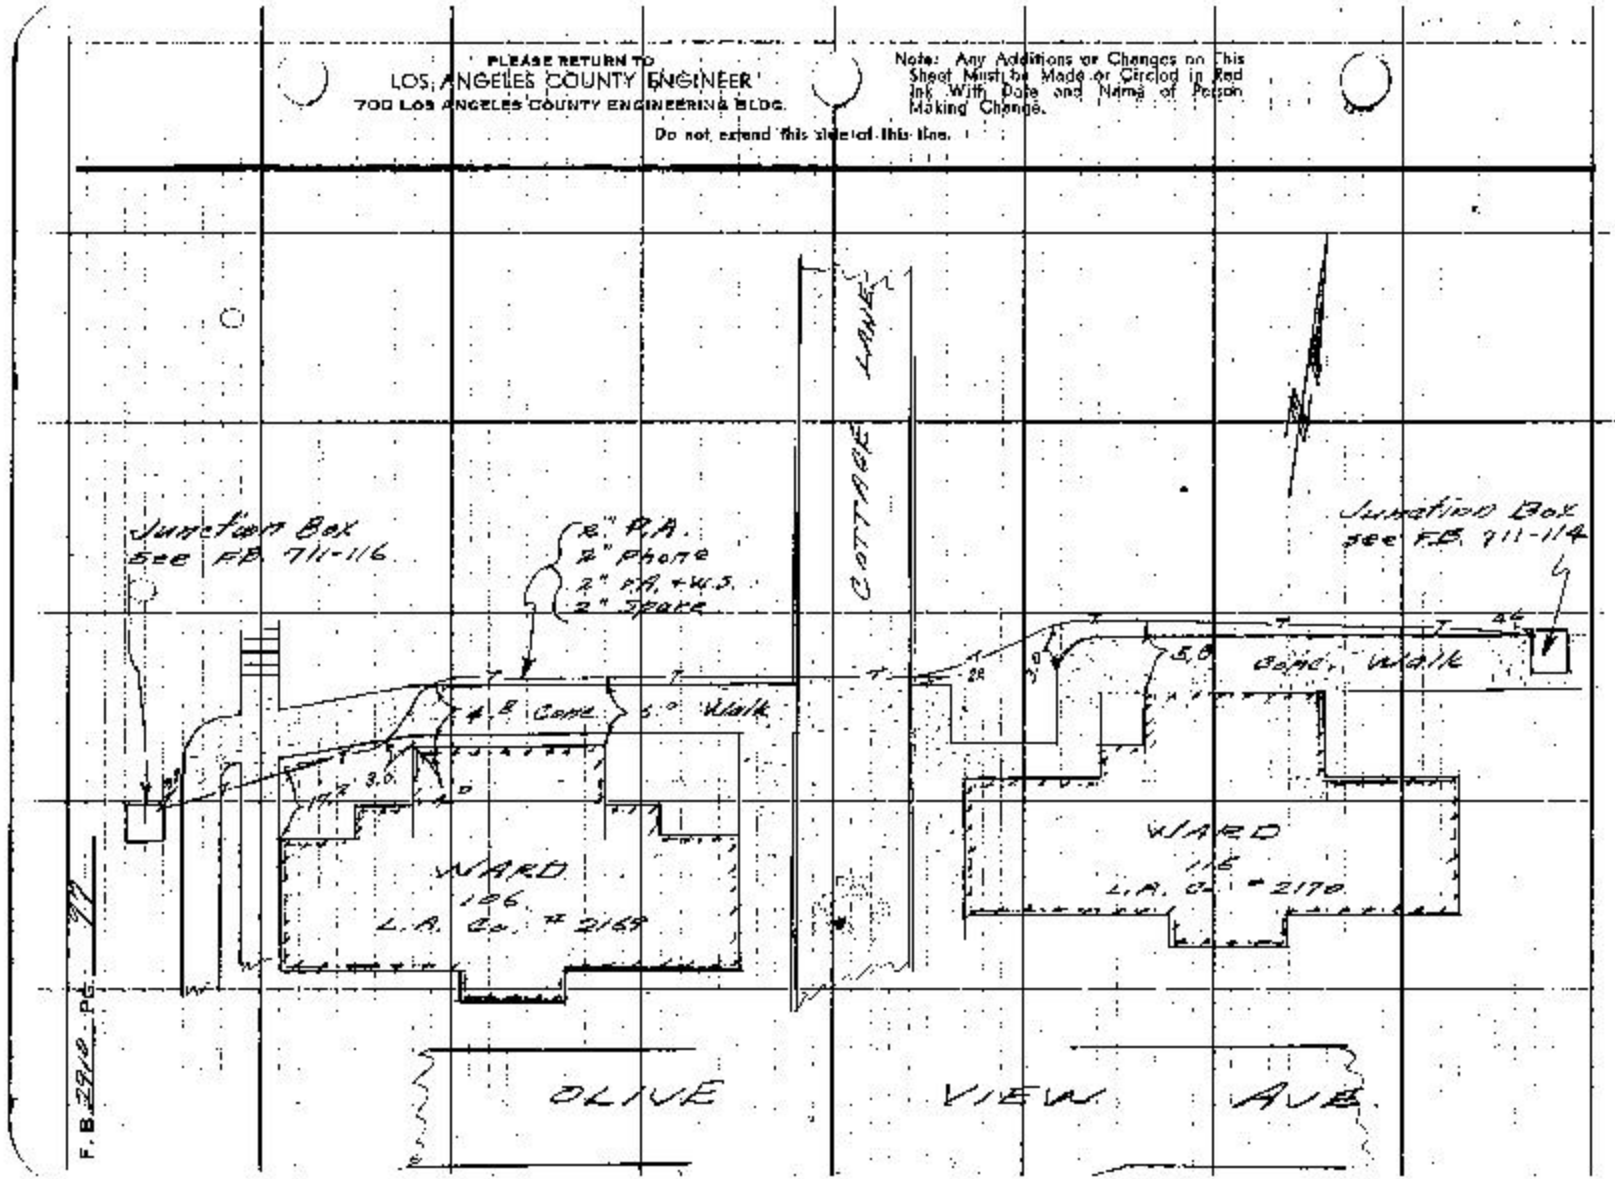

Notes Ck'd by
Map No.
Office Work SJ
Checked
Date 4-5-62

Survey of Olive View Hosp F. B. 2910 Pg. 98
JN 0022-28 Tape Std °F.
Surveyed by Sutro
Notes Angles Date 2-6-62
Incased C. J. CALLI

WARD No 112
CO No 2177

53

CONC. WALK

22.2

12" Cdn.

197

Steam Tunnel

M.H.

2" Electric Conduit

335

46

WARD No 116
CO No 2170

Notes: Any Additions or Changes on this Sheet, Must be Made, or Circled, in Red Ink, With Date and Name of Person Making Changes.

Do not extend this side of the drawing

PLEASE RETURN TO
LOS ANGELES COUNTY ENGINEER
7000 LOS ANGELES COUNTY ENGINEER-HQ BLDG.

78F9059 9SE A247 11-58

F.B. 4910 Pg. 99

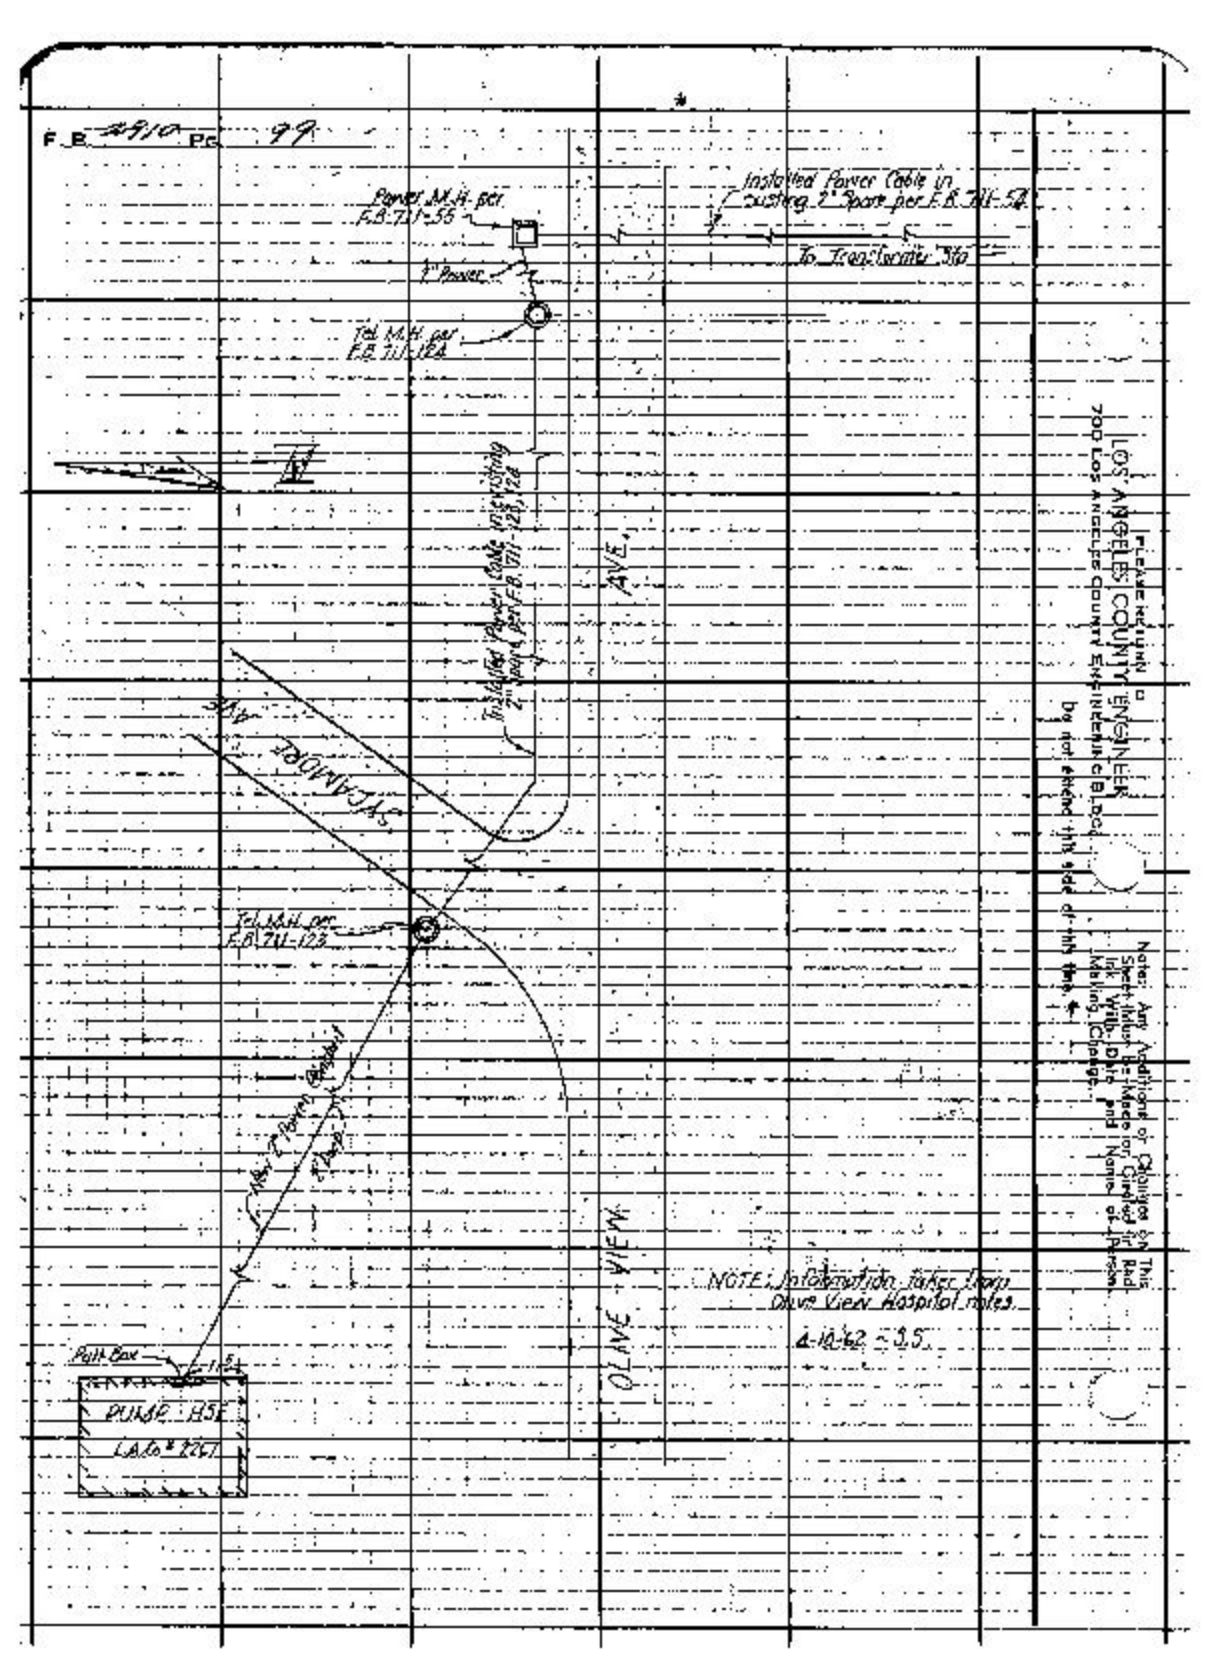
Power M.H. per F.B. 711-55
Installed Power Cable in Conduit e. 2" Spare per F.B. 711-52
To Transformer "36"
2" Power
Tel. M.H. per F.B. 711-124
N
Installed Power Cable in Conduit 2" Spare per F.B. 711-128, 124
AVE.
SYCAMORE
Tel. M.H. per F.B. 711-123
New Power Circuit
Pull Box
PULSE BSE
LA. Co. # 2261
OLIVE VIEW
NOTE: Information taken from Olive View Hospital plans.
4-10-62 - J.S.
PLEASE RETURN TO
LOS ANGELES COUNTY ENGINEER
700 LOS ANGELES COUNTY ENGINEERING BLDG.
Do not detach this side of this sheet
Note: Any Additions or Changes on This Sheet Must Be Made in Ink and Red Ink With Date and Name of Person Making Change.

Noted Ch'd by
Map No.
Office Wor
Checked
Date 5/18/62

Survey of OLIVE-VIEW HOSPITAL
JN 0022.08 Tape Std °F.
Surveyed by
Notes J. Santana Date 5-10-62
Indexed E. J. GALLI

F. B. 2910 Pg. 100

Note: Any Additions or Changes on this Sheet Must be Made or Circled in Red Ink with Date and Name of Person Making Changes

Please Return to
Los Angeles County Engineer
Bldg. 1
Los Angeles County Engineering Bldg.
Do not remove this tag or title.

POWER HOUSE
LACo # 2522

Existing Tel. MH for FB. 71-10

BUCHER AVE

18" Deep

3" Tel. Conduit

3" Spare

12" Deep T.P.

Main Tel. Feed Line (Overhead)

T.P.

COBALT AVE

70F3088 (62 X 210 8-61)

F. B. 2910 PG. 101

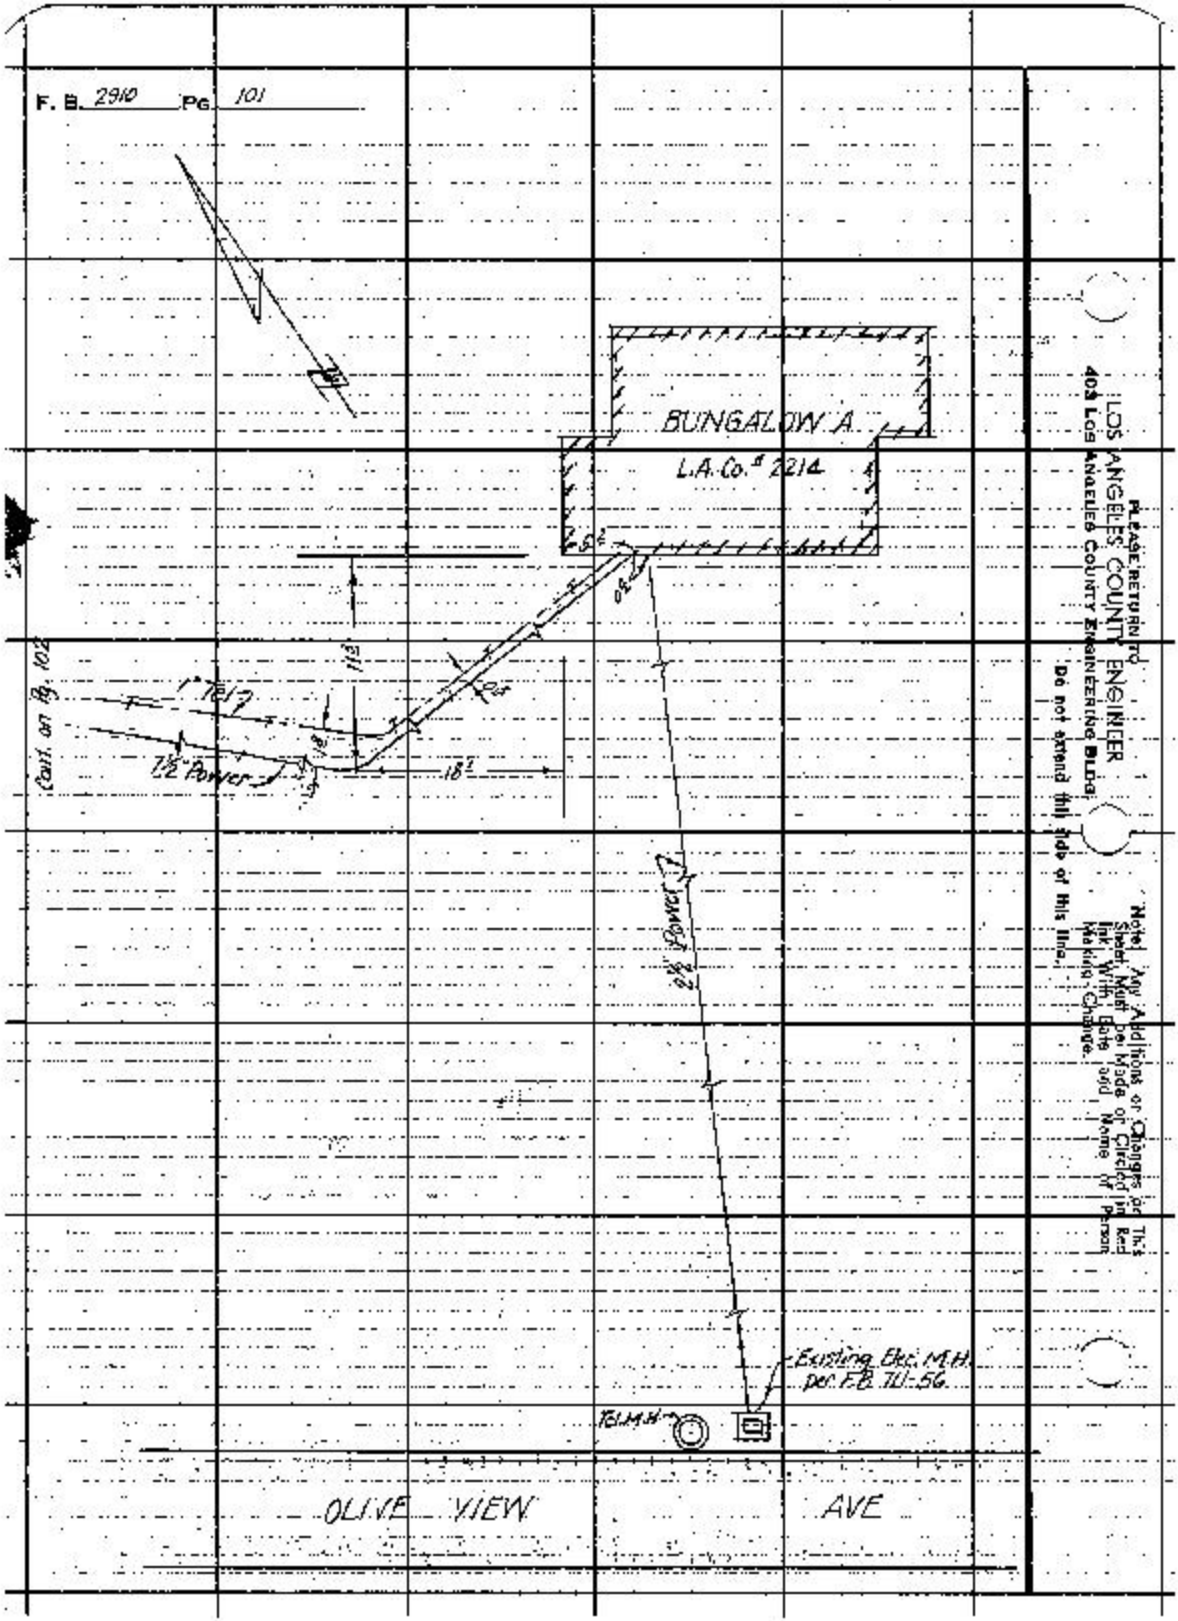


LOS ANGELES COUNTY ENGINEER
403 Los Angeles County Engineering Bldg.

PLEASE RETURN TO

Do not extend this Job of this line.

Note! Any Additions or Changes or Sheet Must Be Made or Circled in Red Ink With Date and Name of Person Making Change.

Notes Ck'd by
Map No.
Office Work 3-3
Checked
Date 8/8/62

Survey of OLIVE-VIEW HOSPITAL
JN 002790 Tape Sta °F.
Surveyed by
Notes S. SHINODA Date 5/31/62
Indexed C. L. GELLI

F. B. 2910 Pg. 102

MESA AVE

BUNGALOW 6
L.A. Co. # 2212

5'

11'

1" Tel.

15" Pavement

Curb Line

Note: Any Additions or Changes on this Sheet Must Be Made by City Ed to Red Ink. Write Datestrend Name bit Revision Making Change.

Do not extend this area of this line

PLEASE RETURN TO
LOS ANGELES COUNTY ENGINEER
408 LOS ANGELES COUNTY ENGINEERING BLDG.

PLEASE RETURN TO
LOS ANGELES COUNTY ENGINEER
409 LOS ANGELES COUNTY ENGINEERING BLDG.

Note: Any Additions or Changes on This Sheet Must be Made or Circled in Red Ink With Date and Name of Person Making Change.

Do not extend this side of this line.

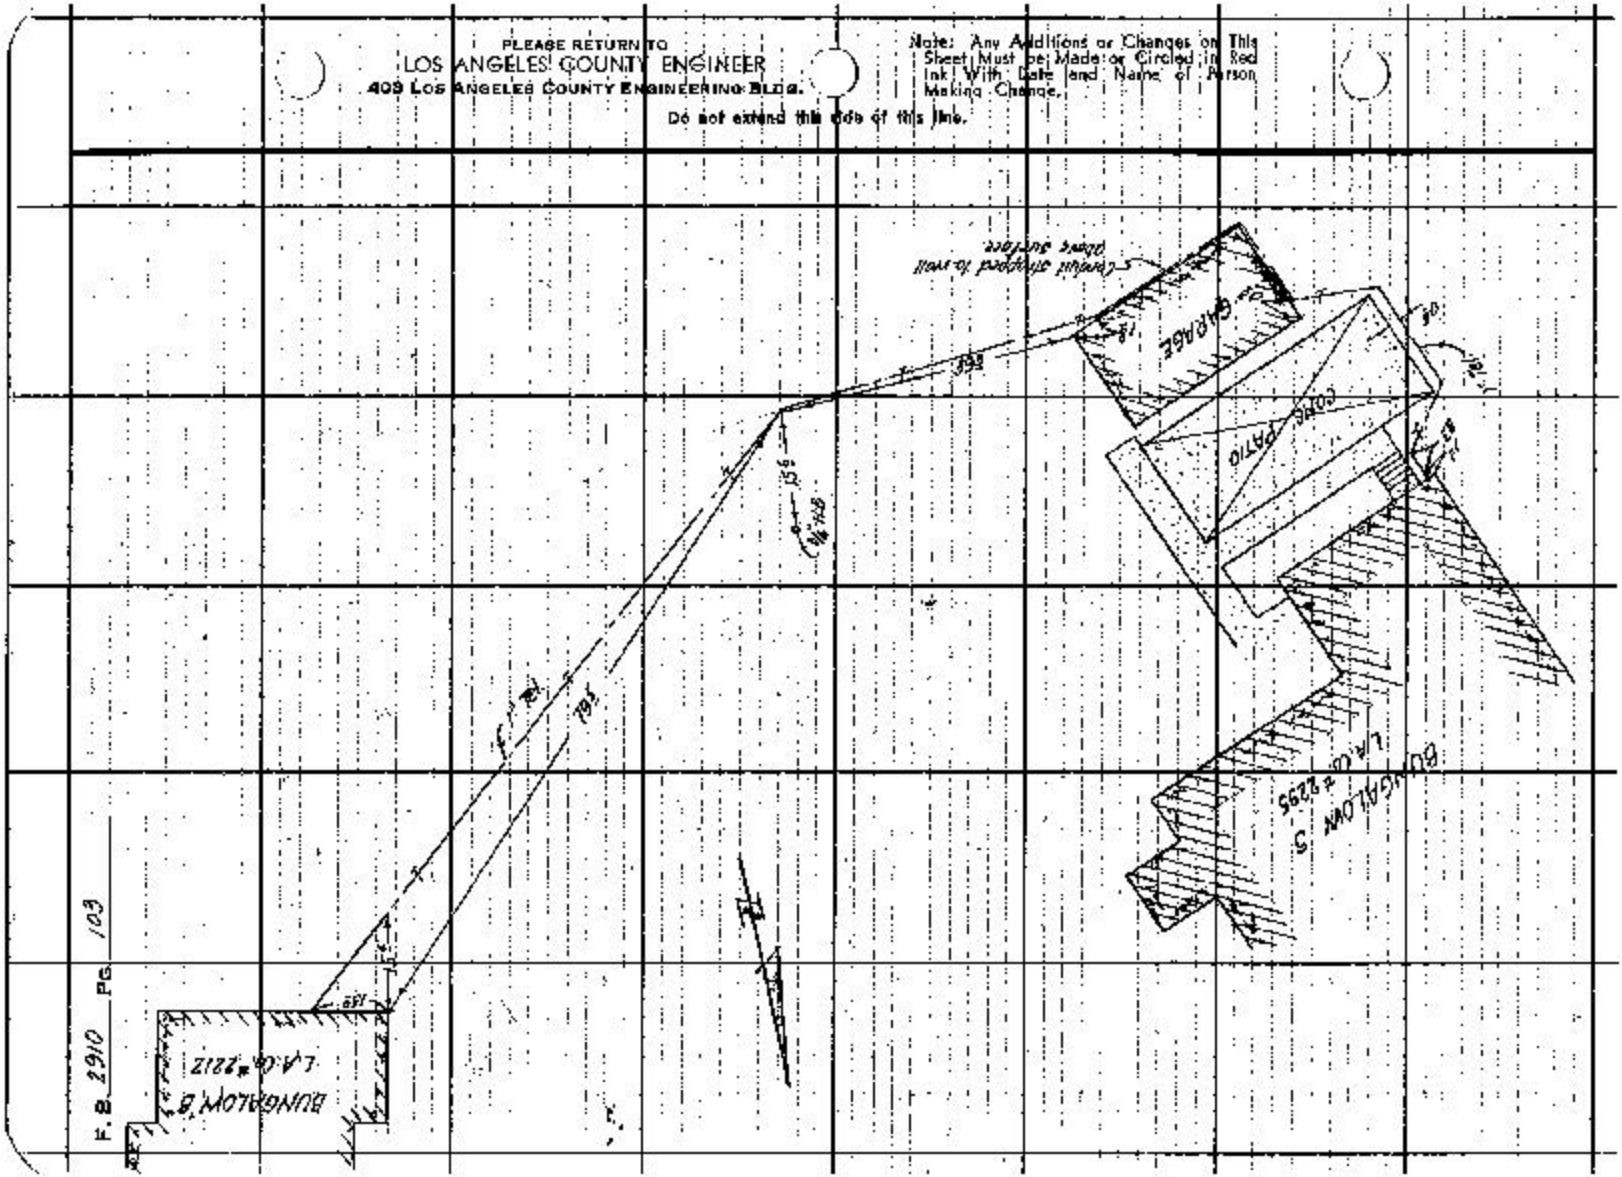


F. B. 2910 PG. 103

Notes Ck'd by
Vsn No.
Office Work
Checked
Date 12/6/62

Survey of OLIVE VIEW HOSPITAL
N 2022.68 Tapa Std °F.
Surveyed by STEVENSON
Notes Date 10-25-62
Indexed C. J. GAUL

F. B. 2310 PG. 104

Notes: Any Additions or Changes on this Sheet, Must be Made or Checked in Red Ink With Date Added Make Alt. Portion Marking Change

Do not extend this side of this line

PLEASE RETURN TO
LOS ANGELES COUNTY ENGINEER
408 Los Angeles County Engineering Bldg.

STEAM TUNNEL

MH

1½" CPEP CONDUIT IN STEAM TUNNEL

CLOCKHOUSE
L.ACO. 1972

WATER LINE

WARD AVE
L.ACO. 2125

7-67 2085 GE W 3rd 3-61

F.B. 2910 PG. 105

PLEASE RETURN TO
LOS ANGELES COUNTY ENGINEER
403 LOS ANGELES COUNTY ENGINEERING BLDG.

Do not extend this side of this line.

Note: Any Additions or Changes on This Sheet Must Be Made or Checked in Red Ink With Date and Name of Person Making Changes.

Power Manhole F.B. 211-35

Tel. M.H.

3' Power in Vasco Tunnel

TUNNEL

STEAM

WARD 303

L.A. Co. No. 2387

WARD 305

L.A. Co. No. 2166

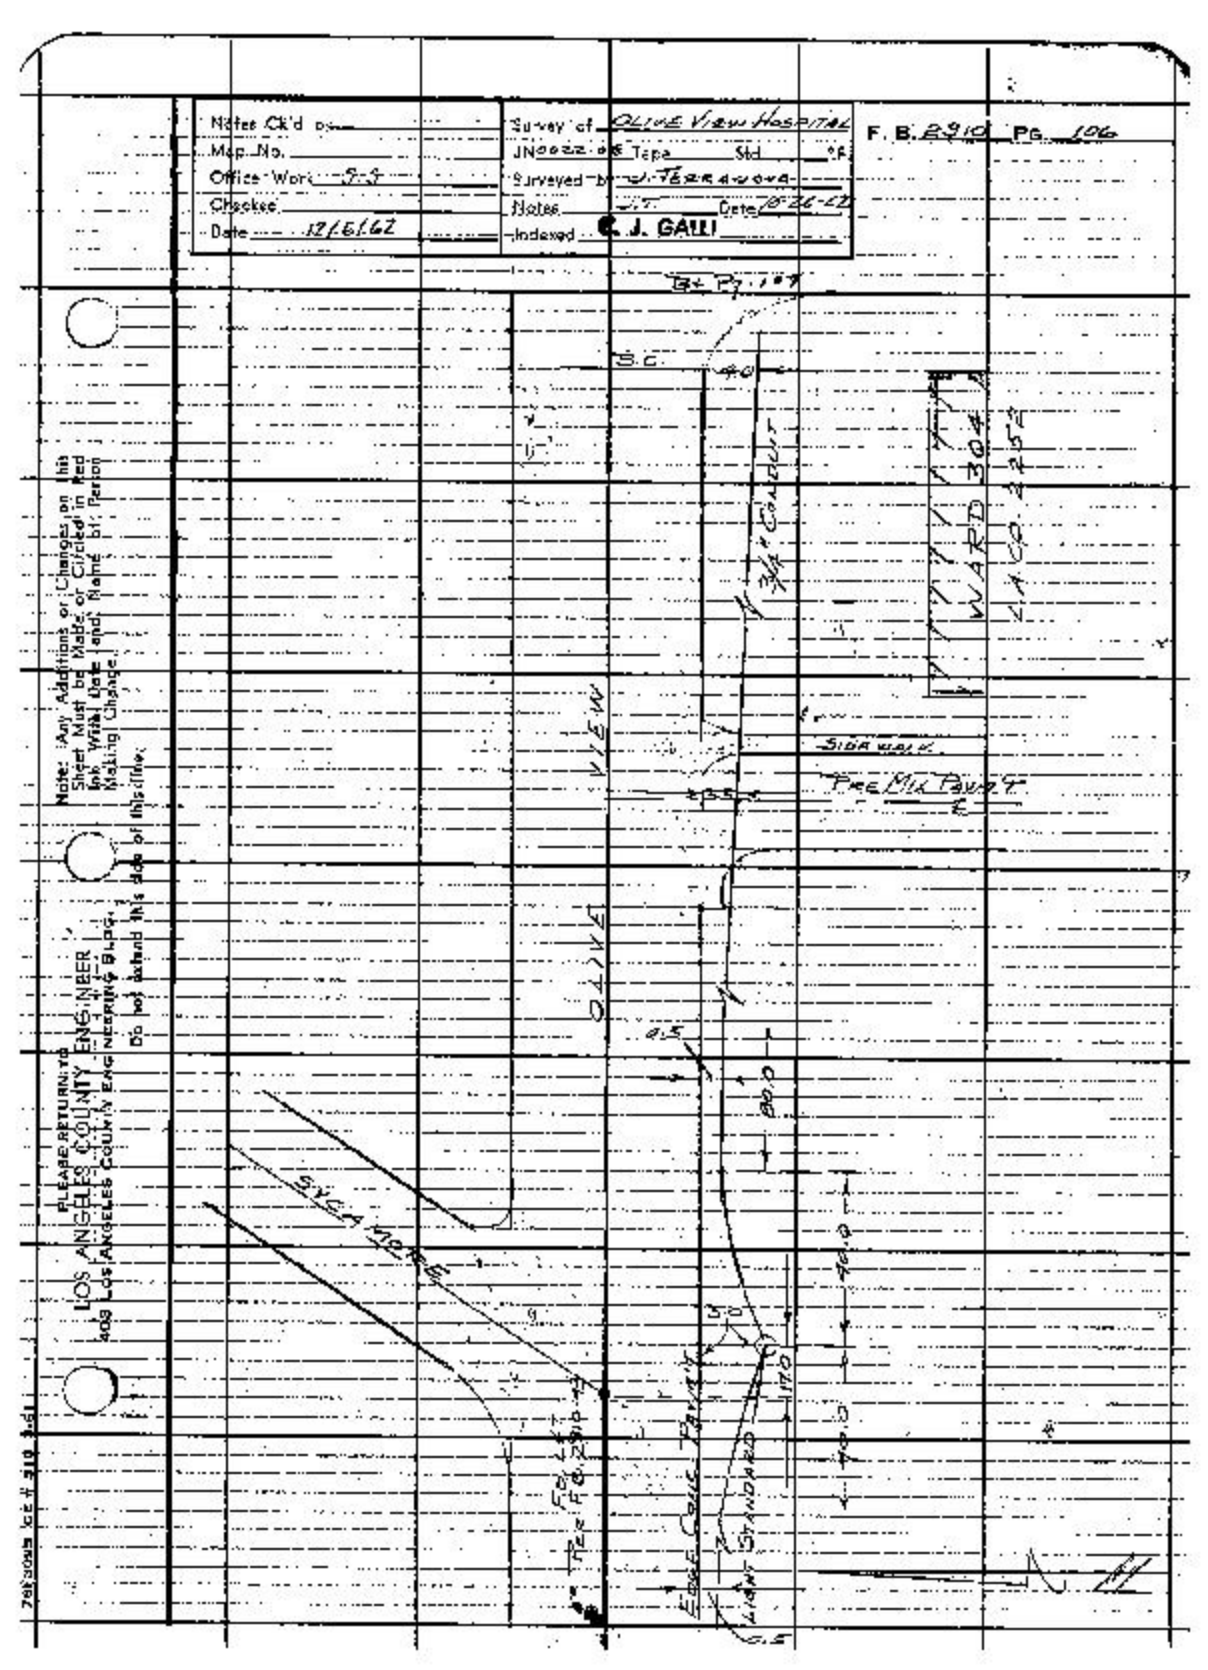
Notes Ck'd by
Map No.
Office Work
Checked
Date 12/6/62
Survey of OLIVE VIEW HOSPITAL
JN 0022-08 Tape Std °F
Surveyed by J. TERRAZAS
Notes Date 8-24-62
Indexed C. J. GALLI
F. B. 2910 Pg. 106
Note: Any Additions or Changes on this Sheet Must be Made or Circled in Red Ink With Date and Name of Person Making Change.
Do not extend this side of this office
LOS ANGELES COUNTY ENGINEER
PLEASE RETURN to
409 LOS ANGELES COUNTY ENGINEERING BLDG.
B.C.
WARD 304
L.A. CO. 4253
OLIVE VIEW
SIDEWALK
SYCAMORE
EDGE CABLE
STANDARD
Pg. 107

F.B. 2310 PG. 107

B7, Pg. 102

Edge of Conc. Pavmt

3/4" Conduit

16.0

Pull Box

WARD 302 LA00,2254

WARD 308 LA00,2253

LINE ABANDONED IN THIS AREA

3/4" Conduit

Tp. Pg. 102

LOS ANGELES COUNTY ENGINEER
403 Los Angeles County Engineering Bldg.

PLEASE RETURN TO

Do not extend this side of this line.

Note: Any Additions or Changes on This Sheet Must Be Made in Red Ink and Name of Person Making Change.

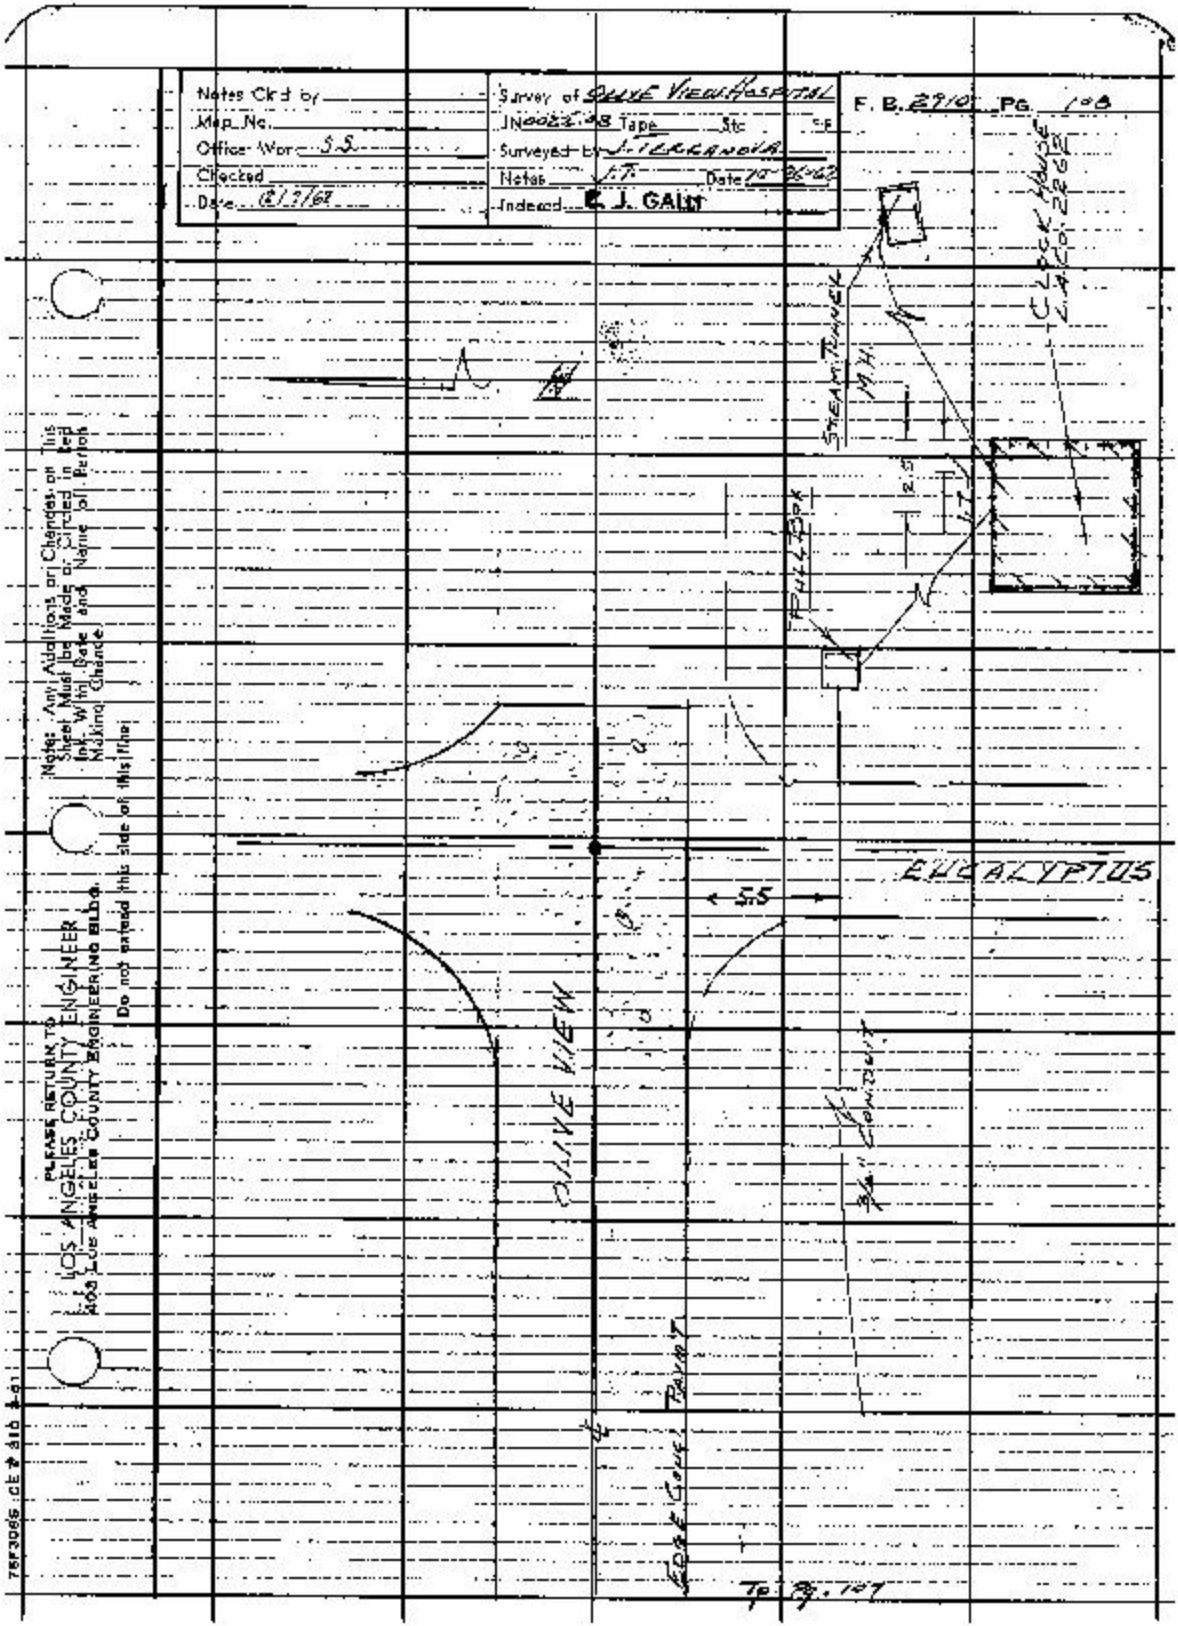
Notes Ckd by
Map No.
Office Work S.S.
Checked
Date 8/2/62
Survey of OLIVE VIEW HOSPITAL
INDEX 48 Tape Sht
Surveyed by J. ALEXANDER
Notes J.F. Date 10-26-62
Indexed C. J. GAITT
F. B. 2910 Pg. 108
Note: Any Additions or Changes on This Sheet Must Be Made or Circled in Red Ink With Date and Name of Person Making Change
PLEASE RETURN TO LOS ANGELES COUNTY ENGINEER
Los Angeles County Engineer No Bldg.
Do not extend this side of this line
OLIVE VIEW
EUCALYPTUS
55
STEAM TRUNK
MH
PULLBOX
CLOCK HOUSE
24" Conduit
EDGE COVE
Tp Pg. 107

F.B. 2910 Pg. 109

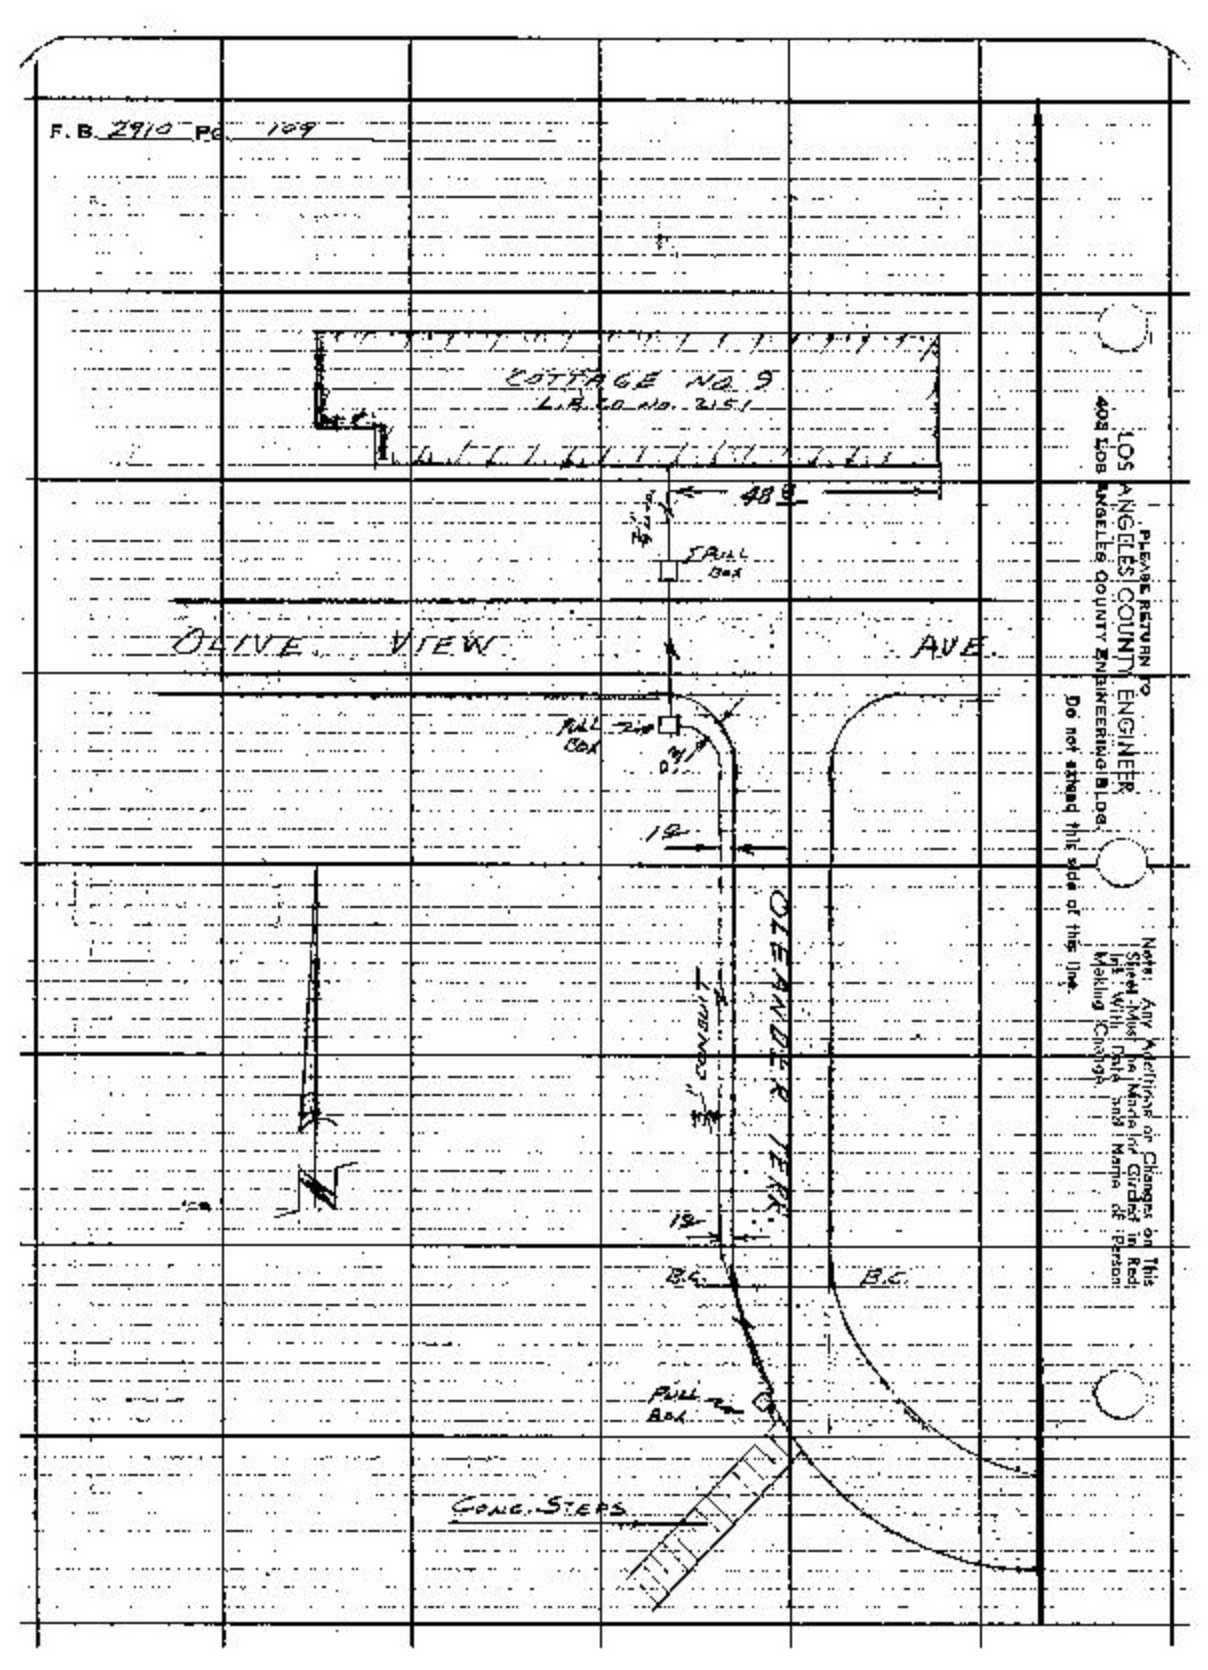


PLEASE RETURN TO
LOS ANGELES COUNTY ENGINEER
ENGINEERING LOG
408 LOS ANGELES COUNTY

Do not extend this side of this line.

Note: Any Additions or Changes on This Sheet Must Be Made in Red Ink With Date and Name of Person Making Change.

Notes Ck'd by
Map. No.
Office Work S.S.
Checked
Date 12/7/62

Survey of OLIVEVIEW Hospital
JN 2222-46 Tape Std °F
Surveyed by J. TERRANOVA
Notes Date 10-31-62
Indexed C. L. GALL

F. B. 2910 Pg. 110

BUNGS
L.A.CO.2235

30
14.2

GARAGE
L.A.CO.2296

GARAGE



Note! Any Additions or Changes on this Sheet Must be Made or Checked in Red Ink With Base Land Name of Person Making Change.

Do not extend this side of this line.

PLEASE RETURN TO
LOS ANGELES COUNTY ENGINEER
700 Los Angeles County Engineering Bldg.

7-63 3M SAE 8241 11-58

MAIL RETURN TO
LOS ANGELES COUNTY ENGINEER
700 LOS ANGELES COUNTY ENGINEERING BLDG.
Do not extend this box or this line.

Note: Any Additions or Changes on This Sheet Must Be Made or Checked in Red Ink With Date and Name of Person Making Change.

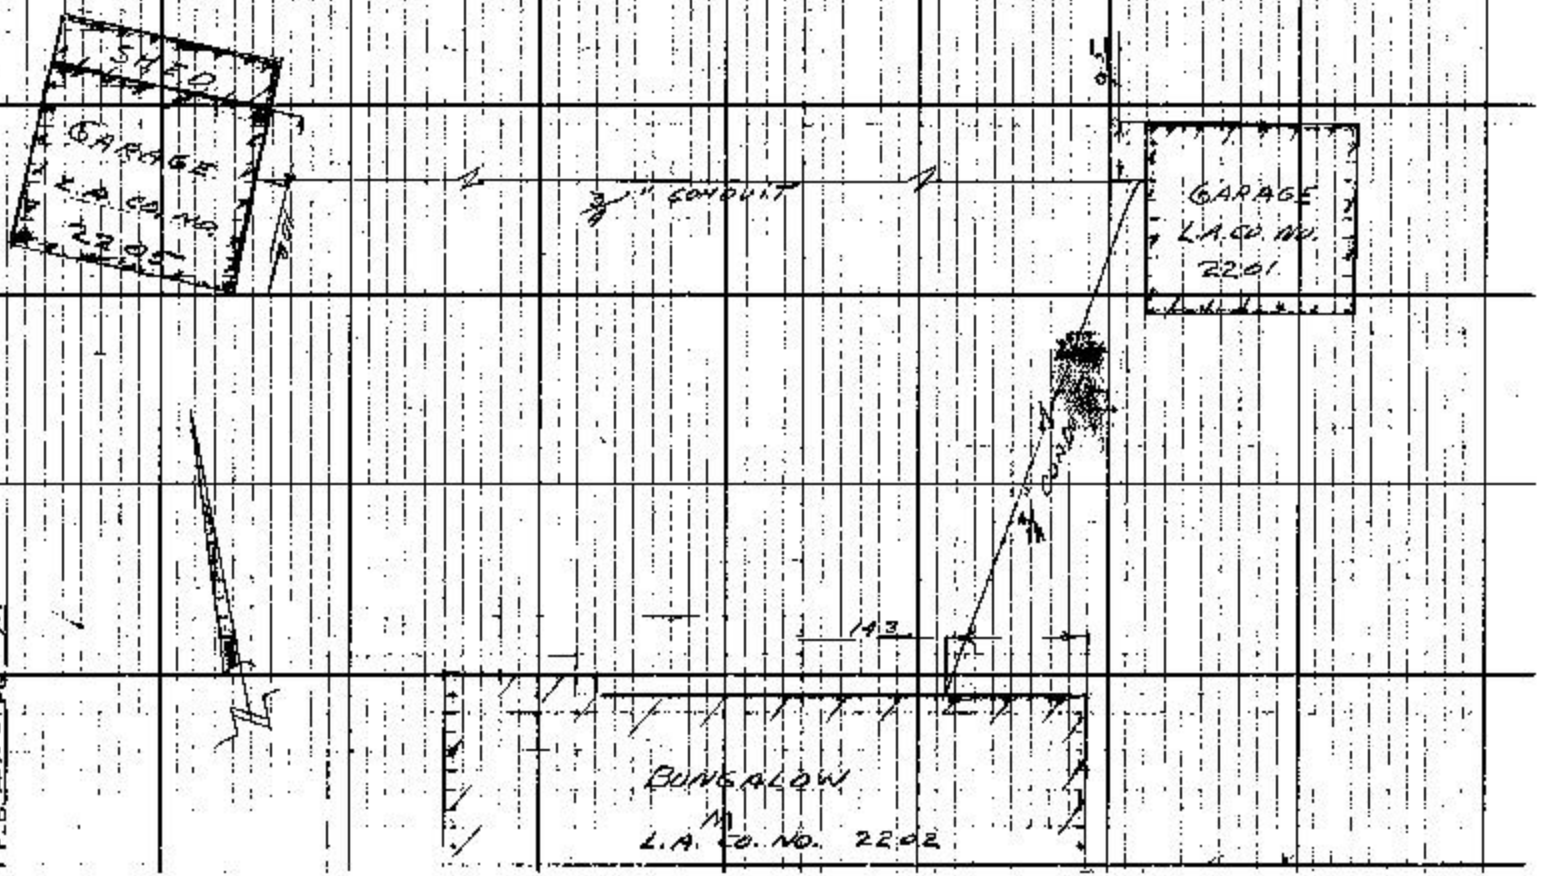


F.B. 270 PG 111

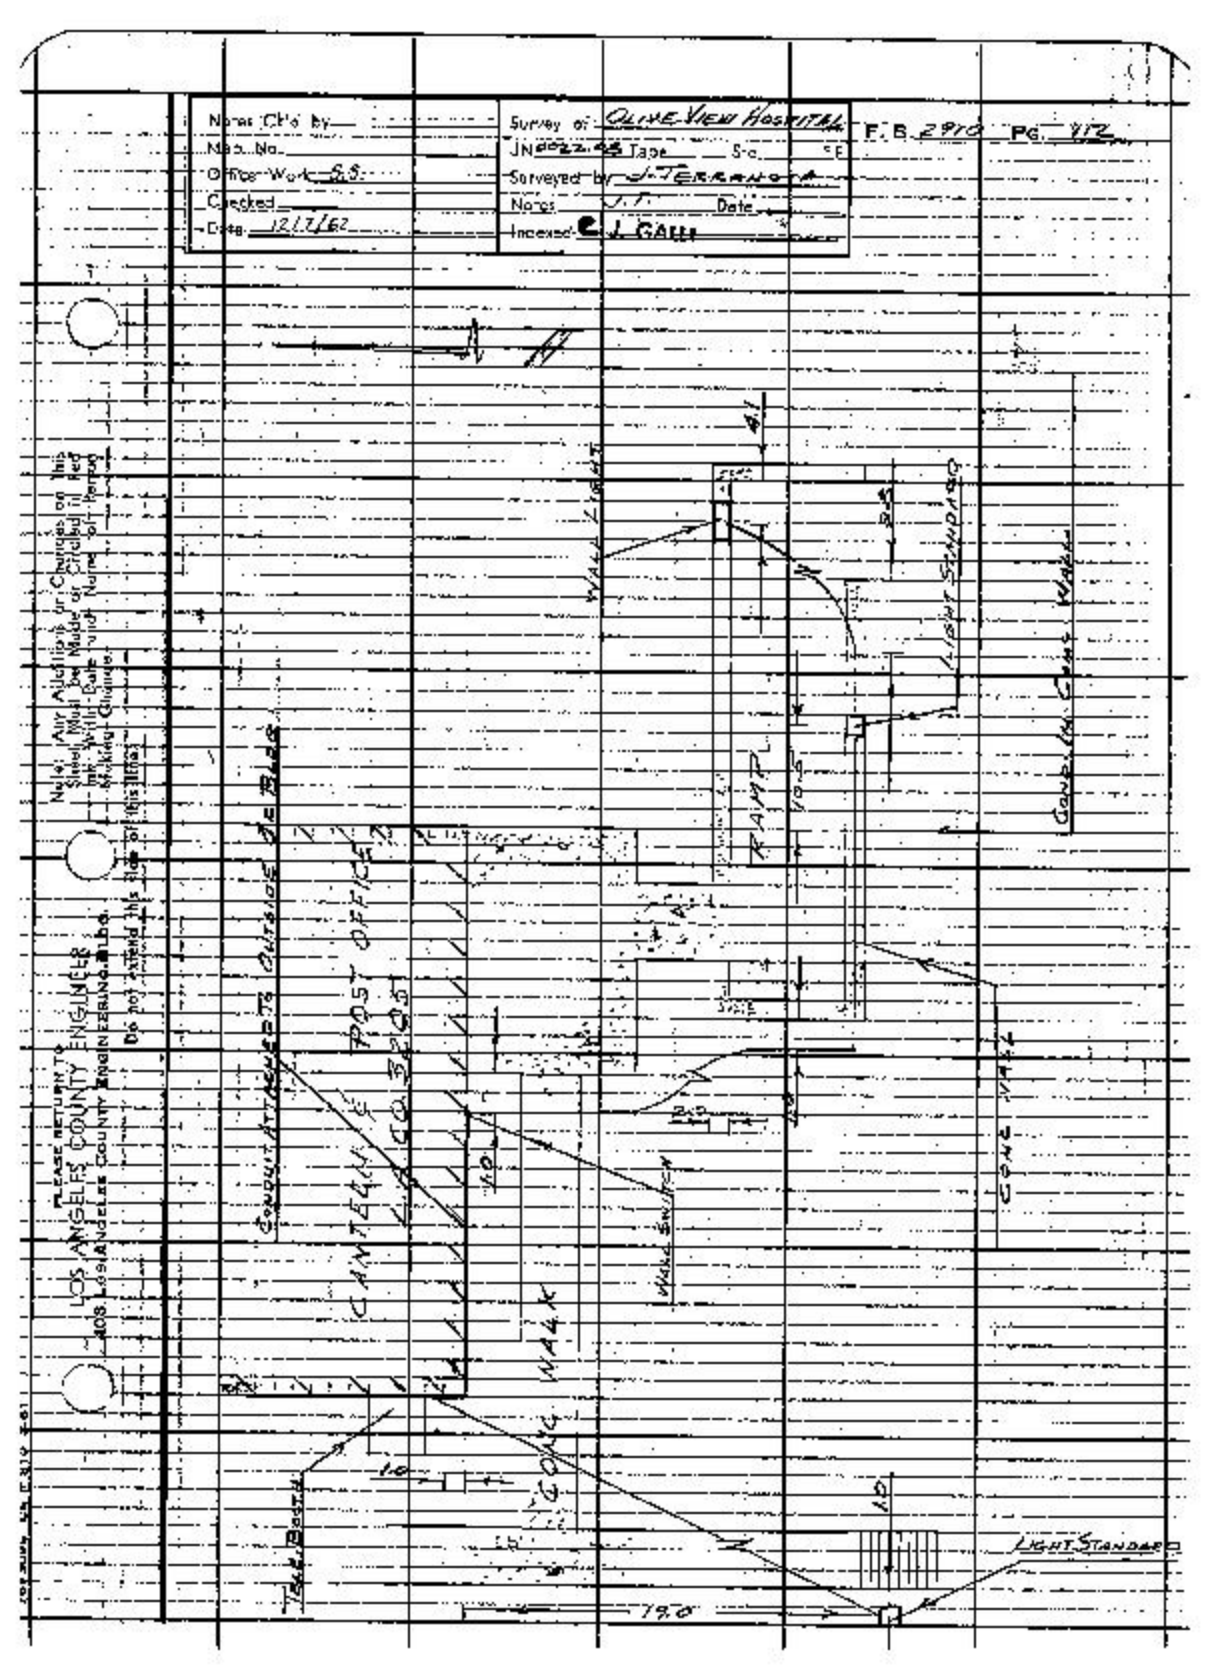
Notes Chkd by
Map No.
Office Work S.S.
Checked
Date 12/7/62
Survey of OLIVE VIEW HOSPITAL F.B. 2910 PG. 112
JN 0222-45 Tape S-c SE
Surveyed by J. TERRANOVA
Notes J.T. Date
Indexed C. J. GALLI
Notes: Any Alterations or Changes on this Sheet, Must be Made or Credited to Red Ink, With Date and Name of Person Making Changes.
Do not extend this line beyond this item.
LOS ANGELES COUNTY ENGINEER
PLEASE RETURN TO
LOS ANGELES COUNTY ENGINEER
POST OFFICE
CANTEEN
CONC. WALK
CONC. WALL
RAMP
LIGHT STANDARD

F. B. 2910 PG 113

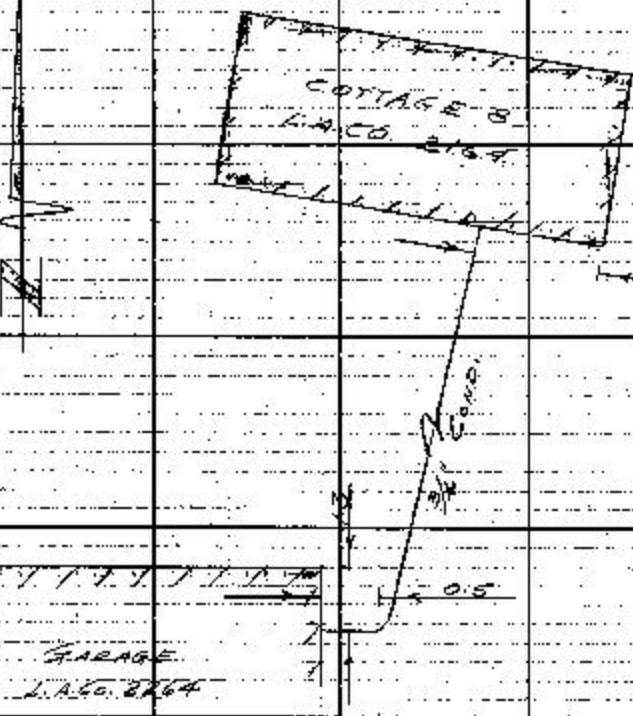


PLEASE RETURN TO
LOS ANGELES COUNTY ENGINEER
404 Los Angeles County Engineering Bldg.

Do not extend this side of this line.

Notice: Any Additions or Changes on This Sheet Must Be Made or Clearly Indicated in Red Ink With Date and Name of Person Making Change.

Notes Ckd by:
Map No.
Office Work
Checked
Date 12/7/62

Survey of OLIVE VIEW HOSPITAL F. B. 2910 PG. 114
JN 0922-69 Tape Sta P.
Surveyed by J. TERRAZAS
Notes J.T. Date 11-7-62
Indexed J. CARR

Note: Any Additions or Changes on this Sheet must be Made or Checked in Ink. Write Date and Name of Person Making Change.

LOS ANGELES COUNTY ENGINEER
PLEASE RETURN TO
COUNTY ENGINEERING BLDG.
LOS ANGELES COUNTY ENGINEER
Do not erase this title or this line

GARAGE
FINISH FLR. 216.2

2.0

13.0

ROAD ATTACHED TO MAIN AVENUE OF ENTRANCE

10.0

CONC. STEPS

11 CONC.

8.9.4

12.8

COTTAGE
FINISH FLR. 216.1

PLEASE RETURN TO
LOS ANGELES COUNTY ENGINEER
403 LOS ANGELES COUNTY ENGINEERING BLDG.

Note: Any Additions or Changes on This Sheet Must be Made or Circled in Red Ink With Date and Name of Person Making Change.

Do not extend this side of this line.

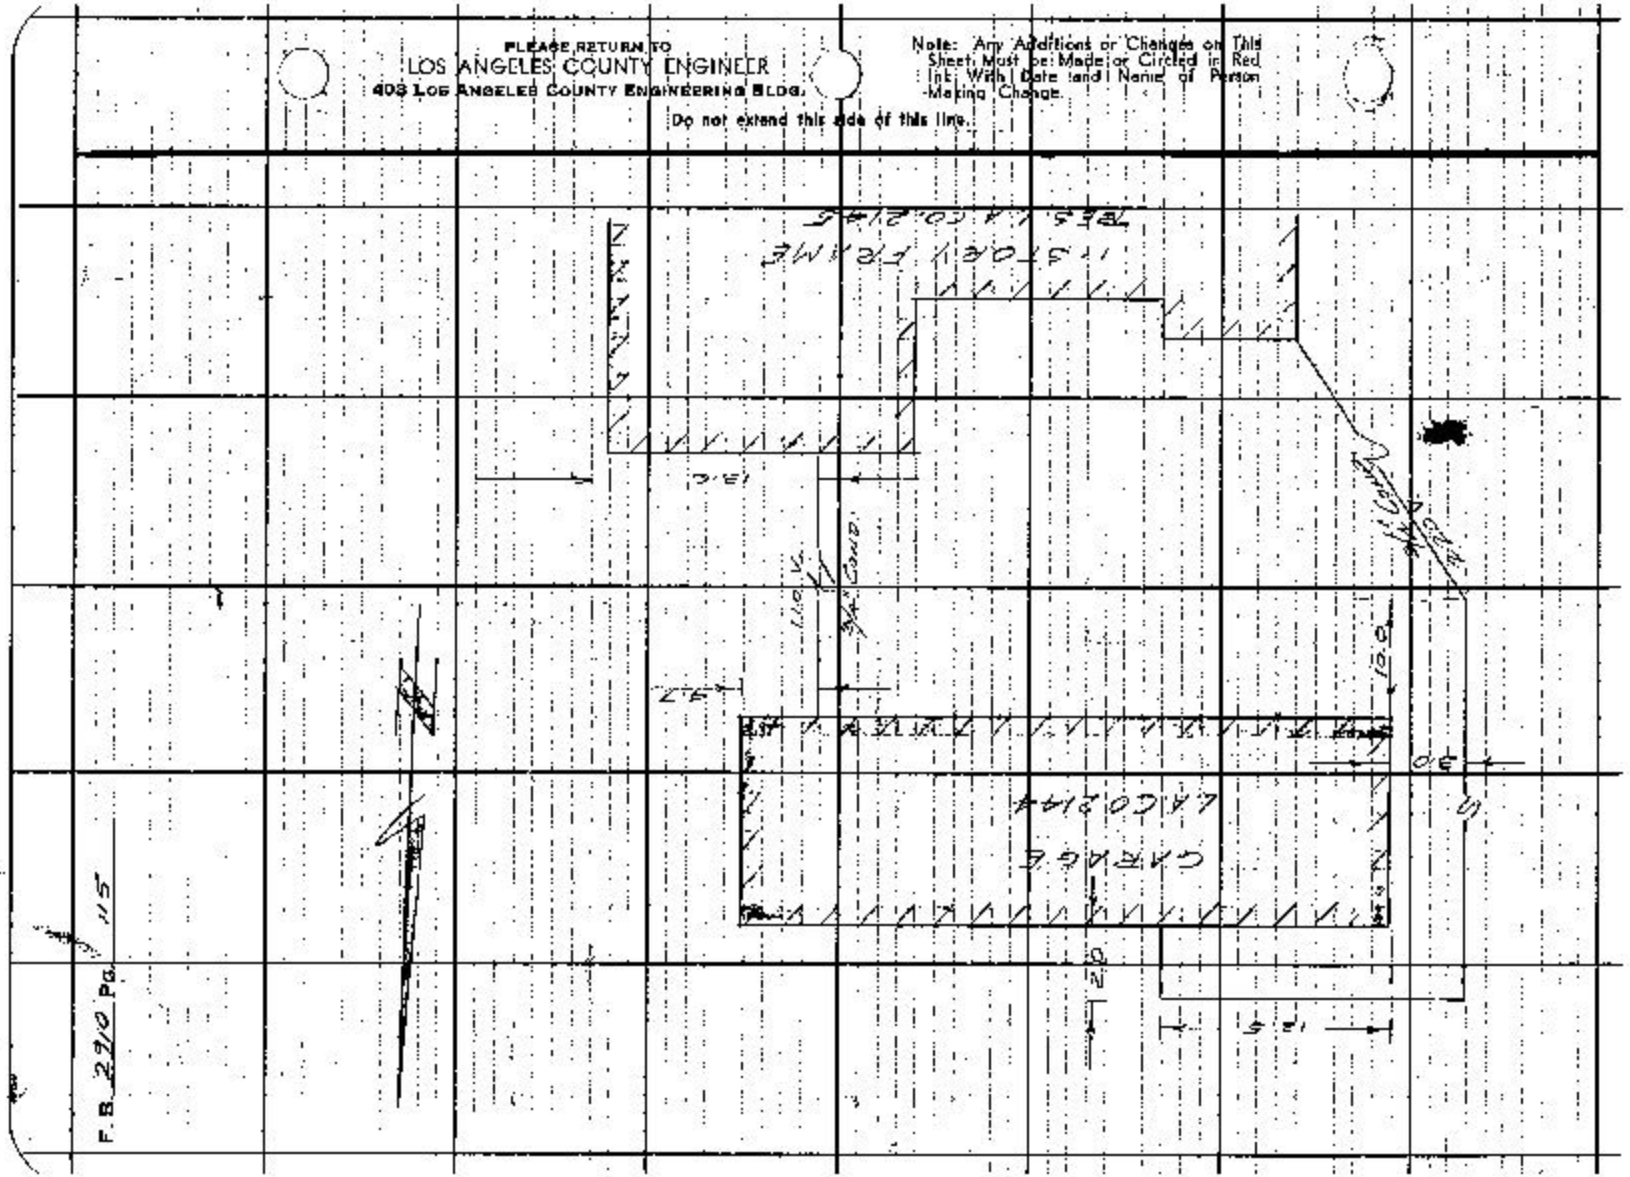

F.B. 220 Pg. 115

Notes Ck'd by:
Map No.
Office Work: S.S.
Checked:
Date: 5/13/63

Survey of: OLIVE VIEW HOSPITAL
JN 0022.08 Type: S-0
Surveyed by:
Notes: R. Swinson Date: 2/20/63
Indexed: G. J. GALLI

F.B. 1910 Pg. 116

ELECTRICAL

OFFICES

L.A. Co. No. 2186

CONC.

WALL

17.5'

14.5'

3/4" Conduit (Buried)

3/4" Conduit (Buried)

15'

18'

To Pg 117

To Pg 118

To Pg 119

Note: Any Additions or Changes on This Sheet Must be Made or Checked in Ink — Will Delay Record — Name of Person Making Change.

PLEASE RETURN TO
LOS ANGELES COUNTY ENGINEER
402 LOS ANGELES COUNTY ENGINEERING BLDG.
Do not detach this sheet from this set of plans

7-65 RDS EE #8 10 A-82

F.B. 2910 Pg. 117

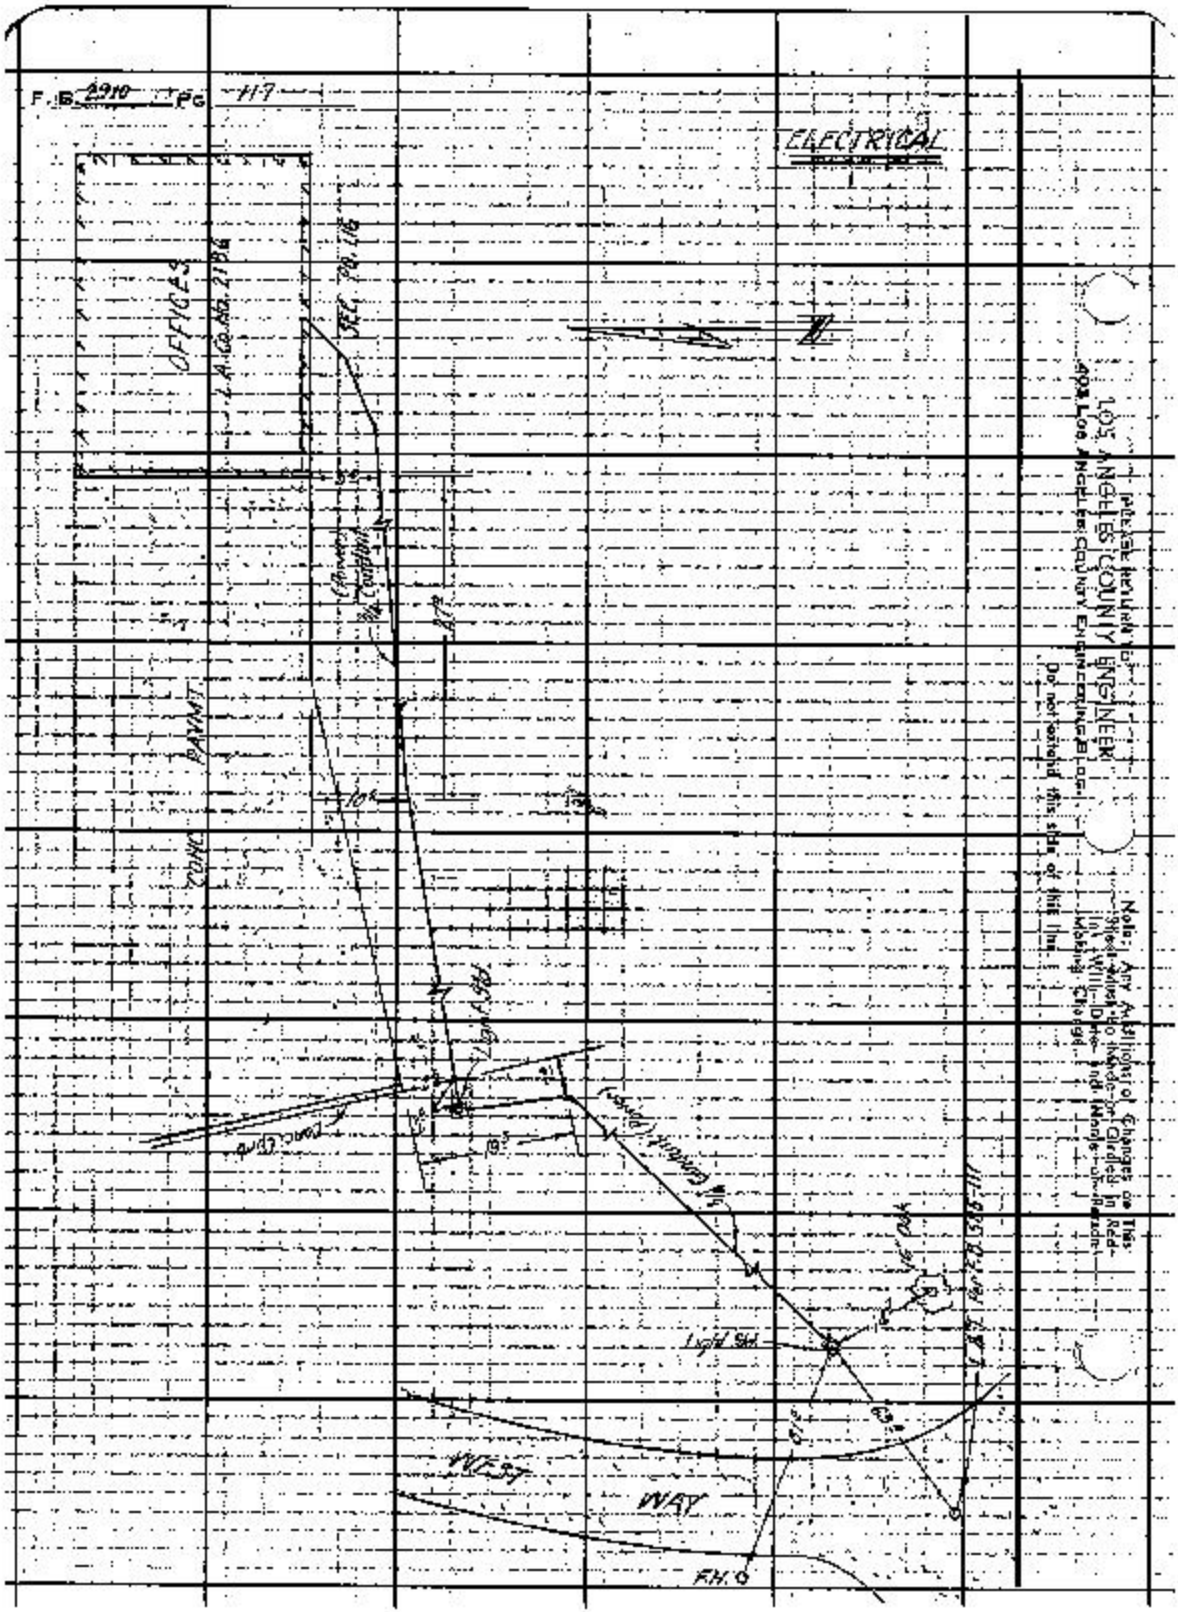

Notes Ck'd by
Map No.
Office Work S.S.
Checked
Date 5/15/63

Survey of OLIVE VIEW HOSPITAL
JN 0022.09 Tape Rod °F
Surveyed by
Notes S. SHINODA Date 2-21-63
Indexed E. J. GALLI

F. B. 2910 Pg. 118

WARD 118
L.A.Co No 2183

ELECTRICAL

69.5

Light Std.

30.9

WAY

Surface Drain

CYPRESS ST

4" Conduit (typ.)

31.9

16'

Light Std.

Fence (typ.)

41'

86'

10.5

20.9

37'

OFFICES
L.A.Co No 2186
SEE PB 116

Note: Any Additions or Changes on this Sheet Must be Made or Circled in Red Ink With Dated and Name of Person Making Change.
Do not extend this side of this line.

PLEASE RETURN TO
LOS ANGELES COUNTY ENGINEER
ADMIN. BLDG.
LOS ANGELES COUNTY ENGINEERING BLDG.

TO PG 116

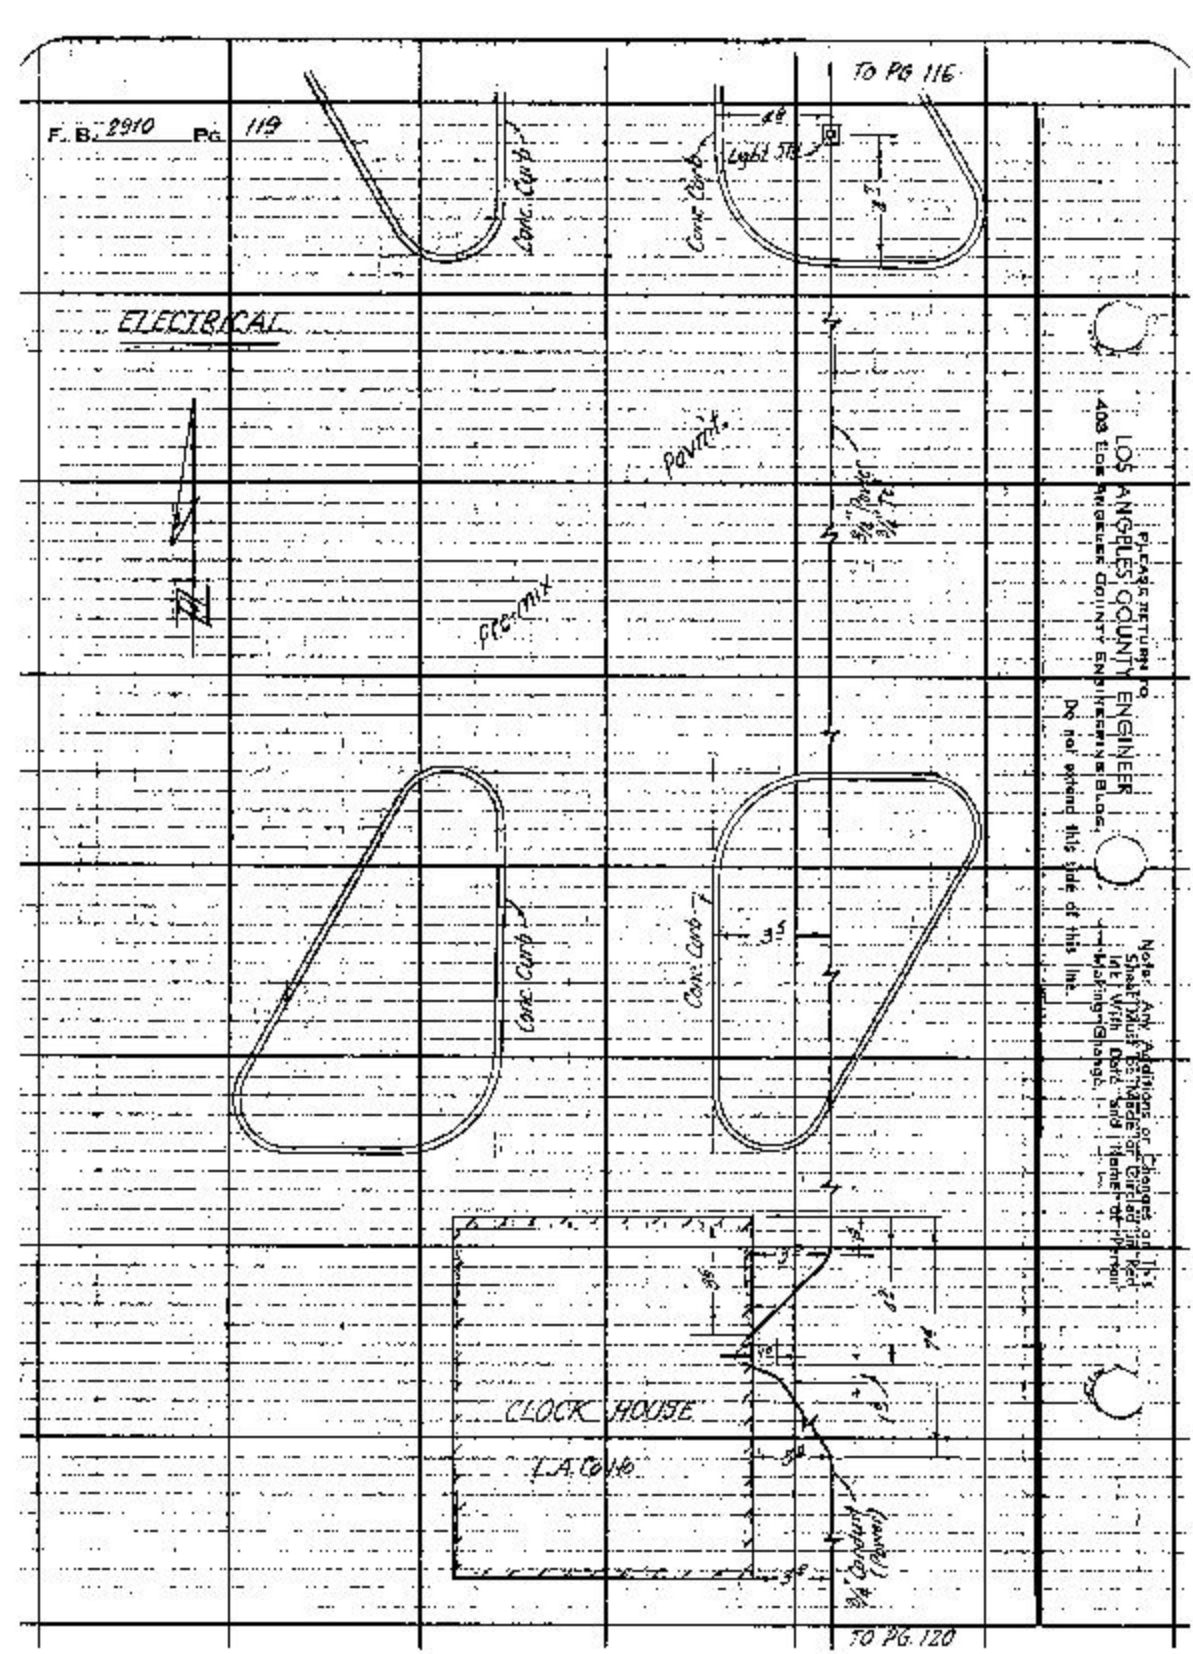


PLEASE RETURN TO
LOS ANGELES COUNTY ENGINEER
403 EDR BRIDGE COUNTY ENGINEERING BLDG.

Note: Any Additions or Changes on this Sheet Must Be Made or Circled in Red Ink With Date and Name of Person Making Change.

Do not extend this side of this line.

TO PG. 120

Notes Co'd by:
Map No.
Office Work: S.S.
Checked:
Date: 5/19/69

Survey of: OLIVE VIEW HOSPITAL
J.S. 0022.68 Tape Std °F
Surveyed by:
Notes: S. SHINODA Date: 2/21/69
Indexed: S. J. GALLI

F.B. 2910 PG. 120

To Pg. 119

ELECTRICAL

Conc. Curb

Light Std.

Conc. Steps

CYPRESS AVE.

Conc. Pavmt.

4" Conduit (Power)

Conc. Curb

Light Std.

Planters

Notes: Any Additions or Changes on this Sheet Must Be Made on Attached Page.
Job With Personal Manuscript Report
Mailed Changes
Do not Write on this side of this line.

PLEASE RETURN TO:
LOS ANGELES COUNTY ENGINEER
ATTN: LOS ANGELES COUNTY ENGINEERING BLDG.
900 S. LOS ANGELES

P6F3095 CS #21 0 8-62

F. B. 2910 Pg. 121

ELECTRICAL

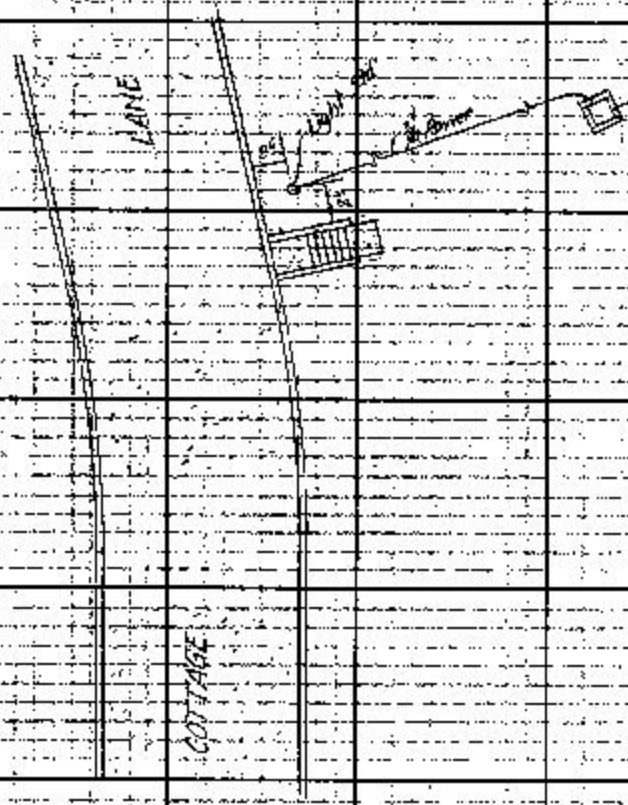


WARD 112
L.A. Co. No. 21 77

LOS ANGELES COUNTY ENGINEER
PLEASE RETURN TO
409 LOS ANGELES COUNTY ENGINEERING BLDG.

Do not extend this ___ day of ___

Note: Any Additions or Changes on This Sheet Must Be Noted on Red Ink With Date and Name of Person Making Change

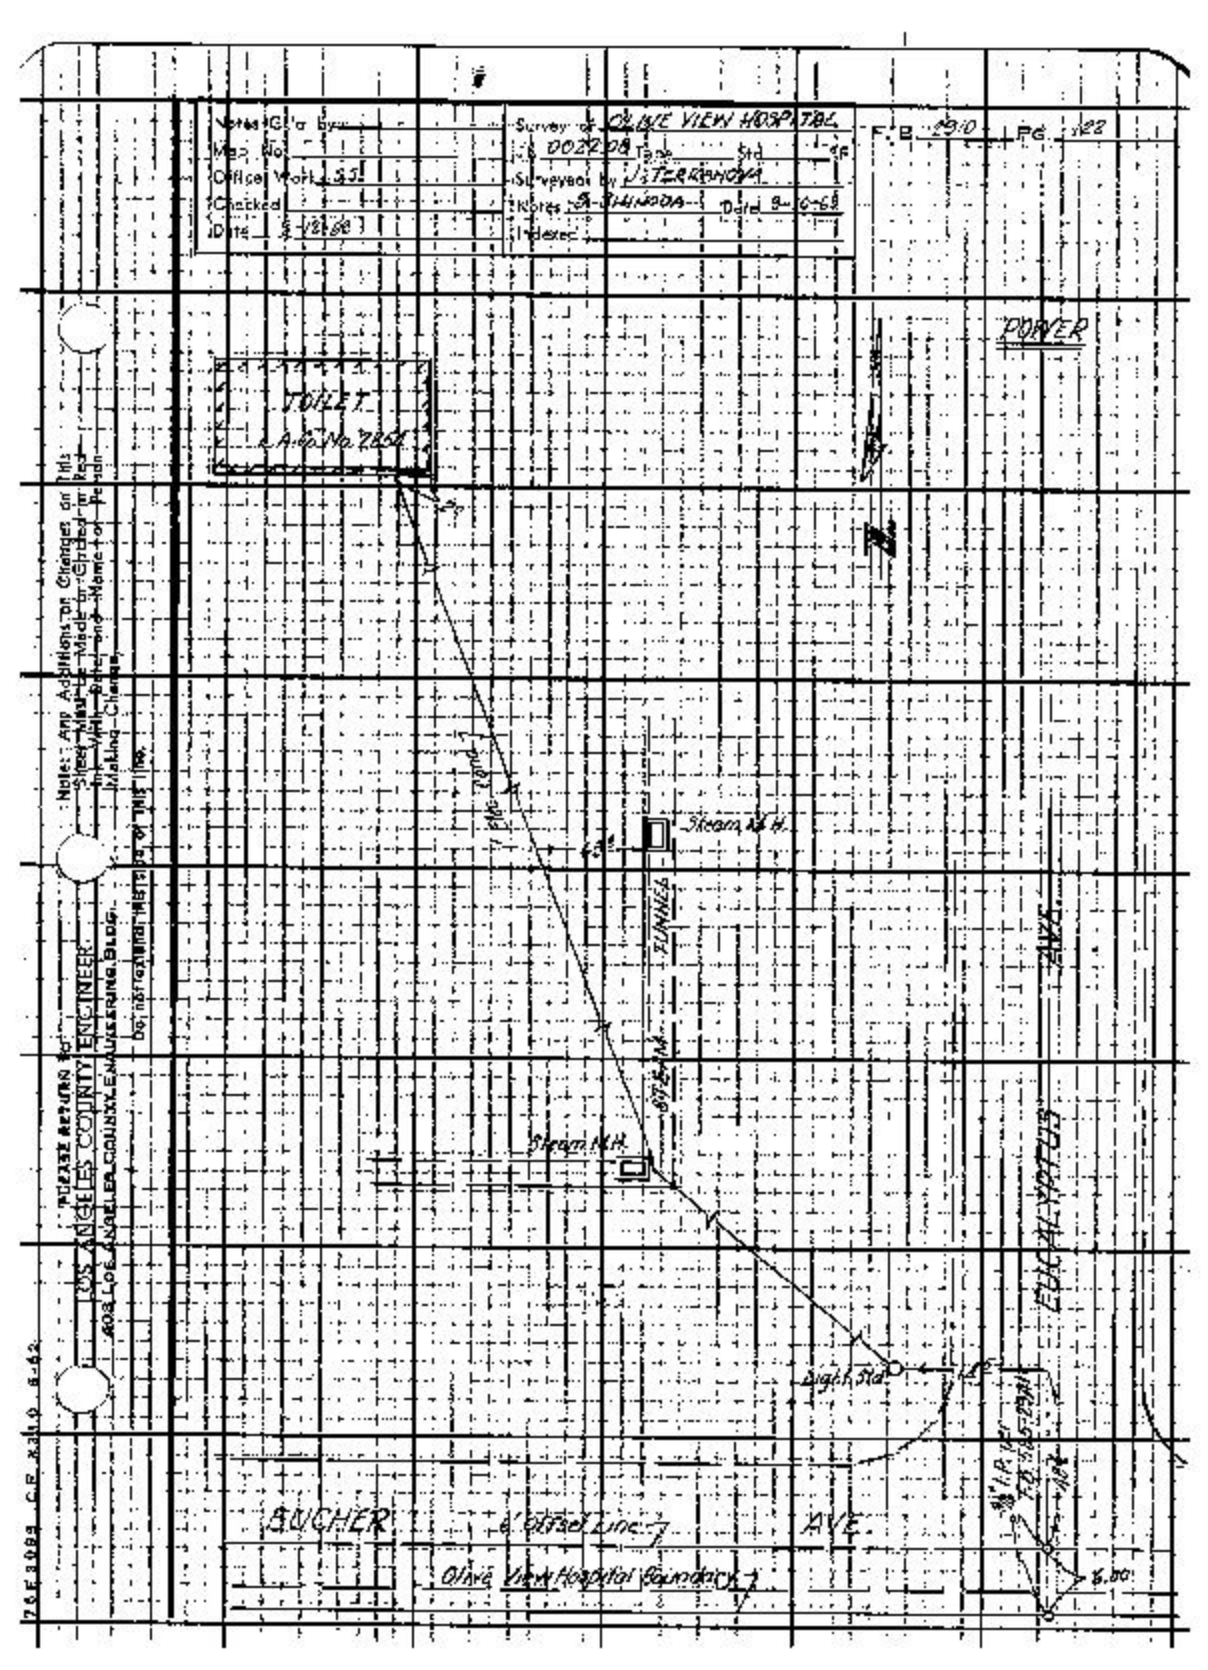
Survey of OLIVE VIEW HOSPITAL
Surveyed by J. TERRANOVA
Notes S. SHANDA Date 8-6-58
F.B. 290 Pg. 122
POWER
TOILET
L.A.Co. No. 7854
Note: Any Additions or Changes on This Sheet Must Be Made or Ordered by the Chief Engineer. Memo for Making Changes.
Please Return for
LOS ANGELES COUNTY ENGINEER
408 LOS ANGELES COUNTY ENGINEERING BLDG.
Do not remove this sheet from the files.
7 Pipe Bond
Steam M.H.
TUNNEL
Steam M.H.
Light Std.
BUCHER
AVE
Offset Line
Olive View Hospital Boundary
6.00
7-E-1088 C.E. 2-10-60 8-62

F. B. 2910 PG. 129

ELECTRICAL

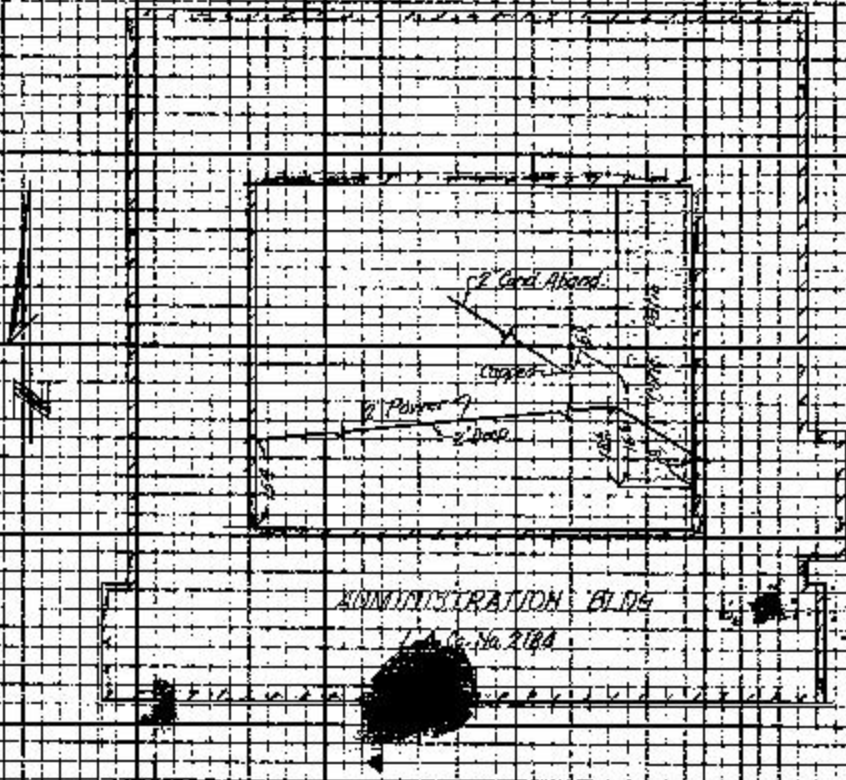


PLEASE RETURN TO
LOS ANGELES COUNTY ENGINEER
900 S. FREMONT AVE.
ALHAMBRA, CA 91803
DO NOT ERASE THIS LINE OR BELOW

Record Any Additions or Changes on This Mylar With Date and Initials of Person Making Change

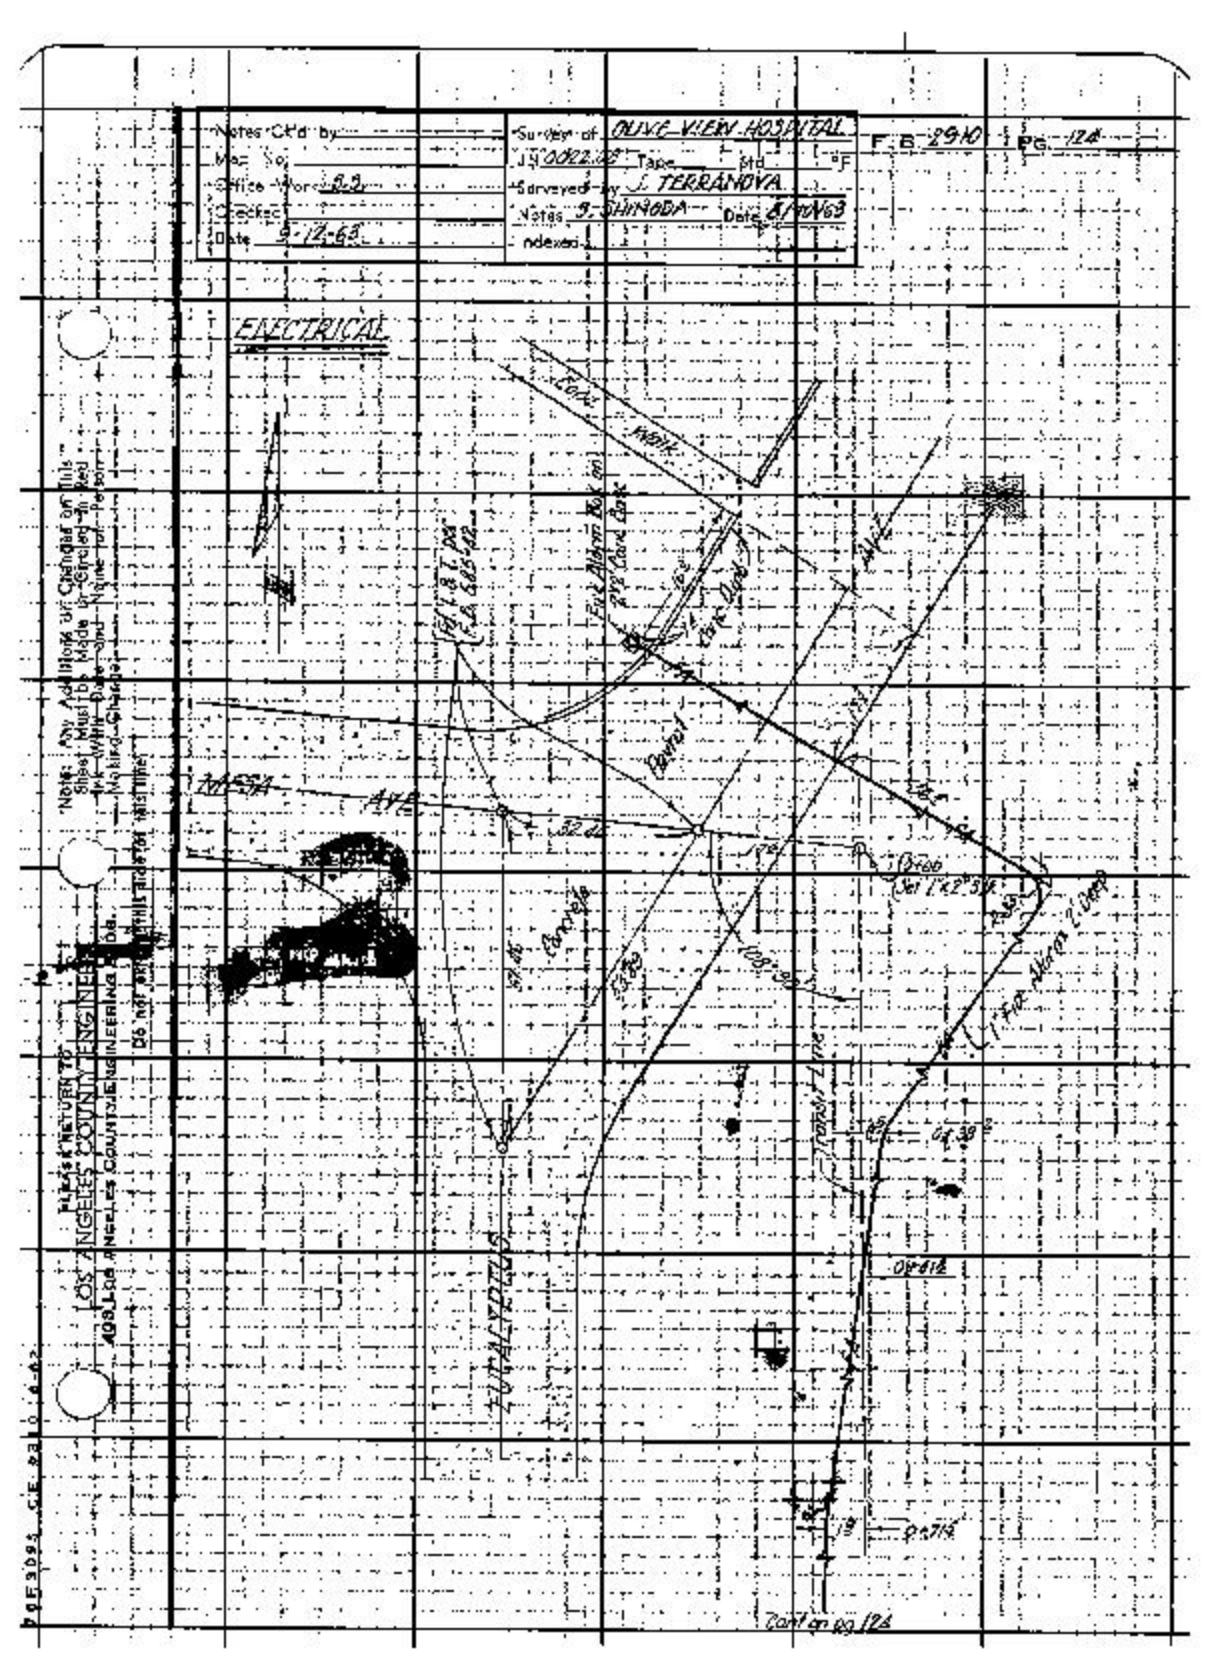
Notes Ckd by
Map No
Office Work
Checked
Date 9-12-63
Survey of OLIVE VIEW HOSPITAL
Tape Std °F
Surveyed by J. TERRANOVA
Notes S. SHINODA Date 8/20/63
Indexed
F.B. 2910 Pg. 124
ELECTRICAL
Note: Any Additions or Changes on This Sheet Must Be Made by Surveyor in Red Ink. Write Date and Name for Each Item Added or Changed.
Do not write in this area
LOS ANGELES COUNTY ENGINEER
FILES RETURN TO
LOS ANGELES COUNTY ENGINEERING Div.
409 Los Angeles County Engineering Bldg.
MESA AVE

F. B. 2910 : Pg. 125

ELECTRICAL

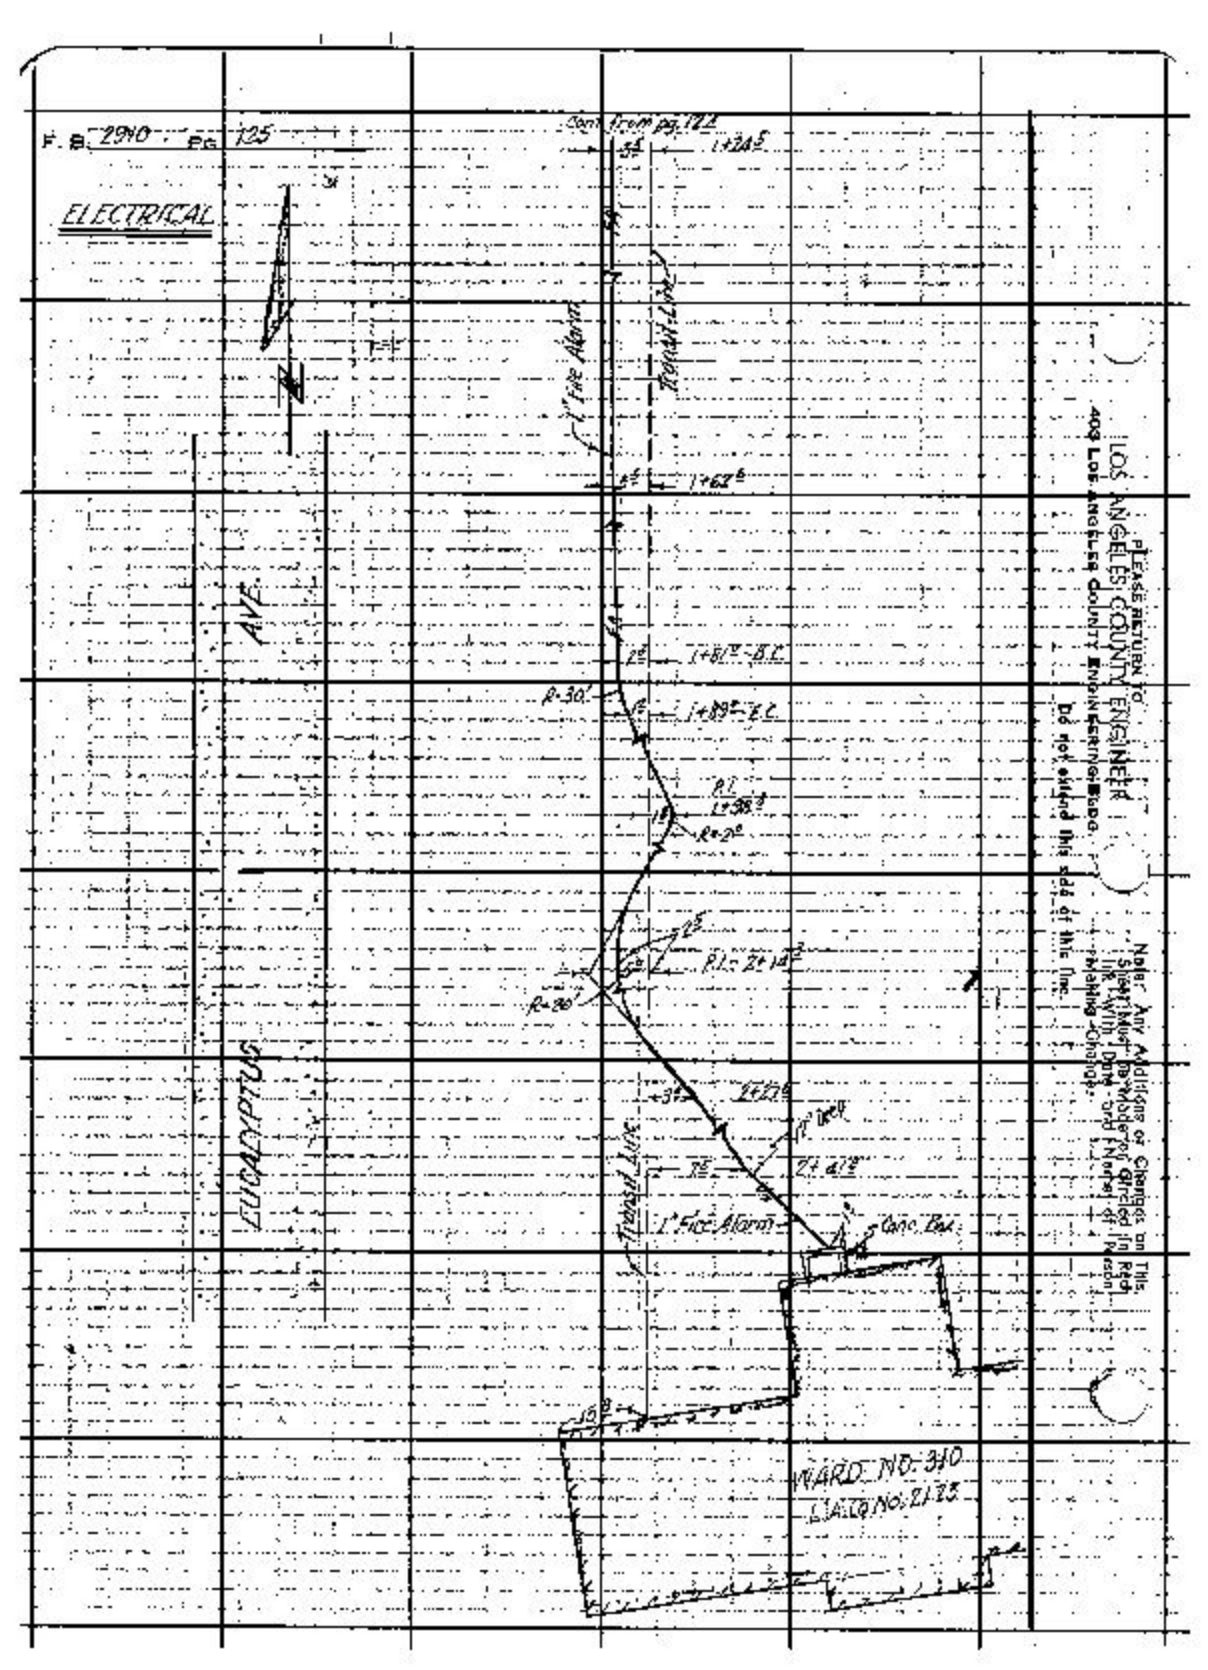

Notes Ckd. by
Map No.
Office Work
Checked
Date

Survey of
J.N. Tape Std °
Surveyed by
Notes Date 12-5-59
Indexed J. GALLI

F. B. 2910 Pg. 12

# OLIVE VIEW HOSPITAL

J.N. 0022.08

# SEWER LINES

PLEASE RETURN TO
LOS ANGELES COUNTY ENGINEER
700 LOS ANGELES COUNTY ENGINEERING BLDG.

- Note: Any Additions or Changes on this Sheet Must be Made on Cached Ink With Dark Lead. Name of Person Making Change.
- Do not extend this line of print

76P9099 SAE #247 11-58

Notes C'k'd by
Map No.
Office Work SS
Checked
Date 5/4/61

Survey of OLIVE VIEW HOSPITAL
JN 002208 Tape Etc
Surveyed by
Notes T. SUMODA
Indexed J. Gallo

F. B. 2910 Pg. 128

NOTE: TIES WERE TAKEN FROM PLUMBERS SKETCH

SEWER LINES

TOILET
L.A.C. # 2513

CAR HOUSE
L.A.C. # 2512

6" Tile Pipe

Please Return To
LOS ANGELES COUNTY ENGINEER
900 Los Angeles County Engineering Mdg.

Do not extend this description lines.

Note: Any Additions or Changes on This Sheet Must Be Made or Circled in Ink With Date and Name of Person Making Change.

75F3098 5M5 (347) 11-59

F. B. 2910 Pg. 129

NOTE: TIES WERE TAKEN FROM PLUMBERS SKETCH AND ALSO SCALED FROM P.I.F. 550-14.

SEWER LINES

WARD 111

L.B. Co. #2025

CONC. WALK

TOILETS L.B. Co. #2852

JACARANDA TERR.

LOS ANGELES COUNTY ENGINEER
700 LOS ANGELES COUNTY ENGINEER BLDG.

PLEASE RETURN TO

Note: Any Additions or Changes on This Sheet Must Be Made on Original Ink Work. Date and Name of Person Making Change.

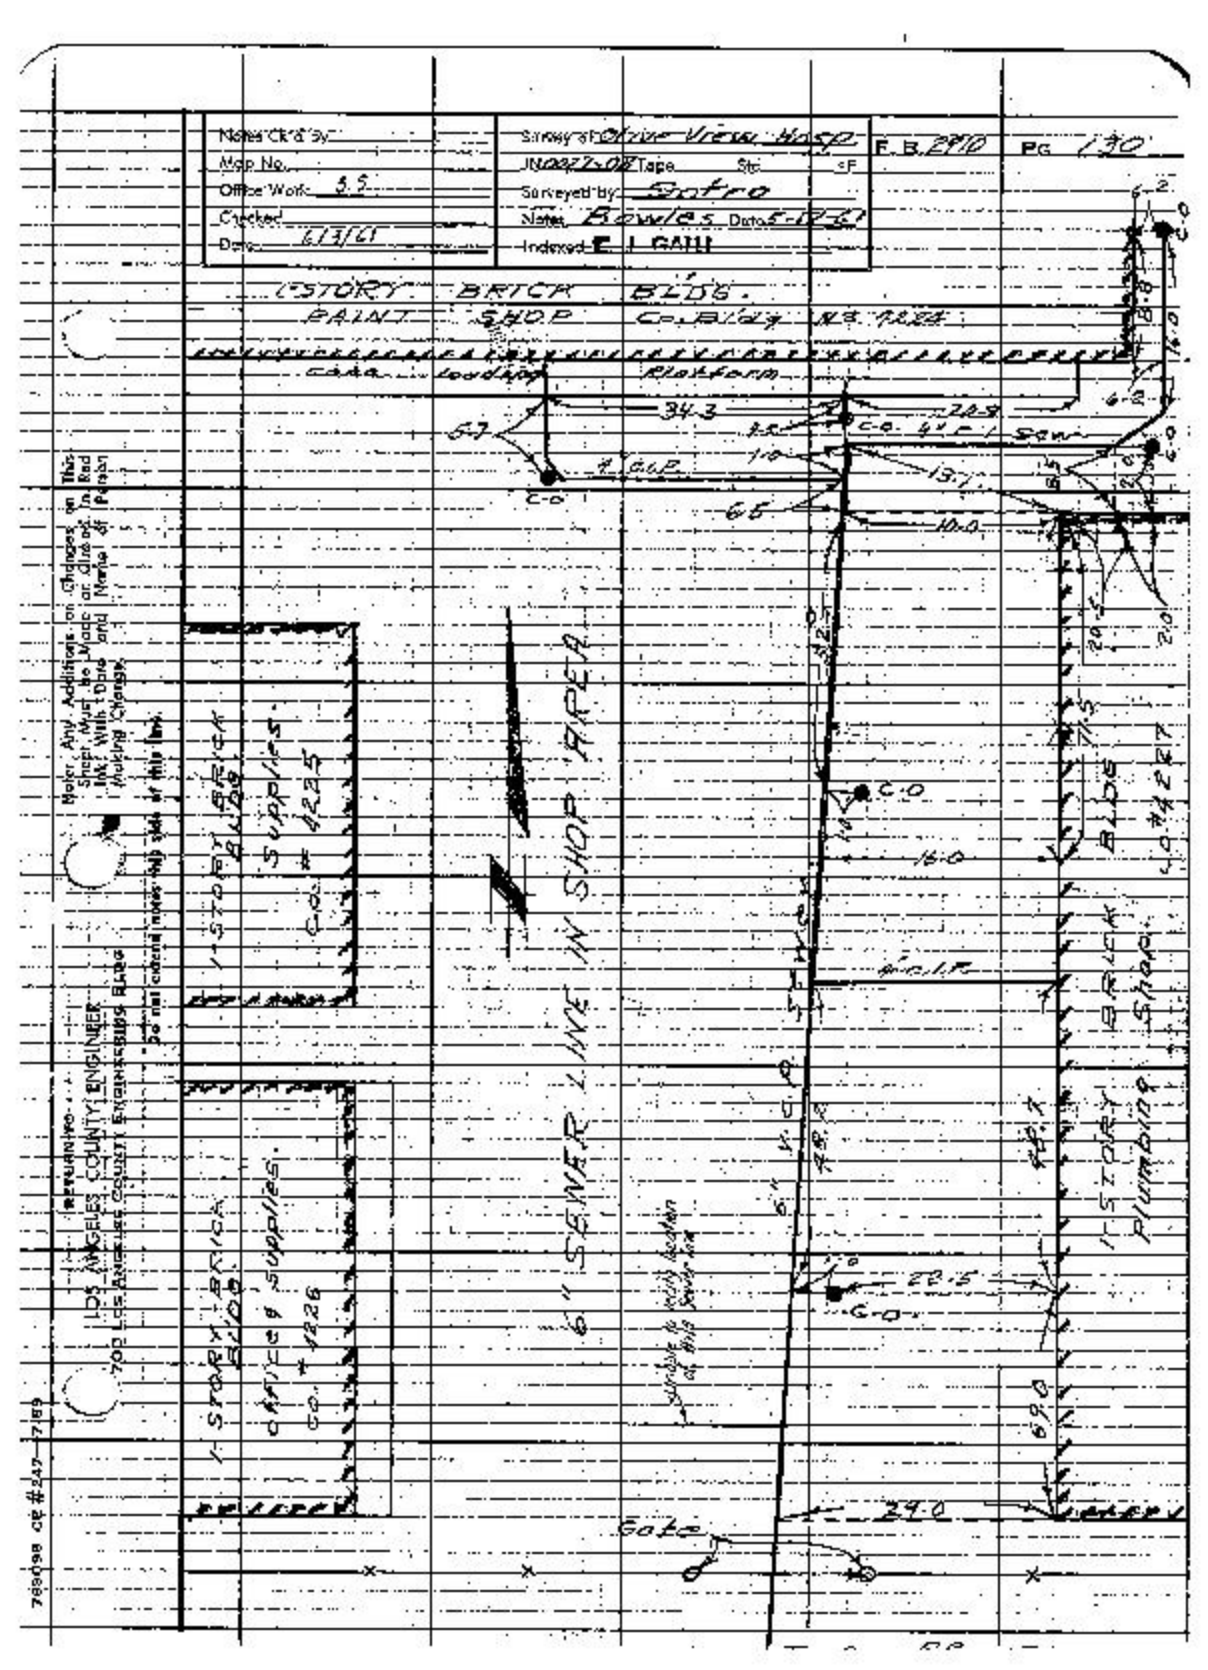
Notes Ck'd by
Map No.
Office Work 5.5
Checked
Date 6/3/61
Survey of Olive View Hosp
JN 00220B Tape Sta SF
Surveyed by Sotro
Notes Bowles Date 5-17-61
Indexed E. I. GAIII
F. B. 2910 Pg 130
1 STORY BRICK BLDG.
PAINT SHOP
Co. Bldg. No. 1225
Loading Platform
34.3
6.7
4" G.I.P.
C.O.
C.O. 4" C.I. Sew.
13.7
6.5
10.0
C.O.
16.0
6" C.I.P.
1 STORY BRICK BLDG.
SUPPLIES
CO. # 1225
1 STORY BRICK BLDG.
CARPENTER SHOP & SUPPLIES
CO. # 1226
6" I SEWER LINE IN SHOP AREA
Junction to main section of this building
1 STORY BRICK BLDG.
PLUMBING SHOP
CO. # 1227
22.5
C.O.
29.0
Gate
LOS ANGELES COUNTY ENGINEER
700 Los Angeles County Engineers Bldg.
Returning to
Make Any Additions or Changes on This Sheet. Must Be Made or Checked in Red Ink With Date and Name of Person Making Change
Do not extend notes into this area
788098 CE #247 7/59

F.B. 2910 Pg. 131

Cont. from Bot pg 130

SHED

AREA

Gate

Wire Fence

later made by prod
CMP to R.C.P.

8" Sewer
(V.C.P.)

160.9

S.S.M.H.

BUCHER AVE.

See F.B. 713-308

LOS ANGELES COUNTY ENGINEER
900 Los Angeles County Engineering Bldg.

Number any Additions or Changes on this Sheet. Must be Made or Called in Red Ink With Date and Name of Making Changes.

Do not extend notes into this side of this line.

76F3088 QAE 8-247, 8-54

RETURN TO
LOS ANGELES COUNTY SURVEYOR
725 LOS ANGELES COUNTY
ENGINEERING BLDG.

Notes: Any Additions or Changes on This Sheet Must Be Made or Circled in Red Ink! With Date and Name of Person Making Change.

Do not extend notes this side of this line.

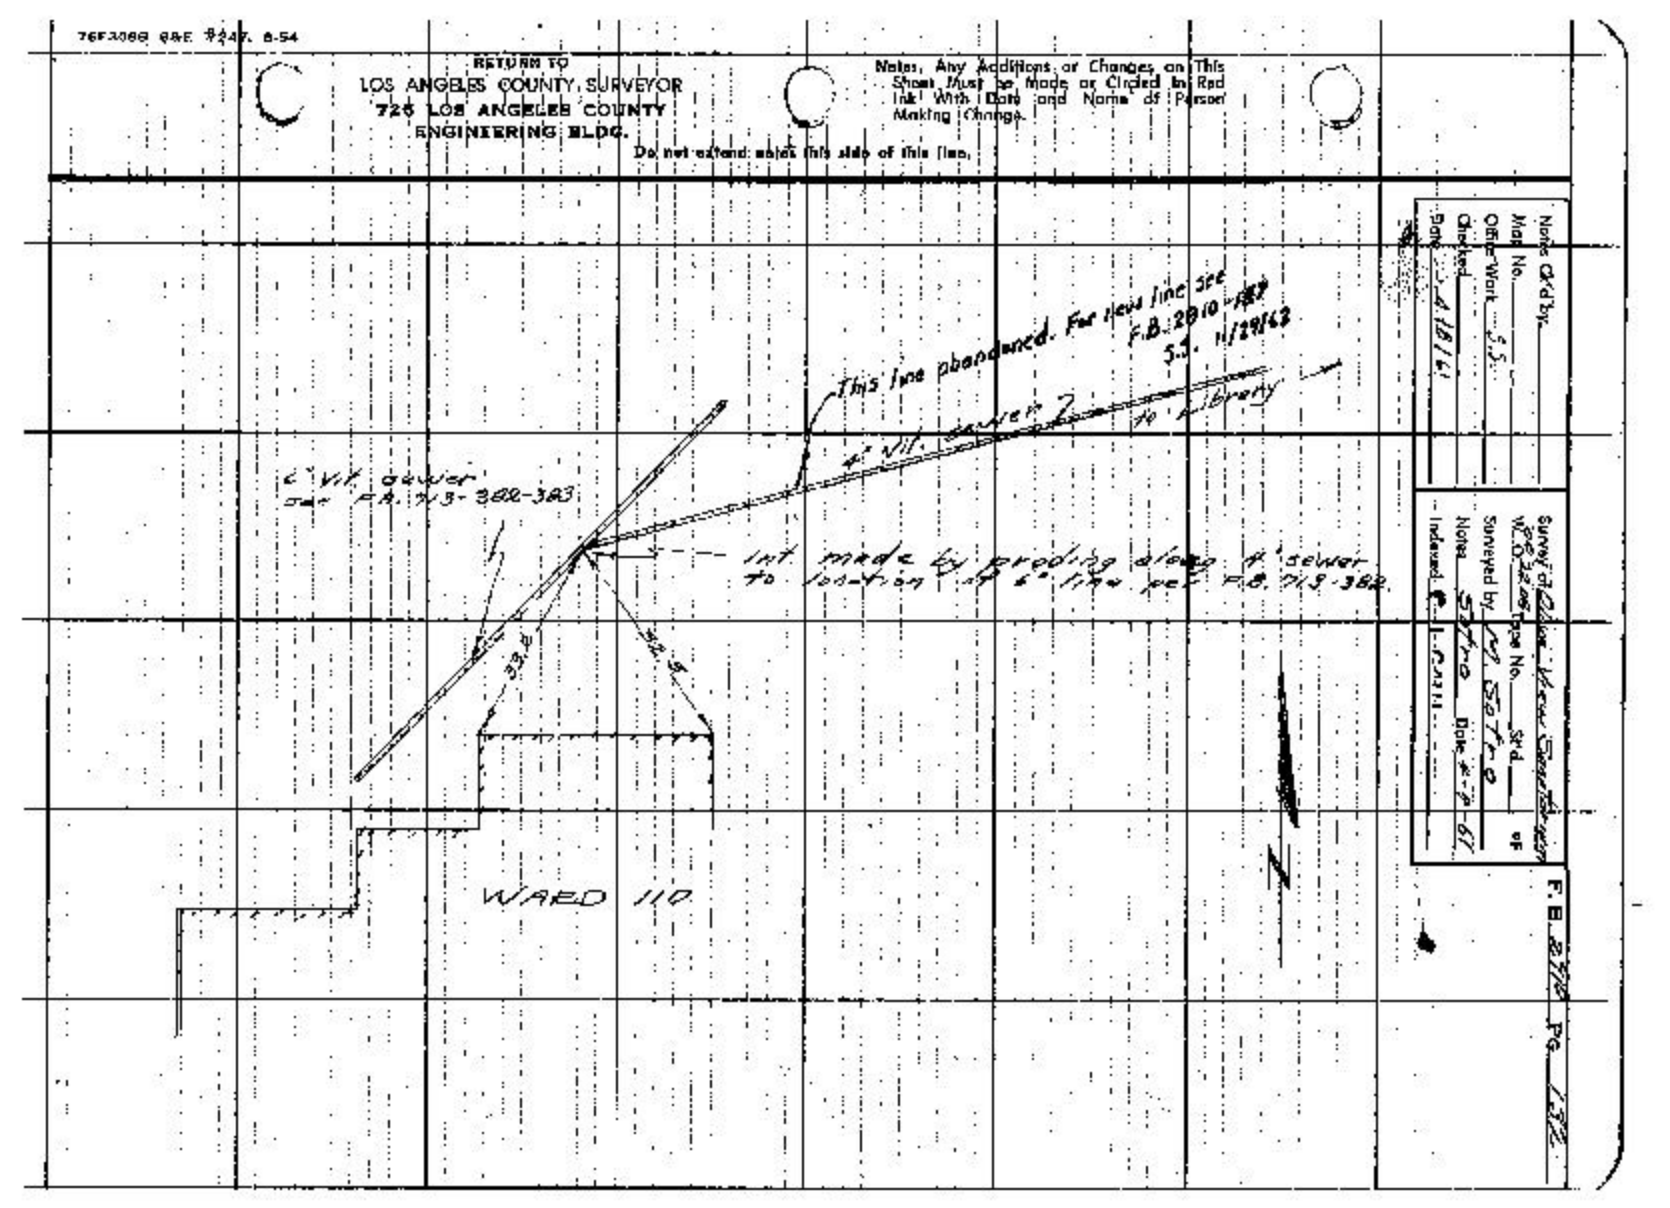


Notes Cpd by _____
Map No. _____
Office Work S.S.
Checked _____

Noted _____ Date _____
Indexed _____


RETURN TO
LOS ANGELES COUNTY SURVEYOR
726 LOS ANGELES COUNTY
ENGINEERING BLDG.

Do not extend notes this side of this line.

Note: Any Additions or Changes on This Sheet Must be Made or Circled in Red Ink With Date and Name of Person Making Change.

WARD NO. 126
L.A. Co. No. 2199

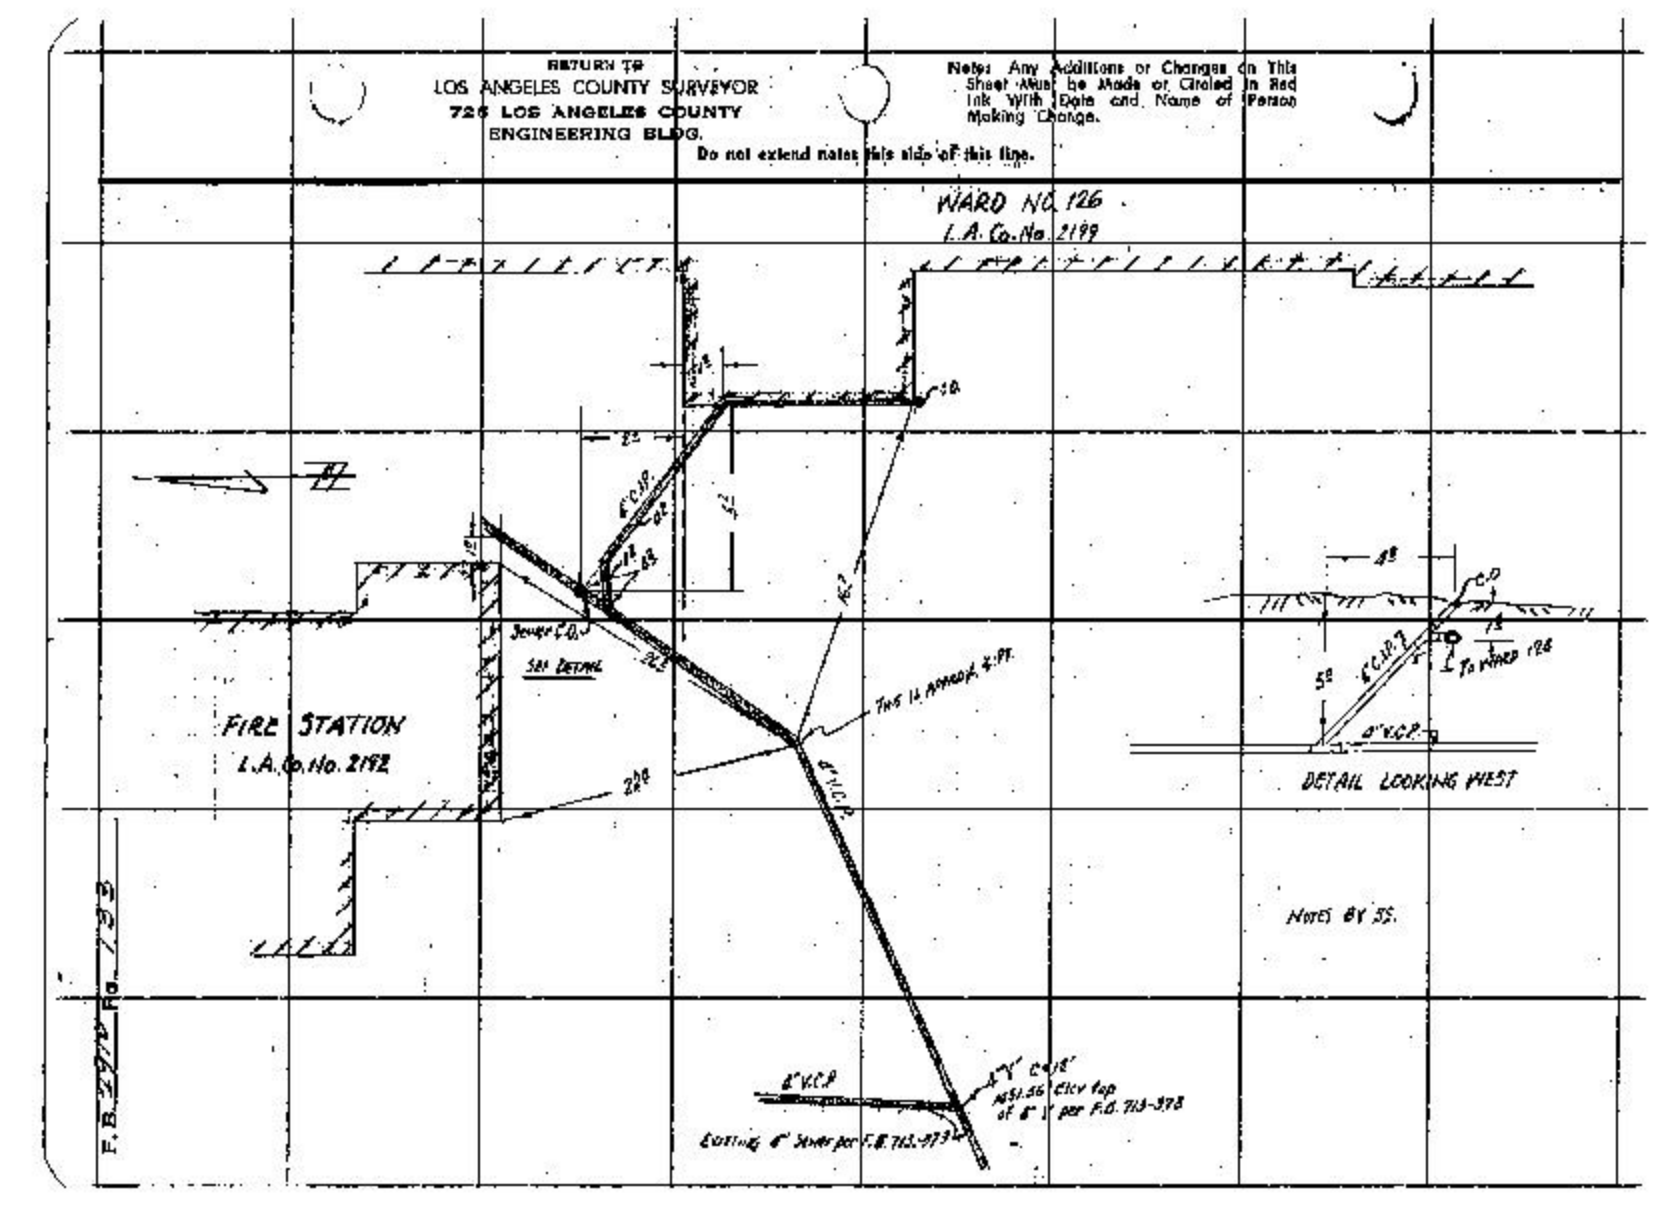

| | |
|---|---|
| Notes Ck'd by | Survey of Olive View Hospital |
| Map No. | SP 22.08 Tape Std. °F |
| Office Work 55 | Surveyed by M. Sotro |
| Checked | Notes Sotro Date 6-7-61 |
| Date 7/10/61 | Indexed R. J. GALLI |

F. B. 2910 Pg. 134

Note: Any Additions or Changes on This Sheet Must be Made or Circled in Red Ink With Date and Name of Person Making Change.

Do not extend this side of this line.

PLEASE RETURN TO
LOS ANGELES COUNTY ENGINEER
700 Los Angeles County Engineering Bldg.

# LOCATION
# of
# NEW 4" C.I.P. SEWER
# from
# NEW PICNIC GROUND
(Bldgs. L.A. Co. Nos. 2268 and 2269)
# SOUTH ALONG COBALT AVE. to SEWER BOX NORTH EAST of WAREHOUSE

76F3098 SAE #247 11-58

F. B. 2910 Pg. 135

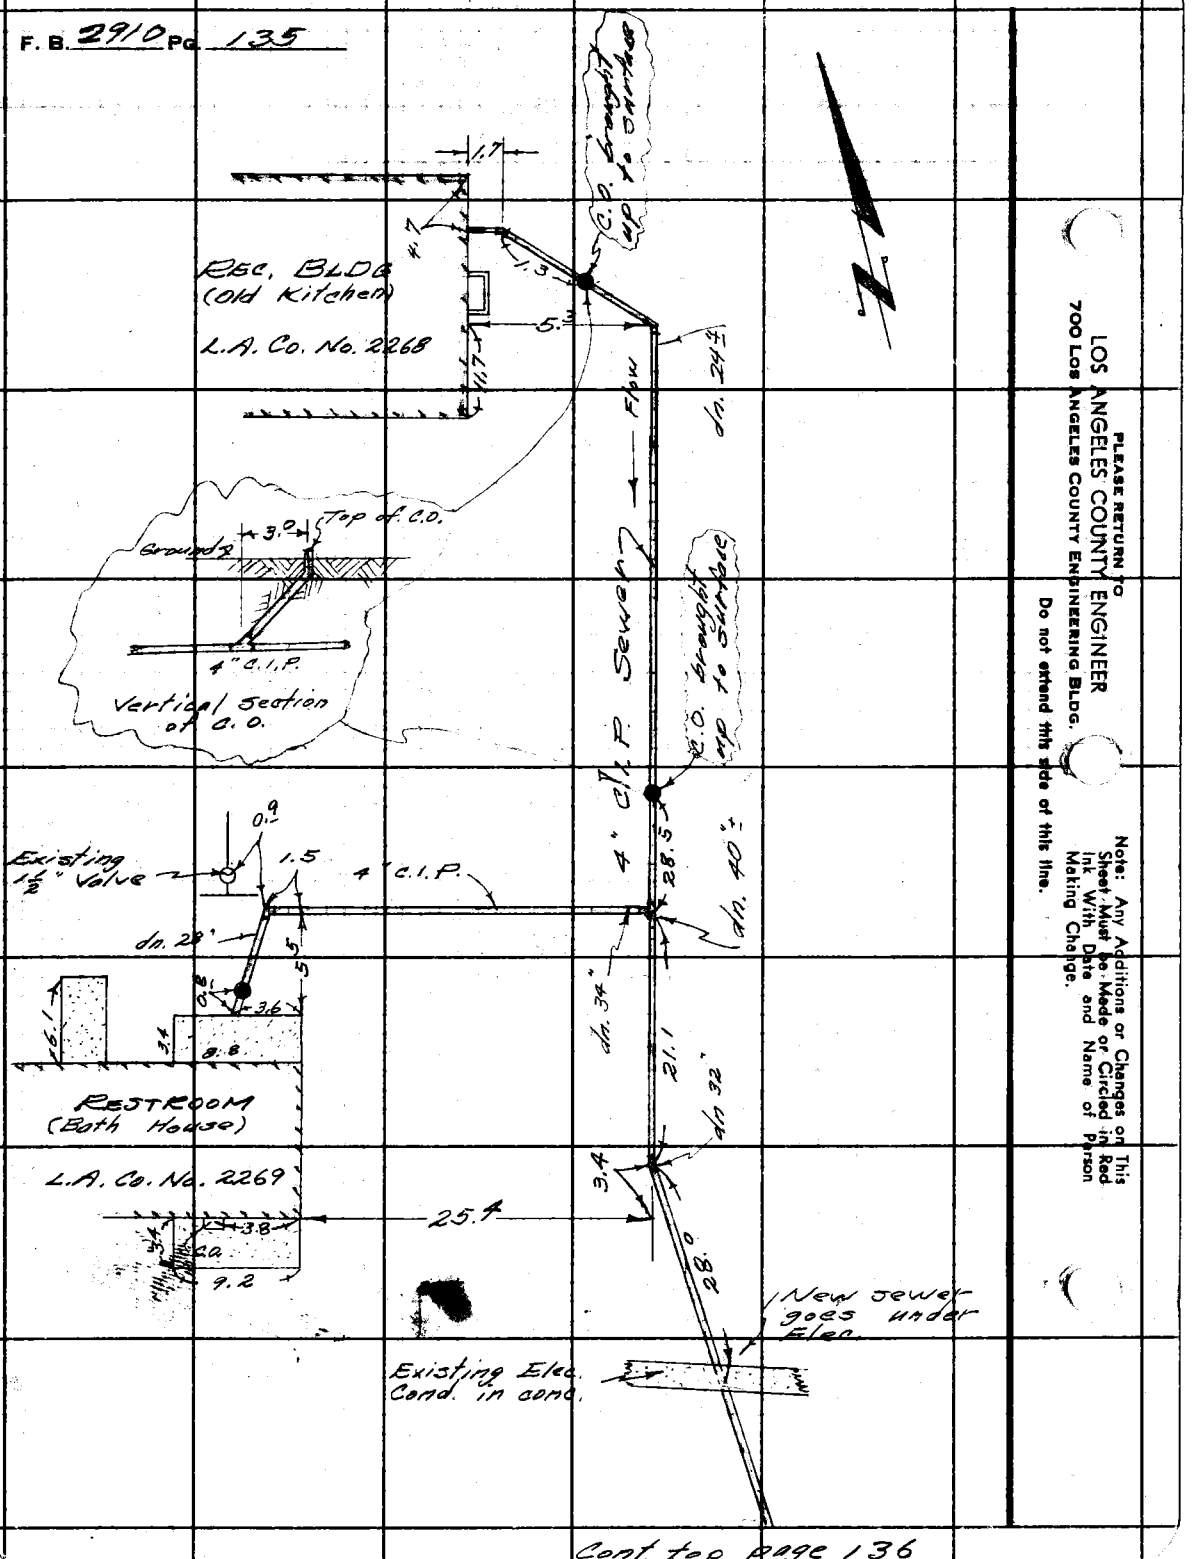


Cont. top Page 136

PLEASE RETURN TO
LOS ANGELES COUNTY ENGINEER
700 Los Angeles County Engineering Bldg.

Do not extend this side of this line.

Note: Any Additions or Changes on This Sheet Must be Made or Circled in Red Ink With Date and Name of Person Making Change.

| | |
|---|---|
| Notes Ck'd by | Survey of Olive View Hospital |
| Map No. | JN 22.08 Tape Std. °F |
| Office Work S.S. | Surveyed by M. Sotro |
| Checked | Notes Sotro Date 6-9-61 |
| Date 7/10/61 | Indexed J. GALLI |

F. B. 2910 Pg. 136

Cont. fr. bot page 135

Int. Fd. ¾" I.P. dm 6" set S.W.+T. Plush F.B. 585-84

E. CANYON DR. to P.I. # 2

78.4

Flow Line

dm. 24"

19.2

11.8

Sewer

Vertical Sec. of C.O.

2.4

C.O.

4 pt.

17.1

AVE.

10.1

See F.B. 713-41 Connected to existing 4" V.C.P. sewer

4" C.I.P.

13.2

12.5

7.5

dm. 24"

15.6

3.0

COBALT

0.7

20.0

7.6

P.I. #8 Fd. ¾" I.P. dm. 3" set 3g. Nail & tin F.B. 585-70, 84

Cont. top page 137

Note: Any Additions or Changes on This Sheet Must be Made or Circled in Red Ink With Date and Name of Person Making Change.

Do not extend this side of this line.

PLEASE RETURN TO
LOS ANGELES COUNTY ENGINEER
700 LOS ANGELES COUNTY ENGINEERING BLDG.

76F3095 SBE #247 11-58

PLEASE RETURN TO
LOS ANGELES COUNTY ENGINEER
700 LOS ANGELES COUNTY ENGINEERING BLDG.

Note: Any Additions or Changes on This Sheet Must be Made or Circled in Red Ink With Date and Name of Person Making Change.

Do not extend this side of this line.

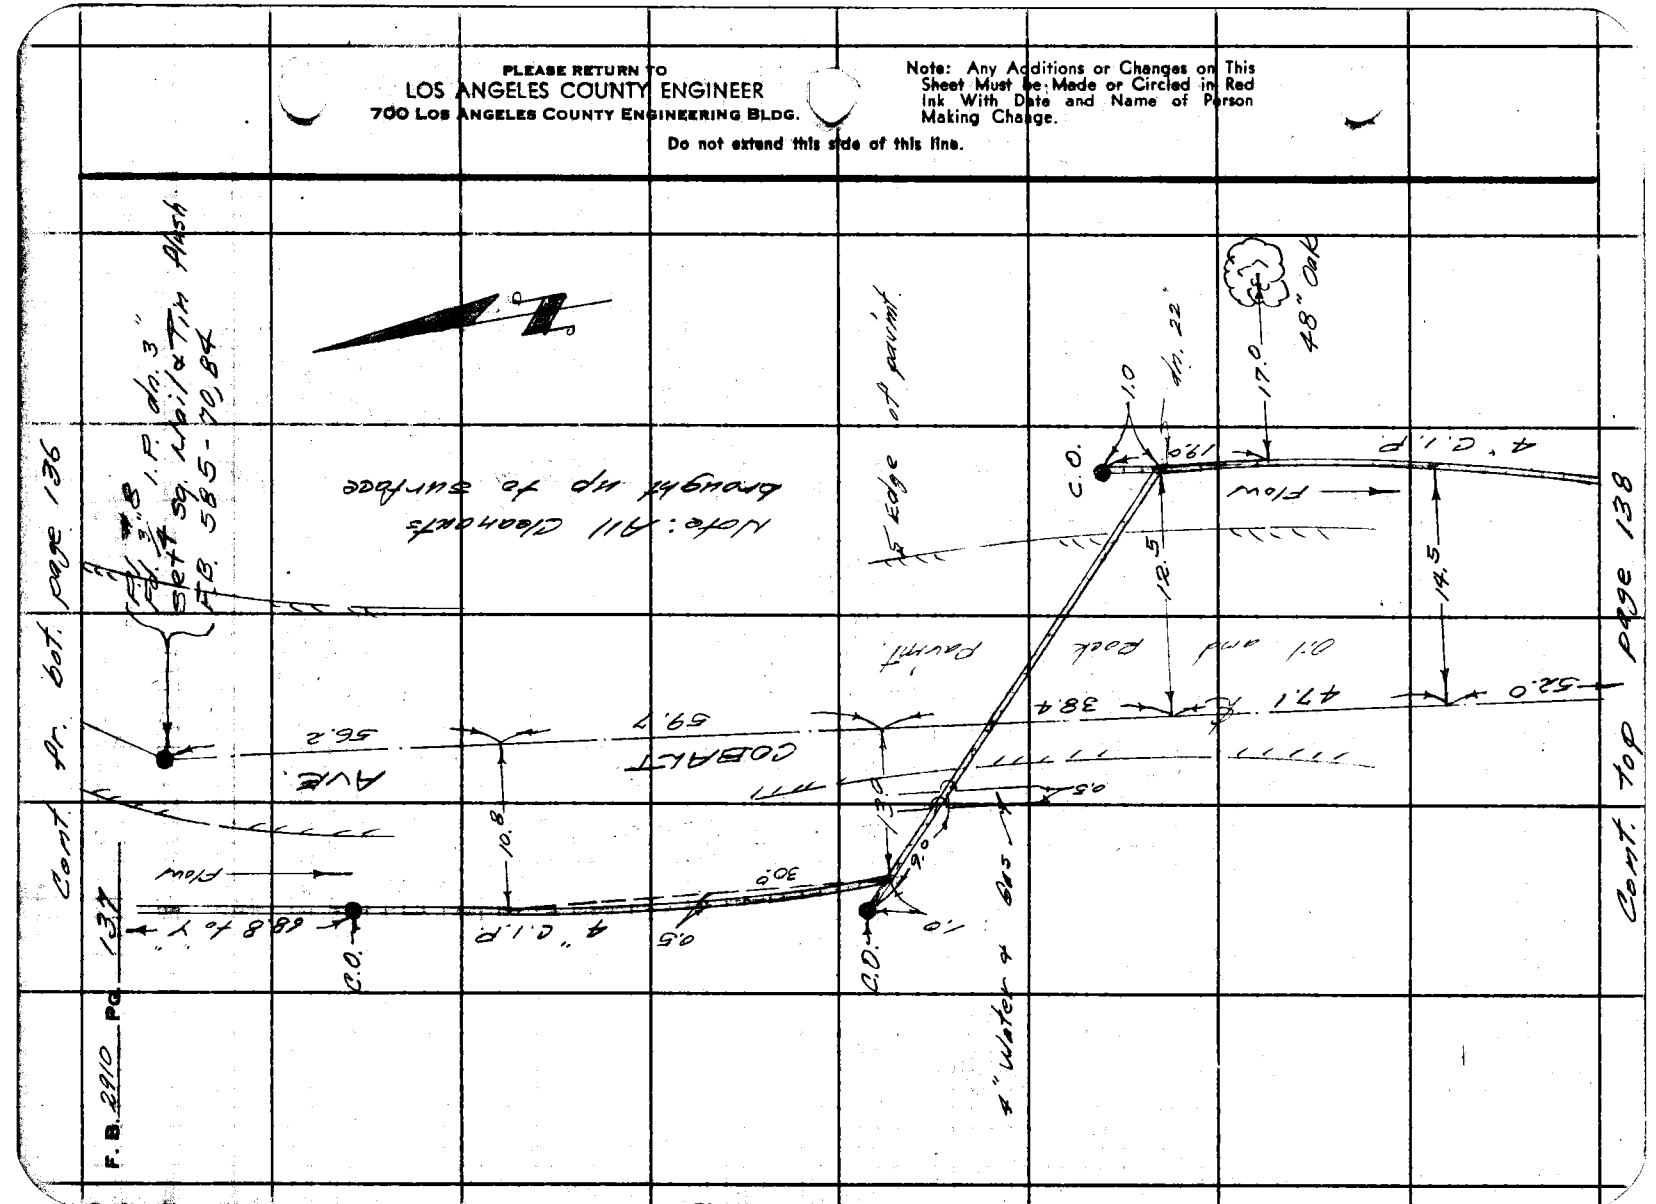

| | |
|---|---|
| Notes Ck'd by | Survey of Olive View Hospital F. B. 2910 Pg. 138 |
| Map No. | JN 0022.08 Tape Std. °F |
| Office Work S.S. | Surveyed by M. Sotro |
| Checked | Notes Sotro Date 6-14-61 |
| Date 7/10/61 | Indexed C. J. GAITH |

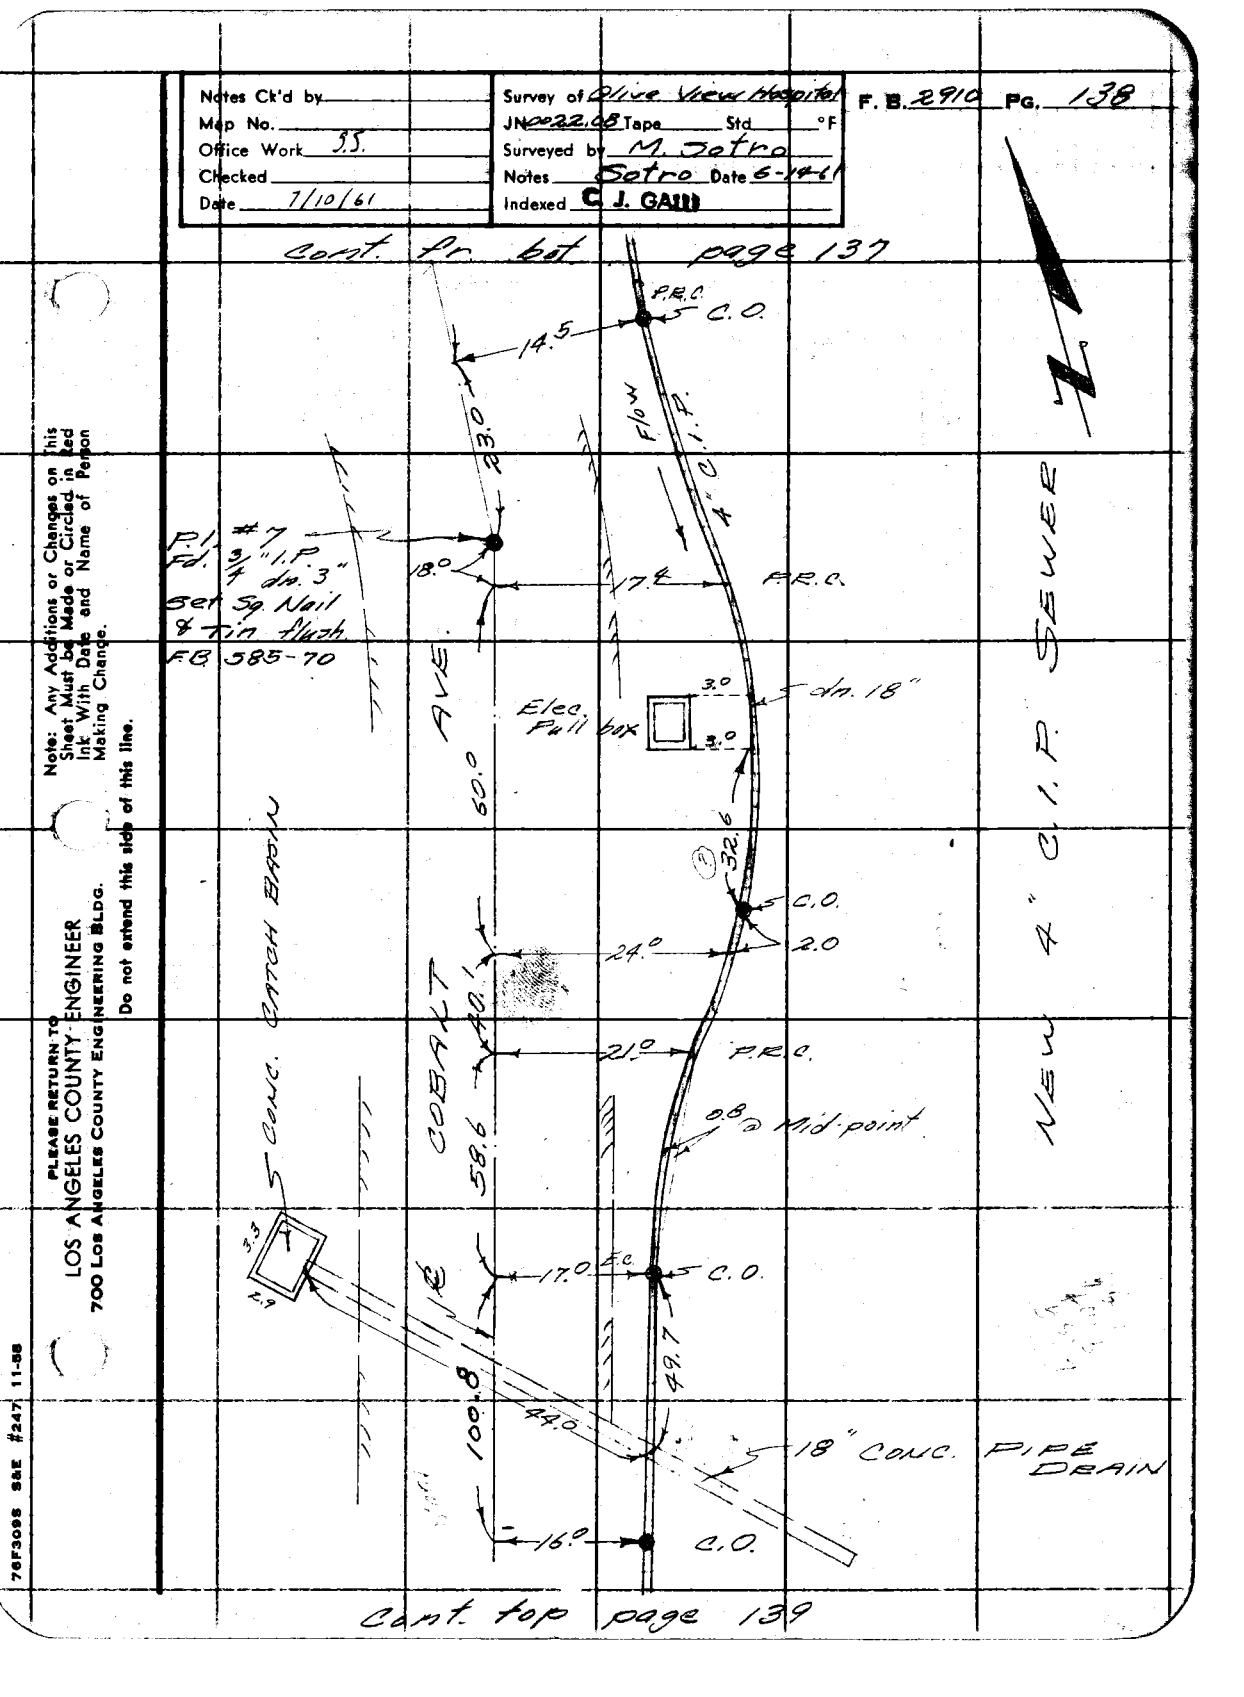


Note: Any Additions or Changes on this Sheet Must be Made or Circled in Red Ink With Date and Name of Person Making Change.

Do not extend this side of this line.

PLEASE RETURN TO
LOS ANGELES COUNTY ENGINEER
700 Los Angeles County Engineering Bldg.

76F3095 S&E #247 11-58

PLEASE RETURN TO
LOS ANGELES COUNTY ENGINEER
700 LOS ANGELES COUNTY ENGINEERING BLDG.

Note: Any Additions or Changes on This Sheet Must be Made or Circled in Red Ink With Date and Name of Person Making Change.

Do not extend this side of this line.

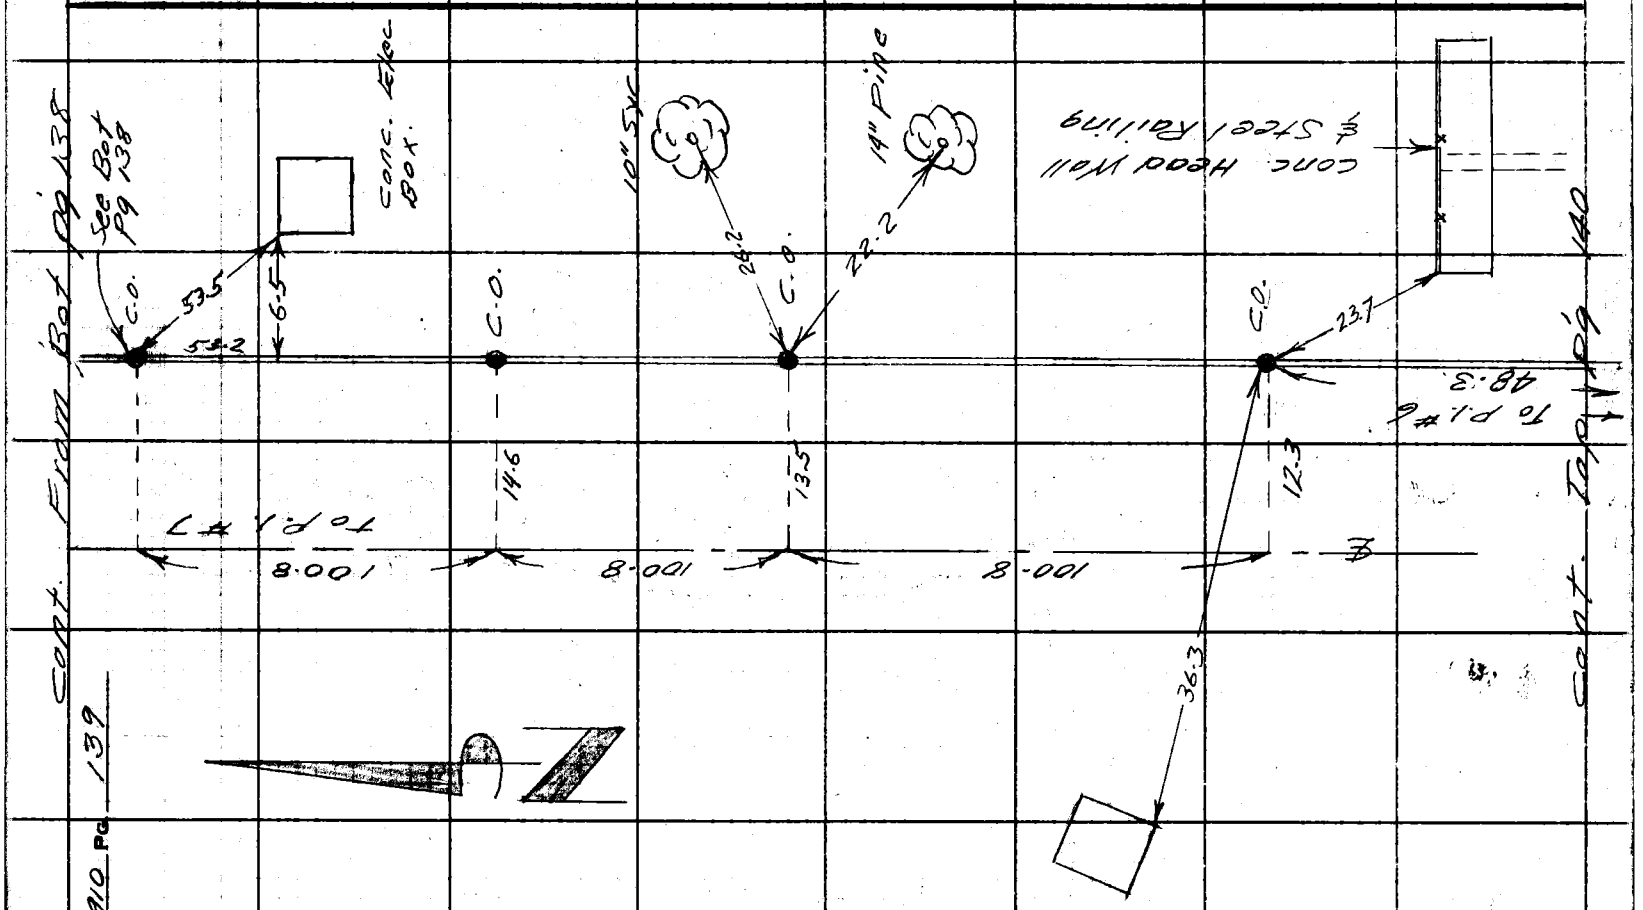


F.B. 2910 Pg. 139

763098 CE #247—7-55

RETURN TO
LOS ANGELES COUNTY ENGINEER
700 LOS ANGELES COUNTY ENGINEERING BLDG.

Note: Any Additions or Changes on This Sheet Must be Made or Circled in Red Ink With Date and Name of Person Making Change.

Do not extend notes this side of this line.

Notes Ck'd by
Map No.
Office Work SS
Checked
Date 7/10/61

Survey of Olive View Hosp
JN 4227 Tape Std. °F
Surveyed by Santos Reynoles Date 6-12-61
Notes
Indexed C. J. GALLI

F. B. 2710 Pg. 140

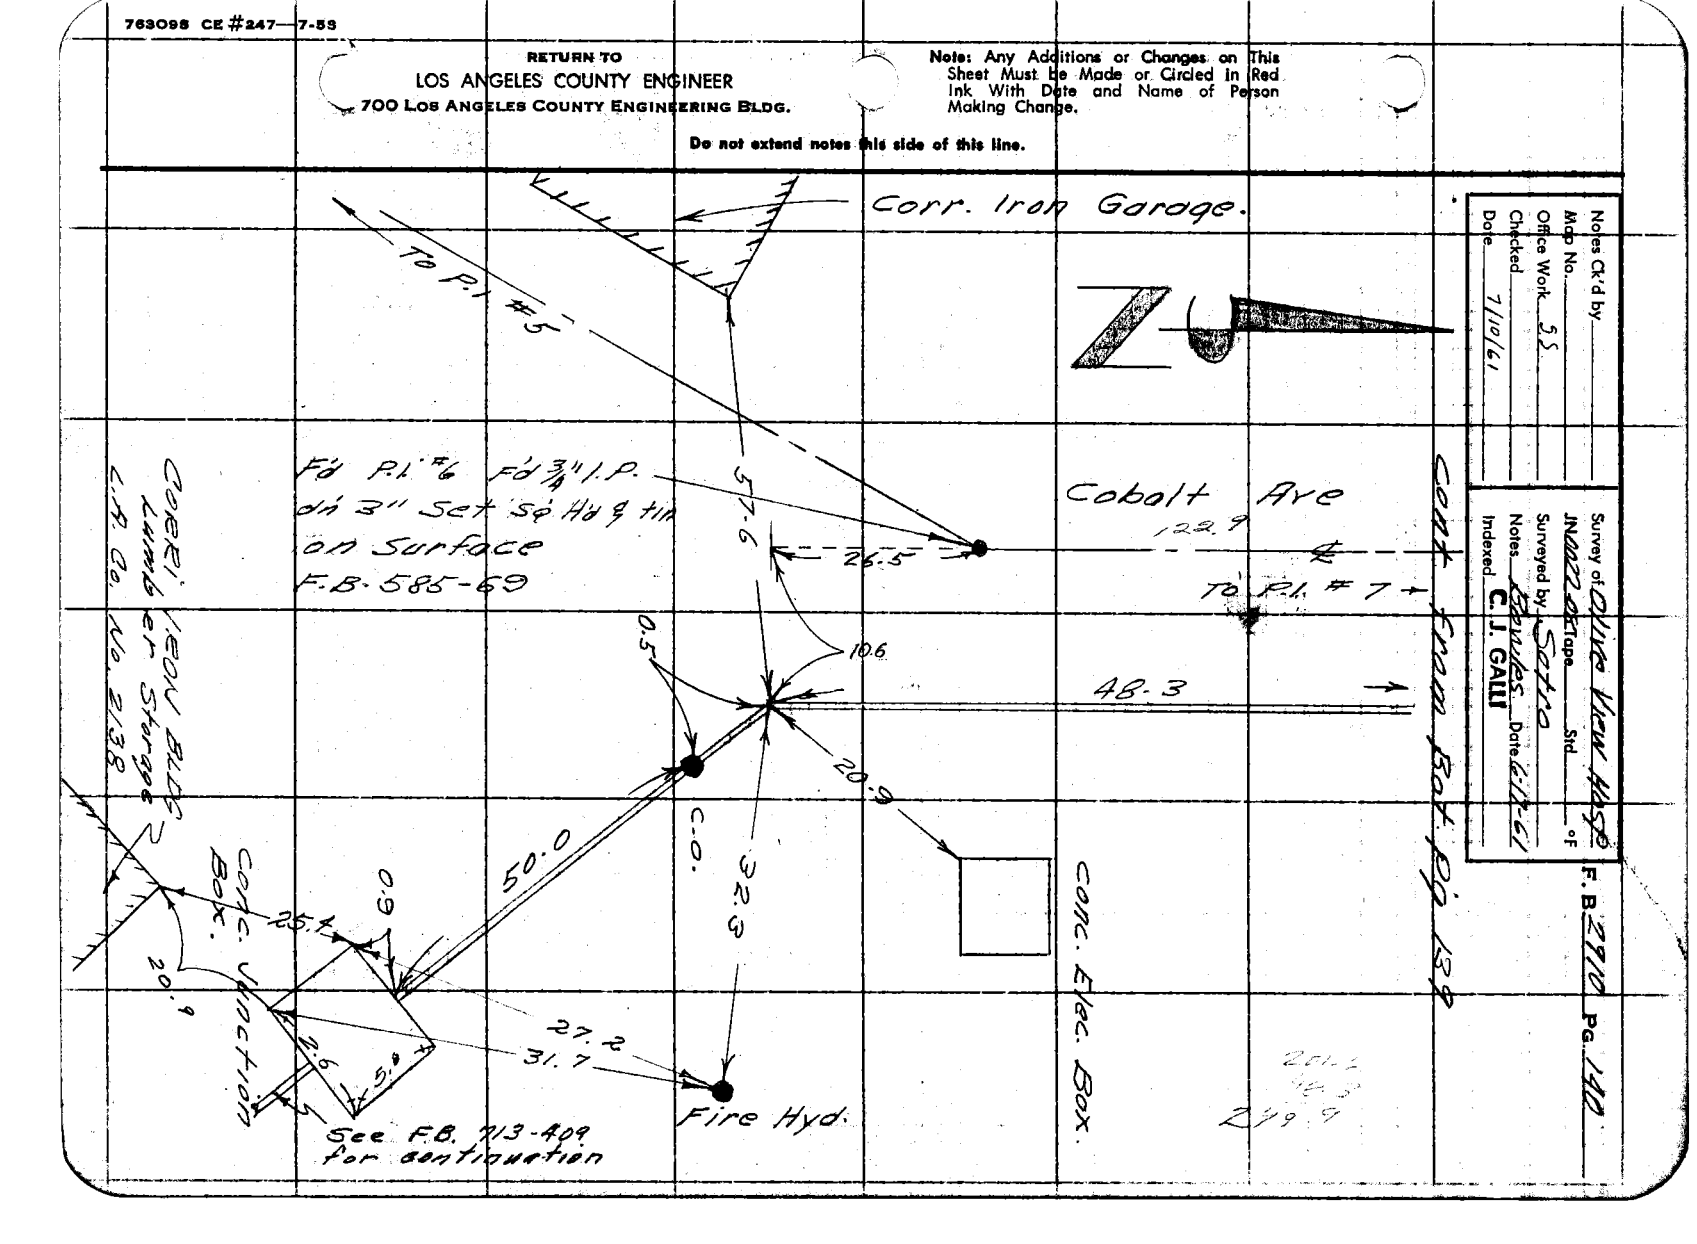

F.B. 2510 Pg. 14

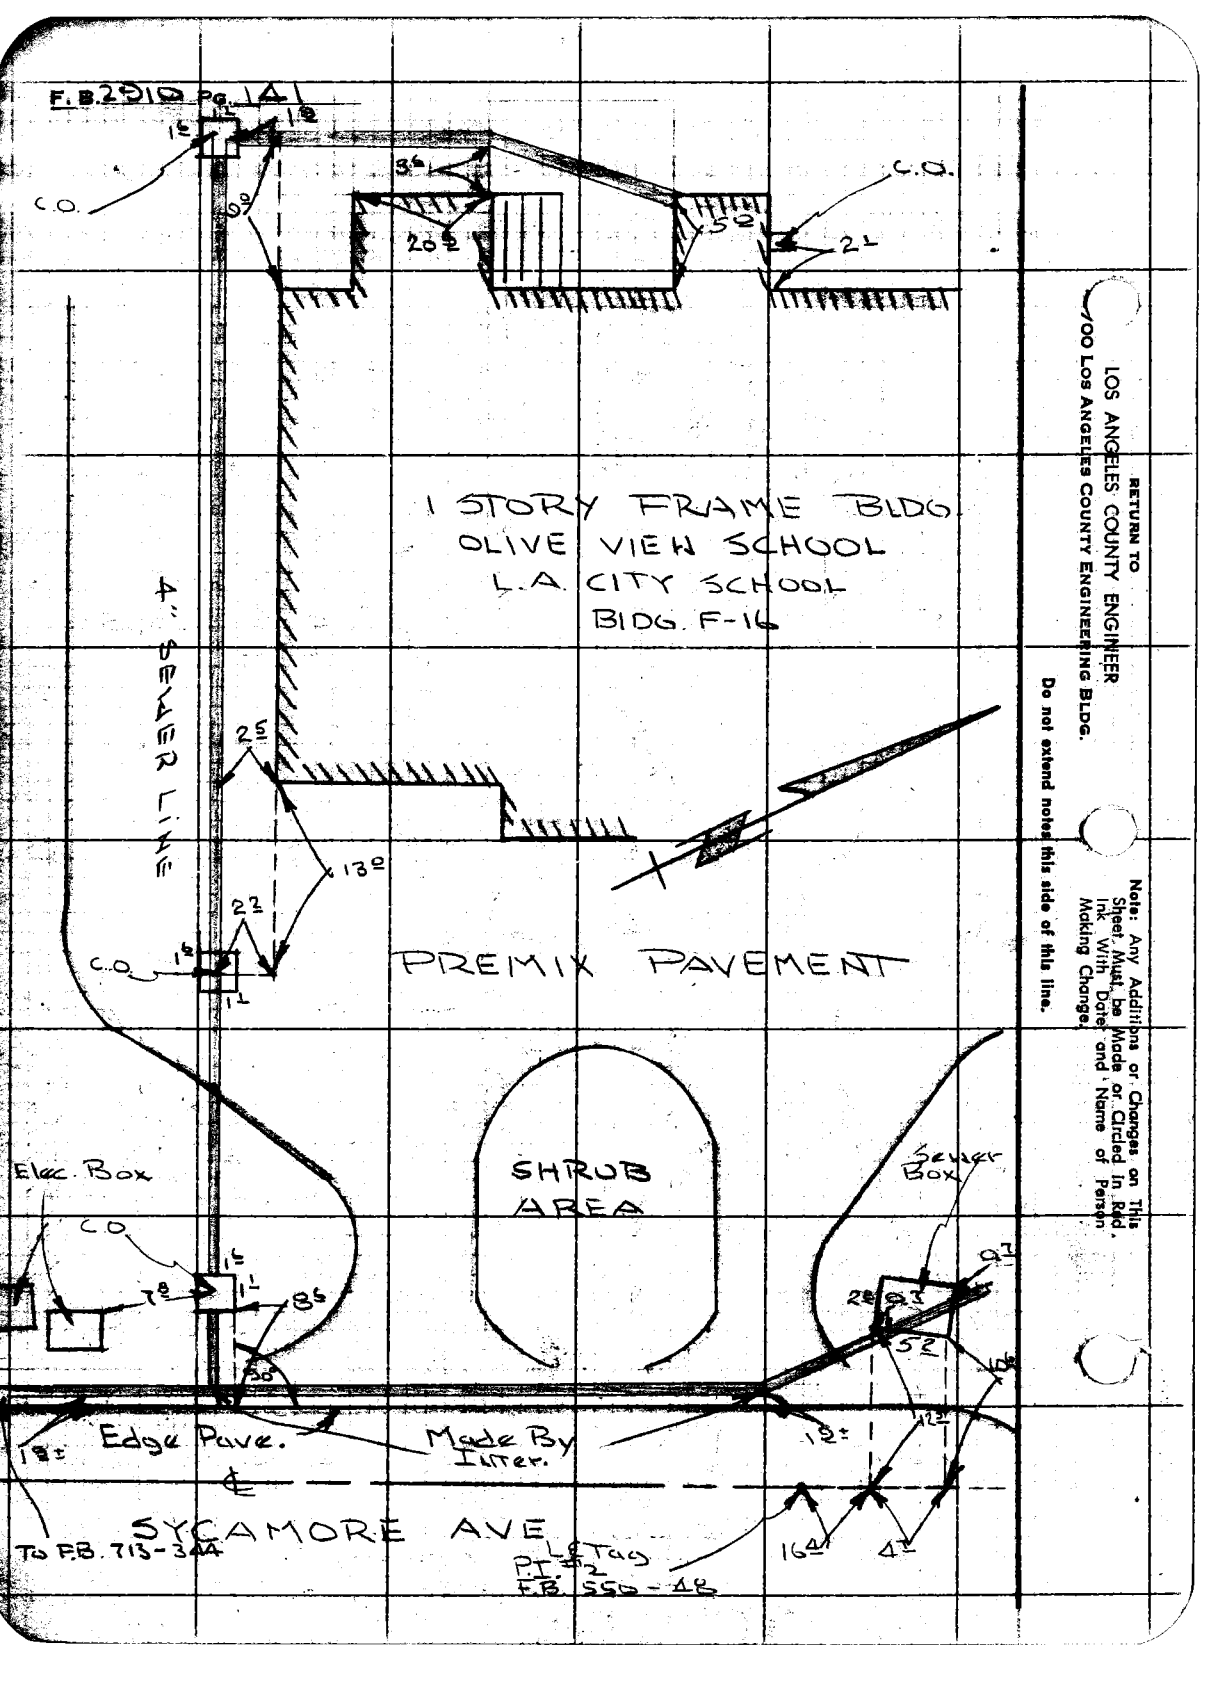


RETURN TO
LOS ANGELES COUNTY ENGINEER
900 Los Angeles County Engineering Bldg.

Note: Any Additions or Changes on This Sheet Must be Made or Circled in Red Ink With Date and Name of Person Making Change.

Do not extend notes this side of this line.

| | |
|---|---|
| Notes Ck'd by | Survey of OLIVE VIEW HOSPITAL |
| Map No. | JN 0022.08 Tape Std °F |
| Office Work S.S. | Surveyed by |
| Checked | Notes S. SHINODA Date 3/16/62 |
| Date 3/20/62 | Indexed E. I. GALLI |

F. B. 2910 Pg. 142

SEWERS

Note: Sewer Lines replace Sewer shown in F.B. 713-374

See Page 145

COTTAGE LANE

3' Deep

18

'B'

Note: For elevations at Points "A" & "B" See page 146

4" V.C.P. Drain

WALK

108

2½ Deep

5

18

CONC

61

105

112

4

'A'

108

58

C.O.

4" C.I.P.

C.O.

19

30

C.O.

23

WARD NO 108
L.A. Co. # 2168

WARD NO. 106
L.A. Co. No. 2169

Note: All Clean-Outs Brought up to surface.

Note: Any Additions or Changes on this Sheet Must be Made or Circled in Red Ink With Date and Name of Person Making Change.

Do not extend this side of this line.

PLEASE RETURN TO
LOS ANGELES COUNTY ENGINEER
403 LOS ANGELES COUNTY ENGINEERING BLDG.

76F3095 CE # 310 3-61

F. B. 2910 Pg. 143

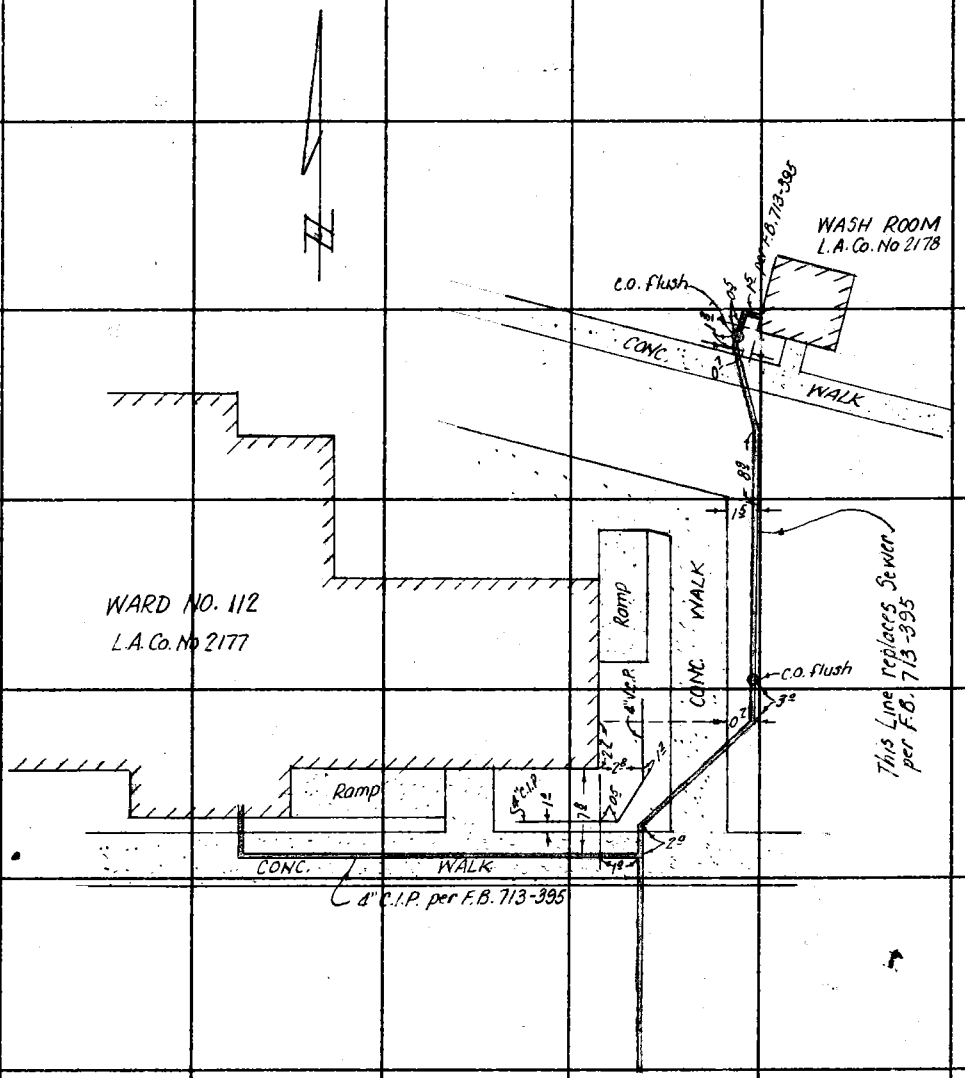


See Page 144

PLEASE RETURN TO
LOS ANGELES COUNTY ENGINEER
403 Los Angeles County Engineering Bldg.

Do not extend this side of this line.

Note: Any Additions or Changes on This Sheet Must be Made or Circled in Red Ink With Date and Name of Person Making Change.

| | | | |
|---|---|---|---|
| Notes Ck'd by | | Survey of OLIVE VIEW HOSPITAL | F. B. 2910 Pg. 144 |
| Map No. | | JN 002207 Tape Std °F | |
| Office Work 35 | | Surveyed by | |
| Checked | | Notes S. SAKODA Date 2/2/62 | |
| Date 3/20/62 | | Indexed C. J. GALLI | |

Note: Any Additions or Changes on This Sheet Must be Made or Circled in Red Ink With Date and Name of Person Making Change.

Do not extend this side of this line.

PLEASE RETURN TO
LOS ANGELES COUNTY ENGINEER
700 LOS ANGELES COUNTY ENGINEERING BLDG.

76F3098 S&E #247 11-58

# SEWERS

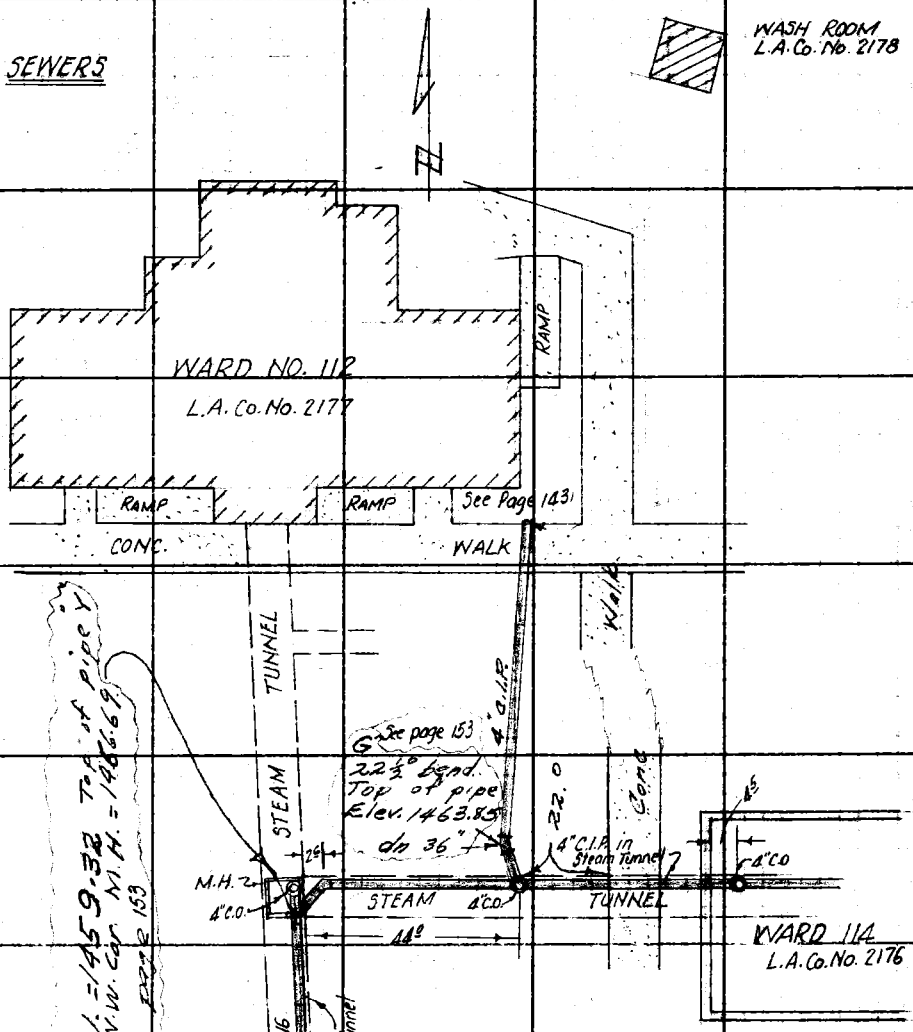


Note - Sewer Lines replace Sewers per F.B. 713-393

PLEASE RETURN TO
LOS ANGELES COUNTY ENGINEER
700 LOS ANGELES COUNTY ENGINEERING BLDG.

Note: Any Additions or Changes on This Sheet Must be Made or Circled in Red Ink With Date and Name of Person Making Change.

Do not extend this side of this line.

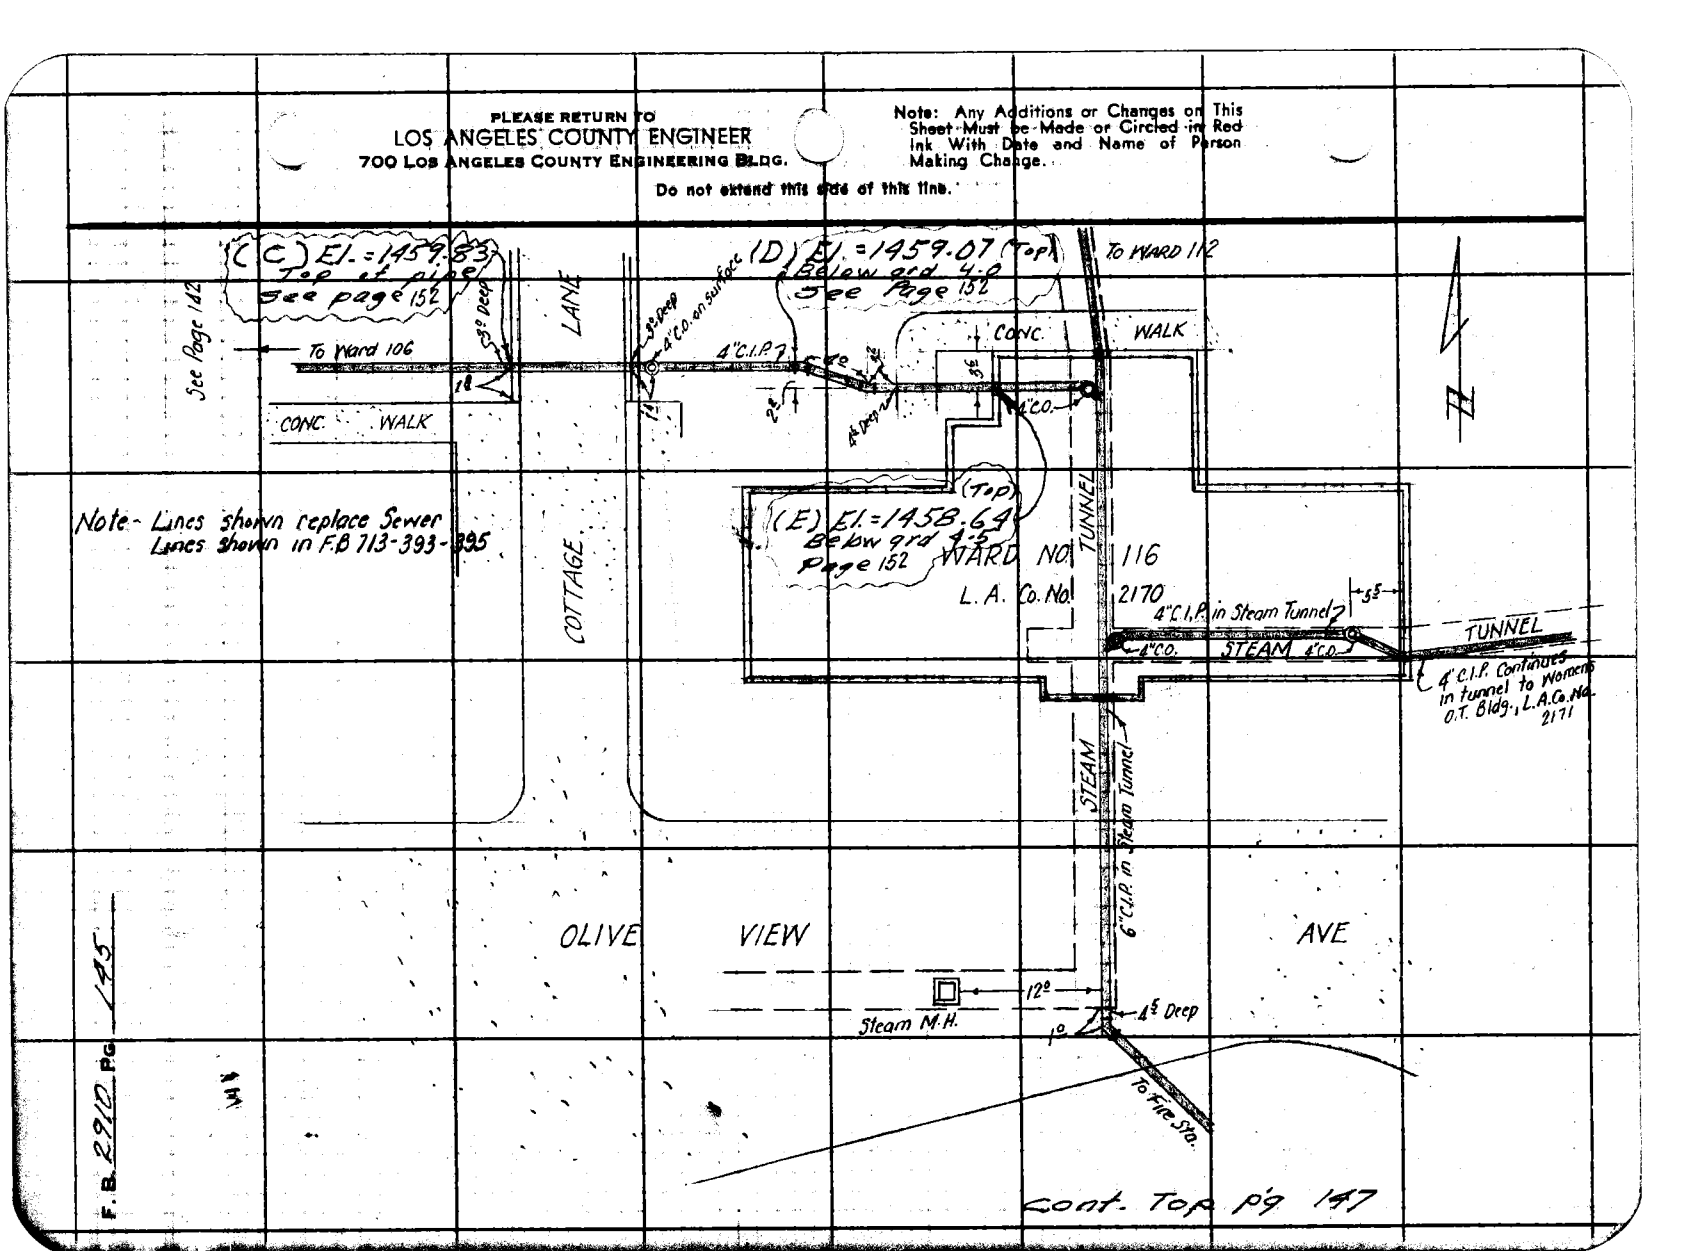

76F3098 S&E #247 11-58

PLEASE RETURN TO
LOS ANGELES COUNTY ENGINEER
700 Los Angeles County Engineering Bldg.

Note: Any Additions or Changes on This Sheet Must be Made or Circled in Red Ink With Date and Name of Person Making Change.

Do not extend this side of this line.

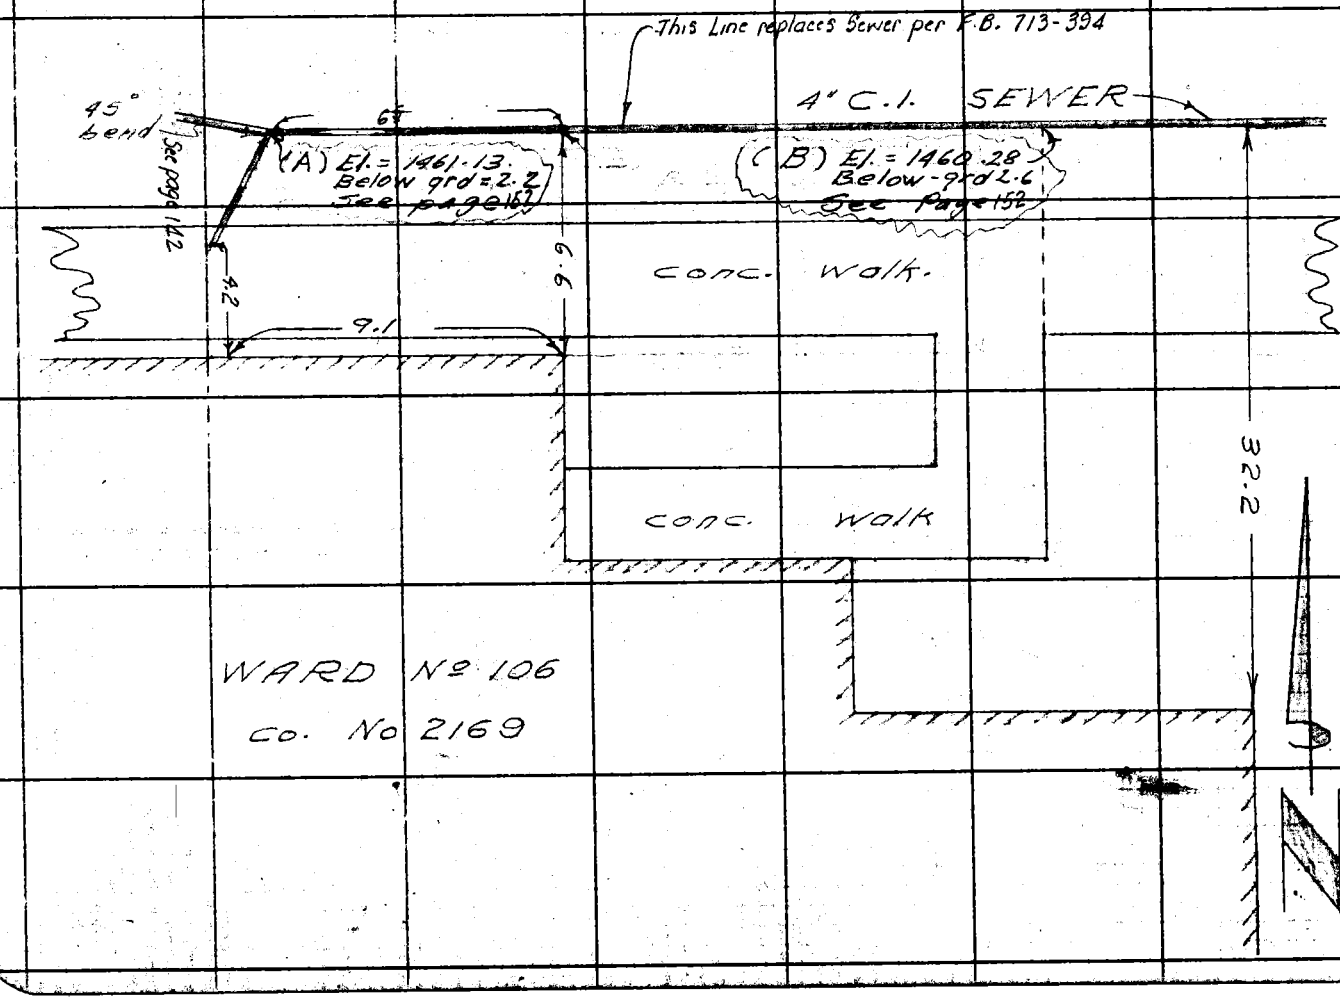


Notes Ck'd by
Map No.
Office Work S.S
Checked
Date 3/20/62

Survey of Olive View Hosp. F.B. 2210 Pg. 156
JN 022-08 Tape Std. °F
Surveyed by Sotro
Notes Bdy. Les. Date 2-6-62
Indexed J. GALLP

Cont. From Left Side Pg 145

F. B. 2910 Pg 197

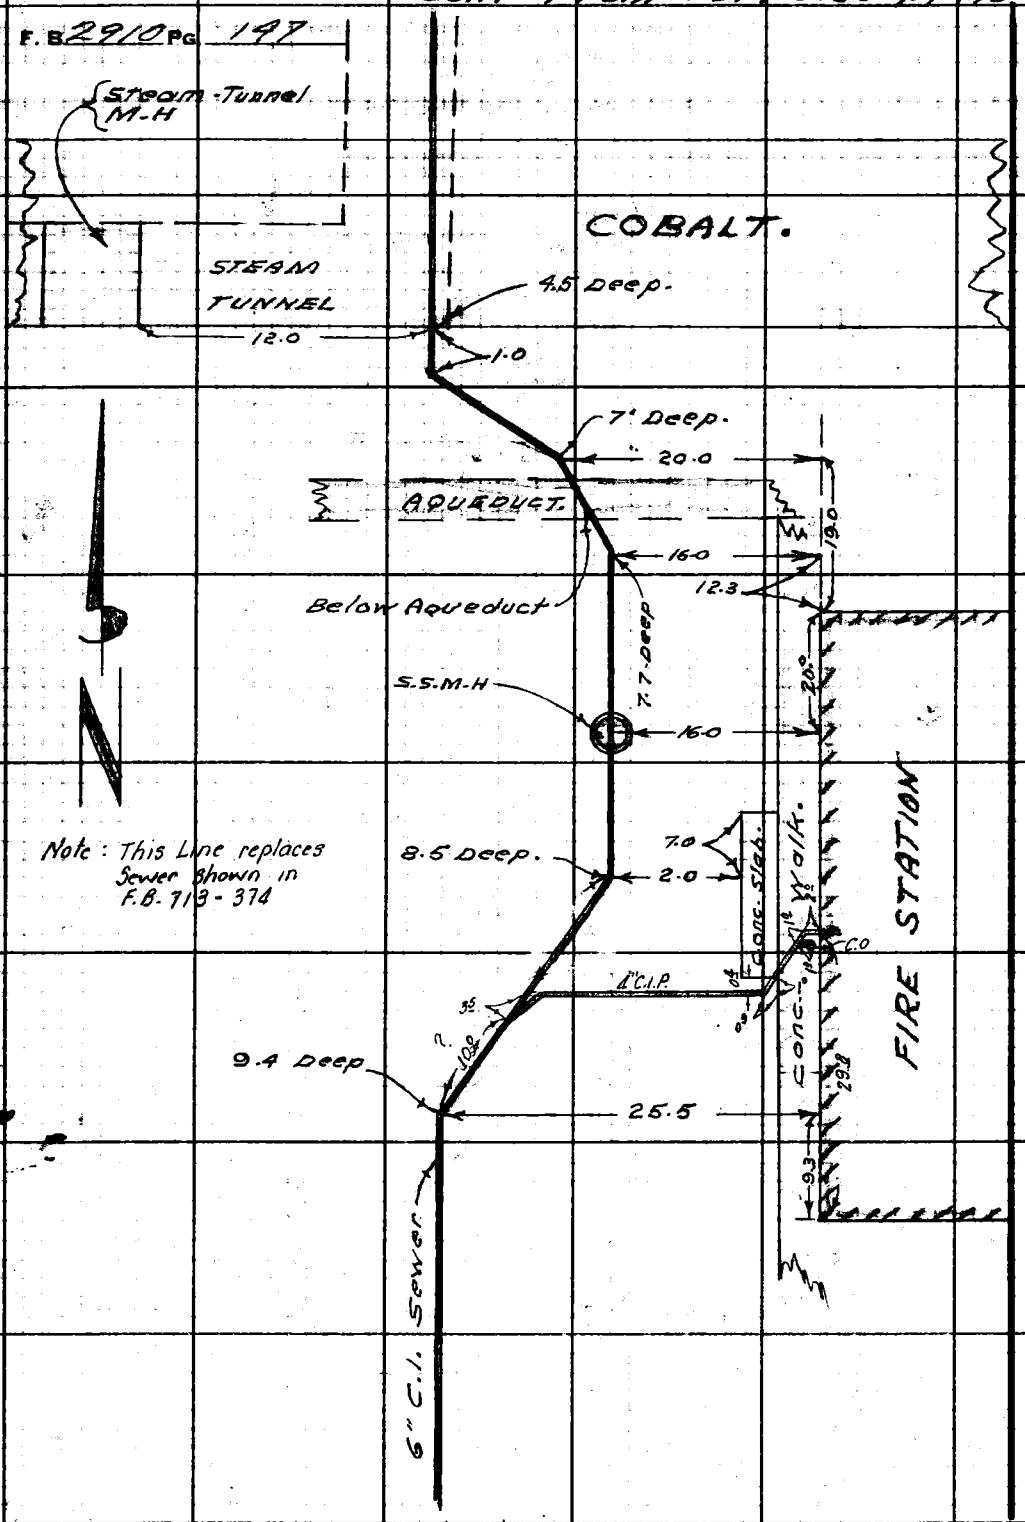


Cont. on left side page 148

PLEASE RETURN TO
LOS ANGELES COUNTY ENGINEER
700 Los Angeles County Engineering Bldg.

Do not extend this side of this line.

Note: Any Additions or Changes on This Sheet Must be Made or Circled in Red Ink With Date and Name of Person Making Change.

76F309S CE # 310 3-61

PLEASE RETURN TO
LOS ANGELES COUNTY ENGINEER
403 LOS ANGELES COUNTY ENGINEERING BLDG.

Note: Any Additions or Changes on this Sheet Must be Made or Circled in Red Ink With Date and Name of Person Making Change.

Do not extend this side of this line.

Notes Ck'd by
Map No.
Office Work 5.5.
Checked
Date 3/20/62

Survey of OLIVE VIEW HOSPITAL
JN 0022.02 Tape Std °F
Surveyed by
Notes S. SHINODA Date 3/6/62
Indexed C. J. GALLI

F. B. F.B. 2910 PG. 148

SEWERS

WARD 104
L.A. Co. No 2191

Cont. from bottom page 147

Ramp
Ramp
Ramp

1" per F.B. 713-373

6" C.I.P.

7°

14.2

4" C.I.P.

13.3

4" V.C.P. Drain
3° Dp.

4" C.I.P.

9.5

5° Rev.

13.4

2°

5.5

3°

4° Deep

C.O. Flush

C.O. Flush

4" V.C.P.

11 Deep

5.85 Deep

5 Abandoned 4" V.C.P. per F.B. 713-373

Cont. Rt. Side page 149

PLEASE RETURN TO
LOS ANGELES COUNTY ENGINEER
403 LOS ANGELES COUNTY ENGINEERING BLDG.

Note: Any Additions or Changes on This Sheet Must be Made or Circled in Red Ink With Date and Name of Person Making Change.

Do not extend this side of this line.

F. B. 2910 Pg 149

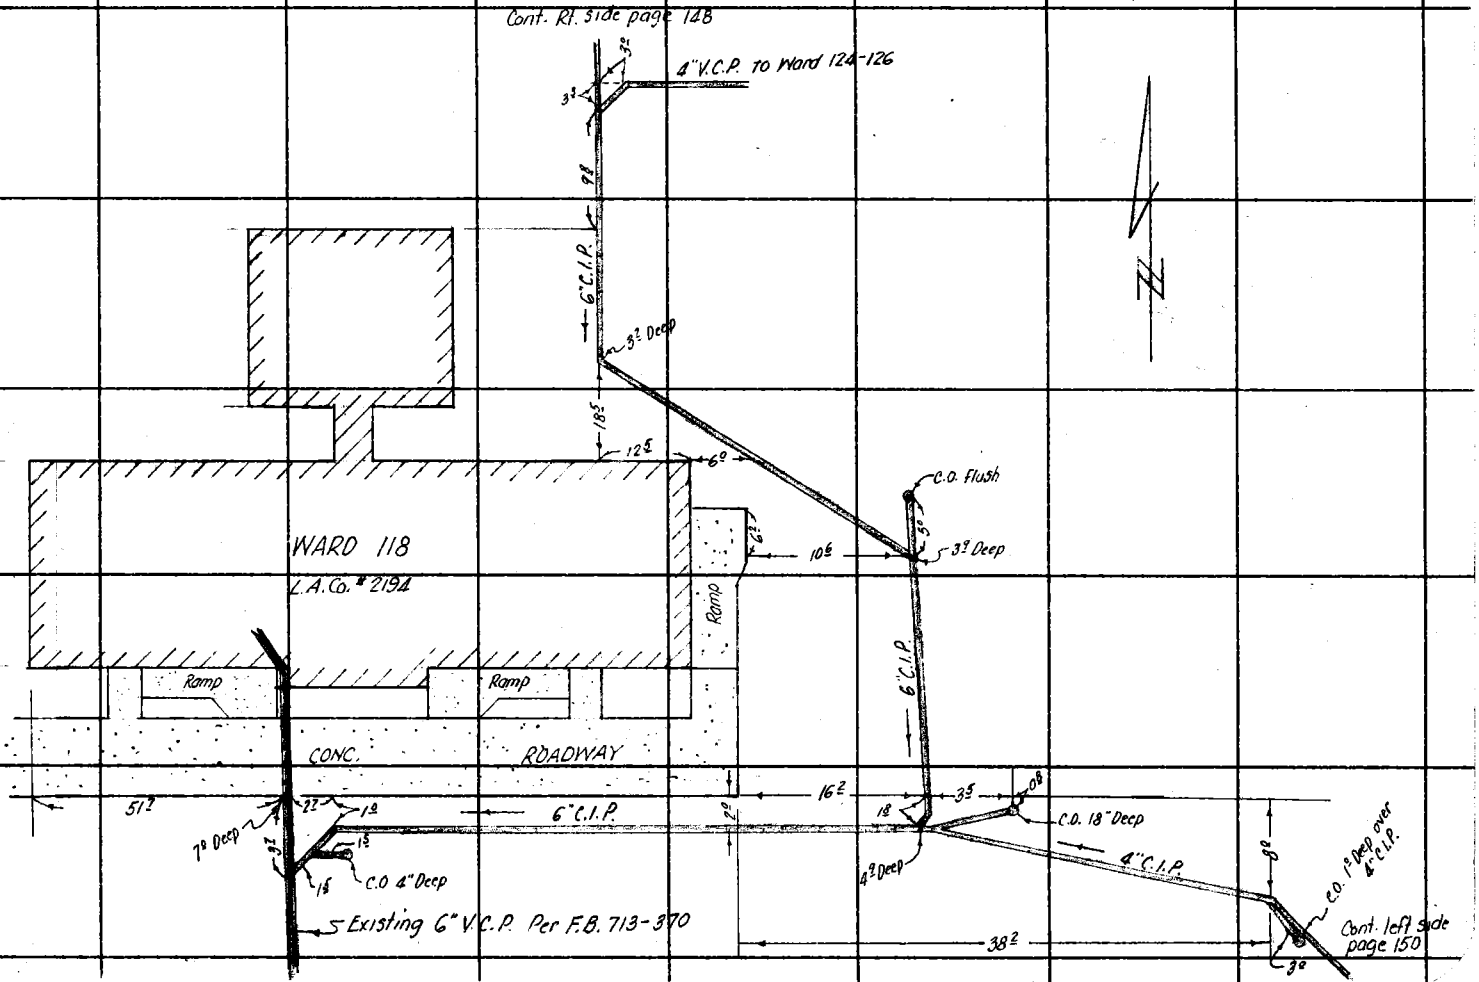

| | | | |
|---|---|---|---|
| Notes Ck'd by | | Survey of OLIVE VIEW HOSP. | F. B. 2910 Pg. 150 |
| Map No. | | JN 0022.06 Tape Std °F | |
| Office Work S.S | | Surveyed by | |
| Checked | | Notes S. SHINODA Date 3/16/62 | |
| Date 3/20/62 | | Indexed C. J. GALLI | |

SEWERS

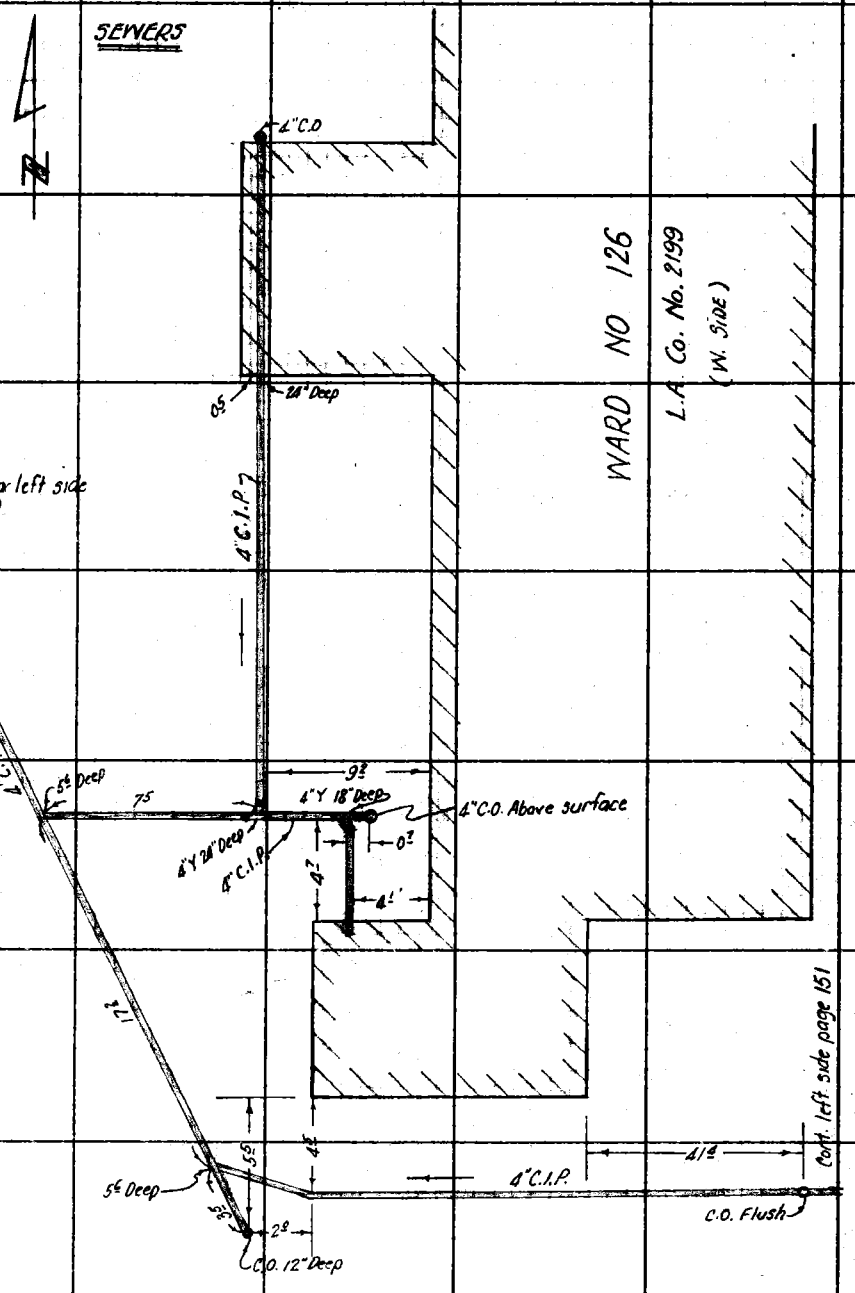


Note: Any Additions or Changes on this Sheet Must be Made or Circled in Red Ink With Date and Name of Person Making Change.

Do not extend this side of this line.

PLEASE RETURN TO
LOS ANGELES COUNTY ENGINEER
700 LOS ANGELES COUNTY ENGINEERING BLDG.

76F3098 SAE #247 11-58

F. B. F.B. 2910 Pg 151

PLEASE RETURN TO
LOS ANGELES COUNTY ENGINEER
700 Los Angeles County Engineering Bldg.

Note: Any Additions or Changes on This Sheet Must be Made or Circled in Red Ink With Date and Name of Person Making Change.

Do not extend this side of this line.

COBALT AVE.

WARD 124
L.A. Co. No. 2199
(E. SIDE)

NOTE: ALL CLEAN-OUTS BROUGHT UP TO SURFACE.




Cont Rt. side page 150

76298 S & E #307—7-55

PLEASE RETURN TO
LOS ANGELES COUNTY ENGINEER
700 LOS ANGELES COUNTY ENGINEERING BLDG.

NOTE: ANY ADDITIONS OR CHANGES ON THIS SHEET MUST BE MADE OR CIRCLED IN RED INK, WITH DATE AND NAME OF PERSON MAKING CHANGE.

Do not extend notes this side of this line.

Profile Noted Red No. Date Plotted Date
X-Sec. Noted Chkd. No. Date Checked Date
Job No. 6022.06 Division No. 11
Survey of Olive View Hosp. Date 2-6-56
Survey by Sorg Noted Bowles Date
Map No. Indexed E. J. GALL Date
F. B. 2910 Pg. 152

| STATION | B. S. | H. I. | F. S. | ELEV. | | |
|---|---|---|---|---|---|---|
| Fd chis. X | | | | | | {X in top steps, N. side |
| B.M. Nº11 | 4 821 | 1461 451 | | 1456 630 | B.M. Nº11-Ward-103 | {Bldg. F.B. 585-16 |
| T.P. | | | 5 136 | 1456 315 | | |
| | 4 402 | 1460 717 | | | | |
| T.P. | | | 3 329 | 1457 388 | | |
| | 3160 | 1460 598 | | | | |
| T.P. | | | 4 515 | 1456 033 | | |
| | 4 544 | 1460 577 | | | | |
| Fd chis ⊠ | | | 3 448 | 1457 129 | Fd chis ⊠ El.=1457.133 | {on top wall 3.1' E. of S.E. cor. service Bldg. O.V.-2 F.B. 713-438 |
| | 3645 | 1460 778 | | 1457 133 | See above. | |
| T.P. | | | 1 870 | 1458 908 | | |
| | 9 378 | 1468 286 | | | | |
| set chis ⊠ T.B.M. | | | 1 198 | 1467 088 | T.B.M. | {chis ⊠ 1' S. of S.W. cor. conc. Loading dock E. of Ward-105 on 6" conc. curb. |
| | 0 629 | 1467 717 | | | | |
| A | | | 6 59 | 1461 13 | Top of 4" C.I. Sewer | page 146 |
| B. | | | 7 44 | 1460 28 | " " " | " " " |
| C. | | | 7 89 | 1459 83 | " " " | " " page 145 |
| D | | | 8 65 | 1459 07 | " " " | " " " |
| E. | | | 9 08 | 1458 64 | " " " | " " page 144 |
| ~~F.~~ | | | ~~1232~~ ~~9 08~~ | ~~1458 66~~ | " " " | " " in Steam Tunn. |
| | | | 1 03 | 1466 69 | Top Steam Tunnel | M.H. page 144 |
| T.P. | | | 4 179 | 1463 538 | | |

76298 S & E #307—7-55

PLEASE RETURN TO
LOS ANGELES COUNTY ENGINEER
700 Los Angeles County Engineering Bldg.

NOTE: ANY ADDITIONS OR CHANGES ON THIS SHEET MUST BE MADE OR CIRCLED IN RED INK, WITH DATE AND NAME OF PERSON MAKING CHANGE.

**Do not extend notes this side of this line.**

F. B. 2910 Pg. 153 | Job No. 0022.05 | Division No. | Notes Red. | Plotted | Profile
Survey of Olive View Hospital | Date | No. | X-Sec.
Survey by Sotelo Notes Bowles | Notes Chkd. | Checked
Indexed | Date 2-7-62 | Date | Date | No.

| STATION | B. S. | H. I. | F. S. | ELEV. | | |
|---|---|---|---|---|---|---|
| T.P. | | | | 1463538 | | |
| | 4514 | 1468052 | | | | |
| T.P. | | | 9681 | 1458371 | | |
| | 9605 | 1462976 | | | | |
| T.P. | | | 5880 | 1457096 | | |
| | 4601 | 1461697 | | | | |
| | | | 5062 | 1456635 | | |
| T.B.M. | | | | 1467088 | See page | |
| | 4550 | 1471638 | | | | |
| G | | | 779 | 146385 | Top 4"C.I.P. (sewer) where it enters Steam Tunnel "W." of Ward No 114 (Top 22½° Bend | |
| F | | | 1232 | 145932 | Top 6" C.I. sewer in Steam Tunnel. | |
| H | | | 640 | 146524 | Top 4" C.I. Sewer "N." of Walk | |

| | |
|---|---|
| Notes Ck'd by | Survey of OLIVE VIEW HOSPITAL |
| Map No. | JN 0022.08 Tape Std °F |
| Office Work S.S. | Surveyed by |
| Checked | Notes S. SHINODA Date 3/9/62 |
| Date 3/10/62 | Indexed E. J. GALLI |

F. B. 2910 PG. 154

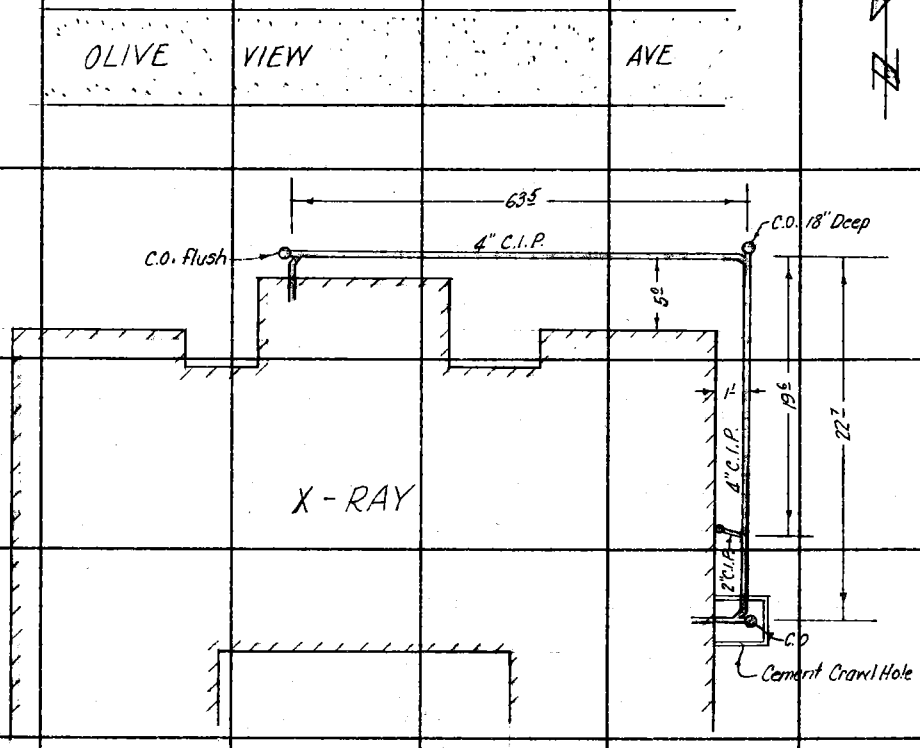


NOTE : Ties shown were copied from Plumbers Record of Installations And Alterations.

Note: Any Additions or Changes on This Sheet Must be Made or Circled in Red Ink With Date and Name of Person Making Change.

Do not extend this side of this line.

PLEASE RETURN TO
LOS ANGELES COUNTY ENGINEER
403 LOS ANGELES COUNTY ENGINEERING BLDG.

76F3095 CE # 310 2-61

F. B. 2910 Pg. 155

SEWERS

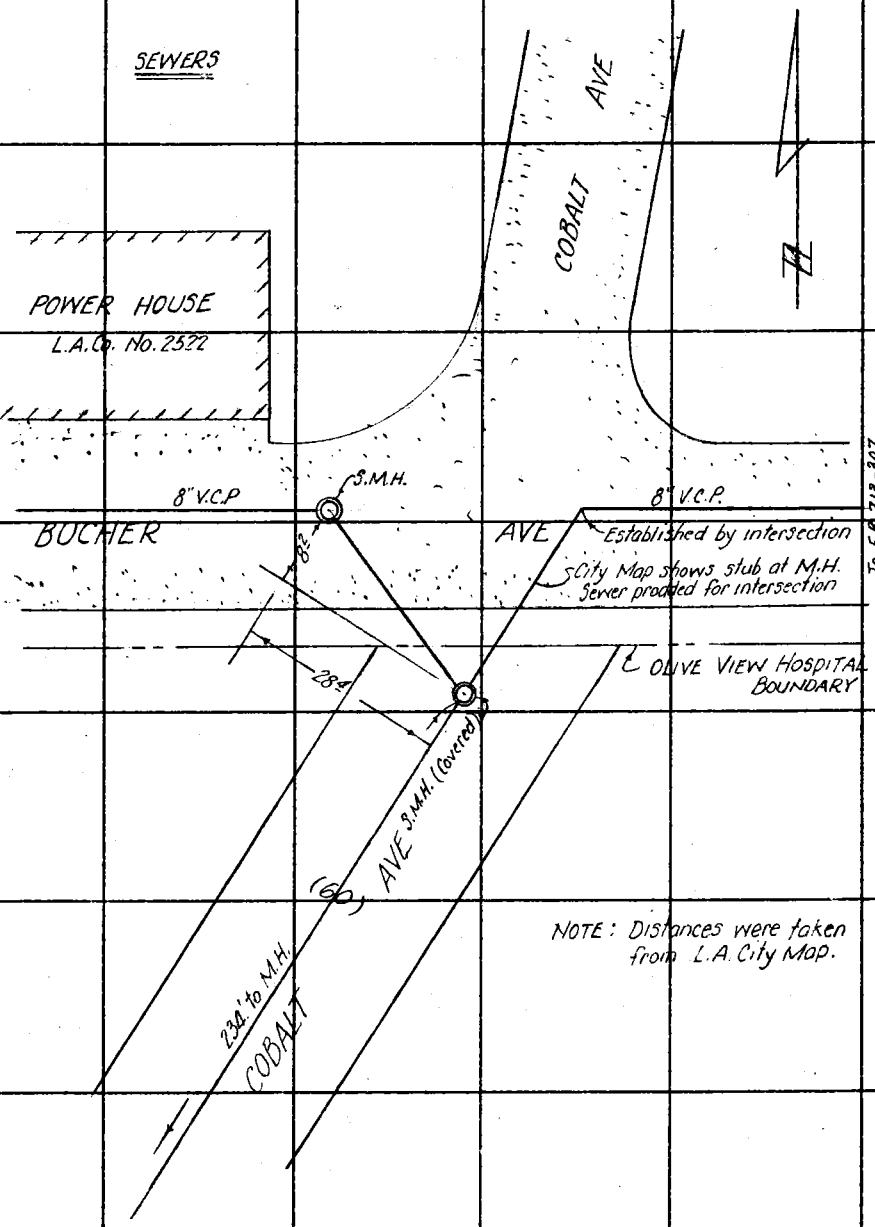


PLEASE RETURN TO
LOS ANGELES COUNTY ENGINEER
403 Los Angeles County Engineering Bldg.

Do not extend this side of this line.

Note: Any Additions or Changes on This Sheet Must be Made or Circled in Red Ink With Date and Name of Person Making Change.

76F309S CE # 310 3-61

PLEASE RETURN TO
LOS ANGELES COUNTY ENGINEER
403 LOS ANGELES COUNTY ENGINEERING BLDG.

Note: Any Additions or Changes on This Sheet Must be Made or Circled in Red Ink With Date and Name of Person Making Change.

Do not extend this side of this line.

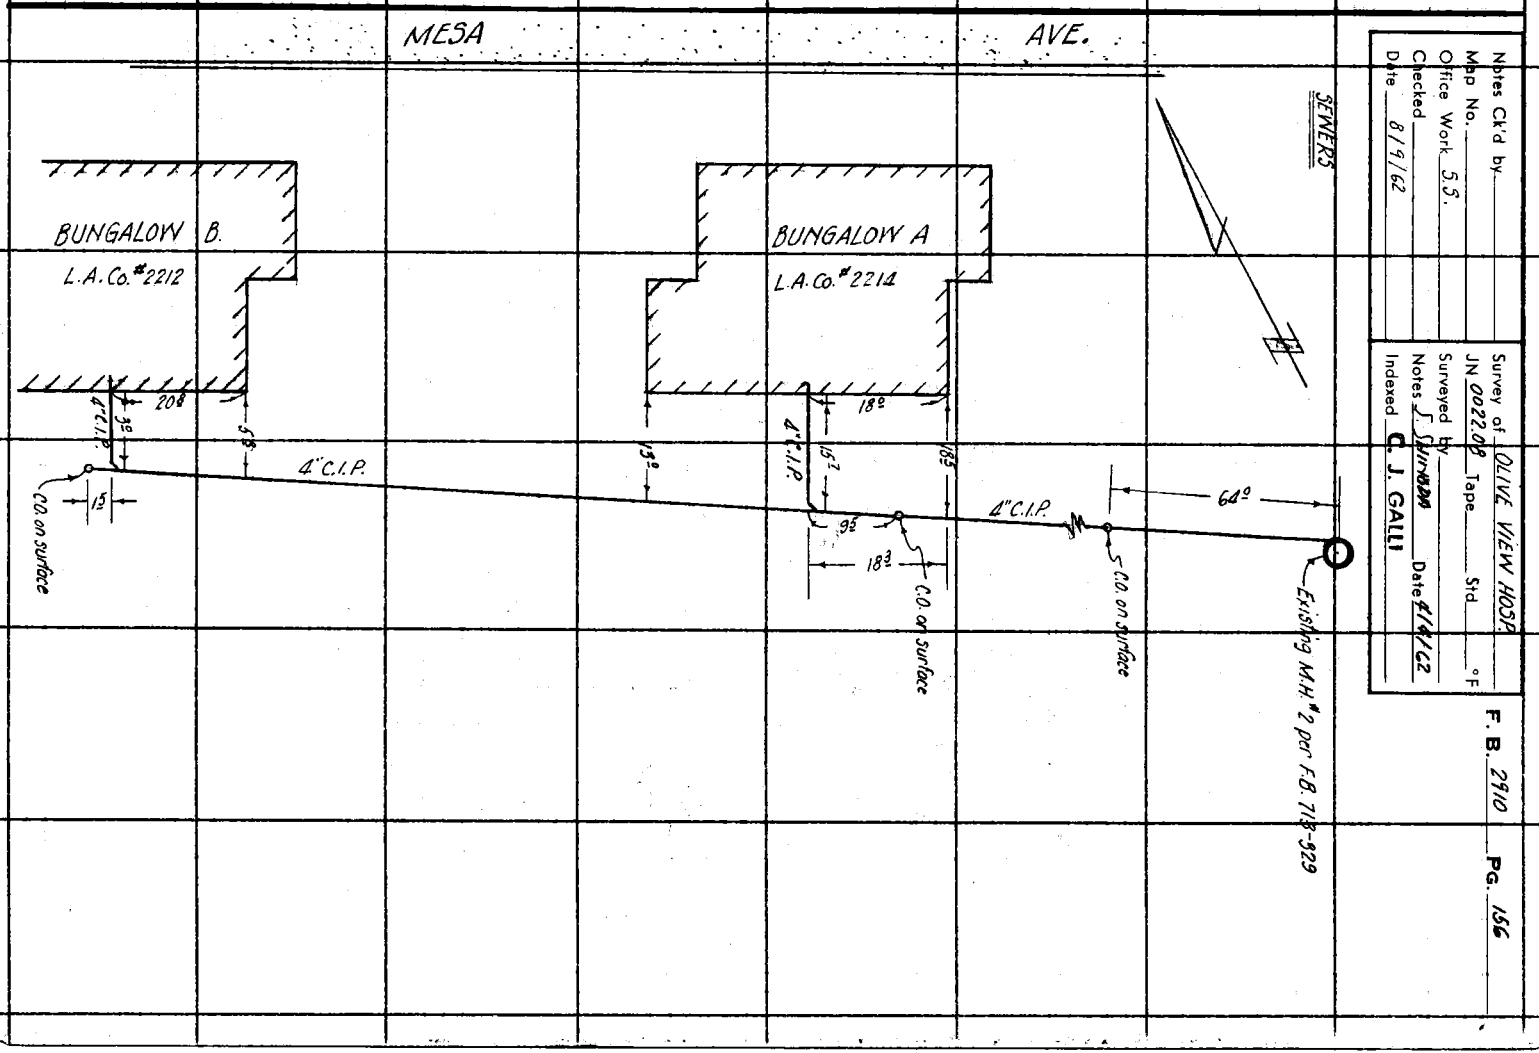


Notes Ck'd by
Map No.
Office Work S.S.
Checked
Date 8/9/62

Survey of OLIVE VIEW HOSP.
JN 0022.08 Tape Std °F
Surveyed by
Notes J. Sammons Date 4/4/62
Indexed C. J. GALLI

F. B. 2910 PG. 156

F. B. 2910 PG. 157

SEWERS

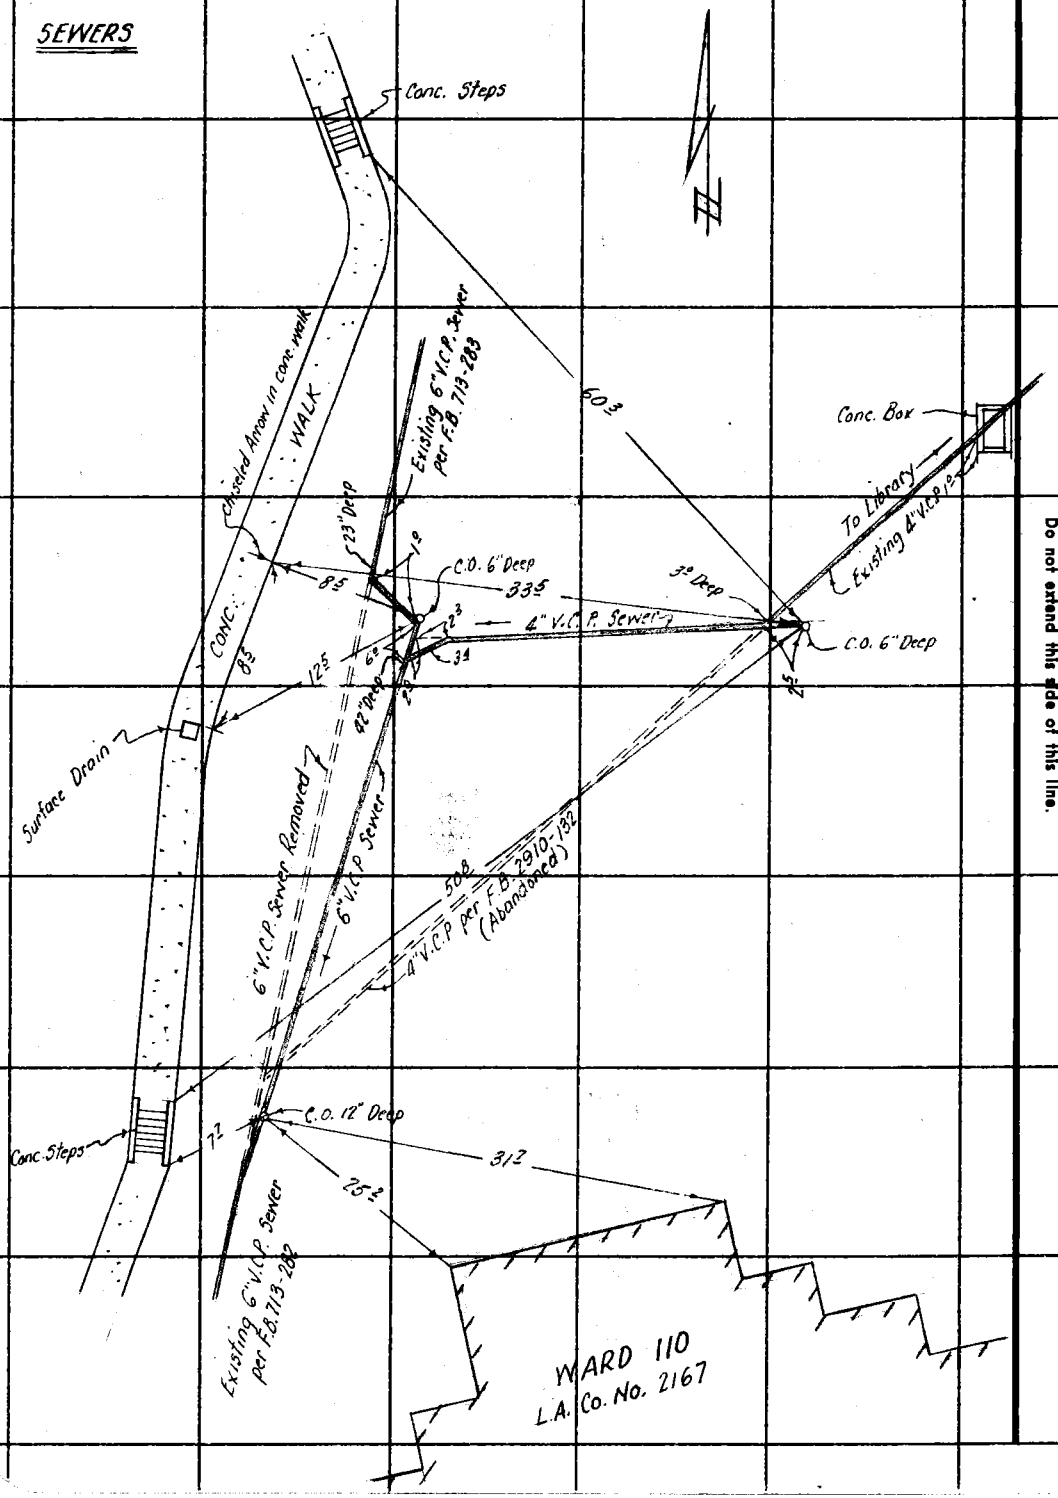


PLEASE RETURN TO
LOS ANGELES COUNTY ENGINEER
403 Los Angeles County Engineering Bldg.

Do not extend this side of this line.

Note: Any Additions or Changes on This Sheet Must be Made or Circled in Red Ink With Date and Name of Person Making Change.

| | |
|---|---|
| Notes Ck'd by | Survey of OLIVE VIEW HOSPITAL |
| Map No. | JN 0022.08 Tape Std °F |
| Office Work S.S. | Surveyed by |
| Checked | Notes S. SHINODA Date 11/29/62 |
| Date 1/9/63 | Indexed C. J. GALLI |

F. B. 2910 Pg. 158

Note: Any Additions or Changes on This Sheet Must be Made at Circled in Red Ink With Date and Name of Person Making Change.

Do not extend notes this side of this line.

RETURN TO
LOS ANGELES COUNTY ENGINEER
700 Los Angeles County Engineering Bldg.

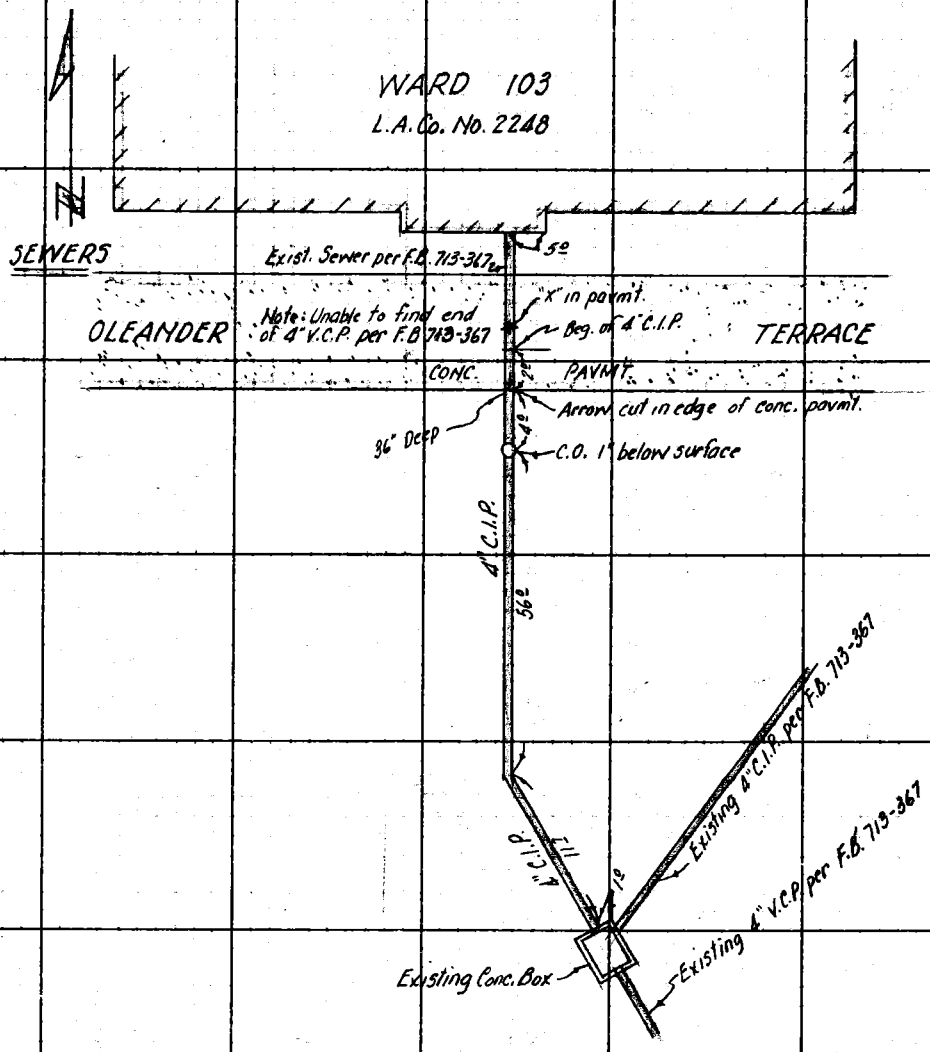


763098 CE #247 7-59

F. B. 2910 Pg. 159

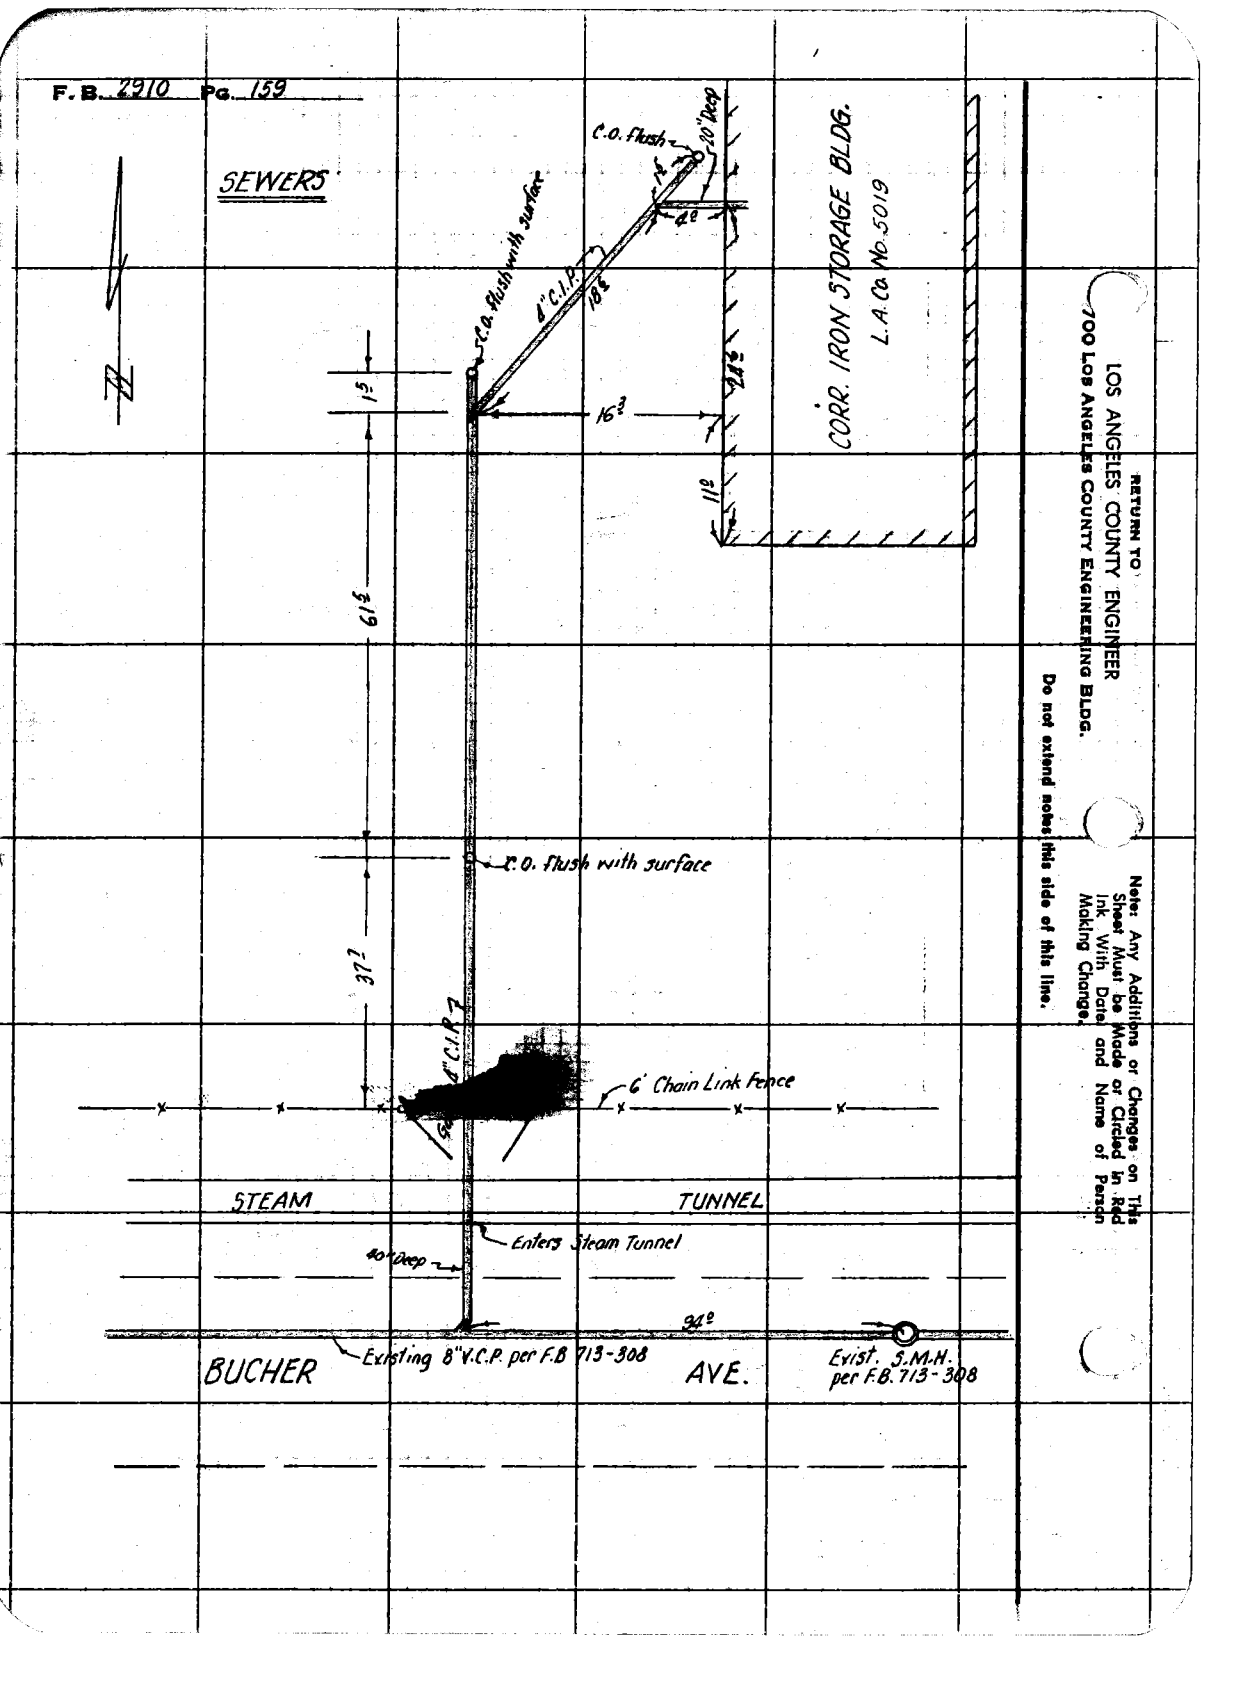


RETURN TO
LOS ANGELES COUNTY ENGINEER
700 Los Angeles County Engineering Bldg.

Do not extend notes this side of this line.

Note: Any Additions or Changes on This Sheet Must be Made or Circled in Red Ink With Date and Name of Person Making Change.

Notes Ck'd by
Map No.
Office Work S.S.
Checked
Date 5/14/63

Survey of OLIVE VIEW HOSPITAL
JN 0022.08 Tape Std °F
Surveyed by
Notes S. SHIMODA Date 2/27/63
Indexed C. J. GALLI

F. B. 2910 PG. 160

SEWERS

OFFICES
L.A.Co.No.2186

17'
3'
3' Deep
42'
C.O. flush with surface
70'
4" C.I.P.
3/4" Elec. Riser
84'
C.O. flush with surface
53'
55'
4" V.C.P. per F.B. 713-366 Abandoned to North
CLOCK HOUSE
5' Deep
C.O. flush with surface
4" C.I.P.
0.9
11.7
Beg. new 4" C.I.P directly below curb
34'
2%
6'-6" below curb
Conc. Curb
4" V.C.P per F.B. 713-366
CYPRESS
AVE

Note: Any Additions or Changes on This Sheet Must be Made or Circled in Red Ink With Date and Name of Person Making Change.

PLEASE RETURN TO
LOS ANGELES COUNTY ENGINEER
403 LOS ANGELES COUNTY ENGINEERING BLDG.
Do not extend this side of this line.

76F3093 C.E. #310 8-62

PLEASE RETURN TO
LOS ANGELES COUNTY ENGINEER
403 LOS ANGELES COUNTY ENGINEERING BLDG.

Note: Any Additions or Changes on This Sheet Must be Made or Circled in Red Ink With Date and Name of Person Making Change.

Do not extend this side of this line.

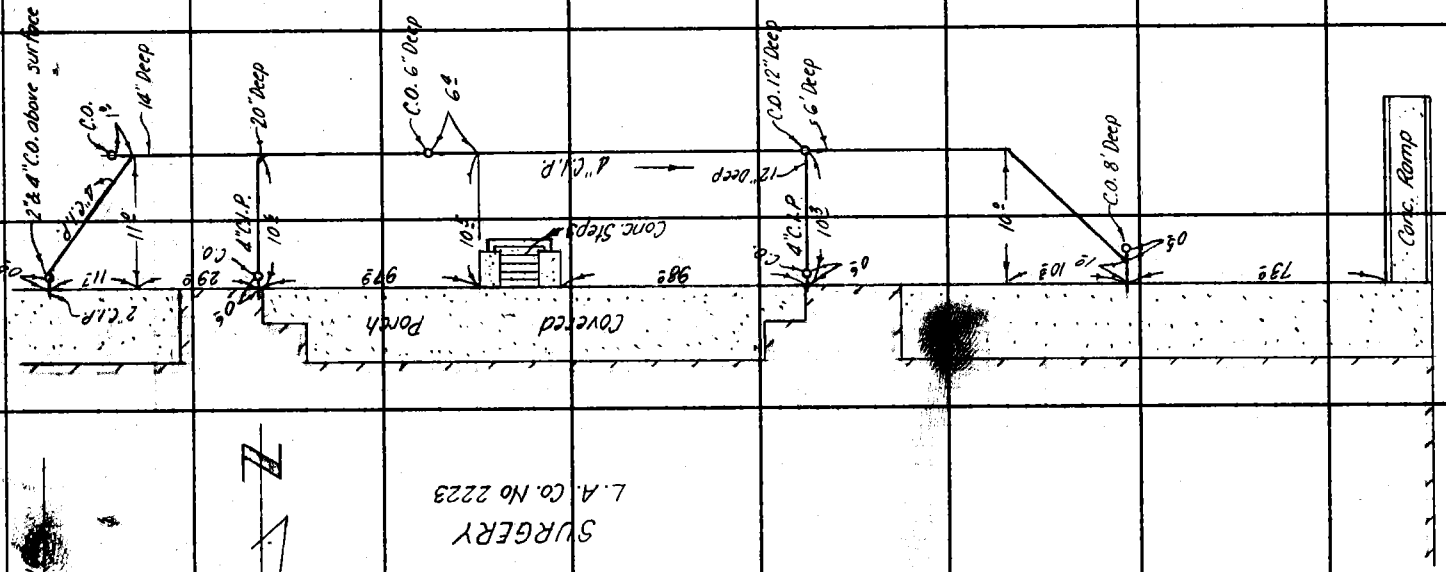


SURGERY
L. A. Co. No 2223

F. B. 2910 PG

SEWERS

| | | | |
|---|---|---|---|
| Notes Ck'd by | | Survey of OLIVE VIEW HOSPITAL | F. B. 2910 Pg. 162 |
| Map No. | | JN 0022.08 Tape Std °F | |
| Office Work | | Surveyed by J. TERRANOVA | |
| Checked | | Notes S. SHIMODA Date 8/15/63 | |
| Date | | Indexed G. J. GALLI | |

SEWERS

End of pipe 4"x6" Y
Elev. Top of Pipe = 1444.17, C=3'

38⁵ — 4+86.5

6" V.C.P.

EUCALYPTUS AVE.

Elev. Top of Pipe = 1430.63
C = 3⁵'

23.2 — 1+25.0

3+47.3

Sewer M.H.
Rim Elev. = 1427.45
F.L. " = 1417.37

0+18⁵

Sewer M.H.
Rim Elev. = 1429.83
F.L. Elev. = 1419.32

8" V.C.P.

8" Stub

0+00 going N. & W

13⁵

BUCHER AVE.

6' Offset Line

14⁵

To. F.B. 713-32

OLIVE VIEW HOSPITAL BDRY

6.00

3/4" I.P. per F.B. 585-29, 41

Note: Any Additions or Changes on This Sheet Must be Made or Circled in Red Ink With Date and Name of Person Making Change.

Do not extend this side of this line.

PLEASE RETURN TO
LOS ANGELES COUNTY ENGINEER
403 Los Angeles County Engineering Bldg.

76F3095 C.E. #310 6-62

PLEASE RETURN TO
LOS ANGELES COUNTY ENGINEER
403 LOS ANGELES COUNTY ENGINEERING BLDG.

Note: Any Additions or Changes on This Sheet Must be Made or Circled in Red Ink With Date and Name of Person Making Change.

Do not extend this side of this line.

F. B. 2910 PG. 163

| | | | |
|---|---|---|---|
| Notes Ck'd by | Survey of OLIVE VIEW HOSPITAL | F. B. 2910 | Pg. |
| Map No. | JN Tape Std °F | | |
| Office Work | Surveyed by | | |
| Checked | Notes Date | | |
| Date | Indexed | | |

NOTE : THERE ARE NO NOTES FROM PAGE 164 TO 169 . THEY ARE TO BE ENTERED AS NEW SEWER LINES ARE LOCATED.

Note: Any Additions or Changes on This Sheet Must Be Made or Circled in Red Ink With Date and Name of Person Making Change.

Do not extend this side of this line.

PLEASE RETURN TO
LOS ANGELES COUNTY ENGINEER
403 LOS ANGELES COUNTY ENGINEERING BLDG.

76F3095 CE #310 6-63

PLEASE RETURN TO
LOS ANGELES COUNTY ENGINEER
403 LOS ANGELES COUNTY ENGINEERING BLDG.

Note: Any Additions or Changes on This Sheet Must be Made or Circled in Red Ink With Date and Name of Person Making Change.

Do not extend this side of this line.

F. B. 2910 PG ____

Notes Ck'd by
Map No.
Office Work
Checked
Date

Survey of
JN Tape Std °F
Surveyed by
Notes Date
Indexed C. J. GALLI JUL 25 '83

F. B. 2910 Pg. 170

# OLIVE VIEW HOSPITAL

J.N. 0022.08

## DRAINS

Note: Any Additions or Changes on this Sheet Must be Made or Circled in Red Ink With Date and Name of Person Making Change.

PLEASE RETURN TO
LOS ANGELES COUNTY ENGINEER
700 Los Angeles County Engineering Bldg.

Do not extend this side of this line.

7673088 SBE #247 11-58

F. B. 2910 PG. 171

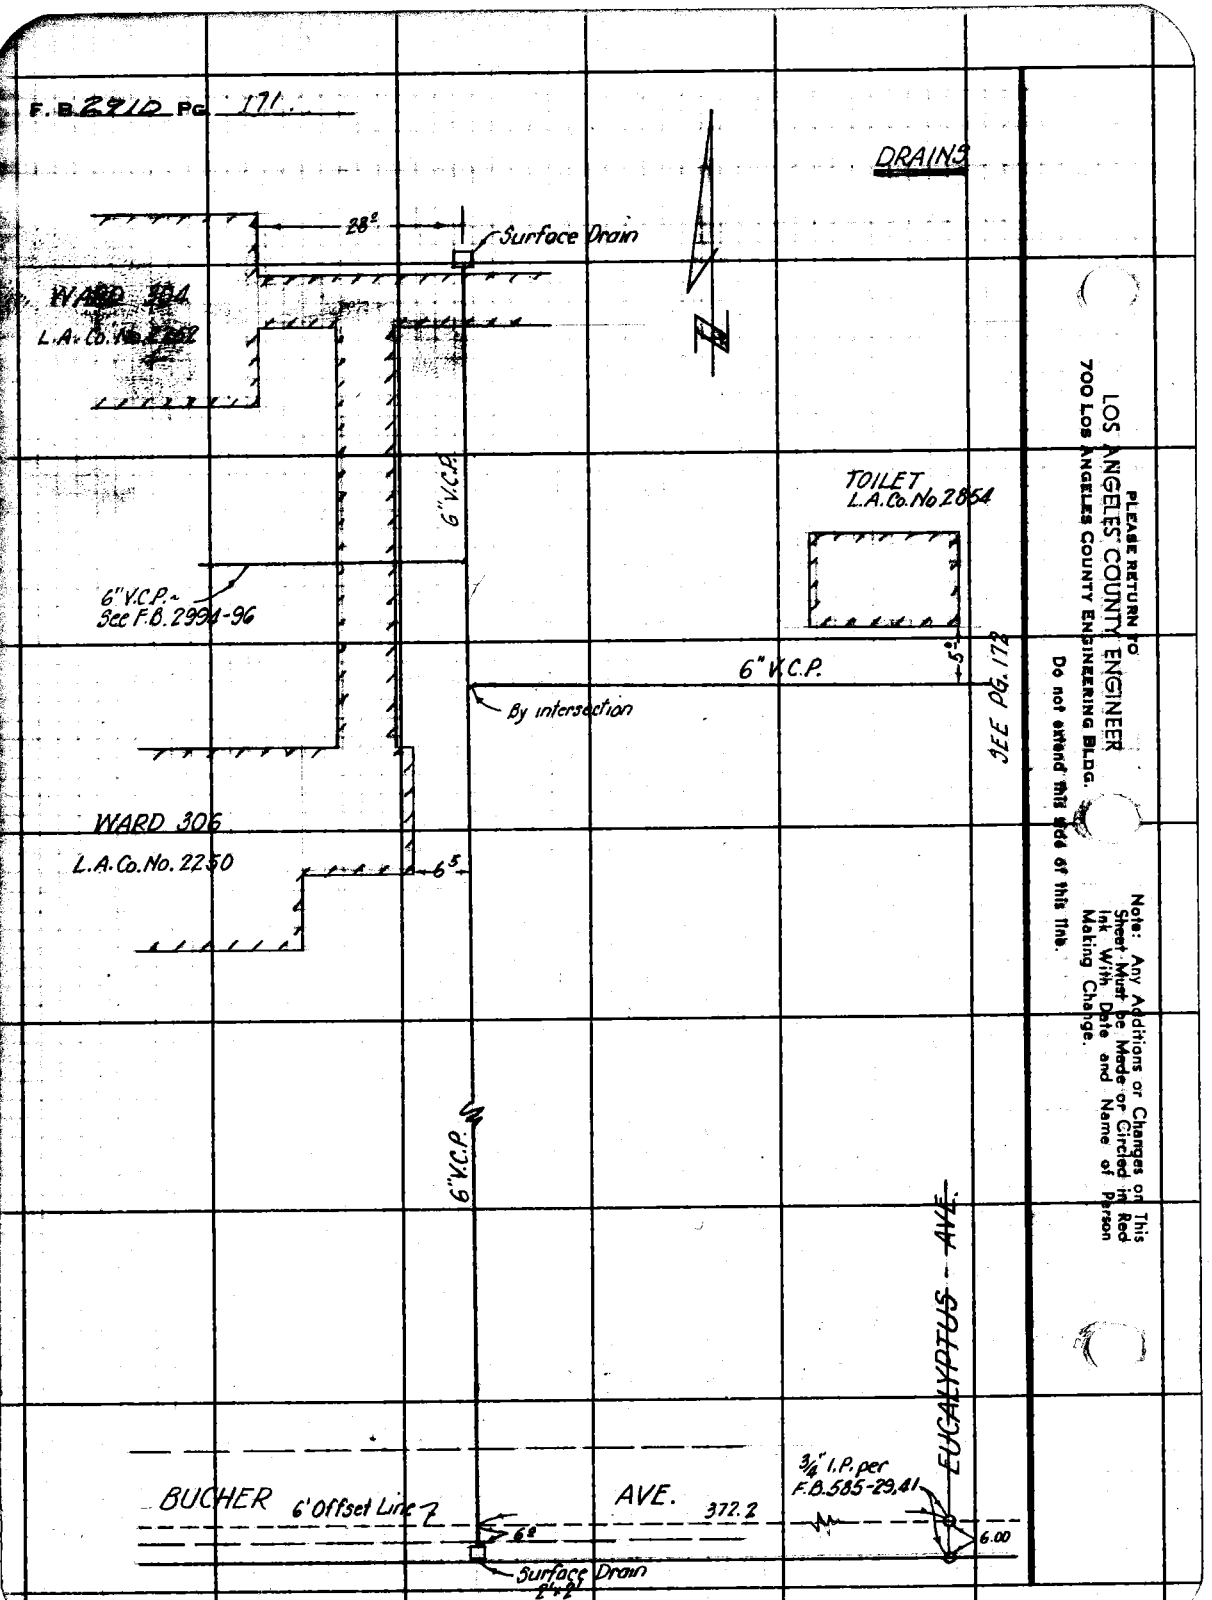


PLEASE RETURN TO
LOS ANGELES COUNTY ENGINEER
700 Los Angeles County Engineering Bldg.

Do not extend this side of this film.

Note: Any Additions or Changes on This Sheet Must be Made or Circled in Red Ink With Date and Name of Person Making Change.

76F3095 CE # 310 3-61

PLEASE RETURN TO
LOS ANGELES COUNTY ENGINEER
403 LOS ANGELES COUNTY ENGINEERING BLDG.

Note: Any Additions or Changes on This Sheet Must be Made or Circled in Red Ink With Date and Name of Person Making Change.

Do not extend this side of this line.

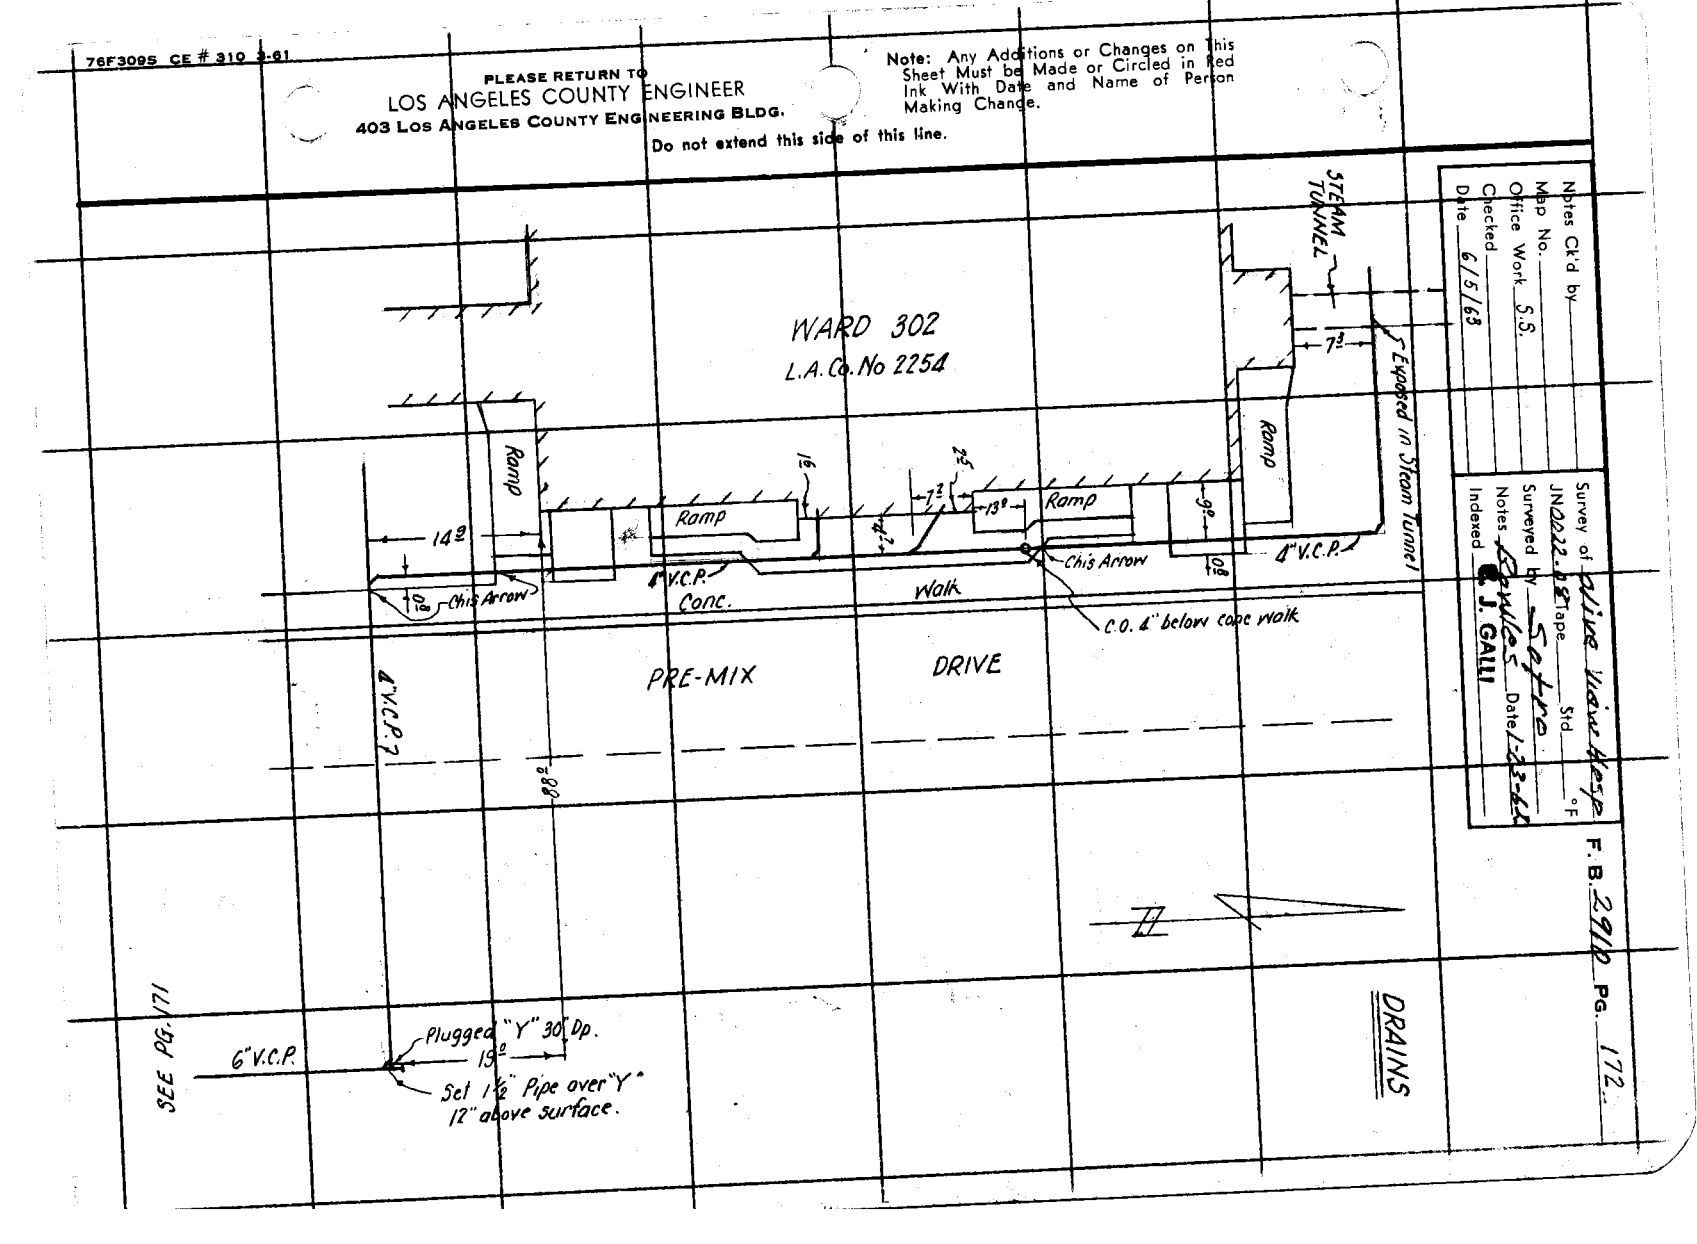


Notes Ck'd by
Map No.
Office Work S.S.
Checked
Date 6/5/63

Indexed E. J. GALLI

F. B. 2910 PG. 172

F. B. 2918 PG. 173

EAST WAY.

51.5

7.5

Conc. Steps

To catch basin Cypress Way

6"

90°

Clean-out

21 ±

5 dn. 12"

19°

6" V.C.P. Drain

Conc. Block Bldg. CHAPEL

L.A. Co. 1983.

64°

53.2

3

Storm Tunnel M.H.

PLEASE RETURN TO
LOS ANGELES COUNTY ENGINEER
403 LOS ANGELES COUNTY ENGINEERING BLDG.

Do not extend this side of this line.

Note: Any Additions or Changes on This Sheet Must be Made or Circled in Red Ink With Date and Name of Person Making Change.

Notes Ck'd by
Map No.
Office Work
Checked
Date

Survey of OLIVE VIEW HOSPITAL F. B. 2910 Pg. 174
JN 0022.08 Tape Std °F
Surveyed by
Notes S. Shimoda Date 2/7/63
Indexed

## DRAINS

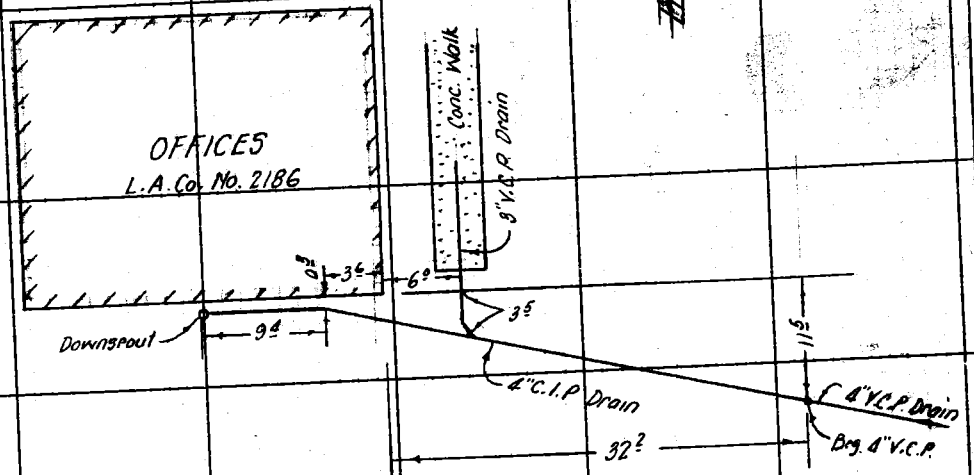


Notes: Any Additions or Changes on This Sheet Must be Made in Red Ink With Date and Name of Person Making Change.

Do not extend notes this side of this line.

RETURN TO
LOS ANGELES COUNTY ENGINEER
700 LOS ANGELES COUNTY ENGINEERING BLDG.

763095 CE #247—7-58

RETURN TO
LOS ANGELES COUNTY ENGINEER
700 LOS ANGELES COUNTY ENGINEERING BLDG.

Note: Any Additions or Changes on This Sheet Must be Made or Circled in Red Ink With Date and Name of Person Making Change.

Do not extend notes this side of this line.

F. B. 1910 Pg. 175

Notes Ck'd by
Map No.
Office Work
Checked
Date

Survey of
JN Tape Std °F
Surveyed by
Notes Date
Indexed E. J. GALLI JUL 25 '63

F. B. 2910 PG. 176

# OLIVE VIEW HOSPITAL

J. N. 0022.08

## GAS LINES

Note: Any Additions or Changes on This Sheet Must be Made or Circled in Red Ink With Date and Name of Person Making Change.

PLEASE RETURN TO
LOS ANGELES COUNTY ENGINEER
700 Los Angeles County Engineering Bldg.

Do not extend this side of this line.

76F3098 SSE #247 11-58

PLEASE RETURN TO
LOS ANGELES COUNTY ENGINEER
700 LOS ANGELES COUNTY ENGINEERING BLDG.

Note: Any Additions or Changes on This Sheet Must be Made or Circled in Red Ink With Date and Name of Person Making Change.

Do not extend this side of this line.

F.B. 2910 PG. 177

76F309S CE # 310 9-61

PLEASE RETURN TO
LOS ANGELES COUNTY ENGINEER
403 LOS ANGELES COUNTY ENGINEERING BLDG.

Do not extend this side of this line.

Note: Any Additions or Changes on This Sheet Must be Made or Circled in Red Ink With Date and Name of Person Making Change.

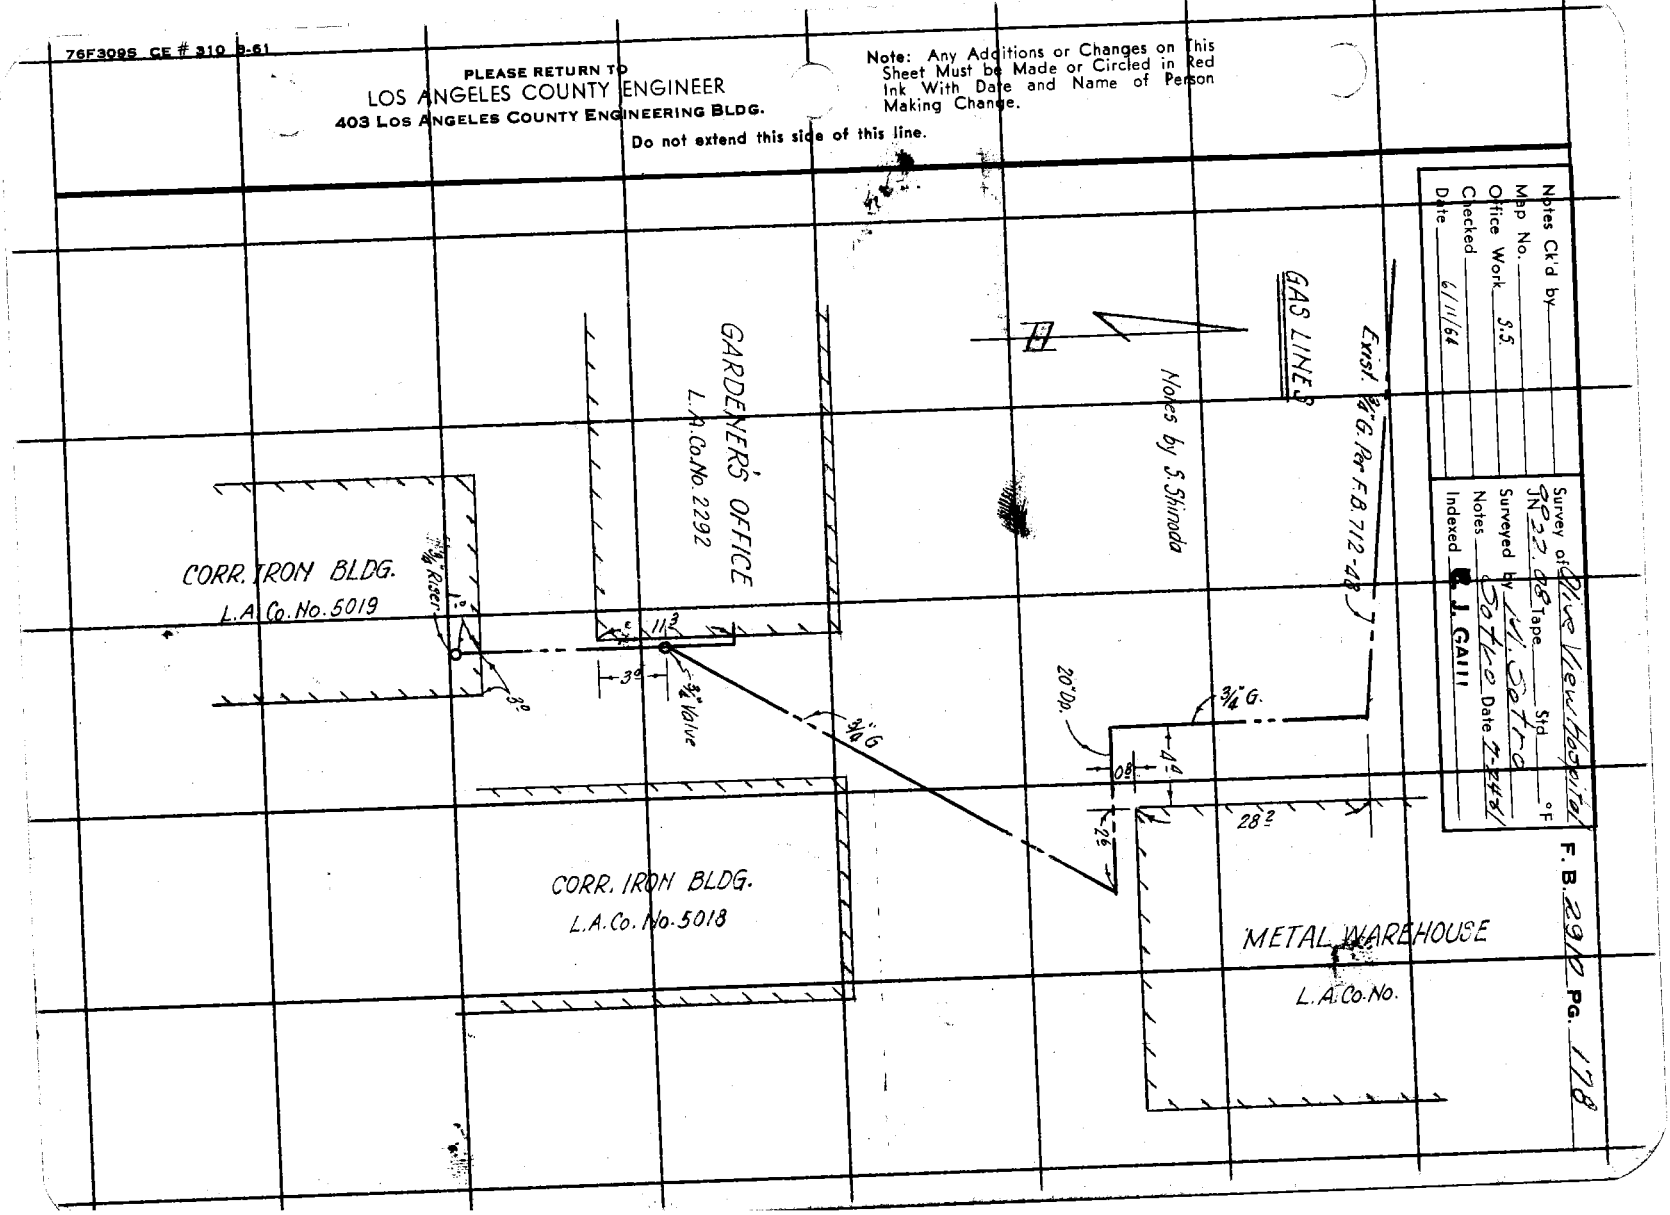


Notes Ck'd by _____
Map No. _____
Office Work S.S.
Checked _____
Date 6/11/64

Survey of Olive View Hospital
Notes _____
Indexed R. J. GALLI


PLEASE RETURN TO
LOS ANGELES COUNTY ENGINEER
403 LOS ANGELES COUNTY ENGINEERING BLDG.

Note: Any Additions or Changes on This Sheet Must be Made or Circled in Red Ink With Date and Name of Person Making Change.

Do not extend this side of this line.

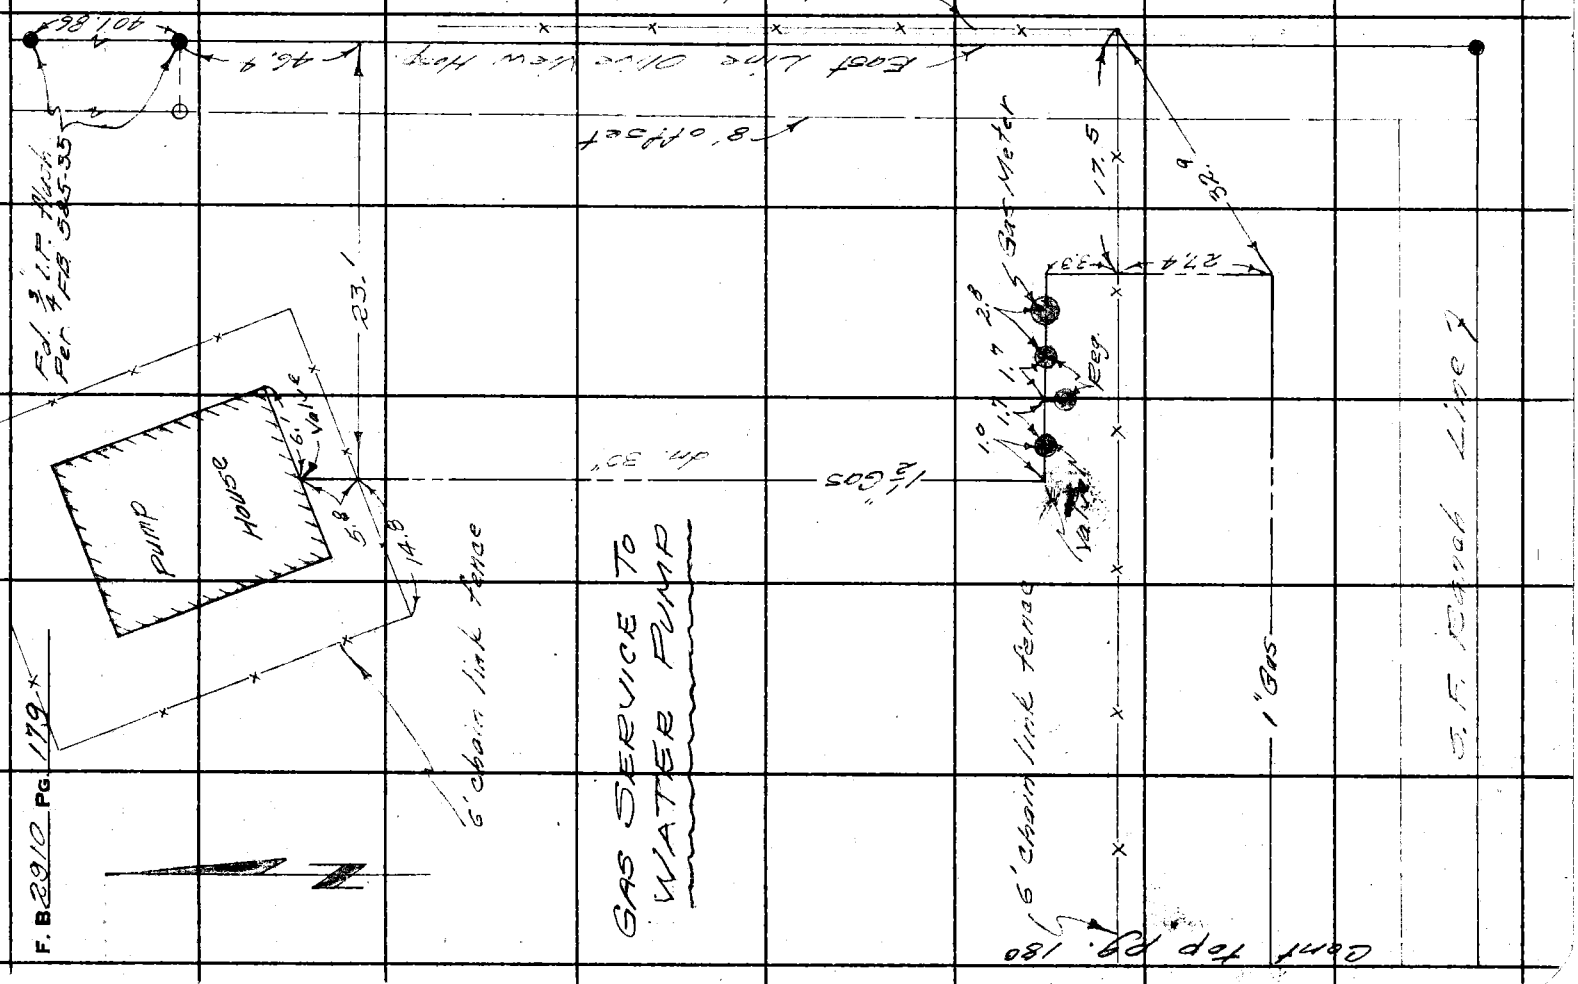

76F3095 CE # 310 3.61

PLEASE RETURN TO
LOS ANGELES COUNTY ENGINEER
403 LOS ANGELES COUNTY ENGINEERING BLDG.

Note: Any Additions or Changes on This Sheet Must be Made or Circled in Red Ink With Date and Name of Person Making Change.

Do not extend this side of this line.

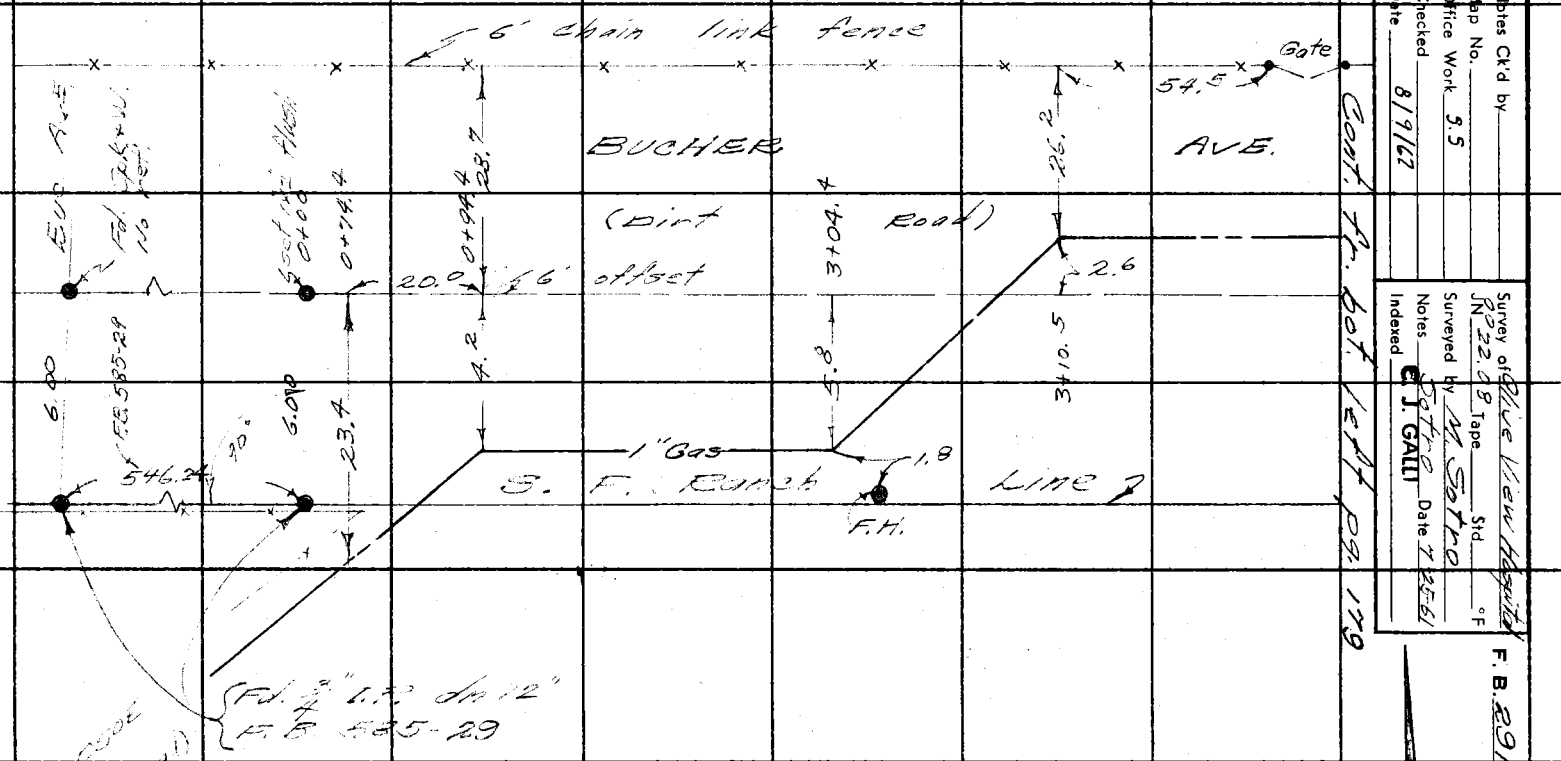


Notes Ck'd by
Map No.
Office Work 3.5
Checked

JN 222.08 Tape Std °F
Surveyed by M. Soto
Notes
Indexed E. J. GALLI Date 7-25-61


PLEASE RETURN TO
LOS ANGELES COUNTY ENGINEER
403 LOS ANGELES COUNTY ENGINEERING BLDG.

Do not extend this side of this line.

Note: Any Additions or Changes on This Sheet Must be Made or Circled in Red Ink With Date and Name of Person Making Change.

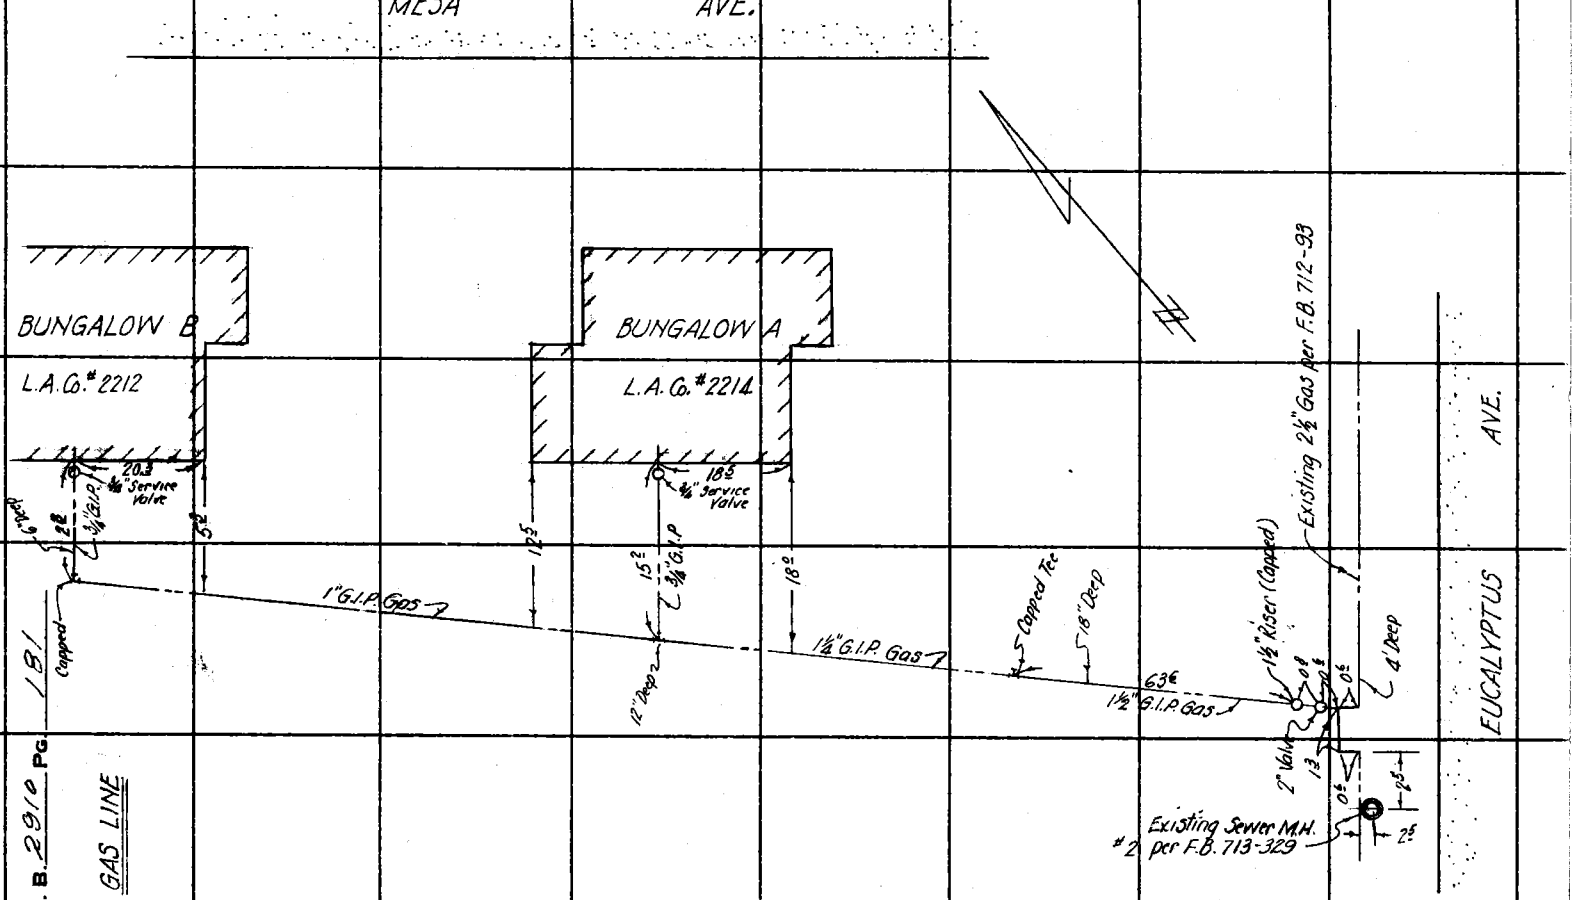

Notes Ck'd by
Map No.
Office Work S.S.
Checked
Date 6/5/63

Survey of OLIVE VIEW HOSPITAL
JN 0022 08 Tape Std °F
Surveyed by J. TERRANOVA
Notes J.T. Date 8-1-62
Indexed C. J. GALLI

F. B. 2910 PG. 182

# GAS LINE EAST OF LABORATORY

PER. F.B. 712-49

8.5

1¼" VALVE & REGULATOR

CONC. BOX SEWER C.O. BOX

1¼ GAS

LAB.
L.A. Co. #3564

15.0

9.5

18.5

PER F.B. 712-49

Note: Any Additions or Changes on This Sheet Must be Made or Circled in Red Ink With Date and Name of Person Making Change.

PLEASE RETURN TO
LOS ANGELES COUNTY ENGINEER
403 Los Angeles County Engineering Bldg.
Do not extend this side of this line.

76F3095 CE # 310 3-61

F. B. 2910 Pg. 183

GAS LINES

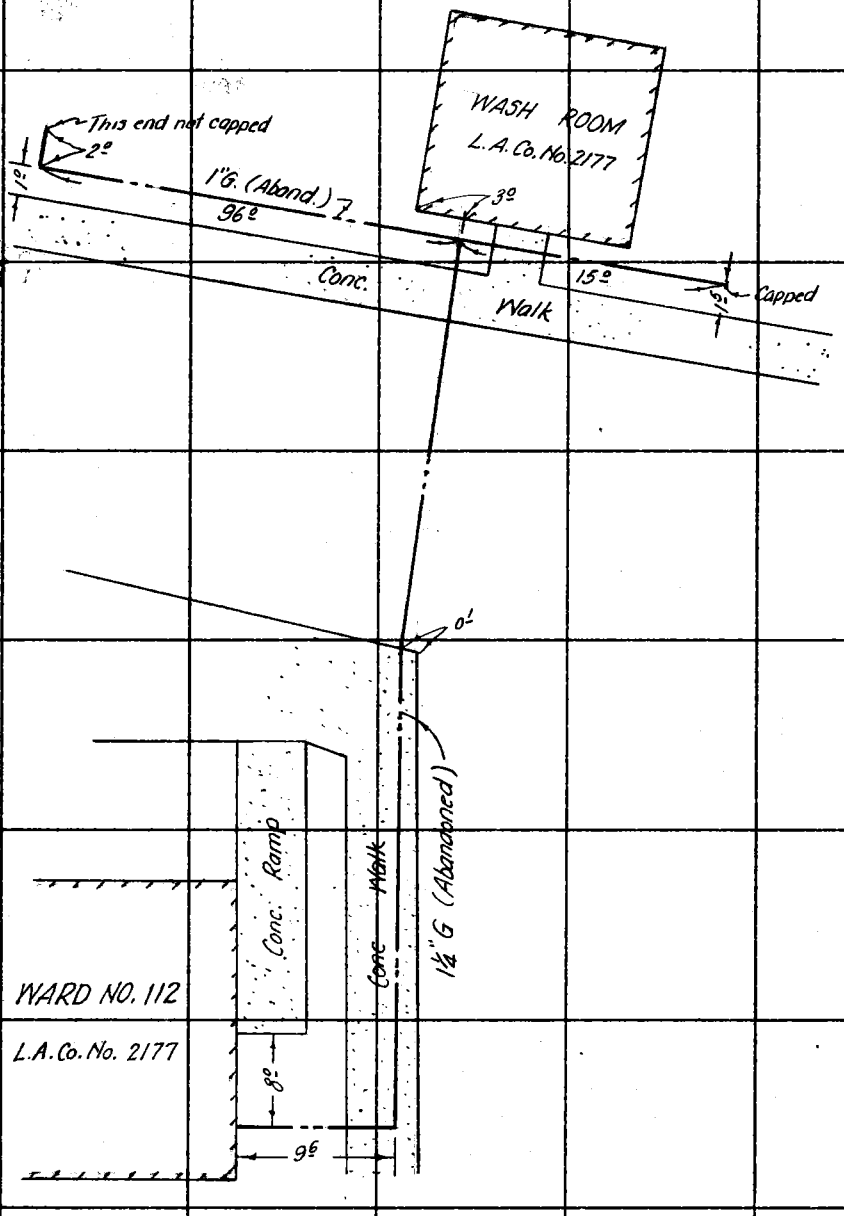


WARD NO. 112

L.A. Co. No. 2177

PLEASE RETURN TO
LOS ANGELES COUNTY ENGINEER
403 Los Angeles County Engineering Bldg.

Do not extend this side of this line.

Note: Any Additions or Changes on This Sheet Must be Made or Circled in Red Ink With Date and Name of Person Making Change.

Notes Ck'd by
Map No.
Office Work S.S
Checked
Date 6/11/64

Survey of OLIVE VIEW HOSPITAL
JN 0022.08 Tape Std °F
Surveyed by
Notes S. Shinoda Date 6/4/63
Indexed

F. B. 2910 Pg. 184

GAS LYNES

OLIVE VIEW AVE

Conc. Pavm't.

29'

7' Deep

Existing 3" Gas per F.B. 712-45

3" Valve

2'-6" Deep

62 3

RD.

2'-6" Deep

1 3

Conc. Walk

Pre-mix Pavm't.

LABORATORY BLDG.
L.A. Co. No. 3664

Pre-mix Pavm't.

3" W.

3" GAS

1'

GARDEN

2' Deep

84 2

Cont. on Pg 185

Note: Any Additions or Changes on This Sheet Must be Made or Circled in Red Ink With Date and Name of Person Making Change.

Do not extend this side of this line.

PLEASE RETURN TO
LOS ANGELES COUNTY ENGINEER
403 Los Angeles County Engineering Bldg.

76F3095 C.E. #310 8-62

F. B. 2910 Pg. 185

GAS LINES

PLEASE RETURN TO
LOS ANGELES COUNTY ENGINEER
403 Los Angeles County Engineering Bldg.
Do not extend this side of this line.

Note: Any Additions or Changes on This Sheet Must be Made or Circled in Red Ink With Date and Name of Person Making Change.

VIVARIUM
L.A. Co. No.

Conc. Dock

Regulator
3" Valve

3"G
3"W
2' Deep
2' Deep

Cont. from Pg. 184

Notes Ck'd by
Map No.
Office Work
Checked
Date

Survey of
JN Tape Std °F
Surveyed by
Notes Date
Indexed G. J. GALLI III 2 5 38

F. B. 2910 Pg. 186

# OLIVE VIEW HOSPITAL

J. N. 0022.08

## WATER LINES

Note: Any Additions or Changes on this Sheet Must be Made or Circled in Red Ink With Date and Name of Person Making Change.

PLEASE RETURN TO
LOS ANGELES COUNTY ENGINEER
700 LOS ANGELES COUNTY ENGINEERING BLDG.

Do not extend this side of this line.

76F3098 SAE #247 11-58

PLEASE RETURN TO
LOS ANGELES COUNTY ENGINEER
700 LOS ANGELES COUNTY ENGINEERING BLDG.

Note: Any Additions or Changes on This Sheet Must be Made or Circled in Red Ink With Date and Name of Person Making Change.

Do not extend this side of this line.

F. B. 2910 PG. 187

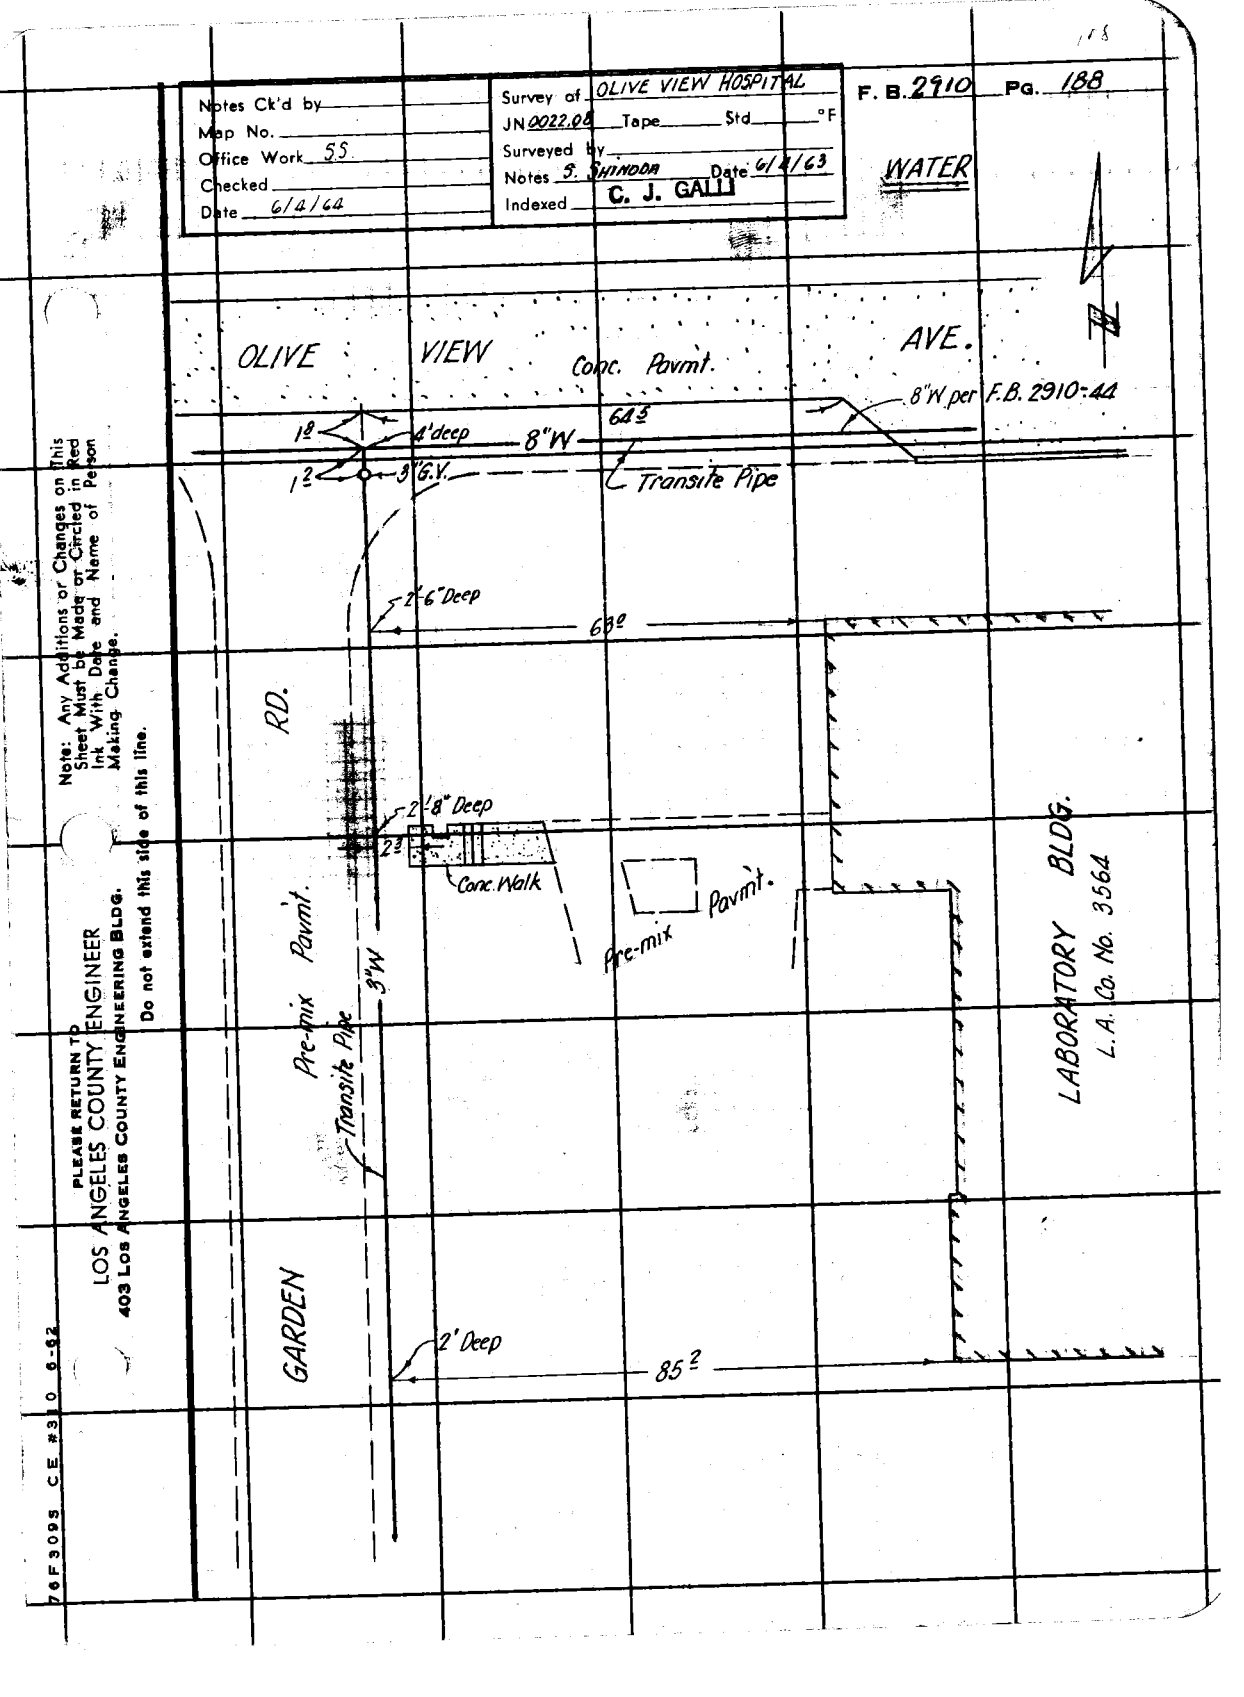
Notes Ck'd by
Map No.
Office Work 55
Checked
Date 6/4/64
Survey of OLIVE VIEW HOSPITAL
JN 0022.08 Tape Std °F
Surveyed by
Notes S. SHINDOA Date 6/4/63
Indexed C. J. GALLI
F. B. 2910 Pg. 188
WATER
OLIVE VIEW Conc. Pavmt. AVE.
8"W per F.B. 2910:44
1½ 4' deep 8"W 64½
1½ 3' G.V.
Transite Pipe
2'-6" Deep
68½
RD.
2'8" Deep
2½
Conc. Walk
Pavmt.
Pre-mix
Pre-mix Pavmt.
3"W
Transite Pipe
LABORATORY BLDG.
L.A. Co. No. 3564
GARDEN
2' Deep
85½
Note: Any Additions or Changes on This Sheet Must be Made or Circled in Red Ink With Date and Name of Person Making Change.
Do not extend this side of this line.
PLEASE RETURN TO
LOS ANGELES COUNTY ENGINEER
403 Los Angeles County Engineering Bldg.
76F3095 CE #310 6-62

F. B. 2910 PG. 189

WATER




PLEASE RETURN TO
LOS ANGELES COUNTY ENGINEER
403 LOS ANGELES COUNTY ENGINEERING BLDG.

Do not extend this side of this line.

Note: Any Additions or Changes on This Sheet Must be Made or Circled in Red Ink With Date and Name of Person Making Change.

76F3095 CE #310 6-62

PLEASE RETURN TO
LOS ANGELES COUNTY ENGINEER
403 LOS ANGELES COUNTY ENGINEERING BLDG.

Note: Any Additions or Changes on This Sheet Must be Made or Circled in Red Ink With Date and Name of Person Making Change.

Do not extend this side of this line.

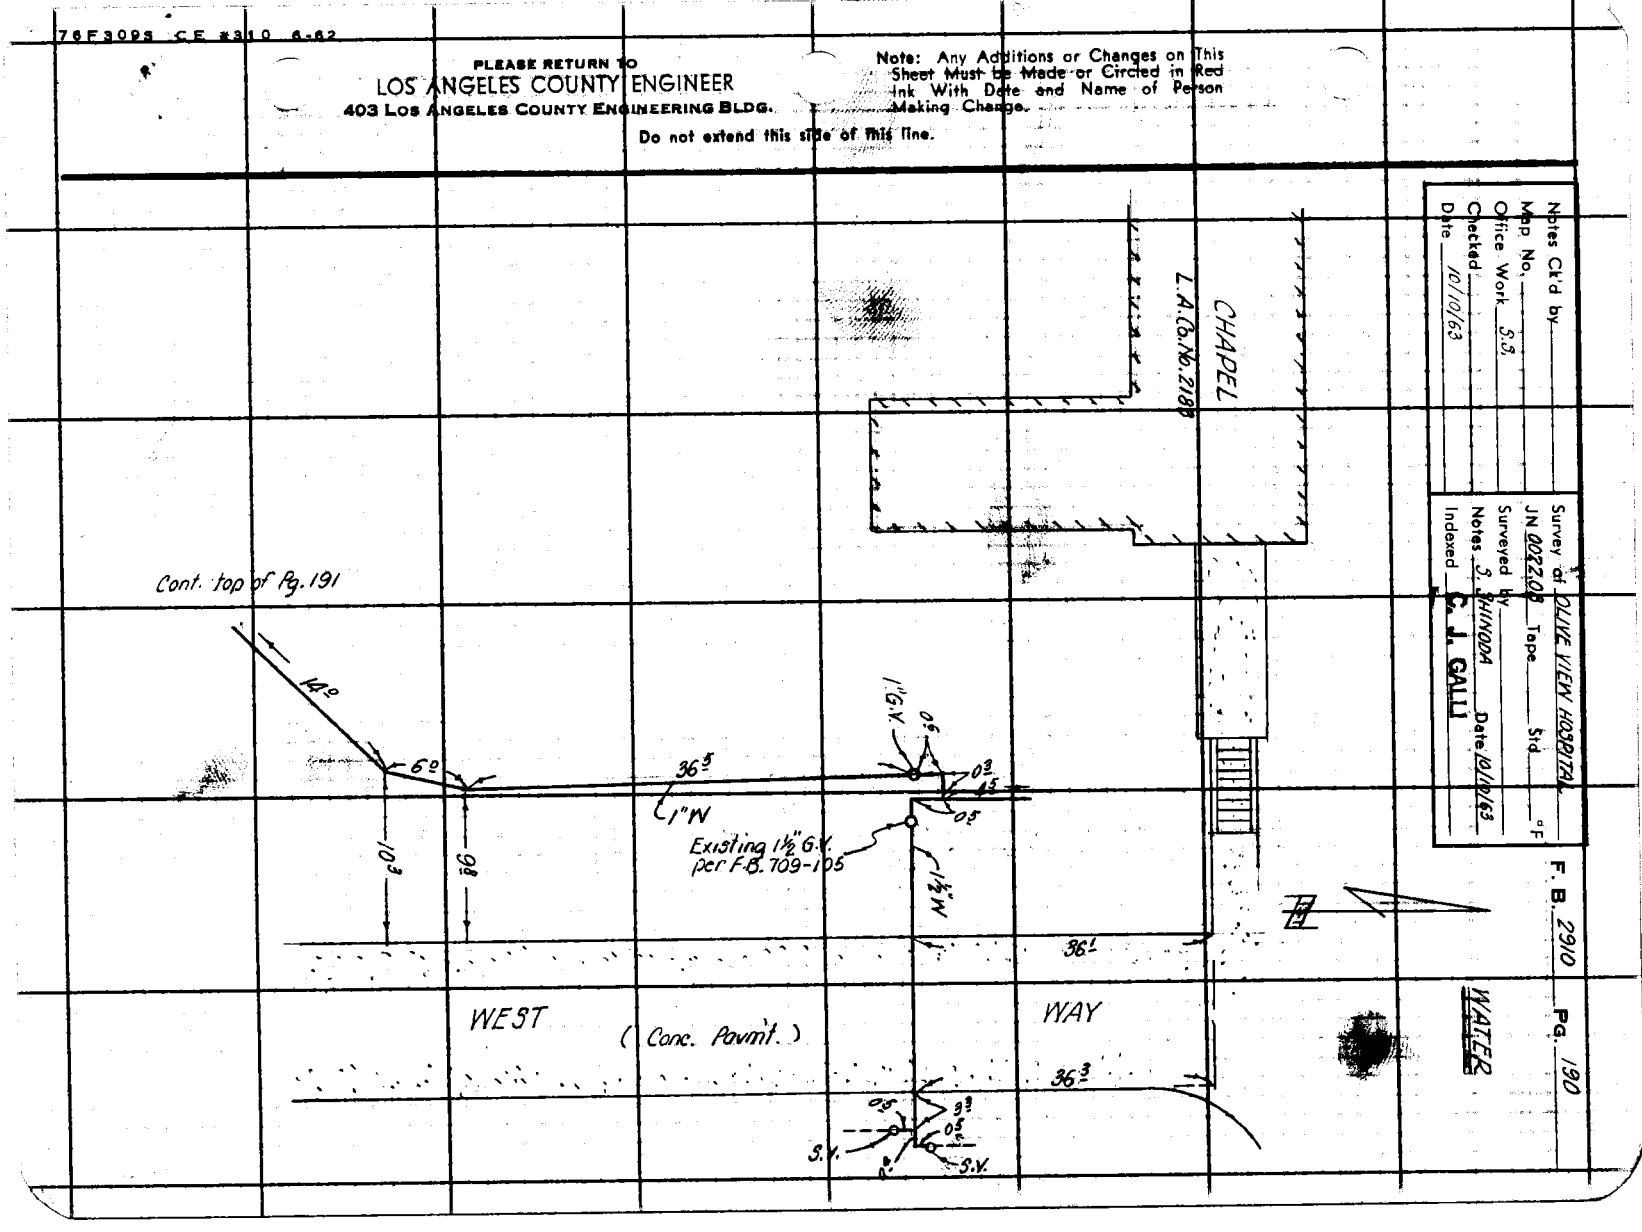


Notes Ck'd by
Map No.
Office Work 5.3.
Checked
Date 10/10/63

Survey of OLIVE VIEW HOSPITAL
JN 002200 Tape Std °F
Surveyed by
Notes J. SHINODA Date 10/10/63
Indexed C. J. GALLI

F.B. 2910 PG. 190

WATER

BK 2910 PG 191

WATER




PLEASE RETURN TO
LOS ANGELES COUNTY ENGINEER
403 Los Angeles County Engineering Bldg.

Note: Any Additions or Changes on This Sheet Must be Made or Circled in Red Ink With Date and Name of Person Making Change.

Do not extend this side of this line.

76F309S CE #310 6-62

PLEASE RETURN TO
LOS ANGELES COUNTY ENGINEER
403 LOS ANGELES COUNTY ENGINEERING BLDG.

Note: Any Additions or Changes on This Sheet Must be Made or Circled in Red Ink With Date and Name of Person Making Change.

Do not extend this side of this line.

Notes Ck'd by
Map No.
Office Work S.S.
Checked
Date 10/10/63

Survey of OLIVE VIEW HOSPITAL
JN 0022.08 Tape Std °F
Surveyed by
Notes J. SHINODA
C. J. GALLI Date 10/11/63
Indexed

F. B. 2910 Pg. 192

WATER

Sur. Spr.
S.V.
¾" H.B.
-2.0
-45
25.7
Conc. Ramp
MEN'S SOLARIUM
L.A. Co. No. 2182
Conc. Wall
Concrete
Pavement
1" W.L.
Sur. Spr.
S.V.
¾" H.B.
20.2
LANTANA
TERRACE

F. B. 2910 Pg. 193

WATER LINES

SEE F.B. 709-24

SEE F.B. 2994-51

WASH ROOM
L.A. CO. NO. 2178

Walk

Conc.

Valves

WARD NO. 112

L.A. CO. NO. 2174

PLEASE RETURN TO
LOS ANGELES COUNTY ENGINEER
403 Los Angeles County Engineering Bldg.
Do not extend this side of this line.

Note: Any Additions or Changes on This Sheet Must be Made or Circled in Red Ink With Date and Name of Person Making Change.

Notes Ck'd by
Map No.
Office Work S.S.
Checked
Date 9-16-63

Survey of OLIVE VIEW HOSPITAL
JN 0022.08 Tape Std °F
Surveyed by J. TERRANOVA
Notes S. SHIMODA Date 8/13/63
Indexed C. J. GALLI

F. B. 2910 Pg. 194

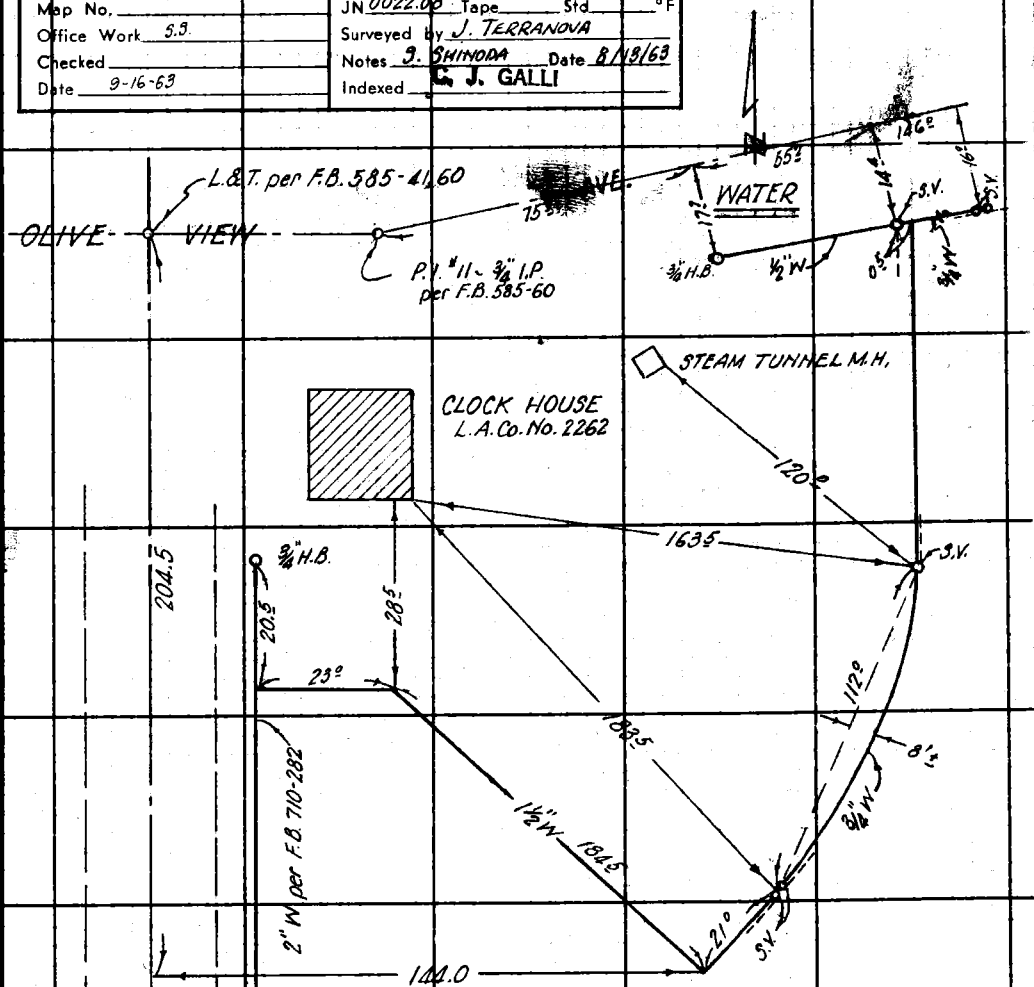


Note: Any Additions or Changes on This Sheet Must be Made or Circled in Red Ink With Date and Name of Person Making Change.
Do not extend this side of this line.

PLEASE RETURN TO
LOS ANGELES COUNTY ENGINEER
403 Los Angeles County Engineering Bldg.

76F3095 CE #310 6-62

F. B. 2910 PG 195

HOT WATER

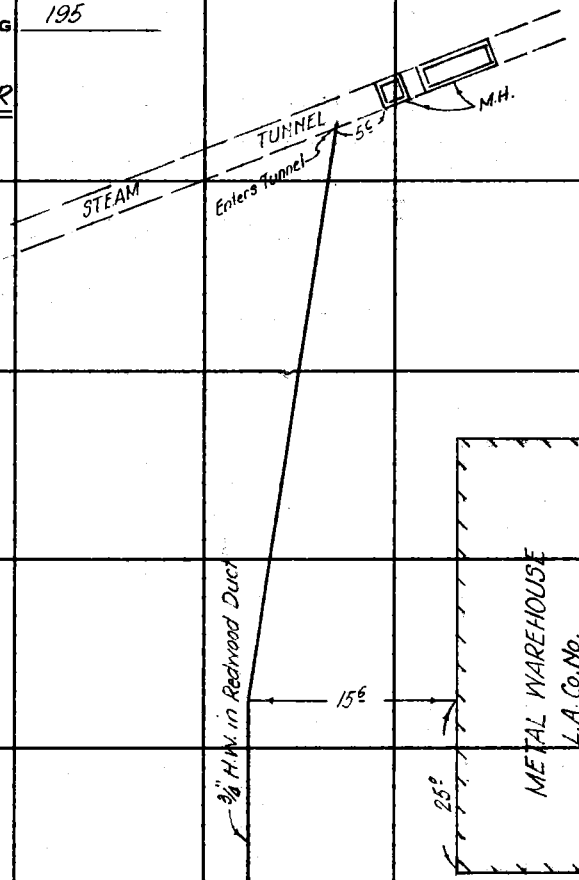


PLEASE RETURN TO
LOS ANGELES COUNTY ENGINEER
403 Los Angeles County Engineering Bldg.

Do not extend this side of this line.

Note: Any Additions or Changes on This Sheet Must be Made or Circled in Red Ink With Date and Name of Person Making Change.

| | |
|---|---|
| Notes Ck'd by | Survey of OLIVE VIEW HOSPITAL |
| Map No. | JN 0022.08 Tape Std °F |
| Office Work S.S. | Surveyed by |
| Checked | Notes S. SHINODA Date 5/14/63 |
| Date 9-15-63 | Indexed C. J. GALLI |

F. B. 2910 PG. 196

WATER

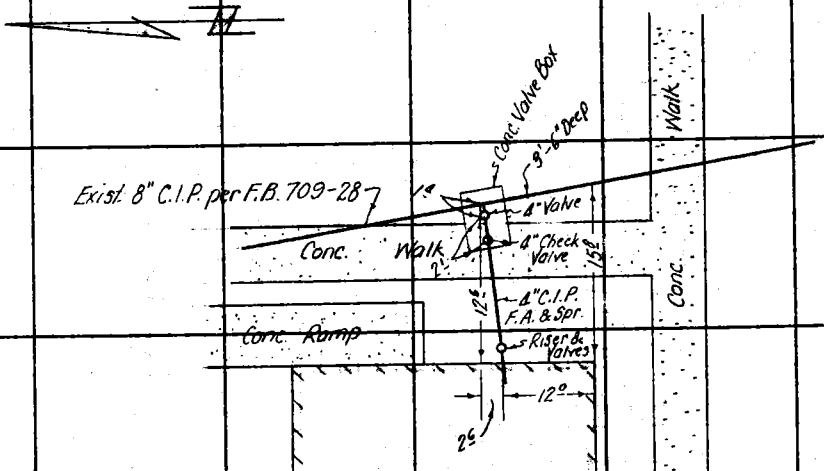


WARD NO. 112

L.A. Co. No. 2177

Note: Any Additions or Changes on This Sheet Must be Made or Circled in Red Ink With Date and Name of Person Making Change.

Do not extend this side of this line.

PLEASE RETURN TO
LOS ANGELES COUNTY ENGINEER
403 Los Angeles County Engineering Bldg.

76F3093 CE #310 6-62

PLEASE RETURN TO
LOS ANGELES COUNTY ENGINEER
403 LOS ANGELES COUNTY ENGINEERING BLDG.

Note: Any Additions or Changes on This Sheet Must be Made or Circled in Red Ink With Date and Name of Person Making Change.

Do not extend this side of this line.

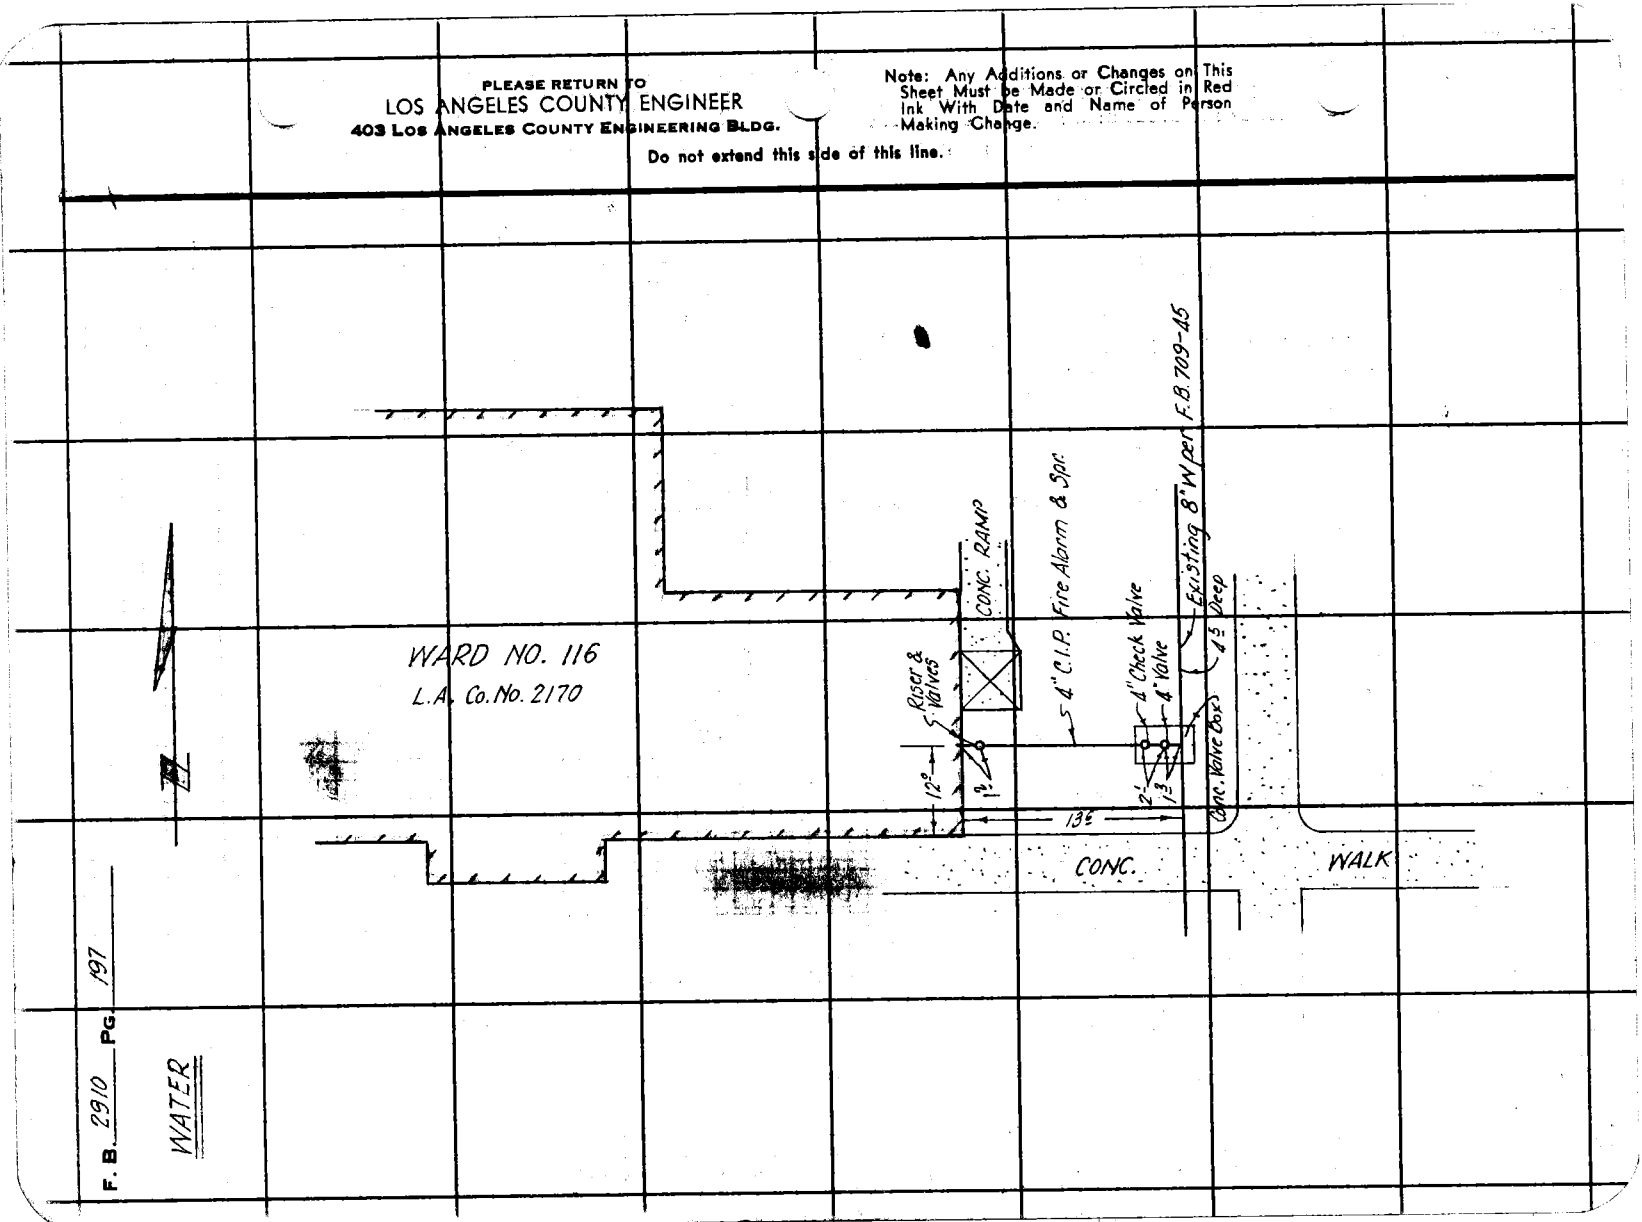


F. B. 2910 PG. 197

WATER

Notes Ck'd by
Map No.
Office Work S.S.
Checked
Date 9-16-63

Survey of OLIVE VIEW HOSPITAL
JN 0022.08 Tape Std °F
Surveyed by
Notes S. SHINODA Date 7/9/63
Indexed C. J. GALLI

F. B. 2910 Pg. 198

WATER

WARD NO. 110
L.A. Co. No. 2167

WARD NO. 108
L.A. Co. No. 2168

WARD NO. 106
L.A. Co. No. 2169

2⁵ 13³ 3⁰ 4" C.I.P.
3' Deep
0⁹
12
Riser & Valves
6" C.I.P.
8⁹
9²
Riser & Valves
Conc. Walk
4'-3" below walk
Fire Alarm & Sprinkler
1⁰
6" C.I.P.
Conc. Walk
1³
4²
1⁰
32" Deep
Riser & Valves
Conc. Steps
2⁵
Existing 6" C.I.P. per F.B. 709-50
Conc Valve Box SEE DETAIL ABOVE
2' Deep
1⁴

DETAIL
Check Valve
4" Riser
1² 1² 6" C.I.P.
1¹
1²
2²
1³
O.S. & Y. Valve
Check Valve
Tapping Valve
6" C.I.P.

Note: Any Additions or Changes on This Sheet Must be Made or Circled in Red Ink With Date and Name of Person Making Change.

PLEASE RETURN TO
LOS ANGELES COUNTY ENGINEER
403 Los Angeles County Engineering Bldg.
Do not extend this side of this line.

76F3095 CE #310 8-62

F. B. 2910 · PG. 199

WATER

WARD NO. 302

L.A. Co. No. 2254

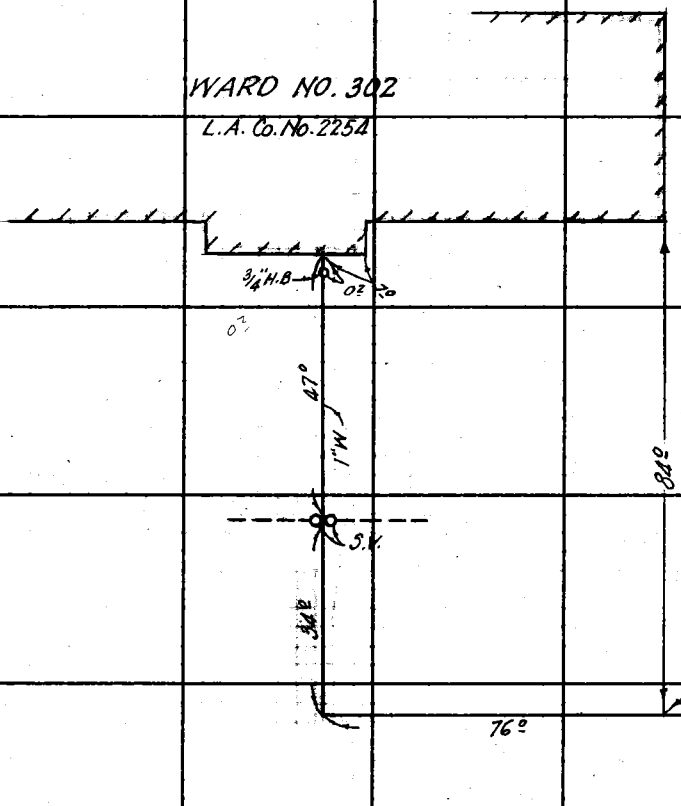


PLEASE RETURN TO
LOS ANGELES COUNTY ENGINEER
403 Los Angeles County Engineering Bldg.

Do not extend this side of this line.

Note: Any Additions or Changes on This Sheet Must be Made or Circled in Red Ink With Date and Name of Person Making Change.

| | |
|---|---|
| Notes Ck'd by | Survey of OLIVE VIEW HOSPITAL |
| Map No. | JN 0022.08 Tape Std °F |
| Office Work S.S. | Surveyed by |
| Checked | Notes S. SHINODA Date 9-4-63 |
| Date 9-16-63 | Indexed C. J. GALLI |

F. B. 2910 PG. 200

SEE PAGE 201

WATER

6" C.I.P. Fire Alarm & Sprinkler

6"

6"

L.A. Co. No. 2233

WARD NO 109
L.A. Co. No. 2232

18

44.4

4" C.I.P.

4" Riser & Valves

0.5

3.5

3.9

23

6" Valve

Existing 6" Transite pipe per F.B. 2910-52

PLEASE RETURN TO
LOS ANGELES COUNTY ENGINEER
403 LOS ANGELES COUNTY ENGINEERING BLDG.

Note: Any Additions or Changes on This Sheet Must Be Made or Circled in Red Ink With Date and Name of Person Making Change.

Do not extend this side of this line.

76F3095 CE #310 6-62

PLEASE RETURN TO
LOS ANGELES COUNTY ENGINEER
403 LOS ANGELES COUNTY ENGINEERING BLDG.

Note: Any Additions or Changes on This Sheet Must be Made or Circled in Red Ink With Date and Name of Person Making Change.

Do not extend this side of this line.

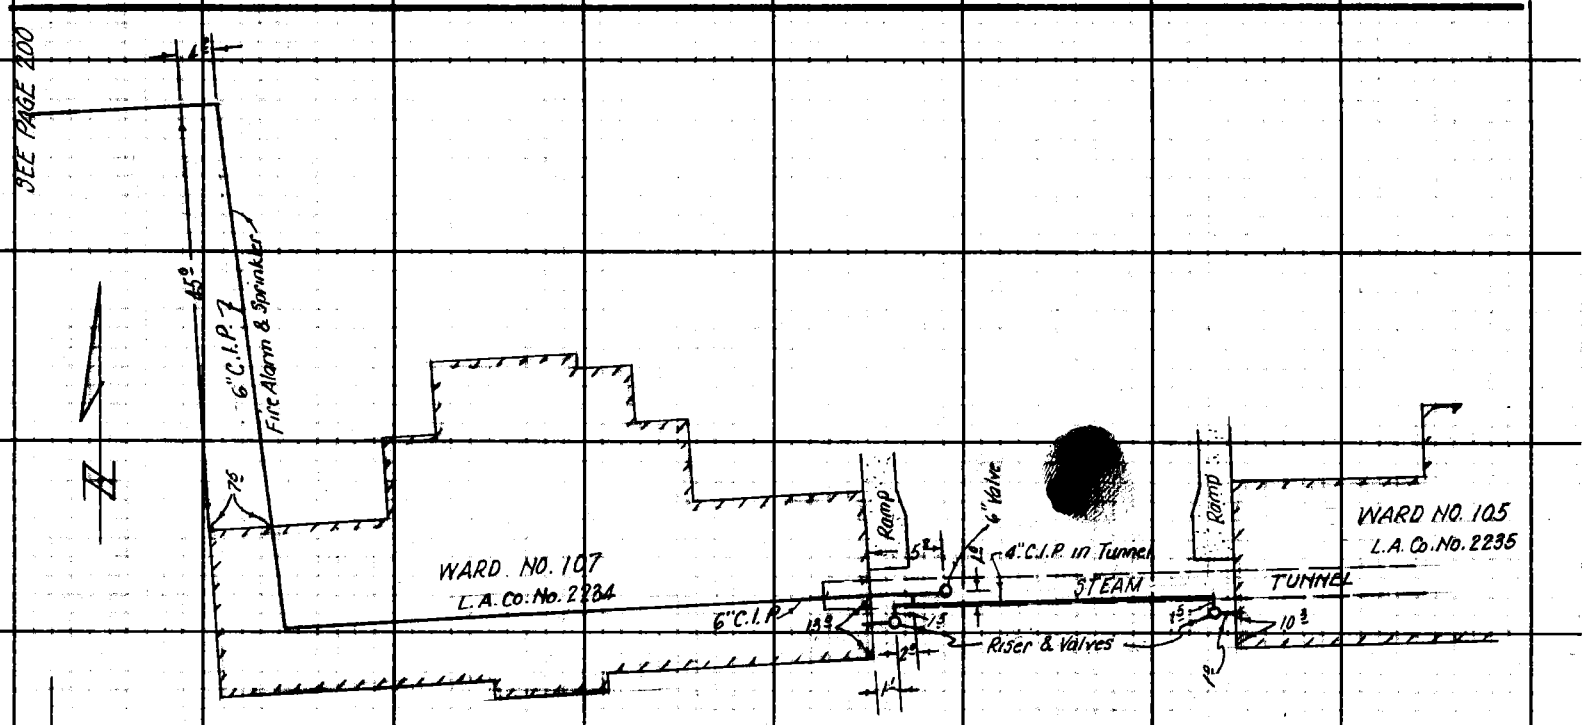


F. B. 2910 Pg. 201

WATER

| | |
|---|---|
| Notes Ck'd by | Survey of OLIVE VIEW HOSPITAL |
| Map No. | JN 2022.08 Tape Std °F |
| Office Work S.S | Surveyed by |
| Checked | Notes J. SHIMODA Date 4-26-63 |
| Date 9/16/63 | Indexed C. J. GALLI |

F. B. 2910 Pg. 202

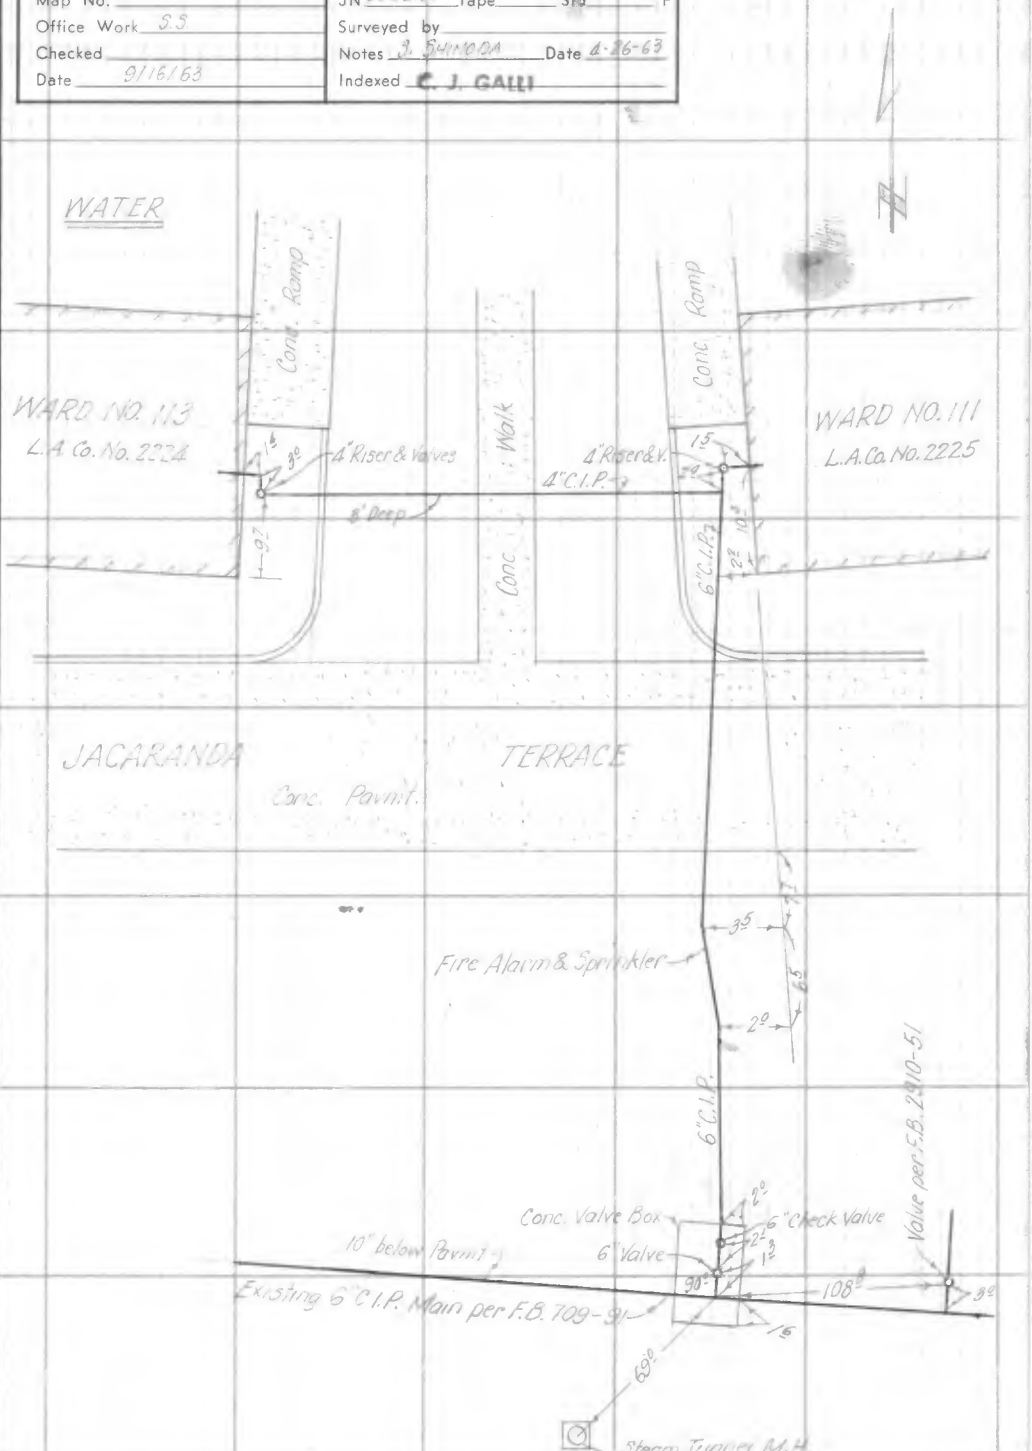


Note: Any Additions or Changes on This Sheet Must be Made or Circled in Red Ink With Date and Name of Person Making Change.

Do not extend this side of this line.

PLEASE RETURN TO
LOS ANGELES COUNTY ENGINEER
403 LOS ANGELES COUNTY ENGINEERING BLDG.

76F309S CE #310 6-62

PLEASE RETURN TO
LOS ANGELES COUNTY ENGINEER
403 LOS ANGELES COUNTY ENGINEERING BLDG.

Note: Any Additions or Changes on This Sheet Must be Made or Circled in Red Ink With Date and Name of Person Making Change.

Do not extend this side of this line.

LAUNDRY BLDG.
L.A. Co. No. 2521

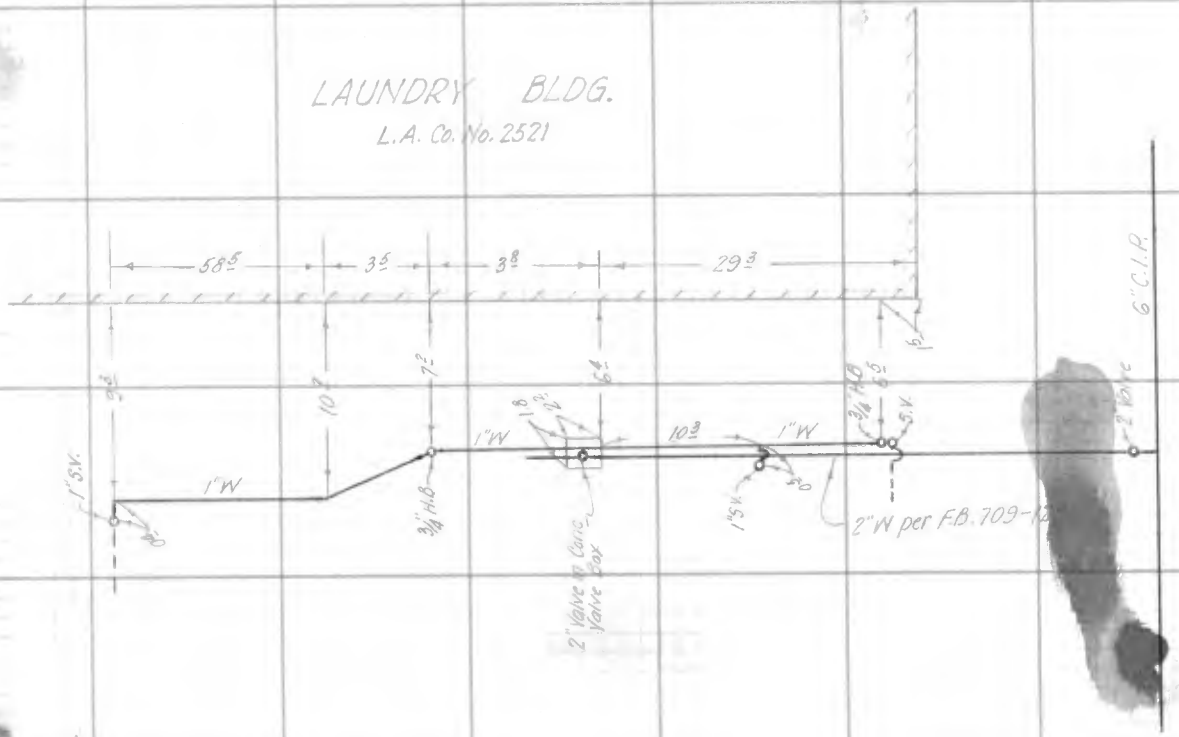


F. B. 2910 Pg 208

WATER

| | |
|---|---|
| Notes Ck'd by | Survey of OLIVE VIEW HOSPITAL |
| Map No. | JN 00222.08 Tape Std °F |
| Office Work S.S. | Surveyed by J. TERRANOVA |
| Checked | Notes J.T. Date 4-12-63 |
| Date 5/23/63 | Indexed C. J. GALLI |

F. B. 2910 PG. 204

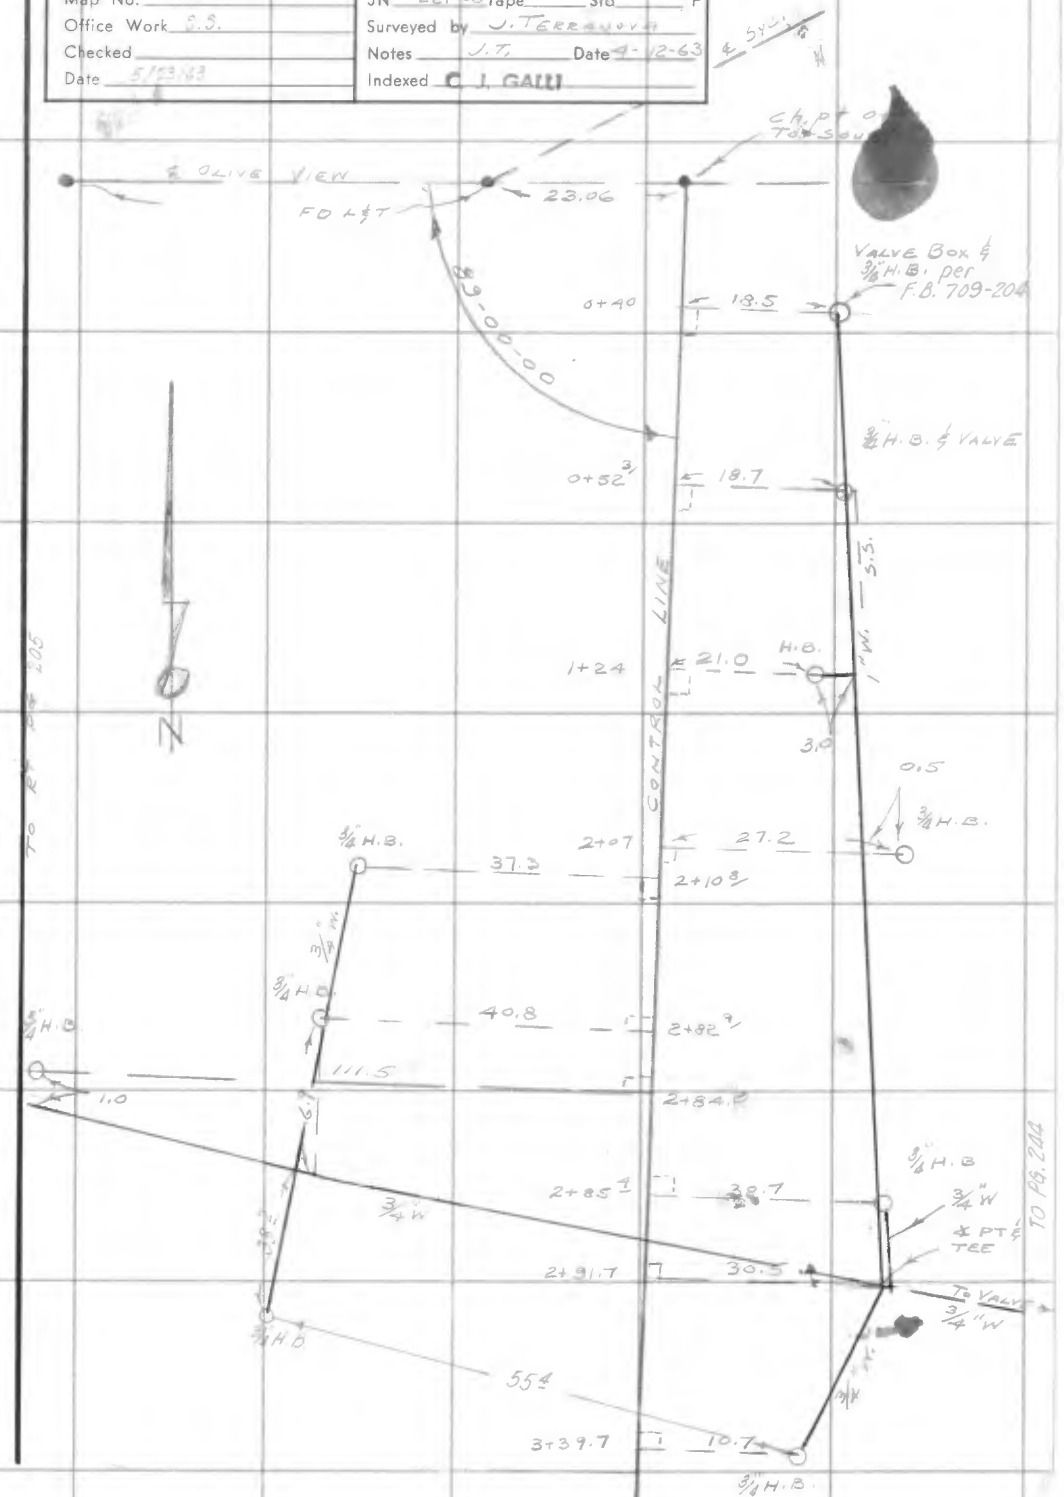


PLEASE RETURN TO
LOS ANGELES COUNTY ENGINEER
403 LOS ANGELES COUNTY ENGINEERING BLDG.

Note: Any Additions or Changes on This Sheet Must be Made or Circled in Red Ink With Date and Name of Person Making Change.

Do not extend this side of this line.

76F3095 CE # 310 3-61

PLEASE RETURN TO
LOS ANGELES COUNTY ENGINEER
403 LOS ANGELES COUNTY ENGINEERING BLDG.

Note: Any Additions or Changes on This Sheet Must be Made or Circled in Red Ink With Date and Name of Person Making Change.

Do not extend this side of this line.

| | |
|---|---|
| Notes Ck'd by | Survey of CLIVE VIEW HOSPITAL |
| Map No. | JN 002208 Tape Std °F |
| Office Work S.S | Surveyed by |
| Checked | Notes S. SHIMODA Date 2/26/63 |
| Date 3/6/63 | Indexed C. J. GALLI |

F. B. 2910 PG. 206

WATER

CYPRESS AVE.

N

TO F.B. 2910-210

SEE PG 207

SEE PG 207

Note: Any Additions or Changes on This Sheet Must be Made or Circled in Red Ink With Date and Name of Person Making Change.

Do not extend this side of this line.

PLEASE RETURN TO
LOS ANGELES COUNTY ENGINEER
403 Los Angeles County Engineering Bldg.

76F309S CE #310 6-62

PLEASE RETURN TO
LOS ANGELES COUNTY ENGINEER
403 LOS ANGELES COUNTY ENGINEERING BLDG.

Note: Any Additions or Changes on This Sheet Must be Made or Circled in Red Ink With Date and Name of Person Making Change.

Do not extend this side of this line.

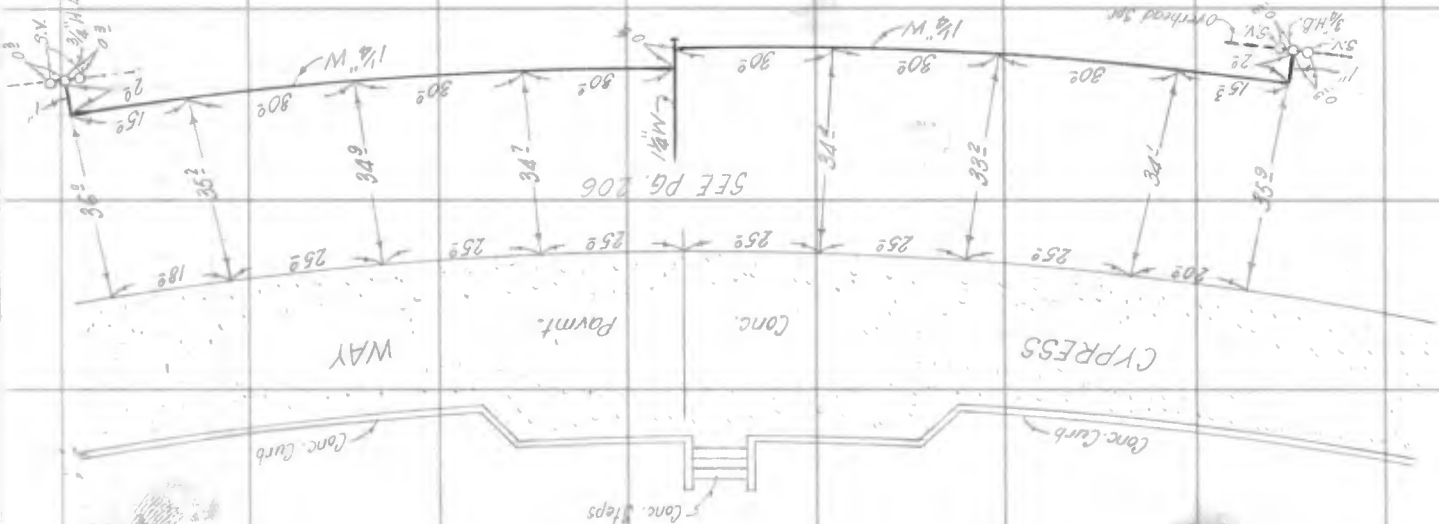


F. B. 2910 Pg. 207

WATER

N

| | |
|---|---|
| Notes Ck'd by | Survey of OLIVE VIEW HOSPITAL |
| Map No. | JN 0022.08 Tape Std °F |
| Office Work S.S. | Surveyed by |
| Checked | Notes S. SHINODA Date 2/25/63 |
| Date 5/6/63 | Indexed C. J. GALLI |

F. B. 8910 PG. 208

TO PG. 210

Note: Any Additions or Changes on This Sheet Must be Made or Circled in Red Ink With Date and Name of Person Making Change.

Do not extend this side of this line.

PLEASE RETURN TO
LOS ANGELES COUNTY ENGINEER
403 Los Angeles County Engineering Bldg.

76F309S CE #310 6-62

PLEASE RETURN TO
LOS ANGELES COUNTY ENGINEER
403 LOS ANGELES COUNTY ENGINEERING BLDG.

Note: Any Additions or Changes on This Sheet Must be Made or Circled in Red Ink With Date and Name of Person Making Change.

Do not extend this side of this line.

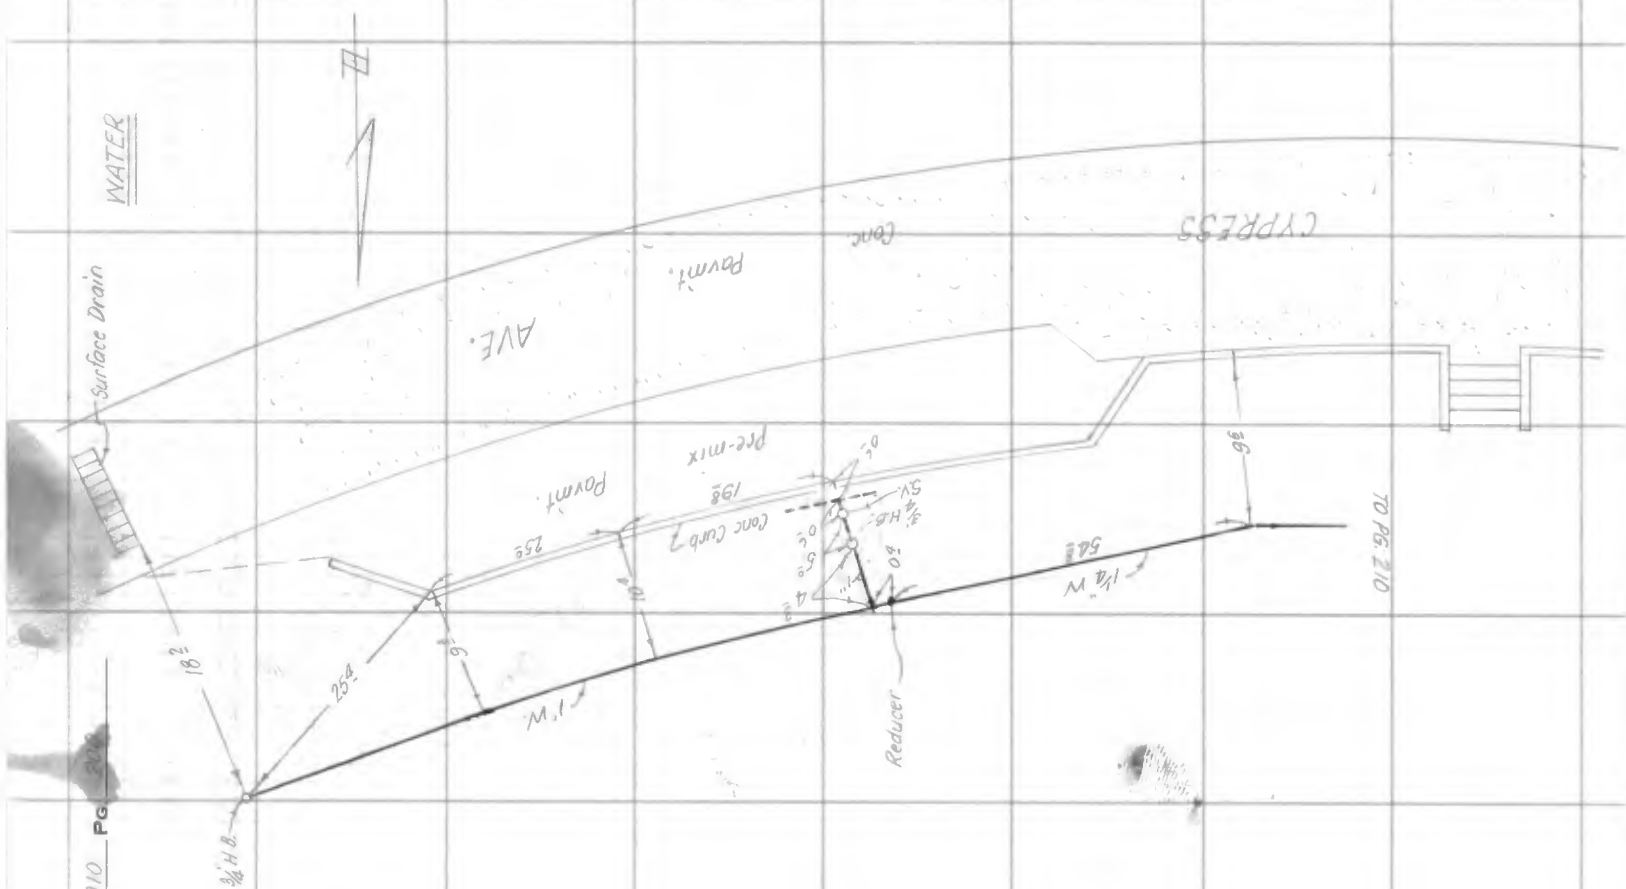


F. B. 2910 Pg. 209

| | |
|---|---|
| Notes Ck'd by | Survey of OLIVE VIEW HOSPITAL |
| Map No. | JN 0022.08 Tape Sta °F |
| Office Work S.S. | Surveyed by |
| Checked | Notes S. SHINODA Date 2/25/63 |
| Date 3/6/63 | Indexed E. I. GALLI |

F. B. 2910 PG. 210

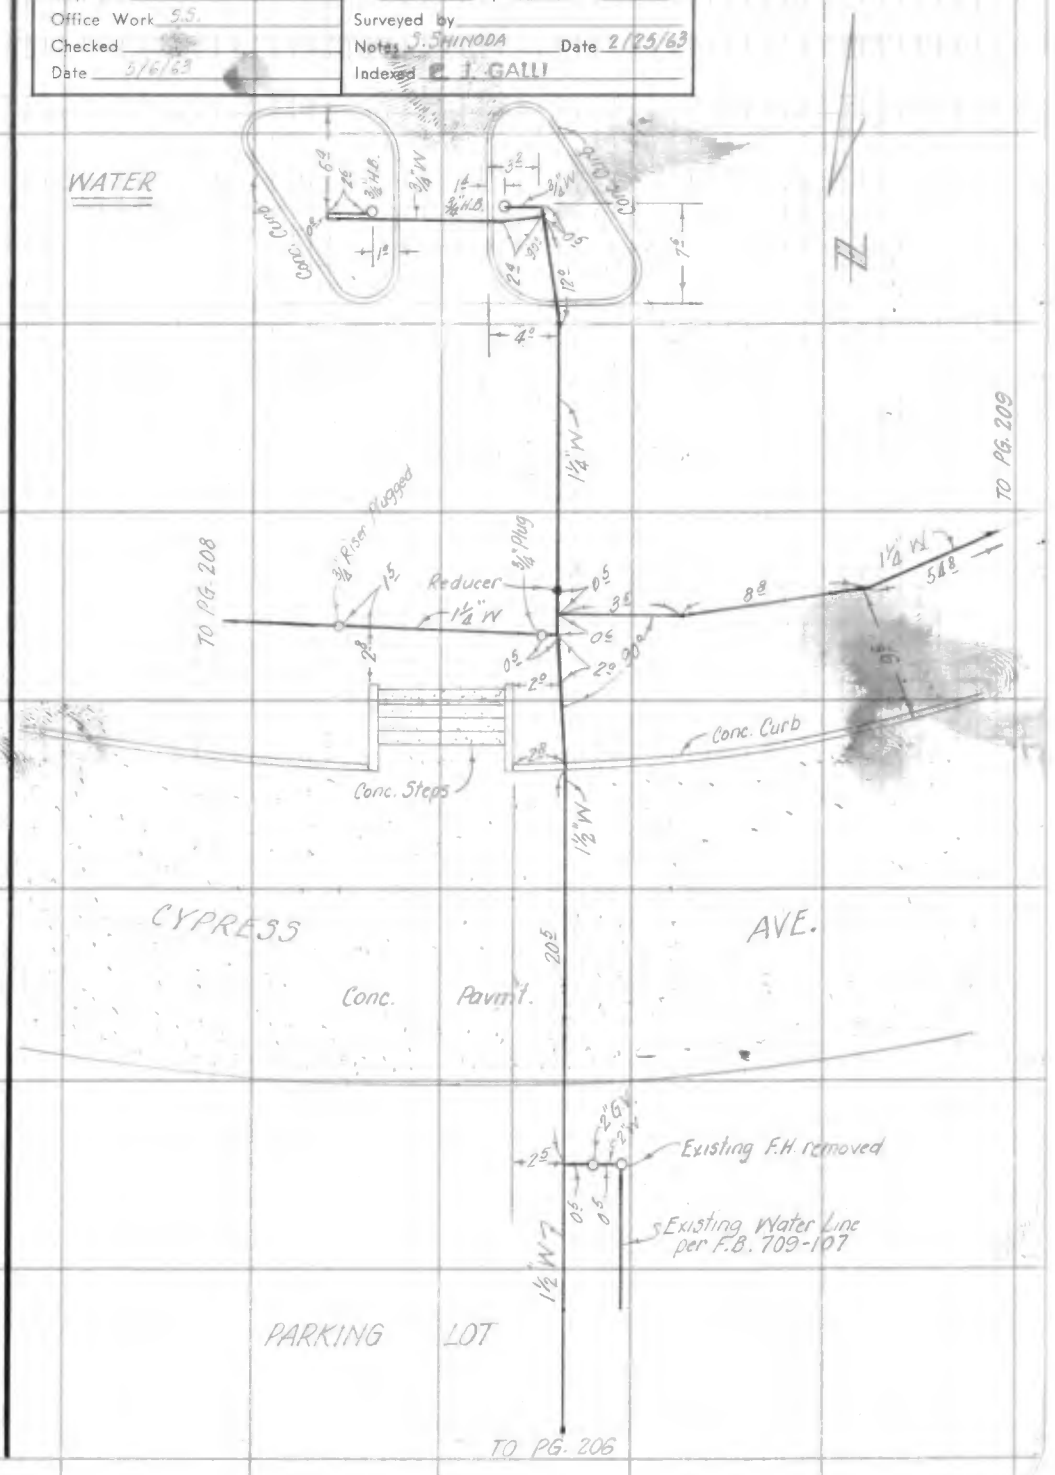


Note: Any Additions or Changes on This Sheet Must be Made or Circled in Red Ink With Date and Name of Person Making Change.

Do not extend this side of this line.

PLEASE RETURN TO
LOS ANGELES COUNTY ENGINEER
403 Los Angeles County Engineering Bldg.

76F309S CE #310 6-62

F. B. 2910 Pg. 214

SEE PG. 214

PLEASE RETURN TO
LOS ANGELES COUNTY ENGINEER
403 Los Angeles County Engineering Bldg.

Do not extend this side of this line.

Note: Any Additions or Changes on This Sheet Must be Made or Circled in Red Ink With Date and Name of Person Making Change.

| | |
|---|---|
| Notes Ck'd by | Survey of OLIVE VIEW HOSPITAL |
| Map No. | JN 0022.08 Tape Std °F |
| Office Work S.S. | Surveyed by |
| Checked | Notes S. SHIMODA Date 2/25/63 |
| Date 5/2/63 | Indexed E. J. GALLI |

F. B. 2910 Pg. 212

Note: Any Additions or Changes on This Sheet Must be Made or Circled in Red Ink With Date and Name of Person Making Change.

Do not extend this side of this line.

PLEASE RETURN TO
LOS ANGELES COUNTY ENGINEER
403 Los Angeles County Engineering Bldg.

76F309S CE #310 6-62

PLEASE RETURN TO
LOS ANGELES COUNTY ENGINEER
403 LOS ANGELES COUNTY ENGINEERING BLDG.

Note: Any Additions or Changes on This Sheet Must be Made or Circled in Red Ink With Date and Name of Person Making Change.

Do not extend this side of this line.

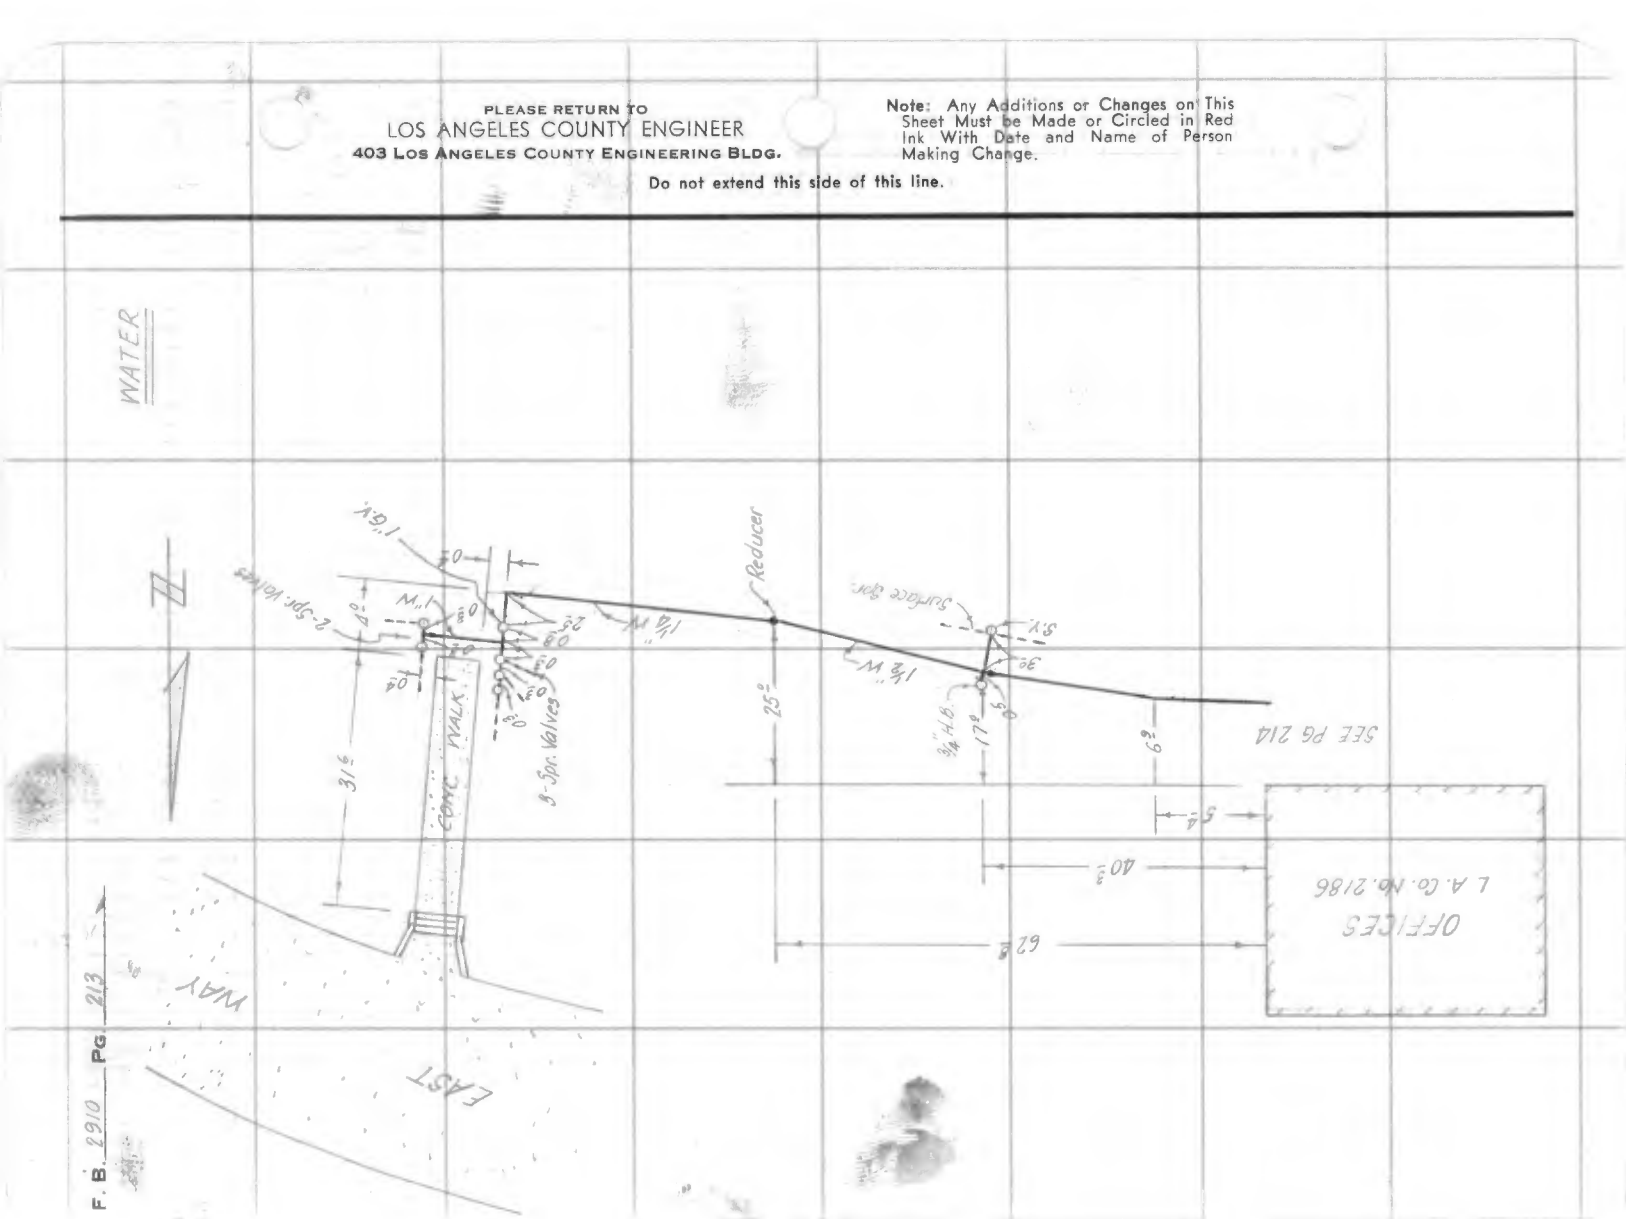


F. B. 2910 Pg 213

Notes Ck'd by
Map No.
Office Work
Checked
Date 5/6/63

Survey of OLIVE VIEW HOSPITAL
JN 0022.08 Tape Std °F
Surveyed by
Notes S. SHIMODA Date 2/25/63
Indexed C. J. GALLI

F. B. 2910 Pg. 214

To Pg. 213

WATER

OFFICES
L.A. Co. No. 2186

Reducer

TO PG. 211

TO PG. 212

Note: Any Additions or Changes on This Sheet Must be Made or Circled in Red Ink With Date and Name of Person Making Change.

Do not extend this side of this line.

PLEASE RETURN TO
LOS ANGELES COUNTY ENGINEER
403 Los Angeles County Engineering Bldg.

76F3095 CE #310 6-62

F. B. 2910 PG. 215

HOT WATER & STEAM

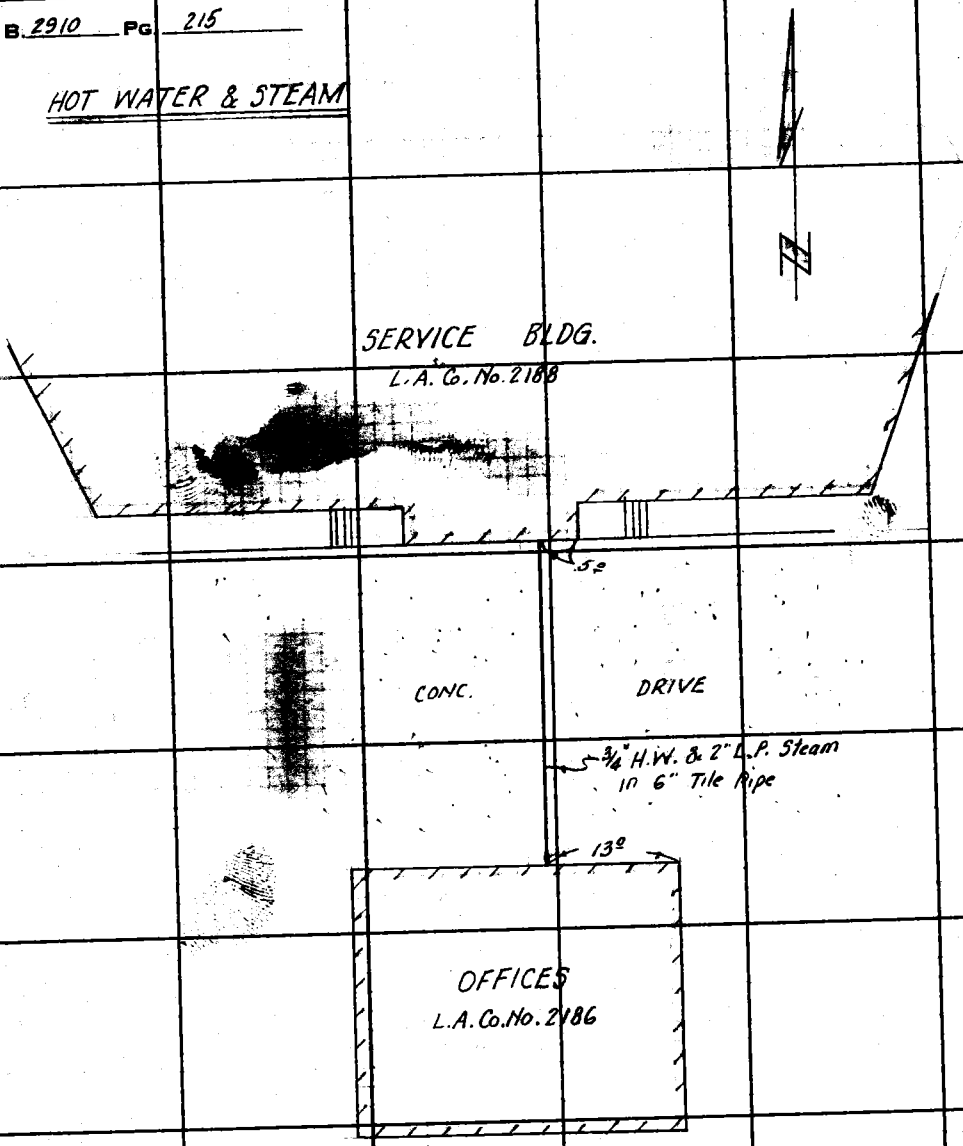


PLEASE RETURN TO
LOS ANGELES COUNTY ENGINEER
403 Los Angeles County Engineering Bldg.

Do not extend this side of this line.

Note: Any Additions or Changes on This Sheet Must be Made or Circled in Red Ink With Date and Name of Person Making Change.

Notes Ck'd by
Map No.
Office Work S.S.
Checked
Date 1/9/63

Survey of OLIVE VIEW HOSPITAL
JN 0022.08 Tape Std °F
Surveyed by J. TERRANOVA
Notes J.T. Date 1-5-62
Indexed R. J. GALLI

F. B. 2910 PG. 216
S.S.-2-26-64

Conc. Steps
Conc. Walk
St.
S.S.
3/4" W.
39.5
3.5
Valve
Existing 3/4" W.
25.7
30
25.0
3/4" W.
To Pg. 217
W
Existing
27.2
3/4" H.B.
61.0
Existing Valve
23.0
27.0
1/2" C.W.
1/2" H.W.
0.5
BLDG. U
L.A.CO. #2145
GARAGE
5.0
0.8
12.5
SPR.V.

Note: Any Additions or Changes on this Sheet Must be Made or Circled in Red Ink With Date and Name of Person Making Change.

Do not extend this side of this line.

PLEASE RETURN TO
LOS ANGELES COUNTY ENGINEER
403 Los Angeles County Engineering Bldg.

78F3095 CE # 310 3-61

PLEASE RETURN TO
LOS ANGELES COUNTY ENGINEER
403 LOS ANGELES COUNTY ENGINEERING BLDG.

Note: Any Additions or Changes on This Sheet Must be Made or Circled in Red Ink With Date and Name of Person Making Change.

Do not extend this side of this line.

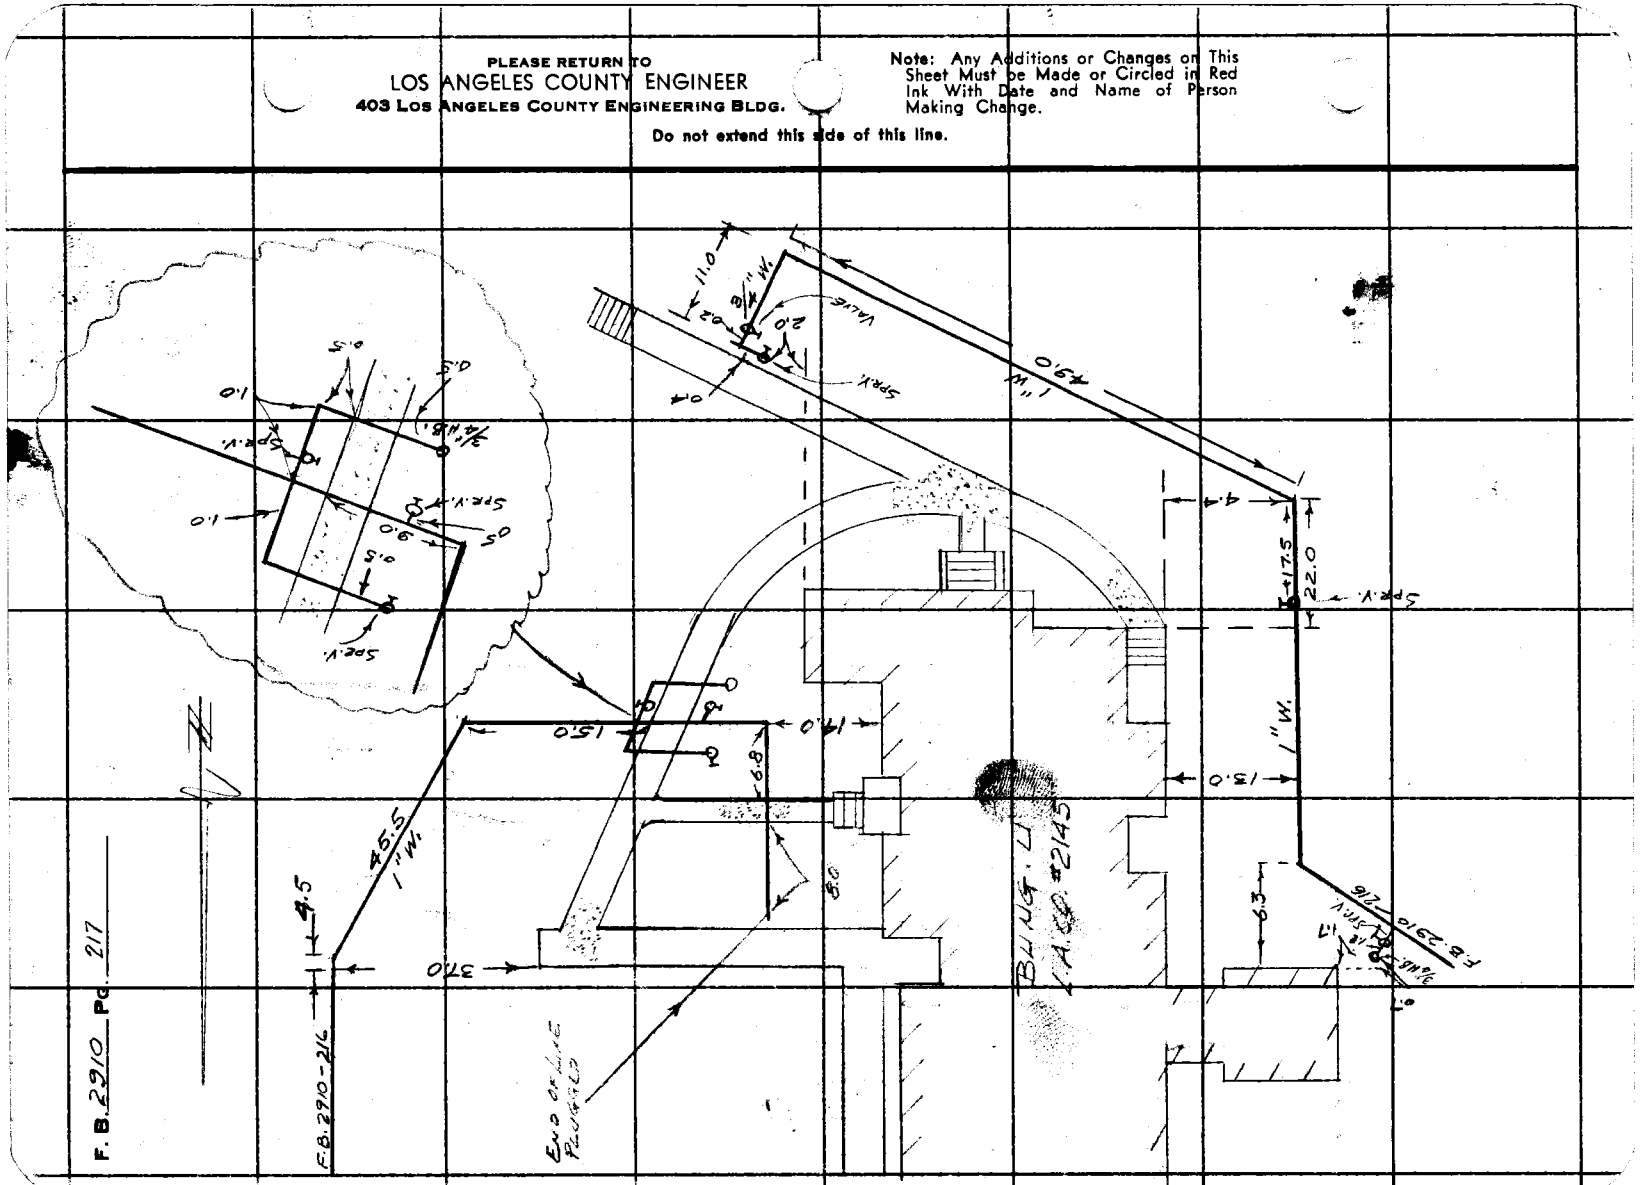

76F3098 CE # 310 3-61

PLEASE RETURN TO
LOS ANGELES COUNTY ENGINEER
403 LOS ANGELES COUNTY ENGINEERING BLDG.

Note: Any Additions or Changes on This Sheet Must be Made or Circled in Red Ink With Date and Name of Person Making Change.

Do not extend this side of this line.

Notes Ck'd by
Map No.
Office Work 3.3.
Checked
Date 12/10/62

JN 022.08 Tape
Surveyed by J. F. [illegible] °F
Notes Date 5-62
Indexed C. J. GALLI

3.5~1-14-65

SEE F.B. 709-135

COTT 6
L.A.CO. 2163

19.3

0.2

CONC WALK

Spr.

AT EDGE OF WALK

2½" W. VALVES

27.5

F.B. 2910-221

F.B. 709-28

33.6

28.0

3/4" H.B.

3/4" W.

3/4" H.B.

83.0

Spr. Y. 1.0

36.1

5.2

15.0

28.5

19.3

16.0

6" W.

6" G.V.

49.0

Sur. Spr.

6.0

NEW CURB

COBALT AVE.

℄

F.B. 2910 PG. 218

PLEASE RETURN TO
LOS ANGELES COUNTY ENGINEER
403 LOS ANGELES COUNTY ENGINEERING BLDG.

Note: Any Additions or Changes on This Sheet Must be Made or Circled in Red Ink With Date and Name of Person Making Change.

Do not extend this side of this line.

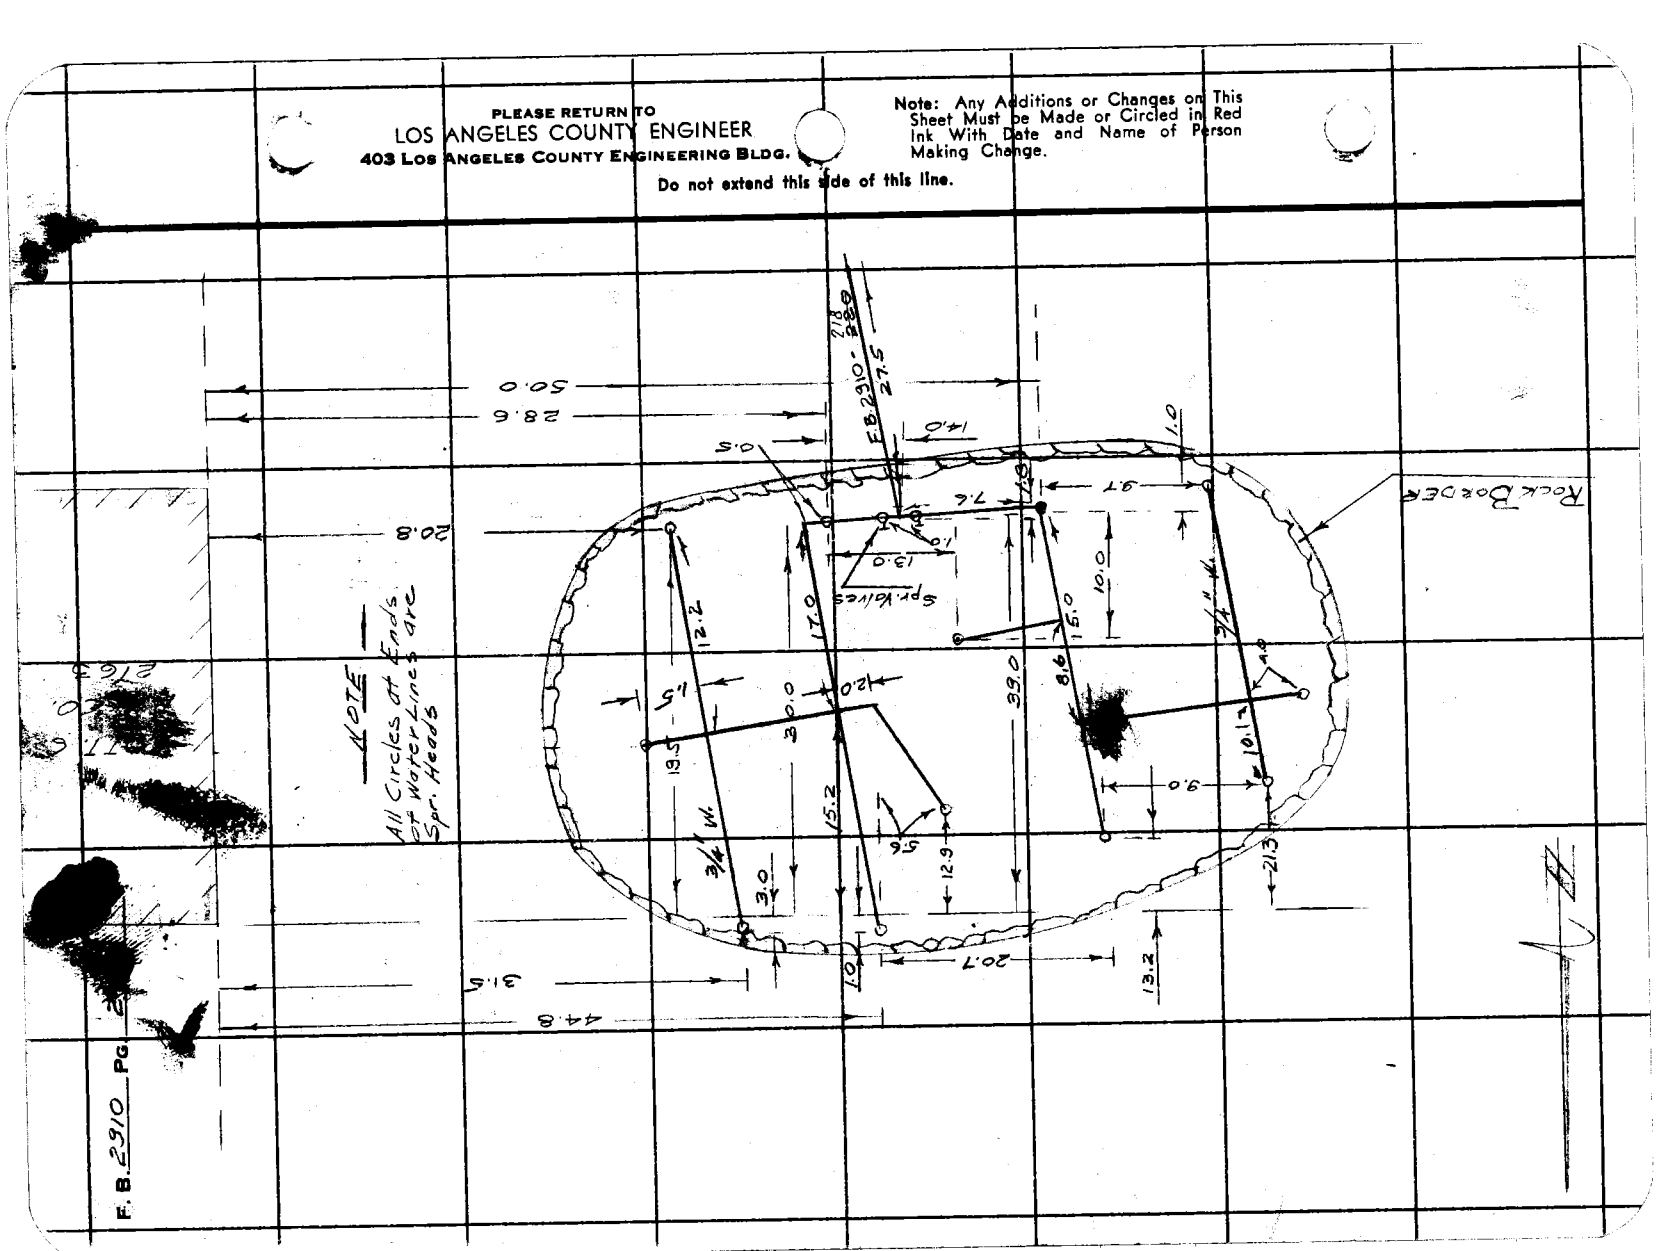

| | |
|---|---|
| Notes Ck'd by | Survey of OLIVE VIEW HOSPITAL F.B. 2910 PG. 220 |
| Map No. | JN 0022.48 Tape Std °F |
| Office Work S.S. | Surveyed by J. TERRANOVA |
| Checked | Notes J.T. Date 11-2-62 |
| Date 12/11/62 | Indexed C. J. GALLI |

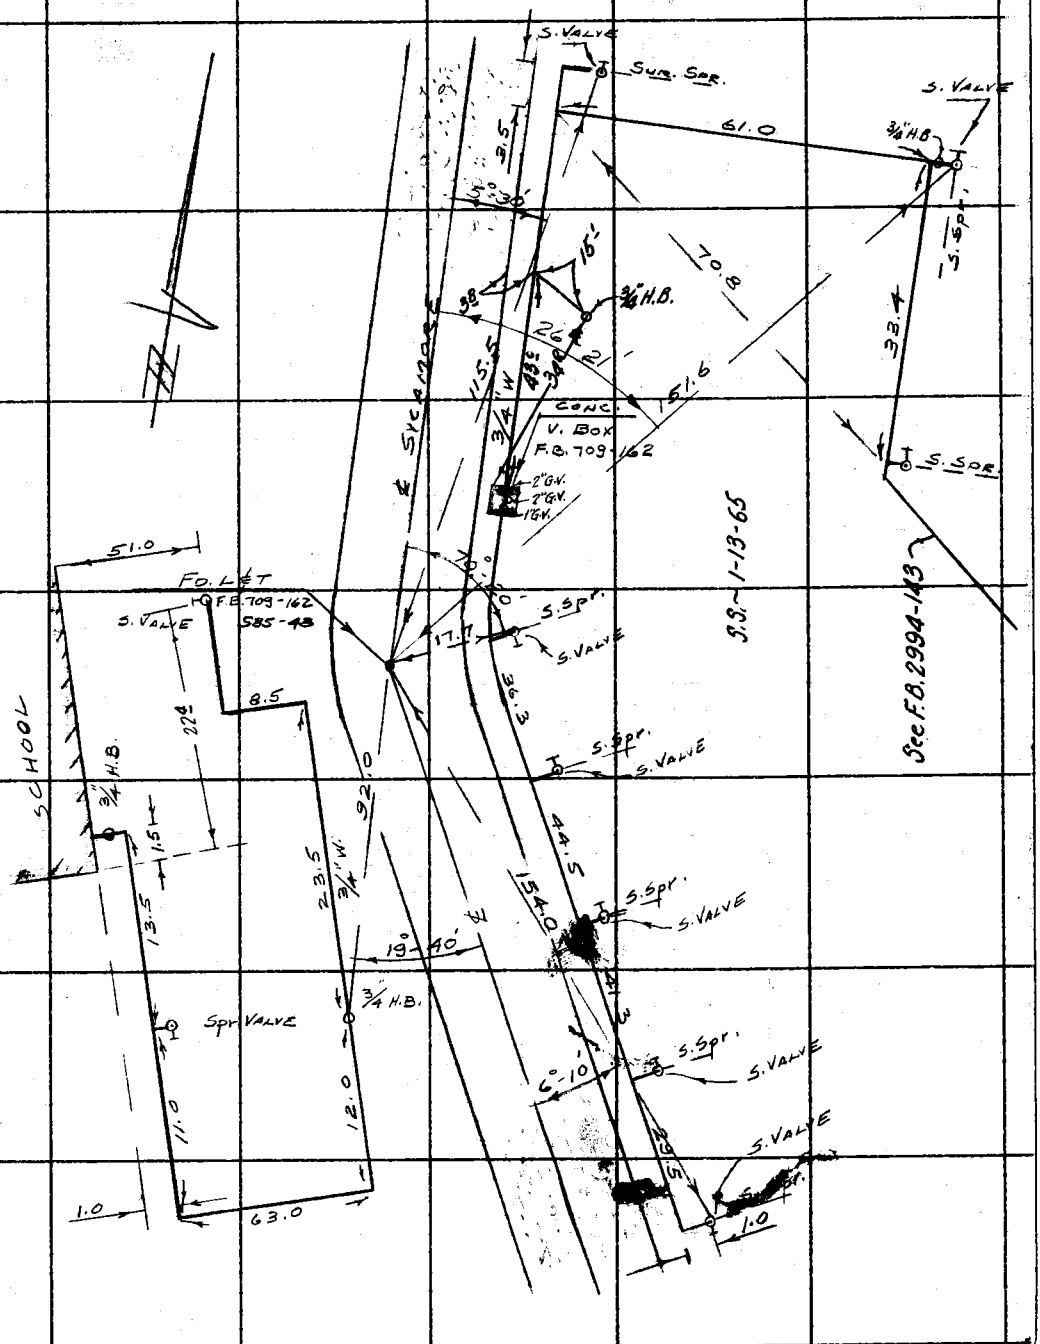


PLEASE RETURN TO
LOS ANGELES COUNTY ENGINEER
403 LOS ANGELES COUNTY ENGINEERING BLDG.

Note: Any Additions or Changes on This Sheet Must be Made or Circled in Red Ink With Date and Name of Person Making Change.
Do not extend this side of this line.

76F3098 CE # 310 2-61

F. B. 2910 PG. 221

See F.B. 2994-502

COBALT AVE.

COTTAGE LANE

LIBRARY

PRE-MIX PARKING

CONC. STEPS

POWER PULL BOX

S. VALVE

1" W.

1¼" W.

1¼ G.V.

3/4" W.

3/4" W.B.

1/2 W.

3/4" W.B.

97.0

18.7

10.5

13.5

23.0

33.0

30.0

53.8

11.0

1.5

17.0

61.5

1.2

76.0

10.0

Please Return To
LOS ANGELES COUNTY ENGINEER
403 Los Angeles County Engineering Bldg.

Do not extend this side of this line.

Note: Any Additions or Changes on This Sheet Must be Made or Circled in Red Ink With Date and Name of Person Making Change.

| | |
|---|---|
| Notes Ck'd by | Survey of OLIVE VIEW HOSPITAL |
| Map No. | JN 0022-63 Tape Std °F |
| Office Work 9.S. | Surveyed by J. TERRANOVA |
| Checked | Notes J. T. Date 10-30-62 |
| Date 12/11/62 | Indexed B. J. GALLI |

F. B. 2910 PG. 222

Note: Any Additions or Changes on this Sheet Must be Made or Circled in Red Ink With Date and Name of Person Making Change.

Do not extend this side of this line.

PLEASE RETURN TO
LOS ANGELES COUNTY ENGINEER
700 Los Angeles County Engineering Bldg.

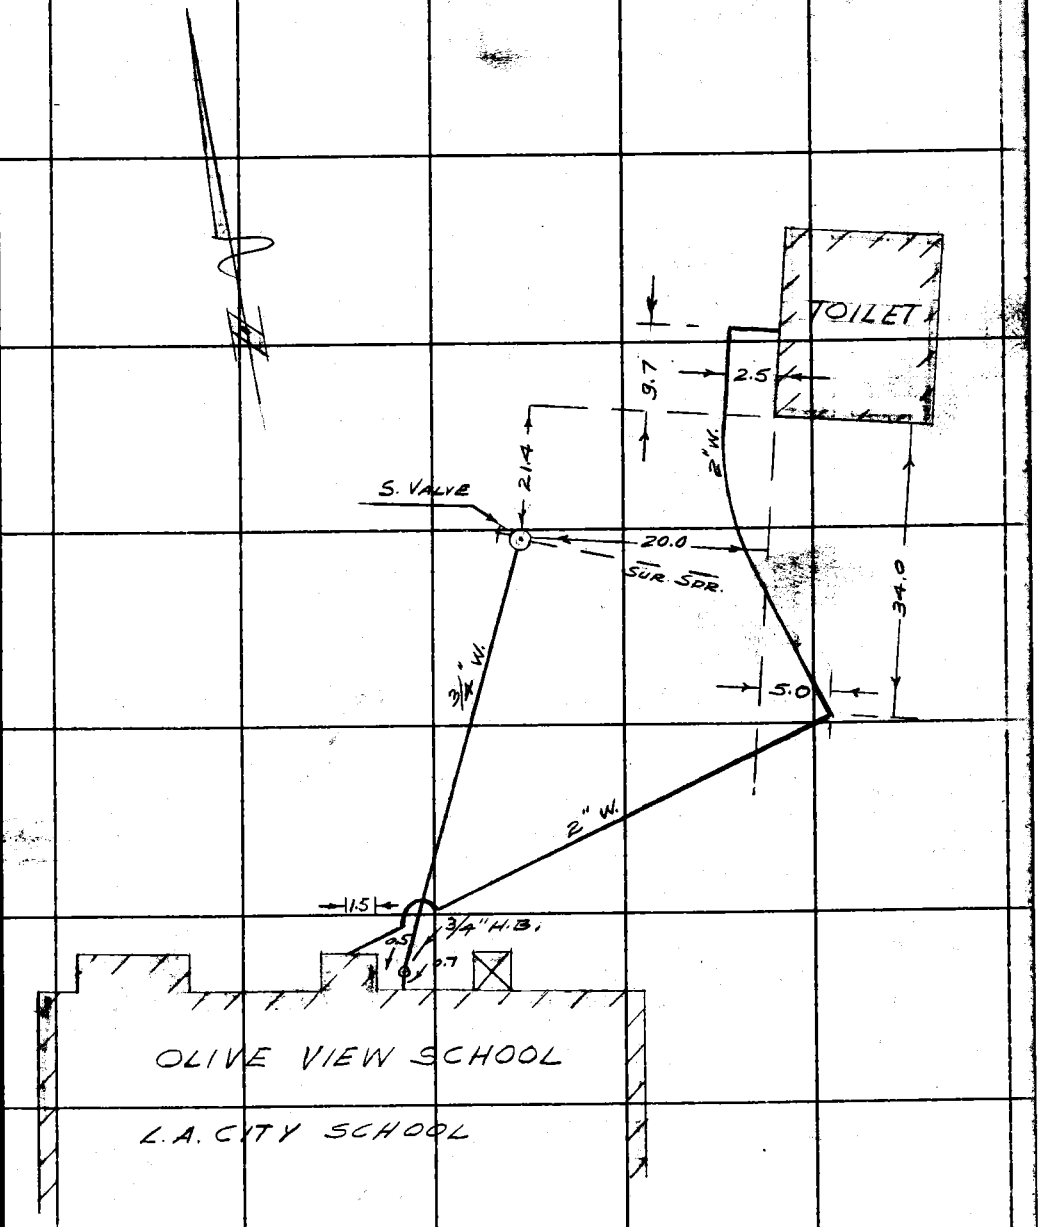


78F3098 SAE #247 11-58

PLEASE RETURN TO
LOS ANGELES COUNTY ENGINEER
700 LOS ANGELES COUNTY ENGINEERING BLDG.

Note: Any Additions or Changes on This Sheet Must be Made or Circled in Red Ink With Date and Name of Person Making Change.

Do not extend this side of this line.

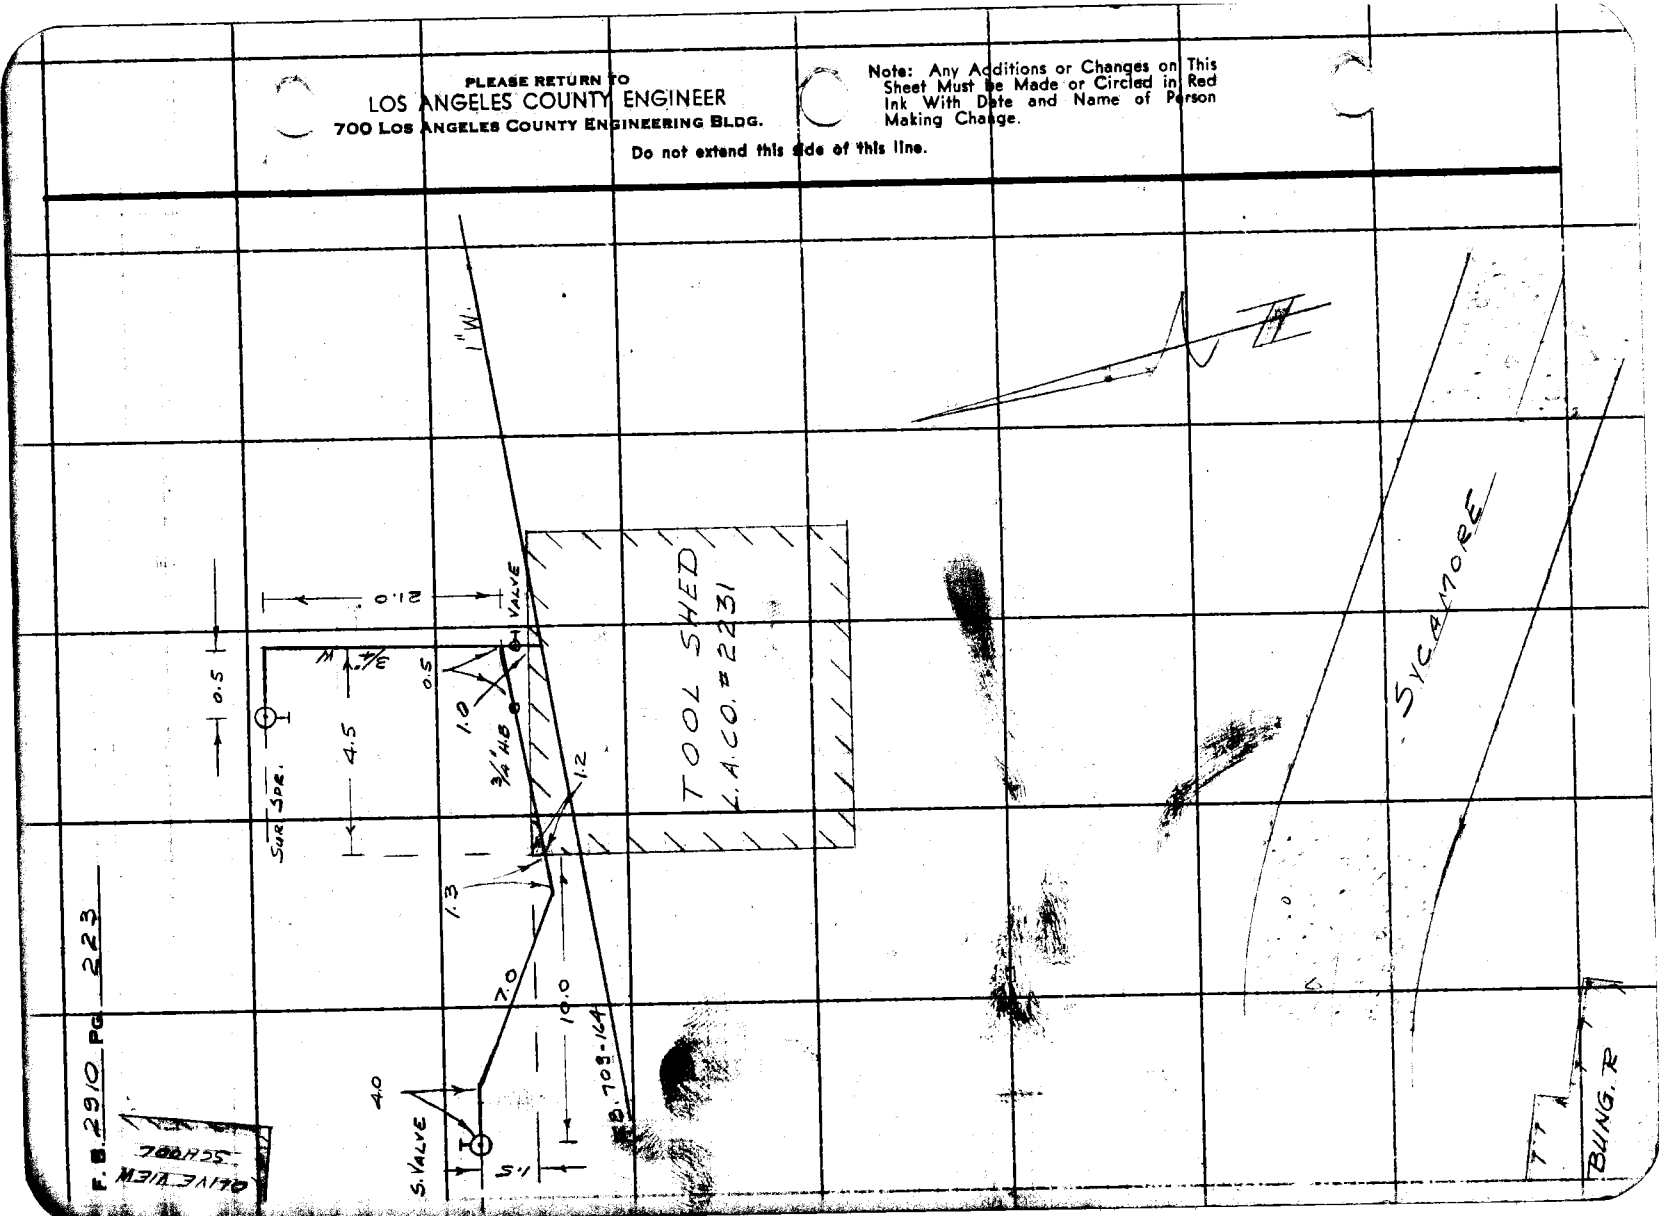

76F3095 CE # 310 2-61

PLEASE RETURN TO
LOS ANGELES COUNTY ENGINEER
403 LOS ANGELES COUNTY ENGINEERING BLDG.

Note: Any Additions or Changes on This Sheet Must be Made or Circled in Red Ink With Date and Name of Person Making Change.

Do not extend this side of this line.

Notes Ck'd by
Map No.
Office Work S.S.
Checked
Date 12/13/62

Survey of OLIVE VIEW HOSPITAL
JN 2222.03 Tape Std °F
Surveyed by J. TERRANOVA
Notes J.T.
Date 10-24-62
Indexed E. J. GALLI

3/4" H.B.
VALVE
3/4" W.
7.0
3/4" H.B.
3/4" H.B.
44.0
S.S.
S.S.
72.3
49.3
38.5
50.7
20.0
26.3
3.0
3.0
10.2
0.4
3/4" W.
3/4" H.B.
16.5
55.3
3/4" H.B.
16.0
VALVE
FB 709-224
4.7
2" V.
5.5
5.5
6.5
7.2
0.5
WARD 310
L.A.CO. 2173
1.5
3/4" H.B.
9.2
3/4" H.B.
3/4" H.B.
3/4" W.
39.0
33.0
3.5
3.5
15.0
43.6
25.5
OLIVE VIEW AVE
℄
112.5

FB 291 PG. 224

F. B. 2910 PG. 225




COLD & HOT WATER
STEAM TO CAN STER. BLDG.

PLEASE RETURN TO
LOS ANGELES COUNTY ENGINEER
403 Los Angeles County Engineering Bldg.

Do not extend this side of this line.

Note: Any Additions or Changes on This Sheet Must Be Made or Circled in Red Ink With Date and Name of Person Making Change.

| | |
|---|---|
| Notes Ck'd by | Survey of |
| Map No. | JN 0022.08 Tape Std °F |
| Office Work S.S. | Surveyed by J. TERRANOVA |
| Checked | Notes J.W. MOORE Date 10-16-62 |
| Date 12-14-62 | Indexed C. J. GALLI |

F. B. 2910 Pg. 226

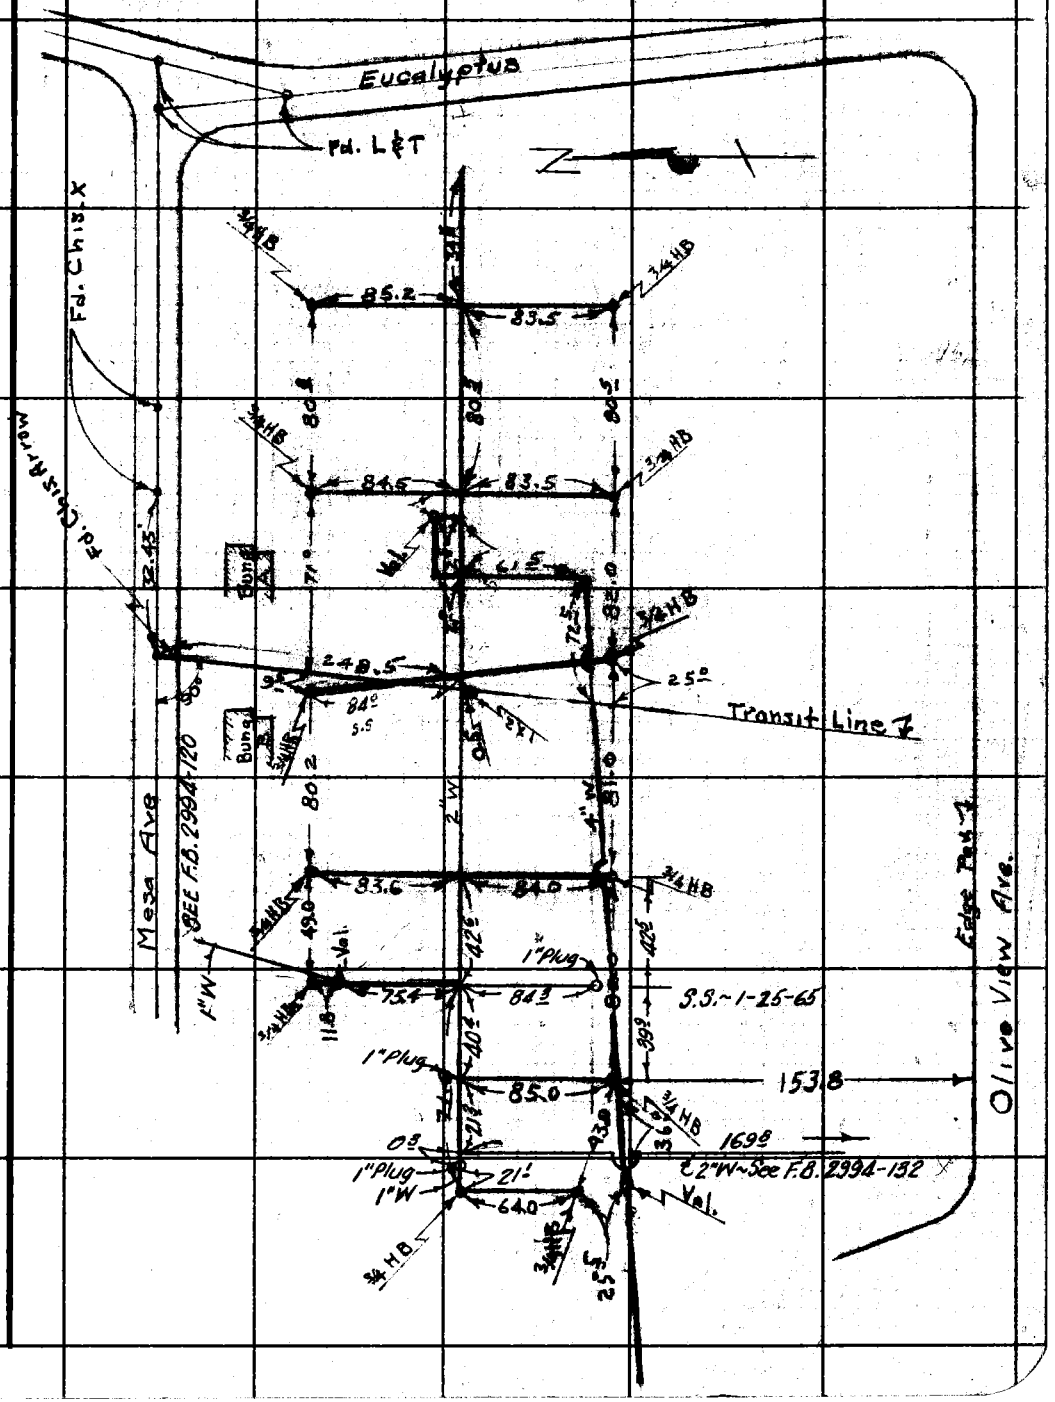


Note: Any Additions or Changes on This Sheet Must be Made or Circled in Red Ink With Date and Name of Person Making Change.

Do not extend this side of this line.

PLEASE RETURN TO
LOS ANGELES COUNTY ENGINEER
403 LOS ANGELES COUNTY ENGINEERING BLDG.

76F3085 GE # 310 2-61

F. B. 2910 PG. 227

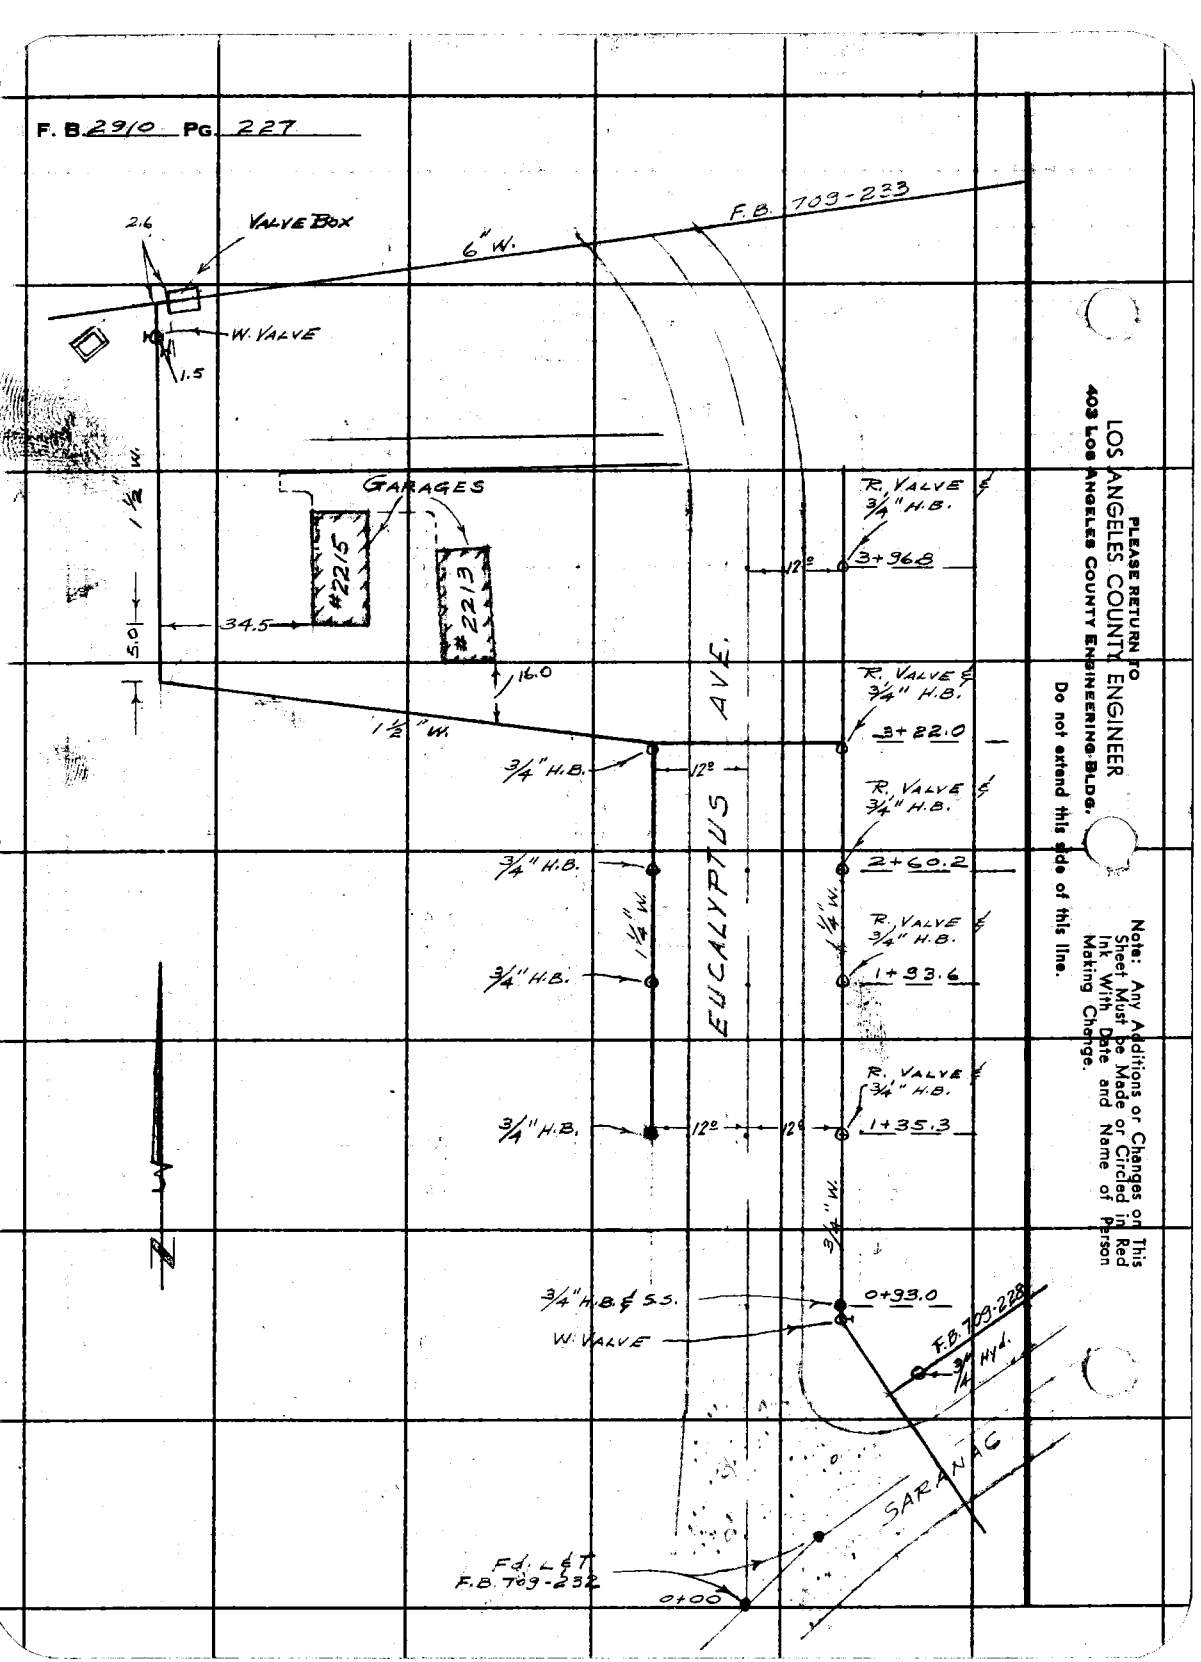


PLEASE RETURN TO
LOS ANGELES COUNTY ENGINEER
403 Los Angeles County Engineering Bldg.

Do not extend this side of this line.

Note: Any Additions or Changes on This Sheet Must be Made or Circled in Red Ink With Date and Name of Person Making Change.

| | |
|---|---|
| Notes Ck'd by | Survey of Olive View Hospital |
| Map No. | JN 0022.08 Tape Std °F |
| Office Work S.S. | Surveyed by M. Sotro |
| Checked | Notes S.S. & M.S. Date 10-30-61 |
| Date 12-17-62 | Indexed E. J. GALLI |

F. B. 2910 Pg. 228

# WATER LINES

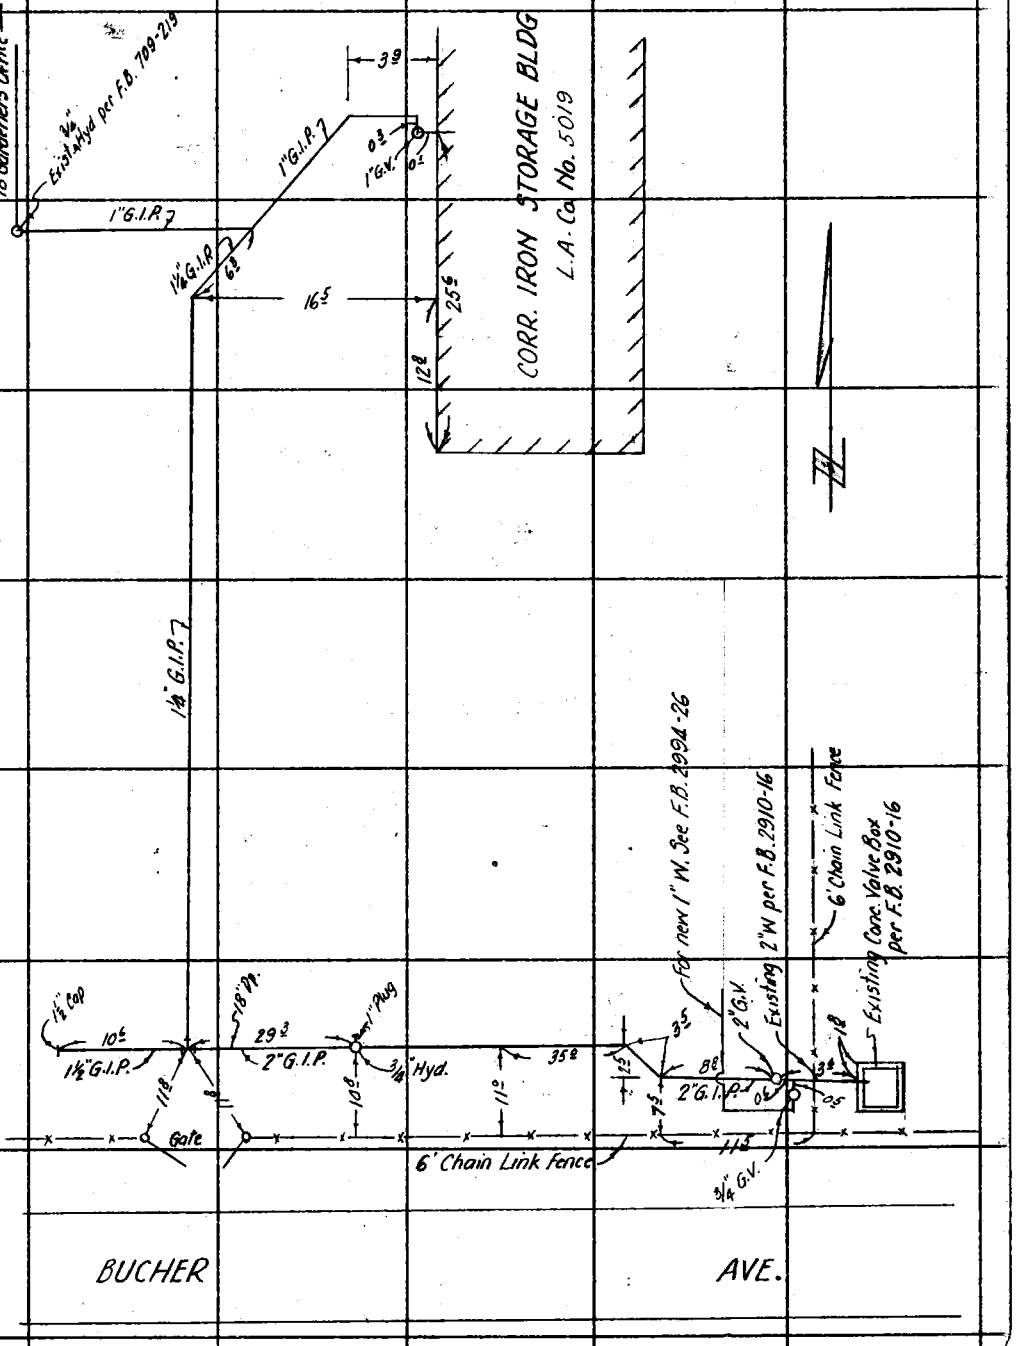


Note: Any Additions or Changes on This Sheet Must be Made or Circled in Red Ink With Date and Name of Person Making Change.

Do not extend this side of this line.

PLEASE RETURN TO
LOS ANGELES COUNTY ENGINEER
403 LOS ANGELES COUNTY ENGINEERING BLDG.

76F3095 CE # 310 3-61

F. B. 2910 Pg. 229

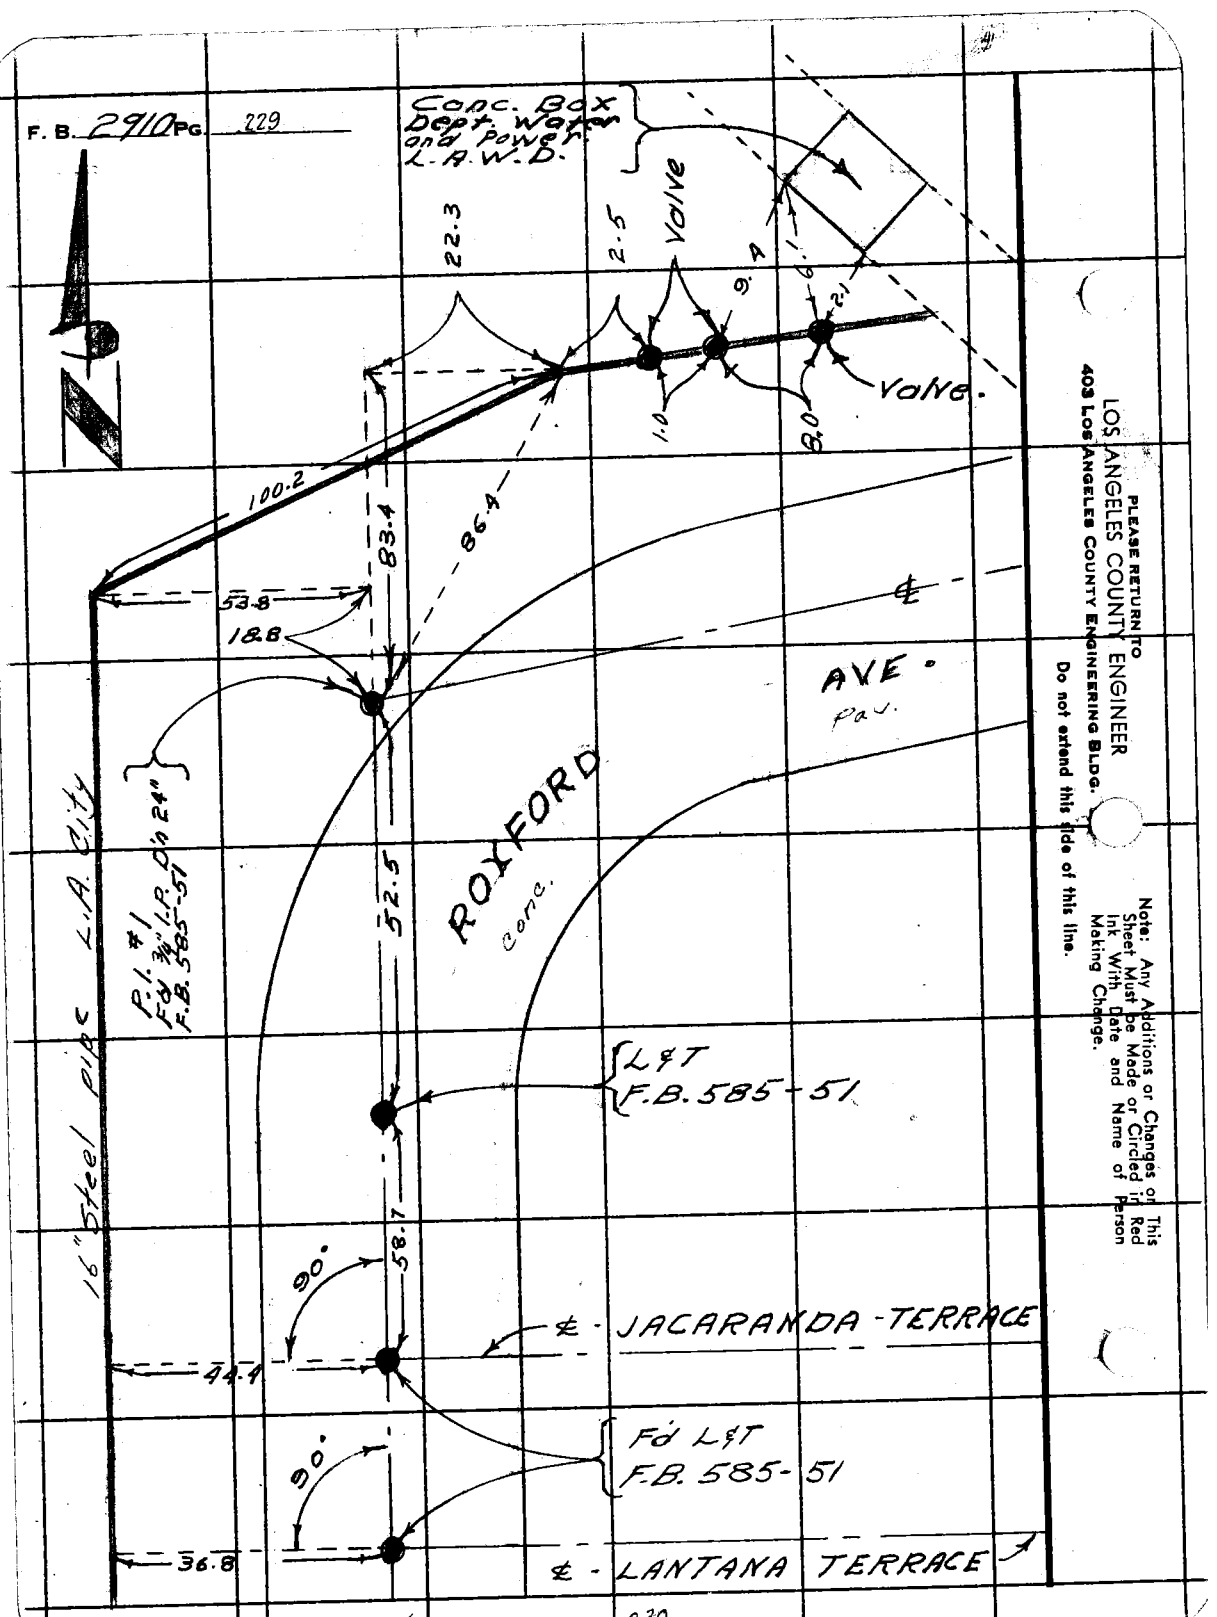


Cont. top page 230

PLEASE RETURN TO
LOS ANGELES COUNTY ENGINEER
403 Los Angeles County Engineering Bldg.

Do not extend this side of this line.

Note: Any Additions or Changes on This Sheet Must be Made or Circled in Red Ink With Date and Name of Person Making Change.

Notes Ck'd by
Map No.
Office Work S.S
Checked
Date 4-6-62

Survey of Olive View Hosp.
JN 20 22.08 Tape Std °F
Surveyed by Sotro
Notes Sotro Date 10-31-61
Indexed J. GALLI

F. B. 2910 PG. 230

Cont. fr. bot. page 229

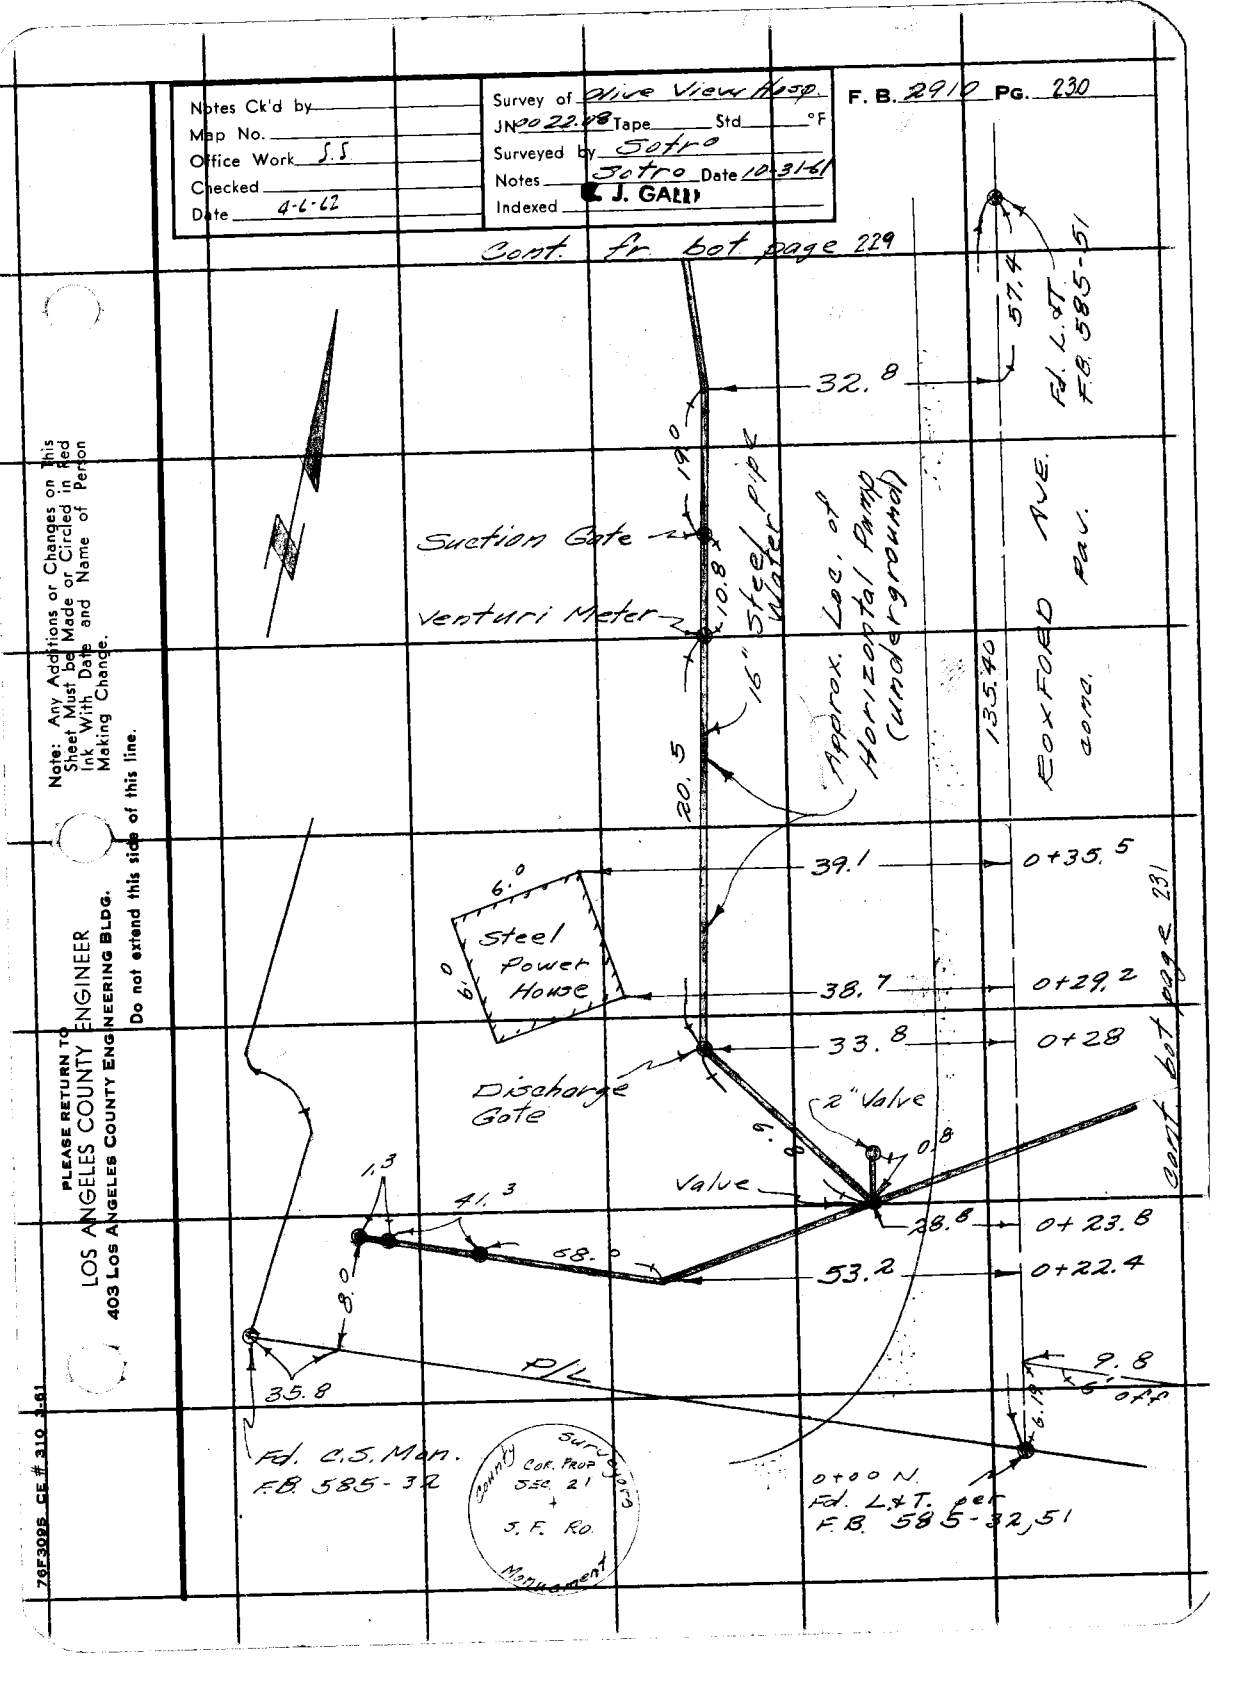


Note: Any Additions or Changes on This Sheet Must be Made or Circled in Red Ink With Date and Name of Person Making Change.

PLEASE RETURN TO
LOS ANGELES COUNTY ENGINEER
403 LOS ANGELES COUNTY ENGINEERING BLDG.
Do not extend this side of this line.

76F3095 CE # 310 1-61

F. B. 2910 PG. 231

cont. bot. page 232

Catch Basin

Ave.

414.6

6.00

35.3

L.A. City (Water)

N.H. 2

45.6

34.0

16" Steel pipe

6' approx. set

Burmere

Pre-sod

640.4

P/L

29.3

9.8

Fd. L. & T. per FB. 585-32

61.9

Boxford

Ave.

cont. to right page 230

PLEASE RETURN TO
LOS ANGELES COUNTY ENGINEER
403 Los Angeles County Engineering Bldg.

Do not extend this side of this line.

Note: Any Additions or Changes on This Sheet Must be Made or Circled in Red Ink With Date and Name of Person Making Change.

76F3098 CE # 310 3-61

PLEASE RETURN TO
LOS ANGELES COUNTY ENGINEER
403 LOS ANGELES COUNTY ENGINEERING BLDG.

Note: Any Additions or Changes on This Sheet Must be Made or Circled in Red Ink With Date and Name of Person Making Change.

Do not extend this side of this line.

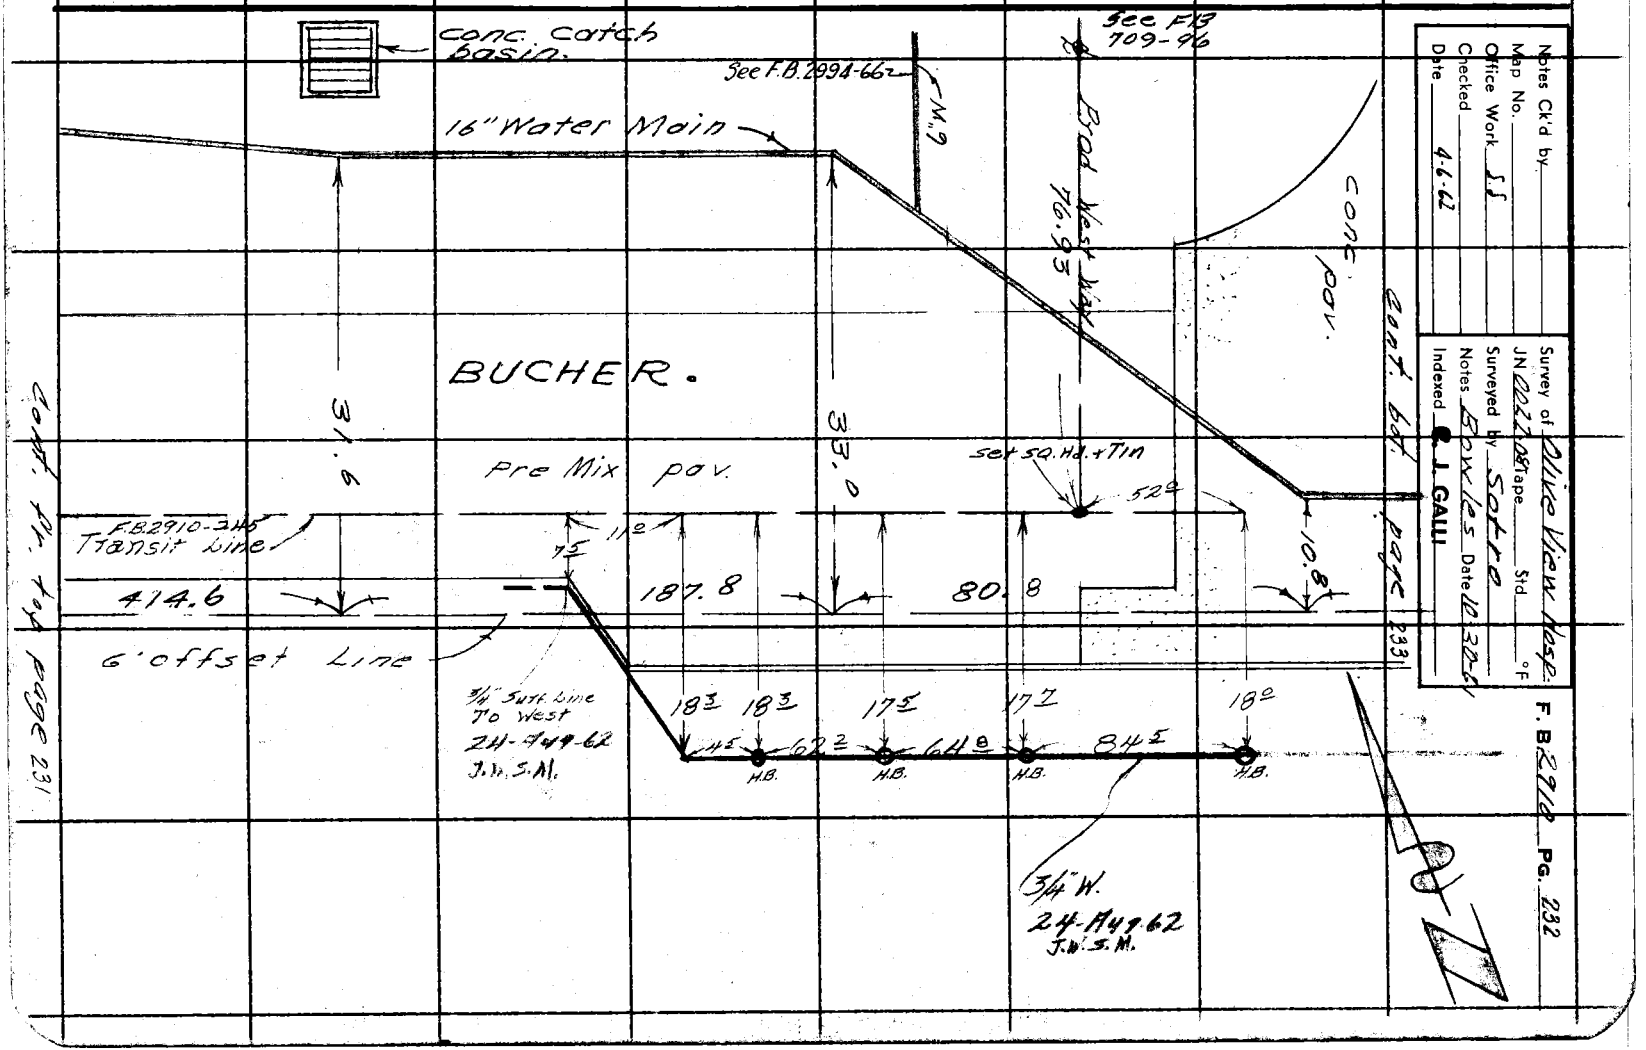


Notes Ck'd by
Map No.
Office Work S.S.
Checked
Date 4-6-62




F. B. 2910 PG. 283

PLEASE RETURN TO
LOS ANGELES COUNTY ENGINEER
403 Los Angeles County Engineering Bldg.
Do not extend this side of this line.

Note: Any Additions or Changes or This Sheet Must be Made or Circled in Red Ink With Date and Name of Person Making Change.

EASTWAY

To L.+T. per F.B. 585-180

182.21

Pav.

Fd. Co. Engr. tag in lead N6 rad.

342.3

384.96

to L.+T. int.

11.7

Conc.

16" Water Main

303.7

6' offset Line

BUCHER.

Cont. fr. top page 232

76F3095 CE # 310 3-61

PLEASE RETURN TO
LOS ANGELES COUNTY ENGINEER
403 LOS ANGELES COUNTY ENGINEERING BLDG.

Note: Any Additions or Changes on This Sheet Must be Made or Circled in Red Ink With Date and Name of Person Making Change.

Do not extend this side of this line.

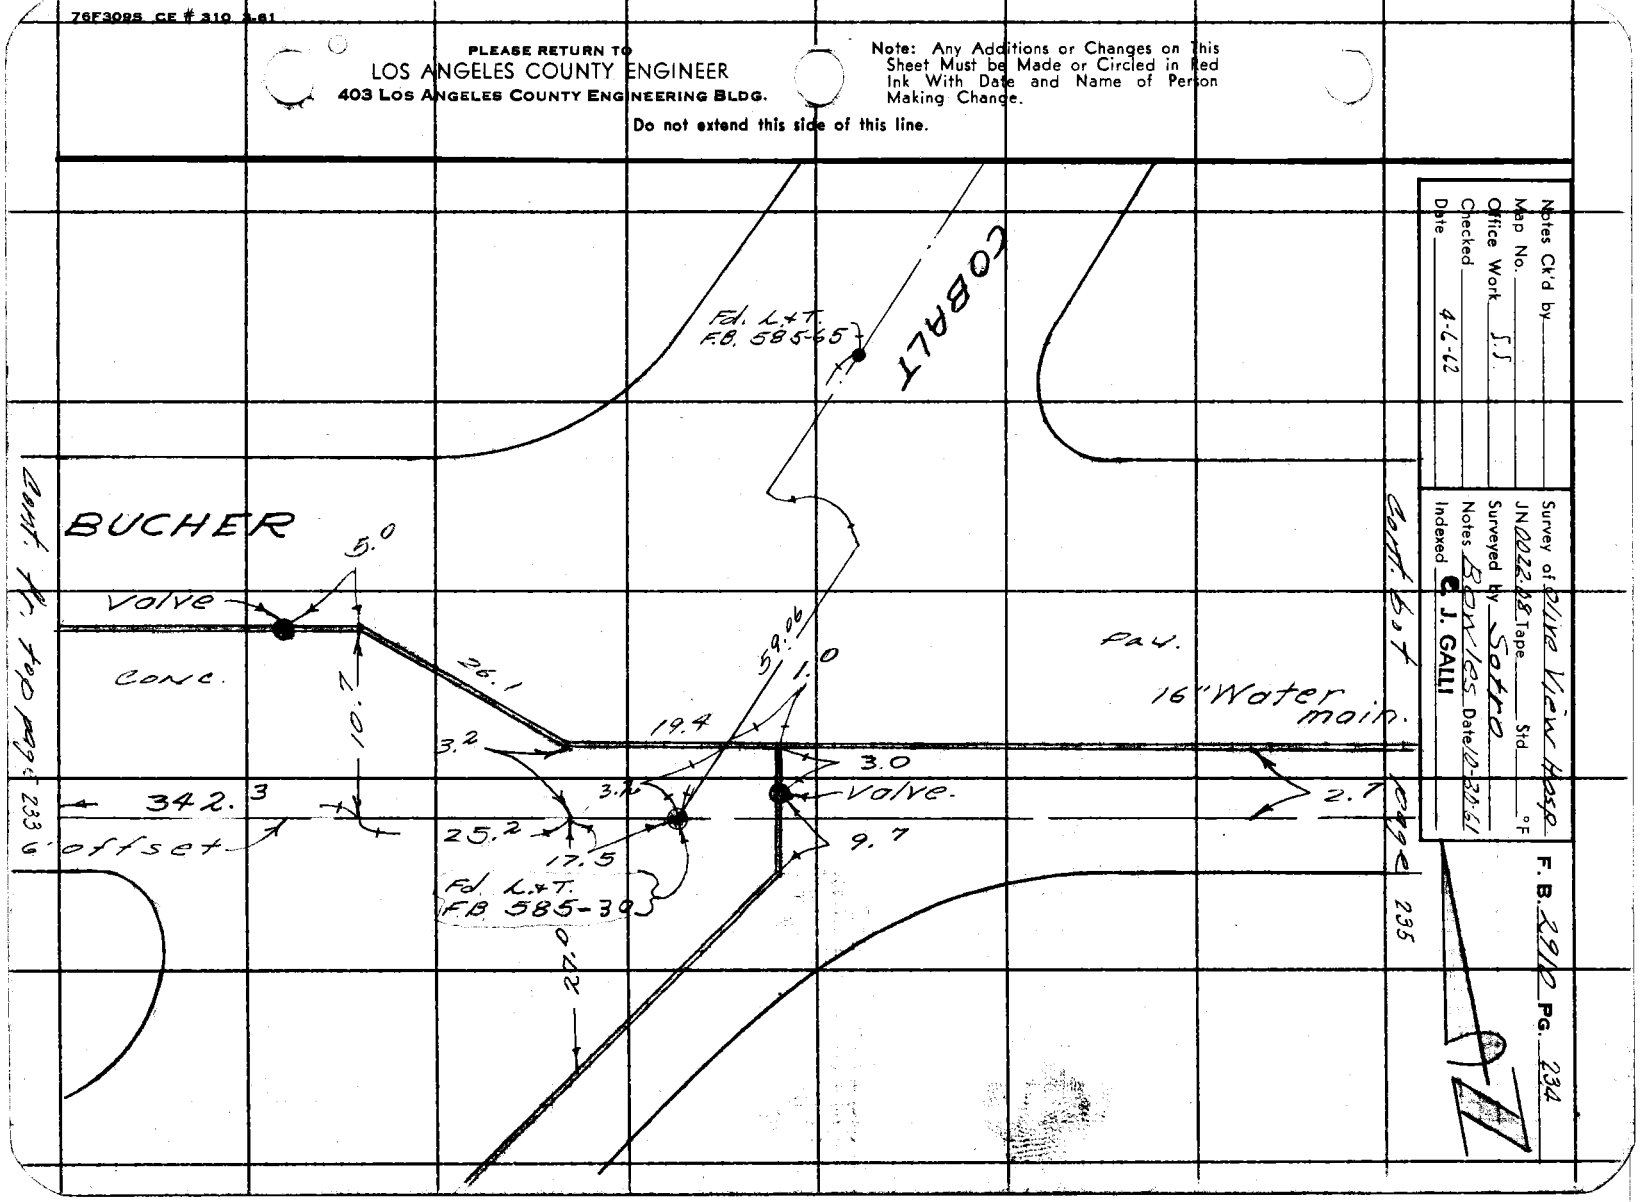


Notes Ck'd by _____
Map No. _____
Office Work J.J.
Checked _____
Date 4-6-62

JN 0222.28 Tape _____ Std. _____ °F
Surveyed by Soto
Notes Bonds Date 10-30-61
Indexed C. J. GALLI


PLEASE RETURN TO
LOS ANGELES COUNTY ENGINEER
403 LOS ANGELES COUNTY ENGINEERING BLDG.

Note: Any Additions or Changes on This Sheet Must be Made or Circled in Red Ink With Date and Name of Person Making Change.

Do not extend this side of this line.

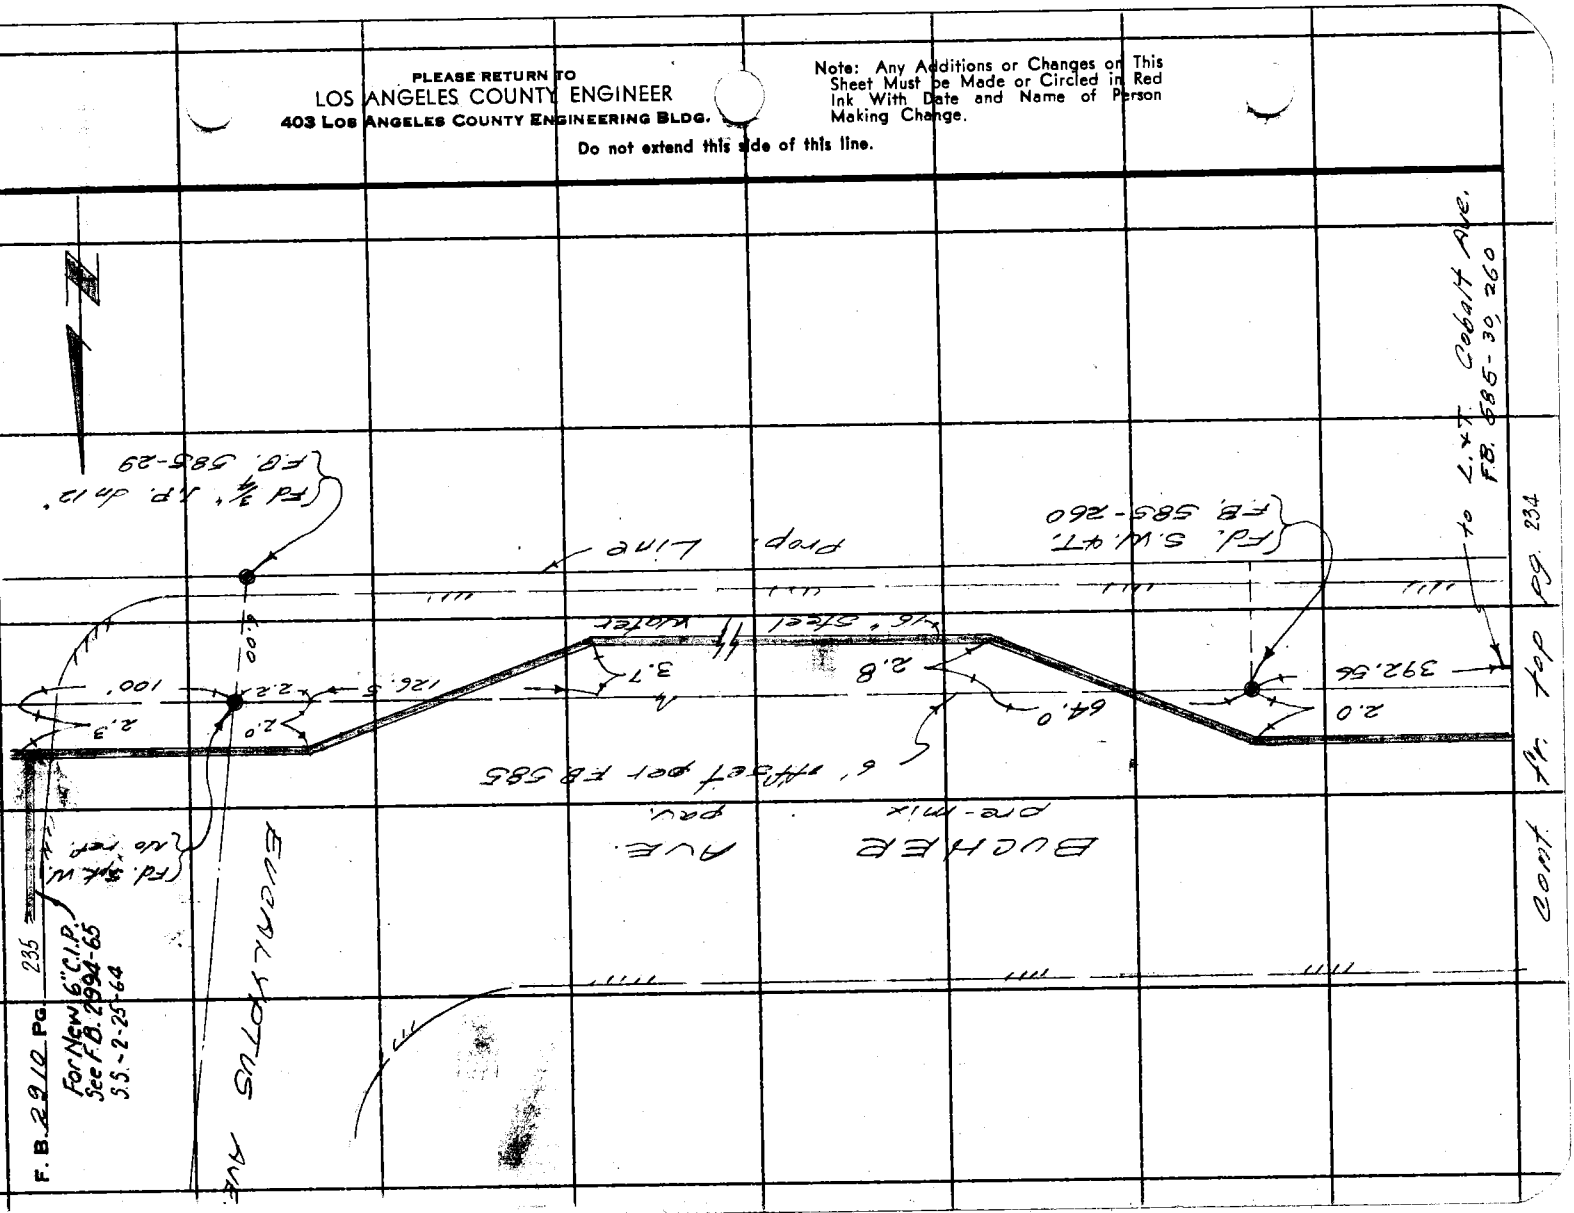

Notes Ck'd by
Map No.
Office Work S.S.
Checked
Date 4-6-62

Survey of OLIVE VIEW HOSP
JN 0022 Tape Std °F
Surveyed by M. SOTRO
Notes P. LATTERI Date Nov 2, 1961
Indexed E. J. GALLI

F. B. 2910 PG. 236

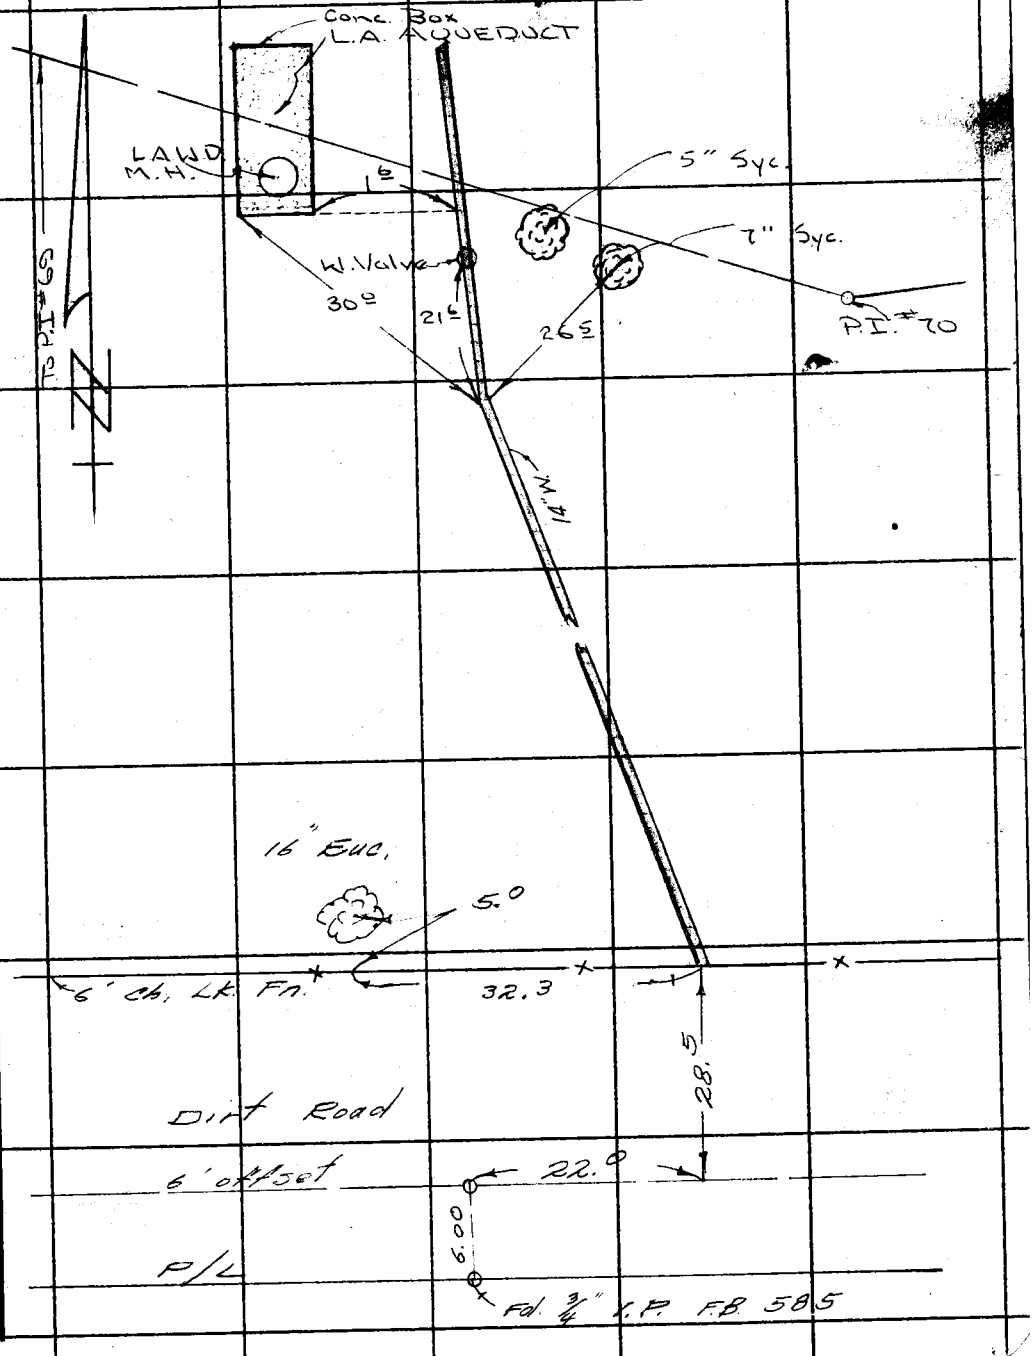


Note: Any Additions or Changes on This Sheet Must be Made or Circled in Red Ink With Date and Name of Person Making Change.

Do not extend this side of this line.

PLEASE RETURN TO
LOS ANGELES COUNTY ENGINEER
403 LOS ANGELES COUNTY ENGINEERING BLDG.

76F3095 CE # 310 3-61

F. B. 2910 PG. 237

℄ OLIVE VIEW HOSPITAL BOUNDARY

12" Water Main (L.A. City)

5'

℄ OLIVE VIEW HOSPITAL BOUNDARY

188'±

6"W

14'

(60)

(30)

(30)

BLEDSOE ST.

16" Water Main (L.A. City)

8'

Note: Distances were taken from L.A. City Sub Structure Map No. 10
4-9-62 - S.S.

Cont. from Pg. 235

PLEASE RETURN TO
LOS ANGELES COUNTY ENGINEER
403 Los Angeles County Engineering Bldg.
Do not extend this side of this line.

Note: Any Additions or Changes on This Sheet Must be Made or Circled in Red Ink With Date and Name of Person Making Change.

| | |
|---|---|
| Notes Ck'd by | Survey of Olive View Hosp. F. B. 2910 PG. 238 |
| Map No. | JN P022.08 Tape Std °f |
| Office Work SS | Surveyed by |
| Checked | Notes S. SHINODA Date 4-10-62 |
| Date 4-10-62 | Indexed C. J. GALLI |

WATER

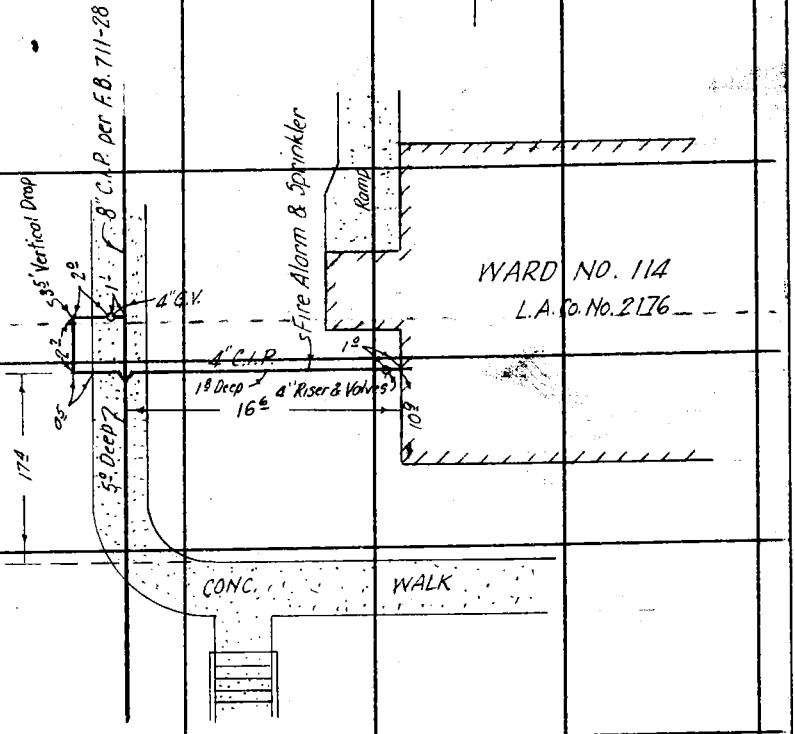


Note: Any Additions or Changes on This Sheet Must be Made or Circled in Red Ink With Date and Name of Person Making Change.

Do not extend this side of this line.

PLEASE RETURN TO
LOS ANGELES COUNTY ENGINEER
403 LOS ANGELES COUNTY ENGINEERING BLDG.

76F3098 CE # 310 3-61

F. B. 2910 PG. 239

WATER




PLEASE RETURN TO
LOS ANGELES COUNTY ENGINEER
403 Los Angeles County Engineering Bldg.

Do not extend this side of this line.

Note: Any Additions or Changes on This Sheet Must be Made or Circled in Red Ink With Date and Name of Person Making Change.

Notes Ck'd by
Map No.
Office Work 55.
Checked
Date 8/8/62

Survey of Olive View Hospital
JN 0022.06 Tape Std °F
Surveyed by
Notes S. Shinoda Date 5/4/62
Indexed C. J. GALLI

F. B. 2910 Pg. 240

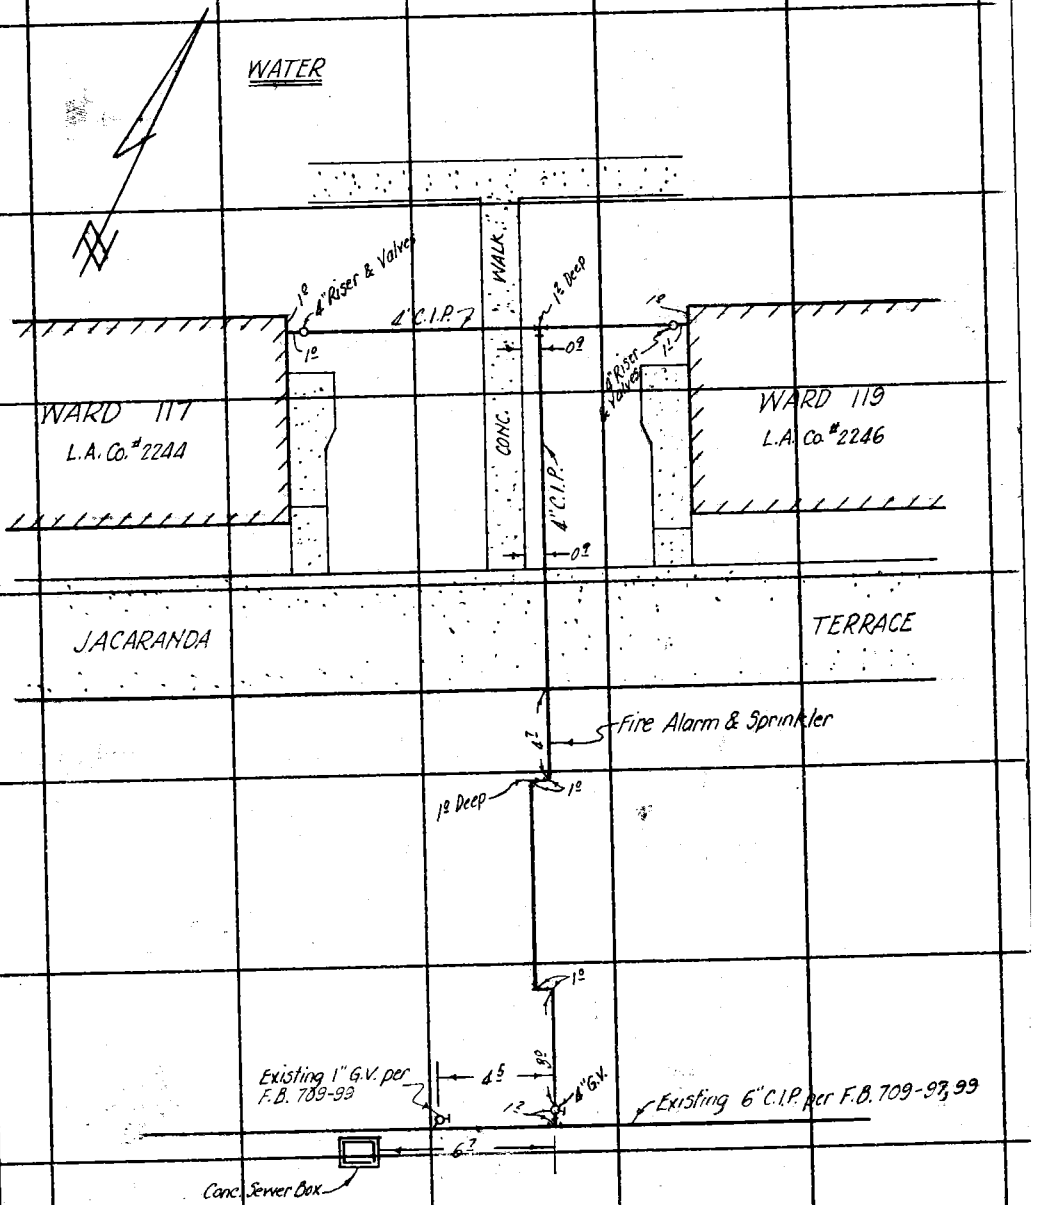


Note: Any Additions or Changes on This Sheet Must be Made or Circled in Red Ink With Date and Name of Person Making Change.

Do not extend this side of this line.

PLEASE RETURN TO
LOS ANGELES COUNTY ENGINEER
403 Los Angeles County Engineering Bldg.

76F3095 CE # 310 3-61

F. B. 2910 PG. 241

WATER

15'

BUNGALOW A
L.A. Co. # 2214

1"G.I.P.
Plug
1"G.V. & ¾" H.B.
1½"G.I.P.
2"G.I.P.
1" Riser
14" Deep
1½" G.I.P.

Cont. on Pg. 242

AVE.

MESA

BUNGALOW B
L.A. Co. # 2212

1"G.V. & ¾" H.B.
Plug
1"G.I.P.

PLEASE RETURN TO
LOS ANGELES COUNTY ENGINEER
403 Los Angeles County Engineering Bldg.

Do not extend this side of this line.

Note: Any Additions or Changes on This Sheet Must be Made or Circled in Red Ink With Date and Name of Person Making Change.

| | |
|---|---|
| Notes Ck'd by | Survey of OLIVE VIEW HOSPITAL |
| Map No. | JN 0022.08 Tape Std °F |
| Office Work | Surveyed by |
| Checked | Notes S. SHINODA Date 5-28-62 |
| Date | Indexed C. J. GALLI |

F. B. 2910 PG. 242

## WATER

Cont from Pg. 242

To Bungalow A.

1" G.I.P.

To Bungalow B

1½" G.I.P.

1½" G.I.P.

88

1½" Riser (Capped)

63.8

2" G.I.P.

1½" Riser (Capped)

63.2

18" Deep

07

1½" Riser (Capped

2" G.V.

1" G.I.P

3" G.I.P. per F.B. 2910-59

2"

1"

2½

2º Deep

07

Note: Any Additions or Changes on This Sheet Must be Made or Circled in Red Ink With Date and Name of Person Making Change.

Do not extend this side of this line.

PLEASE RETURN TO
LOS ANGELES COUNTY ENGINEER
403 Los Angeles County Engineering Bldg.

76F3095 CE # 310 3-61

F. B. 2910 PG. 243

WATER LINES

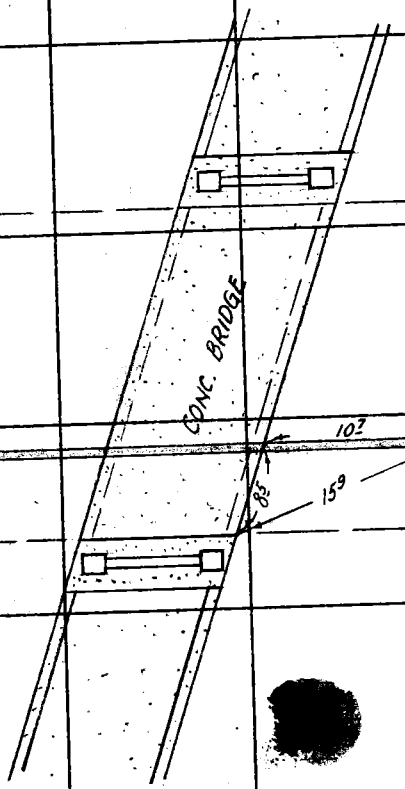


To F.B. 749-184

To F.B. 709-237

PLEASE RETURN TO
LOS ANGELES COUNTY ENGINEER
403 Los Angeles County Engineering Bldg.

Do not extend this side of this line.

Note: Any Additions or Changes on This Sheet Must be Made or Circled in Red Ink With Date and Name of Person Making Change.

| | | |
|---|---|---|
| Notes Ck'd by | Survey of OLIVE VIEW HOSPITAL | F. B. 2910 PG. 244 |
| Map No. | JN 0022 88 Tape Std °F | |
| Office Work S.S. | Surveyed by J. TERRANOVA | |
| Checked | Notes J.T. Date 8-1-62 | |
| Date 12/18/62 | Indexed C. J. GALLI | |

AREA EAST OF LAB. & WEST OF WARDS NO. 304 & 306
UNDERGROUND WATER

OLIVE VIEW AVE.

EDGE OF PAVMT

46.0 — 108.5 — 31.0

0.10 — 3/4" W. — GATE VALVE — 3" G.I.P. (MAIN) PER F.B. 709-207

3/4" H.B.

90°00'

155

1½W — 83.0 — G. VALVE

83.5 — 3/4" H.B.

3/4" W. — 94.5

1½ W. — 104.5

2" W. PER F.B. 709-207 — 147.0

1¼ G.I.P. F.B. 709-207 — 143.4 — 104.7

3/4" H.B. — SURFACE SPR.

63.0

SPR. VALVES — 42.5 — SPR. VALVES — 42.5 — SPR. VALVES — 42.2

1½ W

GATE VALVES

3/4" H.B. — SURFACE SPR.

TO Pg. 204 — 36.5

57.5

Spr. V. — SURFACE SPR.

3/4" GATE VALVE

Note: Any Additions or Changes on This Sheet Must be Made or Circled in Red Ink With Date and Name of Person Making Change.

PLEASE RETURN TO LOS ANGELES COUNTY ENGINEER
403 Los Angeles County Engineering Bldg.
Do not extend this side of this line.

76F3095 CE # 310 8-61

PLEASE RETURN TO
LOS ANGELES COUNTY ENGINEER
403 LOS ANGELES COUNTY ENGINEERING BLDG.

Note: Any Additions or Changes on This Sheet Must be Made or Circled in Red Ink With Date and Name of Person Making Change.

Do not extend this side of this line.

F.B. 2910 Pg. 245

SPR. LINES ON NORTH & SOUTH SIDES OF BLICHER

BUCHER AVE.

ROXFORD AVE

Edge of Pvmt.

Edge of Pvmt.

Fd. Left

Fd. Left Per F.B. 585-32 2910-231

Fd. Left

Sur. Spk. Nail

Surf. Spk.

Surf. Spk.

Fence

Chain link

Fence

Sta.

Sta.

Sta.

76F309S CE # 310 3-61

PLEASE RETURN TO
LOS ANGELES COUNTY ENGINEER
403 LOS ANGELES COUNTY ENGINEERING BLDG.

Note: Any Additions or Changes on This Sheet Must be Made or Circled in Red Ink With Date and Name of Person Making Change.

Do not extend this side of this line.

Notes Ck'd by
Map No.
Office Work S.S.
Checked
Date 12/18/62

Survey of OLIVE VIEW HOSPITAL
JN 0222 Tape Std °F
Surveyed by J. TERRAZAS
Notes J.T.
Indexed E. J. GAI!!! Date 8-3-62

F. B. 2910 PG. 2-16

5 PR. N. OF LANTANA
BETWEEN WARD
#303 & MENS SOLARIUM

WARD #303

ROXFORD AVE

0+00

LANTANA TERR.

3/4" H.B.

612

602

608

345

185

344

344 W

53°

58°

15'

Rock Curbing

Fd. Per F.B.

6" F.P. Reff.
Per. F.B. 709-90

Fd. 3/4" I.P. F
Per F.B. 585-107

Fd. L.S.T.
Per F.B. 585-108

F. B. 2910 PG. 247

Contin. Btm. F.B. 702-96

PLEASE RETURN TO
LOS ANGELES COUNTY ENGINEER
403 Los Angeles County Engineering Bldg.
Do not attend this side of this line.

Note: Any Additions or Changes on This Sheet Must Be Made or Circled in Red Ink With Date and Name of Person Making Change.

PATIO

MEAS SOLARIUM WARDS 12/4/123
LAGO NO. 8182

VOID

TERRACE

LANTANA

ED UNIT
PER F.B. 585-108

VOID

CONTIN. TO P.B. #2116

BM 5

3/4" H.B.

18"

| | |
|---|---|
| Notes Ck'd by | Survey of Oliv View |
| Map No. | JN 002210 Tape Std 8F |
| Office Work S.S. | Surveyed by J.T.W.S.M. |
| Checked | Notes M.E. Valvex Date Aug 62 |
| Date 12/18/62 | Indexed C. J. GALLI |

F. B. 2910 PG. 248

Note: Any Additions or Changes on This Sheet Must be Made or Circled in Red Ink With Date and Name of Person Making Change.

Do not extend this side of this line.

PLEASE RETURN TO
LOS ANGELES COUNTY ENGINEER
700 LOS ANGELES COUNTY ENGINEERING BLDG.

76F309S S&E #247 11-58

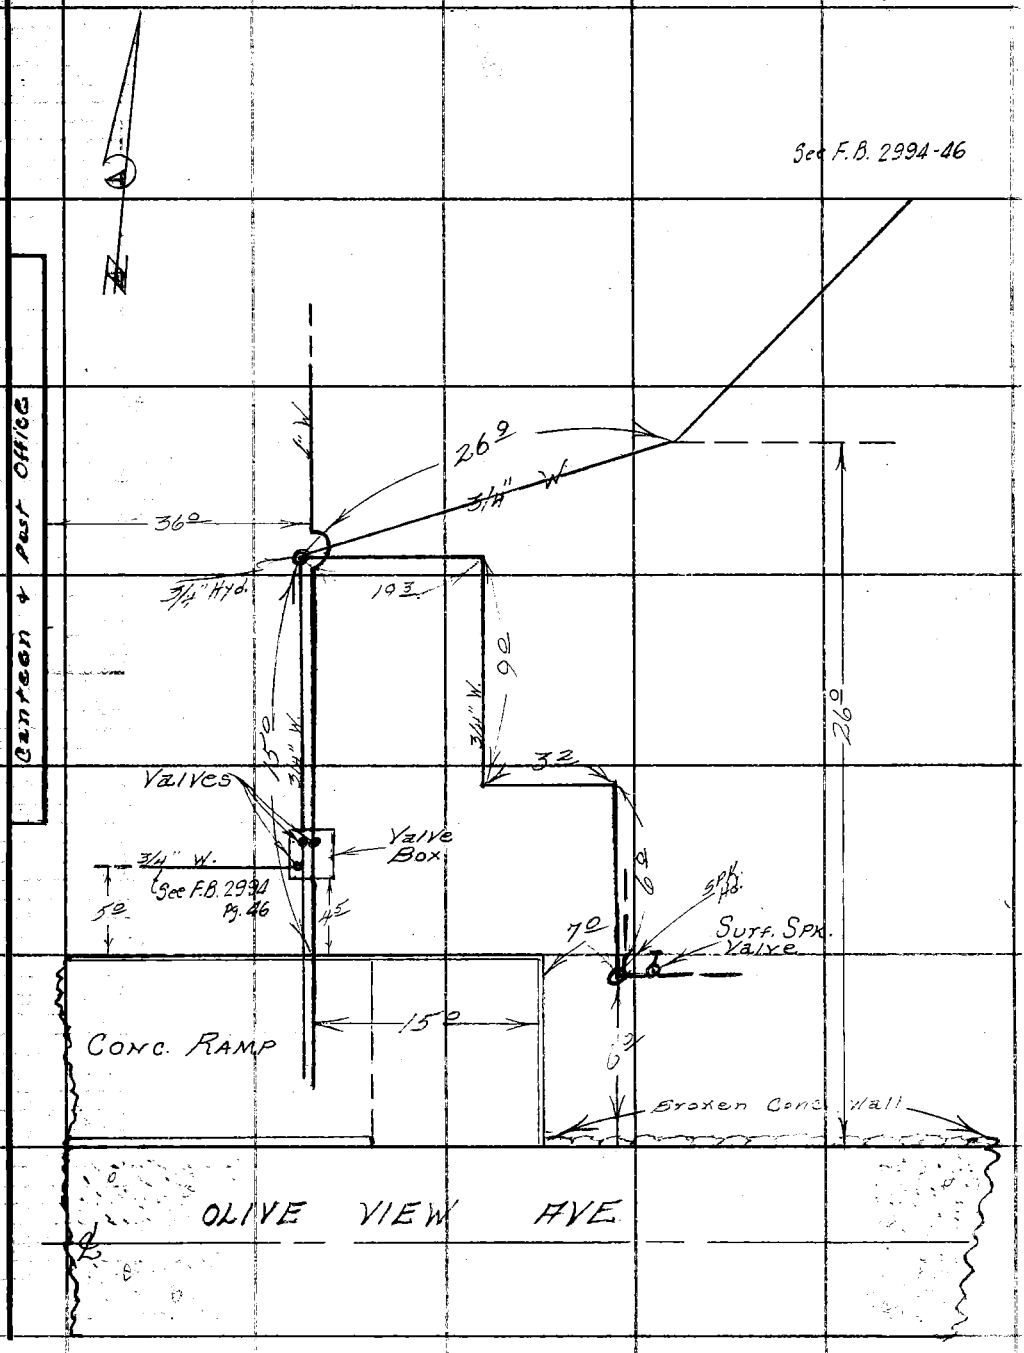

F. B. 2910 PG 249
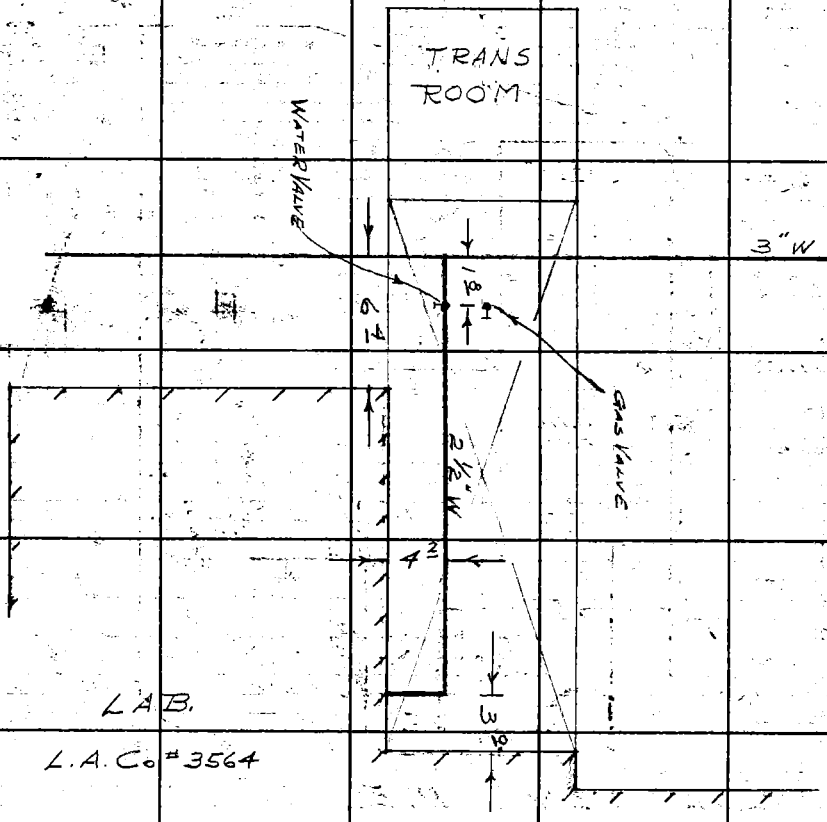
# MAIN WATER SUPPLY FOR LAB.