Notes Ck'd by
Map No.
Office Work
Checked
Date

Survey of
JN Tape Std °F
Surveyed by
Notes Date
Indexed

F.B. 2915 Pg.

Page	Lot	Description
1-9	C.L. Mon.	168TH ST. EC AL. - 0202.00 Replacement of Mo. Dpat. SEK & W with C.E. Monument at 172nd St. & Grevilleas; 173rd St. & Grevillea & 172nd St. & last Alley W. of Hawthorne Blvd.
		SUPREME COURT CASE BWC-2619 C.N. 0086.00
10-26	Bdy.	Survey of the N. 12. of Lot 46, to determine Ir. btwn Parcel A & B Lot 46, Div. 2 - Tract 874.
		CENTINELA AVE. C095.20
31-32	Index	
33-56	C.L.	& Prop. C.L. retracement from Sepulveda Blvd. to Centinela Ave. W. of Rnadall St.
57-	Good.	Geodetic Control @ Centinela Ave. & Jefferson Blvd.
59-60	Topo.	Loc. of Bldg. under Const. on Hughes property near Messmer Ave. & Centinela Ave.
61-70	C.L.	Prop. Alignment 'B' W'ly. of Sepulveda Blvd.

Note: Any Additions or Changes to this Sheet Must be Made or Circled in Red Ink with Date and Name of Person Making Change

Do not extend this side of this line.

PLEASE RETURN TO LOS ANGELES COUNTY ENGINEER 402 LOS ANGELES COUNTY ENGINEERING BLDG.

RECORDS OF SURVEY

Microfilmed April '85

Notes Ck'd by
Mon. No.
Office Work
Checked
Date

Survey of Survey for C.L. Work
Job 2351.04 Tape 1"=10' Std. 66 of
Surveyed by Chas. Lind
Notes Chas Date 8-19-26
Indexed H.E.O.M. 10-1-26

F. B. 2915 Pg. 5

Note: Any Additions or Changes on this Sheet Must Be Made or Circled in Red Ink With Date and Name of Person Making Change.

Do not extend notes this side of this line.

DEPARTMENT OF
COUNTY ENGINEER
LOS ANGELES COUNTY
LOS ANGELES COUNTY Engineering Bldg.

Traced 12-27-26

M. 03 07 00

Survey for C.L. Work

16th St. et al

Replacement of Mon. Kept for C.L.

with C.L. Mon. at the Int.

of 17th St. & Greville Pl.

17½ St. & Greville Pl.

18th St. & the Alley West

of Hawthorne Blvd.

B-17-26

Chas

Wilkes

Chas

Lind

Mason

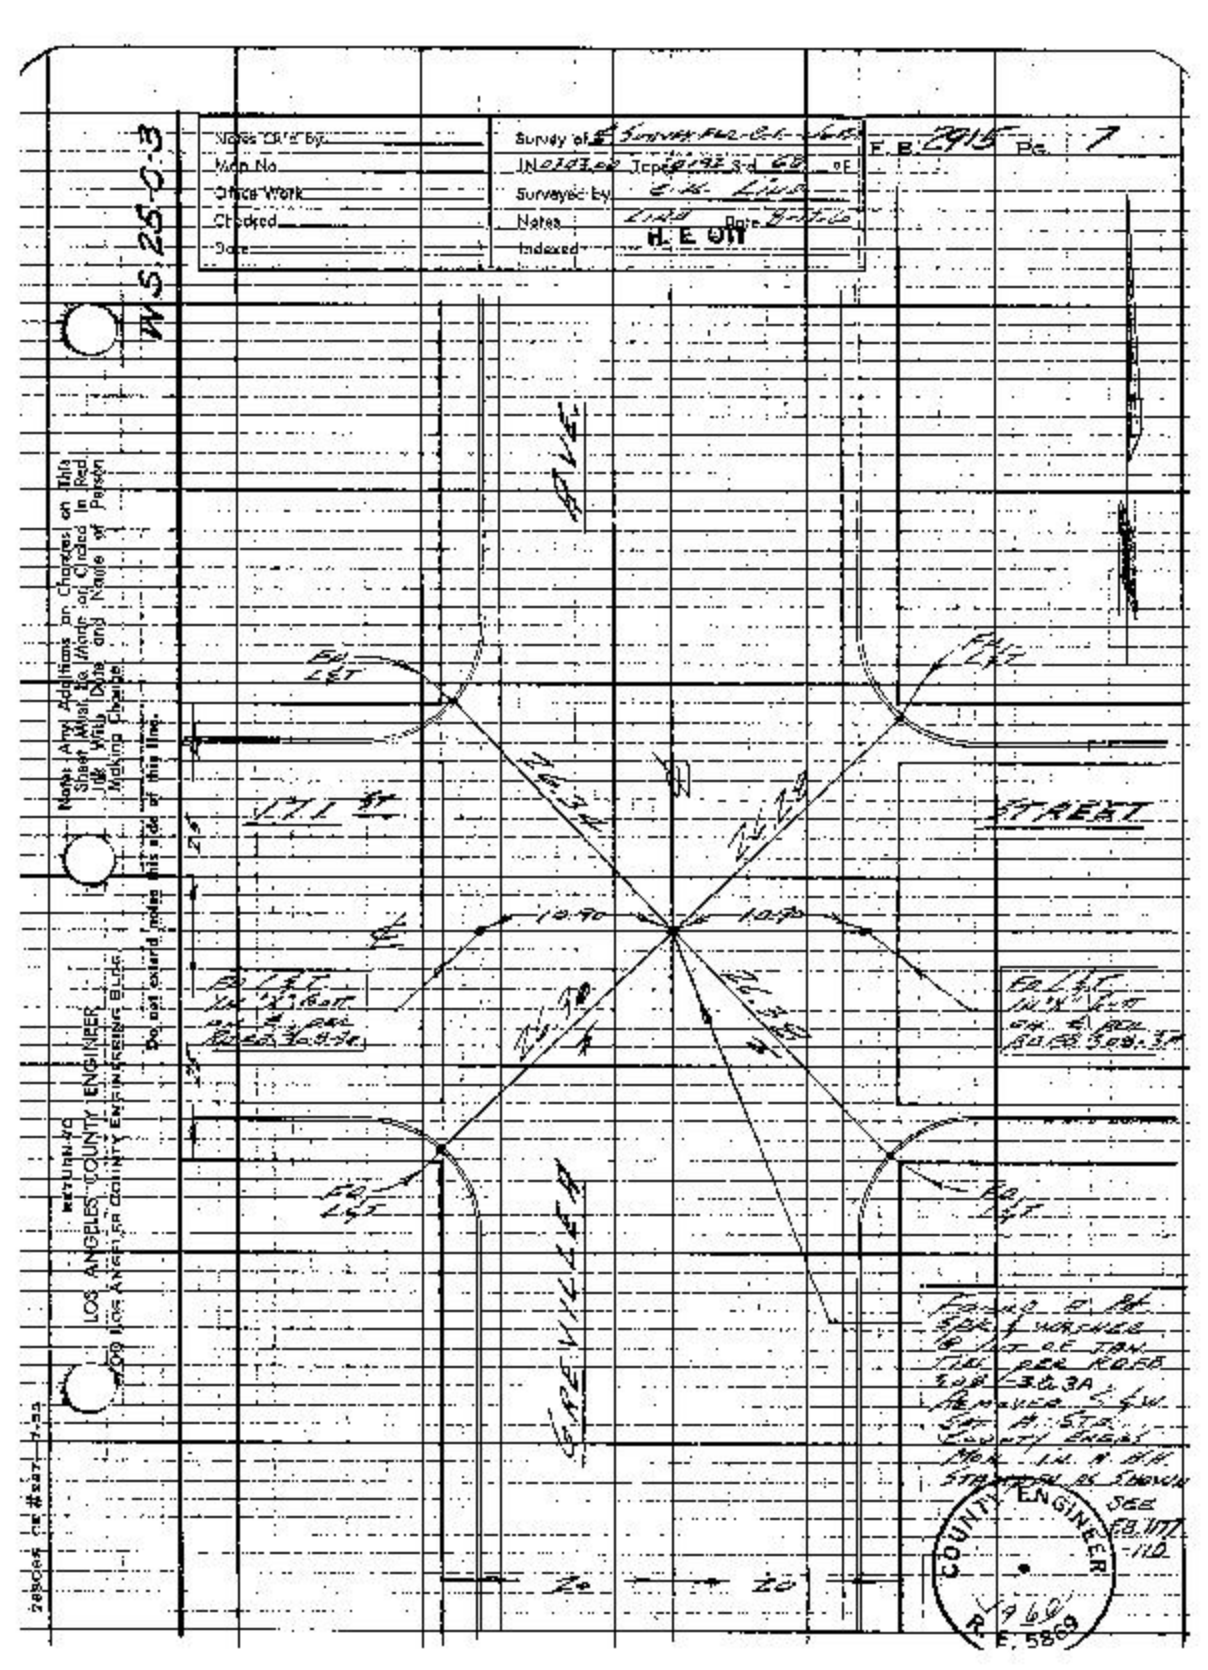
W.S.25-C-3
Notes Drawn by
Mdn No
Office Work
Checked
Date
Survey of
Surveyed by
Notes
Indexed
H. E. OTT
F. B. 2915 Pg. 7
Make Any Additions or Changes on This Sheet in Red Ink. Also Check and Initial & Write Date and Name of Person Making Change.
Do not extend notes this side of this line.
LOS ANGELES COUNTY ENGINEER
RETURN TO
LOS ANGELES COUNTY ENGINEER BLDG.
STREET
COUNTY ENGINEER
R.L. 4609
E. 5869

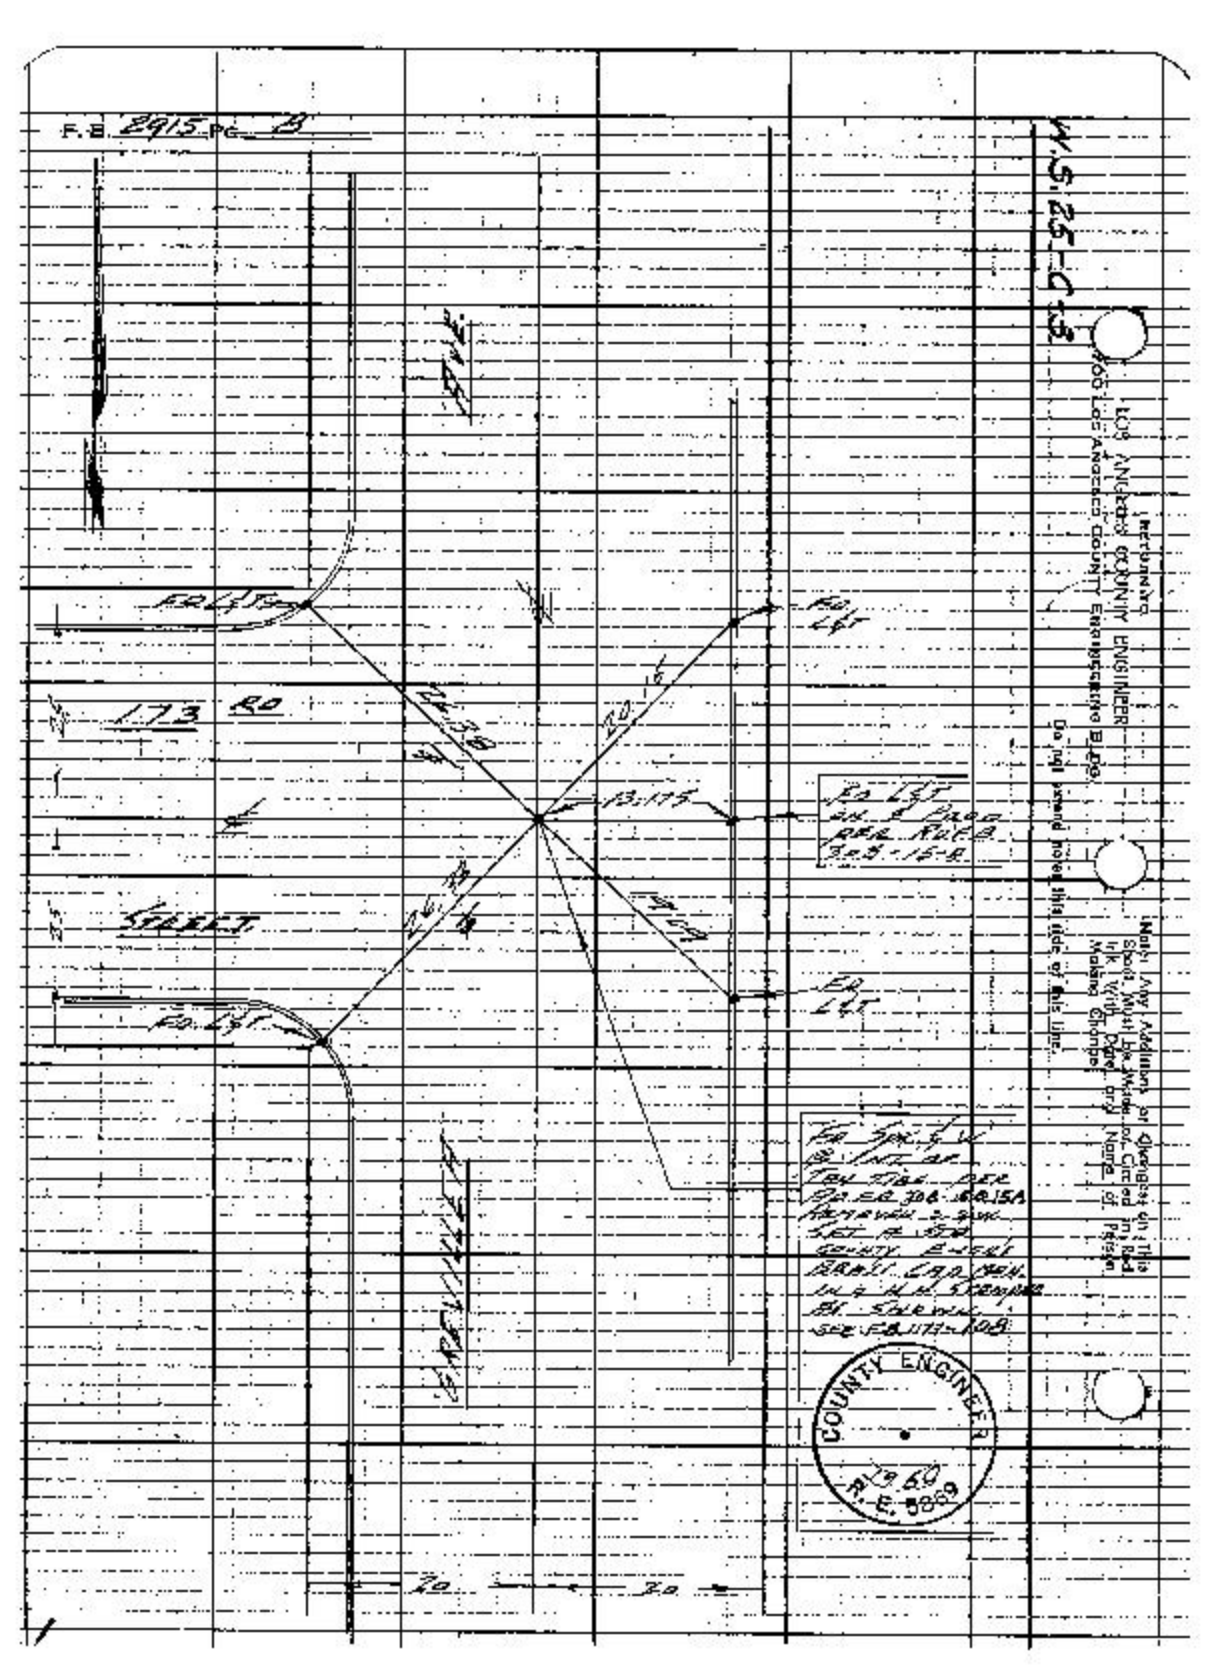
F.B. 2915 PG. B
W.S. 25-0.13
LOS ANGELES COUNTY ENGINEER
LOS ANGELES COUNTY ENGINEERING BLDG.
Do not extend notes this side of this line.
Notary Map Additions or Changes on This Sheet Must Be Made in Red Ink With Dated and Signed Name of Person Making Change
FD. 1/2" IP
FD. L&T
20'
13.17'
FD. L&T
173 RD
STREET
FD. L&T
FD. L&T
FOR SEC. 4 W.C. & INTERIOR TIES SEE SEC. 306-6R15A
FOR SEC. 4 W.C. & INTERIOR TIES SEE F.B. 1173-108
COUNTY ENGINEER
R.E. 5869
20
20

W.S. 25 - C-3

Notes Ck'd by
Map No.
Office Work
Checked
Date

Survey of Surveyed 1945
JN 2247 Tape 6192 Sta 68 F
Surveyed by E. A. Lind
Notes Lind Date 8-11-45
Inexed H. E. OTT

F. B. 2915 PG. 9

Notes: Any Additions or Changes on this Sheet, Must be Made or Circled in Red Ink, With Date and Name of Person Making Change.
Do not extend this side of this line.

LOS ANGELES COUNTY ENGINEER
700 Los Angeles County Engineering Bldg.

10 — 10

HAWTHORNE BLVD

PC LT

PC LT

172 40

20

22.23

STREET

E

To GRENVILLE AVE.

To HAWTHORNE BLVD

12.38

PC LT

PC LT

1/2 ALLEY WIDE OF

FOUND TACK & W. 2 INT. OF THIS PER RD. S.B. 308-288 REMOVED S. & W. AND SET P. STD. COUNTY SURVEY MARK. END MAK. IN P.M.H. STAMPED RS. 5 HAWTHORNE

SEE F.B. 1177-92 & 285

COUNTY ENGINEER
R.E. 5869

TRACING SIDE FAST

Notes Ckd by W. J. BRENNER
Map No. B 2448
Office-Work L. H. BURNS
Checked W. J. BRENNER
Date JUN 1965

Survey of Superior Court Case
JN 0086.02 Tape 250 Stadia
Surveyed by English
Notes Ed. Date 5-25-65
Indexed C. M. GALL

F.B. 2-915 PG. 11

SUPERIOR COURT CASE
No. SW C-2616

JN. 0086.02

Survey of
the North
line of Lot
4a, Div. B,
Tract 874.

May 25, 1965
English
Faulger
Tollison
Dupuis

Note: Any Additions or Changes on This Sheet Must Be Made by Circled-in Red Ink With Date and Name of Party Making Change

Please Return to LOS ANGELES COUNTY ENGINEER 400 Los Angeles County Engineering Bldg. Do not remove this side of this line

Permanent carbon 3-65

PLEASE RETURN TO
LOS ANGELES COUNTY ENGINEER
403 LOS ANGELES COUNTY ENGINEERING BLDG.

Note: Any Additions or Changes on This Sheet Must Be Made on Circled in Red ink With Date and Name of Person Making Change.

Do not extend this side of this line.

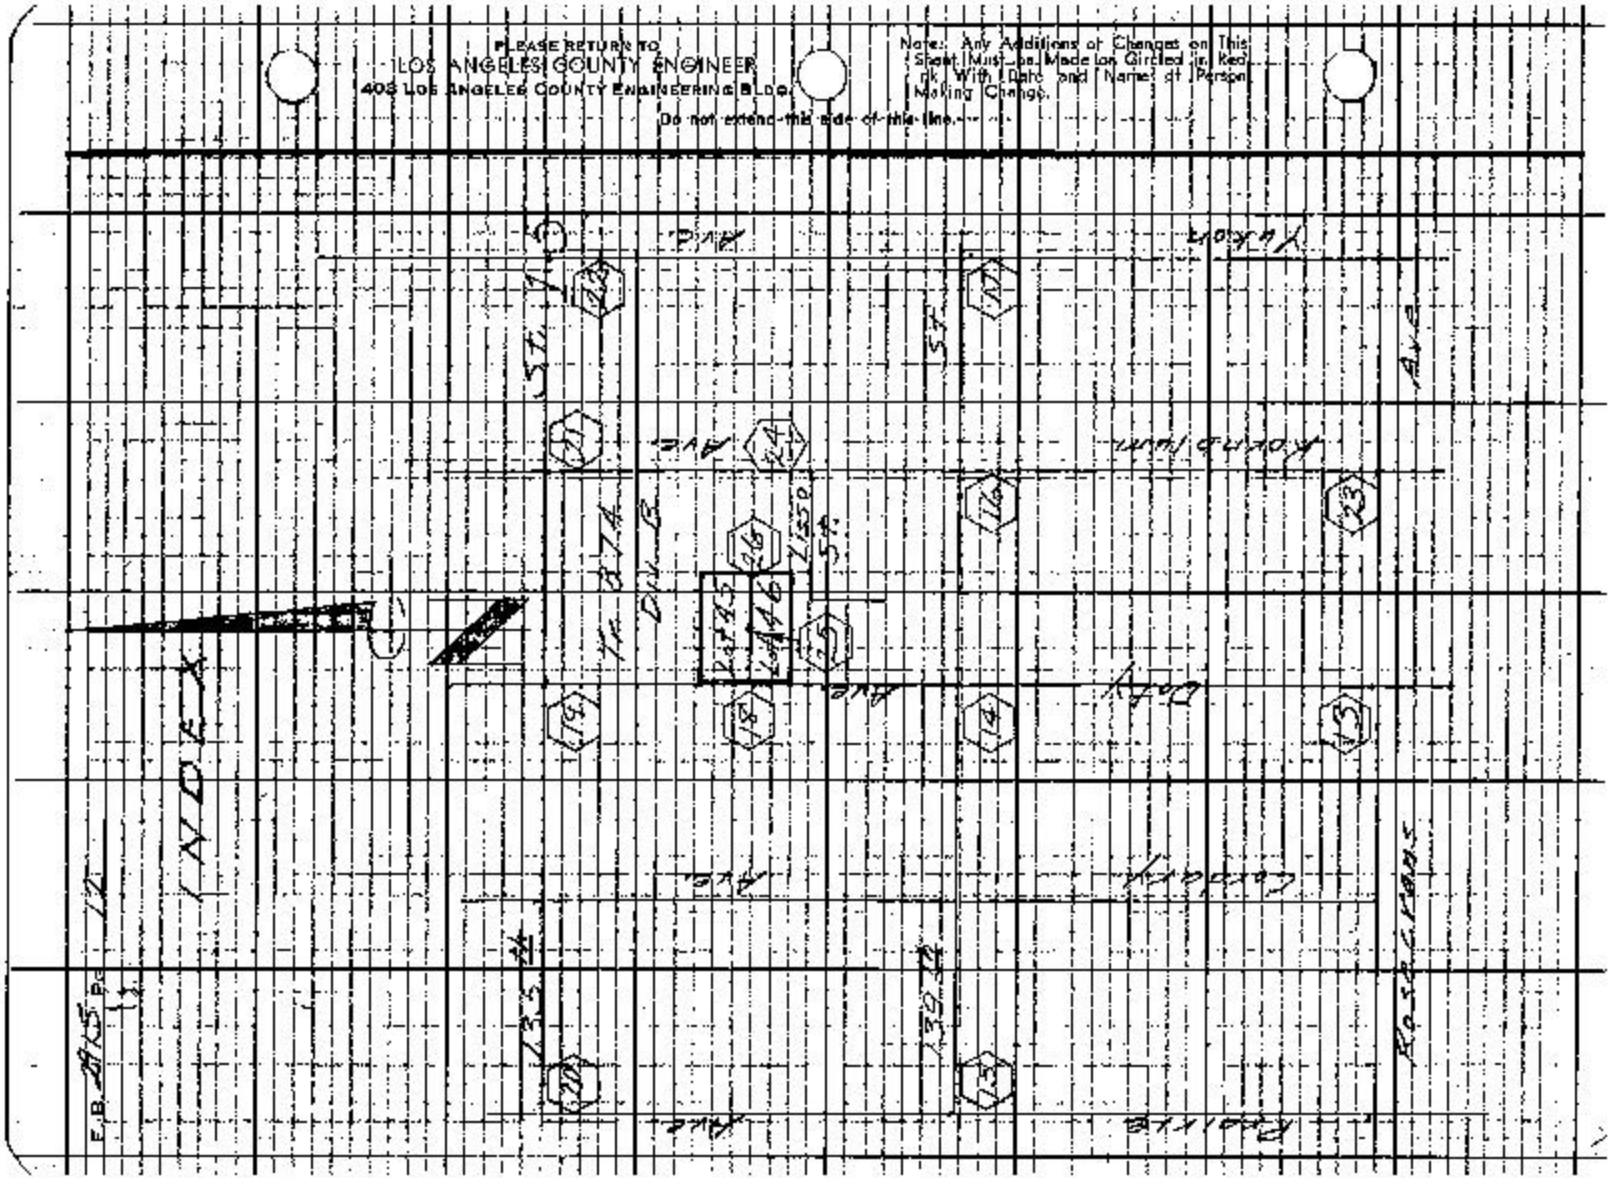

Notes Ck'd. by W. J. BRENNER
Map No. B-2948
Office Work T. B. Dillon
Checked W. J. BRENNER
Date JUN 1965

Surveyed by Engineer Land Surv.
JN 11788.02 Tape Std. 66 °F
Notes 2nd Dates 2-24-65
Indexed C. J. Wells

F.B. 2915 Pgs. 13

Cont. Fig. 14
















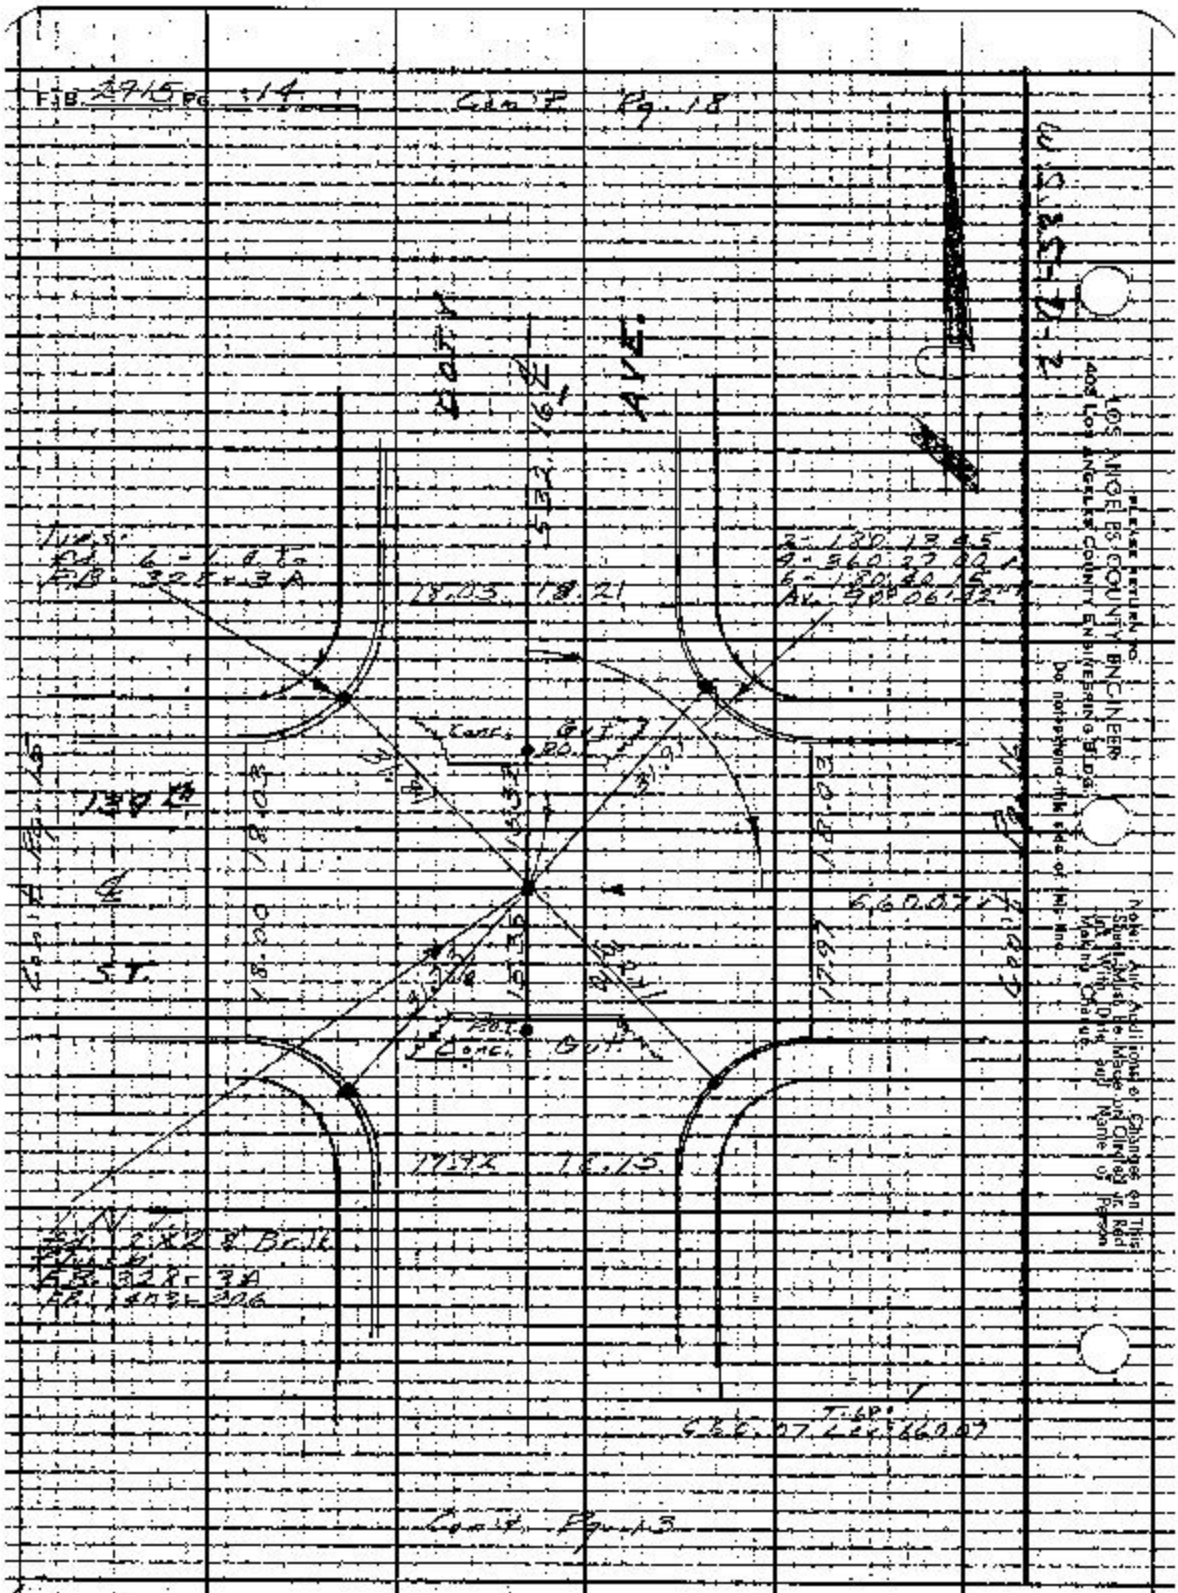
Cen. St.
AVE.
Conc.
Conc.
Conc

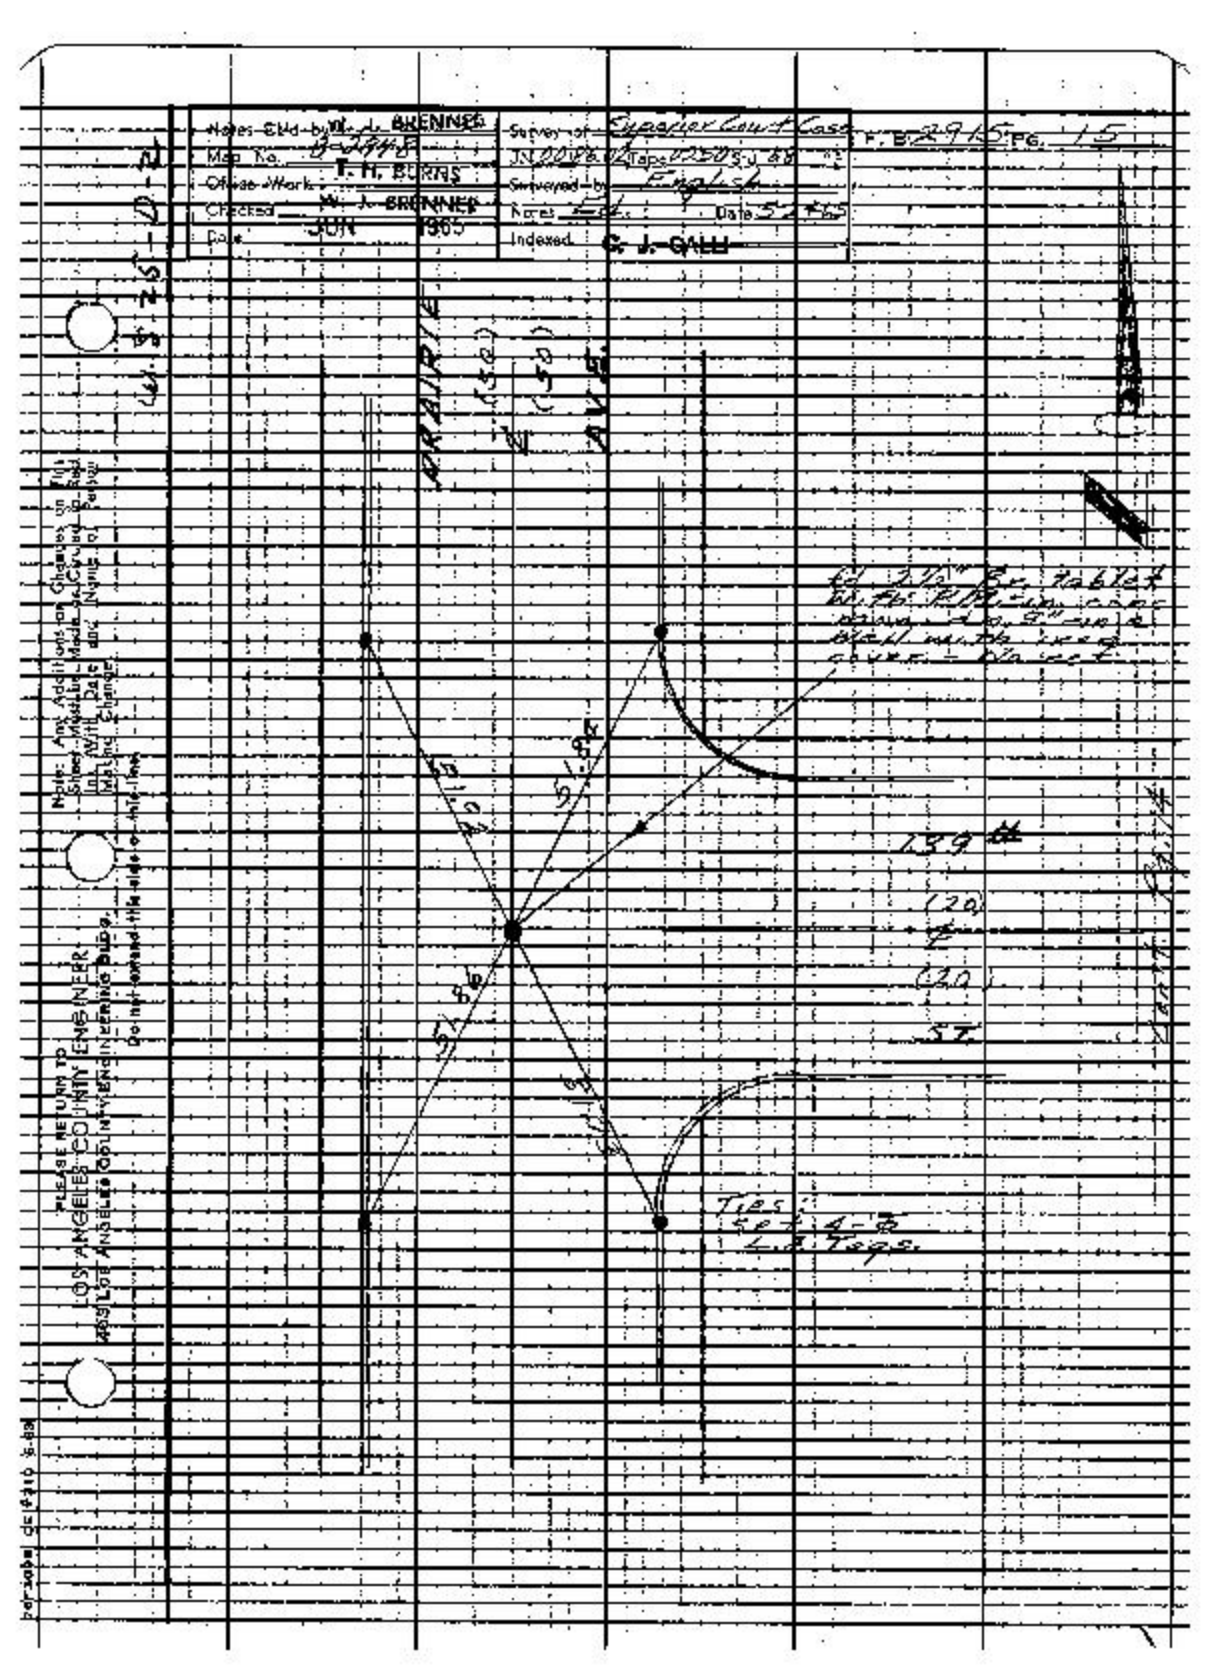
Notes Cld by W. J. BRENNER
Map No. 6-1944-B
Office Work T. H. BURNS
Checked W. J. BRENNER
Date JUN 1965
Survey of Superior Court Case
Surveyed by English
Notes Cld. Date 5-24-65
Indexed C. J. GALL
F. B. 294 PG. 15
Note: Any Additions or Changes on This Sheet Must be Made by Owner of Record and Name of Person Making Change Must Be Shown
PLEASE RETURN TO LOS ANGELES COUNTY ENGINEER 900 LOS ANGELES COUNTY ENGINEERING BLDG. Do not remove this side of this tag
139.66'
(20')
(20')
ST.
Ties:
Lot 4-B
L.A. Tags.

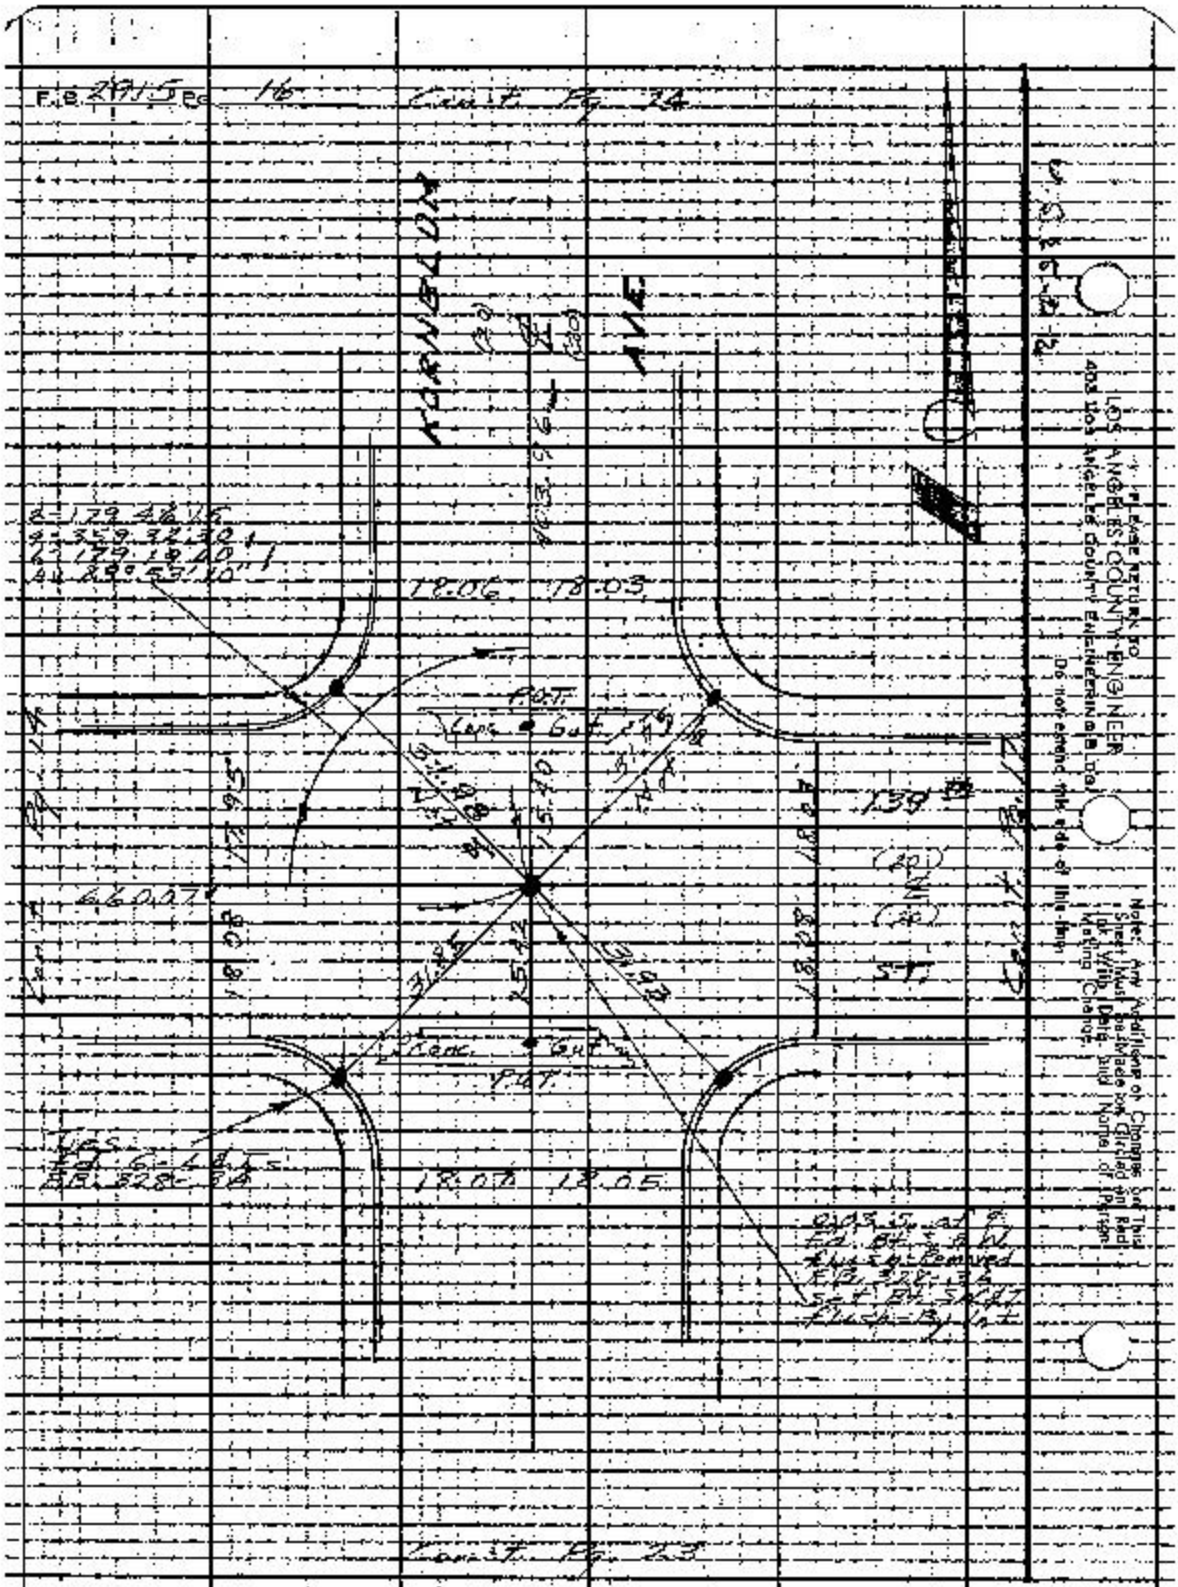
F.B. 217/5 Pg. 16
Count Pg. 24
AVE
(80)
(80)
Δ=129°48'16"
Δ=359°32'30"
Δ=179°19'20"
Δ=89°53'10"
18.06
18.03
P.O.T.
Con. & Cut
139
460.27'
Con. & Cut
P.O.T.
18.02
18.05
Count Pg. 23
LOS ANGELES COUNTY ENGINEER
PLEASE RETURN TO
LOS ANGELES COUNTY ENGINEERING DIV.
Do not remove this side of this map

Name: ENG. BY J. BRENNER
Map No. B-2948
Officer-Work J. D. RILEY
Checked W. J. BRENNER
Date JUN 1965

Surveyed by Spencer Cook Co. F. B. 2915 PG. 17
JN 0086.02 Tape 0.25V Std 68 °F
Surveyed by English
Notes Ad. / Date 5-4-65
Indexed C. J. GALLI

Notes: Any Additions or Changes on this Sheet Must be Made by Engineer-in-Charge Only. Date and Nature of Making Change Must be Noted.

Do not write on this side of this line.

PLEASE RETURN TO
LOS ANGELES COUNTY ENGINEER
4081 DE ANGELO COUNTY ENGINEERING BLDG.

Revised 6/1/10 bdg

TIES ARE ON LOT LINES DO NOT SET

S 53.5 E

S 53.5 E

139.14

(20)

(20)

S T.

Ed. 2-9-A on M.H. Elev. E.B. 328.32

YUKON AVE

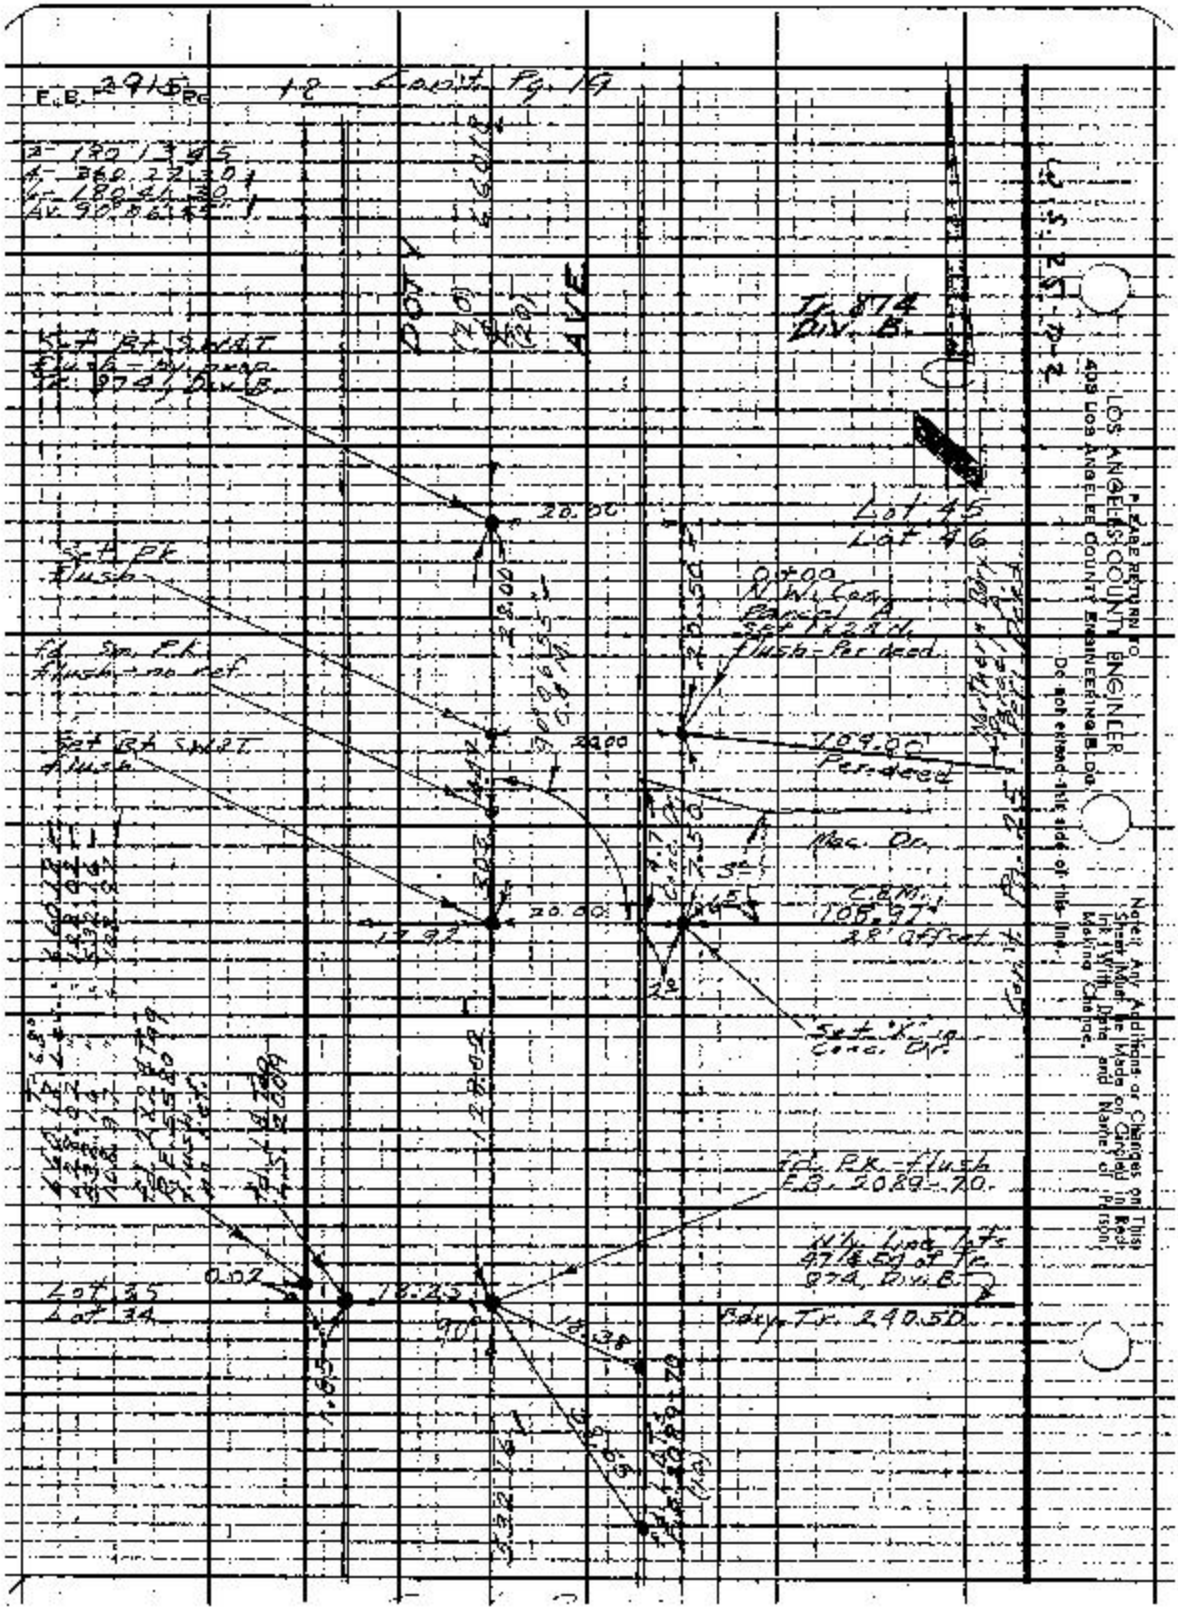
E.B. 2915 Pg. 18
Count Pg. 19
Δ = 170° 13' 45"
R = 360.22
L = 180.41
Rad. 90° 02' 30"
DOTY AVE
Tan. 874 Div. B.
Lot 45
Lot 46
20.00
0+00
N. W. Cor. Parcel A
Tan. 874 Div. B.
Flush - Per deed
109.00' Per deed
Rec. Dr.
C.B.M.
106.97'
32' offset
Set "X" in Conc. Ext.
P.C. P.K. - Flush
E.B. 2089 - 70.
Ely. Line Lots 47 & 69 of Tr. 874, Div. B.
Easy. T.C. 240.50
Lot 35
Lot 34
0.02
16.25
90°
38
Flush
No. Ref.
Set P.K. Flush
Set P.K. Flush
Flush - No Ref.
Set P.K. Flush
LOS ANGELES COUNTY ENGINEER
Please Return To
458 Los Angeles County Engineering Bldg.
Do not extend this side of this line.
Note: Any Additions or Changes on This Sheet Must Be Made on Clearly Ink Written Data and Name of Person Making Changes.

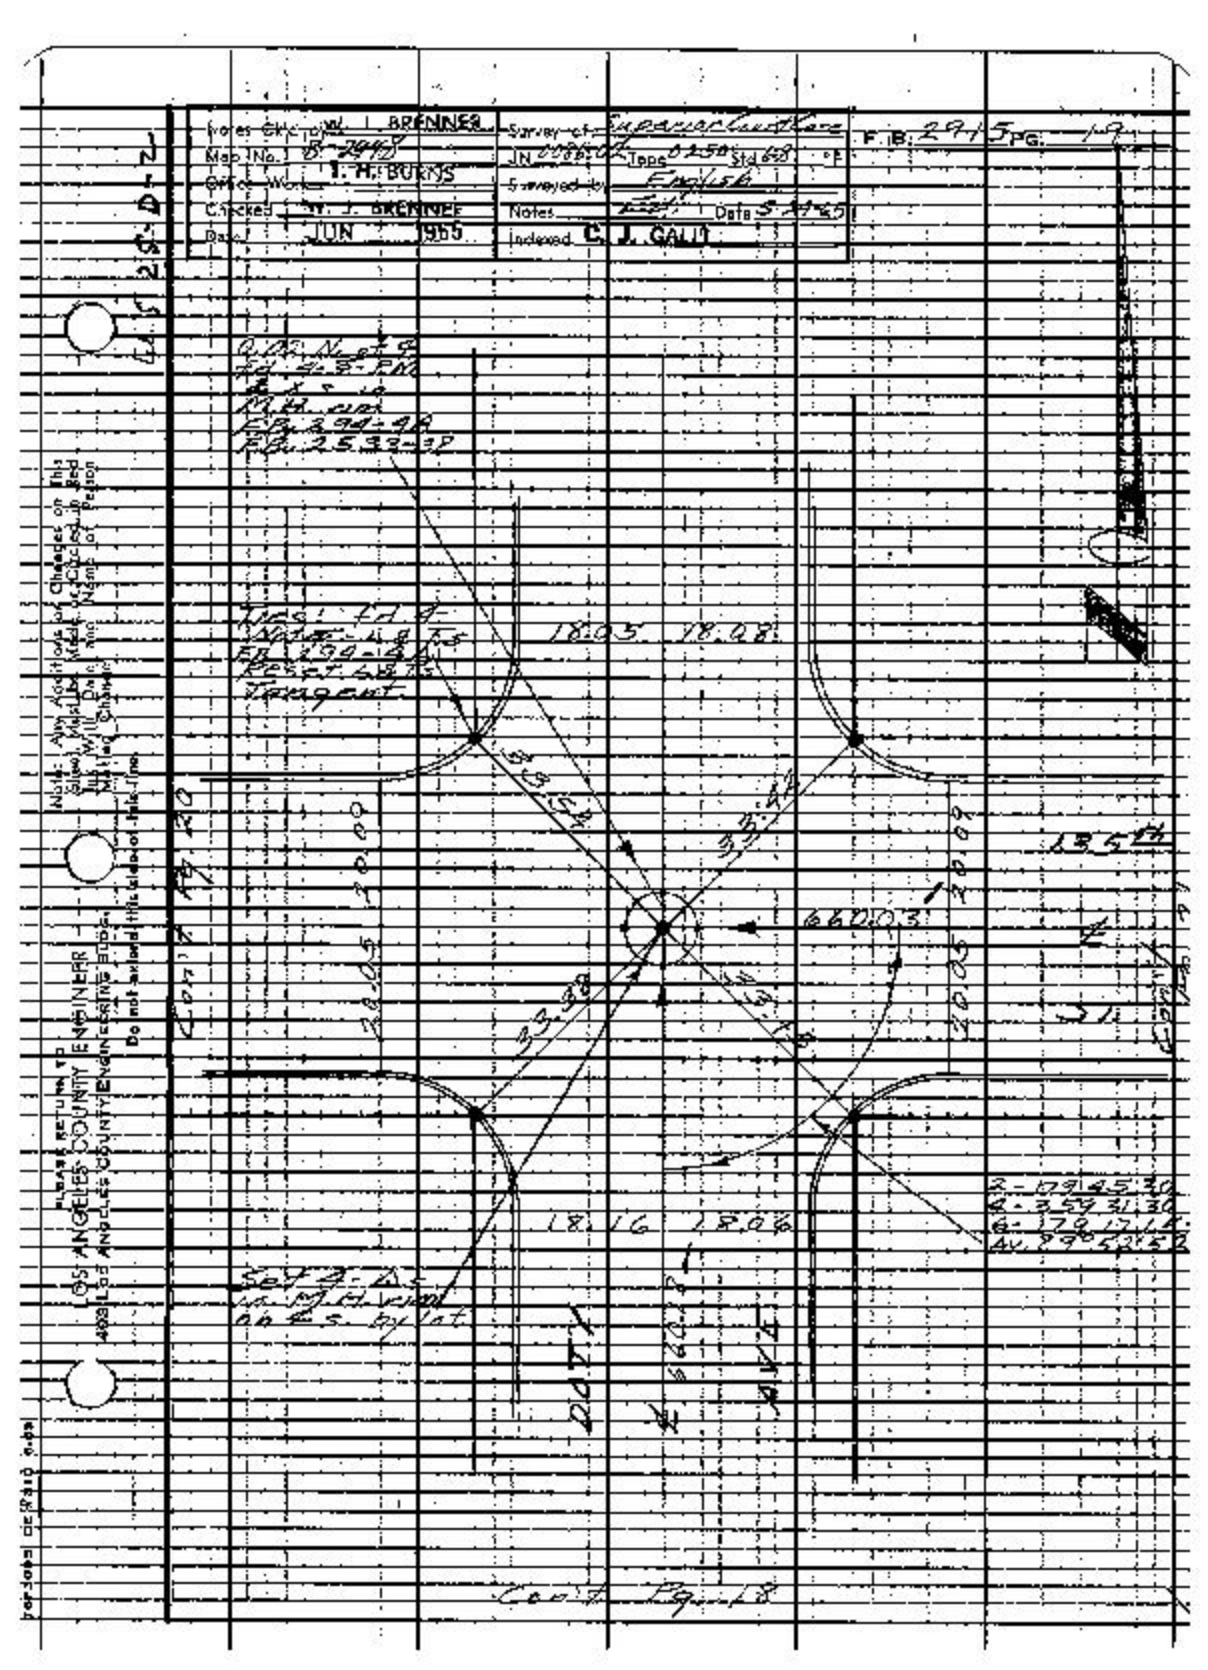
Surveyed by W. J. BRENNER
Map No. B-2445
Office Work T. H. BURNS
Checked W. J. BRENNER
Date JUN 1965
Survey of Superior Court Case
JN 2088.01
Tapes 0.250 Std 66ft
Surveyed by English
Notes
Indexed C. J. CALIT
F.B. 2915 PG. 19
Please return to
LOS ANGELES COUNTY ENGINEER
Los Angeles County Engineering Bldg.
Los Angeles 12, Calif.
Do not submit this side of this map
Note: Any Additions or Changes on this Sheet Should be Checked with Name of Person Making Change
Tie: 1 d.f.
Note: 4.8 ft S
FB 290-98
Post set
Tangent
18.05
18.08
18.16
18.06
66.03
20.00
20.05
20.09

PLEASE RETURN TO
LOS ANGELES COUNTY ENGINEER
403 LOS ANGELES COUNTY ENGINEERING BLDG.

Do not extend this side of this Rec.

Notes: Any Additions or Changes on This Sheet Must Be Made or Circled In Red Ink With Date and Name of Person Making Change.

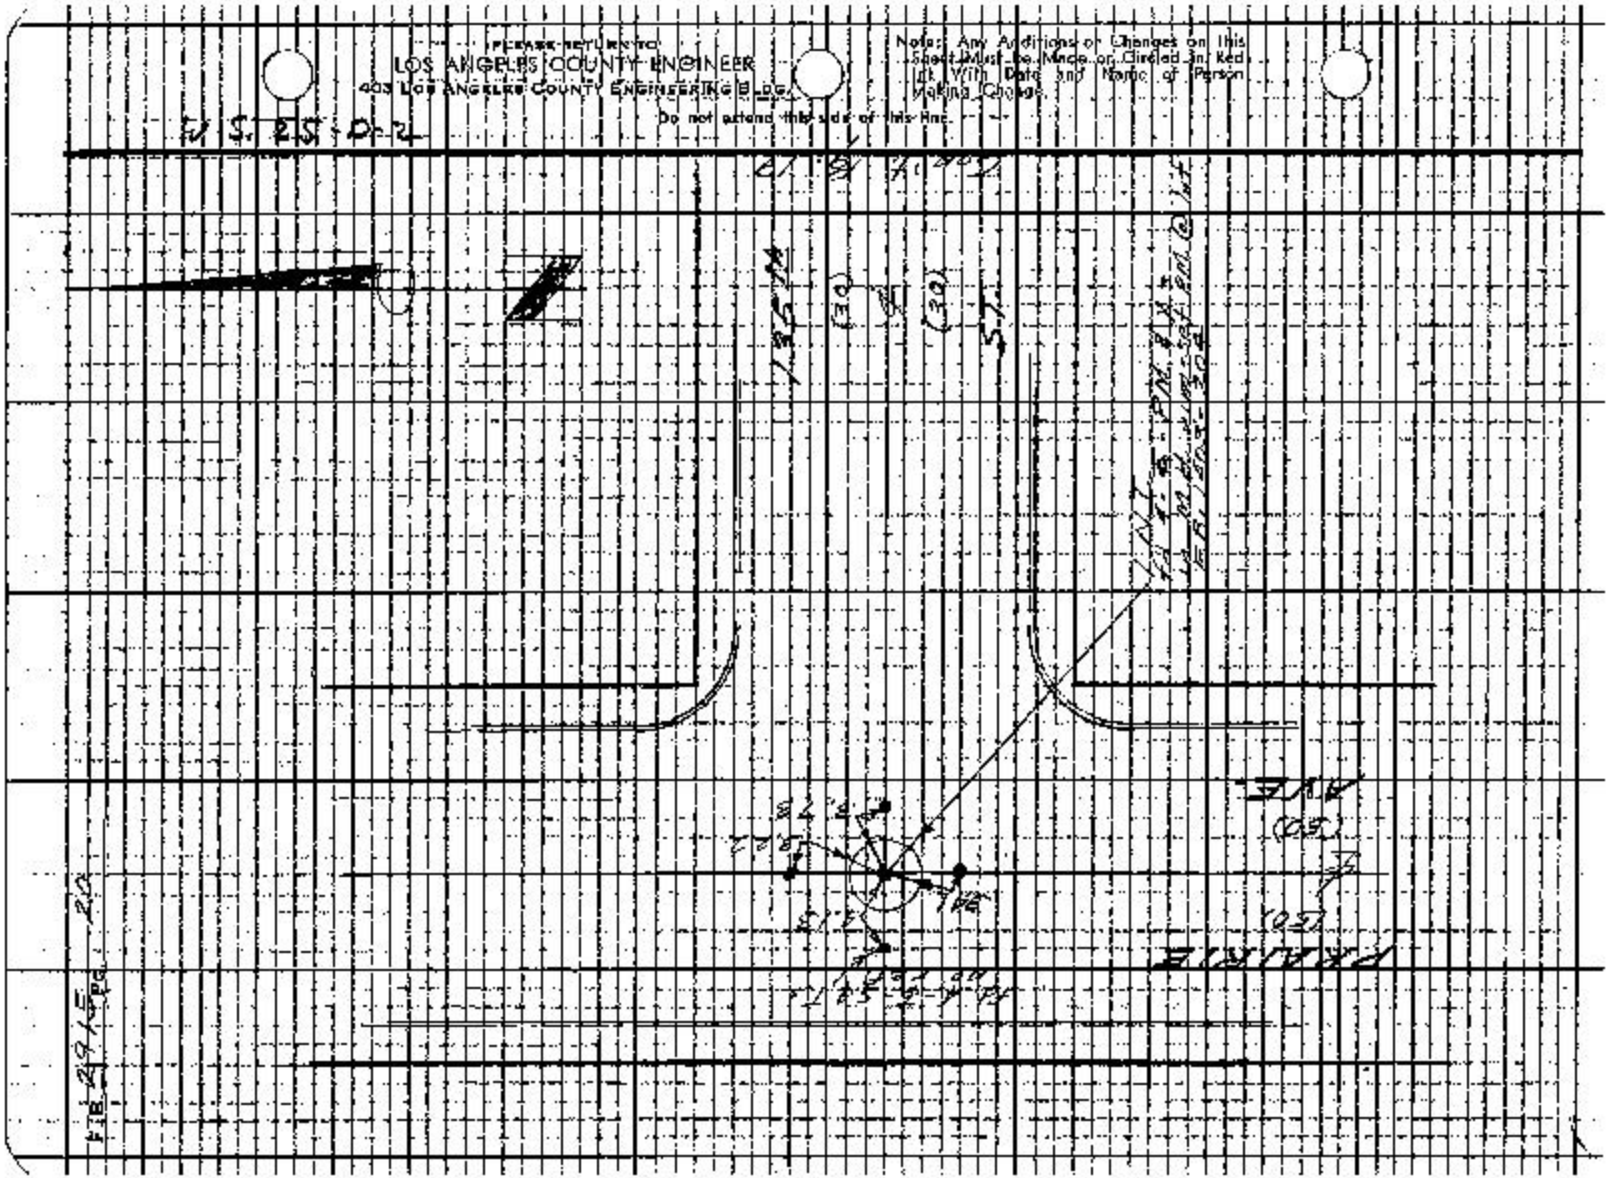

Notes-Clkd. by W. J. BRENNER
Map No. 2-2445
Office Work T. H. BURNS
Checked W. J. BRENNER
Date JUN 1965

Survey of Superior Court Case
JN 00860 Tape Std. F.
Surveyed by English
Notes Ed. Date 5-1965
Indexed C. J. GALLI

F. B. 2915 PG. 21

Notes: Any Additions, Changes or This Sheet Must Be Made by Circle of Person Who Will Make Any Necessary Corrections

Please Return to Los Angeles County Engineer 409 Los Angeles County Engineering Bldg.

Do not append this side of this line.








PLEASE RETURN TO
LOS ANGELES COUNTY ENGINEER
ROOM 1005 LOS ANGELES COUNTY ENGINEERING BLDG.

Do not extend this side of this Rec.

Note: Any Additions or Changes on This Sheet Must Be Made on Circled In Red Ink With Date and Name of Person Making Change.

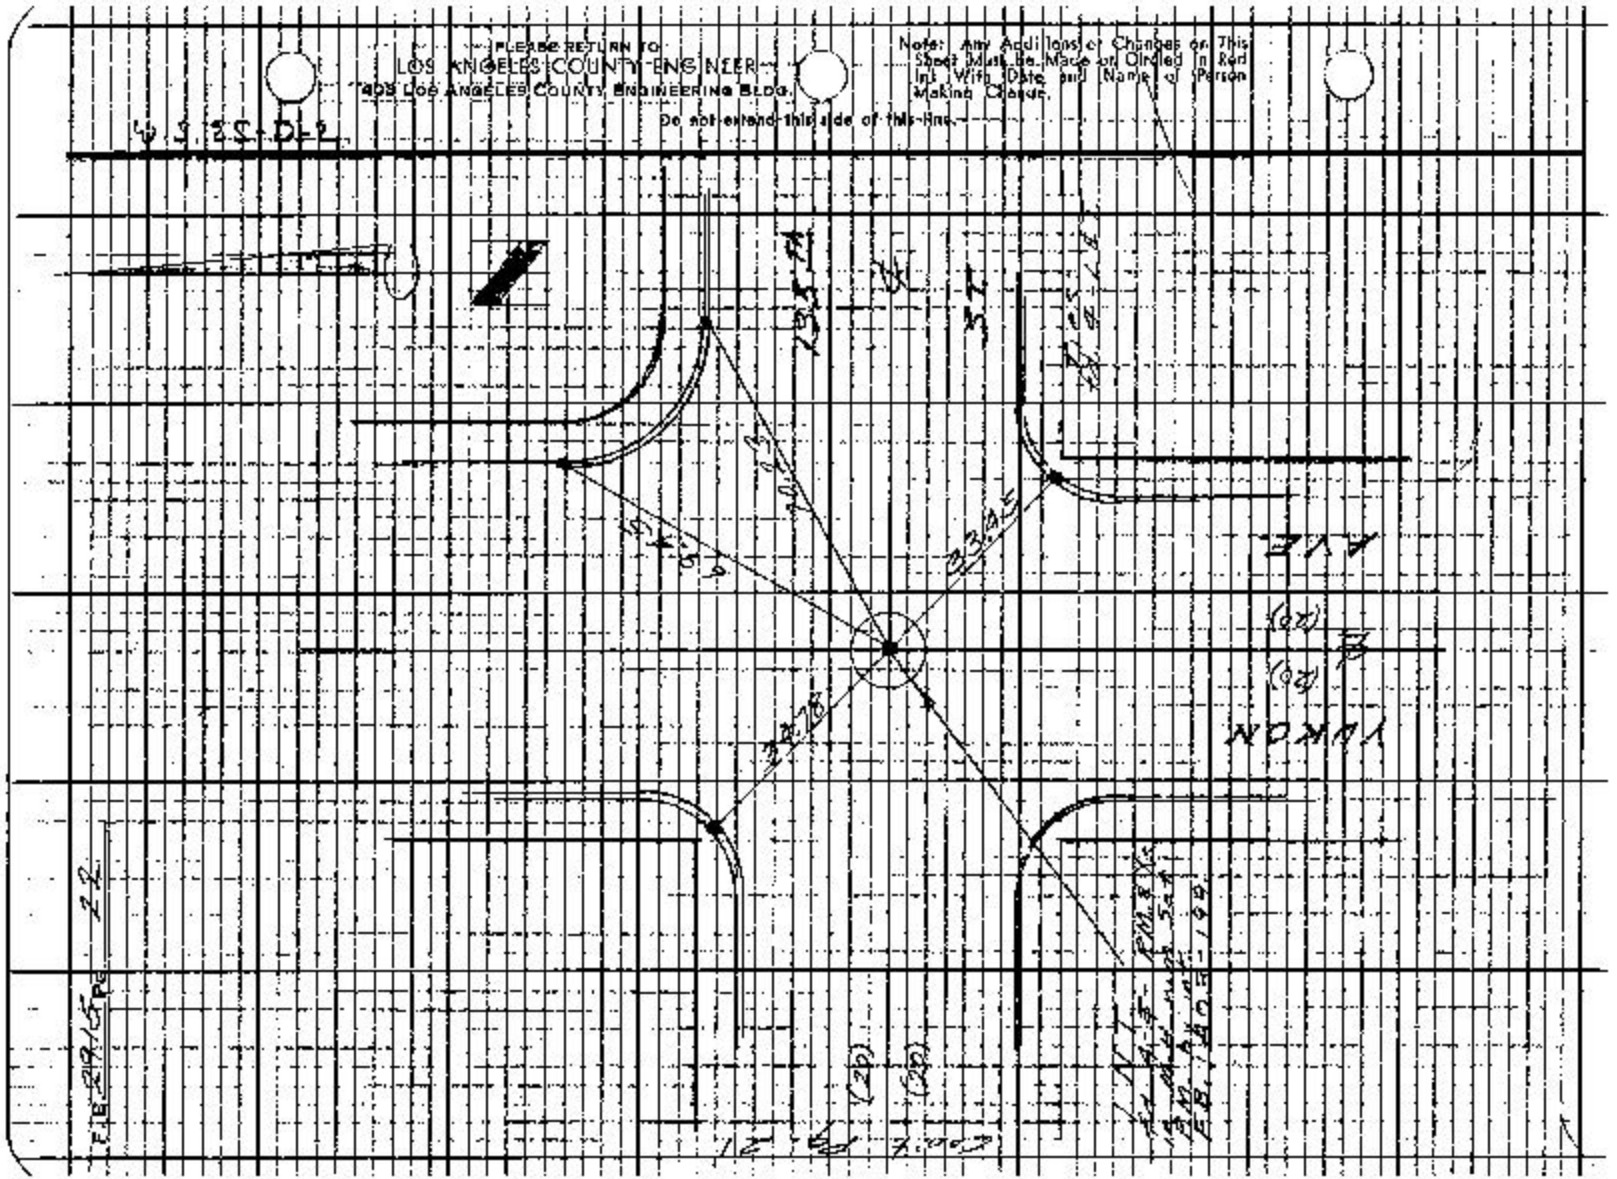

Notes Entered by W. L. BRENNER
Map No. B 2948
Office Work T. H. BURNS
Checked W. L. BRENNER
Date JUN 1965

Survey of Superior Court Case
JN 0096.02 Topo 1965 Sheet "F"
Surveyed by English
Notes Ed. Date 5 APR 65
Indexed C. J. GALT

F.B. 294 PG. 23

Cont. Pg 16

W. 1/2 SEC. 20-T2S-R11W

KORNBLUM

Ed. L & T.

KASECKANS

(50)

(50)

AVE

Ed. Large St. S & W Flush Rd. RE. 307-10

Ed. L & T. in Conc. Curb

Ed. L & T.

Ed. L & T. Tag in conc. curb

Ed. Nothing RE. 7-304-16 RE. 307-10 Set L & T. tag Flush By Fire

0.09 W

Note: Any Additions or Changes will be Shown, Listed by Made or Caused to be Made, and Dated, With Name of Person Making Change

PLEASE RETURN TO LOS ANGELES COUNTY ENGINEER 108 Los Angeles County Engineering Bldg. Do not extend this side of this line

FORM CE 1510 2-63

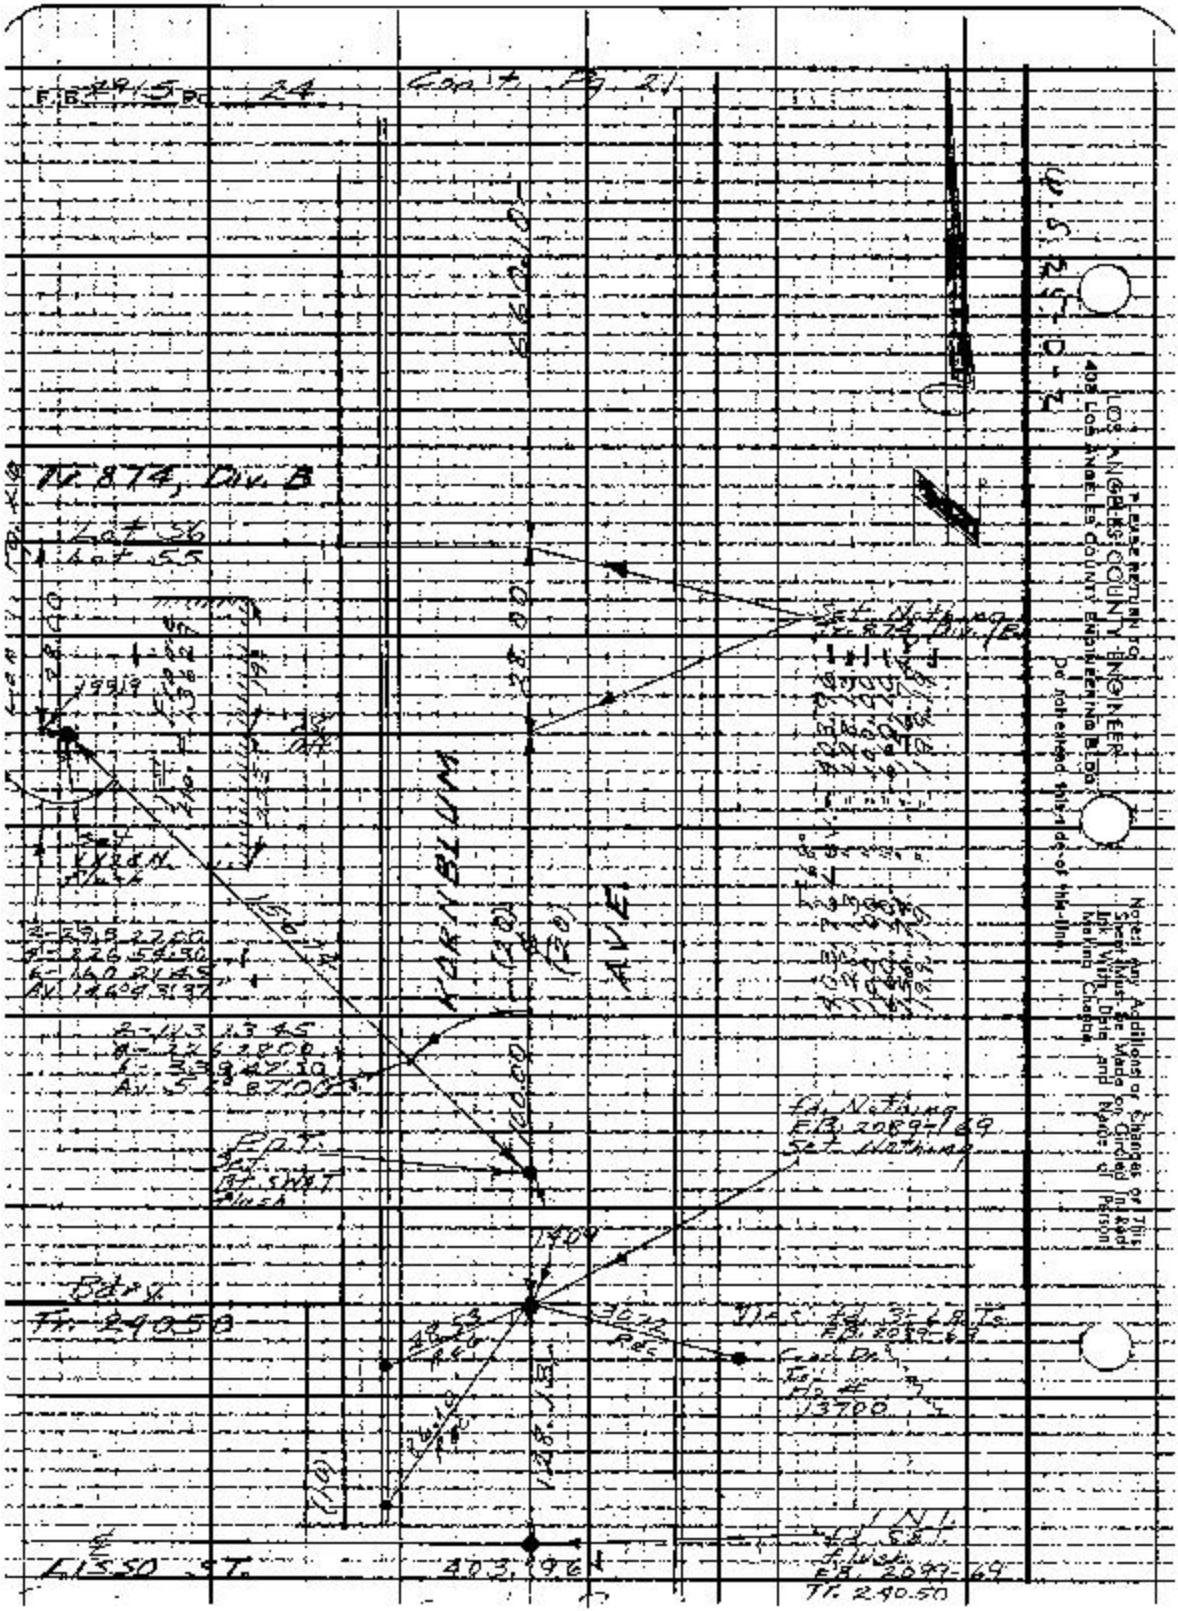
F.B. 249-5 Pg. 24
Cor. 7 Pg. 21
U.S. 2570-2
LOS ANGELES COUNTY ENGINEER
Please return to
COUNTY ENGINEERING BLDG.
Los Angeles County Engineer
Notice! Any Additions or Changes or This Sheet Must Be Made On Circled Ink With This Data and Name of Person Making Change.
Do not erase this side of this line.
Tr. 874, Div. B
Lot 36
Lot 55
(100' R/W)
AVE.
(100' R/W)
N 59° 22' 00" E 228.00'
R=1143.13'
Δ=12° 28' 00"
L=248.72'
Ad. Nothing
F.B. 2089-169
See Nothing
1400
Bdy.
Tr. 24905

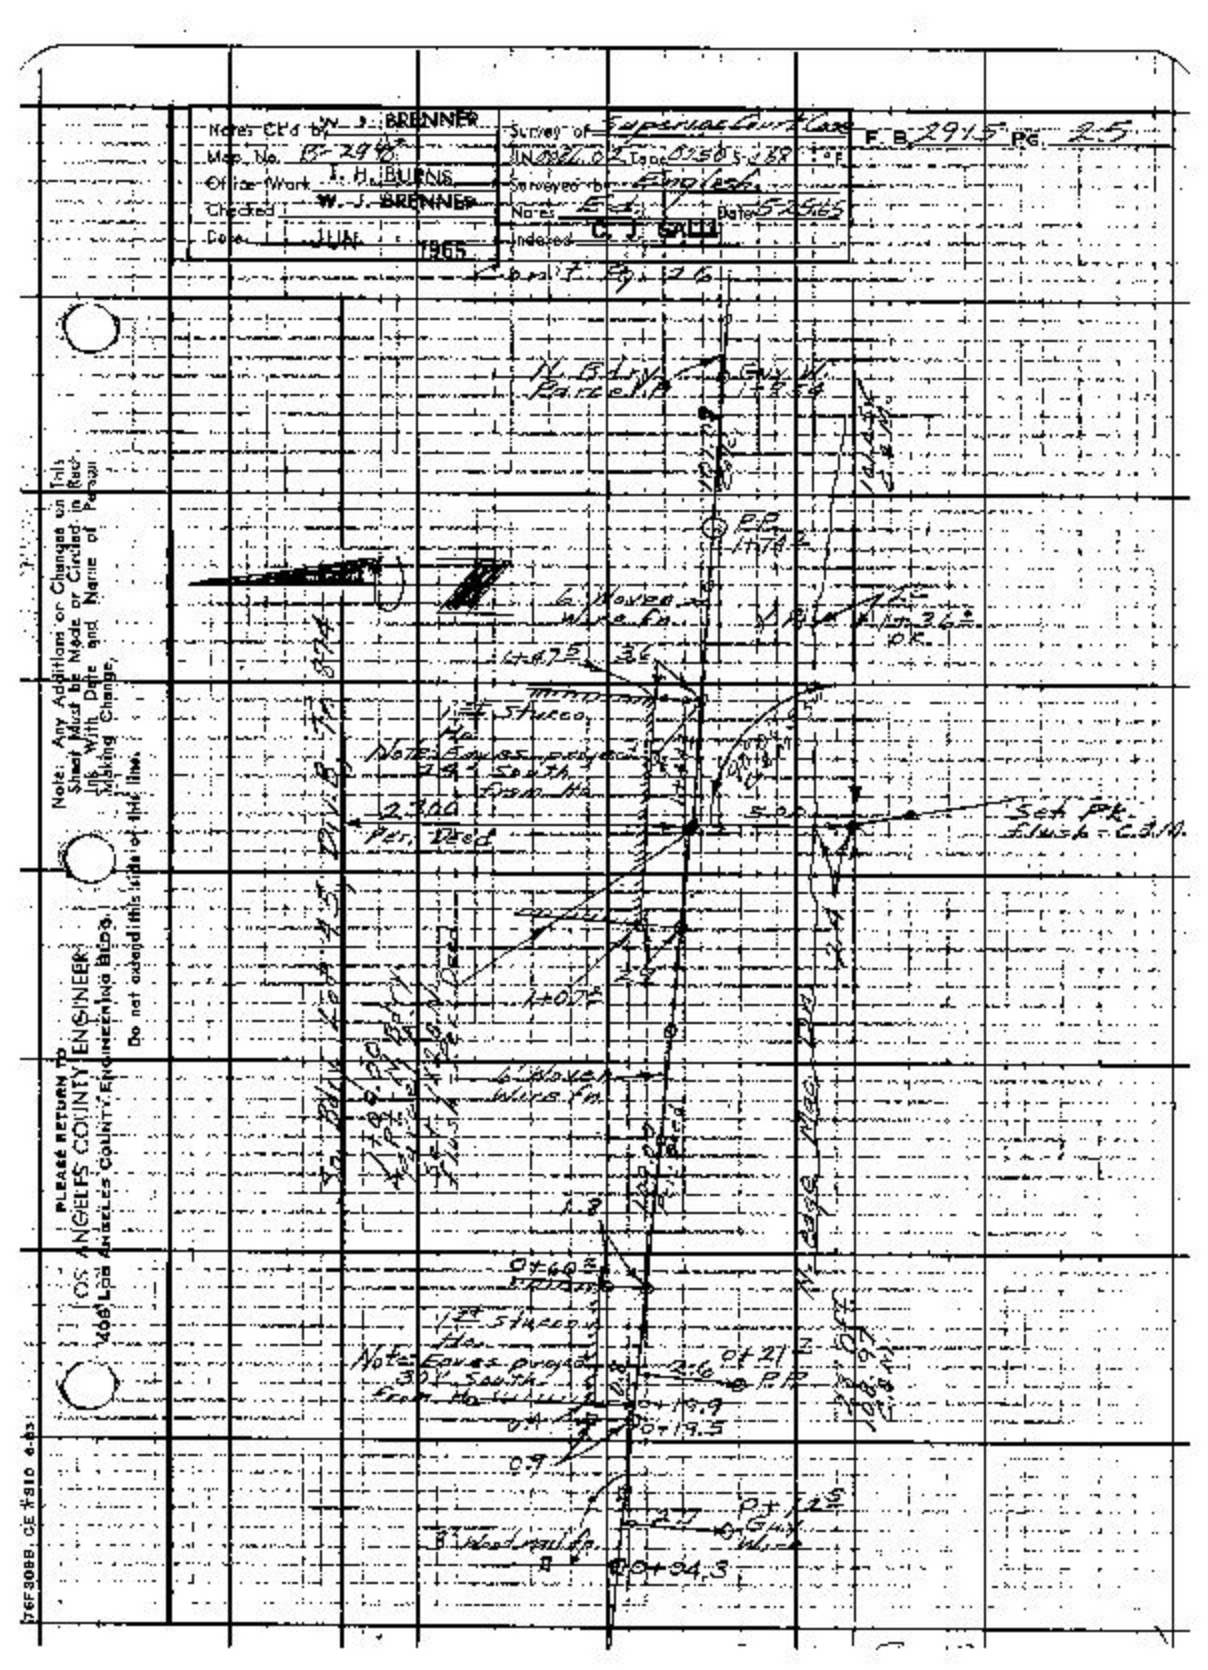
Notes Ckd by W. J. BRENNER
Map No. B-2945
Office Work I. H. BURNS
Checked W. J. BRENNER
Date JUNE 1965
Survey of Superior Court Case
Tape
Surveyed by Engineer
Notes E. J. V. Date 5-26-65
Indexed C. J. GALLI
F. B. 2945 PG. 25
Cont. F. Bk. 26
N. 8 Lines Parcel 2
Gate
P.O. Inlet
6 Power wires on
Note: Leaves project 29.7 South from No.
2.100 Per. Rec'd
Sch. Pk. Stucco - C.B.M.
Note: Leaves project 30' South from No.
Wood mail bx.
Please Return To
Los Angeles County Engineer
Los Angeles County Engineering Bldg.
Do not extend this side of this line.
Note: Any Additions or Changes on This Sheet Must be Made or Circled in Red Ink With Date and Name of Person Making Change.

Cont. Pg. 24

F.B. 2915 Pg. 26

199.192

5' Waved Wire Fn.

6' Woven Wire Fn.

2.502 Rec. Dist

3.00 C.&M.

Fd. Nothing Cor. Lot 5 Sec. 46 S.S.B.&M. Div. B T.= 874

N.E. Cor. Parcel B 3.710.08 Set 1" I.P. 2.00 Rec. Dist

Set 1" I.P. 2.00 Flush C.&M.

6' Woven Wire Fn.

0.3

2+70.6

.5 Woven Wire Fn.

0.3

2+34.9

Set 1" I.P. 2.00 Flush C.&M.

Frame Garage

2+10.08 to Pt. on Div. Line Parcel B Set 1" I.P. 2.00 Flush Rec. Dist

25.00 Rec. Dist

3.00 C.&M.

1+98.8

1+95.9

6' Woven Wire Fn.

Set 1" I.P. 2.00 Flush C.&M.

Note: Any Additions or Changes on This Sheet Must Be Made by Clerk in Red Ink and Initialed

Return to COUNTY ENGINEER 108 Hall of Records Los Angeles County Engineering Bldg. 900 North Broadway

Do not extend this side of this line.

W. EDMONDSON

Notes Ck'd
Mer. No.
Office Work
Checked
Date

Survey of CENTINELA AVE
Job 009520 Tape 047 Sts 65 °F
Surveyed by S.E. DREIER
Notes S.E. Dreier Date 5-5-67
Indexed T.C.J. GALLI No. 2 P. 68

F.B. 245 Pg. 31

JOB NO 009520

CENTINELA AVE

℄ & PROPOSED ℄ RETRACEMENT FROM SEPULVEDA BLVD. TO CENTINELA AVE. W. OF RANDALL ST.

REFERENCES:-

C.S.B. 135
E.B. 285
E.B. 325
E.B. 1794
R.D. E.B. 441 (E.B. 5509)
R.D. V.C. 873
E.B. 2673
C.T.E.B. 20205
" " 72504 (C.B. 1430)

DREIER
WILKS
SIEMANN
MCKNIGHT

LOS ANGELES COUNTY ENGINEER
PLEASE RETURN

7 OF 9 SHTS C.E. M3 10 6-62

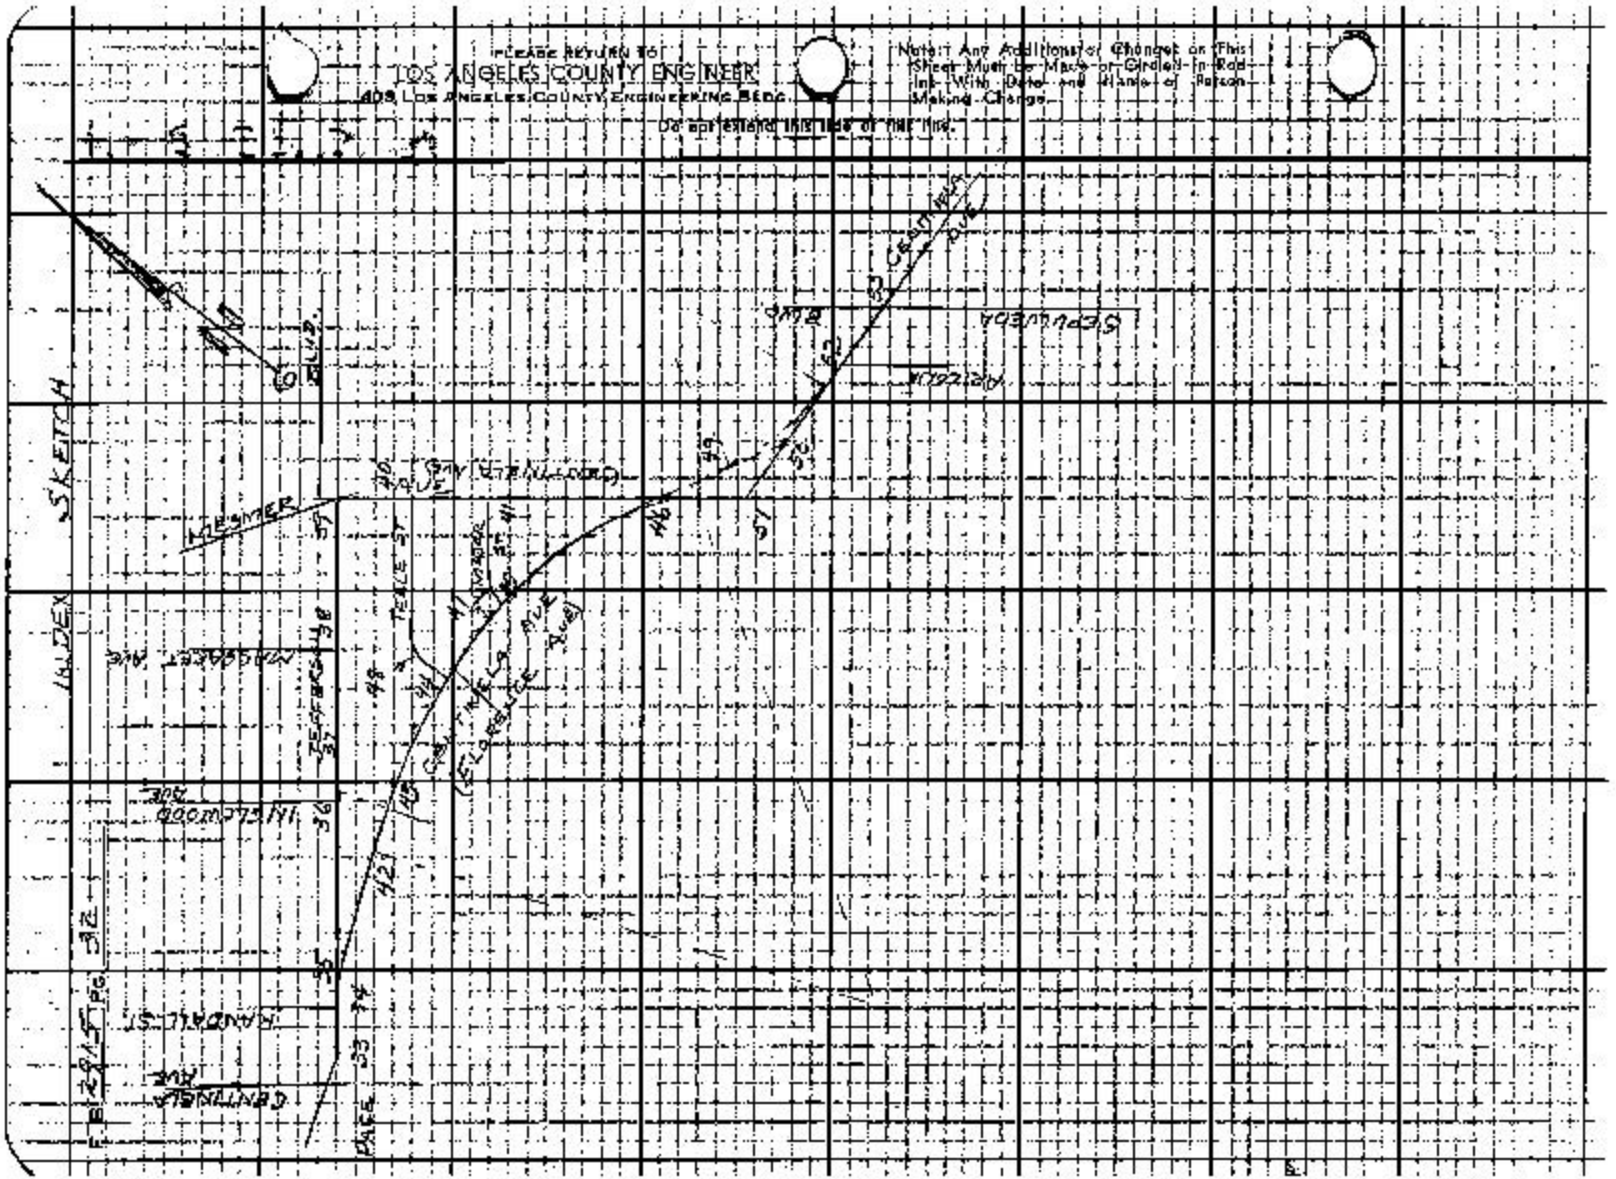
PLEASE RETURN TO
LOS ANGELES COUNTY ENGINEER
Note: If Any Additions or Changes on This Sheet Must Be Made or Circled in Red Ink With Date and Name of Person Making Change
SKETCH
INDEX
SEPULVEDA
CENTINELA AVE
MESMER
MARSHALL
INGLEWOOD
RANDALL ST
PACE
BLVD.

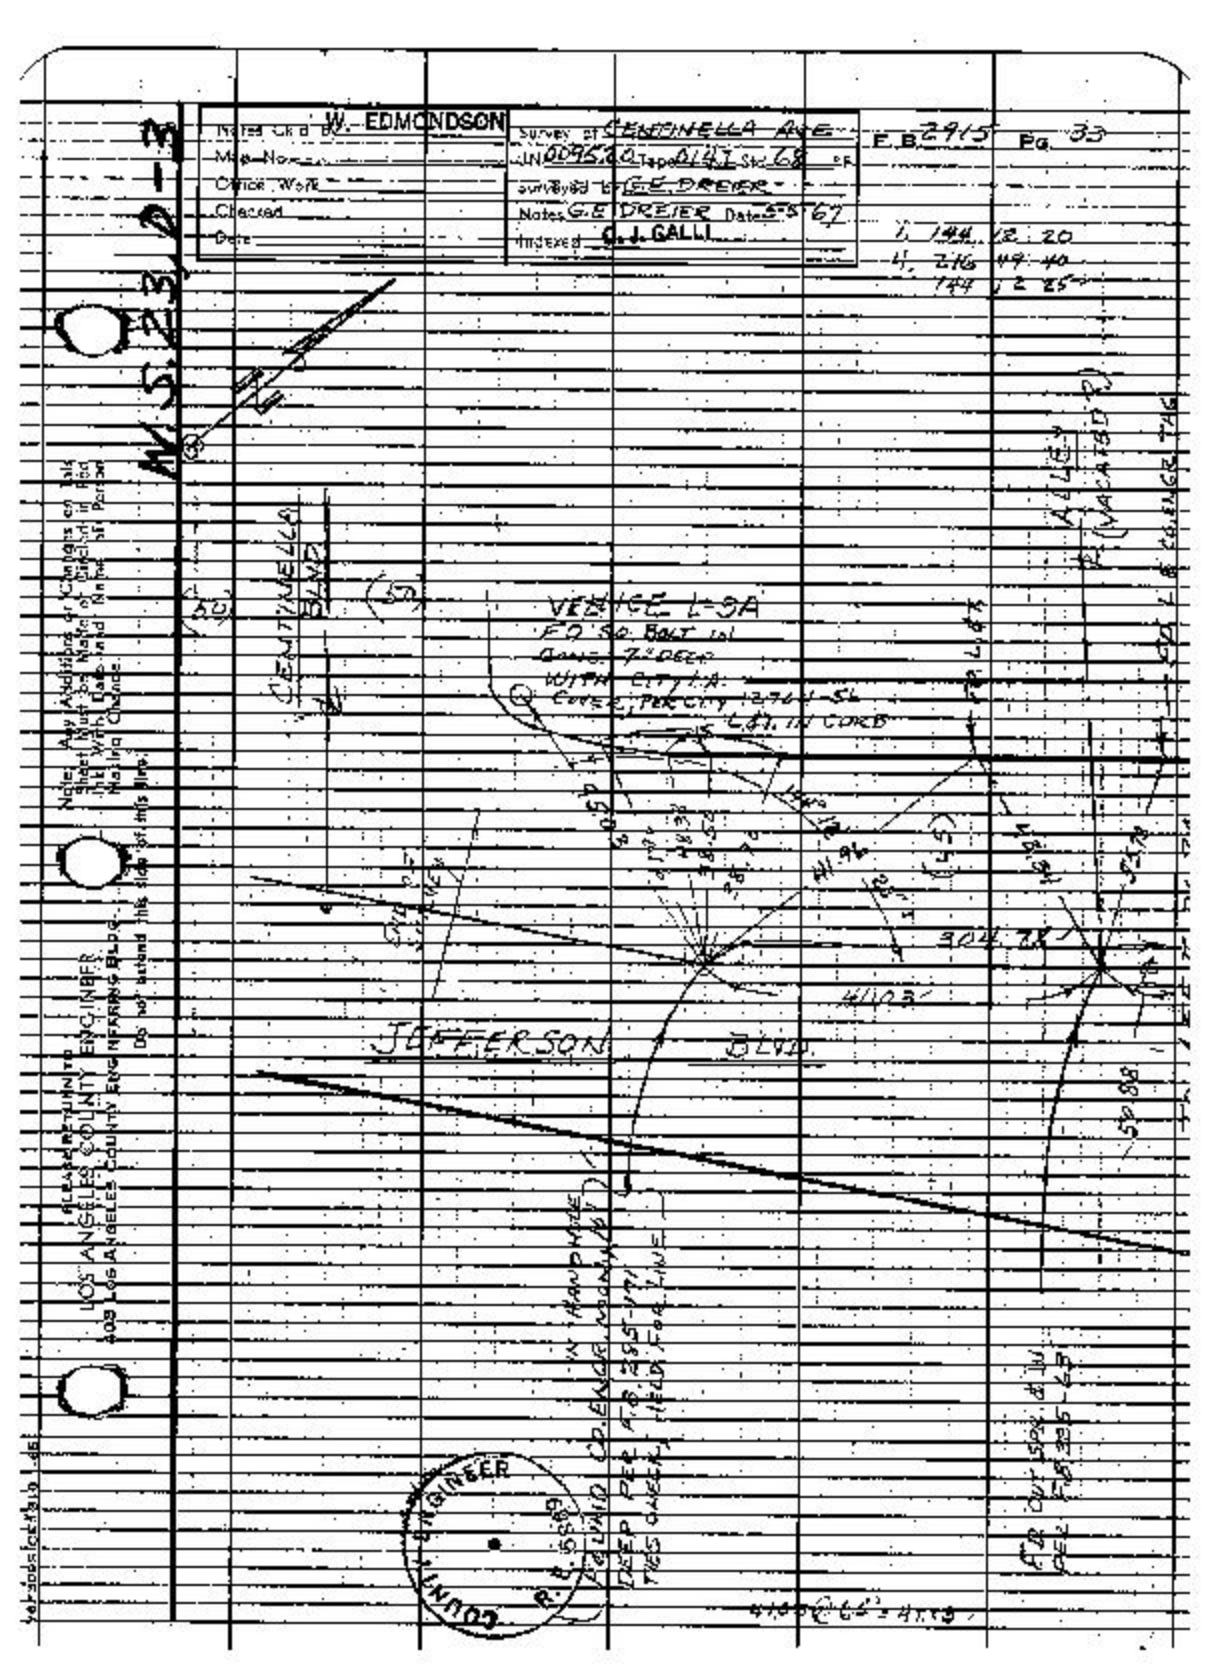
Notes Card By W. EDMONDSON
Survey of CENTINELLA AVE
Map No.
Office Work
Checked
Date
Surveyed by G.E. DREIER
Notes G.E. DREIER Date 5-5-67
Indexed G.J. GALLI
F.B. 2915 Pg. 33
W 5.22 I-3
CENTINELLA BLVD
JEFFERSON BLVD
VENICE L-9A
FD SQ. BOLT in conc. 7" DEEP
WITH CITY I.A.
CURB, PER CITY 12744-SL
CAT. IN CURB
ALLEY
LOS ANGELES COUNTY ENGINEER
COUNTY ENGINEER
Note: Any Additions or Changes on this Sheet Must Be Made by Digital or Person Initialed With Date and Name of Person Making Change.
Do not extend this side of this line.

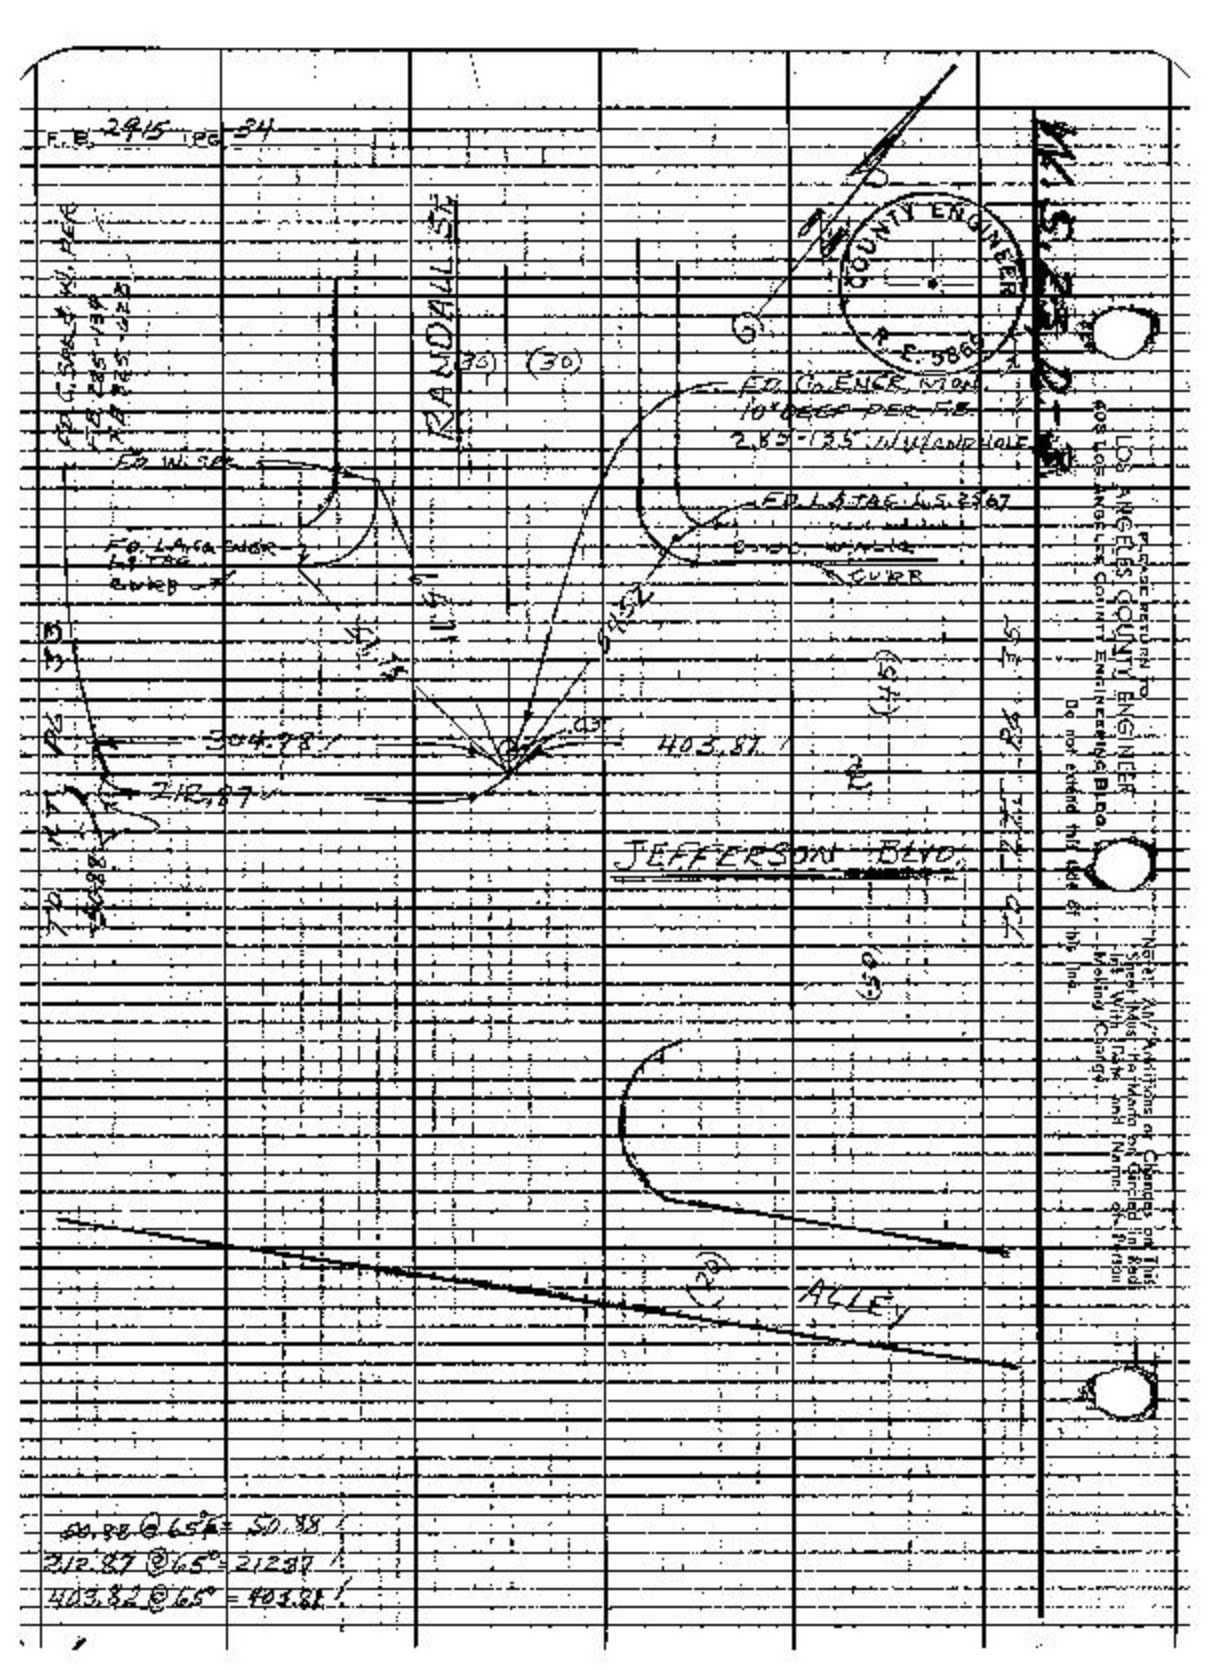
RANDALL ST.
(30)
(30)
FD. CONC. MON. IN WELL
FD. L.A.C.O. TAG L.S. 2967
FD. L.A.C.O. TAG L.S. 2967
10" DEEP PER F.B.
2.85-125 IN LEAD HOLE
CURB
CURB
(54)
(54)
304.98'
212.87'
403.87'
JEFFERSON BLVD.
(30)
ALLEY
(20)
COUNTY ENGINEER
R.E. 5868
LOS ANGELES COUNTY ENGINEER
PLEASE RETURN TO
LOS ANGELES COUNTY ENGINEERING BLDG.
Do not extend this title off this line.
50.88 @ 65° = 50.88'
212.87 @ 65° = 212.87'
403.82 @ 65° = 403.82'

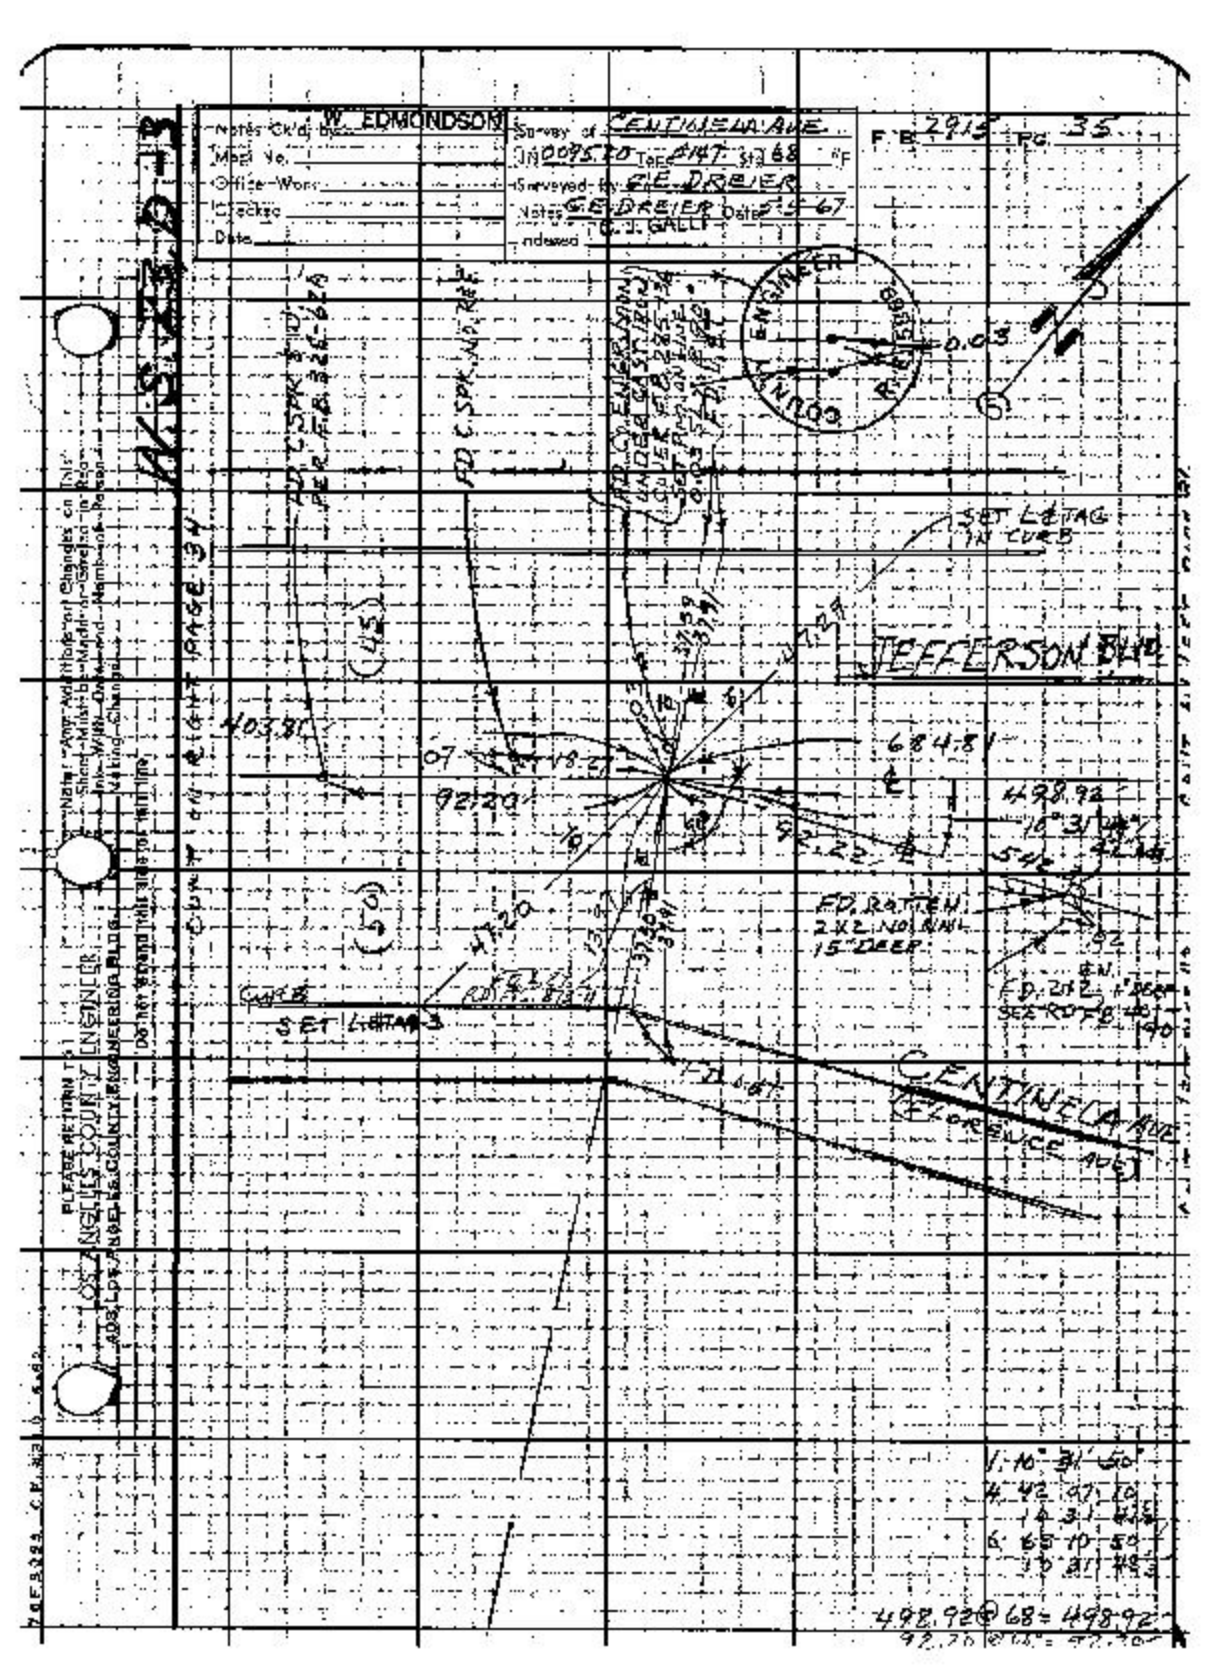
W. EDMONDSON
Survey of CENTINELA AVE.
JN 2095.20 Tape 2147 Sht 68 "F"
Surveyed by G.E. DREIER
Notes G.E. DREIER Date 5-67
Indexed C.J. GALLI
F.B. 2915 Pg. 35
Notes Ck'd by
Mod No.
Office Work
Checked
Date
ENGINEER
N 10°03'
0.03
FD. C.SPK. NO REF.
FD. C.SPK. NO REF. PER F.B. 226-62
FD. C.SPK. & WASH. UNDER CAST IRON COVER FOR E.B. 0.03' S. & 0.03' E. OF C.L.
SET L&T TAG IN CURB
JEFFERSON BLVD.
(45)
403.81'
92.20'
68 4.81'
498.92'
10°31'50"
42.44'
S 42°
92'
FD. RAILROAD SPIKE 2X2 NO NAIL 15" DEEP
FD. 2X2 1" DEEP SEE NOTE #2
190'
(50)
CURB
SET L&T TAG
CENTINELA AVE.
1. 10° 31' 50"
4. 42 97.10
1 4 3.1 6.8
6. 65 10 50
10 31 49.3
498.92 @ 68 = 498.92
92.20 @ 68° = 92.20
LOS ANGELES COUNTY ENGINEER
PLEASE RETURN TO
Name Amp And Holes or Changes on Sheet Mileage Mandrel Grade Tie Rod Inlet With Date and Remarks Person Making Change

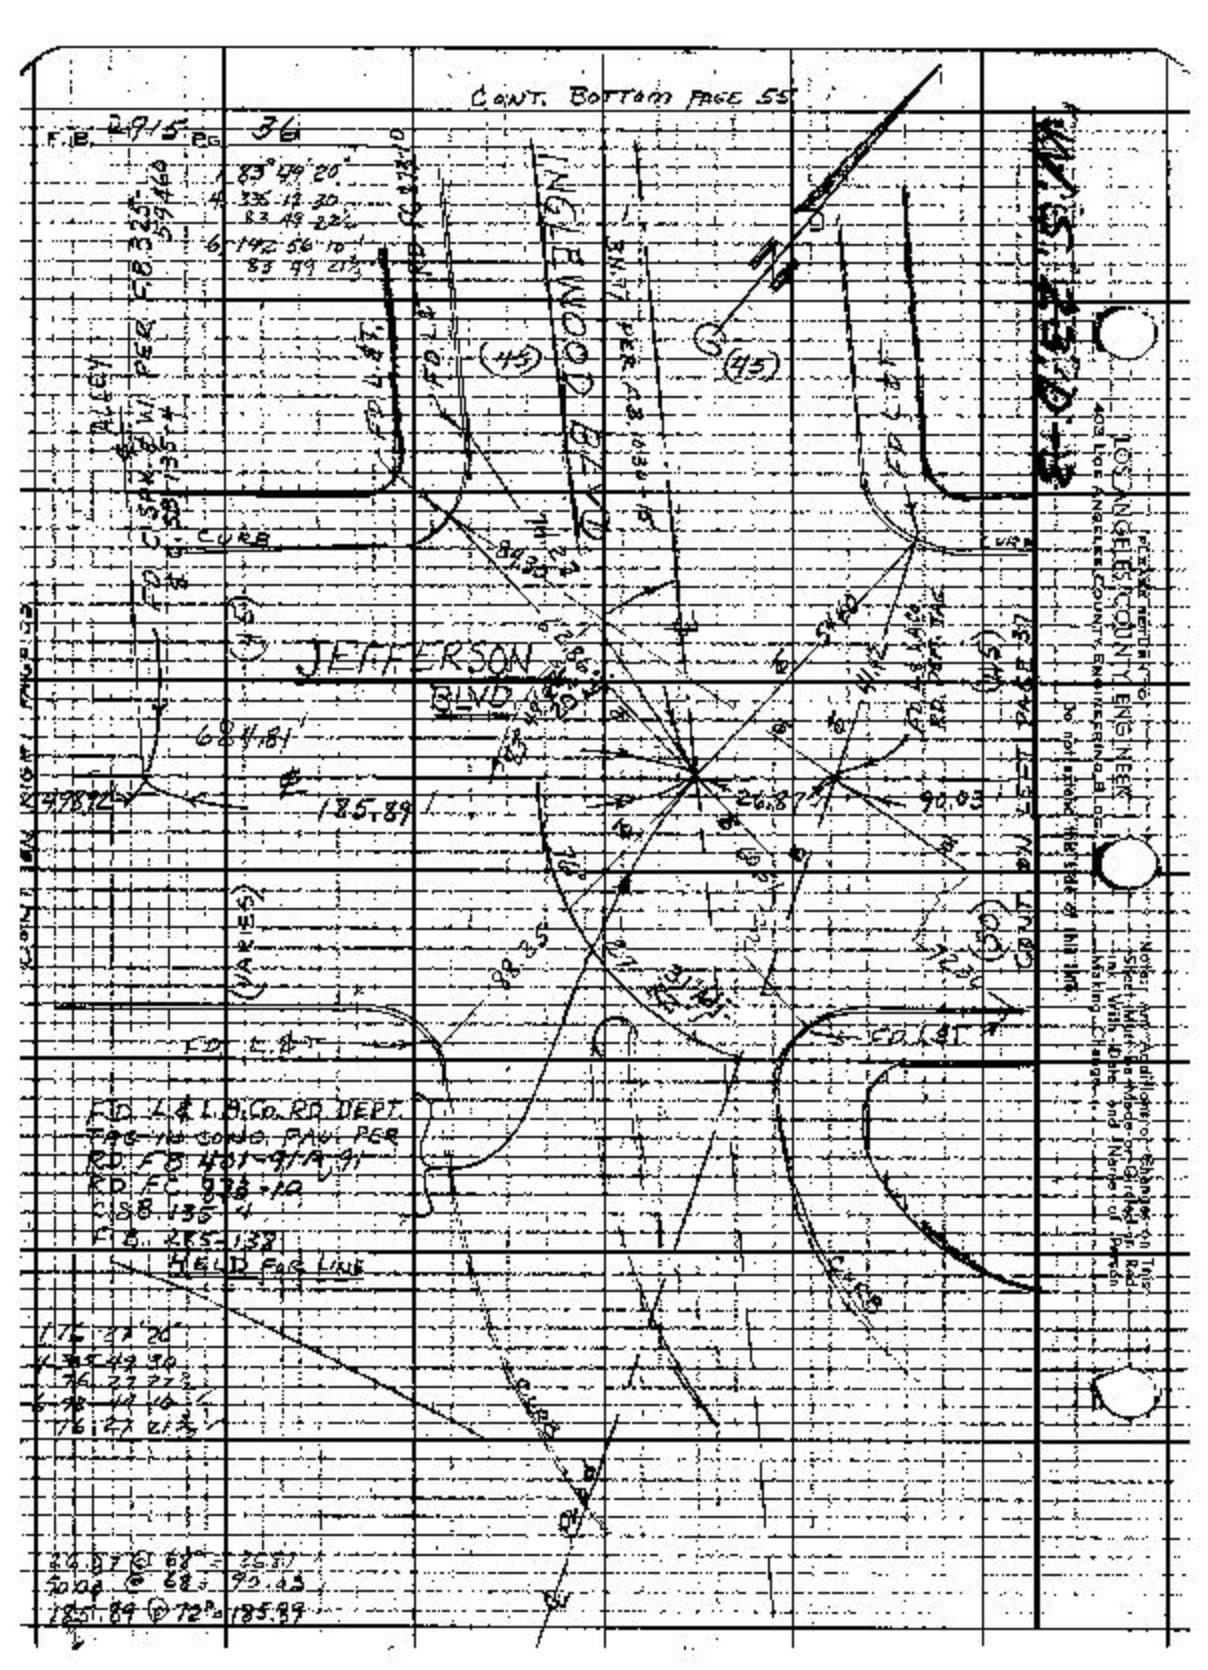
CONT. BOTTOM PAGE 55
F.B. 2915 PG. 36
JEFFERSON BLVD.
LOS ANGELES COUNTY ENGINEER
403 LOS ANGELES COUNTY ENGINEERING BLDG.
ALLEY
C.L.
CURB
FD. L & L.B. CO. RD. DEPT. TAG IN CONC. PAVT. PER R.D. F.B. 401-9/19/41
R.D. F.C. 933-10
S.B. 135-4
F.B. 2815-138
HELD FOR LINE
FD. L.&L.B.CO.
(45)
(WIS)
(PRC)
684.81'
185.89
90.03
26.87
N
E

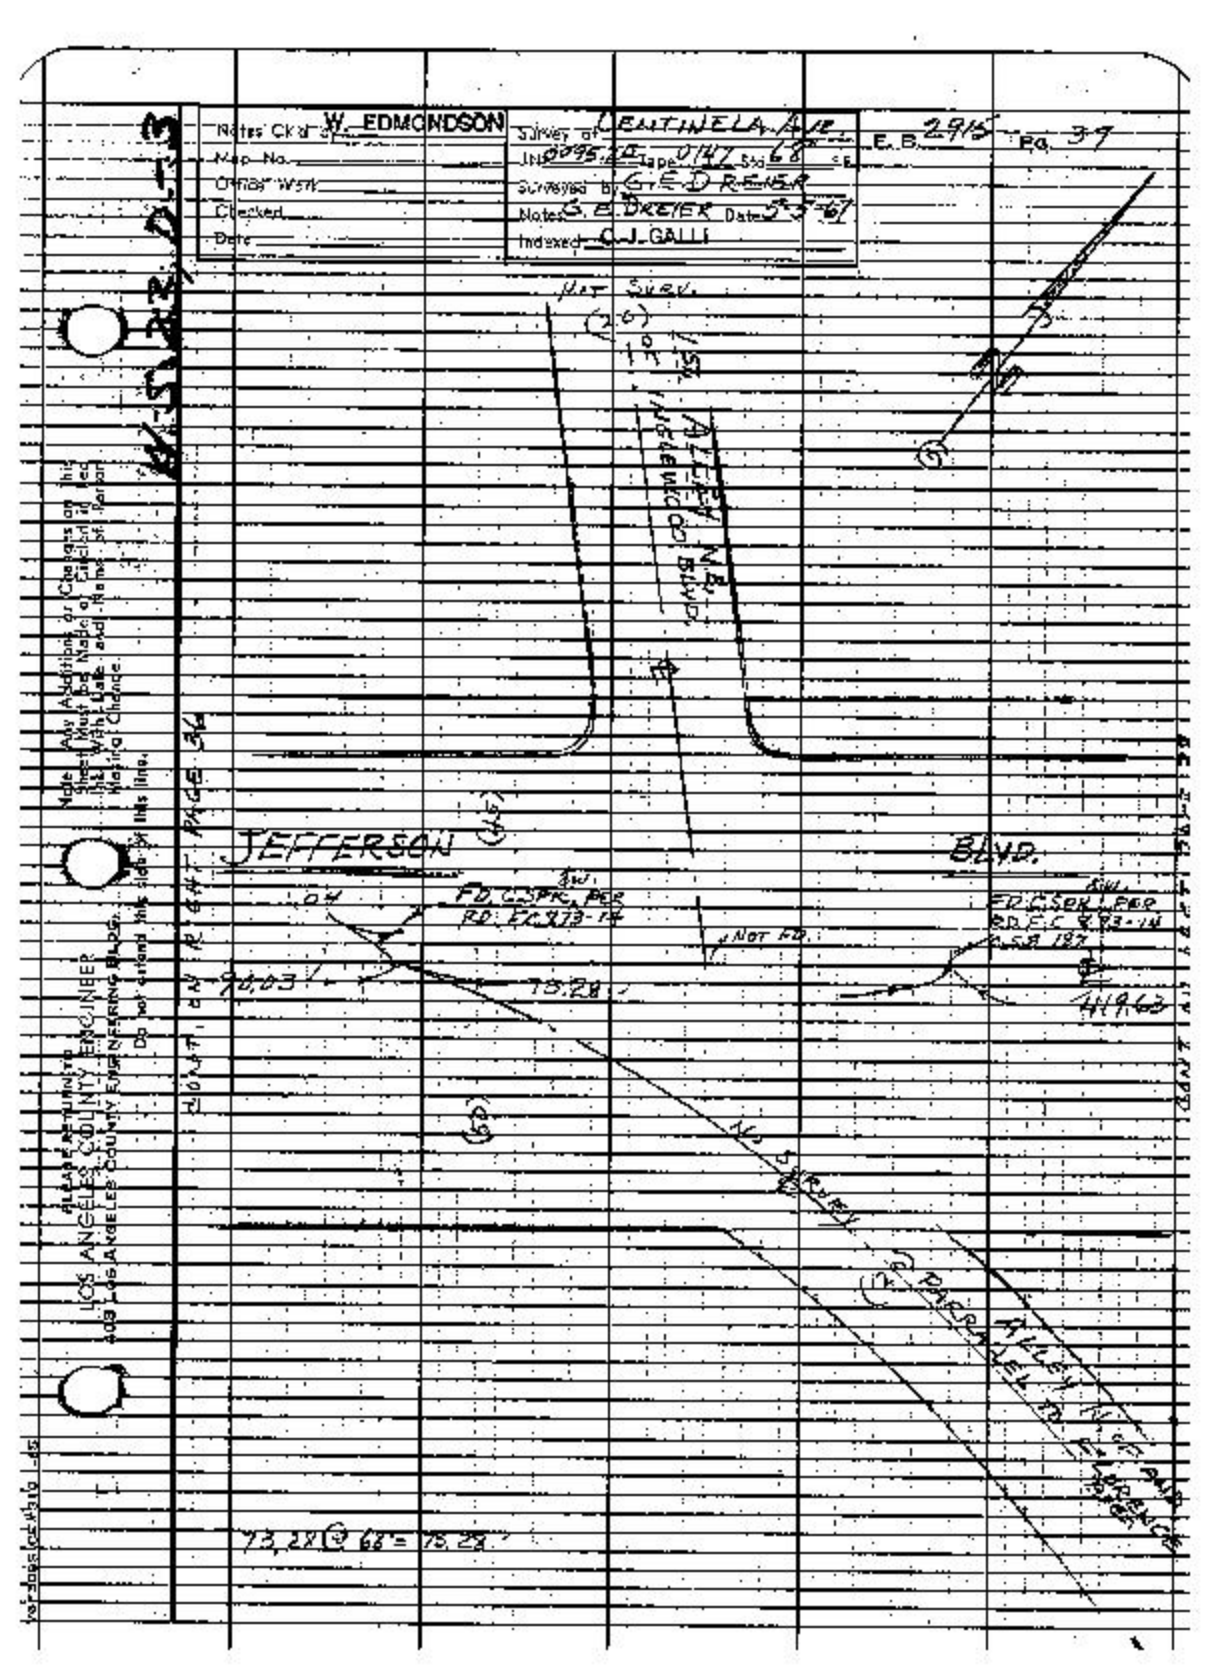
Notes Ckd. W. EDMONDSON
Map No.
Office Work
Checked
Date
Survey of CENTINELA AVE.
Job 0095.10 Tape V147 Sht 68
Surveyed by G.E.D. REINER
Notes G.E. DREIER Date 5-3-67
Indexed C.J. GALLI
E.B. 295 Pg. 37
NOT SURV.
JEFFERSON
BLVD.
FD COPR. PGE
RD. EC 873-14
NOT FD.
FD COPR. PGE
RD. EC 873-14
CSA 187
4H 9.60
9.03'
79.28'
73.2' @ 68° = 79.28'
Note: Any Alterations or Changes of this Sheet Must Be Noted on Index Sheet With Date and Name of Person Making Change.
Do not extend this side of this line.
LOS ANGELES COUNTY ENGINEER
ADD LOS ANGELES COUNTY ENGINEERING BLDG.
PLEASE RETURN TO

F.B. 2915 PG 38

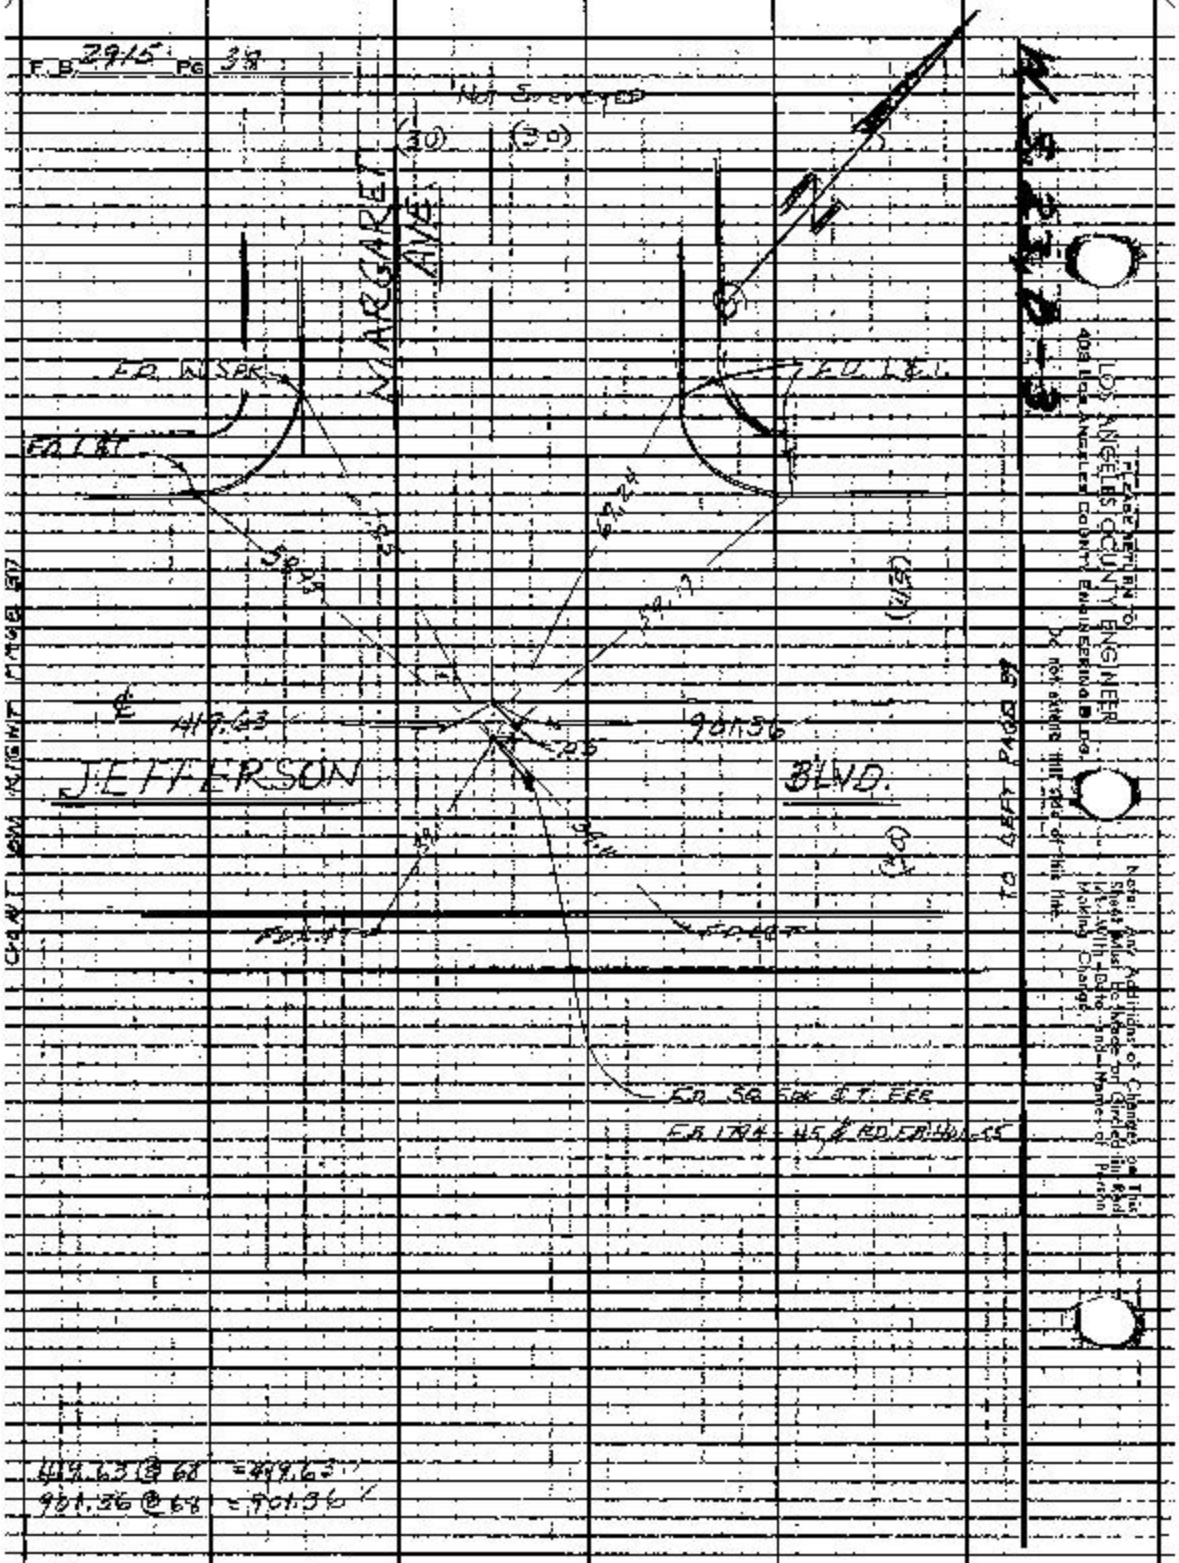
MARGARET AVE.
(30)
(30)
Not Surveyed
E.O. W.S.P.K.
E.O. I.R.
E.O. I.R.
S 89°55'
N 89°55'
419.63
90.36
JEFFERSON
BLVD.
(S 89°55' E)
E.O. 56 Sec. R.T. E.R.S.
E.O. 1784 U.S.L. RD. E.O. W.S.P.K.
LOS ANGELES COUNTY ENGINEER
403 Los Angeles County Engineering Bldg.
Los Angeles 12, Calif.
Do not write this area of this map.
Note: Any Additions or Changes to This Sheet Must Be Noted on Corrected Print With Date and Name of Person Making Change.
419.63 @ 68 = 419.63'
90.36 @ 64 = 90.36'

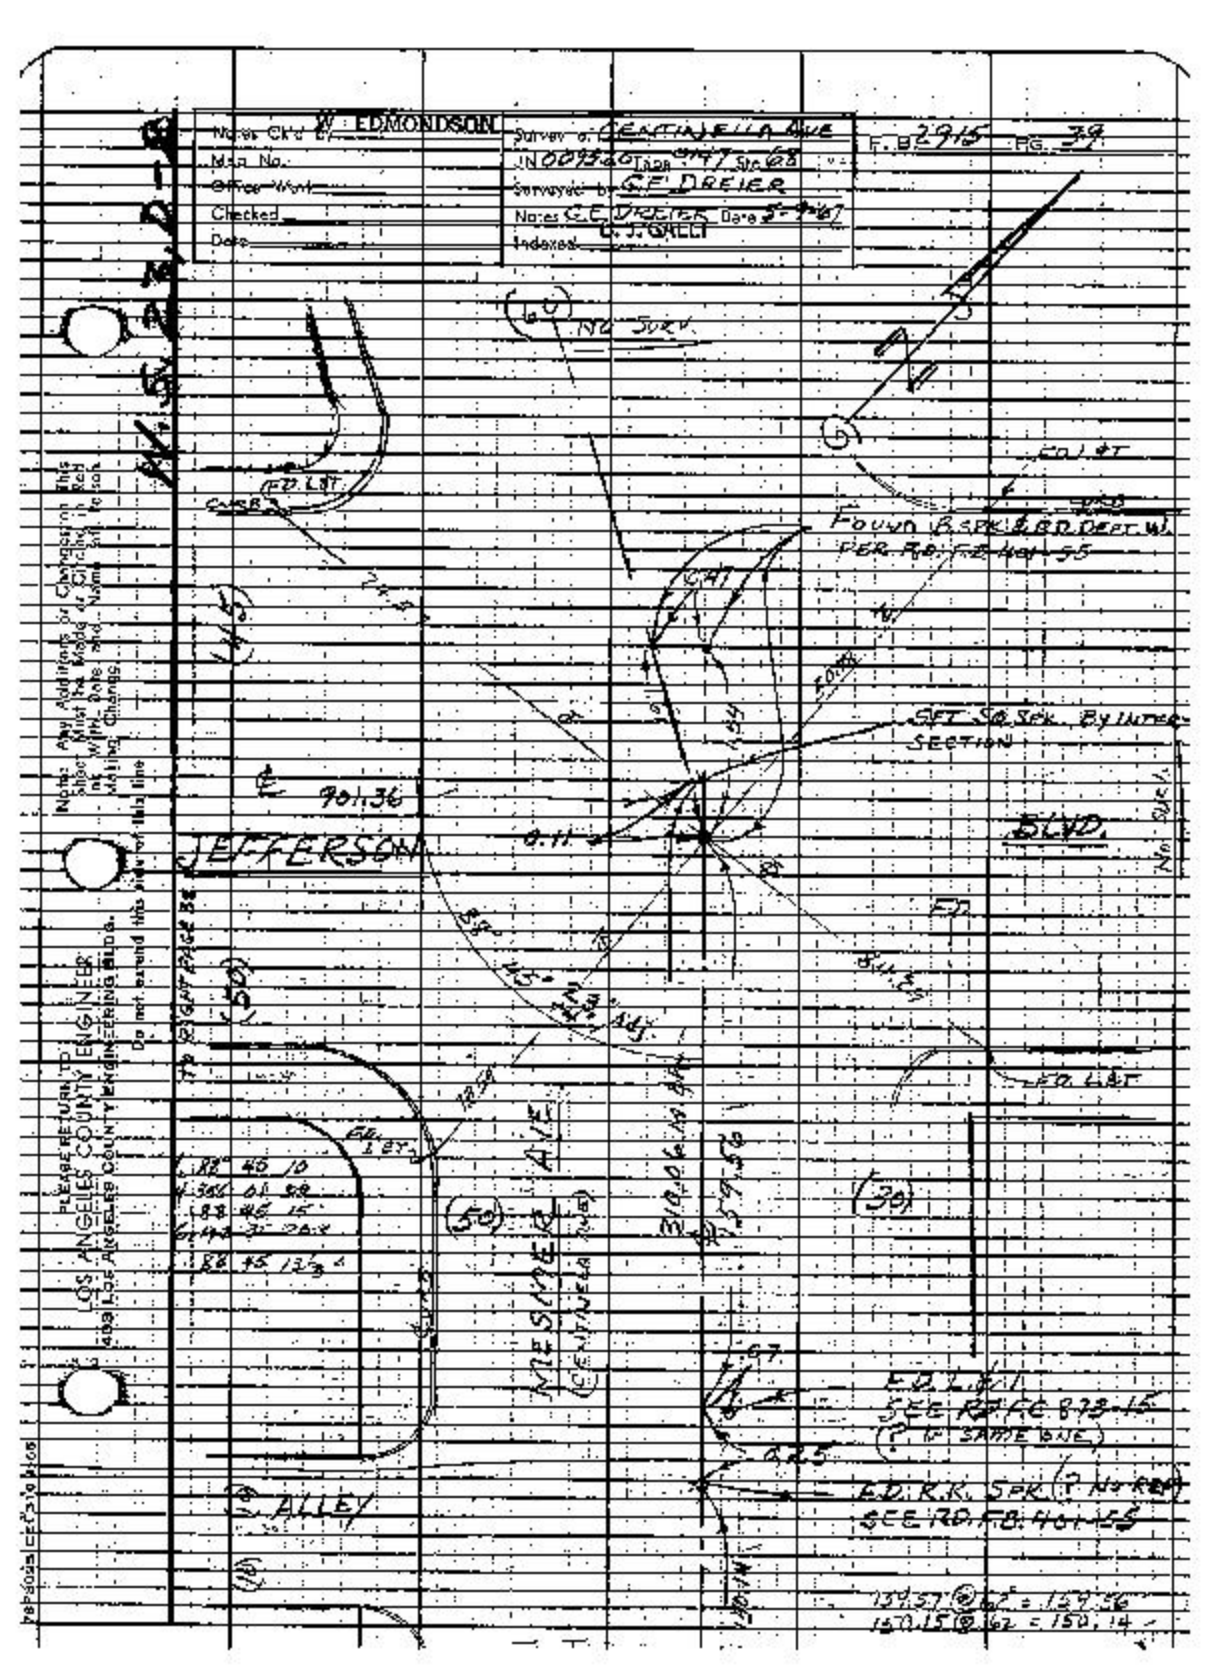
W. EDMONDSON
Survey of CENTINELLA AVE
Surveyed by G.E. DREIER
Notes G.E. DREIER Date 5-9-67
Checked
Indexed
F.B. 2915 PG. 39
M.S. 2-D-6
Notes: Any Additions or Changes to this Sheet Must be Made or Checked in Red Ink With Date and Name of Making Changes
PLEASE RETURN TO LOS ANGELES COUNTY ENGINEER 108 LOS ANGELES COUNTY ENGINEERING BLDG.
Do not extend this side of this line
TO RIGHT PAGE 38
JEFFERSON
BLVD.
CENTINELLA AVE
MESMER
ALLEY
FD. L&T
FD. NAIL
FD. L&T
SEE R&T AC 873-15
(? IN SAME LINE)
E.D. R.R. SPK (? No REF)
SEE 120 F.B. 401-155
FOUND B. SPK & BD. DEPT. W.
PER R.S. F.B. 401-35
CAL
NO SURV.
CAL
SET SO. SPK. By Lines
SECTION
No Curb
No Curb
FD.
Curb
Curb
(50)
(50)
(30)
(16)
901.36
0.11
0.97
6.25
82° 46' 10"
366.61' 52.28'
82° 46' 15"
193.21' 27.54'
82° 45' 12½"
120.37 @ .62 = 124.56
150.15 @ .62 = 150.14

TO BOT. OF PAGE 39

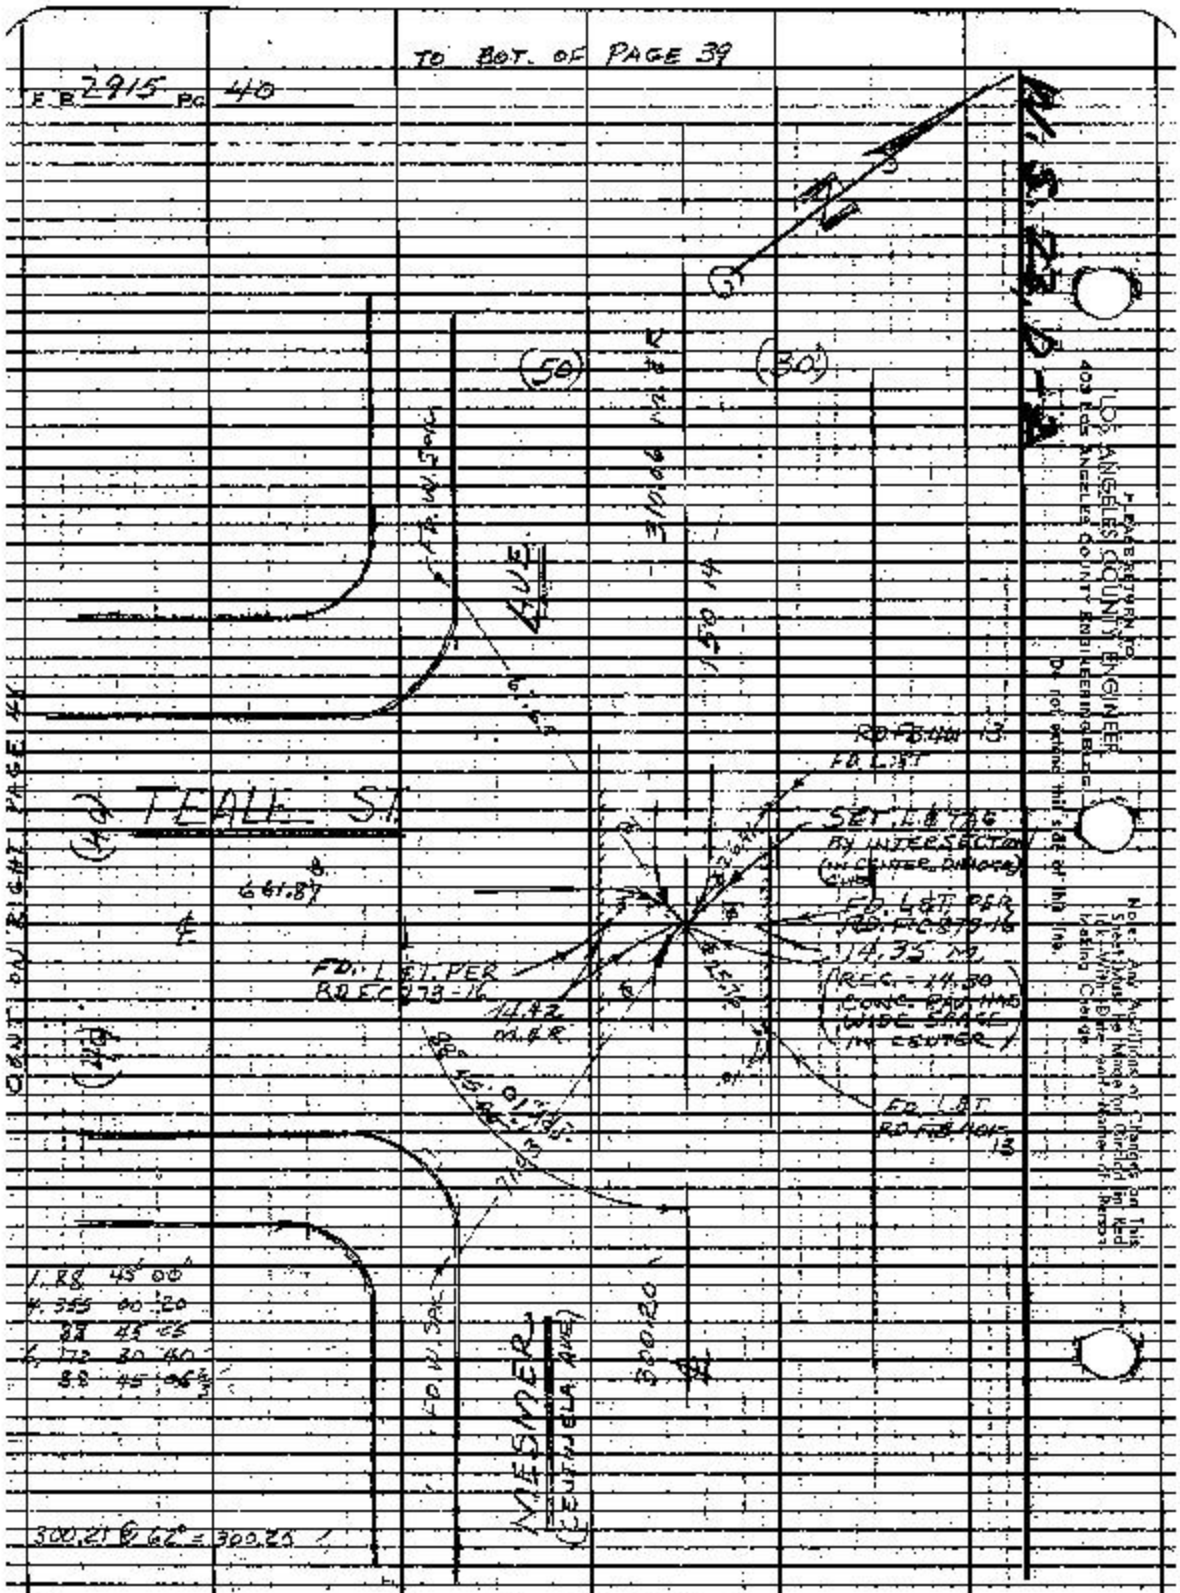
TEALE ST.
641.87'
FD. L&T. PER R.O.S. 2378-16
14.42 M.&R.
FD. L&T. PER R.O.S. 2378-16
14.35 M.&R.
(REC. = 14.50)
CONC. BND. IN 6 WIDE SHALE IN CENTER
SET L&T TAG BY INTERSECTION (IN CENTER OF CURB)
FD. L&T

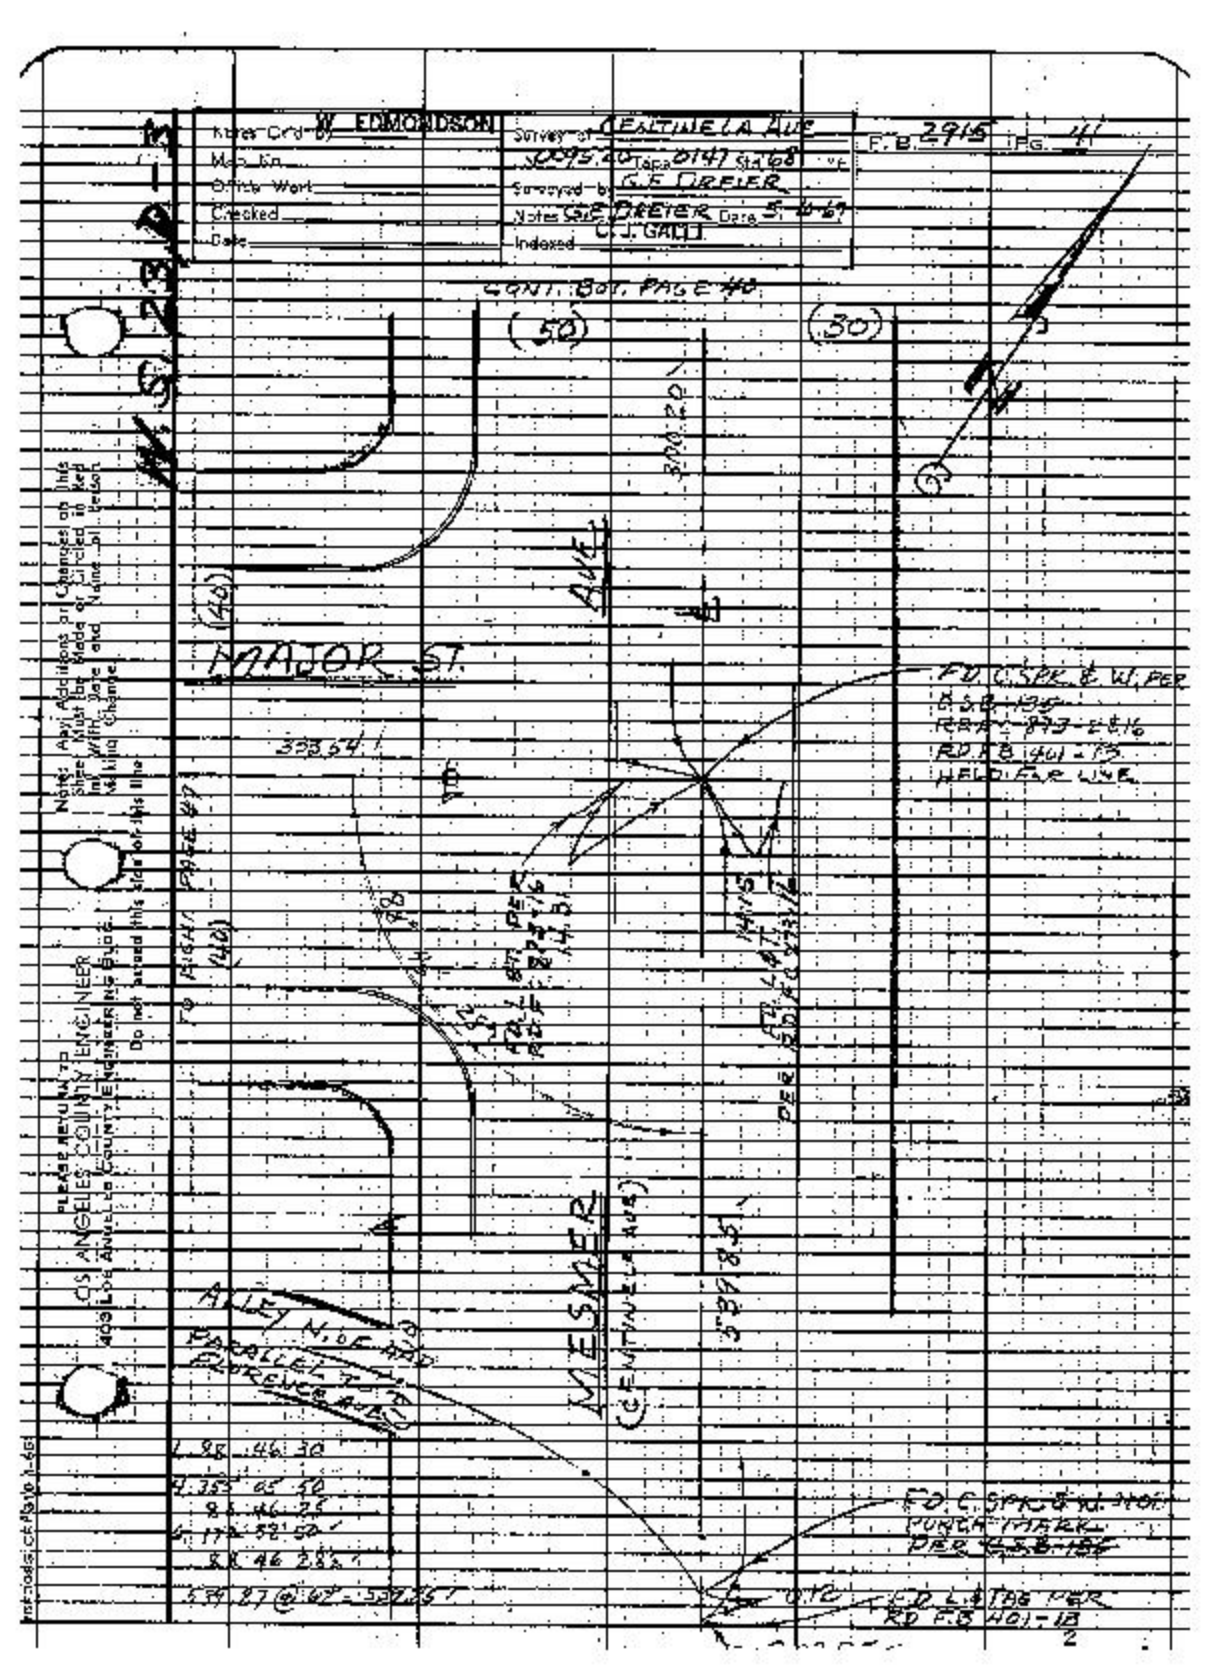
W. EDMONDSON
Notes Cmd by
Map Up
Office Work
Checked
Date
Survey of CENTINELA AVE
5095.20 Tape 0147 Sta 68
Surveyed by G.E. GREER
Notes G.E. GREER Date 5-4-67
C.J. GALLI
Indexed
F.B. 2915 PG. 41
CONT. BOT. PAGE 40
(50)
(30)
MAJOR ST.
(40)
AVE.
300.20'
FD. C SPK & W. PER R.S.B. 185 REF. 877-E&16 RD F.B. 401-13 HELD FOR LINE
323.64'
TO
AGAIN PAGE 41
(40)
MESMER
(CENTINELA AVE)
339.85'
PER RD F.B. 401-13
ALLEY N. OF ADD
PARALLEL TO
LORENCE AVE
L 98 46 30
4.35 66 40
86 46 25
5 17.52 52 50
RR 46 28.5
339.87 @ 62 = 522.36'
FD. C SPK & W. HOT. PUNCH MARK PER R.S.B. 185
C.P.C. L & TAG PER RD F.B. 401-13
2
PLEASE RETURN TO LOS ANGELES COUNTY ENGINEER 900 East Ave. LOS ANGELES COUNTY ENGINEERING BLDG.
Do not detach this side for this line
Notes: Any Additions or Changes on this Sheet Must be Made or Circled in Red Ink With Date and Name of Person Making Change
Instructions on Page 1-46

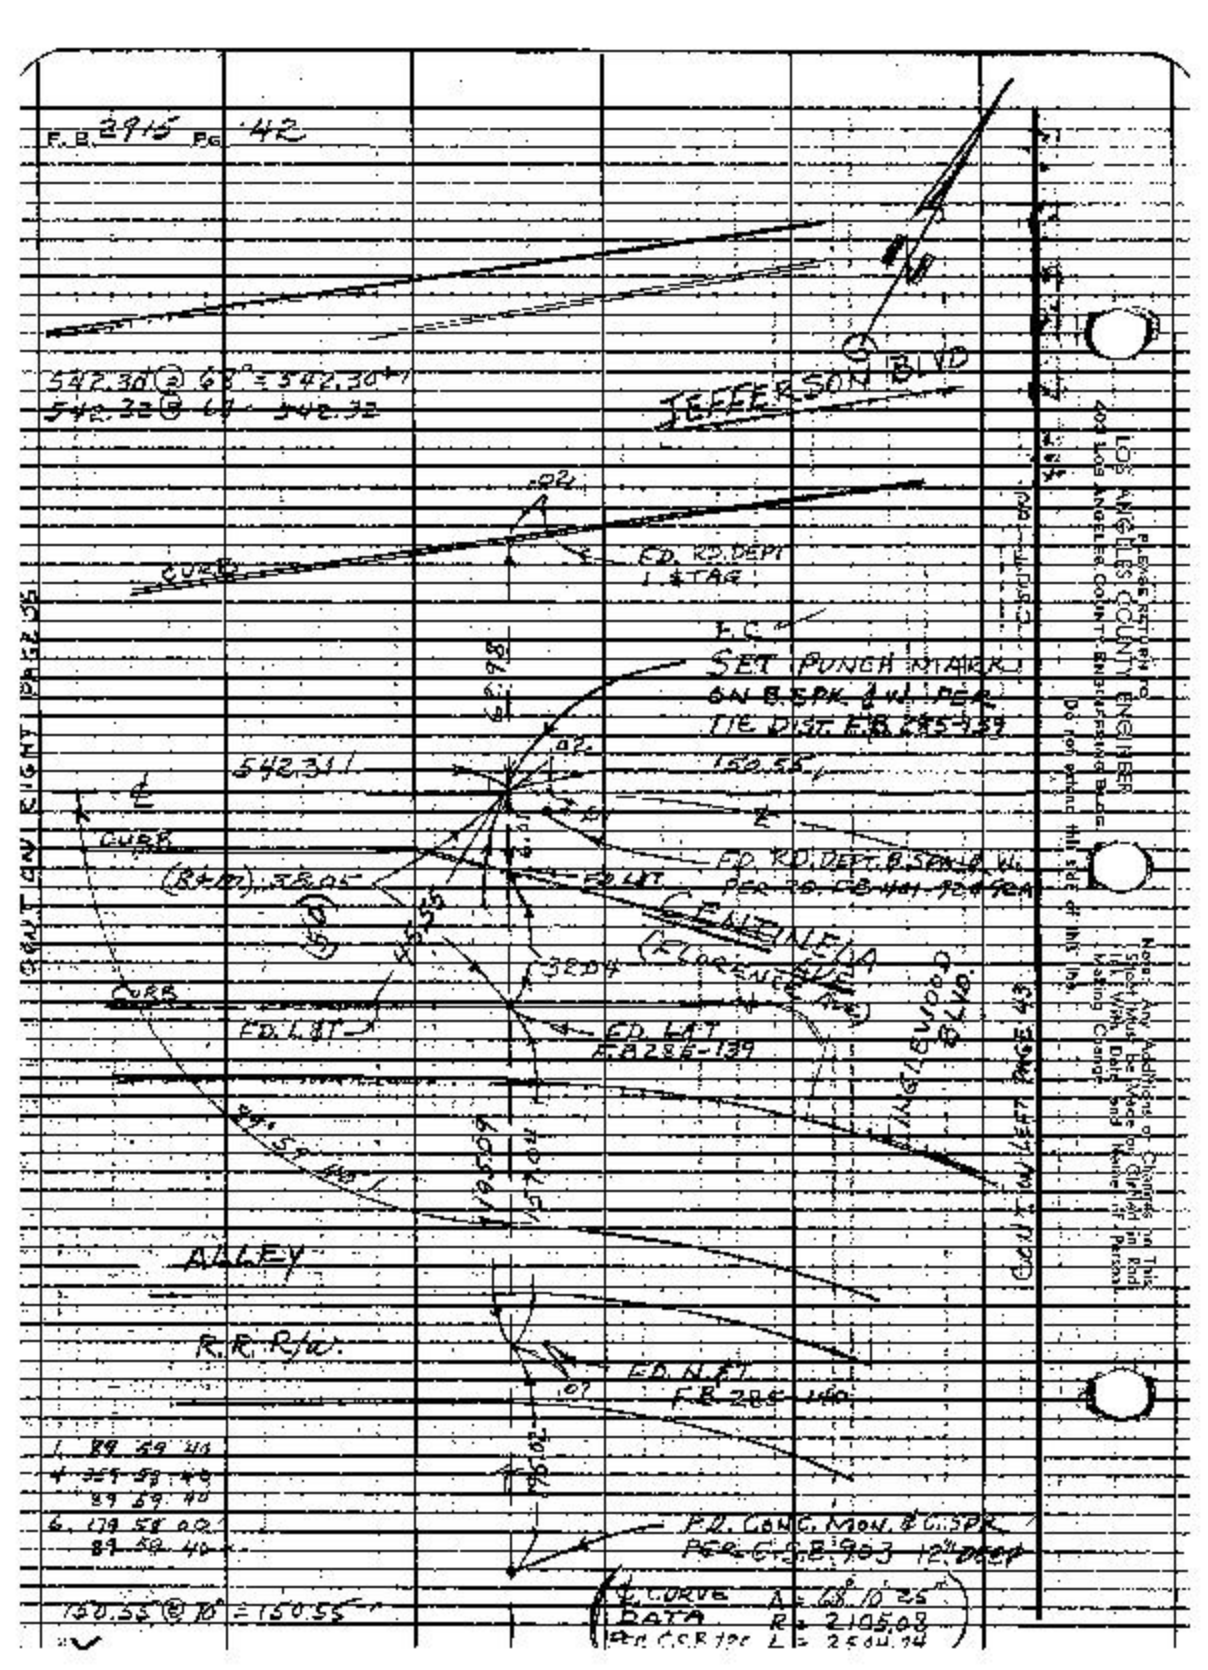
F.B. 2915 PG 42
542.30@ 68° = 542.30+/-
542.32@ 68° = 542.32
JEFFERSON BLVD
CURB
ED. RD. DEPT I.S. TAG
P.C.
SET PUNCH MARK ON B.SPK. & W. PER TIE DIST. F.B. 285-139
542.31
150.55
CURB
(R+M) 38.05
ED. RD. DEPT. B.SPK. & W. PER R.O. F.B. 4141-124 PGA
ED. LAT
CURB
ED. LAT
F.B. 286-139
INGLEWOOD BLVD.
ALLEY
R.R. R/W.
ED. N.F.T.
F.B. 286-140
1. 89 59 40
4. 359 58 40
89 59 40
6. 179 58 00
89 59 40
150.55@ 90° = 150.55
P.C. CONC. MON. & C.SPK. PER C.S.B. 903 12" DEEP
CURVE DATA
Δ = 68° 10' 25"
R = 2105.08
L = 2504.14
PLEASE RETURN TO LOS ANGELES COUNTY ENGINEER 402 LOS ANGELES COUNTY ENGINEERING BLDG. LOS ANGELES 12, CALIF.
Do not remove this side of this tag.
Note: Any Additions or Changes to This Sheet Must Be Made by Surveyor in Charge and Noted on Plan. Date and Method of Change.
INGLEWOOD BLVD.
JEFFERSON BLVD

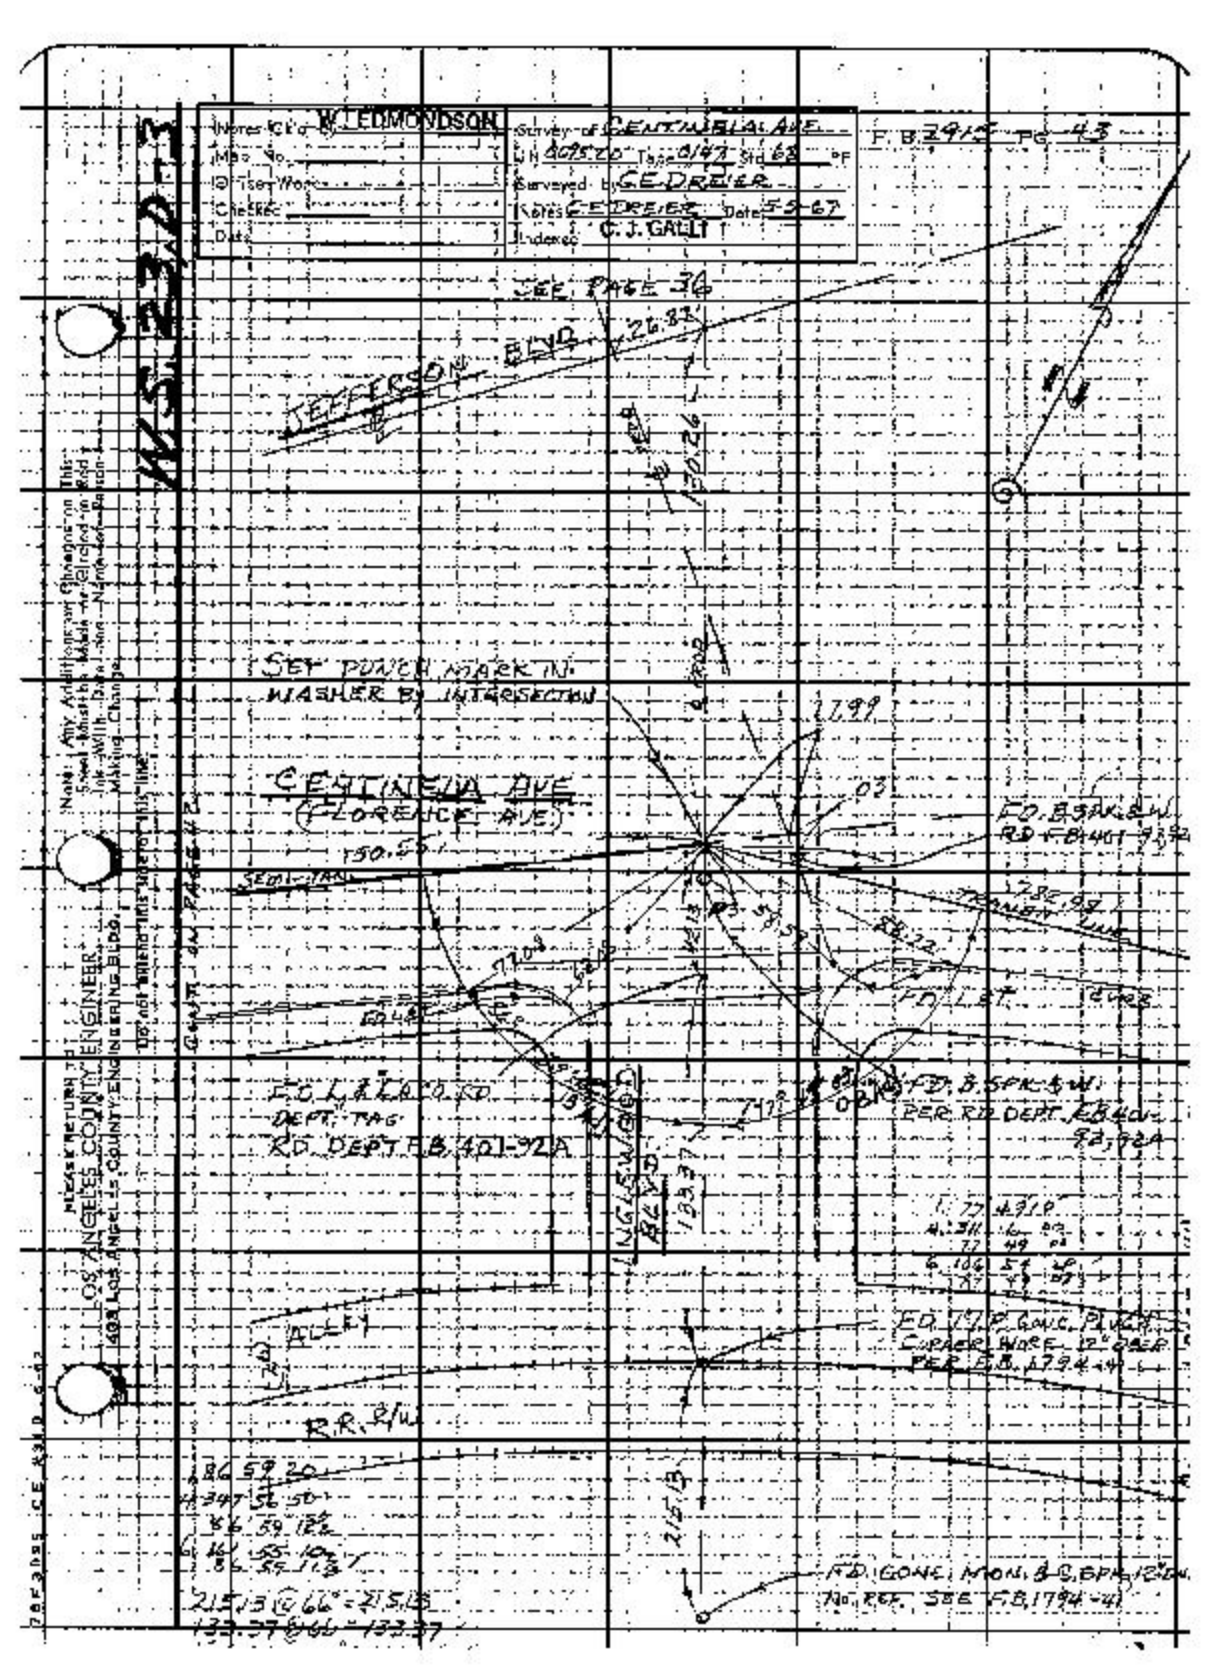
W.S. 32-23
W. EDMONDSON
Notes by
Map No.
Tracing of Work
Checked
Date
Survey of CENTINELA AVE.
Line 4075.20 Tape 0/47 Std. 62 °F
Surveyed by G.E. DREIER
Notes G.E. DREIER Date 5-3-67
Indexed C.J. GALLI
F.B. 2915 Pg. 43
SEE PAGE 36
SET POWER MARK IN WASHER BY INTERSECTION
CENTINELA AVE.
(FLORENCE AVE.)
SEMI-TAN
FD. B.SPK. & W.
RD. F.B. 1401-72
FD. L.S.T.
FD. L.S.C.O.
DEPT. TAG
RD. DEPT. F.B. 401-72A
INGLEWOOD BLVD.
ALLEY
R.R. R/W
FD. B.SPK. & W.
PER RD. DEPT. F.B. 401-72A
FD. C.P. CONC. PLUG
CURB & GUTTER
PER F.B. 1794-41
FD. CONC. MON. B.C. B.SPK. 12" DEEP
NO REF. SEE F.B. 1794-41
215.13 @ 66° = 215.13
133.37 @ 66° = 133.37
Note: Any Additions or Changes on This Sheet Must Be Made To Be Reflected on Mylar With Date, Name and Reason for Making Change.
DO NOT WRITE NOTES OUTSIDE THIS LINE
MAIL RETURN TO
LOS ANGELES COUNTY ENGINEER
ENGINEERING BLDG.
LOS ANGELES, CALIF.

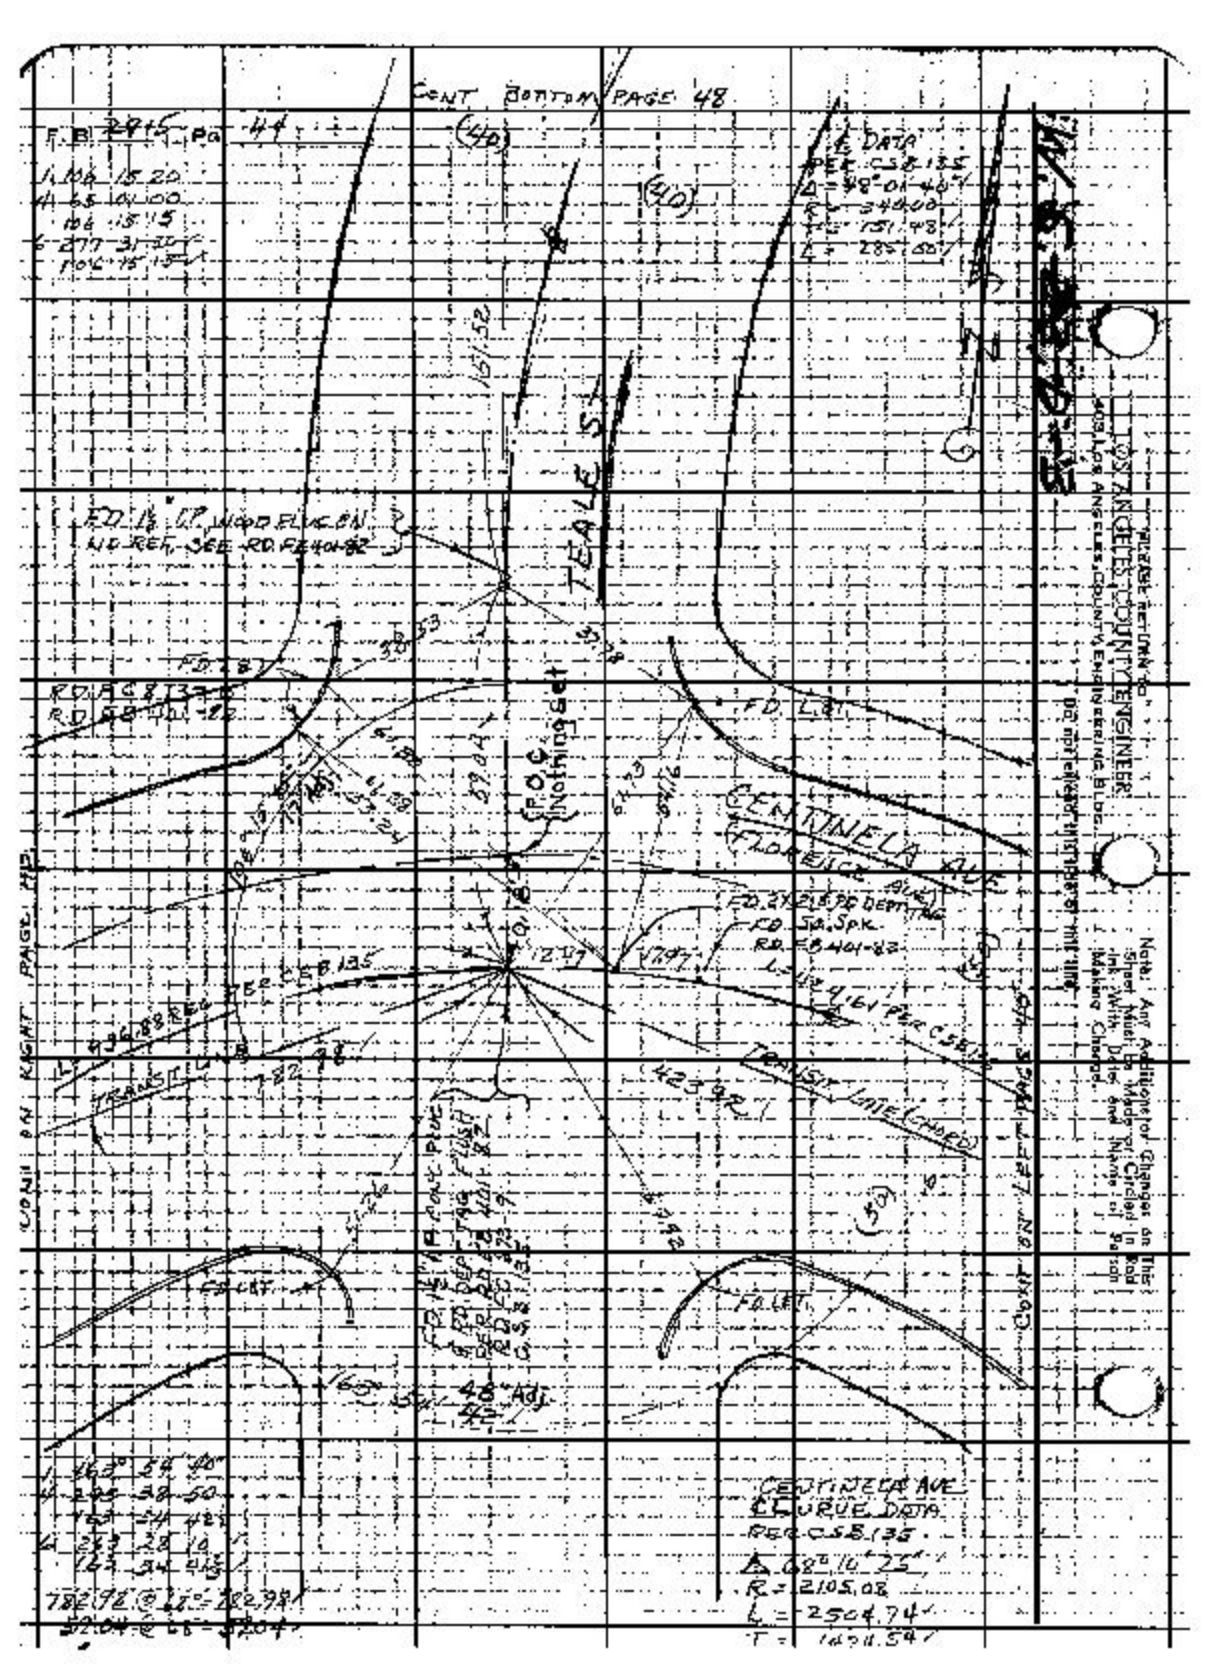
CENT BOTTOM PAGE 48
F.B. 2916 PG 44
(40)
(40)
L & DATA
PER C.S.B. 135
Δ = 48° 01' 40"
R = 340.00
T = 131.48
L = 285.01
LOS ANGELES COUNTY ENGINEER
CENTINELA AVE
FD 1/2" I.P. NO TAG
NO REF. SEE RD. FB 401-82
RD. FB 401-82
(F.O.C. Nothing Set)
CENTINELA AVE
FD. 2" I.P. NO TAG
NO REF.
RD. FB 401-82
TRANSIT LINE (CHORD)
CENTINELA AVE
CL CURVE DATA
PER C.S.B. 135
Δ 02° 10' 25"
R = 2105.08
L = 250.474
T = 125.54
48" ADJ.

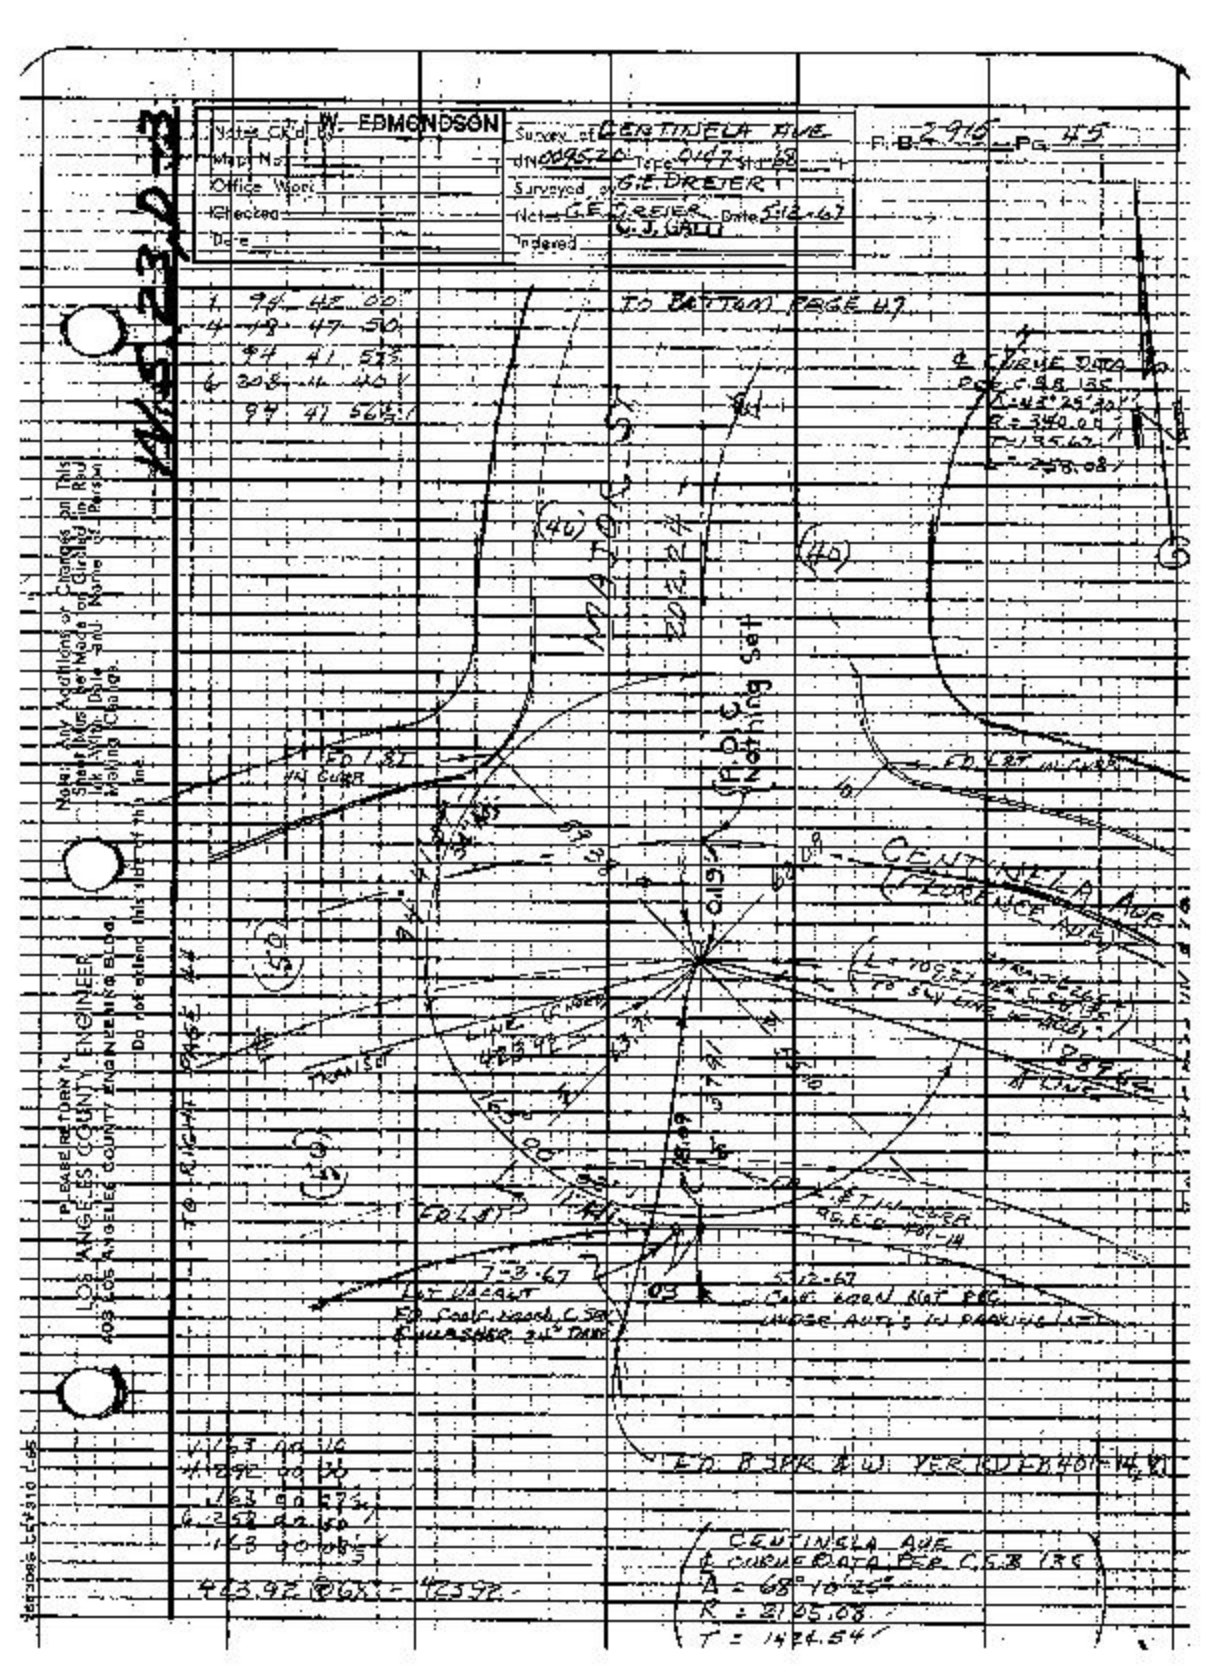
W. EDMONDSON
Survey of CENTINELA AVE
Survey Date 9-17-68
Surveyed by G.E. DREIER
Notes G.E. DREIER Date 5-12-67
G. J. GALLI
P.B. 2-916 Pg. 45
TO BOTTOM PAGE 47
CENTINELA AVE
CENTINELA AVE



































PLEASE RETURN TO LOS ANGELES COUNTY ENGINEER 108 Los Angeles County Engineering Bldg.

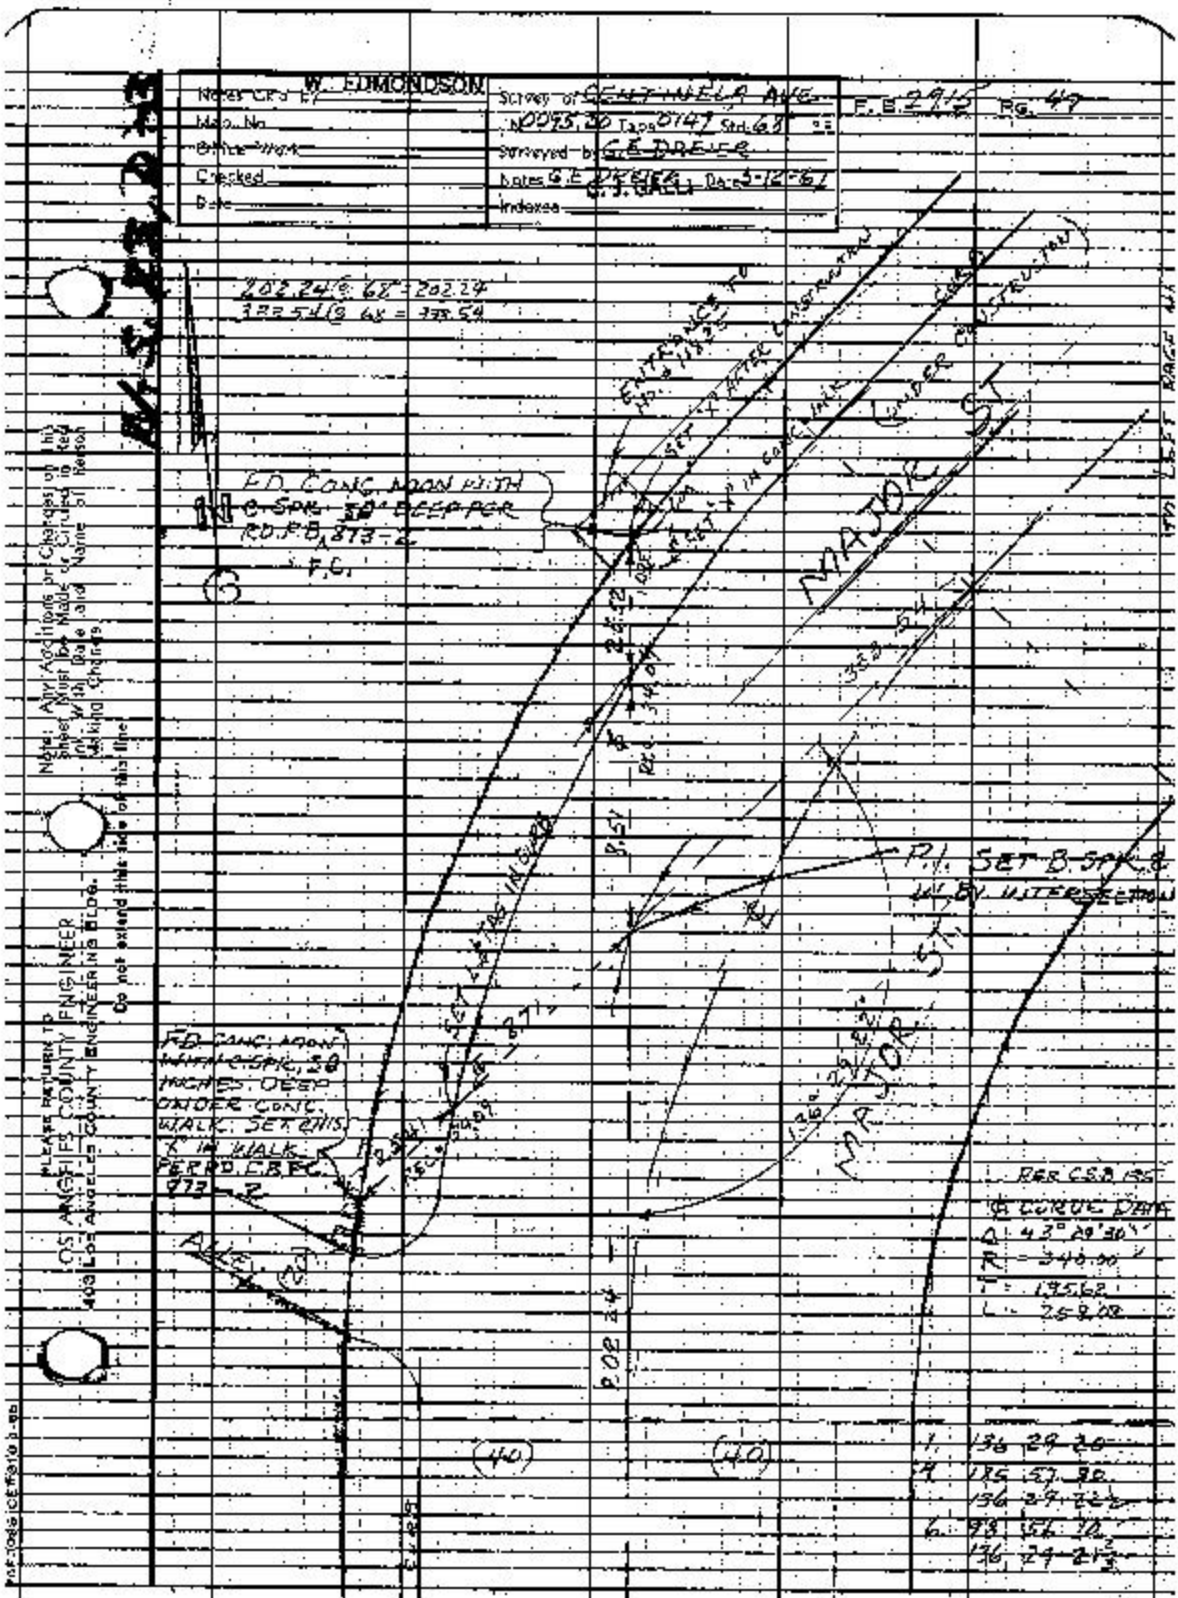
W. EDMONDSON
Survey of CENTINELA AVE.
F.B. 2915 PG. 47
Tape 0747 Std. 63
Surveyed by G.E. DREGER
Dates G.E. DREGER Date 3-12-67
G.J. GALLI
Checked
Date
Indexes
202.24 @ 68° = 202.24
322.54 @ 68° = 322.54
FD. CONC. MON. WITH
6" SPK. 30" DEEP PER
RD. F.B. 873-2
F.C.
CENTINELA AVE.
MARJON
S.L.
P.I. SET B. SPK. &
W. BY INTERSECTION
P.O.B.
PER C.S.B. 156
& CURVE DATA
Δ = 43° 29' 30"
R = 340.00'
T = 135.62'
L = 258.02'
FD. CONC. MON.
W/BRASS SPK. 30
INCHES DEEP
UNDER CONC.
WALK. SET THIS
"X" IN WALK
PER RD. F.B. F.C.
873-2
(40)
(40)
1. 136 29 30
2. 135 57 30
136 27 22
6. 98 56 22
136 29 22½
PLEASE RETURN TO
LOS ANGELES COUNTY ENGINEER
Los Angeles County Engineer
Note: Any Additions or Changes on this Sheet Must Be Made or Circled in Red (or with the Rod Man's Name of Person Making Changes)
Do not extend this side of this line
FORM 3068 (CE) 7-67 0.5 RD

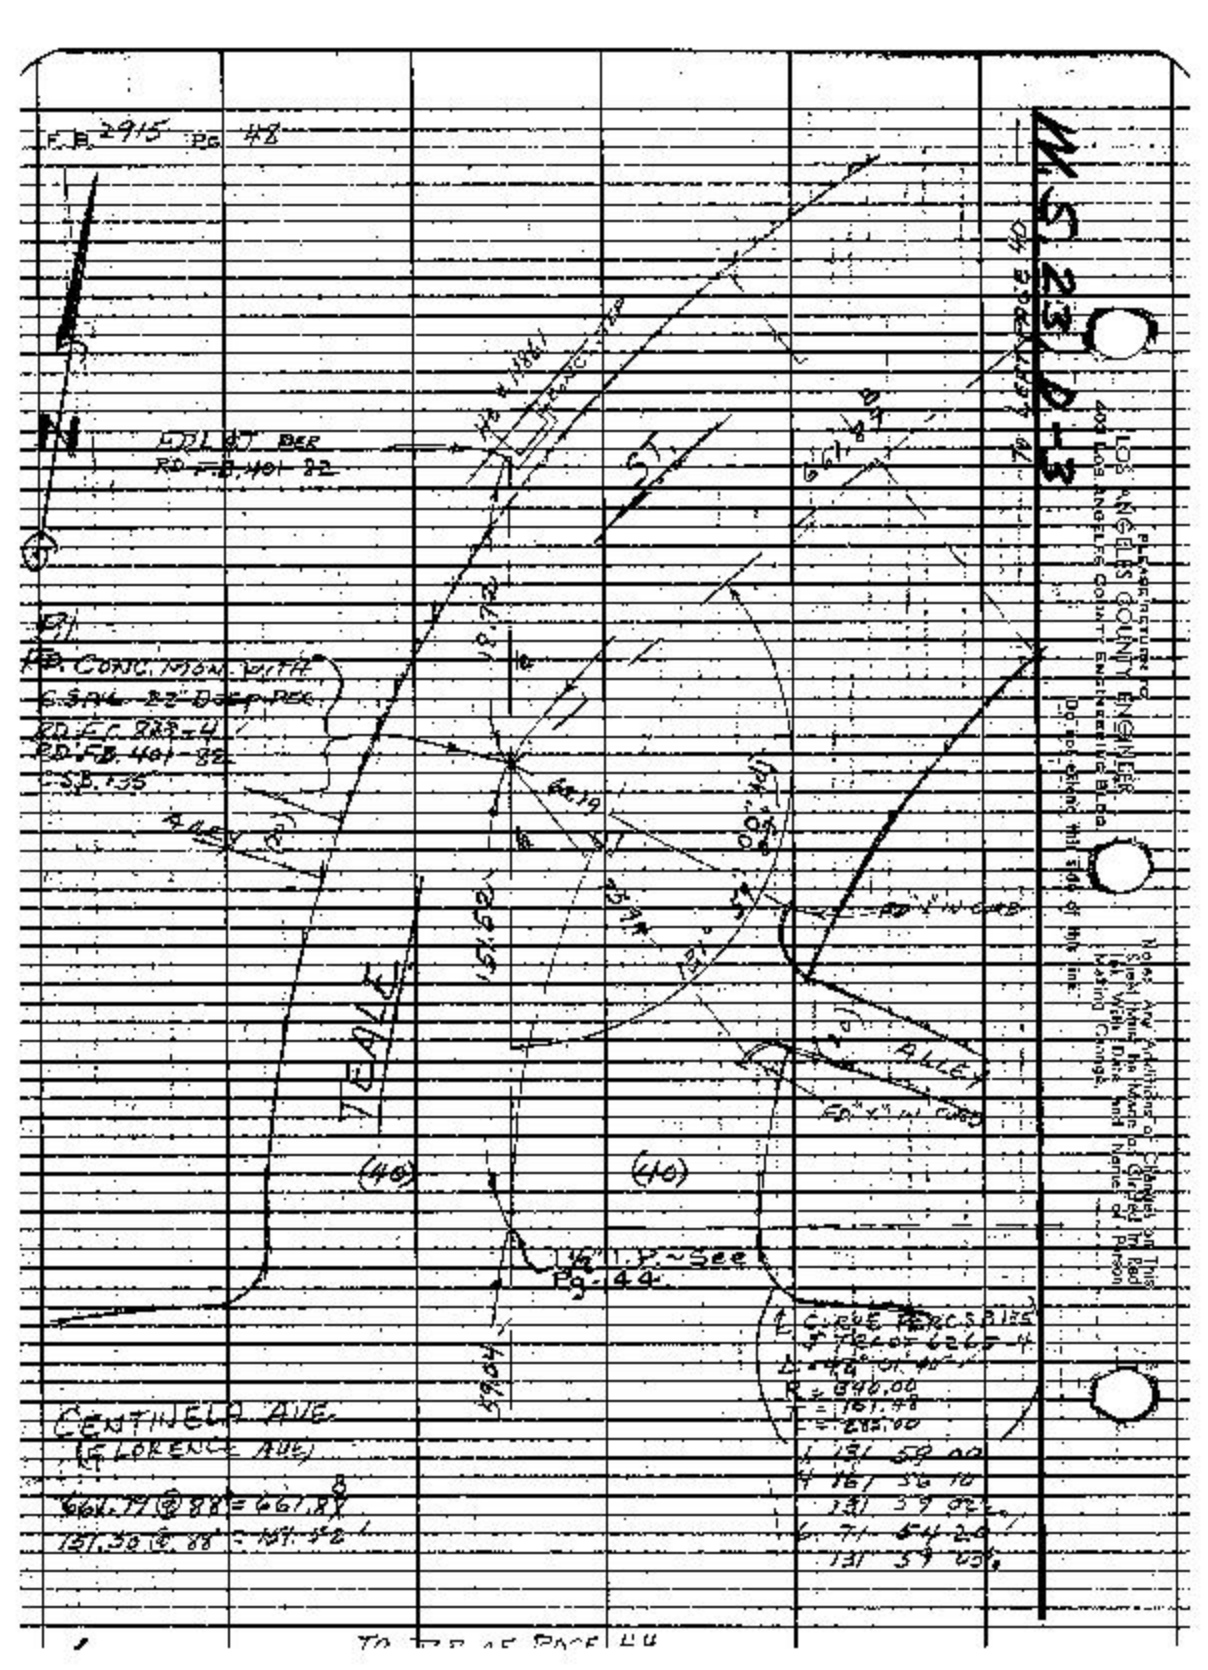
F.B. 2915 Pg 48
N
DELTA 87° 58' 00" BEG
RD F.B. 401-32
(E)
FD. CONC. MON. WITH
C.S.M.L. 22" DEEP DEG.
RD. F.C. 283-4
RD. F.B. 401-32
S.B. 135
ALLEY
1.5' R
1.5' R
ALLEY
(40)
(40)
FD 3/4" I.P. See Pg. 44
CENTINELA AVE.
(FLORENCE AVE)
L.C. CURVE TANGENT BEARS
S 1°E OF 6265.4'
Δ = 46° 01' 40"
R = 840.00
T = 161.48
L = 288.00
1 131 58 00
4 116 56 10
131 39 02
6 71 54 20
131 39 02
Notice: Any Additions or Changes Shown on This Map Must Be Made With Ink and Name of Person Making Changes.
TO TIE AT PAGE 44

W. EDMONDSON
Notes Ckd By:
Map Ckd
Office Work
Checked
Date

Survey of CENTINELA AVE
INGLEWOOD Topo 1947 Sta 46
Surveyed by G.E. DREIER
Notes Date 8-22-47
Indexed C.J. CALL

F.B. 2915 Pg. 47

CONT'D PAGE 46

EDISON PED. ST. PER C.B. 3500-27

(50)

AD 2X2 IN # CO. LA. RD DEPT TAG FLUSH PER RD. R.B. 4041-11

AB 2612-13

PROP. STD. 2.40 W.

(50)

(40)

PROP. STD.

ED. SQ. SPK. ST. PER C.B. 2679-12 FLUSH

AD 2X2 IN # CO. LA. RD DEPT TAG FLUSH PER ED. R.B. 4041-11

1 12.32 10
4 50.48.30
3 12.32 8½
6 19 12.30
112.312.28.3

198.28 @ 74° = 198.24'
260.93 @ 54° = 260.97'

Notes: Any Additions or Changes on This Sheet Must Be Made by Original Party and Name of Party Making Change.

FOR LOS ANGELES COUNTY ENGINEER
APPROVED LOS ANGELES COUNTY ENGINEERING BLDG.
Do Not Write Below This Line.

PLEASE RETURN TO LOS ANGELES COUNTY ENGINEER
108 Los Angeles County Engineering Bldg.

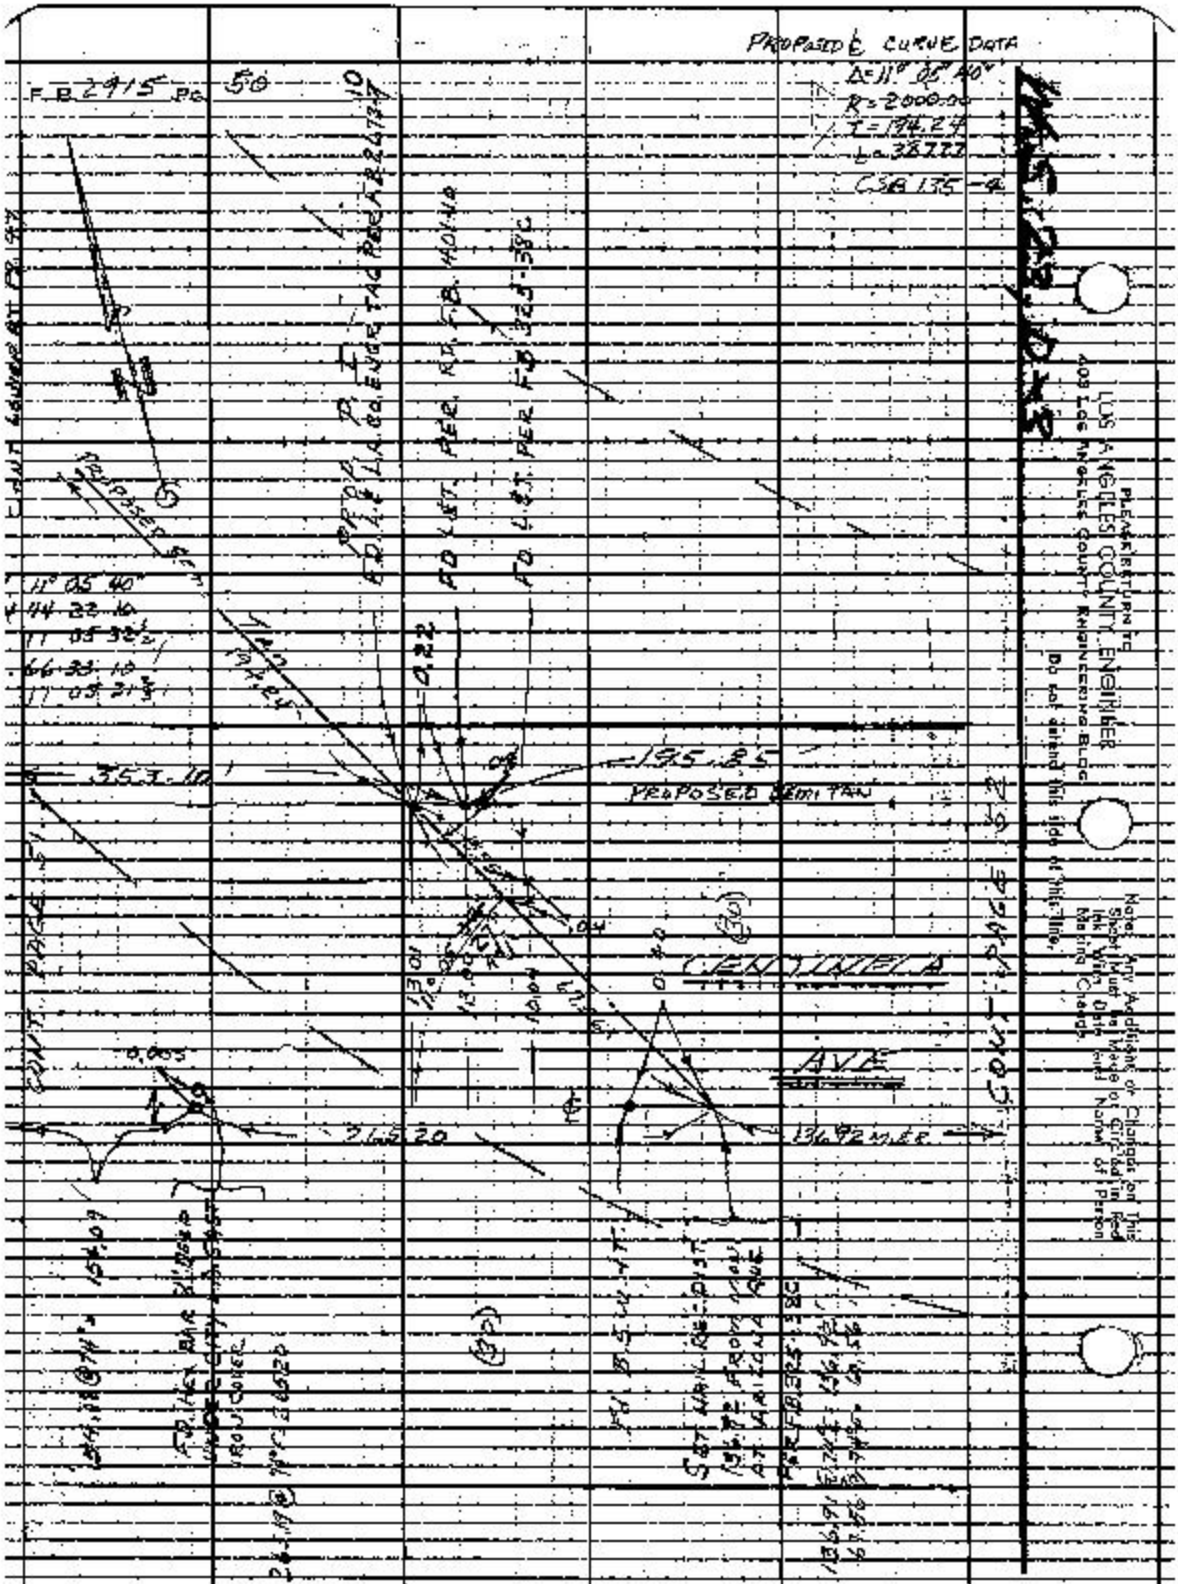
PROPOSED ℄ CURVE DATA
Δ=11° 05' 40"
R=2000.00
T=194.24
L=387.22
C=386.75
F.B. 2915 Pg. 50
PLEASE RETURN TO
LOS ANGELES COUNTY ENGINEER
409 LOS ANGELES COUNTY ENGINEERING BLDG
DO not detach this side of this Title
Note: Any Additions or Changes on This Sheet Must be Made or Certified to in Ink With Date and Name of Person Making Changes
PROPOSED 66' R/W
PROPOSED 40' F.B.
PROPOSED 32' F.B.
PROPOSED SEMI-TAN
CENTER LINE
AVE.

W. EDMONDSON

Notes C'k'd. By
Maps Nos.
Office Work
Checked
Date

Survey CENTINELA AVE
dm 0095.20 Tape 0147 Std 66 °F
Surveyed by G. E. DREIER
Notes G.E. DREIER Date 2-7-67
Indexed C. J. GALLI

F.B. 2915 Pg. 51

1 156 22 20
2 205 20 20
736 22 20
3 218 14 00
154 22 20

LD CHISELED X
PER F.B. 4678-11

FD L.P.

SET L & TAG IN CURB

359 70 /

152.07

CENTINELA AVE

ANGLENAIL A.S.
TW HEX BAR. FLUSH
UNDER CMP 44.0 S.E.
IRON COVER
PER CITY RDDS 11-2
B.A.B. 3E3 L
PB 58 401-11

SET PK NAIL & WASHER IN
TW BOLT IN PR.
BRIDGE SUPPORT

371.64 @ 70° = 371.64 /
359.09 @ 72° = 359.10 /


RETURN TO
LOS ANGELES COUNTY ENGINEER
900 Los Angeles County Engineering Bldg.
Do not extend this side of this line.

Form 5-1-63-2M

F.B. 2915 PG. 52

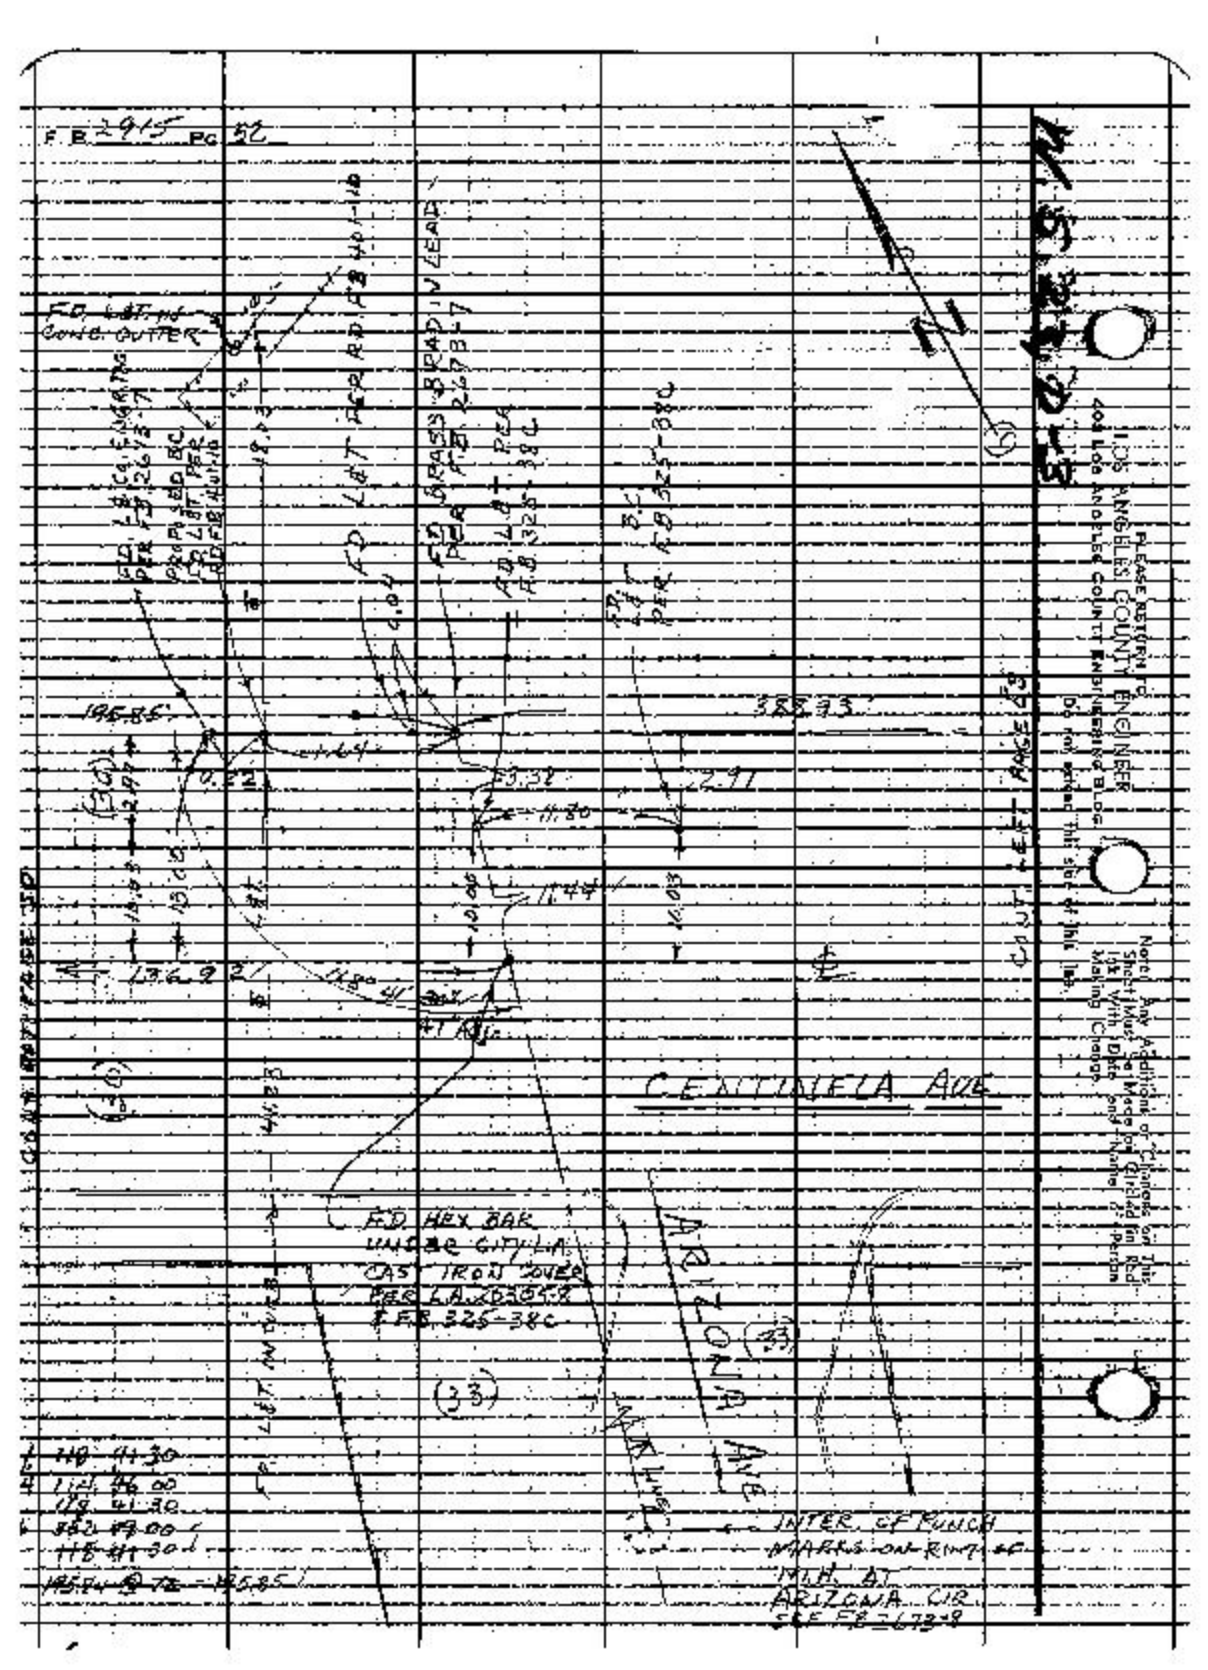
FD. L&T. PK. CONC. OUTER
FD. L&T. PK. PER F.B. 325-38C
FD. BRASS BRAD IN LEAD PER F.B. 325-38C
FD. L&T. PK. PER F.B. 325-38C
FD. L&T. PK. PER F.B. 325-38C
FD. L&T. PK.

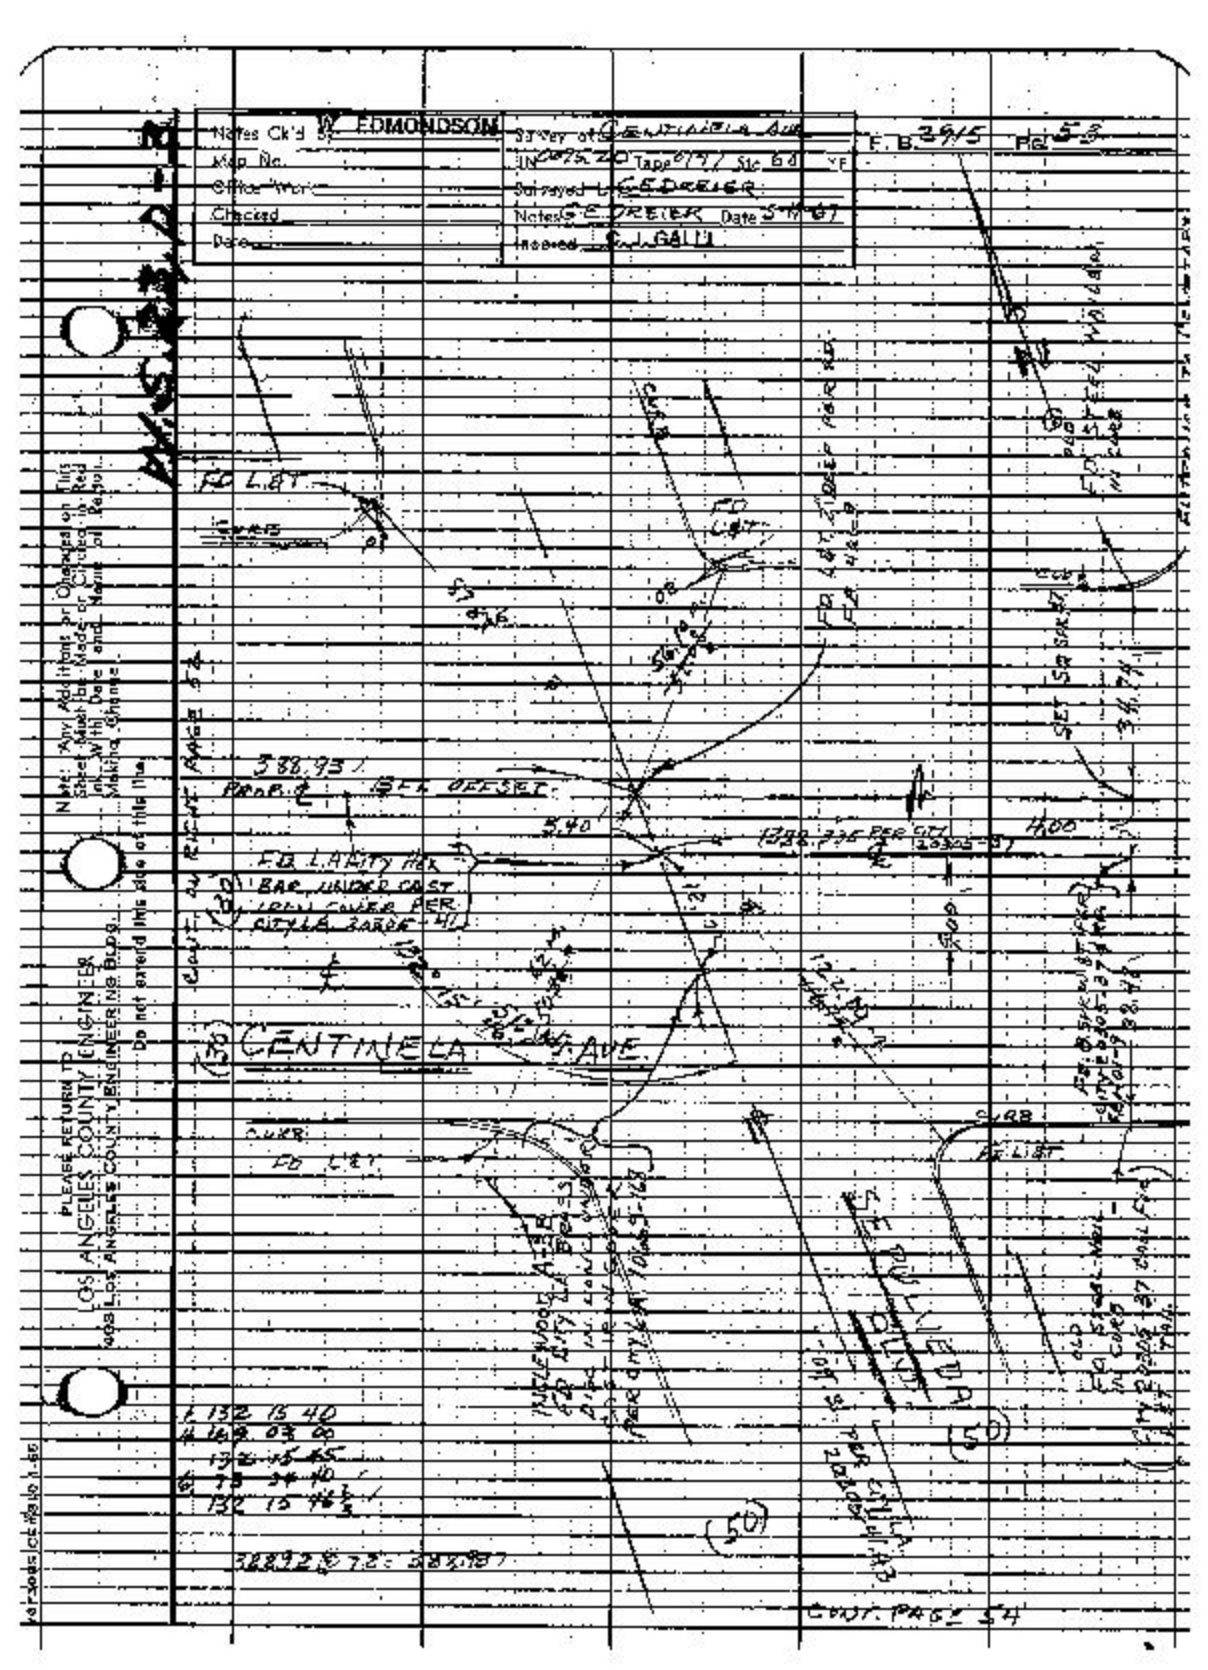
Notes Ck'd W. EDMONDSON
Map No.
Office Work
Checked
Date
Survey of CENTINELA AVE
IN 2075-20 Tape 0797 Sic 60 VF
Surveyed by G.E. DREIER
Notes G.E. DREIER Date 5-14-87
Inked J.J. GALLI
Note: Any Additions or Changes on this Sheet Must be Made or Checked in Red Ink With Date and Name of Person Making Change.
Do not extend ink side of this line.
PLEASE RETURN TO
LOS ANGELES COUNTY ENGINEER
1034 LOS ANGELES COUNTY ENGINEERING BLDG.
FD L&T
388.93'
PROP. ℄ ELY OFFSET
FD LAHITY HOK
BAR, UNDER CAST
IRON COVER PER
CITY LA 2ARDE-41
CENTINELA AVE.
COVER
FD L&T
INGLEWOOD
PER CITY LA
PER CITY LA
FD L&T
SET SPK MT
FD L&T
FD L&T
FD L&T

F.B. 2945 Pg. 54 COUNT. BAT. PAGE 53

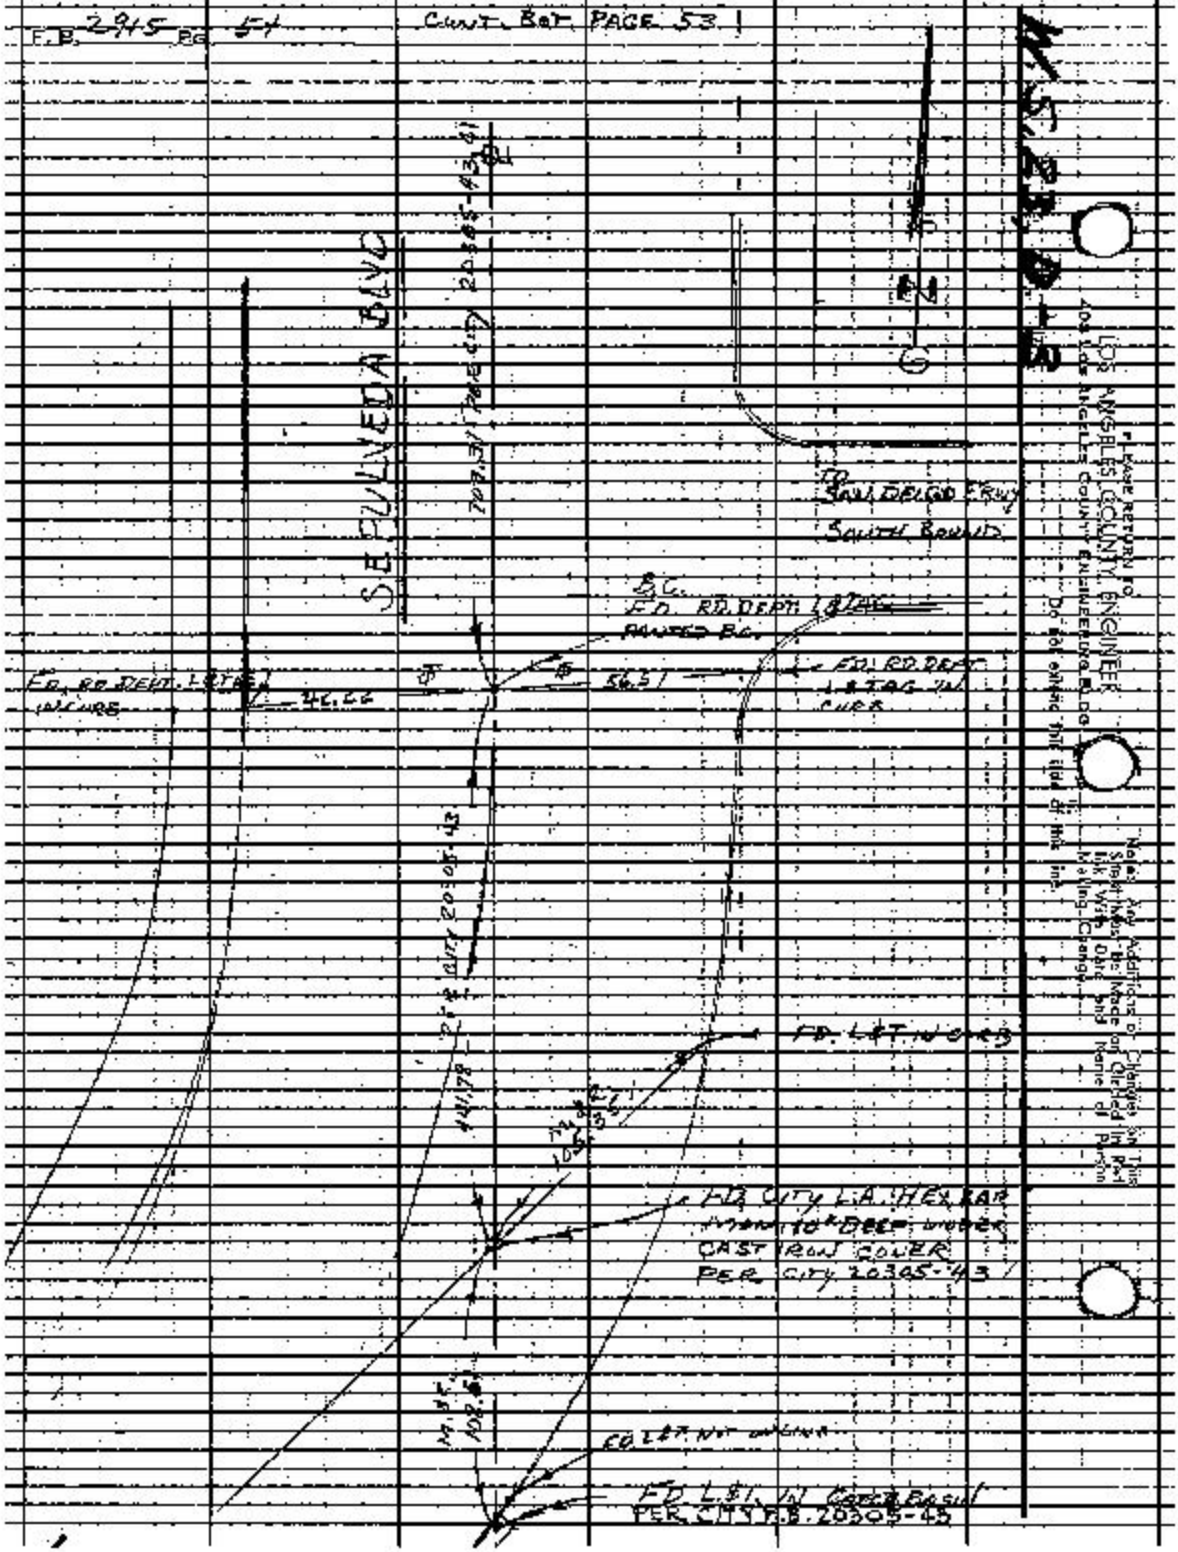

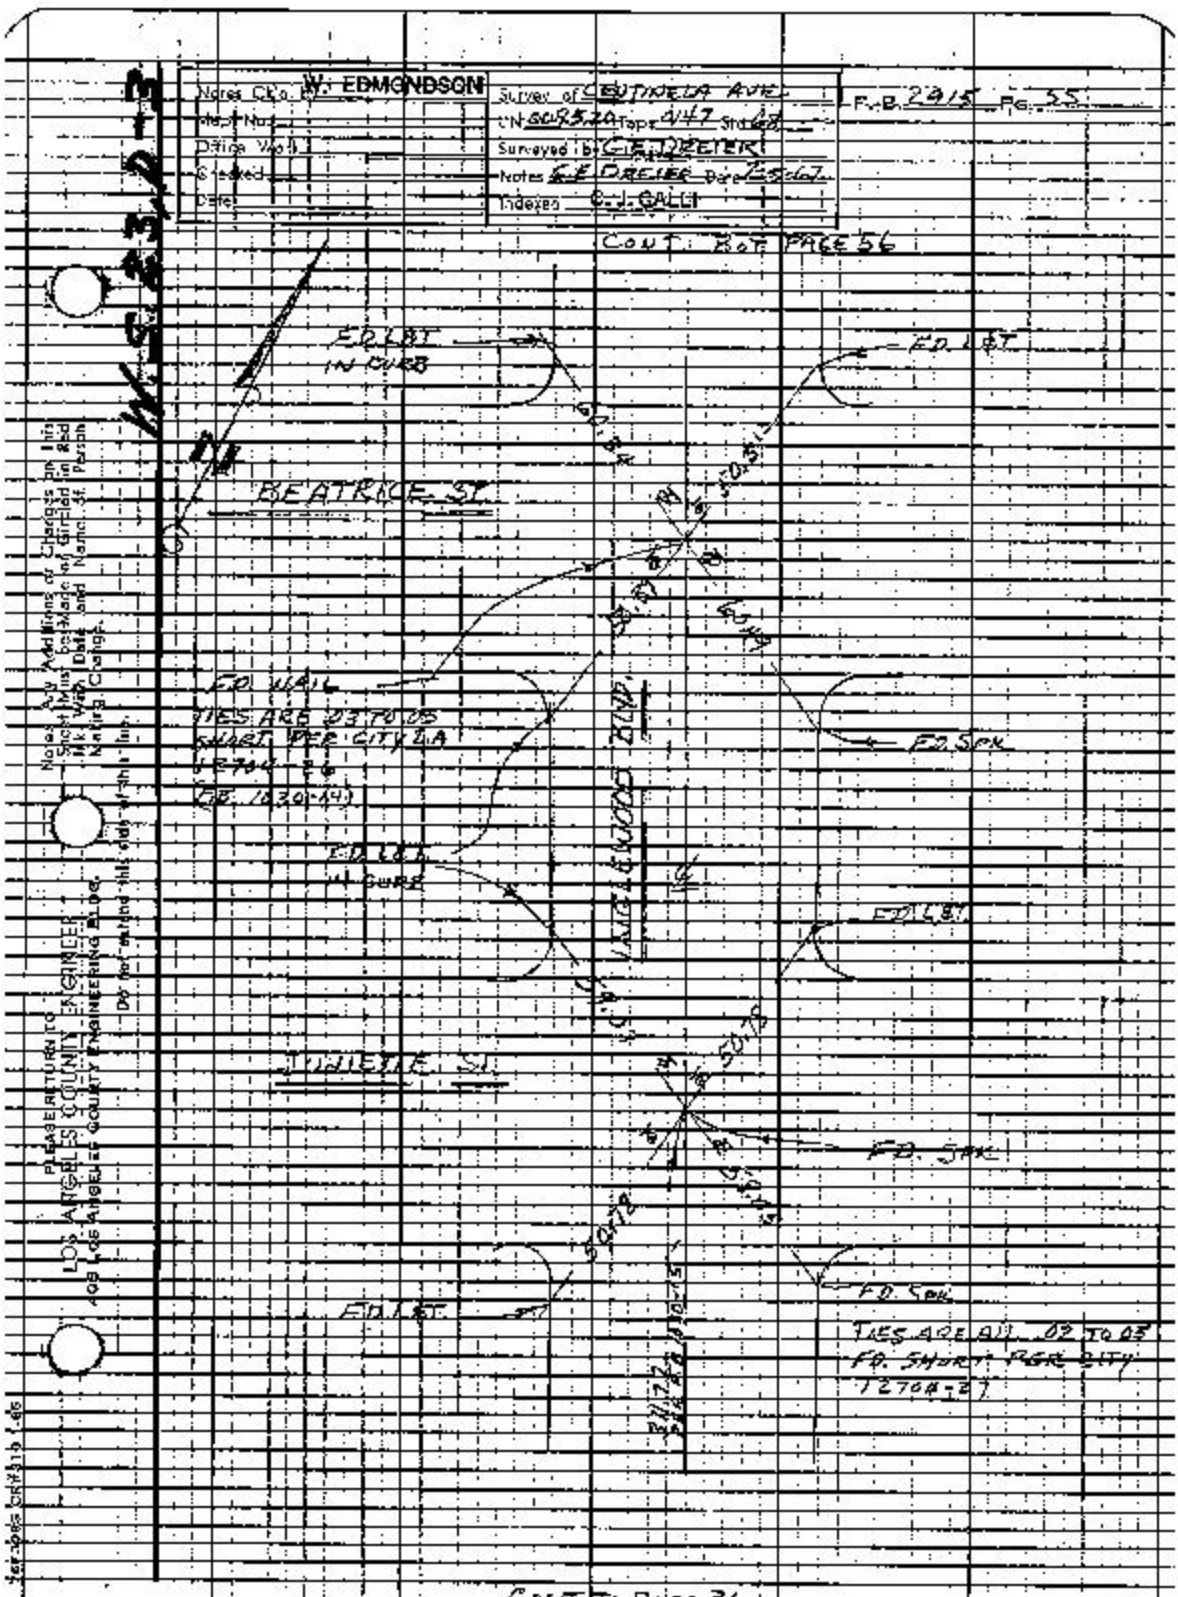
W. EDMONDSON
Notes C.E.D. By
Plot Plan
Office Work
Checked
Date
Survey of CENTINELA AVE
U.N. 60825.20 Topo 447 Sheet 68
Surveyed by C.E. DREIER
Notes C.E. DREIER Date 2-15-67
Indexed C.J. GALLI
F.B. 2015 Pg. 55
CONT. FROM PAGE 56
ED. L&T.
IN CURB
BEATRICE ST.
ED. L&T.
ED. WALK
TIES ARE 03 TO 05
SHORT PER CITY LA
T2704-26
(SE 1220-14)
ED. L&T.
IN CURB
ED. L&T.
JULIETTE ST.
FD. SPK.
FD. SPK.
ED. L&T.
TIES ARE ALL 02 TO 03
FD. SHORT PER CITY
T2704-27
CONT. TO PAGE 34
LOS ANGELES COUNTY ENGINEER
PLEASE RETURN TO
FOR LOS ANGELES COUNTY ENGINEERING BLDG.
Do not retain this plat after use.
Notes Any Additions or Changes on this Sheet Must be Made on Original in Red Ink With Date and Name of Person Making Change.

F.B 2915 Pg. 56

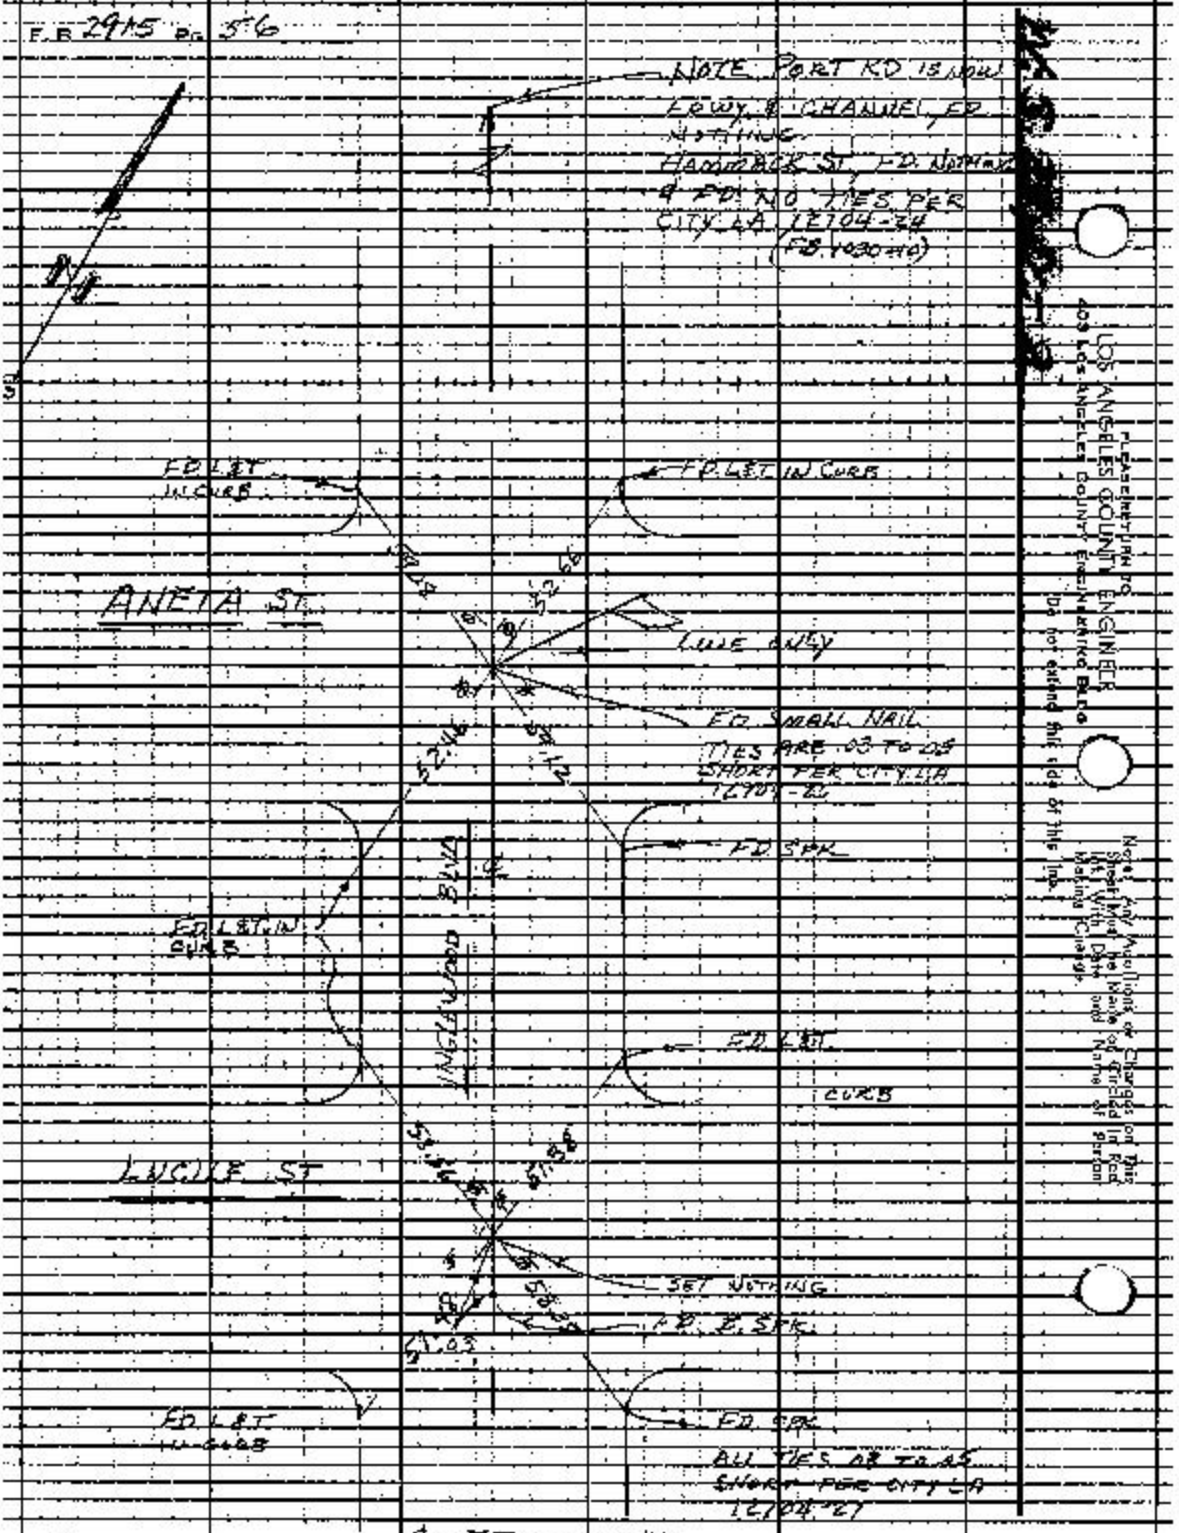
NOTE PORT RD IS NOW
F.D.W.D. CHANNEL, FD
NOTHING
HAMMOCK ST, FD NOTHING
& FD NO TIES PER
CITY L.A. (2704-24
(F.B. 1030 pg 40)
FD LEAD IN CURB
FD LEAD IN CURB
ANETA ST.
(USE ONLY
FD SMALL NAIL
TIES ARE .03 TO .05
SHORT PER CITY L.A.
(2704-2)
FD SPK
FD LEAD IN
CURB
LUCILE ST
FD LEAD
CURB
SET NOTHING
FD. L. SPK.
FD L&T
IN CURB
FD SPK
ALL TIES ARE TO AS
SHORT PER CITY L.A.
(2704-2)
LOS ANGELES COUNTY ENGINEER
PLEASE RETURN TO
403 LOS ANGELES COUNTY ENGINEERING BLDG
Do not extend this side of this line
Note: Any Additions or Changes on this Sheet Must be Made in Red Ink With Date and Name of Person Making Change.

7678095 CE # 210 5-51

PLEASE RETURN TO
LOS ANGELES COUNTY ENGINEER
903 LOS ANGELES COUNTY ENGINEERING BLDG.

Notice: Any Additions or Changes on This Sheet Must be Made or Circled in Red Ink With Date and Name of Person Making Change.

Do not extend this side of this line.

K-3.2, 2-1

FD. 1"HGY BAR 8" DEEP IN HANDHOLE CITY OF L.A. TRAN STATION VENICE K-3 PER F.B. 285-147

FD. "H" BRASS CAP MON. 9" DEEP IN HANDHOLE, STAMPED VENICE L-38 1948" REC. F.B. 285-133

COUNTY ENGINEER

FD. C.E. MON. 10" DEEP IN HANDHOLE PER F.B. 285-101 SEE PAGE 33

ESTABLISHED BY INTERSECTION, SET NOTHING

124.78 @ 70° 124.78

CENTINELA AVE. PER F.B. 285-133

JEFFERSON BL.

Notes Cmld. by: W. EDMONDSON
Map No.
Office Work
Checked
Date
Surveyed by: C.E. DIEBLER Date: 1947
Notes: C.E. DIEBLER Date: 1947
Indexed
Surveyed by: F.J. GALLI Date: 6-48

CENTINELA AVE.

F.B. 2915 Pg. 57

1. 169° 33' 30"
H. 338 02 10
169 30 32½
E. 852 03.70
169 30 31.3

Notes C/d by
Map No.
Office Work
Checked
Date

Survey of CENTINELA AVE F.B. 2915 PG. 59
J.N. 009520 Tape Std °F
Surveyed by G.E. DREIER
Notes G.E. DREIER Date 11-10-67
Indexed C. J. GALLI

009520
CENTINELA AVE.

LOCATION OF BLDG UNDER CONSTRUCTION ON
HUGHES PROPERTY NEAR MESSMER AVE.
& CENTINELA AVE.

DREIER
WILKS
SIEMANN
MCKNIGHT

Notes: Any Additions or Changes on This Sheet Must be Made or Circled in Red Ink. With Both Hand and Name of Person Making Change.
Do not submit this sheet on this file.

PLEASE RETURN to
LOS ANGELES COUNTY ENGINEER
403 LOS ANGELES COUNTY ENGINEERING BLDG.

70F3095 CE # 810 2-51

F.B. 2915 Pg. 60

HUGHES AIRCRAFT

To B. Spr. W. St. at Main St. per page 45

AVE

CENTINELA

TRANSIT LINE PER PAGE 46

3+43.2

67.2

64.2

R 21

65

64.2

72.1

2+48.1

CONC. FOOTING WITH MOVED IN SHEET METAL BLDG ON BLOCKS ABOVE FOOTING

34.2

34.8

81.5

2+29.8

13.8

36.2

85.2

1+49.4

96.4

114.4

CONC. ADDITION FOR BLDG

50.2

102.9

AS SURVEYED 1+00

OR 81.9

ALLEY

ESS 4.4

PROPOSED LINE "A" SEMI-TAN

CO. LINE PER PAGE 46

LOS ANGELES COUNTY ENGINEER
403 Los Angeles County Engineering Bldg.

PLEASE RETURN TO

Do not extend this side of this line.

Note: Any Additions or Changes on This Sheet Must Be Made or Certified to by Init. With Date and Name of Person Making Change.

Notes Ck'd by W. EDMONDSON
Map No.
Office Work
Checked
Date

Survey of CENTINELA AVE.
JN 009520 Tape 0178 Std 68 °F
Surveyed by G.E. DREIER
Notes G.E. DREIER Date 11-15-67
Indexed C. J. GALLI

F. B. 2915 PG. 61

JOB NO. 009520
CENTINELA AVE.
PROPOSED ALIGNMENT "B"

REF (D. DEPT. E.B. 428 - 17 TH 20 INCL.

DREIER
KUERS
STEPMANN
MCKNIGHT

Note: Any Additions or Changes on this Sheet Must be Made or Circled in Red Ink With Date and Name of Person Making Change.

Do not write on this side for Microfilm

PLEASE RETURN TO
LOS ANGELES COUNTY ENGINEER
403 Los Angeles County Engineering Bldg.

78F5088 CE # 810 (rev.)

F.B. 2915 Pg. 62

INDEX SKETCH

RE DEPT. ℄ ALIGNMENT "B"

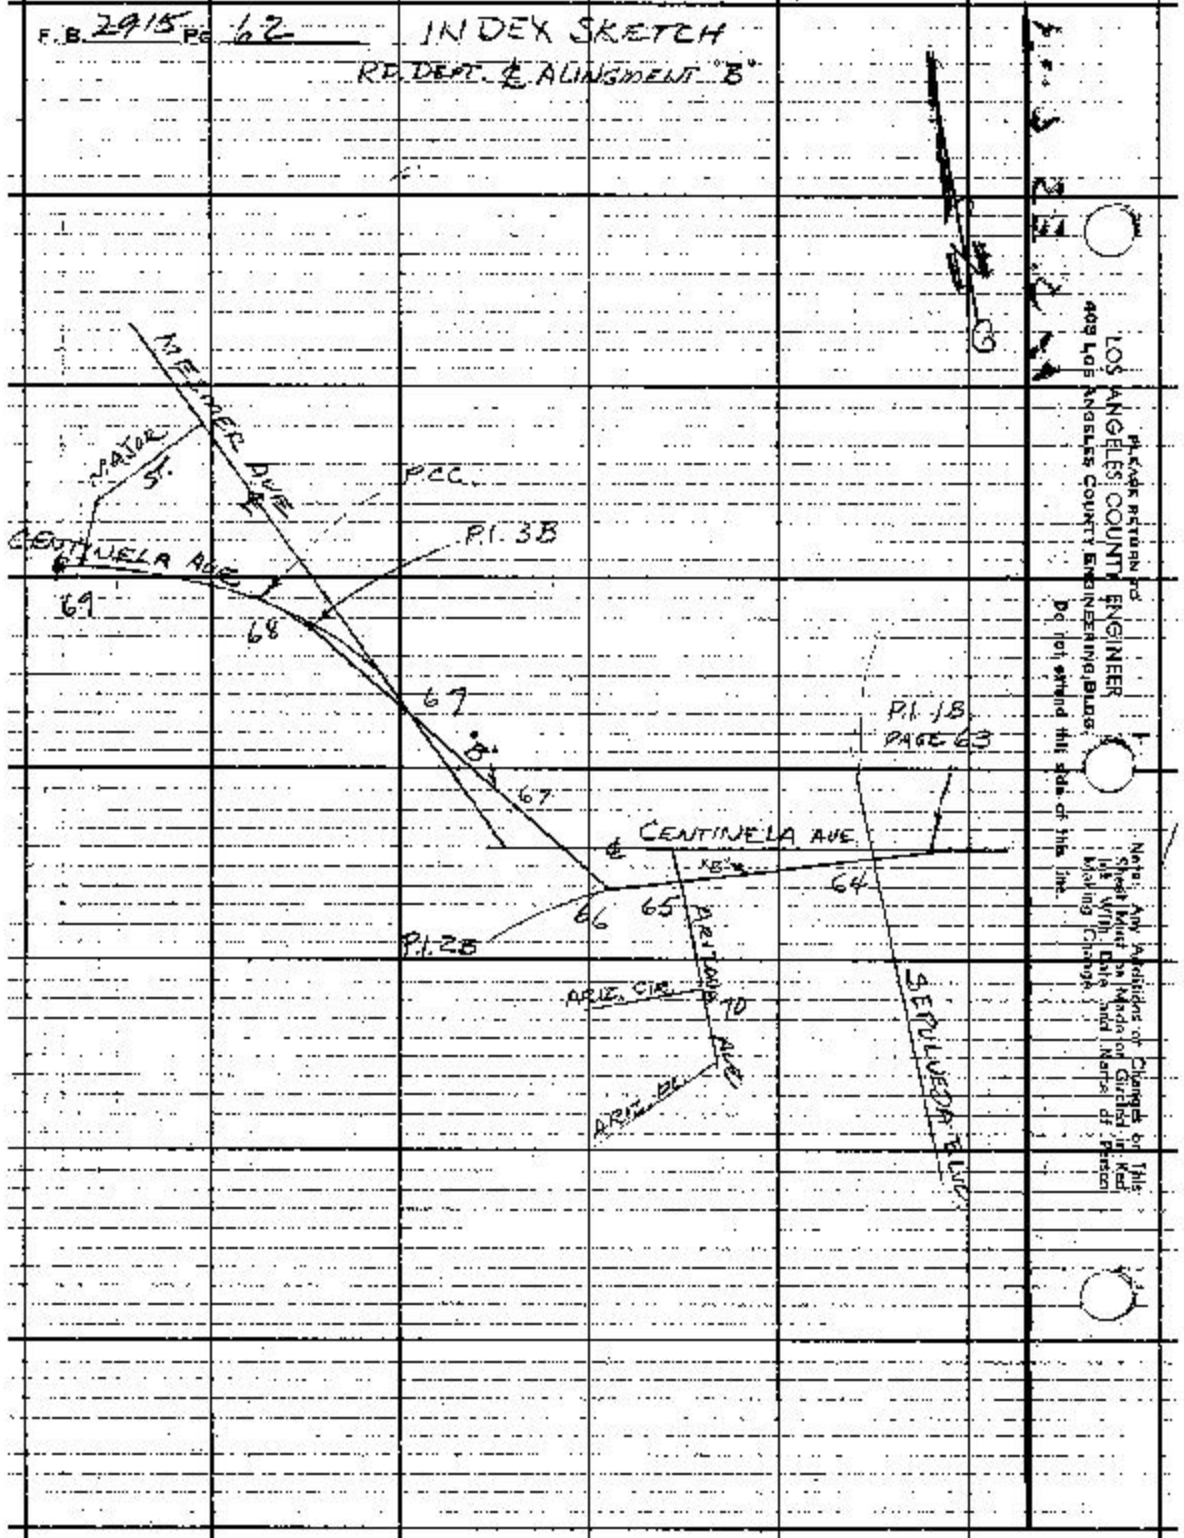

PLEASE RETURN TO
LOS ANGELES COUNTY ENGINEER
409 LOS ANGELES COUNTY ENGINEERING BLDG.

Do not extend this side of this line.

Note: Any Additions or Changes to This Sheet Must Be Made on Check-in Work Slip With Date and Name of Person Making Change.

W. EDMONDSON

Notes Checked by:
Map No.
Office Work
Checked
Date

Survey of CENTINELA AVE
J.N. 030500 Tab 0229 Std GS °F
Surveyed by G.E. DREIER
Notes G.E. DREIER Date 11-15-67
Indexed L. J. GALLI

F.B. 2915 Pg. 63

W.S. 23, D-3

Note: Any Additions or Changes on this Sheet Must be Made or Circled in Red Ink With Date and Name of Person Making Change

Do not submit this sheet for distillar

PLEASE RETURN TO
LOS ANGELES COUNTY ENGINEER
ENGINEERING BLDG.
900 S. FREMONT AVE.
LOS ANGELES COUNTY ENGINEERING
403

74P3035 GE # 310 1/61

CENTINELA AVE

CURB

FD. L & T.

FD. L & L.A.Co. RD. DEPT. 1½" IP in conc. ctr. DIVIDER PER RD. F.B. 428-17

FD. B. SPK. IN L & T. PER RIGHT PAGE 53' ± FROM P.I. AZ 344° 37' RD. AZ 344° 01'

(54)

150.01'

R=1400

52.27' M.R.

52.27' M.R.

89.13 PROPOSED "B"

CURB

CURB

(39)

P.I. 18

FD 1½" IP Conc. PLUG & L.A.Co. RD. DEPT. TAG FLUSH PER RD. F.B. 428-17

FD. L & T.

S.C. FD. SPK. (HUB) PER RD. F.B. 428-17

CENTINELA RIGHT PAGE 44

58.48

"LINE "B" CURVE DATA PER RD. F.B. 428-17"

A = 3° 59' 28"
R = 1400
T = 52.27
L = 104.49

L 176° 00' 10"
M 344° 01' 00"
176 00 45
336 01 20
176 00 13½

52.27 @ 72° = 52.27
150.01 @ 70° = 150.01
52.27 " = 52.27

SEPULVEDA BLVD.

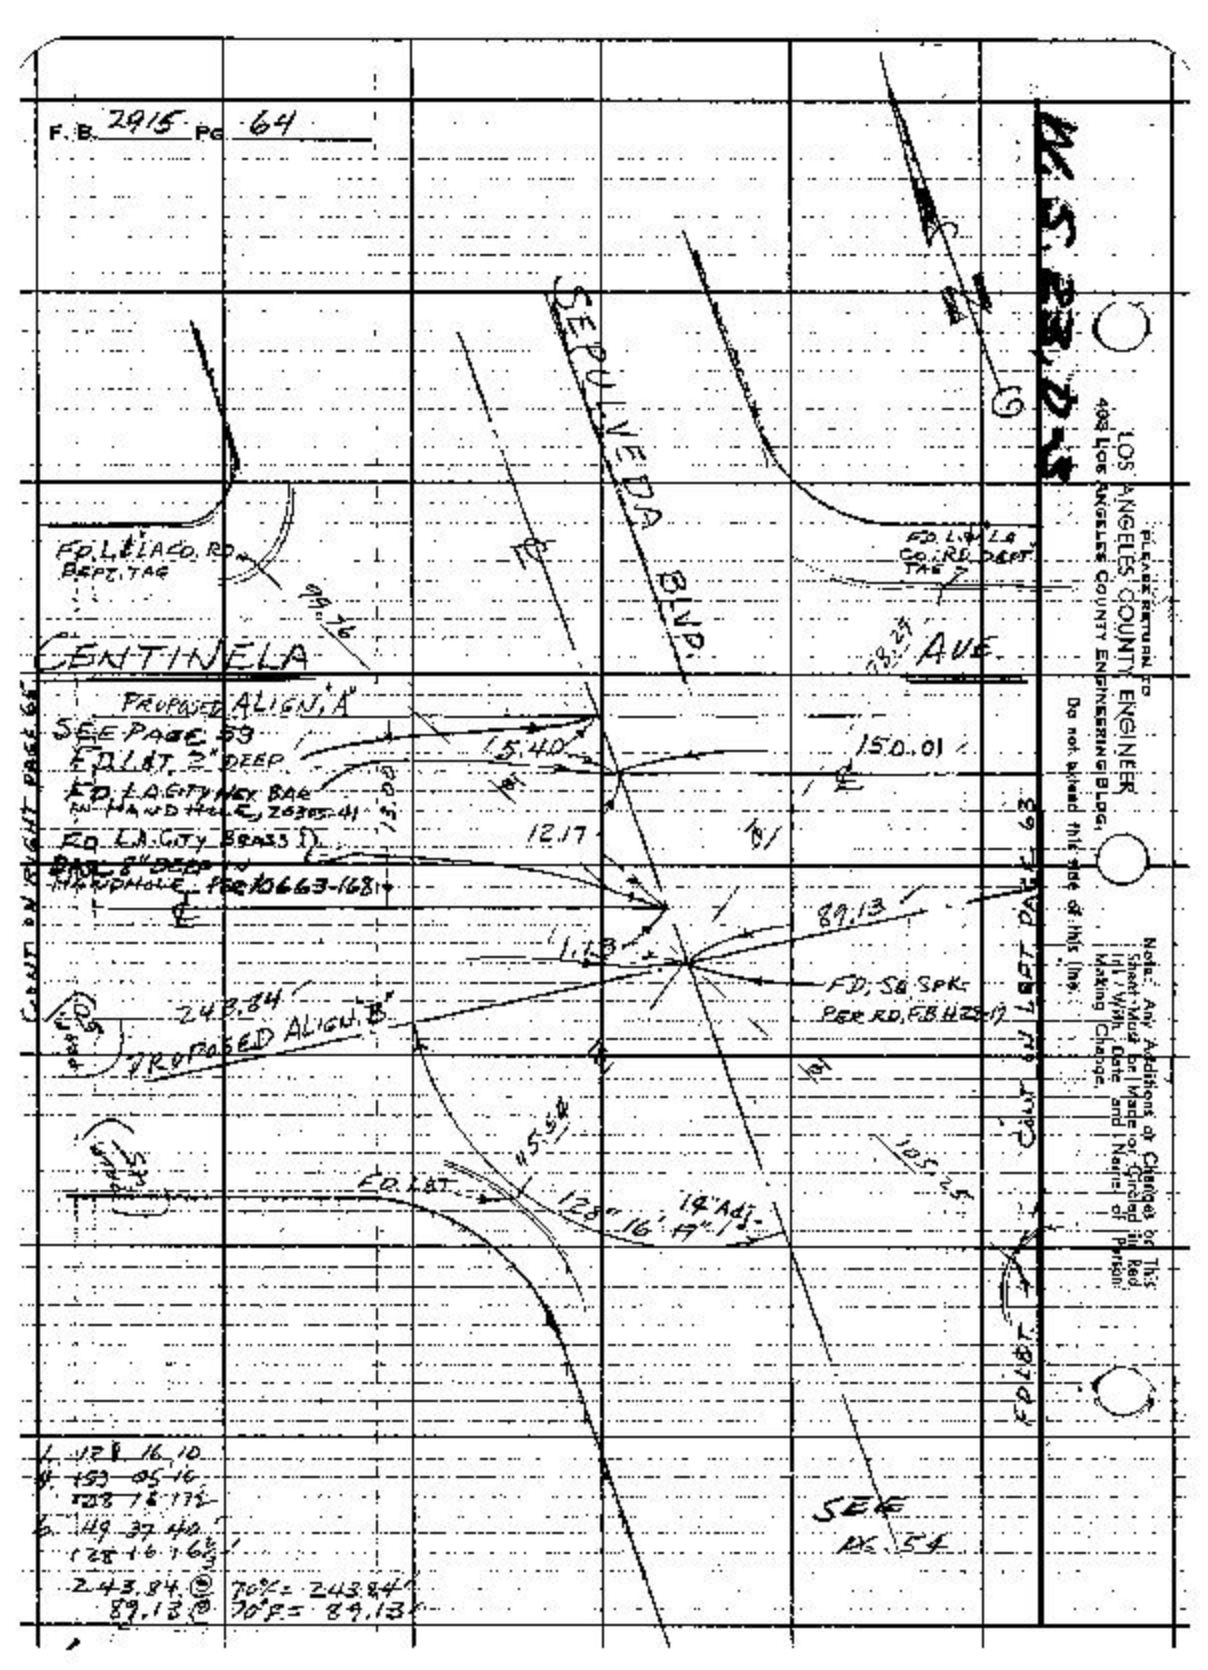
F.B. 2915 Pg. 64
SEPULVEDA BLVD.
CENTINELA
AVE.
PROPOSED ALIGN. 'A'
SEE PAGE 53
FD. L&T. 2" DEEP
FD. L.A. CITY HEX BAR IN HAND HOLE, 2635-41
FD. L.A. CITY BRASS DISC 8" DEEP IN HANDHOLE PER 10663-168
PROPOSED ALIGN. 'B'
FD. L&T.
FD. L.A. CO. RD. DEPT. TAG
FD. L&T. L.A. CO. RD. DEPT. TAG
FD; SQ SPK PER RD. FB H22-9
15.40
15.01
12.17
89.13
1.13
SEE PAGE 54
L 128 16 10
Δ 153 05 16
128 16 17½
L 49 37 40
128 16 16½
89.13 @ 70°F = 89.13
LOS ANGELES COUNTY ENGINEER
PLEASE RETURN TO
Do not Remove this side of this Map
Notice: Any Additions or Changes to this Sheet Must Be Made or Circled in Ink With Date and Name of Person Making Change.
This Red Line Is Not Part of Map

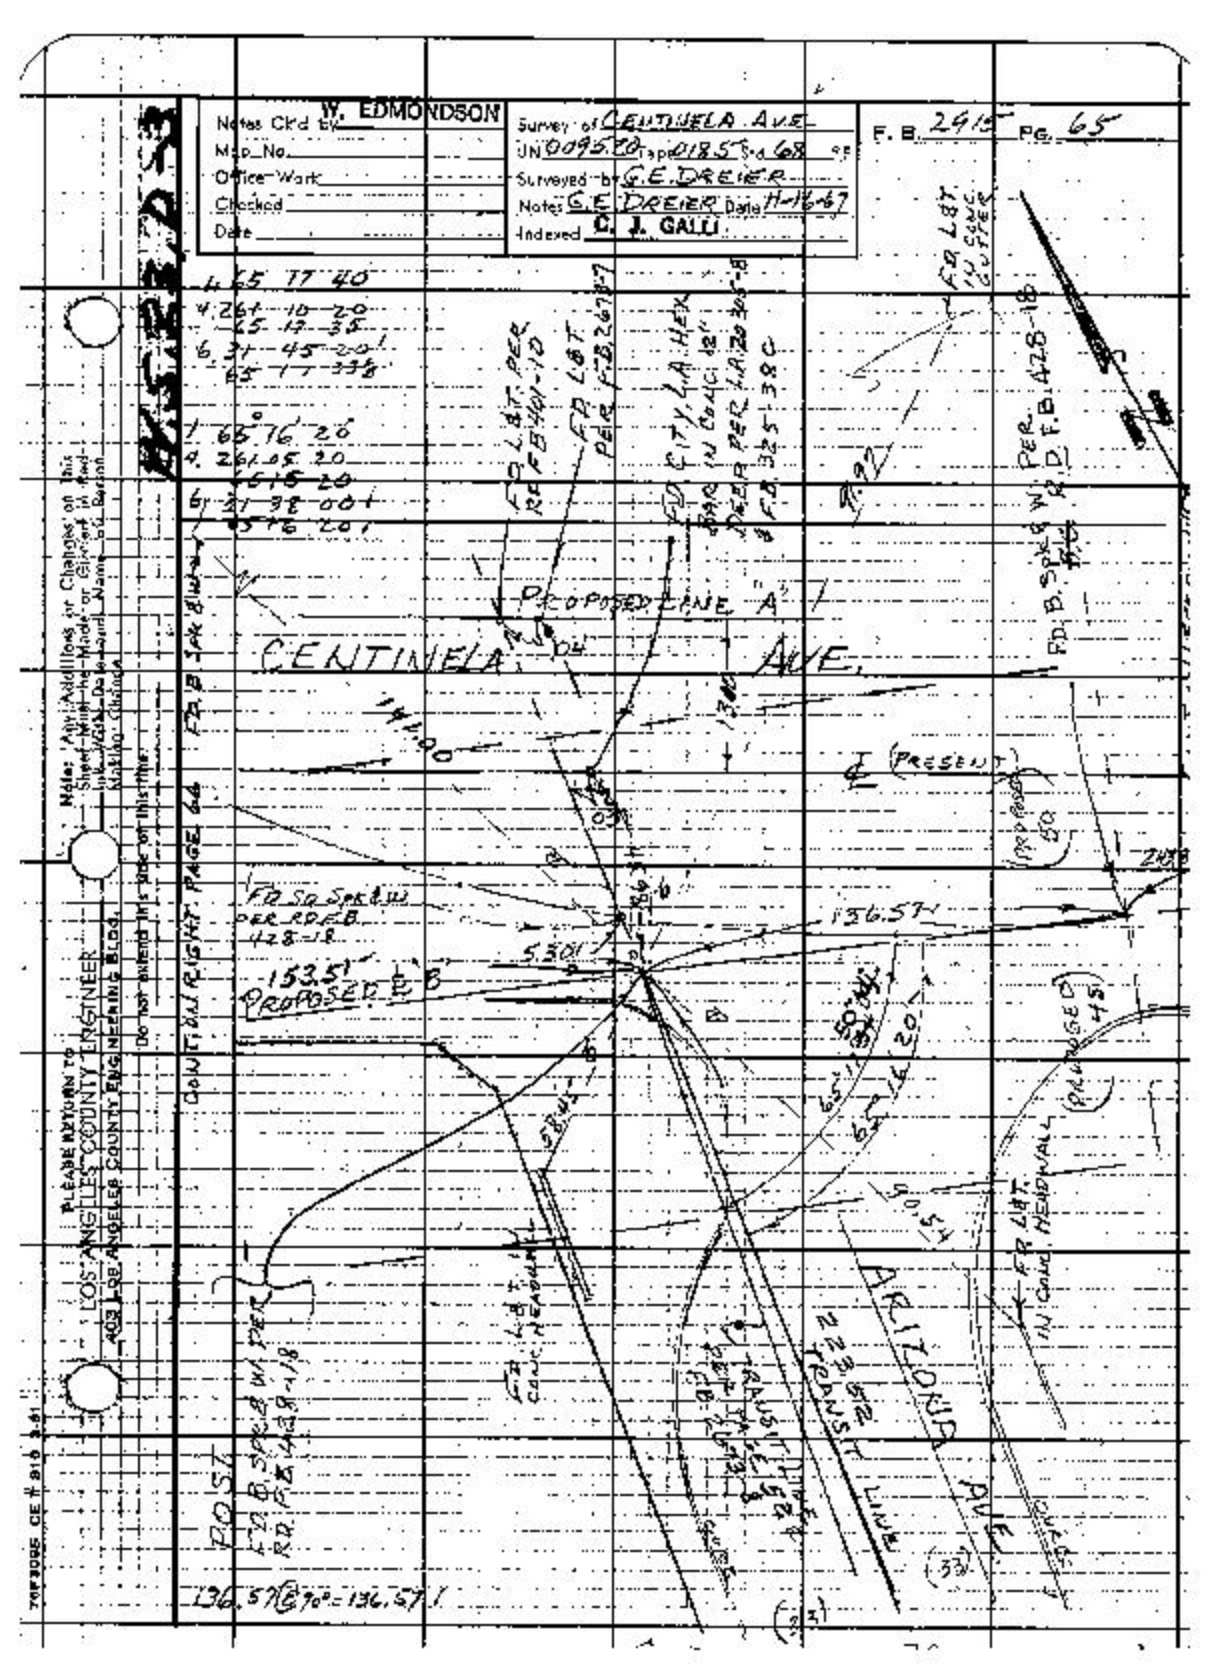
W. EDMONDSON
Notes Cked by
Map No.
Office Work
Checked
Date
Survey of CENTINELA AVE.
UN 009520 Tape 0185 Sht 68
Surveyed by G.E. DREIER
Notes G.E. DREIER Date H-16-67
Indexed C. J. GALLI
F. B. 2915 Pg. 65
CENTINELA AVE.
PROPOSED LINE A
PRESENT
ARIZONA AVE.
PROPOSED
FD. LAT. PER R/S FB 340-10
FD. CITY L.A. HEX CONC. IN CONC. 12" DEEP PER LA 20 #5-8 & FD 325-38 C
FD. B. SPK & W. PER R/S F.B. 428-18
FD. LAT. IN CONC. PER R/S F.B. 428-18
FD. SPK & WSR PER R/S F.B. 428-18
FD. B. SPK & WSR PER R/S F.B. 428-18
FD. LAT. IN CONC. HEADWALL
FD. LAT. IN CONC. HEADWALL
POST
136.57 @ 70° = 136.57'
153.51' PROPOSED E.B.
136.57'
5.50'
60'
45'
30'
33'
31'
2+23 TRANSIT LINE
COUNTY RIGHT OF WAY PAGE 64
Notes: Any Additions or Changes on this Sheet Must Be Made or Signed by Road Inspector. Do Not Extend This Side on This Tracing
PLEASE RETURN TO LOS ANGELES COUNTY ENGINEER 403 LOS ANGELES COUNTY ENGINEERING BLDG.
7073085 CE # 815 3-61

F.B. 2915 Pg. 66

1, 163° 30' 00"
4 294 00 00
163 30 00
6 260 59 50
163 29 58 3/4

@ 74°
290.05 = 290.06'
153.51 @ 70 = 153.51'

℄ "B" CURVE DATA
PER RD. F.B. 428-18
Δ = 16° 30' 13"
R = 2000
T = 290.05
L = 576.08

FD. 2x2 "L.A.Co. RD. DEPT." TAG (1/2 DRILL CUT BANK) PER RD. DEPT. F.B. 428-19.

FD. 1" I.P. "L.A.Co. RD. DEPT." TAG PER RD. DEPT. F.B. 428-18.

FD. R. SPK. & W. PER RD. F.B. 428-18

CONTROL RIGHT OF WAY 60'

CENTINELA AVE.

PROPOSED A'

EXIST. A

PROPOSED B'

SEMI-TAN

163°

153.51

4.03

P.I. 2-B

FD. 1/2" I.P. CONC. PLUG & L.A.Co. RD. DEPT. TAG 1.5' DEEP PER R.D. F.B. 428-18

FD. 1/2" I.P. 1.2' DEEP WITH CONC. PLUG & L.A.Co. RD. DEPT. TAG PER RD. DEPT. F.B. 428-18

COUNTY OF LOS ANGELES

PLEASE RETURN TO
LOS ANGELES COUNTY ENGINEER
409 Los Angeles County Engineering Bldg.

Do not extend this side of this line.

Note: Any Additions or Changes on This Sheet Must Be Made or Circled in Red Ink With Data and Name of Person Making Change.

Notes Ck'd By W. EDMONDSON
Map No.
Office Work
Checked
Date

Survey of CENTINELA AVE
J.N. 00952.04 Type 0185 Std. 68' °F
Surveyed by G.E. DREIER
Notes G.E. DREIER Date 11-17-67
Indexed G. J. GALLI

F. B. 2915 Pg. 67

1,168' 53' 20'
4,315 35 00
168 53 15
6,293 19 301
168 53 15'

CONT. BOT PAGE 4H

CONT. ON RIGHT PAGE 6

SEE PAGE 46

FD. L&T

℄ LINE PAGE 46

104° 53' 0.25" Adj.

94.71'

98.29'

FD. 1/2" I.P. & CAP PLUG & FLAG
FD. DEPT. TAG PER RD. DEPT. F.B. 428-19

CENTINELLA AVE

N 23° 33' E

FD. 1/2" I.P. & CAP PLUG & FLAG
FD. DEPT. TAG PER RD. DEPT. F.B. 428-19

3.2

3.1

NYESMER

276.93'

B.C.
FD. L&T L.A. CO. RD. DEPT. TAG PER RD. F.B. 428-19

PROPOSED E.P.

(PROP 50')

280.84' PROPOSED E.P.

(PROP 50')

FD. HEX BAR W. HANDHOLE

SEE PAGE 61

FD. L&T IN CONC. SLAB BY INCINERATOR PER RD. DEPT. F.B. 428-19

CENTINELLA AVE

CONT. ON PAGE 6

180.44 @ 76° = 180.45'
37.92 @ R.L. = 37.92'
282.83 @ 76° = 282.84'
77.25 @ 72° = 77.25'
94.71 @ 68° = 94.71'

LOS ANGELES COUNTY ENGINEER
603 LOS ANGELES COUNTY ENGINEERING BLDG.

Make—Any Additions or Changes on this Sheet—Must be Made on Cronkite in Red Ink With Date and Name of Person Making Change.

Do not extend this side of the line.

F.B. 2915 PG. 68

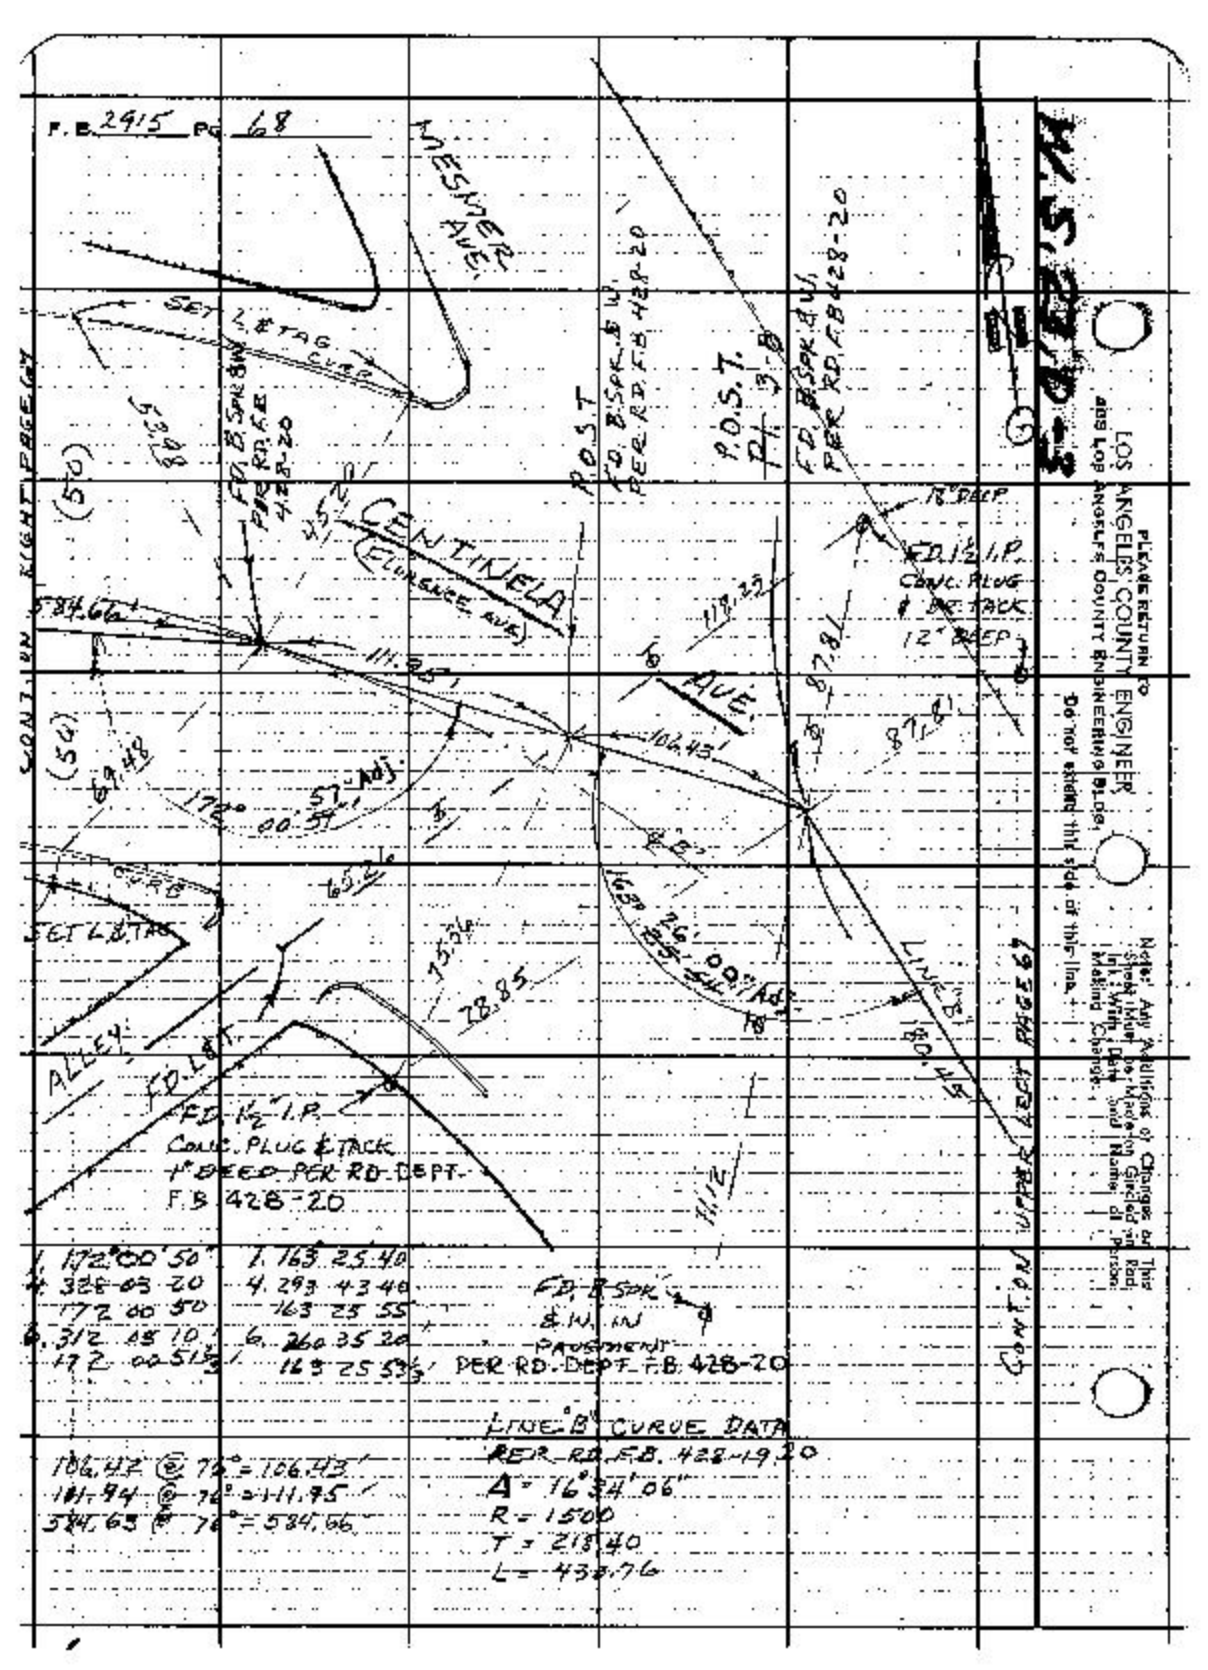

1.	172°00'50"	1. 163 25 40
4.	328 03 20	4. 293 43 40
	172 00 50	163 25 55
6.	312 05 10	6. 260 35 20
	172 00 51½	163 25 53½

106.42' @ 72° = 106.43'
111.94' @ 72° = 111.95'
584.63' @ 72° = 584.66'

LINE "B" CURVE DATA
PER RD. F.B. 428-19-20
Δ = 16°34'06"
R = 1500
T = 218.40
L = 433.76

LOS ANGELES COUNTY ENGINEER
900 Los Angeles County Engineering Bldg.

PLEASE RETURN TO

Do not extend this side of this line.

Notice! Any Additions or Changes or Erasures must be Initialed and Dated by Author. Sheet Must Be Checked and Signed in Ink With Date and Name of Person Making Change.

This Road

N.P.L.

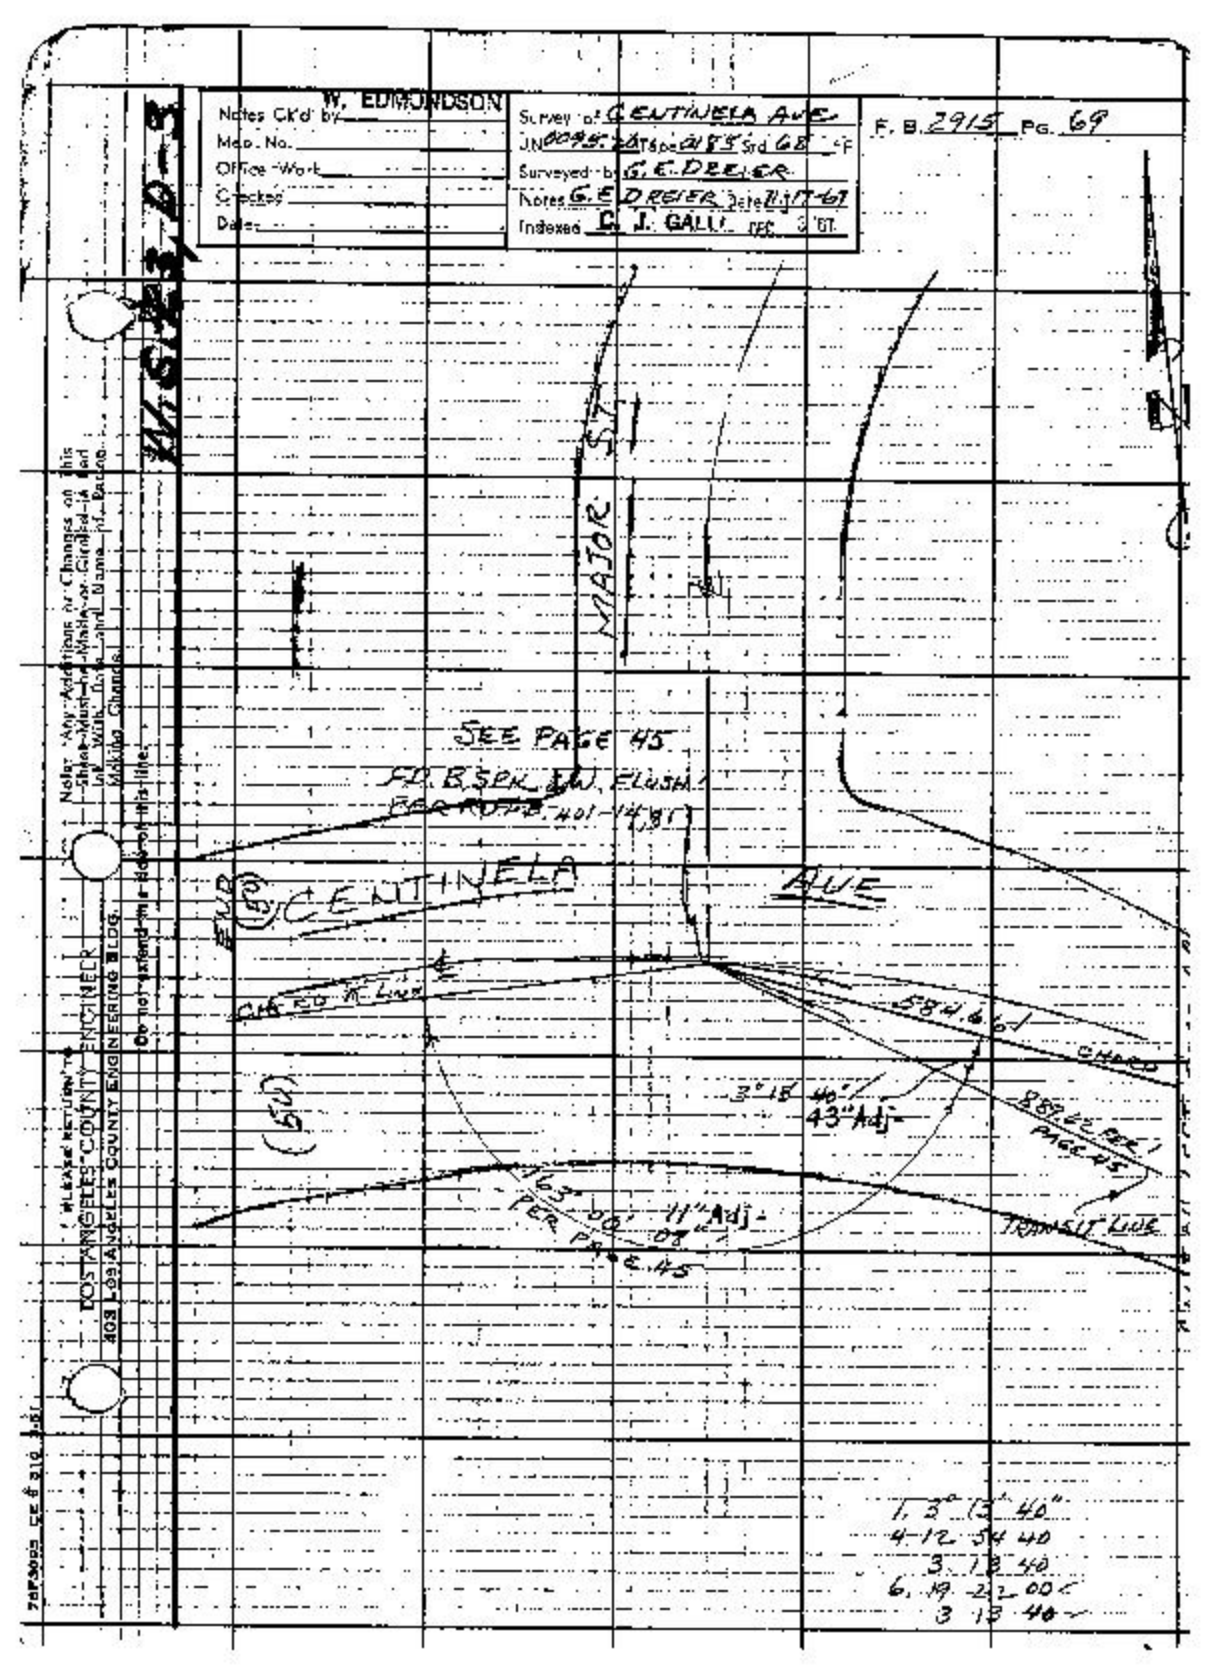
W. EDMONDSON
Notes C'k'd by
Map No.
Office Work
Checked
Dated
Survey of CENTINELA AVE.
JN 00457 Sta 0+85 Std 68 °F
Surveyed by G.E. DREIER
Notes G.E. DREIER Date 7-17-67
Indexed C. J. GALLI DEC 67
F. B. 2915 Pg. 69
W 63.2-3
MAJOR ST
SEE PAGE 45
FD. B.S.&K. IN W. FLUSH
BARRETT 401-14/81
CENTINELA AVE
CHKD
584.6 401
3°18 40"
43" Adj
887.62 REC'
PAGE 45
TRANSIT LINE
63.00' REC'
PER PAGE 45
11" Adj
1, 3° 18' 40"
4 12 54 40
3 18 40
6, 19 -24 00
3 18 40
7-67 3000 CE # 210

CONT. BOTTOM PAGE 55

F. B. 2915 PG. 70

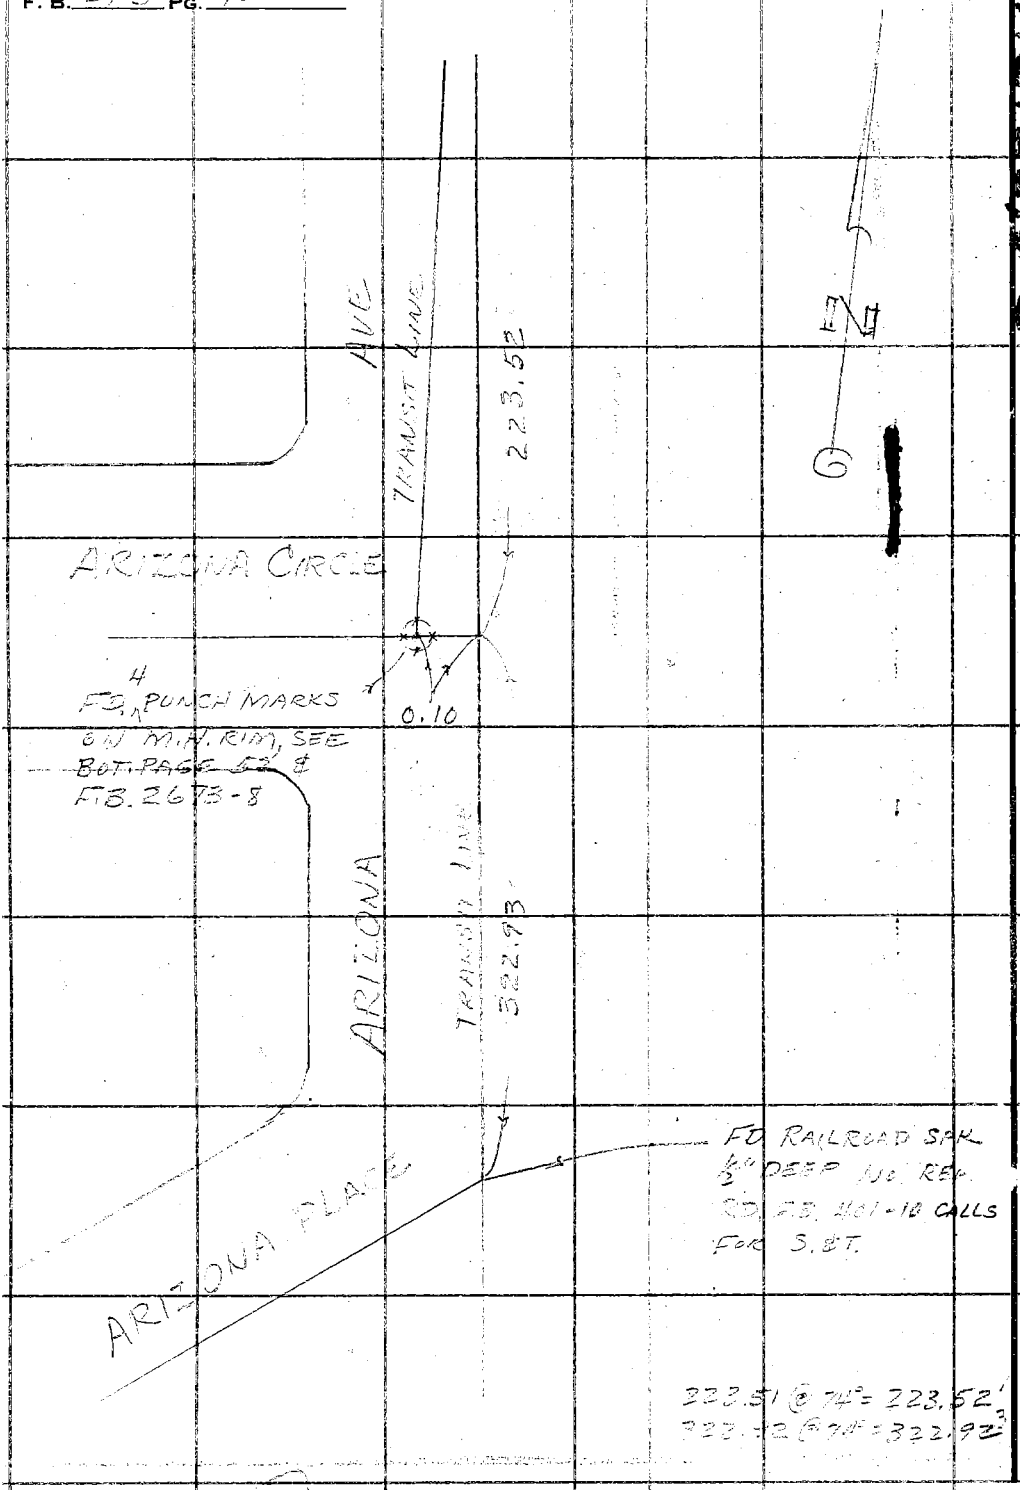

PLEASE RETURN TO
LOS ANGELES COUNTY ENGINEER
403 Los Angeles County Engineering Bldg.

Do not extend this side of this line.

Note: Any Additions or Changes on This Sheet Must be Made or Circled in Red Ink With Date and Name of Person Making Change.